

**GENERAL NOTES:**

- ZONING: SITE IS BEING DEVELOPED UNDER MXD-3 REGULATIONS, PER ZB45M, APPROVED ON 2/26/01 AND ZB-120M APPROVED 03/22/06 AND THE COMPREHENSIVE ZONING PLAN DATED 02/22/04. UNDERLYING ZONING IS RR-DEO AND THE COMP LITE ZONING REGULATION AMENDMENTS DATED 01/29/06.
- THE PREVIOUS DEPARTMENT OF PLANNING AND ZONING FILE NUMBERS: S-01-11, S-06-16, ZB-495M, ZB-1029M, PB-353, PB-318, NP-01-11, NP-03-02, F-05-13, F-06-162, F-06-214, F-01-14, F-01-12, F-01-140, F-01-210, F-08-04, F-08-15, F-08-16, F-08-12, NP-03-120, F-12-24, F-12-30.
- THIS PROJECT IS IN CONFORMANCE WITH THE LATEST HOWARD COUNTY STANDARDS UNLESS MAINTENANCE HAVE BEEN APPROVED.
- THE CEMETERY INVENTORY MAPS DO NOT SHOW ANY CEMETERIES WITHIN THE PROJECT LIMITS. THE EXISTING CEMETERY ONCE LOCATED ON THE KESSEL PROPERTY WAS RELOCATED UNDER NP-05-12.
- THE SCENIC ROADS MAP DOES NOT INDICATE ANY SCENIC ROADS WITHIN OR ADJACENT TO THE PROJECT LIMITS.
- THIS PROPERTY WAS BROUGHT INTO THE METROPOLITAN DISTRICT ON APRIL 26, 2011.
- THIS AREA OF DEVELOPMENT HAS BOTH PUBLIC AND PRIVATE ROADS, WHICH HAVE BEEN DENOTED ON THE PLAN.
- SITE ANALYSIS  
GROSS SITE AREA FOR PHASES 1 THROUGH 4D: 444.93 ACRES ±  
AREA OF THIS PLAN SUBMISSION: 34.08 ACRES ±  
DISTURBED AREA: 18.5 ACRES ±  
AREA OF OPEN SPACE: 15.60 ACRES ±  
AREA OF 100 YR FLOODPLAIN: 4.15 ACRES ±  
AREA OF ROADWAY (PUBLIC): 4.25 ACRES ±  
AREA OF ROADWAY (PRIVATE): 0.41 ACRES ±  
AREA OF RESIDENTIAL LOTS: 14.78 ACRES ±  
AREA OF LOT PARCELS: 0.0 ACRES ±  
AREA OF SFD LOTS: 14.78 ACRES ±  
TOTAL UNITS (PER S-06-16 ALLOCATIONS): 128 LOTS  
TOTAL NUMBER OF LOTS / PARCELS (THIS PLAN SUBMISSION): 85 LOTS  
NO. OF LOT PARCELS: 0 LOTS  
NO. OF SFD LOTS: 85 LOTS  
AREA OF NON-BUILDABLE PARCELS: 0.00 ACRES ±  
NO. NON-BUILDABLE PARCELS: 0 PARCELS
- OPEN SPACE REQUIREMENTS  
MINIMUM OPEN SPACE REQUIREMENT FOR PROJECT IS 35%  
TOTAL OPEN SPACE REQUIRED FOR THIS PLAN SUBMISSION: 11.93 ACRES ±  
TOTAL OPEN SPACE PROVIDED: 15.60 ACRES ±  
RECREATIONAL OPEN SPACE REQUIRED FOR THIS PLAN SUBMISSION: 1.36 ACRES ±  
RECREATIONAL OPEN SPACE PROVIDED: 5.04 ACRES ±  
(SEE CHART-SHEET 2)

EXCESS OPEN SPACE FROM THIS PHASE WILL BE USED TO FULFILL THE MINIMUM OPEN SPACE REQUIREMENTS FOR FUTURE PHASES.

- THE 128 UNITS WILL BE BROUGHT INTO THE PROJECT AS FOLLOWS:  
43 FROM THE WESTSIDE DISTRICT (F-13-003)  
85 FROM THE MIDTOWN WEST DISTRICT (F-13-007)
- SOILS DATA WAS TAKEN FROM THE SOIL SURVEY OF HOWARD COUNTY, MARYLAND ISSUED JULY 1968.
- CONTOURS SHOWN WERE TAKEN FROM AERIAL TOPOGRAPHY PREPARED DURING MARCH 1991 BY SDI AND THEN UPDATED BY GRADE CHECKS PERFORMED BY GUTSCHICK, LITTLE & WEBER, P.A. AND BASED ON F-12-30. BOUNDARY INFORMATION SHOWN IS BASED UPON A FIELD SURVEY PREPARED BY GUTSCHICK, LITTLE, AND WEBER, P.A. ON OR ABOUT JUNE, 2001.
- WETLAND DELINEATION WAS DETERMINED BY EXPLORATION RESEARCH, INC. AND APPROVED BY THE CORPS OF ENGINEERS UNDER 10 CEM1183 ON 05/14/03. IMPACTS TO WETLANDS AND WATERS OF THE STATE RESULTING FROM THIS DEVELOPMENT ARE AUTHORIZED BY MDE PERMIT 10-N-031-20065421.
- THE 100-YEAR FLOOD PLAIN LIMITS WERE DETERMINED BY THE FLOODPLAIN STUDY PREPARED BY GUTSCHICK, LITTLE AND WEBER, P.A. AS PART OF P-02-12 AND P-11-02.
- HORIZONTAL AND VERTICAL DATUM IS BASED ON HOWARD COUNTY STATION 46BC AND 46BD.
- EXISTING UTILITIES WERE TAKEN FROM AVAILABLE HOWARD COUNTY RECORDS.
- PUBLIC WATER AND SEWER TO BE UTILIZED:  
EXISTING WATER CONTRACT NUMBER: 24-4102-D THRU 24-4104-D  
EXISTING SEWER CONTRACT NUMBER: 24-4102-D THRU 24-4104-D
- TRAFFIC STUDY WAS PREPARED AND SUBMITTED AS PART OF S-06-16, WHICH WAS SIGNED BY THE PLANNING BOARD ON 02/22/07.
- PERENNIAL STREAM BUFFERS ARE DETERMINED BY LAND USE ADJOINING THE OPEN SPACE (I.E. EMPLOYMENT = 50' BUFFER, RESIDENTIAL = 75' BUFFER). ALL USES ADJOINING AN INTERMITTENT STREAM = 50' BUFFER.
- STORMWATER MANAGEMENT FOR BOTH QUALITY AND QUANTITY FOR THE INFRASTRUCTURE ASSOCIATED WITH THE RESIDENTIAL LOTS PROPOSED BY THESE PLANS WILL BE SATISFIED BY AN EXISTING REGIONAL FACILITY CONSTRUCTED UNDER F-12-30. THE EXISTING FACILITY IS A P-3 POND WITH EXTENDED DETENTION AND IS PUBLICLY OWNED WITH JOINT MAINTENANCE. THE RECHARGE REQUIREMENTS FOR THIS DEVELOPMENT WILL BE PROVIDED BY A PRIVATELY OWNED AND MAINTAINED FACILITY ON OPEN SPACE LOT 102. THE RECHARGE FACILITY WILL BE AN INFILTRATION TRENCH.
- THE RESIDENTIAL LOTS, PARCELS AND EMPLOYMENT USE STRUCTURES DEVELOPED OR PROPOSED ON THE ORIGINAL 501 ACRE TRACT FOR MAPLE LAWN FARMS ARE GRANDFATHERED TO THE FOURTH EDITION OF THE SUBDIVISION AND LAND DEVELOPMENT REGULATIONS AS DEVELOPED UNDER S-01-11, PB CASE 293 AND ZB CASE NO. 103M. HOWEVER, THE PROPOSED RESIDENTIAL AND EMPLOYMENT USES THAT ARE TO BE DEVELOPED UNDER THE AMENDED CSP, S-06-16 AND ZB CASE NO. 103M FOR THE FORMER KESSEL AND OLIVER PROPERTIES ARE SUBJECT TO THE AMENDED FIFTH EDITION OF THE SUBDIVISION AND LAND DEVELOPMENT REGULATIONS PER COUNCIL BILL NO. 45-2003 AND THE ZONING REGULATIONS PER COUNCIL BILL NO. 13-2003.
- AS STATED IN THE DECISION AND ORDER FOR THIS PLAN, THE PLANNING BOARD SHALL REVIEW AND APPROVE SITE DEVELOPMENT PLANS FOR ALL SINGLE FAMILY ATTACHED AND MULTI-FAMILY RESIDENTIAL USES, AND ALL EMPLOYMENT AND OPEN SPACE USE DEVELOPMENT FOR THE SUBJECT MAPLE LAWN FARMS PROJECT. ALL OF THE IMPROVEMENTS THAT WERE NECESSARY FOR THE MAPLE LAWN FARMS PROJECT TO BE IN COMPLIANCE WITH THE FUNDING TEST EVALUATION RESTRICTIONS ENACTED BY THE ZONING BOARD ON PAGE 22-23 OF ITS DECISION ON THE PDF HAVE BEEN CONSTRUCTED.
- NO GRADING, REMOVAL OF VEGETATIVE COVER OR TREES, OR PLACEMENT OF NEW STRUCTURES IS PERMITTED WITHIN LIMITS OF WETLANDS, STREAMS OR THEIR REQUIRED BUFFERS, AND 100 YEAR FLOOD PLAIN AREAS, EXCEPT AS PERMITTED UNDER NP-02-54, NP-03-02, AND NP-03-120.
- OPEN SPACE LOTS MAY CONTAIN ACTIVE RECREATIONAL FACILITIES AS ALLOWED BY THE APPROVED COMPREHENSIVE DEVELOPMENT CRITERIA.
- PHASING FOR THIS PROJECT IS IN ACCORDANCE WITH THE DECISION AND ORDER FOR ZONING BOARD CASE NO. ZB-495M & ZB-1029M AND THE DECISION AND ORDER FOR PB CASE NO. 353 (COMPREHENSIVE SKETCH PLAN, S-01-11) AND NO. 310 (COMPREHENSIVE SKETCH PLAN, S-06-16) AND THE DPZ AFFO RE-PHASING LETTER DATED JULY 2, 2008.
- DEVELOPMENT FOR THIS PHASE WILL BE DONE IN ACCORDANCE WITH THE COMPREHENSIVE DEVELOPMENT CRITERIA APPROVED WITH S-01-11, S-06-16, PB-353, AND PB-310.
- THE TRANSPORTATION AND TRANSIT DESIGN WILL BE IMPLEMENTED AS OUTLINED IN THE PETITIONER'S EXHIBIT 55 AS SUBMITTED AS PART OF ZB45M.
- A NOISE STUDY WAS PREPARED BY WILDMAN & ASSOCIATES FOR S-01-11, (APPROVED BY PLANNING BOARD ON AUGUST 8, 2001), AND UPDATED BY NELSON T. BALLARD COMPANY IN MAY 2006 FOR S-06-16 (APPROVED BY PLANNING BOARD ON FEBRUARY 20, 2007).
- THE LIMITS OF THIS SUBMISSION DOES NOT INCLUDE MODERATE INCOME HOUSING UNITS.
- FOR SOIL TYPES, DESCRIPTIONS AND LIMITATIONS, SEE S-01-11, AND S-06-16.

**GENERAL NOTES (cont.):**

- THE FOREST CONSERVATION REQUIREMENTS PER SECTION 16.1202 OF THE HOWARD COUNTY CODE AND THE FOREST CONSERVATION MANUAL FOR PHASE 4C OF THIS PROJECT WILL BE PROVIDED BY THIS PLAN. FOREST CONSERVATION SURVEY WILL BE POSTED WITH THE DEVELOPER AGREEMENT. NO CLEARING, GRADING OR CONSTRUCTION IS PERMITTED WITHIN THE FOREST CONSERVATION EASEMENT HOWEVER, FOREST MANAGEMENT PRACTICES AS DEFINED IN THE DEED OF FOREST CONSERVATION EASEMENT ARE ALLOWED.
- THE 15' TREE CONFLICT EASEMENT SHOWN ON THESE PLANS GRANTS FERCO THE RIGHT TO ENTER THE EASEMENT FOR THE PURPOSES OF CUTTING DOWN, TRIMMING, REMOVING AND/OR KEEPING CUT ALL TREES WHICH MAY INTERFERE WITH ANY TOWERS, POLES, STRUCTURES, WIRES, GAS CONDUITS OR OTHER IMPROVEMENTS WITHIN THE FERCO R/W, AS PER LIBER 2305 FOLIO 33.
- MINIMUM BUILDING SETBACK RESTRICTIONS FROM PUBLIC ROADS AND PROPERTY LINES WILL BE PROVIDED IN ACCORDANCE WITH THE COMPREHENSIVE DEVELOPMENT CRITERIA APPROVED FOR THIS PROJECT UNDER S-06-16, PB-310 AND ZB-1039M.
- ALL DIFFERING AND OTHER LANDSCAPING REQUIREMENTS/FEATURES WILL BE PROVIDED AT THE SITE DEVELOPMENT PLAN STAGE AND/OR THE FINAL PLAN STAGE AND WILL BE PROVIDED IN ACCORDANCE WITH THE COMPREHENSIVE SKETCH PLAN CRITERIA.
- STORMWATER MANAGEMENT IS PROVIDED IN ACCORDANCE WITH THE 2000 MARYLAND STORMWATER DESIGN MANUAL, VOLUMES I AND II. IT WAS DETERMINED THAT THIS PROJECT MET THE CRITERIA OUTLINED IN THE WDE STORMWATER MANAGEMENT REGULATIONS GUIDANCE FOR IMPLEMENTATION FOR ACCEPTANCE OF THE 2000 DESIGN CRITERIA AND THROUGH THE ADMINISTRATIVE REVIEW PROCESS, WAS GRANTED A WAIVER. THIS PLAN RECEIVED COMPREHENSIVE SKETCH PLAN APPROVAL (S-06-16) ON JANUARY 25, 2007. THIS PLAN IS ALSO SUBJECT TO THE EXPIRATION OF THIS WAIVER UNLESS ALL OF THE STORMWATER MANAGEMENT IS CONSTRUCTED BY MAY 4, 2011.
- PER TABLE 2.11 IN SECTION 2.4.B OF THE HOWARD COUNTY DESIGN MANUAL VOLUME II (ROADS AND BRIDGES), 43 ON STREET GUEST/OVERLAP PARKING SPACES ARE REQUIRED. THEY ARE BEING PROVIDED AT A RATE OF 0.5 SPACES PER DWELLING. ON-STREET PARKING IS ONLY PERMITTED ON THE 20' ROAD SECTIONS.

**NP-01-11**  
ON MAY 2, 2001, NP-01-11 WAS GRANTED FOR THE FOLLOWING:  
• ADDITIONAL POINTS OF ACCESS ALLOTTED ONTO SANNER ROAD OTHER THAN THOSE PERMITTED BY 16.1001(i), SUBJECT TO FURTHER ANALYSIS AND APPROVALS AT LATER PLAN STAGES.  
• RESIDENTIAL LOTS ARE ALLOWED TO FRONT ON NEIGHBORHOOD PARKS INSTEAD BEING LIMITED FRONTAGE ON PUBLIC R/W'S AS IN 16.1202(c)(2), SUBJECT TO ADEQUATE PRIVATE ALLEY ACCESS.

**NP-03-02**  
ON OCT. 12, 2002, NP-03-02 WAS GRANTED TO ALLOW:  
• GRADING WITHIN THE 75' STREAM BUFFER AND FLOODPLAIN AS SHOWN ON THE REVISED GRADING EXHIBIT SUBMITTED 7/6/02 (WAIVER FROM SECTION 16.16 (A)(2)(ii) AND SECTION 16.15 (C)(2) RESPECTIVELY).  
• ELIMINATION OF TRUNCATION AT RIGHT-OF-WAY CORNERS OF RESIDENTIAL LOTS AND OTHER PARCEL CORNERS AT RIGHT-OF-WAYS WHERE NECESSARY TO ACHIEVE THE TRADITIONAL NEIGHBORHOOD DESIGN WAIVER FROM SECTION 16.19 (E)(5). THE DISTURBANCE WITHIN THE FLOODPLAIN AND STREAM BUFFER IS SUBJECT TO OBTAINING THE NECESSARY PERMITS FROM HDE AND DNR. ELIMINATION OF THE TRUNCATIONS IS SUBJECT TO HAVING ADEQUATE SIGHT AND INTERSECTION DISTANCE AS DETERMINED BY THE DPZ, DEVELOPMENT - ENGINEERING DIVISION.

**NP-03-120**  
ON JULY 24, 2003, NP-03-120 WAS GRANTED FOR THE FOLLOWING:  
• INSTALLATION OF A TEMPORARY STREAM CROSSING FOR THE PURPOSE OF EARTH MOVING OPERATIONS.

APPROVED: HOWARD COUNTY DEPARTMENT OF PUBLIC WORKS  
*Diane Schwarz* Acting  
Chief, Bureau of Highways  
11/24/12  
Date

APPROVED: HOWARD COUNTY DEPARTMENT OF PLANNING & ZONING  
*Kate Schaefer*  
Chief, Division of Land Development  
12/11/12  
Date  
*Chad Edwards*  
Chief, Development Engineering Division  
12-6-12  
Date

**GLWGUTSCHICK LITTLE & WEBER, P.A.**  
CIVIL ENGINEERS, LAND SURVEYORS, LAND PLANNERS, LANDSCAPE ARCHITECTS  
3909 NATIONAL DRIVE - SUITE 230 - BURTNSVILLE OFFICE PARK  
BURTNSVILLE, MARYLAND 20868  
TEL: 301-421-4024 FAX: 410-880-1820 DC/VA: 301-589-2524 FAX: 301-421-4186


DES. DEV.	DRN. KLP	CHK. CKG	DATE	REVISION	BY	APPR.
-----------	----------	----------	------	----------	----	-------

# ROAD CONSTRUCTION PLANS

## MAPLE LAWN FARMS

### MIDTOWN WEST DISTRICT - AREA 2

#### LOTS 93 THRU 177, OPEN SPACE LOTS 178 THRU 183, AND COMMON OPEN AREA LOTS 184 THRU 186

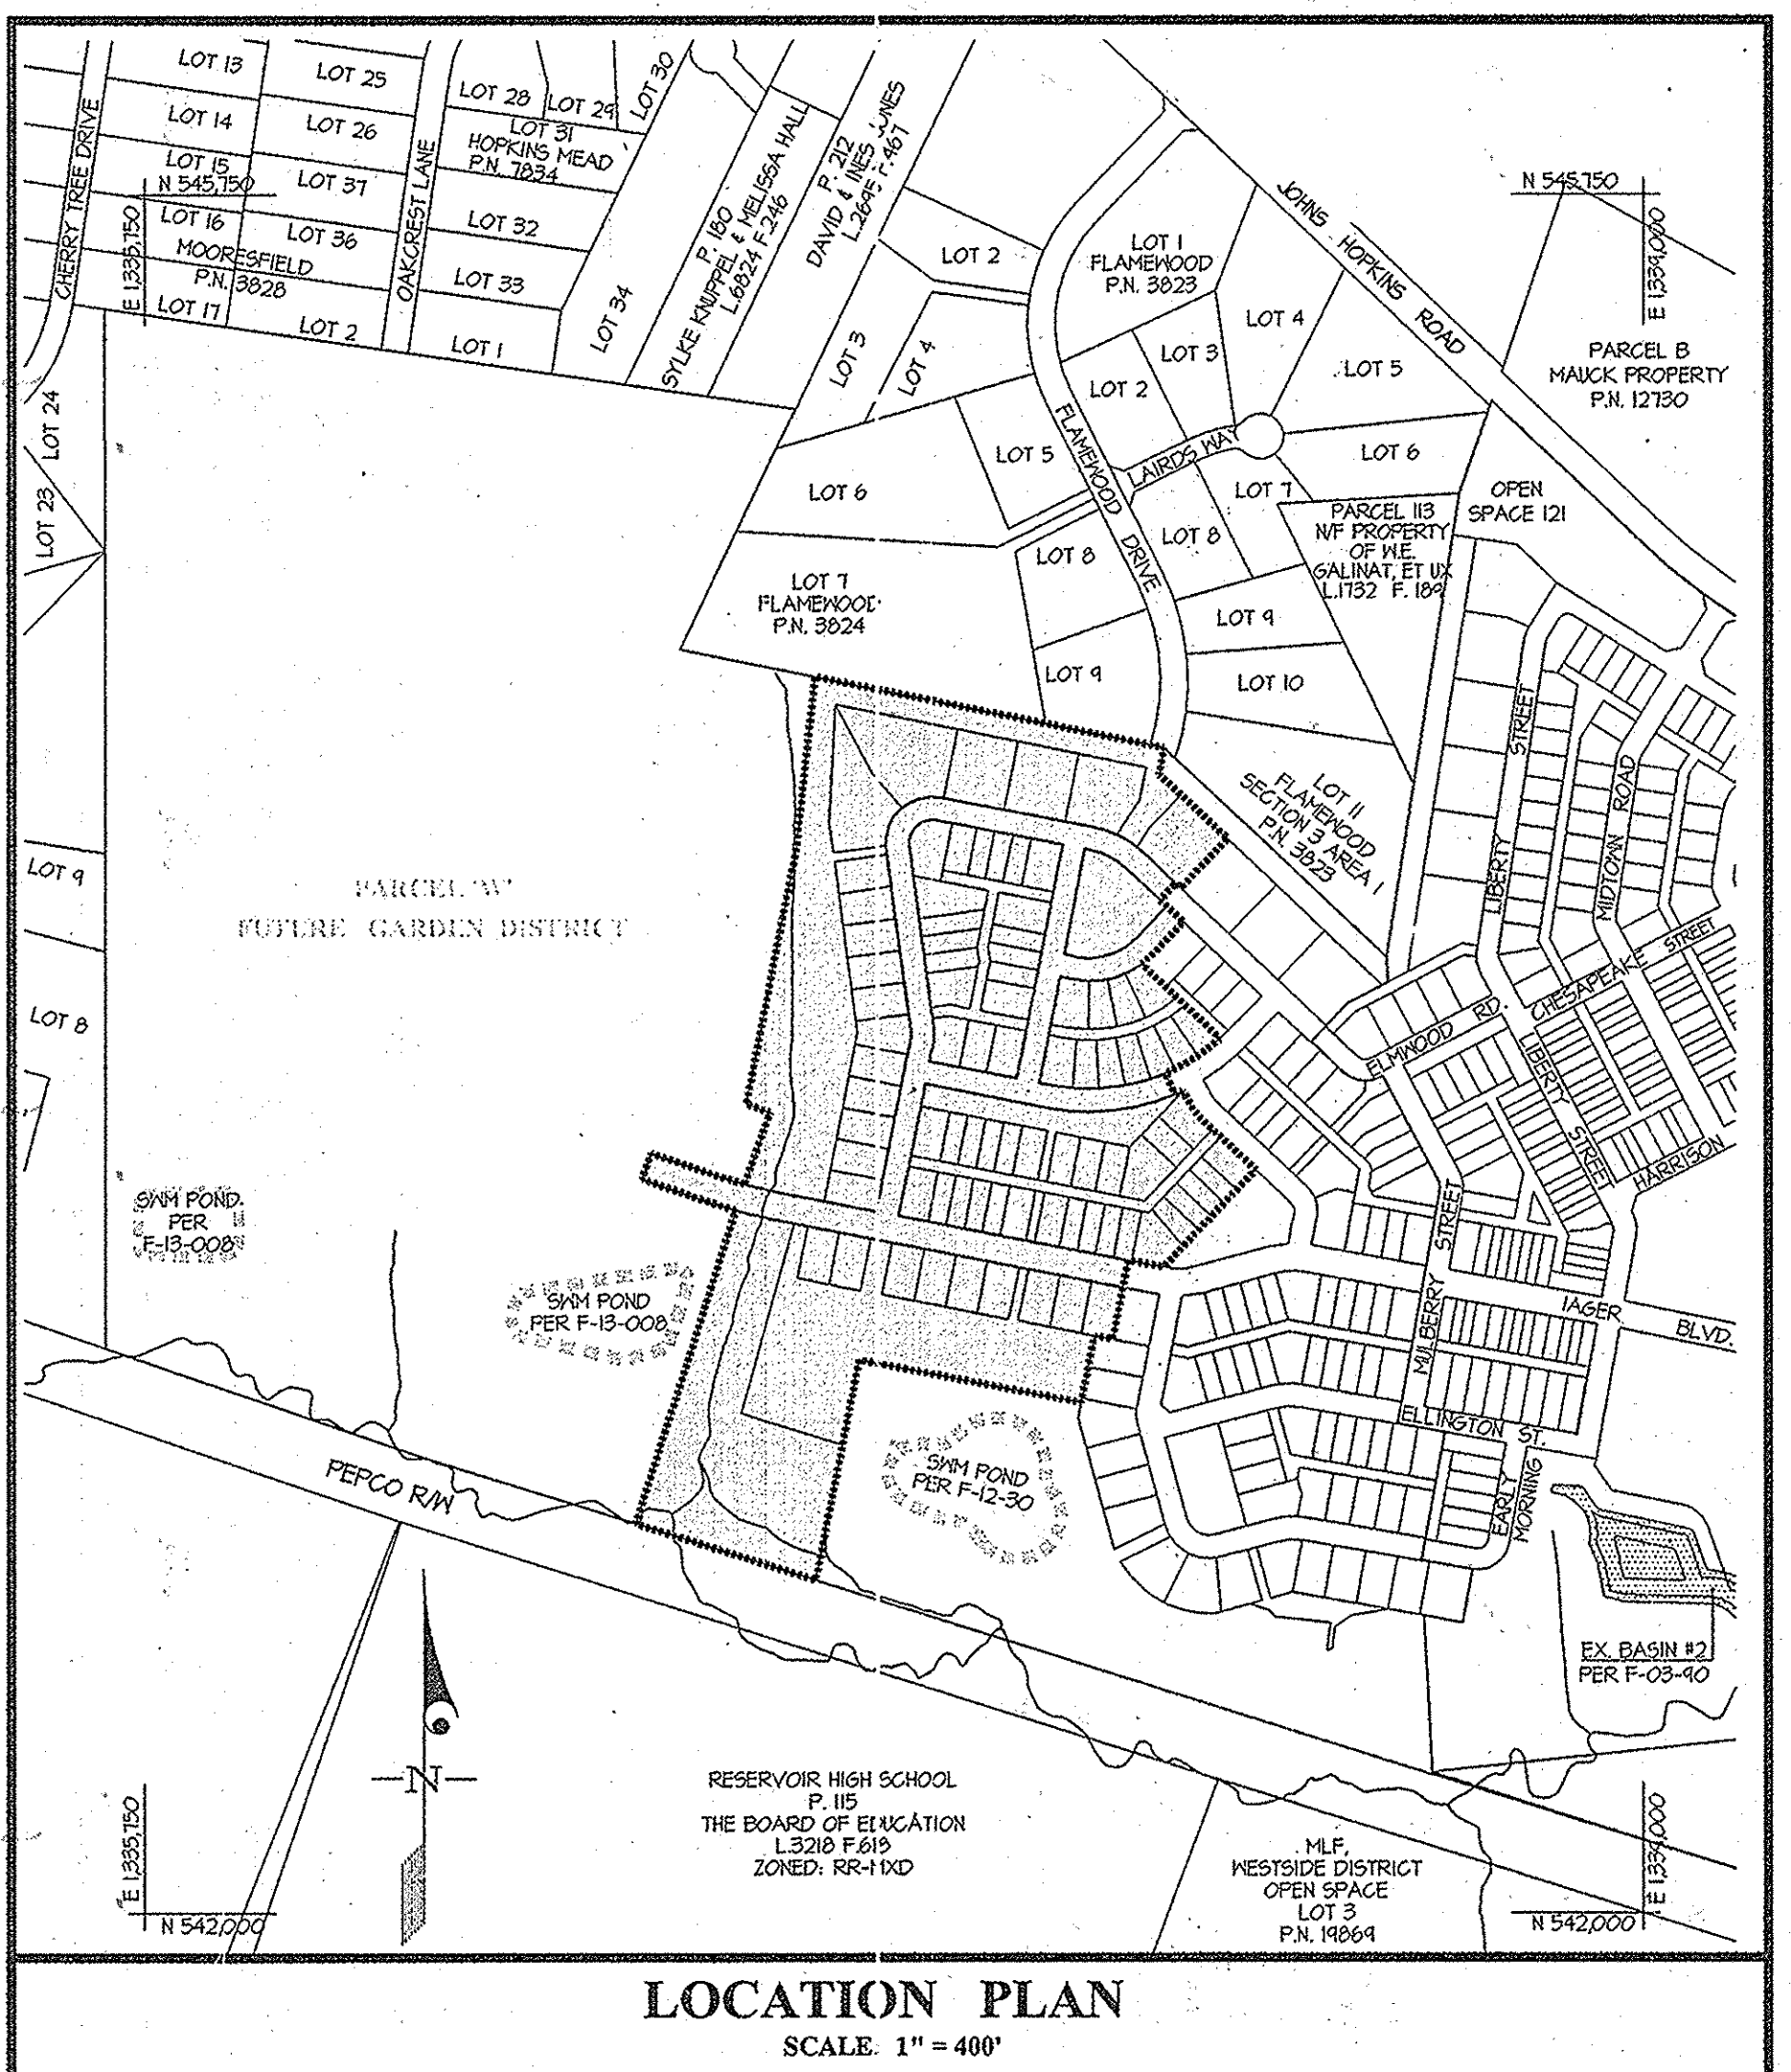


**LOCATION PLAN**  
SCALE: 1" = 400'

**SHEET INDEX**

- COVER SHEET
- OVERALL PROJECT CRITERIA AND INFORMATION
- ROAD CONSTRUCTION PLAN
- ROAD CONSTRUCTION PROFILES - ELMWOOD RD, ALFALFA LN AND SPRING AVE
- ROAD CONSTRUCTION PROFILES - IAGER BOULEVARD AND GRAND CHAMPION STREET
- ROAD DETAILS
- ADA COMPLIANT SIDEWALK RAMP
- STORMING STREET TREE AND LIGHTING
- STORM DRAIN INFORMATION PLAN
- STORM DRAIN DRAINAGE AREA MAP
- STORM DRAIN PROFILES
- STORM DRAIN PROFILES
- STORM DRAIN PROFILES
- RECHARGE FACILITY DETAILS
- SEDIMENT CONTROL PLAN
- SEDIMENT CONTROL NOTES AND DETAILS
- SEDIMENT CONTROL NOTES AND DETAILS - WATERWAY CONSTRUCTION
- ARCH SPAN - PLAN PROFILE AND SOIL BORING INFORMATION
- ARCH SPAN - PLAN 4 DETAILS
- ARCH SPAN - SPECIFICATIONS
- LAND USE PLAN
- LANDSCAPE PLAN / NOTES AND DETAILS
- FOREST CONSERVATION PLAN
- FOREST CONSERVATION NOTES AND DETAILS

**PROFESSIONAL CERTIFICATION**  
I hereby certify that these documents were prepared or approved by me, and that I am a duly licensed professional engineer under the laws of the State of Maryland, License No. 12475, Expiration Date: May 26, 2016.


10-29-15  
Date  
*Carl K. Gutschick*  
Professional Engineer  
Maryland Reg. No. 12475

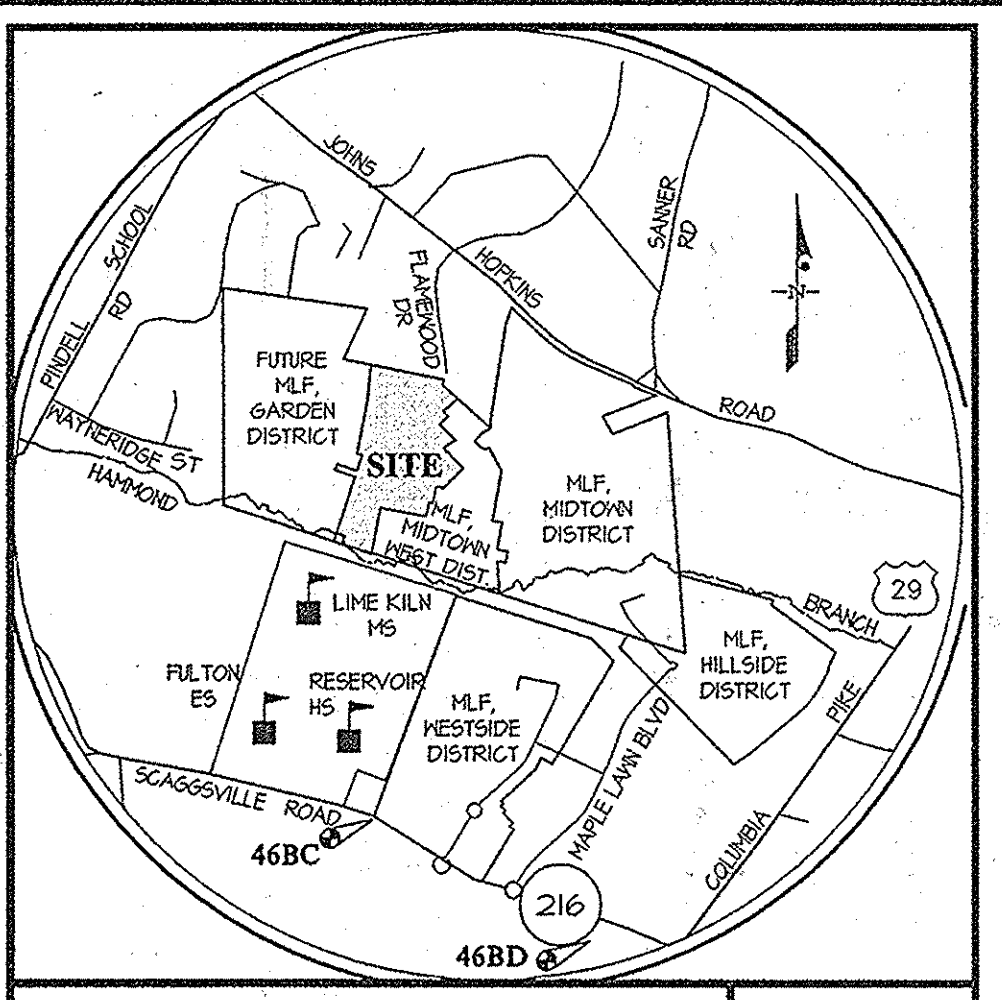


**VICINITY MAP**  
SCALE: 1" = 2000'

**BENCHMARKS**

<b>46BC</b> ELEV. = 412.16 N = 534125.19 E = 1331205.71 STANDARD DISC. ON CONCRETE MONUMENT	<b>46BD</b> ELEV. = 491.17 N = 538656.16 E = 1334461.55 STANDARD DISC. ON CONCRETE MONUMENT
--	--

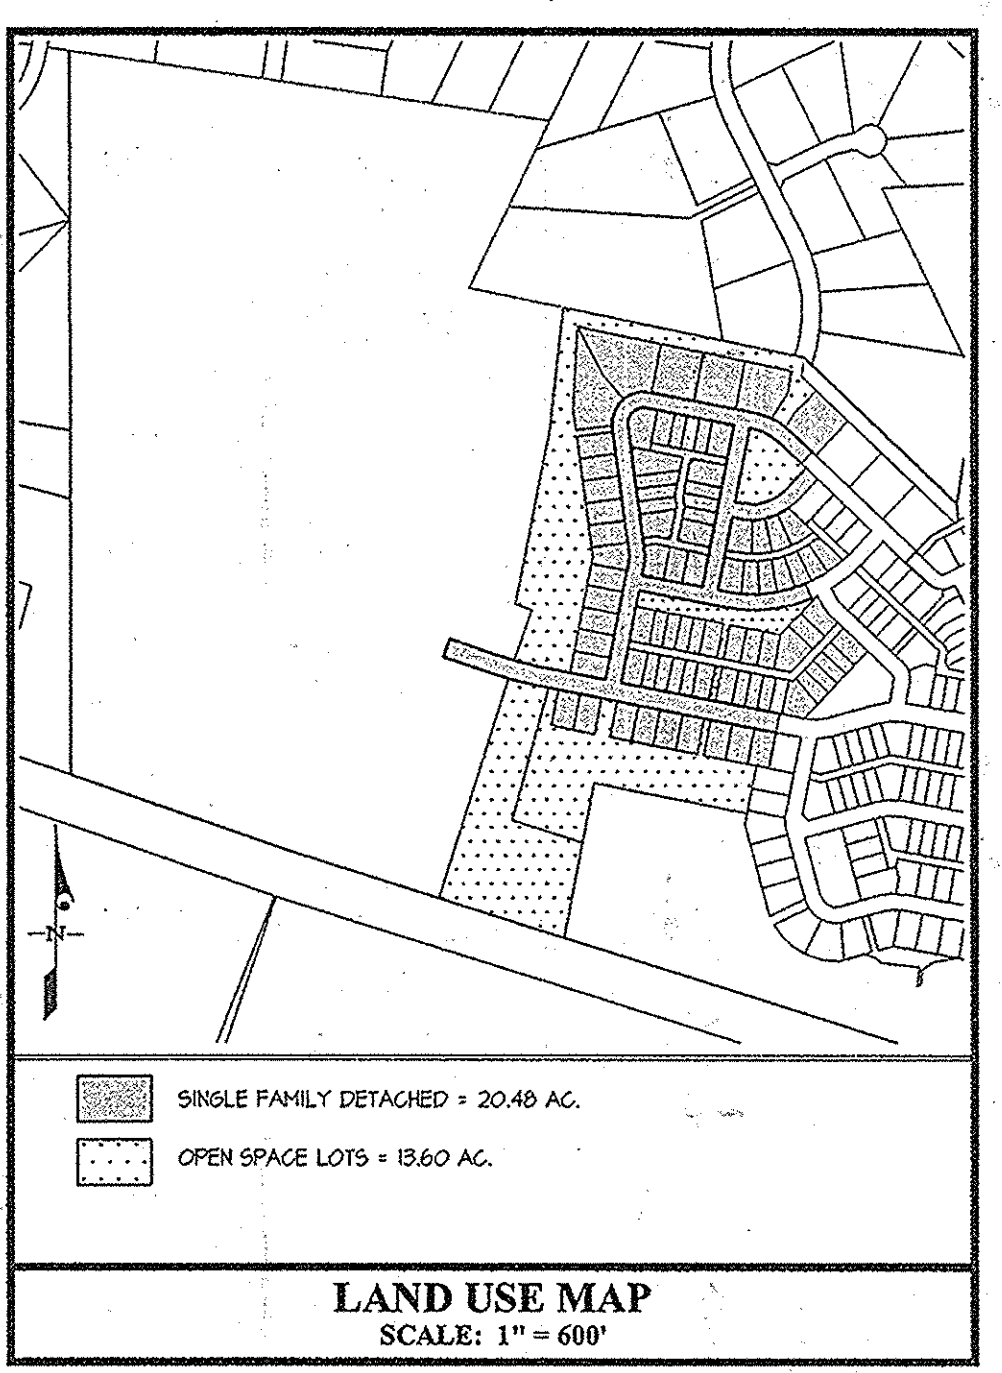

**LAND USE MAP**  
SCALE: 1" = 600'

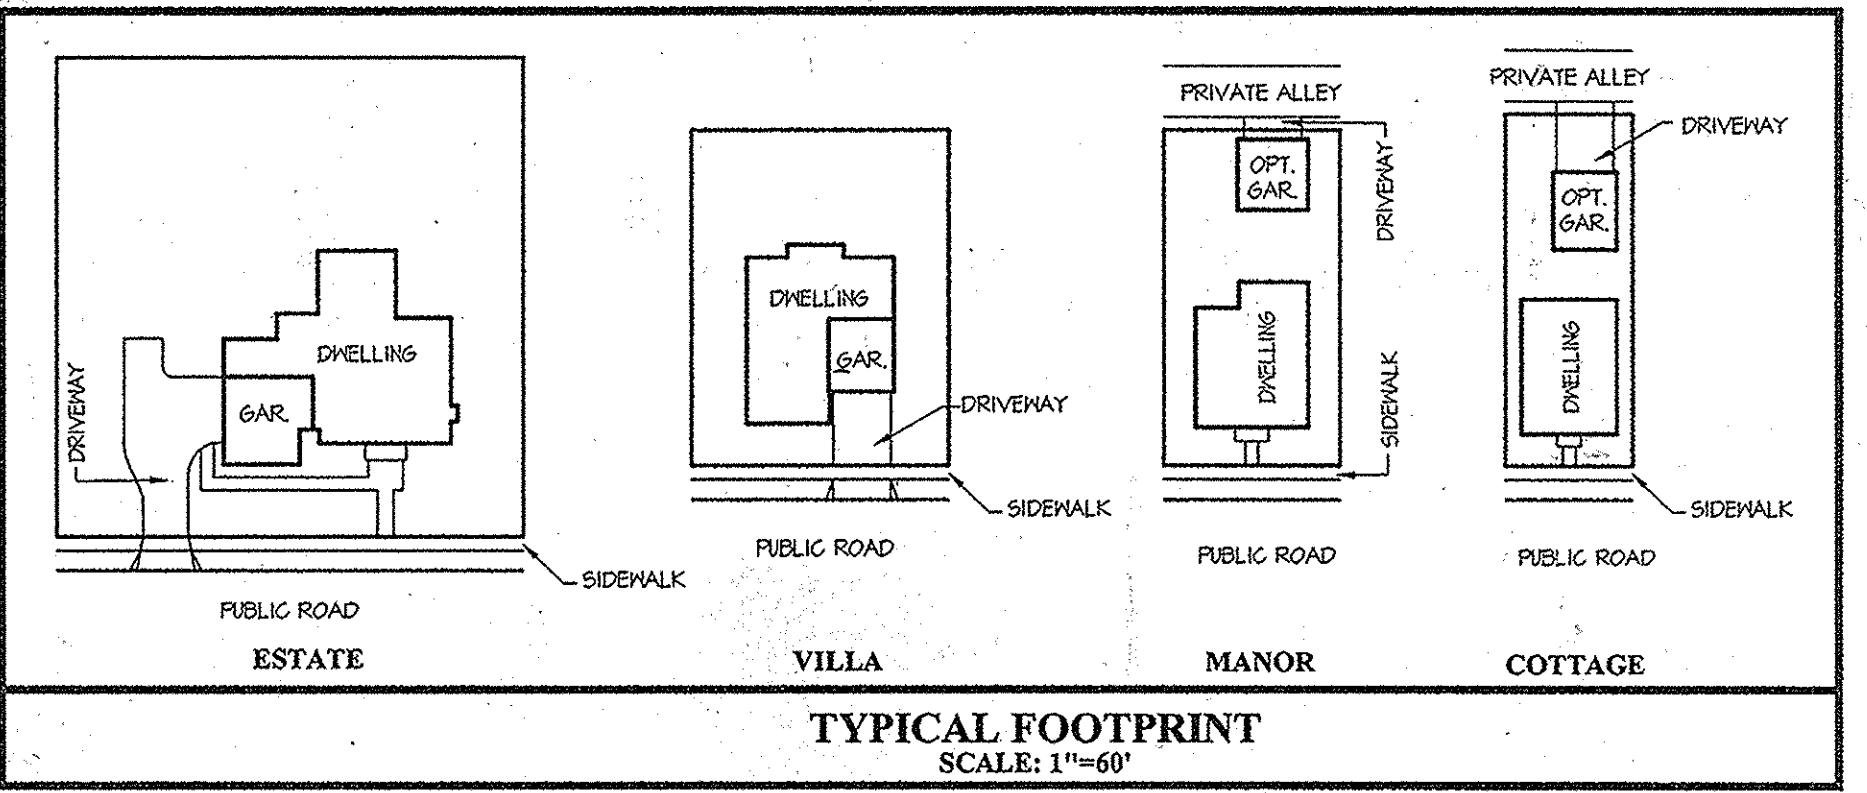

**LOT INFORMATION**

LOT TYPE	LOTS	MINIMUM LOT SIZE & WIDTH AT FRONT BRL	MINIMUM SETBACK REQUIREMENTS
COTTAGE	103-106, 108-111, 114-117, 120-123, 131-136, 139-141, 143-145, 151-153, 151-154	SEE SHEET 2	SEE SHEET 2
MANOR	102, 101, 112, 113, 124-127, 129, 130, 131, 136, 154-156	SEE SHEET 2	SEE SHEET 2
VILLA	43-101, 103, 114, 128, 142, 146-150, 160, 167-171	SEE SHEET 2	SEE SHEET 2
ESTATE	161-166	SEE SHEET 2	SEE SHEET 2

PREPARED FOR:  
MAPLE LAWN FARMS 1, LLC  
SUITE 300 WOODHOLME CENTER  
1829 REGISTERSTOWN ROAD  
BALTIMORE, MD 21208  
ATTN: MARK BENNETT  
410-484-8400

**PROFESSIONAL CERTIFICATION**  
I HEREBY CERTIFY THAT THESE PLANS WERE PREPARED OR APPROVED BY ME, AND THAT I AM A DULY LICENSED PROFESSIONAL ENGINEER UNDER THE LAWS OF THE STATE OF MARYLAND, LICENSE NO. 12475, EXPIRATION DATE: MAY 26, 2016.

11-7-12  
*Carl K. Gutschick*  
Professional Engineer  
Maryland Reg. No. 12475



ELECTION DISTRICT No. 5

**ASBUILTS**  
COVER SHEET  
**MAPLE LAWN FARMS**  
MIDTOWN WEST DISTRICT - AREA 2  
LOTS 93 THRU 177, OPEN SPACE LOTS 178 THRU 183, AND COMMON OPEN AREA LOTS 184 THRU 186

SCALE	ZONING	G. L. W. FILE NO.
AS SHOWN	MXD-3	11001
DATE	TAX MAP - GRID	SHEET
OCT. 2015 OCT. 2012	41-21/46-3	1 OF 25

HOWARD COUNTY, MARYLAND



STREET NAME	CURVE	PC STA	PT STA	RADIUS (FEET)	ARC	CHORD	BEARINGS	DELTA
ELMWOOD ROAD	1	10+24.53	11+24.21	185.00'	53.14'	104.64'	N 62°44'40" W	32°25'14"
ELMWOOD ROAD	2	14+64.06	15+11.26	150.00'	104.44'	142.21'	S 40°43'35" W	108°30'12"
ELMWOOD ROAD	3	20+53.36	20+30.00	450.00'	130'	14.64'	N 01°43'39" E	0°38'12"
ALFALFA LANE	1	11+81.21	2+05.68	185.00'	40.67'	185.81'	N 12°19'20" E	57°34'48"
GRAND CHAMPION STREET	1	3+09.36	5+11.08	444.00'	136.17'	285.52'	N 84°06'12" E	35°52'57"
JAGER BOULEVARD	1	23+63.45	25+11.10	1000.00'	18.26'	156.22'	S 74°53'02" E	87°02'51"

PT. NO.	STATION	OFFSET	ELEV.	ASBUILT
(E1)	8+25.08	14.0' RT.	445.25	445.03
(E2)	10+24.53	14.0' RT.	446.86	446.62
(E3)	11+24.21	14.0' RT.	448.70	448.70
(E4)	14+64.06	14.0' RT.	448.22	441.83
(E5)	18+11.26	14.0' RT.	444.31	443.96
(E6)	20+53.36	14.0' RT.	439.36	
(E7)	20+30.00	14.0' RT.	438.41	433.12
(E8)	24+18.14	14.0' RT.	426.30	426.31
(E9)	4+25.68	12.0' LT.	445.32	445.10
(E10)	4+33.68	20.0' LT.	445.29	445.21
(E11)	10+24.53	20.0' LT.	446.79	446.83
(E12)	10+10.81	20.0' LT.	441.55	441.63
(E13)	10+14.23	12.4' LT.	441.42	441.98
(E14)	11+20.15	15.8' LT.	448.56	448.71
(E15)	11+25.58	14.0' LT.	448.64	448.24
(E16)	12+04.63	14.0' LT.	444.45	444.91
(E17)	14+64.06	14.0' LT.	448.22	448.24
(E18)	18+11.26	14.0' LT.	443.88	444.13
(E19)	20+53.36	14.0' LT.	439.36	433.44
(E20)	20+30.00	14.0' LT.	439.11	433.11
(E21)	24+18.14	14.0' LT.	426.17	431.14
(E22)	24+18.14	14.0' LT.	426.25	426.53

PT. NO.	STATION	OFFSET	ELEV.	ASBUILT
(G1)	3+09.36	14.0' RT.	434.18	434.22
(G2)	5+11.08	14.0' RT.	440.16	440.12
(G3)	5+88.07	14.0' RT.	434.82	434.85
(G4)	8+16.01	14.0' RT.	437.48	437.46
(G5)	8+24.07	14.0' RT.	432.22	432.24
(G6)	3+09.36	14.0' LT.	434.18	434.21
(G7)	5+11.08	14.0' LT.	440.16	440.13
(G8)	8+24.07	14.0' LT.	432.22	432.24

PT. NO.	STATION	OFFSET	ELEV.	ASBUILT
(J1)	5+17.81	20.0' RT.	425.07	425.07
(J2)	17+67.82	20.0' RT.	424.83	424.82
(J3)	17+55.82	12.0' RT.	430.25	430.22
(J4)	18+28.01	12.0' RT.	430.84	444.13
(J5)	18+36.01	20.0' RT.	430.70	430.72
(J6)	20+18.01	20.0' RT.	421.41	421.51
(J7)	20+86.01	12.0' RT.	421.52	
(J8)	20+46.01	12.0' RT.	421.28	421.41
(J9)	21+64.01	12.0' RT.	425.68	425.63
(J10)	21+14.01	12.0' RT.	425.44	425.43
(J11)	21+82.01	20.0' RT.	425.01	425.02
(J12)	22+10.01	20.0' RT.	422.83	422.91
(J13)	22+18.01	12.0' RT.	422.84	422.81
(J14)	23+44.41	12.0' RT.	421.50	421.45
(J15)	23+05.34	13.4' RT.	421.66	421.72
(J16)	26+64.61	14.0' RT.	424.62	424.58
(J17)	15+17.81	12.0' LT.	424.81	424.78
(J18)	23+17.24	12.0' LT.	421.18	421.15
(J19)	23+39.83	14.0' LT.	422.26	422.24
(J20)	26+64.61	14.0' LT.	424.62	424.68

PT. NO.	STATION	OFFSET	ELEV.	ASBUILT
(S1)	0+31.00	14.0' RT.	448.61	448.74
(S2)	5+24.00	14.0' RT.	438.87	438.42
(S3)	0+31.00	12.0' LT.	448.61	444.72
(S4)	0+24.00	12.0' LT.	448.44	448.48
(S5)	0+67.00	20.0' LT.	448.12	448.07
(S6)	2+12.00	20.0' LT.	445.62	445.71
(S7)	2+28.00	12.0' LT.	445.68	445.62
(S8)	2+14.00	12.0' LT.	445.21	445.21
(S9)	3+23.00	14.0' LT.	443.50	443.44
(S10)	5+24.00	14.0' LT.	438.87	438.90


PT. NO.	STATION	OFFSET	ELEV.	ASBUILT
(A1)	0+41.58	12.0' RT.	444.63	444.70
(A2)	0+44.15	12.0' RT.	444.56	444.70
(A3)	0+51.15	20.0' RT.	444.62	444.93
(A4)	1+49.81	20.0' RT.	446.08	446.03
(A5)	2+13.81	20.0' RT.	445.00	445.01
(A6)	2+82.44	12.0' RT.	445.03	445.00
(A7)	3+02.81	12.0' RT.	444.36	444.66
(A8)	0+41.58	14.0' LT.	444.37	444.31
(A9)	1+49.81	14.0' LT.	446.28	446.14
(A10)	2+85.84	14.0' LT.	444.86	444.91
(A11)	3+02.81	14.0' LT.	444.95	444.44

**NOTES**

- ROAD CONSTRUCTION PROFILE FOR ELMWOOD ROAD, ALFALFA LANE AND SPRING AVENUE IS ON SHEET 4.
- ROAD CONSTRUCTION PROFILE FOR JAGER BOULEVARD AND GRAND CHAMPION STREET IS ON SHEET 5.
- ALL CURB RADIUS ARE 25' UNLESS OTHERWISE NOTED.
- FOR TYPICAL ROAD SECTIONS SEE SHEET 6.
- FOR STREET TREE AND STREET LIGHT INFORMATION SEE SHEET 7.
- FOR STORM DRAIN INFORMATION SEE SHEET 8.
- ALL STORM DRAIN IN COMMON OPEN AREAS SHALL BE PRIVATELY OWNED AND MAINTAINED.
- A PUBLIC SIDEWALK MAINTENANCE, WATER HOUSE CONNECTION, SEWER HOUSE CONNECTION & UTILITY EASEMENT HAS BEEN ADDED TO LOTS WITH FRONT AND/OR REAR LOT LINES ADJACENT TO A PUBLIC RIGHT-OF-WAY.
- ALL SIDEWALK IS 4' UNLESS OTHERWISE NOTED.
- ALL SIDEWALKS THAT END WITH A HANDICAP RAMP MUST MEET HOWARD COUNTY STANDARD R-4.02 SIDEWALK RAMP TYPE 'B'.
- THERE WILL BE A 10' TRANSITION FROM 4' SIDEWALK TO 5' SIDEWALK ADJACENT TO THE CURB. THE 5' WIDTH IS TO BE MEASURED FROM THE BACK OF CURB.

APPROVED: HOWARD COUNTY DEPARTMENT OF PUBLIC WORKS  
*Diane Schury*, Acting Chief, Bureau of Highways, 11/29/12 Date

APPROVED: HOWARD COUNTY DEPARTMENT OF PLANNING & ZONING  
*Walt DeLush*, Chief, Division of Land Development, 12/16/12 Date  
*Chad Edwards*, Chief, Development Engineering Division, 12-16-12 Date

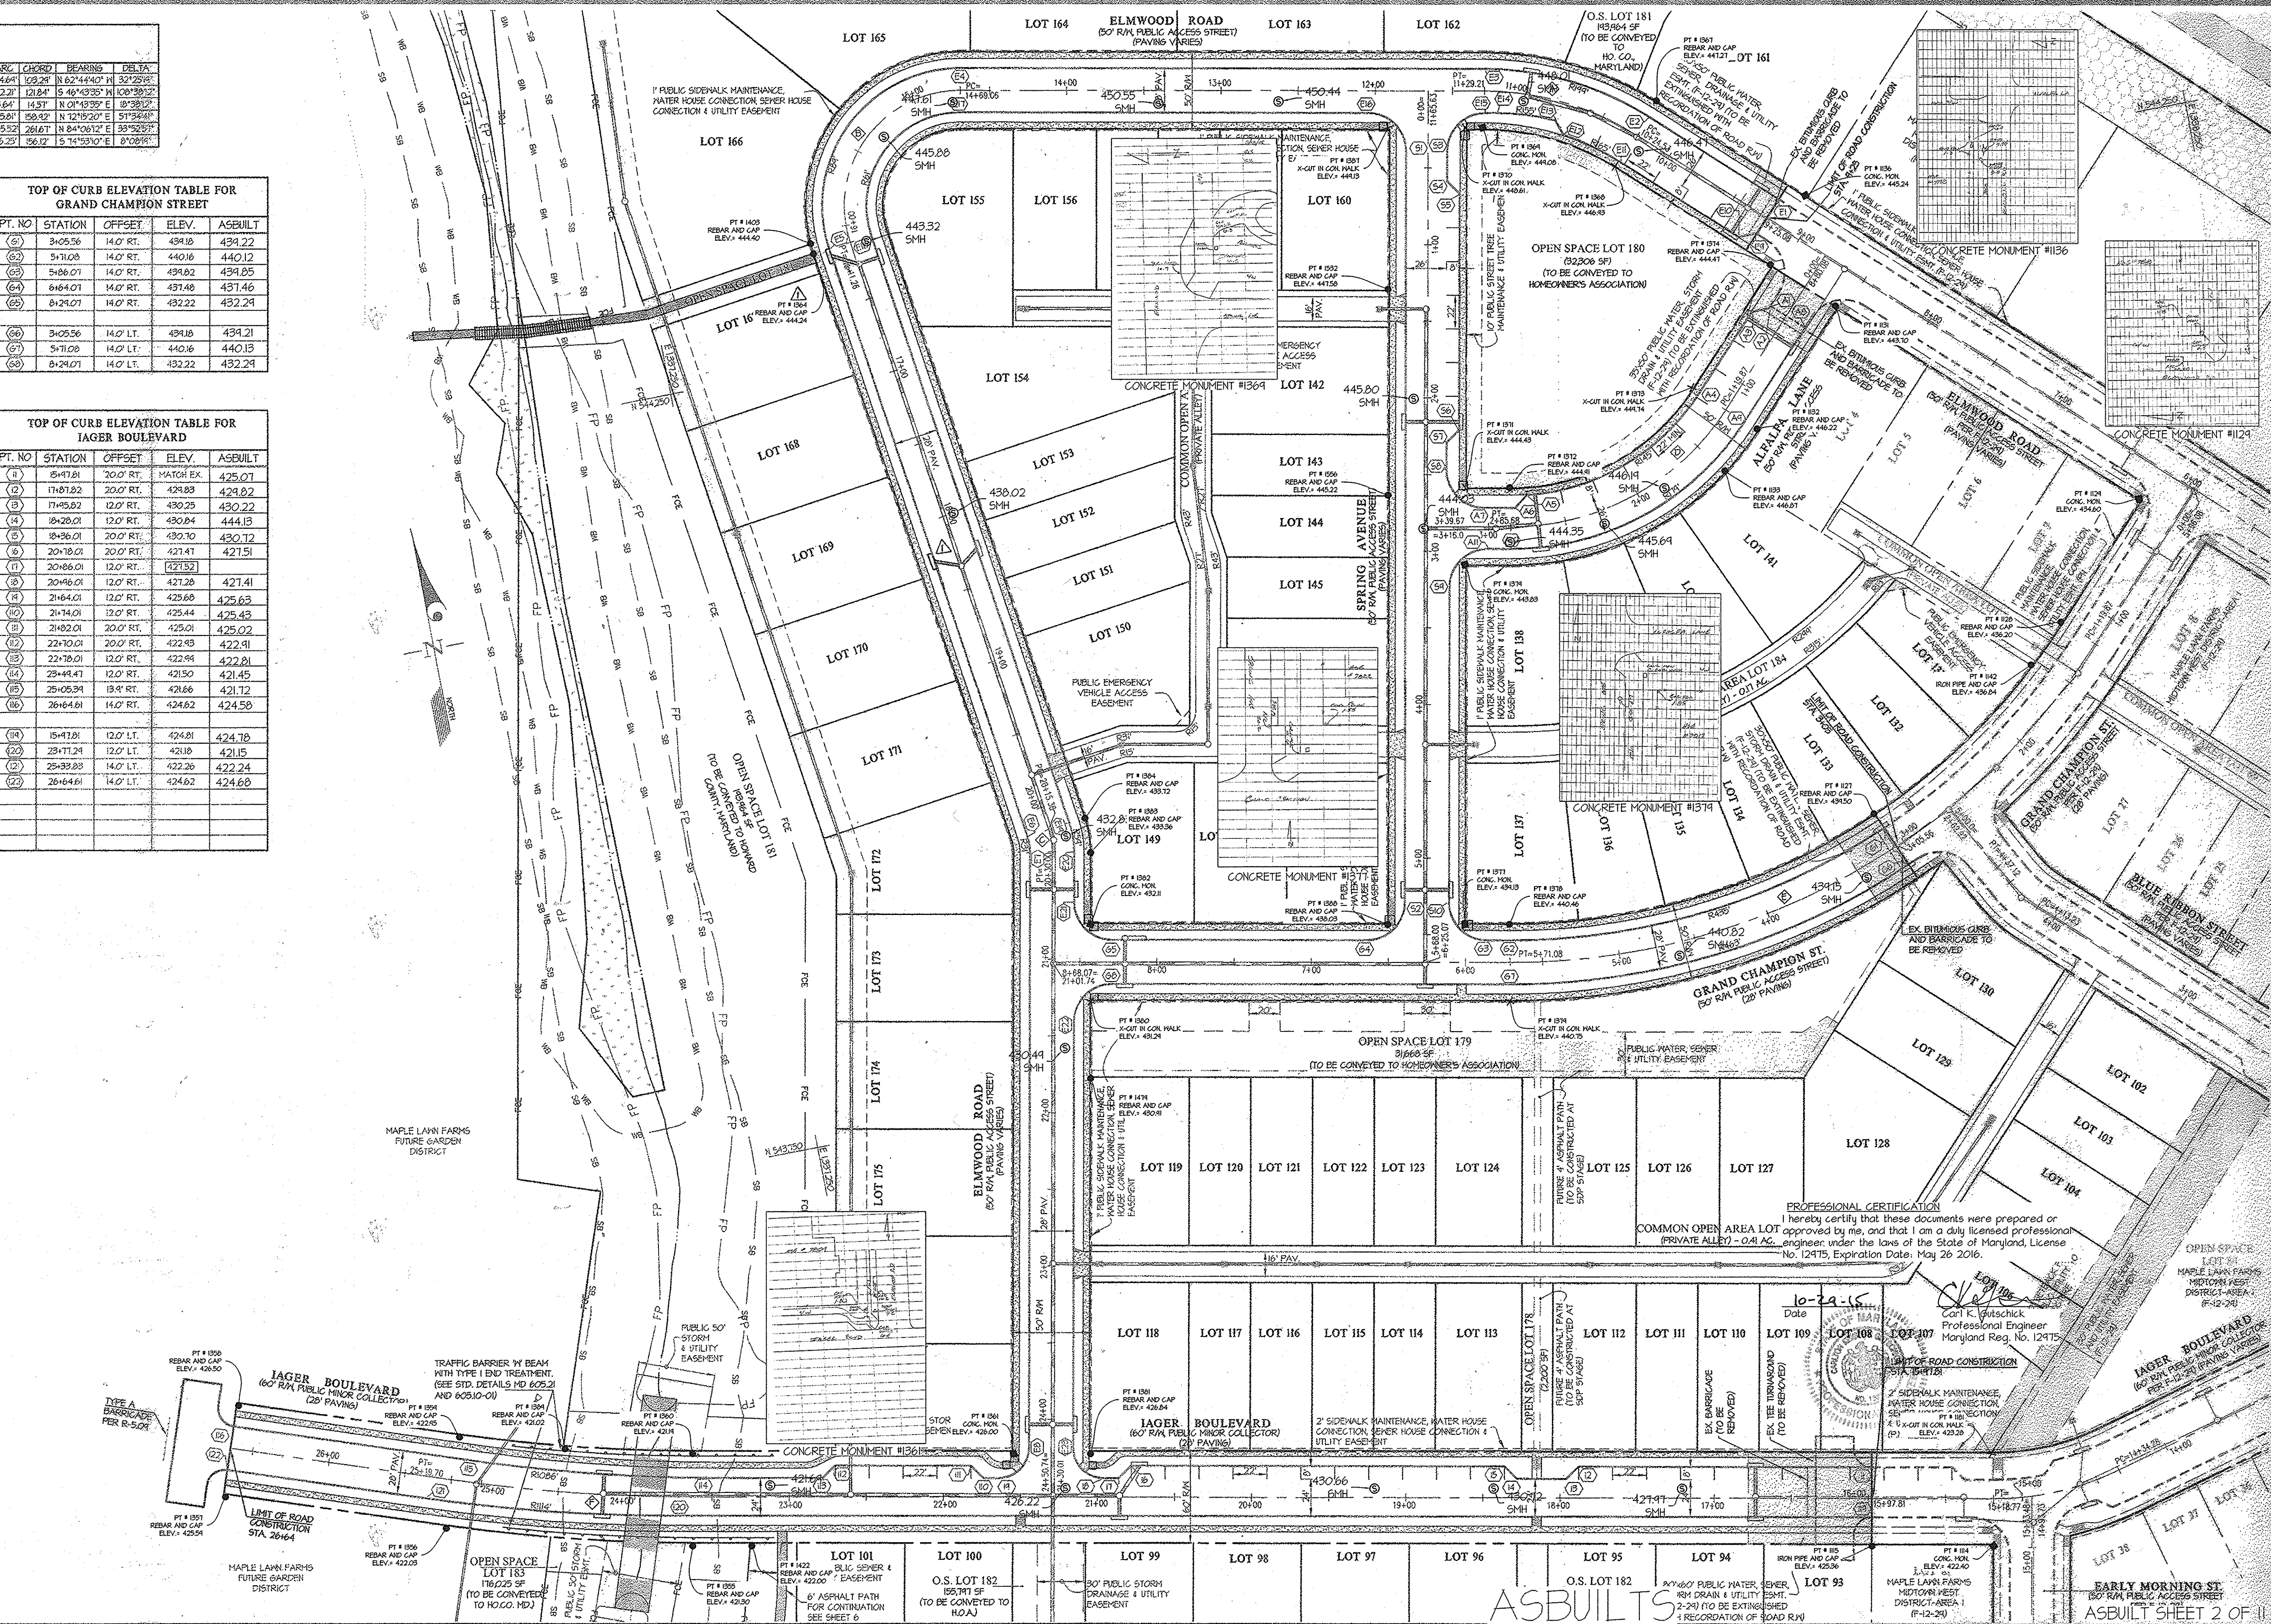


**GLWGUTSCHICK LITTLE & WEBER, P.A.**  
 CIVIL ENGINEERS, LAND SURVEYORS, LAND PLANNERS, LANDSCAPE ARCHITECTS  
 3000 NATIONAL DRIVE - SUITE 250 - BURTONSVILLE OFFICE PARK  
 BURTONSVILLE, MARYLAND 20886  
 TEL: 301-421-4024 BAL: 410-880-1820 DC/VA: 301-889-2524 FAX: 301-421-4186

DATE	REVISION	BY	APP.

PREPARED FOR:  
 MAPLE LAWN FARMS, LLC  
 SUITE 300 WOODHOLM CENTER  
 1829 REISTERSTOWN ROAD  
 BALTIMORE, MD 21208  
 ATTN: MARK BENNETT  
 410-484-8400

PROFESSIONAL CERTIFICATION  
 I HEREBY CERTIFY THAT THESE PLANS WERE PREPARED OR APPROVED BY ME, AND THAT I AM A DULY LICENSED PROFESSIONAL ENGINEER UNDER THE LAWS OF THE STATE OF MARYLAND, LICENSE NO. 12475  
 EXPIRATION DATE: MAY 26, 2016  
 11-7-12

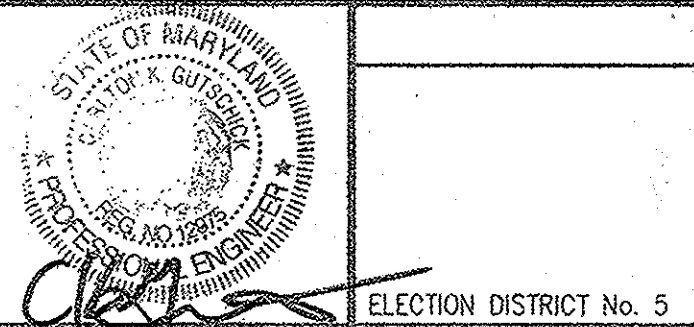

**ROAD CONSTRUCTION PLAN**  
**MAPLE LAWN FARMS**  
 MIDDOWN WEST DISTRICT - AREA 2  
 LOTS 93 THRU 177, OPEN SPACE LOTS 178 THRU 183, AND  
 COMMON OPEN AREA LOTS 184 THRU 186

SCALE	ZONING	G. L. W. FILE NO.
1" = 50'	MXD-3	11001
DATE	FAX MAP - GRID	SHEET
OCT, 2015 OCT, 2012	41-21/46-3	3 OF 25



STREET NAME	CURVE	PC STA	PT STA	RADIUS (FEET)	ARC	CHORD	BEARINGS	DELTA
ELMWOOD ROAD	1	10+24.53	11+24.21	185.00'	53.14'	104.64'	N 62°44'40" E	32°25'14"
ELMWOOD ROAD	2	14+64.06	15+11.26	15.00'	104.44'	142.21'	S 40°43'35" W	108°30'12"
ELMWOOD ROAD	3	20+53.36	20+30.00	45.00'	130'	14.64'	N 01°43'39" E	0°38'12"
ALFALFA LANE	4	11+81.21	2+05.68	185.00'	40.67'	185.81'	N 12°19'20" E	57°34'48"
GRAND CHAMPION STREET	5	3+09.56	5+11.08	444.00'	136.17'	285.52'	N 84°06'12" E	35°52'57"
JAGER BOULEVARD	6	23+63.45	25+11.10	100.00'	19.26'	156.22'	S 74°53'02" E	87°02'51"

PT. NO.	STATION	OFFSET	ELEV.	ASBUILT
(E1)	8+25.08	14.0' RT.	445.25	445.03
(E2)	10+24.53	14.0' RT.	446.86	446.62
(E3)	11+24.21	14.0' RT.	448.70	448.70
(E4)	14+64.06	14.0' RT.	448.22	441.83
(E5)	18+11.26	14.0' RT.	444.31	443.96
(E6)	20+53.36	14.0' RT.	439.50	
(E7)	20+30.00	14.0' RT.	438.41	433.12
(E8)	24+18.14	14.0' RT.	426.30	426.31
(E9)	14+25.68	12.0' LT.	445.32	445.10
(E10)	14+33.68	20.0' LT.	445.29	445.21
(E11)	10+24.53	20.0' LT.	446.79	446.83
(E12)	10+10.81	20.0' LT.	441.55	441.63
(E13)	10+14.23	12.4' LT.	441.42	441.98
(E14)	11+20.15	15.8' LT.	448.56	448.71
(E15)	11+25.58	14.0' LT.	448.64	448.24
(E16)	12+04.63	14.0' LT.	444.45	444.91
(E17)	14+64.06	14.0' LT.	448.22	448.24
(E18)	18+11.26	14.0' LT.	443.88	444.13
(E19)	20+53.36	14.0' LT.	439.56	433.44
(E20)	20+30.00	14.0' LT.	439.11	433.11
(E21)	21+40.74	14.0' LT.	431.17	431.14
(E22)	24+18.14	14.0' LT.	428.55	426.53

PT. NO.	STATION	OFFSET	ELEV.	ASBUILT
(G1)	3+09.56	14.0' RT.	434.18	434.22
(G2)	5+11.08	14.0' RT.	440.16	440.12
(G3)	5+88.07	14.0' RT.	434.82	434.85
(G4)	8+16.07	14.0' RT.	437.48	437.46
(G5)	8+24.07	14.0' RT.	432.22	432.24
(G6)	3+09.56	14.0' LT.	434.18	434.21
(G7)	5+11.08	14.0' LT.	440.16	440.13
(G8)	8+24.07	14.0' LT.	432.22	432.24

PT. NO.	STATION	OFFSET	ELEV.	ASBUILT
(J1)	5+11.21	20.0' RT.	425.07	425.07
(J2)	17+61.82	20.0' RT.	424.83	424.82
(J3)	17+55.82	12.0' RT.	430.25	430.22
(J4)	18+28.01	12.0' RT.	430.84	444.13
(J5)	18+36.01	20.0' RT.	430.70	430.72
(J6)	20+18.01	20.0' RT.	421.41	421.51
(J7)	20+86.01	12.0' RT.	421.52	
(J8)	20+46.01	12.0' RT.	421.28	421.41
(J9)	21+64.01	12.0' RT.	425.68	425.63
(J10)	21+14.01	12.0' RT.	425.44	425.43
(J11)	21+82.01	20.0' RT.	425.01	425.02
(J12)	22+10.01	20.0' RT.	422.83	422.91
(J13)	22+18.01	12.0' RT.	422.84	422.81
(J14)	23+44.47	12.0' RT.	421.50	421.45
(J15)	23+05.34	13.4' RT.	421.66	421.72
(J16)	26+64.61	14.0' RT.	424.62	424.58
(J17)	15+47.81	12.0' LT.	424.81	424.78
(J18)	23+11.24	12.0' LT.	421.18	421.15
(J19)	23+33.83	14.0' LT.	422.26	422.24
(J20)	26+64.61	14.0' LT.	424.62	424.68


PT. NO.	STATION	OFFSET	ELEV.	ASBUILT
(S1)	0+31.00	14.0' RT.	448.61	448.74
(S2)	5+24.00	14.0' RT.	438.87	438.42
(S3)	0+31.00	12.0' LT.	448.61	444.72
(S4)	0+24.00	12.0' LT.	448.44	448.48
(S5)	0+67.00	20.0' LT.	448.12	448.07
(S6)	2+12.00	20.0' LT.	445.62	445.71
(S7)	2+28.00	12.0' LT.	445.68	445.62
(S8)	2+41.00	12.0' LT.	445.21	445.21
(S9)	3+23.00	14.0' LT.	443.50	443.44
(S10)	5+24.00	14.0' LT.	438.87	438.90

PT. NO.	STATION	OFFSET	ELEV.	ASBUILT
(A1)	0+41.58	12.0' RT.	444.63	444.70
(A2)	0+44.15	12.0' RT.	444.56	444.70
(A3)	0+51.15	20.0' RT.	444.62	444.93
(A4)	1+48.97	20.0' RT.	446.08	446.03
(A5)	2+13.81	20.0' RT.	445.00	445.01
(A6)	2+82.44	12.0' RT.	445.03	445.00
(A7)	3+02.87	12.0' RT.	444.36	444.66
(A8)	0+41.58	14.0' LT.	444.37	444.31
(A9)	1+48.28	14.0' LT.	446.28	446.14
(A10)	2+85.84	14.0' LT.	444.86	444.91
(A11)	3+02.87	14.0' LT.	444.95	444.44

**NOTES**

- ROAD CONSTRUCTION PROFILE FOR ELMWOOD ROAD, ALFALFA LANE AND SPRING AVENUE IS ON SHEET 4.
- ROAD CONSTRUCTION PROFILE FOR JAGER BOULEVARD AND GRAND CHAMPION STREET IS ON SHEET 5.
- ALL CURB RADIUS ARE 25' UNLESS OTHERWISE NOTED.
- FOR TYPICAL ROAD SECTIONS SEE SHEET 6.
- FOR STREET TREE AND STREET LIGHT INFORMATION SEE SHEET 7.
- FOR STORM DRAIN INFORMATION SEE SHEET 8.
- ALL STORM DRAIN IN COMMON OPEN AREAS SHALL BE PRIVATELY OWNED AND MAINTAINED.
- A PUBLIC SIDEWALK MAINTENANCE, WATER HOUSE CONNECTION, SEWER HOUSE CONNECTION & UTILITY EASEMENT HAS BEEN ADDED TO LOTS WITH FRONT AND/OR REAR LOT LINES ADJACENT TO A PUBLIC RIGHT-OF-WAY.
- ALL SIDEWALK IS 4' UNLESS OTHERWISE NOTED.
- ALL SIDEWALKS THAT END WITH A HANDICAP RAMP MUST MEET HOWARD COUNTY STANDARD R-4.02 SIDEWALK RAMP TYPE 'B'.
- THERE WILL BE A 10' TRANSITION FROM 4' SIDEWALK TO 5' SIDEWALK ADJACENT TO THE CURB. THE 5' WIDTH IS TO BE MEASURED FROM THE BACK OF CURB.

APPROVED: HOWARD COUNTY DEPARTMENT OF PUBLIC WORKS  
*Diane Schury*, Acting Chief, Bureau of Highways, 11/29/12  
 APPROVED: HOWARD COUNTY DEPARTMENT OF PLANNING & ZONING  
*Walt DeLuca*, Chief, Division of Land Development, 12/16/12  
*Chad Edwards*, Chief, Development Engineering Division, 12-6-12

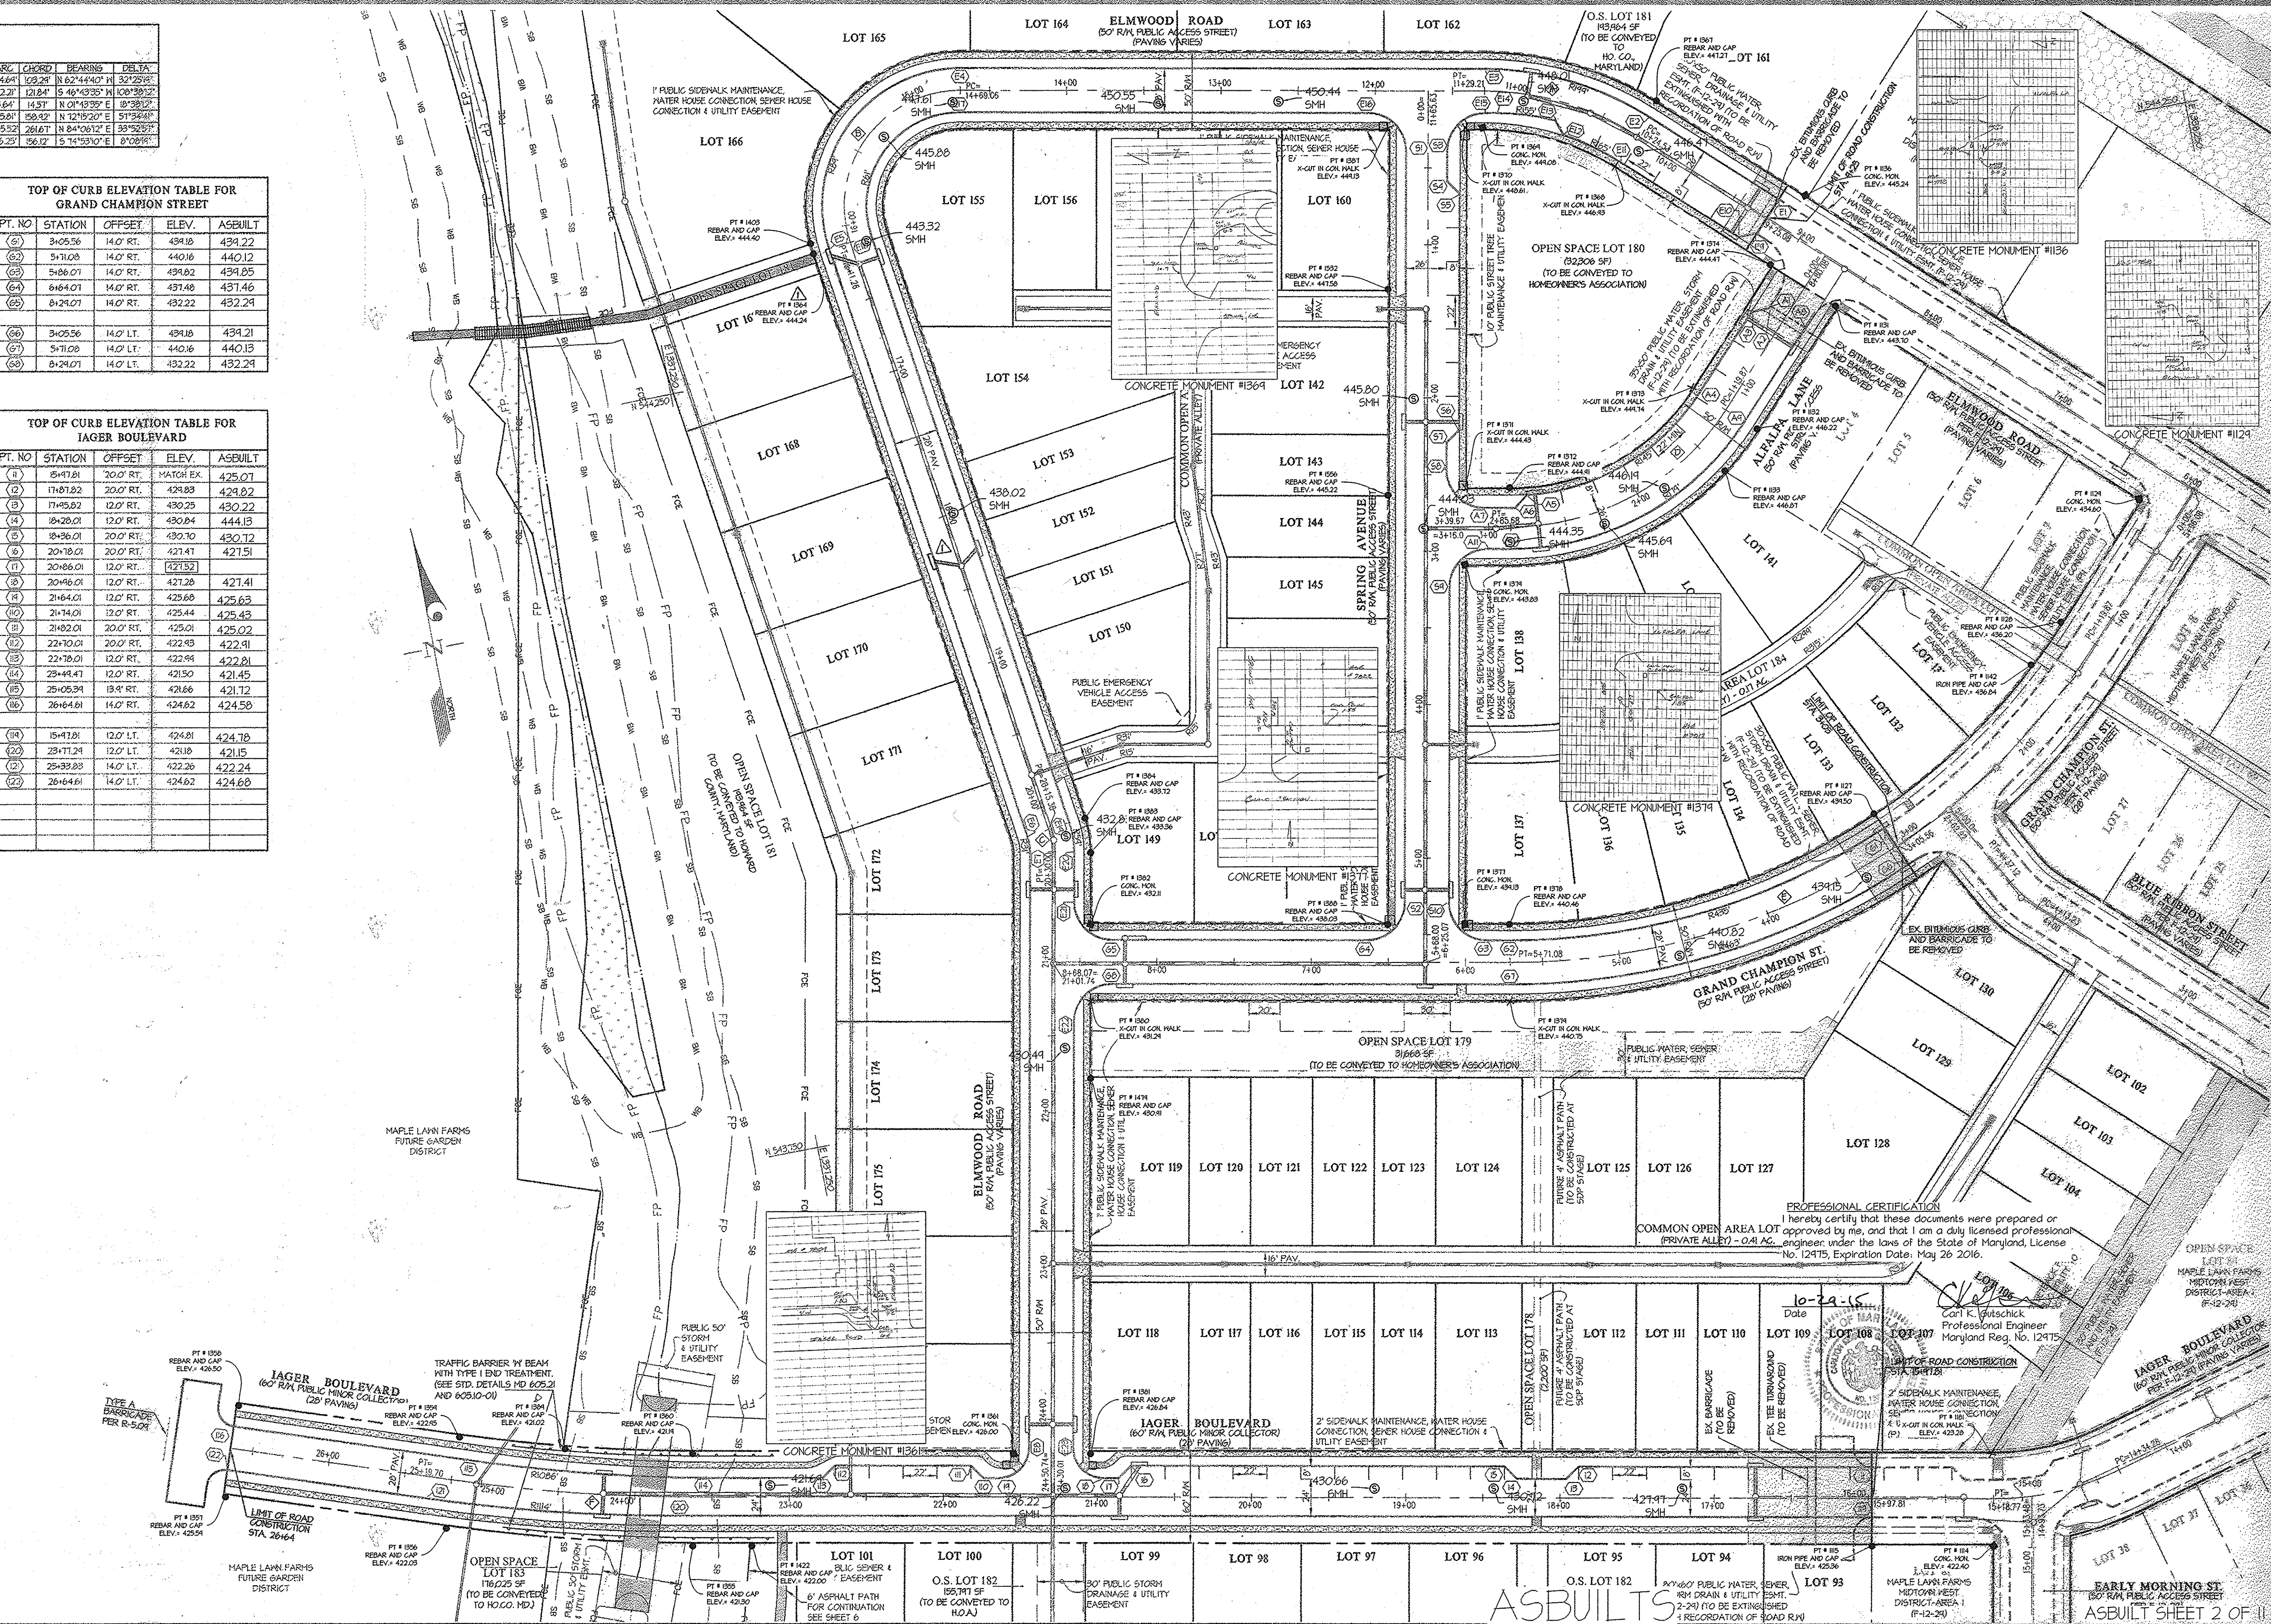

**GLWGUTSCHICK LITTLE & WEBER, P.A.**  
 CIVIL ENGINEERS, LAND SURVEYORS, LAND PLANNERS, LANDSCAPE ARCHITECTS  
 3000 NATIONAL DRIVE - SUITE 250 - BURTONSVILLE OFFICE PARK  
 BURTONSVILLE, MARYLAND 20886  
 TEL: 301-421-4024 BAL: 410-880-1820 DC/VA: 301-888-2524 FAX: 301-421-4186


PREPARED FOR:  
 MAPLE LAWN FARMS, LLC  
 SUITE 300 WOODHOLM CENTER  
 1829 REISTERSTOWN ROAD  
 BALTIMORE, MD 21208  
 ATTN: MARK BENNETT  
 410-484-8400

PROFESSIONAL CERTIFICATION  
 I HEREBY CERTIFY THAT THESE PLANS WERE PREPARED OR APPROVED BY ME, AND THAT I AM A DULY LICENSED PROFESSIONAL ENGINEER UNDER THE LAWS OF THE STATE OF MARYLAND, LICENSE NO. 12475  
 EXPIRATION DATE: MAY 26, 2016  
 11-7-12

**ROAD CONSTRUCTION PLAN**  
**MAPLE LAWN FARMS**  
 MIDDOWN WEST DISTRICT - AREA 2  
 LOTS 93 THRU 177, OPEN SPACE LOTS 178 THRU 183, AND  
 COMMON OPEN AREA LOTS 184 THRU 186

SCALE: 1" = 50'  
 ZONING: MXD-3  
 G. L. W. FILE NO.: 11001  
 DATE: OCT. 2015  
 OCT. 2012  
 TAX MAP - GRID: 41-21/46-3  
 SHEET: 3 OF 25  
 HOWARD COUNTY, MARYLAND



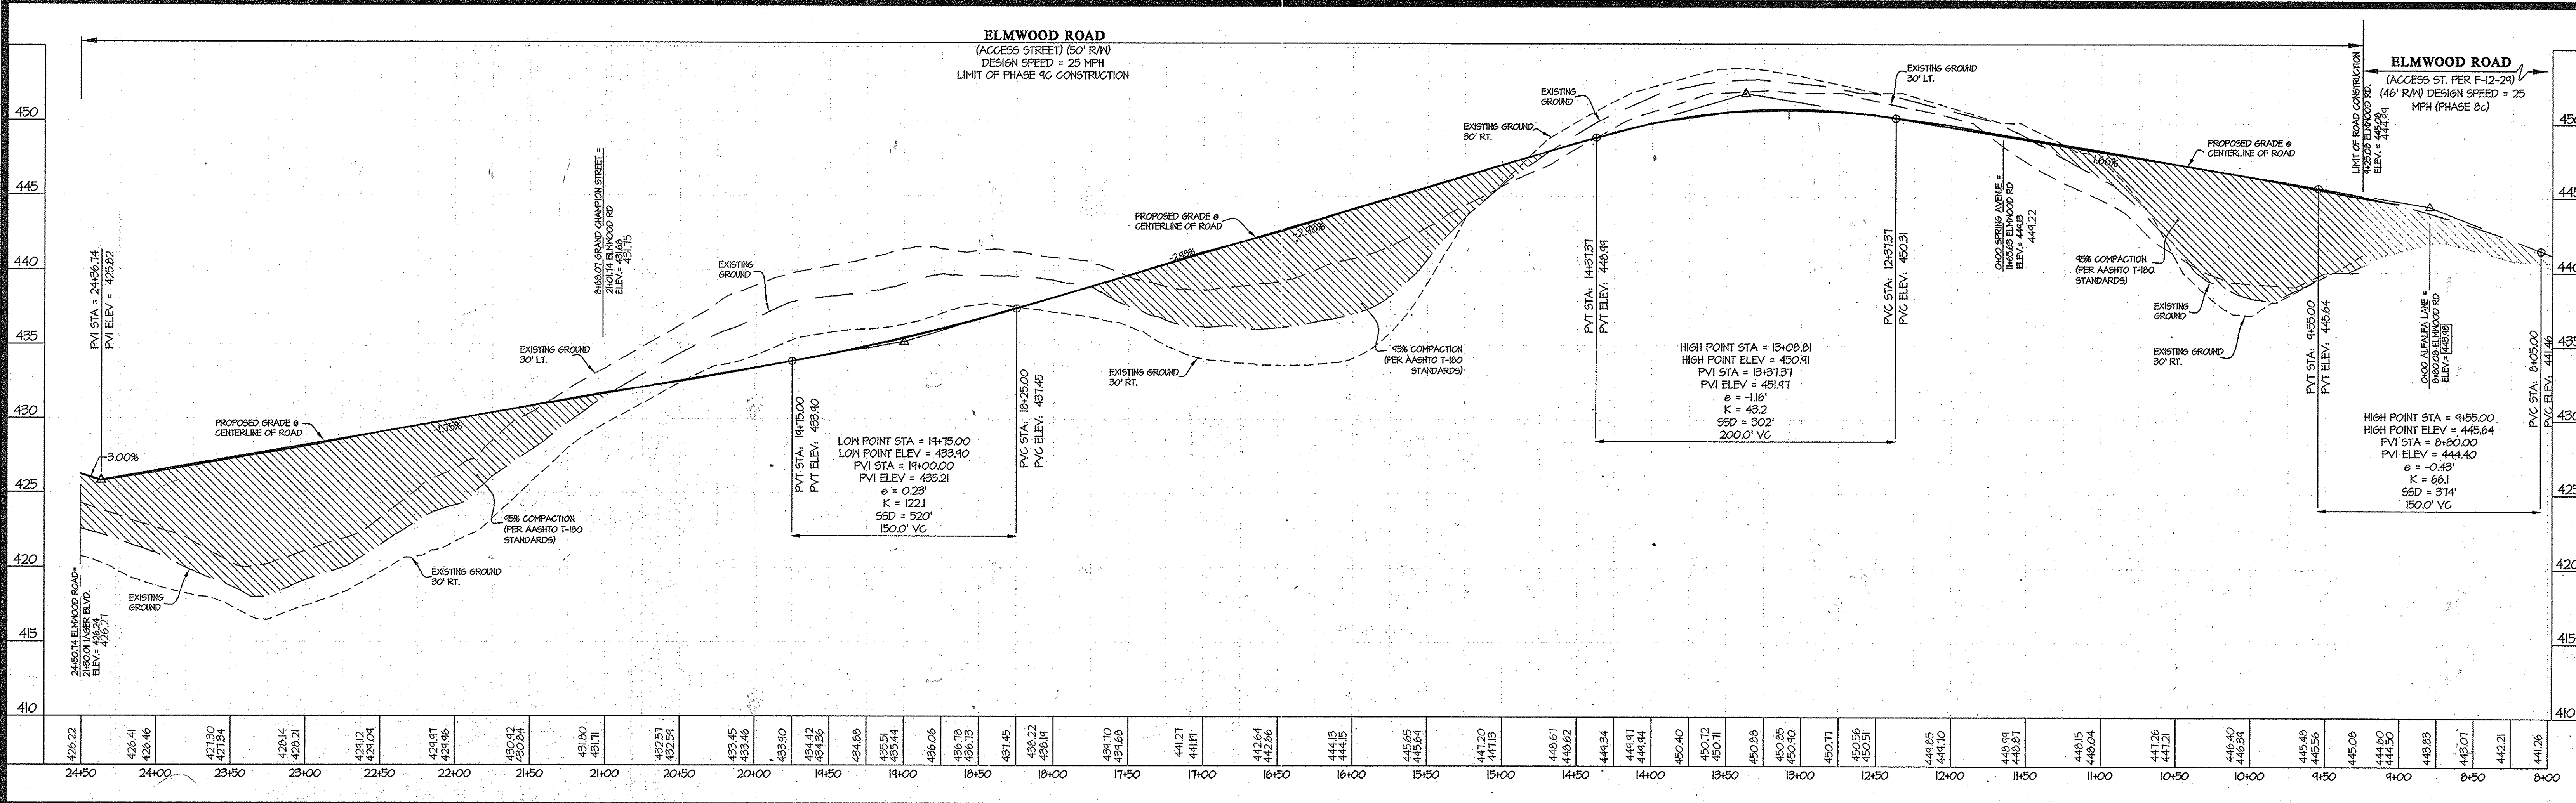


ROAD CONSTRUCTION PROFILE - ELMWOOD ROAD

**LEGEND**


- EXISTING GRADE
- EXISTING GRADE LEFT
- EXISTING GRADE RIGHT
- PROPOSED GRADE - CENTERLINE

APPROVED: HOWARD COUNTY DEPARTMENT OF PUBLIC WORKS  
*Diane Schum*, Acting Chief, Bureau of Highways, Date: 11/29/12

APPROVED: HOWARD COUNTY DEPARTMENT OF PLANNING & ZONING  
*Wesley Deane*, Chief, Division of Land Development, Date: 12/10/12  
*Chad Edwards*, Chief, Development Engineering Division, Date: 12-6-12

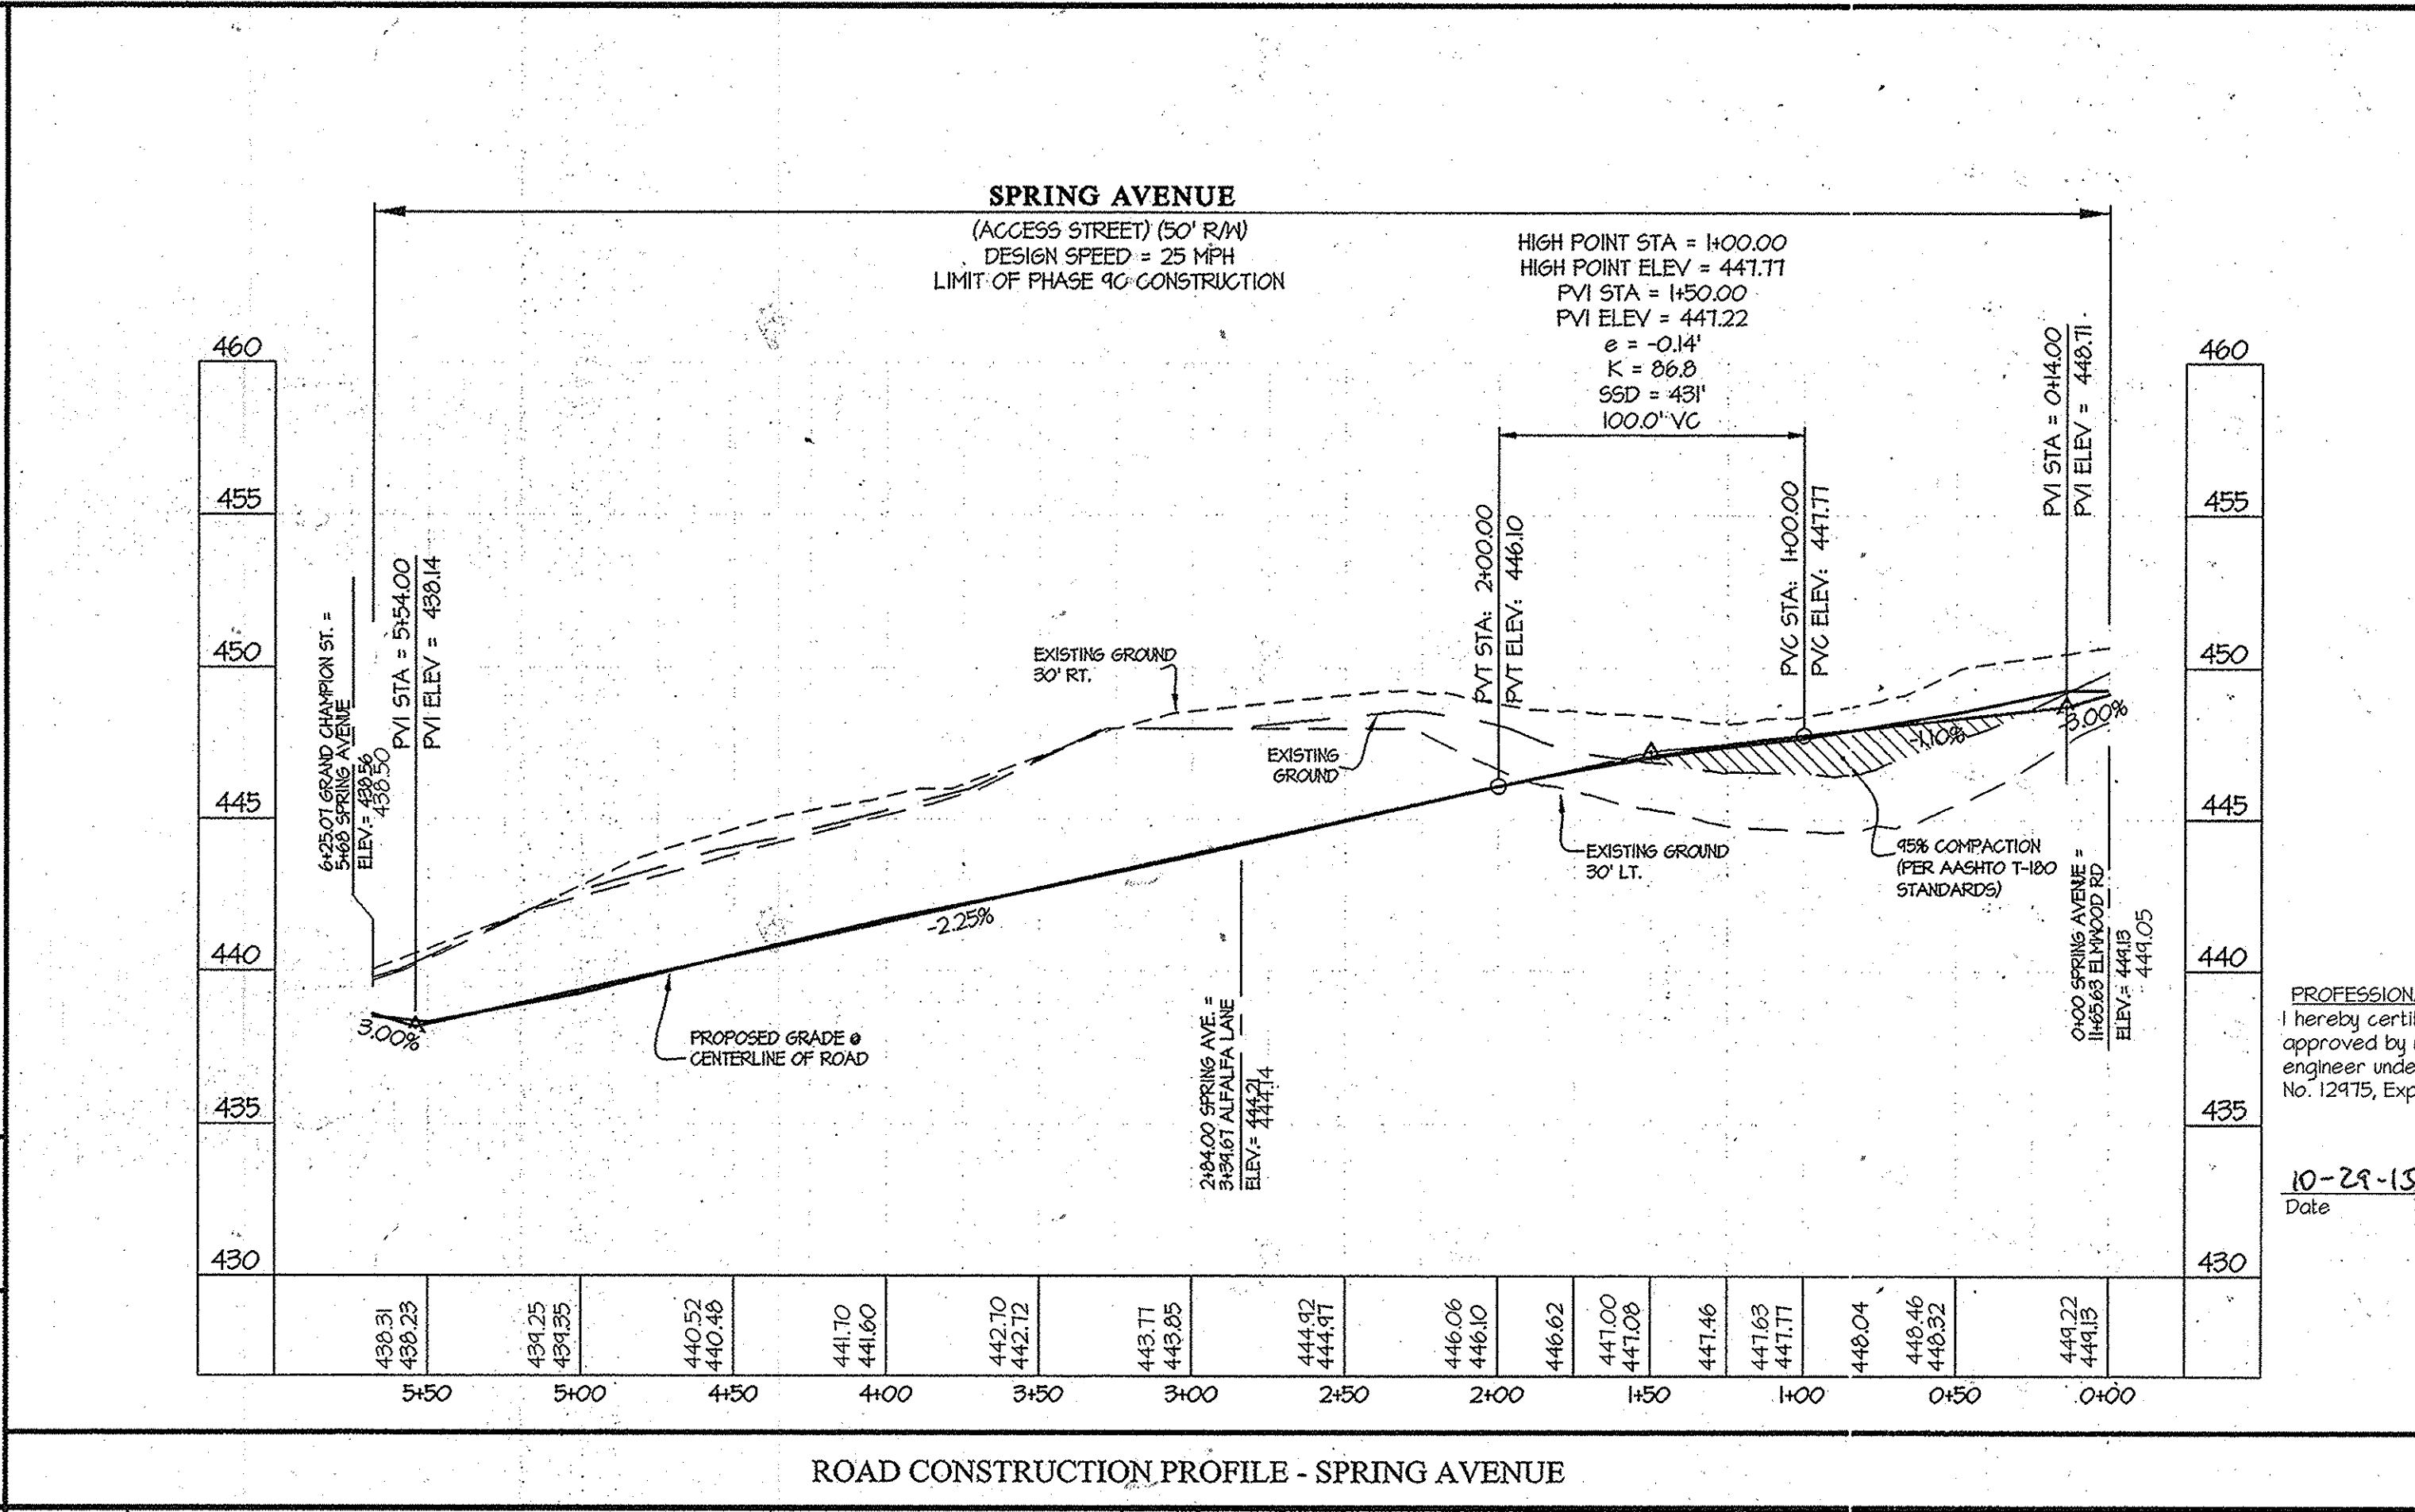

ROAD CONSTRUCTION PROFILE - SPRING AVENUE

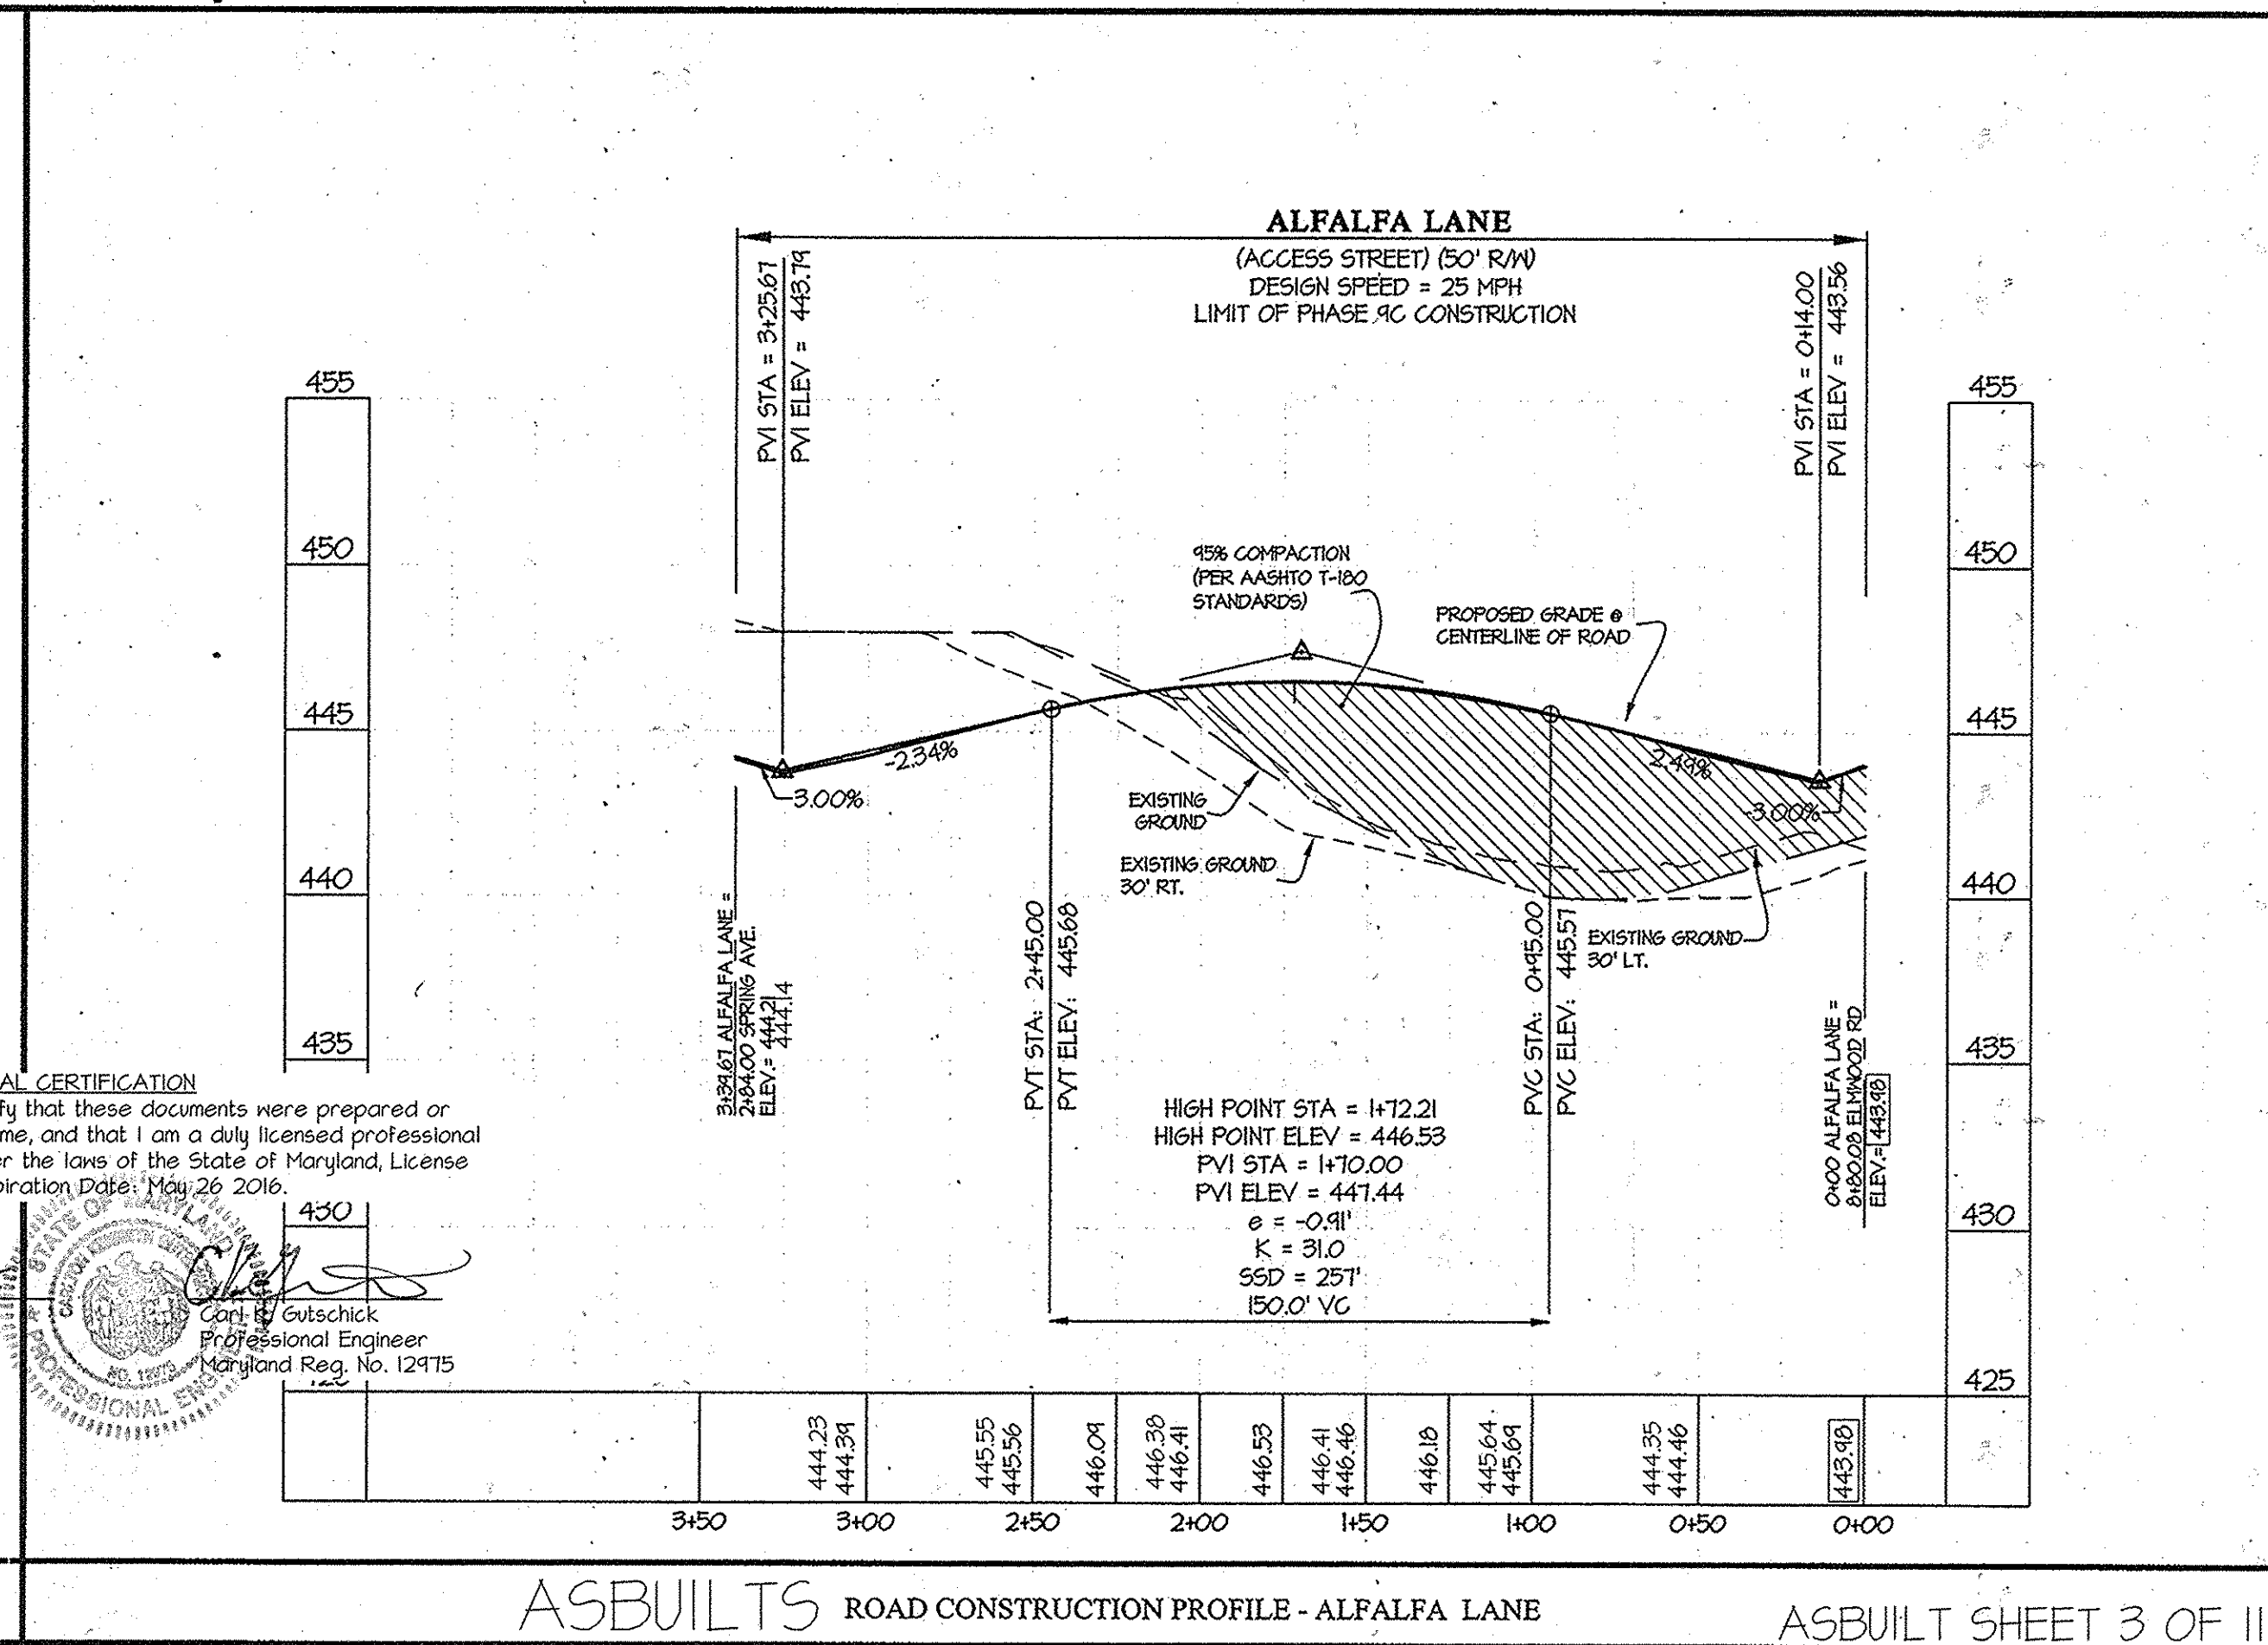


ROAD CONSTRUCTION PROFILE - ALFALFA LANE

**GLWGUTSCHICK LITTLE & WEBER, P.A.**  
 CIVIL ENGINEERS, LAND SURVEYORS, LAND PLANNERS, LANDSCAPE ARCHITECTS  
 3909 NATIONAL DRIVE - SUITE 250 - BURTONSVILLE OFFICE PARK  
 BURTONSVILLE, MARYLAND 20866  
 TEL: 301-421-4024 BAL: 410-889-1820, DC/VA: 301-288-2524 FAX: 301-421-4186

DATE	REVISION	BY	APPR.

PREPARED FOR:  
 MAPLE LAWN FARMS I, LLC  
 SUITE 300 WOODHOLME CENTER  
 1829 REISTERSTOWN ROAD  
 BALTIMORE, MD 21208  
 ATTN: MARK BENNETT  
 410-484-8400

PROFESSIONAL CERTIFICATION  
 I HEREBY CERTIFY THAT THESE PLANS WERE PREPARED OR APPROVED BY ME, AND THAT I AM A DULY LICENSED PROFESSIONAL ENGINEER UNDER THE LAWS OF THE STATE OF MARYLAND, LICENSE NO. 12975  
 EXPIRATION DATE: MAY 26, 2014  
 11-7-12

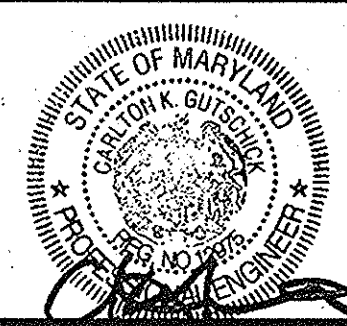


ROAD CONSTRUCTION PROFILES - ELMWOOD RD, ALFALFA LN. and SPRING AVE.

**MAPLE LAWN FARMS**  
 MIDTOWN WEST DISTRICT - AREA 2  
 LOTS 93 THRU 177, OPEN SPACE LOTS 178 THRU 183, AND  
 COMMON OPEN AREA LOTS 184 THRU 186


SCALE 1" = 50' HORIZ. 1" = 5' VERT.	ZONING MXD-3	G. L. W. FILE NO. 11001
DATE OCT. 2015 OCT. 2012	TAX MAP - GRID 41-21/46-3	SHEET 4 OF 25

HOWARD COUNTY, MARYLAND  
 ELECTION DISTRICT No. 5



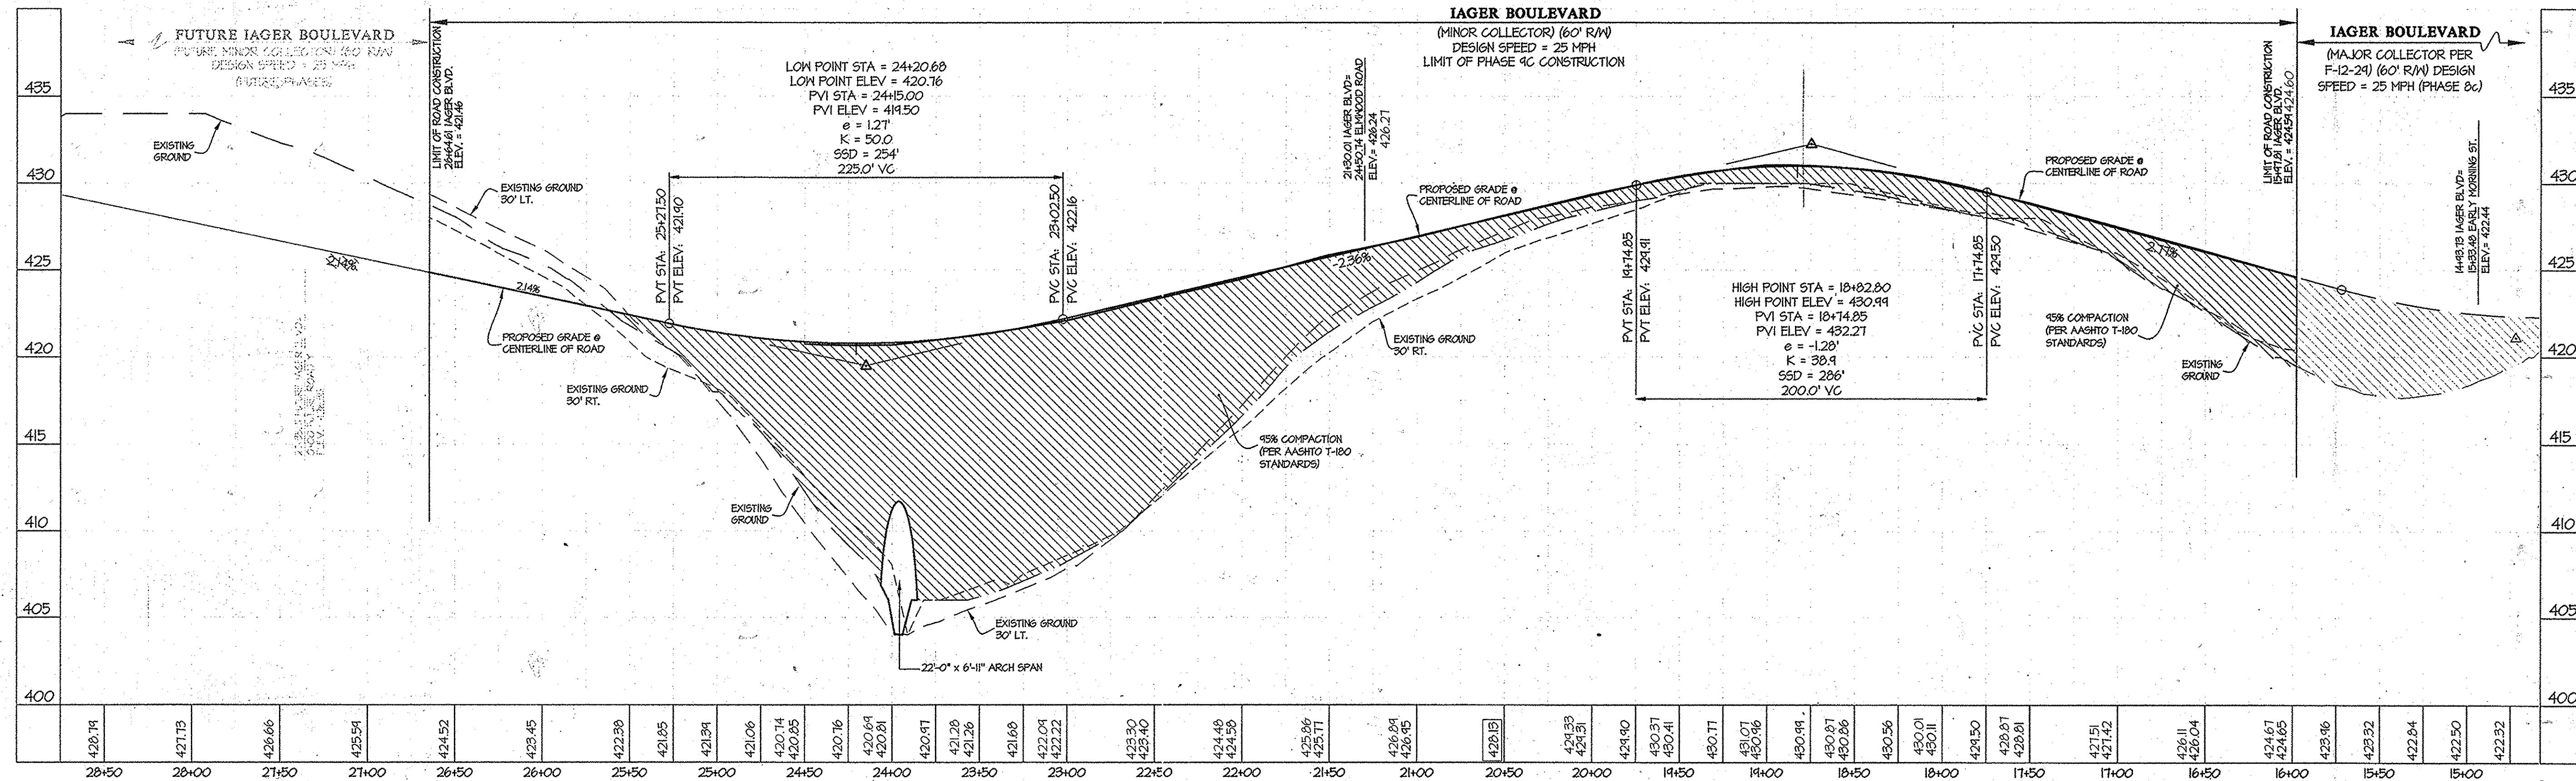

ROAD CONSTRUCTION PROFILE - IAGER BOULEVARD

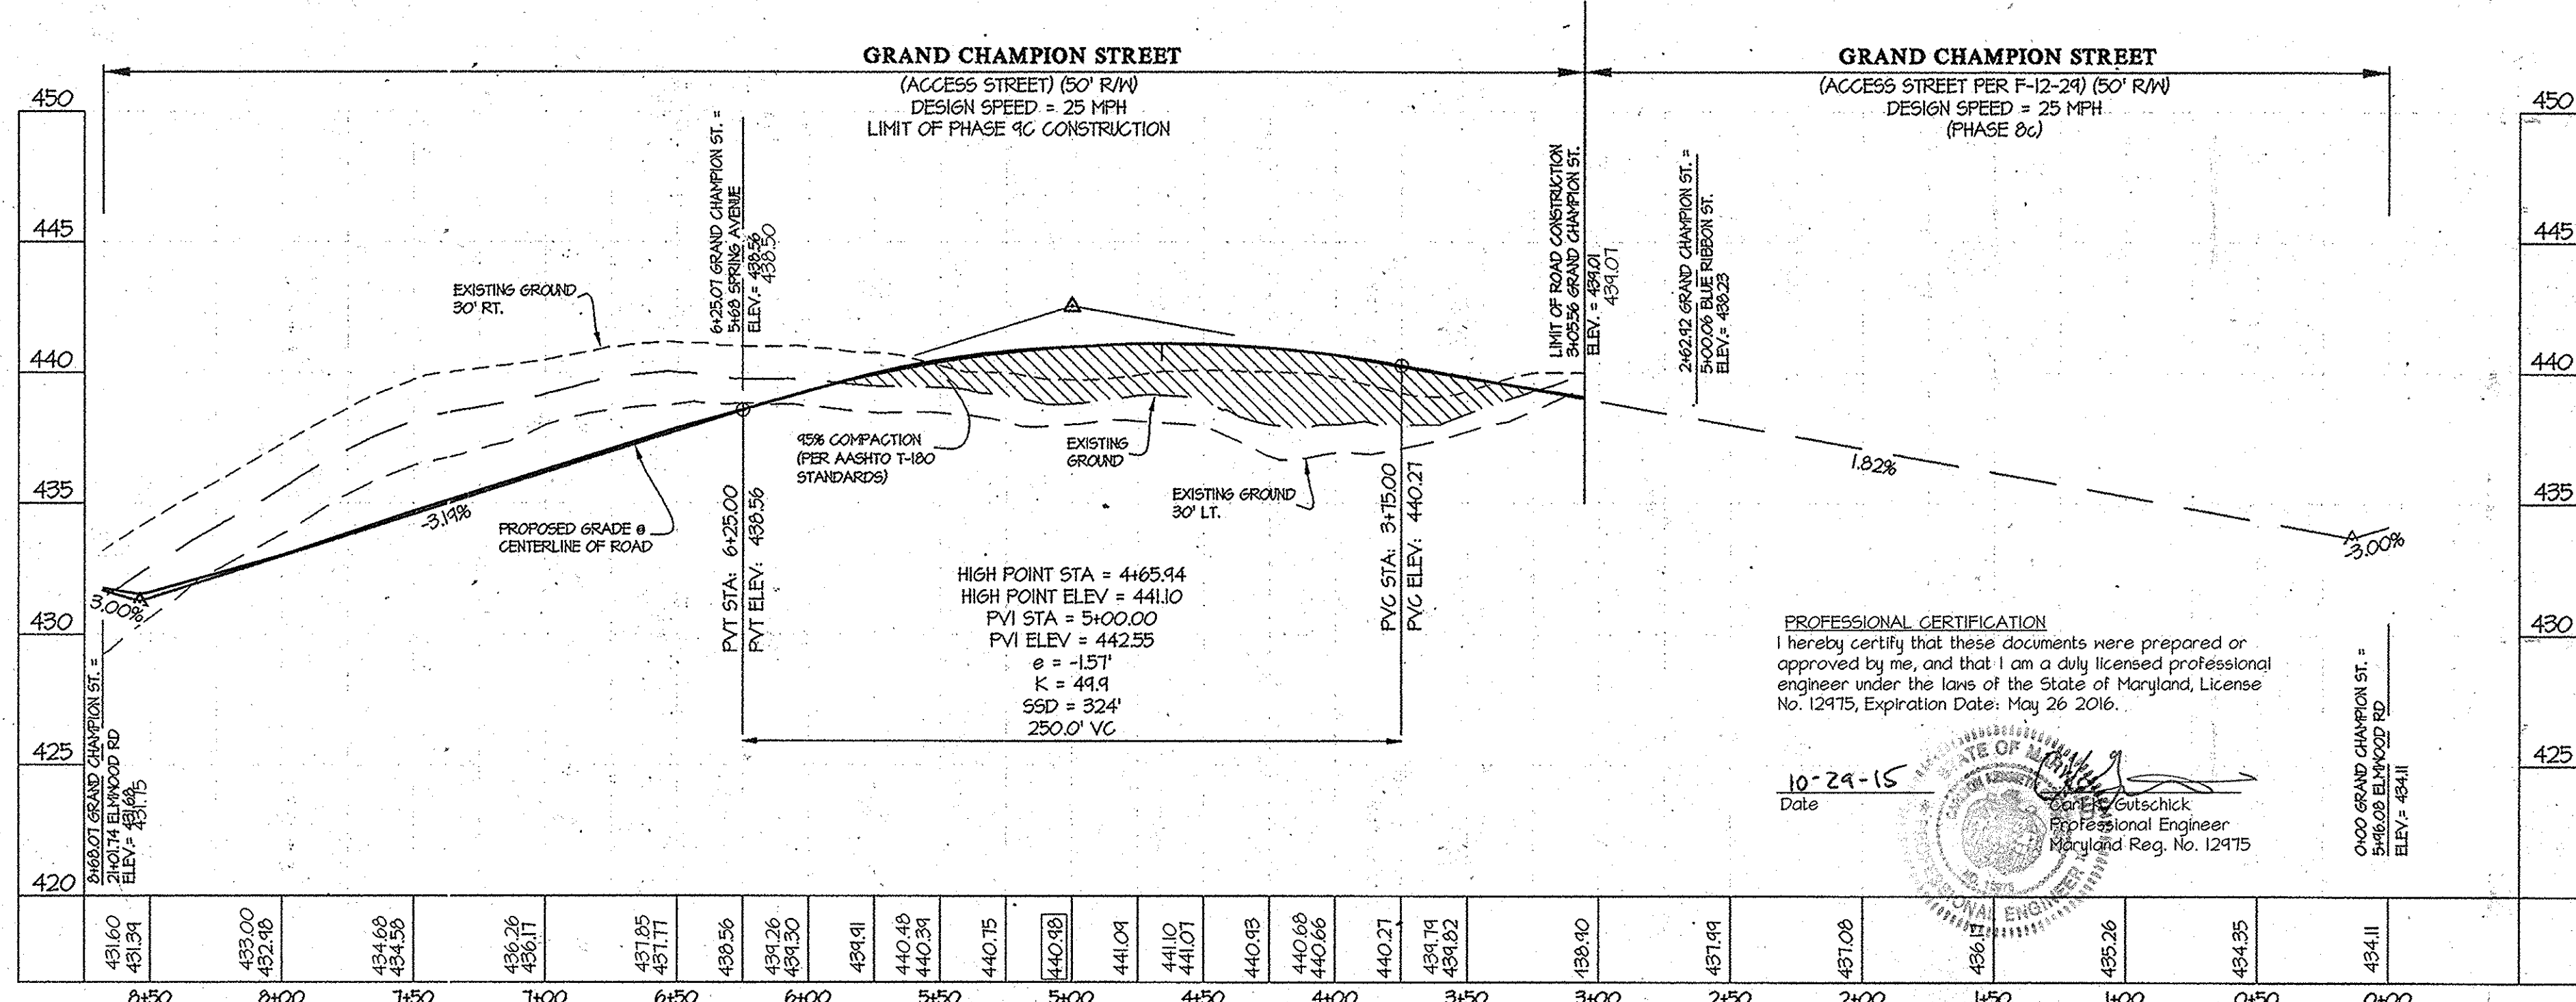

PROFESSIONAL CERTIFICATION  
I hereby certify that these documents were prepared or approved by me, and that I am a duly licensed professional engineer under the laws of the State of Maryland, License No. 12475, Expiration Date: May 26, 2016.

10-29-15  
Date  
Professional Engineer  
Maryland Reg. No. 12475

**LEGEND**

---	EXISTING GRADE
---	EXISTING GRADE LEFT
---	EXISTING GRADE RIGHT
---	PROPOSED GRADE @ CENTERLINE

APPROVED: HOWARD COUNTY DEPARTMENT OF PUBLIC WORKS  
*Diane Johnson*, Acting Chief, Bureau of Highways, 11/29/12 Date

APPROVED: HOWARD COUNTY DEPARTMENT OF PLANNING & ZONING  
*Ketola*, Chief, Division of Land Development, 12/11/12 Date

*Chad Edmondson*, Chief, Development Engineering Division, 12-6-12 Date

**GLWGUTSCHICK LITTLE & WEBER, P.A.**  
CIVIL ENGINEERS, LAND SURVEYORS, LAND PLANNERS, LANDSCAPE ARCHITECTS  
3909 NATIONAL DRIVE - SUITE 250 - BORTONSVILLE OFFICE PARK  
BORTONSVILLE, MARYLAND 20886  
TEL: 301-421-4024 BALT: 410-880-1820 DC/VA: 301-989-2524 FAX: 301-421-4186

PREPARED FOR:  
MAPLE LAWN FARMS 1, LLC  
SUITE 300 WOODHOLME CENTER  
1828 REISTERSTOWN ROAD  
BALTIMORE, MD 21208  
ATTN: MARK BENNETT  
410-484-3400

PROFESSIONAL CERTIFICATION  
I HEREBY CERTIFY THAT THESE PLANS WERE PREPARED OR APPROVED BY ME, AND THAT I AM A DULY LICENSED PROFESSIONAL ENGINEER UNDER THE LAWS OF THE STATE OF MARYLAND, LICENSE NO. 12475, EXPIRATION DATE: MAY 26, 2014  
11-7-12


ROAD CONSTRUCTION PROFILES - GRAND CHAMPION STREET and IAGER BOULEVARD

**MAPLE LAWN FARMS**  
MIDTOWN WEST DISTRICT - AREA 2  
LOTS 93 THRU 177, OPEN SPACE LOTS 178 THRU 183, AND COMMON OPEN AREA LOTS 184 THRU 186


ELECTION DISTRICT No. 5

SCALE	ZONING	G. L. W. FILE No.
1"=50' HORIZ. 1"=5' VERT.	MXD-3	11001
DATE	TAX MAP - GRID	SHEET
OCT., 2015 OCT. 2012	41-21/46-3	5 OF 25




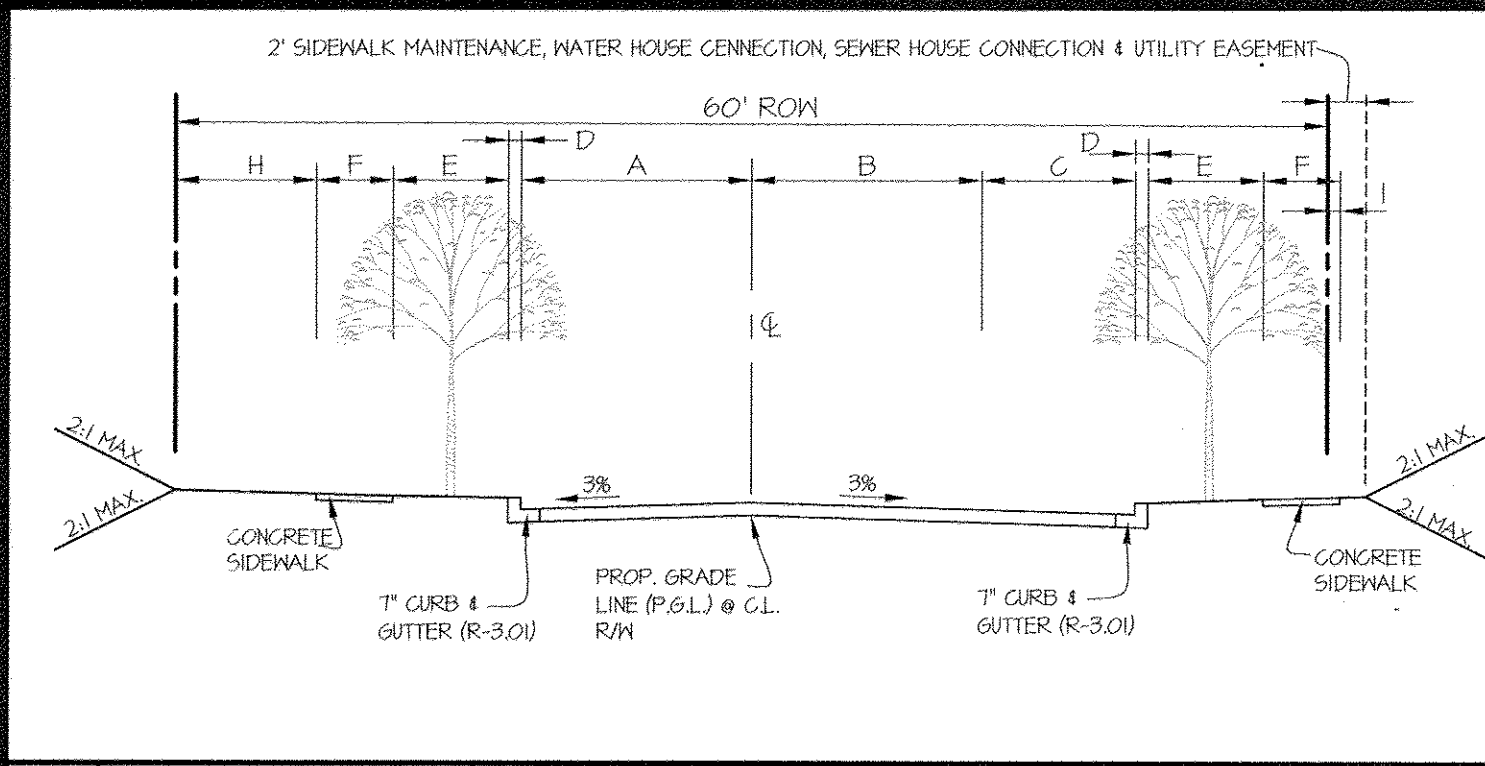


1 TYPICAL SECTION FOR 60' R/W WITH RIGHT PARALLEL PARKING NO SCALE

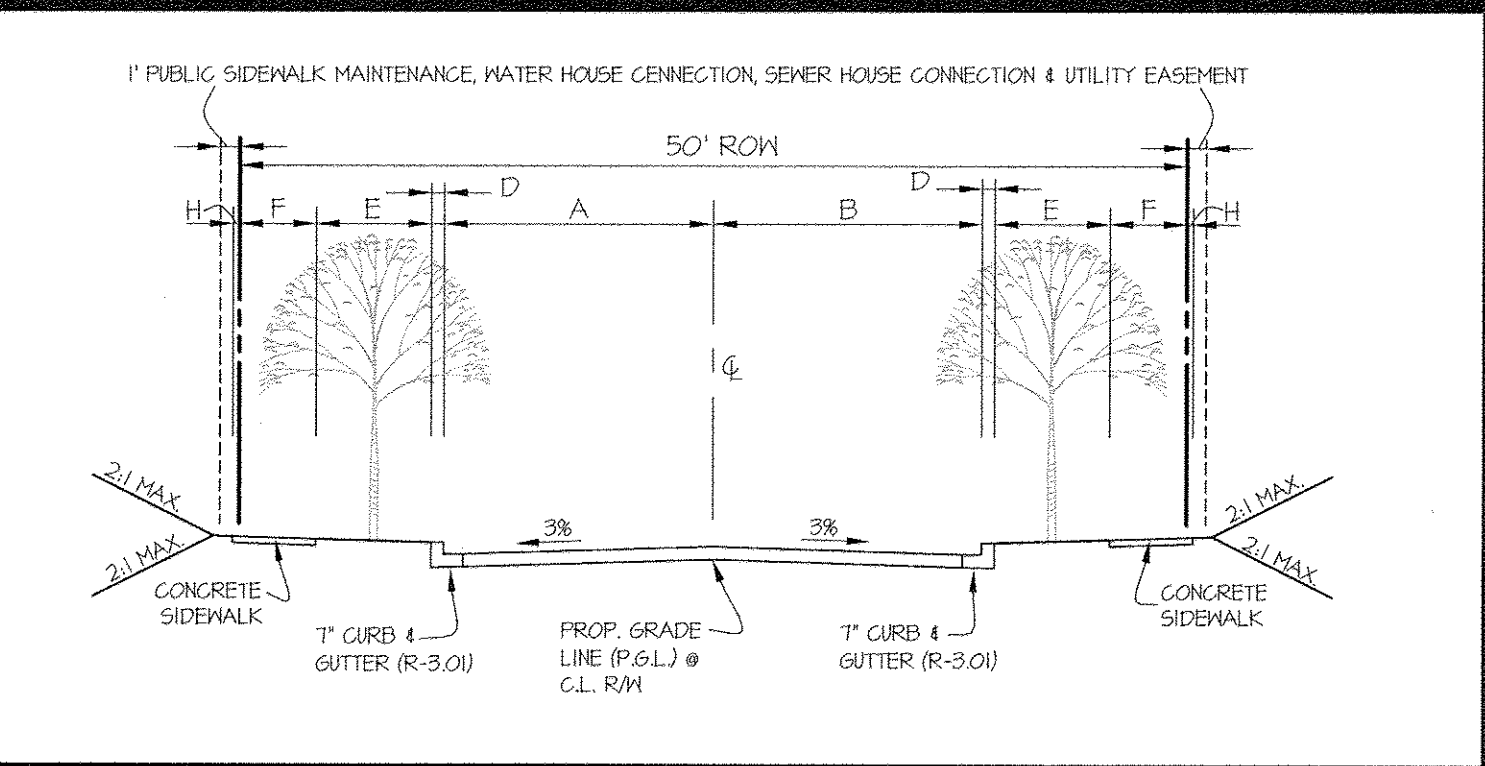


5 TYPICAL SECTION FOR 50' R/W WITH NO PARALLEL PARKING NO SCALE

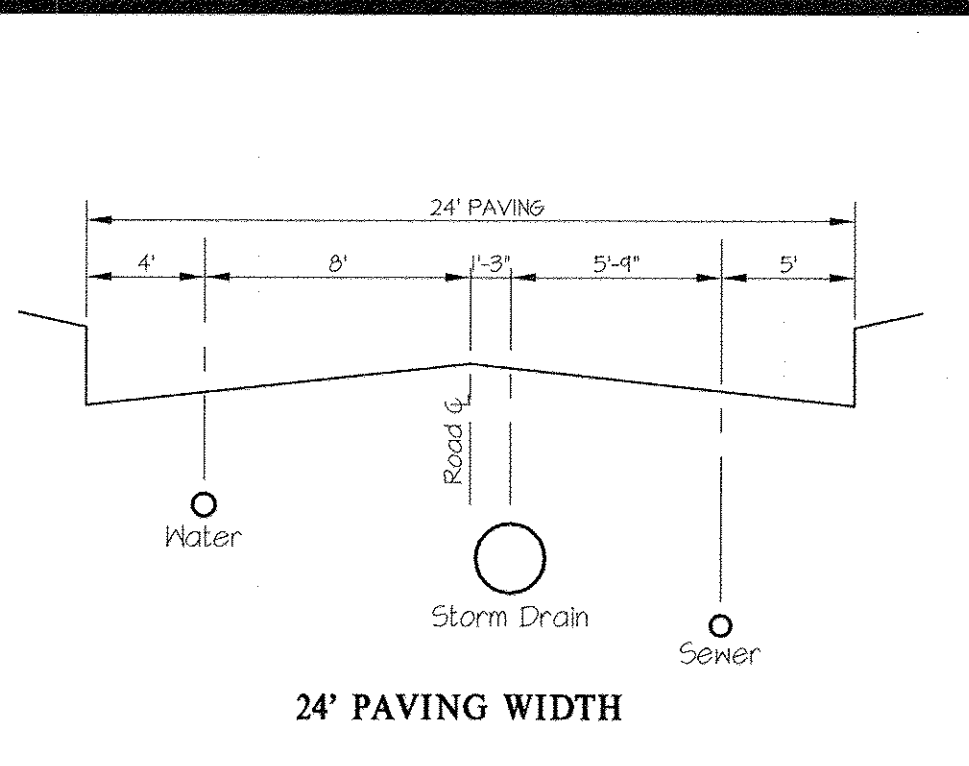


12 24' PAVING WIDTH

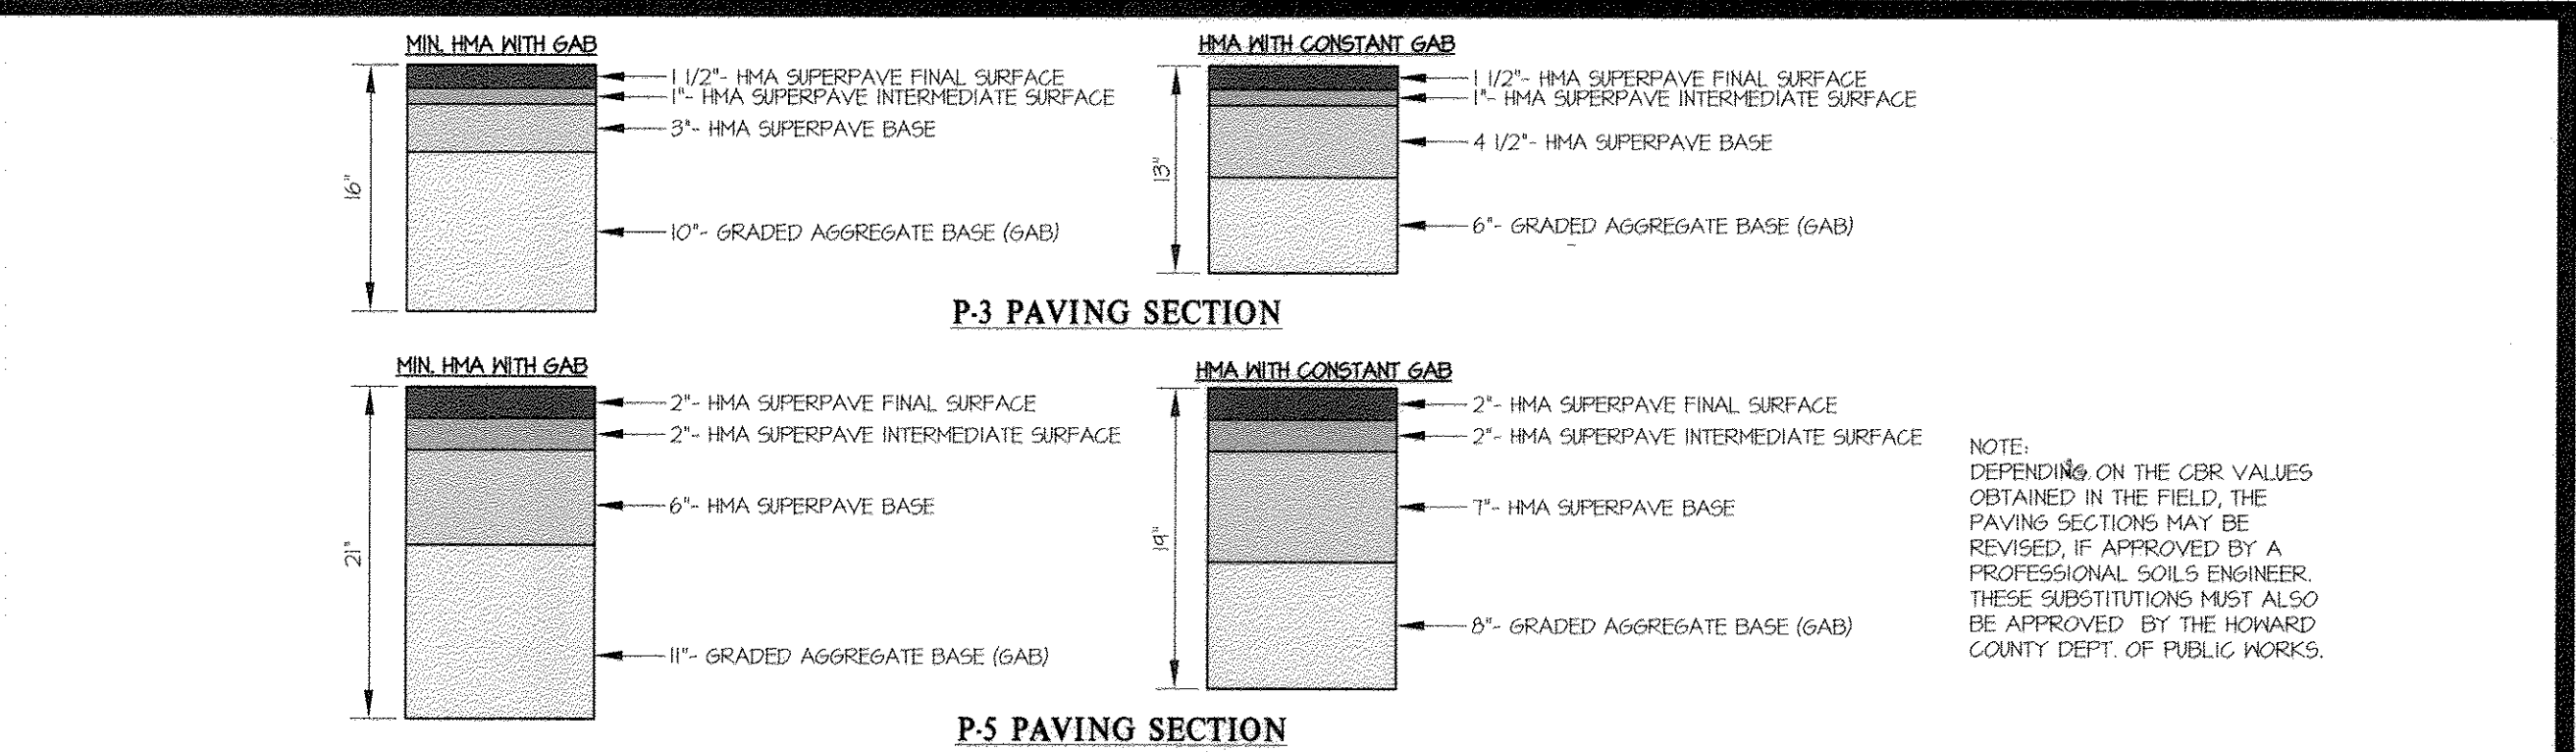


12 PAVING SECTIONS NO SCALE

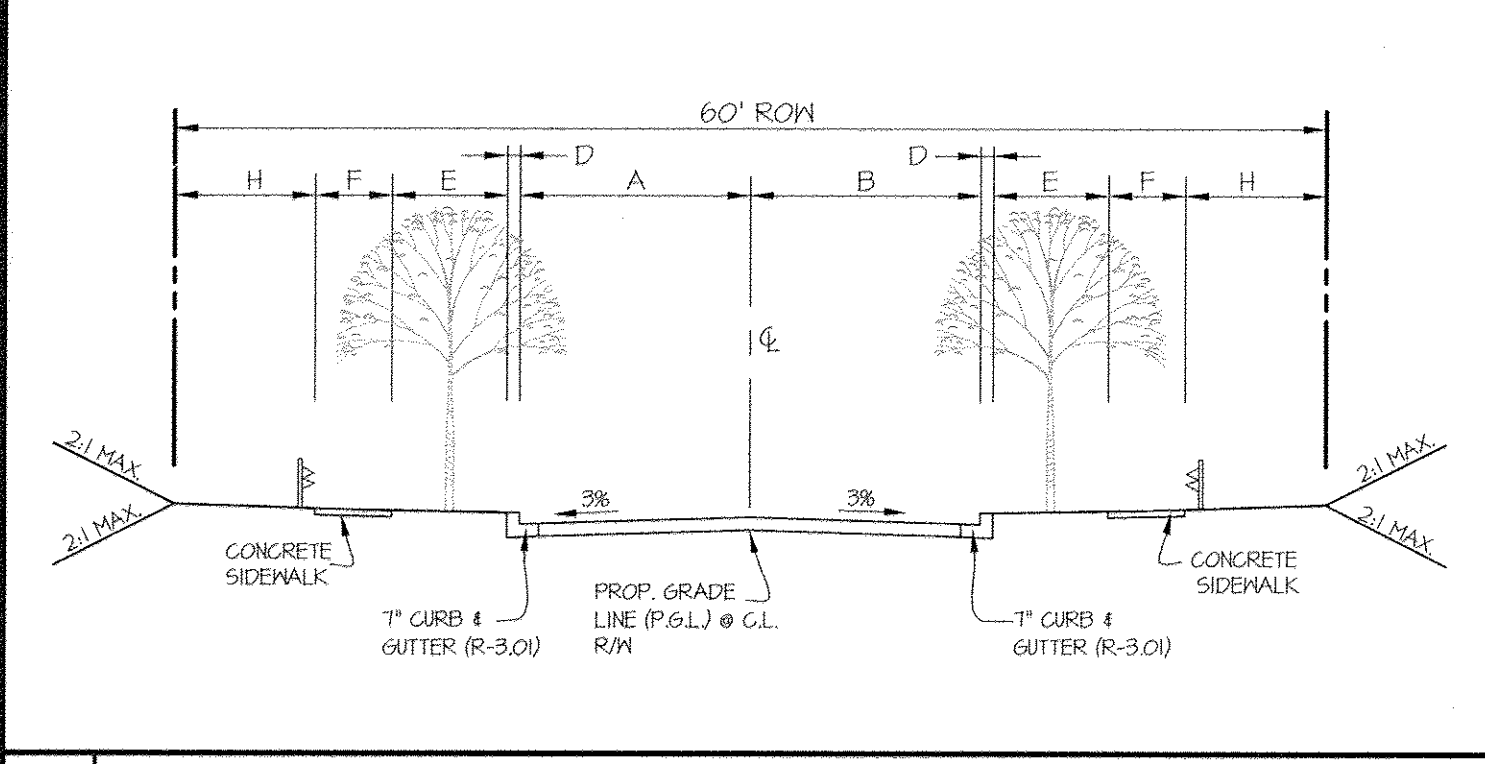


2 TYPICAL SECTION FOR 60' R/W WITH NO PARALLEL PARKING NO SCALE

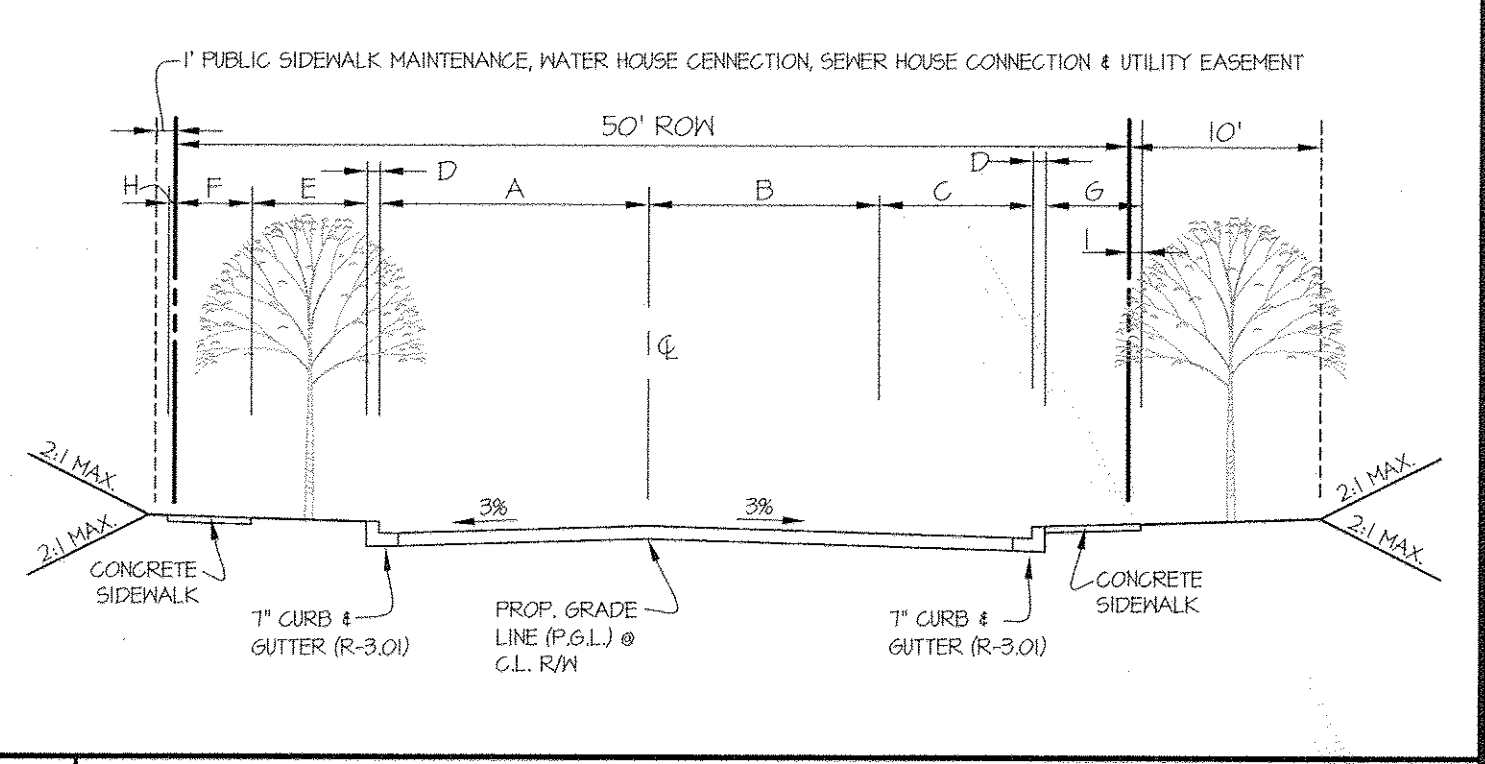


6 TYPICAL SECTION FOR 50' R/W WITH RIGHT PARALLEL PARKING NO SCALE

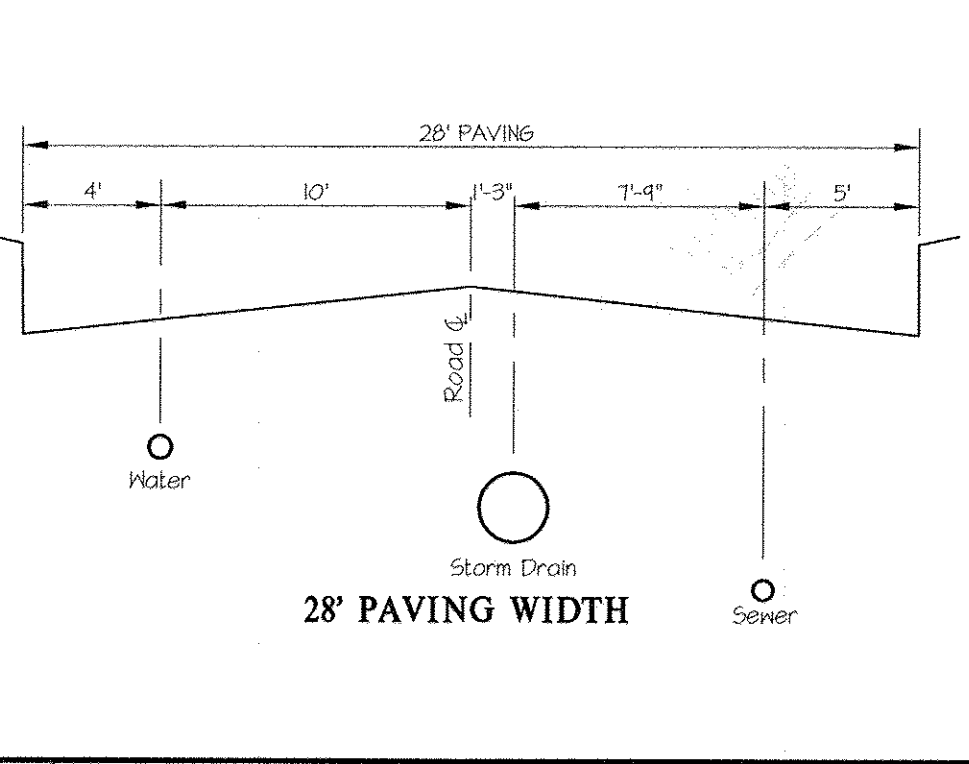


9 28' PAVING WIDTH

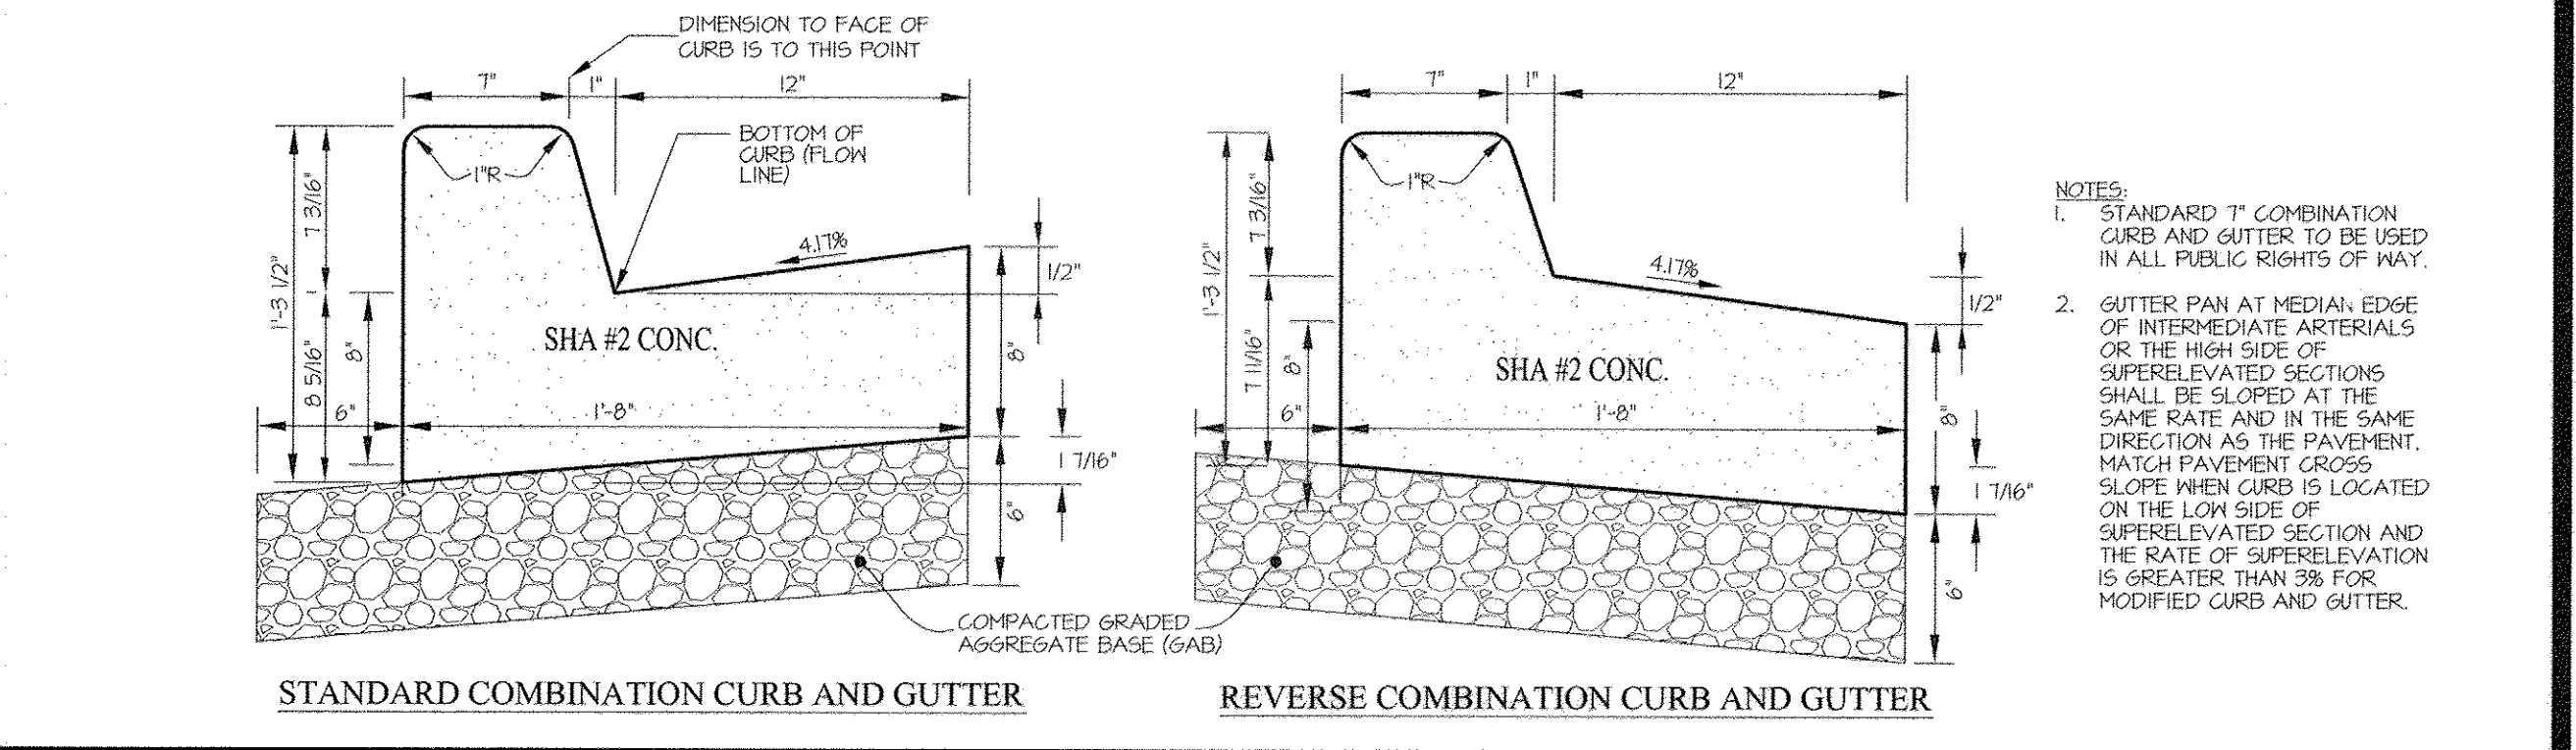


13 7\"/>

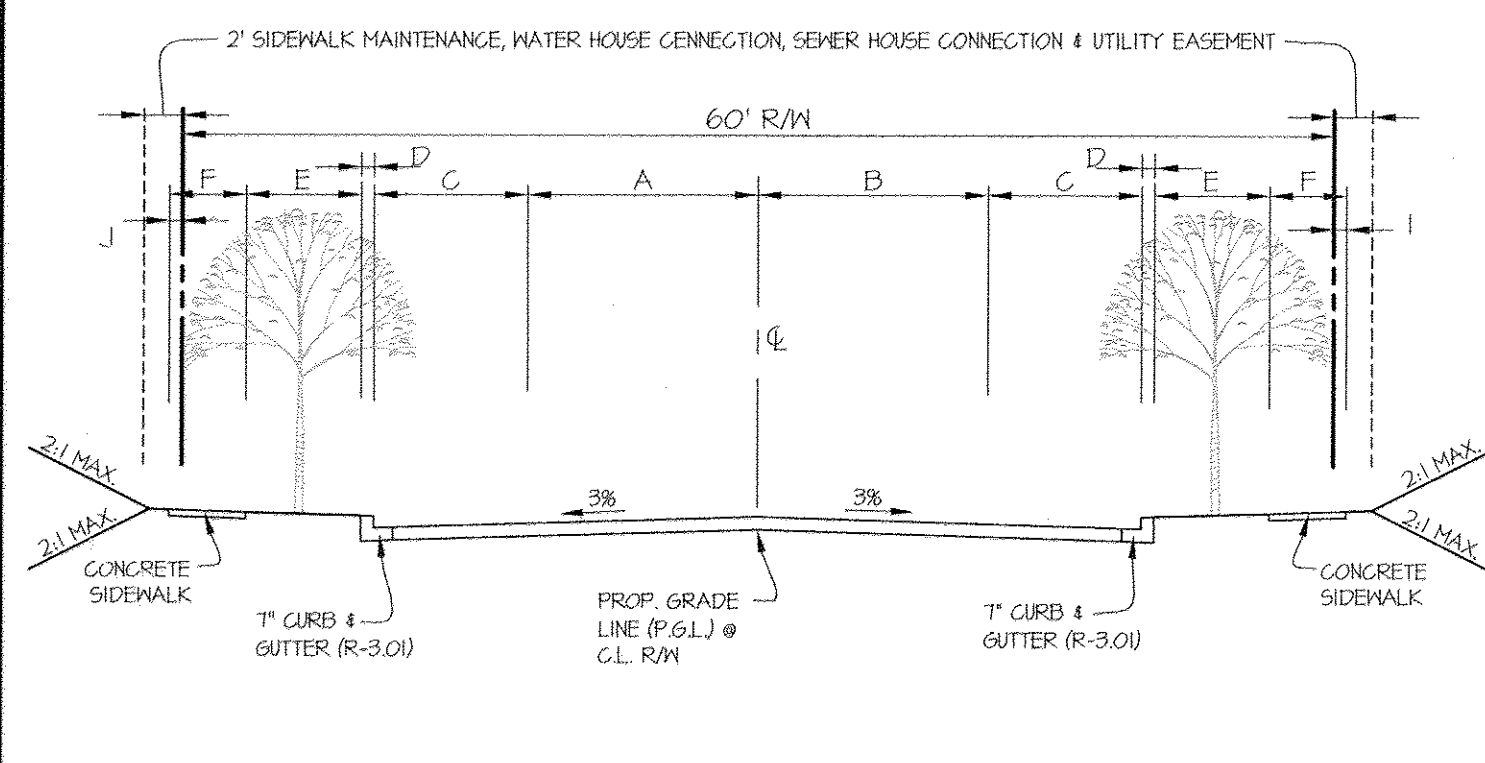


3 TYPICAL SECTION FOR 60' R/W WITH LEFT & RIGHT PARALLEL PARKING NO SCALE

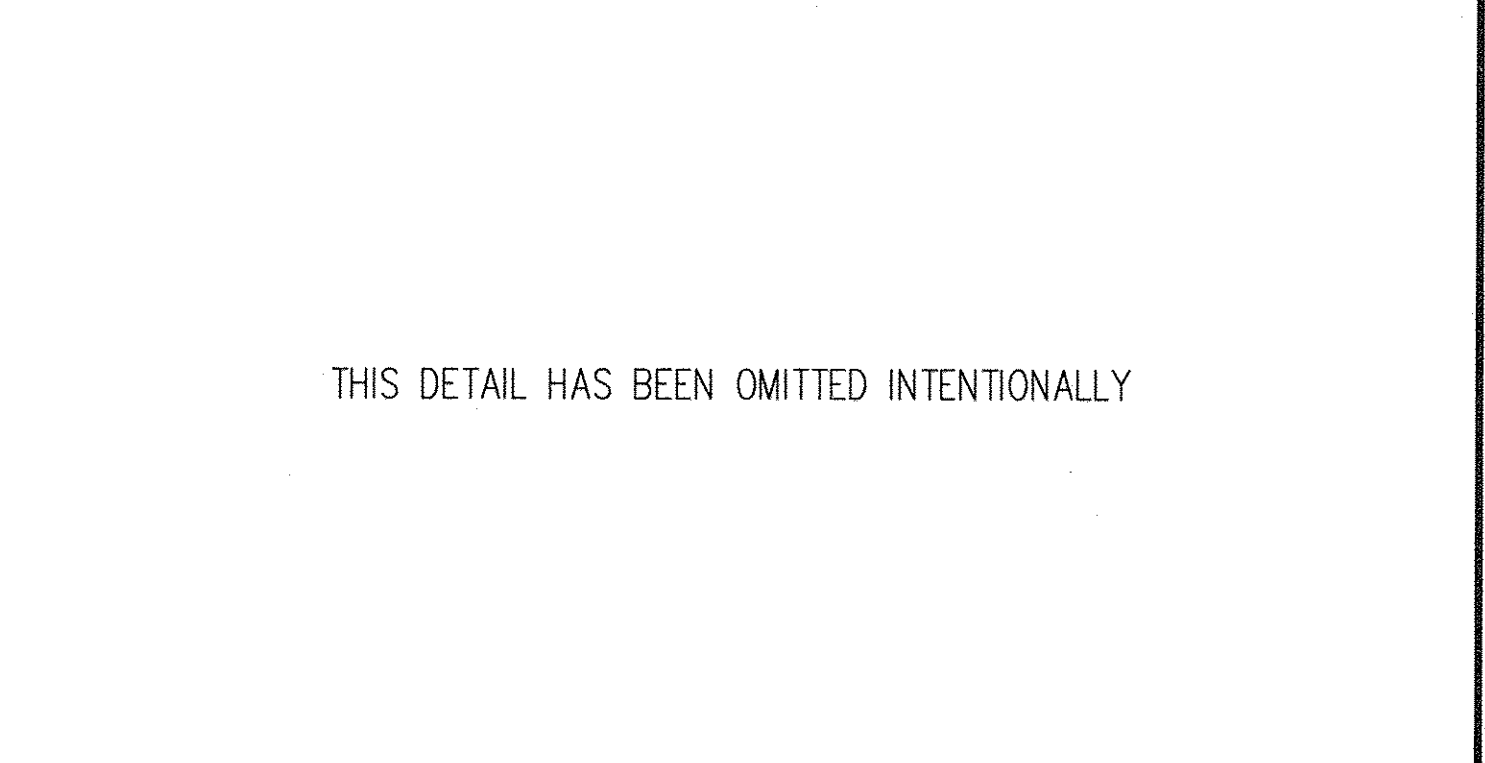


7 THIS DETAIL HAS BEEN OMITTED INTENTIONALLY

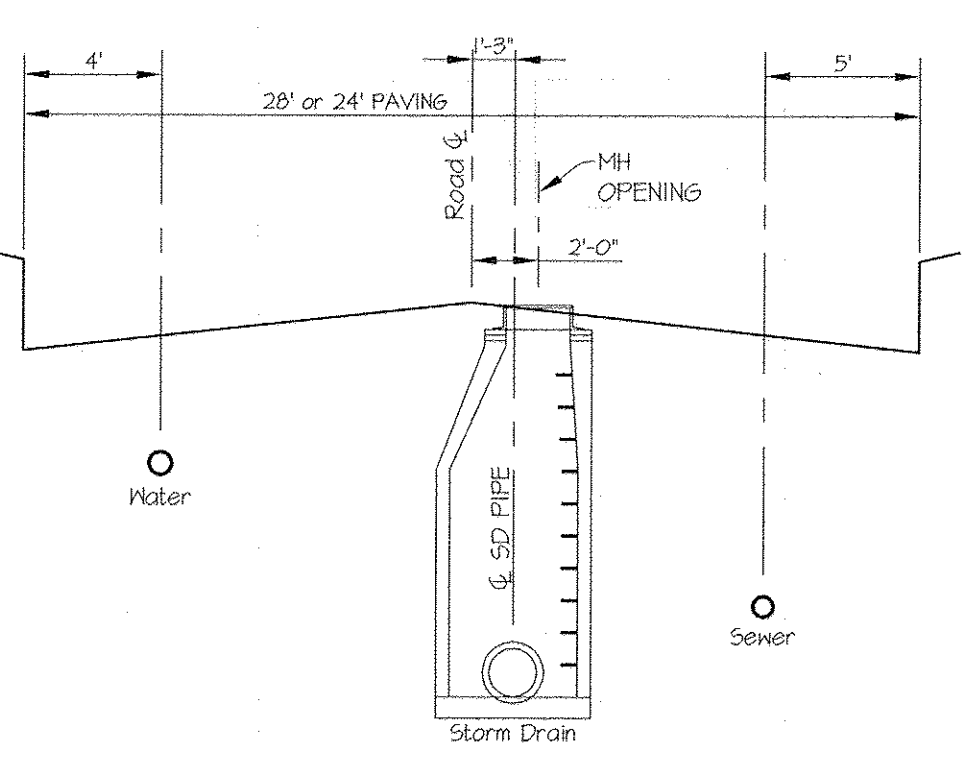


9 TYPICAL UTILITY LOCATIONS SCALE: 1\"/>

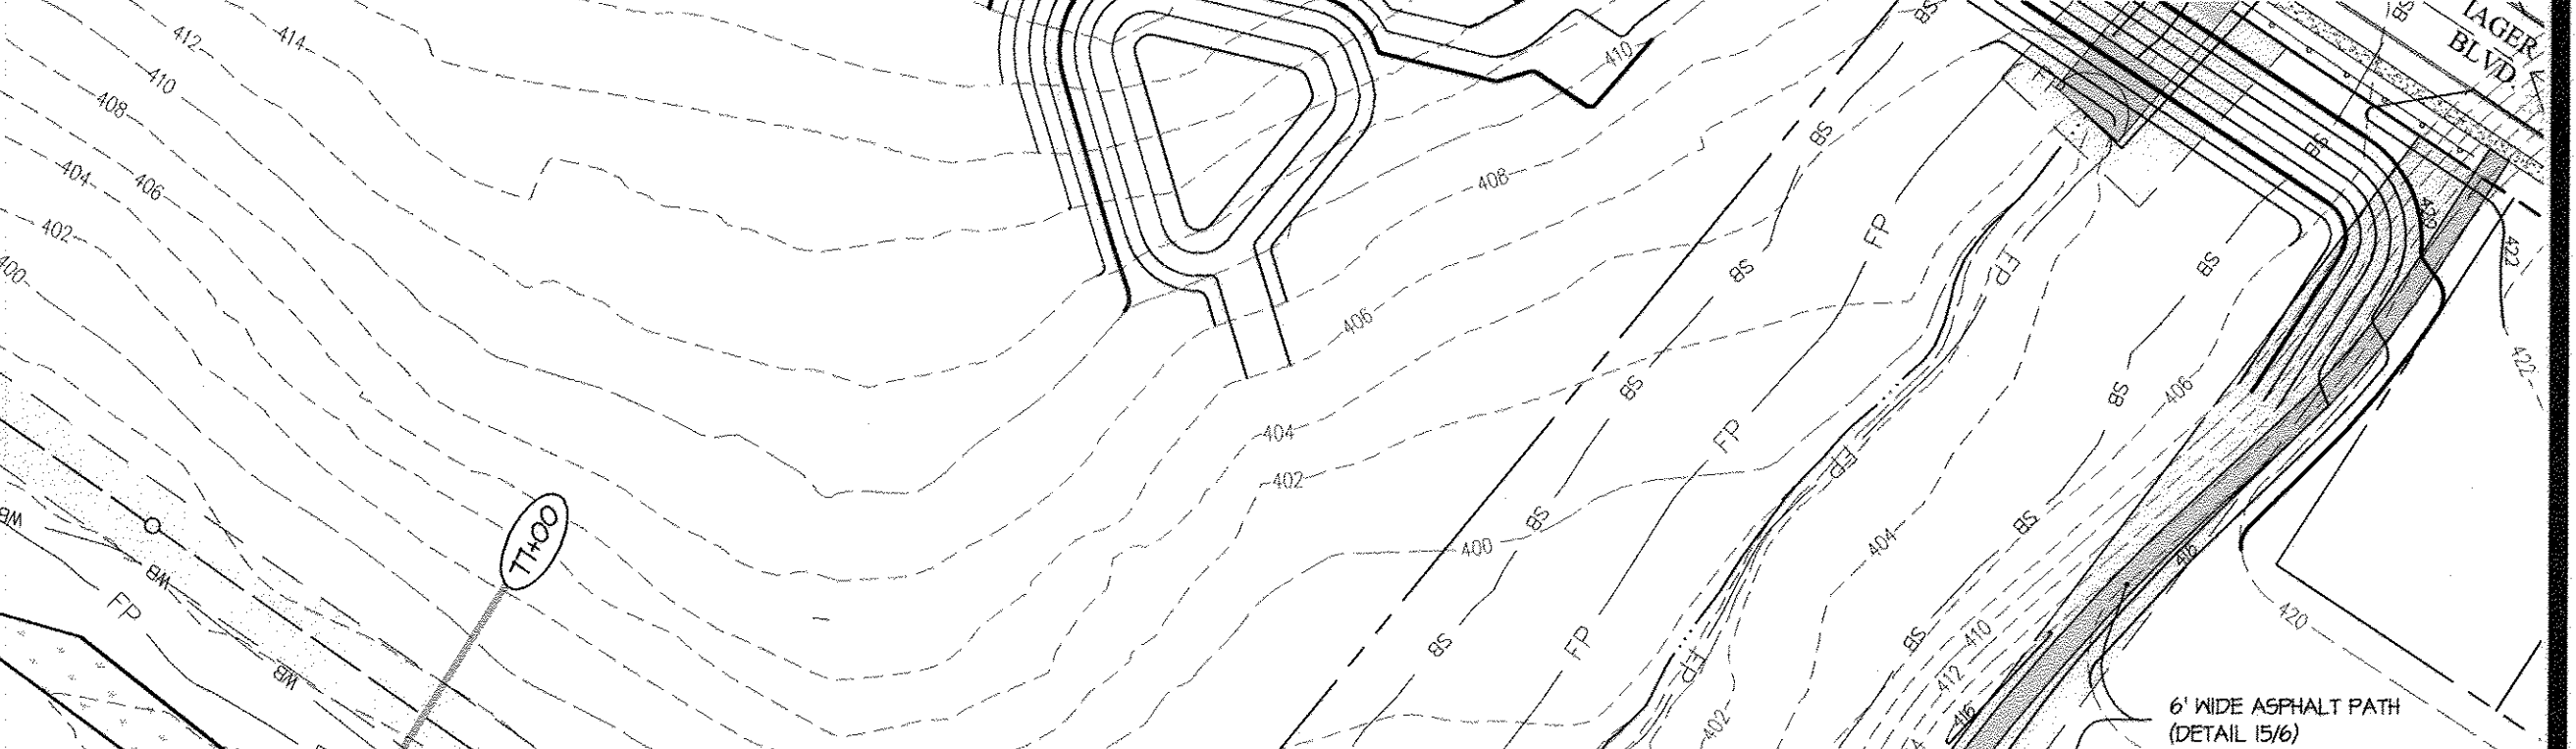


13 7\"/>

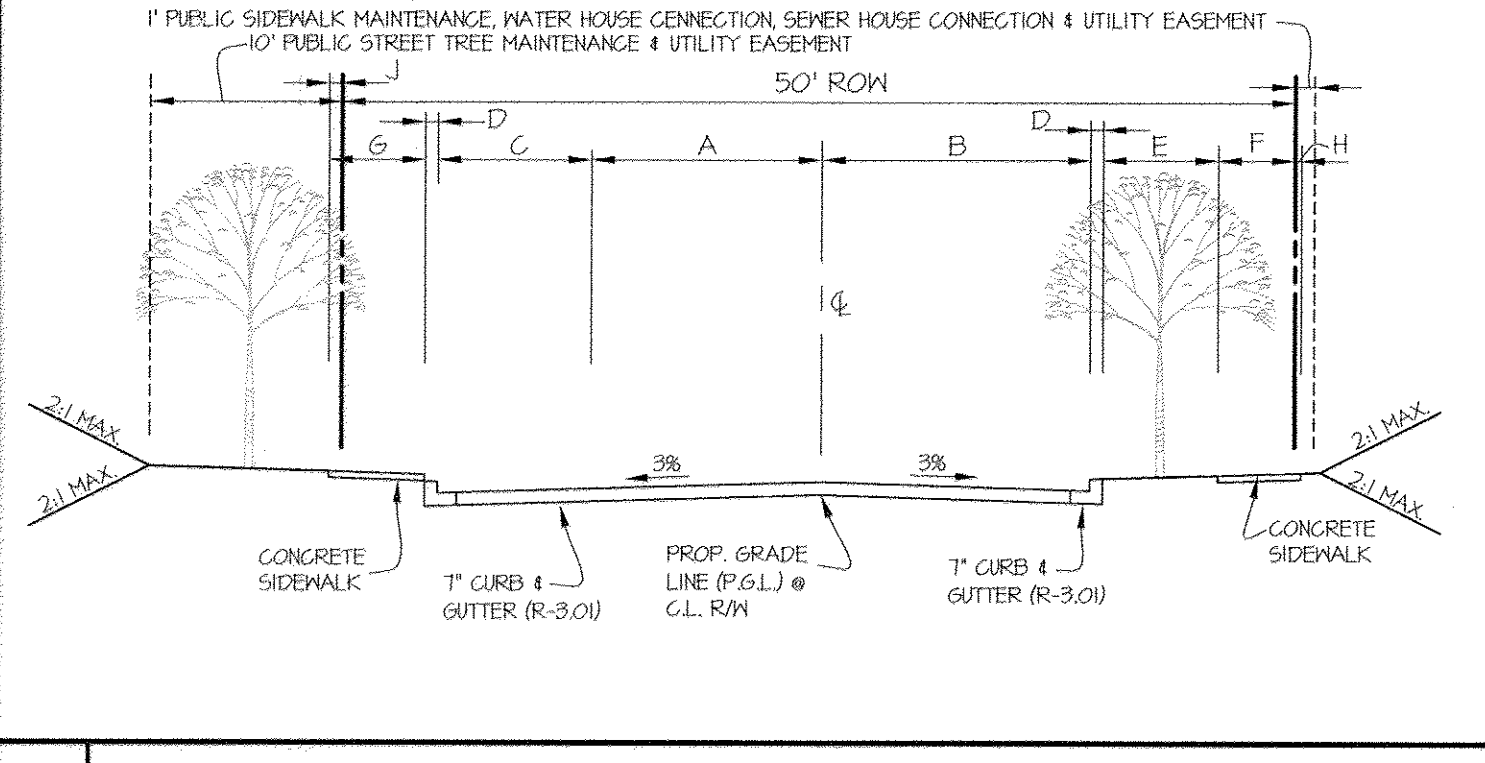


4 TYPICAL SECTION FOR 50' R/W WITH LEFT PARALLEL PARKING NO SCALE

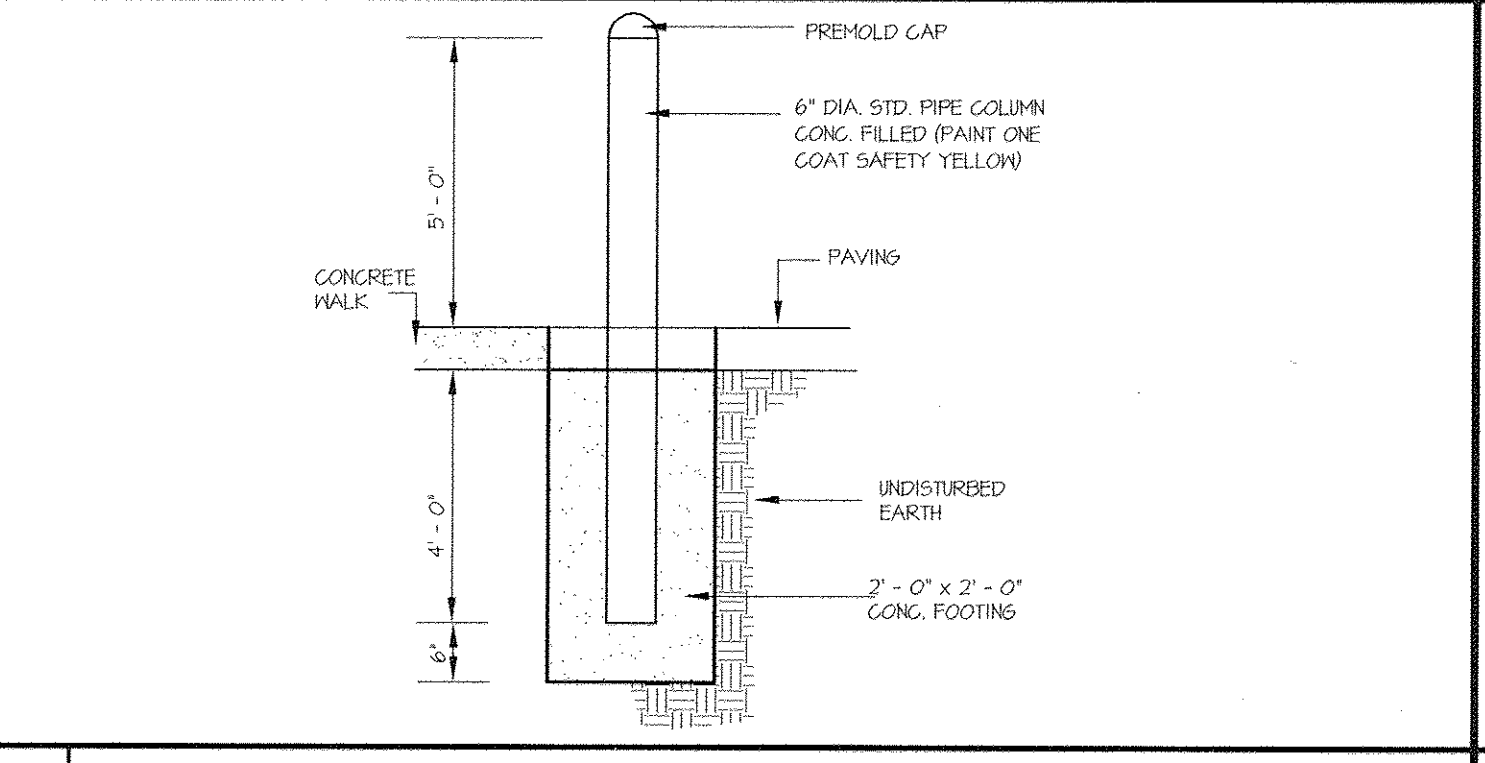

8 BOLLARD DETAIL NO SCALE

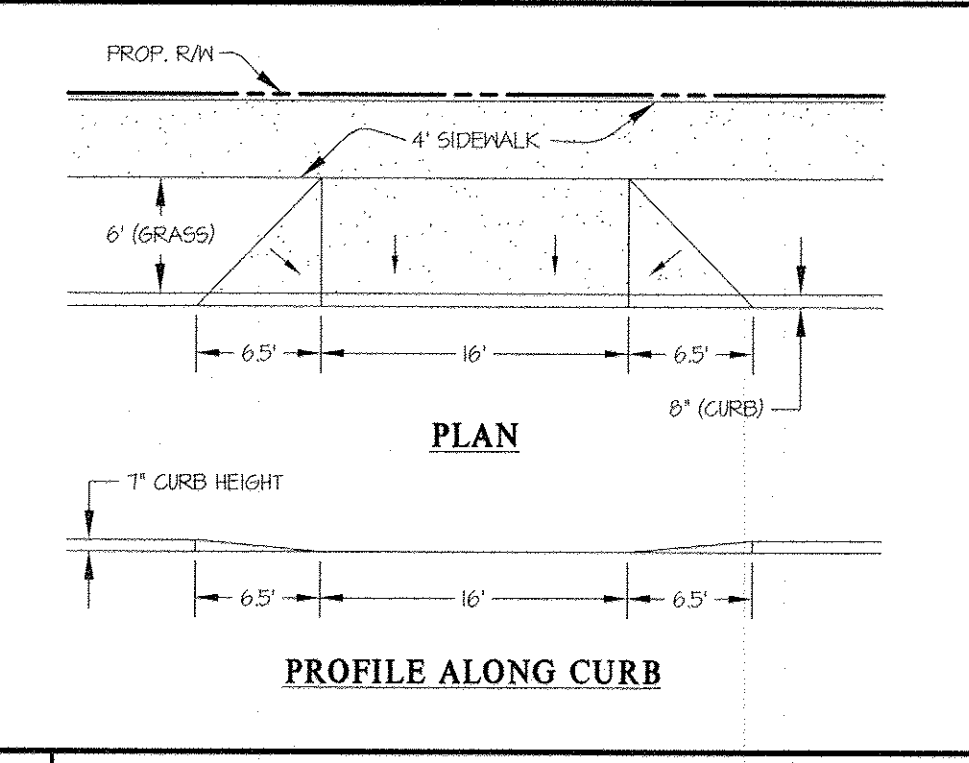

10 DETAIL FOR SETTING STORM DRAIN MANHOLES IN ROADS SCALE: 1\"/>

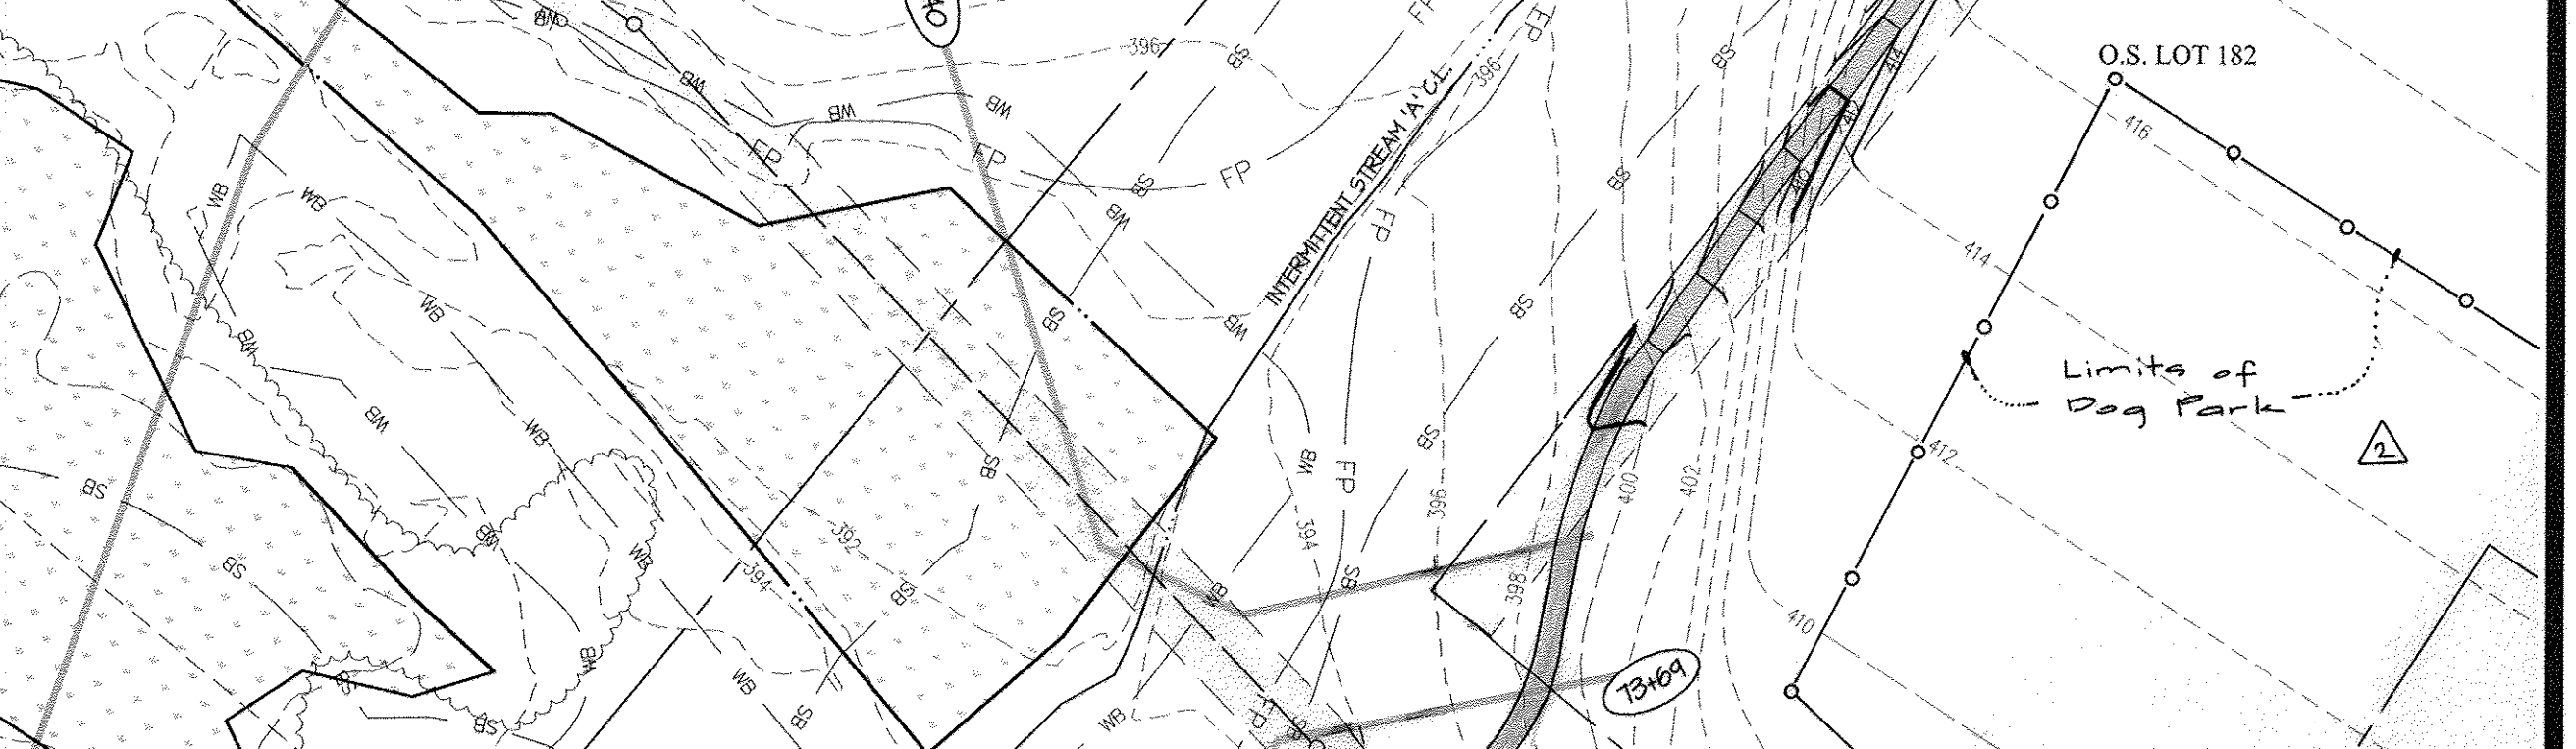


14 6\"/>

NOTE: ALL TYPICAL SECTIONS HAVE BEEN SHOWN LOOKING UP STATION


APPROVED: HOWARD COUNTY DEPARTMENT OF PUBLIC WORKS  
*Diane Adams*, Acting Chief, Bureau of Highways, 11/21/12

APPROVED: HOWARD COUNTY DEPARTMENT OF PLANNING & ZONING  
*Kathleen Lamb*, Chief, Division of Land Development, 12/4/12  
*Chad Edwards*, Chief, Development Engineering Division, 12-6-12

ROAD INFORMATION															
ROAD NAME	STATION	CLASSIFICATION	DESIGN SPEED	A	B	C	D	E	F	G	H	I	J	R/W	PAVING SECTION
LASER BOULEVARD	15417.81 TO 22+19	MINOR COLLECTOR	25 MPH	12'	12'	8"	6'	4"	7'-4"	-	-	-	-	60'	P-3 1
LASER BOULEVARD	22+19 TO 24+43	MINOR COLLECTOR	25 MPH	12'	12'	8"	6'	4"	7'-4"	-	-	-	-	60'	P-5 2
LASER BOULEVARD	24+43 TO 26+64.60	MINOR COLLECTOR	25 MPH	12'	12'	8"	6'	4"	7'-4"	-	-	-	-	60'	P-5 3
ELMWOOD ROAD	11425.00 TO 11+65.63	ACCESS STREET	25 MPH	12'	14'	8"	6'	4"	5'-4"	-	8"	-	-	50'	P-3 4
ELMWOOD ROAD	11+65.63 TO 24+52.14	ACCESS STREET	25 MPH	14'	14'	-	8"	6'	4"	-	4"	-	-	50'	P-3 5
ALFALFA LANE	0+00 TO 3+16.00	ACCESS STREET	25 MPH	14'	12'	8"	6'	4"	5'	-	8"	-	-	50'	P-3 6
SPRING STREET	0+00 TO 3+39.61	ACCESS STREET	25 MPH	12'	14'	8"	6'	4"	5'-4"	-	8"	-	-	50'	P-3 4
SPRING STREET	3+39.61 TO 5+60.00	ACCESS STREET	25 MPH	14'	14'	-	8"	6'	4"	-	4"	-	-	50'	P-3 5
GRAND CHAMPION STREET	3+05 TO 8+60.01	ACCESS STREET	25 MPH	14'	14'	-	8"	6'	4"	-	4"	-	-	50'	P-3 5

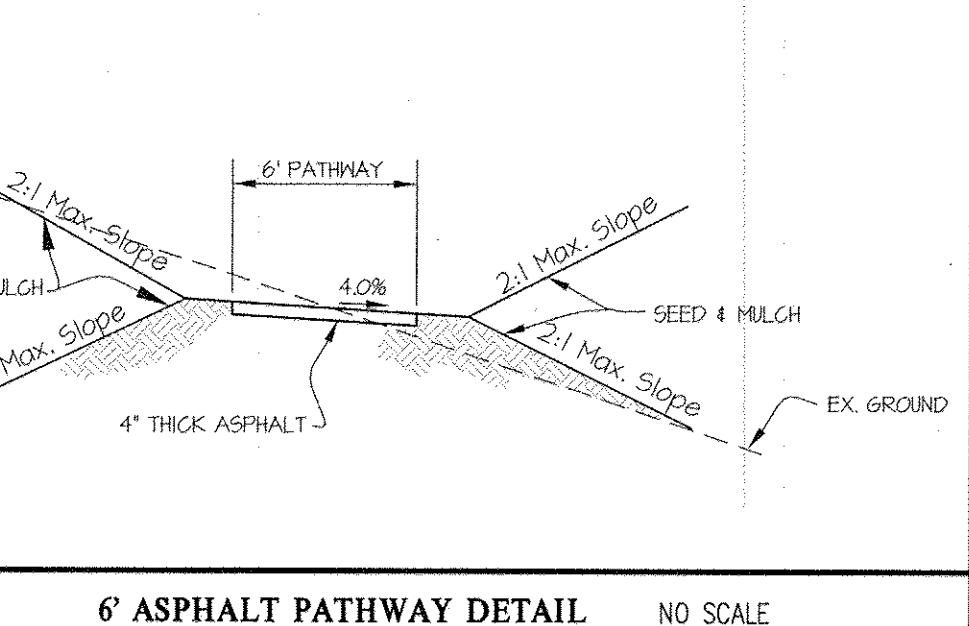

15 6\"/>

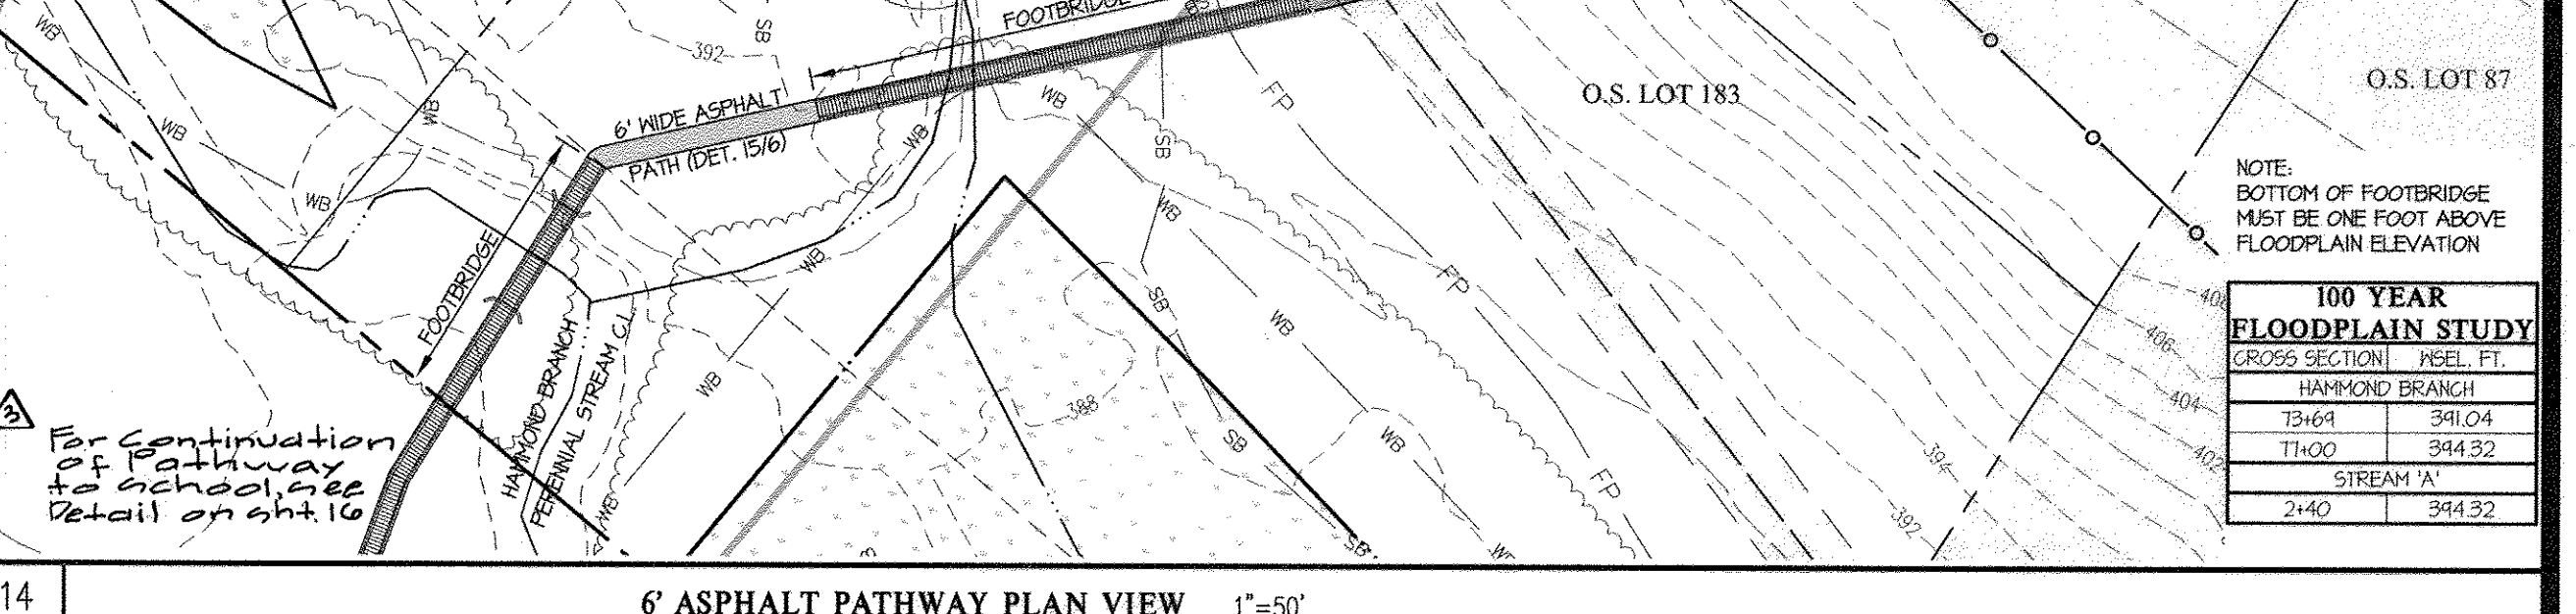

14 6\"/>

**GLWGUTSCHICK LITTLE & WEBER, P.A.**  
 CIVIL ENGINEERS, LAND SURVEYORS, LAND PLANNERS, LANDSCAPE ARCHITECTS  
 3909 NATIONAL DRIVE - SUITE 250 - BURTNSVILLE OFFICE PARK  
 BURTNSVILLE, MARYLAND 21086  
 TEL: 301-421-4024 BAL: 410-880-1820 DC/VA: 301-989-2524 FAX: 301-421-4186

DATE	REVISION	BY	APPR.
11-17-2012	Added limits of dog park.	gt	RLW
12-6-2012	Added note for bath connection to school campus	gt	RLW

PREPARED FOR:  
 MAPLE LAWN FARMS 1, LLC  
 SUITE 300 WOODHOLME CENTER  
 1829 REISTERSTOWN ROAD  
 BALTIMORE, MD 21208  
 ATTN: MARK BENNETT  
 410-484-8400

PROFESSIONAL CERTIFICATION  
 I HEREBY CERTIFY THAT THESE PLANS WERE PREPARED OR APPROVED BY ME, AND THAT I AM A DULY LICENSED PROFESSIONAL ENGINEER UNDER THE LAWS OF THE STATE OF MARYLAND, LICENSE NO. 12975  
 EXPIRATION DATE: MAY 26, 2014  
 11-7-12 *Chad Edwards*

**ROAD DETAILS**

**MAPLE LAWN FARMS**  
 MIDTOWN WEST DISTRICT - AREA 2  
 LOTS 93 THRU 177, OPEN SPACE LOTS 178 THRU 183, AND COMMON OPEN AREA LOTS 184 THRU 186



SCALE	ZONING	G. L. W. FILE NO.
AS SHOWN	MXD-3	11001
DATE	TAX MAP - GRID	SHEET
OCT. 2012	41-21/46-3	6 OF 25

HOWARD COUNTY, MARYLAND  
 ELECTION DISTRICT No. 5







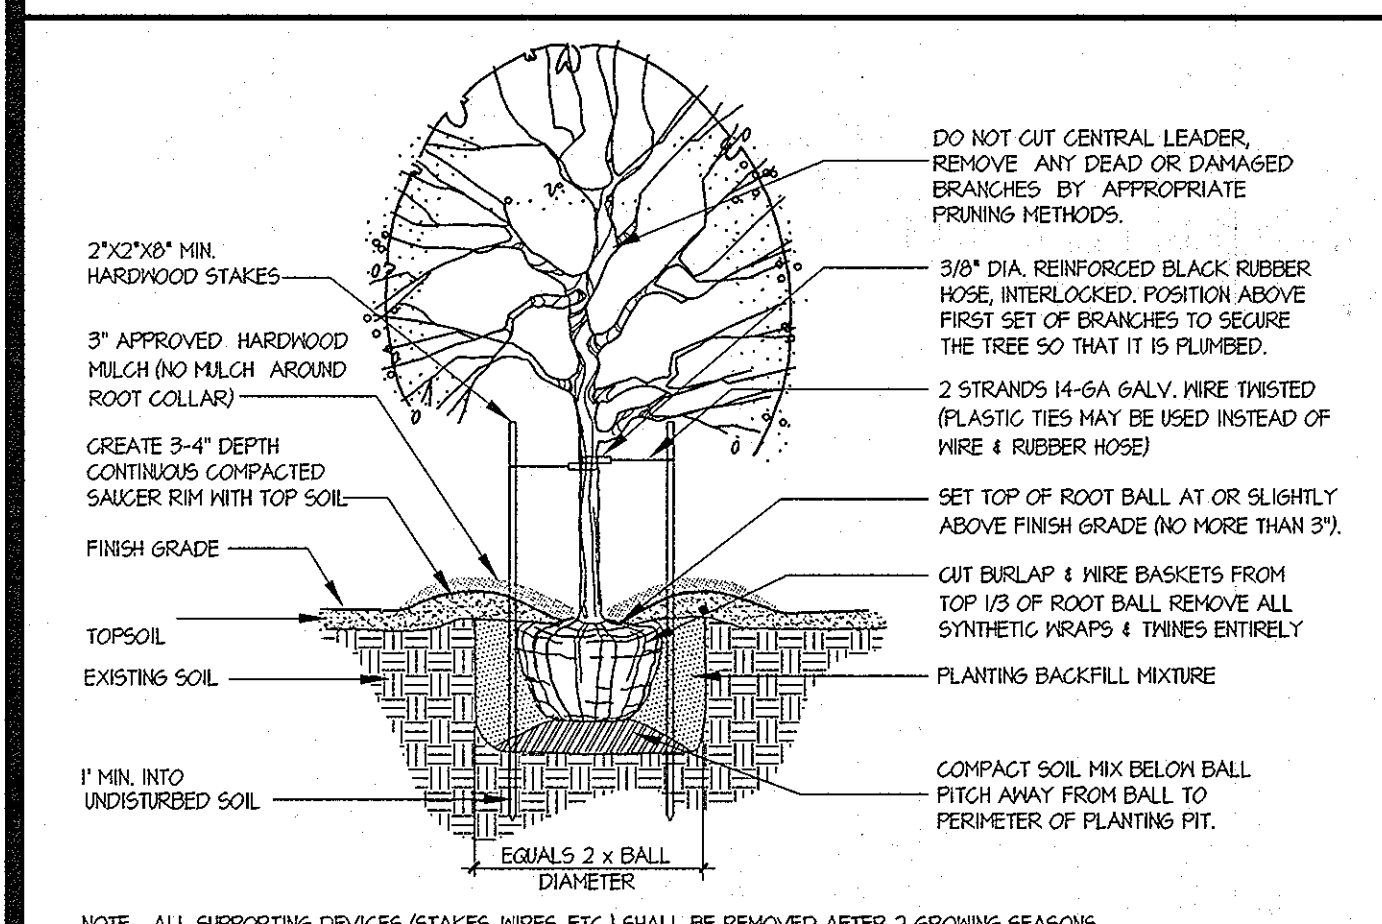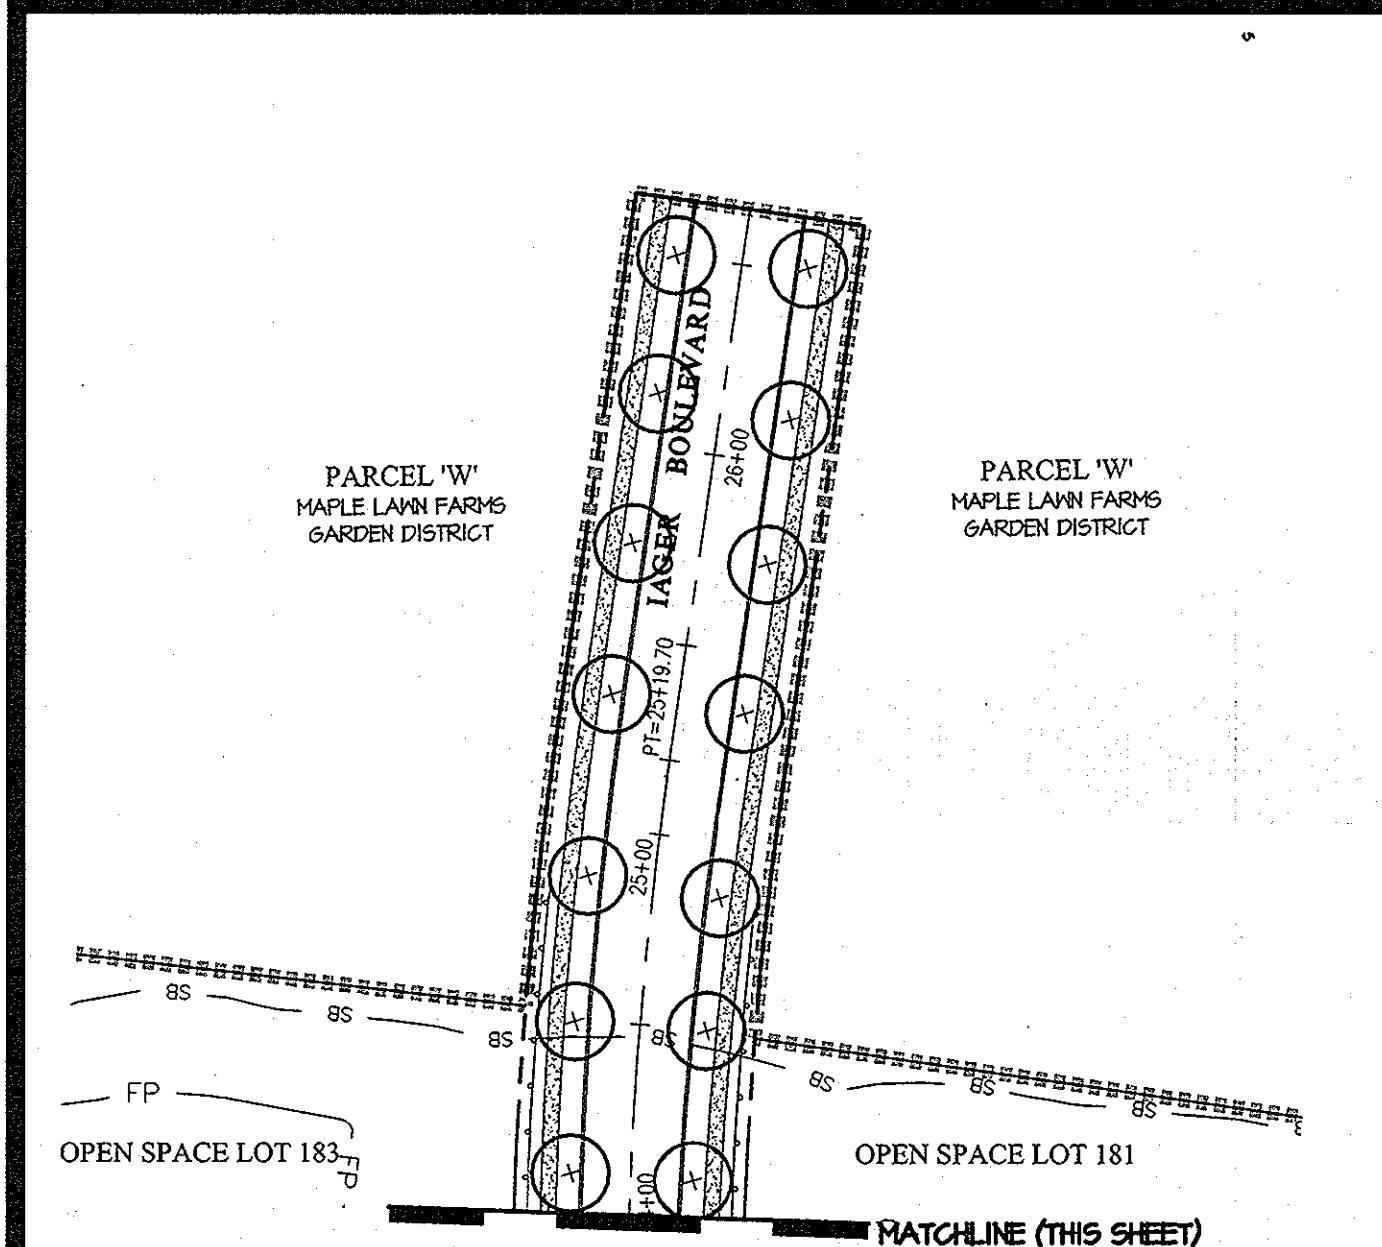

NOTE: ALL SUPPORTING DEVICES (STAKES, WIRES, ETC.) SHALL BE REMOVED AFTER 2 GROWING SEASONS.

**DECIDUOUS TREE PLANTING DETAIL**  
FOR PLANTING MATERIAL UP TO 3" 1/2" CALIF. NTS

ROAD	LENGTH OF CURB (L.F.)	# OF TREES REQUIRED	# OF TREES PROVIDED
LAGER BOULEVARD	2,086'	52	52
GRAND CHAMPION STREET	964'	25	25
ALFALFA LANE	527'	14	14
SPRING AVENUE	854'	22	22
ELMWOOD STREET	2,805'	70	70
TOTAL		183	183

SYMBOL	NAME (BOTANICAL/COMMON)	SIZE	REMARKS
(X)	ACER SACHARUM / GREEN MOUNTAIN SUGAR MAPLE	2 1/2" cal.	8' 4" B FULL HEADS


LOCATION	LAMP TYPE	FIXTURE	POLE TYPE
STA. 10+64.00	ELMWOOD ROAD	10' R	100-MATT HPS VAPOR
STA. 13+54.00	ELMWOOD ROAD	10' R	100-MATT HPS VAPOR
STA. 15+36.00	ELMWOOD ROAD	10' R	100-MATT HPS VAPOR
STA. 17+10.00	ELMWOOD ROAD	17' L	100-MATT HPS VAPOR
STA. 18+44.00	ELMWOOD ROAD	17' L	100-MATT HPS VAPOR
STA. 21+85.00	ELMWOOD ROAD	17' L	100-MATT HPS VAPOR
STA. 6+24.00	GRAND CHAMPION ST.	17' L	100-MATT HPS VAPOR
STA. 8+31.00	GRAND CHAMPION ST.	10' L	100-MATT HPS VAPOR
STA. 1+36.66	ALFALFA LANE	17' L	100-MATT HPS VAPOR
STA. 10+00.00	LAGER BOULEVARD	17' R	100-MATT HPS VAPOR
STA. 20+96.00	LAGER BOULEVARD	17' R	100-MATT HPS VAPOR
STA. 23+20.00	LAGER BOULEVARD	17' R	100-MATT HPS VAPOR
STA. 0+31.00	SPRING AVENUE	10' R	100-MATT HPS VAPOR
STA. 1+56.00	SPRING AVENUE	10' R	100-MATT HPS VAPOR
STA. 3+15.50	SPRING AVENUE	10' L	100-MATT HPS VAPOR
STA. 4+40.00	SPRING AVENUE	10' R	100-MATT HPS VAPOR

APPROVED: HOWARD COUNTY DEPARTMENT OF PUBLIC WORKS  
*Diane Schury* Acting 11/21/12  
 Chief, Bureau of Highways

APPROVED: HOWARD COUNTY DEPARTMENT OF PLANNING & ZONING  
*Kate Schuch* 12/11/12  
 Chief, Division of Land Development

*Chad Edwards* 12.6.12  
 Chief, Development Engineering Division

**GLWGUTSCHICK LITTLE & WEBER, P.A.**  
 CIVIL ENGINEERS, LAND SURVEYORS, LAND PLANNERS, LANDSCAPE ARCHITECTS  
 3909 NATIONAL DRIVE - SUITE 250 - BURTONSVILLE OFFICE PARK  
 BURTONSVILLE, MARYLAND 20866  
 TEL: 301-421-4024 BALT: 410-880-1820 DC/VA: 301-989-2524 FAX: 301-421-4186

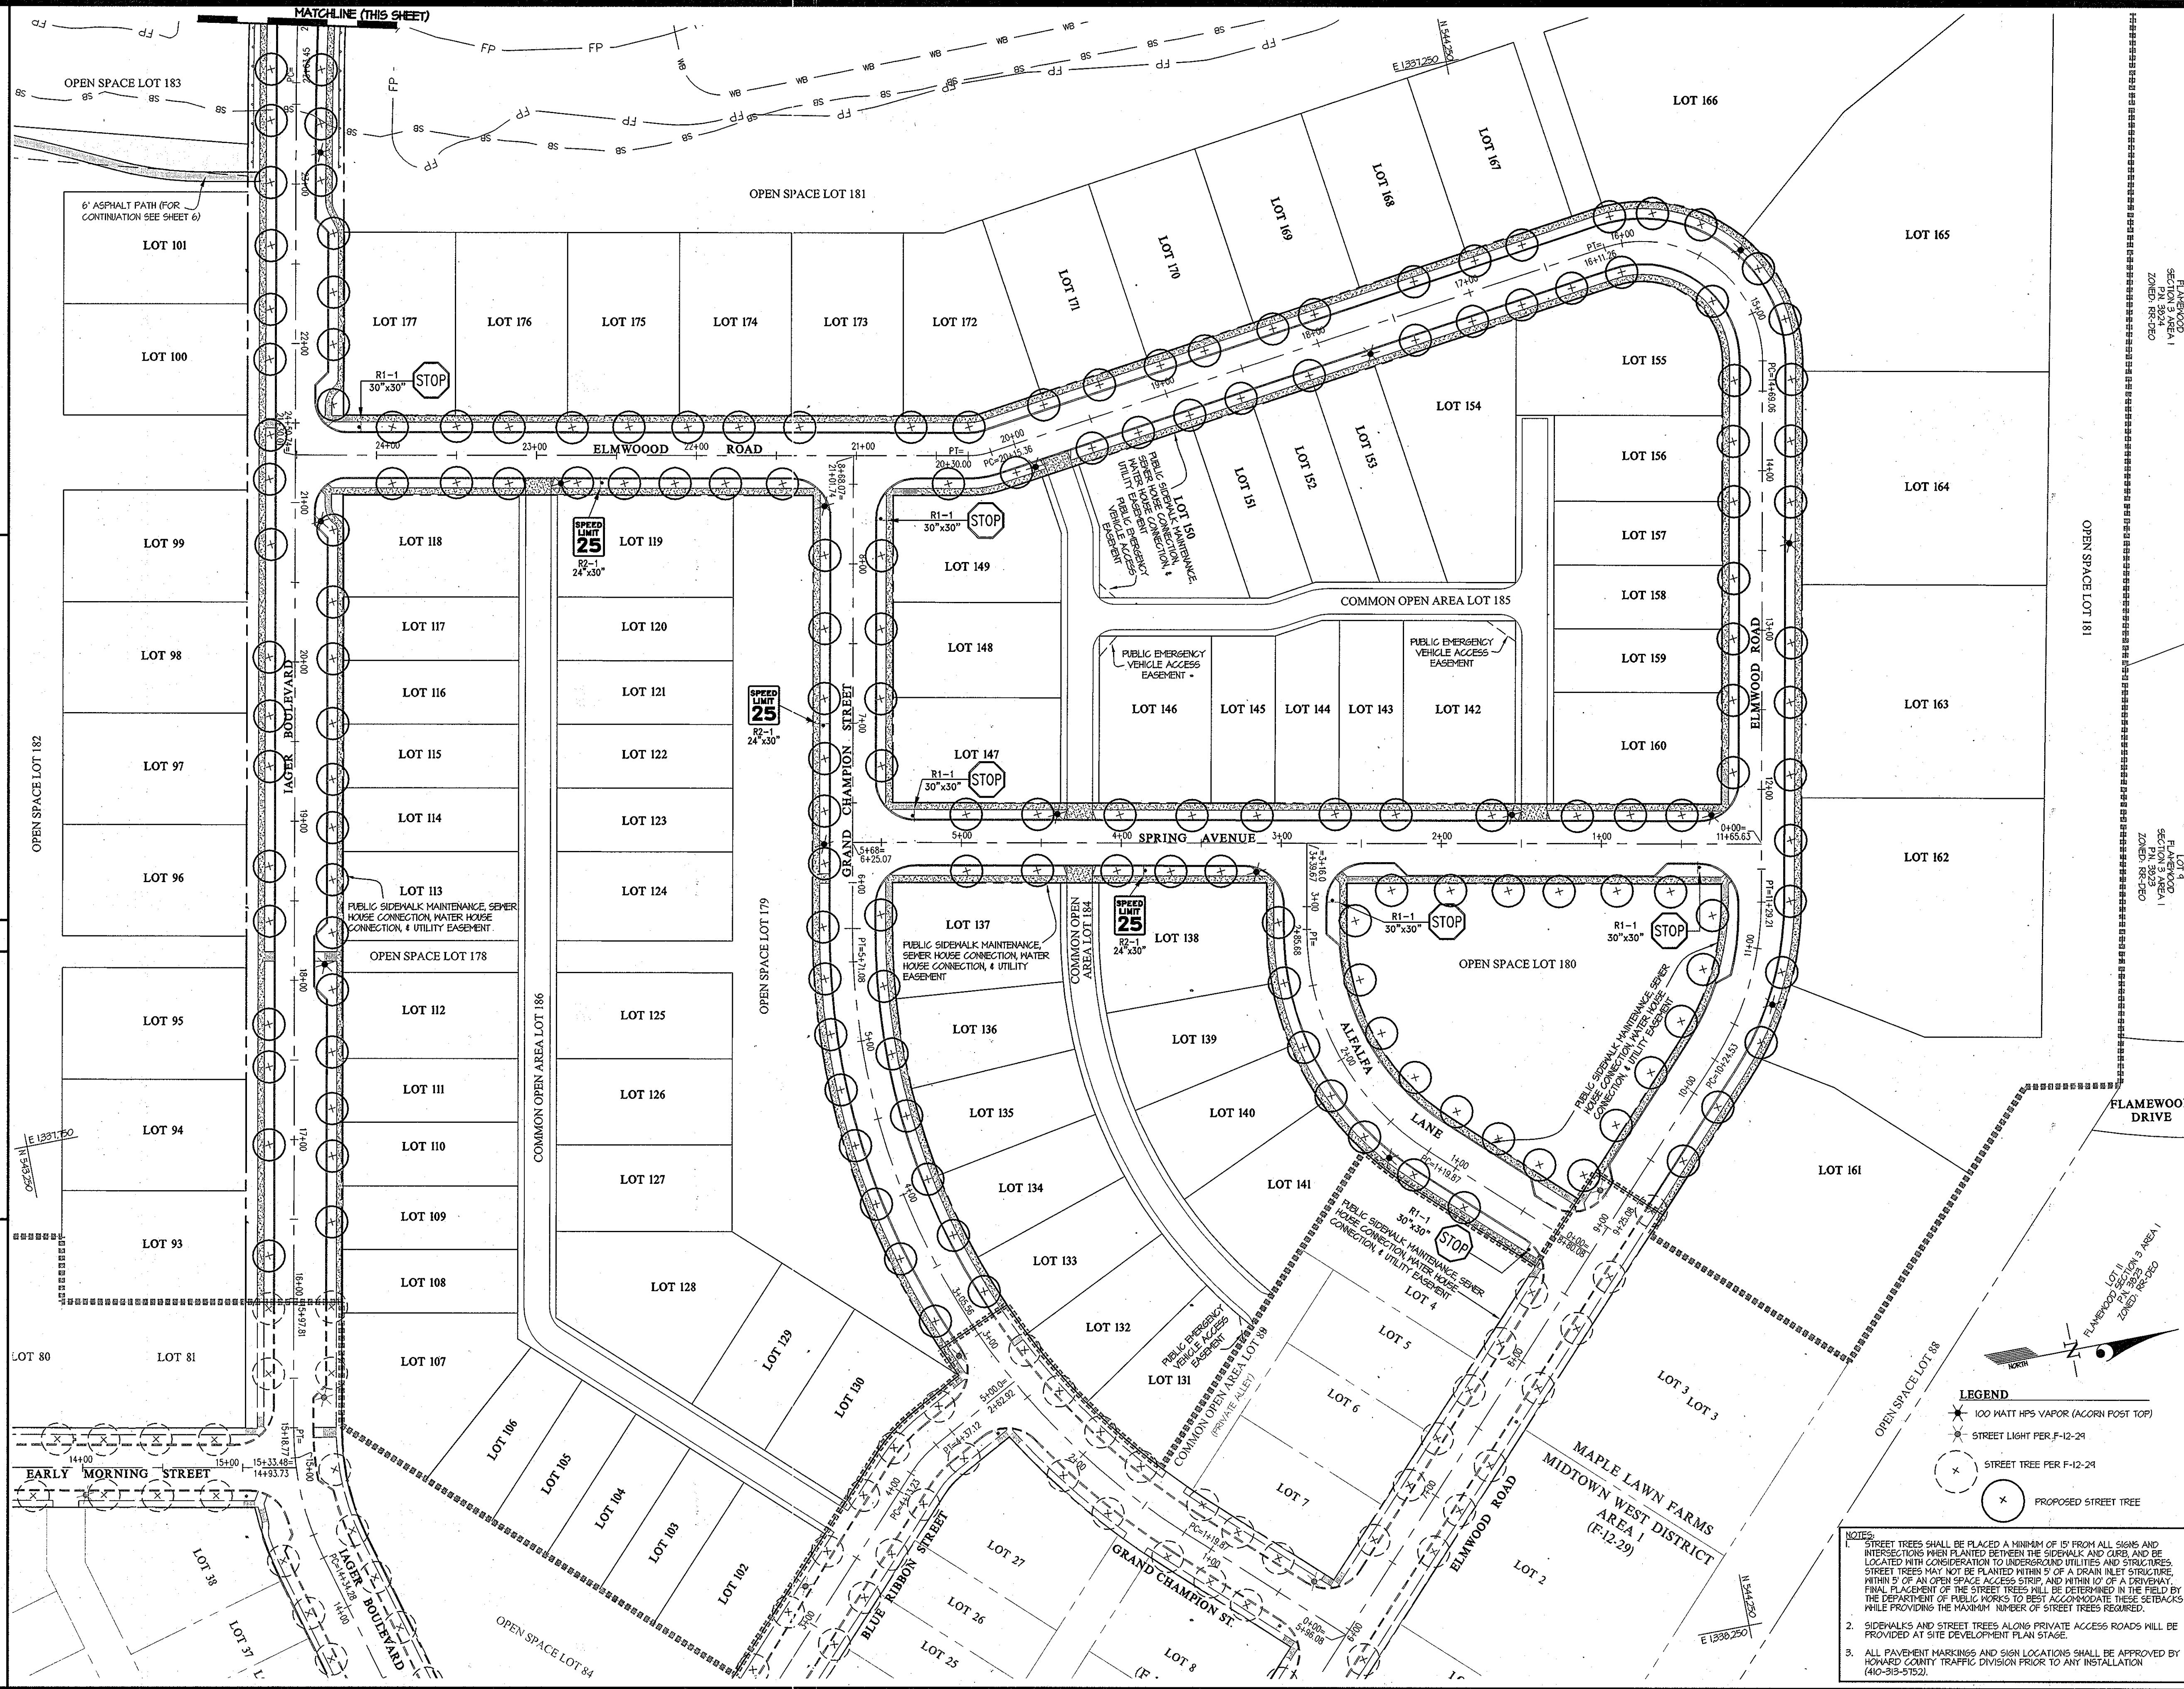

PREPARED FOR:  
 MAPLE LAWN FARMS 1, LLC  
 SUITE 300 WOODHOLME CENTER  
 1829 REISTERSTOWN ROAD  
 BALTIMORE, MD 21208  
 ATTN: MARK BENNETT  
 410-484-8400

PROFESSIONAL CERTIFICATION  
 I HEREBY CERTIFY THAT THESE PLANS WERE PREPARED OR APPROVED BY ME, AND THAT I AM A DULY LICENSED PROFESSIONAL ENGINEER UNDER THE LAWS OF THE STATE OF MARYLAND, LICENSE NO. 12975  
 EXPIRATION DATE: MAY 26, 2014  
*11-7-12* *CKR*


**SIGNING, STREET TREE & LIGHTING PLAN**  
**MAPLE LAWN FARMS**  
 MIDDOWN WEST DISTRICT - AREA 2  
 LOTS 93 THRU 177, OPEN SPACE LOTS 178 THRU 183, AND  
 COMMON OPEN AREA LOTS 184 THRU 186

SCALE: 1" = 50'  
 ZONING: MXD-3  
 G. L. W. FILE NO.: 11001

DATE: OCT. 2012  
 TAX MAP - GRID: 41-21/46-3  
 SHEET: 8 OF 25

HOWARD COUNTY, MARYLAND



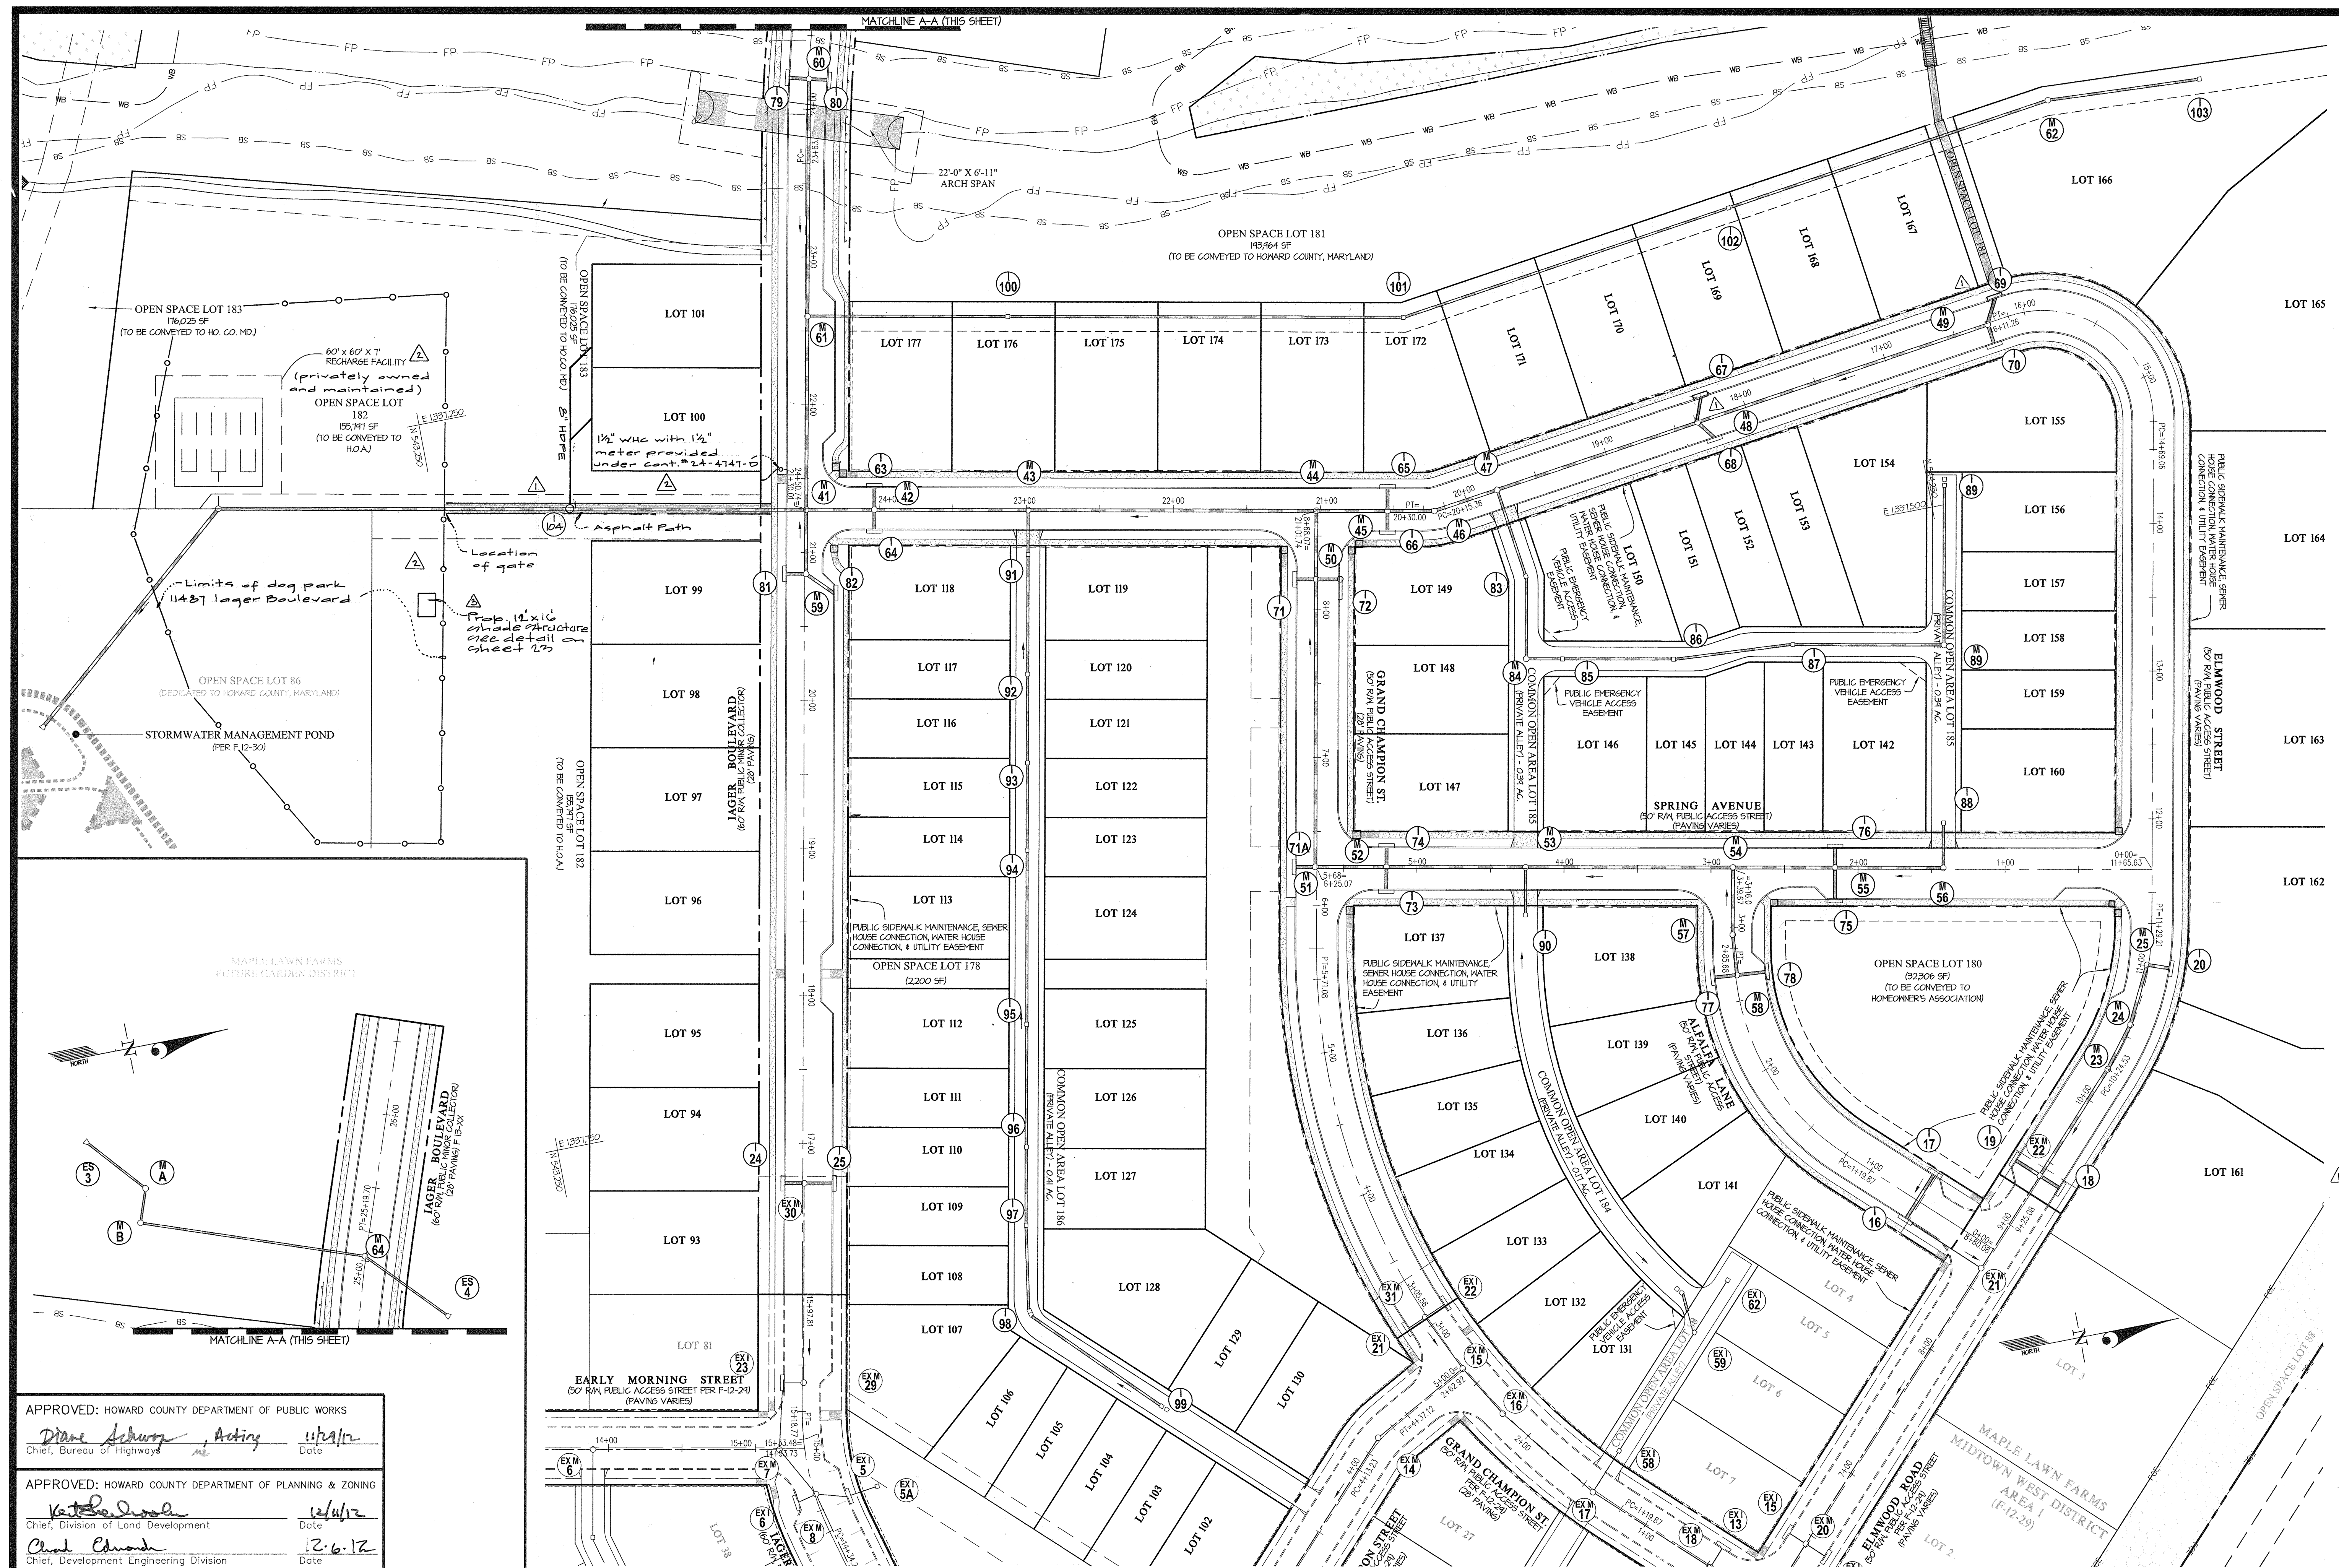

FROM NO.	TO NO.	DIA. (IN) & TYPE OF PIPE	L (FT)
I-20	M-25	15" HDPE	12
M-25	M-24	18" HDPE	38
M-24	M-23	18" HDPE	30
M-23	EX M-22	18" HDPE	82
I-18	EX M-22	15" HDPE	13
I-14	EX M-22	15" HDPE	17
EX M-22	EX M-21	18" HDPE	N.L.C.
I-17	I-16	15" HDPE	34
I-16	EX M-21	15" HDPE	N.L.C.
I-25	EX M-30	15" HDPE	17
I-24	EX M-30	15" HDPE	10
EX M-30	EX M-24	18" HDPE	N.L.C.
I-64	M-44	15" HDPE	12
I-70	M-44	15" HDPE	10
M-44	M-40	18" HDPE	204
I-67	M-40	15" HDPE	12
I-60	M-40	15" HDPE	140
I-84	M-84	15" HDPE	106
M-84	I-87	15" HDPE	94
I-87	I-86	15" HDPE	78
I-86	I-85	15" HDPE	72
I-85	I-84	15" HDPE	21
I-84	I-83	15" HDPE	52
I-83	M-41	18" HDPE	58
M-41	M-46	24" HDPE	41
M-46	M-45	15" HDPE	28
I-66	M-45	15" HDPE	11
M-45	M-44	24" HDPE	44
I-88	M-58	18" HDPE	10
M-58	M-55	18" HDPE	10
I-75	M-55	15" HDPE	19
I-76	M-55	15" HDPE	10
M-55	M-54	18" HDPE	65
I-77	M-58	15" HDPE	13
I-78	M-58	15" HDPE	11
M-58	M-57	18" HDPE	23
M-57	M-54	18" HDPE	42
M-54	M-53	18" HDPE	131
I-50	M-53	15" HDPE	28
M-53	M-52	18" HDPE	41
I-73	M-52	15" HDPE	12
I-74	M-52	15" HDPE	11
M-52	M-51	24" HDPE	44
I-71A	M-51	15" HDPE	11
M-51	M-50	24" HDPE	111
I-71	M-50	15" HDPE	11
I-72	M-50	15" HDPE	12
M-50	M-44	24" HDPE	42
M-44	M-43	30" HDPE	142
I-44	I-48	15" HDPE	101
I-48	I-47	15" HDPE	57
I-47	I-46	18" HDPE	53
I-46	I-45	18" HDPE	81
I-45	I-44	24" HDPE	118
I-44	I-43	24" HDPE	54
I-43	I-42	24" HDPE	60
I-42	I-41	24" HDPE	31
I-41	M-43	24" HDPE	26
M-43	M-42	36" HDPE	101
I-43	M-42	15" HDPE	15
I-64	M-42	15" HDPE	10
M-42	M-41	36" HDPE	42
I-81	M-54	15" HDPE	11
I-82	M-54	15" HDPE	20
M-54	M-41	18" HDPE	34
I-71	M-60	15" HDPE	10
I-80	M-60	15" HDPE	4
M-60	M-61	18" HDPE	157
I-103	M-62	15" HDPE	100
M-62	I-102	18" HDPE	225
I-102	I-101	18" HDPE	224
I-101	I-100	18" HDPE	265
I-100	M-61	18" HDPE	132
M-61	M-41	24" HDPE	171
M-40	ES-2	36" HDPE	181
ES-4	M-64	30" HDPE	65
M-64	M-8	30" HDPE	152
M-8	M-A	30" HDPE	24
M-A	ES-3	30" HDPE	41
M-41	I-104	24" HDPE	15-1
I-104	M-40	24" HDPE	240
Lot 101	I-104	24" HDPE	110

NOTE: STORM DRAINS WITHIN COMMON OPEN AREAS ARE PRIVATELY OWNED AND MAINTAINED.

APPROVED: HOWARD COUNTY DEPARTMENT OF PUBLIC WORKS  
 Diane Schweg, Acting Chief, Bureau of Highway, 11/29/12  
 APPROVED: HOWARD COUNTY DEPARTMENT OF PLANNING & ZONING  
 Kathleen... 12/4/12  
 Chad... 12-6-12

**GLWGUTSCHICK LITTLE & WEBER, P.A.**  
 CIVIL ENGINEERS, LAND SURVEYORS, LAND PLANNERS, LANDSCAPE ARCHITECTS  
 3909 NATIONAL DRIVE - SUITE 250 - BURTONVILLE OFFICE PARK  
 BURTONVILLE, MARYLAND 20886  
 TEL: 301-421-4024 BAL: 410-880-1820 DC/VA: 301-989-2524 FAX: 301-421-4186


NO.	DATE	REVISION	BY	APPR.
1	11-17-12	Added dog park limits, maintenance note, gate location, asphalt path, who information, and address.	JK	CKG
2	12-2-12	Added shade structure within Dog Park Limits	JK	CKG

PREPARED FOR:  
 MAPLE LAWN FARMS 1, LLC  
 SUITE 300 WOODHOLME CENTER  
 1829 REISTERSTOWN ROAD  
 BALTIMORE, MD 21208  
 ATTN: MARK BENNETT  
 410-484-8400

PROFESSIONAL CERTIFICATION  
 I HEREBY CERTIFY THAT THESE PLANS WERE PREPARED OR APPROVED BY ME, AND THAT I AM A DULY LICENSED PROFESSIONAL ENGINEER UNDER THE LAWS OF THE STATE OF MARYLAND, LICENSE NO. 12975, EXPIRATION DATE: MAY 26, 2014.  
 11-7-12 [Signature]

**STORM DRAIN INFORMATION PLAN**  
**MAPLE LAWN FARMS**  
 MIDTOWN WEST DISTRICT - AREA 2  
 LOTS 93 THRU 177, OPEN SPACE LOTS 178 THRU 183, AND COMMON OPEN AREA LOTS 184 THRU 186  
 SCALE: 1" = 50'  
 ZONING: MXD-3  
 G. L. W. FILE NO.: 11001  
 DATE: OCT. 2012  
 TAX MAP - GRID: 41-21/46-3  
 SHEET: 9 OF 25  
 HOWARD COUNTY, MARYLAND



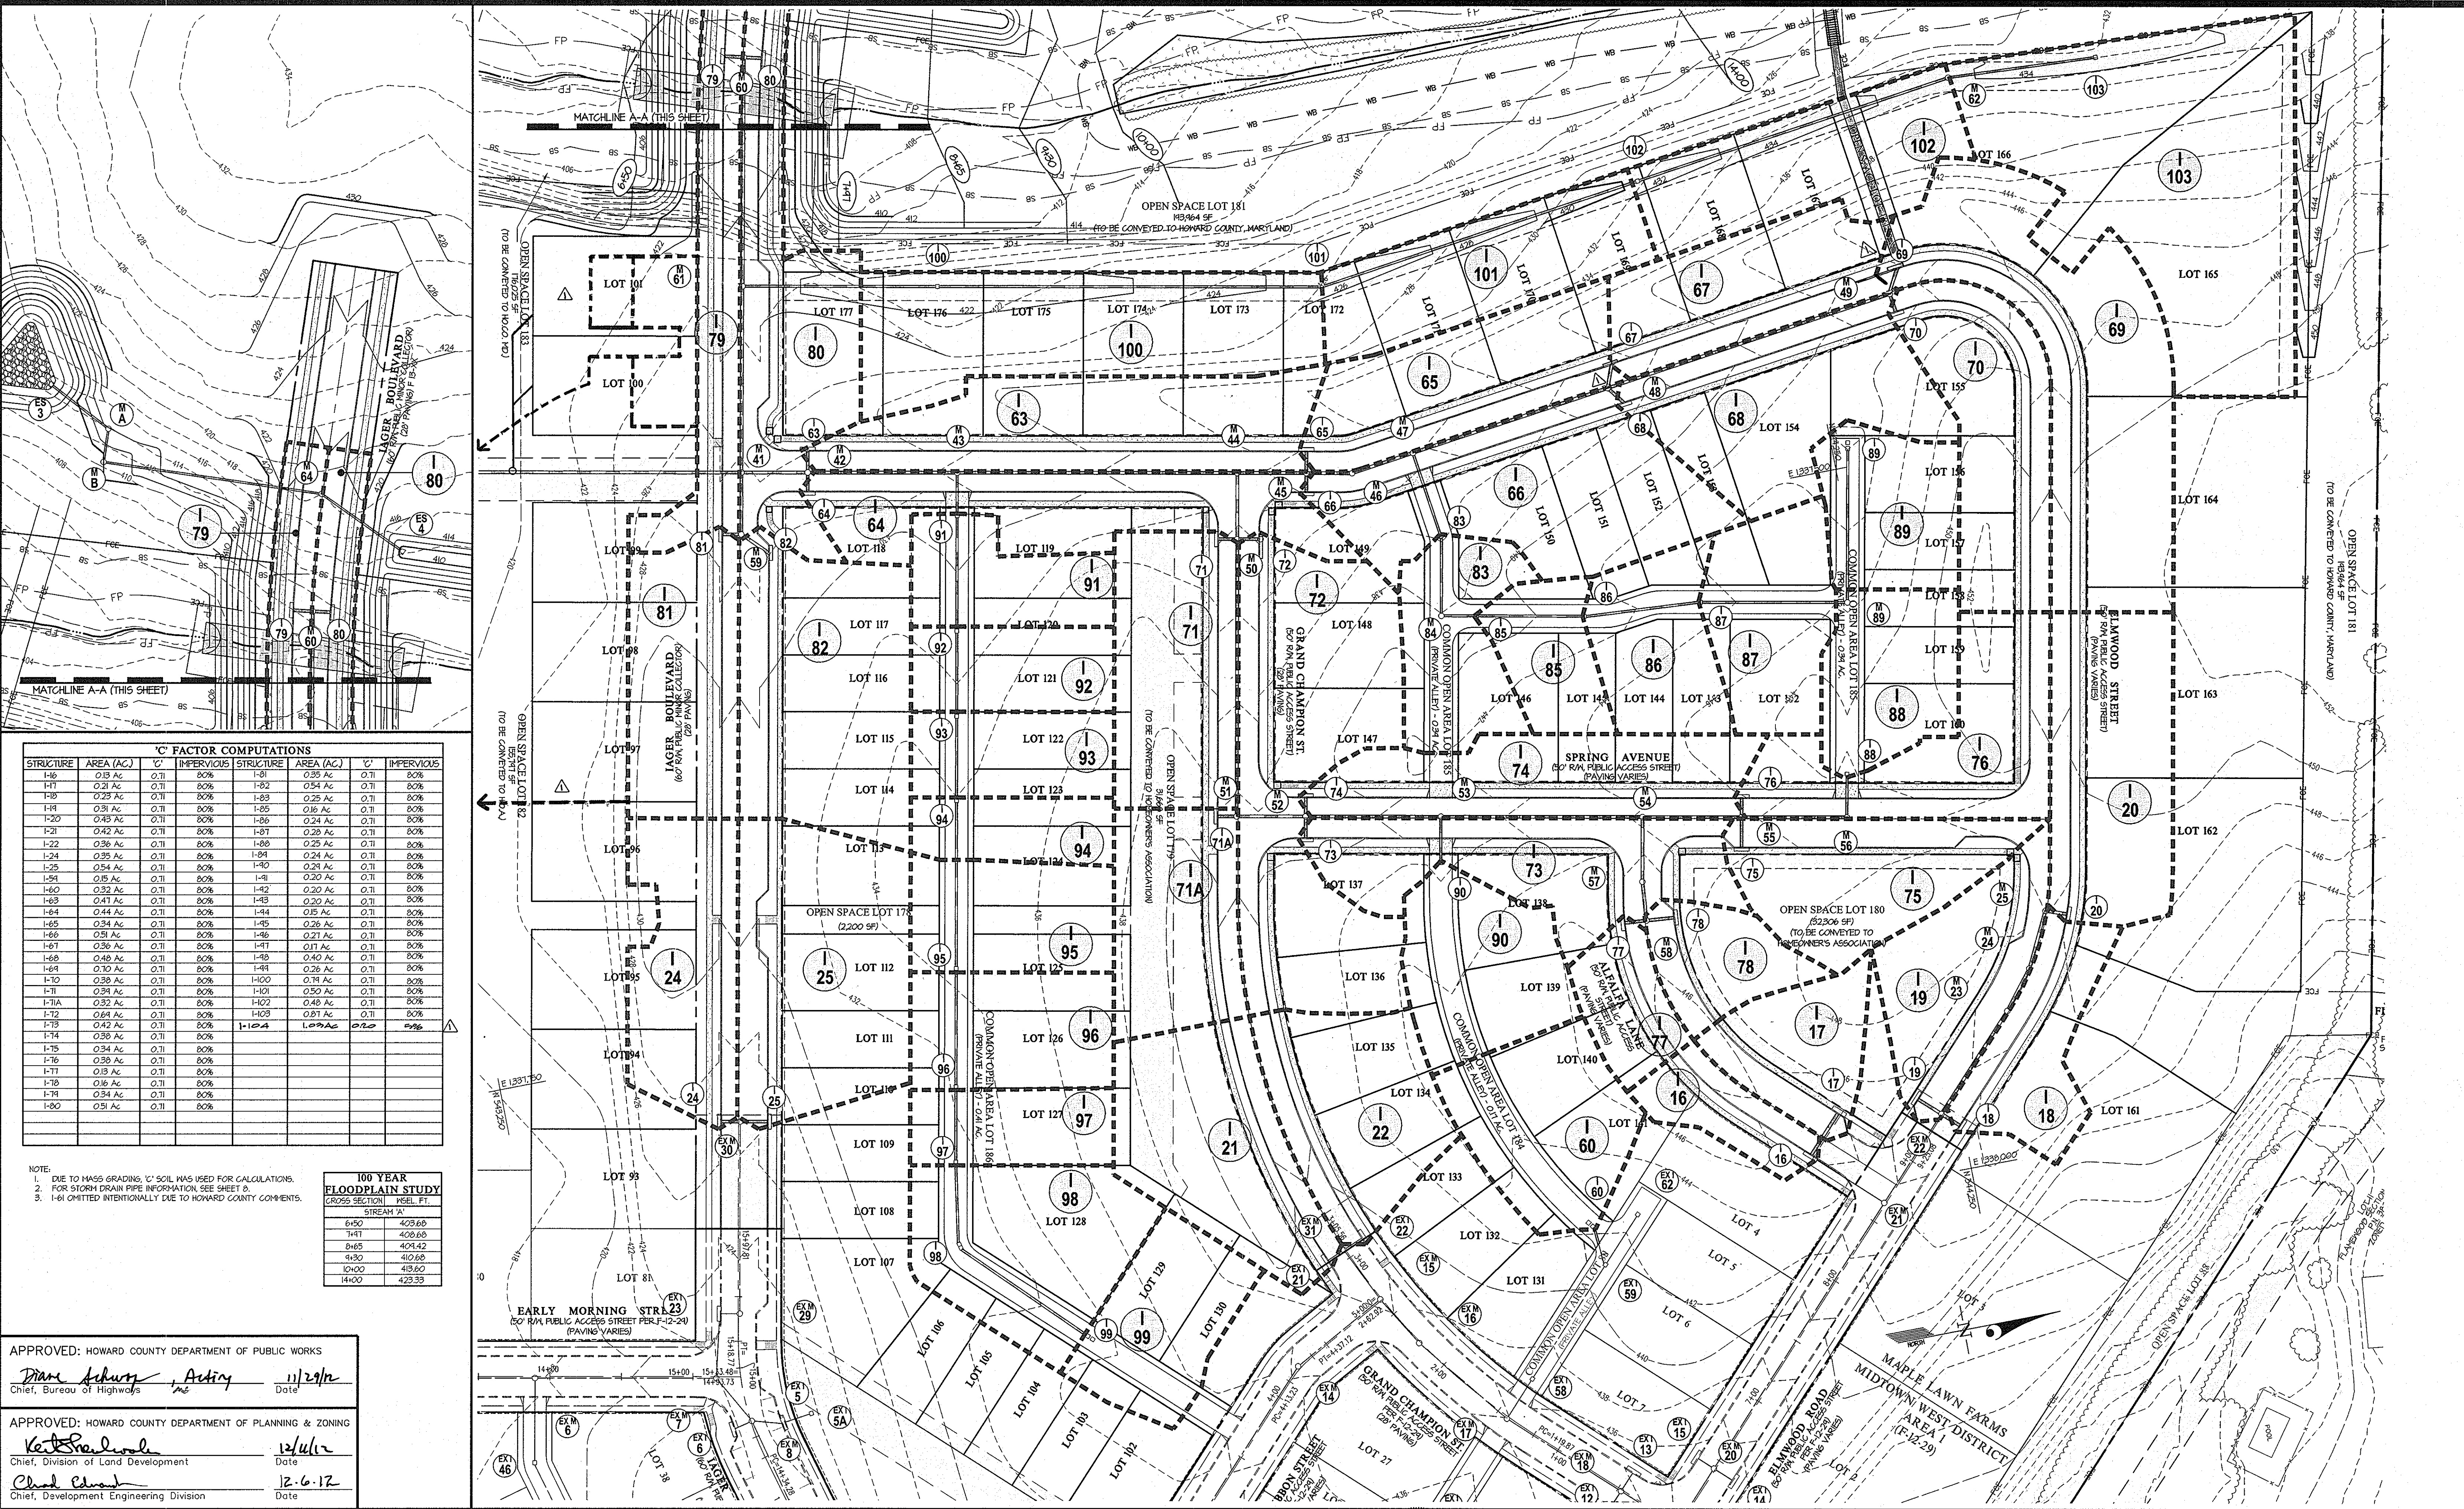

**C' FACTOR COMPUTATIONS**

STRUCTURE	AREA (AC.)	C'	IMPERVIOUS	STRUCTURE	AREA (AC.)	C'	IMPERVIOUS
I-16	0.18 AC.	0.71	80%	I-81	0.35 AC.	0.71	80%
I-17	0.21 AC.	0.71	80%	I-82	0.34 AC.	0.71	80%
I-18	0.23 AC.	0.71	80%	I-83	0.32 AC.	0.71	80%
I-19	0.31 AC.	0.71	80%	I-84	0.36 AC.	0.71	80%
I-20	0.43 AC.	0.71	80%	I-85	0.24 AC.	0.71	80%
I-21	0.42 AC.	0.71	80%	I-86	0.28 AC.	0.71	80%
I-22	0.36 AC.	0.71	80%	I-87	0.25 AC.	0.71	80%
I-23	0.36 AC.	0.71	80%	I-88	0.25 AC.	0.71	80%
I-24	0.35 AC.	0.71	80%	I-89	0.24 AC.	0.71	80%
I-25	0.34 AC.	0.71	80%	I-90	0.23 AC.	0.71	80%
I-26	0.35 AC.	0.71	80%	I-91	0.23 AC.	0.71	80%
I-27	0.32 AC.	0.71	80%	I-92	0.20 AC.	0.71	80%
I-28	0.32 AC.	0.71	80%	I-93	0.20 AC.	0.71	80%
I-29	0.41 AC.	0.71	80%	I-94	0.20 AC.	0.71	80%
I-30	0.44 AC.	0.71	80%	I-95	0.18 AC.	0.71	80%
I-31	0.34 AC.	0.71	80%	I-96	0.26 AC.	0.71	80%
I-32	0.34 AC.	0.71	80%	I-97	0.21 AC.	0.71	80%
I-33	0.36 AC.	0.71	80%	I-98	0.11 AC.	0.71	80%
I-34	0.48 AC.	0.71	80%	I-99	0.40 AC.	0.71	80%
I-35	0.10 AC.	0.71	80%	I-100	0.26 AC.	0.71	80%
I-36	0.38 AC.	0.71	80%	I-101	0.26 AC.	0.71	80%
I-37	0.34 AC.	0.71	80%	I-102	0.31 AC.	0.71	80%
I-38	0.32 AC.	0.71	80%	I-103	0.48 AC.	0.71	80%
I-39	0.42 AC.	0.71	80%	I-104	0.81 AC.	0.71	80%
I-40	0.38 AC.	0.71	80%				
I-41	0.34 AC.	0.71	80%				
I-42	0.16 AC.	0.71	80%				
I-43	0.34 AC.	0.71	80%				
I-44	0.31 AC.	0.71	80%				
I-45	0.31 AC.	0.71	80%				

**100 YEAR FLOODPLAIN STUDY**

CROSS SECTION	WGL. FT.
6150	402.60
1411	400.60
6165	404.42
4130	410.60
1400	413.60
1400	423.30

APPROVED: HOWARD COUNTY DEPARTMENT OF PUBLIC WORKS  
*Diane Schum*, Acting Chief, Bureau of Highways, 11/29/12

APPROVED: HOWARD COUNTY DEPARTMENT OF PLANNING & ZONING  
*Kurt Schum*, Chief, Division of Land Development, 12/6/12  
*Chad Conrad*, Chief, Development Engineering Division, 12-6-12

**GLWGUTSCHICK LITTLE & WEBER, P.A.**  
 CIVIL ENGINEERS, LAND SURVEYORS, LAND PLANNERS, LANDSCAPE ARCHITECTS  
 3909 NATIONAL DRIVE - SUITE 250 - BURTONSVILLE OFFICE PARK  
 BURTONSVILLE, MARYLAND 20866  
 TEL: 301-421-4024 BAL: 410-880-1820 DC/VA: 301-989-2524 FAX: 301-421-4186

NO.	DATE	REVISION	BY	APPR.

PREPARED FOR:  
 MAPLE LAWN FARMS 1, LLC  
 SUITE 300 WOODHOLME CENTER  
 1829 REISTERSTOWN ROAD  
 BALTIMORE, MD 21208  
 ATTN: MARK BENNETT  
 410-484-8400

PROFESSIONAL CERTIFICATION  
 I HEREBY CERTIFY THAT THESE PLANS WERE PREPARED OR APPROVED BY ME, AND THAT I AM A DULY LICENSED PROFESSIONAL ENGINEER UNDER THE LAWS OF THE STATE OF MARYLAND, LICENSE NO. 18292, EXPIRATION DATE: MAY 26, 2014.  
 11-7-12




**STORM DRAIN DRAINAGE AREA MAP**  
**MAPLE LAWN FARMS**  
 MIDTOWN WEST DISTRICT - AREA 2  
 LOTS 93 THRU 177, OPEN SPACE LOTS 178 THRU 183, AND COMMON OPEN AREA LOTS 184 THRU 186  
 HOWARD COUNTY, MARYLAND



SCALE	ZONING	G. L. W. FILE NO.
1" = 50'	MXD-3	11001
DATE	TAX MAP - GRID	SHEET
OCT. 2012	41-21/46-3	10 OF 25

L:\CADD\DRAWINGS\11001\FINALS\ROADS-SO\11001\_10\_SD\_DWG.dwg  
 PLOTTED: 11/29/12 8:44 AM. LAST SAVED: 11/29/12 8:42 AM. PLOTTED BY: Jennifer R. Dicks  
 © GLW 2012



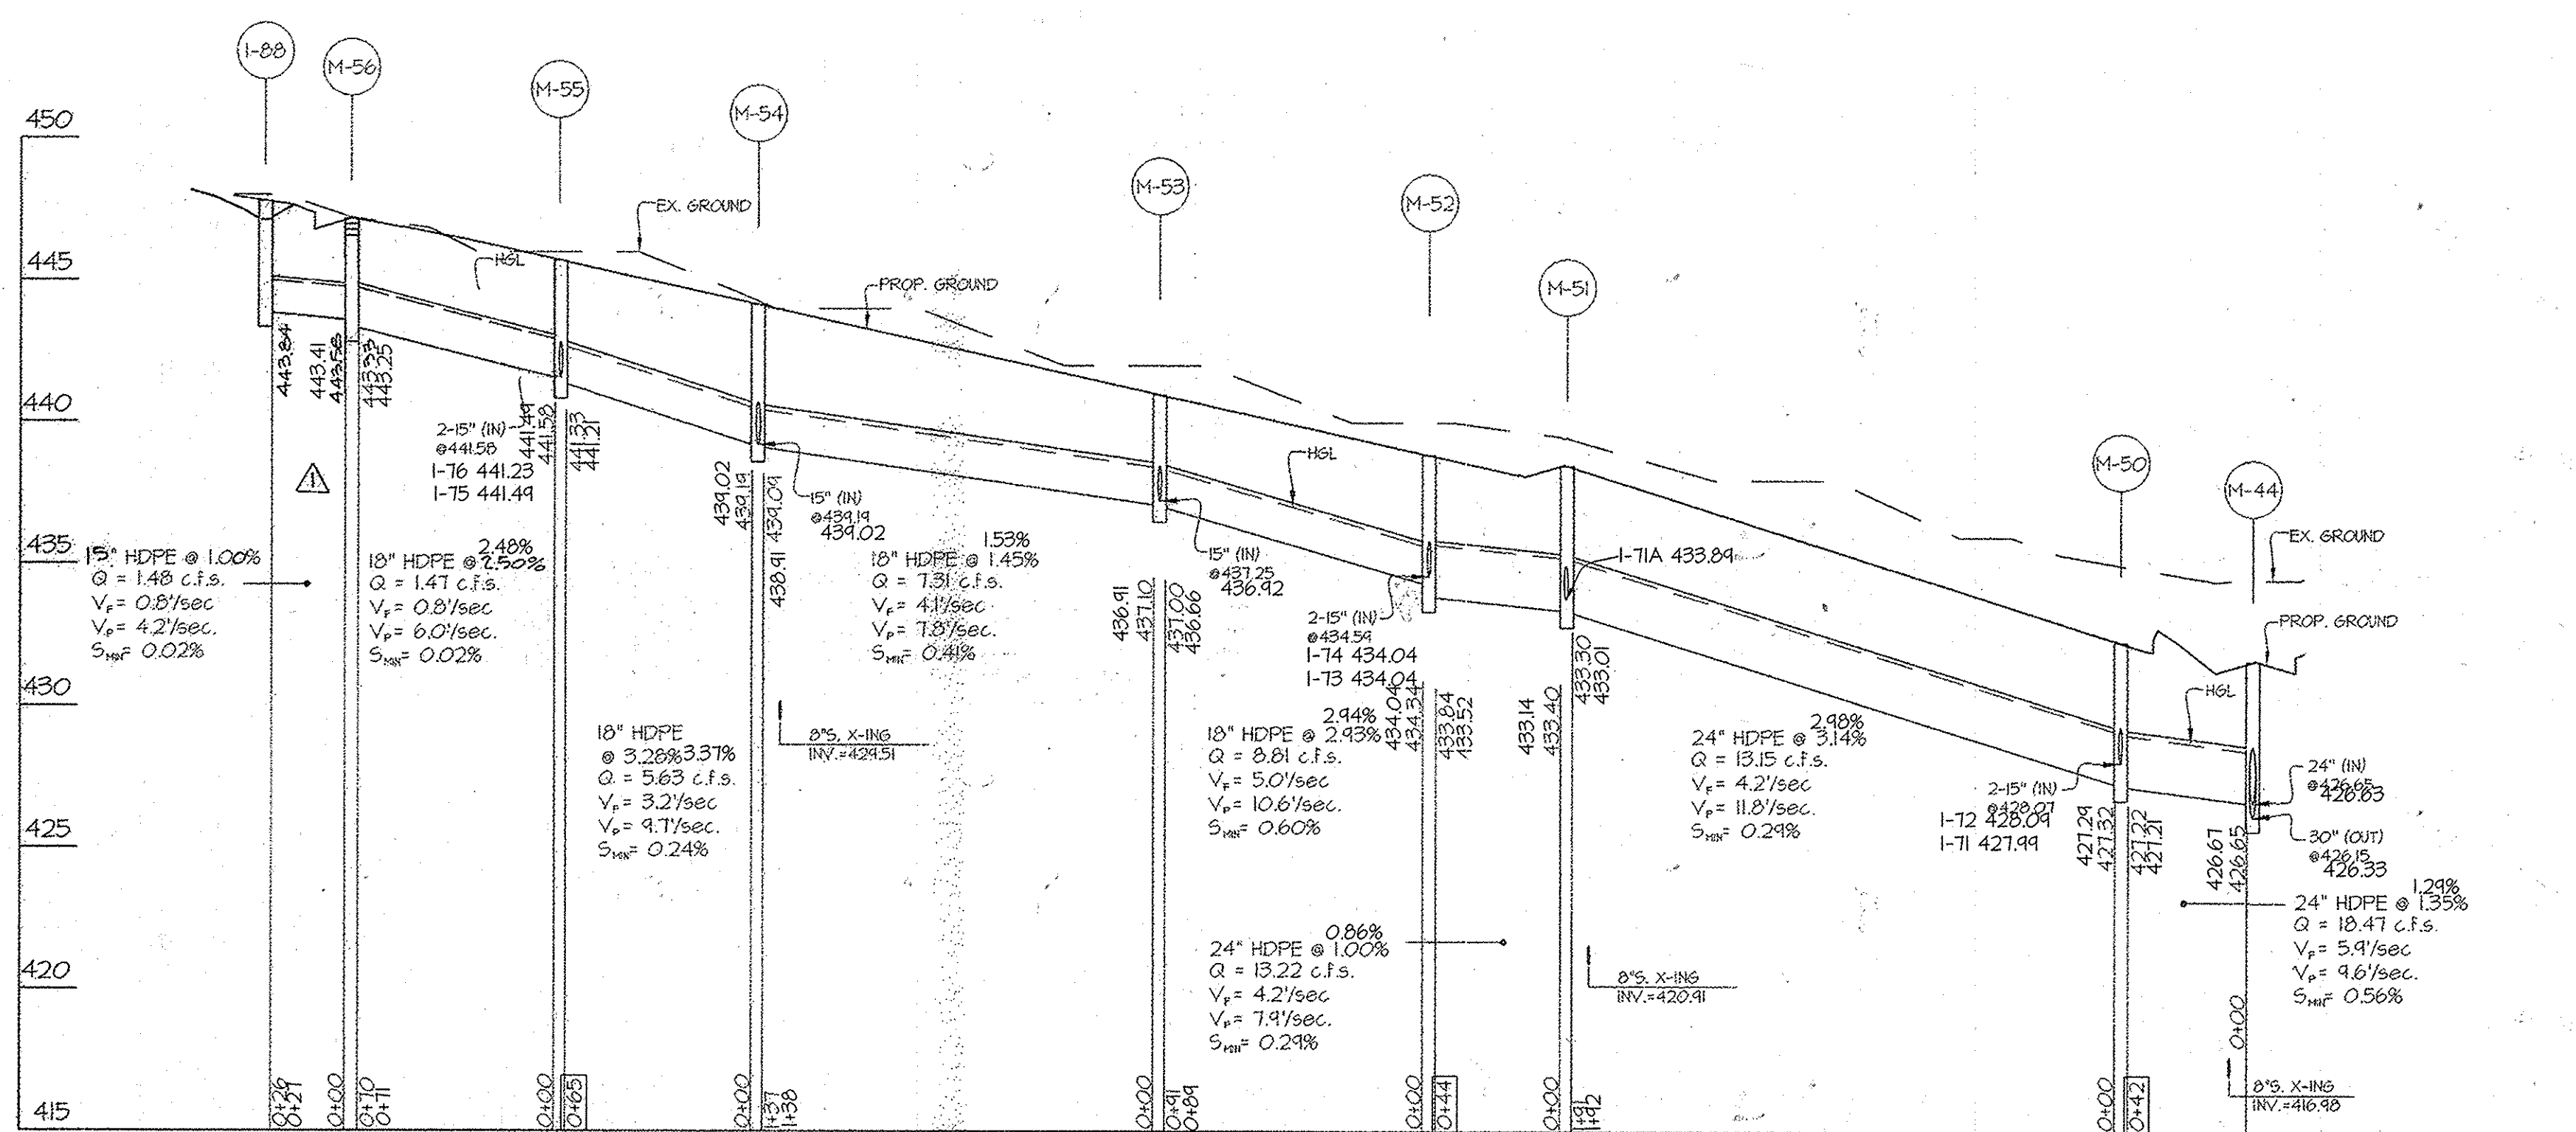

NO	TYPE	WIDTH (INSIDE)	TOP ELEVATION				INVERT				STD. DETAIL	LOCATIONS	REMARKS
			PROPOSED		AS-BUILT		PROPOSED		AS-BUILT				
			UPPER	LOWER	UPPER	LOWER	UPPER	LOWER	UPPER	LOWER			
I-60	DOUBLE 'S' INLET	2'-15"	442.24	442.06				431.34			HO. CO. D-4.23	N 543,882 E 1331,990	
I-71	A-10 INLET	2'-6"	432.66	432.38	432.77	432.48		428.18		428.10	HO. CO. D-4.03	N 543,811 E 1331,466	
I-71A	A-10 INLET	2'-6"	438.88	438.54	438.91	438.55		434.51		434.12	HO. CO. D-4.03	N 543,780 E 1331,657	
I-72	A-TYPE INLET	2'-6"	432.44	432.44	432.47	432.52		428.20		428.24	SHA MD 314.62	N 543,844 E 1331,471	
I-73	A-10 INLET	2'-6"	434.18	433.94	434.02	433.86		434.12		434.57	HO. CO. D-4.03	N 543,831 E 1331,683	
I-74	A-10 INLET	2'-6"	434.18	434.44	434.18	433.97		434.72		434.27	HO. CO. D-4.03	N 543,842 E 1331,656	
I-75	A-10 INLET	2'-6"	445.86	445.62	445.98	445.72		441.71		441.32	HO. CO. D-4.03	N 544,135 E 1331,748	
I-76	A-10 INLET	2'-6"	446.04	445.80	445.98	445.72		441.64		441.32	HO. CO. D-4.03	N 544,141 E 1331,714	
I-77	A-10 INLET	2'-6"	445.43	445.20	445.34	445.16		440.31		440.22	HO. CO. D-4.03	N 544,045 E 1331,785	
I-78	A-10 INLET	2'-6"	445.28	445.00	445.26	445.03		440.35		440.32	HO. CO. D-4.03	N 544,079 E 1331,787	
I-88	'S' INLET	2'-15" Δ	441.24	441.24				445.84		445.84	HO. CO. D-4.22	N 544,211 E 1331,711	
I-90	'S' INLET	2'-15"	441.00	441.00				431.41		431.41	HO. CO. D-4.22	N 543,926 E 1331,714	
M-44	STANDARD MANHOLE	5'-0"		431.63	431.53	426.65	426.15	426.67	426.33	426.33	HO. CO. G-5.13	N 543,838 E 1331,423	
M-50	STANDARD MANHOLE	4'-0"		432.24	432.08	428.07	427.22	428.09	427.21	427.21	HO. CO. G-5.12	N 543,850 E 1331,468	
M-51	STANDARD MANHOLE	4'-0"		438.50	438.36	433.84	433.84	433.84	433.01	433.01	HO. CO. G-5.12	N 543,742 E 1331,651	
M-52	STANDARD MANHOLE	4'-0"		438.86	438.62	434.54	433.84	434.04	433.52	433.52	HO. CO. G-5.12	N 543,840 E 1331,684	
M-53	STANDARD MANHOLE	4'-0"		440.94	440.42	437.25	437.00	436.92	436.66	436.66	HO. CO. G-5.12	N 543,832 E 1331,681	
M-54	STANDARD MANHOLE	4'-0"		444.16	443.91	434.19	434.09	434.02	433.91	433.91	HO. CO. G-5.12	N 544,071 E 1331,714	
M-55	STANDARD MANHOLE	4'-0"		445.71	445.46	441.58	441.33	441.44	441.21	441.21	HO. CO. G-5.12	N 544,134 E 1331,727	
M-56	STANDARD MANHOLE	4'-0"		447.18	446.98	444.58	443.99	443.41	443.25	443.25	HO. CO. G-5.12	N 544,211 E 1331,714	
M-57	STANDARD MANHOLE	4'-0"		444.47	444.13	434.70	434.60	434.61	434.47	434.47	HO. CO. G-5.12	N 544,062 E 1331,754	
M-58	STANDARD MANHOLE	4'-0"		445.12	444.93	440.18	434.93	440.06	434.88	434.88	HO. CO. G-5.12	N 544,060 E 1331,786	

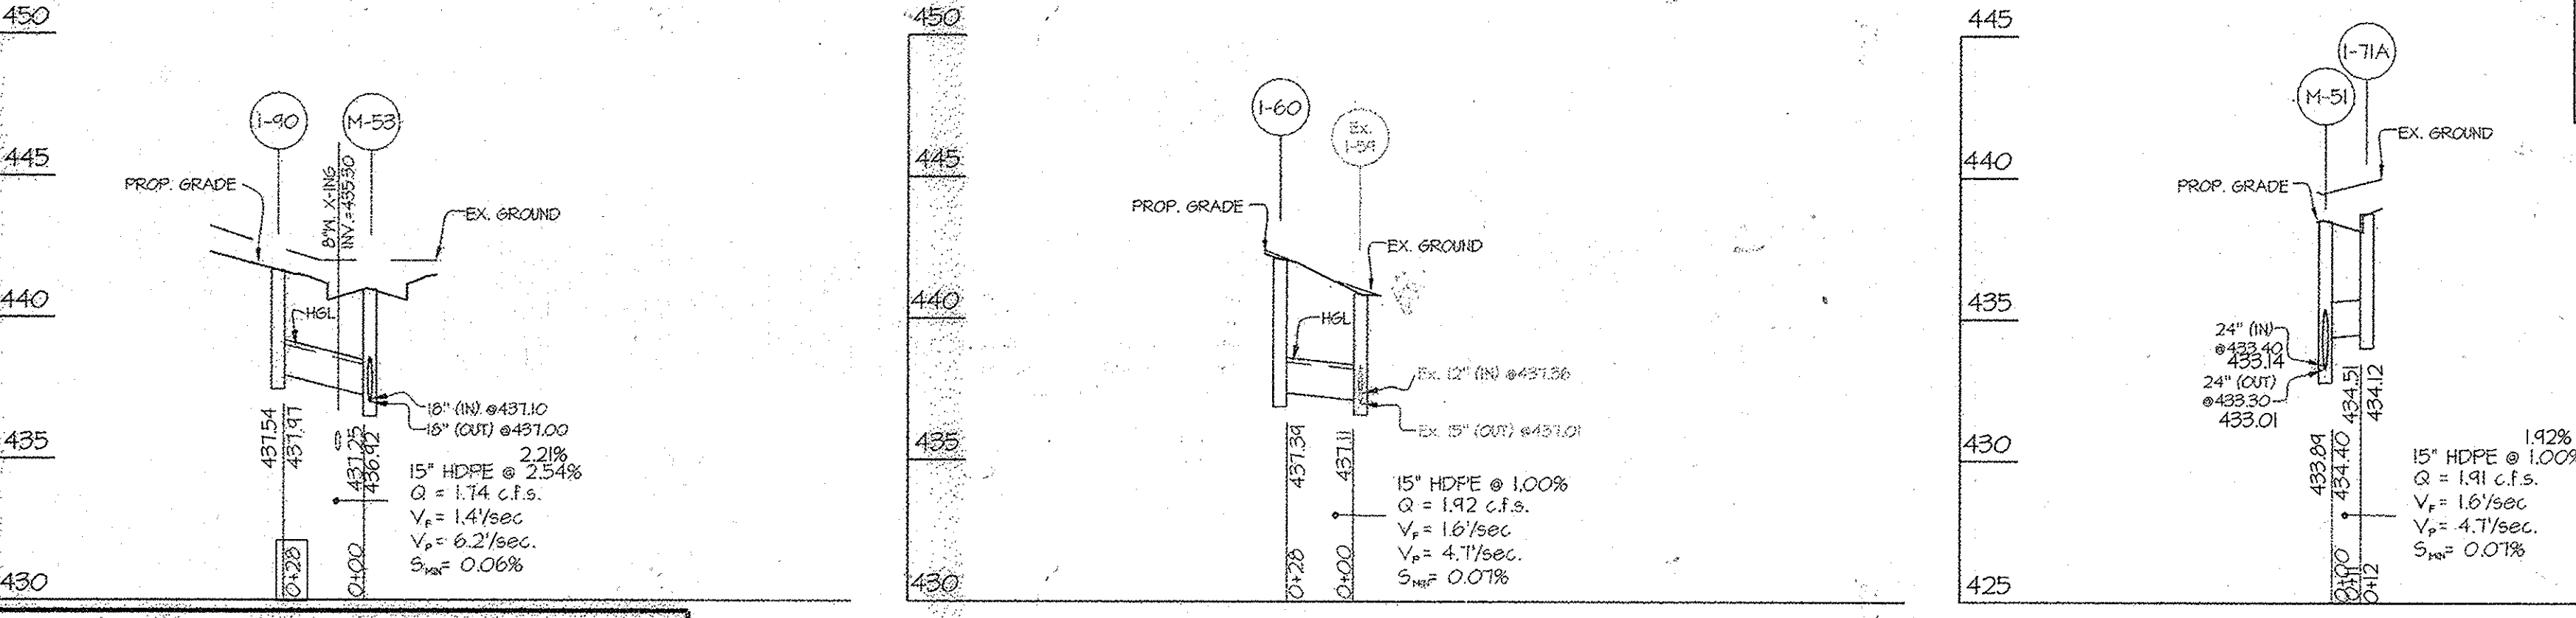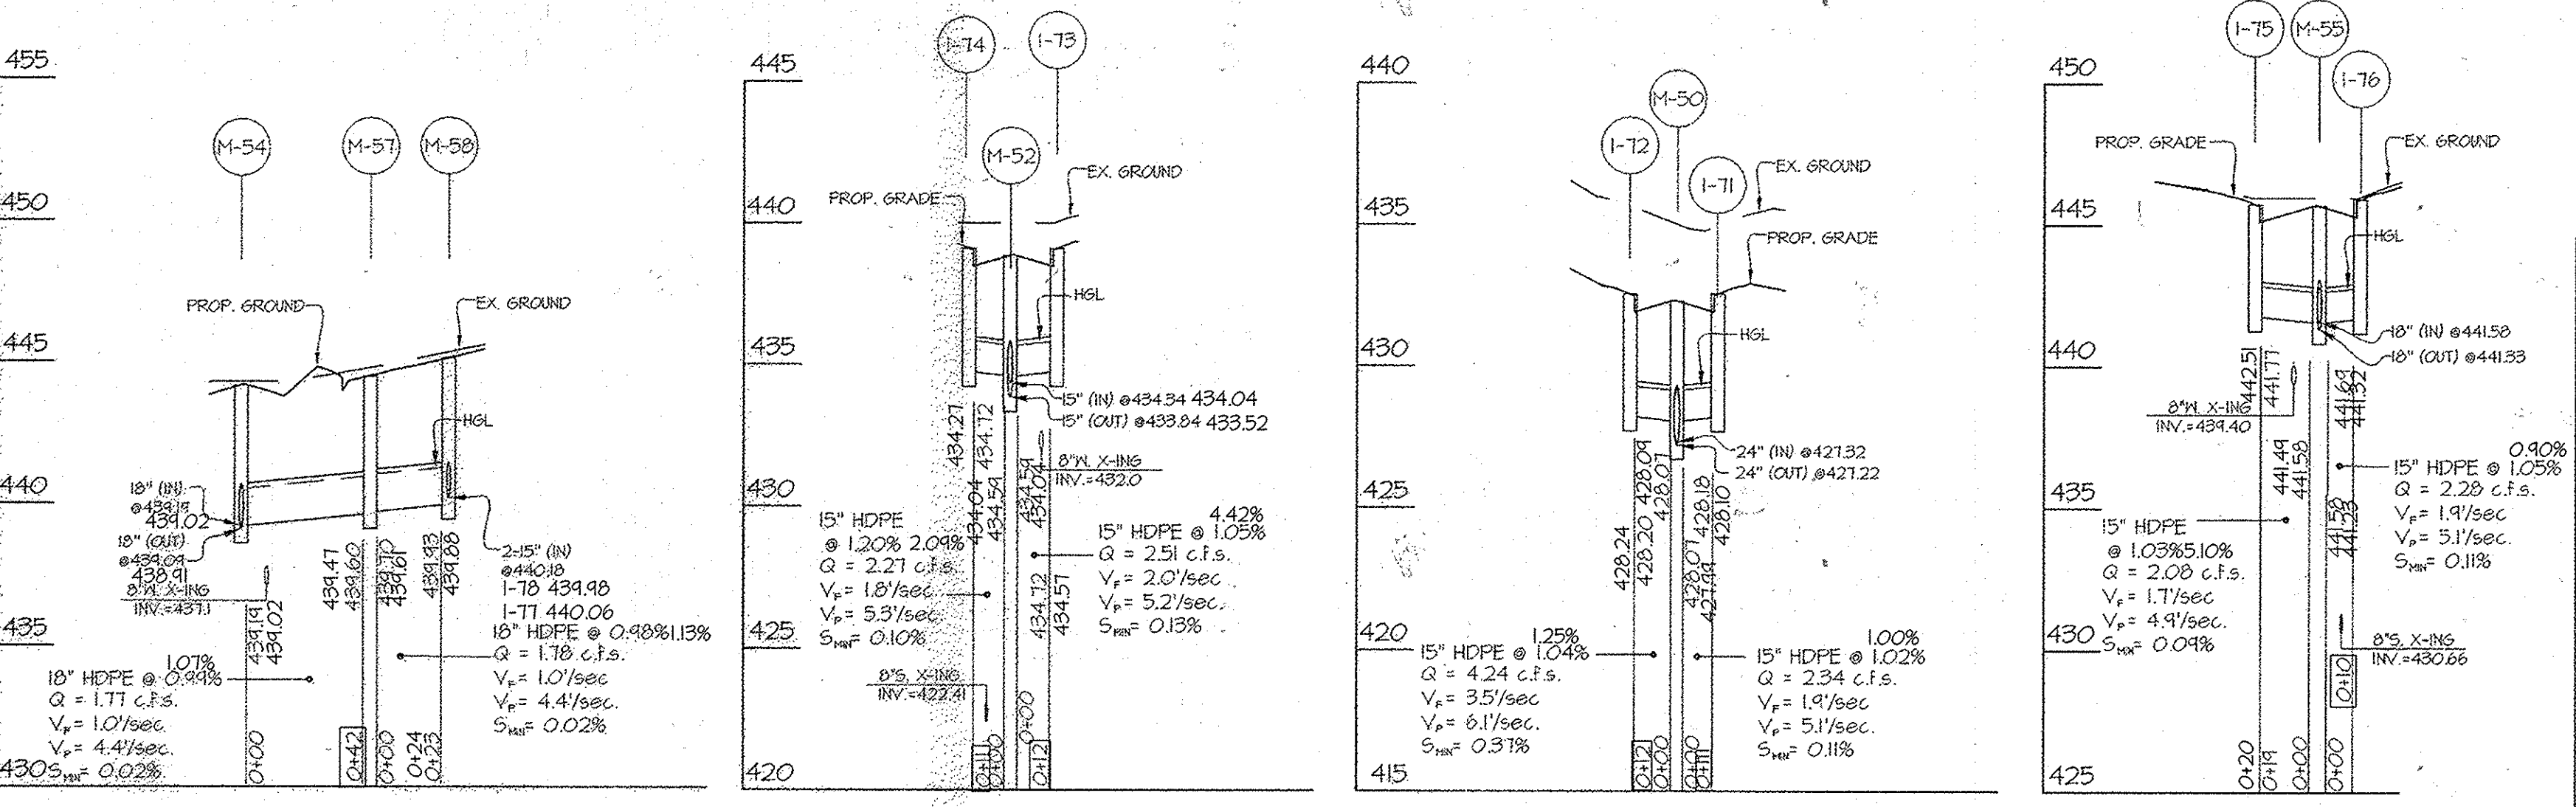

COORDINATE POINT GIVEN IS TO THE CENTERLINE OF STRUCTURE AT THE FACE OF CURB FOR INLETS AND TO THE CENTERLINE OF STRUCTURE FOR MANHOLES AND END SECTIONS.  
 ALL 'S' INLETS SHALL UTILIZE BICYCLE SAFE GRATES (EAST JORDAN IRON WORKS, OR APPROVED EQUAL)

PIPE SCHEDULE			
SIZE	TYPE	QUANTITY (L.F.)	REMARKS
15"	HDPE	128	
18"	HDPE	428	
24"	HDPE	271	

NOTES:  
 1. HDPE INDICATES HIGH DENSITY POLYETHYLENE PIPE, SUCH AS HD-12 BY ADS, OR HD-10 BY HANCOCK, OR AN APPROVED EQUAL.  
 2. TRENCH BEDDING TO BE PROVIDED PER HOWARD COUNTY DETAIL G 201, "TRENCH FOR P.V.C. PIPE AND HDPE."  
 3. ALL WATER AND SEWER CROSSINGS SHOWN ARE PER CONTRACT 24-4480-D.

PROFESSIONAL CERTIFICATION  
 I hereby certify that these documents were prepared or approved by me, and that I am a duly licensed professional engineer under the laws of the State of Maryland, License No. 12475, Expiration Date: May 26, 2016.  
 Date: 10-29-15  
 Carl K. Gutschick  
 Professional Engineer  
 Maryland Reg. No. 12475

APPROVED: HOWARD COUNTY DEPARTMENT OF PUBLIC WORKS  
 Diane Johnson, Acting Chief, Bureau of Highways, 11/24/12  
 APPROVED: HOWARD COUNTY DEPARTMENT OF PLANNING & ZONING  
 Kate DeLorenzo, Chief, Division of Land Development, 12/11/12  
 Chad Edmund, Chief, Development Engineering Division, 12-6-12

GLW GUTSCHICK LITTLE & WEBER, P.A.  
 CIVIL ENGINEERS, LAND SURVEYORS, LAND PLANNERS, LANDSCAPE ARCHITECTS  
 3909 NATIONAL DRIVE - SUITE 250 - BURTONVILLE OFFICE PARK  
 BURTONVILLE, MARYLAND 20866  
 TEL: 301-421-4024 BALT: 410-885-1820 DC/VA: 301-985-2524 FAX: 301-421-4186

NO.	DATE	REVISION	BY	APP'R





PREPARED FOR:  
 MAPLE LAWN FARMS I, LLC  
 SUITE 300 WOODHOLME CENTER  
 1829 REISTERSTOWN ROAD  
 BALTIMORE, MD 21208  
 ATTN: MARK BENNETT  
 410-484-8400

PROFESSIONAL CERTIFICATION  
 I HEREBY CERTIFY THAT THESE PLANS WERE PREPARED OR APPROVED BY ME, AND THAT I AM A DULY LICENSED PROFESSIONAL ENGINEER UNDER THE LAWS OF THE STATE OF MARYLAND, LICENSE NO. 12475, EXPIRATION DATE: MAY 26, 2016.  
 11-7-12  
 Carl K. Gutschick  
 ELECTION DISTRICT No. 5

ASBUILTS  
 STORM DRAIN PROFILES  
 MAPLE LAWN FARMS  
 MIDTOWN WEST DISTRICT - AREA 2  
 LOTS 93 THRU 177, OPEN SPACE LOTS 178 THRU 183, AND  
 COMMON OPEN AREA LOTS 184 THRU 186

SCALE	ZONING	G. L. W. FILE NO.
1" = 50' (H) 1" = 5' (V)	MXD-3	11001
DATE	TAX MAP - GRID	SHEET
OCT. 2015 OCT. 2012	41-21/46-3	11 OF 25



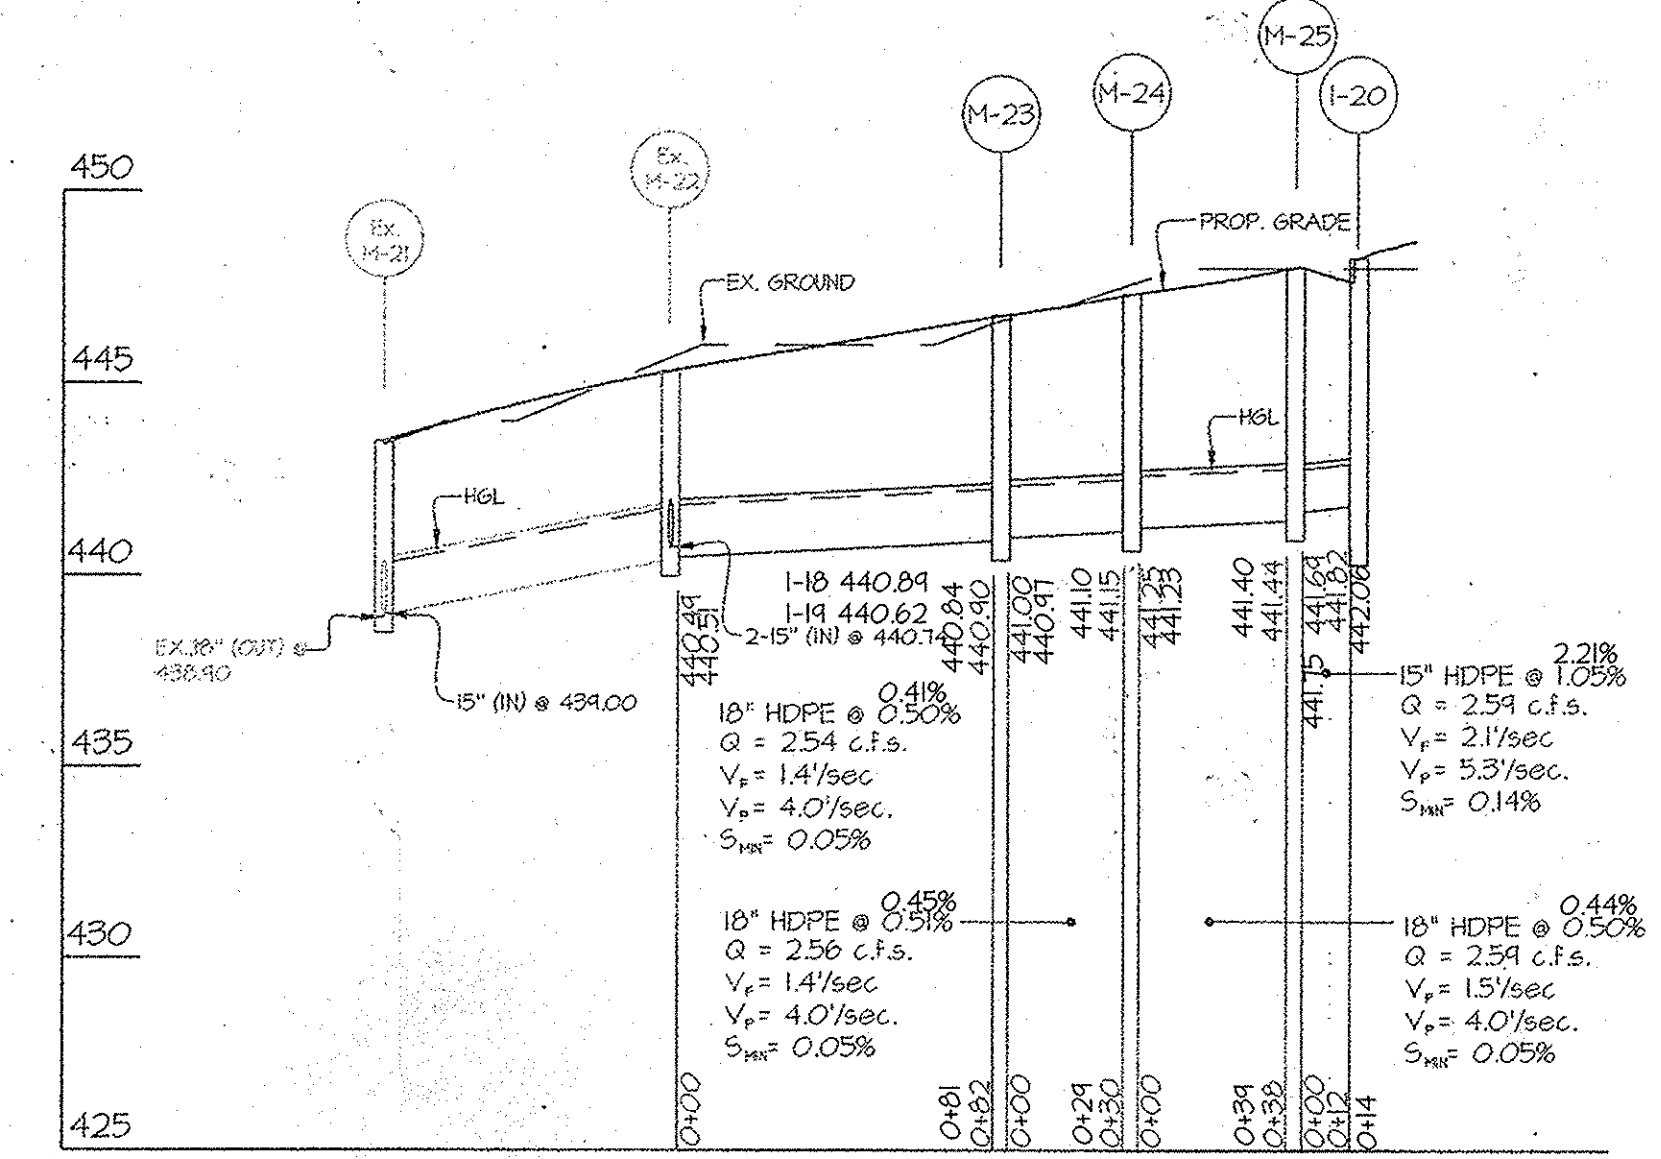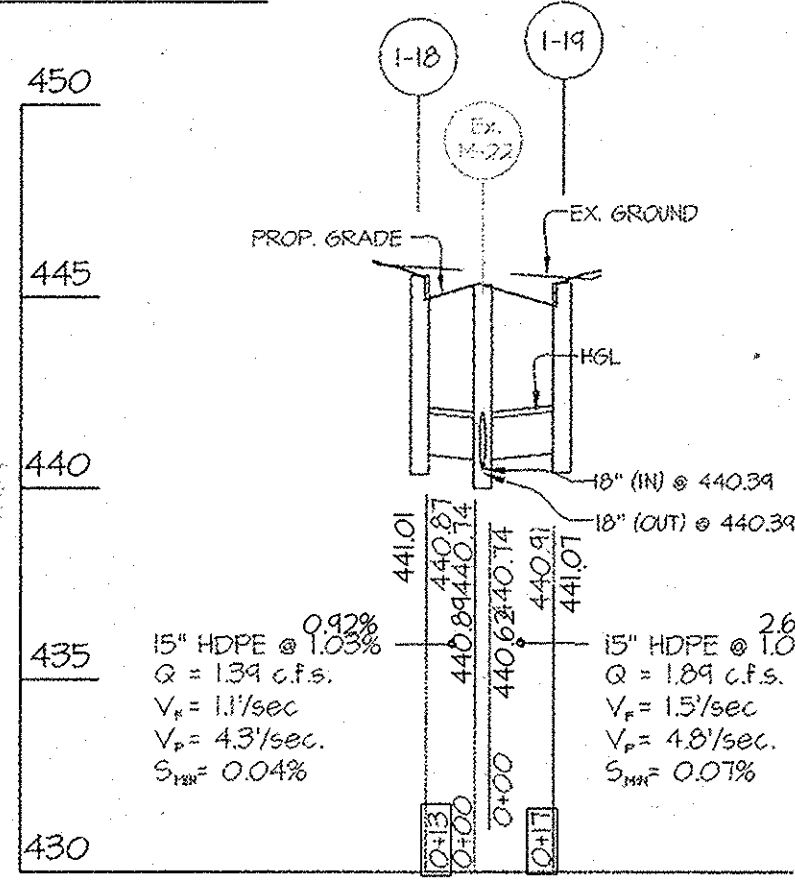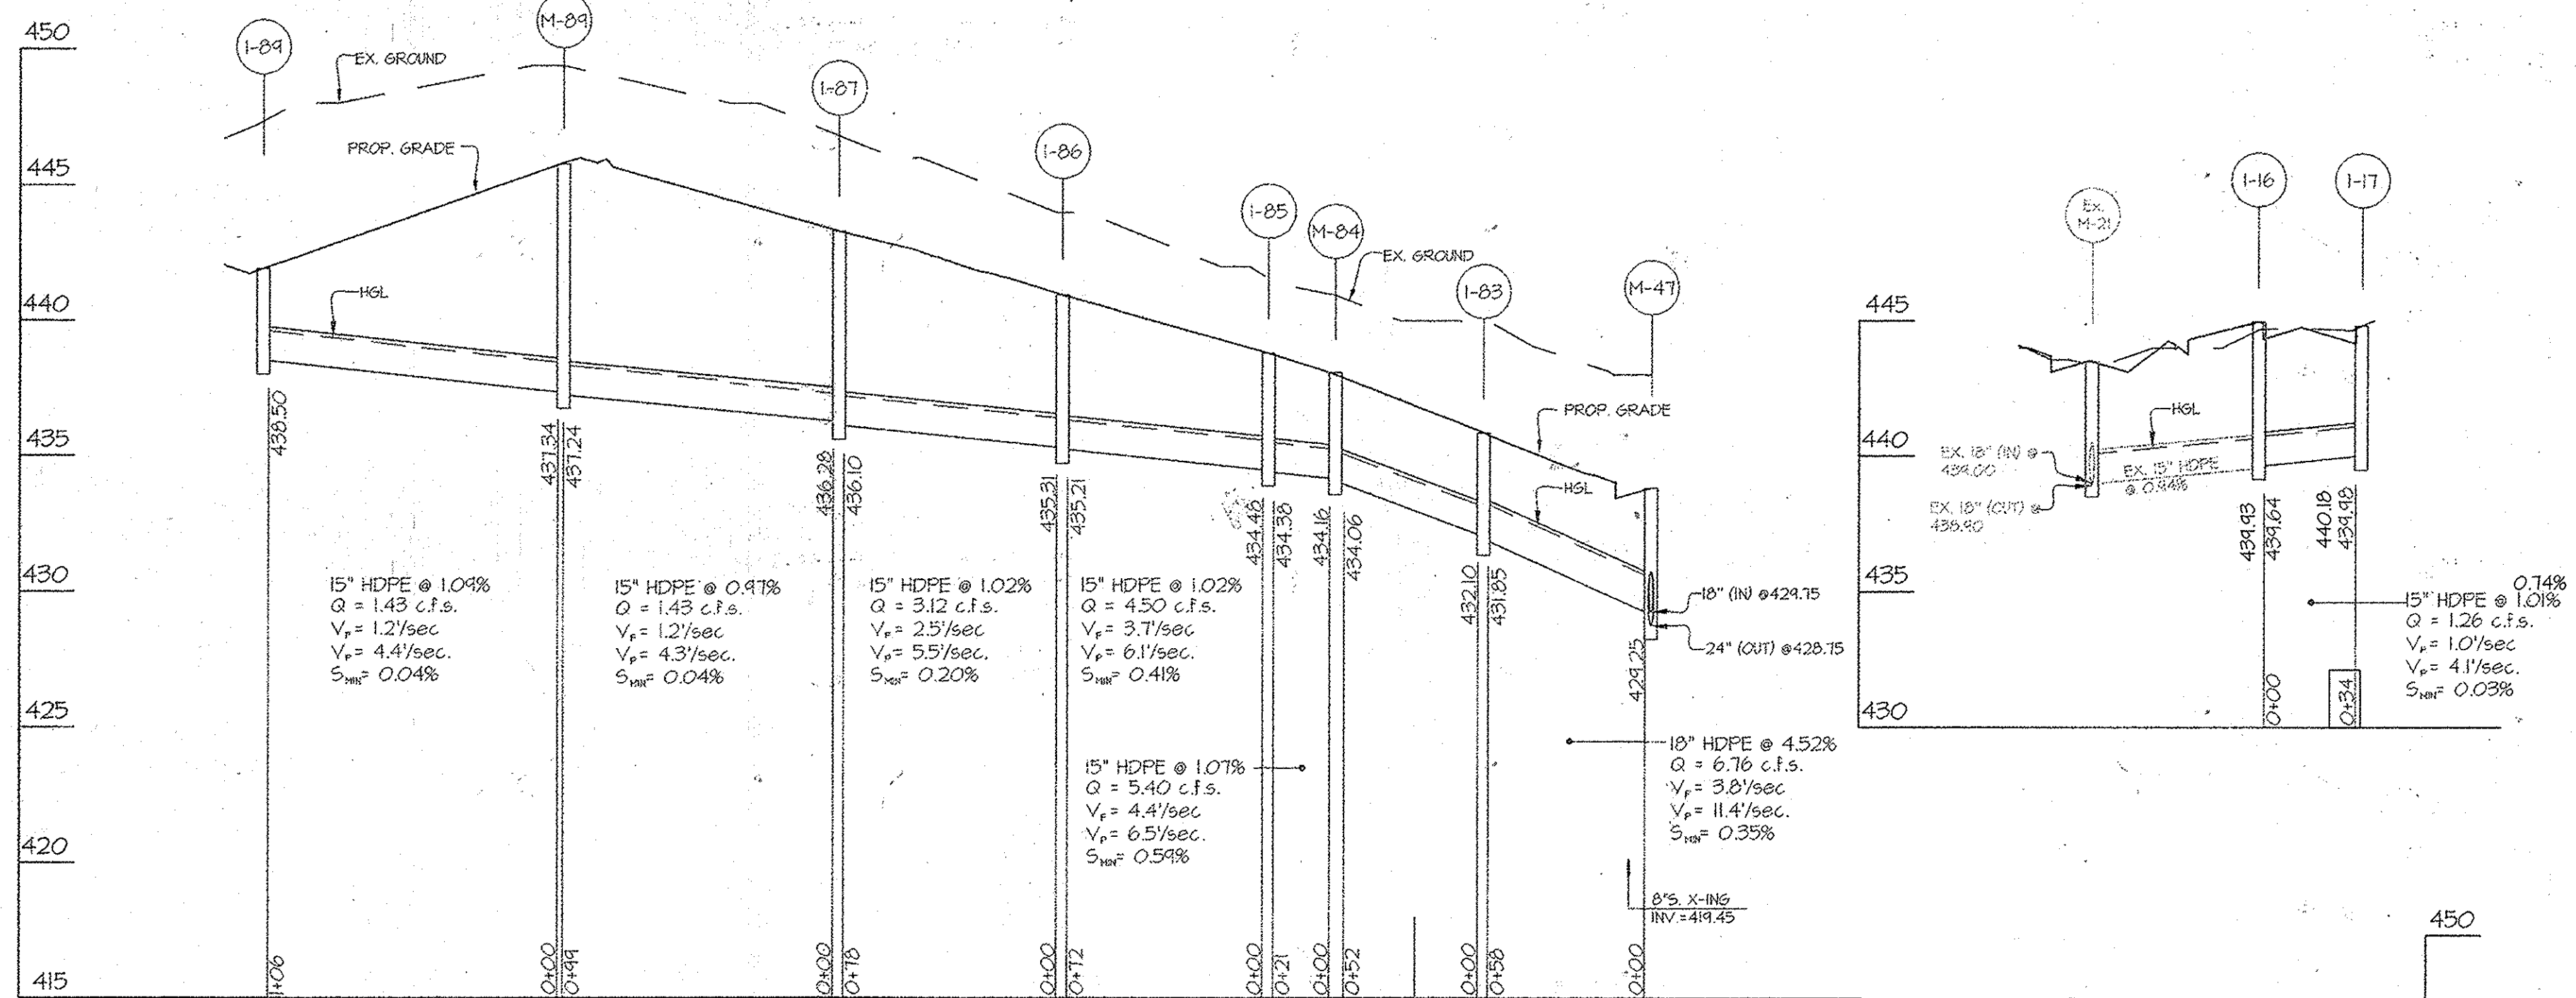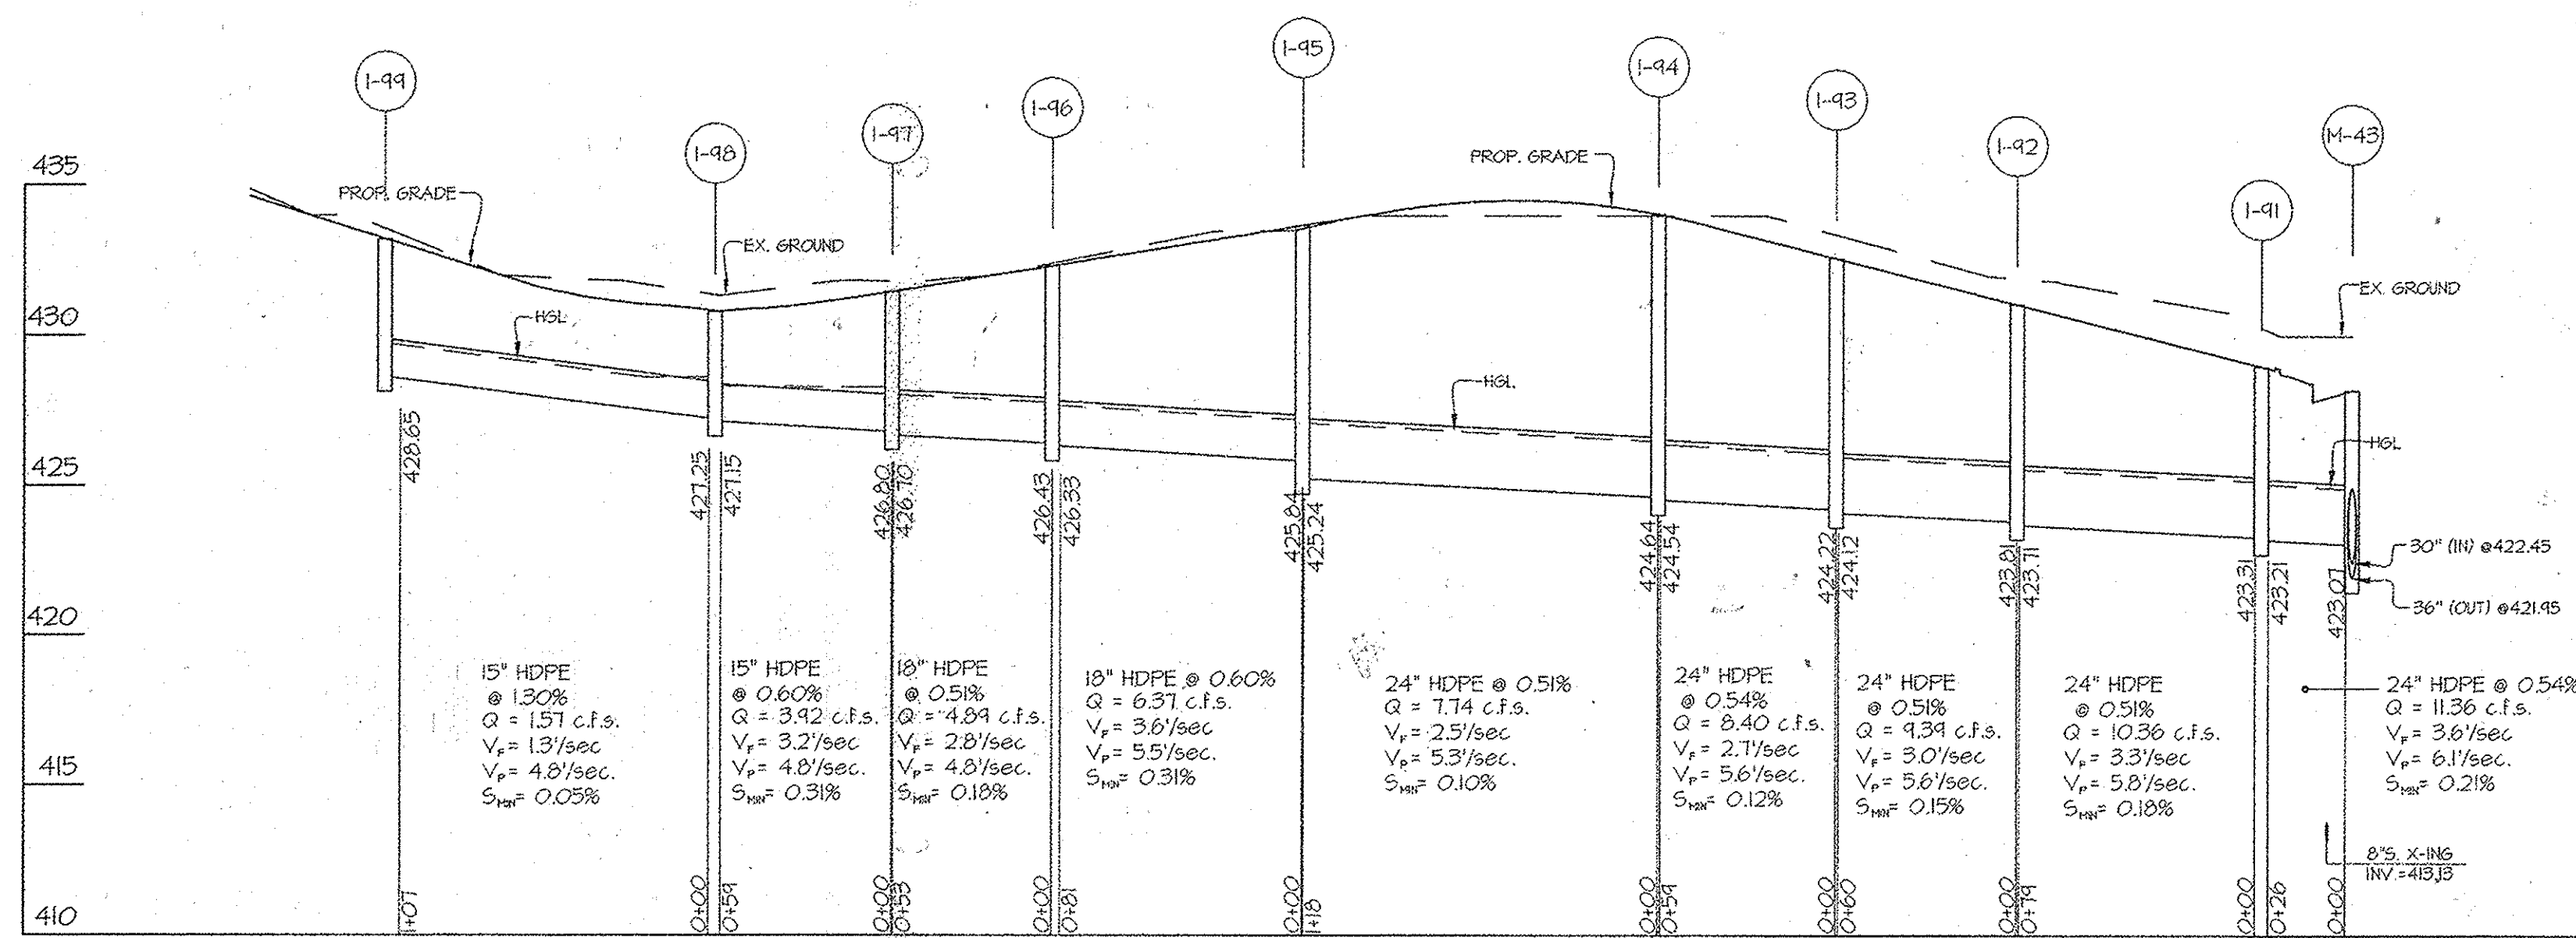

NO	TYPE	WIDTH (INSIDE)	TOP ELEVATION				INVERT				STD. DETAIL	LOCATIONS	REMARKS
			PROPOSED		AS-BUILT		PROPOSED		AS-BUILT				
			UPPER	LOWER	UPPER	LOWER	UPPER	LOWER	UPPER	LOWER			
I-16	A-10 INLET	2'-6"	445.06	444.80	445.10	444.81	439.64	439.54	439.93	439.77	HO. CO. D-4.03	N 544142 E 1331969	
I-17	A-10 INLET	2'-6"	444.88	444.62	445.05	444.82	---	439.98	---	440.18	HO. CO. D-4.03	N 544165 E 1331944	
I-18	A-10 INLET	2'-6"	445.63	445.43	445.54	445.35	---	440.87	---	441.01	HO. CO. D-4.03	N 544241 E 1331969	
I-19	A-10 INLET	2'-6"	445.45	445.21	445.35	445.11	---	440.91	---	441.07	HO. CO. D-4.03	N 544223 E 1331945	
I-20	A-10 INLET	2'-6"	448.31	448.15	448.32	448.18	---	441.82	---	442.06	HO. CO. D-4.03	N 544344 E 1331837	
I-83	'S' INLET	2'-15"	435.90	435.78	---	---	432.10	---	431.85	---	HO. CO. D-4.22	N 543910 E 1331943	
I-85	'S' INLET	2'-15"	438.83	438.75	---	---	434.48	---	434.38	---	HO. CO. D-4.22	N 543984 E 1331553	
I-86	'S' INLET	2'-15"	440.48	440.91	---	---	435.31	---	435.21	---	HO. CO. D-4.22	N 544058 E 1331566	
I-87	'S' INLET	2'-15"	443.33	443.26	---	---	436.20	---	436.10	---	HO. CO. D-4.22	N 544139 E 1331573	
I-84	DOUBLE 'S' INLET	2'-15"	442.04	441.75	---	---	---	---	438.50	---	HO. CO. D-4.23	N 544261 E 1331965	
I-91	'S' INLET	2'-15"	428.70	428.70	---	---	423.31	---	423.21	---	HO. CO. D-4.22	N 543640 E 1331915	
I-92	'S' INLET	2'-15"	431.10	431.00	---	---	423.81	---	423.71	---	HO. CO. D-4.22	N 543625 E 1331944	
I-93	'S' INLET	2'-15"	432.64	432.53	---	---	424.22	---	424.12	---	HO. CO. D-4.22	N 543613 E 1331553	
I-94	'S' INLET	2'-15"	434.09	434.01	---	---	424.64	---	424.54	---	HO. CO. D-4.22	N 543602 E 1331811	
I-95	'S' INLET	2'-15"	433.70	433.64	---	---	425.84	---	425.24	---	HO. CO. D-4.22	N 543579 E 1331727	
I-96	'S' INLET	2'-15"	432.36	432.29	---	---	426.43	---	426.33	---	HO. CO. D-4.22	N 543563 E 1331809	
I-97	'S' INLET	2'-15"	431.50	431.44	---	---	426.80	---	426.70	---	HO. CO. D-4.22	N 543553 E 1331826	
I-98	DOUBLE 'S' INLET	2'-15"	430.79	430.79	---	---	427.25	---	427.15	---	HO. CO. D-4.23	N 543545 E 1331919	
I-99	DOUBLE 'S' INLET	2'-15"	433.42	433.16	---	---	---	---	428.65	---	HO. CO. D-4.23	N 543621 E 1331998	
M-23	STANDARD MANHOLE	4'-0"	---	---	446.76	446.71	441.00	440.90	440.97	440.84	HO. CO. G-5.12	N 544295 E 1331896	
M-24	STANDARD MANHOLE	4'-0"	---	---	447.32	447.31	441.25	441.15	441.23	441.10	HO. CO. G-5.12	N 544316 E 1331870	
M-25	STANDARD MANHOLE	4'-0"	---	---	448.03	448.03	441.69	441.44	441.75	441.40	HO. CO. G-5.12	N 544336 E 1331832	
M-43	STANDARD MANHOLE	5'-0"	---	---	428.20	428.04	423.07	421.95	422.64	422.26	HO. CO. G-5.13	N 543646 E 1331385	
M-47	STANDARD MANHOLE	4'-0"	---	---	433.82	433.65	429.75	428.75	429.03	428.73	HO. CO. G-5.12	N 543962 E 1331932	
M-21	STANDARD MANHOLE	4'-0"	---	---	438.74	---	434.16	---	434.06	---	HO. CO. G-5.12	N 543959 E 1331548	
M-22	STANDARD MANHOLE	4'-0"	---	---	445.76	---	437.34	---	437.24	---	HO. CO. G-5.12	N 544240 E 1331593	

COORDINATE POINT GIVEN IS TO THE CENTERLINE OF STRUCTURE AT THE FACE OF CURB FOR INLETS AND TO THE CENTERLINE OF STRUCTURE FOR MANHOLES AND END SECTIONS.

\* ALL 'S' INLETS SHALL UTILIZE BICYCLE SAFE GRATES (EAST JORDAN IRON WORKS, OR APPROVED EQUAL)

PIPE SCHEDULE			
SIZE	TYPE	QUANTITY (LF)	REMARKS
15"	HDPE	670	
18"	HDPE	342	
24"	HDPE	342	

NOTES:  
 1. HDPE INDICATES HIGH DENSITY POLYETHYLENE PIPE, SUCH AS N-12 BY ADS, OR H-Q BY HANCOX OR AN APPROVED EQUAL.  
 2. TRENCH BEDDING TO BE PROVIDED PER HOWARD COUNTY DETAIL G 2.01. \*TRENCH FOR P.V.C. PIPE AND HDPE.\*  
 3. ALL WATER AND SEWER CROSSINGS SHOWN ARE PER CONTRACT: 24-4418-D

PROFESSIONAL CERTIFICATION  
 I hereby certify that these documents were prepared or approved by me, and that I am a duly licensed professional engineer under the laws of the State of Maryland, License No. 12475, Expiration Date: May 26 2016.

10-29-15  
 Date  
 Carl K. Gieschick  
 Professional Engineer  
 Maryland Reg. No. 12475

APPROVED: HOWARD COUNTY DEPARTMENT OF PUBLIC WORKS  
 Diane Schreyer Acting 11/26/12  
 Chief, Bureau of Highways Date

APPROVED: HOWARD COUNTY DEPARTMENT OF PLANNING & ZONING  
 Keith DeLund 12/11/12  
 Chief, Division of Land Development Date

Chad Edwards 12-6-12  
 Chief, Development Engineering Division Date

GLWGUTSCHICK LITTLE & WEBER, P.A.  
 CIVIL ENGINEERS, LAND SURVEYORS, LAND PLANNERS, LANDSCAPE ARCHITECTS  
 3909 NATIONAL DRIVE - SUITE 250 - BURTONSVILLE OFFICE PARK  
 BURTONSVILLE, MARYLAND 20886  
 TEL: 301-421-4024 FAX: 410-880-1820 DC/MD: 301-989-2524 FAX: 301-421-4188

NO.	REVISION	DATE	BY	APP'R.
1	Prep. storm drain to accommodate lot grading			

PREPARED FOR:  
 MAPLE LAWN FARMS I, LLC  
 SUITE 300 WOODHOLME CENTER  
 1829 REISTERSTOWN ROAD  
 BALTIMORE, MD 21208  
 ATTN: MARK BENNETT  
 410-484-8400






PROFESSIONAL CERTIFICATION  
 I HEREBY CERTIFY THAT THESE PLANS WERE PREPARED OR APPROVED BY ME, AND THAT I AM A DULY LICENSED PROFESSIONAL ENGINEER UNDER THE LAWS OF THE STATE OF MARYLAND, LICENSE NO. 12875, EXPIRATION DATE: MAY 26, 2014.

11-7-12  
 [Signature]

ASBUILTS  
 STORM DRAIN PROFILES  
 MAPLE LAWN FARMS  
 MIDTOWN WEST DISTRICT - AREA 2  
 LOTS 93 THRU 177, OPEN SPACE LOTS 178 THRU 183, AND COMMON OPEN AREA LOTS 184 THRU 186

SCALE	ZONING	G. L. W. FILE NO.
1" = 50' (H) 1" = 5' (V)	MXD-3	11001
DATE	TAX MAP - GRID	SHEET
OCT. 2015 OCT. 2012	41-21/46-3	12 OF 25



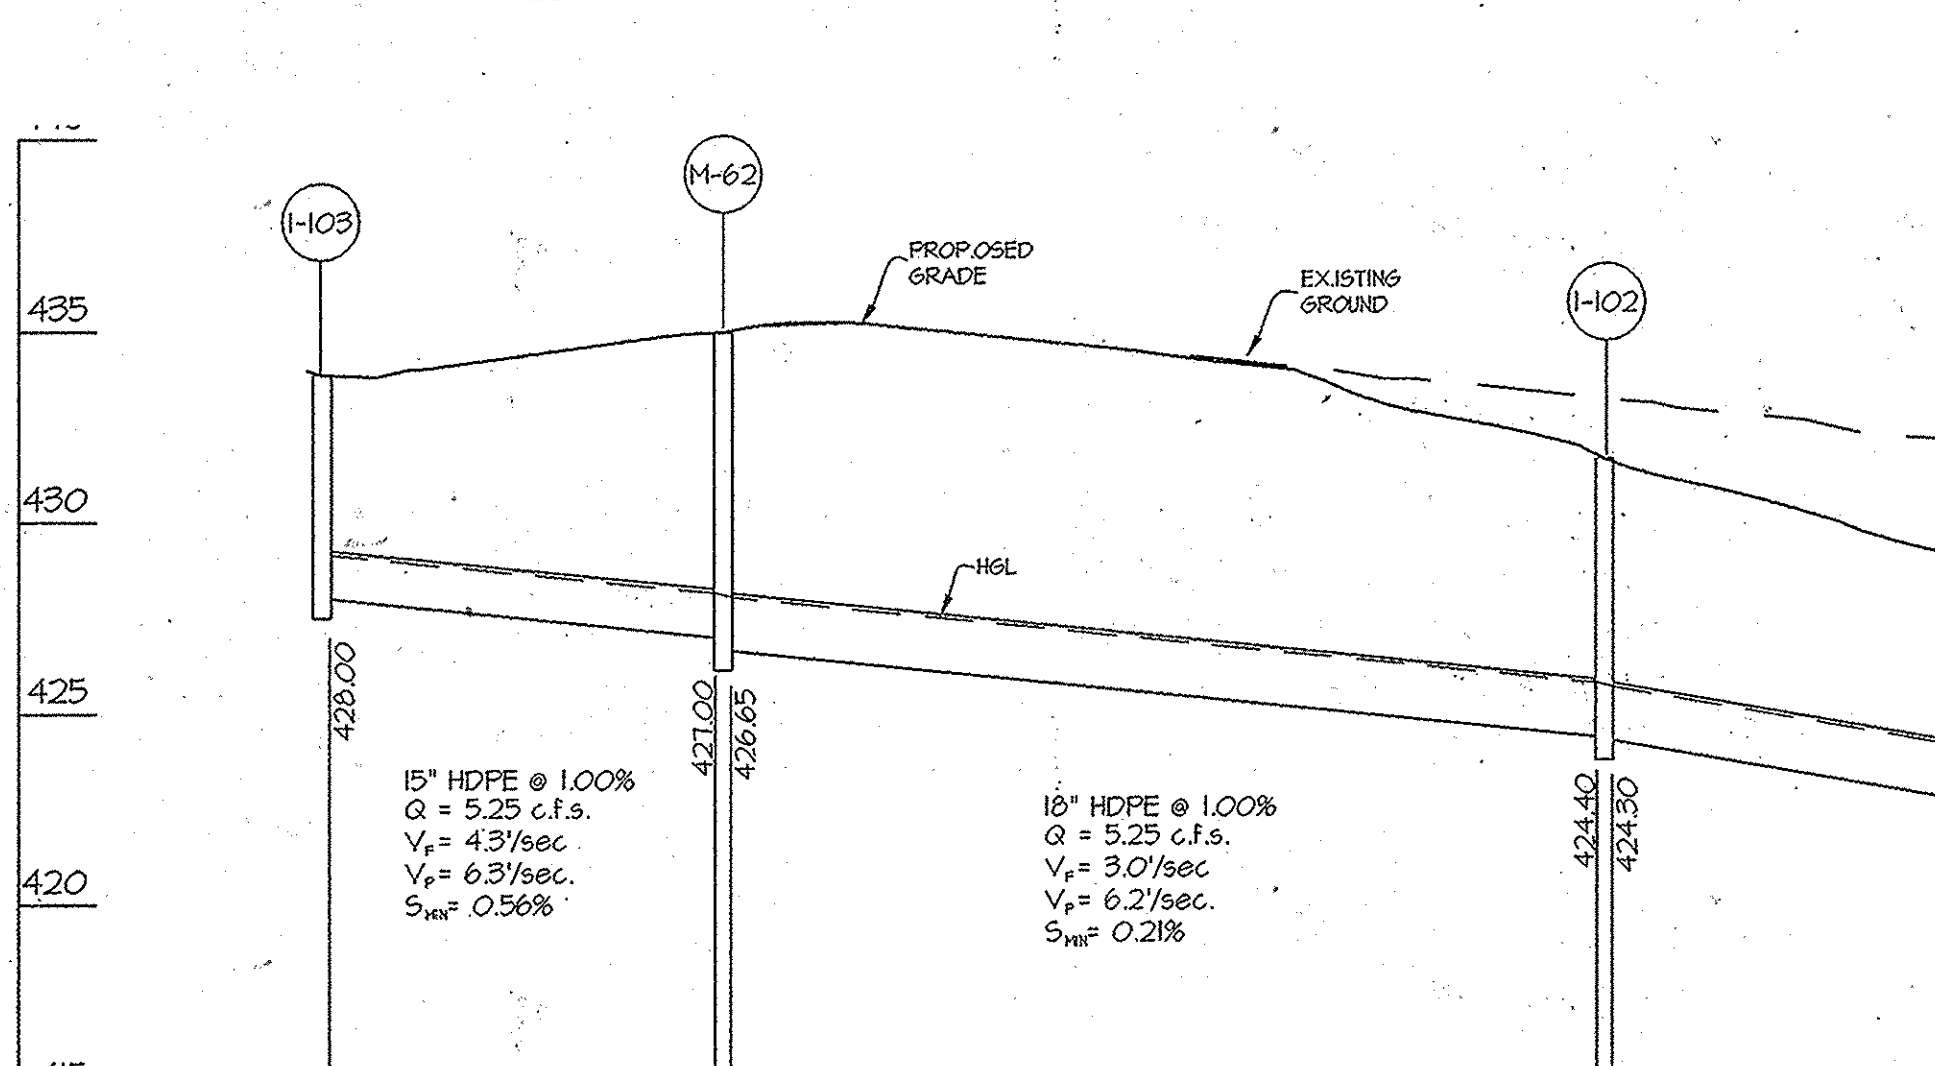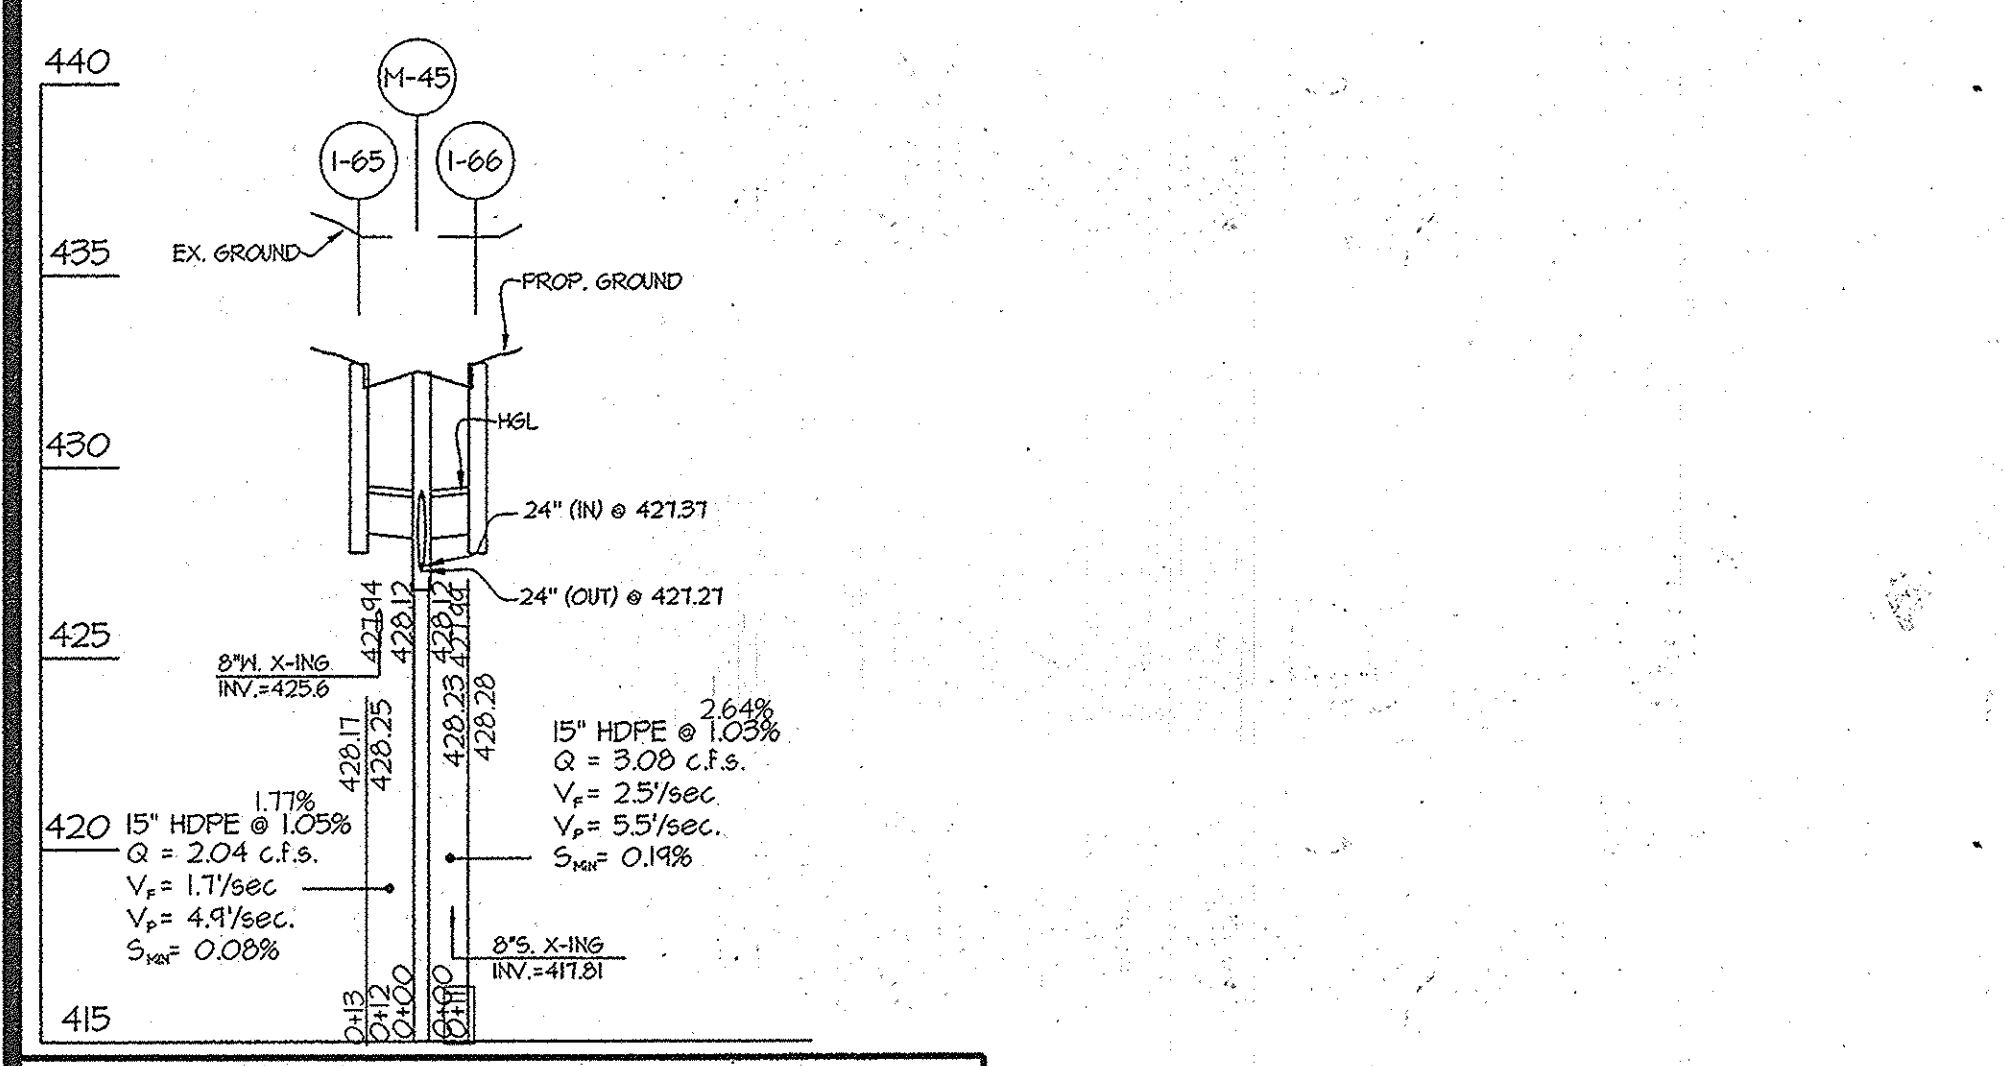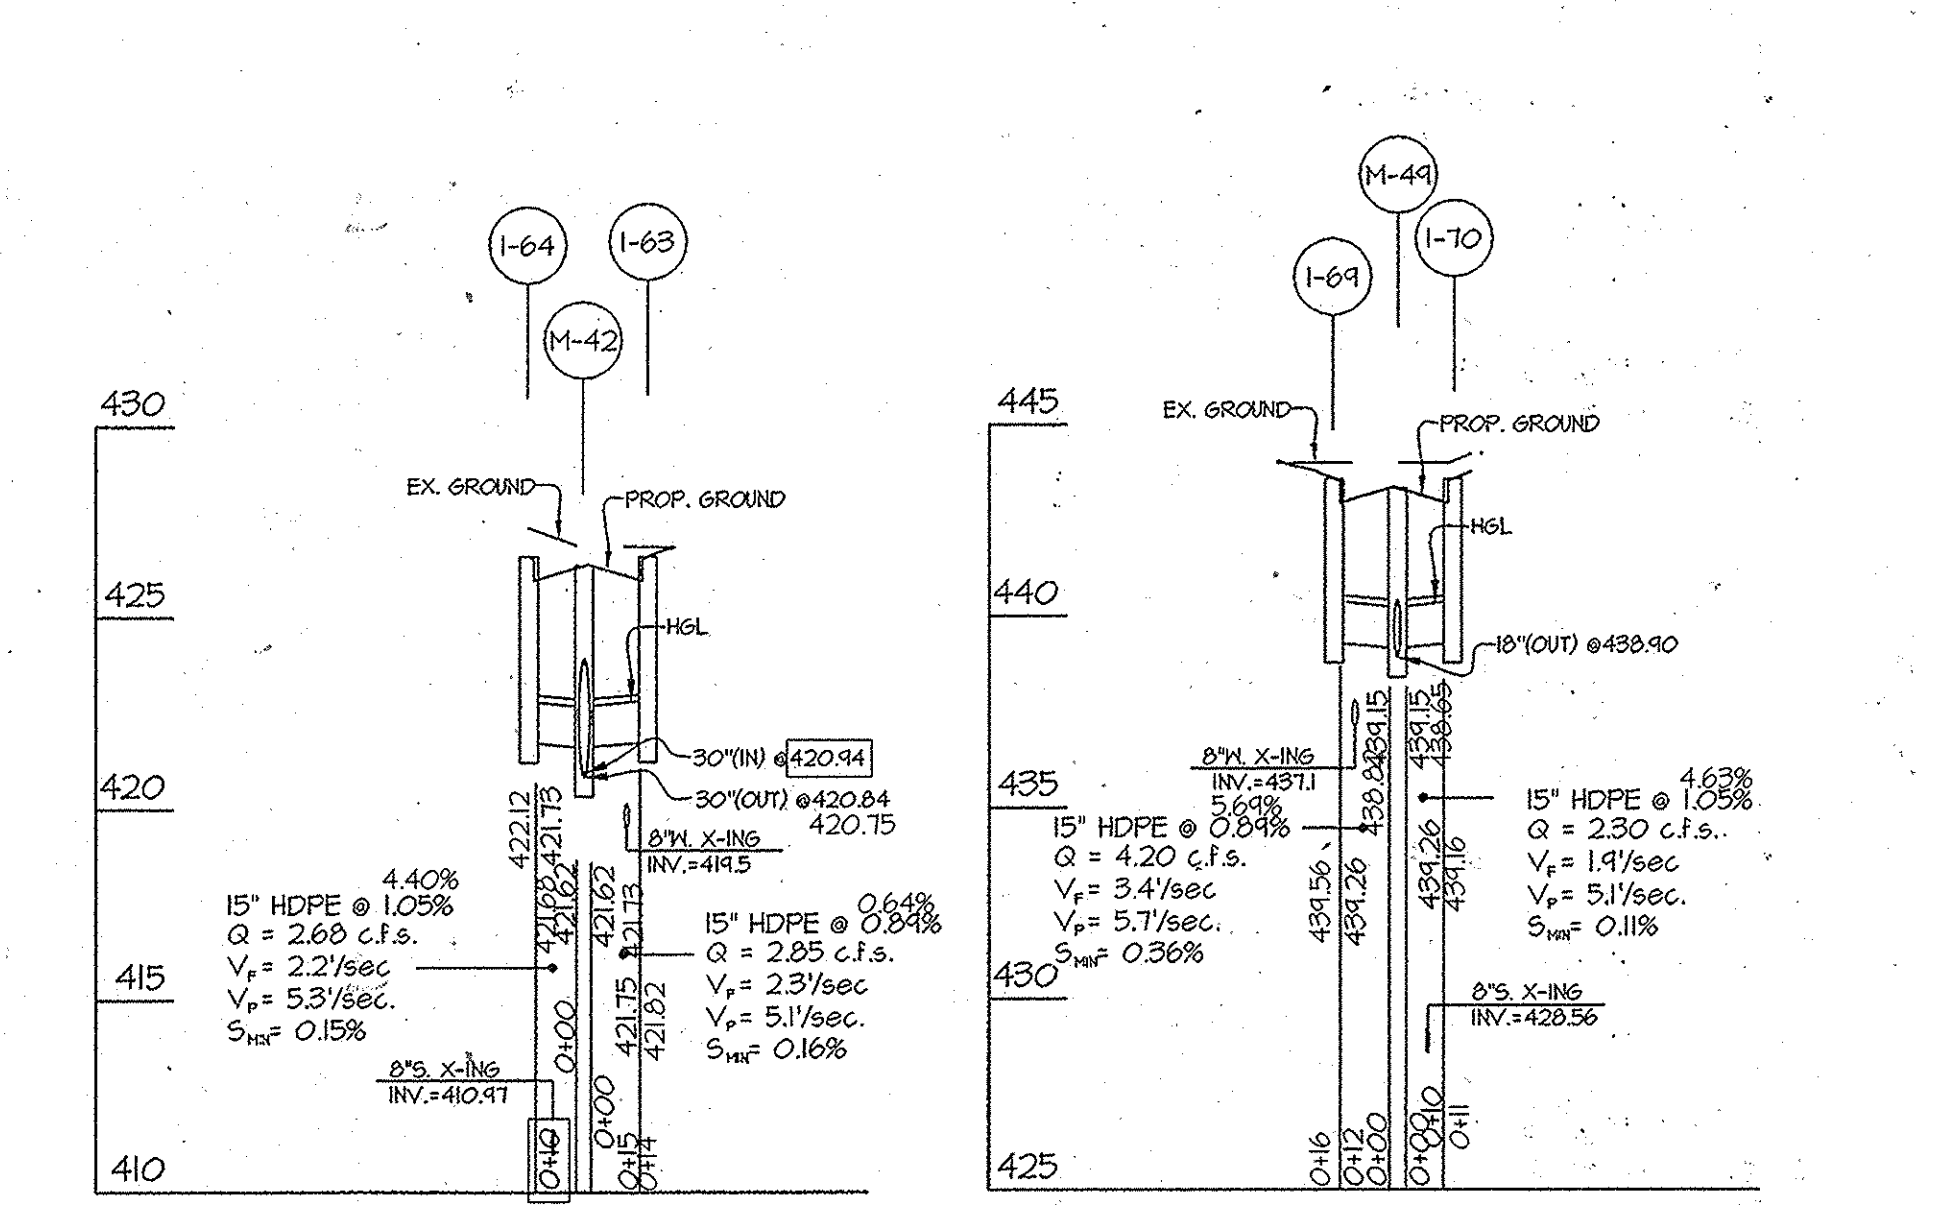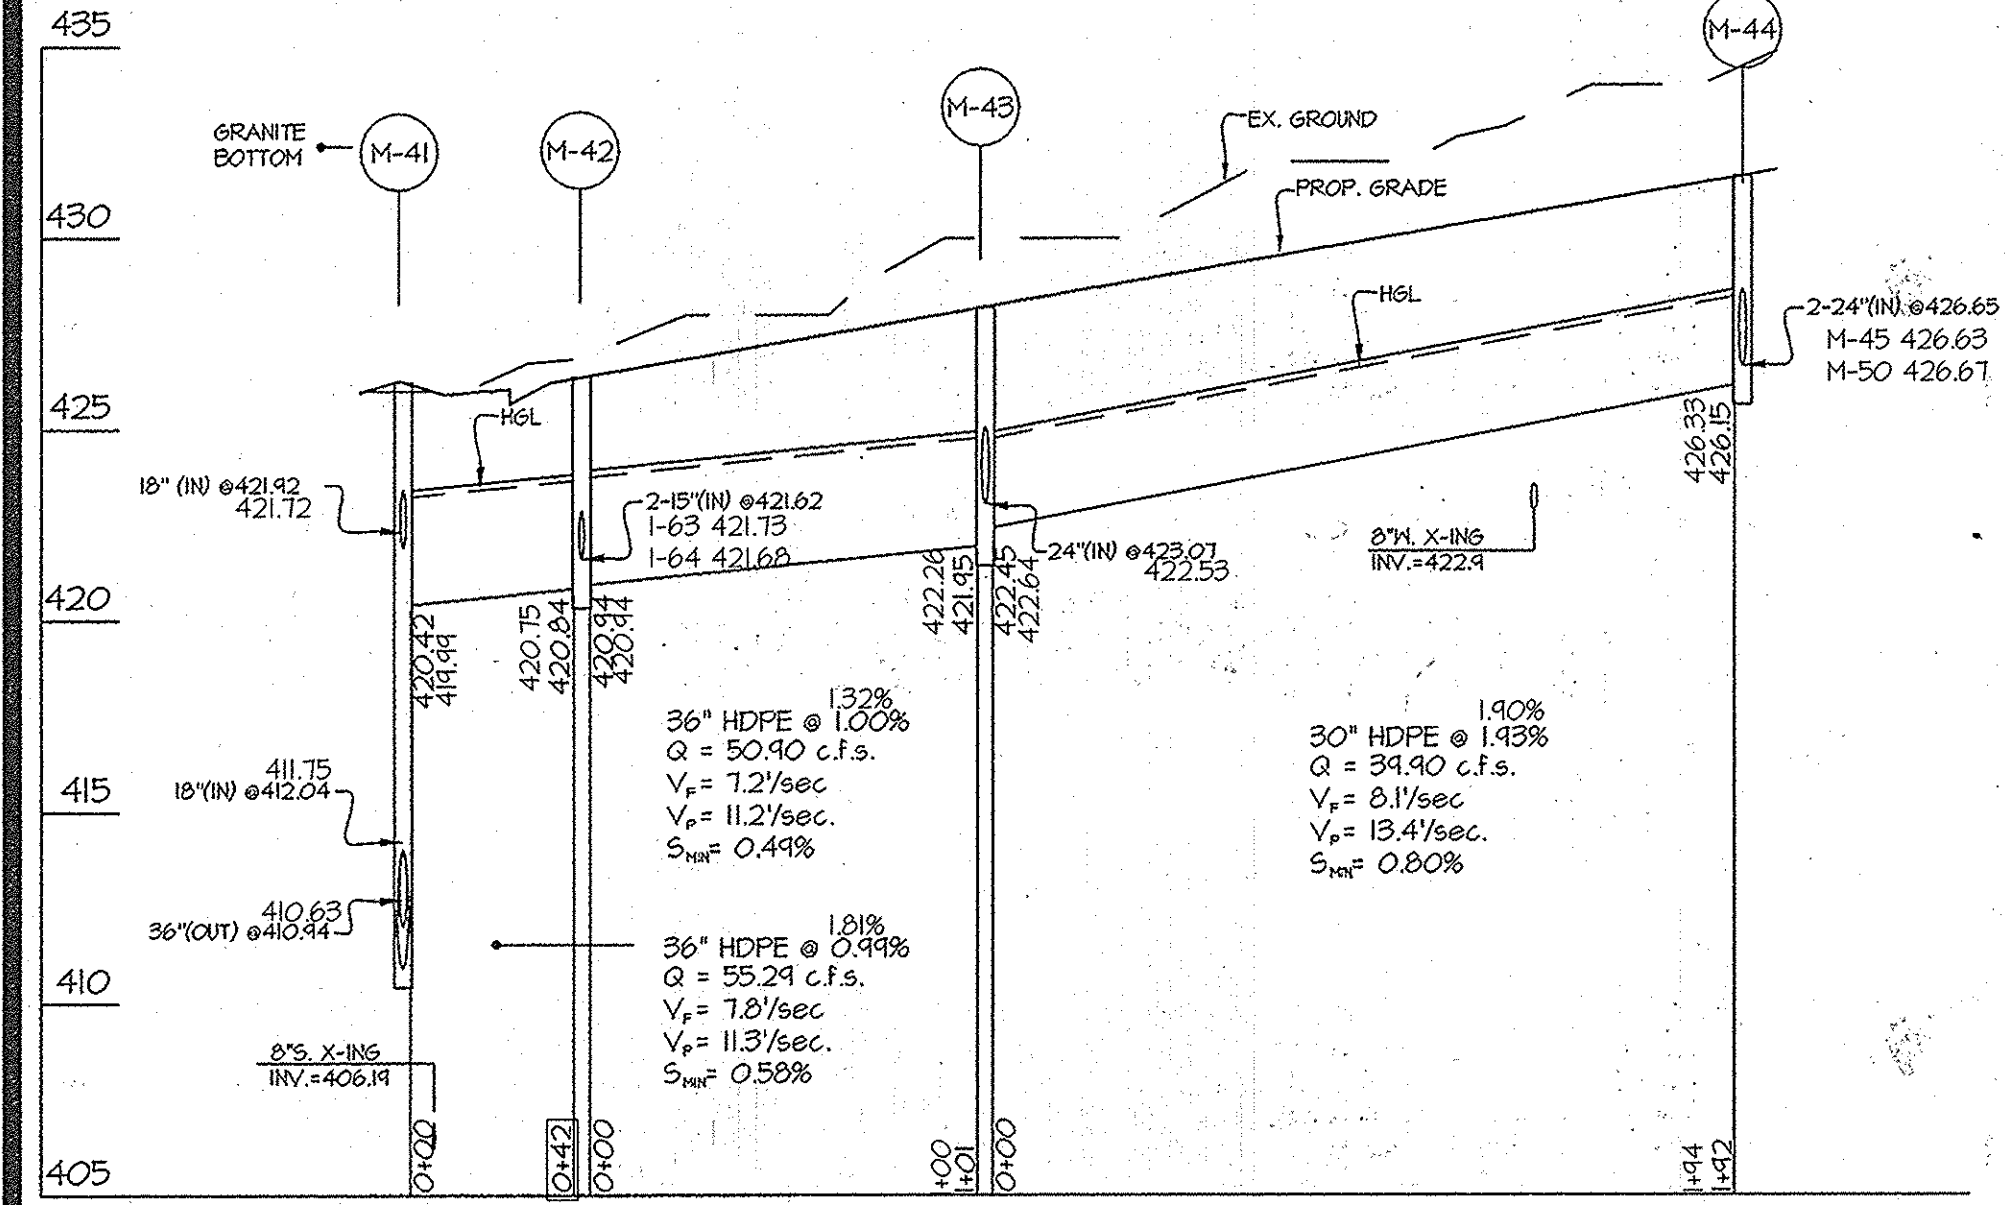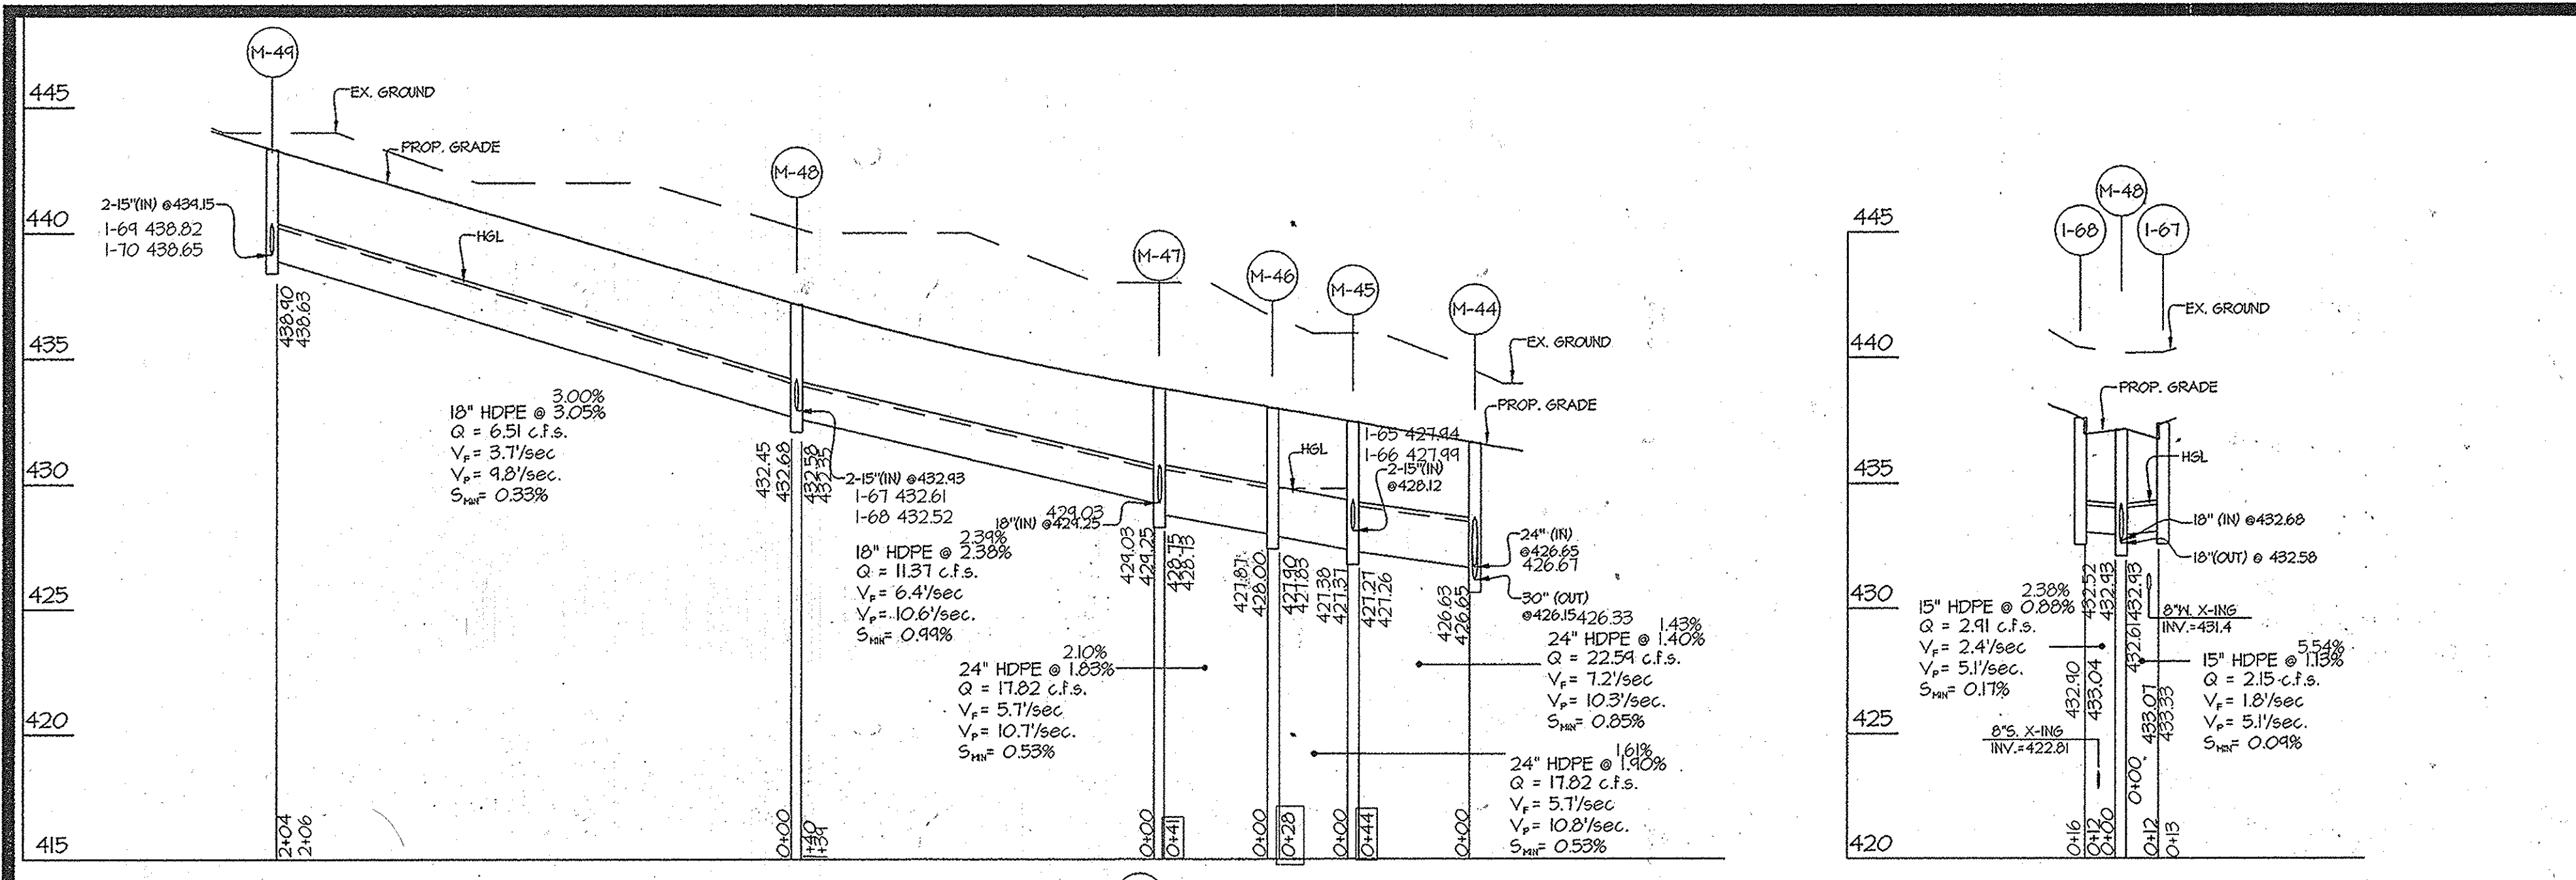

NO	TYPE	WIDTH (INSIDE)	TOP ELEVATION				INVERT				STD. DETAIL	LOCATIONS	REMARKS
			PROPOSED		AS-BUILT		PROPOSED		AS-BUILT				
			UPPER	LOWER	UPPER	LOWER	UPPER	LOWER	UPPER	LOWER			
I-63	A-10 INLET	2'-6"	426.67	426.48	426.74	426.44	---	421.75	421.82	HO. CO. D-4.03	N 543,546 E 1,331,351		
I-64	A-10 INLET	2'-6"	426.67	426.48	426.61	426.42	---	421.73	422.12	HO. CO. D-4.03	N 543,541 E 1,331,378		
I-65	A-10 INLET	2'-6"	432.71	432.54	432.75	432.58	---	428.25	428.17	HO. CO. D-4.03	N 543,884 E 1,331,417		
I-66	A-10 INLET	2'-6"	432.71	432.54	432.71	432.62	---	428.23	428.28	HO. CO. D-4.03	N 543,883 E 1,331,445		
I-67	A-10 INLET	2'-6"	431.50	431.14	431.72	431.41	---	433.07	433.33	HO. CO. D-4.03	N 544,102 E 1,331,348		
I-68	A-10 INLET	2'-6"	431.71	431.40	431.73	431.34	---	433.04	432.90	HO. CO. D-4.03	N 544,113 E 1,331,425		
I-69	A-10 INLET	2'-6"	443.64	443.31	443.91	443.63	---	434.26	434.56	HO. CO. D-4.03	N 544,308 E 1,331,371		
I-70	A-10 INLET	2'-6"	443.68	443.31	443.58	443.46	---	434.26	434.16	HO. CO. D-4.03	N 544,312 E 1,331,344		
I-100	S' INLET		---	420.63			415.91	415.81		HO. CO. D-4.22	N 543,651 E 1,331,254		
I-101	S' INLET		---	426.06			420.36	420.26		HO. CO. D-4.22	N 543,821 E 1,331,306		
I-102	S' INLET		---	431.70			424.40	424.30		HO. CO. D-4.22	N 544,152 E 1,331,275		
I-103	S' INLET		---	433.88			---	428.00		HO. CO. D-4.22	N 544,483 E 1,331,250		
M-41	STANDARD MANHOLE	5'-0"	---	426.23	426.14	421.92	410.94	421.72	410.63	HO. CO. 6-5.13	N 543,448 E 1,331,356		
M-42	STANDARD MANHOLE	5'-0"	---	426.31	426.15	421.62	420.84	421.73	420.75	HO. CO. 6-5.13	N 543,543 E 1,331,365		
M-43	STANDARD MANHOLE	5'-0"	---	428.20	428.04	423.07	421.45	422.53	422.26	HO. CO. 6-5.13	N 543,646 E 1,331,385		
M-44	STANDARD MANHOLE	5'-0"	---	431.63	431.53	426.65	426.15	426.61	426.33	HO. CO. 6-5.13	N 543,838 E 1,331,423		
M-45	STANDARD MANHOLE	4'-0"	---	432.48	432.30	428.12	421.21	421.94	421.26	HO. CO. 6-5.12	N 543,886 E 1,331,432		
M-46	STANDARD MANHOLE	4'-0"	---	433.02	432.83	428.00	421.80	421.83	421.83	HO. CO. 6-5.12	N 543,911 E 1,331,438		
M-47	STANDARD MANHOLE	4'-0"	---	433.82	433.65	424.25	428.75	424.03	428.73	HO. CO. 6-5.12	N 543,961 E 1,331,432		
M-48	STANDARD MANHOLE	4'-0"	---	431.14	430.93	432.93	432.58	432.52	432.35	HO. CO. 6-5.12	N 544,104 E 1,331,413		
M-49	STANDARD MANHOLE	4'-0"	---	443.33	443.14	---	438.90	438.82	438.63	HO. CO. 6-5.12	N 554,310 E 1,331,386		
M-62	STANDARD MANHOLE	4'-0"	---	434.94	---	421.00	426.65	---	---	HO. CO. 6-5.12	N 544,374 E 1,331,245		

COORDINATE POINT GIVEN IS TO THE CENTERLINE OF STRUCTURE AT THE FACE OF CURB FOR INLETS AND TO THE CENTERLINE OF STRUCTURE FOR MANHOLES AND END SECTIONS.  
 ALL S' INLETS SHALL UTILIZE BICYCLE SAFE GRATES (EAST JORDAN IRON WORKS, OR APPROVED EQUAL)

SIZE	TYPE	QUANTITY (LF)	REMARKS
15"	HDPE	144	
18"	HDPE	145	
24"	HDPE	113	
30"	HDPE	142	
36"	HDPE	143	

NOTES:  
 1. HDPE INDICATES HIGH DENSITY POLYETHYLENE PIPE, SUCH AS H-12 BY ADS, OR H-9 BY HANCOX OR AN APPROVED EQUAL.  
 2. TRENCH BEDDING TO BE PROVIDED PER HOWARD COUNTY DETAIL 6.2.01, "TRENCH FOR P.V.C. PIPE AND HDPE."  
 3. ALL WATER AND SEWER CROSSINGS SHOWN ARE PER CONTRACT: 24-4448 D.

APPROVED: HOWARD COUNTY DEPARTMENT OF PUBLIC WORKS  
*Diane Schwab, Acting* *11/16/12*  
 Chief, Bureau of Highways Date

APPROVED: HOWARD COUNTY DEPARTMENT OF PLANNING & ZONING  
*Keith DeLoach* *12/11/12*  
 Chief, Division of Land Development Date

*Chad Edwards* *12-6-12*  
 Chief, Professional Engineering Division Date


PROFESSIONAL CERTIFICATION  
 I hereby certify that these documents were prepared or approved by me, and that I am a duly licensed professional engineer under the laws of the State of Maryland, License No. 12475, Expiration Date: May 26, 2016.  
 10-29-15  
 Date  
 PROFESSIONAL ENGINEER  
 STATE OF MARYLAND  
 PROFESSIONAL ENGINEER  
 Maryland Reg. No. 12475

GLWGUTSCHICK LITTLE & WEBER, P.A.  
 CIVIL ENGINEERS, LAND SURVEYORS, LAND PLANNERS, LANDSCAPE ARCHITECTS  
 3609 NATIONAL DRIVE - SUITE 250 - BURTONSVILLE OFFICE PARK  
 BURTONSVILLE, MARYLAND 20886  
 TEL: 301-421-4024 BALT: 410-880-1820 DC/VA: 301-989-2524 FAX: 301-421-4186

DATE	REVISION	BY	APPR.

PREPARED FOR:  
 MAPLE LAWN FARMS I, LLC  
 SUITE 300 WOODHOLME CENTER  
 1829 REISTERSTOWN ROAD  
 BALTIMORE, MD 21208  
 ATTN: MARK BENNETT  
 410-484-8400


PROFESSIONAL CERTIFICATION  
 I HEREBY CERTIFY THAT THESE PLANS WERE PREPARED OR APPROVED BY ME, AND THAT I AM A DULY LICENSED PROFESSIONAL ENGINEER UNDER THE LAWS OF THE STATE OF MARYLAND, LICENSE NO. 12875, EXPIRATION DATE: MAY 26, 2014.  
 11-7-12  
 ELECTION DISTRICT No. 5

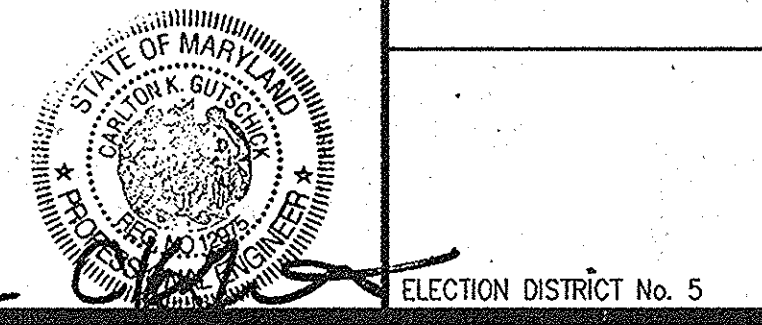


STORM DRAIN PROFILES  
**MAPLE LAWN FARMS**  
 MIDTOWN WEST DISTRICT - AREA 2  
 LOTS 93 THRU 177, OPEN SPACE LOTS 178 THRU 183, AND COMMON OPEN AREA LOTS 184 THRU 186

SCALE	ZONING	G. L. W. FILE NO.
1" = 50' (H) 1" = 5' (V)	MXD-3	11001
DATE	TAX MAP - GRID	SHEET
OCT. 2015 OCT. 2012	41-21/46-3	13 OF 25



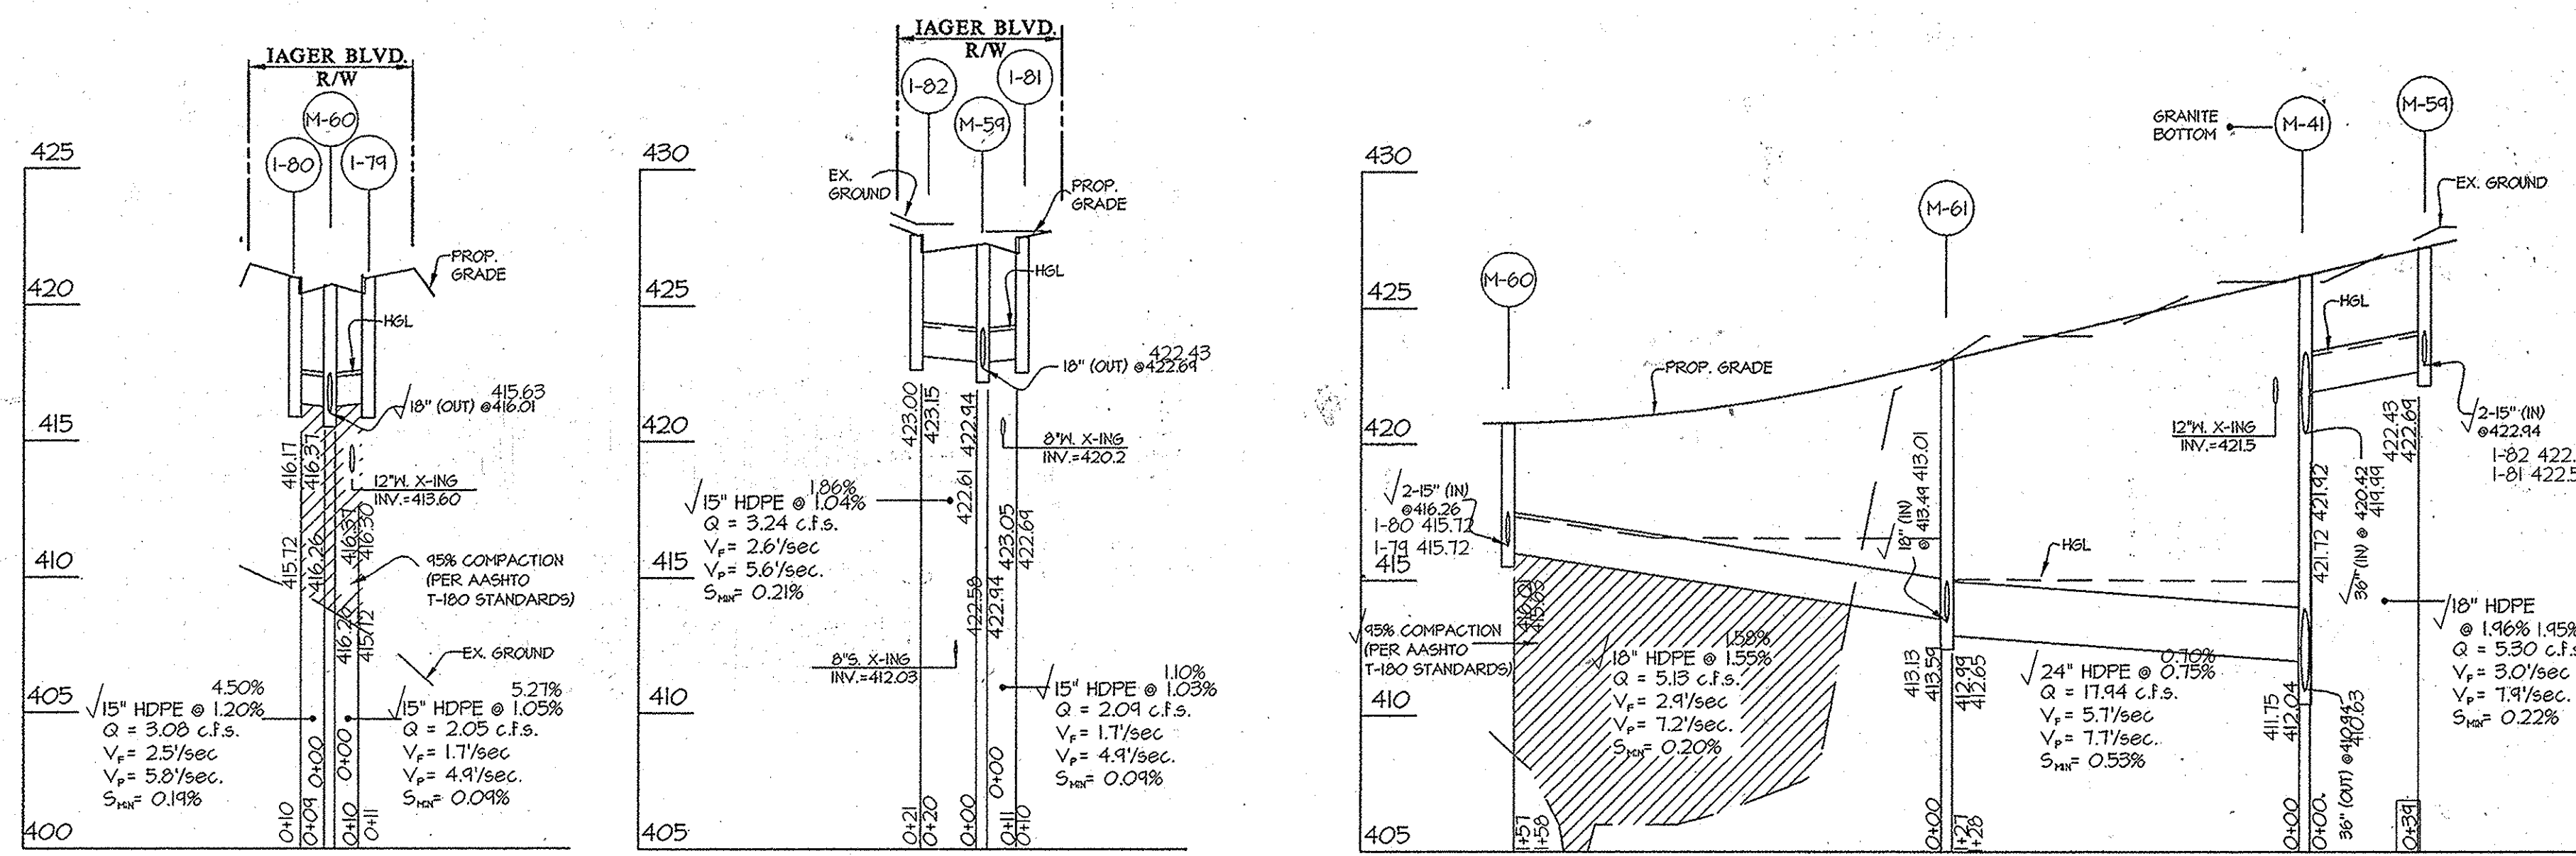



NO	TYPE	WIDTH (INSIDE)	TOP ELEVATION				INVERT				STD. DETAIL	LOCATIONS	REMARKS
			PROPOSED		AS-BUILT		PROPOSED		AS-BUILT				
			UPPER	LOWER	UPPER	LOWER	UPPER	LOWER	UPPER	LOWER			
I-24	A-10 INLET	2'-6"	442.35	442.03	421.03	426.71	---	422.33	---	422.40	HO. CO. D-4.03	N 543,398 E 1331,801	
I-25	A-10 INLET	2'-6"	442.35	442.03	426.80	426.48	---	422.34	---	422.67	HO. CO. D-4.03	N 543,424 E 1331,801	
I-79	A-10 INLET	2'-6"	421.00	421.00	420.84	420.84	---	416.31	---	416.30	HO. CO. D-4.03	N 543,542 E 1331,067	
I-80	A-10 INLET	2'-6"	421.00	421.00	420.76	420.68	---	416.31	---	416.17	HO. CO. D-4.03	N 543,566 E 1331,073	
I-81	A-10 INLET	2'-6"	421.58	421.40	422.82	422.56	---	423.05	---	422.64	HO. CO. D-4.03	N 543,471 E 1331,346	
I-82	A-10 INLET	2'-6"	421.72	421.47	421.76	421.53	---	423.15	---	423.00	HO. CO. D-4.03	N 543,506 E 1331,415	
ES-2	END SECTION	3'-0"	341.00	---	---	---	---	341.00	---	343.93		N 542,954 E 1331,403	
M-40	STANDARD MANHOLE	5'-0"	---	410.43	420.61	403.61	403.50	402.92	402.81	402.81	HO. CO. G-5.13	N 543,105 E 1331,280	
M-41	STANDARD MANHOLE	5'-0"	---	426.23	426.14	421.92	410.94	421.72	410.63	410.63	HO. CO. G-5.13	N 543,498 E 1331,356	
M-59	STANDARD MANHOLE	4'-0"	---	421.26	421.15	422.94	422.64	422.61	422.43	422.43	HO. CO. G-5.12	N 543,484 E 1331,344	
M-60	STANDARD MANHOLE	4'-0"	---	420.83	420.50	416.26	416.01	415.72	415.63	415.63	HO. CO. G-5.12	N 543,555 E 1331,070	
M-61	STANDARD MANHOLE	4'-0"	---	423.12	422.90	413.54	412.94	413.13	412.65	412.65	HO. CO. G-5.12	N 543,523 E 1331,228	
M-A	STANDARD MANHOLE	5'-0"	---	413.84	414.03	405.94	404.34	404.38	404.28	404.28	HO. CO. G-5.13	N 543,434 E 1336,911	
M-B	STANDARD MANHOLE	5'-0"	---	410.00	411.49	406.33	406.23	404.99	404.84	404.84	HO. CO. G-5.13	N 543,431 E 1336,940	
M-64	STANDARD MANHOLE	5'-0"	---	421.42	421.40	408.70	408.50	408.65	408.35	408.35	HO. CO. G-5.13	N 543,576 E 1336,941	
ES-3	END SECTION	2'-6"	402.50	---	---	---	---	400.00	---	403.54		N 534,340 E 1336,913	
ES-4	END SECTION	2'-6"	412.50	---	---	---	---	410.00	---	404.92		N 543,625 E 1331,042	

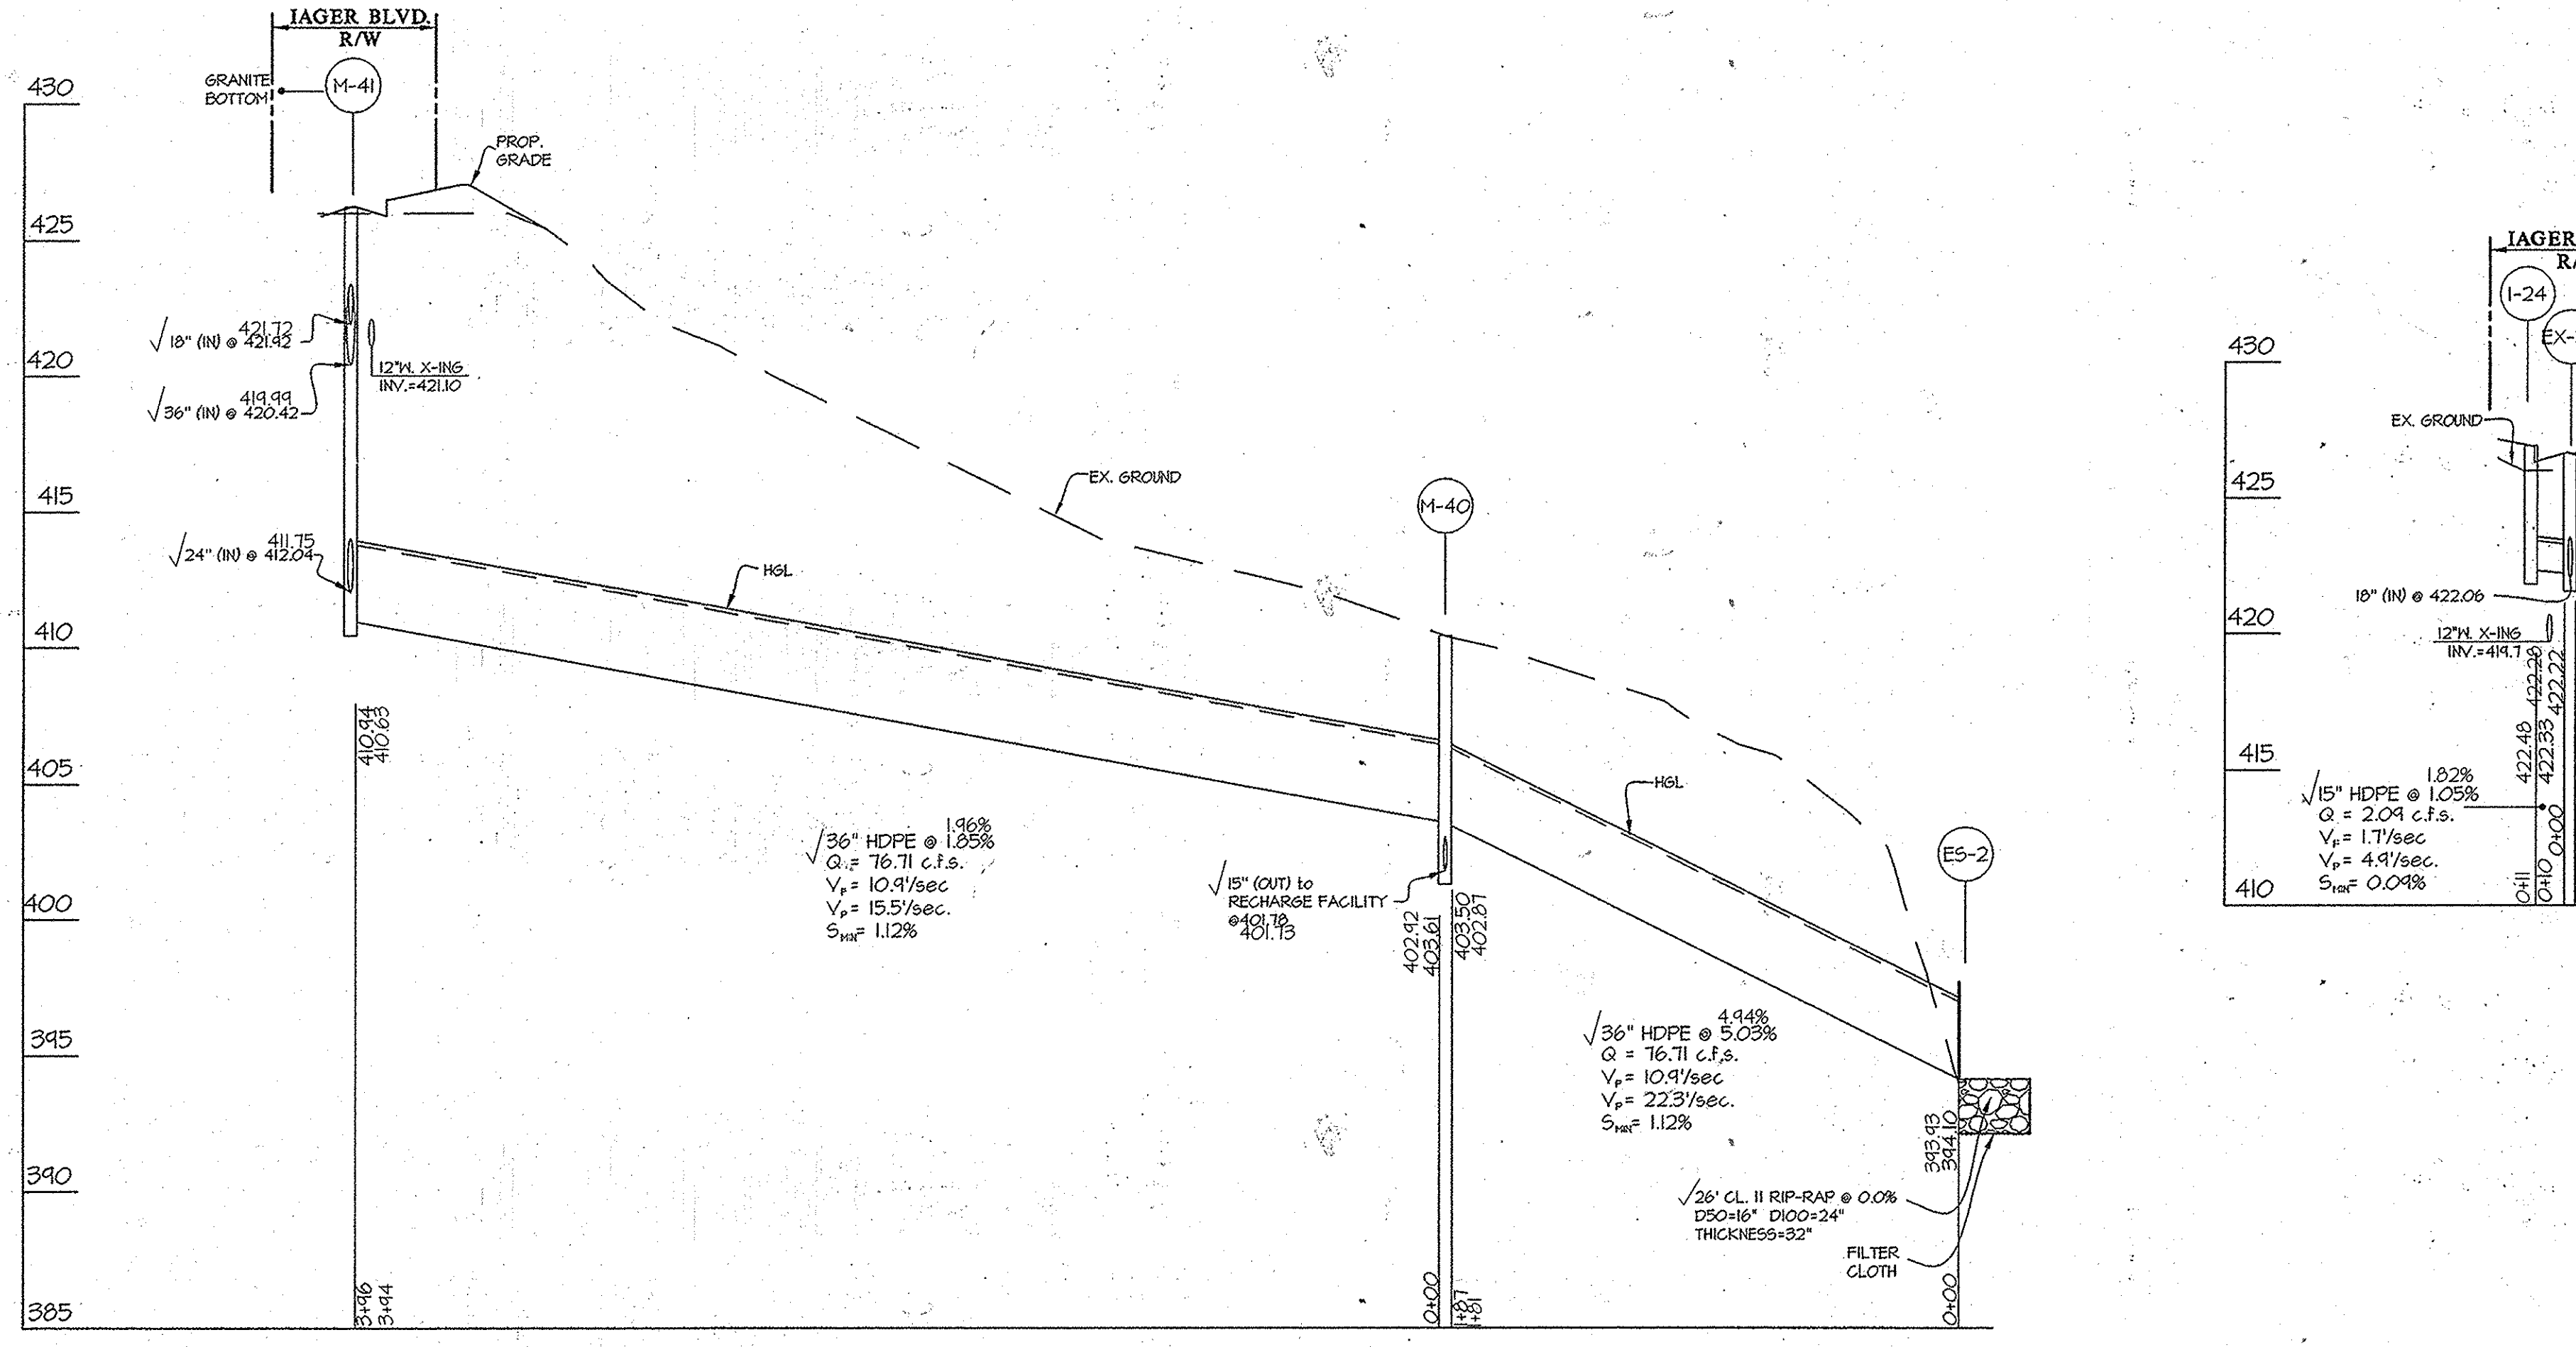

- 1. COORDINATE POINT GIVEN IS TO THE CENTERLINE OF STRUCTURE AT THE FACE OF CURB FOR INLETS AND TO THE CENTERLINE OF STRUCTURE FOR MANHOLES AND END SECTIONS.
- 2. NYLOPLAST- ADS END SECTION OR APPROVED EQUAL.
- 3. ALL 18" INLETS SHALL UTILIZE BICYCLE SAFE GRATES (EAST JORDAN IRON WORKS, OR APPROVED EQUAL).

PIPE SUMMARY			
SIZE	TYPE	QUANTITY (LF)	REMARKS
15"	HDPE	77	
18"	HDPE	146	
24"	HDPE	127	
30"	HDPE	240	
36"	HDPE	583	

- NOTES:
- HDPE INDICATES HIGH DENSITY POLYETHYLENE PIPE, SUCH AS N-12 BY ADS, OR H-9 BY HANCOX OR AN APPROVED EQUAL.
  - TRENCH BEDDINGS TO BE PROVIDED PER HOWARD COUNTY DETAIL G 2.01, "TRENCH FOR P.V.C. PIPE AND HDPE."
  - ALL WATER AND SEWER CROSSINGS SHOWN ARE PER CONTRACT: 24-4448-D

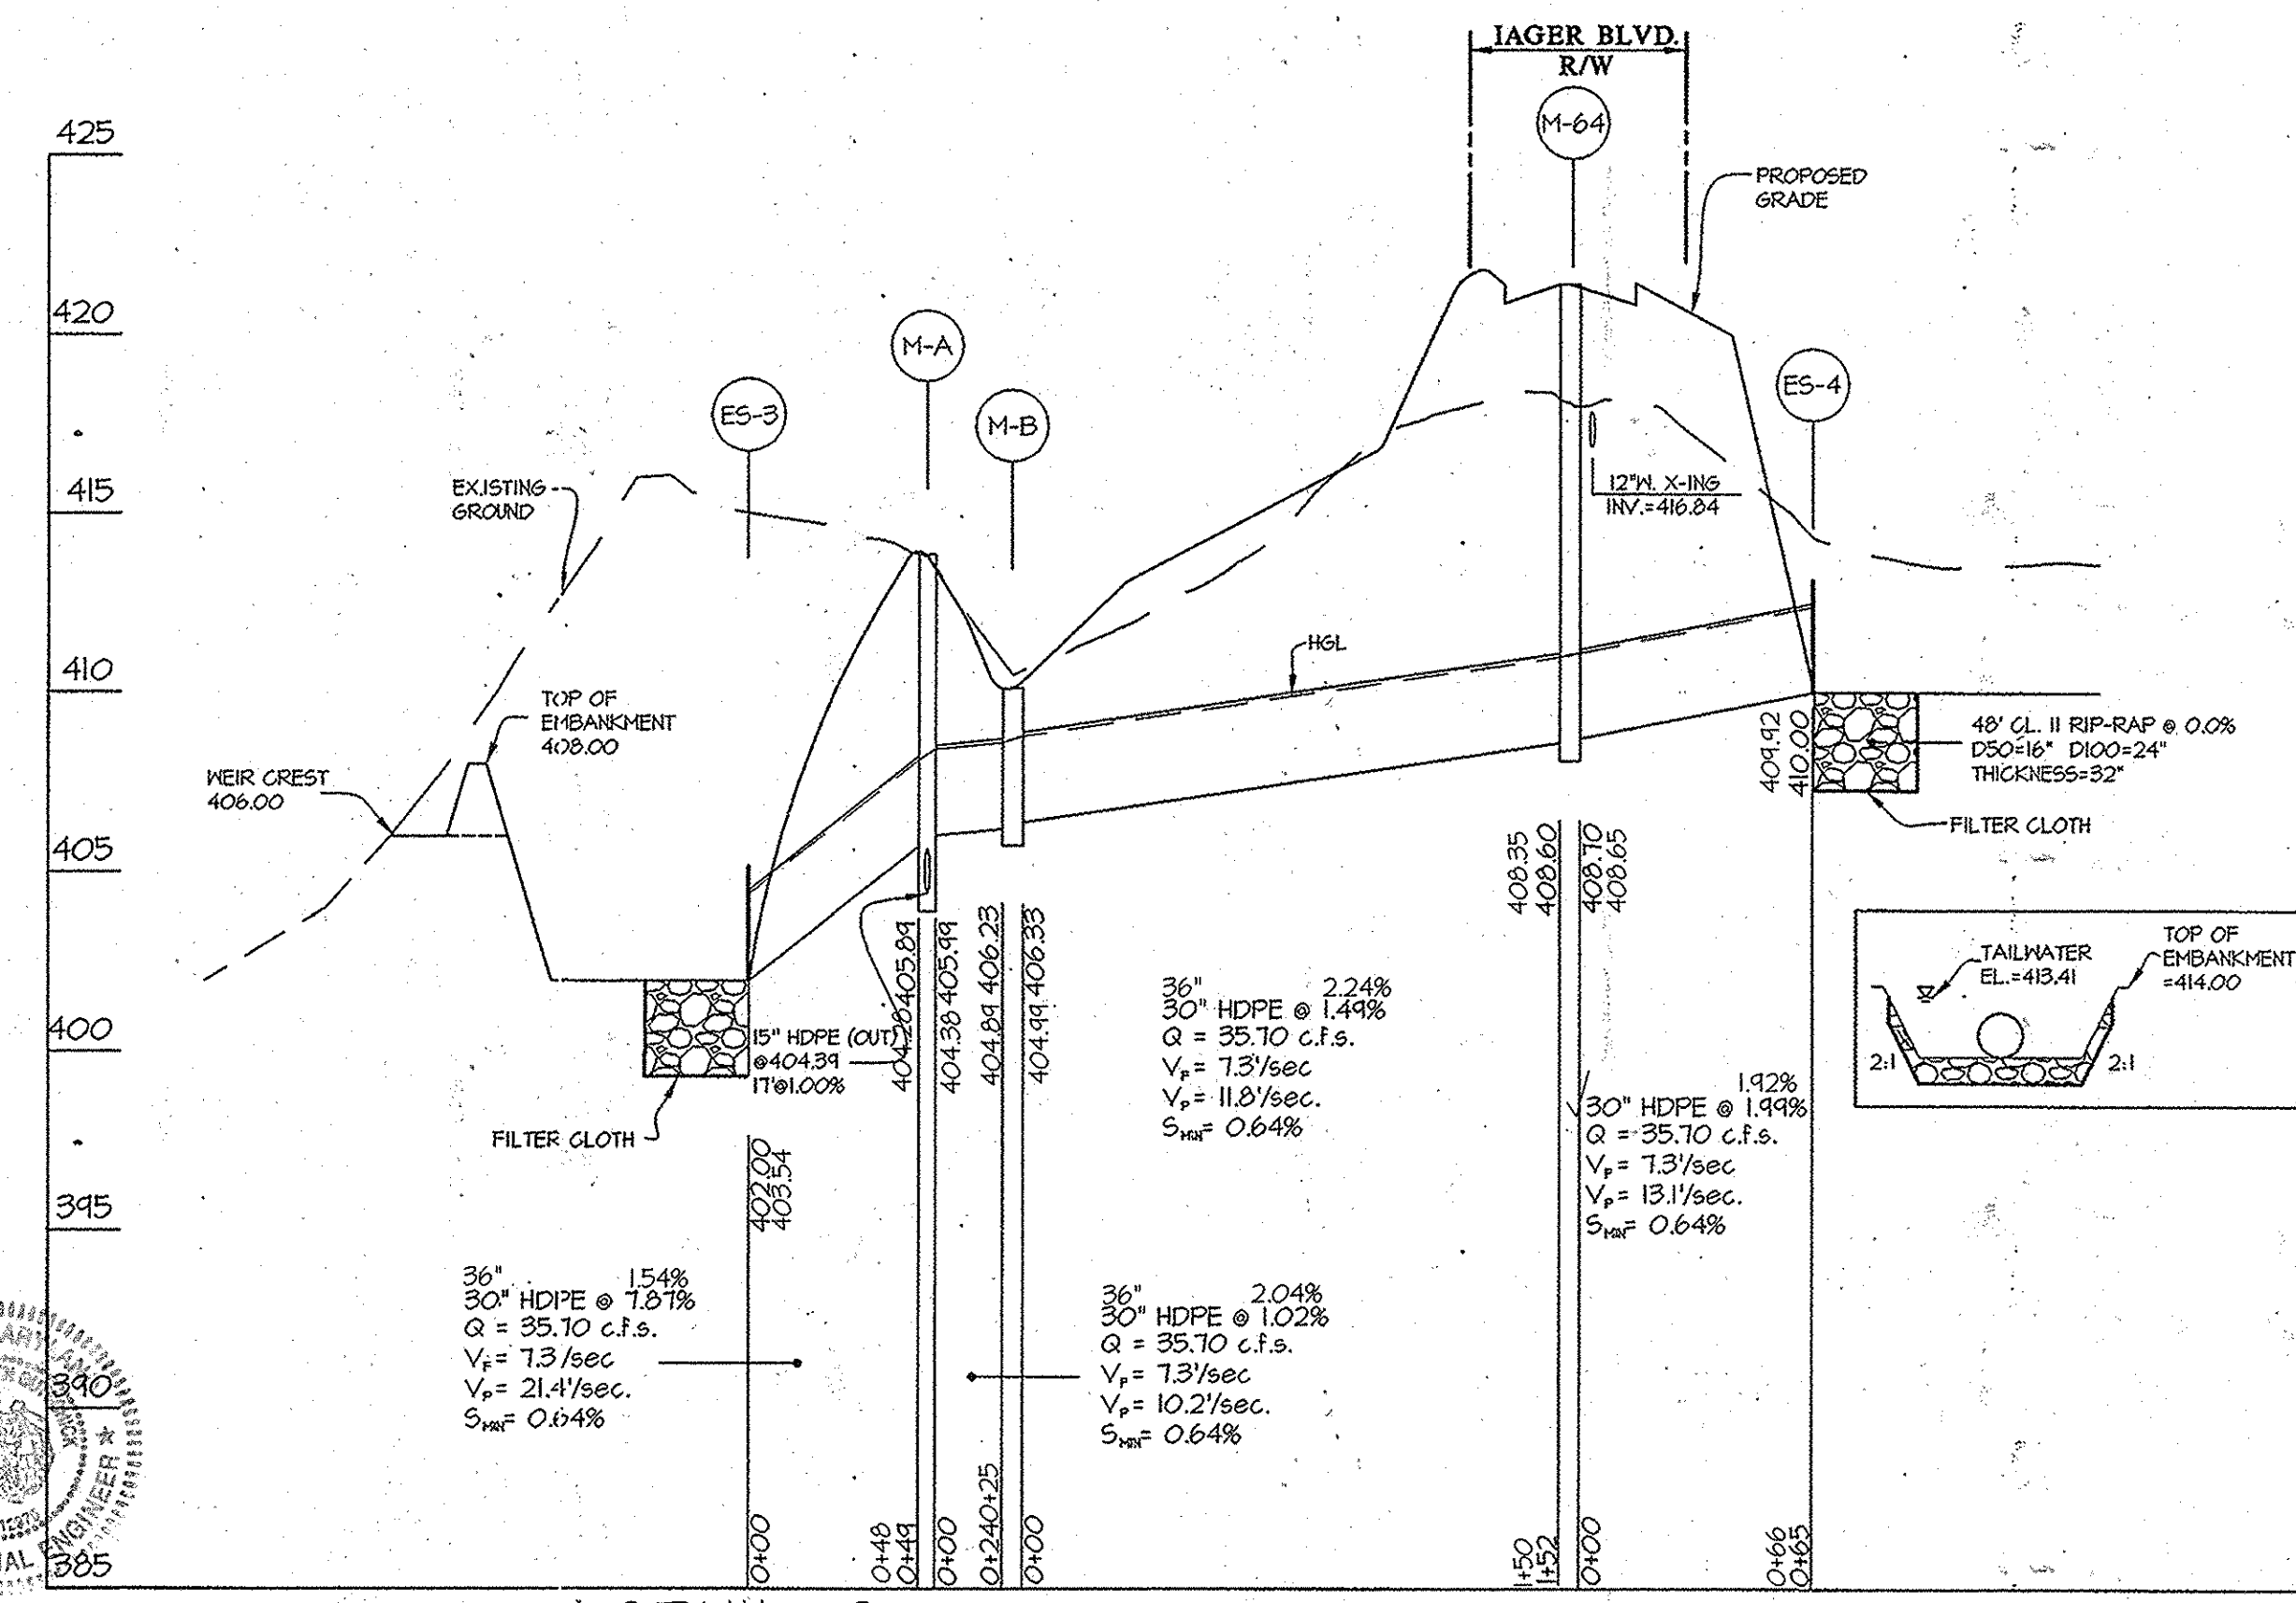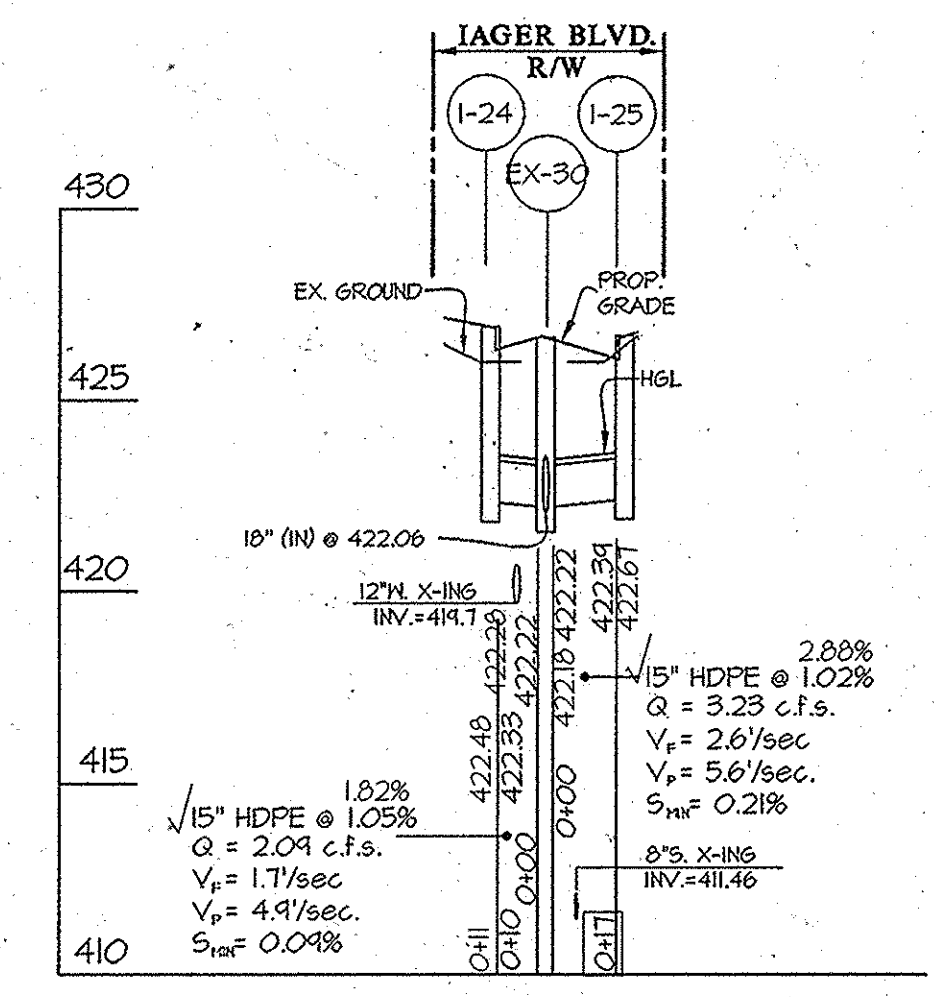

PROFESSIONAL CERTIFICATION  
 I hereby certify that these documents were prepared or approved by me, and that I am a duly licensed professional engineer under the laws of the State of Maryland, License No. 12415, Expiration Date: May 26 2016.

10-29-15  
 Date

Carl K. Gutschick  
 Professional Engineer  
 Maryland Reg. No. 12415

APPROVED: HOWARD COUNTY DEPARTMENT OF PUBLIC WORKS  
 Dave Schwegel, Acting Chief, Bureau of Highways, 11/19/12  
 APPROVED: HOWARD COUNTY DEPARTMENT OF PLANNING & ZONING  
 Kate Seidel, Chief, Division of Land Development, 12/11/12  
 Chad Edwards, Chief, Development Engineering Division, 12-6-12

GLWGUTSCHICK LITTLE & WEBER, P.A.  
 CIVIL ENGINEERS, LAND SURVEYORS, LAND PLANNERS, LANDSCAPE ARCHITECTS  
 3909 NATIONAL DRIVE - SUITE 250 - BURTONSVILLE OFFICE PARK  
 BURTONSVILLE, MARYLAND 20866  
 TEL: 301-421-4024 BAL: 410-880-1820 DC/VA: 301-989-2524 FAX: 301-421-4186

DATE	REVISION	BY	APPR.

PREPARED FOR:  
 MAPLE LAWN FARMS 1, LLC  
 SUITE 300 WOODHOLME CENTER  
 1829 REISTERSTOWN ROAD  
 BALTIMORE, MD 21208  
 ATTN: MARK BENNETT  
 410-484-8400

PROFESSIONAL CERTIFICATION  
 I HEREBY CERTIFY THAT THESE PLANS WERE PREPARED OR APPROVED BY ME, AND THAT I AM A DULY LICENSED PROFESSIONAL ENGINEER UNDER THE LAWS OF THE STATE OF MARYLAND, LICENSE NO. 12978, EXPIRATION DATE: MAY 26, 2014.

11-7-12  
 Date


Carl K. Gutschick  
 Professional Engineer  
 Maryland Reg. No. 12415

ASBUILTS  
 STORM DRAIN PROFILES  
 MAPLE LAWN FARMS  
 MIDTOWN WEST DISTRICT - AREA 2  
 LOTS 93 THRU 177, OPEN SPACE LOTS 178 THRU 183, AND COMMON OPEN AREA LOTS 184 THRU 186

ELECTION DISTRICT No. 5

SCALE	ZONING	G. L. W. FILE NO.
1" = 50' (H) 1" = 5' (V)	MXD-3	11001
DATE	TAX MAP - GRID	SHEET
OCT. 2015 OCT. 2012	41-21/46-3	14 OF 25



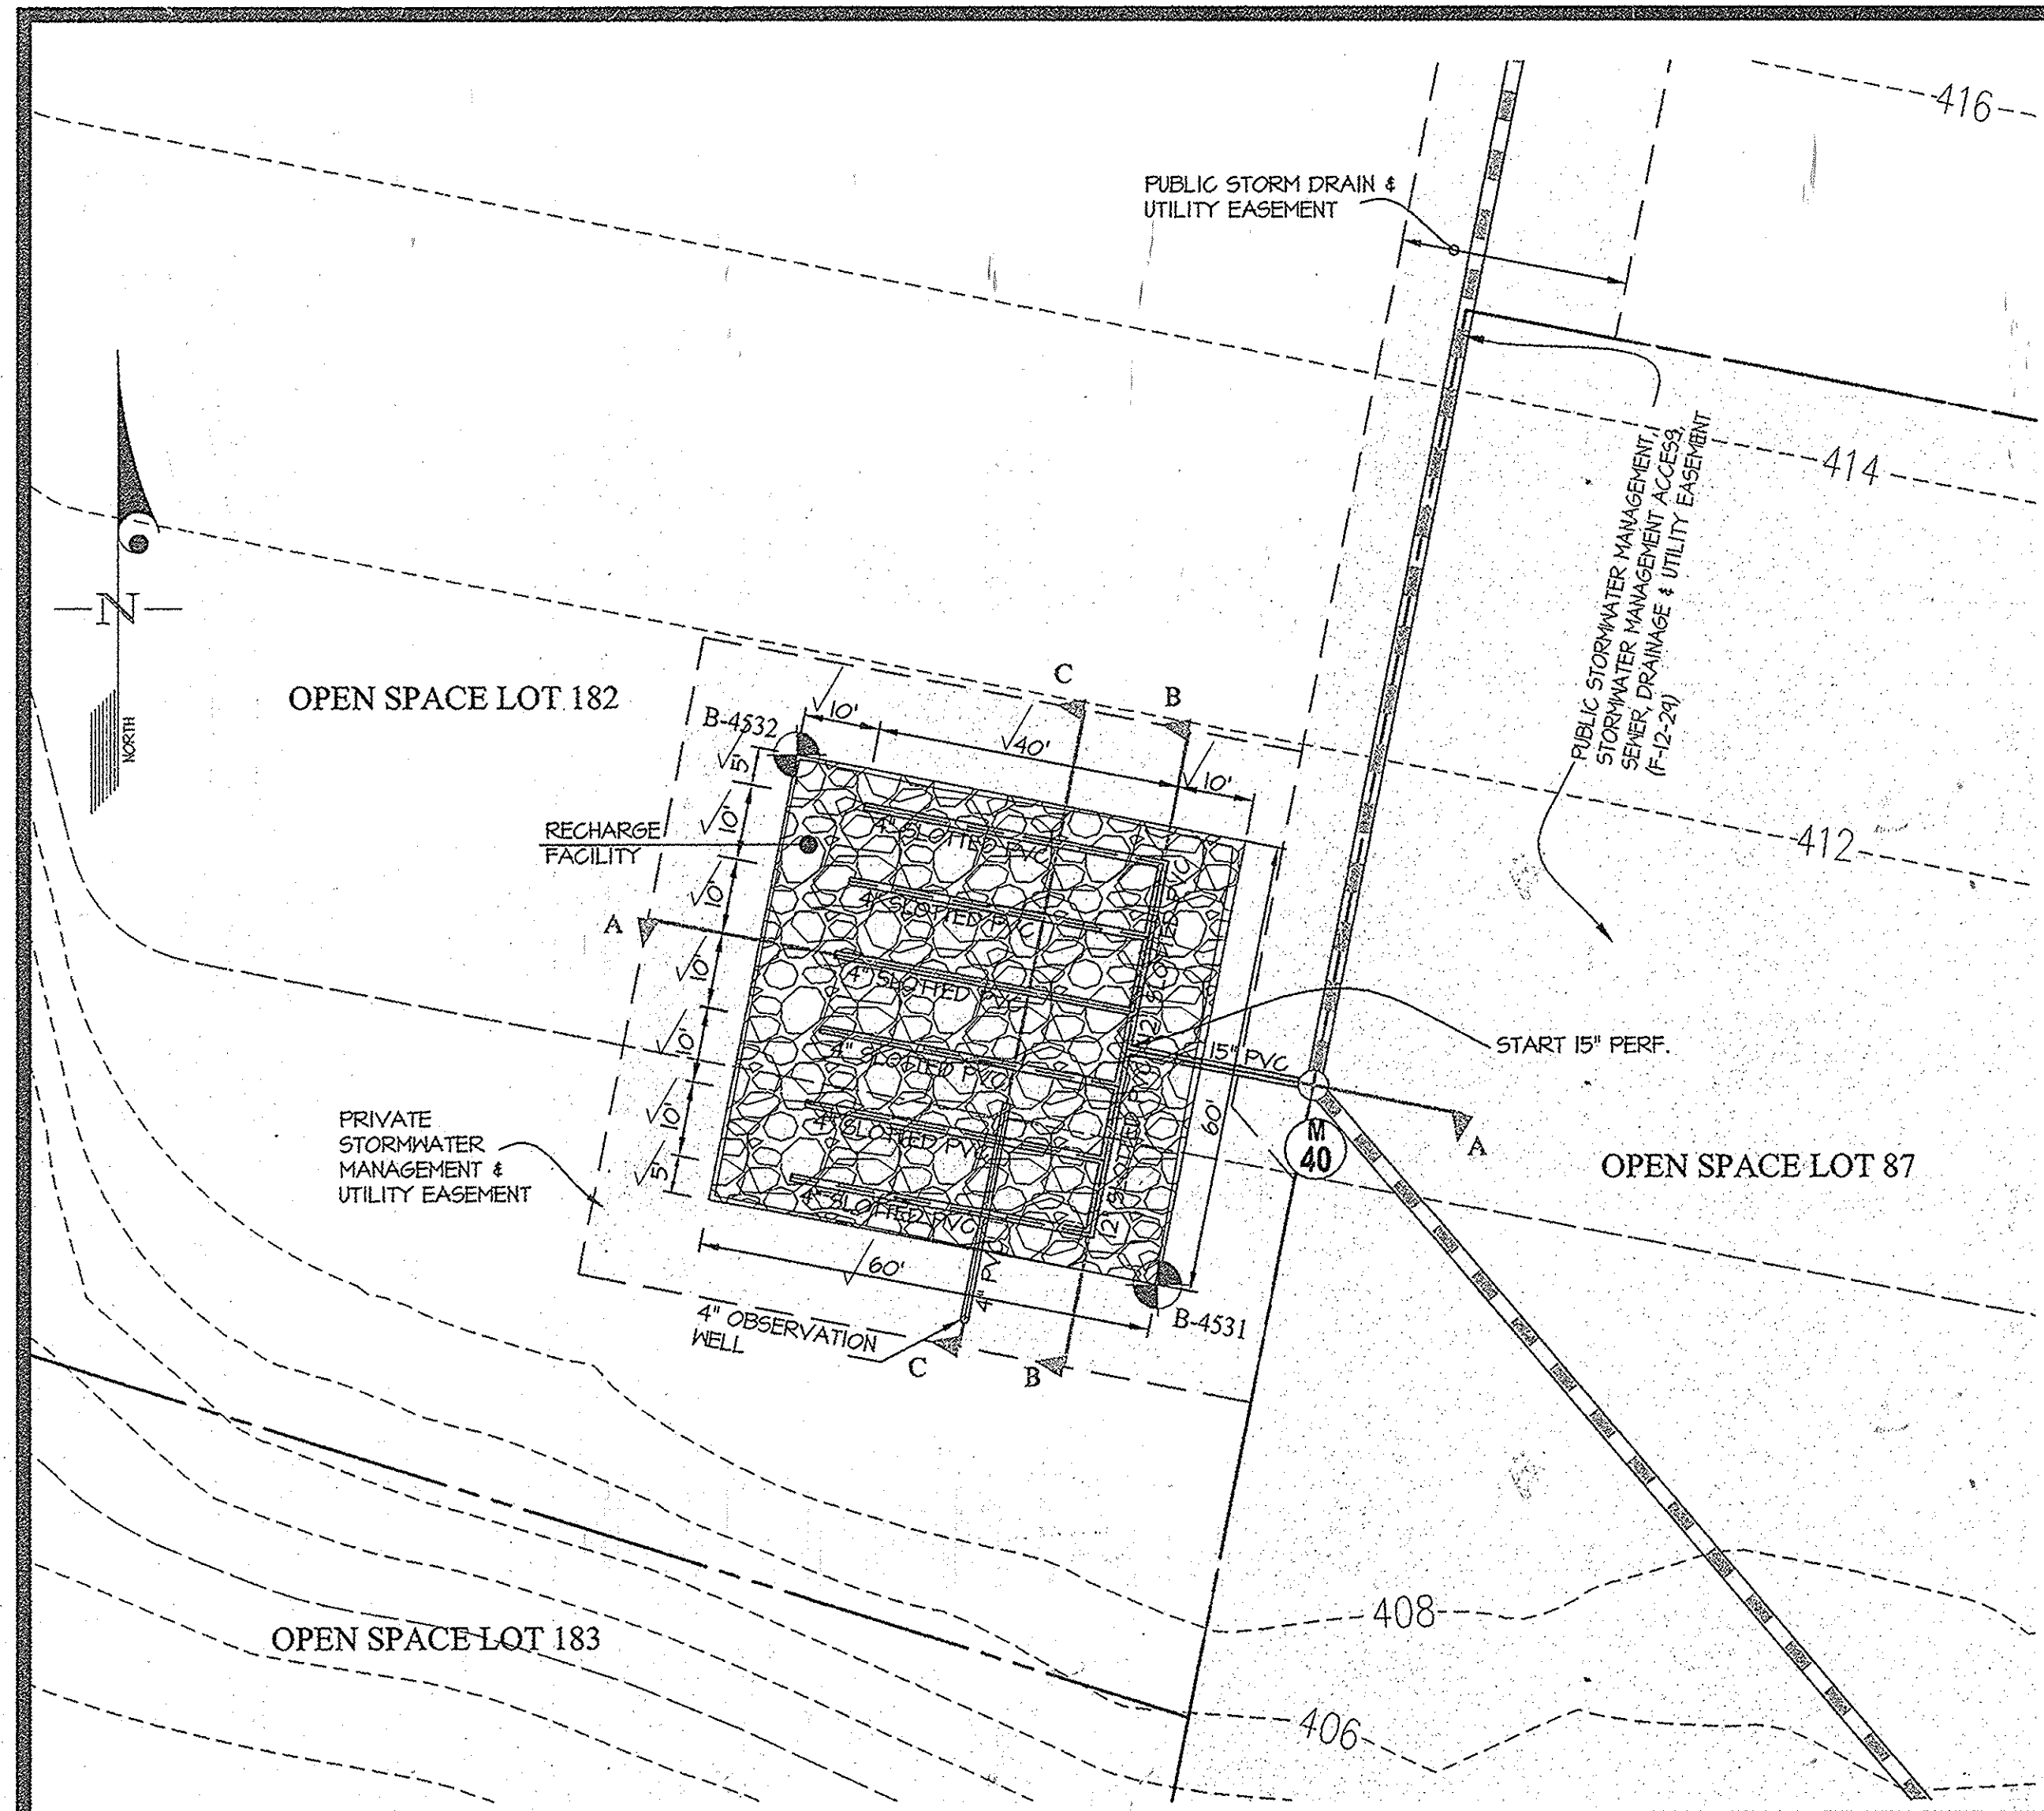

RECHARGE FACILITY PLAN VIEW SCALE: 1" = 20'

HILLIS, GARNES ENGINEERING ASSOCIATES, INC. RECORD OF SOIL EXPLORATION

Project Name: Maple Lawn Farms - Midtown West Boring No. B-4531  
 Location: Howard County, Maryland Job # 12222A

Date: 6-05-12 Hammer Wt. 140 lbs. Hole Diameter 6" Foreman J. Balk  
 Surf. Elev. 419.8 ft. Hammer Drop 30 in. Rock Core Diameter Inspector  
 Date Started 6-05-12 Pipe Size 2.0 in. Boring Method HSA Date Completed 6-05-12

Elvelevator Depth	SOIL SAMPLE CONDUITS	Description	Boring and Sampling Notes	Roc.	N.M.S.	SPT Blows N	SPT Blows/Feet C.U.T.V.E.
0		0" Topsoil		12"	3-3.5	8	10 20 30
1		1" silty sandy CLAY, trace mica (CL-M)		14"	6-8	16	
2		2" silty sandy CLAY, trace mica (CL-M)		14"	4-7	13	
3		3" dense micaceous silty SAND to sandy SILT (SM-ML)		14"	3-5.8	13	
4		4" Brown, moist, medium dense micaceous silty SAND with weathered rock (SM)	1/2" silt pipe set at 21.0'	14"	3-6.10	16	
5		5" Backfilled after 24 hrs		14"	6-9-11	20	
6		6" 6-7		14"	6-7	15	
7		7" 6-8-11		14"	6-8-11	19	

Bottom of Hole at 26.5'


HILLIS, GARNES ENGINEERING ASSOCIATES, INC. RECORD OF SOIL EXPLORATION

Project Name: Maple Lawn Farms - Midtown West Boring No. B-4532  
 Location: Howard County, Maryland Job # 12222A

Date: 6-05-12 Hammer Wt. 140 lbs. Hole Diameter 6" Foreman J. Balk  
 Surf. Elev. 419.7 ft. Hammer Drop 30 in. Rock Core Diameter Inspector  
 Date Started 6-05-12 Pipe Size 2.0 in. Boring Method HSA Date Completed 6-05-12

Elvelevator Depth	SOIL SAMPLE CONDUITS	Description	Boring and Sampling Notes	Roc.	N.M.S.	SPT Blows N	SPT Blows/Feet C.U.T.V.E.
0		0" Topsoil		12"	3-3.4	7	10 20 30
1		1" silty sandy CLAY, trace mica (CL-M)		14"	10-12	21	
2		2" Brown, moist, medium dense micaceous silty SAND with weathered rock (SM)	No groundwater encountered while drilling	14"	8-7.9	18	
3		3" 1/2" silt pipe set at 22.0'		14"	10-8-10	19	
4		4" Backfilled after 24 hrs		12"	8-9-12	21	
5		5" 11-10-10		15"	7-7.9	16	

Bottom of Hole at 26.5'

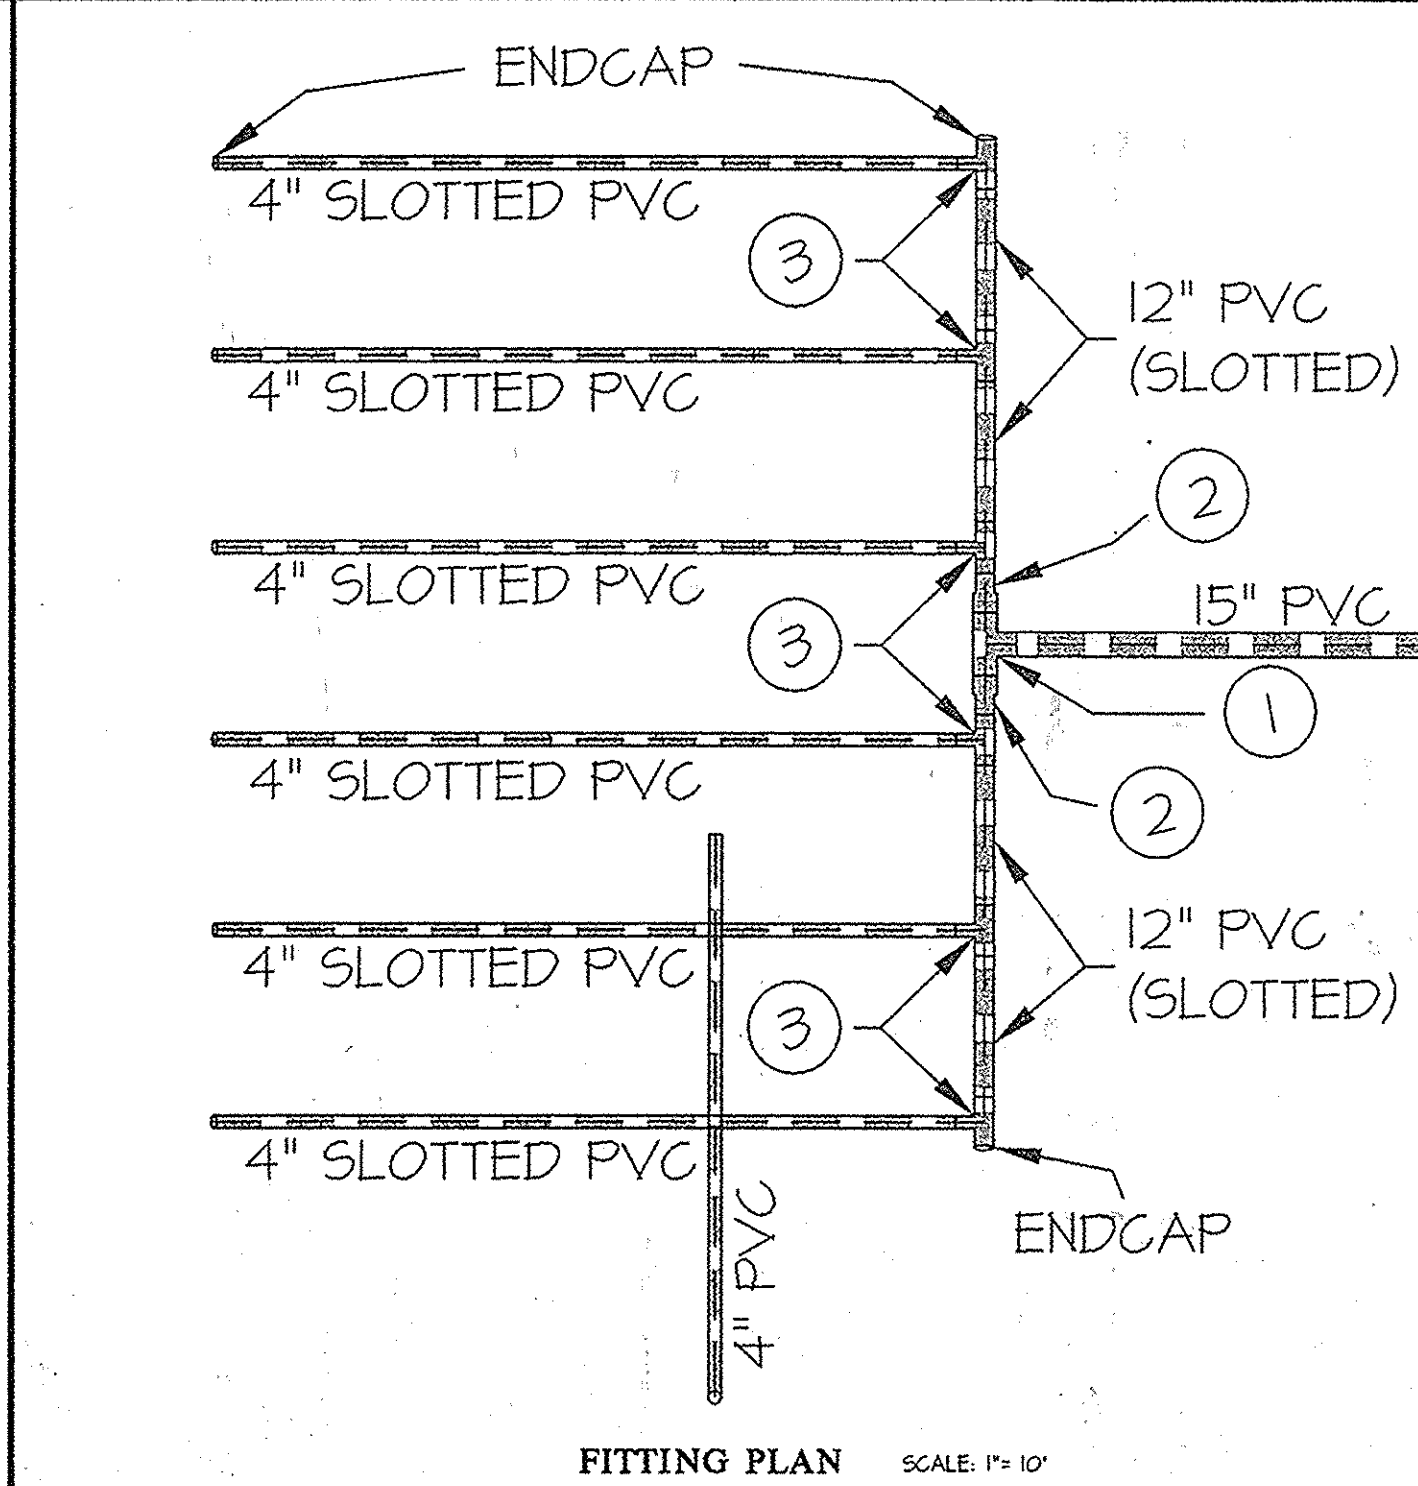


FITTING PLAN SCALE: 1" = 10'

PARTS LIST			
	TYPE	QUANTITY	ADS PART #
①	15" x 12" TEE	1	1565AN05B
②	15" x 12" REDUCER	2	1574AN05B
③	12" x 4" TEE	6	1260AN05B

OPERATION AND MAINTENANCE SCHEDULE FOR PRIVATELY OWNED AND MAINTAINED STORMWATER INFILTRATION TRENCHES

- THE MONITORING WELLS AND STRUCTURES SHALL BE INSPECTED ON A QUARTERLY BASIS AND AFTER EVERY LARGE STORM EVENT.
- WATER LEVELS AND SEDIMENT BUILD UP IN THE MONITORING WELLS SHALL BE RECORDED OVER A PERIOD OF SEVERAL DAYS TO INSURE TRENCH DRAINAGE.
- A LOG BOOK SHALL BE MAINTAINED TO DETERMINE THE RATE AT WHICH THE FACILITY DRAINS.
- WHEN THE FACILITY BECOMES CLOGGED SO THAT IT DOES NOT DRAIN DOWN WITHIN THE 12 HOUR TIME PERIOD, CORRECTIVE ACTION SHALL BE TAKEN.
- THE MAINTENANCE LOG BOOK SHALL BE AVAILABLE TO HOWARD COUNTY FOR INSPECTION TO INSURE COMPLIANCE WITH OPERATION AND MAINTENANCE CRITERIA.
- ONCE THE PERFORMANCE CHARACTERISTICS OF THE INFILTRATION FACILITY HAVE BEEN VERIFIED, THE MONITORING SCHEDULE CAN BE REDUCED TO AN ANNUAL BASIS UNLESS THE PERFORMANCE DATA INDICATES THAT A MORE FREQUENT SCHEDULE IS REQUIRED.



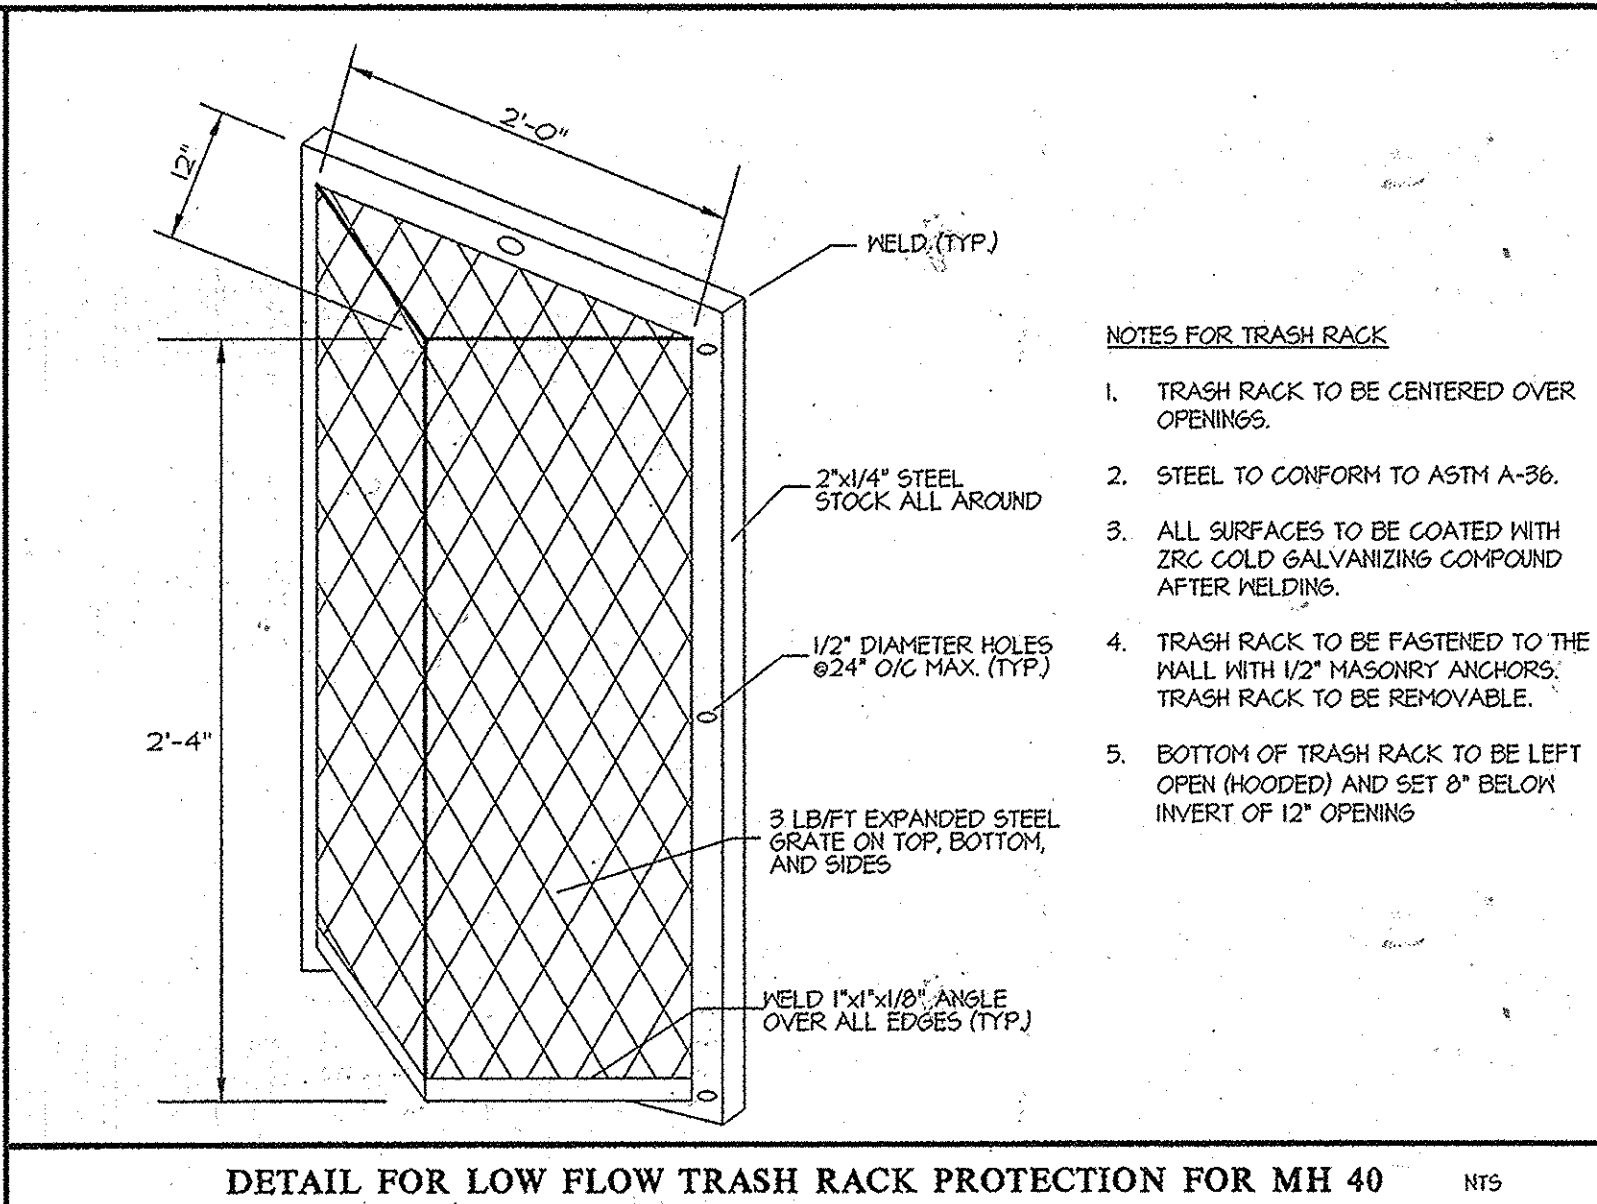


APPROVED: HOWARD COUNTY DEPARTMENT OF PUBLIC WORKS  
*Diane Schwan*, Acting Chief, Bureau of Highways, 11/24/12

APPROVED: HOWARD COUNTY DEPARTMENT OF PLANNING & ZONING  
*Vet. Decker*, Chief, Division of Land Development, 12/11/12  
*Chad Edwards*, Chief, Development Engineering Division, 12-6-12

S.D. PIPE SUMMARY TABLE PRIVATELY OWNED AND MAINTAINED

SIZE (INCHES)	TYPE	QUANTITY (L.F.)	REMARKS
4	SLOTTED PVC	264	SCHEDULE 40
4	PVC	20	SCHEDULE 40
12	SLOTTED PVC	50	SCHEDULE 40
15	PVC	23	SCHEDULE 40

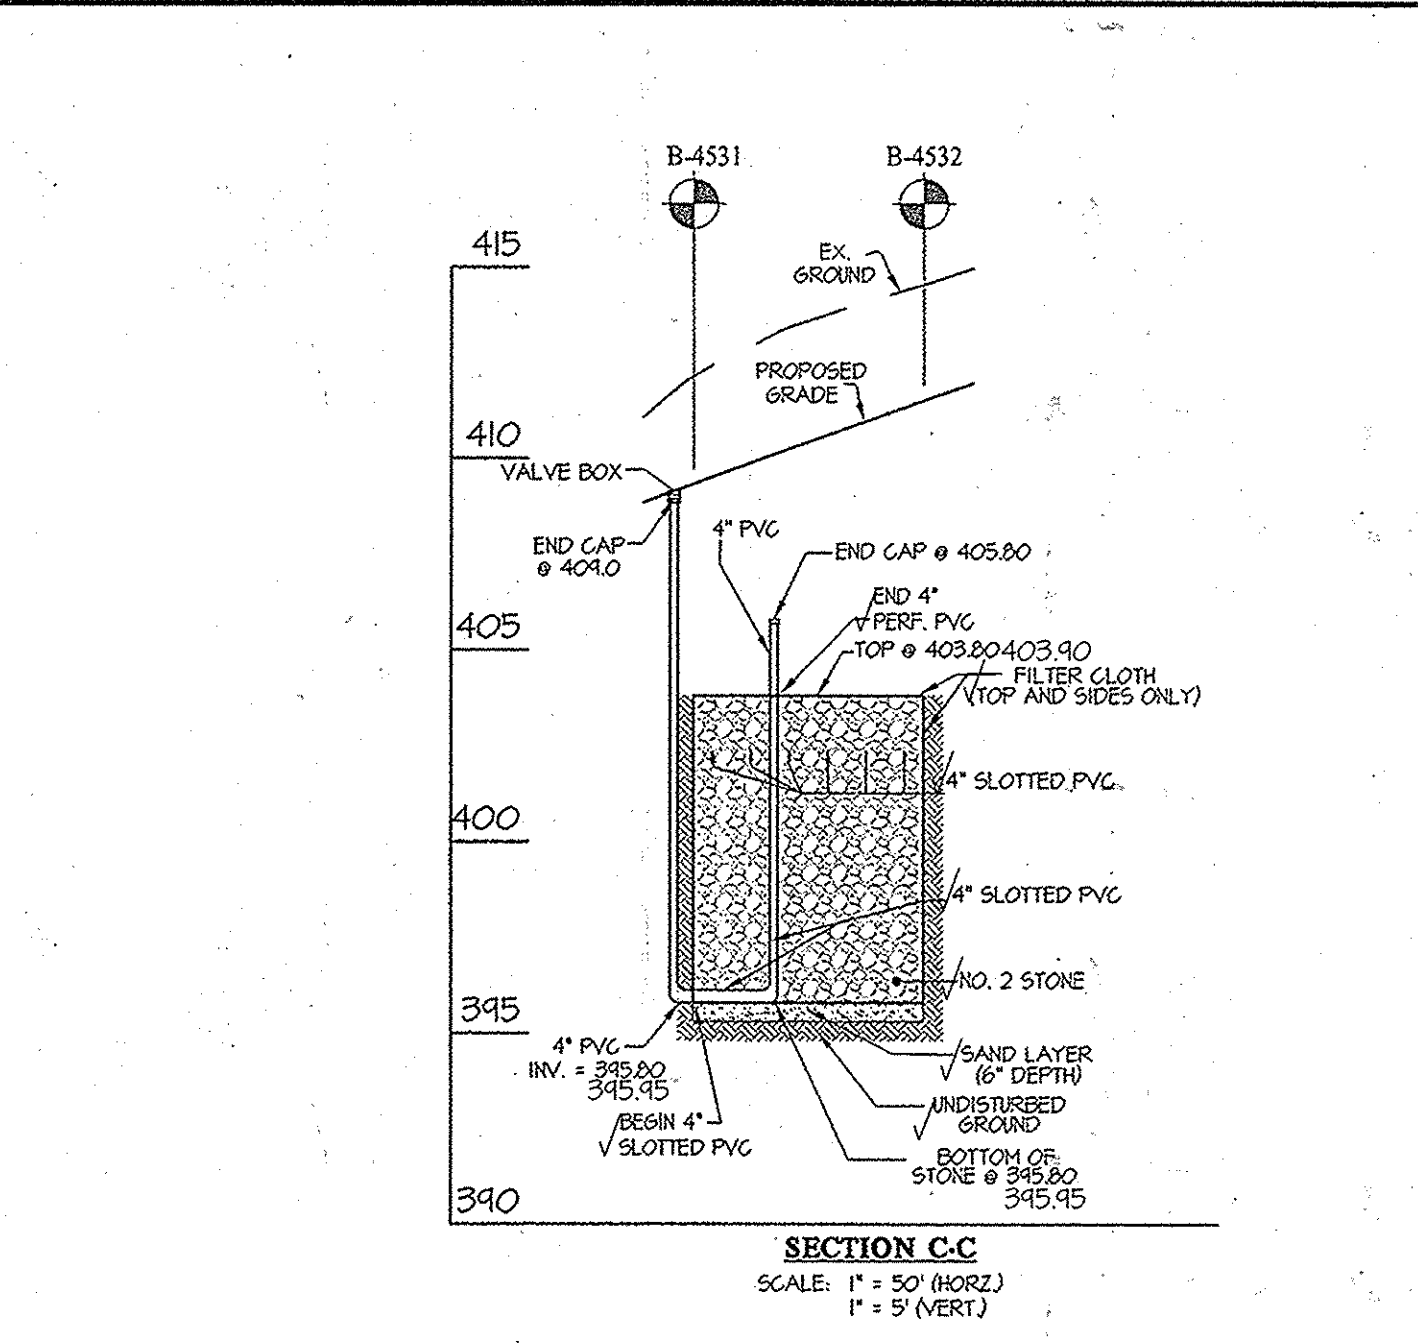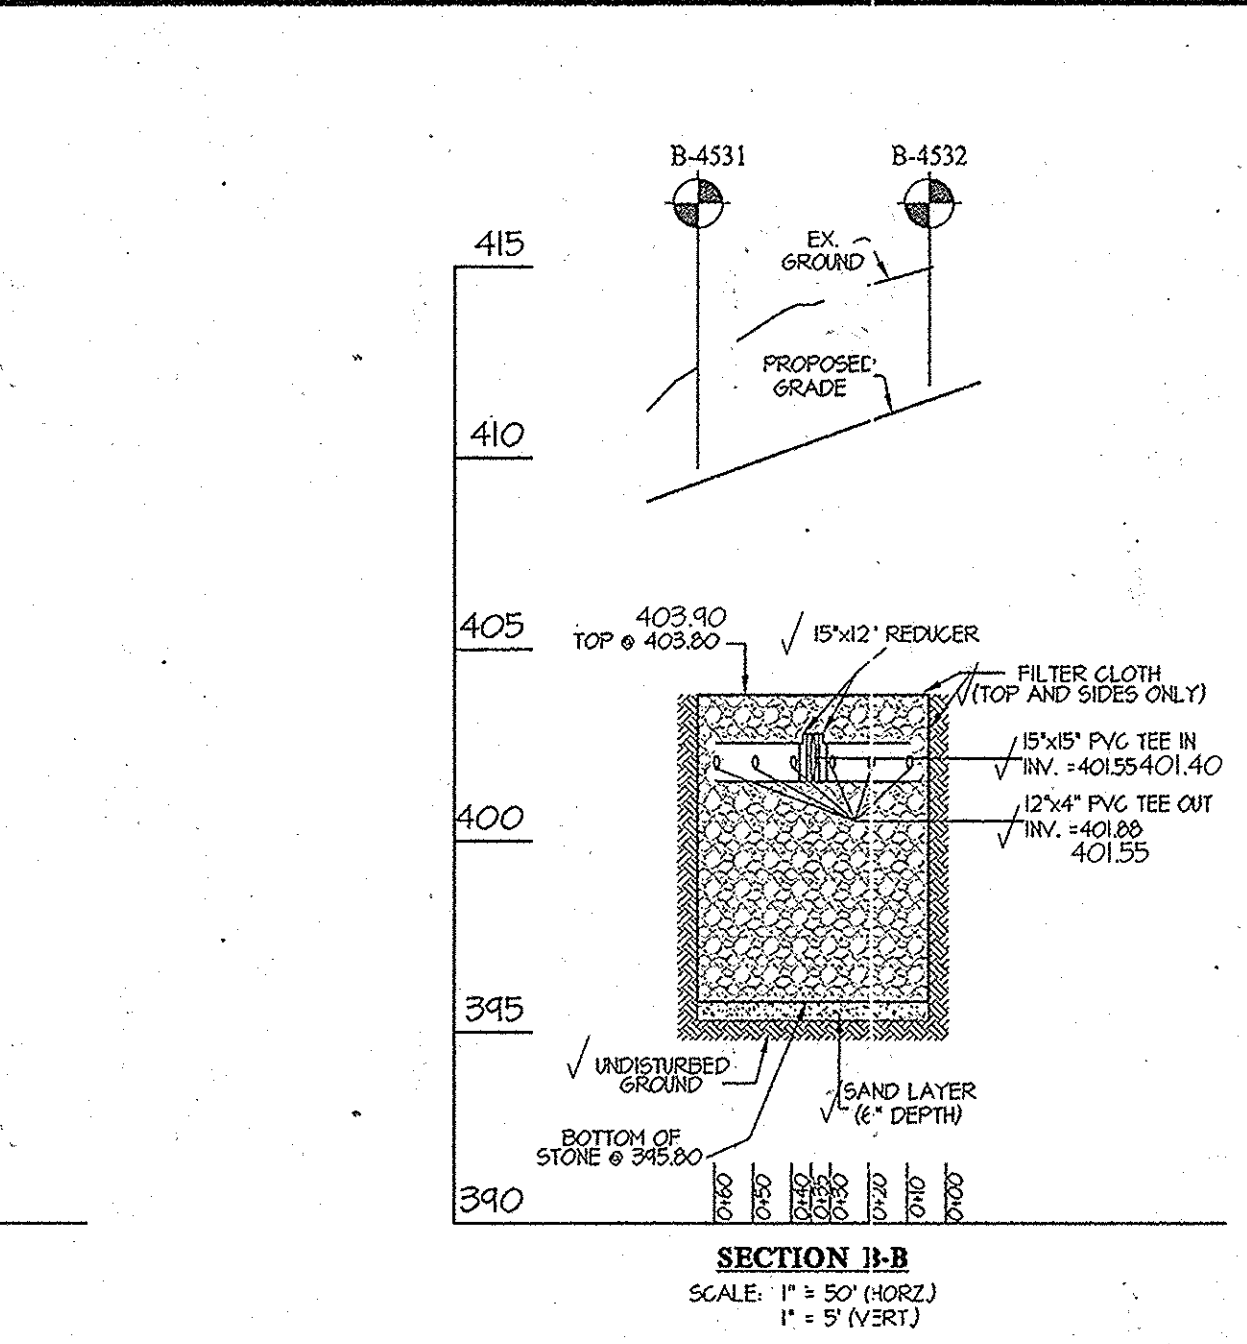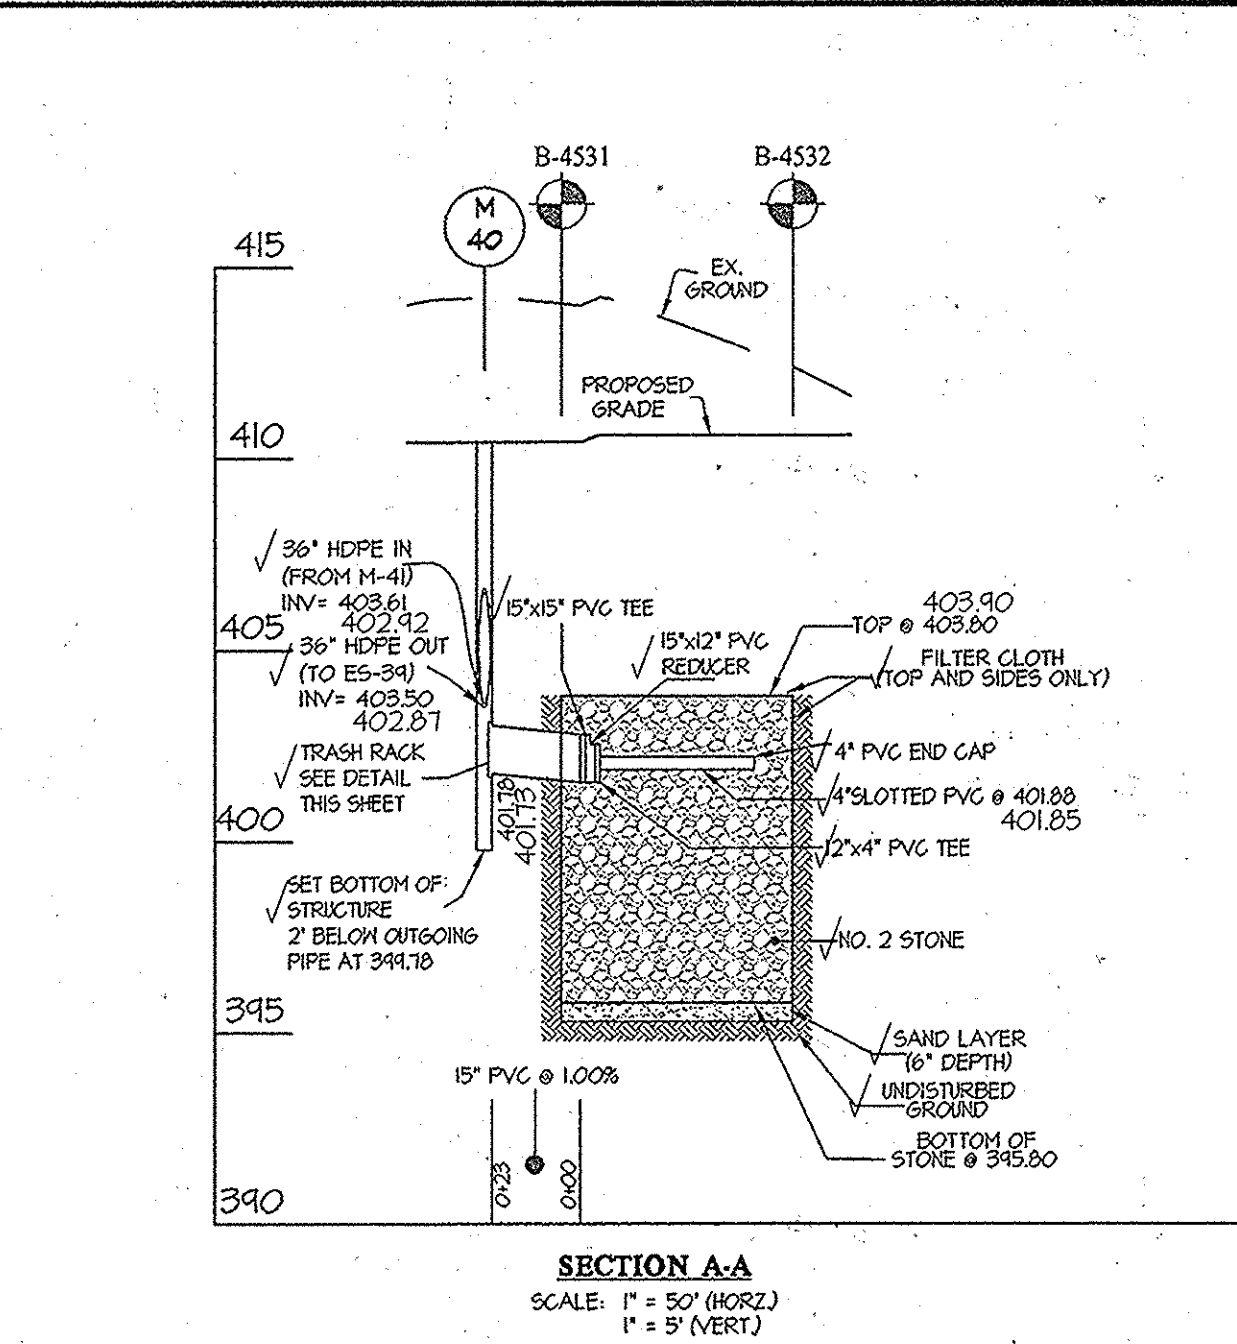

PROFESSIONAL CERTIFICATION  
 I hereby certify that these documents were prepared or approved by me, and that I am a duly licensed professional engineer under the laws of the State of Maryland, License No. 12475, Expiration Date: May 26 2016.

10-28-15 Date  
 Carl K. Gutschick, Professional Engineer, Maryland Reg. No. 12475

GLWGUTSCHICK LITTLE & WEBER, P.A.  
 CIVIL ENGINEERS, LAND SURVEYORS, LAND PLANNERS, LANDSCAPE ARCHITECTS  
 3809 NATIONAL DRIVE - SUITE 250 - BURTONSVILLE OFFICE PARK  
 BURTONSVILLE, MARYLAND 20866  
 TEL: 301-421-4024 BALT: 410-880-1820 DC/VA: 301-889-2524 FAX: 301-421-4186

DATE	REVISION	BY	APP'R.

PREPARED FOR:  
 G&R DEVELOPMENT, INC.  
 SUITE 300 WOODHOLME CENTER  
 1829 REISTERSTOWN ROAD  
 BALTIMORE, MD 21208  
 ATTN: MARK BENNETT  
 410-484-8400

PROFESSIONAL CERTIFICATION  
 I HEREBY CERTIFY THAT THESE PLANS WERE PREPARED OR APPROVED BY ME, AND THAT I AM A DULY LICENSED PROFESSIONAL ENGINEER UNDER THE LAWS OF THE STATE OF MARYLAND, LICENSE NO. 12825, EXPIRATION DATE: MAY 26, 2014.


11-7-12 Date  
 Carl K. Gutschick, Professional Engineer, Maryland Reg. No. 12475

ASBUILTS RECHARGE FACILITY DETAILS

SCALE	ZONING	G. L. W. FILE NO.
AS SHOWN	MXD-3	11001
DATE	TAX MAP -- GRID	SHEET
OCT 11 2015 OCT. 2012	41-21/46-3	15 OF 25

HOWARD COUNTY, MARYLAND



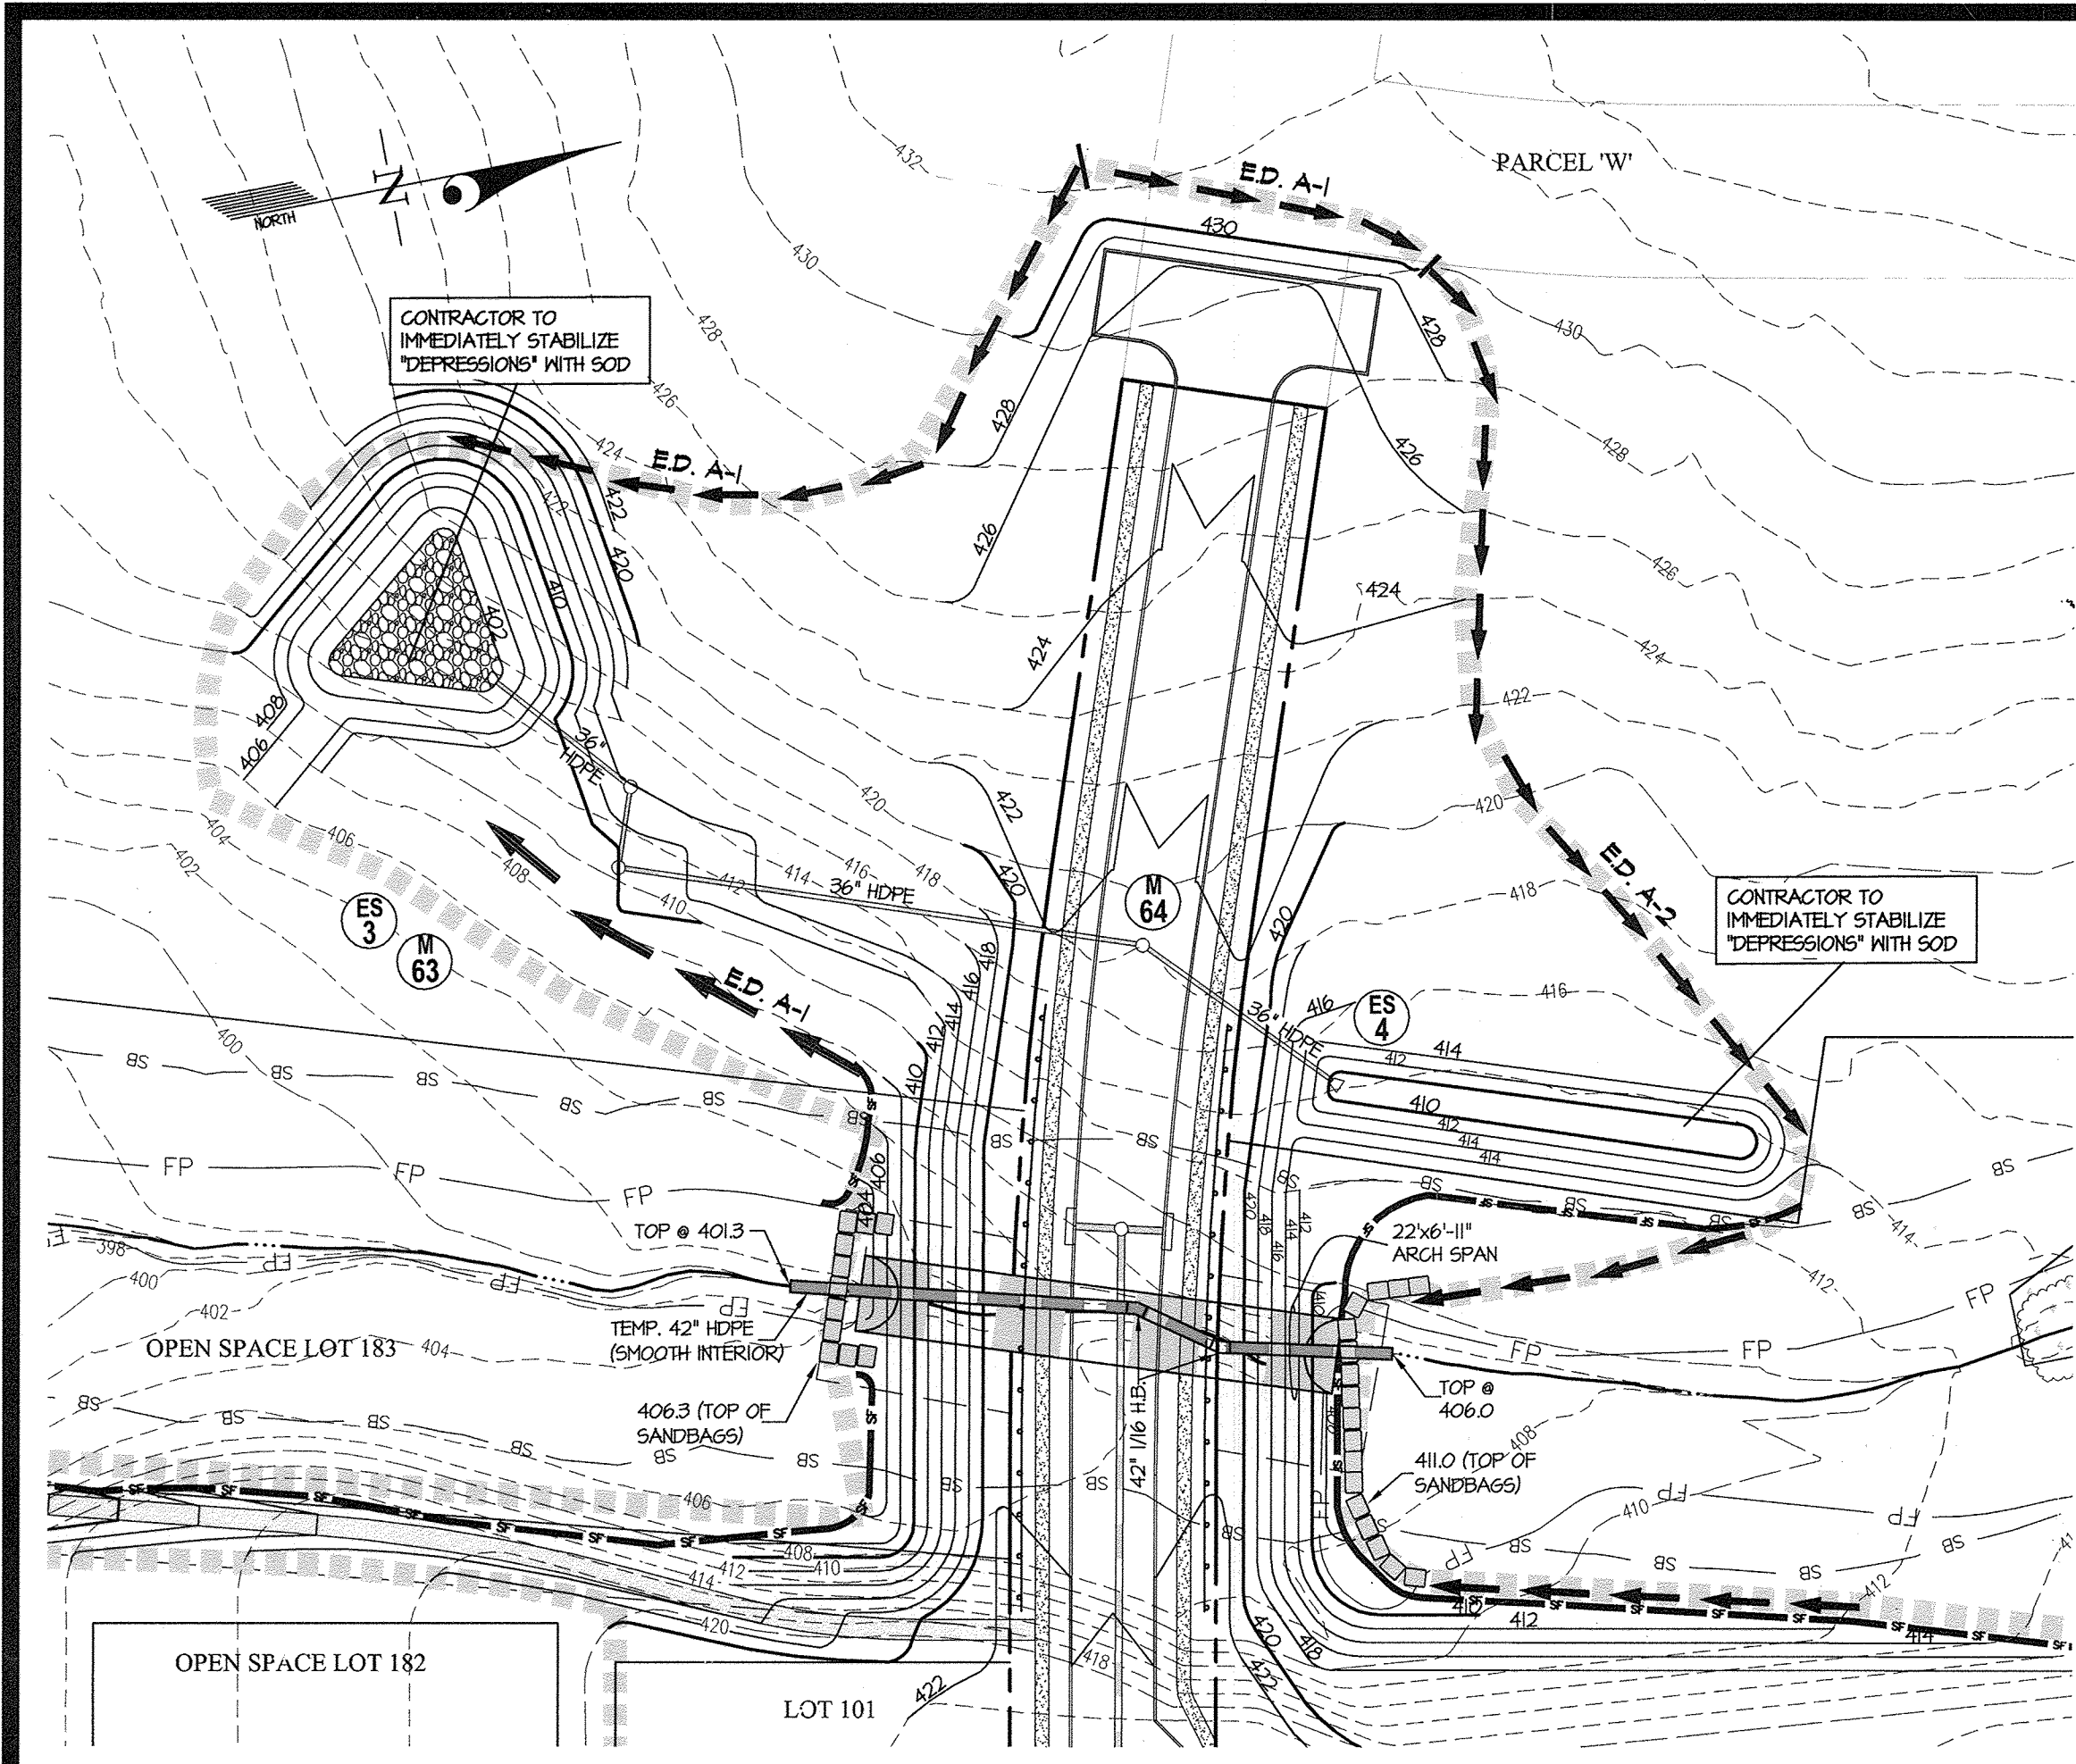

DETAIL SCALE: 1" = 50'

**SEDIMENT CONTROL LEGEND**

- 400 EXISTING CONTOUR
- PROPOSED CONTOUR
- EXISTING TREELINE
- STABILIZED CONSTRUCTION ENTRANCE
- INITIAL EARTH DIKE
- FINAL EARTH DIKE
- BOTH CONDITIONS EARTH DIKE
- PROPOSED SANDBAGS
- EXISTING SUPER SILT FENCE
- PROPOSED SILT FENCE
- PROPOSED SUPER SILT FENCE
- LIMIT OF DISTURBANCE
- PROPOSED STORM DRAIN
- 100 YEAR FLOODPLAIN
- STREAM BUFFER
- CENTERLINE OF STREAM
- METLAND BUFFER
- LIMIT OF METLAND
- METLAND AREA

**NOTES:**


1. FOR STORM DRAIN SIZES SEE SHEET B.
2. WHERE L.O.D. IS NOT SHOWN, THE SEDIMENT CONTROL DEVICES WILL INDICATE THE LIMIT OF DISTURBANCE.
3. CONTRACTOR MUST TURN ALL SILT FENCE AND SUPER SILT FENCE UPHILL BY 2' IN ELEVATION EVERY 25 FEET.
4. FOR DUST CONTROL INFORMATION SEE SHEET 16.
5. FOR RIP-RAP INFORMATION THIS SHEET.
6. FOR PROFILE ES-3 TO ES-4 SEE SHEET 13.

100 YEAR FLOODPLAIN STUDY		100 YEAR FLOODPLAIN STUDY	
CROSS SECTION	FEET FT.	CROSS SECTION	FEET FT.
HAMMOND BRANCH		STREAM A	
64-22	383.95	34-02	394.32
67-02	385.11	61-50	403.68
68-44	386.20	71-17	408.68
10-12	388.21	81-65	404.42
72-38	384.58	41-30	410.68
73-64	391.04	101-00	413.60
74-00	394.32	14-00	423.33
	394.51	14-00	435.84

RIP RAP INFORMATION									
LOCATION	PIPE SIZE	Q <sub>ACT</sub>	Q <sub>CAP</sub>	LENGTH	CLASS	D <sub>50</sub>	D <sub>100</sub>	THICKNESS	
				REQUIRED	PROVIDED				
ES-2	36"	66.31	66.31	26'	26'	I	16"	24"	32"
ES-3	30"	35.7	62.5	47'	48'	I	16"	24"	32"

1. On August 29, 2012 the Division of Land Development determined that the proposed work indicated as Revision #2 is an essential disturbance.

2. On July 26, 2012 an email was received from PEPD granting approval for the work within their right-of-way. The approved work has been indicated as Revision #3.

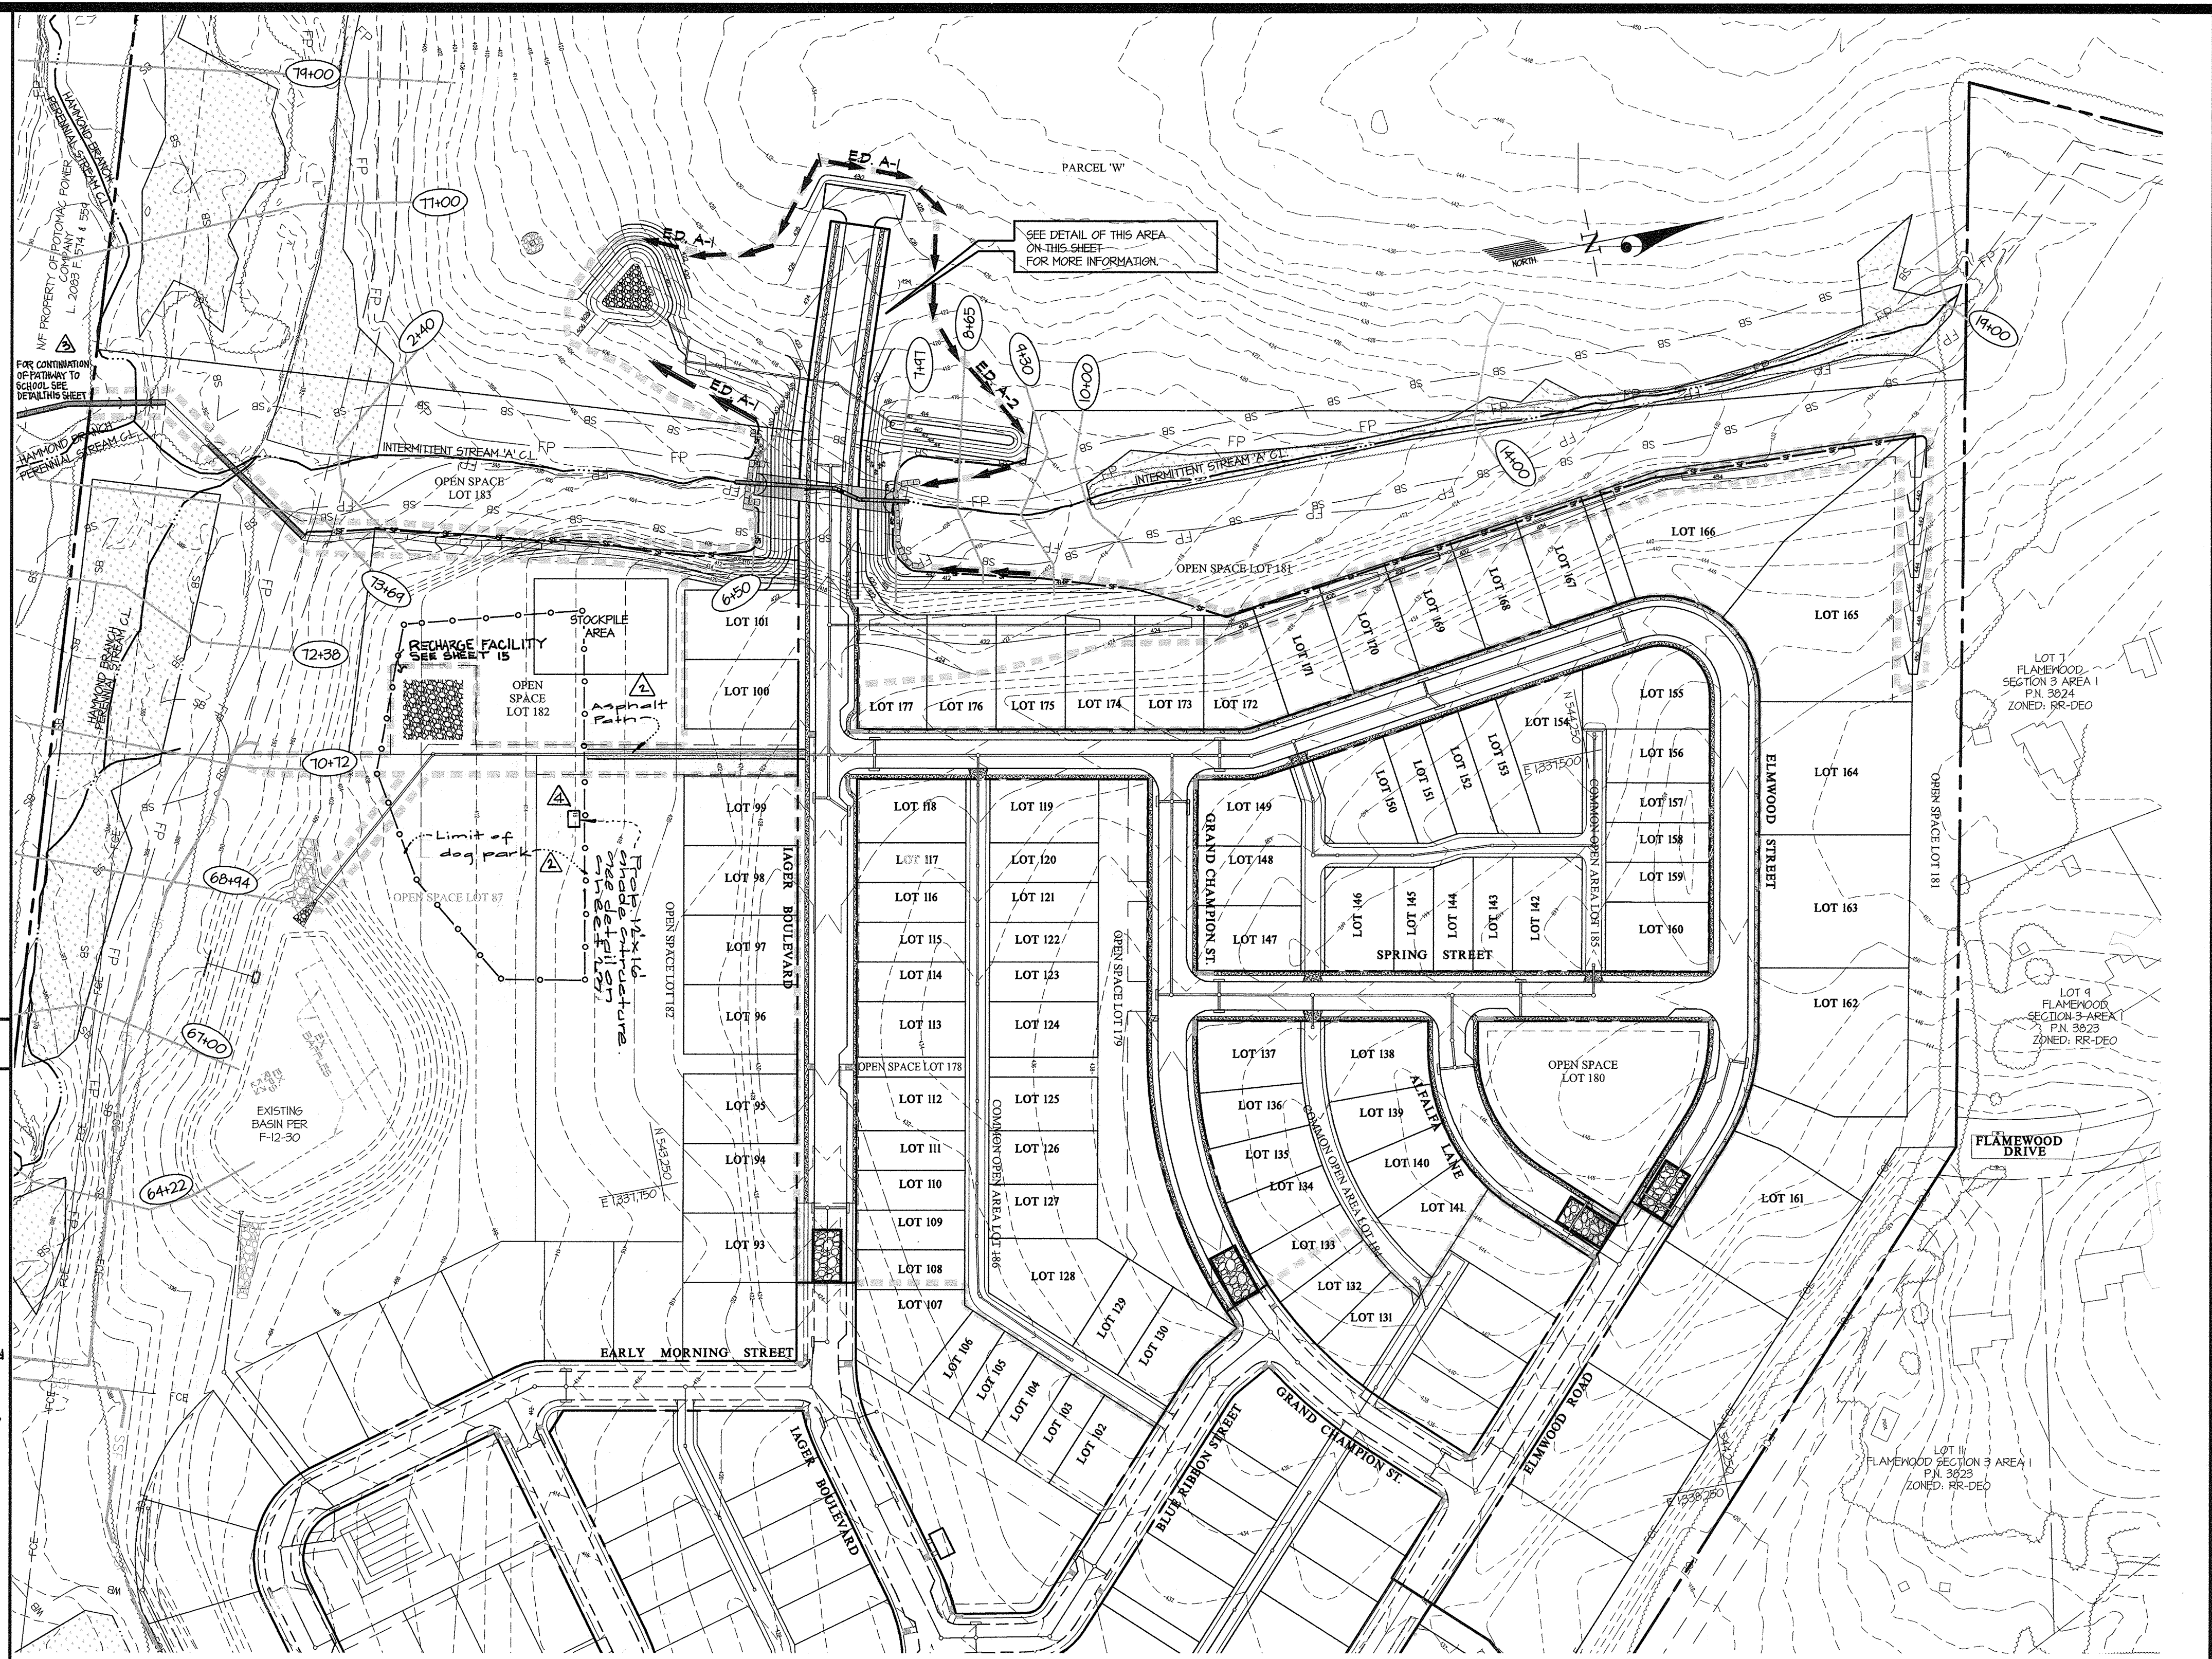

THIS DEVELOPMENT PLAN IS APPROVED FOR SOIL EROSION AND SEDIMENT CONTROL BY THE HOWARD COUNTY DEPARTMENT OF PUBLIC WORKS.

*John R. Roberts* 11/23/12  
 HOWARD S.C.D. DATE

**BUILDER'S CERTIFICATE**

"I/WE CERTIFY THAT ALL DEVELOPMENT AND/OR CONSTRUCTION WILL BE DONE ACCORDING TO THIS PLAN AND THAT ANY RESPONSIBLE PERSONNEL INVOLVED IN THE CONSTRUCTION PROJECT WILL HAVE A CERTIFICATE OF ATTENDANCE AT A MARYLAND DEPARTMENT OF THE ENVIRONMENT APPROVED TRAINING PROGRAM FOR THE CONTROL OF SEDIMENT AND EROSION BEFORE BEGINNING THE PROJECT. I ALSO AUTHORIZE PERIODIC ON-SITE INSPECTION BY THE H.C.D."

*W. H. R. St. V. P. P. P.* 10/25/12  
 SIGNATURE OF DEVELOPER/BUILDER DATE

APPROVED: HOWARD COUNTY DEPARTMENT OF PUBLIC WORKS

*Diane Schweg* Acting 11/21/12  
 Chief, Bureau of Highways Date

**ENGINEER'S CERTIFICATE**

"I CERTIFY THAT THIS PLAN FOR EROSION AND SEDIMENT CONTROL REPRESENTS A PRACTICAL AND WORKABLE PLAN BASED ON MY PERSONAL KNOWLEDGE OF THE SITE CONDITIONS AND THAT IT WAS PREPARED IN ACCORDANCE WITH THE REQUIREMENTS OF THE HOWARD COUNTY DEPARTMENT OF THE ENVIRONMENT."

*CKG* 11-7-12  
 SIGNATURE OF ENGINEER DATE

APPROVED: HOWARD COUNTY DEPARTMENT OF PLANNING & ZONING

*K. S. D. L.* 12/16/12  
 Chief, Division of Land Development Date

*Chad Edwards* 12-6-12  
 Chief, Development Engineering Division Date

**GLWGUTSCHICK LITTLE & WEBER, P.A.**


CIVIL ENGINEERS, LAND SURVEYORS, LAND PLANNERS, LANDSCAPE ARCHITECTS  
 3909 NATIONAL DRIVE, SUITE 250 - BURTONTOWN OFFICE PARK  
 BURTONTOWN, MARYLAND 20866  
 TEL: 301-421-4024 BALT: 410-880-1820 DC/VA: 301-989-2524 FAX: 301-421-4186

L:\CAD\DRAWINGS\11001\FINALS\ROADS-SD\11001-16-18-SC.dwg DES. DEV DRN. KLP CHK. CKG

NO.	DATE	REVISION	BY	APP'R.
11-7-2012		Added limits of dog park and asphalt path.	CKG	DEV.
11-02-2012		Added detail for path connection to school campus in sequence of construction.	CKG	DEV.
10-2-2012		Added shade structures within Dog Park Limits.	CKG	DEV.

- SEQUENCE OF CONSTRUCTION**
1. OBTAIN GRADING PERMIT AND ARRANGE FOR AN ON-SITE PRE-CONSTRUCTION MEETING. (1 WEEK)
  2. INSTALL STONE CONSTRUCTION ENTRANCES, SILT FENCE AS SHOWN ON THESE PLANS. (3 WEEKS)
  3. INSPECT SEDIMENT CONTROL DEVICES CONSTRUCTED UNDER F 12-30 AND MAKE REPAIRS AS NEEDED. (1 WEEK)
- NOTE: WITH THE PERMISSION OF THE SEDIMENT CONTROL INSPECTOR, ITEMS 4 THROUGH 6 AND ITEM 1 MAY BE PERFORMED CONCURRENTLY.
4. INSTALL SILT FENCE, TEMPORARY PIPE AND SANDBAGS IN THE AREA OF THE ARCH SPAN AS SHOWN ON SHEET 15. (1 WEEK)
  5. WITH THE PERMISSION OF THE SEDIMENT CONTROL INSPECTOR, BEGIN CONSTRUCTION OF THE ARCH SPAN (1 MONTH)
  6. ONCE ENOUGH COVER HAS BEEN PLACED ON THE ARCH SPAN TO ALLOW CONSTRUCTION TRAFFIC, INSTALL THE LOCAL DEPRESSION, THE STORM DRAIN SYSTEM ES-4 TO ES-3, AND THE EARTH DIKES ON THE WEST SIDE OF THE TRIBUTARY AS SHOWN ON SHEET 15. (1 WEEK)
  7. BEGIN CONSTRUCTION OF THE STORM DRAINS PER THIS PLAN, AND THE WATER AND SEWER PER THE CONSTRUCTION DRAWINGS, CONT. #24-4747-D AND CONT. #24-4748-D. (6 MONTHS)
  8. INSTALL THE CURB AND GUTTER, SIDEWALKS, PATHWAY, AND BASE PAVING. (2 MONTHS)
  9. FINE GRADE SITE AND STABILIZE DISTURBED AREAS. (1 MONTH)
  10. INSTALL SURFACE COURSE. (1 MONTH)
  11. REMOVE REMAINING SEDIMENT CONTROL DEVICES AND STABILIZE ANY REMAINING DISTURBED AREAS. (2 WEEKS)
  12. WITH THE PERMISSION OF THE SEDIMENT CONTROL INSPECTOR, FLUSH THE STORM DRAIN SYSTEM. (1 WEEK)

- SEQUENCE OF CONSTRUCTION FOR ELEVATED BOARDWALK AND WOODEN BRIDGE.**
1. THIS WORK WILL BE PERFORMED UNDER THE SAME GRADING PERMIT AS THE REST OF THE WORK SHOWN ON THESE FINAL PLANS.
  2. ARRANGE FOR AN ON-SITE PRE-CONSTRUCTION MEETING WITH THE HOWARD COUNTY INSPECTOR.
  3. INSTALL THE SUPER SILT FENCE AND STONE CONSTRUCTION ENTRANCE AS SHOWN ON THESE PLANS.
  4. BEGIN THE CONSTRUCTION OF THE ELEVATED BOARDWALK FROM THE MAPLE LAWN (NORTH) END OF THE BOARDWALKS.
  5. FROM THE EXISTING PAVEMENT, SET THE FIRST AND SECOND SET OF PILING AND BEGIN THE INSTALLATION OF THE FIRST SECTION OF THE BOARDWALK.
  6. ONCE THE FIRST SECTION OF THE BOARDWALK IS IN PLACE, THE CONTRACTOR WILL SET UP AT THE END OF IT AND SET THE NEXT SET OF PILING. THIS PROCESS WILL CONTINUE UNTIL THE PILING FOR THE WOODEN BRIDGE IS REACHED.
- CONCURRENT TO CONSTRUCTION ITEMS 4 THROUGH 8 ABOVE, THE FOLLOWING CONSTRUCTION CAN TAKE PLACE GAINING ACCESS TO THE WORK AREA FROM THE SOUTH:
7. BEGIN CONSTRUCTION OF THE EARTHEN CAUSEWAY.
  8. CONTINUE PILING FILL UNTIL THE CAUSEWAY REACHES THE GRADES SHOWN ON THESE PLANS FILL SLOPES ARE TO BE STABILIZED IMMEDIATELY WITH SOD.
  9. BEGIN THE CONSTRUCTION OF THE ELEVATED BOARDWALK BETWEEN THE PERC R/W AND THE BRIDGE.
  10. INSTALL THE 30'x6" BRIDGE SECTION WHEN CALLED FOR IN THE CONTRACTOR'S PROCEDURE.
  11. REMOVE ALL SEDIMENT CONTROL DEVICES AND STABILIZE ANY REMAINING DISTURBED AREAS.
- NOTE: THE CONTRACTOR MUST FOLLOW THE BEST MANAGEMENT SPECIFICATIONS SHOWN ON THIS PLAN.

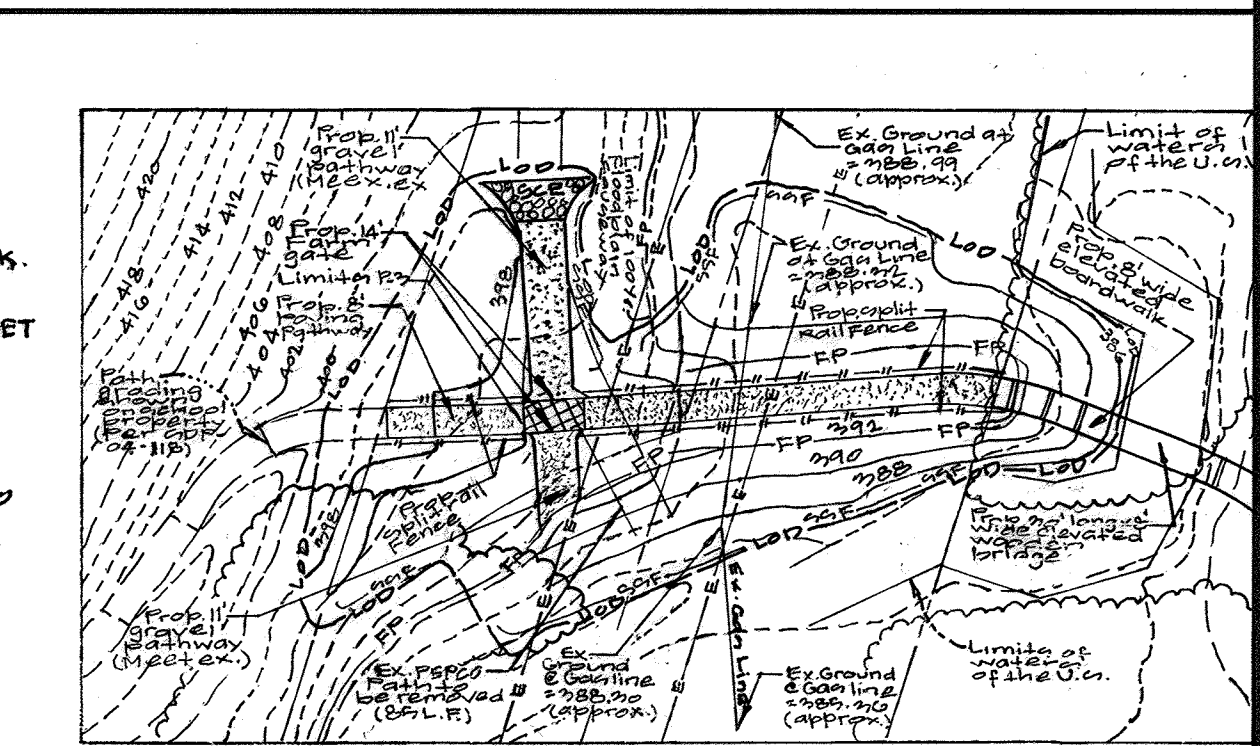

THIS PLAN IS FOR SEDIMENT CONTROL PURPOSES ONLY

**SEDIMENT CONTROL PLAN**

**MAPLE LAWN FARMS**  
 MIDDLETOWN WEST DISTRICT - AREA 2  
 LOTS 93 THRU 177, OPEN SPACE LOTS 178 THRU 183, AND  
 COMMON OPEN AREA LOTS 184 THRU 186


SCALE	ZONING	G. L. W. P.L.E. No.
AS SHOWN	MXD-3	11001
DATE	TAX MAP - GRID	SHEET
OCT. 2012	41-21-46-3	16 OF 25

PREPARED FOR:  
 MAPLE LAWN FARMS, LLC  
 SUITE 300 WOODHOLME CENTER  
 1625 REISTERSTOWN ROAD  
 BALTIMORE, MD 21208  
 ATTN: MARK BENNETT  
 410-484-8400

**PROFESSIONAL CERTIFICATION**

I HEREBY CERTIFY THAT THESE PLANS WERE PREPARED OR APPROVED BY ME, AND THAT I AM A DULY LICENSED PROFESSIONAL ENGINEER UNDER THE LAWS OF THE STATE OF MARYLAND, LICENSE NO. 12875, EXPIRATION DATE: MAY 28, 2014.

*CKG* 11-7-12

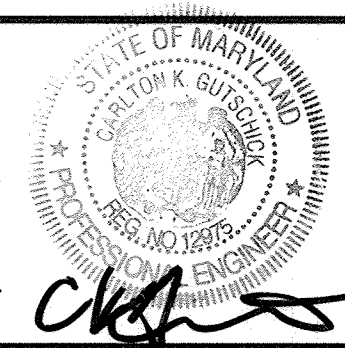



**B-4-2 STANDARD AND SPECIFICATIONS FOR SOIL PREPARATION, TOPSOILING, AND SOIL AMENDMENTS**

**DEFINITION**  
THE PROCESS OF PREPARING THE SOILS TO SUSTAIN ADEQUATE VEGETATIVE STABILIZATION.

**PURPOSE**  
TO PROVIDE A SUITABLE SOIL MEDIUM FOR VEGETATIVE GROWTH.

**CONDITIONS WHERE PRACTICE APPLIES**  
WHERE VEGETATIVE STABILIZATION IS TO BE ESTABLISHED.

**CRITERIA**

- A. SOIL PREPARATION**
1. TEMPORARY STABILIZATION
- SEEDING PREPARATION CONSISTS OF LOOSENING SOIL TO A DEPTH OF 3 TO 5 INCHES BY MEANS OF SUITABLE AERIAL OR CONSTRUCTION EQUIPMENT, SUCH AS DISC HARROWS OR CHISEL PLOWS OR RIPPERS MOUNTED ON CONSTRUCTION EQUIPMENT. THE SOIL IS LOOSENED. IT MUST NOT BE ROLLED OR DRAGGED SMOOTH BUT LEFT IN THE ROUGHENED CONDITION. SLOPES 3:1 OR FLATTER ARE TO BE TILLED WITH RIDGES RUNNING PARALLEL TO THE CONTOUR OF THE SLOPE.
  - APPLY FERTILIZER AND LIME AS PRESCRIBED ON THE PLANS.
  - INCORPORATE LIME AND FERTILIZER INTO THE TOP 3 TO 5 INCHES OF SOIL BY DISKING OR OTHER SUITABLE MEANS.
2. PERMANENT STABILIZATION
- A SOIL TEST IS REQUIRED FOR ANY EARTH DISTURBANCE OF 5 ACRES OR MORE. THE MINIMUM SOIL CONDITIONS REQUIRED FOR PERMANENT VEGETATIVE ESTABLISHMENT ARE:
    - SOIL PH BETWEEN 6.0 AND 7.0.
    - SOLUBLE SALTS LESS THAN 500 PARTS PER MILLION (PPM).
    - SOIL CONTAINS LESS THAN 40 PERCENT CLAY BUT ENOUGH FINE GRAINED MATERIAL (GREATER THAN 30 PERCENT SILT PLUS CLAY) TO PROVIDE THE CAPACITY TO HOLD A MODERATE AMOUNT OF MOISTURE. AN EXCEPTION IS FLOORSIDE WHICH WILL BE A SANDY SOIL (LESS THAN 50 PERCENT SILT PLUS CLAY) WOULD BE ACCEPTABLE.
    - SOIL CONTAINS 15 PERCENT MINIMUM ORGANIC MATTER BY WEIGHT.
    - SOIL CONTAINS SUFFICIENT PORE SPACE TO PERMIT ADEQUATE ROOT PENETRATION.
  - APPLICATION OF AMENDMENTS OR TOPSOIL IS REQUIRED IF ON-SITE SOILS DO NOT MEET THE ABOVE CONDITIONS.
  - GRADED AREAS MUST BE MAINTAINED IN A TRUE AND EVEN GRADE AS SPECIFIED ON THE APPROVED PLAN. THEN SCARIFIED OR OTHERWISE LOOSENED TO A DEPTH OF 3 TO 5 INCHES.
  - APPLY SOIL AMENDMENTS AS SPECIFIED ON THE APPROVED PLAN OR AS INDICATED BY THE RESULTS OF A SOIL TEST.
  - MIX SOIL AMENDMENTS INTO THE TOP 3 TO 5 INCHES OF SOIL BY DISKING OR OTHER SUITABLE MEANS. RANGE FROM 1/2 INCH TO 1 INCH. REMOVE LARGE OBJECTS LIKE STONES AND BRANCHES, AND READY THE AREA FOR LARGE EQUIPMENT. LOOSEN SURFACE SOIL BY DRAGGING WITH A HEAVY CHAIN OR TRACTOR TO ROUGHEN THE SURFACE. THESE SITE CONDITIONS WILL NOT PERMIT NORMAL SEEDING PREPARATION. TRACK SLOPES 3:1 OR FLATTER WITH OTHER EQUIPMENT LEAVING THE SOIL IN AN IRREGULAR CONDITION WITH RIDGES RUNNING PARALLEL TO THE CONTOUR OF THE SLOPE. LEAVE THE TOP 1 TO 3 INCHES OF SOIL LOOSE AND FRAGILE. SEEDING MIXTURES WILL BE UNNECESSARY ON NEWLY DISTURBED AREAS.

**B. TOPSOILING**

- TOPSOIL IS PLACED OVER PREPARED SUBSOIL PRIOR TO ESTABLISHMENT OF PERMANENT VEGETATION. THE PURPOSE IS TO PROVIDE A SUITABLE SOIL MEDIUM FOR VEGETATIVE GROWTH. THE SOIL SHOULD HAVE A MOISTURE CONTENT, LOW NUTRIENT LEVELS, LOW PH, MATERIALS TOXIC TO PLANTS, AND/OR UNACCEPTABLE SOIL GRADATION.
- TOPSOIL SALVAGED FROM AN EXISTING SITE MAY BE PROVIDED IF IT MEETS THE STANDARDS AND SPECIFICATIONS. THE DEPTH OF THE TOPSOIL TO BE SALVAGED FOR A GIVEN SOIL TYPE CAN BE FOUND IN THE REPRESENTATIVE SOIL PROFILE SECTION OF THE SOIL SURVEY PUBLISHED BY USDA-NRCS.
- TOPSOILING IS LIMITED TO AREAS HAVING 2:1 OR FLATTER SLOPES INHERE:
  - THE TEXTURE OF THE EXPOSED SUBSOIL/PARENT MATERIAL IS NOT ADEQUATE TO PRODUCE VEGETATIVE GROWTH.
  - THE SOIL IS TOO SHALLOW FOR THE ROOTING ZONE. IT DOES NOT DEEP ENOUGH TO SUPPORT PLANTS OR FURNISH CONTAINING SUPPLIES OF MOISTURE AND PLANT NUTRIENTS.
  - THE ORIGINAL SOIL TO BE VEGETATED CONTAINS MATERIAL TOXIC TO PLANT GROWTH.
  - THE SOIL IS SO ACIDIC THAT TREATMENT WITH LIMESTONE IS NOT FEASIBLE.
- AREAS HAVING SLOPES STEEPER THAN 2:1 REQUIRE SPECIAL CONSIDERATION AND DESIGN.
- SOIL SPECIFICATIONS: SOIL TO BE USED AS TOPSOIL MUST MEET THE FOLLOWING CRITERIA:
  - TOPSOIL MUST BE A LOAM, SANDY LOAM, CLAY LOAM, SILT LOAM, SANDY CLAY LOAM, OR LOAMY SAND. OTHER SOILS MAY BE USED IF RECOMMENDED BY AN AGRONOMIST OR SOIL SCIENTIST AND APPROVED BY THE APPROPRIATE APPROVAL AUTHORITY. TOPSOIL MUST NOT BE A MIXTURE OF CONTRASTING TEXTURED SUBSOILS. IT MUST CONTAIN LESS THAN 5 PERCENT BY VOLUME OF SANDS, STONES, SLAG, COARSE FRAGMENTS, GRAVEL, STICKS, ROOTS, TRASH, OR OTHER MATERIALS LARGER THAN 1.5 INCHES IN DIAMETER.
  - TOPSOIL MUST BE FREE OF NOXIOUS PLANTS OR PLANT PARTS SUCH AS BERMA GRASS, QUACK GRASS, JOHNSON GRASS, NUT SEDGE, POISON IVY, TRIFLE, OR OTHERS AS SPECIFIED.
  - TOPSOIL SUBSTITUTES OR AMENDMENTS AS RECOMMENDED BY A QUALIFIED AGRONOMIST OR SOIL SCIENTIST AND APPROVED BY THE APPROPRIATE APPROVAL AUTHORITY, MAY BE USED IN LIEU OF NATURAL TOPSOIL.
- TOPSOIL APPLICATION
  - EROSION AND SEDIMENT CONTROL PRACTICES MUST BE MAINTAINED WHEN APPLYING TOPSOIL.
  - UNIFORMLY DISTRIBUTE TOPSOIL IN A 5 TO 8 INCH LAYER AND LIGHTLY COMPACT TO MINIMIZE LOSS BY WIND OR WATER. THIS MAY BE DONE BY ONE OF THE FOLLOWING METHODS LISTED BY PREFERENCE, DEPENDING UPON THE SIZE OF THE AREA AND EROSION HAZARD:
    - FLATTER SLOPES: USE CONVENTIONAL SPRINKLING. MANSURE TAKEN FOR ENGINEERING PURPOSES MAY ALSO BE USED FOR CHEMICAL ANALYSES.
    - FERTILIZERS MUST BE UNIFORM IN COMPOSITION AND EVEN FLOWING AND SUITABLE FOR ACCURATE APPLICATION BY APPROPRIATE EQUIPMENT. MANURE MAY BE SUBSTITUTED FOR FERTILIZER WITH PRIOR APPROVAL FROM THE APPROPRIATE APPROVAL AUTHORITY. APPLICATIONS BY APPROPRIATE EQUIPMENT SHALL BE LIMITED TO SLOPING LAND. THIS PRACTICE SHOULD FOLLOW THE CONTOUR.
    - WOOD CELLULOSE FIBER MUST BE USED FOR ANCHORING STRAIN. APPLY THE FIBER BINDER AT A NET DRY WEIGHT OF 150 POUNDS PER ACRE. MIX THE WOOD CELLULOSE FIBER WITH WATER AT A MAXIMUM OF 50 POUNDS OF WOOD CELLULOSE FIBER PER 100 GALLONS OF WATER.
    - SYNTHETIC BINDERS SUCH AS ACRYLIC DLR (AGRO-TACK), DCA-10, TROZEXT, TERRA TAC, TERRA MANUFACTURER. APPLICATION OF LIQUID BINDERS NEEDS TO BE HEAVIER AT THE EDGES WHERE WIND CATCHES. MULCH, SUCH AS IN VALLEYS AND ON CRESTS OF BANKS. USE OF ASPHALT BINDERS IS STRICTLY PROHIBITED.
    - LIGHTWEIGHT PLASTIC NETTING MAY BE STAPLED OVER THE MULCH ACCORDING TO MANUFACTURER RECOMMENDATIONS. NETTING IS USUALLY AVAILABLE IN ROLLS 4 TO 15 FEET WIDE AND 300 TO 5000 FEET LONG.

**C. SOIL AMENDMENTS (FERTILIZER AND LIME SPECIFICATIONS)**

- SOIL TESTS MUST BE PERFORMED TO DETERMINE THE EXACT RATIOS AND APPLICATION RATES FOR LIME AND FERTILIZER ON SITES HAVING DISTURBED AREAS OF 5 ACRES OR MORE. SOIL ANALYSES MAY BE PERFORMED BY A RECOGNIZED PRIVATE OR COMMERCIAL LABORATORY. SAMPLES TAKEN FOR ENGINEERING PURPOSES MAY ALSO BE USED FOR CHEMICAL ANALYSES.
- FERTILIZERS MUST BE UNIFORM IN COMPOSITION AND EVEN FLOWING AND SUITABLE FOR ACCURATE APPLICATION BY APPROPRIATE EQUIPMENT. MANURE MAY BE SUBSTITUTED FOR FERTILIZER WITH PRIOR APPROVAL FROM THE APPROPRIATE APPROVAL AUTHORITY. APPLICATIONS BY APPROPRIATE EQUIPMENT SHALL BE LIMITED TO SLOPING LAND. THIS PRACTICE SHOULD FOLLOW THE CONTOUR.
- WOOD CELLULOSE FIBER MUST BE USED FOR ANCHORING STRAIN. APPLY THE FIBER BINDER AT A NET DRY WEIGHT OF 150 POUNDS PER ACRE. MIX THE WOOD CELLULOSE FIBER WITH WATER AT A MAXIMUM OF 50 POUNDS OF WOOD CELLULOSE FIBER PER 100 GALLONS OF WATER.
- SYNTHETIC BINDERS SUCH AS ACRYLIC DLR (AGRO-TACK), DCA-10, TROZEXT, TERRA TAC, TERRA MANUFACTURER. APPLICATION OF LIQUID BINDERS NEEDS TO BE HEAVIER AT THE EDGES WHERE WIND CATCHES. MULCH, SUCH AS IN VALLEYS AND ON CRESTS OF BANKS. USE OF ASPHALT BINDERS IS STRICTLY PROHIBITED.
- LIGHTWEIGHT PLASTIC NETTING MAY BE STAPLED OVER THE MULCH ACCORDING TO MANUFACTURER RECOMMENDATIONS. NETTING IS USUALLY AVAILABLE IN ROLLS 4 TO 15 FEET WIDE AND 300 TO 5000 FEET LONG.

APPROVED: HOWARD COUNTY DEPARTMENT OF PUBLIC WORKS

*Diane Schuyler, Acting* 11/29/12  
Chief, Bureau of Highways Date

APPROVED: HOWARD COUNTY DEPARTMENT OF PLANNING & ZONING

*Kathleen* 12/12/12  
Chief, Division of Land Development Date

*Chad Edmund* 12-6-12  
Chief, Development Engineering Division Date

**GLWGUTSCHICK LITTLE & WEBER, P.A.**

CIVIL ENGINEERS, LAND SURVEYORS, LAND PLANNERS, LANDSCAPE ARCHITECTS  
3909 NATIONAL DRIVE - SUITE 250 - BURTNSVILLE OFFICE PARK  
BURTNSVILLE, MARYLAND 20866  
TEL: 301-421-4024 BALTIMORE: 410-880-1820 DC/VA: 301-989-2524 FAX: 301-421-4186

DES. DEV. DRN. CLP. CHK. CKG.

DATE REVISION BY APPR.

**B-4-3 STANDARDS AND SPECIFICATIONS FOR SEEDING AND MULCHING**

**DEFINITION**  
THE APPLICATION OF SEED AND MULCH TO ESTABLISH VEGETATIVE COVER.

**PURPOSE**  
TO PROTECT DISTURBED SOILS FROM EROSION DURING AND AT THE END OF CONSTRUCTION.

**CONDITIONS WHERE PRACTICE APPLIES**  
TO THE SURFACE OF ALL PERIMETER CONTROLS, SLOPES, AND ANY DISTURBED AREA NOT UNDER ACTIVE GRADING.

**CRITERIA**

**A. SEEDING**

1. SPECIFICATIONS

- ALL SEED MUST MEET THE REQUIREMENTS OF THE MARYLAND STATE SEED LAW. ALL SEED MUST BE SUBJECT TO RE-TESTING BY A RECOGNIZED SEED LABORATORY. ALL SEED MUST HAVE BEEN TESTED WITHIN THE 6 MONTHS IMMEDIATELY PRECEDING THE DATE OF SEEDING. SUCH MATERIAL ON ANY PROJECT, REFER TO TABLE B-4 REGARDING THE QUALITY OF SEED. SEED TAGS MUST BE AVAILABLE UPON REQUEST TO THE INSPECTOR TO VERIFY TYPE OF SEED AND SEEDING RATE.
- MULCH ALONE MAY BE APPLIED BEFORE THE FALL AND SPRING SEEDING DATES ONLY IF THE GROUND IS FROZEN. THE APPROPRIATE SEEDING MIXTURE MUST BE APPLIED WHEN THE GROUND THAW.
- INOCULANTS: THE INOCULANT FOR TREATING LEGUME SEED IN THE SEED MIXTURES MUST BE A PURE CULTURE OF NITROGEN FIXING BACTERIA. PREPARED SPECIFICALLY FOR THE SPECIES. INOCULANTS MUST NOT BE USED LATER THAN THE DATE INDICATED ON THE CONTAINER. ADD FRESH INOCULANTS AS COOL AS POSSIBLE UNTIL USED. TEMPERATURE ABOVE 75 TO 80 DEGREES FAHRENHEIT CAN KILL BACTERIA AND MAKE THE INOCULANT LESS EFFECTIVE.
- SOIL OR SEED MUST NOT BE PLACED ON SOIL WHICH HAS BEEN TREATED WITH SOIL STERILANTS OR CHEMICALS USED FOR WEED CONTROL UNTIL SUFFICIENT TIME HAS ELAPSED (4 DAYS MIN) TO PERMIT DISAPPEARANCE OF PHYTO-TOXIC MATERIALS.

2. APPLICATION

- DRY SEEDING: THIS INCLUDES USE OF CONVENTIONAL DROP OR BROADCAST SPREADERS.
  - INCORPORATE SEED INTO THE SUBSOIL AT THE RATES PRESCRIBED ON TEMPORARY SEEDING TABLE B, PERMANENT SEEDING TABLE B.3, OR SITE-SPECIFIC SEEDING RATES.
  - APPLY SEED IN TWO DIRECTIONS, PERPENDICULAR TO EACH OTHER. APPLY HALF THE SEEDING RATE IN EACH DIRECTION. ROLL THE SEEDED AREA WITH A WEIGHTED ROLLER TO PROVIDE GOOD SEED TO SOIL CONTACT.
- DRILL OR OUTDRAGGER SEEDING: MECHANIZED SEEDING THAT APPLY AND COVER SEED WITH SOIL.
  - CULTIPACKING SEEDERS ARE REQUIRED TO BURY THE SEED IN SUCH A FASHION AS TO PROVIDE AT LEAST 1/4 INCH OF SOIL COVERING. SEEDS MUST BE PLACED AFTER PLANTING.
  - APPLY SEED IN TWO DIRECTIONS, PERPENDICULAR TO EACH OTHER. APPLY HALF THE SEEDING RATE IN EACH DIRECTION.
- HYDROSEEDING: APPLY SEED UNIFORMLY WITH HYDROSEEDER (SLURRY INCLUDES SEED AND FERTILIZER).
  - FERTILIZER IS BEING APPLIED AT THE TIME OF SEEDING, THE APPLICATION RATES SHOULD NOT EXCEED THE FOLLOWING: NITROGEN, 100 POUNDS PER ACRE; PHOSPHORUS, 100 POUNDS PER ACRE; POTASSIUM, 200 POUNDS PER ACRE.
  - LIME: USE ONLY AGRICULTURAL LIMESTONE (UP TO 3 TONS PER ACRE) MAY BE APPLIED BY HYDROSEEDING. NORMALLY, NOT MORE THAN 2 TONS ARE APPLIED AT ANY ONE TIME. DO NOT USE BURNT OR HYDRATED LIME WHEN HYDROSEEDING.
  - SEED AND FERTILIZER ON SITE AND SEED IMMEDIATELY AND WITHOUT INTERRUPTION.
  - WHEN HYDROSEEDING DO NOT INCORPORATE SEED INTO THE SOIL.

**B. MULCHING**

1. MULCH MATERIALS (IN ORDER OF PREFERENCE)

- STRAW CONSISTING OF THOROUGHLY THRESHED WHEAT, RYE, OAT, OR BARLEY AND REASONABLY BRIGHT IN COLOR. STRAW IS TO BE FREE OF NOXIOUS NEST SEEDS AS SPECIFIED IN THE LAW AND NOT BE SEEDY, UNCLE TOM'S, CACKED, DECAYED, OR EXCESSIVELY DUSTY. NOTE: USE ONLY STRAW FROM MULCH AREAS WHERE ONE SPECIES OF GRASS IS DESIRED.
- WOOD CELLULOSE FIBER: MULCH CONSISTING OF SPECIALLY PREPARED WOOD CELLULOSE PROCESSED INTO A UNIFORM FIBROUS PHYSICAL STATE.
  - KMFM IS TO BE DYED GREEN OR CONTAIN A GREEN DYE IN THE PACKAGE THAT WILL PROVIDE AN APPROPRIATE COLOR TO FACILITATE VISUAL INSPECTION OF THE UNIFORMLY SPREAD SLURRY.
  - KMFM INCLUDING DYE, MUST CONTAIN NO GERMINATION OR GROWTH INHIBITING FACTORS.
  - KMFM MATERIALS ARE TO BE MANUFACTURED AND PROCESSED IN SUCH A MANNER THAT THE WOOD CELLULOSE FIBER WILL REMAIN IN A UNIFORM SUSPENSION IN WATER. FERTILIZER AND OTHER ADDITIVES TO FORM A HOMOGENEOUS SLURRY. THE MULCH MATERIAL MUST FORM A BLOTTER-LIKE GROUND COVER. ON APPLICATION, HAVING MOISTURE ABSORPTION AND PERCOLATION PROPERTIES AND MUST COVER AND HOLD GRASS SEED IN CONTACT WITH THE SOIL WITHOUT INHIBITING THE GROWTH OF THE GRASS SEEDLINGS.
  - KMFM MATERIAL MUST NOT CONTAIN ELEMENTS OR COMPOUNDS AT CONCENTRATION LEVELS THAT WILL BE PHYTO-TOXIC.
  - KMFM MUST CONFORM TO THE FOLLOWING PHYSICAL REQUIREMENTS: FIBER LENGTH OF APPROXIMATELY 10 MILLIMETERS, DIAMETER APPROXIMATELY 1 MILLIMETER, PH RANGE OF 4.0 TO 5.5, ASH CONTENT OF 16 PERCENT MAXIMUM AND WATER HOLDING CAPACITY OF 90 PERCENT MINIMUM.

2. APPLICATION

- APPLY MULCH TO ALL SEEDED AREAS IMMEDIATELY AFTER SEEDING.
- WHEN STRAW MULCH IS USED, SPREAD IT OVER ALL SEEDED AREAS AT THE RATE OF 2 TONS PER ACRE TO A MINIMUM LOOSE DEPTH OF 1 TO 2 INCHES. APPLY MULCH TO ACHIEVE A UNIFORM DISTRIBUTION AND DEPTH SO THAT THE SOIL SURFACE IS NOT EXPOSED. WHEN USING A MULCH ANCHORING TOOL, INCREASE THE APPLICATION RATE TO 2.5 TONS PER ACRE.
- WOOD CELLULOSE FIBER: MULCH MUST BE APPLIED AT A NET DRY WEIGHT OF 500 POUNDS PER ACRE. MIX THE WOOD CELLULOSE FIBER WITH WATER TO ATTAIN A MIXTURE WITH A MAXIMUM OF 50 POUNDS OF WOOD CELLULOSE FIBER PER 100 GALLONS OF WATER.

**BUILDER'S CERTIFICATE**

I/WE CERTIFY THAT ALL DEVELOPMENT AND/OR CONSTRUCTION WILL BE DONE ACCORDING TO THIS PLAN, AND THAT ANY RESPONSIBLE PERSONNEL INVOLVED IN THE CONSTRUCTION PROJECT WILL HAVE A CERTIFICATE OF ATTENDANCE AT A MARYLAND DEPARTMENT OF THE ENVIRONMENT APPROVED TRAINING PROGRAM FOR THE CONTROL OF SEDIMENT AND EROSION BEFORE BEGINNING THE PROJECT. I ALSO AUTHORIZE PERIODIC ON-SITE INSPECTION BY THE HCD.

*John R. Roberts* 11/29/12  
WARD S.O.D. DATE

**ENGINEER'S CERTIFICATE**

I CERTIFY THAT THIS PLAN FOR EROSION AND SEDIMENT CONTROL REPRESENTS A PRACTICAL AND WORKABLE PLAN BASED ON MY PERSONAL KNOWLEDGE OF THE SITE CONDITIONS AND THAT IT HAS BEEN PREPARED IN ACCORDANCE WITH THE REQUIREMENTS OF THE HOWARD COUNTY CONSERVATION DISTRICT.

*Chad Edmund* 11-7-12  
DATE

**B-4-4 STANDARDS AND SPECIFICATIONS FOR TEMPORARY STABILIZATION**

**DEFINITION**  
TO STABILIZE DISTURBED SOILS WITH VEGETATION FOR UP TO 6 MONTHS.

**PURPOSE**  
TO USE FAST GROWING VEGETATION THAT PROVIDES COVER ON DISTURBED SOILS. CONDITIONS WHERE PRACTICE APPLIES EXPOSED SOILS WHERE GROUND COVER IS NEEDED FOR A PERIOD OF 6 MONTHS OR LESS. FOR LONGER DURATION OF TIME, PERMANENT STABILIZATION PRACTICES ARE REQUIRED.

**CRITERIA**

1. SELECT ONE OR MORE OF THE SPECIES OR SEED MIXTURES LISTED IN TABLE B.1 FOR THE APPROPRIATE PLANT HARDNESS ZONE (FROM FIGURE B.3) AND ENTER THEM IN THE TEMPORARY SEEDING SUMMARY. SEEDING DATES AND SEEDING DEPTHS (IF THIS SUMMARY IS NOT PUT ON THE PLAN AND COMPLETED, THEN TABLE B.1 PLUS FERTILIZER AND LIME RATES MUST BE PUT ON THE PLAN).

2. FOR SITES HAVING SOIL TESTS PERFORMED, USE AND SHOW THE RECOMMENDED RATES BY THE TESTING AGENCY. SOIL TESTS ARE NOT REQUIRED FOR TEMPORARY SEEDING.

3. WHEN STABILIZATION IS REQUIRED OUTSIDE OF A SEEDING SEASON, APPLY SEED AND MULCH OR STRAW MULCH ALONE AS PRESCRIBED IN SECTION B-4-3.A.1.D AND MAINTAIN UNTIL THE NEXT SEEDING SEASON.

TEMPORARY SEEDING SUMMARY

HARDNESS ZONE: Bb		SEED MIXTURE:		FERTILIZER RATE (10-10-10)	LIME RATE
No.	SPECIES	APPLICATION RATE (lb./ac.)	SEEDING DATES	SEEDING DEPTHS	
1	ANNUAL KYBERGRASS	40 lb./ac.	Mar. 1 to May 15 Aug. 1 to Oct. 15	0.5 INCHES	2 tons/ac. (90 lb./1,000 sq)
2	PEARL MILLET	20 lb./ac.	May 16 to July 31	0.5 INCHES	2 tons/ac. (90 lb./1,000 sq)

**SEDIMENT CONTROL NOTES**

- A MINIMUM OF 24 HOURS NOTICE MUST BE GIVEN TO THE HOWARD COUNTY OFFICE OF INSPECTION AND PERMITS PRIOR TO THE START OF ANY CONSTRUCTION. (410) 313-1055
- ALL VEGETATIVE AND STRUCTURAL PRACTICES ARE TO BE INSTALLED ACCORDING TO THE PROVISIONS OF THIS PLAN AND ARE TO BE IN CONFORMANCE WITH THE 2011 MARYLAND STANDARDS AND SPECIFICATIONS FOR SOIL EROSION AND SEDIMENT CONTROL AND REVISIONS THERETO.
- FOLLOWING INITIAL SOIL DISTURBANCE OR REDISTURBANCE, PERMANENT OR TEMPORARY STABILIZATION SHALL BE COMPLETED WITHIN:
  - A 3 CALENDAR DAYS AS TO THE SURFACE OF ALL PERIMETER DIKES, SHALES, DITCHES, PERIMETER SLOPES, AND ALL SLOPES STEEPER THAN 3 HORIZONTAL TO 1 VERTICAL (3:1) AND
  - 7 CALENDAR DAYS AS TO ALL OTHER DISTURBED OR GRADING AREAS ON THE PROJECT SITE UNDER ACTIVE GRADING.
- ALL SEDIMENT TRAP/BASINS SHOWN MUST BE FREED AND MARKED SIGNS POSTED AROUND THEIR PERIMETER IN ACCORDANCE WITH VOL. 1, CHAPTER 1, OF THE HOWARD COUNTY DESIGN MANUAL, STORM DRAINAGE.
- ALL DISTURBED AREAS MUST BE STABILIZED WITHIN THE TIME PERIOD SPECIFIED ABOVE IN ACCORDANCE WITH THE 2011 MARYLAND STANDARDS AND SPECIFICATIONS FOR SOIL EROSION AND SEDIMENT CONTROL FOR PERMANENT SEEDING, TEMPORARY SEEDING AND MULCHING (SEC. B). TEMPORARY STABILIZATION WITH MULCH ALONE CAN ONLY BE DONE WHEN RECOMMENDED SEEDING DATES DO NOT ALLOW FOR PROPER GERMINATION AND ESTABLISHMENT OF GRASSES.
- ALL SEDIMENT CONTROL STRUCTURES ARE TO REMAIN IN PLACE AND ARE TO BE MAINTAINED IN OPERATIVE CONDITION UNTIL PERMISSION FOR THEIR REMOVAL HAS BEEN OBTAINED FROM THE HOWARD COUNTY SEDIMENT CONTROL INSPECTOR.

**STANDARDS AND SPECIFICATIONS FOR DUST CONTROL**

**DEFINITION**  
CONTROLLING THE SUSPENSION OF DUST PARTICLES FROM CONSTRUCTION ACTIVITIES.

**PURPOSE**  
TO PREVENT BLOWING AND MOVEMENT OF DUST FROM EXPOSED SOIL SURFACES TO REDUCE ON AND OFF-SITE DAMAGE INCLUDING HEALTH AND TRAFFIC HAZARDS.

**CONDITIONS WHERE PRACTICE APPLIES**  
AREAS SUBJECT TO DUST BLOWING AND MOVEMENT OF DUST ON AND OFF-SITE DAMAGE IS LIKELY WITHOUT TREATMENT.

**CRITERIA**

- MULCH: SEE SECTION B-4-2 SOIL PREPARATION, TOPSOILING, AND SOIL AMENDMENTS, SECTION B-4-3 SEEDING AND MULCHING, AND SECTION B-4-4 TEMPORARY STABILIZATION. MULCH MUST BE ANCHORED TO PREVENT BLOWING.
- VEGETATIVE COVER: SEE SECTION B-4-4 TEMPORARY STABILIZATION.
- TILLAGE: TILL TO ROUGHEN SURFACE AND BRING GLOBS TO THE SURFACE. BEGIN FLOWING ON INWARD SIDE OF SITE. CHISEL-TYPE TILLS SPACED ABOUT 12 INCHES APART, SPRAY-ROOTED HARROWS, AND SIMILAR PLOWS ARE EXAMPLES OF EQUIPMENT THAT MAY PRODUCE THE DESIRED EFFECT.
- IRRIGATION: SPRINKLE SITE WITH WATER UNTIL THE SURFACE IS MOIST. EQUIPMENT AS NEEDED. THE SITE MUST NOT BE IRRIGATED TO THE POINT THAT RUNOFF OCCURS.
- BARBERS: SOLID BOARD FENCES, SILT FENCES, SNOW FENCES, BURGLAR FENCES, STRAIN BALES, AND SIMILAR MATERIAL CAN BE USED TO CONTROL AIR CURRENTS AND SOIL BLOWING.
- CHEMICAL TREATMENT: USE OF CHEMICAL TREATMENT REQUIRES APPROVAL BY THE APPROPRIATE PLANT REVIEW AUTHORITY.

THIS DEVELOPMENT PLAN IS APPROVED FOR SOIL EROSION AND SEDIMENT CONTROL BY THE HOWARD COUNTY CONSERVATION DISTRICT.

*John R. Roberts* 11/29/12  
WARD S.O.D. DATE

**ENGINEER'S CERTIFICATE**

I HEREBY CERTIFY THAT THESE PLANS WERE PREPARED OR APPROVED BY ME, AND THAT I AM A DULY LICENSED PROFESSIONAL ENGINEER UNDER THE LAWS OF THE STATE OF MARYLAND, LICENSE NO. 12975.

*Chad Edmund* 11-7-12  
EXPIRATION DATE: MAY 26, 2014

**B-4-5 STANDARDS AND SPECIFICATIONS FOR PERMANENT STABILIZATION**

**DEFINITION**  
TO STABILIZE DISTURBED SOILS WITH PERMANENT VEGETATION.

**PURPOSE**  
TO USE LONG-LIVED PERENNIAL GRASSES AND LEGUMES TO ESTABLISH PERMANENT GROUND COVER ON DISTURBED SOILS.

**CONDITIONS WHERE PRACTICE APPLIES**  
EXPOSED SOILS WHERE GROUND COVER IS NEEDED FOR 6 MONTHS OR MORE.

**CRITERIA**

**A. SEED MIXTURES**

1. GENERAL USE

- SELECT ONE OR MORE OF THE SPECIES OR MIXTURES LISTED IN TABLE B.3 FOR THE APPROPRIATE PLANT HARDNESS ZONE (FROM FIGURE B.3) AND BASED ON THE SITE CONDITIONS OR PURPOSES FOUND ON TABLE 2.2 (ENTER SELECTED MIXTURES), APPLICATION RATES, AND SEEDING DATES IN THE PERMANENT SEEDING SUMMARY. THE SUMMARY IS TO BE PLACED ON THE PLAN.
- ADDITIONAL PLANTING SPECIFICATIONS FOR EXCEPTIONAL SITES SUCH AS SHORELINES, STREAM BANKS, OR DAMS OR FOR SPECIAL PURPOSES SUCH AS EROSION CONTROL ARE TO BE FOUND IN USDA-NRCS TECHNICAL FIELD OFFICE GUIDE, SECTION 342 - CRITICAL AREA PLANTING.
- FOR SITES HAVING DISTURBED AREA OVER 5 ACRES, USE AND SHOW THE RATES RECOMMENDED BY THE SOIL TESTING AGENCY.
- FOR AREAS RECEIVING LOW MAINTENANCE, APPLY UREA FORM FERTILIZER (46-0-0) AT 3 1/2 POUNDS PER 1000 SQUARE FEET (50 POUNDS PER ACRE) AT THE TIME OF SEEDING IN ADDITION TO THE SOIL AMENDMENTS SHOWN IN THE PERMANENT SEEDING SUMMARY.

2. TURFGRASS MIXTURES

- AREAS WHERE TURFGRASS MAY BE DESIRED INCLUDE LAWNS, PARKS, PLAYGROUNDS, AND COMMERCIAL SITES WHICH WILL REQUIRE A MEDIUM TO HIGH LEVEL OF MAINTENANCE.
- SELECT ONE OR MORE OF THE SPECIES OR MIXTURES LISTED BELOW BASED ON THE SITE CONDITIONS OR PURPOSES. ENTER SELECTED MIXTURES, APPLICATION RATES, AND SEEDING DATES IN THE PERMANENT SEEDING SUMMARY. THE SUMMARY IS TO BE PLACED ON THE PLAN.

1. KENTUCKY BLUEGRASS: FILL SUN MIXTURE. FOR USE IN AREAS THAT RECEIVE INTENSIVE MANAGEMENT. IRRIGATION REQUIRED IN THE AREAS OF CENTRAL MARYLAND AND EASTERN SHORE. RECOMMENDED CERTIFIED KENTUCKY BLUEGRASS CULTIVARS SEEDING RATE: 15 TO 20 POUNDS PER 1000 SQUARE FEET. CHOOSE A MINIMUM OF THREE KENTUCKY BLUEGRASS CULTIVARS WITH EACH RANGE FROM 10 TO 25 PERCENT OF THE TOTAL MIXTURE BY WEIGHT.

2. KENTUCKY BLUEGRASS/PERENNIAL RYE: FILL SUN MIXTURE. FOR USE IN FULL SUN AREAS WHERE RAPID ESTABLISHMENT IS NECESSARY AND WHEN TURF WILL RECEIVE MEDIUM TO INTENSIVE MANAGEMENT. CERTIFIED PERENNIAL RYEGRASS CULTIVARS WITH EACH RANGE FROM 10 TO 25 PERCENT OF THE TOTAL MIXTURE PER 1000 SQUARE FEET. CHOOSE A MINIMUM OF THREE KENTUCKY BLUEGRASS CULTIVARS WITH EACH RANGE FROM 10 TO 25 PERCENT OF THE TOTAL MIXTURE BY WEIGHT.

3. TALL FESCUE/KENTUCKY BLUEGRASS: FILL SUN MIXTURE. FOR USE IN DROUGHT PRONE AREAS AND/OR AREAS RECEIVING LOW TO MEDIUM MAINTENANCE IN FULL SUN TO MEDIUM SHADE.

4. RECOMMENDED MIXTURE INCLUDES: CERTIFIED TALL FESCUE CULTIVARS 95 TO 100 PERCENT, CERTIFIED KENTUCKY BLUEGRASS CULTIVARS 0 TO 5 PERCENT. SEEDING RATE: 5 TO 8 POUNDS PER 1000 SQUARE FEET. ONE OR MORE CULTIVARS MAY BE SELECTED.

5. KENTUCKY BLUEGRASS/FINE FESCUE: SHADE MIXTURE. FOR USE IN AREAS WITH SHADE IN BLUEGRASS LAWNS. FOR ESTABLISHMENT IN HIGH QUALITY, INTENSIVELY MANAGED TURF AREA. MIXTURE INCLUDES: CERTIFIED KENTUCKY BLUEGRASS CULTIVARS 30 TO 40 PERCENT AND CERTIFIED FINE FESCUE 60 TO 70 PERCENT. SEEDING RATE: 11/2 TO 3 POUNDS PER 1000 SQUARE FEET.

**PERMANENT SEEDING SUMMARY**

HARDNESS ZONE: Bb		SEED MIXTURE: Bb (Tall Fescue)		FERTILIZER RATE (10-20-20)	LIME RATE
No.	SPECIES	APPLICATION RATE	SEEDING DATES	SEEDING DEPTHS	
8	*Certified Tall Fescue blend: equal amounts of Felon IV, Penn 1907 & Rebel Credo	6-8 lb./1000 sq ft.	Mar. 1 to May 15 Aug. 15 to Oct. 15	1/4 - 1/2 IN.	1.0 lb./1000 sq ft. e.l. (45 lb./acre)

\* Other cultivars listed as "proven" in the most current MD-T1-77 may also be used.

**B. SOD: TO PROVIDE QUICK COVER ON DISTURBED AREAS (2:1 GRADE OR FLATTER).**

1. GENERAL SPECIFICATIONS

- CLASS OF TURFGRASS SOD MUST BE MARYLAND STATE CERTIFIED. SOD LABELS MUST BE AVAILABLE TO THE USER AND MUST BE AVAILABLE TO THE USER.
- SOD MUST BE MACHINE CUT AT A UNIFORM SOIL THICKNESS OF 3/4 INCH PLUS OR MINUS 1/8 INCH, AT THE TIME OF CUTTING. MEASUREMENT FOR THICKNESS MUST EXCLUDE TOP AND BOTTOM AND THATCH. BROKEN PADS AND STORM OR UNEVEN ENDS WILL NOT BE ACCEPTABLE.
- STANDARD SIZE SECTIONS OF SOD MUST BE STORIED SUFFICIENTLY TO SUPPORT THEIR OWN WEIGHT AND RETAIN THEIR SIZE AND SHAPE WHEN SUPPORTED VERTICALLY WITH A FIRM GRASP ON THE UPPER 10 PERCENT OF THE SECTION.
- WOOD CELLULOSE FIBER MUST BE USED TO CONTROL AIR CURRENTS AND SOIL BLOWING. EXCESSIVELY WET OR WET MAY ADVERSELY AFFECT ITS SURVIVAL.
- SOD MUST BE HARVESTED, DELIVERED, AND INSTALLED WITHIN A PERIOD OF 36 HOURS. SOD NOT TRANSPORTED WITHIN THIS PERIOD MUST BE APPROVED BY AN AGRONOMIST OR SOIL SCIENTIST PRIOR TO ITS INSTALLATION.

2. SOD INSTALLATION

- DURING PERIODS OF EXCESSIVELY HIGH TEMPERATURE OR IN AREAS HAVING DRY SUBSOIL, LIGHTLY IRRIGATE THE SUBSOIL IMMEDIATELY PRIOR TO LAYING THE SOD.
- LAY THE FIRST ROW OF SOD IN A STRAIGHT LINE WITH SUBSEQUENT ROWS PLACED PARALLEL TO IT AND TIGHTLY MATED AGAINST EACH OTHER. STAGGERS LATERAL JOINTS TO PROMOTE MORE UNIFORM GROWTH AND STRENGTH. ENSURE THAT SOD IS NOT STRETCHED OR OVERLAPPED AND THAT ALL JOINTS ARE BUTTED TIGHT IN ORDER TO PREVENT VOIDS WHICH WOULD CAUSE AIR CURRENTS TO PASS THROUGH THE SOD.
- WHEREVER POSSIBLE, LAY SOD WITH THE LONG EDGES PARALLEL TO THE CONTOUR AND WITH STAGGERS JOINTS, ROLL AND TAMP FIRM OR OTHERWISE SECURE THE SOD TO PREVENT SLIPPAGE ON SLOPES. ENSURE SOLID CONTACT EXISTS BETWEEN SOD ROOTS AND THE UNDERLYING SOIL SURFACE.
- WATER THE SOD IMMEDIATELY FOLLOWING ROLLING AND TAMPING UNTIL THE UNDERSIDE OF THE NEW SOD PAD AND SOIL SURFACE BELOW THE SOD ARE THOROUGHLY WET. COMPLETE THE OPERATIONS OF LAYING, TAMPING AND IRRIGATING FOR ANY PIECE OF SOD WITHIN EIGHT HOURS.

3. SOD MAINTENANCE

- IN THE ABSENCE OF ADEQUATE RAINFALL, WATER DAILY DURING THE FIRST WEEK OR 14 DAYS AND SUFFICIENTLY AS NECESSARY TO MAINTAIN MOISTURE TO A DEPTH OF 4 INCHES. WATER SOD DURING THE HEAT OF THE DAY TO PREVENT MITLING.
- AFTER THE FIRST WEEK, SOD WATERING IS REQUIRED AS NECESSARY TO MAINTAIN ADEQUATE MOISTURE CONTENT.
- DO NOT MOW UNTIL THE SOD IS FIRMLY ROOTED. NO MORE THAN 1/3 OF THE GRASS LEAF MUST BE REMOVED BY THE INITIAL CUTTING. SUBSEQUENT CUTTINGS, MAINTAIN A GRASS HEIGHT OF AT LEAST 3 INCHES UNLESS OTHERWISE SPECIFIED.





PREPARED FOR:

MAPLE LAWN FARMS 1, LLC  
SUITE 300 WOODHOLME CENTER  
1829 REISTERSTOWN ROAD  
BALTIMORE, MD 21208  
ATTN: MARK BENNETT  
410-484-8400

**PROFESSIONAL CERTIFICATION**

I HEREBY CERTIFY THAT THESE PLANS WERE PREPARED OR APPROVED BY ME, AND THAT I AM A DULY LICENSED PROFESSIONAL ENGINEER UNDER THE LAWS OF THE STATE OF MARYLAND, LICENSE NO. 12975.

*Chad Edmund* 11-7-12  
EXPIRATION DATE: MAY 26, 2014

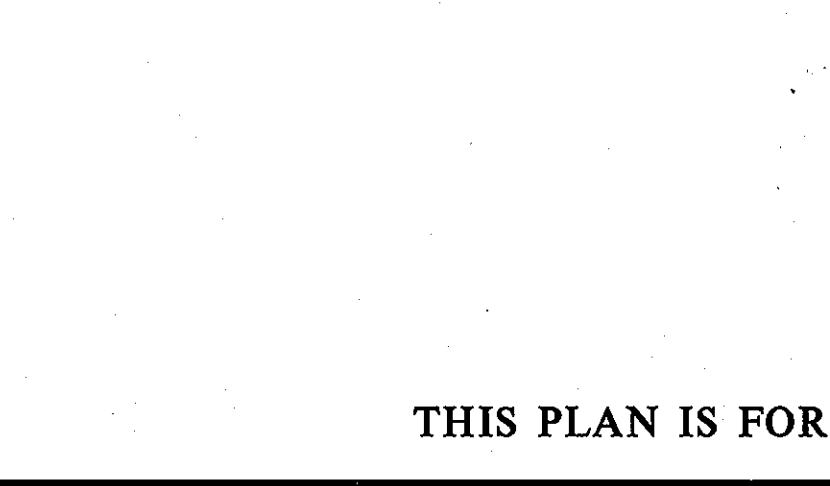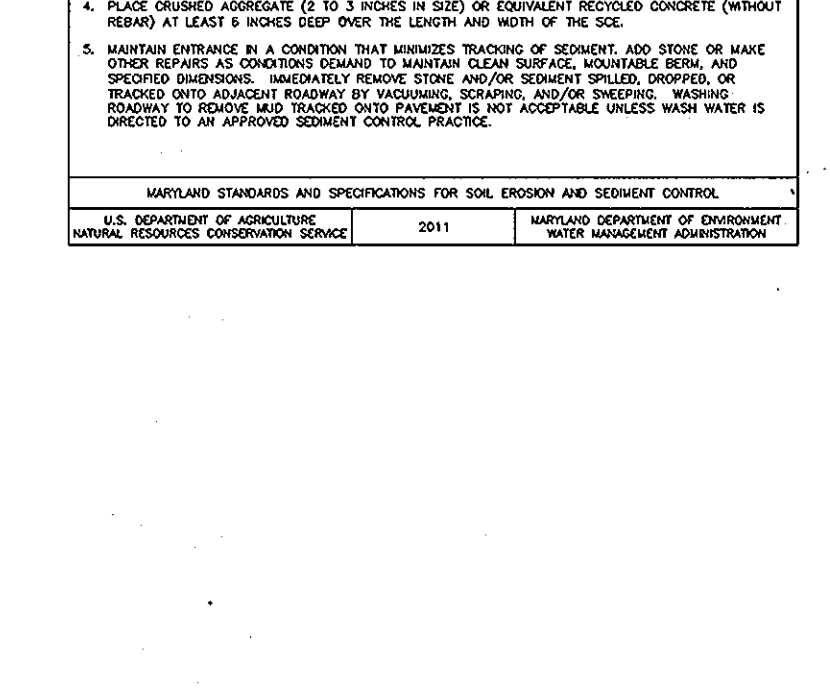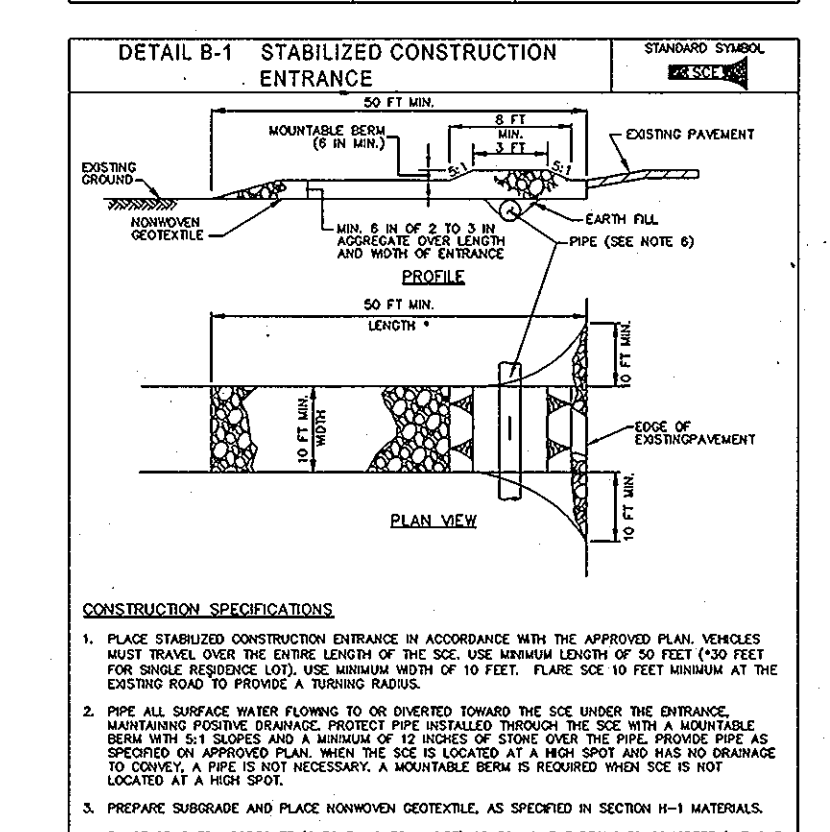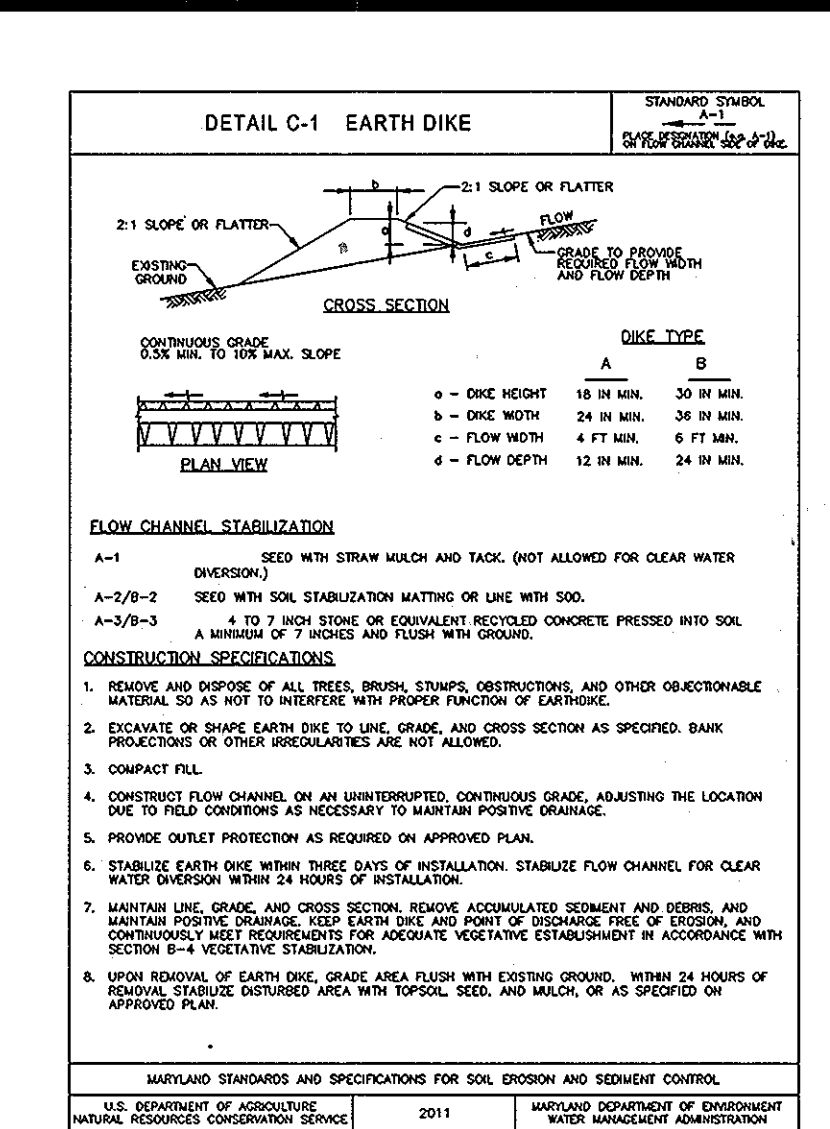

APPROVED: HOWARD COUNTY DEPARTMENT OF PUBLIC WORKS

*Diane Schuyler, Acting* 11/29/12  
Chief, Bureau of Highways Date

APPROVED: HOWARD COUNTY DEPARTMENT OF PLANNING & ZONING

*Kathleen* 12/12/12  
Chief, Division of Land Development Date

*Chad Edmund* 12-6-12  
Chief, Development Engineering Division Date

**CONSTRUCTION SPECIFICATIONS**

- USE WOOD POSTS 1 1/2 X 3 1/2 X 36 (MINIMUM) SQUARE END SOUND QUALITY HARDWOOD AS BEST ALTERNATIVE TO METAL. USE 1/2 X 3 1/2 X 36 (MINIMUM) SQUARE END SOUND QUALITY HARDWOOD AS BEST ALTERNATIVE TO METAL.
- USE 36 INCH MINIMUM POSTS DIVIDED 15 INCH MINIMUM INTO GROUND NO MORE THAN 3 FEET APART.
- USE 36 INCH MINIMUM POSTS DIVIDED 15 INCH MINIMUM INTO GROUND NO MORE THAN 3 FEET APART. SECURELY TO WEDGE EACH END OF POSTS INTO GROUND. SECURELY TO WEDGE EACH END OF POSTS INTO GROUND. SECURELY TO WEDGE EACH END OF POSTS INTO GROUND.
- PROVIDE MANUFACTURER CERTIFICATION TO THE AUTHORIZED REPRESENTATIVE OF THE REQUIREMENTS IN SECTION B-1 MATERIALS.
- ENURE COVERTER A MINIMUM OF 6 INCHES VERTICALLY INTO THE GROUND BACKFILL AND COMPACT THE SOIL IN AROUND THE POSTS.
- WEDGE EACH END OF THE POSTS INTO THE GROUND. SECURELY TO WEDGE EACH END OF POSTS INTO GROUND. SECURELY TO WEDGE EACH END OF POSTS INTO GROUND.
- USE 36 INCH MINIMUM POSTS DIVIDED 15 INCH MINIMUM INTO GROUND NO MORE THAN 3 FEET APART. SECURELY TO WEDGE EACH END OF POSTS INTO GROUND. SECURELY TO WEDGE EACH END OF POSTS INTO GROUND.

**CONSTRUCTION SPECIFICATIONS**


- REMOVE AND DISPOSE OF ALL BRICK, RUBBER, STAMPS, OBSTRUCTIONS, AND OTHER OBSTRUCTIVE MATERIAL TO AS NOT TO INTERFERE WITH PROPER FUNCTION OF TEMPORARY SWALE.
- PREPARE SUBGRADE AND PLACE HOMOGENEOUS GEOTEXTILE AS SPECIFIED IN SECTION B-1 MATERIALS.
- PREPARE SUBGRADE AND PLACE HOMOGENEOUS GEOTEXTILE AS SPECIFIED IN SECTION B-1 MATERIALS.
**CONSTRUCTION SPECIFICATIONS**

- REMOVE AND DISPOSE OF ALL BRICK, RUBBER, STAMPS, OBSTRUCTIONS, AND OTHER OBSTRUCTIVE MATERIAL TO AS NOT TO INTERFERE WITH PROPER FUNCTION OF TEMPORARY SWALE.
- PREPARE SUBGRADE AND PLACE HOMOGENEOUS GEOTEXTILE AS SPECIFIED IN SECTION B-1 MATERIALS.
- PREPARE SUBGRADE AND PLACE HOMOGENEOUS GEOTEXTILE AS SPECIFIED IN SECTION B-1 MATERIALS.
-



Maryland's Guidelines To Waterway Construction  
DETAIL 1.2: PUMP-AROUND PRACTICE

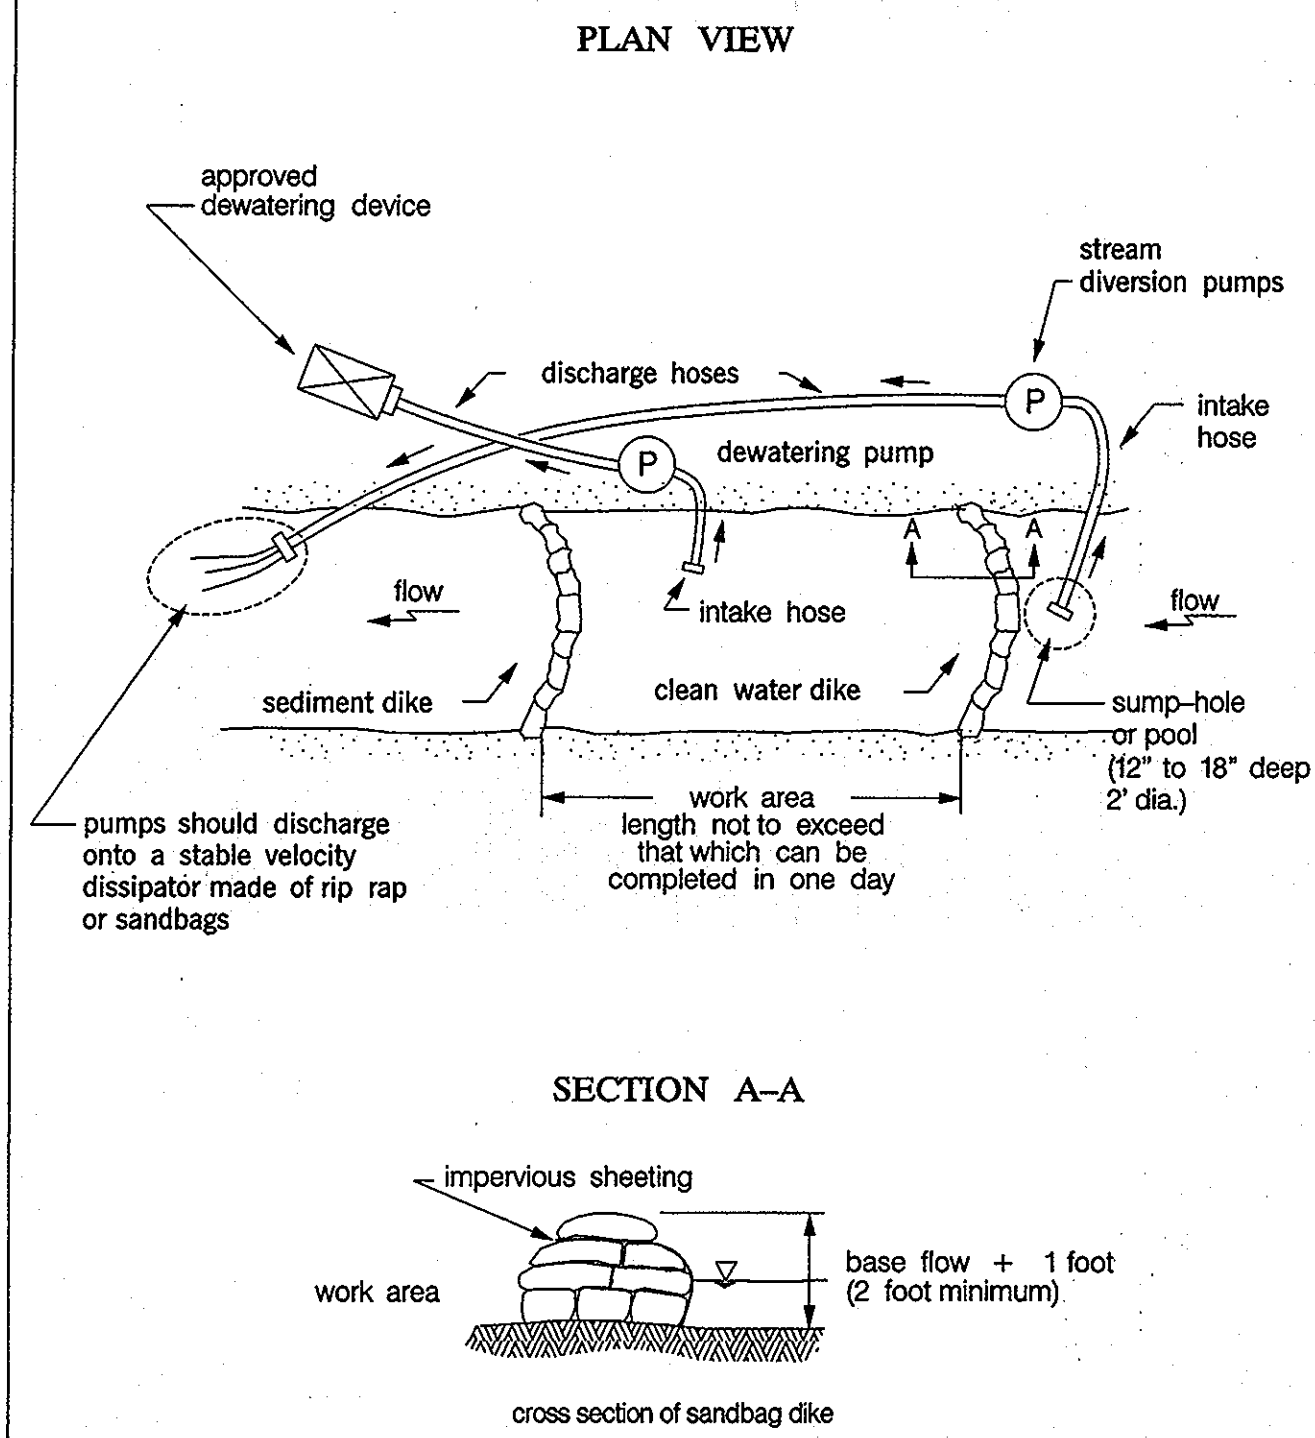


TEMPORARY INSTREAM CONSTRUCTION MEASURES  
REVISED NOVEMBER 2000  
PAGE 1.2 - 5  
MARYLAND DEPARTMENT OF THE ENVIRONMENT  
WATER MANAGEMENT ADMINISTRATION

BEST MANAGEMENT PRACTICES

- FOR WORKING IN NONTIDAL WETLANDS, WETLAND BUFFERS, WATERWAYS, AND 100-YEAR FLOODPLAINS
- NO EXCESS FILL, CONSTRUCTION MATERIAL, OR DEBRIS SHALL BE STOCKPILED OR STORED IN NON-TIDAL WETLANDS, NONTIDAL WETLAND BUFFERS, WATERWAYS, OR 100-YEAR FLOODPLAIN.
  - PLACE MATERIALS IN A LOCATION AND MANNER WHICH DOES NOT ADVERSELY IMPACT SURFACE OR SUBSURFACE WATER FLOW INTO OR OUT OF NONTIDAL WETLANDS, NONTIDAL WETLAND BUFFERS, WATERWAYS, OR THE 100-YEAR FLOODPLAIN.
  - DO NOT USE THE EXCAVATED MATERIAL AS BACKFILL IF IT CONTAINS HASTE METAL PRODUCTS, INSIGHTLY DEBRIS, TOXIC MATERIAL, OR ANY OTHER DELETERIOUS SUBSTANCE. IF ADDITIONAL BACKFILL IS REQUIRED, USE CLEAN MATERIAL FREE OF WASTE METAL PRODUCTS, INSIGHTLY DEBRIS, TOXIC MATERIAL, OR ANY OTHER DELETERIOUS SUBSTANCE.
  - PLACE HEAVY EQUIPMENT ON MATS OR SUITABLY OPERATE THE EQUIPMENT TO PREVENT DAMAGE TO NONTIDAL WETLANDS, NONTIDAL WETLAND BUFFERS, WATERWAYS, OR THE 100-YEAR FLOODPLAIN.
  - REPAIR AND MAINTAIN ANY SERVICEABLE STRUCTURE OR FILL SO THERE IS NO PERMANENT LOSS OF NONTIDAL WETLANDS, NONTIDAL WETLAND BUFFERS, OR WATERWAYS, OR PERMANENT MODIFICATION OF THE 100-YEAR FLOODPLAIN IN EXCESS OF THAT LOST UNDER THE ORIGINALLY AUTHORIZED STRUCTURE OR FILL.
  - RECTIFY ANY NONTIDAL WETLANDS, WETLAND BUFFERS, WATERWAYS OR 100-YEAR FLOODPLAIN TEMPORARILY IMPACTED BY ANY CONSTRUCTION.
  - ALL STABILIZATION IN THE NONTIDAL WETLAND AND NONTIDAL WETLAND BUFFER SHALL CONSIST OF THE FOLLOWING SPECIES:  
ANNUAL RYE GRASS (LOLIUM MULTICOLOR)  
MILLET (SETARIA ITALICA) BARLEY (HORDEUM SPECIES)  
OATS (SP.)  
RYE (SECALE CEREALE)  
THESE SPECIES WILL ALLOW FOR THE STABILIZATION OF THE SITE WHILE ALSO ALLOWING FOR THE VOLUNTARY REVEGETATION OF NATURAL WETLAND SPECIES. OTHER NON-PERSISTENT VEGETATION MAY BE ACCEPTABLE, BUT MUST BE APPROVED BY THE NONTIDAL WETLANDS AND WATERWAYS DIVISION. KENTUCKY 31 FESCUE SHALL NOT BE UTILIZED IN WETLAND OR BUFFER AREAS. THE AREA SHOULD BE SEEDED AND MULCHED TO REDUCE EROSION AFTER CONSTRUCTION ACTIVITIES HAVE BEEN COMPLETED.
  - AFTER INSTALLATION HAS BEEN COMPLETED, MAKE POST-CONSTRUCTION GRADES AND ELEVATIONS THE SAME AS THE ORIGINAL GRADES AND ELEVATIONS IN TEMPORARILY IMPACTED AREAS.
  - TO PROTECT AQUATIC SPECIES, IN-STREAM WORK IS PROHIBITED AS DETERMINED BY THE CLASSIFICATION OF THE STREAM USE I WATERS. IN STREAM WORK SHALL BE CONDUCTED DURING THE PERIOD MARCH 1 THROUGH JUNE 15, INCLUSIVE, DURING ANY YEAR.
  - STORMWATER RUNOFF FROM IMPERVIOUS SURFACES SHALL BE CONTROLLED TO PREVENT THE WASHING OF DEBRIS INTO THE WATERWAY.
  - CULVERTS SHALL BE CONSTRUCTED AND ANY RIPRAP PLACED SO AS NOT TO OBSTRUCT THE MOVEMENT OF AQUATIC SPECIES, UNLESS THE PURPOSE OF THE ACTIVITY IS TO IMPOUND WATER.

Maryland's Guidelines To Waterway Construction  
DETAIL 1.4: DIVERSION PIPE

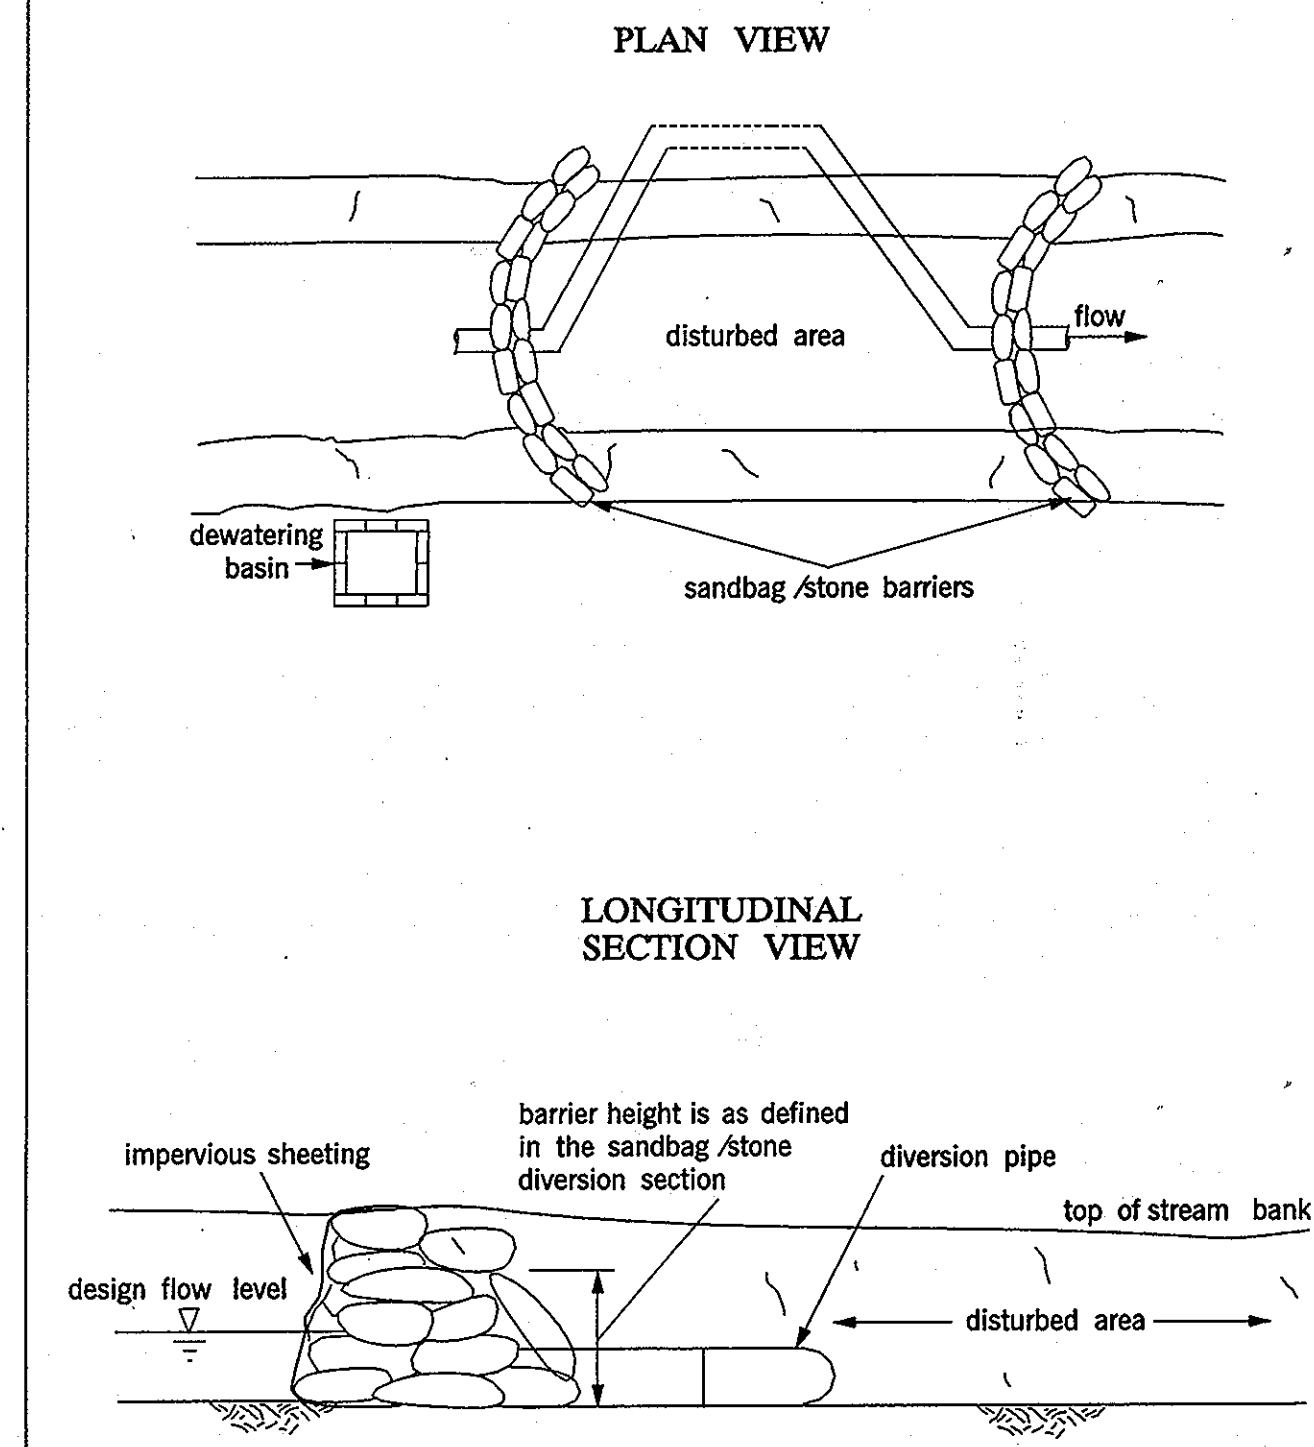

TEMPORARY INSTREAM CONSTRUCTION MEASURES  
REVISED NOVEMBER 2000  
PAGE 1.4 - 2  
MARYLAND DEPARTMENT OF THE ENVIRONMENT  
WATER MANAGEMENT ADMINISTRATION

MGWC 1.2: PUMP-AROUND PRACTICE

Temporary measure for dewatering in-channel construction sites

DESCRIPTION

The work should consist of installing a temporary pump around and supporting measures to divert flow around in-stream construction sites.

IMPLEMENTATION SEQUENCE

Sediment control measures, pump-around practices, and associated channel and bank construction should be completed in the following sequence (refer to Detail 1.2):

- Construction activities including the installation of erosion and sediment control measures should not begin until all necessary easements and/or right-of-ways have been acquired. All existing utilities should be marked in the field prior to construction. The contractor is responsible for any damage to existing utilities that may result from construction and should repair the damage at his/her own expense to the county's or utility company's satisfaction.
- The contractor should notify the Maryland Department of the Environment or WMA sediment control inspector at least 5 days before beginning construction. Additionally, the contractor should inform the local environmental protection and resource management inspection and enforcement division and the provider of local utilities a minimum of 48 hours before starting construction.
- The contractor should conduct a pre-construction meeting on site with the WMA sediment control inspector, the county project manager, and the engineer to review limits of disturbance, erosion and sediment control requirements, and the sequence of construction. The contractor should stake out all limits of disturbance prior to the pre-construction meeting so they may be reviewed. The participants will also designate the contractor's staging areas and flag all trees within the limit of disturbance which will be removed for construction access. Trees should not be removed within the limit of disturbance without approval from the WMA or local authority.
- Construction should not begin until all sediment and erosion control measures have been installed and approved by the engineer and the sediment control inspector. The contractor should stay within the limits of the disturbance as shown on the plans and minimize disturbance within the work area whenever possible.
- Upon installation of all sediment control measures and approval by the sediment control inspector and the local environmental protection and resource management inspection and enforcement division, the contractor should begin work at the upstream section and proceed downstream beginning with the establishment of stabilized construction entrances. In some cases, work may begin downstream if appropriate. The sequence of construction must be followed unless the contractor gets written approval for deviations from the WMA or local authority. The contractor should only begin work in an area which can be completed by the end of the day including grading adjacent to the channel. At the end of each work day, the work area must be stabilized and the pump around removed from the channel. Work should not be conducted in the channel during rain events.
- Sandbag dikes should be situated at the upstream and downstream ends of the work area as shown on the plans, and stream flow should be pumped around the work area. The pump should discharge onto a stable velocity dissipater made of riprap or sandbags.
- Water from the work area should be pumped to a sediment filtering measure such as a dewatering basin, sediment bag, or other approved source. The measure should be located such that the water drains back into the channel below the downstream sandbag dike.
- Traversing a channel reach with equipment within the work area where no work is proposed should be avoided. If equipment has to traverse such a reach for access to another area, then timber mats or similar measures should be used to minimize disturbance to the channel. Temporary stream crossings should be used only when necessary and only where noted on the plans or specified. (See Section 4, Stream Crossings, Maryland Guidelines to Waterway Construction).
- All stream restoration measures should be installed as indicated by the plans and all banks graded in accordance with the grading plans and typical cross-sections. All grading must be stabilized at the end of each day with seed and mulch or seed and matting as specified on the plans.
- After an area is completed and stabilized, the clean water dike should be removed. After the first sediment flush, a new clean water dike should be established upstream from the old sediment dike. Finally, upon establishment of a new sediment dike below the old one, the old sediment dike should be removed.
- A pump around must be installed on any tributary or storm drain outfall which contributes baseflow to the work area. This should be accomplished by locating a sandbag dike at the downstream end of the tributary or storm drain outfall and pumping the stream flow around the work area. This water should discharge onto the same velocity dissipater used for the main stem pump around.
- If a tributary is to be restored, construction should take place on the tributary before work on the main stem reaches the tributary confluence. Construction in the tributary, including pump around practices, should follow the same sequence as for the main stem of the river or stream. When construction on the tributary is completed, work on the main stem should resume. Water from the tributary should continue to be pumped around the work area in the main stem.
- The contractor is responsible for providing access to and maintaining all erosion and sediment control devices until the sediment control inspector approves their removal.
- After construction, all disturbed areas should be regraded and revegetated as per the planting plan.

MGWC 1.4: DIVERSION PIPE

Temporary measure for dewatering in-channel construction sites

DESCRIPTION

The work should consist of installing flow diversion pipes in combination with sandbag or stone diversions when construction activities occur within the stream channel.

EFFECTIVE USES & LIMITATIONS

Diversion pipes with an insufficient flow capacity can cause the channel diversion to fail thereby resulting in severe erosion of the disturbed channel section under construction. Therefore, in-channel construction activities should occur only during periods of low flow.

MATERIAL SPECIFICATIONS

Materials for stream diversions should meet the following requirements:

- Riprap: Stone should be washed and have a minimum diameter of 6 inches (15 centimeters).
- Sandbags: Sandbags should consist of materials which are resistant to ultra-violet radiation, tearing, and puncture and should be woven tightly enough to prevent leakage of fill material (i.e., sand, fine gravel, etc.).
- Sheeting: Sheeting should consist of polyethylene or other material which is impervious and resistant to puncture and tearing.

INSTALLATION GUIDELINES

All erosion and sediment control devices including mandatory dewatering basins should be installed as the first order of business according to a plan approved by the WMA or local authority. Installation should proceed from upstream to downstream during low flow conditions. If necessary, silt fence or straw bales should be installed around the perimeter of the work area.

Diversion pipes with sandbag or stone barriers should be completed as follows (refer to Detail 1.4):

- Sandbag/stone barriers should be sized and installed as detailed in MGWC 1.5: Sandbag/Stone Diversion. The materials should be sized to withstand baseflow velocities.
- All excavated material should be deposited and stabilized in an approved area outside the 100-year floodplain unless otherwise authorized by the WMA.
- Sediment-laden water from the construction area should be pumped to a dewatering basin.
- The diversion pipe should have a minimum capacity sufficient to convey the 2-year flow for projects with a duration of two weeks or greater. For projects of shorter duration, the capacity of the pipe can be reduced accordingly.
- If necessary, silt fence or straw bales should be installed around the perimeter of the work area.
- Sediment control devices are to remain in place until all disturbed areas are stabilized and the inspecting authority approves their removal.

APPROVED: HOWARD COUNTY DEPARTMENT OF PUBLIC WORKS

*Diane Schuyler*, Acting  
Chief, Bureau of Highways  
Date: 11/16/12

APPROVED: HOWARD COUNTY DEPARTMENT OF PLANNING & ZONING

*Kate DeLeon*  
Chief, Division of Land Development  
Date: 12/11/12  
*Chad Edwards*  
Chief, Development Engineering Division  
Date: 12-6-12

ENGINEER'S CERTIFICATE

"I CERTIFY THAT THIS PLAN FOR EROSION AND SEDIMENT CONTROL REPRESENTS A PRACTICAL AND WORKABLE PLAN BASED ON MY PERSONAL KNOWLEDGE OF THE SITE CONDITIONS AND THAT IT WAS PREPARED IN ACCORDANCE WITH THE REQUIREMENTS OF THE HOWARD SOIL CONSERVATION DISTRICT."

*John R. Roberts*  
SIGNATURE OF ENGINEER  
DATE: 11-7-12

BUILDER'S CERTIFICATE

"I ME CERTIFY THAT ALL DEVELOPMENT AND/OR CONSTRUCTION WILL BE DONE ACCORDING TO THIS PLAN, AND THAT ANY RESPONSIBLE PERSONNEL INVOLVED IN THE CONSTRUCTION PROJECT WILL HAVE A CERTIFICATE OF ATTENDANCE AT A MARYLAND DEPARTMENT OF THE ENVIRONMENT APPROVED TRAINING PROGRAM FOR THE CONTROL OF SEDIMENT AND EROSION BEFORE BEGINNING THE PROJECT. I ALSO AUTHORIZE PERIODIC ON-SITE INSPECTION BY THE HSCD."

*John R. Roberts v. P. Rao*  
SIGNATURE OF DEVELOPER/BUILDER  
DATE: 10/25/12

THIS DEVELOPMENT PLAN IS APPROVED FOR SOIL EROSION AND SEDIMENT CONTROL BY THE HOWARD SOIL CONSERVATION DISTRICT.

*John R. Roberts*  
FORWARD S.C.D.  
DATE: 11/24/12

THIS PLAN IS FOR SEDIMENT CONTROL PURPOSES ONLY


**GLWGUTSCHICK LITTLE & WEBER, P.A.**  
CIVIL ENGINEERS, LAND SURVEYORS, LAND PLANNERS, LANDSCAPE ARCHITECTS  
3909 NATIONAL DRIVE - SUITE 250 - BURTONSVILLE OFFICE PARK  
BURTONSVILLE, MARYLAND 20866  
TEL: 301-421-4024 BAL: 410-880-1820 DC/WA: 301-989-2524 FAX: 301-421-4186

DES. DEV DRN. KLP CHK. CKG  
DATE REVISION BY APP'R

PREPARED FOR:  
MAPLE LAWN FARMS 1, LLC  
SUITE 300 WOODHOLME CENTER  
1829 REISTERSTOWN ROAD  
BALTIMORE, MD 21208  
ATTN: MARK BENNETT  
410-484-8400

PROFESSIONAL CERTIFICATION

I HEREBY CERTIFY THAT THESE PLANS WERE PREPARED OR APPROVED BY ME, AND THAT I AM A DULY LICENSED PROFESSIONAL ENGINEER UNDER THE LAWS OF THE STATE OF MARYLAND, LICENSE NO. 12975  
EXPIRATION DATE: MAY 26, 2014  
11-7-12

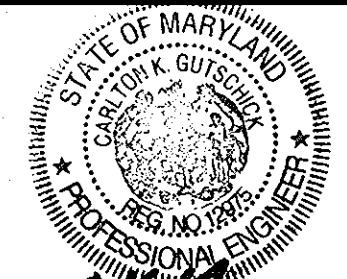

SEDIMENT CONTROL NOTES and DETAILS - WATERWAY CONSTRUCTION





**MAPLE LAWN FARMS**  
MIDTOWN WEST DISTRICT - AREA 2  
LOTS 93 THRU 177, OPEN SPACE LOTS 178 THRU 183, AND  
COMMON OPEN AREA LOTS 184 THRU 186

SCALE	ZONING	G. L. W. FILE No.
NO SCALE	MXD-3	11001
DATE	TAX MAP - GRID	SHEET
OCT. 2012	41-21/46-3	18 OF 25

ELECTION DISTRICT No. 5

HOWARD COUNTY, MARYLAND



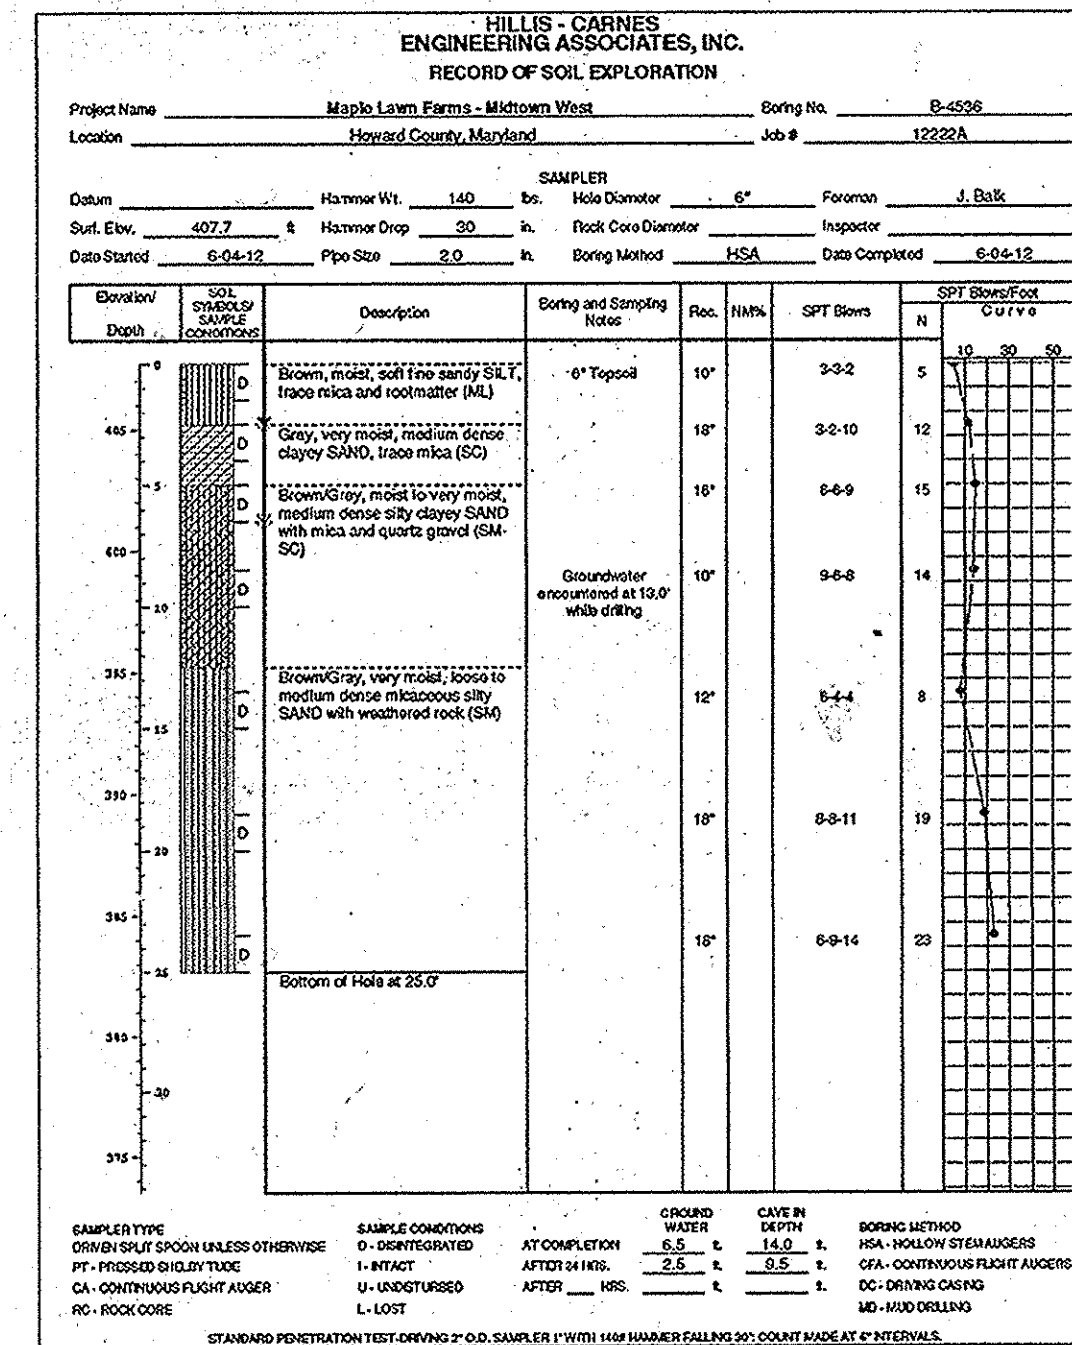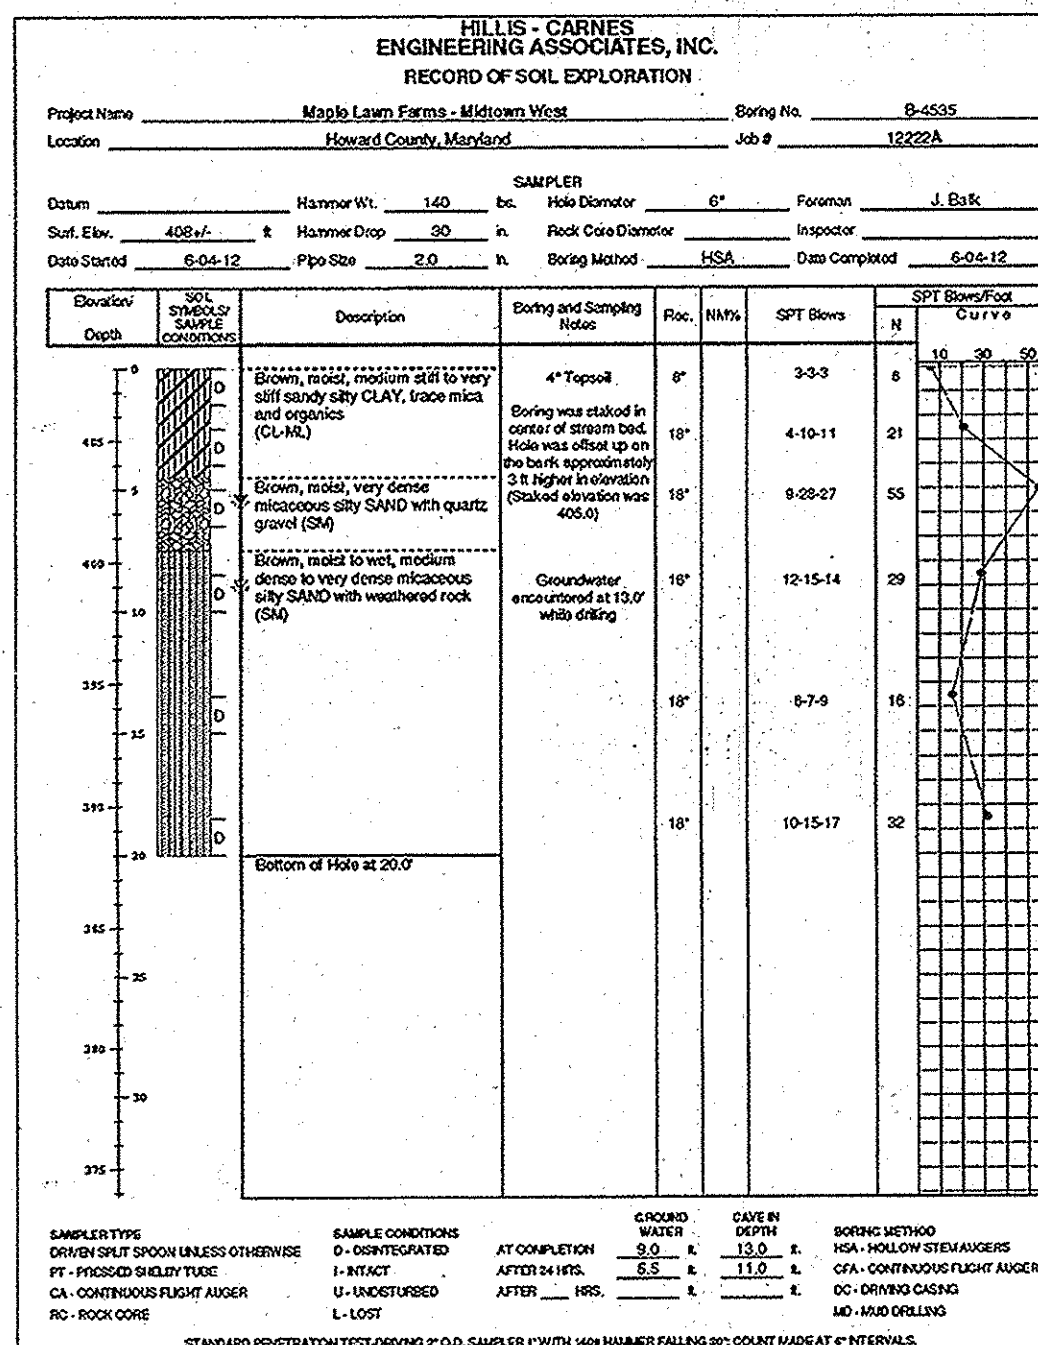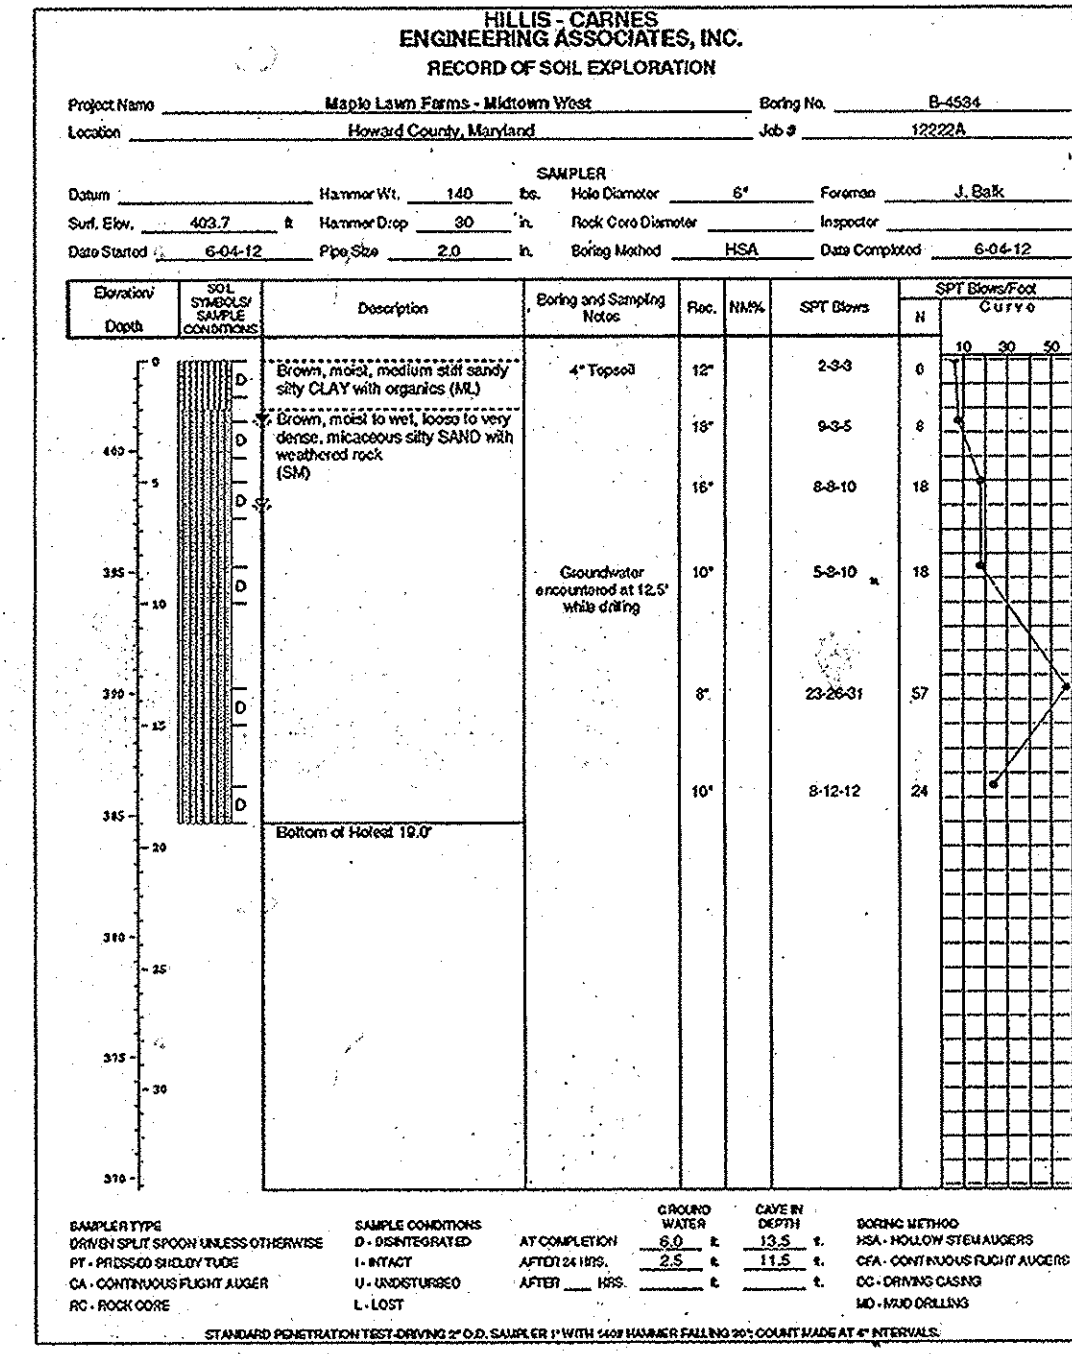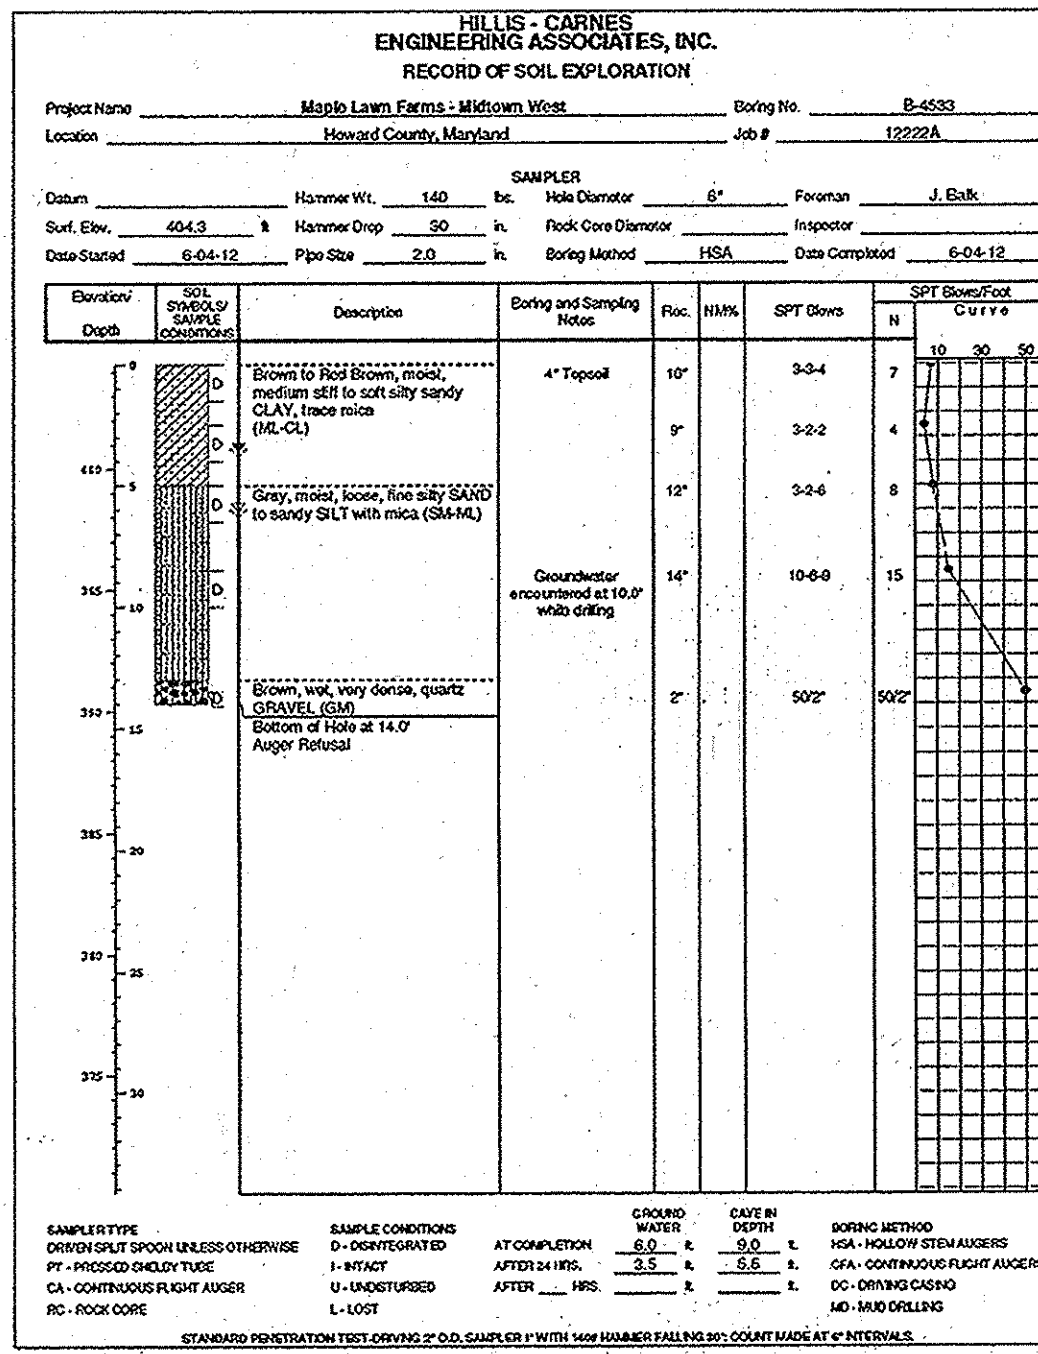

5.1 General Site Preparation - Culvert

The initial step in the development of this site should be the controlled removal of surficial topsoil, wet or soft soils, and deleterious materials from the areas to be developed. Stripping operations should be performed in a manner consistent with good erosion and sediment control practices.

After the initial stripping process is completed, areas of the site to receive fill, or areas of the site at grade where structures will be located, should be profiled. The profiling operations should be performed using a 20-ton, fully-loaded dump truck. The purpose of the profiling will be to provide surficial denaturation and to locate any near-surface pockets of soft or loose soils requiring undercutting. A Geotechnical Engineer or experienced Soils Inspector should witness the profiling operations and should determine which areas need further undercutting and/or stabilization. For areas that are not accessible to a dump truck, the exposed materials should be observed and tested by a geotechnical engineer or his representative utilizing a Dynamic Cone Penetrometer. Any excessively soft or loose materials identified by profiling or penetrometer testing should be excavated to suitable firm soil, and then grades re-established by backfilling with suitable soil.

5.2 Fill Selection, Placement and Compaction - Culvert

All material to be used as fill or backfill should be inspected, tested and approved by the Geotechnical Engineer. In general, the on-site soils which are free from organic and other deleterious components can be re-used as general site fill. Materials suitable for various construction purposes can be identified by an experienced Soils Inspector during grading operations.

Moisture conditioning (that is, wetting or drying) of the soils should be anticipated to achieve proper compaction. The moisture contents of the soils should be controlled properly to avoid extensive construction delays. If imported fill material is required, those materials should have Unified Soil Classifications of SM or better.

All fill should be placed in relatively horizontal 8-inch (maximum) loose lifts and should be compacted to a minimum of 95 percent of the Standard Proctor (ASTM D-698) maximum dry density or higher if required by the manufacturer of the proposed culvert. Fill materials in landscape and other non-structural areas should be compacted to at least 90 percent of the Standard Proctor maximum dry density if significant subsidence of the fill under its own weight is to be avoided. Field moisture contents should be maintained within 2 percentage points of the optimum moisture content in order to provide adequate compaction.

Fill slopes no steeper than 2(H):1(V), or flatter, should be used. New fill materials should be properly benched into existing slopes. A sufficient number of in-place density tests should be performed by an experienced Engineering Technician on a full-time basis to verify that the proper degree of compaction is being obtained.

5.3 Groundwater and Drainage

As stated previously, it should be anticipated that groundwater will be encountered at levels near the levels of the existing stream. It is expected that the water flow will be diverted around the foundation areas during construction. It should be expected that groundwater will also have to be pumped from the footing excavations prior to concreting.

It should also be anticipated that undercutting of wet, loose/soft or other unsuitable materials may be necessary. Additional dewatering procedures may also be necessary to prevent any potential bearing subgrade from becoming wet and/or soft. Any unsuitable materials removed should be replaced with lean (2000 psi) concrete.

Adequate drainage should be provided at the site to minimize any increases in the moisture contents of the foundation soils. All other graded areas should be sloped away from the structures to prevent the ponding of water.

5.4 Culvert Foundations

Our findings indicate that the proposed culvert structure can be supported on foundations bearing on firm natural soils. It has been assumed that the foundation for the culvert will be located at least 4' below the existing site grades at the proposed boring locations. If foundations are to be supported at shallower depths, then some additional modification to the shallow subsurface conditions should be anticipated.






Based on the maximum anticipated structural loads, the maximum allowable settlement, and the general soil conditions which were encountered, it is our judgment that a net allowable design soil bearing pressure of 2,500 psf will be appropriate for proportioning foundations supported on firm, natural materials for the culvert.

The exposed foundation subgrades should be inspected by a Geotechnical Engineer or experienced Soils Inspector prior to the placement of concrete. The purpose of the inspection would be to verify that the exposed materials will be capable of supporting the design bearing pressure. If soft or loose pockets are encountered in the footing excavations, the unsuitable materials should be removed and replaced with lean (2000 psi) concrete or with a clean, washed #57 stone or other approved freely drainage coarse-granular material back to the proposed culvert bearing level.

Foundation subgrades should be located at depths of at least 2.5 ft below final exterior grades so as to provide adequate protection from frost heave.

PROFESSIONAL CERTIFICATION  
I hereby certify that these documents were prepared or approved by me, and that I am a duly licensed professional engineer under the laws of the State of Maryland, License No. 12475, Expiration Date: May 26 2016.

10-29-15  
Date  
Carl K. Gutschick  
Professional Engineer  
Maryland Reg. No. 12475

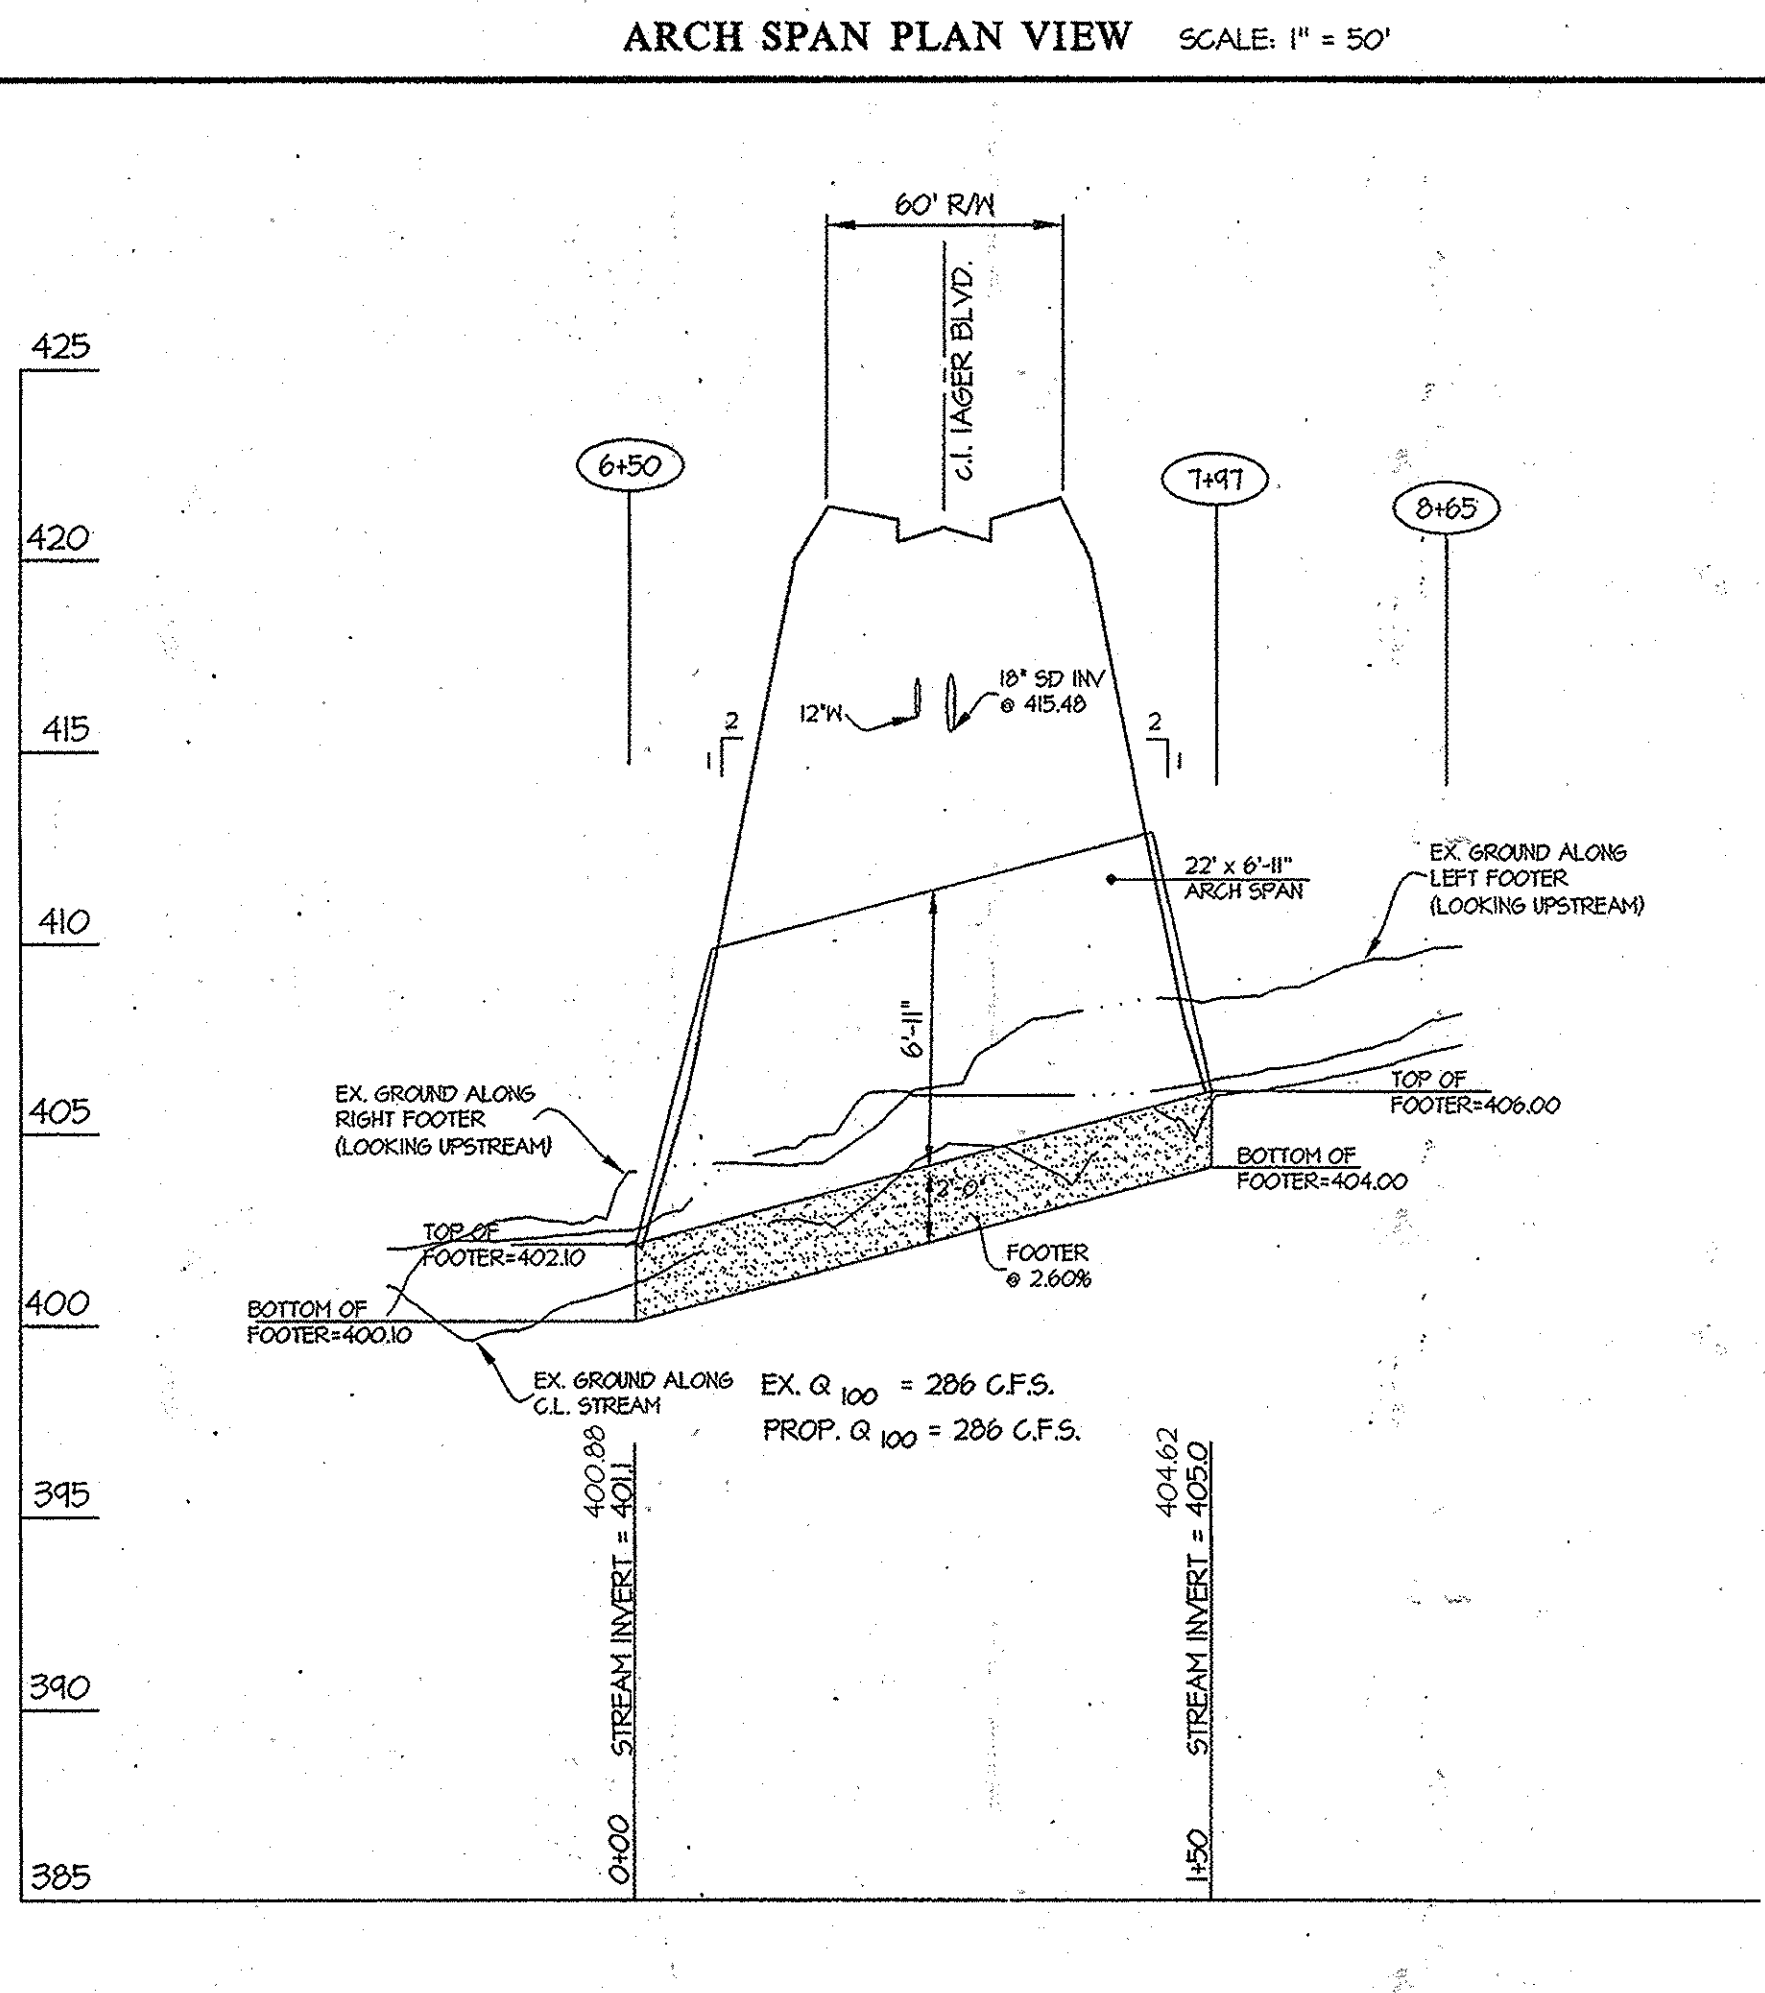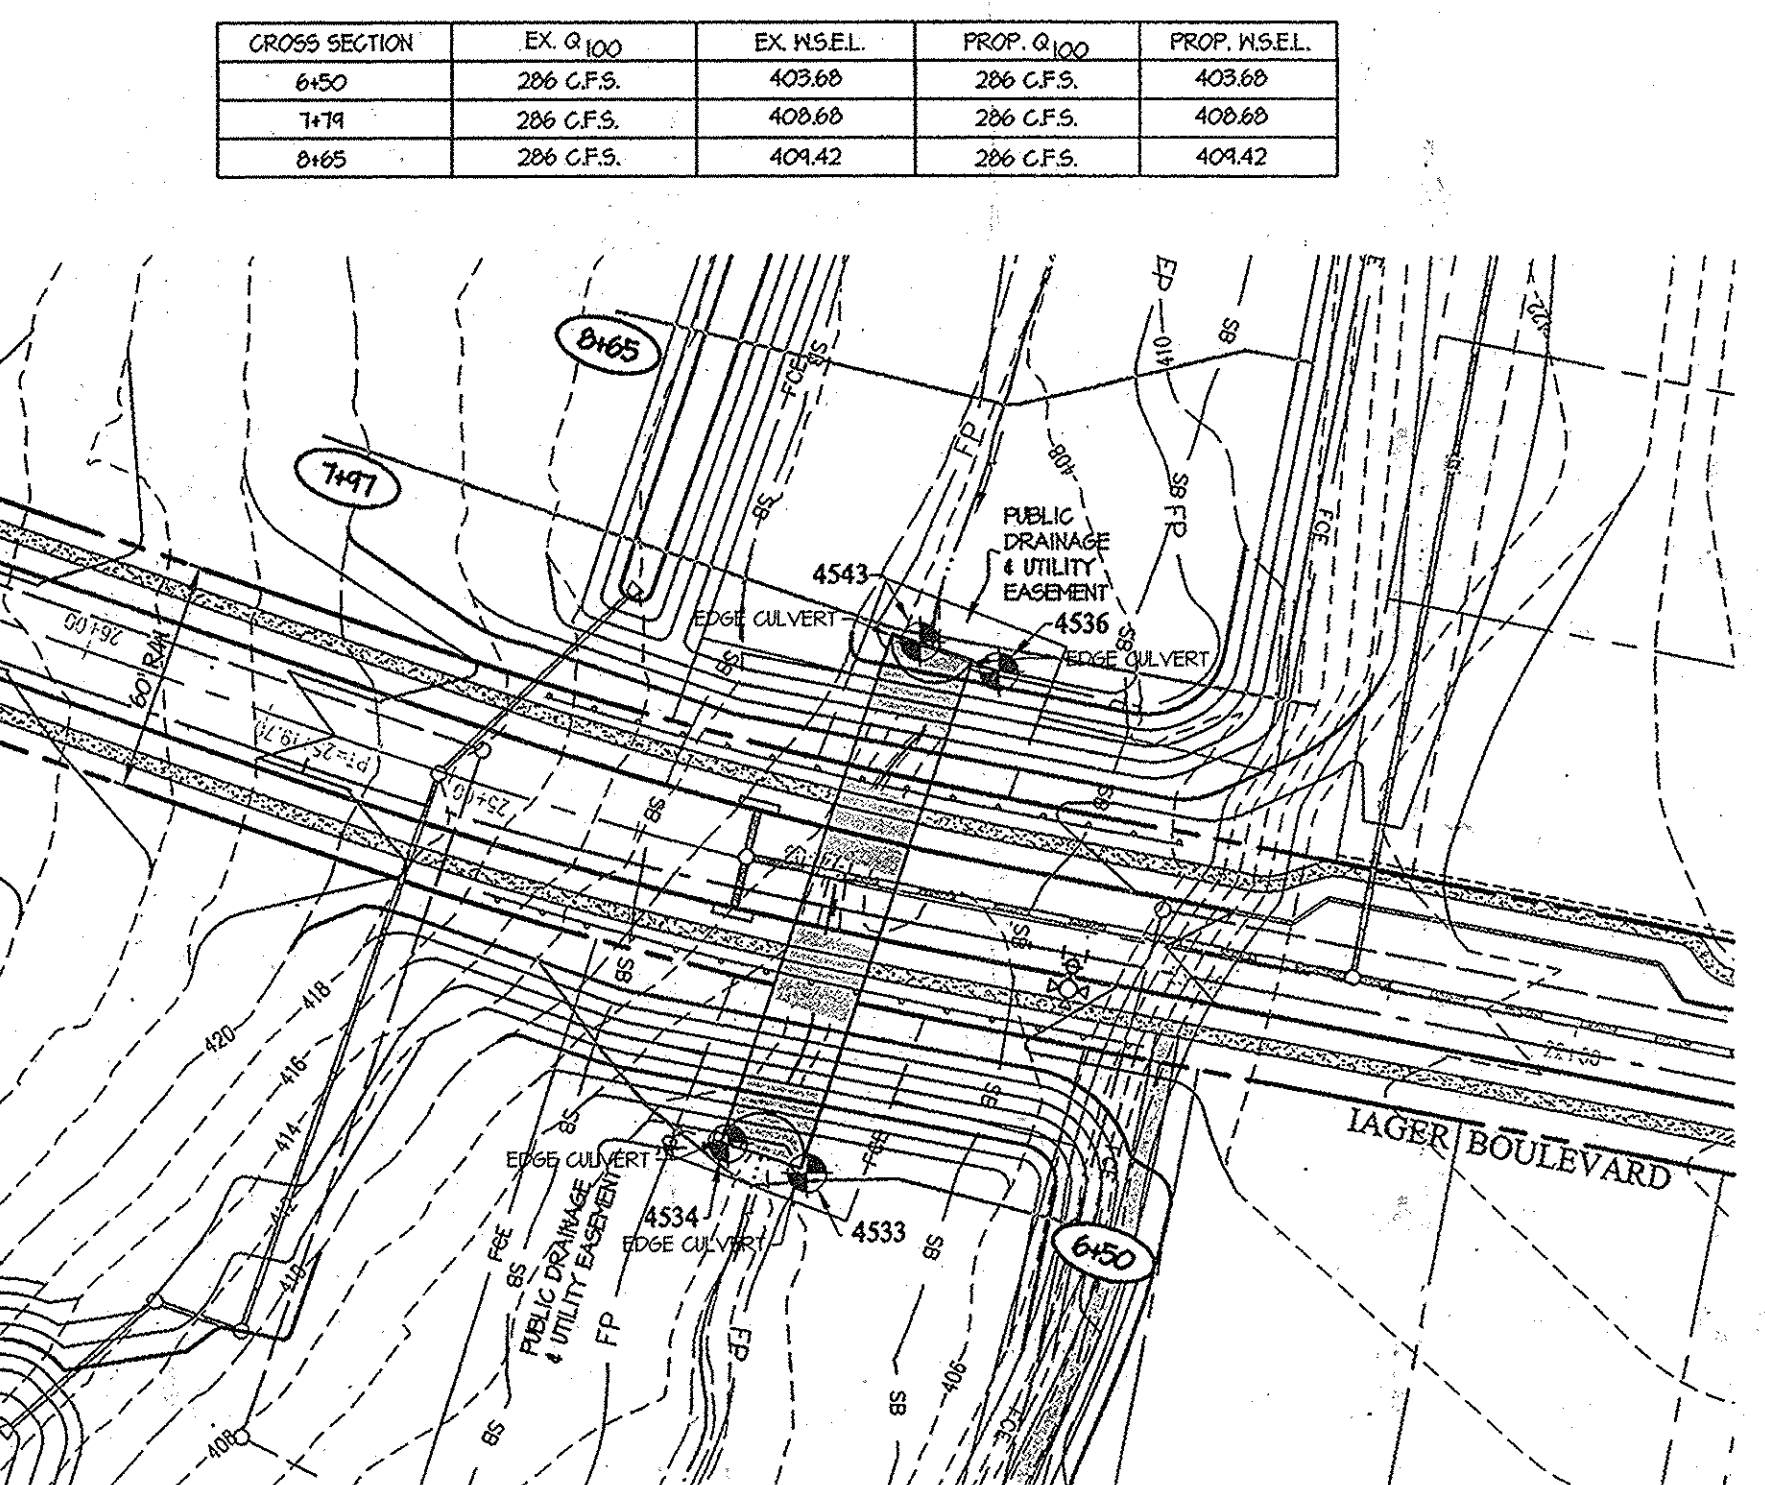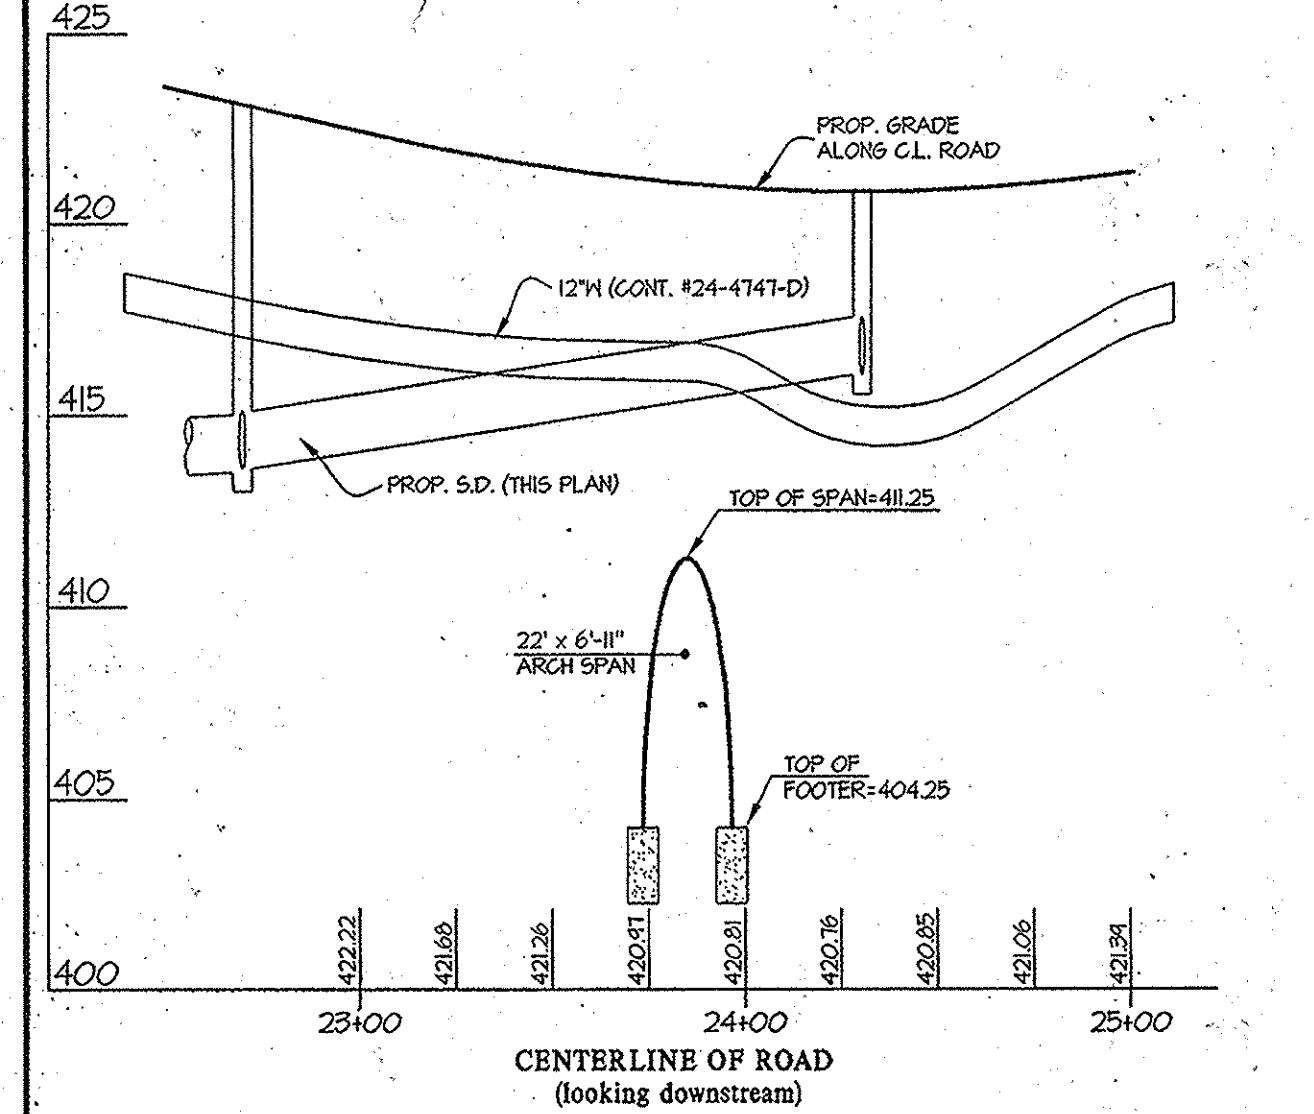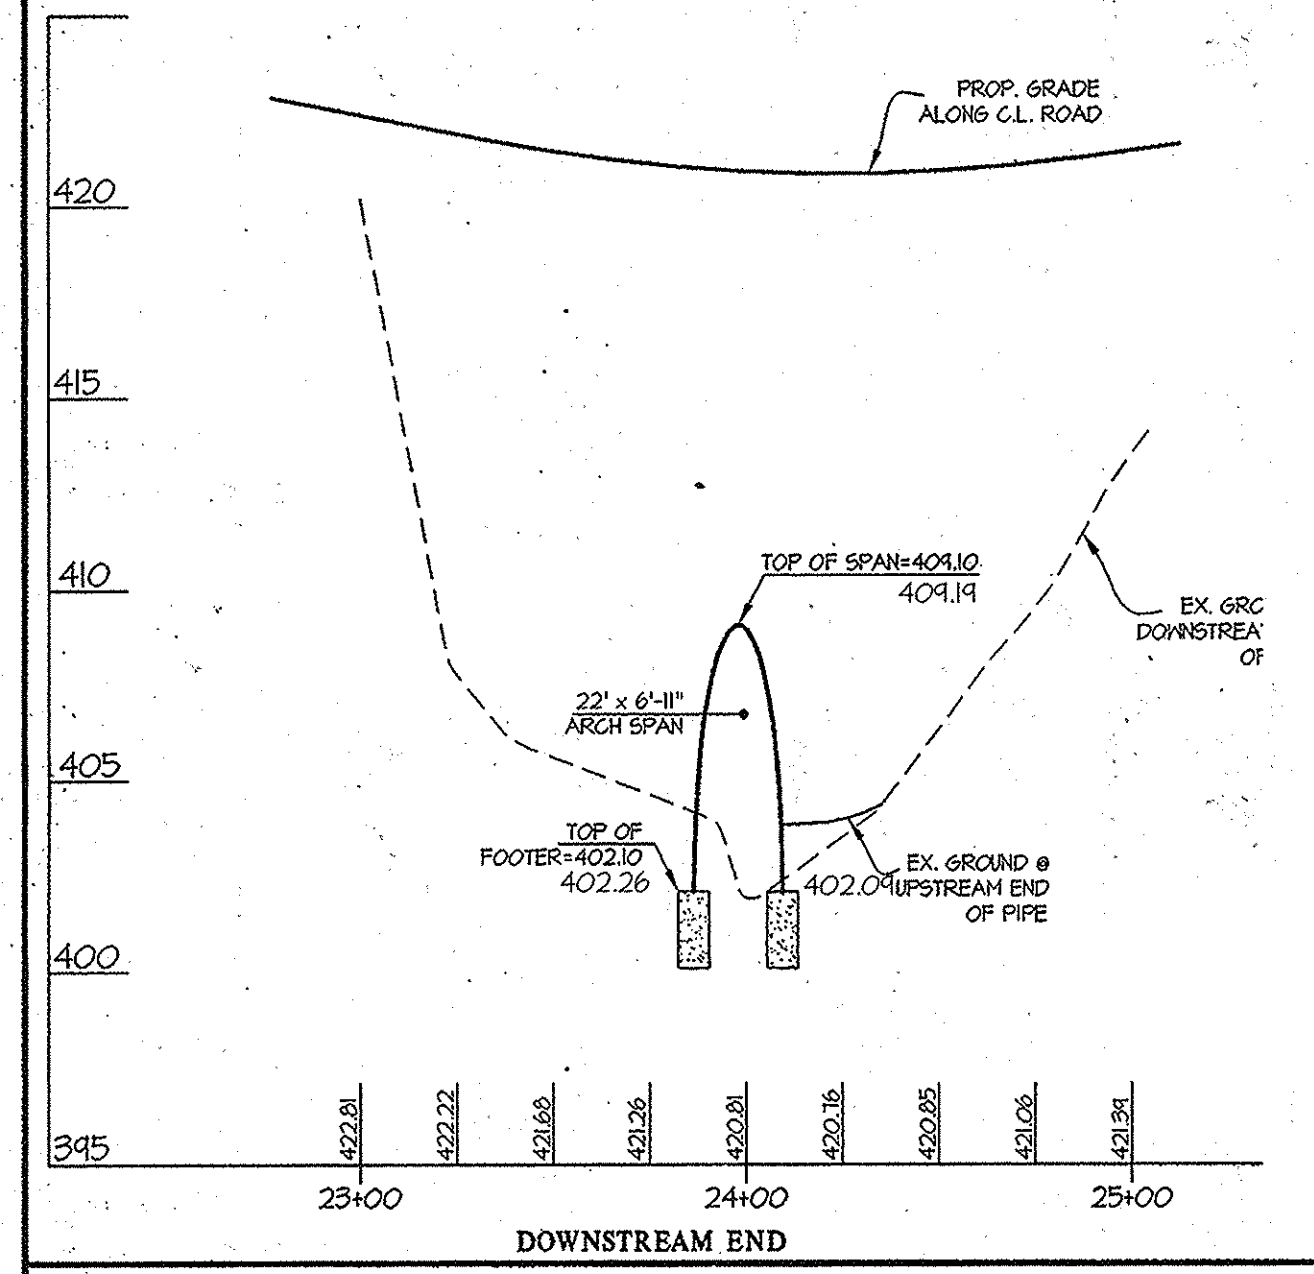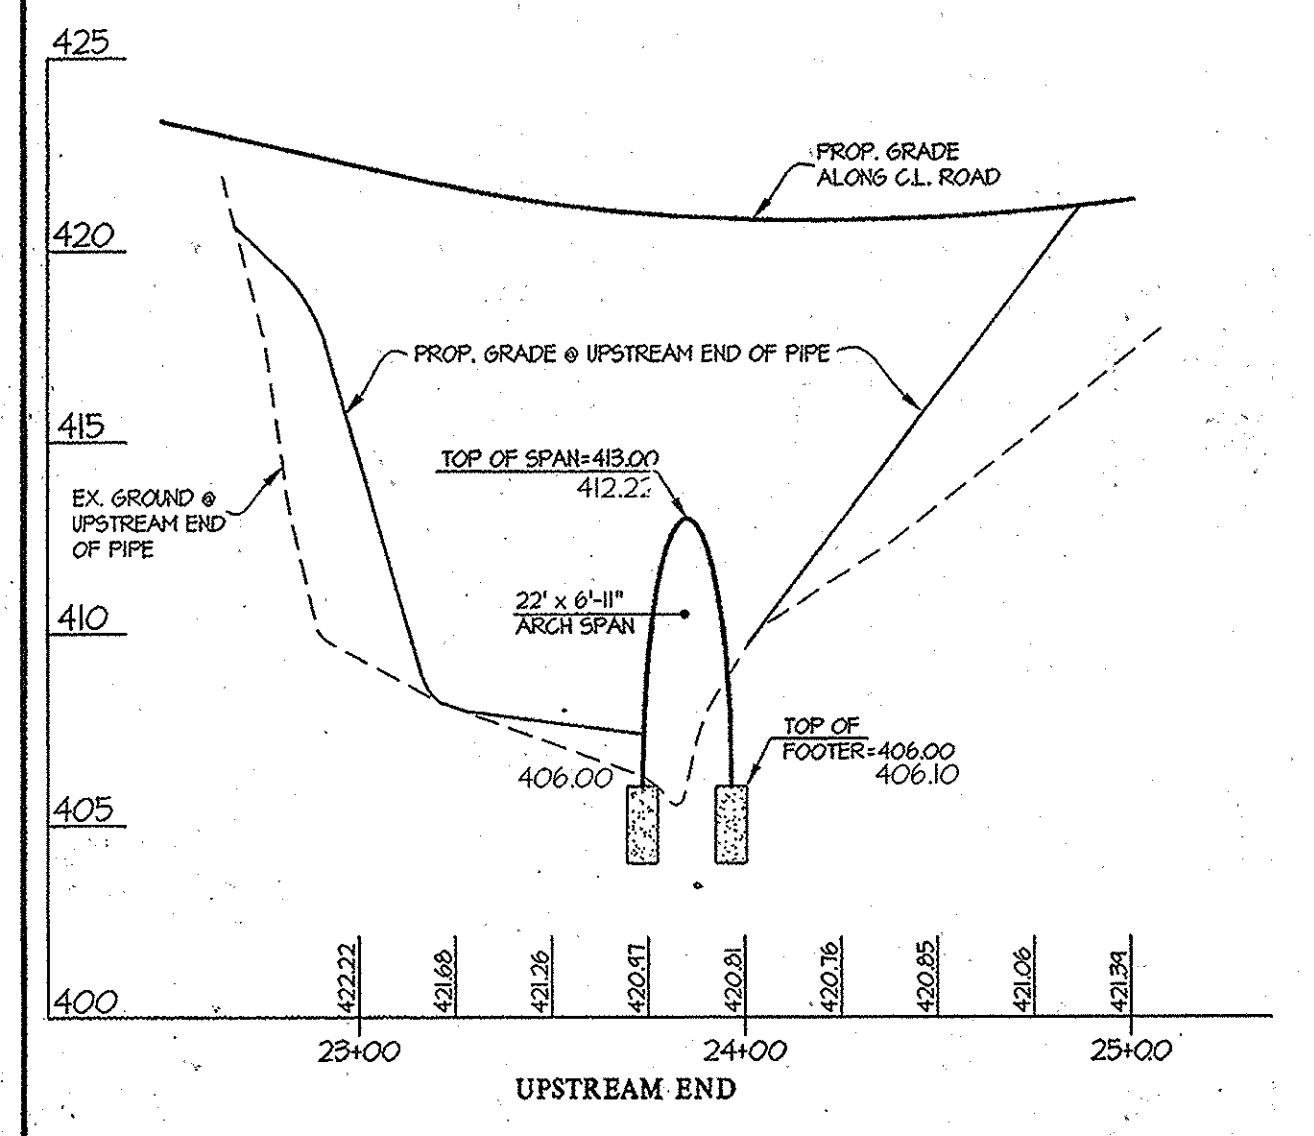

THESE PLANS FOR SMALL POND CONSTRUCTION, SOIL EROSION AND SEDIMENT CONTROL MEET THE REQUIREMENTS OF THE HOWARD SOIL CONSERVATION DISTRICT.

John R. Robertson  
HOWARD S.C.D. DATE 11-7-12

ENGINEER'S CERTIFICATE  
I CERTIFY THAT THIS PLAN FOR POND CONSTRUCTION, EROSION AND SEDIMENT CONTROL REPRESENTS A PRACTICAL AND WORKABLE PLAN BASED ON MY PERSONAL KNOWLEDGE OF THE SITE CONDITIONS. THIS PLAN WAS PREPARED IN ACCORDANCE WITH THE REQUIREMENTS OF THE HOWARD SOIL CONSERVATION DISTRICT. I HAVE NOTIFIED THE DEVELOPER THAT HE/MUST ENGAGE A REGISTERED PROFESSIONAL ENGINEER TO SUPERVISE POND CONSTRUCTION AND PROVIDE THE HOWARD SOIL CONSERVATION DISTRICT WITH AN AS-BUILT PLAN OF THE POND WITHIN 30 DAYS OF COMPLETION.

11-7-12  
DATE

APPROVED: HOWARD COUNTY DEPARTMENT OF PUBLIC WORKS  
Diane Schumy, Acting  
Chief, Bureau of Highways DATE 11/16/12

APPROVED: HOWARD COUNTY DEPARTMENT OF PLANNING & ZONING  
Kest Sheppard  
Chief, Division of Land Development DATE 12/16/12

Chief, Development Engineering Division DATE 12-6-12

BUILDER'S CERTIFICATE  
I HAVE CERTIFIED THAT ALL DEVELOPMENT AND/OR CONSTRUCTION WILL BE DONE ACCORDING TO THESE PLANS, AND THAT ANY RESPONSIBLE PERSONNEL INVOLVED IN THE CONSTRUCTION PROJECT WILL HAVE A CERTIFICATE OF ATTENDANCE AT A MARYLAND DEPARTMENT OF THE ENVIRONMENT APPROVED TRAINING PROGRAM FOR THE CONTROL OF SEDIMENT AND EROSION BEFORE BEGINNING THE PROJECT. I SHALL ENGAGE A REGISTERED PROFESSIONAL ENGINEER TO SUPERVISE POND CONSTRUCTION AND PROVIDE THE HOWARD SOIL CONSERVATION DISTRICT WITH AN AS-BUILT PLAN OF THE POND WITHIN 30 DAYS OF COMPLETION. I ALSO AUTHORIZE PERIODIC ON-SITE INSPECTIONS BY THE HOWARD SOIL CONSERVATION DISTRICT.


12/25/12  
DATE

GLWGUTSCHICK LITTLE & WEBER, P.A.  
CIVIL ENGINEERS, LAND SURVEYORS, LAND PLANNERS, LANDSCAPE ARCHITECTS  
3909 NATIONAL DRIVE - SUITE 250 - BURTNSVILLE OFFICE PARK  
BURTNSVILLE, MARYLAND 21085  
TEL: 301-421-4024 BAL: 410-880-1820 DC/VA: 301-989-2524 FAX: 301-421-4186

PREPARED FOR:  
MAPLE LAWN FARMS 1, LLC  
SUITE 300 WOODBINE CENTER  
1823 REISTERSTOWN ROAD  
BALTIMORE, MD 21208  
ATTN: MARK BENNETT  
410-484-8400

PROFESSIONAL CERTIFICATION  
I HEREBY CERTIFY THAT THESE PLANS WERE PREPARED OR APPROVED BY ME, AND THAT I AM A DULY LICENSED PROFESSIONAL ENGINEER UNDER THE LAWS OF THE STATE OF MARYLAND, LICENSE NO. 12475, EXPIRATION DATE: MAY 26, 2016.


11-7-12  
DATE

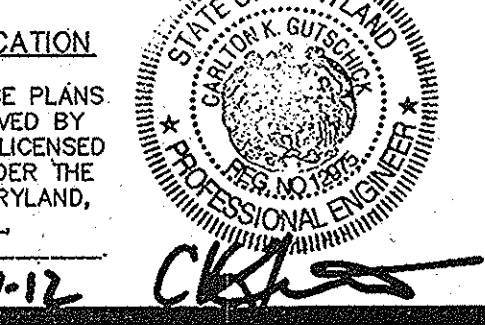


ARCH SPAN - PLAN, PROFILE AND SOIL BORING INFORMATION  
MAPLE LAWN FARMS  
MIDTOWN WEST DISTRICT - AREA 2  
LOTS 93 THRU 177, OPEN SPACE LOTS 178 THRU 183, AND  
COMMON OPEN AREA LOTS 184 THRU 186

SCALE	ZONING	G. L. W. FILE NO.
AS SHOWN	MXD-3	11001
DATE	TAX MAP - GRID	SHEET
OCT. 2015 OCT. 2012	41-21/46-3	19 OF 25




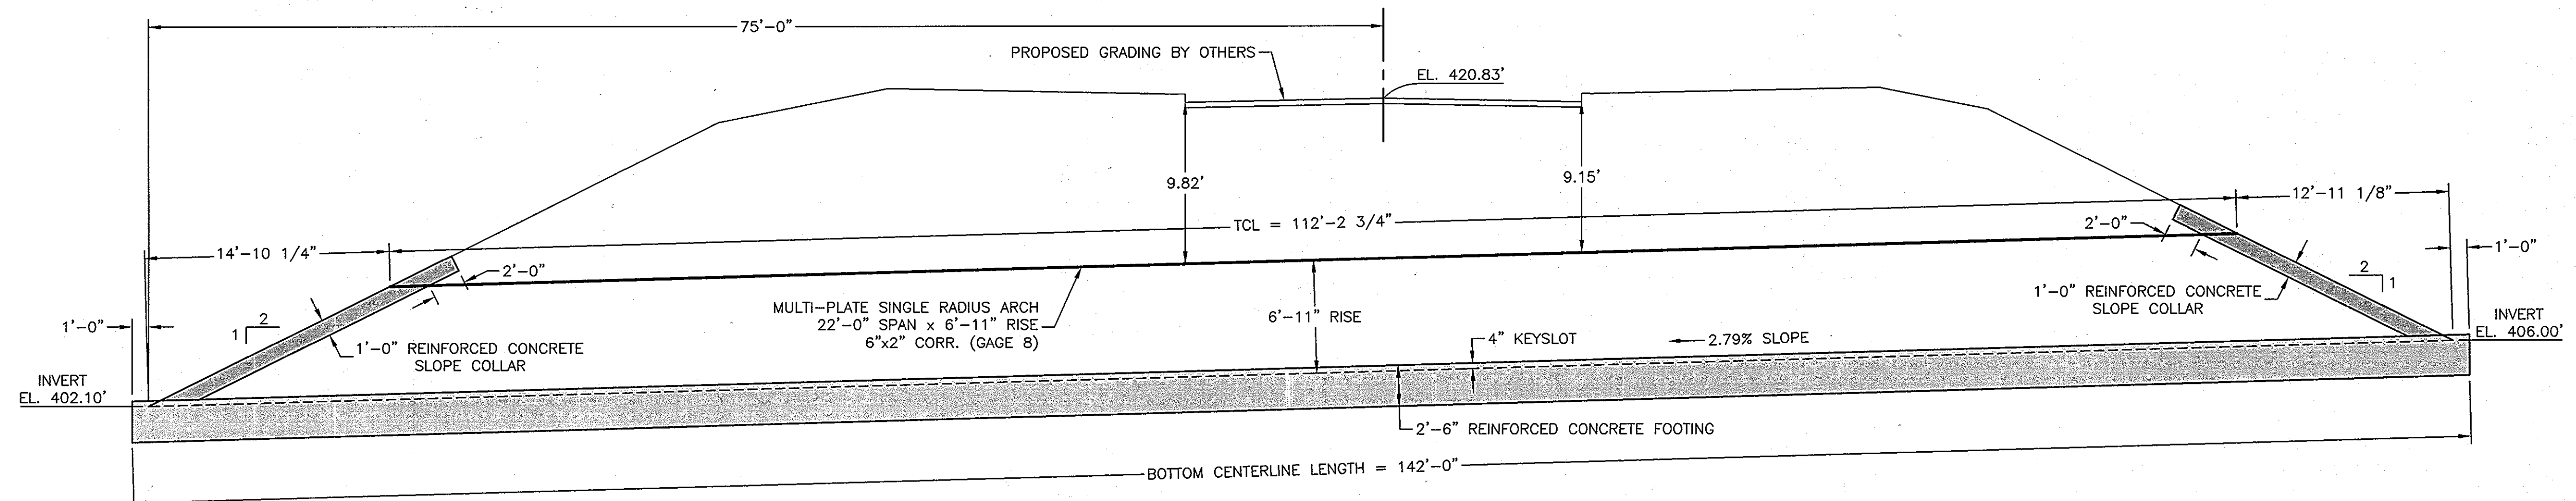

PROFILE THROUGH CENTERLINE OF STRUCTURE

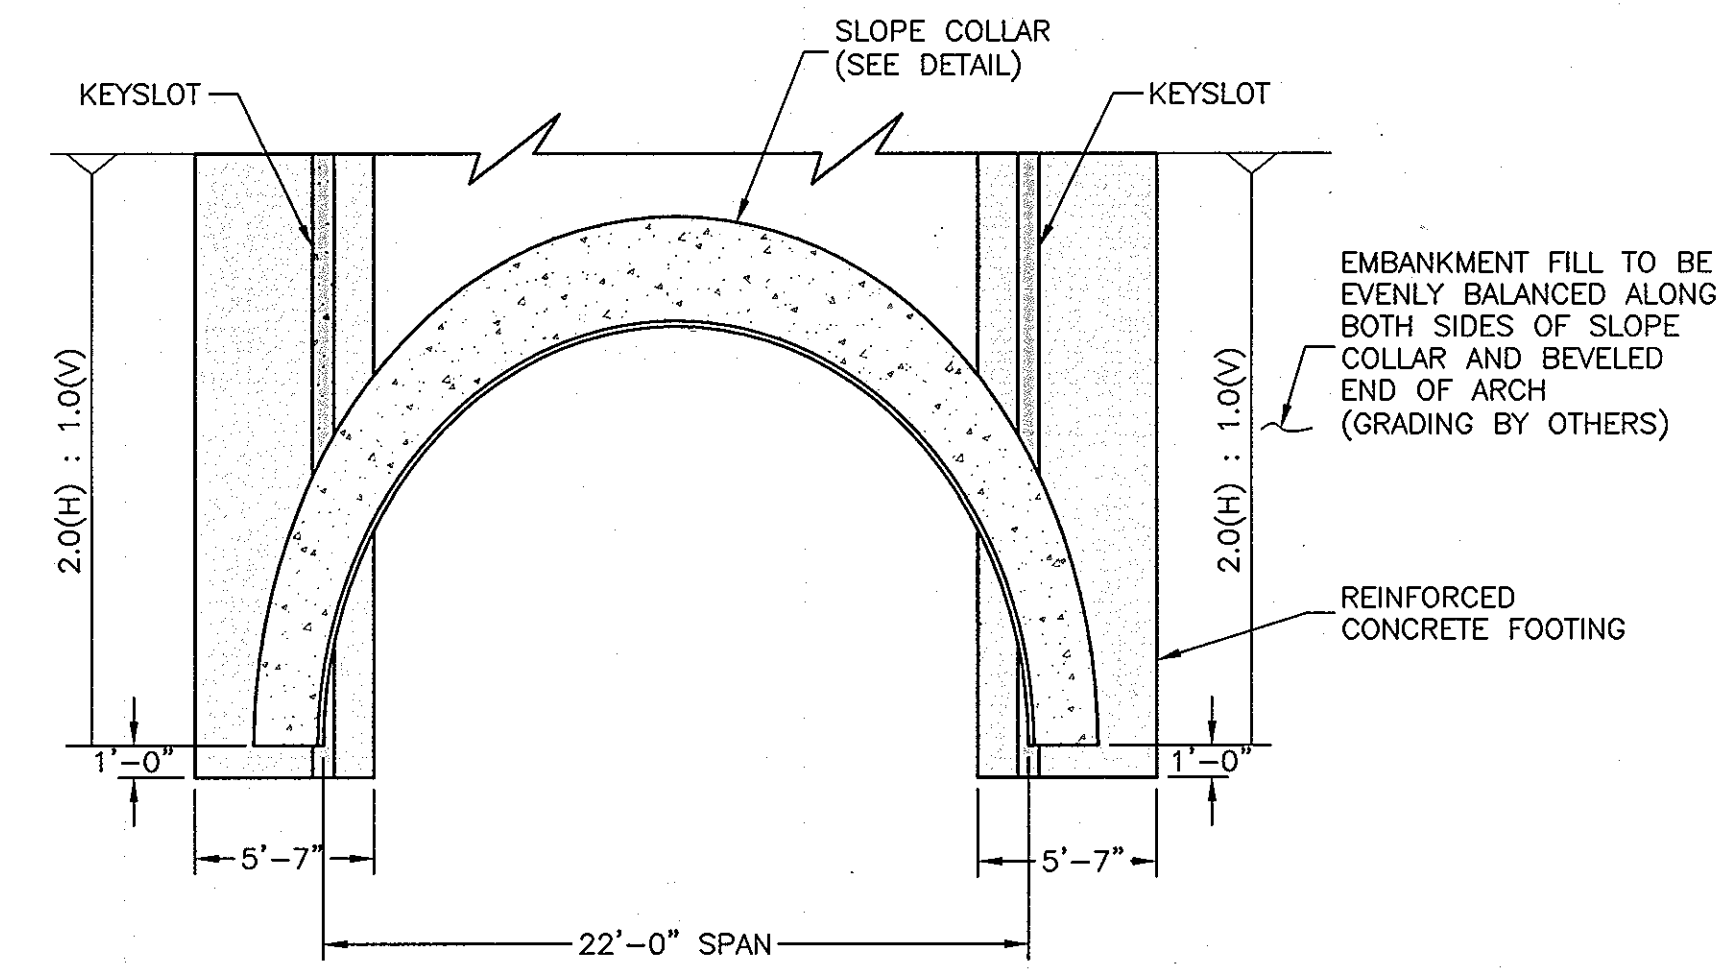


TYPICAL END PLAN VIEW


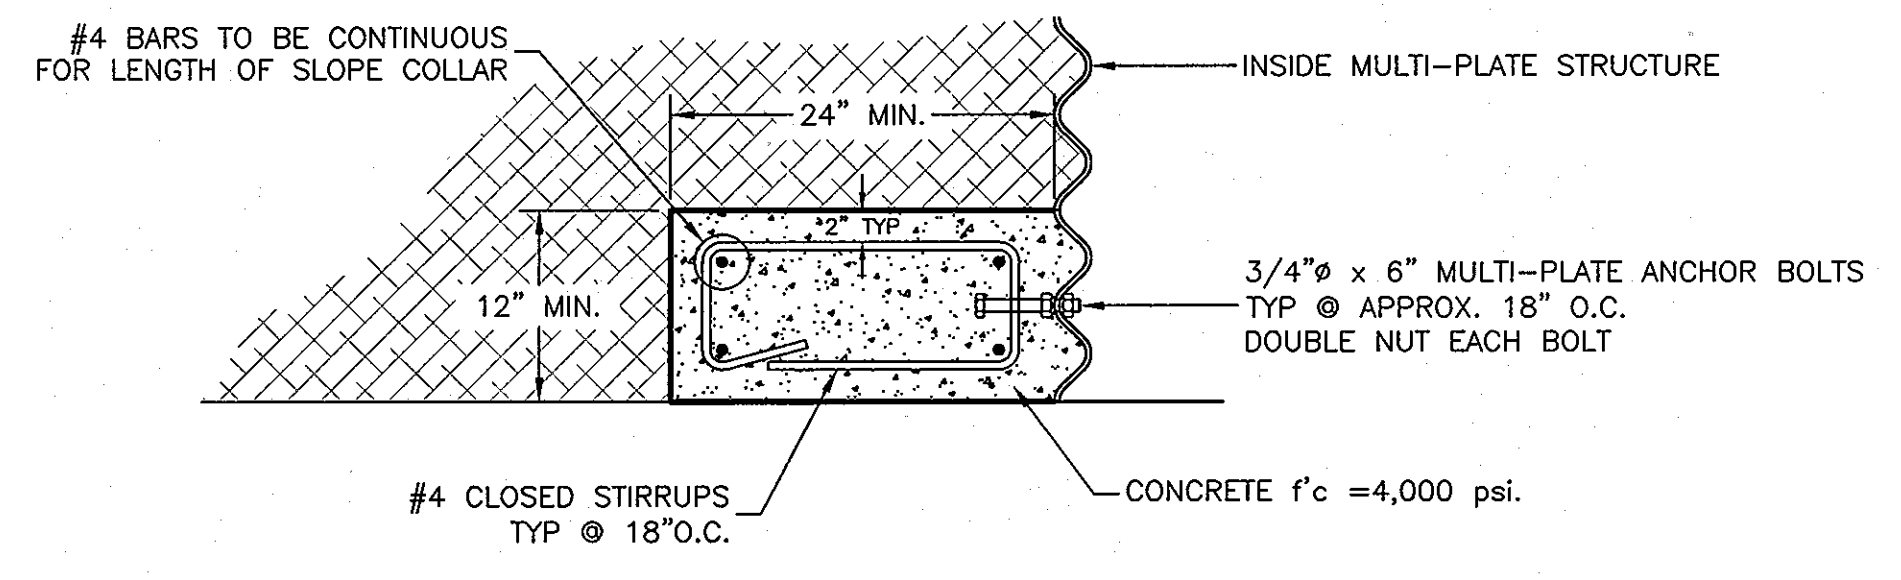


TYPICAL DETAIL OF SLOPE COLLAR



NOT TO SCALE

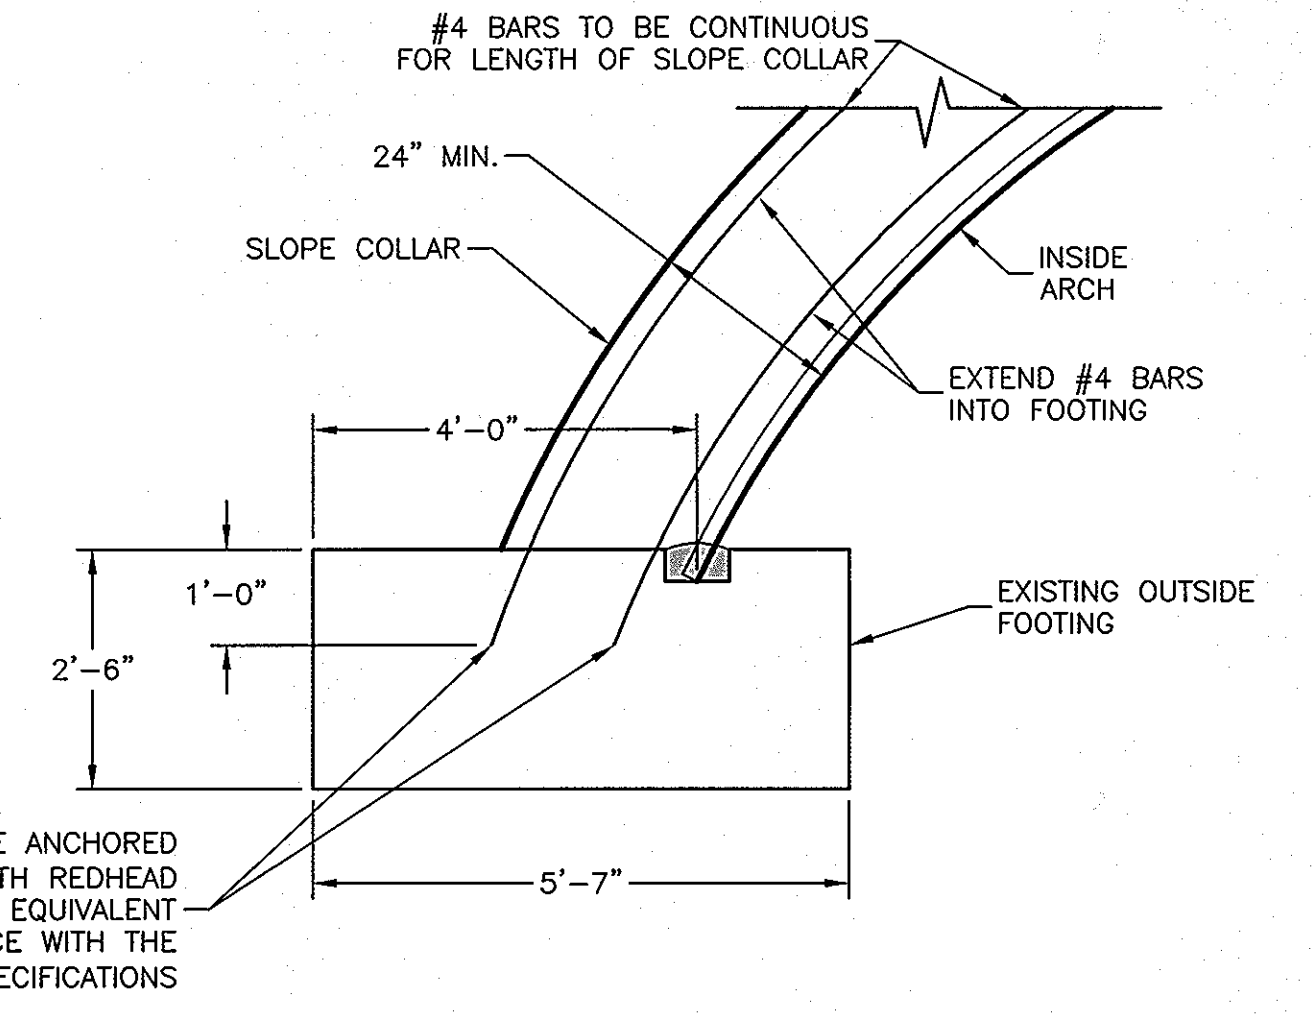

DETAIL OF SLOPE COLLAR ATTACHMENT TO FOOTINGS

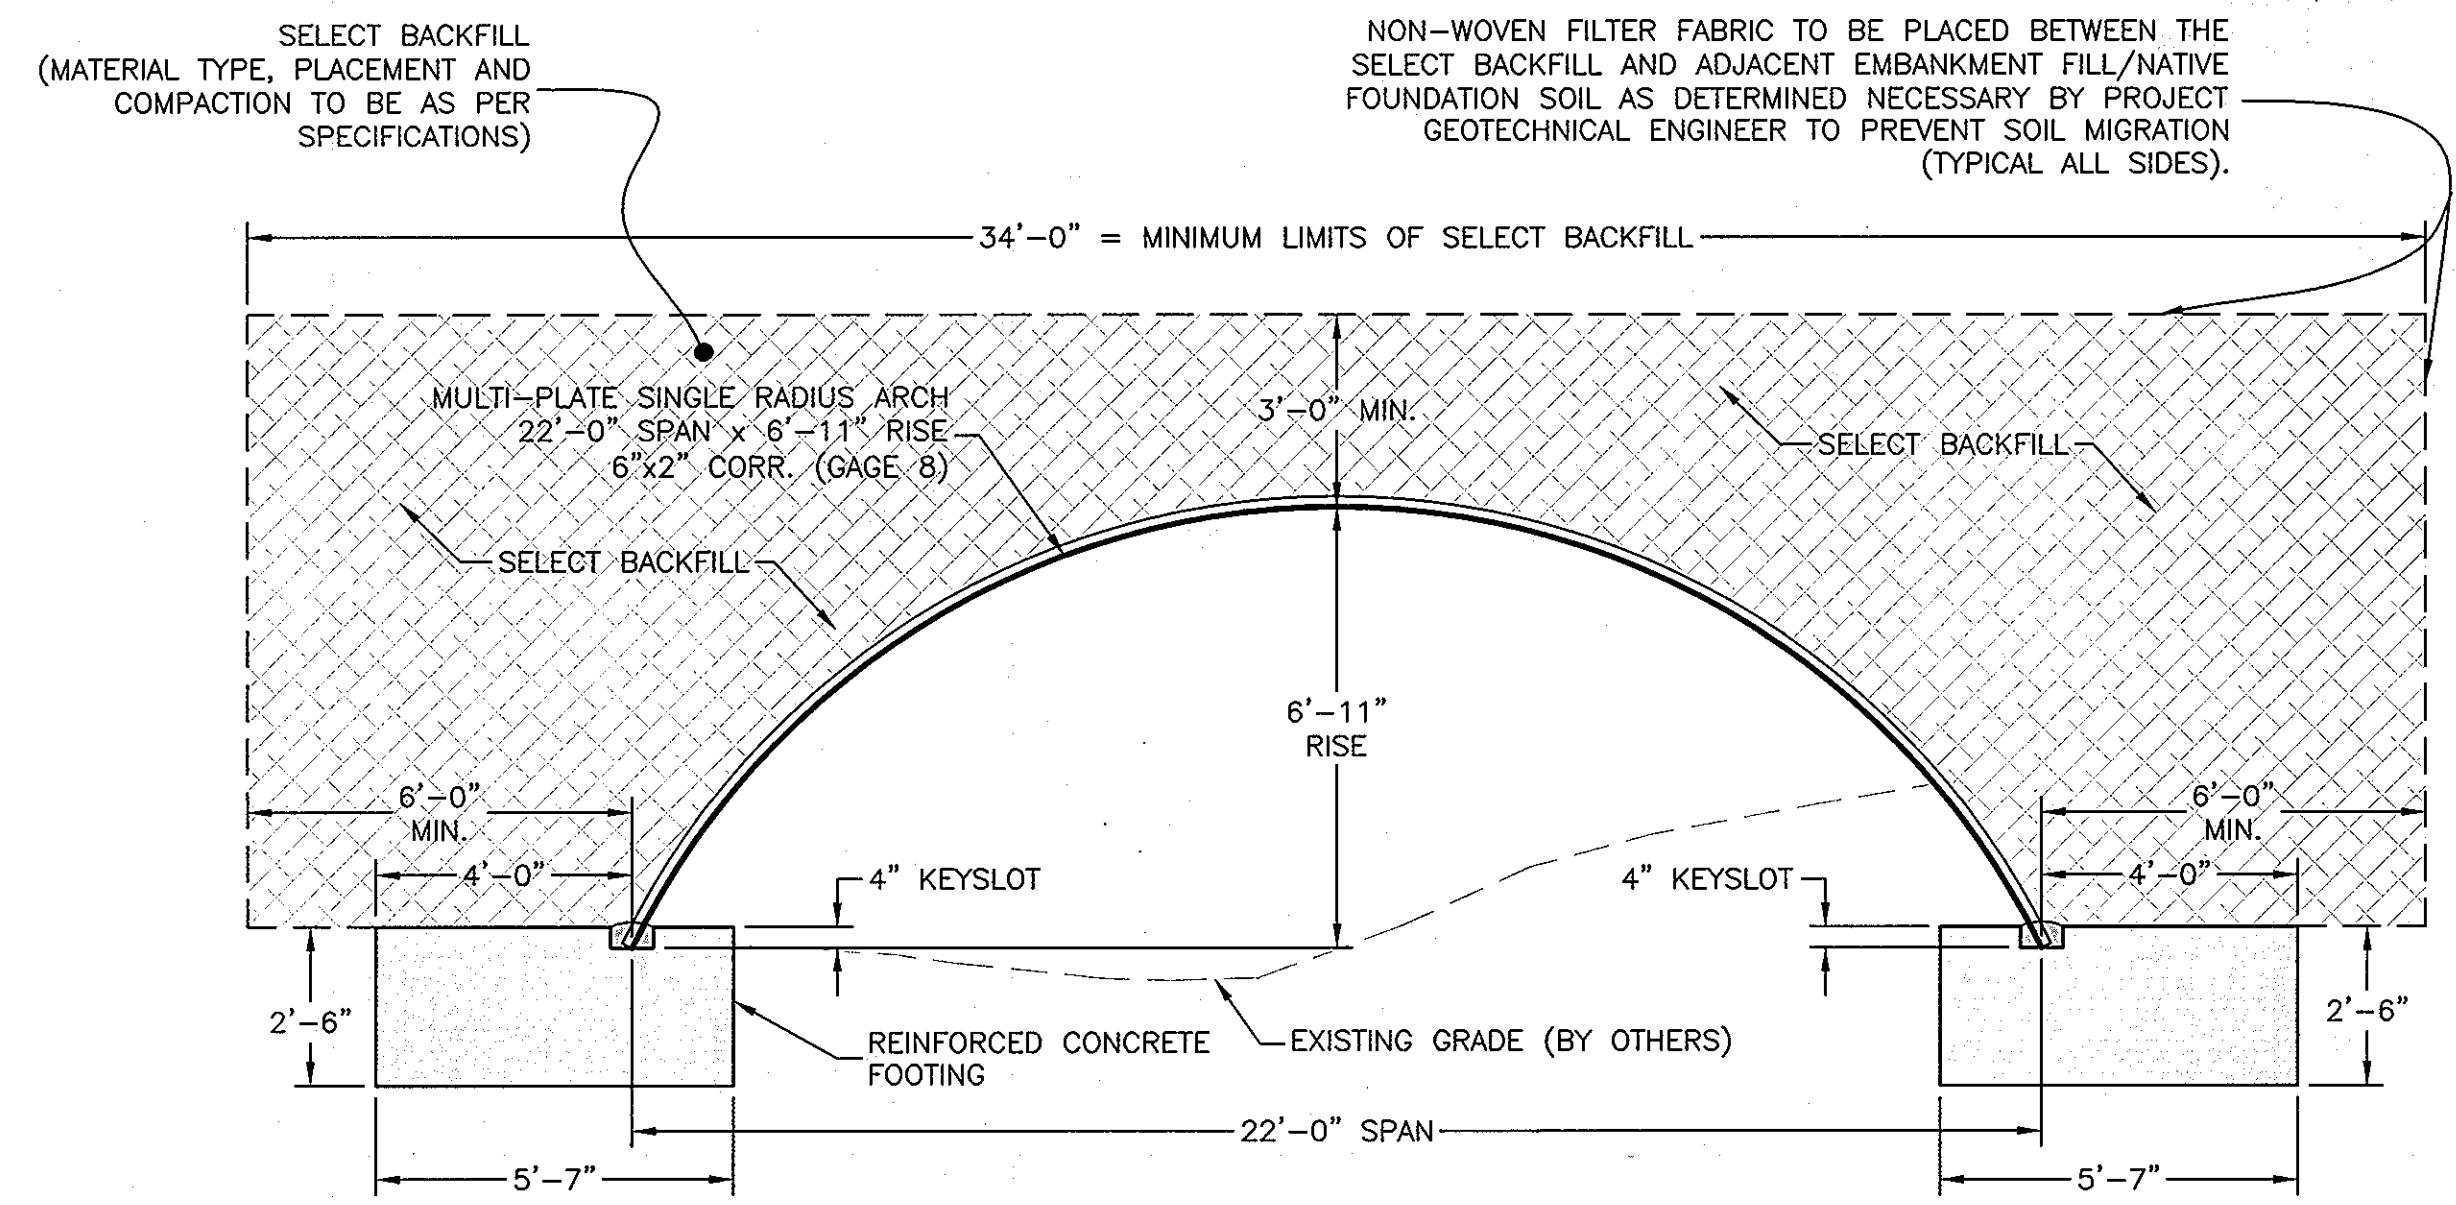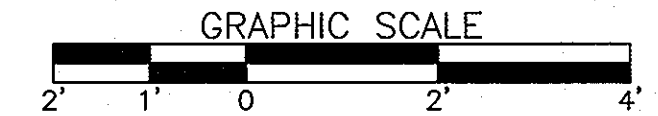

TYPICAL SELECT BACKFILL DETAIL

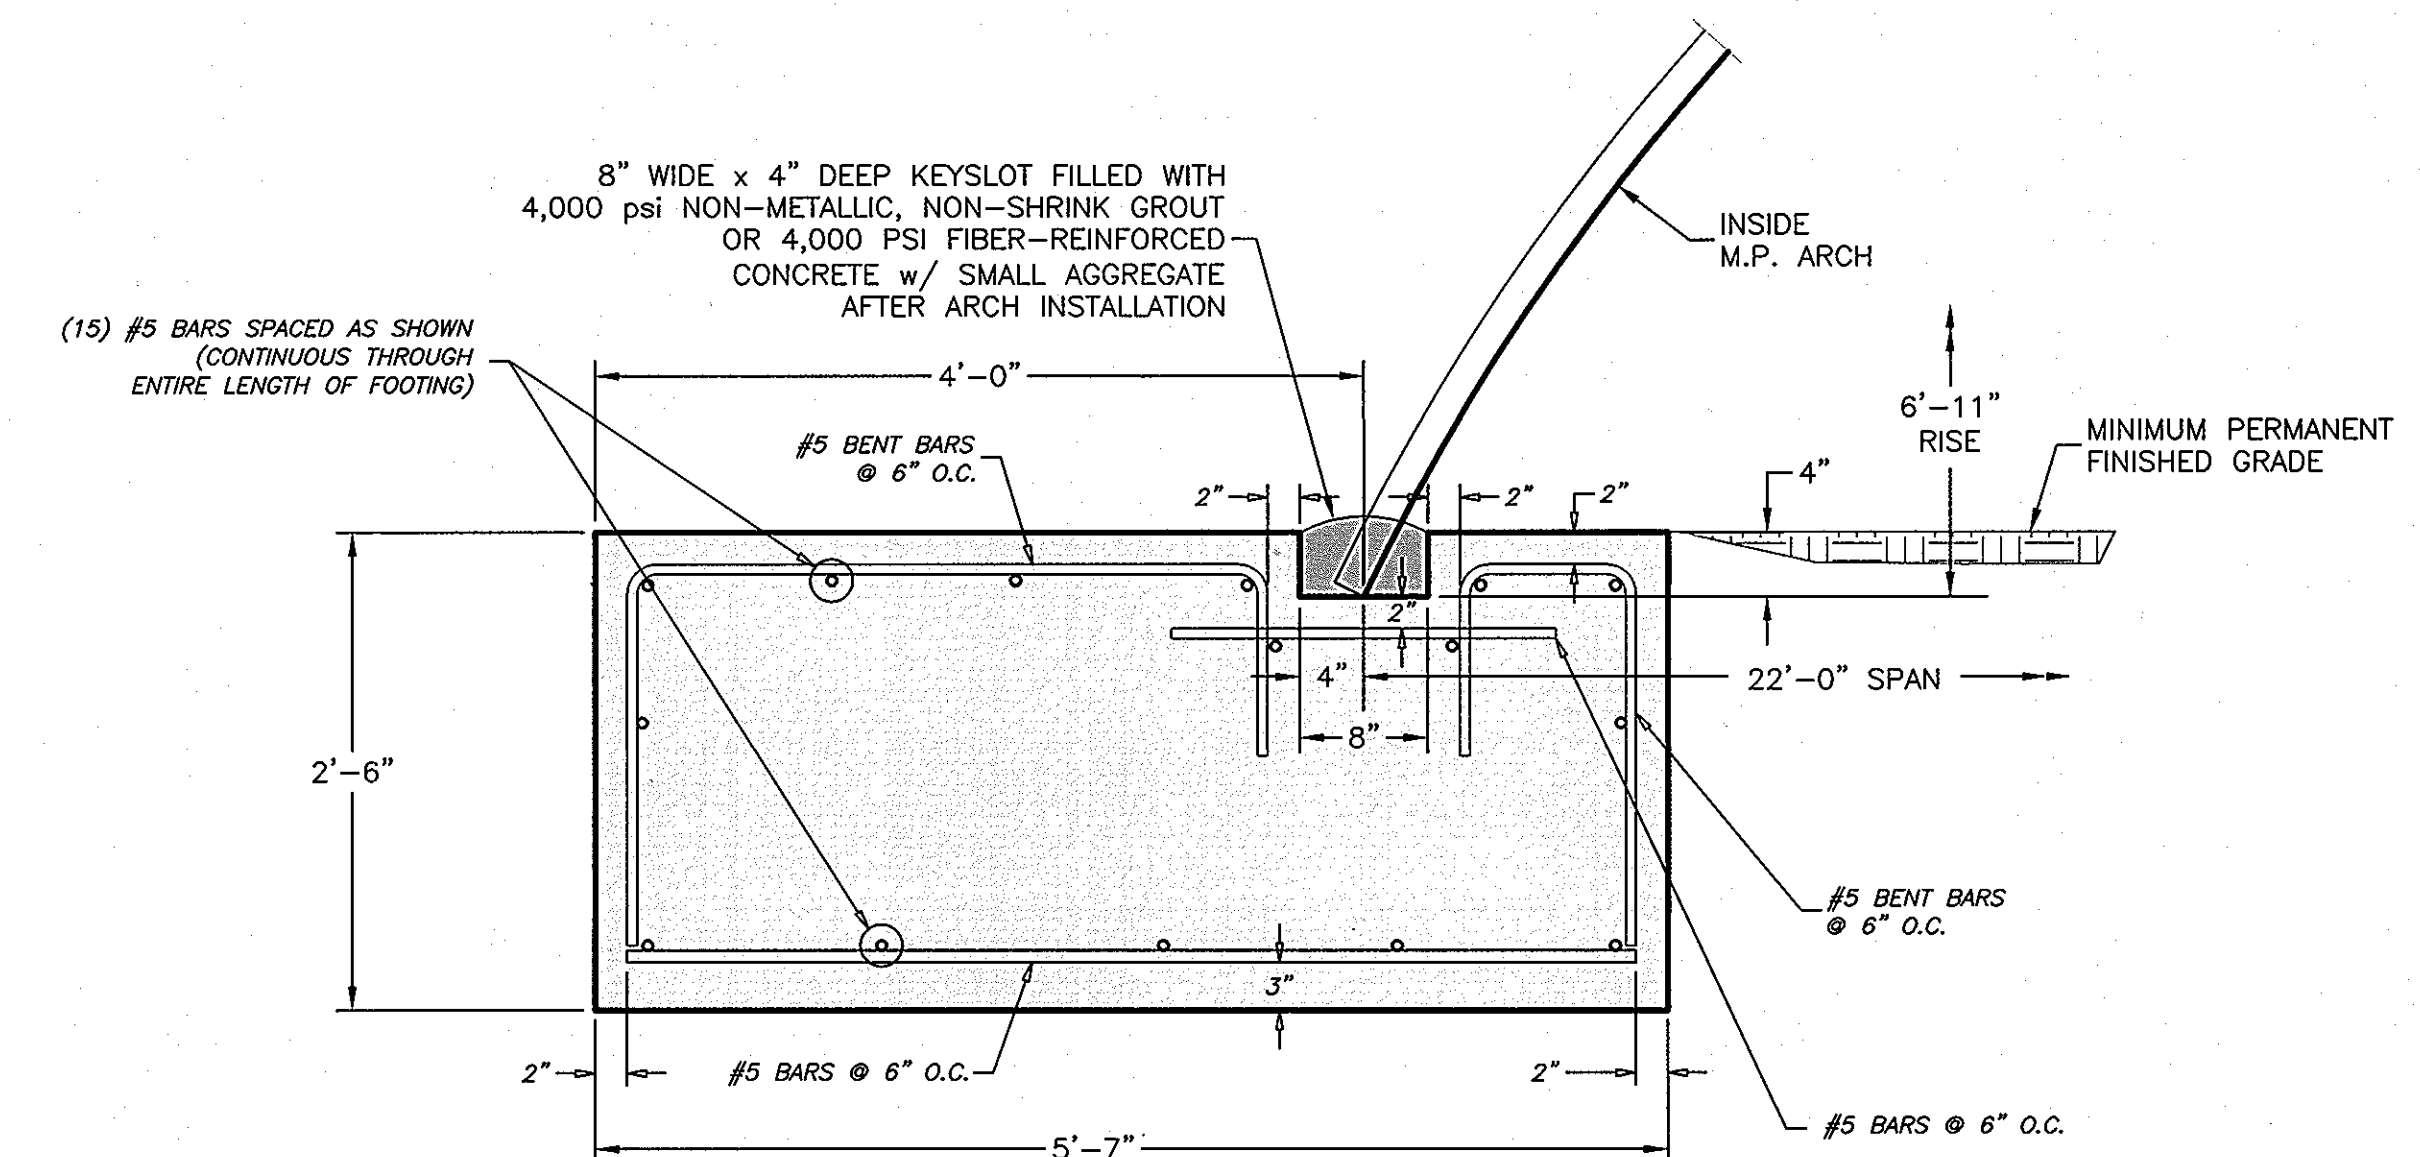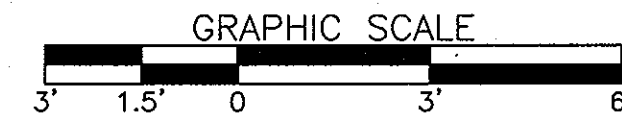

TYPICAL FOOTING DETAIL



- NOTE:
- 1.) CONCRETE SHALL BE  $f'_c = 4,000$  psi.
  - 2.) ALL REINFORCEMENT SHALL BE ASTM A-615, GRADE 60.
  - 3.) FOOTING IS DESIGNED FOR A 5,000 psf ALLOWABLE BEARING CAPACITY. THIS VALUE MUST BE FIELD VERIFIED PRIOR TO CONSTRUCTION.
  - 4.) SCOUR IS NOT ADDRESSED HEREIN AND IS THE RESPONSIBILITY OF OTHERS THAN CBC ENGINEERS.

PROFESSIONAL CERTIFICATION:  
I HEREBY CERTIFY THAT THESE DOCUMENTS WERE PREPARED BY ME, AND I AM A DULY LICENSED PROFESSIONAL ENGINEER UNDER THE LAWS OF THE STATE OF MARYLAND, LICENSE NO. 40240, EXPIRATION DATE: 5/13/13



APPROVED: HOWARD COUNTY DEPARTMENT OF PUBLIC WORKS  
*Diane Schrey*, Acting  
CHIEF, BUREAU OF HIGHWAYS  
DATE: 11/29/12

APPROVED: HOWARD COUNTY DEPT. OF PLANNING AND ZONING  
*Keith Chelovich*  
CHIEF, DIVISION OF LAND DEVELOPMENT  
DATE: 12/11/12

*Chad Edmunds*  
CHIEF, DEVELOPMENT ENGINEERING DIVISION  
DATE: 12.6.12

**CBC Engineers**

**PROFILE & DETAILS**

Drawn By	Date	CONTECH ENGINEERED SOLUTIONS, LLC DESIGN OF CONCRETE SPREAD FOOTING FOUNDATIONS, CONCRETE SLOPE COLLARS, AND SELECT BACKFILL SPECIFICATIONS FOR MP ARCH MAPLE LAWN FARMS HOWARD COUNTY, MARYLAND	
DJH/JBE	10/31/12	CBC Sheet No.	Rev.
Approved By	Date	1 of 2	-
Scale	CBC Project No.	CBC-14610	Sheet
GRAPHIC			20 of 25



**1.0 STANDARDS AND DEFINITIONS**

- 1.1 STANDARDS** - All standards refer to latest edition unless otherwise noted.
- 1.1.1** ASTM D-698-70 (Method C) "Standard Test Methods for Moisture, Density Relations of Soils and Soil Aggregate Mixtures Using 5.5-lb (2.5 kg.) Rammer and 12" (305-mm) Drop".
- 1.1.2** ASTM D-1557 "Test Method for Laboratory Compaction Characteristics of Soil Using Modified Effort (56,000 ft-lb/ft<sup>3</sup> [2,700 kN m/m<sup>3</sup>])".
- 1.1.3** ASTM D-2922 "Standard Test Method for Density of Soil and Soil Aggregate in Place by Nuclear Methods (Shallow Depth)".
- 1.1.4** ASTM D-1556 "Standard Test Method for Density of Soil in Place by the Sand-Cone Method".
- 1.1.5** All construction and materials shall be in accordance with the current AASHTO Specifications.

**1.2 DEFINITIONS**

- 1.2.1** Owner - In these specifications the word "Owner" shall mean Maple Lawn Farms, Howard County, Maryland.
- 1.2.2** Engineer - In these specifications the word "Engineer" shall mean the Owner designated engineer.
- 1.2.3** Design Engineer - In these specifications the words "Design Engineer" shall mean CBC Engineers and Associates, Ltd.
- 1.2.4** Contractor - In these specifications the word "Contractor" shall mean the firm or corporation undertaking the execution of any work under the terms of these specifications.
- 1.2.5** Approved - In these specifications the word "approved" shall refer to the approval of the Engineer or his designated representative.
- 1.2.6** As Directed - In these specifications the words "as directed" shall refer to the directions to the Contractor from the Owner or his designated representative.

**2.0 GENERAL CONDITIONS**

- 2.1** The Contractor shall furnish all labor, material and equipment and perform all work and services except those set out and furnished by the Owner, necessary to complete in a satisfactory manner the site preparation, excavation, footings, culvert installation, slope collars, filling, compaction, and grading as shown on the plans and as described therein.
- This work is to be accomplished under the observation of the Owner or his designated representative.
- 2.2** The Contractor shall examine, investigate and inspect the construction site as to the nature and location of the work, and the general and local conditions at the construction site, including, without limitation, the character of surface or subsurface conditions and obstacles to be encountered on and around the construction site; and shall make such additional investigation as he may deem necessary for the planning and proper execution of the work.
- If conditions other than those indicated are discovered by the Contractor, the Owner should be notified immediately. The material which the Contractor believes to be a changed condition should not be disturbed so that the owner can investigate the condition.
- 2.3** The construction shall be performed under the direction of an experienced engineer who is familiar with MULTI-PLATE arches.

**II - FOOTINGS**

**1.0 EXCAVATION FOR FOOTINGS**

- 1.1** Footing excavation shall consist of the removal of all material, of whatever nature, necessary for the construction of foundations.
- 1.2** It shall be the responsibility of the Contractor to identify and relocate all existing utilities which conflict with the proposed footing locations shown on the plan. The Contractor must call the appropriate utility company at least 48 hours before any excavation to request exact field location of utilities, and coordinate removal and installation of all utilities with the respective utility company.
- 1.3** The side of all excavations shall be cut to prevent sliding or caving of the material above the footings.
- 1.4** Excavated material shall be disposed in accordance with the plan established by the Engineer.
- 1.5** The footings are designed for a net allowable bearing capacity of 5,000 psf, and this shall be verified in the field before construction. The bottom of the footings should be permanently embedded at least 30 inches below finished grade for frost protection, and this is to be verified in the field.

**2.0 CONCRETE FOOTING DIMENSIONS**

The footings shall be reinforced in accordance with the construction drawings.

**III - CONCRETE**

**1.0 CODES AND STANDARDS**

- 1.1** Reinforced concrete shall conform to the requirements of AASHTO Standard Specifications for Highway Bridges, Division II - Construction, Section 8, "Concrete Structures", for Class A concrete, having a minimum compressive strength of 4,000 psi.

**2.0 STANDARDS FOR MATERIALS**

- 2.1** Portland Cement - Conforming to ASTM Specification C-150, Type I or II.
- 2.2** Water - The water shall be drinkable, clean free from injurious amounts of oils, acids, alkalis, organic materials, or deleterious substances.
- 2.3** Aggregates - Fine and coarse aggregates shall conform to current ASTM Specification C-33 "Specification for Concrete Aggregates" except that local aggregates which have been shown by tests and by actual service to produce satisfactory qualities may be used when approved by the Engineer.
- 2.4** Submittals - Test data and/or certifications to the Owner shall be furnished upon request.

**3.0 PROPORTIONING OF CONCRETE**

**3.1 COMPOSITION**

- 3.1.1** The concrete shall be composed of cement, fine aggregate, coarse aggregate and water.
- 3.1.2** The concrete shall be homogeneous, readily placeable, and uniformly workable, and shall be proportioned in accordance with ACI-211.1.
- 3.1.3** Proportions shall be established on the basis of field experience with the materials to be employed. The amount of water used shall not exceed the maximum 0.49 water/cement ratio, and shall be reduced as necessary to produce concrete of the specified consistency at the time of placement.
- 3.1.4** An air-entraining admixture, conforming to the requirements of ASTM C260, shall be used in all concrete furnished under this contract. The quantity of admixture shall be such as to produce an air-content in the freshly mixed concrete of 6 percent plus or minus 1 percent as determined in accordance with ASTM C231 or C173.

**3.2** Qualities Required - As indicated in the table below:

TABLE III-1 QUALITIES REQUIRED	
ITEM	QUALITY REQUIRED
AASHTO Class	A
Type of Cement	I or II
Compressive Strength $f_c$ @ 28 days	4,000 psi
Slump, inches	2 - 4 in.

- 3.3** Maximum Size of Coarse Aggregates - Maximum size of coarse aggregates shall not be larger than 38 mm (1 1/2 inches).
- 3.4** Rate of Hardening of Concrete - Concrete mix shall be adjusted to produce the required rate of hardening for varied climatic conditions:
- Under 40°F Ambient Temperature - Accelerate calcium chloride at 2% is acceptable when used within the recommendations of ACI-306R "Cold Weather Concreteing." Admixtures containing chloride ion in excess of 1% by weight of admixture shall not be used in reinforced concrete.

**4.0 MIXING AND PLACING**

- 4.1** Equipment - Ready Mix Concrete shall be used and shall conform to the "Specifications for Ready-Mix Concrete," ASTM C-94. Approval is required prior to using job mixed concrete.
- 4.2** Preparation - All work shall be in accordance with ACI-304, "Recommended Practice for Measuring, Mixing, Transporting and Placing Concrete." All construction debris and extraneous matter shall be removed from within the forms. Concrete shall be placed on clean surfaces, free from water. Concrete that has to be dropped four (4) feet or more shall be placed through a tremie.
- 4.3** All concrete shall be consolidated by internal mechanical vibration immediately after placement. Vibrators shall be of a size appropriate for the work, capable of transmitting vibration to concrete at frequencies of not less than 4,500 impulses per minute.

**5.0 FORM WORK**

- 5.1** Forms shall be of wood, steel or other approved material and shall be set and held true to the dimensions, lines and grades of the structure prior to and during the placement of concrete.
- 5.2** Forms shall not be removed until the concrete has sufficient strength to prevent concrete damage and/or drainage.

**6.0 CURING**

- 6.1** Fresh concrete shall be protected from rains, flowing water and mechanical injury for a period of four (4) days.

**7.0 REINFORCING STEEL**

**7.1 MATERIAL**

- 7.1.1** All reinforcing bars shall be deformed bars (ASTM-A615) Grade 60.

**7.2 BENDING AND SPLICING**

- 7.2.1** Bar reinforcement shall be cut and bent to the shapes shown on the plans. Fabrication tolerances shall be in accordance with ACI 315. All bars shall be bent cold, unless otherwise permitted.
- 7.2.2** All reinforcement shall be furnished in the full lengths indicated on the plans unless otherwise permitted. Except for splices shown on the plans and splices for No. 5 or smaller bars, splicing of bars will not be permitted without written approval. Splices shall be staggered as far as possible.
- 7.2.3** In lapped splices, the bars shall be placed and wired in such a manner as to maintain the minimum distance to the surface of the concrete shown on the plans.
- 7.2.4** Substitution of different size bars will be permitted only when authorized by the engineer. The substituted bars shall have an area equivalent to the design area, or larger.

**7.3 PLACING AND FASTENING**

- 7.3.1** Steel reinforcement shall be accurately placed as shown on the plans and firmly held in position during the placing and setting of concrete. Bars shall be tied at all intersections around the perimeter of each mat and at not less than 2 foot centers or at every intersection, whichever is greater, elsewhere. Welding of cross bars (tack welding) will not be permitted for assembly of reinforcement.
- 7.3.2** Reinforcing steel shall be supported in its proper position by use of mortar blocks, wire bar supports, supplementary bars or other approved devices. Such devices shall be of such height and placed at sufficiently frequent intervals so as to maintain the distance between the reinforcing and the formed surface or the top surface within 1/4 inch of that indicated on the plans.

**IV - SLOPE COLLARS**

- 1.0** A reinforced concrete slope collar shall be formed and poured at each end of the structures in accordance with the plan dimensions.
- 2.0** The ends of the corrugated structure shall be step beveled as shown on the plans. The reinforced concrete slope collars shall be formed and poured to conform to the backfill at the finished grade of each end.
- 3.0** It must be emphasized that temporary bracing of the beveled ends of the structure may be required during the pipe backfilling and collar construction. Any required temporary bracing should remain in place until the collars and backfilling have been fully completed, and until the concrete in the collars has reached its design strength. The design of the temporary bracing is beyond the scope of this project. Others are responsible for the design of the temporary bracing. Unless the temporary bracing is adequate and supports the structure during filling, the structure could deform and collapse.

**V - SELECT BACKFILL SPECIFICATIONS FOR THE MULTI-PLATE ARCH**

**1.0 GENERAL CONDITIONS**

- 1.1** The contractor shall furnish all labor, materials, and equipment, and perform all work and services necessary to complete in a satisfactory manner the site preparation, excavation, filling, compaction and grading as shown on the plans and as described therein.
- 1.2** This work shall consist of all clearing and grading, removal of existing structures unless otherwise stated, preparation of the land to be filled, spreading and compaction of the fill, and all subsidiary work necessary to complete the grading of the cut and fill areas to conform with the lines, grades, slopes, and specifications.

**2.0 SUBSURFACE CONDITIONS**

- 2.1** The Contractor shall examine, investigate and inspect the construction site as to the nature and location of the work, and the general and local conditions at the construction site, including, without limitation, the character of surface or subsurface conditions and obstacles to be encountered on and around the construction site; and shall make such additional investigation as he may deem necessary for the planning and proper execution of the work.

**3.0 SITE PREPARATION**

- 3.1** Within the specified areas, all debris, existing stockpile material, and structures scheduled for demolition shall be removed and disposed of.
- 3.2** Any rubbish, organic and other objectionable soils, and other deleterious material, shall be disposed of off the site, or as directed by the Owner or his designated representative if on site disposal is provided. In no case shall such objectionable material be allowed in, or under the fill.

**4.0 FORMATION OF FILL AREAS**

**4.1 SELECT BACKFILL**

- 4.1.1** Select backfill shall be placed to a minimum distance of 6 feet horizontally, as measured from the springline of the structure, and to a distance of 3 feet above the crown of the structure as shown on the construction drawings.

**5.0 MINIMUM BACKFILL REQUIREMENTS**

**5.1 MATERIAL**

A granular type of material shall be used around and over the structure. This select structural backfill material shall conform to AASHTO Specification M-145, A-1-a, A-1-b, A-2-4, or A-2-5. Maximum particle size shall not exceed 3 inches. The gradation must conform to the following table:

TABLE V-1 BACKFILL REQUIREMENTS				
GROUP CLASSIFICATION	AASHTO M-145 - TABLE 2 (MODIFIED)*			
	A-1		A-2 (Modified)	
	A-1-a	A-1-b	A-2-4	A-2-5
Sieve Analysis, Percent Passing				
No. 10 (2.00 mm)	50 max.	--	--	--
No. 40 (0.425 mm)	30 max.	50 max.	--	--
No. 100 (1.50 mm)	--	--	50 max.	50 max.
No. 200 (0.075 mm)	15 max.	25 max.	20 max.	20 max.
CHARACTERISTICS OF FRACTION PASSING NO. 40 (0.425 mm)				
Liquid Limit	--	--	40 max.	41 min.
Plasticity Index	6 max.		10 max.	10 max.
USUAL TYPES OF SIGNIFICANT CONSTITUENT MATERIALS	Stone Fragments, Gravel and Sand		Silty or Clayey Gravel and Sand	

- \*Modified to be more select than M-145.  
Additional Backfill Material Requirements:
- Backfill must be dense-graded material. Open-graded or gap-graded materials are not allowed.
  - On-site mixing or blending to achieve specified gradation is not allowed.
  - The maximum particle size shall not exceed 3 inches.
  - The stone particles shall be angular and not rounded.
  - The backfill should have a Los Angeles Abrasion Test loss no greater than 50%. Other backfill materials which provide equivalent long term structural properties in the environmental conditions expected (saturation, freeze-thaw, etc.) may be used. Such materials shall be approved only after thorough investigation and testing by a soils engineer.

**5.2 BACKFILL LIMITS**

The required width of the structural backfill shall be 6 feet minimum outside the springline and to 3 feet over the top of the structure.

**5.3 BACKFILL PLACEMENT**

- Before backfilling, the erected structures shall meet the tolerance and symmetry requirements of AASHTO and Contech.
- Approved backfill material shall be placed in horizontal, uniform layers not exceeding 8" in thickness, before compaction, and shall be brought up uniformly on both sides of the structures. Each layer of backfill shall be compacted to a density of not less than 90%, modified Proctor per AASHTO Test Method No. T-180. Field density tests of each lift of compacted backfill on each side of the structure shall be made at regular intervals during backfill.

Flexible structures, due to their size and shape, are sensitive to the types and weights of equipment used to place and compact the select backfill material. This is especially critical in the areas immediately adjacent to and above the structures. Therefore, equipment types will be restricted in those critical zones. Compaction equipment or methods that produce horizontal or vertical earth pressures which cause excessive distortion or damage to these structures shall not be used.

Contractors should plan to have a D4 (approximately 20,000 lbs.) or similar weight tracked dozer to place and grade backfill immediately alongside and above the structures until minimum cover level is reached. Lightweight vibratory plate or roller type compaction equipment must be used to compact the backfill in these zones. Use of heavier equipment and/or rubber tired equipment such as scrapers, graders and front end loaders are prohibited inside the select fill envelope zone until appropriate minimum cover height has been obtained.

**6.0 SLOPE RATIO AND STORM WATER RUN-OFF**

Protected slopes shall not be greater than 2.0 (horizontal) to one (1) (vertical) in both cut and fill, and storm water shall not be drained over the slopes.

**7.0 GRADING**

The Contractor shall furnish, operate, and maintain such equipment as is necessary to construct uniform layers, and control smoothness of grade for maximum compaction and drainage.

**8.0 COMPACTING**

- 8.1** The compaction equipment shall be approved equipment of such design, weight, and quantity to obtain the required density in accordance with these specifications, without distorting the structures.
- 8.2** During backfill, only small tracked vehicles (D-4 or smaller) shall be near the structures as fill progresses above the crown and to finished grade. The contractor is cautioned that the minimum cover may need to be increased to handle temporary construction vehicle loads (larger than a D-4).


**9.0 TESTING AND INSPECTION SERVICES**

- 9.1** Testing and inspection services will be provided by the Owner.

**9.2** Regular inspection during erection and backfilling is required to achieve a structures with proper shape and backfill compacted to the specified density. Soil materials and compaction methods must be verified by testing which is supplied by the Owner.

**VI - FILTER FABRIC (GEOTEXTILE SCREEN)**

- 1.0** Filter fabric shall be placed at all locations shown on the construction drawings and as necessary to maintain a soil tight system.
- 2.0** Filter fabric cloth shall conform to Contech specification for C60-NW or equivalent and shall meet the following ASTM tests:
- ASTM D4751 - Apparent opening size equal to #70 U.S. Standard Sieve Size.
  - ASTM D4632 (Grab Tensile Test) - Minimum Strength = 160 pounds.
  - ASTM D4632 (Grab Elongation) - 30-70%.
  - ASTM D4533 (Trapezoidal Tear) - Minimum Strength = 60 pounds.
  - ASTM D4355 (Stabilized for Heat and Ultra-Violet Degradation) - 70% strength retained.
- 3.0** The minimum fabric coefficient of permeability (ASTM D4491) shall be 0.24 cm/sec.
- 4.0** The fabric shall be non-woven with a minimum thickness (ASTM D5199) of 60 mils.
- 5.0** Fabric shall not be placed over sharp or angular rocks that could tear or puncture it.
- 6.0** Care should be exercised to prevent any puncturing or rupture of the filter fabric. Should such rupture occur the damaged area should be covered with a patch of filter fabric using an overlap minimum of one (1) foot.

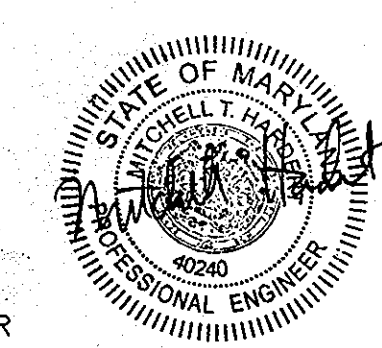

PROFESSIONAL CERTIFICATION:  
I HEREBY CERTIFY THAT THESE DOCUMENTS WERE PREPARED BY ME, AND I AM A DULY LICENSED PROFESSIONAL ENGINEER UNDER THE LAWS OF THE STATE OF MARYLAND, LICENSE NO. 40240, EXPIRATION DATE: 5/13/13

APPROVED: HOWARD COUNTY DEPARTMENT OF PUBLIC WORKS  
*Diane Schwy*, Acting  
 CHIEF, BUREAU OF HIGHWAYS  
 DATE: 11/21/12

APPROVED: HOWARD COUNTY DEPT. OF PLANNING AND ZONING  
*Keith Redmond*  
 CHIEF, DIVISION OF LAND DEVELOPMENT  
 DATE: 12/11/12

*Charles Edmondson*  
 CHIEF, DEVELOPMENT ENGINEERING DIVISION  
 DATE: 12-6-12

		<b>SPECIFICATIONS</b>	
Drawn By DJH/JBE	Date 10/31/12	Approved By Date	Scale CBC Sheet No. 2 of 2 CBC Project No. CBC-14610 Rev. - Sheet 21 of 25





**LEGEND**

- OPEN SPACE AREA
- SINGLE FAMILY DETACHED
- ROAD RIGHT OF WAY (PUBLIC & PRIVATE)
- LIMIT OF SUBMISSION

APPROVED: HOWARD COUNTY DEPARTMENT OF PUBLIC WORKS  
*Diane Ashway*, Acting Chief, Bureau of Highways, 11/28/12  
 APPROVED: HOWARD COUNTY DEPARTMENT OF PLANNING & ZONING  
*Kate DeLoach*, Chief, Division of Land Development, 12/11/12  
*Chad Edwards*, Chief, Development Engineering Division, 12-6-12

**GLWGUTSCHICK LITTLE & WEBER, P.A.**  
 CIVIL ENGINEERS, LAND SURVEYORS, LAND PLANNERS, LANDSCAPE ARCHITECTS  
 3909 NATIONAL DRIVE - SUITE 250 - BURTONSVILLE OFFICE PARK  
 BURTONSVILLE, MARYLAND 20866  
 TEL: 301-421-4024 BALT: 410-899-1820 DC/VA: 301-989-2524 FAX: 301-421-4186

DATE	REVISION	BY	APP'R.
11-17-2014	Added limits of dog park.	DBV	DBV

PREPARED FOR:  
 MAPLE LAWN FARMS I, LLC  
 SUITE 300 WOODHOLME CENTER  
 1829 REISTERSTOWN ROAD  
 BALTIMORE, MD 21208  
 ATTN: MARK BENNETT  
 410-484-8400

**PROFESSIONAL CERTIFICATION**  
 I HEREBY CERTIFY THAT THESE PLANS WERE PREPARED OR APPROVED BY ME, AND THAT I AM A DULY LICENSED PROFESSIONAL ENGINEER UNDER THE LAWS OF THE STATE OF MARYLAND. LICENSE NO. 12875  
 EXPIRATION DATE: MAY 26, 2015  
 11-7-12

**LAND USE PLAN**  
**MAPLE LAWN FARMS**  
 MDTOWN WEST DISTRICT - AREA 2  
 LOTS 93 THRU 177, OPEN SPACE LOTS 178 THRU 183, AND COMMON OPEN AREA LOTS 184 THRU 186

SCALE	ZONING	G. L. W. FILE No.
1" = 80'	MXD-3	11001
DATE	TAX MAP - GRID	SHEET
OCT. 2012	41-21/46-3	22 OF 25



**LANDSCAPE LEGEND**

	EXISTING CONTOUR
	EXISTING TREELINE
	EXISTING TREE
	BOTTOM OF STREAM
	CENTERLINE OF STREAM
	STREAM BUFFER
	LIMIT OF WETLAND
	WETLAND AREA
	WETLAND BUFFER
	EXISTING FOREST CONSERVATION EASEMENT
	LIMIT OF PROPOSED SUBDIVISION
	LIMIT OF DISTURBANCE/EASEMENT
	EASEMENT
	STEEP SLOPES - 15% TO 25%
	STEEP SLOPES - 25% AND GREATER


- LANDSCAPING NOTES:**
- SEE SHEET 7 FOR STREET TREE REQUIREMENTS AND QUANTITIES.
  - LOT PLANTING WILL BE PROVIDED WITH THE SITE DEVELOPMENT PLANS.
  - THE BUFFERS SHOWN IN THE SCHEDULES ARE IN ACCORDANCE WITH THE LANDSCAPE MANUAL ACCORDING TO THE COMPREHENSIVE SKETCH PLAN CRITERIA. THE FOLLOWING ARE THE MINIMUM PLANTINGS TO BE PROVIDED ALONG A PERIMETER EDGE:
 

SHADE TREE:	1.80 LINEAR FEET OF MEASURED PERIMETER EDGE
SMALL ORNAMENTAL DECIDUOUS TREE:	1.60 LINEAR FEET OF MEASURED PERIMETER EDGE
EVERGREEN TREE:	1.20 LINEAR FEET OF MEASURED PERIMETER EDGE
  - AFFORESTATION PLANTING SIZE SHALL BE LARGE ENOUGH TO MEET THE LANDSCAPE BUFFERING REQUIREMENT ALONG EXTERNAL PERIMETERS WHERE APPLICABLE.
  - UNLESS NOTED, ALL STEEP SLOPES AREAS WITHIN THE LIMITS OF SUBMISSION ARE LESS THAN 5,000 S.F.

- NOTES:**
- AT THE TIME OF PLANT INSTALLATION ALL SHRUBS AND TREES LISTED AND APPROVED ON THE LANDSCAPE PLAN SHALL COMPLY WITH THE PROPER HEIGHT REQUIREMENT IN ACCORDANCE WITH THE HOWARD COUNTY LANDSCAPE MANUAL AND THE MFL LANDSCAPE DESIGN CRITERIA. IN ADDITION, NO SUBSTITUTIONS OR REALLOCATIONS OF THE REQUIRED PLANTINGS MAY BE MADE WITHOUT PRIOR REVIEW AND APPROVAL FROM THE DEPARTMENT OF PLANNING AND ZONING. ANY DEVIATION FROM THE APPROVED LANDSCAPE PLAN MAY RESULT IN THE DENIAL OR DELAY IN THE RELEASE OF LANDSCAPE SURETY UNTIL SUCH TIME AS ALL REQUIRED MATERIALS ARE PLANTED AND/OR REVISIONS ARE MADE TO THE APPLICABLE PLANS.
  - THE OWNER, TENANTS AND/OR THEIR AGENTS SHALL BE RESPONSIBLE FOR MAINTENANCE OF THE REQUIRED LANDSCAPING INCLUDING BOTH PLANT MATERIALS AND BERMS, FENCES AND WALLS. ALL PLANT MATERIALS SHALL BE MAINTAINED IN GOOD GROWING CONDITION AND WHEN NECESSARY, REPLACED WITH NEW MATERIALS TO ENSURE CONTINUED COMPLIANCE WITH APPLICABLE REGULATIONS. ALL OTHER REQUIRED LANDSCAPING SHALL BE PERMANENTLY MAINTAINED IN GOOD CONDITION AND WHEN NECESSARY, REPAIRED OR REPLACED.
  - THIS PLAN HAS BEEN PREPARED IN ACCORDANCE WITH SECTION 16.124 OF THE HOWARD COUNTY CODE, THE LANDSCAPE MANUAL, AND THE MFL LANDSCAPE DESIGN CRITERIA. A LANDSCAPE SURETY IN THE AMOUNT OF \$\_\_\_\_\_ WILL BE POSTED TO DFW WITH THE DEVELOPER'S AGREEMENT.

**RESIDENTIAL LOT LANDSCAPE PERIMETER REQUIREMENTS SCHEDULE**

RESIDENTIAL LOT LINE	LENGTH OF SIDE PERIMETER	REQUIRED LANDSCAPING
R1	105'	THE REQUIRED LOT LANDSCAPING PER THE MFL LANDSCAPE DESIGN CRITERIA (5-06-16, SHEET 13 OF 15) SHALL BE PROVIDED AT SCP STAGE
R2	110'	
R3	110'	
R4	108'	
R5	105'	
R6	105'	
R7	105'	
R8	95'	
R9	115'	
R10	105'	
R11	115'	

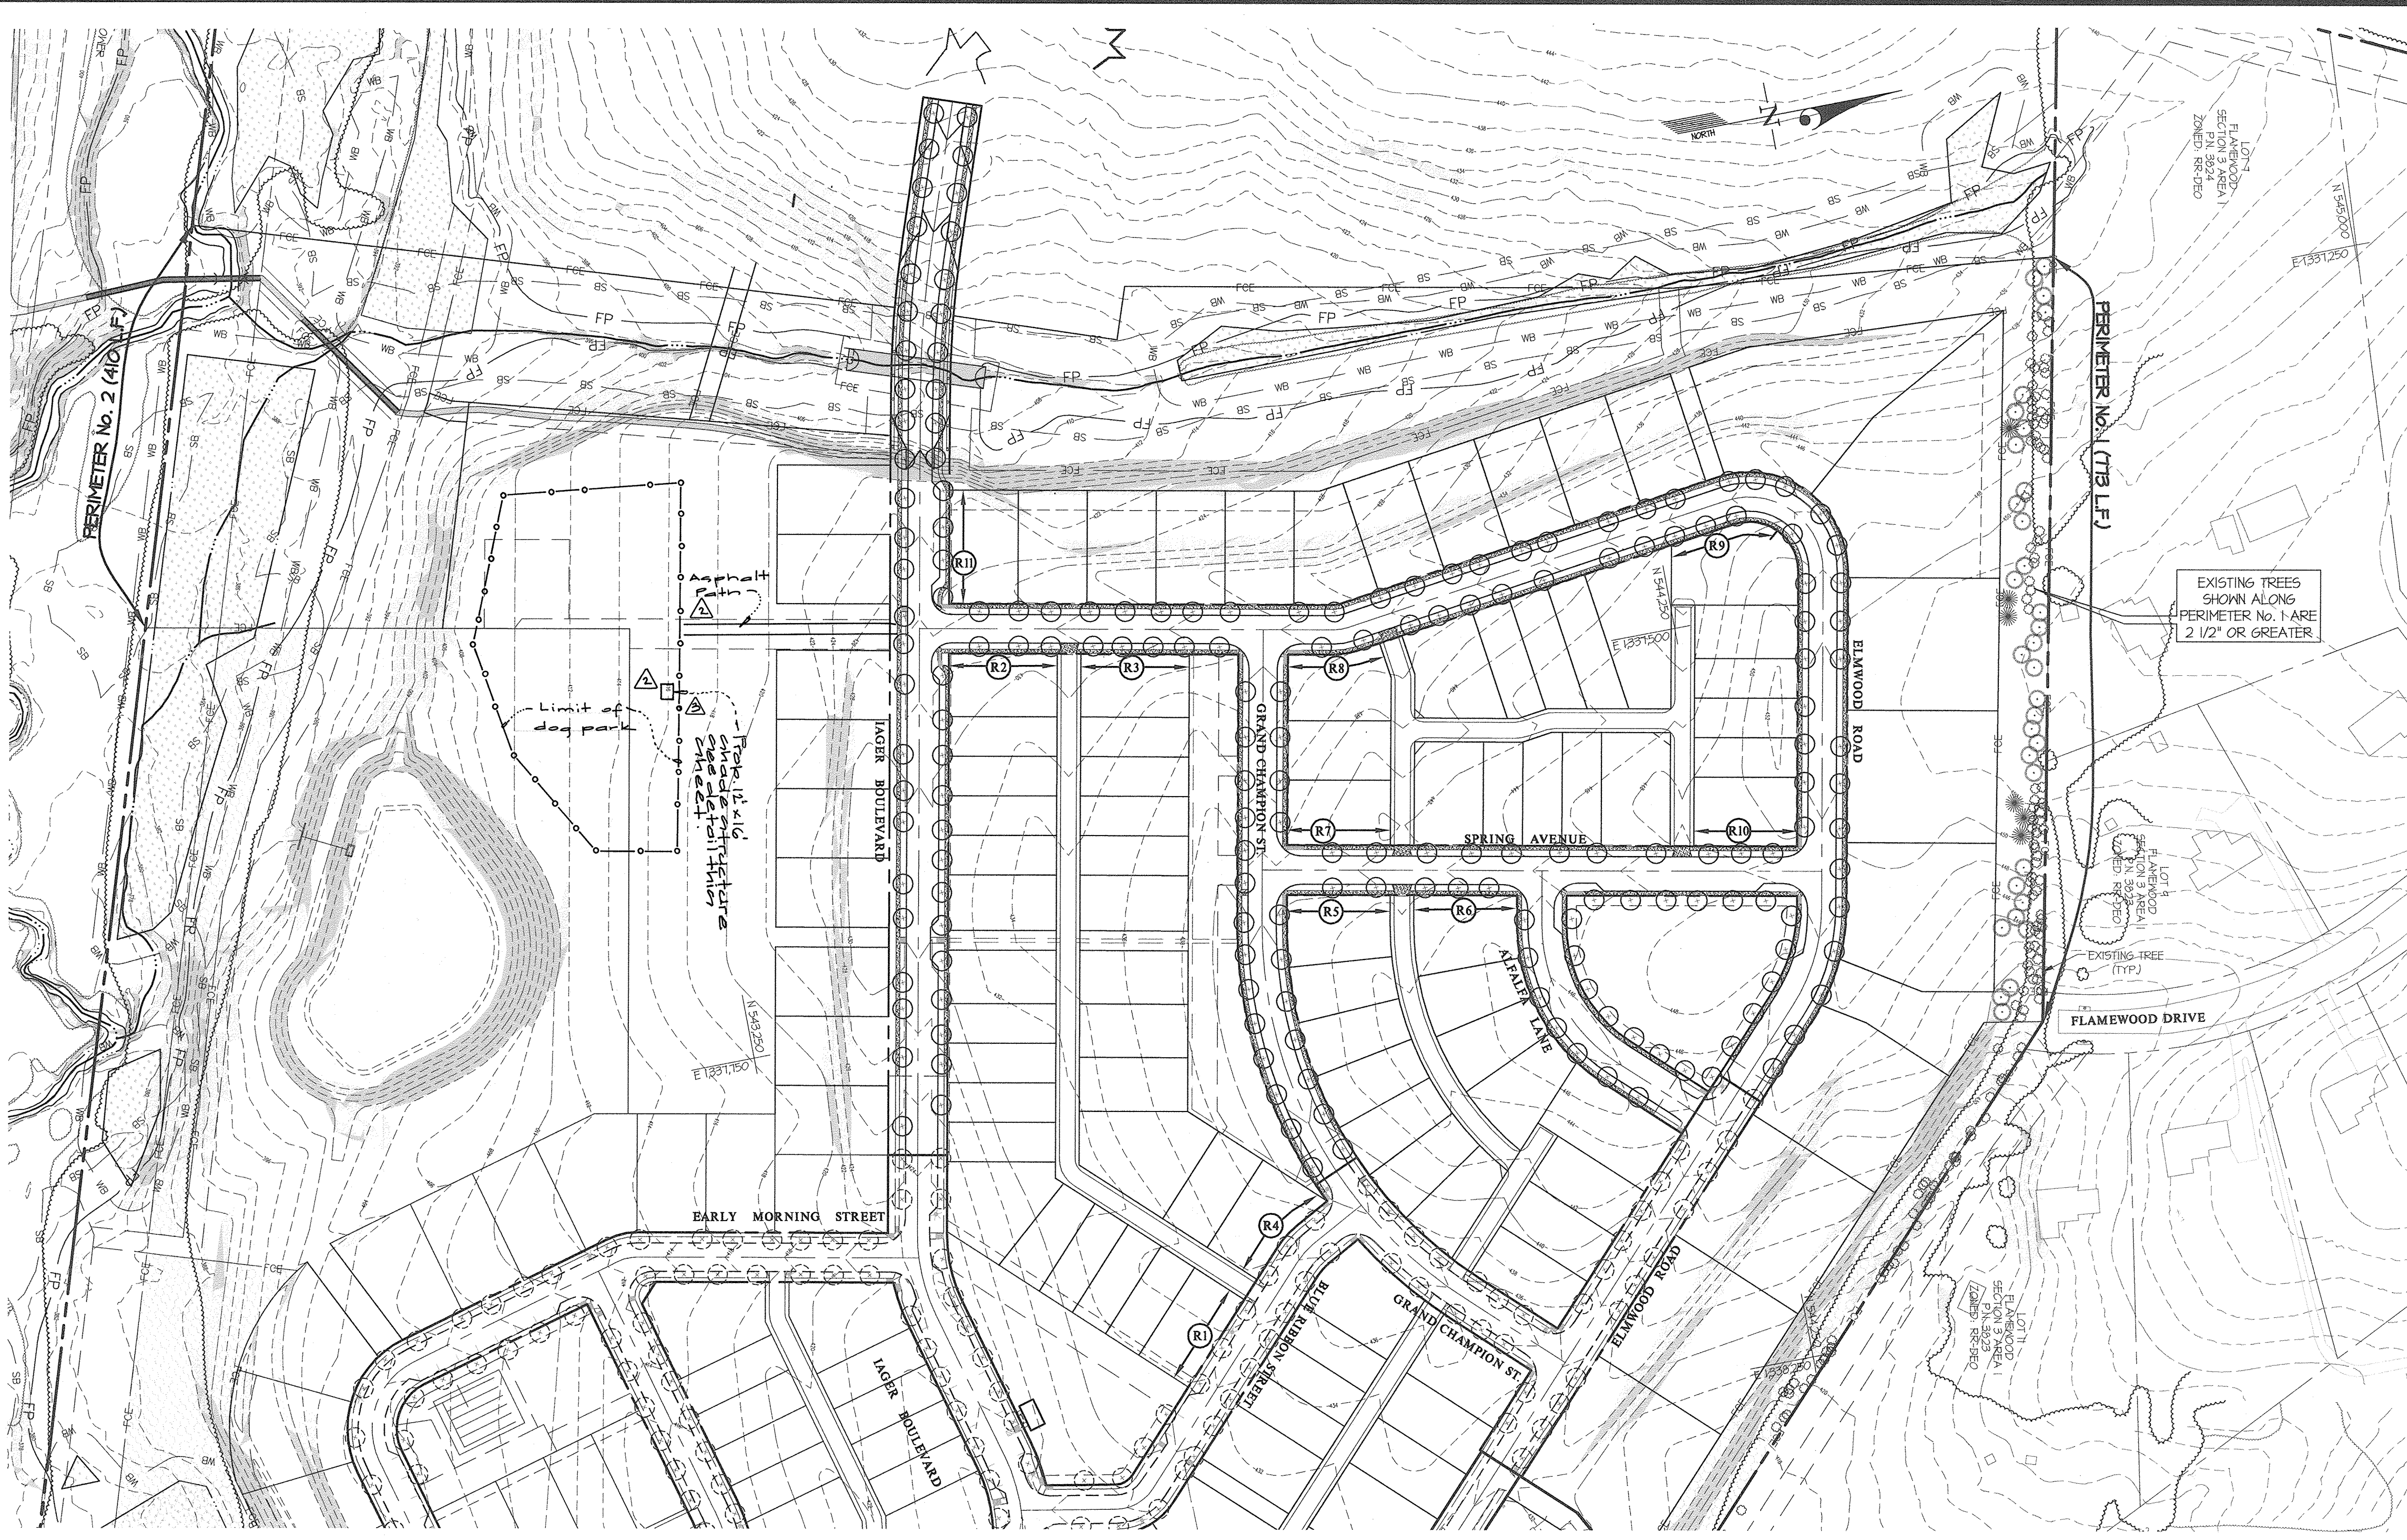

**DEVELOPER'S LANDSCAPE CERTIFICATE**  
 I HEREBY CERTIFY THAT THE LANDSCAPING SHOWN ON THIS PLAN WILL BE DONE ACCORDING TO THE PLAN, SECTION 16.124 OF THE HOWARD COUNTY CODE AND THE LANDSCAPE MANUAL, AND THE MFL LANDSCAPE DESIGN CRITERIA. I FURTHER CERTIFY THAT UPON COMPLETION A LETTER OF LANDSCAPE INSTALLATION ACCOMPANIED BY AN EXIGENT ONE YEAR GUARANTEE OF PLANT MATERIALS, WILL BE SUBMITTED TO THE DEPARTMENT OF PLANNING AND ZONING.

*John B. Smith* Vice Pres. 11/7/12  
 DEVELOPER'S NAME

APPROVED: HOWARD COUNTY DEPARTMENT OF PUBLIC WORKS  
*Diane Ahern* Acting Chief, Bureau of Highway 11/29/12  
 Date

APPROVED: HOWARD COUNTY DEPARTMENT OF PLANNING & ZONING  
*Kestle Joseph* Chief, Division of Land Development 12/11/12  
 Date  
*Chad Egan* Chief, Development Engineering Division 12-6-12  
 Date

**GLWGUTSCHICK LITTLE & WEBER, P.A.**  
 CIVIL ENGINEERS, LAND SURVEYORS, LAND PLANNERS, LANDSCAPE ARCHITECTS  
 3909 NATIONAL DRIVE - SUITE 250 - BURNINGTREE OFFICE PARK  
 BURNINGTREE, MARYLAND 20886  
 TEL: 301-421-4024 BAL: 410-880-1820 DC/VA: 301-989-2524 FAX: 301-421-4186


**EXTERNAL PERIMETER PLANTING SCHEDULE - SCHEDULE A**

PERIMETER	LAND USE	ADJACENT LAND USE	TYPE OF BUFFER	LINEAR FEET OF ROADWAY FRONTAGE/ PERIMETER	NUMBER OF PLANTS REQUIRED			CREDIT FOR EXISTING VEGETATION (YES, NO, LINEAR FEET) DESCRIBE BELOW IF NEEDED.	CREDIT FOR WALL, FENCE OR BERM (YES, NO, LINEAR FEET) DESCRIBE BELOW IF NEEDED.	NUMBER OF PLANTS PROVIDED		
					SHADE TREES	ORNAMENTALS TREES	EVERGREEN TREES			SHADE TREES	ORNAMENTALS TREES	EVERGREEN TREES
PERIMETER 1	SFD RESIDENTIAL	SFD RESIDENTIAL	'A' Buffer	713'	10	13	34	YES (1)	NO	SEE NOTE (1)	SEE NOTE (1)	34
PERIMETER 2	SFD RESIDENTIAL	INSTITUTIONAL	'A' Buffer	410'	5	7	21	YES, 100% (2)	NO	EXISTING WOODLAND (2)		

\* FOLLOWS COMPREHENSIVE SKETCH PLAN GUIDELINE REQUIREMENTS  
 (1) CREDIT FOR EXISTING TREES RETAINED ALONG THIS PERIMETER.  
 (2) CREDIT FOR FOREST RETENTION ALONG THIS PERIMETER.

**PLANT LIST**

SYMBOL	QTY.	NAMES (BOTANICAL / SCIENTIFIC)	SIZE	ROOT	COMMENTS
	35	PINUS STROBILIS WHITE PINE	6'-8" HL.	B4B	
	6	ILEX OPACA AMERICAN HOLLY	6'-8" HL.	B4B	

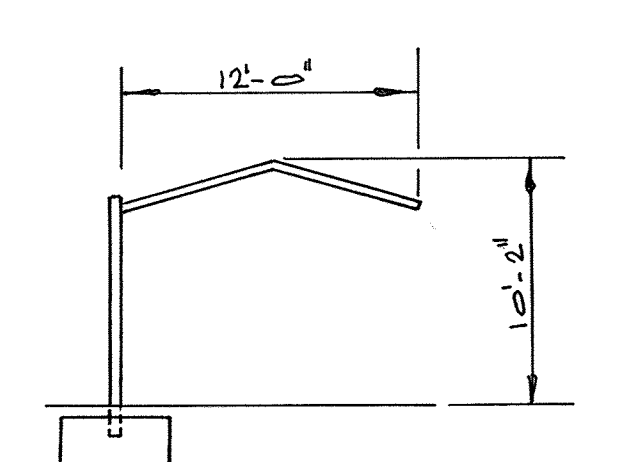


Shade structure side Elevation  
 (see structural Plans for details)

DATE	REVISION	BY	APP'R.
11-17-2014	Added limit of dog park + asphalt path.	DEV. ST	CKG
12-1-2014	Added shade structure within Dog Park limits to side Elev. Detail.	DEV. ST	CKG

PREPARED FOR:  
 MAPLE LAWN FARMS 1, LLC  
 SUITE 300 WOODHOLME CENTER  
 1829 REISTERSTOWN ROAD  
 BALTIMORE, MD 21208  
 ATTN: MARK BENNETT  
 410-484-8400

PROFESSIONAL CERTIFICATION  
 I HEREBY CERTIFY THAT THESE PLANS WERE PREPARED OR APPROVED BY ME, AND THAT I AM A DULY LICENSED PROFESSIONAL ENGINEER UNDER THE LAWS OF THE STATE OF MARYLAND, LICENSE NO. 12375  
 EXPIRATION DATE: MAY 28, 2014

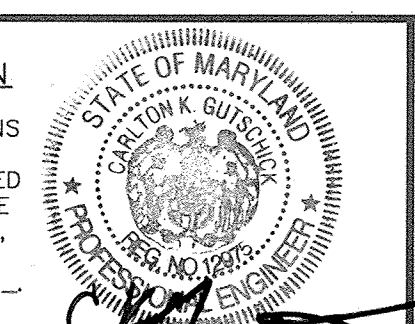


**LANDSCAPE PLAN / NOTES and DETAILS**  
**MAPLE LAWN FARMS**  
 MDTOWN WEST DISTRICT - AREA 2  
 LOTS 93 THRU 177, OPEN SPACE LOTS 178 THRU 183, AND COMMON OPEN AREA LOTS 184 THRU 186

SCALE	ZONING	G. L. W. FILE NO.
1" = 100'	MXD-3	11001
DATE	TAX MAP - GRID	SHEET
OCT. 2012	41-21/46-3	23 OF 25

L:\CADD\DRAWINGS\11001\FINALS\ROADS-5\11001\_23\_L5.dwg PLOTTED: 11/17/2012 9:32 AM, LAST SAVED: 11/16/2012 2:18 PM, PLOTTED BY: Jennifer R. Dick



**FOREST CONSERVATION LEGEND**

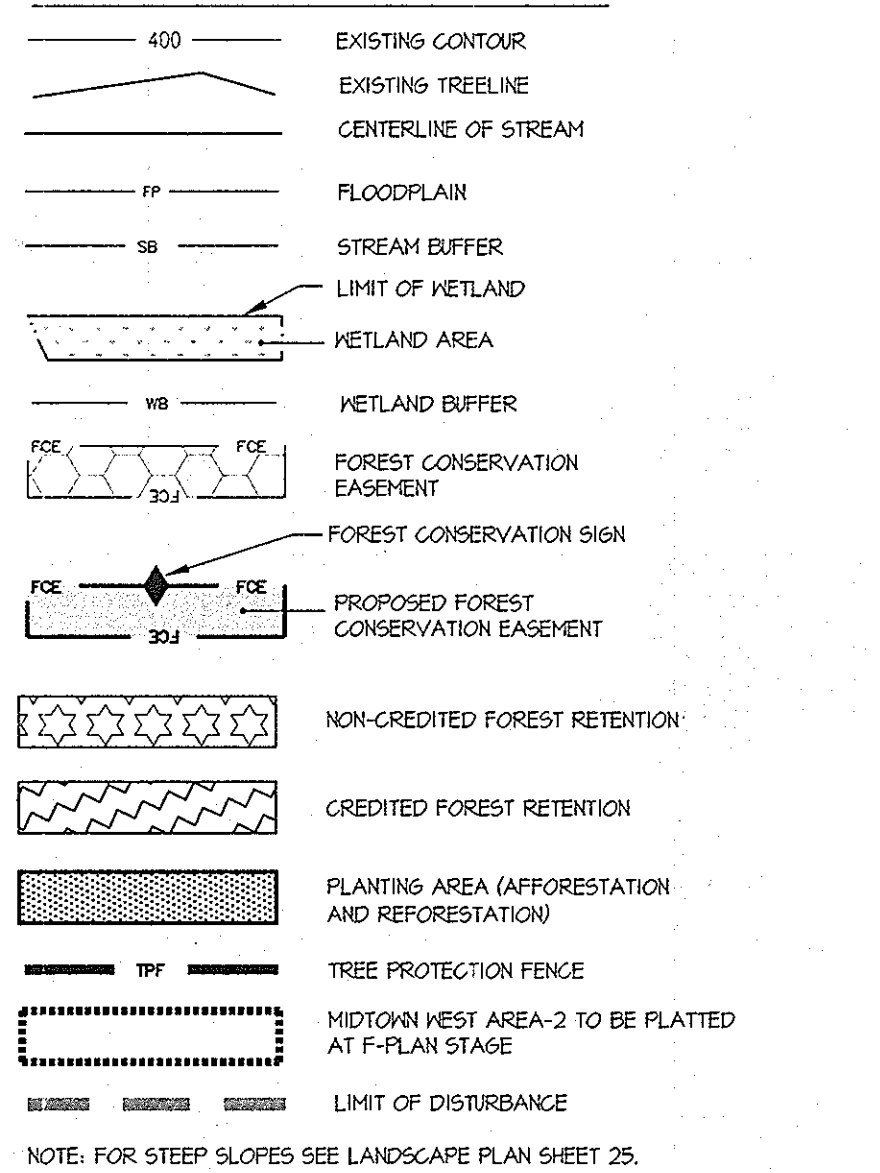


**TREE PLANTING AND MAINTENANCE CALENDAR**

TASKS	MONTHS											
	JAN	FEB	MAR	APR	MAY	JUNE	JULY	AUG	SEPT	OCT	NOV	DEC
TRANSPLANT OF 2" DBH OR GREATER												
PLANTING SEEDLINGS, SOPS												
MAXIMUM MONITORING		*				*				*		
FERTILIZER (IF NEEDED)												
WATER **												
PRUNING												

KEY  
 \* ACTIVITIES DURING THESE MONTHS ARE DEPENDANT UPON GROUND CONDITIONS  
 GREATLY RECOMMENDED  
 RECOMMENDED WITH ADDITIONAL CARE  
 RECOMMENDED  
 + DEPENDANT UPON SITE CONDITIONS  
 \*\* DEPENDANT UPON SITE CONDITIONS; WEEKLY WATERING IS GREATLY RECOMMENDED FROM MAY THROUGH OCTOBER UNLESS WEEKLY RAINFALL EQUALS 1"

**TREE PROTECTION FENCE** NOT TO SCALE

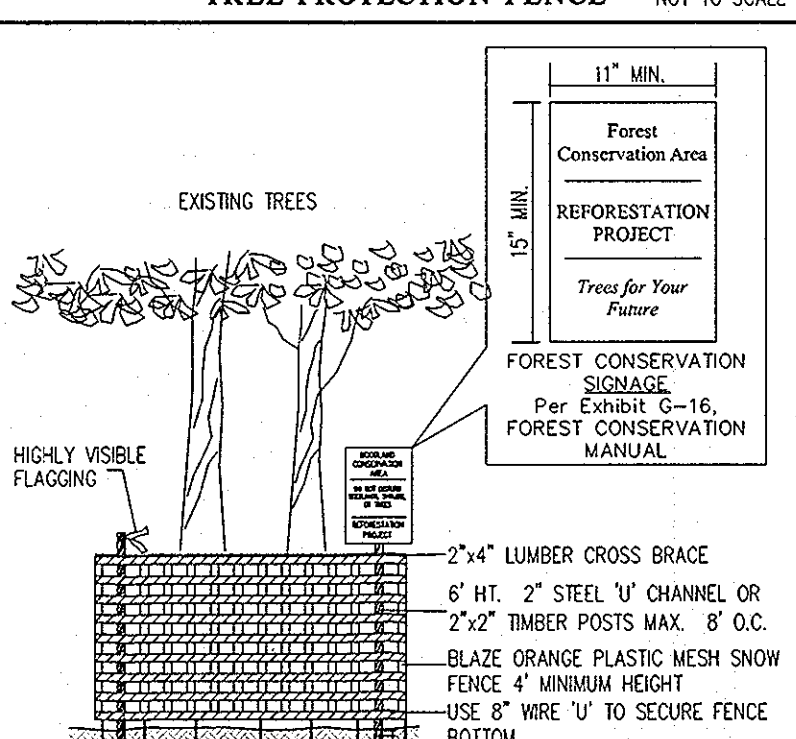

TREE PROTECTION FENCING  
 1. FOREST PROTECTION DEVICE ONLY.  
 2. AVOID ROOT DAMAGE.  
 3. DEVICE MUST BE MAINTAINED THROUGHOUT CONSTRUCTION.


NOTES:  
 1. THE TREE PROTECTION FENCING SHOWN ON THESE PLANS IS TEMPORARY AND SHALL REMAIN IN PLACE DURING CONSTRUCTION ACTIVITY, BUT THE FOREST CONSERVATION SIGNAGE IS PERMANENT AND SHALL REMAIN IN PLACE AROUND THE FOREST CONSERVATION EASEMENTS AFTER THE REMOVAL OF THE TREE PROTECTION FENCING.  
 2. FOREST CONSERVATION SIGNAGE SHALL BE INSTALLED ALONG THE PERIMETER OF THE CONSERVATION EASEMENT AT 50' TO 100' APART AND AT ALL CORNERS WHERE THE EASEMENT CHANGES DIRECTION.  
 3. ATTACHMENT OF SIGNS TO TREES IS PROHIBITED.

APPROVED: HOWARD COUNTY DEPARTMENT OF PUBLIC WORKS  
 Diane Schwegel Acting 11/29/12  
 Chief, Bureau of Highways Date

APPROVED: HOWARD COUNTY DEPARTMENT OF PLANNING & ZONING  
 Keth Schaefer 12/11/12  
 Chief, Division of Land Development Date

Chad Egan 12-6-12  
 Chief, Development Engineering Division Date

**GLWGUTSCHICK LITTLE & WEBER, P.A.**  
 CIVIL ENGINEERS, LAND SURVEYORS, LAND PLANNERS, LANDSCAPE ARCHITECTS  
 3909 NATIONAL DRIVE - SUITE 250 - BURTONSVILLE OFFICE PARK  
 BURTONSVILLE, MARYLAND 20866  
 TEL: 301-421-4024 BALT: 410-880-1820 DC/VA: 301-959-2524 FAX: 301-421-4186

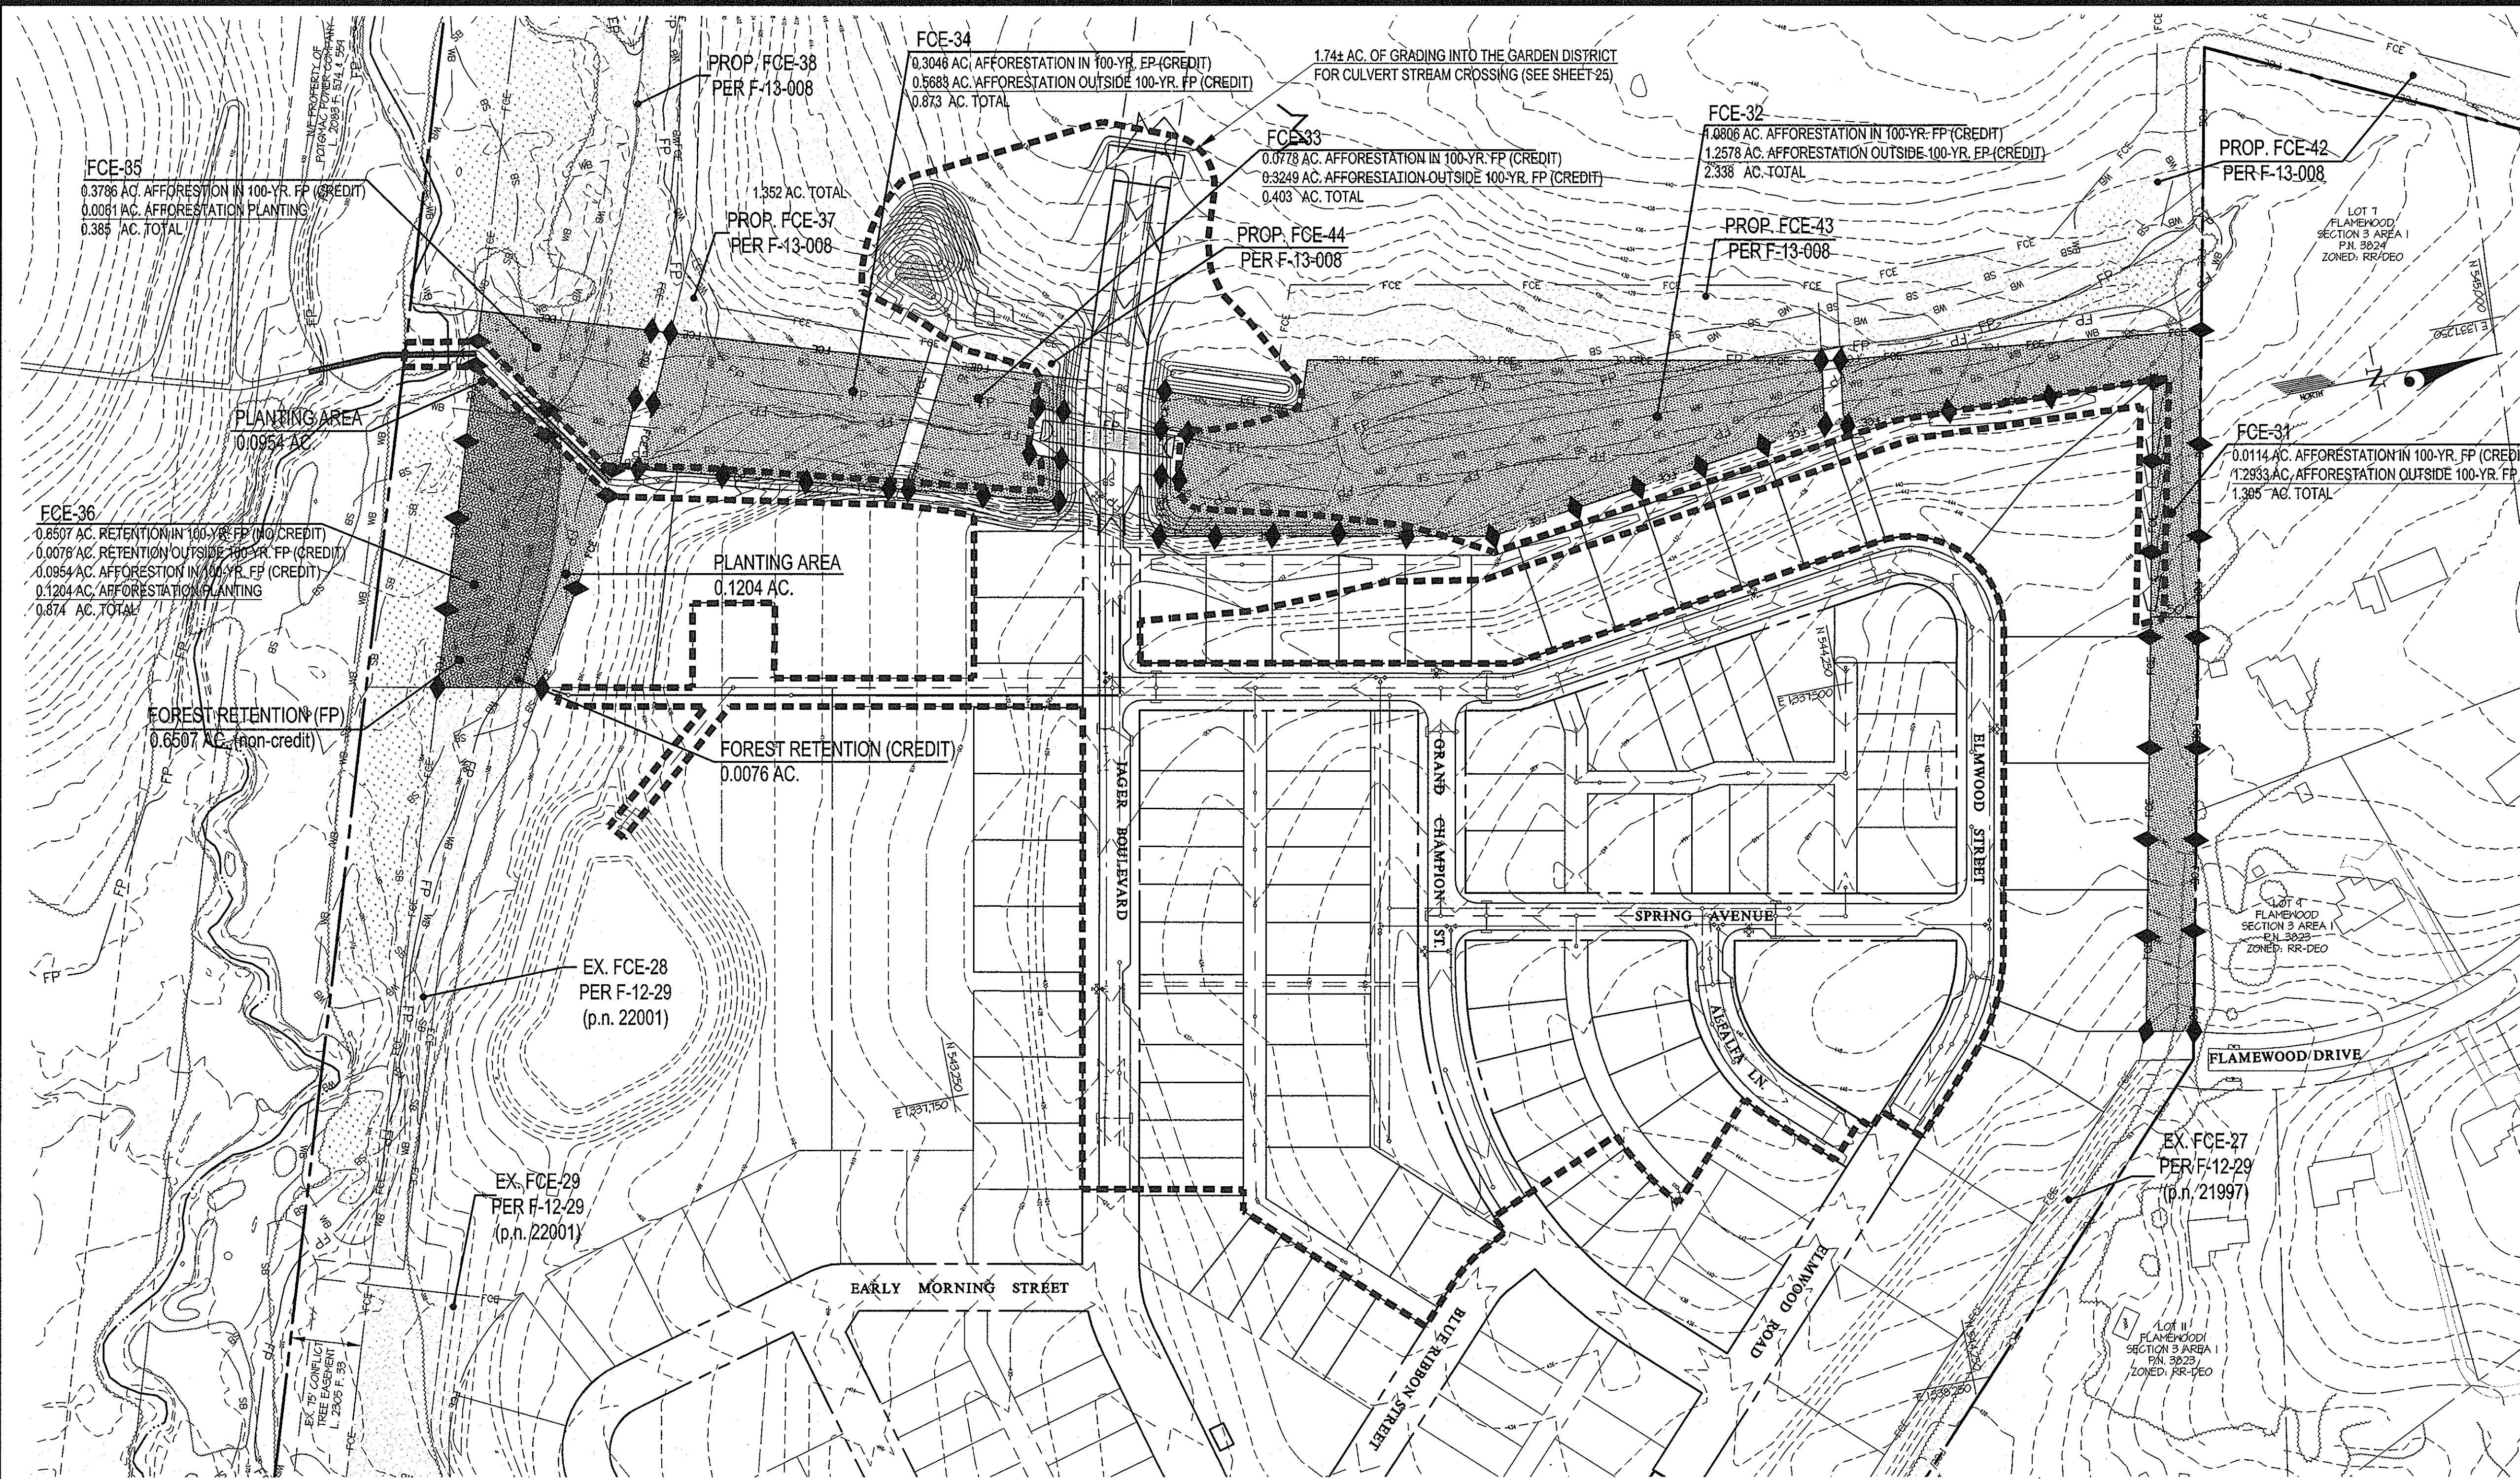

**FOREST CONSERVATION PLANT LIST**

PLANT NAME (BOTANICAL/COMMON)	FOREST PLANTING AREA						TOTAL
	FCE-31	FCE-32	FCE-33	FCE-34	FCE-35	FCE-36	
AMELANGHER CANADENSIS/SERVICEBERRY	4	25	4			5	43
ACER RUBRUM/RED MAPLE	15	74	4	17	20	31	171
CERCIS CANADENSIS/EASTERN REDBUD	15	26	4	17		11	78
LIRIODENDRON TULIPERA/TULIP TREE	10	25	4	17		7	68
PLATANUS OCCIDENTALIS/AMERICAN SYCAMORE (PLANE TREE)	15	74		14	14	26	158
QUERCUS PALUSTRIS/PIN OAK	15						15
QUERCUS RUBRUM/RED OAK	15		4	17		7	48
TOTAL	94	234	40	87	34	87	581

NOTES:  
 1. THE QUANTITY SHOWN ABOVE IS FOR PLANTING WITH 2 1/2" CAL. TREES AT 20' X 20' SPACINGS. EVERGREEN TREES SHALL BE 6'-8" HT.  
 2. LANDSCAPE TREES WITHIN THE FCE AREAS WOULD REDUCE THE ABOVE QUANTITIES ACCORDINGLY.

**FOREST CONSERVATION PLANTING QUANTITY SCHEDULE**


FOREST PLANTING LOCATION NO.	FCE-31	FCE-32	FCE-33	FCE-34	FCE-35	FCE-36	TOTAL
AREA TO BE PLANTED (IN AC.)	1.305	2.34	0.403	0.873	0.305	0.874	6.10
BASE QUANTITY OF 2" CAL. TREES REQUIRED (AT 100 TREES/AC.)	131	234	40	87	34	87	610
CREDIT FOR LANDSCAPE TREES TO BE PLANTED	37*	0	0	0	0	0	37
REQUIRED QUANTITY OF 2" CAL. TREES TO BE PLANTED	94	234	40	87	34	87	581

\* SEE "LANDSCAPE PLAN" SHEET 23 FOR THE 37 EVERGREEN TREES.


PREPARED FOR: MAPLE LAWN FARMS 1, LLC SUITE 300 WOODHOLME CENTER 1829 REISTERSTOWN ROAD BALTIMORE, MD 21208 ATTN: MARK BENNETT 410-484-8400	<b>FOREST CONSERVATION PLAN</b> <b>MAPLE LAWN FARMS</b> MIDTOWN WEST DISTRICT - AREA 2 LOTS 93 THRU 177, OPEN SPACE LOTS 178 THRU 183, AND COMMON OPEN AREA LOTS 184 THRU 186	SCALE 1" = 100'	ZONING MXD-3	G. L. W. FILE No. 11001
DATE OCT. 2012	TAX MAP - GRID 41-21/46-3	SHEET 24 OF 25	HOWARD COUNTY, MARYLAND	

STATE OF MARYLAND  
 Michael B. Tran  
 933  
 11.07.12




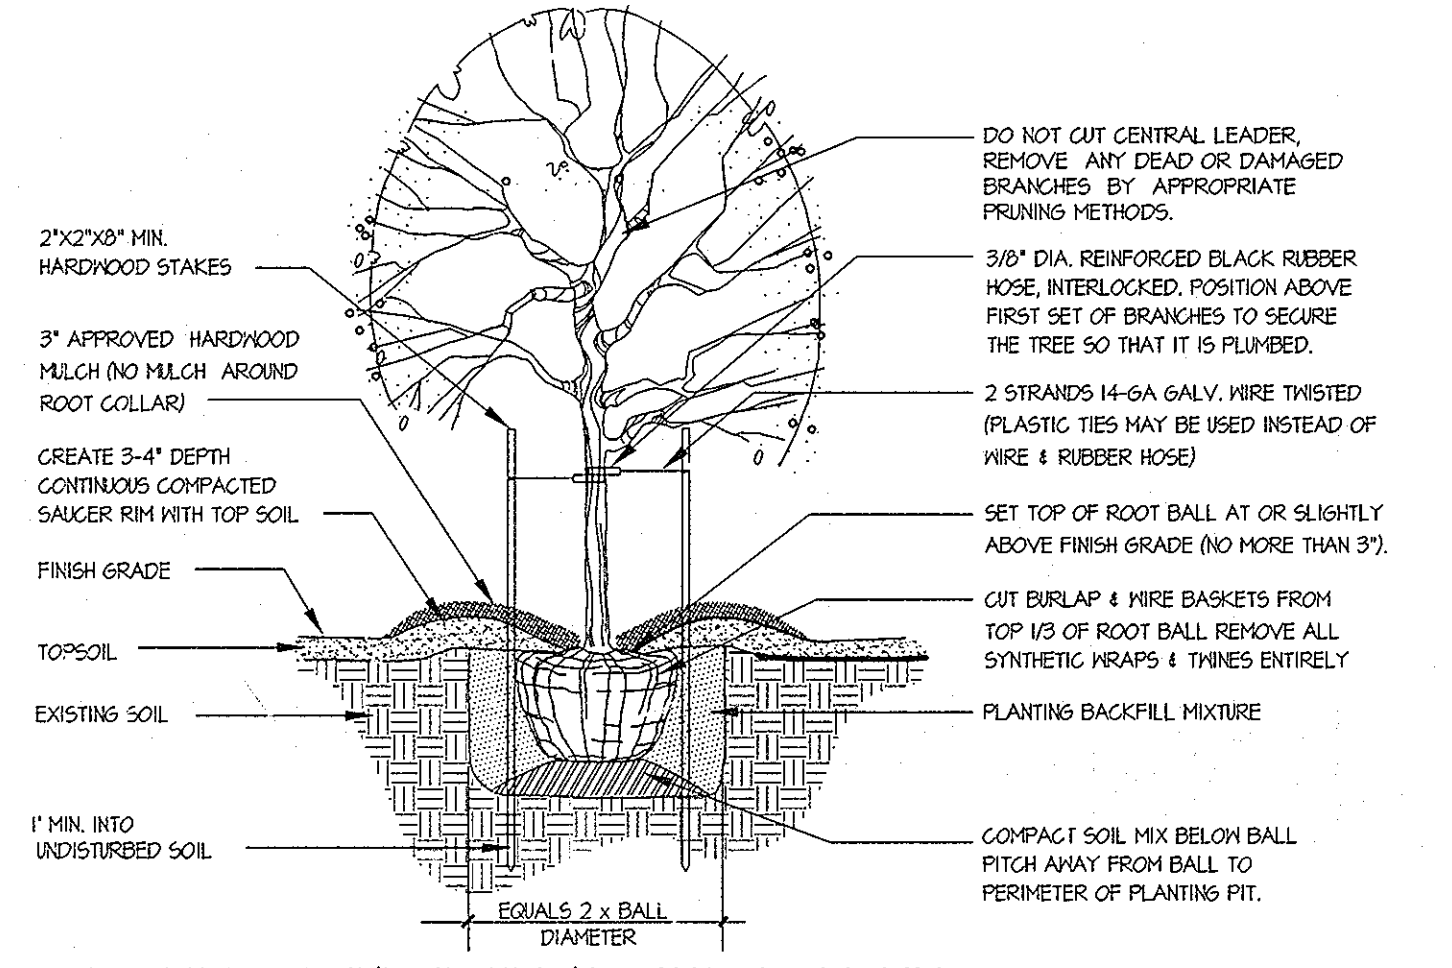

**DECIDUOUS TREE PLANTING DETAIL**  
FOR PLANTING MATERIAL UP TO 2" CALIFER

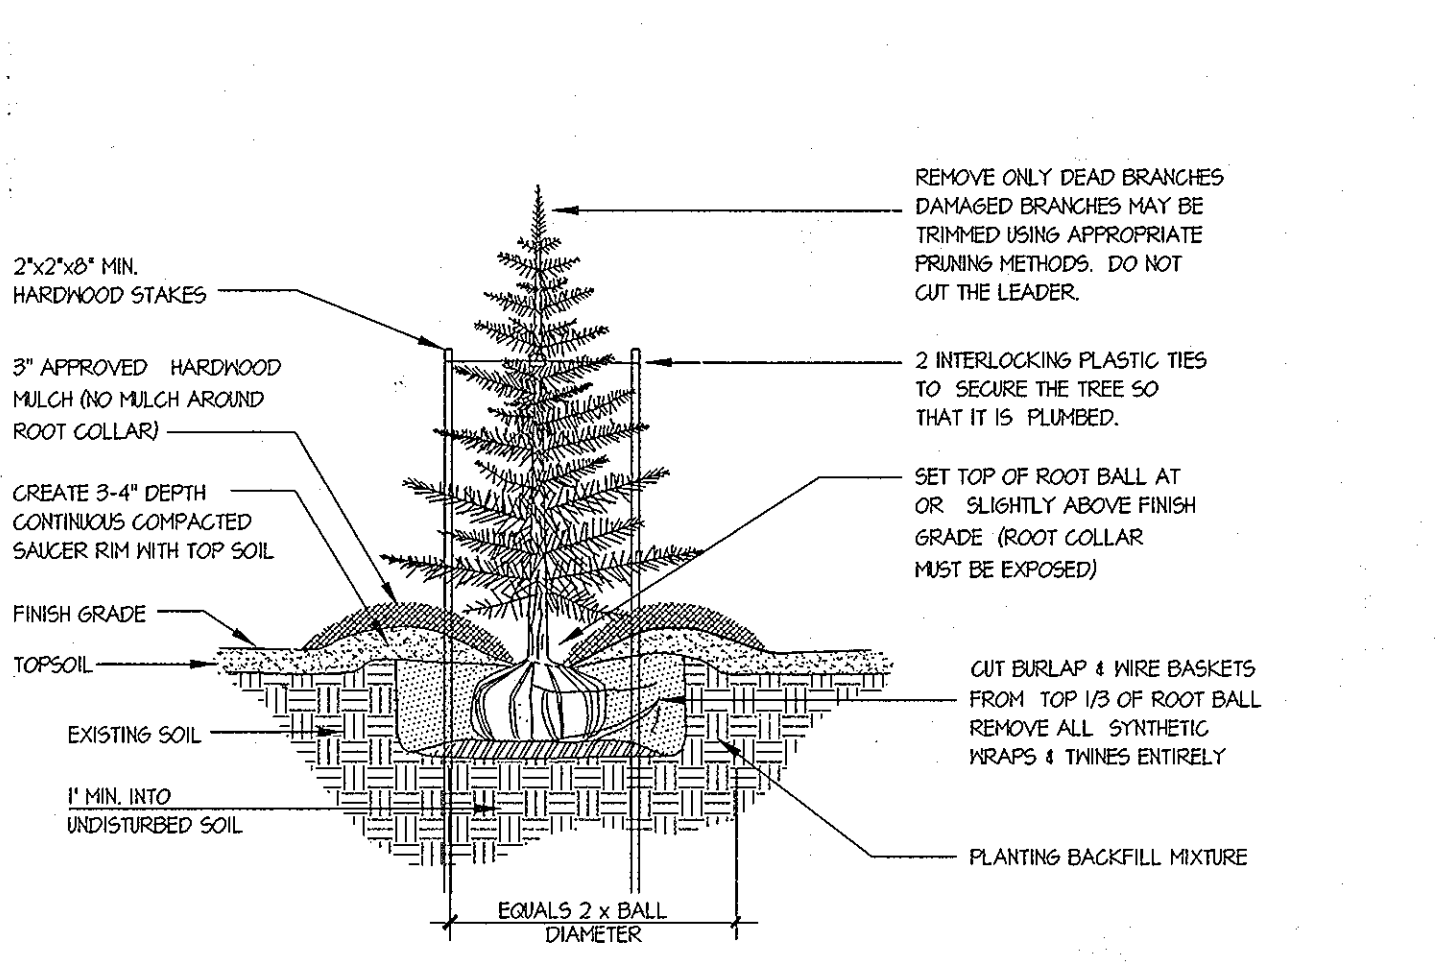

**EVERGREEN TREE PLANTING DETAIL**

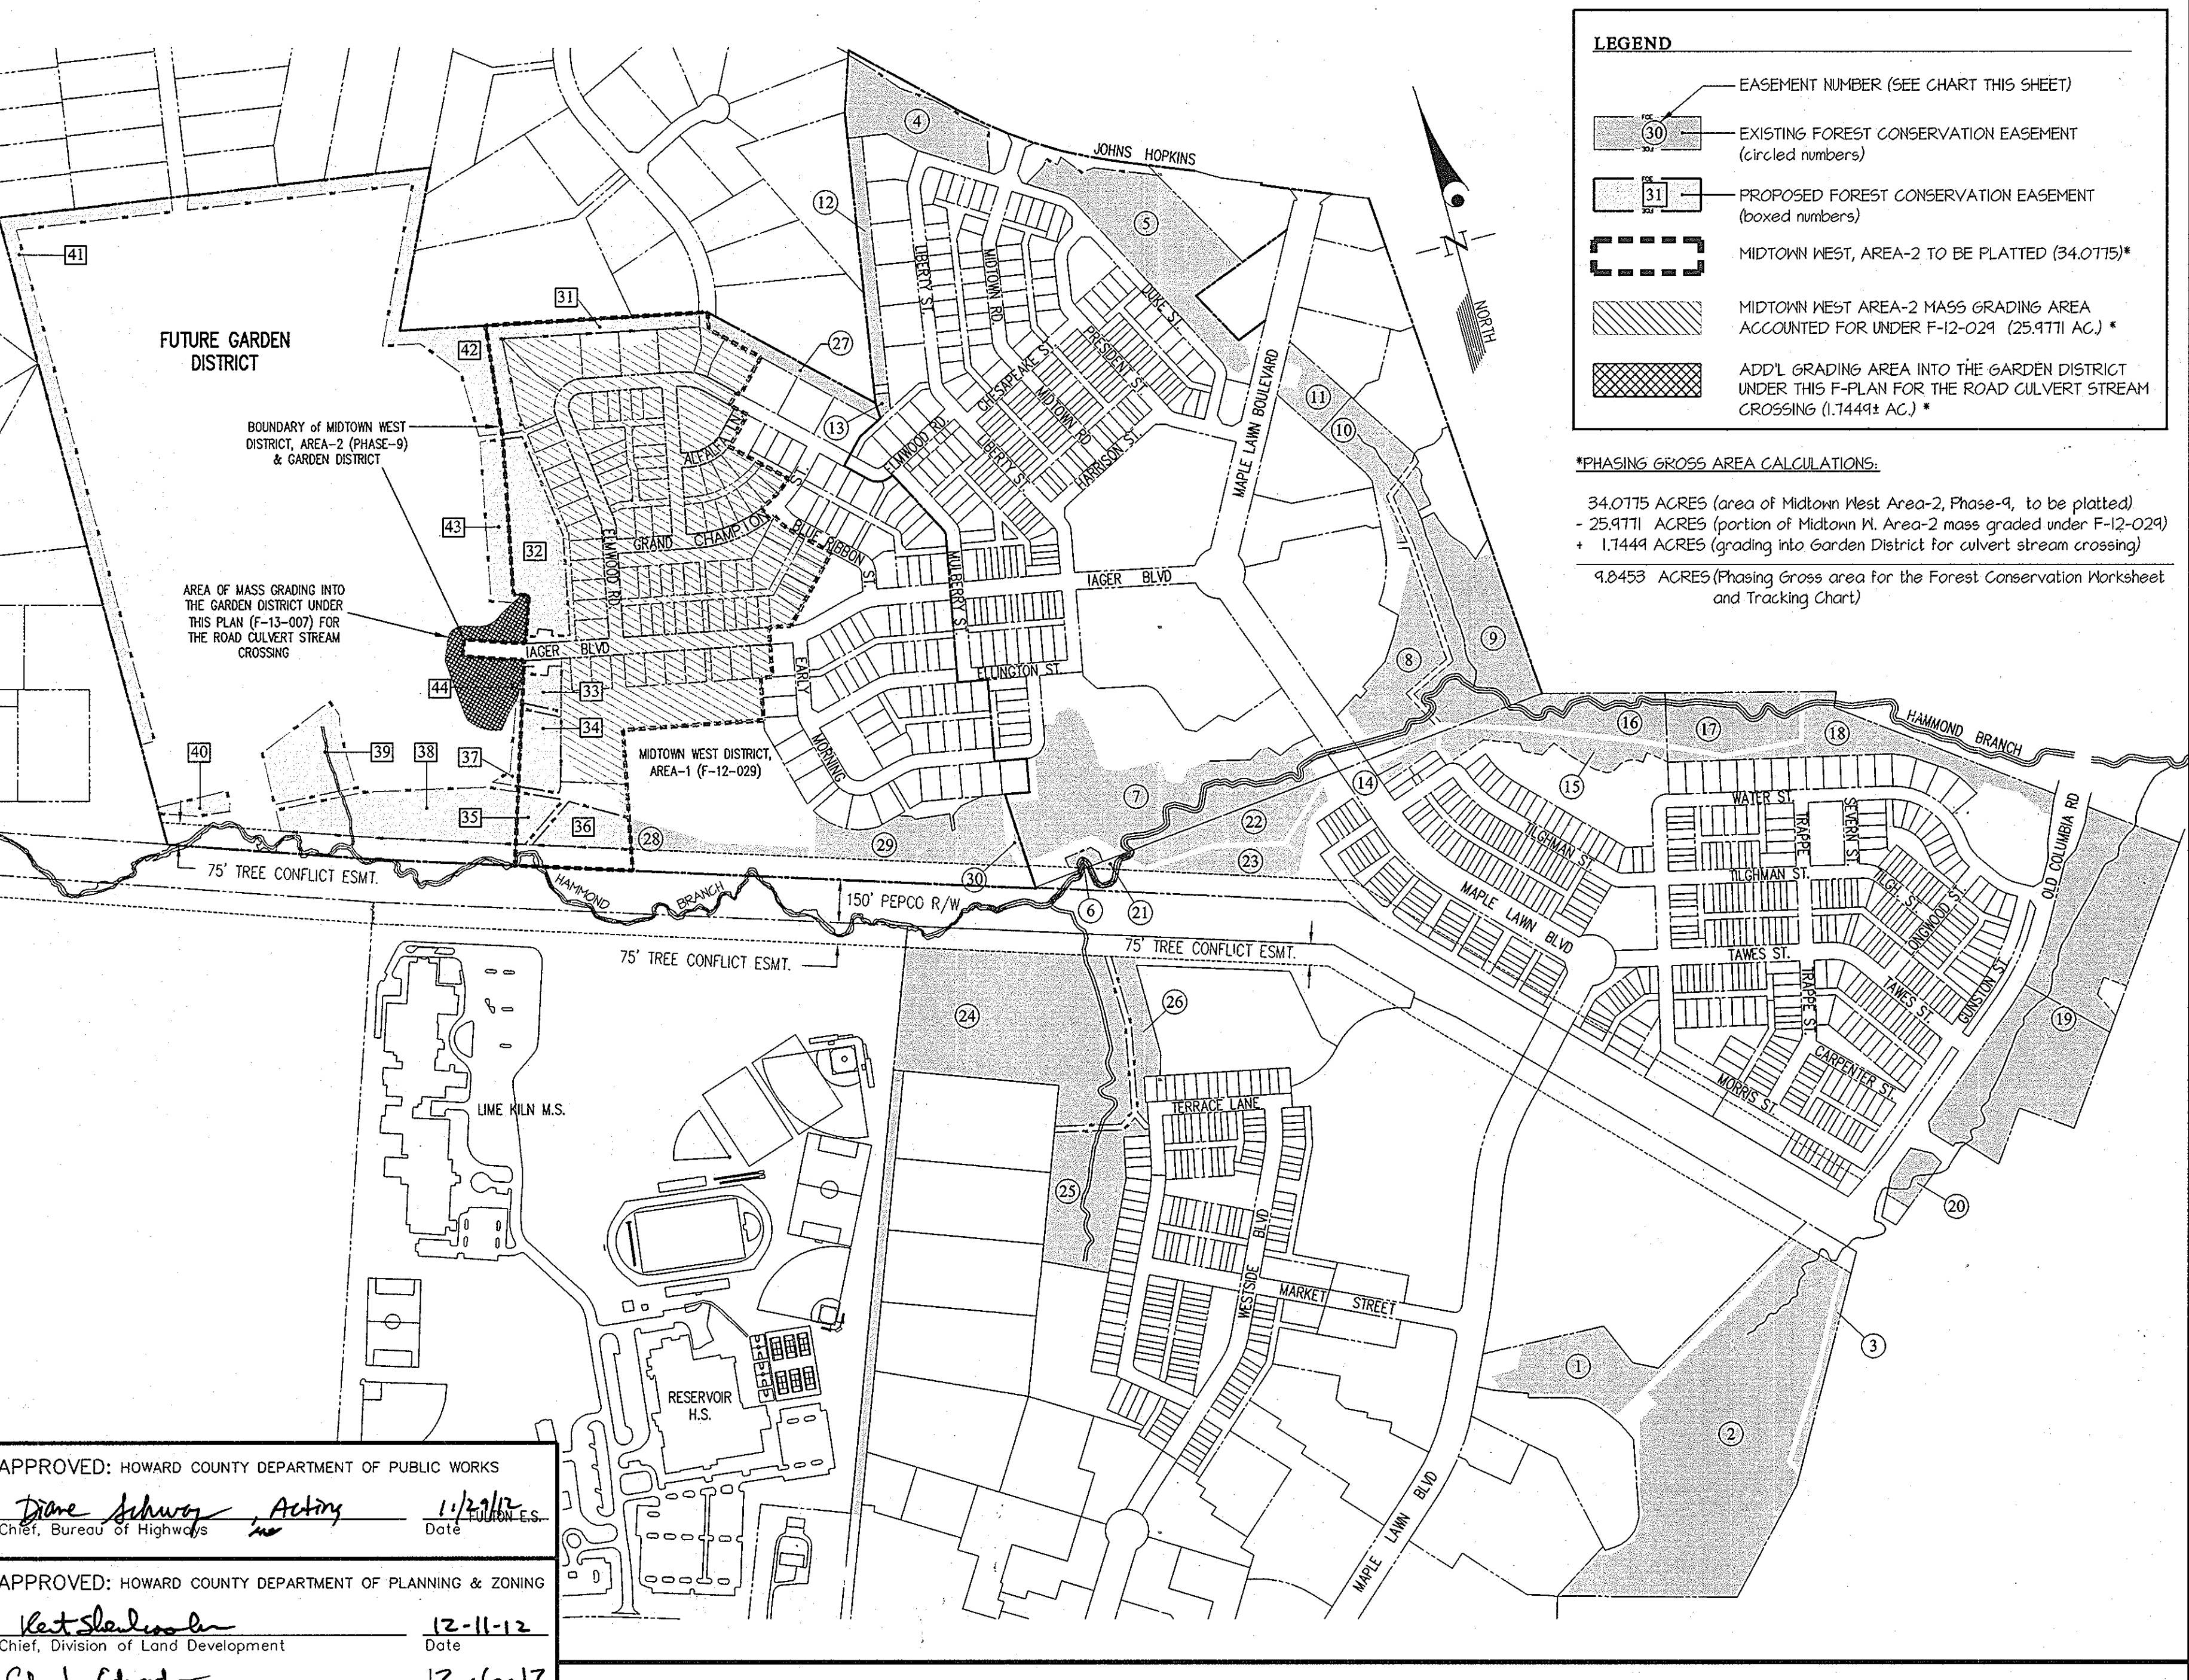

APPROVED: HOWARD COUNTY DEPARTMENT OF PUBLIC WORKS  
Date: 11/20/12

APPROVED: HOWARD COUNTY DEPARTMENT OF PLANNING & ZONING  
Date: 12-11-12

APPROVED: HOWARD COUNTY DEPARTMENT OF PLANNING & ZONING  
Date: 12-6-12

APPROVED: HOWARD COUNTY DEPARTMENT OF PLANNING & ZONING  
Date: 12-6-12

APPROVED: HOWARD COUNTY DEPARTMENT OF PLANNING & ZONING  
Date: 12-6-12

APPROVED: HOWARD COUNTY DEPARTMENT OF PLANNING & ZONING  
Date: 12-6-12

**DIAGRAM OF FOREST CONSERVATION EASEMENTS** SCALE: 1" = 400'

NO.	DATE	REVISION	BY	APPR.

PREPARED FOR:  
MAPLE LAWN FARMS 1, LLC  
SUITE 300 WOODHOLME CENTER  
1829 REISTERSTOWN ROAD  
BALTIMORE, MD 21208  
ATTN: MARK BENNETT  
410-484-8400

FOREST CONSERVATION TRACKING CHART											
RETENTION / AFFORESTATION / REFORESTATION SUMMARY TABLE FOR MAPLE LAWN PROJECT											
PHASE	NEW GROSS ACRES	FLOODPLAIN AREA (AC.)	NET TRACT AREA (AC.)	EX. FOREST AREA (AC.)	FOREST CLEARED	FOREST RETAINED	EXCESS RETENTION	REAFF. REQUIRED	CREDITED PLANTING PROVIDED	EXCESS FOREST CONSERVATION (Planting & Retention)	COMMENTS
1	51.98	3.40	48.58	9.45	0.51	8.94	0.63	-1.14	4.57	-0.70	F-03-07 (created FCE 1-3)
2	75.20 (1)	2.39	72.82	0.00	0.00	0.00	0.00	10.92	6.57	-3.35	F-03-99 (created FCE 4-8)
	5.70 (1)	0.00	5.70	0.00	0.00	0.00	0.00	0.86	0.00	-0.86	SDP-03-140 (for mass grading)
3	19.09 (2)	14.85	4.24	0.21	0.00	0.21	0.00	0.43	10.49	-10.06	F-04-79 (adjusted FCE 4)
											F-04-88 (adjusted FCE 5)
4A	15.48	3.00	12.48	1.92	1.65	0.27	0.00	3.25	0.90	-2.35	F-05-82 (adjusted FCE 7 & 8)
4B	3.12 (3)	0.35	2.77	0.00	0.00	0.00	0.00	0.42	-0.12	-0.54	F-05-81 (created FCE 14-16)
											F-05-189 (adjusted FCE 11)
											F-06-239 (decreased FCE 9-9 and increased FCE-10 by same, net = 0)
4C	3.00	0.00	3.00	0.00	0.00	0.00	0.00	0.45	0.00	-0.45	F-05-112/113 (created ML Blvd R/W to connect Hillside & Business Distr.)
5A	0.00	0.00	0.00	0.00	0.00	0.00	0.00	0.00	0.00	0.00	F-06-43 (re-subdivided parcels from F-05-81)
5B	54.61 (4)	7.27	47.34	3.76	0.51	3.25	0.00	4.36	5.75	-1.39	F-06-161 (created FCE 17-20)
											F-06-162 (adjusted FCE 15)
6A	10.30 (5)	3.84	6.46	0.00	0.00	0.00	0.00	0.97	1.70	-0.73	F-08-72 (created FCE 21-23)
6B	69.86 (6)	1.22	68.64	4.59	2.10	2.49	0.00	9.91	11.22	-1.31	F-08-54 (created FCE 24-26)
	25.05	0.00	25.05	0.00	0.00	0.00	0.00	3.76	0.00	-3.76	SDP-07-43 (for mass grading)
Forestation Planting to be used to fulfill obligation for "Rockland at Rogers" (F-10-64)								2.07		-2.07	F-10-64
Part of 8C (F-12-20)	0.00	0.00	0.00	0.00	0.00	0.00	0.00	0.00	0.00	0.00	F-10-61 (re-subdivided area from F-06-161)
8A	0.00	0.00	0.00	0.00	0.00	0.00	0.00	0.00	0.00	0.00	F-11-127 (re-subdivided area from F-06-161)
8B	0.00	0.00	0.00	0.00	0.00	0.00	0.00	0.00	0.00	0.00	F-12-21 (re-subdivided area from F-08-54)
F-12-015 (No Phase)	9.37	0.00	9.37	0.00	0.00	0.00	0.00	1.40	0.00	-1.40	9.97 (area of C-27 + area of Parcel F) less area of B-1 from PN 19870
Part of 8C (F-12-29)	1.66	0.00	1.66	0.00	0.00	0.00	0.00	0.25	0.00	-0.25	1.6583 ac = area of subdivision to be recorded by the plat for F-12-020
Part of 8C (F-12-29)	56.14 (7)	2.44	53.70	2.34	0.19	2.15	0.00	6.10	1.22	-4.88	F-12-029 (created FCE 27-30)
This F-Plan (F-13-007)	9.85	4.04	5.80	0.01	0.00	0.01	0.00	6.86	5.22	-1.64	F-13-007 (created FCE 31-36)
Forestation Planting to fulfill additional obligation for the construction of a WHC to a lot adjacent to "Rockland at Rogers"								0.03		-0.03	For reference see F-10-054 & F-13-014
<b>Subtotal</b>	<b>410.41</b>	<b>42.79</b>	<b>367.62</b>	<b>22.28</b>	<b>4.96</b>	<b>17.32</b>	<b>0.63</b>	<b>44.88</b>	<b>46.74</b>	<b>-1.85</b>	
Business Distr. Residual Area	10.48 (8)	0	10.48	0	0	0	0	1.57	0	-1.57	
Garden District	74.04	5.68	68.36	0.50	0.01	0.48	0.00	9.79	10.61	0.83	See F-13-008 (for FCE 37-44)
<b>Total</b>	<b>494.93 (9)</b>	<b>48.47</b>	<b>446.45</b>	<b>22.78</b>	<b>4.97</b>	<b>17.80</b>	<b>0.63</b>	<b>56.24</b>	<b>57.35</b>	<b>-1.11</b>	

(1) Includes future phase areas of Maple Lawn Farms. When these areas are recorded in three phases, the forest conservation requirements will already have been met.

(2) 19.09 acres + 99.89 acres (phase 3 site total) = 118.98 acres (area of forest con. in phase 3 already provided by F-03-99 (55.01 ac) and SDP-03-140 (5.70 ac)).

(3) 3.12 acres + 4.38 acres (phase 4 site total) = 7.50 acres (area of forest con. in phase 4 already provided by F-03-99 and F-04-92).

(4) Total area for phase-5B (54.61 ac) = area platted (33.06 ac) + area mass graded under platted area (21.55 ac).

(5) Total area for phase-6A (10.30 ac) = area platted (10.30 ac) + area already provided under F-06-161 (0.00 ac).

(6) Total area for phase-6B (69.86 ac) = area platted (68.64 ac) + area of F-116 (per re-platting (8.21 ac)) + area of SDP-07-43 within limits of this submission (23.79 ac) - area covered by this plan (0.56 ac).

(7) The 56.14 ac = area to be platted under F-12-029 (30.21 ac) + adjacent mass grading area (25.93 ac).

(8) Adjustments for areas in the Business District not yet accounted for in order to total 494.94 acres (see footnote 8B below).

(9) 494.93 acres = entire gross areas of the 6 Districts of MLP (Hillside, Westside, Midtown, Hillside, Midtown West and Garden). The 494.93 acres does not include the Old Farm District.

**NOTE:** The entire MLP project is in an afforestation condition. Due to afforestation, the forest area is 1.44 acres greater than the area of forest con. in phase 3 already provided by F-03-99 (55.01 ac) and SDP-03-140 (5.70 ac). However, this means condition created an artificial offset planting requirement (through conservation). The adjusted values shown in the table below are for the three phases minus the offset planting requirement and with the overall Forest Conservation Worksheet for 6 of the MLP Districts (Hillside, Midtown, Hillside, Midtown West and Garden).

FOREST CONSERVATION WORKSHEET		Acres
<b>1 Site Data</b>		
A. Gross Site Area (of Midtown West, Area-2, adjusted for phased development)		9.845
B. Area within 100-y floodplain		4.043
C. Net Tract Area		5.802
E. Land Use Category		RR-MXD3
<b>2 Input Data</b>		
A. Net Tract Area		5.802
B. Reforestation Threshold (percent of net tract = 15%)		0.870
C. Afforestation Threshold (percent of net tract = 15%)		0.870
D. Existing Forest on Net Tract Area		0.006
E. Forest Clearing on Net Tract Area		0.000
F. Forest Retention on Net Tract Area		0.008
<b>3 Reforestation and/or Afforestation Calculations</b>		
A. Net tract forest clearing above reforestation threshold, if applicable		0.00
B. Net tract forest clearing below reforestation threshold, if applicable		0.00
C. Planting up to afforestation threshold, if applicable		0.86
D. Reforestation planting required for clearing above threshold (3A x 0.25)		0.00
E. Reforestation planting required for clearing below threshold (3B x 2.0)		0.00
F. Net tract forest retention above reforestation threshold (2F-2B, available credit)		0.00
G. Total reforestation planting required for MLF (3C+3D+3E-3F)		0.86
<b>4 Break Even Point (BEP) Calculations</b>		
A. Maximum clearing allowed with no reforestation planting (2D-2B)/1.25		Not Applicable
B. Minimum net tract retention at BEP 0.20(2D-2B)+2B or 2D-4A		Not Applicable
<b>5 Forest Conservation Required</b>		
A. Forest Retention Area (2F)		0.01
B. Forest Planting Area (3G)		0.86
C. Total minimum FCE required for retention and reforestation		0.87

FOREST CONSERVATION EASEMENT AREAS											
District	Phase	File No.	Easement	Forest Retention on Net Tract (Credits)	Forest Retention on Net Tract (Non-Credits)	Forest Planting on Net Tract	Forest Planting on Net Tract	TOTAL			
Business	1	F-03-07	1	0.88	0.21	1.27	0.00	2.49			
			2	7.90	7.02	0.88	0.00	15.80			
			3	0.36	0.05	0.00	0.00	0.41			
			4	0.00	0.00	0.00	0.00	0.00			
			5	0.00	0.00	0.00	0.00	0.00			
			6	0.00	0.00	0.00	0.00	0.00			
			7	0.00	0.00	0.00	0.00	0.00			
			8	0.00	0.00	0.00	0.00	0.00			
			9	0.00	0.00	0.00	0.00	0.00			
			10	0.00	0.00	0.00	0.00	0.00			
Midtown and Hillside	3	F-04-92	1	0.00	0.00	0.00	0.00	0.00			
			2	0.15	0.00	1.03	0.00	1.18			
			3	0.00	0.00	0.00	0.00	0.00			
			4	0.00	0.00	0.00	0.00	0.00			
			5	0.00	0.00	0.00	0.00	0.00			
			6	0.00	0.00	0.00	0.00	0.00			
			7	0.00	0.00	0.00	0.00	0.00			
			8	0.00	0.00	0.00	0.00	0.00			
			9	0.00	0.00	0.00	0.00	0.00			
			10	0.00	0.00	0.00	0.00	0.00			
Westside	4	F-05-81	1	0.00	0.00	0.00	0.00	0.00			
			2	0.00	0.00	0.00	0.00	0.00			
			3	0.00	0.00	0.00	0.00	0.00			
			4	0.00	0.00	0.00	0.00	0.00			
			5	0.00	0.00	0.00	0.00	0.00			
			6	0.00	0.00	0.00	0.00	0.00			
			7	0.00	0.00	0.00	0.00	0.00			
			8	0.00	0.00	0.00	0.00	0.00			
			9	0.00	0.00	0.00	0.00	0.00			
			10	0.00	0.00	0.00	0.00	0.00			
Hillside	5	F-06-161	1	0.01	1.97	0.02	0.00	2.00			
			2	0.00	0.00	1.00	0.00	1.00			
			3	0.00	0.00	0.00	0.00	0.00			
			4	0.00	0.00	0.00	0.00	0.00			
			5	0.00	0.00	0.00	0.00	0.00			
			6	0.00	0.00	0.00	0.00	0.00			
			7	0.00	0.00	0.00	0.00	0.00			
			8	0.00	0.00	0.00	0.00	0.00			
			9	0.00	0.00	0.00	0.00	0.00			
			10	0.00	0.00	0.00	0.00	0.00			
Midtown West	6A	F-08-72	1	0.00	0.00	0.00	0.00	0.00			
			2	0.00	0.00	0.00	0.00	0.00			
			3	0.00	0.00	0.00	0.00	0.00			
			4	0.00	0.00	0.00	0.00	0.00			
			5	0.00	0.00	0.00	0.00	0.00			
			6	0.00	0.00	0.00	0.00	0.00			
			7	0.00	0.00	0.00	0.00	0.00			
			8	0.00							