

PARKSIDE ESTATES

LOTS 2 THRU 6 AND OPEN SPACE LOTS 1 & 7

FINAL CONSTRUCTION PLANS

LEGEND

- EXISTING CONTOURS
- PROPOSED CONTOURS
- SOIL DELINEATION
- EXISTING FOREST LINE
- PROPOSED WOODS LINE
- PROPERTY BOUNDARY
- EXISTING TREES
- EXISTING TREES TO BE REMOVED
- EXISTING HOUSES
- PROPOSED HOUSES
- PROPOSED PAVEMENT
- FACILITY DRAINAGE AREA
- LIMIT OF DISTURBANCE
- 30' PUBLIC WATER, SEWER & UTILITY EASEMENT
- 24' PRIVATE ACCESS & DRAINAGE EASEMENT FOR THE BENEFIT OF LOTS 2-7
- 10' PUBLIC TREE MAINTENANCE EASEMENT
- 15' PRIVATE DRAINAGE EASEMENT


DOC STORMWATER MANAGEMENT CHART

LOT NUMBER	MICRO-BIORETENTION M-6 (NUMBER)
LOT 2	1
LOT 3	1
LOT 4	1
LOT 5	1
LOT 6	1

BENCHMARKS NAD'83 HORIZONTAL

GPS#1
REBAR AND CAP SET NORTH SIDE TO THE REAR OF SUBJECT PROPERTY WITHIN PROPERTY BOUNDARY.
N 528709.91' E 1359118.00'
ELEVATION: 262.22'

GPS#2
REBAR AND CAP SET NORTH SIDE TO THE FRONT OF SUBJECT PROPERTY OUTSIDE OF PROPERTY BOUNDARY.
N 528570.97' E 1358878.47'
ELEVATION: 262.29'

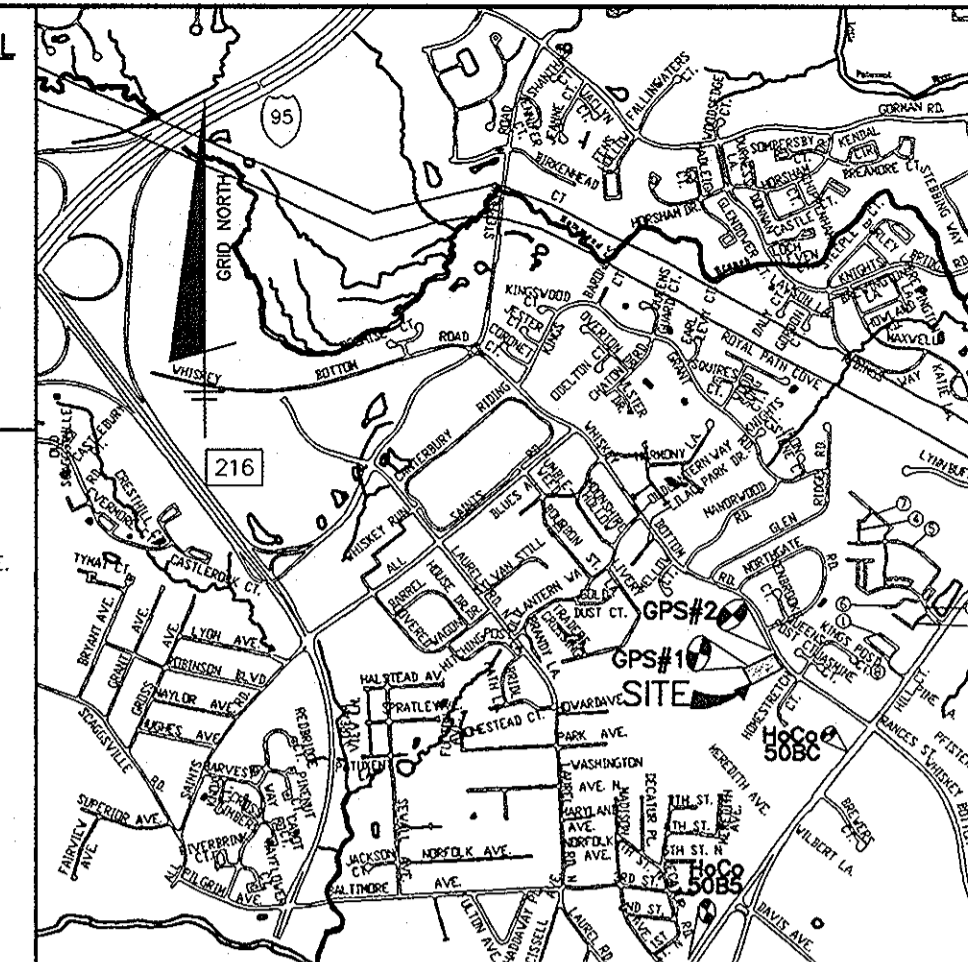

GENERAL NOTES

- ALL CONSTRUCTION SHALL BE IN ACCORDANCE WITH THE LATEST STANDARDS AND SPECIFICATIONS OF HOWARD COUNTY PLUS MSHA STANDARDS AND SPECIFICATIONS IF APPLICABLE.
- SUBJECT PROPERTY ZONED R-SC PER THE 2-2-04 COMPREHENSIVE ZONING PLAN AND THE COMP LITE ZONING AMENDMENTS EFFECTIVE 7-28-06.
- THE CONTRACTOR SHALL NOTIFY THE DEPARTMENT OF PUBLIC WORKS/BUREAU OF ENGINEERING /CONSTRUCTION INSPECTION DIVISION AT 410-313-1880 AT LEAST FIVE (5) WORKING DAYS PRIOR TO THE START OF WORK.
- THE CONTRACTOR SHALL NOTIFY WES UTILITY AT 1-800-257-7777 AT LEAST 48 HOURS PRIOR TO ANY EXCAVATION WORK IS DONE.
- IF APPLICABLE, TRAFFIC CONTROL DEVICES, MARKINGS AND SIGNING SHALL BE IN ACCORDANCE WITH THE LATEST EDITION OF THE MANUAL OF UNIFORM TRAFFIC CONTROL DEVICES (MUTCD).
- THIS PROJECT IS SUBJECT TO THE AMENDED FIFTH EDITION OF THE SUBDIVISION AND LAND DEVELOPMENT REGULATIONS PER COUNCIL BILL NO 45-2003, EFFECTIVE 10-02-03 AND THE ZONING REGULATIONS AMENDED BY COUNCIL BILL 75-2003. DEVELOPMENT OR CONSTRUCTION ON THESE LOTS MUST COMPLY WITH SETBACK AND BUFFER REGULATIONS IN EFFECT AT THE TIME OF SUBMISSION OF THE SITE DEVELOPMENT PLAN, WAIVER PETITION APPLICATION, OR BUILDING/GRADING PERMIT.
- PROJECT BOUNDARY AND TOPOGRAPHY WITHIN THE SUBDIVISION AREA ARE BASED ON FIELD RUN BOUNDARY SURVEY AND TOPO PERFORMED BY BENCHMARK ENGINEERING INC. DATED JULY, 2011.
- EXISTING OFFSITE TOPOGRAPHY SHOWN HEREON IS BASED ON HOWARD COUNTY GIS.
- THE COORDINATES SHOWN HEREON ARE BASED UPON GLOBAL POSITIONING SYSTEM COORDINATES WHICH ARE BASED UPON THE MARYLAND STATE PLANE COORDINATE SYSTEM. GPS#1 AND GPS#2 AS DEFINED ON THIS SHEET WERE USED FOR THIS PROJECT.
- PREVIOUS DPZ SUBMISSIONS: EOP-12-007 APPROVED SEPTEMBER 14, 2011, WP-12-023 (VOIDED), F-12-048 (VOIDED)-WITHDRAWN MARCH 5, 2012, WP-13-094.
- NO WETLANDS, STREAMS, FLOODPLAINS, FOREST, FOREST CONSERVATION EASEMENTS, STEEP SLOPES OR ENVIRONMENTAL BUFFERS ARE LOCATED WITHIN THIS SITE. A CERTIFICATION LETTER TO THIS EFFECT DATED AUGUST 15, 2011 BY ECO-SCIENCE PROFESSIONALS, INC. HAS BEEN PROVIDED.
- PERIMETER LANDSCAPING SHALL BE PROVIDED AS SHOWN ON THE LANDSCAPE PLAN OF THE FINAL CONSTRUCTION DRAWINGS FOR THIS FINAL PLAN IN ACCORDANCE WITH SECTION 16.124 OF THE LANDSCAPE MANUAL. FINANCIAL SURETY IN THE AMOUNT OF \$10,350 FOR 20 SHADE TREES, 29 EVERGREEN TREES SHALL BE PROVIDED WITHIN THE DEVELOPER'S AGREEMENT UNDER THIS FINAL PLAN.
- A SIMPLIFIED FOREST STAND DELINEATION WAS PREPARED BY ECO-SCIENCE PROFESSIONALS, INC., AUGUST 2011.
- TO THE BEST OF OUR KNOWLEDGE THERE ARE NO CEMETERIES LOCATED ON THIS SITE.
- A NOISE STUDY IS NOT REQUIRED FOR THIS DEVELOPMENT.
- WATER AND SEWER SERVICE TO THESE LOTS WILL BE GRANTED UNDER THE PROVISIONS OF SECTION 18.122.B OF THE HOWARD COUNTY CODE.
- PUBLIC WATER AND SEWERAGE ALLOCATION WILL BE GRANTED AT THE TIME OF ISSUANCE OF THE BUILDING PERMIT IF CAPACITY IS AVAILABLE AT THAT TIME.
- THE FOREST CONSERVATION ACT OBLIGATION FOR THIS PROJECT WILL BE MET BY PAYMENT OF FEE-IN-LIEU IN THE AMOUNT OF \$6,861 FOR AN OBLIGATION OF 0.21 ACRES. (9148 S.F. X \$0.75 = \$6,861)
- STORMWATER MANAGEMENT IS PROVIDED IN ACCORDANCE WITH THE 2000 MDE DESIGN MANUAL AND HOWARD COUNTY REQUIREMENTS. TREATMENT IS PROVIDED USING ENVIRONMENTAL SITE DESIGN METHODS, INCLUDING MICRO-BIORETENTION FACILITIES AND NON-ROOFTOP DISCONNECTION.
- EXISTING UTILITIES ARE BASED ON FIELD LOCATIONS AND RECORD DRAWINGS.
- NO TRAFFIC STUDY IS REQUIRED FOR THIS PROJECT.
- WP-12-023 WAS SUBMITTED TO REQUEST CREDIT FOR OPEN SPACE AREA WHICH DOES NOT MEET THE 35' MINIMUM WIDTH, AND WAS VOIDED WITH F-12-048.
- WATER AND SEWER SERVICE SHALL BE PERMITTED TO BE CONSTRUCTED OR PLACED WITHIN THE PUBLIC WATER, SEWER AND UTILITY EASEMENTS THAT WILL IMPROVE OR HINDER ACCESS TO THE PUBLIC WATER AND SEWER MAINS. IMPROVEMENTS SUCH AS AIR CONDITIONING UNITS, DECKS, FENCING, FOUNDATION PLANTINGS AND TREES SHALL NOT BE PLACED WITHIN THE EASEMENTS.
- A PRIVATE RANGE OF ADDRESS SIGN ASSEMBLY SHALL BE FABRICATED AND INSTALLED BY HOWARD COUNTY BUREAU OF HIGHWAYS AT THE DEVELOPERS/OWNERS EXPENSE. CONTACT HOWARD COUNTY TRAFFIC DIVISION AT 410-313-2430 FOR DETAILS AND COST ESTIMATE.
- APPROVAL OF A SITE DEVELOPMENT PLAN IS REQUIRED FOR THE DEVELOPMENT OF ALL RESIDENTIAL LOTS WITHIN THIS SUBDIVISION PRIOR TO ISSUANCE OF ANY GRADING OR BUILDING PERMITS FOR NEW HOUSE CONSTRUCTION IN ACCORDANCE WITH SECTION 16.155 OF THE SUBDIVISION AND LAND DEVELOPMENT REGULATIONS.
- LAND DEDICATED TO HOWARD COUNTY, MARYLAND FOR PURPOSES OF A PUBLIC ROAD (0.13 ACRES, 5,544 SQUARE FEET).
- THE EXISTING DWELLING ON LOT 4 WAS CONSTRUCTED CIRCA 1952, AND SHALL BE REMOVED PRIOR TO REGRADING OF THE PLAT.
- ALL TRASH AND RECYCLABLES COLLECTION WILL BE AT WHISKEY BOTTOM ROAD, WITHIN 5' OF THE PUBLIC RIGHT OF WAY.
- DRIVEWAYS SHALL BE PROVIDED PRIOR TO ISSUANCE OF A USE AND OCCUPANCY PERMIT FOR ANY NEW DWELLINGS TO INSURE SAFE ACCESS FOR FIRE AND EMERGENCY VEHICLES PER THE FOLLOWING MINIMUM REQUIREMENTS:
(a) WIDTH - 12' (16' SERVING MORE THAN ONE RESIDENCE)
(b) SURFACE - 7" OF COMPACT CRUSHER RUN BASE WITH TAR AND CHIP COATING (1-1/2" MIN.)
(c) GEOMETRY - MAXIMUM 15% GRADE, MAXIMUM 10% GRADE CHANGE AND MINIMUM 45' TURNING RADII.
(d) STRUCTURES (CULVERTS/BRIDGES) - CAPABLE OF SUPPORTING 25 GROSS TONS (425 LOADING).
(e) DRAINAGE ELEMENTS - CAPABLE OF SAFELY PASSING 100 YEAR FLOODPLAIN WITH NO MORE THAN 1 FOOT DEPTH OVER DRIVEWAY.
(f) STRUCTURE CLEARANCES - MINIMUM 12 FEET.
(g) MAINTENANCE - SUFFICIENT TO INSURE ALL WEATHER USE.
- WP-13-094 WAS APPROVED JANUARY 16, 2013, WAIVING SECTION 16.121(c)(3) TO ALLOW CREDIT FOR OPEN SPACE LAND LESS THAN 35' IN WIDTH, AND SECTION 16.144(b) AND 16.145 TO WAIVE THE REQUIREMENT OF SKETCH OR PRELIMINARY EQUIVALENT SKETCH PLANS. THE APPROVAL IS SUBJECT TO THE FOLLOWING CONDITIONS:
A. THE FINAL PLAN MUST BE SUBMITTED TO DPZ ON OR BEFORE MAY 16, 2013.
B. SECTION 16.121(c)(3)(ii) OF THE SUBDIVISION AND LAND DEVELOPMENT REGULATIONS CONTAINS SEVERAL ITEMS THAT ARE NOT PERMITTED TO BE CREDITED TOWARD THE REQUIRED OPEN SPACE OBLIGATION. THIS WAIVER APPROVAL IS TO ALLOW OPEN SPACE CREDIT FOR NARROW STRIPS LESS THAN 35 FEET WIDE FOR OPEN SPACE LOT 7 ONLY. NOT OTHER REQUESTS ARE BEING ENDORSED BY THIS WAIVER APPROVAL.
C. THE PROPOSED OPEN SPACE LOT SHALL ACCOMMODATE A PATHWAY THAT MEETS THE DEPARTMENT OF RECREATION AND PARKS STANDARDS, WHILE INCORPORATING A SITE DESIGN THAT PROVIDES ADEQUATE STORMWATER MANAGEMENT AND LANDSCAPING PER THE COUNTY CODE AND LANDSCAPE MANUAL.
D. THE PROPOSAL MUST BE IN COMPLIANCE WITH THE DEPARTMENT OF RECREATION AND PARKS COMMENTS DATED SEPTEMBER 21, 2011. THE APPLICANT SHALL CONTINUE TO COOPERATE WITH THE DEPARTMENT OF RECREATION AND PARKS TO ENSURE THE PATHWAY COMES INTO FRUITION AND THE OPEN SPACE WITH THE PATHWAY DEDICATED TO THE COUNTY.
- ON-LOT STORMWATER FACILITIES ARE SUBJECT TO DECLARATIONS OF COVENANTS, WHICH SHALL BE RECORDED IN THE HOWARD COUNTY LAND RECORDS AT THE TIME OF PLAT RECORDATION. ALL ASSOCIATED DECLARATIONS OF COVENANTS SHALL BE AMENDED, AS NEEDED, BASED ON ANY FUTURE DESIGN.
- THIS PROJECT WAS PRESENTED TO THE HISTORIC DISTRICT COMMISSION ON MARCH 7, 2013. A TYPE C LANDSCAPE SCREENING ALONG THE HOWARD COUNTY, MARYLAND, AND MAINTAINED BY THE DEPARTMENT OF RECREATION AND PARKS. OPEN SPACE LOT 7 SHALL BE DEDICATED TO NORTH PROPERTY.
- A RIGHT OF ENTRY AGREEMENT MUST BE OBTAINED FROM HOWARD COUNTY REAL ESTATE SERVICES PRIOR TO PERFORMING CONSTRUCTION ACTIVITIES WITHIN THE EXISTING PARKLAND.
- THE DEPARTMENT OF RECREATION AND PARKS (410-627-3762) MUST APPROVE STAKEOUT LOCATIONS OF PARKLAND PATH AND PLANTINGS IN THE FIELD BEFORE CONSTRUCTION AND INSTALLATION. DPR SHALL BE NOTIFIED 7 DAYS PRIOR TO THE INSTALLATION OF THE PLANTS WITHIN OPEN SPACE LOT 7 WITH THE DATE AND TIME OF PLANTING.

TRAVERSE POINT CHART (NAD '83)


No.	NORTH	EAST
1	528,709.906	1,359,118.020
2	528,570.9748	1,358,978.4676
3	528,510.0430	1,358,978.0485
4	528,531.7514	1,359,175.7200

BOUNDARY COORDINATE CHART (NAD '83)

No.	NORTH	EAST
100	528,588.9339	1,359,236.1617
101	528,712.4785	1,359,147.0378
102	528,546.8361	1,358,827.4587
103	528,412.8103	1,358,895.9058
104	528,729.7561	1,359,180.3701
105	528,604.2822	1,359,264.9668

MINIMUM LOT SIZE CHART

LOT NO.	GROSS AREA	PIPESTEM AREA	MINIMUM LOT SIZE
2	6,290	168	6,122
3	6,707	461	6,246
4	7,280	746	6,534
5	7,854	1,032	6,822
6	8,213	1,317	6,896

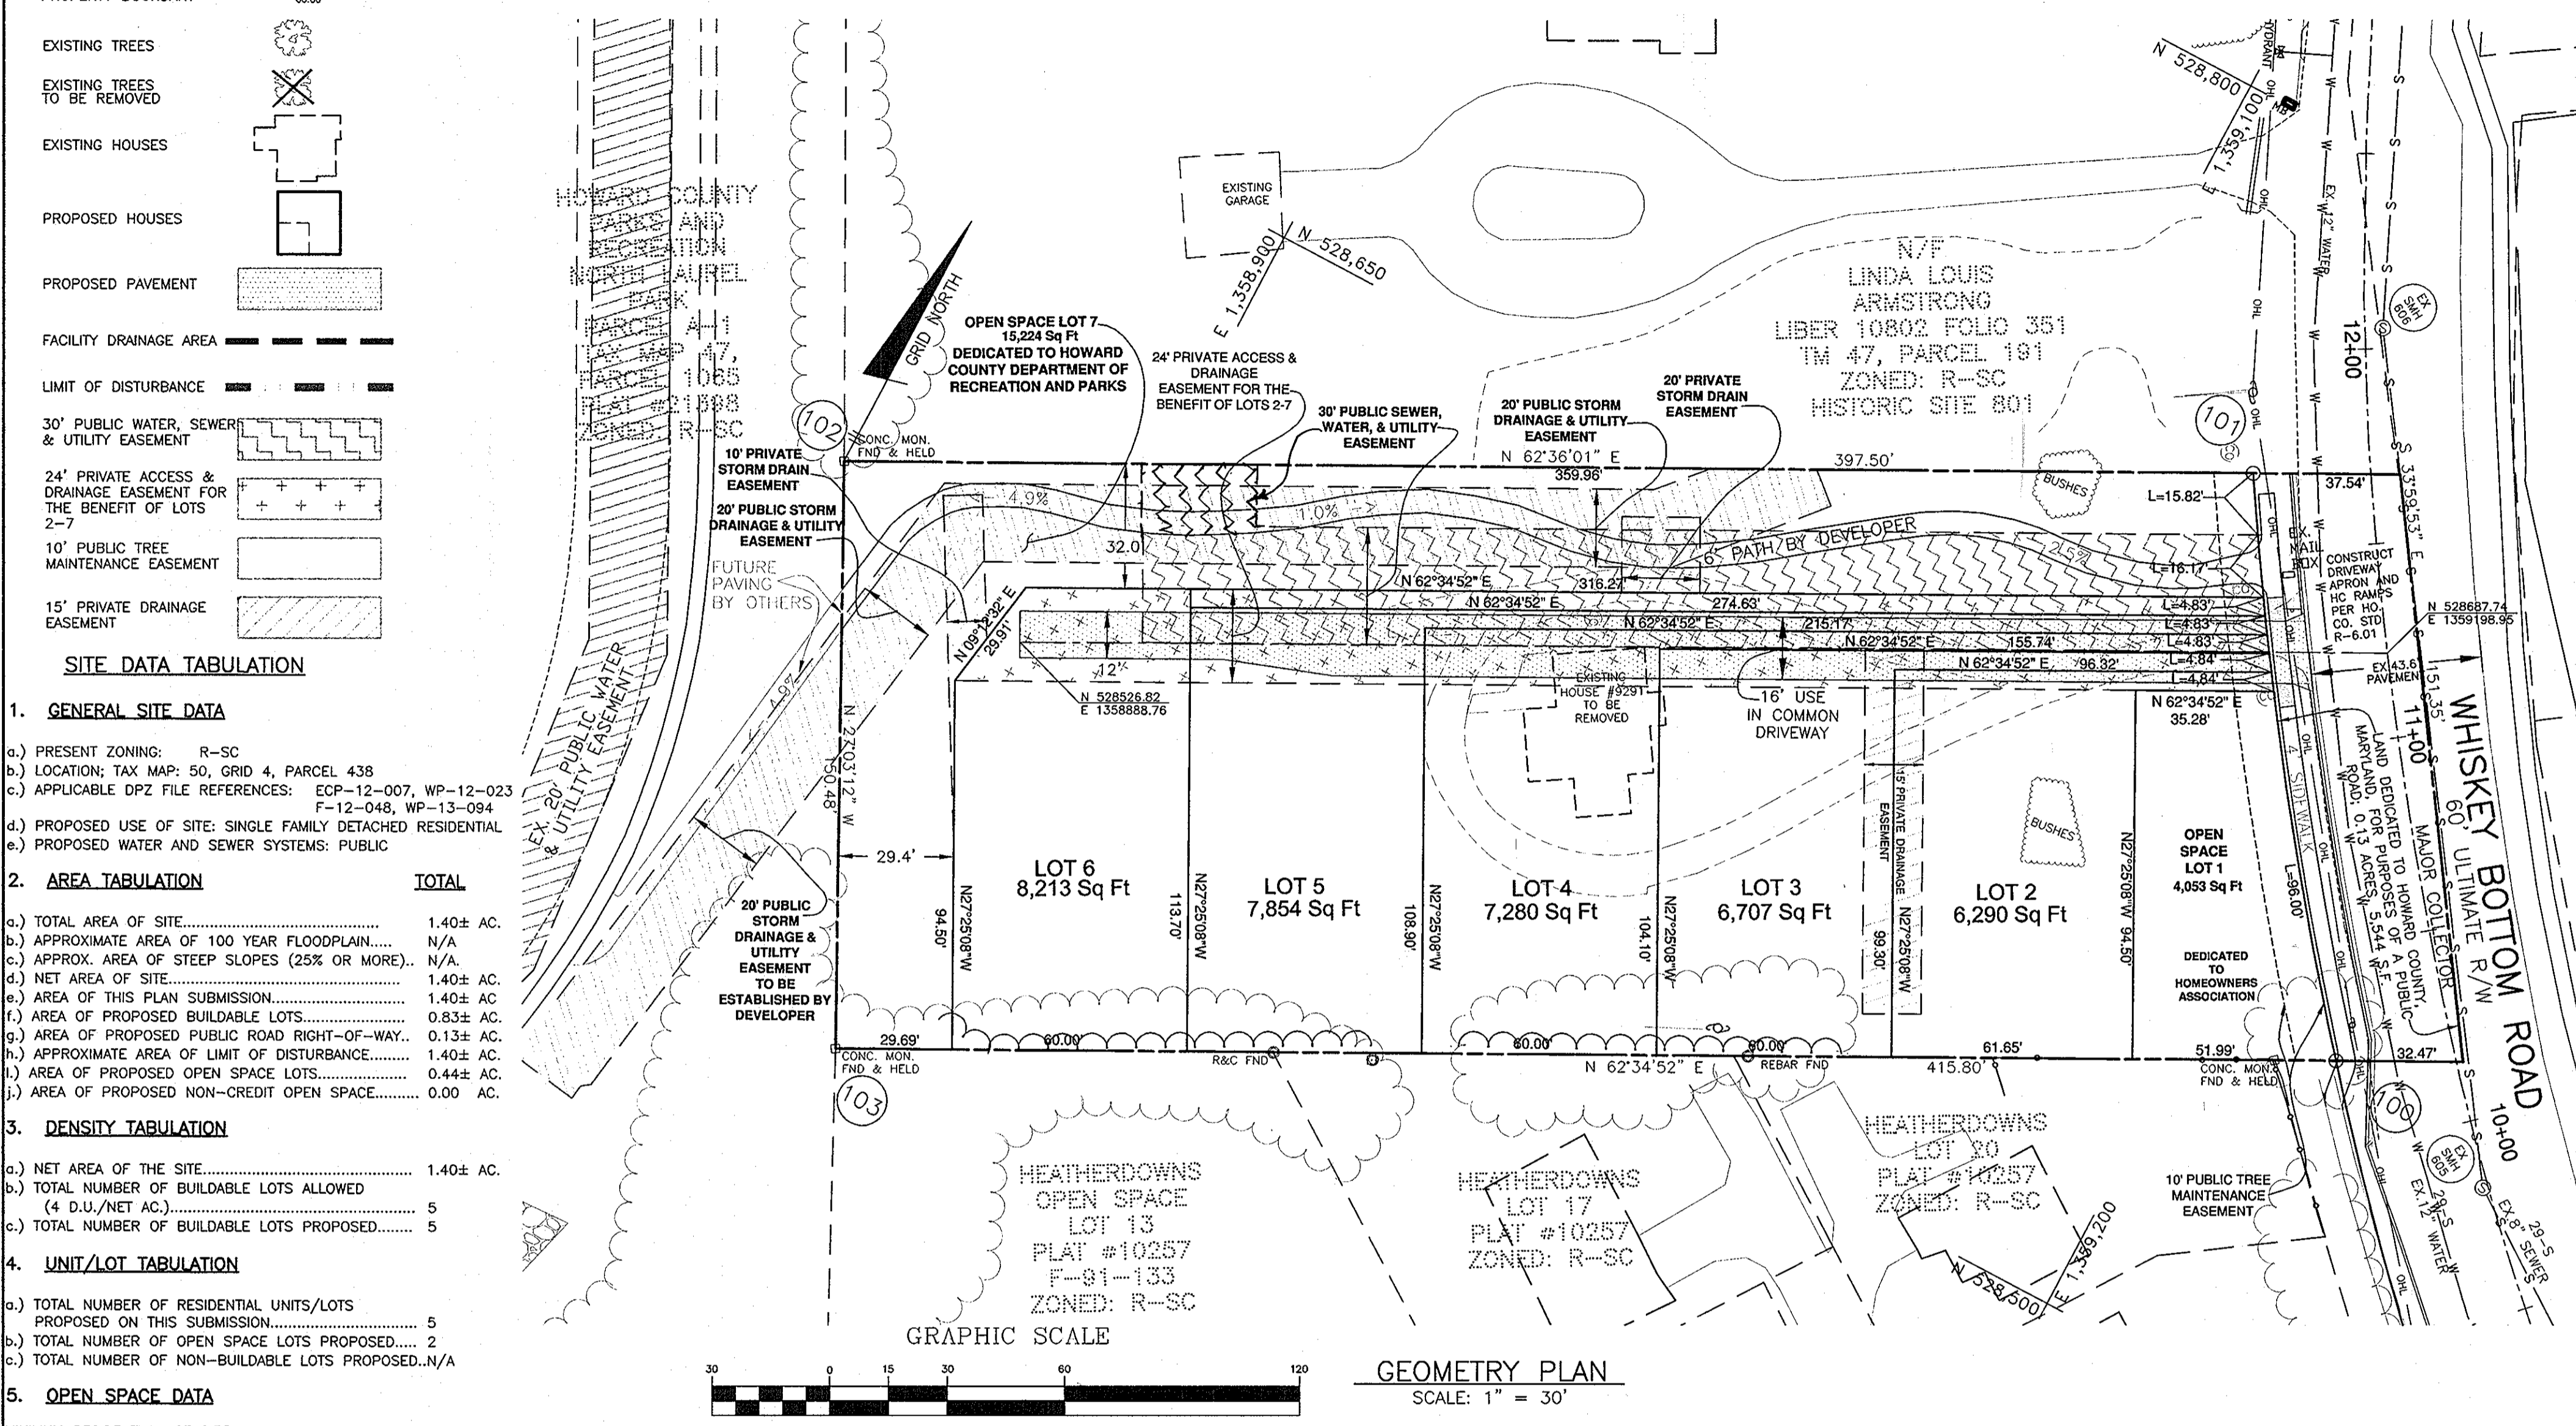

SITE DATA TABULATION

- GENERAL SITE DATA**
 - a) PRESENT ZONING: R-SC
 - b) LOCATION: TAX MAP: 50, GRID 4, PARCEL 438
 - c) APPLICABLE DPZ FILE REFERENCES: EOP-12-007, WP-12-023
 - d) PROPOSED USE OF SITE: SINGLE FAMILY DETACHED RESIDENTIAL
 - e) PROPOSED WATER AND SEWER SYSTEMS: PUBLIC
- AREA TABULATION**

	TOTAL
a) TOTAL AREA OF SITE	1.40± AC.
b) APPROXIMATE AREA OF 100 YEAR FLOODPLAIN	N/A
c) APPROX. AREA OF STEEP SLOPES (25% OR MORE)	N/A
d) NET AREA OF SITE	1.40± AC.
e) AREA OF THIS PLAN SUBMISSION	1.40± AC.
f) AREA OF PROPOSED BUILDABLE LOTS	0.83± AC.
g) AREA OF PROPOSED PUBLIC ROAD RIGHT-OF-WAY	0.13± AC.
h) APPROXIMATE AREA OF LIMIT OF DISTURBANCE	1.40± AC.
i) AREA OF PROPOSED OPEN SPACE LOTS	0.44± AC.
j) AREA OF PROPOSED NON-CREDIT OPEN SPACE	0.00 AC.
- DENSITY TABULATION**
 - a) NET AREA OF THE SITE: 1.40± AC.
 - b) TOTAL NUMBER OF BUILDABLE LOTS ALLOWED: 5
 - c) (4 D.U./NET AC.): 5
 - d) TOTAL NUMBER OF BUILDABLE LOTS PROPOSED: 5
- UNIT/LOT TABULATION**
 - a) TOTAL NUMBER OF RESIDENTIAL UNITS/LOTS PROPOSED ON THIS SUBMISSION: 5
 - b) TOTAL NUMBER OF OPEN SPACE LOTS PROPOSED: 2
 - c) TOTAL NUMBER OF NON-BUILDABLE LOTS PROPOSED: N/A
- OPEN SPACE DATA**
 - MINIMUM RESIDENTIAL LOT SIZE: 6,000 S.F.
 - OPEN SPACE REQUIRED (25% OF 1.40 AC.): 0.35 AC.±
 - AREA OF PROPOSED OPEN SPACE LOTS: 0.44 AC.±
 - AREA OF PROPOSED NON-CREDITED O.S. LOTS: *SEE NOTE #31
 - AREA OF CREDITED OPEN SPACE PROVIDED: 0.44 AC.±

ENGINEER'S CERTIFICATE

I HEREBY CERTIFY THAT THIS PLAN FOR SOIL EROSION AND EROSION CONTROL REPRESENTS A PRACTICAL AND WORKABLE PLAN BASED ON MY PERSONAL KNOWLEDGE OF THE SITE CONDITIONS AND THAT IT WAS PREPARED IN ACCORDANCE WITH THE REQUIREMENTS OF THE HOWARD SOIL CONSERVATION DISTRICT.

Michael J. ... 9-23-13
ENGINEER

DEVELOPER'S CERTIFICATE

I/WE CERTIFY THAT ALL DEVELOPMENT AND CONSTRUCTION WILL BE DONE ACCORDING TO THIS PLAN OF DEVELOPMENT FOR SOIL EROSION AND EROSION CONTROL, AND THAT ALL RESPONSIBLE PERSONNEL INVOLVED IN THE CONSTRUCTION PROJECT WILL HAVE A CERTIFICATE OF ATTENDANCE AT A DEPARTMENT OF THE ENVIRONMENT APPROVED TRAINING PROGRAM FOR THE CONTROL OF SOIL EROSION AND EROSION BEFORE BEGINNING THE PROJECT. I ALSO AUTHORIZE PERIODIC ON-SITE INSPECTION BY THE HOWARD SOIL CONSERVATION DISTRICT.

R. D. By ... 9/24/13
DEVELOPER

REVIEWED FOR HOWARD SCD AND MEETS TECHNICAL REQUIREMENTS

THIS DEVELOPMENT PLAN IS APPROVED FOR SOIL EROSION AND SEDIMENT CONTROL BY THE HOWARD SOIL CONSERVATION DISTRICT.

John R. Robertson 9/26/13
HOWARD SCD





APPROVED: HOWARD COUNTY DEPARTMENT OF PUBLIC WORKS

Michelle ... 10-24-13
CHIEF, BUREAU OF HIGHWAYS

APPROVED: HOWARD COUNTY DEPARTMENT OF PLANNING AND ZONING

Vict ... 11-13-13
CHIEF, DIVISION OF LAND DEVELOPMENT

Paul ... 10-31-13
CHIEF, DEVELOPMENT ENGINEERING DIVISION

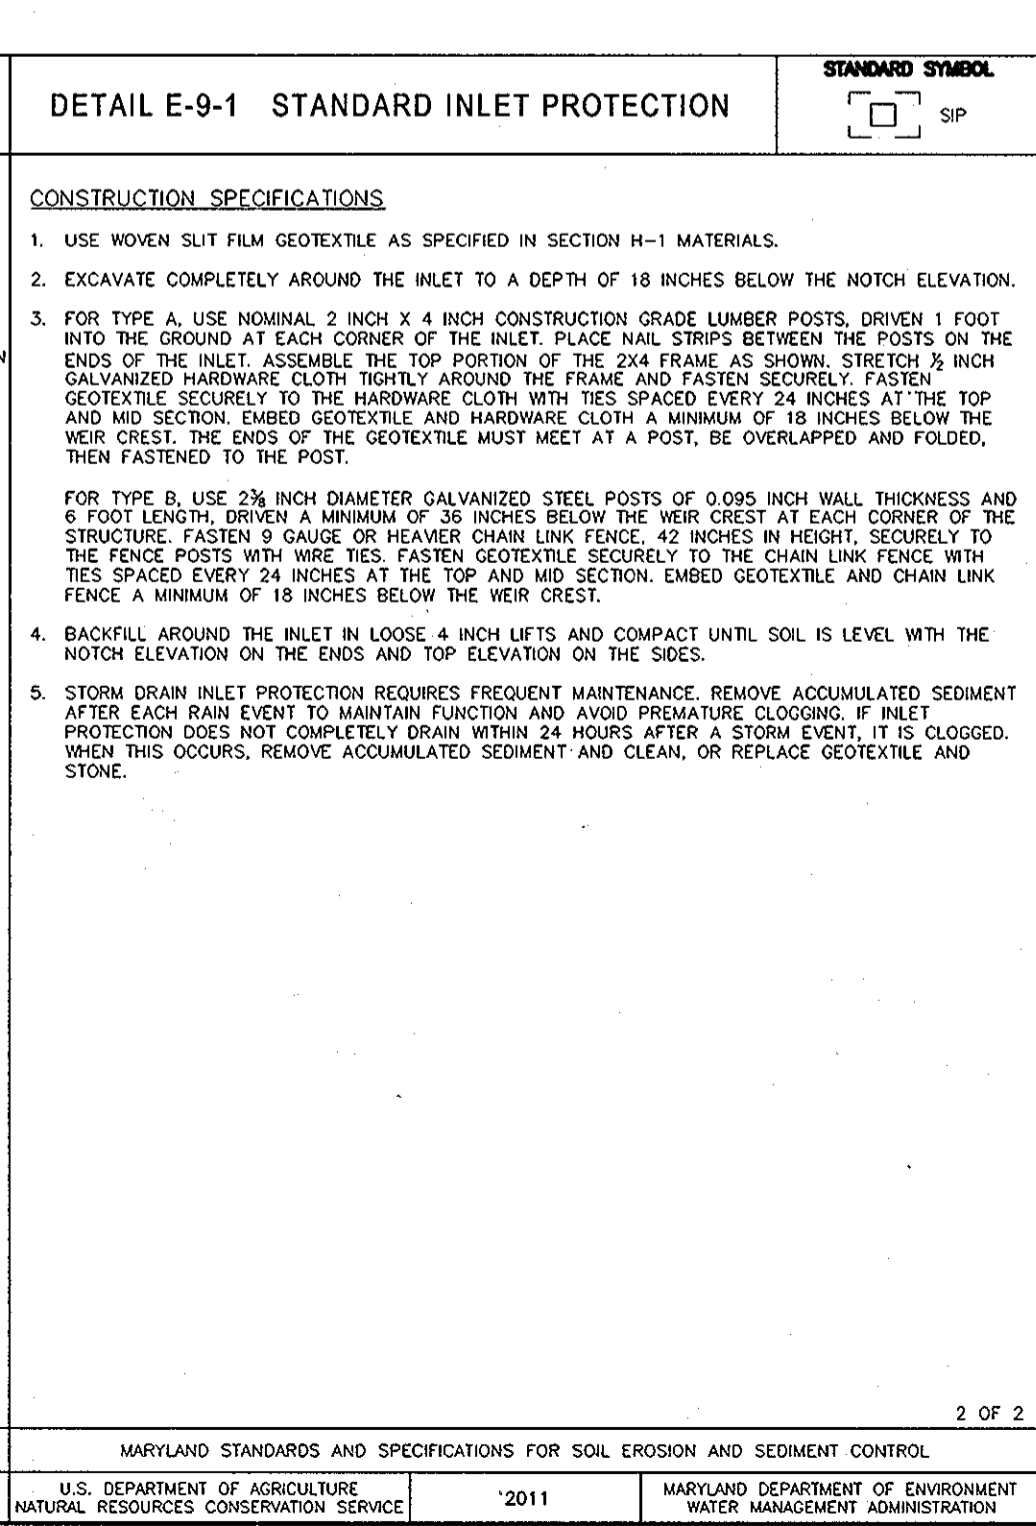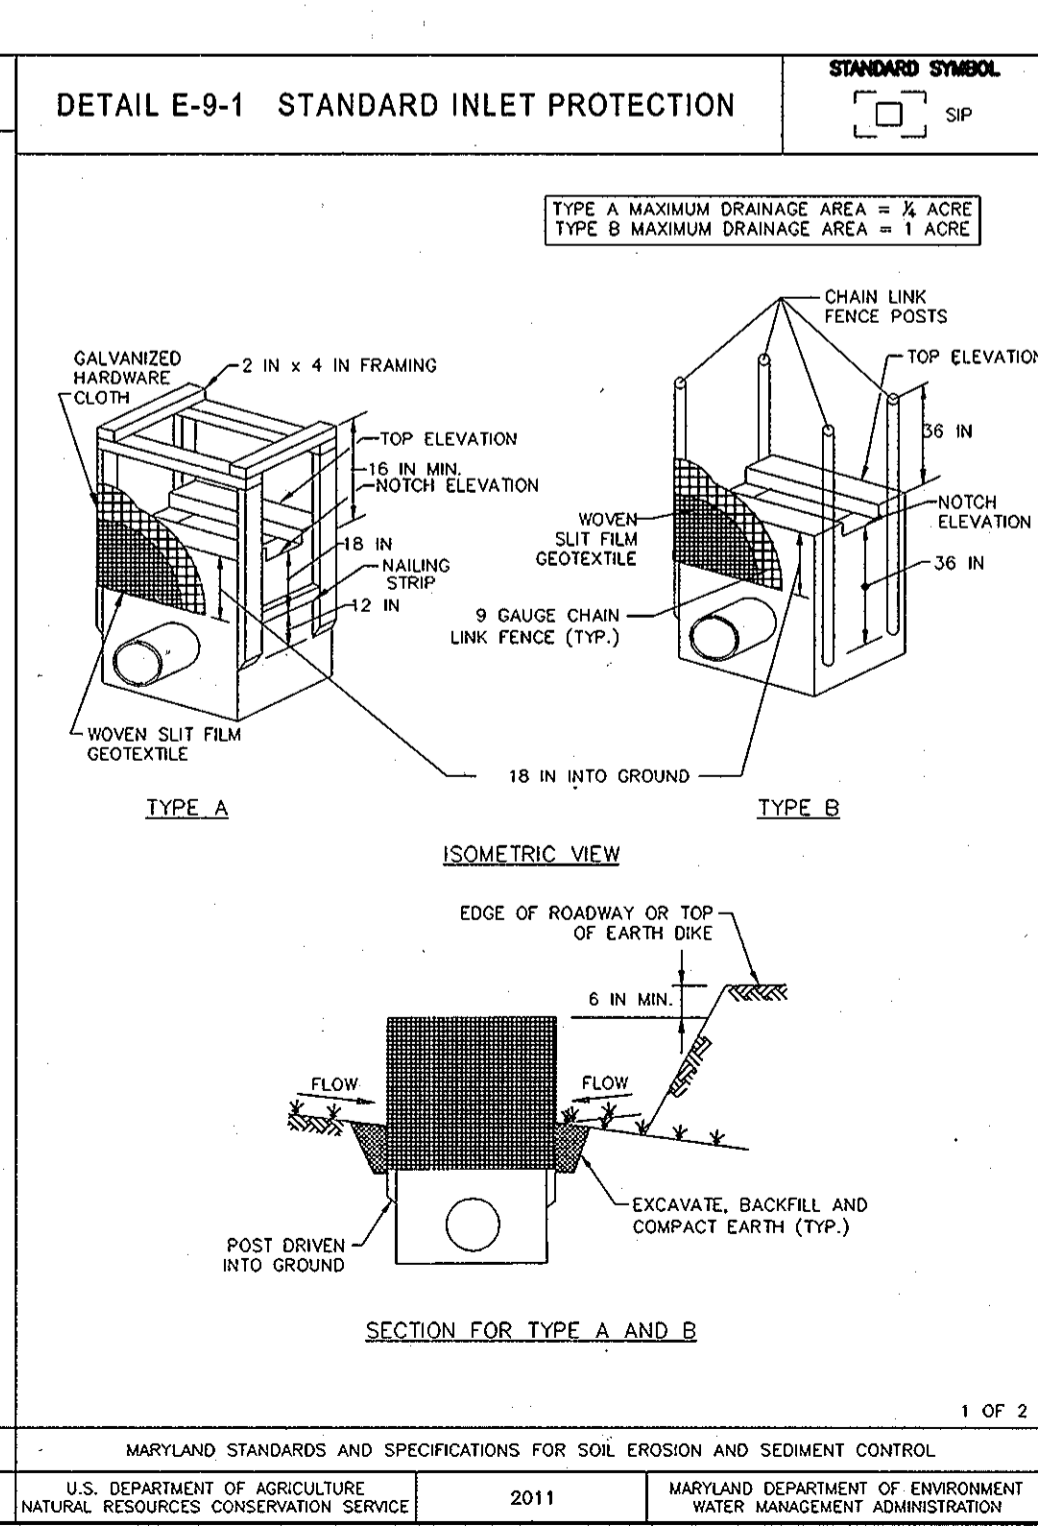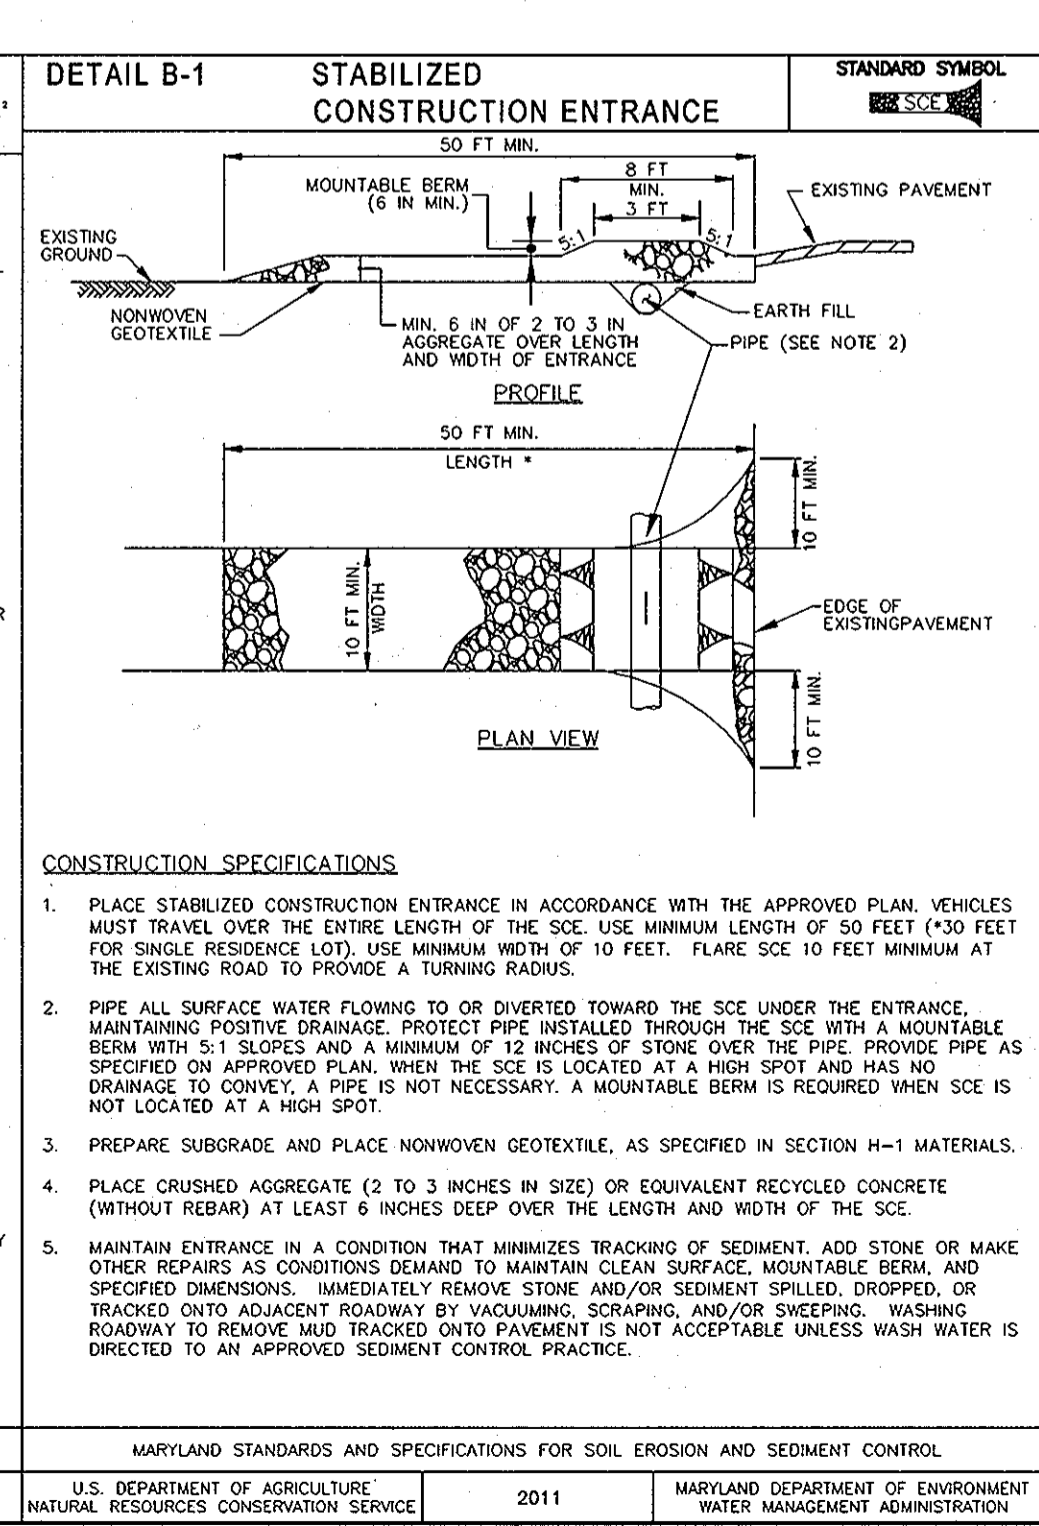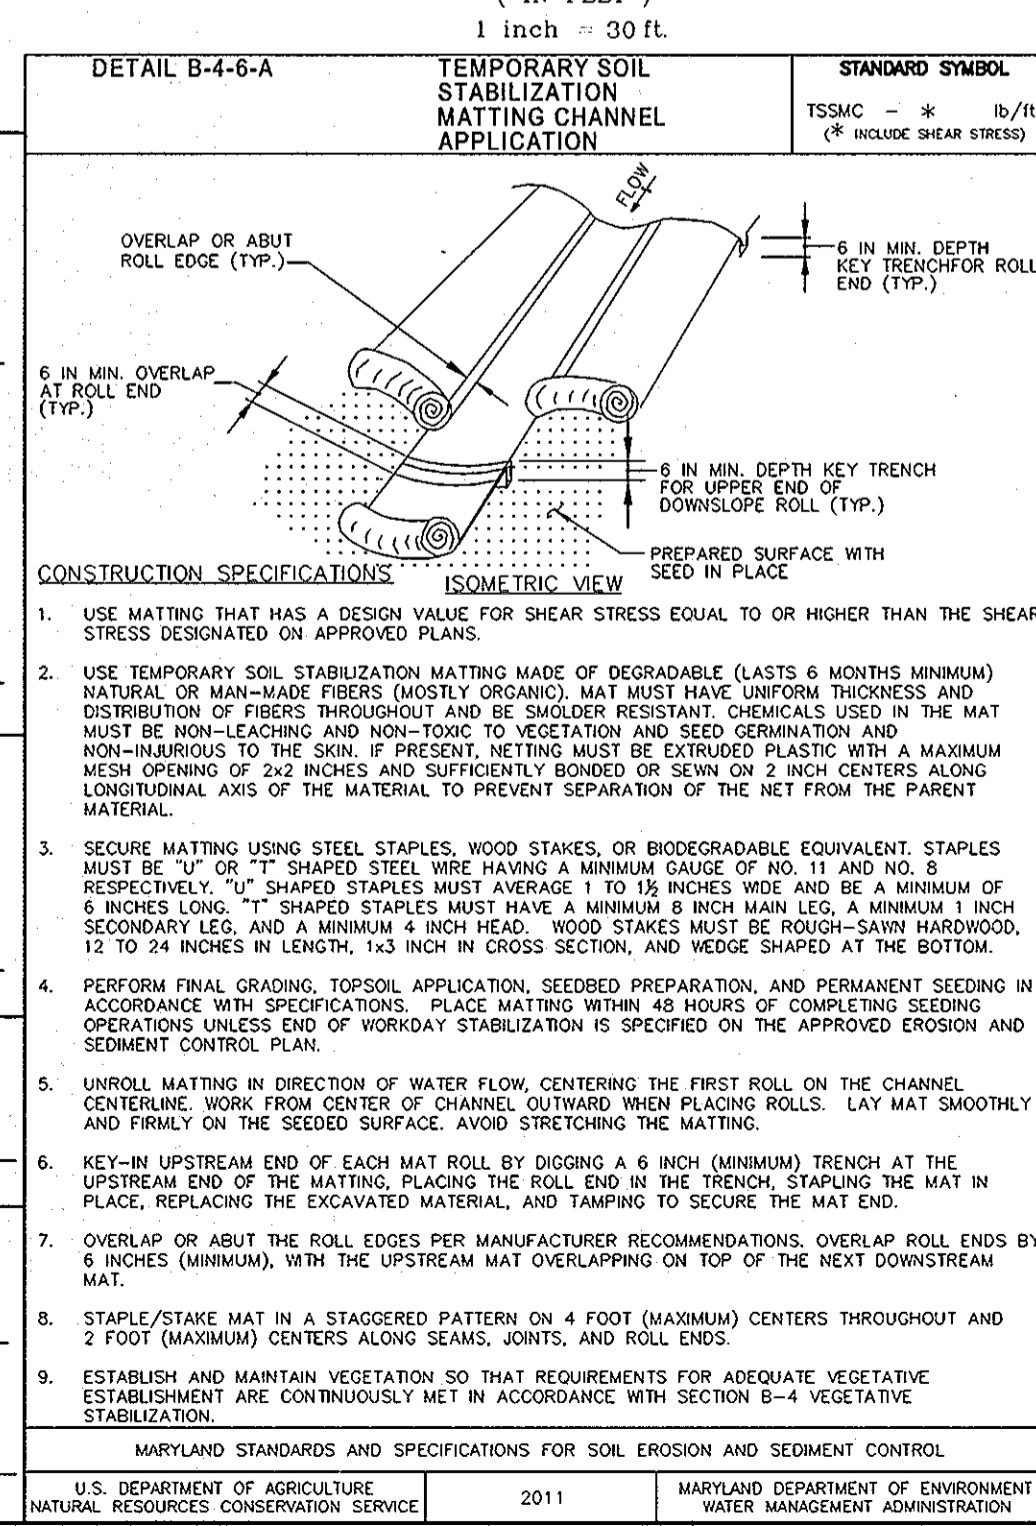

SHEET INDEX

NO.	DESCRIPTION
1	GEOMETRY PLAN AND SEDIMENT CONTROL DETAILS
2	STORMWATER MANAGEMENT, MAINTENANCE OF TRAFFIC, LANDSCAPE PLAN AND DETAILS
3	STORM DRAIN DRAINAGE AREA MAP AND PROFILES AND WHISKEY BOTTOM ROAD CROSS SECTIONS
4	SEDIMENT CONTROL PLAN, NOTES AND DETAILS

BENCHMARK ENGINEERING, INC.

ENGINEERS & LAND SURVEYORS & PLANNERS

6480 BALTIMORE NATIONAL PkE & SUITE 315A ELKLOTT CITY, MARYLAND 21043
(P) 410-465-8103 (F) 410-465-6644

75 THOMAS JOHNSON DRIVE SUITE A FREDERICK, MARYLAND 21702
301-710-5688
WWW.BE-CIVILENGINEERING.COM

Professional Certification: I am a Professional Engineer under the laws of the State of Maryland, License No. 28736, Expiration Date: 12/31/2015.

PARKSIDE ESTATES

LOTS 2-6 & OPEN SPACE LOTS 1 & 7



TAX MAP: 50 GRID: 4 PARCEL: 438
ZONED: R-SC
ELECTION DISTRICT NO. 6 - HOWARD COUNTY, MARYLAND

GEOMETRY PLAN AND SEDIMENT CONTROL DETAILS

DATE: JANUARY 2013
SEPTEMBER 2013

BEI PROJECT NO. 2384-C

DESIGN: AAM DRAWN: AAM SCALE: AS SHOWN SHEET 1 OF 4

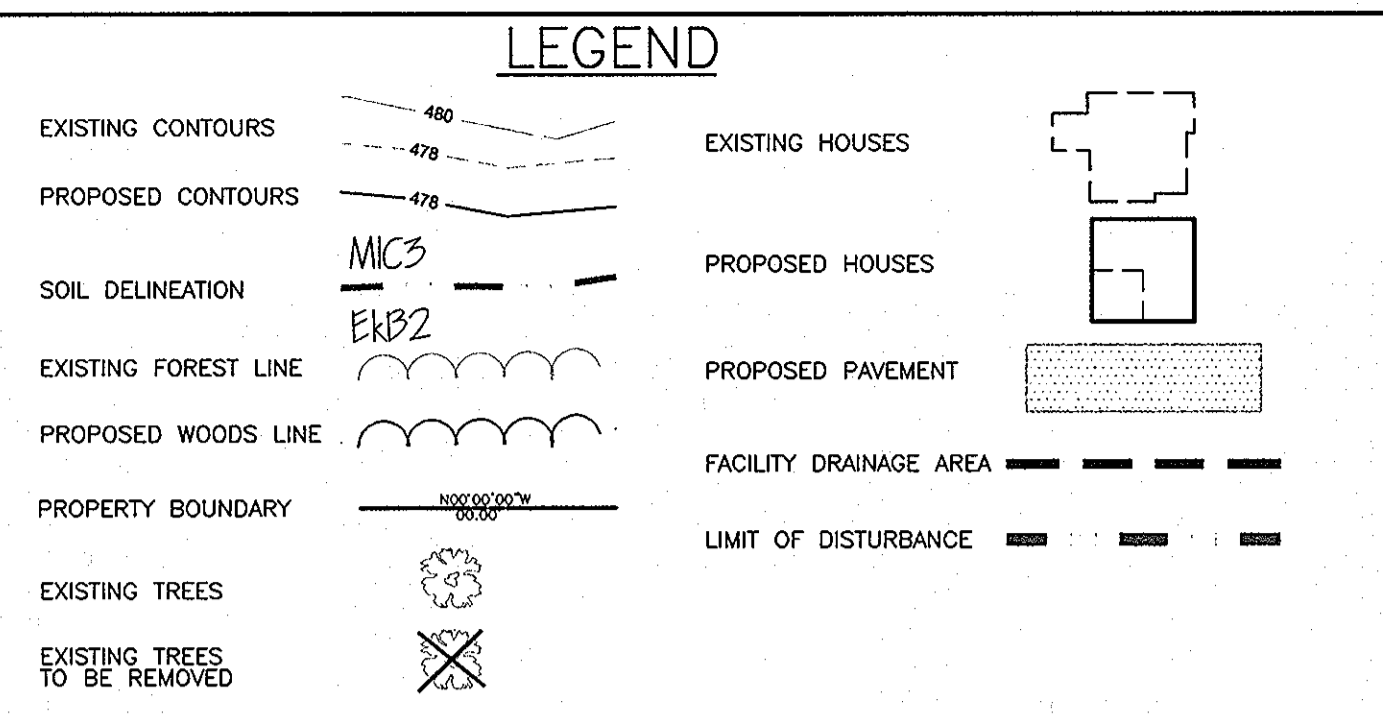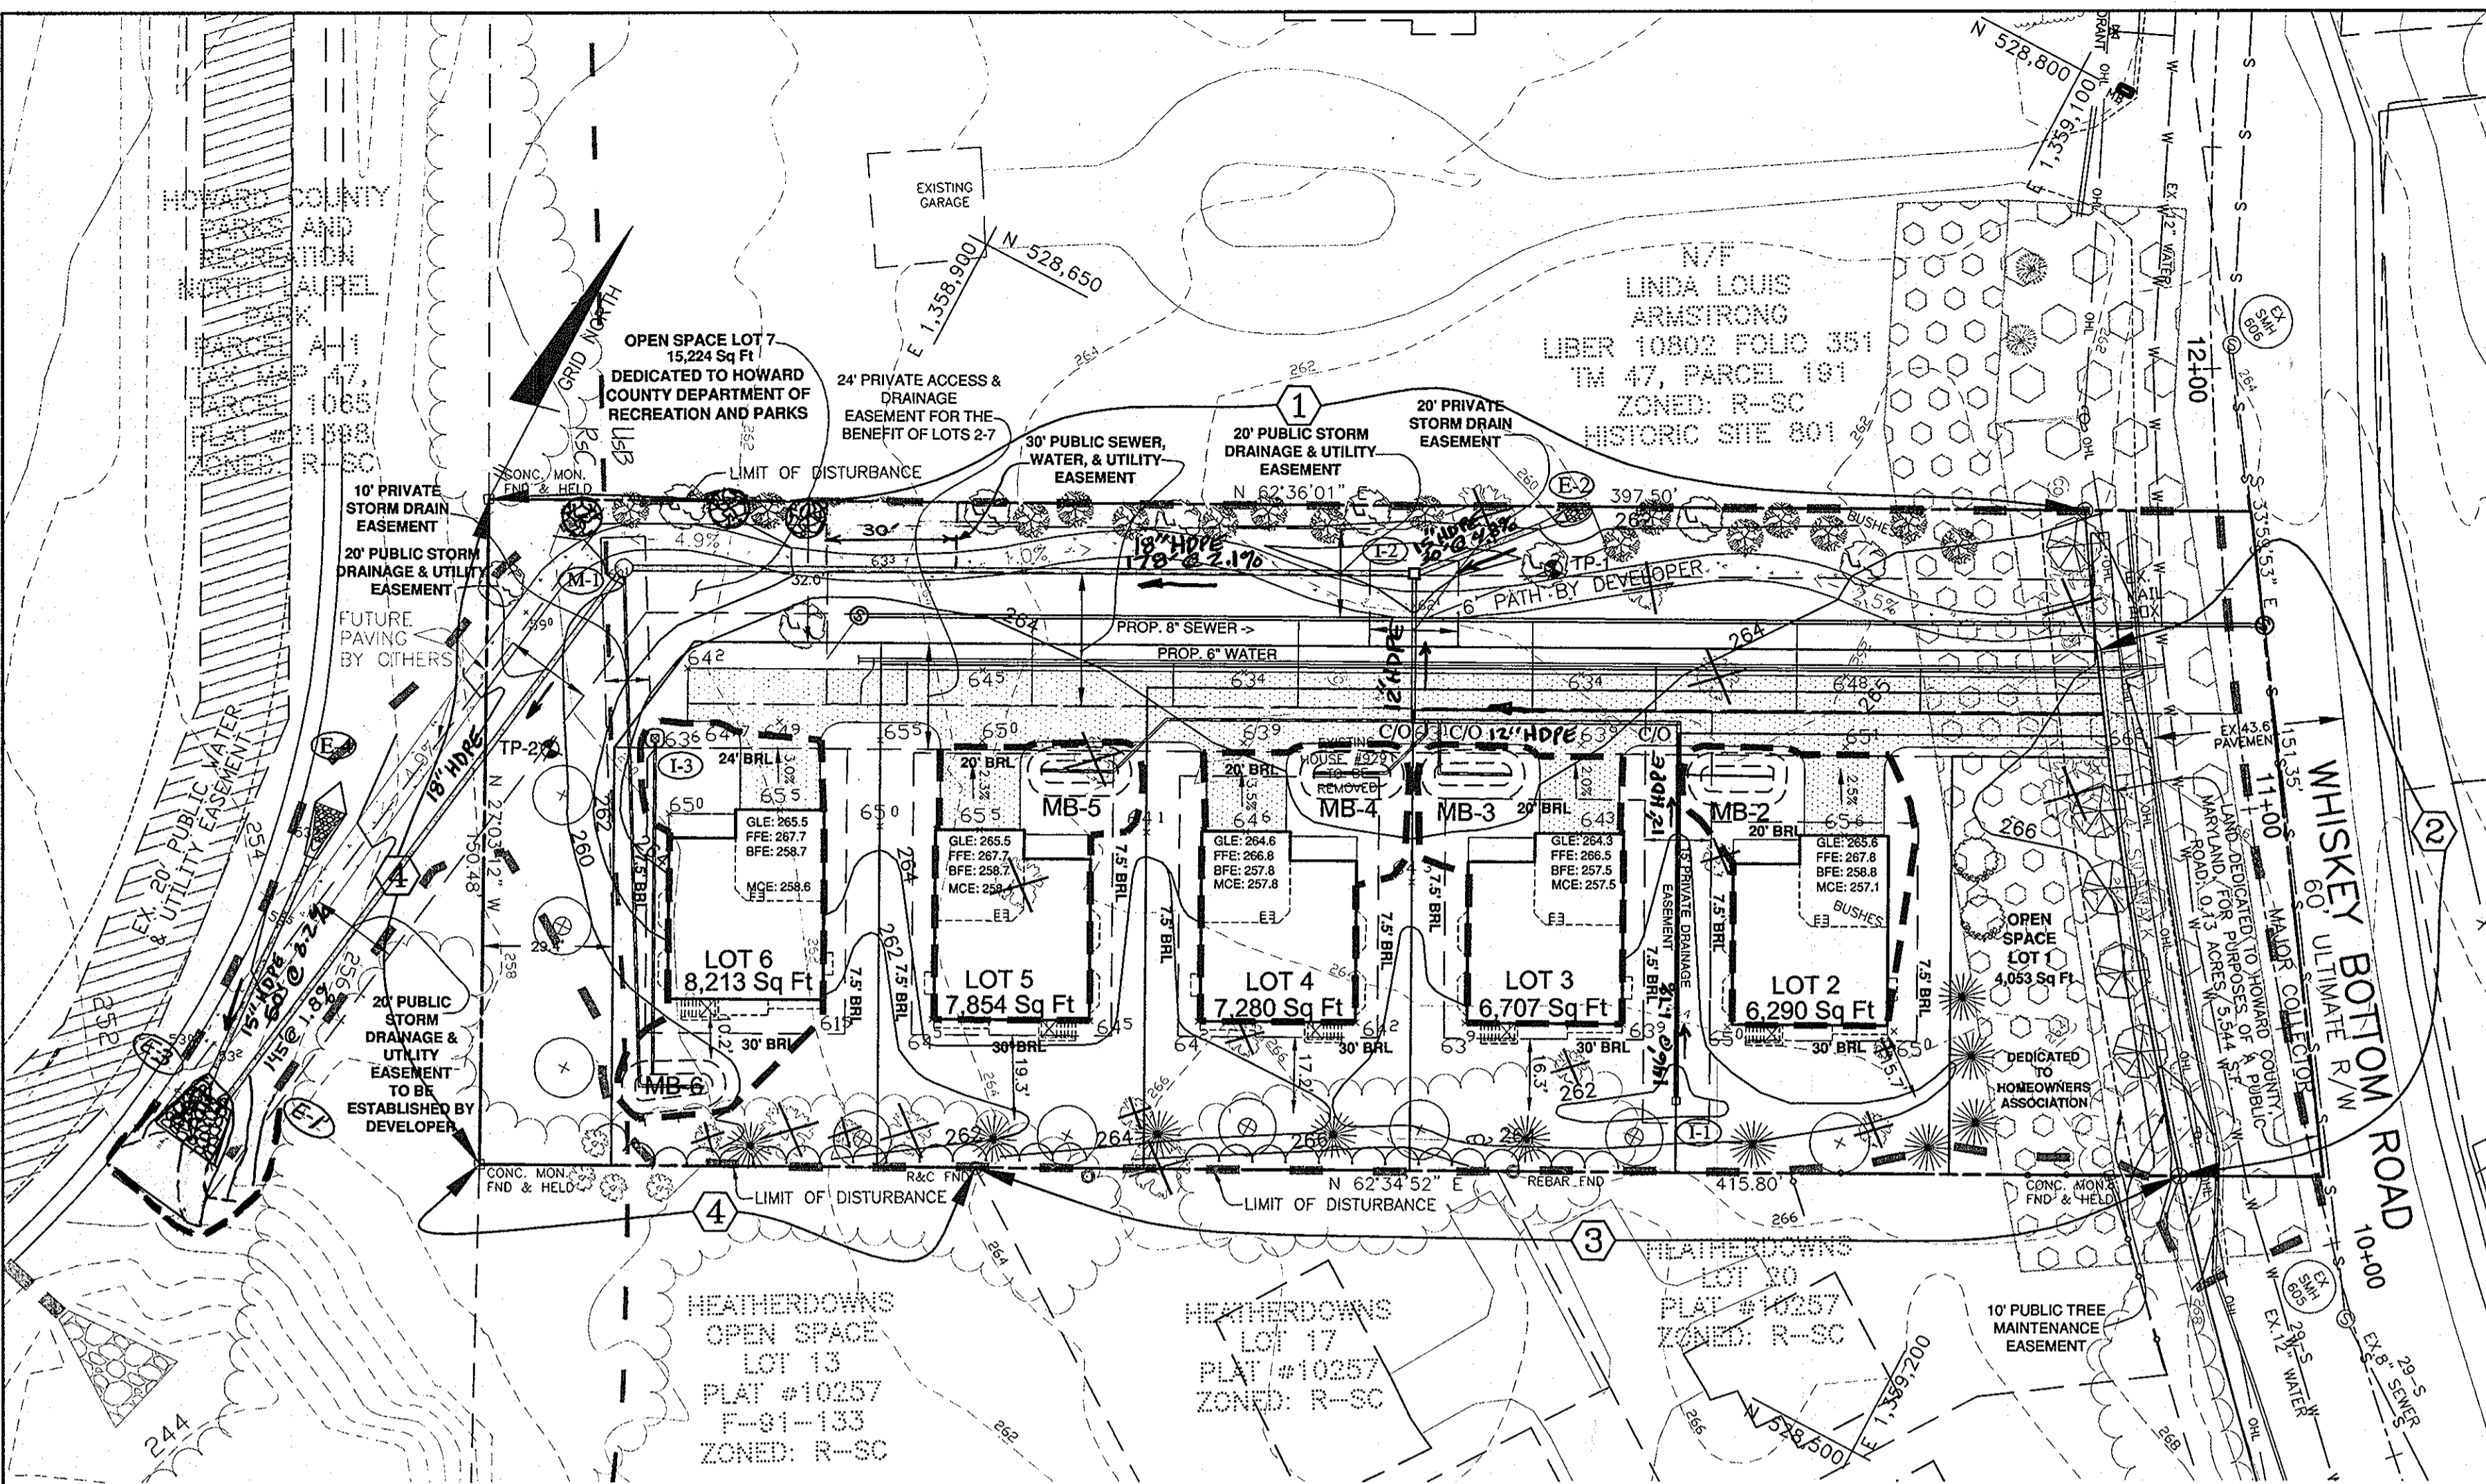

Practices and Sizing Pe: 1.20 inches

Driveway - for overcompensation	Treated by Micro-Bioretenion
Total Drainage Area: 5104 s.f.	
Impervious Area: 5104 s.f.	
Rv = 0.950	
ESDV = 161.6 c.f.	
75% Req'd Storage: 121	


Drainage Area MB-2	Treated by Micro-Bioretenion
Total Drainage Area: 2580 s.f.	
Impervious Area: 1813 s.f.	
Rv = 0.682	
ESDV = 176.1 c.f.	
75% Req'd Storage: 132	
Plus 1/5 of driveway storage: 156	

Drainage Area MB-3	Treated by Micro-Bioretenion
Total Drainage Area: 2441 s.f.	
Impervious Area: 1902 s.f.	
Rv = 0.714	
ESDV = 174.4 c.f.	
75% Req'd Storage: 131	
Plus 1/5 of driveway storage: 155	

Drainage Area MB-4	Treated by Micro-Bioretenion
Total Drainage Area: 2480 s.f.	
Impervious Area: 1909 s.f.	
Rv = 0.706	
ESDV = 175.2 c.f.	
75% Req'd Storage: 131	
Plus 1/5 of driveway storage: 156	

Drainage Area MB-5	Treated by Micro-Bioretenion
Total Drainage Area: 2377 s.f.	
Impervious Area: 1828 s.f.	
Rv = 0.742	
ESDV = 176.4 c.f.	
75% Req'd Storage: 132	
Plus 1/5 of driveway storage: 157	

Drainage Area MB-6	Treated by Micro-Bioretenion
Total Drainage Area: 3066 s.f.	
Impervious Area: 1858 s.f.	
Rv = 0.616	
ESDV = 182.6 c.f.	
75% Req'd Storage: 137	
Plus 1/5 of driveway storage: 161	

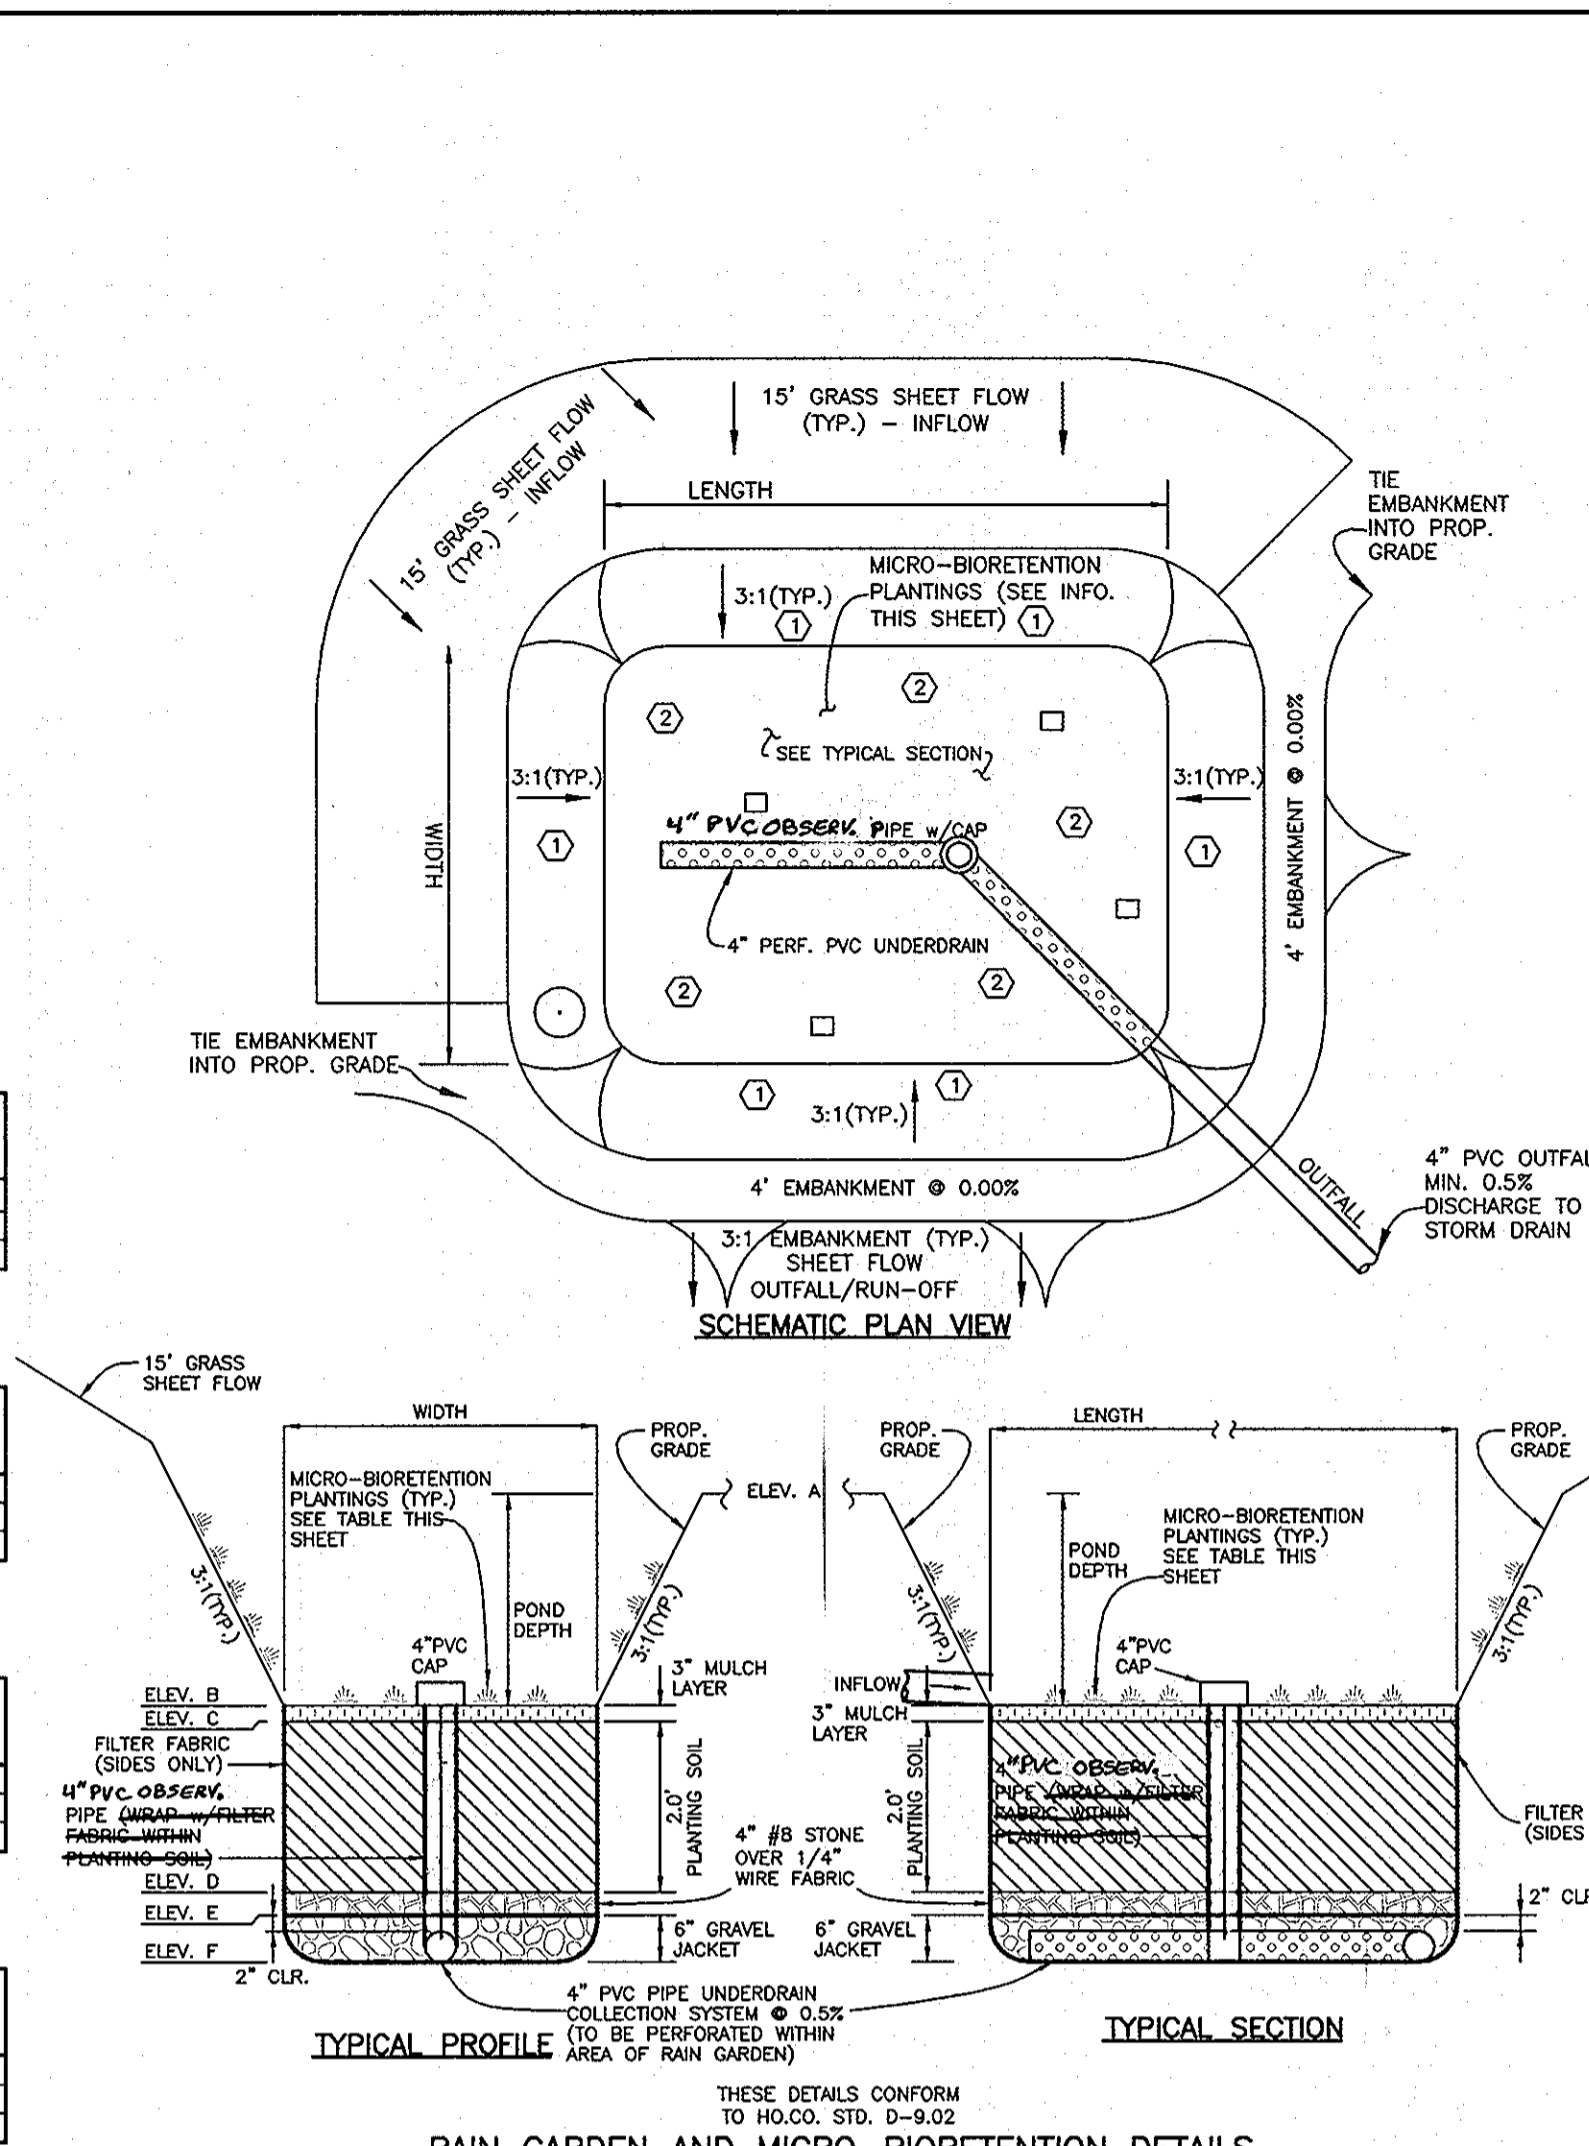

SCHEDULE A PERIMETER LANDSCAPE EDGE

CATEGORY	ADJACENT TO:	HISTORIC PROPERTY	ROAD	EXISTING HOMES	PERIMETER	TOTALS
LANDSCAPE TYPE		1 C	2 B	3 B	4 A	
LINEAR FEET OF PERIMETER		360'	120'	272'	262'	
CREDIT FOR EXISTING VEGETATION (YES, NO, LINEAR FEET) (DESCRIBE BELOW IF NEEDED)		NO	NO	NO	NO	
CREDIT FOR WALL, FENCE OR BERM (YES, NO, LINEAR FEET) (DESCRIBE BELOW IF NEEDED)		NO	NO	NO	NO	
NUMBER OF PLANTS REQUIRED		9	2	5	4	20
SHADE TREES		18	3	7	-	28
EVERGREEN TREES		-	-	-	-	-
OTHER TREES (2-1 SUBSTITUTED)		-	-	-	-	-
SHRUBS		-	-	-	-	-
NUMBER OF PLANTS PROVIDED		9	2	5	4	20
SHADE TREES		19	3	6	1*	29
EVERGREEN TREES		-	-	-	-	-
OTHER TREES (2-1 SUBSTITUTED)		-	-	-	-	-
SHRUBS (10-1 SUBSTITUTED)		-	-	-	-	-

PERIMETER LANDSCAPE PLANTING LIST

SYMBOL	QUANTITY	NAME	REMARKS
①	5	PLANTANUS ACERFOJA 'BLOODGOOD' (Bloodgood London Plane)	2 1/2" MIN. CAL. FULL HEAD
②	4	QUERCUS COCCINEA SCARLET OAK	2 1/2" MIN. CAL. FULL HEAD
③	10	CEDRUS DEODORA CEDAR	6"-8" H.L. UNSHEARED
④	2	PRUNUS SERRULATA KWANZAN	1 1/2" MIN. CAL. FULL HEAD
⑤	19	ILEX 'NELLIE R. STEVENS' NELLIE STEVENS HOLLY	5"-6" H.L.
⑥	9	ACER RUBRUM 'OCTOBER GLORY' OCTOBER GLORY RED MAPLE	2 1/2" MIN. CAL. FULL HEAD



FOREST CONSERVATION WORKSHEET Version 1.0

Project: 9291 Whiskey Bottom Road Date: August 9, 2011

NET TRACT AREA	Acres
A. Total tract area	1.4
B. Area within 100 Year Floodplain	0.00
C. Area of site included in overhead transmission line	0
D. Net Tract Area	1.4

LAND USE CATEGORY: (from table 3.2.1, page 40, Manual)

Category	Percentage	0.15	0.21
E. Afforestation Threshold	(percentage)	0.15	0.21
F. Conservation Threshold	(percentage)	0.20	0.28

EXISTING FOREST COVER:

Category	Value
G. Existing forest cover (including floodplain)	0
H. Area of forest above afforestation threshold	0
I. Area of forest above conservation threshold	0

BREAK EVEN POINT:


Category	Value
J. Forest retention above threshold with no mitigation	--
K. Clearing permitted without mitigation	Break-Even Point

PROPOSED FOREST CLEARING:

Category	Value
L. Total area of forest to be Cleared or Retained Outside FCE	0.0
M. Total area of forest to be Retained in FCE	0.0

PLANTING REQUIREMENTS:

Category	Value
N. Reforestation for clearing above Conservation Threshold	0
P. Reforestation for clearing below Conservation Threshold	0
Q. Credit for retention above conservation threshold	0
R. Total reforestation required	0
S. Total afforestation required	0.21
T. Total reforestation and afforestation required	0.21

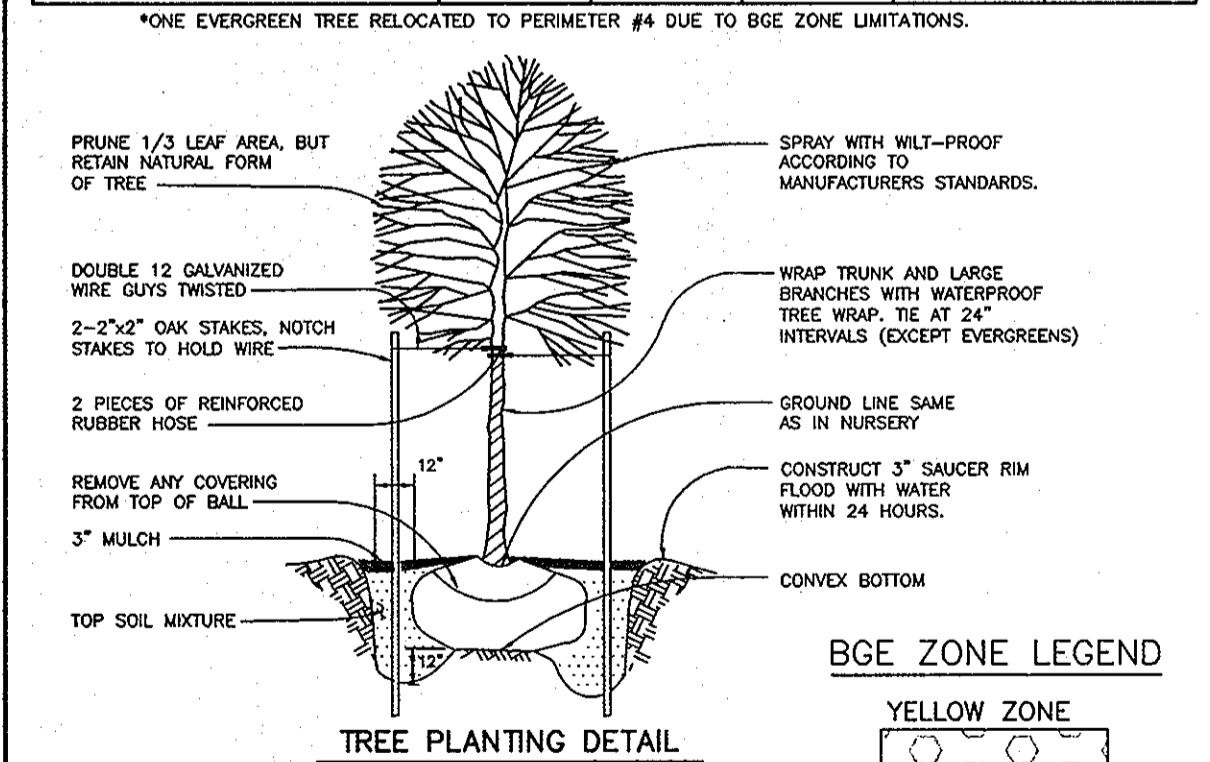

STREET TREE CALCULATIONS WHISKEY BOTTOM ROAD

STREET TREES REQUIRED FOR 152 LF OF RIGHT-OF-WAY = 5 TREES REQUIRED
5 TREES PROVIDED

STREET TREE PLANTING LIST

SYMBOL	QUANTITY	NAME	REMARKS
⑦	5	ACER GRiseum 'PAPERBARK MAPLE'	2.5"-3.0" MIN. CAL. FULL HEAD

DEVELOPER'S/BUILDER'S CERTIFICATION

I/WE CERTIFY THAT THE LANDSCAPING SHOWN ON THIS PLAN WILL BE DONE ACCORDING TO THE PLAN, SECTION 16.124 OF THE HOWARD COUNTY SUBDIVISION AND LAND DEVELOPMENT REGULATIONS AND LANDSCAPE MANUAL. I/WE FURTHER CERTIFY THAT UPON COMPLETION, A LETTER OF NOTICE, ACCOMPANIED BY AN EXECUTED ONE YEAR GUARANTEE OF PLANT MATERIALS, WILL BE SUBMITTED TO THE DEPARTMENT OF PLANNING AND ZONING.

NAME: *KOB* DATE: *9/24/13*

- LANDSCAPING NOTES**
- PERIMETER LANDSCAPING SHALL BE PROVIDED BY THE PLANTINGS AS SHOWN ON THESE PLANS.
 - TREES MUST BE A MINIMUM OF FOUR (4) FEET FROM ANY STORM DRAIN AND 10 FEET FROM A DRIVEWAY APRON.
 - AT THE TIME OF INSTALLATION, ALL SHRUBS AND OTHER PLANTINGS HEREWITH LISTED AND APPROVED FOR THIS SITE, SHALL BE OF THE PROPER HEIGHT REQUIREMENTS IN ACCORDANCE WITH THE HOWARD COUNTY LANDSCAPE MANUAL. IN ADDITION, NO SUBSTITUTIONS OR RELOCATION OF REQUIRED PLANTINGS MAY BE MADE WITHOUT PRIOR REVIEW AND APPROVAL FROM THE DEPARTMENT OF PLANNING AND ZONING. ANY DEVIATION FROM THIS APPROVED LANDSCAPE PLAN MAY RESULT IN DENIAL OR DELAY IN RELEASE OF LANDSCAPE SURETY UNTIL SUCH TIME AS ALL REQUIRED MATERIALS ARE PLANTED AND/OR REVISIONS ARE MADE TO APPLICABLE PLANS AND CERTIFICATIONS.
 - IN THE EDGE GREEN ZONE, ONLY TREES WITH A MATURE HEIGHT OF LESS THAN 25 FEET SHALL BE ALLOWED.
 - IN THE BGE YELLOW ZONE, ONLY TREES WITH A MATURE HEIGHT OF LESS THAN 40 FEET SHALL BE ALLOWED.
 - THE OWNER, TENANTS AND/OR THEIR AGENTS SHALL BE RESPONSIBLE FOR MAINTENANCE OF THE REQUIRED LANDSCAPING, PLANT MATERIALS, BERMS, FENCES AND WALLS. ALL PLANT MATERIALS SHALL BE MAINTAINED IN GOOD GROWING CONDITION, AND WHEN NECESSARY, REPLACED WITH NEW MATERIALS TO ENSURE CONTINUED COMPLIANCE WITH APPLICABLE REGULATIONS. ALL OTHER REQUIRED LANDSCAPING SHALL BE PERMANENTLY MAINTAINED IN GOOD CONDITION, AND WHEN NECESSARY, REPAIRED OR REPLACED.
 - NO CLEARING OF EXISTING VEGETATION IS PERMITTED WITHIN THE LANDSCAPE EDGE FOR WHICH CREDIT IS BEING TAKEN; HOWEVER, LANDSCAPE MAINTENANCE IS AUTHORIZED.
 - SHOULD ANY TREE DESIGNATED FOR PRESERVATION, FOR WHICH CREDIT IS GIVEN, DIE PRIOR TO RELEASE OF BONDS, THE OWNER WILL BE REQUIRED TO REPLACE THE TREE WITH THE EQUIVALENT SPECIES OR WITH A TREE WHICH WILL OBTAIN THE SAME HEIGHT, SPREAD AND GROWTH CHARACTERISTICS. THE REPLACEMENT TREE MUST BE A MINIMUM OF 3 INCHES IN CALIPER AND INSTALLED AS REQUIRED IN THE LANDSCAPE MANUAL.
 - PERIMETER LANDSCAPING SHALL BE PROVIDED AS SHOWN ON THE LANDSCAPE PLAN OF THE FINAL CONSTRUCTION DRAWINGS FOR THIS FINAL PLAN IN ACCORDANCE WITH SECTION 16.124 OF THE LANDSCAPE MANUAL. FINANCIAL SURETY IN THE AMOUNT OF \$10,350 FOR 20 SHADE TREES AND 29 EVERGREEN TREES SHALL BE POSTED AS PART OF THE DEVELOPER'S AGREEMENT.
 - THE DEPARTMENT OF RECREATION AND PARKS (410-627-9762) MUST APPROVE STAKEOUT LOCATIONS OF PARKLAND PATH AND PLANTINGS IN THE FIELD BEFORE CONSTRUCTION AND INSTALLATION. DPR SHALL BE NOTIFIED 7 DAYS PRIOR TO THE INSTALLATION OF THE PLANTS WITHIN OPEN SPACE LOT 7 WITH THE DATE AND TIME OF PLANTING.

APPROVED: HOWARD COUNTY DEPARTMENT OF PUBLIC WORKS




W. R. ... 10-24-13
CHIEF, BUREAU OF HIGHWAYS

APPROVED: HOWARD COUNTY DEPARTMENT OF PLANNING AND ZONING

K. ... 11-13-13
CHIEF, DIVISION OF LAND DEVELOPMENT

Chad ... 10-31-13
CHIEF, DEVELOPMENT ENGINEERING DIVISION

Eco-Science Professionals, Inc. Consulting Ecologists
710, Box 890 Glen Arden, Maryland 21027 Telephone: (410) 453-3488 Fax: (410) 832-3488

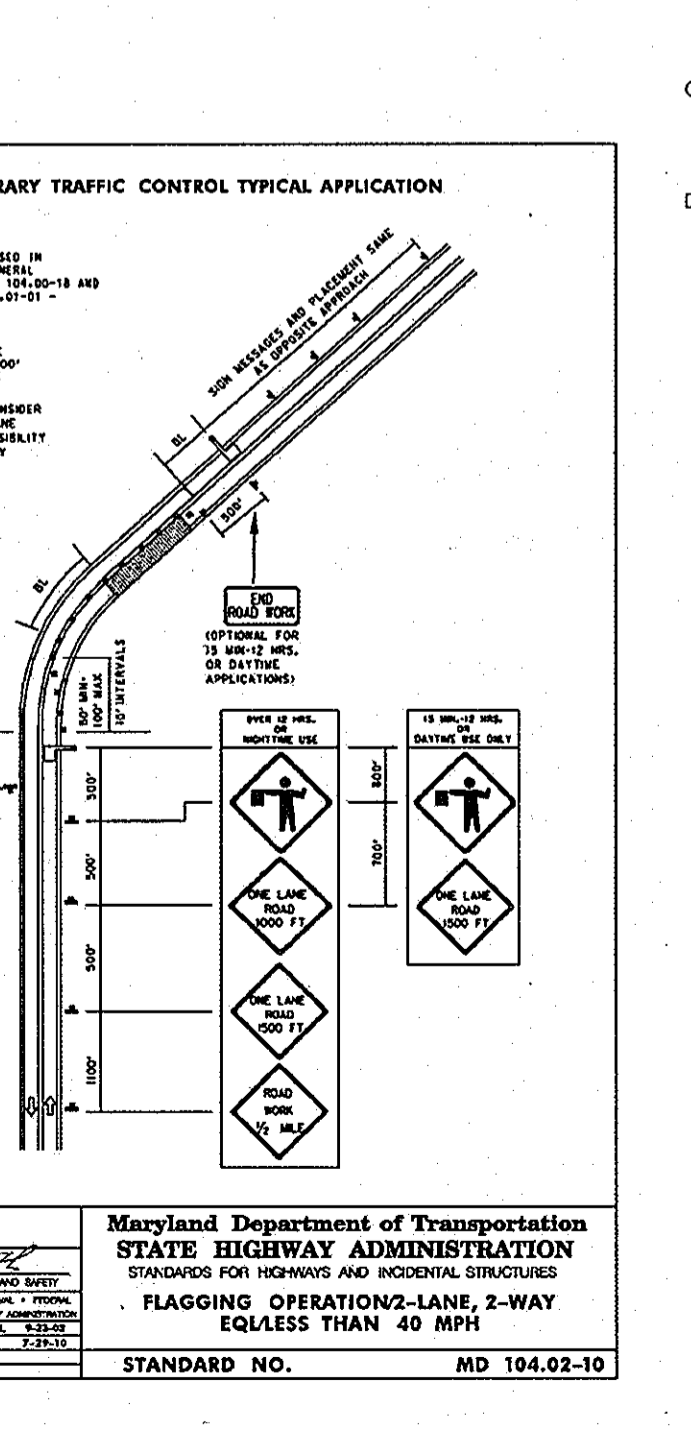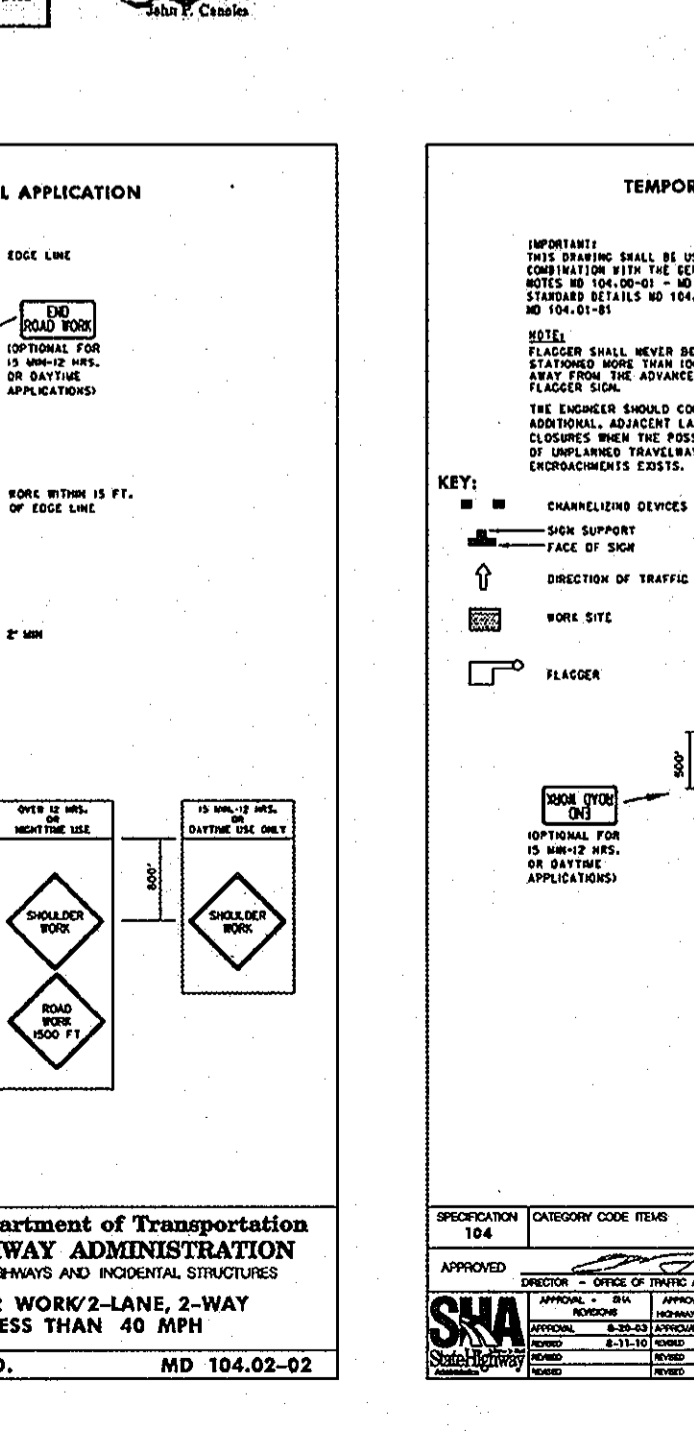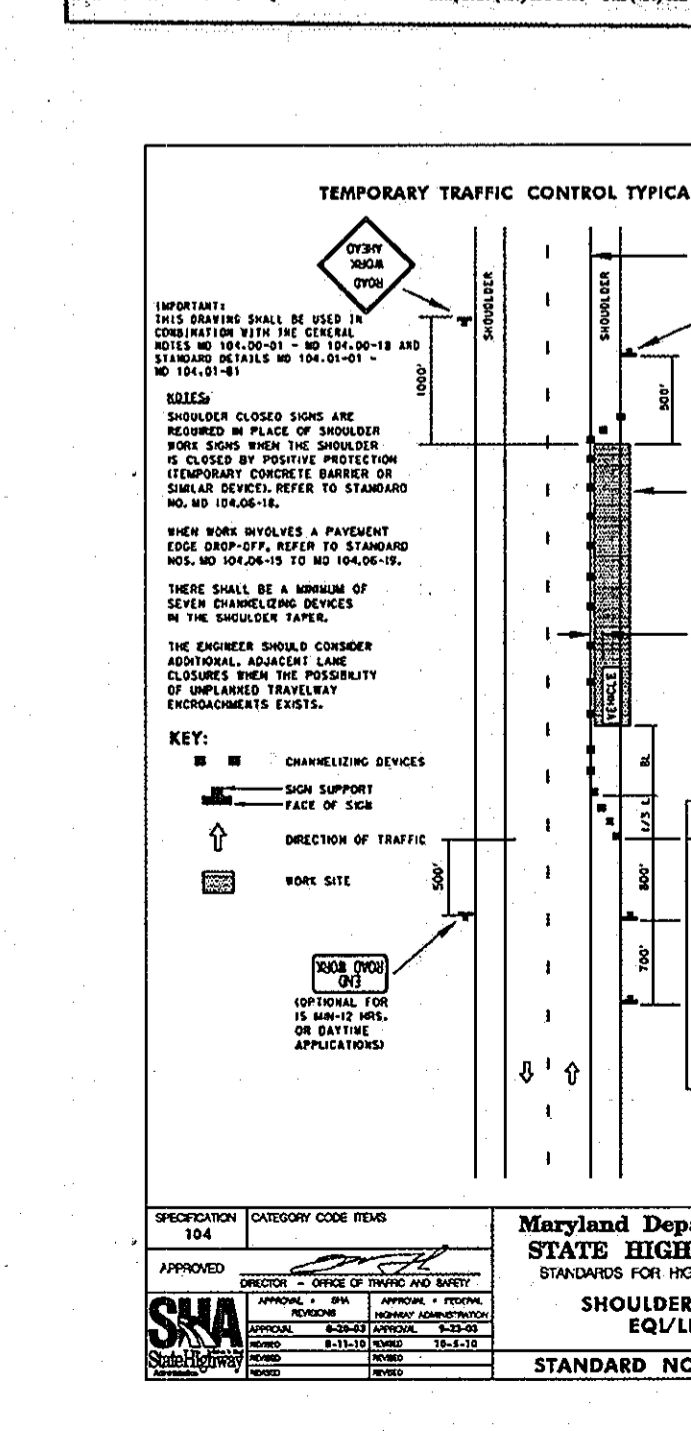

MICRO-BIORETENION GEOMETRY (M-6)

LOT	LENGTH	WIDTH	DEPTH	A	B	C	D	E	F
MB-2	17.5'	4.5'	1.0'	263.8	262.8	260.5	260.2	259.7	259.7
MB-3	17.5'	4.5'	1.0'	263.0	262.0	261.7	259.7	259.4	258.9
MB-4	17.5'	4.5'	1.0'	263.0	262.0	261.7	259.7	259.4	258.9
MB-5	17.5'	4.5'	1.0'	263.8	262.8	262.5	260.5	260.2	259.7
MB-6	17.5'	4.5'	1.0'	259.0	258.0	257.7	255.2	254.9	254.4

- OPERATION AND MAINTENANCE SCHEDULE FOR MICRO-BIORETENION (M-6)**
- THE OWNER SHALL MAINTAIN THE PLANT MATERIAL, MULCH LAYER AND SOIL LAYER ANNUALLY. MAINTENANCE OF MULCH AND SOIL IS LIMITED TO CORRECTING AREAS OF EROSION OR WASH OUT. ANY MULCH REPLACEMENT SHALL BE DONE IN THE SPRING. PLANT MATERIAL SHALL BE CHECKED FOR DISEASE AND INSECT INFESTATION AND MAINTENANCE WILL ADDRESS DEAD MATERIAL AND PRUNING. ACCEPTABLE REPLACEMENT PLANT MATERIAL IS LIMITED TO THE FOLLOWING: 2000 MARYLAND STORMWATER DESIGN MANUAL VOLUME II, TABLE A-4.1 AND 2.
 - THE OWNER SHALL PERFORM A PLANT INSPECTION IN THE SPRING AND IN THE FALL OF EACH YEAR. DURING THE INSPECTION, THE OWNER SHALL REMOVE DEAD AND DISEASED VEGETATION CONSIDERED BEYOND TREATMENT, REPLACE DEAD PLANT MATERIAL WITH ACCEPTABLE REPLACEMENT PLANT MATERIAL, TREAT DISEASED TREES AND SHRUBS, AND REPLACE ALL DEFICIENT STAKES AND WIRES.
 - THE OWNER SHALL INSPECT THE MULCH EACH SPRING. THE MULCH SHALL BE REPLACED EVERY TWO TO THREE YEARS. THE PREVIOUS MULCH LAYER SHALL BE REMOVED BEFORE THE NEW LAYER IS APPLIED.
 - THE OWNER SHALL CORRECT SOIL EROSION ON AN AS NEEDED BASIS, WITH A MINIMUM OF ONCE PER MONTH AND AFTER EACH HEAVY STORM.

PLANTING SCHEDULE




PLANTING SCHEDULE	PLANTING DATE
1 IRIS VERSICOLOR - IRIS	4
2 RUBECKIA SUBTENTOSA - SWEET CONFLOWER	4
3 LOBELIA CARDINALIS - CARDINAL FLOWER	4
4 ACER RUBRUM - RED MAPLE	1

BENCHMARK ENGINEERING, INC.
ENGINEERS & LAND SURVEYORS & PLANNERS
9480 BALTIMORE NATIONAL PIKE SUITE 315 A ELICOTT CITY, MARYLAND 21043
(410) 410-6500 (410) 410-6504
75 THOMAS JOHNSON DRIVE SUITE E ABERDEEN, MARYLAND 21702
410-710-5688
WWW.BEC-ENGINEERING.COM

PARKSIDE ESTATES
LOTS 2-6 & OPEN SPACE LOTS 1 & 7
TAX MAP: 50 GRID: 4 PARCEL: 438
ZONED: R-SC
ELECTION DISTRICT NO. 6 - HOWARD COUNTY, MARYLAND


OWNER/DEVELOPER:
CONESTONE HOLDINGS LLC
9695 NORFOLK AVENUE
LAUREL, MARYLAND 20723
410-792-2565

DESIGN: AAM DRAWN: AAM
DATE: JANUARY 2013 BEI PROJECT NO. 2384-C
SCALE: AS SHOWN SHEET 2 OF 4

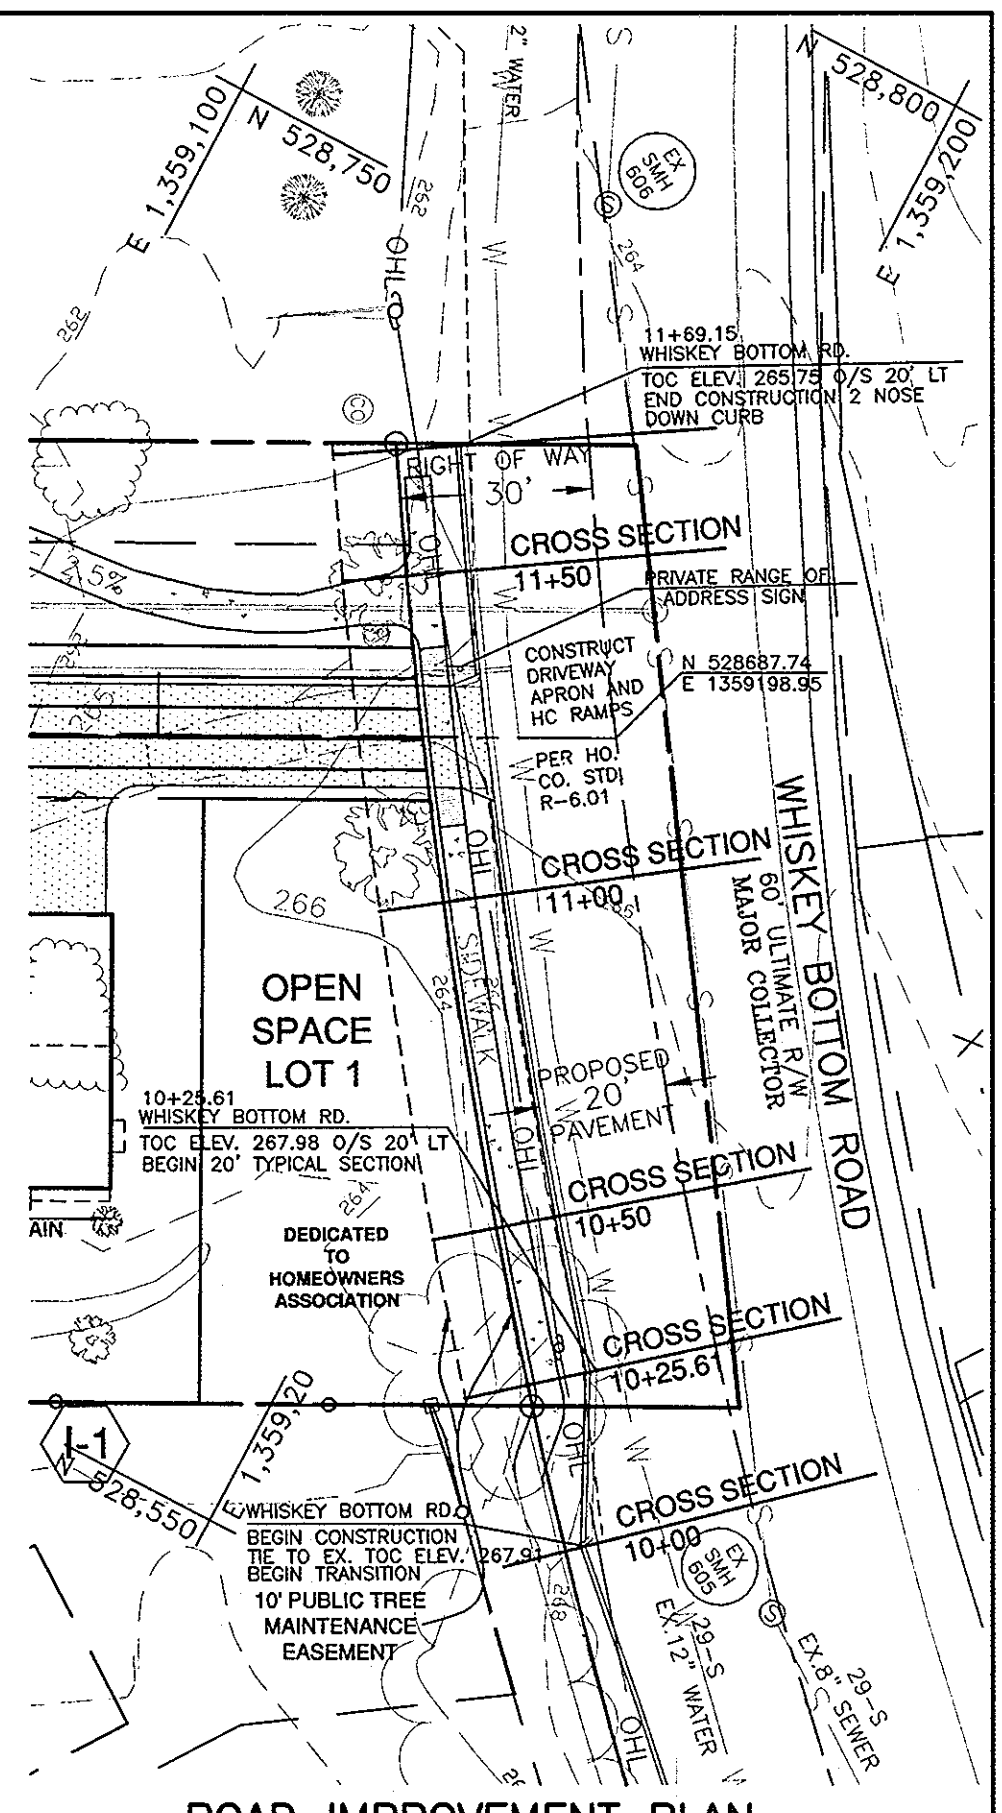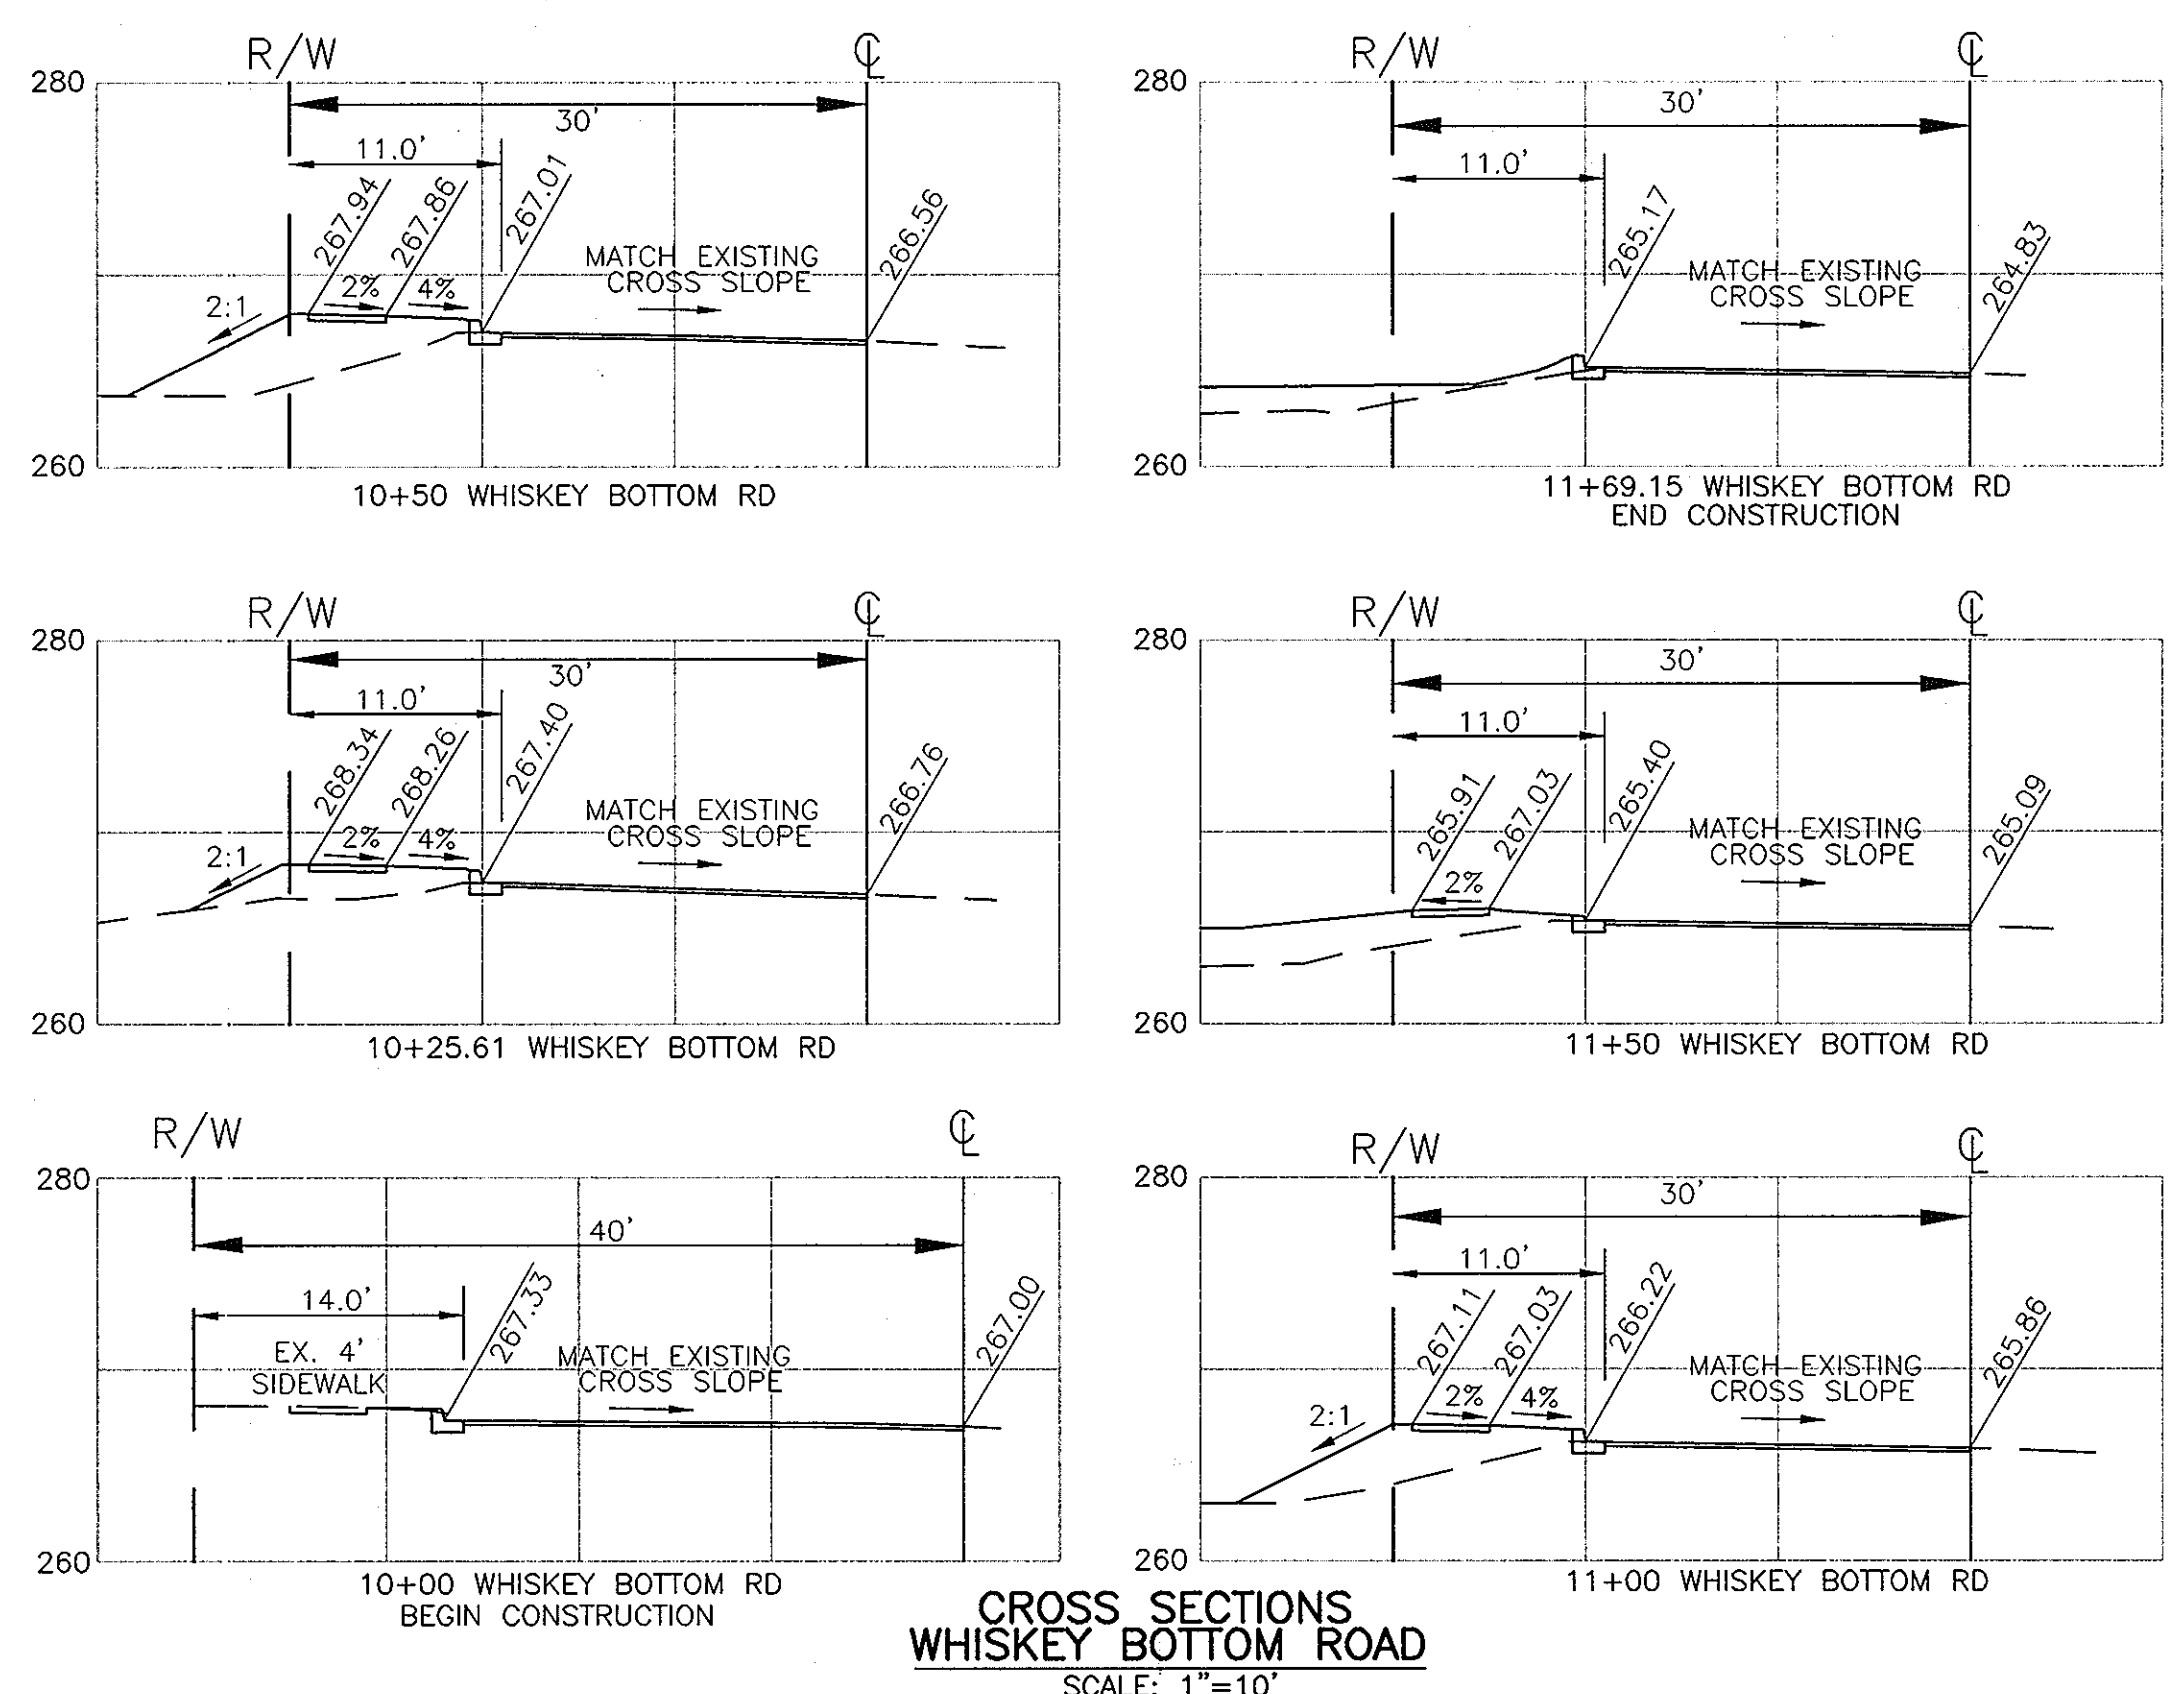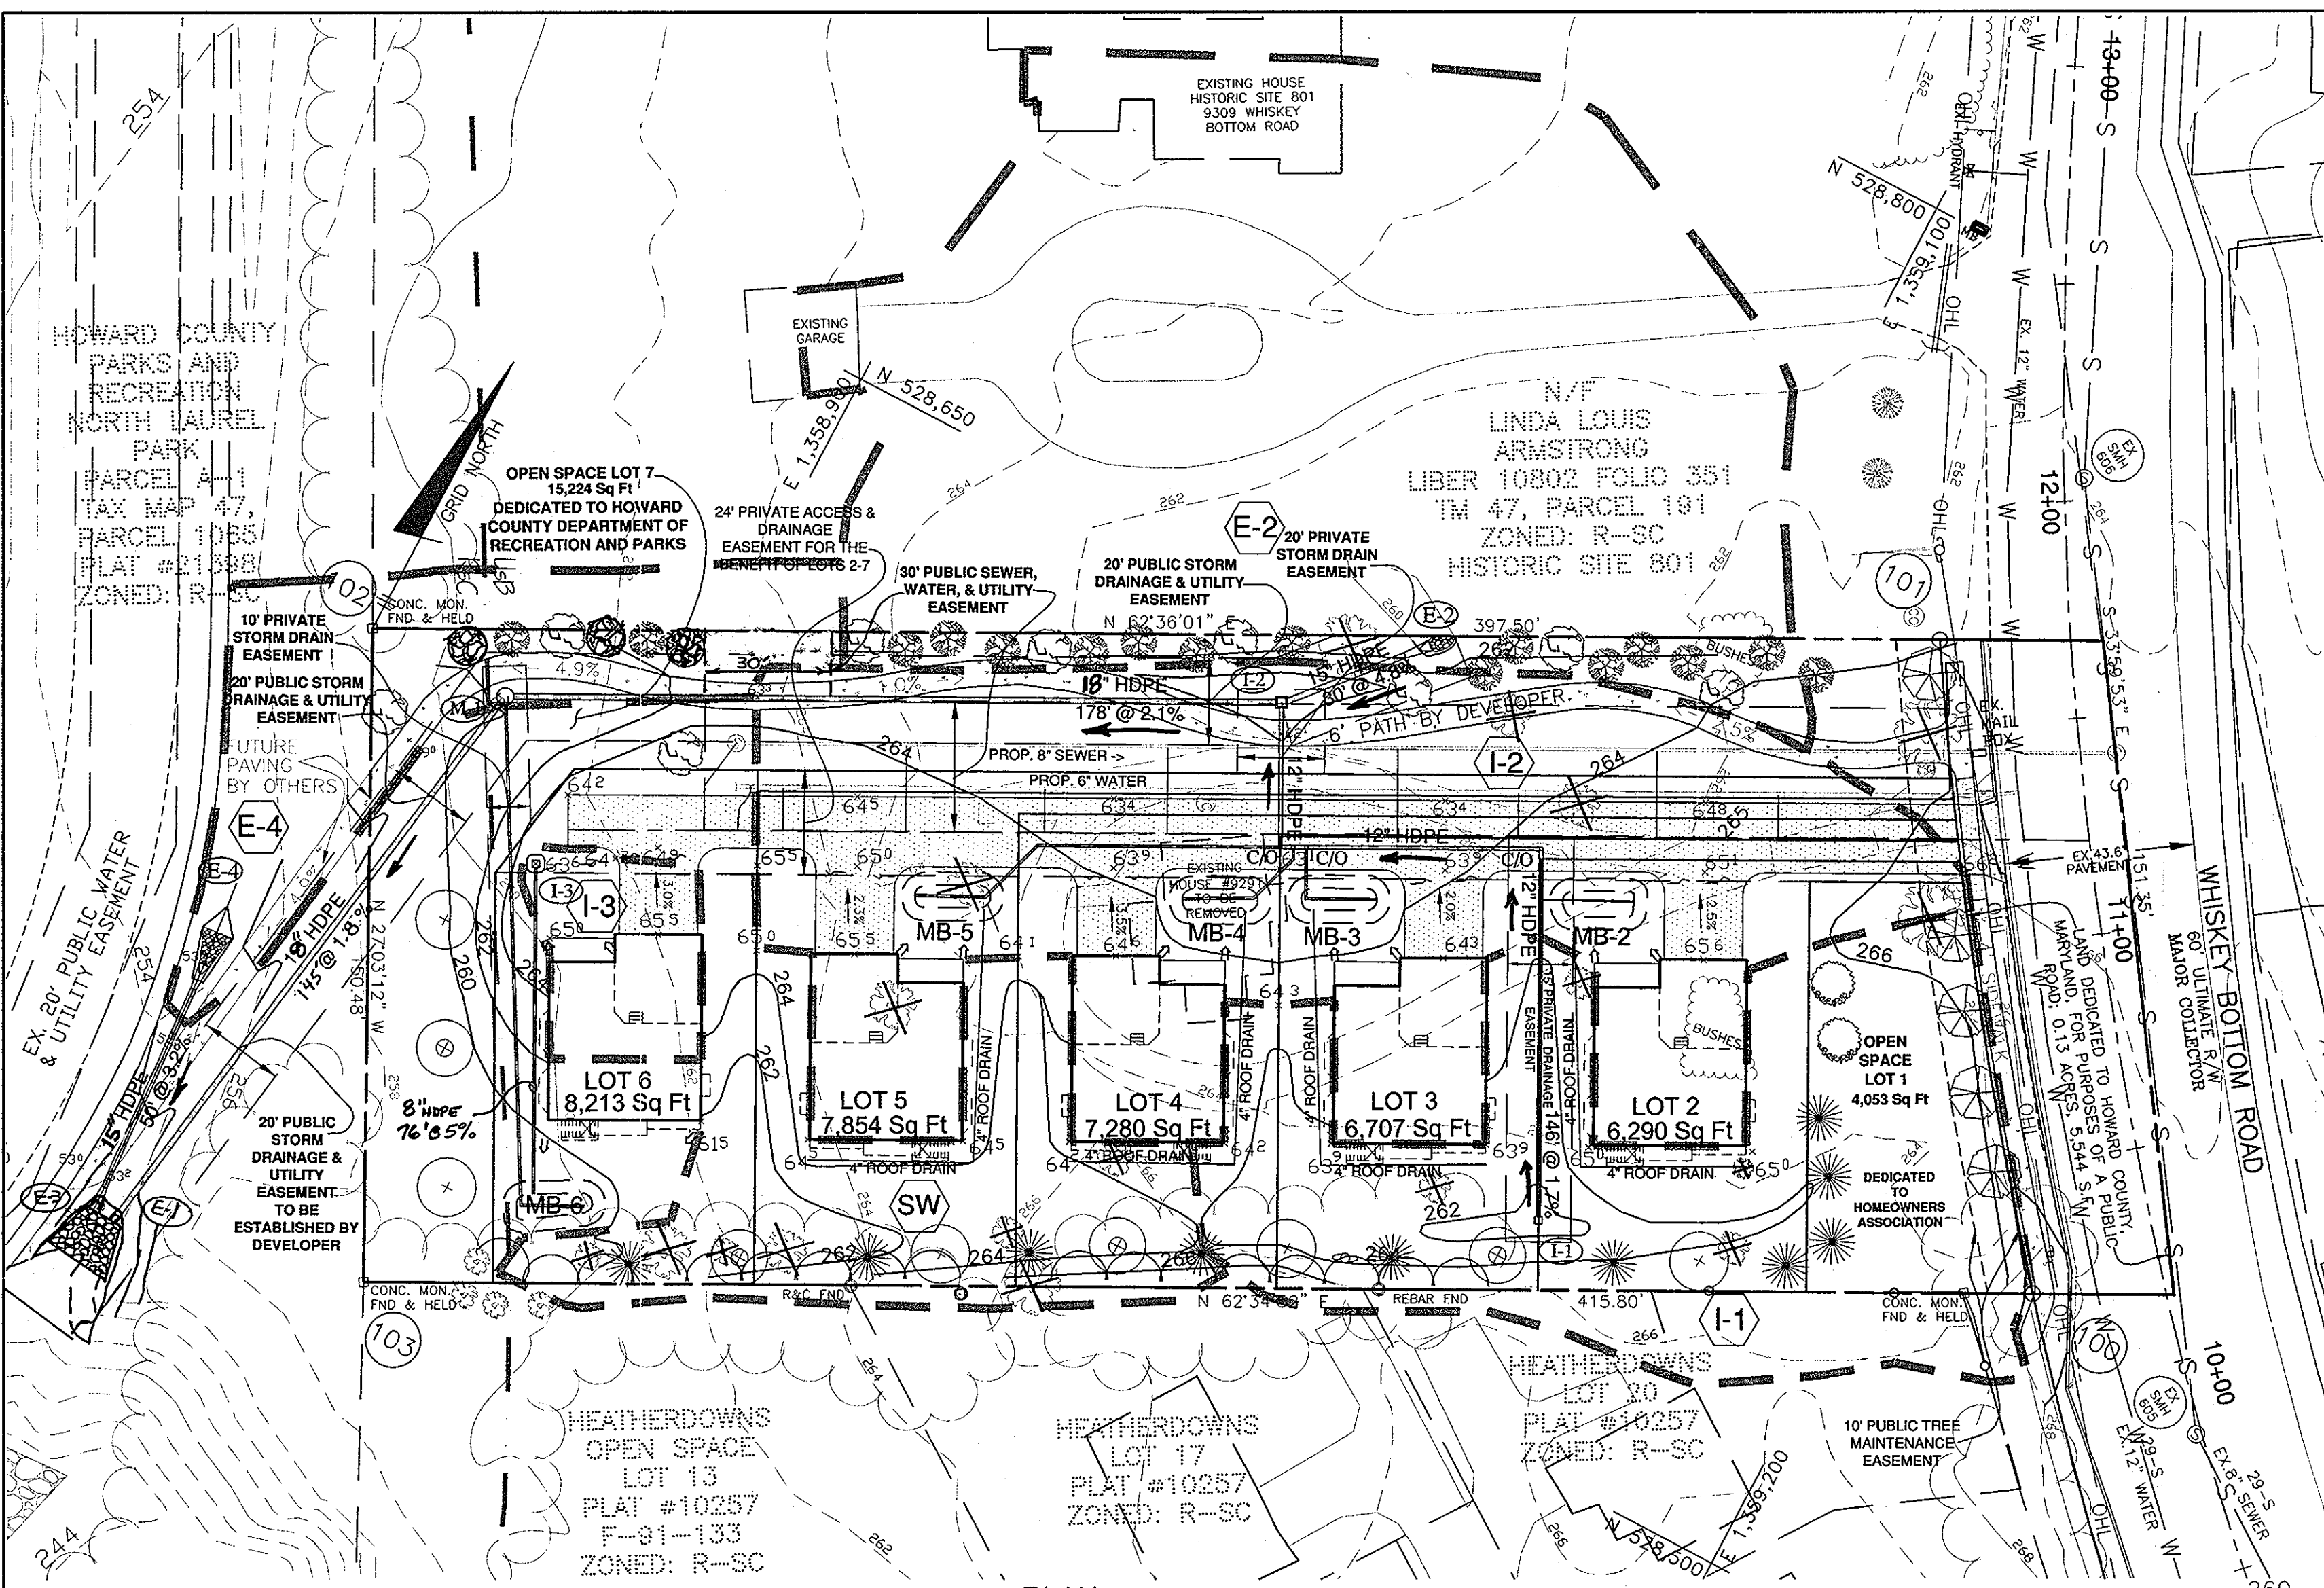

CROSS SECTIONS WHISKEY BOTTOM ROAD
SCALE: 1" = 10'

SECTION NUMBER	ROAD AND STREET CLASSIFICATION	CALIFORNIA BEARING RATIO (CBR)	3 TO <5 TO <7 TO >7		3 TO <5 TO <7 TO >7	
			MIN HMA WITH GAB	HMA WITH CONSTANT GAB	MIN HMA WITH GAB	HMA WITH CONSTANT GAB
P-4	MINOR COLLECTORS, NON-RESIDENTIAL MAJOR COLLECTORS	HMA SUPERPAVE FINAL SURFACE	2.0	2.0	2.0	2.0
		HMA SUPERPAVE INTERMEDIATE SURFACE	2.0	2.0	2.0	2.0
		HMA SUPERPAVE BASE	2.0	2.0	2.0	2.0
		GRADED AGGREGATE BASE (GAB)	4.0	4.0	3.0	6.0
			13.0	7.0	4.0	6.0




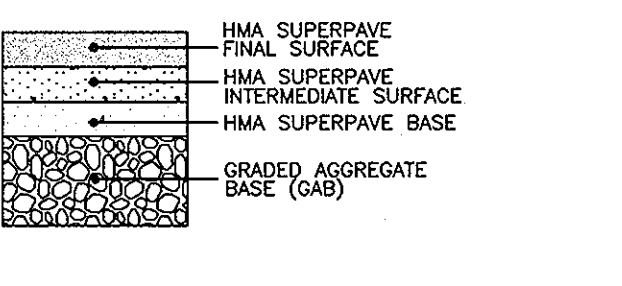


ROAD IMPROVEMENT PLAN
SCALE: 1" = 30'

CONSTRUCTION SPECIFICATIONS


- THE SUBGRADE FOR THE FILTER, RIP-RAP, OR GABION SHALL BE PREPARED TO THE REQUIRED LINES AND GRADES. ANY FILL REQUIRED IN THE SUBGRADE SHALL BE COMPACTED TO A DENSITY OF APPROXIMATELY THAT OF THE SURROUNDING UNDISTURBED MATERIAL.
- THE ROCK OR GRAVEL SHALL CONFORM TO THE SPECIFIED GRADING LIMITS WHEN INSTALLED RESPECTIVELY IN THE RIP-RAP OR FILTER.
- GEOTEXTILE CLASS C28 OR BETTER SHALL BE PROTECTED FROM PUNCHING, CUTTING, OR TEARING. ANY DAMAGE OTHER THAN AN OCCASIONAL SMALL HOLES SHALL BE REPAIRED BY PLACING ANOTHER PIECE OF GEOTEXTILE FABRIC OVER THE DAMAGED PART OR BY COMPLETELY REPLACING THE GEOTEXTILE FABRIC. ALL DIMENSIONS WHETHER FOR REPAIRS OR FOR JOINING TWO PIECES OF GEOTEXTILE FABRIC SHALL BE A MINIMUM OF ONE FOOT.
- STONE FOR THE RIP-RAP OR GABION OUTLETS MAY BE PLACED BY EQUIPMENT. THEY SHALL BE CONSTRUCTED TO THE FULL COURSENESS IN ONE OPERATION AND IN SUCH A MANNER AS TO AVOID DISPLACEMENT OF UNDERLYING MATERIALS. THE STONE FOR THE RIP-RAP OR GABION OUTLETS SHALL BE DELIVERED AND PLACED IN A MANNER THAT WILL ENSURE THAT IT IS REASONABLY HOMOGENEOUS WITH THE SMALLER STONES AND SPALLS FILLING THE VOIDS BETWEEN THE LARGER STONES. RIP-RAP SHALL BE PLACED IN A MANNER TO PREVENT DAMAGE TO THE FILTER BLANKET OR GEOTEXTILE FABRIC. HAND PLACEMENT WILL BE REQUIRED TO THE EXTENT NECESSARY TO PREVENT DAMAGE TO THE PERMANENT WORKS.
- THE STONE SHALL BE PLACED SO THAT IT BLENDS IN WITH THE EXISTING GROUND. IF THE STONE IS PLACED TOO HIGH THEN THE FLOW WILL BE FORCED OUT OF THE CHANNEL, AND SCOUR ADJACENT TO THE STONE WILL OCCUR.

P-4 PAVING DETAIL

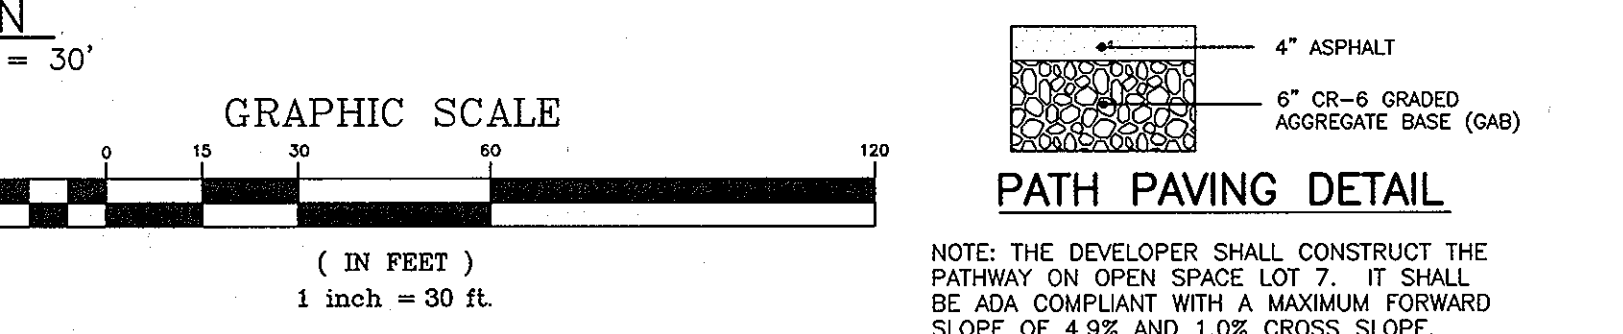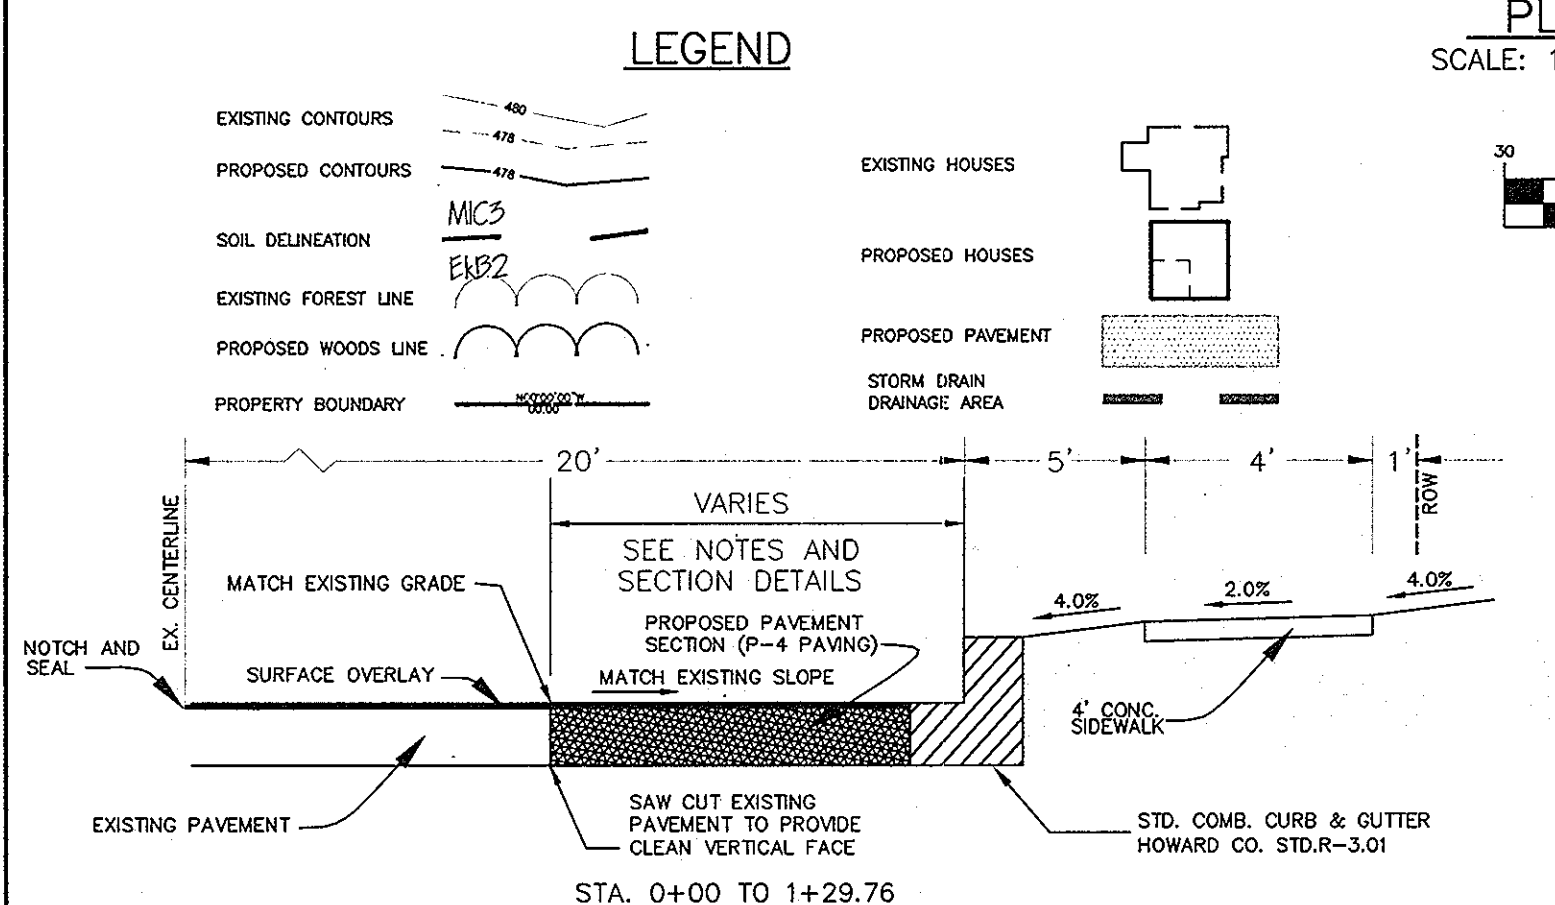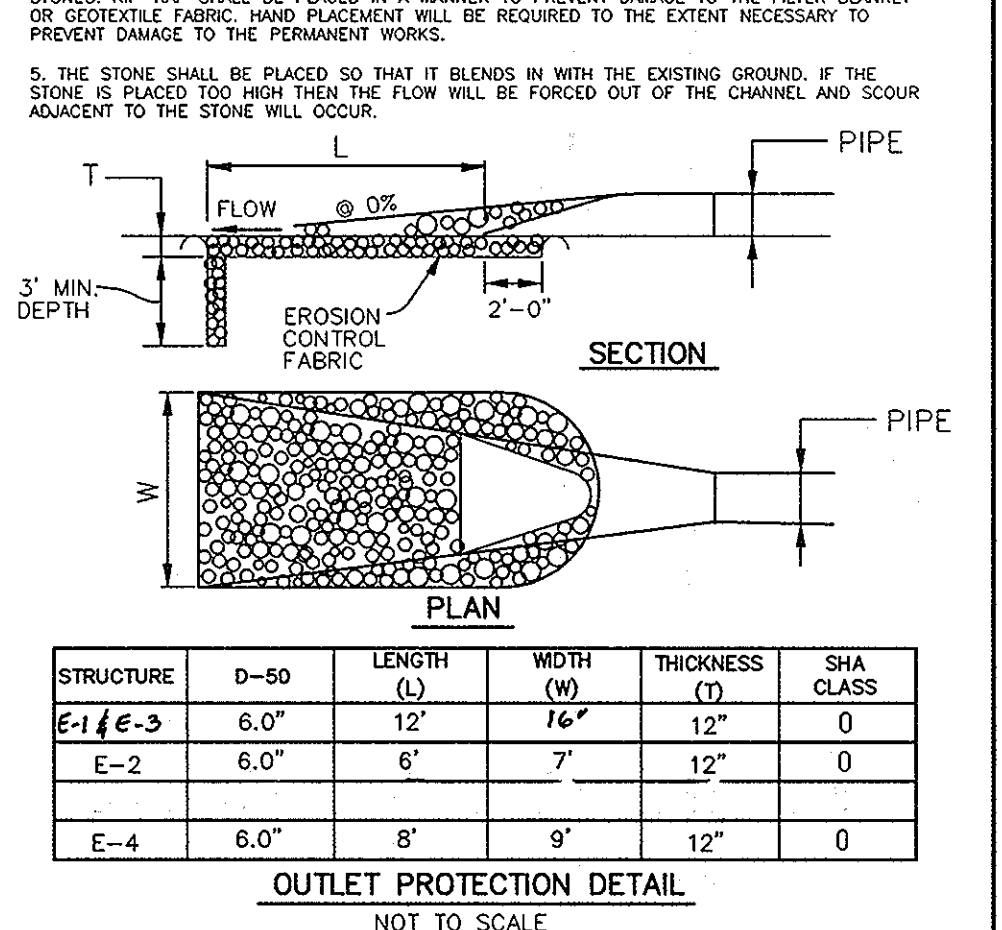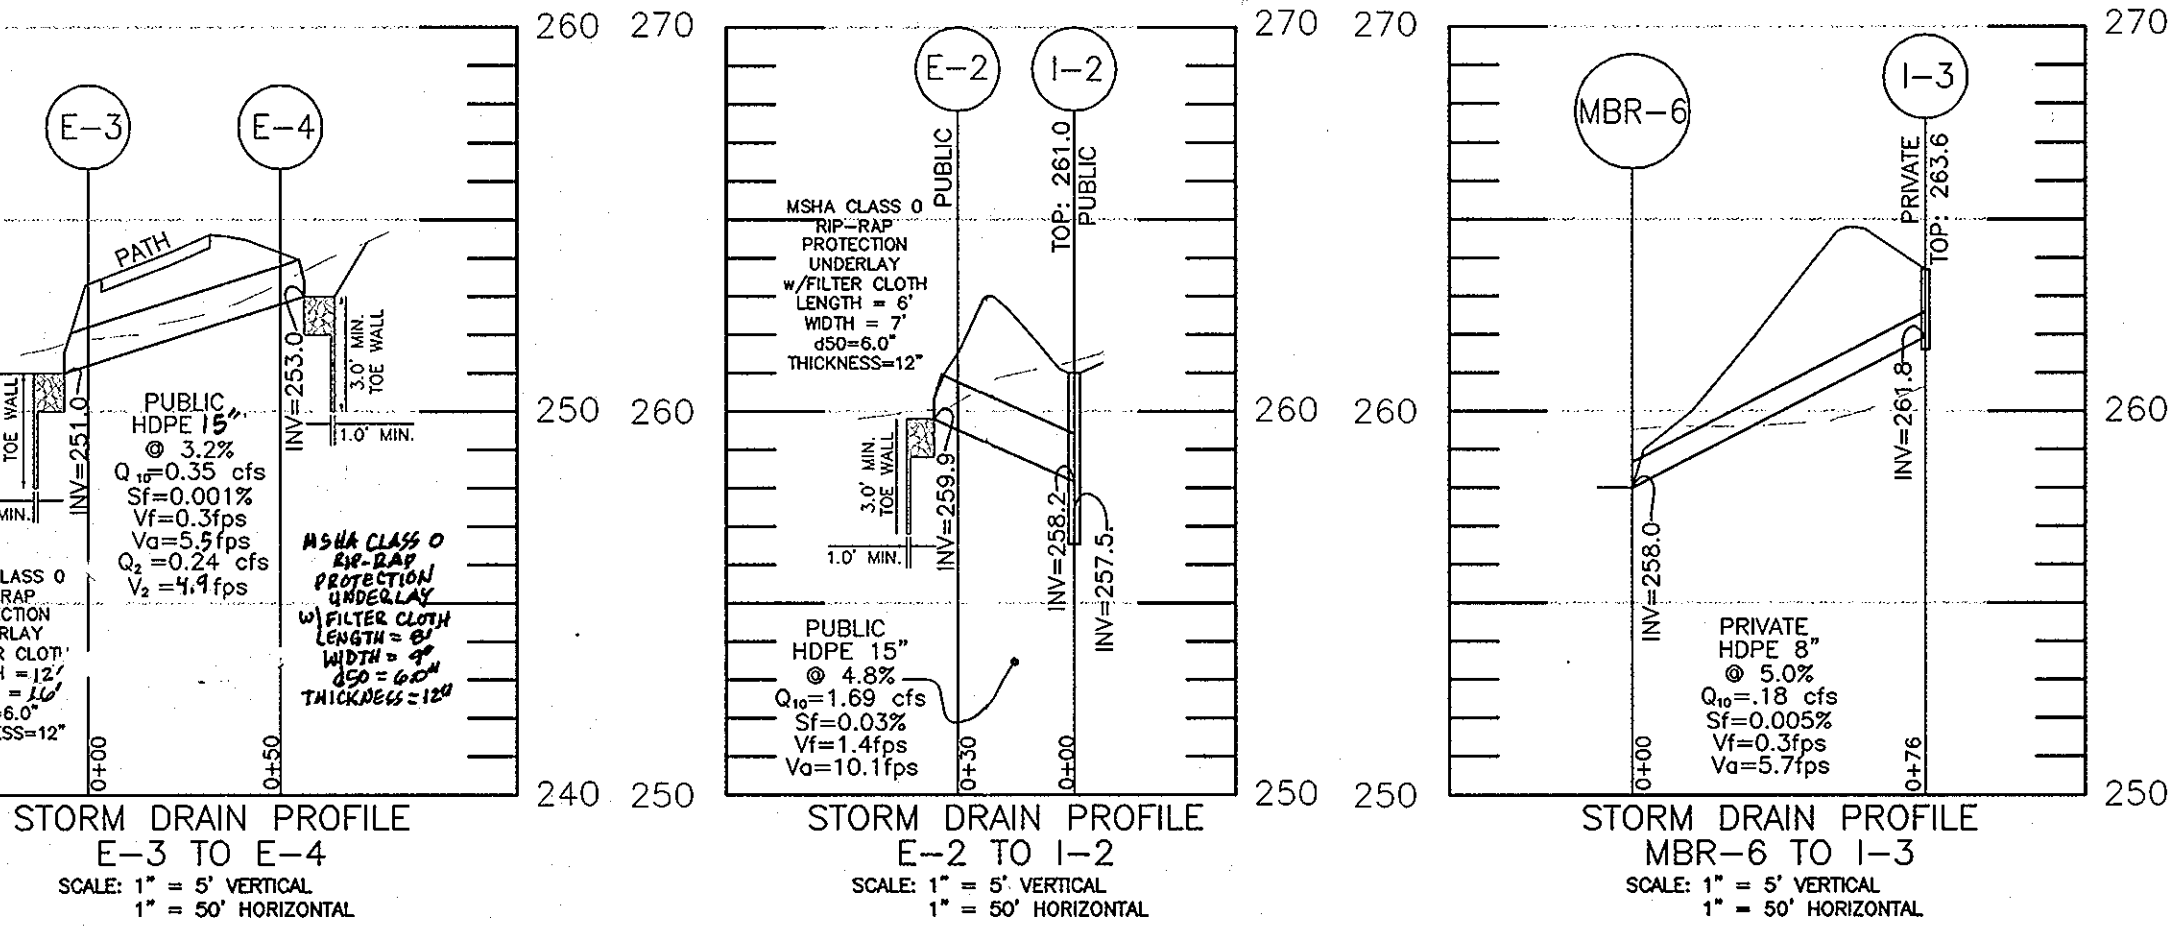

STORM DRAIN DRAINAGE AREA DATA

INLET NO.	ZONING	AREA (AC)	'C' FACTOR	% IMPERVIOUS
I-1	R-SC	0.30	0.36	0
I-2	R-SC	0.52	0.56	52
I-3	R-SC	0.04	0.68	71
E-2	R-SC	0.63	0.36	7
E-4	R-SC	0.15	0.36	15
SW	R-SC	0.16	0.36	0

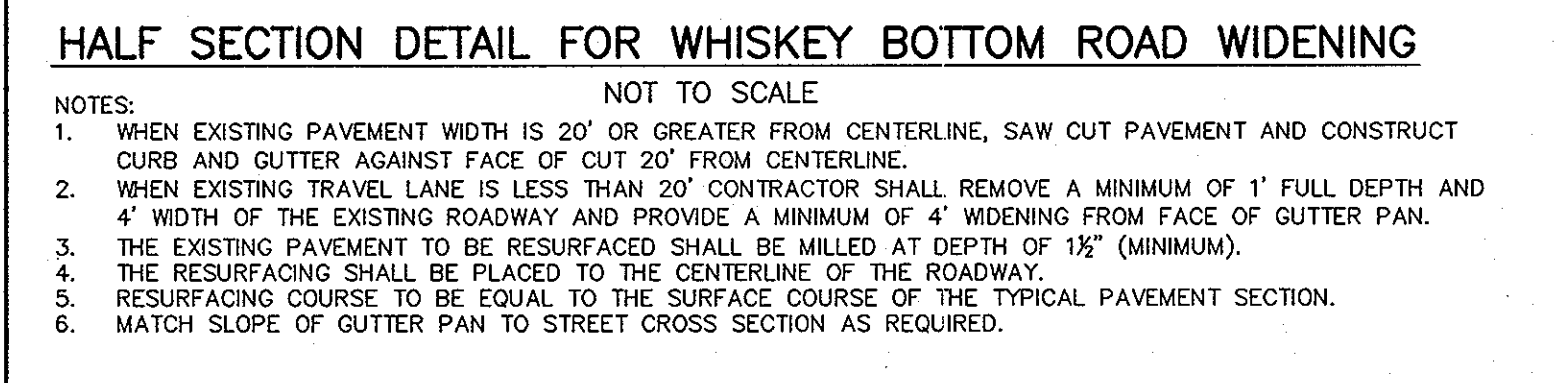

PIPE SCHEDULE

SIZE	LENGTH	TYPE & CLASS	OWNER
8"	76 LF	HDPE	PRIVATE
12"	178 LF	HDPE	PRIVATE
15"	80 LF	HDPE	PUBLIC
18"	323 LF	HDPE	PUBLIC

SOILS LEGEND


MAP SYMBOL	SOIL GROUP	SOIL TYPE
R&C	C	RUSSETT FINE SANDY LOAM, 5 TO 10 PERCENT SLOPES
UsB	D	URBAN LAND-SASSAFRAS-BELTSVILLE COMPLEX, 0 TO 5 PERCENT SLOPES

TAKEN FROM HOWARD COUNTY SOILS SURVEY, ISSUED MAY 2008, MAP NO. 28

STORM DRAIN STRUCTURE SCHEDULE

NO	LOCATION	INV. IN	INV. OUT	TOP ELEV.	HO. CO. STD.	OWNER
I-1	N 528,551.35 E 1,359,127.86	-	259.2	261.0	CB-18"	PRIVATE
I-2	N 528,629.24 E 1,359,019.93	258.2	257.7	257.2	261.0	D-4.14
I-3	N 528,516.46 E 1,358,885.91	-	261.8	263.6	CB-12"	PRIVATE
M-1	N 528,547.24 E 1,358,861.74	253.7	253.8	253.6	G-5.12	PUBLIC
E-1	N 528,383.26 E 1,358,836.12	-	251.0	-	HDPE**	PUBLIC
E-2	N 528,656.65 E 1,359,044.07	-	259.9	-	HDPE**	PUBLIC
E-3	N 528,398.20 E 1,358,833.33	-	251.0	-	HDPE**	PUBLIC
E-4	N 528,460.40 E 1,358,829.39	-	253.0	-	HDPE**	PUBLIC

*HANCOR 18" SQUARE CATCH BASIN WITH RISER AND GRATE, OR APPROVED EQUAL. ADJUST INVERT OUT TO MATCH SELECTED STRUCTURES.
**HANCOR HI-Q FLARED END SECTION OR EQUAL.

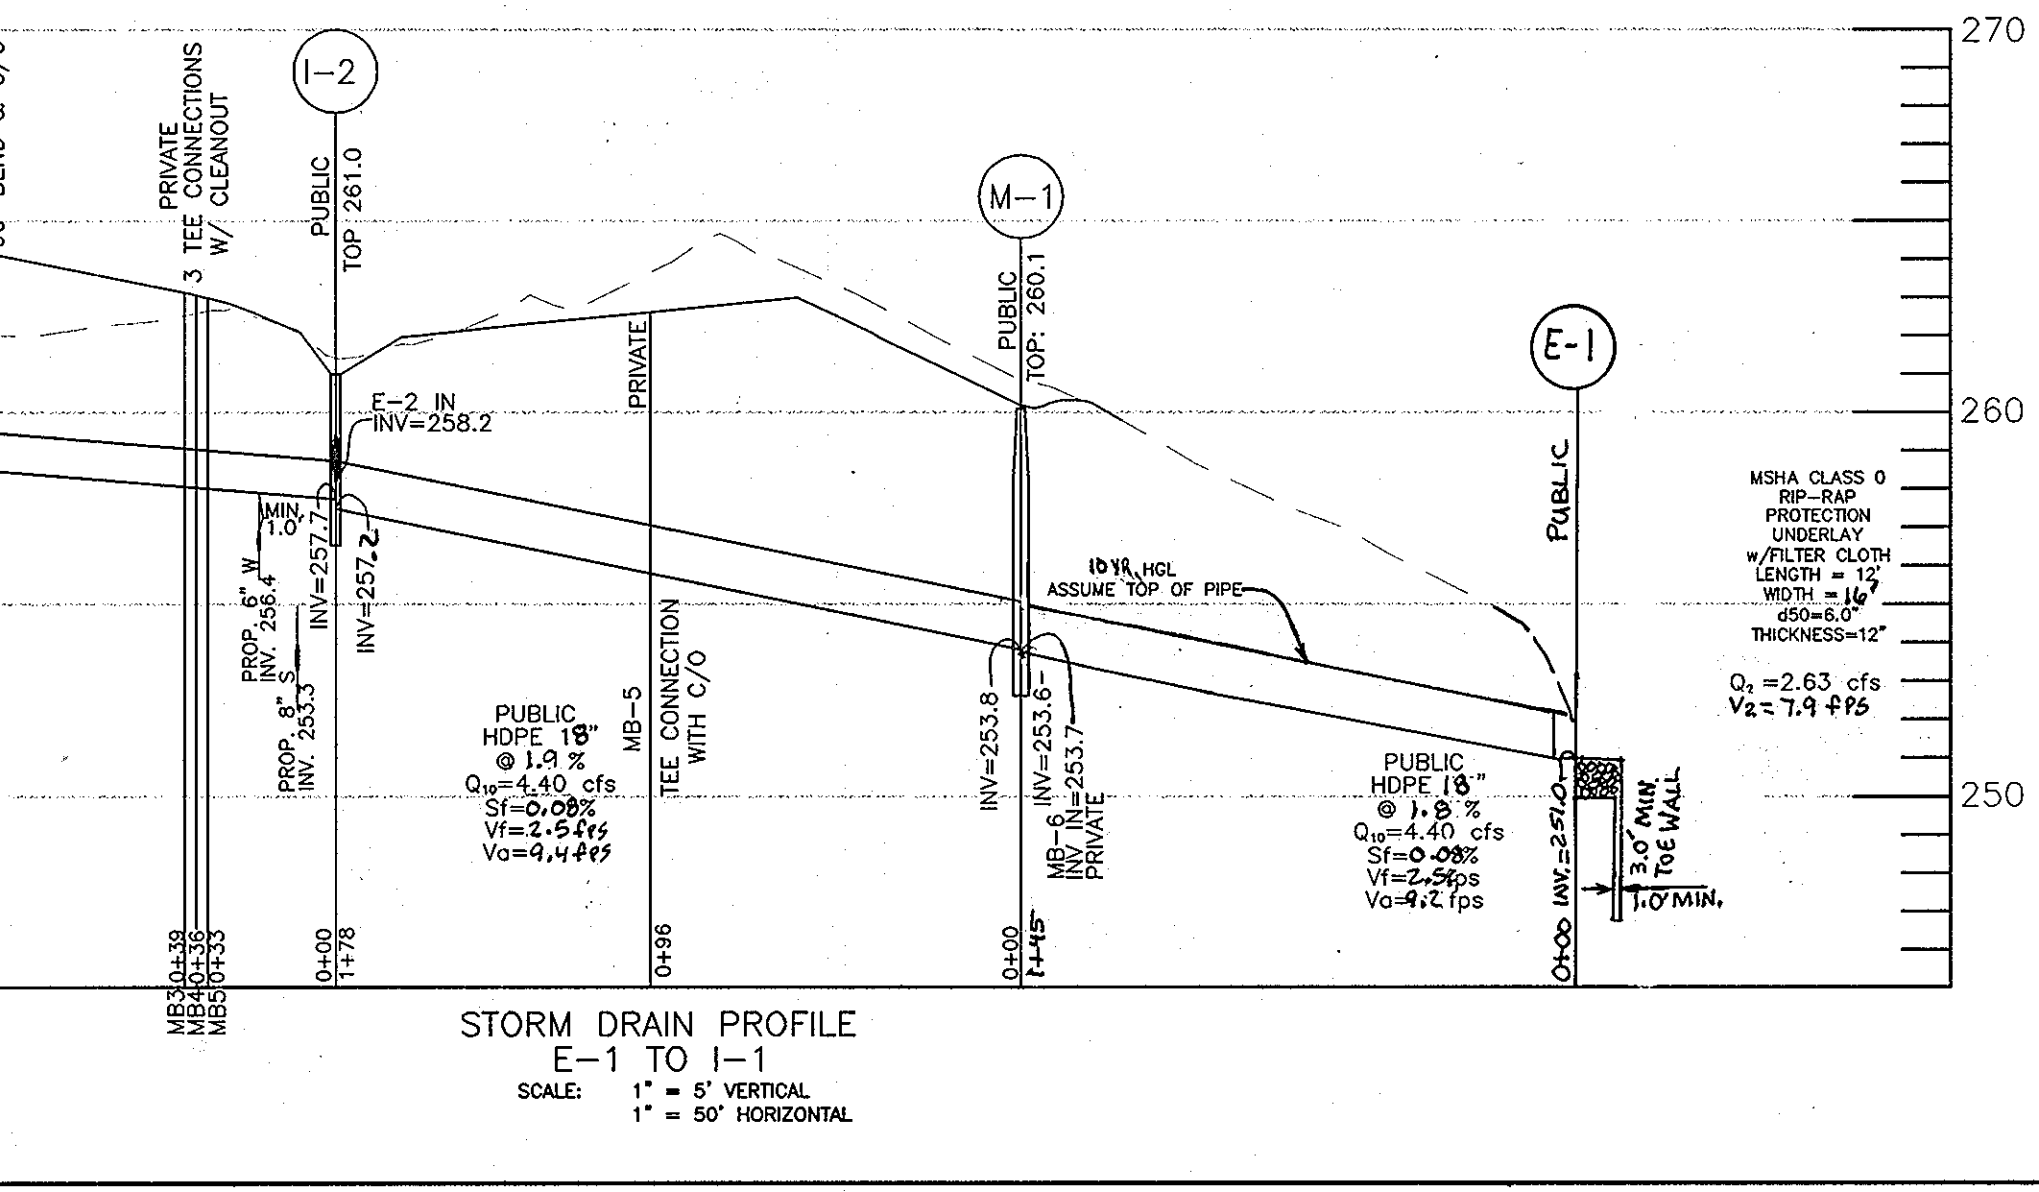

APPROVED: HOWARD COUNTY DEPARTMENT OF PUBLIC WORKS
 [Signature] 10-24-13
 CHIEF, BUREAU OF HIGHWAYS

APPROVED: HOWARD COUNTY DEPARTMENT OF PLANNING AND ZONING
 [Signature] 11-13-13
 CHIEF, DIVISION OF LAND DEVELOPMENT

[Signature] 10-31-13
 CHIEF, DEVELOPMENT ENGINEERING DIVISION

- STRUCTURE LOCATION FOR MANHOLES IS AT THE CENTER OF THE MANHOLE.
- STRUCTURE LOCATION FOR INLETS IS AT THE CENTER TOP.
- STRUCTURE LOCATION FOR END SECTIONS IS AT THE MIDPOINT OF THE END OF END SECTION.

NO. DATE REVISION

BENCHMARK ENGINEERS & LAND SURVEYORS & PLANNERS
 8480 BALTIMORE NATIONAL PIKE SUITE 315 & ELLICOTT CITY, MARYLAND 21045
 (703) 465-8100 (703) 465-8844
 75 THOMAS JOHNSON DRIVE SUITE A FREDRICK, MARYLAND 21702
 301-710-5688
 WWW.BE-CMENGINEERING.COM

OWNER/DEVELOPER:
 CORNERSTONE HOLDINGS, LLC
 9695 NORFOLK AVENUE
 LAUREL, MARYLAND 20723
 410-792-2565

PARKSIDE ESTATES
 LOTS 2-6 & OPEN SPACE LOTS 1 & 7


TAX MAP: 50 GRID: 4 PARCEL: 438
 ZONED: R-SC
 ELECTION DISTRICT NO. 6 - HOWARD COUNTY, MARYLAND

STORM DRAIN DRAINAGE AREA MAP AND PROFILES AND WHISKEY BOTTOM ROAD CROSS SECTIONS

DATE: JANUARY 2013 BEI PROJECT NO. 2384-C
 SEPTEMBER 2013

DESIGN: AAM DRAWN: AAM SCALE: AS SHOWN SHEET 3 OF 4

Professional Certification: I hereby certify that these documents were prepared or approved by me, and that I am a duly licensed professional engineer under the laws of the State of Maryland. License No. 21766 Expiration Date: 1/1/2015.

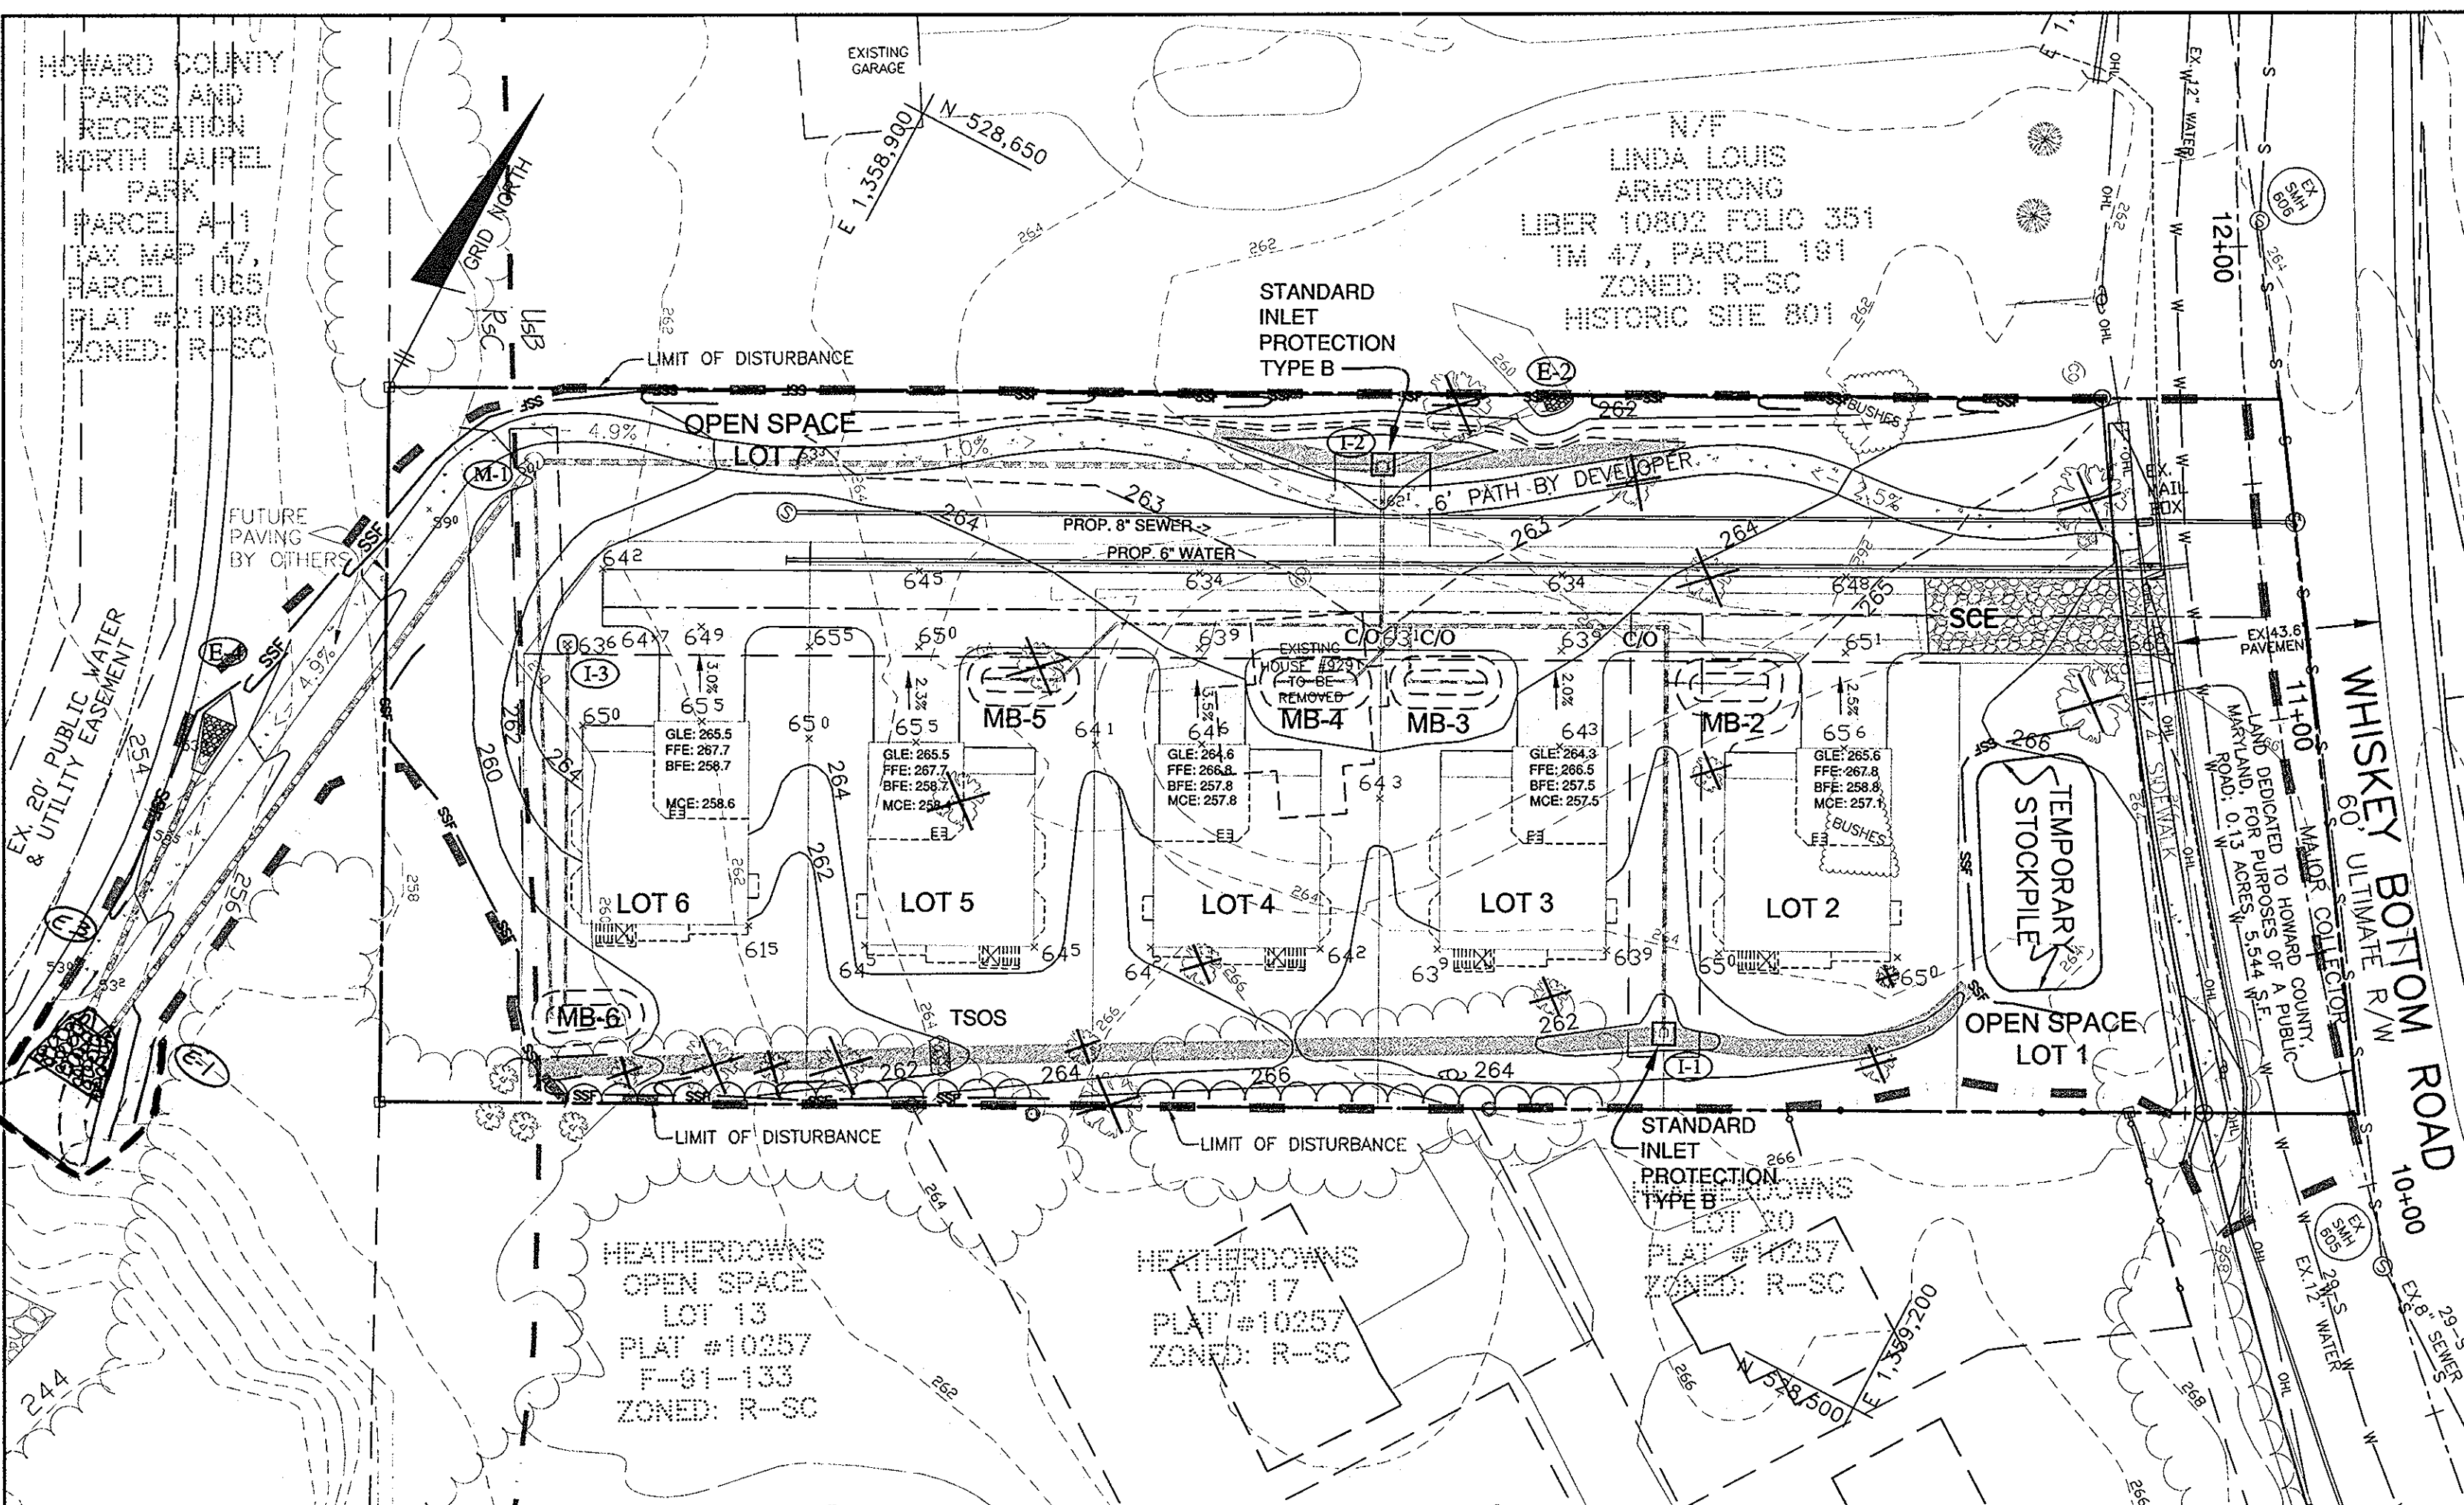

4-3 STANDARDS AND SPECIFICATIONS FOR SEEDING AND MULCHING

A. Seeding

1. All seed must meet the requirements of the Maryland State Seed Law. All seed must be subject to re-testing by a recognized seed laboratory. All seed must have been tested within the 8 months immediately preceding the date of sowing such material on any project. Refer to Table B.4 regarding the quality of seed. Seed tags must be available upon request to the inspector to verify the type of seed and seeding rates.
2. Mulch alone may be applied between the fall and spring seeding dates only if the ground is frozen. The appropriate seeding mixture must be applied when the ground thaws.
3. Inoculants: The inoculant for trucking seedlings in the seed mixtures must be a pure culture of nitrogen fixing bacteria prepared specifically for the species. Inoculants must be used later than the date indicated on the container. Add fresh inoculants as directed on the package. Use four times the recommended rate when hydroseeding. Note: It is very important to keep inoculants as cool as possible until used. Temperatures above 75 to 80 degrees Fahrenheit can weaken bacteria and make the inoculant less effective.
4. Soil or seed must not be placed on soil which has been treated with soil sterilants or chemicals used for weed control and sufficient time has elapsed (14 days min.) to permit dissipation of phytotoxic materials.

2. Application

- i. Incorporate seed into the subsoil of the rates prescribed on Temporary Seeding Table B.1, Permanent Seeding Table B.3 for site-specific soils, or application rates as specified on the approved plan.
- ii. Apply seed in two directions, perpendicular to each other. Apply half the seeding rate in each direction. Roll the seeded area with a weighted roller to provide good seed to soil contact.
- iii. Drill or Cultipacker Seeding: Mechanized seeders that apply and cover seed with soil. Cultipacker seeders are required to bury the seed in such a fashion as to provide at least 1/4 inch of soil covering. Seeded must be firm after planting.
- iv. Apply seed in two directions, perpendicular to each other. Apply half the seeding rate in each direction.
- v. Hydroseeding: Apply seed uniformly with hydroseeder (slurry includes seed and fertilizer).
- vi. If fertilizer is being applied at the time of seeding, the application rates should not exceed the following: nitrogen, 100 pounds per acre total of soluble nitrogen; P2O5 (phosphorus), 200 pounds per acre; K2O (potassium), 200 pounds per acre.
- vii. Lime: Use only ground agricultural limestone (up to 3 tons per acre may be applied by hydroseeding). Normally, not more than 2 tons are applied by hydroseeding at any one time. Do not use burnt or hydrated lime when hydroseeding.
- viii. Mulch: Seed and mulch must be applied simultaneously and without interruption. When hydroseeding do not incorporate seed into the soil.

3. Mulching

- i. Mulch Materials (in order of preference)
 - a. Straw consisting of thoroughly threshed wheat, rye, oat, or barley and reasonably bright in color. Straw to be free of noxious weeds as specified in the Maryland Seed Law and not more than 1/2 inch in diameter. Mulch must be applied in a uniform layer 2 to 3 inches in areas where one species of grass is desired.
 - b. Wood Cellulose Fiber (WCFM) consisting of specially prepared wood cellulose processed into a uniform fibrous physical state.
 - c. WCFM to be dyed green or contain a green dye in the package that will provide an appropriate color to facilitate visual control of the mulch.
 - d. WCFM, including dye, must contain no germination or growth inhibiting factors.
 - e. WCFM materials used must be free of any material that may contain toxic substances. The wood cellulose fiber mulch will remain in uniform suspension in water under agitation and will blend with seed, fertilizer and other additives to form a homogeneous slurry. The mulch material must form a biodegradable ground cover, on application, having moisture absorption and permeation properties and must cover and hold grass seed in contact with the soil without inhibiting the growth of the grass seedlings.
 - f. WCFM material must not contain elements or compounds at concentration levels that will be phytotoxic.
 - g. WCFM must conform to the following physical requirements: fiber length of approximately 10 millimeters, diameter approximately 1 millimeter, pH range of 4.0 to 8.5, ash content of 1.6 percent, maximum organic matter of 50 percent minimum.
- ii. Application
 - a. Apply mulch to all seeded areas immediately after seeding.
 - b. When straw mulch is used, spread it over all seeded areas at the rate of 2 tons per acre to a uniform loose depth of 1 to 2 inches. Apply mulch to achieve a uniform distribution and depth so that the soil surface 100% is covered. When using a mulch anchoring tool, increase the application rate to 2.5 tons per acre.
 - c. Wood cellulose fiber used as mulch must be applied at a net dry weight of 1500 pounds per acre. Mix the wood cellulose fiber with water to obtain a mixture with a maximum of 50 pounds of wood cellulose fiber per 100 gallons of water.
- iii. Perform mulch anchoring immediately following application of mulch to minimize loss by wind or water. This may be done by one of the following methods (listed by preference), depending upon the size of the area and erosion hazard:
 - a. A mulch anchoring tool is a tractor drawn implement designed to punch and anchor mulch into the soil surface a minimum of 2 inches. This practice is most effective on large areas, but is limited to flatter slopes where equipment can operate safely. If used on sloping land, this practice should follow the contour.
 - b. Wood cellulose fiber mulch may be used for anchoring straw. Apply the fiber binder at a net dry weight of 750 pounds per acre. Mix the wood cellulose fiber with water at a maximum of 50 pounds of wood cellulose fiber per 100 gallons of water. Its synthetic binders such as Acrylic DLR (Agra-Tack), DCA-70, Patroset, Terra Tex II, Terra Tack Air or other approved liquid binders needs to be heavier at the edges where wind catches, such as in valleys and on crests of banks. Use of asphalt binders is strictly prohibited.
 - c. Lightweight plastic netting may be stapled over the mulch according to manufacturer recommendations. Netting is usually available in rolls 4 to 15 feet wide and 300 to 3,000 feet long.

B-4-2 STANDARDS AND SPECIFICATIONS FOR SOIL PREPARATION, TOPSOILING, AND SOIL AMENDMENTS

A. Soil Preparation

1. Temporary Stabilization
 - a. Seeded preparation consists of loosening soil to a depth of 3 to 5 inches by means of suitable agricultural or construction equipment, such as disc harrows or chisel plows or rippers mounted on tracked or crawler equipment. After the soil is loosened, it must be rolled or dropped smooth. Soil left in the roughened condition. Slips 3:1 or flatter are to be tracked with ridges running parallel to the slope.
 - b. Apply fertilizer and lime as prescribed on the plans.
 - c. Incorporate lime and fertilizer into the top 3 to 5 inches of soil by disking or other suitable means.
 - d. A soil test is required for any earth disturbance of 5 acres or more. The minimum soil conditions required for permanent vegetative establishment are:
 - i. Soil pH between 6.0 and 7.0.
 - ii. Soluble salts less than 500 parts per million (ppm).
 - iii. Soil contains less than 40 percent minimum organic matter. Fine grained material (greater than 30 percent silt plus clay) to provide the capacity to hold a moderate amount of moisture. An exception: if loess will be planted, then a sandy soil (less than 30 percent silt plus clay) would be acceptable.
 - iv. Soil contains 1.5 percent minimum organic matter.
 - e. Soil contains sufficient pore space to permit adequate root penetration.
 - f. Application of amendments as required by the above conditions. If amendments are not applied, the soil must be maintained in a true and even grade as specified on the approved plan, then scarified or otherwise loosened to a depth of 3 to 5 inches.
 - g. Apply soil amendments as specified on the approved plan or as indicated by the results of a soil test.
 - h. Mix soil amendments into the top 3 to 5 inches of soil by disking or other suitable means. Rate: Loam areas to smooth the surface, remove large objects like stones and branches, and ready the area for seed application. Loam surface soil by dragging with a heavy chain or other equipment to roughen the surface where site conditions will not permit normal seeded preparation. Track slopes 3:1 or flatter with tracked equipment leaving the soil in an irregular condition with ridges running parallel to the contour of the slope. Leave the top 1 to 3 inches of soil loose and friable. Seeded loosening may not be disturbed areas.
2. Topsoiling
 - a. Topsoil is placed over prepared subsoil prior to establishment of permanent vegetation. The purpose is to provide a suitable soil medium for vegetative growth. Soils of concern have low moisture content, low nutrient levels, low pH, materials toxic to plants, and/or unacceptable soil gradation. Topsoil subsoil from an existing site may be used provided it is not deep enough to set forth in these specifications. Typically, the depth of topsoil to be salvaged for a given soil type can be found in the representative soil profile section in the Soil Survey publication by USDA-NRCS.
 - b. Topsoiling is limited to areas having 2:1 or flatter slopes where:
 - i. The texture of the exposed subsoil/parent material is not adequate to produce vegetative growth.
 - ii. The soil moisture is so low that the rooting zone is not deep enough to support plants or furnish sufficient supplies of moisture and plant nutrients.
 - iii. The soil contains toxic materials that are toxic to plant growth.
 - iv. The soil is so acidic that treatment with limestone is not feasible.
 - v. Areas having slopes steeper than 2:1 require special consideration and design.
 - c. Topsoil must be a loam, sandy loam, clay loam, silt loam, sandy clay loam, or loamy sand. Other soils may be used if recommended by an agronomist or soil scientist and approved by the appropriate authority. Topsoil must not be a mixture of contrasting textured subsoils and must contain less than 5 percent by volume of cinders, stones, gravel, coarse fragments, gravel, sticks, roots, trash, or other materials larger than 1 1/2 inches in diameter.
 - d. Topsoil must be free of noxious plants or plant parts such as Bermuda grass, quack grass, Johnson grass, and other weeds, poison ivy, thistle, or others as specified.
 - e. Topsoil substitutes or amendments, as recommended by a qualified agronomist or soil scientist and approved by the appropriate authority, may be used in lieu of natural topsoil.
3. Soil Amendments (Fertilizer and Lime Specifications)
 - a. Soil tests must be performed to determine the exact ratios and application rates for both lime and fertilizer. Fertilizer application rates may be determined by soil analysis or may be performed by a recognized private or commercial laboratory. Soil samples taken for engineering purposes may also be used for chemical analysis.
 - b. Fertilizers must be uniform in composition, free flowing and suitable for accurate application by appropriate equipment. Manure may be substituted for fertilizer with prior approval from the appropriate authority. Fertilizer must be delivered to the site fully labeled according to the applicable laws and must bear the name, trade name or trademark and warranty of the producer. Lime materials must be ground limestone (hydrated or burnt lime may be substituted except when hydroseeding) which contains total oxides (calcium oxide plus magnesium oxide). Limestone must be ground to such fineness that at least 50 percent will pass through a #100 mesh sieve and 98 to 100 percent will pass through a #200 mesh sieve.
 - c. Uniformly distribute topsoil in a 5 to 8 inch layer and lightly compact to a minimum thickness of 4 inches. Spreading is to be performed in such a manner that sodding or seeding can proceed with a minimum of additional soil preparation and tillage. Any irregularities in the surface resulting from topsoiling or other operations must be corrected in order to prevent the formation of depressions or water pockets.
 - d. Topsoil must not be placed if the topsoil or subsoil is in a frozen or muddy condition, when the subsoil is excessively wet or in a condition that may otherwise be detrimental to proper grading and seeded preparation.

H-5 STANDARDS AND SPECIFICATIONS FOR DUST CONTROL

Definition: Controlling the suspension of dust particles from construction activities.

Purpose: To prevent blowing and movement of dust from exposed soil surfaces to reduce on and off-site damage including health and safety concerns.

Conditions Where Practice Applies: Areas subject to dust blowing and movement where on and off-site damage is likely without treatment.

1. Mixture: See Section B-4-2 Soil Preparation, Topsoiling, and Soil Amendments, Section B-4-3 Seeding and Mulching, and Section B-4-4 Temporary Stabilization. Mixture must be applied to prevent blowing.
2. Tilling: Tilling to roughen surface and bring clods to the surface. Begin plowing on windward side of site. Chisel-type plows spaced about 12 inches apart, spring-toothed harrows, or similar are examples of equipment that may produce the desired effect.
3. Irrigation: Sprinkle site with water until the surface is moist. Repeat as needed. The site must not be irrigated to the point that runoff occurs.
4. Barriers: Solid board fences, silt fences, snow fences, burlap fences, straw bales, and similar material can be used to control air currents and soil blowing.
5. Chemical Treatment: Use of chemical treatment requires approval by the appropriate plan review authority.

Definition: To stabilize disturbed soils with permanent vegetation.

Purpose: To use long-lived perennial grasses and legumes to establish permanent ground cover on disturbed soils.

Conditions Where Practice Applies: Exposed soils where ground cover is needed for 6 months or more.

Criteria:

1. General Use
 - a. Select one or more of the species or mixtures listed in Table B.3 for the appropriate Plant Hardness Zone (from Figure B.3) and based on the site condition or purpose found in Table B.2. Enter selected mixture(s), application rates, and seeding dates in the Permanent Seeding Summary. The Summary is to be placed on the plan.
 - b. Additional planting specifications for exceptional sites such as shorelines, stream banks, or areas for aesthetic purposes such as golf courses, may be included on the plan.
 - c. Use USDA-NRCS Technical Field Office Guide, Section 342 - Critical Area Planting.
 - d. For sites having disturbed areas over 5 acres, use and show the rates recommended by the appropriate authority.
 - e. For areas receiving low maintenance, apply urea form fertilizer (46-0-0) at 3 1/2 pounds per 1000 square feet (150 pounds per acre) at the time of seeding in addition to the soil amendments shown in the Permanent Seeding Summary.
2. Turfgrass Mixtures
 - a. Turfgrass mixtures may be desired include lawns, parks, playgrounds, and commercial sites which will receive a medium to high level of maintenance.
 - b. Select one or more species or mixtures listed based on the site conditions or purpose. Enter selected mixture(s), application rates, and seeding dates in the Permanent Seeding Summary. The summary is to be placed on the plan.
 - c. Kentucky Bluegrass/Perennial Oryzopsis Full Sun Mixture: For use in areas that receive intensive maintenance. Irrigation required in the areas of central Maryland and Eastern Shore. Recommended Kentucky Bluegrass/Cultivars Seeding Rate: 1.5 to 2.0 pounds per 1000 square feet. Choose a minimum of three Kentucky Bluegrass Cultivars with each ranging from 10 to 35 percent of the total mixture by weight.
 - d. Kentucky Bluegrass/Perennial Oryzopsis Full Sun Mixture: For use in full sun areas where rapid establishment is necessary and when turf will receive medium to intensive maintenance. Certified Perennial Ryegrass/Cultivars/Certified Kentucky Bluegrass Seeding Rate: 2 pounds per 1000 square feet. Choose a minimum of three Kentucky Bluegrass Cultivars with each ranging from 10 to 35 percent of the total mixture by weight.
 - e. Full Sun Mixture: For use in drought prone areas and/or for areas receiving low to medium maintenance in full sun to medium shade. Recommended mixture includes: Certified Tall Fescue/Cultivars 50 to 100 percent, Certified Kentucky Bluegrass/Cultivars 30 to 40 percent, Certified Fine Fescue and 20 to 30 percent. Seeding Rate: 1 1/2 to 3 pounds per 1000 square feet. One or more cultivars may be blended.
 - f. Kentucky Bluegrass/Fine Fescue Shade Mixture: For use in areas with shade in full sun to medium shade. Recommended mixture includes: Certified Tall Fescue/Cultivars 50 to 100 percent, Certified Kentucky Bluegrass/Cultivars 30 to 40 percent, Certified Fine Fescue and 20 to 30 percent. Seeding Rate: 1 1/2 to 3 pounds per 1000 square feet.

Notes:

1. Select turfgrass varieties from those listed in the best current University of Maryland Publication Agronomy Monograph #77, Turfgrass Cultivar Recommendations for Maryland.
2. Choose certified material. Certified material is the most guarantee of cultivar purity, the quality of the seed, and the genetic purity of the seed. The Maryland Department of Agriculture, Turf and Seed Section, provides a reliable means of consumer protection and assures a pure genetic line.
3. Ideal Times of Seeding for Turf Grasses:
 - a. Warm Season: March 1 to May 15, August 15 to October 15 (Hardiness Zones: 5b, 6a)
 - b. Cool Season: March 1 to May 15, August 15 to October 15 (Hardiness Zones: 6b)
 - c. Southern MD: March 1 to May 15, August 15 to October 15 (Hardiness Zones: 6b)
 - d. Central MD: March 1 to May 15, August 15 to October 15 (Hardiness Zones: 6b)
 - e. Northern MD: March 1 to May 15, August 15 to October 15 (Hardiness Zones: 6b)
4. Turf areas to receive seed by disking or other approved methods to a depth of 2 to 4 inches, level and rake the areas to prepare a proper seedbed. Remove stones and debris over 1 1/2 inches in diameter. The resulting seedbed must be in such a condition that future mowing of grasses will pose no difficulty.
5. If soil moisture is deficient, supply new seedlings with adequate water for plant growth (3 to 1 inch every 3 to 4 days depending on soil texture) until they are firmly established. This is not especially true when seedlings are made late in the planting season, in abnormal dry or hot seasons, or on adverse sites.

B.Sod: to provide quick cover on disturbed areas (2:1 grade or flatter).

1. General Specifications
 - a. Sod of turfgrass must be Maryland State Certified. Sod labels must be made available to the job foreman and inspector.
 - b. Sod must be machine cut to a uniform soil thickness of 3 inches, plus or minus 1/8 inch, at the time of cutting. Measurement for thickness must exclude top growth and thatch. Broken sods and torn or uneven ends will not be acceptable.
 - c. Standard size sections of sod must be strong enough to support their own weight and retain their size and shape when suspended vertically with a firm grasp on the upper 10 percent of the section.
 - d. Sod must not be harvested or transported when moisture content (excessively dry or wet) may adversely affect its survival.
 - e. Sod must be harvested, cleaned, and installed within a period of 36 hours. Sod not transported within this period must be approved by an agronomist or soil scientist prior to its installation.
2. Sod Installation
 - a. During periods of excessively high temperature or in areas having dry subsoil, lightly irrigate the sod immediately prior to laying the sod.
 - b. Lay the first row of sod in a straight line with subsequent rows placed parallel to it. Sod must be applied to each other. Stagger joints between rows and between sods in each row. Ensure that sod is not stretched or overlapped and that all joints are butted tight in order to prevent voids which would cause air drying of the roots.
 - c. Lay sods in the same direction, lay sods on the long edge parallel to the contour with staggering joints. Roll and tamp, peg or otherwise secure the sod to prevent slippage on slopes.
 - d. Water the sod immediately following rolling and tamping until the underside of the new sod has sufficient surface moisture between sods and the underlying soil. Complete the operations of laying, tamping and irrigating for any piece of sod every eight hours.
3. Sod Maintenance
 - a. In the absence of adequate rainfall, water daily during the first week or so often and sufficiently as necessary to maintain moist soil to a depth of 4 inches. Water sod during the rest of the day to prevent wilting.
 - b. After the first week, soil watering is required as necessary to maintain adequate moisture content.
 - c. Do not mow until the sod is firmly rooted. No more than 1/3 of the grass leaf must be removed by the initial cutting or subsequent cuttings. Maintain a grass height of at least 3 inches unless otherwise specified.

B-4-3 STANDARDS AND SPECIFICATIONS FOR STOCKPILE AREA

Definition: A mound or pile of soil protected by appropriately designed erosion and sediment control measures.

Purpose: To provide a designated location for the temporary storage of soil that controls the potential for erosion and sedimentation, and changes to drainage patterns.

Conditions Where Practice Applies: Stockpile areas are utilized when it is necessary to salvage and store soil for later use.

Criteria:

1. The stockpile location and all related sediment control practices must be clearly indicated on the erosion and sediment control plan.
2. Access to the stockpile must be sized to accommodate the anticipated volume of material and based on a side slope ratio no steeper than 2:1. Benching must be provided in accordance with Section B-3 Land Grading.
3. Runoff from the stockpile area must drain to a suitable sediment control practice.
4. Access to the stockpile must be from the stockpile area. Synthetic binders such as Acrylic DLR (Agra-Tack), DCA-70, Patroset, Terra Tex II, Terra Tack Air or other approved liquid binders needs to be heavier at the edges where wind catches, such as in valleys and on crests of banks. Use of asphalt binders is strictly prohibited.
5. Lightweight plastic netting may be stapled over the mulch according to manufacturer recommendations. Netting is usually available in rolls 4 to 15 feet wide and 300 to 3,000 feet long.

SOILS LEGEND

MAP SYMBOL	SOIL GROUP	SOIL TYPE
RSC	C	RUSSETT FINE SANDY LOAM, 5 TO 10 PERCENT SLOPES
USB	D	URBAN LAND-SASSAFRAS-BELTSVILLE COMPLEX, 0 TO 5 PERCENT SLOPES

TAKEN FROM HOWARD COUNTY SOIL SURVEY, ISSUED MAY 2008, MAP NO. 28

Table B.4: Temporary Seeding by Plant Hardness Zone

Plant Species	Seeding Rate*		Seeding Depth (inches)	Recommended Seeding Dates by Plant Hardness Zone**	
	lb/1000 sq ft	lb/acre		5b	6a
Annual Ryegrass (Cultivars perennials, 100% winter hardy)	1.0	0.5	1/2	Mar 1 to May 31, Aug 1 to Sep 30	Mar 1 to May 31, Aug 1 to Sep 30
Bahia (Breviflorus variety)	0.6	2.0	1/2	Mar 1 to May 31, Aug 1 to Sep 30	Mar 1 to May 31, Aug 1 to Sep 30
Orn (Cultivars annual)	1.2	1.0	1/2	Mar 1 to May 31, Aug 1 to Sep 30	Mar 1 to May 31, Aug 1 to Sep 30
Orn (Cultivars annual)	1.2	1.0	1/2	Mar 1 to May 31, Aug 1 to Sep 30	Mar 1 to May 31, Aug 1 to Sep 30
Centaury (Cultivars annual)	1.2	1.0	1/2	Mar 1 to May 31, Aug 1 to Sep 30	Mar 1 to May 31, Aug 1 to Sep 30
Perennial Ryegrass (Cultivars annual)	2.0	0.7	0.5	Jan 1 to Jul 31	Mar 1 to May 31, Aug 1 to Sep 30
Perennial Ryegrass (Cultivars annual)	2.0	0.7	0.5	Jan 1 to Jul 31	Mar 1 to May 31, Aug 1 to Sep 30

NOTES:

1. Seeding rates are based on a seed purity of 90%.
2. Seeding dates are based on the planting date of the seed.
3. Seeding rates are based on a seed purity of 90%.
4. Seeding rates are based on a seed purity of 90%.

FOLLOWING INITIAL SOIL DISTURBANCE OR RE-DISTURBANCE, PERMANENT OR TEMPORARY STABILIZATION SHALL BE COMPLETED WITHIN:

- A) 3 CALENDAR DAYS FOR ALL PERIMETER SEDIMENT CONTROL STRUCTURES, DIKES, PERIMETER SLOPES AND ALL SLOPES GREATER THAN 3:1;
- B) 7 DAYS AS TO ALL OTHER DISTURBED OR GRADED AREAS ON THE PROJECT SITE.

ENGINEER'S CERTIFICATE

I HEREBY CERTIFY THAT THIS PLAN FOR SEDIMENT AND EROSION CONTROL REPRESENTS A PRACTICAL AND WORKABLE PLAN BASED ON MY PERSONAL KNOWLEDGE OF THE SITE CONDITIONS AND THAT IT WAS PREPARED IN ACCORDANCE WITH THE REQUIREMENTS OF THE HOWARD COUNTY DEPARTMENT OF PUBLIC WORKS.

9-23-13 DATE

DEVELOPER'S CERTIFICATE

I/WE CERTIFY THAT ALL DEVELOPMENT AND CONSTRUCTION WILL BE DONE ACCORDING TO THIS PLAN OF DEVELOPMENT FOR SEDIMENT AND EROSION CONTROL, AND THAT ALL RESPONSIBLE PERSONNEL INVOLVED IN THE CONSTRUCTION PROJECT WILL HAVE A CERTIFICATE OF ATTENDANCE AT A DEPARTMENT OF THE ENVIRONMENT APPROVED TRAINING PROGRAM FOR THE CONTROL OF SEDIMENT AND EROSION BEFORE BEGINNING THE PROJECT. I ALSO AUTHORIZE PERIODIC ON-SITE INSPECTION BY THE HOWARD COUNTY DEPARTMENT OF PUBLIC WORKS.

2/26/13 DATE

REVIEWED FOR HOWARD SCD AND MEETS TECHNICAL REQUIREMENTS

THIS DEVELOPMENT PLAN IS APPROVED FOR SOIL EROSION AND SEDIMENT CONTROL BY THE HOWARD COUNTY DEPARTMENT OF PUBLIC WORKS.

9/26/13 DATE

APPROVED: HOWARD COUNTY DEPARTMENT OF PUBLIC WORKS

10-24-13 DATE

APPROVED: HOWARD COUNTY DEPARTMENT OF PLANNING AND ZONING

11-13-13 DATE




10-31-13 DATE

NO CHANGES TO THE SEQUENCE OF CONSTRUCTION ARE ALLOWED WITHOUT PRIOR APPROVAL FROM THE HOWARD COUNTY DEPARTMENT OF PUBLIC WORKS.

SEDIMENT CONTROL NOTES

1. A MINIMUM OF 48 HOURS NOTICE MUST BE GIVEN TO THE HOWARD COUNTY DEPARTMENT OF PUBLIC WORKS PRIOR TO THE START OF ANY CONSTRUCTION (410-333-1855).
2. ALL VEGETATIVE AND STRUCTURAL PROVISIONS ARE TO BE INSTALLED ACCORDING TO THE PROVISIONS OF THIS PLAN AND ARE TO BE IN CONFORMANCE WITH THE MOST CURRENT MARYLAND STANDARDS AND SPECIFICATIONS FOR SOIL EROSION AND SEDIMENT CONTROL AND REVISIONS THERETO.
3. FOLLOWING INITIAL SOIL DISTURBANCE OR RE-DISTURBANCE, PERMANENT OR TEMPORARY STABILIZATION SHALL BE COMPLETED WITHIN: A) 3 CALENDAR DAYS FOR ALL PERIMETER SEDIMENT CONTROL STRUCTURES, DIKES, PERIMETER SLOPES AND ALL SLOPES GREATER THAN 3:1; B) 7 DAYS AS TO ALL OTHER DISTURBED OR GRADED AREAS ON THE PROJECT SITE.
4. ALL DISTURBED AREAS MUST BE STABILIZED WITHIN THE TIME PERIOD SPECIFIED ABOVE IN ACCORDANCE WITH THE 2011 MARYLAND STANDARDS AND SPECIFICATIONS FOR SOIL EROSION AND SEDIMENT CONTROL, FOR PERMANENT SEEDING (SEC. B-4-3), TEMPORARY SEEDING (SEC. B-4-4) AND MULCHING (SEC. B-4-3). TEMPORARY STABILIZATION WITH MULCH ALONE CAN ONLY BE DONE WHEN RECOMMENDED SEEDING DATES DO NOT ALLOW FOR PROPER GERMINATION AND ESTABLISHMENT OF GRASSES.
5. ALL SEDIMENT CONTROL STRUCTURES ARE TO REMAIN IN PLACE AND ARE TO BE MAINTAINED IN OPERATIVE CONDITION UNTIL PERMITS FOR THEIR REMOVAL HAS BEEN OBTAINED FROM THE HOWARD COUNTY DEPARTMENT OF PUBLIC WORKS.
6. SITE ANALYSIS:

TOTAL AREA OF SITE	1.4	ACRES
AREA TO BE ROOFED OR PAVED	0.43	ACRES
AREA TO BE VEGETATIVELY STABILIZED	0.97	ACRES
TOTAL CUT	18.38	CU. YDS.
TOTAL FILL	0.00	CU. YDS.
OFFSITE WASTE/BORROW AREA LOCATION	N/A	
7. ANY SEDIMENT CONTROL PRACTICE THAT IS DISTURBED BY GRADING ACTIVITY FOR PLACEMENT OF UTILITIES MUST BE REPAIRED ON THE SAME DAY OF DISTURBANCE.
8. ADDITIONAL SEDIMENT CONTROL MUST BE PROVIDED, IF DEEMED NECESSARY BY THE HOWARD COUNTY DEPARTMENT OF PUBLIC WORKS.
9. ON ALL SITES WITH DISTURBED AREAS IN EXCESS OF 2 ACRES, APPROVAL OF THE INSPECTION AGENCY SHALL BE REQUIRED UPON COMPLETION OF INSTALLATION OF PERIMETER EROSION AND SEDIMENT CONTROLS, BUT BEFORE PROCEEDING WITH ANY OTHER EARTH DISTURBANCE OR GRADING OTHER THAN MAINTENANCE OF EXISTING AREAS. APPROVALS MAY NOT BE AUTHORIZED UNTIL THIS INITIAL APPROVAL BY THE INSPECTION AGENCY IS MADE.
10. TRENCHES FOR UTILITIES IS LIMITED TO THREE PIPE LENGTHS OR THAT WHICH SHALL BE BACK-FILLED AND STABILIZED BY THE END OF EACH WORKDAY, WHICHEVER IS SHORTER.
11. ANY CHANGES OR REVISIONS TO THE SEQUENCE OF CONSTRUCTION MUST BE REVIEWED AND APPROVED BY THE PLAN APPROVAL AUTHORITY PRIOR TO PROCEEDING WITH CONSTRUCTION.
12. A PROJECT IS TO BE SEQUENCED SO THAT GRADING ACTIVITIES BEGON ON ONE GRADING UNIT (MAXIMUM ACREAGE OF 20 AC. PER GRADING UNIT) AT A TIME. WORK MAY PROCEED TO A SUBSEQUENT GRADING UNIT WHEN AT LEAST 50 PERCENT OF THE DISTURBED AREA IN THE PRECEDING GRADING UNIT HAS BEEN STABILIZED AND APPROVED BY THE PLAN APPROVAL AUTHORITY. NO MORE THAN 30 ACRES CUMULATIVELY MAY BE DISTURBED AT A GIVEN TIME.

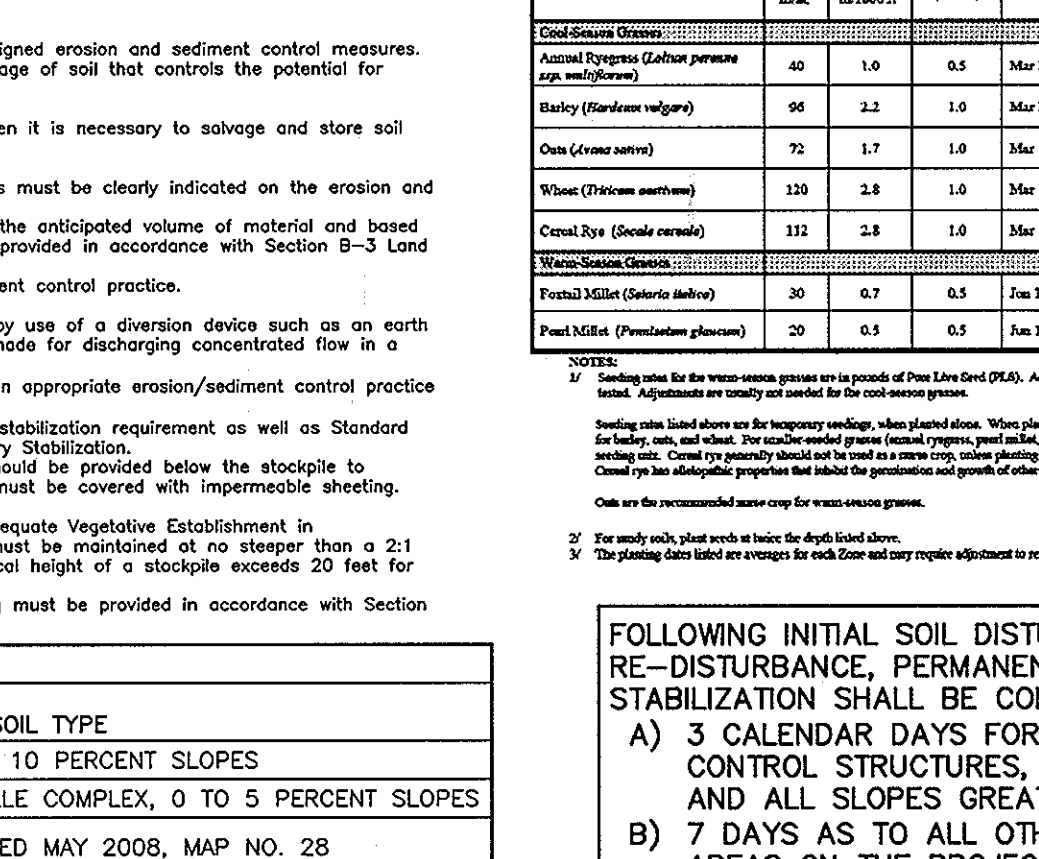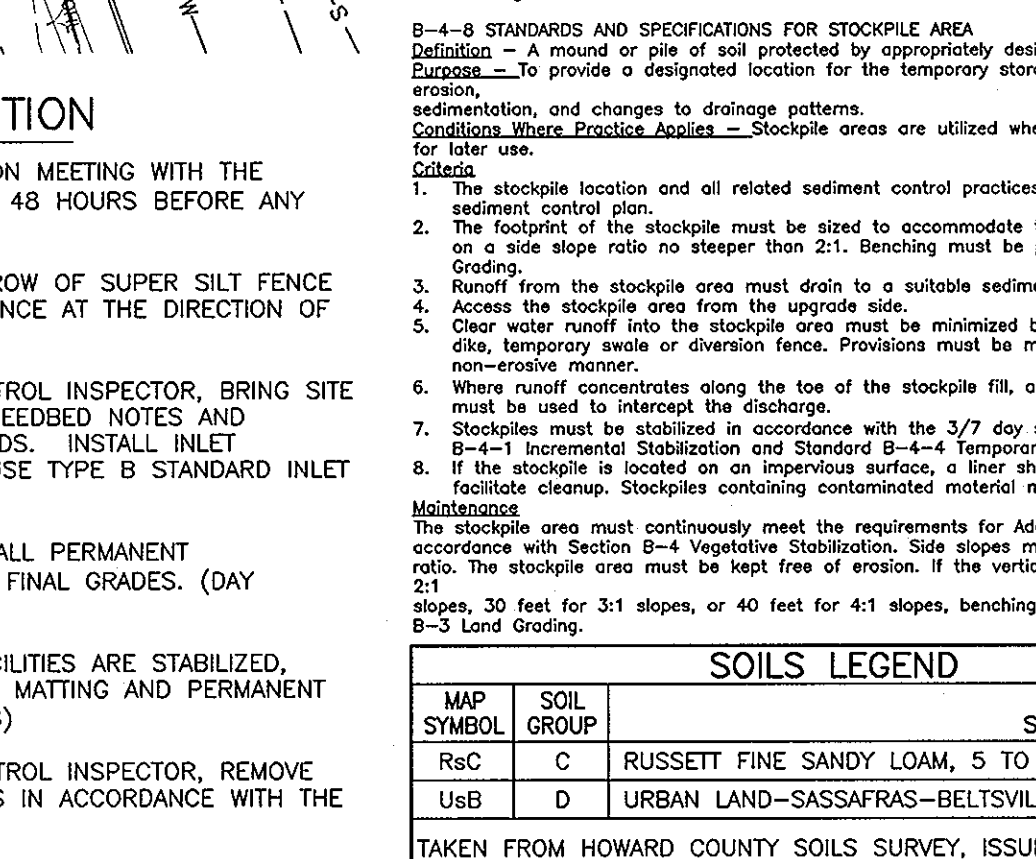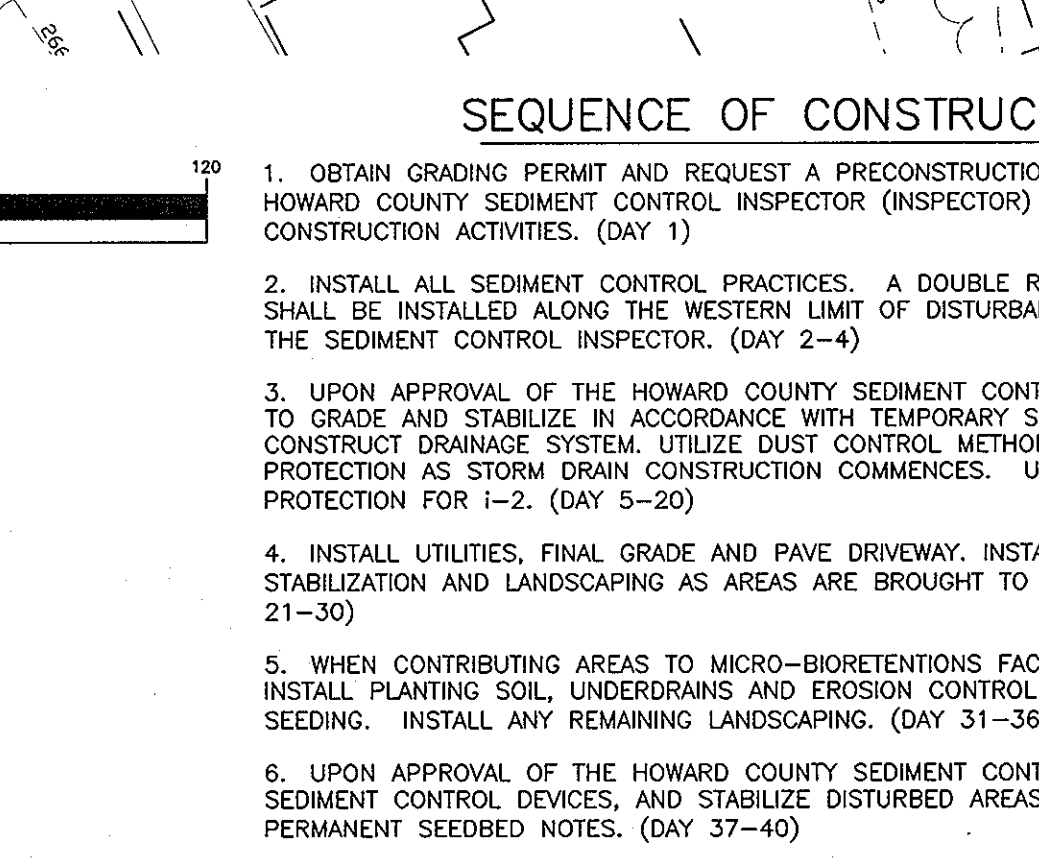

CONSTRUCTION SPECIFICATIONS

1. INSTALL 3/8 INCH DIAMETER GALVANIZED STEEL POSTS OF 60% MIN. WALL THICKNESS AND SIX FOOT LENGTH SPACED NO FURTHER THAN 10 FEET APART. DRIVE THE POSTS A MINIMUM OF 36 INCHES INTO THE GROUND.
2. FASTEN 9 GAUGE OR HEAVIER GALVANIZED CHAIN LINK FENCE (3/8 INCH MAXIMUM OPENING) 42 INCHES IN HEIGHT SECURELY TO THE FENCE POSTS WITH WIRE NAIL RINGS.
3. FASTEN WOVEN SILT FILM GEOTEXTILE AS SPECIFIED IN SECTION H-1 MATERIALS, SECURELY TO THE UPSLOPE SIDE OF CHAIN LINK FENCE WITH SPACED EVERY 24 INCHES AT THE TOP AND MID SECTION. HARBED GEOTEXTILE AND CHAIN LINK FENCE A MINIMUM OF 6 INCHES INTO THE GROUND.
4. WHERE ENDS OF THE GEOTEXTILE COME TOGETHER, THE ENDS SHALL BE OVERLAPPED BY 6 INCHES, FOLDED, AND STAPLED TO PREVENT SEDIMENT BYPASS.
5. EXTEND BOTH ENDS OF THE SUPER SILT FENCE A MINIMUM OF FIVE HORIZONTAL FEET UPSLOPE AT AN ANGLE TO THE MAIN FENCE ALIGNMENT TO PREVENT RUNOFF FROM GOING AROUND THE ENDS OF THE SUPER SILT FENCE.
6. PROVIDE MANUFACTURER CERTIFICATION TO THE INSPECTION/ENFORCEMENT AUTHORITY SHOWING THAT GEOTEXTILE MEETS THE REQUIREMENTS IN SECTION H-1 MATERIALS.
7. REMOVE ACCUMULATED SEDIMENT AND DEBRIS WHEN BUILDS UP IN FENCE OR WHEN SEDIMENT REACHES 25% OF FENCE HEIGHT. REPLACE WITH 10% UNDERGRAIN. REINSTALL CHAIN LINK FENCING AND GEOTEXTILE.

MARYLAND STANDARDS AND SPECIFICATIONS FOR SOIL EROSION AND SEDIMENT CONTROL

U.S. DEPARTMENT OF AGRICULTURE, NATURAL RESOURCES CONSERVATION SERVICE, 2011

CONSTRUCTION SPECIFICATIONS

1. PROVIDE STORAGE VOLUME AS SPECIFIED ON APPROVED PLANS.
2. USE NONWOVEN GEOTEXTILE ON INTERFACE BETWEEN GROUND AND STONE.
3. PERFORATE BAFFLE BOARD WITH 3 ROWS OF 1/2 INCH DIAMETER HOLES 6 INCHES IN CENTER. EMBED A MINIMUM OF 4 INCHES INTO GROUND, AND EXTEND BAFFLE BOARD MINIMUM OF 12 INCHES INTO EARTH DIKE.
4. USE CLEAN 2 TO 3 INCH STONE OR EQUIVALENT RECYCLED CONCRETE. PLACE WOVEN MONOLAYER GEOTEXTILE ON UPSLOPE FACE AND COVER WITH A MINIMUM OF 6 INCHES OF ADDITIONAL STONE.
5. USE NONWOVEN AND WOVEN MONOLAYER GEOTEXTILES AS SPECIFIED IN SECTION H-1 MATERIALS.
6. SET WET CREST OF STONE 6 INCHES LOWER THAN THE TOP OF EARTH DIKE. USE MINIMUM LENGTH OF 6 FEET FOR WET CREST.
7. REMOVE SEDIMENT WHEN IT HAS ACCUMULATED TO WITHIN 6 INCHES OF WET CREST. REPLACE GEOTEXTILE AND STONE FACING WHEN STRUCTURE CEASES TO DRAIN, MAINTAIN LINE, GRADE, AND CROSS SECTION.
8. UPON REMOVAL OF STONE OUTLET STRUCTURE, GRADE AREA FLUSH WITH EXISTING GROUND, WITHIN 24 HOURS STABILIZE DISTURBED AREA WITH TOPSOIL, SEED, AND MULCH, OR AS SPECIFIED ON APPROVED PLAN.

MARYLAND STANDARDS AND SPECIFICATIONS FOR SOIL EROSION AND SEDIMENT CONTROL

U.S. DEPARTMENT OF AGRICULTURE, NATURAL RESOURCES CONSERVATION SERVICE, 2011

CONSTRUCTION SPECIFICATIONS

1. PROVIDE STORAGE VOLUME AS SPECIFIED ON APPROVED PLANS.
2. USE NONWOVEN GEOTEXTILE ON INTERFACE BETWEEN GROUND AND STONE.
3. PERFORATE BAFFLE BOARD WITH 3 ROWS OF 1/2 INCH DIAMETER HOLES 6 INCHES IN CENTER. EMBED A MINIMUM OF 4 INCHES INTO GROUND, AND EXTEND BAFFLE BOARD MINIMUM OF 12 INCHES INTO EARTH DIKE.
4. USE CLEAN 2 TO 3 INCH STONE OR EQUIVALENT RECYCLED CONCRETE. PLACE WOVEN MONOLAYER GEOTEXTILE ON UPSLOPE FACE AND COVER WITH A MINIMUM OF 6 INCHES OF ADDITIONAL STONE.
5. USE NONWOVEN AND WOVEN MONOLAYER GEOTEXTILES AS SPECIFIED IN SECTION H-1 MATERIALS.
6. SET WET CREST OF STONE 6 INCHES LOWER THAN THE TOP OF EARTH DIKE. USE MINIMUM LENGTH OF 6 FEET FOR WET CREST.
7. REMOVE SEDIMENT WHEN IT HAS ACCUMULATED TO WITHIN 6 INCHES OF WET CREST. REPLACE GEOTEXTILE AND STONE FACING WHEN STRUCTURE CEASES TO DRAIN, MAINTAIN LINE, GRADE, AND CROSS SECTION.
8. UPON REMOVAL OF STONE OUTLET STRUCTURE, GRADE AREA FLUSH WITH EXISTING GROUND, WITHIN 24 HOURS STABILIZE DISTURBED AREA WITH TOPSOIL, SEED, AND MULCH, OR AS SPECIFIED ON APPROVED PLAN.

MARYLAND STANDARDS AND SPECIFICATIONS FOR SOIL EROSION AND SEDIMENT CONTROL

U.S. DEPARTMENT OF AGRICULTURE, NATURAL RESOURCES CONSERVATION SERVICE, 2011

THIS PLAN IS FOR SEDIMENT CONTROL PURPOSES ONLY

NO.	DATE	REVISION

BENCHMARK ENGINEERING, INC.

8490 BALTIMORE NATIONAL PIKE SUITE 315 ELLICOTT CITY, MARYLAND 21043
(P) 410-465-6105 (F) 410-465-8644

75 THOMAS JOHNSON DRIVE SUITE E AFFRICK, MARYLAND 21702
301-770-7000

OWNER/DEVELOPER: CORNERSTONE HOLDINGS, LLC
9895 NORFOLK AVENUE
LAUREL, MARYLAND 20723
410-792-2865

PARKSIDE ESTATES
LOTS 2-6 & OPEN SPACE LOTS 1 & 7

TAX MAP: 50 GRID: 4 PARCEL: 438
ZONED: R-SC
ELECTION DISTRICT NO. 6 - HOWARD COUNTY, MARYLAND

SEDIMENT CONTROL PLAN, NOTES AND DETAILS

DATE: JANUARY 2013
SEPTEMBER 2013
BEI PROJECT NO. 2384-C

DESIGN: AAM DRAWN: AAM SCALE: AS SHOWN SHEET 4 OF 4

F-13-065