

| SHEET INDEX |  |
|-------------|--|
| SHEET NO.   | DESCRIPTION  |
| 1           | TITLE SHEET  |
| 2-3         | SUPPLEMENTAL TOPOGRAPHY & GRADING, STORMWATER MANAGEMENT AND SOILS |
| 4-5         | SEDIMENT CONTROL PLAN  |
| 6           | SEDIMENT AND EROSION CONTROL NOTES & DETAILS                       |
| 7           | STORMWATER MANAGEMENT DETAILS & SOIL BORINGS                       |
| 8           | DETAIL SHEET   |
| 9           | DRAINAGE AREA & SOILS MAP  |

# SUPPLEMENTAL PLAN TOPOGRAPHY, GRADING AND STORMWATER MANAGEMENT FULTON MANOR VALLEY-PART TWO

**LOTS 6 THRU 9  
ZONING: RR-DEO**

**TAX MAP No. 41 GRID No. 19 PARCEL Nos. 78 AND 456**


| U.S. Equivalent Coordinate Table |             | Metric Coordinate Table |      |               |               |
|----------------------------------|-------------|-------------------------|------|---------------|---------------|
| POINT                            | EAST        | POINT                   | EAST |               |               |
| 128                              | 54246.9284  | 133199.8757             | 126  | 165307.681738 | 405971.051814 |
| 129                              | 54178.5431  | 133159.3851             | 406  | 165134.369855 | 405799.133919 |
| 408                              | 542108.1161 | 1331185.8611            | 408  | 165234.984277 | 405746.249910 |
| 409                              | 541862.9234 | 133253.3859             | 439  | 165147.724300 | 406106.124408 |
| 440                              | 541768.2401 | 133259.6518             | 440  | 165130.680268 | 406073.254048 |
| 441                              | 541811.9727 | 1332198.9979            | 441  | 165144.662913 | 406059.235818 |
| 442                              | 541866.4984 | 1332188.0469            | 442  | 165161.237326 | 406045.208817 |
| 443                              | 541942.4991 | 1332067.0818            | 443  | 165184.404111 | 406014.896625 |
| 444                              | 54225.5483  | 133169.9955             | 444  | 165286.991267 | 405928.646411 |
| 445                              | 541920.4777 | 1331726.7403            | 445  | 165189.884014 | 405911.124738 |
| 447                              | 541783.9734 | 1331683.9955            | 447  | 165136.095572 | 405909.093603 |
| 449                              | 542029.9415 | 133173.8666             | 449  | 165233.929183 | 405912.609583 |
| 456                              | 541871.1217 | 133147.5859             | 456  | 165162.448227 | 405829.083828 |
| 457                              | 541706.4758 | 1331408.2858            | 457  | 165112.440390 | 405914.148928 |
| 458                              | 541710.6207 | 1331374.4464            | 458  | 165113.244247 | 405905.232409 |
| 459                              | 542994.2321 | 133282.0341             | 459  | 165383.053635 | 406153.282814 |
| 460                              | 542962.2787 | 133282.0341             | 460  | 165379.507761 | 406149.805560 |
| 461                              | 54213.2456  | 133226.5481             | 461  | 165254.222781 | 406071.388614 |
| 462                              | 542010.2208 | 1332476.9249            | 462  | 165205.083985 | 406159.779298 |

| Minimum Lot Size Tabulation |                |                |                  |
|-----------------------------|----------------|----------------|------------------|
| Lot No.                     | Gross Area     | Pipestem Area  | Minimum Lot Size |
| 6                           | 31,103 Sq. Ft. | 4,993 Sq. Ft.  | 46,110 Sq. Ft.   |
| 7                           | 26,224 Sq. Ft. | 6,602 Sq. Ft.  | 43,822 Sq. Ft.   |
| 8                           | 57,629 Sq. Ft. | 13,214 Sq. Ft. | 44,412 Sq. Ft.   |
| 9                           | 67,019 Sq. Ft. | 8,521 Sq. Ft.  | 58,498 Sq. Ft.   |

| ROADWAY INFORMATION CHART |                |              |           |
|---------------------------|----------------|--------------|-----------|
| ROAD NAME                 | CLASSIFICATION | DESIGN SPEED | R/W WIDTH |
| TEDDYS WAY                | USE-IN-COMMON  | -            | 24'       |
| FULTON ESTATES COURT      | USE-IN-COMMON  | -            | 35'       |

| Density Exchange Chart                                    |  |  |  |
|---|--|--|--|
| Description   | Part One F-14-014  | Part Two F-14-014 and F-14-T.M. 41, Grid 19, Parcel 78 & 456   | Total Site   |
| Receiving Parcel Information                              |  | Fulton Manor Valley, F-14-014 and F-14-T.M. 41, Grid 19, Parcel 78 & 456   | Fulton Manor Valley, F-14-014 and F-14-T.M. 41, Grid 19, Parcel 78 & 456 |
| Gross Area  | 26.372 Ac.   | 26.372 Ac.   | 26.372 Ac.   |
| Area of Steep Slopes                                      | 0.440 Ac.  | 0.440 Ac.  | 0.440 Ac.  |
| Area of Floodplain  | 1.208 Ac.  | 1.208 Ac.  | 1.208 Ac.  |
| Net Tract Area  | 24.724 Ac.   | 24.724 Ac.   | 24.724 Ac.   |
| Allowed Base Density                                      | 6 Units (26.372 Ac. x 1 Unit/4.25)=6.205   | 0 Units  | 6 Units  |
| Total Number of Proposed Units                            | 6 Units  | 4 Units  | 10 Units   |
| Total Number of Density Rights Required to Be Transferred | 0 Units  | 4 Units (Proposed Units - Allowed Units) (10 Units - 6 Units)  | 4 Units  |
| Sending Parcel Information                                | 2 000 Units - T.M. 13, Par. 110 Property of Cathy And Leon Vasquez<br>2 000 Units - T.M. 12, Par. 78 Chasles Ennis, Buildable Preservation Parcel "V", F-14-043(a) | 2 800 Units - T.M. 13, Par. 110 Property of Cathy And Leon Vasquez<br>2 000 Units - T.M. 12, Par. 78 Chasles Ennis, Buildable Preservation Parcel "V", F-14-043(a) |  |

- DENSITY TABULATIONS**
- BASE DENSITY: 26.372 ACRES / 4.25 = 6.205 UNITS OR 6 SINGLE FAMILY DETACHED HOMES
  - MAXIMUM DENSITY (1 LOT PER 2 NET ACRES): 24.724 NET ACRES / 2 = 12.362 UNITS OR 12 SINGLE FAMILY DETACHED HOMES.  
NET TRACT AREA = GROSS AREA - FLOODPLAIN - STEEP SLOPES  
NET TRACT AREA = 26.372 ACRES - 1.208 AC. - 0.440 AC.  
NET TRACT AREA = 24.724 AC.
  - TOTAL NUMBER OF PROPOSED DWELLING UNITS = 9 CLUSTER LOTS + 1 BUILDABLE PRESERVATION PARCEL = 10 UNITS.
  - DEVELOPMENT RIGHTS WILL BE TRANSFERRED TO THIS SUBDIVISION PURSUANT TO THE DEO DENSITY TRANSFER PROVISION OF SECTION 106.B.2 OF THE ZONING REGULATIONS FOR THIS PROPERTY'S UNDERLYING RR ZONING DISTRICT. (10 PROPOSED - 6 BY-RIGHT = 4 DEO RIGHTS REQUIRED).

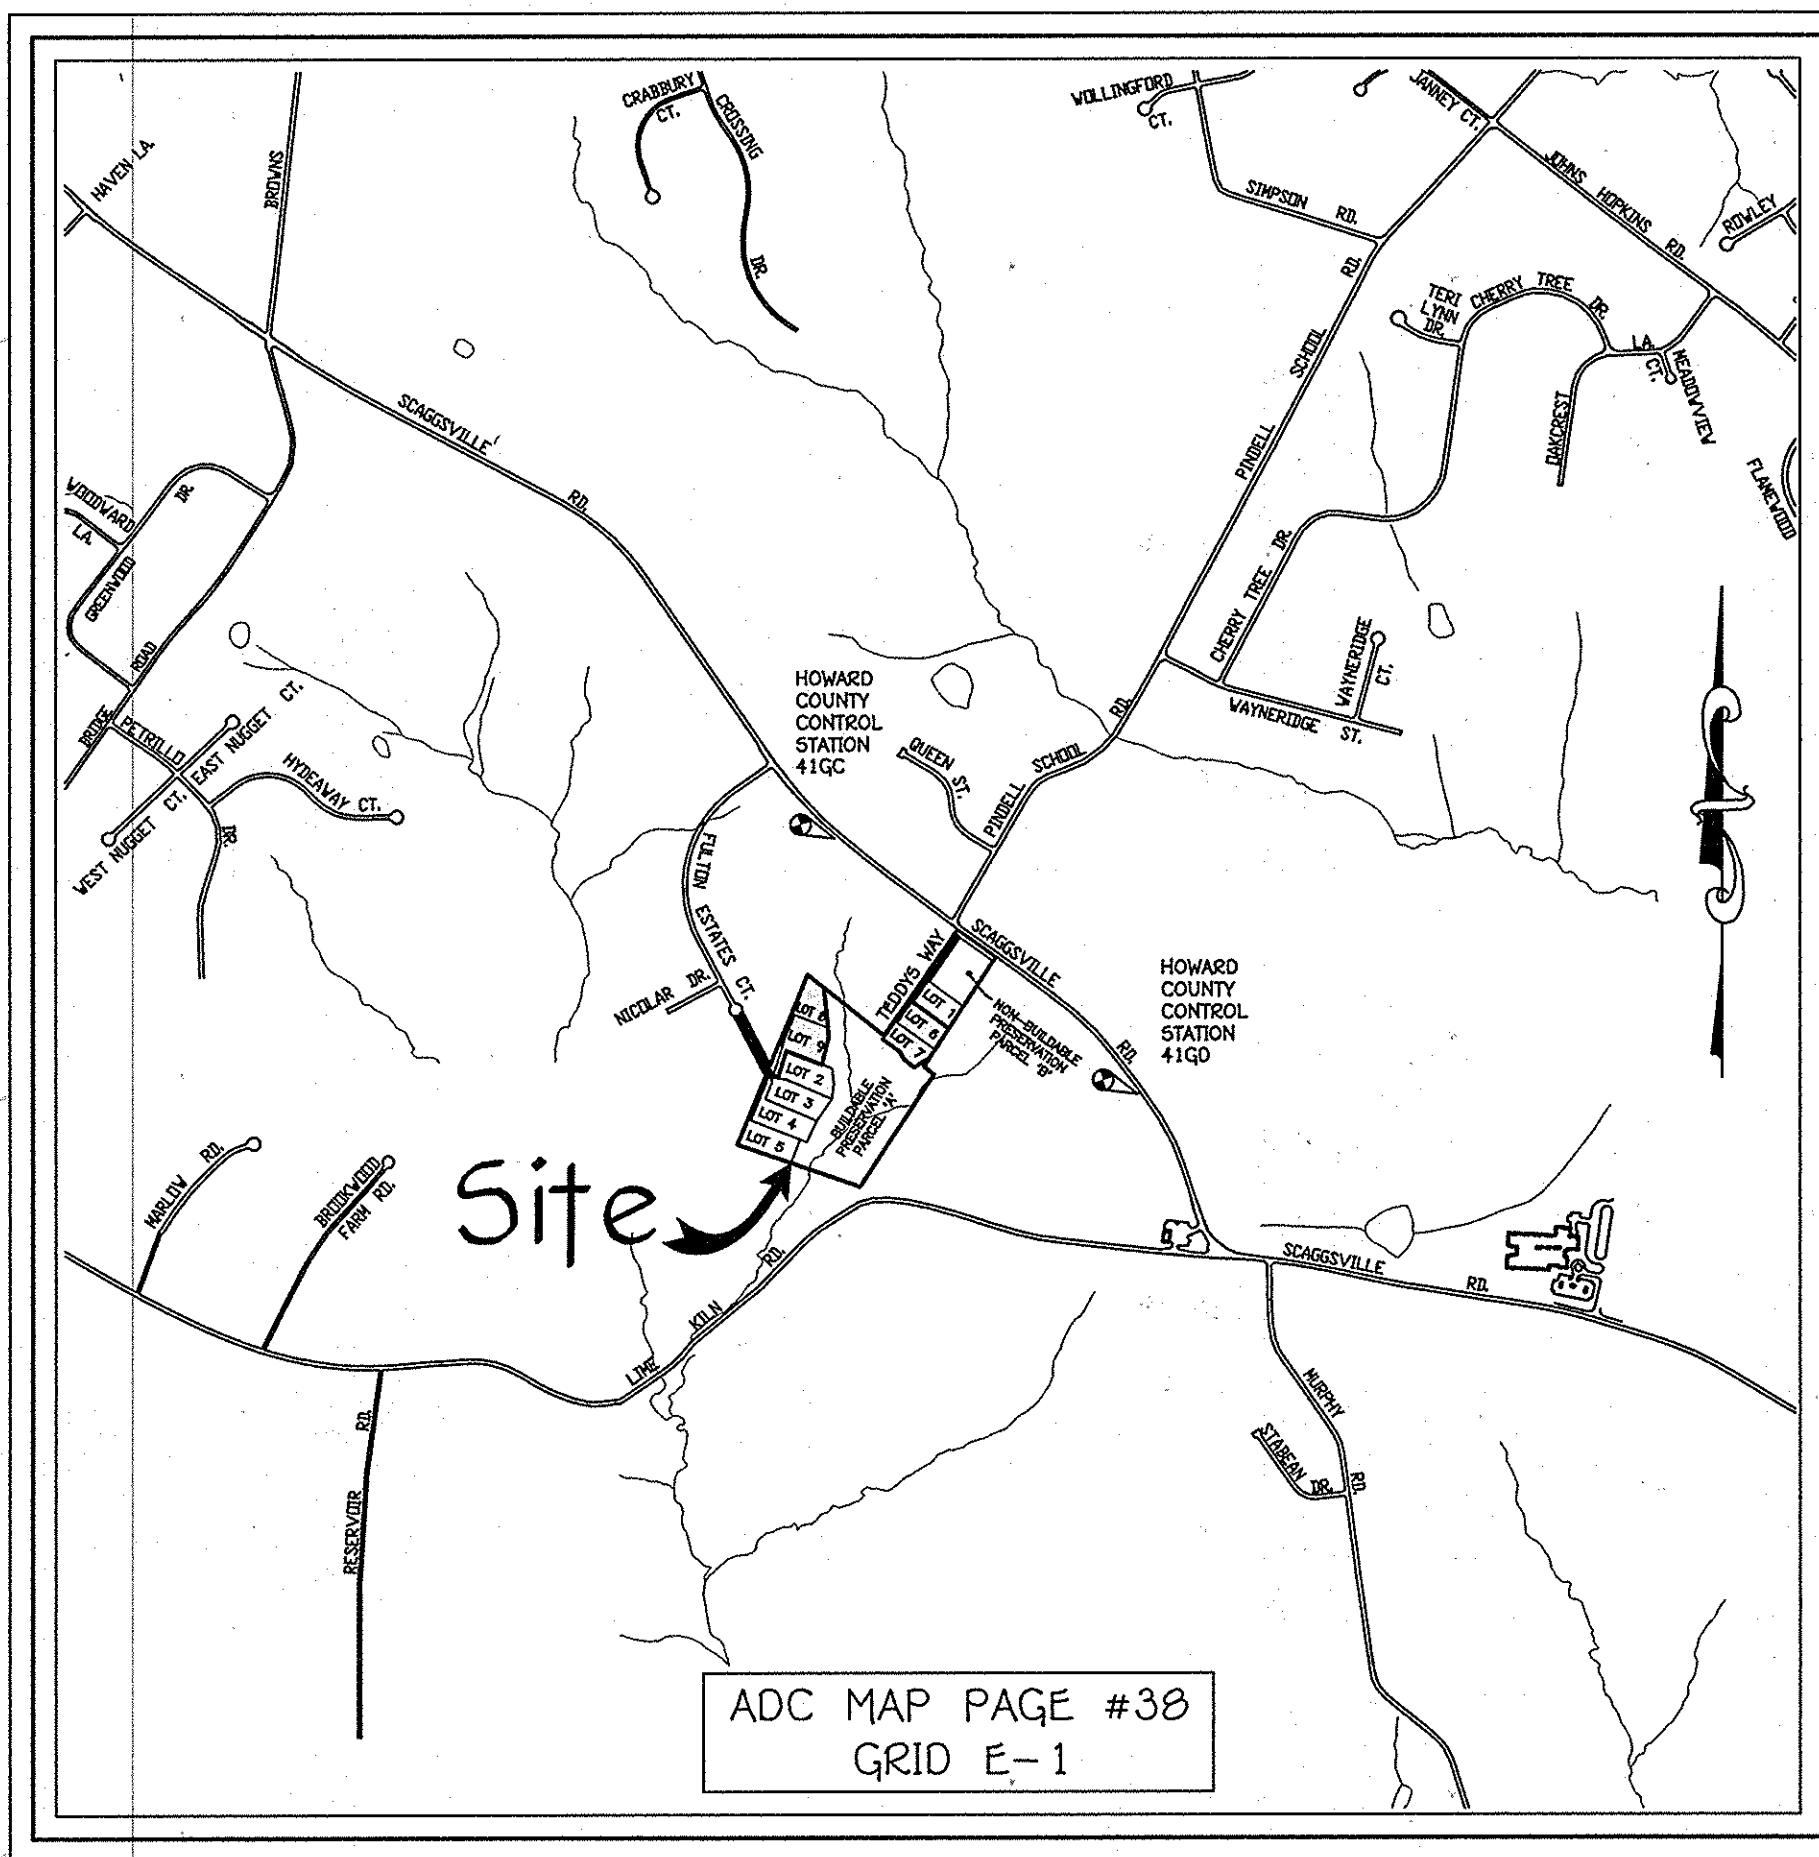

VICINITY MAP  
SCALE: 1" = 1200'

## FIFTH ELECTION DISTRICT HOWARD COUNTY, MARYLAND

| LEGEND |  |
|--------|--|
| SYMBOL | DESCRIPTION  |
| ---    | EXISTING E CONTOURS  |
| ---    | EXISTING I/O CONTOURS  |
| ---    | PROPOSED CONTOUR   |
| +      | SPOT ELEVATION   |
| ---    | LIMITS OF PRESERVATION   |
| ---    | EXISTING TREELINE  |
| ---    | PROPOSED TREELINE  |
| ---    | PROPOSED PAVING  |
| ---    | EXISTING PAVING TO BE REMOVED                                    |
| ---    | SOILS LINES AND TYPE   |
| ---    | SUPER SILT FENCE   |
| ---    | STABILIZES CONSTRUCTION ENTRANCE                                 |
| ---    | PROPOSED SWM DRYWELL (M-5)                                       |
| ---    | PROPOSED MICRO BIORETENTION (M-6)                                |
| ---    | GRASS SWALE (M-6)  |
| ---    | NON-ROOFTOP DISCONNECTION (N-2)                                  |
| ---    | ROOFTOPLEADS   |
| ---    | UNDERDRAIN PIPE  |
| ---    | 15% TO 24.9% STEEP SLOPES  |
| ---    | 25% AND GREATER STEEP SLOPES                                     |
| ---    | DRAINAGE AREA FOR MICRO-BIORETENTION AND BIORETENTION FACILITIES |
| ---    | DRAINAGE AREA FOR STORM DRAIN                                    |
| ---    | TREE PROTECTION  |
| ---    | FOREST CONSERVATION EASEMENT                                     |
| ---    | FOREST CONSERVATION SIGNAGE PROVIDED UNDER PART ONE, F-14-014    |
| ---    | PERIMETER LANDSCAPE TREES PROVIDED UNDER PART ONE, F-14-014      |

- GENERAL NOTES**
- THIS SUBDIVISION PLAN IS SUBJECT TO THE AMENDED FIFTH EDITION OF THE SUBDIVISION AND LAND DEVELOPMENT REGULATIONS AND THE 2004 ZONING REGULATIONS PER COUNCIL BILL NO. 45-2003 AND THE ZONING REGULATIONS AS AMENDED BY COUNCIL BILL NO. 79-2003. DEVELOPMENT OF CONSTRUCTION ON THESE LOTS OR PARCELS SHALL BE IN ACCORDANCE WITH THE ZONING REGULATIONS IN EFFECT AT THE TIME OF SUBMISSION OF A BUILDING OR GRADING PERMIT APPLICATION.
  - THE SUBJECT PROPERTY IS ZONED RR-DEO AND IS CONSIDERED TO BE "GRANDFATHERED" TO THE 2004/04 COMPREHENSIVE ZONING PLAN AND THE "COMP LITE" ZONING AMENDMENTS EFFECTIVE 7/26/06. THE GRANDFATHERING OF THIS MAJOR SUBDIVISION PLAN IS IN ACCORDANCE WITH SECTION 100.05.5 OF THE NEW ZONING REGULATIONS (EFFECTIVE 10/6/13) SINCE THE INITIAL PLAN SUBMISSION OF THE PRELIMINARY EQUIVALENT SKETCH PLAN WAS GRANTED A "TECHNICALLY COMPLETE" STATUS PRIOR TO THE ENACTMENT DATE OF THE NEW REGULATIONS.
  - TOTAL PROJECT AREA TABULATION:
    - GROSS AREA OF TRACT = 26.372 AC.
    - AREA OF FLOODPLAIN = 1.208 AC.
    - AREA OF 25% OR GREATER SLOPES = 0.440 AC. (OUTSIDE FLOODPLAIN)
    - NET AREA OF TRACT = 24.724 AC.
    - AREA OF PROPOSED ROAD R/W (PART TWO) = 0.000 AC.
    - AREA OF PROPOSED BUILDABLE LOTS (PART TWO) = 5.189 AC.
    - AREA OF PROPOSED BUILDABLE PRESERVATION PARCELS (PART TWO) = 0.000 AC.
    - AREA OF PROPOSED NON-BUILDABLE PRESERVATION PARCELS (PART TWO) = 0.000 AC.
    - AREA OF PROPOSED BULK PARCELS (PART TWO) = 0.000 AC.
    - TOTAL AREA PART TWO = 5.189 AC.
  - NUMBER OF LOTS PROPOSED: (PART TWO) = 4
    - BUILDABLE PRESERVATION PARCELS = 0
    - NON-BUILDABLE PRESERVATION PARCELS = 0
  - PERMITS AND FEES:
    - PERMITS: ECF, ECF-1, ECF-2, ECF-3, ECF-99, ECF-100.
    - FEES: PERMITS, ECF, ECF-1, ECF-2, ECF-3, ECF-99, ECF-100.
  - PERMITS AND FEES:
    - PERMITS: ECF, ECF-1, ECF-2, ECF-3, ECF-99, ECF-100.
    - FEES: PERMITS, ECF, ECF-1, ECF-2, ECF-3, ECF-99, ECF-100.
  - PERMITS AND FEES:
    - PERMITS: ECF, ECF-1, ECF-2, ECF-3, ECF-86,



| SCHEDULE A PERIMETER LANDSCAPE EDGE (PROVIDED WITH PART ONE (F-14-014)) |                                |                |  |  |   |                           |                                    |
|---|--------------------------------|----------------|--|--|---|---------------------------|------------------------------------|
| PERIMETER   | CATEGORY (PROPERTIES/ROADWAYS) | LANDSCAPE TYPE | LINEAR FEET OF ROADWAY FRONTAGE PERMETER | CREDIT FOR EXISTING VEGETATION (YES, NO, LINEAR FEET) (DESCRIBE BELOW IF NEEDED) | CREDIT FOR WALL, FENCE OR BERTH (YES, NO, LINEAR FEET) (DESCRIBE BELOW IF NEEDED) | NUMBER OF PLANTS REQUIRED | SHADE TREES EVERGREEN TREES SHRUBS |
| P-1   | ADJACENT TO PERIMETER          | A              | 336.31'                                  | NO   | NO  | 6                         | -                                  |
| P-2   | ADJACENT TO PERIMETER          | A              | 262.78'                                  | NO   | NO  | 4                         | -                                  |
| P-3   | ADJACENT TO PERIMETER          | A              | 495.83'                                  | YES - 100%   | NO  | 0                         | -                                  |
| P-4   | ADJACENT TO PERIMETER          | A              | 258.96'                                  | YES - 45'  | NO  | 4                         | -                                  |
| P-5   | ADJACENT TO PERIMETER          | A              | 772.83'                                  | NO   | NO  | 13                        | -                                  |
| P-6   | ADJACENT TO ROADWAY            | N/A            | 40'                                      | NO   | NO  | -                         | -                                  |
| P-7   | ADJACENT TO PERIMETER          | A              | 372.63'                                  | YES - (3 EX. TREES)  | NO  | 3                         | -                                  |
| P-8   | ADJACENT TO PERIMETER          | A              | 615.62'                                  | NO   | NO  | 10                        | 5 (SEE NOTE 1)                     |
| P-9   | ADJACENT TO PERIMETER          | A              | 130.01'                                  | YES - 100%   | NO  | 0                         | -                                  |
| P-10  | ADJACENT TO PERIMETER          | A              | 1262.50'                                 | YES - 100% (F.C.E.)  | NO  | 0                         | -                                  |
| P-11  | ADJACENT TO PERIMETER          | A              | 354.18'                                  | NO   | NO  | 6                         | -                                  |
| P-12  | ADJACENT TO PERIMETER          | A              | 466.56'                                  | NO   | NO  | 8                         | 5 (SEE NOTE 1)                     |
| P-13  | ADJACENT TO PERIMETER          | A              | 414.16'                                  | NO   | NO  | 7                         | -                                  |
| P-14  | ADJACENT TO ROADWAY            | N/A            | 52.35'                                   | NO   | NO  | -                         | -                                  |

NOTE: A TOTAL OF TEN (10) EVERGREEN TREES ALONG P-8 AND P-12 ARE REPLACEMENT FOR THE REMOVAL OF FIVE (5) SPECIMEN TREES (H, I, J, K, AND L) AS A CONDITION OF APPROVAL OF WP-13-092

Stormwater Management Summary Table

Total Site Area=Developable Area=12.506 acre/Impervious Area=1.39 Acre  
Target RCU=55  
Target P=1.00 inches

| ESDV Summary Table                                |                  |                  |              |   |
|---|------------------|------------------|--------------|---|
| AREA ID   | ESDV Req. Cu.Ft. | ESDV Pvd. Cu.Ft. | % Impervious | Remarks                                     |
| Lot 6   | 305              | 554              | 20%          | Micro-Bioretenion                           |
| Lot 7   | 295              | 623              | 20%          | Micro-Bioretenion                           |
| Lot 8   | 195              | 505              | 54%          | Micro-Bioretenion Non-Rooftop Disconnection |
| Lot 9   | 306              | 619              | 59%          | Micro-Bioretenion Non-Rooftop Disconnection |
| Portion of UIC Driveway which serves Lots 8 and 9 | 514              | 514              | 100%         | Non-Rooftop Disconnection                   |
| Totals  | 1,615            | 2,615            |              |   |


| M-6 (5) BORING #2 |        | M-6 (6) BORING #3 |        |
|-------------------|--------|-------------------|--------|
| EXISTING ELEV.    | 444.00 | EXISTING ELEV.    | 438.00 |
| MICRO-BIO. TOP    | 441.00 | MICRO-BIO. TOP    | 434.50 |
| MICRO-BIO. BOTTOM | 437.17 | MICRO-BIO. BOTTOM | 431.67 |
| BORING BOTTOM     | 430.00 | BORING BOTTOM     | 424.00 |

| NO. | BY  | REVISION  | DATE    |
|-----|-----|---|---------|
| 1   | RHV | REVISE THE HOUSE, GRADING AND BIO-RETENTION FACILITY ON LOT 7 | 6/22/16 |

| Specimen Tree Chart |                         |                |           |
|---------------------|-------------------------|----------------|-----------|
| Key                 | Species, Size (dbh)     | Comment        | Status    |
| A                   | Quercus rubra, 39"      | good condition | to remain |
| B                   | Quercus rubra, 33"      | good condition | to remain |
| C                   | Quercus falcata, 31.5"  | good condition | to remain |
| D                   | Quercus alba, 33.5"     | good condition | to remain |
| E                   | Quercus velutina, 33.5" | good condition | to remain |
| F                   | Quercus velutina, 31.5" | good condition | to remain |

**FISHER, COLLINS & CARTER, INC.**  
CIVIL ENGINEERING CONSULTANTS & LAND SURVEYORS  
CENTRAL OFFICE: 1872 BALTIMORE NATIONAL PKWY  
ELICOTT CITY, MARYLAND 21042  
(410) 481-2895

APPROVED: DEPARTMENT OF PLANNING AND ZONING  
*Kate DeLoach* 6/16/14  
CHIEF, DIVISION OF LAND DEVELOPMENT DATE  
*Paul Edmund* 5-30-14  
CHIEF, DEVELOPMENT ENGINEERING DIVISION DATE

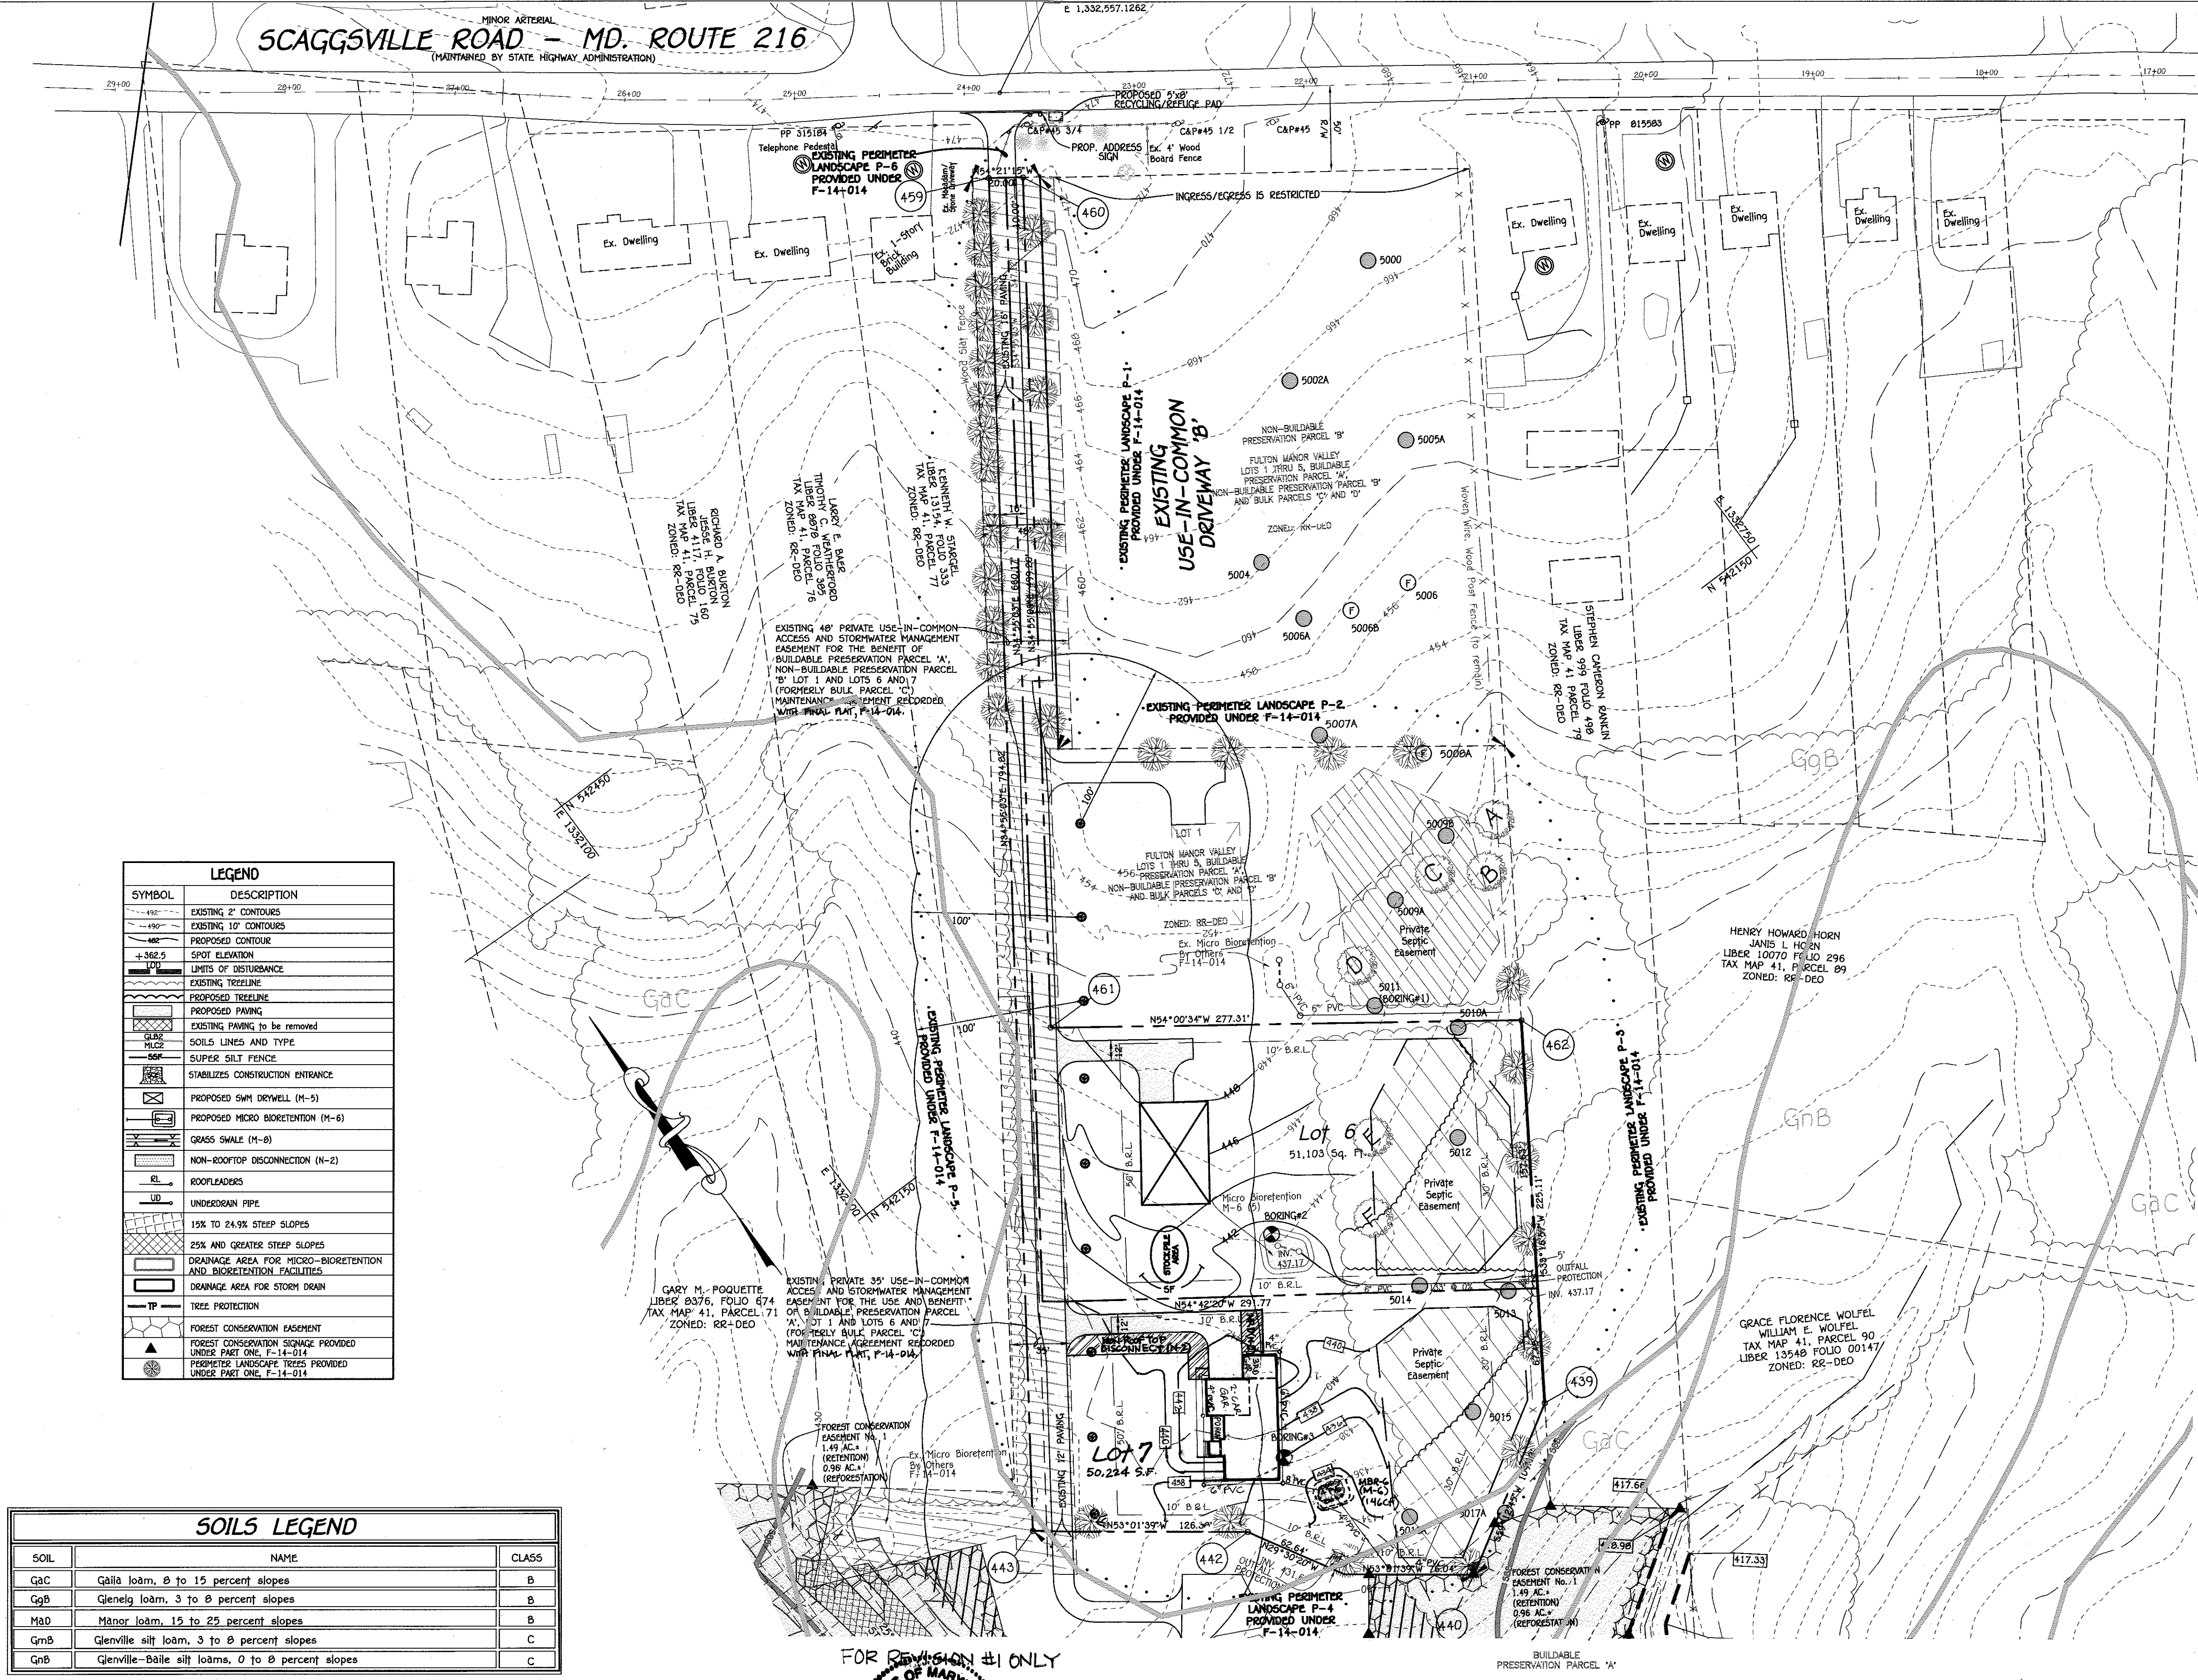


| LEGEND |  |
|--------|--|
| SYMBOL | DESCRIPTION  |
| ---    | EXISTING 2' CONTOURS   |
| ---    | EXISTING 10' CONTOURS  |
| ---    | PROPOSED CONTOUR   |
| ○      | SPOT ELEVATION   |
| ---    | LIMITS OF DISTURBANCE  |
| ---    | EXISTING TREELINE  |
| ---    | PROPOSED TREELINE  |
| ---    | PROPOSED PAVING  |
| ---    | EXISTING PAVING TO BE REMOVED                                    |
| ---    | SOILS LINES AND TYPE   |
| ---    | SUPER SILT FENCE   |
| ---    | STABILIZED CONSTRUCTION ENTRANCE                                 |
| ---    | PROPOSED SHM DRYWELL (M-5)                                       |
| ---    | PROPOSED MICRO BIORETENTION (M-6)                                |
| ---    | GRASS SWALE (M-8)  |
| ---    | NON-ROOFTOP DISCONNECTION (M-2)                                  |
| ---    | ROOFLEADERS  |
| ---    | UNDERDRAIN PIPE  |
| ---    | 15% TO 24.9% STEEP SLOPES  |
| ---    | 25% AND GREATER STEEP SLOPES                                     |
| ---    | DRAINAGE AREA FOR MICRO-BIORETENTION AND BIORETENTION FACILITIES |
| ---    | DRAINAGE AREA FOR STORM DRAIN                                    |
| ---    | TREE PROTECTION  |
| ---    | FOREST CONSERVATION EASEMENT                                     |
| ---    | FOREST CONSERVATION SIGNAGE PROVIDED UNDER PART ONE, F-14-014    |
| ---    | PERIMETER LANDSCAPE TREES PROVIDED UNDER PART ONE, F-14-014      |

| SOILS LEGEND |   |       |
|--------------|---|-------|
| SOIL         | NAME  | CLASS |
| GaC          | Gailla loam, 0 to 15 percent slopes               | B     |
| GgB          | Glenelg loam, 3 to 8 percent slopes               | B     |
| MdD          | Major loam, 15 to 25 percent slopes               | B     |
| GmB          | Glenville silt loam, 3 to 8 percent slopes        | C     |
| GnB          | Glenville-Baile silt loams, 0 to 8 percent slopes | C     |

NOTES:  
 \* Hydric soils and/or contains hydric inclusions  
 \*\* May contain hydric inclusions  
 † Generally only within 100-year floodplain areas



FOR REVISION #1 ONLY  
 6/22/16  
 ROBERT H. VOGEL PE NO 16193  
 FRANK J. MANALANSAN, II, L.S. 21476  
 5-20-14  
 "Professional certification, I hereby certify that these documents were prepared by me, and that I am a duly Licensed Professional Surveyor under the laws of the State of Maryland, License No. 21476, expiration date 7-14-15."

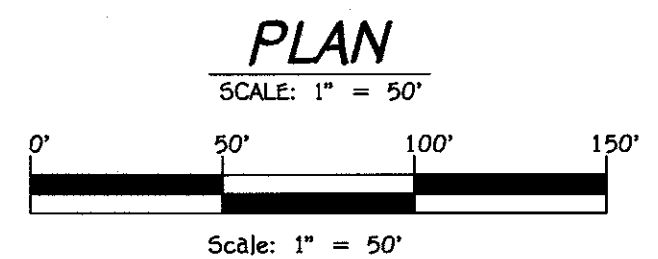

SUPPLEMENTAL PLAN  
 TOPOGRAPHY, GRADING, STORMWATER  
 MANAGEMENT AND SOILS  
**FULTON MANOR VALLEY  
 PART TWO**  
 LOTS 6 THRU 9  
 ZONED: RR-DEO  
 TAX MAP NO. 41 GRID NO. 19 PARCEL NO. 78 AND 456  
 FIFTH ELECTION DISTRICT HOWARD COUNTY, MARYLAND  
 SCALE: AS SHOWN DATE: MAY 20, 2014  
 SHEET 2 OF 7



| SOILS LEGEND |   |       |
|--------------|---|-------|
| SOIL         | NAME  | CLASS |
| GaC          | Gaia loam, 0 to 15 percent slopes                 | B     |
| GgB          | Glenelg loam, 3 to 8 percent slopes               | B     |
| MaD          | Manor loam, 15 to 25 percent slopes               | B     |
| GnB          | Glenville silt loam, 3 to 8 percent slopes        | C     |
| GnB          | Glenville-Baile silt loams, 0 to 8 percent slopes | C     |

- NOTES:
- Hydric soils and/or contains hydric inclusions
  - May contain hydric inclusions
  - Generally only within 100-year floodplain areas

| M-6 (7) BORING #4               |        | M-6 (6) BORING #5 PERC HOLE 5034 |        |
|---------------------------------|--------|----------------------------------|--------|
| EXISTING ELEV. & MICRO-BIO. TOP | 434.00 | EXISTING ELEV. & MICRO-BIO. TOP  | 435.00 |
| MICRO-BIO. BOTTOM               | 430.17 | MICRO-BIO. BOTTOM                | 430.17 |
| BORING BOTTOM                   | 420.00 | BORING BOTTOM                    | 423.80 |

Specimen Tree Chart

| Key | Species, Size (dbh)            | Comment                                    | Status        |
|-----|--------------------------------|--|---------------|
| G   | Quercus alba, 31"              | poor condition, trunk & limb dieback noted | to remain     |
| H   | Liriodendron tulipifera, 36.5" | fair condition, some limb dieback noted    | to be removed |
| I   | Liriodendron tulipifera, 35"   | good condition                             | to be removed |
| J   | Quercus velutina, 33"          | good condition                             | to be removed |
| K   | Liriodendron tulipifera, 42"   | good condition                             | to be removed |
| L   | Liriodendron tulipifera, 36.5" | good condition                             | to be removed |
| M   | Liriodendron tulipifera, 37"   | good condition                             | to remain     |
| N   | Liriodendron tulipifera, 35"   | good condition                             | to remain     |
| O   | Liriodendron tulipifera, 34"   | good condition                             | to remain     |
| P   | Liriodendron tulipifera, 31"   | good condition                             | to remain     |

| SYMBOL | DESCRIPTION  |
|--------|--|
| ---    | EXISTING 2' CONTOURS   |
| ---    | EXISTING 10' CONTOURS  |
| ---    | PROPOSED CONTOUR   |
| +      | SPOT ELEVATION   |
| ---    | LIMITS OF DISTURBANCE  |
| ---    | EXISTING TREELINE  |
| ---    | PROPOSED TREELINE  |
| ---    | PROPOSED PAVING  |
| ---    | EXISTING PAVING TO BE REMOVED                                    |
| ---    | SOILS LINES AND TYPE   |
| ---    | SUPER SILT FENCE   |
| ---    | STABILIZED CONSTRUCTION ENTRANCE                                 |
| ---    | PROPOSED SWM DRYWELL (M-5)                                       |
| ---    | PROPOSED MICRO BIORETENTION (M-6)                                |
| ---    | GRASS SWALE (M-8)  |
| ---    | NON-ROOFTOP DISCONNECTION (N-2)                                  |
| ---    | ROOFLEADERS  |
| ---    | UNDERDRAIN PIPE  |
| ---    | 15% TO 24.9% STEEP SLOPES  |
| ---    | 25% AND GREATER STEEP SLOPES                                     |
| ---    | DRAINAGE AREA FOR MICRO-BIORETENTION AND BIORETENTION FACILITIES |
| ---    | DRAINAGE AREA FOR STORM DRAIN                                    |
| ---    | TREE PROTECTION  |
| ---    | FOREST CONSERVATION EASEMENT                                     |
| ---    | FOREST CONSERVATION SIGNAGE PROVIDED UNDER PART ONE, F-14-014    |
| ---    | PERIMETER LANDSCAPE TREES PROVIDED UNDER PART ONE, F-14-014      |

|    |   |         |
|----|---|---------|
| 2  | REVISE THE PLAN TO SHOW THE NEW HOUSE TYPE AND GRADING ON LOT 9 WITH REVISED SWMA | 1-14-19 |
| BY | REVISION  | DATE    |

**FISHER, COLLINS & CARTER, INC.**  
 CIVIL ENGINEERING CONSULTANTS & LAND SURVEYORS  
 CENTRAL SQUARE OFFICE PARK - 10272 BALTIMORE NATIONAL PIKE  
 ELLSWORTH CITY, MARYLAND 21042  
 (410) 461-2299

APPROVED: DEPARTMENT OF PLANNING AND ZONING  
 [Signature] 6/16/19 DATE  
 CHIEF, DIVISION OF LAND DEVELOPMENT  
 [Signature] 5-30-14 DATE  
 CHIEF, DEVELOPMENT ENGINEERING DIVISION

**OWNER**  
 DEBRA E. TAYLOR  
 P.O. BOX 535  
 FULTON, MARYLAND 21044  
 410-977-1327

**DEVELOPER**  
 PLEASANT PROSPECT FARM, INC.  
 4401 JENNINGS CHAPEL ROAD  
 DAVIS, MD 20833  
 ATTN: MR. DONALD G. GRUVER, JR., PRESIDENT  
 443-367-0422


REVISION #2 ONLY  
 [Professional Engineer Seal]  
 [Professional Engineer Seal]  
 FRANK J. MANALANSAN, II, L.S. 21476 DATE 5-20-14  
 "Professional certification. I hereby certify that these documents were prepared by me and that I am a duly Licensed Professional Surveyor under the laws of the State of Maryland, License No. 21476, Expiration Date 7-14-15."

**FULTON ESTATES COURT**  
 (PUBLIC ACCESS STREET)

NICOLAR DRIVE



\* OFF-SITE RUNOFF SHOULD BY PASS THE BIO RETENTION ON LOT 9.

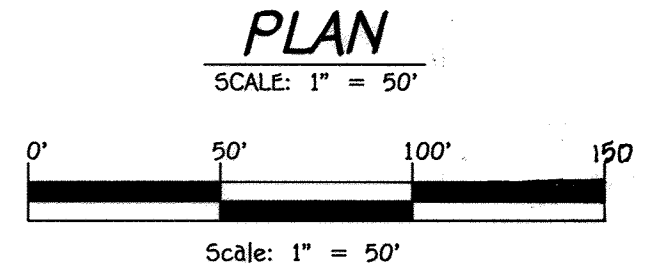

SUPPLEMENTAL PLAN  
 TOPOGRAPHY, GRADING, STORMWATER  
 MANAGEMENT AND SOILS  
**FULTON MANOR VALLEY**  
**PART TWO**  
 LOTS 6 THRU 9  
 ZONED: RR-DEO  
 TAX MAP No. 41 GRID No. 19 PARCEL No. 78 AND 456  
 FIFTH ELECTION DISTRICT HOWARD COUNTY, MARYLAND  
 SCALE: AS SHOWN DATE: MAY 20, 2014  
 SHEET 3 OF 7



SCAGGSVILLE ROAD - MD. ROUTE 216  
(MAINTAINED BY STATE HIGHWAY ADMINISTRATION)

| LEGEND |  |
|--------|--|
| SYMBOL | DESCRIPTION  |
| ---    | EXISTING 2' CONTOURS   |
| ---    | EXISTING 10' CONTOURS  |
| ---    | PROPOSED CONTOUR   |
| +      | SPOT ELEVATION   |
| ---    | LIMITS OF DISTURBANCE  |
| ---    | EXISTING TREELINE  |
| ---    | PROPOSED TREELINE  |
| ---    | PROPOSED PAVING  |
| ---    | EXISTING PAVING TO BE REMOVED                                    |
| ---    | SOILS LINES AND TYPE   |
| ---    | SUPER SILT FENCE   |
| ---    | STABILIZES CONSTRUCTION ENTRANCE                                 |
| ---    | PROPOSED SWM DRYWELL (M-5)                                       |
| ---    | PROPOSED MICRO BIORETENTION (M-6)                                |
| ---    | GRASS SWALE (M-6)  |
| ---    | NON-ROOFTOP DISCONNECTION (N-2)                                  |
| ---    | ROOFLEADERS  |
| ---    | UNDERDRAIN PIPE  |
| ---    | 15% TO 24.9% STEEP SLOPES  |
| ---    | 25% AND GREATER STEEP SLOPES                                     |
| ---    | DRAINAGE AREA FOR MICRO-BIORETENTION AND BIORETENTION FACILITIES |
| ---    | DRAINAGE AREA FOR STORM DRAIN                                    |
| ---    | TREE PROTECTION  |
| ---    | FOREST CONSERVATION EASEMENT                                     |
| ---    | FOREST CONSERVATION SIGNAGE PROVIDED UNDER PART ONE, F-14-014    |
| ---    | PERIMETER LANDSCAPE TREES PROVIDED UNDER PART ONE, F-14-014      |

| NO. | BY  | REVISION  | DATE    |
|-----|-----|---|---------|
| 1   | RHV | REVISE THE HOUSE, GRADING AND BIO RETENTION FACILITY ON LOT 7 | 6/22/16 |

**FISHER, COLLINS & CARTER, INC.**  
CIVIL ENGINEERING CONSULTANTS & LAND SURVEYORS  
CENTENNIAL SQUARE OFFICE PARK - 10275 BALTIMORE NATIONAL PIKE  
ELLSWORTH CITY, MARYLAND 21042  
(410) 461-5885

APPROVED: DEPARTMENT OF PLANNING AND ZONING

*Debra E. Taylor* 6/16/14  
CHIEF, DIVISION OF LAND DEVELOPMENT DATE

*Paul E. Carter* 5-30-14  
CHIEF, DEVELOPMENT ENGINEERING DIVISION DATE

FOR REVISION #1 ONLY

STATE OF MARYLAND  
ROBERT H. VOGEL, PE NO 16193  
PROFESSIONAL ENGINEER  
6/28/16


OWNER  
DEBRA E. TAYLOR  
P.O. BOX 535  
FULTON, MARYLAND 21044  
410-977-1327

DEVELOPER  
PLEASANT PROSPECT FARM, INC.  
4401 JENNINGS CHAPEL ROAD  
DANBY, MD 20683  
ATTN: MR. DONALD R. SEUWIC, JR., PRESIDENT  
443-367-0422

STATE OF MARYLAND  
FRANK J. MANALANSAN, II, L.S. 21476  
PROFESSIONAL LAND SURVEYOR  
5-20-14  
DATE

\*Professional certification. I hereby certify that these documents were prepared by me, and that I am a duly Licensed Professional Surveyor under the laws of the State of Maryland, License No. 21476, Expiration Date 7-14-15.\*

NOTE: THE LOCATION FOR THE PROPOSED DWELLING ON LOT 7 WITH RESPECT TO THE BRLLS AND LOT LINES WILL BE REVIEWED AND APPROVED AT THE TIME OF THE BUILDING PERMIT.

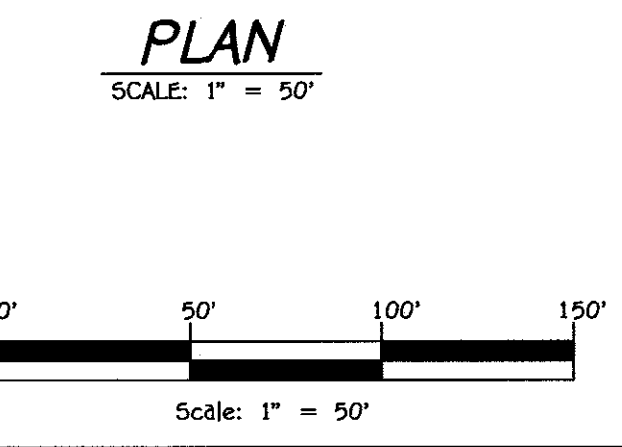

THIS DEVELOPMENT PLAN IS APPROVED FOR SOIL EROSION AND SEDIMENT CONTROL BY THE HOWARD SOIL CONSERVATION DISTRICT

Approved: *John C. Robertson*  
6/3/14

SEDIMENT CONTROL PLAN  
**FULTON MANOR VALLEY PART TWO**  
LOTS 6 THRU 9  
ZONED: RR-DEO  
TAX MAP No. 41 GRID No. 19 PARCEL No. 78 AND 456  
FIFTH ELECTION DISTRICT HOWARD COUNTY, MARYLAND  
SCALE: AS SHOWN DATE: MAY 20, 2014  
SHEET 4 OF 7



I:\2011\1015\dwg\2nd 3D SUPPLEMENTAL PLAN.dwg, SHEET 4, 5/20/2014 11:06:35 AM, 1:1











**Infiltration and Filter System Construction Specifications**

Infiltration and filter systems either take advantage of existing permeable soils or create a permeable medium such as sand for WC, and Re V. In some instances where permeability is great, these facilities may be used for 0.5 ft. The most common systems include infiltration trenches, infiltration basins, sand filters, and organic filters.

When properly planted, vegetation will thrive and enhance the functioning of these systems. For example, pre-treatment buffers will trap sediments that often are bound with phosphorus and metals. Vegetation planted in the facility will aid in nutrient uptake and water storage. Additionally, plant roots will provide arteries for stormwater to permeate soil for groundwater recharge. Finally, successful plantings provide aesthetic value and wildlife habitat making these facilities more desirable to the public.

**Design Constraints:**

- > Planting buffer strips of at least 20 feet will cause sediments to settle out before reaching the facility, thereby reducing the possibility of clogging.
- > Determine areas that will be saturated with water and water table depth so that appropriate plants may be selected (hydrology will be similar to bioretention facilities, see figure A.5 and Table A.4 for planting material guidance).
- > Plants known to send down deep taproots should be avoided in systems where filter fabric is used as part of facility design.
- > Test soil conditions to determine if soil amendments are necessary.
- > Plants shall be located so that access is possible for structure maintenance.
- > Stabilize heavy flow areas with erosion control mats or soil.
- > Temporarily divert flows from seeded areas until vegetation is established.
- > See Table A.5 for additional design considerations.

**Soil Bed Characteristics**

The characteristics of the soil for the bioretention facility are perhaps as important as the facility location, size, and treatment volume. The soil must be permeable enough to allow runoff to filter through the media, while having characteristics suitable to promote and sustain a robust vegetative cover crop. In addition, much of the nutrient pollutant uptake (nitrogen and phosphorus) is accomplished through absorption and microbial activity within the soil profile. Therefore, soils must balance their chemical and physical properties to support biotic communities above and below ground.

The planting soil should be a sandy loam, loamy sand, loam (USDA), or a loam/sand mix (should contain a minimum 35 to 60% sand, by volume). The clay content for these soils should be less than 25% by volume (Environmental Quality Resources (EQR), 1996; Engineering Technology Inc. and Biohabitats, Inc. (ETAB), 1993). Soils should fall within the SM, ML, SC classifications of the Unified Soil Classification System (USCS). A permeability of at least 1.0 feet per day (0.5"/hr) is required (a conservative value of 0.5 feet per day is used for design). The soil should be free of stones, stumps, roots, or other woody material over 1" in diameter. Brush or seeds from noxious weeds (e.g., Johnson Grass, Mugwort, Nutsedge, and Canada Thistle or other noxious weeds as specified under COMAR 15.08.01.05) should not be present in the soils. Placement of the planting soil should be in 12 to 18 lifts that are loosely compacted (tamped lightly with a backhoe bucket or traversed by dozer tracks). The specific characteristics are presented in Table A.3.

Table A.3 Planting Soil Characteristics

| Parameter                     | Value                     |
|-------------------------------|---------------------------|
| pH range                      | 5.2 to 7.00               |
| Organic matter                | 1.5 to 4.0% (by weight)   |
| Magnesium                     | 35 lbs. per acre, minimum |
| Phosphorus (phosphate - P2O5) | 75 lbs. per acre, minimum |
| Potassium (potash - K2O)      | 85 lbs. per acre, minimum |
| Soluble salts                 | 500 ppm                   |
| Clay                          | 10 to 25 %                |
| Silt                          | 30 to 55 %                |
| Sand                          | 35 to 60 %                |

**Mulch Layer**

The mulch layer plays an important role in the performance of the bioretention system. The mulch layer helps maintain soil moisture and avoids surface sealing, which reduces permeability. Mulch helps prevent erosion, and provides a microenvironment suitable for soil biota at the mulch/soil interface. It also serves as a pretreatment layer, trapping the finer sediments, which remain suspended after the primary pretreatment.

The mulch layer should be standard landscape style, single or double shredded hardwood mulch or chips. The mulch layer should be well aged (stockpiled or stored for at least 12 months), uniform in color, and free of other materials, such as weed seeds, soil, roots, etc. The mulch should be applied to a maximum depth of three inches. Grass clippings should not be used as a mulch material.

**Planting Guidance**

Plant material selection should be based on the goal of simulating a terrestrial forested community of native species. Bioretention simulates an upland-species ecosystem. The community should be dominated by trees, but have a distinct community of understory trees, shrubs and herbaceous materials. By creating a diverse, dense plant cover, a bioretention facility will be able to treat stormwater runoff and withstand urban stresses from insects, disease, drought, temperature, wind, and exposure. The proper selection and installation of plant materials is key to a successful system. There are essentially three zones within a bioretention facility (Figure A.5). The lowest elevation supports plant species adapted to standing and flowing water levels. The middle elevation supports plants that like drier soil conditions, but can still tolerate occasional inundation by water. The outer edge is the highest elevation and generally supports plants adapted to dryer conditions. A sample of appropriate plant materials for bioretention facilities are included in Table A.4. The layout of plant material should be flexible, but should follow the general principals described in Table A.5. The objective is to have a system, which resembles a random, and natural plant layout, while maintaining optimal conditions for plant establishment and growth. For a more extensive bioretention plan, consult ETAB, 1993 or Clayton and Schueler, 1997.

**OPERATION AND MAINTENANCE SCHEDULE FOR PRIVATELY OWNED AND MAINTAINED STORMWATER DRY WELLS (M-5)**

1. THE MONITORING WELLS AND STRUCTURES SHALL BE INSPECTED ON A QUARTERLY BASIS AND AFTER EACH MAJOR STORM EVENT.
2. WATER LEVELS AND SEDIMENT BUILD UP IN THE MONITORING WELLS SHALL BE RECORDED OVER A PERIOD OF SEVERAL DAYS TO INSURE TRENCH DRAINAGE.
3. A LOG BOOK SHALL BE MAINTAINED TO DETERMINE THE RATE AT WHICH THE FACILITY DRAINS.
4. WHEN THE FACILITY BECOMES CLOGGED SO THAT IT DOES NOT DRAIN DOWN WITHIN THE 72 HOUR TIME PERIOD, CORRECTIVE ACTION SHALL BE TAKEN.
5. THE MAINTENANCE LOG BOOK SHALL BE AVAILABLE TO HOWARD COUNTY FOR INSPECTION TO INSURE COMPLIANCE WITH OPERATION AND MAINTENANCE CRITERIA.
6. ONCE THE PERFORMANCE CHARACTERISTICS OF THE INFILTRATION FACILITY HAVE BEEN VERIFIED, THE MONITORING SCHEDULE CAN BE REDUCED TO AN ANNUAL BASIS UNLESS THE PERFORMANCE DATA INDICATES THAT A MORE FREQUENT SCHEDULE IS REQUIRED.

**FISHER, COLLINS & CARTER, INC.**  
CIVIL ENGINEERING CONSULTANTS & LAND SURVEYORS  
CENTRAL SQUARE OFFICE PARK - 10772 BALDORNE NATIONAL PIKE  
ELLSWORTH CITY, MARYLAND 21042  
410-461-3200

**GUTTER DRAIN FILTER DETAIL**

NOT TO SCALE


APPROVED: DEPARTMENT OF PLANNING AND ZONING

*Kate Deane* 6/16/14  
CHIEF, DIVISION OF LAND DEVELOPMENT DATE

*Chad Edwards* 5.30.14  
CHIEF, DEVELOPMENT ENGINEERING DIVISION DATE

**OWNER**  
DEBRA E. TAYLOR  
P.O. BOX 535  
FULTON, MARYLAND 21044  
410-977-1327

**DEVELOPER**  
PLASANT PROSPECT FARM, INC.  
4401 JENNINGS CHAPEL ROAD  
DANBY, MD 20835  
ATTN: MR. DONALD G. REUMER, JR., PRESIDENT  
443-367-0422

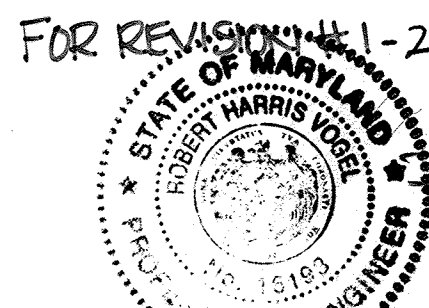

FOR REVISION 11-1-2

1/20/19

5/20/14

DATE

"Professional certification, I hereby certify that these documents were prepared by me, and that I am a duly Licensed Professional Surveyor under the laws of the State of Maryland, License No. 21476, Expiration Date 7-14-15."

**OPERATION AND MAINTENANCE SCHEDULE FOR BIO-RETENTION AREAS (M-6)**

1. ANNUAL MAINTENANCE OF PLANT MATERIAL, MULCH LAYER AND SOIL LAYER IS REQUIRED. MAINTENANCE OF MULCH AND SOIL IS LIMITED TO CORRECTING AREAS OF EROSION OR WASH OUT. ANY MULCH REPLACEMENT SHALL BE DONE IN THE SPRING. PLANT MATERIAL SHALL BE CHECKED FOR DISEASE AND INSECT INFESTATION AND MAINTENANCE WILL ADDRESS DEAD MATERIAL AND PRUNING.
2. SCHEDULE OF PLANT INSPECTION WILL BE TWICE A YEAR IN SPRING AND FALL. THIS INSPECTION WILL INCLUDE REMOVAL OF DEAD AND DISEASED VEGETATION BEYOND TREATMENT. TREATMENT OF ALL DISEASED TREES AND SHRUBS AND REPLACEMENT OF ALL DEFICIENT STAKES AND WIRES.
3. MULCH SHALL BE INSPECTED EACH SPRING. REMOVE EXCESS MULCH LAYER BEFORE APPLYING NEW LAYERS ONCE EVERY 2 TO 3 YEARS.
4. SOIL EROSION TO BE ADDRESSED ON AN AS NEEDED BASIS, WITH A MINIMUM OF ONCE PER MONTH AND AFTER HEAVY STORM EVENTS.

| STORMWATER MANAGEMENT PRACTICES |                            |   |                         |                   |
|---------------------------------|----------------------------|---|-------------------------|-------------------|
| LOT NO.                         | ADDRESS                    | DISCONNECTION OF NON-ROOFTOP RUNOFF N-2 | MICRO BIO-RETENTION M-6 | BIO-RETENTION F-6 |
| 1                               | 11805 TEDDYS WAY           | N                                       | Y                       | Y                 |
| 2                               | 12163 FULTON ESTATES COURT | Y                                       | N                       | Y                 |
| 3                               | 12167 FULTON ESTATES COURT | Y                                       | N                       | Y                 |
| 4                               | 12171 FULTON ESTATES COURT | Y                                       | Y                       | N                 |
| 5                               | 12175 FULTON ESTATES COURT | Y                                       | Y                       | N                 |
| 6                               | 11809 TEDDYS WAY           | N                                       | Y                       | N                 |
| 7                               | 11813 TEDDYS WAY           | N                                       | Y                       | N                 |
| 8                               | 12155 FULTON ESTATES COURT | Y                                       | N                       | N                 |
| 9                               | 12159 FULTON ESTATES COURT | Y                                       | Y                       | N                 |
| Pres A                          | 11281 TEDDYS WAY           | N                                       | N                       | N                 |
| Pres B                          | 11813 SCAGSVILLE ROAD      | Y                                       | N                       | N                 |


\* PRIVATE ROOF DRAIN DRYWELLS (M-5)

| DRAINAGE AREA M-6 (5) MICRO-BIORETENTION PLANT MATERIAL |                  |                       |  |
|---|------------------|-----------------------|--|
| QUANTITY  | NAME             | MAXIMUM SPACING (FT.) |  |
| 110   | MIXED PERENNIALS | 1 FT.                 |  |
| 55  | SHRUBS           | 2 FT.                 |  |

| DRAINAGE AREA M-6 (6) MICRO-BIORETENTION PLANT MATERIAL |                  |                       |  |
|---|------------------|-----------------------|--|
| QUANTITY  | NAME             | MAXIMUM SPACING (FT.) |  |
| 109   | MIXED PERENNIALS | 1 FT.                 |  |
| 54  | SHRUBS           | 2 FT.                 |  |


| DRAINAGE AREA M-6 (7) MICRO-BIORETENTION PLANT MATERIAL |            |                       |  |
|---|------------|-----------------------|--|
| QUANTITY  | NAME       | MAXIMUM SPACING (FT.) |  |
| 35  | PERENNIALS | 1 FT.                 |  |
| 10  | SHRUBS     | 2 FT.                 |  |

| DRAINAGE AREA M-6 (8) MICRO-BIORETENTION PLANT MATERIAL |                  |                       |  |
|---|------------------|-----------------------|--|
| QUANTITY  | NAME             | MAXIMUM SPACING (FT.) |  |
| 108   | MIXED PERENNIALS | 1 FT.                 |  |
| 54  | SHRUBS           | 2 FT.                 |  |

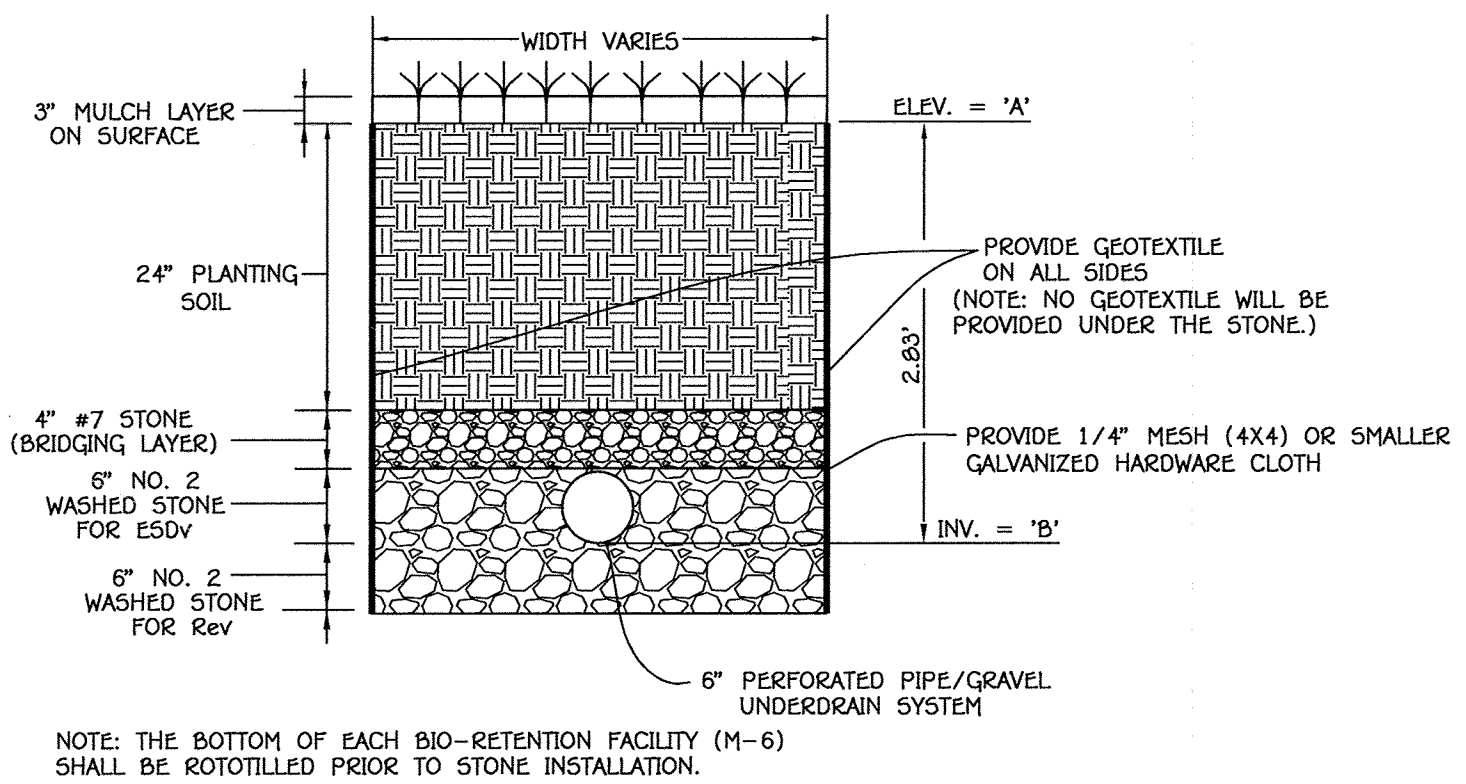


NOTE: THE BOTTOM OF EACH BIO-RETENTION FACILITY (M-6) SHALL BE ROTOTILLED PRIOR TO STONE INSTALLATION.

**TYPICAL SECTION - BIO-RETENTION FACILITY (M-6)**

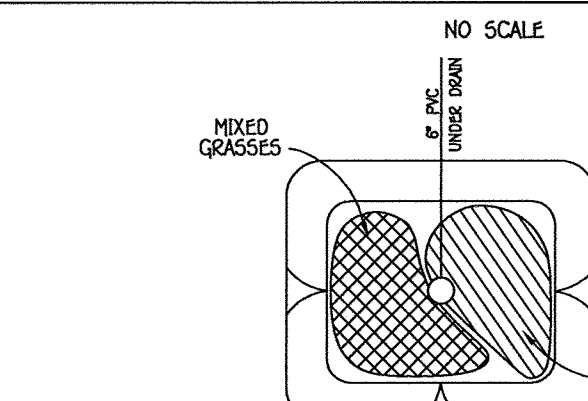


**MICRO-BIORETENTION PLANTING DETAIL**

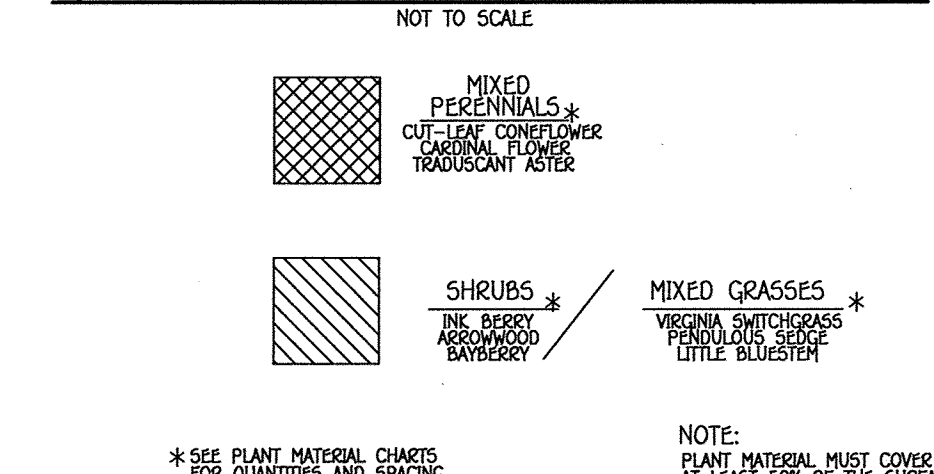

NOTE: PLANT MATERIAL MUST COVER AT LEAST 50% OF THE SURFACE AREA OF THE MICRO-BIORETENTION FACILITIES

**(MICRO - BIORETENTION FACILITIES)**

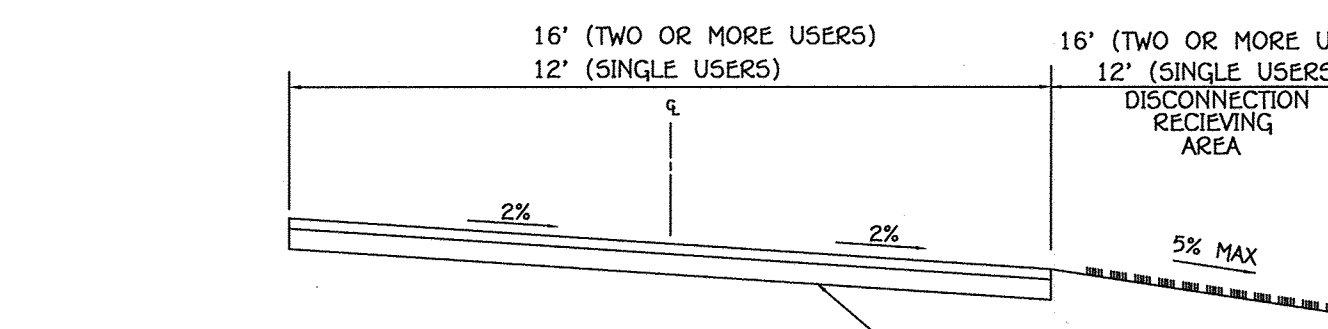

NOTE: ALL MATERIALS AND CONSTRUCTION SHALL BE IN ACCORDANCE WITH HOWARD COUNTY DESIGN MANUAL VOLUME 11, STANDARD SPECIFICATION AND DETAILS FOR CONSTRUCTION.

**Typical Private Drive Cross Slope Section**




**Operation & Maintenance Schedule For Privately Owned And Maintained Disconnection Of Rooftop Runoff (N-1) And Nonrooftop Runoff (N-2)**

1. MAINTENANCE OF AREAS RECEIVING DISCONNECTION RUNOFF IS GENERALLY NO DIFFERENT THAN THAT REQUIRED FOR OTHER LAWN OR LANDSCAPED AREAS. THE AREAS RECEIVING RUNOFF SHOULD BE PROTECTED FROM FUTURE COMPACTION OR DEVELOPMENT OF IMPERVIOUS AREA. IN COMMERCIAL AREAS, FOOT TRAFFIC SHOULD BE DISCOURAGED AS WELL.
2. OPERATION AND MAINTENANCE SCHEDULE FOR PRIVATELY OWNED AND MAINTAINED DISCONNECTION OR ROOFTOP RUNOFF (N-1), DISCONNECTION OF NON-ROOFTOP RUNOFF (N-2)
3. MAINTENANCE OF AREAS RECEIVING DISCONNECTION RUNOFF IS GENERAL AND DIFFERENT THAN THAT REQUIRED FOR LAWN OR LANDSCAPE AREAS. THE AREAS RECEIVING RUNOFF SHOULD BE PROTECTED FROM FUTURE COMPACTION OR DEVELOPMENT OF IMPERVIOUS AREA. IN COMMERCIAL AREAS FOOT TRAFFIC SHOULD BE DISCOURAGED AS WELL.

|           |   |
|-----------|---|
| [Pattern] | NON-ROOFTOP DISCONNECTION (N-2)                             |
| [Pattern] | DRAINAGE AREA TO NON-ROOFTOP DISCONNECTION (N-2) (1,963 SF) |
| [Pattern] | DRAINAGE AREA TO DRYWELLS (M-5) (2,820 SF)                  |



| M-6 (7) (MICRO BIO-RETENTION FACILITY) |             |  |  |
|--|-------------|--|--|
| SCALE:                                 | 1" = 30'    |  |  |
| DRAINAGE AREA:                         | 4,429 SqFt. |  |  |
| FILTER AREA:                           | 344 SqFt.   |  |  |
| ELEVATION:                             | 433.00      |  |  |
| PERIMETER:                             | 77'         |  |  |
| WEIR ELEVATION:                        | 434.00      |  |  |

NOTE: THE LOCATION FOR THE PROPOSED DWELLING ON LOT 7 WITH RESPECT TO THE B.R.L.'S AND LOT LINES WILL BE REVIEWED AND APPROVED AT THE TIME OF THE BUILDING PERMIT.

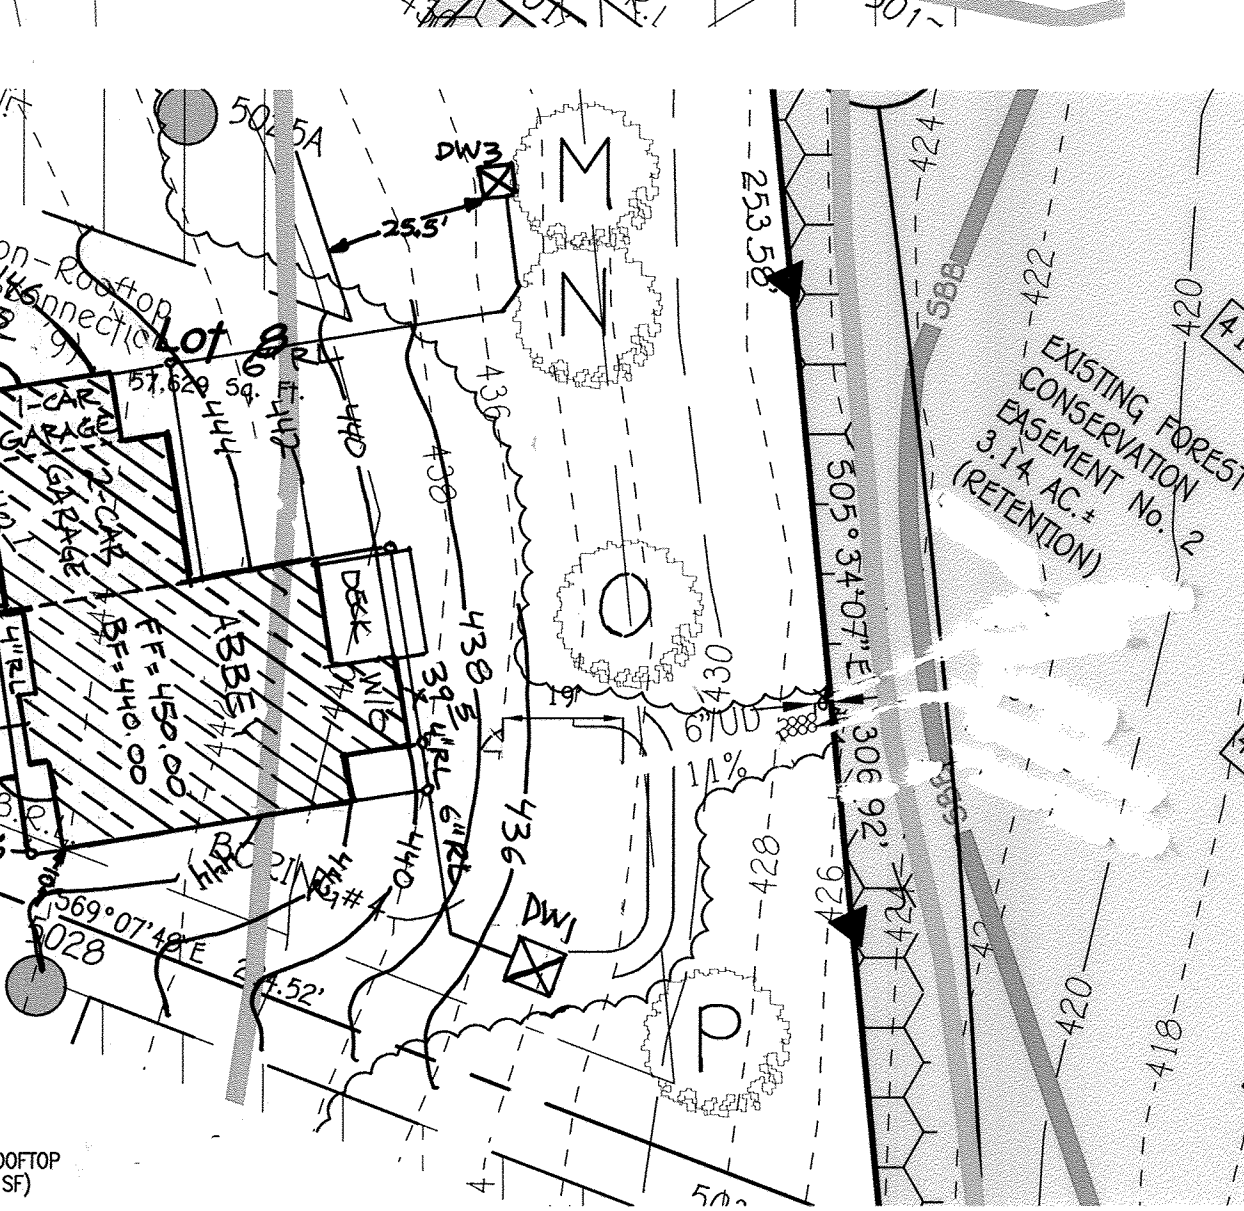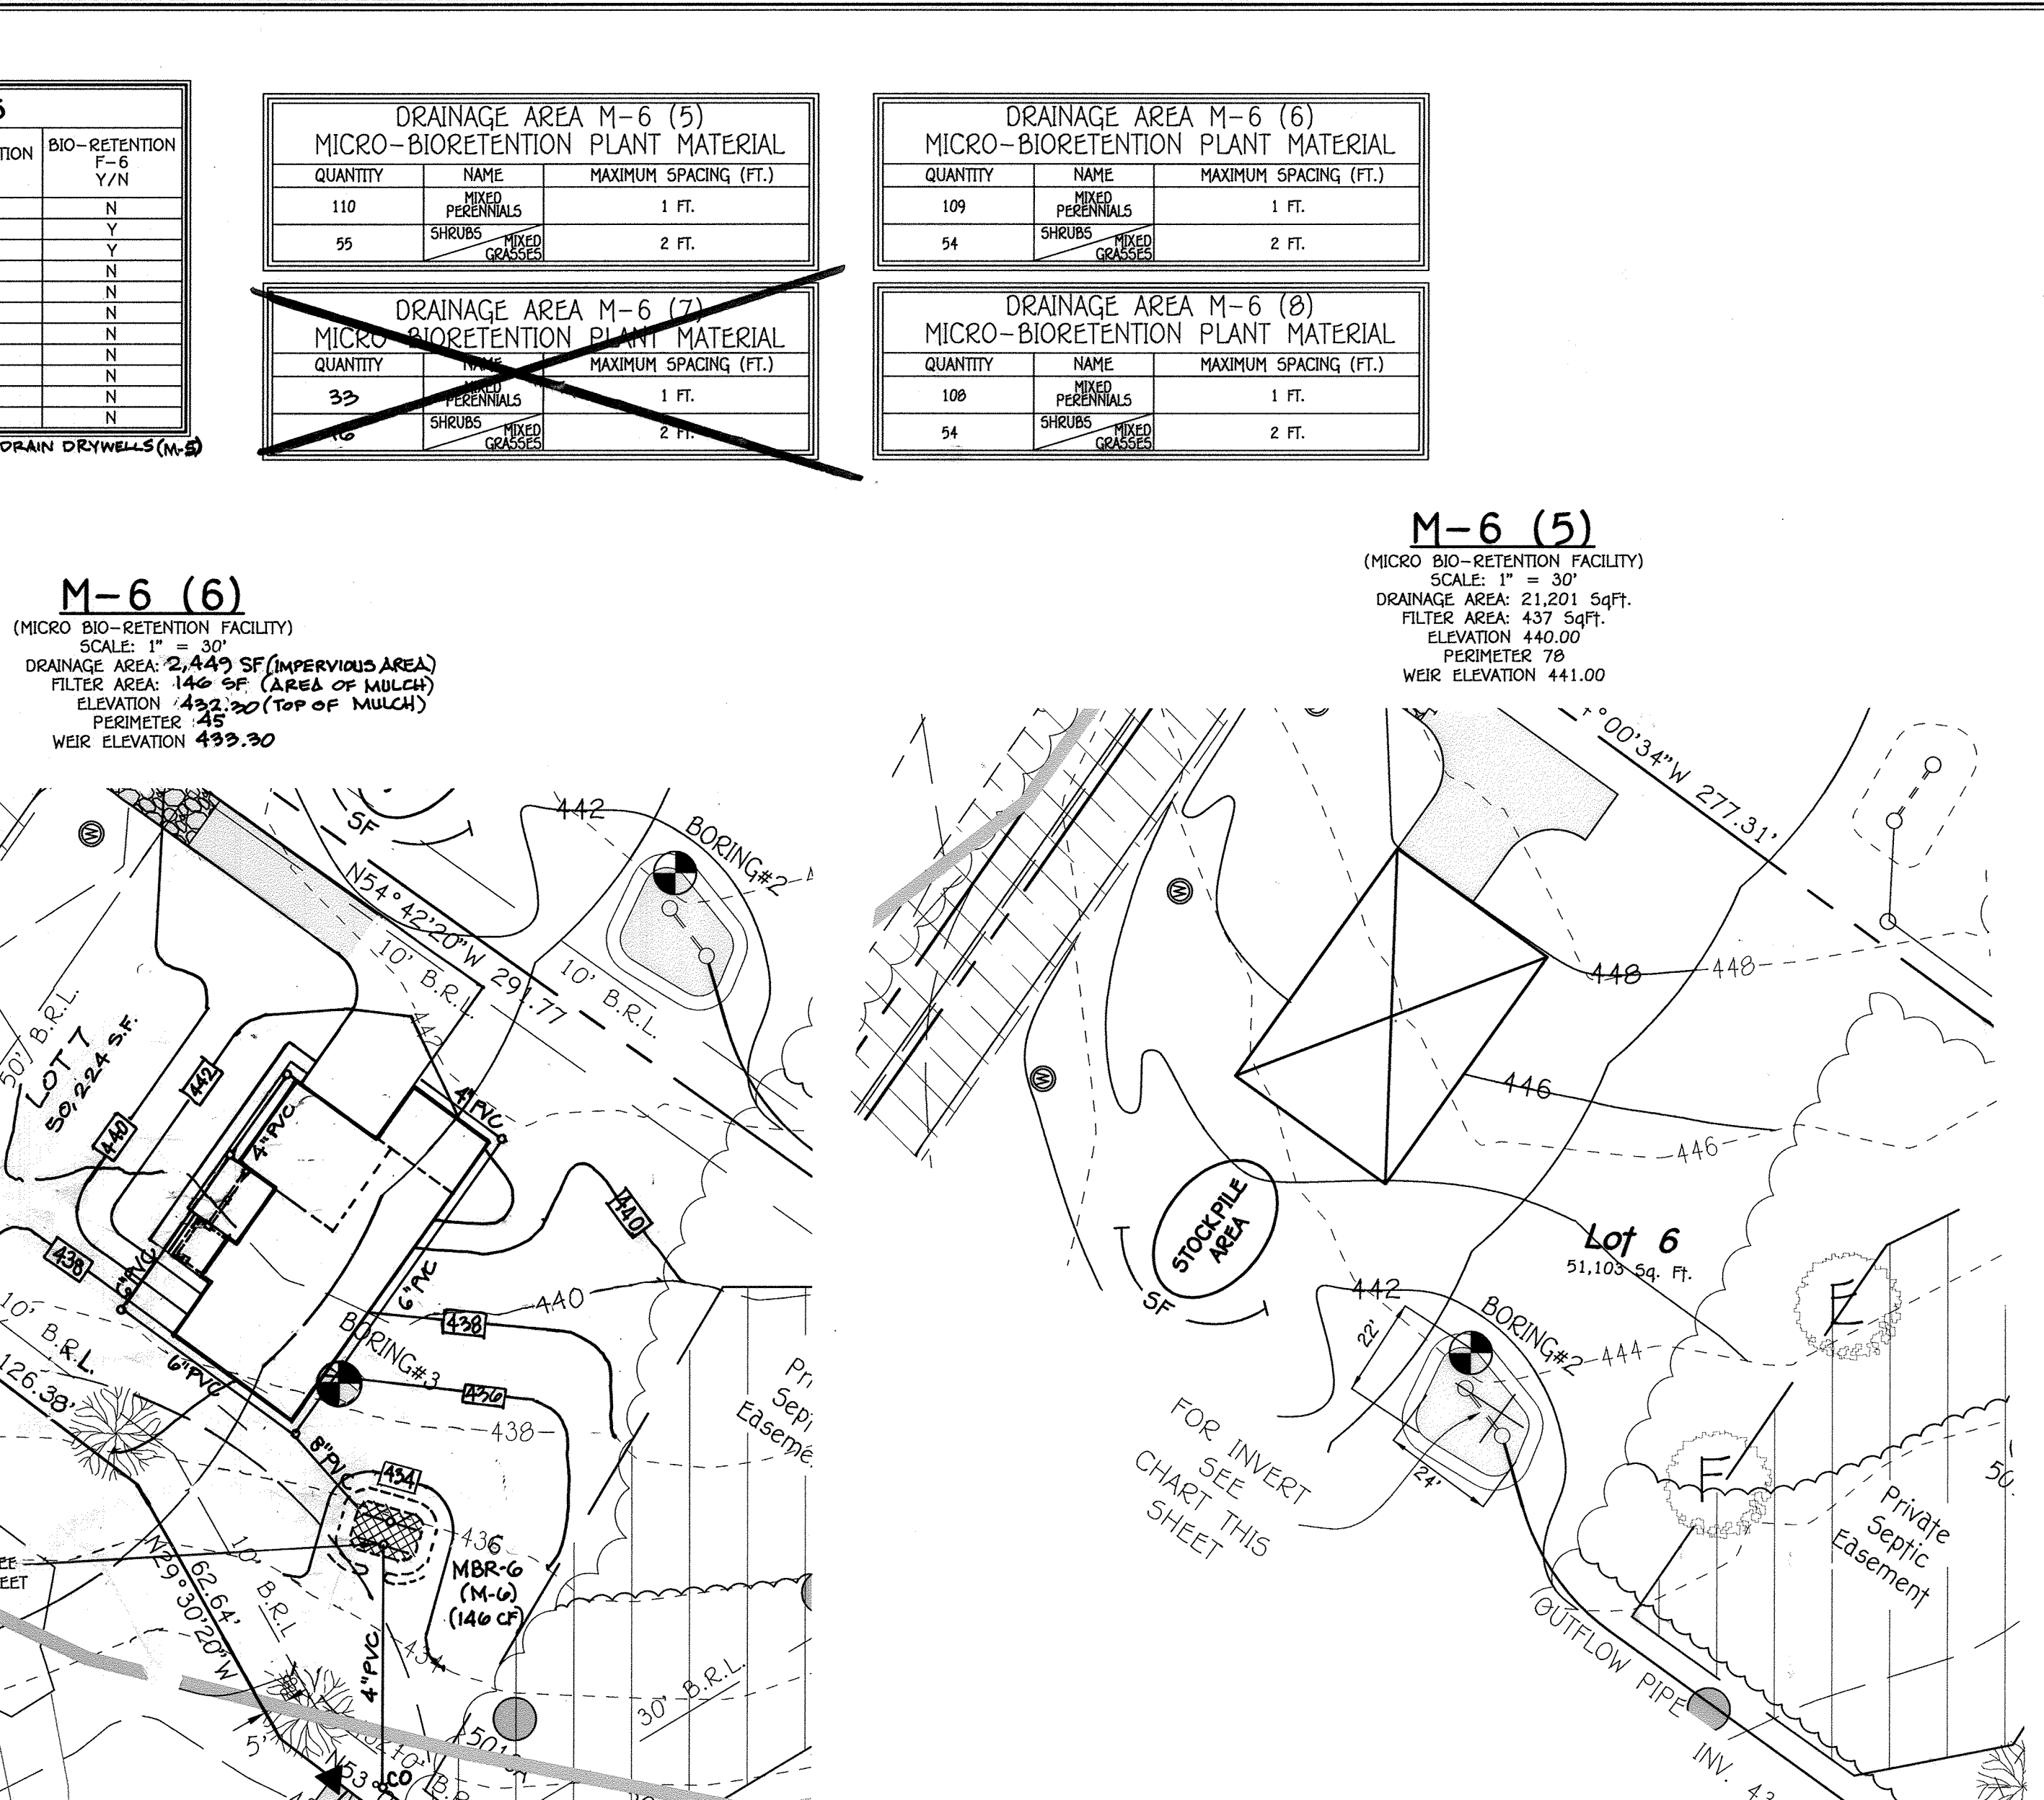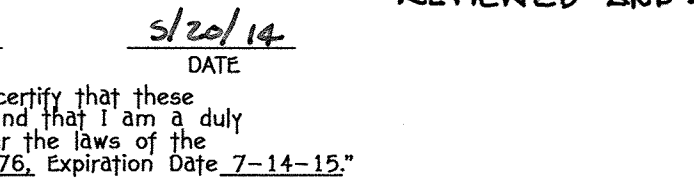


| M-6 (8) (MICRO BIO-RETENTION FACILITY) |             |  |  |
|--|-------------|--|--|
| SCALE:                                 | 1" = 30'    |  |  |
| DRAINAGE AREA:                         | 4,095 SqFt. |  |  |
| FILTER AREA:                           | 344 SqFt.   |  |  |
| ELEVATION:                             | 433.00      |  |  |
| PERIMETER:                             | 77'         |  |  |
| WEIR ELEVATION:                        | 434.00      |  |  |

NOTE: THE LOCATION FOR THE PROPOSED DWELLING ON LOT 7 WITH RESPECT TO THE B.R.L.'S AND LOT LINES WILL BE REVIEWED AND APPROVED AT THE TIME OF THE BUILDING PERMIT.

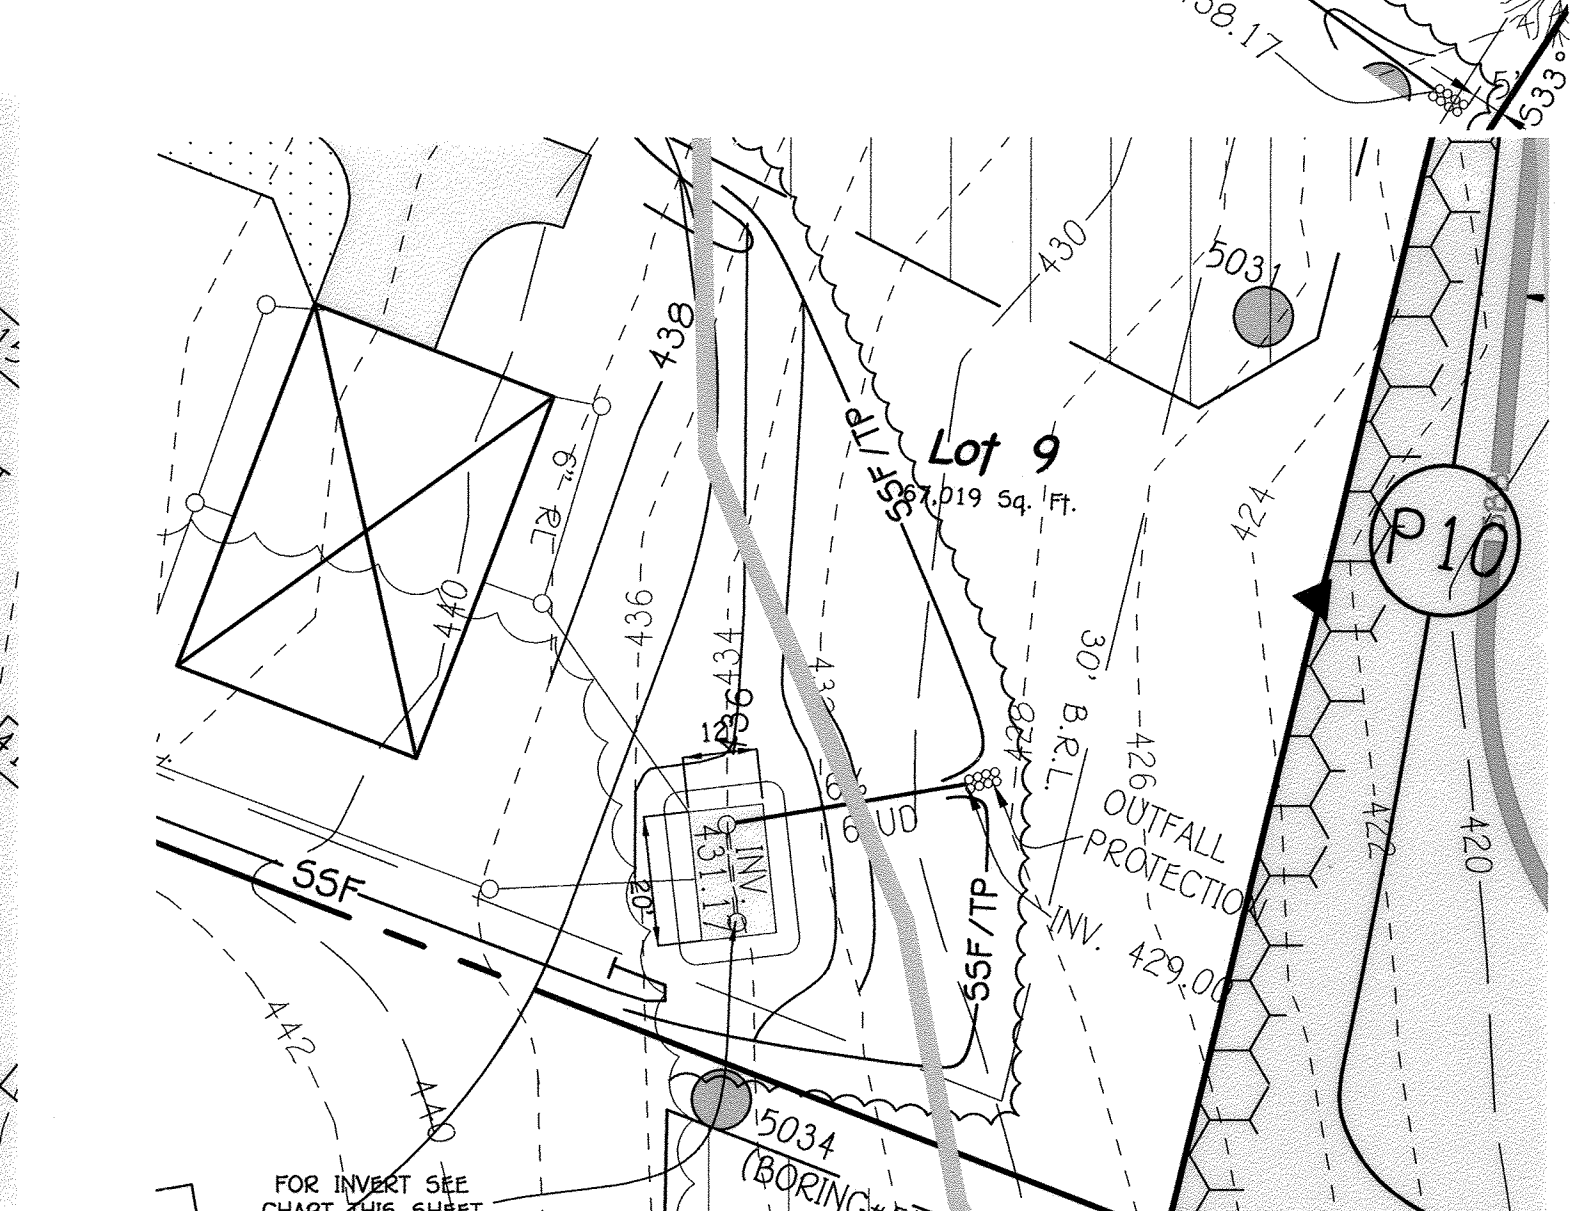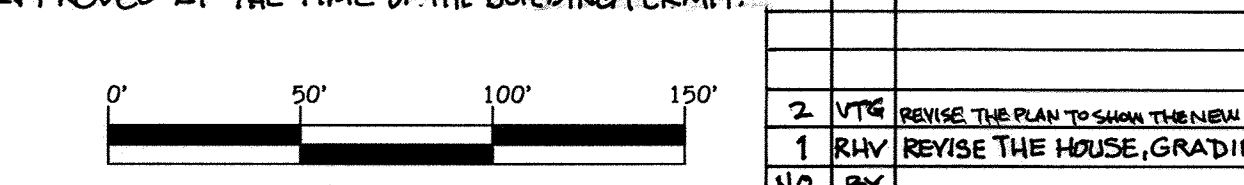

| M-6 (8) (MICRO BIO-RETENTION FACILITY) |             |  |  |
|--|-------------|--|--|
| SCALE:                                 | 1" = 30'    |  |  |
| DRAINAGE AREA:                         | 4,095 SqFt. |  |  |
| FILTER AREA:                           | 344 SqFt.   |  |  |
| ELEVATION:                             | 433.00      |  |  |
| PERIMETER:                             | 77'         |  |  |
| WEIR ELEVATION:                        | 434.00      |  |  |

NOTE: THE LOCATION FOR THE PROPOSED DWELLING ON LOT 7 WITH RESPECT TO THE B.R.L.'S AND LOT LINES WILL BE REVIEWED AND APPROVED AT THE TIME OF THE BUILDING PERMIT.

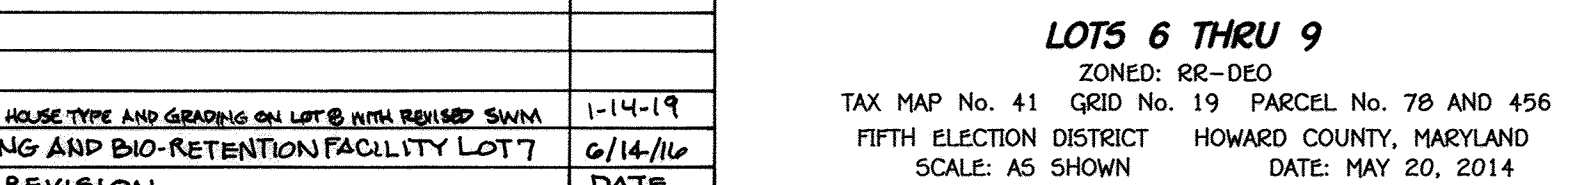

**STORMWATER MANAGEMENT NOTES & DETAILS**  
**FULTON MANOR VALLEY PART TWO**  
LOTS 6 THRU 9  
ZONED: RR-DEO  
TAX MAP No. 41 DISTRICT No. 19 PARCEL No. 78 AND 456  
FIFTH ELECTION DISTRICT HOWARD COUNTY, MARYLAND  
SCALE: AS SHOWN DATE: MAY 20, 2014  
SHEET 7 OF 7

| NO. | BY  | REVISION   | DATE    |
|-----|-----|--|---------|
| 2   | VTC | REVISE THE PLAN TO SHOW THE NEW HOUSE TYPE AND GRADING ON LOT 6 WITH REBUILT SWM | 1-14-19 |
| 1   | RHV | REVISE THE HOUSE, GRADING AND BIO-RETENTION FACILITY LOT 7                       | 6/14/16 |