| Densi | ty Exchange Tabulation |
|---|---|
| | Initial Exchange |
| Receiving Parcel Information | Property Of: BV Business Trust Tax Map No. 29, Grid 11, Parcel No. 49 Liber 11276, Folio 36 Walnut Creek Subdivision (5P-06-007) |
| Total Parcel Acreage | Lot 6 (38.250) Acres |
| Preservation Parcel Acreage | N/A |
| Preservation Acreage wailable For Sending Density | 34.000 Acres (38.250 Ac 4.25 Ac.) (1 Unit Retained For Lot 6) |
| CEO Units Created (1:4.25) | 34.000 Ac. * 1 CEO Unit/4.25 Ac. = 9.00 |
| CEO Units Sent (1:4.25) | 7 CEO Units |
| Acreage Of Preservation Easement Remaining To Be Sent | 4.250 Acres (34.000 Ac (7 CEO x 4.25 Ac./CEO)) |

| | Property L | | | Minimum Lo | ot Size Tabul | ațion | |
|------|----------------------|---------------|--|--|------------------|---------------------|--|
| LINE | Line Tabl Bearing | e LENGTH | Lot No. | Gross Ared | Pipestem Area | Minimum Lot Size | |
| PL1 | 574°30'53"W | 409.44' | 1 | 3.139 Ac.± | 0.134 Ac.± | 3.005 Ac. | |
| PL2 | NØ9°52'13"W | 60.18' | 2 | 3.206 Ac.± | 0,202 Ac.± | 3,004 Ac. | |
| PL3 | N60°30'13"W | 279.74 | 3 | 3.237 Ac.± | 0.237 Ac.± | 3.000 Ac. | |
| PL4 | 540°57'15"W | 53.69' | 4 | 3.205 Ac.± | 0.193 Ac.± | 3.092 Ac. | |
| PL5 | 573°30'39"W | 286.49' | 5 | 4.075 Ac.± | 0.143 Ac.± | 3.932 Ac. | |
| L6 | R=138.00' | L=150.17' | | | | | |
| PL7 | 509°47'11"W | 12.25' | 6 | 38.250 Ac.± | 0.218 Ac.± | 38.032 Ac | |
| PLØ | N09°47'11"E | 12.25' | The state of the s | | | | |
| PL9 | R=142.00' | L=162.69' | | | | | |
| L10 | N73°30'39"E | 287.26' | | | | | |
| 2L11 | N40°57'15"E | 59.84 | | the state of the s | | Same Same State | |
| - | | | | | | | |

LEGEND

EXISTING 10' CONTOUR

-492--- EXISTING 2' CONTOURS

-482 PROPOSED CONTOUR

LIMITS OF DISTURBANCE

EXISTING TREELINE

PROPOSED TREELINE

SPOT ELEVATION

PROPOSED PAVING

STABILIZES CONSTRUCTION ENTRANCE

PROPOSED MICRO BIORETENTION (M-6)

NON-ROOFTOP DISCONNECTION (N-2)

15% TO 24.9% STEEP SLOPES

25% AND GREATER STEEP SLOPES

AND BIORETENTION FACILITIES

DRAINAGE AREA FOR STORM DRAIN

DRAINAGE AREA FOR MICRO-BIORETENTION

FOREST CONSERVATION EASEMENT (RETENTION)

00 YEAR PUBLIC FLOODPLAIN, DRAINAGE AND

PROPOSED FOREST CONSERVATION EASEMENT SIGNAGE

GLB2 SOILS LINES AND TYPE

ROOFLEADERS

TREE PROTECTION

WETLAND AREA

FLOODPLAIN ELEVATION

STREAM BANK BUFFER

BORING (PERC) TEST HOLE

– — — — | 25' WETLAND BUFFER

SILT FENCE

EARTH DIKE

SPECIMEN TREE

UNDERDRAIN PIPE

-55F SUPER SILT FENCE

__RL

396.13

L O₅₀₃

—5BB ——

| 1 - 3 | | /// | 111 | | | | | |
|-------|-------------|--------------|------------|------------------------|-----------------------------|---------------------|--|--|
| | 570766.3047 | 1299569.3571 | Total P | arcel Acreage | Lot 6 (30.250) Acres | , | | |
| å | 578700.8530 | 1300939.7935 | - 11 | | | | | |
| | 578700.7124 | 1301001.7934 | | ation Parcel | N/A | | | |
| | 578809.4555 | 1301394.2963 | A | creage | <u> </u> | | | |
| | 578739.0574 | 1300711.4064 | | ration Acreage | 34.000 Acres | | | |
| | 578767.0372 | 1299571.4999 | | e For Sending | (38.250 Ac 4.25 Ac.) | | | |
| | 578843.4922 | 1299737.6977 | | Density | (1 Unit Retained For Lot 6) | | | |
| | 570079.3569 | 1299908.5745 | CEO Ur | | 34.000 Ac. + 1 CEO Uni | +/4 25 Ac - 000 | | |
| | 578886.2249 | 1300065.6544 | Created | (1:4.25) | 37.000 AC. 4 1 CEO 019 | 1/ T.E.) No 0.00 | | |
| | 578829.6458 | 1300377.6152 | CEO Ur | ite | | | | |
| | 578754.9108 | 1300616.6337 | 5em (1 | | 7 CEO Units | | | |
| | 578804.2257 | 1300624.6630 | | | <u> </u> | | | |
| | 578862.9177 | 1301399.9948 | Acreage | e Of ation Easement | 4.250 Acres | | | |
| | 578750.7278 | 1300995.0507 | | ing To Be Sent | (34.000 Ac (7 CEO x | 4.25 Ac./CEO)) | | |
| | 578750.8435 | 1300944.0029 | L CEITIGHT | ing to be delig | <u> </u> | <u> </u> | | |
| - | | | | | | | | |
| = | Property | Line | | Minimum | Lot Size Tabul | ation | | |
| | Line Ta | ble | 1-1- | T - C | Discourse . | Minferior | | |
| _ | <u> </u> | | Lot No. | Gross | Pipestem Ared | Minimum Lot Size | | |
| M | e bearing | LENGTH | 140. | Area | | | | |
| | C740001F091 | 1 100 111 | 191 1 | 3 130 Ac. | 0134 40+ | 3 005 Ac + | | |

| w | M CT OC - DON | 6/7./4 | 11 11 | 3 3.23 | 7 Ac. ± 0 | 1.237 A | c.± 3.000 Ac. | ± |
|-----|---------------|-----------|--------------|--------------------|------------------|---------|--|--|
| L4 | 540°57'15"W | 53.69' | | 4 3.28 | 5 Ac.± (| 0.193 A | c.± 3.092 Ac. | ± |
| 'L5 | 573°30'39"W | 288.49' | | | |).143 A | | |
| L6 | R=138.00' | L=150.17' | | | | | | |
| L7 | 509°47'11"W | 12.25' | | 6 38.2 | 50 Ac.± (| 0.218 A | c.± 38.032 Ac | 2.± |
| LØ | N09°47'11"E | 12.25' | = | | | | | |
| L9 | R=142.00' | L=162.69' | | | | | | |
| L10 | N73°30'39"E | 287.26' | | | | | | |
| L11 | N40°57'15"E | 59.84' | l | | | | and the same of th | i di selah di Cilipia ki ki jangan kepada da Kabapatan s |
| L12 | 500°30'13"E | 278.65' | | | | | | |
| L13 | 509°52'13"E | 58.35' | | 1 | roadway - | INFO | RMATION C | HART |
| L14 | N74°30'53"E | 411.59' | - | | ···· | | ,, | |
| L15 | 574°30'53"W | 413.74 | | 0040 1444 | OL ACCUMONT | TON | OFFICH COREO | SASSMENT LEOTH |
| L16 | N89°52'13"W | 56.53' | | ROAD NAME | CLASSIFICATION I | | DESIGN SPEED | EASEMENT WIDTH |
| L17 | N80°30'13"W | 277.56' | - <u>-</u> - | 107 (C) (A) (14) | 1167 111 001 | 1401 | 45 454 | |
| L18 | 540°57'15"W | 65.99' | | DRIVEWAY 'A' | USE-IN-COM | IMON | 15 MPH | 36' |
| | | | | | | | | |

| | STORMWATER MANAGEMENT PRACTICES | | | | | | | | |
|---------|---------------------------------|---|---|---|--|--|--|--|--|
| LOT No. | ADDRESS | ROOFTOP DISCONENCTION N-1 (NUMBER) | NON-ROOFTOP DISCONENCTION N-2 (NUMBER) | MICRO BIO-RETENTION M-6 (NUMBER) | | | | | |
| 1 | 15105 DEVLIN DRIVE | | | M-6 (1) | | | | | |
| 2 | 15111 DEVLIN DRIVE | 4 | 1 | M-6 (2) | | | | | |
| 3 | 15117 DEVLIN DRIVE | 5 | 1 | M-6 (3) | | | | | |
| 4 | 15135 DEVLIN DRIVE | | 0 | M-6 (4) | | | | | |
| 5 | 15141 DEVLIN DRIVE | | <u> </u> | M-6 (5) | | | | | |
| 6 | 15125 DEVLIN DRIVE | 8 | | | | | | | |
| | COMMON DRIVEWAY | | 3 | M-6 (6) | | | | | |

Private Use-In-Common Driveway Access Easement Line Table

REVISIONS

DESCRIPTION

2 3/15/24 REVISE HOUSE TYPE & GRADING LOT 3

7/18/23 REVISE LOT 3 HOUSE TYPE AND GRADING

SITE ANALYSIS DATA CHART

AREA OF PROPOSED ROAD R\W = 0.000 Ac±
AREA OF PROPOSED BUILDABLE LOTS = 55.192 Ac±
AREA OF PROPOSED BUILDABLE PRESERVATION PARCELS = 0.000 Ac±

AREA OF PROPOSED NON-BUILDABLE PRESERVATION PARCELS = 0.000 Ac+

CATEGORY

LANDSCAPE TYPE

SHADE TREES

SUBSTITUTION)

SHADE TREES

SHADE TREES

SHRUB5

EVERGREEN TREES

LINEAR FEET OF PERIMETER

CREDIT FOR EXISTING VEGETATION

NUMBER OF PLANTS REQUIRED

NUMBER OF PLANTS PROVIDED

SMALL/MEDIUM DECIDUOUS TREES (2:1

SMALL/MEDIUM DECIDUOUS TREES (2:1 5UB.)

. AREA TABULATION: A. TOTAL TRACT AREA = 55.196 Ac±

. NUMBER OF LOTS/PARCELS PROPOSED = 6

. AREA OF FLOODPLAIN = 5.48 Ac+

BUILDABLE LOTS = 6
BUILDABLE PRESERVATION PARCELS = 0

NON-BUILDABLE PRESERVATION PARCELS = 0

1. AREA OF DENSITY SENDING (55.192 Ac - 25.5 Ac) = 29.692 Ac

THIS DEVELOP

FOR SOIL REPOS

CONTROL BY TH

CONSTRUCTION

5/13/24 REVISE HOUSE TYPE, SWM, & GRADING LOT 1

SUPPLEMENTAL PLAN TOPOGRAPHY, STORMWATER MANAGEMENT AND PERIMETER LANDSCAPING


CATTAIL OVERLOOK

LOTS 1 THRU 6

ZONING: RR-DEO

TAX MAP No. 21 GRID No. 20 & 21 PARCEL Nos. 24 & 84

FOURTH ELECTION DISTRICT HOWARD COUNTY, MARYLAND

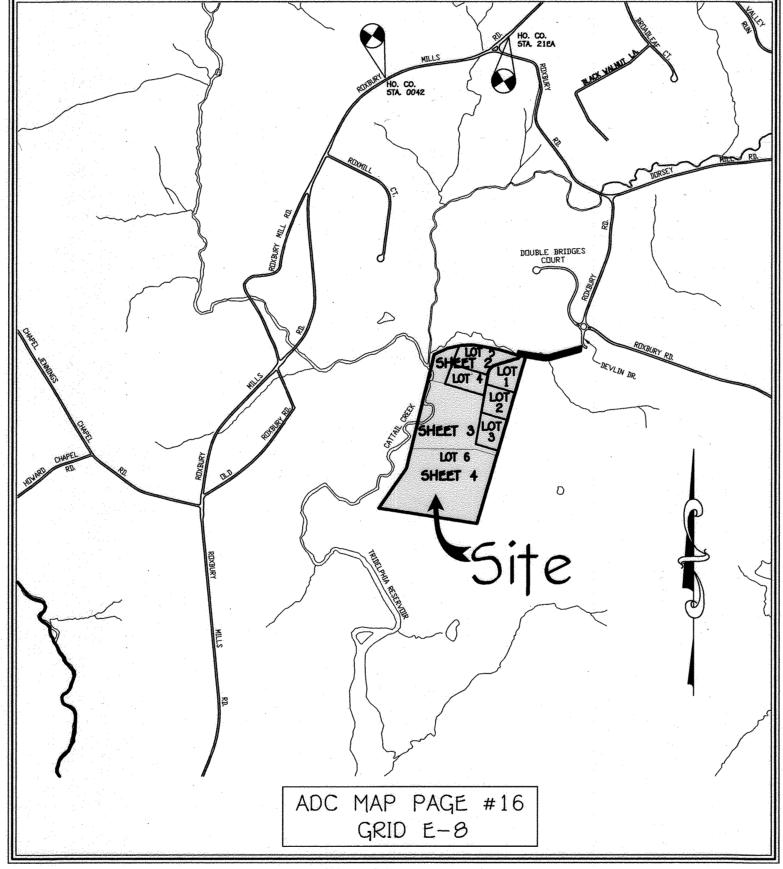



5CALE: 1" = 1200"

SCHEDULE A - PERIMETER LANDSCAPE EDGE

ADJACENT TO

ERIMETER PROPERTIE

1460 LF

1460 LF

O LF REMAINING

ADJACENT TO

rimeter proper

1082 LF

1082 LF

O LF REMAINING


P-4

ADJACENT TO

603 LF

603 LF

O LF REMAINING

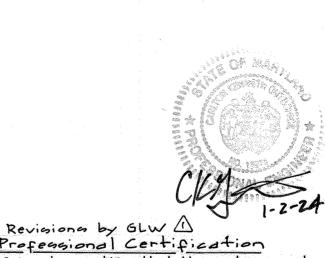

Professional Certification I hereby certify that these documents were prepared or approved by me, and that I am a duly licensed professional engineer under the laws of the state of Maryland. License No. 12975 Expiration Date: May 26, 2024

TRASH PAD | TOTAL

16 LF

FISHER, COLLINS & CARTER, INC. ELLICOTT CITY, MARYLAND 21042

CHIEF, DEVELOPMENT ENGINEERING DIVISION

APPROVED: DEPARTMENT OF PLANNING AND ZONING

CHIEF, DIVISION OF LAND DEVELOPMENT

8-28-14 Chil Elich 8-23-14

I/We certify that the landscaping shown on this plan will be done according to Section 16.124 of the Howard County Code and the Howard County Landscape Manual. I/We further certify that upon completion a letter of notice of Landscape Installation accompanied by an executed one year quarantee of plant materials will be submitted to the Department of Planning and Zoning.

Developer's / Builder's Certificate


P-1

ADJACENT TO

ERIMETER PROPERTIE

701 LF

701'/60' = 11.7 OR 1

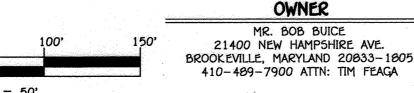

P-2

2164 LF

2164 LF

O LF REMAINING

EX. 24" SHINGLE OAK TREE TO REMAIN CREDITED TO P-8.

ADJACENT TO

ERIMETER PROPERTI

P-3

1241 LF

1241 LF

O LF REMAINING

EX. 36" NORTHERN RED OAK TREE & EX. TRIPLE RED MAPLE TREE TO REMAIN CREDITED TO P-1.

*** 3 EXISTING SHADE TREES HAVE BEEN CREDITED TOWARD 3 OF THE 19 REQUIRED SHADE TREES.

ADJACENT TO

DEVELOPER HERITAGE LAND DEVELOPMENT 15950 NORTH AVENUE P.O. BOX 482 LISBON, MARYLAND 21765

410-489-7900

P-7

1ETER PROPERTIES

50 LF

O LF REMAINING

ADJACENT TO

ERIMETER PROPERTIE

795 LF

**1 & 395 LF

400 LF REMAININ

 $(400^{\circ}/60^{\circ} = 6.7 \text{ OR } 7$

ADJACENT TO

documents were prepared by me, and that I am a duly Licensed Professional Engineer under the laws of the State of Maryland, License No. 38386, Expiration Date 1-12-16.

This Area Designates A Private Sewerage Easement Of A Minimum Of 10,000 Square Feet As Required B The Maryland State Department Of The Environment For Individual Sewage Disposal. Improvements Of Any Nature In This Area Are Restricted Until Public Sewerage Is Available. These Easements Shall Become Null And Void Upon Connection To A Public Sewerage System. The County Health Officer Shall Have The Authority To Grant Adjustments To The Private Sewerage Easement. Recordation Of A Modified Easement Shall Not Be Necessary. The Lots Shown Hereon Comply With The Minimum Ownership Width And Lot Area As Required By The Maryland State Department Of

Subject Property Zoned RC-DEO Per The 10/06/13 Comprehensive Zoning Plan. Coordinates Based On Nad '83, Maryland Coordinate System As Projected By Howard County Geodetic Control Stations No. 21EA And No. 0042.

Sta. 21EA N 582715.167 (feet), E 1300496.024 (feet)

5ta. 0042 N 582213.383 (feet), E 1298954.905 (feet) This Plat Is Based On Field Run Monumented Boundary Survey Performed On Or About October, 2013, By Fisher,

Collins And Carter, Inc. B.R.L. Denotes Building Restriction Line.

• Denotes Iron Pin Set Capped "F.C.C. 105" Denotes Iron Pipe Or Iron Bar Found.

O Denotes Angular Change In Bearing Of Boundary Or Rights-Of-Way. Denotes Concrete Monument Set With Aluminum Plate "F.C.C. 106".

■ Denotes Concrete Monument Or Stone Found. of Flag Or Pipestern And The Road Right-Of-Way Line And Not Onto The Flag Or Pipestern Driveway. Driveway(s) Shall Be Provided Prior To Issuance Of A Residential Occupancy Permit For Any New Dwelling To Insure

Safe Access For Fire And Emergency Vehicles Per The Following Minimum Requirements: a) Width - 12 Feet (16 Feet Serving More Than One Residence):

b) Surface - Six (6") Inches Of Compacted Crusher Run Base With Tar And Chip Coating. (1-1/2" Minimum): c) Geometry - Maximum 15% Grade, Maximum 10% Grade Change And 45-Foot Turning Radius:

d) Structures (Culverts/Bridges) - Capable Of Supporting 25 Gross Tons (1-125-Loading): e) Drainage Elements - Capable Of Safety Passing 100 Year Flood With No More Than 1 Foot Depth Over

f) Structure Clearances - Minimum 12 Feet

g) Maintenance - Sufficient To Ensure All Weather Use 13. All Lot Areas Are More Or Less (+ or -).

14. Distances Shown Are Based On Surface Measurement And Not Reduced To NAD' 83 Grid Measurement 15. No Grading, Removal Of Vegetative Cover Or Trees, Or Placement Of New Structures Is Permitted Within The Limits Of Wetlands, Stream(s), Or Their Buffers And Forest Conservation Easement Areas.

16. Previous Department Of Planning And Zoning File Numbers: VP-81-101, F-83-51, ECP-14-041, WP-14-108. 17. Articles Of Incorporation For The Cattail Overlook Homeowner's Association, Inc. Will Be Filed With The Maryland State Department Of Assessments And Taxation Prior To Submission Of The Original Record Plat For Signature. 19. This Plan Is In Compliance With The Amended Fifth Edition Of The Subdivision And Land Development Regulations.

Time Of Submission Of The Site Development Plan, Waiver Petition Application, Or Building/ Grading Permit. 19. No Cemeteries Exists On This Site Based On A By Visual Site Visit And Based On A Examination Of The Howard 20. Because The Property Owner Had Applied For A Soil Percolation Test Application and Plan To The Health Departmen

Development Or Construction On These Lots Must Comply With Setback And Buffer Regulations in Effect At The

Prior To July 1, 2012 Approval By The Planning Board Is Not Required. 21. There Are No Existing Dwellings Or Structures Located On Lots 1 Thru 6. 22. Stormwater Management Will Be In Accordance With MDE Storm Water Design Manual, Volumes 1 & II, Revised

2009. Use Of Six (6) Micro Bio-Retention Facilities And Eight (8) Areas Of Non-Rooftop Runoff And Seventeen (17) Rooftop Disconnections Are Proposed For This Subdivision 23. The Lots Shown Hereon Comply With The Minimum Ownership Width And Lot Area As Required By The Maryland State Department Of The Environment.

24. No Noise Study Is Required For This Project. 25. Private Well And Septic Shall Be Utilized Within This Development

26. This Property Is Located Outside Of The Metropolitan District. 27. The Traffic Study Dated November, 2013 Was Prepared By Mars Group And Approved on January 8, 2014.

28. Speed Study Dated November, 2013 Was Prepared By Mars Group Ad Approved on January 8, 2014. 29. The Forest Stand Delineation And Wetland Delineation Report For This Project, Dated December 17, 2013 Was

Prepared By Eco-Science Professionals, Inc. And Approved on January 14, 2014. 30. The Forest Conservation Requirements Per Section 16.1200 Of The Howard County Code And The Forest Conservation Manual For This Subdivision Will Be Fulfilled By On-Site Retention Of 19.14 Acres Of Forest Which Meets The Breakeven Point Of 19.14 Acres Of Required Retention. There is No Surety For Forest Retention.

31. The Floodplain Study For This Project Was Prepared By Fisher, Collins & Carrer, Inc. In December, 2013 Approved 32. The Private Use-In-Common Driveway Access Easement Maintenance Agreement For The Use And Benefit C

Thru 6 Is Recorded Simultaneously With This Plat. 33. This Plan Has Been Prepared In Accordance With The Provisions Of Section 16.124 Of The Howard County Code And The Landscape Manual. In Accordance With Section 16.124 Of The Howard County Code And The Landscape Manual A Landscape Surety For Perimeter Landscape And Trash Pad Screening Requirements For 7 Shade Trees And 10 Evergreen Trees, And 6 Shrubs in The Amount Of (\$4,980.00) Shall Be Provided With The DPW Developers Agreement

34. A Pre-Submission Community Meeting Was Held For This Project On September 19, 2013. 35. All Wells Shall Be Drilled Prior To Final Plat Recordation. It is The Developers Responsibility To Schedule The Well Drilling Prior To Final Plat Submission. It Will Not Be Considered "Governmental Delay" If The Well Drilling Holds Up

Health Department Signature Of The Record Plat. 36. The Forest Conservation Easements Shown On This Plat Have Been Established To Fulfill The Requirements Of Section 16.1200 Of The Howard County Code And The Forest Conservation Act. No Clearing, Grading Or Construction Is Permitted Within The Forest Conservation Easement; However, Forest Management Practices As Defined in The Deed C Forest Conservation Are Allowed.

37. Should Disturbance Occur In The Forest Conservation Easement Areas Or After Construction, Civil Penalties Of

38. The Development Proposal For This Property Is A Major Subdivision Within The RC-DEO Zoning District. However The Property Owner Had Applied For A Soil Percolation Test And Received Approval For A Percolation Certification Plan By The Health Officer On April 19, 2005 Which Is Prior To July 1, 2012 And Is Therefore Grandfathered To 58-236. A Preliminary Plan Must Be Submitted Within 18 Months From July 1, 2012 Or January 1, 2014 And Approved No Late Than October 1, 2016.

39. Lot 6 is Encumbered With A Preservation Easement Agreement With Howard County, Maryland And The Cattail Overlool Homeowners Association, Inc. This Agreement Outlines The Maintenance Responsibilities Of The Owner, Prohibits Subdivision Of The Parcel, And Enumerates The Uses Permitted On The Property. 40. Section 16.121 Of The Subdivision Regulations Require A \$9,000.00 Per Lot Fee-In-Lieu Of Open Space For

Non-Cluster Subdivisions in The RC Zoning District. The Developer Will Pay The Fee-In-Lieu. 41. Density Sending Parcel Tabulation: See Density Sending Tabulation This Sheet.

42. An Executed M.I.H.U. Agreement And Covenants With The Howard County Housing Department Will Be Recorded Simultaneously With The Record Plat. 43. Soils Information Taken From NCRS Web Site Survey.

44. Topography Shown Is From Howard County GIS And Supplemented With Field Run Topo Dated November, 2013 By Fisher, Collins & Carter, Inc. 45. All Existing Well And Septic Fields Within 100 Feet Of The Subject Property Boundary Have Been Shown.

46. Any Changes To A Private Sewerage Area Shall Require A Revised Percolation Certification Plan. 47. There Are Steep Slopes Of 25% Or Greater On-Site. 48. An Address Range Sign Shall Be Provided For Lots 1 Thru 6 At The Intersection Of Devlin Drive And The Use-in-Common Driveway For Lots 1 Thru 6 The Private Range Of The Address Signs Shall Be Fabricated And

Installed By Howard County Traffic Division At 410-313-2430 For Details And Cost Estimate. There Shall Be An Address Sign At The Point Where Each Individual Driveway Intersects With The Use-In-Common Driveway. 49. All Sign Posts Used For Traffic Control Signs Installed In The County Right-Of-Way Shall Be Mounted On A 2"

Galvanized Steel, Perforated, Square Tube Post (14 Gauge) Inserted Into a 2-1/2" Galvanized Steel, Perforated, Square Tube Sleeve (12 Gauge) 3' Long. A Galvanized Steel Pole Cap Shall Be Mounted On Top Of Each Post. 50. The Project Is In Conformance With The Latest Howard County Standards Unless Waivers Have Been Approved. 51. This Resubdivision Plan Is Located In The Designated Tier Iv Growth Area Of Howard County, Per The Planhoward

2030 Tier Map And Would Be Subject To The State's 5B-236, But Is Considered Grandfathered To 5B-236 To Allow This Major Subdivision Because The Property Owner Had Applied For A Soil Percolation Test Application And A Percolation Test Plan To The Howard County Health Department Prior To July 1, 2012.

52. All Construction Shall Be In Accordance With The Latest Standards And Specifications Of Howard County Plus MSHA Standards And Specifications If Applicable. 53. The Contractor Shall Notify The Department Of Public Works/Bureau Of Engineering/Construction Inspection Division At

(410) 313-1880 At Least Five (5) Working Days Prior To The Start Of Work. 54. The Contractor Shall Notify "Miss Utility" At 1-800-257-7777 At Least 48 Hours Prior To Any Excavation Work Being

55. Traffic Control Devices, Markings And Signing Shall Be In Accordance With The Latest Edition Of The Manual Of Uniform Traffic Control Devices (MUTCD). All Street And Regulatory Signs Shall Be In Place Prior To The Placement Of Any Asphalt

56. Existing Utilities Are Based On Existing Road Plans On File With Meriwether Farm (F-08-139) and field locations as part of the topographic survey.

57. The Homeowners Association Covenants And Restrictions Are Recorded Simultaneously With This Final Plat In The Land Records Office Of Howard County, Maryland 50. This Plan is Subject To WP-14-100, Approved On April 7, 2014 Waiving Section 16.120(b)(4)(iii)(b) Prohibiting

Floodplains, Wetlands, Streams, Their Buffers And Forest Conservation On Lots Less Than 10 Acres So As To Allow An Area Of FLoodplain. A Perennial Stream An The 100' Stream Bank Buffer On Lots 1 and 5 And Within The Pipestern Areas For Lots 1 to 6 And Section 16.120(b)(6)(vi) Requiring A 10' Setback From The Project Boundary For Shared Driveways. Approval is Subject To The Following Conditions:

(1) A 35' Environmental Building Restriction Line on Lots 1 and 5 Shall Be Dimensioned From The Floodplain And/Or 100' Stream Bank Buffer (From Whichever Extends Farthest On The Lot). (2) Maryland Department Of The Environment Permts Shall Be Obtained For Disturbance in The Floodplain, 100'

Stream Bank Buffer And Perennial Stream (As Applicable) For The Construction Of The Shared Driveway. A Notation Shall Be Added To The Plat Referencing The Permit Number(s) And Date Of Application. (3) A Reduction in The 10' Setback From The Property Boundary For The Location Of The Shared Driveway Is

Approved. The Driveway May Be Shifted Southward Within The Pipestern Area Of The Lots To The Extent Necessary To Limit Of Disturbance Of The Northern Environmental Features Located Within The Pipestern Areas. Existing Vegetation And Planting Of Shade Trees On Both Sides Of The Shared Driveway Shall Fulfill Required Screening Of The Driveway From The Property Boundaries.

59. This Plan is Subject To Design Manual Waiver, Approved On March 27, 2014 Waiving Design Manual, Volume I, Section 2.6.8 Which Requires A Public Access Place Be Provided If A Shared Residential Driveway Crosses A 100-Year Floodplain Which Would Allow A Shared Use-In-Common Driveway To Be Constructed. Approval is Subject To The Reconstruction Of The Culvert To Meet Current Howard County Standards. The Reconstruction Shall Include Headwalls, Replacement Of The Existing Culvert, And Bringing The Road Up So That It Would Meet The 1' Freeboard Requirement To The Edge Of Pavement Of The Driveway. The Driveway And Culvert Reconstruction Shall Be Bonded With The Supplemental Plan From The Public Road To Where It Meets The Existing Driveway On The Far Side Of The Crossing. 60. Maryland Department Of The Environment Permits Are Being Applied For

12/27/2023 Revise sheet index for Lot 4 house, grading & SWM to be built

Title Sheet


Cattail Overlook


Lots 1 Thru 6 (A Resubdivision Of Lot 2 Buice Property - Plat Nos. 5426 - 5429) And (A Resubdivision of


Meriwether Farm Section One Non-Buildable Parcel 'E' Plat Nos. 21339 - 21344) ZONED: RC-DEO TAX MAP: 21 PARCELS: 24 & 84 GRIDS: 20 & 21

FOURTH ELECTION DISTRICT - HOWARD COUNTY, MARYLAND SCALE: 1"=100' DATE: JULY, 2014 SHEET 1 OF 8

F-14-072

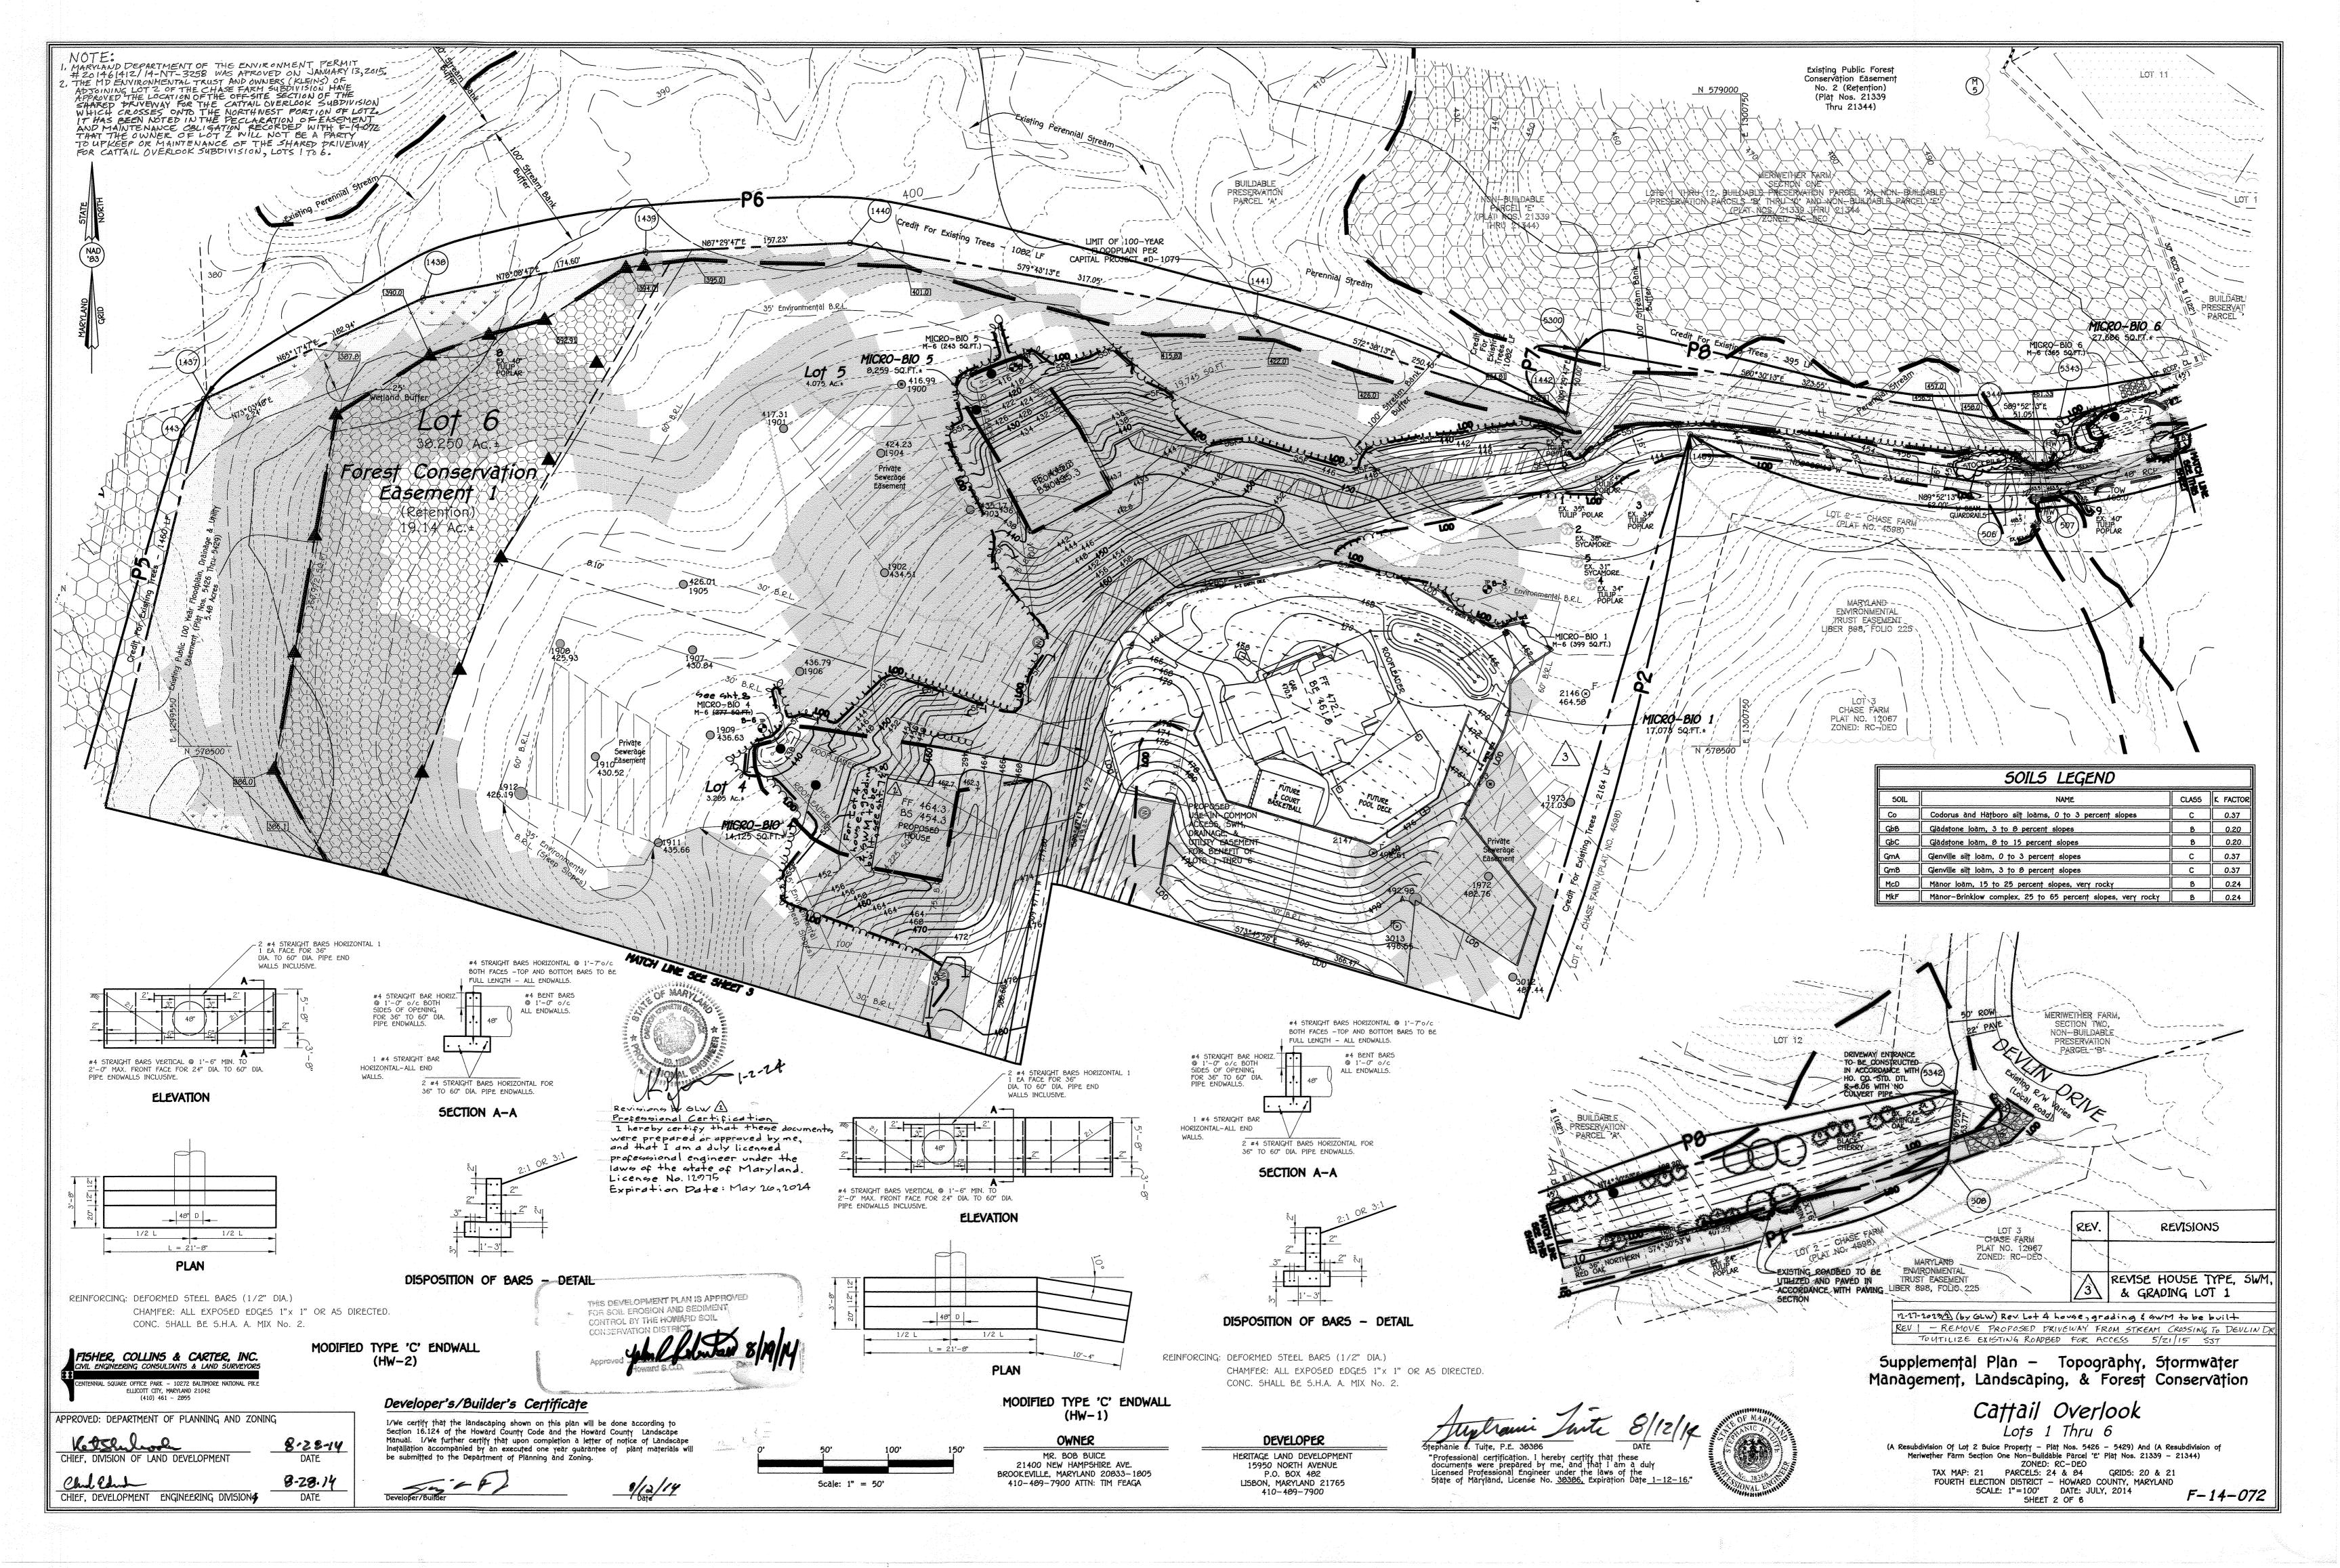

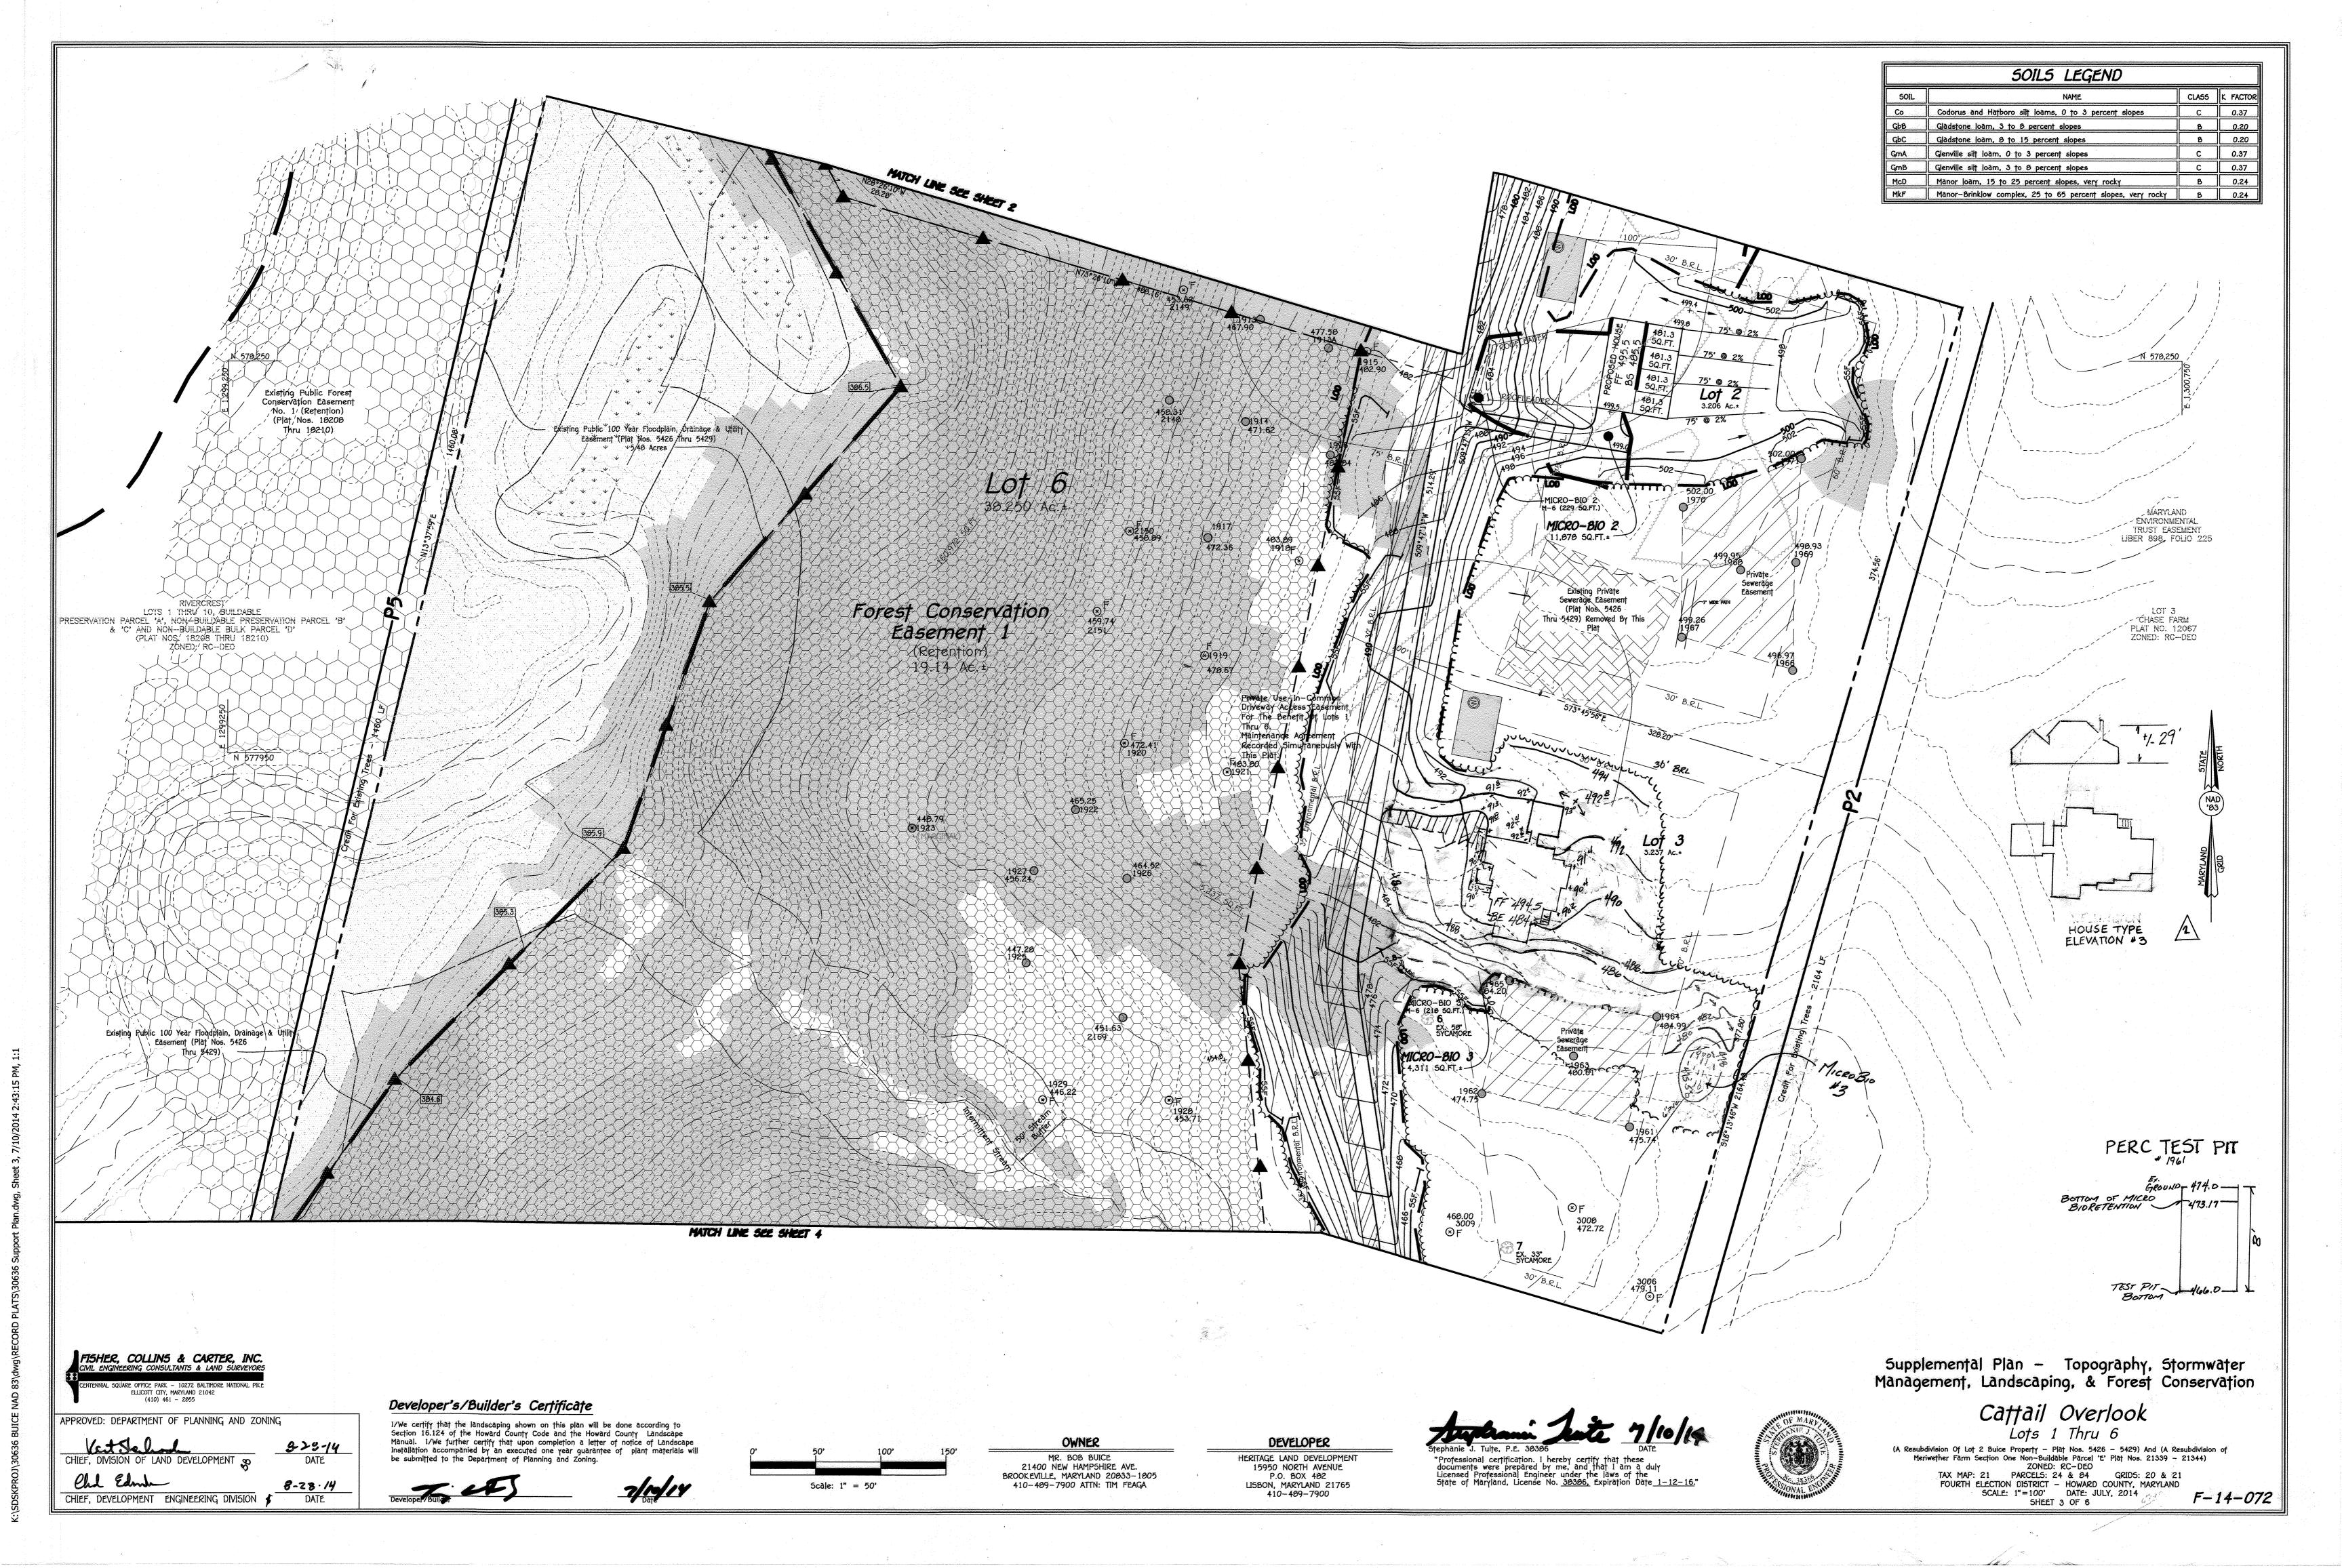

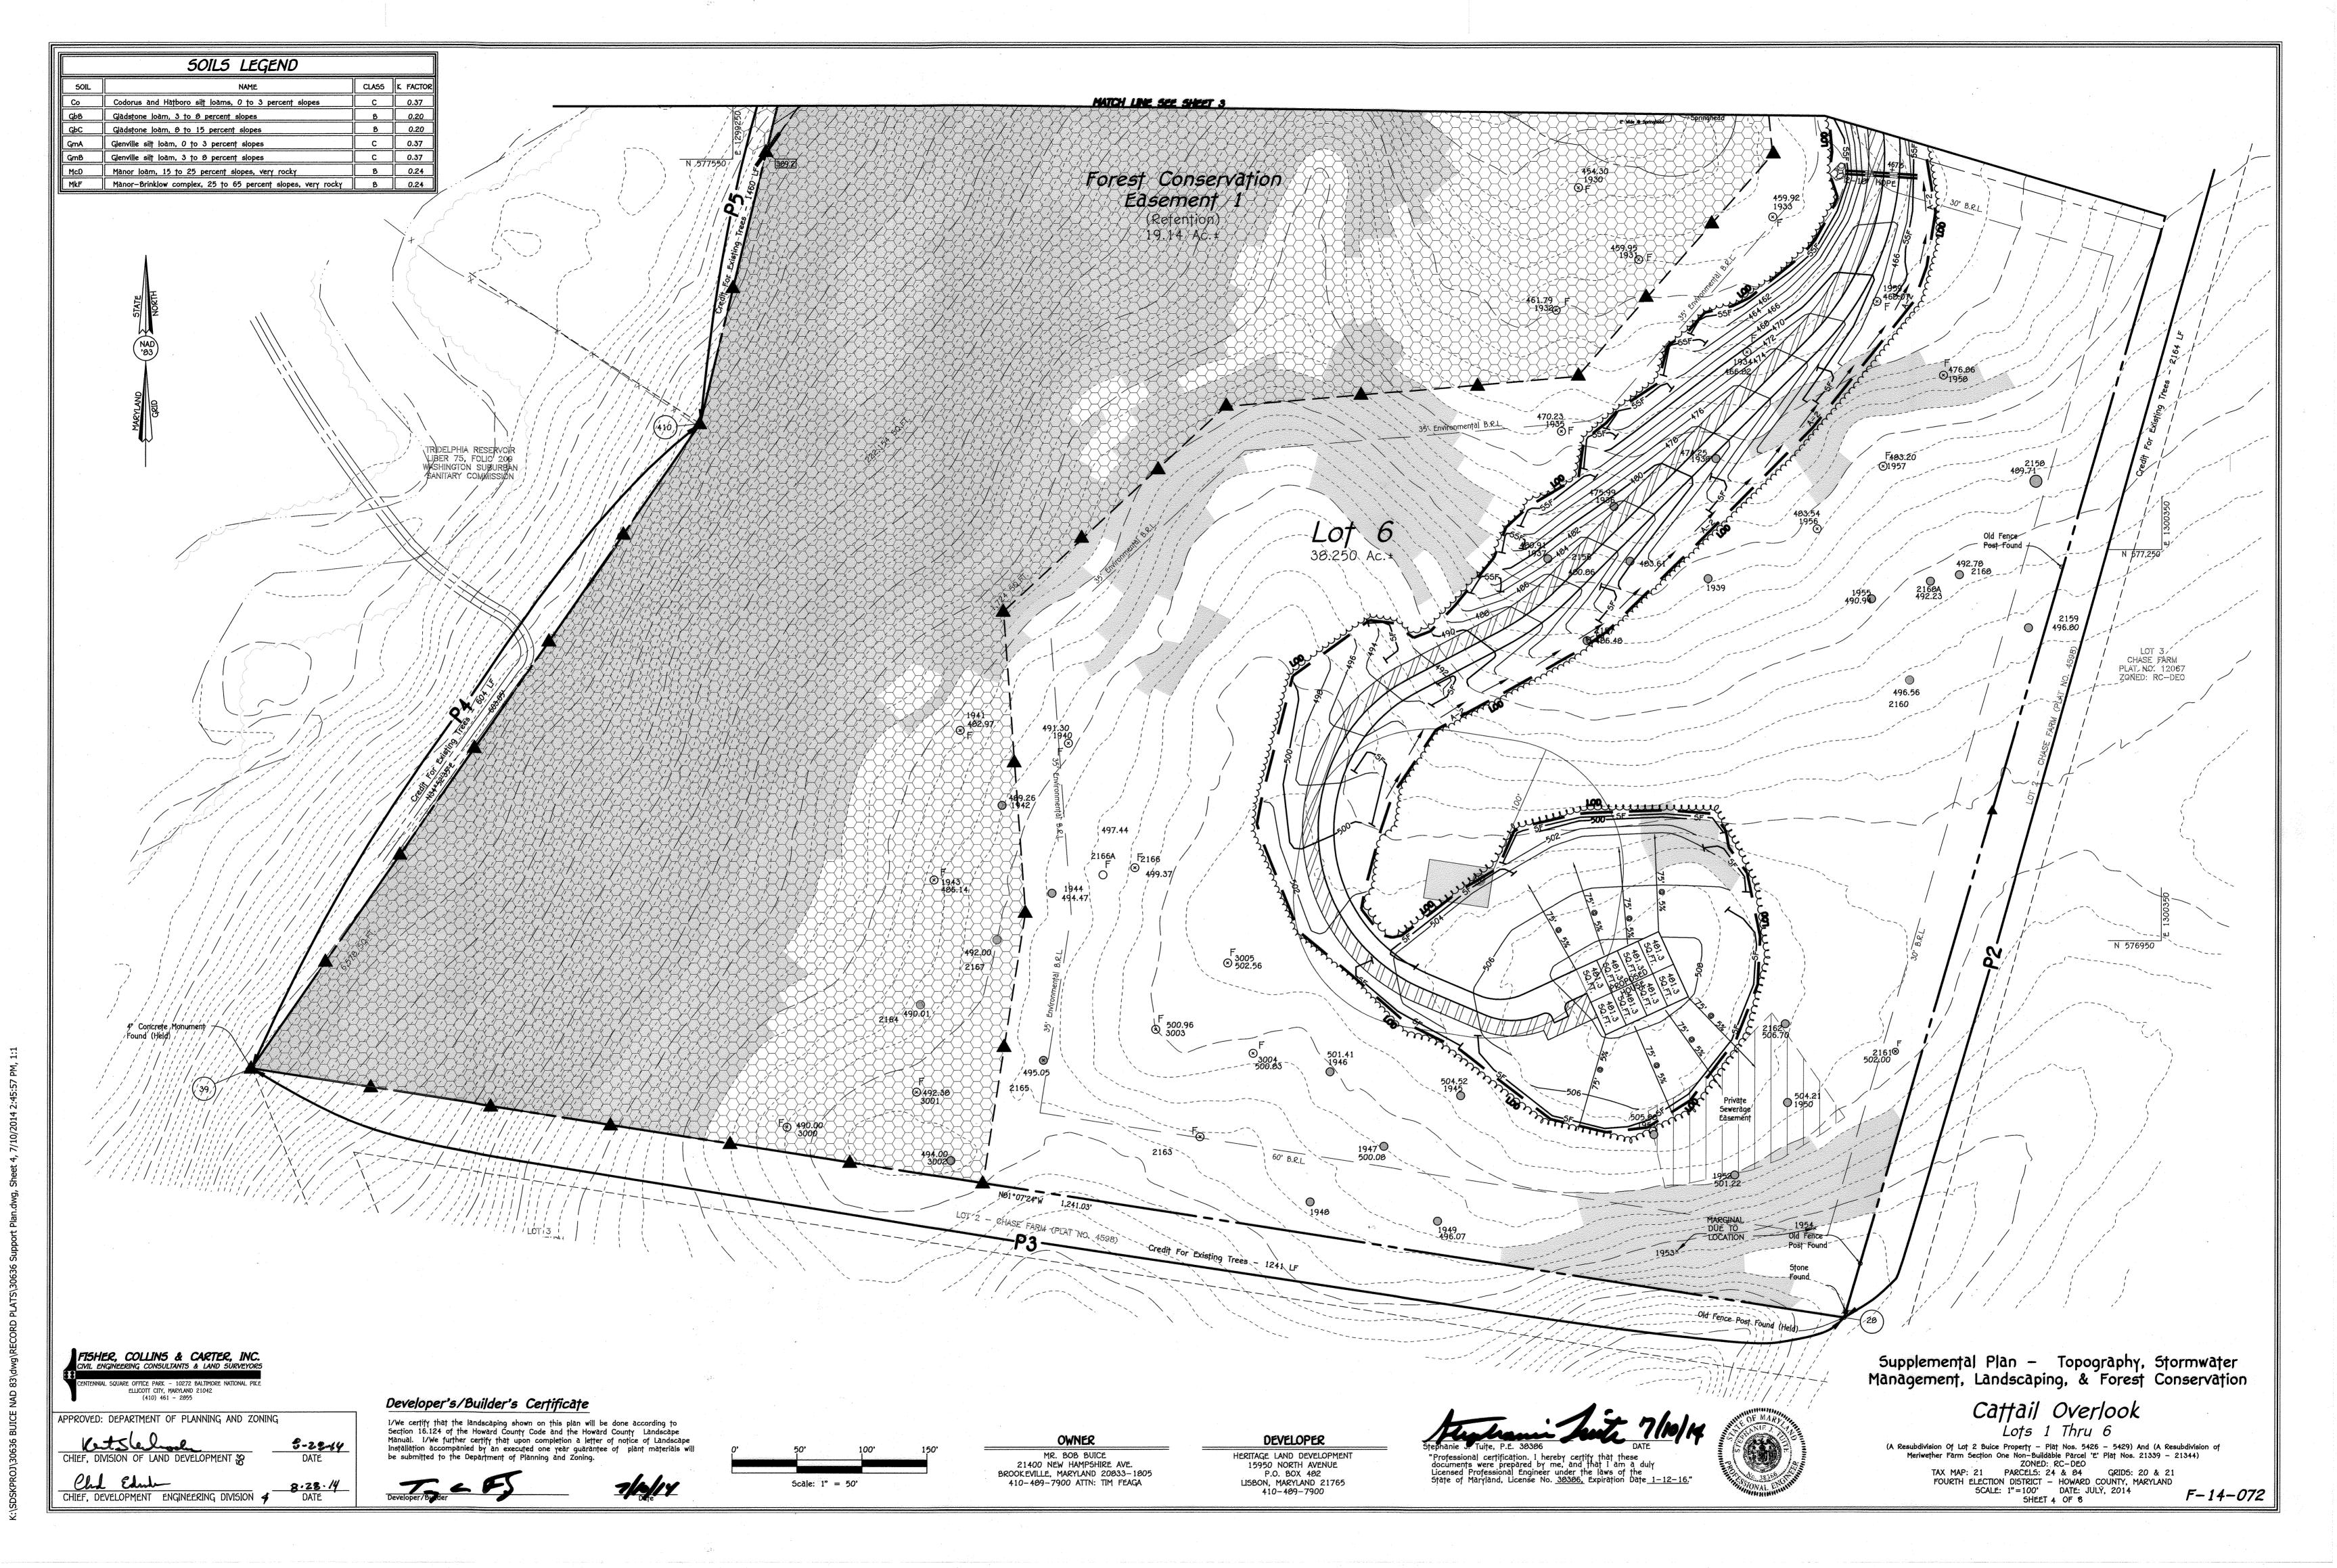

2. THIS PLAN HAS BEEN PREPARED IN ACCORDANCE WITH THE PROVISIONS OF SECTION 16.124 OF THE HOWARD COUNTY CODE AND THE LANDSCAPE MANUAL. IN ACCORDANCE WITH SECTION 16.124 OF THE HOWARD COUNTY CODE AND THE LANDSCAPE MANUAL A LANDSCAPE SURETY FOR THE PERIMETER LANDSCAPING AND TRASH PAD SCREENING FOR 7 SHADE TREES. 10 EVERGREENS, AND 6 SHRUBS IN THE AMOUNT OF (\$4,900.00) SHALL BE PROVIDED WITH THE GRADING

LOT 1 SURETY: (3) SHADE TREES @300/SHADE TREE & (6) EVERGREENS @150/EVERGREEN = \$1.800.00 LOT 5 SURETY: (4) SHADE TREES @300/SHADE TREE & (12) EVERGREENS @150/EVERGREEN & (6) SHRUBS @ \$30/SHRUB =\$3,180.00

AT THE TIME OF INSTALLMENT, ALL SHRUBS AND OTHER PLANTINGS HEREWITH LISTED AND APPROVED FOR THIS SITE. SHALL BE OF THE PROPER HEIGHT REQUIREMENTS IN ACCORDANCE WITH THE HOWARD COUNTY LANDSCAPING MANUAL. IN ADDITION, NO SUBSTITUTIONS OR RELOCATION OF REQUIRED PLANTINGS MAY BE MADE WITHOUT PRIOR REVIEW AND APPROVAL FROM THE DEPARTMENT OF PLANNING AND ZONING. ANY DEVIATION FROM THIS APPROVED LANDSCAPE PLAN MAY RESULT IN DENIAL OR DELAY IN THE RELEASE OF LANDSCAPE SURETY UNTIL SUCH TIME AS ALL REQUIRED MATERIALS ARE PLANTED AND/OR REVISIONS ARE MADE TO APPLICABLE PLANS AND CERTIFICATES.

4. THE OWNER, TENANT, AND/OR THEIR AGENTS SHALL BE RESPONSIBLE FOR MAINTENANCE OF THE REQUIRED LANDSCAPING, INCLUDING BOTH PLANT MATERIALS AND BERMS, FENCES AND WALLS, ALL PLANT MATERIALS SHALL BE MAINTAINED IN GOOD GROWING CONDITION, AND WHEN NECESSARY, REPLACED WITH NEW MATERIALS TO ENSURE CONTINUED COMPLIANCE WITH APPLICABLE REGULATIONS. ALL OTHER REQUIRED LANDSCAPING SHALL BE PERMANENTLY MAINTAINED IN GOOD CONDITION, AND WHEN NECESSARY, REPAIRED OR REPLACED.

5. SEE THE RECORD PLAT FOR THE BEARING AND DISTANCE DESCRIPTIONS OF THE FOREST CONSERVATION EASEMENTS

GUARANTEE REQUIREMENTS

A 75 PERCENT SURVIVAL RATE OF REFORESTATION PLANTINGS WILL BE REQUIRED AT THE END OF THE 24 MONTH MAINTENANCE PERIOD. ALL PLANT MATERIAL BELOW THE 75 PERCENT THRESHOLD WILL BE REPLACED AT THE BEGINNING OF THE NEXT GROWING SEASON.

PLANTING / SOIL SPECIFICATIONS

- 1. Planting Of Nursery Stock Shall Take Place Between March 15th And April 30th Or September 15th And November 15th.
- 2. A Twelve (12) Inch Layer Of Topsoil Shall Be Spread Over All Reforestation Areas Impacted By Site Grading To Assure A Suitable Planting Area, If Applicable. Disturbed Areas Shall Be Seeded And Stabilized In Accordance With The Sediment & Erosion Control Plan For This Project. Planting Areas Not Impacted By Site Grading Shall Have No Additional Topsoil Installed.
- 3. All Bare Rood Planting Stock Shall Have Their Root System Dipped Into An Anti-Desiccant Gel Prior To 4. Plants Shall Be Installed So That The Top Of The Root Mass Is Level With The Top Of Existing Grade.
- BackFill In The Planting Pits Shall Consist of 3 Parts Existing Soil to 1 Part Pine Fines Or Equivalent 5. Fertilizer Shall Consist Of Agriform 22-8-2, Or Equivalent, Applied As Per Manufacturer's Specifications. 6. A Two (2) Inch Layer Of Hardwood Mulch Shall Be Placed Over The Root Area Of All Plantings. See Planting Detail.
- 7. Plant Material Shall Be Transported To The Site In A Tarped Or Covered Truck. Plants Shall Be Kept
- 8. All Non-Organic Debris Associated With The Planting Operation Shall Be Removed From The Site By The

MULTIFLORA ROSE CONTROL NOTE:

PRIOR TO PLANTING ALL MULTIFLORA ROSE WITHIN PLANTING AREAS SHALL BE REMOVED. Removal Of The Multiflora Rose May Be Performed With Mowing And Herbicide Treatments. Physical Removal Of All Top Growth Followed By A Periodic Herbicide Treatment Of Stump Sprouts Is Recommended. Native Tree And Shrub Species Occurring Within The Rose Thickets Should Be Retained Wherever Possible. Herbicide Treatments Shall Occur On Two (2) Month Intervals During The First Growing Seaseon And Once In The Spring And Once In the Fall For Subsequent Years. Herbicide Used Shall Be Made Specifically To Address Woody Plant Material And Shall Be Applied As Per Manufacturers Specifications. Care Should Be Taken Not To Spray Planted Trees Or Naturally Occurring Native Tree And Shrub Seedlings. It is Recommended That Initiation Of Rose Removal Begin At Least Six Months Prior To Planting So That New Growth OF Roses Is Able To Be More Successfully Managed.

PRE-CONSTRUCTION MEETING

- AFTER THE BOUNDARIES OF THE FOREST RETENTION AREAS HAVE BEEN FIELD LOCATED AND MARKED, AND AFTER THE FOREST PROTECTION DEVICES HAVE BEEN INSTALLED. BUT BEFORE ANY OTHER DISTURBANCE HAS TAKEN PLACE ON SITE, A PRE-CONSTRUCTION MEETING SHALL TAKE PLACE ON SITE. THE DEVELOPER. CONTRACTOR OR PROJECT MANAGER. AND HOWARD
- COUNTY INSPECTORS SHALL ATTEND. THE PURPOSE OF THIS MEETING WILL BE: A. TO IDENTIFY THE LOCATIONS OF THE FOREST RETENTION AREAS, SPECIMEN TREES WITHIN 50 FEET OF THE LIMIT OF DISTURBANCE, LIMITS OF CONSTRUCTION, EMPLOYEE PARKING AREAS AND EQUIPMENT STAGING AREAS;
- B. INSPECT ALL FLAGGED BOUNDARIES AND PROTECTION DEVICES; . MAKE ALL NECESSARY ADJUSTMENTS; D. ASSIGN RESPONSIBILITIES AS APPROPRIATE AND DISCUSS PENALTIES.

CONSTRUCTION MONITORING

- THE SITE SHALL BE INSPECTED PERIODICALLY DURING THE CONSTRUCTION PHASE OF THE PROJECT. A QUALIFIED PROFESSIONAL SHALL BE RESPONSIBLE FOR IDENTIFYING DAMAGE TO PROTECTED FOREST AREAS OR INDIVIDUAL TREES WHICH MAY HAVE BEEN CAUSED BY CONSTRUCTION ACTIVITIES, SUCH AS SOIL COMPACTION, ROOT INJURY, TRUNK WOUNDS, LIMB INJURY, OR STRESS CAUSED BY FLOODING OR DROUGHT CONDITIONS.
- ANY SUCH DAMAGE THAT MAY OCCUR SHALL BE REMEDIED IMMEDIATELY USING APPROPRIATE MEASURES. SEVERE PROBLEMS MAY REQUIRE CONSULTATION WITH A PROFESSIONAL ARBORIST. THE CONSTRUCTION PROCEDURE SHALL NOT DAMAGE AREAS OUTSIDE OF THE LIMITS OF DISTURBANCE AS DESIGNATED ON THE PLANS. ANY DAMAGE SHALL BE RESTORED BY THE CONTRACTOR AT HIS EXPENSE AND TO THE SATISFACTION OF THE DESIGN TEAM OR ENGINEER.

SEQUENCE OF CONSTRUCTION

- 1. Sediment Controls And Tree Protective Devices Shall Be Installed In Accordance With Sediment & Erosion Control Plans For This Site, If Applicable. (2 Days) Site Shall Be Graded In Accordance With The Plans. (1 Week
- 2. Proposed Landscape Planting Areas (Along The Common Driveway) Impacted By The Site Grading Shall Be Topsoiled And Stabilized As Per Note 2 Of The "Planting / Soil Specifications". (1 Day) 3. Plants Shall Be Installed and Maintained As Per Notes and Specifications. (1 Year)
- NOTE: Plantings Shall Be Guaranteed and Maintained In Accordance With The "Guarantee Requirements" (1 Year) And "Maintenance Of Plantings" Associated With This Project.

FOREST PROTECTION GENERAL NOTES

- ALL FOREST RETENTION AREAS SHALL BE TEMPORARILY PROTECTED BY WELL ANCHORED BLAZE ORANGE PLASTIC MESH FENCING, AS NECESSARY, AND SIGNAGE AS INDICATED ON THE PLANS. THE DEVICES SHALL BE INSTALLED ALONG THE FOREST RETENTION BOUNDARY PRIOR TO ANY LAND CLEARING, GRUBBING, OR GRADING ACTIVITIES.
- THE FOREST PROTECTION DEVICES SHALL BE INSTALLED SUCH THAT THE CRITICAL ROOT ZONES OF ALL TREES WITHIN THE RETENTION AREA NOT OTHERWISE PROTECTED WILL BE WITHIN FOREST PROTECTION DEVICES, UNLESS ROOT PRUNING IS PROPOSED.
- ALL PROTECTION DEVICES SHALL BE MAINTAINED THROUGHOUT CONSTRUCTION, INCLUDING SILT FENCE BEING USED AS PROTECTIVE FENCING. ALL DEVICES SHALL REMAIN IN PLACE UNTIL ALL CONSTRUCTION HAS CEASED IN THE IMMEDIATE VICINITY.
- ATTACHMENT OF SIGNS, OR ANY OTHER OBJECTS TO TREES IS PROHIBITED. NO EQUIPMENT, MACHINERY, VEHICLES, MATERIALS OR EXCESSIVE PEDESTRIAN TRAFFIC SHALL BE ALLOWED WITHIN THESE PROTECTED AREAS.
- INSTALLATION AND MAINTENANCE OF PROTECTIVE FENCING AND SIGNAGE SHALL BE THE RESPONSIBILITY OF THE GENERAL CONTRACTOR. THE GENERAL CONTRACTOR SHALL TAKE THE UTMOST CARE TO PROTECT TREE ROOT SYSTEMS DURING ALL CONSTRUCTION ACTIVITIES. TREE ROOT SYSTEMS SHALL BE PROTECTED FROM SMOTHERING, FLOODING, EXCESSIVE WETTING FROM DE-WATERING OPERATIONS, OFF-SITE RUN OFF, SPILLAGE AND DRAINING OF MATERIALS THAT MAY BE HARMFUL TO TREES. THE GENERAL CONTRACTOR SHALL PREVENT PARKING OF CONSTRUCTION VEHICLES AND EQUIPMENT.

AND THE STORING OF BUILDING SUPPLIES OR STOCKPILING OF EARTH WITHIN FOREST CONSERVATION

8.2844


- REMOVAL OF TOPSOIL OR ROOT MAT WITHIN THE TREE PRESERVATION AREA SHALL BE PROHIBITED. THE GENERAL CONTRACTOR SHALL BE HELD RESPONSIBLE FOR ANY TREES DAMAGED OR DESTROYED
- WITHIN THE FOREST CONSERVATION EASEMENTS. ROOT PRUNING SHALL BE USED AT THE LIMIT OF DISTURBANCE OR LIMIT OF GRADING WITHIN AND ADJACENT TO ALL PRESERVATION AREAS, AS NECESSARY.



APPROVED: DEPARTMENT OF PLANNING AND ZONING

Ket5lebook CHIEF, DIVISION OF LAND DEVELOPMENT &

CHIEF, DEVELOPMENT ENGINEERING DIVISION

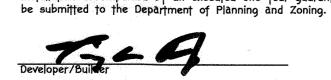


Developer's/Builder's Certificate

I/We certify that the landscaping shown on this plan will be done according to Section 16.124 of the Howard County Code and the Howard County Landscape

Manual. I/We further certify that upon completion a letter of notice of Landscape



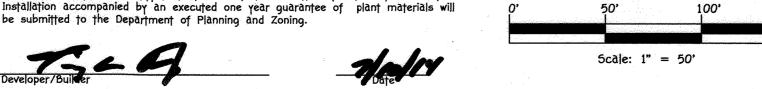

SPECIMEN TREE TABLE

SYCAMORE 33" TWIN STEMS INCLUDES A 31" TRUNK

NOTE: ALL SPECIMEN TREES ARE TO BE RETAINED

FOREST CONSERVATION WORKSHEET

VERSION 1.0

GOOD CONDITION

GOOD CONDITION

19.14

GOOD CONDITION

58" SPLITS INTO 3 ABOVE BREAST HEIGHT

GOOD CONDITION

SPECIES .

SYCAMORE

4 TULIP POPLAR 34"

3 TULIP POPLAR 34"

5YCAMORE

8 TULIP POPLAR 40"

9 TULIP POPLAR 40"

10 NORTHERN RED OAK 36"

B. AREA WITHIN 100 YEAR FLOODPLAIN

INFORMATION FOR CALCULATIONS:

E. FOREST CONSERVATION THRESHOLD.....

I. CLEARING PERMITTED WITHOUT MITIGATION ...

J. TOTAL AREA OF FOREST TO BE CLEARED

K. TOTAL AREA OF FOREST TO BE RETAINED

PROPOSED FOREST CLEARING

P. TOTAL REFORESTATION REQUIRED

- ANCHOR POST SHOULD BE

MINIMUM 2" STEEL "U" CHANNEL OR 2" x 2" TIMBER 6' IN LENGTH

Q. TOTAL AFORESTION REQUIRED

5. EXCESS FOREST CREDIT.

PLANTING REQUIREMENTS:

D. AFFORESTATION THRESHOLD...

EXISTING FOREST COVER:

AREA TO REMAIN IN AGRICULTURAL PRODUCTION

LAND USE CATEGORY: (from table 3.2.1, page 40, Manual)

ARA MOR IDA HOR MPD CIA

F. EXISTING FOREST COVER (EXCLUDING FLOODPLAIN).

G. AREA OF FOREST ABOVE CONSERVATION THRESHOLD:

H. FOREST RETENTION ABOVE THRESHOLD WITH NO MITIGATION

L. REFORESTATION FOR CLEARING ABOVE CONSERVATION THRESHOLD....
M. REFORESTATION FOR CLEARING BELOW CONSERVATION THRESHOLD...

BLAZE ORANGE PLASTIC MESH

HIGHLY VISIABLE FLAGGING

OUNDARIES OF RETENTION AREA SHOULD BE STAKED AND FLAGGED PRIOR TO INSTALLING DEVICE.

Specification

loamy sand 60-65%

Min. 10% by dry weight

pea gravel: ASTM-D-448

ornamental stone: washed

F 750, Type P5 20 or AASHTO M-270

M5HA Mix No. 3; f = 3500

air-entrained; reinforcing to meet ASTM-615-60

AASHTO-M-6 or ASTM-C-33

psi at 28 days, normal weigh

compost 35-40%

sandy loam 30%

coarse sand 30%

(ASTM D 2974)

shredded hardwood

compost 40%

see Appendix A; Table A.4

TREE PROTECTION DETAIL

NOT TO SCALE

USE 3' WIRE "U" TO SECURE

Table B.4. Materials Specifications for Micro-Bioretention, Rain Gardens & Landscape Infiltration

stone: 2" to 5

No. 57 or No.

Aggregate (3/8" to 3/4")

4" to 6" rigid schedule

40 PVC or 5DR35

0.02" to 0.04"

n/a

n/a

ANCHOR POST MUST BE INSTALLED

OF THE TOTAL HEIGHT OF POS

. FOREST PROTECTION DEVICE ONLY. . RETENTION AREA WILL BE SET AS PART OF THE REVIEW PROCESS.

DEVICE SHOULD BE MAINTAINED THROUGHOUT CONSTRUCTION.

ROOT DAMAGE SHOULD BE AVOIDED PROTECTIVE SIGNAGE MAY ALSO BE USED.

Material

Plantings

Planting soil

Organic Content

Curtain drain

Geotextile

Pea gravel diaphragm

Gravel (underdrains and

Poured in place concrete (if

Underdrain piping

NOTES:

TO A DEPTH OF NO LESS THAN 1/3


N. CREDIT FOR RETENTION ABOVE CONSERVATION THRESHOLD.


R. TOTAL REFORESTATION AND AFFORESTATION REQUIRED.

BASIC SITE DATA:

A TOTAL TRACT AREA.

TULIP POPLAR 35"

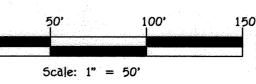

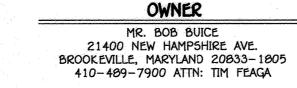

16' (TWO OR MORE USERS) 12' (SINGLE USERS)

-ON-SITE P-1 PAVING SECTION

TYPICAL PRIVATE DRIVE CROSS SLOPE SECTION

GALVANIZED CHAIN LINK FENCE WITH WOVEN SLIT FILM GEOTEXTILE

WOVEN SLIT FILM GEOTEXTILE-FLOW -

INSTALL 2% INCH DIAMETER GALVANIZED STEEL POSTS OF 0.095 INCH WALL THICKNESS AND SIX FOOT LENGTH SPACED NO FURTHER THAN 10 FEET APART. DRIVE THE POSTS A MINIMUM OF 36 INCHES INTO THE GROUND.

FASTEN 9 GAUGE OR HEAVIER GALVANIZED CHAIN LINK FENCE (23/4 INCH MAXIMUM OPENING) 42 INCHES IN HEIGHT SECURELY TO THE FENCE POSTS WITH WIRE TIES OR HUG RINGS.

FASTEN WOVEN SLIT FILM GEOTEXTILE AS SPECIFIED IN SECTION H-1 MATERIALS, SECURELY TO THE UPSLOPE SIDE OF CHAIN LINK FENCE WITH TIES SPACED EVERY 24 INCHES AT THE TOP AND MID SECTION. EMBED GEOTEXTILE AND CHAIN LINK FENCE A

WHERE ENDS OF THE GEOTEXTILE COME TOGETHER, THE ENDS SHALL BE OVERLAPPED BY 6 INCHES, FOLDED, AND STAPLED TO PREVENT SEDIMENT BY PASS.

EXTEND BOTH ENDS OF THE SUPER SILT FENCE A MINIMUM OF FIVE HORIZONTAL FEET

UPSLOPE AT 45 DEGREES TO THE MAIN FENCE ALIGNMENT TO PREVENT RUNOFF FROM GOING AROUND THE ENDS OF THE SUPER SILT FENCE.

PROVIDE MANUFACTURER CERTIFICATION TO THE INSPECTION/ENFORCEMENT AUTHORITY SHOWING THAT GEOTEXTILE USED MEETS THE REQUIREMENTS IN SECTION H-1 MATERIALS.

SUPER SILT FENCE

TREE PROTECTION FENCE

USDA soil types loamy sand or sandy loam; clay content <5%

Slotted or perforated pipe; 3/8" pert. @ 6" on center,

4 holes per row; minimum of 3" of gravel over pipes; not necessary underneath pipes. Perforated pipe shall be wrapped with 1/4 inch galvanized hardware cloth

on-site testing of poured-in-place concrete required

28 day strength and slump test; all concrete design

and approved by a professional structural engineer

H-20]; allowable horizontal loading (based on soil

pressures); and analysis of potential cracking

licensed in the State of Maryland - design to include

meeting ACI Code 350.R/89; vertical loading EH-10 or

Sand substitutions such as Diabase and Graystone (AASHTO)

#10 are not acceptable. No calcium carbonated or dolomitic

sand substitutions are acceptable. No "rock dust" can be

(cast-in-place or pre-cast) not using previously approved

State or local standards requires design drawings sealed

NOT TO SCALE

REMOVE ACCUMULATED SEDIMENT AND DEBRIS WHEN BULGES DEVELOP IN FENCE OR WHEN SEDIMENT REACHES 25% OF FENCE HEIGHT. REPLACE GEOTEXTILE IF TORN. IF UNDERMINING OCCURS, REINSTALL CHAIN LINK FENCING AND GEOTEXTILE.

CROSS SECTION

ELEVATION

STANDARD SYMBO

CONSTRUCTION SPECIFICATIONS

plantings are site-specific

aged 6 months, minimum

PE Type 1 nonwoven

2's ORANGE STREAMERS

ALL MATERIALS AND CONSTRUCTION SHALL BE IN

VOLUME IV, STANDARD SPECIFICATION AND DETAILS FOR CONSTRUCTION.

ACCORDANCE WITH HOWARD COUNTY DESIGN MANUA

5% MAX

DEVELOPER HERITAGE LAND DEVELOPMENT 15950 NORTH AVENUE P.O. BOX 482 LISBON, MARYLAND 21765

410-489-7900

TOTAL: 7 SHADE TREES, 18 EVERGREEN

KEY

QTY.

"Professional certification. I hereby certify that these documents were prepared by me, and that I am a duly Licensed Professional Engineer under the laws of the 5tate of Maryland, License No. <u>38386</u>, Expiration Date <u>1-12-16</u>."

SIZE

2.5"-3" CAL.

FULL CROWN, B&B

2.5"-3" CAL

FULL CROWN

8&8

' - 6' H

B&B


B&B


5' - 6' HT



OPERATION & MAINTENANCE SCHEDULE FOR PRIVATELY OWNED AND MAINTAINED DISCONNECTION OF ROOFTOP RUNOFF (N-1) DISCONNECTION OF NONROOFTOP RUNOFF (N-2)

> 1. MAINTENANCE OF AREAS RECEIVING DISCONNECTION RUNOFF IS GENERALLY NO DIFFERENT THAN THAT REQUIRED FOR OTHER LAWN OR LANDSCAPED AREAS. THE AREAS RECEIVING RUNOFF SHOULD BE PROTECTED FROM FUTURE COMPACTION OR DEVELOPMENT OF IMPERVIOUS AREA. IN COMMERCIAL AREAS FOOT TRAFFIC SHOULD BE DISCOURAGED AS WELL.

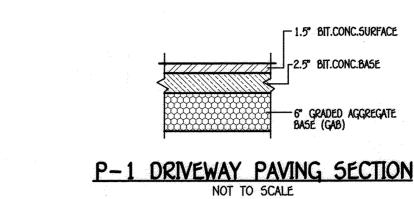

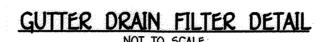


STORMWATER MANAGEMENT NOTES

1. STORMWATER MANAGEMENT IS PROVIDED IN ACCORDANCE WITH WITH CHAPTER 5, "ENVIRONMENTAL SITE DESIGN" OF THE 2007 MARYLAND STORMWATER MANAGEMENT DESIGN MANUAL, EFFECTIVE MAY 4, 2010.

4. FINAL GRADING IS SHOWN ON THE SITE DEVELOPMENT PLAN

2. MAXIMUM CONTRIBUTING ROOF TOP AREA TO EACH DOWNSPOUT SHALL BE 1,000 SQ. FT. OR LESS. 3. DRYWELLS SHALL BE PROVIDED AT LOCATIONS WHERE THE LENGTH OF DISCONNECTION IS LESS THAN 75' AT 5%. THE SIZE AND CONSTRUCTION OF THE DRYWELL SHALL BE IN ACCORDANCE WITH THE DETAIL SHOWN ON THIS SHEET.

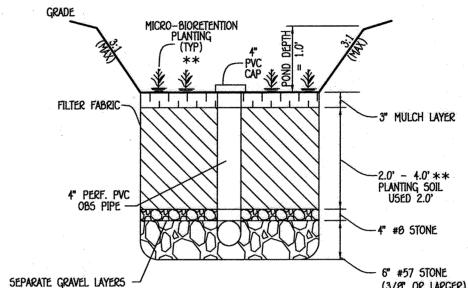

SECTION A-A

GRADING FOR PLANTING


TURNBUCKLE -

STAKING DETAIL

1'-0" HIGH

2-1/2"

CALIPER MIN.

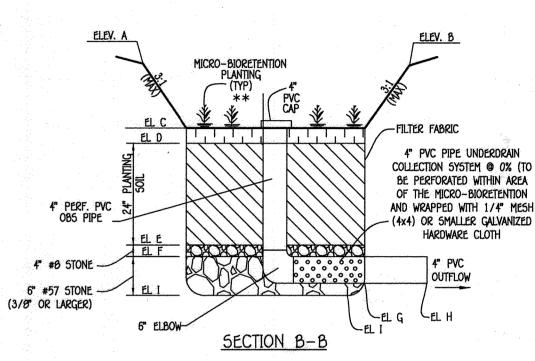

-TURNBUCKLE

__2 x 4 STAKE

-RUBBER HOSE

-WRAPPING

TWICE BALL

TREE PLANTING

MICRO-BIORETENTION DETAIL (M-6)

(3/8" OR LARGER)

QUANTITY

QUANTITY


QUANTITY


<u>PERENNIALS</u>

BEEBALM (1.5' SP.)

JOE-PYE-WEED (3' SP.)

SILKY DOGWOOD

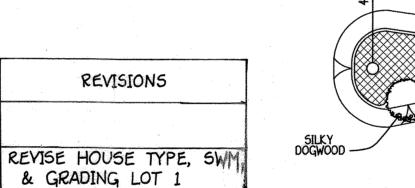

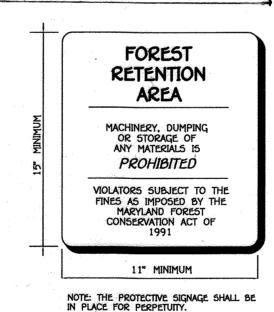

FOREST CONSERVATION SIGN DETAIL NOT TO SCALE

LANDSCAPING PLANT LIST

ACER RUBRUM 'OCTOBER GLORY'

(OCTOBER RED MAPLE)

TILIA CODATA 'GREENSPIRE'


(GREENSPIRE LITTLELEAF LINDEN)

ILEX 'NELLIE R. STEVENS'

(NELLIE R. STEVENS HOLLY)

THUJA PLICATA


(GIANT ARBORVITAE 'GREEN GIANT')

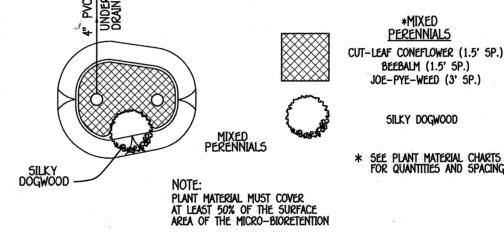


MICRO-BIORETENTION PLANTING DETAIL

OPERATION & MAINTENANCE SCHEDULE FOR MICRO-BIORETENTION (M-6)

- A. THE OWNER SHALL MAINTAIN THE PLANT MATERIAL, MULCH LAYER AND SOIL LAYER ANNUALLY. MAINTENANCE OF MULCH AND SOIL IS LIMITED TO CORRECTING AREAS OF EROSION OR WASH OUT. ANY MULCH REPLACEMENT SHALL BE DONE IN THE SPRING. PLANT MATERIAL SHALL BE CHECKED FOR DISEASE AND INSECT INFESTATION AND MAINTENANCE WILL ADDRESS DEAD MATERIAL AND PRUNING. ACCEPTABLE REPLACEMENT PLANT MATERIAL IS LIMITED TO THE FOLLOWING: 2000
- MARYLAND STORMWATER DESIGN MANUAL VOLUME II, TABLE A.4.1 AND 2. B. THE OWNER SHALL PERFORM A PLANT IN THE SPRING AND IN THE FALL OF EACH YEAR. DURING THE INSPECTION, THE OWNER SHALL REMOVE DEAD AND DISEASED VEGETATION CONSIDERED BEYOND TREATMENT, REPLACE DEAD PLANT MATERIAL WITH ACCEPTABLE REPLACEMENT PLANT MATERIAL, TREAT DISEASED TREES AND SHRUBS AND REPLACE ALL DEFICIENT STAKES AND WIRES. C. THE OWNER SHALL INSPECT THE MULCH EACH SPRING. THE MULCH SHALL BE REPLACED EVERY TWO TO THREE YEARS. THE PREVIOUS MULCH LAYER SHALL BE REMOVED BEFORE THE NEW LAYER
- D. THE OWNER SHALL CORRECT SOIL EROSION ON AN AS NEEDED BASIS, WITH A MINIMUM OF ONCE PER MONTH AND AFTER EACH HEAVY STORM.

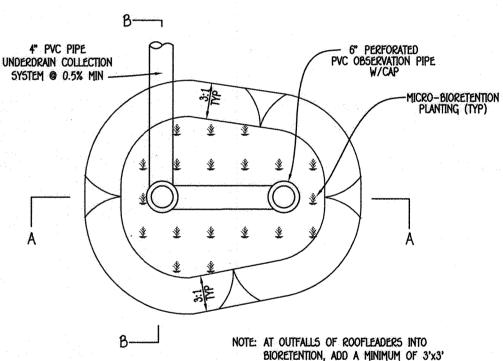


RIPRAP TO DISPERSE RUNOFF. PLAN NOT TO SCALE

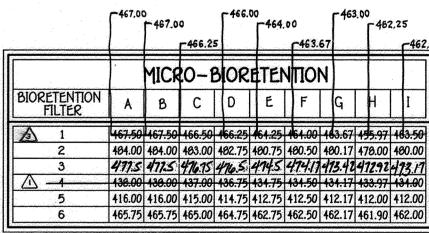

A Note: For MBR-4 & Plant materials on Lot 4 nee sheet &

NAME

MAXIMUM SPACING (FT.)

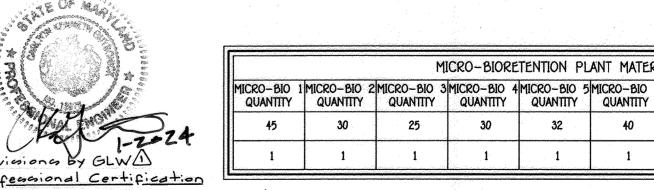

Revisions by GLW(1) Professional Certification I hereby certify that these documents were prepared or approved by me, and that I am a duly licensed professional engineer under the laws of the state of Maryland.

License No. 12975

Expiration Date: May 20, 2024

MIXED PERENNIALS 1.5 TO 3.0 FT. SILKY

QUANTITY

MICRO-BIORETENTION PLANT MATERIAL

QUANTITY

12/27/2023 (by GLW) Rev. for Lot 4 house, grading & SWM to be built, see sheet 7 & 8

Supplemental Plan - Topography, Stormwater Management, Landscaping, & Forest Conservation


Cattail Overlook Lots 1 Thru 6

(A Resubdivision Of Lot 2 Buice Property - Plat Nos. 5426 - 5429) And (A Resubdivision of Meriwether Farm Section One Non-Buildable Parcel 'E' Plat Nos. 21339 - 21344)

ZONED: RC-DEO PARCELS: 24 & 84 GRID5: 20 & 21 FOURTH ELECTION DISTRICT - HOWARD COUNTY, MARYLAND SCALE: 1"=100' DATE: JULY, 2014

SHEET 5 OF 8

F-14-072

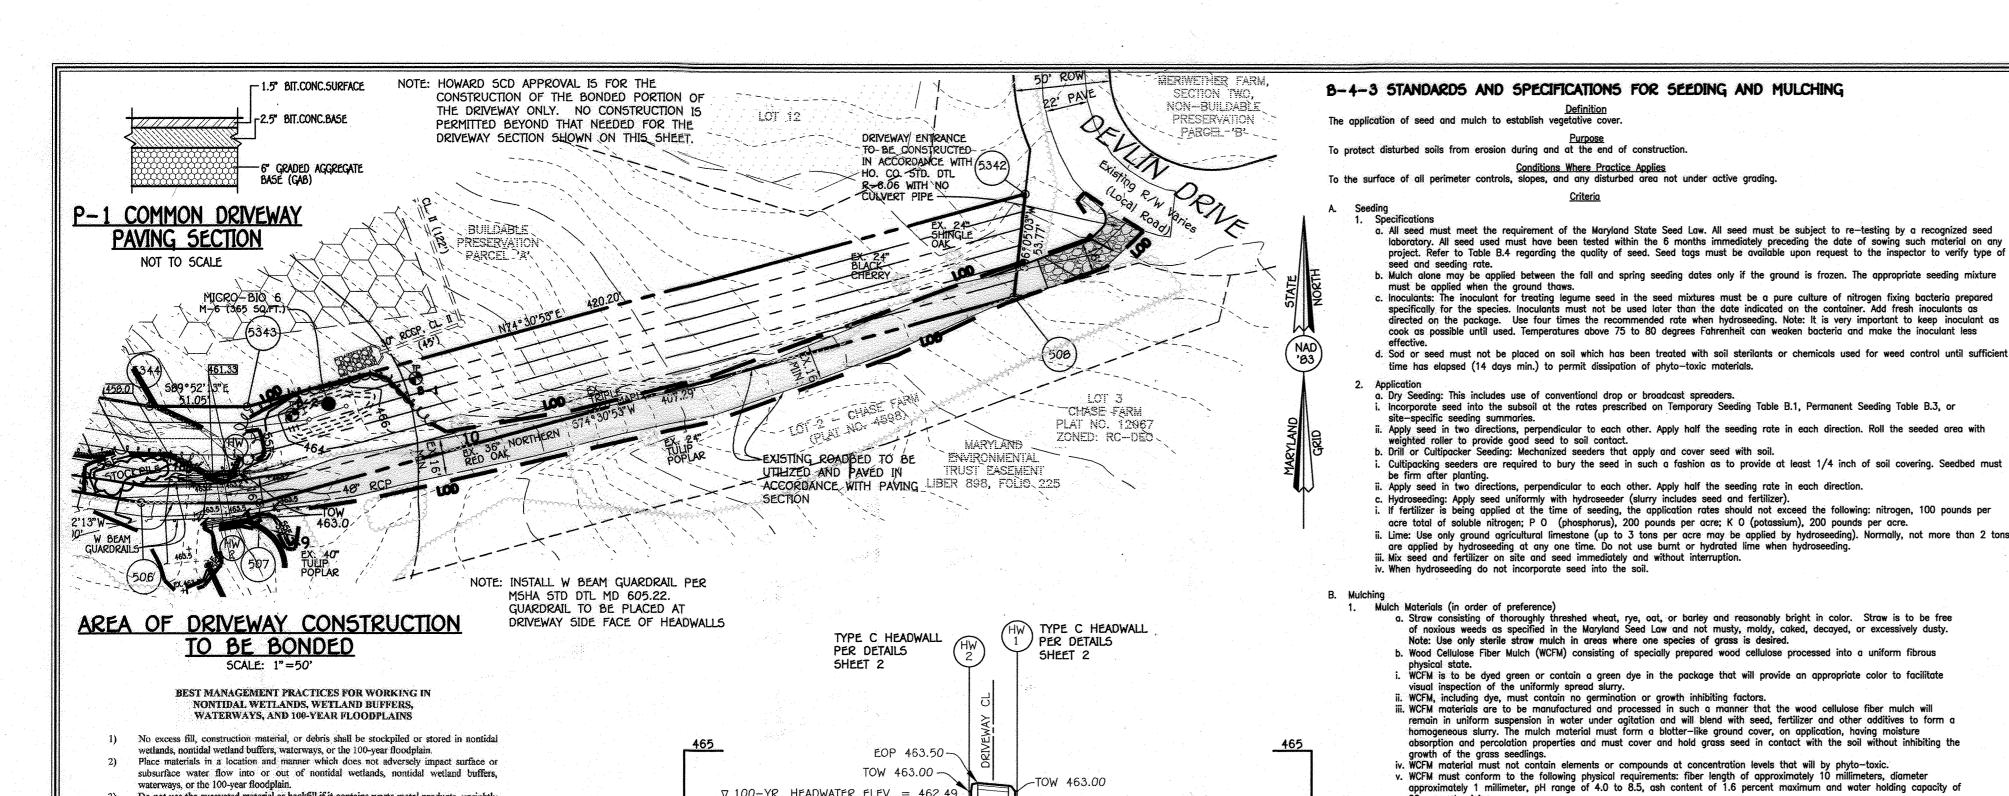

approved by the Nontidal Wetlands and Waterways Division. Kentucky 31 fescue shall not be utilized in wetland or buffer areas. The area should be seeded and mulched to reduce erosion after construction activities have been completed. EX. 48" RCCP @ 0.012% After installation has been completed, make post-construction grades and elevations the Q2 = 92.01 C.F.5 same as the original grades and elevations in temporarily impacted areas. To protect aquatic species, in-stream work is prohibited as determined by the classification V2 = 7.98 F.P.5.Q10 = 209.00 C.f.5V10 = 6.44 F.P.5.

through June 15, inclusive, during any year. Use III waters: In-stream work shall not be conducted during the period October 1 through April 30, inclusive, during any year. Use IV waters: In-stream work shall not be conducted during the period March I through May 31, inclusive, during any year.

Use I waters; In-stream work shall not be conducted during the period March 1

Do not use the excavated material as backfill if it contains waste metal products, unsight

debris, toxic material, or any other deleterious substance. If additional backfill is required,

use clean material free of waste metal products, unsightly debris, toxic material, or any

Place heavy equipment on mats or suitably operate the equipment to prevent damage to

Repair and maintain any serviceable structure or fill so there is no permanent loss of

nontidal wetlands, nontidal wetland buffers, or waterways, or permanent modification of

the 100-year floodplain in excess of that lost under the originally authorized structure or

Rectify any nontidal wetlands, wetland buffers, waterways, or 100-year floodplain

All stabilization in the nontidal wetland and nontidal wetland buffer shall consist of the

following species: Annual Ryegrass (Lolium multiflorum), Millet (Setaria italica), Barley

(Hordeum sp.), Oats (Liniola sp.), and/or Rye (Secale cereale). These species will allow

for the stabilization of the site while also allowing for the voluntary revegetation of natural

wetland species. Other non-persistent vegetation may be acceptable, but must be

nontidal wetlands, nontidal wetland buffers, waterways, or the 100-year floodplain.

 Stormwater runoff from impervious surfaces shall be controlled to prevent the washing of debris into the waterway. 11) Culverts shall be constructed and any riprap placed so as not to obstruct the movement of

SOIL PREPARATION. TOPSOILING AND SOIL AMENDMENTS (B-4-2)

A. Soil Preparation

1. Temporary Stabilization

a. Seedbed preparation consists of loosening soil to a depth of 3 to 5 inches by means of suitable agricultural or construction equipment, such as disc harrows or chisel plows or rippers mounted on construction equipment. After the soil is loosened, it must not be rolled or dragged smooth but left in the roughened condition. Slopes 3:1 or flatter are to be tracked with ridges running parallel to the contour of the slope.

b. Apply fertilizer and lime as prescribed on the plans.

waterways, or the 100-year floodplain.

temporarily impacted by any construction.

other deleterious substance.

c. Incorporate lime and fertilizer into the top 3 to 5 inches of soil by disking or other suitable means. 2. Permanent Stabilization a. A soil test is required for any earth disturbance of 5 acres or more. The minimum soil conditions

required for permanent vegetative establishment are: i. Soil pH between 6.0 and 7.0. Soluble salts less than 500 parts per million (ppm

iii. Soil contains less than 40 percent clay but enough fine grained material (greater than 30 percent silt plus clay) to provide the capacity to hold a moderate amount of moisture. An exception: if lovegrass will be planted, then a sandy soil (less than 30 percent silt plus clay) would be acceptable. iv. Soil contains 1.5 percent minimum organic matter by weight. v. Soil contains sufficient pore space to permit adequate root penetration.

b. Application of amendments or topsoil is required if on-site soils do not meet the above conditions. c. Graded areas must be maintained in a true and even grade as specified on the approved plan, then scarified or otherwise loosened to a depth of 3 to 5 inches.

d. Apply soil amendments as specified on the approved plan or as indicated by the results of a soil test. e. Mix soil amendments into the top 3 to 5 inches of soil by disking or other suitable means. Rake lawn areas to smooth the surface, remove large objects like stones and branches, and ready the area for seed application Loosen surface soil by dragging with a heavy chain or other equipment to roughen the surface where site conditions will not permit normal seedbed preparation. Track slopes 3:1 or flatter with tracked equipment leaving the soil in an irregular condition with ridges running parallel to the contour of the slope. Leave the top 1 to 3 inches of soil loose and friable. Seedbed loosening may be unnecessary on newly disturbed areas.

B. Topsoiling

1. Topsoil is placed over prepared subsoil prior to establishment of permanent vegetation. The purpose is to provide a suitable soil medium for vegetative growth. Soils of concern have low moisture content, low nutrient levels, low pH, materials toxic to plants, and/or unacceptable soil gradation.

2. Topsoil salvaged from an existing site may be used provided it meets the standards as set forth in these specifications. Typically, the depth of topsoil to be salvaged for a given soil type can be found in the representative soil profile section in the Soil Survey published by USDA-NRCS.

3. Topsoiling is limited to areas having 2:1 or flatter slopes where:

FISHER, COLLINS & CARTER, INC

IVIL ENGINEERING CONSULTANTS & LAND SURVEYORS

ELLICOTT CITY, MARYLAND 21042

APPROVED: DEPARTMENT OF PLANNING AND ZONING

CHIEF, DEVELOPMENT ENGINEERING DIVISION

KetStelsvol

CHIEF. DIVISION OF LAND DEVELOPMENT

AL SQUARE OFFICE PARK - 10272 BALTIMORE NATIONAL PI

a. The texture of the exposed subsoil/parent material is not adequate to produce vegetative growth.

b. The soil material is so shallow that the rooting zone is not deep enough to support plants or furnish continuing supplies of moisture and plant nutrients.

8-28.14

c. The original soil to be vegetated contains material toxic to plant growth

d. The soil is so acidic that treatment with limestone is not feasible.

REV I - REVISE DISTURBANCE & USE OF EX. DRIVE THIS DEVELOPMENT IS APPROVED FOR SOIL EROSION AND SEDIMENT CONTROL BY THE HOWARD SOIL CONSERVATION DISRICT.

APPROVED:

Thybrani Inte

4. Areas having slopes steeper than 2:1 require special consideration and design.

5. Topsoil Specifications: Soil to be used as topsoil must meet the following criteria: a. Topsoil must be a loam, sandy loam, clay loam, silt loam, sandy clay loam, or loamy sand. Other soils may be used if recommended by an agronomist or soil scientist and approved by the appropriate approval authority. Topsoil must not be a mixture of contrasting textured subsoils and must contain less than 5 percent by volume of cinders, stones, slag, coarse fragments, gravel, sticks, roots, trash, or other materials larger than 1 1/2 inches in diameter. b. Topsoil must be free of noxious plants or plant parts such as Bermuda grass, quack grass, Johnson grass, nut sedge, poison ivy, thistle, or others as specified.

EX. CULVERT PROFILE

SCALE: 1" = 50' HOR.

1" = 5' VERT.

c. Topsoil substitutes or amendments, as recommended by a qualified agronomist or soil scientist and approved by the appropriate approval authority, may be used in lieu of natural topsoil.

 $\sqrt{100}$ -YR. HEADWATER ELEV. = 462.4 = 10-YR. HEADWATER ELEV. = 461.94

Q100 = 349.90 C.F.

V100 = 11.10 F.P.5.

a. Erosion and sediment control practices must be maintained when applying topsoil

b. Uniformly distribute topsoil in a 5 to 0 inch layer and lightly compact to a minimum thickness of 4 inches. Spreading is to be performed in such a manner that sodding or seeding can proceed with a minimum of additional soil preparation and tillage. Any irregularities in the surface resulting from topsoiling or other operations must be corrected in order to

c. Topsoil must not be placed if the topsoil or subsoil is in a frozen or muddy condition, when the subsoil is excessively wet or in a condition that may otherwise be detrimental to proper grading and seedbed preparation.

C. Soil Amendments (Fertilizer and Lime Specifications)

1. Soil tests must be performed to determine the exact ratios and application rates for both lime and fertilizer or sites having disturbed areas of 5 acres or more. Soil analysis may be performed by a recognized private or commercial laboratory. Soil samples taken for engineering purposes may also be used for chemical analyses. 2. Fertilizers must be uniform in composition, free flowing and suitable for accurate application by appropriate equipment. Manure may be substituted for fertilizer with prior approval from the appropriate approval authority. Fertilizers must all be delivered to the site fully labeled according to the applicable laws and must bear the name, trade name or trademark and warranty of the producer. 3. Lime materials must be ground limestone (hydrated or burnt lime may be substituted except when hydroseeding) which contains at least 50 percent total oxides (calcium oxide plus magnesium oxide). Limestone must be ground to such fineness that at least 50 percent will pass through a #100 mesh sieve and 90 to 100 percent will pass through

4. Lime and fertilizer are to be evenly distributed and incorporated into the top 3 to 5 inches of soil by disking or other suitable means.

5. Where the subsoil is either highly acidic or composed of heavy clays, spread ground limestone at the rate of 4 to 8 tons/acre (200-400 pounds per 1,000 square feet) prior to the placement of topsoil.

BUILDER/DEVELOPER'S CERTIFICATE

 $\nabla 100$ -YR. /TAILWATER ELEV. = 461.33

 $\nabla 10 - YR.$ TAILWATER ELEV. = 458.99

EX. GROUND

"I/WE CERTIFY THAT ALL DEVELOPMENT AND CONSTRUCTION WILL BE DONE ACCORDING TO THIS PLAN. FOR SEDIMENT AND EROSION CONTROL AND THAT ANY RESPONSIBLE PERSONNEL INVOLVED IN THE CONSTRUCTION PROJECT WILL HAVE A CERTIFICATE OF ATTENDANCE AT A DEPARTMENT OF THE ENVIRONMENT APPROVED TRAINING PROGRAM FOR THE CONTROL OF SEDIMENT AND EROSION BEFORE BEGINNING THE PROJECT: I ALSO AUTHORIZE PERIODIC ON-SITE INSPECTION BY THE HOWARD SOIL

SIGNATURE OF DEVELOPER

ENGINEER'S CERTIFICATE

"I/WE CERTIFY THAT THIS PLAN FOR EROSION AND SEDIMENT CONTROL REPRESENTS A PRACTICAL AND WORKABLE PLAN BASED ON MY PERSONAL KNOWLEDGE OF THE SITE CONDITIONS AND THAT IT WAS PREPARED IN ACCORDANCE WITH THE REQUIREMENTS OF THE HOWARD SOIL CONSERVATION DISTRICT."

OWNER MR. BOB BUICE 21400 NEW HAMPSHIRE AVE. BROOKEVILLE, MARYLAND 20833-1805 410-489-7900 ATTN: TIM FEAGA

Conditions Where Practice Applies

a. Apply mulch to all seeded areas immediately after seeding.
b. When straw mulch is used, spread it over all seeded areas at the rate of 2 tons per acre to a uniform loose depth of

c. Wood cellulose fiber used as mulch must be applied to a net dry weight of 1500 pounds per acre. Mix the wood

a. Perform mulch anchoring immediately following application of mulch to minimize loss by wind or water. This may be

i. A mulch anchoring tool is a tractor drawn implement designed to punch and anchor mulch into the soil surface a minimum of 2 inches. This practice is most effective on large areas, but is limited to flatter slopes where equipment

ii. Wood cellulose fiber may be used for anchoring straw. Apply the fiber binder at a net dry weight of 750 pounds per

iii. Synthetic binders such as Acrylic DLR (Agro-Tack), DCA-70, Petroset, Terra Tax II, Terra Tack AR or other approved

iv. Lightweight plastic netting may be stapled over the mulch according to manufacturer recommendations. Netting is

equal may be used. Follow application rates as specified by the manufacturer. Application of liquid binders needs to be

heavier at the edges where wind catches mulch, such as in valleys and on crests of banks. Use of asphalt binders is

Exposed soils where ground cover is needed for a period of 6 months or less. For longer

1. Select one or more of the species or seed mixtures listed in Table B.1 for the appropriate

Plant Hardiness Zone (from Figure B.3), and enter them in the Temporary Seeding Summary below

along with application rates, seeding dates and seeding depths. If this Summary is not put on

the plan and completed, then Table B.1 plus fertilizer and lime rates must be put on the plan.

3. When stabilization is required outside of a seeding season, apply seed and mulch or straw

Temporary Seeding Summary

Dates

3/1 - 5/15

8/15 - 10/15

mulch alone as prescribed in Section B-4-3.A.1.b and maintain until the next seeding season.

a. Select one or more of the species or mixtures listed in Table 8.3 for the appropriate Plant Hardiness Zone (from

Figure B.3) and based on the site condition or purpose found on Table B.2. Enter selected mixture(s), application

rates, and seeding dates in the Permanent Seeding Summary. The Summary is to be placed on the plan.

b. Additional planting specifications for exceptional sites such as shorelines, stream banks, or dunes or for

c. For sites having disturbed area over 5 acres, use and show the rates recommended by the soil testing

agency. d. For areas receiving low maintenance, apply urea form fertilizer (46-0-0) at 3 1/2 pounds per

1000 square feet (150 pounds per acre) at the time of seeding in addition to the soil amendments shown

a. Areas where turfgrass may be desired include lawns, parks, playgrounds, and commercial sites which will

b. Select one or more of the species or mixtures listed below based on the site conditions or purpose.

i. Kentucky Bluegrass: Full Sun Mixture: For use in areas that receive intensive management. Irrigation

bluegrass cultivars with each ranging from 10 to 35 percent of the total mixture by weight.

Rate: 5 to 8 pounds per 1000 square feet. One or more cultivars may be blended.

ii. Kentucky Bluegrass/Perennial Rye: Full Sun Mixture: For use in full sun areas where rapid

Enter selected mixture(s), application rates, and seeding dates in the Permanent Seeding Summary. The

required in the areas of central Maryland and Eastern Shore. Recommended Certified Kentucky Bluegrass

Cultivars Seeding Rate: 1.5 to 2.0 pounds per 1000 square feet. Choose a minimum of three Kentucky

establishment is necessary and when turf will receive medium to intensive management. Certified Perennial

Choose a minimum of three Kentucky bluegrass cultivars with each ranging from 10 to 35 percent of the

iii. Tall Fescue/Kentucky Bluegrass: Full Sun Mixture: For use in drought prone areas and/or for areas

Tall Fescue Cultivars 95 to 100 percent, Certified Kentucky Bluegrass Cultivars 0 to 5 percent. Seeding

iv. Kentucky Bluegrass/Fine Fescue: Shade Mixture: For use in areas with shade in Bluegrass lawns. For

establishment in high quality, intensively managed turf area. Mixture includes; Certified Kentucky Bluegrass

Cultivars 30 to 40 percent and Certified Fine Fescue and 60 to 70 percent. Seeding Rate: 1 1/2 to 3

receiving low to medium management in full sun to medium shade. Recommended mixture includes; Certified

Ryegrass Cultivars/Certified Kentucky Bluegrass Seeding Rate: 2 pounds mixture per 1000 square feet.

special purposes such as wildlife or aesthetic treatment may be found in USDA-NRCS Technical Field Office

Fertilizer Rate

436 lb/ac

1000 sf)

(10-20-20)

2. For sites having soil tests performed, use and show the recommended rates by the

acre. Mix the wood cellulose fiber with water at a maximum of 50 pounds of wood cellulose fiber per 100 gallons of

using a mulch anchoring tool, increase the application rate to 2.5 tons per acre.

can operate safely. If used on sloping land, this practice should follow the contour.

To stabilize disturbed soils with vegetation for up to 6 months

duration of time, permanent stabilization practices are required.

testing agency. Soil tests are not required for Temporary Seeding.

To use fast growing vegetation that provides cover on disturbed soils

Conditions Where Practice Applies

usually available in rolls 4-15 feet wide and 300 to 3,000 feet long.

TEMPORARY SEEDING NOTES (B-4-4)

Hardiness Zone (from Figure B.3): ____6b 3

Application Rate

PERMANENT SEEDING NOTES (B-4-5)

Guide, Section 342 - Critical Area Planting

receive a medium to high level of maintenance.

in the Permanent Seeding Summary.

summary is to be placed on the plan.

pounds per 1000 square feet.

(lb/ac)

Seed Mixture (from Table B.1):

BARLEY

OAT5

RYE

General Use

A. Seed Mixtures

1 to 2 inches. Apply mulch to achieve a uniform distribution and depth so that the soil surface is not exposed. When

cellulose fiber with water to attain a mixture with a maximum of 50 pounds of wood cellulose fiber per 100 gallons of

done by one of the following methods (listed by preference), depending upon the size of the area and erosion hazard:

HERITAGE LAND DEVELOPMENT 15950 NORTH AVENUE P.O. BOX 482 LISBON, MARYLAND 21765 410-489-7900

DEVELOPER

Select turfordss varieties from those listed in the most current University of Maryland Publication, Agronomy Memo #77, "Turfgrass Cultivar Recommendations for Maryland"

Choose certified material. Certified material is the best guarantee of cultivar purity. The certification program of the Maryland Department of Agriculture, Turf and Seed Section, provides a reliable means of consumer protection and assures a pure genetic line

c. Ideal Times of Seeding for Turf Grass Mixtures Western MD: March 15 to June 1, August 1 to October 1 (Hardiness Zones: 5b, 6a) Central MD: March 1 to May 15, August 15 to October 15 (Hardiness Zone: 6b) Southern MD, Eastern Shore: March 1 to May 15, August 15 to October 15 (Hardiness Zones: 7a. 7b)

d. Till areas to receive seed by disking or other approved methods to a depth of 2 to 4 inches, level and rake the areas to prepare a proper seedbed. Remove stones and debris over 1 1/2 inches in diameter The resulting seedbed must be in such condition that future moving of grasses will pose no difficulty. e. If soil moisture is deficient, supply new seedings with adequate water for plant growth (1/2 to 1 inch every 3 to 4 days depending on soil texture) until they are firmly established. This is especially true when seedings are made late in the planting season, in abnormally dry or hot seasons, or on adverse sites.

Permanent Seeding Summary

| 5eed | Mixture | e (from Figure B. (from Table B.3): | <u>8</u> | | | | | |
|------|----------------|--|----------------------------------|-------------------|----------------------|-------------------------------|--------------------|----------|
| No. | Species | Application Rate (lb/ac) | Seeding Dates | Seeding Depths | N | P ₂ O ₅ | K ₂ 0 | |
| 8 | TALL FESCUE | 100 | Mar. 1-May 15 Aug. 15-Oct. 15 | 1/4-1/2 in. | 45 lbs. per acre | 90 lb/ac (2 lb/ | 90 lb/ac (2 lb/ | (90 lb/ |
| | - | | | | (1.0 lb/ 1000 sf) | 1000 sf) | 1000 sf) | 1000 sf) |
| | | | | | | | | |

Sod: To provide quick cover on disturbed areas (2:1 grade or flatter)

1. General Specifications a. Class of turfgrass sod must be Maryland State Certified. Sod labels must be made available to the job foreman and

b. Sod must be machine cut at a uniform soil thickness fo % inch, plus or minus ¼ inch, at the time of cutting. Measurement for thickness must exclude top growth and thatch. Broken pads and torn or uneven ends will not be

c. Standard size sections of sod must be strong enough to support their own weight and retain their size and shape whe suspended vertically with a firm grasp on the upper 10 percent of the section. Sod must not be harvested or transplanted when moisture content (excessively dry of wet) may adversely affect its survival.

e, Sod must be harvested, delivered, and installed within a period of 36 hours. Sod not transplanted within this period must be approved by an agronomist or soil scientist prior to its installation.

a. During periods of excessively high temperature or in areas having dry subsoil, lightly irrigate the subsoil immediately prior to laying the sod.

b. Lay the first row of sod in a straight line with subsequent rows placed parallel to it and tightly wedged against each other. Stagger lateral joints to promote more uniform growth and strength. Ensure that sod is not stretched or overlapped and that all joints are butted tight in order to prevent voids which would cause air drying of the roots. c. Wherever possible, lay sod with the long edges parallel to the contour and with staggering joints. Roll and tamp, peg or

otherwise secure the sod to prevent slippage on slopes. Ensure solid contact exists between sod roots and the underlying d. Water the sod immediately following rolling and tamping until the underside of the new sod pad and soil surface below the sod are thoroughly wet. Complete the operations of laying, tamping, and irrigating for any piece of sod within eight hours.

a. In the absence of adequate rainfall, water daily during the first week or as often and sufficiently as necessary to maintain moist soil to a depth of 4 inches. Water sod during the heat of the day to prevent wilting.

b. After the first week, sod watering is required as necessary to maintain adequate moisture content c. Do not mow until the sod is firmly rooted. No more than 1/2 of the grass leaf must be removed by the initial cutting or subsequent cuttings. Maintain a grass height of at least 3 inches unless otherwise specified.

B-4-8 STANDARDS AND SPECIFICATIONS FOR STOCKPILE AREAS

A mound or pile of soil protected by appropriately designed erosion and sediment control measures To provide a designated location for the temporary storage of soil that controls the potential for erosion, sedimentation, and changes to drainage patterns.

Conditions Where Practice Applies Stockpile areas are utilized when it is necessary to salvage and store soil for later use.

1. The stockpile location and all related sediment control practices must be clearly indicated on the erosion and sediment control plan.

2. The footprint of the stockpile must be sized to accommodate the anticipated volume of material and based on a side slope ratio no steeper than 2:1. Benching must be provided in accordance with Section 8-3 Land Grading. 3. Runoff from the stockpile area must drain to a suitable sediment control practice.

. Access the stockpile area from the upgrade side. 5. Clear water runoff into the stockpile area must be minimized by use of a diversion device such as an earth dike, temporary swale or diversion fence. Provisions must be made for discharging concentrated flow in a non-erosive manner. 6. Where runoff concentrates along the toe of the stockpile fill, an appropriate erosion/sediment control practice must be used to intercept the discharge. 7. Stockpiles must be stabilized in accordance with the 3/7 day stabilization requirement as well as Standard 8-4-1 incrementa abilization and Standard B-4-4 Temporary Stabilization. 8. If the stockpile is located on an impervious surface, a liner should be provided below the stockpile to facilitate cleanup. Stockpiles

The stockpile area must continuously meet the requirements for Adequate Vegetative Establishment in accordance with Section B-4 Vegetative Stabilization. Side slopes must be maintained at no steeper than a 2:1 ratio. The stockpile area must be kept

free of erosion. If the vertical height of a stockpile exceeds 20 feet for 2:1 slopes, 30 feet for 3:1 slopes, or 40 feet for 4:1 slopes, benching must be provided in accordance with Section B-3 Land Grading.

HOWARD SOIL CONSERVATION DISTRICT

STANDARD SEDIMENT CONTROL NOTES 1) A MINIMUM OF 40 HOURS NOTICE MUST BE GIVEN TO THE HOWARD COUNTY DEPARTMENT OF INSPECTIONS, LICENSES AND PERMITS,

CONTROL DIVISION PRIOR TO THE START OF ANY CONSTRUCTION (410-313-1055).

2) ALL VEGETATIVE AND STRUCTURAL PRACTICES ARE TO BE INSTALLED ACCORDING TO THE PROVISIONS OF THIS PLAN AND ARE TO BE IN CONFORMANCE WITH THE MOST CURRENT MARYLAND STANDARDS AND SPECIFICATIONS FOR SOIL EROSION AND SEDIMENT

3) FOLLOWING INITIAL SOIL DISTURBANCE OR RE-DISTURBANCE, PERMANENT OR TEMPORARY STABILIZATION SHALL BE COMPLETED WITHIN: a) 3 CALENDAR DAYS FOR ALL PERIMETER SEDIMENT CONTROL STRUCTURES, DIKES, PERIMETER SLOPES AND ALL SLOPES GREATER THAN 3:1, b) 7 DAYS AS TO ALL OTHER DISTURBED OR GRADED AREAS ON THE PROJECT SITE ALL DISTURBED AREAS MUST BE STABILIZED WITHIN THE TIME PERIOD SPECIFIED ABOVE IN ACCORDANCE WITH THE 2011 MARYLAND

STANDARDS AND SPECIFICATIONS FOR SOIL EROSION AND SEDIMENT CONTROL FOR PERMANENT SEEDING (SEC. B-4-5), REMPORARY SEEDING (SEC. B-4-4) AND MULCHING (SEC. B-4-3). TEMPORARY STABILIZATION WITH MULCH ALONE CAN ONLY BE DONE WHEN RECOMMENDED SEEDING DATES DO NOT ALLOW FOR PROPER GERMINATION AND ESTABLISHMENT OF GRASSES.
5) ALL SEDIMENT CONTROL STRUCTURES ARE TO REMAIN IN PLACE AND ARE TO BE MAINTAINED IN OPERATIVE CONDITION UNTIL ermission for their removal has been obtained from the howard county sediment control inspector

6) SITE ANALYSIS: TOTAL AREA OF SITE

AREA TO BE ROOFED OR PAVED AREA TO BE VEGETATIVELY STABILIZED

0.41 ACRES 0.19 ACRES 0.22 ACRES 100 CU.YDS 100 CU.YDS.

OFFSITE WASTE/BORROW AREA LOCATION ANY SEDIMENT CONTROL PRACTICE THAT IS DISTURBED BY GRADING ACTIVITY FOR PLACEMENT OF UTILITIES MUST BE REPAIRED ON THE SAME DAY OF DISTURBANCE 8) ADDITIONAL SEDIMENT CONTROL MUST BE PROVIDED, IF DEEMED NECESSARY BY THE HOWARD COUNTY SEDIMENT CONTROL

9) ON ALL SITES WITH DISTURBED AREAS IN EXCESS OF 2 ACRES, APPROVAL OF THE INSPECTION AGENCY SHALL BE REQUESTED UPON COMPLETION OF INSTALLATION OF PERIMETER EROSION AND SEDIMENT CONTROLS, BUT BEFORE PROCEEDING WITH ANY OTHER EARTH DISTURBANCE OR GRADING. OTHER BUILDING OR GRADING INSPECTION APPROVALS MAY NOT BE AUTHORIZED UNTIL

THIS INITIAL APPROVAL BY THE INSPECTION AGENCY IS MADE. 10) TRENCHES FOR THE CONSTRUCTION OF UTILITIES IS LIMITED TO THREE PIPE LENGTHS OR THAT WHICH SHALL BE BACK-FILLED AND STABILIZED BY THE END OF EACH WORKDAY, WHICHEVER IS SHORTER. 11) ANY CHANGES OR REVISIONS TO THE SEQUENCE OF CONSTRUCTION MUST BE REVIEWED AND APPROVED BY THE PLAN APPROVAL AUTHORITY PRIOR TO PROCEEDING WITH CONSTRUCTION.

12) A PROJECT IS TO BE SEQUENCED SO THAT GRADING ACTIVITIES BEGIN ON ONE GRADING UNIT (MAXIMUM ACREAGE OF 20 ACRE PER GRADING UNIT) AT A TIME. WORK MAY PROCEED TO A SUBSEQUENT GRADING UNIT WHEN AT LEAST 50 PERCENT OF THE DISTURBED AREA IN THE PROCEEDING GRADING UNIT HAS BEEN STABILIZED AND APPROVED BY THE ENFORCEMENT AUTHORITY. UNLESS OTHERWISE SPECIFIED AND APPROVED BY THE APPROVAL AUTHORITY, NO MORE THAN 30 ACRES CUMULATIVELY MAY BE

SEQUENCE OF CONSTRUCTION

OBTAIN A GRADING PERMIT AND HOLD PRE-CONSTRUCTION MEETING WITH COUNTY INSPECTOR

NOTIFY "MISS UTILITY" AT LEAST 48 HOURS BEFORE BEGINNING ANY WORK AT 1-200-257-7777. NOTIFY THE HOWARD COUNTY OFFICE OF CONSTRUCTION / INSPECTION AT

410-313-1330 AT LEAST 24 HOURS BEFORE STARTING WORK INSTALL STABILIZED CONSTRUCTION ENTRANCE, SILT FENCE, SUPER-SILT FENCE, AND DIVERSION FOR OFF-SITE WATER THRU EXISTING CULVERT PIPE AS OUTLINED WITH THE MDE PERMIT (AS NECESSARY), (3 DAYS)


REMOVE NECESSARY TREES AND TEMPORARY SEED DISTURBED AREAS AS NECESSARY. (5 DAYS) CONSTRUCT HEADWALLS AND GUARDRAIL (30 DAYS)

UPON CURING OF POURED WALLS, ROUGH GRADE AND INSTALL DRIVEWAY. (1 WEEK) INSTALL EROSION CONTROL MATTING AND PERMANENT SEEDING. (3 DAYS) UPON COMPLETION OF ALL GRADING WITHIN DRAINAGE AREA TO MICRO-BIORETENTION AREA. CONSTRUCT MICRO-BIORETENTION FACILITY AND UNDERDRAIN. (2 DAYS)

INSTALL MICRO-BIORETENTION PLANT MATERIAL AND MULCH. (1 DAY) ALL FINAL GRADES AND STABILIZATION SHOULD BE COMPLETED BEFORE ANY REMOVAL OF CONTROLS. WHEN ALL CONTRIBUTING AREAS TO THE SEDIMENT CONTROL DEVICES HAVE BEEN STABILIZED AND WITH THE PERMISSION OF THE SEDIMENT CONTROL INSPECTOR. THE SEDIMENT CONTROL DEVICES MAY BE REMOVED. (3 DAYS)

NOTE: THE CONTRACTOR SHALL INSPECT AND PROVIDE NECESSARY MAINTENANCE EACH RAINFALL AND ON A DAILY BASIS


Professional certification. I hereby certify that these documents were prepared by me, and that I am a duly Licensed Professional Engineer under the laws of the State of Maryland, License No. 30306, Expiration Date 1-12-16."

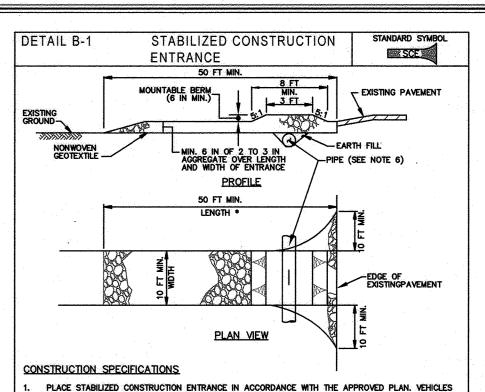

MUST TRAVEL OVER THE ENTIRE LENGTH OF THE SCE. USE MINIMUM LENGTH OF 50 FEET (*30 FEET FOR SINGLE RESIDENCE LOT). USE MINIMUM WIDTH OF 10 FEET. FLARE SCE 10 FEET MINIMUM AT THE EXISTING ROAD TO PROVIDE A TURNING RADIUS. PIPE ALL SURFACE WATER FLOWING TO OR DIVERTED TOWARD THE SCE UNDER THE ENTRANCE, MAINTAINING POSITIVE DRAINAGE. PROTECT PIPE INSTALLED THROUGH THE SCE WITH A MOUNTABLE BERM WITH 5.1 SLOPES AND A MINIMUM OF 12 INCHES OF STONE OVER THE PIPE. PROVIDE PIPE AS SPECIFIED ON APPROVED PLAN. WHEN THE SCE IS LOCATED AT A HIGH SPOT AND HAS NO DRAINAGE TO CONVEY, A PIPE IS NOT NECESSARY. A MOUNTABLE BERM IS REQUIRED WHEN SCE IS NOT LOCATED AT A HIGH SPOT.

PREPARE SUBGRADE AND PLACE NONWOVEN GEOTEXTILE, AS SPECIFIED IN SECTION H-1 MATERIAL: PLACE CRUSHED AGGREGATE (2 TO 3 INCHES IN SIZE) OR EQUIVALENT RECYCLED CONCRETE

MAINTAIN ENTRANCE IN A CONDITION THAT MINIMIZES TRACKING OF SEDIMENT. ADD STONE OR MAKE OTHER REPAIRS AS CONDITIONS DEMAND TO MAINTAIN CLEAN SURFACE, MOUNTABLE BERM, AND SPECIFIED DIMENSIONS. IMMEDIATELY REMOVE STONE AND/OR SEDIMENT SPILLED, DROPPED, OR TRACKED ONTO ADJACENT ROADWAY BY VACUUMING, SCRAPING, AND/OR SWEEPING. WASHING ROADWAY TO REMOVE MUD TRACKED ONTO PAVEMENT IS NOT ACCEPTABLE UNLESS WASH WATER IS DIRECTED TO AN APPROVED SEDIMENT CONTROL PRACTICE.

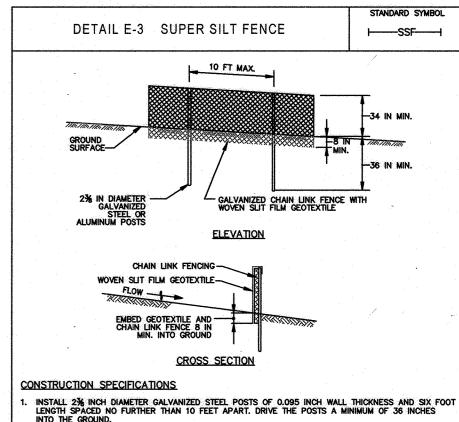


WHERE ENDS OF THE GEOTEXTILE COME TOGETHER, THE ENDS SHALL BE OVERLAPPED BY 6 INCHES, FOLDED, AND STAPLED TO PREVENT SEDIMENT BY PASS.

PROVIDE MANUFACTURER CERTIFICATION TO THE INSPECTION/ENFORCEMENT AUTHORITY SHOWING THAT GEOTEXTILE USED MEETS THE REQUIREMENTS IN SECTION H-1 MATERIALS. REMOVE ACCUMULATED SEDIMENT AND DEBRIS WHEN BULGES DEVELOP IN FENCE OR WHEN SEDIMENT REACHES 25% OF FENCE HEIGHT. REPLACE GEOTEXTILE IF TORN. IF UNDERMINING OCCURS, REINSTALL CHAIN LINK FENCING AND GEOTEXTILE.

MARYLAND STANDARDS AND SPECIFICATIONS FOR SOIL EROSION AND SEDIMENT CONTROL 2011

BLAZE ORANGE PLASTIC MESH

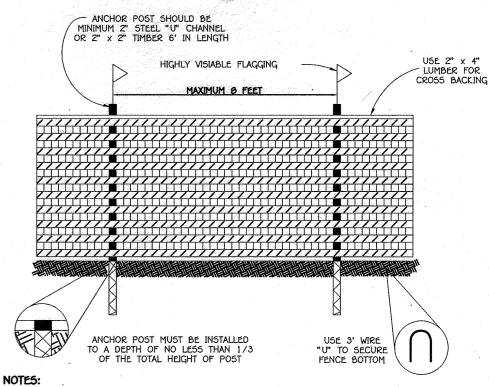

FOREST PROTECTION DEVICE ONLY RETENTION AREA WILL BE SET AS PART OF THE REVIEW PROCESS. BOUNDARIES OF RETENTION AREA SHOULD BE STAKED AND FLAGGED PRIOR TO INSTALLING DEVICE. ROOT DAMAGE SHOULD BE AVOIDED. PROTECTIVE SIGNAGE MAY ALSO BE USED

TREE PROTECTION DETAIL

Sediment & Erosion Control Plan, Notes, & Details

Cattail Overlook

Lots 1 Thru 6 (A Resubdivision Of Lot 2 Buice Property - Plat Nos. 5426 - 5429) And (A Resubdivision of Meriwether Farm Section One Non-Buildable Parcel 'E' Plat Nos. 21339 - 21344)

ZONED: RC-DEO TAX MAP: 21 PARCELS: 24 & 84 GRIDS: 20 & 21 FOURTH ELECTION DISTRICT - HOWARD COUNTY, MARYLAND SCALE: 1"=100' DATE: MAY, 2014 SHEET 6 OF 8

F-14-072

