

**GENERAL NOTES**

- 1.) ALL CONSTRUCTION SHALL BE IN ACCORDANCE WITH THE LATEST STANDARDS AND SPECIFICATIONS OF HOWARD COUNTY PLUS MSHA STANDARDS AND SPECIFICATIONS, IF APPLICABLE.
- 2.) BOUNDARY IS BASED ON A FIELD RUN MONUMENTED SUBURBAN BOUNDARY SURVEY PERFORMED BY JOHN A. MILDENBERG IN MARCH, 2006.
- 3.) THE SUBJECT PROPERTY IS ZONED PGCC PER THE 10-6-2013 COMPREHENSIVE ZONING PLAN.
- 4.) THE EXISTING TOPOGRAPHY SHOWN IS BASED ON AERIAL TOPOGRAPHIC SURVEY PERFORMED BY WINGS AERIAL MAPPING CO., INC. FLOWN ON OR ABOUT JANUARY, 2006. TOPOGRAPHY WITHIN THE STREAM CHANNEL IS BASED ON FIELD RUN SURVEY PERFORMED BY BENCHMARK ENGINEERING, INC. IN MAY, 2015.
- 5.) THE COORDINATES SHOWN HEREON ARE BASED UPON THE HOWARD COUNTY GEODETIC CONTROL WHICH IS BASED UPON THE MARYLAND STATE PLANE COORDINATE SYSTEM. HOWARD COUNTY MONUMENT NOS. 161A AND 161B WERE USED FOR THIS PROJECT.
- 6.) WATER IS PUBLIC. THE CONTRACT NUMBER IS 44-4934-D. THE DRAINAGE AREA IS LITTLE PATUXENT.
- 7.) SEWER IS PUBLIC. THE CONTRACT NUMBER IS 24-4354-D. THE DRAINAGE AREA IS LITTLE PATUXENT.
- 8.) THIS PROJECT IS LOCATED WITHIN THE METROPOLITAN DISTRICT.
- 9.) EXISTING UTILITIES SHOWN ARE BASED ON CONTRACT DRAWINGS, AERIAL AND FIELD SURVEYED LOCATIONS.
- 10.) THE FLOODPLAIN STUDY FOR THIS PROJECT WAS PREPARED BY BENCHMARK ENGINEERING, INC. IN JULY, 2015 AND APPROVED BY THE DEPARTMENT OF PLANNING AND ZONING ON SEPTEMBER 30, 2015.
- 11.) A NOISE STUDY IS NOT REQUIRED FOR THIS PROJECT SINCE NO RESIDENTIAL LOTS/UNITS ARE PROPOSED.
- 12.) A TRAFFIC STUDY IS NOT NEEDED FOR THIS PROJECT AS IT CREATES NO NEW (ADDITIONAL) LOTS.
- 13.) A GEOTECHNICAL REPORT WAS PREPARED BY HILLIS-CARNES ENGINEERING ASSOCIATES, INC. IN JUNE, 2015 AND BY BENCHMARK ENGINEERING, INC. IN JULY 2015.
- 14.) THERE ARE NO EXISTING STRUCTURES LOCATED ON-SITE.
- 15.) TO THE BEST OF OUR KNOWLEDGE, THERE ARE NO BURIAL GROUNDS, CEMETERIES OR HISTORIC STRUCTURES LOCATED ON THIS SITE.
- 16.) THE GRADING, REMOVAL OF VEGETATIVE COVER OR TREES, AND PAVING ASSOCIATED WITH THE CONSTRUCTION OF RESORT ROAD WITHIN THE LIMITS OF WETLANDS, STREAM, THEIR BUFFERS, 100-YEAR FLOODPLAIN AND STEEP SLOPES GREATER THAN 25% IN EXCESS OF 20,000 CONTIGUOUS SQUARE FEET HAS BEEN DETERMINED NECESSARY BY THE DEPARTMENT OF PLANNING AND ZONING BASED ON THE APPROVAL OF THE FOURTH AMENDMENT TO THE TURF VALLEY COMPREHENSIVE SKETCH PLAN (S-88-013, PG 368) ON 7-28-2006. THE MDE PERMIT ASSOCIATED WITH THIS DISTURBANCE IS #02-NP-009/200261464.
- 17.) LANDSCAPING FOR THIS SUBDIVISION IS PROVIDED IN ACCORDANCE WITH A CERTIFIED LANDSCAPE PLAN INCLUDED WITH THIS ROAD CONSTRUCTION PLAN SET IN ACCORDANCE WITH SECTION 16.124 OF THE HOWARD COUNTY CODE AND THE LANDSCAPE MANUAL. FINANCIAL SURETY FOR THE REQUIRED STREET TREES SHALL BE POSTED AS A PART OF THE DPW DEVELOPER'S AGREEMENT.
- 18.) THIS PROJECT IS SUBJECT TO THE REQUIREMENTS OF SECTION 16.1202 OF THE HOWARD COUNTY CODE FOR FOREST CONSERVATION. THE REQUIREMENT HAS BEEN DEFERRED PER APPROVAL OF WP-15-153. SEE GENERAL NOTE #27 BELOW.
- 19.) THE FOREST STAND DELINEATION FOR THIS PARCEL WAS PREPARED BY ECO-SCIENCE PROFESSIONALS, INC. ON JULY 16 2007.
- 20.) THE WETLANDS DELINEATION FOR THIS PARCEL WAS PREPARED BY ECO-SCIENCE PROFESSIONALS, INC. ON SEPTEMBER 29, 2009.
- 21.) STREET LIGHT PLACEMENT AND THE TYPE OF FIXTURES AND POLES SHALL BE IN ACCORDANCE WITH THE HOWARD COUNTY DESIGN MANUAL VOLUME III (2006), SECTION 5.5.A. A MINIMUM OF 20' SHALL BE MAINTAINED BETWEEN ANY STREET LIGHT AND ANY TREE.
- 22.) TRAFFIC CONTROL DEVICES:
  - A) THE 8x11 "STOP" SIGN AND STREET NAME SIGN (SNS) ASSEMBLY FOR THIS DEVELOPMENT MUST BE INSTALLED BEFORE THE BASE PAVING IS COMPLETED.
  - B) THE TRAFFIC CONTROL DEVICE LOCATIONS SHOWN ON THE PLANS ARE APPROXIMATE AND MUST BE FIELD APPROVED BY HOWARD COUNTY TRAFFIC DIVISION (410-313-2430) PRIOR TO THE INSTALLATION OF ANY OF THE TRAFFIC CONTROL DEVICES.
  - C) ALL TRAFFIC CONTROL DEVICES AND THEIR LOCATIONS SHALL BE IN ACCORDANCE WITH THE LATEST EDITION OF THE "MARYLAND MANUAL ON UNIFORM TRAFFIC CONTROL DEVICES (MUMUTCD).
  - D) ALL SIGN POSTS USED FOR TRAFFIC CONTROL SIGNS INSTALLED IN THE COUNTY RIGHT-OF-WAY SHALL BE MOUNTED ON A 2" GALVANIZED STEEL, PERFORATED "QUICK PUNCH", SQUARE TUBE POST (14 GAUGE) INSERTED INTO A 2-1/2" GALVANIZED STEEL, PERFORATED, SQUARE TUBE SLEEVE (12 GAUGE) - 3' LONG. THE ANCHOR SHALL NOT EXTEND MORE THAN TWO "QUICK PUNCH" HOLES ABOVE GROUND LEVEL. A GALVANIZED STEEL POLE CAP SHALL BE MOUNTED ON TOP OF EACH POST.
- 23.) THE PROJECT SHALL COMPLY WITH THE REQUIREMENTS OF SECTION 16.129 OF THE HOWARD COUNTY CODE.
- 24.) PROPERTIES DEPICTED ON THESE PLANS ARE ZONED "PGCC" UNLESS OTHERWISE NOTED.
- 25.) ALL FILL AREAS SHALL BE AT 95% COMPACTION IN ACCORDANCE WITH AASHTO T-180 STANDARDS
- 26.) STORMWATER MANAGEMENT IS PROVIDED BY TWO (M-6) MICRO BIO-RETENTION PRACTICES AND ONE (F-6) BIO-RETENTION FACILITY. THESE PRACTICES SHALL BE PRIVATELY OWNED AND JOINTLY MAINTAINED.
- 27.) WP-15-153, TO WAIVE SECTION 16.148 AND SECTION 16.1202(c) OF THE HOWARD COUNTY SUBDIVISION AND LAND DEVELOPMENT REGULATIONS WAS APPROVED ON JUNE 16, 2015 WITH THE FOLLOWING CONDITIONS:
  - A. THE PETITIONER SHALL SUBMIT TO DPZ A PRELIMINARY PLAN IN ACCORDANCE WITH S-11-002 AND THE REQUIREMENTS OF SECTION 16.148 OF THE COUNTY CODE ON OR BEFORE JUNE 5, 2016. THIS PLAN MAY OMIT THE AREA WITHIN THE LIMITS OF THE BLUFFS AT TURF VALLEY, RESORT ROAD EXTENSION FINAL SUBDIVISION PLAN.
  - B. THE PETITIONER SHALL INDICATE THE BULK PARCELS RECORDED AS PART OF THE FINAL SUBDIVISION PLAN FOR THE BLUFFS AT TURF VALLEY, RESORT ROAD EXTENSION AS NON-BUILDABLE.
  - C. THE PETITIONER SHALL SUBMIT A FOREST CONSERVATION PLAN TO INCLUDE THE RELATED DATA WITHIN THE LIMITS OF DISTURBANCE OF THE FINAL SUBDIVISION PLAN SUBMITTED FOR THE BLUFFS AT TURF VALLEY, RESORT ROAD EXTENSION UPON SUBMISSION OF THE FIRST OF THE FOLLOWING:
    1. A FINAL SUBDIVISION PLAN SUBDIVIDING PARCEL 706
    2. A FINAL SUBDIVISION PLAN RESUBDIVIDING BULK PARCELS RECORDED AS PART OF THE BLUFFS AT TURF VALLEY, RESORT ROAD EXTENSION; OR
    3. A SITE DEVELOPMENT PLAN LOCATED ON PARCEL 706.
- 28.) THIS PROJECT IS SUBJECT TO THE AMENDED FIFTH EDITION OF THE SUBDIVISION AND LAND DEVELOPMENT REGULATIONS AND THE 2ND AMENDMENT TO THE TURF VALLEY RESIDENTIAL SUBDISTRICT FINAL DEVELOPMENT PLAN.
- 29.) RESORT ROAD IS CLASSIFIED AS A LOCAL ROAD PER THE HOWARD COUNTY GENERAL PLAN. IT SHALL BE DESIGNED AND CONSTRUCTED AS A MINOR COLLECTOR.
- 30.) BULK PARCELS 'A' AND 'B' SHALL BE RE-SUBDIVIDED UNDER A FUTURE PHASE.
- 31.) WP-16-029, TO WAIVE SECTION 16.1205(a)(1) OF THE HOWARD COUNTY SUBDIVISION AND LAND DEVELOPMENT REGULATIONS WAS APPROVED ON SEPTEMBER 15, 2015 WITH THE FOLLOWING CONDITION:
  1. THE PETITIONER SHALL PLANT TWO SHADE TREES AS REPLACEMENTS FOR THE SEVEN (7) TREES REMOVED. THE REPLACEMENT PLANTINGS SHALL BE ADDED TO THE F-16-024 LANDSCAPE PLAN OR TO LANDSCAPE PLANS SUBMITTED AS PART OF THE FUTURE THE BLUFFS AT TURF VALLEY, RESORT ROAD EXTENSION. THE PLANTING SURETY SHALL BE POSTED FOR THE REPLACEMENT PLANTINGS.


# ROAD CONSTRUCTION PLANS

## THE BLUFFS AT TURF VALLEY

### RESORT ROAD EXTENSION


#### HOWARD COUNTY, MARYLAND

| BENCHMARKS |              |                |           |  |
|------------|--------------|----------------|-----------|--|
| NUMBER     | NORTHING     | EASTING        | ELEVATION | DESCRIPTION                                |
| 161A       | 589,509.3676 | 1,346,343.632  | 462.988   | RT.40 0.35 MILES WEST OF RT-144 JOINT      |
| 161B       | 590,475.2538 | 1,344,753.9350 | 469.892   | RT.40 0.8 MILES EAST OF MARRIOTTVILLE ROAD |

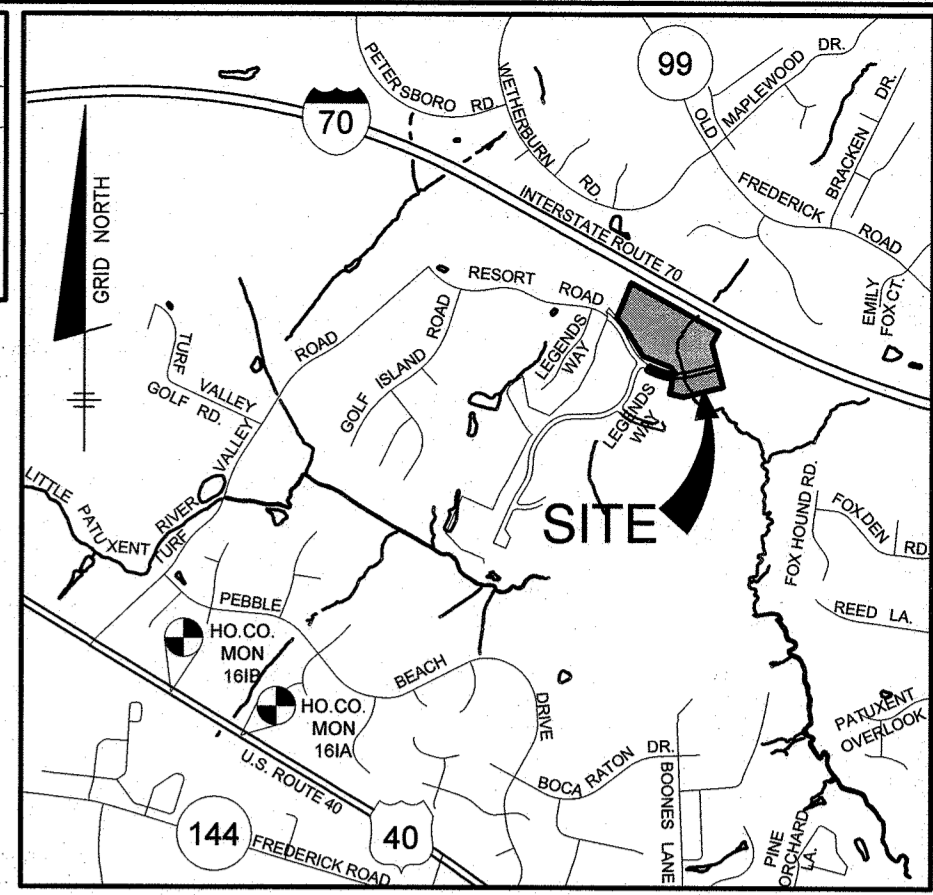

- AS-BUILT NOTES:**
- 1.) HORIZONTAL AND VERTICAL DATUM FOR THIS AS-BUILT IS BASED ON THE MARYLAND STATE REFERENCE SYSTEM NAD 83 / ADJ C/A S PROJECTED FROM HO CO. GEODETIC CONTROL STATIONS K18 AND 17AB.
  - 2.) THE INSTRUMENTS USED IN PERFORMING THE AS-BUILT WERE A 5" TOTAL STATION AND PRISM AND RTK GPS.
  - 3.) THIS AS-BUILT WAS PERFORMED BY BENCHMARK ENGINEERING, INC.

**LEGEND**

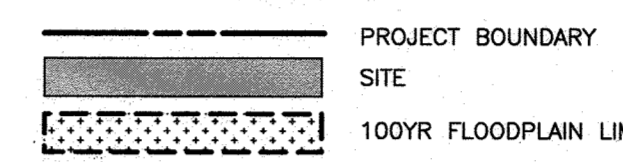

| R/W PT. NO. | DESCRIPTION | ELEVATION |
|-------------|-------------|-----------|
| 809         | REBAR & CAP | 446.07'   |
| 810         | REBAR & CAP | 446.04'   |
| 811         | REBAR & CAP | 444.48'   |
| 818         | REBAR & CAP | 449.29'   |
| 819         | REBAR & CAP | 449.03'   |
| 820         | REBAR & CAP | 462.80'   |
| 821         | REBAR & CAP | 462.36'   |
| 9           | CONC. MON.  | 444.87'   |

| SHEET INDEX |  |
|-------------|--|
| SHEET       | TITLE  |
| 1           | TITLE SHEET  |
| 2           | ROAD PLAN, PROFILE AND DETAILS                                     |
| 3           | STRIPING, SIGNAGE, & STREET LIGHTING PLAN AND CURB FILLET PROFILES |
| 4           | STORM DRAIN DRAINAGE AREA MAP                                      |
| 5           | 100YR FLOODPLAIN CROSS-SECTION & ELEVATION PLAN                    |
| 6           | STORM DRAIN PROFILES AND DETAILS                                   |
| 7           | TWIN 60" CULVERT PROFILE AND DETAILS                               |
| 8           | ESD STORMWATER MANAGEMENT NOTES AND DETAILS                        |
| 9           | ESD STORMWATER MANAGEMENT NOTES AND DETAILS                        |
| 10          | LANDSCAPE PLAN   |
| 11          | GRADING, SEDIMENT & EROSION CONTROL PLAN                           |
| 12          | SEDIMENT & EROSION CONTROL NOTES AND SEQUENCE OF CONSTRUCTION      |
| 13          | SEDIMENT & EROSION CONTROL DETAILS                                 |
| 14          | TEMPORARY STREAM DIVERSION PLAN & DETAILS                          |
| 15          | SOIL BORING LOGS   |


**SITE ANALYSIS DATA CHART**

**GENERAL SITE DATA**

- 1.) PRESENT ZONING: PGCC
- 2.) APPLICABLE DPZ FILE REFERENCES: S-86-13, S-11-002, ECP-11-053, ECP-11-052, F-07-158, WP-15-153
- 3.) PROPOSED USE OF SITE: PUBLIC ROAD
- 4.) PROPOSED WATER AND SEWER SYSTEMS: PUBLIC

**AREA TABULATION**

- 1.) GROSS TRACT AREA: 16.19± AC.
- 2.) AREA WITHIN 100-YEAR FLOODPLAIN: 1.27± AC.
- 3.) TOTAL AREA OF 25% OR GREATER STEEP SLOPES AREA NOT IN FLOODPLAIN (FOR NTA CALC): 0.78± AC.
- 4.) NET TRACT AREA: 14.14± AC.
- 5.) TOTAL NUMBER OF LOTS ALLOWED PER ZONING: N/A
- 6.) TOTAL NUMBER OF RESIDENTIAL UNITS/LOTS PROPOSED ON THIS SUBMISSION: 0
- 7.) AREA OF BUILDABLE LOTS: 0
- 8.) AREA OF OPEN SPACE LOTS: 0
- 9.) AREA OF BULK PARCELS: 15.33± AC.
- 10.) AREA OF PUBLIC RIGHT-OF-WAY: 0.86± AC.

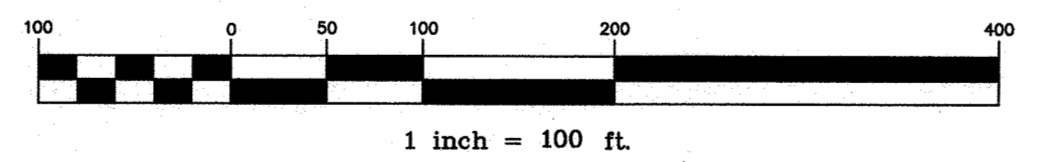

THE CONTRACTOR SHALL NOTIFY THE DEPARTMENT OF PUBLIC WORKS/BUREAU OF ENGINEERING/CONSTRUCTION INSPECTION DIVISION AT 410-313-1880 AT LEAST FIVE (5) WORKING DAYS PRIOR TO THE START OF WORK.

THE CONTRACTOR SHALL NOTIFY "MISS UTILITY" AT 1-800-257-7777 AT LEAST 48 HOURS PRIOR TO ANY EXCAVATION WORK BEING DONE.

| ESD STORMWATER MANAGEMENT SUMMARY TABLE |                     |                           |     |      |             |             |           |             |             |          |           |
|---|---------------------|---------------------------|-----|------|-------------|-------------|-----------|-------------|-------------|----------|-----------|
| Practice                                | DA to practice (sf) | Imp Area to practice (sf) | Pe  | Qe   | At (s.f.)   |             | ESDv      |             | Rev         |          | Ownership |
|   |                     |                           |     |      | Required    | Provided    | Required* | Provided    | Required    | Provided |           |
| (M-6) MicroBioretention #1              | 12,651              | 4,520                     | 1.8 | 0.74 | 253         | 460         | PASS      | 584         | 593         | 1.8      | Private   |
| (M-6) MicroBioretention #2              | 13,732              | 4,520                     | 1.8 | 0.66 | 275         | 448         | PASS      | 584         | 588         | 1.8      | Private   |
| (F-6) Bioretention #1                   | 30,701              | 18,371                    | 1.9 | 1.12 | 614         | 1988        | PASS      | 2151        | 2269        | 1.9      | Private   |
| <b>Total Treated</b>                    | <b>57,084</b>       | <b>27,411</b>             |     |      | <b>1142</b> | <b>2896</b> |           | <b>3298</b> | <b>3450</b> |          |           |

\* Required ESDv for Bio-Retentions and Micro Bio-Retentions is based on 75% of total ESDv calculated per MDE treatment criteria  
Rev is met via 7" stone chamber below outlet pipe in F-6 Bio-Retention Facility

**SWM DESIGN NARRATIVE:**

NATURAL RESOURCES SHALL BE PRESERVED AS NO RESOURCES ARE BEING IMPACTED BY THE IMPLEMENTATION OF THE SWM ESD PRACTICES.

EXISTING FLOW PATTERNS SHALL BE MAINTAINED. THE SITE HAS A STREAM BI-SECTING IT THAT FLOWS FROM THE NORTH TO THE SOUTH. THE ESD PRACTICE UNDERDRAINS SHALL DISCHARGE TOWARDS THE STREAM CHANNEL. THIS MIMICS THE EXISTING CONDITION DRAINAGE PATTERN.

IMPERVIOUS AREA IS BEING HELD TO A MINIMUM BY UTILIZING THE SMALLEST ROAD PAVEMENT WIDTH (24 FEET) ALLOWED BASED ON ROAD CLASSIFICATION.

SEDIMENT AND EROSION CONTROL SHALL BE PROVIDED MAINLY THROUGH THE IMPLEMENTATION OF SUPER SILT FENCES AROUND THE PERIMETER EDGE. OFF-SITE DRAINAGE SHALL BE BYPASSED AROUND THE SITE VIA CLEAN WATER DIVERSION DIKES OR THROUGH THE SITE VIA DIKES DISCHARGING TO A TEMPORARY DIVERSION PIPE. NO TRAPS OR BASINS SHALL BE NEEDED. THERE ARE NO IMPACTS TO SWM DESIGN BASED ON SEDIMENT AND EROSION CONTROL.

THE PROPOSED TWO (M-6) MICRO BIO-RETENTION PRACTICES AND ONE (F-6) BIO-RETENTION PRACTICE ADEQUATELY TREAT THE PROPOSED IMPERVIOUS AREAS. THE PRACTICES SHALL ALL DISCHARGE AT A LOCATION THAT IS NOT DETRIMENTAL TO THE ADJACENT PROPERTIES. INLETS SHALL BE PLACED IN THE M'S WHERE HIGHER STORMS MIGHT CREATE OVERFLOW ISSUES. FULL TREATMENT IS BEING PROVIDED THEREFORE THIS PROJECT CAN BE CONSIDERED TO BE TREATED TO THE MAXIMUM EXTENT PRACTICAL.

Professional Certification. I hereby certify that these documents were prepared or approved by me, and that I am a duly licensed professional engineer under the laws of the State of Maryland.

License No. 21443, Expiration Date: 12-2-22



**AS-BUILT CERTIFICATION**  
I hereby certify, by my seal, that to the best of my knowledge and belief the facilities shown on this "AS-BUILT" Plan meet the Approved Plans and Specifications

Donald Mason, P.E. Date: 9/20/21

APPROVED: DEPARTMENT OF PUBLIC WORKS  
*Michael* 10/19/2015  
CHIEF, BUREAU OF HIGHWAYS

APPROVED: DEPARTMENT OF PLANNING AND ZONING  
*K. Schuler* 10-28-15  
CHIEF, DIVISION OF LAND DEVELOPMENT

*Chad* 10-19-15  
CHIEF, DEVELOPMENT ENGINEERING DIVISION

Professional Certification. I hereby certify that these documents were prepared or approved by me, and that I am a duly licensed professional engineer under the laws of the State of Maryland. License No. 21443, Expiration Date: 6-30-2017.

**BENCHMARK ENGINEERING, INC.**  
8480 BALTIMORE NATIONAL PIKE SUITE 315 ELLICOTT CITY, MARYLAND 21043  
(P) 410-465-8105 (F) 410-465-8644  
WWW.BEI-CIVILENGINEERING.COM

OWNER: MANGIONE ENTERPRISES OF TURF VALLEY, LIMITED PARTNERSHIP  
1205 YORK ROAD, PENTHOUSE LUTHERVILLE, MARYLAND 21093 410-825-8400


DEVELOPER: MANGIONE ENTERPRISES OF TURF VALLEY, LIMITED PARTNERSHIP  
1205 YORK ROAD, PENTHOUSE LUTHERVILLE, MARYLAND 21093 410-825-8400

**THE BLUFFS AT TURF VALLEY RESORT ROAD EXTENSION**  
NON-BUILDABLE BULK PARCELS 'A' AND 'B'  
A SUBDIVISION OF PART OF PARCEL 706

TAX MAP: 17 - GRID: 13 - PARCEL: p/o 706  
ZONED: PGCC  
ELECTION DISTRICT NO. 2 - HOWARD COUNTY, MARYLAND

**TITLE SHEET**

DATE: SEPTEMBER, 2015 BEI PROJECT NO. 2697  
DESIGN: DBT DRAFT: DBT SCALE: AS SHOWN SHEET 1 OF 15

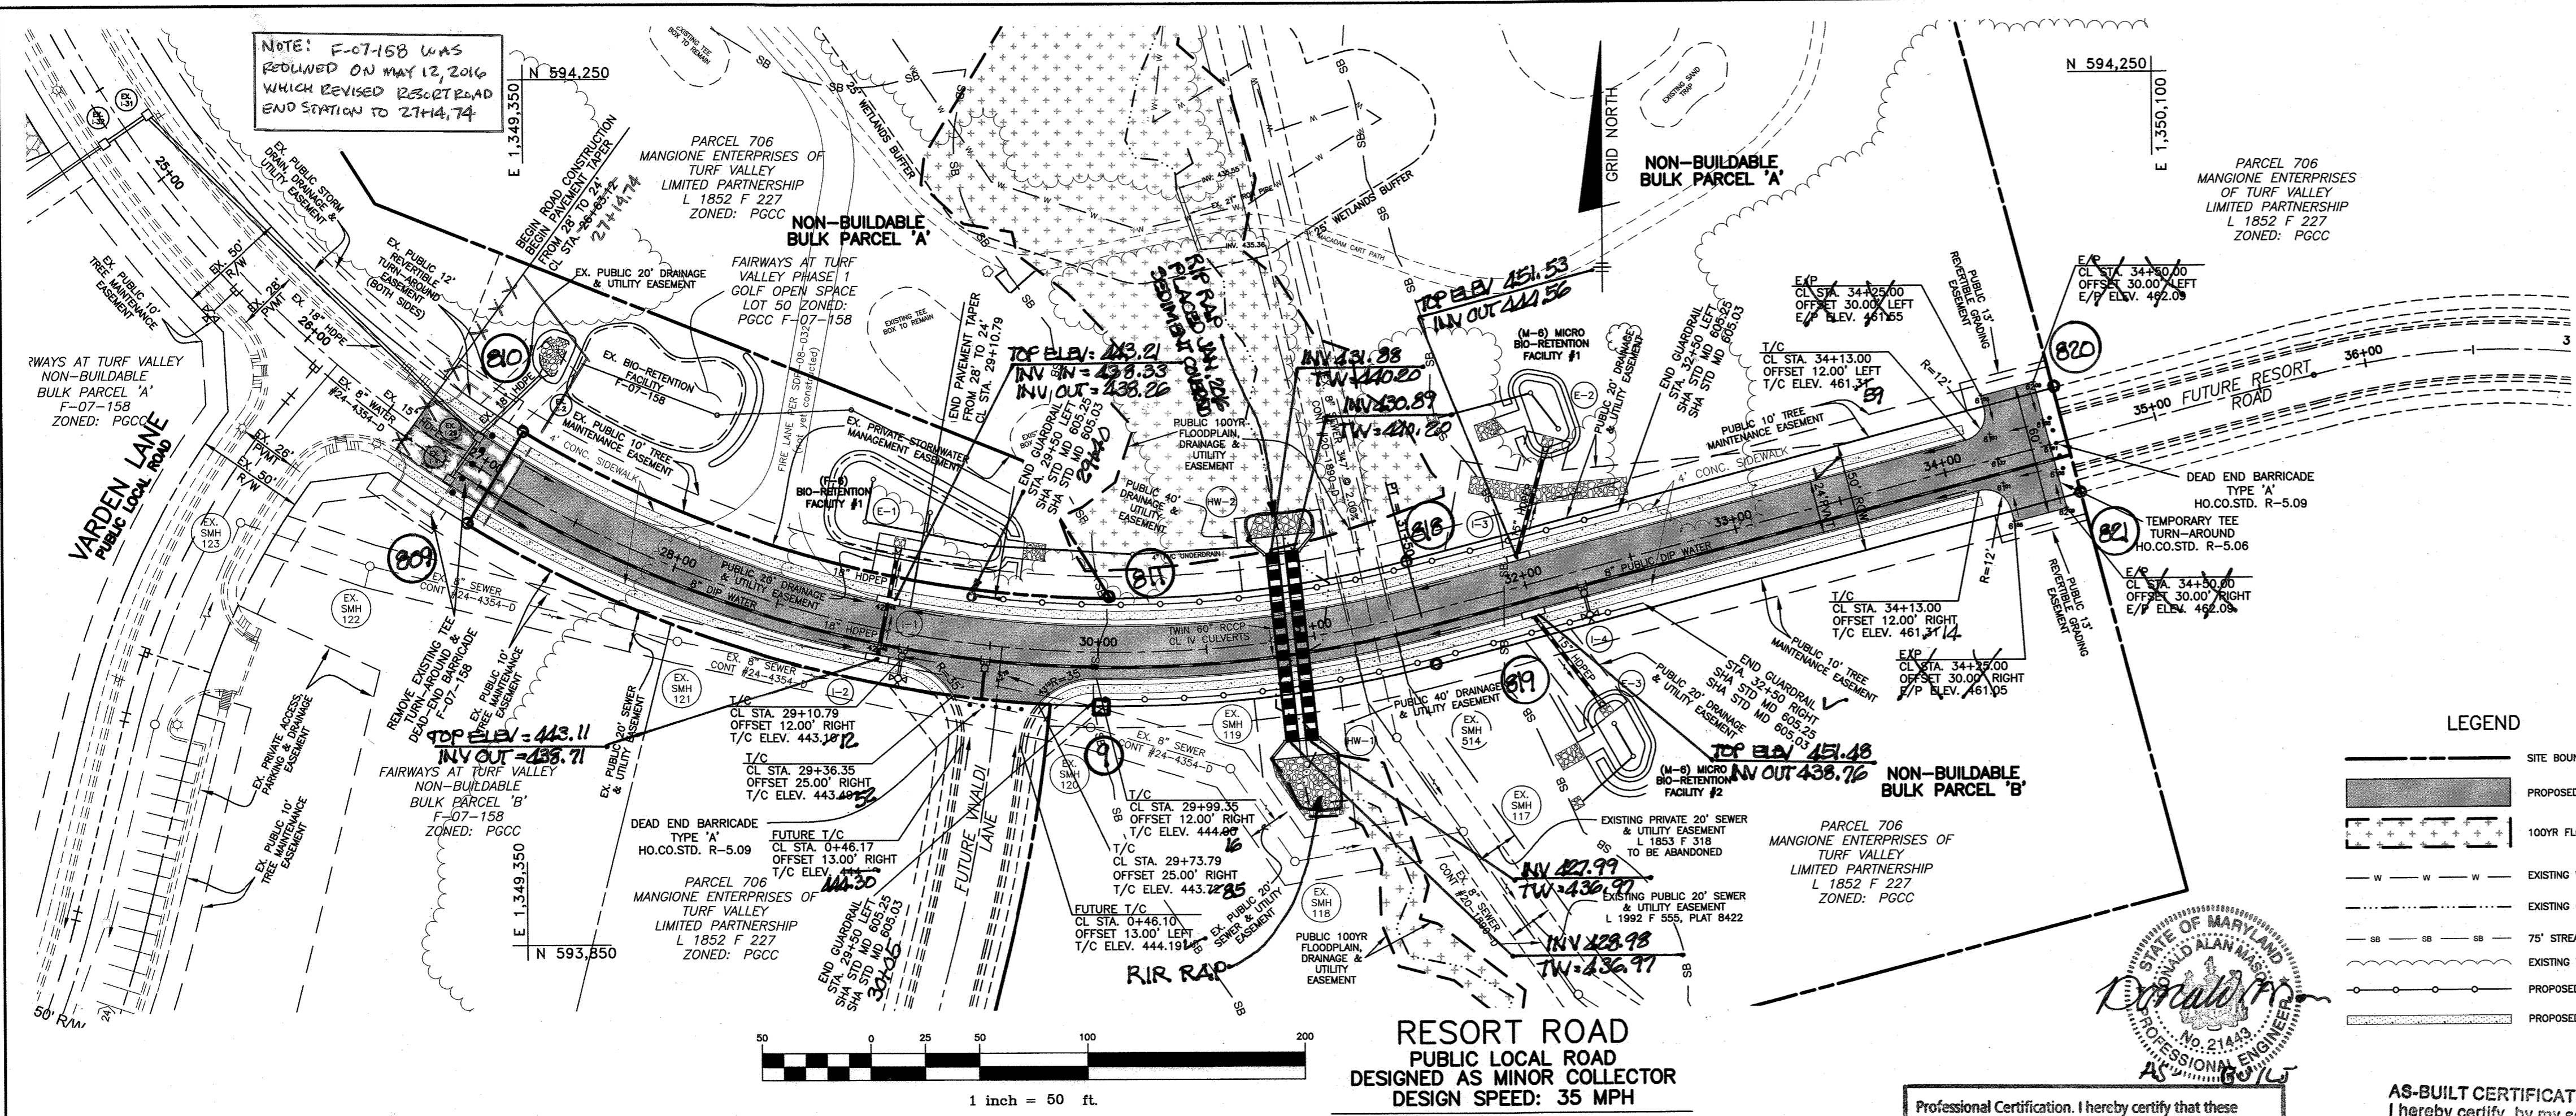


| ROAD CHART  |                      |                   |              |           |
|-------------|----------------------|-------------------|--------------|-----------|
| ROAD        | LIMITS               | CLASSIFICATION    | DESIGN SPEED | PVMT TYPE |
| RESORT ROAD | 26+92.88 TO 34+50.00 | PUBLIC LOCAL ROAD | 35 MPH       | P-3       |


| CENTER LINE CURVE DATA |                      |         |           |               |                             |
|------------------------|----------------------|---------|-----------|---------------|-----------------------------|
| CURVE                  | STATION              | RADIUS  | ARC DELTA | TANGENT CHORD |                             |
| 1                      | 26+92.88 TO 31+50.00 | 550.00' | 457.12'   | 473°37'14"    | 242.70' S80°44'15"E 444.08' |

| CENTER CONTROL DATA |           |            |
|---------------------|-----------|------------|
| STATION             | NORTHING  | EASTING    |
| 26+82.88            | 594073.98 | 1349323.64 |
| 29+55.51            | 593987.60 | 1349569.03 |
| 31+50.00            | 594002.50 | 1349761.93 |
| 34+50.00            | 594071.85 | 1350052.31 |



**RESORT ROAD**  
**STA. 29+10.79 TO 34+13.00**  
**TYPICAL ROADWAY SECTION**  
 PUBLIC LOCAL ROAD  
 DESIGNED AS MINOR COLLECTOR  
 DESIGN SPEED: 35 MPH  
 SCALE: 1" = 10'

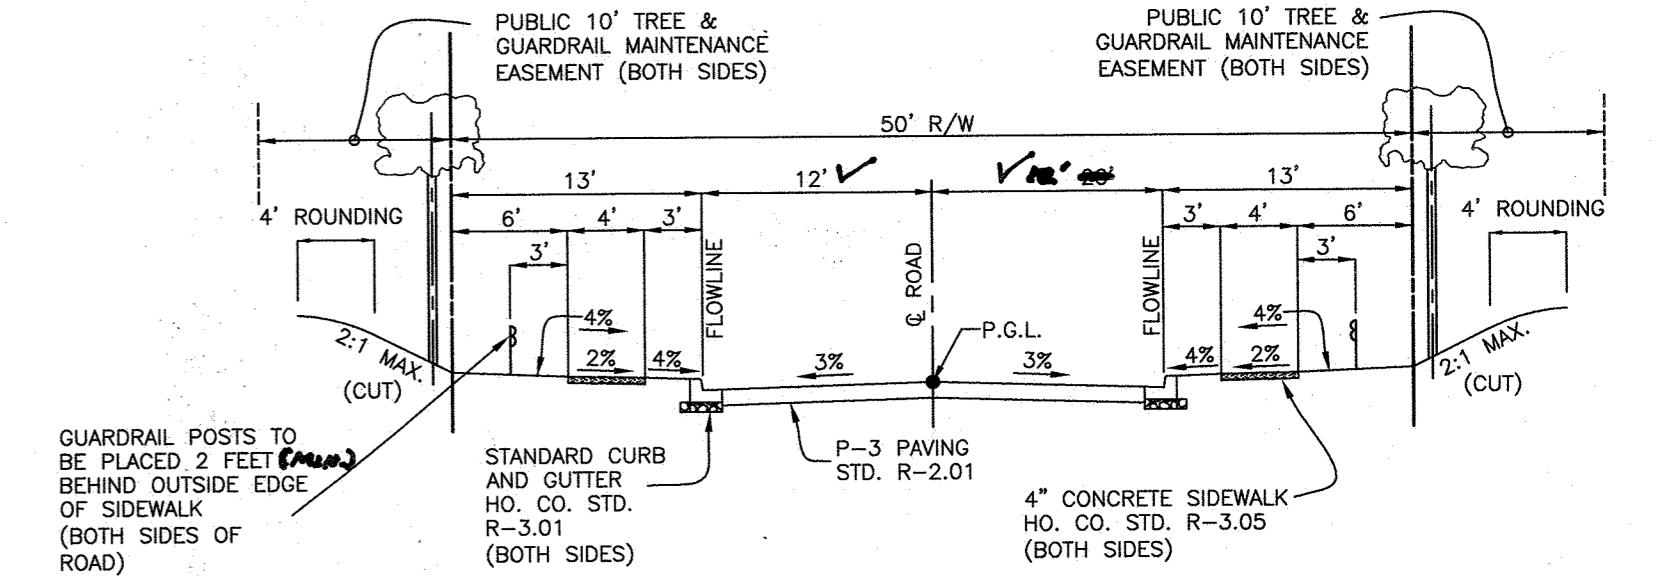

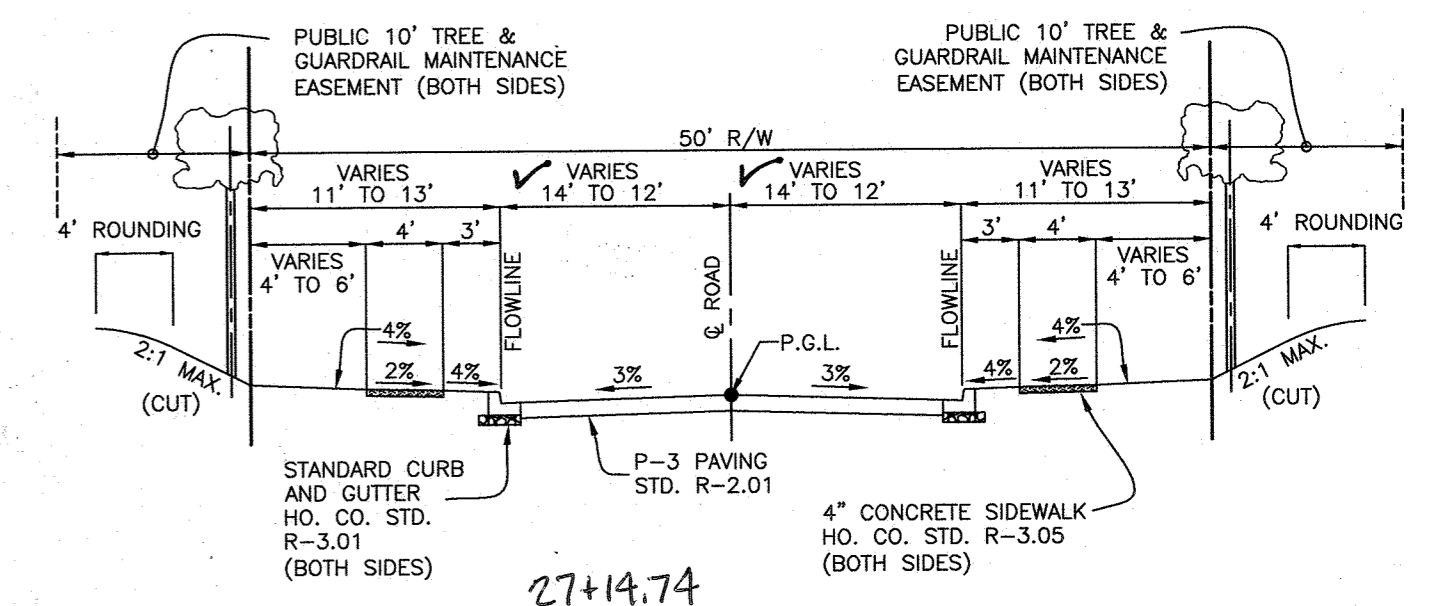**RESORT ROAD**  
**STA. 26+63.12 TO 29+10.79**  
**TYPICAL ROADWAY SECTION**  
 PUBLIC LOCAL ROAD  
 DESIGNED AS MINOR COLLECTOR  
 DESIGN SPEED: 35 MPH  
 SCALE: 1" = 10'


APPROVED: DEPARTMENT OF PUBLIC WORKS  
*[Signature]* 10/19/2015  
 CHIEF, BUREAU OF HIGHWAYS  
 APPROVED: DEPARTMENT OF PLANNING AND ZONING  
*[Signature]* 10-27-15  
 CHIEF, DIVISION OF LAND DEVELOPMENT  
*[Signature]* 10/19/15  
 CHIEF, DEVELOPMENT ENGINEERING DIVISION

| NO. | DATE | REVISION |
|-----|------|----------|
|     |      |          |
|     |      |          |


  

|   |  |
|---|--|
| <b>BENCHMARK</b><br>ENGINEERS, LAND SURVEYORS & PLANNERS<br>840 BALTIMORE NATIONAL PIKE & SUITE 315 & ELLICOTT CITY, MARYLAND 21043<br>(P) 410-465-8108 (F) 410-465-8444<br>WWW.BE-CVLENGINEERING.COM |  |
|   |  |
| OWNER:<br>MANGIONE ENTERPRISES OF TURF VALLEY, LIMITED PARTNERSHIP<br>1205 YORK ROAD, PENTHOUSE LUTHERVILLE, MARYLAND 21093<br>410-825-8400   | <b>ROAD PLAN, PROFILE AND DETAILS</b><br>DATE: SEPTEMBER, 2015<br>BEI PROJECT NO. 2697 |
| DEVELOPER:<br>MANGIONE ENTERPRISES OF TURF VALLEY, LIMITED PARTNERSHIP<br>1205 YORK ROAD, PENTHOUSE LUTHERVILLE, MARYLAND 21093<br>410-825-8400   | DESIGN: DBT<br>DRAFT: DBT<br>SCALE: AS SHOWN<br>SHEET 2 OF 15                          |

| SECTION NUMBER | ROAD AND STREET CLASSIFICATION  | CALIFORNIA BEARING RATIO (CBR)   | 3 TO <5 | 5 TO <7 | >7  | 3 TO <5 | 5 TO <7 | >7  |
|----------------|---|--|---------|---------|-----|---------|---------|-----|
| P-3            | PARKING DRIVE ASIDES, RESIDENTIAL AND NON-RESIDENTIAL TRUCKS PER DAY, LOCAL ROADS, ACCESS PLACE, ACCESS STREET, CUL-DE-SACS, NON-RESIDENTIAL MINOR COLLECTORS, INTERSECTION | HMA SUPERPAVE FINAL SURFACE<br>9.5 MM PG 64-22, LEVEL 1 (LOW ESAL)<br>HMA SUPERPAVE INTERMEDIATE SURFACE<br>9.5 MM PG 64-22, LEVEL 1 (LOW ESAL)<br>HMA SUPERPAVE BASE<br>19.0 MM PG 64-22, LEVEL 1 (LOW ESAL)<br>GRADED AGGREGATE BASE (GAB) | 1.5     | 1.5     | 1.5 | 1.5     | 1.5     | 1.5 |

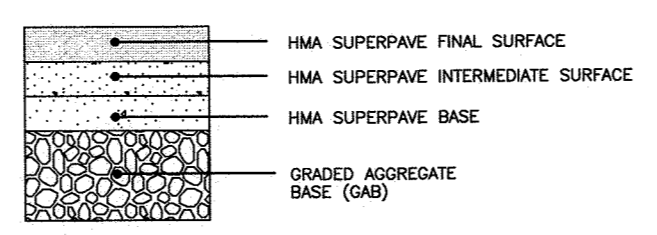

P-3 PAVING DETAIL

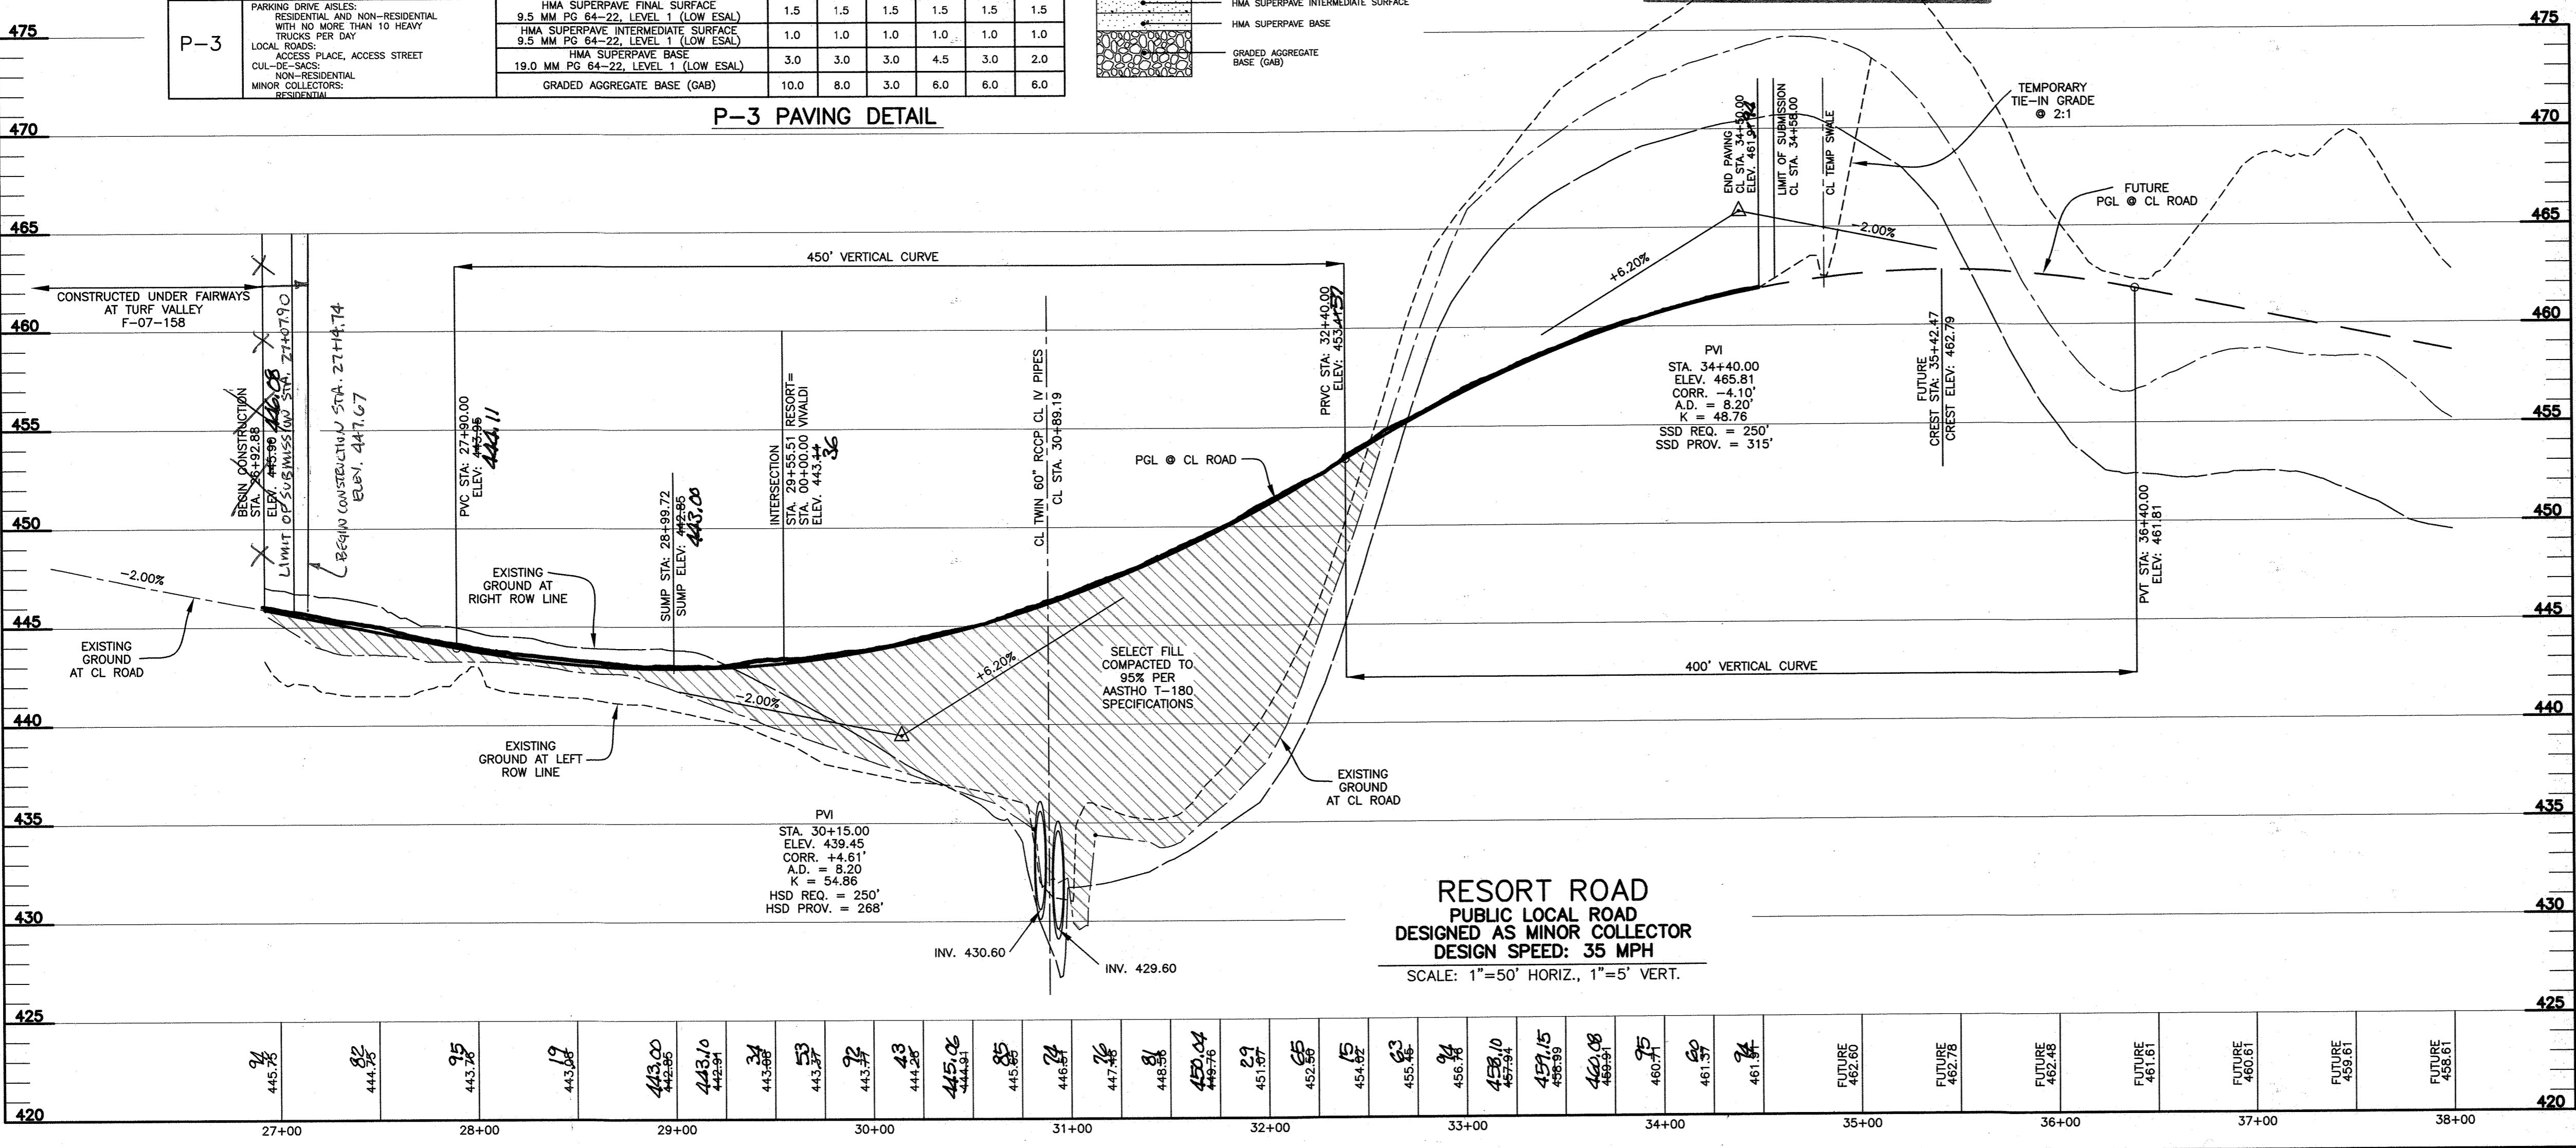


**RESORT ROAD**  
**PUBLIC LOCAL ROAD**  
**DESIGNED AS MINOR COLLECTOR**  
**DESIGN SPEED: 35 MPH**  
 SCALE: 1"=50' HORIZ., 1"=5' VERT.

Professional Certification. I hereby certify that these documents were prepared or approved by me, and that I am a duly licensed professional engineer under the laws of the State of Maryland.  
 License No. 21443 Expiration Date: 12-21-22

**AS-BUILT CERTIFICATION**  
 I hereby certify, by my seal, that to the best of my knowledge and belief the facilities shown on this "AS-BUILT" Plan meet the Approved Plans and Specifications  
**Donald Mason, P.E.** Date: 9-20-21





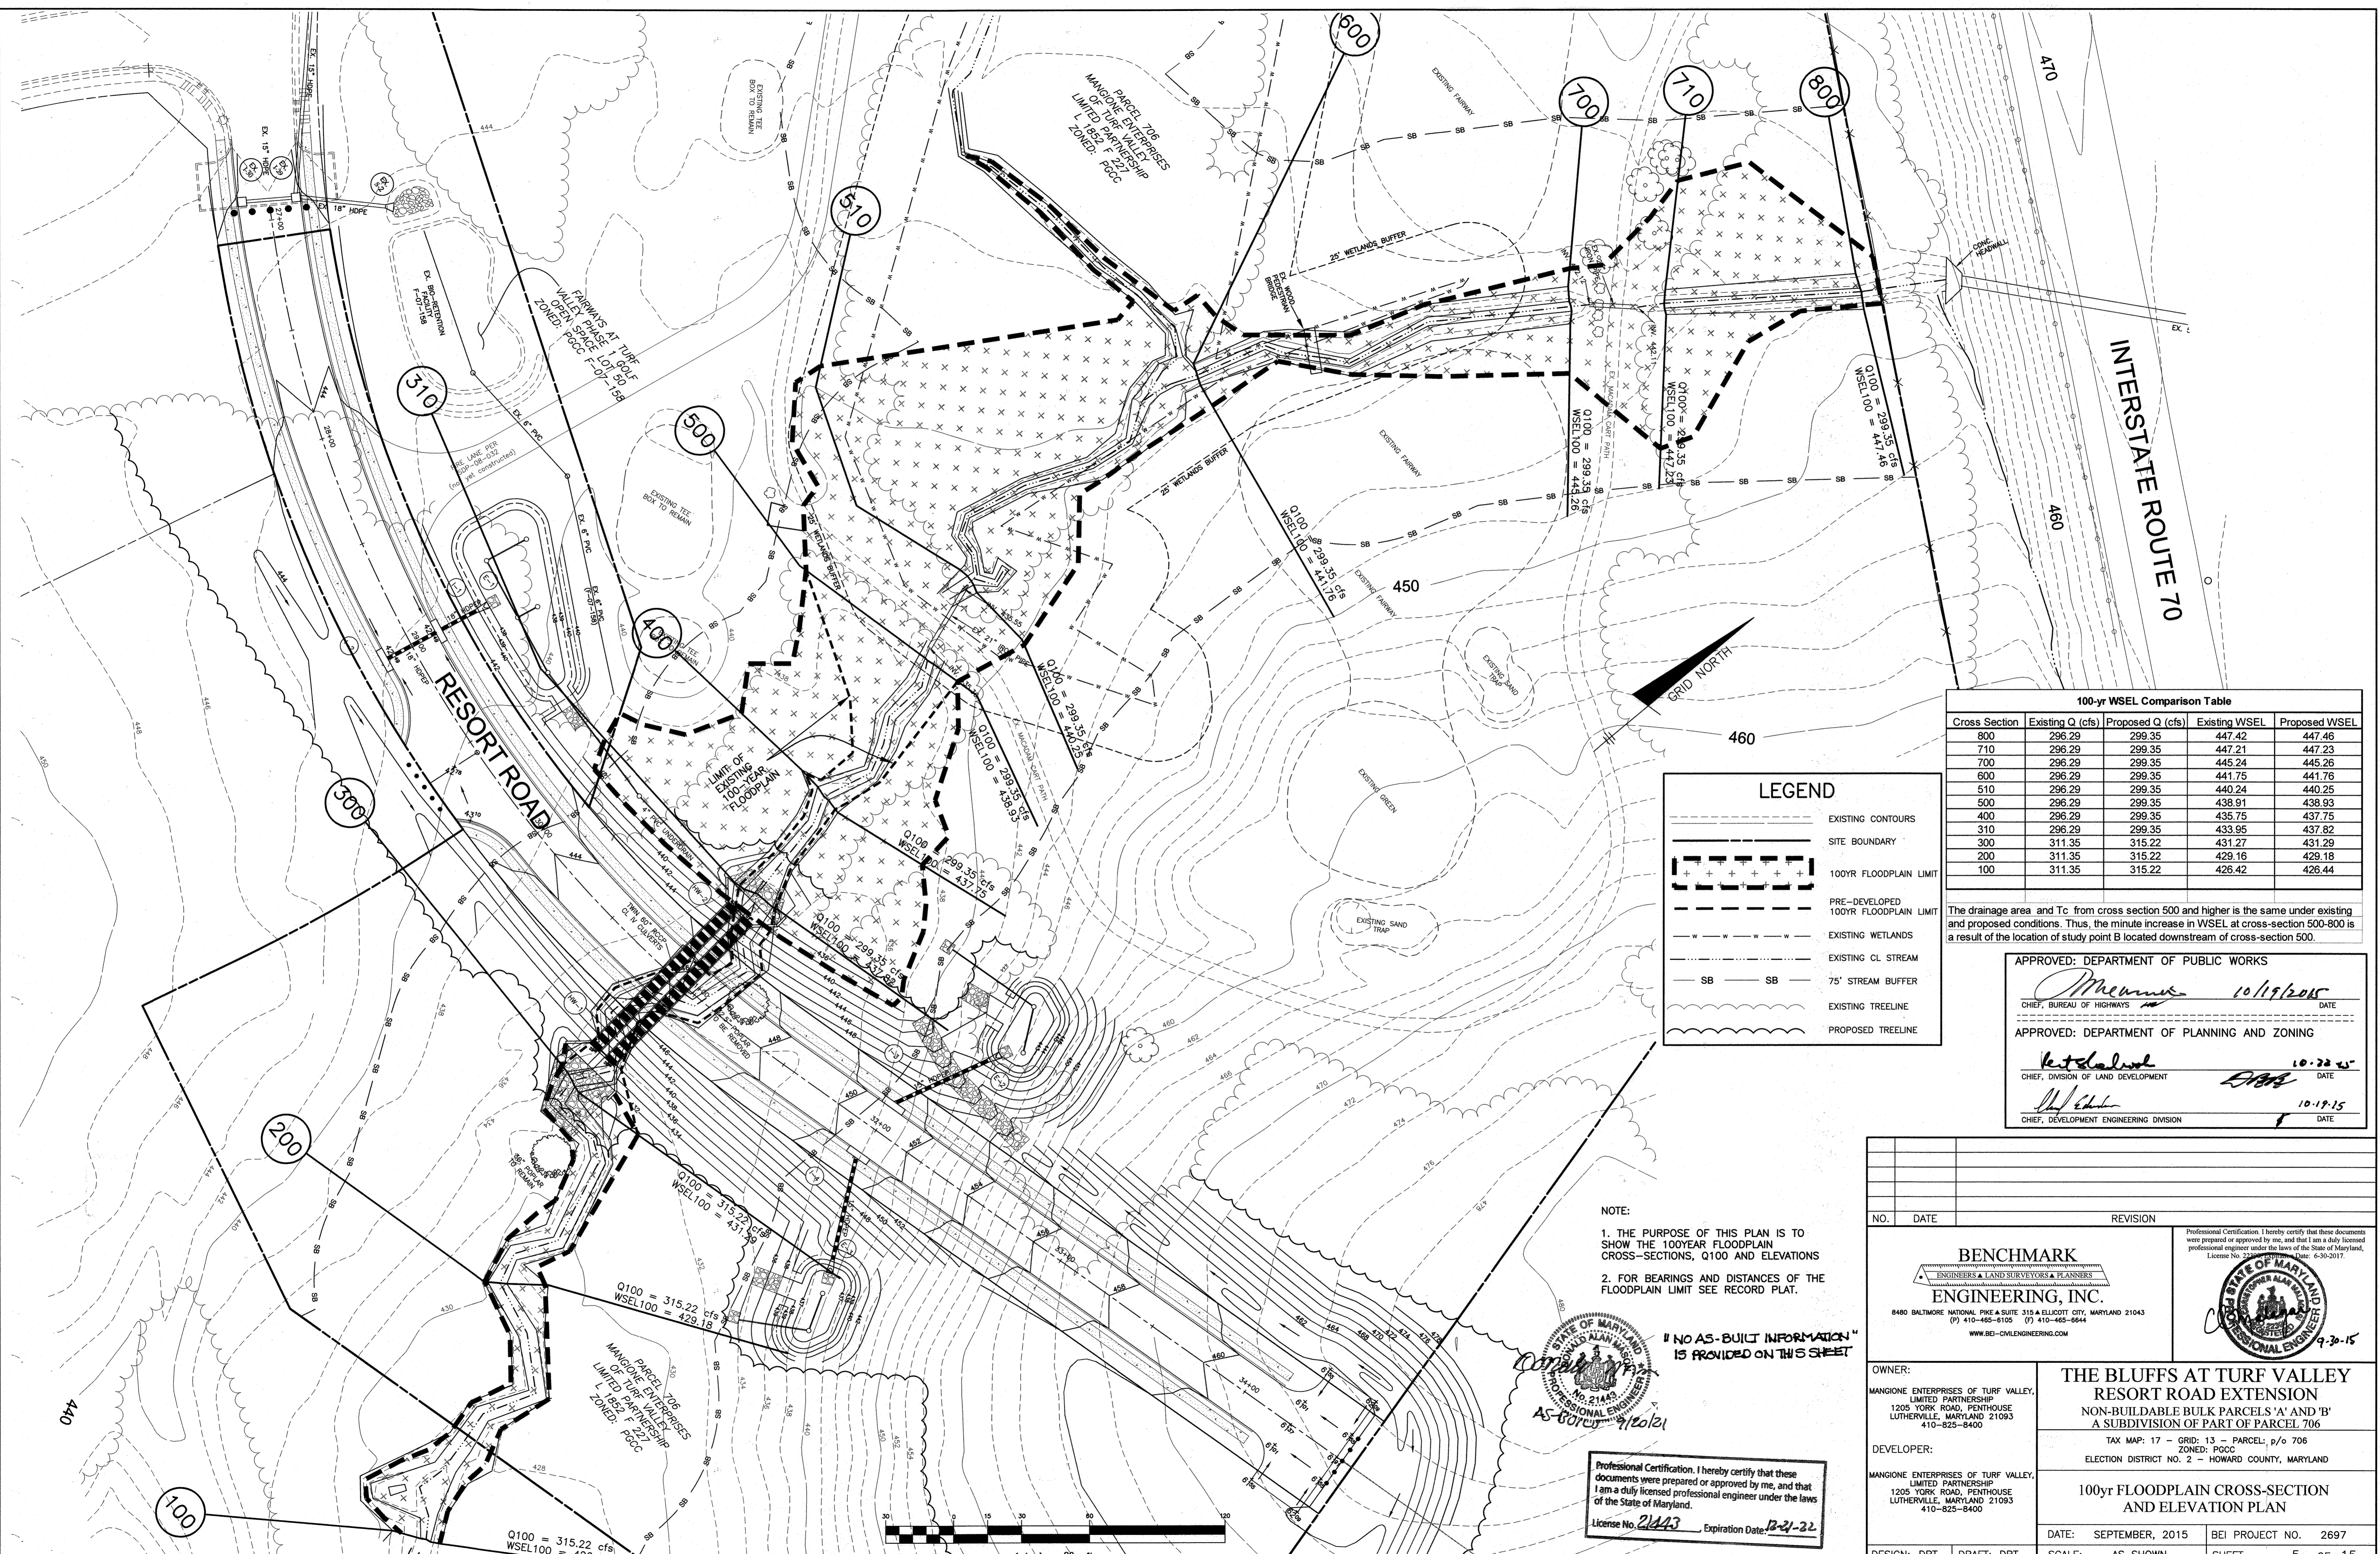

**100-yr WSEL Comparison Table**

| Cross Section | Existing Q (cfs) | Proposed Q (cfs) | Existing WSEL | Proposed WSEL |
|---------------|------------------|------------------|---------------|---------------|
| 800           | 296.29           | 299.35           | 447.42        | 447.46        |
| 710           | 296.29           | 299.35           | 447.21        | 447.23        |
| 700           | 296.29           | 299.35           | 445.24        | 445.26        |
| 600           | 296.29           | 299.35           | 441.75        | 441.76        |
| 510           | 296.29           | 299.35           | 440.24        | 440.25        |
| 500           | 296.29           | 299.35           | 438.91        | 438.93        |
| 400           | 296.29           | 299.35           | 435.75        | 437.75        |
| 310           | 296.29           | 299.35           | 433.95        | 437.82        |
| 300           | 311.35           | 315.22           | 431.27        | 431.29        |
| 200           | 311.35           | 315.22           | 429.16        | 429.18        |
| 100           | 311.35           | 315.22           | 426.42        | 426.44        |

The drainage area and Tc from cross section 500 and higher is the same under existing and proposed conditions. Thus, the minute increase in WSEL at cross-section 500-800 is a result of the location of study point B located downstream of cross-section 500.

**LEGEND**

- EXISTING CONTOURS
- SITE BOUNDARY
- 100YR FLOODPLAIN LIMIT
- PRE-DEVELOPED 100YR FLOODPLAIN LIMIT
- EXISTING WETLANDS
- EXISTING CL. STREAM
- 75' STREAM BUFFER
- EXISTING TREELINE
- PROPOSED TREELINE

- NOTE:
1. THE PURPOSE OF THIS PLAN IS TO SHOW THE 100YEAR FLOODPLAIN CROSS-SECTIONS, Q100 AND ELEVATIONS
  2. FOR BEARINGS AND DISTANCES OF THE FLOODPLAIN LIMIT SEE RECORD PLAT.

**"NO AS-BUILT INFORMATION IS PROVIDED ON THIS SHEET"**

AS-BUILT 12/21/21

Professional Certification. I hereby certify that these documents were prepared or approved by me, and that I am a duly licensed professional engineer under the laws of the State of Maryland.  
 License No. 21443, Expiration Date: 12-21-22

APPROVED: DEPARTMENT OF PUBLIC WORKS  
*Mearns* 10/19/2015  
 CHIEF, BUREAU OF HIGHWAYS DATE

APPROVED: DEPARTMENT OF PLANNING AND ZONING  
*Ketchum* 10-22-15  
 CHIEF, DIVISION OF LAND DEVELOPMENT DATE


*W. Schuler* 10-19-15  
 CHIEF, DEVELOPMENT ENGINEERING DIVISION DATE

|     |      |          |
|-----|------|----------|
| NO. | DATE | REVISION |
|     |      |          |


**BENCHMARK**  
 ENGINEERS & LAND SURVEYORS & PLANNERS  
**ENGINEERING, INC.**  
 8480 BALTIMORE NATIONAL PIKE & SUITE 315 & ELLICOTT CITY, MARYLAND 21043  
 (P) 410-465-8105 (F) 410-465-8644  
 WWW.BE-CMENGINEERING.COM

Professional Certification. I hereby certify that these documents were prepared or approved by me, and that I am a duly licensed professional engineer under the laws of the State of Maryland.  
 License No. 21443, Expiration Date: 12-21-22

|   |   |
|---|---|
| OWNER:<br>MANGIONE ENTERPRISES OF TURF VALLEY, LIMITED PARTNERSHIP<br>1205 YORK ROAD, PENTHOUSE LUTHERVILLE, MARYLAND 21093<br>410-825-8400     | <b>THE BLUFFS AT TURF VALLEY</b><br><b>RESORT ROAD EXTENSION</b><br>NON-BUILDABLE BULK PARCELS 'A' AND 'B'<br>A SUBDIVISION OF PART OF PARCEL 706<br>TAX MAP: 17 - GRID: 13 - PARCEL: p/o 706<br>ZONED: PGCC<br>ELECTION DISTRICT NO. 2 - HOWARD COUNTY, MARYLAND |
| DEVELOPER:<br>MANGIONE ENTERPRISES OF TURF VALLEY, LIMITED PARTNERSHIP<br>1205 YORK ROAD, PENTHOUSE LUTHERVILLE, MARYLAND 21093<br>410-825-8400 | <b>100yr FLOODPLAIN CROSS-SECTION AND ELEVATION PLAN</b>  |
| DESIGN: DBT    DRAFT: DBT   | DATE: SEPTEMBER, 2015    BEI PROJECT NO. 2697<br>SCALE: AS SHOWN    SHEET 5 OF 15   |

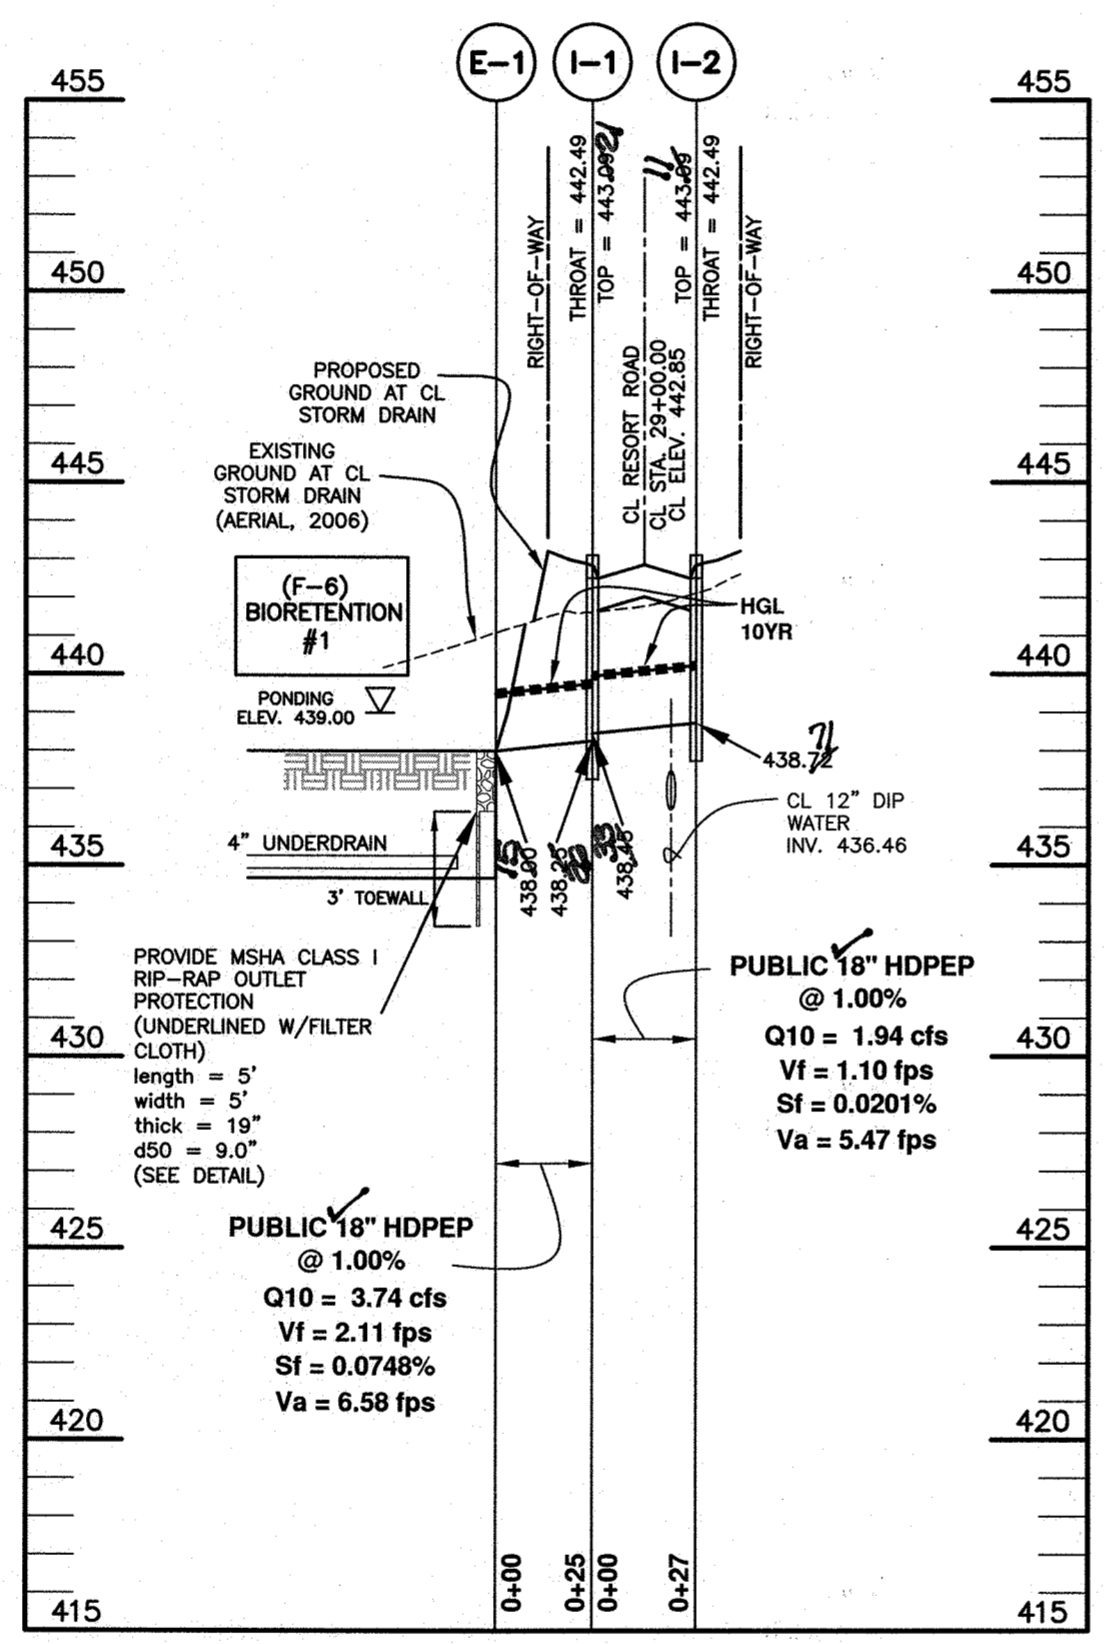


STORM DRAIN PROFILE  
SCALE: 1" = 50' HORZ., 1" = 5' VERT.

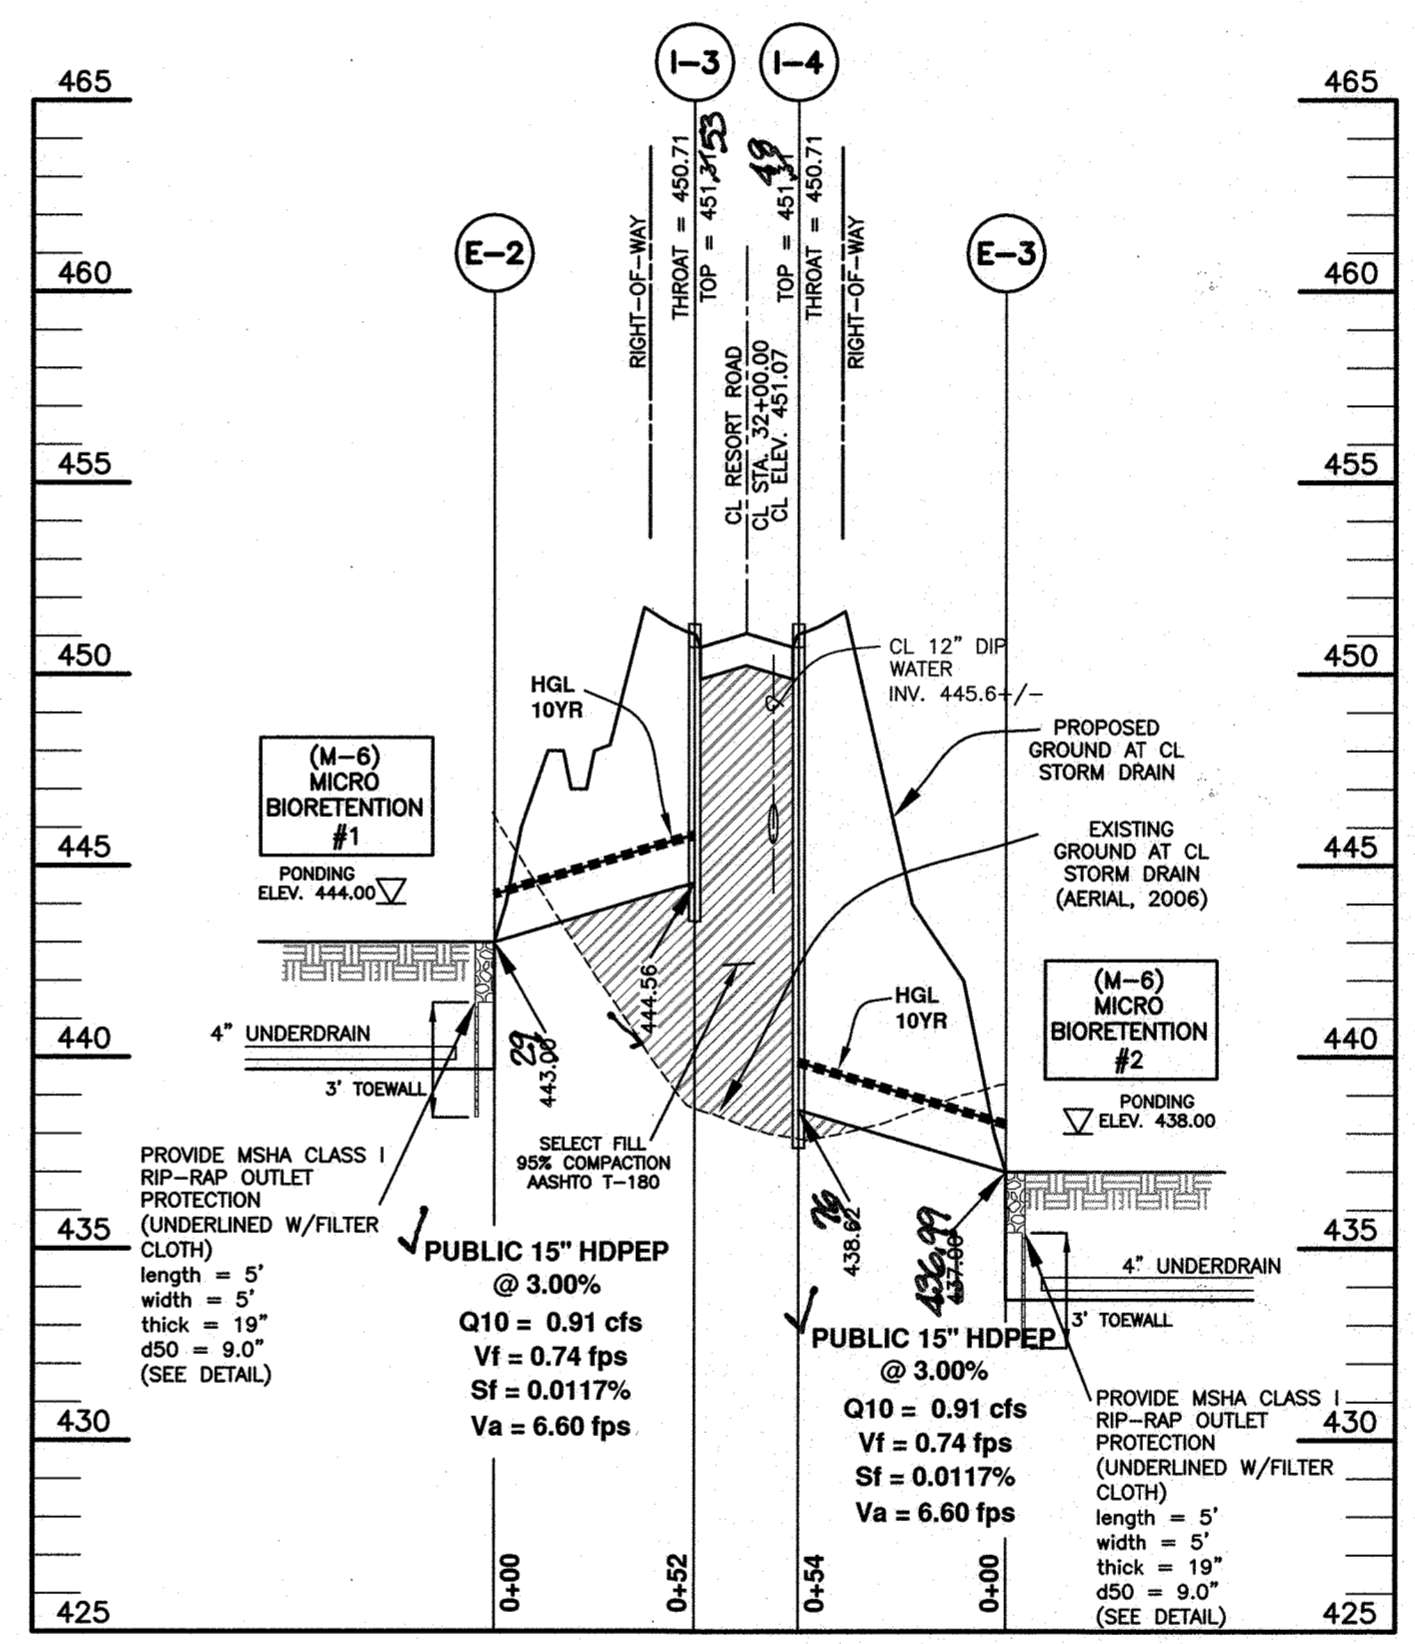

STORM DRAIN PROFILE  
SCALE: 1" = 50' HORZ., 1" = 5' VERT.

- CONSTRUCTION SPECIFICATIONS
1. THE SUBGRADE FOR THE FILTER, RIP-RAP, OR GABION SHALL BE PREPARED TO THE REQUIRED LINES AND GRADES. ANY FILL REQUIRED IN THE SUBGRADE SHALL BE COMPACTED TO A DENSITY OF APPROXIMATELY THAT OF THE SURROUNDING UNDISTURBED MATERIAL.
  2. THE ROCK OR GRAVEL SHALL CONFORM TO THE SPECIFIED GRADING LIMITS WHEN INSTALLED RESPECTIVELY IN THE RIP-RAP OR FILTER.
  3. GEOTEXTILE CLASS C28 OR BETTER SHALL BE PROTECTED FROM PUNCHING, CUTTING, OR TEARING. ANY DAMAGE OTHER THAN AN OCCASIONAL SMALL HOLE SHALL BE PREPARED BY PLACING ANOTHER PIECE OF GEOTEXTILE FABRIC OVER THE DAMAGED PART OR BY COMPLETELY REPLACING THE GEOTEXTILE FABRIC. ALL OVERLAPS WHETHER FOR REPAIRS OR FOR JOINING TWO PIECES OF GEOTEXTILE FABRIC SHALL BE A MINIMUM OF ONE FOOT.
  4. STONE FOR THE RIP-RAP OR GABION OUTLETS MAY BE PLACED BY EQUIPMENT. THEY SHALL BE CONSTRUCTED TO THE FULL COURSE THICKNESS IN ONE OPERATION AND IN SUCH A MANNER AS TO AVOID DISPLACEMENT OF UNDERLYING MATERIALS. THE STONE FOR THE RIP-RAP OR GABION OUTLETS SHALL BE DELIVERED AND PLACED IN A MANNER THAT WILL ENSURE THAT IT IS REASONABLY HOMOGENEOUS WITH THE SMALLER STONES AND SPALLS FILLING THE VOIDS BETWEEN THE LARGER STONES. RIP-RAP SHALL BE PLACED IN A MANNER TO PREVENT DAMAGE TO THE FILTER BLANKET OR GEOTEXTILE FABRIC. HAND PLACEMENT WILL BE REQUIRED TO THE EXTENT NECESSARY TO PREVENT DAMAGE TO THE PERMANENT WORKS.
  5. THE STONE SHALL BE PLACED SO THAT IT BLENDS IN WITH THE EXISTING GROUND. IF THE STONE IS PLACED TOO HIGH THEN THE FLOW WILL BE FORCED OUT OF THE CHANNEL AND SCOUR ADJACENT TO THE STONE WILL OCCUR.

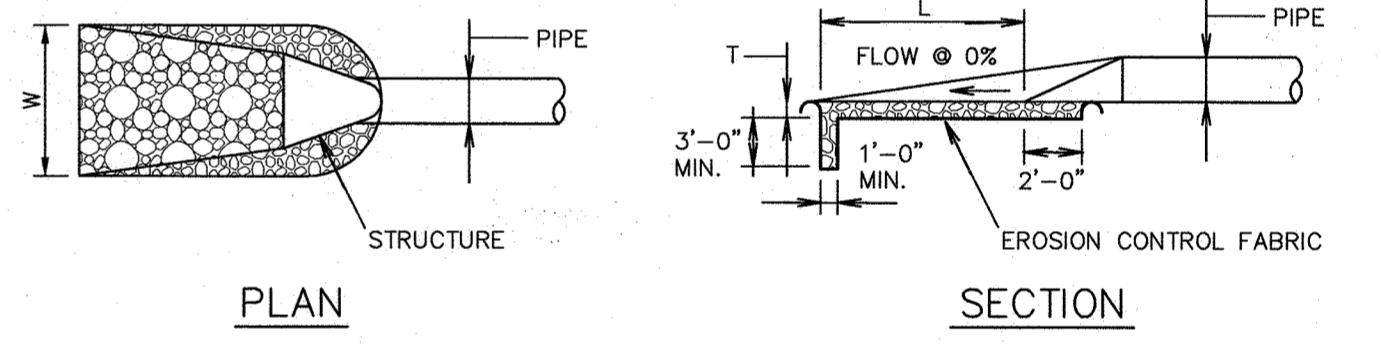

| STRUCTURE | V10 (fps) | d10 (ft) | d50  | LENGTH(L) | WIDTH(W) | THICK.(T) | SHA CLASS |
|-----------|-----------|----------|------|-----------|----------|-----------|-----------|
| E-1       | NA        | NA       | 9.0" | 6.8'      | 4.5'     | 19"       | I         |
| E-2       | NA        | NA       | 9.0" | 5.5'      | 5.5'     | 19"       | I         |
| E-3       | NA        | NA       | 9.0" | 5.5'      | 5.5'     | 19"       | I         |
| HW-1      | 16.0      | 2.26'    | 16"  | 26'       | CHANNEL  | 32"       | II        |
| HW-2      | NA        | NA       | 16"  | 10'       | CHANNEL  | 32"       | II        |

OUTLET PROTECTION DETAIL  
NOT TO SCALE

| SIZE | TYPE       | LENGTH (L.F.) | MAINTENANCE |
|------|------------|---------------|-------------|
| 15"  | HDPEP      | 106           | PUBLIC      |
| 18"  | HDPEP      | 52            | PUBLIC      |
| 60"  | RCCP CL IV | 176           | PUBLIC      |

All HDPEP pipes shall have smooth interior. No interior corrugations.

| STRUCTURE                | TYPE     | LOCATION  | INVERT (IN)     | INVERT (OUT)    | TOP ELEV.       | THROAT ELEV.    | STD. DETAIL       | INLET NOTES | MAINTENANCE |
|--------------------------|----------|---|-----------------|-----------------|-----------------|-----------------|-------------------|-------------|-------------|
| INLETS                   |          |   |                 |                 |                 |                 |                   |             |             |
| I-1                      | A-10     | CL STA. 29+00 RESORT ROAD, OFFSET 12.09' LEFT     | 436.33          | 438.46 (18")    | 438.25 (18")    | 443.00          | HO.CO.STD. D-4.03 | 3.0' WIDTH  | PUBLIC      |
| I-2                      | A-10     | CL STA. 29+00 RESORT ROAD, OFFSET 12.09' RIGHT    | -               | -               | 438.71          | 443.00          | HO.CO.STD. D-4.03 | 3.0' WIDTH  | PUBLIC      |
| I-3                      | A-10     | CL STA. 32+00 RESORT ROAD, OFFSET 12.00' LEFT     | -               | -               | 444.56 (15")    | 451.31          | HO.CO.STD. D-4.03 | 3.0' WIDTH  | PUBLIC      |
| I-4                      | A-10     | CL STA. 32+00 RESORT ROAD, OFFSET 12.00' RIGHT    | -               | -               | 438.67 (15")    | 451.31          | HO.CO.STD. D-4.03 | 3.0' WIDTH  | PUBLIC      |
| END SECTIONS & HEADWALLS |          |   |                 |                 |                 |                 |                   |             |             |
| E-1                      | 18" HDPE | N 594033.58 E 1349521.83                          | -               | -               | 438.00          | -               | NA                | -           | PUBLIC      |
| E-2                      | 15" HDPE | N 594078.56 E 1349820.04                          | -               | -               | 443.00          | -               | NA                | -           | PUBLIC      |
| E-3                      | 15" HDPE | N 593958.65 E 1349845.70                          | -               | -               | 437.00          | -               | NA                | -           | PUBLIC      |
| HW-1                     | CONCRETE | CL STA. 30+87.17 RESORT ROAD, OFFSET 54.60' RIGHT | -               | -               | -               | -               | NA                | -           | PUBLIC      |
| HW-2                     | CONCRETE | CL STA. 30+91.34 RESORT ROAD, OFFSET 48.32' LEFT  | 432.00 (pipe 1) | 431.00 (pipe 2) | 429.00 (pipe 1) | 428.00 (pipe 2) | NA                | -           | PUBLIC      |

STRUCTURE LOCATION FOR INLETS IS AT THE CENTER OF THE INLET FACE.  
STRUCTURE LOCATION FOR THE END-SECTIONS/HEADWALLS IS AT THE MIDPOINT OF THE END OF THE STRUCTURE.  
PRECAST STRUCTURES MEETING HS-20 LOADING MAY BE USED.

Professional Certification. I hereby certify that these documents were prepared or approved by me, and that I am a duly licensed professional engineer under the laws of the State of Maryland.  
License No. 21443 Expiration Date: 12-21-22



AS-BUILT CERTIFICATION  
I hereby certify, by my seal, that to the best of my knowledge and belief the facilities shown on this "AS-BUILT" Plan meet the Approved Plans and Specifications  
Donald Mason, P.E. Date: 9/20/24

APPROVED: DEPARTMENT OF PUBLIC WORKS  
10/19/2015  
APPROVED: DEPARTMENT OF PLANNING AND ZONING  
10-22-15  
10-19-15








Professional Certification. I hereby certify that these documents were prepared or approved by me, and that I am a duly licensed professional engineer under the laws of the State of Maryland.  
License No. 22390, Expiration Date: 6-30-2017.

**BENCHMARK ENGINEERING, INC.**  
ENGINEERS & LAND SURVEYORS & PLANNERS  
8400 BALTIMORE NATIONAL PIKE SUITE 315 A ELLICOTT CITY, MARYLAND 21043  
(P) 410-465-8105 (F) 410-465-8644  
WWW.BEI-ENGINEERING.COM

OWNER: MANGIONE ENTERPRISES OF TURF VALLEY, LIMITED PARTNERSHIP  
DEVELOPER: MANGIONE ENTERPRISES OF TURF VALLEY, LIMITED PARTNERSHIP



**THE BLUFFS AT TURF VALLEY RESORT ROAD EXTENSION**  
NON-BUILDABLE BULK PARCELS 'A' AND 'B' A SUBDIVISION OF PART OF PARCEL 706  
TAX MAP: 17 - GRID: 13 - PARCEL: p/6 706  
ZONED: PGCC  
ELECTION DISTRICT NO. 2 - HOWARD COUNTY, MARYLAND

**STORM DRAIN PROFILES AND DETAILS**  
DATE: SEPTEMBER, 2015 BEI PROJECT NO. 2697  
DESIGN: DBT DRAFT: DBT SCALE: AS SHOWN SHEET 6 OF 15

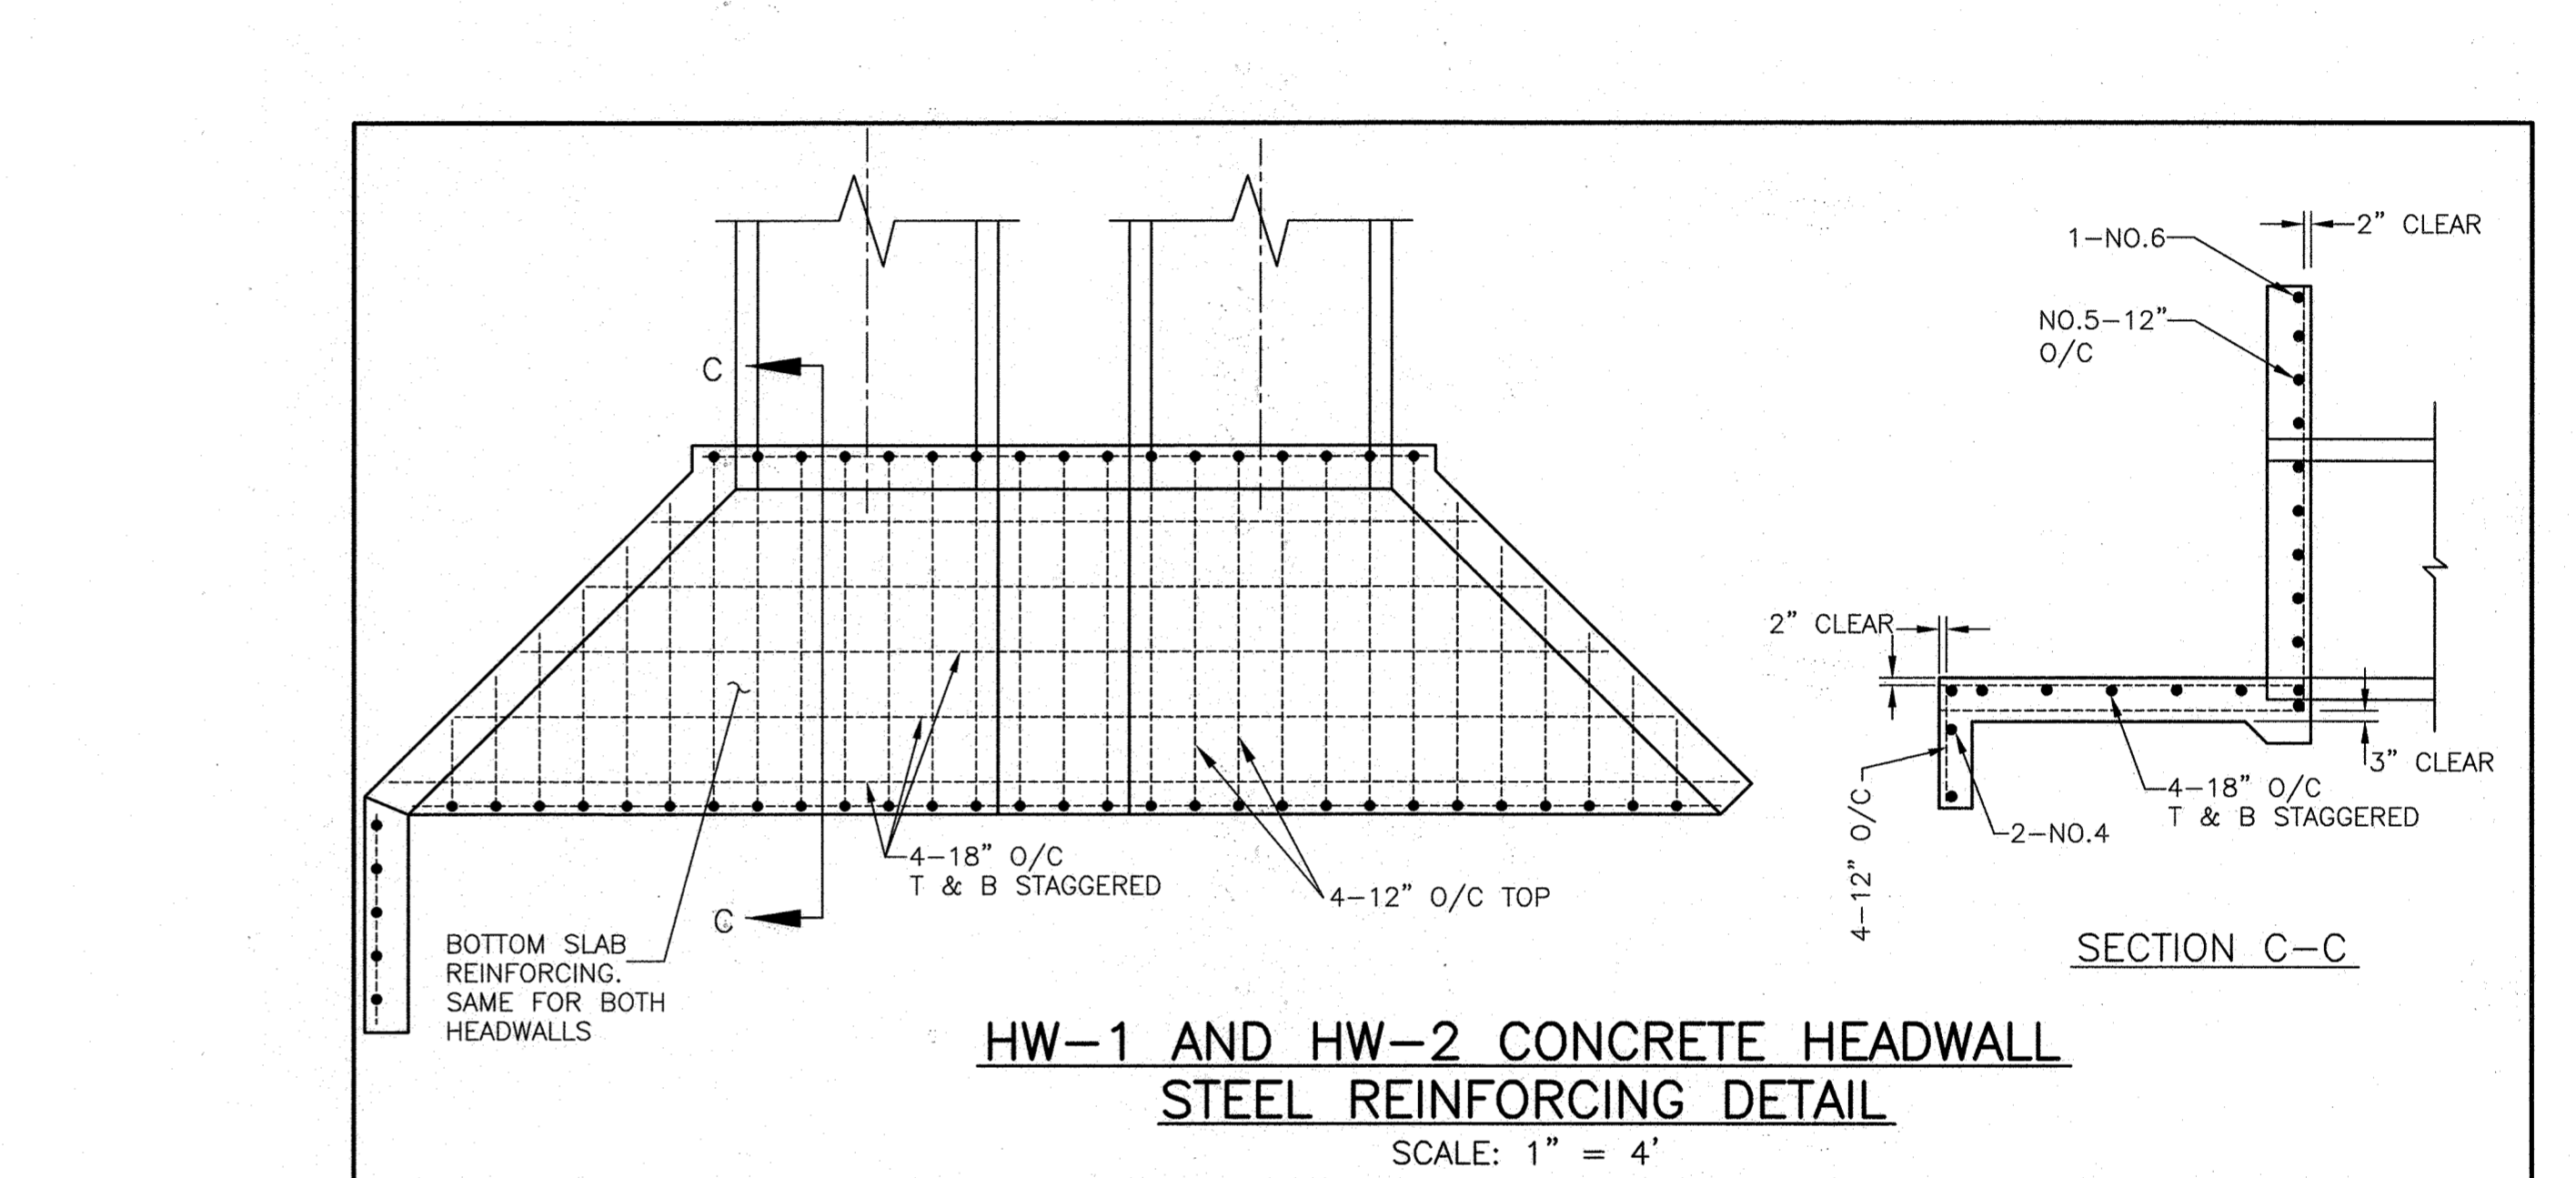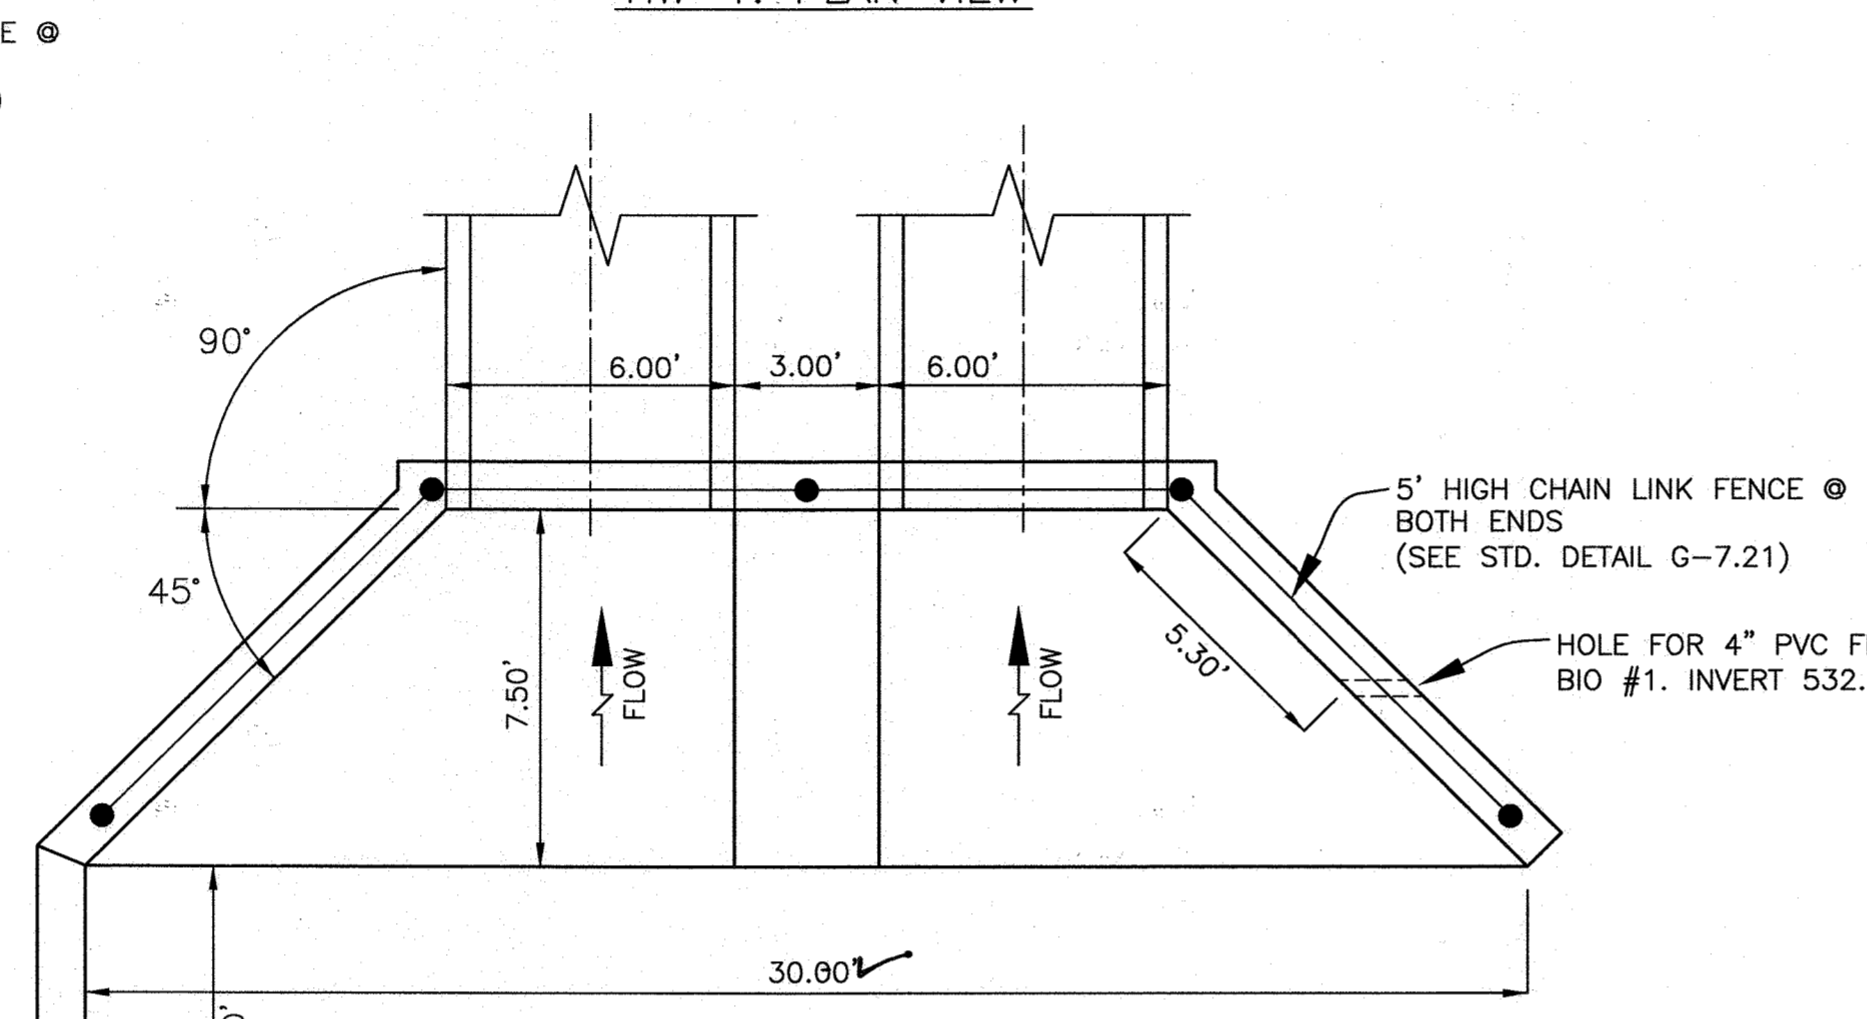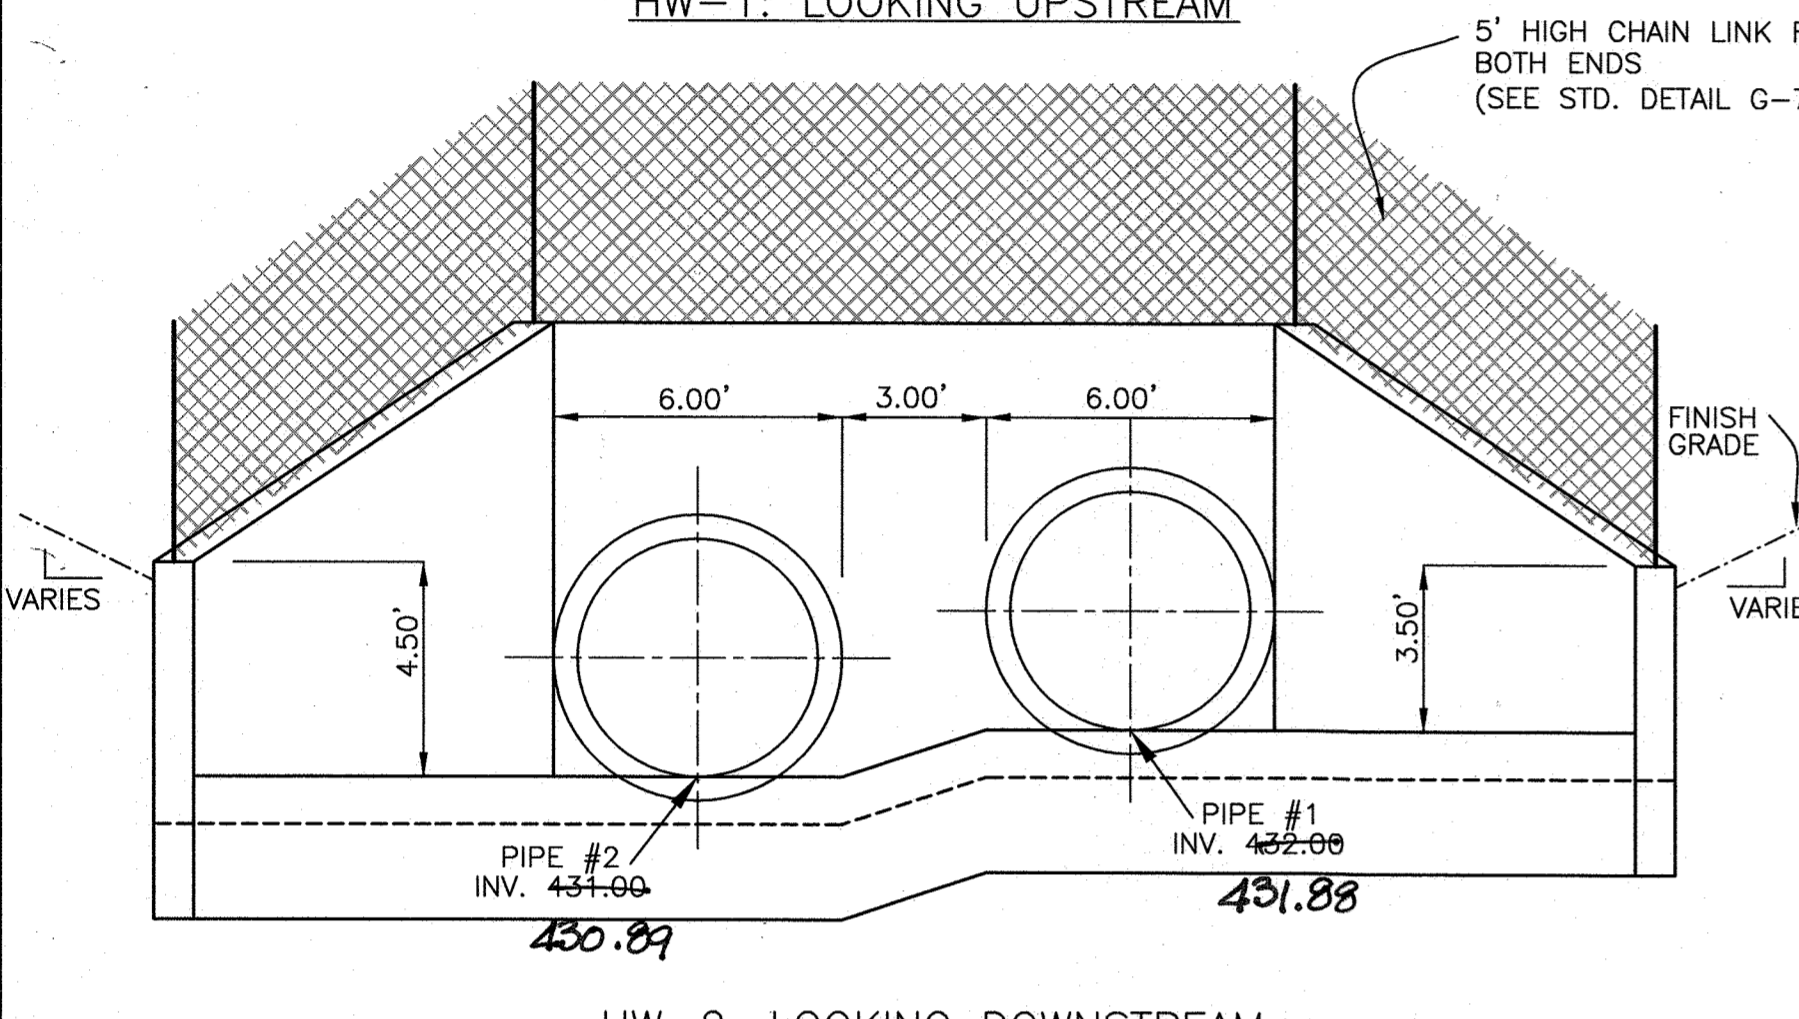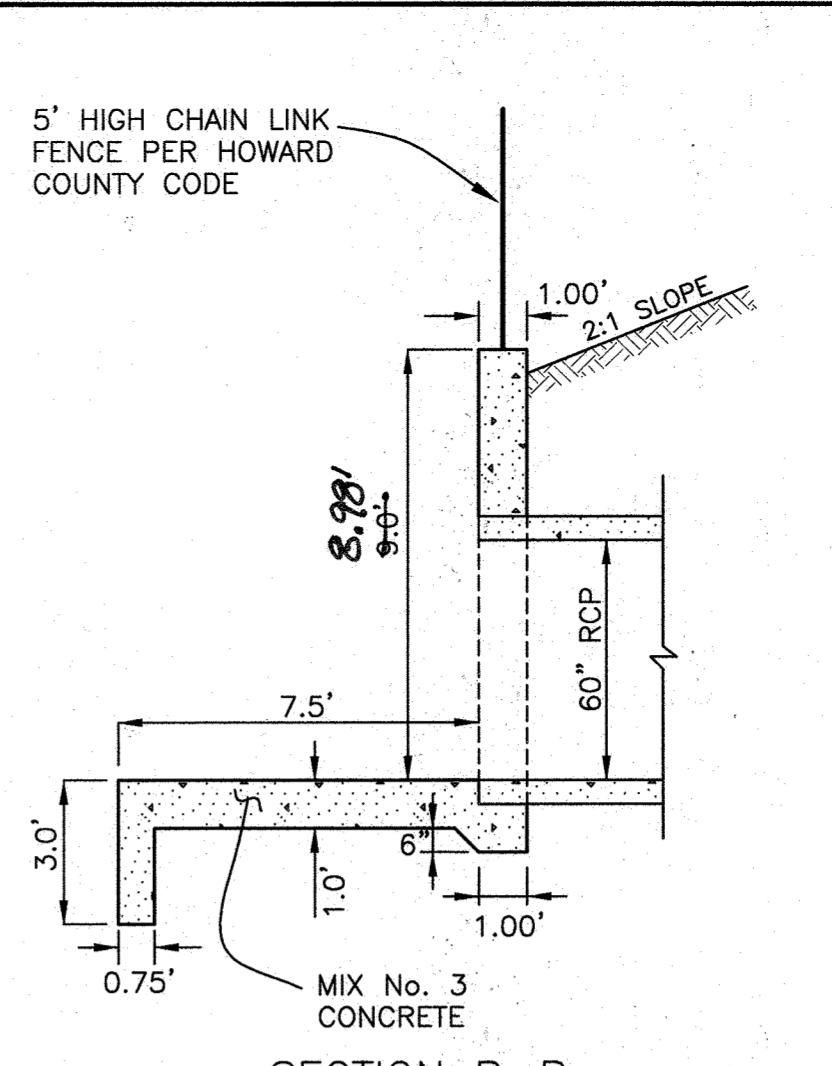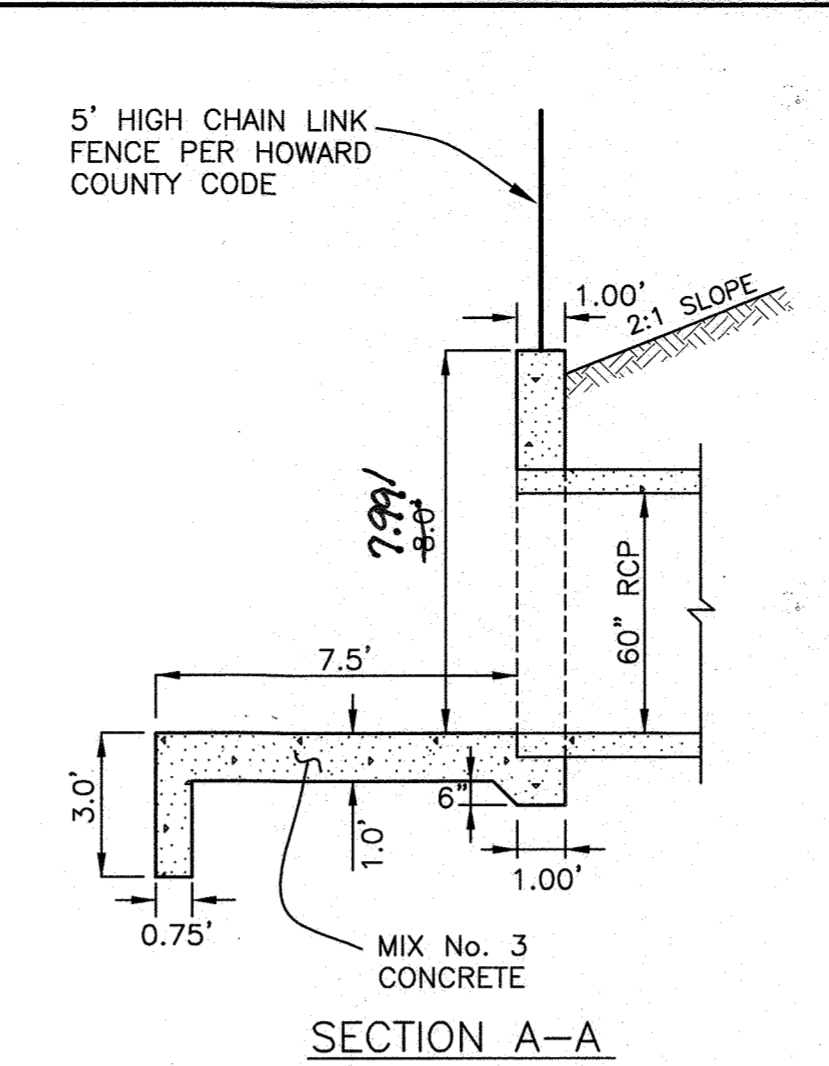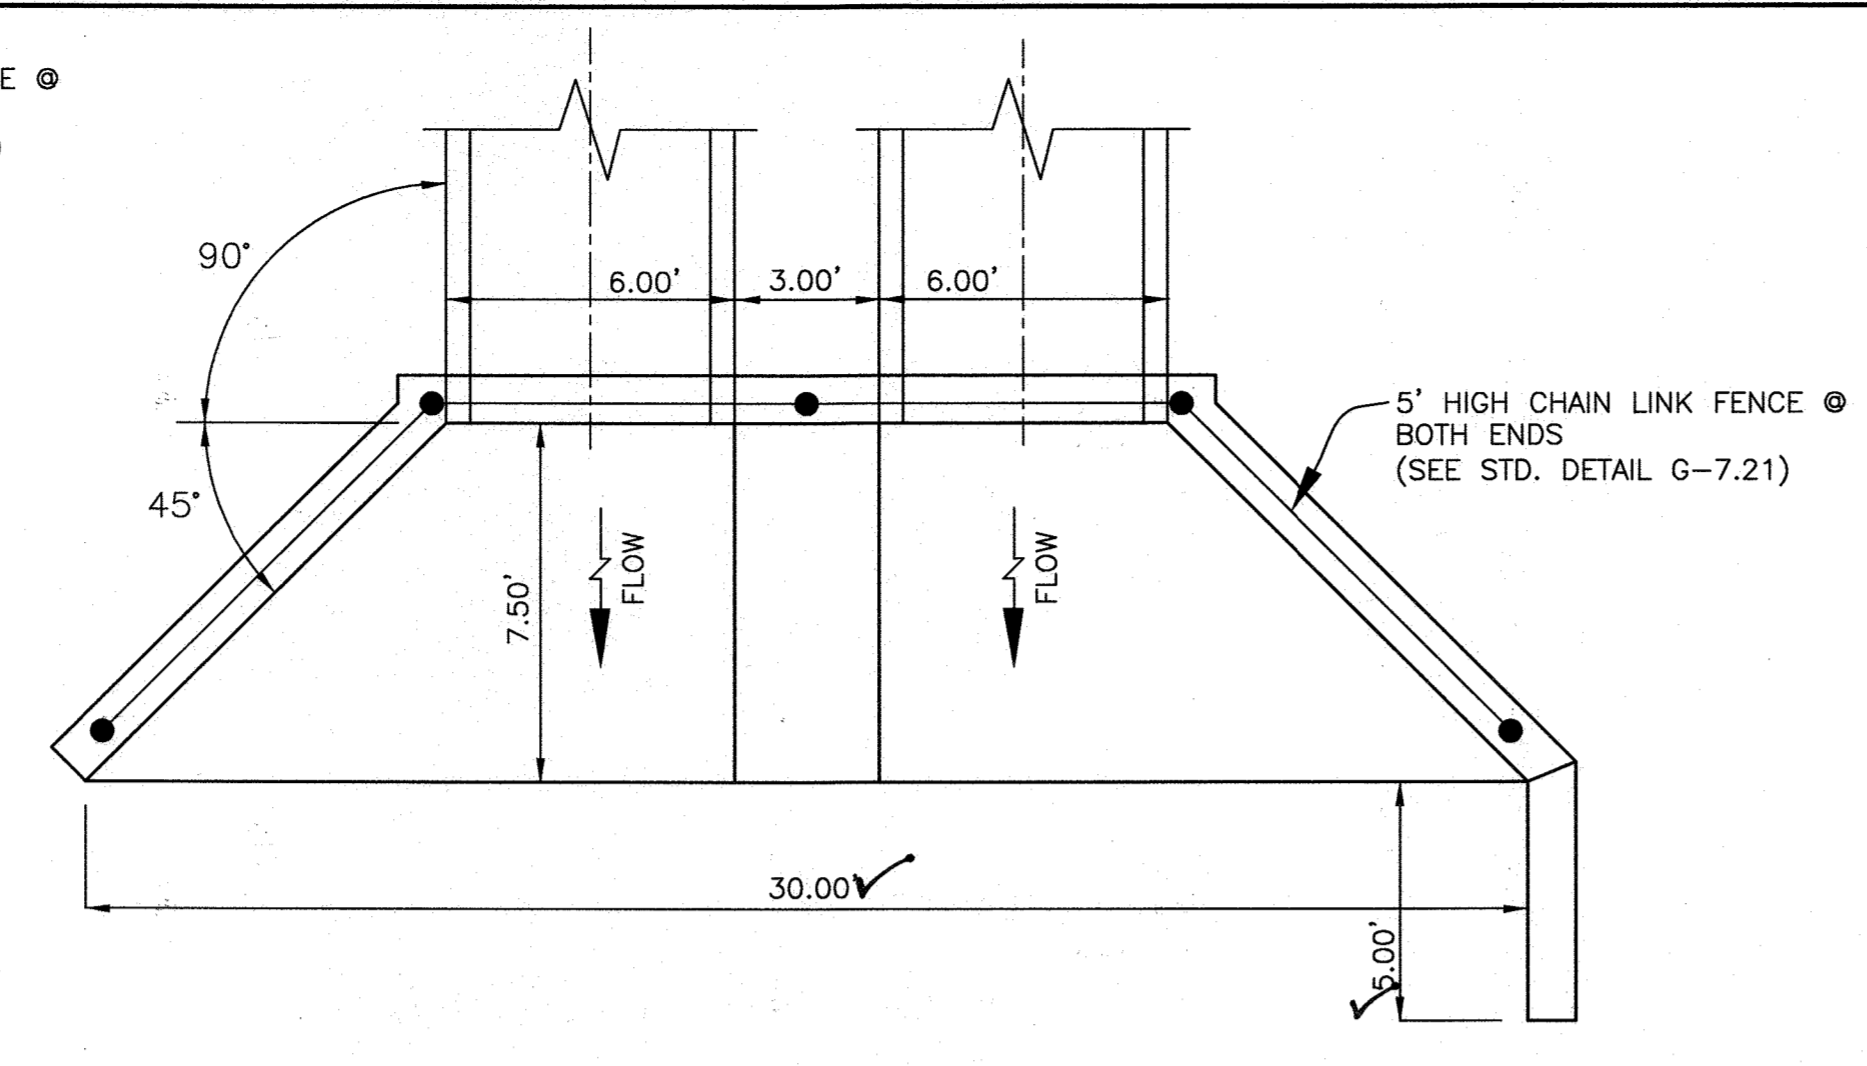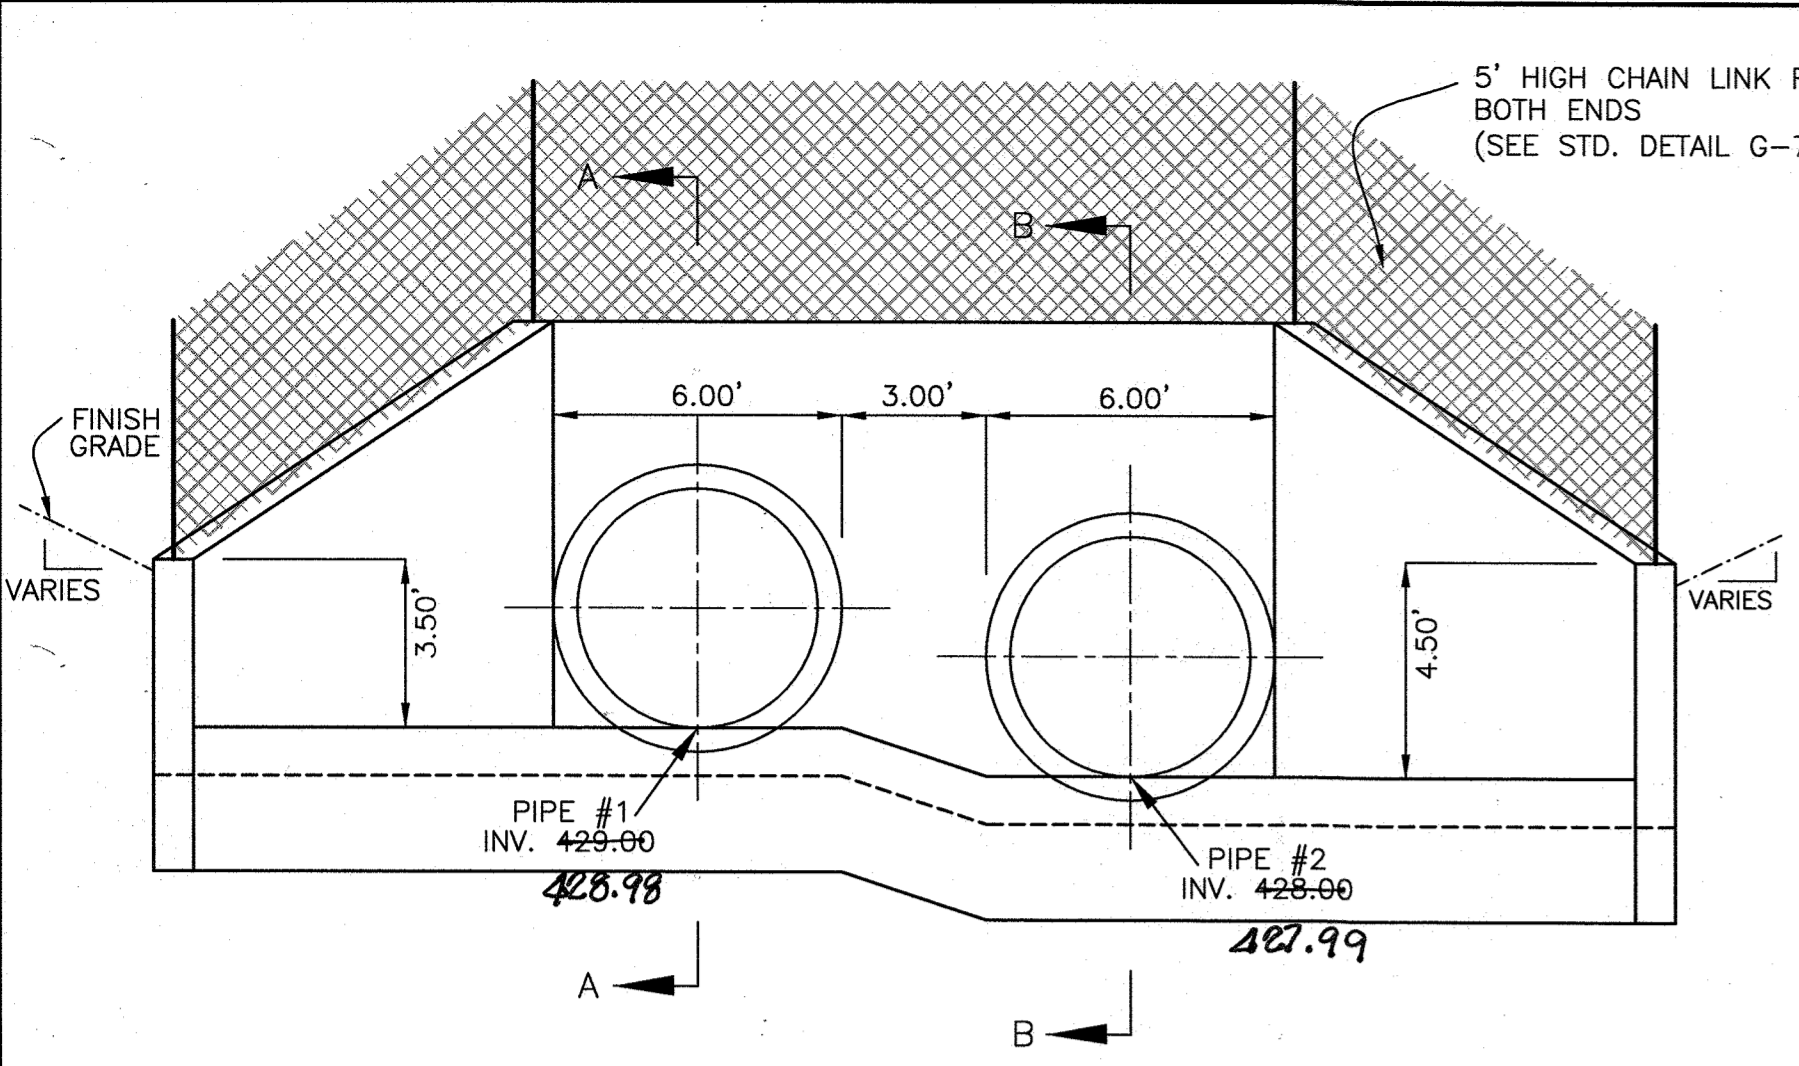

HW-1 AND HW-2 CONCRETE HEADWALL DETAIL  
MODIFIED HO.CO.STD. D-5.11  
SCALE: 1" = 4"

NOTE:  
CONTRACTOR SHALL VERIFY REBAR SIZE AND SPACING ON THE SHOP DRAWINGS.

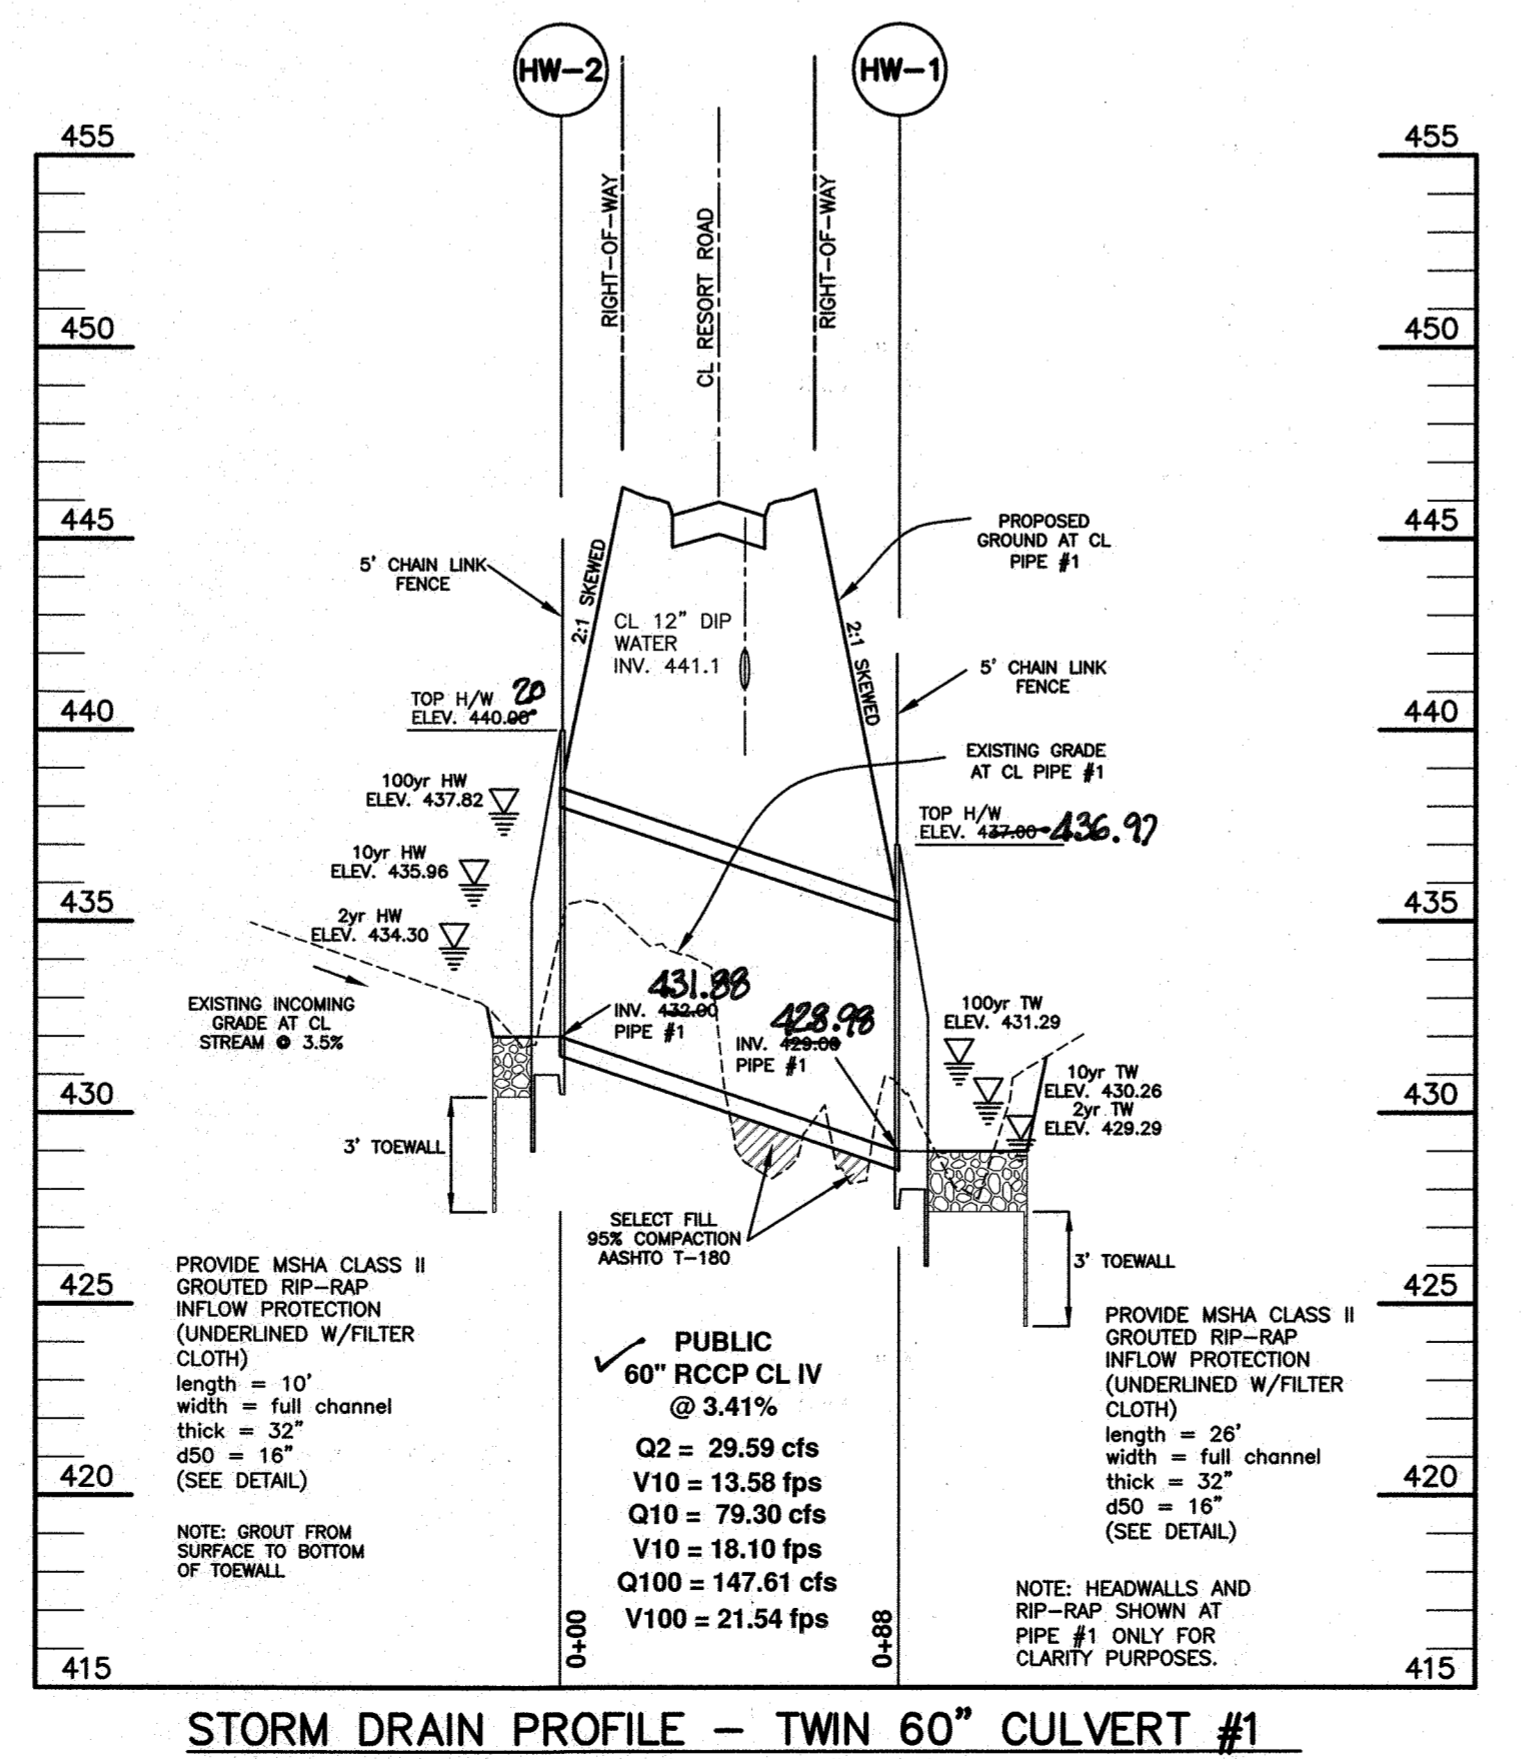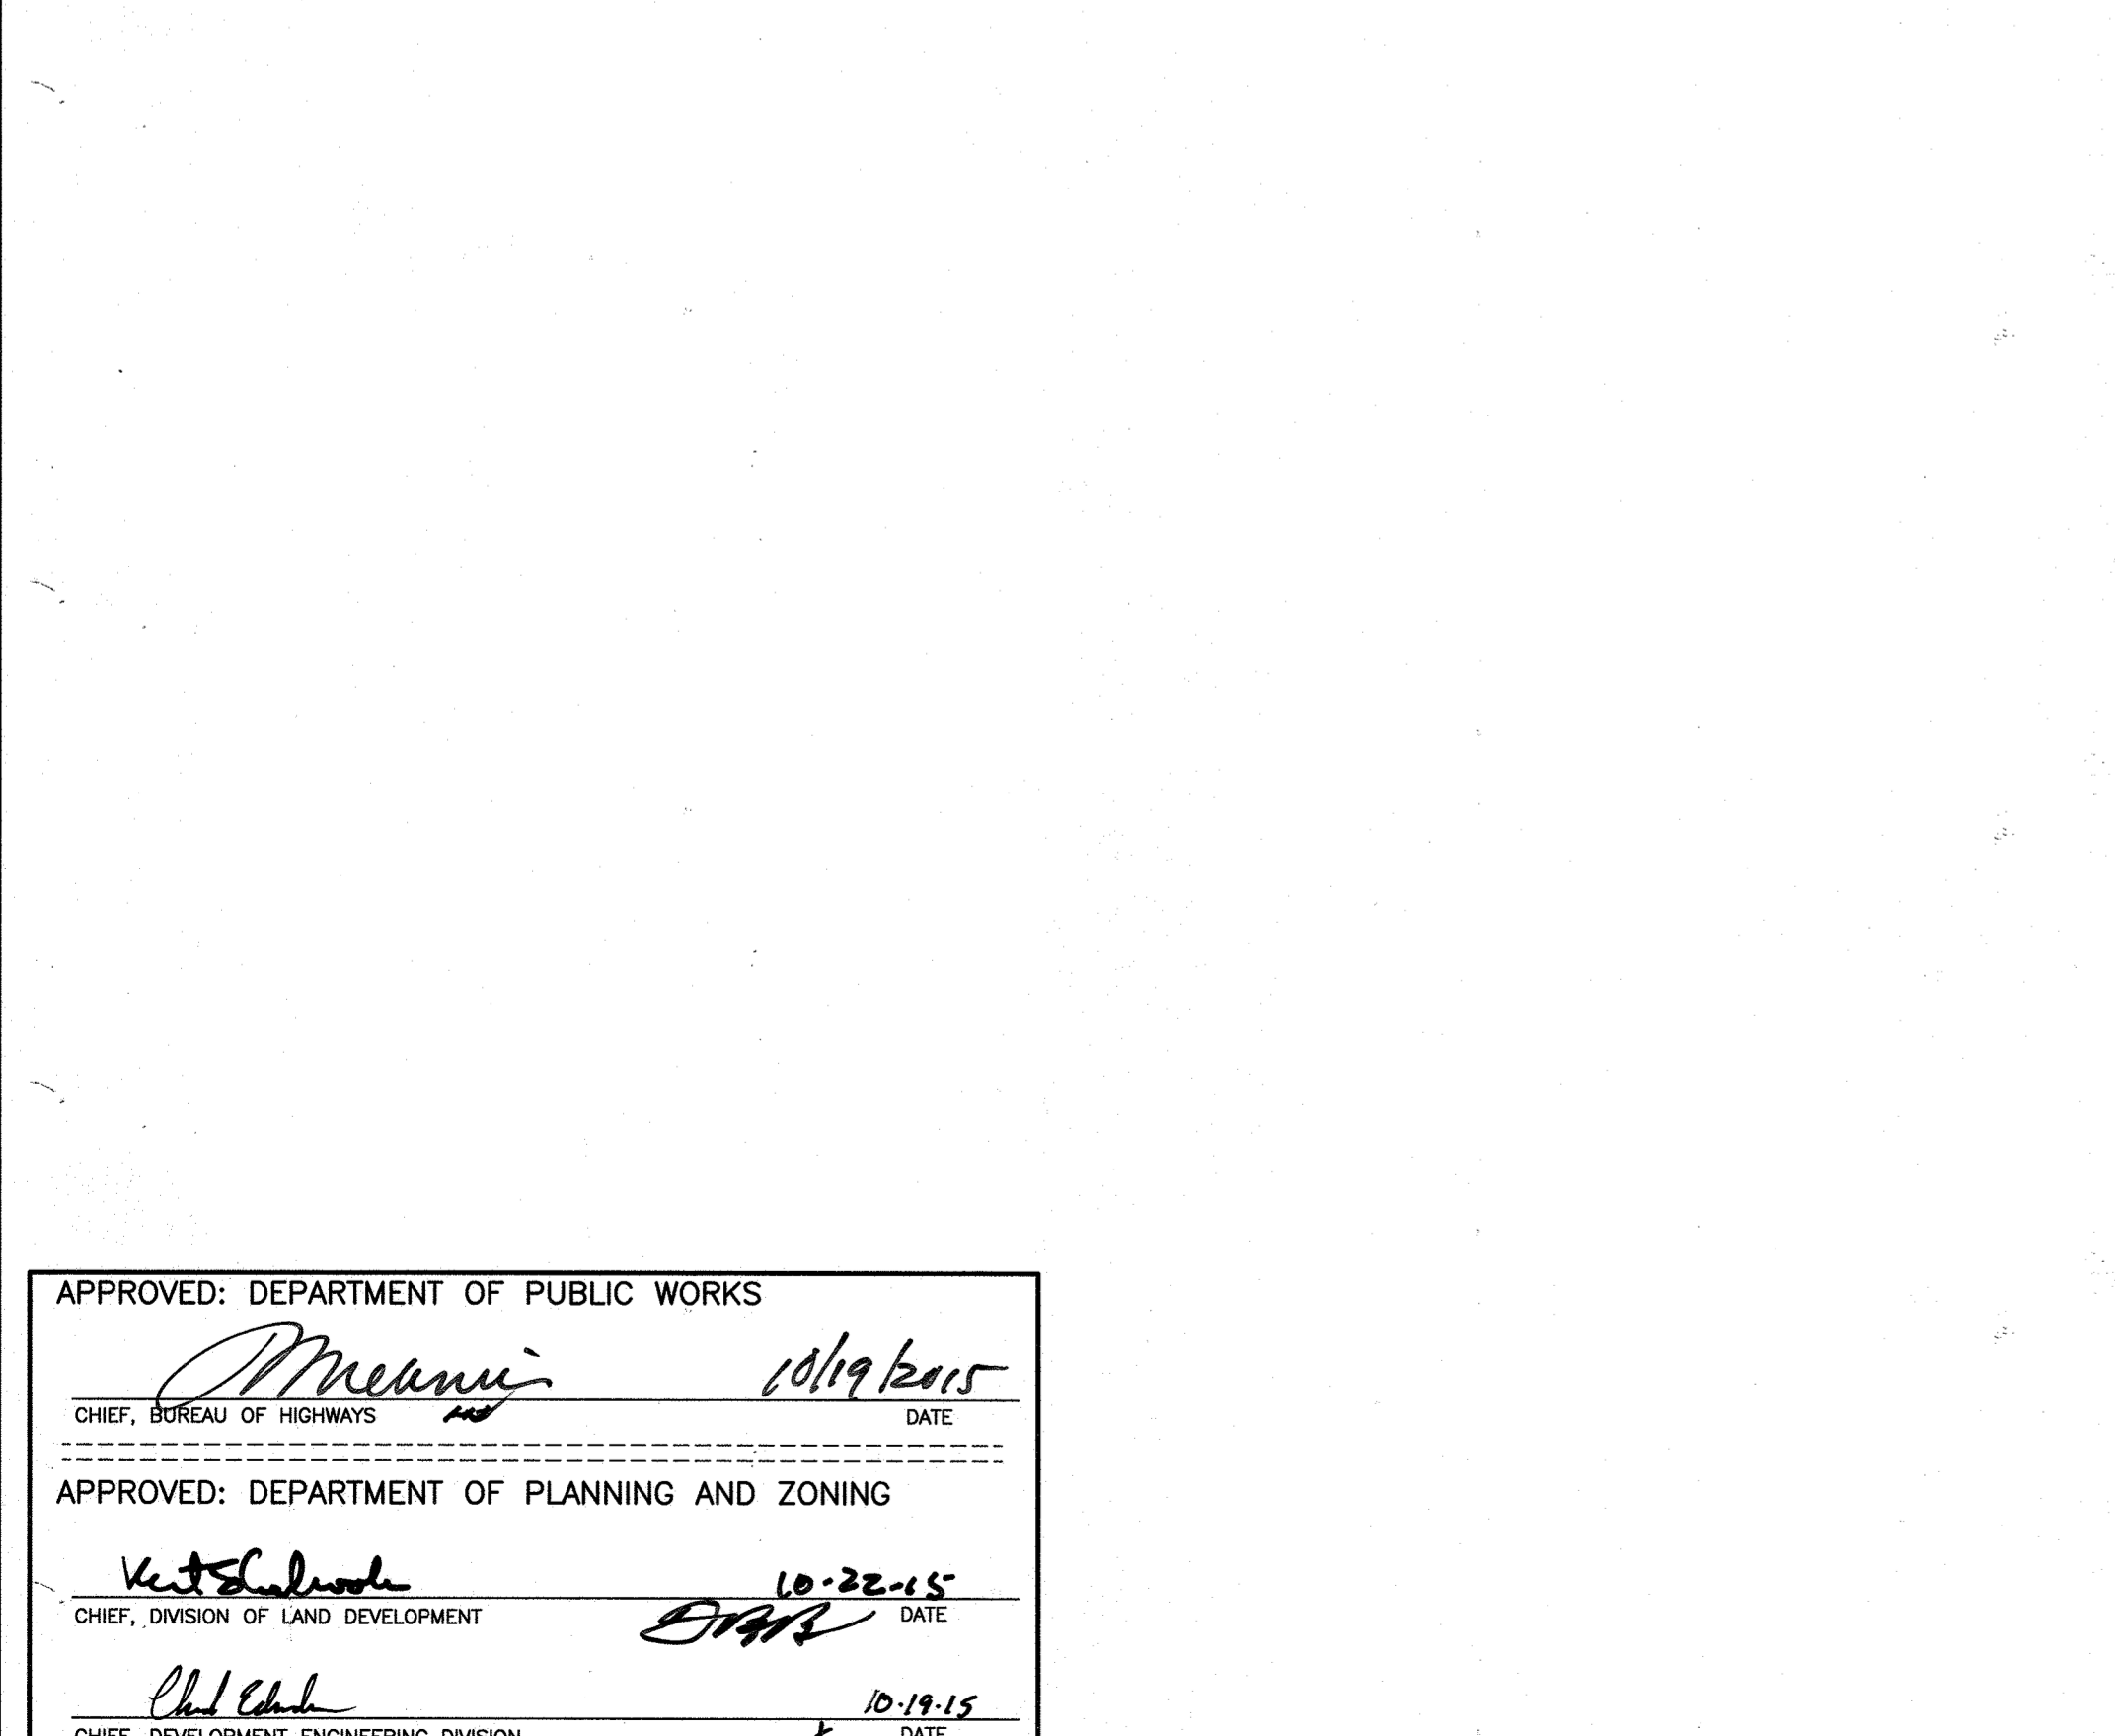

APPROVED: DEPARTMENT OF PUBLIC WORKS  
*Mearns* 10/19/15  
CHIEF, BUREAU OF HIGHWAYS

APPROVED: DEPARTMENT OF PLANNING AND ZONING  
*V. S. ...* 10/22/15  
CHIEF, DIVISION OF LAND DEVELOPMENT

APPROVED: DEPARTMENT OF ENGINEERING  
*Ch. ...* 10/19/15  
CHIEF, DEVELOPMENT ENGINEERING DIVISION

STORM DRAIN PROFILE - TWIN 60" CULVERT #1  
SCALE: 1" = 50' HORIZ., 1" = 5' VERT.

STORM DRAIN PROFILE TWIN 60" CULVERT #2  
SCALE: 1" = 50' HORIZ., 1" = 5' VERT.

Professional Certification. I hereby certify that these documents were prepared or approved by me, and that I am a duly licensed professional engineer under the laws of the State of Maryland.  
License No. 21443, Expiration Date: 12/21/22

AS-BUILT CERTIFICATION  
I hereby certify, by my seal, that to the best of my knowledge and belief the facilities shown on this "AS-BUILT" Plan meet the Approved Plans and Specifications  
Donald Mason, P.E. Date: 9/20/21

Professional Certification. I hereby certify that these documents were prepared or approved by me, and that I am a duly licensed professional engineer under the laws of the State of Maryland.  
License No. 22390, Expiration Date: 6-30-2017

**BENCHMARK ENGINEERING, INC.**  
8480 BALTIMORE NATIONAL PIKE SUITE 315 & ELLICOTT CITY, MARYLAND 21043  
(P) 410-465-8105 (F) 410-465-6644  
WWW.BEI-CIVILENGINEERING.COM

OWNER: MANGIONE ENTERPRISES OF TURF VALLEY, LIMITED PARTNERSHIP, 1205 YORK ROAD, PENTHOUSE LUTHERVILLE, MARYLAND 21093, 410-825-8400

DEVELOPER: MANGIONE ENTERPRISES OF TURF VALLEY, LIMITED PARTNERSHIP, 1205 YORK ROAD, PENTHOUSE LUTHERVILLE, MARYLAND 21093, 410-825-8400

THE BLUFFS AT TURF VALLEY  
RESORT ROAD EXTENSION  
NON-BUILDABLE BULK PARCELS 'A' AND 'B'  
A SUBDIVISION OF PART OF PARCEL 706

TAX MAP: 17 - GRID: 13 - PARCEL: p/o 706  
ZONED: PGCC  
ELECTION DISTRICT NO. 2 - HOWARD COUNTY, MARYLAND

TWIN 60" CULVERT  
PROFILE AND DETAILS

DATE: SEPTEMBER, 2015 BEI PROJECT NO. 2697  
DESIGN: DBT DRAFT: DBT SCALE: AS SHOWN SHEET 7 OF 15

**CONSTRUCTION SPECIFICATIONS**

**B.4.C Specifications for Micro-Bioretenion, Rain Gardens, Landscape Infiltration & Infiltration Berms**

**1. Material Specifications:**

The allowable materials to be used in these practices are detailed in Table B.4.1.

**2. Filtering Media or Planting Soil:**

The soil shall be a uniform mix, free of stones, stumps, roots or other similar objects larger than two inches. No other materials or substances shall be mixed or dumped within the micro-bioretenion practice that may be harmful to plant growth, or prove a hindrance to the planting or maintenance operations. The planting soil shall be free of Bermuda grass, Quackgrass, Johnson grass, or other noxious weeds as specified under COMAR 15.08.01.05. The planting soil shall be tested and shall meet the following criteria:

- Soil Component - Loamy Sand or Sandy Loam (USDA Soil Textural Classification)
- Organic Content - Minimum 10% by dry weight (ASTM D 2974). In general, this can be met with a mixture of loamy and (60%-65%) and compost (35% to 40%) or sandy loam (30%), coarse sand (30%), and compost (40%).
- Clay Content - Media shall have a clay content of less than 5%.
- pH Range - Should be between 5.5 - 7.0. Amendments (e.g., lime, iron sulfate plus sulfur) may be mixed into the soil to increase or decrease pH.

There shall be at least one soil test per project. Each test shall consist of both the standard soil test for pH, and additional tests of organic matter, and soluble salts. A textural analysis is required from the site stockpiled topsoil. If topsoil is imported, then a texture analysis shall be performed for each location where the topsoil was excavated.

**3. Compaction:**

It is very important to minimize compaction of both the base of bioretention practices and the required backfill. When possible, use excavation hoes to remove original soil. If practices are excavated using a loader, the contractor should use wide track or marsh track equipment, or light equipment with turf type tires. Use of equipment with narrow tracks or narrow tires, rubber tires with large lugs, or high-pressure tires will cause excessive compaction resulting in reduced infiltration rates and is not acceptable. Compaction will significantly contribute to design failure.

Compaction can be alleviated at the base of the bioretention facility by using a primary tilling operation such as a chisel plow, ripper, or subsoiler. These tilling operations are to restructure the soil profile through the 12 inch compaction zone. Substitute methods must be approved by the engineer. Rototillers typically do not till deep enough to reduce the effects of compaction from heavy equipment.

Rototill 2 to 3 inches of sand into the base of the bioretention facility before backfilling the optional sand layer. Pump any ponded water before preparing (rototilling) base.

When backfilling the topsoil over the sand layer, first place 3 to 4 inches of topsoil over the sand, then rototill the sand/topsoil to create a gradation zone. Backfill the remainder of the topsoil to final grade.

When backfilling the bioretention facility, place soil in lifts 12" to 18". Do not use heavy equipment within the bioretention basin. Heavy equipment can be used around the perimeter of the basin to supply soils and sand. Grade bioretention materials with light equipment such as a compact loader or a dozer/loader with marsh tracks.

**4. Plant Material:**

Recommended plant material for micro-bioretenion practices can be found in Appendix A, Section A.2.3.

**5. Plant Installation:**

Compost is a better organic material source, is less likely to float, and should be placed in the invert and other low areas. Mulch should be placed in surrounding to a uniform thickness of 2" to 3". Shredded or chipped hardwood mulch is the only accepted mulch. Pine mulch and wood chips will float and move to the perimeter of the bioretention area during a storm event and are not acceptable. Shredded mulch must be well aged (6 to 12 months) for acceptance.

Rootstock of the plant material shall be kept moist during transport and on-site storage. The plant root ball should be planted so 1/8th of the ball is above final grade surface. The diameter of the planting pit shall be at least six inches larger than the diameter of the planting ball. Set and maintain the plant straight during the entire planting process. Thoroughly water ground bed cover after installation.

Trees shall be braced using 2" by 2" stakes only as necessary and for the first growing season only. Stakes are to be equally spaced on the outside of the tree ball.

Grasses and legume seed should be drilled into the soil to a depth of at least one inch. Grass and legume plugs shall be planted following the non-grass ground cover planting specifications.

The topsoil specifications provide enough organic material to adequately supply nutrients from natural cycling. The primary function of the bioretention structure is to improve water quality. Adding fertilizers defeats, or at a minimum, impedes this goal. Only add fertilizer if wood chips or mulch are used to amend the soil. Rototill urea fertilizer at a rate of 2 pounds per 1000 square feet.

**6. Underdrains:**


Underdrains should meet the following criteria:

- Pipe - Should be 4" to 6" diameter, slotted or perforated rigid plastic pipe (ASTM F 758, Type PS 28, or AASHTO-M-278) in a gravel layer. The preferred material is slotted, 4" rigid pipe (e.g., PVC or HDPE).
- Perforations - If perforated pipe is used, perforations should be 3/8" diameter located 6" on center with a minimum of four holes per row. Pipe shall be wrapped with a 1/2" (No. 4 or 4x4) galvanized hardware cloth.
- Gravel - The gravel layer (No. 57 stone preferred) shall be at least 3" thick above and below the underdrain.
- The main collector pipe shall be at a minimum 0.5% slope.
- A rigid, non-perforated observation well must be provided (one per every 1,000 square feet) to provide a clean-out port and monitor performance of the filter.
- A 4" layer of pea gravel (1/2" to 3/4" stone) shall be located between the filter media and underdrain to prevent migration of fines into the underdrain. This layer may be considered part of the filter bed when bed thickness exceeds 24".


The main collector pipe for underdrain systems shall be constructed at a minimum slope of 0.5%. Observation wells and/or clean-out pipes must be provided (one minimum per every 1000 square feet of surface area).

**7. Miscellaneous:**

These practices may not be constructed until all contributing drainage area has been stabilized.

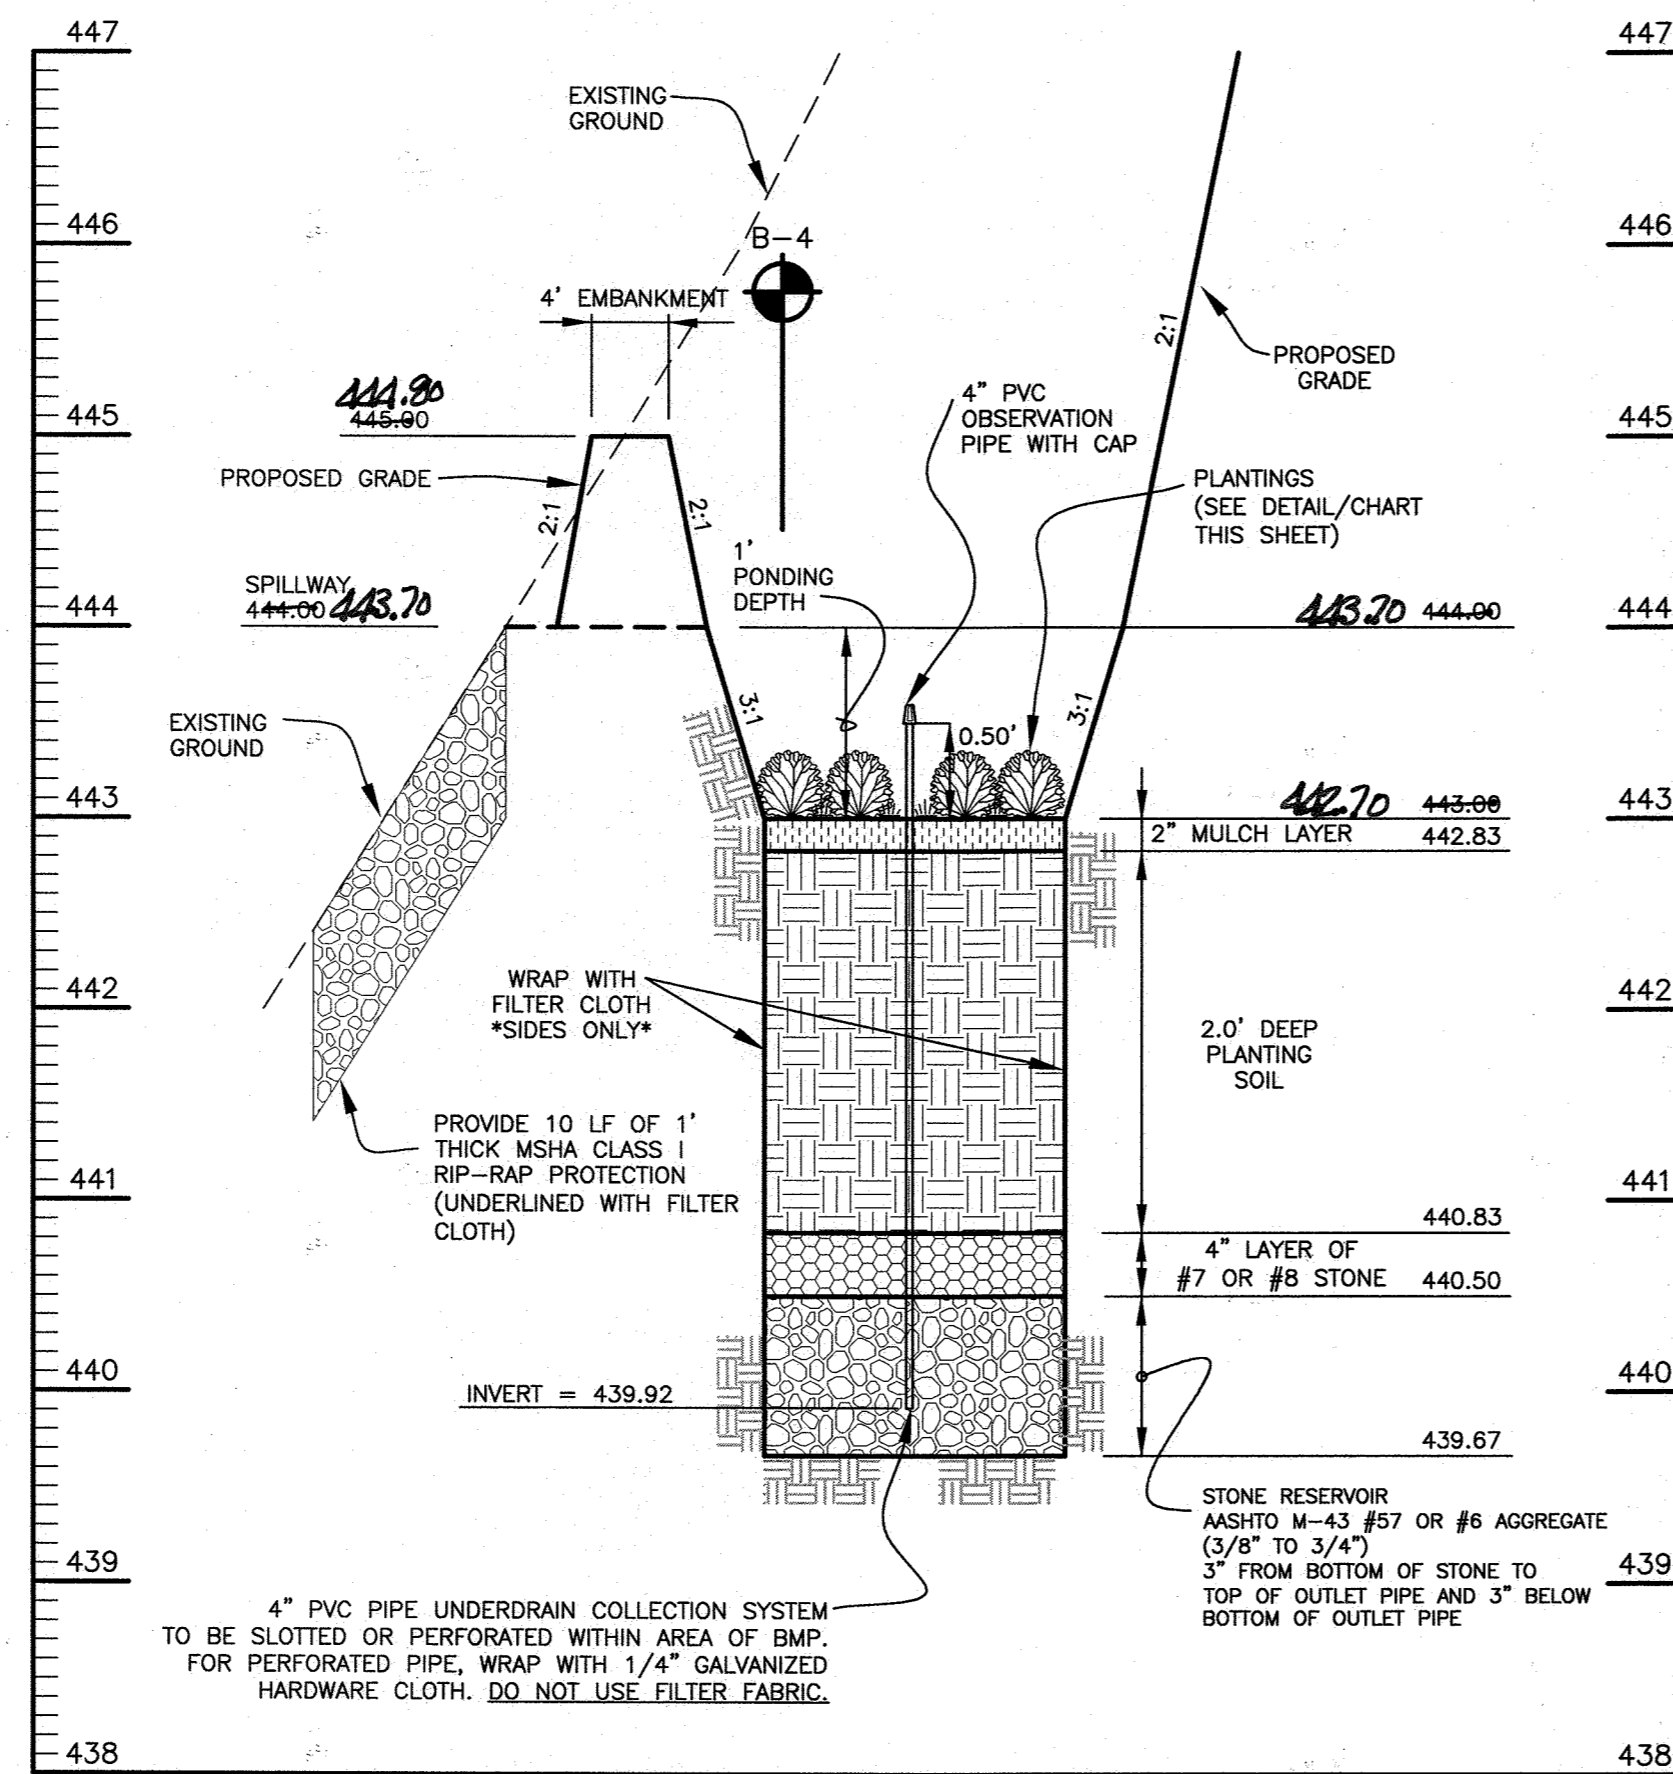


**CROSS-SECTION THROUGH (M-6) MICRO-BIORETENTION #1**  
SCALE: 1"=10' HORIZ., 1"=1' VERT.

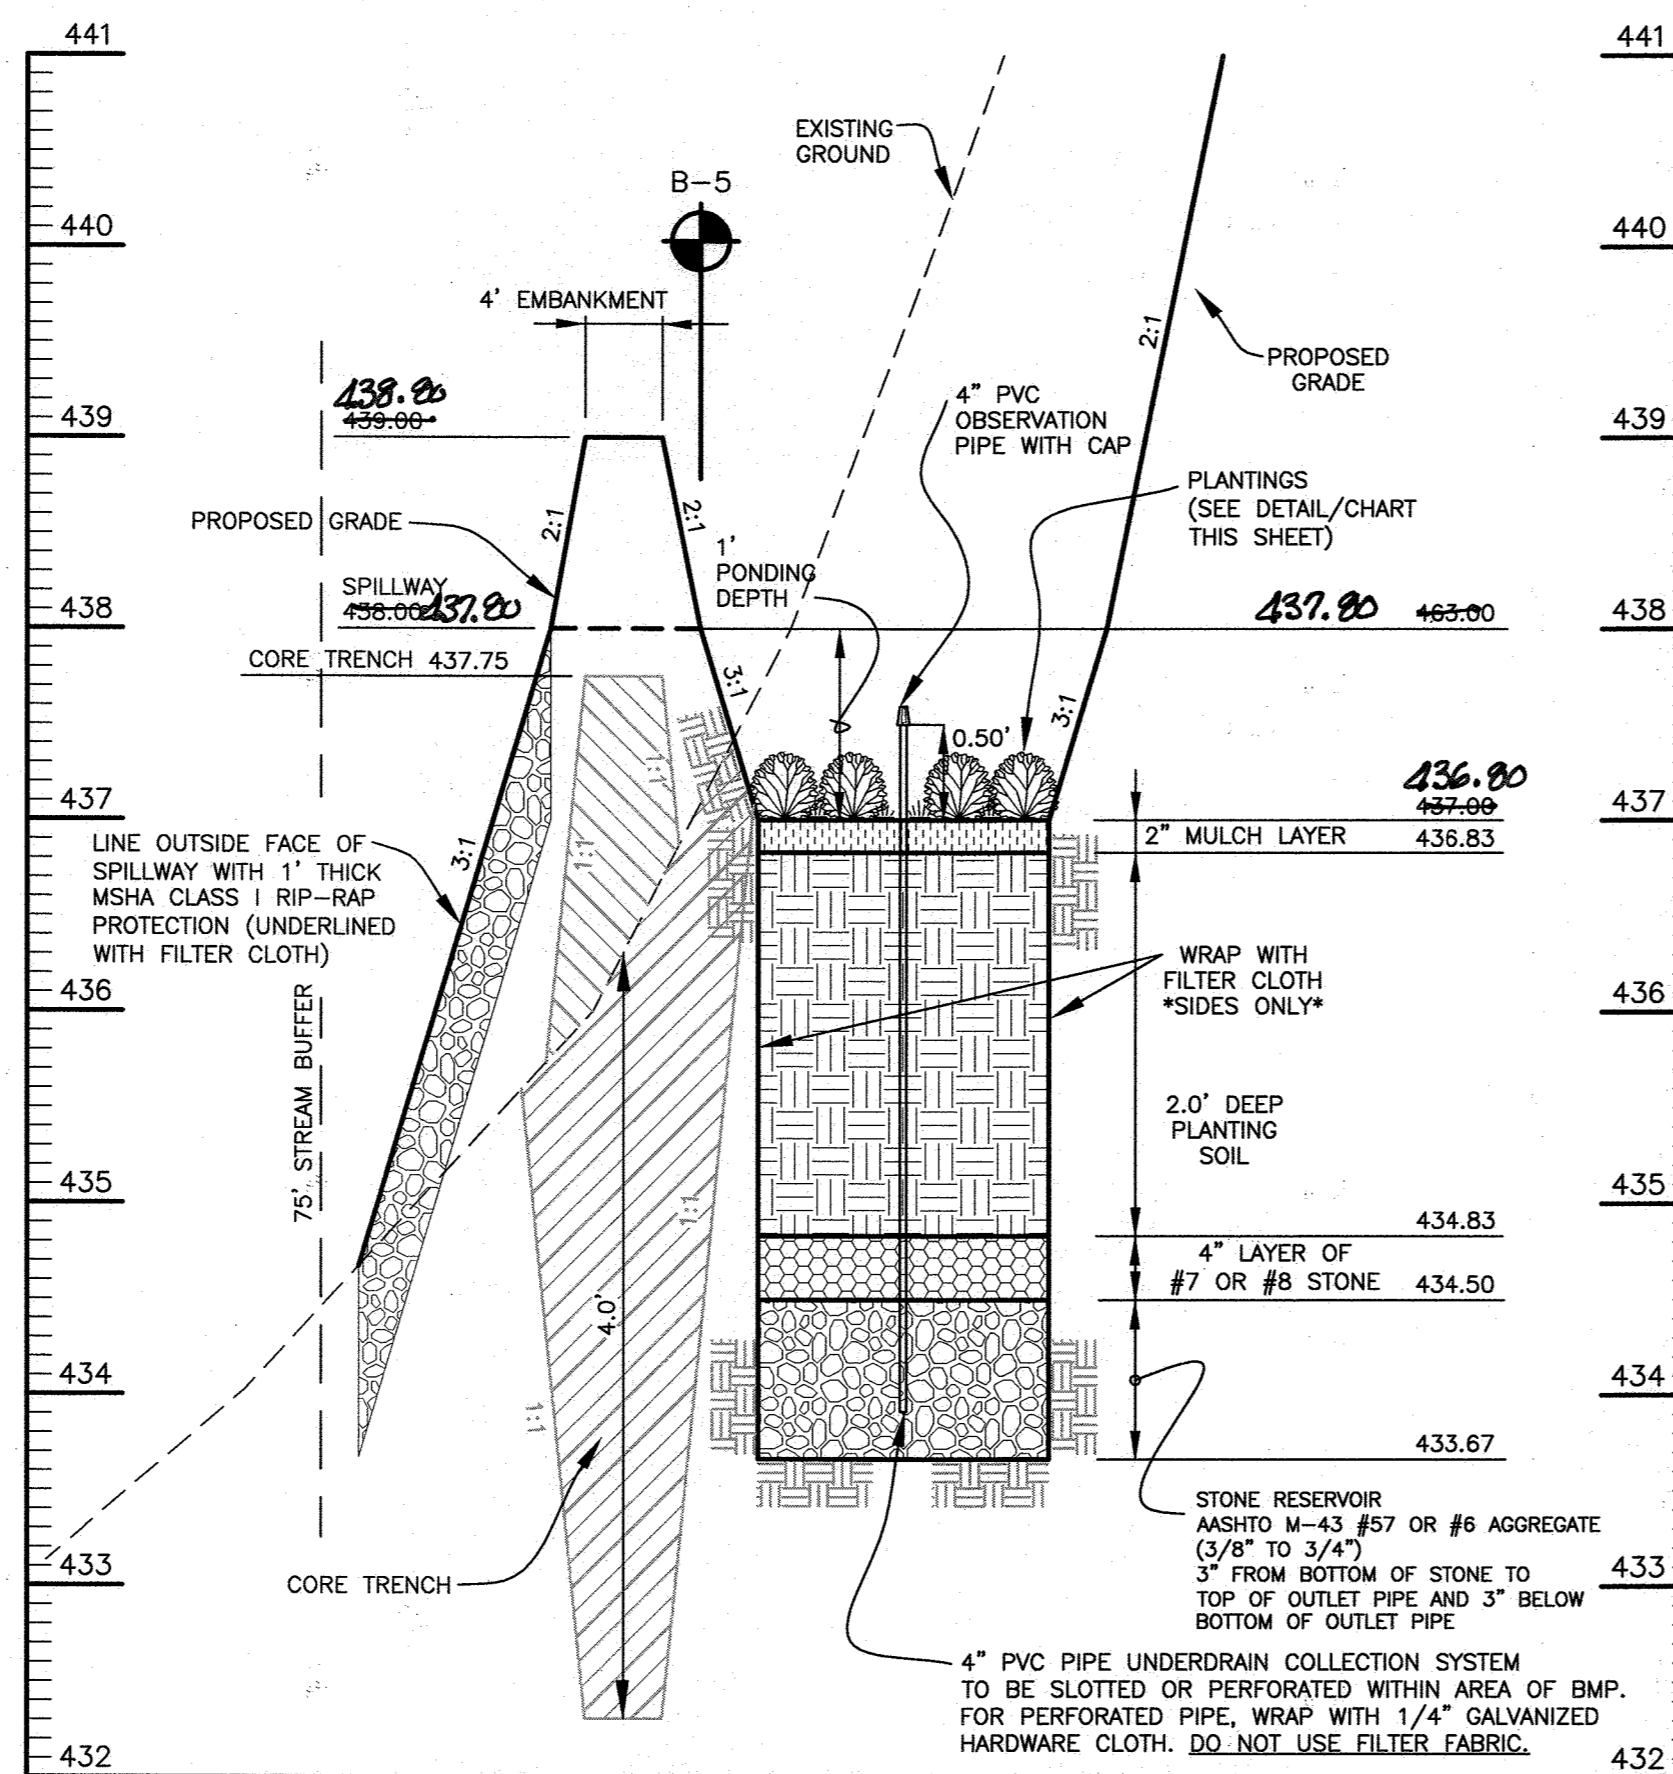


**CROSS-SECTION THROUGH (M-6) MICRO-BIORETENTION #2**  
SCALE: 1"=10' HORIZ., 1"=1' VERT.

**AS-BUILT CERTIFICATION**  
I hereby certify, by my seal, that to the best of my knowledge and belief the facilities shown on this "AS-BUILT" Plan meet the Approved Plans and Specifications.

Donald Mason, P.E. Date: 9/26/21

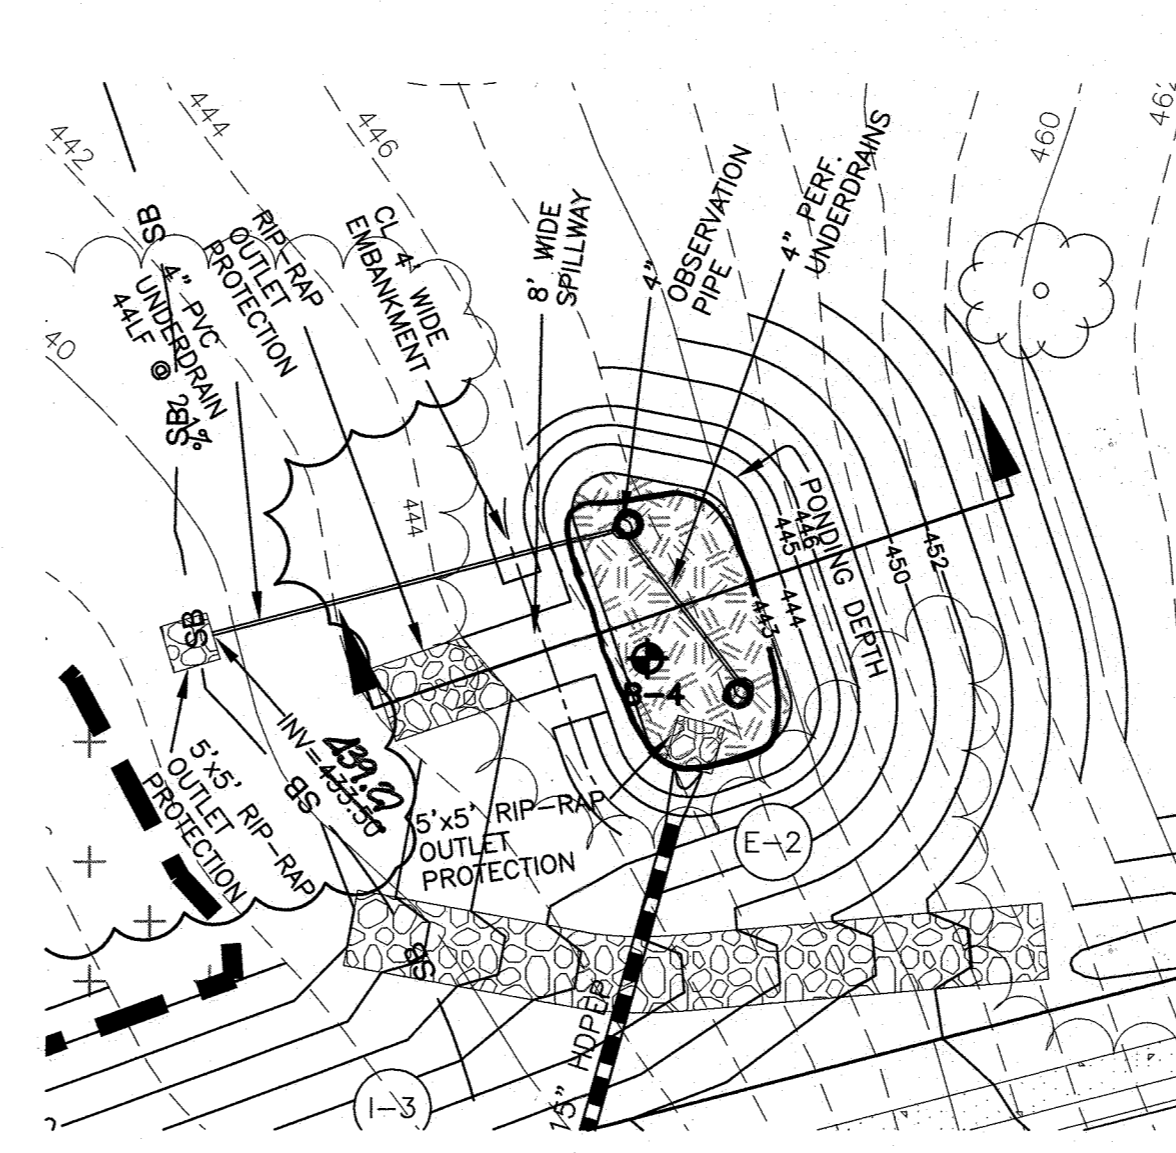


**PLAN VIEW (M-6) MICRO-BIORETENTION #1**  
SCALE: 1"=20'

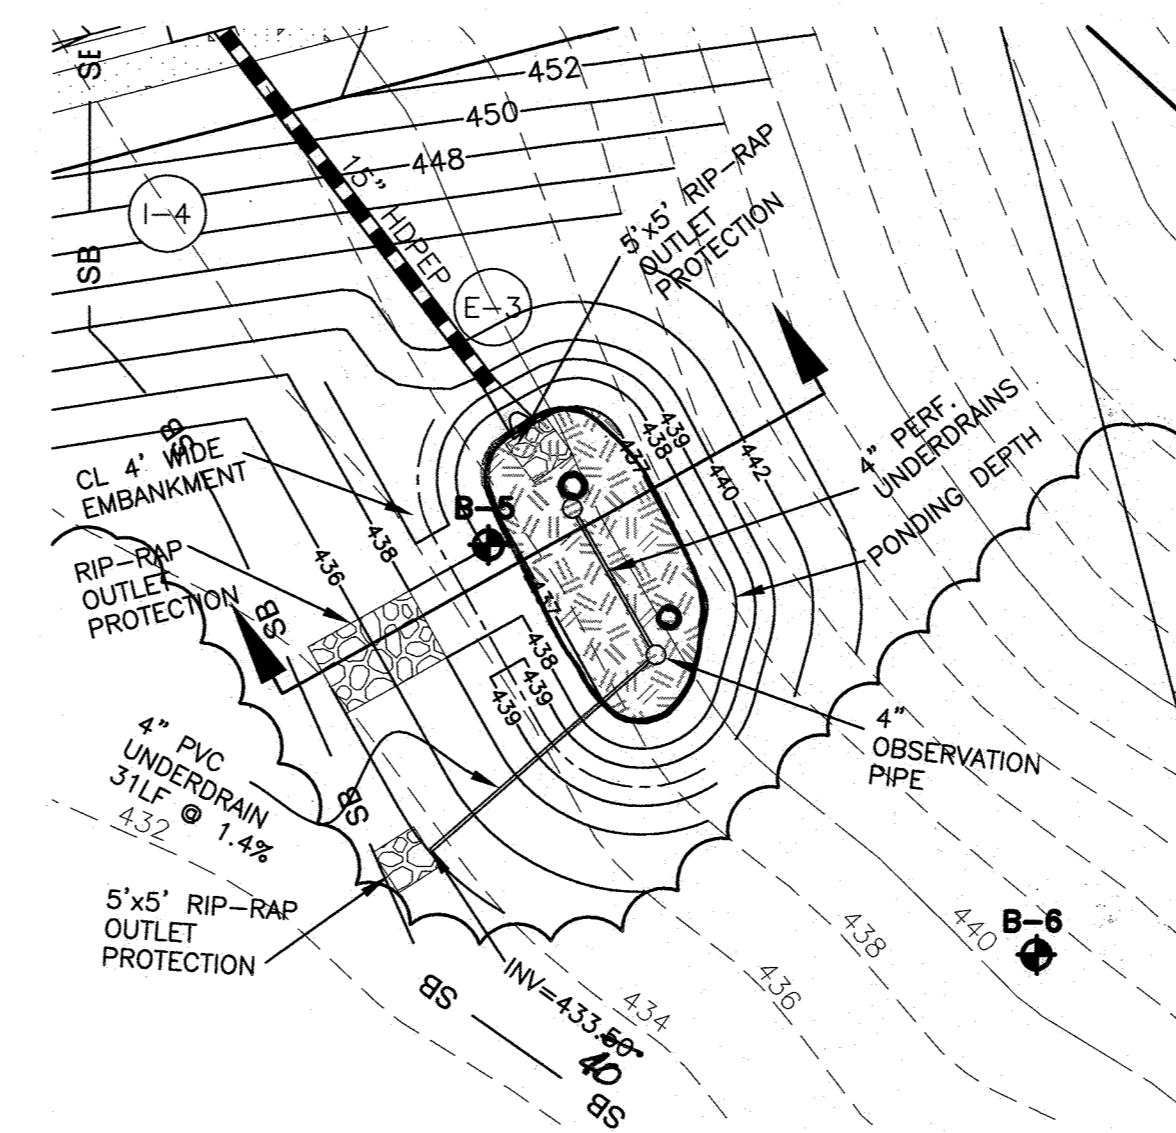

**PLAN VIEW (M-6) MICRO-BIORETENTION #2**  
SCALE: 1"=20'

| ESD PRACTICE INTERNAL LANDSCAPING CHART |                     |                     |                            |            |        |       |       |       |
|---|---------------------|---------------------|----------------------------|------------|--------|-------|-------|-------|
| Facility square footage                 | PLANT NAME          | COMMON NAME         | TYPE                       | SIZE       | BIO #1 | MB #1 | MB #2 | TOTAL |
|   |                     |                     |                            |            | 1988   | 460   | 448   | 2896  |
|   | Ilex verticillata   | Common Winterberry  | shrub                      | 2.5'-3' ht | 20     | 5     | 4     | 29    |
|   | Lobelia cardinalis  | Cardinal flower     | perennial herbaceous plant | quart bulb | 133    | 31    | 30    | 193   |
|   | Lobelia siphilitica | Great Blue Lobelia  | perennial herbaceous plant | quart bulb | 133    | 31    | 30    | 193   |
|   | Carex stricta       | Upright Sedge       | grass                      | quart bulb | 133    | 31    | 30    | 193   |
|   | Iris versicolor     | Blue Water Iris     | perennial herbaceous plant | quart bulb | 133    | 31    | 30    | 193   |
|   | Liatris spicata     | Prairie Gay Feather | perennial herbaceous plant | quart bulb | 133    | 31    | 30    | 193   |

| PLANTING LEGEND |                     |
|-----------------|---------------------|
| SYMBOL          | NAME                |
| ①               | LOBELIA CARDINALIS  |
| ②               | LOBELIA SIPHILITICA |
| □               | CAREX STRICTA       |
| △               | IRIS VERSICOLOR     |
| ○               | LIATRIS SPICATA     |
| ●               | ILEX VERTICILLATA   |

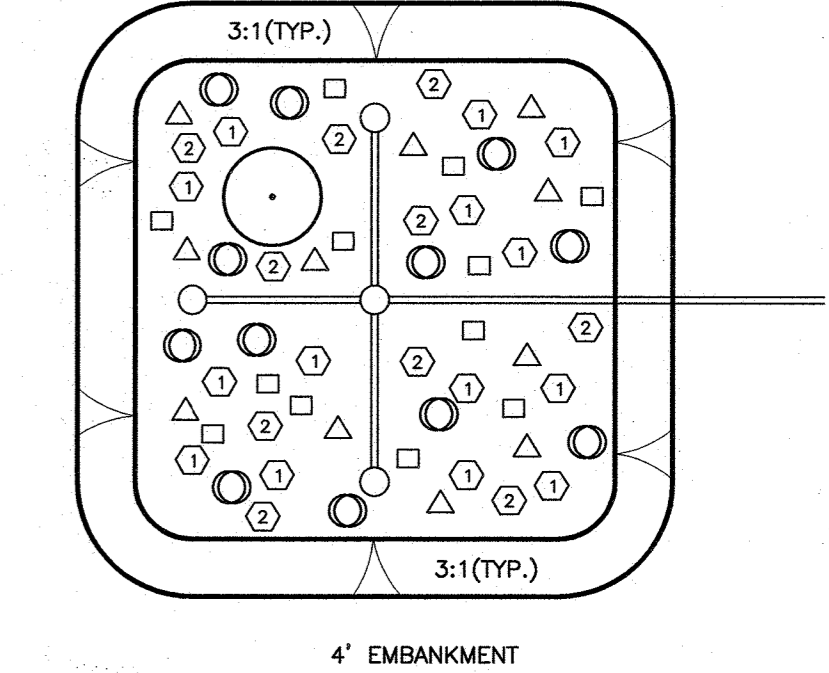

**SCHEMATIC PLANTING DETAIL FOR (M-6) MICRO-BIORETENTION & (F-6) BIORETENTION FACILITIES**  
NOT TO SCALE

**OPERATION AND MAINTENANCE SCHEDULE FOR PRIVATELY OWNED AND JOINTLY MAINTAINED MICRO BIO-RETENTION (M-6) AND BIO-RETENTION (F-6).**

- Routine - (H.O.A.)
- Annual maintenance of plant material, mulch layer and soil layer is required. Maintenance of mulch and soil is limited to correcting areas of erosion or wash out. Any mulch replacement shall be done in the spring. Plant material shall be checked for disease and insect infestation and maintenance will address dead material and pruning. Acceptable replacement plant material is limited to the following: 2000 Maryland Stormwater Design Manual Volume II, Table A.4.1 and 2.
  - Schedule of plant inspection will be twice a year in spring and fall. This inspection will include removal of dead and diseased vegetation considered beyond treatment, treatment of all diseased trees and shrubs and replacement of all deficient stakes and wires.
  - Mulch shall be inspected each spring. Remove previous mulch layer before applying new layer once every 2 to 3 years.
  - Soil erosion to be addressed on an as needed basis, with a minimum of once per month and after heavy storm events.
- Non-Routine - (Howard County)
- Maintenance of public storm drain pipe and end-section from public right-of-way to facility.

APPROVED: DEPARTMENT OF PUBLIC WORKS  
 [Signature] 10/19/2015  
 CHIEF, BUREAU OF HIGHWAYS  
 APPROVED: DEPARTMENT OF PLANNING AND ZONING  
 [Signature] 10-22-15  
 CHIEF, DIVISION OF LAND DEVELOPMENT  
 APPROVED: [Signature] 10-19-15  
 CHIEF, DEVELOPMENT ENGINEERING DIVISION

Professional Certification. I hereby certify that these documents were prepared or approved by me, and that I am a duly licensed professional engineer under the laws of the State of Maryland.  
 License No. 21443, Expiration Date: 12/31/22

NO. DATE REVISION

**BENCHMARK ENGINEERING, INC.**  
 8480 BALTIMORE NATIONAL PIKE SUITE 315 & ELLICOTT CITY, MARYLAND 21043  
 (P) 410-465-8105 (F) 410-465-8644  
 WWW.BE-CHEENGINEERING.COM

OWNER: MANGIONE ENTERPRISES OF TURF VALLEY, LIMITED PARTNERSHIP  
 1205 YORK ROAD, PENTHOUSE LUTHERVILLE, MARYLAND 21093 410-825-8400

DEVELOPER: MANGIONE ENTERPRISES OF TURF VALLEY, LIMITED PARTNERSHIP  
 1205 YORK ROAD, PENTHOUSE LUTHERVILLE, MARYLAND 21093 410-825-8400

**THE BLUFFS AT TURF VALLEY RESORT ROAD EXTENSION**  
 NON-BUILDABLE BULK PARCELS 'A' AND 'B'  
 A SUBDIVISION OF PART OF PARCEL 706

TAX MAP: 17 - GRID: 13 - PARCEL: p/o 706  
 ZONED: PGCC  
 ELECTION DISTRICT NO. 2 - HOWARD COUNTY, MARYLAND

ESD STORM WATER MANAGEMENT NOTES AND DETAILS


DATE: SEPTEMBER, 2015 BEI PROJECT NO. 2697  
 DESIGN: DBT DRAFT: DBT SCALE: AS SHOWN SHEET 8 OF 15







| NRCS SOILS CHART - HoCo Soils Map No. 12 |        |       |      | MAP UNIT NAME                                     |
|--|--------|-------|------|---|
| SYMBOL                                   | HYDRIC | GROUP | Kw   |   |
| GbA                                      |        | B     | 0.28 | GLADSTONE LOAM, 0 TO 3 PERCENT SLOPES             |
| GbB                                      |        | B     | 0.28 | GLADSTONE LOAM, 3 TO 8 PERCENT SLOPES             |
| GbC                                      |        | B     | 0.28 | GLADSTONE LOAM, 8 TO 15 PERCENT SLOPES            |
| GnB*                                     | YES    | C     | 0.43 | GLENNVILLE-BAILE SILT LOAM, 0 TO 8 PERCENT SLOPES |
| BaA*                                     | YES    | D     | 0.43 | BAILE SILT LOAM, 0 TO 3 PERCENT SLOPES            |

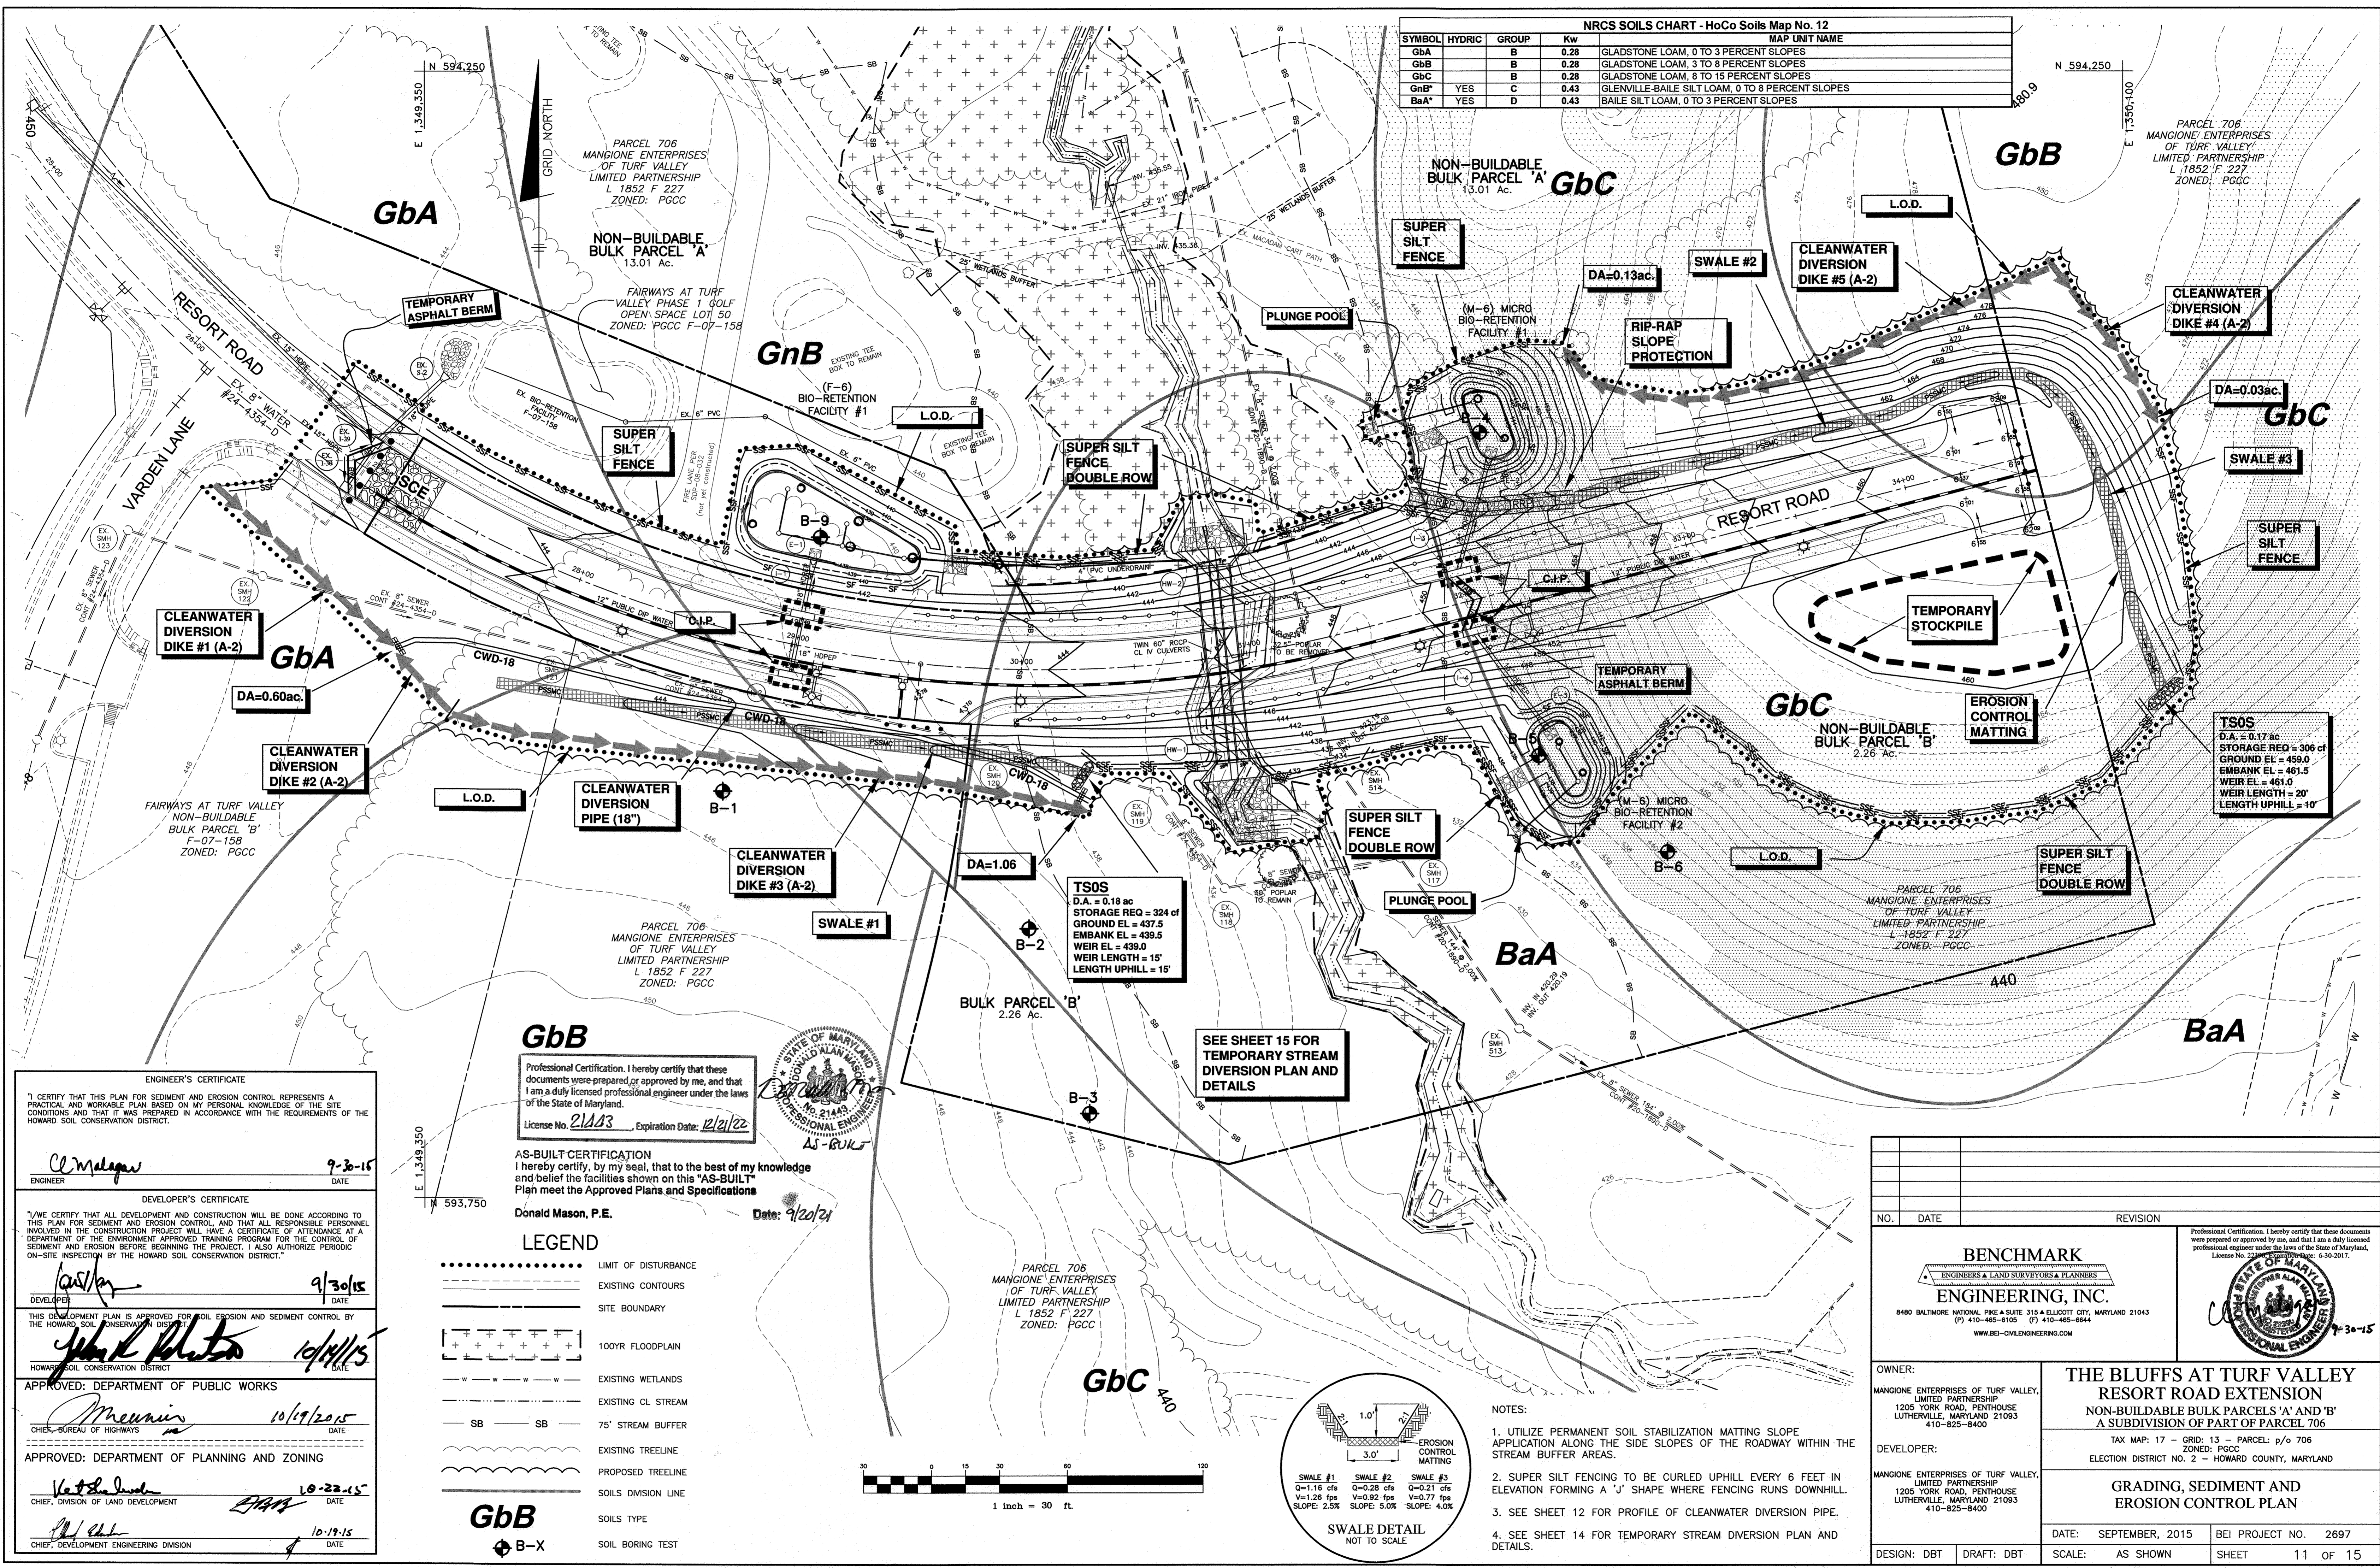

**ENGINEER'S CERTIFICATE**

I CERTIFY THAT THIS PLAN FOR SEDIMENT AND EROSION CONTROL REPRESENTS A PRACTICAL AND WORKABLE PLAN BASED ON MY PERSONAL KNOWLEDGE OF THE SITE CONDITIONS AND THAT IT WAS PREPARED IN ACCORDANCE WITH THE REQUIREMENTS OF THE HOWARD SOIL CONSERVATION DISTRICT.

*C. M. Mason* 9-30-15  
ENGINEER DATE

**DEVELOPER'S CERTIFICATE**

I/WE CERTIFY THAT ALL DEVELOPMENT AND CONSTRUCTION WILL BE DONE ACCORDING TO THIS PLAN FOR SEDIMENT AND EROSION CONTROL, AND THAT ALL RESPONSIBLE PERSONNEL INVOLVED IN THE CONSTRUCTION PROJECT WILL HAVE A CERTIFICATE OF ATTENDANCE AT A DEPARTMENT OF THE ENVIRONMENT APPROVED TRAINING PROGRAM FOR THE CONTROL OF SEDIMENT AND EROSION BEFORE BEGINNING THE PROJECT. I ALSO AUTHORIZE PERIODIC ON-SITE INSPECTION BY THE HOWARD SOIL CONSERVATION DISTRICT.

*John K. Roberts* 9/30/15  
DEVELOPER DATE

THIS DEVELOPMENT PLAN IS APPROVED FOR SOIL EROSION AND SEDIMENT CONTROL BY THE HOWARD SOIL CONSERVATION DISTRICT.

*John K. Roberts* 10/14/15  
HOWARD SOIL CONSERVATION DISTRICT DATE

APPROVED: DEPARTMENT OF PUBLIC WORKS  
*M. Mason* 10/19/2015  
CHIEF, BUREAU OF HIGHWAYS DATE

APPROVED: DEPARTMENT OF PLANNING AND ZONING  
*V. J. Smith* 10-22-15  
CHIEF, DIVISION OF LAND DEVELOPMENT DATE

*D. Mason* 10-19-15  
CHIEF, DEVELOPMENT ENGINEERING DIVISION DATE

**Professional Certification**

I hereby certify that these documents were prepared or approved by me, and that I am a duly licensed professional engineer under the laws of the State of Maryland.

License No. 21403 Expiration Date: 12/21/22

*Donald Mason*  
AS-BUILT



**AS-BUILT CERTIFICATION**

I hereby certify, by my seal, that to the best of my knowledge and belief the facilities shown on this "AS-BUILT" Plan meet the Approved Plans and Specifications

Donald Mason, P.E. Date: 9/20/21

**LEGEND**

|       |                      |
|-------|----------------------|
| ..... | LIMIT OF DISTURBANCE |
| ---   | EXISTING CONTOURS    |
| ---   | SITE BOUNDARY        |
| ..... | 100YR FLOODPLAIN     |
| ..... | EXISTING WETLANDS    |
| ---   | EXISTING CL STREAM   |
| SB SB | 75' STREAM BUFFER    |
| ..... | EXISTING TREELINE    |
| ..... | PROPOSED TREELINE    |
| ---   | SOILS DIVISION LINE  |
| ---   | SOILS TYPE           |
| ⊕ B-X | SOIL BORING TEST     |

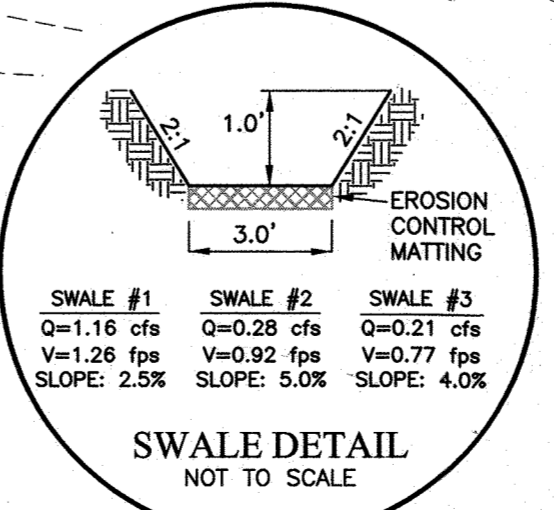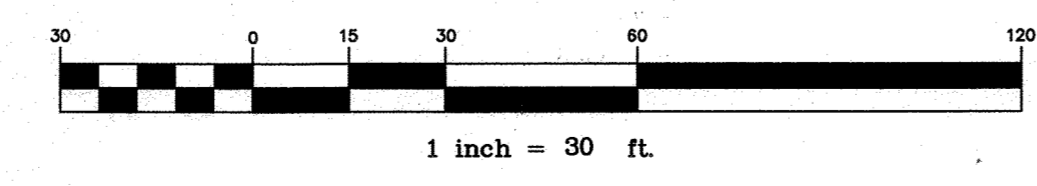

- NOTES:**
- UTILIZE PERMANENT SOIL STABILIZATION MATTING SLOPE APPLICATION ALONG THE SIDE SLOPES OF THE ROADWAY WITHIN THE STREAM BUFFER AREAS.
  - SUPER SILT FENCING TO BE CURLED UPHILL EVERY 6 FEET IN ELEVATION FORMING A 'J' SHAPE WHERE FENCING RUNS DOWNHILL.
  - SEE SHEET 12 FOR PROFILE OF CLEANWATER DIVERSION PIPE.
  - SEE SHEET 14 FOR TEMPORARY STREAM DIVERSION PLAN AND DETAILS.

| NO. | DATE | REVISION |
|-----|------|----------|
|     |      |          |

**BENCHMARK ENGINEERING, INC.**  
ENGINEERS & LAND SURVEYORS & PLANNERS  
8480 BALTIMORE NATIONAL PIKE SUITE 315 ELLICOTT CITY, MARYLAND 21043  
(P) 410-465-6105 (F) 410-465-6644  
WWW.BEI-ENGINEERING.COM

**OWNER:**  
MANGIONE ENTERPRISES OF TURF VALLEY, LIMITED PARTNERSHIP  
1205 YORK ROAD, PENTHOUSE LUTHERVILLE, MARYLAND 21093 410-825-8400

**DEVELOPER:**  
MANGIONE ENTERPRISES OF TURF VALLEY, LIMITED PARTNERSHIP  
1205 YORK ROAD, PENTHOUSE LUTHERVILLE, MARYLAND 21093 410-825-8400

**THE BLUFFS AT TURF VALLEY RESORT ROAD EXTENSION**  
NON-BUILDABLE BULK PARCELS 'A' AND 'B' A SUBDIVISION OF PART OF PARCEL 706  
TAX MAP: 17 - GRID: 13 - PARCEL: p/o 706  
ZONED: PGCC  
ELECTION DISTRICT NO. 2 - HOWARD COUNTY, MARYLAND

**GRADING, SEDIMENT AND EROSION CONTROL PLAN**

DATE: SEPTEMBER, 2015 BEI PROJECT NO. 2697  
SCALE: AS SHOWN SHEET 11 OF 15

**AS-BUILT** F-16-004

**B-4 STANDARDS AND SPECIFICATIONS FOR VEGETATIVE STABILIZATION**  
**Definition**  
 Using vegetation as cover to protect exposed soil from erosion.  
**Purpose**  
 To promote the establishment of vegetation on exposed soil.  
**Conditions Where Practice Applies**  
 On all disturbed areas not stabilized by other methods. This specification is divided into sections on incremental stabilization, soil preparation, soil amendments and topsoiling; seeding and mulching; temporary stabilization; soil preparation, soil amendments and topsoiling; seeding and mulching; temporary stabilization; and permanent stabilization.  
**Effects on Water Quality and Quantity**  
 Stabilization practices are used to promote the establishment of vegetation on exposed soil. When soil is stabilized with vegetation, the soil is less likely to erode and more likely to allow infiltration of rainfall, thereby reducing sediment loads and runoff to downstream areas.  
**Planting Vegetation in Disturbed Areas will have an effect on the water budget, especially on volumes and rates of runoff, infiltration, evaporation, transpiration, percolation, and groundwater recharge. Over time, vegetation will increase organic matter content and improve the water holding capacity of the soil and subsequent plant growth. Vegetation will help reduce the movement of sediment, nutrients, and other chemicals carried by runoff to receiving waters. Plants will also help protect groundwater supplies by assimilating those substances present within the root zone. Sediment control practices must remain in place during grading, seeded preparation, seeding, mulching, and vegetative establishment.**  
**Adequate Vegetative Establishment**  
 Inspect seeded areas for vegetative establishment and make necessary repairs, replacements, and reseedings within the planting season.  
 1. Adequate vegetative stabilization requires 95 percent groundcover.  
 2. If an area has less than 40 percent groundcover, reestablish following the original recommendations for lime, fertilizer, seedbed preparation, and seeding.  
 3. If an area has between 40 and 94 percent groundcover, over-seed and fertilize using half of the rates originally specified.  
 4. Maintenance fertilizer rates for permanent seeding are shown in Table B.6.

**B-4-1 STANDARDS AND SPECIFICATIONS FOR INCREMENTAL STABILIZATION**  
**Definition**  
 Establishment of vegetative cover on cut and fill slopes.  
**Purpose**  
 To provide timely vegetative cover on cut and fill slopes as work progresses.  
**Conditions Where Practice Applies**  
 Any cut or fill slope greater than 15 feet in height. This practice also applies to stockpiles.  
**Criteria**  
**A. Incremental Stabilization - Cut Slopes**  
 1. Excavate and stabilize cut slopes in increments not to exceed 15 feet in height. Prepare seedbed and apply seed and mulch on all cut slopes as the work progresses.  
 2. Construction sequence example (Refer to Figure B.1):  
 a. Construct and stabilize all temporary swales or dikes that will be used to convey runoff around the excavation.  
 b. Perform Phase 1 excavation, prepare seedbed, and stabilize.  
 c. Perform Phase 2 excavation, prepare seedbed, and stabilize. Overseed Phase 1 areas as necessary.  
 d. Perform final phase excavation, prepare seedbed, and stabilize. Overseed previously seeded areas as necessary.  
**Note:** Once excavation has begun the operation should be continuous from grubbing through the completion of grading and placement of topsoil (if required) and permanent seed and mulch. Any interruptions in the operation or completing the operation out of the seeding season will necessitate the application of temporary stabilization.  
**B. Incremental Stabilization - Fill Slopes**  
 1. Construct and stabilize fill slopes in increments not to exceed 15 feet in height. Prepare seedbed and apply seed and mulch on all slopes as the work progresses.  
 2. Stabilize slopes immediately when the vertical height of a fill reaches 15 feet, or when the grading operation ceases as prescribed in the plans.  
 3. At the end of each day, install temporary water conveyance practice(s), as necessary, to intercept surface runoff and convey it down the slope in a non-erosive manner.  
 4. Construction sequence example (Refer to Figure B.2):  
 a. Construct and stabilize all temporary swales or dikes that will be used to divert runoff around the fill. Construct silt fence on low side of fill unless other methods shown on the plans address this area.  
 b. At the end of each day, install temporary water conveyance practice(s), as necessary, to intercept surface runoff and convey it down the slope in a non-erosive manner.  
 c. Place Phase 1 fill, prepare seedbed, and stabilize.  
 d. Place Phase 2 fill, prepare seedbed, and stabilize.  
 e. Place final phase fill, prepare seedbed, and stabilize. Overseed previously seeded areas as necessary.  
**Note:** Once the placement of fill has begun the operation should be continuous from grubbing through the completion of grading and placement of topsoil (if required) and permanent seed and mulch. Any interruptions in the operation or completing the operation out of the seeding season will necessitate the application of temporary stabilization.  
 Figure B.

**"NO AS-BUILT INFORMATION IS PROVIDED ON THIS SHEET"**  
 AS-BUILT 9/20/15

**Professional Certification.** I hereby certify that these documents were prepared or approved by me, and that I am a duly licensed professional engineer under the laws of the State of Maryland.  
 License No. 21463, Expiration Date: 12/31/22

**ENGINEER'S CERTIFICATE**  
 I CERTIFY THAT THIS PLAN FOR SEDIMENT AND EROSION CONTROL REPRESENTS A PRACTICAL AND WORKABLE PLAN BASED ON MY PERSONAL KNOWLEDGE OF THE SITE CONDITIONS AND THAT IT WAS PREPARED IN ACCORDANCE WITH THE REQUIREMENTS OF THE HOWARD SOIL CONSERVATION DISTRICT.  
 CC Malagan 9-30-15  
 ENGINEER DATE

**DEVELOPER'S CERTIFICATE**  
 I/WE CERTIFY THAT ALL DEVELOPMENT AND CONSTRUCTION WILL BE DONE ACCORDING TO THIS PLAN FOR SEDIMENT AND EROSION CONTROL, AND THAT ALL RESPONSIBLE PERSONNEL INVOLVED IN THE CONSTRUCTION PROJECT WILL HAVE A CERTIFICATE OF ATTENDANCE AT A DEPARTMENT OF ENVIRONMENT APPROVED TRAINING PROGRAM FOR THE CONTROL OF SEDIMENT AND EROSION BEFORE BEGINNING THE PROJECT. I ALSO AUTHORIZE PERIODIC ON-SITE INSPECTION BY THE HOWARD SOIL CONSERVATION DISTRICT.  
 John K. Roberton 9/30/15  
 DEVELOPER DATE

**APPROVED: DEPARTMENT OF PUBLIC WORKS**  
 M. M. M. 10/19/2015  
 CHIEF, BUREAU OF HIGHWAYS DATE

**APPROVED: DEPARTMENT OF PLANNING AND ZONING**  
 K. S. S. 10-22-15  
 CHIEF, DIVISION OF LAND DEVELOPMENT DATE  
 J. S. S. 10-19-15  
 CHIEF, DEVELOPMENT ENGINEERING DIVISION DATE

**B-4-2 STANDARDS AND SPECIFICATIONS FOR SOIL PREPARATION, TOPSOILING, AND SOIL AMENDMENTS**  
**Definition**  
 The process of preparing the soils to sustain adequate vegetative stabilization.  
**Purpose**  
 To provide a suitable soil medium for vegetative growth.  
**Conditions Where Practice Applies**  
 Where vegetative stabilization is to be established.  
**Criteria**  
**A. Soil Preparation**  
 1. Temporary Stabilization  
 a. Seedbed preparation consists of loosening soil to a depth of 3 to 5 inches by means of suitable agricultural or construction equipment, such as disc harrows or chisel plows or rippers mounted on construction equipment. After the soil is loosened, it must not be ripped or dragged smooth but left in the roughened condition. Slopes 3:1 or flatter are to be tracked with ridges running parallel to the contour of the slope.  
 b. Apply fertilizer and lime as prescribed on the plans.  
 c. Incorporate lime and fertilizer into the top 3 to 5 inches of soil by disking or other suitable means.  
 2. Permanent Stabilization  
 a. A soil test is required for any earth disturbance of 5 acres or more. The minimum soil conditions required for permanent vegetative establishment are:  
 i. Soil pH between 6.0 and 7.0.  
 ii. Soluble salts less than 500 parts per million (ppm).  
 iii. Soil contains less than 40 percent clay but enough fine grained material (greater than 30 percent silt plus clay) to provide the capacity to hold a moderate amount of moisture. An exception: if (sodgrass will be present), then a sandy soil (less than 30 percent silt plus clay) would be acceptable.  
 iv. Soil contains 1.5 percent minimum organic matter by weight.  
 v. Soil contains sufficient pore space to permit adequate root penetration.  
 An exception: if (sodgrass will be present), then a sandy soil (less than 30 percent silt plus clay) would be acceptable.  
 b. Application of amendments or topsoil is required if on-site soils do not meet the above conditions.  
 c. Graded areas must be maintained in a true and even grade as specified on the approved plan, then scarified or otherwise loosened to a depth of 3 to 5 inches.  
 d. Apply soil amendments as specified on the approved plan or as indicated by the results of a soil test.  
 e. Areas having slopes steeper than 2:1 require special consideration and design.  
 f. Areas having slopes between 2:1 and 3:1 require special consideration and design.  
 g. Areas having slopes between 3:1 and 4:1 require special consideration and design.  
 h. Areas having slopes between 4:1 and 5:1 require special consideration and design.  
 i. Areas having slopes between 5:1 and 6:1 require special consideration and design.  
 j. Areas having slopes between 6:1 and 7:1 require special consideration and design.  
 k. Areas having slopes between 7:1 and 8:1 require special consideration and design.  
 l. Areas having slopes between 8:1 and 9:1 require special consideration and design.  
 m. Areas having slopes between 9:1 and 10:1 require special consideration and design.  
 n. Areas having slopes between 10:1 and 12:1 require special consideration and design.  
 o. Areas having slopes between 12:1 and 15:1 require special consideration and design.  
 p. Areas having slopes between 15:1 and 20:1 require special consideration and design.  
 q. Areas having slopes between 20:1 and 25:1 require special consideration and design.  
 r. Areas having slopes between 25:1 and 30:1 require special consideration and design.  
 s. Areas having slopes between 30:1 and 40:1 require special consideration and design.  
 t. Areas having slopes between 40:1 and 50:1 require special consideration and design.  
 u. Areas having slopes between 50:1 and 60:1 require special consideration and design.  
 cr. Areas having slopes between 6000000000000000000:1 and 7000000000000000000:1 require special consideration and design.  
 cs. Areas having slopes between 7000000000000000000:1 and 8000000000000000000:1 require special consideration and design.  
 ct. Areas having slopes between 8000000000000000000:1 and 9000000000000000000:1 require special consideration and design.  
 cu. Areas having slopes between 9000000000000000000:1 and 1000



**MGWC 1.2: PUMP-AROUND PRACTICE**

Temporary measure for dewatering in-channel construction sites

**DESCRIPTION**

The work should consist of installing a temporary pump around and supporting measures to divert flow around in-stream construction sites.

**IMPLEMENTATION SEQUENCE**

Sediment control measures, pump-around practices, and associated channel and bank construction should be completed in the following sequence (refer to Detail 1.2):


1. Construction activities including the installation of erosion and sediment control measures should not begin until all necessary easements and/or right-of-ways have been acquired. All existing utilities should be marked in the field prior to construction. The contractor is responsible for any damage to existing utilities that may result from construction and should repair the damage at his/her own expense to the county's or utility company's satisfaction.
2. The contractor should notify the Maryland Department of the Environment or WMA sediment control inspector at least 5 days before beginning construction. Additionally, the contractor should inform the local environmental protection and resource management inspection and enforcement division and the provider of local utilities a minimum of 48 hours before starting construction.
3. The contractor should conduct a pre-construction meeting on site with the WMA sediment control inspector, the county project manager, and the engineer to review limits of disturbance, erosion and sediment control requirements, and the sequence of construction. The contractor should stake out all limits of disturbance prior to the pre-construction meeting so they may be reviewed. The participants will also designate the contractor's staging areas and flag all trees within the limit of disturbance which will be removed for construction access. Trees should not be removed within the limit of disturbance without approval from the WMA or local authority.
4. Construction should not begin until all sediment and erosion control measures have been installed and approved by the engineer and the sediment control inspector. The contractor should stay within the limits of the disturbance as shown on the plans and minimize disturbance within the work area whenever possible.
5. Upon installation of all sediment control measures and approval by the sediment control inspector and the local environmental protection and resource management inspection and enforcement division, the contractor should begin work at the upstream section and proceed downstream beginning with the establishment of stabilized construction entrances. In some cases, work may begin downstream if appropriate. The sequence of construction must be followed unless the contractor gets written approval for deviations from the WMA or local authority. The contractor should only begin work in an area which can be completed by the end of the day including grading adjacent to the channel. At the end of each work day, the work area must be stabilized and the pump around removed from the channel. Work should not be conducted in the channel during rain events.
6. Sandbag dikes should be situated at the upstream and downstream ends of the work area as shown on the plans, and stream flow should be pumped around the work area. The pump should discharge onto a stable velocity dissipater made of riprap or sandbags.

**MGWC 1.2: PUMP-AROUND PRACTICE**



7. Water from the work area should be pumped to a sediment filtering measure such as a dewatering basin, sediment bag, or other approved source. The measure should be located such that the water drains back into the channel below the downstream sandbag dike.
8. Traversing a channel reach with equipment within the work area where no work is proposed should be avoided. If equipment has to traverse such a reach for access to another area, then timber mats or similar measures should be used to minimize disturbance to the channel. Temporary stream crossings should be used only when necessary and only where noted on the plans or specified. (See Section 4, Stream Crossings, Maryland Guidelines to Waterway Construction).
9. All stream restoration measures should be installed as indicated by the plans and all banks graded in accordance with the grading plans and typical cross-sections. All grading must be stabilized at the end of each day with seed and mulch or seed and matting as specified on the plans.
10. After an area is completed and stabilized, the clean water dike should be removed. After the first sediment flush, a new clean water dike should be established upstream from the old sediment dike. Finally, upon establishment of a new sediment dike below the old one, the old sediment dike should be removed.
11. A pump around must be installed on any tributary or storm drain outfall which contributes baseflow to the work area. This should be accomplished by locating a sandbag dike at the downstream end of the tributary or storm drain outfall and pumping the stream flow around the work area. This water should discharge onto the same velocity dissipater used for the main stem pump around.
12. If a tributary is to be restored, construction should take place on the tributary before work on the main stem reaches the tributary confluence. Construction in the tributary, including pump around practices, should follow the same sequence as for the main stem of the river or stream. When construction on the tributary is completed, work on the main stem should resume. Water from the tributary should continue to be pumped around the work area in the main stem.
13. The contractor is responsible for providing access to and maintaining all erosion and sediment control devices until the sediment control inspector approves their removal.
14. After construction, all disturbed areas should be regraded and revegetated as per the planting plan.

**Maryland's Guidelines To Waterway Construction  
DETAIL 1.2: PUMP-AROUND PRACTICE**


**PLAN VIEW**

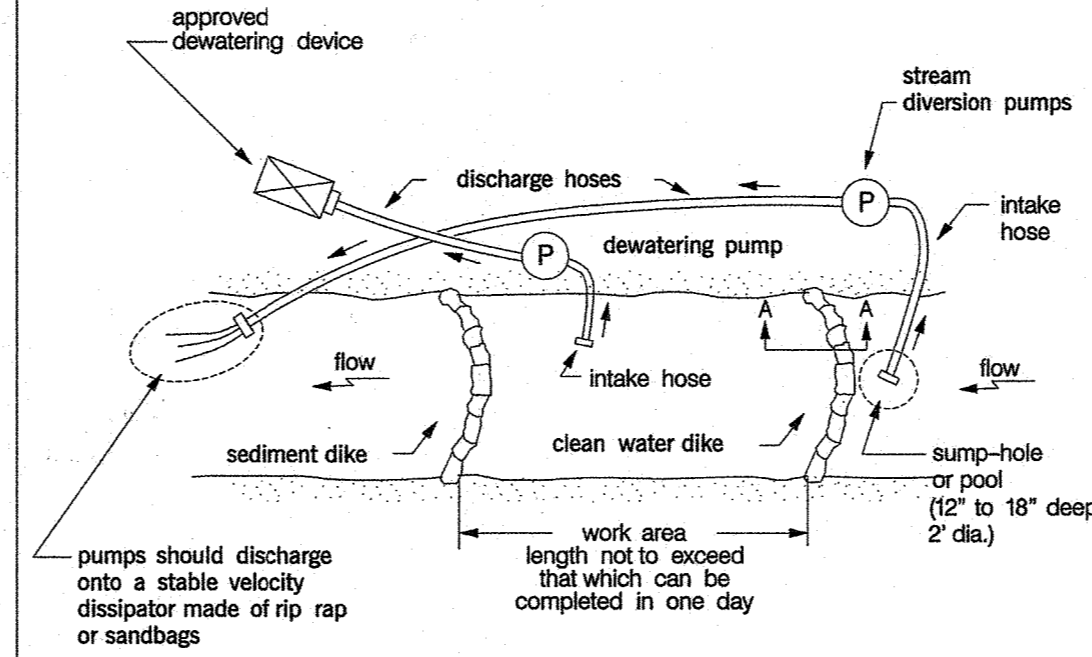

**SECTION A-A**

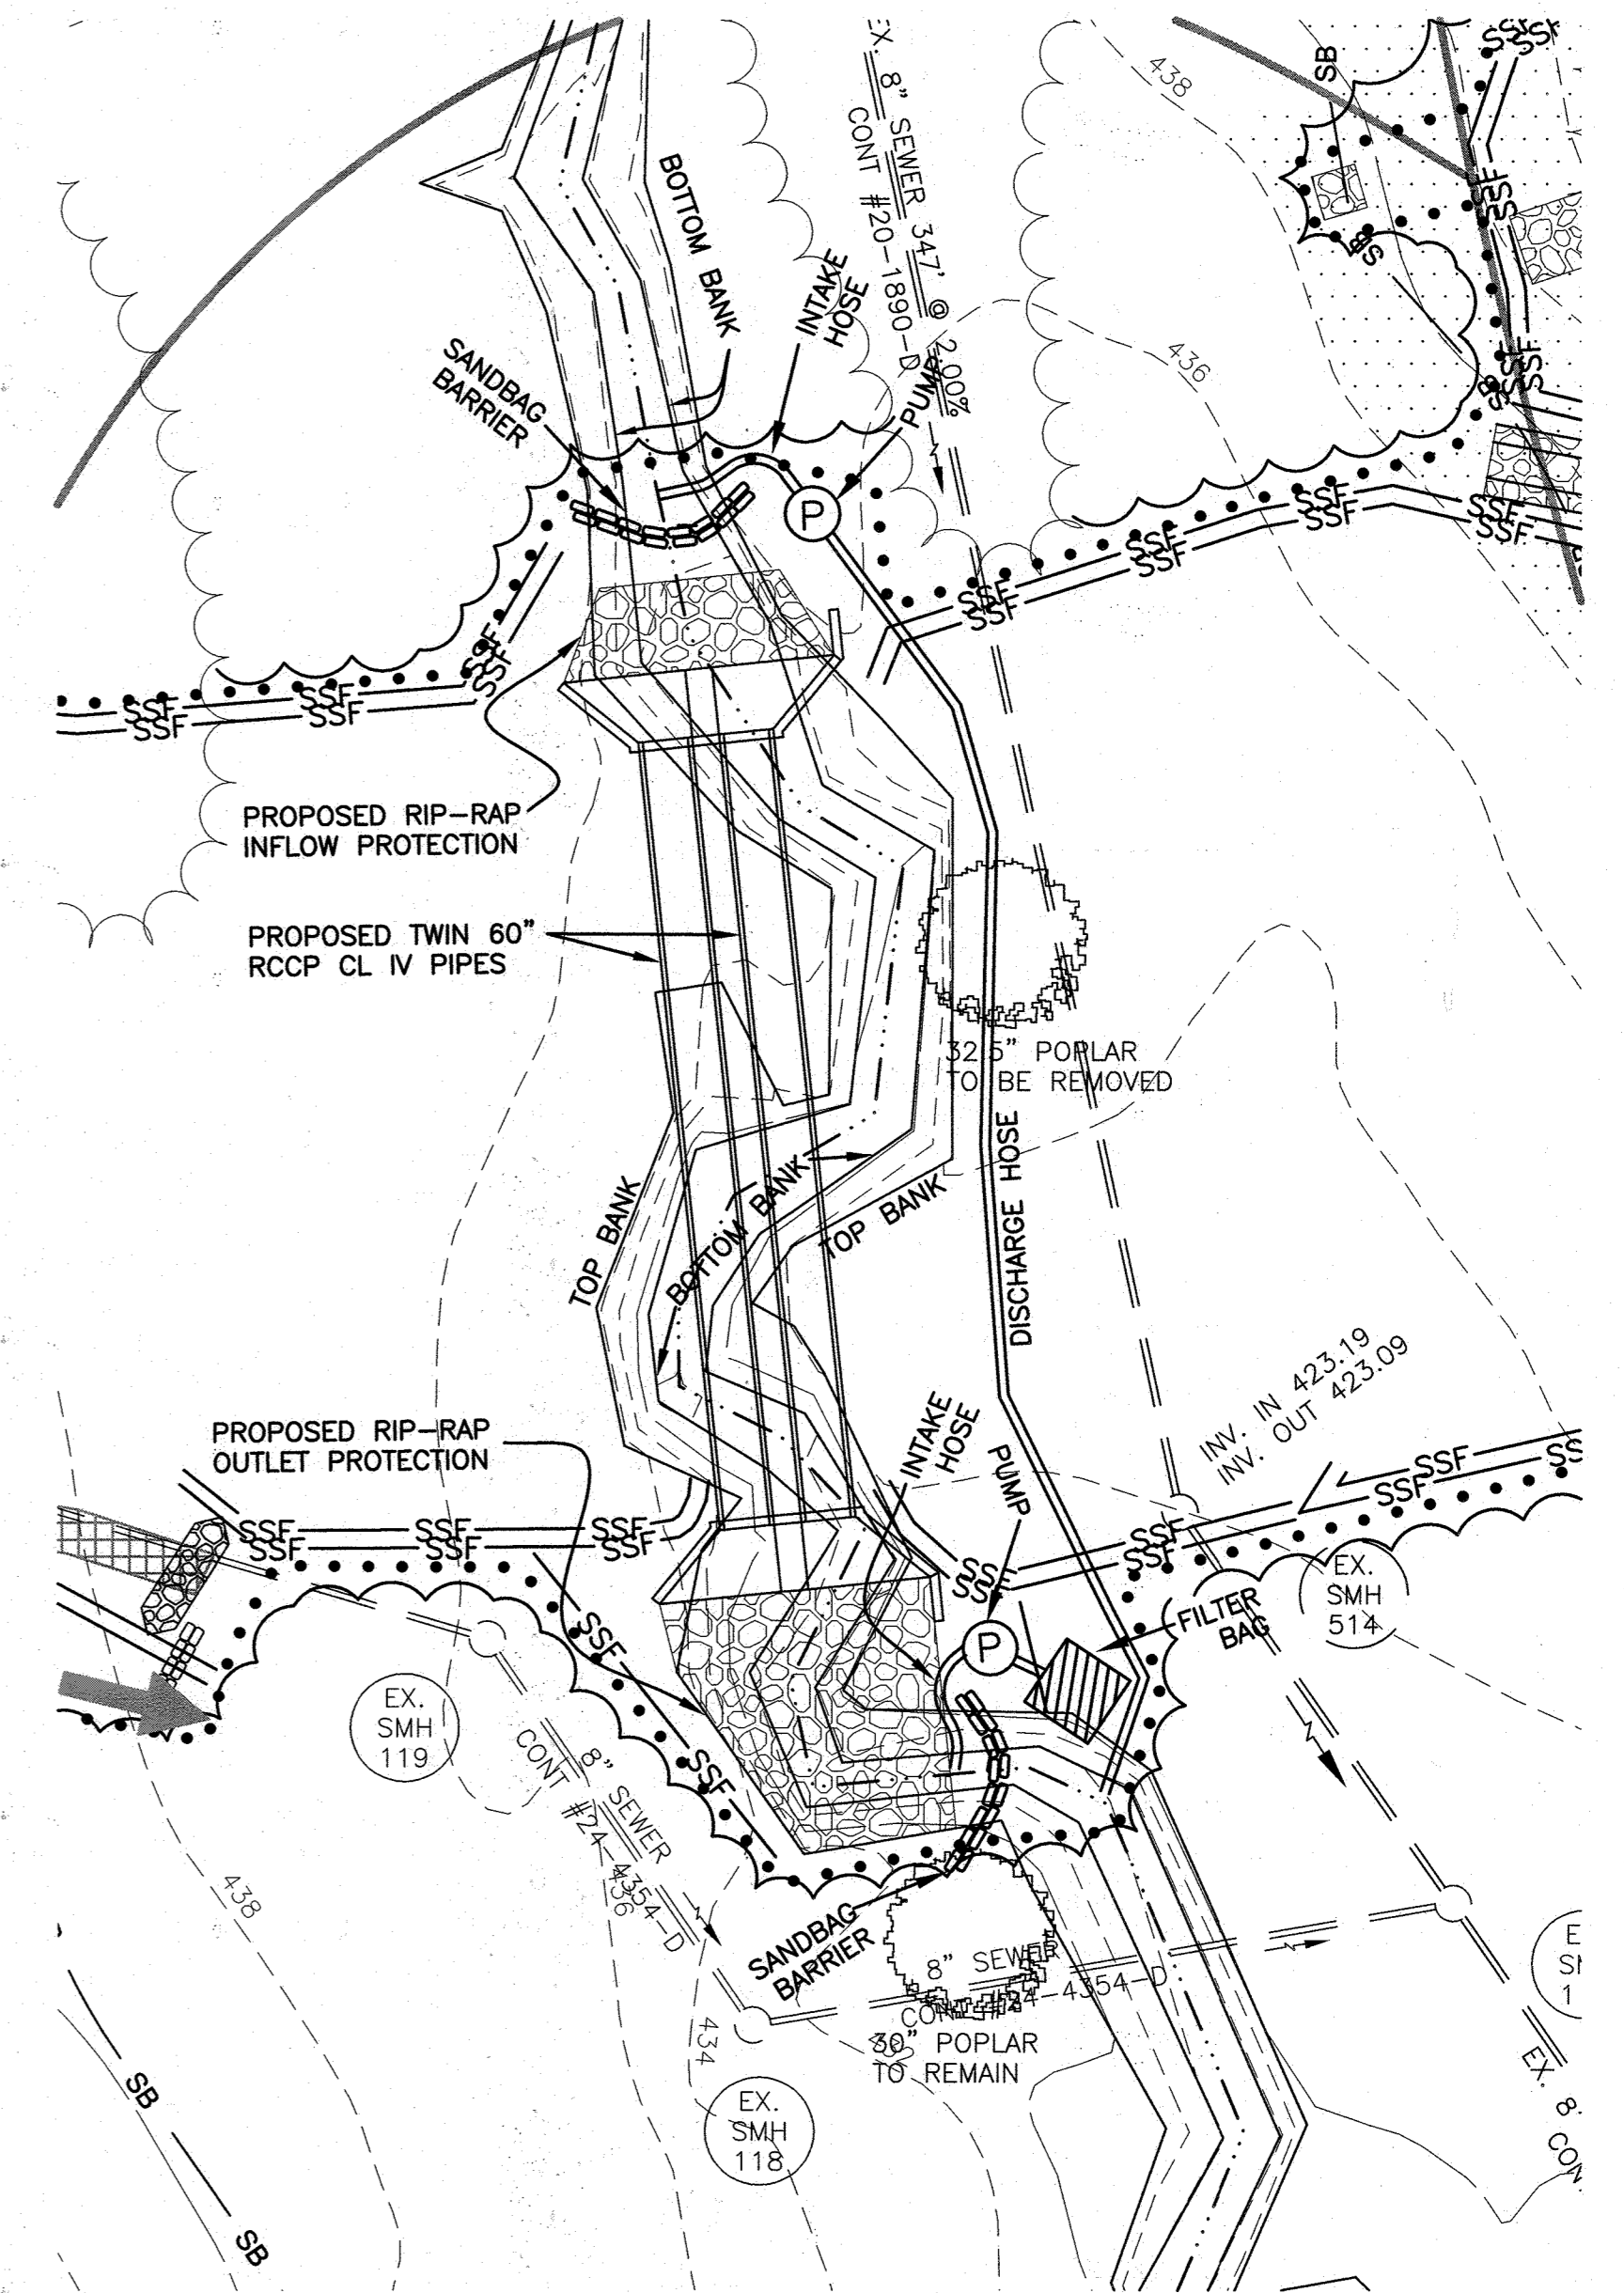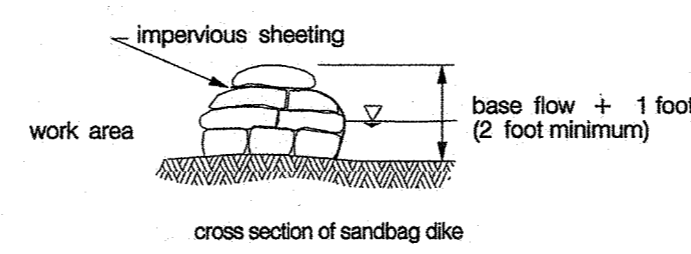

**PLAN VIEW  
PUMP AROUND PRACTICE**

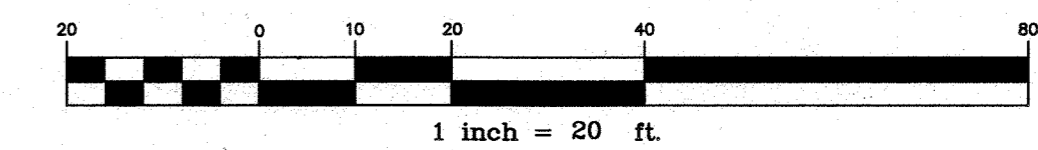

NOTE:  
SEE MDE PERMIT #02-NT-009/200261464 FOR GENERAL REQUIREMENTS AS THEY RELATE TO THE ISSUANCE OF THE PERMIT.

**ENGINEER'S CERTIFICATE**

I CERTIFY THAT THIS PLAN FOR SEDIMENT AND EROSION CONTROL REPRESENTS A PRACTICAL AND WORKABLE PLAN BASED ON MY PERSONAL KNOWLEDGE OF THE SITE CONDITIONS AND THAT IT WAS PREPARED IN ACCORDANCE WITH THE REQUIREMENTS OF THE HOWARD SOIL CONSERVATION DISTRICT.

*Cl Malagan* 9-30-15  
ENGINEER DATE

**DEVELOPER'S CERTIFICATE**

I/WE CERTIFY THAT ALL DEVELOPMENT AND CONSTRUCTION WILL BE DONE ACCORDING TO THIS PLAN FOR SEDIMENT AND EROSION CONTROL, AND THAT ALL RESPONSIBLE PERSONNEL INVOLVED IN THE CONSTRUCTION PROJECT WILL HAVE A CERTIFICATE OF ATTENDANCE AT A DEPARTMENT OF THE ENVIRONMENT APPROVED TRAINING PROGRAM FOR THE CONTROL OF SEDIMENT AND EROSION BEFORE BEGINNING THE PROJECT. I ALSO AUTHORIZE PERIODIC ON-SITE INSPECTION BY THE HOWARD SOIL CONSERVATION DISTRICT.

*[Signature]* 9/30/15  
DEVELOPER DATE

THIS DEVELOPMENT PLAN IS APPROVED FOR SOIL EROSION AND SEDIMENT CONTROL BY THE HOWARD SOIL CONSERVATION DISTRICT.

*[Signature]* 10/14/15  
HOWARD SOIL CONSERVATION DISTRICT


APPROVED: DEPARTMENT OF PUBLIC WORKS

*[Signature]* 10/19/2015  
CHIEF, BUREAU OF HIGHWAYS DATE

APPROVED: DEPARTMENT OF PLANNING AND ZONING

*[Signature]* 10-23-15  
CHIEF, DIVISION OF LAND DEVELOPMENT DATE










*[Signature]* 10-19-15  
CHIEF, DEVELOPMENT ENGINEERING DIVISION DATE

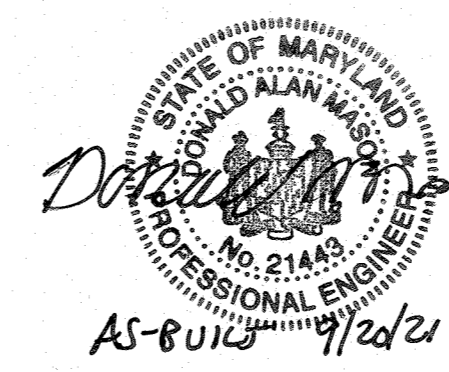

"NO AS-BUILT INFORMATION IS PROVIDED ON THIS SHEET"

Professional Certification. I hereby certify that these documents were prepared or approved by me, and that I am a duly licensed professional engineer under the laws of the State of Maryland.  
License No. 21443 Expiration Date: 12-31-22

|   |  |            |   |  |  |
|---|--|------------|---|--|--|
| NO.   |  | DATE       |   | REVISION   |  |
| <b>BENCHMARK</b><br>ENGINEERS & LAND SURVEYORS & PLANNERS<br><b>ENGINEERING, INC.</b><br>8480 BALTIMORE NATIONAL PIKE & SUITE 315 A ELLICOTT CITY, MARYLAND 21043<br>(P) 410-465-6105 (F) 410-465-6644<br>WWW.BEI-CIVLENGINEERING.COM       |  |            |   |  |  |
| Professional Certification. I hereby certify that these documents were prepared or approved by me, and that I am a duly licensed professional engineer under the laws of the State of Maryland. License No. 21443 Expiration Date: 12-31-22 |  |            |   |  |  |
| OWNER:  |  |            | THE BLUFFS AT TURF VALLEY<br>RESORT ROAD EXTENSION<br>NON-BUILDABLE BULK PARCELS 'A' AND 'B'<br>A SUBDIVISION OF PART OF PARCEL 706 |  |  |
| DEVELOPER:  |  |            | TAX MAP: 17 - GRID: 13 - PARCEL: p/o 706<br>ZONED: PGCC<br>ELECTION DISTRICT NO. 2 - HOWARD COUNTY, MARYLAND                        |  |  |
| MANGIONE ENTERPRISES OF TURF VALLEY, LIMITED PARTNERSHIP<br>1205 YORK ROAD, PENTHOUSE LUTHERVILLE, MARYLAND 21093 410-825-8400  |  |            | <b>TEMPORARY STREAM<br/>DIVERSION PLAN &amp; DETAILS</b>  |  |  |
| DESIGN: DBT   |  | DRAFT: DBT |   | DATE: SEPTEMBER, 2015<br>SCALE: AS SHOWN<br>SHEET 14 OF 15 |  |
| OWNER: MANGIONE ENTERPRISES OF TURF VALLEY, LIMITED PARTNERSHIP<br>1205 YORK ROAD, PENTHOUSE LUTHERVILLE, MARYLAND 21093 410-825-8400   |  |            | BEI PROJECT NO. 2697<br>SHEET 14 OF 15  |  |  |

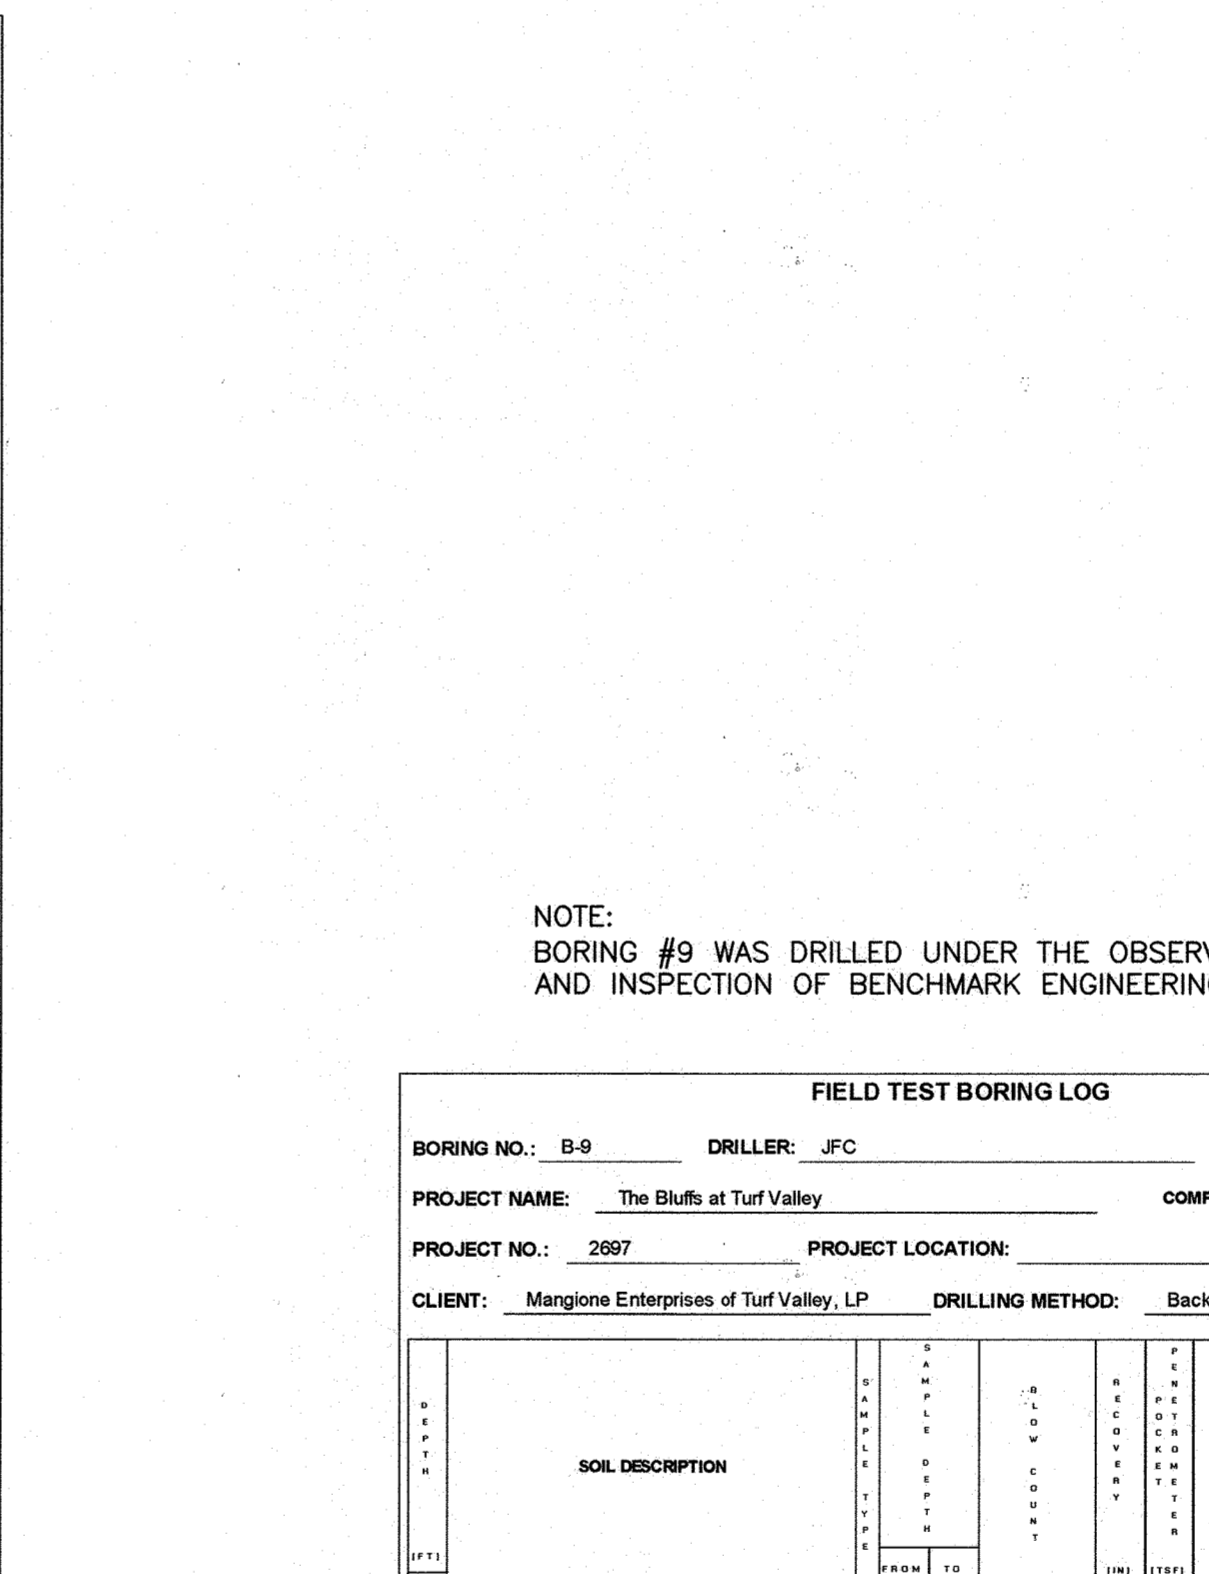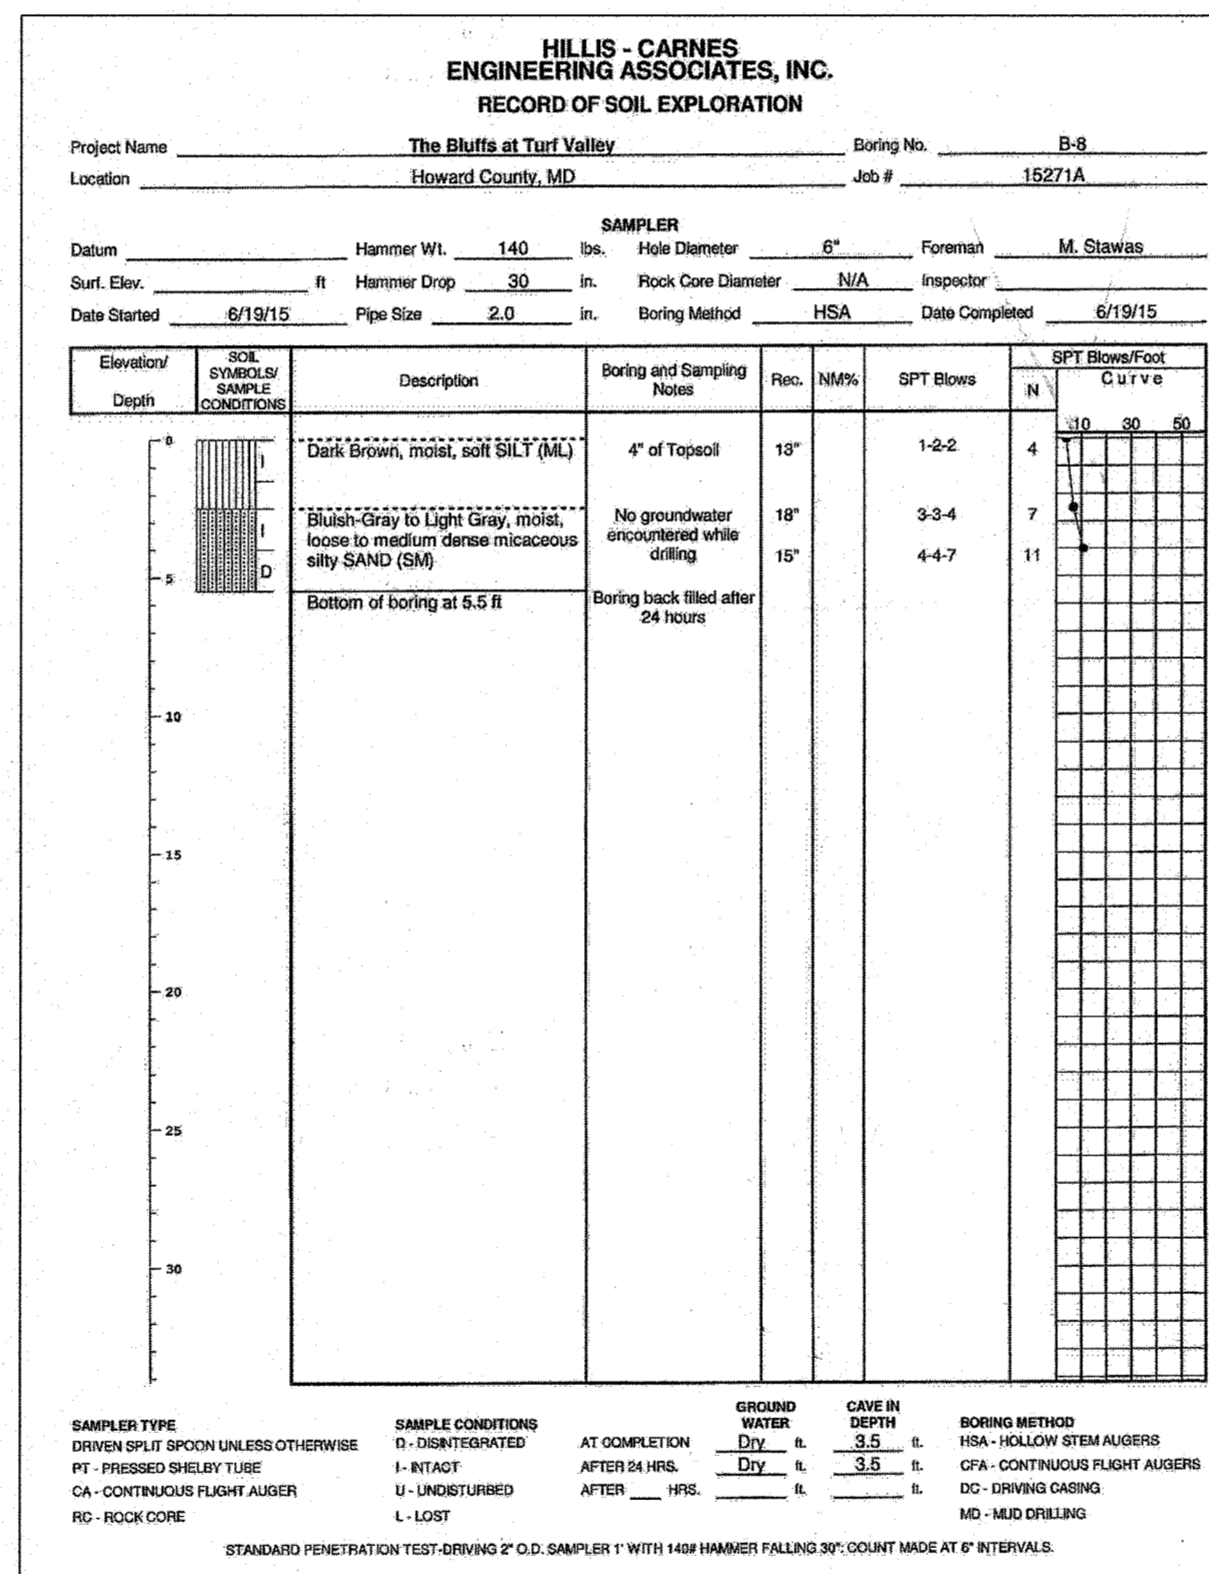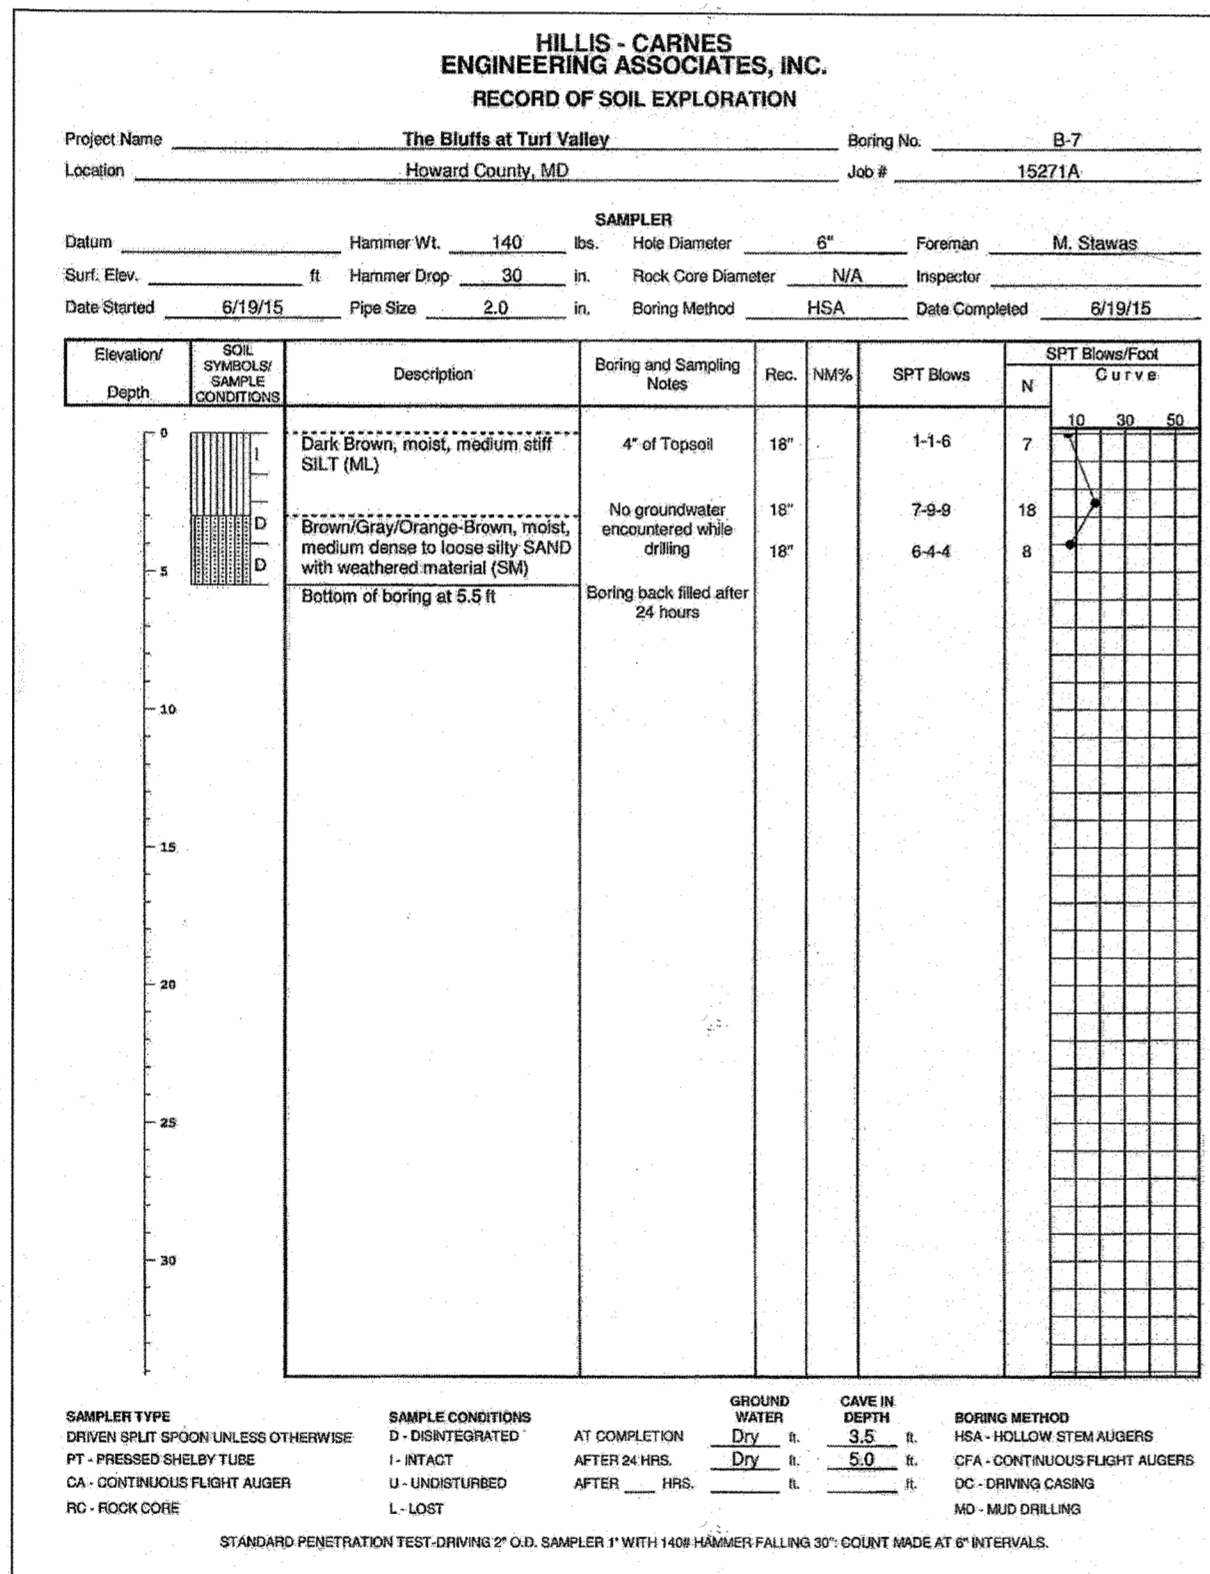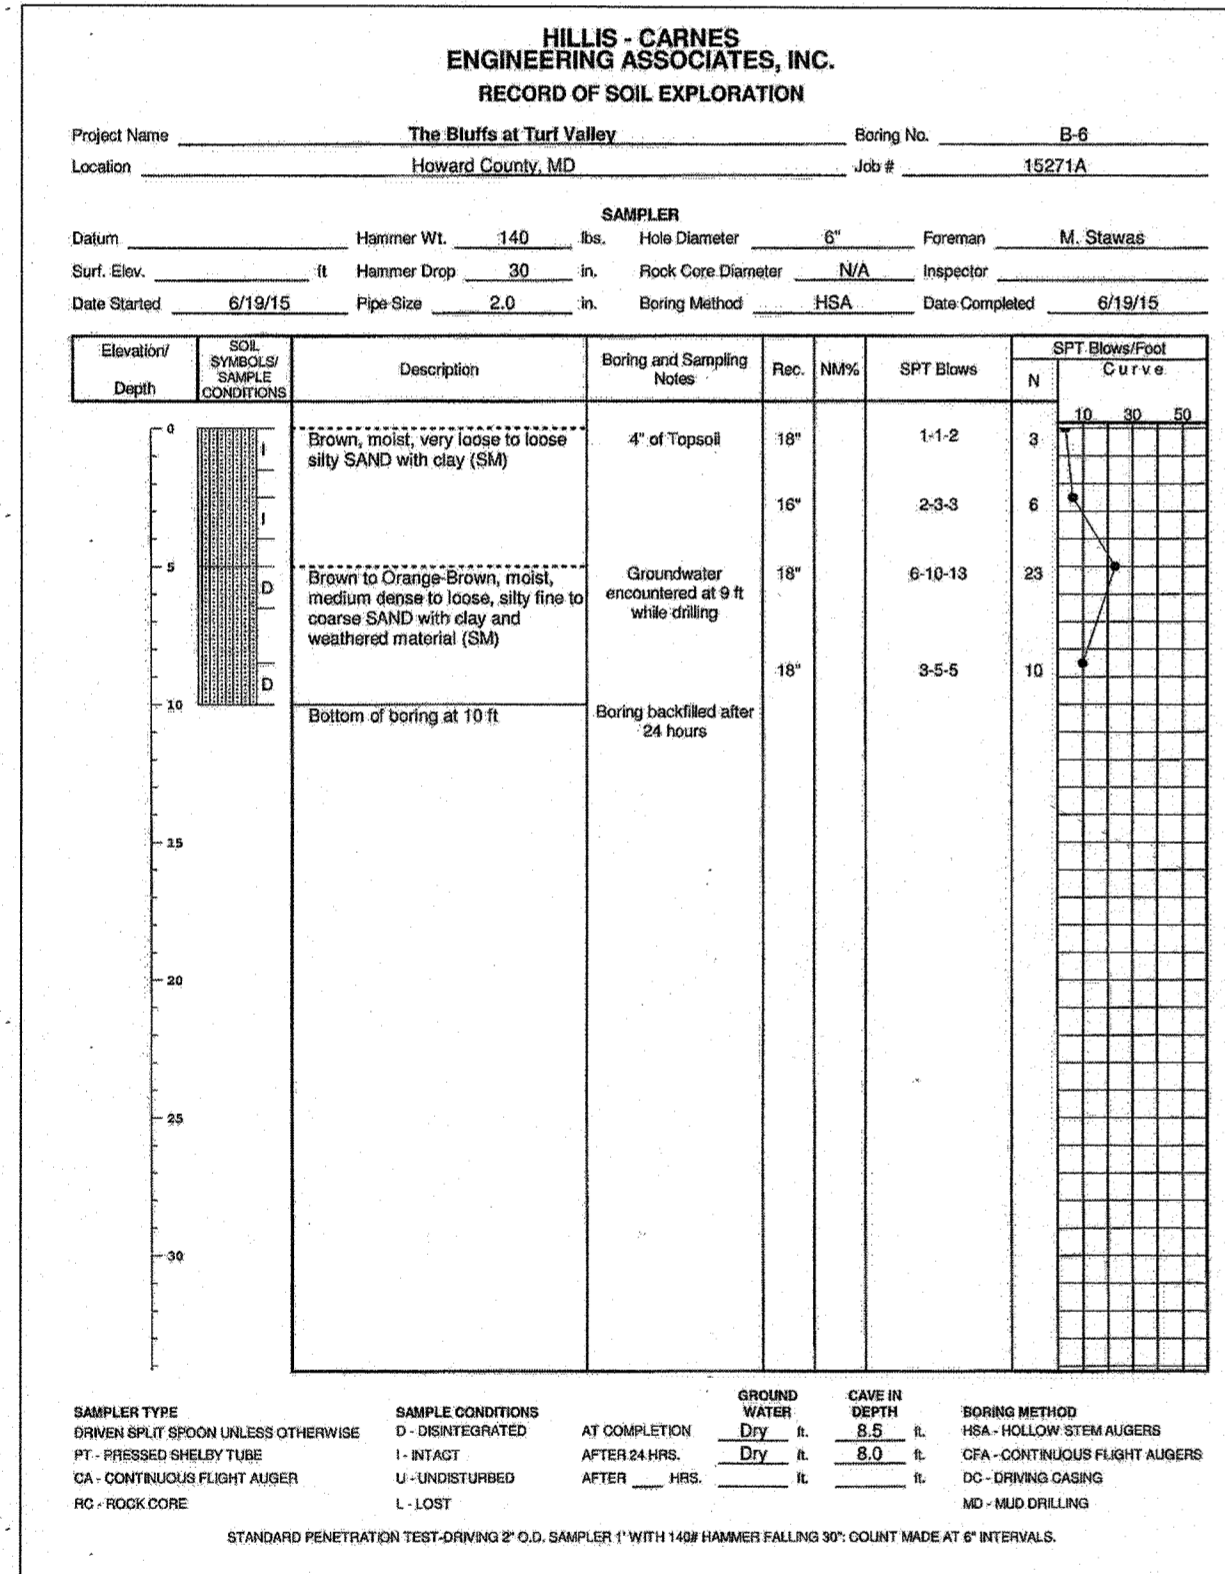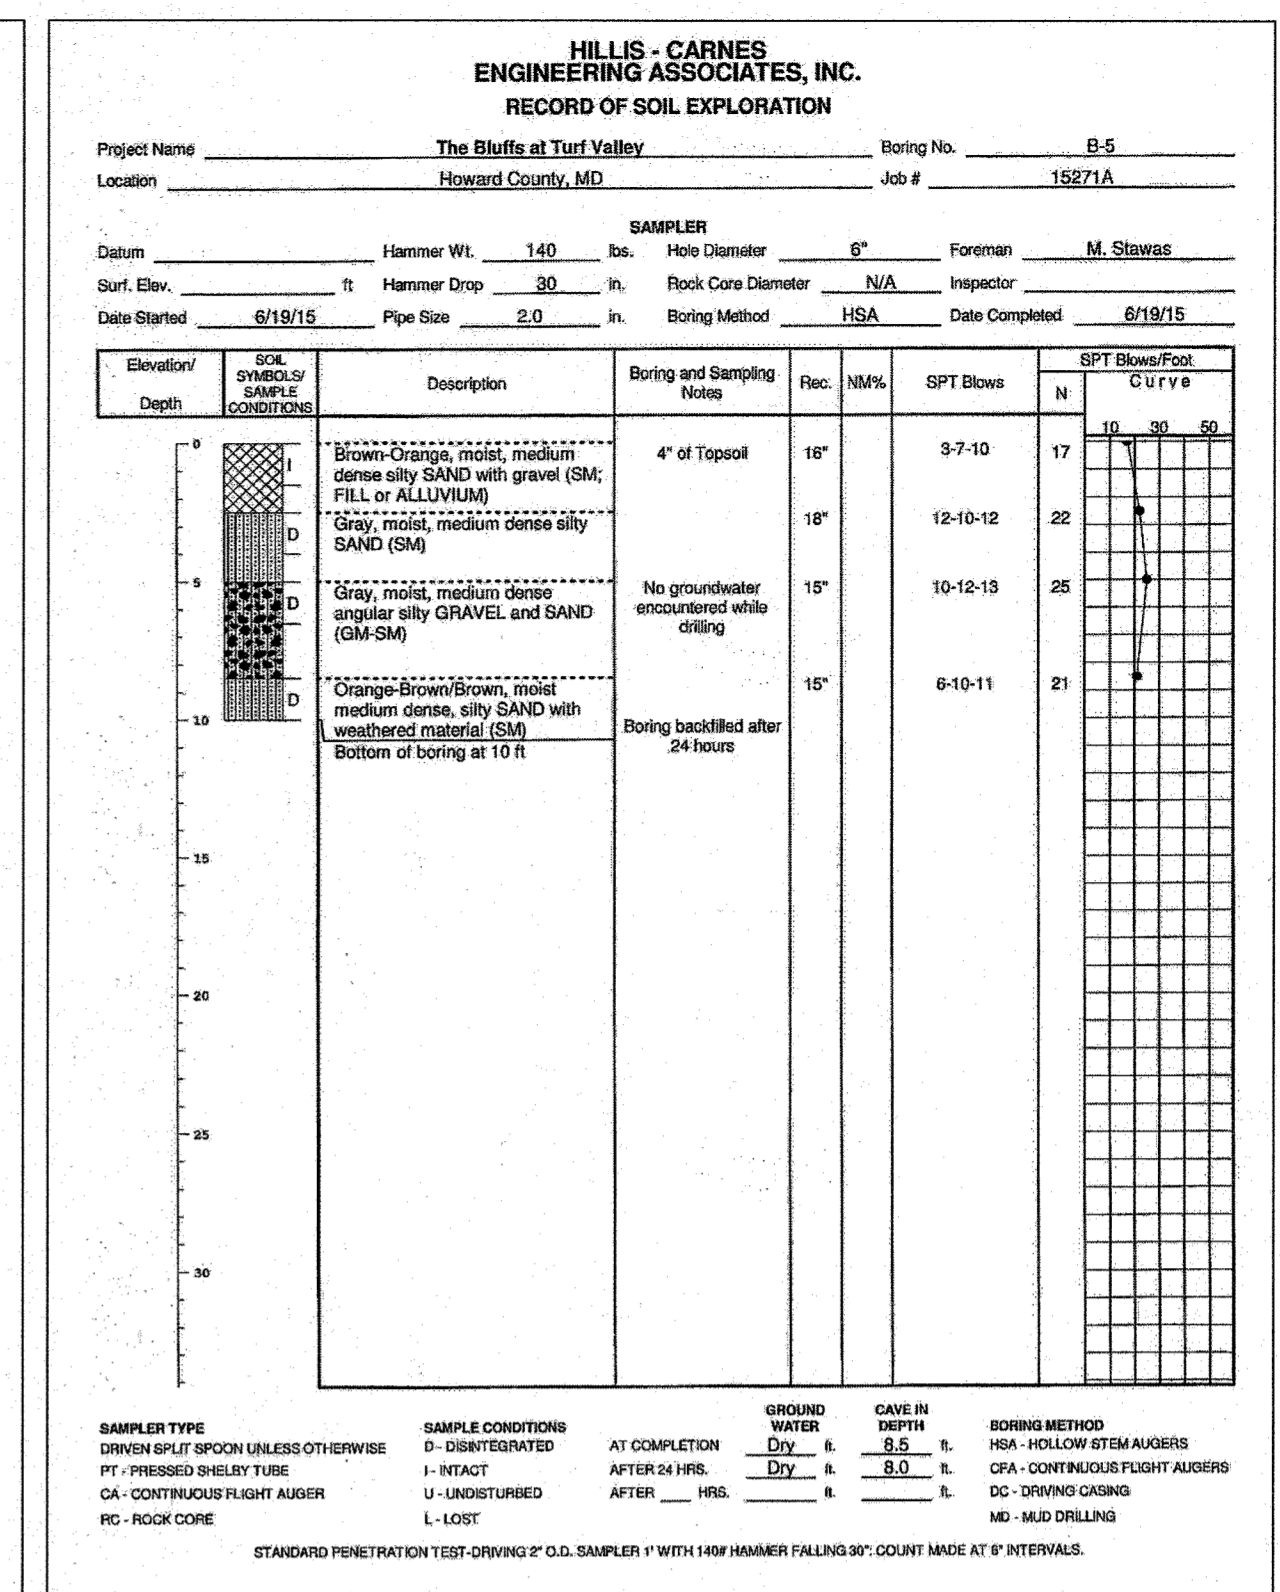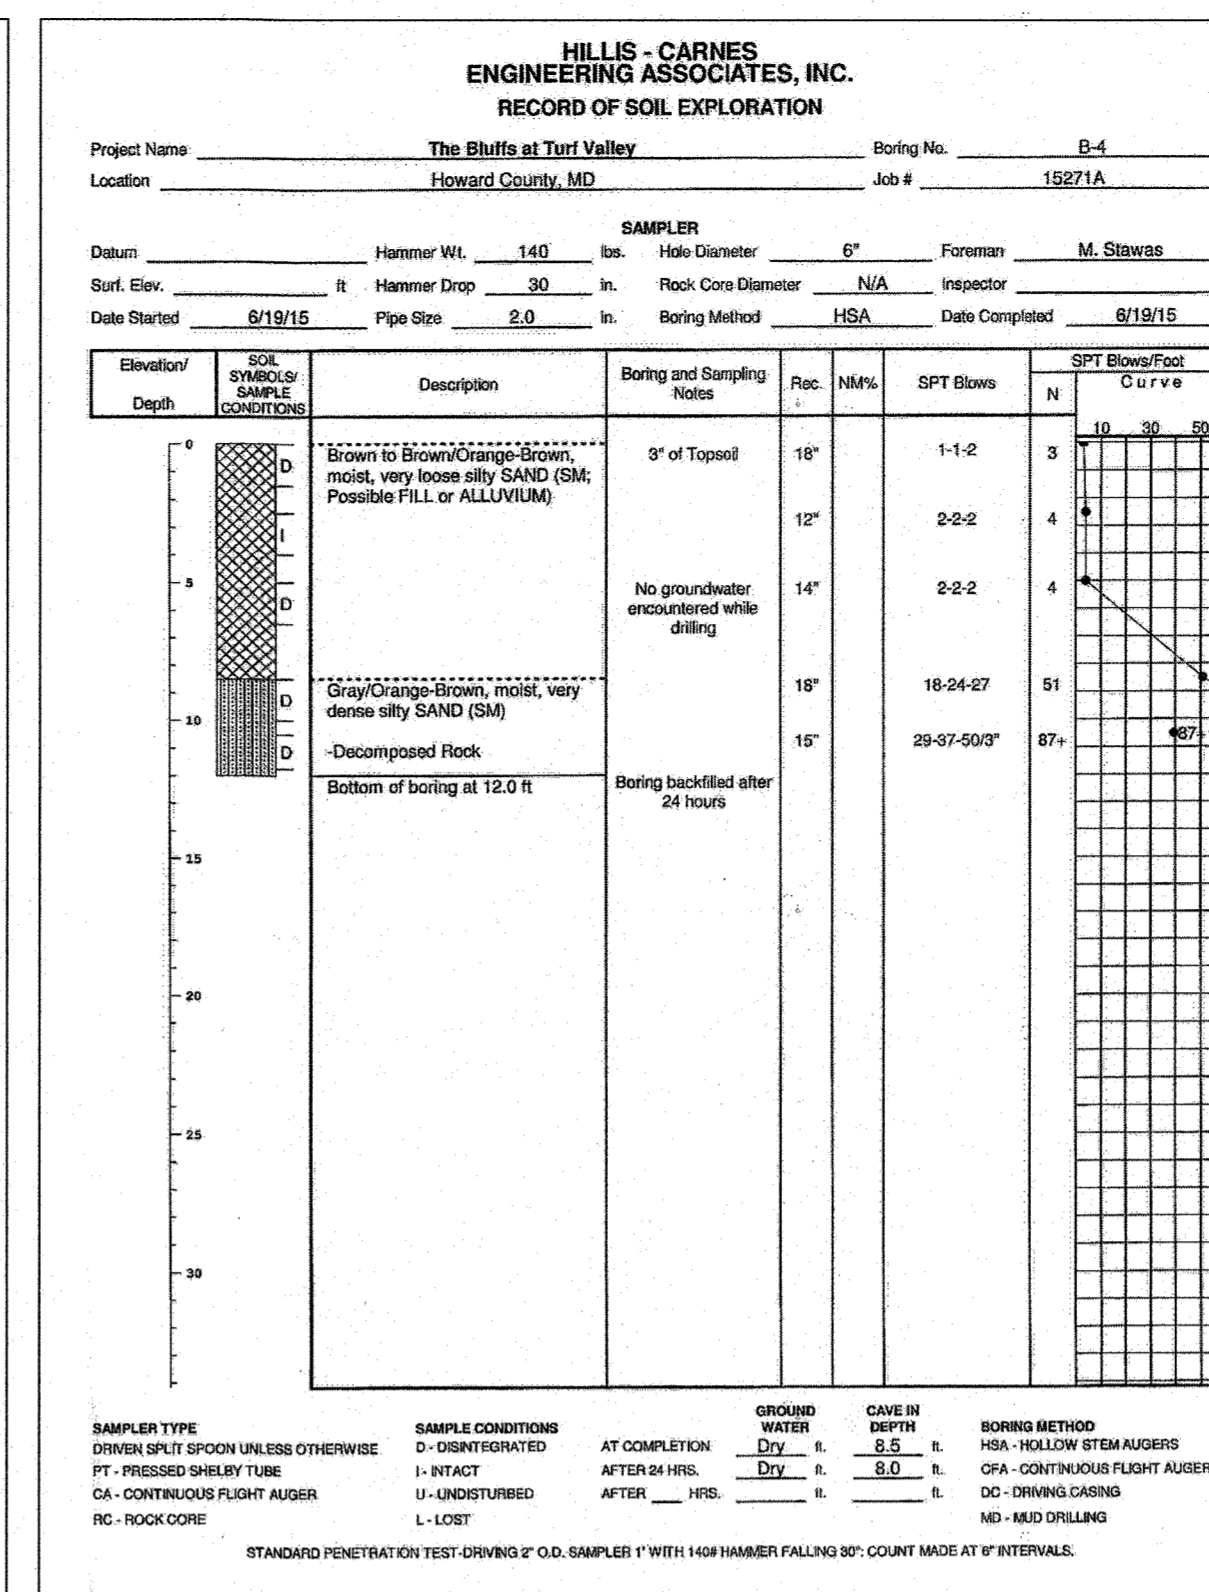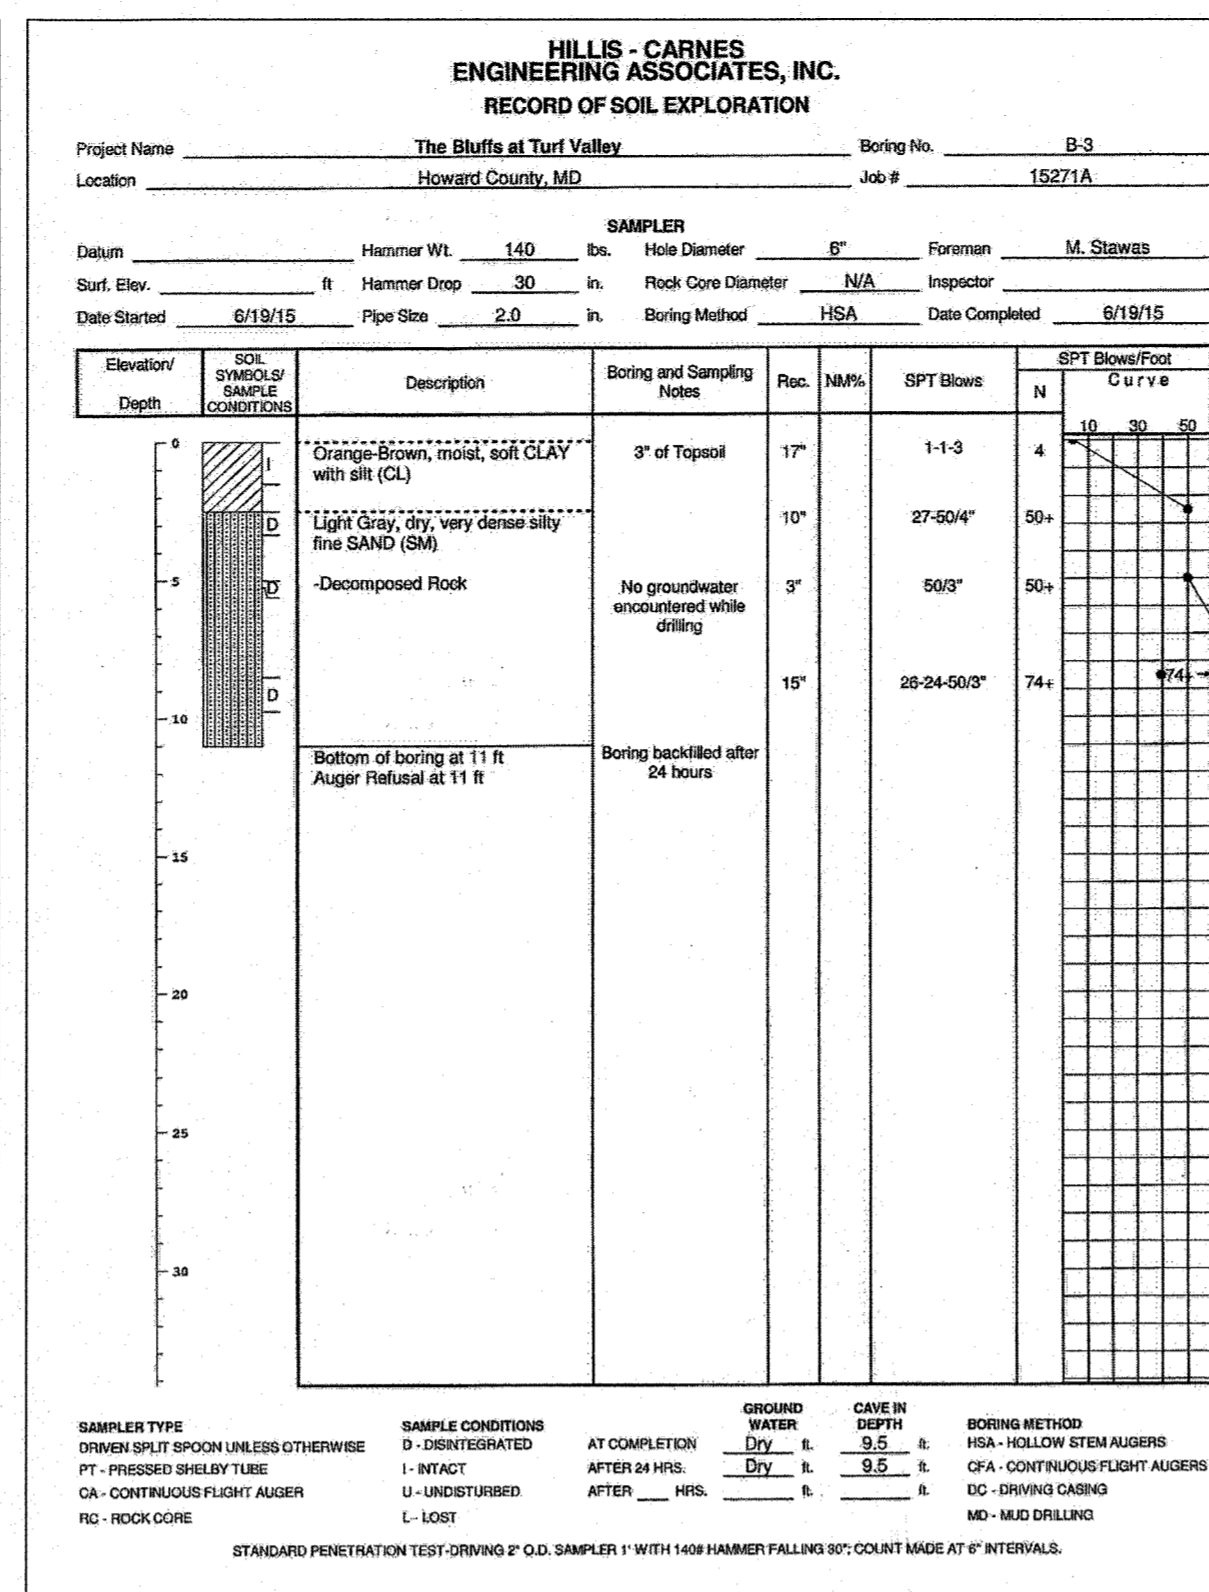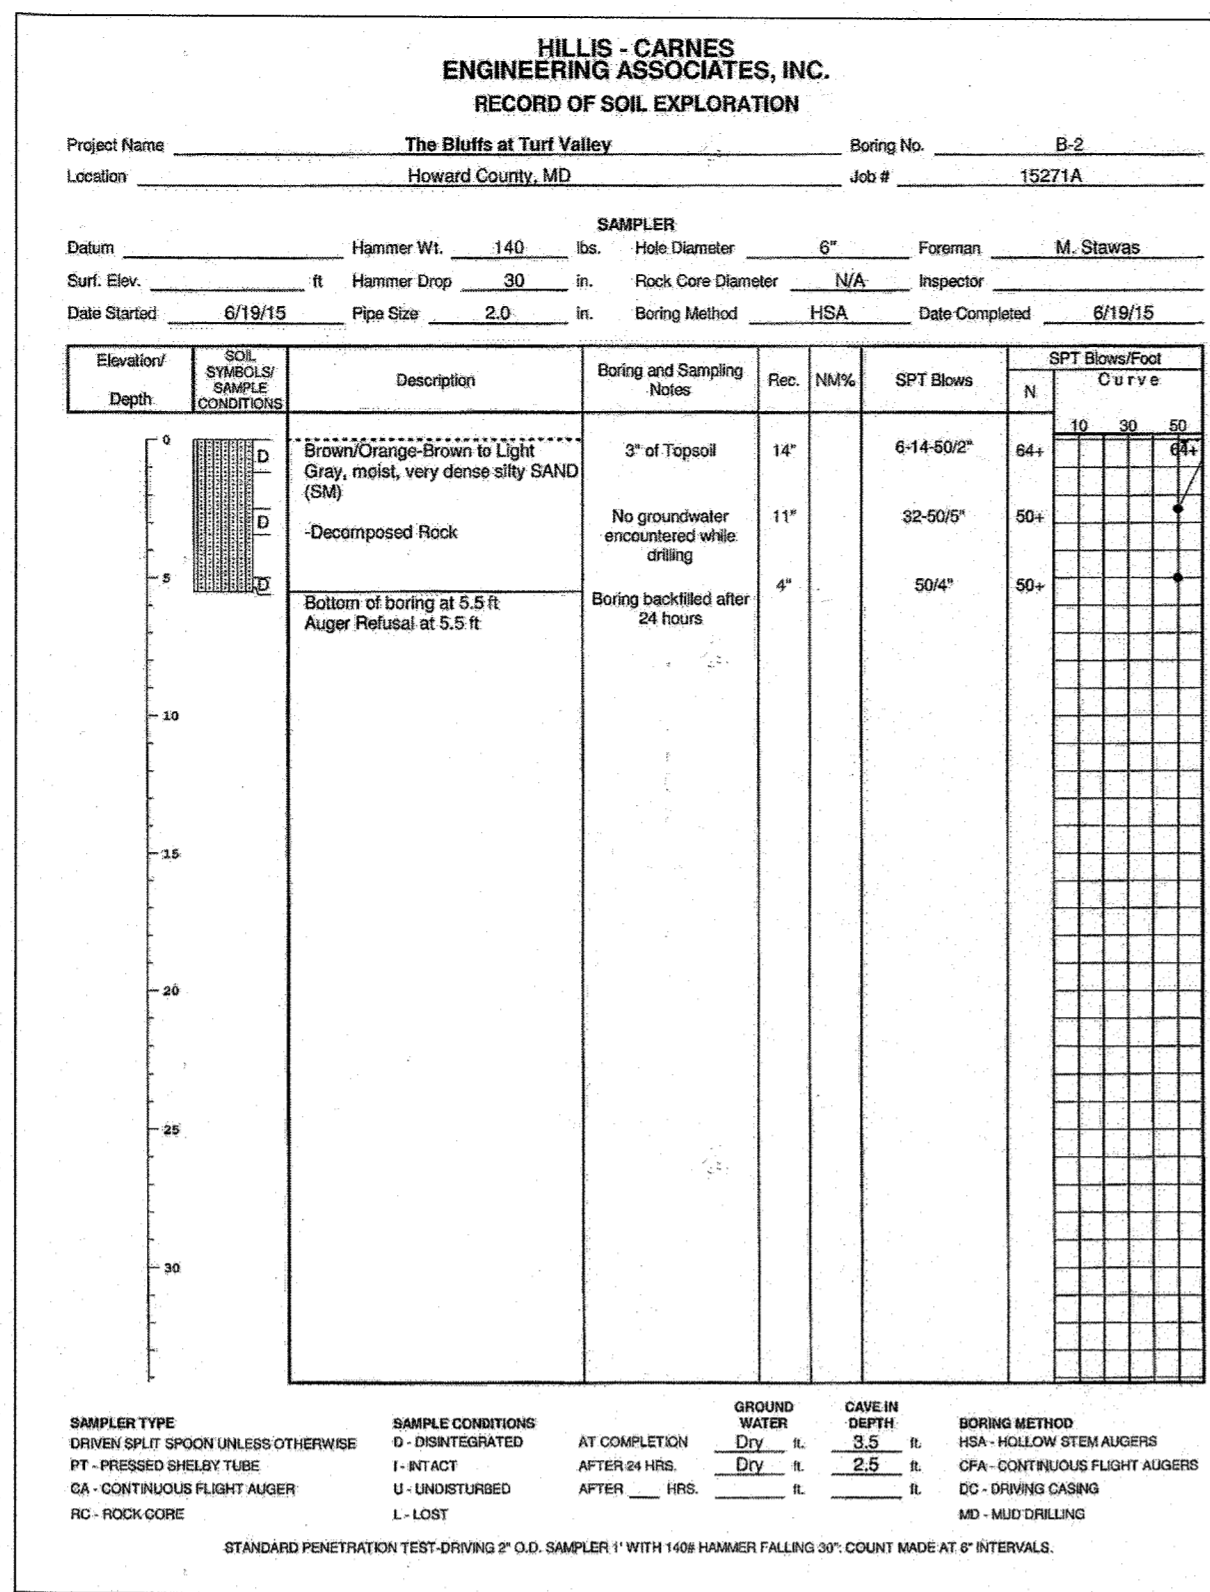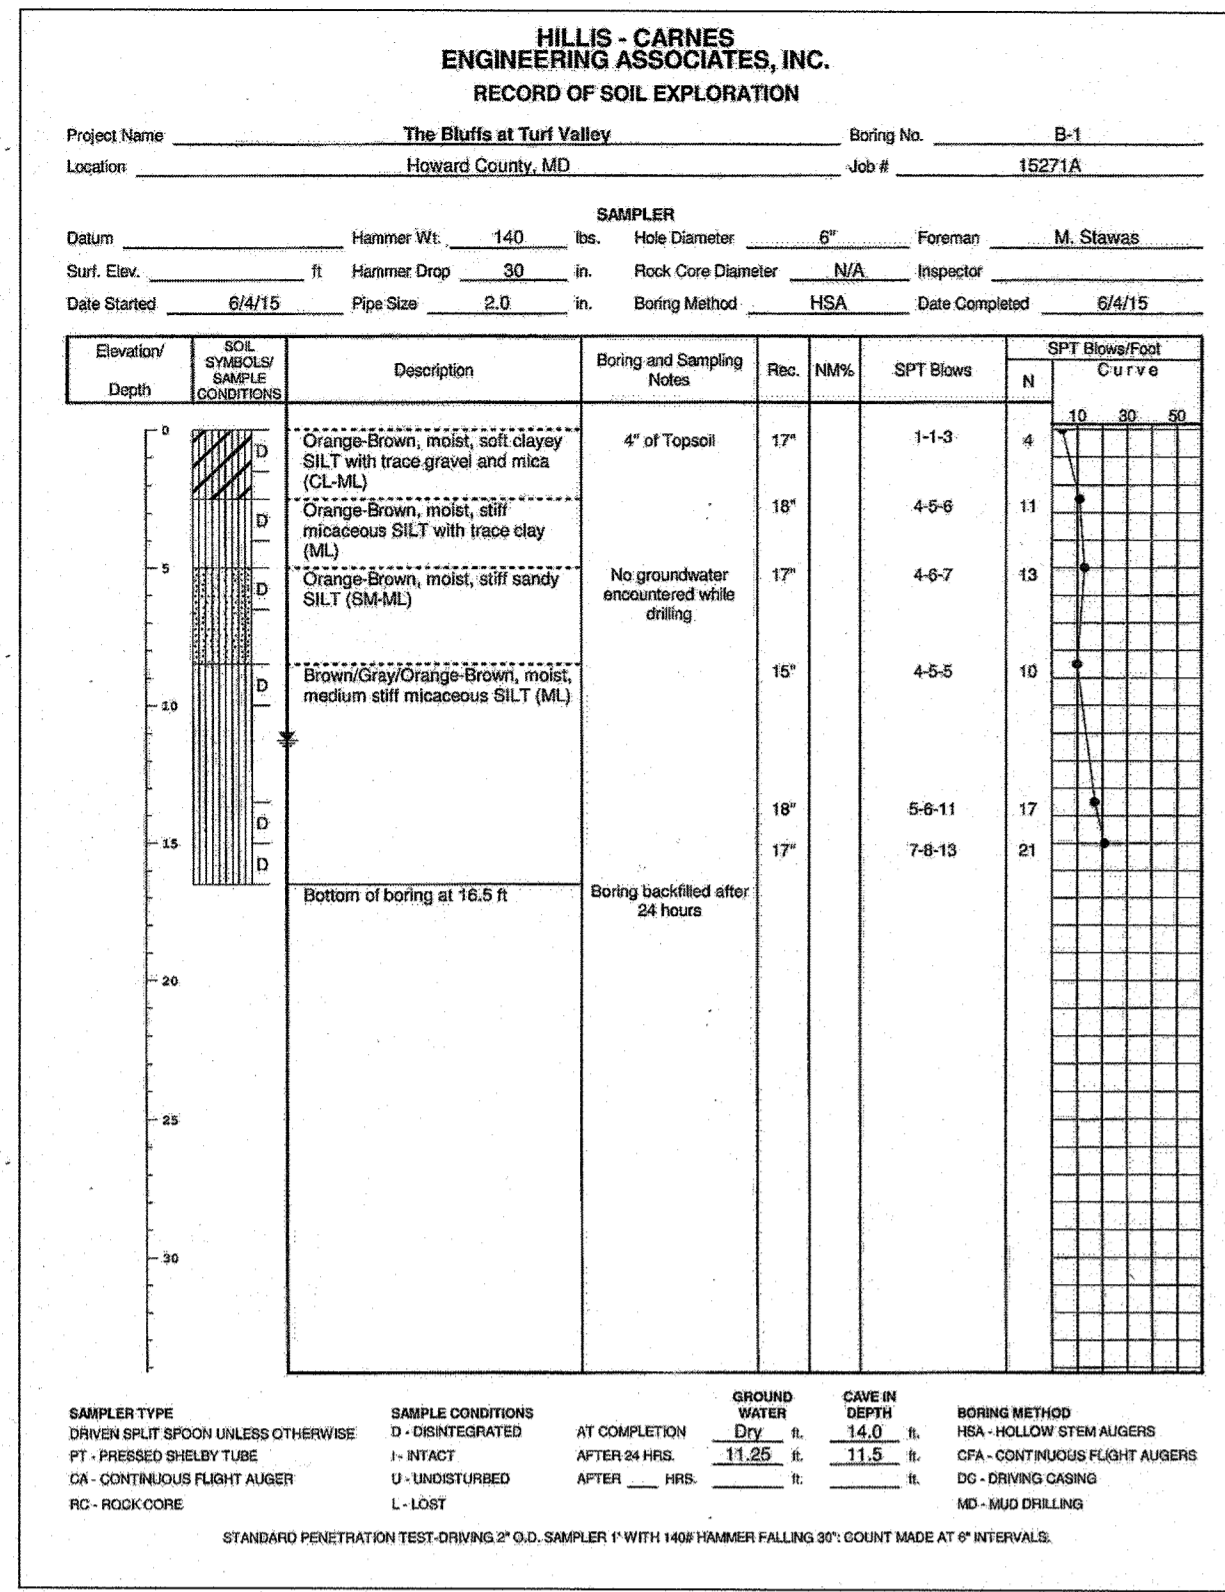

NOTE: BORING #9 WAS DRILLED UNDER THE OBSERVATION AND INSPECTION OF BENCHMARK ENGINEERING, INC.

"NO AS-BUILT INFORMATION IS PROVIDED ON THIS SHEET"


FIELD TEST BORING LOG 1 OF 1

BORING NO.: B-9 DRILLER: JFC START DATE: 6/22/2015

PROJECT NAME: The Bluffs at Turf Valley PROJECT LOCATION: COMPLETION DATE: 6/22/2015

CLIENT: Mangione Enterprises of Turf Valley, LP DRILLING METHOD: Backhoe

| DEPTH                     | SOIL DESCRIPTION                     | REMARKS |
|---------------------------|--------------------------------------|---------|
| 0                         | starting elevation = 440.50          |         |
| 0'                        | topsoil                              |         |
| 2'                        | Reddish brown silty sand             |         |
| 3'                        |                                      |         |
| 6'                        |                                      |         |
| 9'                        | no water encountered during drilling |         |
| Bottom of Boring = 430.50 |                                      |         |

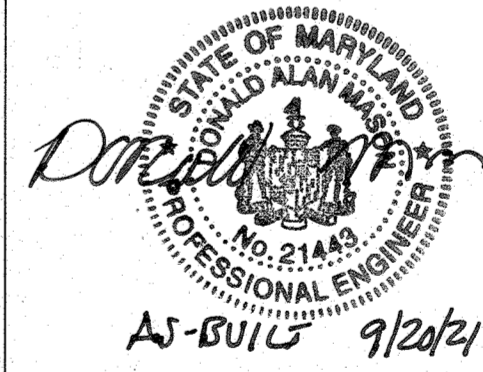

Professional Certification. I hereby certify that these documents were prepared or approved by me, and that I am a duly licensed professional engineer under the laws of the State of Maryland.  
License No. 21443 Expiration Date 12-21-22

NO. DATE REVISION

**BENCHMARK ENGINEERING, INC.**  
8480 BALTIMORE NATIONAL PIKE SUITE 315 ELLICOTT CITY, MARYLAND 21043  
(P) 410-465-8105 (F) 410-465-8644  
WWW.BE-CIVLENGINEERING.COM

OWNER: MANGIONE ENTERPRISES OF TURF VALLEY, LIMITED PARTNERSHIP  
1205 YORK ROAD, PENTHOUSE LUTHERVILLE, MARYLAND 21093 410-825-8400

DEVELOPER: MANGIONE ENTERPRISES OF TURF VALLEY, LIMITED PARTNERSHIP  
1205 YORK ROAD, PENTHOUSE LUTHERVILLE, MARYLAND 21093 410-825-8400

THE BLUFFS AT TURF VALLEY RESORT ROAD EXTENSION  
NON-BUILDABLE BULK PARCELS 'A' AND 'B' A SUBDIVISION OF PART OF PARCEL 706

TAX MAP: 17 - GRID: 13 - PARCEL: p/o 706  
ZONED: PGCC  
ELECTION DISTRICT NO. 2 - HOWARD COUNTY, MARYLAND

SOILS BORING LOGS

DATE: SEPTEMBER, 2015 BEI PROJECT NO. 2697  
SCALE: AS SHOWN SHEET 15 OF 15

APPROVED: DEPARTMENT OF PUBLIC WORKS  
M. Stewas 10/19/2015  
CHIEF, BUREAU OF HIGHWAYS DATE

APPROVED: DEPARTMENT OF PLANNING AND ZONING  
K. Stewas 10-22-15  
CHIEF, DIVISION OF LAND DEVELOPMENT DATE

APPROVED: DEPARTMENT OF PLANNING AND ZONING  
M. Stewas 10-19-15  
CHIEF, DEVELOPMENT ENGINEERING DIVISION DATE