

LEGEND

	PUBLIC EASEMENT		10-25% SLOPES
	PRIVATE EASEMENT AREA		25% SLOPES
	EXISTING EASEMENTS		FLOODPLAIN
	EXISTING PAVING		STREAM CENTERLINE
	EXISTING CONCRETE WALKS		2014 ENVIRONMENTAL RESTORATION LIMITS
	ASPHALT PATH		2016 ENVIRONMENTAL RESTORATION LIMITS
	50' STREAM / BANK BUFFER		E-RL-1
	25' WETLAND BUFFER		E-RL-2

NOTES

- THE EXISTING CONTOURS SHOWN ON PARCELS D-1 THROUGH D-11 AND LOT 10 REFLECT THE MASS GRADING DONE UNDER SDP 16-075.
- SOME OF THE STEEP SLOPES BEING SHOWN AS EXISTING CONDITIONS WERE CREATED AS PART OF THE WORK PERFORMED UNDER SDP 16-075 AND F 16-101. THE SEDIMENT TRAPS WITHIN PARCELS D-3 AND D-7 WERE ALSO CONSTRUCTED UNDER SDP 16-075.
- WITH THE EXCEPTION OF OPEN SPACE LOT 4, ALL OF THE EASEMENTS AND PARCEL LINES SHOWN ARE PROPOSED WITH THIS FINAL PLAN AND ARE NOT PART OF THE EXISTING CONDITIONS. OPEN SPACE LOT 4 IS TO BE RESUBDIVIDED AS OPEN SPACE LOT 10 AS PART OF THIS FINAL PLAN.

THERE IS NO AS-BUILT INFORMATION ON THIS SHEET



10/03/23

G. SCOTT SHANBERGER
SHANBERGER & LANE
PROFESSIONAL LAND SURVEYOR #10819
LICENSE EXPIRATION DATE 4/2/2024
AS-BUILT SURVEY DATES 2/1/22 TO 2/18/22

PROFESSIONAL ENGINEER
AS BUILT CERTIFICATION FOR PSWM

NOTE: THERE IS NO "AS-BUILT" INFORMATION PROVIDED ON THIS SHEET.

NAME: GERALD D. TURNBACH
DATE: AUG. 11, 2023 REG. NO.: 26569

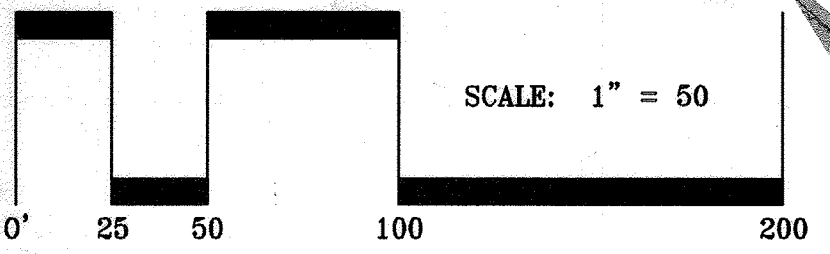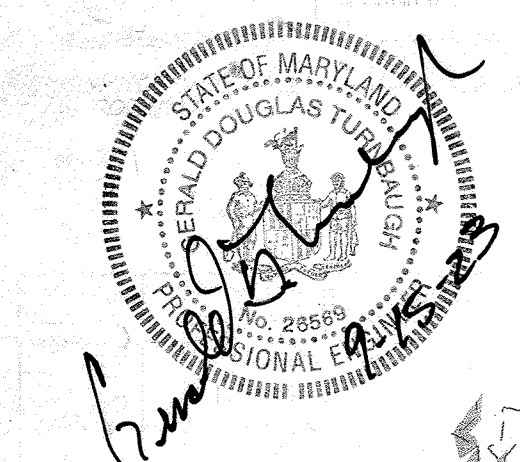

APPROVED: HOWARD COUNTY DEPARTMENT OF PUBLIC WORKS

 Chief, Bureau of Highways 1/3/2018 Date

APPROVED: HOWARD COUNTY DEPARTMENT OF PLANNING & ZONING

 Chief, Division of Land Development 1-19-18 Date


Chief, Development Engineering Division 1-11-18 Date

GLWGUTSCHICK LITTLE & WEBER, P.A.
 CIVIL ENGINEERS, LAND SURVEYORS, LAND PLANNERS, LANDSCAPE ARCHITECTS
 3909 NATIONAL DRIVE - SUITE 250 - BURTONSVILLE OFFICE PARK
 BURTONSVILLE, MARYLAND 20866
 TEL: 301-421-4024 BALT: 410-880-1820 DC/VA: 301-989-2524 FAX: 301-421-4186

DATE	REVISION	BY	APPR.
7-24-14	Revised Easements and Existing Grades	Wes	DEV
12-12-18	REVISED PRIVATE SWM EASEMENT AREA LIMITS	BT	DEV
7-25-18	Additional SWM Easement area and wall Easement	BT	JRC

PREPARED FOR:
 THE HOWARD HUGHES CORPORATION
 10480 LITTLE PATUXENT PARKWAY
 SUITE 400
 COLUMBIA, MARYLAND 21044
 ATTN: BILL ROWE
 410-964-4987

PROFESSIONAL CERTIFICATION
 I HEREBY CERTIFY THAT THESE PLANS WERE PREPARED OR APPROVED BY ME, AND THAT I AM A DULY LICENSED PROFESSIONAL ENGINEER UNDER THE LAWS OF THE STATE OF MARYLAND, LICENSE NO. 26569
 EXPIRATION DATE: MAY 26, 2018

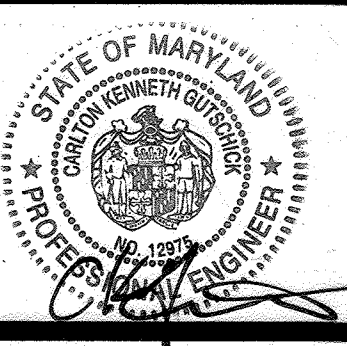


EXISTING CONDITIONS & EASEMENTS PLAN

**DOWNTOWN COLUMBIA
 CRESCENT NEIGHBORHOOD
 PARCELS D1 THRU D14, NON-BUILDABLE BULK PARCELS
 D-15 THRU D-17 & OPEN SPACE LOT 10**

HOWARD COUNTY, MARYLAND


SCALE	ZONING	G. L. W. FILE NO.
1" = 50'	NT	11071
DATE	TAX MAP - GRID	SHEET
DEC, 2017	36 - 01	2 OF 25

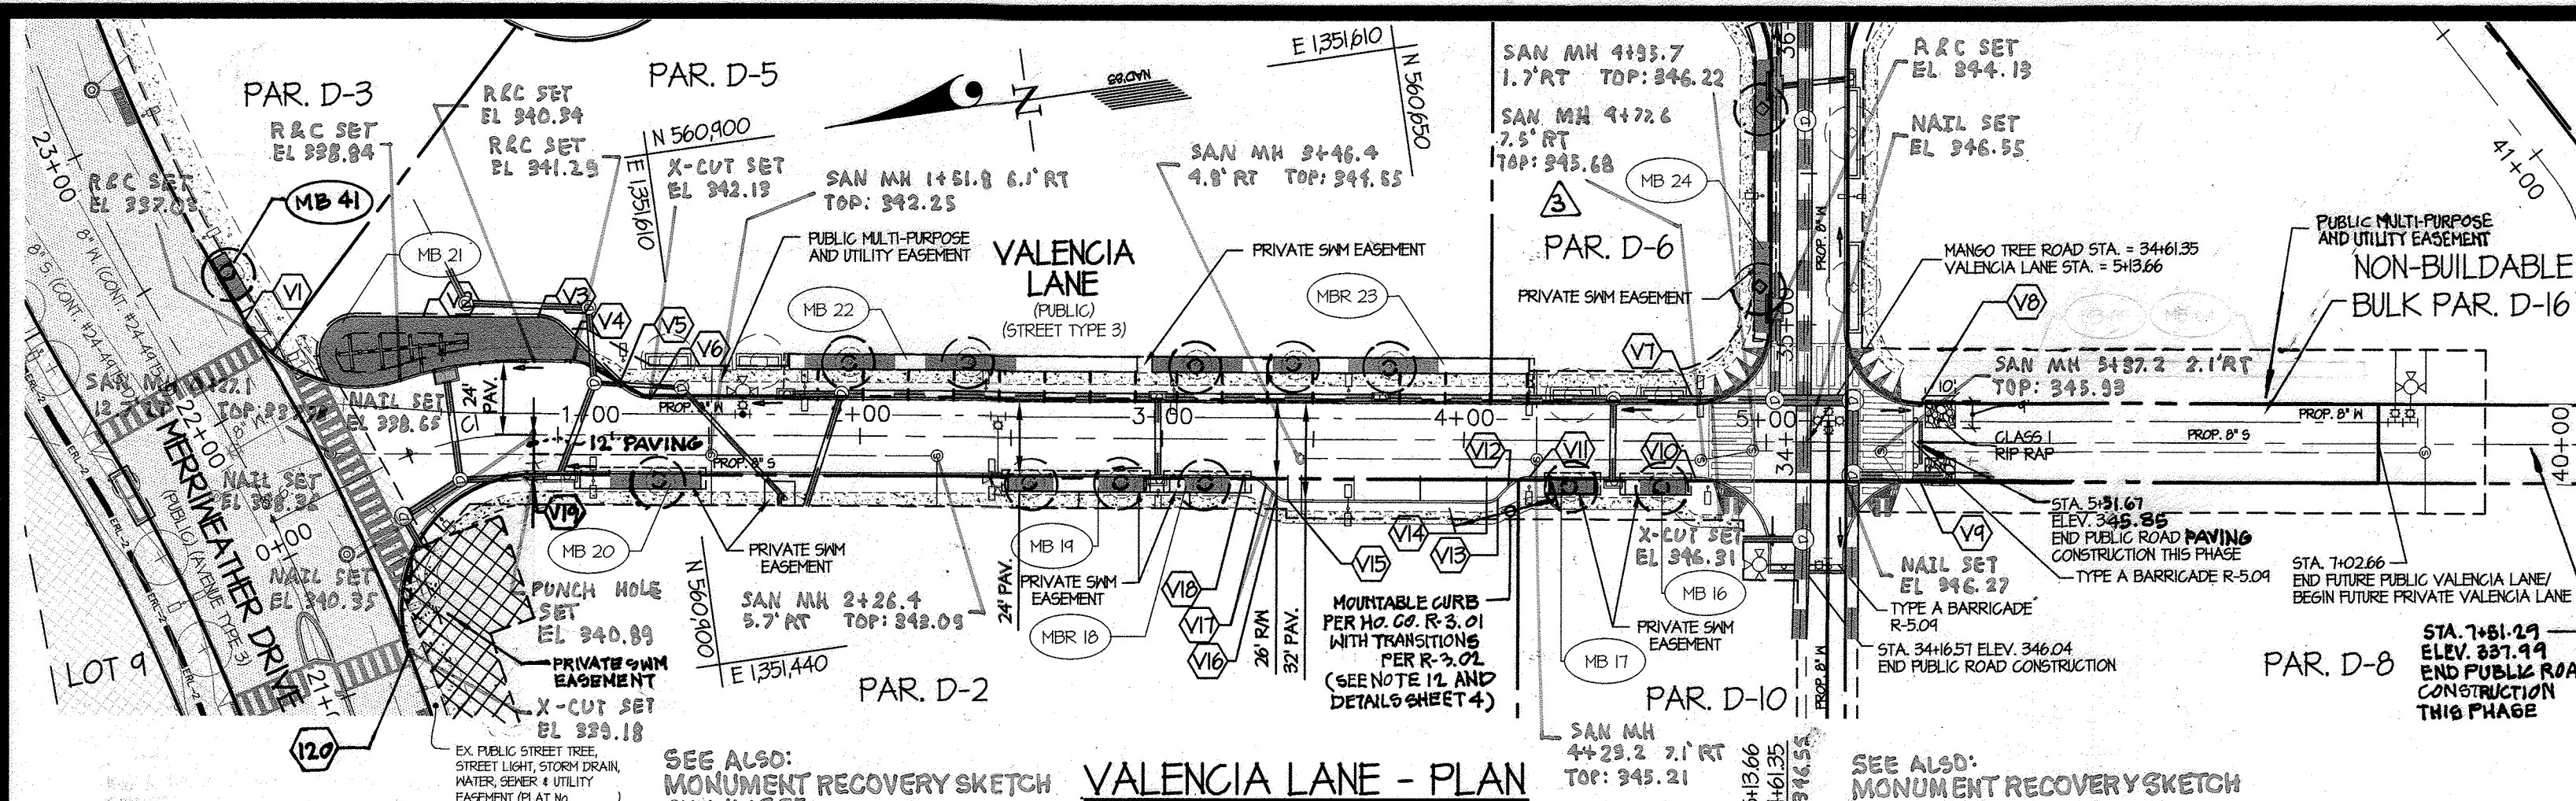

LANE WIDENING NOTE:
 THE VALENCIA LANE 36' PAVING WIDTH (3 LANES) BEGINS TAPERING AT STATION 1+03.4 AND ENDS AT STATION 1+31.0, WITH A 26' PAVING WIDTH (2 LANES). SEE SIGNAGE AND STRIPING PLAN FOR LANE TRANSITION DETAILS.

SEE ALSO: MONUMENT RECOVERY SKETCH SHT. 4 OF 25

SCALE: 1" = 50'

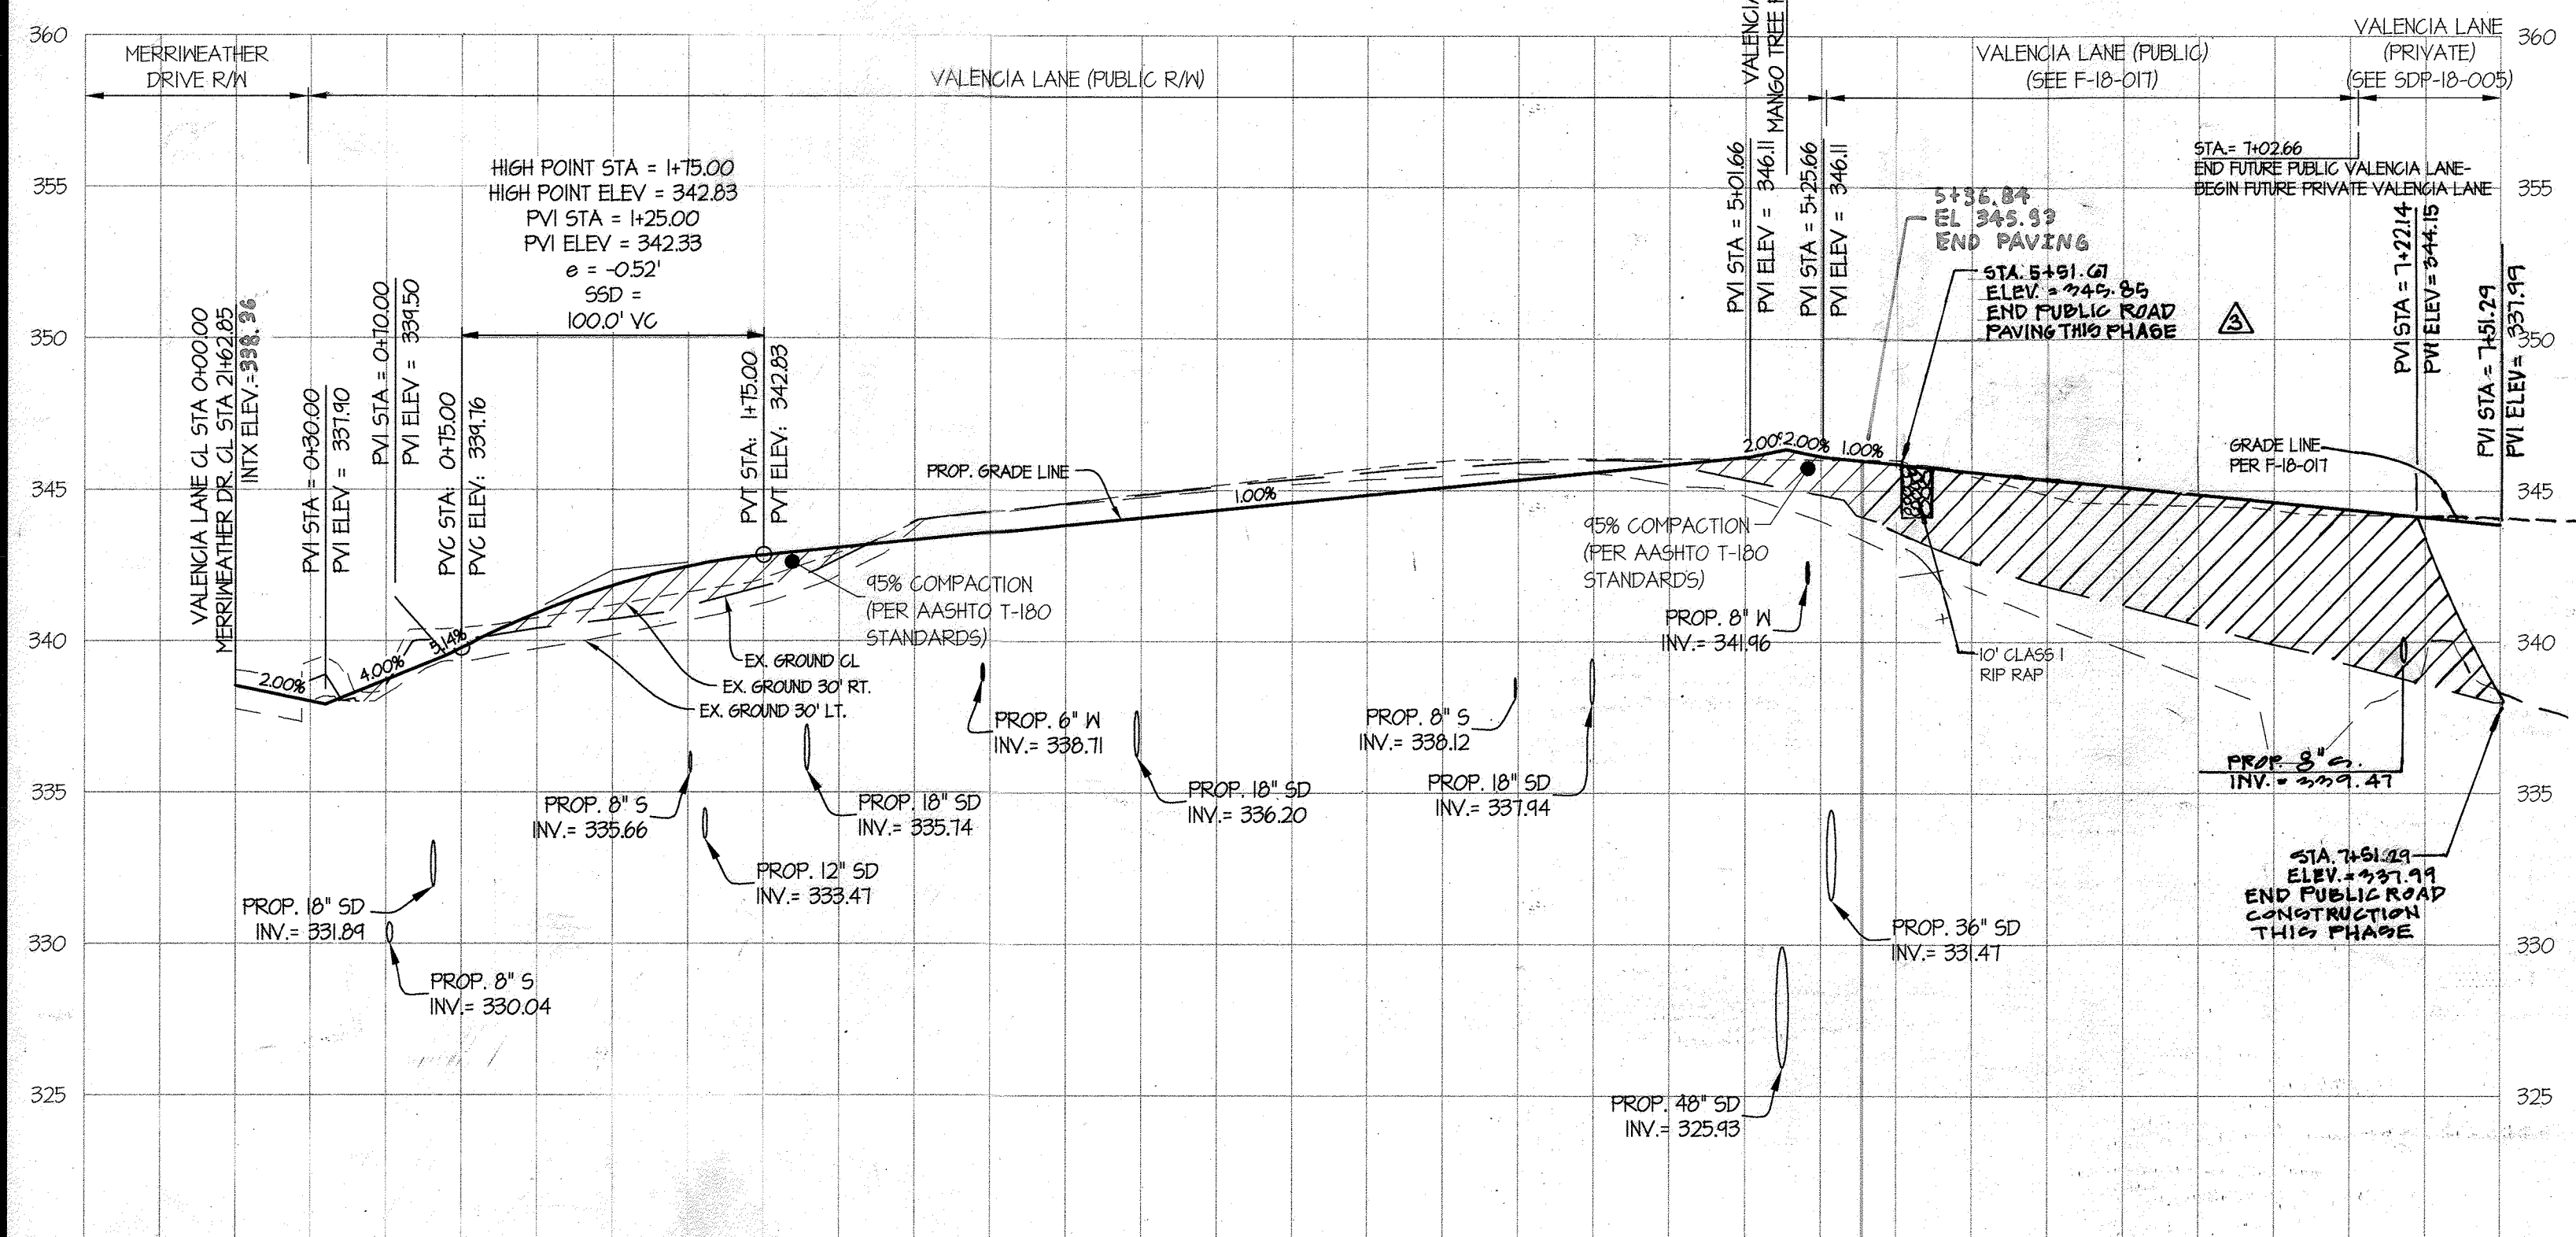

PROFILE LEGEND

- PROP. GRADE LINE
- EX. GROUND CENTERLINE PER SDP 16-075
- EX. GROUND 30' RT. PER SDP 16-075
- EX. GROUND 30' LT. PER SDP 16-075


VALENCIA LANE - PROFILE
 (STREET TYPE 3) (DESIGN SPEED: 25MPH)
 SCALE: (H) 1" = 50'
 SCALE: (V) 1" = 5'

CURVE DATA CHART

CURVE	STREET NAME	PC STA.	PT STA.	RADIUS	TANGENT	ARC	CHORD	BEARING	DELTA
C1	VALENCIA LANE	0+41.24	0+87.68	100.00'	23.65'	46.44'	46.03'	S45°53'41"E	26°36'39"


VALENCIA LANE CURB FLOW LINE ELEVATION TABLE

PT. NO.	STATION	OFFSET	ELEV.
(V1)	0+91.5	63.1' L	336.48
(V2)	0+55.1	24.0' L	338.45
(V3)	0+57.1	24.0' L	339.91
(V4)	1+08.5	24.0' L	340.62
(V5)	1+21.1	18.0' L	341.27
(V6)	1+30.9	12.0' L	341.67
(V7)	4+76.5	12.0' L	345.24
(V8)	5+50.8	12.0' L	345.72
(V9)	5+50.0	12.0' R	345.65
(V10)	4+74.2	12.0' R	345.52
(V11)	4+23.9	12.0' R	345.20
(V12)	4+14.2	15.9' R	345.10
(V13)	4+05.1	20.0' R	345.05
(V14)	3+48.7	20.0' R	344.36
(V15)	3+36.0	16.3' R	344.90
(V16)	3+28.3	12.0' R	344.19
(V17)	0+42.6	12.1' R	340.20
(V18)	0+19.7	62.9' R	339.14

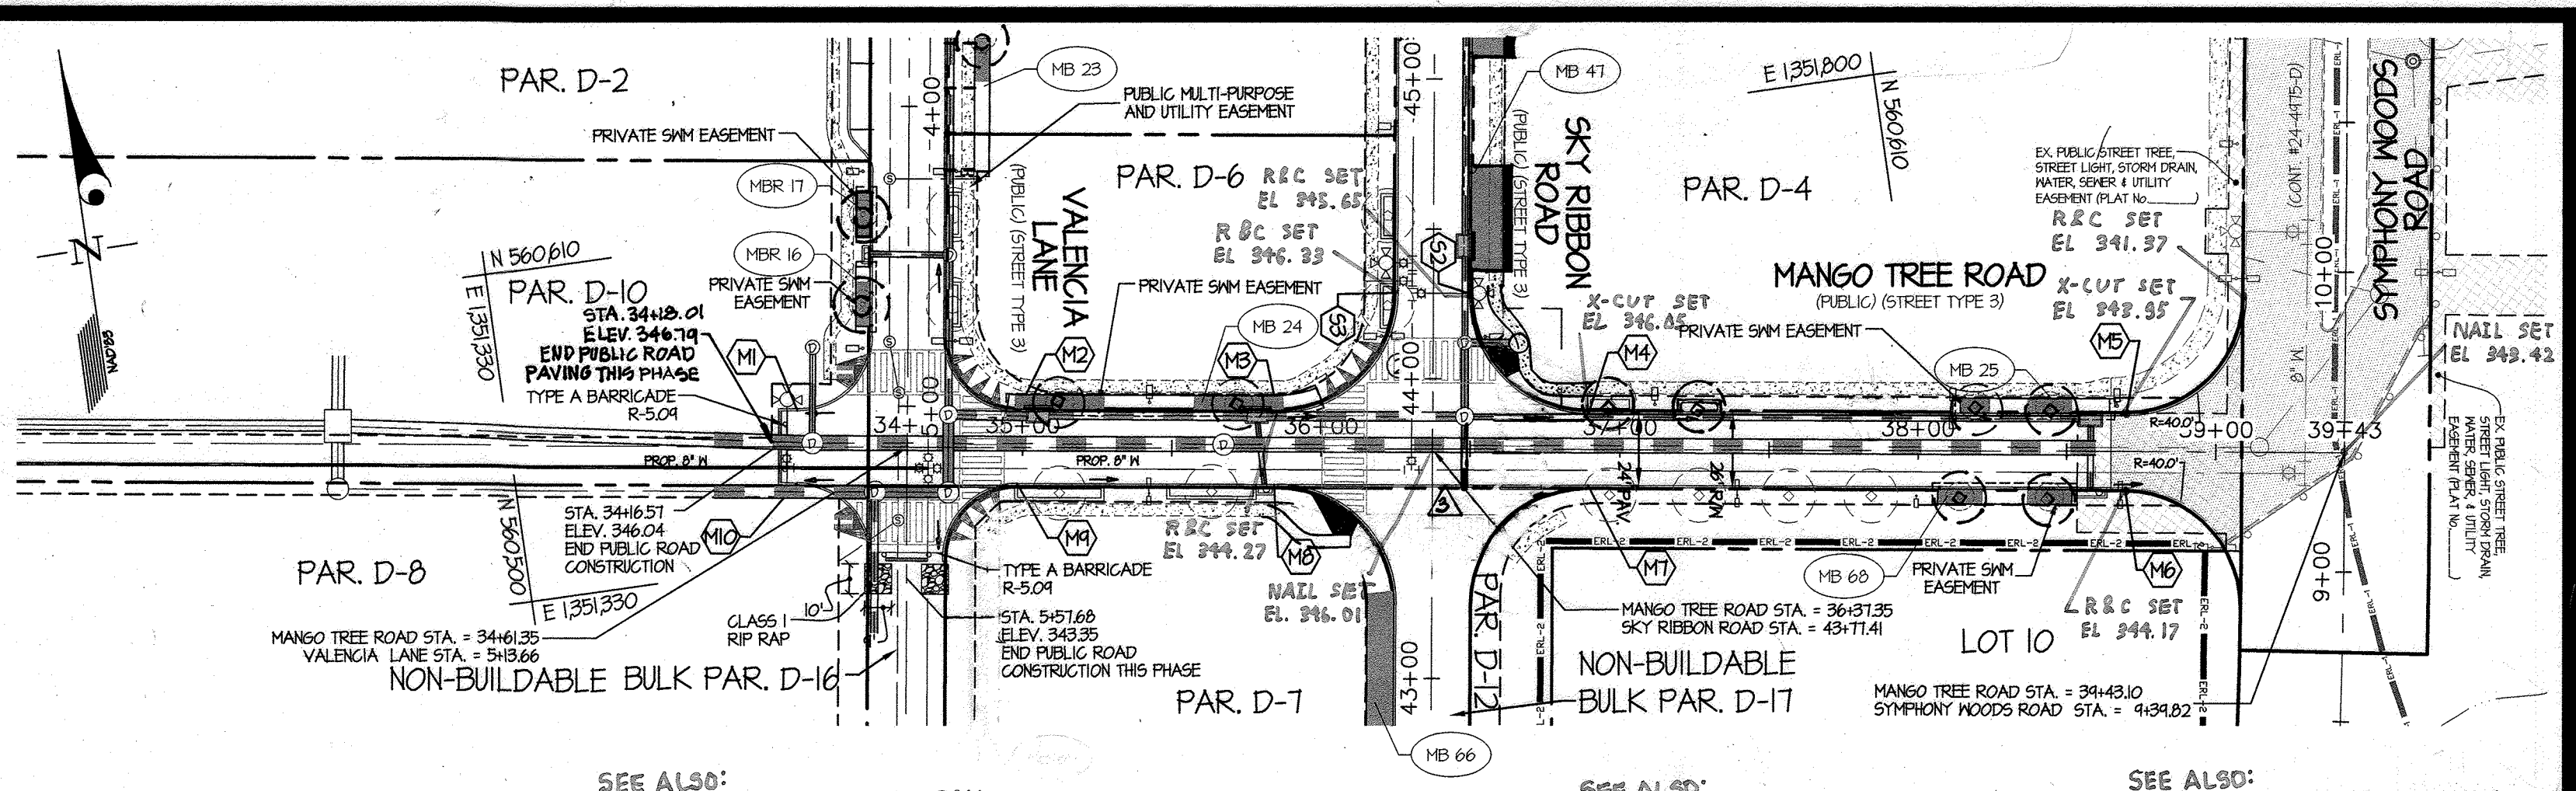

SEE ALSO: MONUMENT RECOVERY SKETCH SHT. 4 OF 25

SCALE: 1" = 50'

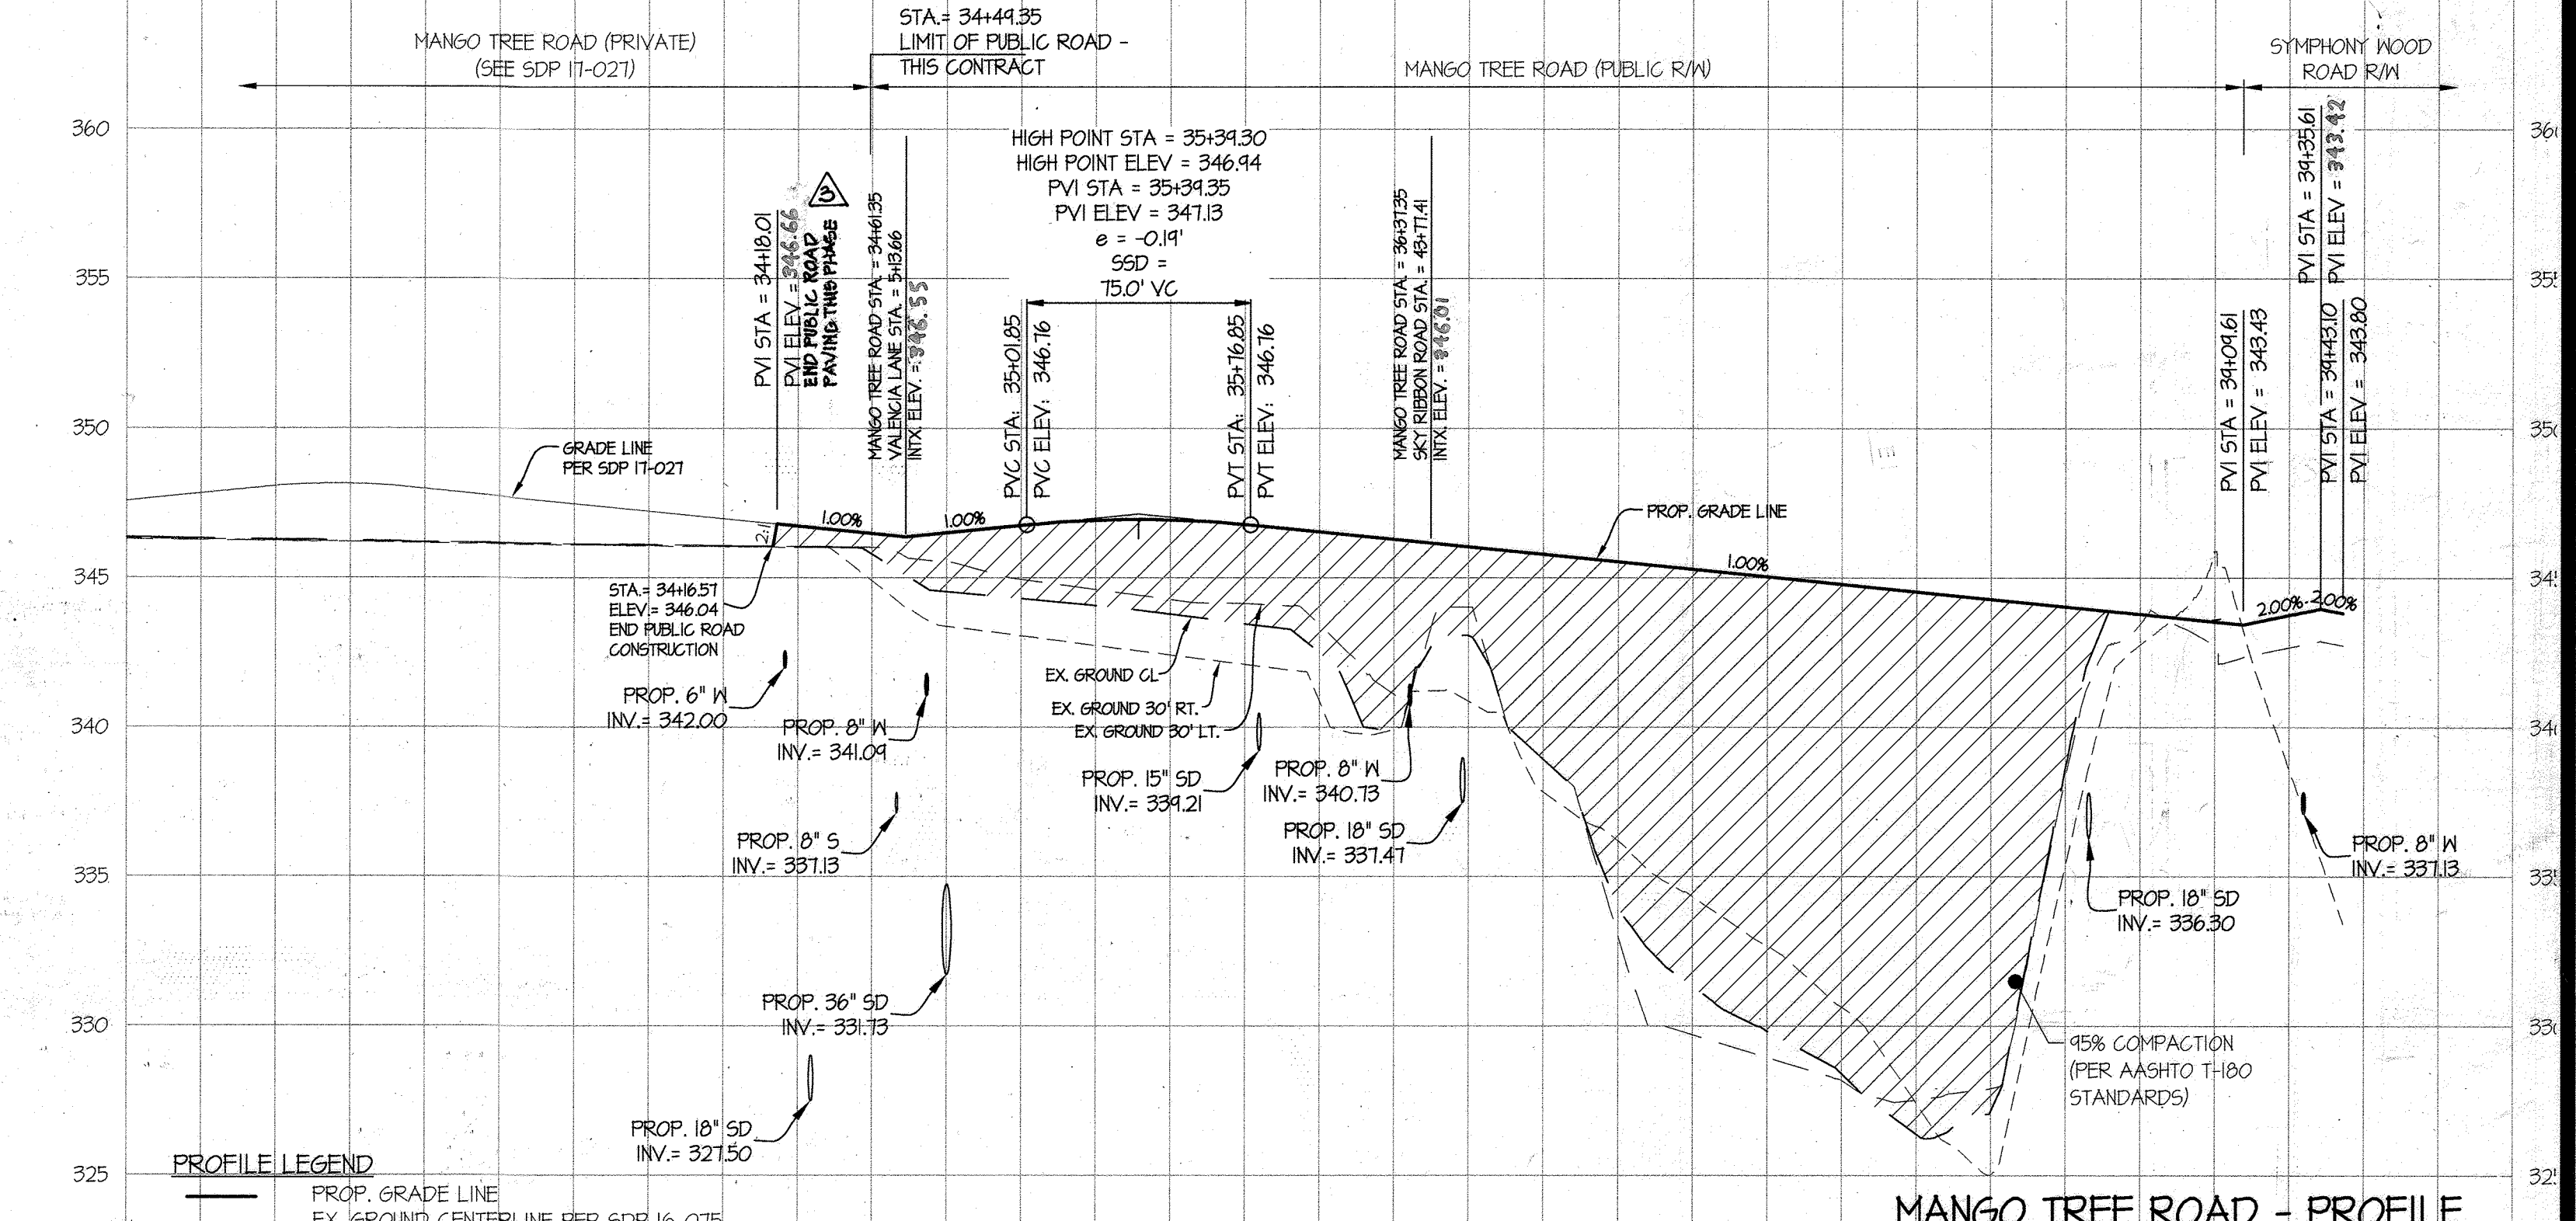

PROFILE LEGEND

- PROP. GRADE LINE
- EX. GROUND CENTERLINE PER SDP 16-075
- EX. GROUND 30' RT. PER SDP 16-075
- EX. GROUND 30' LT. PER SDP 16-075

MANGO TREE ROAD - PROFILE
 (STREET TYPE 3) (DESIGN SPEED: 25MPH)
 SCALE: (H) 1" = 50'
 SCALE: (V) 1" = 5'

APPROVED: HOWARD COUNTY DEPARTMENT OF PUBLIC WORKS
 Chief, Bureau of Highways
 Date: 1/3/2018

APPROVED: HOWARD COUNTY DEPARTMENT OF PLANNING & ZONING
 Chief, Division of Land Development
 Date: 1-17-18

Chief, Development Engineering Division
 Date: 1-11-18

GLWGUTSCHICK LITTLE & WEBER, P.A.
 CIVIL ENGINEERS, LAND SURVEYORS, LAND PLANNERS, LANDSCAPE ARCHITECTS
 3909 NATIONAL DRIVE - SUITE 250 - BURTONSVILLE OFFICE PARK
 BURTONSVILLE, MARYLAND 20866
 TEL: 301-421-4024 FAX: 301-989-2524 FAX: 301-421-4186

LEGEND

- SB 50' STREAM / BANK BUFFER
- WB 25' WETLAND BUFFER
- FLOODPLAIN
- STREAM CENTERLINE
- 2014 ENVIRONMENTAL RESTORATION LIMITS
- 2016 ENVIRONMENTAL RESTORATION LIMITS
- BOND NOTE REFERENCE

PREPARED FOR:
 THE HOWARD HUGHES CORPORATION
 10480 LITTLE PATUXENT PARKWAY
 SUITE 400
 COLUMBIA, MARYLAND 21044
 ATTN: BILL ROWE
 410-964-4987

PROFESSIONAL CERTIFICATION
 I HEREBY CERTIFY THAT THESE PLANS WERE PREPARED OR APPROVED BY ME, AND THAT I AM A DULY LICENSED PROFESSIONAL ENGINEER UNDER THE LAWS OF THE STATE OF MARYLAND, LICENSE NO. 26569.
 EXPIRATION DATE: MAY 28, 2018

MANGO TREE ROAD and VALENCIA LANE - PLAN and PROFILE

DOWNTOWN COLUMBIA
 CRESCENT NEIGHBORHOOD
 PARCELS D-1 THRU D-14, NON-BUILDABLE BULK PARCELS
 D-15 THRU D-17 & OPEN SPACE LOT 10

SCALE: 1" = 50'
 ZONING: NT
 G. L. W. FILE NO.: 11071

DATE: DEC, 2017
 TAX MAP - GRID: 36 - 01
 SHEET: 3 OF 25

GENERAL NOTES:

- SEE SHEET 2 FOR EXISTING ITEMS TO BE REMOVED AND BEARING AND DISTANCES.
- SEE SHEET 5 FOR TYPICAL ROAD SECTIONS.
- SEE SHEET 5 FOR CURB DETAILS.
- SEE SHEET 6 FOR FLOODPLAIN CROSS SECTION AND WHEELS.
- SEE SHEETS 1-4 FOR STORM DRAIN INFORMATION.
- SEE SHEET 11 FOR STREET TREES AND STREET LIGHTS.
- ON MAY 9, 2016 HOWARD COUNTY DEPT. OF PLANNING & ZONING DETERMINED THAT THE DISTURBANCES TO ENVIRONMENTAL SENSITIVE AREAS FOR THE IMPROVEMENTS SHOWN WITHIN THIS FINAL PLAN ARE ESSENTIAL AND NECESSARY.
- TRAFFIC BARRICADES AND CLASS 1 RIP RAP SHOWN AT END OF PUBLIC ROAD CONSTRUCTION SHALL NOT BE REQUIRED IF THE CONSTRUCTION OF MANGO TREE ROAD (PUBLIC), VALENCIA LANE (PUBLIC), AND THEIR CORRESPONDING PRIVATE ROAD EXTENSIONS AS A PART OF F-18-01, SDP IT-021, OR SDP 18-005 OCCUR CONCURRENTLY.
- SEE SDP IT-021 FOR THE SPOT ELEVATIONS TO CONSTRUCT THE HANDICAP RAMPS AT THE INTERSECTION OF VALENCIA LANE AND MANGO TREE ROAD.
- FOR THE INFORMATION THAT ESTABLISHES THE LIMIT OF PUBLIC MAINTENANCE RESPONSIBILITIES FOR THE STORM DRAIN, SEE SHEET 7.
- FOR THE INFORMATION THAT ESTABLISHES THE LIMIT OF THE PUBLIC MAINTENANCE RESPONSIBILITIES FOR THE WATER AND SEWER, SEE CONT. #24-4714-D.
- THE LIMITS OF THE MOUNTABLE CURB ON VALENCIA LANE INCLUDE:
 TRANSITION CURB STA. 4+29.54 TO 4+41.75
 MOUNTABLE CURB STA. 4+29.54 TO 4+41.75
 TRANSITION CURB STA. 4+19.75 TO 4+19.75

BOND NOTES:

THE STREET TREES, STREET LIGHTS, CONCRETE SIDEWALKS, AND SIDEWALK RAMPS (PER HOWARD COUNTY DETAIL R-4.03) ARE SHOWN FOR BONDING PURPOSES ONLY. THE IMPROVEMENTS ALONG THE ROAD FRONTAGE ARE TO BE CONSTRUCTED AS PART OF SDP IT-021. THEY WILL ONLY BE CONSTRUCTED AS A PART OF THESE PLANS IF NEEDED PRIOR TO THE COMPLETION OF THE STREETS/SAFE ASSOCIATED WITH SDP IT-021.

AS-BUILT CERTIFICATION
 I HEREBY CERTIFY, BY SEAL, THAT THE FACILITIES SHOWN ON THIS PLAN WERE CONSTRUCTED AS SHOWN ON THIS PLAN MEET THE CURRENT APPROVED PLANS AND SPECIFICATIONS.

10/08/23


PROFESSIONAL ENGINEER AS BUILT CERTIFICATION FOR PSWMM

NOTE: THERE IS NO "AS-BUILT" INFORMATION PROVIDED ON THIS SHEET.


NAME: GERALD P. TURNBAUGH
 DATE: AUG. 11, 2023 REG. NO. 26369

MANGO TREE ROAD CURB FLOW LINE ELEVATION TABLE

PT. NO.	STATION	OFFSET	ELEV.
(M1)	34+24.9	12.1' L	346.47
(M2)	34+44.0	12.0' L	346.31
(M3)	35+26.4	12.0' L	346.96
(M4)	36+24.9	12.0' L	345.47
(M5)	36+66.2	12.2' L	343.66
(M6)	36+69.5	12.0' R	343.69
(M7)	36+84.1	12.1' R	345.36
(M8)	36+85.7	11.9' R	346.46
(M9)	34+47.6	12.2' R	346.59
(M10)	34+25.9	12.1' R	346.47

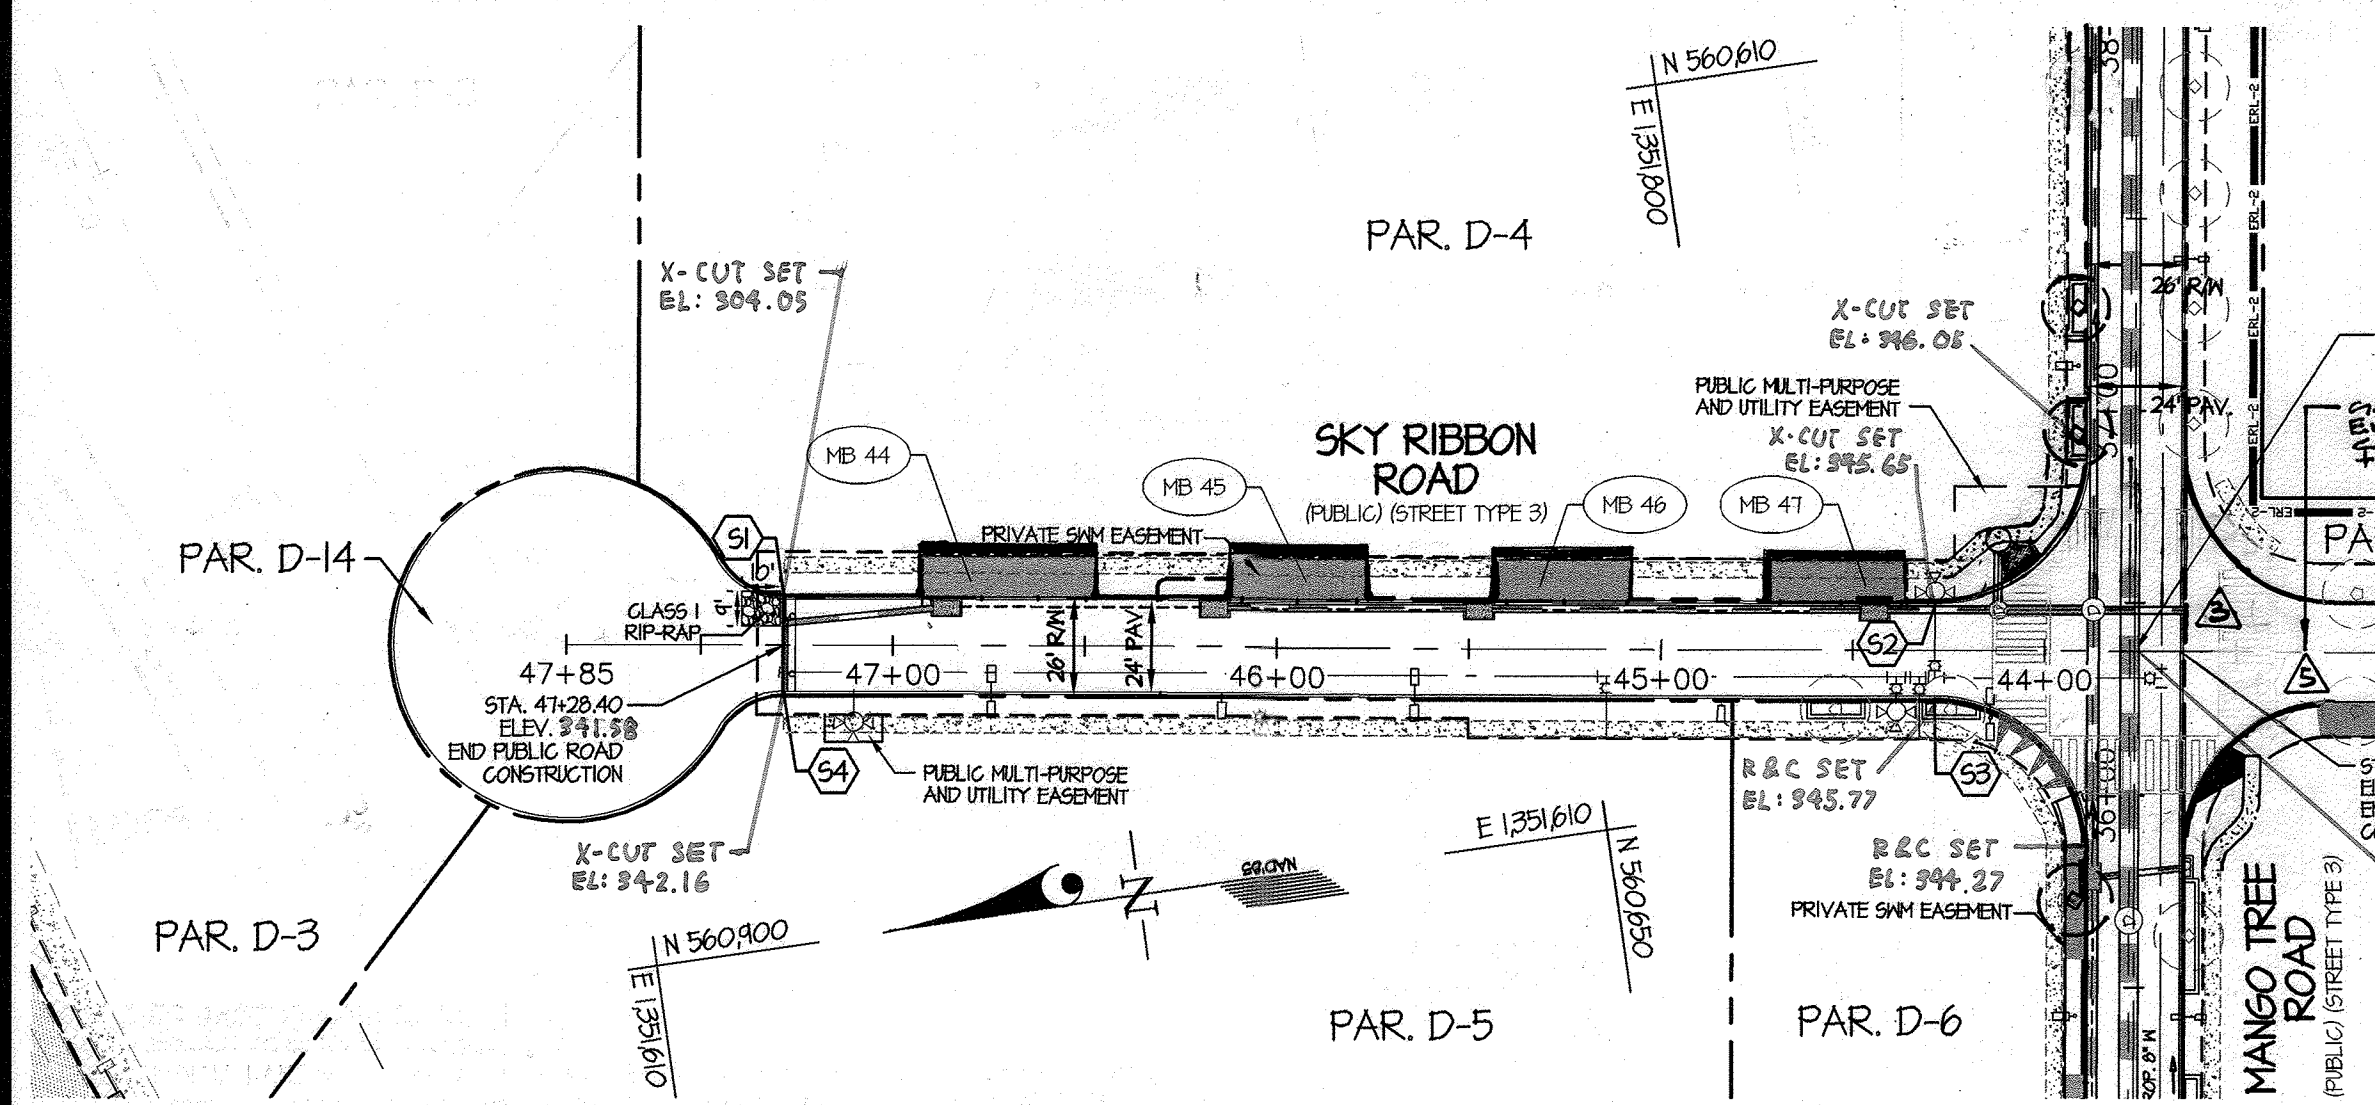

SKY RIBBON ROAD - PLAN
SCALE: 1" = 50'

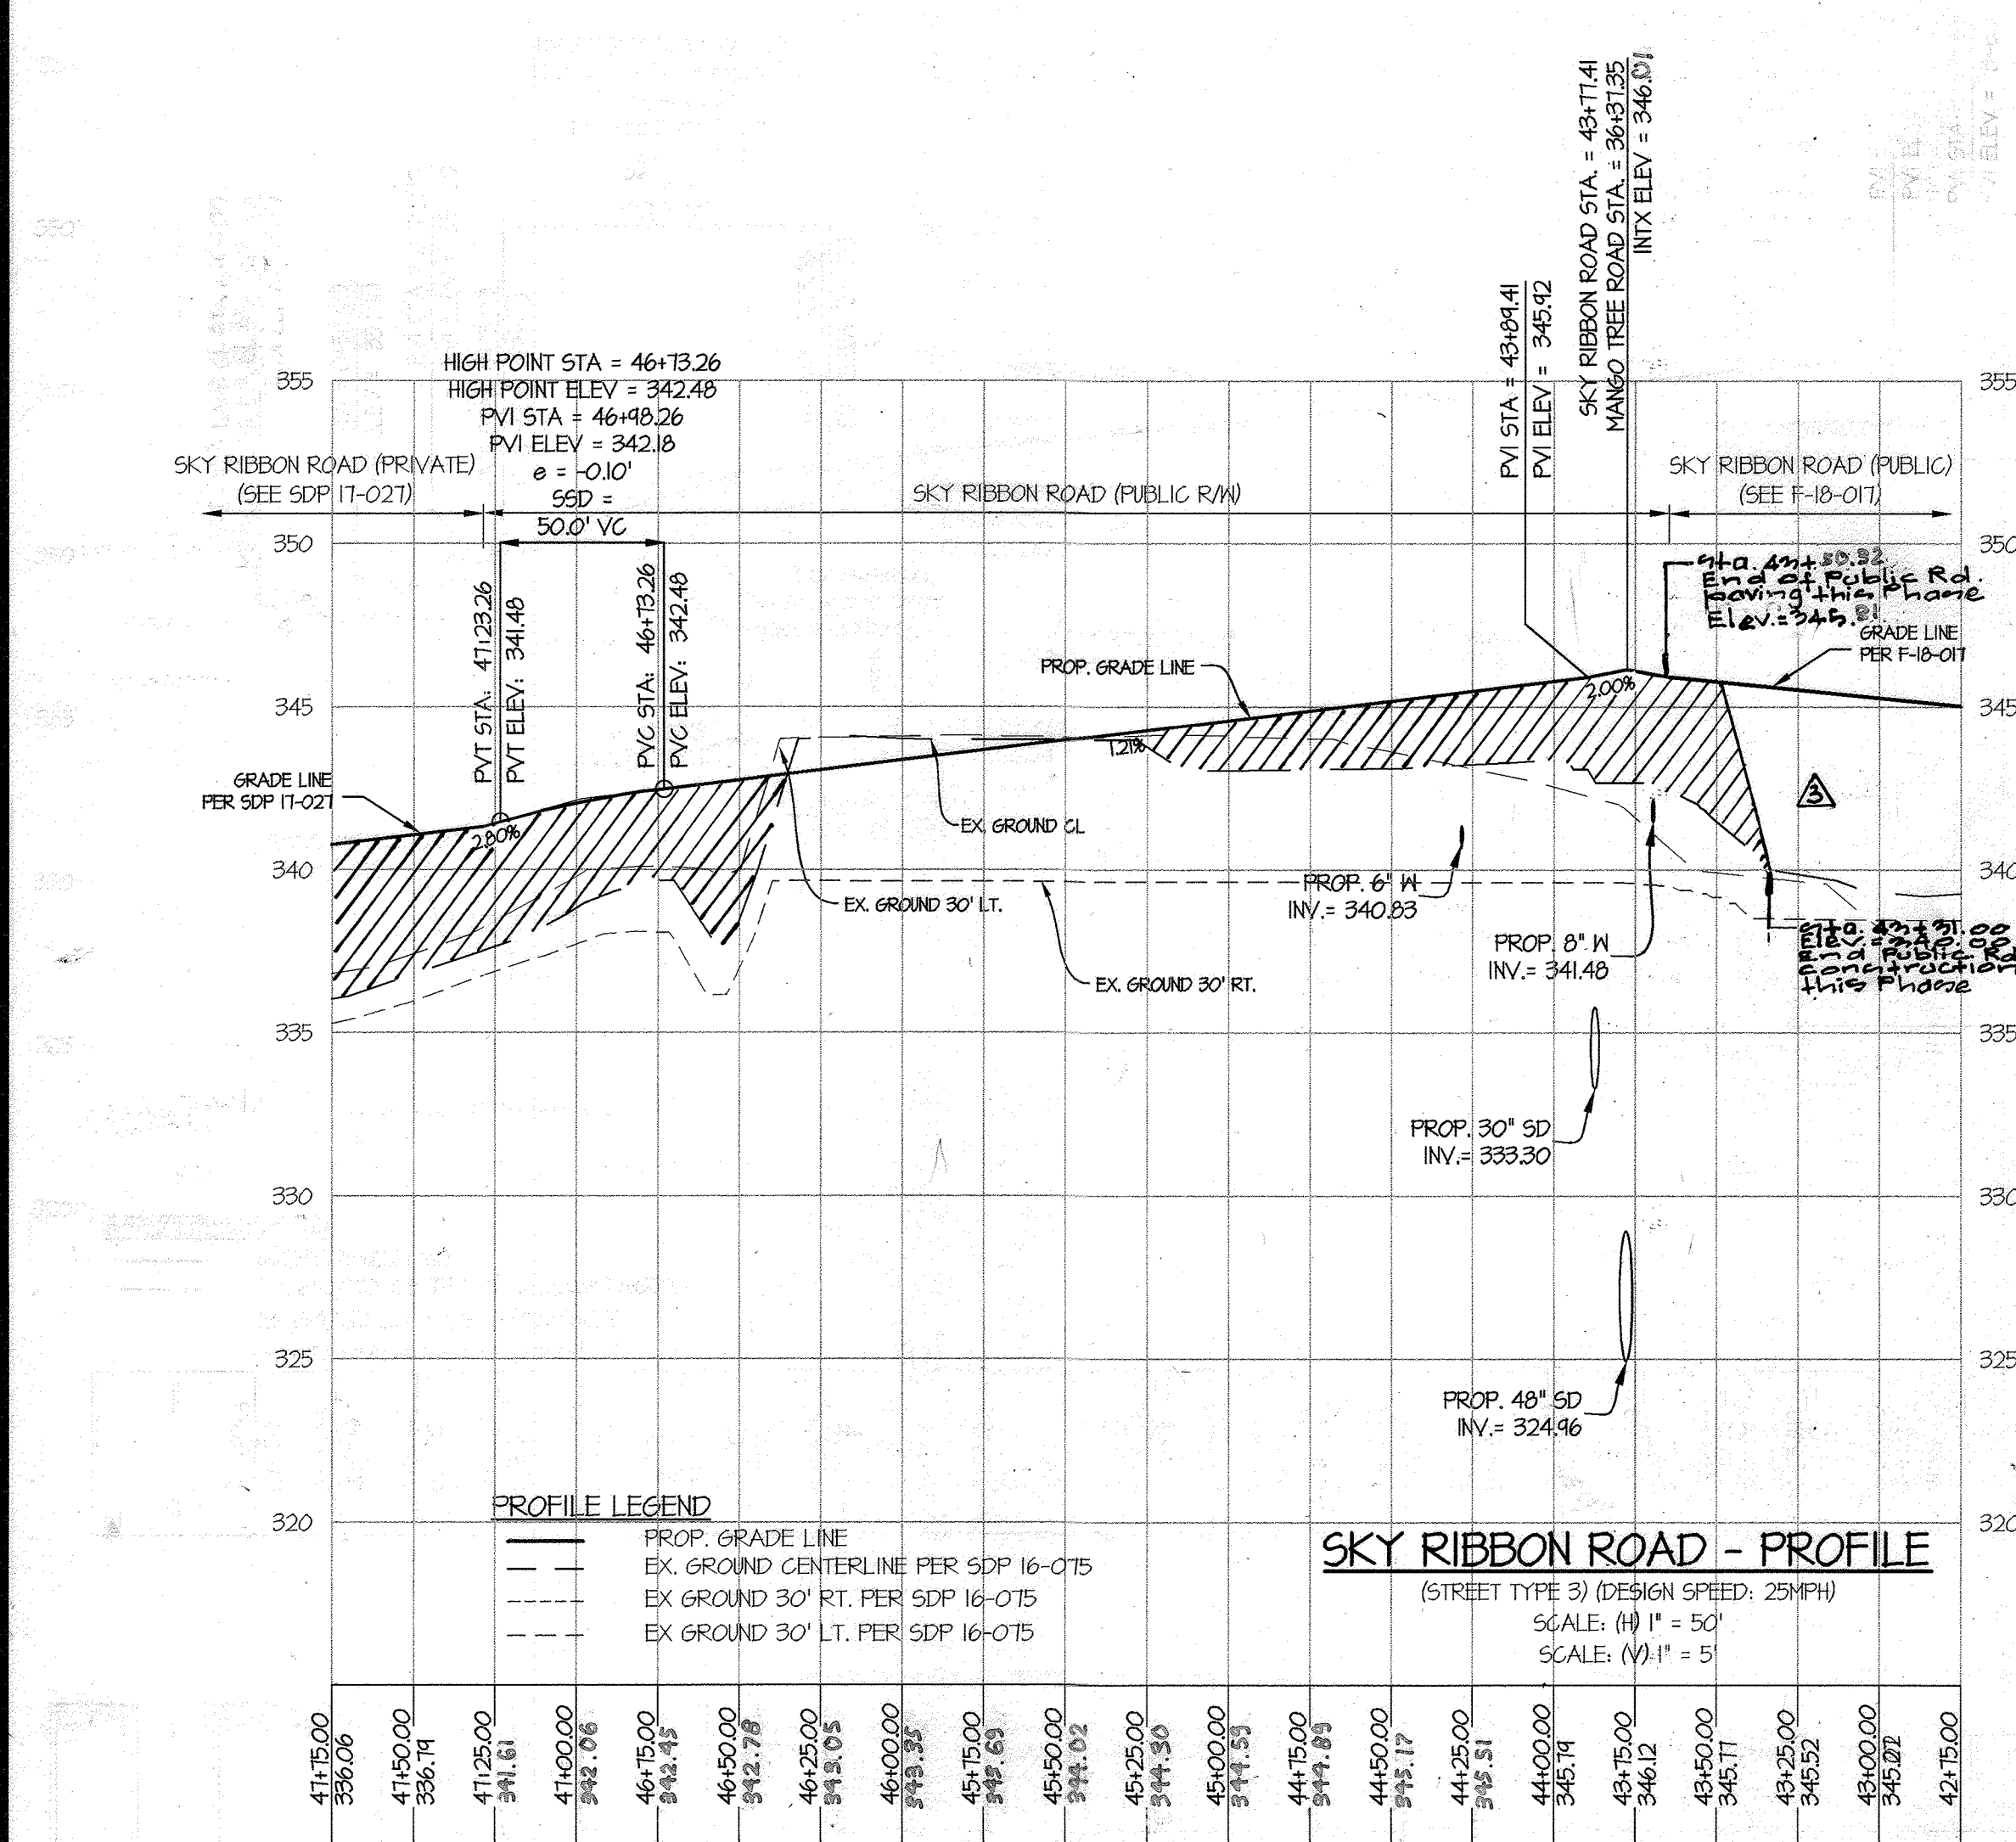


SKY RIBBON ROAD - PROFILE
(STREET TYPE 3) (DESIGN SPEED: 25MPH)
SCALE: (H) 1" = 50'
SCALE: (V) 1" = 5'

PROFILE LEGEND

- PROP. GRADE LINE
- EX. GROUND CENTERLINE PER SDP 16-075
- EX. GROUND 30' RT. PER SDP 16-075
- EX. GROUND 30' LT. PER SDP 16-075

SKY RIBBON ROAD CURB FLOW LINE ELEVATION TABLE

PT. NO.	STATION	OFFSET	ELEV.
(9)	47+81.0	12.5' R	341.01
(9)	44+29.9	11.9' R	345.22
(9)	44+29.5	12.1' L	345.27
(9)	41+29.9	12.2' L	341.59

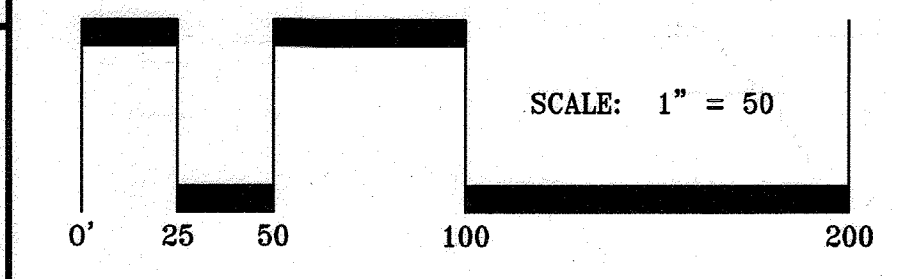


GENERAL NOTES:


- SEE SHEET 2 FOR EXISTING ITEMS TO BE REMOVED AND BEARINGS AND DISTANCES.
- SEE SHEET 5 FOR TYPICAL ROAD SECTIONS.
- SEE SHEET 5 FOR CURB DETAILS.
- SEE SHEET 6 FOR FLOODPLAIN CROSS SECTION AND WEELS.
- SEE SHEETS 7-4 FOR STORM DRAIN INFORMATION.
- SEE SHEET 11 FOR STREET TREES AND STREET LIGHTS.
- ON MAY 9, 2016 HOWARD COUNTY DEPT. OF PLANNING & ZONING DETERMINED THAT THE DISTURBANCES TO ENVIRONMENTAL SENSITIVE AREAS FOR THE IMPROVEMENTS SHOWN WITHIN THIS FINAL PLAN ARE ESSENTIAL AND NECESSARY.
- TRAFFIC BARRICADES AND CLASS 1 RIP RAP SHOWN AT END OF PUBLIC ROAD CONSTRUCTION SHALL NOT BE REQUIRED IF THE CONSTRUCTION OF MANGO TREE ROAD (PUBLIC), VALENCIA LANE (PUBLIC), AND THEIR CORRESPONDING PRIVATE ROAD EXTENSIONS AS A PART OF F-10-01, SDP IT-027, OR SDP 10-005 OCCUR CONCURRENTLY.
- SEE SDP IT-027 FOR THE SPOT ELEVATIONS TO CONSTRUCT THE HANDICAP RAMP AT THE INTERSECTION OF VALENCIA LANE AND MANGO TREE ROAD.
- FOR THE INFORMATION THAT ESTABLISHES THE LIMIT OF PUBLIC MAINTENANCE RESPONSIBILITIES FOR THE STORM DRAIN, SEE SHEET 7.
- FOR THE INFORMATION THAT ESTABLISHES THE LIMIT OF THE PUBLIC MAINTENANCE RESPONSIBILITIES FOR THE WATER AND SEWER, SEE CONT. #24-4914-D.

BOND NOTES:


THE STREET TREES, STREET LIGHTS, 4" CONCRETE SIDEWALKS, AND SIDEWALK RAMP (PER HOWARD COUNTY DETAIL R-4.03) ARE SHOWN FOR BONDING PURPOSES ONLY. THE IMPROVEMENTS ALONG THE ROAD FRONTAGE ARE TO BE CONSTRUCTED AS PART OF SDP IT-027. THEY WILL ONLY BE CONSTRUCTED AS A PART OF THESE PLANS IF NEEDED PRIOR TO THE COMPLETION OF THE STREETScape ASSOCIATED WITH SDP IT-027.

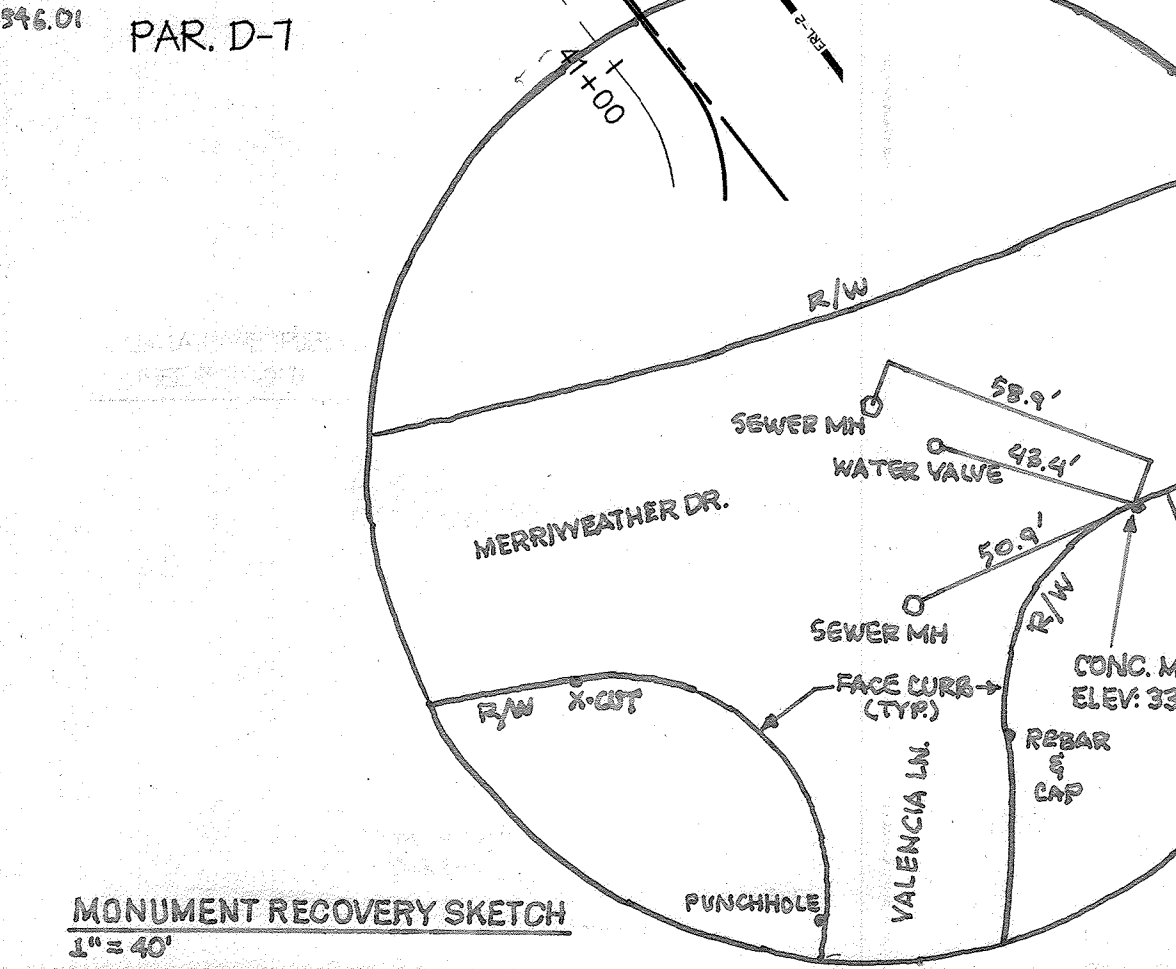


MONUMENT RECOVERY SKETCH
1" = 40'

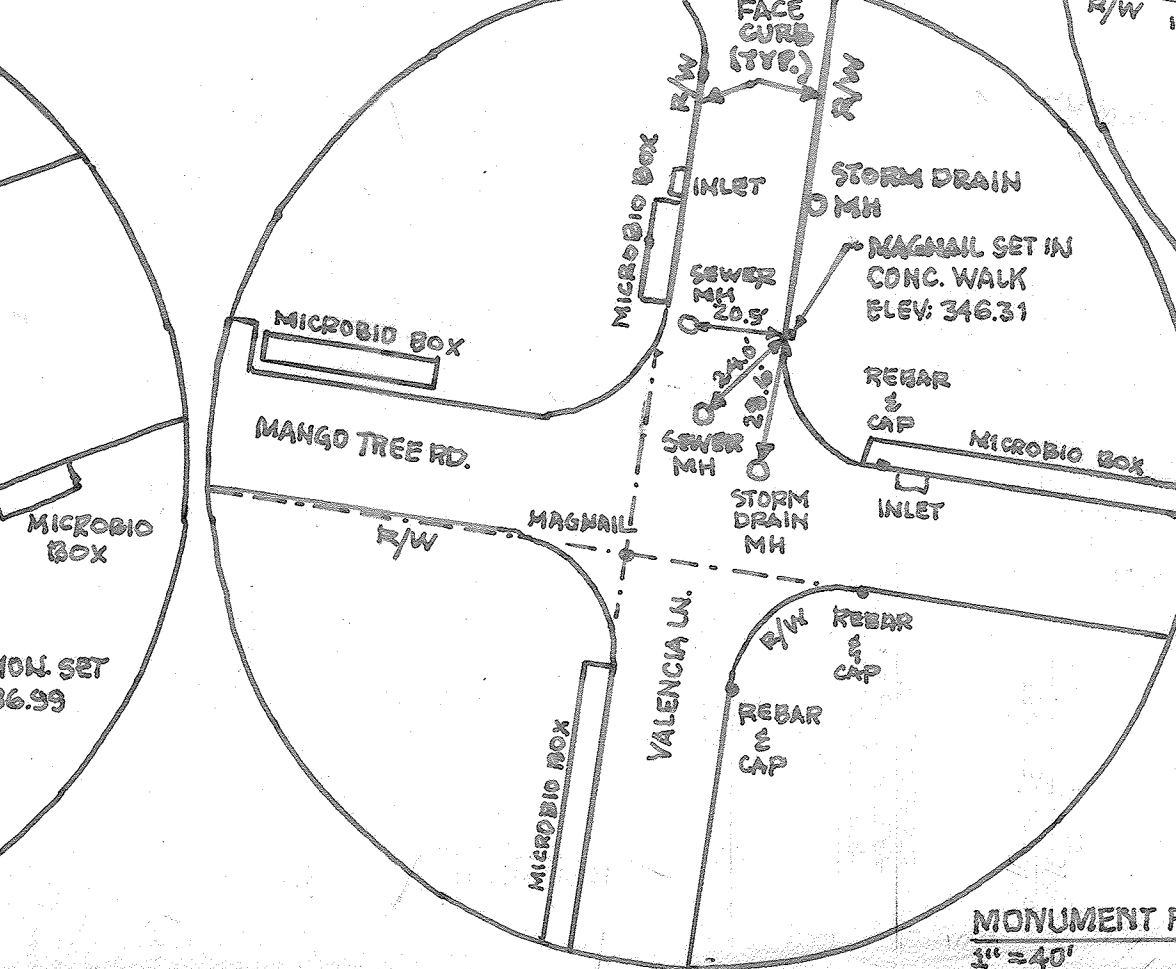


MONUMENT RECOVERY SKETCH
1" = 40'

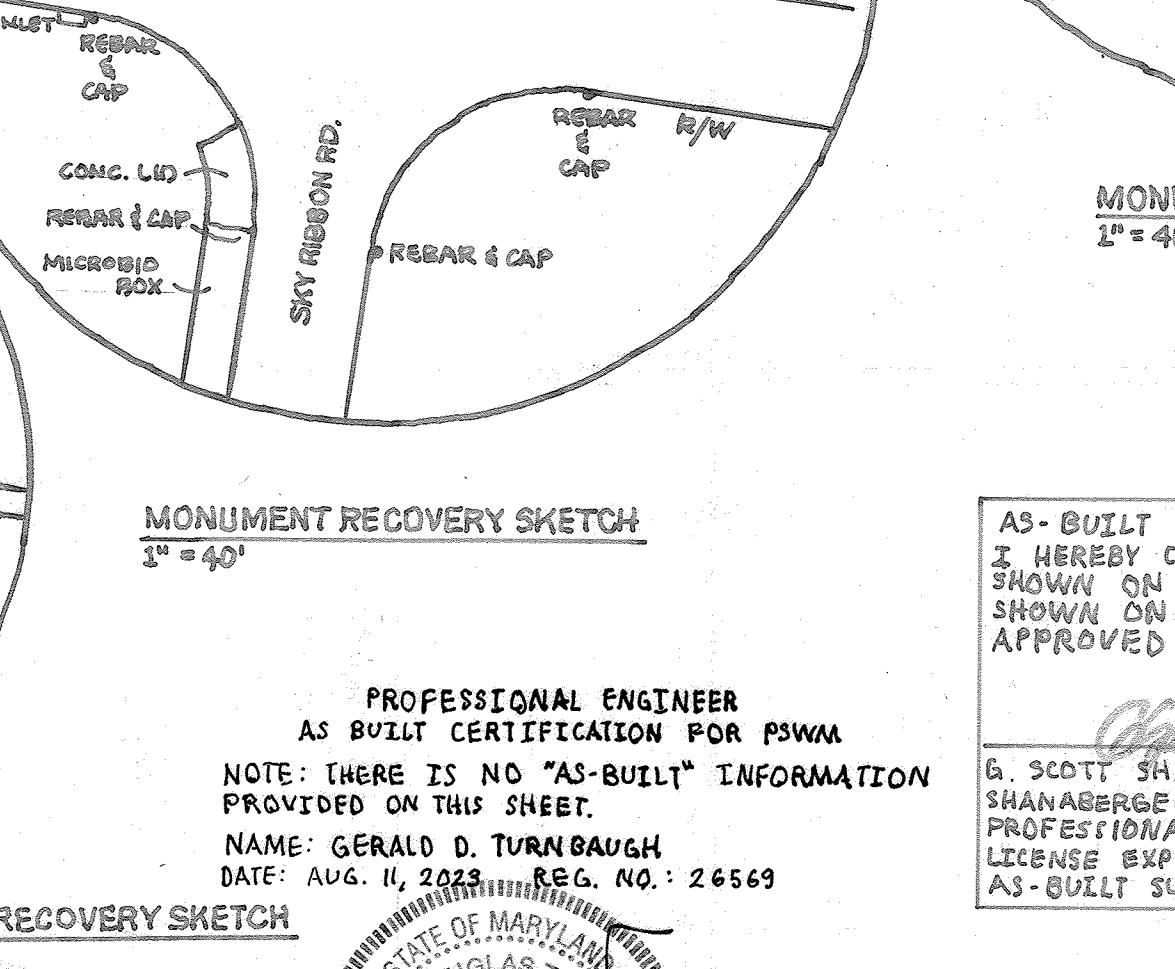


MONUMENT RECOVERY SKETCH
1" = 40'

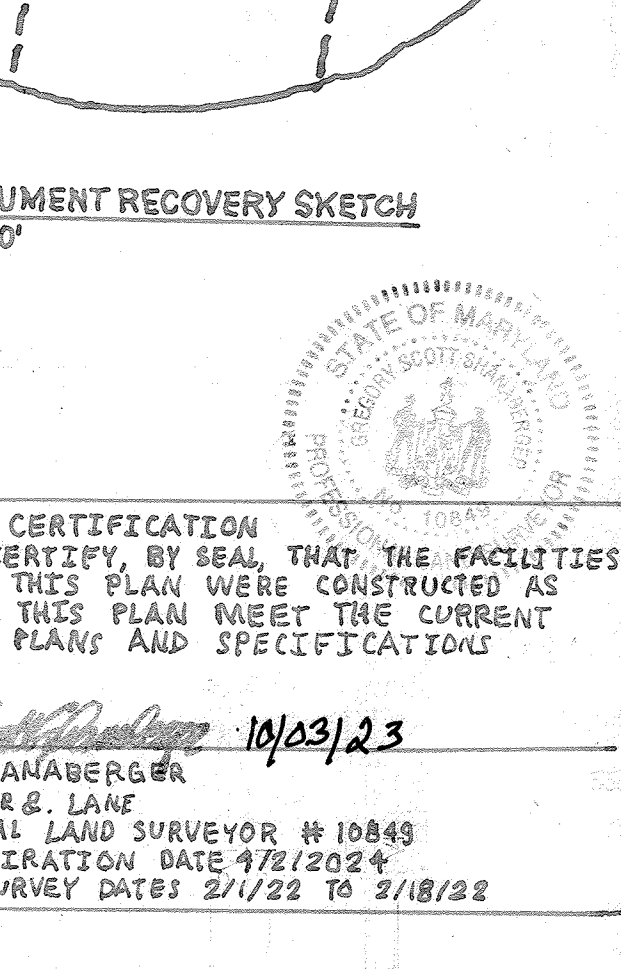


MONUMENT RECOVERY SKETCH
1" = 40'

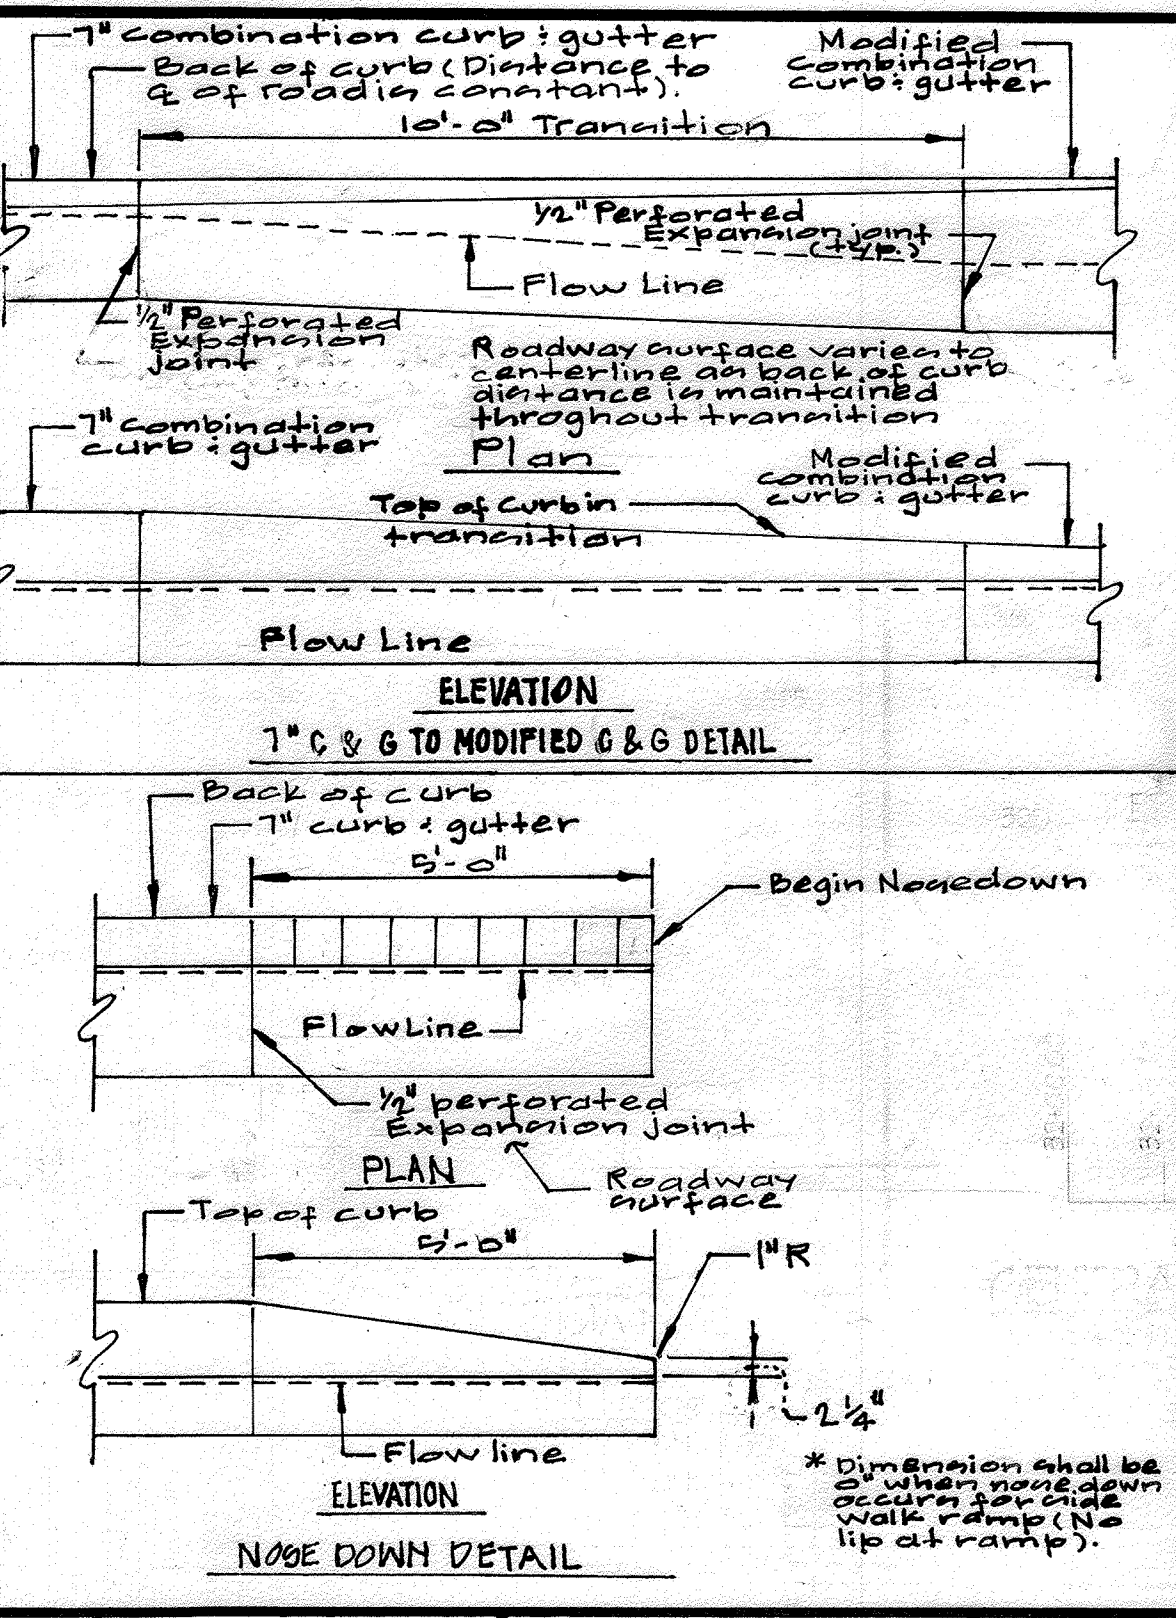


7" COMBINATION CURB AND GUTTER
Detail R-3.02

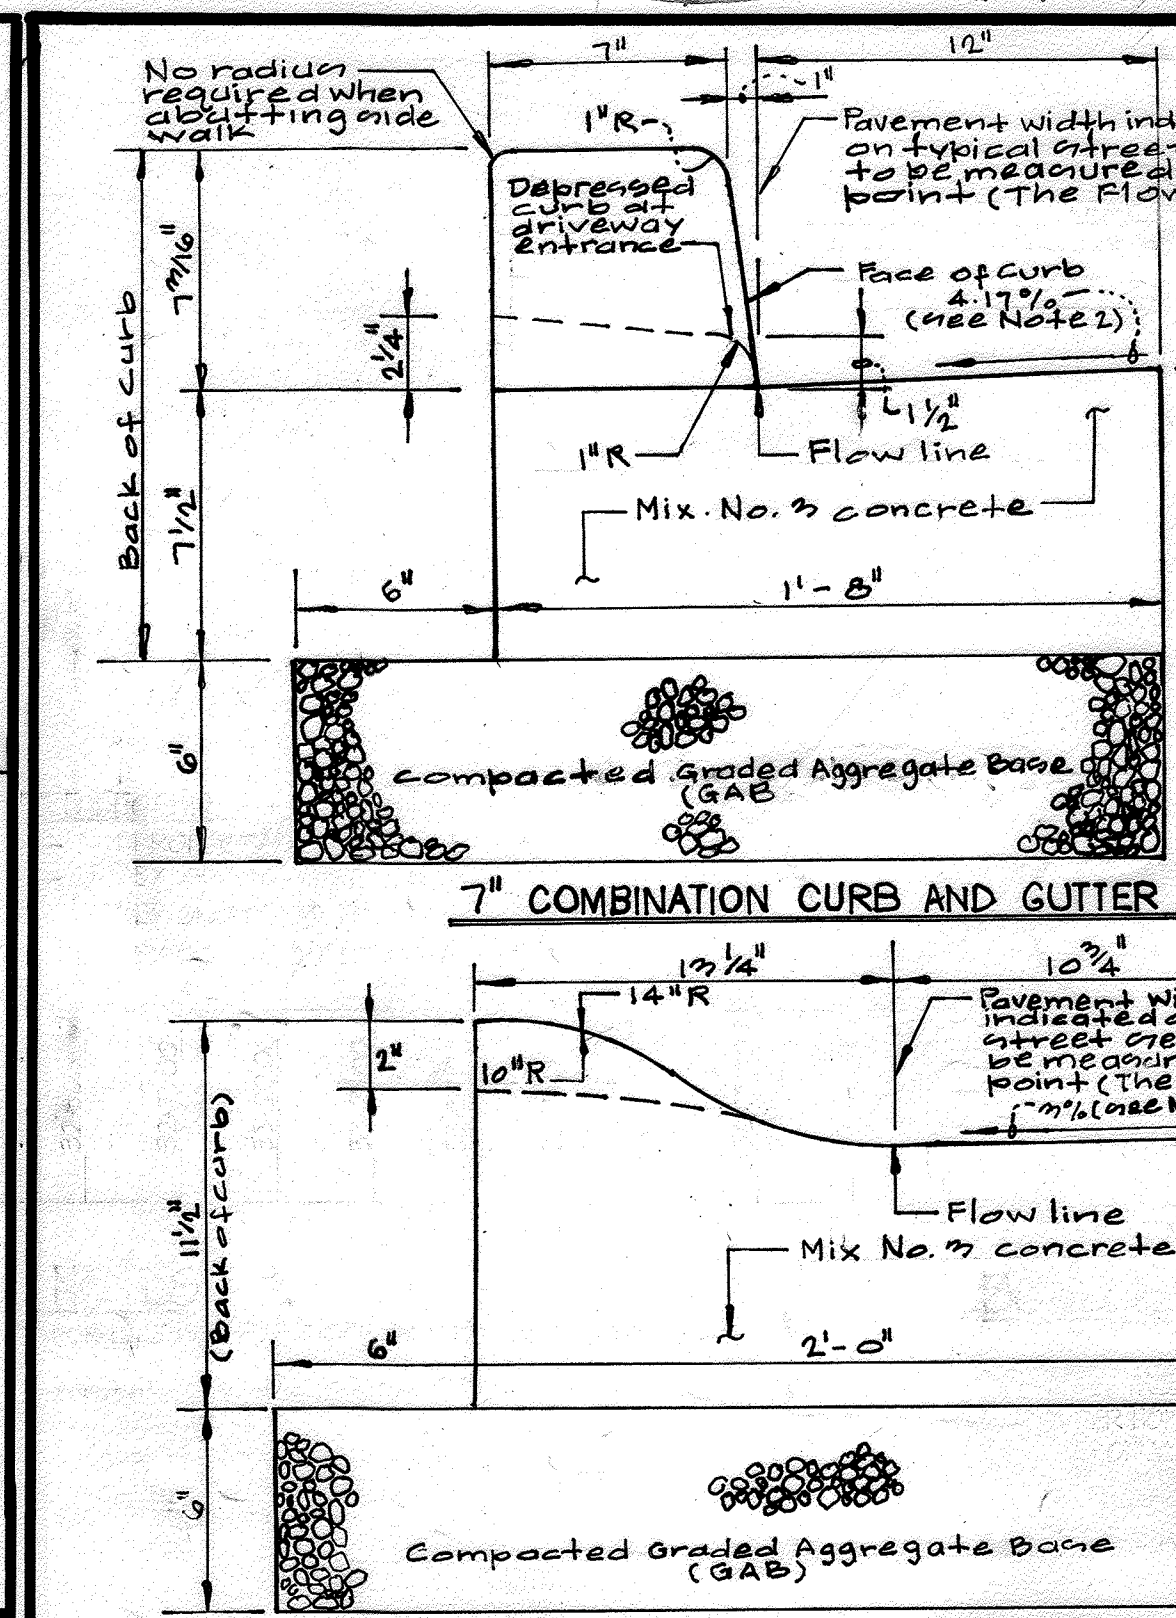

MODIFIED COMBINATION CURB AND GUTTER
Detail R-3.01

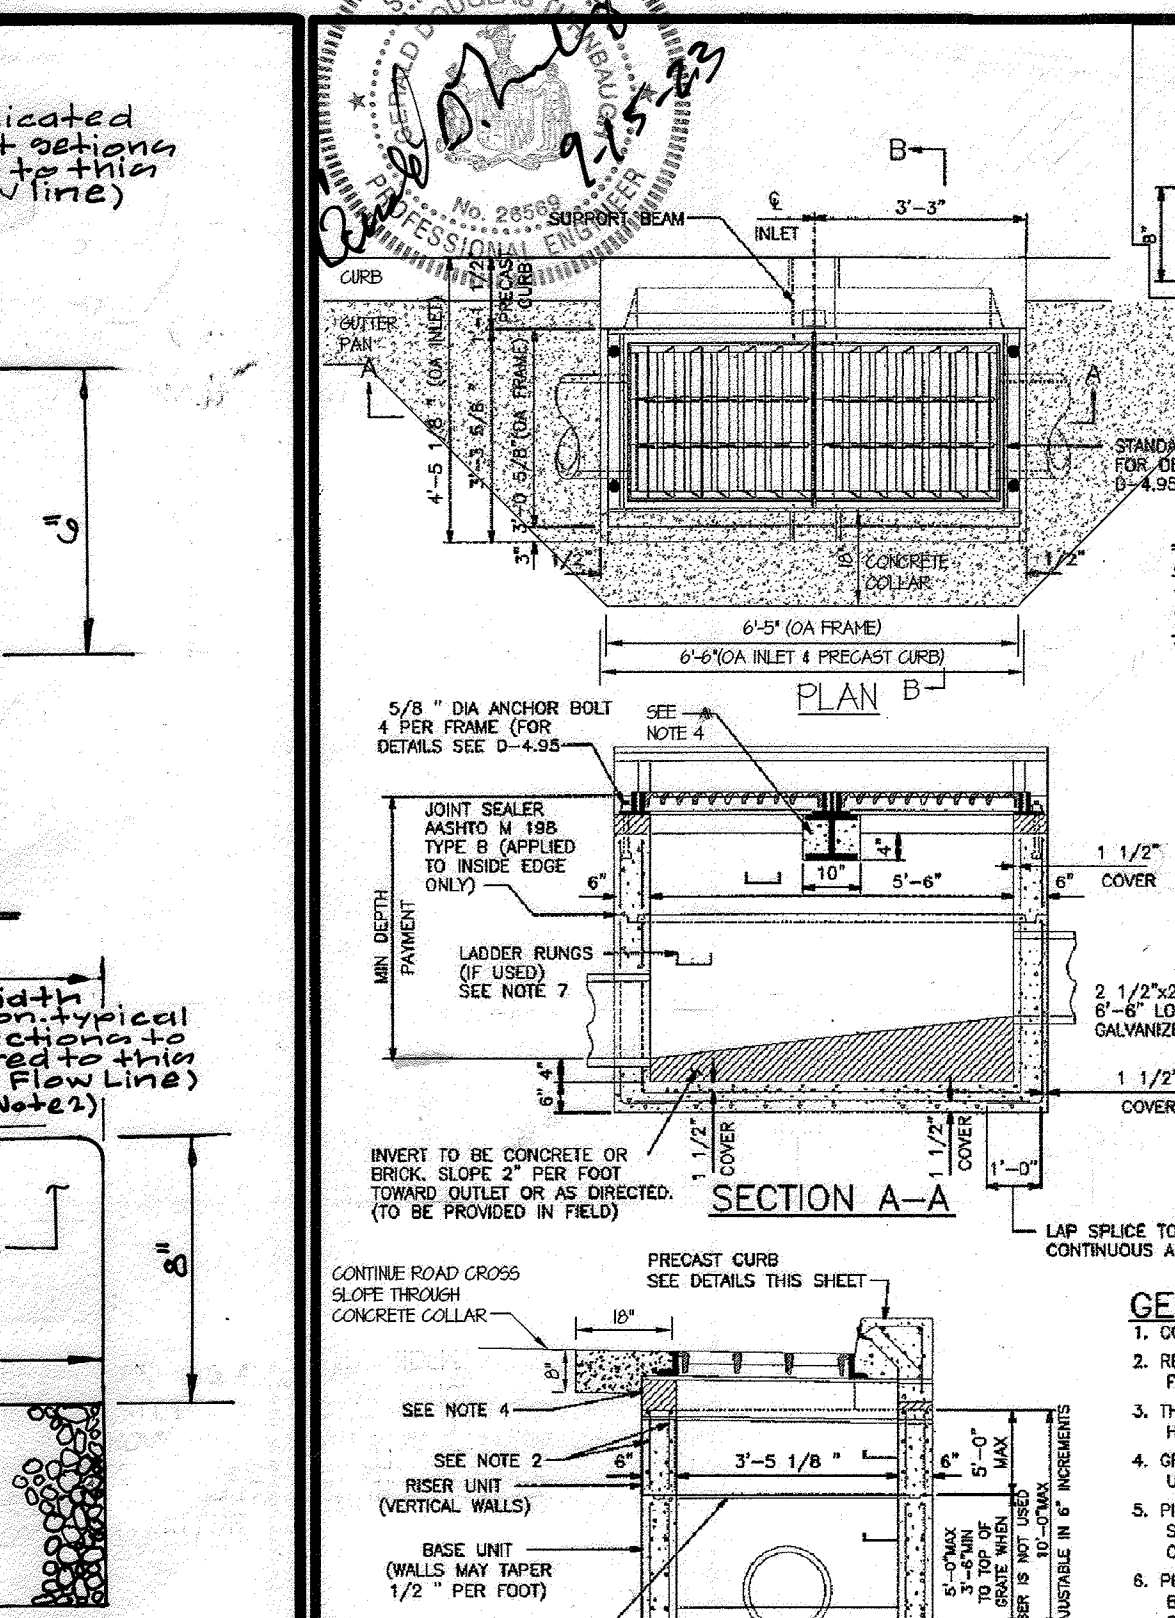

SUPPORT BEAM
Detail D-4.35

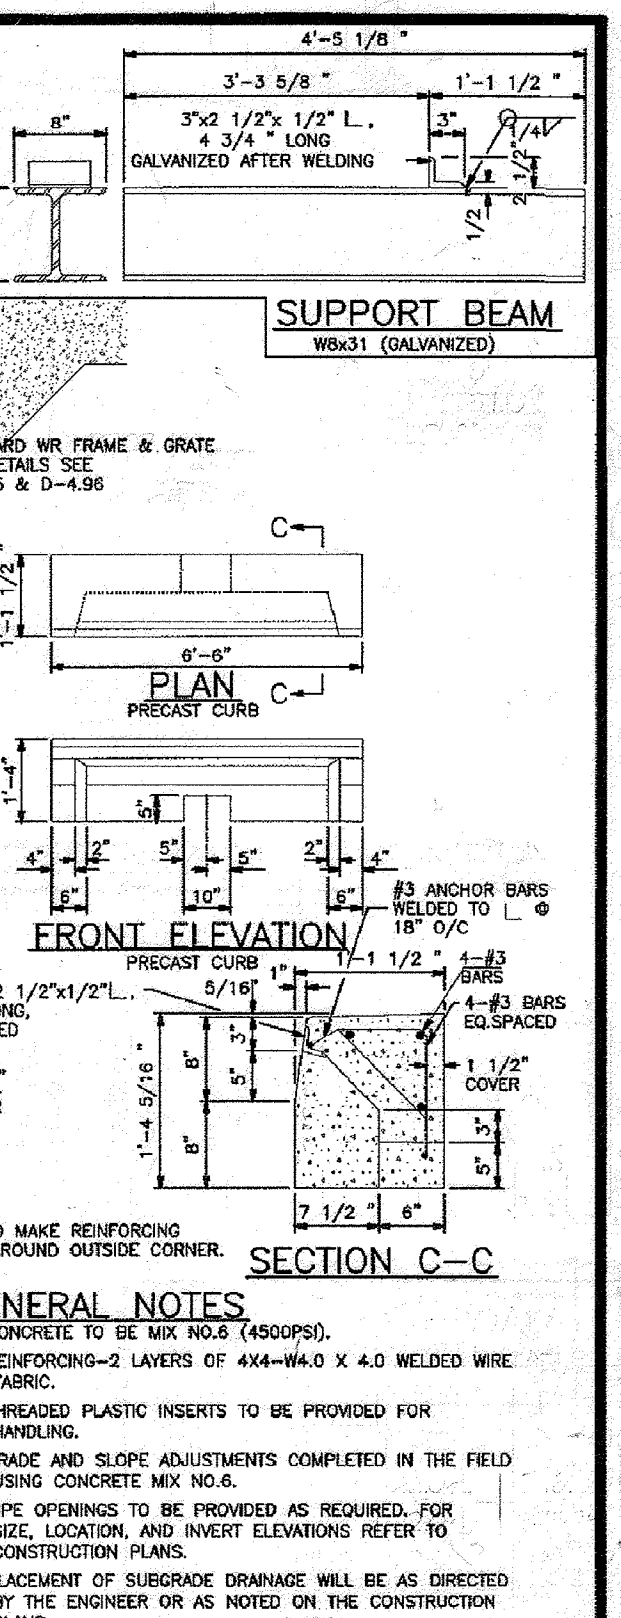

PRECAST CURB
Detail D-4.35

APPROVED: HOWARD COUNTY DEPARTMENT OF PUBLIC WORKS
[Signature] 1/16/18
Chief, Bureau of Highways

APPROVED: HOWARD COUNTY DEPARTMENT OF PLANNING & ZONING
[Signature] 1-19-18
Chief, Division of Land Development


[Signature] 1-11-18
Chief, Development Engineering Division

GLWGUTSCHICK LITTLE & WEBER, P.A.
CIVIL ENGINEERS, LAND SURVEYORS, LAND PLANNERS, LANDSCAPE ARCHITECTS
3909 NATIONAL DRIVE - SUITE 250 - BURTONSVILLE OFFICE PARK
BURTONSVILLE, MARYLAND 20866
TEL: 301-421-4024 BAL: 410-880-1820 DC/VL: 301-389-2524 FAX: 301-421-4186

DATE	REVISION	BY	APPR.
1.24.19	REV. SWM EASEMENT AND REV. WALK/RAMP	9L	DEV
2.7.18	REV. PROFILE FOR SKY RIBBON ROAD, SDP 10-005, AND ADDED CURB DETAILS	9L	JRC


PREPARED FOR:
THE HOWARD HUGHES CORPORATION
10480 LITTLE PATUXENT PARKWAY
SUITE 400
COLUMBIA, MARYLAND 21044
ATTN: BILL RYAN
410-964-4987

PROFESSIONAL CERTIFICATION
I HEREBY CERTIFY THAT THESE PLANS WERE PREPARED OR APPROVED BY ME, AND THAT I AM A DULY LICENSED PROFESSIONAL ENGINEER UNDER THE LAWS OF THE STATE OF MARYLAND, LICENSE NO. 12975
EXPIRATION DATE: MAY 28, 2018
12/14/17

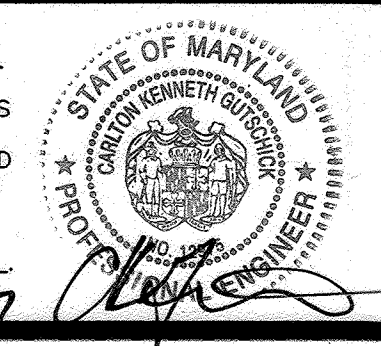


SKY RIBBON ROAD - PLAN and PROFILE
DOWNTOWN COLUMBIA CRESCENT NEIGHBORHOOD
PARCELS D-1 THRU D-14, NON-BUILDABLE BULK PARCELS
D-15 THRU D-17 & OPEN SPACE LOT 10
HOWARD COUNTY, MARYLAND

SCALE	ZONING	G. L. W. FILE No.
1" = 50'	NT	11071
DATE	TAX MAP - GRID	SHEET
DEC., 2017	36 - 01	4 OF 25

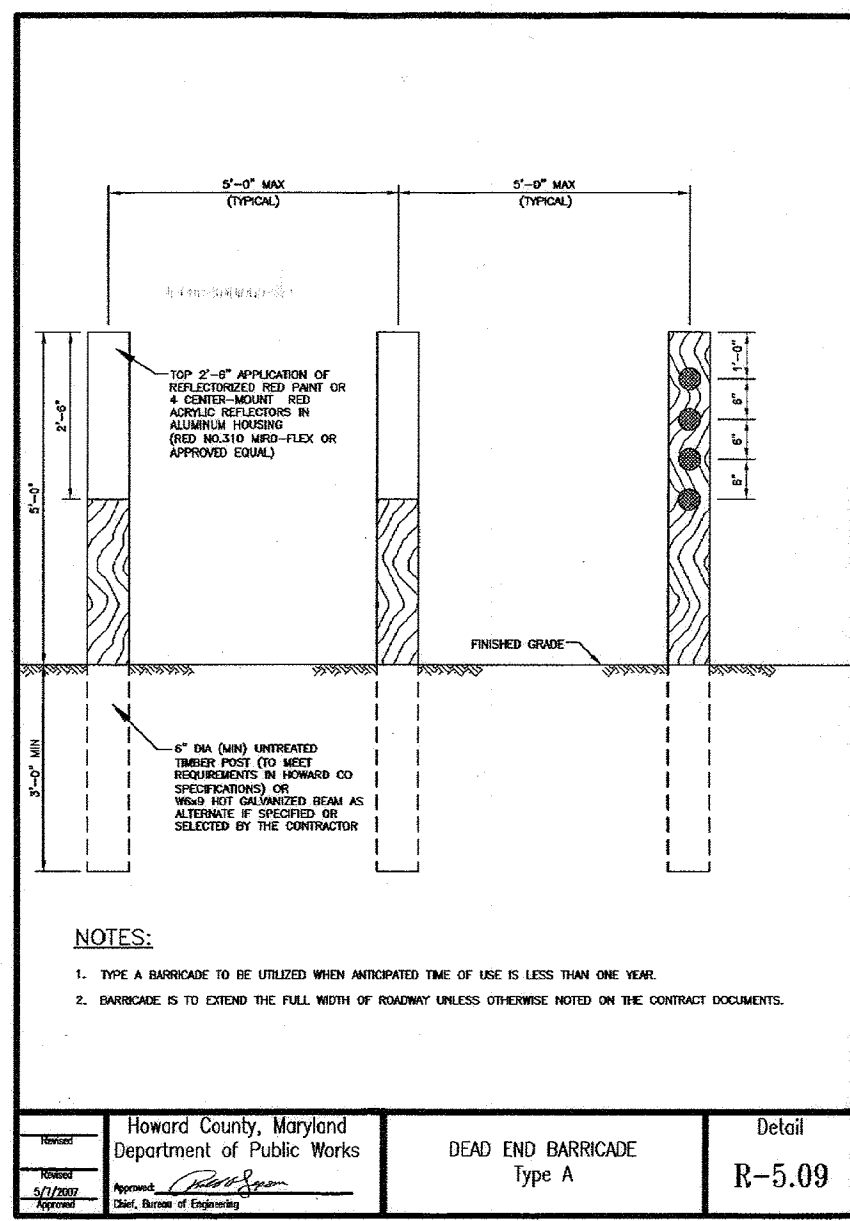


TYPE A STANDARD COMBINATION CURB AND GUTTER
NOT TO SCALE


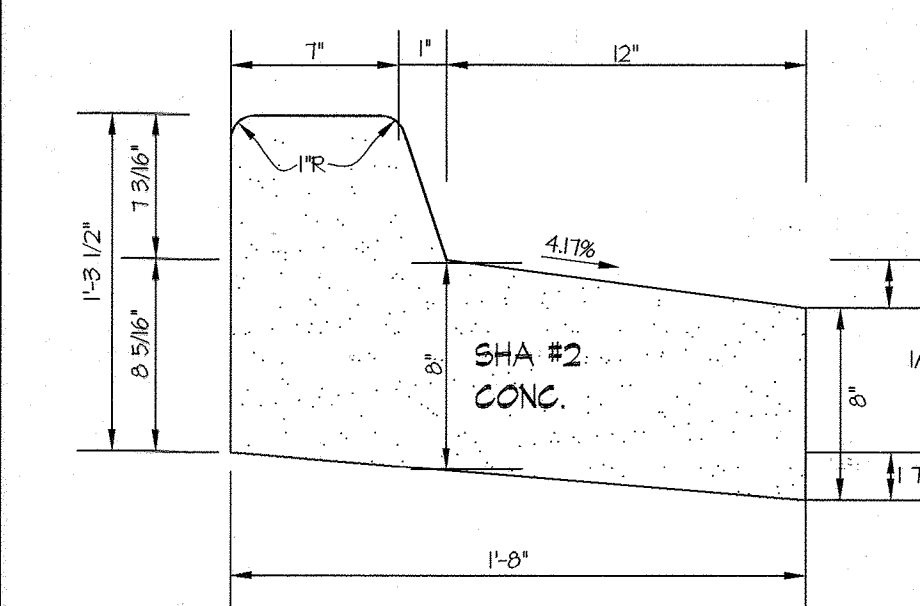


- NOTES:**
- 50' MAX. BETWEEN EXPANSION JOINTS & 10' MAX. BETWEEN CONTROL JOINTS.
 - STANDARD CURB & GUTTER SHALL BE USED WHERE THE DRIVEWAY SLOPES TOWARDS THE CURB & GUTTER. REVERSE CURB & GUTTER SHALL BE USED WHERE THE DRIVEWAY SLOPES AWAY FROM THE CURB & GUTTER.
 - PROVIDE A 5' TRANSITION TO OPEN SECTION.

TYPE-A REVERSE CONCRETE CURB AND GUTTER
NOT TO SCALE

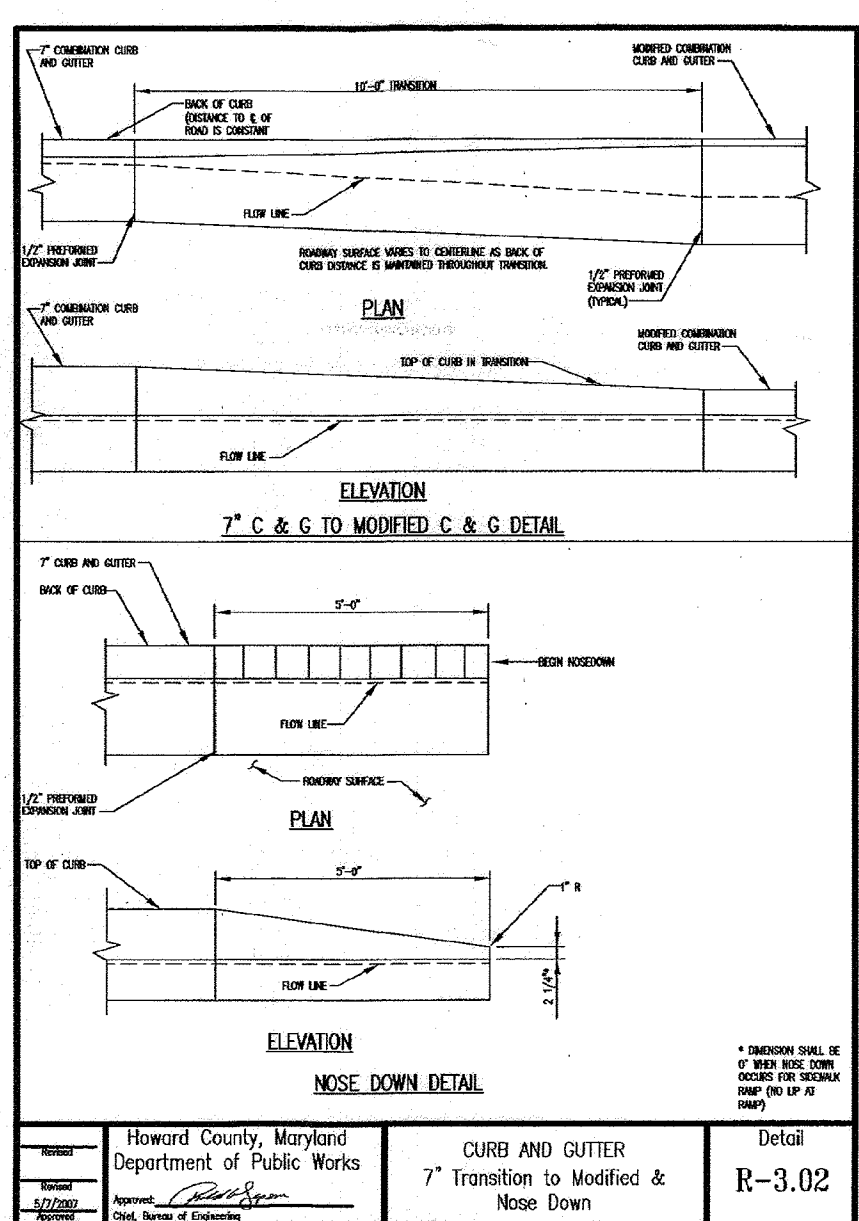

CURB AND GUTTER
7" Transition to Modified & Nose Down
R-3.02

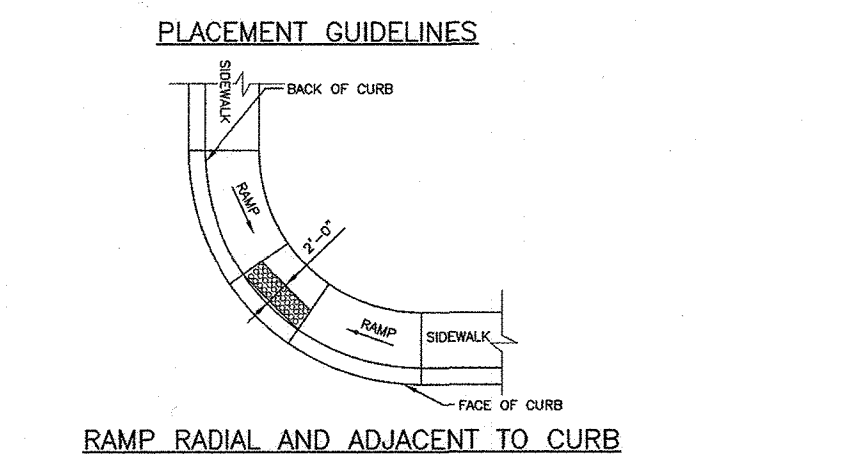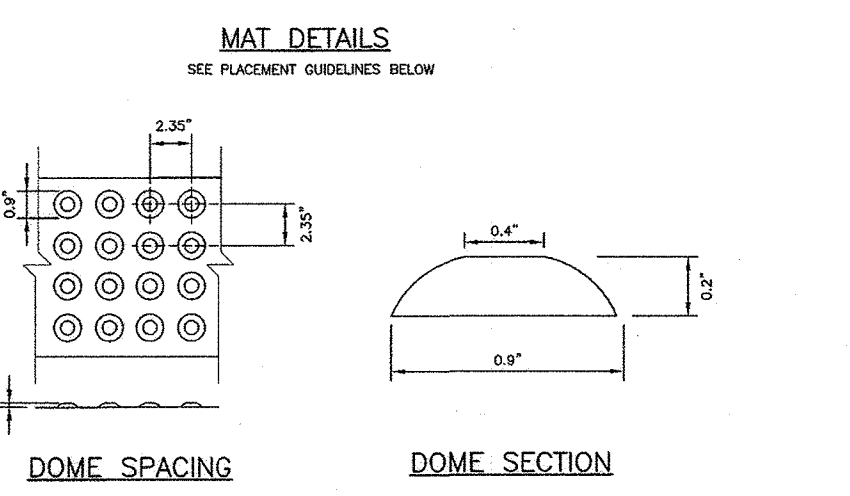

- NOTES:**
- THE DETECTABLE WARNING SURFACE SHALL BE LOCATED SO THAT THE EDGE NEAREST THE CURB LINE IS 6 TO 8 INCHES FROM THE FACE OF THE CURB.
 - FOR SLOPED APPLICATIONS DETECTABLE WARNING SHALL BE PLACED SUCH THAT THE DOMES CLOSEST TO THE BACK OF THE CURB ARE NO LESS THAN 6" AND NO MORE THAN 3" FROM THE BACK OF THE CURB. TRUNCATED DOME SURFACES SHALL BE FABRICATED TO PROVIDE FULL DOME ONLY.

DETECTABLE WARNING
Detectable Warning Truncated Domes
R-4.07

NOTE TO CONTRACTOR:
THIS DETAIL IS ONLY TO BE USED FOR DETERMINING THE LOCATION OF THE DETECTABLE WARNING-TRUNCATED DOMES.


APPROVED: HOWARD COUNTY DEPARTMENT OF PUBLIC WORKS
[Signature] 1/6/2018
Chief, Bureau of Highways

APPROVED: HOWARD COUNTY DEPARTMENT OF PLANNING & ZONING
[Signature] 1-19-18
Chief, Division of Land Development


APPROVED: HOWARD COUNTY DEPARTMENT OF PLANNING & ZONING
[Signature] 1-11-18
Chief, Development Engineering Division

GLWGUTSCHICK LITTLE & WEBER, P.A.
CIVIL ENGINEERS, LAND SURVEYORS, LAND PLANNERS, LANDSCAPE ARCHITECTS
3509 NATIONAL DRIVE - SUITE 250 - BURTONSVILLE OFFICE PARK
BURTONSVILLE, MARYLAND 20866
TEL: 301-421-4024 BALT: 410-880-1820 DC/VA: 301-989-2524 FAX: 301-421-4166


DES. DEV. DRN. LAG. CHK. MUT. DATE REVISION BY APPR.

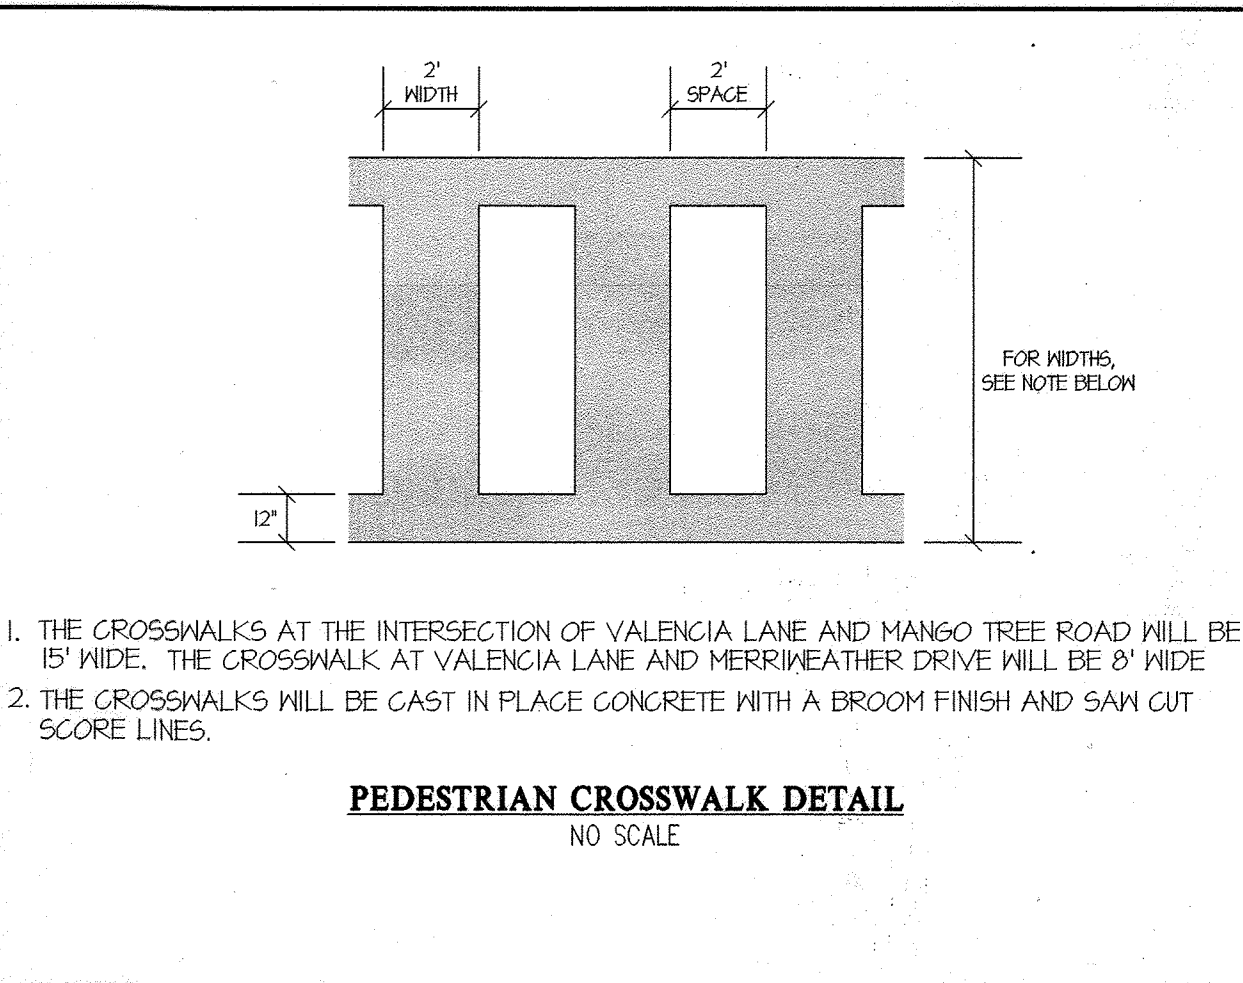


PEDESTRIAN CROSSWALK DETAIL
NO SCALE

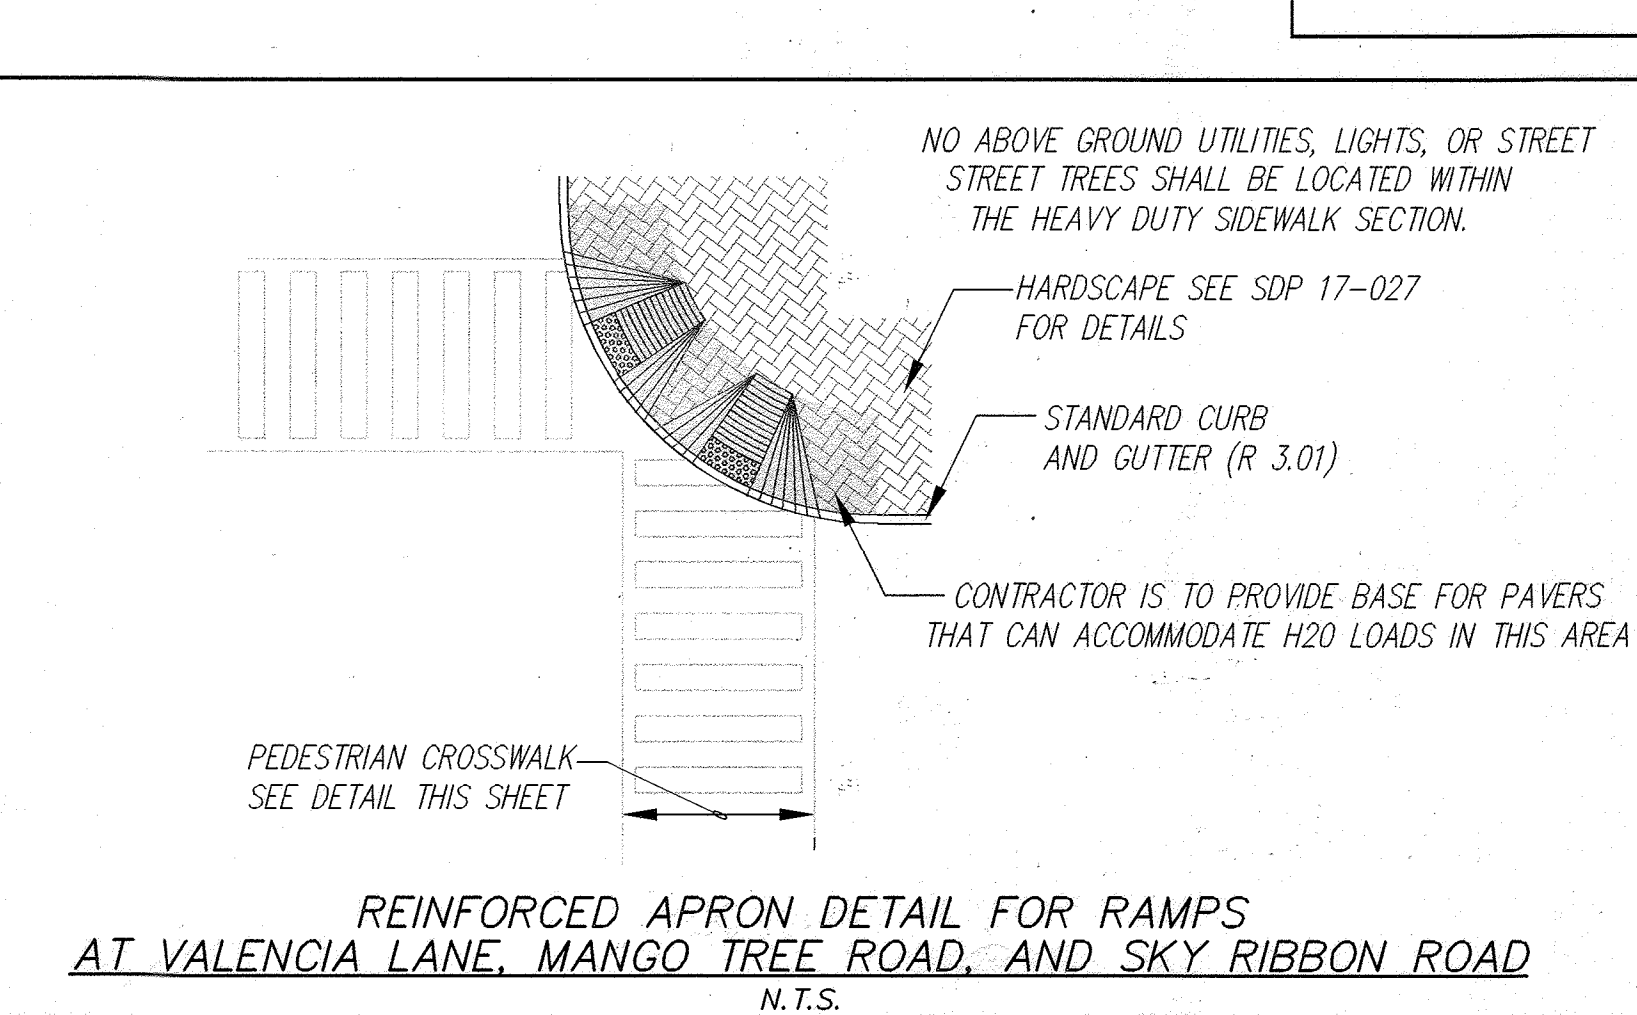

REINFORCED APRON DETAIL FOR RAMPS
AT VALENCIA LANE, MANGO TREE ROAD, AND SKY RIBBON ROAD
N.T.S.

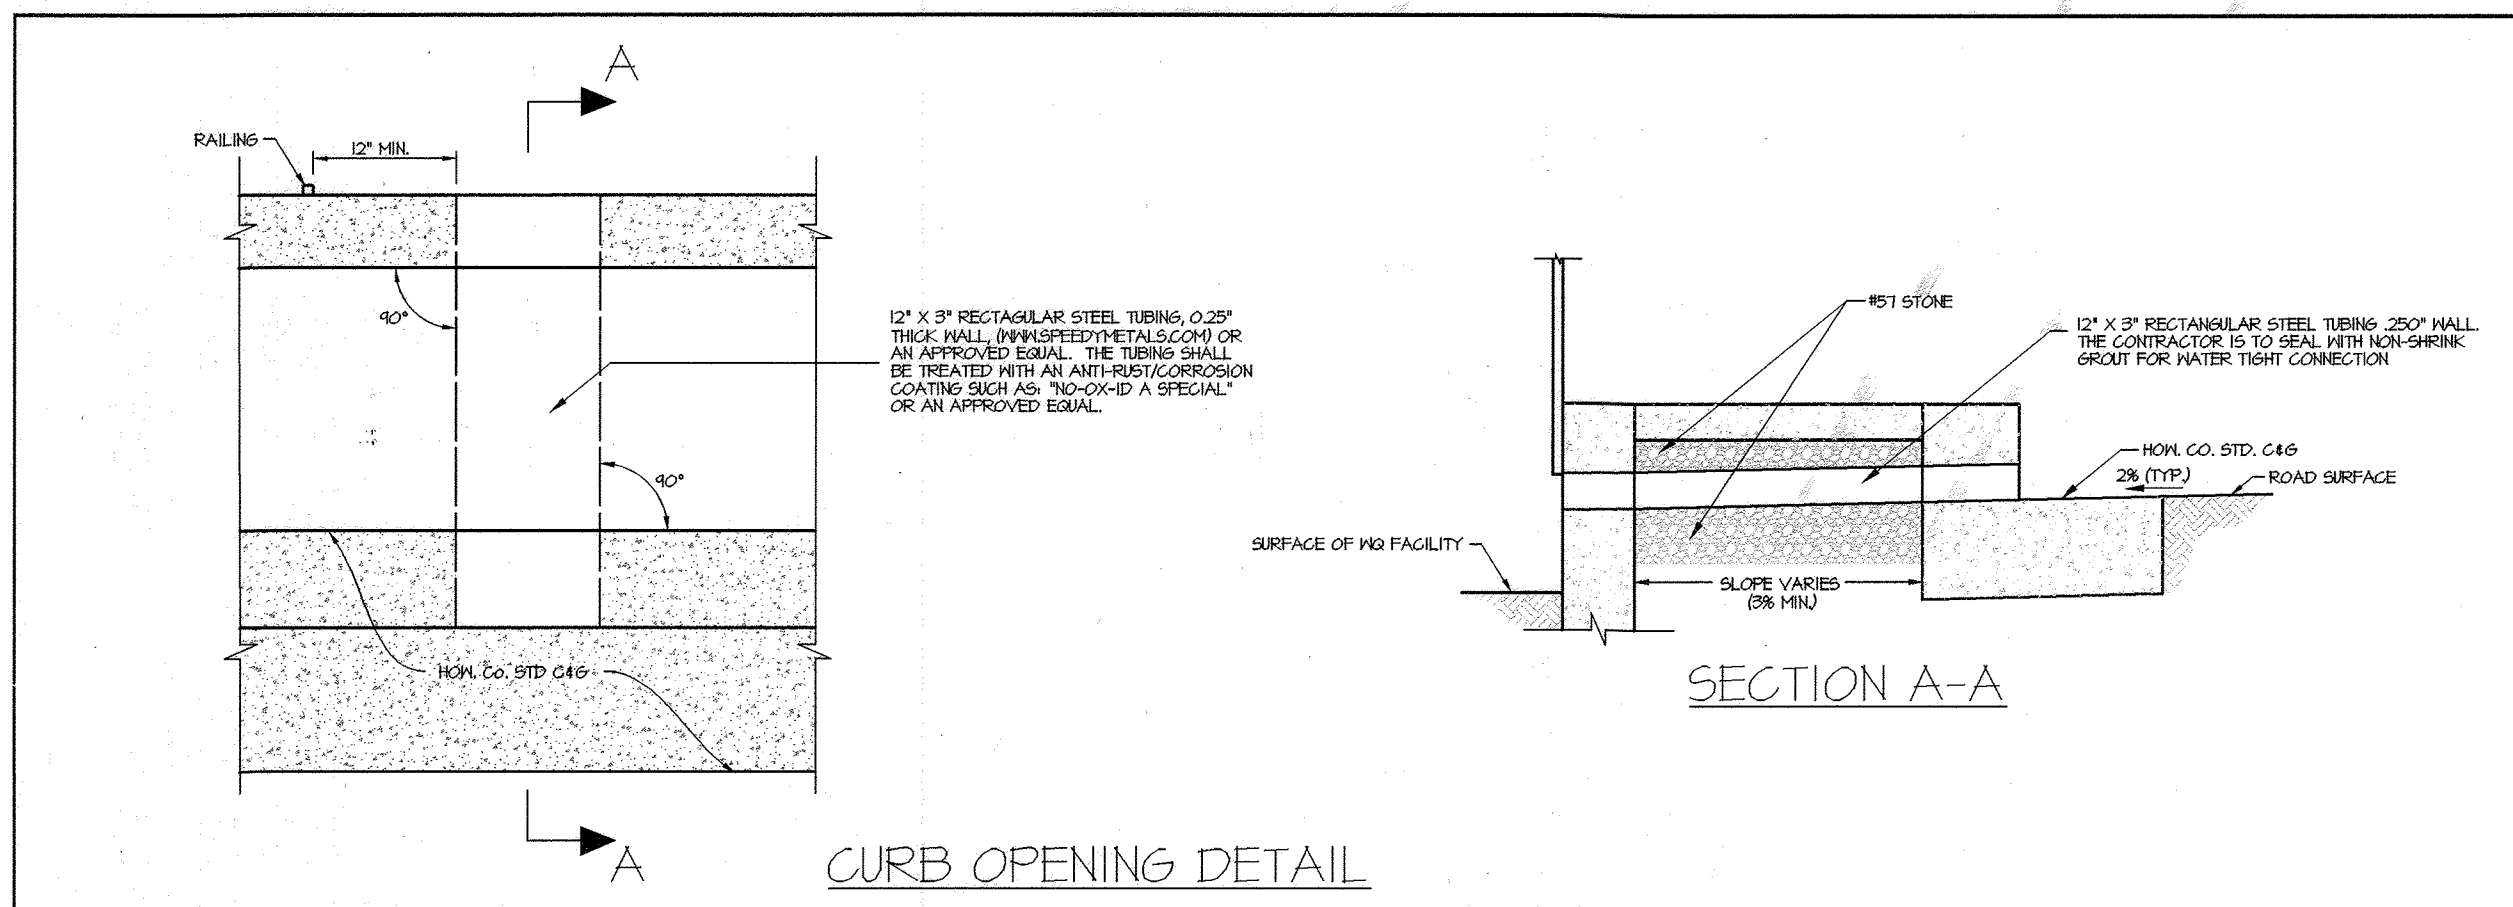


CURB OPENING DETAIL

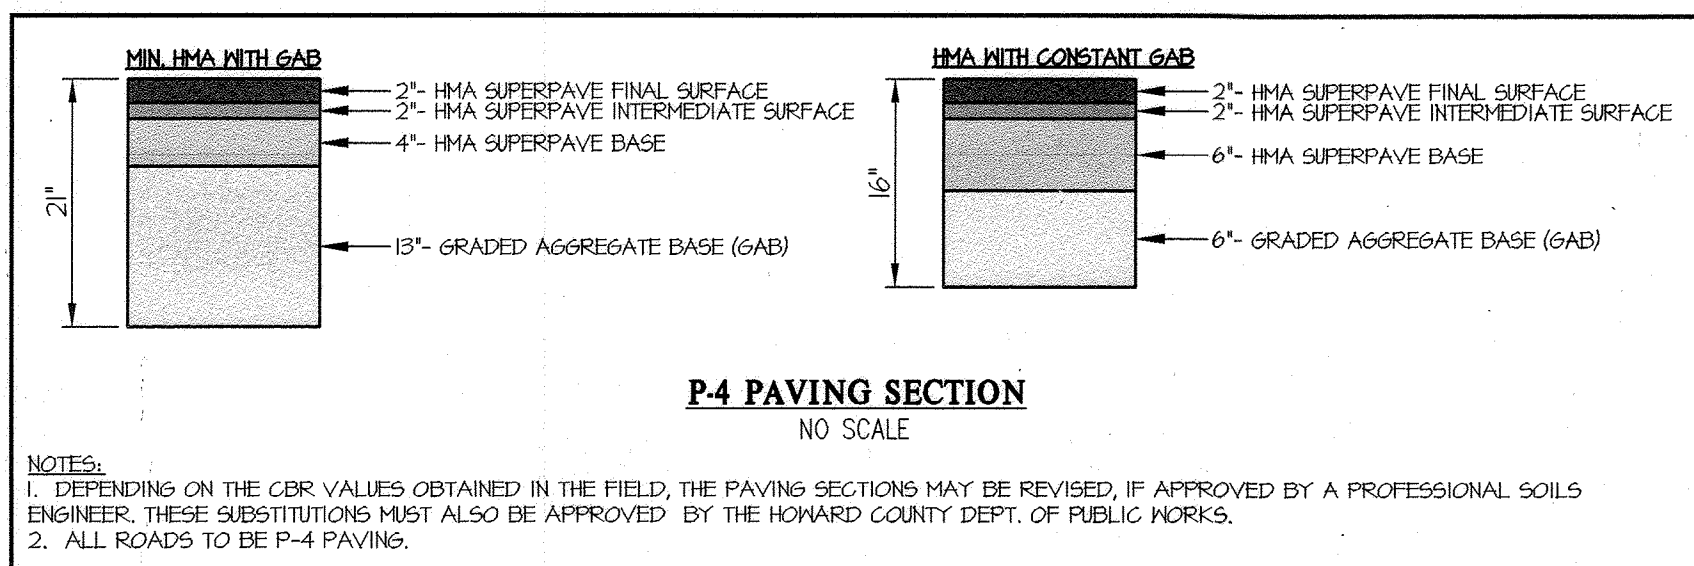


P-4 PAVING SECTION
NO SCALE

- NOTES:**
- DEPENDING ON THE CBR VALUES OBTAINED IN THE FIELD, THE PAVING SECTIONS MAY BE REVISED, IF APPROVED BY A PROFESSIONAL SOILS ENGINEER, THESE SUBSTITUTIONS MUST ALSO BE APPROVED BY THE HOWARD COUNTY DEPT. OF PUBLIC WORKS.
 - ALL ROADS TO BE P-4 PAVING.


PROFESSIONAL CERTIFICATION
I HEREBY CERTIFY THAT THESE PLANS WERE PREPARED OR APPROVED BY ME, AND THAT I AM A DULY LICENSED PROFESSIONAL ENGINEER UNDER THE LAWS OF THE STATE OF MARYLAND, LICENSE NO. 12975, EXPIRATION DATE: MAY 26, 2018
[Signature] 12/11/17

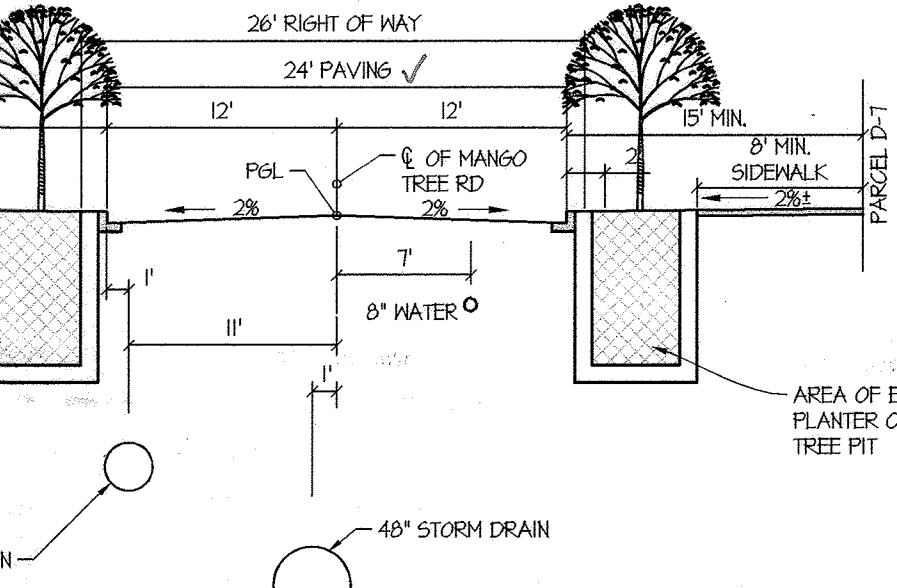


MANGO TREE ROAD (PUBLIC)
(3+461 TO 36+31) (STREET TYPE 3)
SCALE: 1" = 10'

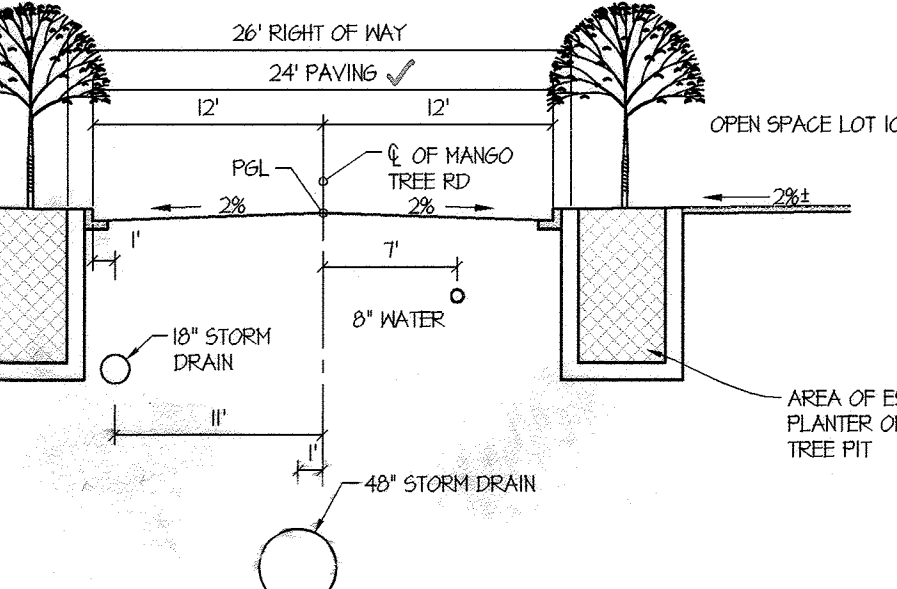


MANGO TREE ROAD (PUBLIC)
(36+31 TO 38+64) (STREET TYPE 3)
SCALE: 1" = 10'

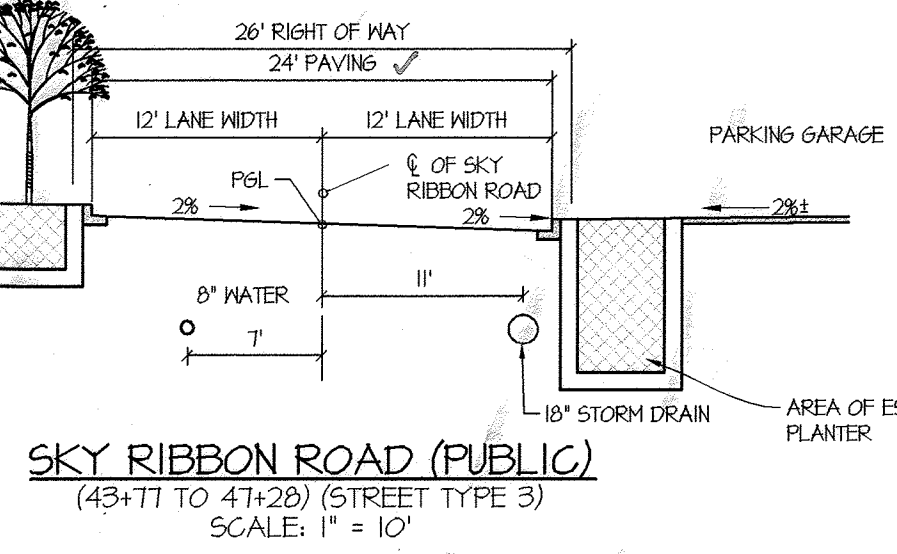


SKY RIBBON ROAD (PUBLIC)
(43+71 TO 47+28) (STREET TYPE 3)
SCALE: 1" = 10'

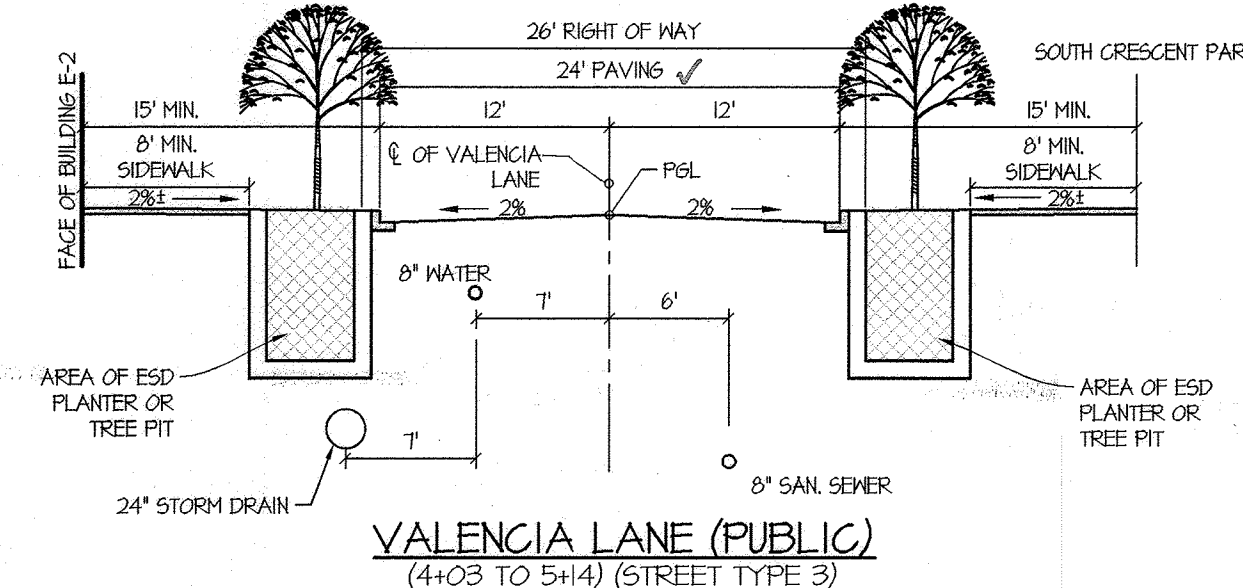


VALENCIA LANE (PUBLIC)
(4+03 TO 5+14) (STREET TYPE 3)
SCALE: 1" = 10'

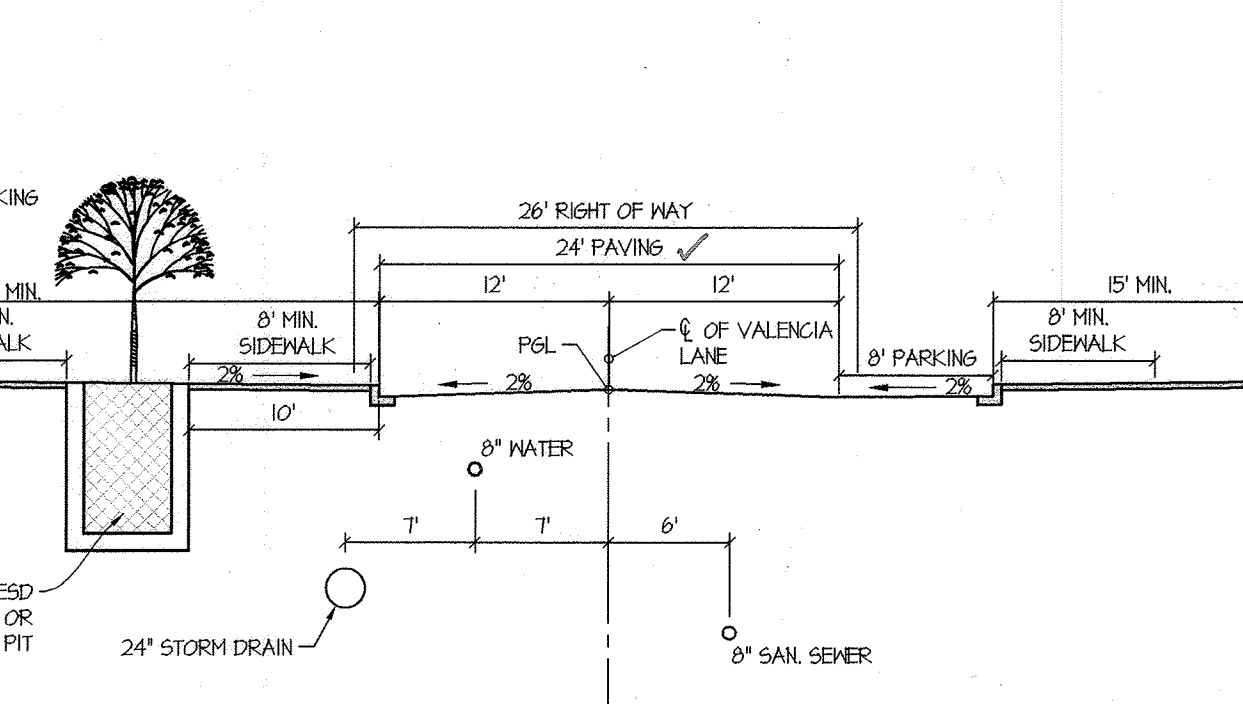

VALENCIA LANE (PUBLIC)
(3+40 TO 4+07) (STREET TYPE 3)
SCALE: 1" = 10'

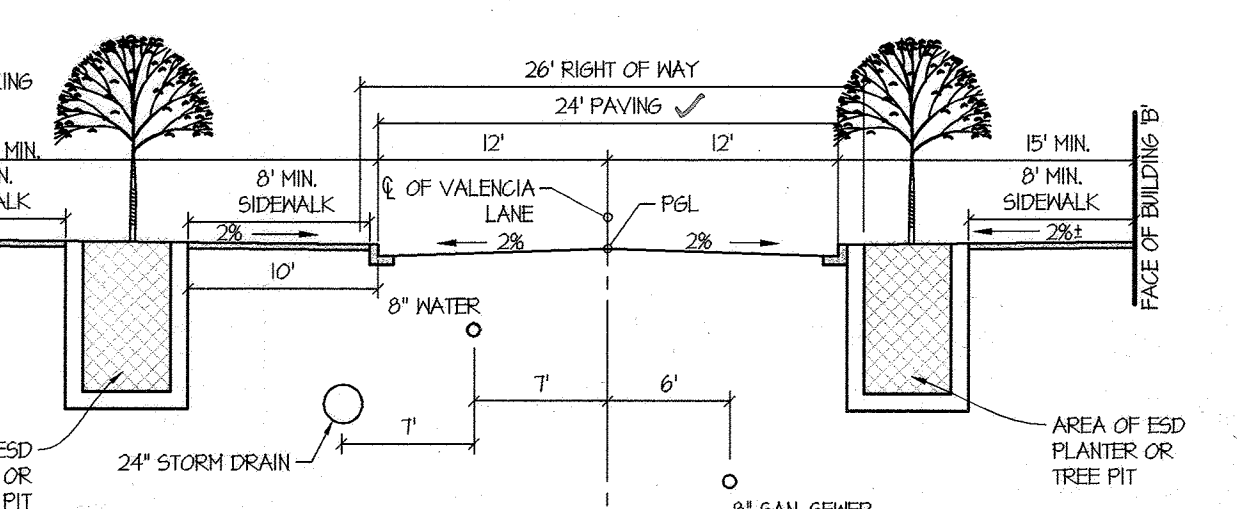

VALENCIA LANE (PUBLIC)
(1+30.34 TO 3+40) (STREET TYPE 3)
SCALE: 1" = 10'

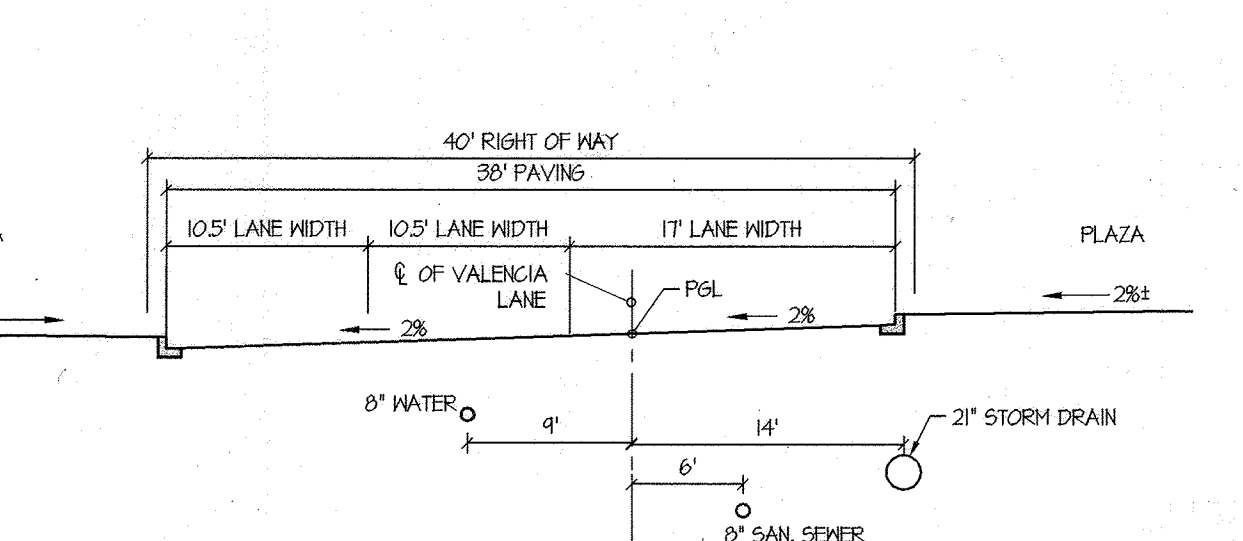

VALENCIA LANE (PUBLIC)
(0+00 TO 1+04.50) (STREET TYPE 3)
SCALE: 1" = 10'

- NOTES:**
- ALL TYPICAL SECTIONS ARE DRAWN LOOKING UP STATION.
 - HOWARD COUNTY'S MAINTENANCE RESPONSIBILITY IS FROM BACK OF CURB TO BACK OF CURB.

AS-BUILT CERTIFICATION
I HEREBY CERTIFY, BY SEAL, THAT THE FACILITIES SHOWN ON THIS PLAN WERE CONSTRUCTED AS SHOWN ON THIS PLAN MEET THE CURRENT APPROVED PLANS AND SPECIFICATIONS.
[Signature] 10/03/23
G. SCOTT SHANBERGER
SHANBERGER & LANE
PROFESSIONAL LAND SURVEYOR #10843
LICENSE EXPIRATION DATE 4/2/2024
AS-BUILT SURVEY DATES 2/1/22 TO 2/18/22

PROFESSIONAL ENGINEER
AS BUILT CERTIFICATION FOR PSWMM
NOTE: THERE IS NO "AS-BUILT" INFORMATION PROVIDED ON THIS SHEET.
NAME: GERALD D. TURNBAUGH
DATE: AUG. 11, 2023 REG. NO.: 26563

TYPICAL ROAD SECTION & CURB DETAILS

DOWNTOWN COLUMBIA
CRESCENT NEIGHBORHOOD
PARCELS D-1 THRU D-14, NON-BUILDABLE BULK PARCELS
D-15 THRU D-17 & OPEN SPACE LOT 10
HOWARD COUNTY, MARYLAND



SCALE	ZONING	G. L. W. FILE NO.
AS SHOWN	NT	11071
DATE	TAX MAP - GRID	SHEET
DEC., 2017	36 - 01	5 OF 25

L:\CADD\DRAWINGS\17071\17071-AREA_3\PLANS BY CURB TYPE\17-009 Plns 17071-AREA_3-P-03 - Road Details.dwg

RIVER STATION	WSEL	RIVER STATION	WSEL
20+73.62	318.83	8+01.60	---
20+14.41	318.54	7+00.06	305.31
14+75.41	318.45	6+38.50	305.23
18+84.71	318.02	5+41.44	304.44
18+28.08	317.76	5+21.03	302.44
17+51.45	317.64	3+48.60	300.07
17+35.04	317.60	3+24.76	298.63
17+13.67	317.44	2+34.86	297.56
16+76.41	317.20	1+77.00	296.96
16+32.75	316.91	1+04.84	296.70
15+86.01	316.81	0+87.90	296.60
15+40.16	316.25	0+41.55	295.80
15+00.14	315.74	1+48.83	291.24
14+44.82	315.32	2+84.83	291.25
13+44.64	314.86	3+10.51	291.26
13+56.92	314.81	4+44.80	291.30
13+00.82	314.65	5+26.24	298.26
12+60.10	313.85	5+41.22	301.27
12+20.44	312.34	6+44.54	---
11+51.50	310.17	6+49.36	---
10+41.95	304.51	7+61.26	---
10+32.25	304.27	8+35.84	---
9+81.61	304.16	9+00.85	---
9+40.87	304.08	9+68.18	---
8+46.06	---	10+14.78	313.44
8+45.27	---	---	---

NOTES:
 1. ON MAY 9, 2016 HOWARD COUNTY DEPT. OF PLANNING & ZONING DETERMINED THAT THE DISTURBANCES SHOWN ARE ESSENTIAL & NECESSARY.
 2. THE EXISTING CONTOURS SHOWN ON PARCELS D-1 THROUGH D-12 AND LOT 10 REFLECT THE MASS GRADING DONE UNDER SDP 16-075.

- LEGEND**
- ERL-1 — 2014 ENVIRONMENTAL RESTORATION LIMITS
 - ERL-2 — 2016 ENVIRONMENTAL RESTORATION LIMITS
 - L.O.O. — LIMIT OF DISTURBANCE ROAD MARK
 - — MULTI-USE PATH LIMITS
 - FP — FLOODPLAIN
 - SB — STREAM BUFFER
 - — STREAM CENTERLINE
 - ESD — ESD FACILITY
 - SSF — SUPER SILT FENCE

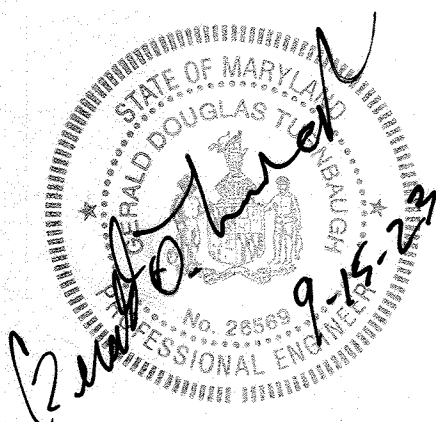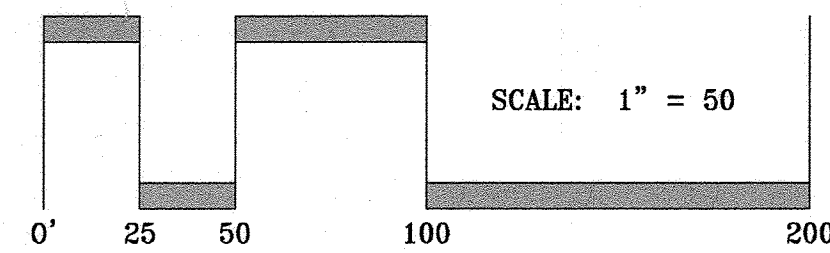

PROFESSIONAL ENGINEER
 AS BUILT CERTIFICATION FOR PSWM
 NOTE: THERE IS NO "AS-BUILT" INFORMATION PROVIDED ON THIS SHEET.
 NAME: GERALD D. TURNBAUGH
 DATE: AUG 11, 2023 REG. NO.: 26569

THERE IS NO AS-BUILT INFORMATION ON THIS SHEET

PURPOSE NOTE:

THE PURPOSE OF THIS PLAN IS TO REFLECT THE REVISION #5 CHANGES TO THE GRADES, PROPOSED ESDs, LOD, FIRE HYDRANT AND SEWER HOUSE CONNECTION.

10/03/23
 G. SCOTT SHANBERGER
 SHANBERGER & LANE
 PROFESSIONAL LAND SURVEYOR #10849
 LICENSE EXPIRATION DATE 4/2/2024
 AS-BUILT SURVEY DATES 2/1/22 TO 2/18/22

APPROVED: HOWARD COUNTY DEPARTMENT OF PUBLIC WORKS
 Chief, Bureau of Highways MK 9/12/2019 Date

APPROVED: HOWARD COUNTY DEPARTMENT OF PLANNING & ZONING
 Chief, Division of Land Development 10/24/19 Date


Chief, Development Engineering Division 9.17.19 Date

GLWGUTSCHICK LITTLE & WEBER, P.A.
 CIVIL ENGINEERS, LAND SURVEYORS, LAND PLANNERS, LANDSCAPE ARCHITECTS
 3909 NATIONAL DRIVE - SUITE 250 - BURTONSVILLE OFFICE PARK
 BURTONSVILLE, MARYLAND 20866
 TEL: 301-421-4024 BAL: 410-880-1820 DC/VA: 301-989-2524 FAX: 301-421-4186

DATE	REVISION	BY	APP'R.
8/12/2019	REMOVED MB-64 & 65, REVISED FHT, SHC, GRADES, AND LOD, ADDED LABEL FOR PRIVATE SWM EASEMENT AREA	JRC	
12/12/2018	REVISED PRIVATE SWM EASEMENT AREA LIMITS	GT	DEV
7/30/2018	REV. GRADING, PROPOSED WALL & REV. STORM DRAIN	GT	JRC


PREPARED FOR:
 THE HOWARD HUGHES CORPORATION
 10480 LITTLE PATUXENT PARKWAY
 SUITE 400
 COLUMBIA, MARYLAND 21044
 ATTN: BILL ROWE
 410-964-4987

PROFESSIONAL CERTIFICATION
 I HEREBY CERTIFY THAT THESE PLANS WERE PREPARED OR APPROVED BY ME, AND THAT I AM A DULY LICENSED PROFESSIONAL ENGINEER UNDER THE LAWS OF THE STATE OF MARYLAND, LICENSE NO. 15979
 EXPIRATION DATE: MAY 28, 2026
 8/21/19

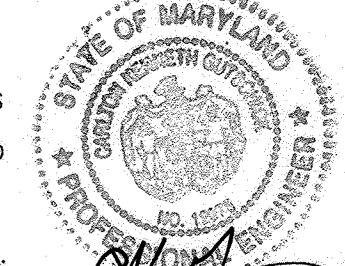

REVISIONS SHEET
REVISED GRADING PLAN
DOWNTOWN COLUMBIA
CRESCENT NEIGHBORHOOD
 PARCELS D-1 THRU D-14, NON-BUILDABLE BULK PARCELS D-15 THRU D-17 & OPEN SPACE LOT 10
 HOWARD COUNTY, MARYLAND


SCALE	ZONING	G. L. W. FILE No.
1" = 50'	NT	11071
DATE	TAX MAP - GRID	SHEET
AUG., 2019	36 - 01	6 OF 25

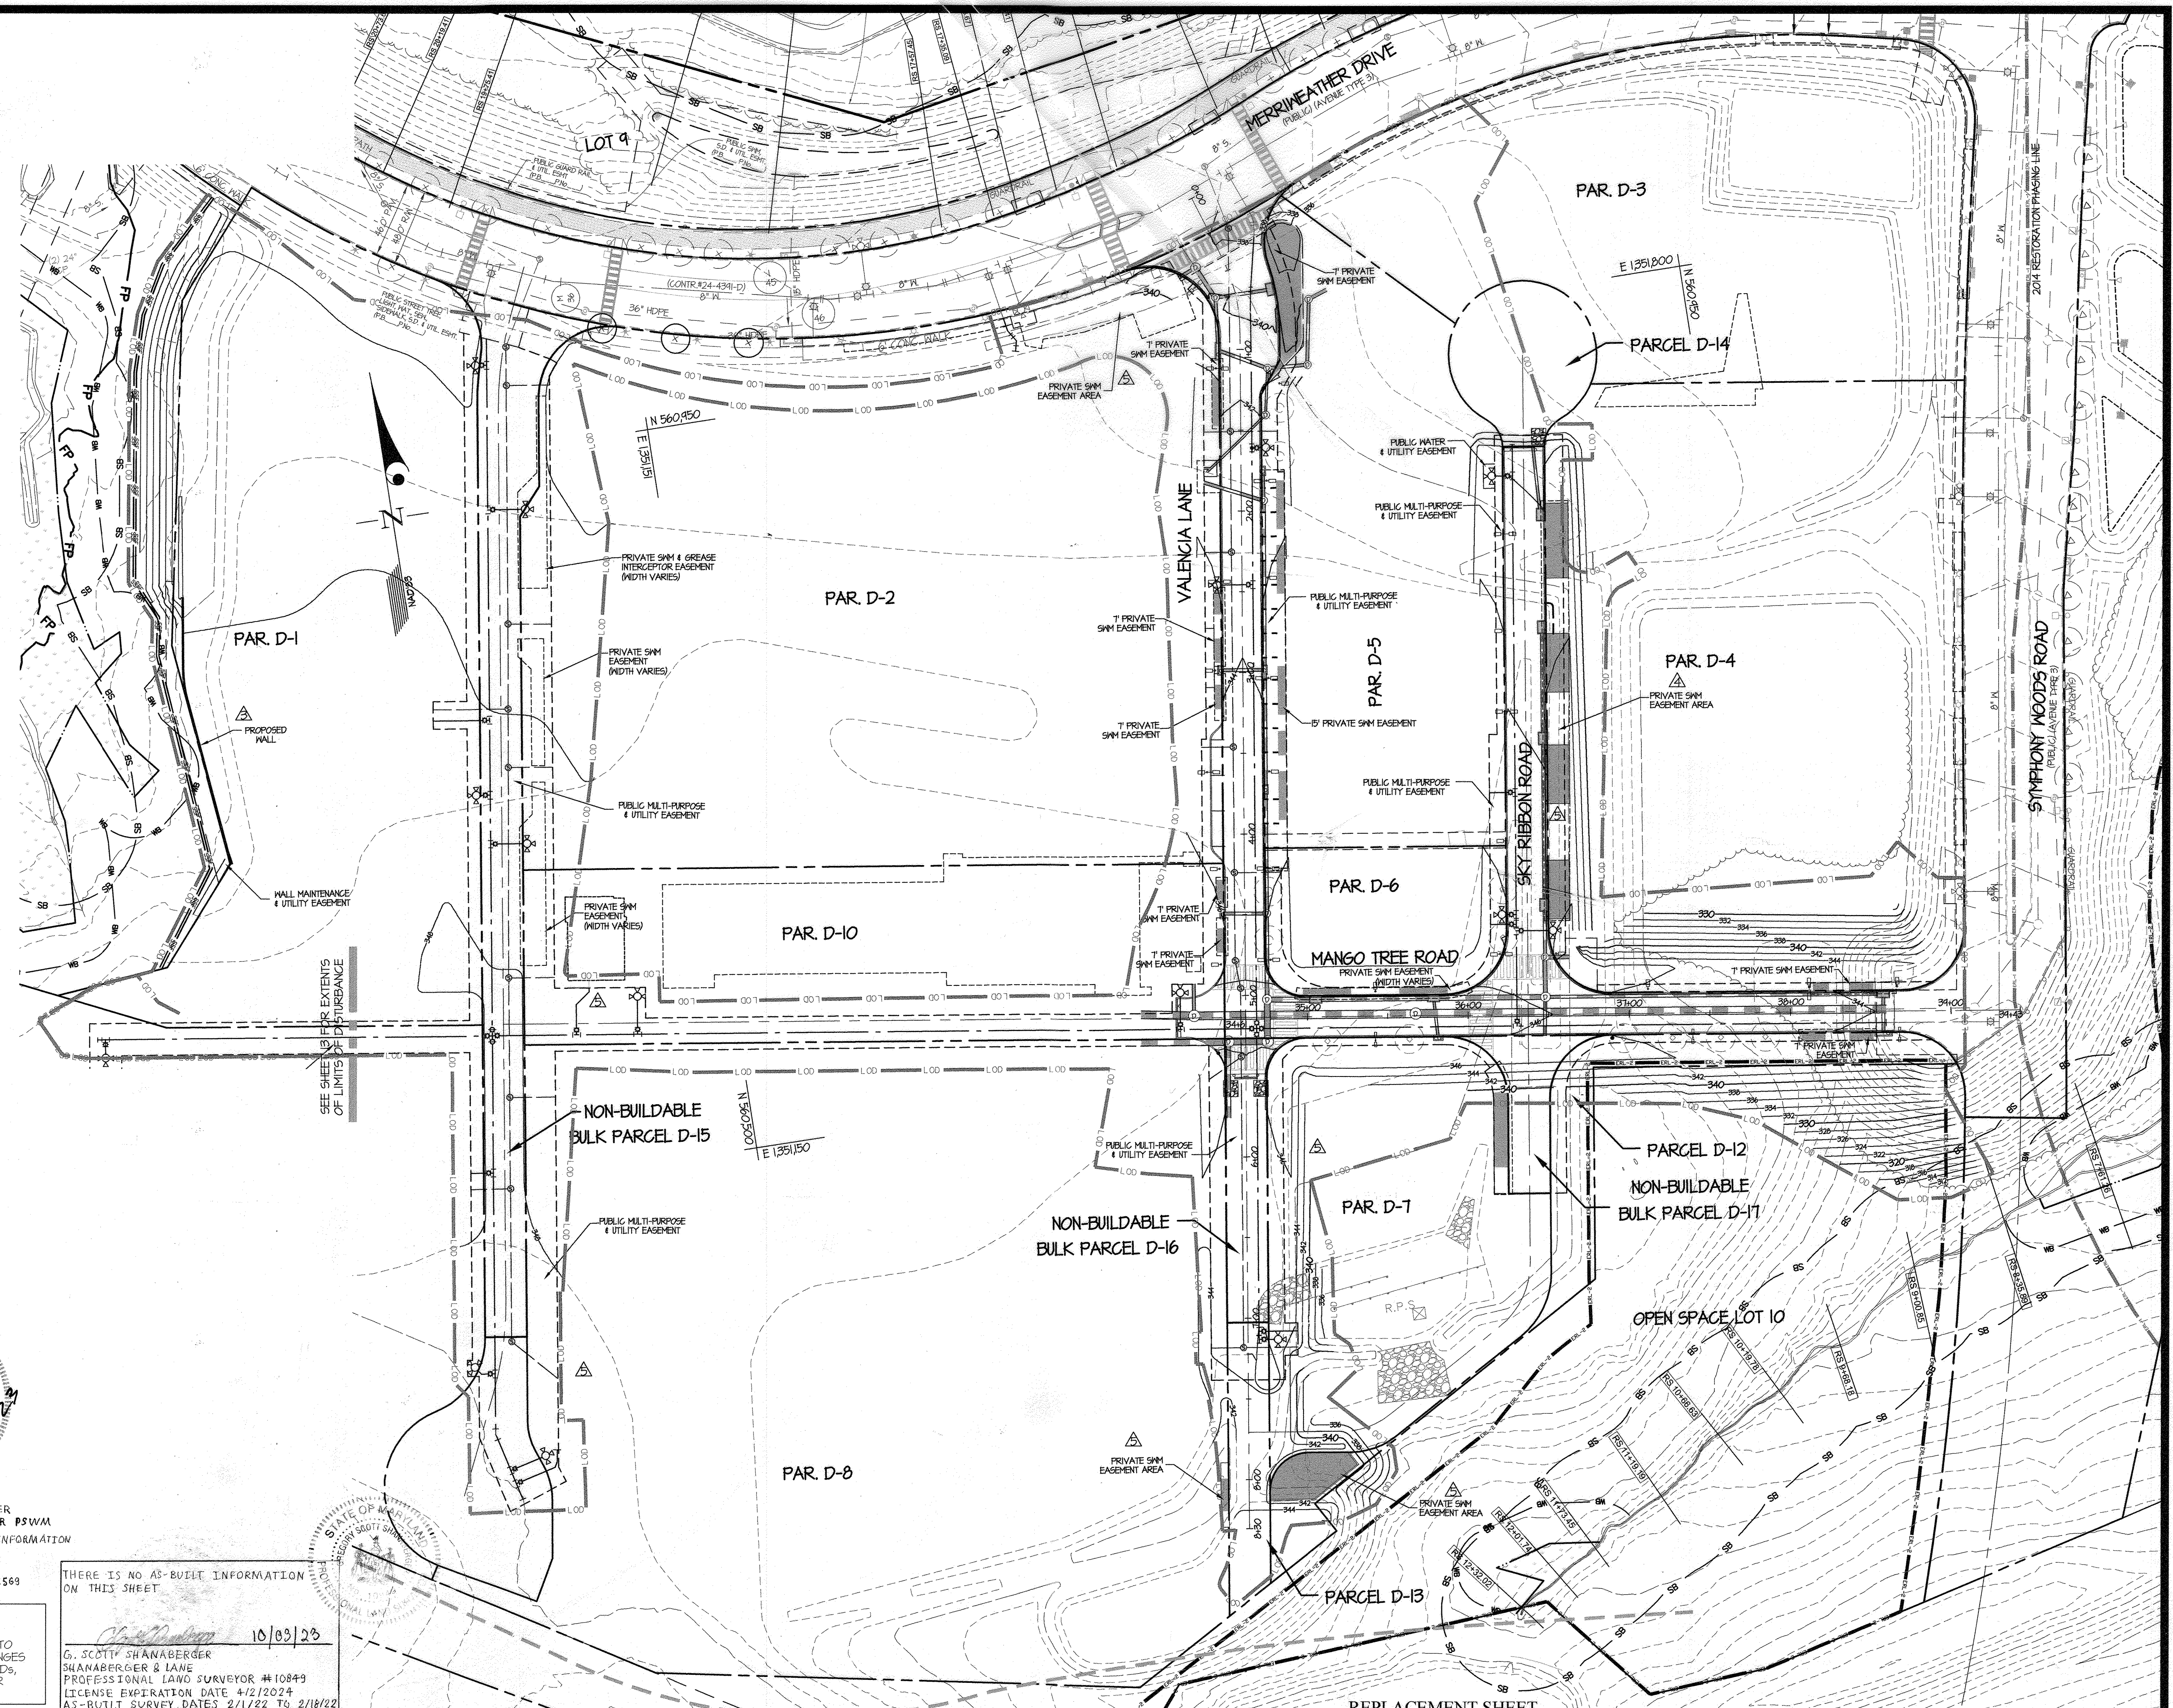

L:\CAD\DRAWINGS\11071\11071-AREA 3\PLANS BY GUY F 17-059 Plans\11071-AREA 3-F-06 - Grading Plan.dwg
 PLOTTED: 8/21/2019 8:33 AM LAST SAVED: 8/21/2019 8:15 PM PLOTTED BY: Jennifer R. Dice


FROM NO.	TO NO.	DIA. (IN) & TYPE OF PIPE	L (FT)	C FACTOR COMPUTATIONS			
STUB	STATION	OFFSET	O/S FACE OF CURB	STRUCTURE	AREA (AC.)	C	IMPERVIOUS
M-3	M-3	12" HDPE	48'	STUB-K	0.26	0.26	100%
M-2	M-2	18" HDPE	28'	H-1	0.46	0.20	42%
M-2	M-2	24" HDPE	30'	I-2	0.16	0.25	49%
M-1	M-1	24" HDPE	28'	STUB-D	0.41	0.26	100%
M-1	M-1	24" HDPE	16'	STUB-E	0.44	0.26	100%
STUB-K	M-1	18" HDPE	4'	STUB-F	0.44	0.26	100%
STUB-D	M-2B	18" HDPE	10'	H-5	0.30	0.24	48%
M-2B	M-2A	18" HDPE	36'	H-1	0.15	0.24	41%
M-2A	M-2	18" HDPE	20'	H-4	0.23	0.24	48%
H-1	M-1	18" HDPE	30'	H-3	0.24	0.25	48%
H-5	M-1	18" HDPE	13'	H-6	0.24	0.25	48%
M-1	H-4	24" HDPE	100'	H-5	0.30	0.24	48%
H-4	H-1	24" HDPE	64'	STUB-G	1.44	0.24	41%
H-3	M-1	24" HDPE	12'	STUB-I	3.10	0.21	41%
M-1	M-1	24" HDPE	48'	I-5	0.11	0.24	41%
STUB-F	M-1	18" HDPE	26'	H-6	0.16	0.25	48%
H-1	H-4	18" HDPE	24'	H-6	0.21	0.26	100%
H-6	M-1	18" HDPE	24'	STUB-J	0.42	0.23	48%
I-21	I-20	18" HDPE	65'	I-1	0.13	0.25	41%
I-20	I-1	18" HDPE	98'	H-8	0.11	0.24	48%
H-1	M-1	18" HDPE	28'	H-1	0.04	0.23	45%
M-1	M-1	24" HDPE	20'	I-4	0.14	0.22	44%
M-1	I-6	30" HDPE	64'	I-2	0.24	0.23	46%
I-6	I-5	30" HDPE	67'	I-4	1.52	0.23	100%
H-1	M-1	30" HDPE	25'	STUB-M	1.52	0.21	64%
M-10	M-10	36" HDPE	21'				
M-4	M-4	36" HDPE	19'				
M-4	STUB-H	42" R/C/P	46'				
STUB-L	M-10	24" HDPE	11'				
I-7	M-12	18" HDPE	21'				
STUB-J	M-12	18" HDPE	202'				
STUB-G	M-6	48" R/C/P	23'				
M-4	M-4	48" R/C/P	124'				
M-4	STUB-B	48" R/C/P	284'				
I-4	STUB-C	15" HDPE	3'				
H-8	I-6	15" HDPE	22'				
STUB-M	M-4	24" HDPE	44'				
STUB-N	M-6	18" R/C/P	11'				

NOTE: DRAINAGE DIVIDES SHOWN REFLECT LIMITS THAT WILL BE CREATED BY IMPROVEMENTS SHOWN ON SHEET 17-021.

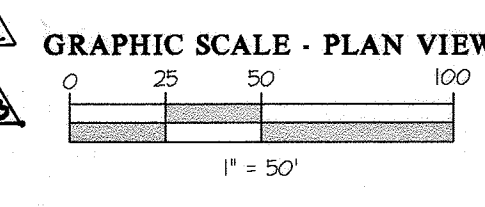

STUB	STATION	OFFSET	O/S FACE OF CURB	CAP LOCATION
VALENCIA LANE				
STUB K	0+40	27.5' R	1.0'	N 560493.0186 E 1351443.4425
M2A-M2	1+11	34.3' L	11.2'	N 560426.8851 E 1351554.4625
STUB E	1+63	13.0' R	1.0'	N 560876.4293 E 1351444.1640
STUB F	1+55	13.0' R	1.0'	N 560851.1118 E 1351441.2332
STUB I	1+16	10.4' R	N/A	N 560413.3234 E 1351442.2312
SKY RIBBON ROAD				
STUB L	44+12	20.2' R	4.2'	N 560534.5564 E 1351661.3545
STUB C	47+28	5.8' R	6.2'	N 560854.6600 E 1351643.3145
MANGO TREE ROAD				
M4-M2	34+48	1.3' L	18.0'	N 560536.2545 E 1351444.3473
STUB J	36+48	13.0' R	1.0'	N 560442.4245 E 1351644.8730

THE INFORMATION SHOWN IN THIS TABLE IS FOR ESTABLISHING THE LIMITS OF THE PUBLIC STORM DRAIN FOR FUTURE MAINTENANCE BY DPW. FOR THE LOCATION OF THE END OF THE STUBS TO BE USED BY THE CONTRACTOR FOR THE INITIAL CONSTRUCTION, SEE THE STRUCTURE SCHEDULE ON SHEET 4.

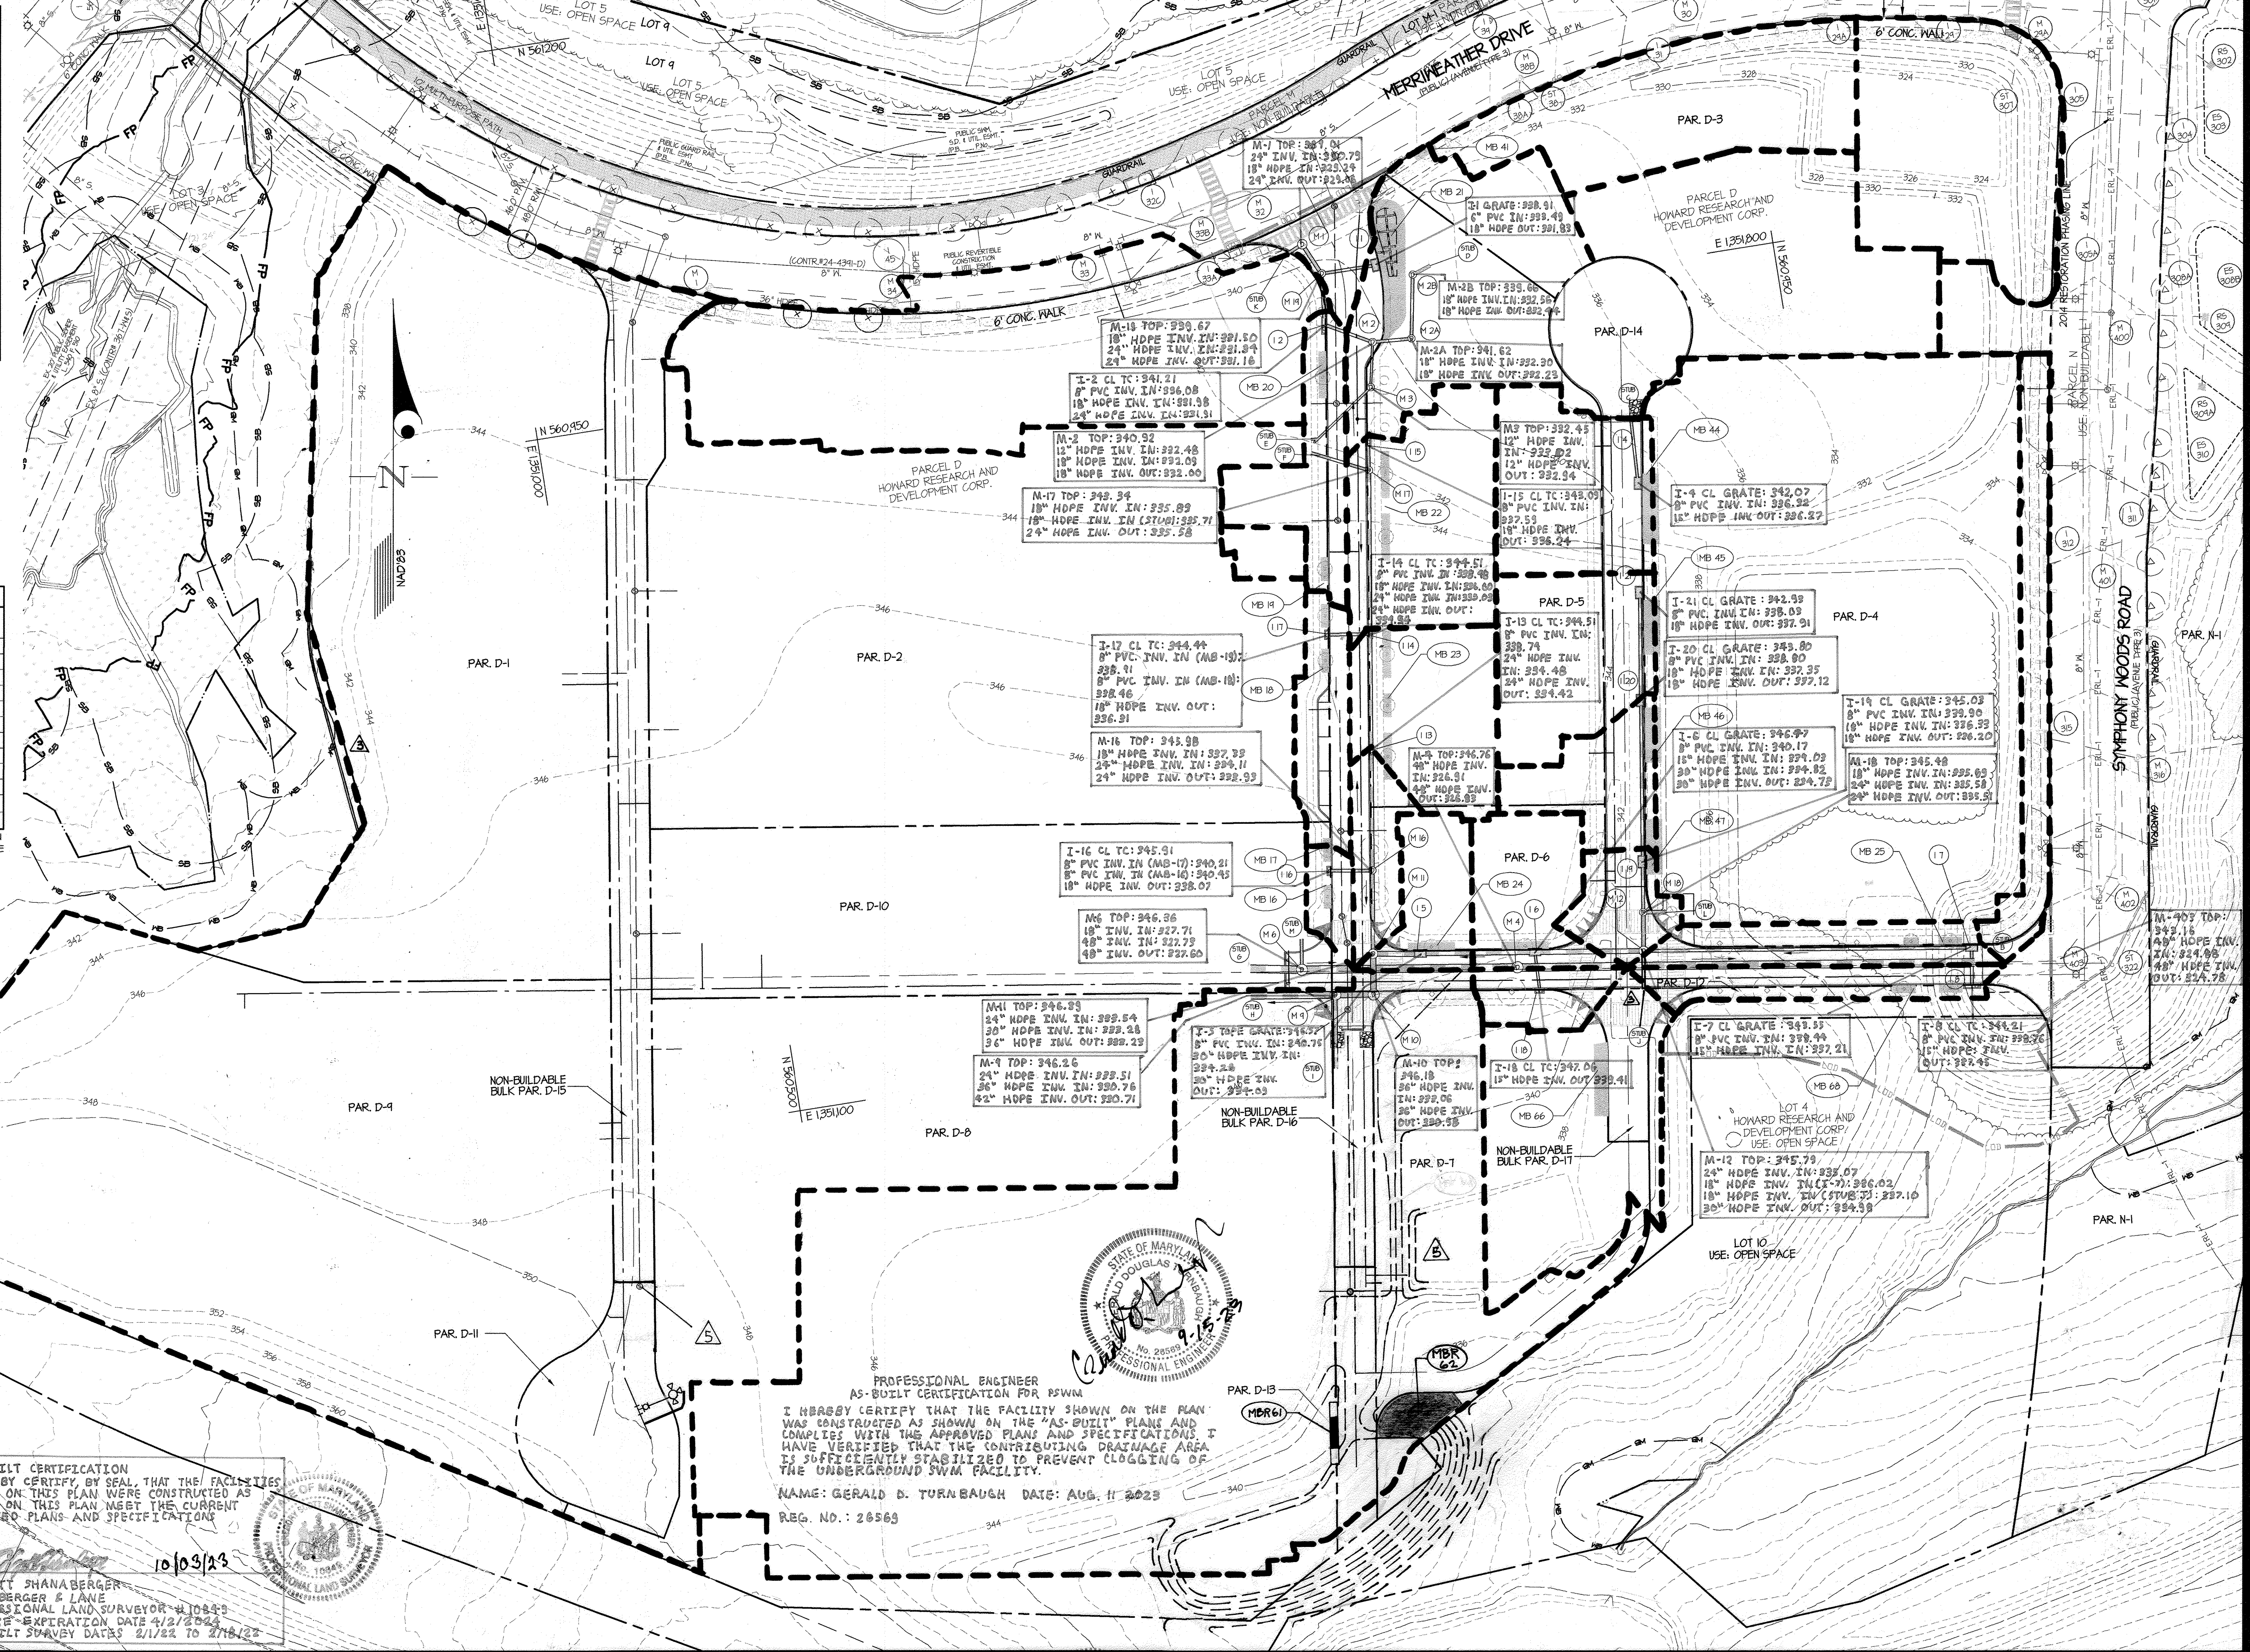

APPROVED: HOWARD COUNTY DEPARTMENT OF PUBLIC WORKS
 Chief, Bureau of Highways
 Date: 1/3/2018

APPROVED: HOWARD COUNTY DEPARTMENT OF PLANNING & ZONING
 Chief, Division of Land Development
 Date: 1-19-18

Chief, Development Engineering Division
 Date: 1-11-18

AS-BUILT CERTIFICATION
 I HEREBY CERTIFY, BY SEAL, THAT THE FACILITIES SHOWN ON THIS PLAN WERE CONSTRUCTED AS SHOWN ON THIS PLAN MEET THE CURRENT APPROVED PLANS AND SPECIFICATIONS.

G. SCOTT SHANBERGER
 SHANBERGER & LANE
 PROFESSIONAL LAND SURVEYOR #10843
 LICENSE EXPIRATION DATE 4/2/2024
 AS-BUILT SURVEY DATES 2/1/22 TO 2/15/22

PROFESSIONAL ENGINEER
 AS-BUILT CERTIFICATION FOR PSWM

I HEREBY CERTIFY THAT THE FACILITY SHOWN ON THE PLAN WAS CONSTRUCTED AS SHOWN ON THE "AS-BUILT" PLANS AND COMPLIES WITH THE APPROVED PLANS AND SPECIFICATIONS. I HAVE VERIFIED THAT THE CONTRIBUTING DRAINAGE AREA IS SUFFICIENTLY STABILIZED TO PREVENT CLOGGING OF THE UNDERGROUND SWM FACILITY.

NAME: GERALD D. TURNBAUGH DATE: AUG. 11 2023
 REG. NO.: 28563

GLWGUTSCHICK LITTLE & WEBER, P.A.
 CIVIL ENGINEERS, LAND SURVEYORS, LAND PLANNERS, LANDSCAPE ARCHITECTS
 3909 NATIONAL DRIVE - SUITE 250 - BURTONSVILLE OFFICE PARK
 BURTONSVILLE, MARYLAND 20866
 TEL: 301-421-4024 FAX: 301-421-4186

NO.	DATE	REVISION	BY	APP'R.
1-24-19		REMOVED MB-64 & 65, ADDED MB-61 & 62, REVISED PHT, SHC AND GRADES	34	DEV
1-24-18		Revised atub and Proposed wall	34	JRC
1-11-18		Revised I-B to I-7 Pipe Diameter	34	DEV

PREPARED FOR:
 THE HOWARD HUGHES CORPORATION
 10480 LITTLE PATUXENT PARKWAY
 SUITE 400
 COLUMBIA, MARYLAND 21044
 ATTN: BILL ROWE
 410-964-4987

PROFESSIONAL CERTIFICATION
 I HEREBY CERTIFY THAT THESE PLANS WERE PREPARED OR APPROVED BY ME, AND THAT I AM A DULY LICENSED PROFESSIONAL ENGINEER UNDER THE LAWS OF THE STATE OF MARYLAND, LICENSE NO. 12975
 EXPIRATION DATE: MAY 28, 2018
 1/14/17




STORM DRAIN - DRAINAGE AREA MAP

DOWNTOWN COLUMBIA
CRESCENT NEIGHBORHOOD
 PARCELS D-1 THRU D-17, NON-BUILDABLE BULK PARCELS D-15 THRU D-17 & OPEN SPACE LOT 10

HOWARD COUNTY, MARYLAND
 ELECTION DISTRICT No. 5



SCALE	ZONING	G. L. W. FILE NO.
1" = 50'	NT	11071
DATE	TAX MAP - GRID	SHEET
DEC., 2017	36 - 01	7 OF 25

L:\CAD\DRAWINGS\11071\11071-AREA 3\PLANS BY G.W.V. 17-029 Plans\11071-AREA 3-F-07 - 50 Dwg.dwg
 PLOTTED 12/14/2017 12:25 PM, LIST SAVE#: 271/2817, 1:25 PM, PLOTTED BY: Luke Coom

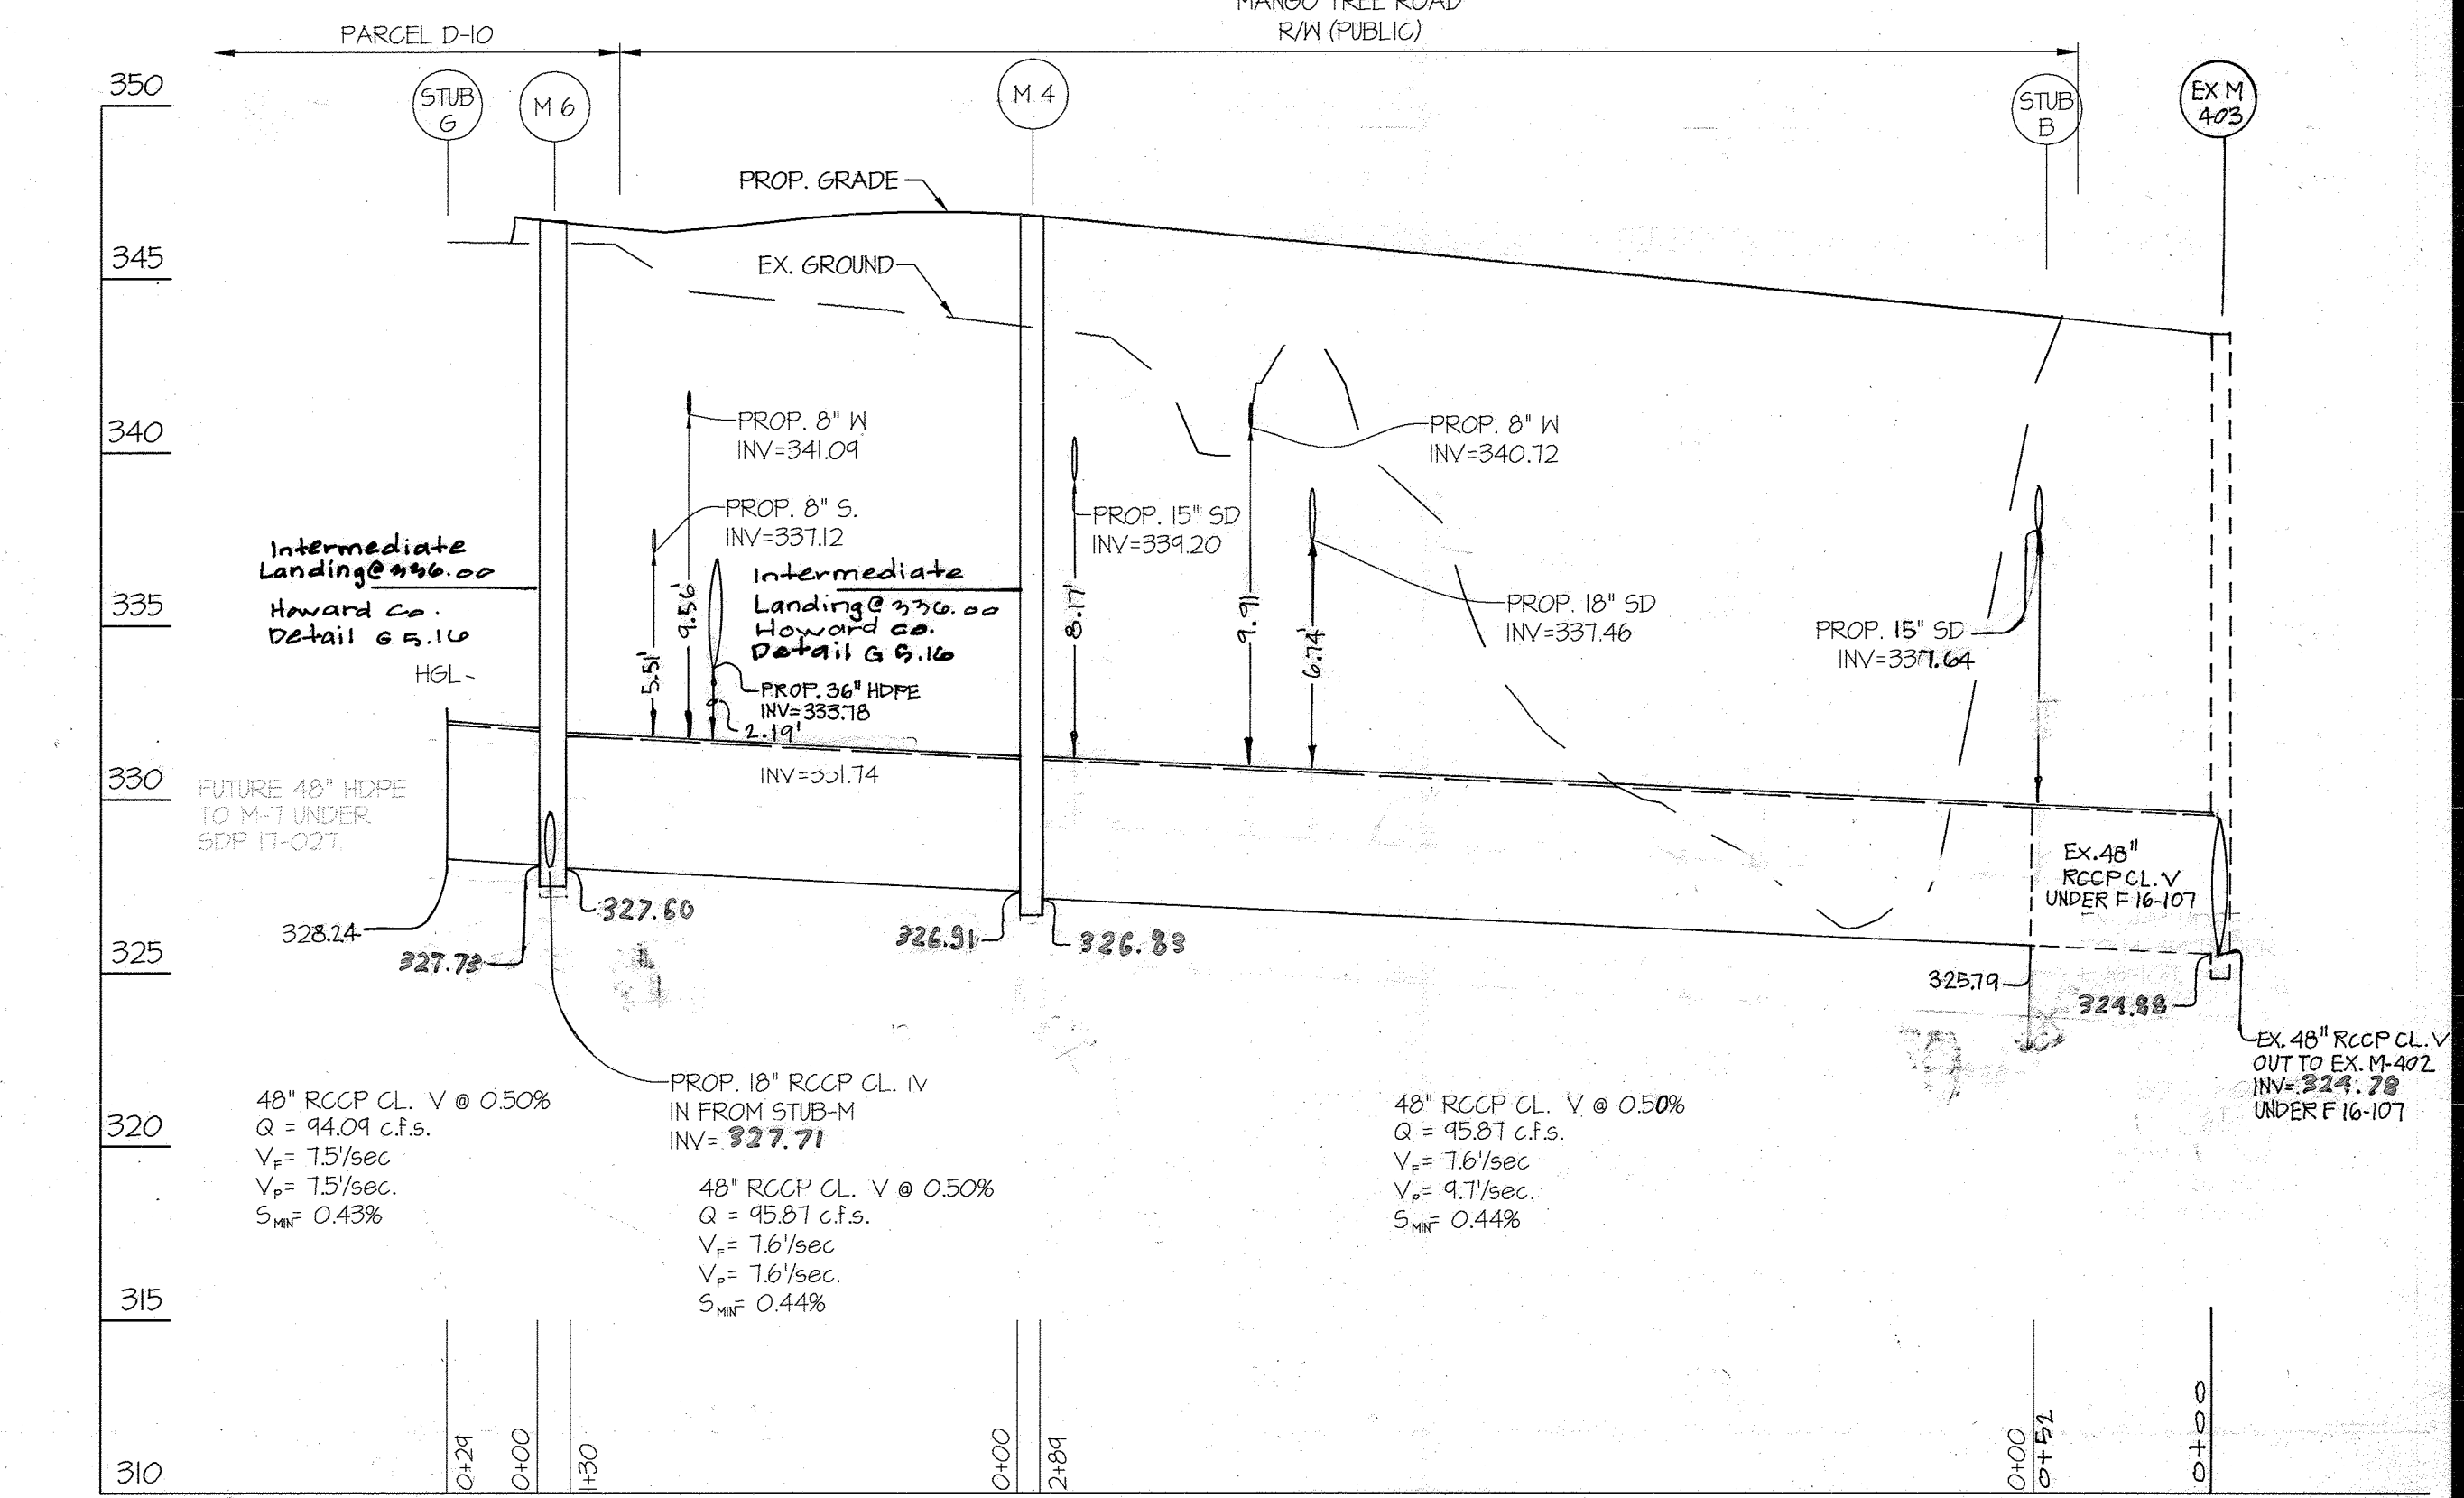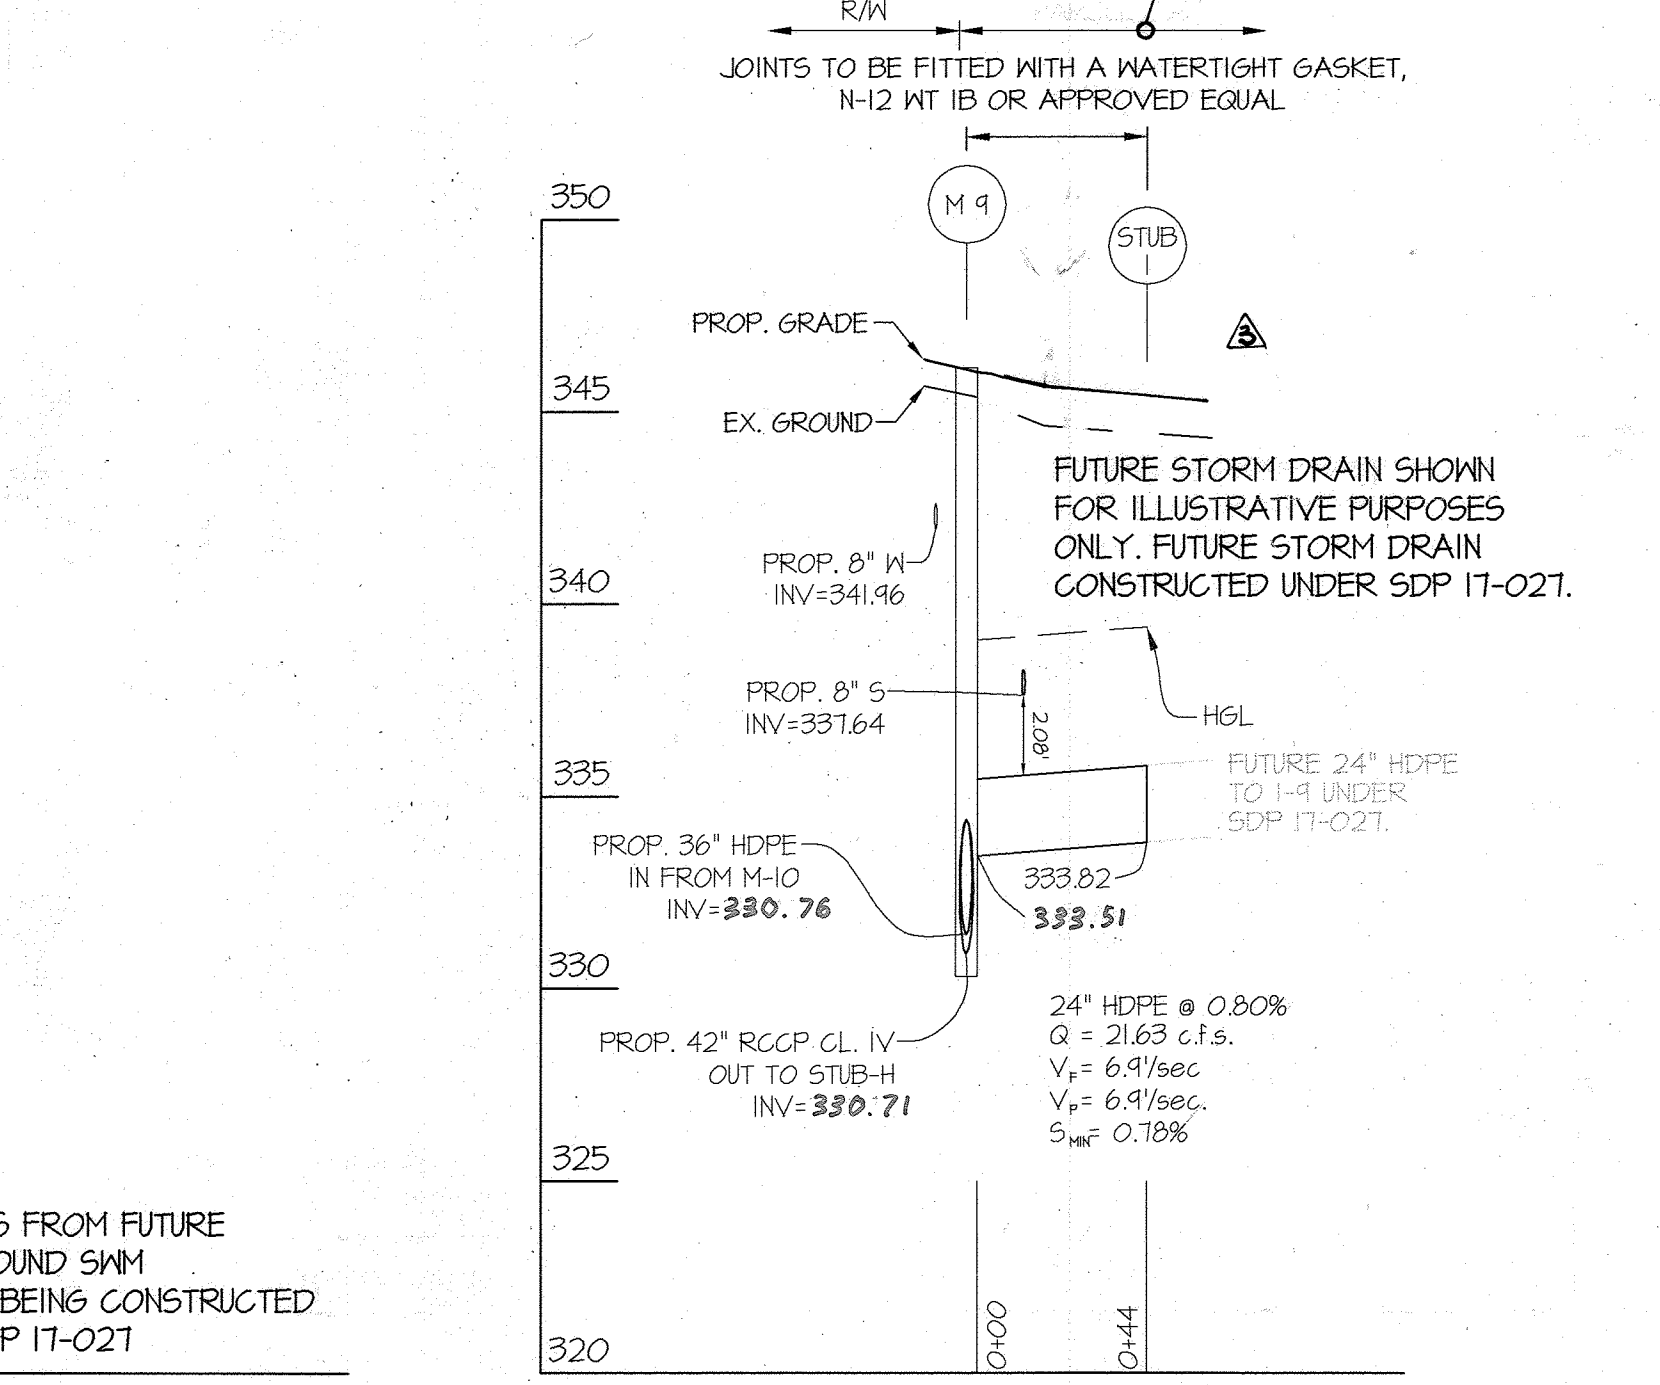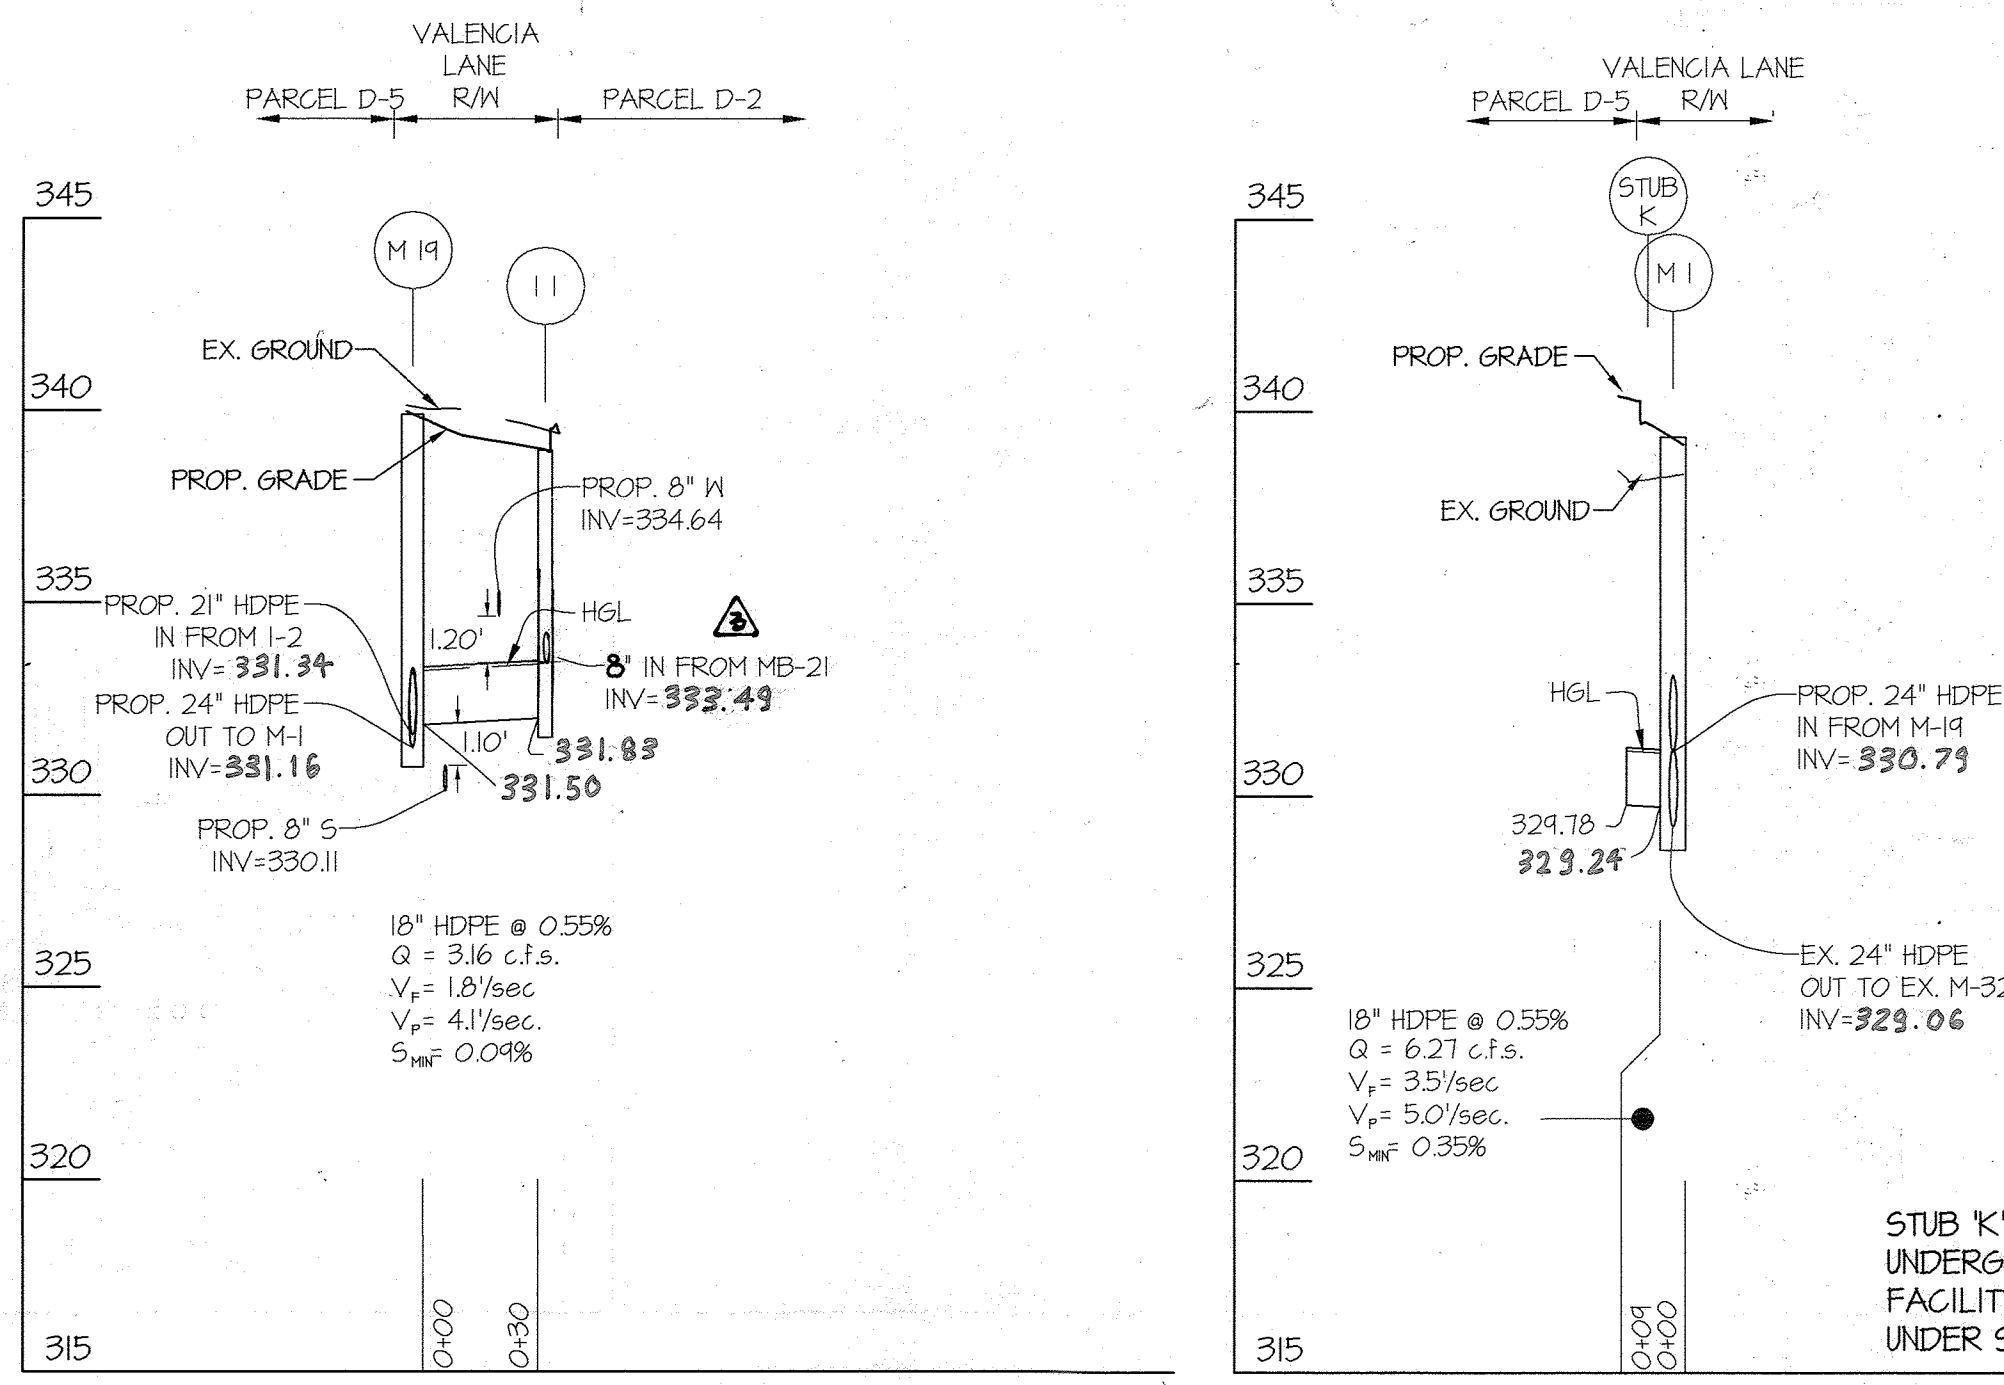

INLET STRUCTURE SCHEDULE													
NO	TYPE	WIDTH (INSIDE)	TOP ELEVATION				INVERT				STD. DETAIL	LOCATIONS	REMARKS
			PROPOSED		AS-BUILT		PROPOSED		AS-BUILT				
			UPPER	LOWER	UPPER	LOWER	UPPER	LOWER	UPPER	LOWER			
I-1	DOUBLE WR INLET	3'-5 1/2"	334.62	334.36	333.63	333.45	333.42	332.00	333.43	331.88	HO.CC. D-4.35	N 560,916 E 1,351,549	
I-2	A-10 INLET	3'-0"	341.51	341.01	341.40	341.01	336.09	331.70	336.09	331.91	HO.CC. D-4.03	N 560,443 E 1,351,510	
I-4	DOUBLE WR INLET	3'-5 1/2"	342.00	342.51	342.64	342.32	336.14	336.10	326.32	326.22	HO.CC. D-4.35	N 560,814 E 1,351,632	
I-5	DOUBLE WR INLET	3'-5 1/2"	347.11	347.04	347.19	347.19	334.09	334.43	340.75	334.33	HO.CC. D-4.35	N 560,534 E 1,351,507	
I-6	DOUBLE WR INLET	3'-5 1/2"	347.12	347.04	347.04	347.01	334.09	334.81	340.17	334.73	HO.CC. D-4.35	N 560,528 E 1,351,579	
I-7	DOUBLE WR INLET	3'-5 1/2"	344.33	344.25	344.20	344.04	338.65	337.51	338.44	338.36	HO.CC. D-4.35	N 560,947 E 1,351,856	
I-8	A-10 INLET	2'-6"	344.34	344.23	344.23	344.20	340.74	337.61	338.76	338.25	HO.CC. D-4.03	N 560,463 E 1,351,852	
I-9	A-5 INLET	2'-6"	345.10	345.10	345.13	345.13	338.94	338.70	338.74	338.41	HO.CC. D-4.01	N 560,671 E 1,351,445	
I-14	A-5 INLET	2'-6"	344.78	344.74	344.83	344.79	338.94	338.15	338.48	338.44	HO.CC. D-4.01	N 560,144 E 1,351,505	
I-15	A-5 INLET	2'-6"	343.23	343.11	343.02	342.84	338.94	338.92	337.53	338.34	HO.CC. D-4.01	N 560,866 E 1,351,523	
I-16	A-5 INLET	2'-6"	345.96	345.90	345.93	345.88	340.42	338.06	340.45	338.07	HO.CC. D-4.01	N 560,544 E 1,351,439	
I-17	A-5 INLET	2'-6"	344.45	344.34	344.43	344.40	338.91	336.32	338.91	338.91	HO.CC. D-4.01	N 560,748 E 1,351,482	
I-18	A-5 INLET	2'-6"	347.04	347.03	347.07	347.04	---	334.34	---	338.41	HO.CC. D-4.01	N 560,504 E 1,351,574	
I-19	DOUBLE WR INLET	3'-5 1/2"	345.64	345.55	345.62	345.55	334.68	334.24	334.90	334.20	HO.CC. D-4.35	N 560,573 E 1,351,658	
I-20	DOUBLE WR INLET	3'-5 1/2"	344.40	344.30	344.38	344.36	338.81	337.14	338.80	337.12	HO.CC. D-4.35	N 560,574 E 1,351,613	
I-21	DOUBLE WR INLET	3'-5 1/2"	343.56	343.47	343.51	343.50	---	338.08	338.02	337.51	HO.CC. D-4.35	N 560,743 E 1,351,683	

MANHOLE STRUCTURE SCHEDULE													
NO	TYPE	WIDTH (INSIDE)	TOP ELEVATION				INVERT				STD. DETAIL	LOCATIONS	REMARKS
			PROPOSED		AS-BUILT		PROPOSED		AS-BUILT				
			UPPER	LOWER	UPPER	LOWER	UPPER	LOWER	UPPER	LOWER			
M-1	STANDARD MANHOLE	5'-0"	339.30	---	339.01	---	331.17	324.23	330.79	328.06	HO.CC. G-5.13	N 560,491 E 1,351,585	
M-2	STANDARD MANHOLE	4'-0"	341.03	---	340.52	---	332.90	332.12	332.48	332.00	HO.CC. G-5.12	N 560,428 E 1,351,538	
M-2A	STANDARD MANHOLE	4'-0"	341.95	---	341.62	---	332.42	332.32	332.36	332.39	HO.CC. G-5.12	N 560,325 E 1,351,562	
M-2B	STANDARD MANHOLE	4'-0"	340.00	---	339.66	---	332.70	332.60	332.56	332.44	HO.CC. G-5.12	N 560,466 E 1,351,568	
M-3	STANDARD MANHOLE	4'-0"	342.71	---	342.45	---	333.14	333.04	333.02	332.94	HO.CC. G-5.12	N 560,593 E 1,351,593	
M-4	STANDARD MANHOLE	6'-0"	346.81	---	346.76	---	327.99	327.29	326.51	326.83	MD 384.05	N 560,514 E 1,351,564	
M-6	STANDARD MANHOLE	6'-0"	346.24	---	346.24	---	328.08	327.98	---	---	MD 384.05	N 560,534 E 1,351,431	
M-4	STANDARD MANHOLE	6'-0"	346.00	---	346.26	---	333.46	330.42	333.51	330.71	MD 384.05	N 560,522 E 1,351,444	
M-10	STANDARD MANHOLE	6'-0"	346.07	---	346.18	---	333.00	331.52	332.06	330.90	MD 384.05	N 560,514 E 1,351,474	
M-11	STANDARD MANHOLE	5'-0"	346.10	---	346.39	---	334.80	333.80	333.54	333.33	HO.CC. G-5.13	N 560,520 E 1,351,475	
M-12	STANDARD MANHOLE	5'-0"	345.84	---	345.79	---	337.38	335.21	337.10	334.90	HO.CC. G-5.12	N 560,514 E 1,351,630	
M-16	STANDARD MANHOLE	4'-0"	345.91	---	345.98	---	337.83	334.44	337.99	337.29	HO.CC. G-5.12	N 560,545 E 1,351,486	
M-17	STANDARD MANHOLE	4'-0"	343.41	---	343.49	---	336.25	335.75	335.99	335.58	HO.CC. G-5.12	N 560,848 E 1,351,523	
M-18	STANDARD MANHOLE	4'-0"	345.48	---	345.48	---	336.18	335.60	335.69	335.51	HO.CC. G-5.12	N 560,541 E 1,351,451	
M-14	STANDARD MANHOLE	4'-0"	339.30	---	339.67	---	331.83	331.24	331.50	328.16	HO.CC. G-5.12	N 560,377 E 1,351,613	

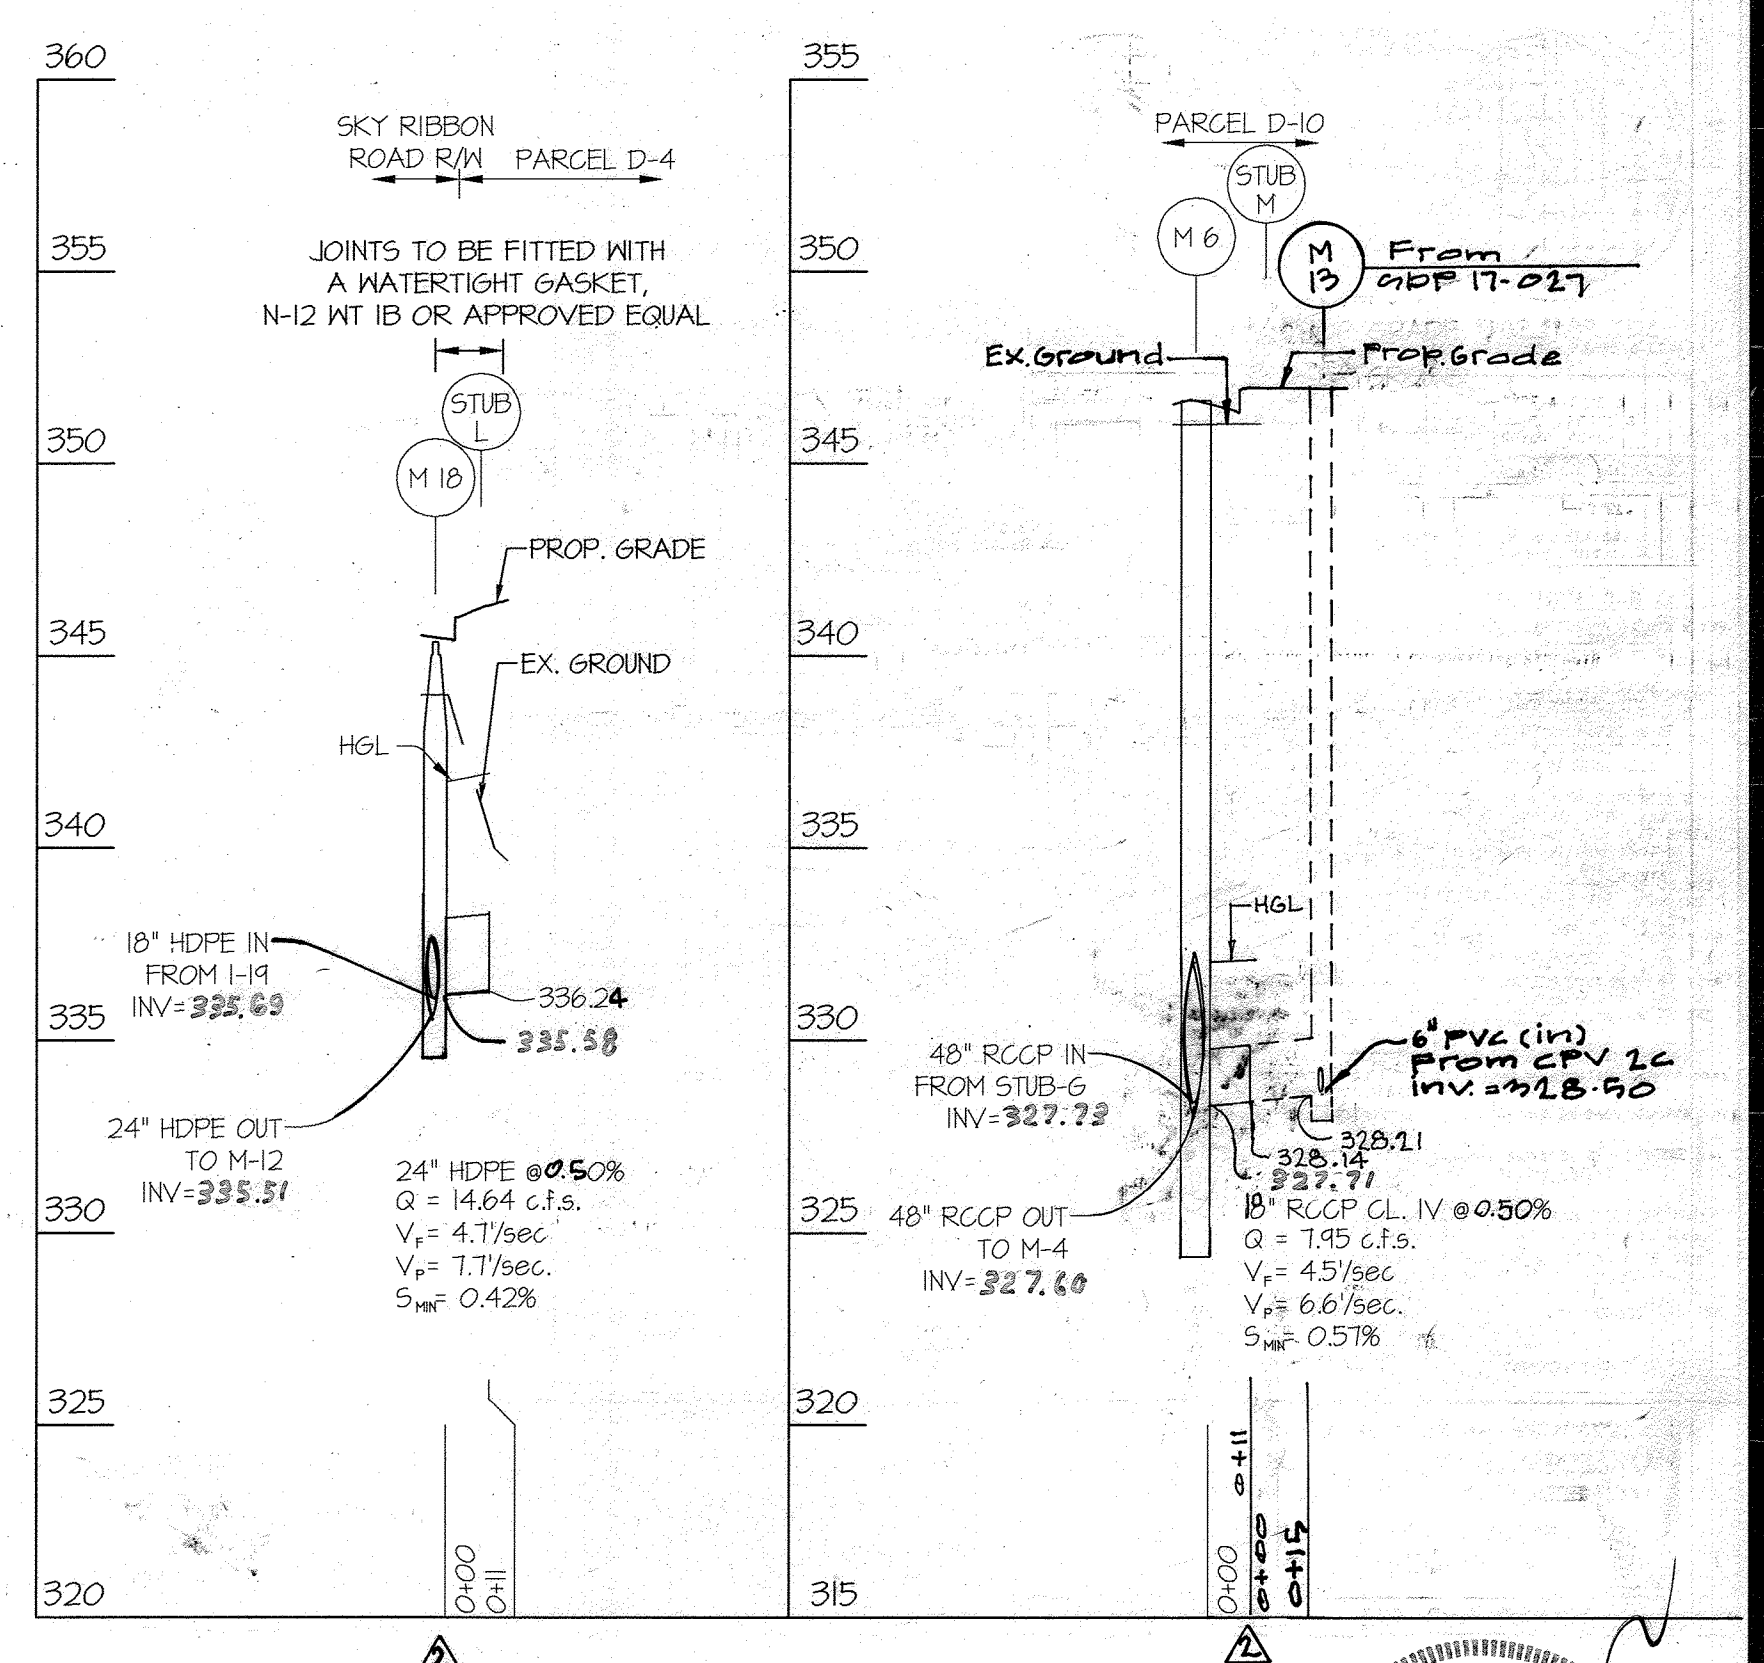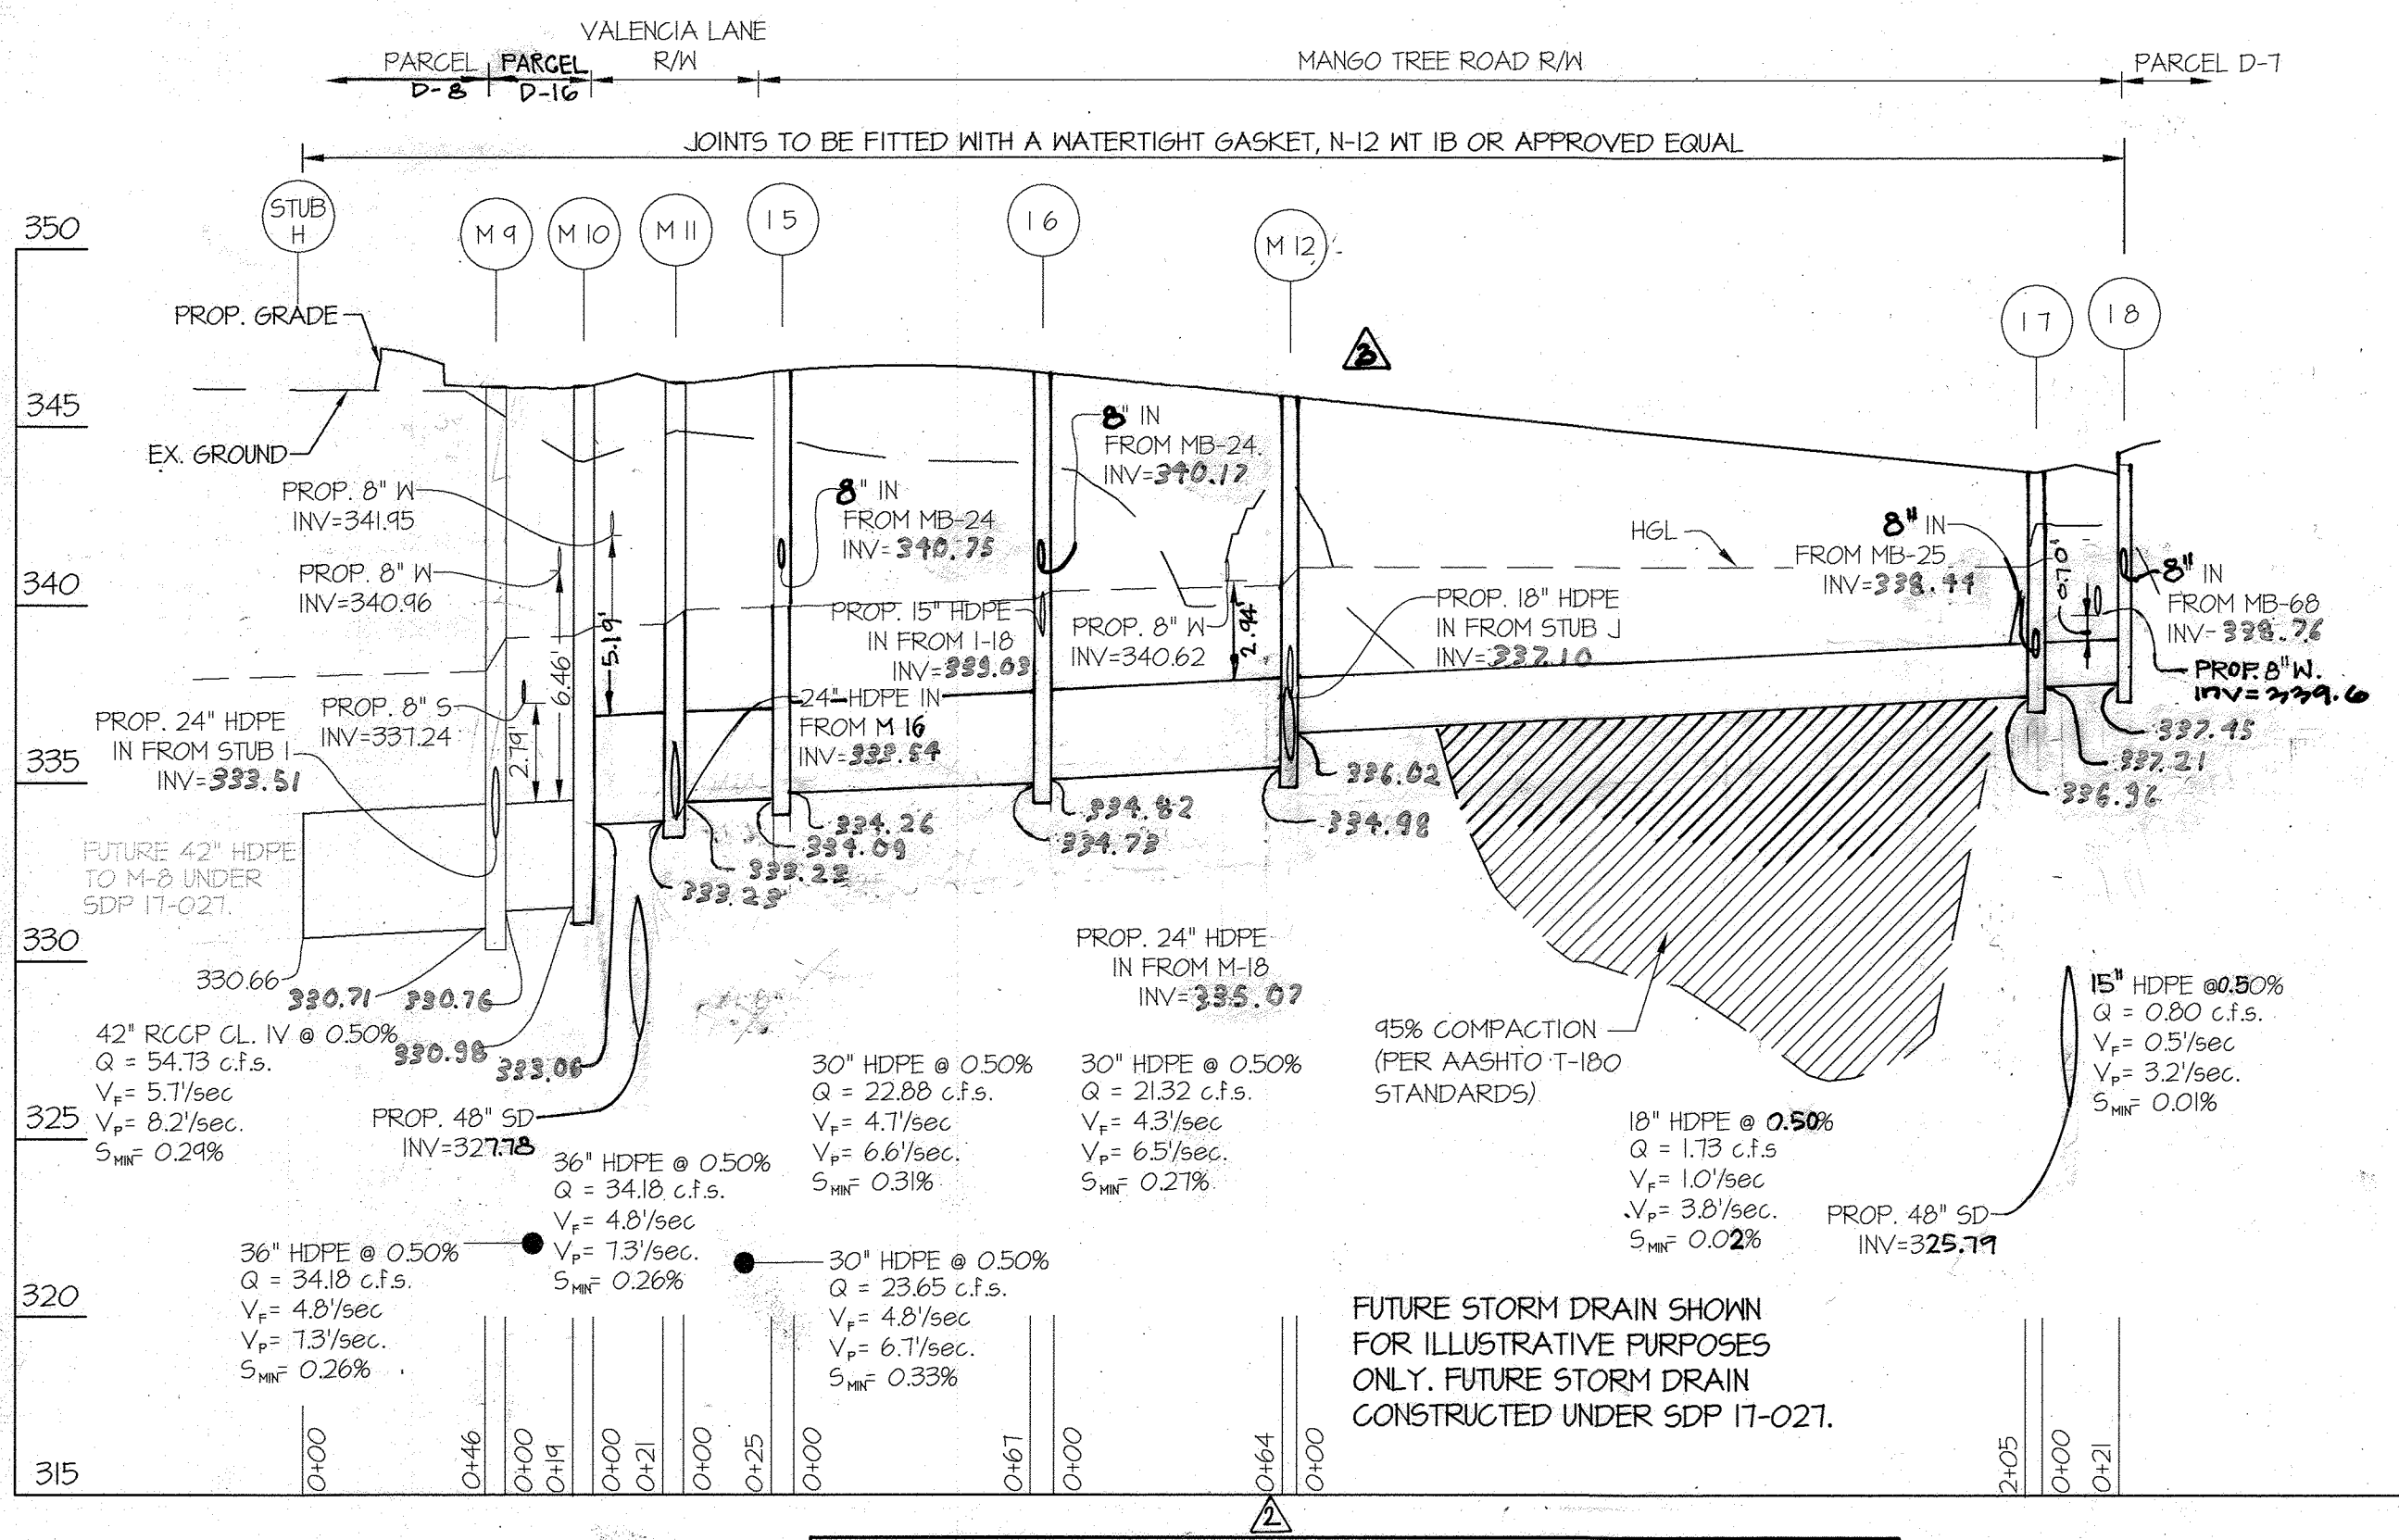

1. COORDINATE POINT GIVEN IS TO THE CENTERLINE OF STRUCTURE AT THE FACE OF CURB FOR INLETS AND TO THE CENTERLINE OF STRUCTURE FOR MANHOLES AND END SECTIONS.
 2. TOP ELEVATIONS FOR ALL INLET TYPES ARE GIVEN AS TOP OF CURB.
 3. SEE SHEET 8 FOR MD 384.05 DETAIL.
 4. SEE SHEET 4 FOR HOWARD COUNTY DETAIL D-4.35, WITH THE MODIFICATION OF A CONCRETE COLLAR.

APPROVED: HOWARD COUNTY DEPARTMENT OF PUBLIC WORKS
 Chief, Bureau of Highways
 Date: 1/3/2018

APPROVED: HOWARD COUNTY DEPARTMENT OF PLANNING & ZONING
 Chief, Division of Land Development
 Date: 1-19-18

Chief, Development Engineering Division
 Date: 1.11.18

GLWGUTSCHICK LITTLE & WEBER, P.A.
 CIVIL ENGINEERS, LAND SURVEYORS, LAND PLANNERS, LANDSCAPE ARCHITECTS
 3909 NATIONAL DRIVE - SUITE 250 - BURTNSVILLE OFFICE PARK
 BURTNSVILLE, MARYLAND 20886
 TEL: 301-421-4024 BALTIMORE: 410-800-1820 DC/VA: 301-988-2524 FAX: 301-421-4186

NO.	REVISION	DATE	BY	APPR.
1	Rev. Pipe Inverts from Micro-Pierretention Planters	7-25-18	JR	JR
2	Revised Profiles and Schedules	8-5-18	JR	JR

PIPE SCHEDULE			
SIZE	TYPE	QUANTITY (LF)	REMARKS
12"	HDPE	74	
15"	HDPE	25	
18"	HDPE	615	
21"	HDPE	28	
24"	HDPE	428	
30"	HDPE	156	
36"	HDPE	40	
18"	RCCP CL. V	11	
42"	RCCP CL. V	46	
48"	RCCP CL. V	447	

STORM DRAIN STUB SCHEDULE					
STUB	TYPE	INVERT		LOCATIONS	REMARKS
		PROPOSED	AS-BUILT		
B	48" RCCP	325.79	---	N 560,476.1240 E 1,351,856.2811	
C	15" HDPE	335.84	---	N 560,254.6600 E 1,351,643.3745	
D	18" HDPE	332.75	---	N 560,970.3543 E 1,351,581.6142	
E	12" HDPE	333.91	---	N 560,873.0240 E 1,351,484.0838	
F	18" HDPE	335.25	---	N 560,864.3158 E 1,351,481.7955	
G	48" RCCP	328.24	---	N 560,544.7481 E 1,351,398.2221	
H	42" RCCP	330.66	---	N 560,527.1090 E 1,351,395.6470	
I	24" HDPE	333.82	---	N 560,473.3294 E 1,351,442.2372	
J	18" HDPE	337.49	---	N 560,442.9815 E 1,351,644.4916	
K	18" HDPE	329.78	---	N 560,442.1344 E 1,351,441.7560	
L	24" HDPE	336.24	---	N 560,538.7425 E 1,351,666.5282	
M	18" RCCP	328.14	---	N 560,558.5412 E 1,351,433.3403	

PROFESSIONAL CERTIFICATION
 I HEREBY CERTIFY THAT THESE PLANS WERE PREPARED OR APPROVED BY ME, AND THAT I AM A DULY LICENSED PROFESSIONAL ENGINEER UNDER THE LAWS OF THE STATE OF MARYLAND, LICENSE NO. 12975, EXPIRATION DATE: MAY 26, 2018.
 12/14/17

AS-BUILT CERTIFICATION
 I HEREBY CERTIFY, BY SEAL, THAT THE FACILITIES SHOWN ON THIS PLAN WERE CONSTRUCTED AS SHOWN ON THIS PLAN MOST CURRENT APPROVED PLANS AND SPECIFICATIONS.
 10/03/23

PROFESSIONAL ENGINEER
 G. SCOTT SHAWBERGER
 SHAWBERGER & LAW
 PROFESSIONAL LAND SURVEYOR #10849
 LICENSE EXPIRATION DATE 4/2/2024
 AS-BUILT SURVEY DATES 3/1/22 TO 2/18/23

PROFESSIONAL ENGINEER
 I HEREBY CERTIFY THAT THE FACILITY SHOWN ON THE PLAN WAS CONSTRUCTED AS SHOWN ON THE "AS-BUILT" PLANS AND COMPLETELY WITH THE APPROVED PLANS AND SPECIFICATIONS. I HAVE VERIFIED THAT THE CONTRIBUTING DRAINAGE AREA IS SUFFICIENTLY STABILIZED TO PREVENT CLOGGING OF THE UNDERGROUND SWM FACILITY.
 NAME: GERALD P. TURBAUGH DATE: AUG. 11, 2023
 REG. NO.: 26569

STORM DRAIN PROFILES		
SCALE	ZONING	G. L. W. FILE NO.
HOR: 1" = 50'	NT	11071
VERT: 1" = 5'		
DATE	TAX MAP - GRID	SHEET
DEC., 2017	36 - 01	9 OF 25

PAVEMENT MARKING INSTALLATION

- (A) INSTALL 5" WHITE PAVEMENT MARKING
- (B) INSTALL 5" DOUBLE YELLOW PAVEMENT MARKING
- (C) INSTALL 5" DOUBLE YELLOW PAVEMENT MARKING (TEMPORARY TAPE STRIPING)
- (D) INSTALL 5" WHITE PAVEMENT MARKING (TEMPORARY TAPE STRIPING)



PAVEMENT MARKING NOTES

1. ALL LONG LINE MARKINGS TO BE APPLIED USING THERMOPLASTIC MATERIAL.
2. THE CROSSWALK AND ARROWS TO BE INSTALLED USING PREFORMED HEAT APPLIED TAPE OR THERMOPLASTIC.
3. ALL PAVEMENT MARKINGS ARE TO BE LOCATED OR APPROVED BY THE TRAFFIC DIVISION PRIOR TO THE PLACEMENT OF ANY MARKINGS.
4. ALL EXISTING PAVEMENT MARKINGS IN CONFLICT WITH THE PROPOSED PAVEMENT MARKINGS ARE TO BE REMOVED BY GRINDING ONLY. HOWARD COUNTY TRAFFIC (410-313-5152) WILL DETERMINE WHICH EXISTING MARKINGS SHALL BE REMOVED.
5. EXISTING CROSSWALKS AND OTHER EXISTING PAVEMENT MARKINGS SHOWN ON MERRIWEATHER DRIVE AND SYMPHONY WOODS ROAD ARE INSTALLED AS PART OF F 16-107 PLAN

SIGNING NOTES

1. ALL SIGN POSTS USED FOR TRAFFIC CONTROL SIGNS INSTALLED IN THE COUNTY RIGHT-OF-WAY SHALL BE MOUNTED ON A 2" GALVANIZED STEEL, PERFORATED, SQUARE TUBE POST (14 GAUGE) INSERTED INTO A 2-1/2" GALVANIZED STEEL, PERFORATED SQUARE TUBE SLEEVE (12 GAUGE) - 3' LONG. A GALVANIZED STEEL POLE SHALL BE MOUNTED ON TOP OF EACH POST. THE ANCHOR SHALL NOT EXTEND MORE THAN TWO QUICK PUNCH HOLES ABOVE THE GROUND.
2. ALL SIGNS LOCATED WITHIN THE PUBLIC RIGHT-OF-WAY SHALL BE APPROVED BY THE HOWARD COUNTY TRAFFIC DIVISION (410-313-5152) PRIOR TO INSTALLATION.
3. FULL LANE BICYCLE USE IS ONLY SUPPORTED WITH POSTED DESIGN SPEEDS OF 25 MPH OR LESS.
4. THE CONTRACTOR SHOULD MAKE EVERY EFFORT FOR STREET TREES TO BE PLACED A MINIMUM OF 15' FROM REGULATORY SIGNS AND ALL INTERSECTIONS, 5' FROM A STREET DRAIN INLET STRUCTURE, 5' FROM AN OPEN SPACE STRIP, 10' FROM A DRIVEWAY, AND LOCATED WITH CONSIDERATION TO UNDERGROUND UTILITIES AND STRUCTURES. THE CONTRACTOR SHALL SET UP A FIELD MEETING WITH THE COUNTY TRAFFIC DIVISION (410-313-5152) PRIOR TO THE INSTALLATION OF THE STREET TREES AND REGULATORY SIGNS.

SIGN SCHEDULE			
VALENCIA LANE			
TYPE	SIZE	STATION	OFFSET
R1-I	30X30	0+44.6	24.5' LT.
R4-II	30X30	0+42.5	15.0' RT.
SPECIAL	30X30	0+44.2	21.0' LT.
R2-I	24X30	1+71.5	15.0' RT.
R2-I	24X30	2+61.2	15.0' LT.
R1-I	30X30	4+91.2	15.5' RT.
MANGO TREE ROAD			
W1-2/W16-TPL	30X30	34+95.9	15.0' LT.
W1-2/W16-TFR	30X30	34+95.9	15.0' RT.
W1-2/W16-TPL	30X30	34+95.9	15.0' RT.
R2-I	24X30	35+51.5	15.0' RT.
R2-I	24X30	37+95.4	15.0' LT.
R4-II	30X30	38+64.8	15.0' LT.
SKY RIBBON ROAD			
R1-I	30X30	44+15.2	17.4' LT.

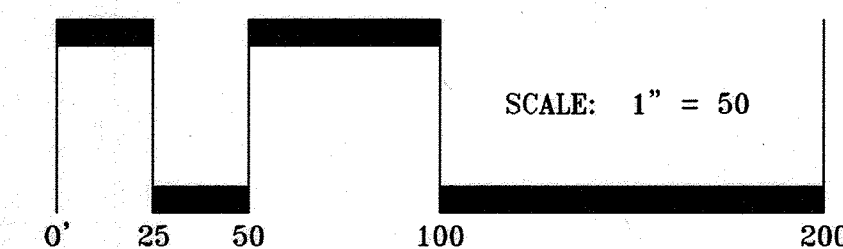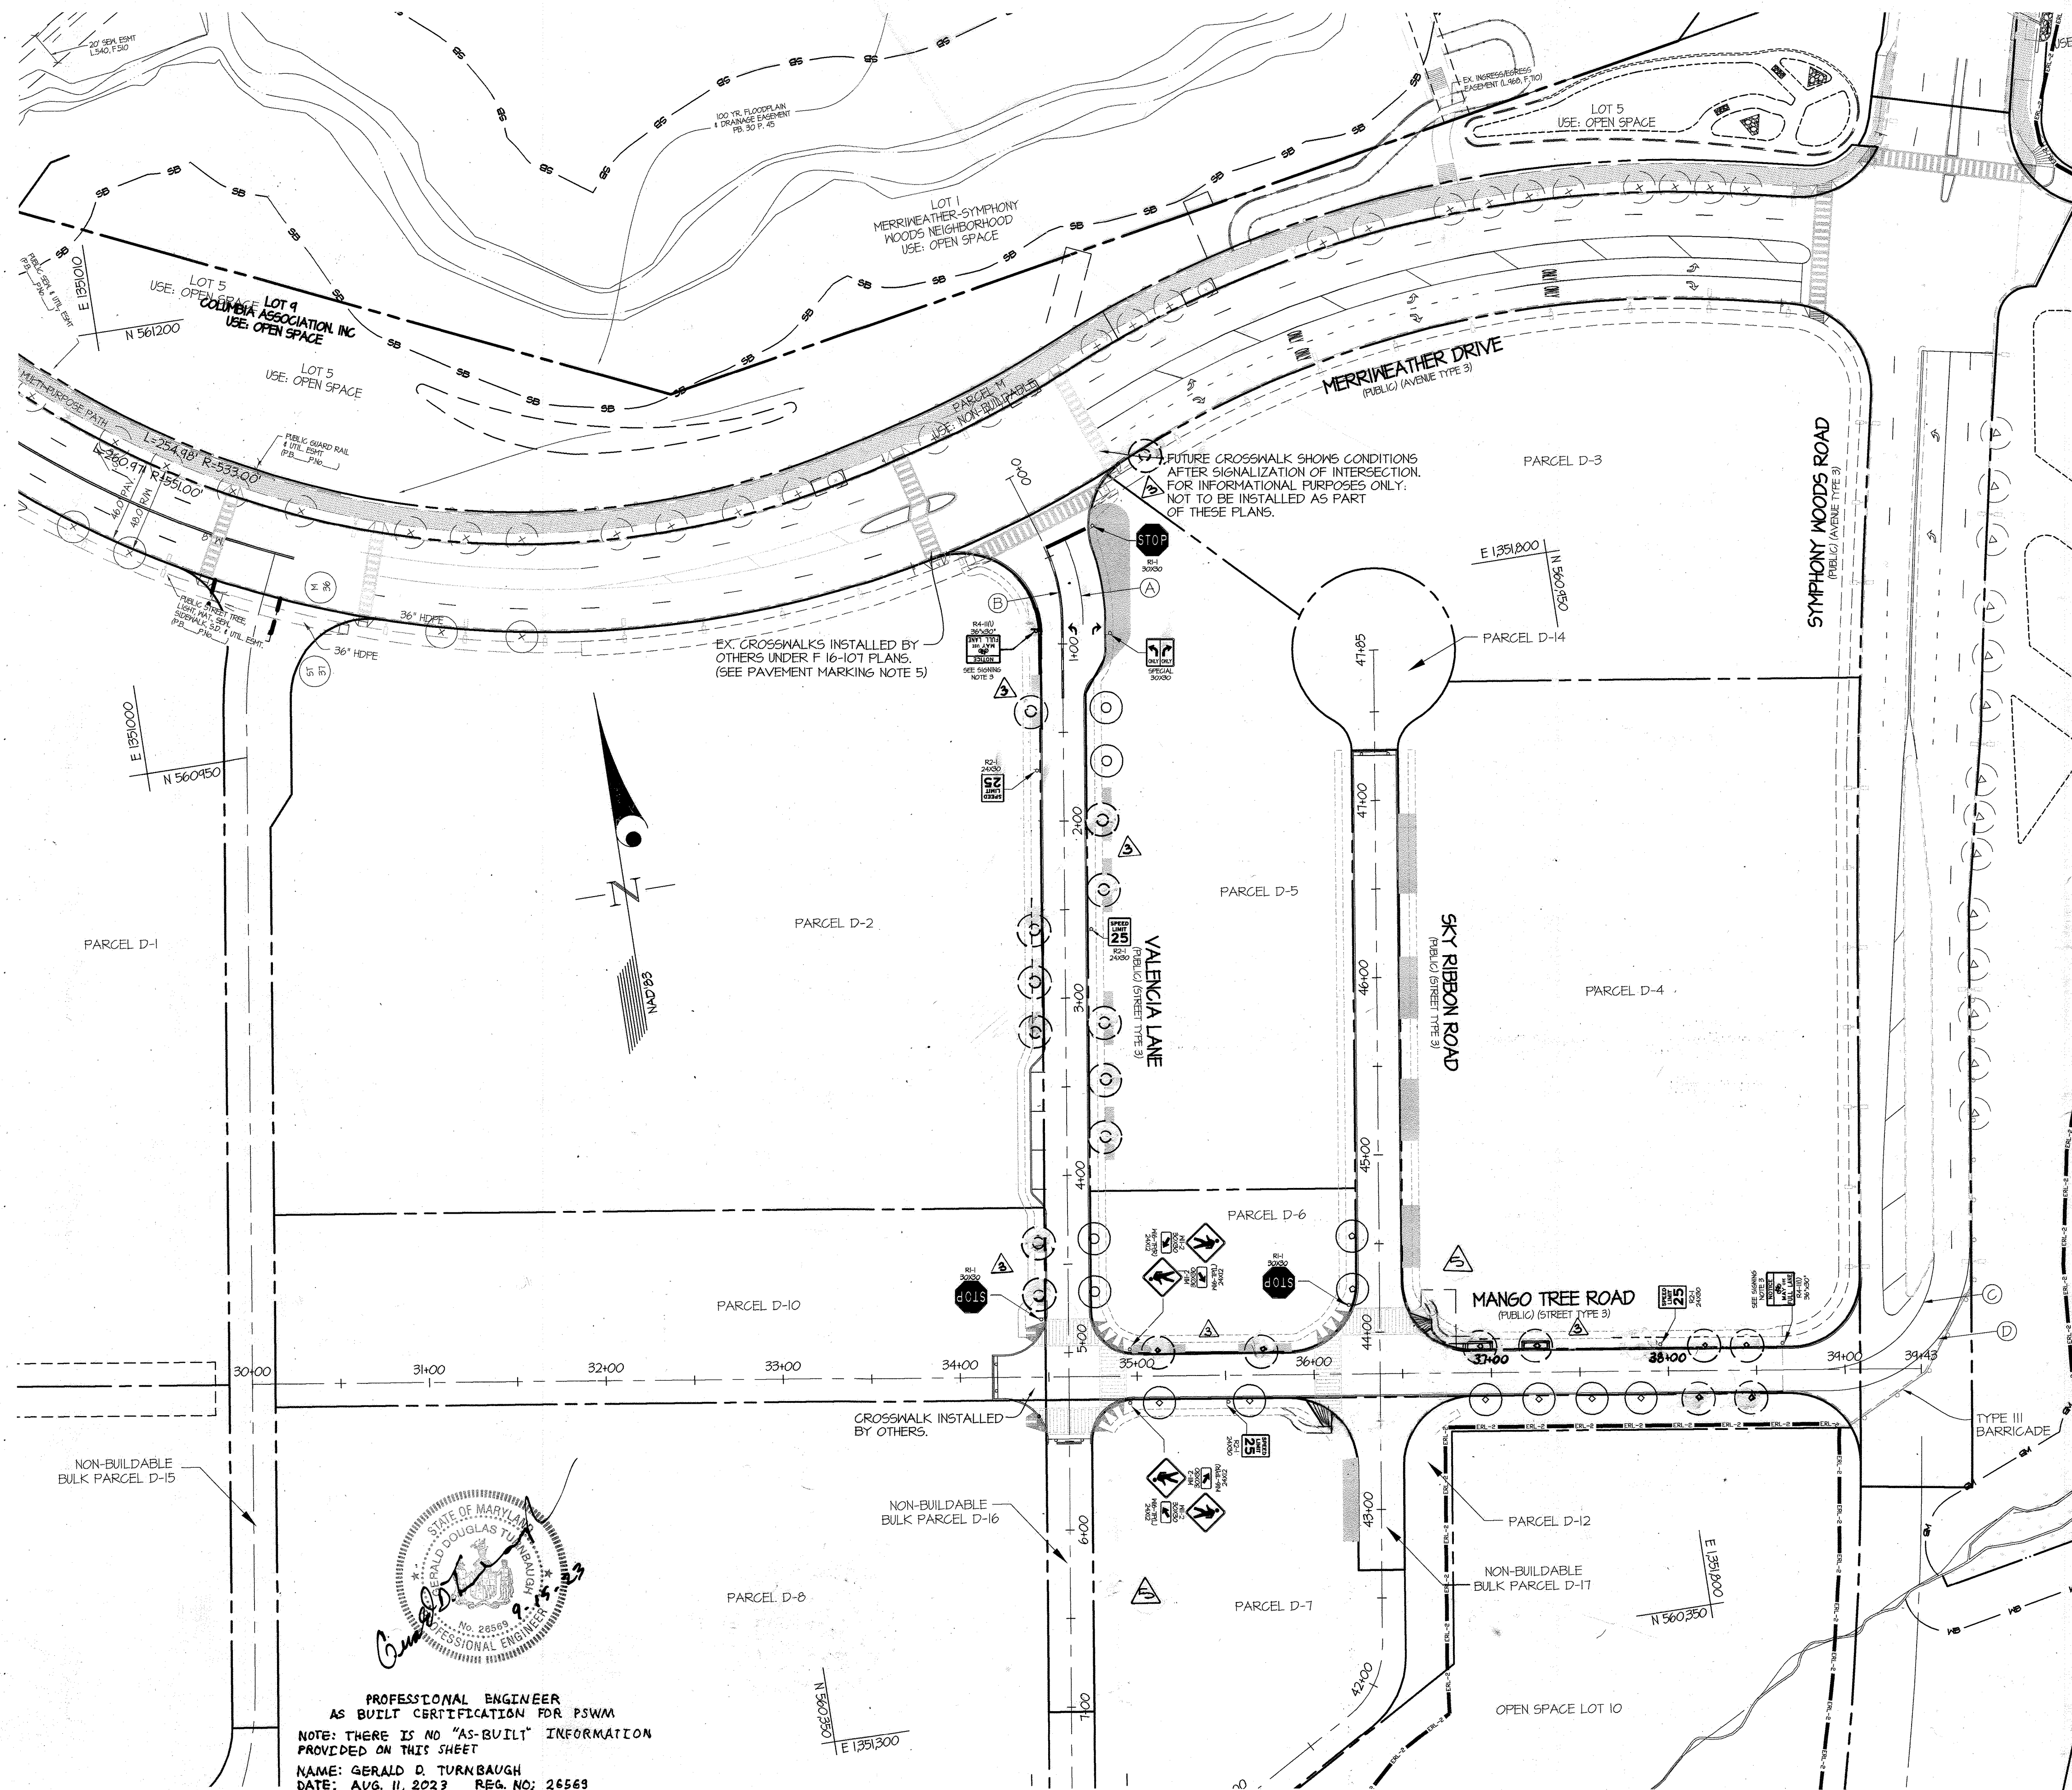

APPROVED: HOWARD COUNTY DEPARTMENT OF PUBLIC WORKS
 Chief, Bureau of Highways
 Date: 1/3/2018

APPROVED: HOWARD COUNTY DEPARTMENT OF PLANNING & ZONING
 Chief, Division of Land Development
 Date: 1-19-18

Chief, Development Engineering Division
 Date: 1.11.18

THERE IS NO AS-BUILT INFORMATION ON THIS SHEET

G. SCOTT SHANABERGER
 SHANABERGER & LANE
 PROFESSIONAL LAND SURVEYOR # 10849
 LICENSE EXPIRATION DATE 4/2/2024
 AS-BUILT SURVEY DATES 2/1/22 TO 2/18/22



PROFESSIONAL ENGINEER
 AS BUILT CERTIFICATION FOR PSWM
 NOTE: THERE IS NO "AS-BUILT" INFORMATION PROVIDED ON THIS SHEET
 NAME: GERALD D. TURNBAUGH
 DATE: AUG. 11, 2023 REG. NO.: 26569

GLW GUTSCHICK LITTLE & WEBER, P.A.
 CIVIL ENGINEERS, LAND SURVEYORS, LAND PLANNERS, LANDSCAPE ARCHITECTS
 3909 NATIONAL DRIVE - SUITE 250 - BURTONSVILLE OFFICE PARK
 BURTONSVILLE, MARYLAND 20866
 TEL: 301-421-4024 FAX: 410-889-1820 DC/VA: 301-989-2524 FAX: 301-421-4186

NO.	DATE	DESCRIPTION	BY	APPR.
1-24-19		Removed EOP and Revised crosswalks/side walk Ramps	WJL	BEV
1-25-18		Rev. tree symbol, size & tree location and removed tree	BT	JRE

PREPARED FOR:
 THE HOWARD HUGHES CORPORATION
 10480 LITTLE PATUXENT PARKWAY
 SUITE 400
 COLUMBIA, MARYLAND 21044
 ATTN: BILL ROWE
 410-964-4987

PROFESSIONAL CERTIFICATION
 I HEREBY CERTIFY THAT THESE PLANS WERE PREPARED OR APPROVED BY ME, AND THAT I AM A DULY LICENSED PROFESSIONAL ENGINEER UNDER THE LAWS OF THE STATE OF MARYLAND.
 LICENSE NO. 12975
 EXPIRATION DATE: MAY 26, 2018
 12/14/17



SIGNING AND STRIPING PLAN

**DOWNTOWN COLUMBIA
 CRESCENT NEIGHBORHOOD
 PARCELS D-1 THRU D-14, NON-BUILDABLE BULK PARCELS
 D-15 THRU D-17 & OPEN SPACE LOT 10**

HOWARD COUNTY, MARYLAND

SCALE	ZONING	G. L. W. FILE NO.
1" = 50'	NT	11071
DATE	TAX MAP - GRID	SHEET
DEC., 2017	36 - 01	10 OF 25

SYMBOL	QTY.	TYPE	NAMES (BOTANICAL / SCIENTIFIC)	SIZE/COMMENTS
SHADE TREES				
△ ○	15	UA	ULMUS AMERICANA 'PRINCETON' / PRINCETON AMERICAN ELM	3 1/2" CAL. B4B
○	14	QP	QUERCUS PHellos / WILLOW OAK	4" CAL. B4B
○	2	GB	GINKGO BILOBA 'PRINCETON SENTRY' / PRINCETON SENTRY GINKGO	3.5" CAL. B4B

- STREET TREE NOTES:**
- PER THE NEIGHBORHOOD DESIGN GUIDELINES, SUPPLEMENTAL PLANTINGS ALONG THE STREETScape CAN BE PROVIDED TO OFFSET THE SHORTAGE OF STREET TREES. SHRUBS AND OTHER PLANTINGS WILL BE PROVIDED WITH THE S.D.P. TO SATISFY THE LANDSCAPE OBLIGATION.
 - PLANTS MUST BE A MINIMUM OF 4' FROM CROSSWALKS AND HANDICAP CURB CUTS.
 - MAINTAIN INTERSECTION SIGHT TRIANGLES AND PEDESTRIAN MOVEMENT BY ENSURING LOWER BRANCHES ARE PRUNED AND MAINTAINED 8' ABOVE GRADE.
 - THE CONTRACTOR SHOULD MAKE EVERY EFFORT FOR STREET TREES TO BE PLACED A MINIMUM OF 15' FROM REGULATORY SIGNS AND ALL INTERSECTIONS, 5' FROM A STREET DRAIN INLET STRUCTURE, 5' FROM AN OPEN SPACE STRIP, 10' FROM A DRIVEWAY, AND LOCATED WITH CONSIDERATION TO UNDERGROUND UTILITIES AND STRUCTURES. THE CONTRACTOR SHALL SET UP A FIELD MEETING WITH THE COUNTY TRAFFIC DIVISION (410-313-5752) PRIOR TO THE INSTALLATION OF THE STREET TREES AND REGULATORY SIGNS.
 - REFER TO PAGE 33 OF THE CRESCENT NEIGHBORHOOD DESIGN GUIDELINES FOR ADDITIONAL STREET TREE PROVISIONS.
 - STREET LIGHTS ARE TO BE PRIVATELY OWNED AND PUBLICLY MAINTAINED.
 - SEE SHEET 12 FOR STREET LIGHT DETAILS.

TOTAL LENGTH OF CURB BEING CONSTRUCTED (R/W): 1904'
 NUMBER OF TREES REQUIRED @ 1 PER 40 FEET: 49
 NUMBER OF TREES PROVIDED: 31

SURETY FOR STREET TREES:

STREET TREES ARE TO BE BONDED WITH THE DPM COST ESTIMATE FOR ROAD CONSTRUCTION

(31) SHADE TREES X \$300 = \$9300
 TOTAL = \$9300


Bond Notes
 The street trees, street lights, & concrete sidewalks & sidewalks, ramps, & curbs for Howard County Detail R-4-003 are shown for bonding purposes only. The improvements along the road frontage are to be constructed as part of 99F-17-021 & 99F-18-005. They will only be constructed as part of these plans if needed prior to the completion of the streetscape associated with 99F-17-021 & 99F-18-005.

STREET LIGHT SCHEDULE

LOCATION	TYPE	LOCATION	TYPE
§ STA. 0+59 VALENCIA LANE 23' RT. B	§ STA. 35+42 MANGO TREE ROAD 15' LT. A		
§ STA. 0+67 VALENCIA LANE 21'2" LT. A	§ STA. 37+02 MANGO TREE ROAD 15' LT. A		
§ STA. 1+02 VALENCIA LANE 15'2" RT. B	§ STA. 39+12 MANGO TREE ROAD 15'2" LT. B		
§ STA. 1+21 VALENCIA LANE 24'5" LT. A	§ STA. 39+61 MANGO TREE ROAD 15'2" LT. A		
§ STA. 1+82 VALENCIA LANE 16'0" LT. A	§ STA. 39+42 MANGO TREE ROAD 15'2" RT. B		
§ STA. 2+42 VALENCIA LANE 16'0" LT. A	§ STA. 37+93 MANGO TREE ROAD 15' RT. A		
§ STA. 2+44 VALENCIA LANE 15' RT. B	§ STA. 37+99 MANGO TREE ROAD 15' RT. A		
§ STA. 2+49 VALENCIA LANE 11'2" RT. A	§ STA. 38+66 MANGO TREE ROAD 15' RT. B		
§ STA. 3+04 VALENCIA LANE 16'0" LT. B	§ STA. 44+14 SKY RIBBON ROAD 17'4" RT. B		
§ STA. 3+62 VALENCIA LANE 16'0" LT. A	§ STA. 44+14 SKY RIBBON ROAD 17'4" RT. A		
§ STA. 3+62 VALENCIA LANE 22' RT. B	§ STA. 44+04 SKY RIBBON ROAD 13'0" LT. A		
§ STA. 4+22 VALENCIA LANE 16'0" LT. B	§ STA. 45+64 SKY RIBBON ROAD 13'0" LT. B		
§ STA. 4+22 VALENCIA LANE 15'4" RT. A	§ STA. 46+14 SKY RIBBON ROAD 13'0" LT. A		
§ STA. 4+78 VALENCIA LANE 15' RT. B	§ STA. 46+14 SKY RIBBON ROAD 13'0" LT. B		
§ STA. 4+81 VALENCIA LANE 15' RT. A			

TYPE:
 A) LED-55 ON A 14' BRONZE FIBERGLASS POLE
 B) LED-55 AT 14' AND LED-165 AT 22' ON A 22' BRONZE FIBERGLASS POLE

I HEREBY CERTIFY THAT THIS PLAN MEETS ALL OF THE REQUIREMENTS AND DESIGN INTENT OF THE CRESCENT NEIGHBORHOOD DESIGN GUIDELINES RECORDED IN THE LAND RECORDS OF HOWARD COUNTY IN LIBER 16305, FOLIO 415.

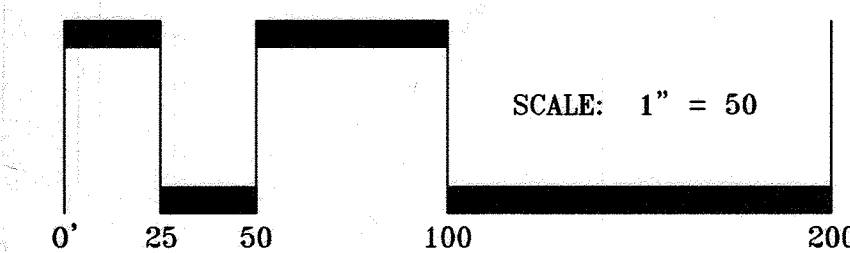

APPROVED: HOWARD COUNTY DEPARTMENT OF PUBLIC WORKS
 Chief, Bureau of Highways
 Date: 1/6/2018


APPROVED: HOWARD COUNTY DEPARTMENT OF PLANNING & ZONING
 Chief, Division of Land Development
 Date: 1-19-18

Chief, Development Engineering Division
 Date: 1-18-18

GLWGUTSCHICK LITTLE & WEBER, P.A.
 CIVIL ENGINEERS, LAND SURVEYORS, LAND PLANNERS, LANDSCAPE ARCHITECTS
 3909 NATIONAL DRIVE - SUITE 250 - BURTONVILLE OFFICE PARK
 BURTONVILLE, MARYLAND 20866
 TEL: 301-421-4024 FAX: 410-889-1620 DC/VA: 301-989-2524 FAX: 301-421-4186


DATE	REVISION	BY	APPR.
12-10-20	REVISED TO MOVE LOT 10 REFORESTATION FROM 1700 TO F18-D17	HKT	DEV
7-24-19	REVISED MBR CROSSWALK RAMP DOWN SIGHT TRIANGLE BOND NOTE	WJG	DEV
12-14-18	REVISED PRIVATE SWM EASEMENT AREA LIMITS	BT	DEV
7-26-18	REV. TREE SYMBOL, SIZE, TREE LOCATION, AND REMOVED TREE	BT	JRE

LEGEND

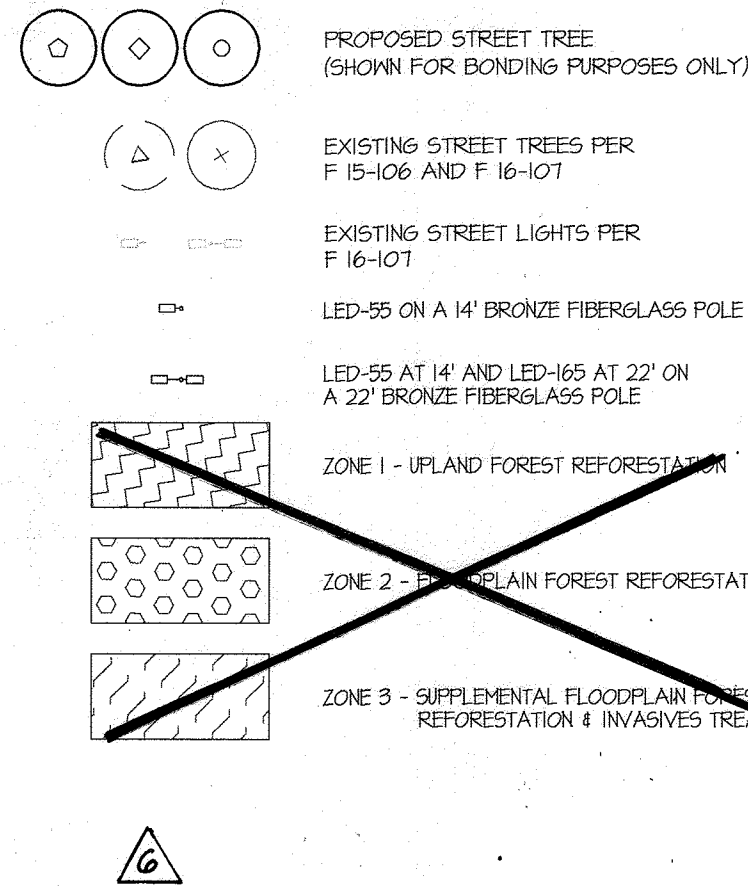

PLANT COMPOSITION SCHEDULE

Overall Minimum Spacing (ft.)	Quantity per acre	Frequency (%)	Species Quantity	Wetland Indicator Status	Vegetation Strata / Species Name	Common Name	Unit	Spacing Type	Size	Individual Minimum Spacing (ft.)	Size (acres)	
20	109	10	16	FACU	Liquidambar styraciflua	Tulip poplar	CONT	Random	2" CAL	63	Zone 1 - Upland Forest Reforestation Size (acres): 1.45	
		10	16	FACU	Fagus grandifolia	American beech	CONT	Random	1.25" CAL	63		
		10	32	FACU	Quercus falcata	Southern red oak	CONT	Random	2" CAL	63		
		25	39		Quercus velutina	Black oak	CONT	Random	2" CAL	40		
		5	8	FACU	Quercus alba	White oak	CONT	Random	1.25" CAL	91		
		5	8		Red oak		CONT	Random	1.25" CAL	91		
		10	16	FAC	Nyssa sylvatica	Black gum	CONT	Random	2" CAL	63		
			135		= total							
		5	8	FACU	Cornus florida	Flowering dogwood	CONT	Random	1.25" CAL	91		
		10	16	FAC	Amelanchier canadensis	Sanicleberry	CONT	Random	1.25" CAL	63		
			100		= total							
30	45	100	24									
		30	21	UPL	Viburnum acerifolium	Maple leaf viburnum	CONT	Random	2" CAL	55		Zone 2 - Floodplain Forest Reforestation Size (acres): 0.24
		15	10	FAC	Viburnum dentatum	Southern arrowwood	CONT	Random	3" GAL	77		
		30	7		Vaccinium pallidum	Lowbush blueberry	CONT	Random	2" GAL	96		
		25	17		Hemodesmia virginiana	Whitewash	CONT	Random	3" GAL	60		
		30	14	FACU	Croton canadensis	Redbud	CONT	Random	2" GAL	68		
			89		= total							
25	70	40	41									
		40	41	FACU	Athyrium filix-femina	Common lady fern	CONT	Random	QUART	39		
		40	41	FACU	Polystichum acrostichoides	Christmas fern	CONT	Random	QUART	39		
		20	20		Euphorbia divaricata	White wood aster	CONT	Random	QUART	55		
			100		= total							
N/A	35											
		30	10	UPL	Carex pensylvanica	Pennsylvania sedge	SEED	LB OF P.L.S. 70%	N/A	N/A	Zone 3 - Supplemental Floodplain Forest Reforestation Size (acres): 0.57	
		25	13	FACU	Elymus virginicus	Virginia wild rye	SEED	LB OF P.L.S. 70%	N/A	N/A		
		25	13	FACU	Tridax flouosa	Purple top	SEED	LB OF P.L.S. 70%	N/A	N/A		
		15	8	FAC	Dichanthium clandestinum	Deertongue	SEED	LB OF P.L.S. 70%	N/A	N/A		
			52		= total							
		30	10	FACU	Quercus palustris	Pin oak	CONT	Random	2" CAL	63		
		15	4	FACU	Quercus bicolor	Swamp white oak	CONT	Random	1.25" CAL	51		
		5	1	OBL	Salix nigra	Black willow	CONT	Random	2" CAL	68		
		5	1	FAC	Quercus prinus	White oak	CONT	Random	2" CAL	68		
		25	7	FACU	Pteris occidentalis	American sycamore	CONT	Random	2" CAL	40		
		10	3	FAC	Nyssa sylvatica	Black gum	CONT	Random	1.25" CAL	63		
			24		= total							
		5	1	FACU	Betula nigra	River birch	CONT	Random	1.5" CAL	88		
		3	1	FAC	Corylus americana	Arrowwood	CONT	Random	1.25" CAL	63		
			100		= total							
12	303	20	15	FACU	Cornus amomum	Silly dogwood	CONT	Random	3" GAL	27		
		15	11	OBL	Pinus strobus	Scotch pine	CONT	Random	2" GAL	31		
		20	22	FAC	Quercus prinus	Common white oak	CONT	Random	2" GAL	23		
		15	11	FACU	Cornus sericea	Red osier dogwood	CONT	Random	3" GAL	31		
		20	15	FAC	Viburnum dentatum	Southern arrowwood	CONT	Random	3" GAL	27		
			74		= total							
N/A	35											
		25	2	FACU	Elymus virginicus	Virginia wild rye	SEED	LB OF P.L.S. 70%	N/A	N/A	Zone 3 - Supplemental Floodplain Forest Reforestation Size (acres): 0.57	
		25	2	FACU	Elymus virginicus	Virginia wild rye	SEED	LB OF P.L.S. 70%	N/A	N/A		
		25	2	OBL	Salix nigra	Black willow	SEED	LB OF P.L.S. 70%	N/A	N/A		
		25	2	OBL	Salix nigra	Black willow	SEED	LB OF P.L.S. 70%	N/A	N/A		
		15	8	FAC	Dichanthium clandestinum	Deertongue	SEED	LB OF P.L.S. 70%	N/A	N/A		
			100		= total							
		25	70	5	2	Ranalis nigra	River birch	CONT	Random	1.5" CAL		111
		25	70	5	2	Acer negundo	Boxelder	CONT	Random	1.25" CAL		63
			100		4	= total						
12	303	30	35	Cornus amomum	Silly dogwood	CONT	Random	3" GAL	27			
		15	15	Cornus sericea	Red osier dogwood	CONT	Random	3" GAL	31			
		30	52	Liriodendron benzoin	Common spicewood	CONT	Random	3" GAL	22			
		15	35	Cornus sericea	Red osier dogwood	CONT	Random	3" GAL	31			
		20	35	Viburnum dentatum	Southern arrowwood	CONT	Random	2" GAL	27			
			100	174	= total							

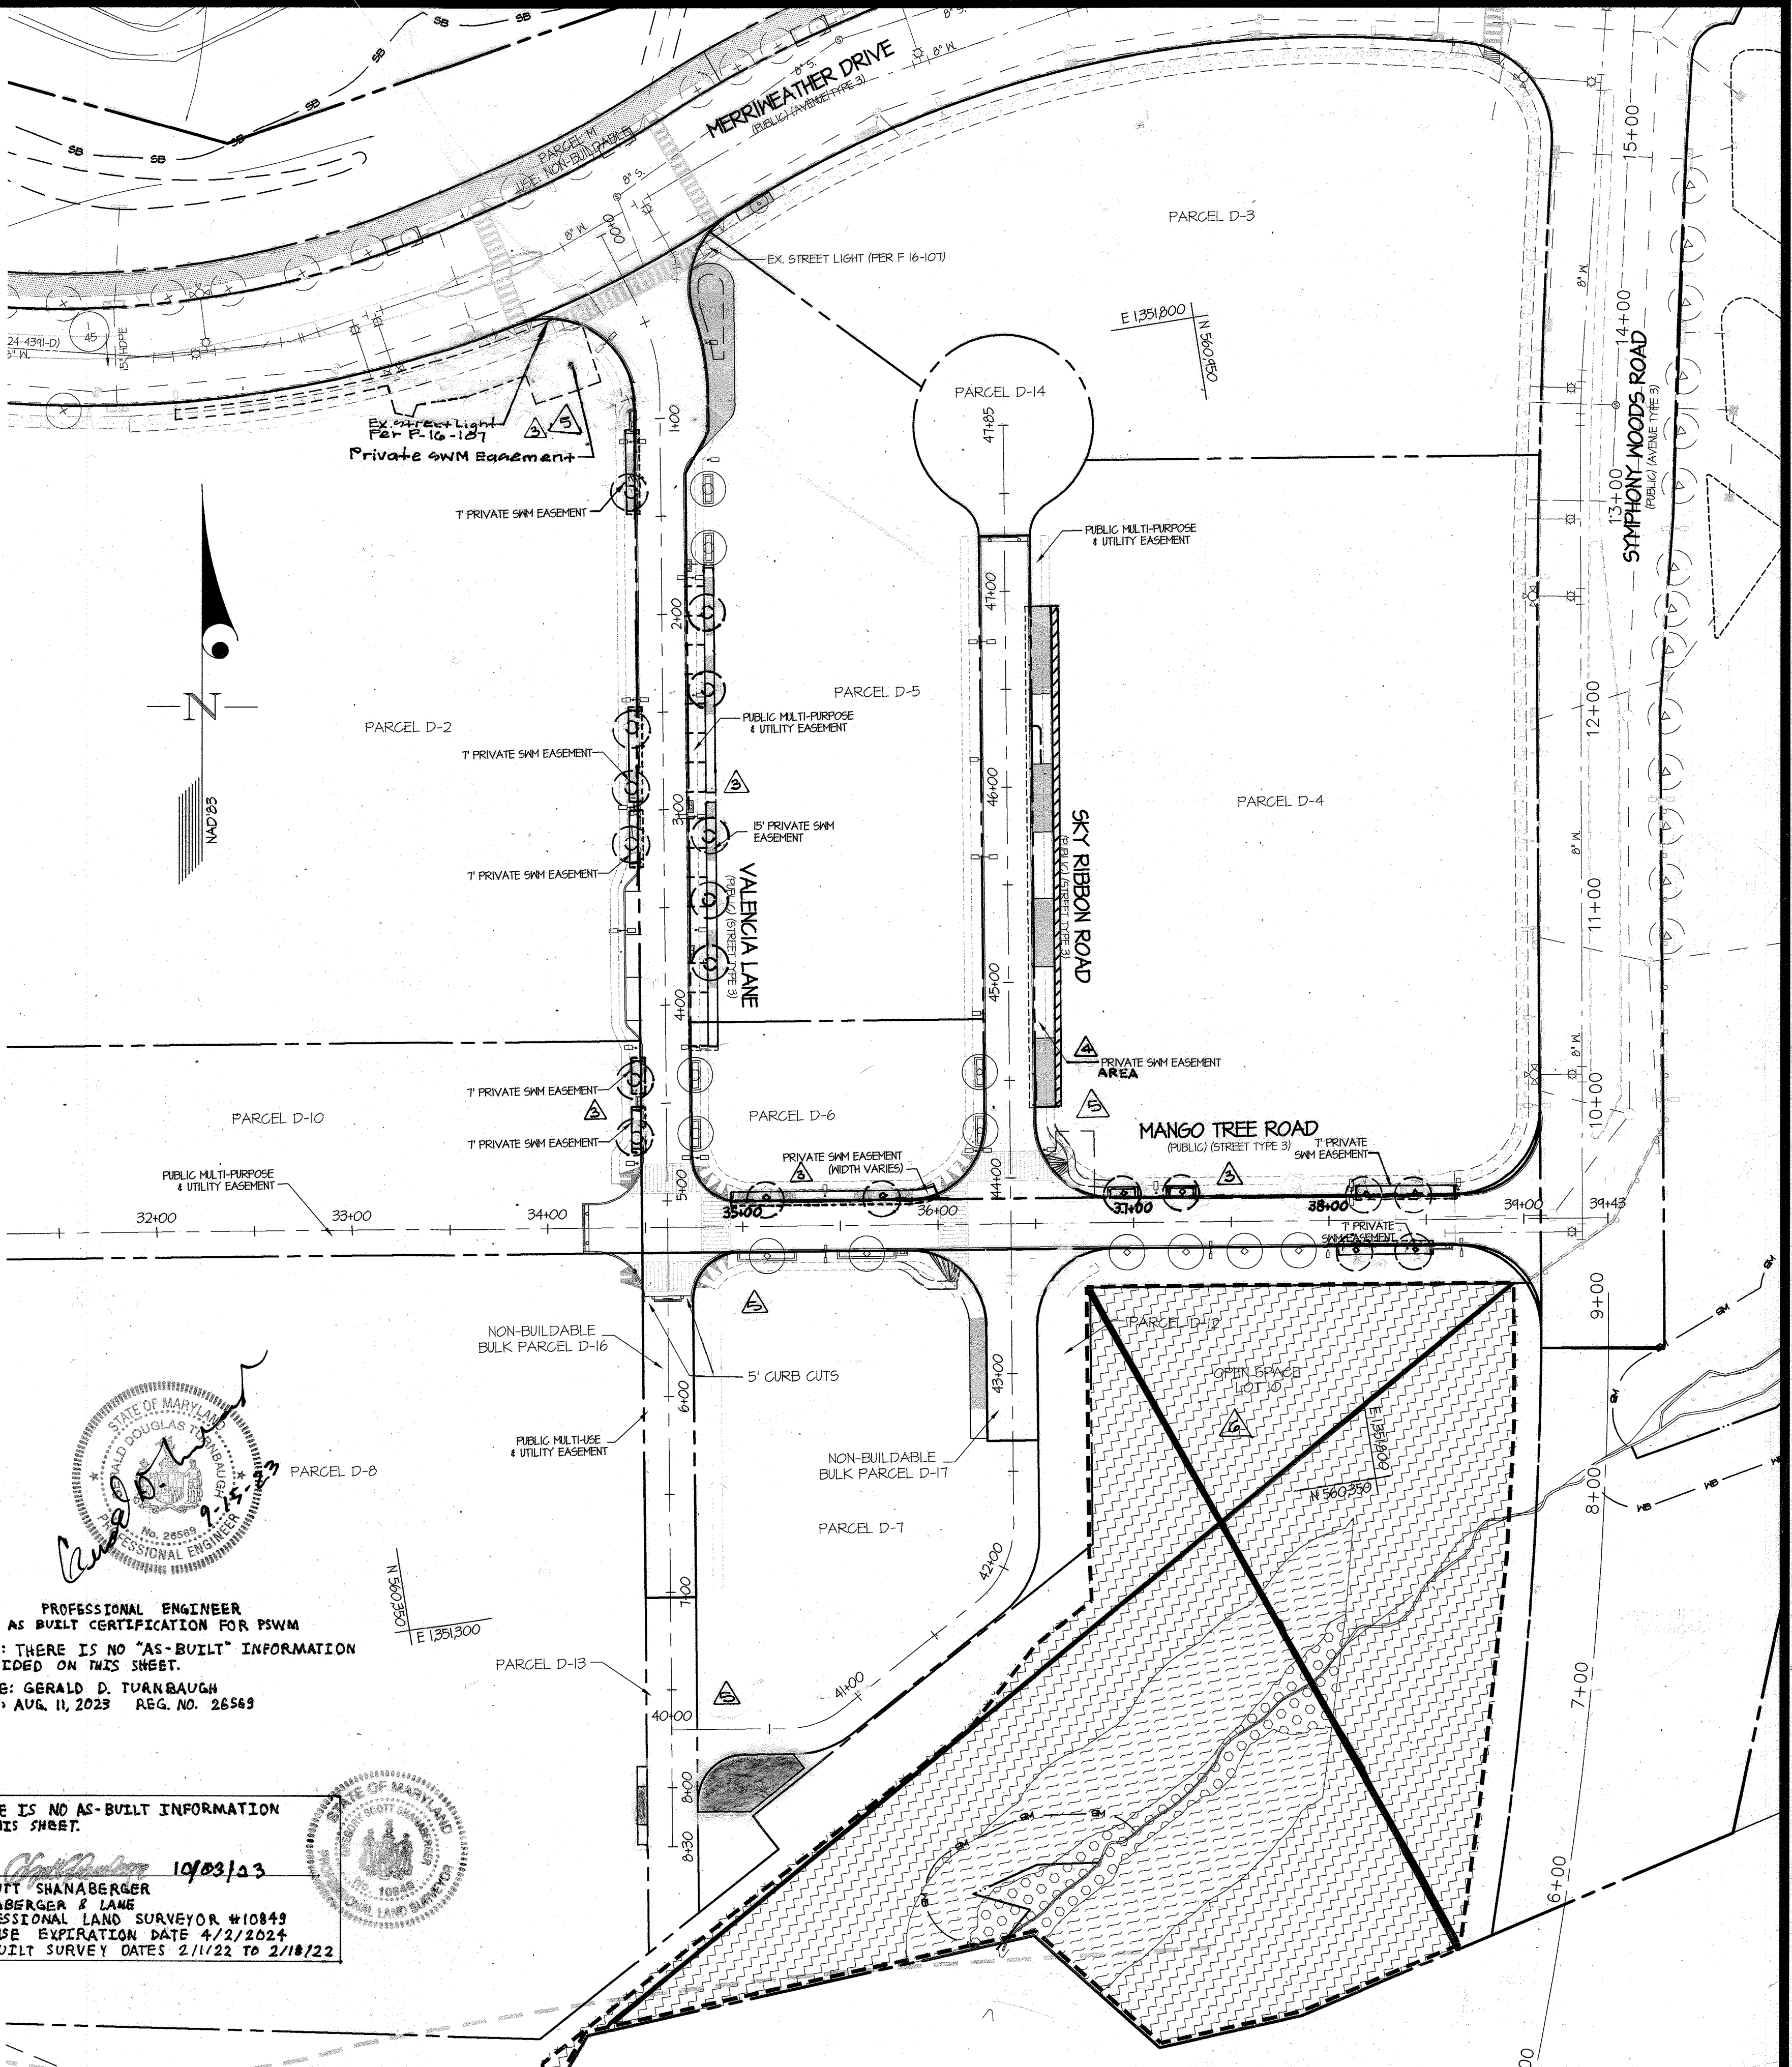

PROFESSIONAL ENGINEER AS BUILT CERTIFICATION FOR PSWM
 NOTE: THERE IS NO "AS-BUILT" INFORMATION PROVIDED ON THIS SHEET.
 NAME: GERALD D. TUANBAUGH
 DATE: AUG. 11, 2023 REG. NO. 26543

THERE IS NO AS-BUILT INFORMATION ON THIS SHEET.
 G. SCOTT SHANBERGER
 SHANBERGER & LANE
 PROFESSIONAL LAND SURVEYOR #10849
 LICENSE EXPIRATION DATE 4/2/2024
 AS-BUILT SURVEY DATES 2/11/22 TO 2/18/22

PREPARED FOR: THE HOWARD HUGHES CORPORATION, 10480 LITTLE PATUXENT PARKWAY, SUITE 400, COLUMBIA, MARYLAND 21044, ATTN: BILL ROWE, 410-964-4987

PROFESSIONAL CERTIFICATION: I HEREBY CERTIFY THAT THESE PLANS WERE PREPARED OR APPROVED BY ME, AND THAT I AM A DULY LICENSED PROFESSIONAL ENGINEER UNDER THE LAWS OF THE STATE OF MARYLAND, LICENSE NO. 12975, EXPIRATION DATE: MAR 26, 2018

STREET TREE, STREET LIGHTS & REFORESTATION PLAN

SCALE: 1" = 50'

ZONING: NT

G. L. W. FILE NO.: 11071

DATE: DEC., 2017


TAX MAP - GRID: 36 - 01

SHEET: 11 OF 25


ELECTION DISTRICT No. 5

HOWARD COUNTY, MARYLAND


L:\CD\DRAWINGS\1071\1071-AREA 3\PLANS BY CLW\17-059 Poma\1071-AREA 3\F-11-12 - Street Tree.dwg
 DATE: 12/14/17 11:52 AM, LAST SAVE: 12/14/2017 11:52 AM, PLOTTED BY: CLW
 © GLW 2017

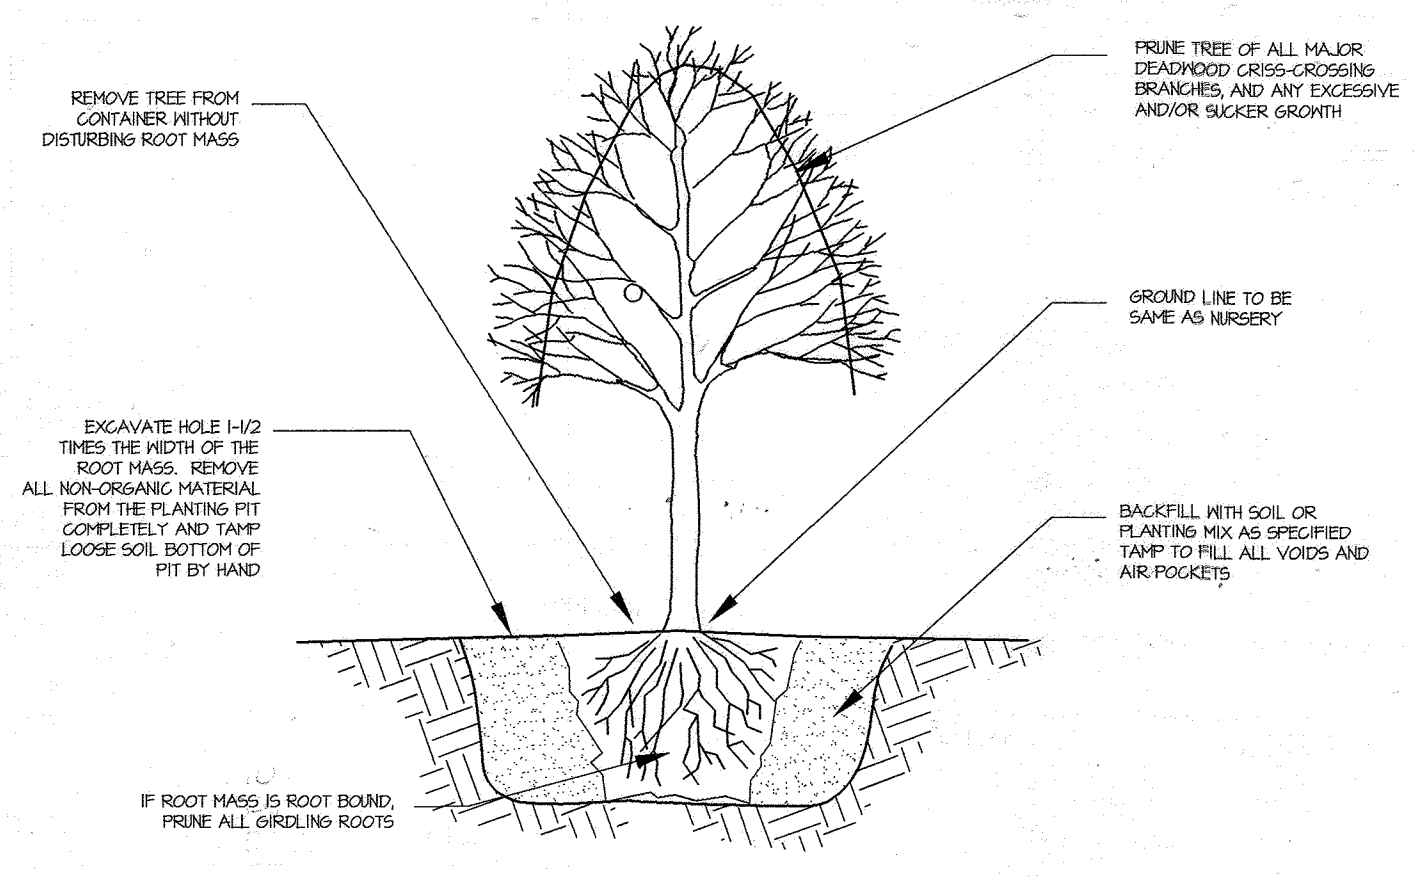


TREE PLANTING - CONTAINER GROWN NOT TO SCALE

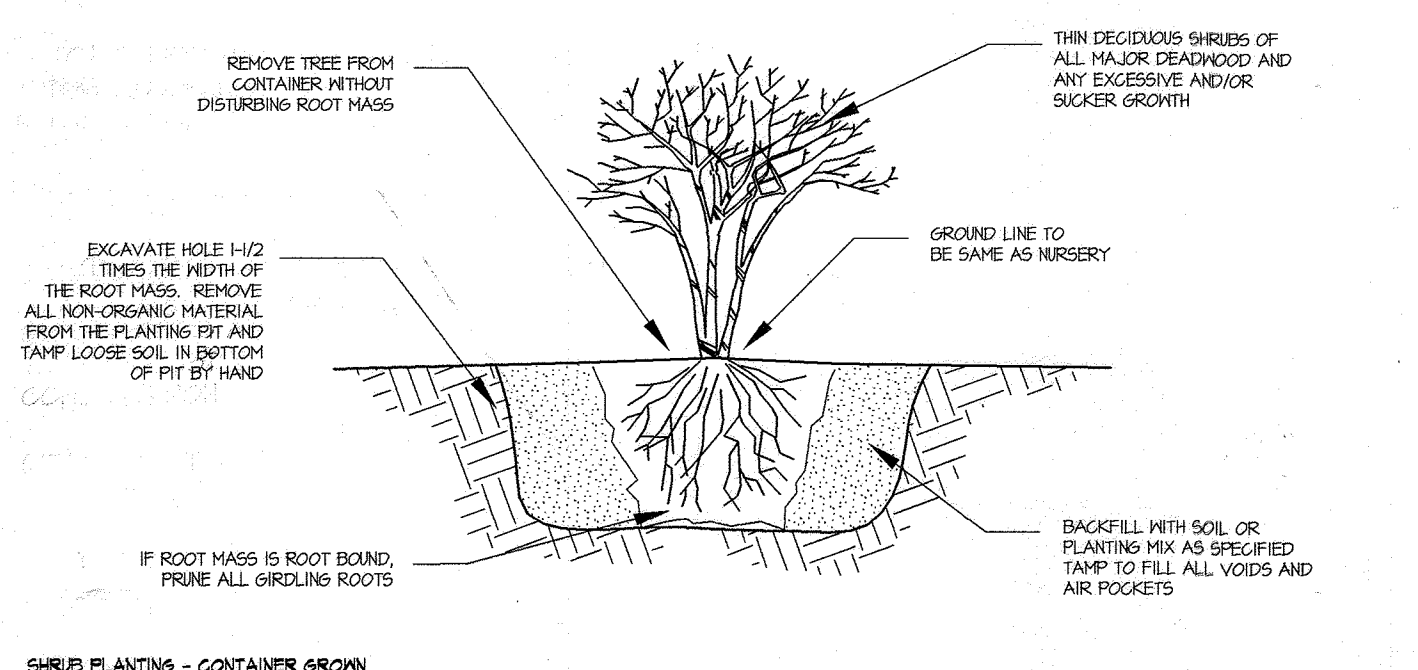


SHRUB PLANTING - CONTAINER GROWN NOT TO SCALE

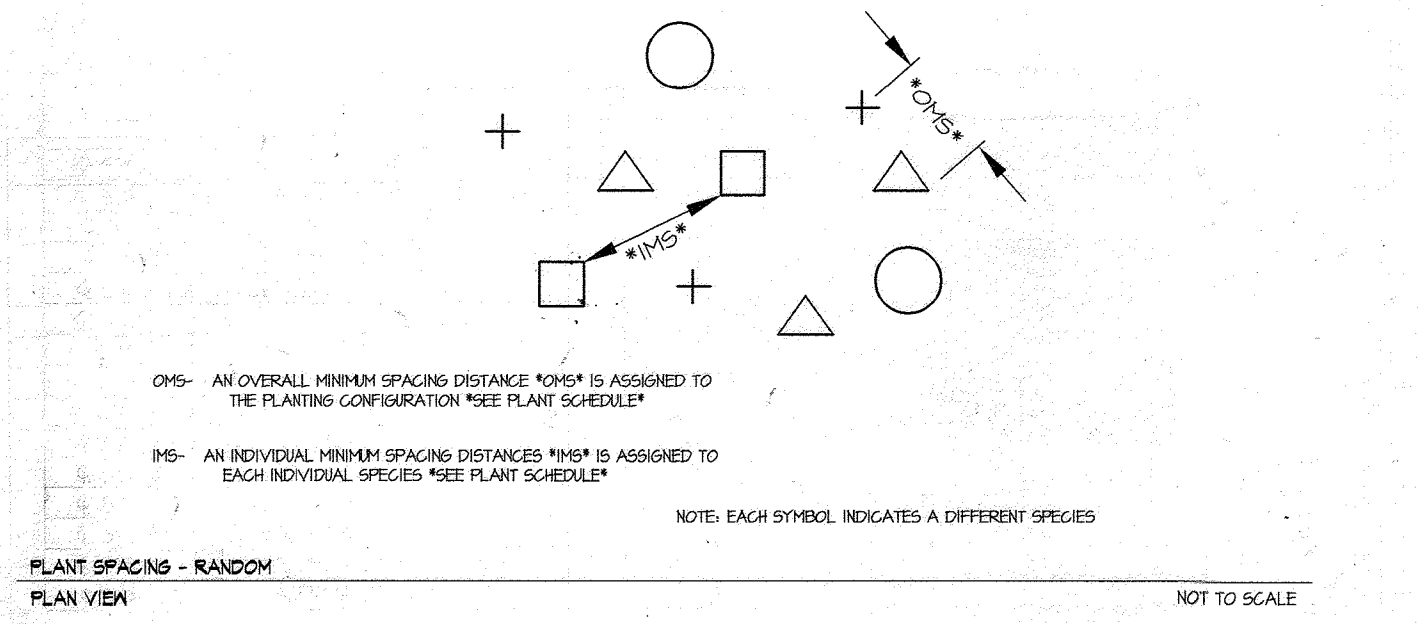


PLANT SPACINGS - RANDOM PLAN VIEW NOT TO SCALE

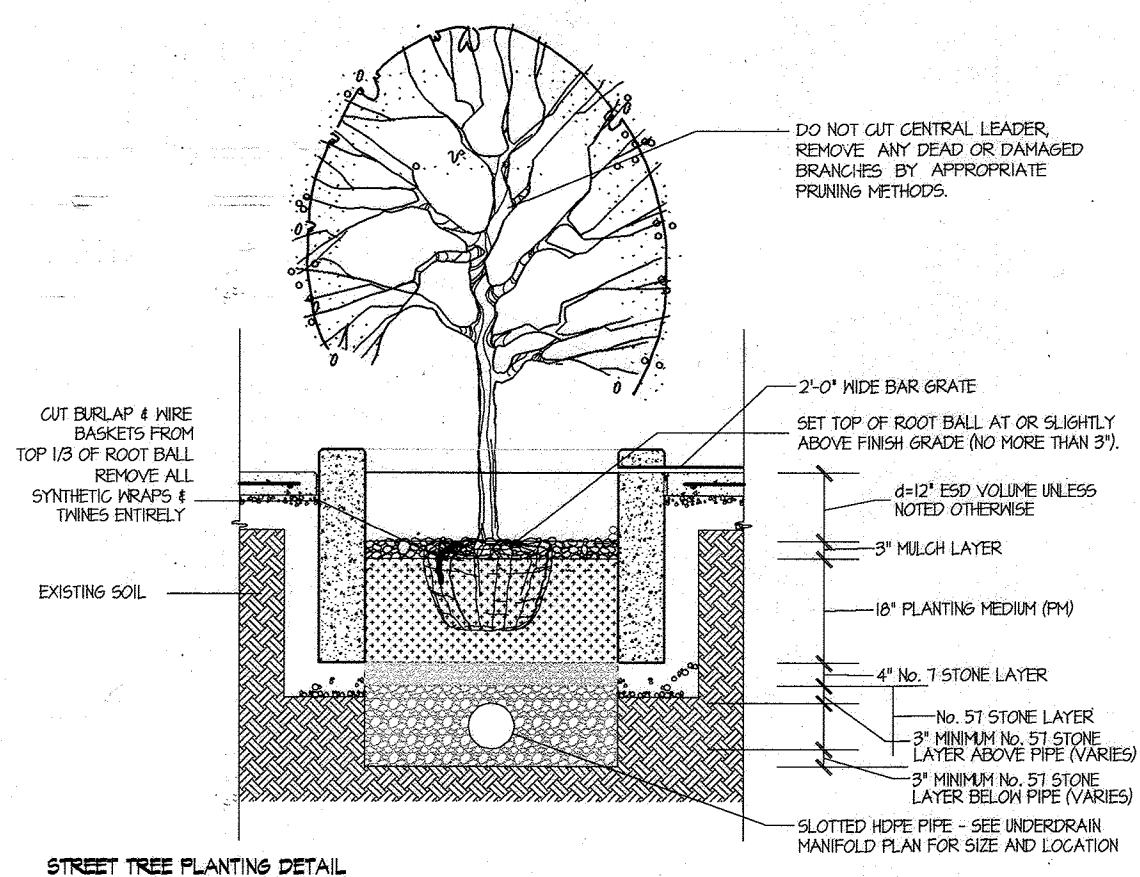

STREET TREE PLANTING DETAIL FOR PLANTING MATERIAL UP TO 3/2\"/>

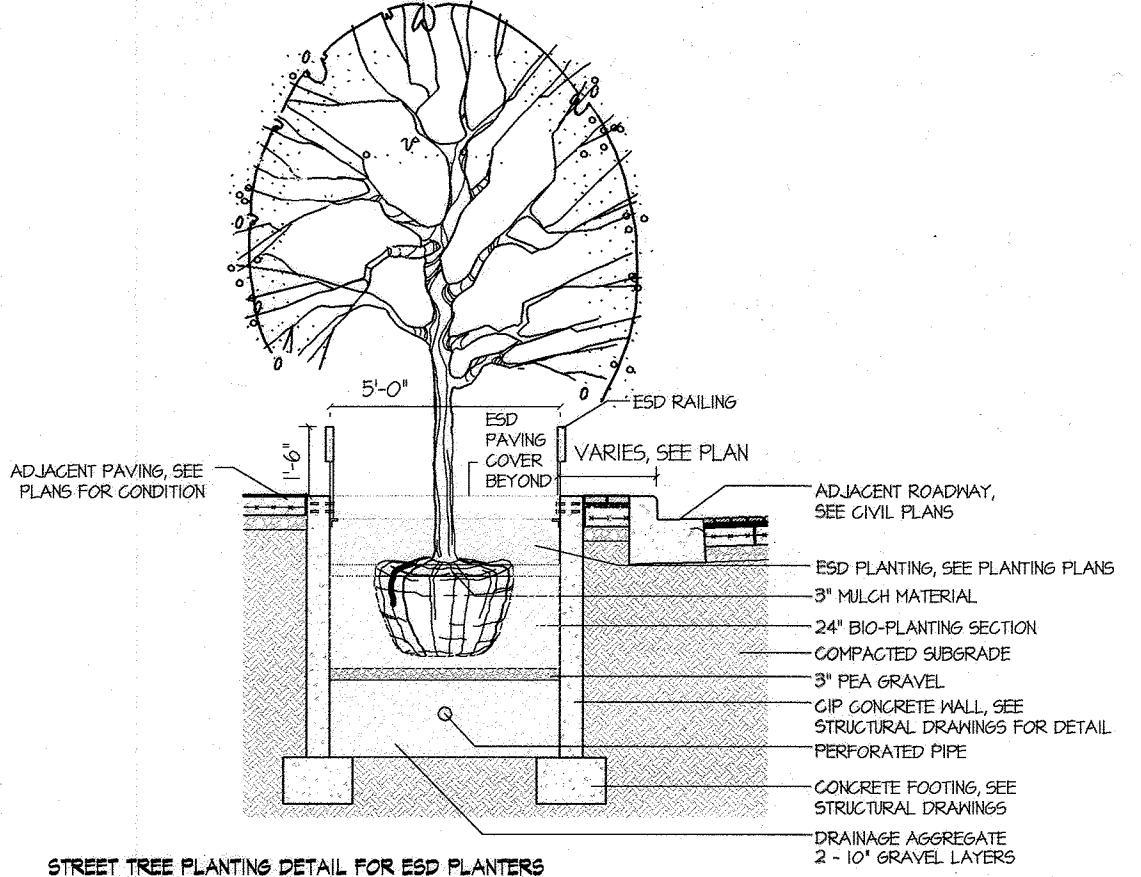

STREET TREE PLANTING DETAIL FOR ESD PLANTERS

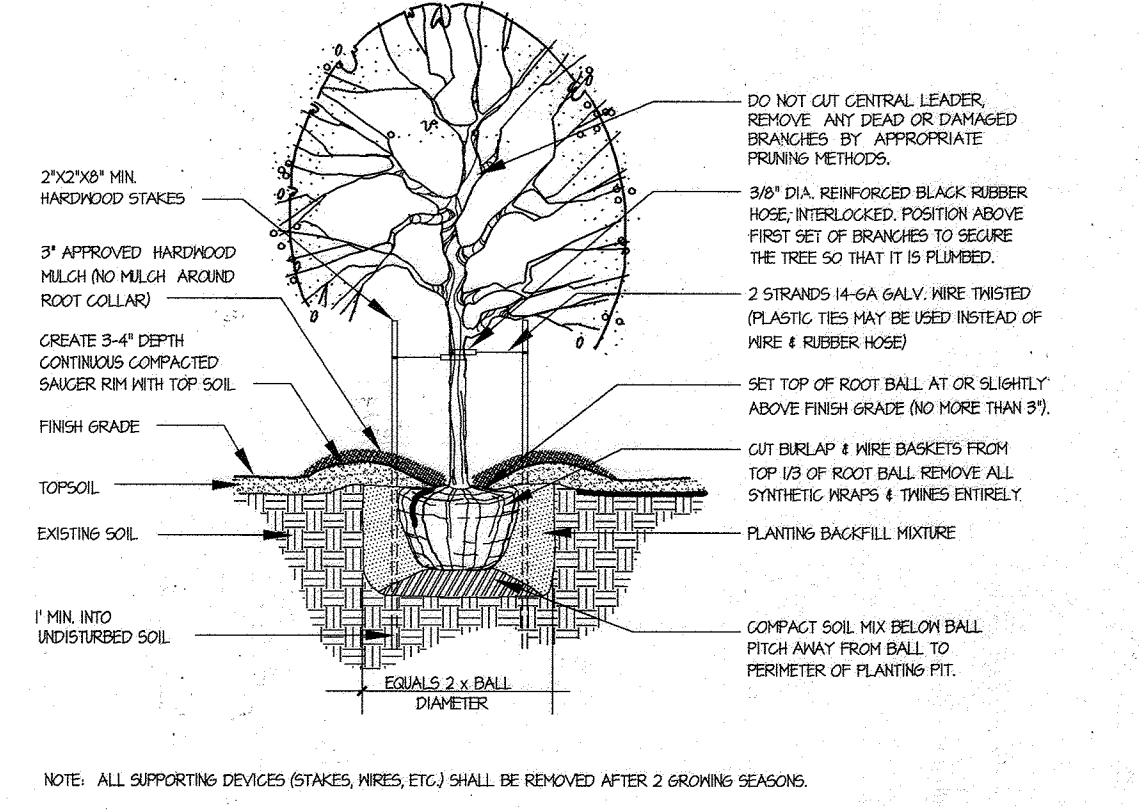


DECIDUOUS TREE PLANTING DETAIL FOR PLANTING MATERIAL UP TO 3/2\"/>

PROFESSIONAL ENGINEER
 AS-BUILT CERTIFICATION FOR P1444
 NOTE: THERE IS NO "AS-BUILT" INFORMATION PROVIDED ON THIS SHEET.
 NAME: GERALD D. TURNBAUGH
 DATE: AUG. 11, 2023 REG. NO.: 26563

Professional Certification
 I, the undersigned, being a duly Licensed Professional Engineer under the Laws of the State of Maryland, License No. 39426, Expiration Date: 08-15-2018, do hereby certify that these plans were prepared or approved by me, and that I am a duly Licensed Professional Engineer under the Laws of the State of Maryland.
 Signature of Registered Engineer: [Signature] Date: 8/9/18
 FOR RETAINING WALL PLAN LAYOUT, SECTION AND SCHEDULES ONLY

AS-BUILT CERTIFICATION
 I HEREBY CERTIFY, BY SEAL, THAT THE FACILITIES SHOWN ON THIS PLAN WERE CONSTRUCTED AS SHOWN ON THIS PLAN MEET THE CURRENT APPROVED PLANS AND SPECIFICATIONS.
 G. SCOTT SHANBERGER
 SHANBERGER & LANE
 PROFESSIONAL LAND SURVEYORS #10849
 LICENSE EXPIRATION DATE 4/2/2024
 AS-BUILT SURVEY DATES 2/1/22 TO 2/18/22
 10/23/23

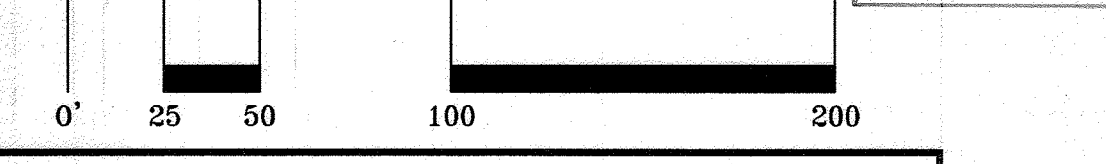

APPROVED: HOWARD COUNTY DEPARTMENT OF PUBLIC WORKS
 Chief, Bureau of Highways Date: 1/8/2018

APPROVED: HOWARD COUNTY DEPARTMENT OF PLANNING & ZONING
 Chief, Division of Land Development Date: 1-19-18

Chief, Development Engineering Division Date: 1-11-18



GLWGUTSCHICK LITTLE & WEBER, P.A.
 CIVIL ENGINEERS, LAND SURVEYORS, LAND PLANNERS, LANDSCAPE ARCHITECTS
 3909 NATIONAL DRIVE - SUITE 250 - BURTONSVILLE OFFICE PARK
 BURTONSVILLE, MARYLAND 20866
 TEL: 301-421-4024 BAL: 410-880-1820 DC/VA: 301-989-2524 FAX: 301-421-4186

DES. DEV.	DRN. JRD	CHK. MJT

DATE	REVISION	BY	APPR.
2-1-18	Proposed wall	JR	JRC


PREPARED FOR:
 THE HOWARD HUGHES CORPORATION
 10480 LITTLE PATUXENT PARKWAY
 SUITE 400
 COLUMBIA, MARYLAND 21044
 ATTN: BILL ROWE
 410-964-4987

PROFESSIONAL CERTIFICATION
 I HEREBY CERTIFY THAT THESE PLANS WERE PREPARED OR APPROVED BY ME, AND THAT I AM A DULY LICENSED PROFESSIONAL ENGINEER UNDER THE LAWS OF THE STATE OF MARYLAND, LICENSE NO. 12975, EXPIRATION DATE: MAY 28, 2018
 12/14/17

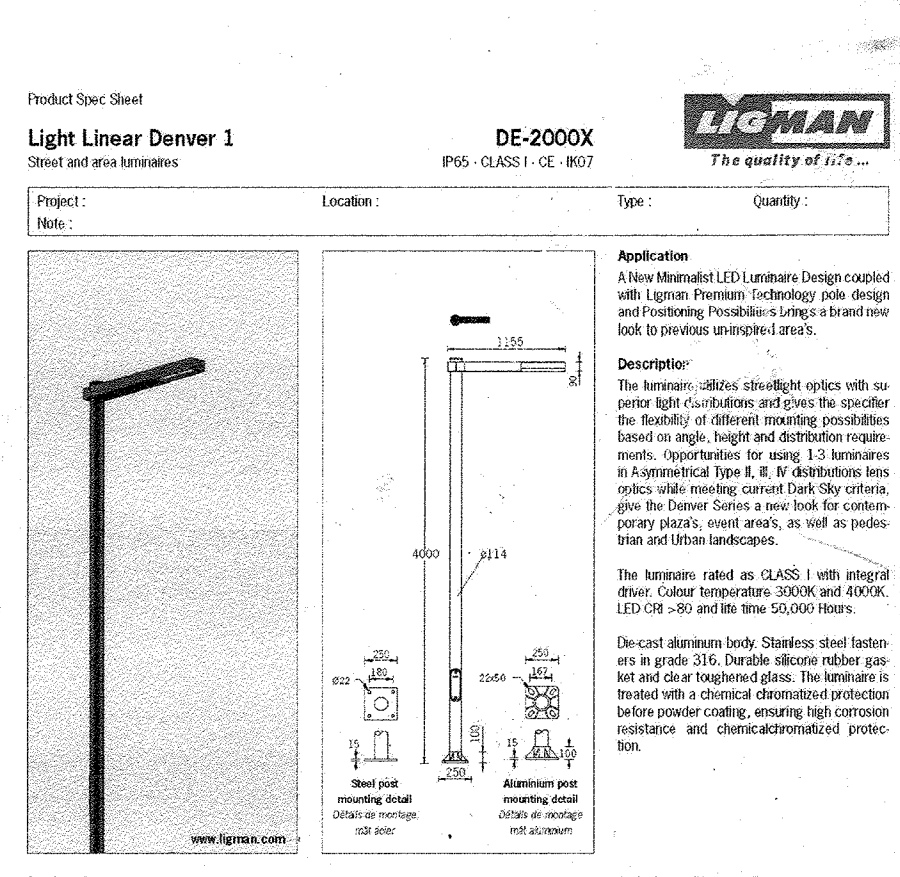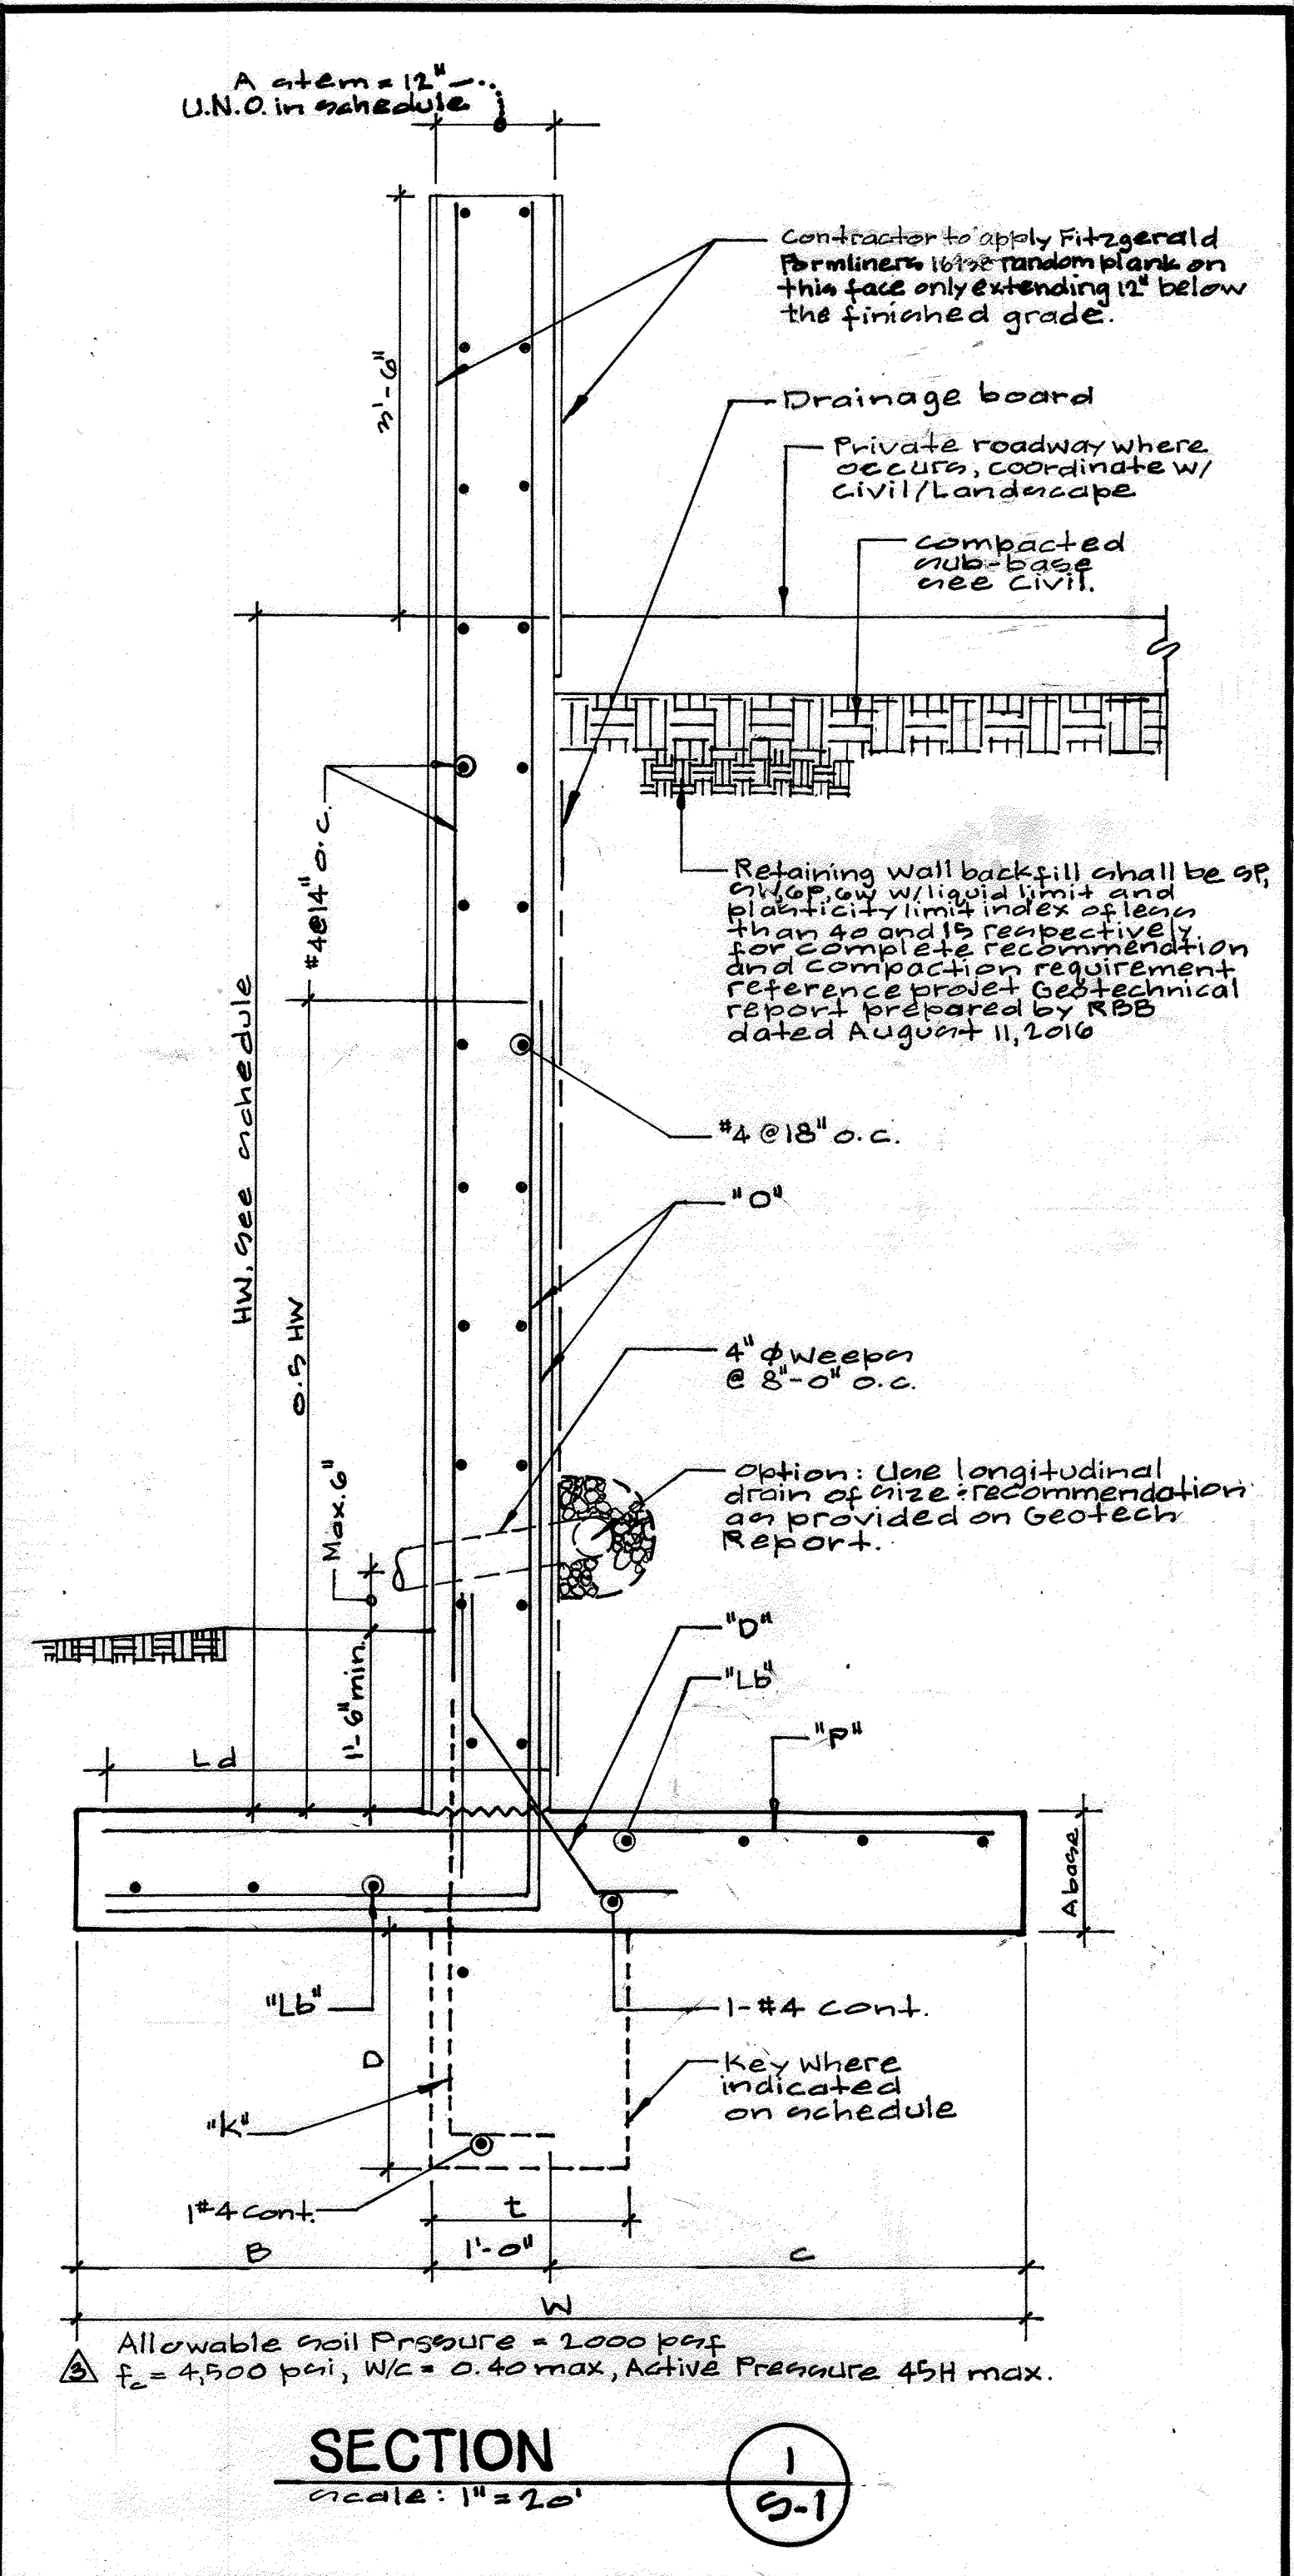


Product Code	Item	Quantity	Unit	Notes
DE-2000X-01	1000	100	EA	
DE-2000X-02	1000	100	EA	
DE-2000X-03	1000	100	EA	
DE-2000X-04	1000	100	EA	
DE-2000X-05	1000	100	EA	
DE-2000X-06	1000	100	EA	
DE-2000X-07	1000	100	EA	
DE-2000X-08	1000	100	EA	
DE-2000X-09	1000	100	EA	
DE-2000X-10	1000	100	EA	
DE-2000X-11	1000	100	EA	
DE-2000X-12	1000	100	EA	
DE-2000X-13	1000	100	EA	
DE-2000X-14	1000	100	EA	
DE-2000X-15	1000	100	EA	
DE-2000X-16	1000	100	EA	
DE-2000X-17	1000	100	EA	
DE-2000X-18	1000	100	EA	
DE-2000X-19	1000	100	EA	
DE-2000X-20	1000	100	EA	

Product Spec Sheet Light Linear Denver 1 DE-2000X

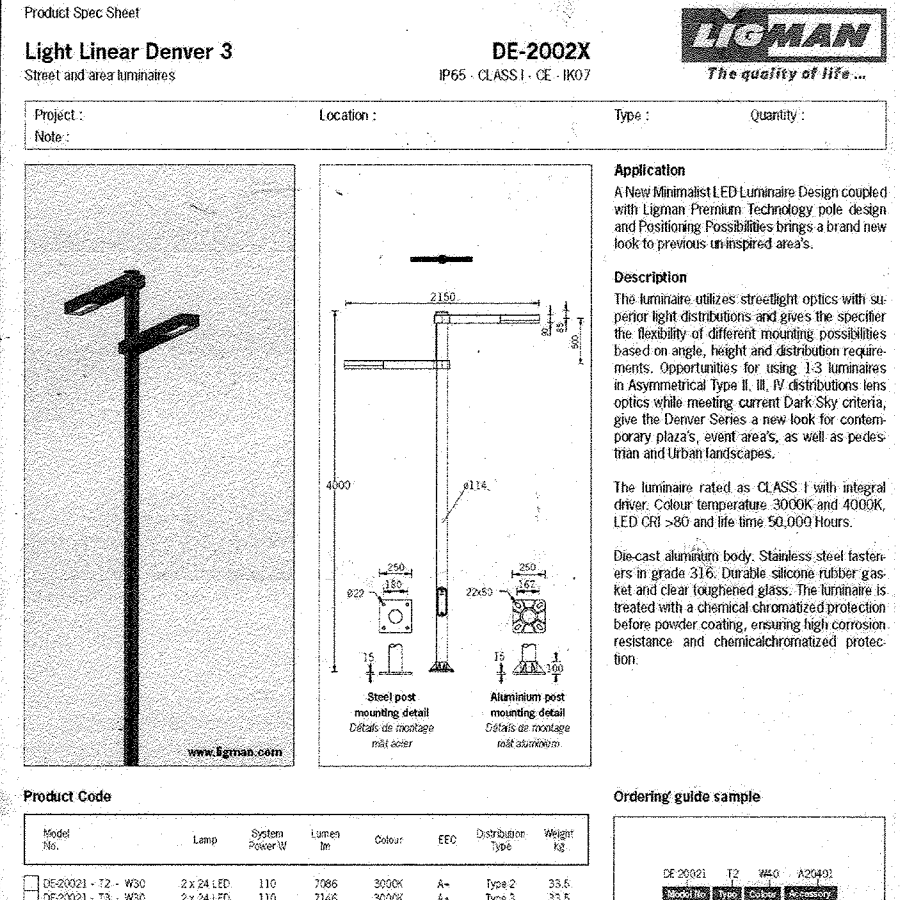


Product Code	Item	Quantity	Unit	Notes
DE-2000X-01	1000	100	EA	
DE-2000X-02	1000	100	EA	
DE-2000X-03	1000	100	EA	
DE-2000X-04	1000	100	EA	
DE-2000X-05	1000	100	EA	
DE-2000X-06	1000	100	EA	
DE-2000X-07	1000	100	EA	
DE-2000X-08	1000	100	EA	
DE-2000X-09	1000	100	EA	
DE-2000X-10	1000	100	EA	
DE-2000X-11	1000	100	EA	
DE-2000X-12	1000	100	EA	
DE-2000X-13	1000	100	EA	
DE-2000X-14	1000	100	EA	
DE-2000X-15	1000	100	EA	
DE-2000X-16	1000	100	EA	
DE-2000X-17	1000	100	EA	
DE-2000X-18	1000	100	EA	
DE-2000X-19	1000	100	EA	
DE-2000X-20	1000	100	EA	

Product Spec Sheet Light Linear Denver 3 DE-2000X

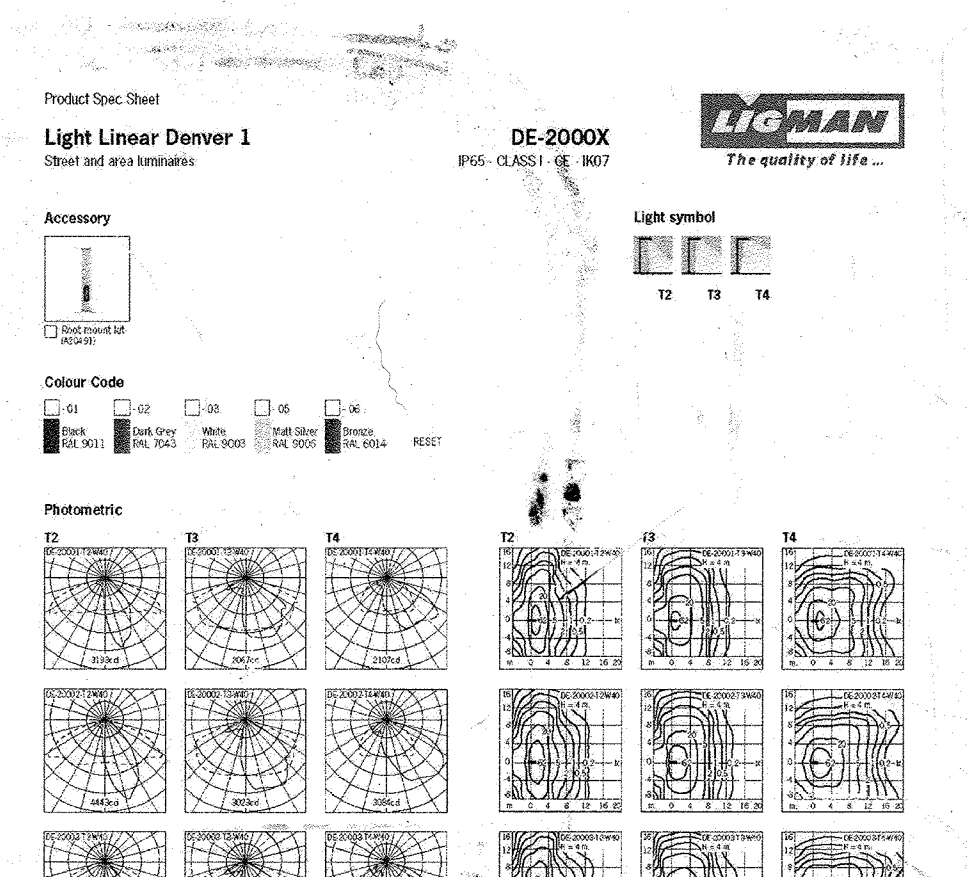

Product Code	Item	Quantity	Unit	Notes
DE-2000X-01	1000	100	EA	
DE-2000X-02	1000	100	EA	
DE-2000X-03	1000	100	EA	
DE-2000X-04	1000	100	EA	
DE-2000X-05	1000	100	EA	
DE-2000X-06	1000	100	EA	
DE-2000X-07	1000	100	EA	
DE-2000X-08	1000	100	EA	
DE-2000X-09	1000	100	EA	
DE-2000X-10	1000	100	EA	
DE-2000X-11	1000	100	EA	
DE-2000X-12	1000	100	EA	
DE-2000X-13	1000	100	EA	
DE-2000X-14	1000	100	EA	
DE-2000X-15	1000	100	EA	
DE-2000X-16	1000	100	EA	
DE-2000X-17	1000	100	EA	
DE-2000X-18	1000	100	EA	
DE-2000X-19	1000	100	EA	
DE-2000X-20	1000	100	EA	

Product Spec Sheet Light Linear Denver 1 DE-2000X

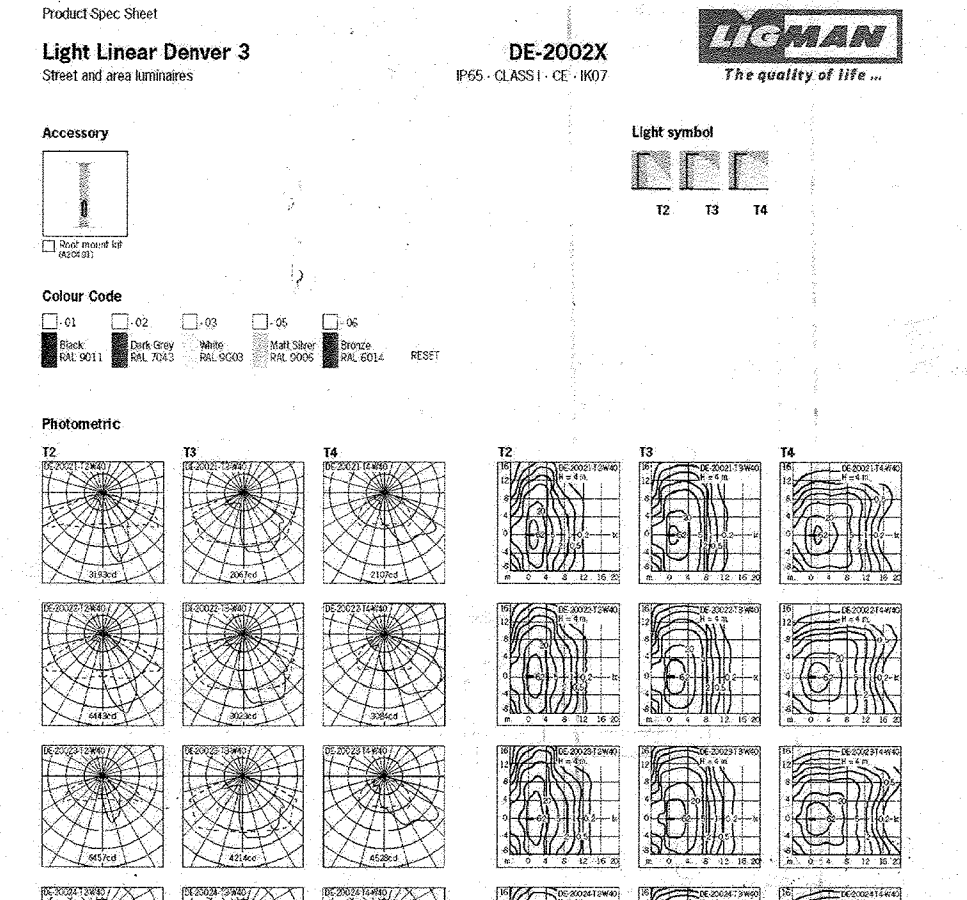



Product Code	Item	Quantity	Unit	Notes
DE-2000X-01	1000	100	EA	
DE-2000X-02	1000	100	EA	
DE-2000X-03	1000	100	EA	
DE-2000X-04	1000	100	EA	
DE-2000X-05	1000	100	EA	
DE-2000X-06	1000	100	EA	
DE-2000X-07	1000	100	EA	
DE-2000X-08	1000	100	EA	
DE-2000X-09	1000	100	EA	
DE-2000X-10	1000	100	EA	
DE-2000X-11	1000	100	EA	
DE-2000X-12	1000	100	EA	
DE-2000X-13	1000	100	EA	
DE-2000X-14	1000	100	EA	
DE-2000X-15	1000	100	EA	
DE-2000X-16	1000	100	EA	
DE-2000X-17	1000	100	EA	
DE-2000X-18	1000	100	EA	
DE-2000X-19	1000	100	EA	
DE-2000X-20	1000	100	EA	

Product Spec Sheet Light Linear Denver 3 DE-2000X

CANTILEVERED RETAINING WALL SCHEDULE										
$f_c = 13,000 \text{ psi}$ $f_y = 60,000 \text{ psi}$ $E_c = 4,500,000 \text{ psi}$ $E_s = 29,000,000 \text{ psi}$ $\mu = 0.25$ $\phi = 30^\circ$ $\beta = 45H$ $\rho = 0.25$ $F_c = 4,500 \text{ psf}$ $F_y = 60,000 \text{ psf}$ Backfill: Level w/ traffic surcharge, Max. w/c Ratio = 0.40 Drained wall soil bearing Pressure = 2,000 psf										
CONCRETE DIMENSIONS			STEM REINFORCEMENT			BASE REINFORCEMENT				
HW (ft)	W (ft-in)	B (ft-in)	C (ft-in)	A base (in)	KEY (O x T)	"o" size @ in	"d" size @ in	"p" size @ in	"Lb" size @ in	"K" size @ in
4.0	4'-0"	1'-0"	2'-0"	12	-	#4 @ 18"	#4 @ 9"	#4 @ 9"	5#4	-
5.0	5'-0"	1'-0"	3'-0"	12	-	#4 @ 18"	#4 @ 9"	#4 @ 9"	7#4	-
6.0	6'-0"	1'-0"	4'-0"	12	-	#4 @ 9"	#4 @ 9"	#4 @ 9"	6#4	-
7.0	6'-9"	1'-3"	4'-6"	12	12x12	#4 @ 9"	#4 @ 9"	#4 @ 8"	6#5	#4 @ 9"
8.0	7'-3"	1'-9"	4'-6"	12	12x12	#4 @ 9"	#4 @ 9"	#5 @ 10"	6#5	#4 @ 9"
9.0	8'-0"	2'-6"	4'-6"	12	12x18	#5 @ 9"	#4 @ 9"	#5 @ 10"	7#5	#4 @ 9"
10.0	8'-0"	3'-0"	4'-6"	12	20x20	#6 @ 9"	#4 @ 9"	#5 @ 10"	7#5	#5 @ 8"
11.0	9'-0"	3'-0"	4'-9"	12	24x20	#6 @ 9"	#4 @ 9"	#6 @ 12"	8#5	#5 @ 8"
12.0	10'-0"	3'-0"	5'-0"	12	24x20	#6 @ 7"	#5 @ 9"	#6 @ 9"	9#5	#5 @ 8"
13.0	11'-0"	4'-3"	5'-9"	15	26x20	#6 @ 7"	#5 @ 9"	#6 @ 9"	9#6	#5 @ 8"
14.0	11'-0"	4'-9"	5'-9"	15	30x20	#6 @ 6"	#5 @ 9"	#6 @ 9"	9#6	#5 @ 8"
15.0	13'-0"	5'-6"	6'-6"	18	30x20	#6 @ 6"	#6 @ 9"	#6 @ 8"	9#7	#5 @ 8"

STREET TREE & STREET LIGHT DETAILS
DOWNTOWN COLUMBIA
 CRESCENT NEIGHBORHOOD
 PARCELS D-1 THRU D-14, NON-BUILDABLE BULK PARCELS
 D-15 THRU D-17 & OPEN SPACE LOT 10
 HOWARD COUNTY, MARYLAND

SCALE	ZONING	G. L. W. FILE NO.
AS SHOWN	NT	11071
DATE	TAX MAP - GRID	SHEET
DEC., 2017	36 - 01	12 OF 25

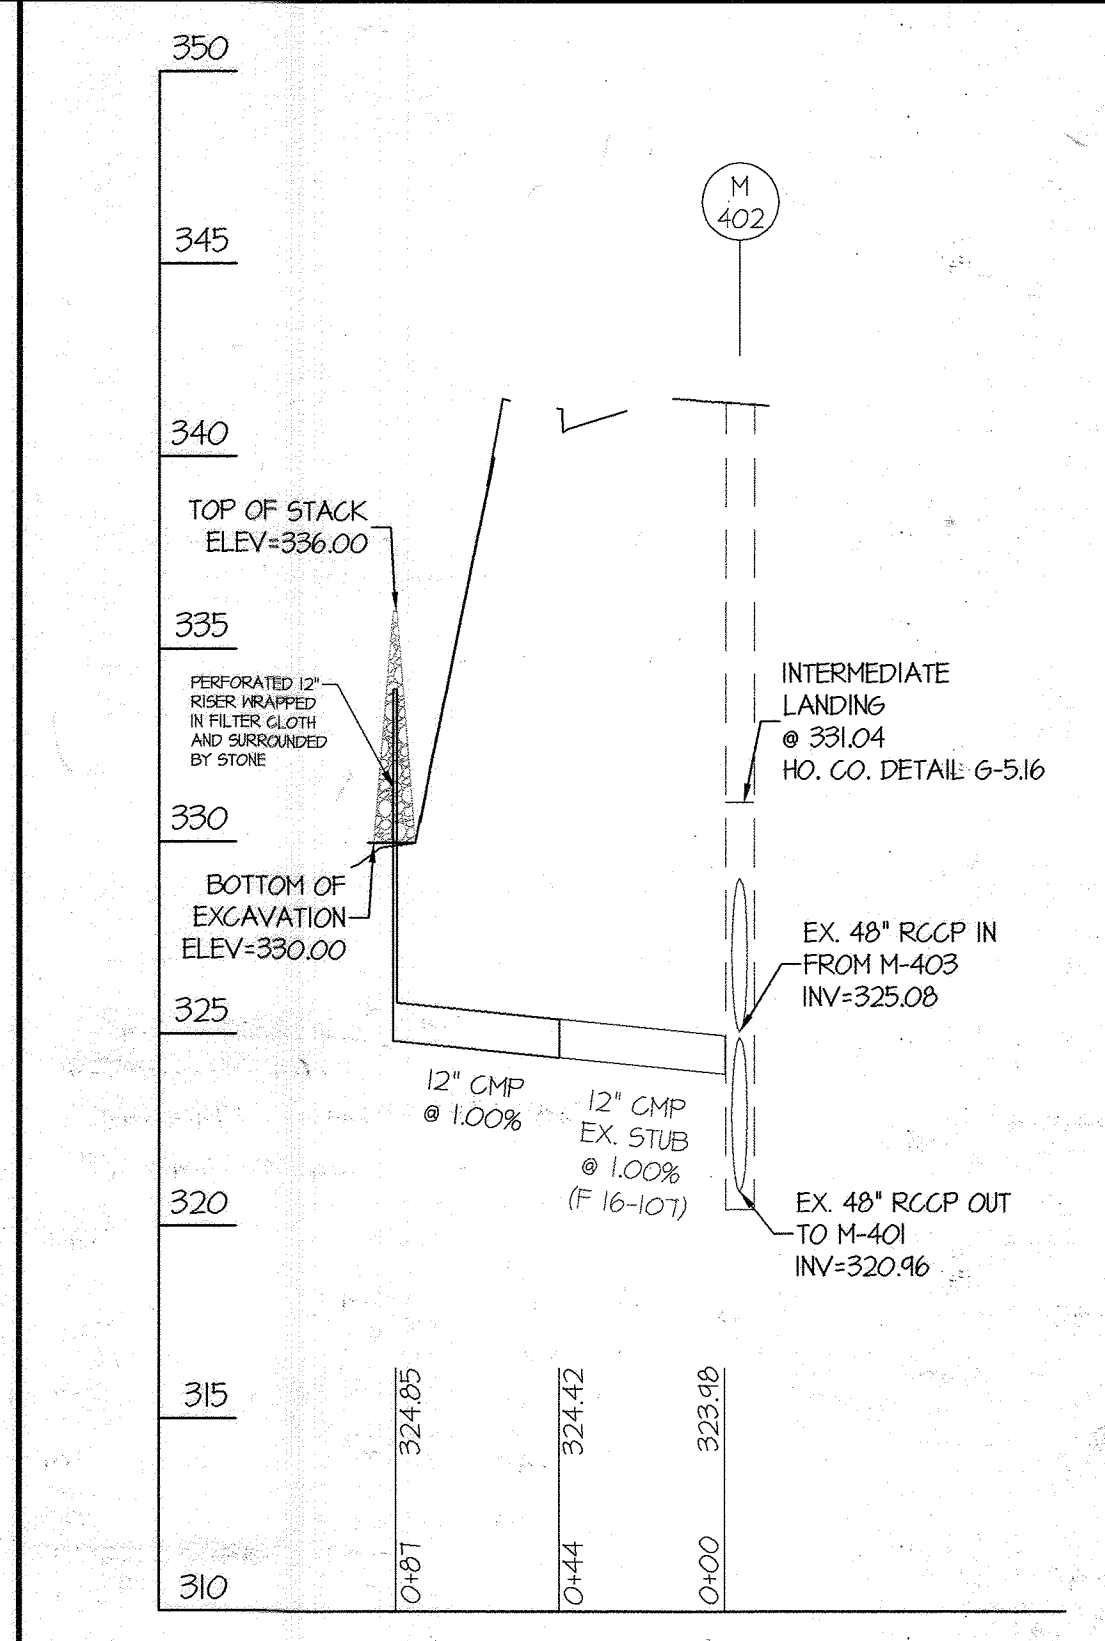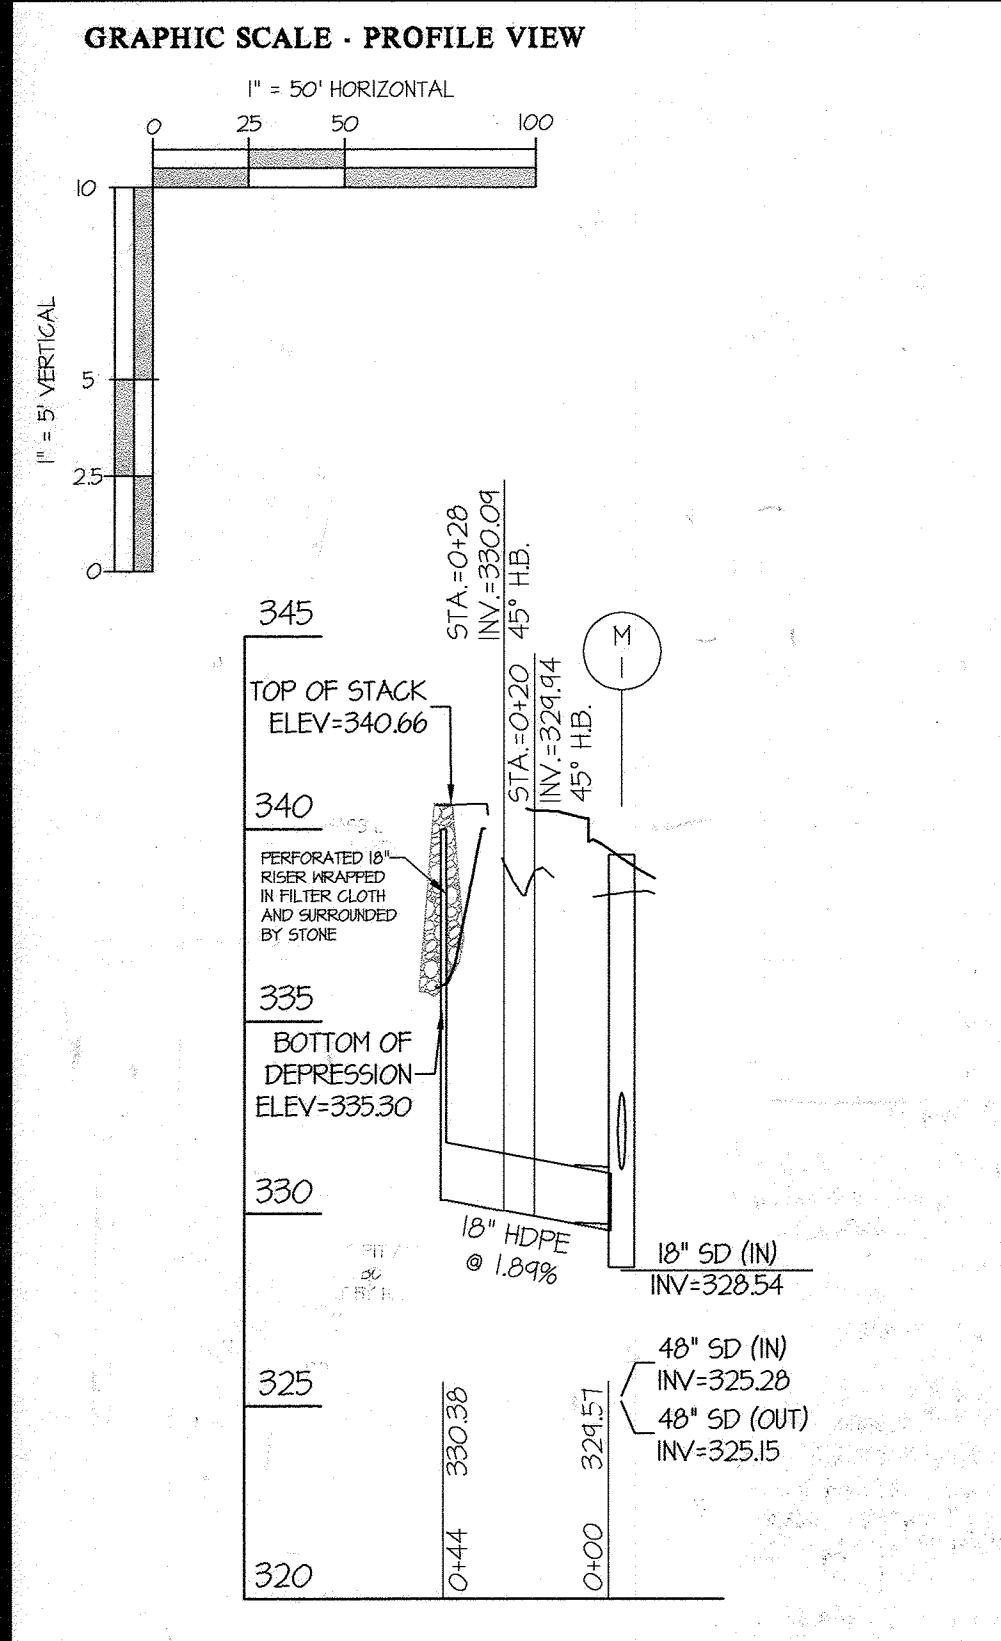

OUTLET FOR CLEAN WATER DIKES #1 AND #2
SCALE: 1"=50' HORIZ. & 1"=5' VERT.

OUTLET FOR CLEAN WATER IN FUTURE GARAGE LOCATION
SCALE: 1"=50' HORIZ. & 1"=5' VERT.

NOTE: 4" PERFORATIONS REQUIRED IN THE RISER PIPE BETWEEN THE ELEVATIONS OF 335.5 AND 340.0. THERE ARE 9 PERFORATIONS PER ROW AND THEY ARE TO BE SPACED EVENLY AROUND THE CIRCUMFERENCE OF THE PIPE. VERTICALLY, THE PERFORATIONS ARE TO BE SPACED 6" APART.

NOTE: 2" PERFORATIONS REQUIRED IN THE RISER PIPE BETWEEN THE ELEVATIONS OF 328.0 AND 332.0. THERE ARE 8 PERFORATIONS PER ROW AND THEY ARE TO BE SPACED EVENLY AROUND THE CIRCUMFERENCE OF THE PIPE. VERTICALLY, THE PERFORATIONS ARE TO BE SPACED 6" APART.

CLEAN WATER DIVERSION DIKES						
No.	DRAINAGE AREA	AVG. SLOPE	TREATMENT	DISCHARGE AT OUTLET	SHEAR STRESS AT OUTLET	FLOW DEPTH
CND #1	1.82 AC.	1.46%	A-2	2.25 CFS	0.24 LB/FT ²	0.54 FT
CND #2	2.95 AC.	0.57%	A-2	6.61 CFS	0.16 LB/FT ²	1.01 FT

EARTH DIKES						
No.	DRAINAGE AREA	AVG. SLOPE	TREATMENT	DISCHARGE AT OUTLET	SHEAR STRESS AT OUTLET	FLOW DEPTH
ED #1	0.84 AC.	0.82%	A-1	0.15 CFS	0.15 LB/FT ²	0.15 FT

This Development Plan is approved for Soil Erosion and Sediment Control by the Howard Soil Conservation District.

John R. Robertson 12/28/17
Howard S.C.D. Date

ENGINEER'S CERTIFICATE
I HEREBY CERTIFY THAT THIS PLAN FOR SEDIMENT AND EROSION CONTROL REPRESENTS A PRACTICAL AND WORKABLE PLAN BASED ON MY PERSONAL KNOWLEDGE OF THE SITE CONDITIONS AND THAT IT WAS PREPARED IN ACCORDANCE WITH THE REQUIREMENTS OF THE HOWARD SOIL CONSERVATION DISTRICT.

CLG 12/14/17
ENGINEER'S SIGNATURE DATE

DEVELOPER'S/BUILDER'S CERTIFICATE
I HAVE CERTIFIED THAT ALL DEVELOPMENT AND CONSTRUCTION WILL BE DONE ACCORDING TO THIS PLAN OF DEVELOPMENT FOR SEDIMENT AND EROSION CONTROL, AND THAT ANY RESPONSIBLE PERSONNEL INVOLVED IN THE CONSTRUCTION PROJECT WILL HAVE A CERTIFICATE OF ATTENDANCE AT A DEPARTMENT OF ENVIRONMENT APPROVED TRAINING PROGRAM FOR THE CONTROL OF SEDIMENT AND EROSION BEFORE BEGINNING THE PROJECT. I ALSO AUTHORIZE PERIODIC ON-SITE INSPECTION BY THE HOWARD SOIL CONSERVATION DISTRICT.

[Signature] 12/14/17
SIGNATURE OF DEVELOPER/BUILDER DATE



APPROVED: HOWARD COUNTY DEPARTMENT OF PUBLIC WORKS
Chief, Bureau of Highways

APPROVED: HOWARD COUNTY DEPARTMENT OF PLANNING & ZONING
Chief, Division of Land Development


APPROVED: HOWARD COUNTY DEPARTMENT OF PLANNING & ZONING
Chief, Development Engineering Division

GLWGUTSCHICK LITTLE & WEBER, P.A.
CIVIL ENGINEERS, LAND SURVEYORS, LAND PLANNERS, LANDSCAPE ARCHITECTS
3909 NATIONAL DRIVE - SUITE 250 - BURTONSVILLE OFFICE PARK
BURTONSVILLE, MARYLAND 20866
TEL: 301-421-4024 FAX: 410-889-1820 DC/VA: 301-989-2524 FAX: 301-421-4186

NO.	DATE	REVISION
1-14-17		REVISED MBR, FHT, SH, GRADES, LOD, SFF
1-26-18		Rev. Grading at Valencia Lane & Proposed wall
3-28-18		Updated Sediment Control Devices & Grading

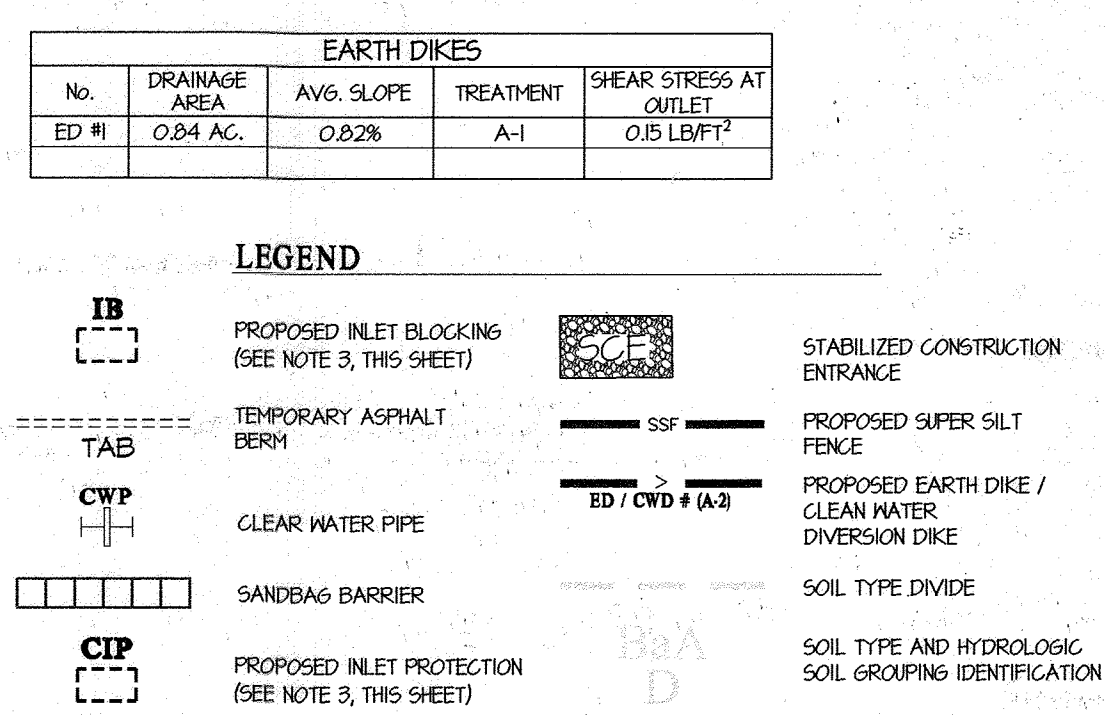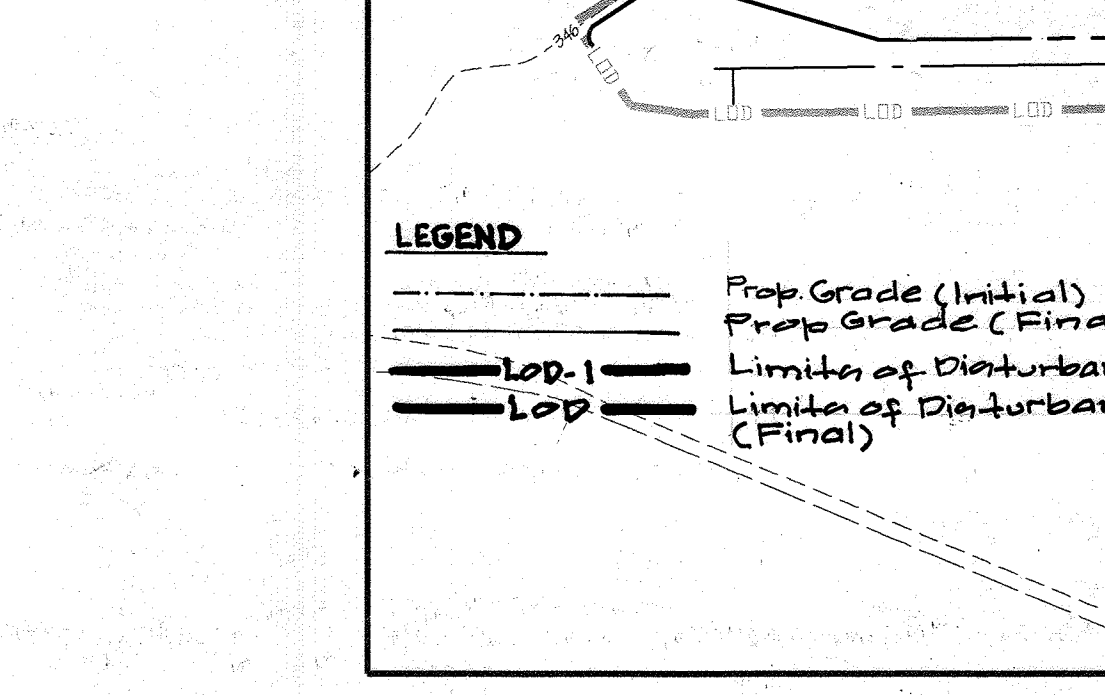


SOIL TYPE	SOIL DESCRIPTION	Kv	SOILS GROUP
BaA	Baile silt loam, 0 to 3 percent slopes	0.32	"D"
GbB	Gladstone loam, 3 to 8 percent slopes	0.20	"B"
GbC	Gladstone loam, 8 to 15 percent slopes	0.28	"B"
GmB	Glenville silt loam, 3 to 8 percent slopes	0.31	"C"
Ha	Harboro - Codorus silt loams, 0 to 3 percent slopes	0.31	"D"
McD	Manor loam 15-25 percent slopes, very rocky	0.32	"D"

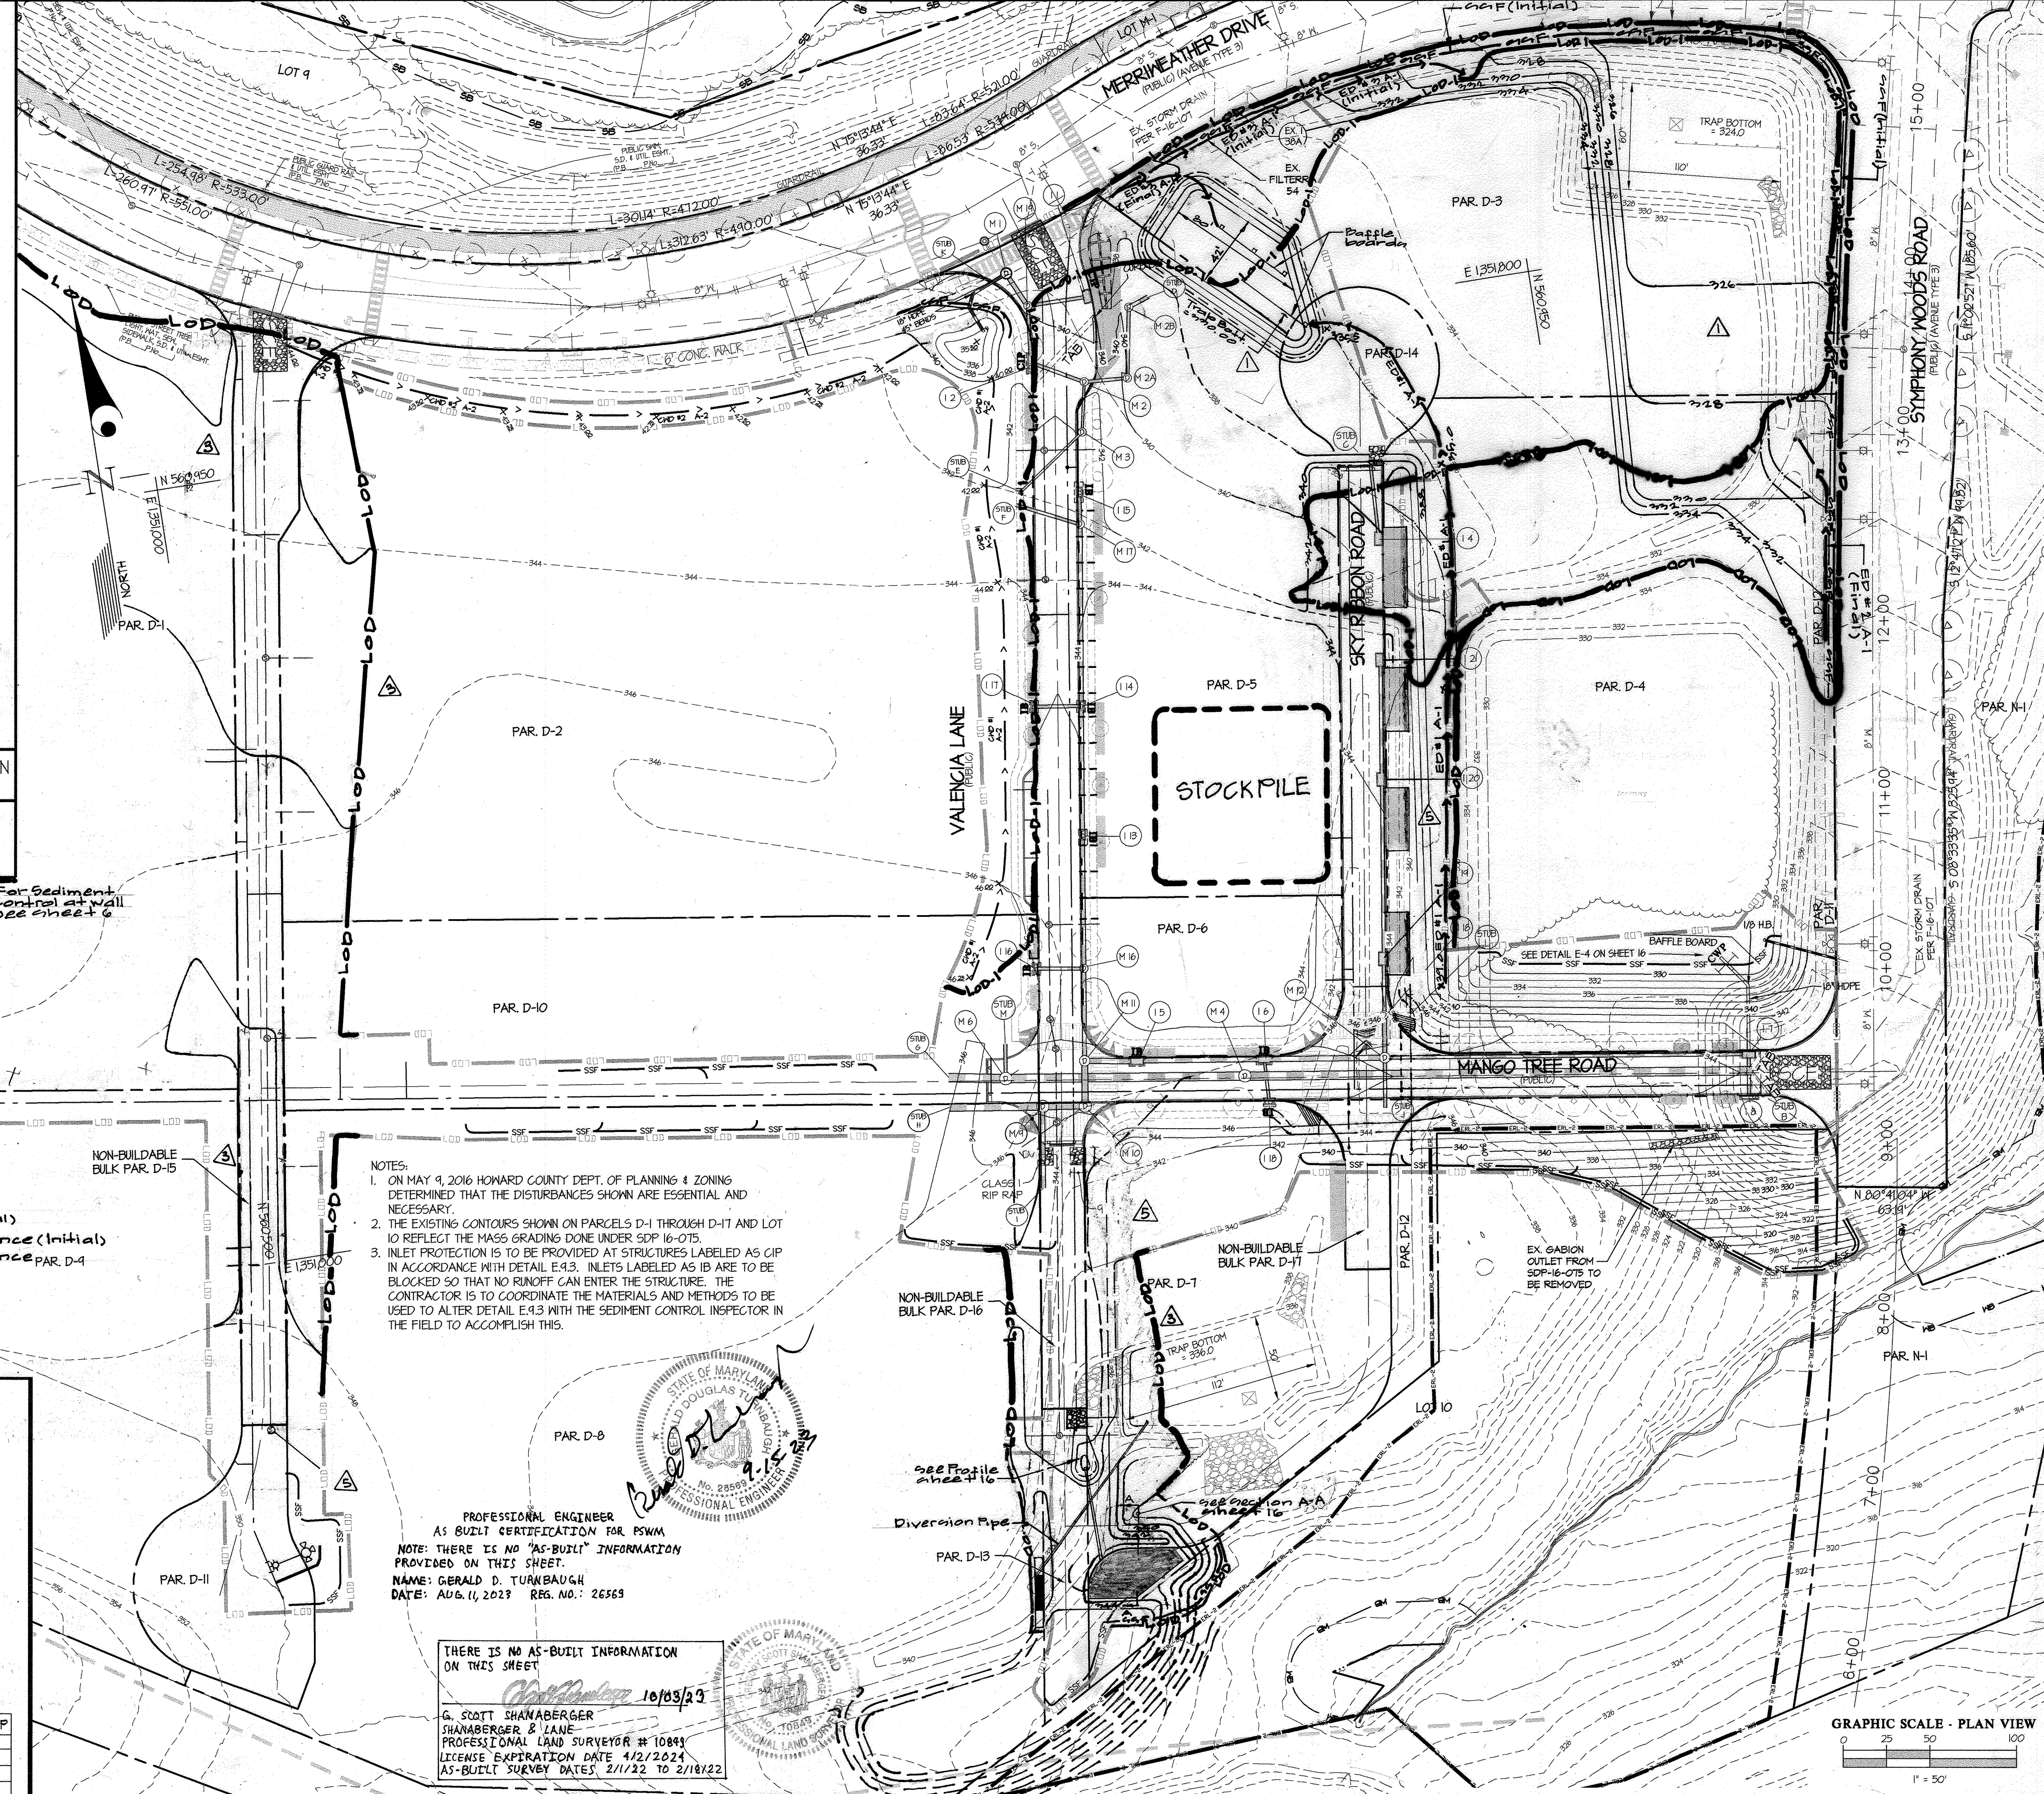

NOTES:
1. ON MAY 9, 2016 HOWARD COUNTY DEPT. OF PLANNING & ZONING DETERMINED THAT THE DISTURBANCES SHOWN ARE ESSENTIAL AND NECESSARY.
2. THE EXISTING CONTOURS SHOWN ON PARCELS D-1 THROUGH D-11 AND LOT 10 REFLECT THE MASS GRADING DONE UNDER SOP 16-075.
3. INLET PROTECTION IS TO BE PROVIDED AT STRUCTURES LABELED AS CIP IN ACCORDANCE WITH DETAIL E-4.3. INLETS LABELED AS IB ARE TO BE BLOCKED SO THAT NO RUNOFF CAN ENTER THE STRUCTURE. THE CONTRACTOR IS TO COORDINATE THE MATERIALS AND METHODS TO BE USED TO ALTER DETAIL E-4.3 WITH THE SEDIMENT CONTROL INSPECTOR IN THE FIELD TO ACCOMPLISH THIS.

PROFESSIONAL ENGINEER
AS BUILT CERTIFICATION FOR PSWM
NOTE: THERE IS NO "AS-BUILT" INFORMATION PROVIDED ON THIS SHEET.
NAME: GERALD D. TURNBAUGH
DATE: AUG. 14, 2023 REG. NO.: 26563

THIS IS NO AS-BUILT INFORMATION ON THIS SHEET
G. SCOTT SHAMBERGER
SHAMBERGER & LANE
PROFESSIONAL LAND SURVEYOR # 10883
LICENSE EXPIRATION DATE 1/2/2024
AS-BUILT SURVEY DATES: 2/11/22 TO 2/18/22

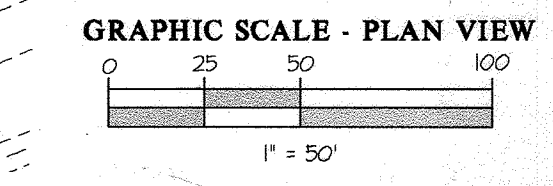

THIS PLAN IS FOR SEDIMENT CONTROL PURPOSES ONLY

NO.	DATE	REVISION
1-14-17		REVISED MBR, FHT, SH, GRADES, LOD, SFF
1-26-18		Rev. Grading at Valencia Lane & Proposed wall
3-28-18		Updated Sediment Control Devices & Grading

PREPARED FOR:
THE HOWARD HUGHES CORPORATION
10480 LITTLE PATUXENT PARKWAY
SUITE 400
COLUMBIA, MARYLAND 21044
ATTN: BILL ROWE
410-964-4987

PROFESSIONAL CERTIFICATION
I HEREBY CERTIFY THAT THESE PLANS WERE PREPARED OR APPROVED BY ME, AND THAT I AM A DULY LICENSED PROFESSIONAL ENGINEER UNDER THE LAWS OF THE STATE OF MARYLAND.
LICENSE NO. 12973
EXPIRATION DATE: MAY 26, 2018
12/14/17

SEDIMENT CONTROL PLAN
DOWNTOWN COLUMBIA
CRESCENT NEIGHBORHOOD
PARCELS D-1 THRU D-14, NON-BUILDABLE BULK PARCELS D-15 THRU D-17 & OPEN SPACE LOT 10
HOWARD COUNTY, MARYLAND

SCALE	ZONING	G. L. W. FILE NO.
1" = 50'	NT	11071
DATE	TAX MAP - GRID	SHEET
DEC, 2017	36 - 01	13 OF 25

X:\CD\DRAWINGS\11071-AREA 3\PLANS BY CLW\17-059 Plans\11071-AREA 3-F-13 - SC Plan.dwg
 PLOTTED: 12/14/17 11:58 AM USER: JWB/2017 324 PLOTTED BY: JWB
 X:\CD\DRAWINGS\11071-AREA 3\PLANS BY CLW\17-059 Plans\11071-AREA 3-F-13 - SC Plan.dwg
 PLOTTED: 12/14/17 11:58 AM USER: JWB/2017 324 PLOTTED BY: JWB

PIPE OULET SEDIMENT TRAP #1
(CONSTRUCTED UNDER SDF 16-075)

SEDIMENT CONTROL DESIGN INFORMATION	
DRAINAGE AREA - INITIAL	5.0 ACRES
DRAINAGE AREA - INTERIM	N/A ACRES
DRAINAGE AREA - FINAL	3.0 ACRES
TOTAL STORAGE REQUIRED	18,000 CF
TOTAL STORAGE PROVIDED	18,140 CF
NET STORAGE REQUIRED	4,000 CF
NET STORAGE PROVIDED	4,140 CF
DRY STORAGE REQUIRED	4,000 CF
DRY STORAGE PROVIDED	4,000 CF
TRAP BOTTOM ELEVATION	324.0 FT
TRAP BOTTOM DIMENSIONS	10' X 60' FT X FT
RISER CREST (DRY STORAGE) ELEVATION	326.25 FT
OUTLET (NET STORAGE) ELEVATION	324.60 FT
CLEANOUT ELEVATION	328.00 FT
TOP OF EMBANKMENT ELEVATION	324.0 FT
SIDE SLOPE	2:1 H:V RATIO
EMBANKMENT TOP WIDTH	4' FT
PRINCIPAL SPILLWAY MATERIAL (BARREL, RISER, ANTI-SEEP COLLAR)	CMP
RISER DIAMETER	42" IN
BARREL DIAMETER	30" IN
TRASH RACK DIAMETER	60" IN
TRASH RACK HEIGHT	21" IN
ANTI-SEEP COLLAR DIMENSIONS	2-1.75' X 1.75' FT
OUTLET PROTECTION - LENGTH	N/A FT
OUTLET PROTECTION - WIDTH	N/A FT
OUTLET PROTECTION - DEPTH	N/A IN

STONE OULET SEDIMENT TRAP #2
(CONSTRUCTED UNDER SDF 16-075)

SEDIMENT CONTROL DESIGN INFORMATION	
DRAINAGE AREA - INITIAL	6.60 ACRES
DRAINAGE AREA - INTERIM	N/A ACRES
DRAINAGE AREA - FINAL	6.72 ACRES
TOTAL STORAGE REQUIRED	24,182 CF
TOTAL STORAGE PROVIDED	25,856 CF
NET STORAGE REQUIRED	12,046 CF
NET STORAGE PROVIDED	13,236.8 CF
DRY STORAGE REQUIRED	12,046 CF
DRY STORAGE PROVIDED	12,194.4 CF
EXISTING GROUND ELEVATION AT OUTLET (NET STORAGE ELEVATION)	338.00 FT
TRAP BOTTOM ELEVATION	336.00 FT
TRAP DIMENSIONS	12' X 50' FT X FT
TRAP LENGTH	20' FT
TRAP WIDTH	20' FT
TRAP CREST (DRY STORAGE) ELEVATION	338.50 FT
CLEANOUT ELEVATION	336.80 FT
TOP OF EMBANKMENT ELEVATION	340.20 FT
SIDE SLOPE	2:1 H:V RATIO
EMBANKMENT TOP WIDTH	6' FT
OUTLET PROTECTION - LENGTH	20' FT
OUTLET PROTECTION - DEPTH	18" IN

10/05/23

G. SCOTT SHANBERGER
SHANBERGER & LANE
PROFESSIONAL LAND SURVEYOR # 10843
LICENSE EXPIRATION DATE 4/2/2024
AS-BUILT SURVEY DATES 2/11/22 TO 2/11/22

PROFESSIONAL ENGINEER
AS BUILT CERTIFICATION FOR PSWM



NOTE: THERE IS NO AS-BUILT INFORMATION PROVIDED ON THIS SHEET

NAME: GERALD D. TURNBAUGH
DATE: AUG. 11, 2023 REG. NO.: 26563

PIPE OULET SEDIMENT TRAP #3
(Constructed with this Plan)

FOR CONSTRUCTION SEE HEAD DETAIL 3-1-1

SEDIMENT CONTROL DESIGN INFORMATION	
DRAINAGE AREA - INITIAL	21 ACRES
DRAINAGE AREA - INTERIM	N/A ACRES
DRAINAGE AREA - FINAL	3.0 ACRES
TOTAL STORAGE REQUIRED	13,284 CF
TOTAL STORAGE PROVIDED	15,664 CF
NET STORAGE REQUIRED	5,400 CF
NET STORAGE PROVIDED	6,240 CF
DRY STORAGE REQUIRED	6,240 CF
DRY STORAGE PROVIDED	6,420 CF
TRAP BOTTOM ELEVATION	332.00 FT
TRAP BOTTOM DIMENSIONS	100' X 42' FT X FT
RISER CREST (DRY STORAGE) ELEVATION	333.00 FT
OUTLET (NET STORAGE) ELEVATION	331.20 FT
CLEANOUT ELEVATION	330.65 FT
TOP OF EMBANKMENT ELEVATION	335.00 FT
SIDE SLOPE	2:1 H:V RATIO
EMBANKMENT TOP WIDTH	4' FT
PRINCIPAL SPILLWAY MATERIAL (BARREL, RISER, ANTI-SEEP COLLAR)	CMP
RISER DIAMETER	33" IN
BARREL DIAMETER	24" IN
TRASH RACK DIAMETER	48" IN
TRASH RACK HEIGHT	23" IN
ANTI-SEEP COLLAR DIMENSIONS	1-5.5' X 5.5' FT
OUTLET PROTECTION - LENGTH	N/A FT
OUTLET PROTECTION - WIDTH	N/A FT
OUTLET PROTECTION - DEPTH	N/A IN

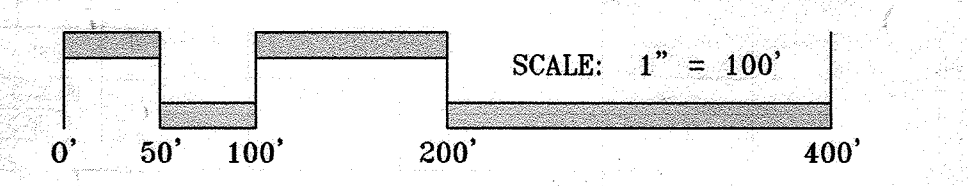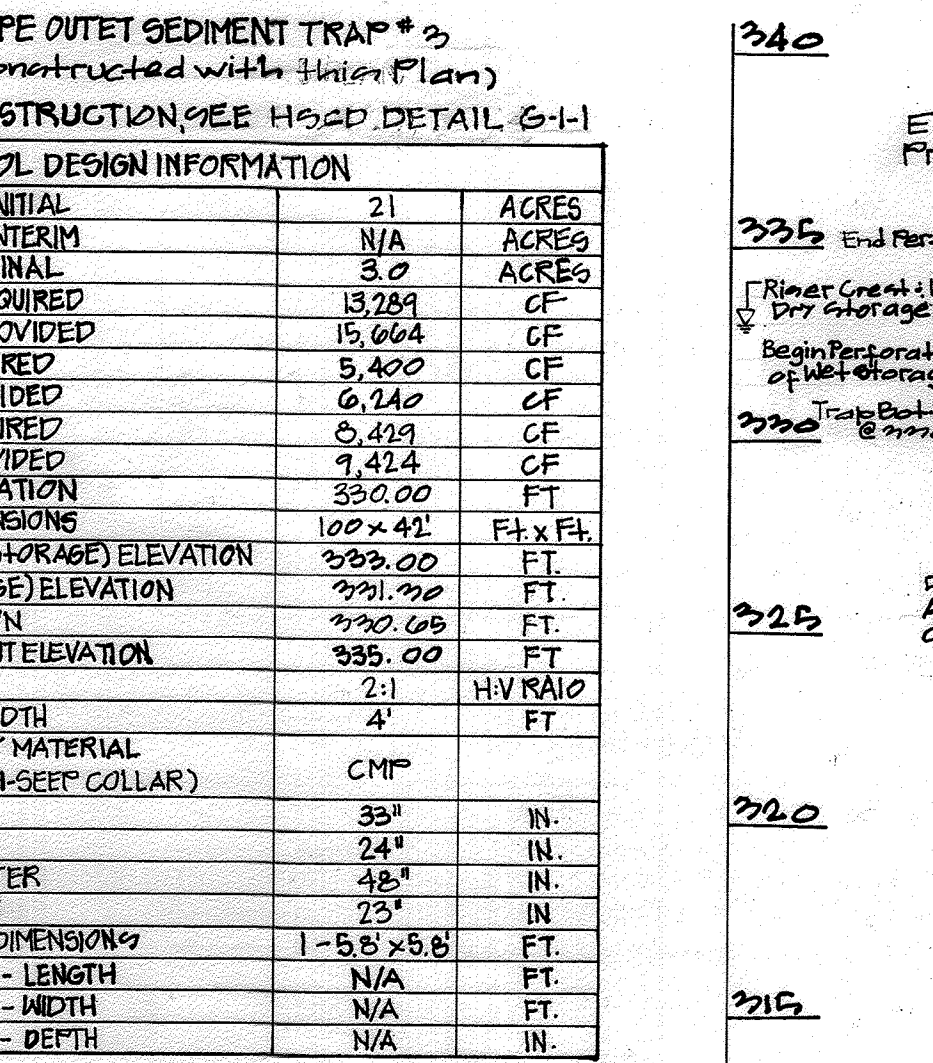

This Development Plan is approved for Soil Erosion and Sediment Control by the Howard Soil Conservation District.

John R. Robertson 12/28/17
Howard S.C.D. Date

ENGINEER'S CERTIFICATE

"I HEREBY CERTIFY THAT THIS PLAN FOR SEDIMENT AND EROSION CONTROL REPRESENTS A PRACTICAL AND WORKABLE PLAN BASED ON MY PERSONAL KNOWLEDGE OF THE SITE CONDITIONS AND THAT IT WAS PREPARED IN ACCORDANCE WITH THE REQUIREMENTS OF THE HOWARD SOIL CONSERVATION DISTRICT."

Clark 12/14/17
ENGINEER'S SIGNATURE DATE

DEVELOPER'S/BUILDER'S CERTIFICATE

"I HEREBY CERTIFY THAT ALL DEVELOPMENT AND CONSTRUCTION WILL BE DONE ACCORDING TO THIS PLAN OF DEVELOPMENT FOR SEDIMENT AND EROSION CONTROL, AND THAT ANY RESPONSIBLE PERSONNEL INVOLVED IN THE CONSTRUCTION PROJECT WILL HAVE A CERTIFICATE OF ATTENDANCE AT A DEPARTMENT OF ENVIRONMENT APPROVED TRAINING PROGRAM FOR THE CONTROL OF SEDIMENT AND EROSION BEFORE BEGINNING THE PROJECT. I ALSO AUTHORIZE PERIODIC ON-SITE INSPECTION BY THE HOWARD SOIL CONSERVATION DISTRICT."

R. J. ... 12/14/17
SIGNATURE OF DEVELOPER/BUILDER DATE

APPROVED: HOWARD COUNTY DEPARTMENT OF PUBLIC WORKS

Melanie 1/3/2018
Chief, Bureau of Highways Date

APPROVED: HOWARD COUNTY DEPARTMENT OF PLANNING & ZONING


L. M. ... 1-19-18
Chief, Division of Land Development Date

Ed ... 1-11-18
Chief, Development Engineering Division Date

GLWGUTSCHICK LITTLE & WEBER, P.A.
CIVIL ENGINEERS, LAND SURVEYORS, LAND PLANNERS, LANDSCAPE ARCHITECTS
3909 NATIONAL DRIVE - SUITE 250 - BURTONSVILLE OFFICE PARK
BURTONSVILLE, MARYLAND 20866
TEL: 301-421-6024 FAX: 410-880-1820 DC/YA: 301-989-2524 FAX: 301-421-4186

LEGEND



- SEDIMENT CONTROL EXISTING CONDITIONS
- SEDIMENT CONTROL PROPOSED CONDITIONS
- ERL-1 2014 ENVIRONMENTAL RESTORATION LIMITS
- ERL-2 2016 ENVIRONMENTAL RESTORATION LIMITS
- MODERATELY STEEP SLOPES (5-25%)
- STEEP SLOPES (25%+)

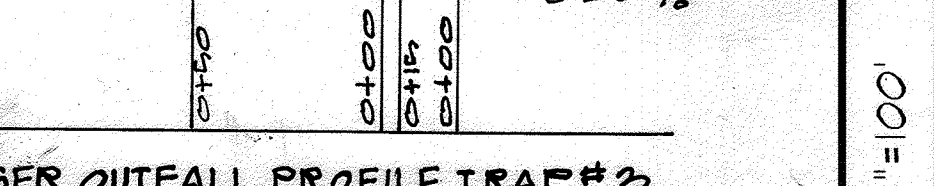

NOTE:
PART OF THE WORK BEING PROPOSED UNDER THIS PLAN IS BACK FILLING SEDIMENT TRAP #1 CONSTRUCTED UNDER SDF 16-075 AND REPLACING IT WITH SEDIMENT TRAP #3 BEING CONSTRUCTED UNDER THESE PLANS

- SEQUENCE OF CONSTRUCTION:
- OBTAIN GRADING PERMIT (1 DAY)
 - ARRANGE FOR AN ON-SITE PRE-CONSTRUCTION MEETING WITH THE SEDIMENT CONTROL INSPECTOR (1 DAY)
 - INSPECT SEDIMENT TRAP #1 AND #2 CONSTRUCTED UNDER SDF 16-075 AND MAKE ANY NECESSARY REPAIRS. THE TRAPS HAVE BEEN SHOWN ON THESE PLANS AS EXISTING (2 DAYS)
 - INSTALL CURB INLET PROTECTION AT EXHIBIT 10-28A. THIS STRUCTURE HAS BEEN CONSTRUCTED UNDER F 16-107. (1 DAY)
 - INSTALL THE STORM DRAIN FROM THE EXISTING 'STUB' OUT OF EXISTING MH 32 THAT WAS CONSTRUCTED UNDER F 16-107 TO MH 1 AND THE 18" HOPE DIRECTED TOWARD THE DEPRESSION TO BE GRADED UNDER ITEM 1. (2 DAYS)
 - INSTALL THE STONE CONSTRUCTION ENTRANCE AT VALENCIA LANE AND MERRIWEATHER DRIVE. (1 DAY)
 - GRADE THE DEPRESSION AT THE 18" HOPE INSTALLED UNDER ITEM 5 ABOVE AS WELL AS THE VERTICAL STACK AND STONE. CONSTRUCTION OF THE VERTICAL STACK AND STONE IS TO BE CONSTRUCTED PER THE SPECIFICATIONS FOR A DE-WATERING DEVICE. SEE HSCD DETAIL 6-2-7. (1 DAY)
 - CONSTRUCT CLEAN WATER DIVERSION #2 ALONG MERRIWEATHER DRIVE. THE CONTRACTOR IS TO BEGIN AT THE DOWNSTREAM END AND WORK UPHILL. (1 WEEK)
 - INSTALL THE EARTH DIKES AND SUPER SILT FENCE TO THE LIMITS SHOWN AS "INITIAL". (2 DAYS)
 - WITH THE PERMISSION OF THE SEDIMENT CONTROL INSPECTOR BEGIN GRADING SHOWN AS "INITIAL". (3 DAYS)
 - RELOCATE THE EARTH DIKES AND SUPER SILT FENCE TO THE LIMITS SHOWN AS "FINAL". (3 DAYS)
 - CONSTRUCT PIPE OULET SEDIMENT TRAP #3 PER HEAD DETAIL 3-1-1. (2 DAYS)
 - INSTALL THE REMAINDER OF THE STONE CONSTRUCTION ENTRANCE AND SUPER SILT FENCE AS SHOWN ON THESE PLANS. SIGNIFICANT FILL IS NEEDED TO BE PLACED IN THE AREA OF THE STONE CONSTRUCTION ENTRANCE AT THE INTERSECTION OF MANGO TREE ROAD AND SYMPHONY WOODS ROAD. INITIALLY, THE CONTRACTOR WILL ONLY HAVE ACCESS TO THE SITE FROM MERRIWEATHER DRIVE UNTIL THE GRAPES IN THE AREA OF MANGO TREE ROAD HAVE BEEN ESTABLISHED AND THE STONE CONSTRUCTION ENTRANCE INSTALLED. (2 DAYS)
 - WITH THE PERMISSION OF THE SEDIMENT CONTROL INSPECTOR BEGIN MASS GRADING. THIS WILL INCLUDE THE BACK FILLING OF THE PIPE OULET SEDIMENT TRAP #1 CONSTRUCTED UNDER SDF 16-075. THE CONTRACTOR IS TO INSTALL THE CLEAN WATER DIVERSION TO THE WEST OF VALENCIA LANE AS SOON AS THE GRADES ALLOW TO DIVERT RUNOFF DRAINING FROM THE WEST TO THE DEPRESSION (CONSTRUCTED UNDER ITEM 1 ABOVE) AT THE INTERSECTION OF VALENCIA LANE AND MERRIWEATHER DRIVE. (2 WEEKS)
 - MANGO TREE ROAD IS PLACED ON GRADE AND RIMPUP CAN NO LONGER BE CONVEYED TO THE TEMPORARY GABION OUTLET STRUCTURE CONSTRUCTED UNDER SDF 16-075. INSTALL THE DENATURING TYPE STRUCTURE IN THE SOUTHEAST CORNER OF PARCEL D.4 AND 12" HOPE PIPE THAT TIES INTO EX. MH 323 WHICH WAS CONSTRUCTED UNDER F 16-107. (2 WEEKS)
 - AS THE ROADS ARE BEING PLACED ON GRADE, INSTALL THE STORM DRAIN, WATER, AND SEWER LINES AS SOON AS THE GRADES ALLOW. WHERE INLETS ARE SHOWN WITH CURB INLET PROTECTION OR INLET BLOCKING, THE DEVICE IS TO BE INSTALLED IMMEDIATELY AFTER FINAL GRADING AROUND THE STRUCTURE HAVE BEEN ESTABLISHED. PROVIDE BERMS AS INDICATED TO DIRECT RUNOFF TO INLETS OR CURB CUTS TO ALLOW RUNOFF TO BE DIRECTED TO PERIMETER SEDIMENT CONTROL DEVICES. THE CONTRACTOR IS TO INSTALL EARTHEN BERMS INITIALLY, AND THEN CONVERT THEM TO ASPHALT BERMS AS DIRECTED BY THE SEDIMENT CONTROL INSPECTOR. INSTALL THE RIP RAP AT THE SOUTH END OF VALENCIA LANE TO PROTECT THE NEWLY PLACED FILL. (1 MONTH)
 - BEGIN FINE GRADING THE AREA OF THE ROADWAYS. (1 WEEK)
 - INSTALL THE CURB AND GUTTER, SIDEWALK, AND BASE PAVING. (2 WEEKS)
 - AS AREAS ARE STABILIZED AND PERMISSION IS OBTAINED FROM THE SEDIMENT CONTROL INSPECTOR, THE SEDIMENT CONTROL DEVICES CAN BE REMOVED. THE CONTRACTOR IS TO IMMEDIATELY STOP ANY AREAS THAT ARE DISTURBED AS A RESULT. THE CURB INLET PROTECTION BLOCKING AND TEMPORARY ASPHALT BERMS, AS WELL AS THE DENATURING DEVICE LOCATED IN THE SOUTHEAST CORNER OF PARCEL D.4 AND AT THE INTERSECTION OF VALENCIA LANE AND MERRIWEATHER DRIVE ARE TO REMAIN UNTIL SUCH TIME THE GRADES AND SEDIMENT CONTROL MEASURES PROPOSED UNDER SDF 16-075 HAVE BEEN ESTABLISHED AND THE DEVICES ARE NO LONGER NEEDED. (2 WEEKS)
 - THE SURFACE COURSE OF PAVING ON ALL ROADS BEING CONSTRUCTED UNDER THIS FINAL PLAN WILL BE DELAYED UNTIL SOME POINT IN THE CONSTRUCTION PROPOSED UNDER SDF 16-075 SO THAT IT IS NOT DAMAGED BY CONSTRUCTION EQUIPMENT BEING USED FOR THE CONSTRUCTION OF THE BUILDINGS. THIS WILL NEED TO BE COORDINATED WITH THE SEDIMENT CONTROL INSPECTOR IN THE FIELD. (1 WEEK)
 - THE STORM WATER MANAGEMENT DEVICES WILL BE INSTALLED WITH THE HARDSCAPE AND OTHER ROAD SIDE IMPROVEMENTS UNDER SDF 16-075. BACK FILL SEDIMENT TRAP #1. SEDIMENT TRAP #2 WILL REMAIN TO BE UTILIZED FOR FUTURE CONSTRUCTION. (2 DAYS)

1-26-18	REV. Grading on Valencia Lane & Proposed wall	3-1	JRE
2-28-18	Added Pipe Riser Profile, Updated sediment Trap Location & Grading	3-1	DEV
	REVISION		APP'R

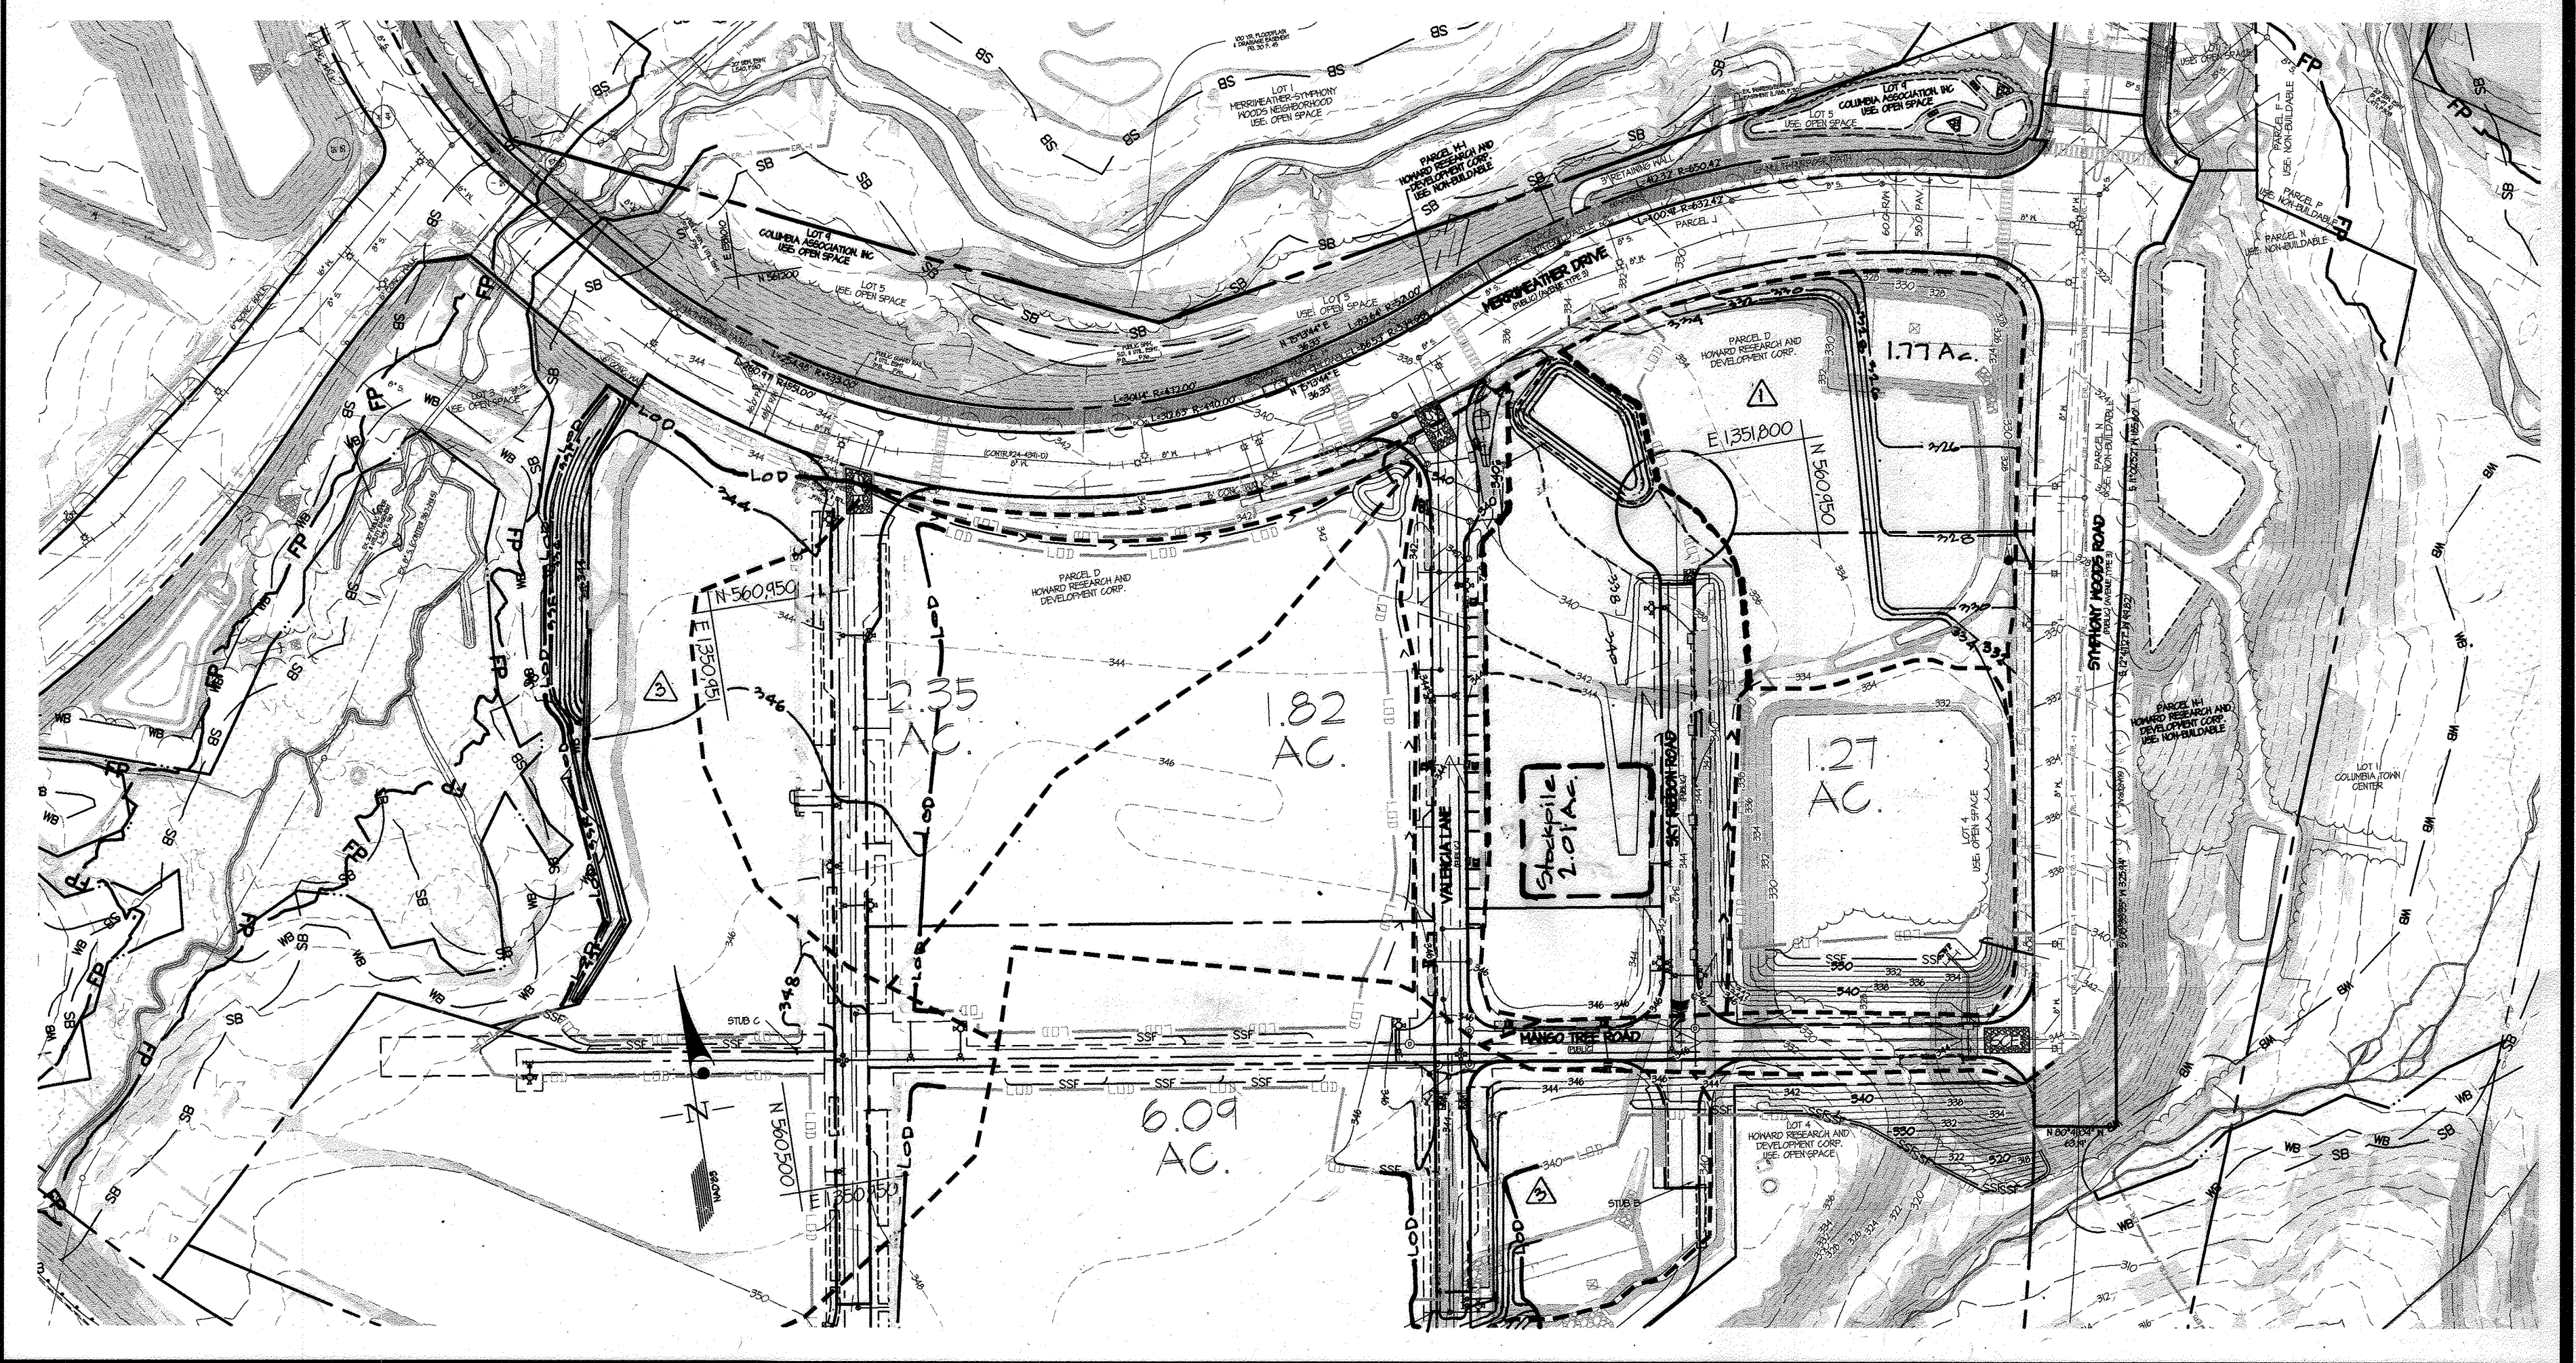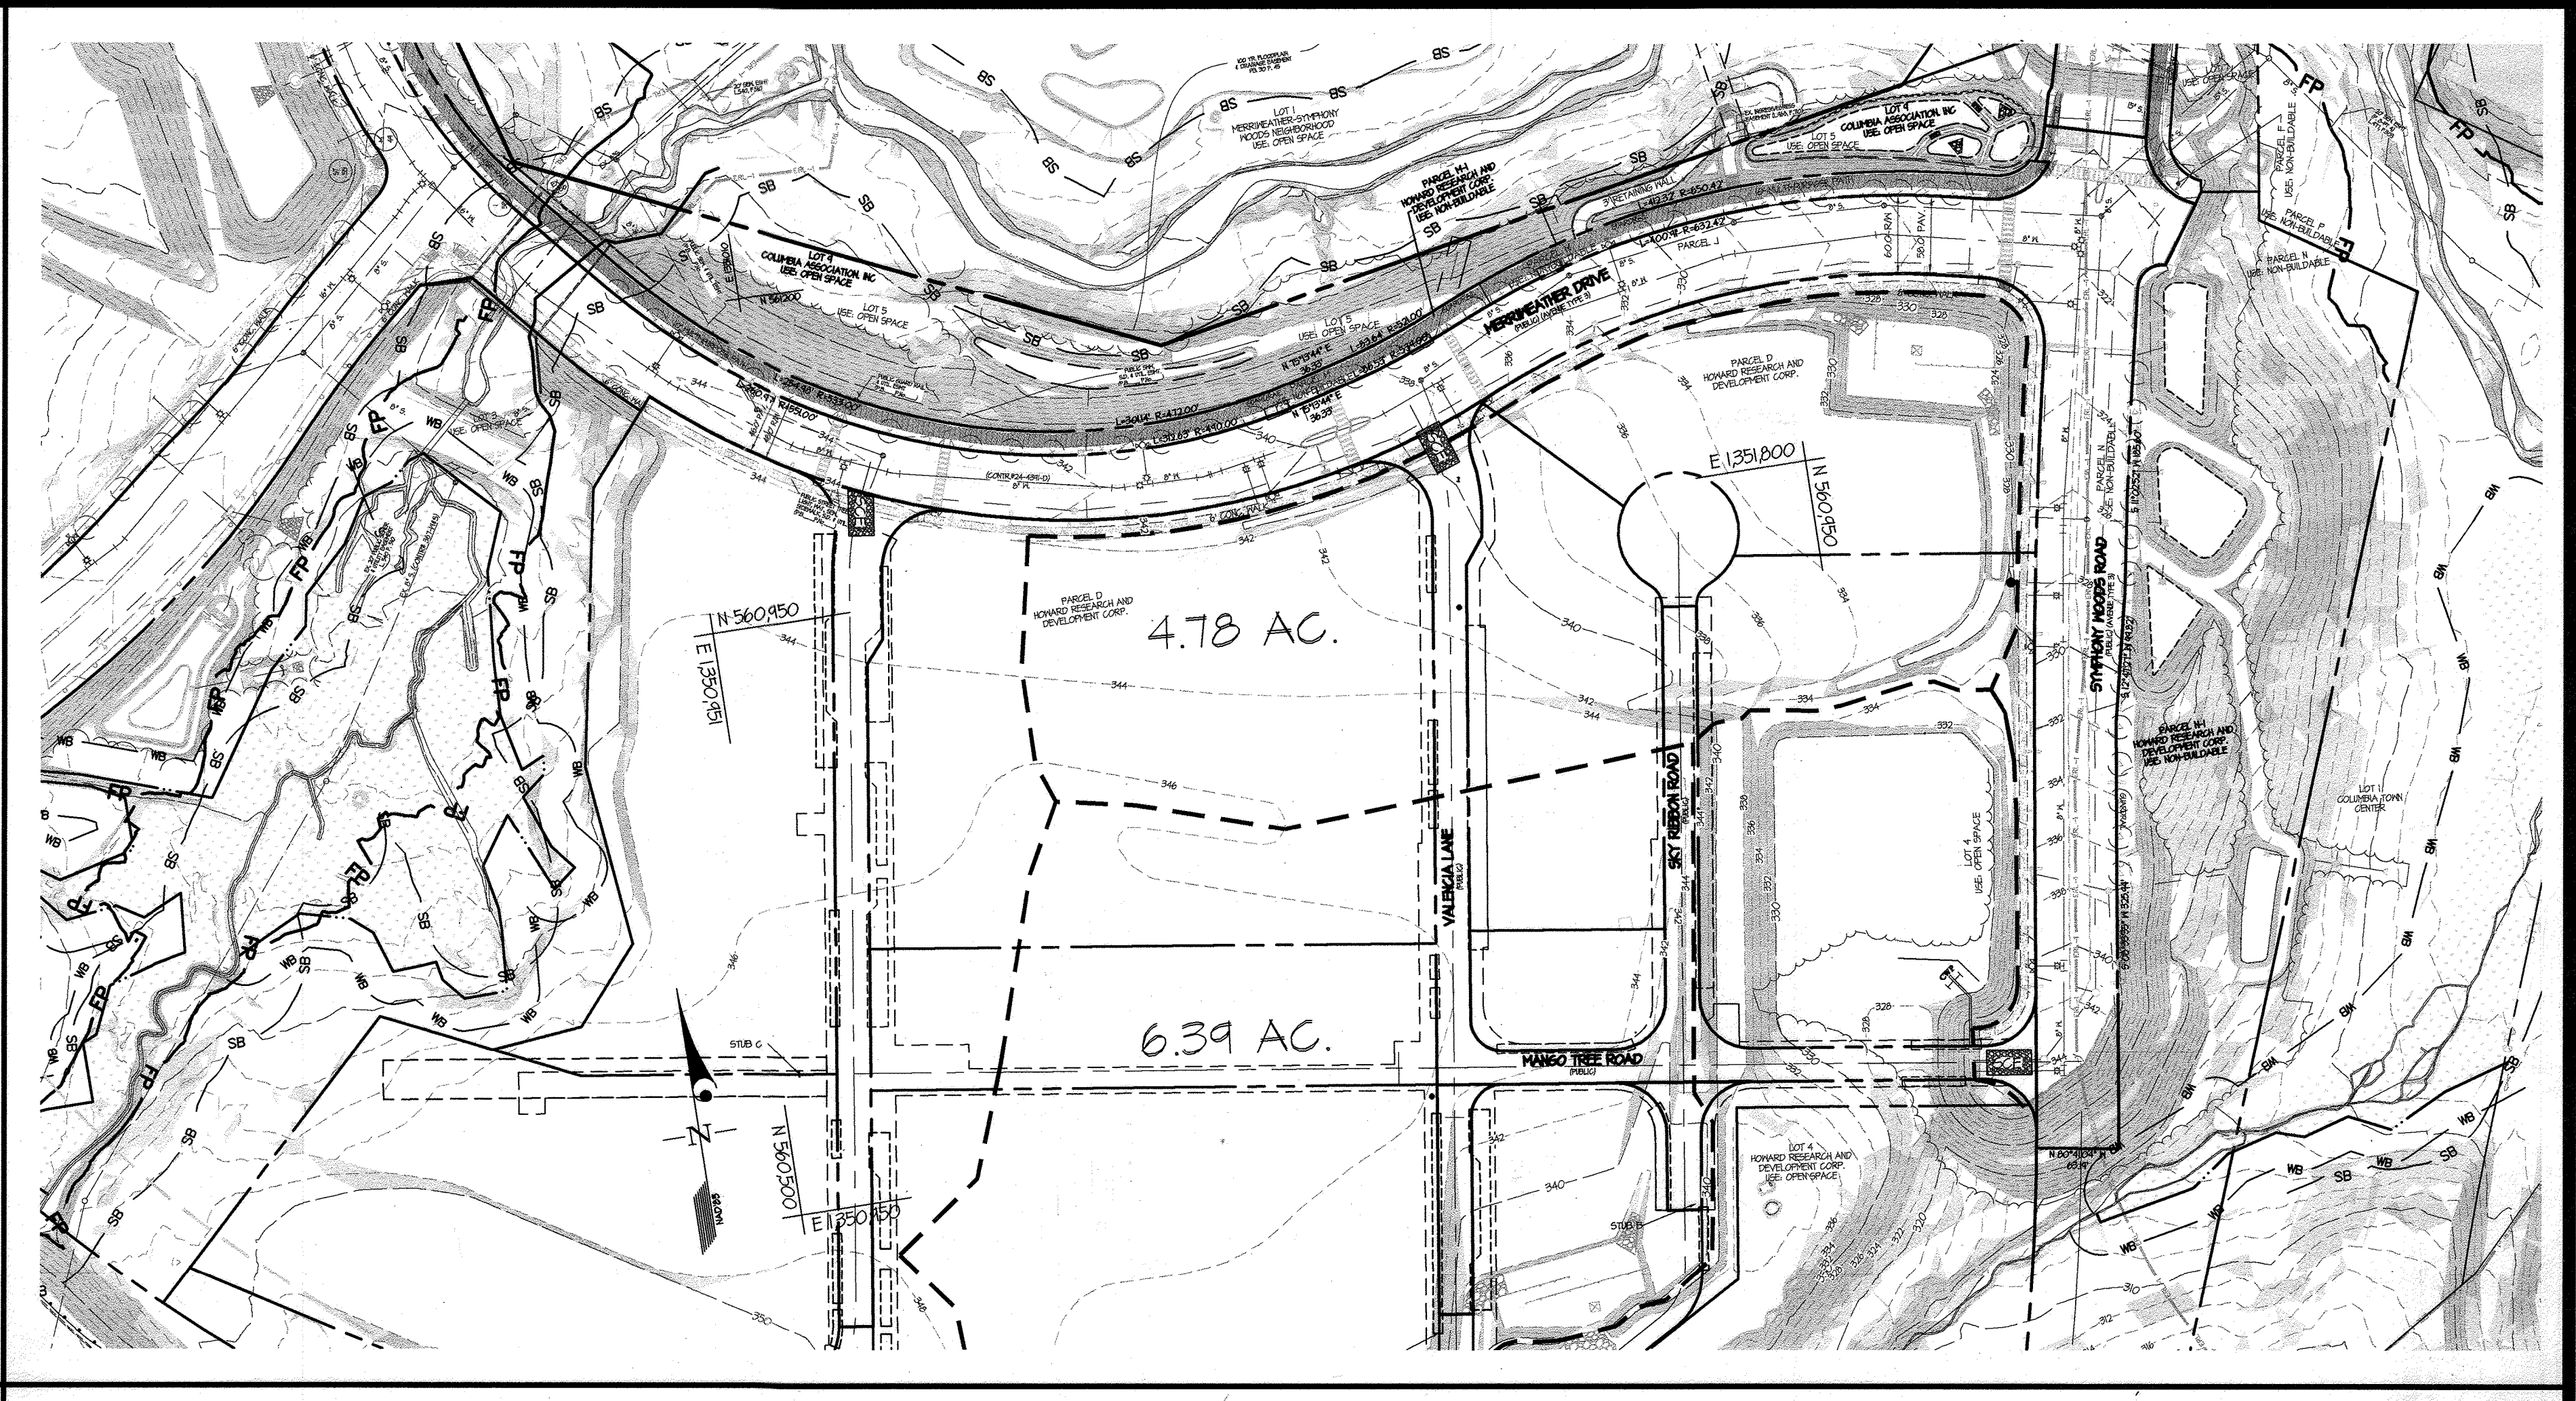

PREPARED FOR:
THE HOWARD HUGHES CORPORATION
10480 LITTLE PATUXENT PARKWAY
SUITE 400
COLUMBIA, MARYLAND 21044
ATTN: BILL ROWE
410-964-4987

PROFESSIONAL CERTIFICATION
I HEREBY CERTIFY THAT THESE PLANS WERE PREPARED OR APPROVED BY ME, AND THAT I AM A DULY LICENSED PROFESSIONAL ENGINEER UNDER THE LAWS OF THE STATE OF MARYLAND, LICENSE NO. 12973
EXPIRATION DATE: MAY 26, 2018

12/14/17

SEDIMENT CONTROL DRAINAGE AREA MAPS

DOWNTOWN COLUMBIA
CRESCENT NEIGHBORHOOD
PARCELS D1 THRU D-14, NON-BUILDABLE BULK PARCELS
D-15 THRU D-17 & OPEN SPACE LOT 10

SCALE: 1" = 100'

ZONING: NT

G. L. W. FILE NO.: 11071

DATE: DEC, 2017

TAX MAP - GRID: 36 - 01

SHEET: 14 OF 25

ELECTION DISTRICT No. 5

HOWARD COUNTY, MARYLAND

SEDIMENT CONTROL NOTES

- 1. PRE-CONSTRUCTION MEETING MUST OCCUR WITH THE HOWARD COUNTY DEPARTMENT OF PUBLIC WORKS...
2. ALL VEGETATIVE AND STRUCTURAL PRACTICES ARE TO BE INSTALLED ACCORDING TO THE PROVISIONS OF THIS PLAN...
3. FOLLOWING INITIAL SOIL DISTURBANCE OR RE-DISTURBANCE...
4. ALL DISTURBED AREAS MUST BE STABILIZED WITHIN THE TIME PERIOD SPECIFIED ABOVE...
5. ALL SEDIMENT CONTROL STRUCTURES ARE TO REMAIN IN PLACE...
6. SITE ANALYSIS: Total Area of Site: 251 Acres, Acres Area Disturbed: 4.0 Acres...

STANDARD AND SPECIFICATIONS FOR TOPSOIL DEFINITION CONSTRUCTION AND MATERIAL SPECIFICATIONS

- I. Topsoil must be free of plant parts such as Bermuda grass, quackgrass, Johnsongrass, misclegrass, poison ivy, thistle, or others as specified in C. Where the subsoil is either highly acidic or composed of heavy clay...
III. For sites having disturbed areas under 5 acres:
a. Place topsoil (if required) and apply soil amendments as specified in 2.0.0 Vegetative Stabilization - Section I - Vegetative Stabilization Methods and Materials.
IV. For sites having disturbed areas over 5 acres:
1. pH for topsoil shall be between 6.0 and 7.5. If the tested soil demonstrates a pH of less than 6.0, sufficient lime shall be prescribed to raise the pH to 6.5 or higher.
2. Organic content of topsoil shall not be less than 15 percent by weight.
3. Topsoil having silt/clay greater than 500 parts per mill shall not be used.
4. No soil or seed shall be placed on soil which has been with soil sterilants or chemicals used for weed control until sufficient time has elapsed (14 days min) to permit dissipation of photo-toxic materials.
Note: Topsoil substitutes or amendments, as recommended by a qualified agronomist or soil scientist and approved by the appropriate approval authority may be used in lieu of topsoil.
b. Place topsoil (if required) and apply soil amendments as specified in 2.0 Vegetative Stabilization - Section I - Vegetative Stabilization Methods and Materials.
V. Topsoil Application
a. When topsoiling, maintain needed erosion and sediment control practices such as diversion, Grade Stabilization Structures, Earth Dams, Slope Silt Fence and Sediment Traps and Bores.
b. Grades on the areas to be topsoiled, which have been previously established, shall be maintained, albeit 4" or higher in elevation.
c. Topsoil shall be uniformly distributed in a 4"-8" layer and lightly compacted to a minimum thickness of 4". Spreading shall be performed in such a manner that sodding or seeding can proceed with a minimum of additional soil preparation and tillage. Any irregularities in the surface resulting from topsoiling or other operations shall be corrected in order to prevent the formation of depressions or water.
d. Topsoil shall not be placed while the topsoil or subsoil is frozen or muddy condition, when the subsoil is excessively wet or in a condition that may otherwise be detrimental to proper grading and seedbed preparation.
VI. Alternative For Permanent Seeding - Instead of applying the full amounts of lime and commercial fertilizer, composted sludge and amendments may be applied as specified below.
a. Composted Sludge Material for use as a soil conditioner for sites having disturbed areas over 5 acres shall be tested to prescribe amendments and for sites having disturbed areas under 5 acres shall conform to the following requirements:
1. Composted sludge shall be supplied by, or originate from, a person or persons that are permitted (at the time of acquisition of the compost) by the Maryland Department of the Environment under COMAR 26.04.06.
2. Composted sludge shall contain at least 1 percent nitrogen, 15 percent phosphorus, and 0.2 percent potassium and have a pH of 7.0 to 9.0. If compost does not meet these requirements, the appropriate ratio to use.
3. Composted sludge shall be applied at a rate of 1 ton/1000 square feet. b. Composted sludge shall be amended with a potassium fertilizer applied at a rate of 4lb/1000 square feet, and 1/3 the normal lime application rate.
References: eXclusive Specifications, Soil Preparation and Sodding, MD-VA Pub. #1, Cooperative Extension Service, University of Maryland and Virginia Polytechnic Institutes, Revised 1973.

STANDARD AND SPECIFICATIONS FOR TOPSOIL DEFINITION

- Placement of topsoil over a prepared subsoil prior to establishment of permanent vegetation.
PURPOSE: To provide a suitable soil medium for vegetative growth. Soils of concern have low moisture content, low nutrient levels, low pH, materials toxic to plants, and/or unacceptable soil gradation.
CONDITIONS WHERE PRACTICE APPLIES: This practice is limited to areas having 2:1 or flatter slopes where:
a. The texture of the exposed subsoil/parent material is not adequate to produce vegetative growth.
b. The soil material is so shallow that the rooting zone is not deep enough to support plants or furnish continuing supplies of moisture and plant nutrients.
c. The original soil to be vegetated contains material toxic to plant growth.
d. The soil is so acidic that treatment with limestone is not feasible.
e. Areas having slopes steeper than 2:1 require special consideration and design.
f. The soil is so acidic that treatment with limestone is not feasible.
II. For the purpose of these Standards and Specifications, areas having slopes steeper than 2:1 require special consideration and design for adequate stabilization. Areas having slopes steeper than 2:1 shall have the appropriate stabilization above on the plans.
CONSTRUCTION AND MATERIAL SPECIFICATIONS:
I. Topsoil salvaged from the existing site may be used provided that it meets the standards as set forth in these specifications. Typically, the depth of topsoil to be salvaged for a given soil type can be found in the respective soil profile section in the Soil Survey published by USDA-NRCS in cooperation with Maryland Agricultural Experimental Station.
II. Topsoil specifications - soil to be used as topsoil must meet the following:
a. Topsoil shall be a loam, sandy loam, clay loam, silt loam, sandy clay loam, loamy sand, or loamy silt. Other soils may be used if recommended by an agronomist or soil scientist and approved by the appropriate approval authority. Regardless, topsoil shall not be a mixture of contrasting textured subsoils and shall contain less than 5% by volume of cinders, stones, slag, coarse fragments, gravel, sticks, roots, trash, or other materials larger than 1 1/2" in diameter. Materials.
III. Topsoil substitutes or amendments, as recommended by a qualified agronomist or soil scientist and approved by the appropriate approval authority, may be used in lieu of natural topsoil.
IV. Topsoil Application
a. Erosion and sediment control practices must be maintained when applying topsoil.
b. Uniformly distribute topsoil in a 5" to 8" inch layer and lightly compact to a minimum thickness of 4 inches. Spreading is to be performed in such a manner that sodding or seeding can proceed with a minimum of additional soil preparation and tillage. Any irregularities in the surface resulting from topsoiling or other operations must be corrected in order to prevent the formation of depressions or water pockets.
c. Topsoil must not be placed if the topsoil or subsoil is in a frozen or muddy condition, when the subsoil is excessively wet or in a condition that may otherwise be detrimental to proper grading and seedbed preparation.
C. Soil Amendments (Fertilizer and Lime Specifications)
I. Soil tests must be performed to determine the exact rates and application rates for both lime and fertilizer on sites having disturbed areas of 5 acres or more. Soil analysis may be performed by a recognized private or commercial laboratory. Soil samples taken for engineering purposes may also be used for chemical analysis.
II. Fertilizers must be uniform in composition, free flowing and suitable for accurate application by appropriate equipment. Manure may be substituted for fertilizer with prior approval by the appropriate approval authority. Fertilizers must be all delivered to the site fully labeled according to the applicable laws and must bear the name, trade name or trademark and warranty of the producer.
III. Lime materials must be ground limestone (hydrated or burnt lime) but be substituted except when hydroseeding which contains at least 50 percent total oxides (calcium oxide plus magnesium oxide). Limestone must be ground to such fineness that at least 50 percent will pass through a #100 mesh sieve and 40 to 100 percent will pass through a #20 mesh sieve.
IV. Lime and fertilizer are to be evenly distributed and incorporated into the top 3 to 5 inches of soil by disk or other suitable means.
V. Where the subsoil is either highly acidic or composed of heavy clay, spread ground limestone at the rate of 4 to 8 tons/acre (200-400 pounds per 1000 square feet) prior to the placement of topsoil.

DUST CONTROL

- Controlling dust blowing and movement on construction sites and roads.
Purpose: To prevent blowing and movement of dust from exposed soil surfaces, reduce on and off-site damage, health hazards, and improve traffic safety.
Conditions Where Practice Applies: This practice is applicable to areas subject to dust blowing and movements where on and off-site damage is likely without treatment.
Specifications:
I. Muffles - See standards for vegetative stabilization with muffles only. Muff should be crimped or tacked to prevent blowing.
II. Vegetative Cover - See standards for temporary vegetative cover.
III. Tillage - To roughen surface and bring clods to the surface. This is an emergency measure which should be used before soil blowing starts. Begin plowing on windward side of site. Chisel-type plows spaced about 12' apart, spring-toothed harrows, and similar plows are examples of equipment which may produce the desired effect.
IV. Irrigation - This is generally done as an emergency treatment. Site is sprinkled with water until the surface is moist. Repeat as needed. At no time should the site be irrigated to the point that runoff begins to flow.
V. Barriers - Solid board barriers, silt fences, burlap fences, straw bales, and similar material can be used to control air currents and soil blowing. Barriers placed at right angles to prevailing currents at intervals of about 10 times their height are effective in controlling soil blowing.
VI. Calcium Chloride - Apply at rates that will keep surface moist. May need retreatment.
Permanent Methods:
I. Permanent Vegetation - See standards for permanent vegetative cover, and permanent stabilization with sod. Existing trees or large shrubs may afford valuable protection if left in place.
II. Topsoiling - Covering with less erosive soil materials. See standards for topsoiling.
III. Stone - Cover surface with crushed stone or coarse gravel.

B-4-2 STANDARDS AND SPECIFICATIONS FOR SOIL PREPARATION, TOPSOILING, AND SOIL AMENDMENTS

- Definition: The process of preparing the soils to sustain adequate vegetative stabilization.
Purpose: To provide a suitable soil medium for vegetative growth.
Conditions Where Practice Applies: Where vegetative stabilization is to be established.
Criteria:
A. Soil Preparation
I. Temporary Stabilization
a. Seedbed preparation consists of loosening soil to a depth of 3 to 5 inches by means of suitable agricultural or construction equipment, such as disc harrows or chisel plows or rippers mounted on construction equipment. After the soil is loosened, it must not be rolled or dragged smooth but left in the roughened condition. Slopes 3:1 or flatter are to be tracked with ridges running parallel to the contour of the slope.
b. Apply fertilizer and lime as prescribed on the plans.
c. Incorporate lime and fertilizer into the top 3 to 5 inches of soil by disk or other suitable means.
II. Permanent Stabilization
a. A soil test is required for any earth disturbance of 5 acres or more. The minimum soil conditions required for permanent vegetative establishment are:
I. Soil pH between 6.0 and 7.0.
II. Soluble soils less than 500 parts per million (ppm).
III. Soil silt plus clay no more than 40 percent clay but enough the graded material (greater than 30 percent silt plus clay) to provide the capacity to hold a moderate amount of moisture. An exception: If limestone will be planted, then a sandy soil (less than 30 percent silt plus clay) would be acceptable.
IV. Soil contains 15 percent minimum organic matter by weight.
V. Soil contains sufficient pore space to permit adequate root penetration.
b. Application of amendments on topsoil is required if on-site soils do not meet the above conditions.
c. Graded areas must be maintained in a true and even grade as specified on the approved plan, then scarified or otherwise loosened to a depth of 3 to 5 inches.
d. Apply soil amendments as specified on the approved plan or as indicated by the results of a soil test.
e. Mix soil amendments into the top 3 to 5 inches of soil by disk or other suitable means. Rows have areas to smooth the surface, remove large objects like stones and branches, and ready the area for seed application. Loosen surface soil by dragging with a heavy chain or other equipment to roughen the surface where site conditions will not permit normal seedbed preparation. Track slopes 3:1 or flatter with tracked equipment leaving the soil in an irregular condition with ridges running parallel to the contour of the slope. Leave the top 1 to 3 inches of soil loose and friable. Seedbed loosening may be unnecessary on newly disturbed areas.
B. Topsoiling
I. Topsoil placed over prepared subsoil prior to establishment of permanent vegetation. The purpose is to provide a suitable soil medium for vegetative growth. Soils of concern have low moisture content, low nutrient levels, low pH, materials toxic to plants, and/or unacceptable soil gradation.
II. Topsoil salvaged from an existing site may be used provided it meets the standards as set forth in these specifications. Typically, the depth of topsoil to be salvaged for a given soil type can be found in the representative soil profile section in the Soil Survey published by USDA-NRCS.
III. Topsoiling is limited to areas having 2:1 or flatter slopes where:
a. The texture of the exposed subsoil/parent material is not adequate to produce vegetative growth.
b. The soil material is so shallow that the rooting zone is not deep enough to support plants or furnish continuing supplies of moisture and plant nutrients.
c. The original soil to be vegetated contains material toxic to plant growth.
d. The soil is so acidic that treatment with limestone is not feasible.
e. Areas having slopes steeper than 2:1 require special consideration and design.
f. The soil is so acidic that treatment with limestone is not feasible.
IV. For the purpose of these Standards and Specifications, areas having slopes steeper than 2:1 require special consideration and design for adequate stabilization. Areas having slopes steeper than 2:1 shall have the appropriate stabilization above on the plans.
C. Soil Amendments (Fertilizer and Lime Specifications)
I. Soil tests must be performed to determine the exact rates and application rates for both lime and fertilizer on sites having disturbed areas of 5 acres or more. Soil analysis may be performed by a recognized private or commercial laboratory. Soil samples taken for engineering purposes may also be used for chemical analysis.
II. Fertilizers must be uniform in composition, free flowing and suitable for accurate application by appropriate equipment. Manure may be substituted for fertilizer with prior approval by the appropriate approval authority. Fertilizers must be all delivered to the site fully labeled according to the applicable laws and must bear the name, trade name or trademark and warranty of the producer.
III. Lime materials must be ground limestone (hydrated or burnt lime) but be substituted except when hydroseeding which contains at least 50 percent total oxides (calcium oxide plus magnesium oxide). Limestone must be ground to such fineness that at least 50 percent will pass through a #100 mesh sieve and 40 to 100 percent will pass through a #20 mesh sieve.
IV. Lime and fertilizer are to be evenly distributed and incorporated into the top 3 to 5 inches of soil by disk or other suitable means.
V. Where the subsoil is either highly acidic or composed of heavy clay, spread ground limestone at the rate of 4 to 8 tons/acre (200-400 pounds per 1000 square feet) prior to the placement of topsoil.

B-4-3 STANDARDS AND SPECIFICATIONS FOR SEEDING AND MULCHING

- Definition: The application of seed and mulch to establish vegetative cover.
Purpose: To protect disturbed soils from erosion during and at the end of construction.
Conditions Where Practice Applies: To the surface of all perimeter controls, slopes, and any disturbed area not under active grading.
Criteria:
A. Seeding
I. Specifications
a. All seed must meet the requirements of the Maryland State Seed Law. All seed must be subject to re-testing by a recognized seed laboratory. All seed used must have been tested within the 6 months immediately preceding the date of sowing such material on any project. Refer to Table B.4 regarding the quality of seed. Seed lots must be available upon request to the inspector to verify type of seed and seeding rate.
b. Mulch alone may be applied between the fall and spring seeding dates only if the ground is frozen. The appropriate seeding mixture must be applied when the ground thaws.
c. Inoculants: The inoculant for treating legume seed in the seed mixtures must be a pure culture of nitrogen fixing bacteria prepared specifically for the species. Inoculants must not be used later than the date indicated on the container. Add fresh inoculants as directed on the package. Use four times the recommended rate when hydroseeding. Note: It is very important to keep inoculants as cool as possible until used. Temperatures above 75 to 80 degrees Fahrenheit can weaken bacteria and make the inoculant less effective.
d. Sod or seed must not be placed on soil which has been treated with soil sterilants or chemicals used for weed control until sufficient time has elapsed (14 days min.) to permit dissipation of photo-toxic materials.
II. Application
a. Dry Seeding: This includes use of conventional drop or broadcast spreaders.
I. Incorporate seed into the subsoil at the rates prescribed on Temporary Seeding Table B.1. Permanent Seeding Table B.3, or site-specific seeding summaries.
II. Apply seed in two directions, perpendicular to each other. Apply half the seeding rate in each direction. Roll the seeded area with a weighted roller to provide good seed to soil contact.
III. Drill or Gullpacker Seeding: Mechanized seeders that apply and cover seed with soil.
I. Gullpacker seeders are required to bury the seed in such a fashion as to provide at least 1/4 inch of soil covering. Seedbed must be firm after planting.
II. Apply seed in two directions, perpendicular to each other. Apply half the seeding rate in each direction.
III. Hydroseeding: Apply seed uniformly with hydroseeder (slurry includes seed and fertilizer).
I. If fertilizer is being applied at the time of seeding, the application rates should not exceed the following: nitrogen, 100 pounds per acre; total of soluble nitrogen, P2O5 (phosphorus), 200 pounds per acre; K2O (potassium), 200 pounds per acre.
II. Lime: Use only ground agricultural limestone 1/4 to 3/8 mesh per acre (5 gal/1000 sq ft) of emulsified asphalt on flat areas. On slopes 8:1 or higher, use 3/4 gal per acre (5 gal/1000 sq ft) for anchoring. Refer to the 1994 MARYLAND STANDARDS AND SPECIFICATIONS FOR SOIL EROSION AND SEDIMENT CONTROL for rate and methods not covered.
III. Mix seed and fertilizer on site and seed immediately and without interruption.
IV. When hydroseeding do not incorporate seed into the soil.
B. Mulching
I. Mulch Materials (in order of preference)
a. Straw consisting of thoroughly threshed wheat, rye, oat, or barley and reasonably bright in color. Straw is to be free of noxious weed seeds as specified in the Maryland Seed Law and not overly moldy, rotted, abnormally green, or heavily nitrogenous. Note: Use only sterile straw mulch in areas where one species of grass is desired.
b. Wood Cellulose Fiber Mulch (WCFM) consisting of specially prepared wood cellulose processed into a uniform fibrous plastic grade.
I. WCFM is to be dyed green or contain a green dye in the package that will provide an appropriate color to facilitate visual inspection of the uniformly spread slurry.
II. WCFM, including dye, must contain no germination or growth inhibiting factors.
III. WCFM materials are to be manufactured and processed in such a manner that the wood cellulose fiber mulch will create a uniform suspension in water under nitrogen and will blend with seed, fertilizer and other additives to form a homogeneous slurry. The mulch material must form a blitter-like ground cover, on application, having moisture absorption and penetration properties and must cover and hold grass seed in contact with the soil without inhibiting the growth of the grass seedlings.
IV. WCFM material must not contain elements or compounds at concentration levels that will be phyo-toxic.
V. WCFM must conform to the following physical requirements: Fiber length of approximately 10 millimeters, diameter approximately 1 millimeter, pH range of 4.0 to 8.5, ash content of 16 percent maximum and water holding capacity of 90 percent minimum.
II. Application
a. Apply mulch to all seeded areas immediately after seeding.
b. When straw mulch is used, spread 8" over all seeded areas at the rate of 2 tons per acre to a uniform loose depth of 1 to 2 inches. Apply mulch to achieve a uniform distribution and depth so that the soil surface is not exposed. When using a mulch anchoring tool, increase the application rate to 2.2 tons per acre.
c. Wood cellulose fiber used as mulch must be applied at a net dry weight of 1500 pounds per acre. Mix the wood cellulose fiber with water to obtain a mixture with a maximum of 50 pounds of wood cellulose fiber per 100 gallons of water.
3. Anchoring
a. Perform mulch anchoring immediately following application of mulch to minimize loss by wind or water. This may be done by one of the following methods (listed by preference), depending upon the size of the area and erosion hazard.
I. A mulch anchoring tool is a tractor drawn implement designed to pinch and anchor mulch into the soil surface a minimum of 2 inches. This practice is most effective on large areas, but is limited to flatter slopes where equipment can operate safely. If used on sloping land, this practice should follow the contour.
II. Wood cellulose fiber may be used for anchoring straw. Apply the fiber binder at a net dry weight of 750 pounds per acre. Mix the wood cellulose fiber with water at a maximum of 50 pounds of wood cellulose fiber per 100 gallons of water.
III. Synthetic binders such as Acrylic DLR (Agra-Tack), DCA-10, Petrosol, Terra Tax II, Terra Tack, AK or other approved equal may be used. Follow application rates as specified by the manufacturer. Application of liquid binders needs to be heavier at the edges where wind catches much, such as in valleys and on crests of banks. Use of asphalt binders is strictly prohibited.
IV. Lightweight plastic netting may be stapled over the mulch according to manufacturer recommendations. Netting is suitable available in rolls 4 to 15 feet wide and 300 to 3000 feet long.
4. Lime and fertilizer are to be evenly distributed and incorporated into the top 3 to 5 inches of soil by disk or other suitable means.
5. Where the subsoil is either highly acidic or composed of heavy clay, spread ground limestone at the rate of 4 to 8 tons/acre (200-400 pounds per 1000 square feet) prior to the placement of topsoil.

B-4-4 STANDARDS AND SPECIFICATIONS FOR TEMPORARY STABILIZATION

- Definition: To stabilize disturbed soils with vegetation for up to 6 months.
Purpose: To use fast growing vegetation that provides cover on disturbed soils.
Conditions Where Practice Applies: Exposed soils where ground cover is needed for a period of 6 months or less. For longer duration of time, permanent stabilization practices are required.
Criteria:
I. Select one or more of the species or seed mixtures listed in Table B.1 for the appropriate Plant Hardness Zone (from Figure B.3) and enter them in the Temporary Seeding Summary below along with application rates, seeding dates and seeding depths. If the Summary is not put on the plan and completed, then Table B.1 plus fertilizer and lime rates must be put on the plan.
II. For sites having soil tests performed, use and show the recommended rates by the testing agency. Soil tests are not required for Temporary Seeding.
III. When stabilization is required outside of a seeding season, apply seed and mulch or straw mulch alone as prescribed in Section B-4-3.A.11 and maintain until the next seeding season.
TEMPORARY SEEDING SUMMARY
Hardness Zone (from Figure B.3): 6b
Seed Mixture (from Table B.3): #9 (Tall Fescue/ Kentucky Bluegrass)
Table: Application Rate (lb/acc), Seeding Dates, Seeding Depths, Fertilizer (lb/1000 sq ft), Lime Rate
I. Incorporate seed into the subsoil at the rates prescribed on Temporary Seeding Table B.1. Permanent Seeding Table B.3, or site-specific seeding summaries.
II. Apply seed in two directions, perpendicular to each other. Apply half the seeding rate in each direction. Roll the seeded area with a weighted roller to provide good seed to soil contact.
III. Drill or Gullpacker Seeding: Mechanized seeders that apply and cover seed with soil.
I. Gullpacker seeders are required to bury the seed in such a fashion as to provide at least 1/4 inch of soil covering. Seedbed must be firm after planting.
II. Apply seed in two directions, perpendicular to each other. Apply half the seeding rate in each direction.
III. Hydroseeding: Apply seed uniformly with hydroseeder (slurry includes seed and fertilizer).
I. If fertilizer is being applied at the time of seeding, the application rates should not exceed the following: nitrogen, 100 pounds per acre; total of soluble nitrogen, P2O5 (phosphorus), 200 pounds per acre; K2O (potassium), 200 pounds per acre.
II. Lime: Use only ground agricultural limestone 1/4 to 3/8 mesh per acre (5 gal/1000 sq ft) of emulsified asphalt on flat areas. On slopes 8:1 or higher, use 3/4 gal per acre (5 gal/1000 sq ft) for anchoring. Refer to the 1994 MARYLAND STANDARDS AND SPECIFICATIONS FOR SOIL EROSION AND SEDIMENT CONTROL for rate and methods not covered.
III. Mix seed and fertilizer on site and seed immediately and without interruption.
IV. When hydroseeding do not incorporate seed into the soil.
B. Mulching
I. Mulch Materials (in order of preference)
a. Straw consisting of thoroughly threshed wheat, rye, oat, or barley and reasonably bright in color. Straw is to be free of noxious weed seeds as specified in the Maryland Seed Law and not overly moldy, rotted, abnormally green, or heavily nitrogenous. Note: Use only sterile straw mulch in areas where one species of grass is desired.
b. Wood Cellulose Fiber Mulch (WCFM) consisting of specially prepared wood cellulose processed into a uniform fibrous plastic grade.
I. WCFM is to be dyed green or contain a green dye in the package that will provide an appropriate color to facilitate visual inspection of the uniformly spread slurry.
II. WCFM, including dye, must contain no germination or growth inhibiting factors.
III. WCFM materials are to be manufactured and processed in such a manner that the wood cellulose fiber mulch will create a uniform suspension in water under nitrogen and will blend with seed, fertilizer and other additives to form a homogeneous slurry. The mulch material must form a blitter-like ground cover, on application, having moisture absorption and penetration properties and must cover and hold grass seed in contact with the soil without inhibiting the growth of the grass seedlings.
IV. WCFM material must not contain elements or compounds at concentration levels that will be phyo-toxic.
V. WCFM must conform to the following physical requirements: Fiber length of approximately 10 millimeters, diameter approximately 1 millimeter, pH range of 4.0 to 8.5, ash content of 16 percent maximum and water holding capacity of 90 percent minimum.
II. Application
a. Apply mulch to all seeded areas immediately after seeding.
b. When straw mulch is used, spread 8" over all seeded areas at the rate of 2 tons per acre to a uniform loose depth of 1 to 2 inches. Apply mulch to achieve a uniform distribution and depth so that the soil surface is not exposed. When using a mulch anchoring tool, increase the application rate to 2.2 tons per acre.
c. Wood cellulose fiber used as mulch must be applied at a net dry weight of 1500 pounds per acre. Mix the wood cellulose fiber with water to obtain a mixture with a maximum of 50 pounds of wood cellulose fiber per 100 gallons of water.
3. Anchoring
a. Perform mulch anchoring immediately following application of mulch to minimize loss by wind or water. This may be done by one of the following methods (listed by preference), depending upon the size of the area and erosion hazard.
I. A mulch anchoring tool is a tractor drawn implement designed to pinch and anchor mulch into the soil surface a minimum of 2 inches. This practice is most effective on large areas, but is limited to flatter slopes where equipment can operate safely. If used on sloping land, this practice should follow the contour.
II. Wood cellulose fiber may be used for anchoring straw. Apply the fiber binder at a net dry weight of 750 pounds per acre. Mix the wood cellulose fiber with water at a maximum of 50 pounds of wood cellulose fiber per 100 gallons of water.
III. Synthetic binders such as Acrylic DLR (Agra-Tack), DCA-10, Petrosol, Terra Tax II, Terra Tack, AK or other approved equal may be used. Follow application rates as specified by the manufacturer. Application of liquid binders needs to be heavier at the edges where wind catches much, such as in valleys and on crests of banks. Use of asphalt binders is strictly prohibited.
IV. Lightweight plastic netting may be stapled over the mulch according to manufacturer recommendations. Netting is suitable available in rolls 4 to 15 feet wide and 300 to 3000 feet long.
4. Lime and fertilizer are to be evenly distributed and incorporated into the top 3 to 5 inches of soil by disk or other suitable means.
5. Where the subsoil is either highly acidic or composed of heavy clay, spread ground limestone at the rate of 4 to 8 tons/acre (200-400 pounds per 1000 square feet) prior to the placement of topsoil.

TEMPORARY SEEDING NOTES

Table with 6 columns: Seed Mixture, Application Rate (lb/acc), Seeding Dates, Seeding Depths, Fertilizer (lb/1000 sq ft), Lime Rate. Includes rows for ANNUAL RYEGRASS and PEARL MILLET.

TEMPORARY SEEDING NOTES

- Apply to graded or cleared areas likely to be restudied where a short-term vegetative cover is needed.
Seeded Preparation: Loosen upper 18 inches of soil by raking, disk or other acceptable means before seeding (unless previously loosened).
Soil Amendments: Apply 600 lbs per acre 10-10-10 fertilizer (4 lbs/1000 sq ft).
Seeding: For periods March 1 thru April 30 and from August 15 thru November 15, seed with 2-1/2 bushel per acre of annual rye (52 lbs/1000 sq ft). For the period May 1 thru August 14, seed with 3 lbs per acre (5 gal/1000 sq ft) of emulsified asphalt on flat areas. On slopes 8:1 or higher, use 3/4 gal per acre (5 gal/1000 sq ft) for anchoring. Refer to the 1994 MARYLAND STANDARDS AND SPECIFICATIONS FOR SOIL EROSION AND SEDIMENT CONTROL for rate and methods not covered.
Mulching: Apply 1/2 to 2 tons per acre (10 to 40 lbs/1000 sq ft) of unrotted small grain straw immediately after seeding. Anchor mulch immediately after application using mulch anchoring tool or 2/8 gal per acre (5 gal/1000 sq ft) of emulsified asphalt on flat areas. On slopes 8:1 or higher, use 3/4 gal per acre (5 gal/1000 sq ft) for anchoring. Refer to the 1994 MARYLAND STANDARDS AND SPECIFICATIONS FOR SOIL EROSION AND SEDIMENT CONTROL for rate and methods not covered.
B-4-5 STANDARDS AND SPECIFICATIONS FOR PERMANENT STABILIZATION
Definition: To stabilize disturbed soils with permanent vegetation.
Purpose: To use long-lived permanent grasses and legumes to establish permanent ground cover on disturbed soils.
Conditions Where Practice Applies: Exposed soils where ground cover is needed for 6 months or more.
Criteria:
A. Seed Mixtures
I. General Use
a. Select one or more of the species or mixtures listed in Table B.3 for the appropriate Plant Hardness Zone (from Figure B.3) and based on the site condition or purpose found on Table B.2. Enter selected mixtures, application rates, and seeding dates in the Permanent Seeding Summary. The Summary is to be placed on the plan.
b. Additional planting specifications for exceptional sites such as shorelines, stream banks, ditches or for special purposes such as wildlife or aesthetic treatment may be found in USDA-NRCS Technical Field Office Guide, Section 342 - Critical Area Planting.
c. For sites having disturbed area over 5 acres, use and show the rates recommended by the soil testing agency.
d. For areas receiving low maintenance, apply urea form fertilizer (46-0-0) at 3 pounds per 1000 square feet (150 pounds per acre) at the time of seeding in addition to the soil amendments shown in the Permanent Seeding Summary.
II. Turfgrass Mixtures
a. Areas where turfgrass may be desired include lawns, parks, playgrounds, and commercial sites which will receive a medium to high level of maintenance.
b. Select one or more of the species or mixtures listed below based on the site conditions or purpose. Enter selected mixtures, application rates, and seeding dates in the Permanent Seeding Summary. The Summary is to be placed on the plan.
I. Kentucky Bluegrass: Full Sun Mixture: For use in areas that receive intensive maintenance. Irrigation required in the areas of central Maryland and Eastern Shore. Recommended Certified Kentucky Bluegrass Cultivar Seeding Rate: 15 to 20 pounds per 1000 square feet. Choose a minimum of three Kentucky bluegrass cultivars with each ranging from 10 to 35 percent of the total mixture by weight.
II. Kentucky Bluegrass/Perennial Rye: Full Sun Mixture: For use in full sun areas where rapid establishment is necessary and when turf will receive medium to intensive management. Certified Perennial Ryegrass Cultivar Seeding Rate: 15 to 20 pounds per 1000 square feet. Choose a minimum of three Kentucky bluegrass cultivars with each ranging from 10 to 35 percent of the total mixture by weight.
III. Tall Fescue/Kentucky Bluegrass: Full Sun Mixture: For use in drought prone areas and/or for areas receiving low to medium management in full sun to medium shade. Recommended mixture includes Certified Tall Fescue Cultivars 15 to 100 percent, Certified Kentucky Bluegrass Seeding Rate: 2 pounds mixture per 1000 square feet. Choose a minimum of three Kentucky bluegrass cultivars with each ranging from 10 to 35 percent of the total mixture by weight.
IV. Kentucky Bluegrass/Fine Fescue: Shade Mixture: For use in areas with shade in Bluegrass lawns. For establishment in high quality, intensively managed turf area. Mixture includes Certified Kentucky Bluegrass Cultivars 30 to 40 percent and Certified Fine Fescue and 60 to 100 percent. Seeding Rate: 1 to 3 pounds per 1000 square feet.
Notes: Select turfgrass varieties from those listed in the most current University of Maryland Publication, Agronomy Memo #71, 'Turfgrass Cultivar Recommendations for Maryland'.
Choose certified material. Certified material is the best guarantee of cultivar purity. The certification program of the Maryland Department of Agriculture, Turf and Seed Section, provides a reliable means of consumer protection and assures a pure genetic line.
c. Ideal Times of Seeding for Turf Grass Mixtures
Western MD: March 15 to June 1, August 1 to October 1 (Hardness Zones: 6a, 6b)
Central MD: March 1 to May 15, August 15 to October 15 (Hardness Zones: 6)
Southern MD, Eastern Shore: March 1 to May 15, August 15 to October 15 (Hardness Zones: 1b, 1a)

B-4-5 STANDARDS AND SPECIFICATIONS FOR PERMANENT STABILIZATION

- d. Fill areas to receive seed by disk or other approved methods to a depth of 2 to 4 inches, level and rake the area to prepare a proper seedbed. Remove stones and debris over 1/2 inches in diameter. The resulting seedbed must be in such condition that future growth of grasses will pose no difficulty.
e. If soil moisture is deficient, apply seed mixtures with adequate water for plant growth (5 to 1 inch every 3 to 4 days depending on soil texture) until they are firmly established. This is especially true when seedings are made late in the planting season, in abnormally dry or hot seasons, or on adverse sites.
PERMANENT SEEDING SUMMARY
Hardness Zone (from Figure B.3): 6b
Seed Mixture (from Table B.3): #9 (Tall Fescue/ Kentucky Bluegrass)
Table: Application Rate (lb/acc), Seeding Dates, Seeding Depths, Fertilizer (lb/1000 sq ft), Lime Rate
I. General Specifications
a. Class of turfgrass sod must be Maryland State Certified. Sod labels must be made available to the job foreman and inspector.
b. Sod must be machine cut at a uniform soil thickness of 1/2 inch plus or minus 1/8 inch, at the time of cutting. Measurement for thickness must exclude top growth and trash. Broken pads and top or uneven ends will not be acceptable.
c. Standard size sections of sod must be strong enough to support their own weight and retain their size and shape when suspended vertically with a firm grip on the upper 10 percent of the section.
d. Sod must not be harvested or transplanted when moisture content (excessively dry or wet) may adversely affect its survival.
e. Sod must be harvested, delivered, and installed within a period of 36 hours. Sod not transplanted within this period must be approved by an agronomist or soil scientist prior to its installation.
II. Sod Installation
a. During periods of excessively high temperature or in areas having dry subsoil, lightly irrigate the sods immediately prior to laying the sod.
b. Lay the first row of sod in a straight line with subsequent rows placed parallel to it and tightly wedged against each other. Stagger lateral joints to promote more uniform growth and strength. Ensure that sod is not stratified or overlapped and that all joints are butted tight in order to prevent weeds which would cause air drying of the roots.
c. Whenever possible, lay sod with the long edges parallel to the contour and with staggering joints. Roll and tamp, peg or otherwise secure the sod to prevent slippage on slopes. Ensure solid contact exists between sod roots and the underlying soil surface.
d. Water the sod immediately following rolling and tamping until the underside of the new sod and soil surface below the sod are thoroughly wet. Complete the operations of laying, tamping and irrigating for any piece of sod within eight hours.
III. Sod Maintenance
a. In the absence of adequate rainfall, water sod during the first week or as often and sufficiently as necessary to maintain moist soil to a depth of 4 inches. Water sod during the heat of the day to prevent wilting.
b. After the first week, sod watering is required as necessary to maintain adequate moisture content.
c. Do not mow until the sod is firmly rooted. No more than 2" of the grass leaf must be removed by the initial cutting or subsequent cuttings. Maintain a grass height of at least 3 inches unless otherwise specified.
PERMANENT SEEDING NOTES
Apply to graded or cleared area not subject to immediate further disturbance where a permanent long-lived vegetative cover is needed.
Seeded Preparation: Loosen upper three inches of soil by raking, disk or other acceptable means before seeding (unless previously loosened).
Soil Amendments: In lieu of soil amendments, use one of the following schedules
1) Preferred - Apply 2 tons per acre dolomitic limestone (42 lbs/1000 square feet) and 600 lbs per acre 10-10-10 fertilizer (4 lbs/1000 sq ft) before seeding. Harrow or disc into upper three inches of soil. At time of seeding, apply 400 lbs per acre 30-0-0 ureadform fertilizer (4 lbs/1000 sq ft).
2) Acceptable - Apply 2 tons per acre dolomitic limestone (42 lbs/1000 sq ft) and 1000 lbs per acre 10-10-10 fertilizer (25 lbs/1000 sq ft) before seeding. Harrow or disc into upper three inches of soil.
Seeding:
I. For the periods March 1 thru April 30 and August 1 thru October 15, seed with 60 lbs per acre (14 lbs/1000 sq ft) of Kentucky 31 Tall Fescue. For the period May 1 thru July 31, seed with 60 lbs Kentucky 31 Tall Fescue per acre and 2 lbs per acre (0.5 lbs/1000 sq ft) of creeping lovegrass. During the period of October 16 thru February 28, protect site with: Option (1) 2 tons per acre of well anchored straw mulch and seed as soon as possible in the spring. Option (2) Seed with 60 lbs/acre Kentucky 31 Tall Fescue and mulch with 2 tons/acre well anchored straw.
II. For the period May 1 thru August 14, seed with 3 lbs per acre (5 gal/1000 sq ft) of emulsified asphalt on flat areas. On slopes 8:1 or higher, use 3/4 gal per acre (5 gal/1000 sq ft) for anchoring. Refer to the 1994 MARYLAND STANDARDS AND SPECIFICATIONS FOR SOIL EROSION AND SEDIMENT CONTROL for rate and methods not covered.
III. Mix seed and fertilizer on site and seed immediately and without interruption.
IV. When hydroseeding do not incorporate seed into the soil.
B-4-6 STANDARDS AND SPECIFICATIONS FOR STOCKPILE AREA
Definition: A mound or pile of soil protected by appropriately designed erosion and sediment control measures.
Purpose: To provide a designated location for the temporary storage of soil that controls the potential for erosion, sedimentation, and changes to drainage patterns.
Conditions Where Practice Applies: Stockpile areas are utilized when it is necessary to salvage and store soil for later use.
Criteria:
I. The stockpile location and all related sediment control practices must be clearly indicated on the erosion and sediment control plan.
II. The footprint of the stockpile must be sized to accommodate the anticipated volume of material and based on a side slope ratio no steeper than 2:1. Benching must be provided in accordance with Section B-3 Land Grading.
III. Runoff from the stockpile area must drain to a suitable sediment control practice.
IV. Access the stockpile area from the upgrade side.
V. Clear water runoff into the stockpile area must be minimized by use of a diversion device such as an earth dike, temporary swale or diversion fence. Provisions must be made for discharging concentrated flow in a non-erosive manner.
VI. Surface runoff concentrates along the toe of the stockpile fill, an appropriate erosion/sediment control practice must be used to intercept the discharge.
VII. Stockpiles must be stabilized in accordance with the 3/7 day stabilization requirement as well as Standard B-4-1 Incremental Stabilization and Standard B-4-4 Temporary Stabilization.
VIII. If the stockpile is located on an impervious surface, a liner should be provided below the stockpile to facilitate cleanup. Stockpiles containing contaminated material must be covered with impermeable sheeting.
Maintenance:
The stockpile area must continuously meet the requirements for Adequate Vegetative Establishment in accordance with Section B-4 Vegetative Stabilization. Side slopes must be maintained at no steeper than a 2:1 ratio. The stockpile area must be kept free of erosion. If the vertical height of a stockpile exceeds 20 feet for 2:1 slopes, 30 feet for 3:1 slopes, or 40 feet for 4:1 slopes, benching must be provided in accordance with Section B-3 Land Grading.

ENGINEER'S CERTIFICATE

I HEREBY CERTIFY THAT THIS PLAN FOR SEDIMENT AND EROSION CONTROL REPRESENTS A PRACTICAL AND FEASIBLE PLAN BASED ON MY PERSONAL KNOWLEDGE OF THE SITE CONDITIONS AND THAT IT WAS PREPARED IN ACCORDANCE WITH THE REQUIREMENTS OF THE HOWARD SOIL CONSERVATION DISTRICT.
Signature: [Signature] Date: 12/14/17

DEVELOPER'S/BUILDER'S CERTIFICATE

I WE CERTIFY THAT ALL DEVELOPMENT AND CONSTRUCTION WILL BE DONE ACCORDING TO THIS PLAN OF DEVELOPMENT FOR SEDIMENT AND EROSION CONTROL AND THAT ANY RESPONSIBLE PERSONNEL INVOLVED IN THE CONSTRUCTION PROJECT WILL HAVE A CERTIFICATE OF ATTENDANCE AT A DEPARTMENT OF ENVIRONMENT APPROVED TRAINING PROGRAM FOR THE CONTROL OF SEDIMENT AND EROSION BEFORE BEGINNING THE PROJECT. I ALSO AUTHORIZE PERIODIC ON-SITE INSPECTION BY THE HOWARD SOIL CONSERVATION DISTRICT.
Signature: [Signature] Date: 12/14/17

APPROVED: HOWARD COUNTY DEPARTMENT OF PUBLIC WORKS

Chief, Bureau of Highways [Signature] Date: 1/19/18

APPROVED: HOWARD COUNTY DEPARTMENT OF PLANNING & ZONING

Chief, Division of Land Development [Signature] Date: 1/11/18

APPROVED: HOWARD COUNTY DEPARTMENT OF ENGINEERING

Chief, Development Engineering Division [Signature] Date: 1/11/18

GLWGUTSCHICK LITTLE & WEBER, P.A.

CIVIL ENGINEERS, LAND SURVEYORS, LAND PLANNERS, LANDSCAPE ARCHITECTS
3909 NATIONAL DRIVE - SUITE 250 - BURTONSVILLE OFFICE PARK
BURTONSVILLE, MARYLAND 20866
TEL: 301-421-4024 FAX: 301-421-4186








This Development Plan is approved for Soil Erosion and Sediment Control by the Howard Soil Conservation District.
Signature: [Signature] Date: 12/28/17

PREPARED FOR:

THE HOWARD HUGHES CORPORATION
10480 LITTLE PATUXENT PARKWAY
SUITE 400
COLUMBIA, MARYLAND 21044
ATTN: BILL ROWE
410-964-4987

PROFESSIONAL CERTIFICATION




I HEREBY CERTIFY THAT THESE PLANS WERE PREPARED OR APPROVED BY ME, AND THAT I AM A DULY LICENSED PROFESSIONAL ENGINEER UNDER THE LAWS OF THE STATE OF MARYLAND, LICENSE NO. 12975
EXPIRATION DATE: MAY 26,

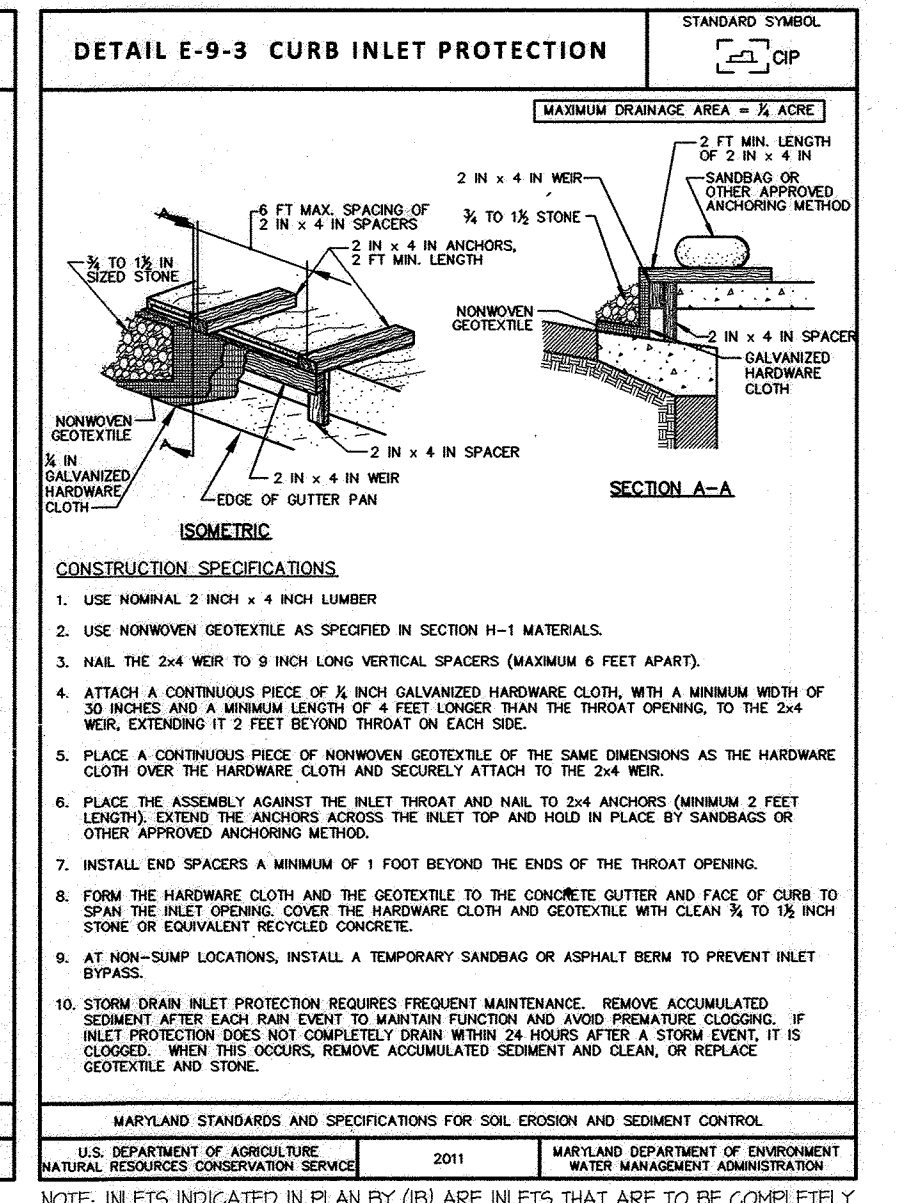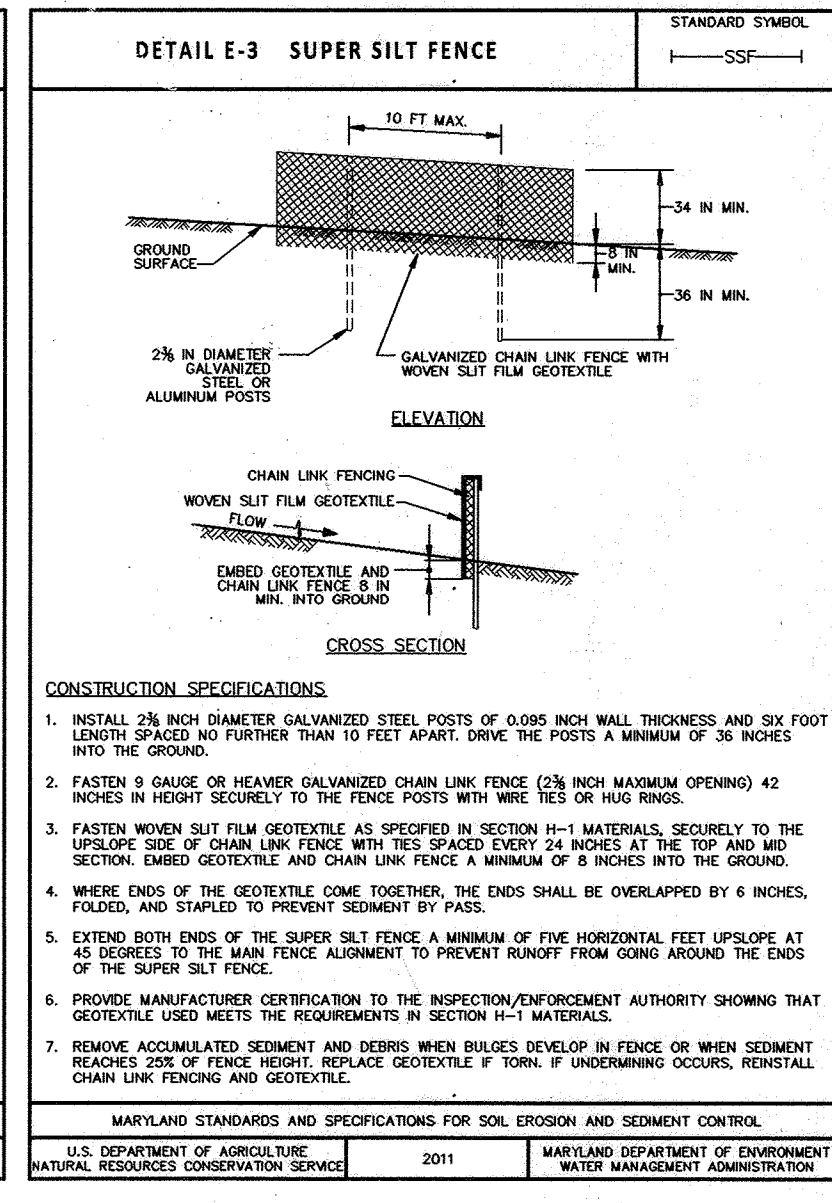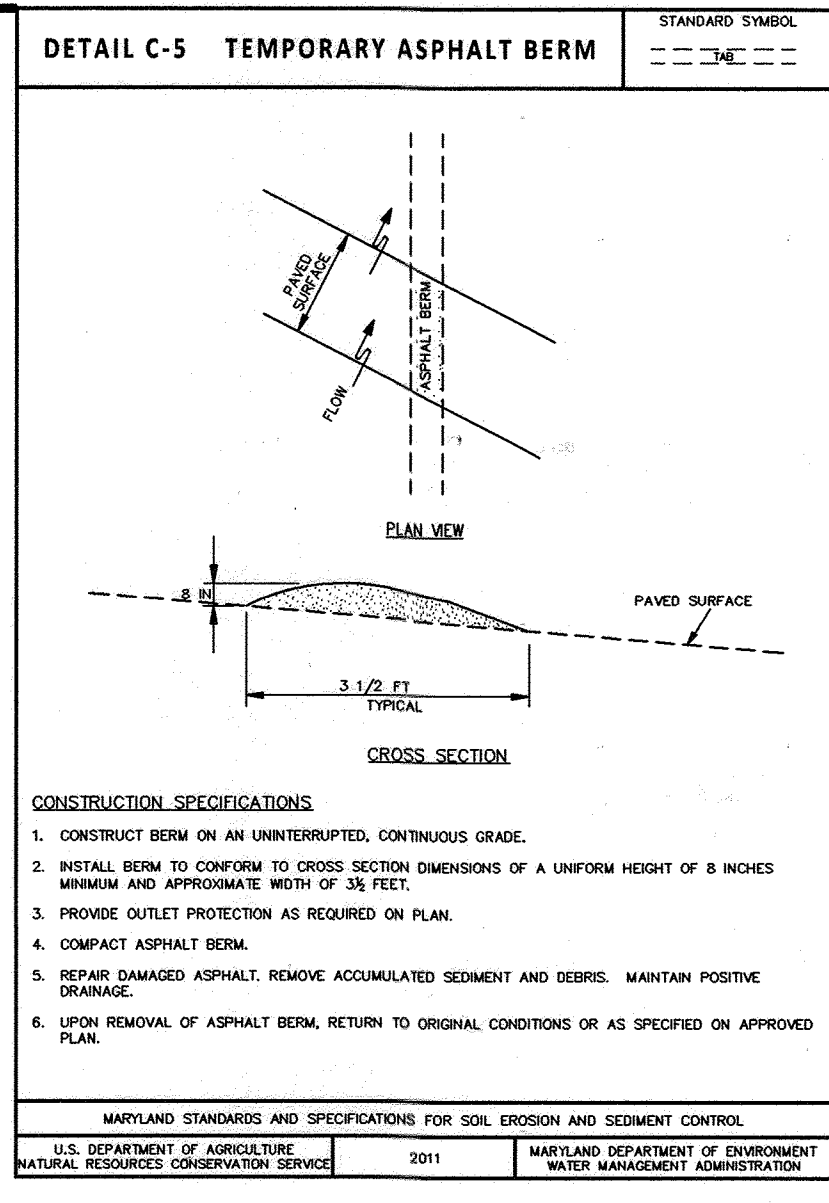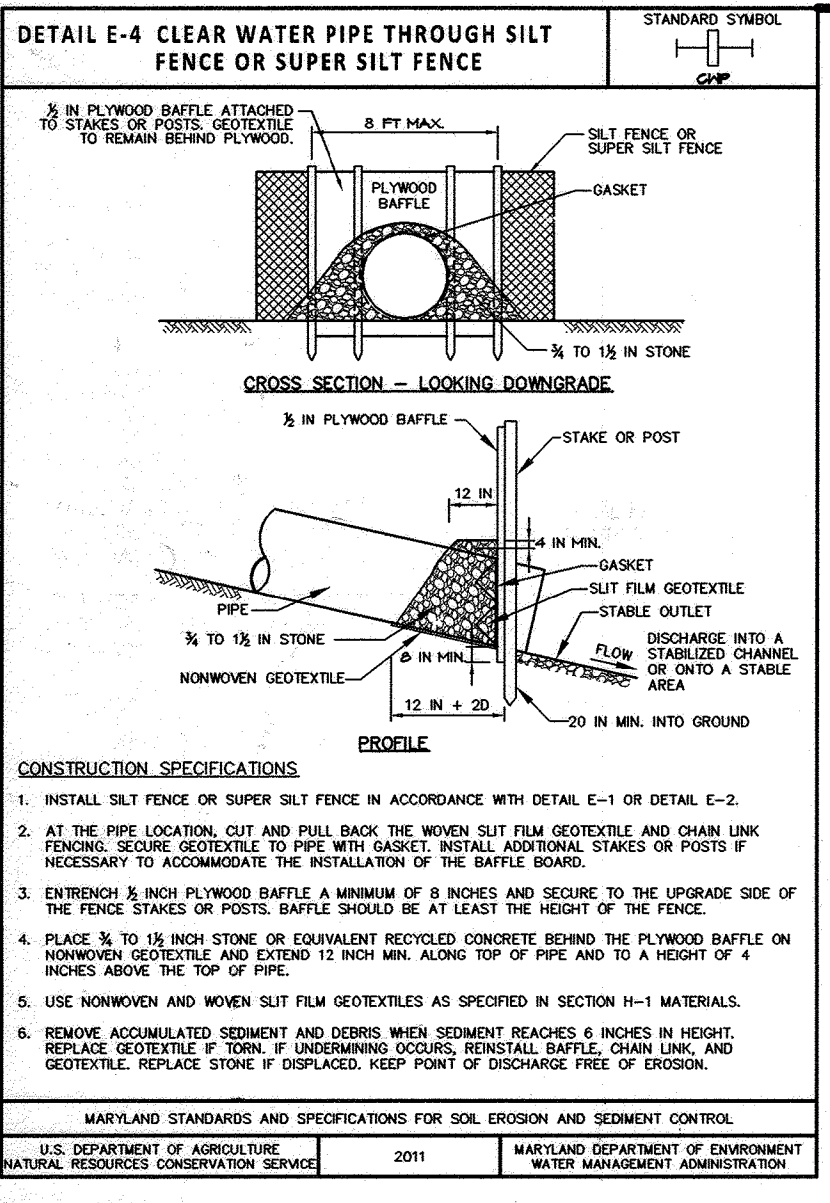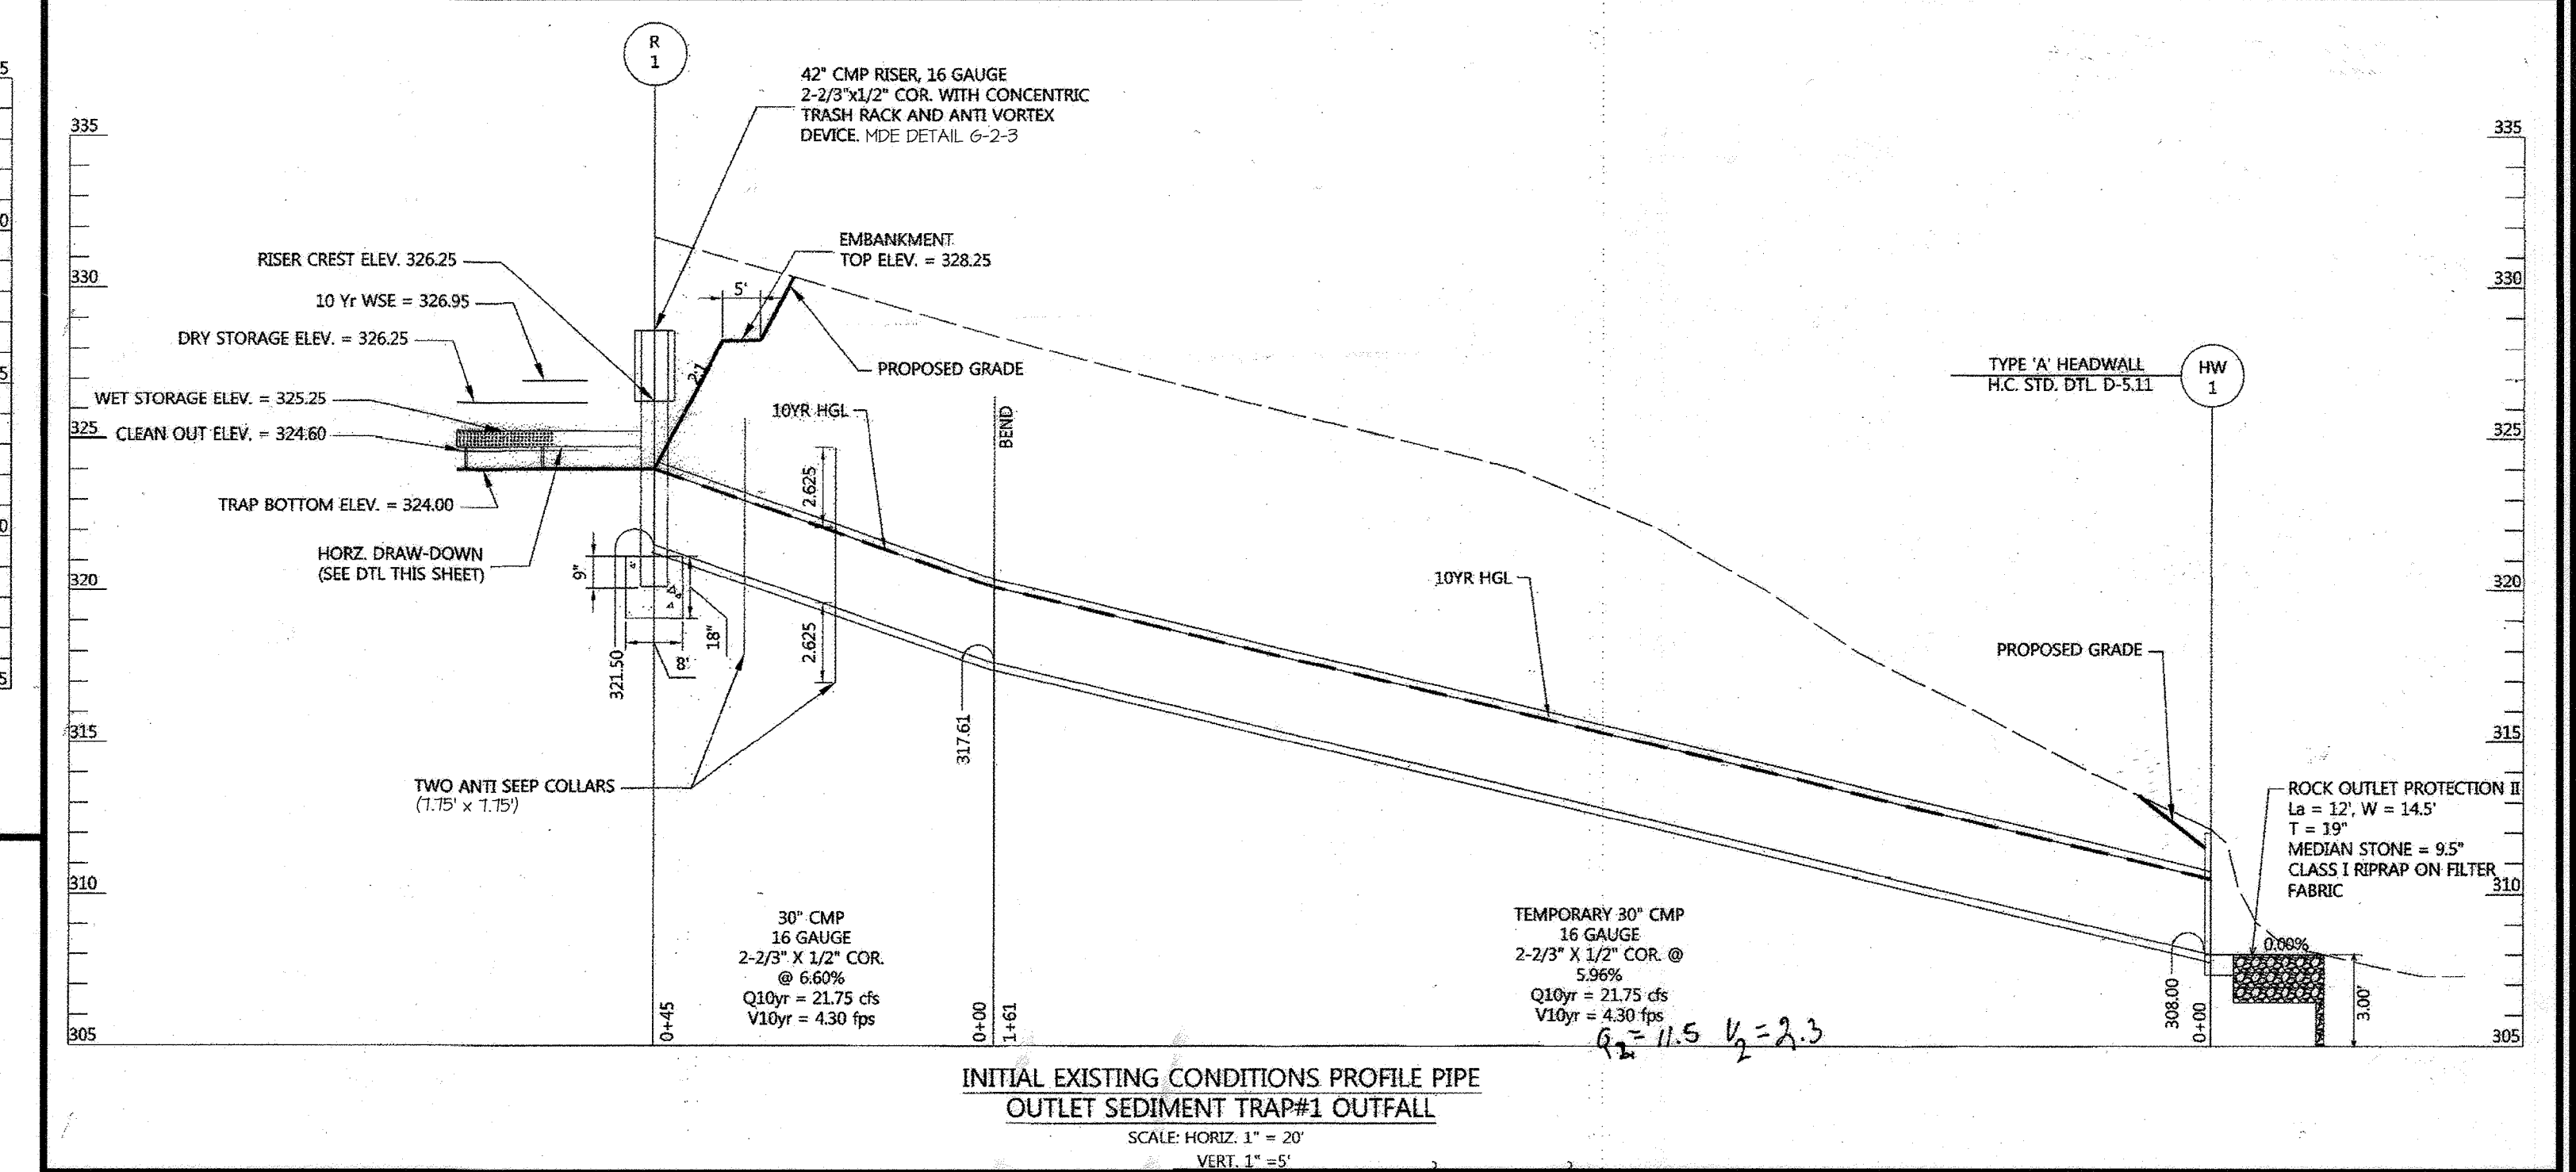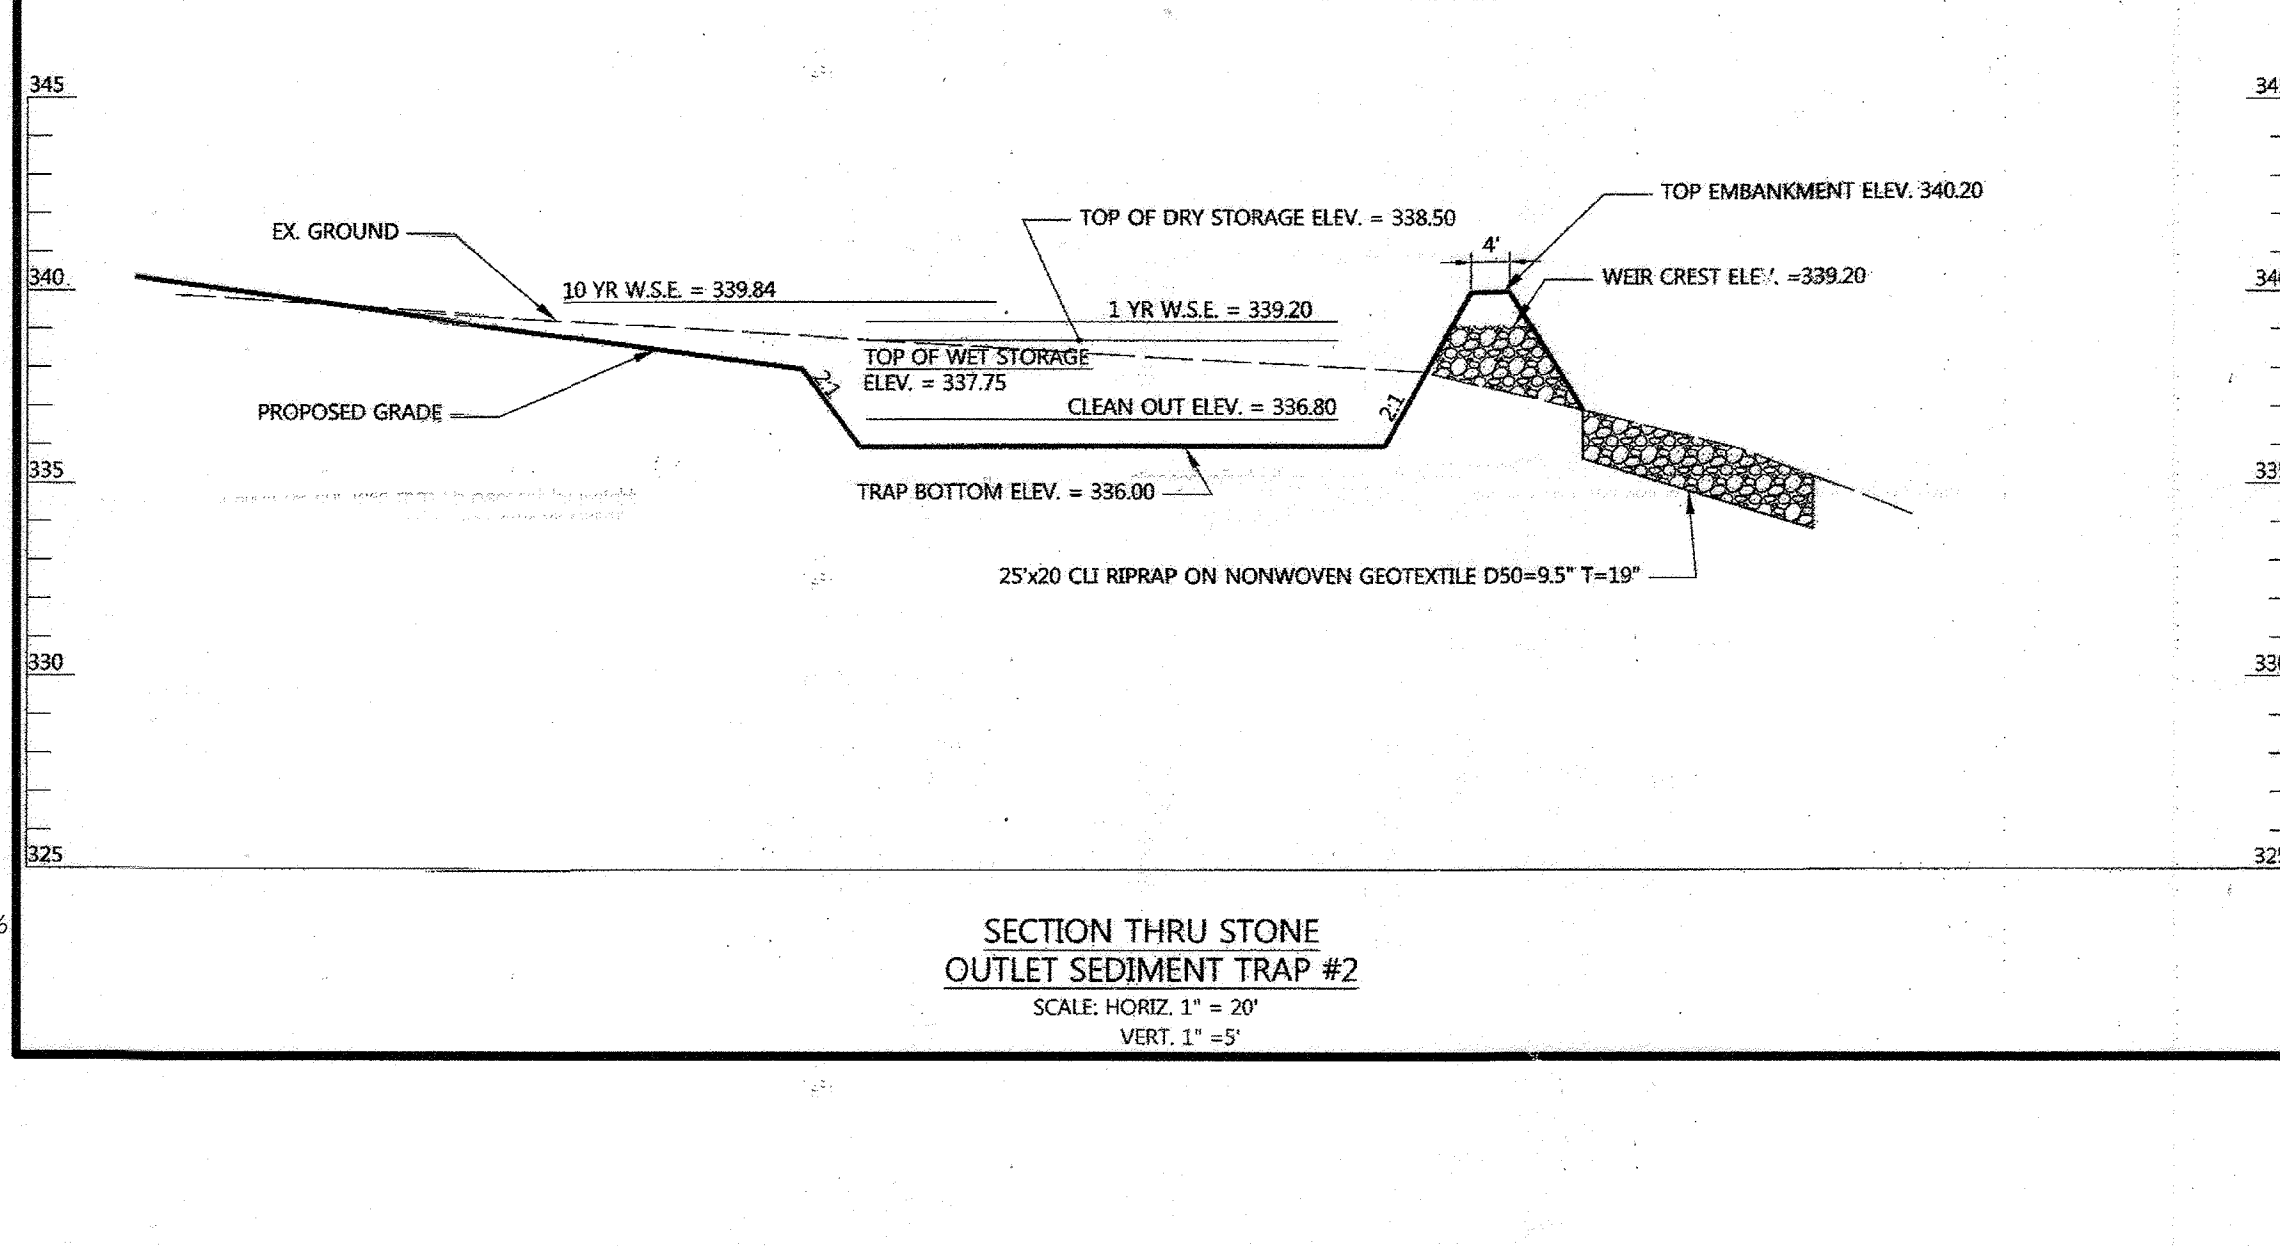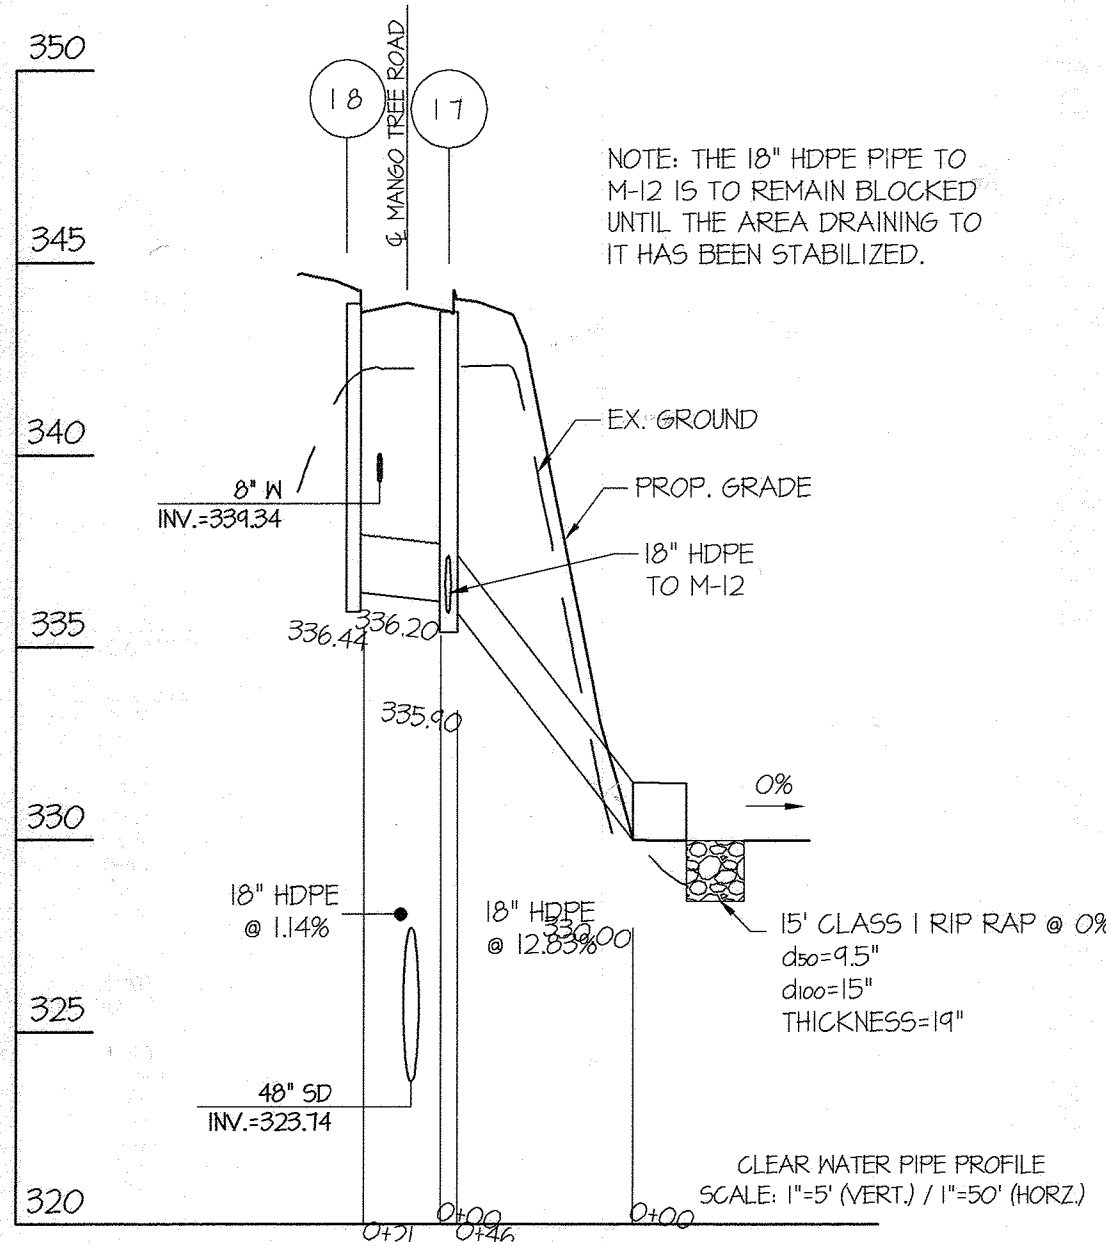

ENGINEER'S CERTIFICATE

I HEREBY CERTIFY THAT THIS PLAN FOR SEDIMENT AND EROSION CONTROL REPRESENTS A PRACTICAL AND WORKABLE PLAN BASED ON MY PERSONAL KNOWLEDGE OF THE SITE CONDITIONS AND THAT IT WAS PREPARED IN ACCORDANCE WITH THE REQUIREMENTS OF THE HOWARD SOIL CONSERVATION DISTRICT.

12/14/17
ENGINEER'S SIGNATURE: *[Signature]*

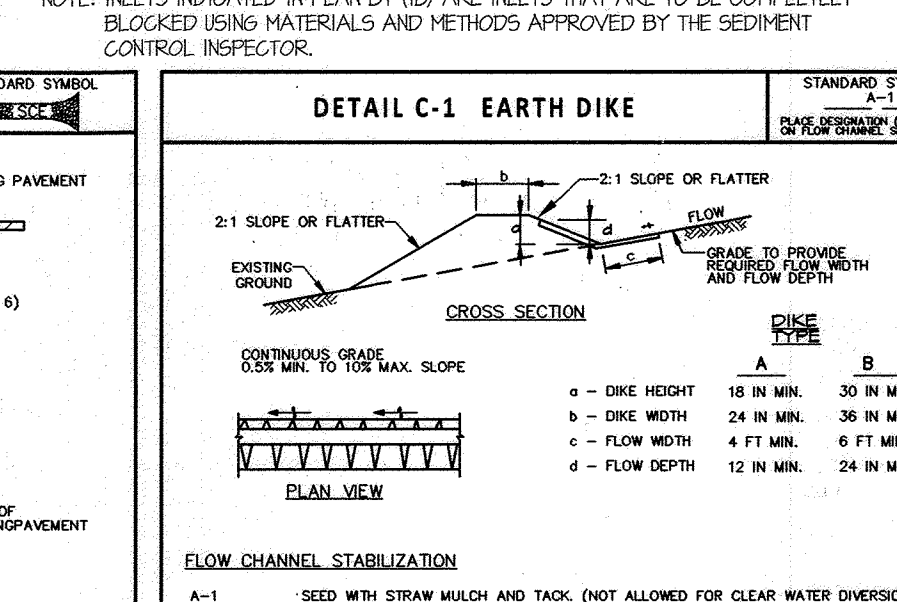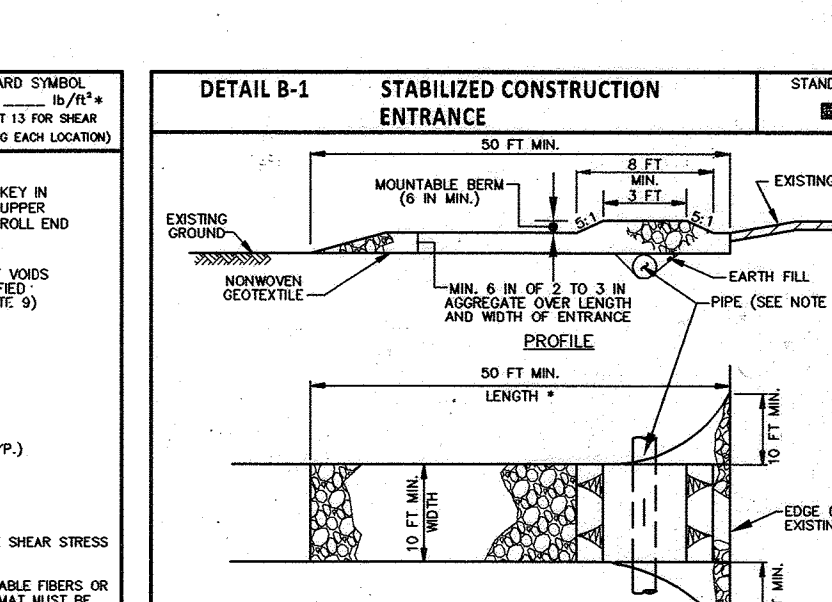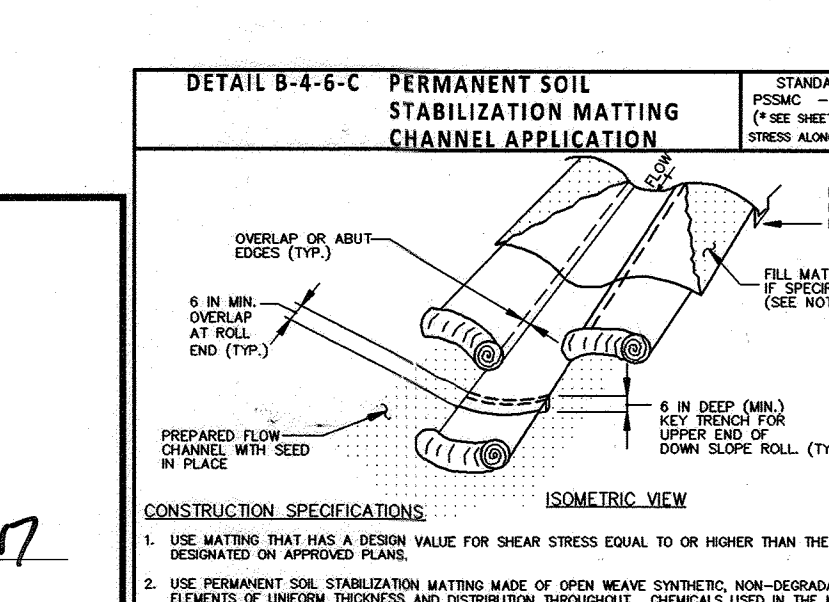

DEVELOPER/BUILDER'S CERTIFICATE

I HEREBY CERTIFY THAT ALL DEVELOPMENT AND CONSTRUCTION WILL BE DONE ACCORDING TO THIS PLAN OF DEVELOPMENT FOR SEDIMENT AND EROSION CONTROL AND THAT ANY RESPONSIBLE PERSONNEL INVOLVED IN THE CONSTRUCTION PROJECT WILL HAVE A CERTIFICATE OF ATTENDANCE AT A DEPARTMENT OF ENVIRONMENT APPROVED TRAINING PROGRAM FOR THE CONTROL OF SEDIMENT AND EROSION BEFORE BEGINNING THE PROJECT. I ALSO AUTHORIZE PERIODIC ON-SITE INSPECTION BY THE HOWARD SOIL CONSERVATION DISTRICT.

12/14/17
SIGNATURE OF DEVELOPER/BUILDER: *[Signature]*

CONSTRUCTION SPECIFICATIONS

- USE MATTING THAT HAS A DESIGN VALUE FOR SHEAR STRESS EQUAL TO OR HIGHER THAN THE SHEAR STRESS DESIGNATED ON APPROVED PLAN.
- SECURE MATTING USING STAPLES OR ANCHORS. STAPLES MUST BE 1/4" DIA. AND 6" LONG. ANCHORS MUST BE 1/2" DIA. AND 6" LONG. STAPLES MUST BE PLACED AT 12" ON CENTER ALONG LONG EDGE OF MATTING. ANCHORS MUST BE PLACED AT 12" ON CENTER ALONG SHORT EDGE OF MATTING.
- UNROLL MATTING IN DIRECTION OF WATER FLOW CENTERING THE FIRST ROLL ON THE CHANNEL CENTER LINE. WORK FROM CENTER OF CHANNEL OUTWARD WHEN PLACING ROLLS. LAY MATTING SMOOTHLY AND FIRMLY FLAT ON THE SURFACE. AVOID STRETCHING THE MATTING.
- OVERLAP OR BUTT EDGES OF MATTING ROLLS FOR MANUFACTURER'S RECOMMENDATIONS. OVERLAP ROLL EDGES BY 1/2 INCHES. STAPLES THE MAT IN PLACE, REPLACING THE EDGES, AND TAMPING TO CONTACT. A PEEB IS NOT NECESSARY. A MOUNTABLE BERM IS REQUIRED WHEN JOBS DO NOT LOCATED AT A HIGH SPOT.
- MAINTAIN ENTRANCE IN A CONDITION THAT MINIMIZES TRACKING OF SEDIMENT, AND STONE OR MAKE OTHER REPAIRS AS CONDITIONS DEMAND TO MAINTAIN CLEAN SURFACE. MOUNTABLE BERM, AND SPECIFIED DIMENSIONS. IMMEDIATELY REMOVE STONE AND/OR SEDIMENT SPILLED, DROPPED, OR TRACKED OVER ADJACENT ROADWAY BY MACHINERY, EQUIPMENT, AND/OR OPERATOR. WORKING ROADWAY TO BE MAINTAINED OPEN TO ACCEPTABLE UNLESS WASH WATER IS DIRECTED TO AN APPROVED SEDIMENT CONTROL PRACTICE.

CONSTRUCTION SPECIFICATIONS

- PLACE STABILIZED CONSTRUCTION ENTRANCE IN ACCORDANCE WITH THE APPROVED PLAN. VEHICLES MUST TRAVEL OVER THE ENTIRE LENGTH OF THE SOE. USE MINIMUM LENGTH OF 50 FEET (100 FEET FOR SINGLE RESIDENCE LOTS). USE MINIMUM WIDTH OF 10 FEET. FLARE SIZE 10 FEET MINIMUM AT THE EXISTING ROAD TO PROVIDE A TURNING RADIUS.
- PREPARE SURFACE MATTING FLOWING TO OR OVERFLOW TOWARD THE SOE UNDER THE ENTRANCE. MAINTAIN POSITIVE DRAINAGE. PROTECT PIPE INSTALLED THROUGH THE SOE WITH A MOUNTABLE BERM WITH 2:1 SLOPE AND A MINIMUM OF 12 INCHES OF STONE OVER THE PIPE. PROVIDE PIPE AS SPECIFIED ON APPROVED PLAN. WHEN THE SOE IS LOCATED AT A HIGH SPOT AND HAS NO DRAINAGE TO CONVEY A PEEB IS NOT NECESSARY. A MOUNTABLE BERM IS REQUIRED WHEN JOBS DO NOT LOCATED AT A HIGH SPOT.
- PREPARE GROUND AND PLACE NONWOVEN GEOTEXTILE AS SPECIFIED IN SECTION H-1 MATERIALS.
- PLACE CROWNED AGGREGATE (C) TO 3 INCHES IN DEPTH OR EQUIVALENT RECYCLED CONCRETE (WITHOUT REBAR) AT LEAST 6 INCHES DEEP OVER THE LENGTH AND WIDTH OF THE SOE.
- MAINTAIN ENTRANCE IN A CONDITION THAT MINIMIZES TRACKING OF SEDIMENT, AND STONE OR MAKE OTHER REPAIRS AS CONDITIONS DEMAND TO MAINTAIN CLEAN SURFACE. MOUNTABLE BERM, AND SPECIFIED DIMENSIONS. IMMEDIATELY REMOVE STONE AND/OR SEDIMENT SPILLED, DROPPED, OR TRACKED OVER ADJACENT ROADWAY BY MACHINERY, EQUIPMENT, AND/OR OPERATOR. WORKING ROADWAY TO BE MAINTAINED OPEN TO ACCEPTABLE UNLESS WASH WATER IS DIRECTED TO AN APPROVED SEDIMENT CONTROL PRACTICE.

CONSTRUCTION SPECIFICATIONS

- REMOVE AND DISPOSE OF ALL TREES, BRUSH, STAMPS, OBSTRUCTIONS, AND OTHER OBSTRUCTABLE MATERIAL SO AS NOT TO INTERFERE WITH PROPER FUNCTION OF EARTHDIKE.
- EQUIVALENT OF SHARP EDGES (SEE TO LINE, GRADE, AND CROSS SECTION AS SPECIFIED. BANK PROJECTIONS OF OTHER OBSTRUCTABLES ARE NOT ALLOWED.
- COMPACT FILL.
- CONSTRUCT FLOW CHANNEL ON AN UNINTERRUPTED, CONTINUOUS GRADE. ADJUSTING THE LOCATION DUE TO FIELD CONDITIONS AS NECESSARY TO MAINTAIN POSITIVE DRAINAGE.
- STABILIZE EARTH DIKE WITHIN THREE DAYS OF INSTALLATION. STABILIZE FLOW CHANNEL FOR CLEAR WATER DIVERSION WITHIN 24 HOURS OF INSTALLATION.
- MAINTAIN LINE, GRADE, AND CROSS SECTION. REMOVE ACCUMULATED SEDIMENT AND DEBRIS, AND MAINTAIN POSITIVE DRAINAGE. PROTECT PIPE INSTALLED THROUGH THE SOE WITH A MOUNTABLE BERM WITH 2:1 SLOPE AND A MINIMUM OF 12 INCHES OF STONE OVER THE PIPE. PROVIDE PIPE AS SPECIFIED ON APPROVED PLAN. WHEN THE SOE IS LOCATED AT A HIGH SPOT AND HAS NO DRAINAGE TO CONVEY A PEEB IS NOT NECESSARY. A MOUNTABLE BERM IS REQUIRED WHEN JOBS DO NOT LOCATED AT A HIGH SPOT.
- UPON REMOVAL OF EARTH DIKE, TOP SOLE FILL WITH EXISTING GROUND. WITHIN 24 HOURS OF REMOVAL STABILIZE DISTURBED AREA WITH GRADE, SOLE, AND MULCH, OR AS SPECIFIED ON APPROVED PLAN.

APPROVED: HOWARD COUNTY DEPARTMENT OF PUBLIC WORKS

12/14/17
SIGNATURE: *[Signature]*

APPROVED: HOWARD COUNTY DEPARTMENT OF PLANNING & ZONING

1-19-18
1-11-18
SIGNATURE: *[Signature]*

This Development Plan is approved for Soil Erosion and Sediment Control by the Howard Soil Conservation District.

12/28/17
SIGNATURE: *[Signature]*

GLWGUTSCHICK LITTLE & WEBER, P.A.
CIVIL ENGINEERS, LAND SURVEYORS, LAND PLANNERS, LANDSCAPE ARCHITECTS
3909 NATIONAL DRIVE - SUITE 250 - BURTNSVILLE OFFICE PARK
BURTNSVILLE, MARYLAND 20866
TEL: 301-421-4024 BALTIMORE: 410-880-1820 DC/VA: 301-989-2524 FAX: 301-421-4186

1-24-19
DATE: 1-24-19
BY: *[Signature]*

REVISION
DATE: 1-24-19
BY: *[Signature]*

PREPARED FOR:
THE HOWARD HUGHES CORPORATION
10480 LITTLE PATUXENT PARKWAY
SUITE 400
COLUMBIA, MARYLAND 21044
ATTN: BILL ROWE
410-964-4987

PROFESSIONAL CERTIFICATION

I HEREBY CERTIFY THAT THESE PLANS WERE PREPARED OR APPROVED BY ME, AND THAT I AM A DULY LICENSED PROFESSIONAL ENGINEER UNDER THE LAWS OF THE STATE OF MARYLAND, LICENSE NO. 12975
EXPIRATION DATE: MAY 28, 2018

12/14/17
SIGNATURE: *[Signature]*

SEDIMENT CONTROL NOTES AND DETAILS



DOWNTOWN COLUMBIA CRESENT NEIGHBORHOOD
PARCELS D-1 THRU D-14, NON-BUILDABLE BULK PARCELS
D-15 THRU D-17 & OPEN SPACE LOT 10

SCALE: AS SHOWN
ZONING: NT
G. L. W. FILE NO.: 11071
DATE: DEC., 2017
TAX MAP - GRID: 36 - 01
SHEET: 16 OF 25

THERE IS NO AS-BUILT INFORMATION ON THIS SHEET

PROFESSIONAL ENGINEER
AS BUILT CERTIFICATION FOR ESWM
NOTE: THERE IS NO "AS-BUILT" INFORMATION PROVIDED ON THIS SHEET.
NAME: GERALD D. TURNBAUGH
DATE: AUG. 11, 2023 REG. NO.: 26569

10/03/23
G. SCOTT SHANABERGER
PROFESSIONAL LAND SURVEYOR #10849
LICENSE EXPIRATION DATE 4/2/2024
AS-BUILT SURVEY DATES 2/1/22 TO 2/18/22

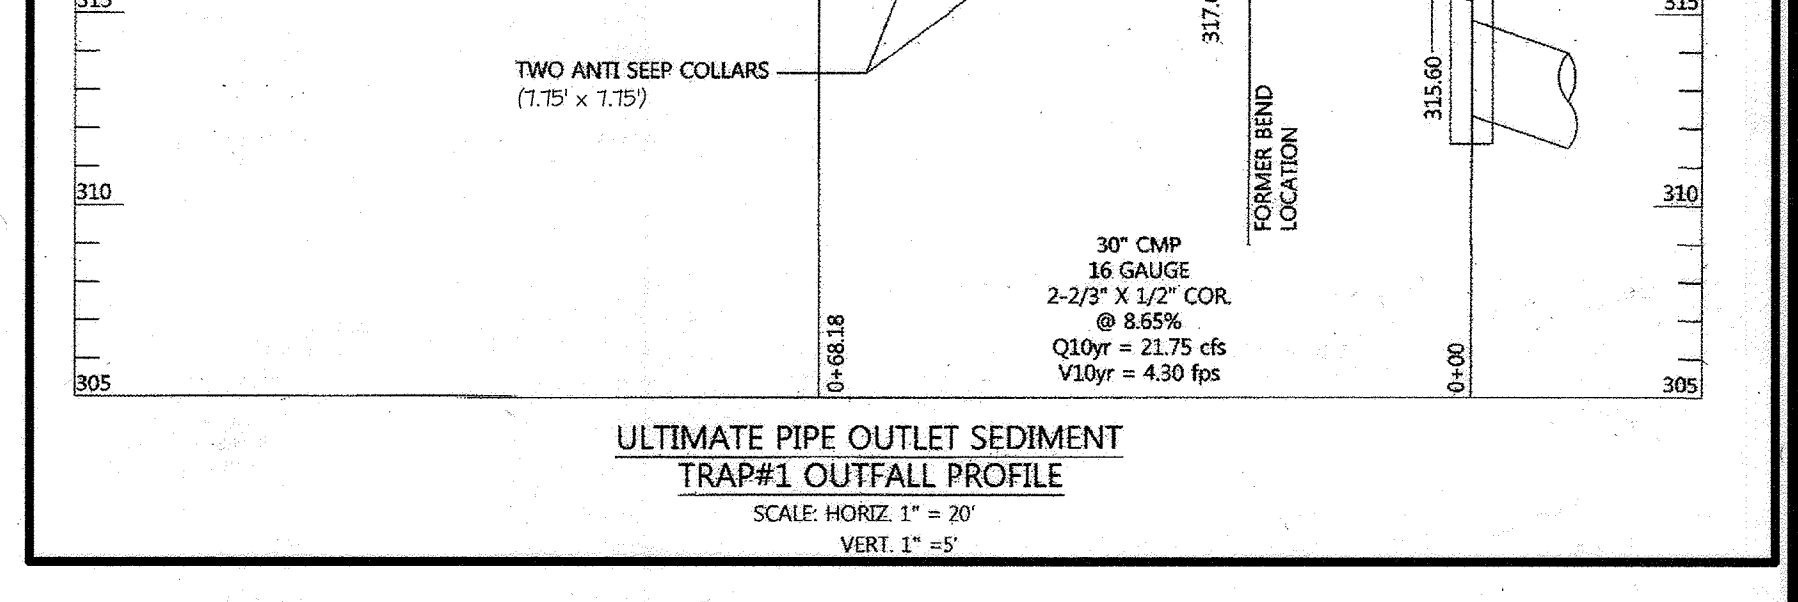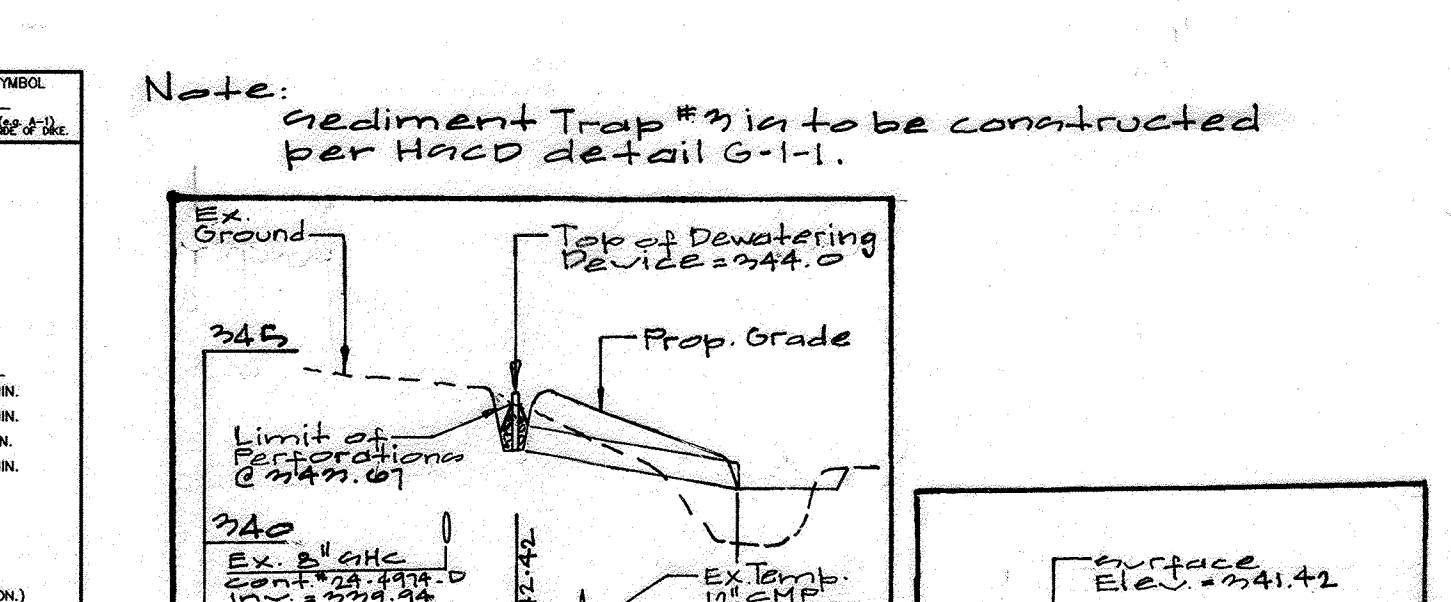



Note: Sediment Trap #3 is to be constructed per H-10 detail G-1-1.

Limit of Erosion Control
345.00
340.00
335.00
330.00
325.00
320.00
315.00
310.00
305.00

Prop. Grade
Top of Dewatering Device = 344.00
Ex. Gnd. Elev. = 344.42
Surface Elev. = 344.42

30" CMP 16 GAUGE 2-2/3" X 1/2" COR. @ 6.65% Q10yr = 21.75 cfs V10yr = 4.30 fps

NOTE: PIPE OUTLET SEDIMENT TRAP #1 AND STONE OUTLET SEDIMENT TRAP #2 WERE CONSTRUCTED UNDER SDP 16-075. FOR ADDITIONAL INFORMATION, NOT SHOWN ON THESE PLANS, REFER TO SDP 16-075. SEE SHEET 14 OF THIS PLAN SET FOR BOTTOM, CLEAN OUT ELEVATIONS AND OTHER INFORMATION FOR THE ROUTINE MAINTENANCE OF THE TRAPS.

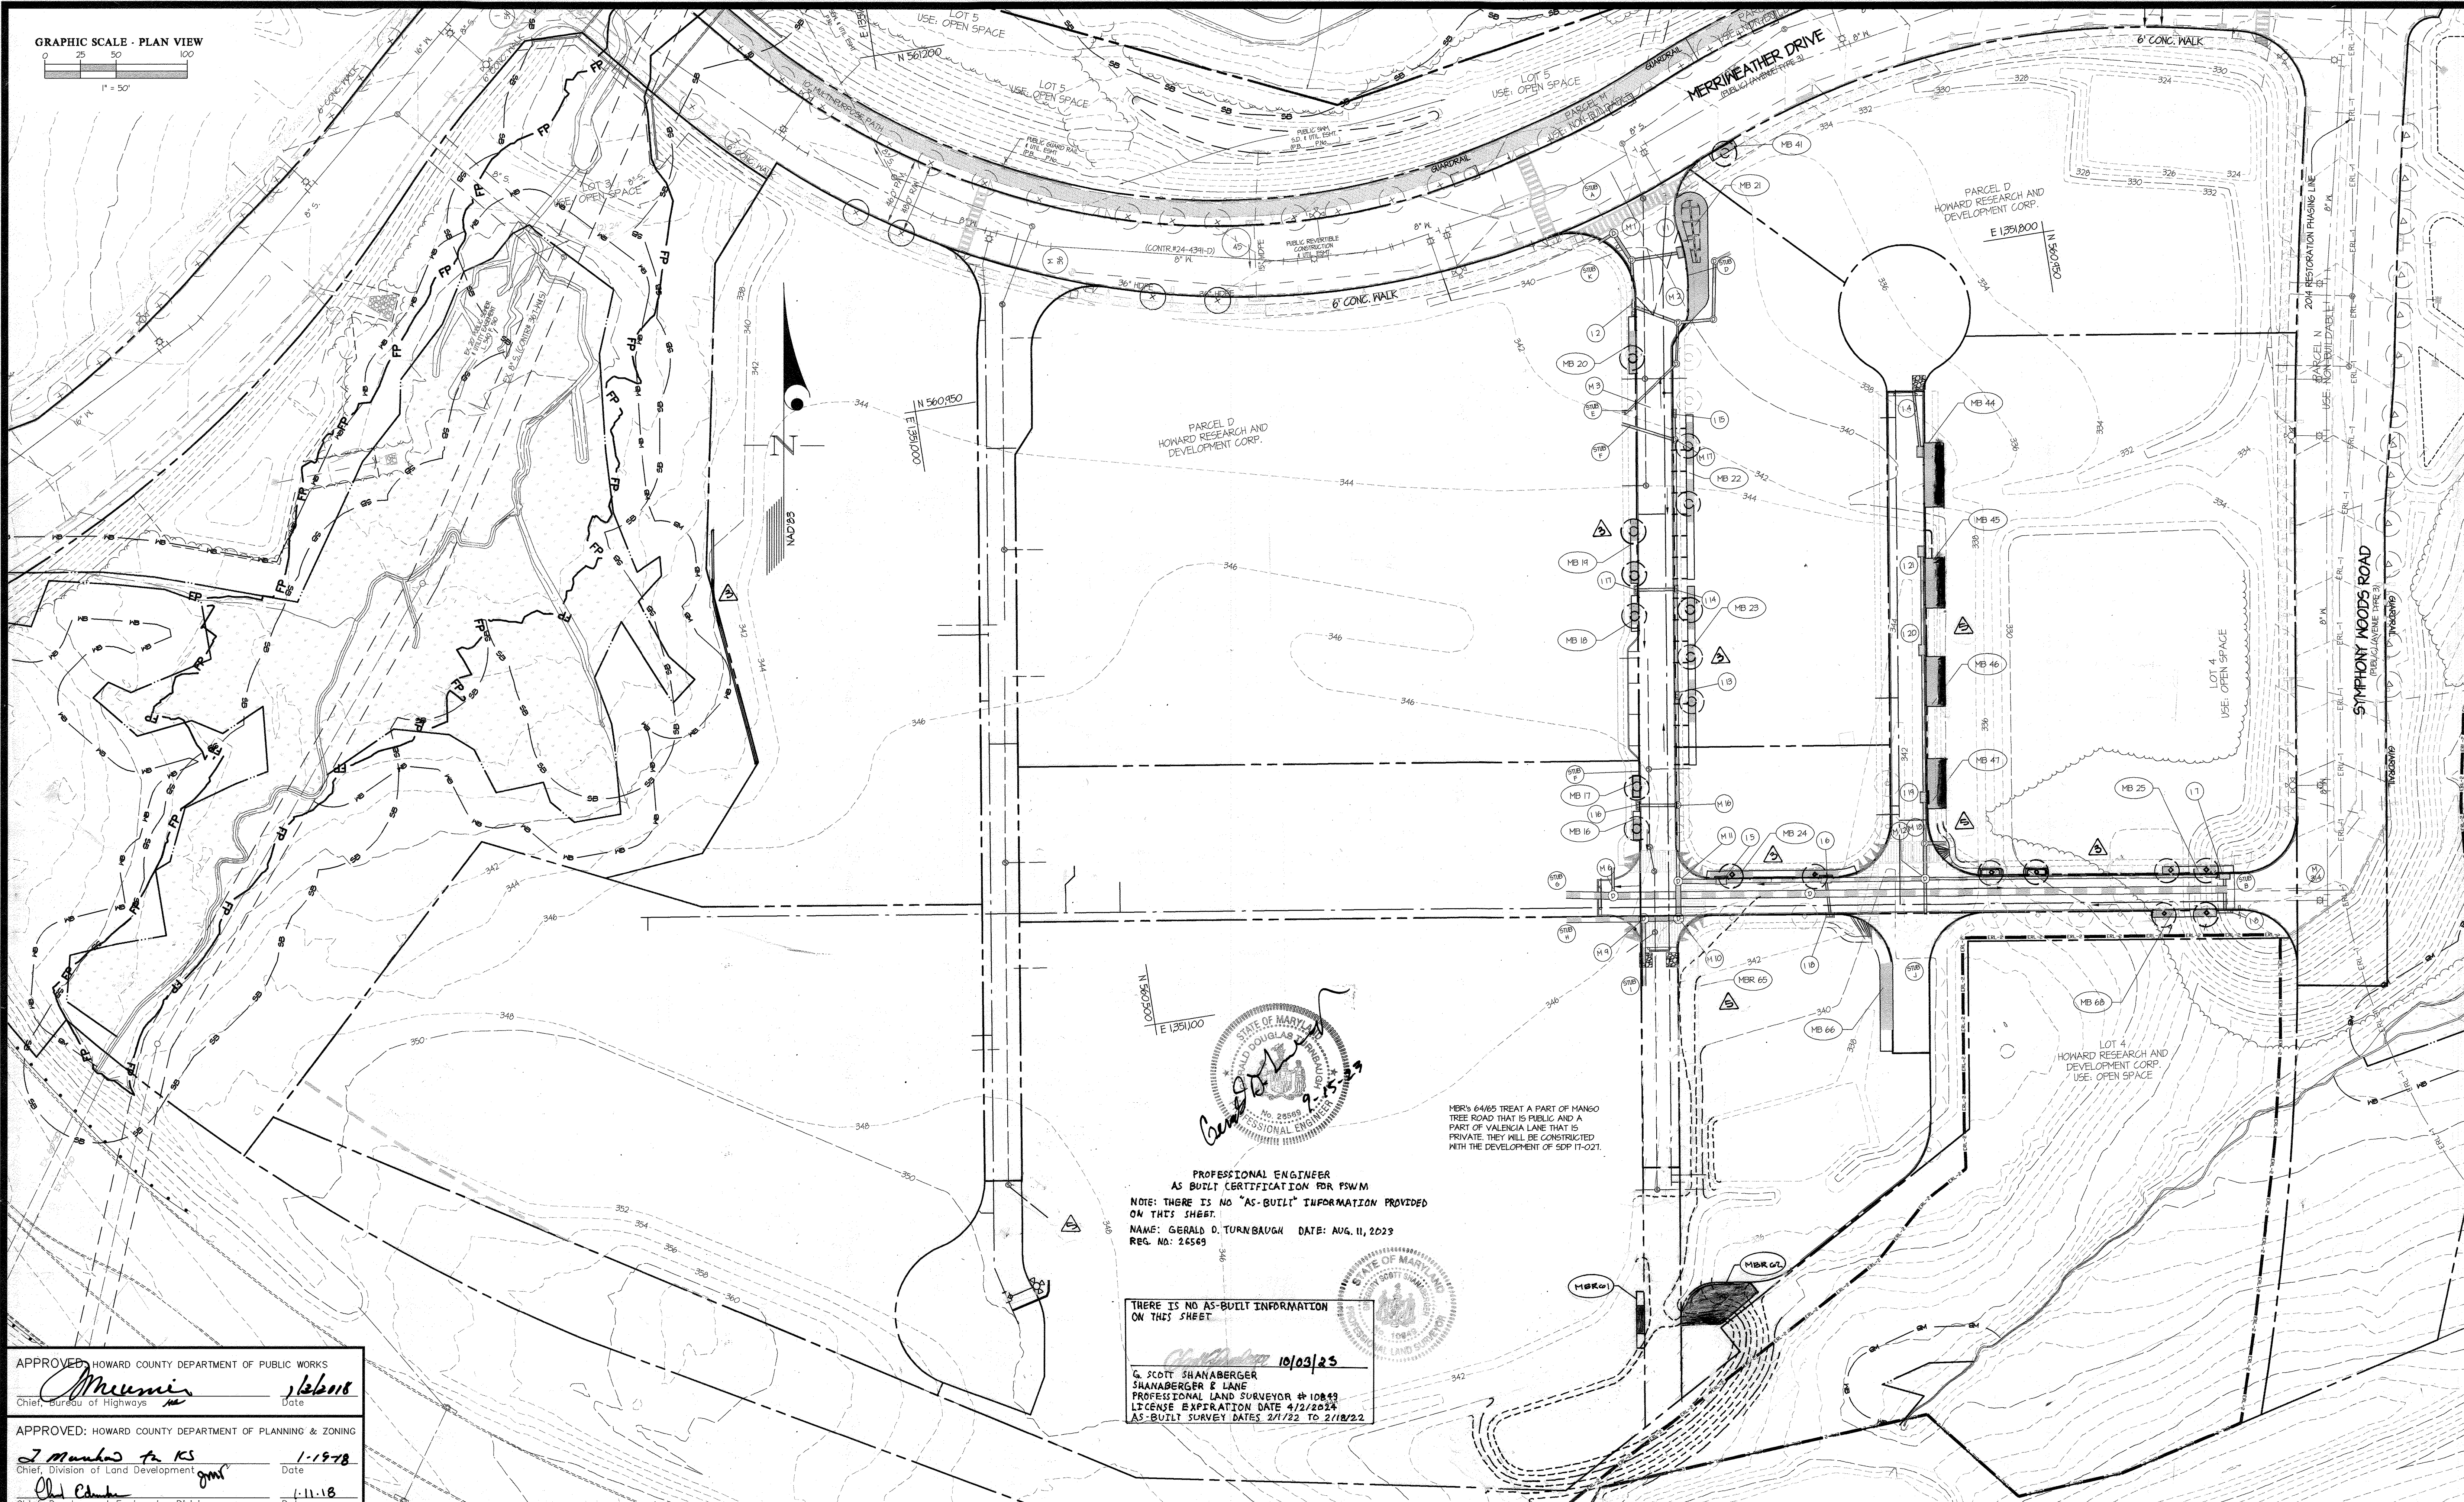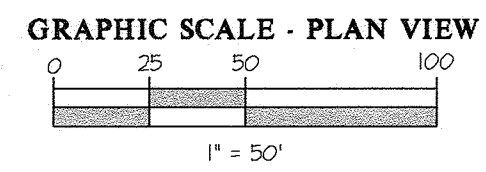

STATE OF MARYLAND
 PROFESSIONAL ENGINEER
 GERALD D. TURNBAUGH
 REG. NO. 24569
 DATE: AUG. 11, 2023

MBR 64/65 TREAT A PART OF MANGO TREE ROAD THAT IS PUBLIC AND A PART OF VALENCIA LANE THAT IS PRIVATE. THEY WILL BE CONSTRUCTED WITH THE DEVELOPMENT OF SDP IT-021.

PROFESSIONAL ENGINEER
 AS BUILT CERTIFICATION FOR PSWM
 NOTE: THERE IS NO "AS-BUILT" INFORMATION PROVIDED ON THIS SHEET.
 NAME: GERALD D. TURNBAUGH DATE: AUG. 11, 2023
 REG. NO. 24569

THERE IS NO AS-BUILT INFORMATION ON THIS SHEET.
 10/03/23
 G. SCOTT SHANABERGER
 SHANABERGER & LANE
 PROFESSIONAL LAND SURVEYOR #10849
 LICENSE EXPIRATION DATE 4/2/2024
 AS-BUILT SURVEY DATES 2/1/22 TO 2/18/22


APPROVED: HOWARD COUNTY DEPARTMENT OF PUBLIC WORKS
 [Signature] 1/26/18
 Chief, Bureau of Highways
 APPROVED: HOWARD COUNTY DEPARTMENT OF PLANNING & ZONING
 [Signature] 1-19-18
 Chief, Division of Land Development
 [Signature] 1-11-18
 Chief, Development Engineering Division

GLWGUTSCHICK LITTLE & WEBER, P.A.
 CIVIL ENGINEERS, LAND SURVEYORS, LAND PLANNERS, LANDSCAPE ARCHITECTS
 3909 NATIONAL DRIVE - SUITE 250 - BURTONSVILLE OFFICE PARK
 BURTONSVILLE, MARYLAND 20886
 TEL: 301-421-4024 BAL: 410-880-1820 DC/VA: 301-989-2524 FAX: 301-421-4186

DATE	REVISION	BY	APPR.
7-24-19	REVISED MBR, FHT, SHC GRADES WALK/RAMPS	JD	DEV.
7-26-18	Rev. street trees, 90' sub. Proposed wall	JD	JRC

PREPARED FOR:
 THE HOWARD HUGHES CORPORATION
 10480 LITTLE PATUXENT PARKWAY
 SUITE 400
 COLUMBIA, MARYLAND 21044
 ATTN: BILL ROWE
 410-964-4987

PROFESSIONAL CERTIFICATION
 I HEREBY CERTIFY THAT THESE PLANS WERE PREPARED OR APPROVED BY ME, AND THAT I AM A DULY LICENSED PROFESSIONAL ENGINEER UNDER THE LAWS OF THE STATE OF MARYLAND, LICENSE NO. 12975
 EXPIRATION DATE: MAY 26, 2018
 12/17/17

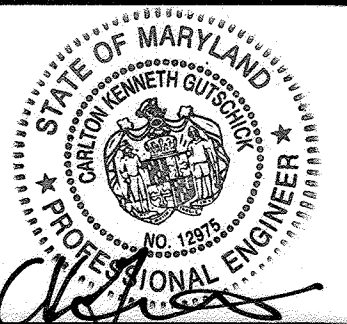

STORMWATER MANAGEMENT LOCATION PLAN
DOWNTOWN COLUMBIA
CRESCENT NEIGHBORHOOD
 PARCELS D1 THRU D-14, NON-BUILDABLE BULK PARCELS D-15 THRU D-17 & OPEN SPACE LOT 10
 HOWARD COUNTY, MARYLAND

SCALE	ZONING	G. L. W. FILE No.
1" = 50'	NT	11071
DATE	TAX MAP - GRID	SHEET
DEC., 2017	36 - 01	17 OF 25

L:\CADD\DRAWINGS\11071\11071-AREA 3\PLANS BY GUY\17-068 Plans\11071-AREA 3-F-17 - SWM Location.dwg, PLOTTED 12/14/2017 3:48 PM, LAST SAVED: 12/14/2017 3:47 PM, PLOTTED BY: Luke Down

LEGEND


- LIMIT OF DISTURBANCE
- PROPERTY LINE
- PARCEL LINE
- EX. CONTOURS
- EX. SEWER
- EX. STORM DRAIN
- EX. WATER
- EX. TREELINE
- PROP. BUILDING
- PROP. CURB
- PROP. CONTOURS
- PROP. EASEMENT
- PROP. SEWER
- PROP. STORM DRAIN
- PROP. WATER
- SOILS
- PROP. 100 YEAR FLOODPLAIN
- 2014/2015 RESTORATION BOUNDARY
- 2014/2015/2016 RESTORATION BOUNDARY
- PROP. STREET LIGHT
- FIRE HYDRANT
- (M-6) WATER QUALITY TREATMENT FACILITY
- TREE

(M-6) MODULAR MICRO-BIORETENTION SEQUENCE OF CONSTRUCTION


- ONCE CONTRIBUTING DRAINAGE AREAS TO FACILITIES HAVE BEEN STABILIZED, EXCAVATE TO SUB-GRADE. SPECIAL CARE SHOULD BE TAKEN NOT TO DAMAGE THE NEWLY CONSTRUCTED STORM DRAIN OVERFLOW INLET AND ASSOCIATED OUTFALL PIPES.
- ONCE VERIFIED SUB-GRADES HAVE BEEN ESTABLISHED, INSTALL CONTAINMENT WALL FOOTING AND WALL SYSTEM.
- PLACE REQUIRED DEPTH OF GRAVEL JACKET OF NO.57 OR NO. 6 AGGREGATE IN BOTTOM OF EXCAVATION UP TO INVERT OF UNDERDRAIN & OVERFLOW PIPES.
- INSTALL UNDERDRAINS AND ASSOCIATED PARTS & TIE PIPES TO INLET WALLS AT THEIR PRESCRIBED INVERT ELEVATIONS.
- PLACE REMAINDER (7") OF THE 20" GRAVEL JACKET. CHECK FOR LEVELNESS.
- PLACE 2" PEA GRAVEL LAYER OVER GRAVEL JACKET.
- BACKFILL TOPSOIL FILTER MEDIA (TOTAL 24") IN LIFTS OF 12" TO 18". DO NOT COMPACT. INSTALL LANDSCAPE PLANTINGS.
- INSTALL RIP RAP INFLOW PROTECTION AT ALL CURB OPENING & ROOF DRAIN INFLOW POINTS.
- ADD 3" MULCH AND STONE LAYER.

(M-6) STANDARD MICRO-BIORETENTION SEQUENCE OF CONSTRUCTION

- ONCE CONTRIBUTING DRAINAGE AREAS TO FACILITIES HAVE BEEN STABILIZED, EXCAVATE TO SUB-GRADE. SPECIAL CARE SHOULD BE TAKEN NOT TO DAMAGE THE NEWLY CONSTRUCTED STORM DRAIN OVERFLOW INLET AND ASSOCIATED OUTFALL PIPES.
- ONCE VERIFIED SUB-GRADES HAVE BEEN ESTABLISHED, PLACE REQUIRED DEPTH OF GRAVEL JACKET OF NO.57 OR NO. 6 AGGREGATE IN BOTTOM OF EXCAVATION UP TO INVERT OF UNDERDRAIN & OVERFLOW PIPES.
- PLACE 3" WIDE STRIPS OF FILTER FABRIC DOWN ON 3" GRAVEL LAYER TO SUPPORT UNDERDRAIN SYSTEM. PLACE UNDERDRAINS IN CENTER OF FABRIC & TIE PIPES TO INLET WALLS AT THEIR PRESCRIBED INVERT ELEVATIONS.
- PLACE REMAINDER (7") OF THE 10" GRAVEL JACKET. CHECK FOR LEVELNESS.
- PLACE 2" PEA GRAVEL LAYER OVER GRAVEL JACKET.
- BACKFILL TOPSOIL FILTER MEDIA (TOTAL 24") IN LIFTS OF 12" TO 18". DO NOT COMPACT. INSTALL LANDSCAPE PLANTINGS.
- INSTALL RIP RAP INFLOW PROTECTION AT ALL CURB OPENING INFLOW POINTS.
- SEED OR SOD 3:1 SIDE SLOPES. ADD 3" MULCH LAYER.

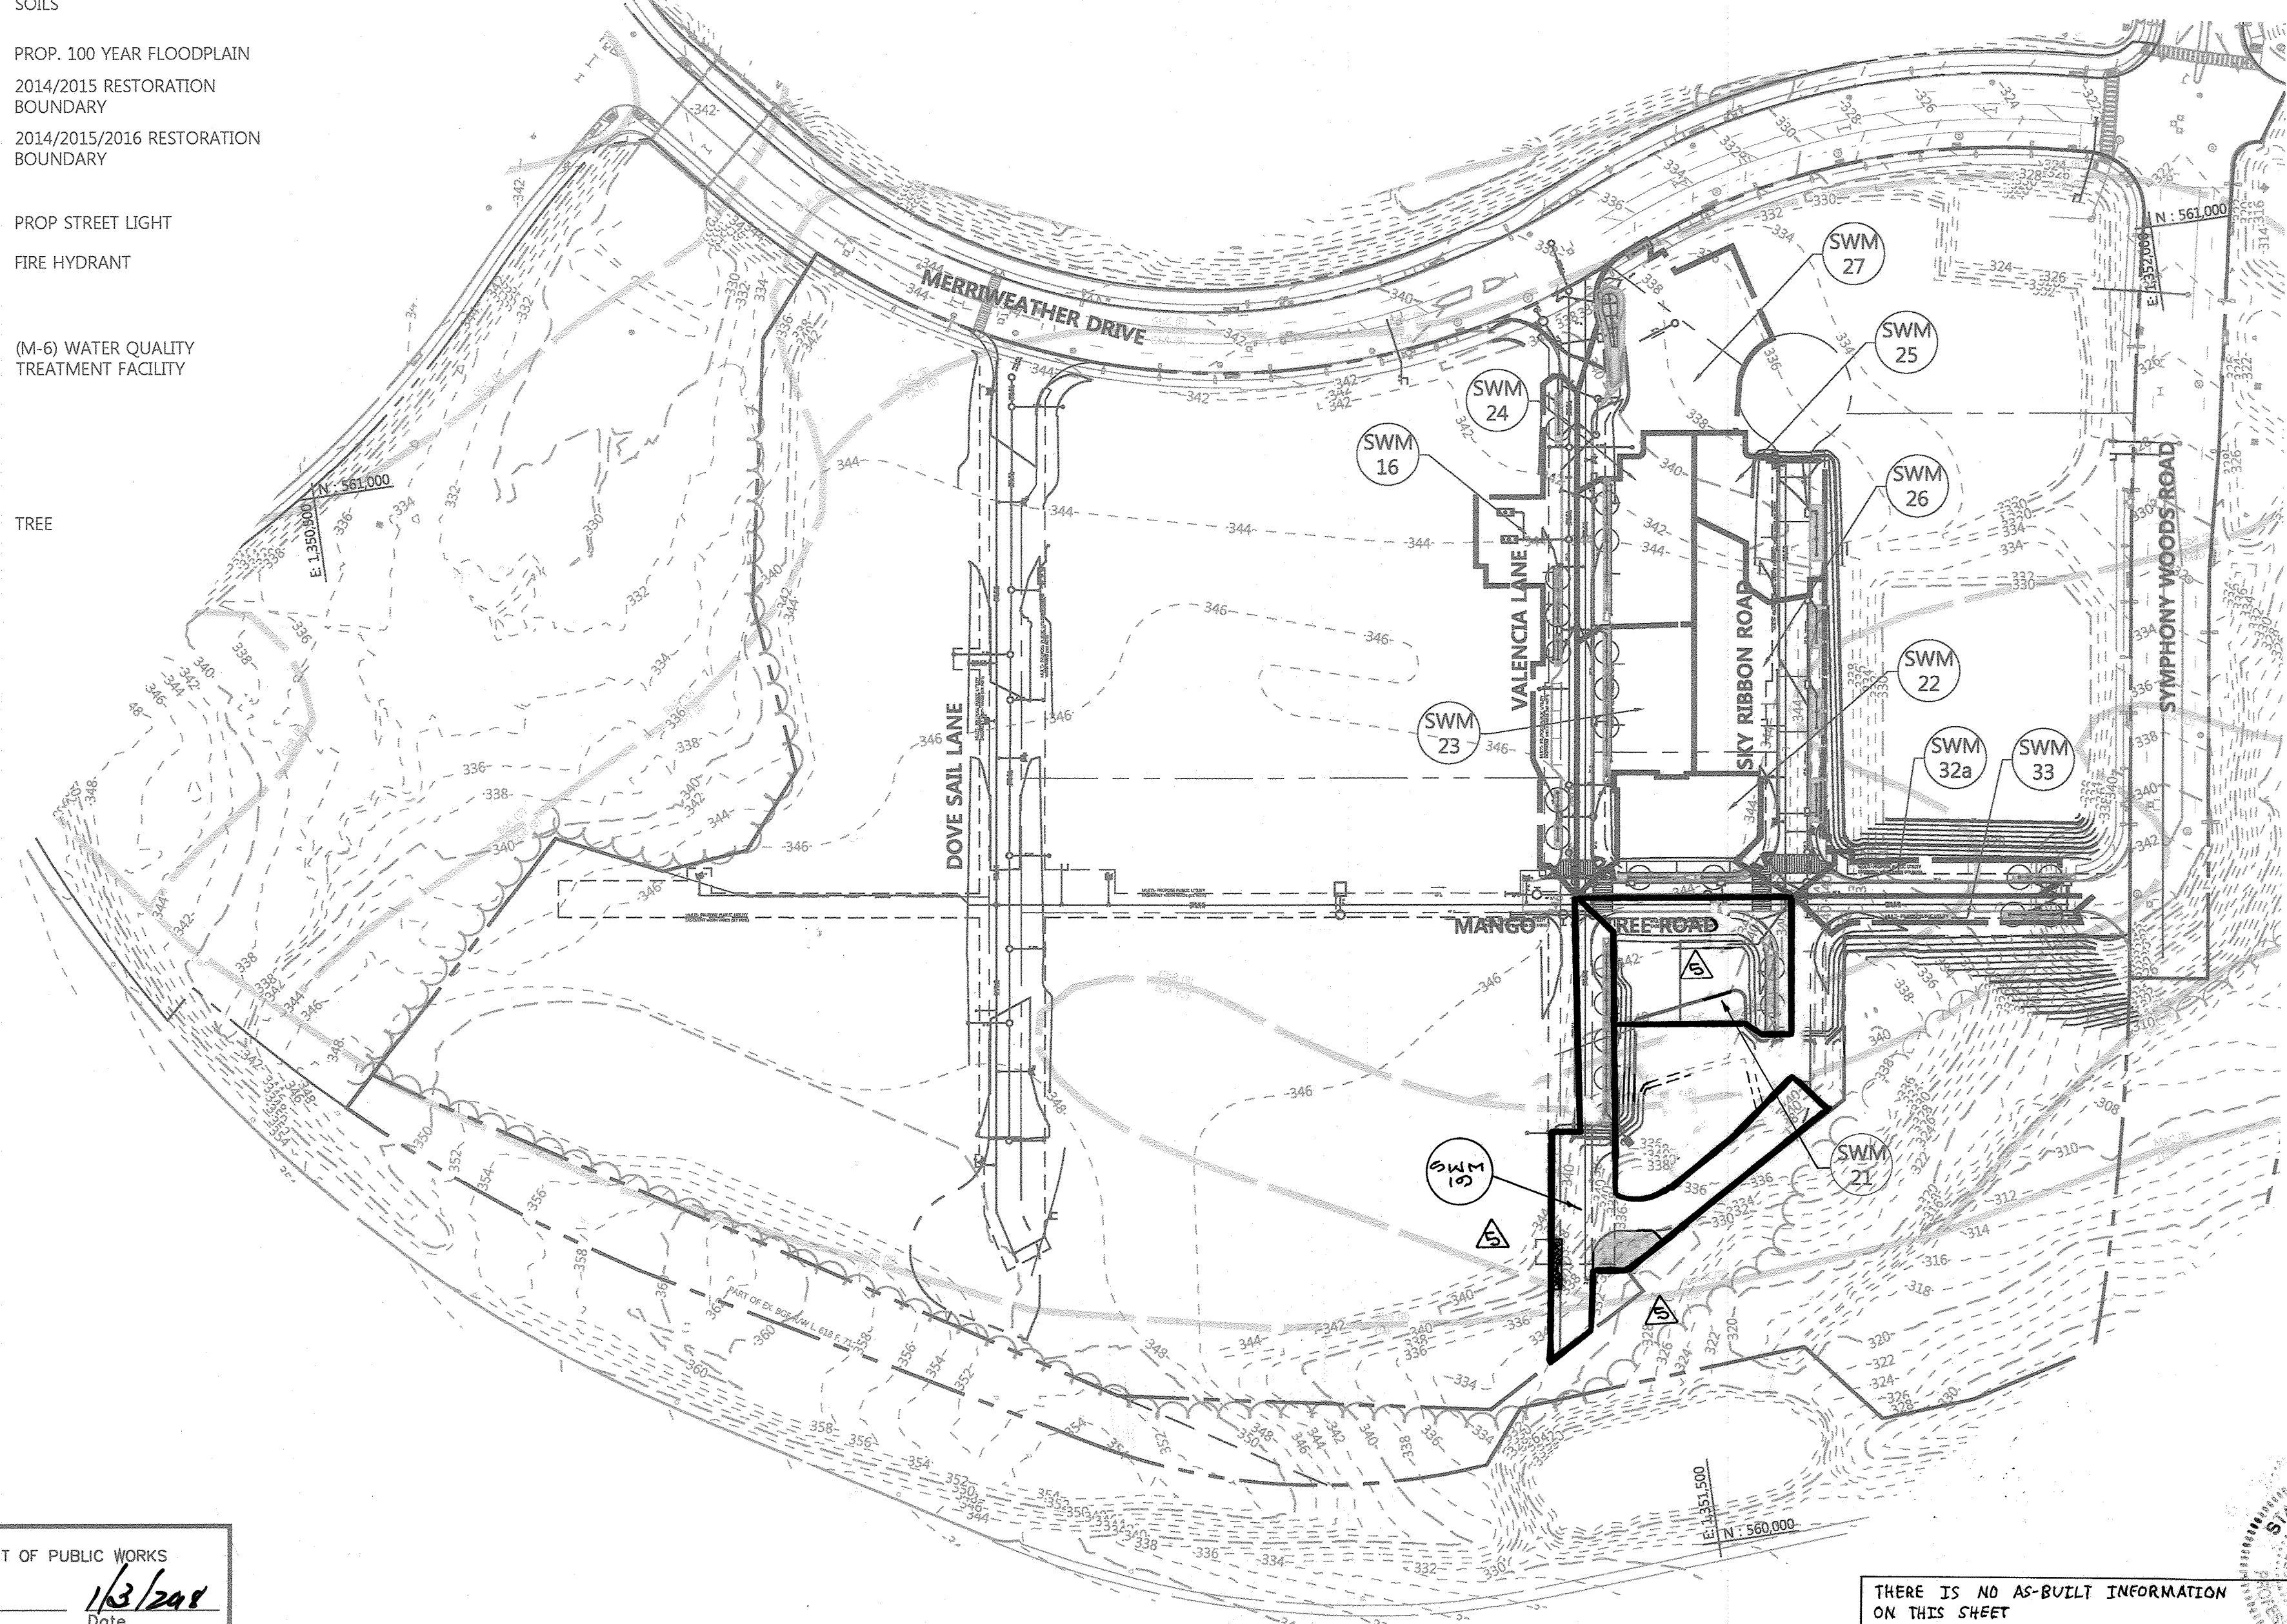

PLAN VIEW

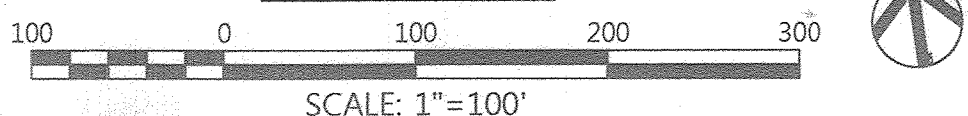

THERE IS NO AS-BUILT INFORMATION ON THIS SHEET

G. SCOTT SHANBERGER
SHANBERGER & LANE
PROFESSIONAL LAND SURVEYOR #10849
LICENSE EXPIRATION DATE 4/2/2024
AS-BUILT SURVEY DATES 2/1/22 TO 2/18/22

TABLE B.4.1 MATERIALS SPECIFICATIONS FOR MICRO-BIORETENTION, RAIN GARDENS & LANDSCAPE INFILTRATION

MATERIAL	SPECIFICATION	SIZE	NOTES
PLANTINGS	SEE APPENDIX A, TABLE A.4	N/A	PLANTINGS ARE SITE-SPECIFIC
PLANTING SOIL (2" TO 4" DEEP)	LOAMY SAND (60 - 65%) & COMPOST (35 - 40%) OR SANDY LOAM (30%), COARSE SAND (30%) & COMPOST (40%)	N/A	
ORGANIC CONTENT	MIN. 10% BY DRY WEIGHT (ASTM D 2974)		
MULCH	SHREDDED HARDWOOD		AGED 6 MONTHS, MINIMUM; NO PINE OR WOOD CHIPS
PEA GRAVEL DIAPHRAGM	PEA GRAVEL: ASTM-D-448	NO. 8 OR NO. 9 (1/8" TO 3/8")	
CURTAIN DRAIN	ORNAMENTAL STONE: WASHED COBBLES	STONE: 2" TO 5"	
GEOTEXTILE		N/A	PE TYPE 1 NONWOVEN
GRAVEL (UNDERDRAINS AND INFILTRATION BERMS)	AASHTO M-43	NO. 57 OR NO. 6 AGGREGATE (3/8" TO 3/4")	
UNDERDRAIN PIPING	F 758, TYPE PS 28 OR AASHTO M-278	4" TO 8" RIGID SCHEDULE 40 PVC OR SDR35	SLOTTED OR PERFORATED PIPE; 3/8" PERF. @ 6" ON CENTER, 4 HOLES PER ROW; MINIMUM OF 3" OF GRAVEL OVER PIPES; NOT NECESSARY UNDERNEATH PIPES. PERFORATED PIPE SHALL BE WRAPPED WITH 1/4-INCH GALVANIZED HARDWARE CLOTH
POURED IN PLACE CONCRETE (IF REQUIRED)	MSHA MIX NO. 3; F _c = 3500 PSI @ 28 DAYS, NORMAL WEIGHT, AIR-ENTRAINMENT; REINFORCING TO MEET ASTM-615-60	N/A	ON-SITE TESTING OF POURED-IN-PLACE CONCRETE REQUIRED: 28 DAY STRENGTH AND SLUMP TEST; ALL CONCRETE DESIGN (CAST-IN-PLACE OR PRE-CAST) NOT USING PREVIOUSLY APPROVED STATE OR LOCAL STANDARDS REQUIRES DESIGN DRAWINGS SEALED AND APPROVED BY A PROFESSIONAL STRUCTURAL ENGINEER LICENSED IN THE STATE OF MARYLAND - DESIGN TO INCLUDE MEETING ACI CODE 350R/89; VERTICAL LOADING (H-10 OR H-20); ALLOWABLE HORIZONTAL LOADING (BASED ON SOIL PRESSURES); AND ANALYSIS OF POTENTIAL CRACKING
SAND	AASHTO-M-6 OR ASTM-C-33	0.02" TO 0.04"	SAND SUBSTITUTIONS SUCH AS DIABASE AND GRAYSTONE (AASHTO) #10 ARE NOT ACCEPTABLE. NO CALCIUM CARBONATED OR DOLOMITIC SAND SUBSTITUTIONS ARE ACCEPTABLE. NO "ROCK DUST" CAN BE USED FOR SAND.

STORMWATER MANAGEMENT SUMMARY CHART

Drainage Area #	Drainage Area (a.f.)	Imp. Area (a.f.)	ESDv Req. (c.f.)	WQv Req. (c.f.)	Pe Req. (inches)	WQv Prov. (c.f.)	Pe Prov. (inches)	REV Prov. (c.f.)	CPv Prov. (c.f.)	(M-6) Facilities Within Drainage Area
SWM 16	15,698	15,077	2,717	907	1.00	967	1.07	0	0	Facilities MB16, MB17, MB18, MB19 & MB20
SWM 20	16,050	16,676	2,062	997	1.00	1,000	1.00	0	0	Facilities MB64 & MB66
SWM 21	13,760	12,341	2,306	803	1.00	948	1.44	0	0	Facility MB68
SWM 22	11,860	11,584	2,066	697	1.00	700	1.00	0	0	Facility MB24
SWM 23	13,978	13,603	2,434	819	1.00	833	1.02	0	0	Facility MB23
SWM 24	13,192	12,893	2,298	776	1.00	776	1.00	0	0	Facility MB22
SWM 25	10,200	9,723	1,777	686	1.00	648	1.44	0	0	Facility MB44
SWM 26	22,450	21,344	2,910	1,284	1.00	1,423	1.44	0	0	Facilities MB45, MB46 & MB47
SWM 27	20,070	18,534	3,496	1,115	1.00	1,215	1.09	0	0	Facilities MB21 & MB41
SWM 32a	5,671	5,521	988	332	1.00	333	1.00	0	0	Facility MB25
SWM 33	4,873	4,761	849	286	1.00	300	1.05	0	0	Facility MB68
SWM 10	20,002	24,703	4,520	1,402	1.00	1,744	1.17	0	0	Facilities MB01 & MB02
SWM 21	15,754	15,390	2,744	923	1.00	945	1.02	0	0	Facilities MB00
SWM 25	10,476	9,171	1,825	552	1.00	623	1.40	0	0	Facilities MB44
SWM 26	23,075	22,800	4,010	1,102	1.00	1,279	1.57	0	0	Facilities MB45, MB46 & MB47

OPERATION AND MAINTENANCE SCHEDULE FOR MICRO-BIORETENTION (M-6)

- THE OWNER SHALL MAINTAIN THE PLANT MATERIAL, MULCH LAYER AND SOIL LAYER ANNUALLY. MAINTENANCE OF MULCH AND SOIL IS LIMITED TO CORRECTING AREAS OF EROSION OR WASH OUT. ANY MULCH REPLACEMENT SHALL BE DONE IN THE SPRING. PLANT MATERIAL SHALL BE CHECKED FOR DISEASE AND INSECT INFESTATION AND MAINTENANCE WILL ADDRESS DEAD MATERIAL AND PRUNING. ACCEPTABLE REPLACEMENT PLANT MATERIAL IS LIMITED TO THE FOLLOWING: 2000 MARYLAND STORMWATER DESIGN MANUAL VOLUME II, TABLE A.4.1 AND 2.
- THE OWNER SHALL PERFORM A PLANT IN THE SPRING AND IN THE FALL OF EACH YEAR. DURING THE INSPECTION, THE OWNER SHALL REMOVE DEAD AND DISEASED VEGETATION CONSIDERED BEYOND TREATMENT, REPLACE DEAD PLANT MATERIAL WITH ACCEPTABLE REPLACEMENT PLANT MATERIAL, TREAT DISEASED TREES AND SHRUBS, AND REPLACE ALL DEFICIENT STAKES AND WIRES.
- THE OWNER SHALL INSPECT THE MULCH EACH SPRING. THE MULCH SHALL BE REAPPLIED EVERY TWO TO THREE YEARS. THE PREVIOUS MULCH LAYER SHALL BE REMOVED BEFORE THE NEW LAYER IS APPLIED. THE OWNER SHALL INSPECT CONCRETE CONTAINMENT WALLS ANNUALLY. REPAIR AND PATCH CONTAINMENT WALLS AS NEEDED PER HOWARD COUNTY STANDARD SPECIFICATIONS AND DETAILS FOR CONSTRUCTION.
- THE OWNER SHALL CORRECT SOIL EROSION ON AN AS NEEDED BASIS, WITH A MINIMUM OF ONCE PER MONTH AND AFTER EACH HEAVY STORM.
- PERIODICALLY REMOVE TRASH & DEBRIS AS IT ACCUMULATES.
- REMOVE AND REPLACE TOP FEW INCHES OF FILTER MEDIA WHEN WATER PONDS FOR MORE THAN 48 HRS.
- PRUNE AND REPLACE DEAD VEGETATION AS NECESSARY.
- WATER VEGETATION DURING DRY PERIODS.

NOTE:

- THE (M-6) MICRO-BIORETENTION FACILITIES SHOWN ON THESE PLANS WILL BE PRIVATELY OWNED AND MAINTAINED.
- (REV) GROUNDWATER RECHARGE VOLUME AND (CPV) CHANNEL PROTECTION VOLUME MANAGEMENT ARE BEING PROVIDED IN SDP-17-027.

PROFESSIONAL ENGINEER
AS BUILT CERTIFICATION FOR PWMA
NOTE: THERE IS NO "AS-BUILT" INFORMATION ON THIS SHEET.
NAME: GERALD D. TURNBAUGH DATE: AUG. 11, 2023
REG. NO.: 24563

PROFESSIONAL CERTIFICATION

I HEREBY CERTIFY THAT THESE DOCUMENTS WERE PREPARED OR APPROVED BY ME, AND THAT I AM A DULY LICENSED PROFESSIONAL ENGINEER UNDER THE LAWS OF THE STATE OF MARYLAND. LICENSE NO. 26569, EXPIRATION DATE: 7/18/19.

12-15-17
DATE

STATE OF MARYLAND
GERALD D. TURNBAUGH
PROFESSIONAL ENGINEER
No. 26569
EXPIRES 7/18/19

PROFESSIONAL ENGR. NO. 26569

APPROVED: HOWARD COUNTY DEPARTMENT OF PUBLIC WORKS
[Signature] 1/3/2018
Chief, Bureau of Highways

APPROVED: HOWARD COUNTY DEPARTMENT OF PLANNING & ZONING
[Signature] 1/19/18
Chief, Division of Land Development

[Signature] 1-11-18
Chief, Development Engineering Division

DW
DAFT McCUNE WALKER INC
501 FAIRMOUNT AVENUE SUITE 300 TOWSON, MD 21286
P: 410 296 3333 F: 410 296 4703 WWW.DMW.COM

DES.	DRN.	CHK.	DATE	REVISION	BY	APPR.
			1-24-19	Update Esp widths, Turbines & data correct, add MB01 & MB02	WDS	

PREPARED FOR:
THE HOWARD HUGHES CORPORATION
10480 LITTLE PATUXENT PARKWAY
SUITE 400
COLUMBIA, MARYLAND 21044
ATTN: BILL ROWE
410-964-4987

STORMWATER MANAGEMENT DRAINAGE AREA MAP

DOWNTOWN COLUMBIA
CRESCENT NEIGHBORHOOD
PARCELS D-2, D-3, D-4,
D-5, D-6, D-10 & D-14

ELECTION DISTRICT No. 5


SCALE: 1" = 100'

SCALE	ZONING	G. L. W. FILE No.
SCALE	NT	11071
DATE	TAX MAP - GRID	SHEET
AUG, 2017	36 - 01	18 OF 25

HOWARD COUNTY, MARYLAND

SEE SHEET 22 FOR CONTINUATION

SEE SHEET 21 FOR CONTINUATION

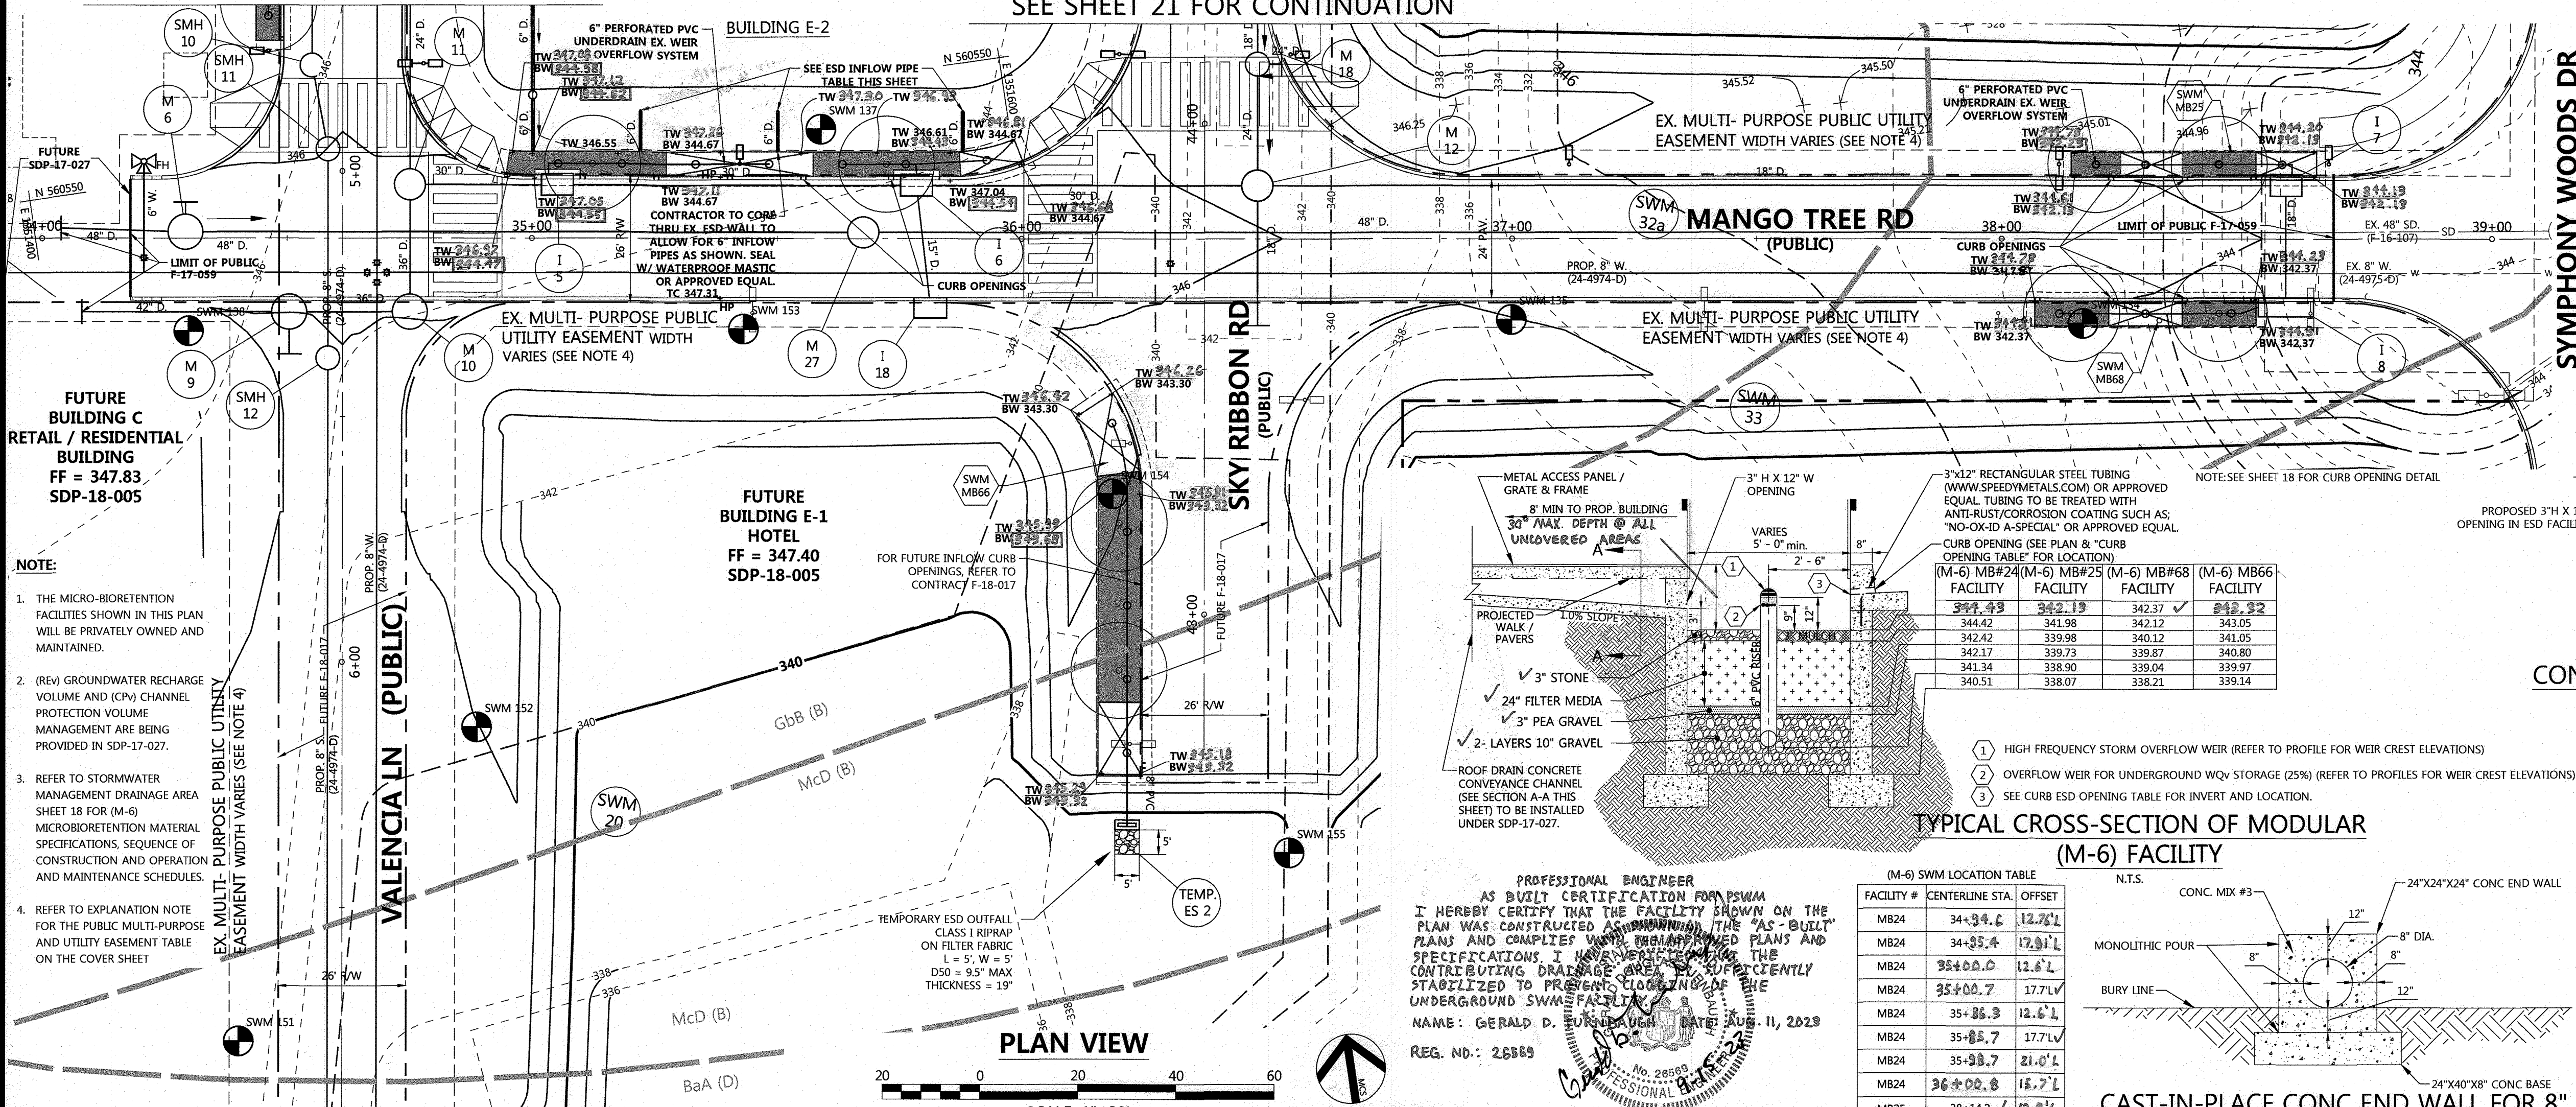

- NOTE:**
- THE MICRO-BIORETENTION FACILITIES SHOWN IN THIS PLAN WILL BE PRIVATELY OWNED AND MAINTAINED.
 - (REV) GROUNDWATER RECHARGE VOLUME AND (CP) CHANNEL PROTECTION VOLUME MANAGEMENT ARE BEING PROVIDED IN SDP-17-027.
 - REFER TO STORMWATER MANAGEMENT DRAINAGE AREA SHEET 18 FOR (M-6) MICROBIORETENTION MATERIAL SPECIFICATIONS, SEQUENCE OF CONSTRUCTION AND OPERATION AND MAINTENANCE SCHEDULES.
 - REFER TO EXPLANATION NOTE FOR THE PUBLIC MULTI-PURPOSE AND UTILITY EASEMENT TABLE ON THE COVER SHEET.

APPROVED: HOWARD COUNTY DEPARTMENT OF PUBLIC WORKS
 Chief, Bureau of Highways MK 9/12/2019 Date

APPROVED: HOWARD COUNTY DEPARTMENT OF PLANNING & ZONING
 Chief, Division of Land Development 10/22/19 Date

APPROVED: HOWARD COUNTY DEPARTMENT OF PLANNING & ZONING
 Chief, Development Engineering Division 10/29/19 Date

DES.	DRN.	CHK.	DATE	REVISION	BY	APPR.
			08/15/2019	UPDATE ESD WIDTHS, TW & BW ELEV'S, & STATION OFFSETS	AC/PAB	

PREPARED FOR:
 THE HOWARD HUGHES CORPORATION
 10480 LITTLE PATUXENT PARKWAY
 SUITE 400
 COLUMBIA, MARYLAND 21044
 ATTN: BILL ROWE
 410-964-4987

ELECTION DISTRICT No. 5

REVISED STORMWATER MANAGEMENT PLAN
 REPLACEMENT SHEET
DOWNTOWN COLUMBIA
 CRESCENT NEIGHBORHOOD
 PARCELS D-2, D-3, D-4, D-5, D-6, D-10 & D-14
 HOWARD COUNTY, MARYLAND

SCALE	ZONING	G. L. W. FILE NO.
SCALE	NT	11071
DATE	TAX MAP - GRID	SHEET
AUG., 2017	36 - 01	20 OF 25

LEGEND

- LIMIT OF DISTURBANCE
- PROPERTY LINE
- PARCEL LINE
- EX. CONTOURS
- EX. SEWER
- EX. STORM DRAIN
- EX. WATER
- EX. TREELINE
- PROP. BUILDING
- PROP. CURB
- PROP. CONTOURS
- PROP. EASEMENT
- PROP. SEWER
- PROP. STORM DRAIN
- PROP. WATER
- SOILS
- PROP STREET LIGHT
- FIRE HYDRANT
- (M-6) WATER QUALITY TREATMENT FACILITY
- SOIL BORING
- TREE

ESD OPENING FROM CURB TABLE

ESD @ ESD BOX	CENTERLINE ROADWAY STATION	INSIDE ELEV @ ESD BOX	ESD
35+10.00	38+00.00	341.14	M868
35+25.36	38+21.00	342.37	M868
35+40.00	38+36.00	342.77	M868
35+55.00	38+50.00	342.67	M868
35+70.00	38+65.00	342.67	M868
35+85.00	38+80.00	342.67	M868
35+100.00	38+95.00	342.67	M868
35+115.00	39+10.00	342.67	M868
35+130.00	39+25.00	342.67	M868
35+145.00	39+40.00	342.67	M868
35+160.00	39+55.00	342.67	M868
35+175.00	40+10.00	342.67	M868
35+190.00	40+25.00	342.67	M868
35+205.00	40+40.00	342.67	M868
35+220.00	40+55.00	342.67	M868
35+235.00	41+10.00	342.67	M868
35+250.00	41+25.00	342.67	M868
35+265.00	41+40.00	342.67	M868
35+280.00	41+55.00	342.67	M868
35+295.00	42+10.00	342.67	M868
35+310.00	42+25.00	342.67	M868
35+325.00	42+40.00	342.67	M868
35+340.00	42+55.00	342.67	M868
35+355.00	43+10.00	342.67	M868
35+370.00	43+25.00	342.67	M868
35+385.00	43+40.00	342.67	M868
35+400.00	43+55.00	342.67	M868

CROSS-SECTION A-A ROOF DRAIN CONCRETE CONVEYANCE CHANNEL DETAIL

SCALE: 1"=1'-0"

AS-BUILT CERTIFICATION
 I HEREBY CERTIFY, BY SEAL, THAT THE FACILITIES SHOWN ON THIS PLAN WERE CONSTRUCTED AS SHOWN ON THIS PLAN MEET THE CURRENT APPROVED PLANS AND SPECIFICATIONS.

10/03/23

G. SCOTT SHANABERGER
 SHANABERGER & LANE
 PROFESSIONAL LAND SURVEYOR #10849
 LICENSE EXPIRATION DATE 4/2/2024
 AS-BUILT SURVEY DATES 2/1/22 TO 2/18/22

ESD INFLOW PIPE LOCATION TABLE

FACILITY NO.	STATION	OFFSET	INVERT	PIPE DIA. (IN.)
MB24	33+31.41	22.30' LT	21.67' LT	343.55
MB24	33+01.94	21.67' LT	21.67' LT	343.55
MB24	32+22.69	21.67' LT	21.67' LT	343.55

ESD OUTFLOW PIPE LOCATION TABLE

FACILITY NO.	STATION	OFFSET	INVERT	PIPE DIA. (IN.)
MB24	35+05.16	12.6' LT	340.25	8" ✓
MB24	35+70.12	12.6' LT	340.17	8" ✓
MB25	38+50.00	12.6' LT	339.49	8" ✓
MB64	6+91.14	27.01' LT	339.44	10"
MB68	38+03.00	15.6' RT	339.26	8" ✓
MB66	** 42+68.02	15.69' RT	339.87	8"

ESD INFLOW PIPE FROM BUILDING E-2 ROOF DRAINAGE

FACILITY NO.	% ROAD STATIONS	OFFSET	INVERT *	PIPE DIA. (IN.)
MB 24	35+00.18	17.67' LT.	344.92	6"
	35+21.00	17.00' LT.	344.75	1'x0.8' TRENCH DRAIN
	35+43.00	17.75' LT.	344.72	1'x0.8' TRENCH DRAIN
	35+65.27	17.70' LT.	344.70	1'x0.8' TRENCH DRAIN

* REFLECTS INSIDE WALL FACE OF ESD PENETRATION

PROFESSIONAL ENGINEER
 AS BUILT CERTIFICATION FOR PSWM I HEREBY CERTIFY THAT THE FACILITY SHOWN ON THE PLAN WAS CONSTRUCTED AS SHOWN ON THE PLAN AND COMPLIES WITH THE APPROVED PLANS AND SPECIFICATIONS. I HAVE REVIEWED THE CONTRIBUTING DRAINAGE AREA, AND THE UNDERGROUND SWM FACILITY NAME: GERALD D. BURKLEIGH DATE: AUG. 11, 2023
 REG. NO.: 26569








(M-6) SWM LOCATION TABLE

FACILITY #	CENTERLINE STA.	OFFSET	N.T.S.
MB24	34+94.6	12.7' LT	
MB24	34+35.4	12.9' LT	
MB24	35+00.0	12.6' LT	
MB24	35+00.7	17.7' LT	
MB24	35+36.9	12.6' LT	
MB24	35+85.7	17.7' LT	
MB24	35+98.7	21.0' LT	
MB24	36+00.0	15.7' LT	
MB25	38+14.2	12.9' LT	
MB25	38+14.2	12.9' LT	
MB25	38+09.8	12.9' LT	
MB25	38+09.2	12.9' LT	
MB68	38+06.2	12.7' RT	
MB68	38+06.9	17.7' RT	
MB68	38+51.2	12.7' RT	
MB68	38+51.2	17.7' RT	
MB66	42+67.9	12.7' LT	
MB66	42+67.9	21.7' LT	
MB66	43+25.6	12.8' LT	
MB66	43+25.4	21.8' LT	
MB66	43+41.4	26.0' LT	
MB66	43+56.6	18.0' LT	

ESD INFLOW PIPE FROM BUILDING E-2 ROOF DRAINAGE

FACILITY NO.	% ROAD STATIONS	OFFSET	INVERT *	PIPE DIA. (IN.)
MB 24	35+00.18	17.67' LT.	344.92	6"
	35+21.00	17.00' LT.	344.75	1'x0.8' TRENCH DRAIN
	35+43.00	17.75' LT.	344.72	1'x0.8' TRENCH DRAIN
	35+65.27	17.70' LT.	344.70	1'x0.8' TRENCH DRAIN


* REFLECTS INSIDE WALL FACE OF ESD PENETRATION

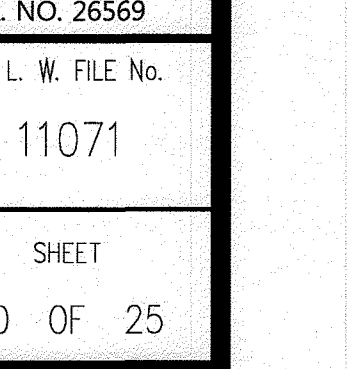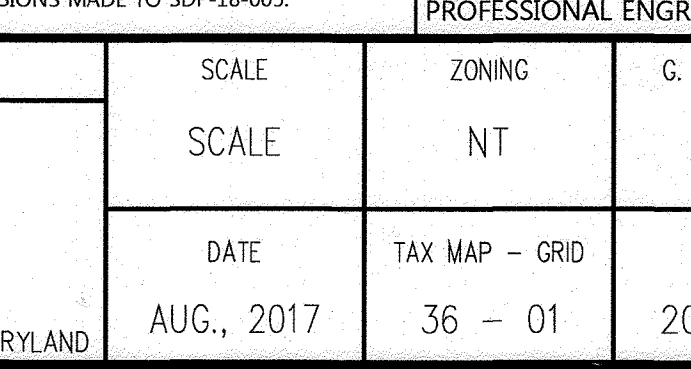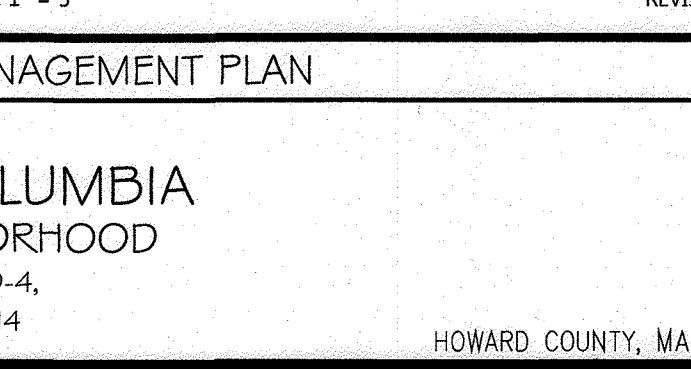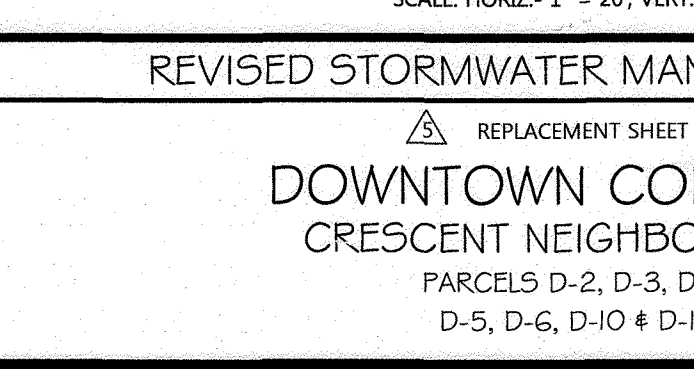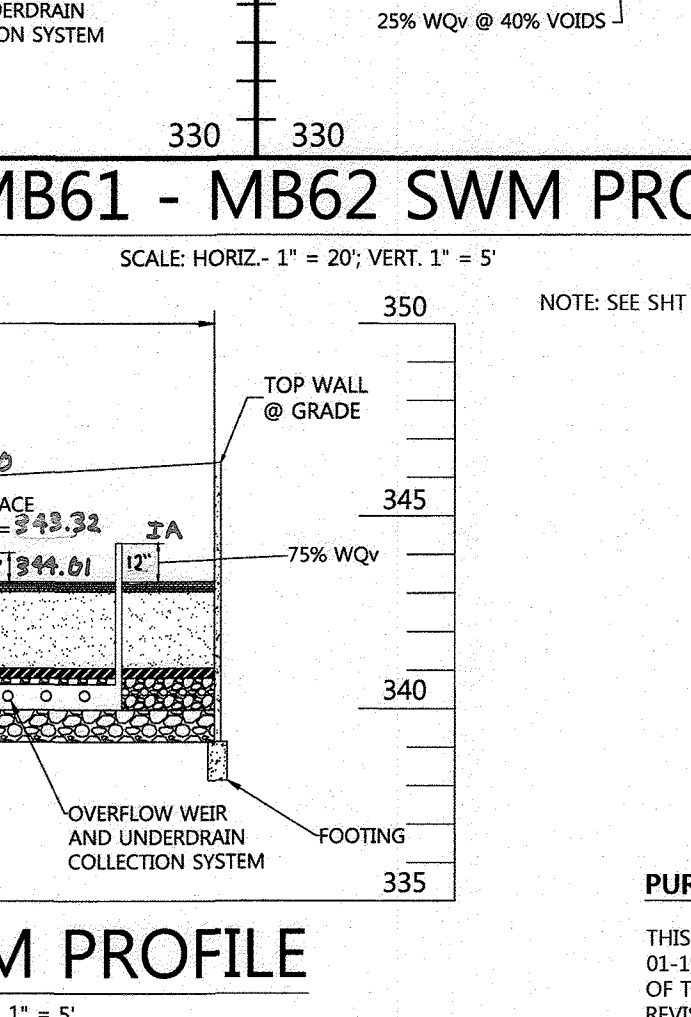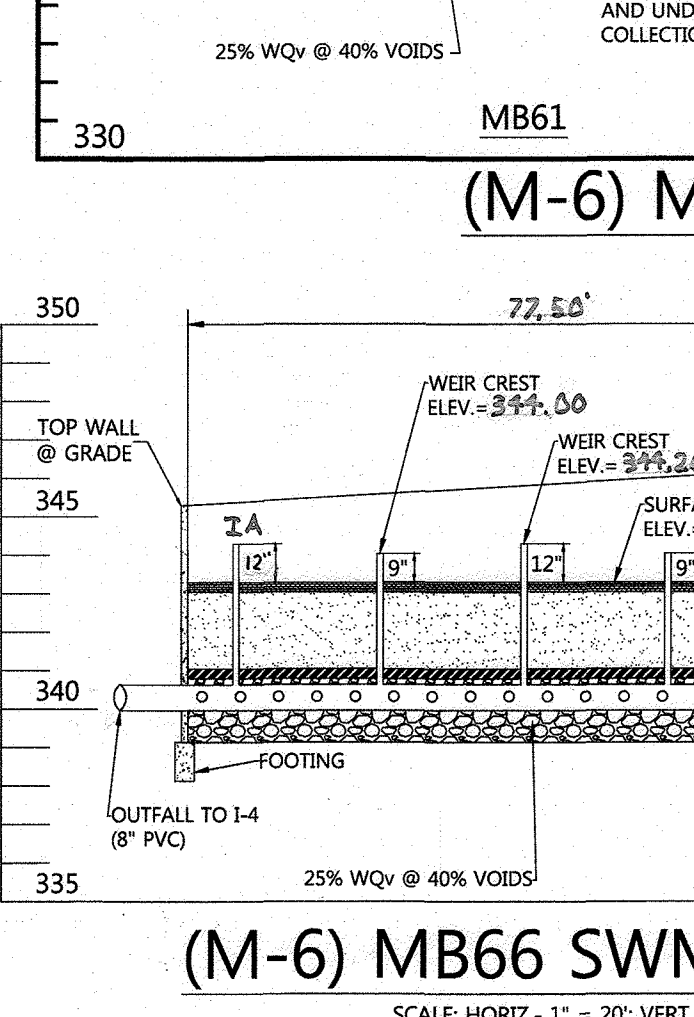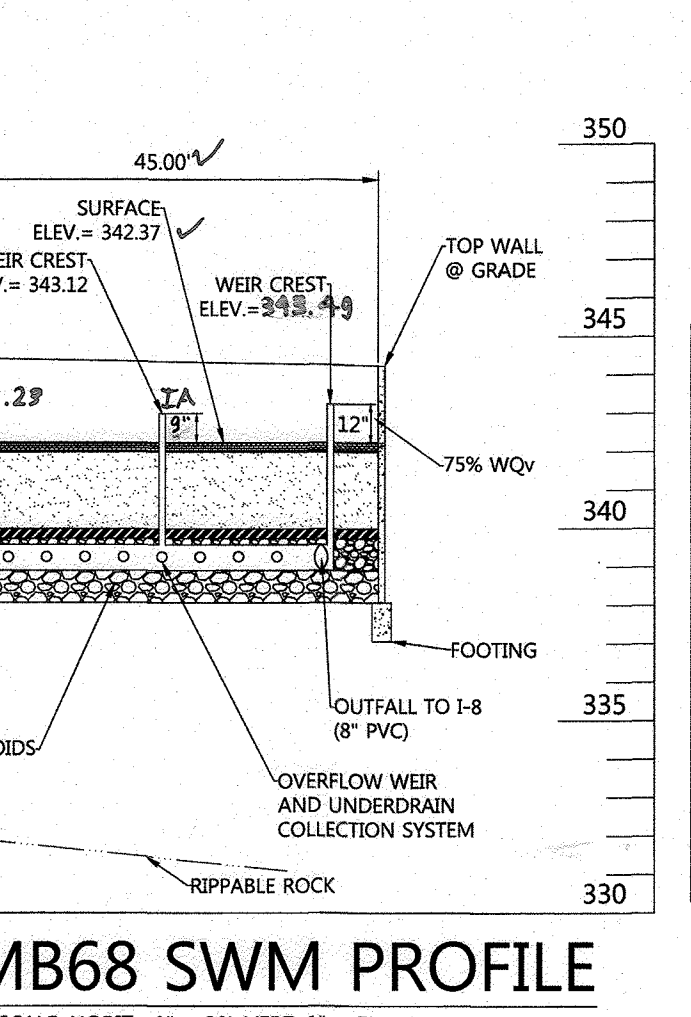

PROFESSIONAL CERTIFICATION
 I HEREBY CERTIFY THAT THESE DOCUMENTS WERE PREPARED OR APPROVED BY ME, AND THAT I AM A DULY LICENSED PROFESSIONAL ENGINEER UNDER THE LAWS OF THE STATE OF MARYLAND, LICENSE NO. 26569, EXPIRATION DATE: 7/18/21

8-20-19 DATE

PROFESSIONAL ENGR. NO. 26569

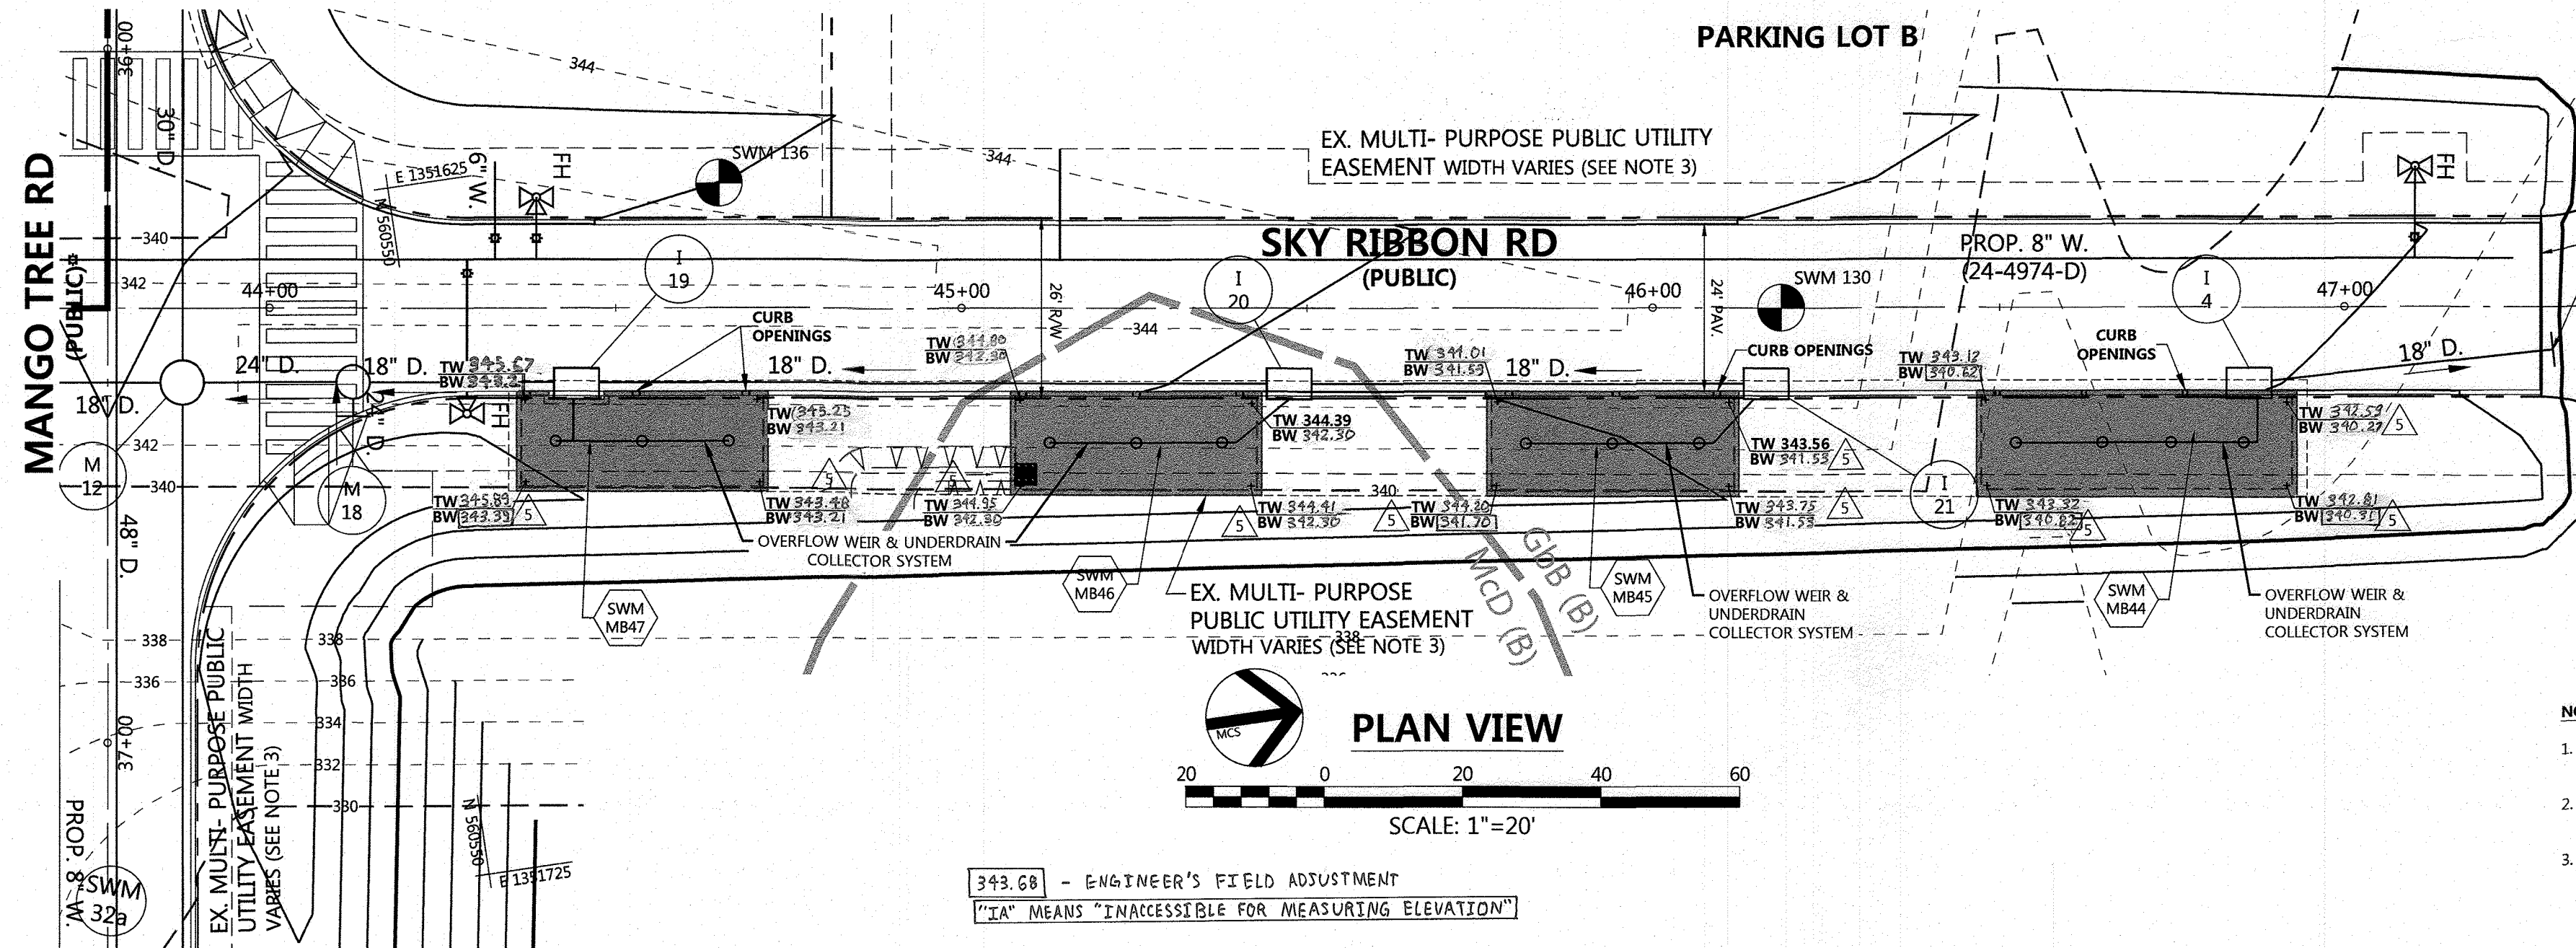

- NOTE:**
- THE MICRO-BIORETENTION FACILITIES SHOWN IN THIS PLAN WILL BE PRIVATELY OWNED AND MAINTAINED.
 - (RW) GROUNDWATER RECHARGE VOLUME AND (CPV) CHANNEL PROTECTION VOLUME MANAGEMENT ARE BEING PROVIDED IN SDP-17-027.
 - REFER TO EXPLANATION NOTE FOR THE PUBLIC MULTI-PURPOSE AND UTILITY EASEMENT TABLE ON THE COVER SHEET




NOTE: SEE SHEET 18 FOR CURB OPENING DETAIL

LEGEND

- LIMIT OF DISTURBANCE
- PROPERTY LINE
- EX. CONTOURS
- EX. SEWER
- EX. STORM DRAIN
- EX. WATER
- EX. TREELINE
- PROP. BUILDING
- PROP. CURB
- PROP. CONTOURS
- PROP. EASEMENT
- PROP. SEWER
- PROP. STORM DRAIN
- PROP. WATER
- SOILS
- PROP STREET LIGHT
- FIRE HYDRANT
- (M-6) WATER QUALITY TREATMENT FACILITY
- SOIL BORING



CURB OPENINGS

STATION	CENTERLINE ROADWAY STATION	
	RIGHT	LEFT
MB47	44+38	NA
	44+53.8	5
	44+62.4	5
MB46	45+13.7	5
	45+23.9	5
	45+43.4	5
	45+62.7	5
MB45	45+92.7	5
	46+11.4	5
	46+21.1	5
	46+31.5	5
MB44	46+63.7	5
	46+77.6	5
	46+91.2	5

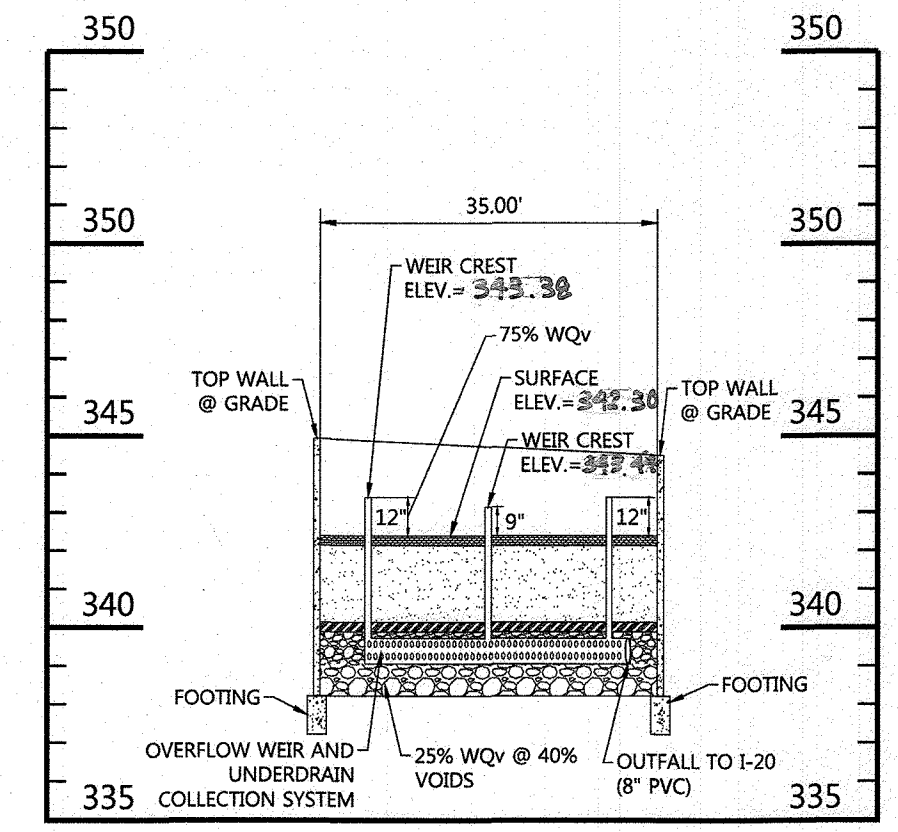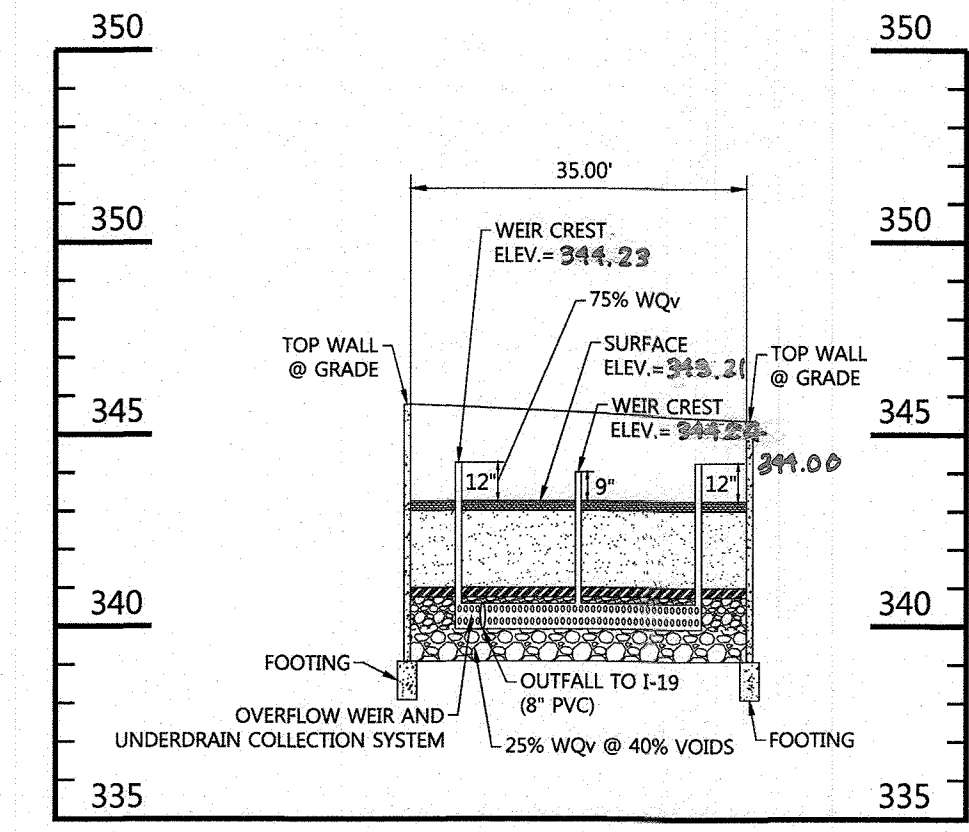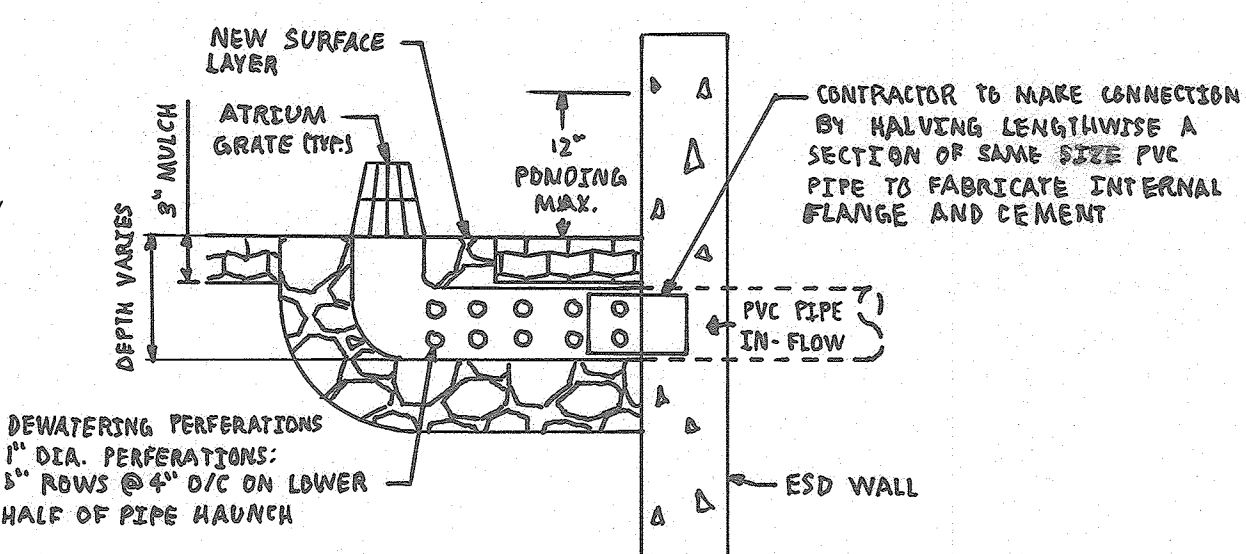





(M-6) SWM LOCATION TABLE

FACILITY #	CENTERLINE STA.	OFFSET
MB47	44+92.26	12.76' R
MB47	44+82.21	23.82' R
MB47	44+72.29	12.50' R
MB47	44+72.25	26.68' R
MB46	45+08.73	12.51' R
MB46	45+08.83	26.11' R
MB46	45+49.31	12.62' R
MB46	45+49.77	26.22' R
MB45	45+72.34	12.74' R
MB45	45+72.38	26.92' R
MB45	46+12.62	12.81' R
MB45	46+12.57	26.32' R
MB44	46+48.19	12.47' R
MB44	46+48.14	26.38' R
MB44	46+58.19	12.49' R
MB44	46+58.31	26.52' R

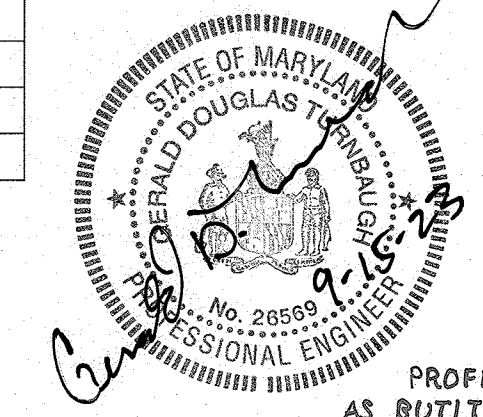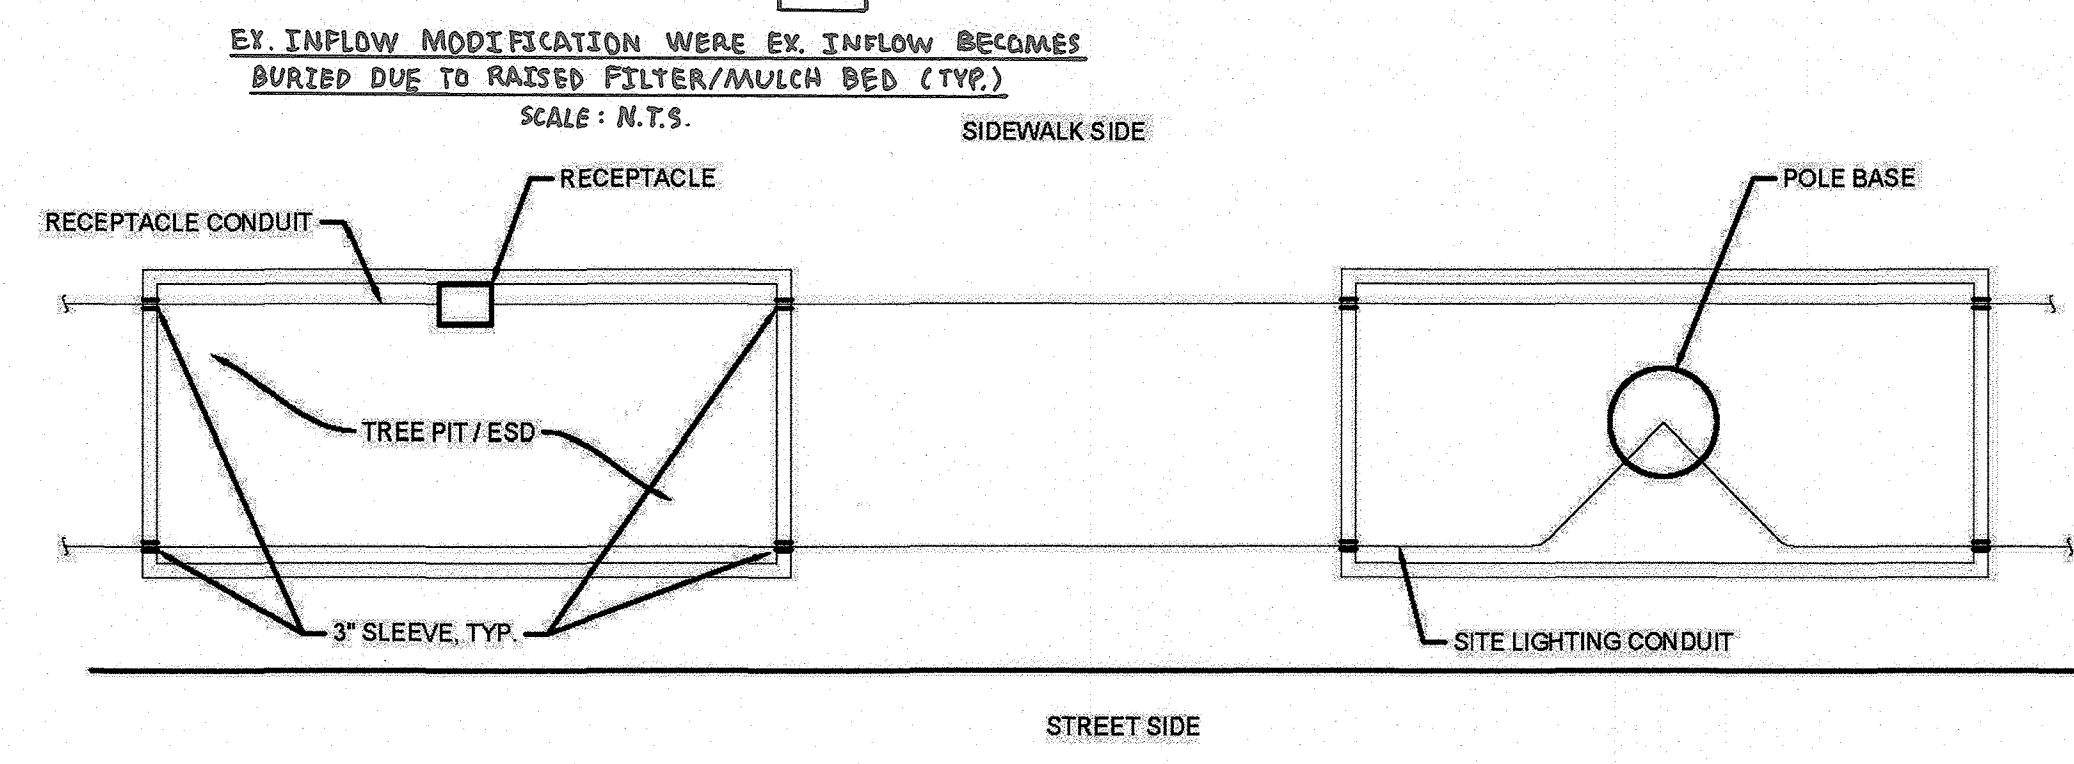

PROFESSIONAL ENGINEER
AS BUILT CERTIFICATION FOR PSWA
I HEREBY CERTIFY THAT THE FACILITY SHOWN ON THE PLAN WAS CONSTRUCTED AS SHOWN ON THE "AS-BUILT" PLANS AND COMPLETES WITH THE APPROVED PLANS AND SPECIFICATIONS. I HAVE VERIFIED THAT THE CONTRIBUTING DRAINAGE AREA IS SUFFICIENTLY STABILIZED TO PREVENT CLOGGING OF THE UNDERGROUND SWM FACILITY.
NAME: GERALD D. TURNBAUGH DATE: AUG. 11, 2023
REG. NO.: 26569

AS-BUILT CERTIFICATION
I HEREBY CERTIFY, BY SEAL, THAT THE FACILITIES SHOWN ON THIS PLAN WERE CONSTRUCTED AS SHOWN ON THIS PLAN MEET THE CURRENT APPROVED PLANS AND SPECIFICATIONS.
10/03/23
G. SCOTT SHANABERGER
SHANABERGER & LANE
PROFESSIONAL LAND SURVEYOR # 10049
LICENSE EXPIRATION DATE: 4/2/2024
AS-BUILT SURVEY DATES 2/1/22 TO 2/10/22

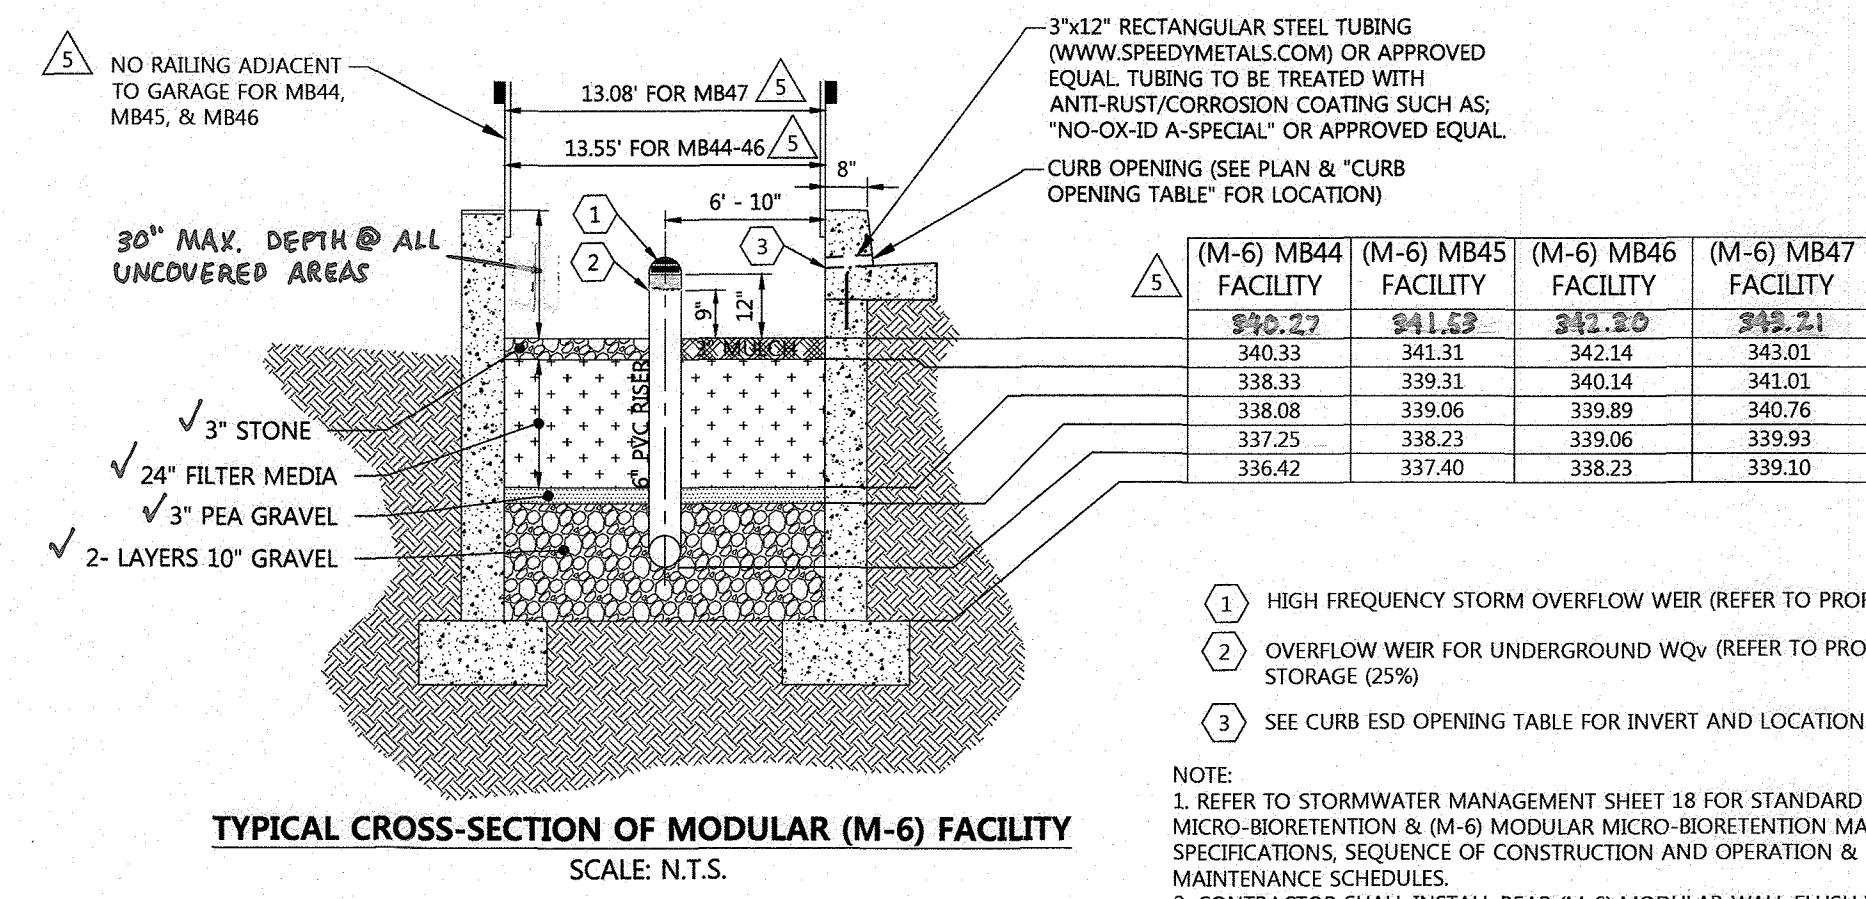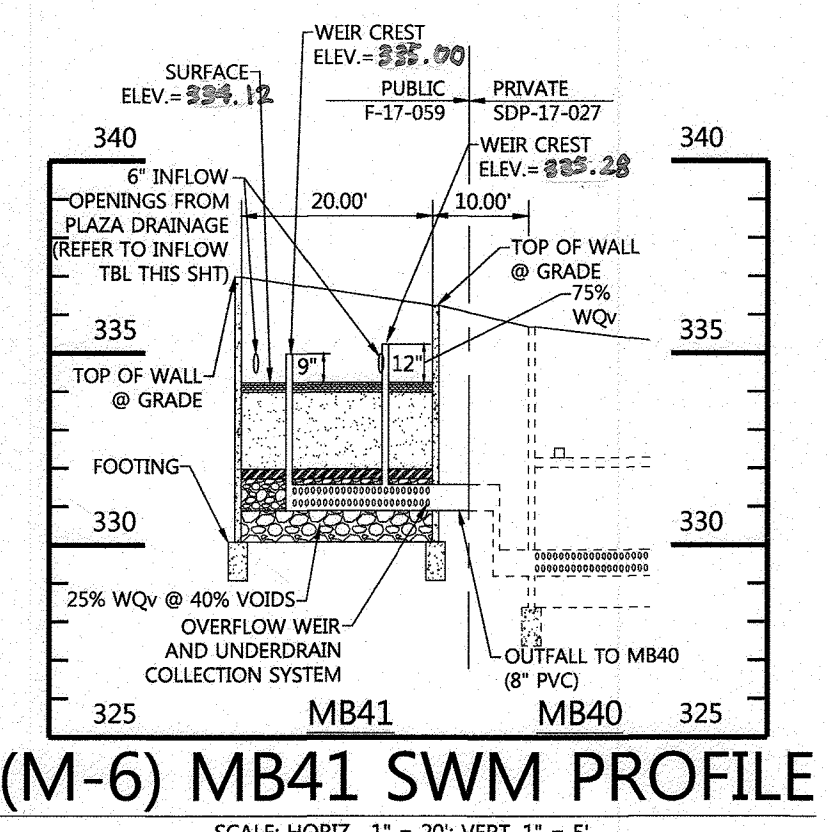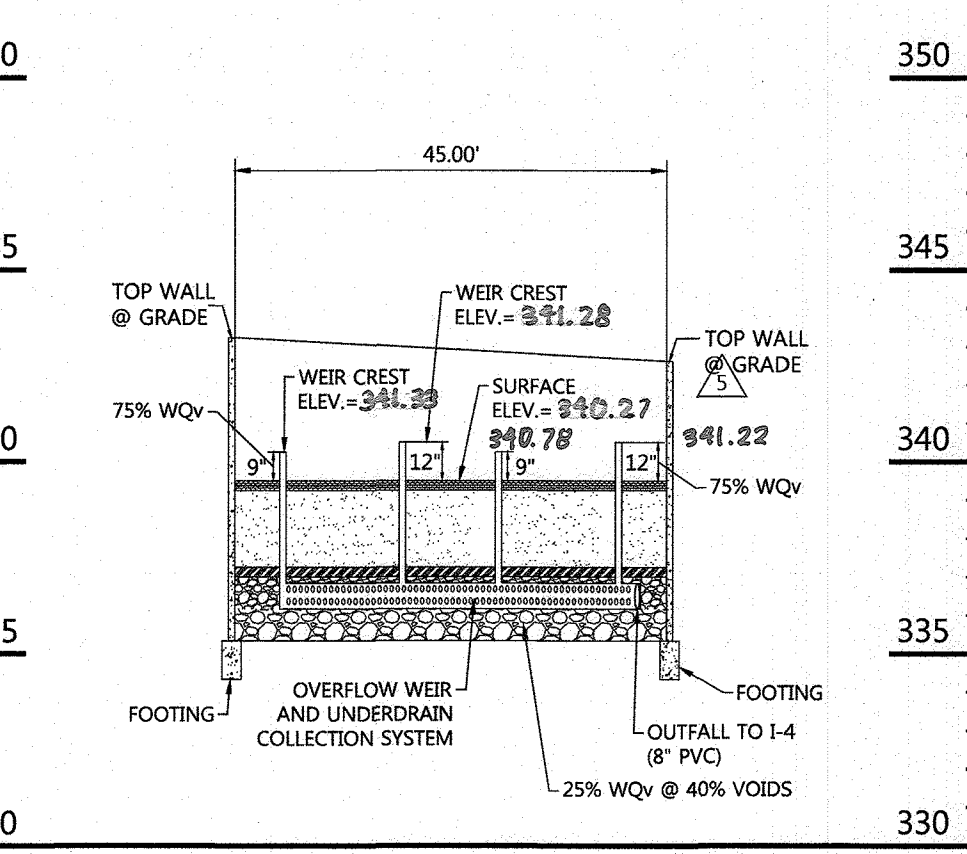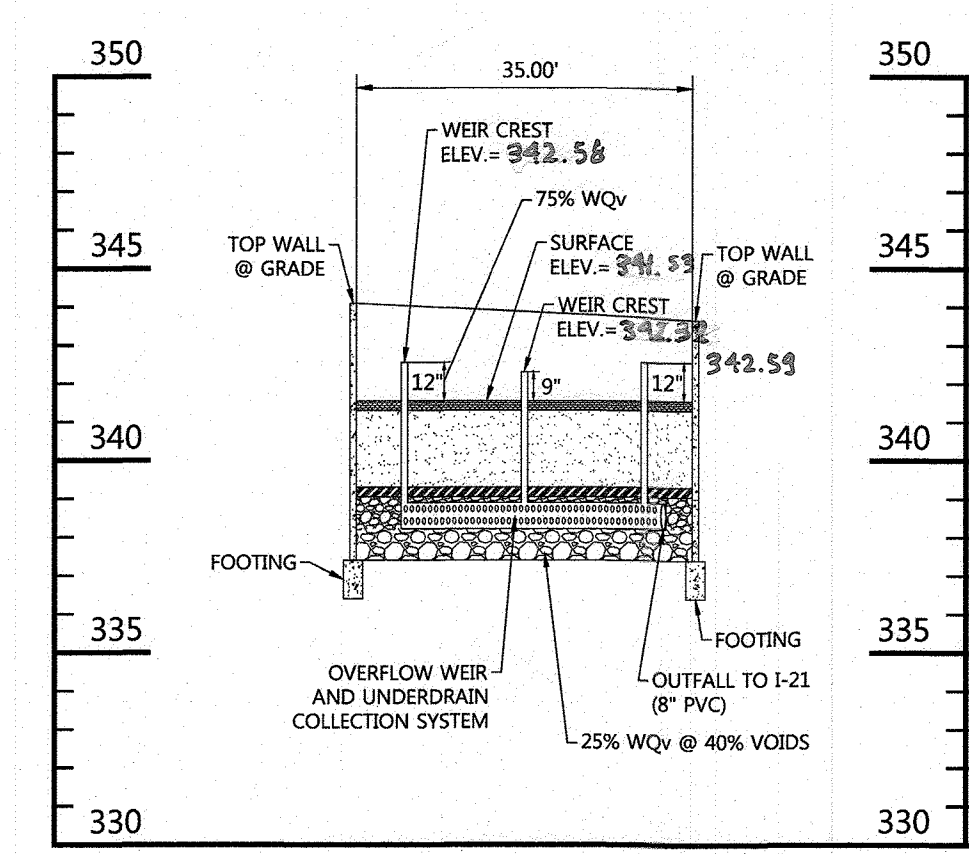


- HIGH FREQUENCY STORM OVERFLOW WEIR (REFER TO PROFILE FOR RIM ELEVATION)
- OVERFLOW WEIR FOR UNDERGROUND WQV (REFER TO PROFILE FOR RIM ELEVATION) STORAGE (25%)
- SEE CURB ESD OPENING TABLE FOR INVERT AND LOCATION.

NOTE:
1. REFER TO STORMWATER MANAGEMENT SHEET 18 FOR STANDARD (M-6) MICRO-BIORETENTION & (M-6) MODULAR MICRO-BIORETENTION MATERIAL SPECIFICATIONS, SEQUENCE OF CONSTRUCTION AND OPERATION & MAINTENANCE SCHEDULES.
2. CONTRACTOR SHALL INSTALL REAR (M-6) MODULAR WALL FLUSH WITH GARAGE WALL. THIS INSTALLATION MAY REQUIRE CAST-IN-PLACE PROCEDURES. (M-6) WIDTH DIMENSIONS WILL VARY ALONG SKY RIBBON RD. GARAGE WALL FACE.

PURPOSE NOTE:
THIS SHEET REPLACES A SHEET SIGNED ON 01-19-2018 AND MODIFIES THE LOCATION OF THE ESD DEVICES TO REFLECT REVISIONS MADE TO SDP-18-005.

PROFESSIONAL CERTIFICATION

I HEREBY CERTIFY THAT THESE DOCUMENTS WERE PREPARED OR APPROVED BY ME, AND THAT I AM A DULY LICENSED PROFESSIONAL ENGINEER UNDER THE LAWS OF THE STATE OF MARYLAND, LICENSE NO. 26569, EXPIRATION DATE: 7/18/21

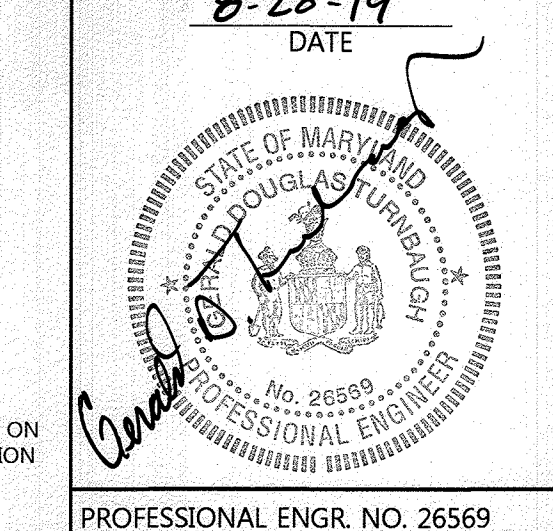

APPROVED: HOWARD COUNTY DEPARTMENT OF PUBLIC WORKS
Chief, Bureau of Highways
9/12/2019
Date

APPROVED: HOWARD COUNTY DEPARTMENT OF PLANNING & ZONING
Chief, Division of Land Development
10/24/19
Date

Chief, Development Engineering Division
9.17.19
Date

DMW
DAFT McCUNE WALKER INC
501 FAIRMOUNT AVENUE SUITE 300 TOWSON, MD 21286
P: 410 296 3333 F: 410 296 4705 WWW.DMW.COM

DES.	DRN.	CHK.	DATE	REVISION	BY	APP'R.
			08/15/2019	UPDATE ESD WIDTHS, TW & BW ELEV'S. & STATION OFFSETS	ACP	
			07/30/2018	ADDED MB41 PROFILE	JT	JRC

PREPARED FOR:
THE HOWARD HUGHES CORPORATION
10480 LITTLE PATUXENT PARKWAY
SUITE 400
COLUMBIA, MARYLAND 21044
ATTN: BILL ROWE
410-964-4987


REVISIONS:
1. REVISION 1: 08/15/2019
2. REVISION 2: 07/30/2018

REVISED STORMWATER MANAGEMENT PLAN
REPLACEMENT SHEET
DOWNTOWN COLUMBIA
CRESCENT NEIGHBORHOOD
PARCELS D-2, D-3, D-4, D-5, D-6, D-10 & D-14
ELECTION DISTRICT No. 5
HOWARD COUNTY, MARYLAND


SCALE	ZONING	G. L. W. FILE NO.
SCALE	NT	11071
DATE	TAX MAP - GRID	SHEET
AUG., 2017	36 - 01	21 OF 25

(M-6) SWM LOCATION TABLE			(M-6) SWM LOCATION TABLE			(M-6) SWM LOCATION TABLE			(M-6) SWM LOCATION TABLE			(M-6) SWM LOCATION TABLE			(M-6) SWM LOCATION TABLE			(M-6) SWM LOCATION TABLE					
FACILITY #	CENTERLINE STA.	OFFSET	FACILITY #	CENTERLINE STA.	OFFSET	FACILITY #	CENTERLINE STA.	OFFSET	FACILITY #	CENTERLINE STA.	OFFSET	FACILITY #	CENTERLINE STA.	OFFSET	FACILITY #	CENTERLINE STA.	OFFSET	FACILITY #	CENTERLINE STA.	OFFSET			
MB16	4+74.24	12.71' R	MB17	4+49.57	12.70' R	MB18	3+27.29	12.74' R	MB19	2+94.04	12.64' R	MB20	1+47.99	12.64' R	MB21	0+98.04	30.0' L	MB22	1+76.58	21.87' L	MB23	2+96.48	21.90' L
MB16	4+78.47	17.60' R	MB17	4+49.55	17.72' R	MB18	3+27.29	17.74' R	MB19	2+94.04	17.67' R	MB20	1+47.99	17.53' R	MB21	0+75.04	31.5' L	MB22	1+76.58	26.98' L	MB23	2+96.48	27.03' L
MB16	4+83.40	12.75' R	MB17	4+28.32	12.69' R	MB18	3+03.93	12.71' R	MB19	2+48.09	12.74' R	MB20	1+07.15	12.74' R	MB21	0+42.04	40.5' L	MB22	2+91.51	21.98' L	MB23	4+21.44	22.04' L
MB16	4+83.40	17.75' R	MB17	4+28.42	17.78' R	MB18	3+03.98	17.80' R	MB19	2+49.04	17.78' R	MB20	1+07.17	17.68' R	MB21			MB22	2+91.40	27.0' L	MB23	4+21.37	22.32' L



(M-6) SWM LOCATION TABLE		
FACILITY #	CENTERLINE STA.	OFFSET
MB41	22+26.71	29.27' W
	22+26.71	29.27' RT
	22+48.44	29.22' RT
	22+48.58	29.33'

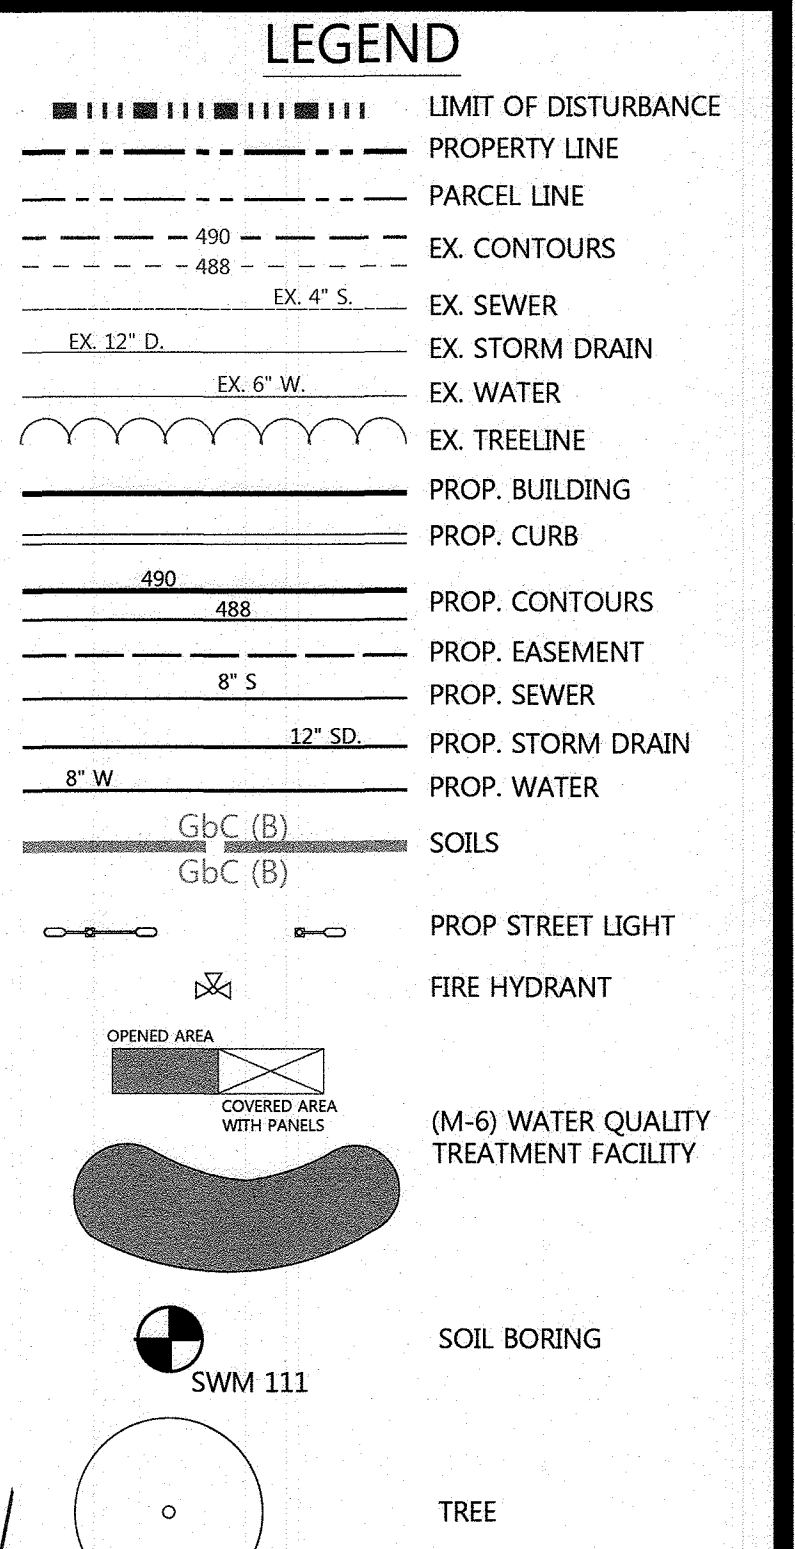



CURB OPENINGS	
CENTERLINE STATION	
LEFT	RIGHT
0+64.84	1+07.98
0+76.96	1+17.75
0+89.27	1+31.53
1+04.27	1+45.39
1+18.87	2+50.00
2+00.85	2+69.17
2+16.06	2+77.80
2+30.94	3+09.85
2+45.98	3+14.88
2+60.77	3+26.28
2+75.87	4+29.98
2+80.84	4+41.98
3+00.59	4+72.95
3+15.57	
3+30.54	
3+45.06	
3+60.06	
3+75.82	
3+90.89	
4+05.91	
4+21.15	

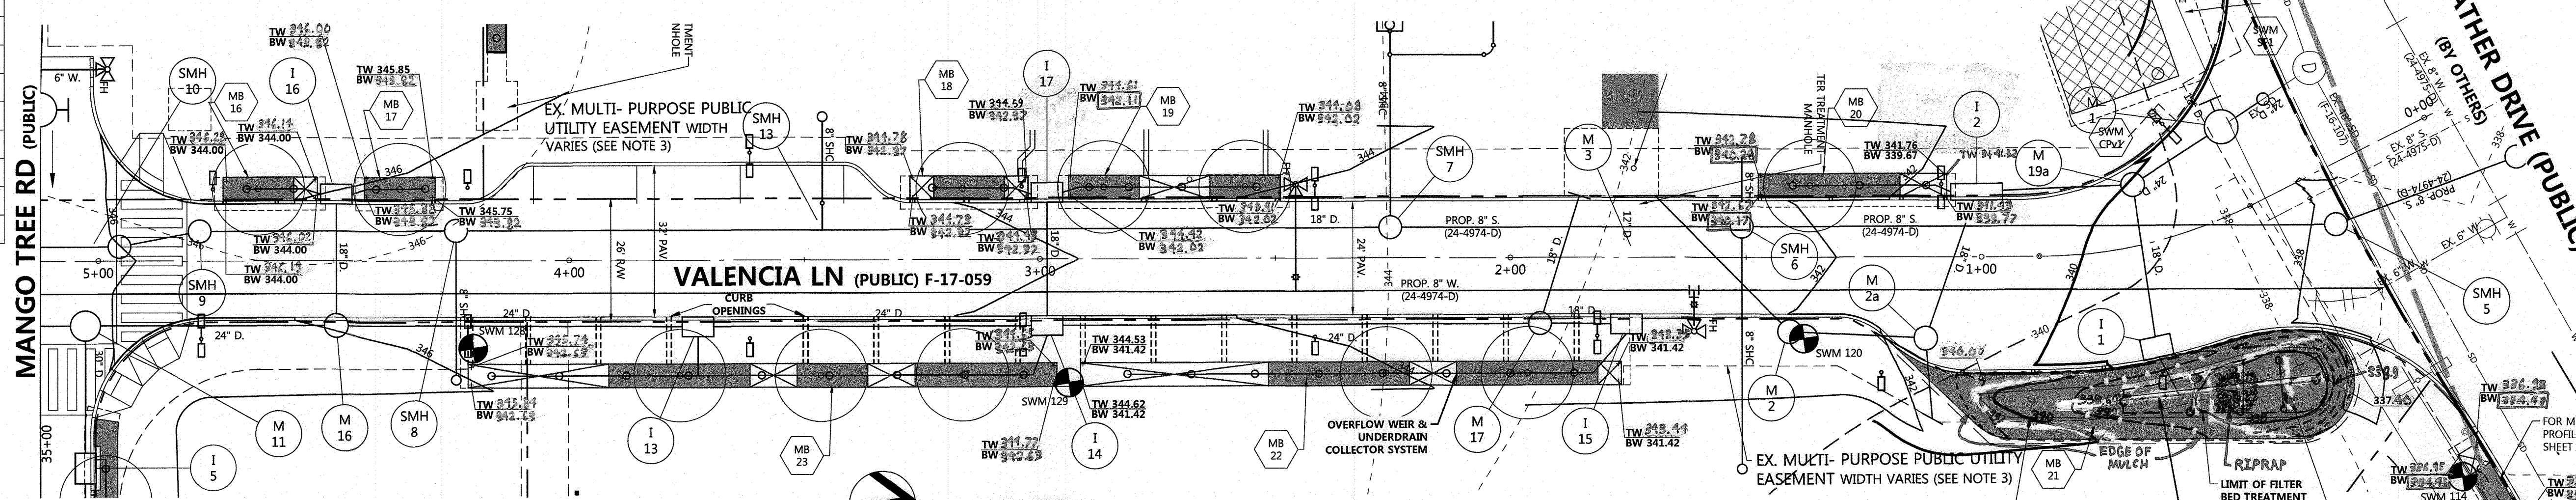

349.68 - ENGINEER'S FIELD ADJUSTMENT
 "IA" MEANS "INACCESSIBLE DUE TO COVERED PANEL"
 "JA" MEANS "INACCESSIBLE FOR MEASURING ELEVATION."

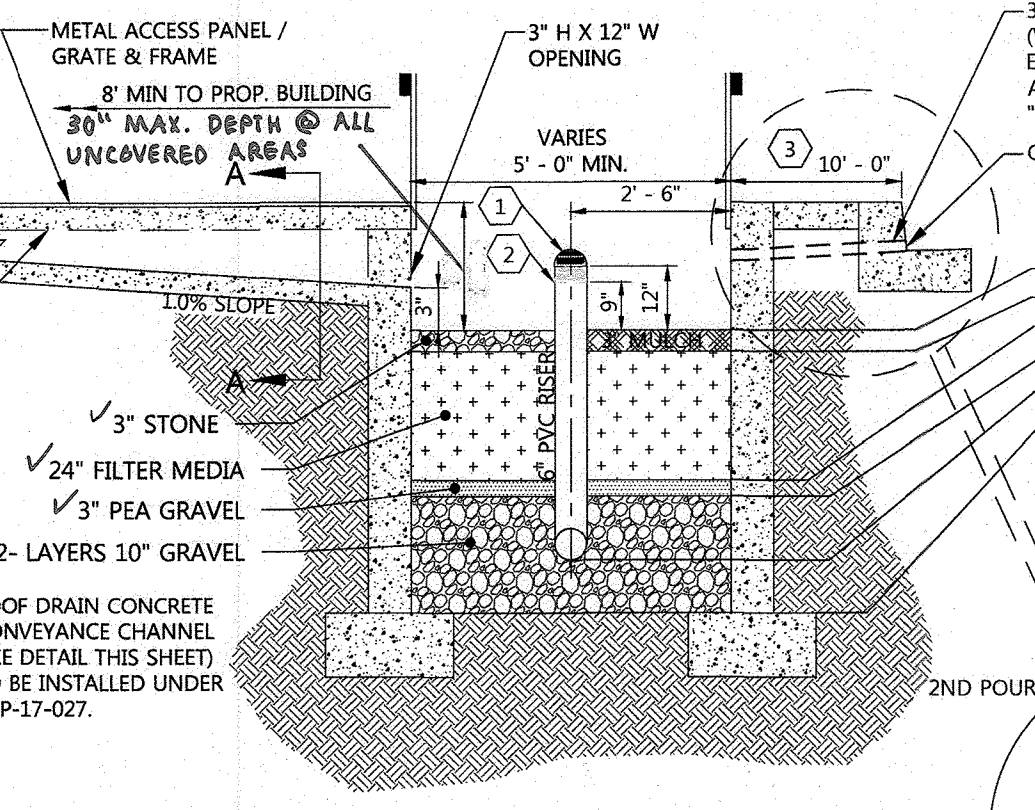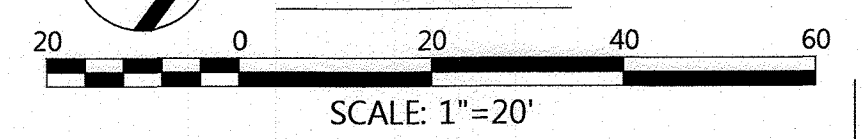


(M-6) MB16 FACILITY	(M-6) MB17 FACILITY	(M-6) MB18 FACILITY	(M-6) MB19 FACILITY	(M-6) MB20 FACILITY	(M-6) MB22 FACILITY	(M-6) MB23 FACILITY	(M-6) MB41 FACILITY
343.75	343.50	342.24	341.70	339.42	339.42	339.97	342.44
341.75	341.50	340.24	339.70	337.42	337.42	340.27	342.44
341.50	341.25	339.99	339.45	337.17	337.17	340.02	342.44
340.67	340.42	339.16	338.62	336.34	336.34	339.19	340.67
339.84	339.59	338.33	337.79	335.51	335.51	338.36	339.84

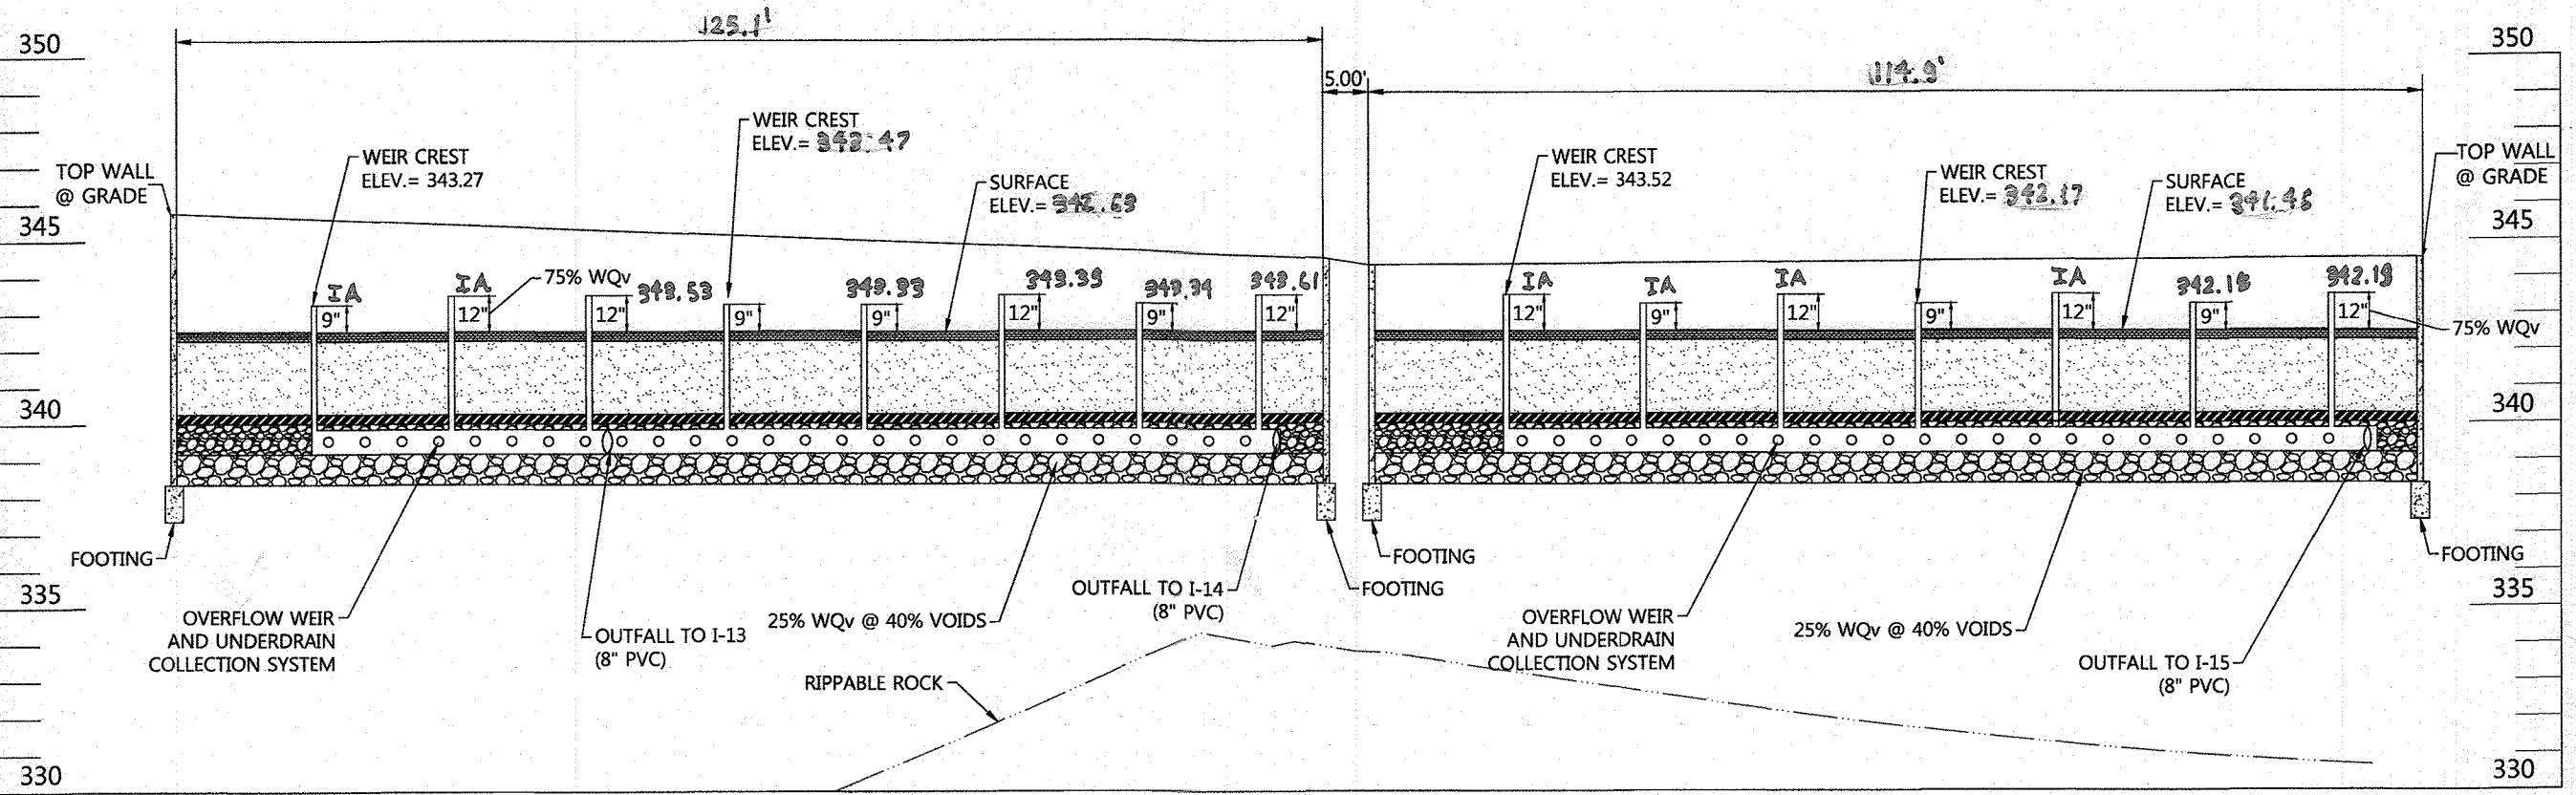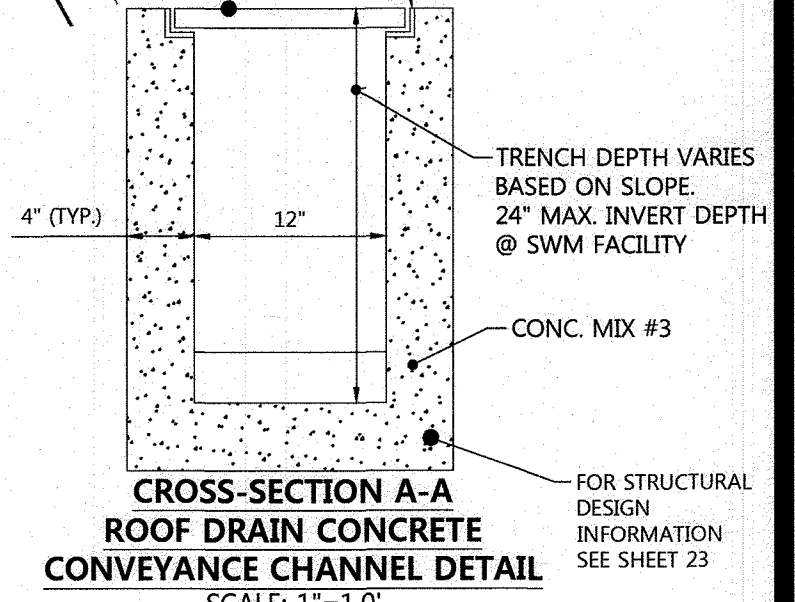


(M-6) MB23 SWM PROFILE
 SCALE: HORIZ. 1" = 20'; VERT. 1" = 5'

(M-6) MB22 SWM PROFILE
 SCALE: HORIZ. 1" = 20'; VERT. 1" = 5'

PROFESSIONAL ENGINEER
 AS BUILT CERTIFICATION FOR PSWM
 I HEREBY CERTIFY THAT THE FACILITY SHOWN ON THE PLAN WAS CONSTRUCTED AS SHOWN ON THE "AS-BUILT" PLANS AND COMPLIES WITH THE APPROVED PLANS AND SPECIFICATIONS. I HAVE VERIFIED THAT THE CONTRIBUTING DRAINAGE AREA IS SUFFICIENTLY STABILIZED TO PREVENT CLOGGING OF THE UNDERGROUND SWM FACILITY.
 NAME: GERALD D. TURNBAUGH
 DATE: AUG 11, 2023 REG. NO.: 26569

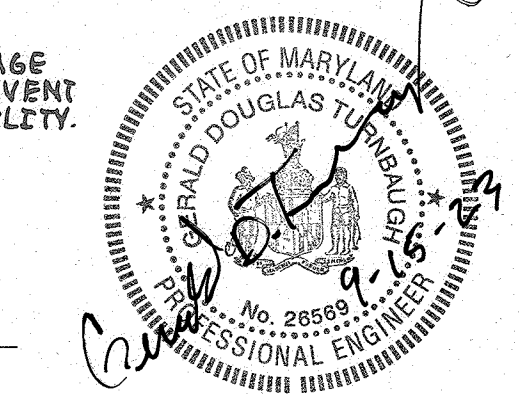


TYPICAL CROSS-SECTION OF NON-STRUCTURAL WALLED MICRO-BIOTRETENTION FACILITY
 SCALE: N.T.S.

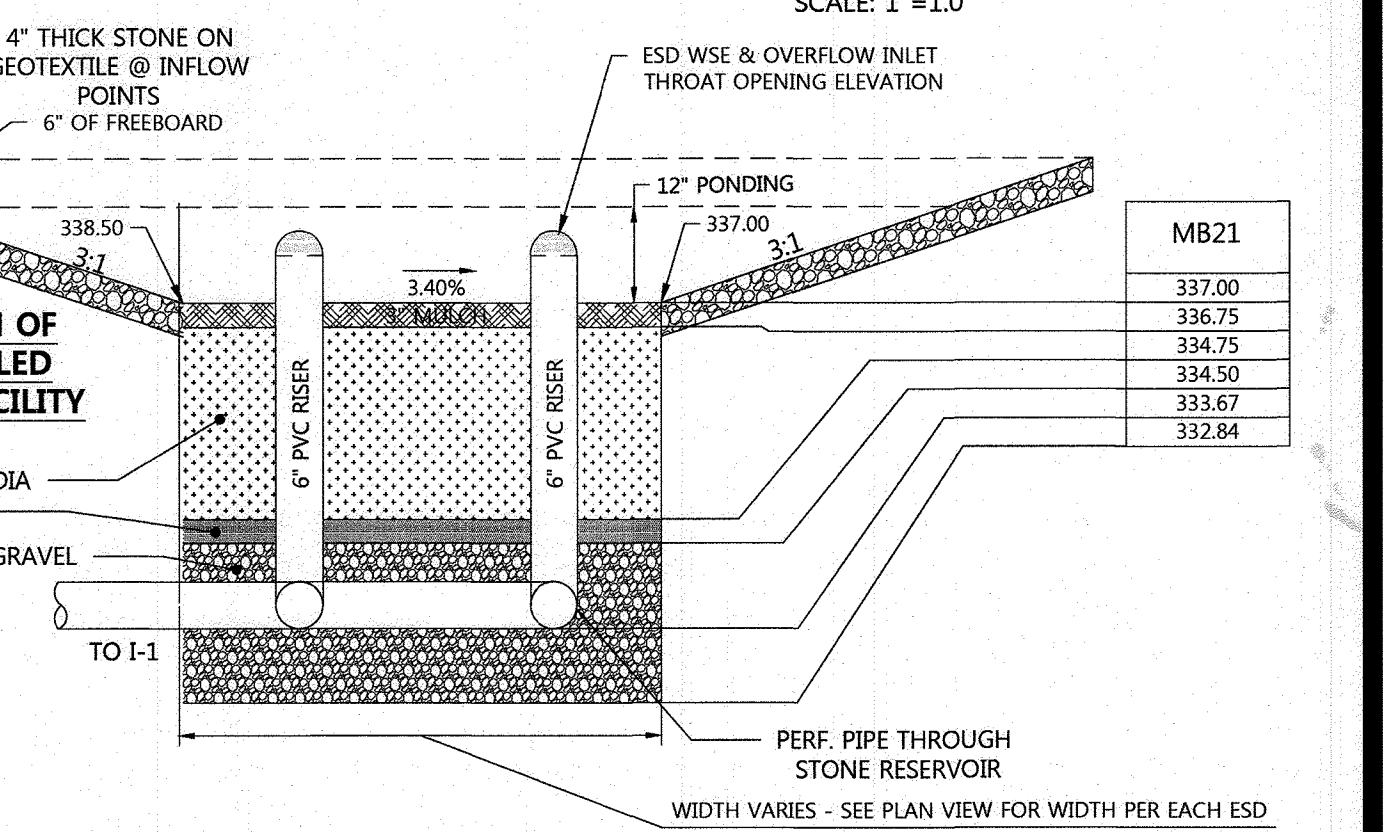


TYPICAL CROSS-SECTION OF ROOF DRAIN CONCRETE CONVEYANCE CHANNEL DETAIL
 SCALE: 1" = 10'


- NOTE:
- THE (M-6) MICRO-BIOTRETENTION FACILITIES SHOWN ON THESE PLANS WILL BE PRIVATELY OWNED AND MAINTAINED.
 - (REV) GROUNDWATER RECHARGE VOLUME AND (CP) CHANNEL PROTECTION VOLUME MANAGEMENT ARE BEING PROVIDED IN SDP-17-027.
 - REFER TO EXPLANATION NOTE FOR THE PUBLIC MULTI-PURPOSE AND UTILITY EASEMENT TABLE ON THE COVER SHEET

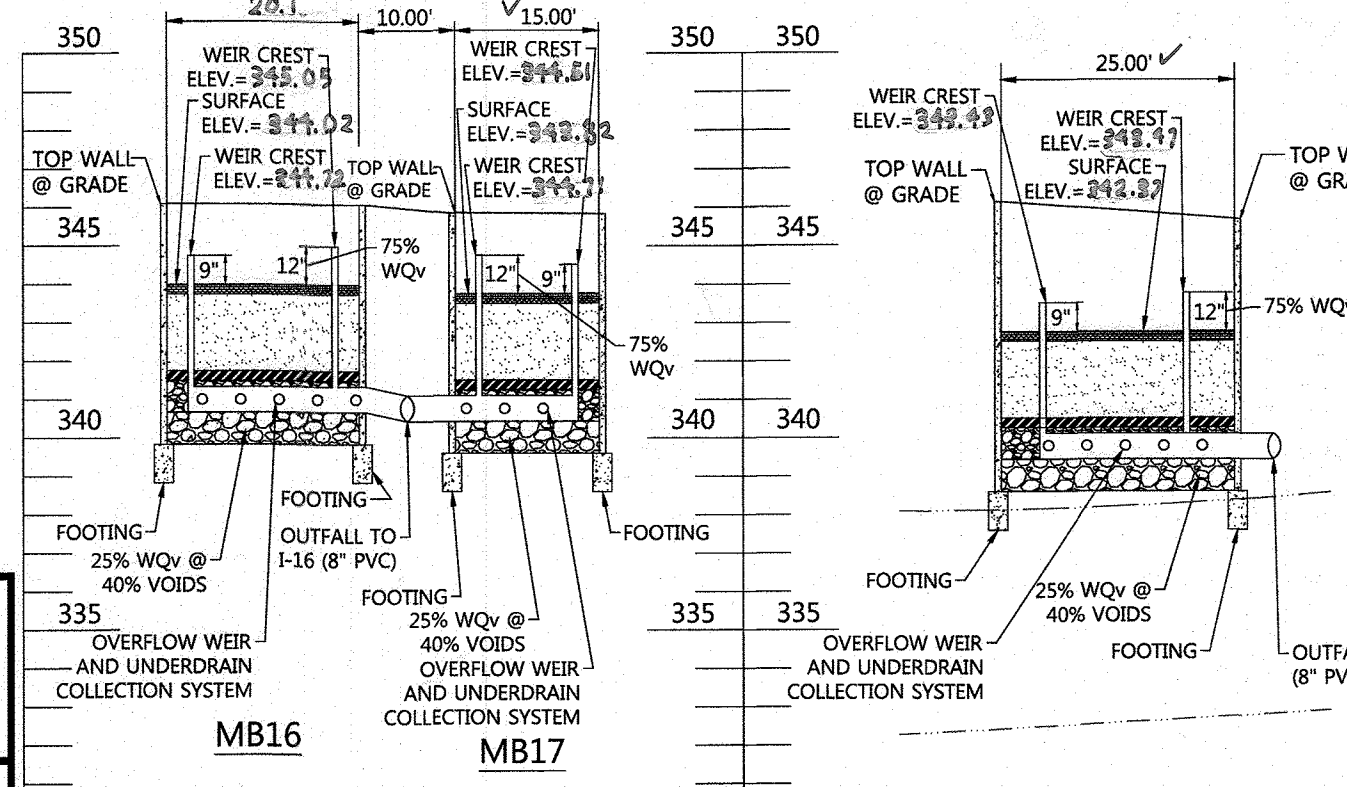


(M-6) MB16 & MB17 SWM PROFILE
 SCALE: HORIZ. 1" = 20'; VERT. 1" = 5'

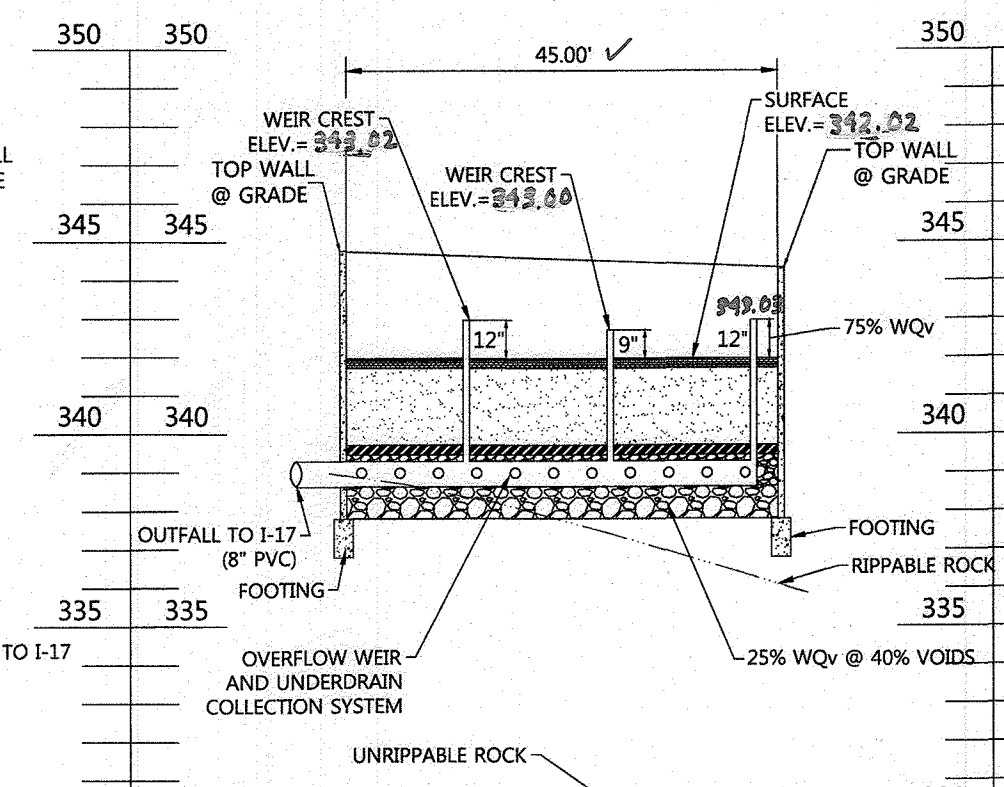


(M-6) MB18 SWM PROFILE
 SCALE: HORIZ. 1" = 20'; VERT. 1" = 5'

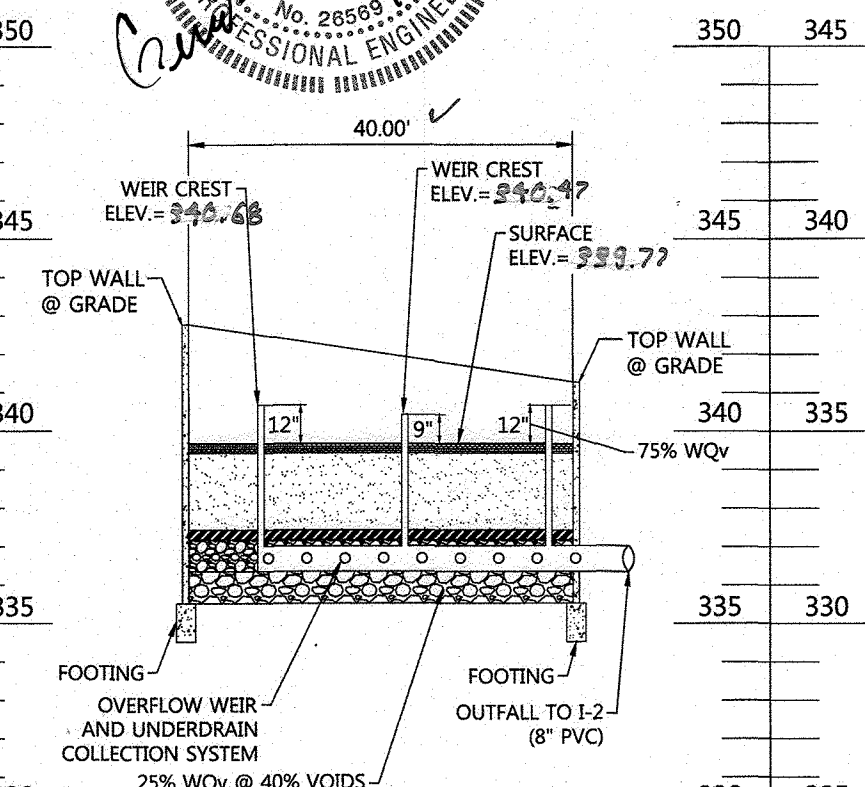

(M-6) MB19 SWM PROFILE
 SCALE: HORIZ. 1" = 20'; VERT. 1" = 5'

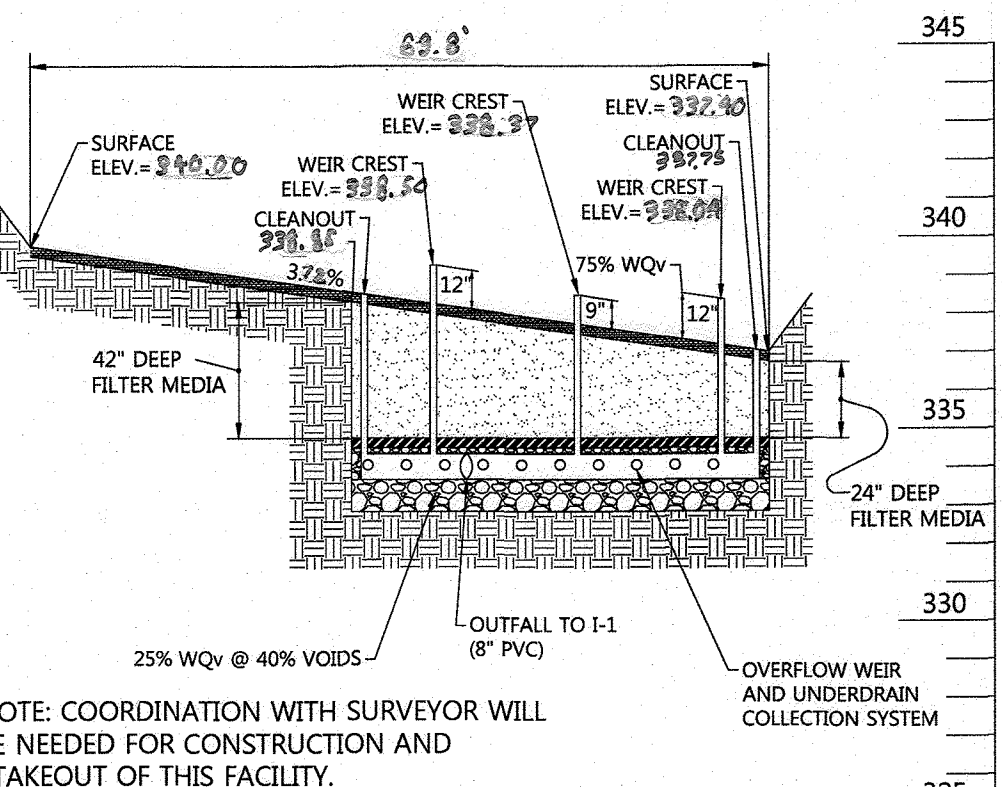

(M-6) MB20 SWM PROFILE
 SCALE: HORIZ. 1" = 20'; VERT. 1" = 5'

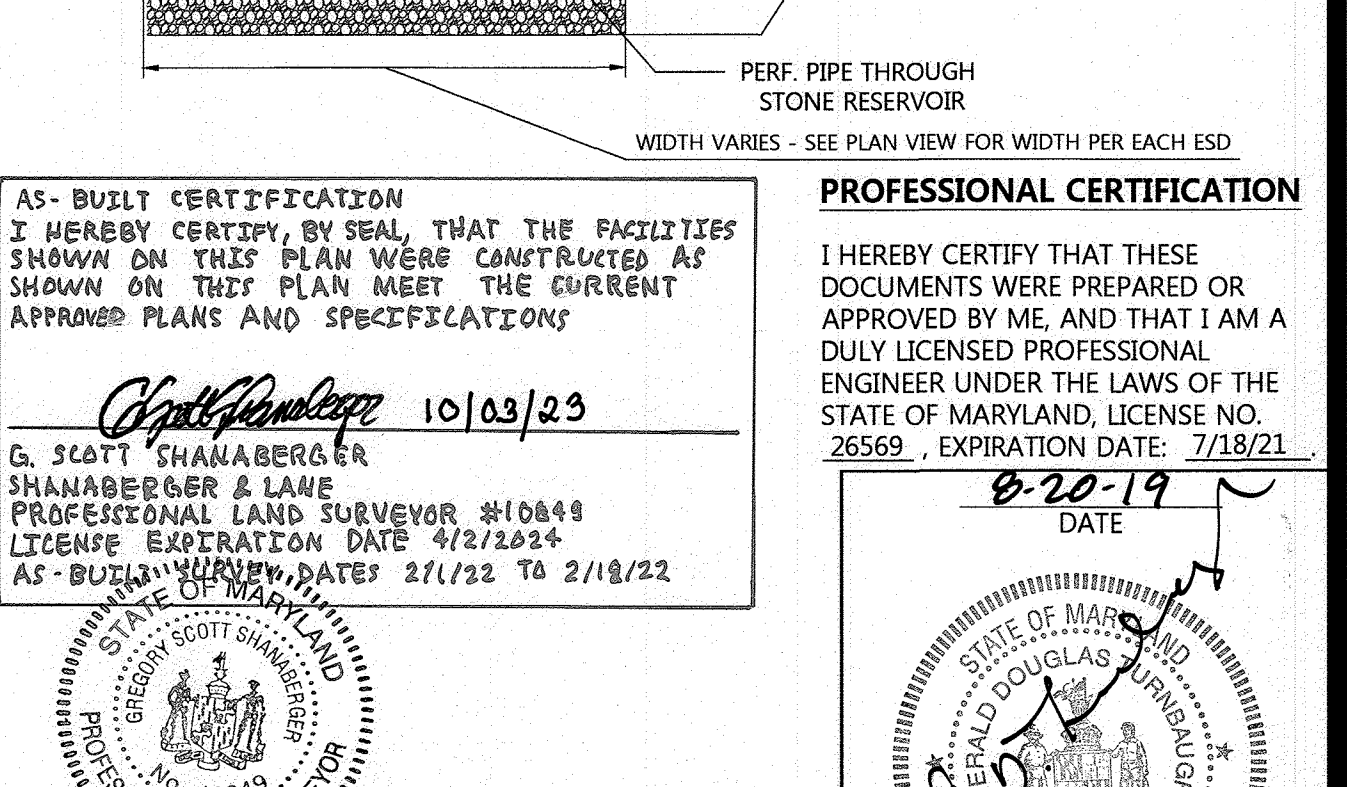


(M-6) MB21 SWM PROFILE
 SCALE: HORIZ. 1" = 20'; VERT. 1" = 5'



APPROVED: HOWARD COUNTY DEPARTMENT OF PUBLIC WORKS
 Chief, Bureau of Highways MK
 Date: 9/12/2019

APPROVED: HOWARD COUNTY DEPARTMENT OF PLANNING & ZONING
 Chief, Division of Land Development
 Date: 10/29/19

AS-BUILT CERTIFICATION
 I HEREBY CERTIFY, BY SEAL, THAT THE FACILITIES SHOWN ON THIS PLAN WERE CONSTRUCTED AS SHOWN ON THE PLAN MEET THE CURRENT APPROVED PLANS AND SPECIFICATIONS.
 G. SCOTT SHANABERGER
 SHANABERGER & LAWE
 PROFESSIONAL LAND SURVEYOR #10048
 LICENSE EXPIRATION DATE 4/2/2024
 AS-BUILT REVIEW DATE: 2/1/22 TO 2/18/22

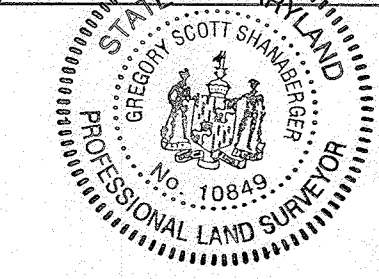

PROFESSIONAL CERTIFICATION
 I HEREBY CERTIFY THAT THESE DOCUMENTS WERE PREPARED OR APPROVED BY ME, AND THAT I AM A DULY LICENSED PROFESSIONAL ENGINEER UNDER THE LAWS OF THE STATE OF MARYLAND, LICENSE NO. 26569, EXPIRATION DATE: 7/18/21

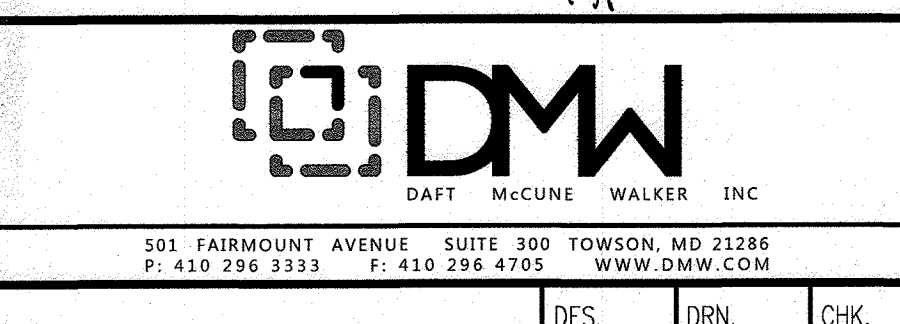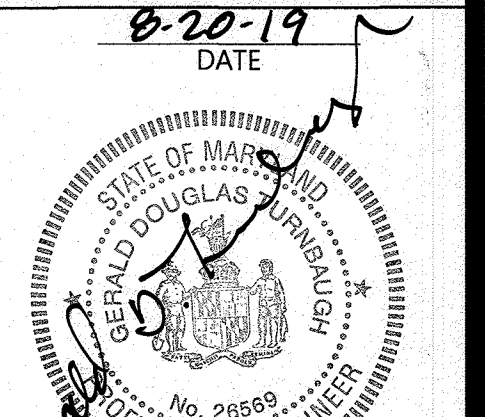


DATE	DESCRIPTION	BY	APPR.
08/15/2019	UPDATE ESD CENTERLINE LOCATIONS & OFFSETS, CURB OPENING LOCATIONS	ACP/PAB	
07/30/2018	ADDED MB41 INFORMATION	JT	JRC

PREPARED FOR:
 THE HOWARD HUGHES CORPORATION
 10480 LITTLE PATUXENT PARKWAY
 SUITE 400
 COLUMBIA, MARYLAND 21044
 ATTN: BILL ROWE
 410-964-4987

REVISED STORMWATER MANAGEMENT PLAN
 REPLACEMENT SHEET
 DOWNTOWN COLUMBIA
 CRESCENT NEIGHBORHOOD
 PARCELS D-2, D-3, D-4,
 D-5, D-6, D-10 # D-14
 HOWARD COUNTY, MARYLAND


SCALE	ZONING	G. L. W. FILE NO.
SCALE	NT	11071
DATE	TAX MAP - GRID	SHEET
AUG, 2017	36 - 01	22 OF 25

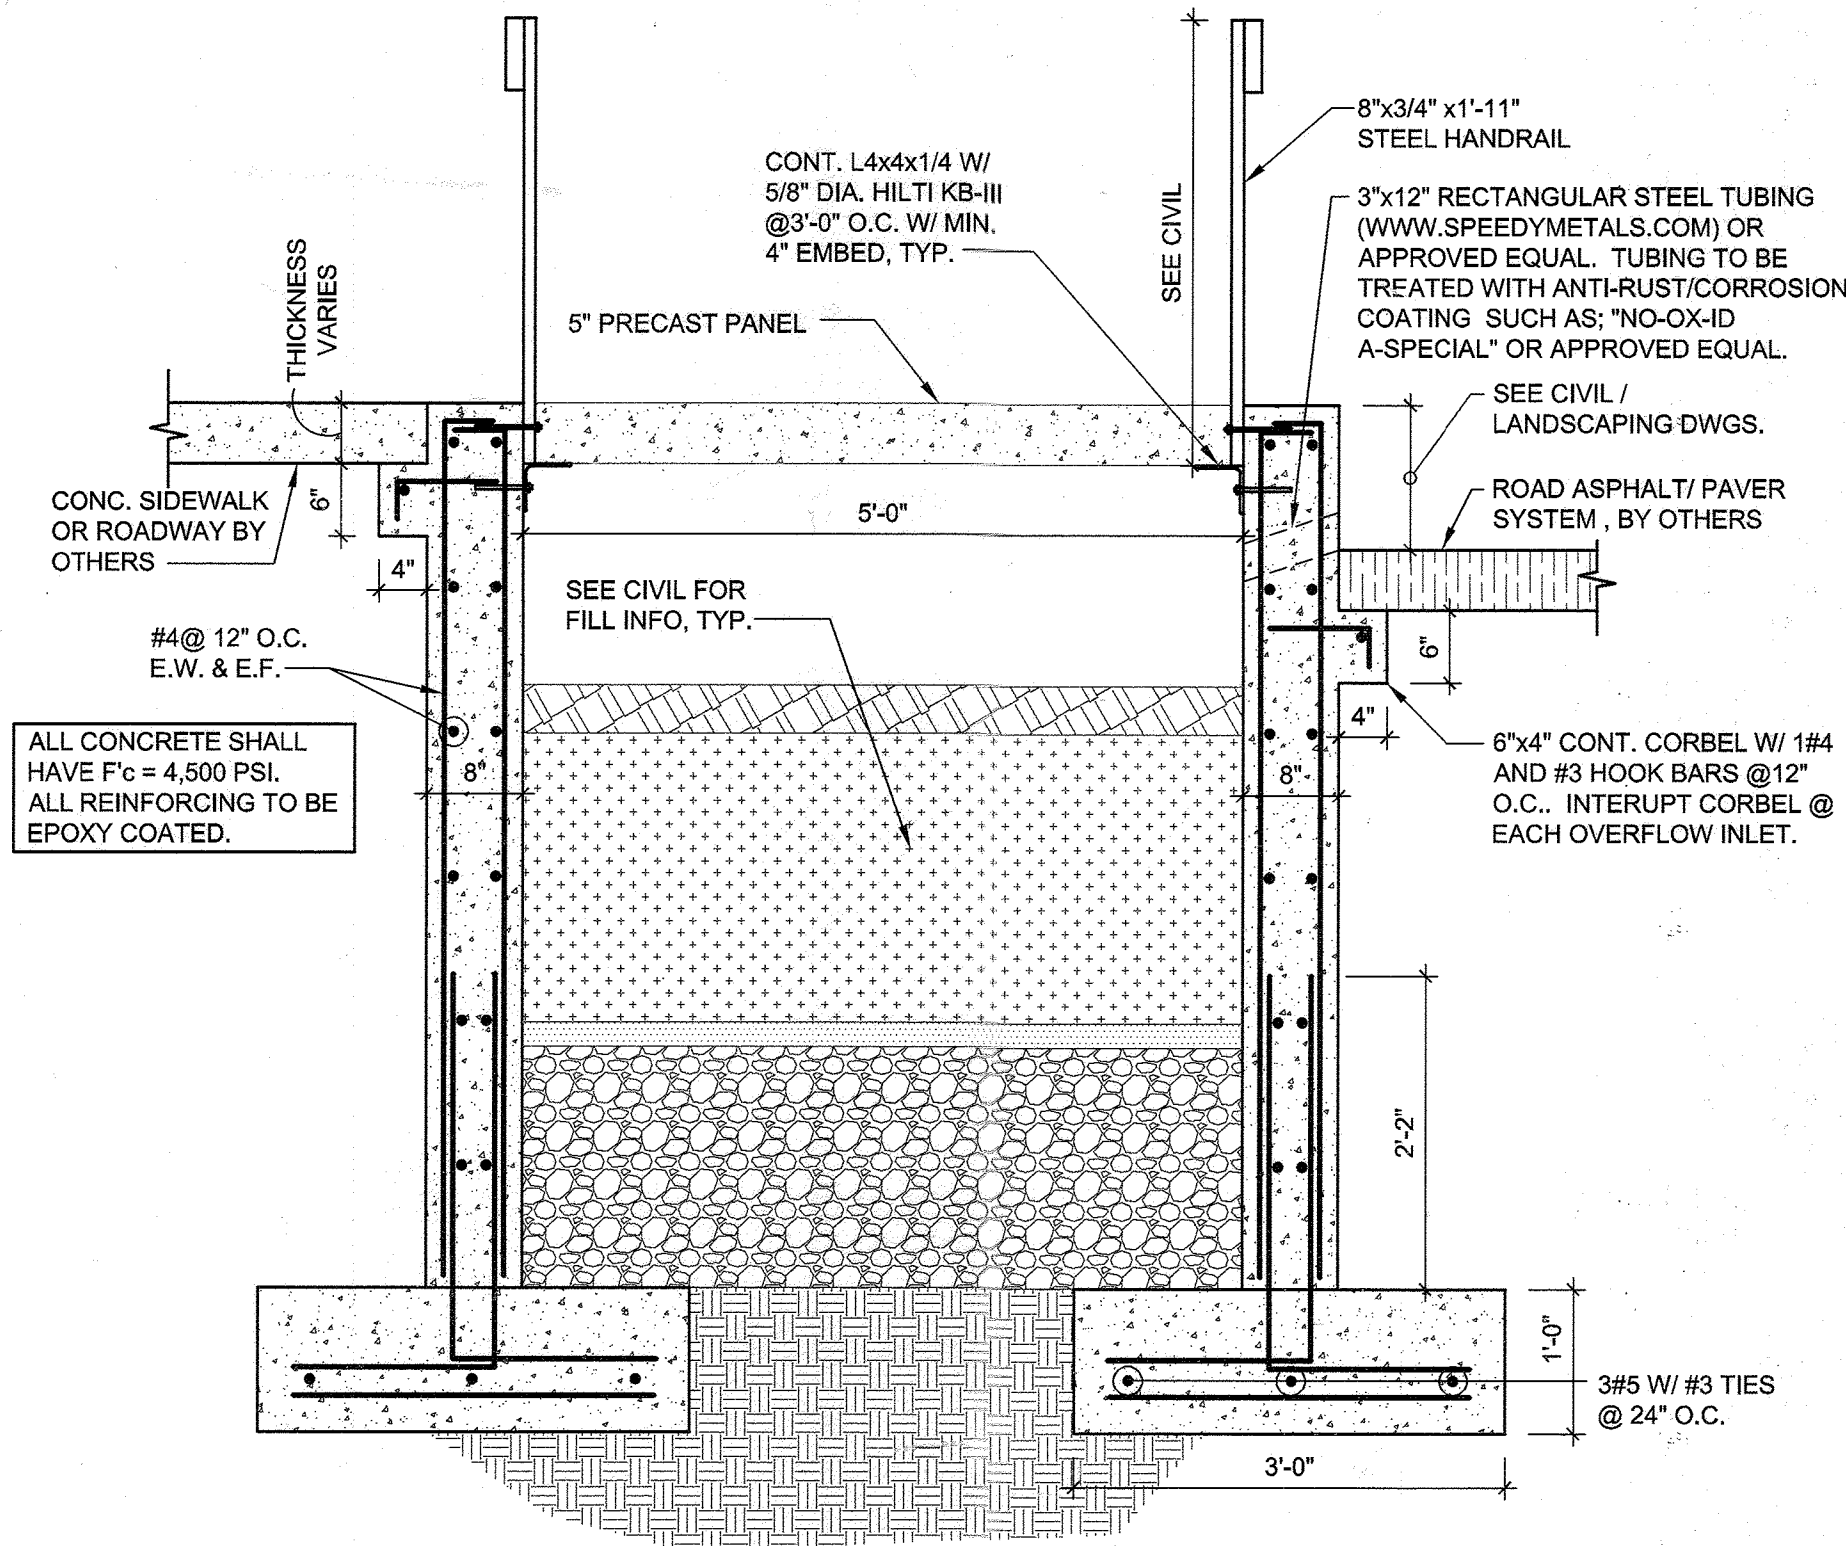

SECTION @ ESD IN OPEN SPACE

SCALE: 3/4" = 1'-0"


1
S-2

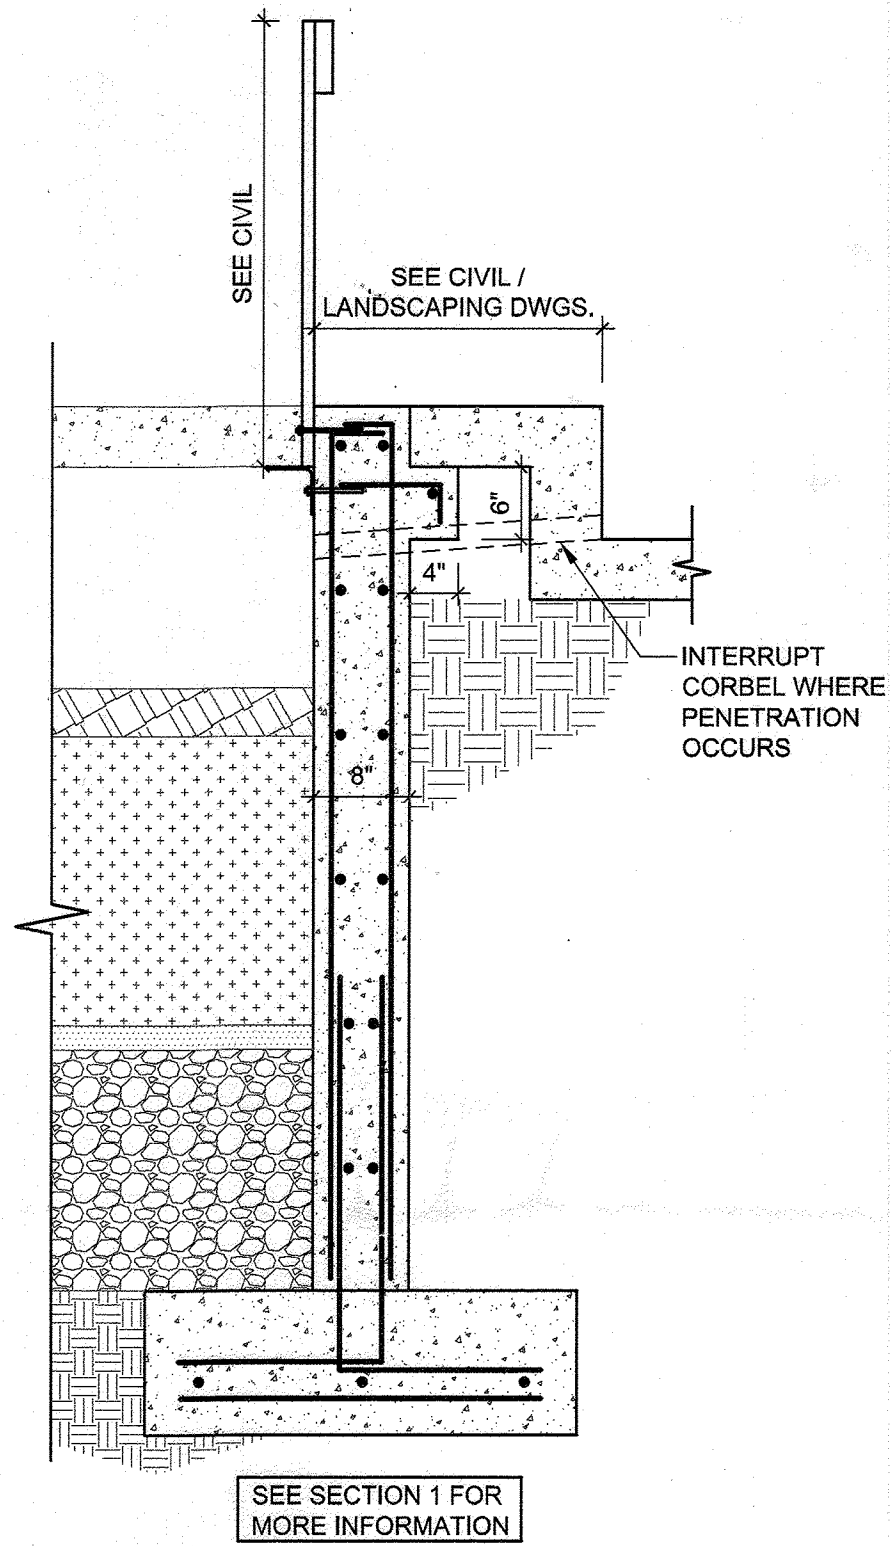

SECTION @ ESD IN CONCRETE PAVING AREA W/ STREET PARKING

SCALE: 3/4" = 1'-0"


2
S-2

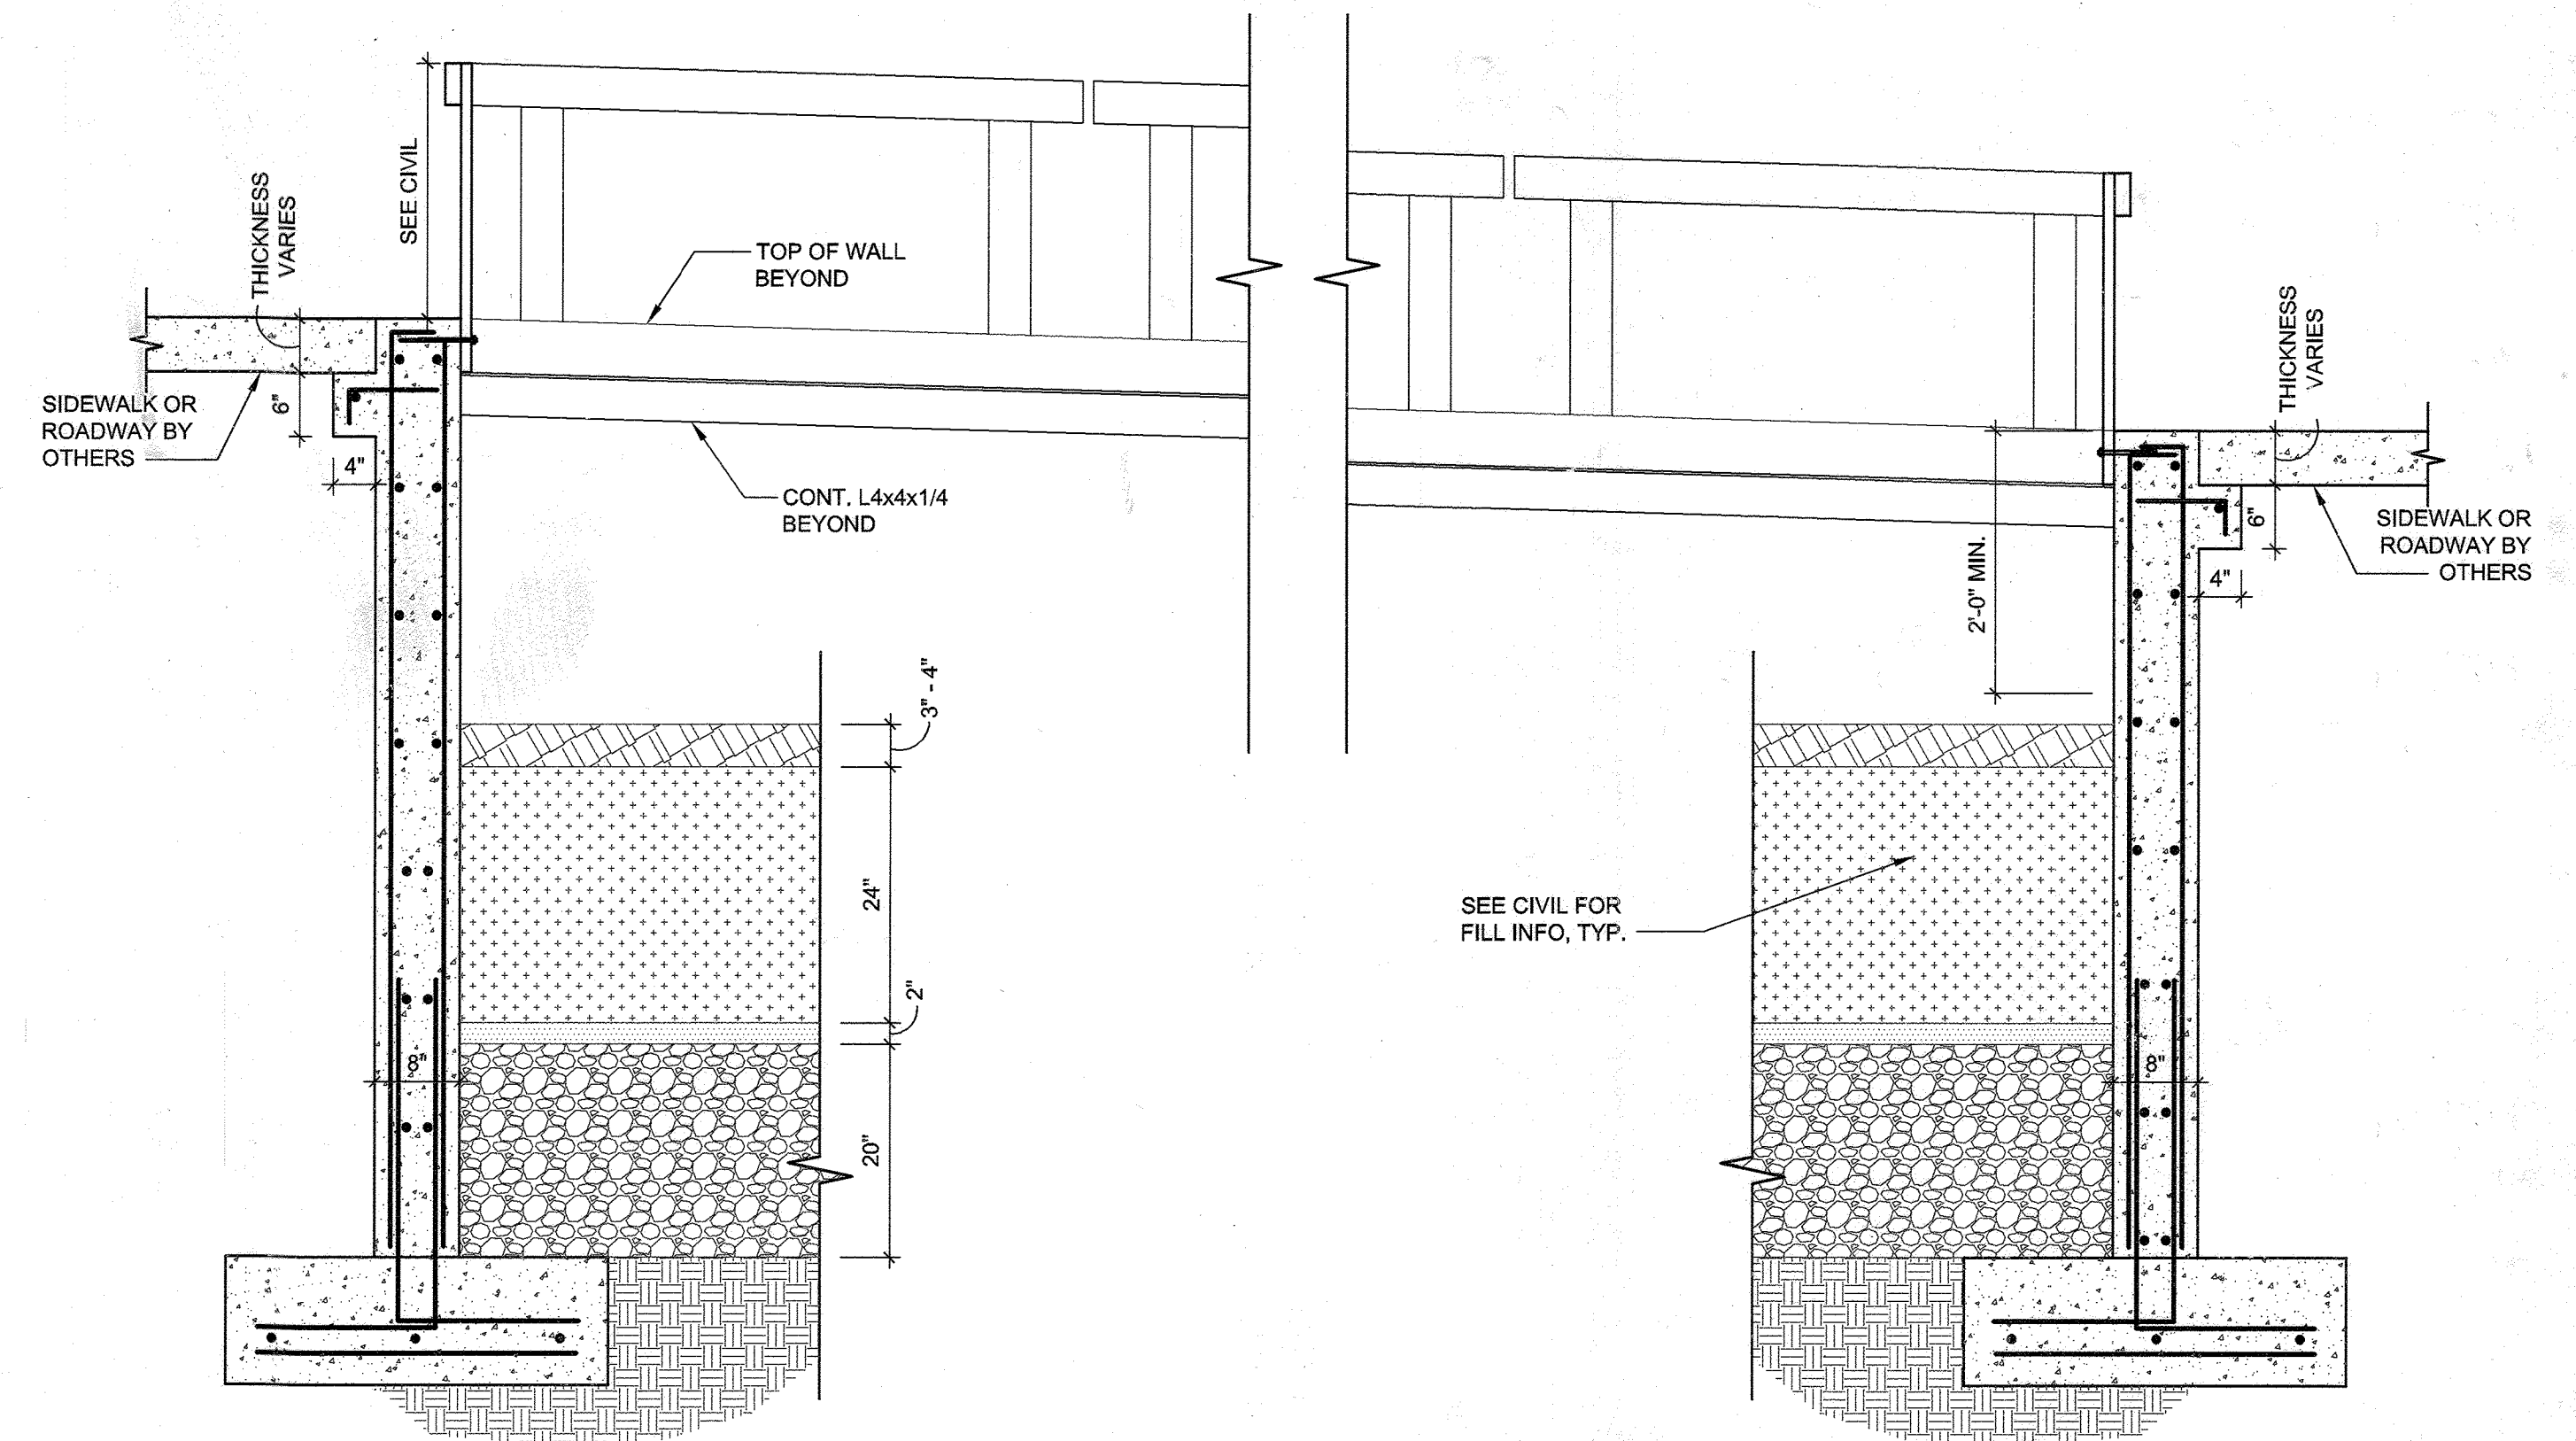

SECTION

SEE SECTION 1 FOR MORE INFORMATION


3
S-2

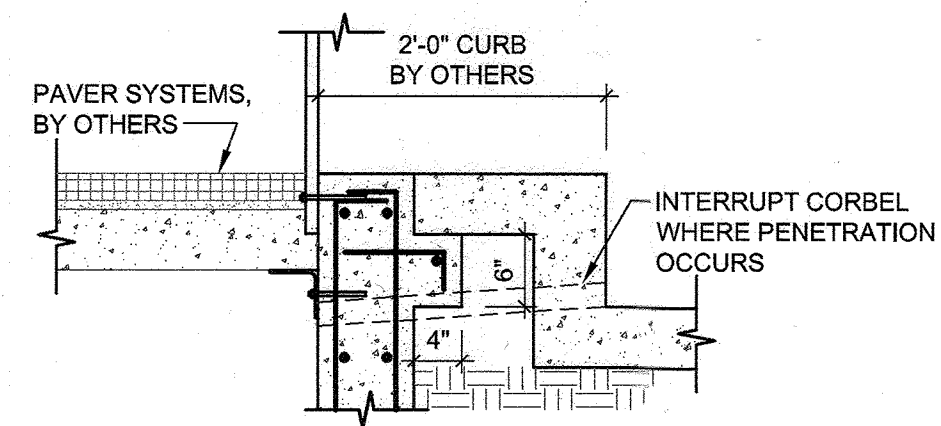

SECTION @ ESD IN PAVER AREA NEXT TO CURB

SCALE: 3/4" = 1'-0"


2A
S-2

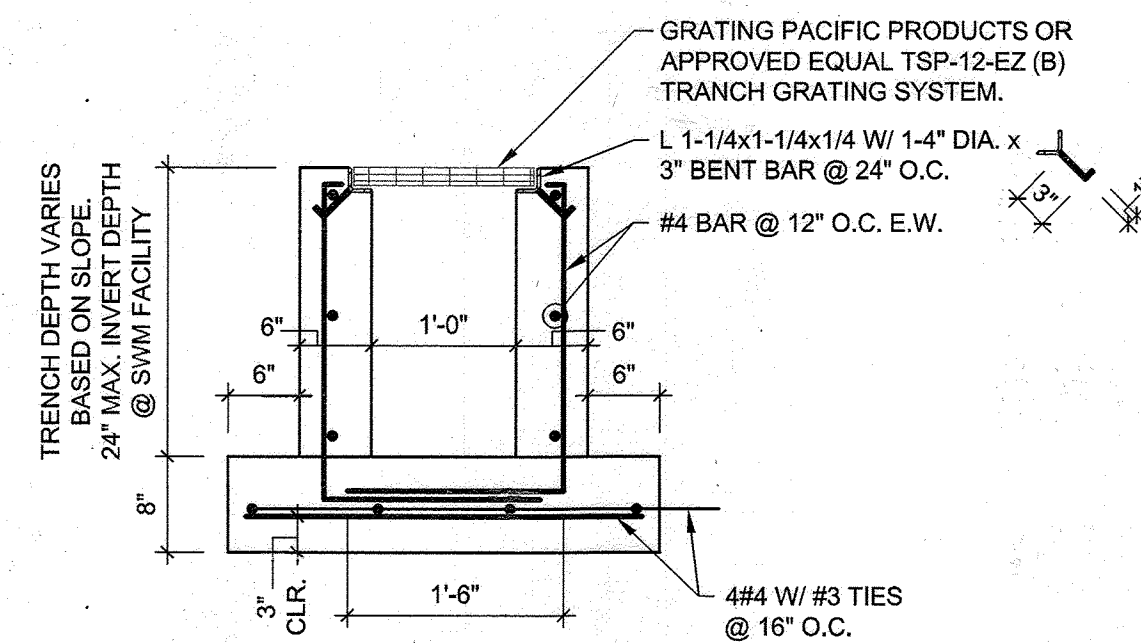

CROSS SECTION A-A ROOF DRAIN CONCRETE CONVEYANCE CHANNEL DETAIL

SCALE: 3/4" = 1'-0"

4
S-2

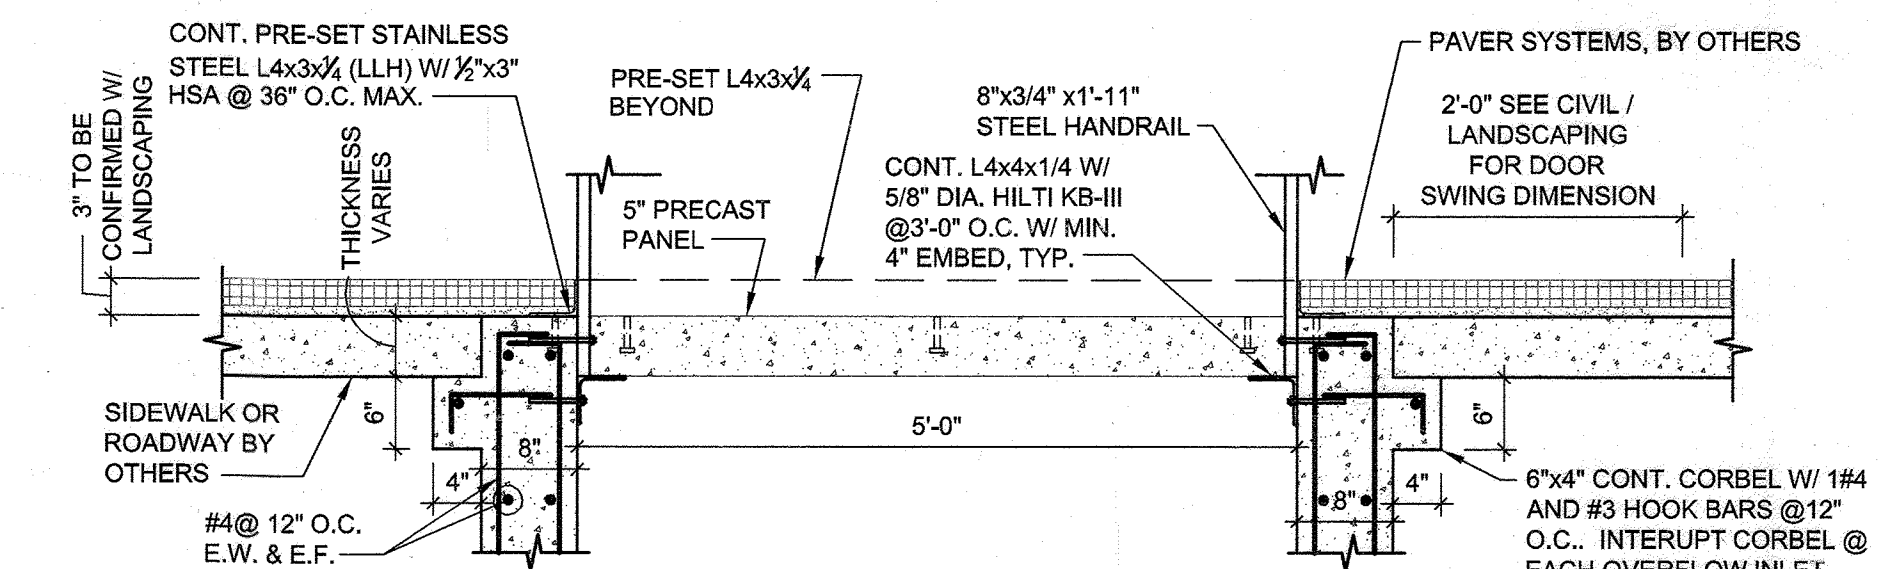

SECTION @ ESD IN PAVER AREA


SCALE: 3/4" = 1'-0"

1A
S-2


APPROVED: HOWARD COUNTY DEPARTMENT OF PUBLIC WORKS
 Chief, Bureau of Highways
 Date: 1/3/2018

APPROVED: HOWARD COUNTY DEPARTMENT OF PLANNING & ZONING
 Chief, Division of Land Development
 Date: 1-19-18

Chief, Development Engineering Division
 Date: 1-11-18

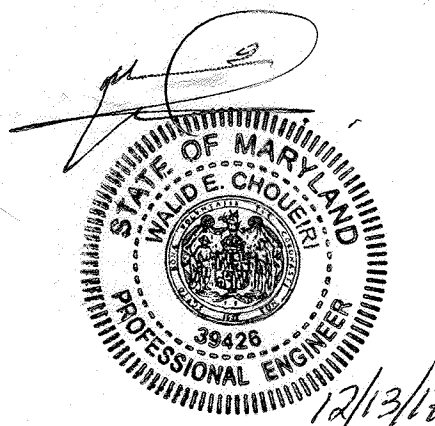

SEE SHEET I2 FOR SITE RETAINING WALL DETAILS.

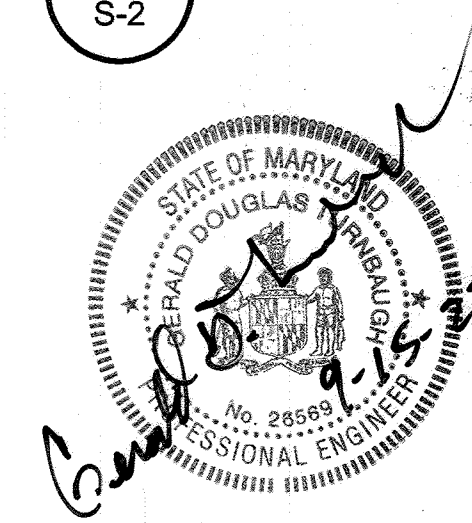

PROFESSIONAL ENGINEER AS BUILT CERTIFICATION FOR PSWMA
 NOTE: THERE IS NO "AS-BUILT" INFORMATION PROVIDED ON THIS SHEET.
 NAME: GERALD D. TURNBAUGH
 DATE: AUG. 11, 2023 REG. NO.: 26569

THERE IS NO AS-BUILT INFORMATION ON THIS SHEET
 Date: 10/03/23
 G. SCOTT SHANABERGER
 SHANABERGER & LANE
 PROFESSIONAL LAND SURVEYOR # 10849
 LICENSE EXPIRATION DATE 4/2/2024
 AS-BUILT SURVEY DATES 2/1/22 TO 2/18/22

SK&A MD
 Smislova, Kehnemui & Associates, PA
 12635 Park Potomac Avenue, Suite 300 • Potomac, MD 20854
 P 301.881.1441 F 301.881.8964 W skandesign.com
 SK&A JOB NUMBER: 1-15079-33/53


DES.	DRN.	CHK.	DATE	REVISION	BY	APPR.
			8-2-18	Note for Proposed Wall	gt	JRC

PREPARED FOR:
 THE HOWARD HUGHES CORPORATION
 10480 LITTLE PATUXENT PARKWAY
 SUITE 400
 COLUMBIA, MARYLAND 21044
 ATTN: BILL ROWE
 410-964-4987

PROFESSIONAL CERTIFICATION
 I HEREBY CERTIFY THAT THESE PLANS WERE PREPARED OR APPROVED BY ME, AND THAT I AM A DULY LICENSED PROFESSIONAL ENGINEER UNDER THE LAWS OF THE STATE OF MARYLAND, LICENSE NO. 39426, EXPIRATION DATE: 08/15/2018.

S-2 ESD STRUCTURES
 DOWNTOWN COLUMBIA CRESCENT NEIGHBORHOOD
 PARCELS D-1 THRU D-15, NON-BUILDABLE BULK PARCELS
 D-16 THRU D-17 & OPEN SPACE LOT 10
 ELECTION DISTRICT No. 5
 HOWARD COUNTY, MARYLAND

SCALE	ZONING	G. L. W. FILE No.
NTS	NT	11071
DATE	TAX MAP - GRID	SHEET
SEPT., 2017	36 - 01	23 OF 25

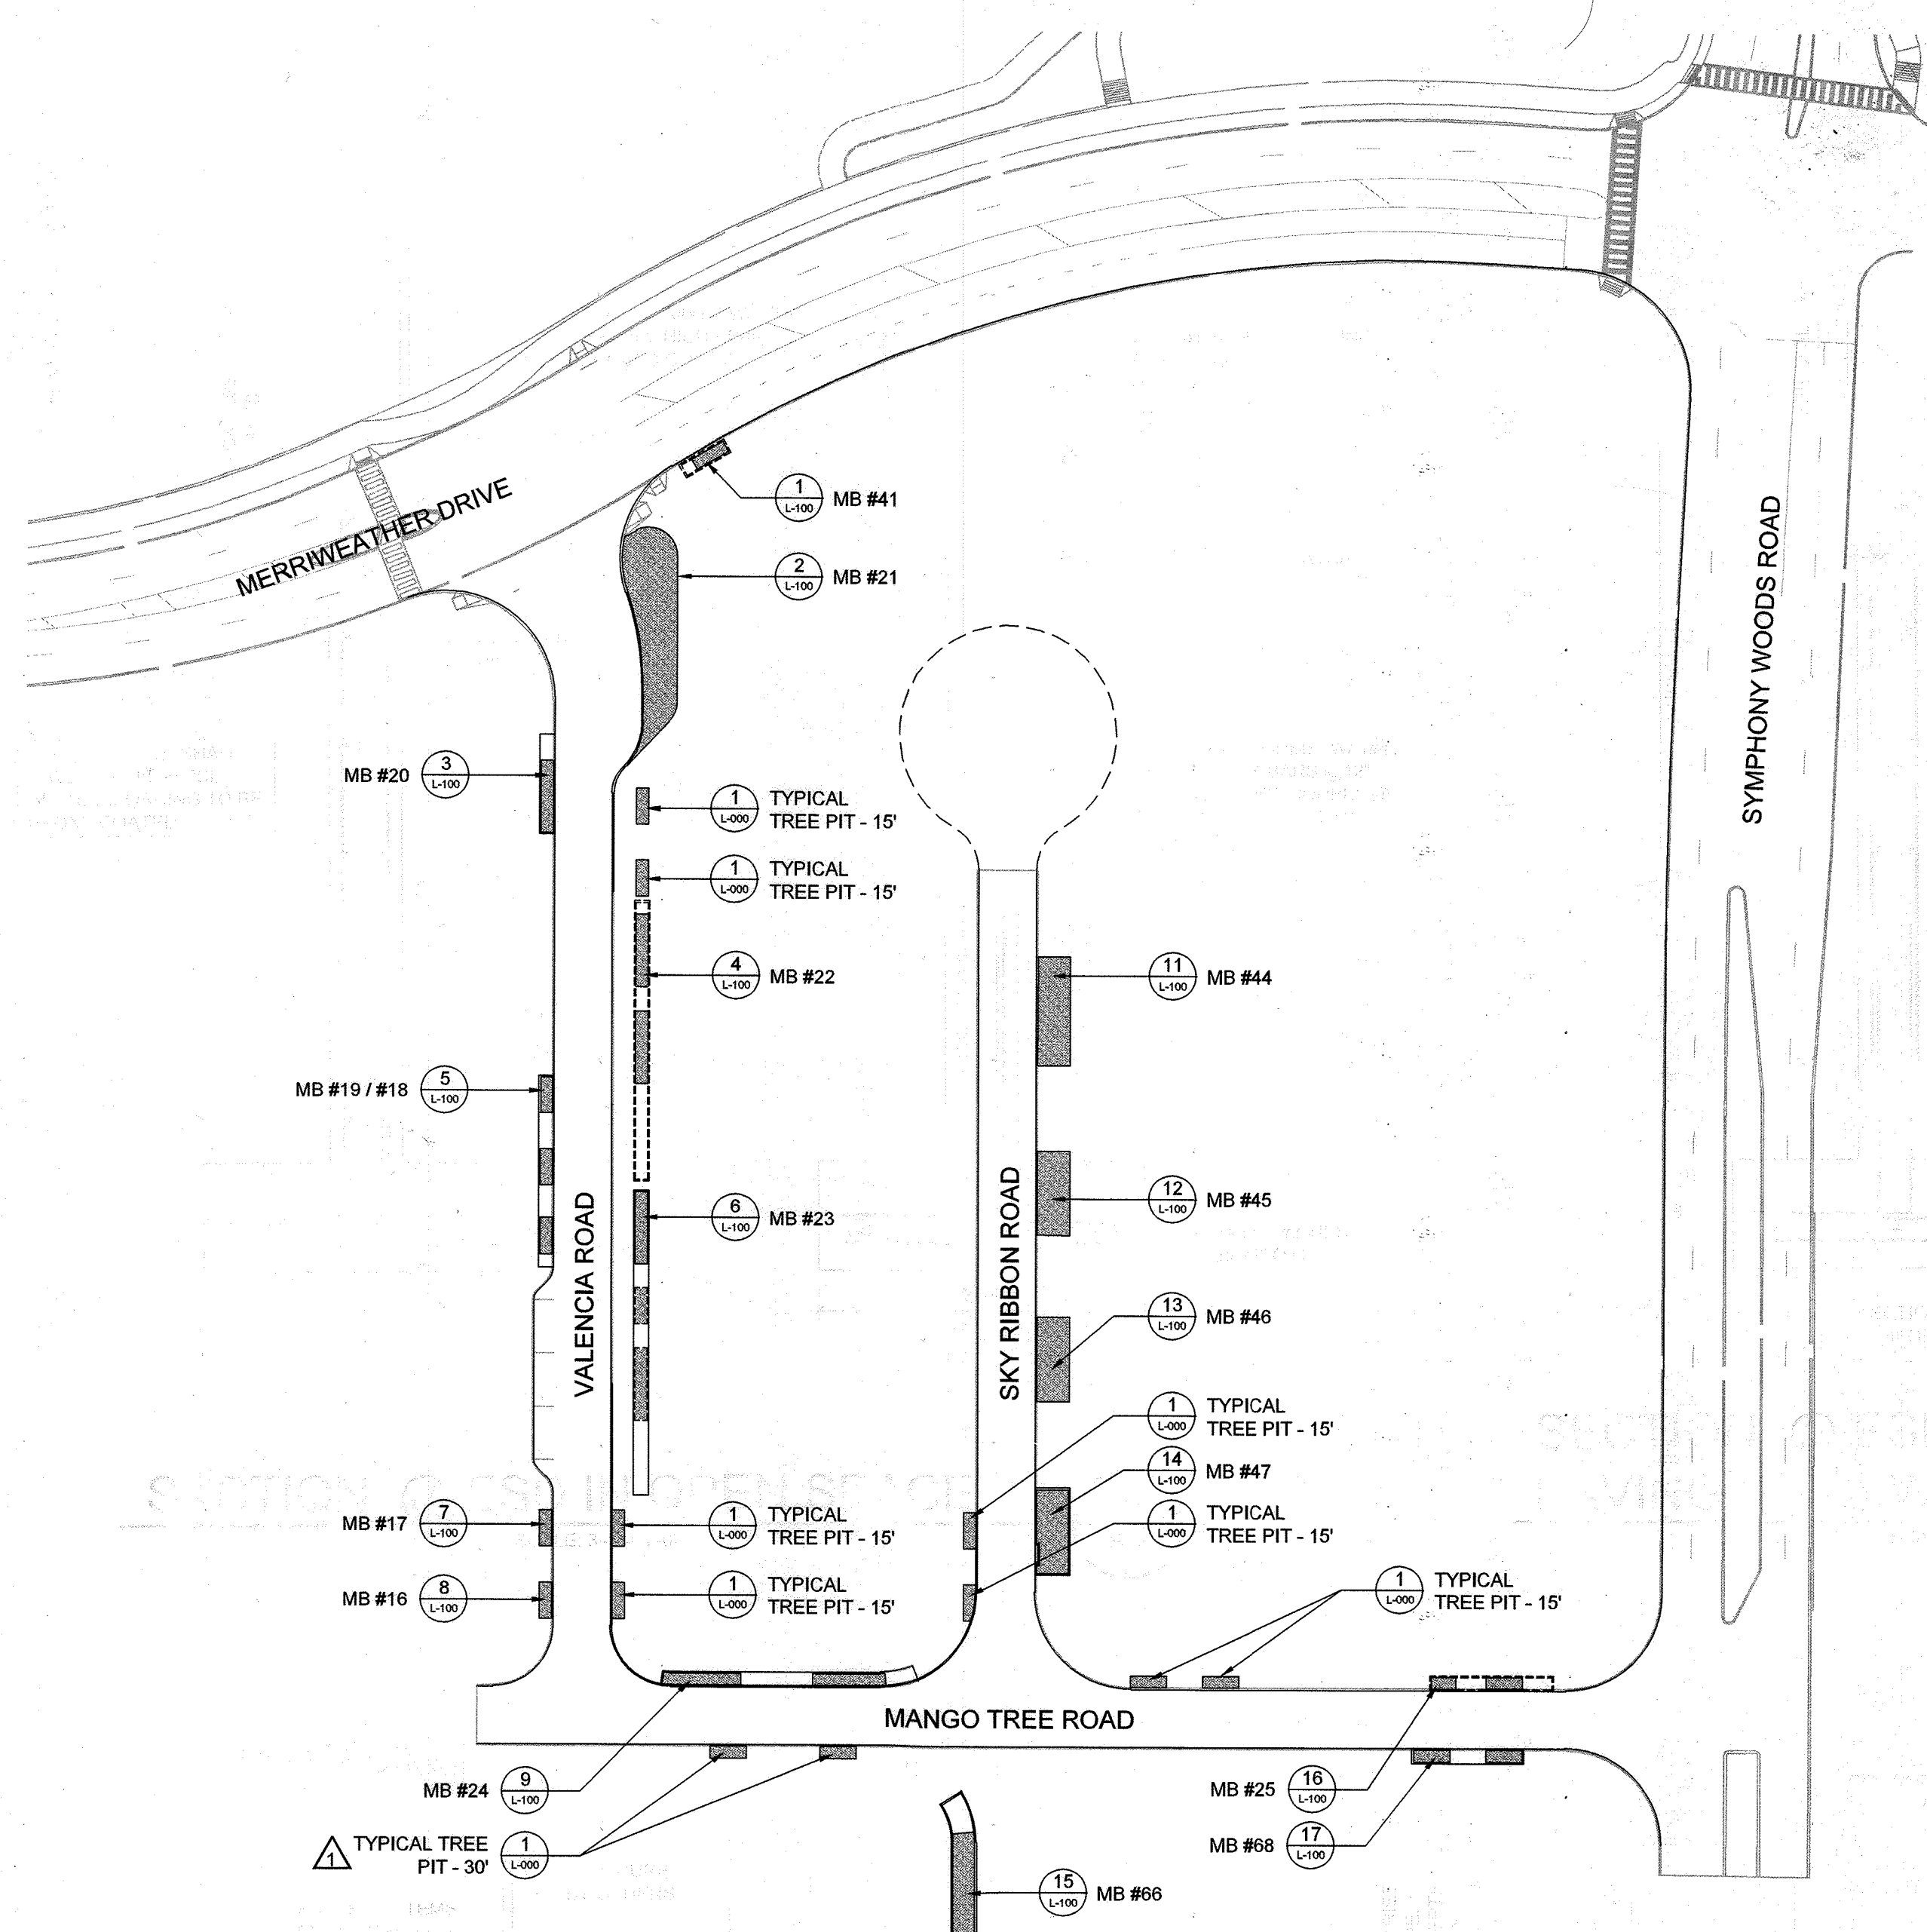

SPECIFICATIONS: PLANTING MATERIAL AND PLANTING METHOD


- PLANTING NOTES
 - THE LANDSCAPE CONTRACTOR SHALL FURNISH AND INSTALL AND/OR DIG, BALL, BURLAP AND TRANSPANT ALL OF THE PLANT MATERIALS CALLED FOR ON DRAWINGS AND/OR LISTED IN THE PLANT SCHEDULE.
 - PLANT NAMES
 - PLANT NAMES USED IN THE PLANT SCHEDULE SHALL CONFORM WITH "STANDARDIZED PLANT NAMES," LATEST EDITION.
 - PLANT STANDARDS
 - ALL PLANT MATERIAL SHALL BE EQUAL TO OR BETTER THAN THE REQUIREMENTS OF THE "USA STANDARD FOR NURSERY STOCK" LATEST EDITION, AS PUBLISHED BY THE AMERICAN ASSOCIATION OF NURSERYMEN (HEREAFTER REFERRED TO AS AAN STANDARDS). ALL PLANTS SHALL BE TYPICAL OF THEIR SPECIES AND VARIETY, SHALL HAVE A NORMAL HABIT OF GROWTH AND SHALL BE FIRST QUALITY, SOUND, VIGOROUS, WELL-BRANCHED AND WITH HEALTHY, WELL-FURNISHED ROOT SYSTEMS. THEY SHALL BE FREE OF DISEASE, INSECT PESTS AND MECHANICAL INJURIES.
 - ALL PLANTS SHALL BE NURSERY GROWN AND SHALL HAVE BEEN GROWN UNDER THE SAME CLIMATE CONDITIONS AS THE LOCATION OF THIS PROJECT FOR AT LEAST TWO YEARS BEFORE PLANTING. NEITHER HEELED-IN PLANTS NOR PLANTS FROM COLD STORAGE WILL BE ACCEPTED.
 - PLANT MEASUREMENTS
 - ALL PLANTS SHALL CONFORM TO THE MEASUREMENTS SPECIFIED IN THE PLANT SCHEDULE AS APPROVED BY THE DESIGN REVIEW COMMITTEE (DRC).
 - CALLIPER MEASUREMENTS SHALL BE TAKEN SIX INCHES (6") ABOVE GRADE FOR TREES UNDER FOUR-INCH (4") CALIPER AND TWELVE (12") ABOVE GRADE FOR TREES FOUR INCHES (4") CALIPER AND OVER.
 - MINIMUM BRANCHING HEIGHT FOR ALL SHADE TREES SHALL BE SIX FEET (6').
 - MAXIMUM EIGHT FEET (8').
 - CALLIPER, HEIGHT, SPREAD AND SIZE OF BALL SHALL BE GENERALLY AS FOLLOWS:

CALLIPER	HEIGHT	SPREAD	SIZE OF BALL
3"	3.5'-14'-16'	6'-8'	32" DIAMETER
3.5"	4'-14'-16'	8'-10'	36" DIAMETER
4"	4.5'-16'-18'	8'-10'	40" DIAMETER
4.5"	5'-16'-17'	10'-12'	44" DIAMETER
5"	5.5'-16'-20'	10'-12'	48" DIAMETER
5.5"	6'-18'-20'	12'-14'	52" DIAMETER
 - ALL PLANT MATERIAL SHALL GENERALLY AVERAGE THE MEDIAN FOR THE SIZE RANGES INDICATED ABOVE AS INDICATED IN THE "AAN STANDARDS".
 - PLANT IDENTIFICATION
 - LEGIBLE LABELS SHALL BE ATTACHED TO ALL SHADE TREES, MINOR TREES, SPECIMEN SHRUBS AND BUNDLES OR BOXES OF OTHER PLANT MATERIAL GIVING THE BOTANICAL AND COMMON NAMES, SIZE AND QUANTITY OF EACH. EACH SHIPMENT OF PLANTS SHALL BEAR CERTIFICATES OF INSPECTION AS REQUIRED BY FEDERAL, STATE AND COUNTY AUTHORITIES.
 - PLANT INSPECTION
 - THE DESIGN REVIEW COMMITTEE MAY, UPON REQUEST BY THE BUILDER OR DEVELOPER, AT LEAST TEN (10) DAYS PRIOR TO THE INSTALLATION OF ANY PROPOSED PLANT MATERIAL, INSPECT ALL PROPOSED PLANT MATERIAL AT THE SOURCE OF ORIGIN.


- PLANTING METHODS
 - ALL PROPOSED PLANT MATERIALS THAT MEET THE SPECIFICATIONS IN SECTION A ARE TO BE PLANTED IN ACCORDANCE WITH THE FOLLOWING METHODS DURING THE PROPER PLANTING SEASONS AS DESCRIBED IN THE FOLLOWING:
 - PLANTING SEASONS
 - THE PLANTING OF DECIDUOUS TREES, SHRUBS AND VINES SHALL BE FROM MARCH 1ST TO JUNE 15TH AND FROM SEPTEMBER 15TH TO DECEMBER 15TH. PLANTING OF DECIDUOUS MATERIAL MAY BE CONTINUED DURING THE WINTER MONTHS PROVIDING THERE IS NO FROST IN THE GROUND AND FROST-FREE TOPSOIL PLANTING MIXTURES ARE USED. THE PLANTING OF EVERGREEN MATERIAL SHALL BE FROM MARCH 15TH TO JUNE 15TH AND FROM AUGUST 15TH TO DECEMBER 1ST. NO PLANTING SHALL BE DONE WHEN THE GROUND IS FROZEN OR EXCESSIVELY MOIST. NO FROZEN OR WET TOPSOIL SHALL BE USED AT ANY TIME.
 - DIGGING
 - ALL PLANT MATERIAL SHALL BE DUG, BALLED AND BURLAPPED (B&B) IN ACCORDANCE WITH THE "AAN STANDARDS".
 - EXCAVATION OF PLANT PITS
 - THE LANDSCAPING CONTRACTOR SHALL EXCAVATE ALL PLANT PITS, VINE PITS, HEDGE TRENCHES AND SHRUB BEDS IN ACCORDANCE WITH THE FOLLOWING SCHEDULE:
 - LOCATIONS OF ALL PROPOSED PLANT MATERIAL SHALL BE STAKED AND APPROVED IN THE FIELD BY THE LANDSCAPE ARCHITECT BEFORE ANY OF THE PROPOSED PLANT MATERIAL IS INSTALLED BY THE LANDSCAPE CONTRACTOR.
 - ALL PITS SHALL BE GENERALLY CIRCULAR IN OUTLINE, VERTICAL SIDES; DEPTH SHALL NOT BE LESS THAN 6" DEEPER THAN THE ROOT BALL, DIAMETER SHALL NOT BE LESS THAN TWO TIMES THE DIAMETER OF THE ROOT BALL AS SET FORTH IN THE FOLLOWING SCHEDULE.

PLANT SIZE	ROOT BALL	PIT DIA.	PIT DEPTH
3'-3.5" CAL	32"	64"	28"
3.5'-4" CAL	36"	72"	32"
4'-4.5" CAL	40"	80"	36"
4.5'-5" CAL	44"	88"	40"
5'-5.5" CAL	48"	96"	44"
5.5'-6" CAL	52"	104"	48"
 - IF AREAS ARE DESIGNATED AS SHRUB BEDS OR HEDGE TRENCHES, THEY SHALL BE EXCAVATED TO AT LEAST 18" DEPTH MINIMUM. AREAS DESIGNATED FOR GROUND COVERS AND VINES SHALL BE EXCAVATED TO AT LEAST 12" IN DEPTH MINIMUM.
 - DIAMETER AND DEPTH OF TREE PITS SHALL GENERALLY BE AS FOLLOWS:

PLANT SIZE	ROOT BALL	PIT DIA.	PIT DEPTH
3'-3.5" CAL	32"	64"	28"
3.5'-4" CAL	36"	72"	32"
4'-4.5" CAL	40"	80"	36"
4.5'-5" CAL	44"	88"	40"
5'-5.5" CAL	48"	96"	44"
5.5'-6" CAL	52"	104"	48"
 - STAKING, GUYING AND WRAPPING
 - ALL PLANT MATERIAL SHALL BE STAKED OR GUYED, AND WRAPPED IN ACCORDANCE WITH THE FOLLOWING SPECIFICATIONS:
 - STAKES: SHALL BE SOUND WOOD 2" X 2" ROUGH SAWN OAK OR SIMILAR DURABLE WOODS, OR LENGTHS, MINIMUM 7'-0" FOR MAJOR TREES AND 5'-0" MINIMUM FOR MINOR TREES.

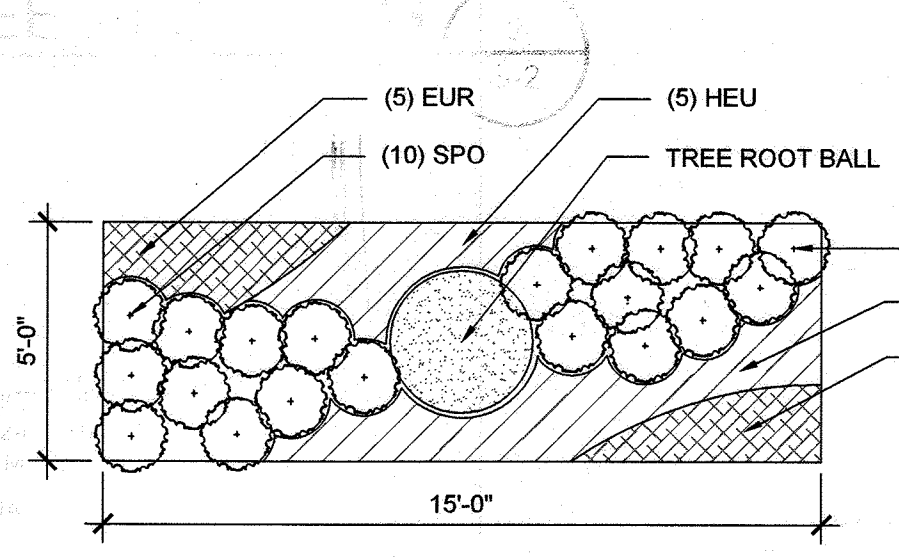


1 TYPICAL TREE PIT PLANTING - 15'
1/4"=1'-0"

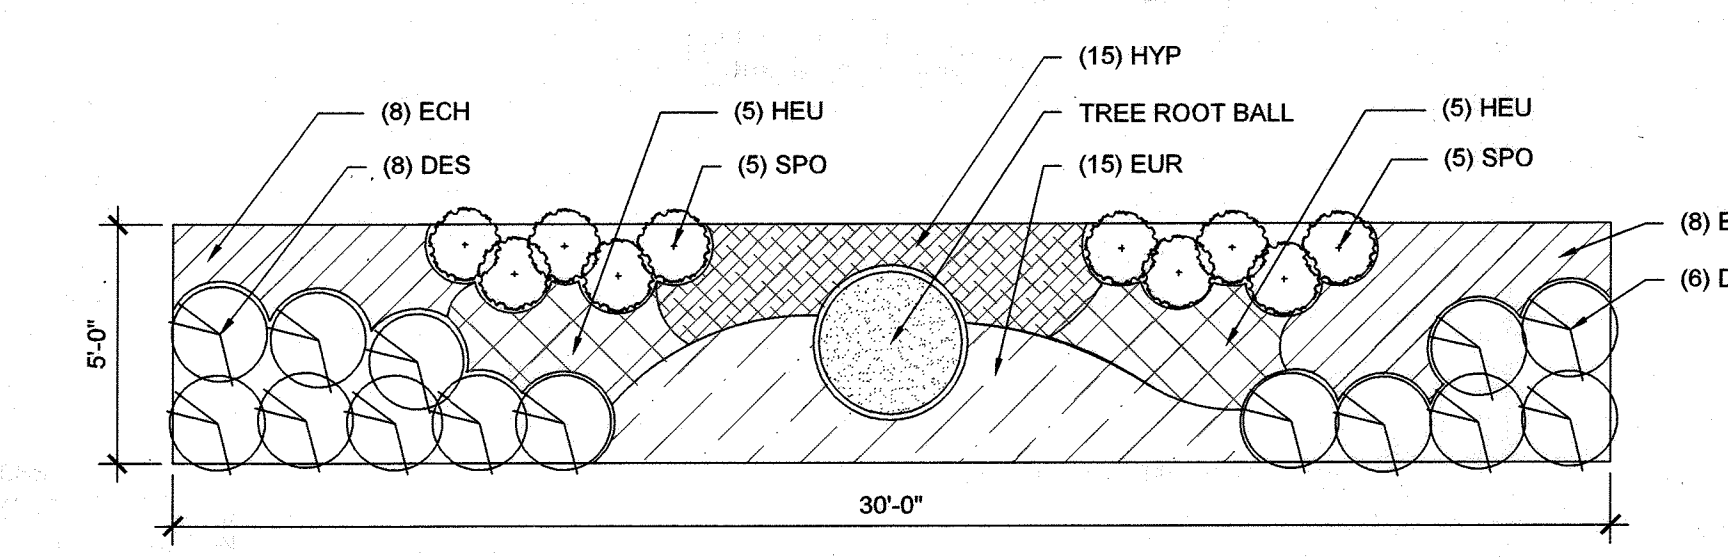

2 TYPICAL TREE PIT PLANTING - 30'
1/4"=1'-0"

MASTER PLANT SCHEDULE											
QTY.	KEY	BOTANICAL/COMMON NAME	SIZE	ROOT	COMMENTS	QTY.	KEY	BOTANICAL/COMMON NAME	SIZE	ROOT	COMMENTS
SHRUBS											
31	CL	Clethra alnifolia 'Sixteen Candles'	#5	Cont.	North American Native	15	AMS	Amsonia hubrichtii	#1	Cont.	North American Native
		Sweet Pepperbush						Threadleaf Bluestar			24" O.C.
12	CS	Cornus sericea	#7	Cont.	North American Native	266	ASC	Asclepias tuberosa	SP#4	Cont.	North American Native
		Red Twig Dogwood						Butterfly Weed			18" O.C.
75	IG	Ilex glabra 'Chamzin'	#5	Cont.	North American Native	100	DES	Deschampsia flexuosa	#1	Cont.	North American Native
		Nordic Inkberry						Wavy Hair Grass			
77	IV	Ilex verticillata 'Red Sprite' / Red Sprite Winterberry	#3	Cont.	North American Native	178	ECH	Echinacea purpurea	#1	Cont.	North American Native
								Purple Coneflower			18" O.C.
						396	EUR	Euphorbia amygdaloides var. robbiae	#1	Cont.	18" O.C.
								Wood Spurge			
						70	HEM	Hemerocallis 'Hyperion'	#1	Cont.	24" O.C.
								Daylily			
						503	HEU	Heuchera 'Palace Purple'	#1	Cont.	North American Native
								Coral Bells			18" O.C.
						114	HYP	Hypericum calycinum	#1	Cont.	12" O.C.
								St. John's Wort			
						65	NEP	Nepeta x faassenii 'Walker's Low'	#1	Cont.	18" O.C.
								Catmint			
						115	PAN	Panicum virgatum	#1	Cont.	North American Native
								Switchgrass			36" O.C.
						452	SPO	Sporobolus heterolepis	#1	Cont.	North American Native
								Prairie Dropseed			24" O.C.

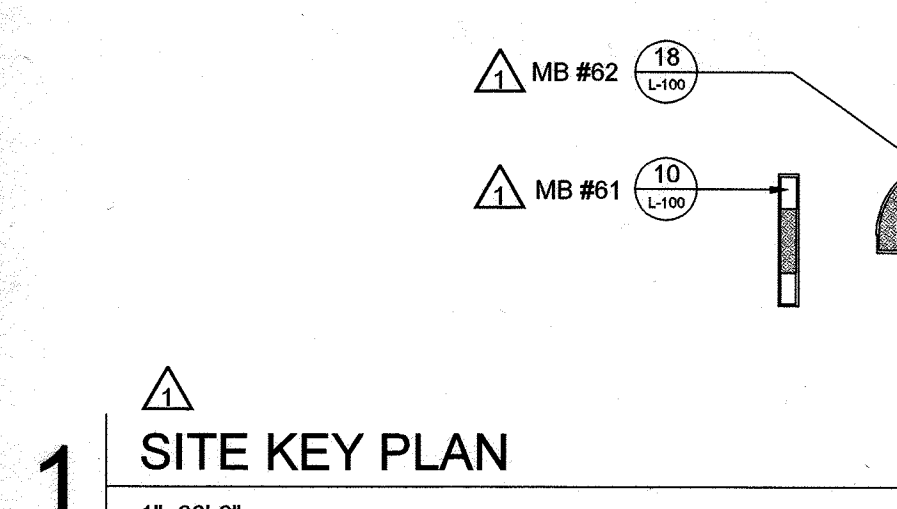

1 SITE KEY PLAN
1"=60'-0"

APPROVED: HOWARD COUNTY DEPARTMENT OF PUBLIC WORKS
Chief, Bureau of Highways *[Signature]* 9/12/2019 Date

APPROVED: HOWARD COUNTY DEPARTMENT OF PLANNING & ZONING
Chief, Division of Land Development *[Signature]* 10/25/19 Date

Chief, Development Engineering Division *[Signature]* 9-17-19 Date

PROFESSIONAL ENGINEER
AS BUILT CERTIFICATION FOR PSWM

NOTE: THERE IS NO "AS-BUILT" INFORMATION PROVIDED ON THIS SHEET.

NAME: GERALD D. TURNBAUGH
DATE: AUG. 11, 2023 REG. NO.: 26564

PURPOSE STATEMENT:
THIS SHEET REPLACES A SHEET SIGNED ON 1/19/2018 AND MODIFIED THE LOCATION OF SOME ESDS AND CLARIFIES THE DETAIL NAMES OF THE CORRESPONDING ENLARGEMENTS.

REPLACEMENT SHEET


THERE IS NO "AS-BUILT" INFORMATION ON THIS SHEET

[Signature] 10/03/23

G. STOTT SHANABERGER
SHANABERGER & LANE
PROFESSIONAL LAND SURVEYOR # 10849
LICENSE EXPIRATION DATE 4/2/2024
AS-BUILT SURVEY DATES 2/1/22 TO 2/18/22

DES.	DRN.	CHK.	DATE	REVISION	BY	APPR.
			4/24/2019	ESD REVISIONS + DETAIL NAME CLARIFICATION		

PREPARED FOR:
THE HOWARD HUGHES CORPORATION
10480 LITTLE PATUXENT PARKWAY
SUITE 400
COLUMBIA, MARYLAND 21044
ATTN: BILL ROWE
410-964-4987

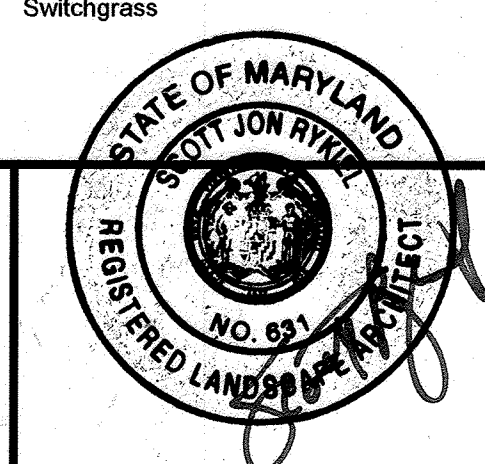

REVISED ESD LOCATION PLAN, NOTES AND LEGEND

DOWNTOWN COLUMBIA
CRESCENT NEIGHBORHOOD
PARCELS D-1 THRU D-14, NON-BUILDABLE
BULK PARCELS D-15 THRU D-17, AND O.S. LOT 10

ELECTION DISTRICT No. 5

HOWARD COUNTY, MARYLAND

SCALE	ZONING	G. L. W. FILE NO.
AS SHOWN	NT	11071
DATE	TAX MAP - GRID	SHEET
DEC.15, 2017	36 - 01	24 OF 25

