


NOTE: All swales, interceptor berms, drainage ditches, etc. to be seeded and pugged during construction

SEEDING FOR DISTURBED AREAS
 Spring Oats - 3 bu.
 (Spring Oats) - 1 1/2 bu.
 (Korona Laspadaza) 20 lb. bulled & inoc.
 Lime - 2 tons agr. ground limestone
 Fertilizer - 500-800 lbs 10-10-10 or 10-20-10
 Above quantities to be used per acre


DEPARTMENT OF PUBLIC WORKS
James M. McLeod 6/1/71
 CHIEF BUREAU OF HIGHWAYS DATE

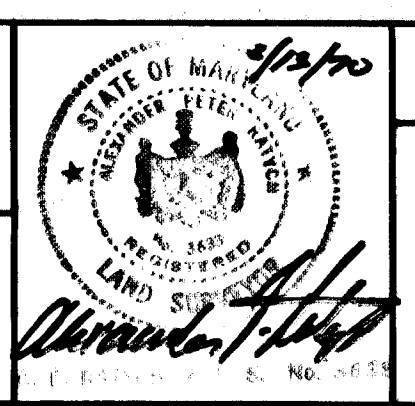

PER ASSOCIATES
 LAND SURVEYORS
 104 200 2220
 1100 N. W. 11th St. 20241
 WASHINGTON, D.C. 20037
 202-775-2100 444-4322

ROAD PLAN, STORM DRAINS & PROFILES
 COVENTRY ROAD
 SECTION 5
PINE ORCHARD MEADOWS
 ELECTION DISTRICT- ELLICOTT CITY NO. 2
 HOWARD COUNTY, MARYLAND
 SCALE: PLAN 1"=50' PROFILE HOR. 1"=50' VERT. 1"=5' SHEET 2 of 2

OWNER & DEVELOPER
 HARRY GIARDINA
 8418 KINGS RIDGE ROAD APT. 12 B
 BALTIMORE, MARYLAND 21234

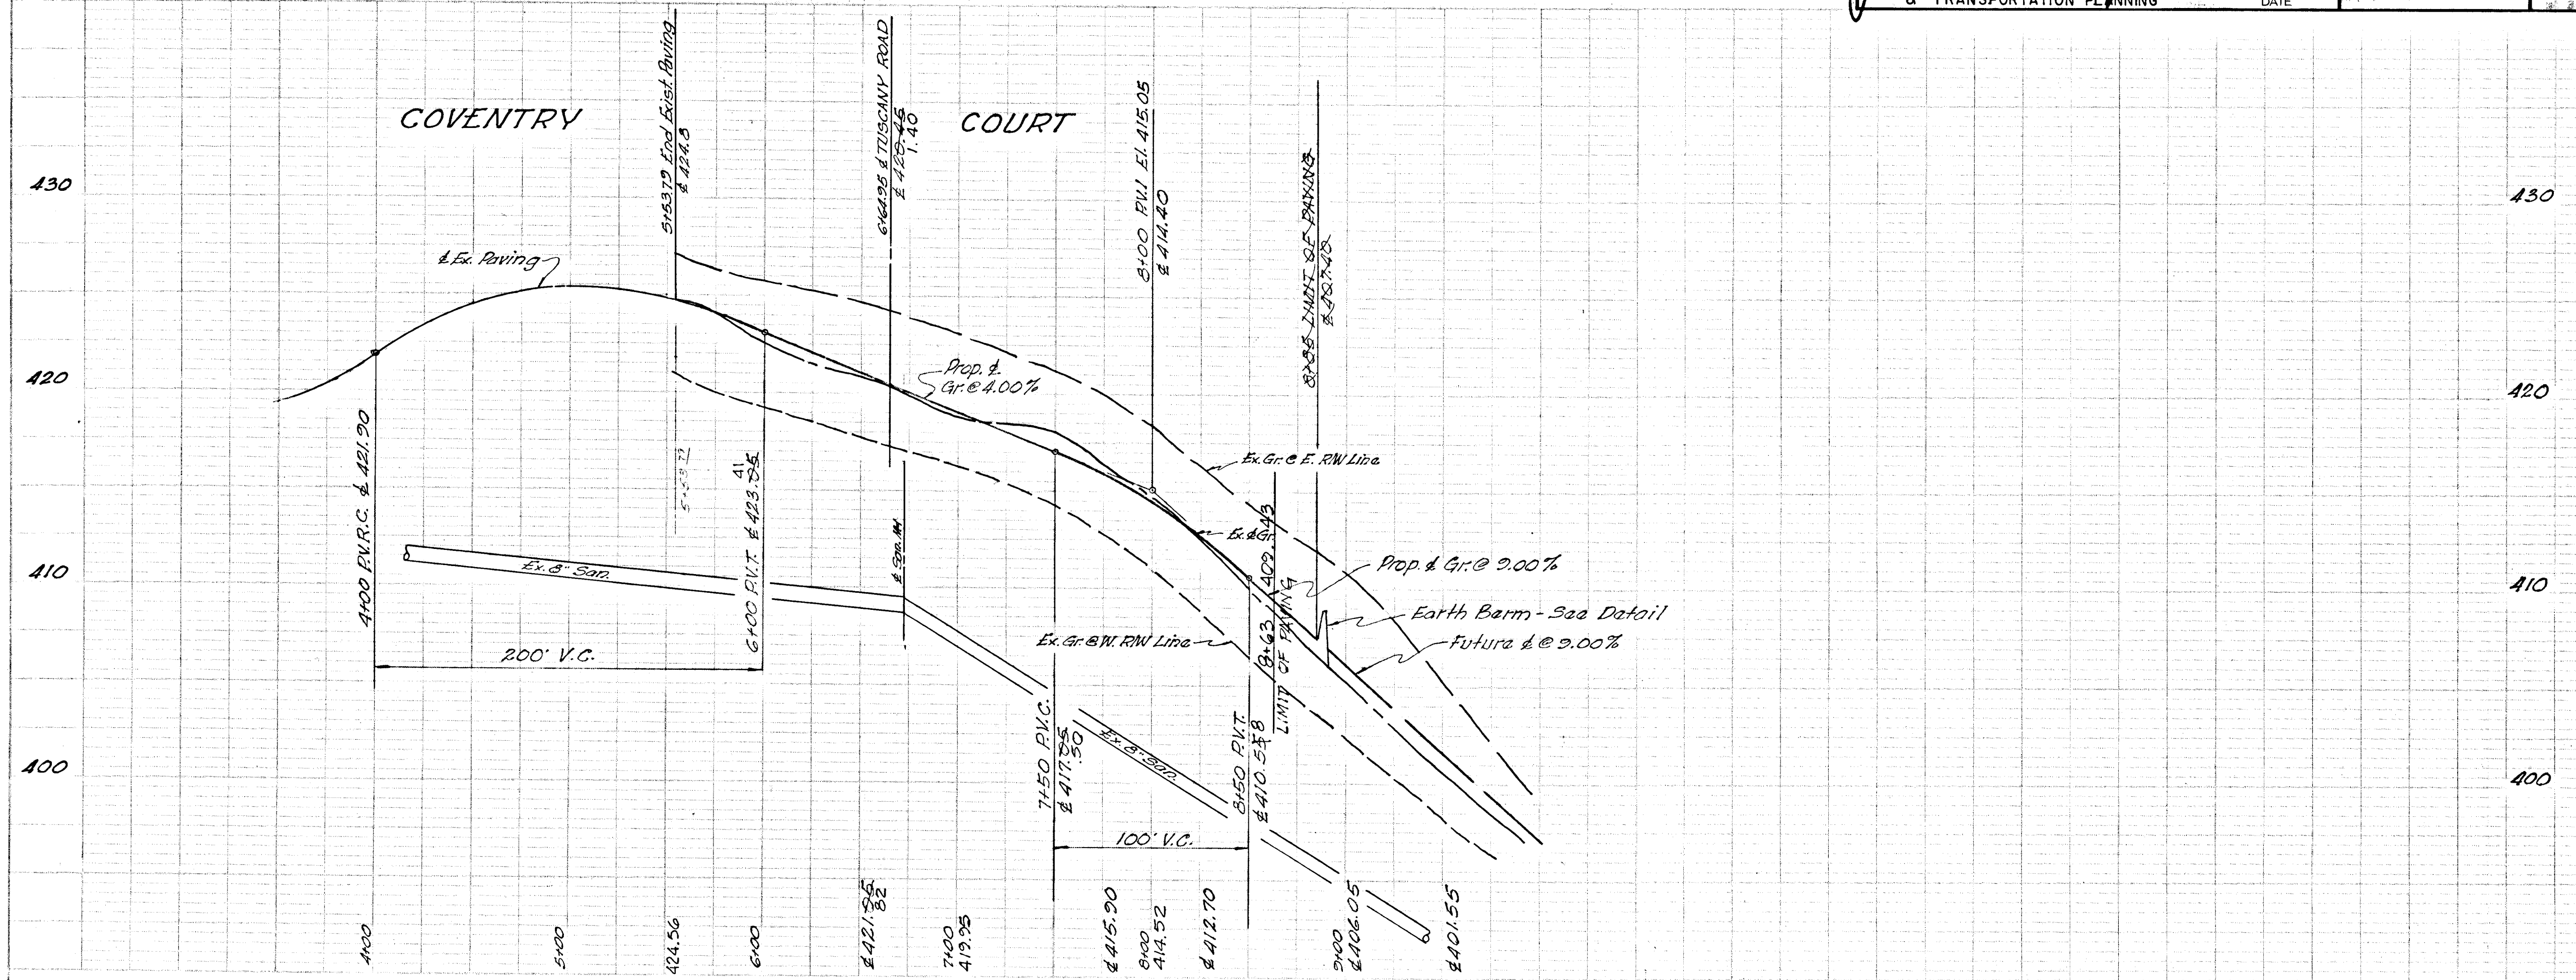

"I CERTIFY THAT THE PLAN OF DEVELOPMENT AND THE PLAN FOR CONTROL OF SILT AND EROSION MEETS THE REQUIREMENTS, STANDARDS AND SPECIFICATIONS OF THE HOWARD SOIL CONSERVATION DISTRICT."
Alexander J. [Signature] 3/13/1970
 DATE

"I CERTIFY THAT ALL DEVELOPMENT AND/OR CONSTRUCTION WILL BE DONE ACCORDING TO THIS PLAN OF DEVELOPMENT AND PLAN OF SILT AND SEDIMENT CONTROL."
H. Giardina
 DEVELOPER DATE

"THIS DEVELOPMENT PLAN IS APPROVED FOR SOIL EROSION AND SEDIMENT CONTROL BY THE HOWARD SOIL CONSERVATION DISTRICT."
 REVIEWED *James M. McLeod* 5-27-71
 DISTRICT CONSERVATIONIST DATE
 APPROVED *Robert B. Campbell* 5-28-71
 HOWARD SOIL CONSERVATION DISTRICT DATE

#27 RP234

F70-55