


DATE	BY

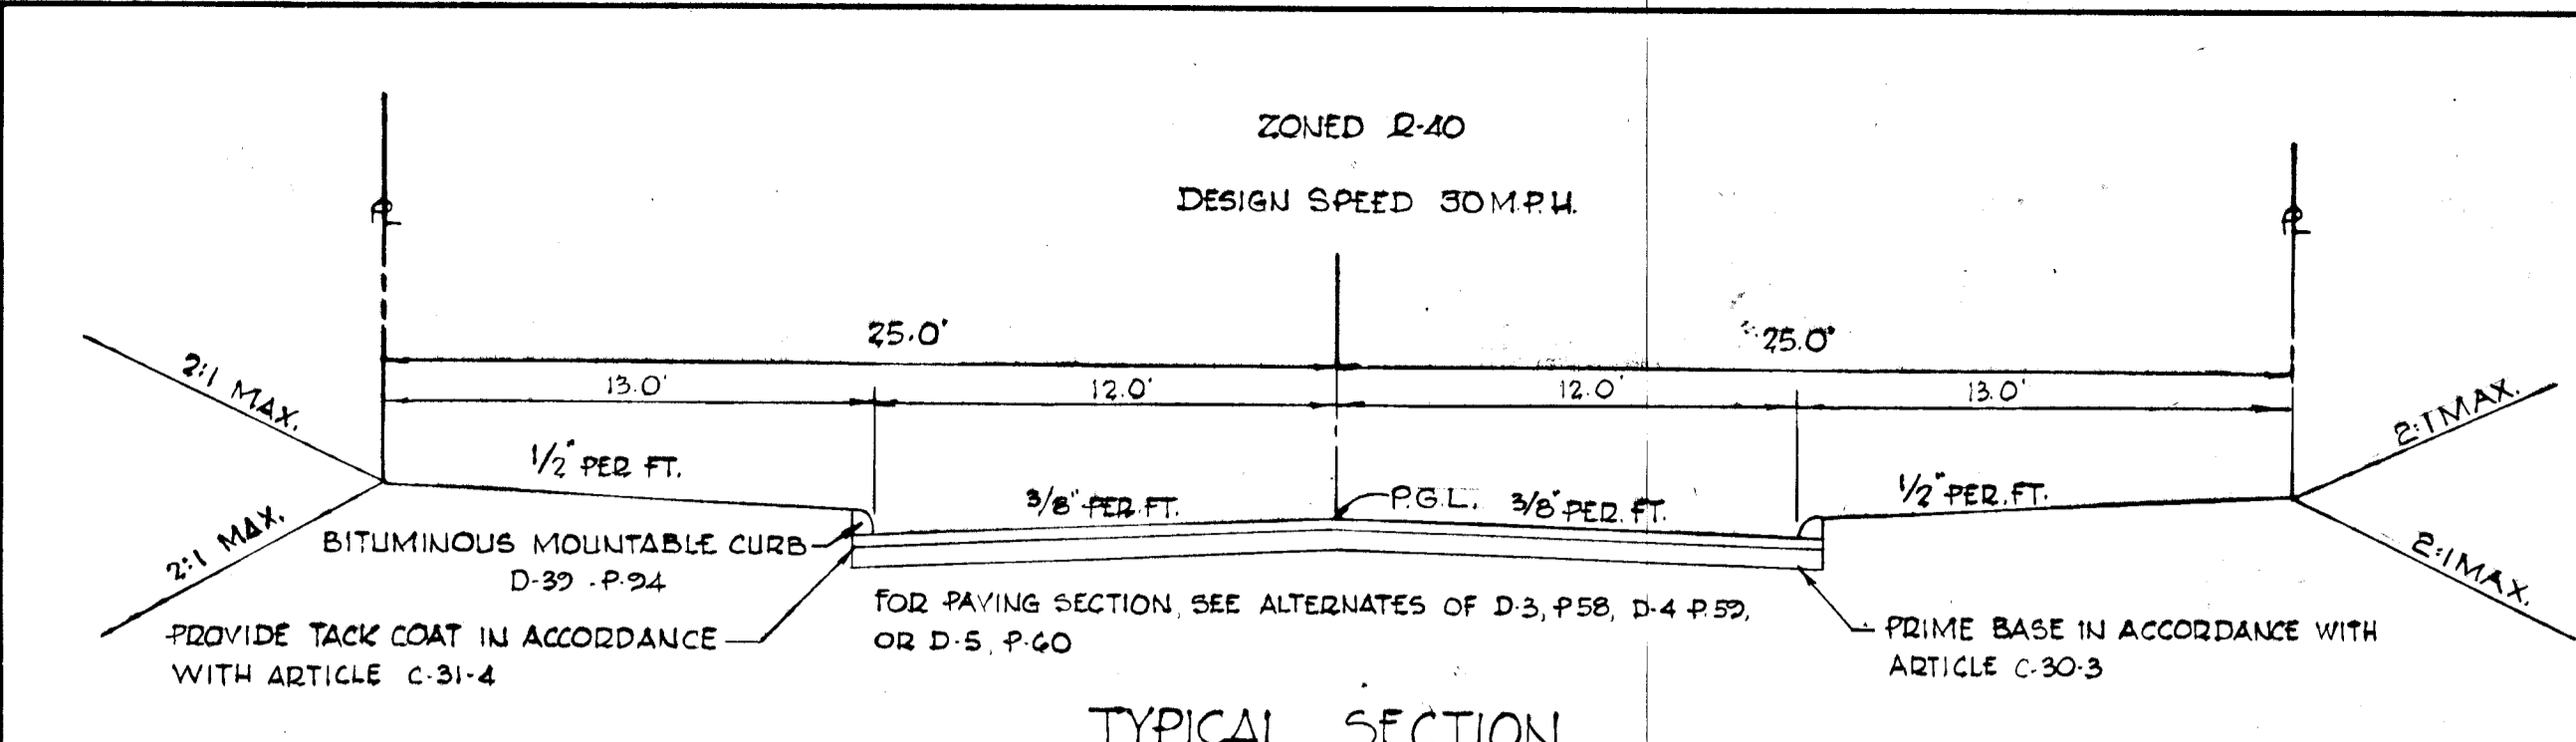

TYPICAL SECTION
NO SCALE
ALL CONSTRUCTION TO BE IN ACCORDANCE WITH THE HOWARD COUNTY ROAD CODE AND STD. SPECIFICATIONS.

I certify that all development and/or construction will be done according to this plan of development and plan for Erosion and Sediment Control, and I also authorize periodic on-site inspection by the Howard Soil Conservation District or their authorized agents, as are deemed necessary. Deviation from this plan will not be made unless authorized by the Howard Soil Conservation District.

E. L. Ramsburg 3/10/73
E.L. Ramsburg Date

I certify that this plan for Erosion and Sediment Control represents a practical and workable plan based on my personal knowledge of the site conditions and that it was prepared in accordance with the requirements of the Howard Soil Conservation District.


William G. Rasch II 3/12/73
William G. Rasch II Date

This development plan is approved for soil erosion and sediment control by the Howard Soil Conservation District.


Reviewed: *Charles E. Nullo* 4/13/73
Date

Approved: *Robert W. Ziehm* 4/13/73
Howard Soil Conservation District Date

GENERAL NOTES
1) All construction shown herein shall be in accordance with Howard County Road Construction Code and Standard Specifications dated November 27, 1962 and revised August, 1967
2) Reference to page and drawing numbers refer to above mentioned specifications.
3) Design speed 30m.p.h.

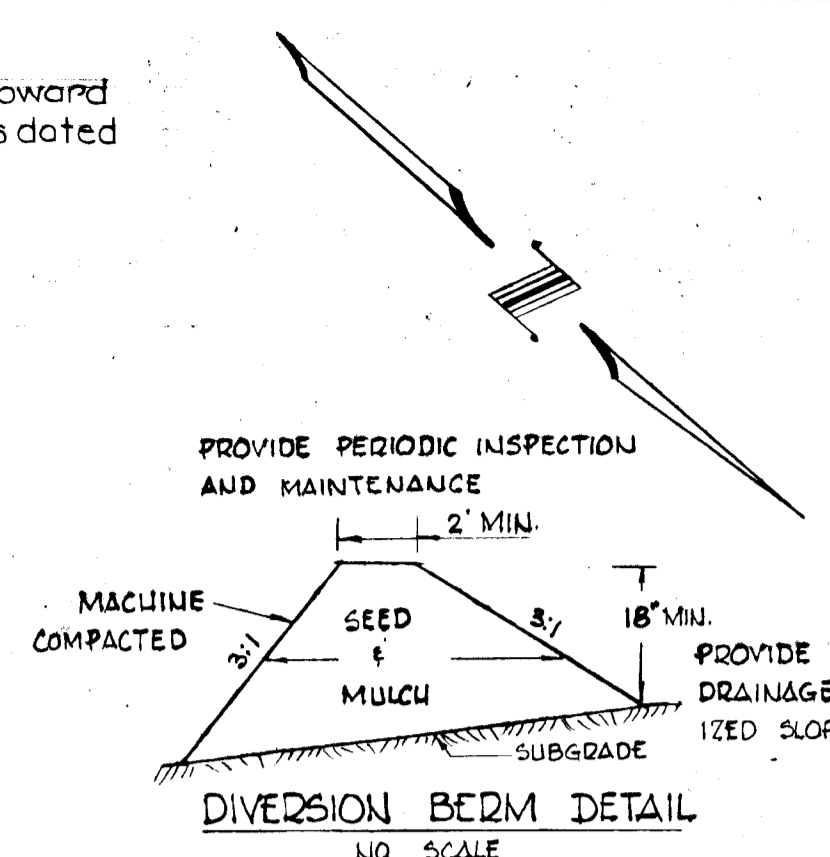

DIVERSION BERM DETAIL
NO SCALE

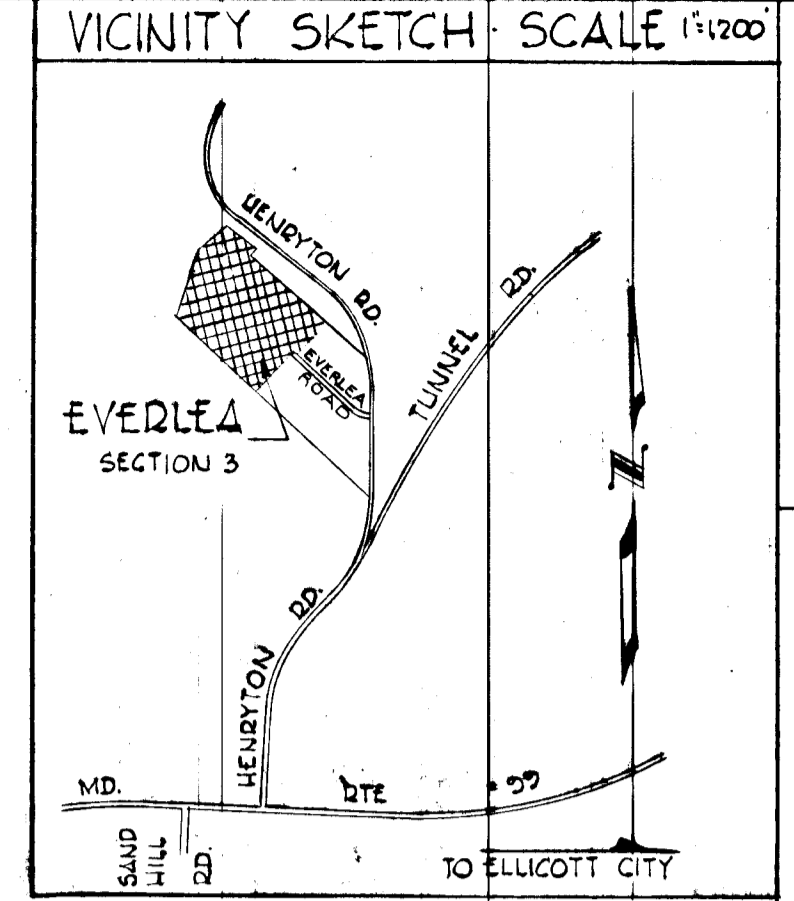

PLAN & PROFILE
EVERLEA
SECTION 3
3rd ELECTION DISTRICT
HOWARD COUNTY, MARYLAND
MARCH 9, 1973
Scale: As Shown Sheet 1 of 1




William G. Rasch II
William G. Rasch II Reg. No. 4575

OWNER & DEVELOPER
E. L. RAMSBURG
5033 HENRYTON ROAD
MARRIOTTSVILLE, MARYLAND
21104

Designed by: C.J.C. Revisions
Drafted by: C.J.C. & R.E.B.
Checked by: R.B.C.




APPROVED: Office of Planning and Zoning
J.W. Clauser 4/13/73
Chief, Bureau of Planning and Zoning Date

B. H. Mahland 4/16/73
Chief, Bureau of Highways Date

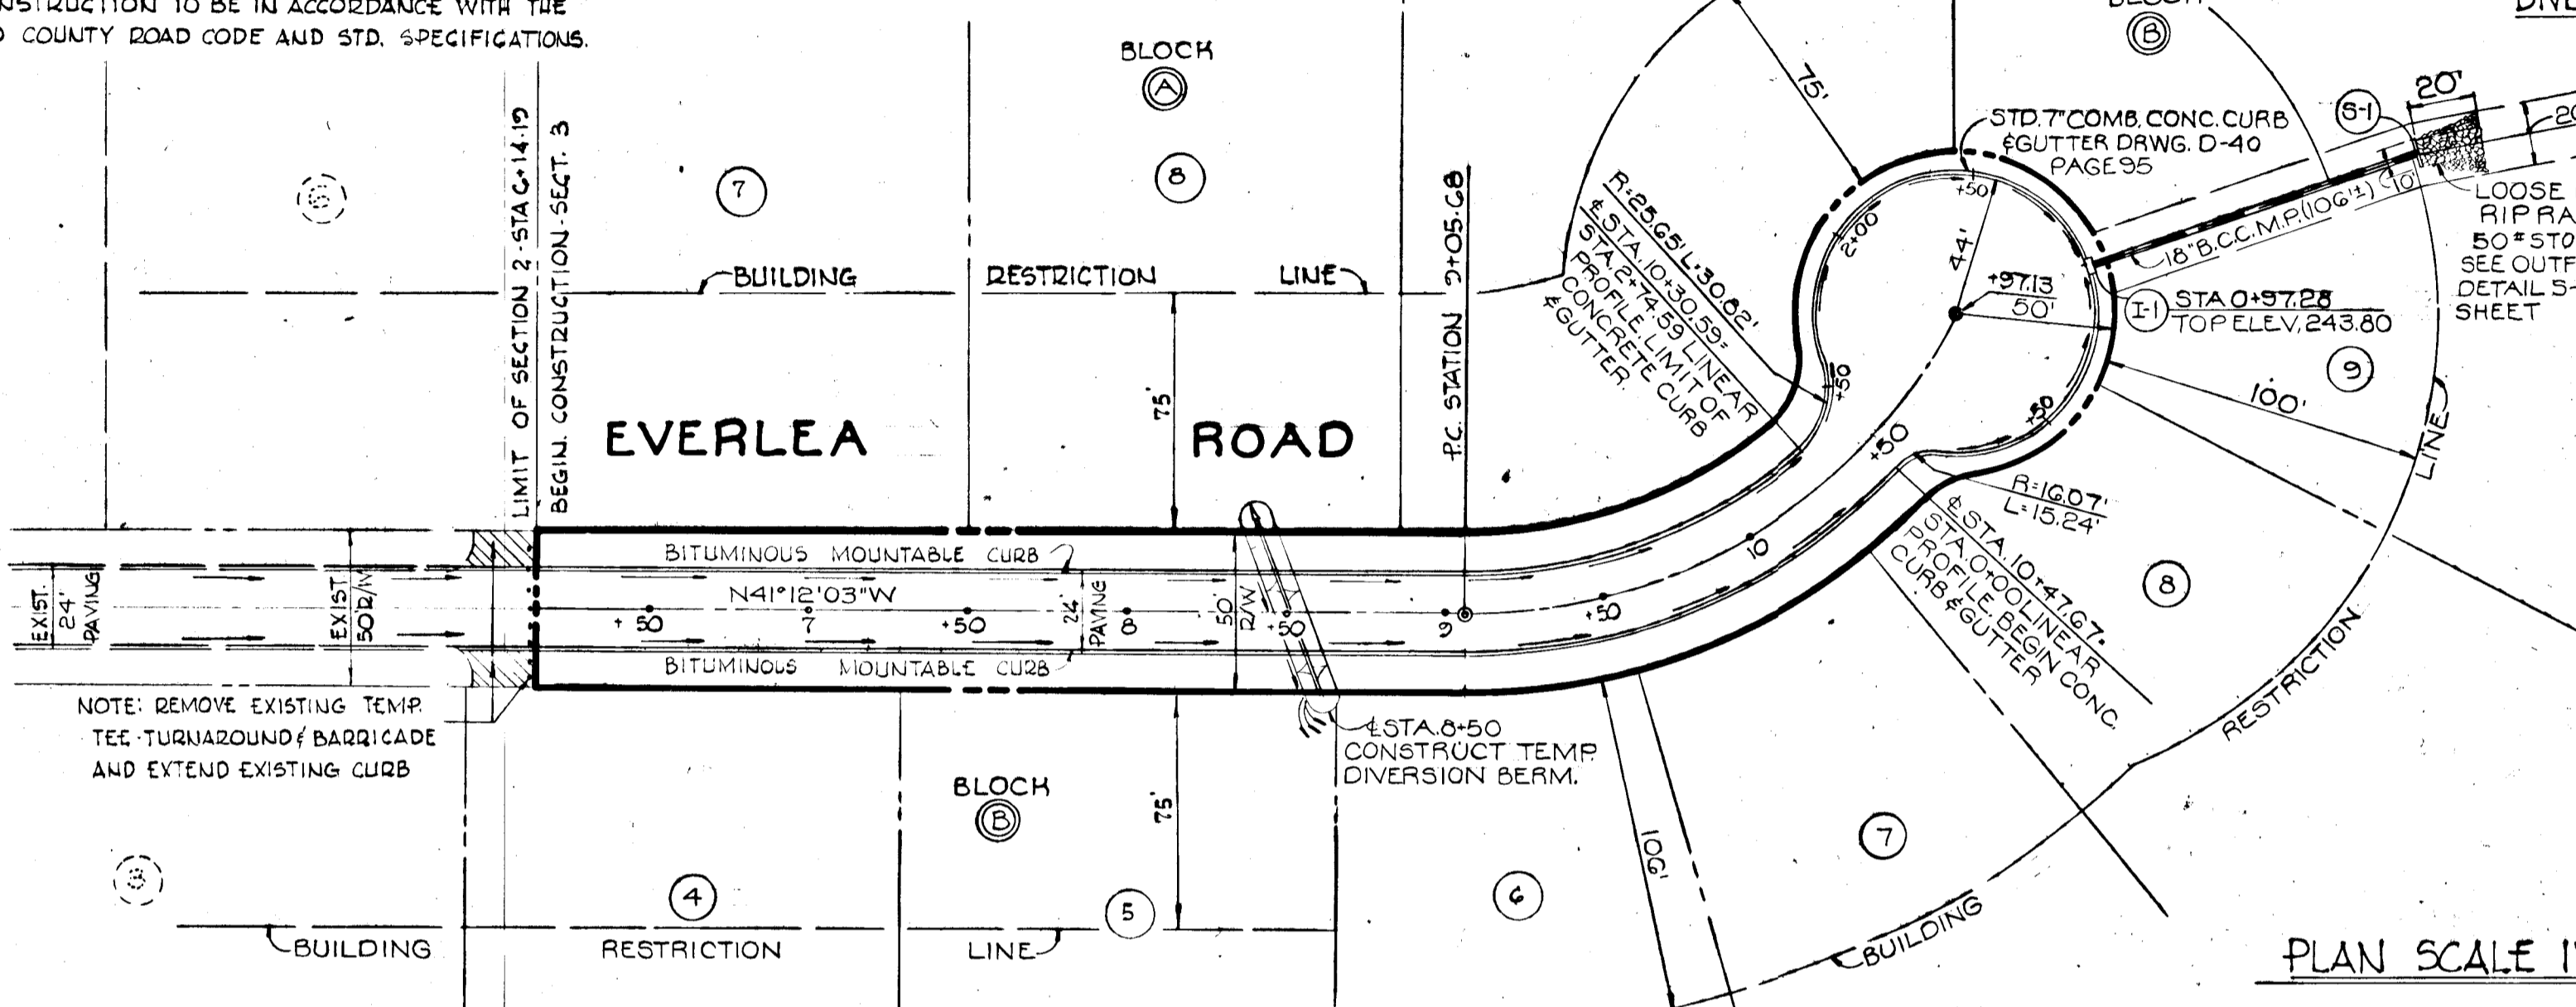

STRUCTURE SCHEDULE

NO.	TYPE	INV. IN	INV. OUT	TOP ELEM	DRWG.	NO.	PAGE NO.
I-1	A-5		239.80	243.80	D-64A	P119-A	
S-1	"C"		231.70	233.95	D-52	P107	

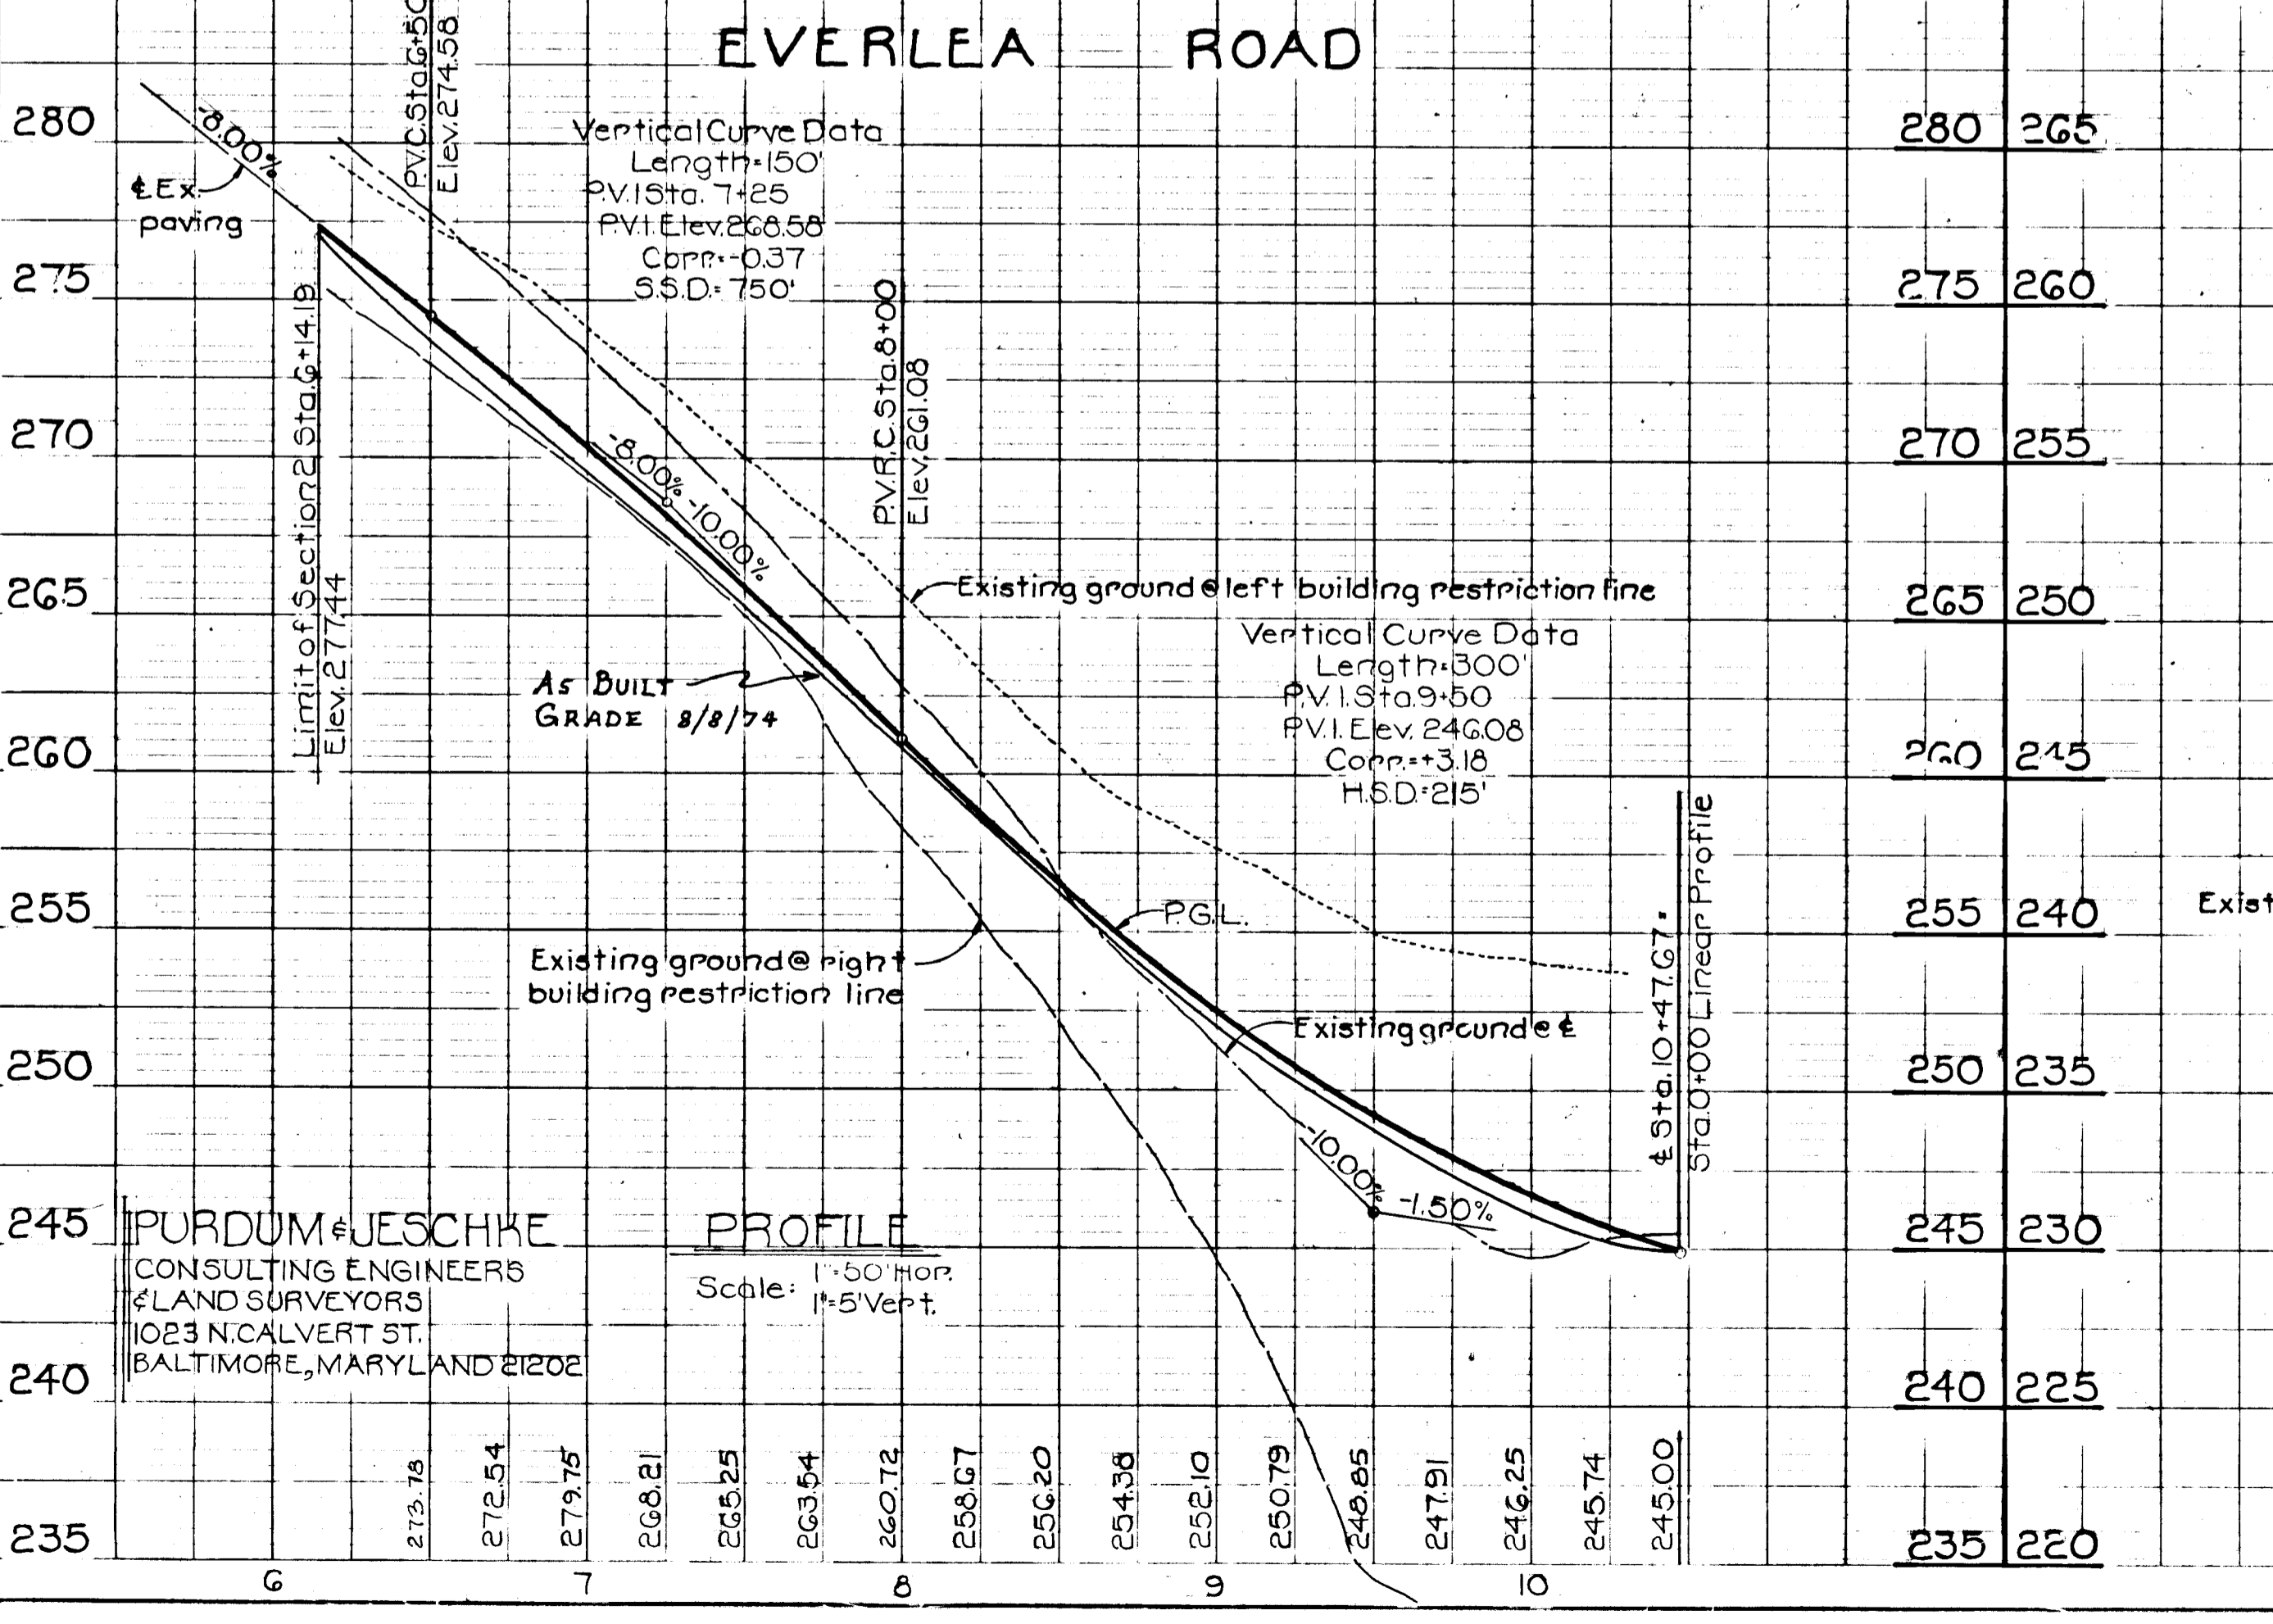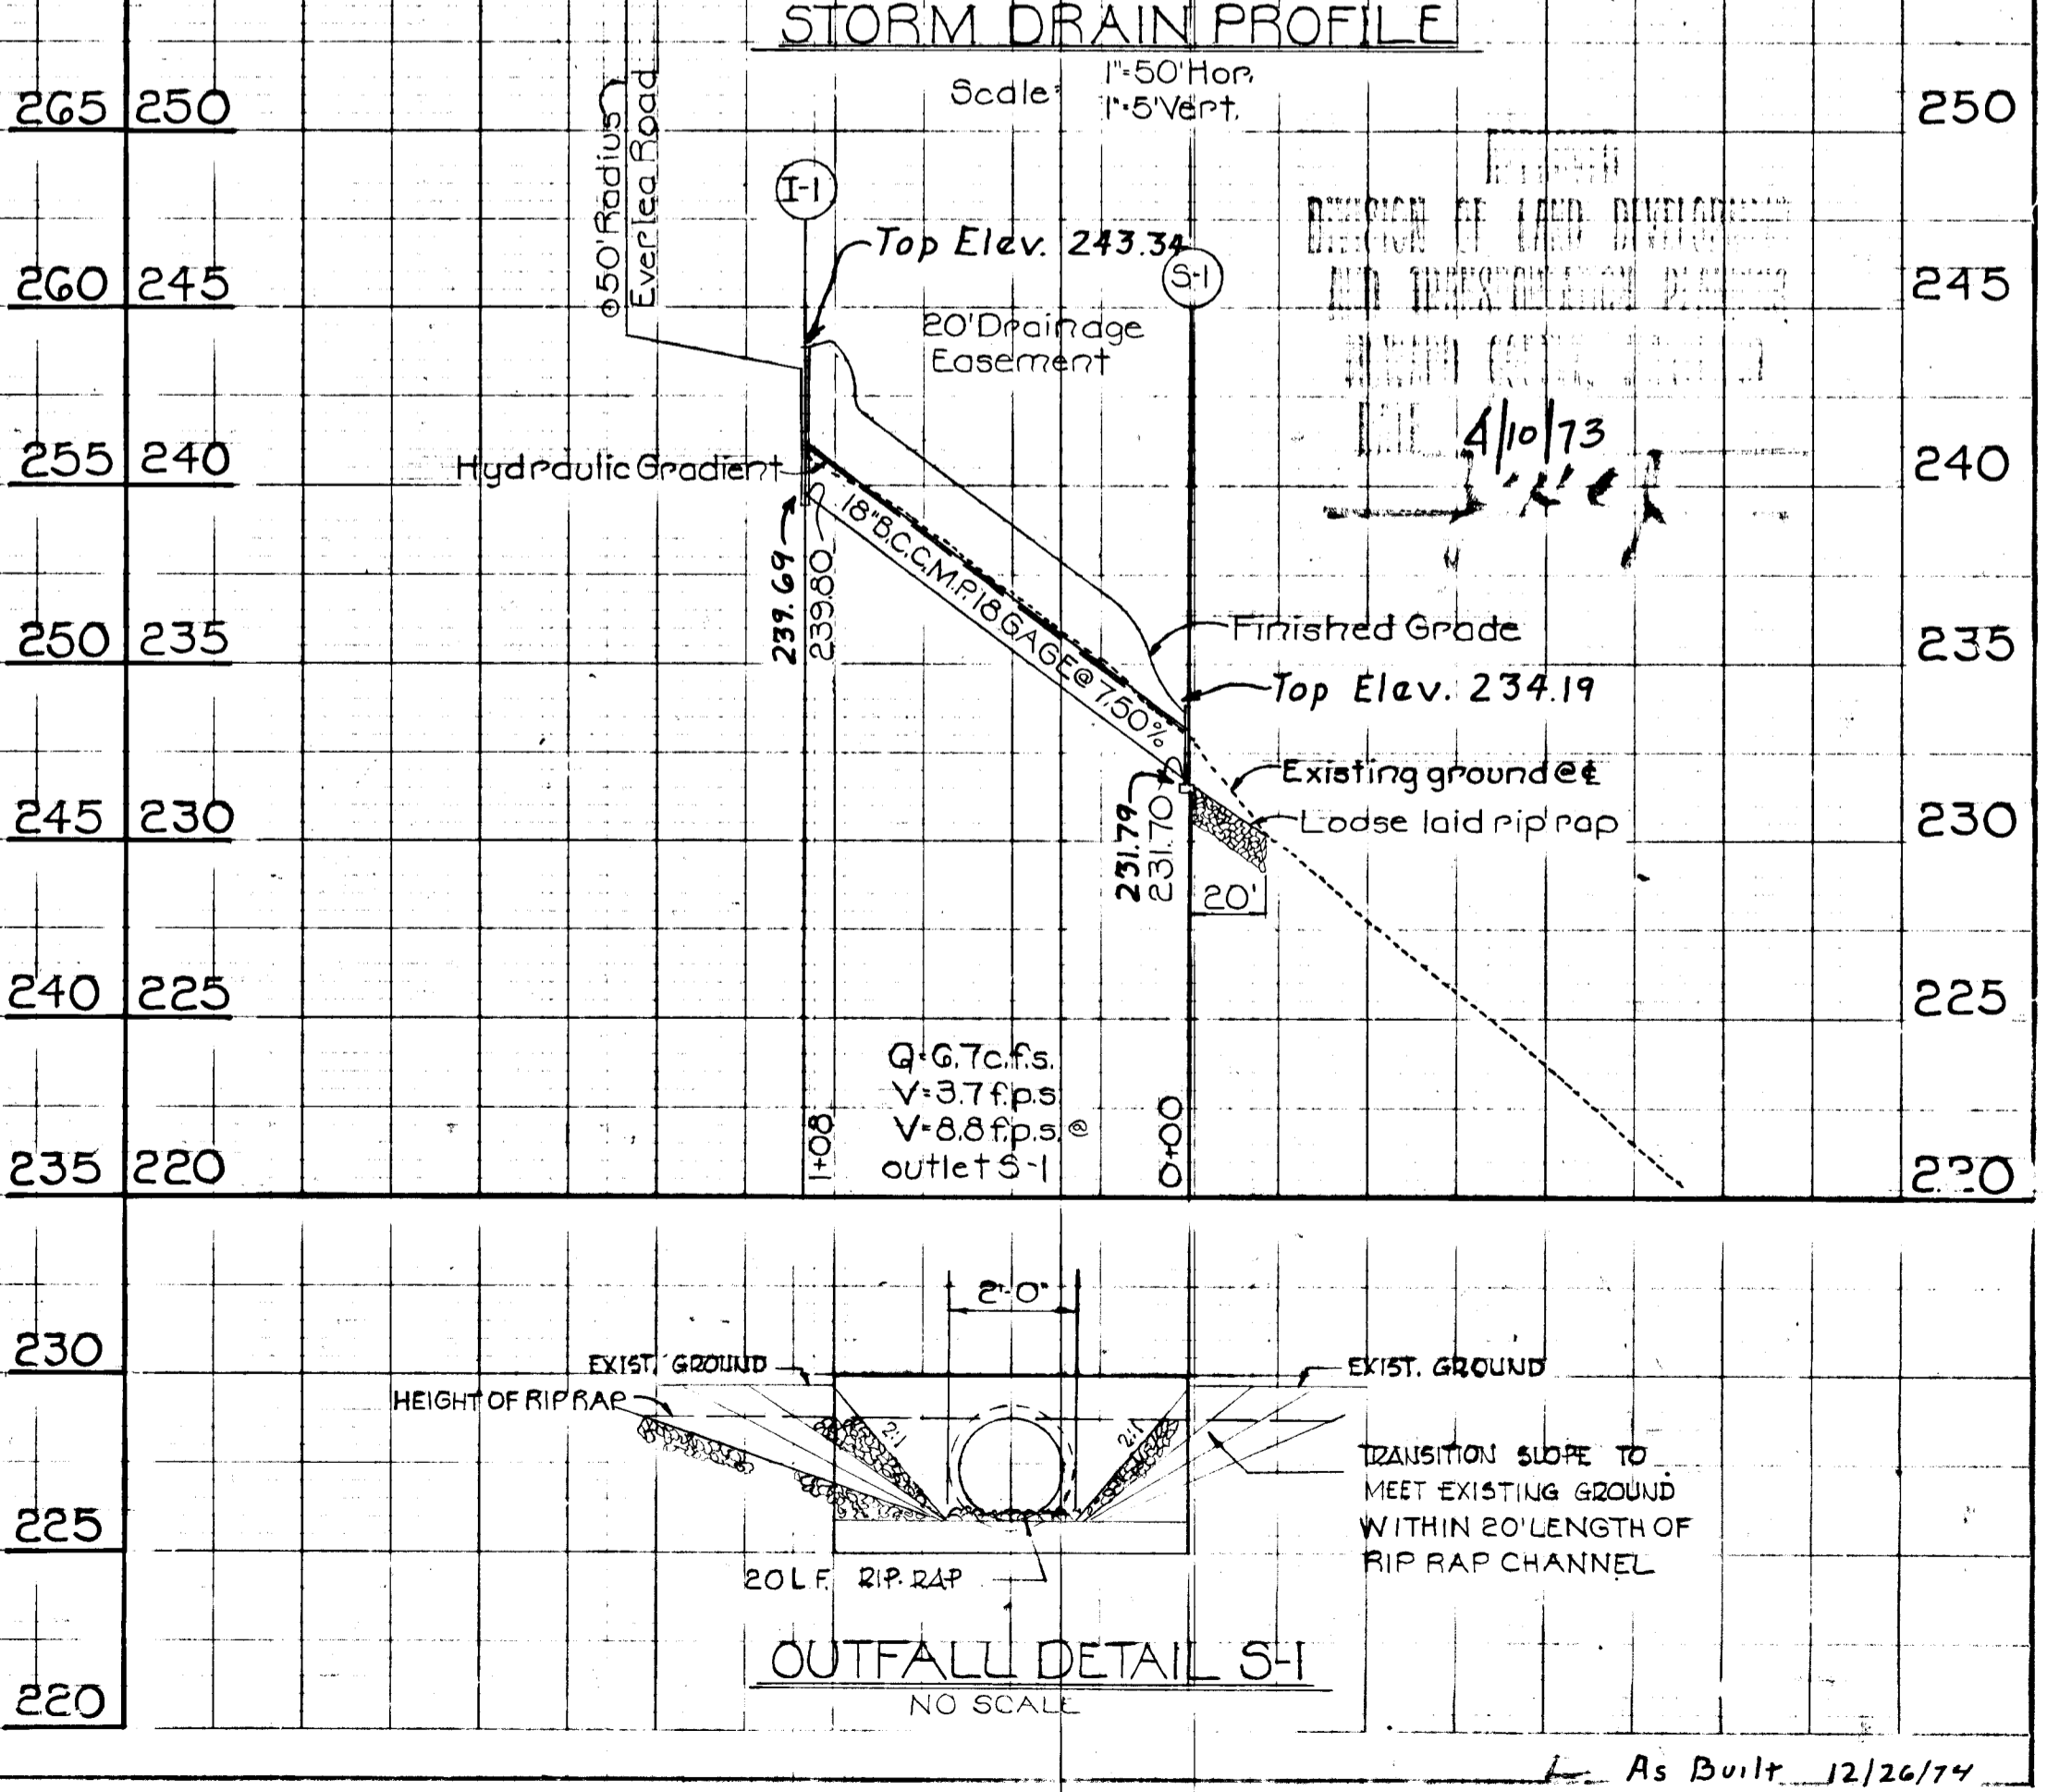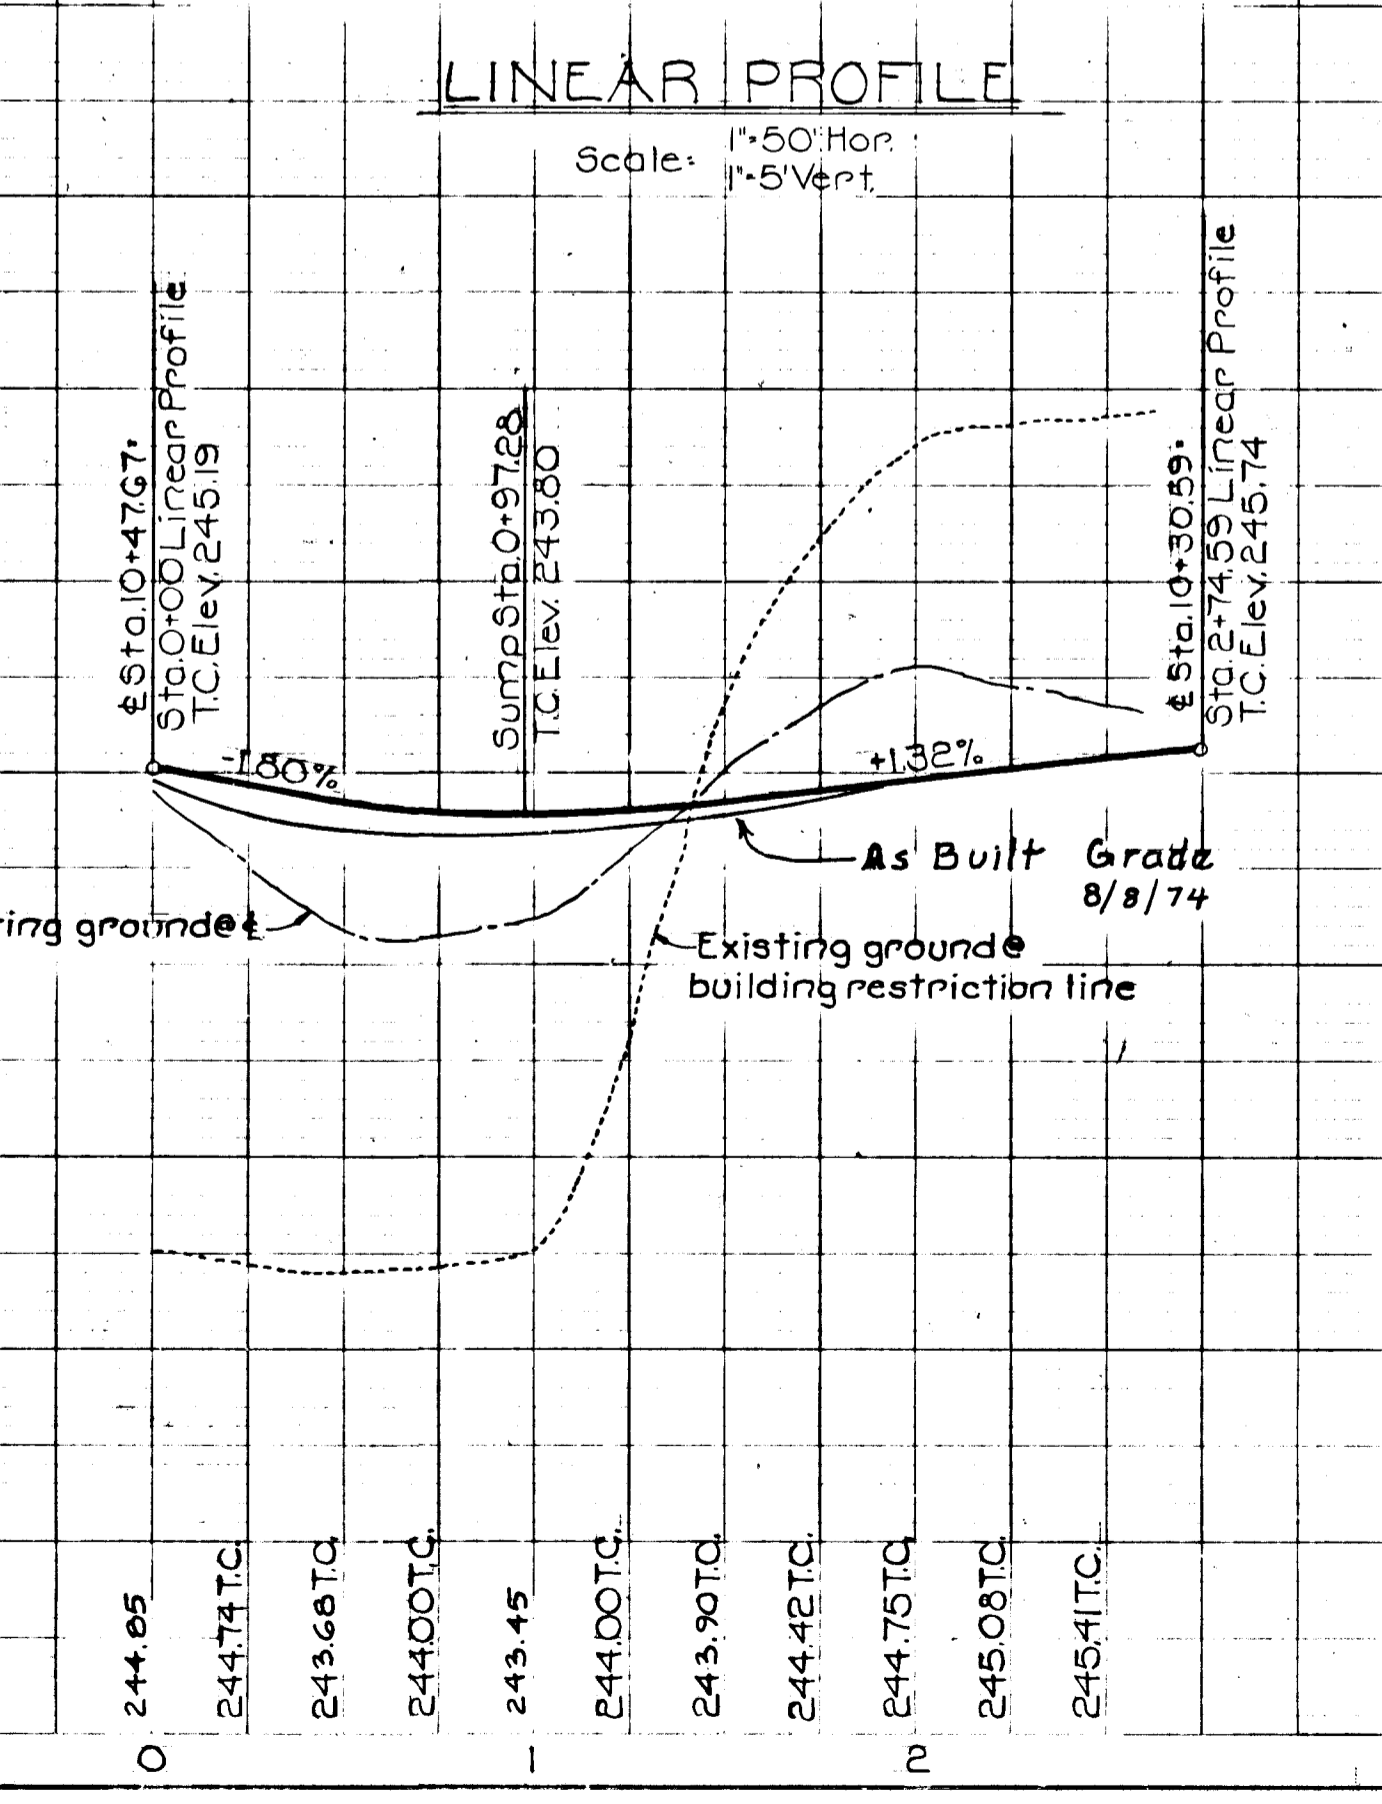

PLAT 1, PLAN PROFILE
KEPPEL & ESSEE CO.
48 7024 MADE IN U.S.A.

As Built 12/26/74
F-13-58