

## ESTIMATE OF QUANTITIES

ITEM	DESCRIPTION	UNIT	TOTAL
1	Pavement Removal (Vollmerhausen Road)	SY	0
2	Topsoil Stripping Under Fills	CY	8,000
3	Unclassified Excavation (Roadway)	CY	74,000
4	Borrow Excavation	CY	0
5	Bit. Conc. Surface Course (1 1/2" Th.)	SY	47,030
6	Bit. Conc. Base Course (5" Th.)	SY	47,030
7	Std. 7" Combination Curb and Gutter	LF	6,620
8	Barrier Curb	LF	2,530
9	Concrete Sidewalk (4" Th.)	LF	16,200
10	R/W and Slope Stabilization	SY	54,000
11	Transition Curb at 'A' Inlets	LF	522
12	Std. A-5 Inlets	Ea.	30
13	Std. A-10 Inlets	Ea.	10
14	Type 'D' Inlets	Ea.	5
15	Special Inlets	Ea.	3
16	Std. Manhole	Ea.	33
17	Std. Type 'B' Manhole	Ea.	16
18	18" Std. Conc. End Section (5-22)	Ea.	1
19	30" Std. Conc. End Section (5-20)	Ea.	1
20	36" Std. Conc. End Section (5-14)	Ea.	1
21	Type 'A' Headwall (5-19)	Ea.	1
22	15" Std. Metal End Section (5-18)	Ea.	1
23	18" Std. Metal End Section (5-17)	Ea.	1
24	36" Std. Metal End Section (5-16)	Ea.	1
25	42" Std. Metal End Section (5-21)	Ea.	1
26	Temporary 18" Cut-Off Wall (5-15)	Ea.	1
27	15" R.C.P. CI. IV	LF	1528
28	18" R.C.P. CI. IV	LF	329
29	21" R.C.P. CI. IV	LF	152
30	24" R.C.P. CI. IV	LF	72
31	30" R.C.P. CI. IV	LF	380
32	15" R.C.P. CI. III	LF	2,538
33	18" R.C.P. CI. III	LF	853
34	21" R.C.P. CI. III	LF	177
35	24" R.C.P. CI. III	LF	614
36	27" R.C.P. CI. III	LF	490
37	30" R.C.P. CI. III	LF	392
38	36" R.C.P. CI. III	LF	416
39	15" B.C.C.M.P. 12 Gage	LF	677
40	18" B.C.C.M.P. 12 Gage	LF	31
41	36" B.C.C.M.P. 12 Gage	LF	297
42	42" B.C.C.M.P. 12 Gage	LF	524
43	Ditch Excavation	CY	250
44	Concrete Ditch Paving	SY	0
45	Rip Rap Ditch (9" Th.)	SY	300
46	Poly Filter X Cloth	SY	300
47	Ditch Stabilization (Seed)	SY	350
7A	Modified Combination Curb and Gutter	LF	20,205
<b>STORM WATER MANAGEMENT (PONDS No. 3 and No. 4)</b>			
48	Excavation (Unclassified)	CY	22,300
49	Stabilization (Seeding)	SY	13,785
50	Rip Rap (9" Th.)	SY	1560
51	Brick Riser Structure Pond No. 3	Ea.	1
52	Brick Riser Structure Pond No. 4	Ea.	1
53	30" Reinforced Concrete Pressure Pipe	LF	48'
54	24" Reinforced Concrete Pressure Pipe	LF	53'
55	24" R.C.P.	LF	4'
56	18" Reinforced Concrete Pressure Pipe	LF	10'
57	30" Concrete End Section	Ea.	1
58	24" Concrete End Section	Ea.	2
59	18" Concrete End Section	Ea.	1
59A	Poly Filter X Cloth	SY	1560
<b>SEDIMENT CONTROL</b>			
60	Sediment Traps (Incl. Excav. Stone & Inlet Treatment)	Ea.	8
61	Diversion Dike (Earth)	LF	1150
62	Straw Bale Dike	LF	800
63	Clean Water Inlet (Incl. Temporary 15" C.M.P.)	Ea.	1
64	Temporary 15" C.M.P. & Fitting (Trap No. 15)	LF	60

\*Reinforced Concrete Pressure Pipe shall be Lock Joint Pipe Products/Interpace specification SP-32 or equal (AWWA Spec. No. C-302).

## SHEET INDEX


NO.	DESCRIPTION
1	Title Sheet
2	Clocktower Lane
3	Golden Rod Path and Corn Tassel Court
4	Sea Shadow Sta. 0+00 to Sta. 14+00
5	Sea Shadow Sta. 14+00 to 18+60.15 and Sandlight Court
6	West Window Way and Morning Leap Terrace and Single Bird Lane
7	Green Moon Path
8	Morning Mews and Cold Star Court
9	Moonrider Lane
10	Vollmerhausen Drive
11	Sweet Grass Ridge and Artic Flower
12	Dragonclaw and Deerfoot Way
13	Lady Bug Row and Gray Mouse Way
14	Keepsake Way
15	Hundred Drums Row and Black Velvet Lane
16	Indigo Court, White Spring Way and Slow Rain Way
17	Roadway Details
18	Roadway Details
19	Storm Drain Profiles
20	Storm Drain Profiles
21	Storm Drain Profiles
22	Storm Drain Profiles
23	Storm Drain Profiles
24	Storm Drain Profiles
25	Storm Drain Plans and Details
26	Storm Drain Details
27	Storm Drain Details
28	Drainage Area Map
29	Drainage Area Map
30	Drainage Area Map
31	Drainage Area Map
32	Drainage Area Map
33	Temporary Sediment Traps
34	Temporary Sediment Traps
35	Storm Water Management Pond No. 3
36	Storm Water Management Pond No. 4
37	Storm Water Management Ponds - Details

### SEQUENCE OF CONSTRUCTION

1. Construct storm water management ponds no. 3 and no. 4.
2. Construct diversion dikes and straw bale dikes for all cut-de-sac sediment traps.
3. Construct sediment traps no. 14 and no. 15.
4. Strip and grade the street areas.
5. Construct the storm drain systems and connect required piping to sediment traps. Construct wood planking and stone filters for all inlets in sediment traps. Block inlets as noted. Construct clean water inlet near sediment trap no. 15. Provide brick bulkhead in storm drain manhole @ sediment trap no. 15.
6. Construct all utilities.
7. Bring all streets to subgrade elevation and construct concrete curb and gutter. Remove cut-de-sac sediment traps, construct curb and gutter and pave all street surfaces.
8. The remaining sediment traps, and the refurbishing of ponds no. 3 and no. 4 may be done after the streets are paved and grass is established on all disturbed graded surfaces.
9. For pond refurbishing see specifications on sheet 37.

### REFERENCES

- \*1 HOWARD COUNTY SURVEY POINT #2141003 - CONC. MON. SOUTH OF MIDDLE PATUXENT RIVER BRIDGE - ELEV. 238.12 N 483032.15, E 841773.50
- \*2 HOWARD COUNTY SURVEY POINT #2142006 - R-CO. MON. NR. VOLLMERHAUSEN ROAD BRIDGE - ELEV. 359.66 - N 481239.72, E 846013.03

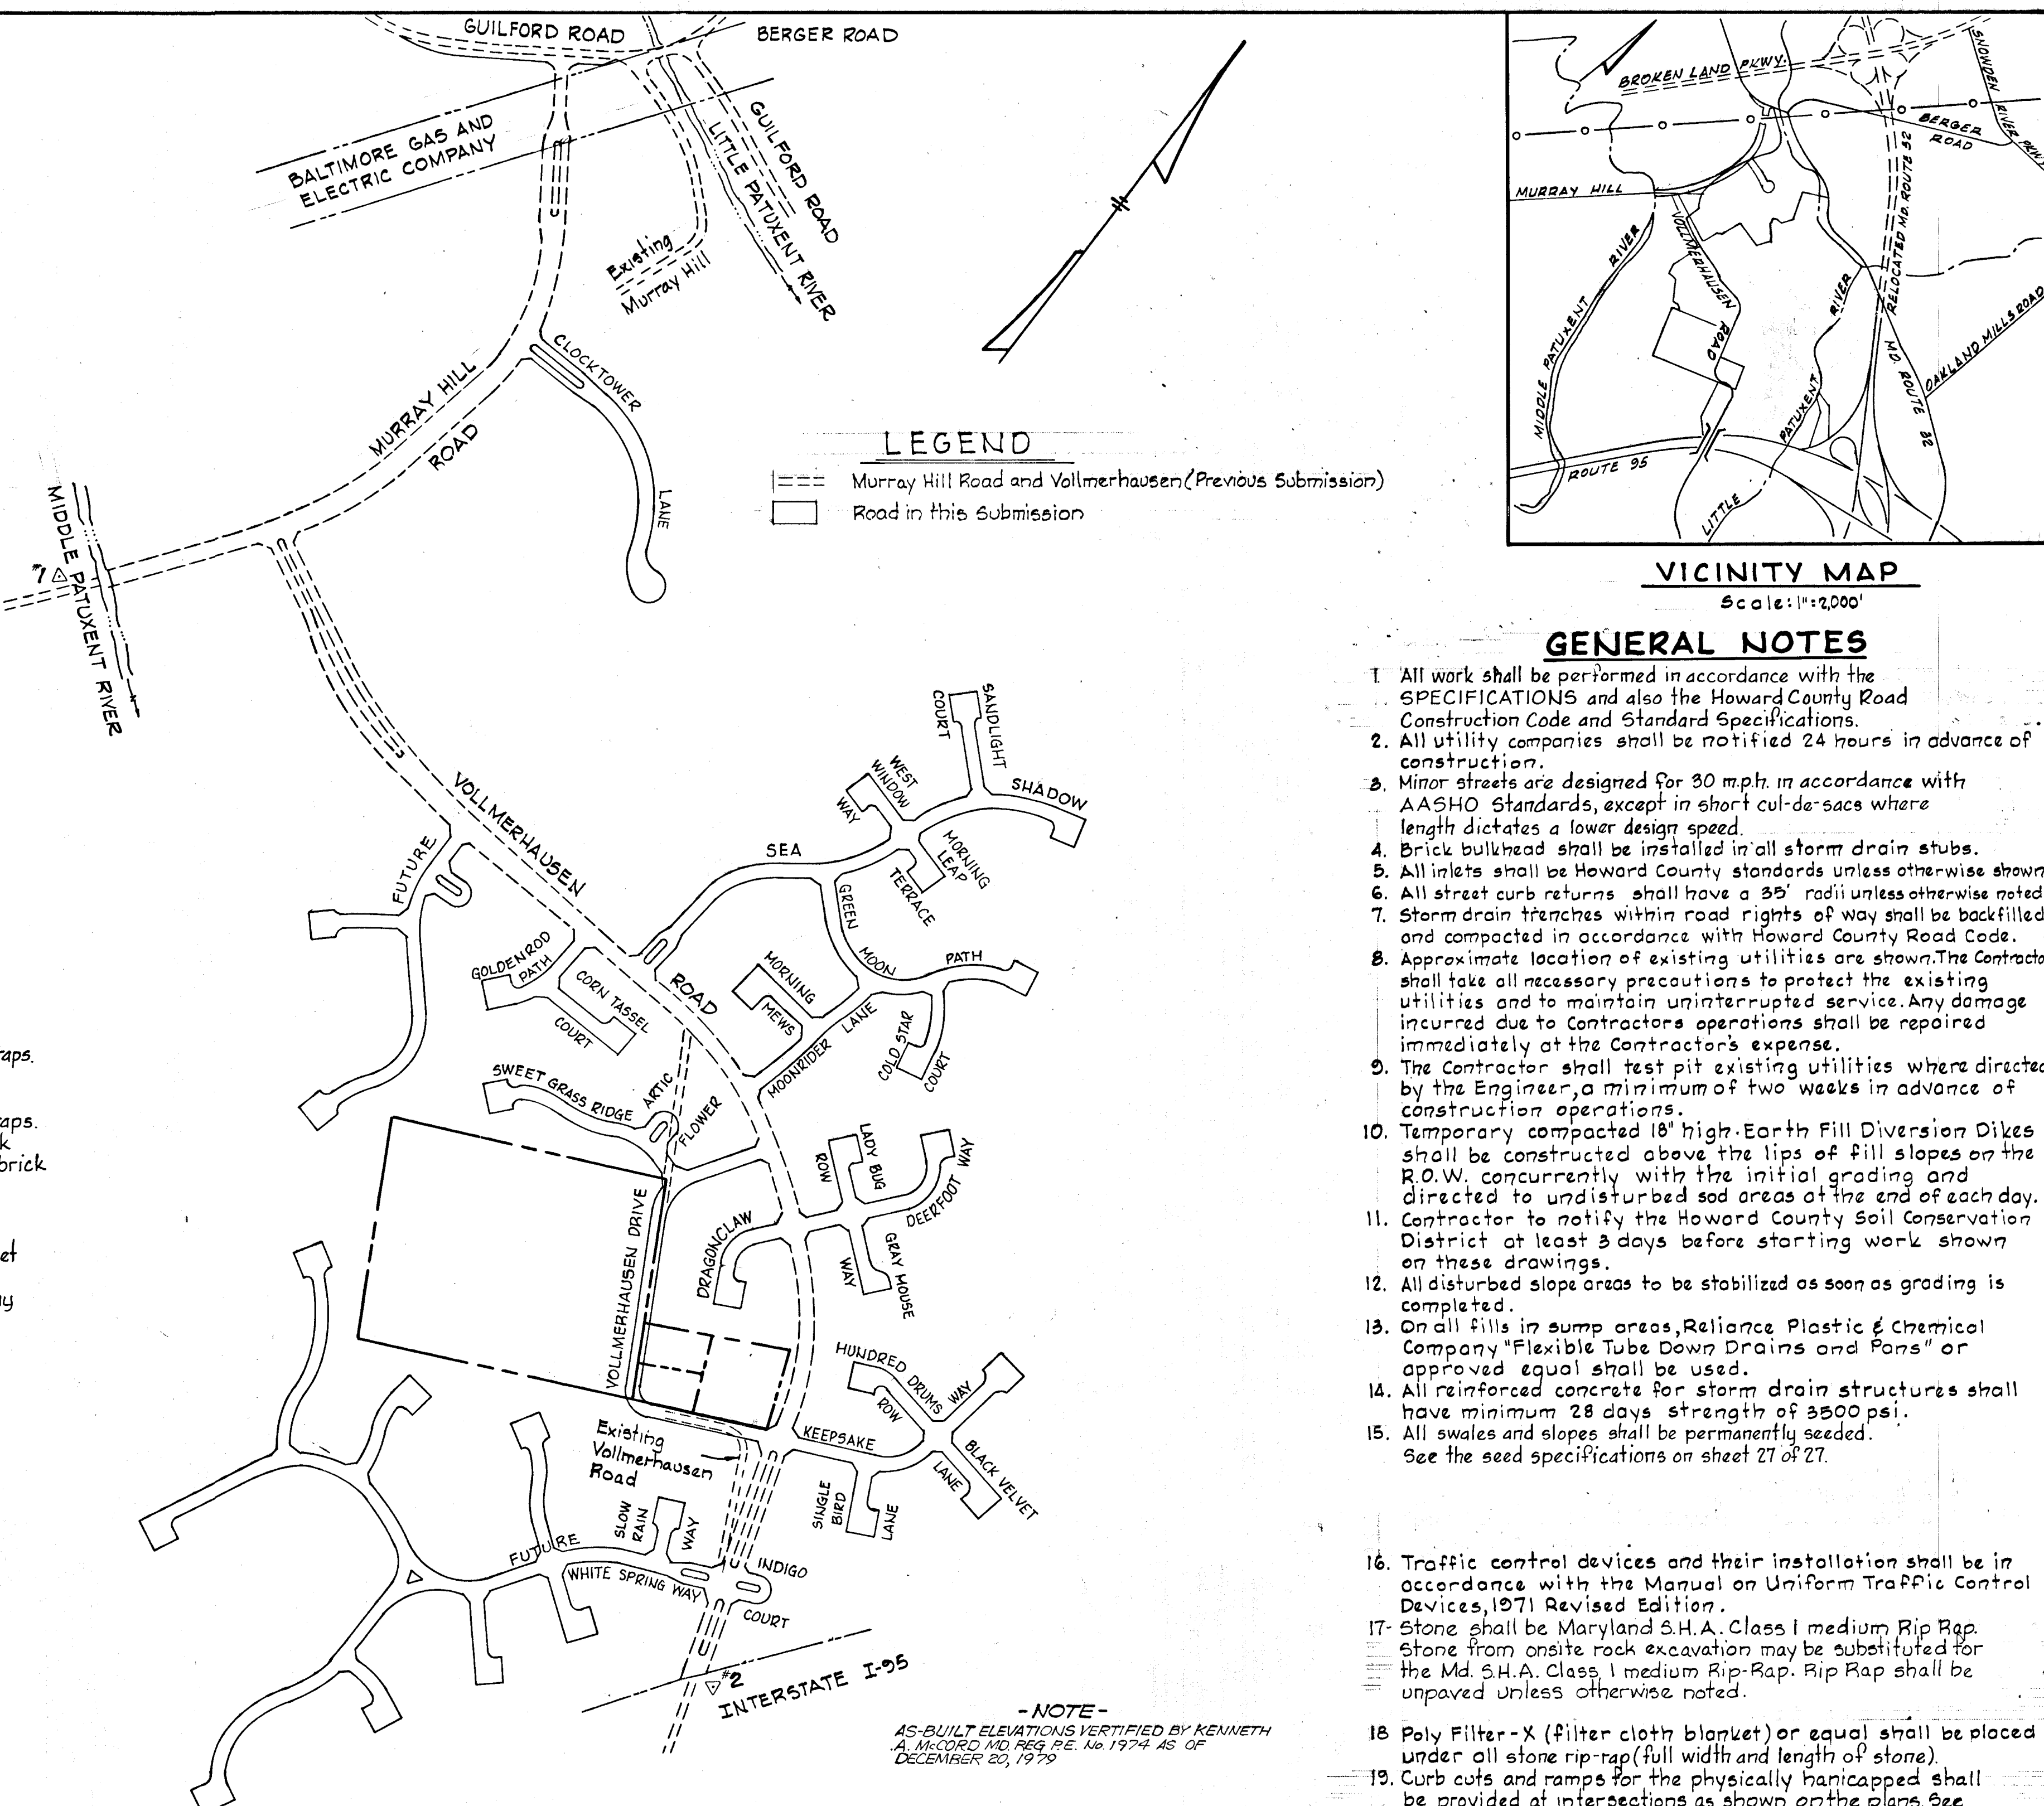

CERTIFICATION BY THE DEVELOPER  
I certify that all development and/or construction will be done according to this plan of development and plan for Erosion and Sediment Control, and I also authorize periodic on-site inspection by the Howard Soil Conservation District or their authorized agents as are deemed necessary. Deviation from this plan will not be made unless authorized by the Howard Soil Conservation District.

*Robert E. Woodruff*  
Signature of Developer      9-2-78  
Date

CERTIFICATION BY THE ENGINEER  
I certify that this plan for Erosion and Sediment Control represents a practical and workable plan based on my personal knowledge of the site conditions and that it was prepared in accordance with the requirements of the Howard Soil Conservation District.

*Kenneth A. McCord*  
Signature of Engineer      9-2-78  
Date

WHITMAN, REQUART & ASSOCIATES  
ENGINEERS  
BALTIMORE, MARYLAND 21202

*Kenneth A. McCord*  
KENNETH A. McCORD  
Registered Engineer  
No. 1974

DEPARTMENT OF PUBLIC WORKS  
CHIEF, BUREAU OF ENGINEERING      12-29-78  
DATE

OFFICE OF PLANNING AND ZONING  
*John W. Musselman, P.E.*  
CHIEF, DIVISION OF LAND DEVELOPMENT      12-27-78  
DATE

OWNER AND DEVELOPER  
THE HOWARD RESEARCH AND DEVELOPMENT CORP.  
COLUMBIA, MARYLAND

THIS PLAN HAS BEEN REVIEWED BY  
THE HOWARD SOIL CONSERVATION DISTRICT  
AND MEETS THE TECHNICAL REQUIREMENTS  
FOR SOIL EROSION AND SEDIMENT CONTROL.

U.S. SOIL CONSERVATION DISTRICT      Date

THIS PLAN FOR SOIL EROSION AND  
SEDIMENT CONTROL MEETS THE  
REQUIREMENTS OF THE HOWARD  
SOIL CONSERVATION DISTRICT

APPROVED \_\_\_\_\_  
HOWARD S.C.D.      Date  
PLAN NUMBER \_\_\_\_\_

**COLUMBIA**  
**VILLAGE OF KINGS CONTRIVANCE**  
SECTION 3 AREA 1  
**ROAD CONSTRUCTION PLANS**  
6<sup>TH</sup> ELECTION DISTRICT OF HOWARD COUNTY MD.

OWNER AND DEVELOPER  
**HOWARD RESEARCH AND DEVELOPMENT CORP.**  
COLUMBIA MARYLAND

Date \_\_\_\_\_      Scale: As Shd




Note  
For Cul-De-Sac Curve Data  
See Sheet 18 of 37

AS-BUILT ELEVATIONS VERIFIED BY  
KENNETH A. McCORD MD REG. P.E.  
1974 DECEMBER 20, 1979

**CURVE DATA**  
P.C. 8+52.70 To P.T. 9+31.82  
Δ: 21°40'35" Tan: 43.08'  
R: 225.00' Chd: 24.02'  
Arc: 25.12' Brg: S55°50'20"E

DEPARTMENT OF PUBLIC WORKS  
*W.O. Lubert* 12-29-78  
CHIEF, BUREAU OF ENGINEERING DATE  
OFFICE OF PLANNING AND ZONING  
*John W. Mueselman/HFD* 12-27-78  
CHIEF, DIVISION OF LAND DEVELOPMENT DATE

**CURVE DATA**  
P.C. 4+35.27 to P.T. 6+22.48  
Δ: 40°20'14" Tan: 202.02'  
R: 550.00' Chd: 379.26'  
Arc: 387.21' Brg: S65°10'15"E

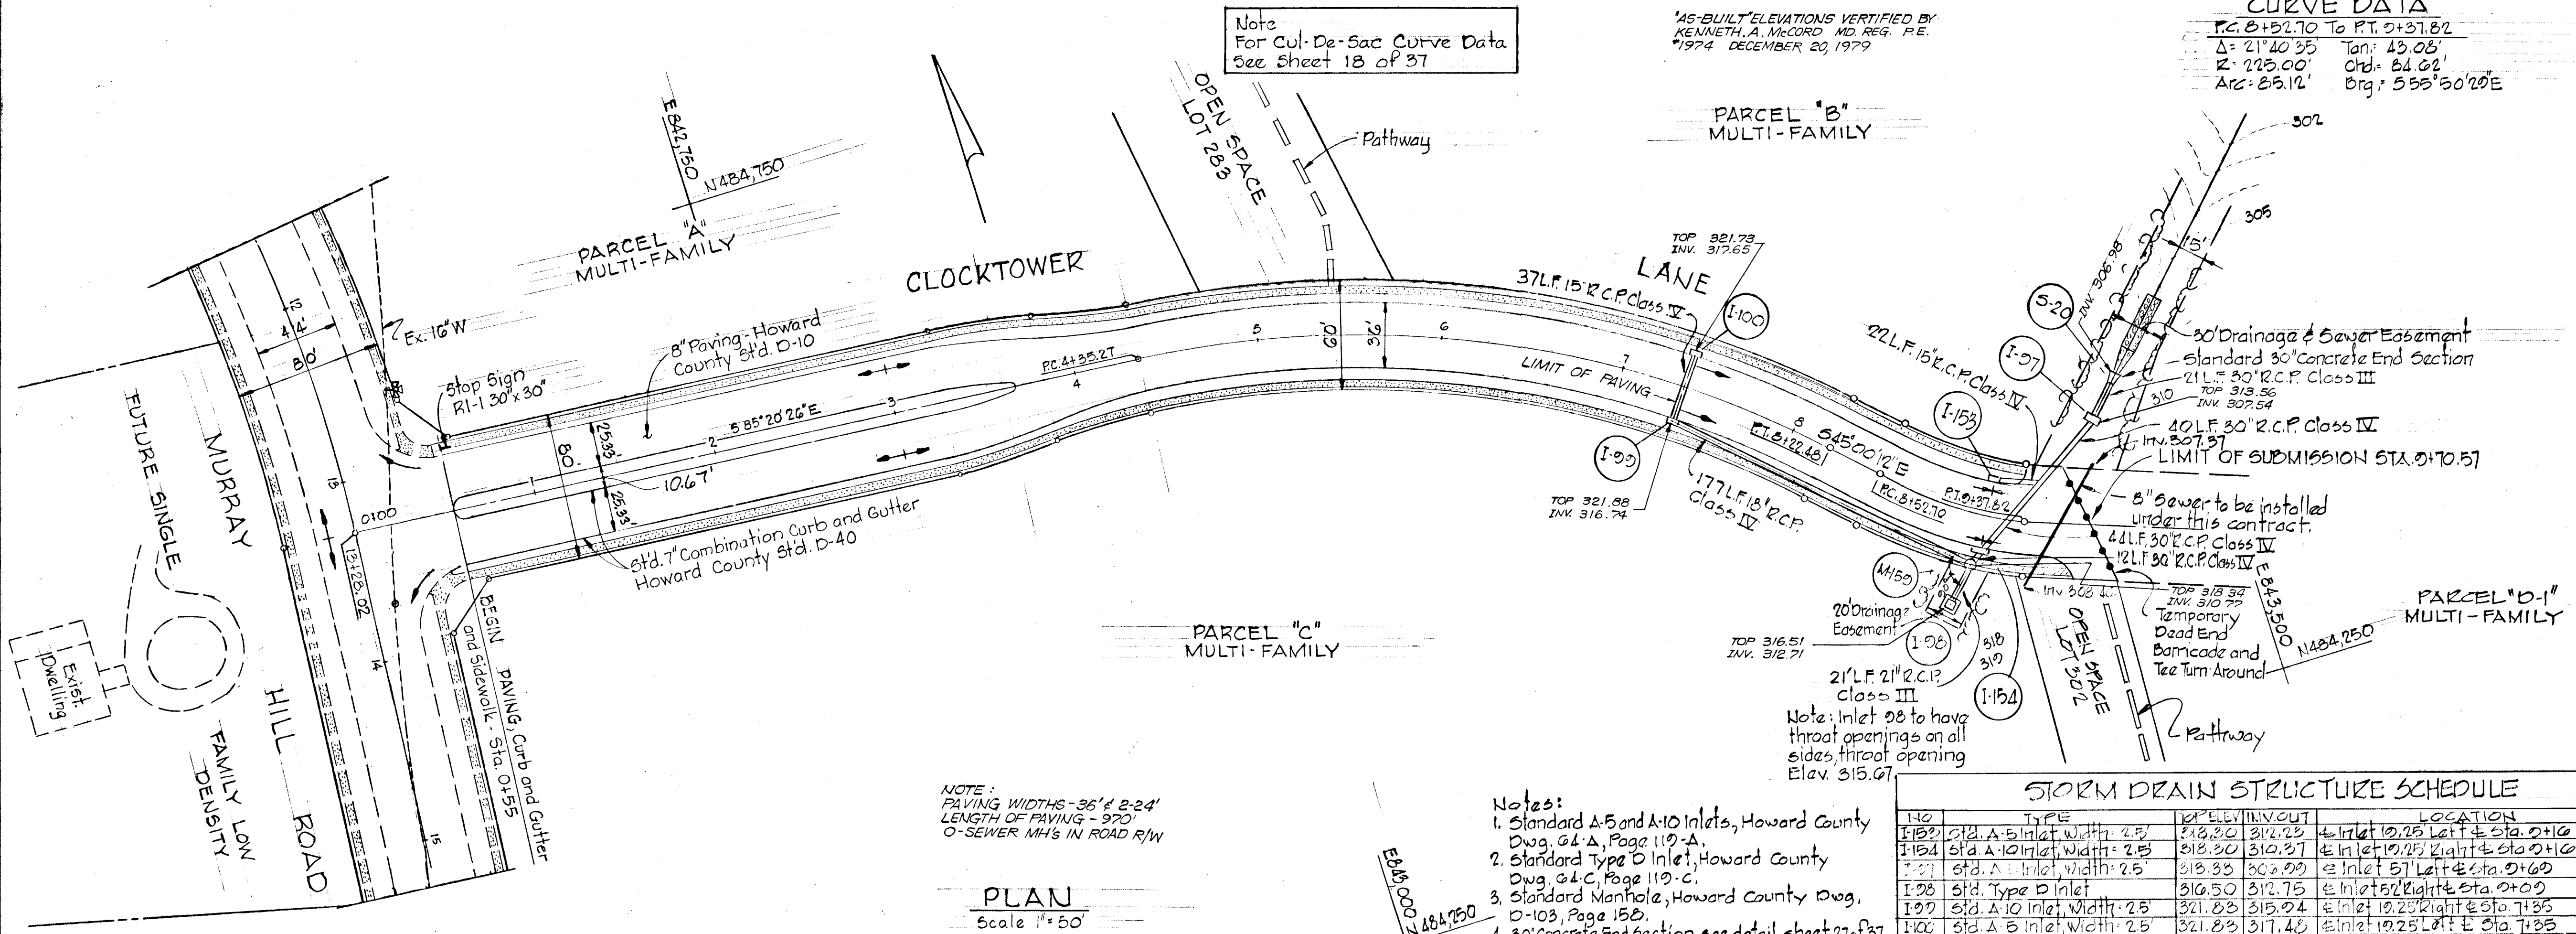

NOTE:  
PAVING WIDTHS - 36' & 2-24'  
LENGTH OF PAVING - 970'  
D-SEWER MH'S IN ROAD R/W

**PLAN**  
Scale 1" = 50'



- Notes:
- Standard A-5 and A-10 Inlets, Howard County Dwg. G-4-A, Page 119-A.
  - Standard Type D Inlet, Howard County Dwg. G-4-C, Page 119-C.
  - Standard Manhole, Howard County Dwg. D-103, Page 150.
  - 30' Concrete End Section, see detail sheet 27 of 37.
  - For Storm Drain Profiles, see sheet 23 of 37.

**STORM DRAIN STRUCTURE SCHEDULE**

NO	TYPE	INVERT	THROAT	LOCATION
I-102	Std. A-5 Inlet, width: 2.5	318.20	312.25	Inlet 10.25 Left of Sta. 0+10
I-104	Std. A-10 Inlet, width: 2.5	318.30	312.27	Inlet 10.25 Right of Sta. 0+10
I-107	Std. A-10 Inlet, width: 2.5	318.35	302.29	Inlet 51 Left of Sta. 0+60
I-108	Std. Type D Inlet	316.50	312.75	Inlet 22 Right of Sta. 0+09
I-109	Std. A-10 Inlet, width: 2.5	321.88	315.24	Inlet 19.25 Right of Sta. 1+35
I-110	Std. A-10 Inlet, width: 2.5	321.83	317.46	Inlet 19.25 Left of Sta. 1+35
M-152	Std. Manhole	318.70	310.82	Manhole 28 Right of Sta. 0+13
S-20	30' Concrete End Section	-	306.79	See Plan and Profile


WHITMAN, REQUARDT & ASSOCIATES  
ENGINEERS  
BALTIMORE, MARYLAND 21202

*Kenneth A. McCord*  
KENNETH A. McCORD  
Registered Engineer  
No. 1974

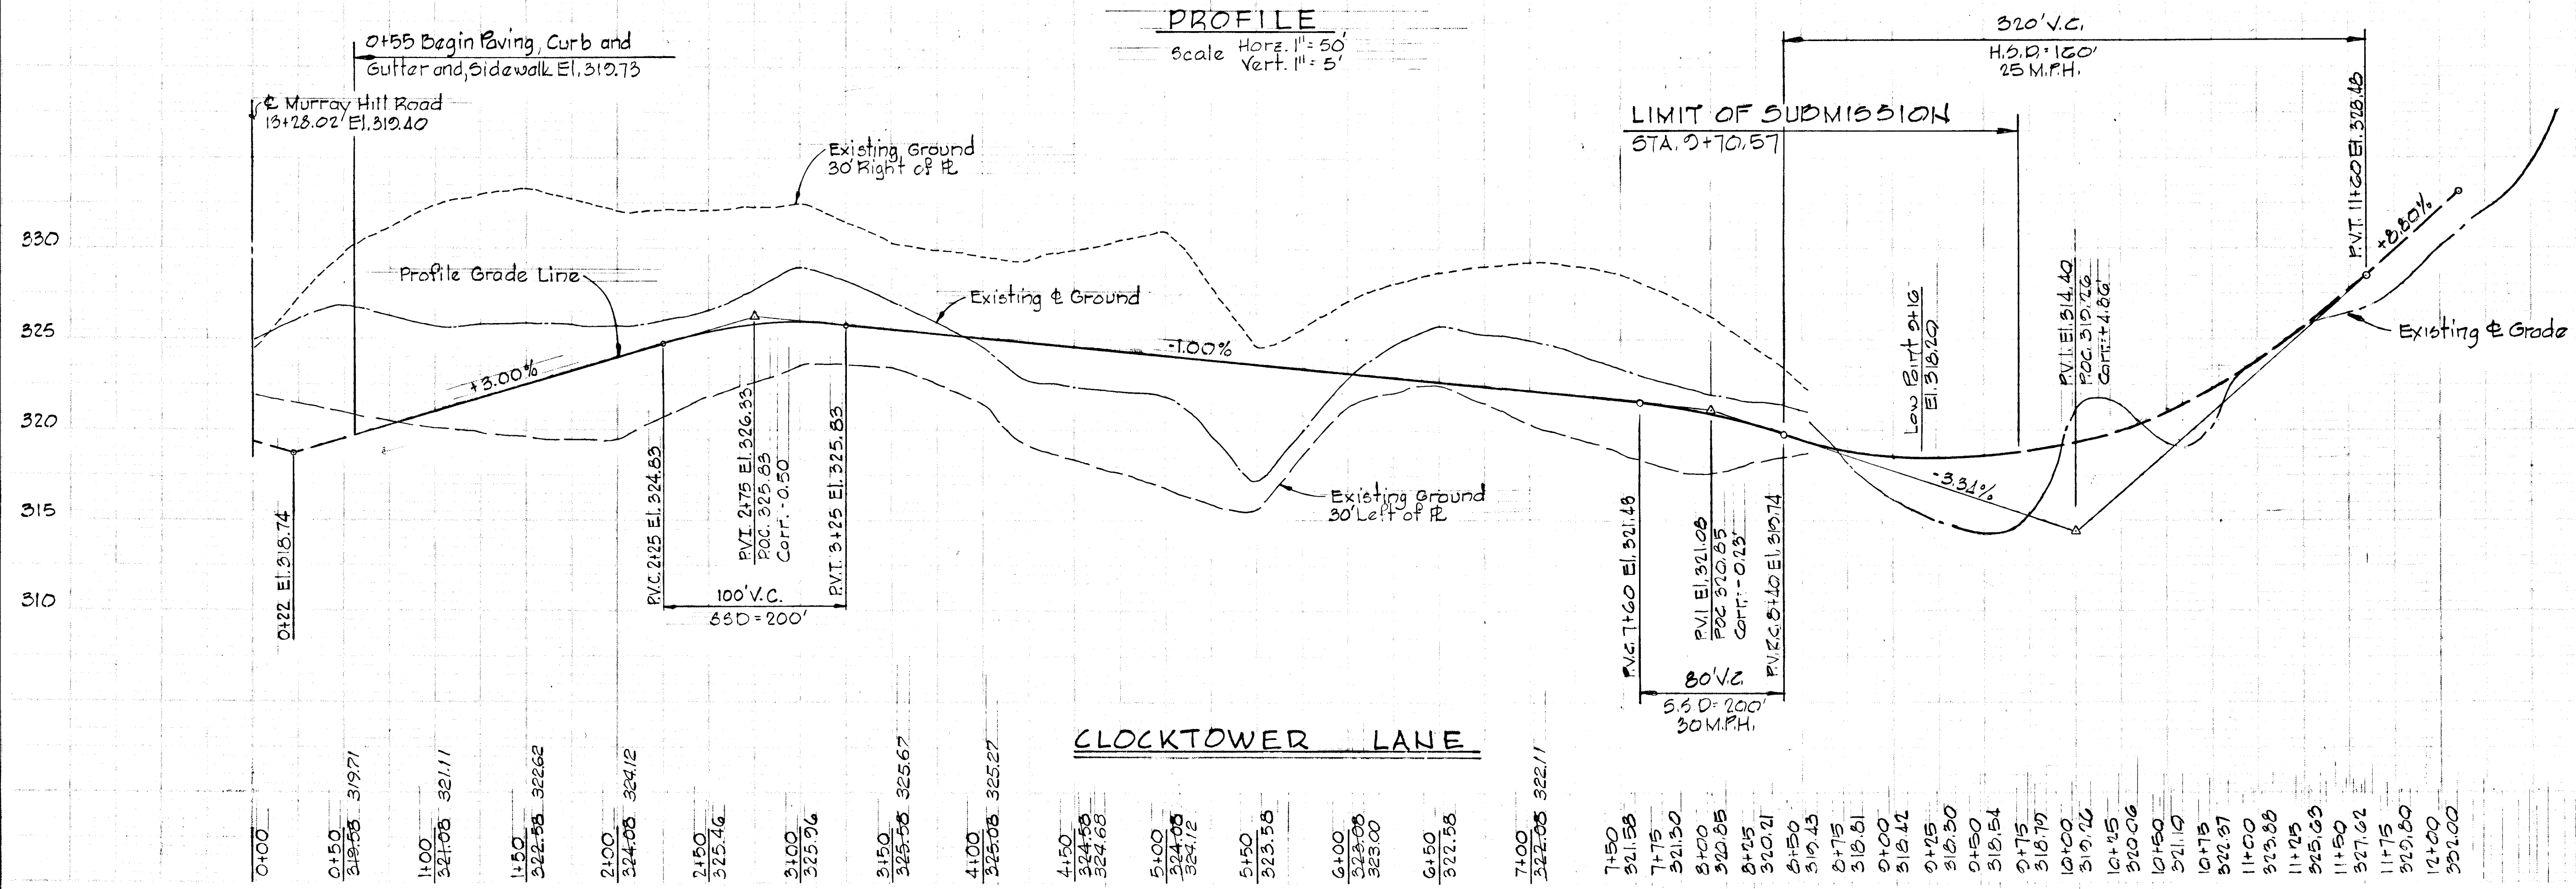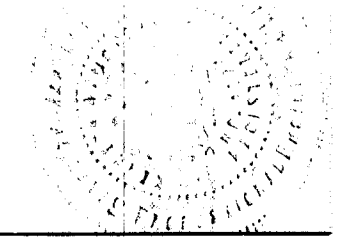

**CLOCKTOWER LANE**



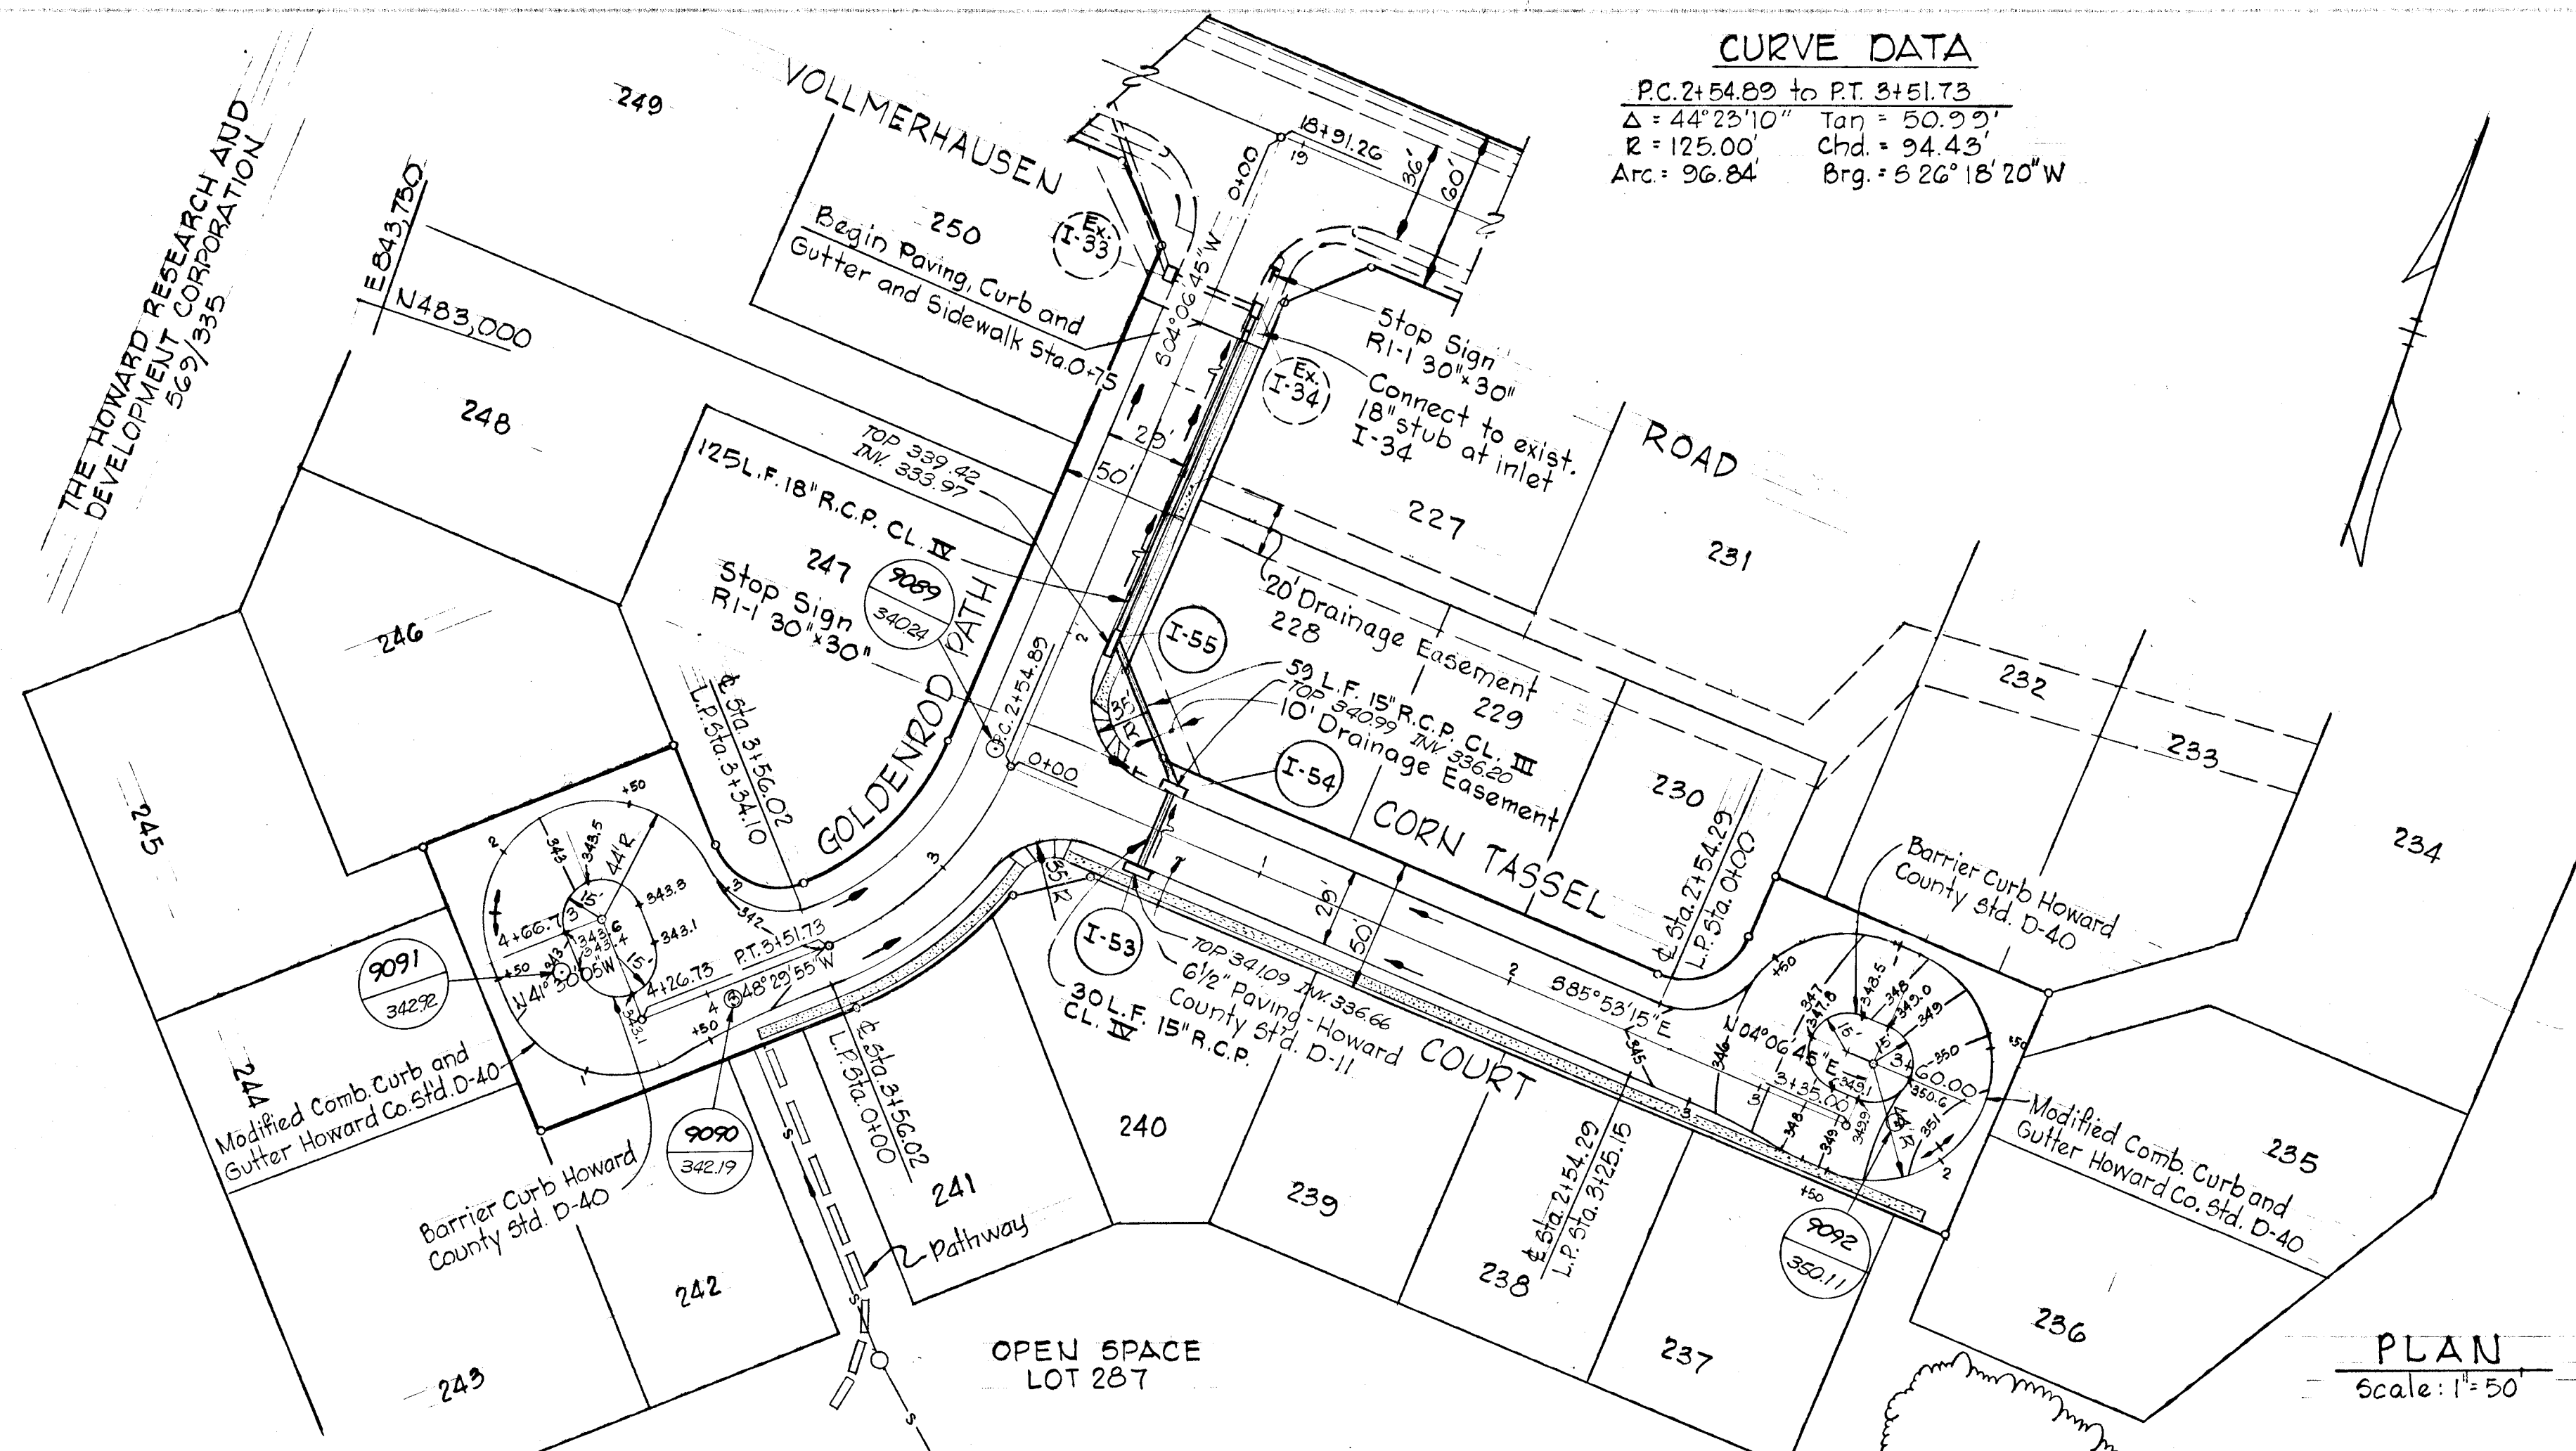

**CURVE DATA**

PC: 2+54.89 to PT: 3+51.73  
 $\Delta = 44^\circ 23' 10''$   $\tan = 50.923'$   
 $R = 125.00'$   $\text{Chd.} = 94.43'$   
 $\text{Arc} = 96.84'$   $\text{Brg.} = 526^\circ 18' 20'' \text{W}$

**STORM DRAIN STRUCTURE SCHEDULE**

No.	TYPE	TOP ELEV.	IN. OUT.	LOCATION
I-53	Std. A-10 Inlet, Width=2.5'	340.86	336.08	Inlet 15.92' Rt. of Sta. 0+57.67
I-54	Std. A-10 Inlet, Width=2.5'	340.86	335.43	Inlet 15.92' Lt. of Sta. 0+57.67
I-55	Std. A-10 Inlet, Width=2.5'	339.26	333.72	Inlet 15.92' Lt. of Sta. 1+97.22

DEPARTMENT OF PUBLIC WORKS  
*W. O. Gilbert* 12-29-78  
 CHIEF, BUREAU OF ENGINEERING DATE  
 OFFICE OF PLANNING AND ZONING  
*John W. Musselman* 12-27-78  
 CHIEF, DIVISION OF LAND DEVELOPMENT DATE



- Notes:
- Standard A-10 Inlets, Howard County Dwg. 04-A, Page 110-A.
  - Standard Type D Inlet, Howard County Dwg. 04-C, Page 113-C.
  - Standard Manhole, Howard County Dwg. 0-103, Page 158.
  - For Storm Drain Profiles, see sheet 20 of 37.

AS-BUILT ELEVATIONS VERIFIED AS OF DECEMBER 20, 1979 BY KENNETH A. McCORD MD. REG. No. 1974

7/16/80	1	Deleted MH 20' ET-101-I-54 to A-10
Rev. Date	Rev. No.	Revision Description
<b>COLUMBIA</b> 6th ELECTION DISTRICT HOWARD COUNTY, MARYLAND		
OWNER AND DEVELOPER HOWARD RESEARCH AND DEVELOPMENT CORP.		
PROJECT AREA VILLAGE OF KINGS CONTRIVANCE SECTION 3 AREA 1		
PROJECT TITLE PLAN AND PROFILE GOLDENROD PATH CORN TASSEL COURT		
SCALE: AS SHOWN	DATE:	
WHITMAN, REGUARDT & ASSOCIATES ENGINEERS BALTIMORE, MARYLAND 21202		
<i>Kenneth A. McCord</i> KENNETH A. McCORD Registered Engineer No. 1974		

**PLAN**  
Scale: 1"=50'

**PROFILE**  
Scale: Horiz. 1"=50'  
Vert. 1"=5'

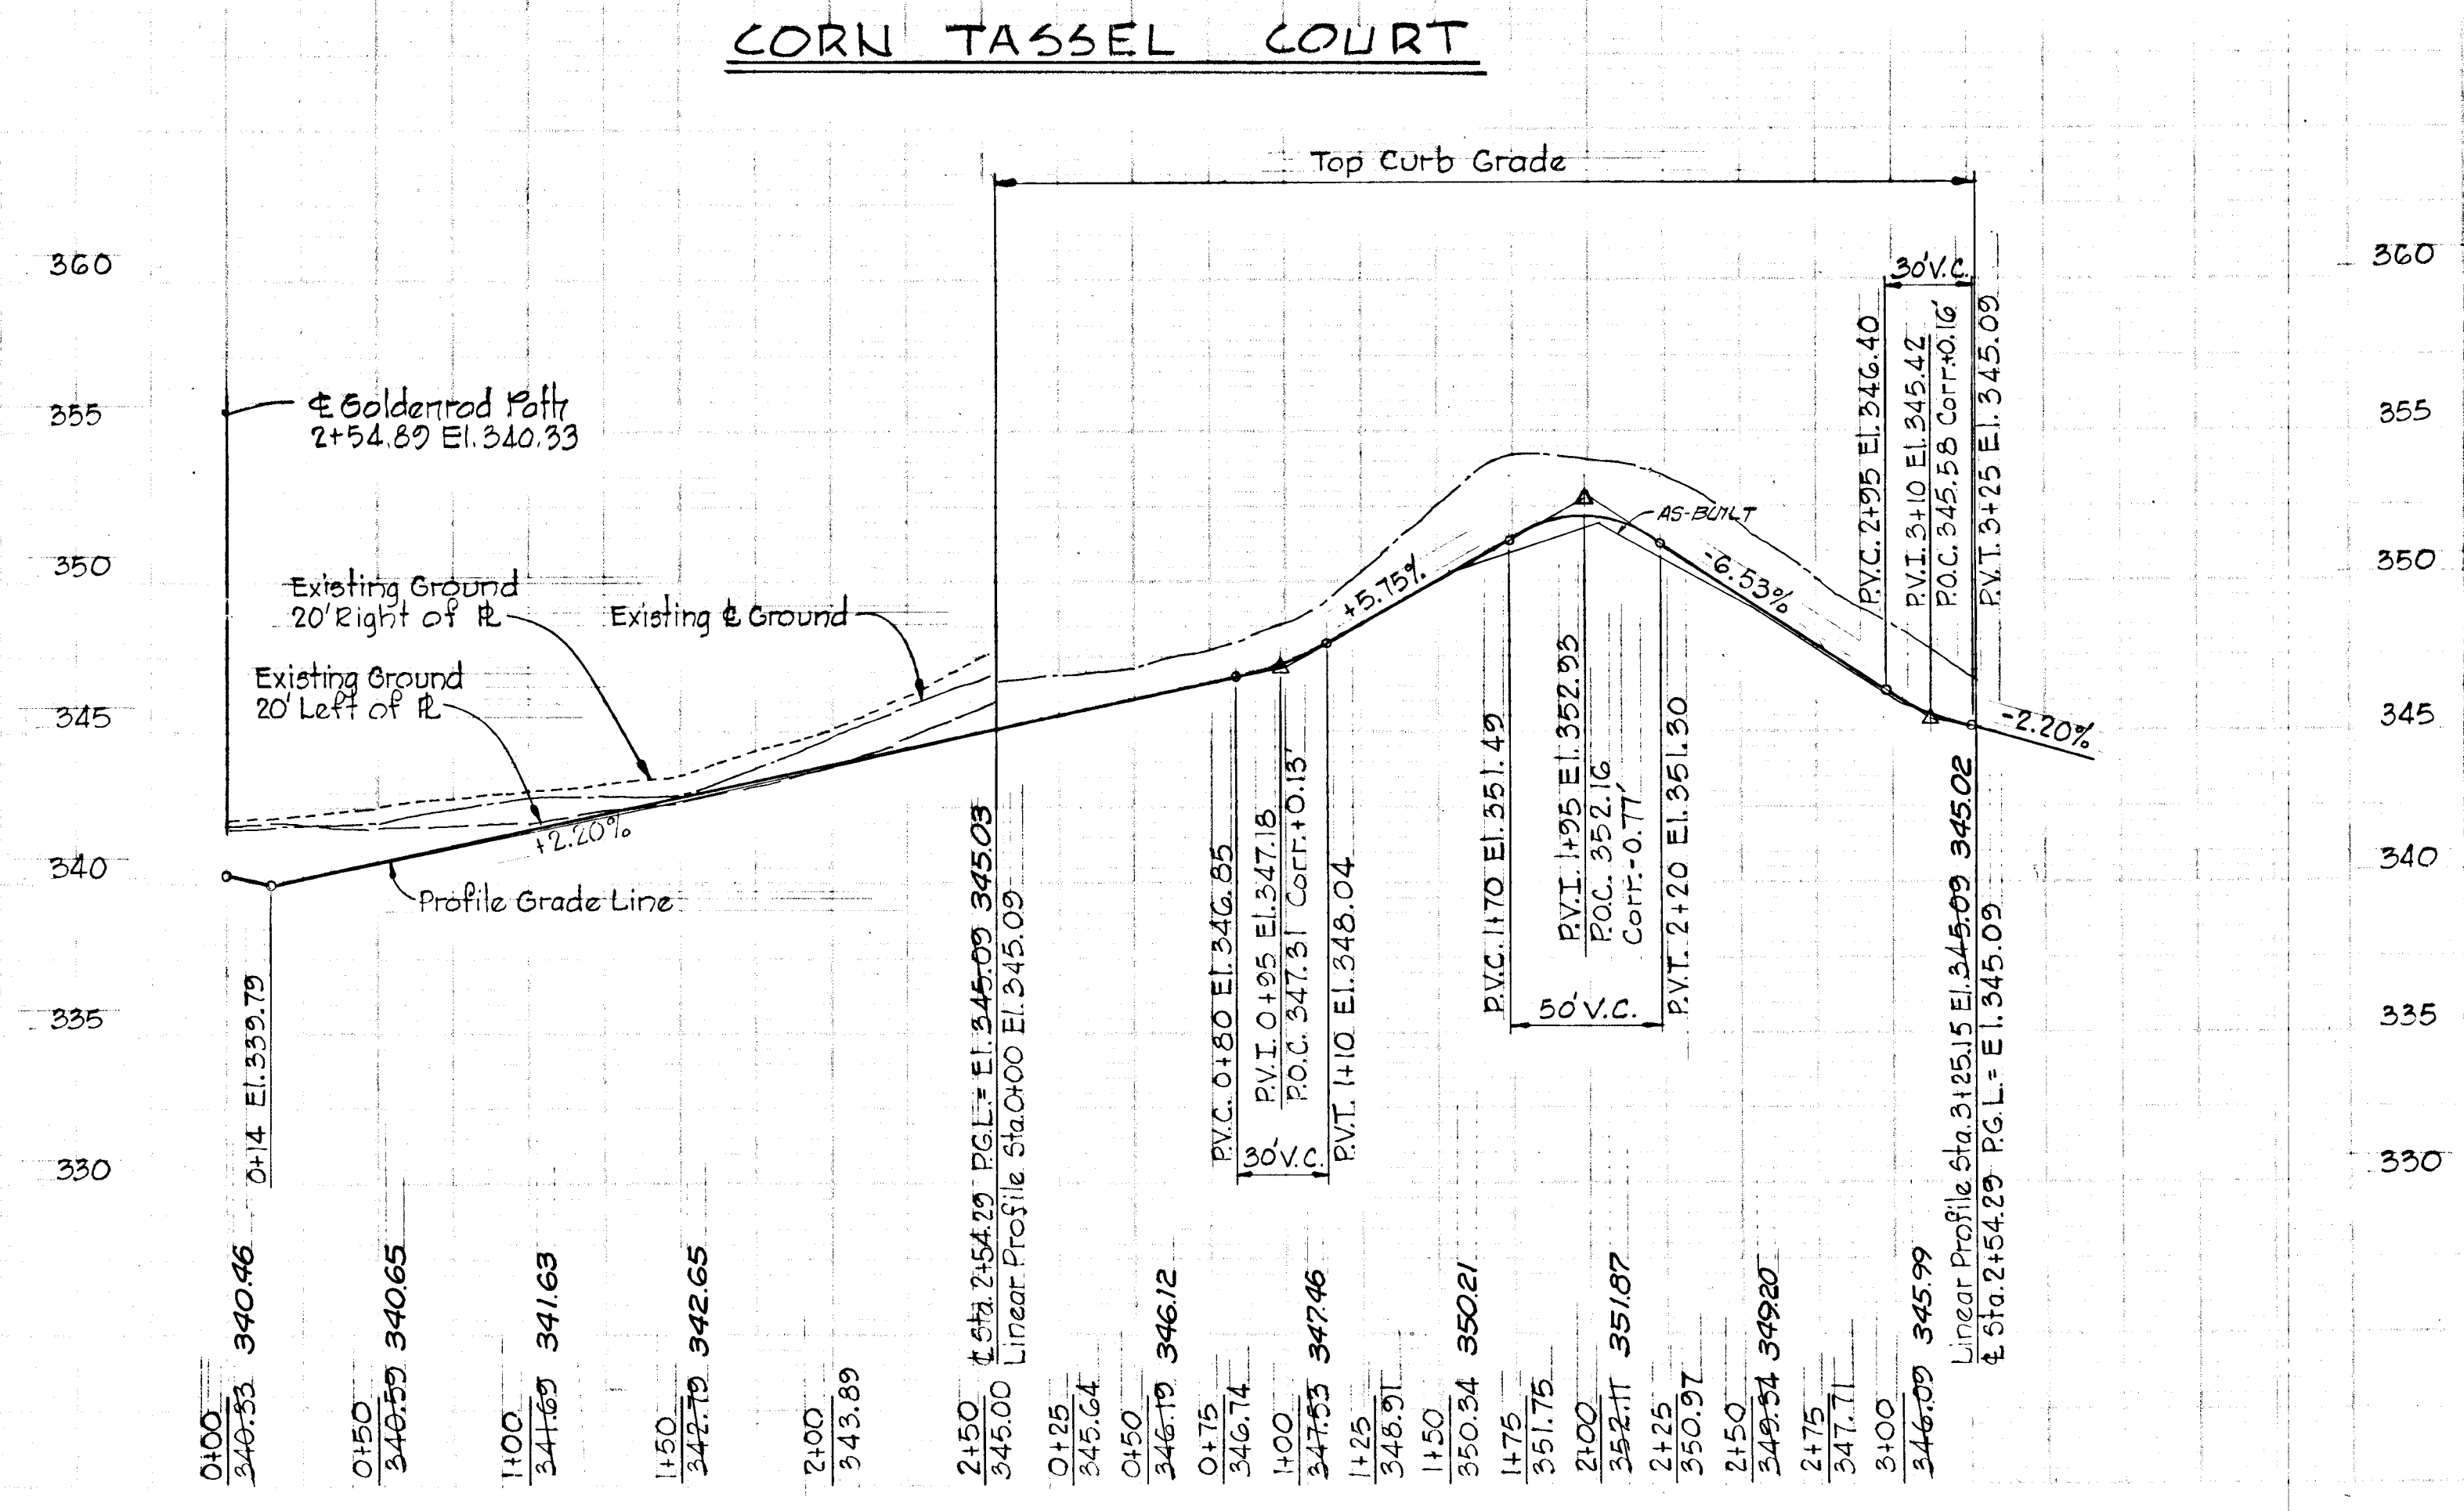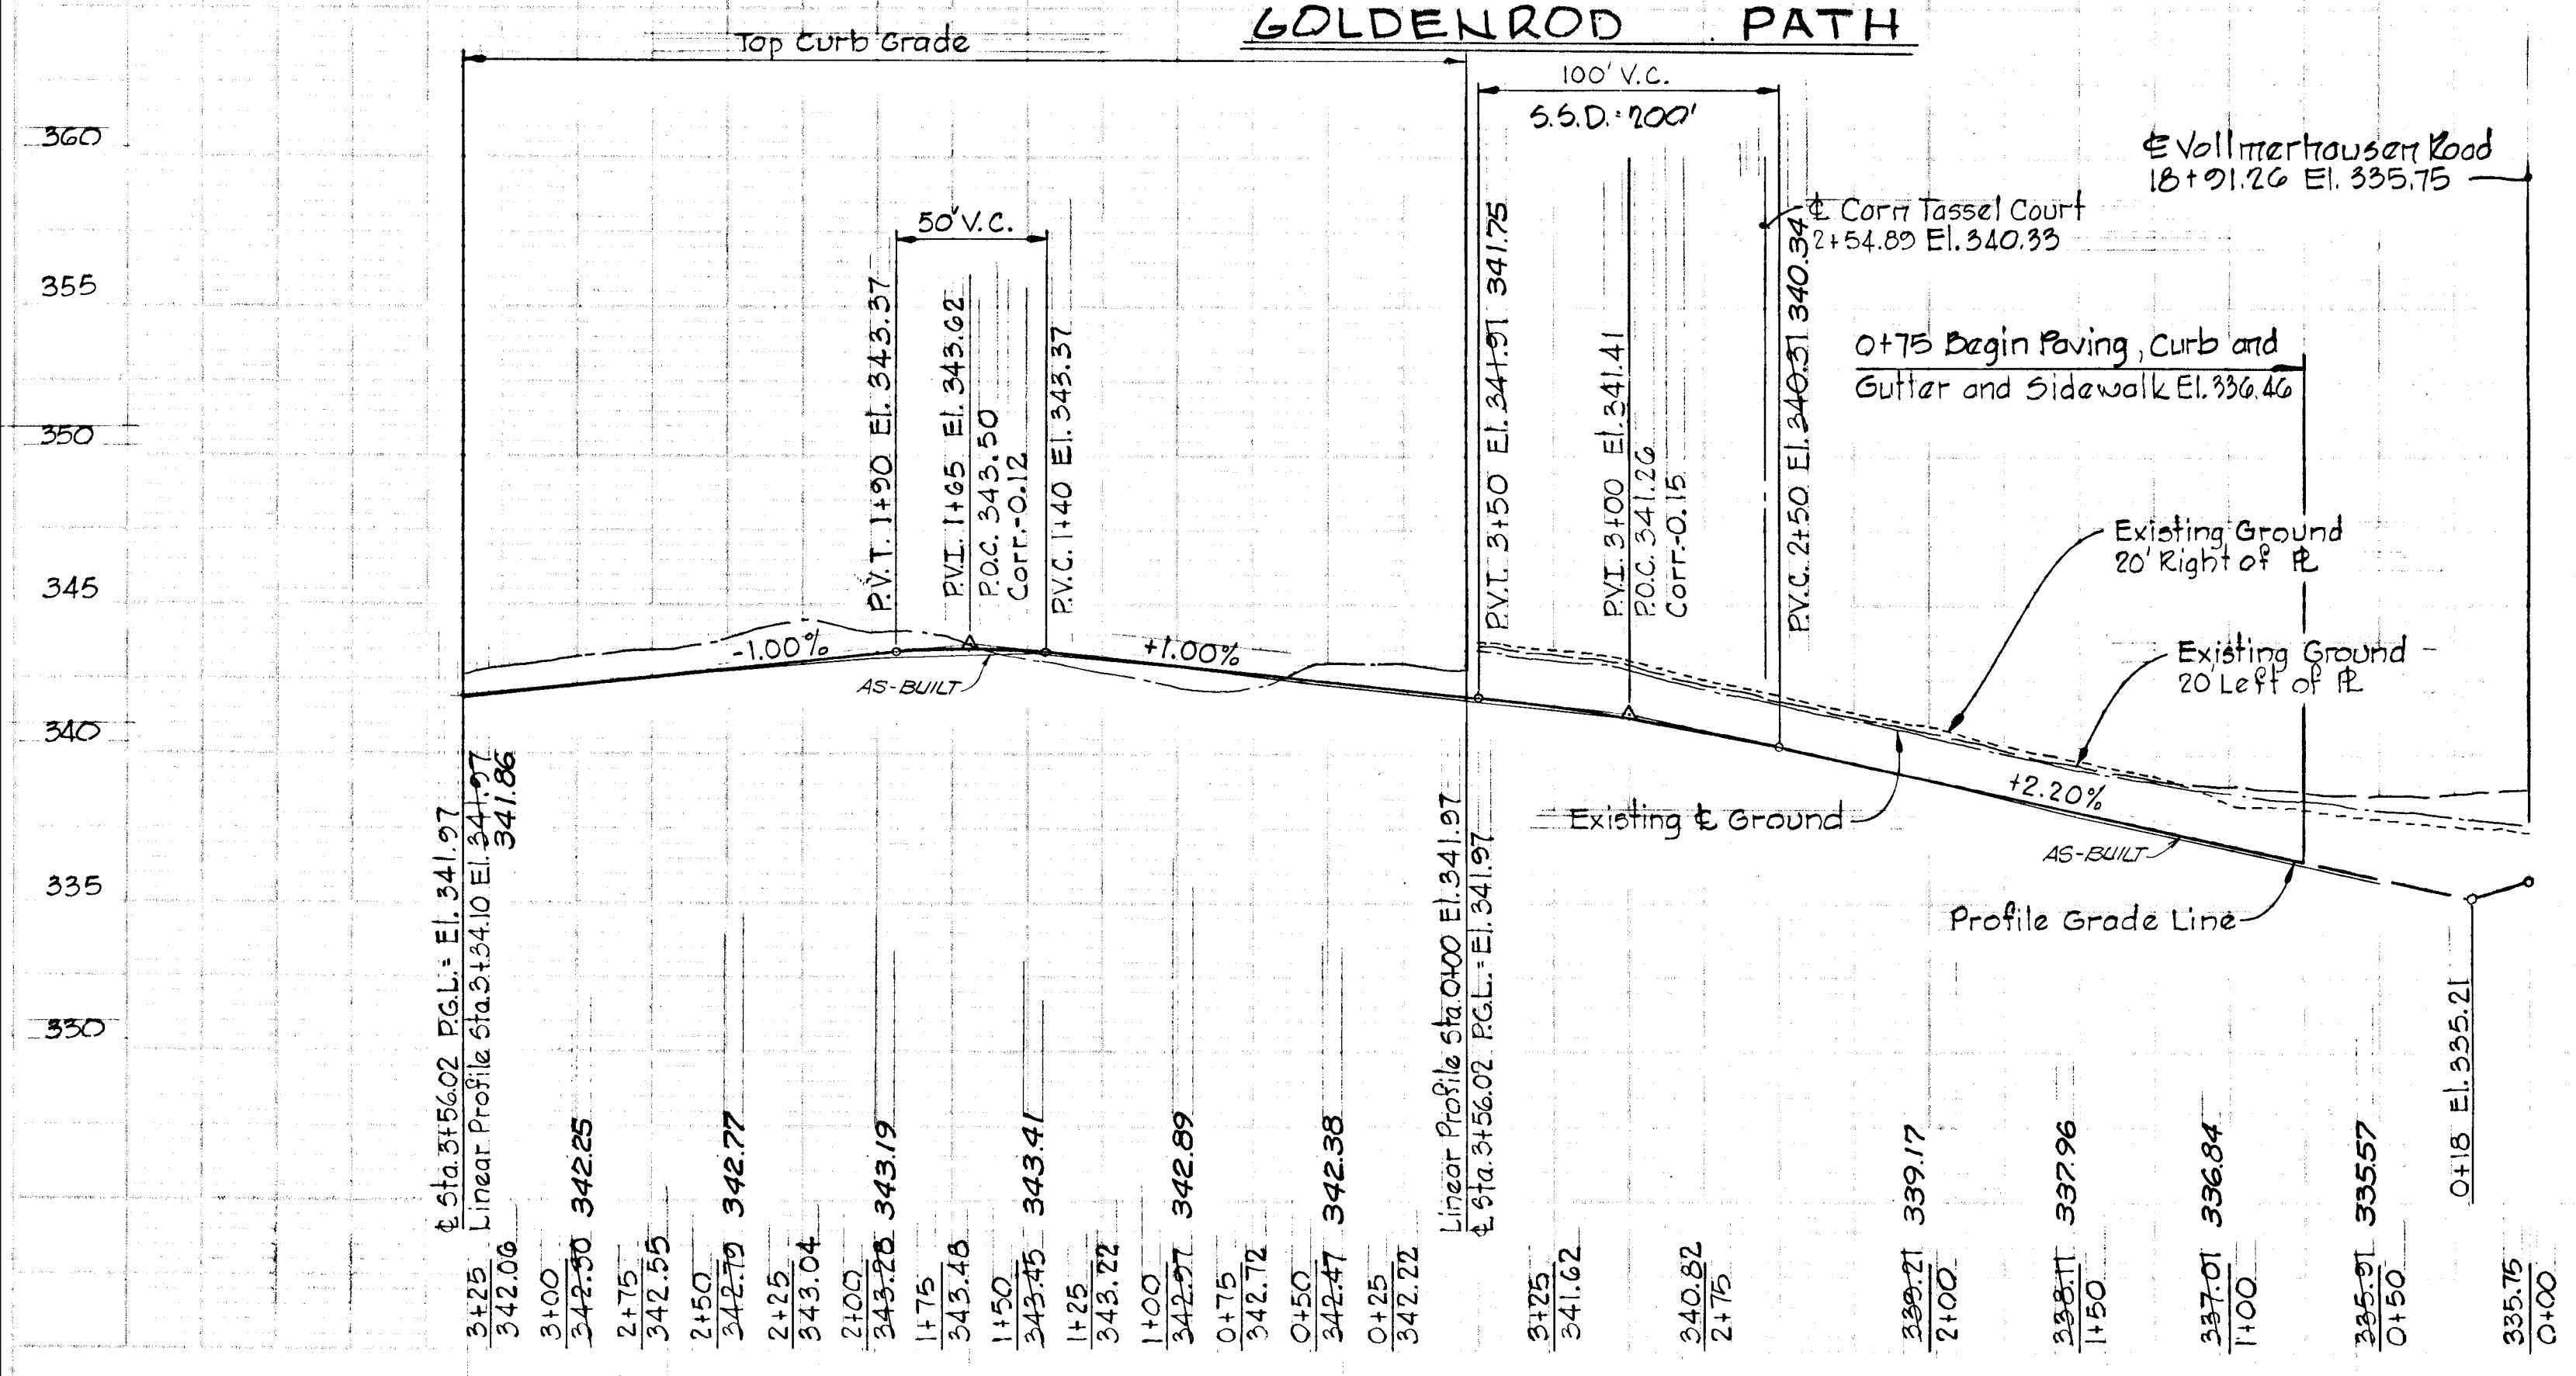




**STORM DRAIN STRUCTURE SCHEDULE**

No.	TYPE	TOP ELEV.	IN/OUT	LOCATION
I-81	A-5 Inlet width 2.5'	336.59	330.74	± Inlet 15.72' left of ± Sta. 8+00 Rd.
I-82	A-10 Inlet width 2.5'	336.59	330.96	± Inlet 15.72' right of ± Sta. 8+00 Rd.
I-83	A-5 Inlet width 2.5'	336.22	331.60	± Inlet 15.72' right of ± Sta. 0+54 Rd.
MH-38	Type B MH (For Detail See Sht. 27)	321.20	316.57	See Plan and Profile

Notes:  
 1. Standard A-5 and A-10 Inlets, Howard County  
 Dwg. G-4, Page 117-A.  
 2. Type B Manhole, see detail sheet 27 of 37.  
 3. For Storm Drain Profiles, see sheet 21 of 37.


DEPARTMENT OF PUBLIC WORKS  
*W. O. Sulbert* 12-29-78  
 CHIEF, BUREAU OF ENGINEERING DATE  
 OFFICE OF PLANNING AND ZONING  
*John W. Musselman / JFD* 12-27-78  
 CHIEF, DIVISION OF LAND DEVELOPMENT DATE

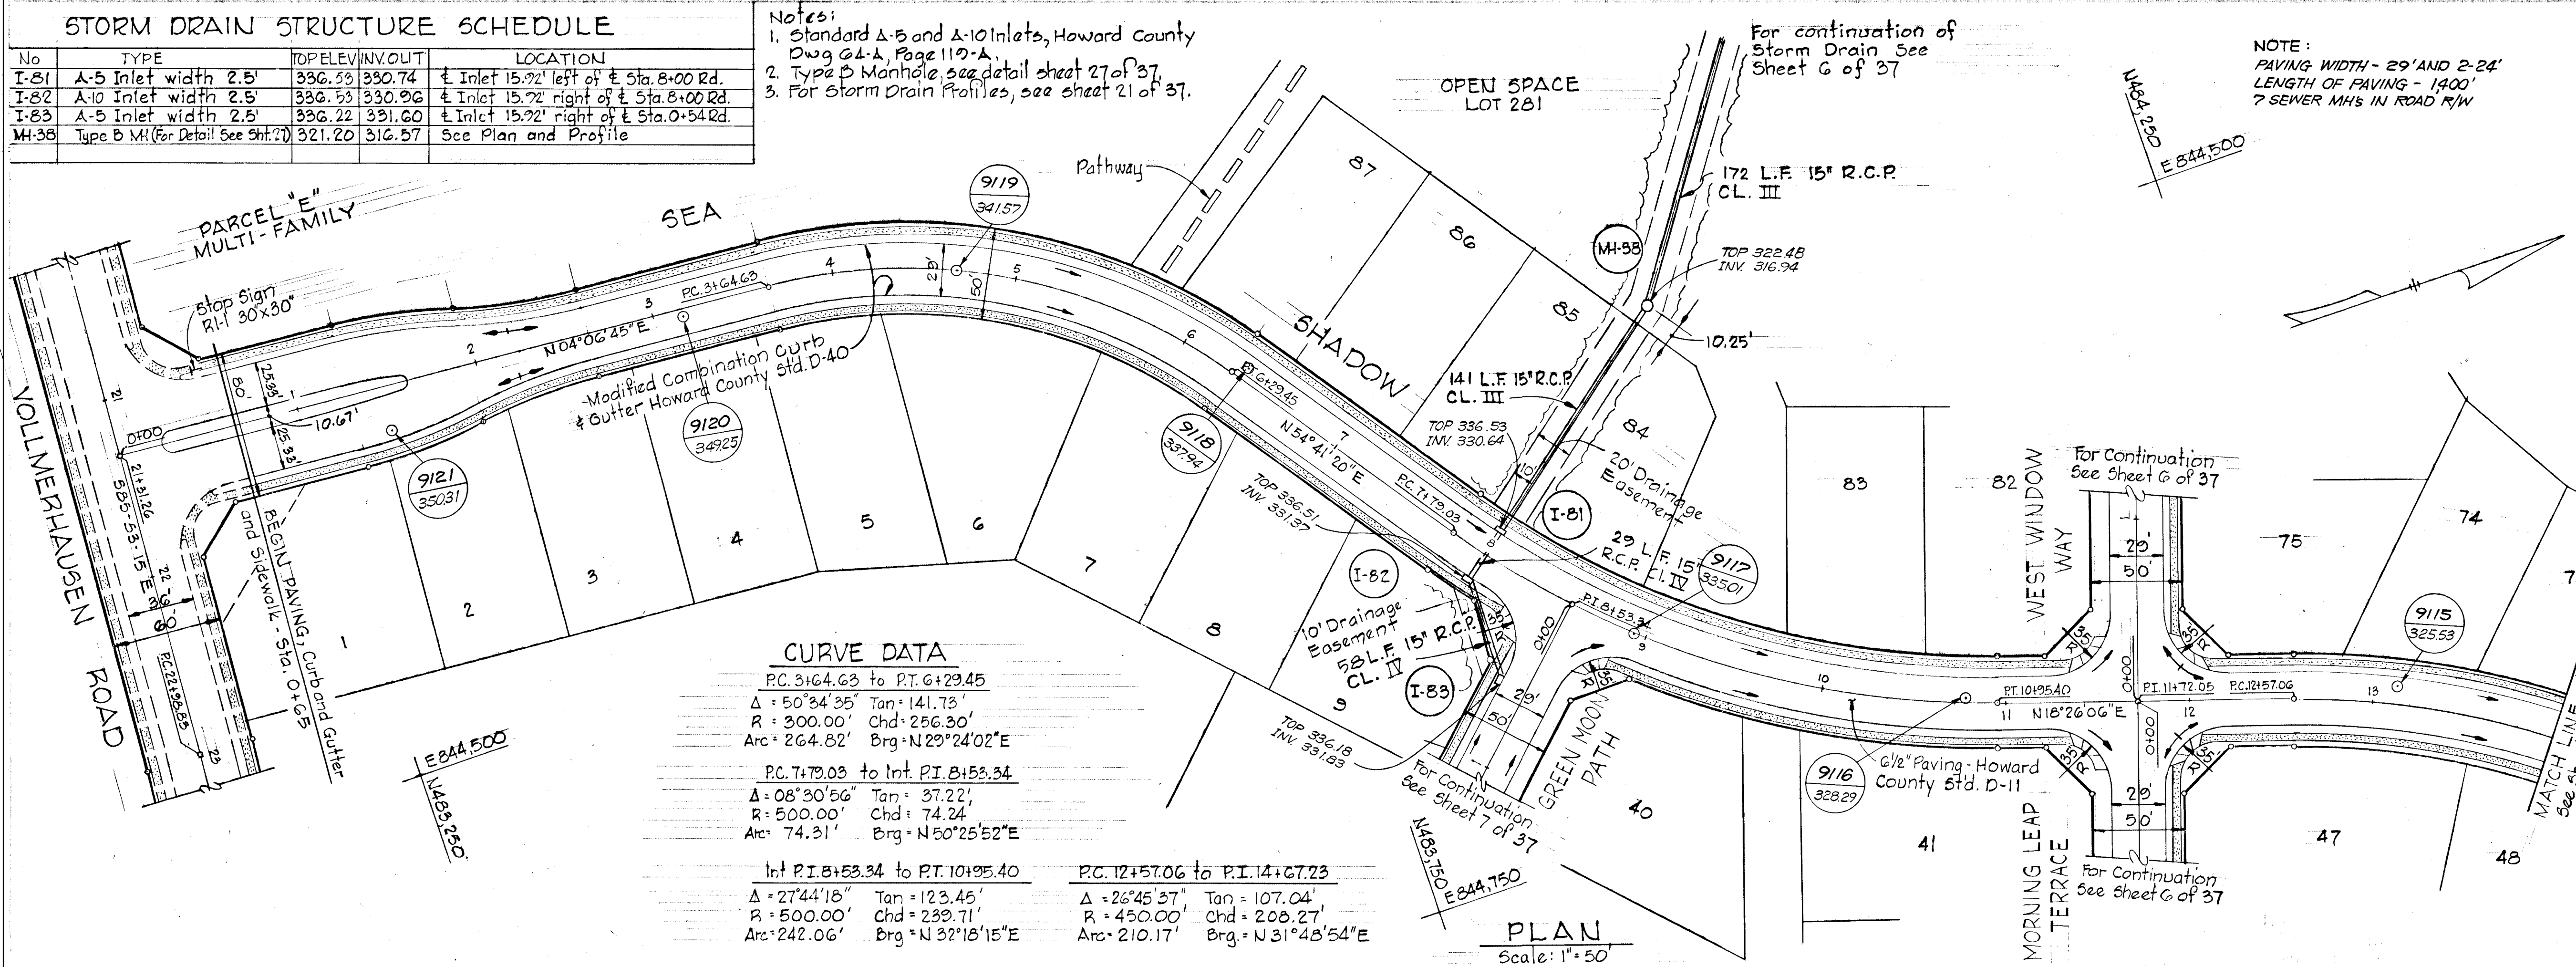

**CURVE DATA**

PC: 3164.63 to PT: 6+29.45 $\Delta = 50^{\circ}34'35''$ Tan = 141.73' $R = 300.00'$ Chd = 256.30' Arc = 264.82' Brg = N29°24'02"E	PC: 7+79.03 to Int. PI: 8+53.34 $\Delta = 08^{\circ}30'56''$ Tan = 37.22' $R = 500.00'$ Chd = 74.24' Arc = 74.31' Brg = N50°25'52"E	Int. PI: 8+53.34 to PT: 10+95.40 $\Delta = 27^{\circ}44'18''$ Tan = 123.45' $R = 500.00'$ Chd = 239.71' Arc = 242.06' Brg = N32°18'15"E
PC: 12+57.06 to PI: 14+67.23 $\Delta = 26^{\circ}45'37''$ Tan = 107.04' $R = 450.00'$ Chd = 206.27' Arc = 210.17' Brg = N31°45'54"E		

**SEA SHADOW PROFILE**

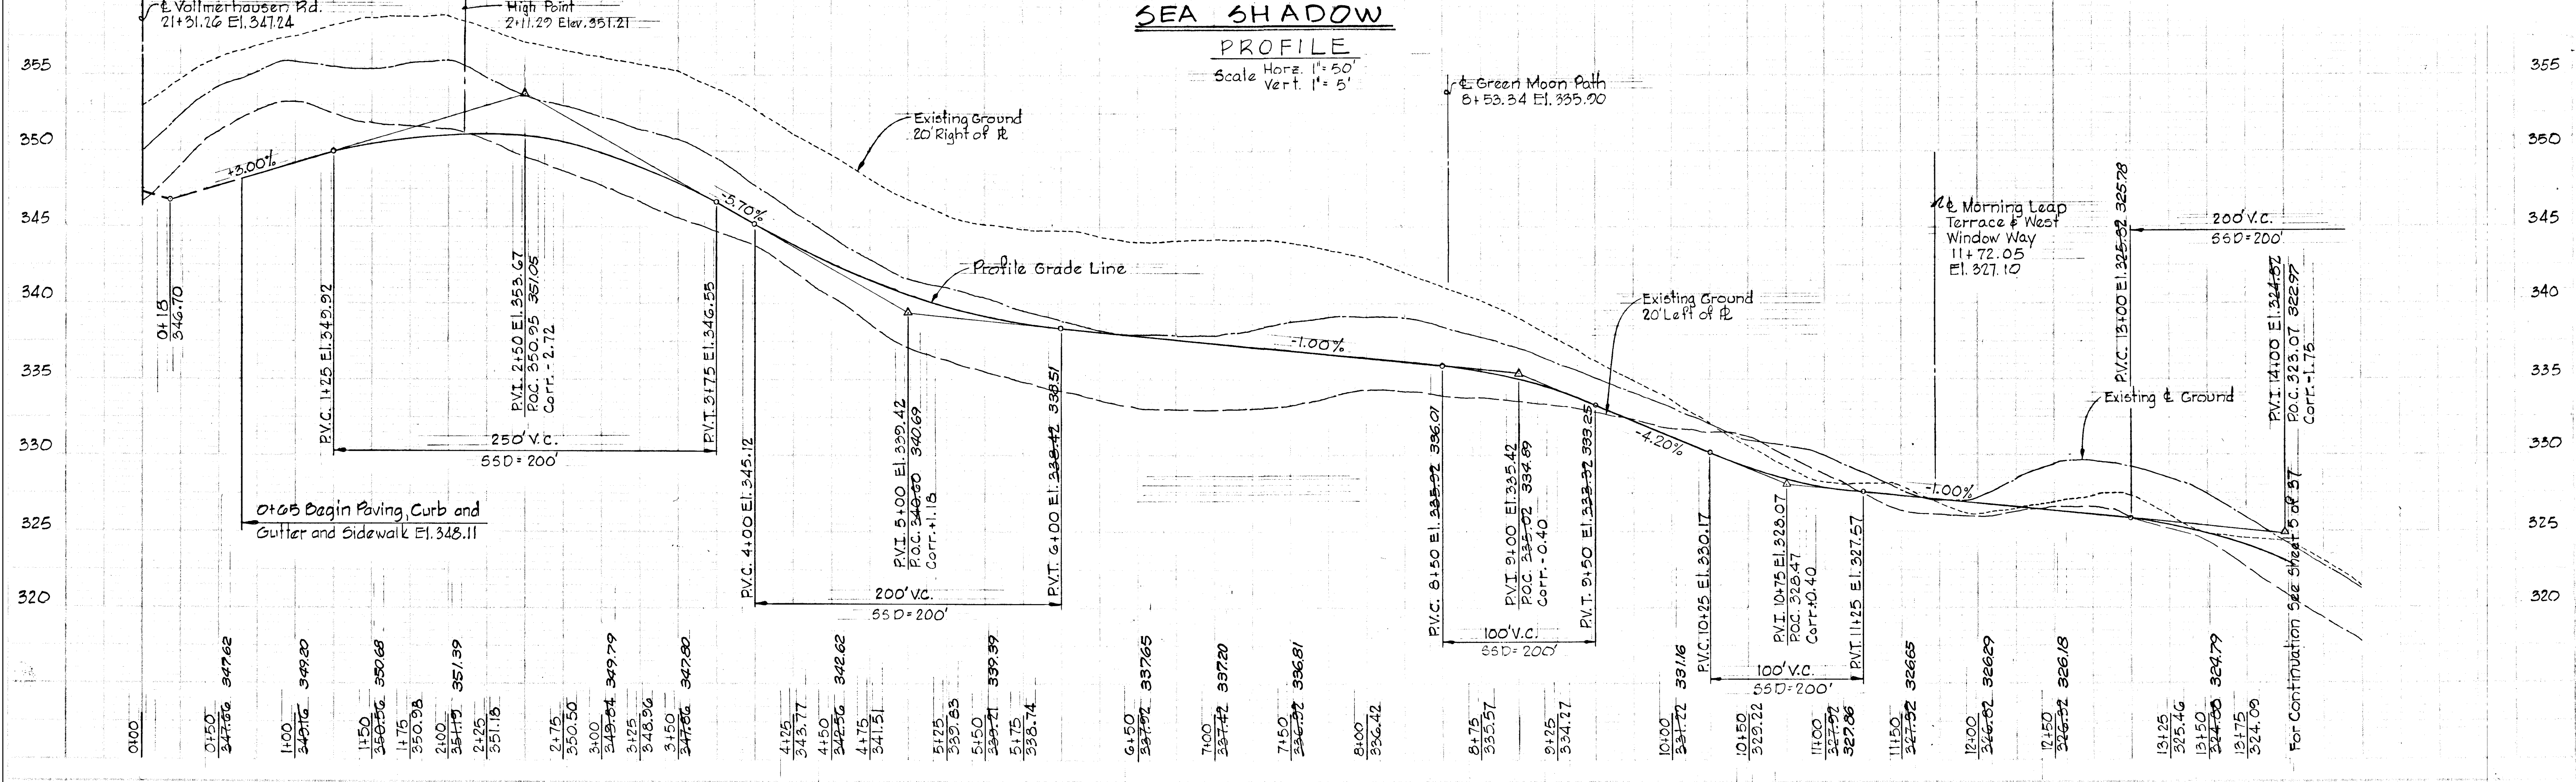

Rev. Date	Rev. No.	Revision Description

**COLUMBIA**  
 6th ELECTION DISTRICT  
 HOWARD COUNTY, MARYLAND

OWNER AND DEVELOPER  
 HOWARD RESEARCH AND DEVELOPMENT CORP.

PROJECT AREA  
 VILLAGE OF KINGS CONTRIVANCE  
 SECTION 3 AREA 1

PROJECT TITLE  
 PLAN AND PROFILE  
 SEA SHADOW  
 STA. 0+00 TO STA. 14+00

SCALE: AS SHOWN DATE


WHITMAN, REARDOT & ASSOCIATES  
 ENGINEERS  
 BALTIMORE, MARYLAND 21202

*Kenneth A. McCord*  
 KENNETH A. MCCORD  
 Registered Engineer  
 No. 1974



NOTE: Storm Water Management Pond #3 See Sheet 35 of 37 For Plan & Section

OPEN SPACE LOT 281

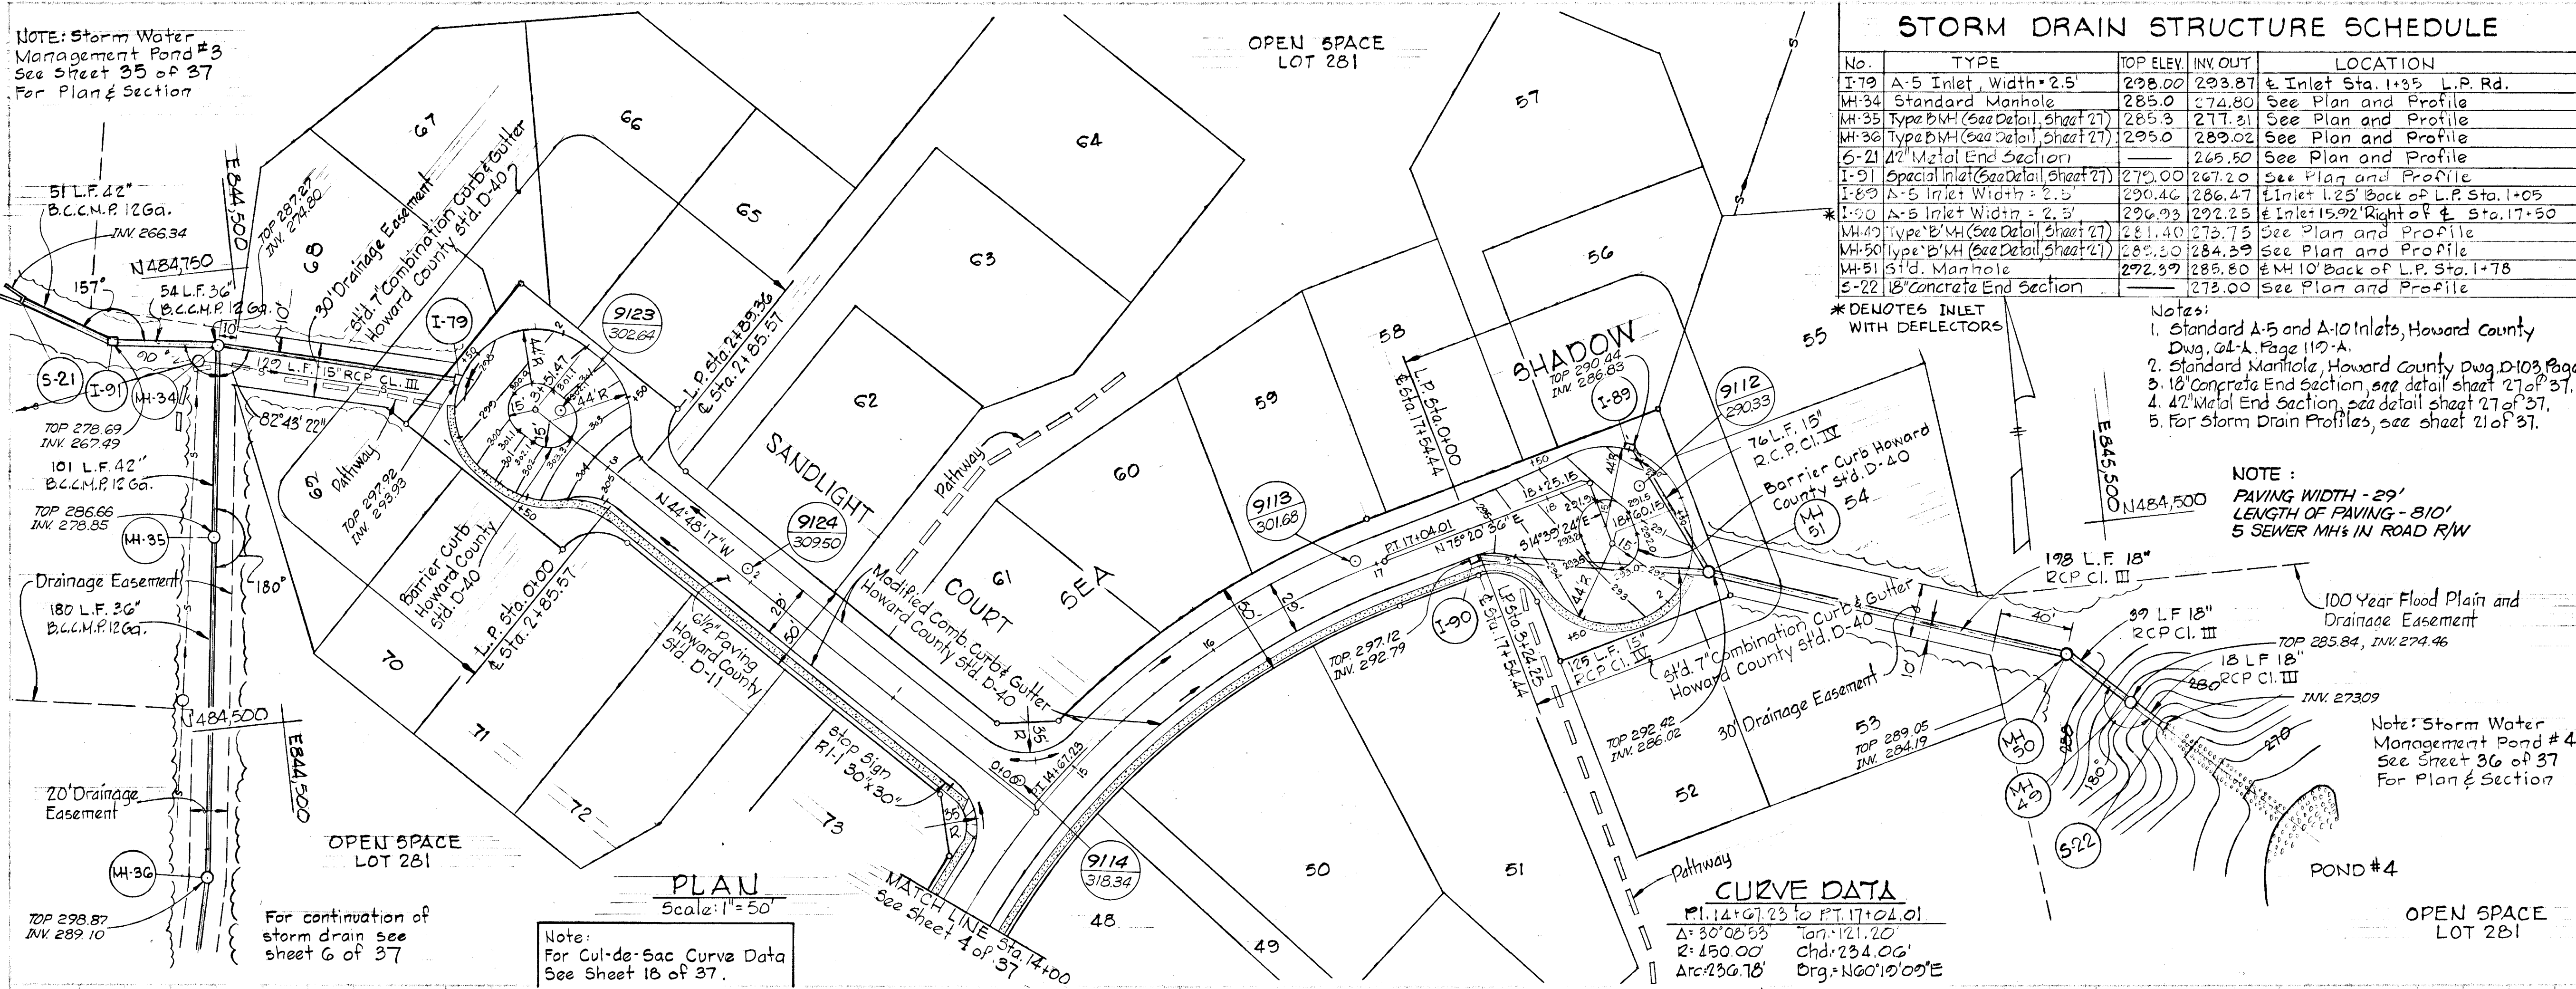

STORM DRAIN STRUCTURE SCHEDULE

No.	TYPE	TOP ELEV.	INV. OUT	LOCATION
I-79	A-5 Inlet, Width = 2.5'	278.00	273.87	At Inlet Sta. 1+35 L.P. Rd.
MH-34	Standard Manhole	285.0	274.80	See Plan and Profile
MH-35	Type B/MH (See Detail, Sheet 27)	285.3	277.31	See Plan and Profile
MH-36	Type B/MH (See Detail, Sheet 27)	285.0	289.02	See Plan and Profile
S-21	42" Metal End Section		269.50	See Plan and Profile
I-91	Special Inlet (See Detail, Sheet 27)	279.00	267.20	See Plan and Profile
I-90	A-5 Inlet Width = 2.5'	290.46	286.47	Inlet 1.25' Back of L.P. Sta. 1+05
I-92	A-5 Inlet Width = 2.5'	296.93	292.23	Inlet 15.92' Right of L.P. Sta. 17+50
MH-40	Type B/MH (See Detail, Sheet 27)	281.40	275.75	See Plan and Profile
MH-50	Type B/MH (See Detail, Sheet 27)	285.30	284.39	See Plan and Profile
MH-51	Std. Manhole	272.97	285.80	At MH 10' Back of L.P. Sta. 1+78
S-22	18" Concrete End Section		273.00	See Plan and Profile

DEPARTMENT OF PUBLIC WORKS  
 W. F. Lubert 12-29-78  
 CHIEF, BUREAU OF ENGINEERING DATE  
 OFFICE OF PLANNING AND ZONING  
 John W. Muscelman (S.D.) 12-27-78  
 CHIEF, DIVISION OF LAND DEVELOPMENT DATE

"AS-BUILT" ELEVATIONS VERIFIED AS OF DECEMBER 20, 1979 BY KENNETH A. McCORD MD. REG. P.E. No. 1974

- Notes:
- Standard A-5 and A-10 Inlets, Howard County Dwg. 04-A, Page 117-A.
  - Standard Manhole, Howard County Dwg. D-103, Page 158.
  - 18" Concrete End Section, see detail sheet 27 of 37.
  - 42" Metal End Section, see detail sheet 27 of 37.
  - For Storm Drain Profiles, see sheet 21 of 37.

NOTE: PAVING WIDTH - 29' LENGTH OF PAVING - 310' 5 SEWER MH'S IN ROAD R/W

CURVE DATA

PI. 14+67.23 TO PT. 17+04.01  
 $\Delta = 30^{\circ}05'55''$  Tan. 121.20'  
 $R = 450.00'$  Chd. 234.06'  
 Arc 236.78' Org. N60°10'09"E

Rev. Date	Rev. No.	Revision Description
<b>COLUMBIA</b>		
6 <sup>th</sup> ELECTION DISTRICT HOWARD COUNTY, MARYLAND		
OWNER AND DEVELOPER HOWARD RESEARCH AND DEVELOPMENT CORP.		
PROJECT AREA VILLAGE OF KINGS CONTRIVANCE SECTION 3 AREA 1		
PROJECT TITLE PLAN AND PROFILE SEA SHADOW 14+00 TO 18+60.15 SANDLIGHT COURT		
SCALE: AS SHOWN DATE		
WHITMAN, REQUARDT & ASSOCIATES ENGINEERS BALTIMORE, MARYLAND 21202		
Kenneth A. McCord KENNETH A. McCORD Registered Engineer No. 1974		

PLAN


Scale: 1" = 50'

Note: For Cul-de-Sac Curve Data See Sheet 18 of 37.

PROFILE


Scale: Horiz. 1" = 50' Vert. 1" = 5'

SANDLIGHT COURT

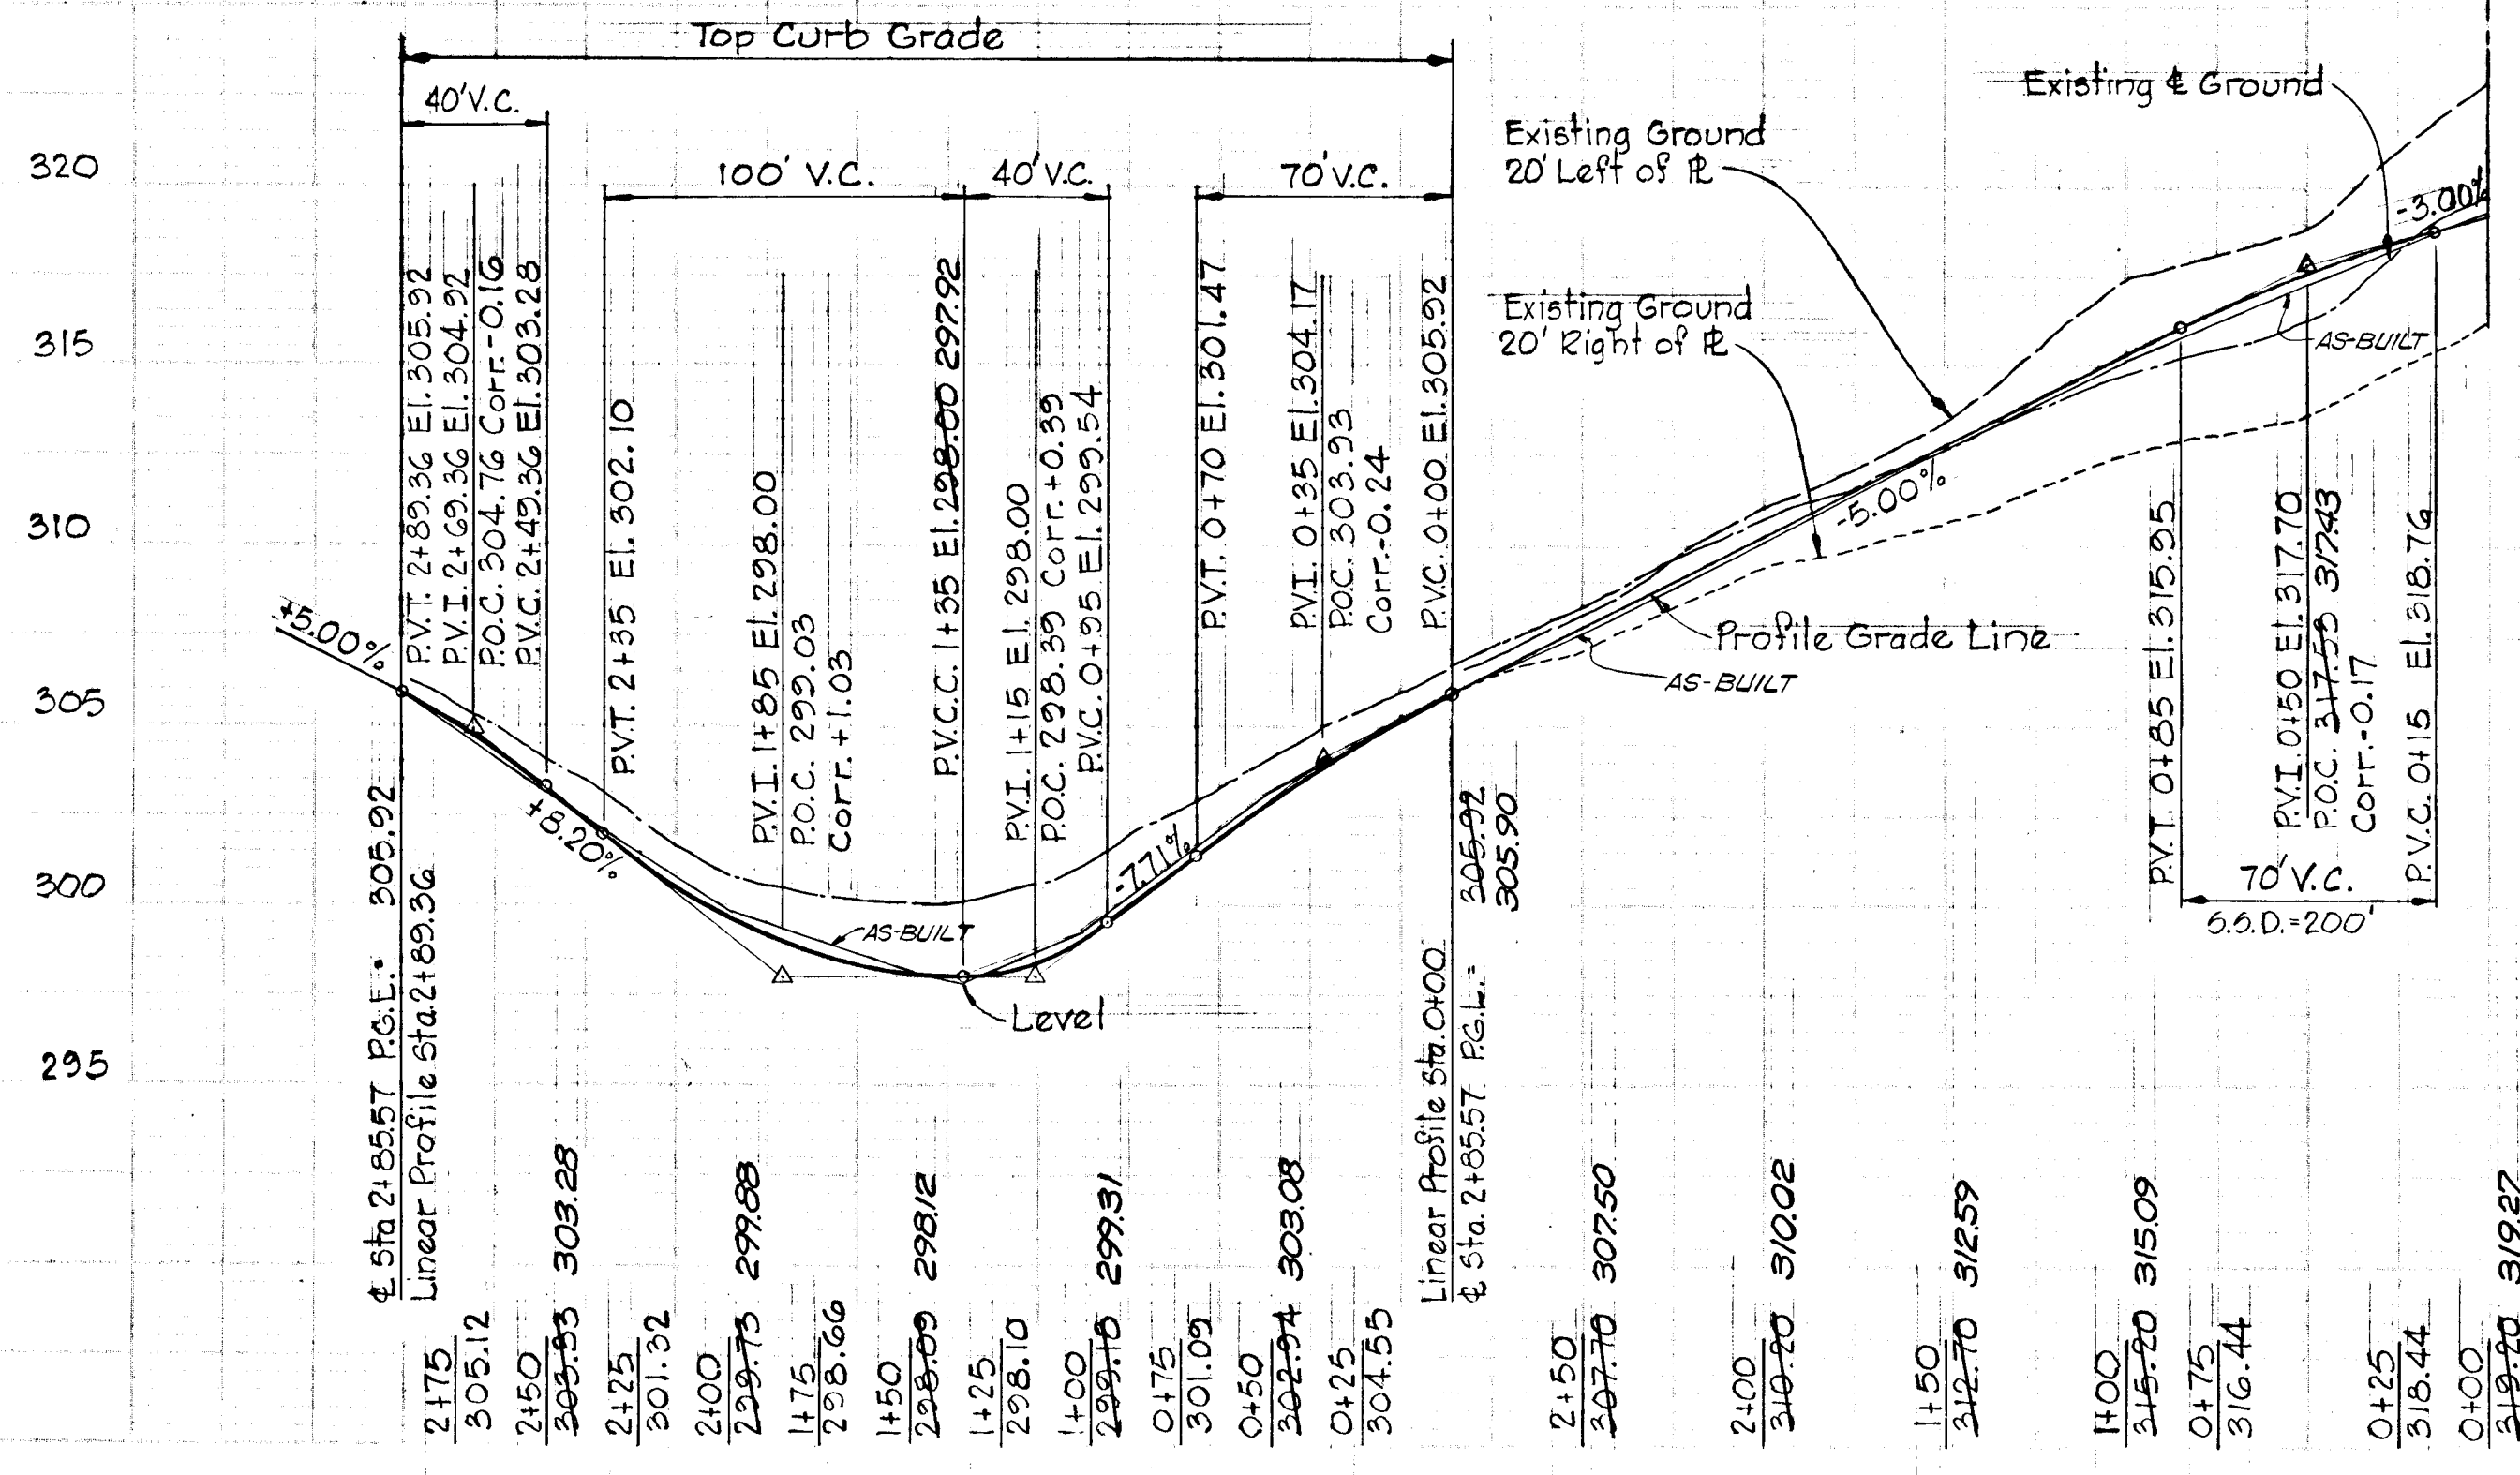

Sea Shadow 14+67.23 El. 319.20

SEA SHADOW


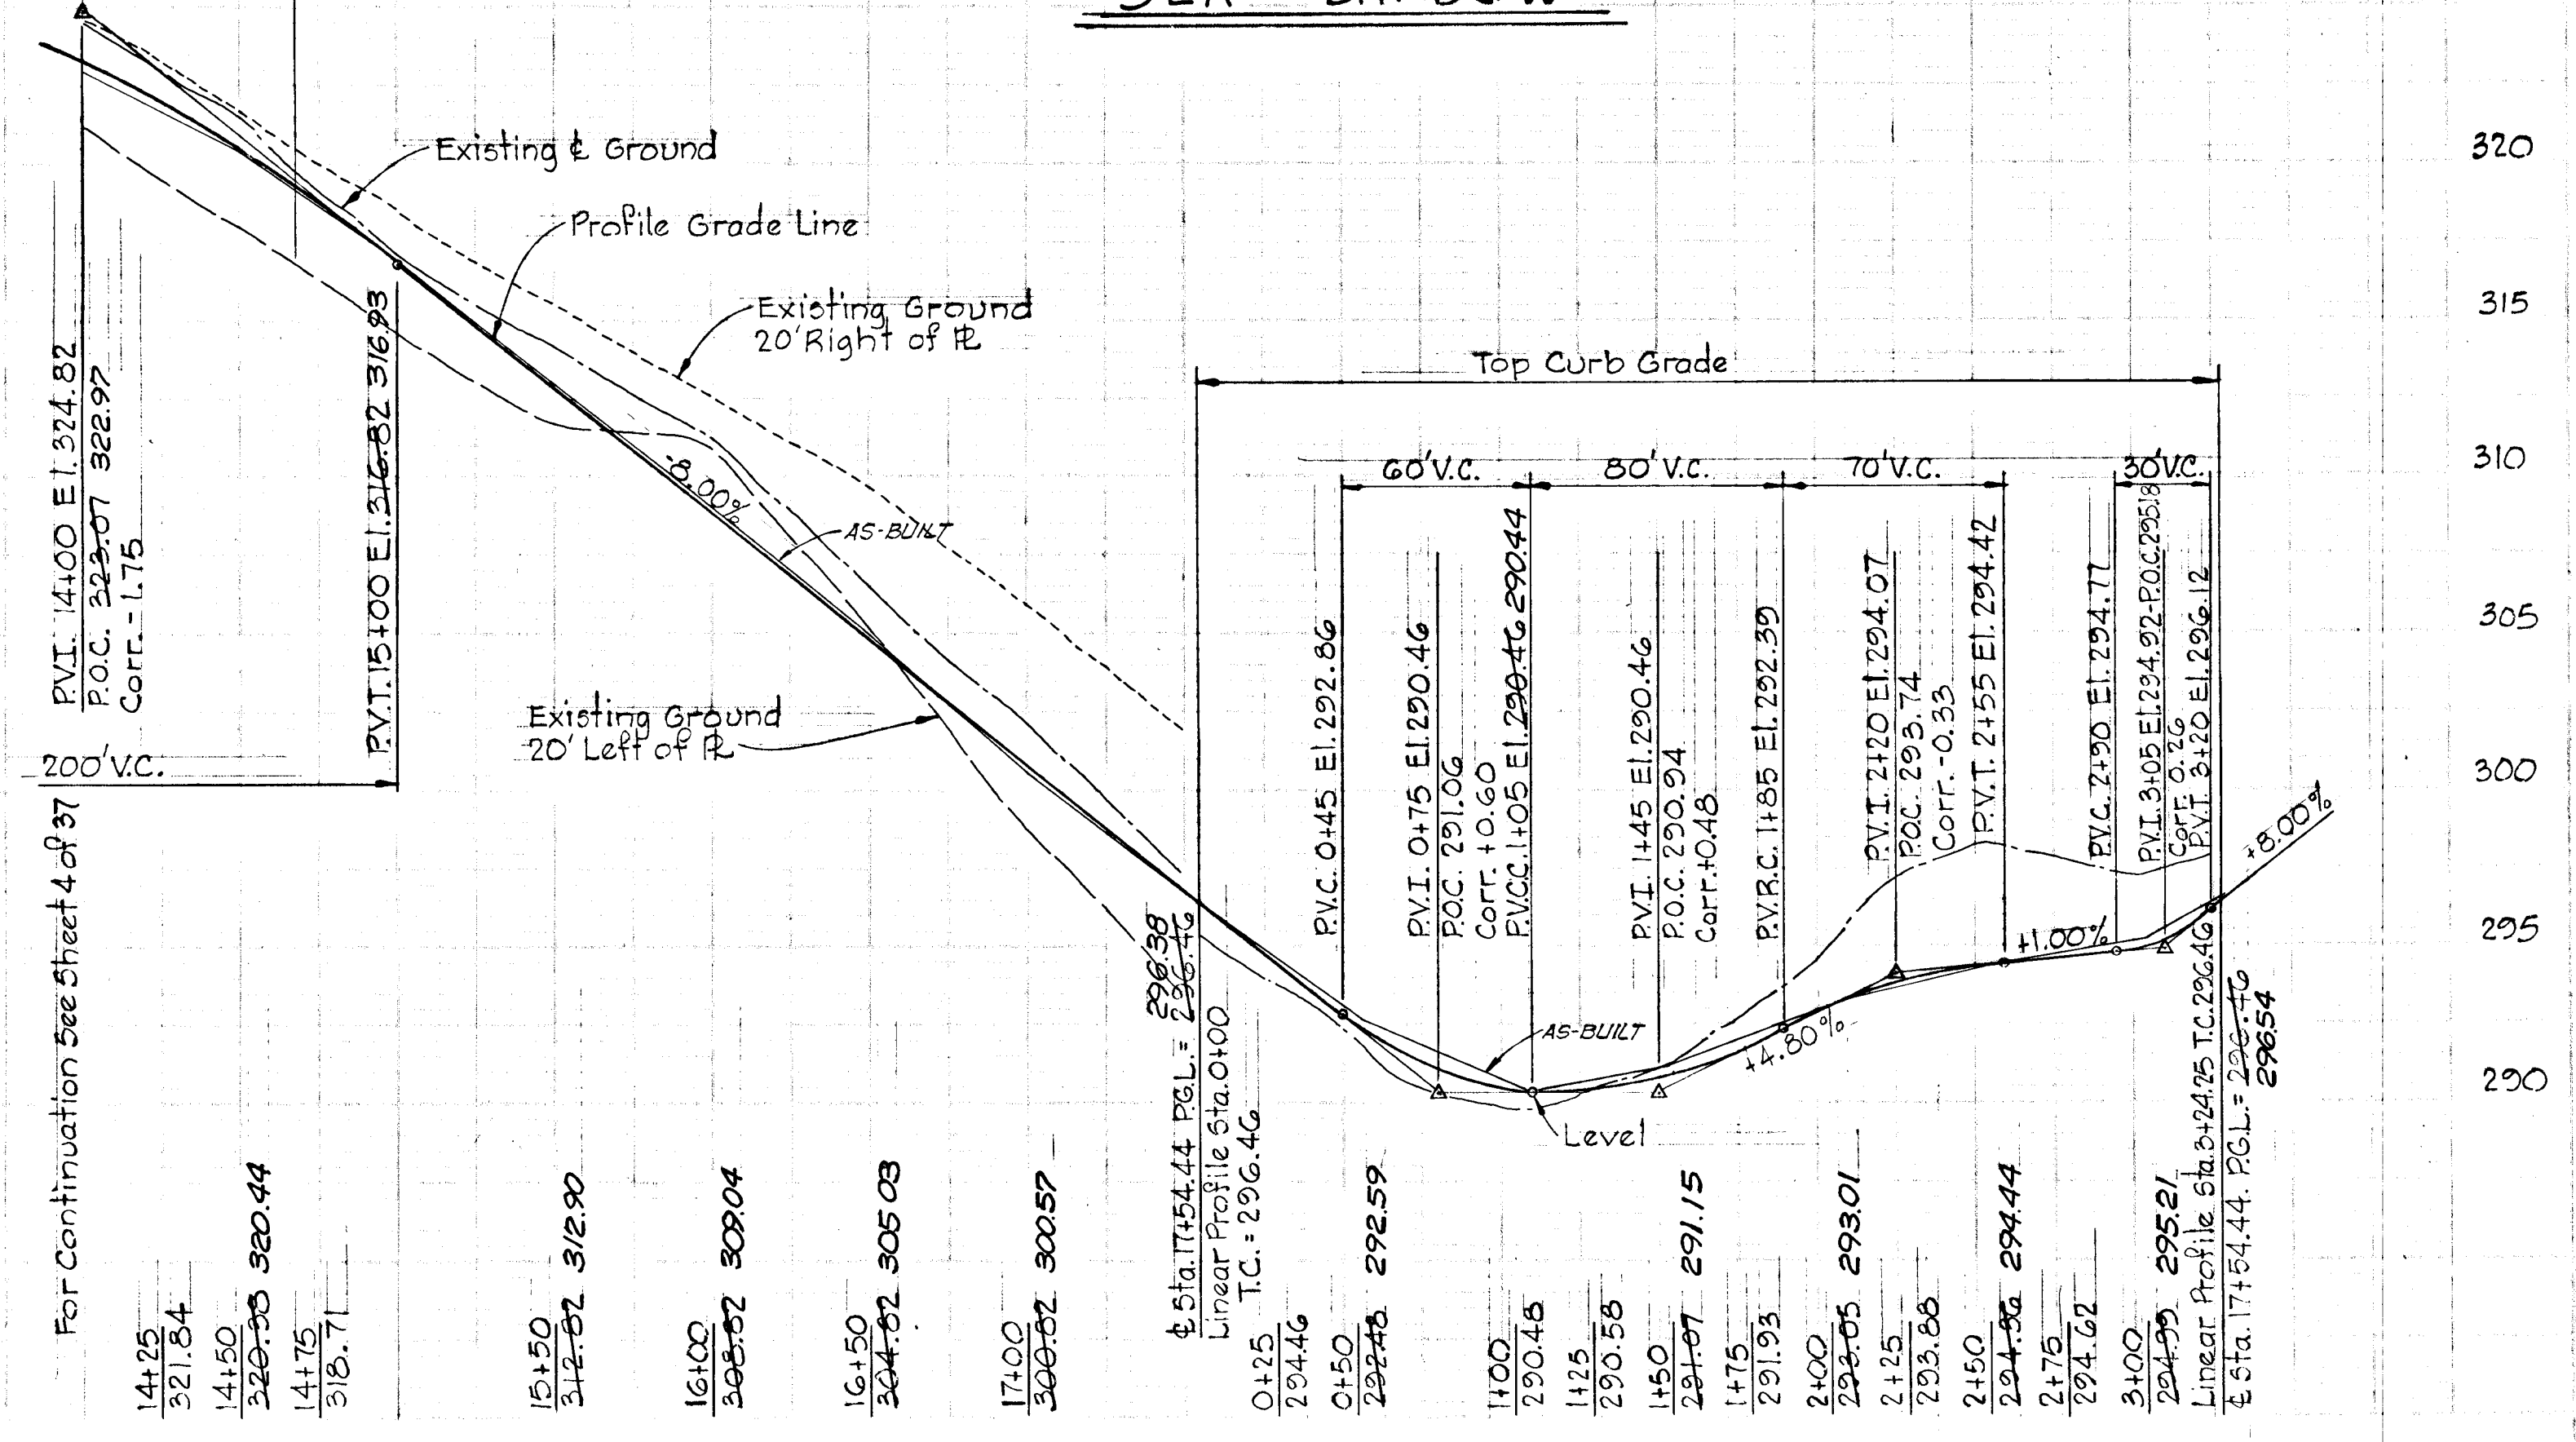




'AS-BUILT' ELEVATIONS VERIFIED BY KENNETH A. McCORD MD. REG. P.E. No. 1974 AS OF DECEMBER 20, 1979

Note  
 For Cul-De-Sac Curve Data  
 See Sheet 18 of 37




NOTE:  
 PAVING WIDTH - 29'  
 LENGTH OF PAVING - 700'  
 3-SEWER MH'S IN ROAD R/W

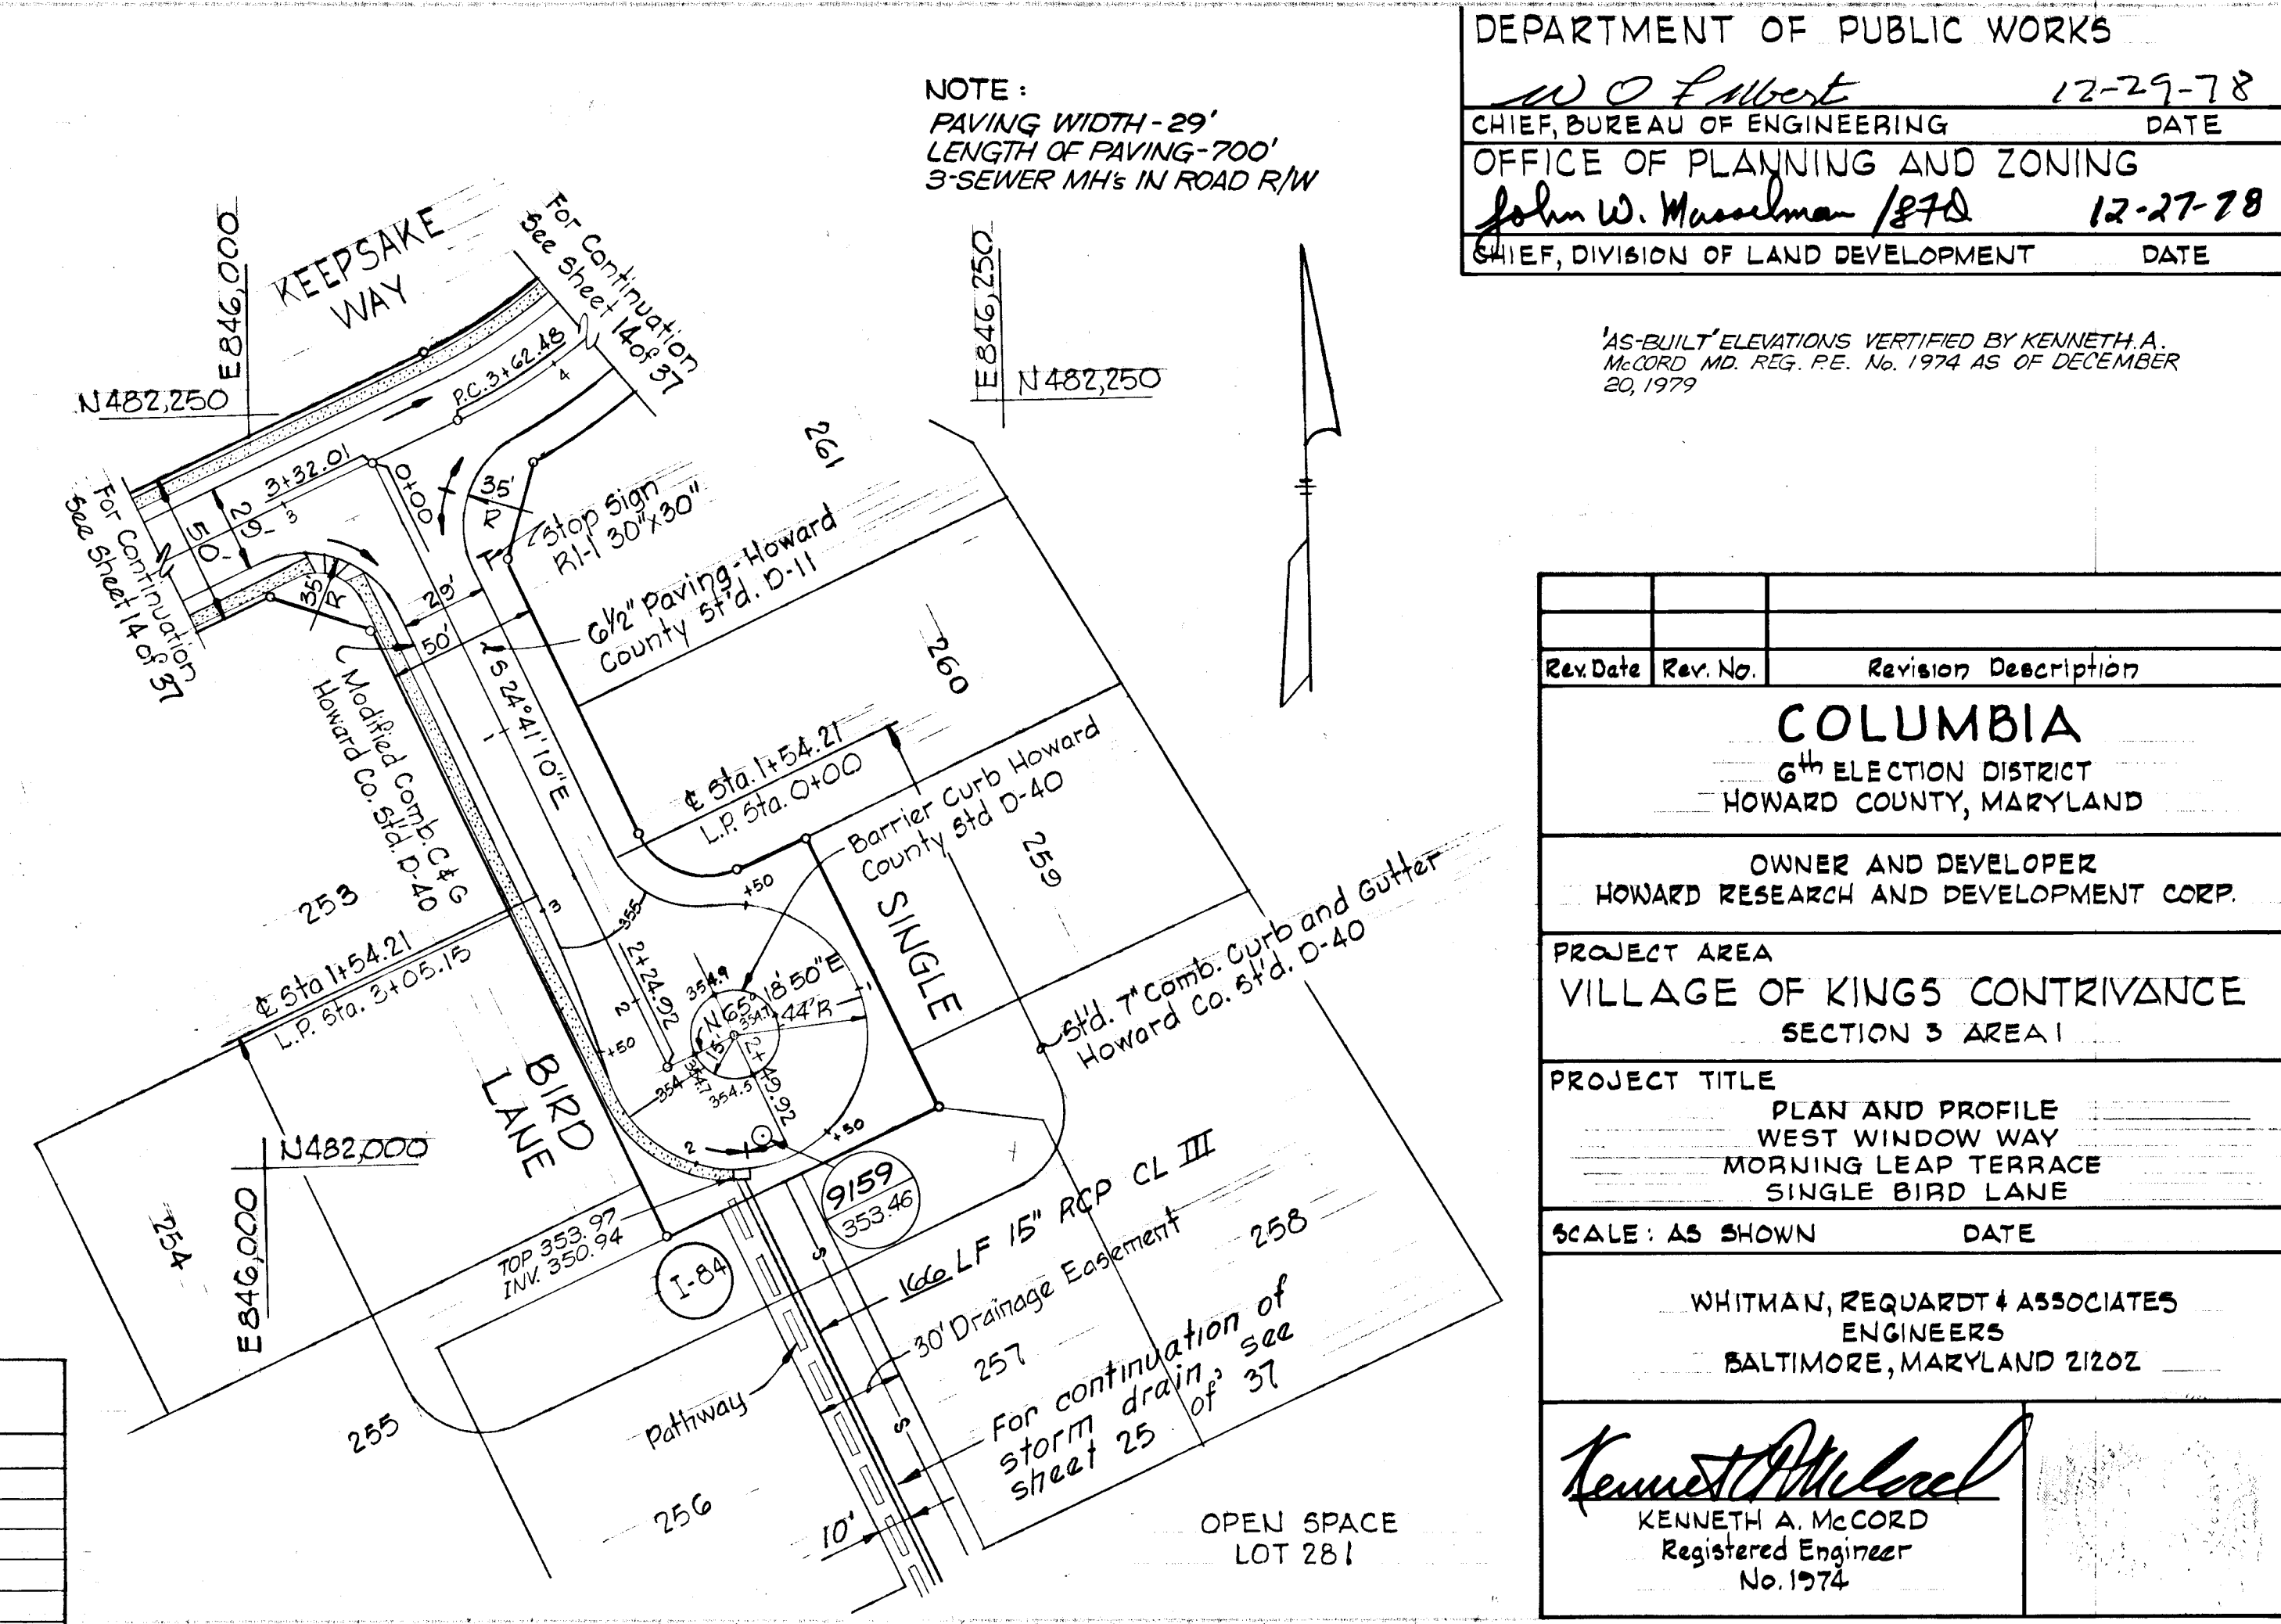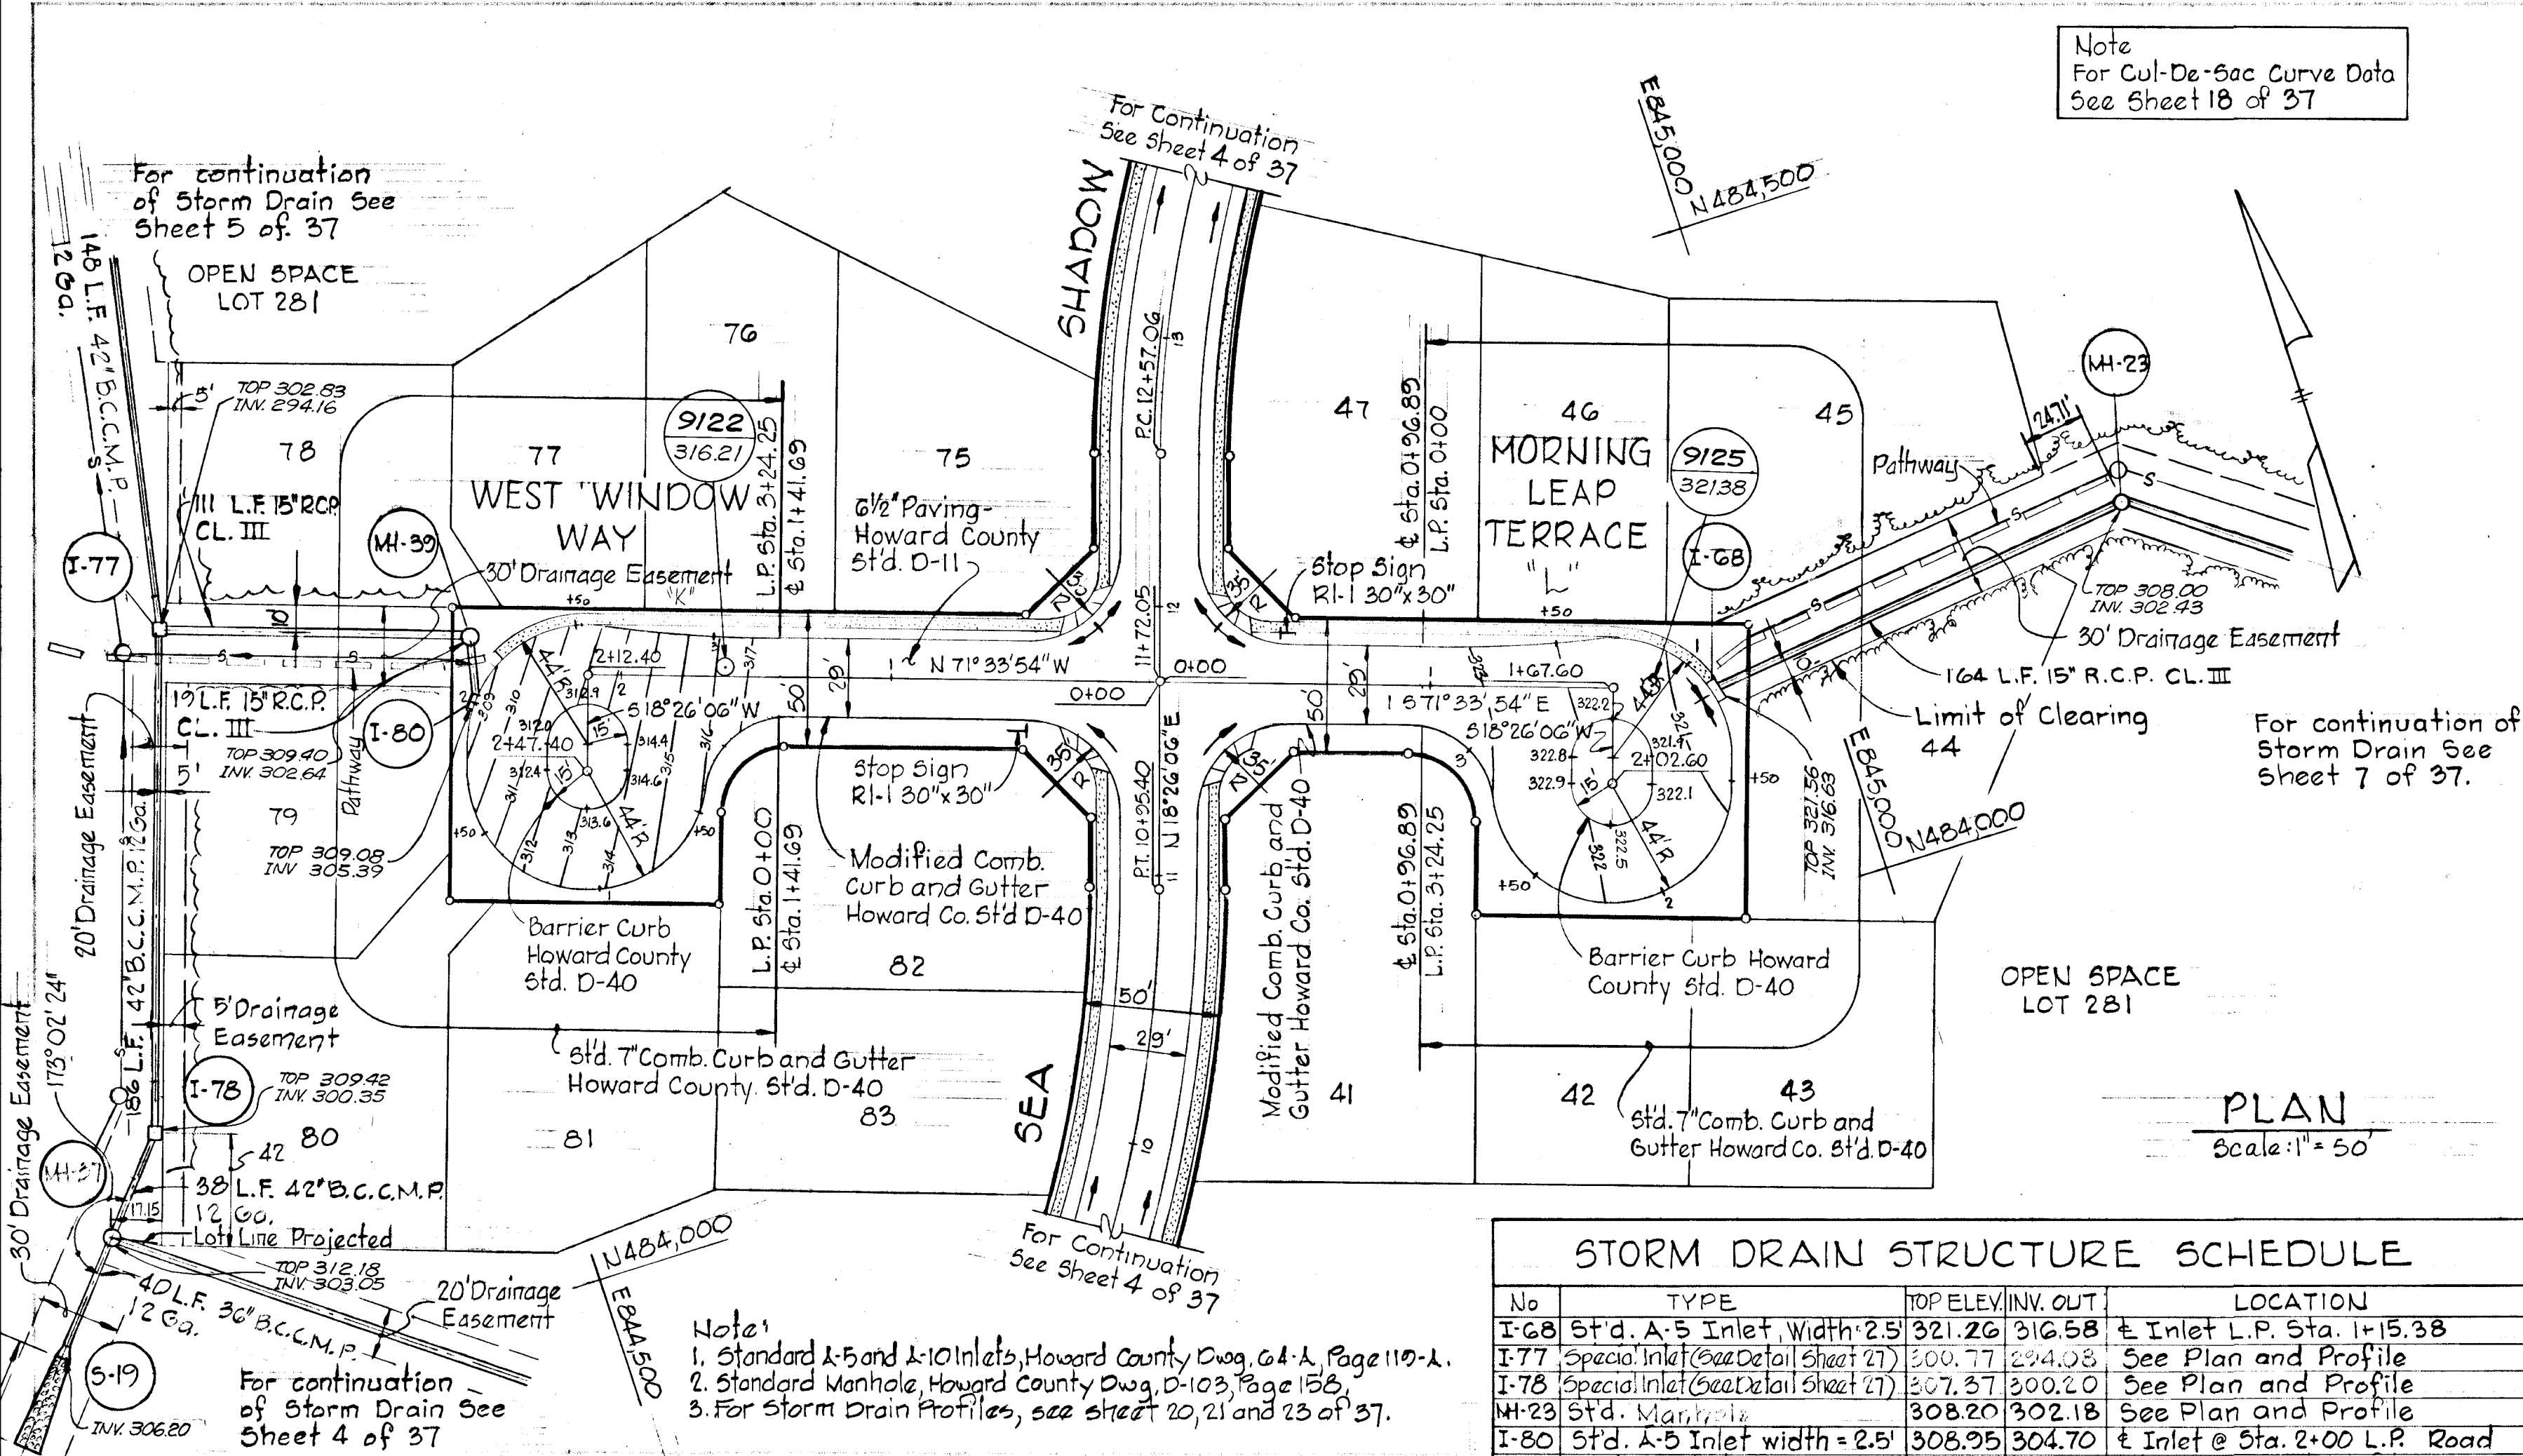

PLAN  
 Scale: 1" = 50'

No	TYPE	TOP ELEV./INV. OUT	LOCATION
I-68	Std. A-5 Inlet Width=2.5	321.26 / 316.58	Inlet L.P. Sta. 1+15.38
I-77	Special Inlet (See Detail Sheet 27)	300.77 / 294.08	See Plan and Profile
I-78	Special Inlet (See Detail Sheet 27)	307.37 / 300.20	See Plan and Profile
M-23	Std. Manhole	308.20 / 302.18	See Plan and Profile
I-80	Std. A-5 Inlet width=2.5	308.95 / 304.70	Inlet @ Sta. 2+00 L.P. Road
M-39	Std. Manhole	309.91 / 302.39	@ MH 15' back of L.P. Sta. 2+17
I-84	Std. A-5 Inlet Width=2.5	308.95 / 300.76	Inlet @ Sta. 1+85.71 L.P. Single Bird Lane
M-37	Type B MH (See Detail Sheet 27)	309.00 / 302.21	See Plan and Profile
S-19	Type A Headwall (See Detail Sheet 18)	302.56	See Plan and Profile

Notes:  
 1. Standard 1-5 and 1-10 Inlets, Howard County Div. 64-A, Page 110-A.  
 2. Standard Manhole, Howard County Div. D-103, Page 153.  
 3. For Storm Drain Profiles, see sheet 20, 21 and 23 of 37.

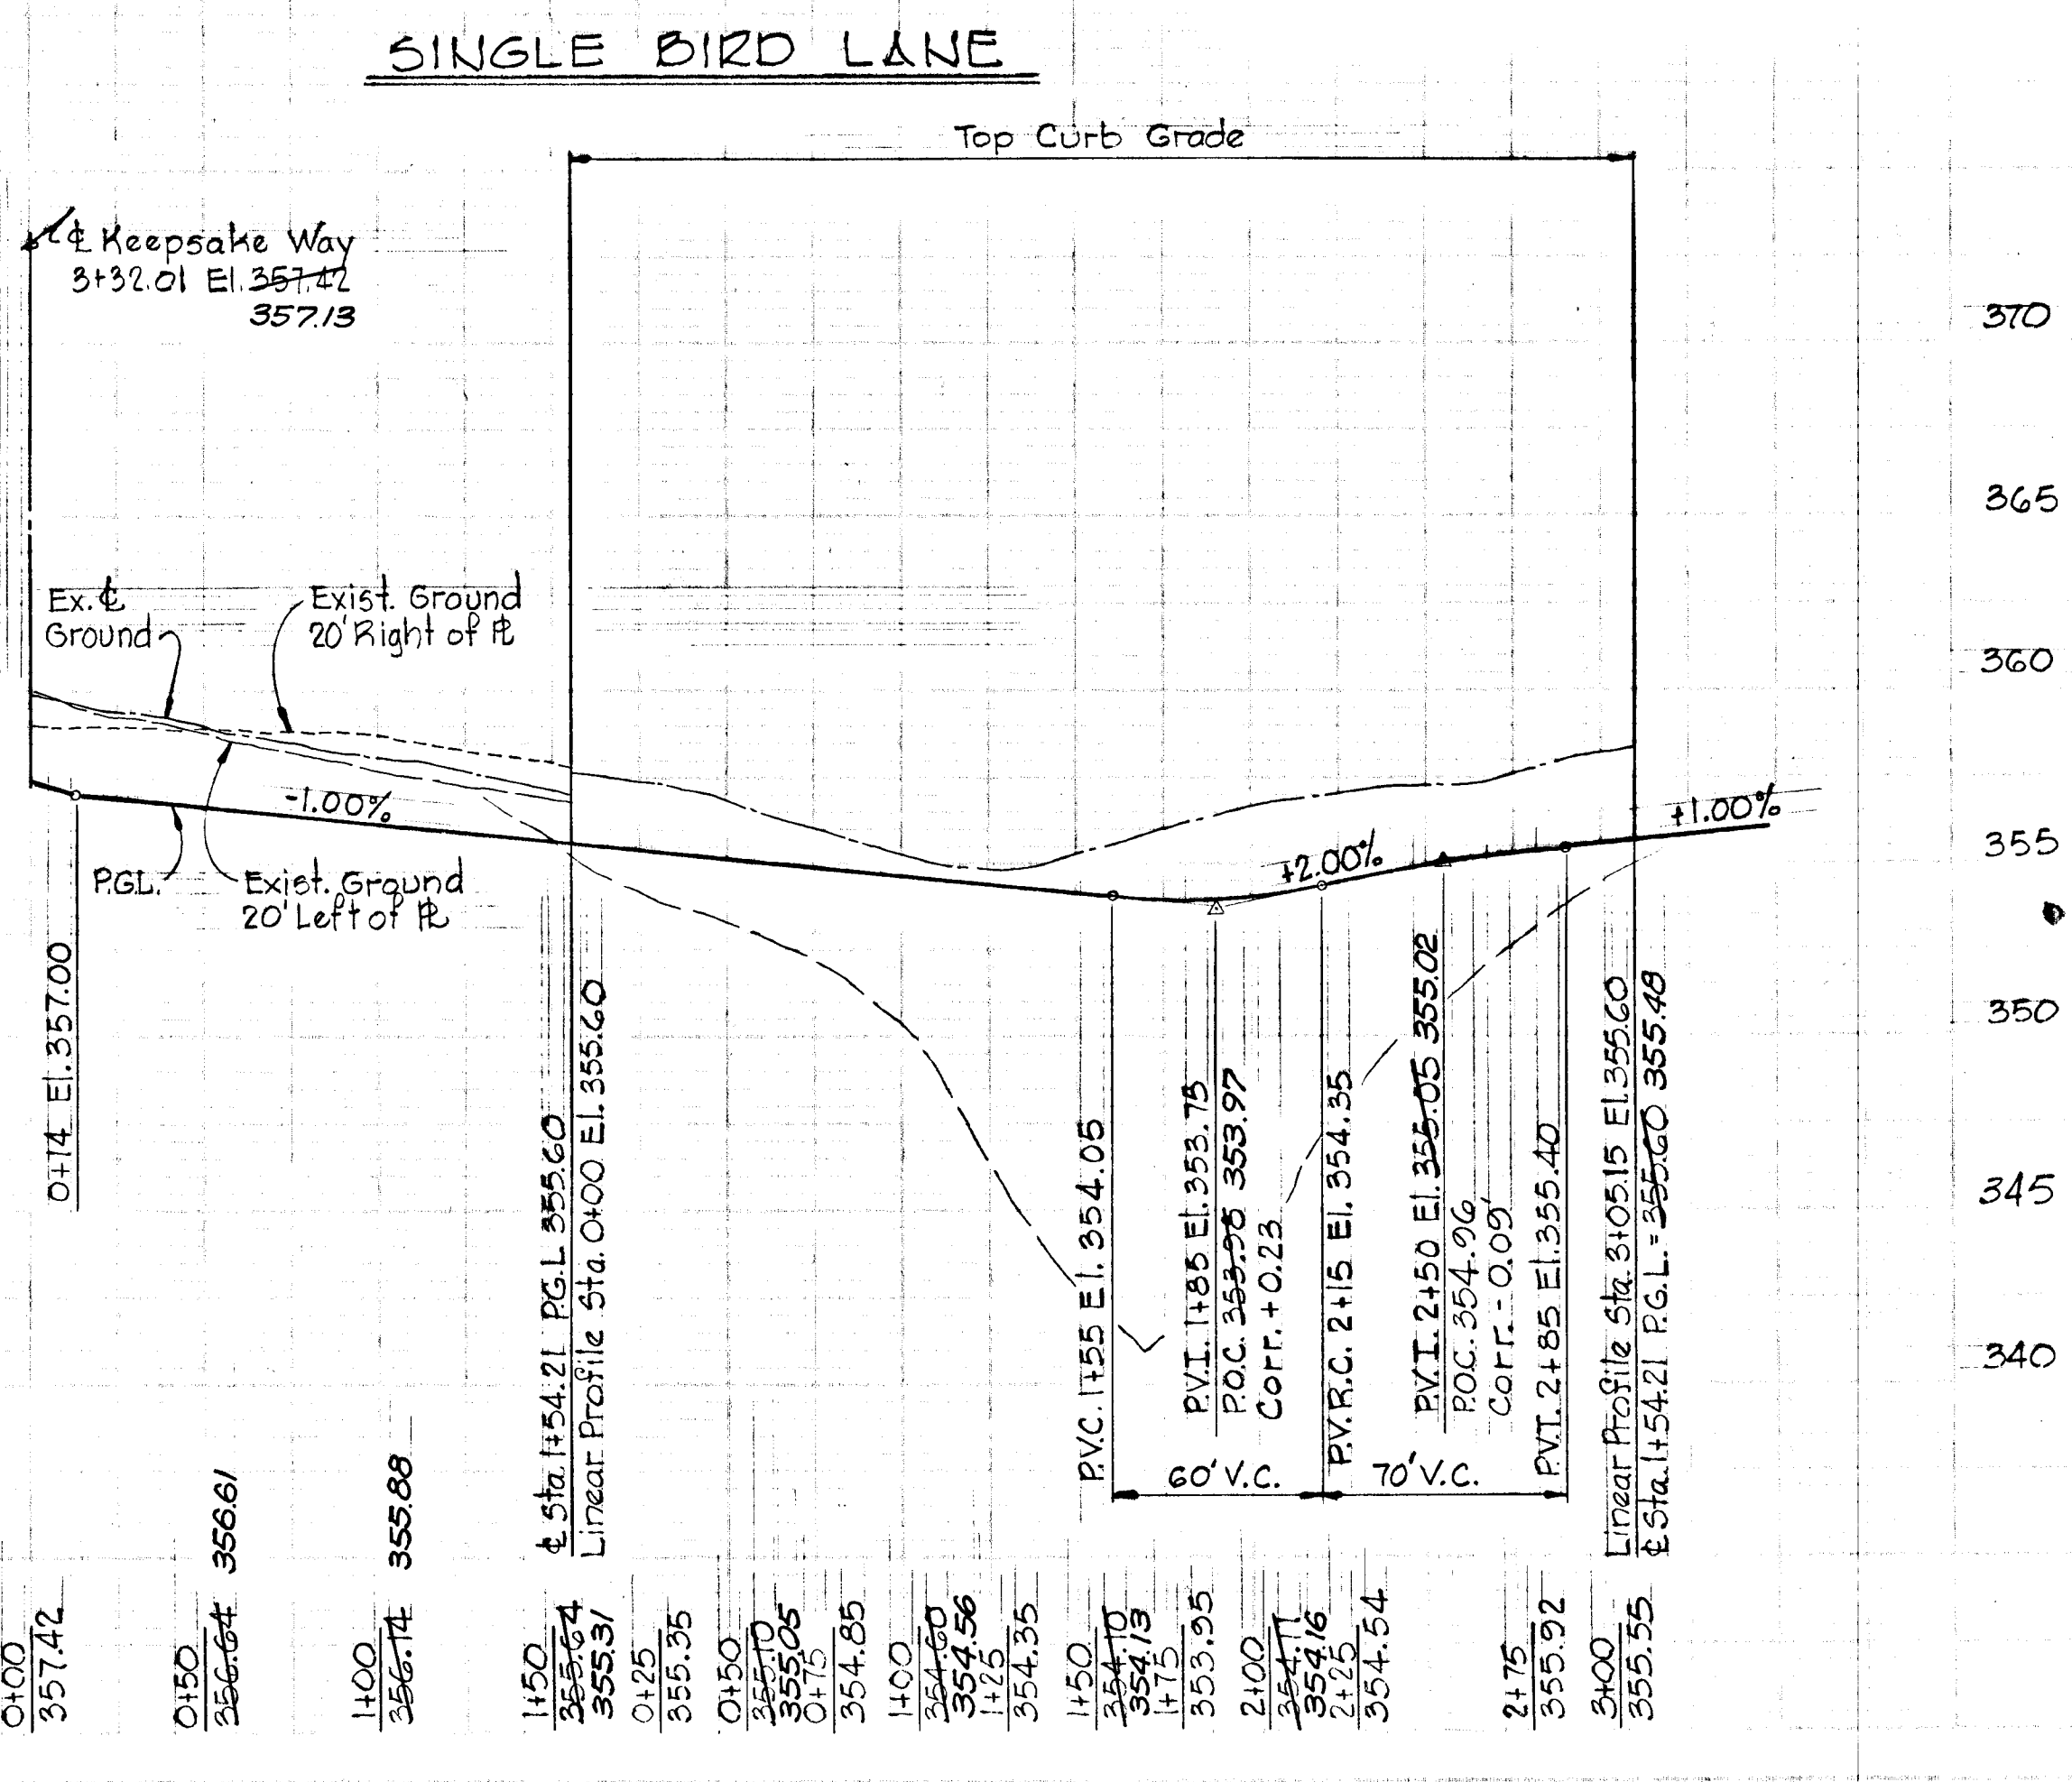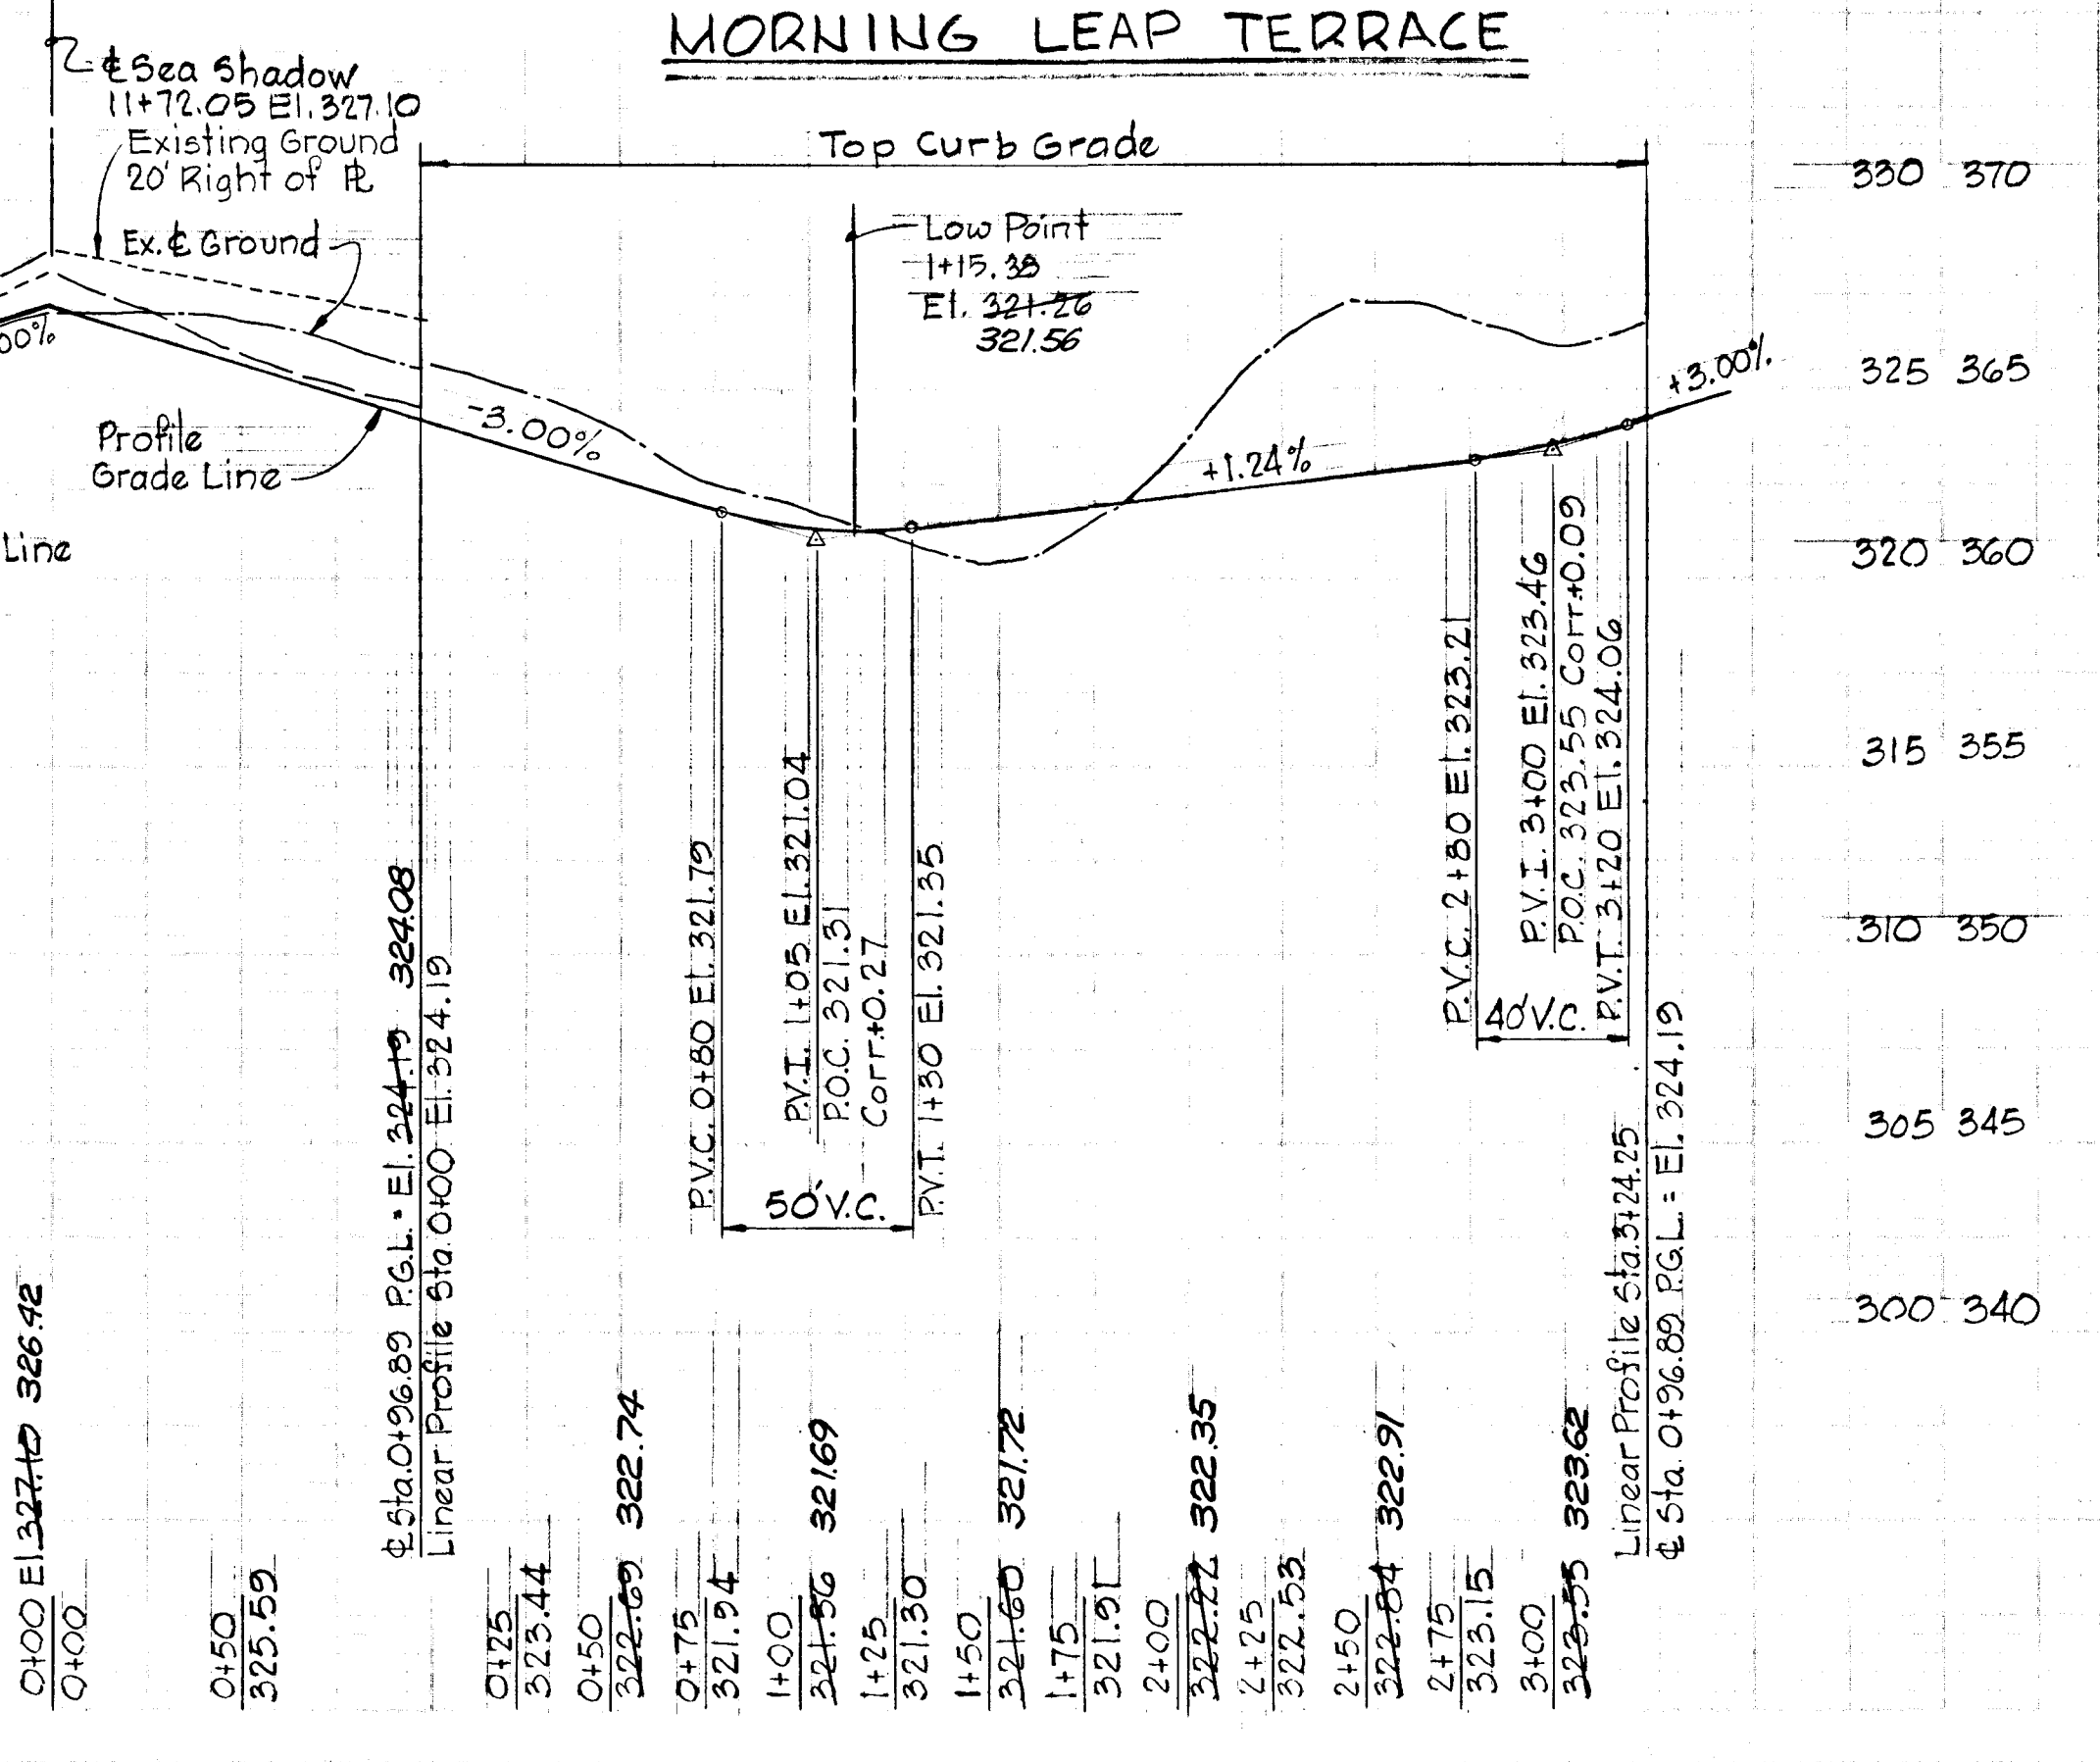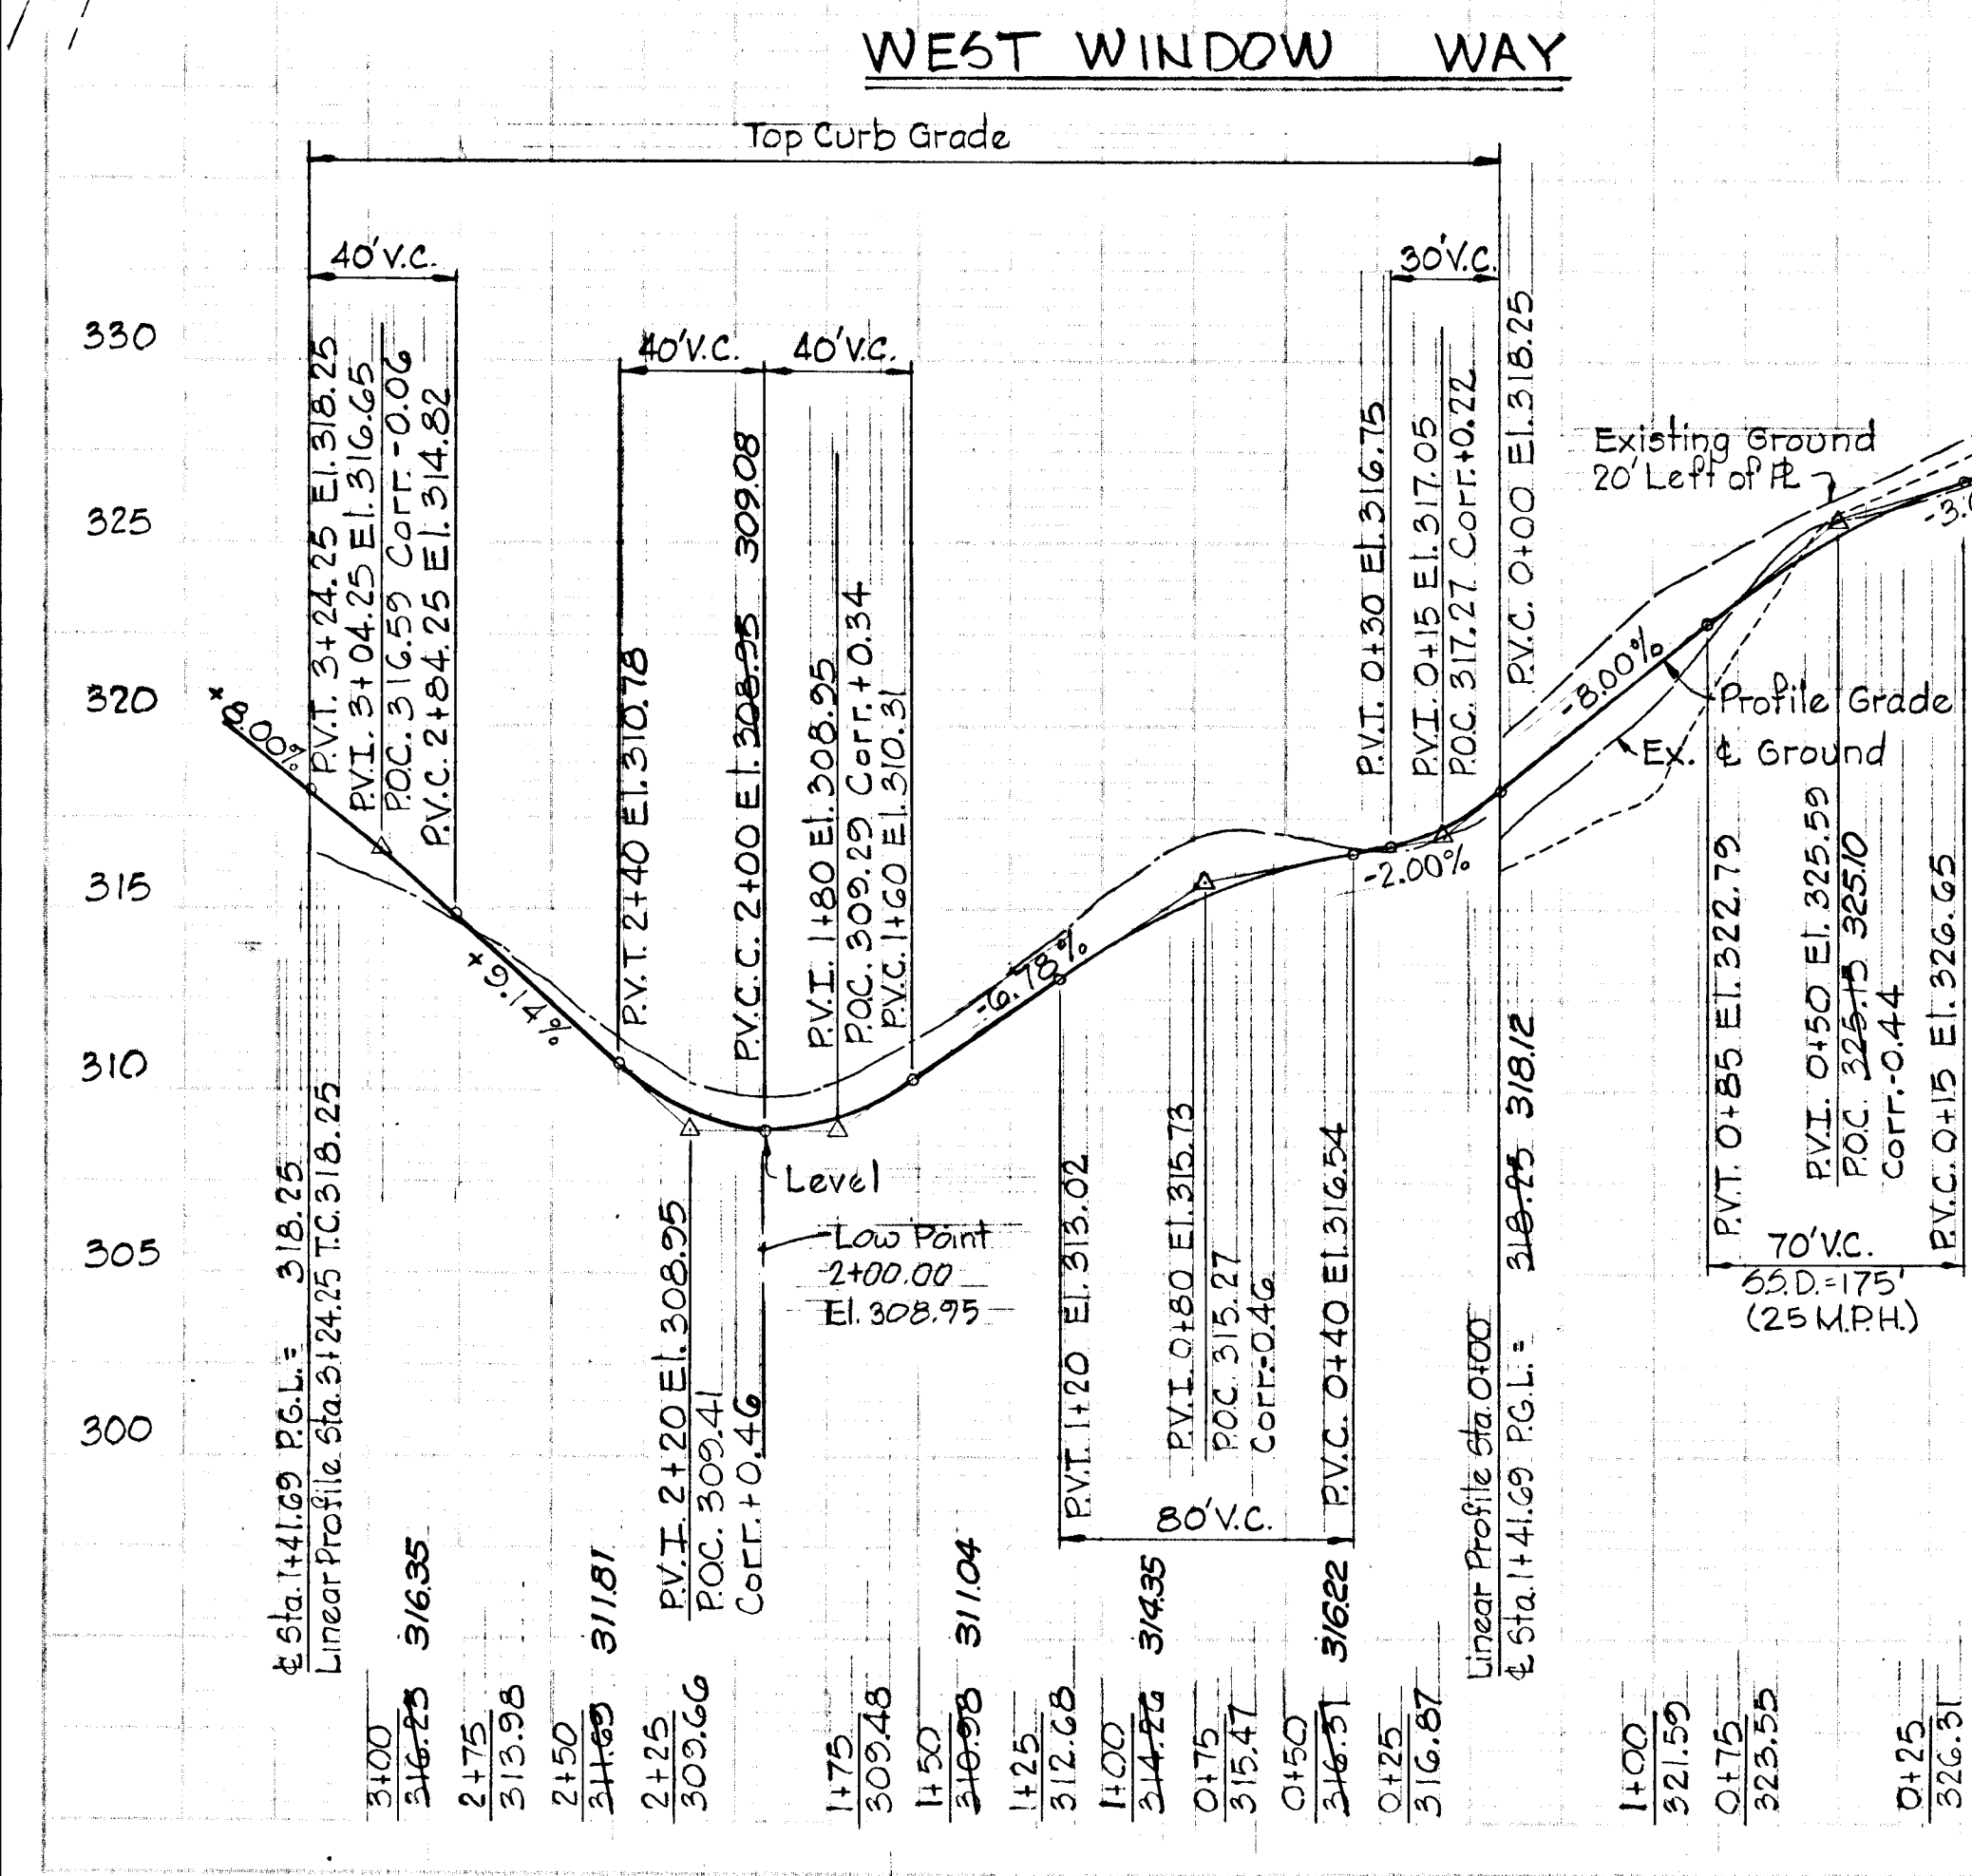

Rev. Date	Rev. No.	Revision Description

**COLUMBIA**  
 6th ELECTION DISTRICT  
 HOWARD COUNTY, MARYLAND

OWNER AND DEVELOPER  
 HOWARD RESEARCH AND DEVELOPMENT CORP.

PROJECT AREA  
 VILLAGE OF KINGS CONTRIVANCE  
 SECTION 3 AREA 1

PROJECT TITLE  
 PLAN AND PROFILE  
 WEST WINDOW WAY  
 MORNING LEAP TERRACE  
 SINGLE BIRD LANE

SCALE: AS SHOWN DATE


WHITMAN, REQUARDT & ASSOCIATES  
 ENGINEERS  
 BALTIMORE, MARYLAND 21202

*Kenneth A. McCord*  
 KENNETH A. McCORD  
 Registered Engineer  
 No. 1974



No.	TYPE	TOP ELEV.	INV. OUT	LOCATION
I-5G	Std. A-5 Inlet, Width: 40"	291.00	279.56	± Inlet L.F. Sta. 1+68.45
I-61	Std. A-10 Inlet, Width: 25"	304.81	293.83	± Inlet 15.92' Left of Sta. 9+20.87
MH-14	Type B MH (See Detail Sheet 27)	273.10	271.88	See Plan and Profile
MH-15	Type C MH (See Detail Sheet 27)	291.50	278.30	See Plan and Profile
MH-16	Std. Manhole	293.00	280.15	See Plan and Profile
MH-17	Type B MH (See Detail Sheet 27)	287.00	281.22	See Plan and Profile
5-14	36" Concrete End Section		270.60	See Plan and Profile

- Notes:  
 1. Standard A-5 and A-10 Inlet, Howard County Dwg. G-4-A, Page 110-A.  
 2. Standard Manhole, Howard County Dwg. D-103, Page 156.  
 3. 36" Concrete End Section, see detail sheet 27 of 37.  
 4. For Storm Drain Profiles, see sheet 19 and 20 of 37.

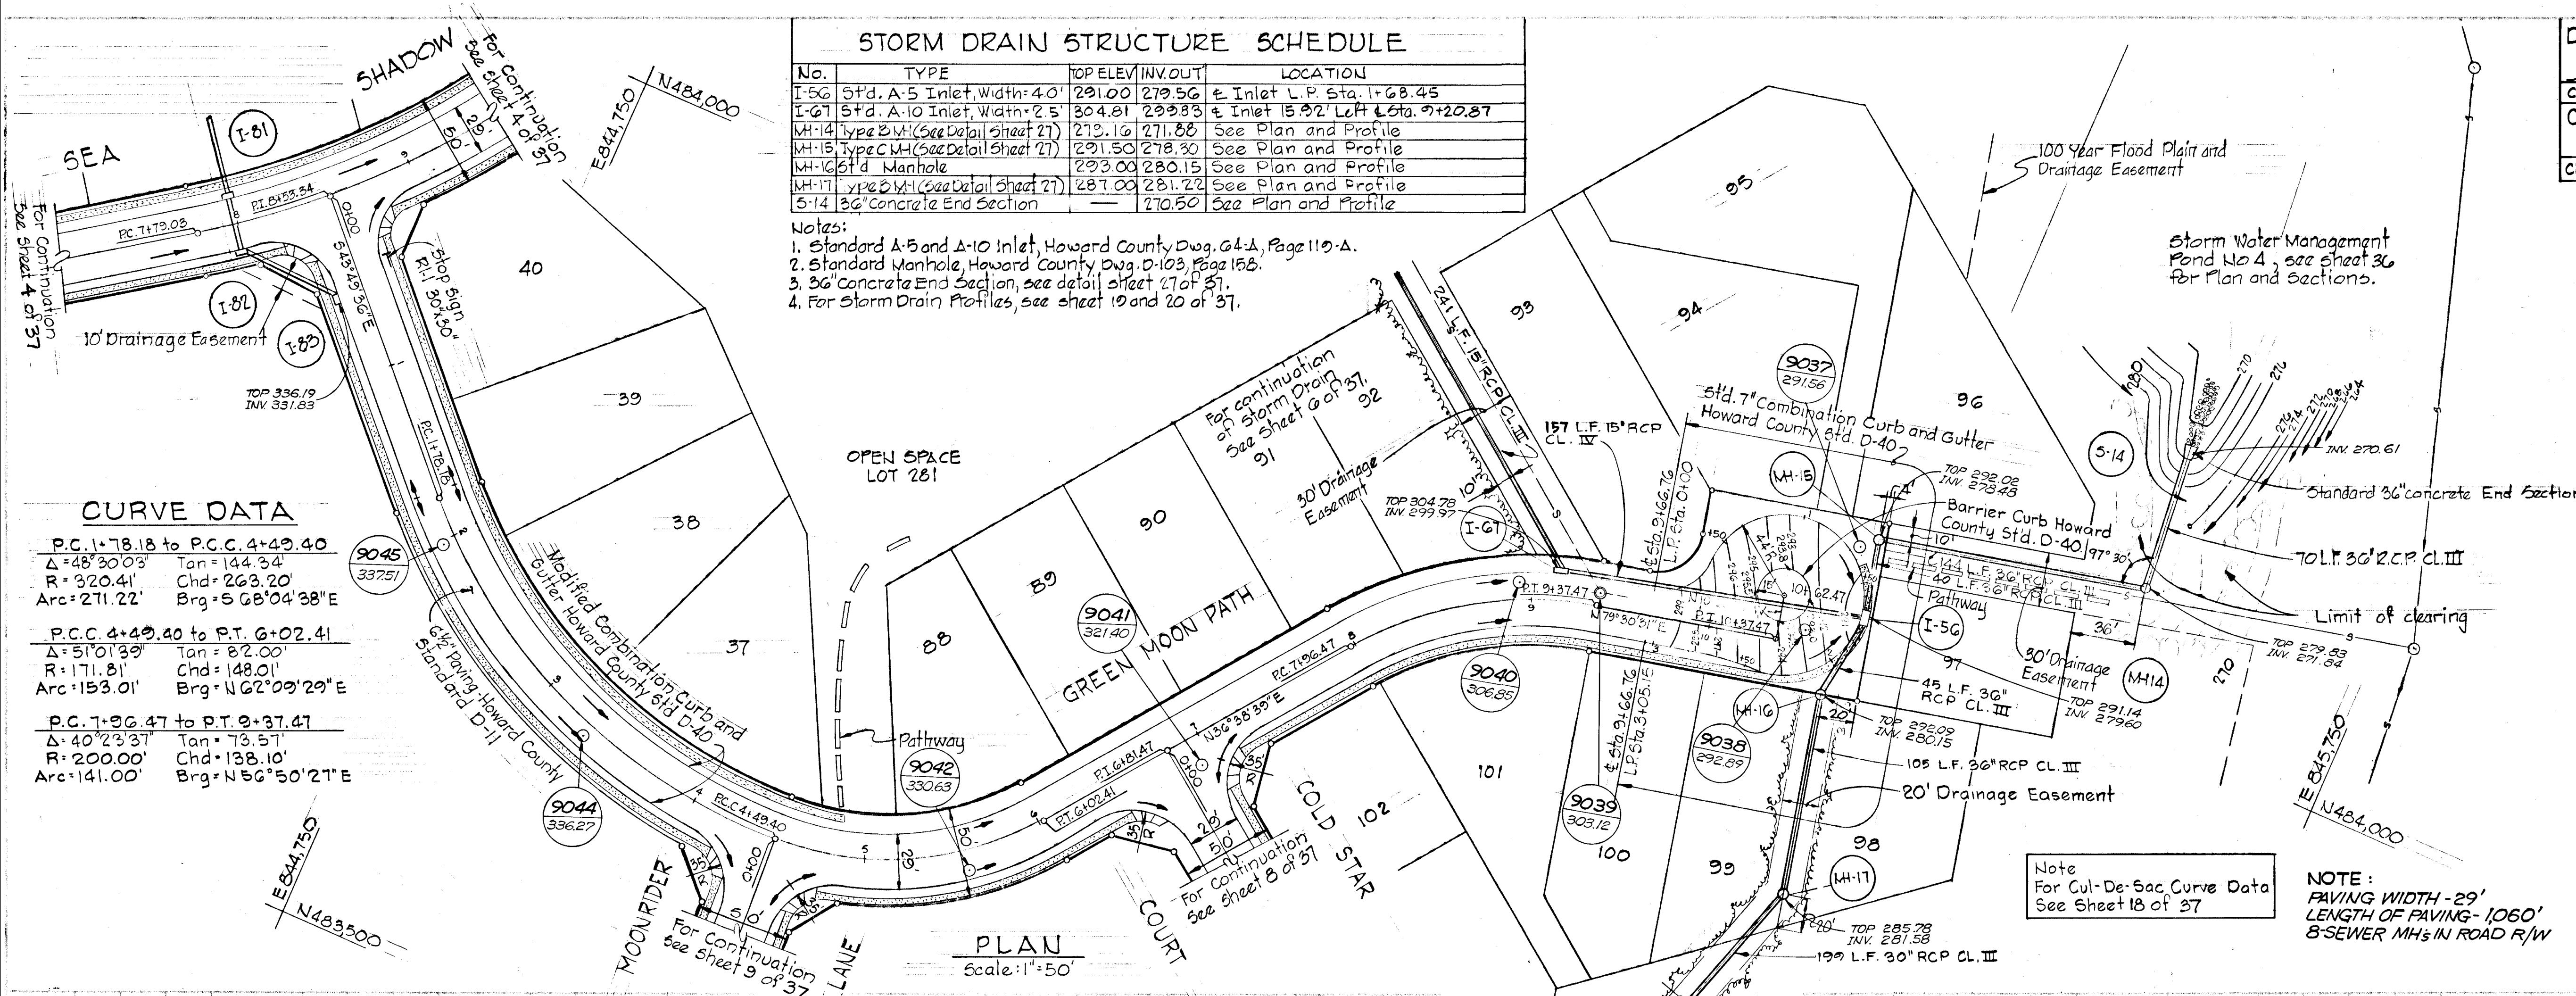

**CURVE DATA**

P.C. 1+78.18 to P.C.C. 4+49.40  
 $\Delta = 48^\circ 30' 03''$  Tan = 144.34  
 $R = 320.41'$  Chd = 263.20'  
 Arc = 271.22' Brg = S 68° 04' 38" E

P.C.C. 4+49.40 to P.T. 6+02.41  
 $\Delta = 51^\circ 01' 39''$  Tan = 82.00'  
 $R = 171.81'$  Chd = 148.01'  
 Arc = 153.01' Brg = N 62° 09' 29" E

P.C. 7+06.47 to P.T. 9+37.47  
 $\Delta = 40^\circ 23' 37''$  Tan = 73.57'  
 $R = 200.00'$  Chd = 138.10'  
 Arc = 141.00' Brg = N 56° 50' 21" E

Rev. Date	Rev. No.	Revision Description

**COLUMBIA**  
 6th ELECTION DISTRICT  
 HOWARD COUNTY, MARYLAND

OWNER AND DEVELOPER  
 HOWARD RESEARCH AND DEVELOPMENT CORP.


PROJECT AREA  
 VILLAGE OF KINGS CONTRIVANCE  
 SECTION 3 AREA 1

PROJECT TITLE  
 PLAN AND PROFILE  
 GREEN MOON PATH

SCALE: AS SHOWN DATE

WHITMAN, REQUARDT & ASSOCIATES  
 ENGINEERS  
 BALTIMORE, MARYLAND 21202

*Kenneth A. McCord*  
 KENNETH A. McCORD  
 Registered Engineer  
 No. 1974

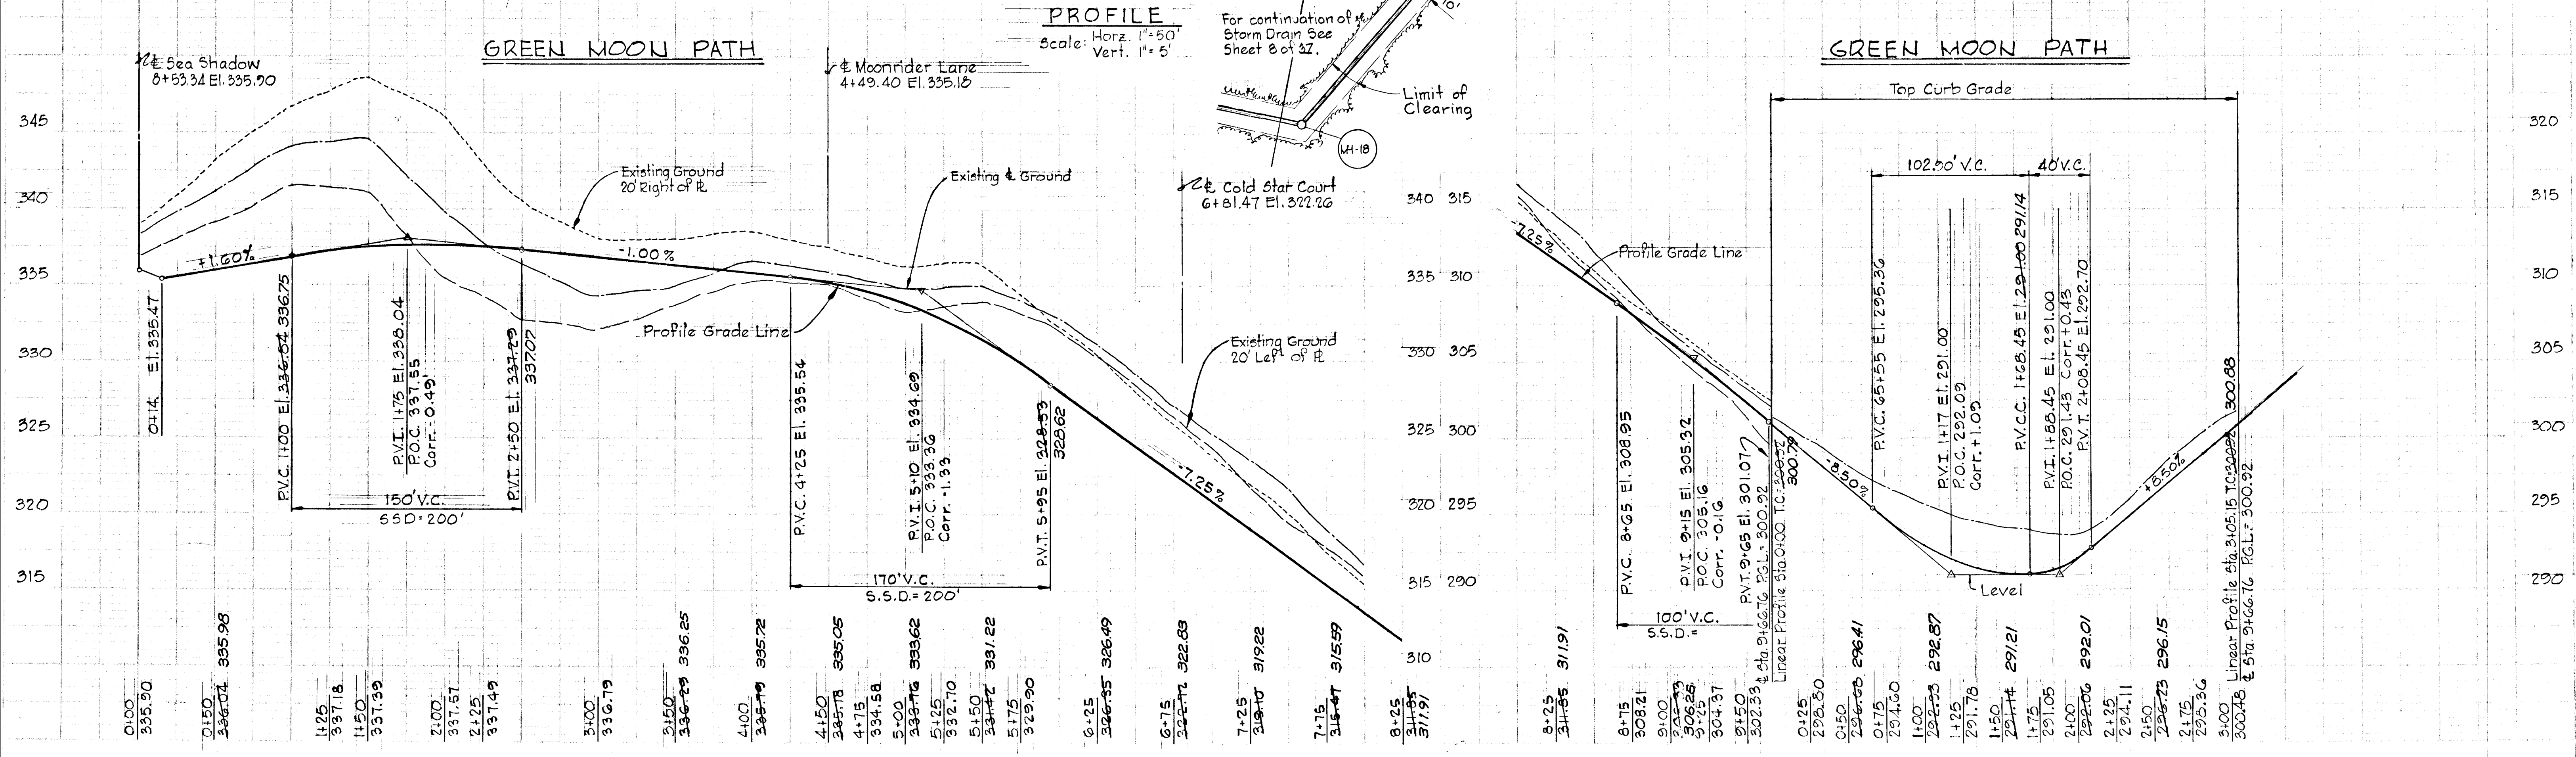



'AS-BUILT' ELEVATIONS VERIFIED BY KENNETH A. McCORD, MD. REG. P.E. No. 1974, AS OF DECEMBER 20, 1979

### STORM DRAIN STRUCTURE SCHEDULE

No.	TYPE	TOP ELEV.	INV. OUT.	LOCATION
I-57	Std. A-10 Inlet, Width=2.5'	316.00	307.98	± Inlet 15.92' Lt. of ± Sta. 2+13.89
I-58	Std. A-5 Inlet, Width=4.0'	316.00	308.58	± Inlet 16.67' Rt. of ± Sta. 2+10.89
MH-18	Std. Manhole	301.00	293.20	See Plan and Profile
MH-19	Std. Manhole	313.00	312.70	See Plan and Profile
MH-20	Std. Manhole	332.40	321.76	See Plan and Profile

Note:  
 1. Standard A-5 and A-10 Inlets, Howard County Dwg. G-4-A, Page 110-A.  
 2. Standard Manhole, Howard County Dwg. P-103, Page 155.  
 3. For Storm Drain Profiles, see sheet 19 of 37.

Note  
 For Cul-De-Sac Curve Data  
 See Sheet 17 & 19 of 37

NOTE:  
 PAVING WIDTH-29'  
 LENGTH OF PAVING-730'  
 4-SEWER MH & IN ROAD R/W

PLAN  
 Scale: 1"=50'

### CURVE DATA


PC: 1+17.88 to PT: 2+14.10  
 $\Delta = 05^{\circ}30'48''$  Tan: 48.15'  
 $R = 1000.00'$  Chd.: 96.19'  
 Arc: 96.22' Brg.: N83°07'51"W

### CURVE DATA


PC: 0+75.94 to PT: 2+17.80  
 $\Delta = 40^{\circ}38'19''$  Tan: 74.06'  
 $R = 200.00'$  Chd.: 138.90'  
 Arc: 141.86' Brg.: S33°02'12"E

### MORNING MEWS PROFILE

Scale: Horz: 1"=50'  
 Vert: 1"=5'

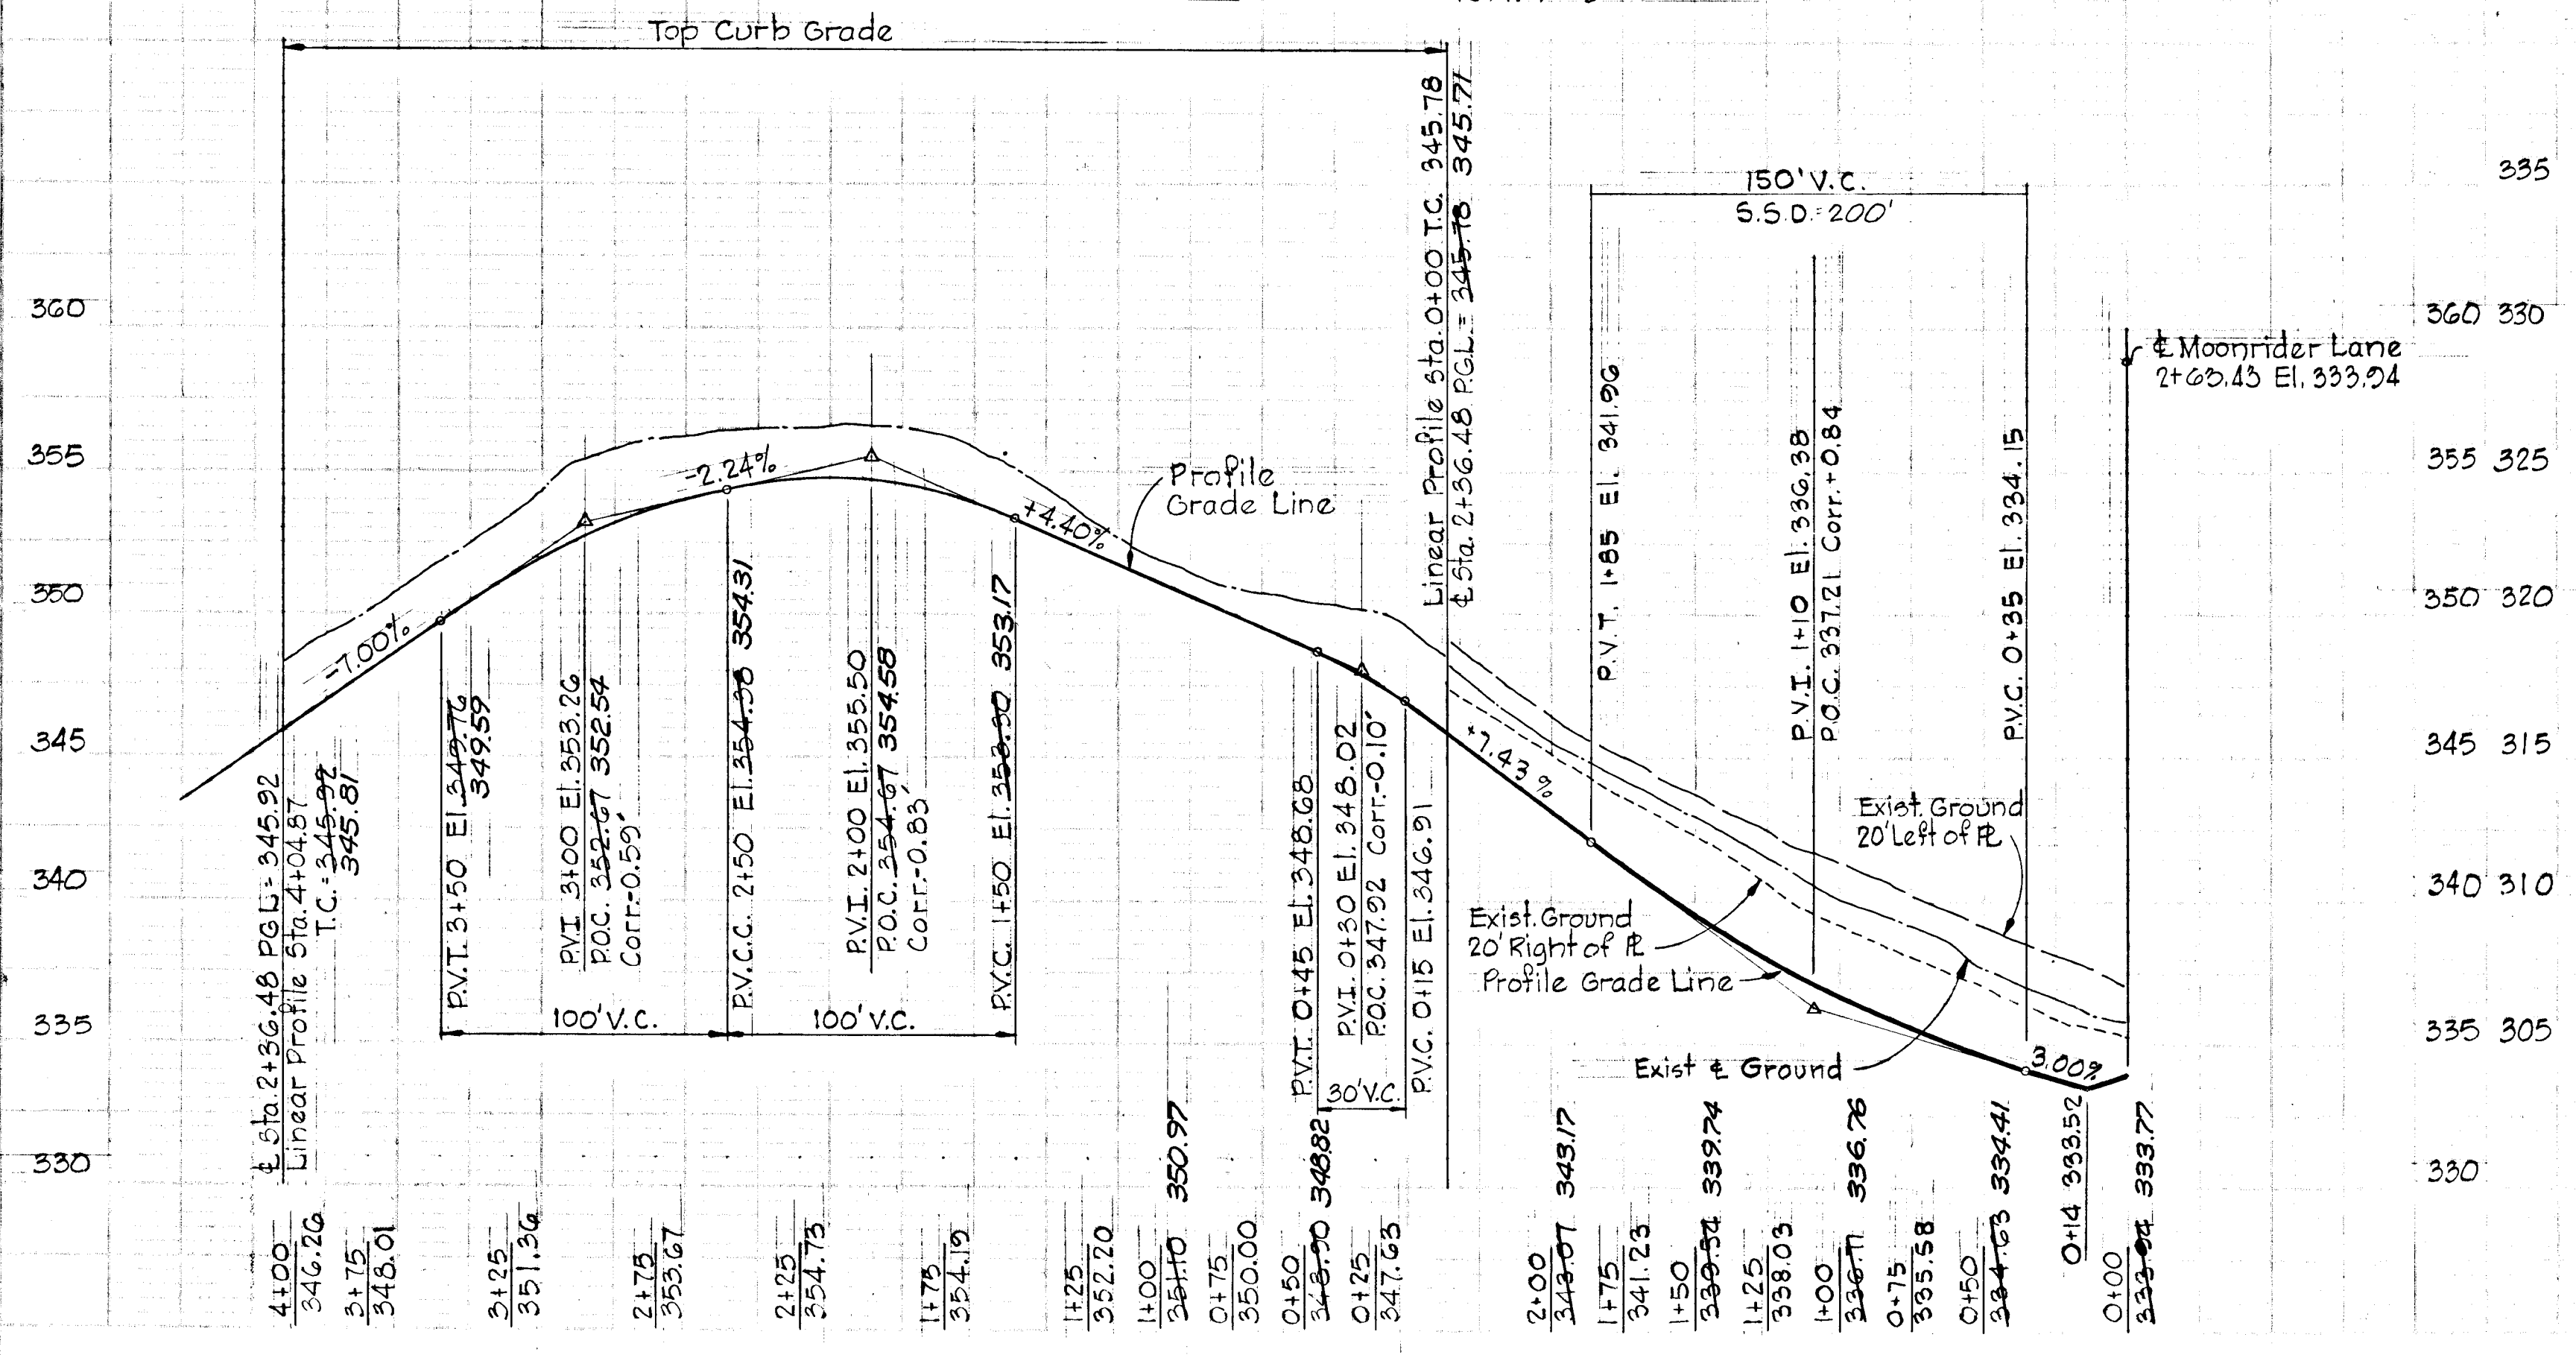

### COLD STAR COURT PROFILE

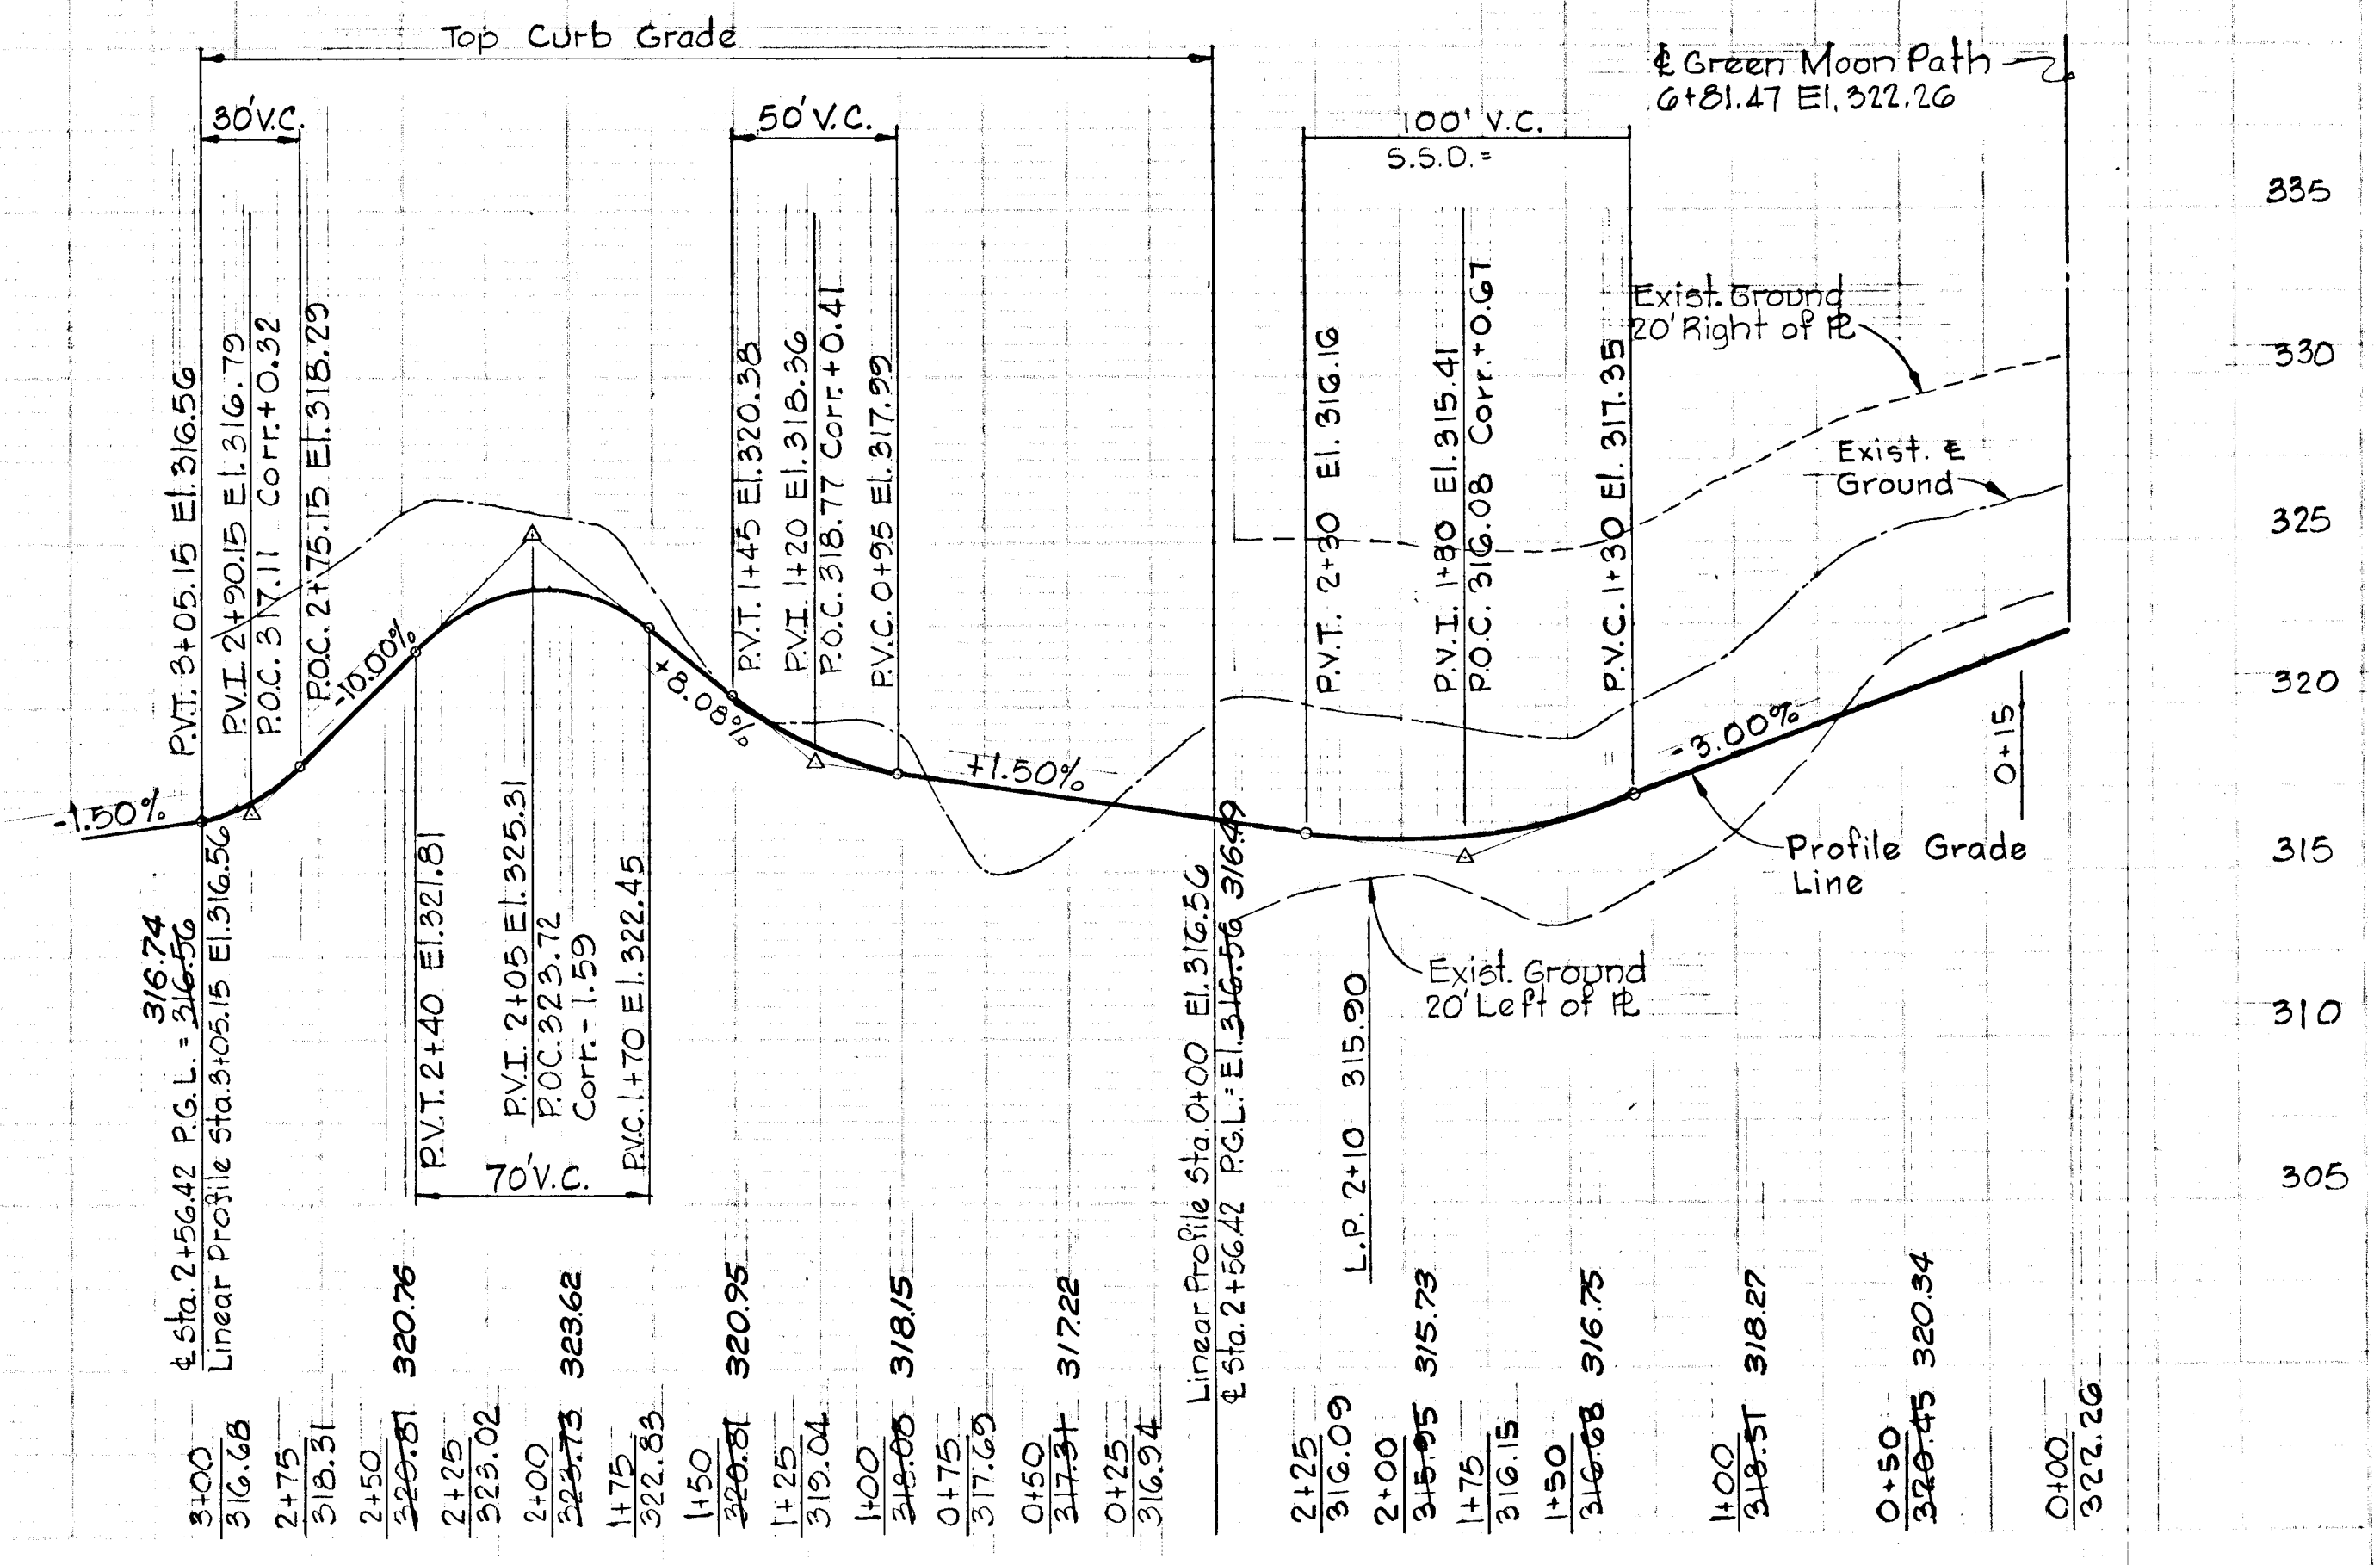

Rev. Date	Rev. No.	Revision Description
<b>COLUMBIA</b> 6th ELECTION DISTRICT HOWARD COUNTY, MARYLAND		
OWNER AND DEVELOPER HOWARD RESEARCH AND DEVELOPMENT CORP.		
PROJECT AREA VILLAGE OF KINGS CONTRIVANCE SECTION 3 AREA 1		
PROJECT TITLE PLAN AND PROFILE MORNING MEWS COLD STAR COURT		
SCALE: AS SHOWN		DATE
WHITMAN, REQUARDT & ASSOCIATES ENGINEERS BALTIMORE, MARYLAND 21202		
<i>Kenneth A. McCord</i> KENNETH A. McCORD Registered Engineer No. 1974		



AS-BUILT ELEVATIONS VERIFIED BY KENNETH A. MCCORD, MD., REG. P.E. No. 1974 AS OF DECEMBER 29, 1979

**CURVE DATA**



PC.0+59.60 to PT.1+39.33	PI.2+63.43 to P.T.3+10.27
$\Delta = 22^\circ 50' 28''$ Tan = 40.40'	$\Delta = 05^\circ 32' 00''$ Tan = 23.44'
R = 200.00' Chd = 79.20'	R = 485.00' Chd = 46.82'
Arc = 79.73' Brg = 509°05'34"W	Arc = 46.84' Brg = 506°51'32"W
PC.1+71.27 to PT.2+63.43	PI.2+63.43 to P.T.3+10.27
$\Delta = 10^\circ 53' 15''$ Tan = 46.22'	$\Delta = 05^\circ 32' 00''$ Tan = 23.44'
R = 485.00' Chd = 92.02'	R = 485.00' Chd = 46.82'
Arc = 92.16' Brg = 515°04'10"W	Arc = 46.84' Brg = 506°51'32"W
PC.3+66.12 to PT.4+57.28	
$\Delta = 17^\circ 24' 37''$ Tan = 45.93'	
R = 300.00' Chd = 90.81'	
Arc = 91.16' Brg = 512°47'51"W	



NOTE:  
 PAVING WIDTH - 29'  
 LENGTH OF PAVING - 617'  
 3-SEWER MHS IN ROAD R/W

- Note:
- Standard A-5 and A-10 Inlets, Howard County Dwg. G4-A, Page 110-A.
  - Standard Type D Inlet, Howard County Dwg. G4-C, Page 110-C.
  - Standard Manhole, Howard County Dwg. D-103, Page 153.
  - For Storm Drain Profiles, see sheet 13 and 20 of 37.

**STORM DRAIN STRUCTURE SCHEDULE**

NO.	TYPE	TOP ELEV.	INV. OUT.	LOCATION
I-59	Std. Type 'D' Inlet	331.33	324.36	See Plan and Profile
I-60	Std. A-5 Inlet, Width=2.5'	333.25	327.65	Inlet 15.92' Lt. of Sta. 1+75.26
I-61	Std. A-5 Inlet, Width=2.5'	333.24	328.24	Inlet 15.92' Rt. of Sta. 1+75.58
I-62	Std. A-10 Inlet, Width=2.5'	335.02	329.47	Inlet 15.92' Rt. of Sta. 0+57.67
I-63	Std. A-10 Inlet, Width=2.5'	335.02	330.25	Inlet 15.92' Lt. of Sta. 0+57.67
I-64	Std. A-5 Inlet, Width=2.5'	335.52	331.90	Inlet 15.92' Rt. of Sta. 3+17.50
MH-21	Type B MH (See Detail Sheet 27)	334.70	329.56	See Plan and Profile
MH-22	Type B MH (See Detail Sheet 27)	341.90	337.24	See Plan and Profile

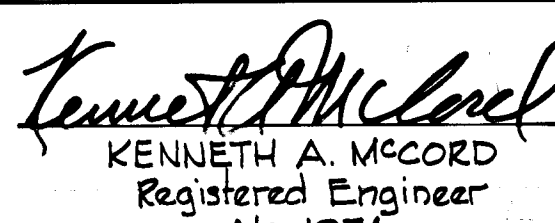116	Deleted MH 24, MH 26 & I-65
Rev. Date	Rev. No. Revision Description
6 <sup>th</sup> ELECTION DISTRICT HOWARD COUNTY, MARYLAND	
OWNER AND DEVELOPER HOWARD RESEARCH AND DEVELOPMENT CORP.	
PROJECT AREA VILLAGE OF KINGS CONTRIVANCE SECTION 3 AREA 1	
PROJECT TITLE PLAN AND PROFILE MOONRIDER LANE	
SCALE: AS SHOWN	DATE
WHITMAN, REQUARDT & ASSOCIATES ENGINEERS BALTIMORE, MARYLAND 21202	
 KENNETH A. MCCORD Registered Engineer No. 1974	
	

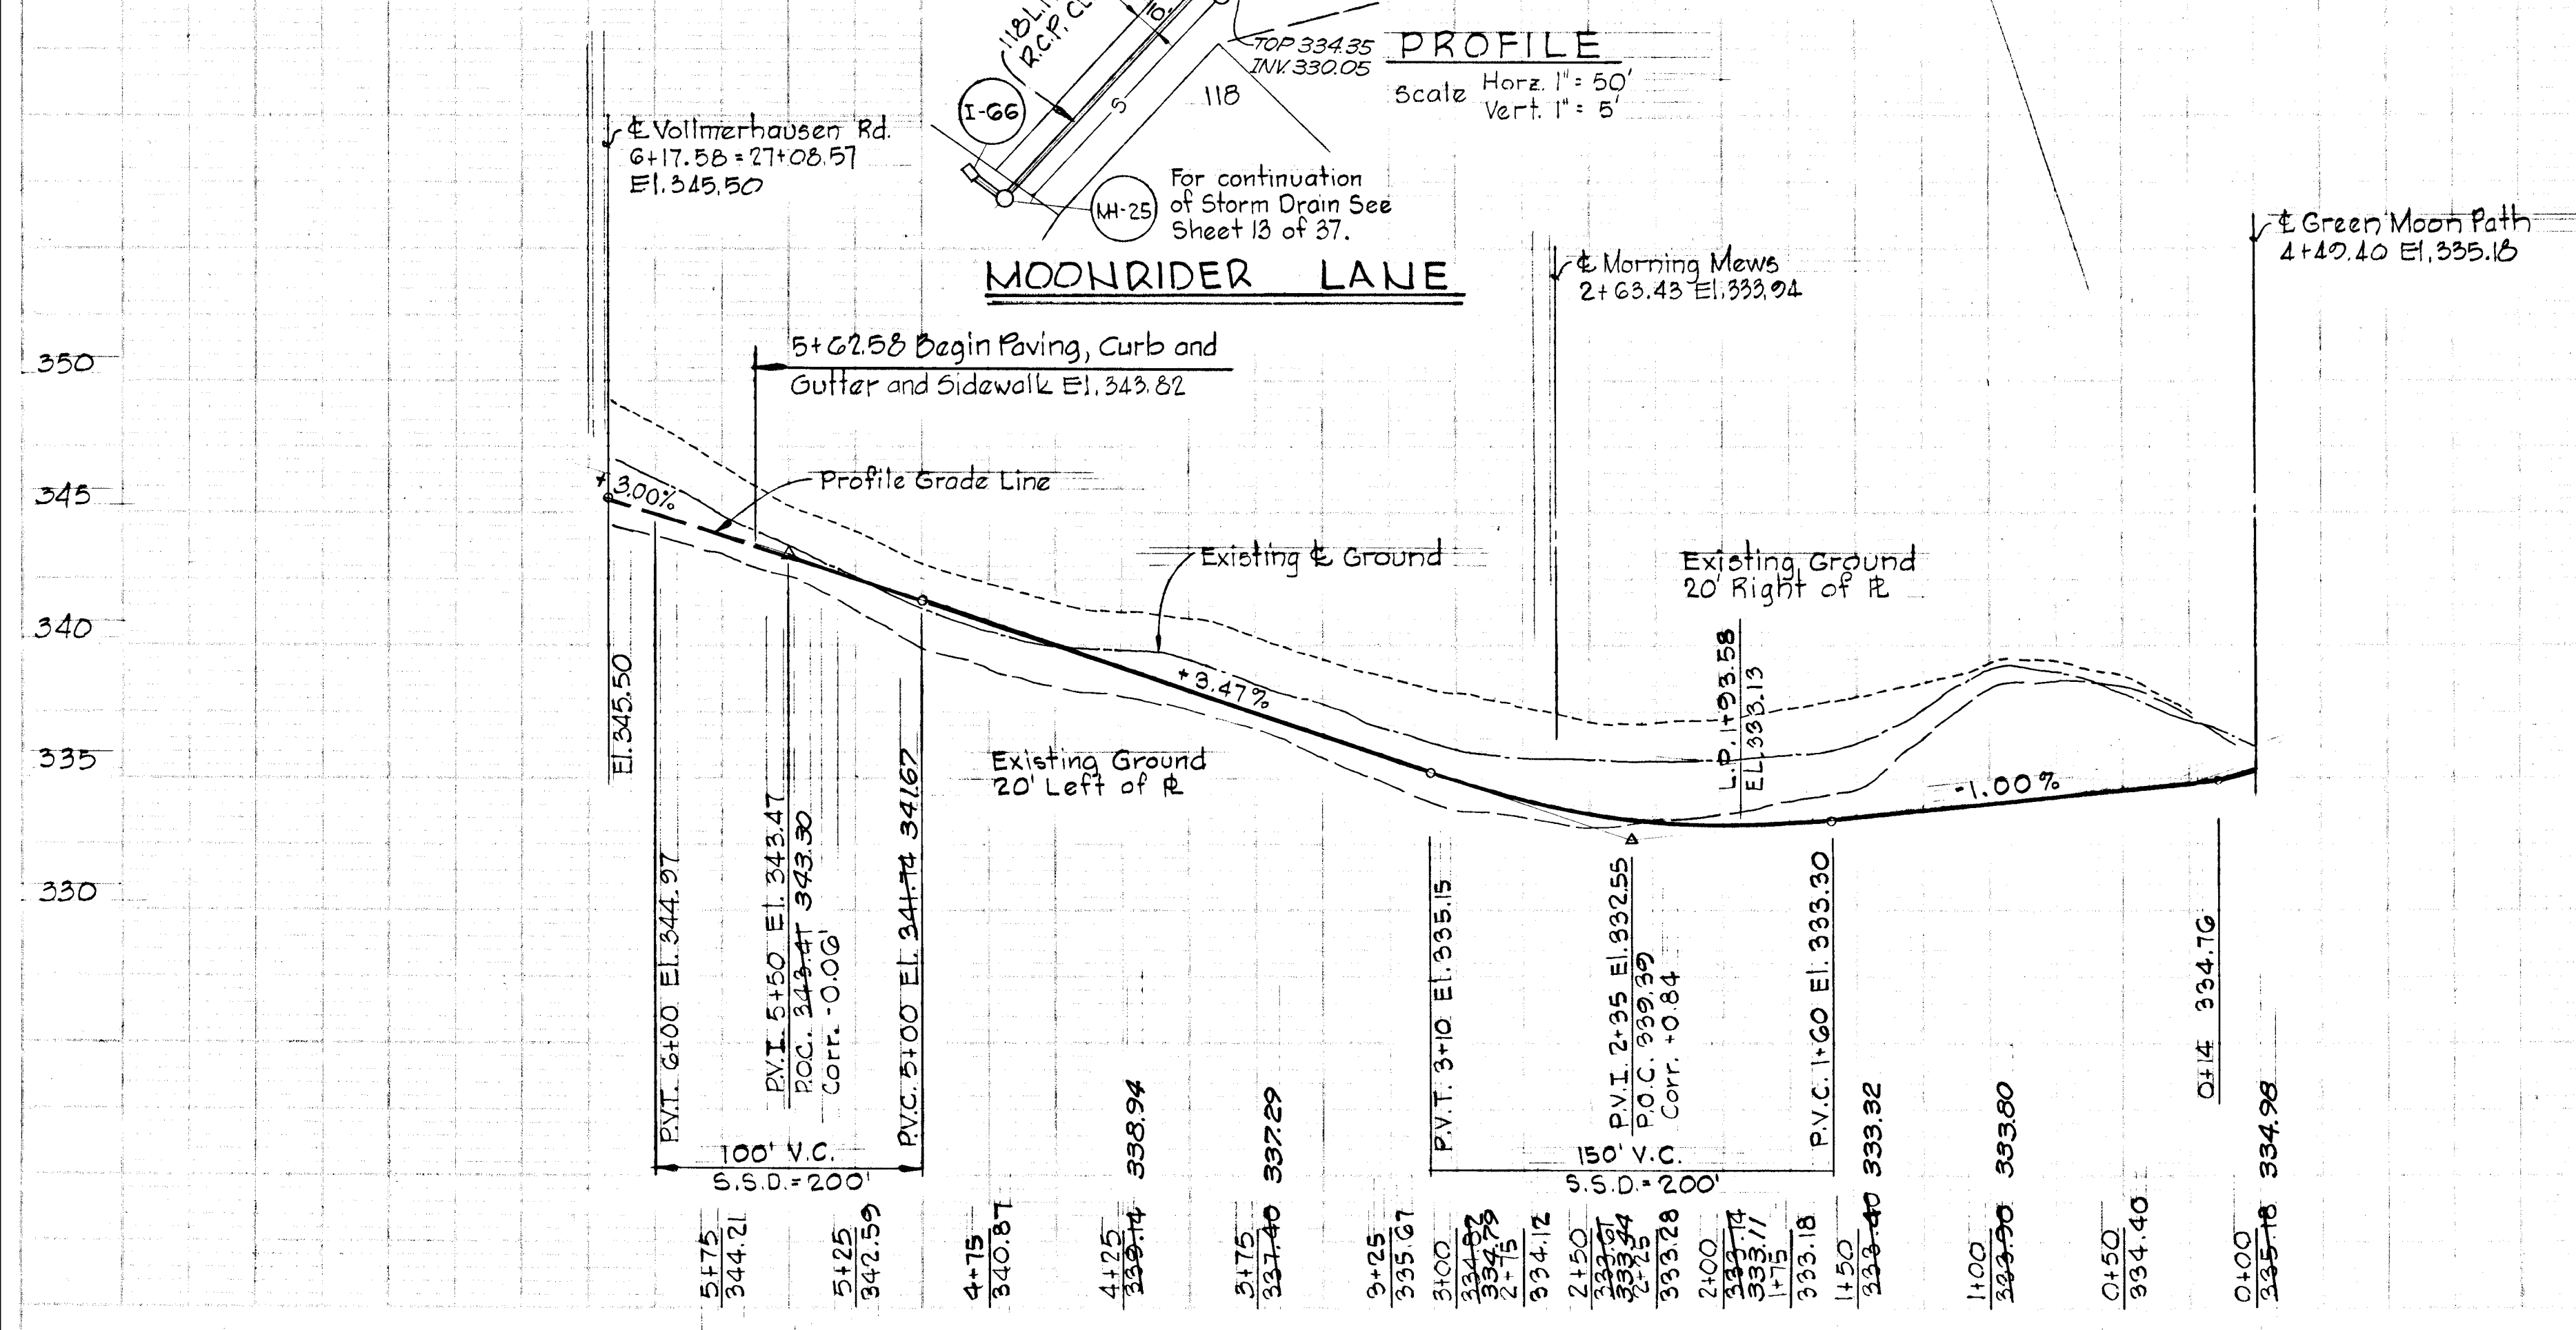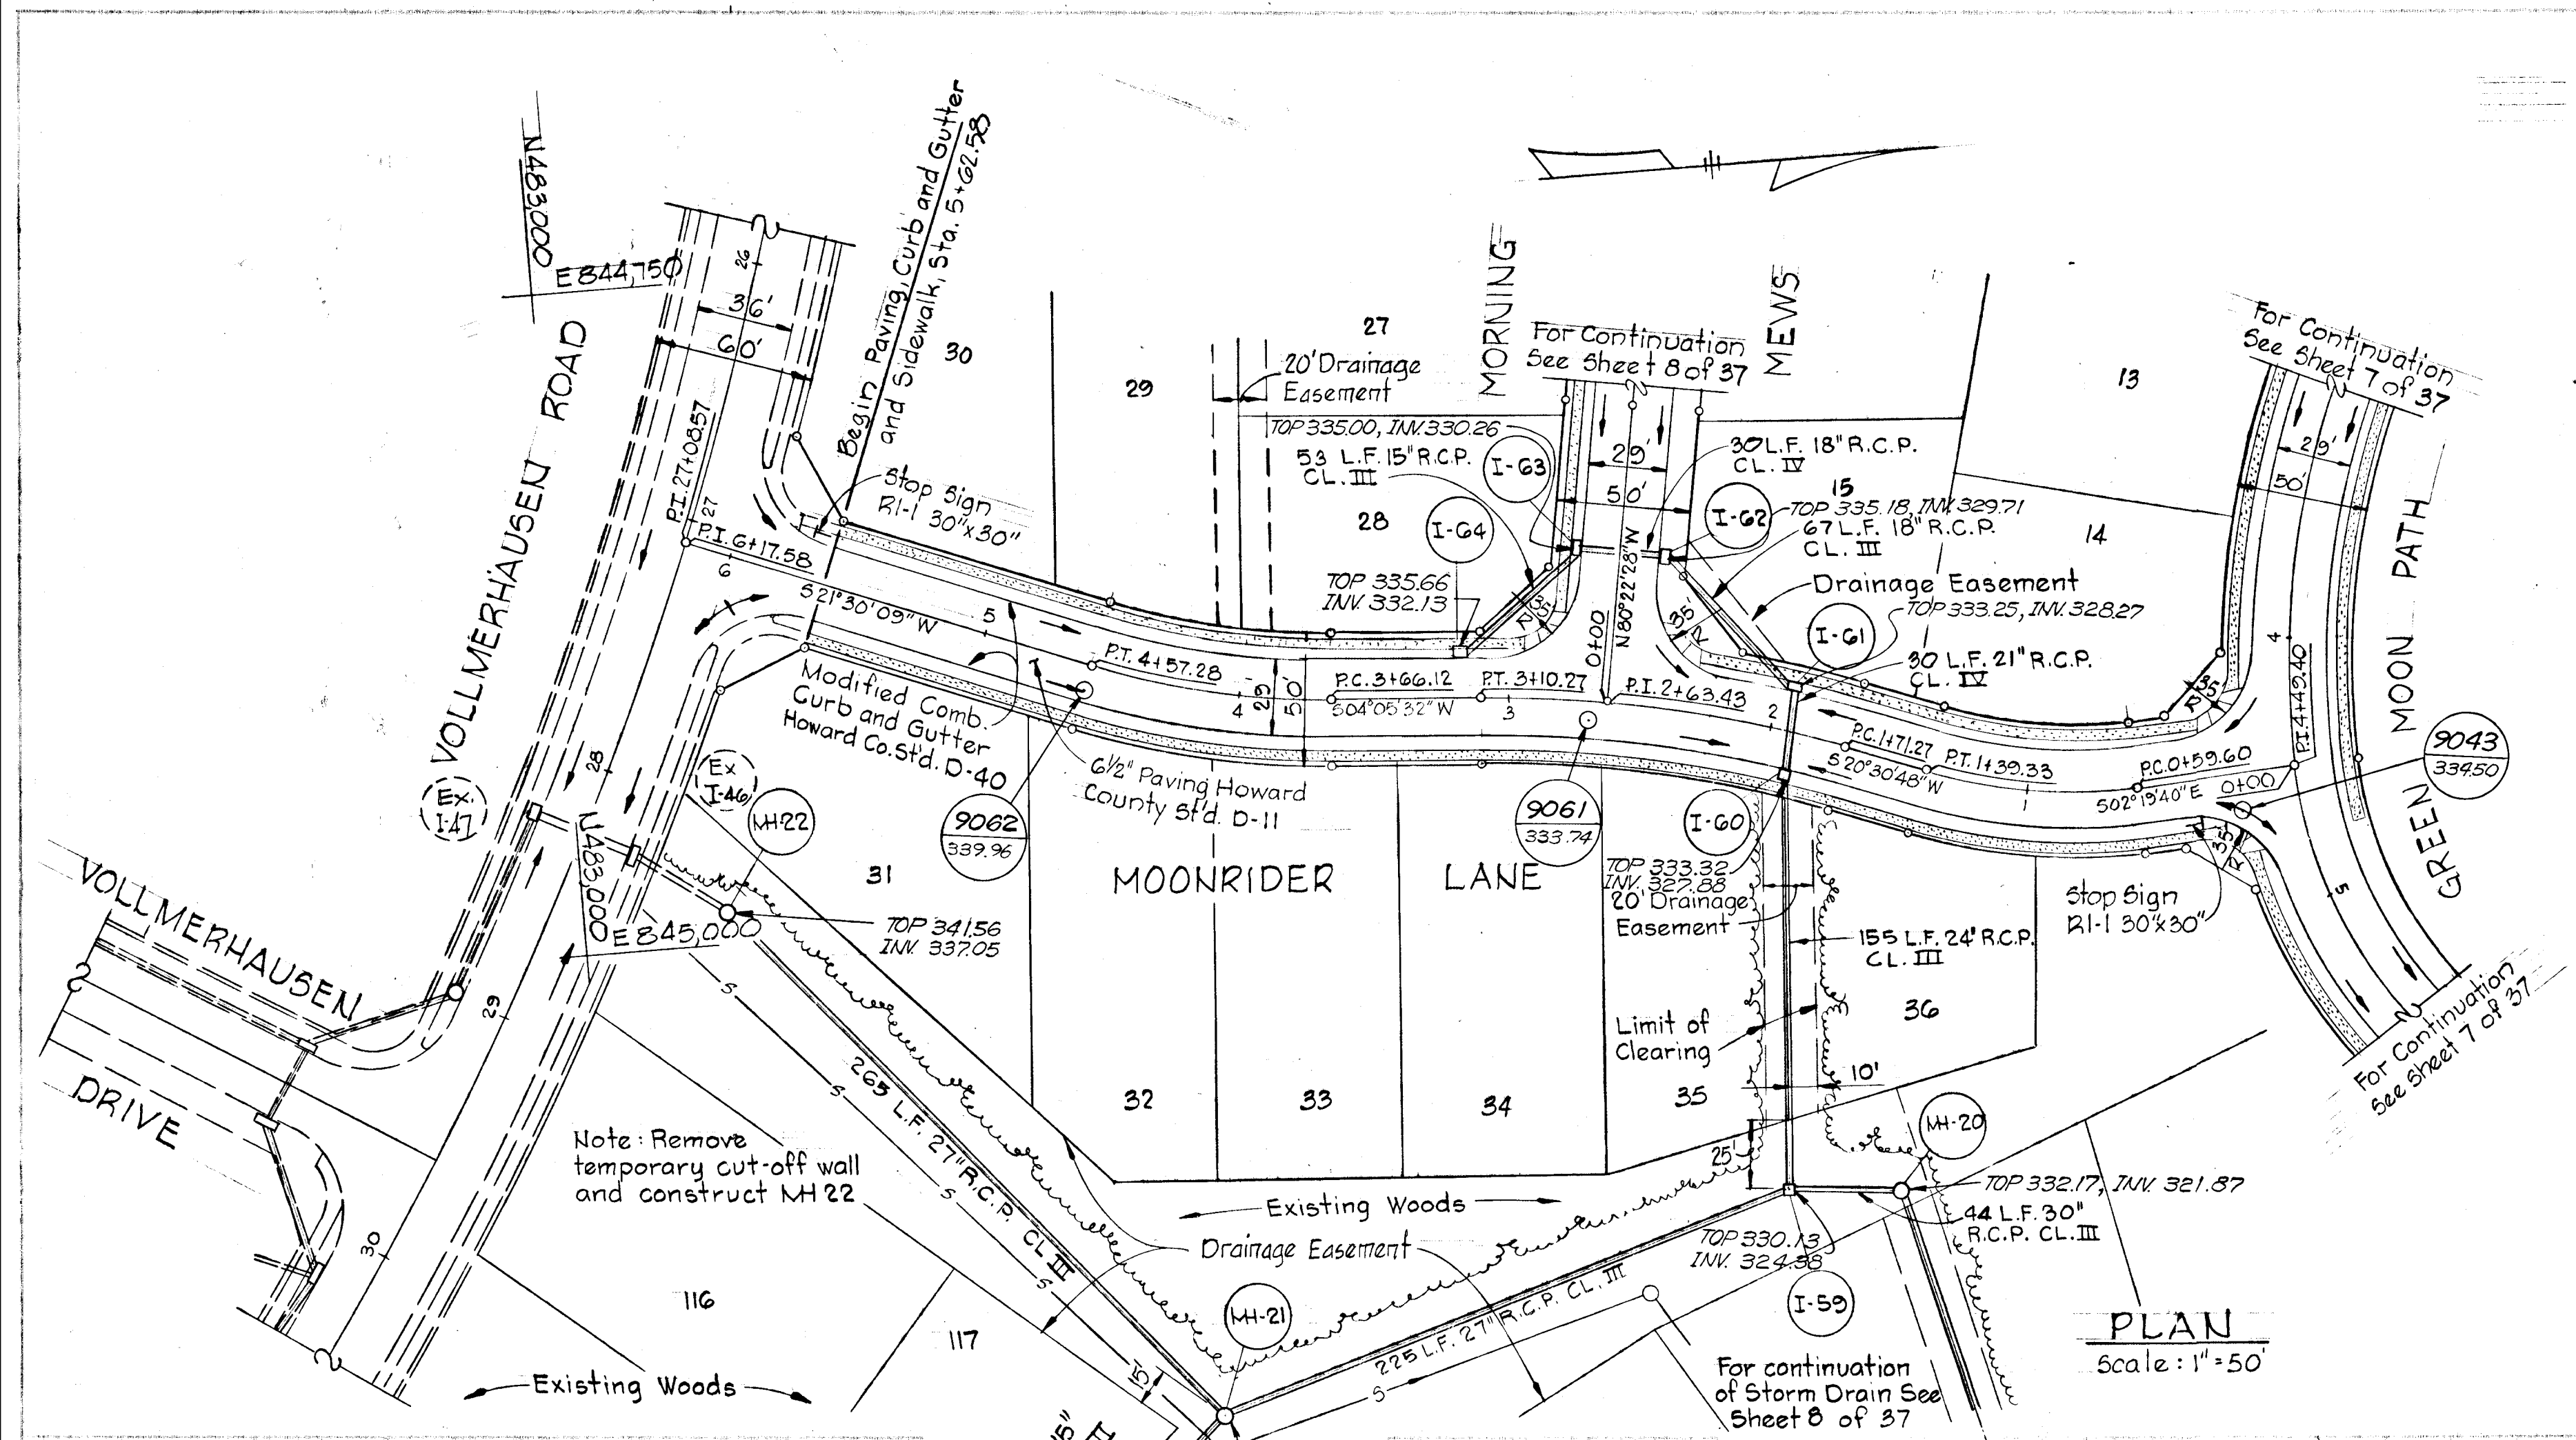




**STORM DRAIN STRUCTURE SCHEDULE**

No.	TYPE	TOP ELEV.	INV. IN	INV. OUT	LOCATION
I-70	Std. A-5 Inlet, Width 2'5"	364.45	360.28	359.28	At Inlet 15' 9" Lt. of Sta. 0+50
M-27	Std. Manhole	361.88	355.53	354.53	At Inlet 17' 50" Rt. of Sta. 3+25

Notes:  
 1. Standard A-5 Inlet, Howard County Dwg. G4-1, Page 110-A.  
 2. Standard Manhole, Howard County Dwg. D-103, Page 153.  
 3. For Storm Drain Profiles, see sheet 20 and 23 of 37.

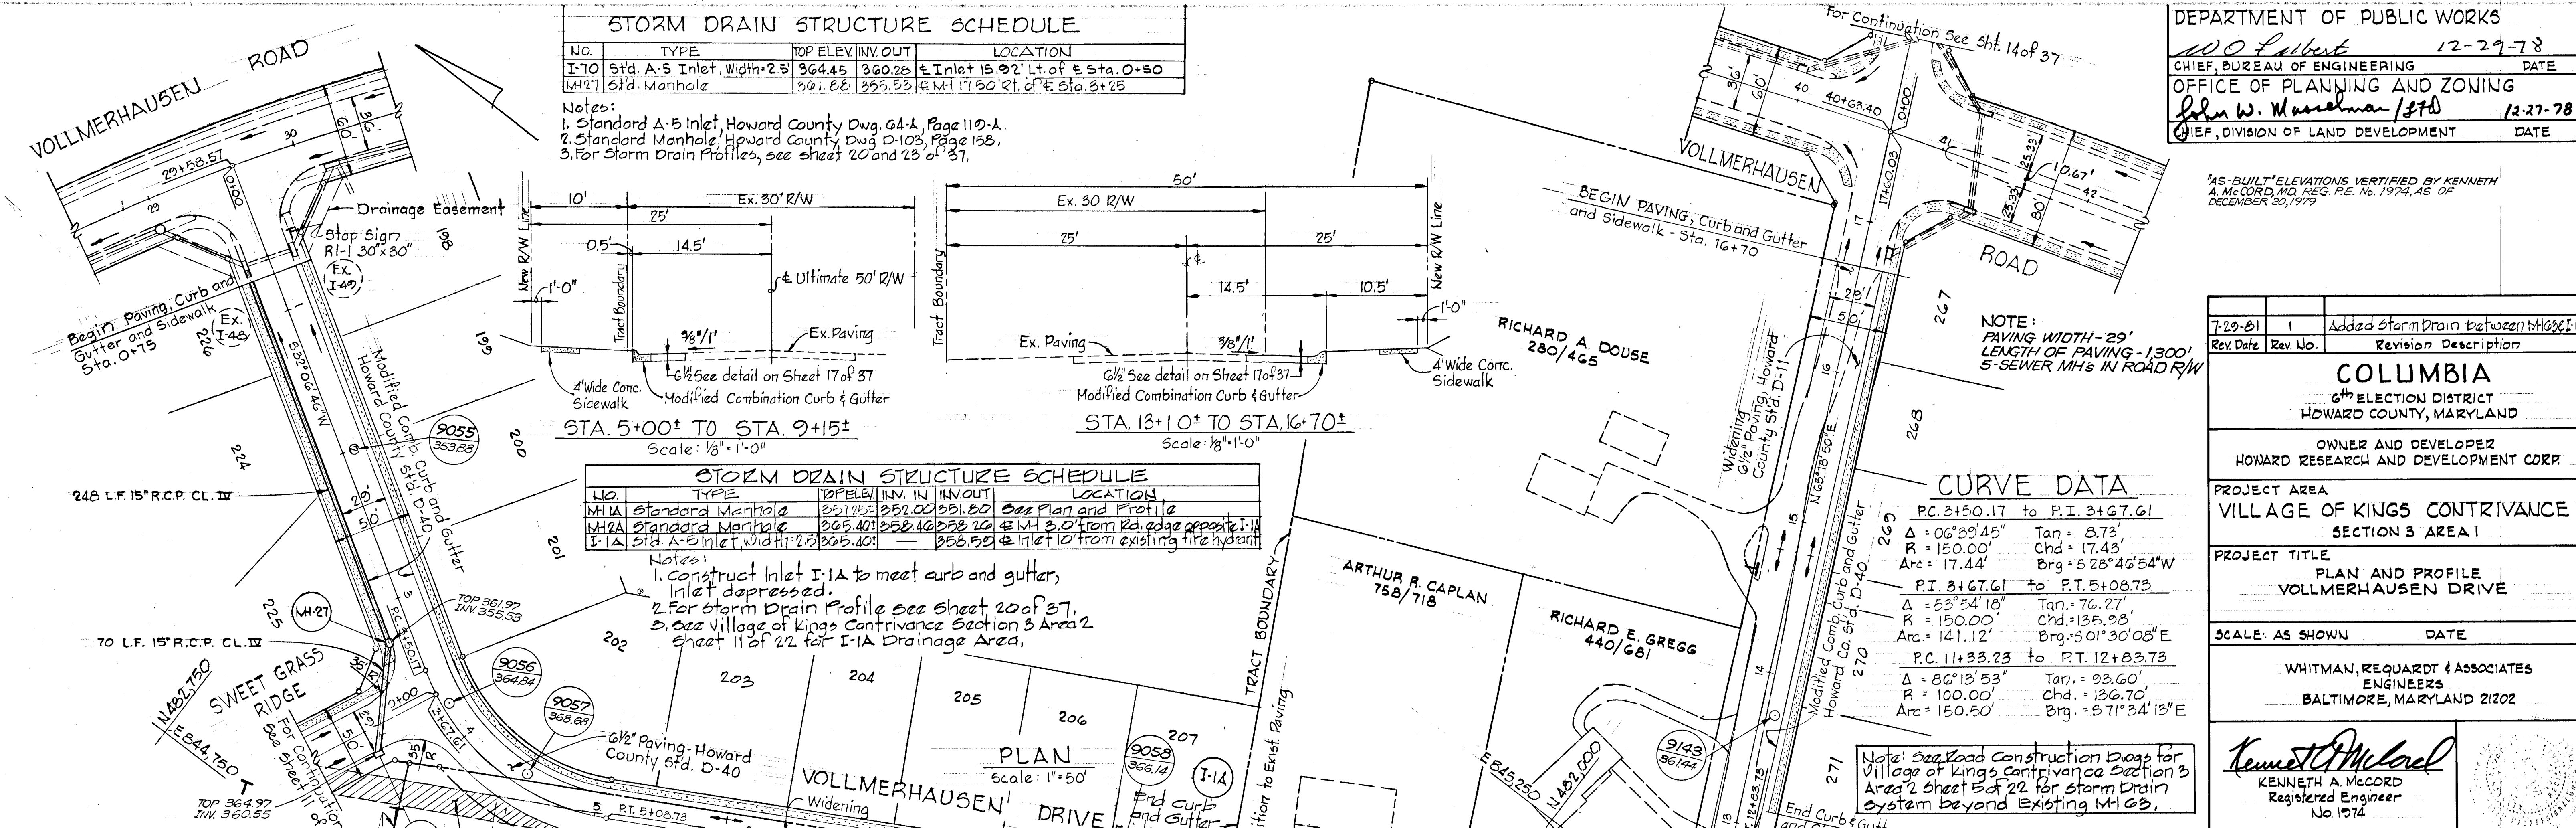

**STORM DRAIN STRUCTURE SCHEDULE**

No.	TYPE	TOP ELEV.	INV. IN	INV. OUT	LOCATION
M-1A	Standard Manhole	361.88	355.53	354.53	See Plan and Profile
M-27	Standard Manhole	361.88	355.53	354.53	At Inlet 17' 50" from Rd. edge approx. I-1A
I-1A	Std. A-5 Inlet, Width 2'5"	365.40	358.40	355.59	At Inlet 10' from existing fire hydrant


Notes:  
 1. Construct Inlet I-1A to meet curb and gutter, inlet depressed.  
 2. For storm drain profile see sheet 20 of 37.  
 3. See Village of Kings Contrivance Section 3 Area 2 sheet 11 of 22 for I-1A Drainage Area.

**CURVE DATA**

P.C. 3+50.17 to P.T. 3+67.61	
$\Delta = 06^{\circ}29'45''$	Tan = 8.73'
$R = 150.00'$	Chd = 17.43'
Arc = 17.44'	Brg = 528'46'54"W
P.I. 3+67.61 to P.T. 5+08.73	
$\Delta = 53^{\circ}54'18''$	Tan = 76.27'
$R = 150.00'$	Chd = 135.93'
Arc = 141.12'	Brg = 501'30'08"E
P.C. 11+33.23 to P.T. 12+83.73	
$\Delta = 86^{\circ}13'53''$	Tan = 93.60'
$R = 100.00'$	Chd = 136.70'
Arc = 150.50'	Brg = 571'34'13"E

Note: See Road Construction Dwg. for Village of Kings Contrivance Section 3 Area 2 sheet 5 of 22 for storm drain system beyond existing M-1A.

**PROFILE**

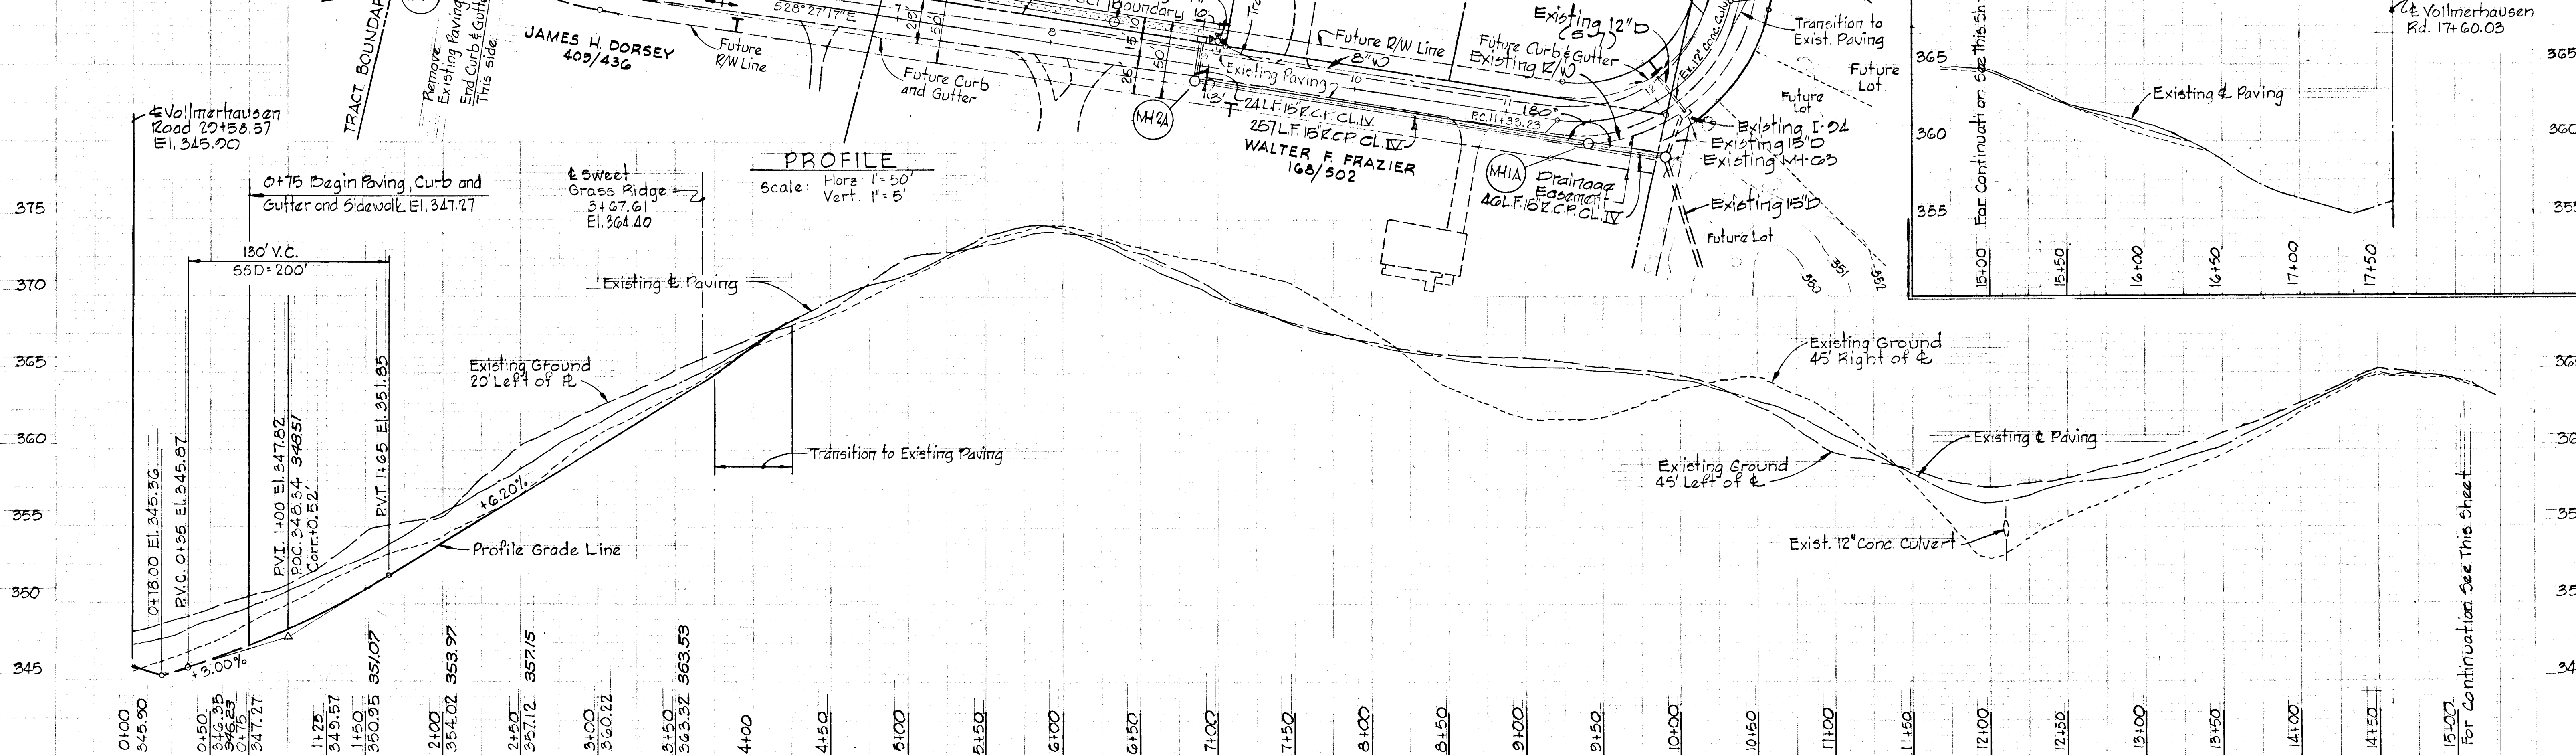

Rev. No.	Rev. Date	Revision Description
1	7-29-81	Added Storm Drain between M-1A & I-1A

**COLUMBIA**  
 6th ELECTION DISTRICT  
 HOWARD COUNTY, MARYLAND  
 OWNER AND DEVELOPER  
 HOWARD RESEARCH AND DEVELOPMENT CORP.  
 PROJECT AREA  
 VILLAGE OF KINGS CONTRIVANCE  
 SECTION 3 AREA 1  
 PROJECT TITLE  
 PLAN AND PROFILE  
 VOLLMERHAUSEN DRIVE  
 SCALE: AS SHOWN DATE

WHITMAN, REQUARDT & ASSOCIATES  
 ENGINEERS  
 BALTIMORE, MARYLAND 21202  
 Kenneth A. McCord  
 KENNETH A. McCORD  
 Registered Engineer  
 No. 1974



\*AS-BUILT\* ELEVATIONS, VERIFIED BY KENNETH A. McCORD, REG. P.E. No. 1974 AS OF DECEMBER 20, 1979

**CURVE DATA**


PC 1405.40 to Int. P.I. 1484.11  
 $\Delta = 20^{\circ}02'39''$  Tan = 39.76'  
 $R = 225.00'$  Chd = 78.81'  
 Arc = 78.71' Brg = N 74°34'18"W

Int. P.I. 1484.11 to PT. 3+32.99  
 $\Delta = 37^{\circ}54'39''$  Tan = 77.28'  
 $R = 225.00'$  Chd = 146.16'  
 Arc = 148.88' Brg = S 76°27'03"W

**CURVE DATA**

PC 3188.24 to PT. 5+30.07  
 $\Delta = 32^{\circ}30'17''$  Tan = 72.88'  
 $R = 250.00'$  Chd = 139.93'  
 Arc = 141.83' Brg = S 78°44'52"W

PC 6407.65 to PT. 7+19.65  
 $\Delta = 47^{\circ}32'03''$  Tan = 59.45'  
 $R = 135.00'$  Chd = 108.82'  
 Arc = 112.00' Brg = S 66°13'58"W

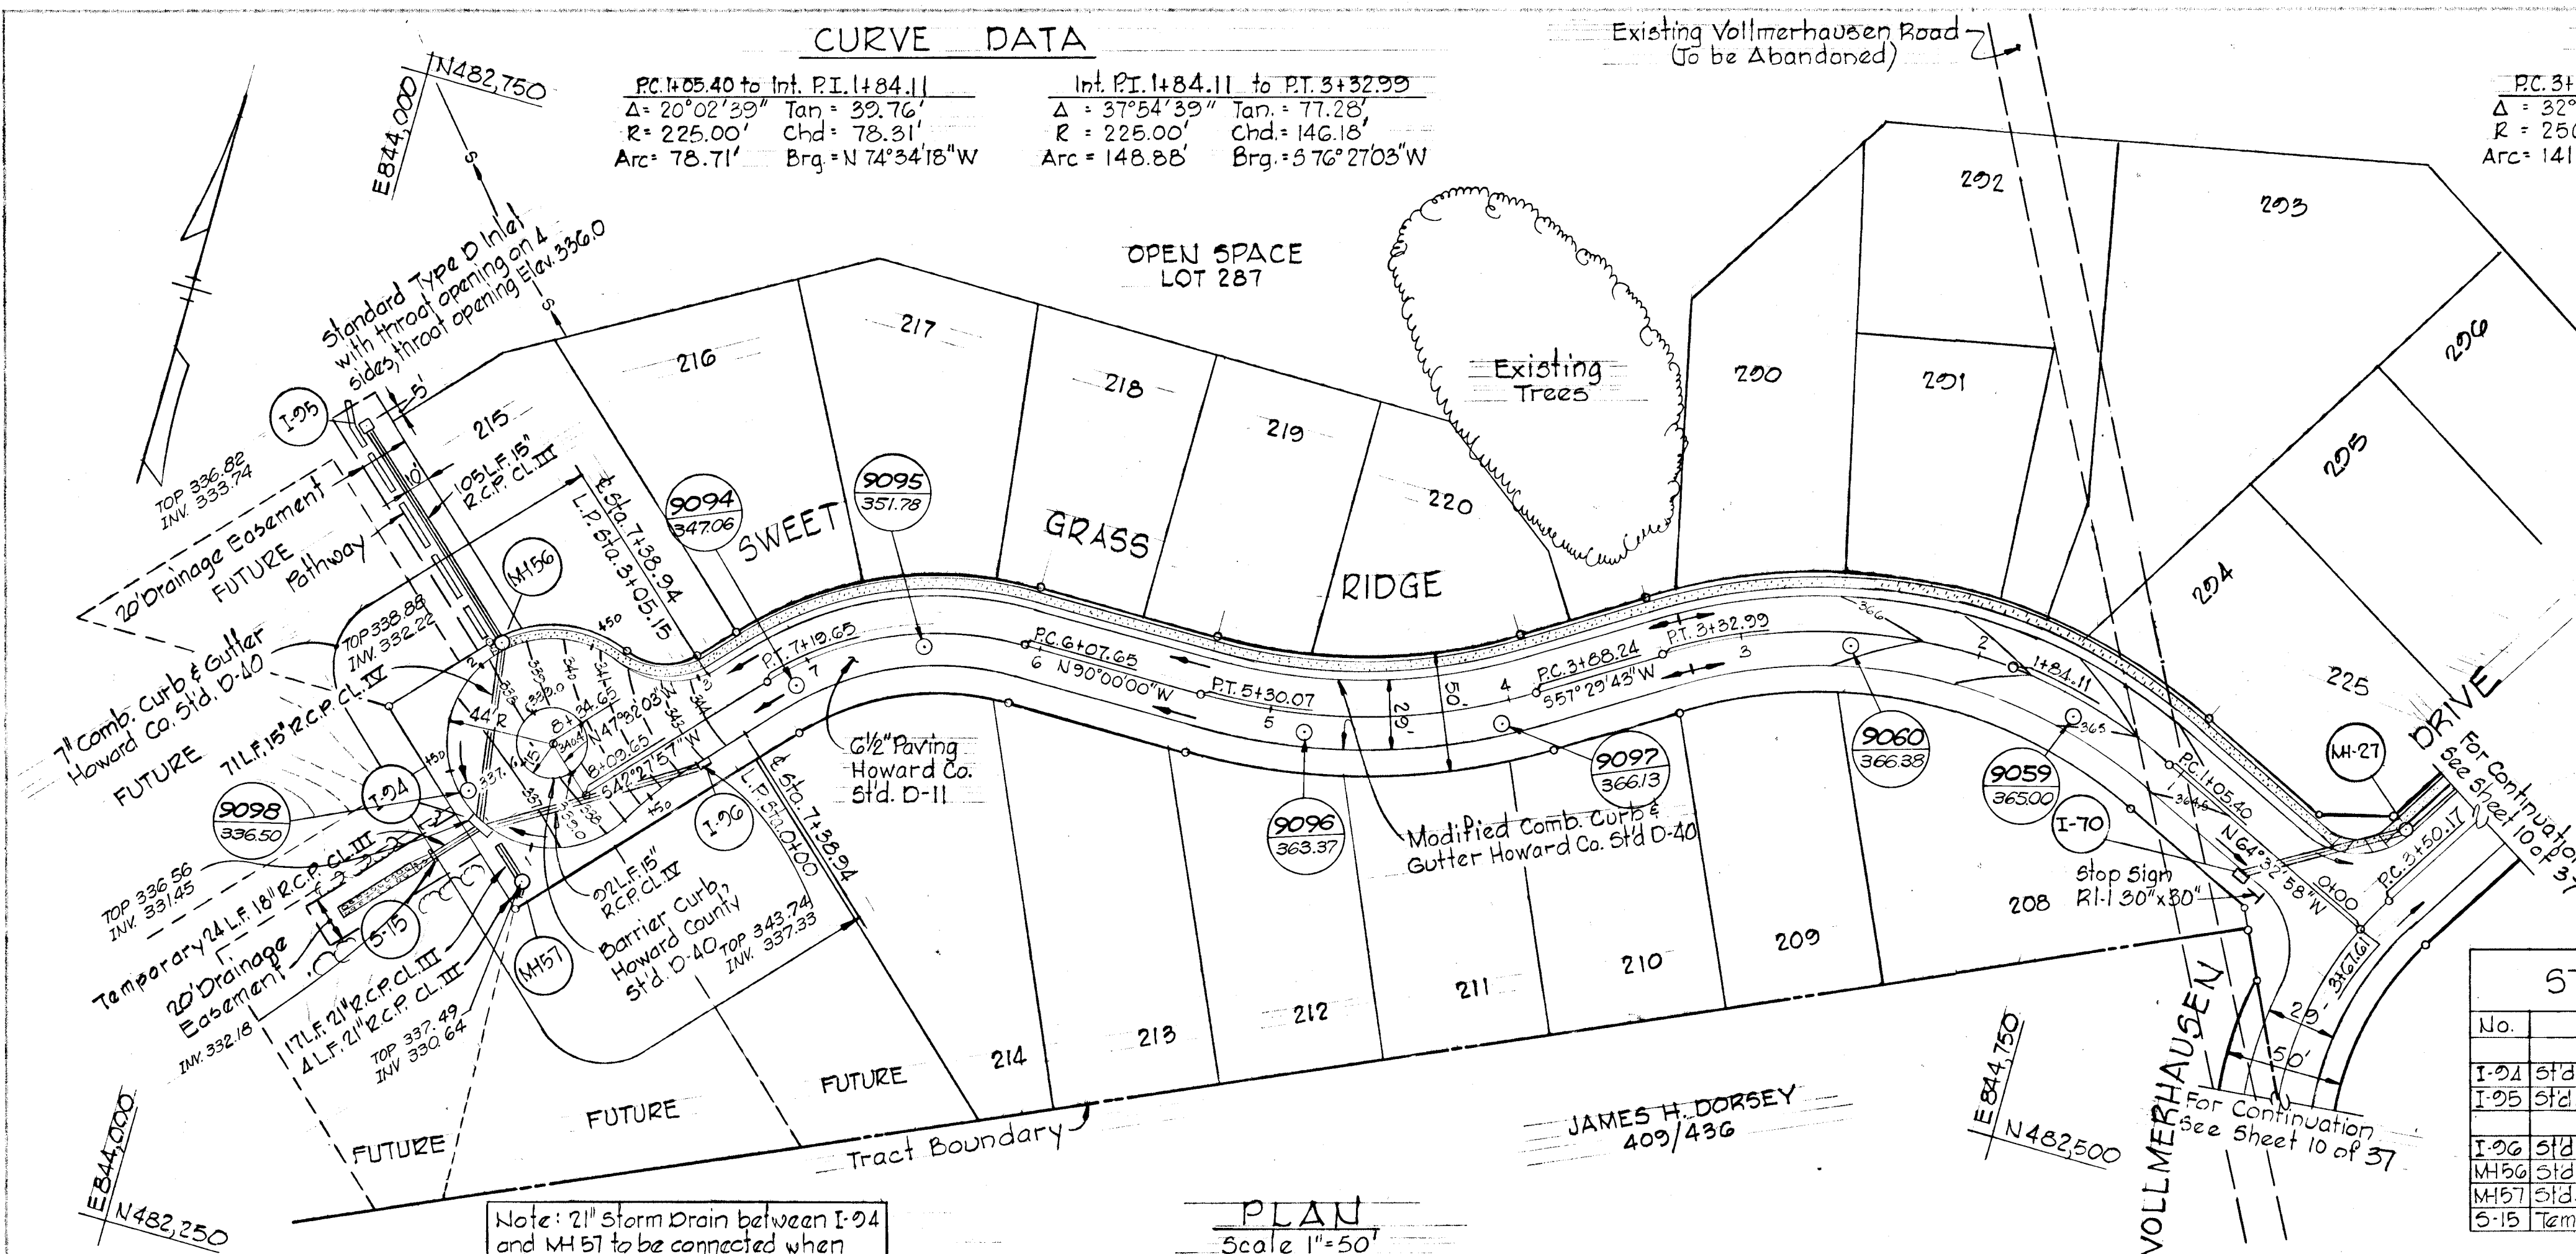

NOTE:  
 PAVING WIDTH - 29'  
 LENGTH OF PAVING - 835'  
 7-SEWER MH IN ROAD R/W

Note:  
 For Cul-De-Sac Curve Data  
 See Sheet 18 of 37

- Notes:
1. Standard A-5 and A-10 Inlets, Howard County Dwg. G-1, Page 119-A.
  2. Standard Type D Inlet, Howard County Dwg. G-1-C, Page 119-C.
  3. Standard Manhole, Howard County Dwg. D-103, Page 153.
  4. Temporary Cutoff Wall, see detail sheet 18 of 37.
  5. For Storm Drain Profiles, see sheet 18 of 37.


**STORM DRAIN STRUCTURE SCHEDULE**

No.	TYPE	TOP ELEV	INV OUT	LOCATION
I-94	Std. A-10 Inlet, width=25'	336.54	331.24	@ Inlet L.P. Sta. 1+25
I-95	Std. Type D Inlet	336.89	333.65	See Plan and Profile
I-96	Std. A-5 Inlet, width=25'	343.60	337.16	@ Inlet L.P. Sta. 0+22
MH-6	Std. Manhole	338.95	332.72	@ Manhole B.L.T. L.P. Sta. 2+12
MH-7	Std. Manhole	337.72	330.68	@ Manhole 10 L.T. L.P. Sta. 1+00
6-15	Temporary Cutoff Wall*	-	339.84	See Plan and Profile

7/16/80	1	Updated Artic. How. & S.D. system
Rev. Date	Rev. No.	Revision Description
<b>COLUMBIA</b> 6th ELECTION DISTRICT HOWARD COUNTY, MARYLAND		
OWNER AND DEVELOPER HOWARD RESEARCH AND DEVELOPMENT CORP.		
PROJECT AREA VILLAGE OF KINGS CONTRIVANCE SECTION 3 AREA 1		
PROJECT TITLE PLAN AND PROFILE SWEET GRASS RIDGE		
SCALE: AS SHOWN DATE		
WHITMAN, REQUARDT & ASSOCIATES ENGINEERS BALTIMORE, MARYLAND 21202		
<i>Kenneth A. McCord</i> KENNETH A. McCORD Registered Engineer No. 1974		

**PROFILE**

Scale Horiz.: 1" = 50'  
 Vert.: 1" = 5'

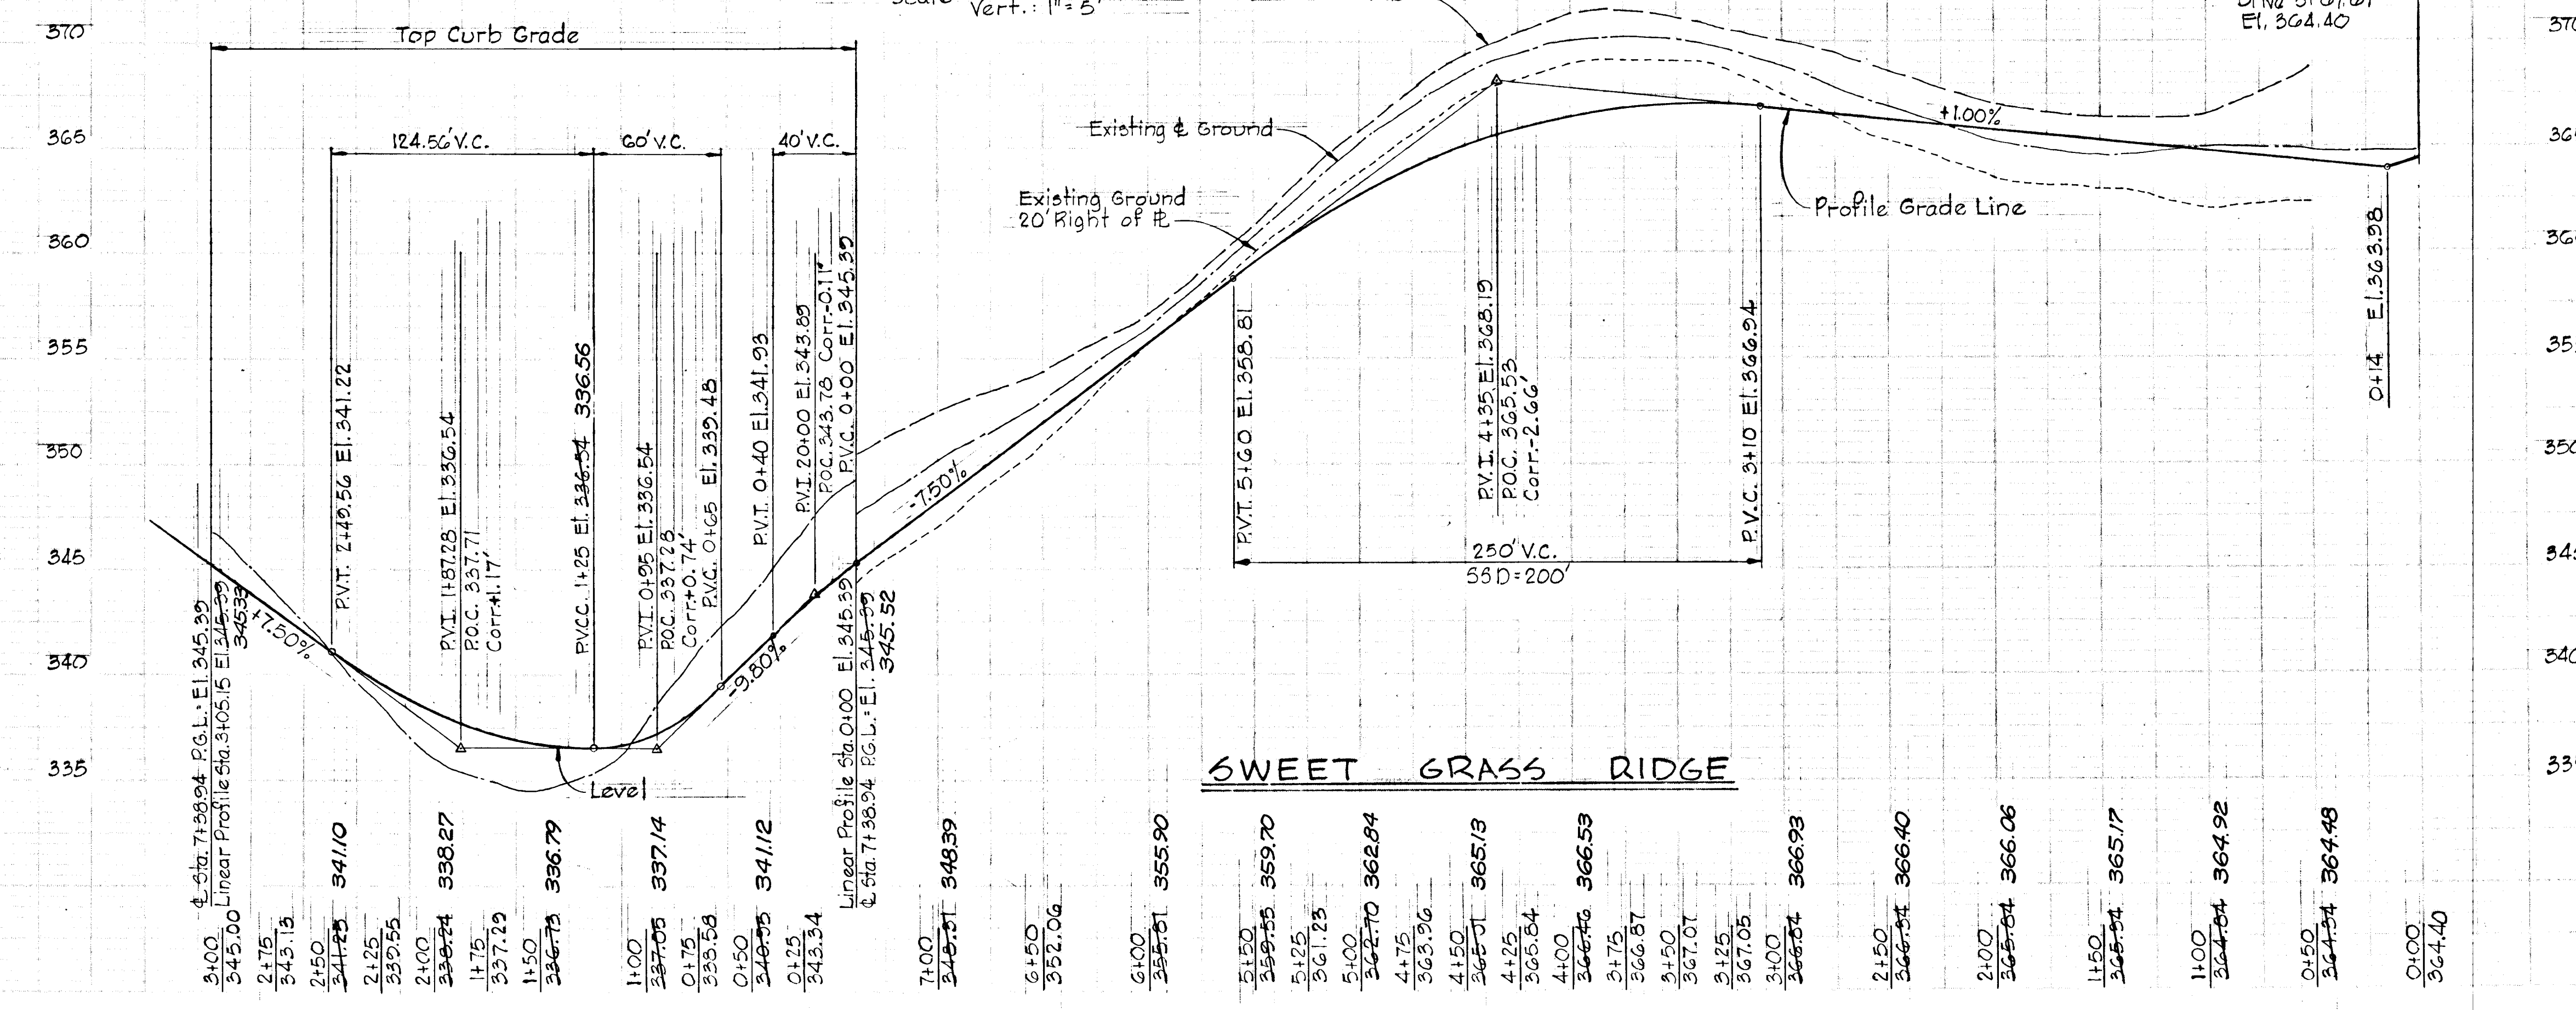

**SWEET GRASS RIDGE**

0+00	345.00	345.00
0+10	343.13	343.13
0+20	341.10	341.10
0+30	338.27	338.27
0+40	336.79	336.79
0+50	337.14	337.14
0+60	333.58	333.58
0+70	341.12	341.12
0+80	343.34	343.34
0+90	348.39	348.39
1+00	352.06	352.06
1+10	355.90	355.90
1+20	359.70	359.70
1+30	361.23	361.23
1+40	362.84	362.84
1+50	365.36	365.36
1+60	365.71	365.71
1+70	366.54	366.54
1+80	366.87	366.87
1+90	367.07	367.07
2+00	367.05	367.05
2+10	366.84	366.84
2+20	366.68	366.68
2+30	365.72	365.72
2+40	364.92	364.92
2+50	364.48	364.48
2+60	364.40	364.40

#445




AS-BUILT ELEVATIONS VERIFIED BY KENNETH A. McCORD MD, REG. P.E. No. 1974 AS OF DECEMBER 20, 1978

**CURVE DATA**  
 P.C. 149.99 to P.T. 2+96.55  
 $\Delta = 67^{\circ}10'32''$  Tan. = 83.01'  
 R = 125.00' Chd. = 138.30'  
 Arc. = 146.56' Brg. =  $506^{\circ}28'29''$ W

**CURVE DATA**  
 P.C. 4+30.00 to P.T. 6+26.35  
 $\Delta = 90^{\circ}00'00''$  Tan. = 125.00'  
 R = 125.00' Chd. = 176.78'  
 Arc. = 196.35' Brg. =  $N 04^{\circ}56'04''$ W

Note  
 For Cul-De-Sac Curve Data  
 See Sheet 13 of 37

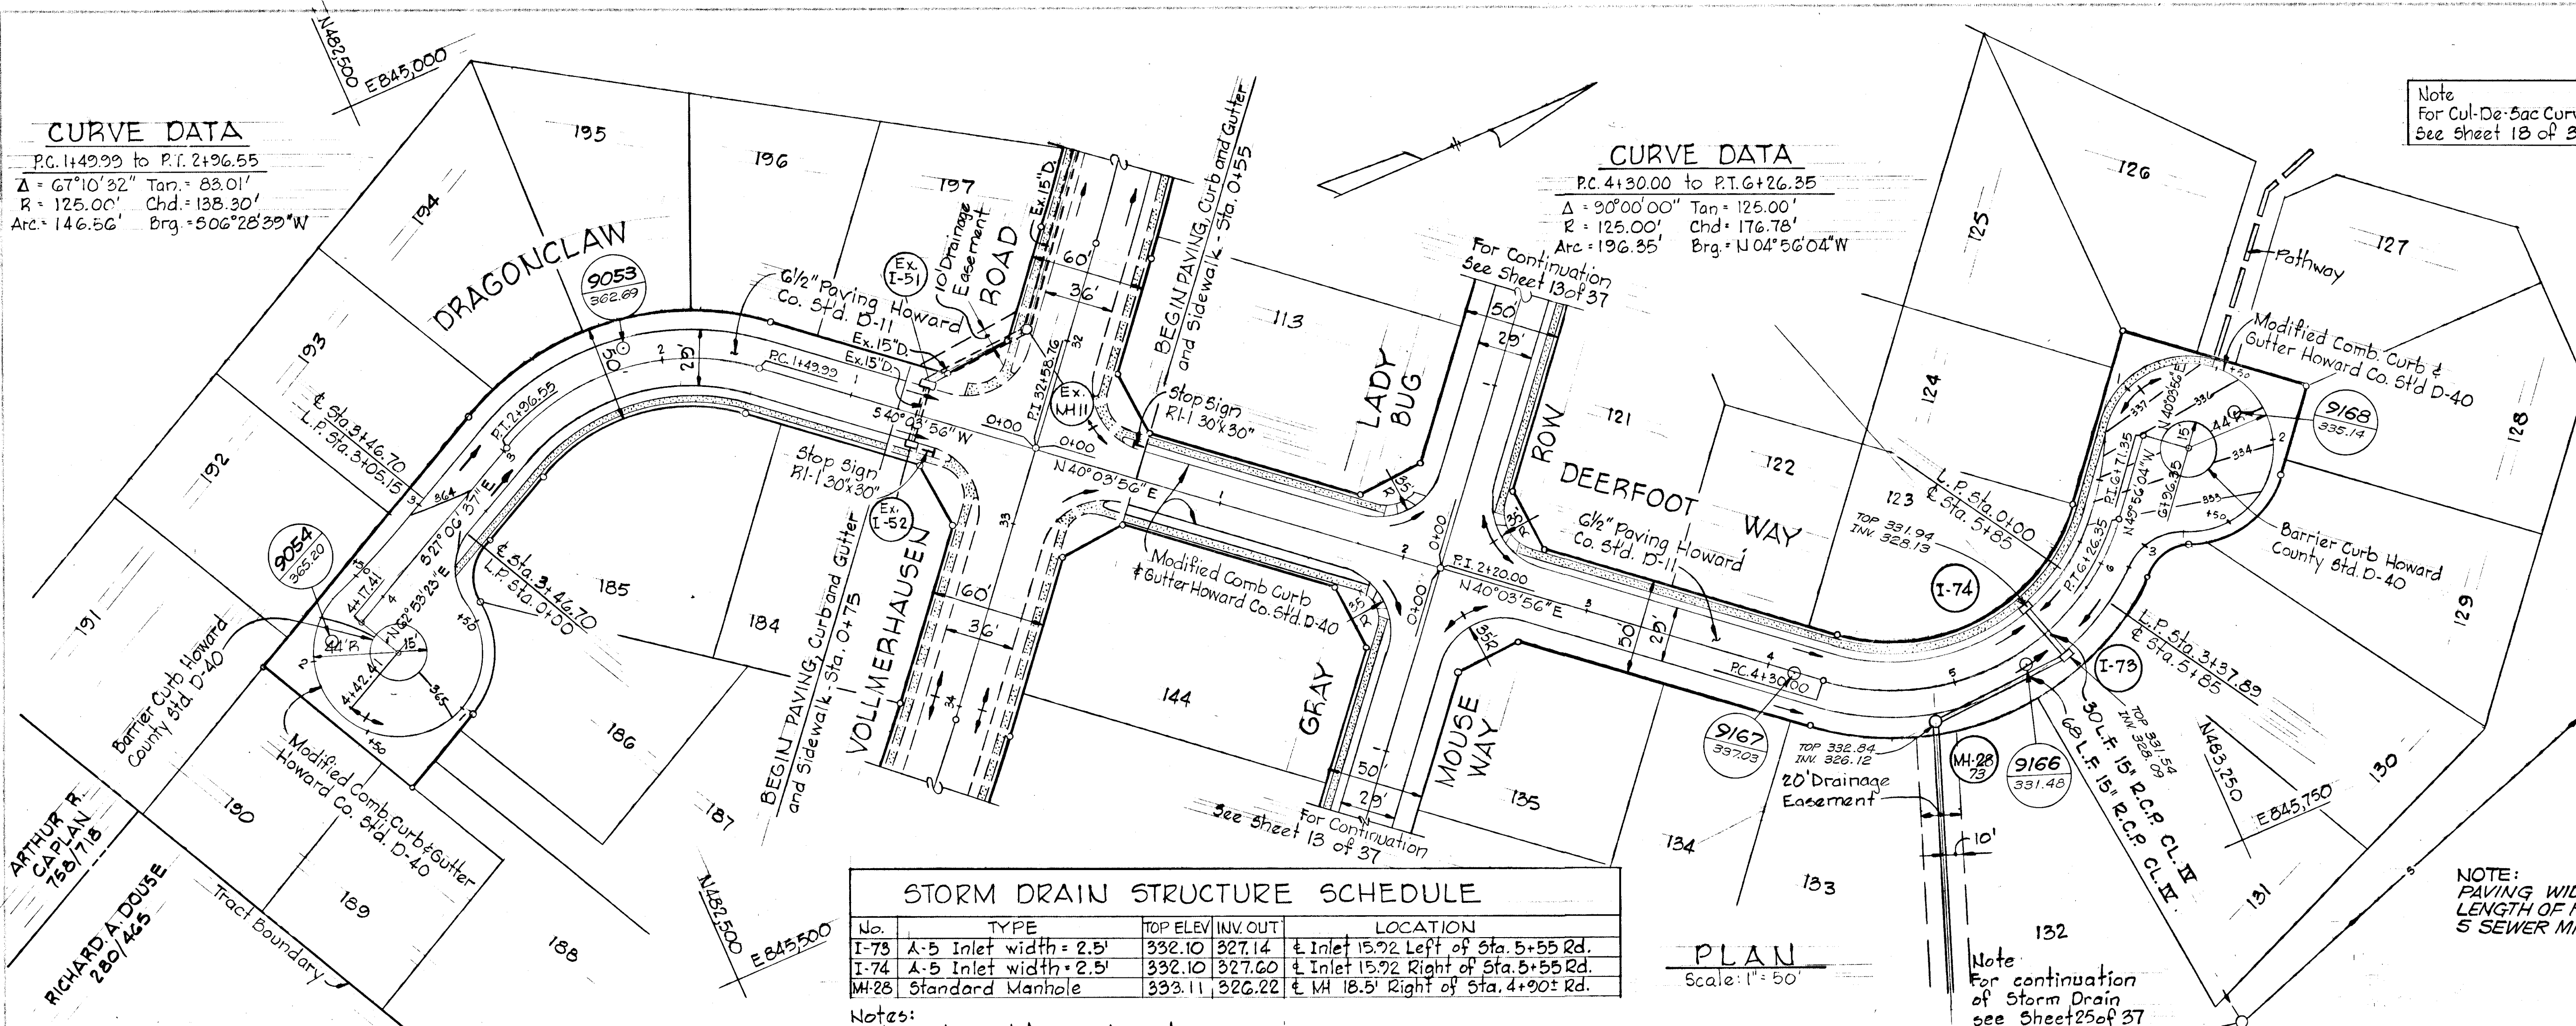


**STORM DRAIN STRUCTURE SCHEDULE**

No.	TYPE	TOP ELEV.	INV. OUT	LOCATION
I-73	A-5 Inlet width = 2.5'	332.10	327.14	Inlet 15.92 Left of Sta. 5+55 Rd.
I-74	A-5 Inlet width = 2.5'	332.10	327.60	Inlet 15.92 Right of Sta. 5+55 Rd.
MH-28	Standard Manhole	333.11	328.22	MH 18.5' Right of Sta. 4+90+ Rd.

Notes:  
 1. Standard A-5 Inlet, Howard County Dwg. G-1-A, Page 110-A.  
 2. Standard Manhole, Howard County Dwg. D-103, Page 158.  
 3. For Storm Drain Profiles, see sheet 22 of 37.

**PLAN**  
 Scale: 1" = 50'


**PROFILE**  
 Scale: Horz. 1" = 50'  
 Vert. 1" = 5'

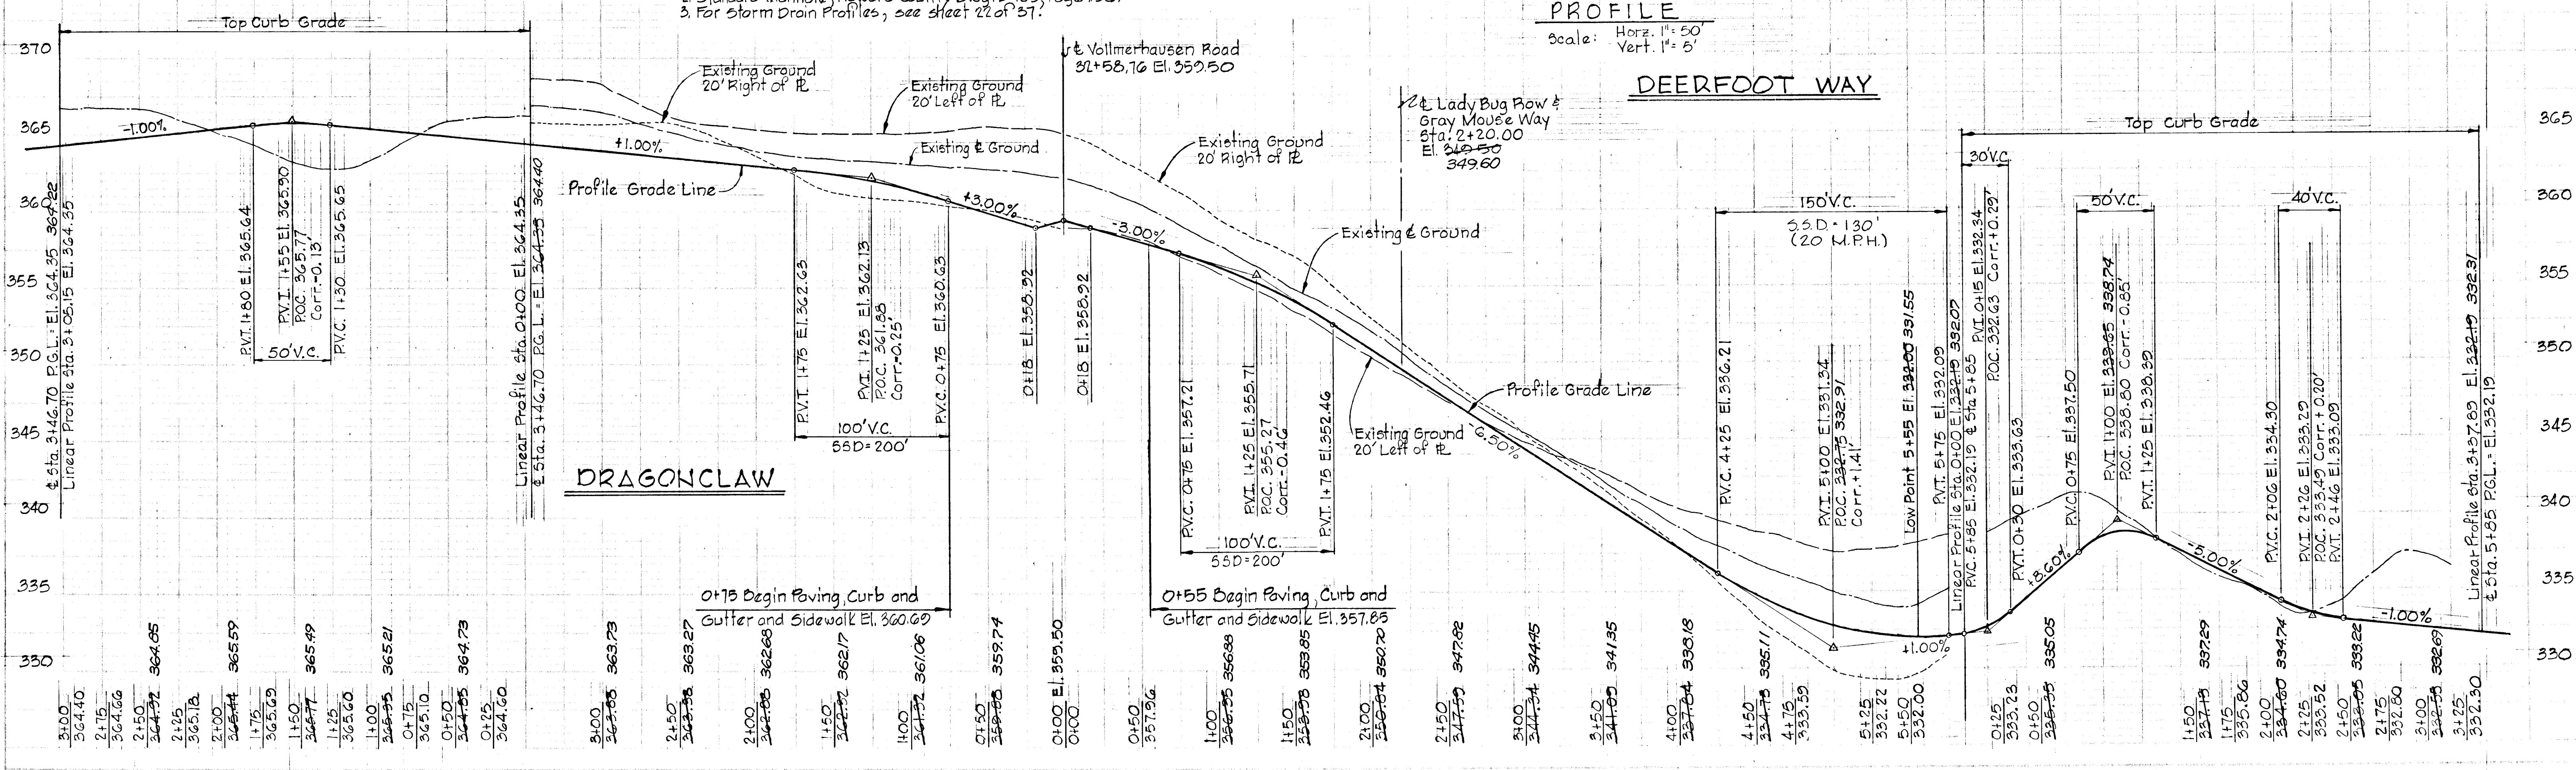

Rev. Date	Rev. No.	Revision Description
<b>COLUMBIA</b> 6th ELECTION DISTRICT HOWARD COUNTY, MARYLAND		
OWNER AND DEVELOPER HOWARD RESEARCH AND DEVELOPMENT CORP.		
PROJECT AREA VILLAGE OF KINGS CONTRIVANCE SECTION 3 AREA 1		
PROJECT TITLE PLAN AND PROFILE DEERFOOT WAY DRAGONCLAW		
SCALE: AS SHOWN		DATE
WHITMAN, REQUARDT & ASSOCIATES ENGINEERS BALTIMORE, MARYLAND 21202		
<i>Kenneth A. McCord</i> KENNETH A. McCORD Registered Engineer No. 1974		



AS-BUILT ELEVATIONS, VERIFIED BY KENNETH A. MCCORD MD. REG. PE. No. 1974 AS OF DECEMBER 20, 1978

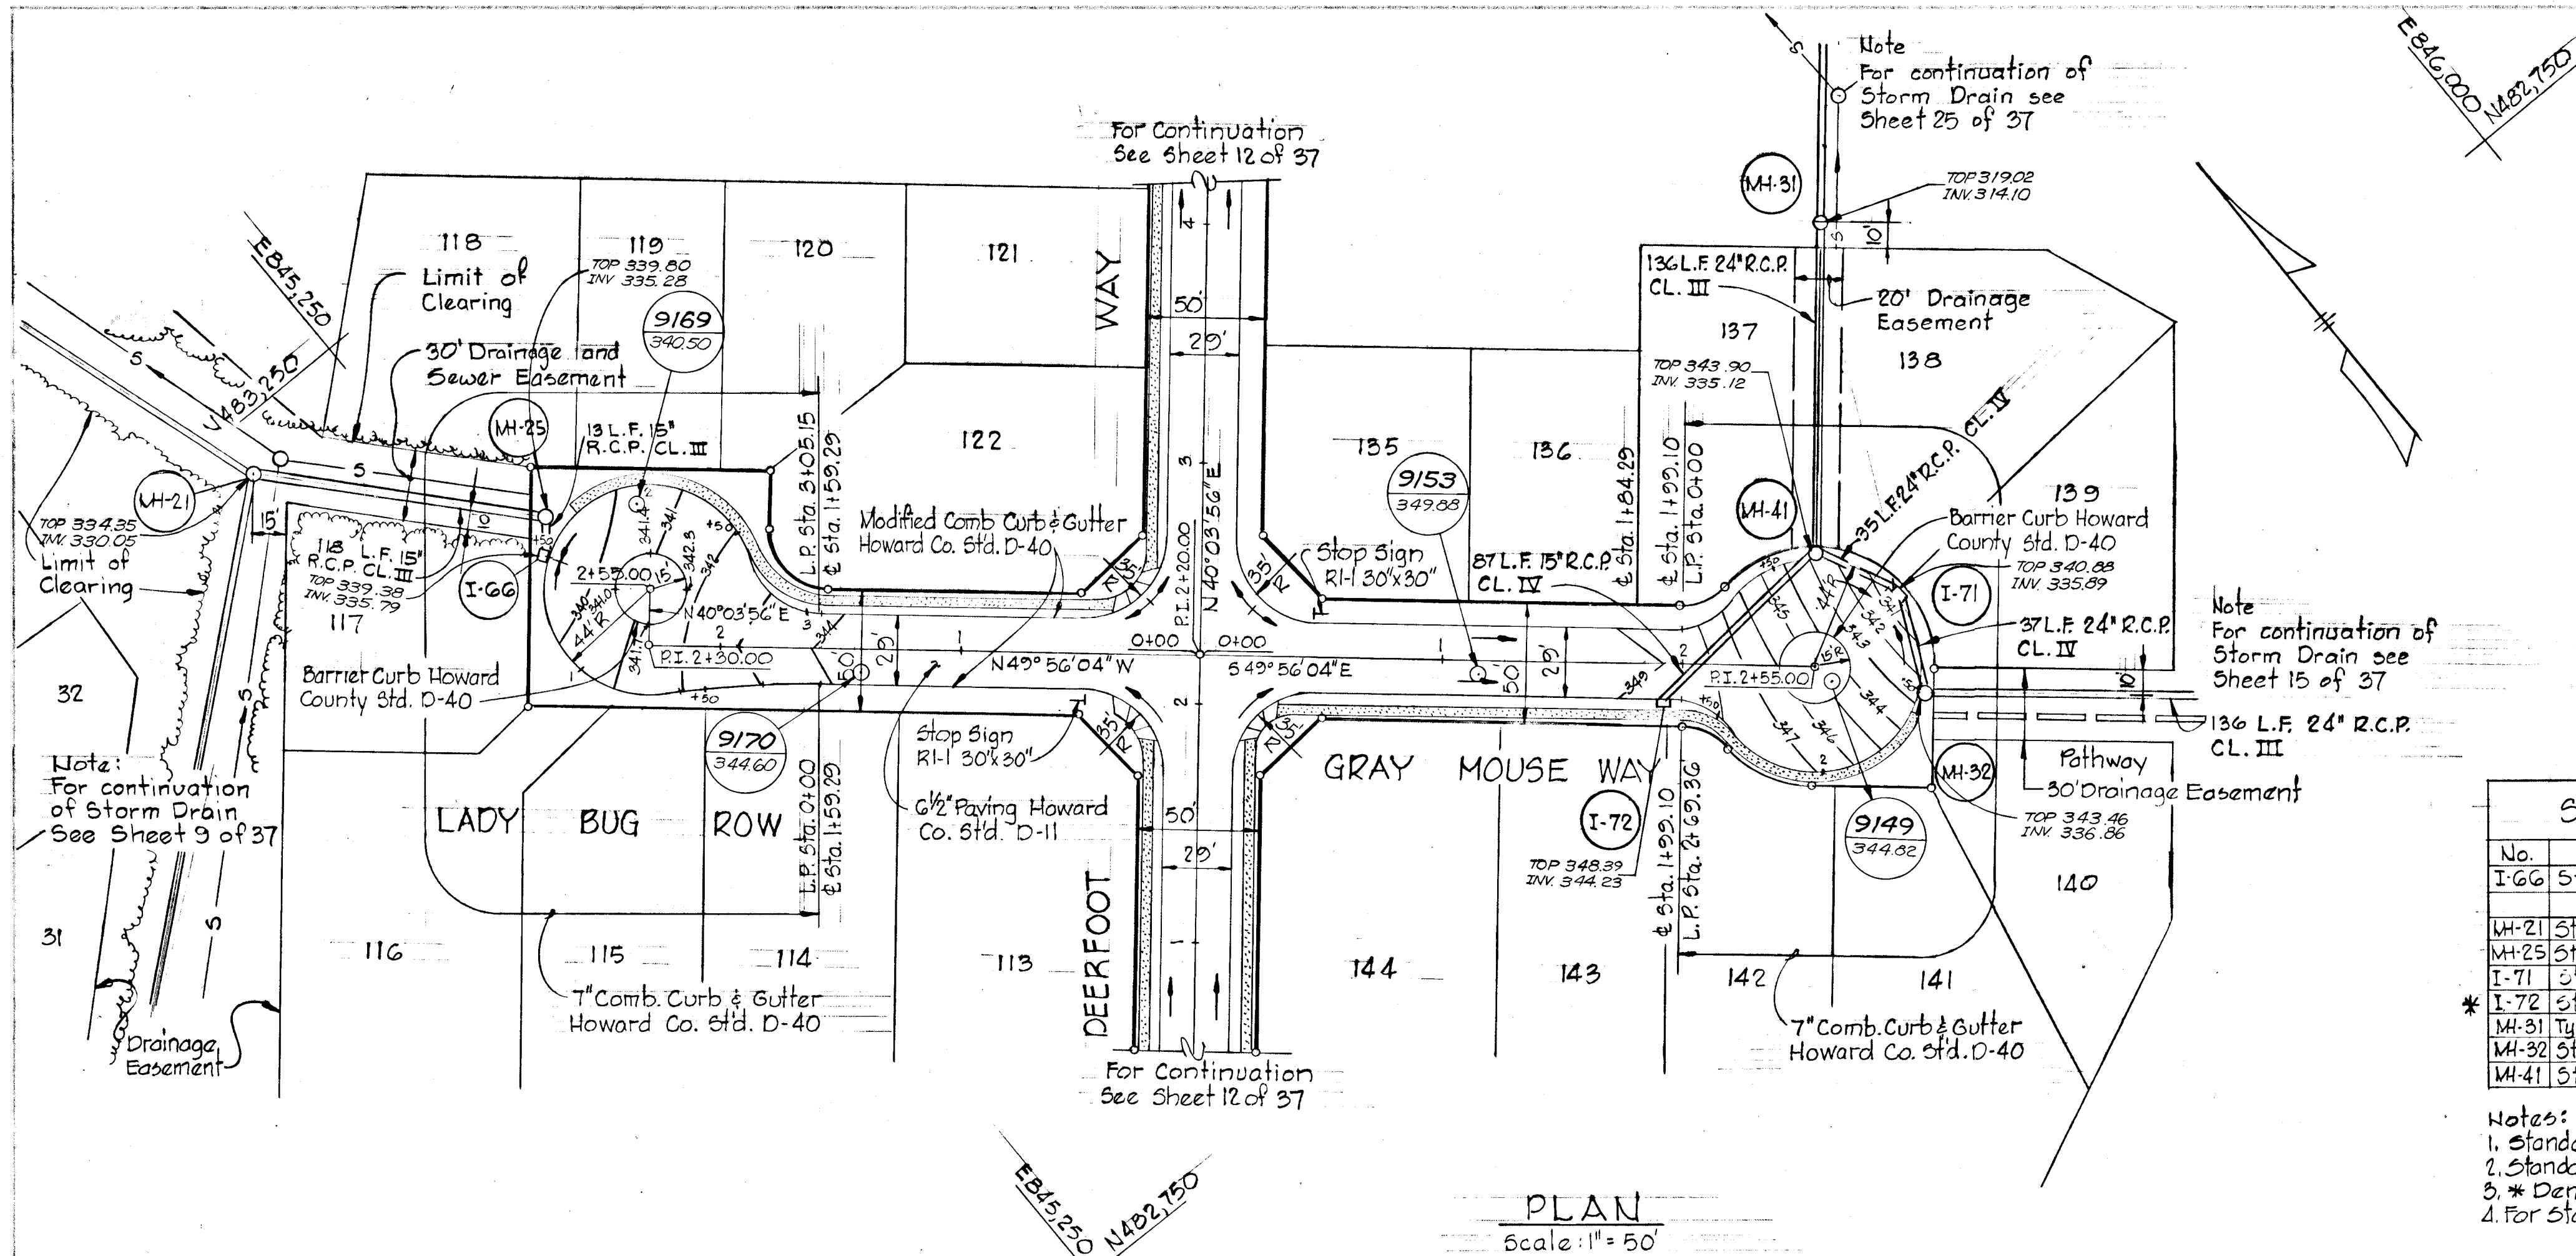

Note  
For Cul-De-Sac Curve Data  
See Sheet 10 of 37

NOTE:  
PAVING WIDTH - 29'  
LENGTH OF PAVING - 485'  
4 SEWER MHS IN ROAD R/W

STORM DRAIN STRUCTURE SCHEDULE

No.	TYPE	TOP ELEV.	INV. OUT.	LOCATION
I-66	Std. A-5 Inlet, Width=2.5'	339.72	335.58	± Inlet L.P. Sta. 1+50.52
MH-21	Standard Manhole	334.90	329.56	± MH 3' Back of L.P. Sta. 1+63
MH-25	Standard Manhole	340.20	335.23	See Plan and Profile
I-71	Std. A-5 Inlet, Width=3.0'	341.00	335.67	± Inlet L.P. Sta. 1+05
* I-72	Std. A-5 Inlet, Width=2.5'	343.48	344.00	± Inlet 15.92 Right of ± Sta. 1+92 Rd.
MH-31	Type B MH (See Detail Sht. 27)	319.60	314.07	See Plan and Profile
MH-32	Standard Manhole	343.42	338.45	± MH 3.0' Back of L.P. Sta. 1+50 ±
MH-39	Standard Manhole	342.92	334.99	± MH 3.0' Back of L.P. Sta. 0+70

- Notes:  
 1. Standard A-5 Inlet, Howard County Dwg. G4-A, Page 110-A.  
 2. Standard Manhole, Howard County Dwg. D-103, Page 135.  
 3. \* Denotes Inlet with Deflectors  
 4. For Storm Drain Profiles, see sheet 10 and 22 of 37.

Rev. Date	Rev. No.	Revision Description

**COLUMBIA**  
 6<sup>th</sup> ELECTION DISTRICT  
 HOWARD COUNTY, MARYLAND

OWNER AND DEVELOPER  
 HOWARD RESEARCH AND DEVELOPMENT CORP.

PROJECT AREA  
 VILLAGE OF KINGS CONTRIVANCE  
 SECTION 3 AREA 1

PROJECT TITLE  
 PLAN AND PROFILE  
 LADY BUG ROW  
 GRAY MOUSE WAY

SCALE: AS SHOWN DATE

WHITMAN, REQUARD & ASSOCIATES  
 ENGINEERS  
 BALTIMORE, MARYLAND 21202


*Kenneth A. McCord*  
 KENNETH A. MCCORD  
 Registered Engineer  
 No. 1974

PROFILE

Scale Horiz. 1"=50'  
 Vert. 1"=5'

LADY BUG ROW

GRAY MOUSE WAY

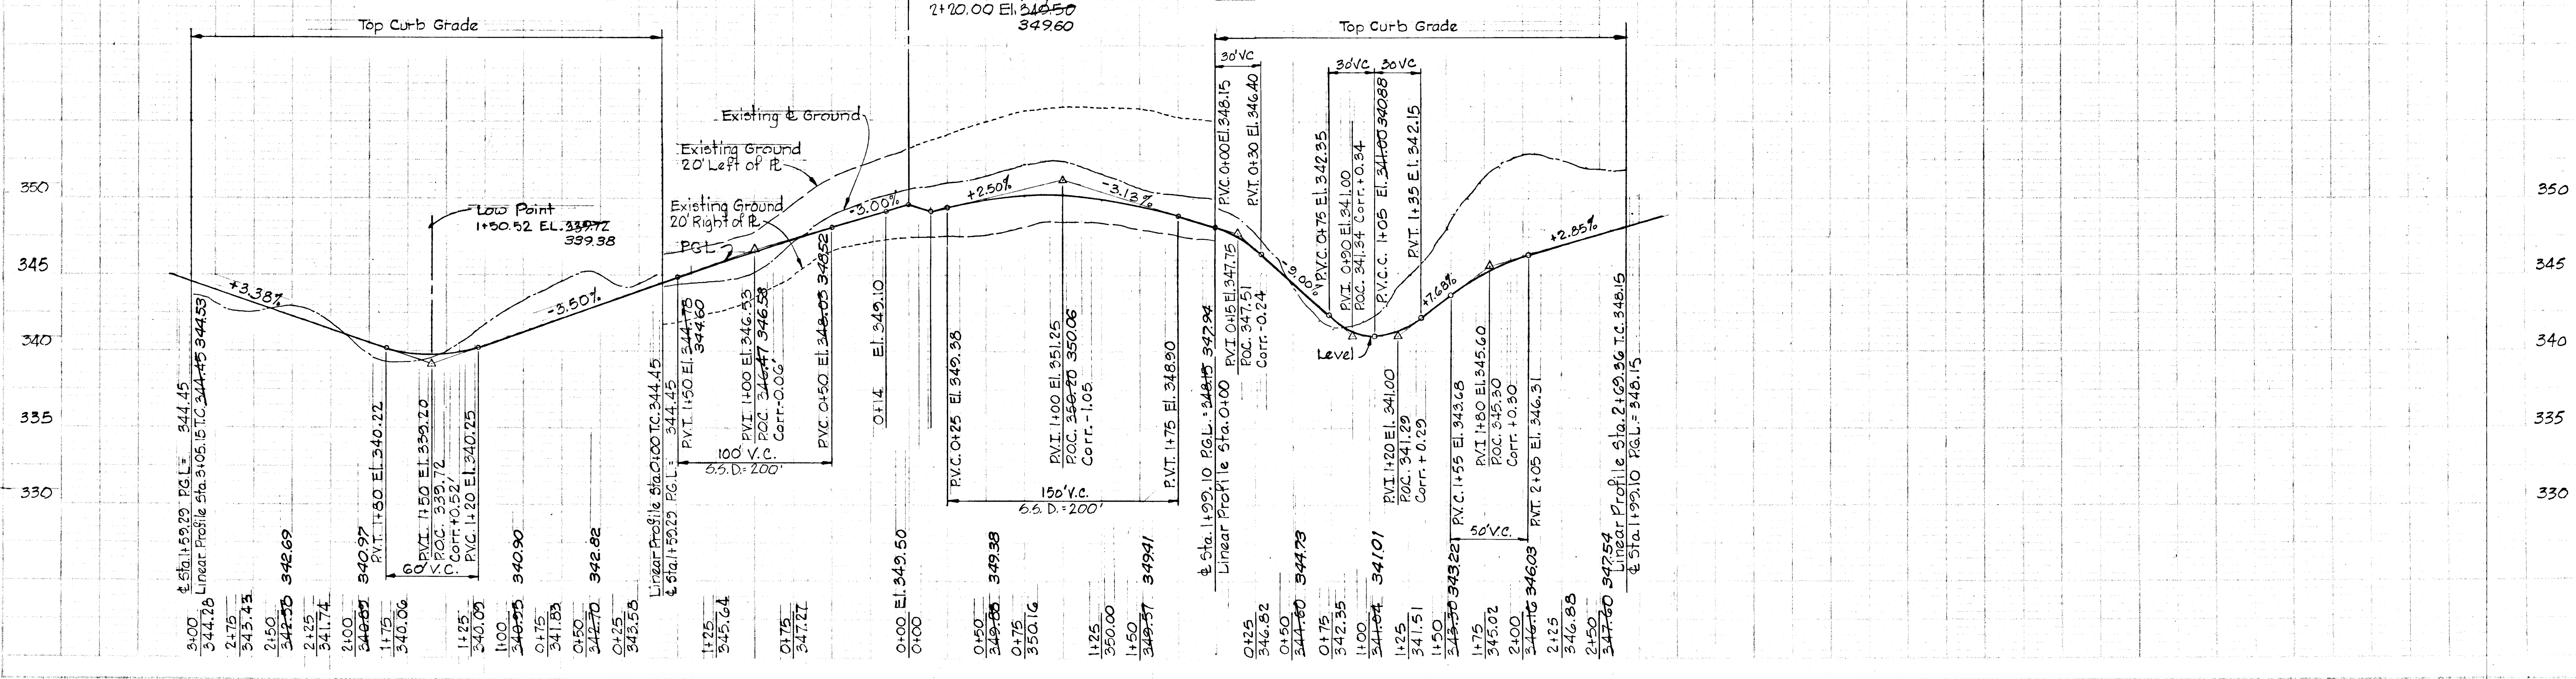

#445

Q&R



**STORM DRAIN STRUCTURE SCHEDULE**


No	TYPE	TOP ELEV	INV OUT	LOCATION
I-75	A-5 Inlet, Width=2.5'	326.00	321.30	± Inlet 1.25' Back of Curb, L.P. Sta. 1+36.67
I-76	A-10 Inlet, Width=2.5'	335.77	330.49	± Inlet 15.92' Left of Sta. 8+10.19 Rd.
MH-30	Standard Manhole	327.72	320.85	± MH 3.5' Back of Curb, L.P. Sta. 0+94

Note  
 For Cul-De-Sac Curve Data  
 See Sheet 12 of 37

For Continuation  
 of Storm Drain  
 see sheet 25 of 37.

Notes:  
 1. Standard A-5 and A-10 Inlets, Howard County Dog. 61-A, Page 110-A.  
 2. Standard Manhole, Howard County Dog. D-103, Page 158.  
 3. For Storm Drain Profiles, see sheet 22 of 37.


AS-BUILT ELEVATIONS VERIFIED BY KENNETH A. McCORD MD. REG. P.E. No. 1974 AS OF DECEMBER 23, 1979

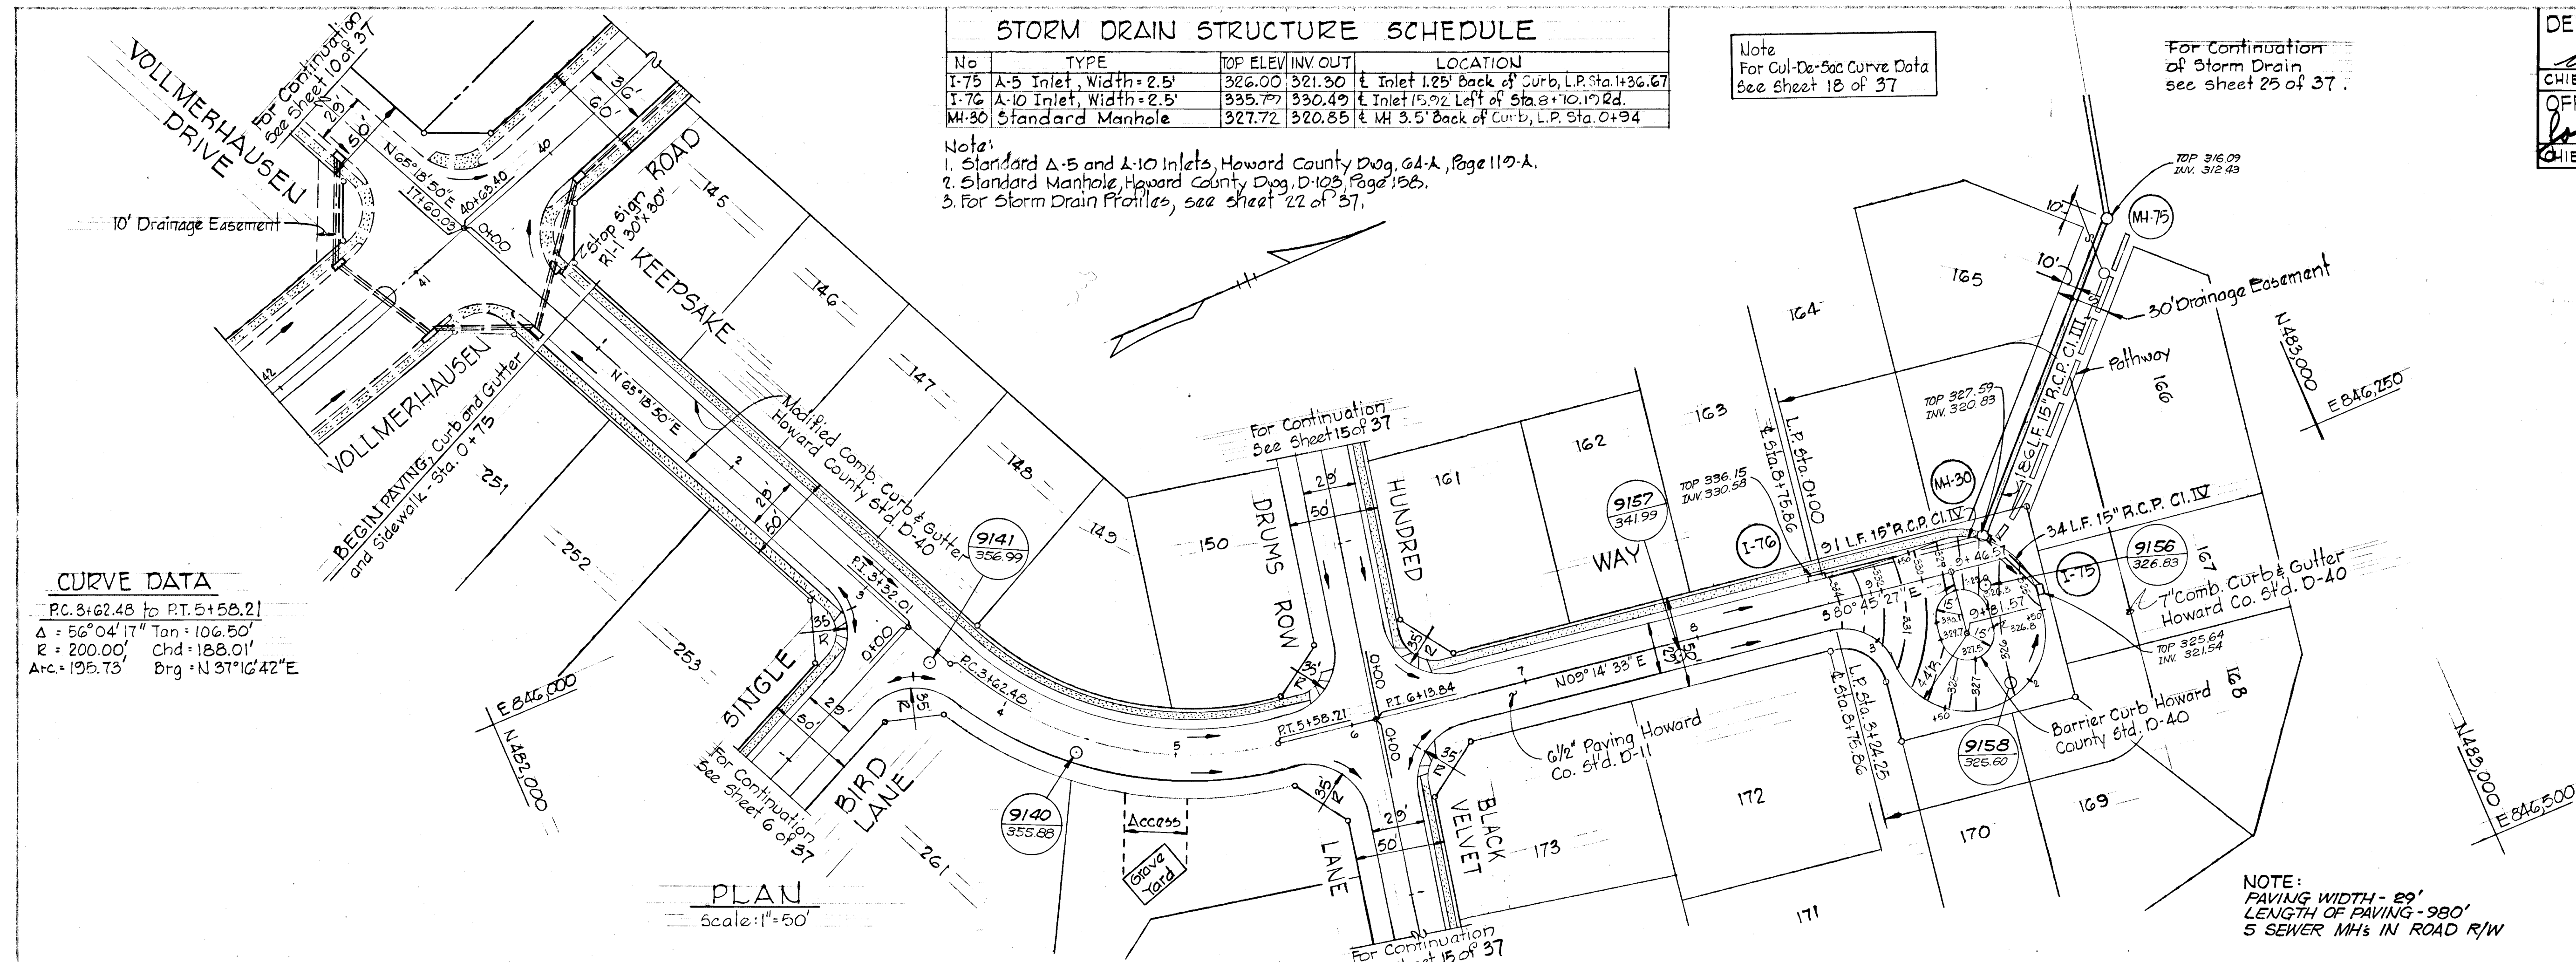

**CURVE DATA**  
 RC: 3+62.48 to PT: 5+58.21  
 $\Delta = 56^\circ 04' 17''$  Tan = 106.50'  
 $R = 200.00'$  Chd = 188.01'  
 Arc = 195.73' Brg = N 37° 16' 42" E

PLAN  
 Scale: 1" = 50'


PROFILE  
 Scale Horiz. 1" = 50'  
 Vert. 1" = 5'

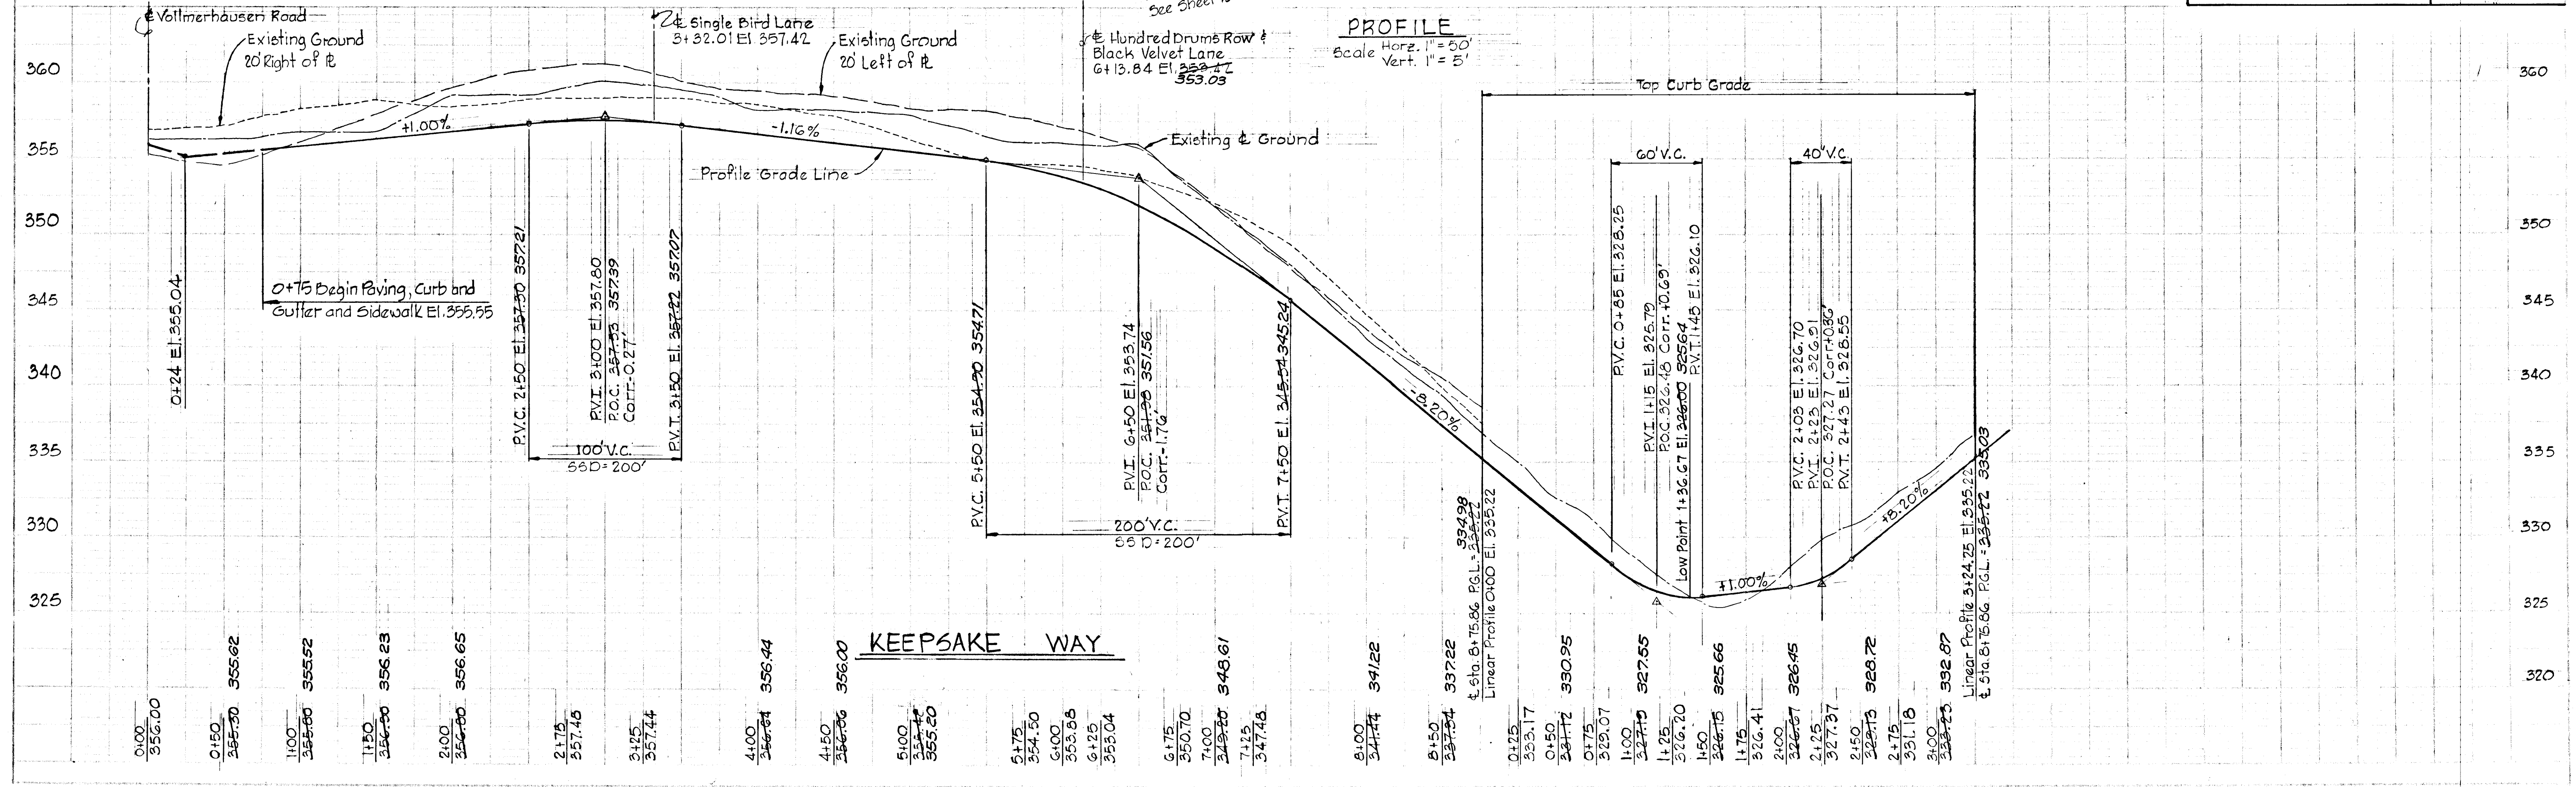

Rev. Date	Rev. No.	Revision Description
<b>COLUMBIA</b> 6th ELECTION DISTRICT HOWARD COUNTY, MARYLAND		
OWNER AND DEVELOPER HOWARD RESEARCH AND DEVELOPMENT CORP.		
PROJECT AREA VILLAGE OF KINGS CONTRIVANCE SECTION 3 AREA 1		
PROJECT TITLE PLAN AND PROFILE KEEPSAKE WAY		
SCALE: AS SHOWN		DATE
WHITMAN, REQUARDT & ASSOCIATES ENGINEERS BALTIMORE, MARYLAND 21202		
<i>Kenneth A. McCord</i> KENNETH A. McCORD Registered Engineer No. 1974		



\*AS-BUILT ELEVATIONS AS OF DECEMBER 20, 1979 -  
 VERIFIED BY KENNETH A. MCCORD MD. REG. P.E.  
 No. 1974

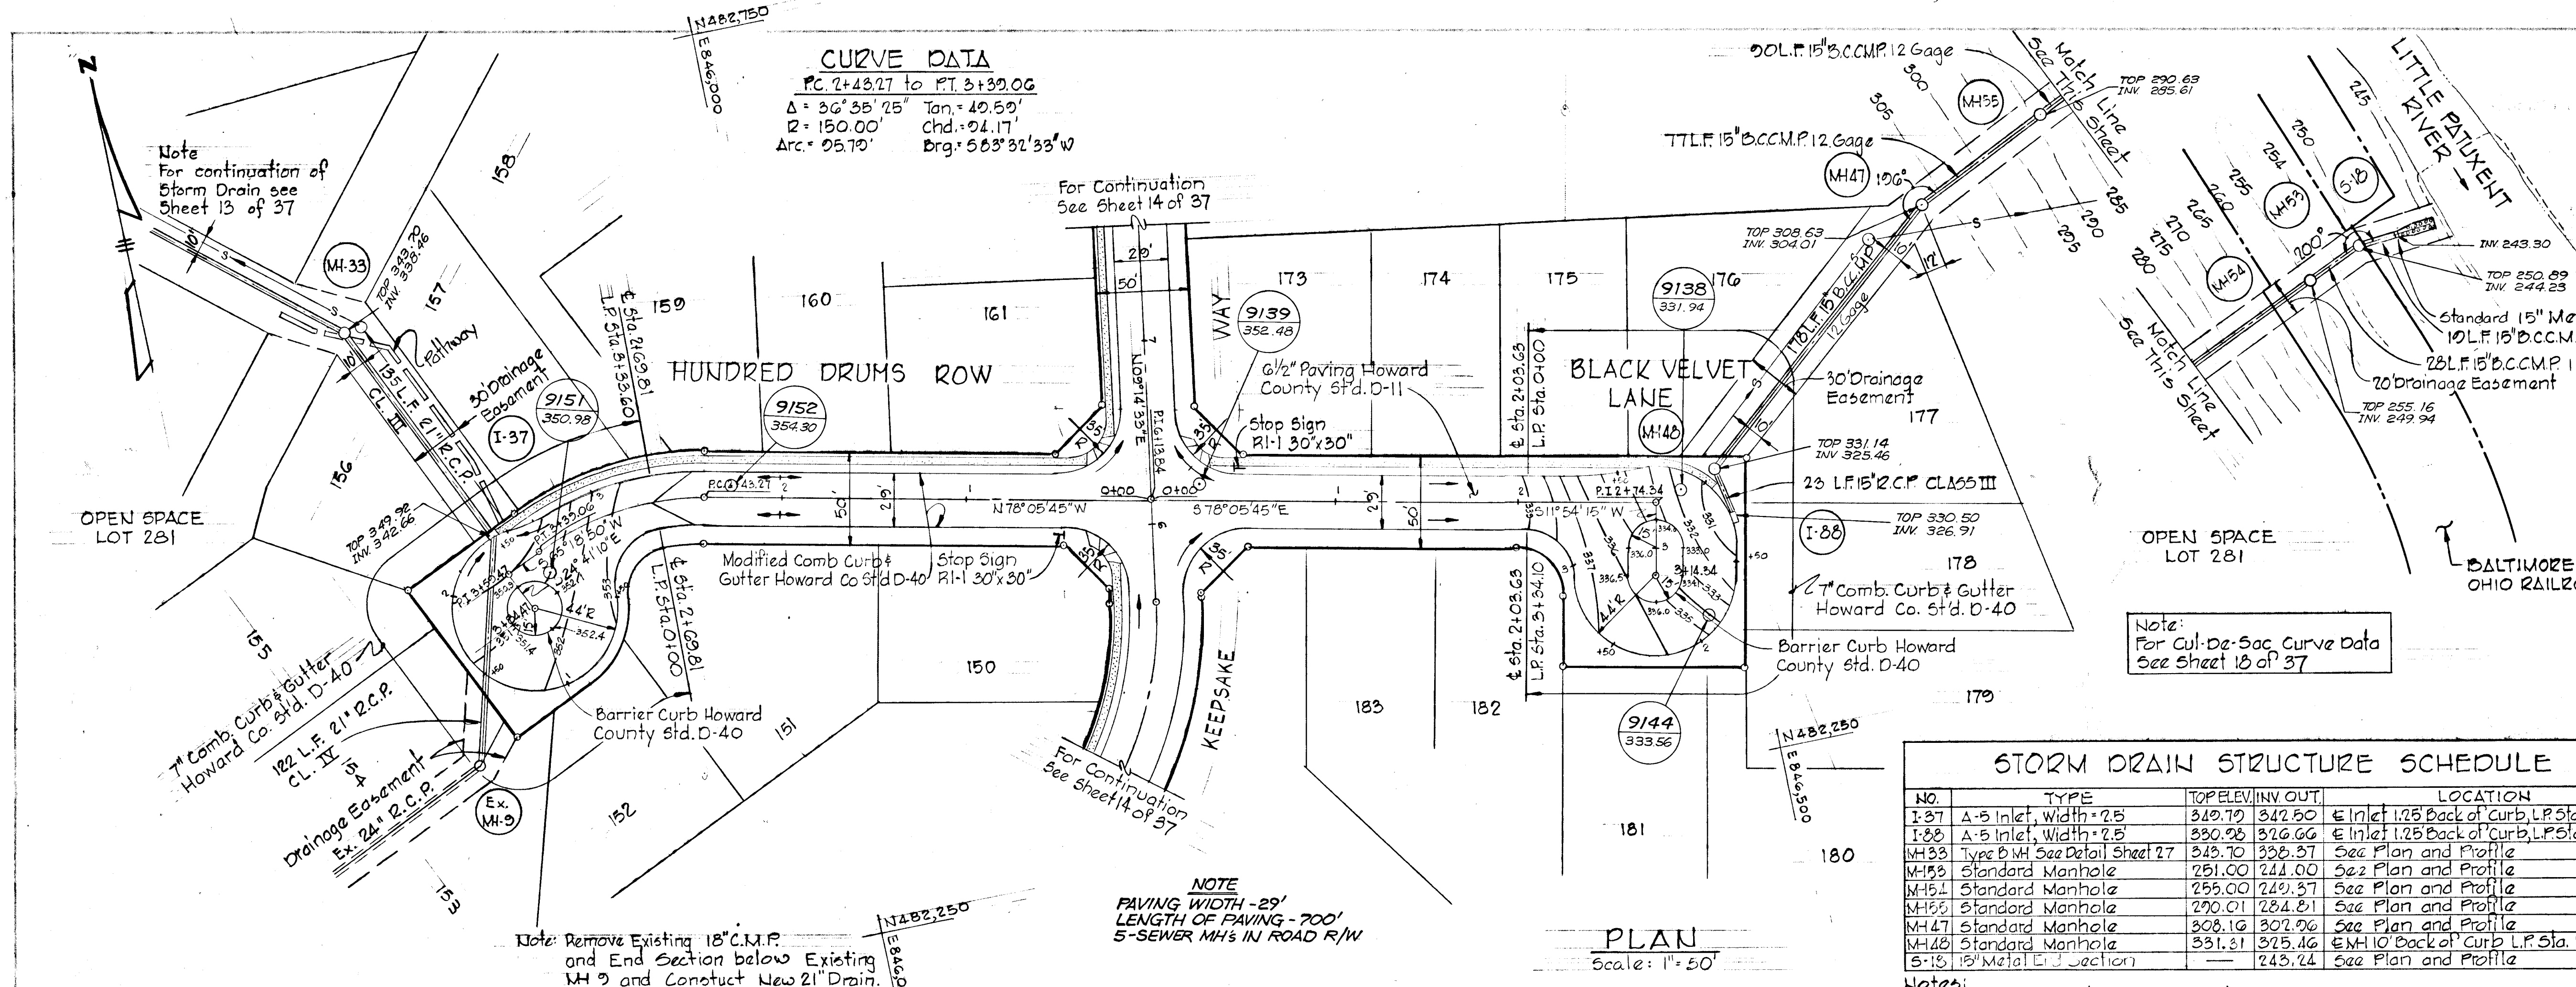

**STORM DRAIN STRUCTURE SCHEDULE**

NO.	TYPE	TOP ELEV.	INV. OUT.	LOCATION
I-37	A-B Inlet, width=2.5	349.70	342.50	Inlet 1.25' Back of Curb, L.P. Sta. 2+42
I-38	A-B Inlet, width=2.5	330.25	326.66	Inlet 1.25' Back of Curb, L.P. Sta. 1+25
MH 33	Types B MH See Detail Sheet 27	343.70	338.37	See Plan and Profile
MH 37	Standard Manhole	251.00	244.00	See Plan and Profile
MH 43	Standard Manhole	255.00	249.37	See Plan and Profile
MH 44	Standard Manhole	290.01	284.81	See Plan and Profile
MH 45	Standard Manhole	308.19	307.96	See Plan and Profile
MH 46	Standard Manhole	331.31	325.46	MH 10' Back of Curb L.P. Sta. 1+00
MH 47	Standard Manhole	—	243.24	See Plan and Profile

Notes:  
 1. Standard A-B Inlet, Howard County Dwg. 04-A, Page 119-A.  
 2. Standard Manhole, Howard County Dwg. D-103, Page 158.  
 3. 15' Metal End Section, see detail, sheet 27 of 37.  
 4. For Storm Drain Profiles, see sheet 22 and 24 of 37.

Rev. Date	Rev. No.	Revision Description

**COLUMBIA**  
 6<sup>th</sup> ELECTION DISTRICT  
 HOWARD COUNTY, MARYLAND

OWNER AND DEVELOPER  
 RESEARCH AND DEVELOPMENT CORP.


PROJECT AREA  
 VILLAGE OF KINGS CONTRIVANCE  
 SECTION 3 AREA 1

PROJECT TITLE  
 PLAN AND PROFILE  
 HUNDRED DRUMS ROW  
 BLACK VELVET LANE

SCALE: AS SHOWN DATE


WHITMAN, REQUARDT & ASSOCIATES  
 ENGINEERS  
 BALTIMORE, MARYLAND 21202

*Kenneth A. McCord*  
 KENNETH A. MCCORD  
 Registered Engineer  
 No. 1974

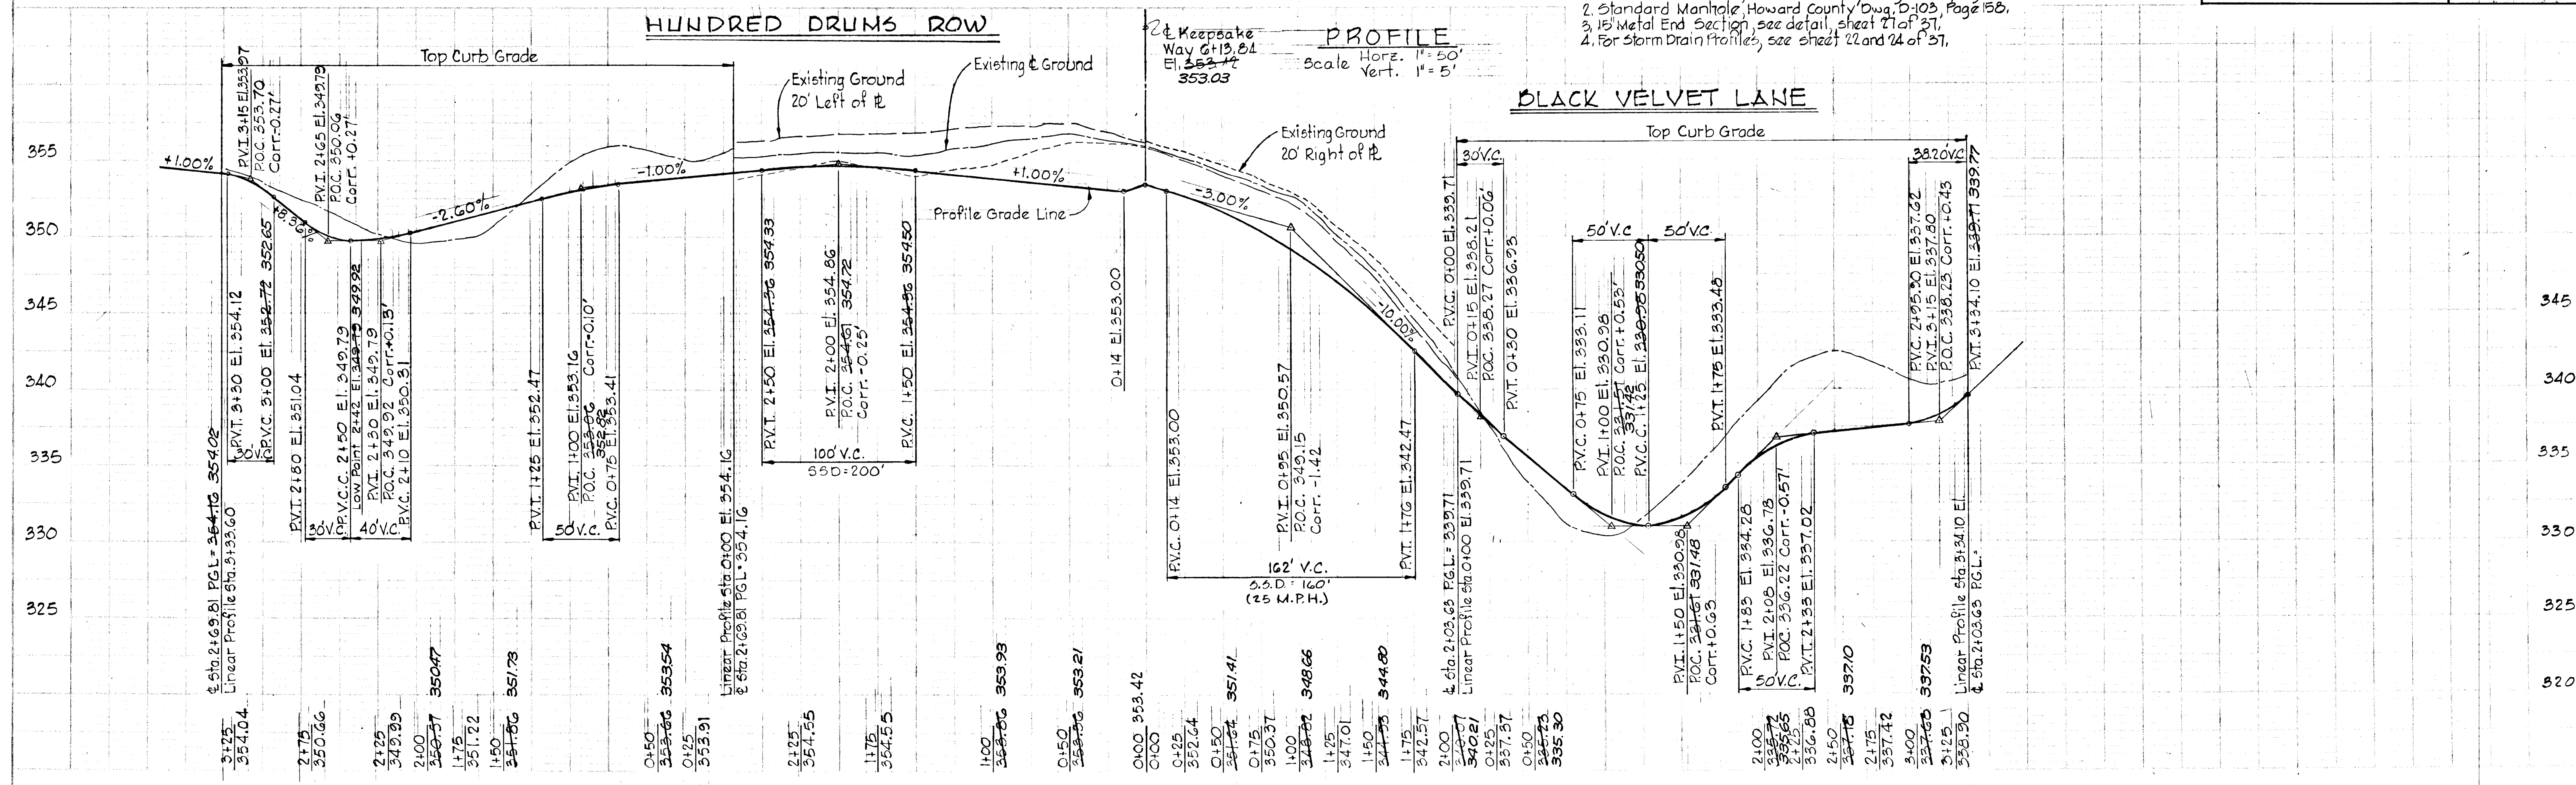



**CURVE DATA**  
 P.C. 3+88.12 to P.T. 6+00.88  
 Δ = 30°28'34" Tan = 108.96'  
 R = 400.00' Chd = 210.26'  
 Arc = 212.76' Brg = N50°04'33"E

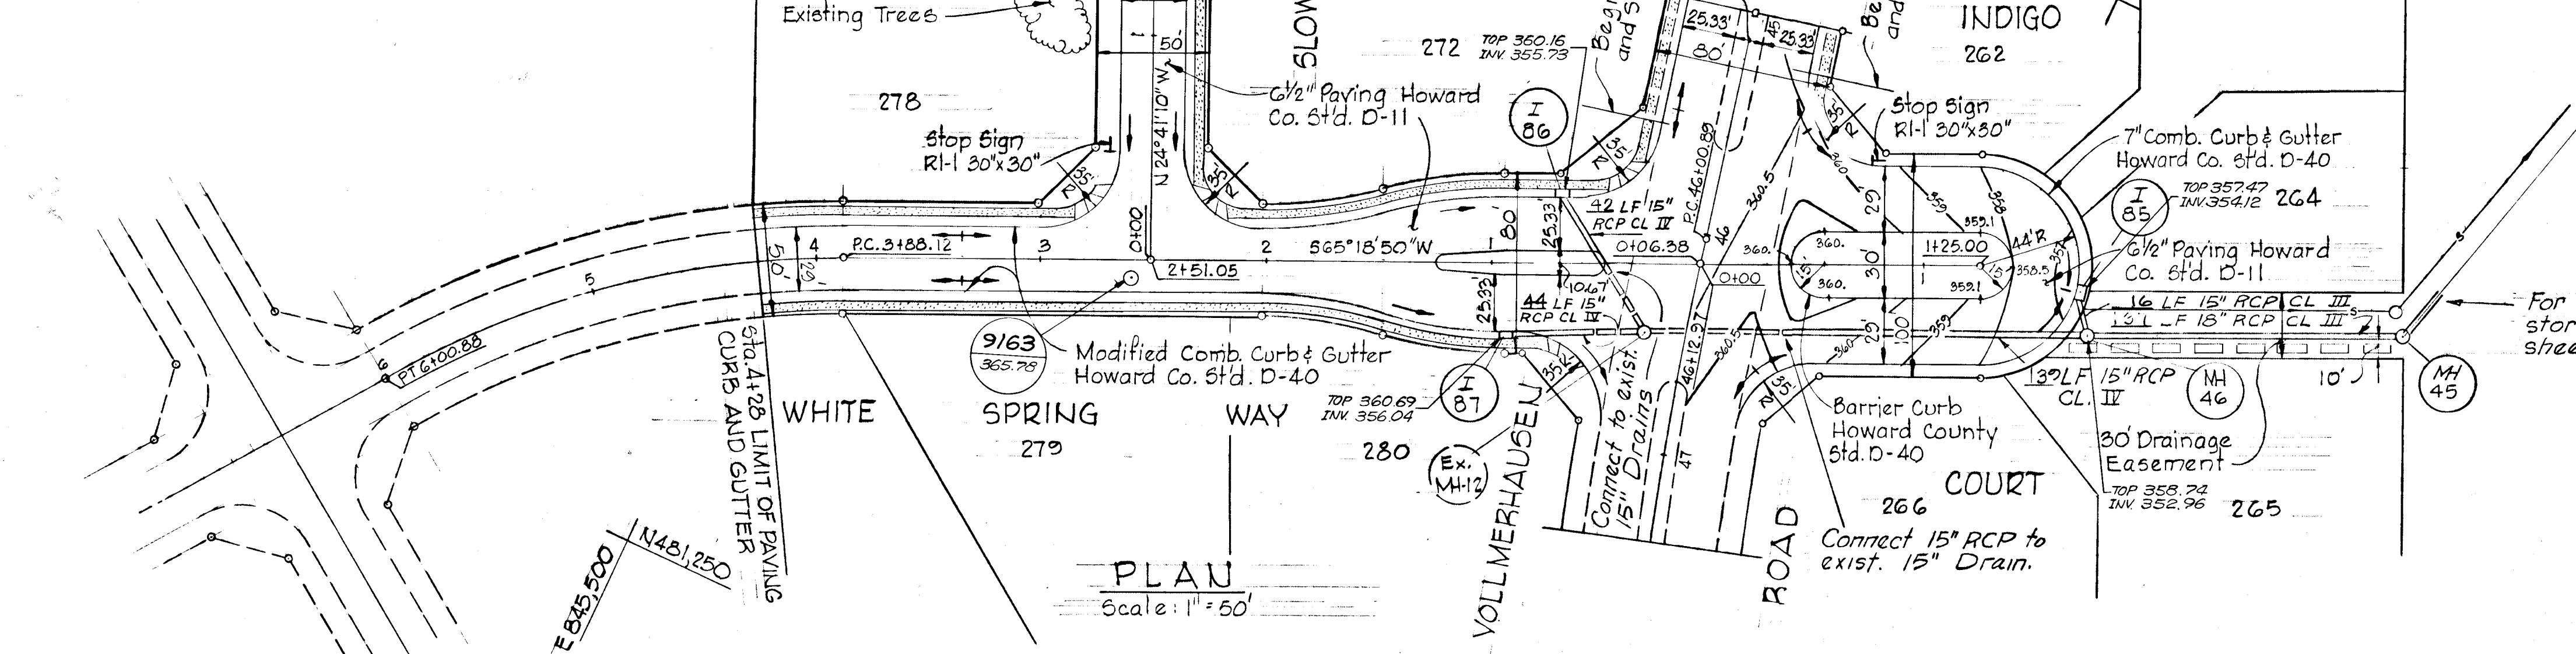

STORM DRAIN STRUCTURE SCHEDULE				
No.	Type	Top Elev.	Inlet	Location
I-85	Type A-5 Inlet width: 2.5'	357.45	353.86	Inlet L.R. Sta. 0+85 Indigo Court
I-86	Type A-5 Inlet width: 2.5'	360.20	355.60	Inlet 3228' L.R. Sta. 0+85 White Spring Way
I-87	Type A-5 Inlet width: 2.5'	360.65	355.85	Inlet 3228' L.R. Sta. 0+85 White Spring Way
MH-46	Standard Manhole	358.60	352.72	See Plan & Profile

DEPARTMENT OF PUBLIC WORKS  
*W.O. Roberts* 12-29-78  
 CHIEF, BUREAU OF ENGINEERING DATE  
 OFFICE OF PLANNING AND ZONING  
*John W. Musselman/afp* 12-27-78  
 CHIEF, DIVISION OF LAND DEVELOPMENT DATE

- Notes:  
 1. Standard A-5 Inlet, Howard County Dwg. 64-1, Page 110-A.  
 2. Standard Manhole, Howard County Dwg. D-103, Page 15B.  
 3. For Storm Drain Profiles, see sheet 23 of 31.


Note  
 For Cul-De-Sac Curve Data  
 See sheet 18 of 37

'AS-BUILT' ELEVATIONS VERIFIED BY KENNETH A. MCCORD AND REG. P.E. No. 1974, AS OF DECEMBER 20, 1978


Rev. Date	Rev. No.	Revision Description
<b>COLUMBIA</b> 6th ELECTION DISTRICT HOWARD COUNTY, MARYLAND		
OWNER AND DEVELOPER HOWARD RESEARCH AND DEVELOPMENT CORP.		
PROJECT AREA VILLAGE OF KINGS CONTRIVANCE SECTION 3 AREA 1		
PROJECT TITLE PLAN AND PROFILE SLOW RAIN WAY WHITE SPRING WAY INDIGO COURT		
SCALE: AS SHOWN DATE		
WHITMAN, REQUARDT & ASSOCIATES ENGINEERS BALTIMORE, MARYLAND 21202		
<i>Kenneth A. McCord</i> KENNETH A. MCCORD Registered Engineer No. 1974		

NOTE:  
 PAVING WIDTHS - 29' AND 2-24'  
 LENGTH OF PAVING - 745'  
 2-SEWER MHS IN ROAD R/W


**WHITE SPRING WAY**

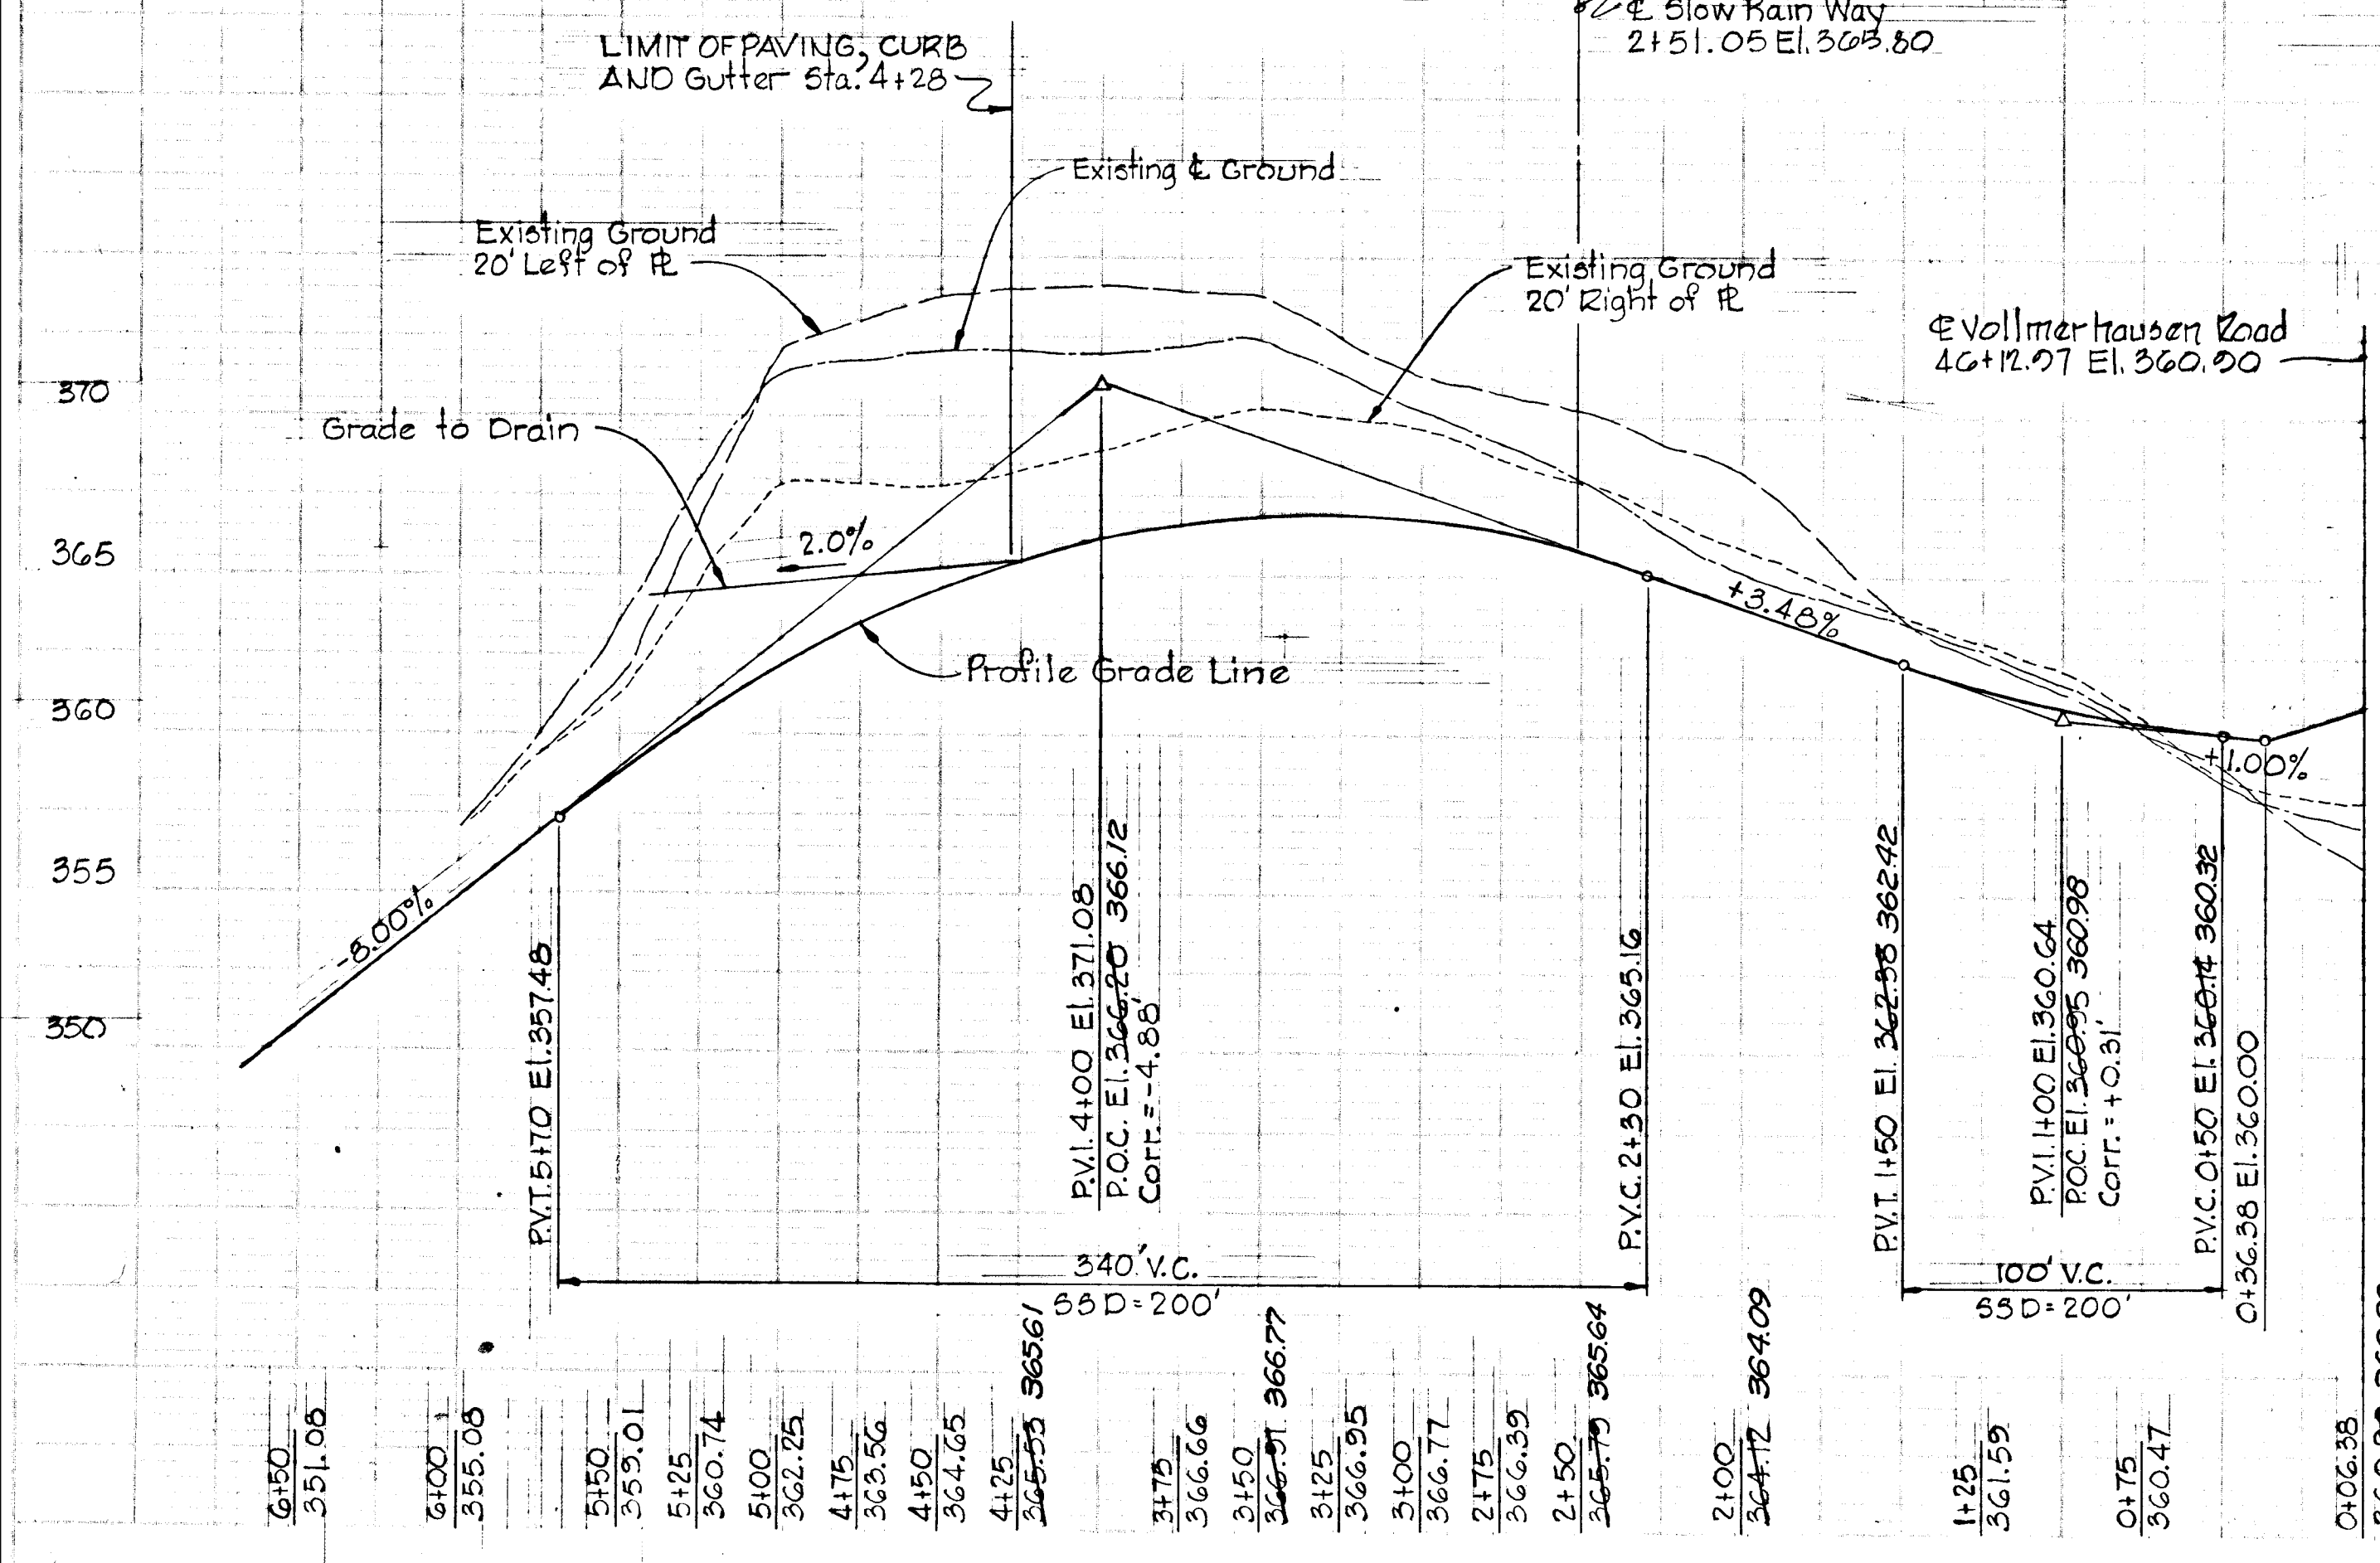

**PROFILES - INDIGO COURT**

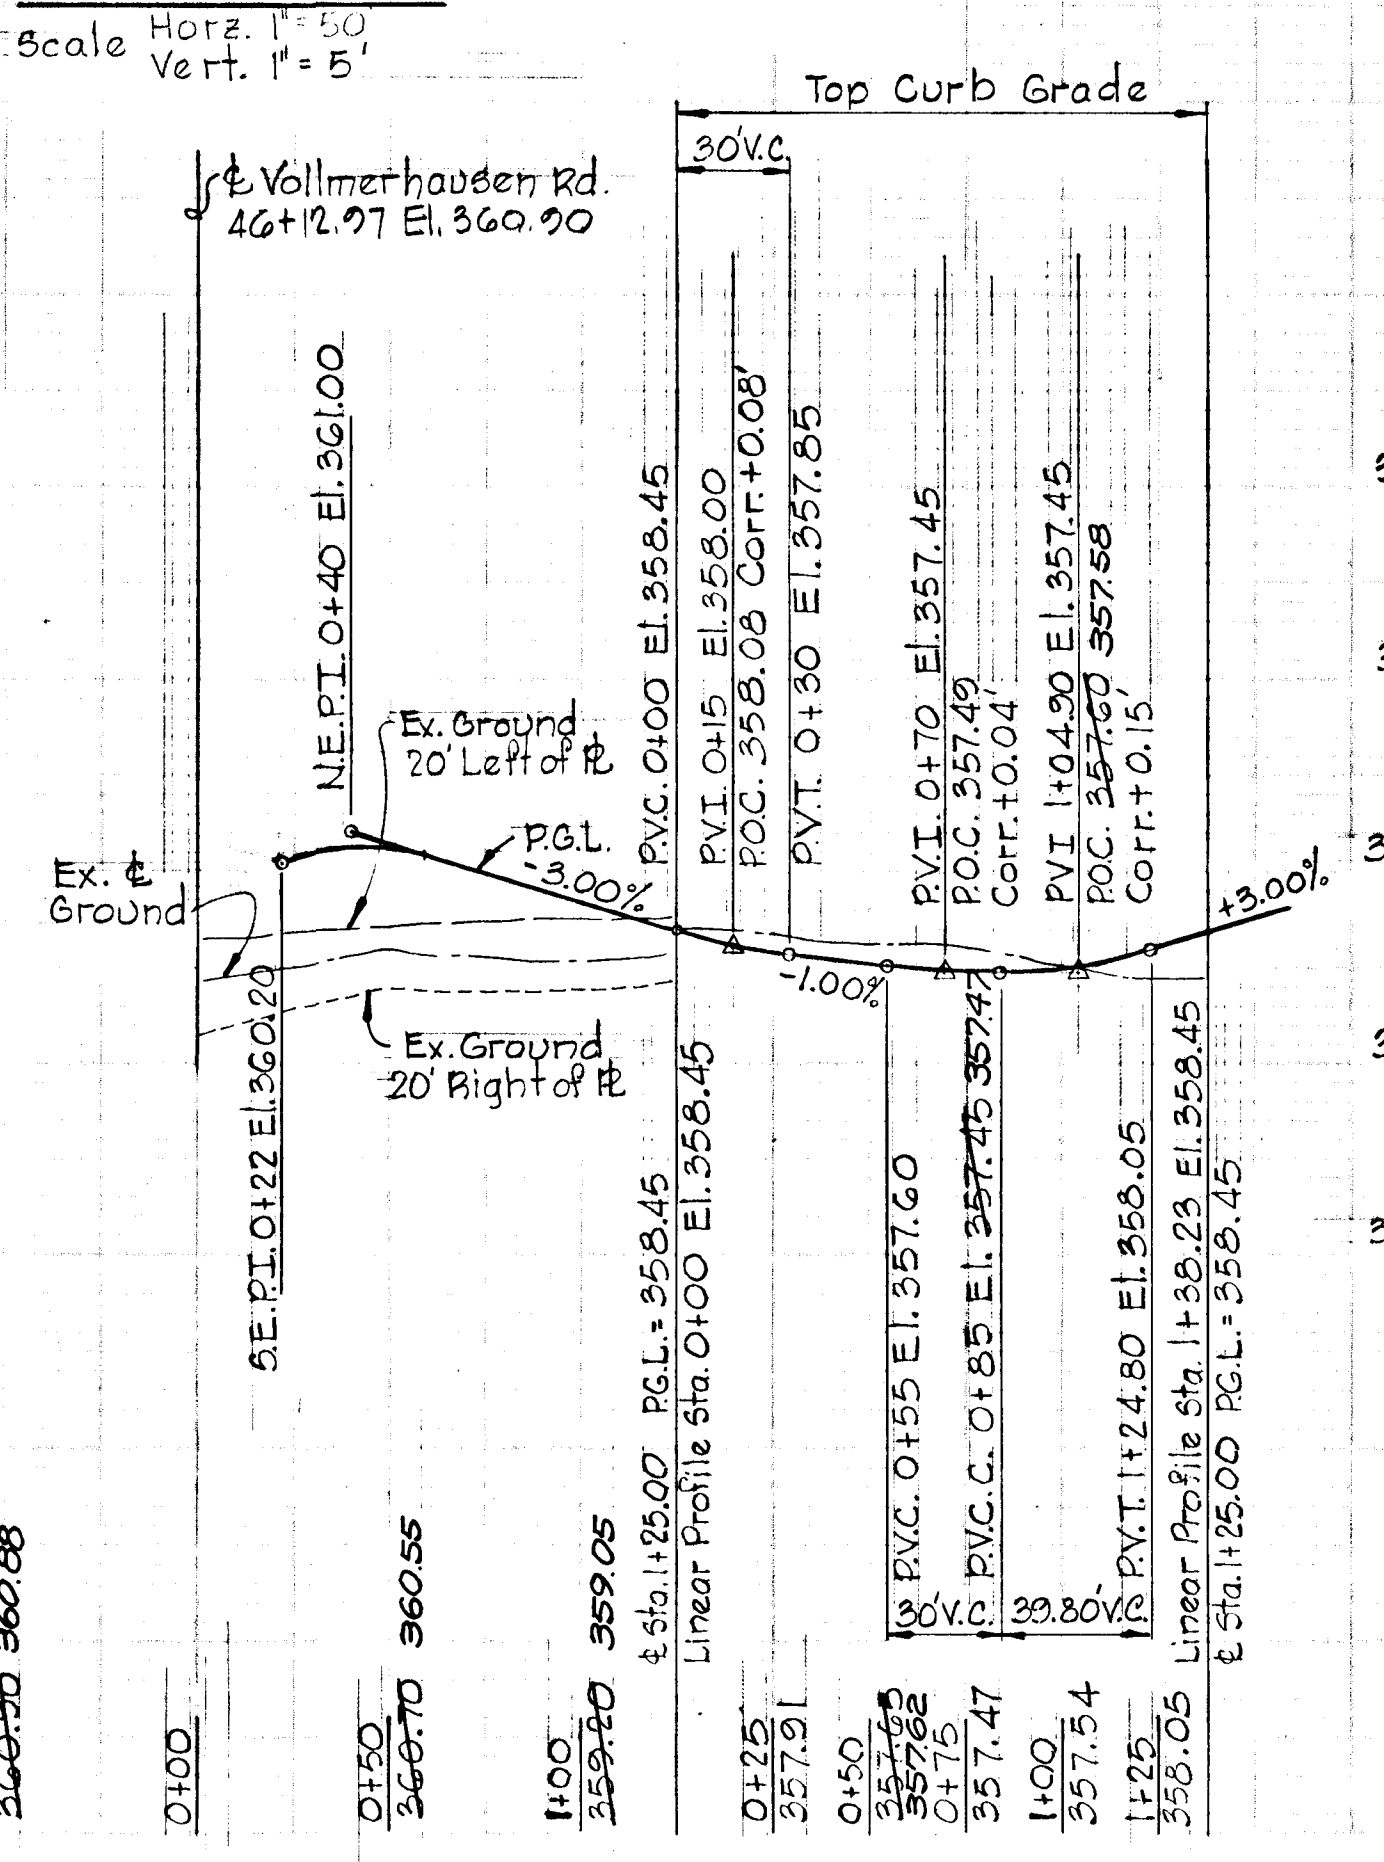


**SLOW RAIN WAY**

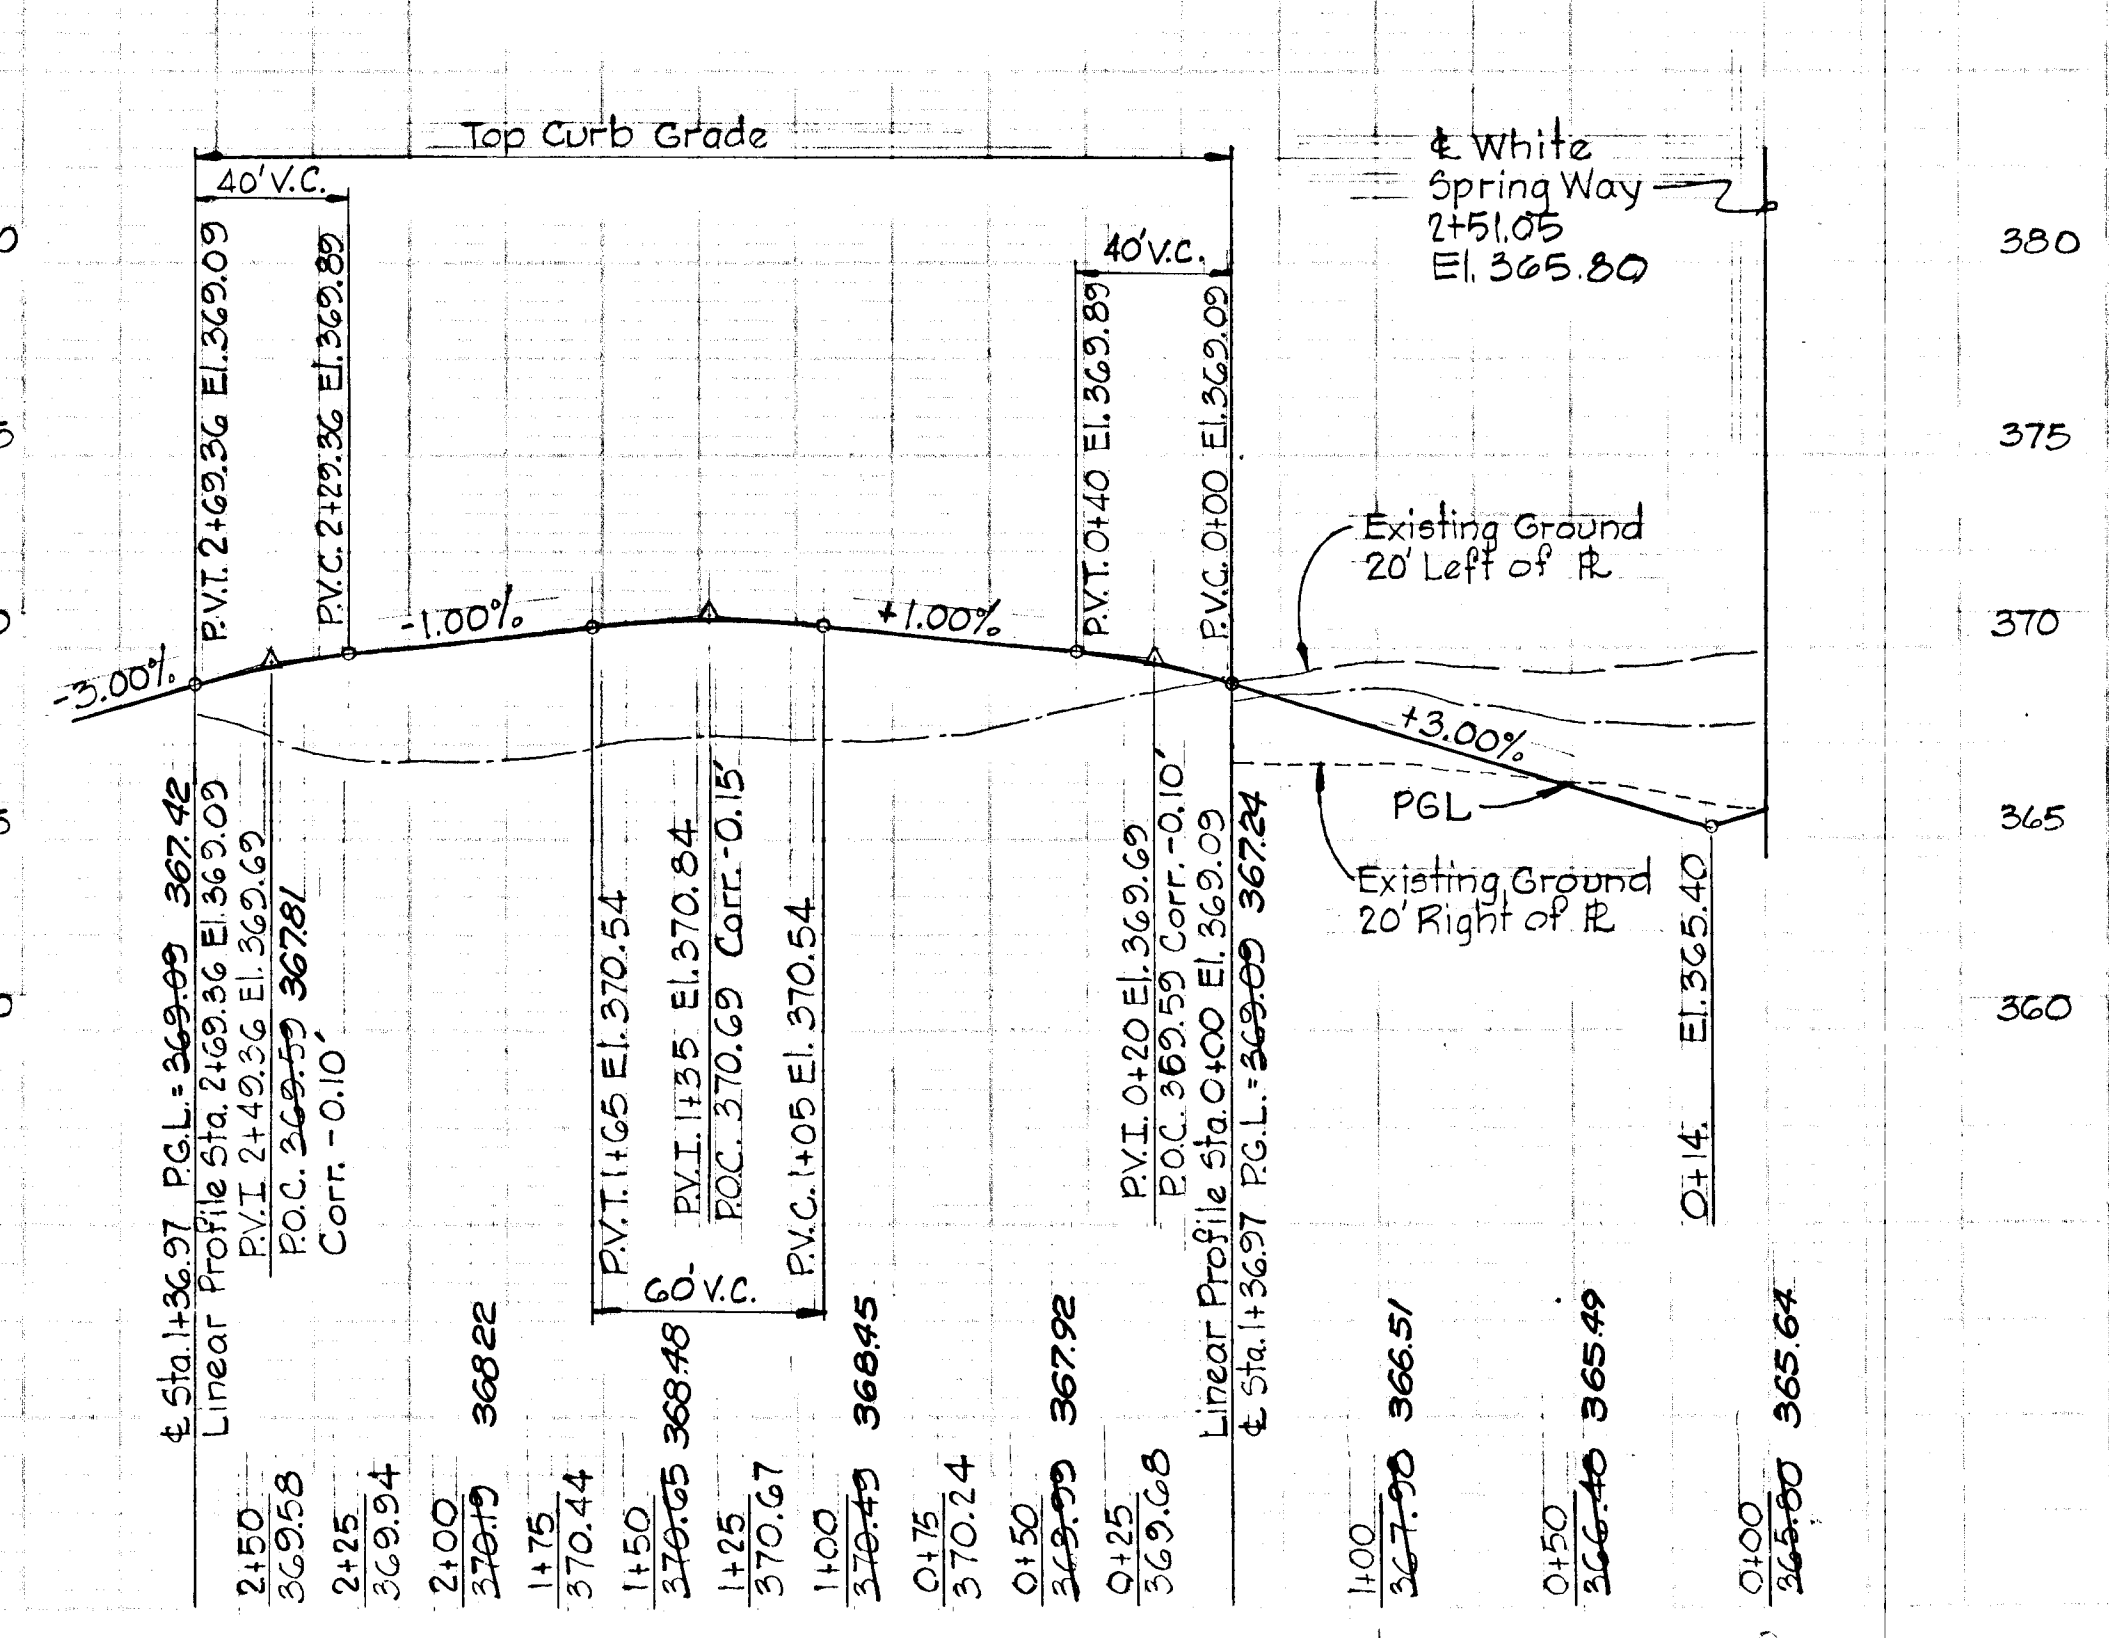




TYPICAL HALF SECTION 50' R/W APPLIES TO:


Golden Rod Path 0+75 to 5+56.02	Vollmarhausen Drive 0+15 to 5+00
Corn Tassel Court 0+00 to 2+54.29	Sweet Grass Ridge 0+00 to 7+38.04
Sea Shadow 2+65 to 17+54.44	Deerfoot Way 0+00 to 5+85
Sandlight Court 0+00 to 2+55.57	Dragonclaw 0+00 to 3+46.10
Single Bird Lane 0+00 to 1+54.21	Gray Mouse Way 0+00 to 11+99.10
Morning Leap Terrace 0+00 to 0+96.89	Lady Bug Row 0+00 to 1+59.25
West Window Way 0+00 to 1+41.60	Keepsake Way 0+75 to 8+75.86
Green Moon Path 0+00 to 2+46.76	Hundred Drums Row 0+00 to 2+69.81
Morning Mews 0+00 to 2+36.46	Black Velvet Lane 0+00 to 2+03.63
Cold Star Court 0+00 to 2+56.42	Slow Rain Way 0+00 to 1+36.97
Moonrider Lane 0+00 to 5+62.58	

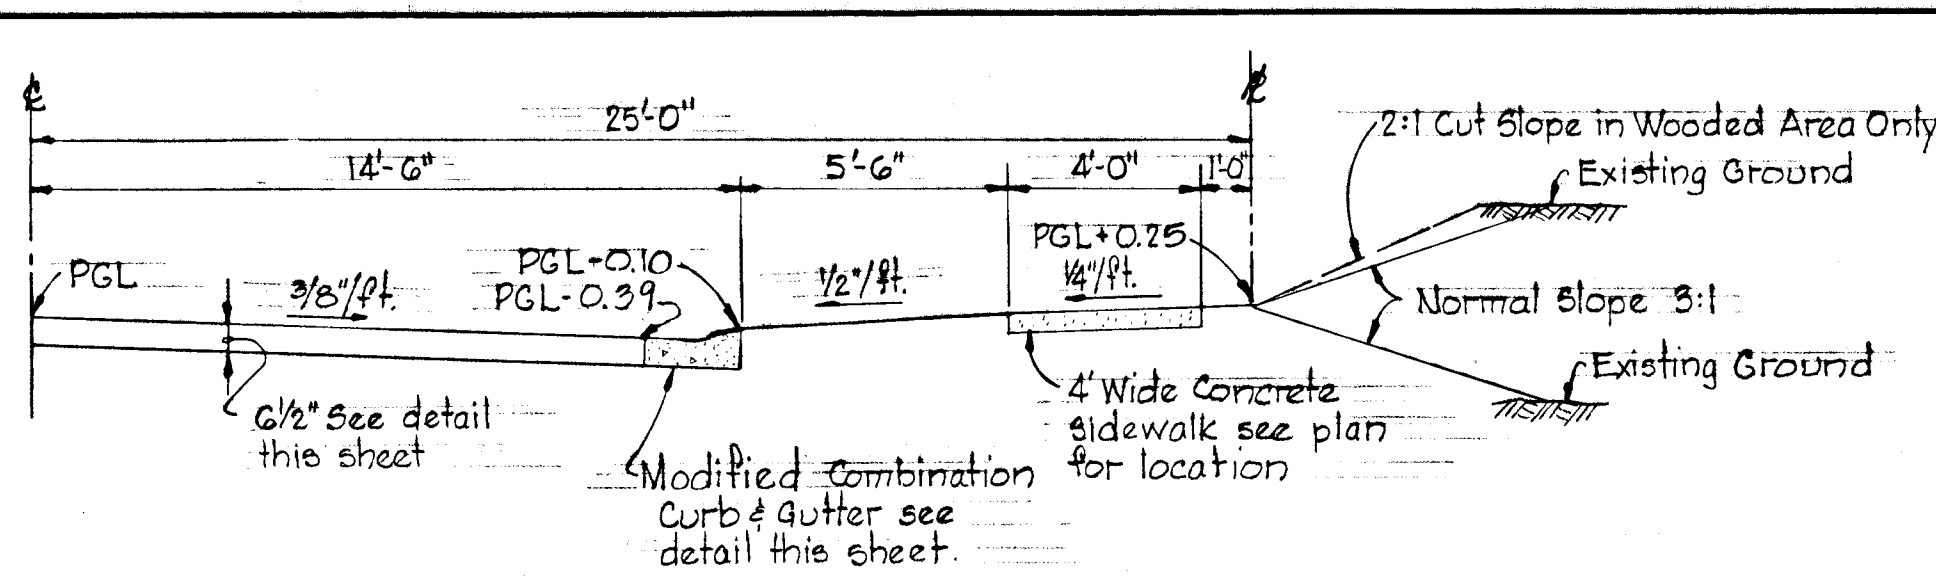


TYPICAL HALF SECTION  
 50' R/W - 29' ROADWAY  
 Scale: 1/4" = 1'-0"

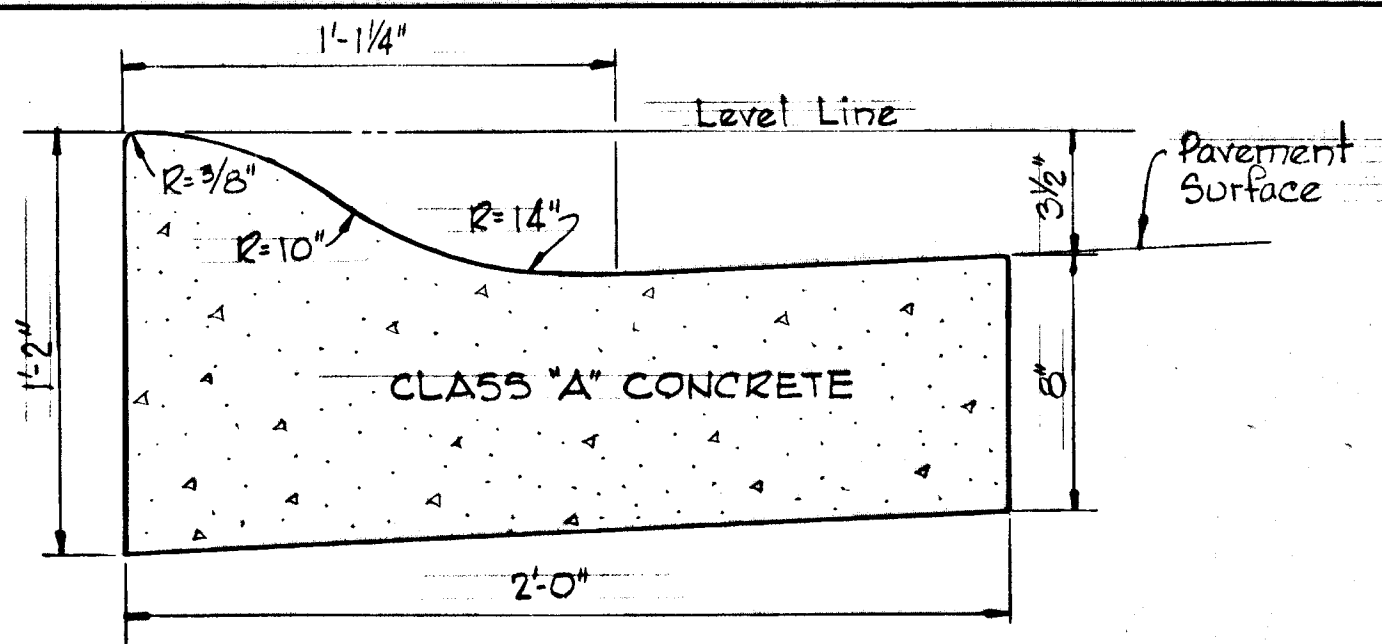


MODIFIED COMBINATION CURB & GUTTER  
 No Scale

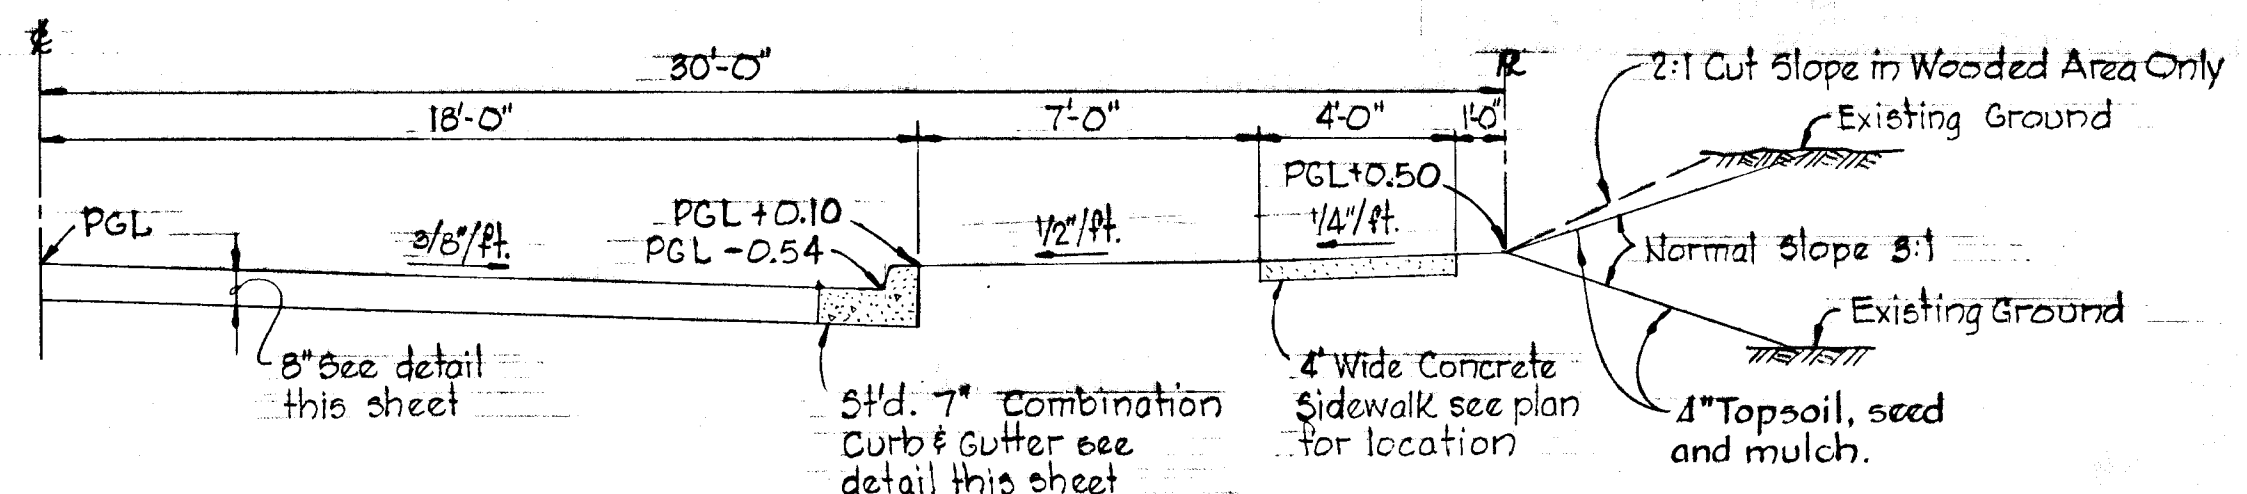


TYPICAL HALF SECTION  
 CLOKTOWER LANE (Sta. 3+25 to 8+53.63)  
 Scale: 1/4" = 1'-0"

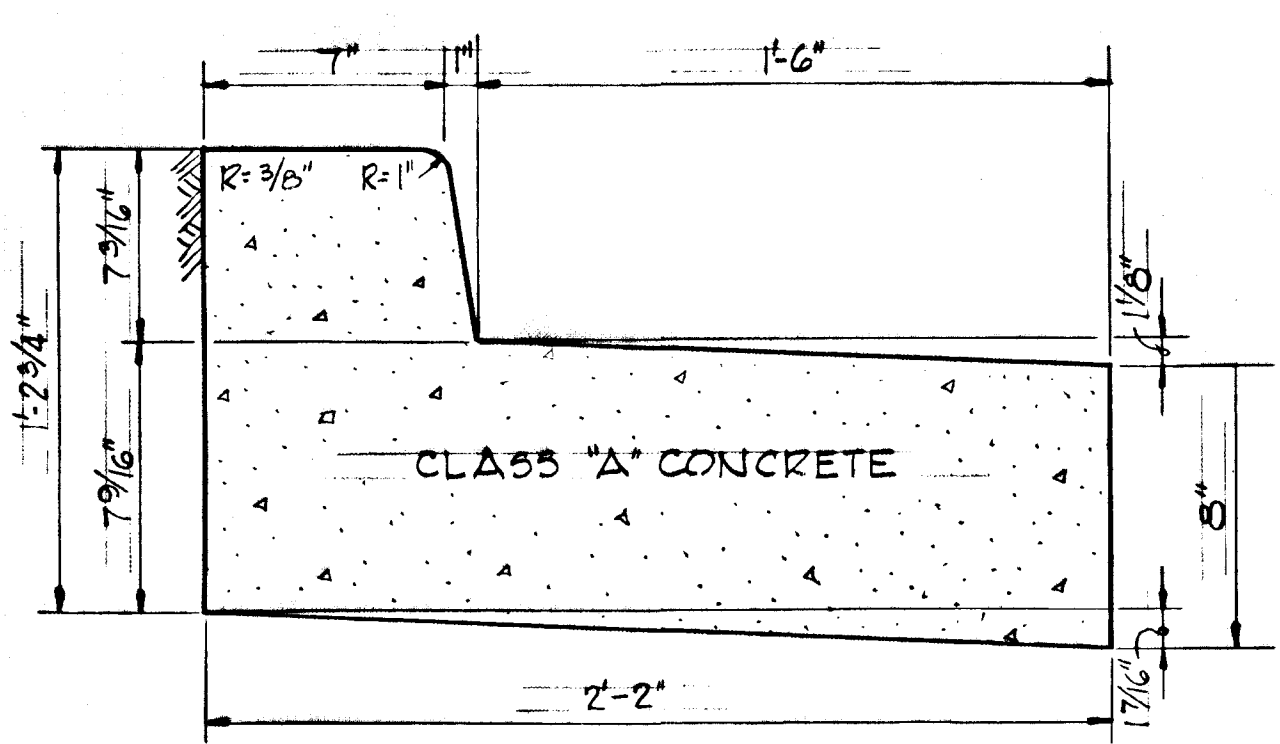


REVERSE 7" COMBINATION CURB & GUTTER  
 No Scale

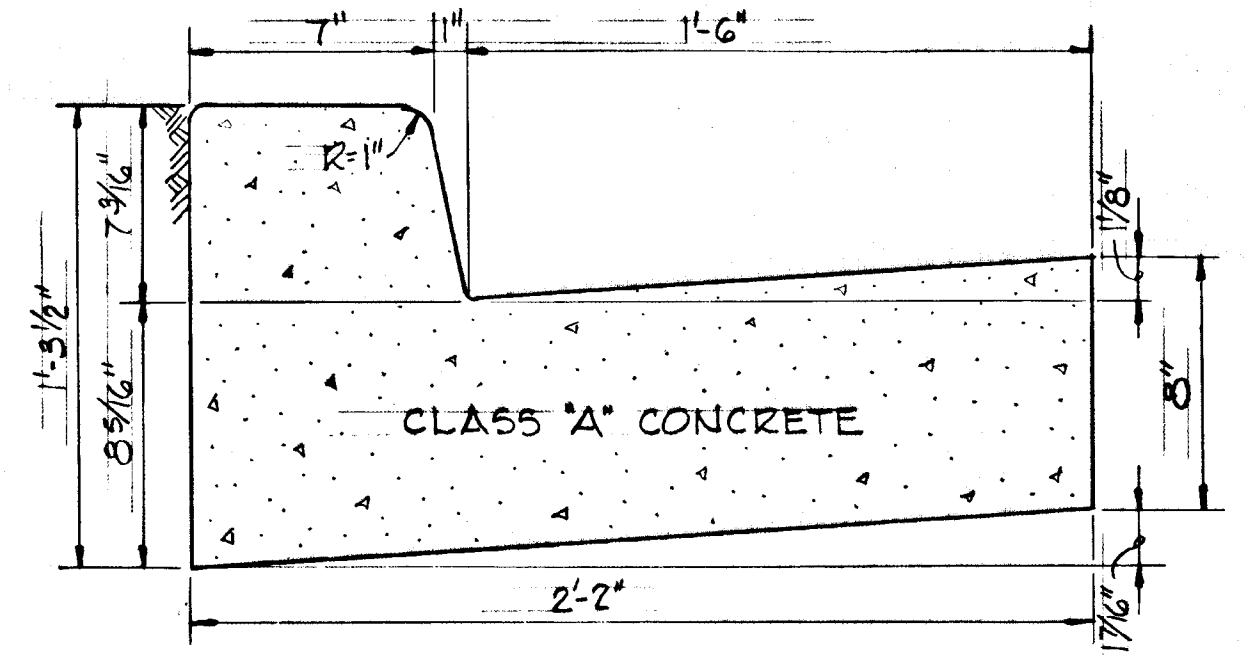

STANDARD 7" COMBINATION CURB & GUTTER  
 No Scale

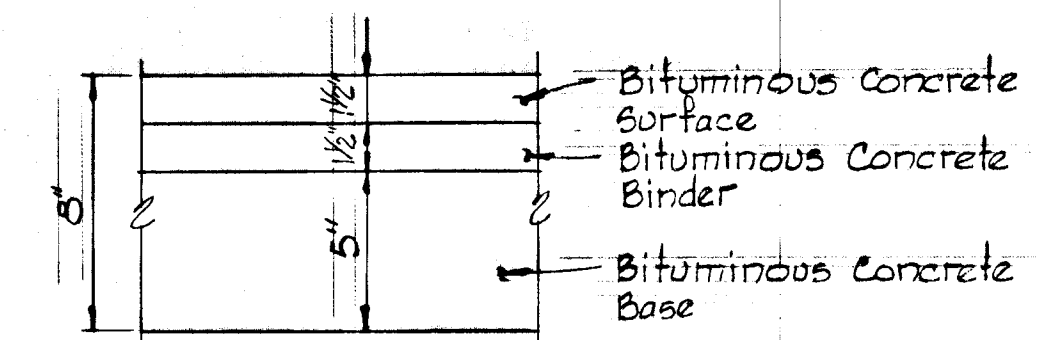


Howard County Std. D-10 page 65

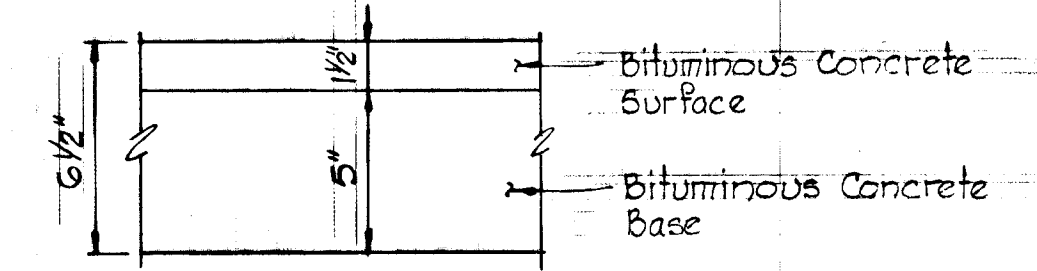


Howard County Std. D-11 page 65

THE DESIGN SPEED IS 30M.P.H.  
 AND THE ZONING IS NEW TOWN  
 FOR ALL TYPICAL SECTIONS  
 SHOWN ON THIS SHEET.


- NOTES
1. Base will be primed in accordance with C-30-C as provided in the Howard County Road Construction Code and Standard Specifications.
  2. Tack Coat is required in accordance with Section C-31-4 of the Howard County Road Construction Code and Standard Specifications.

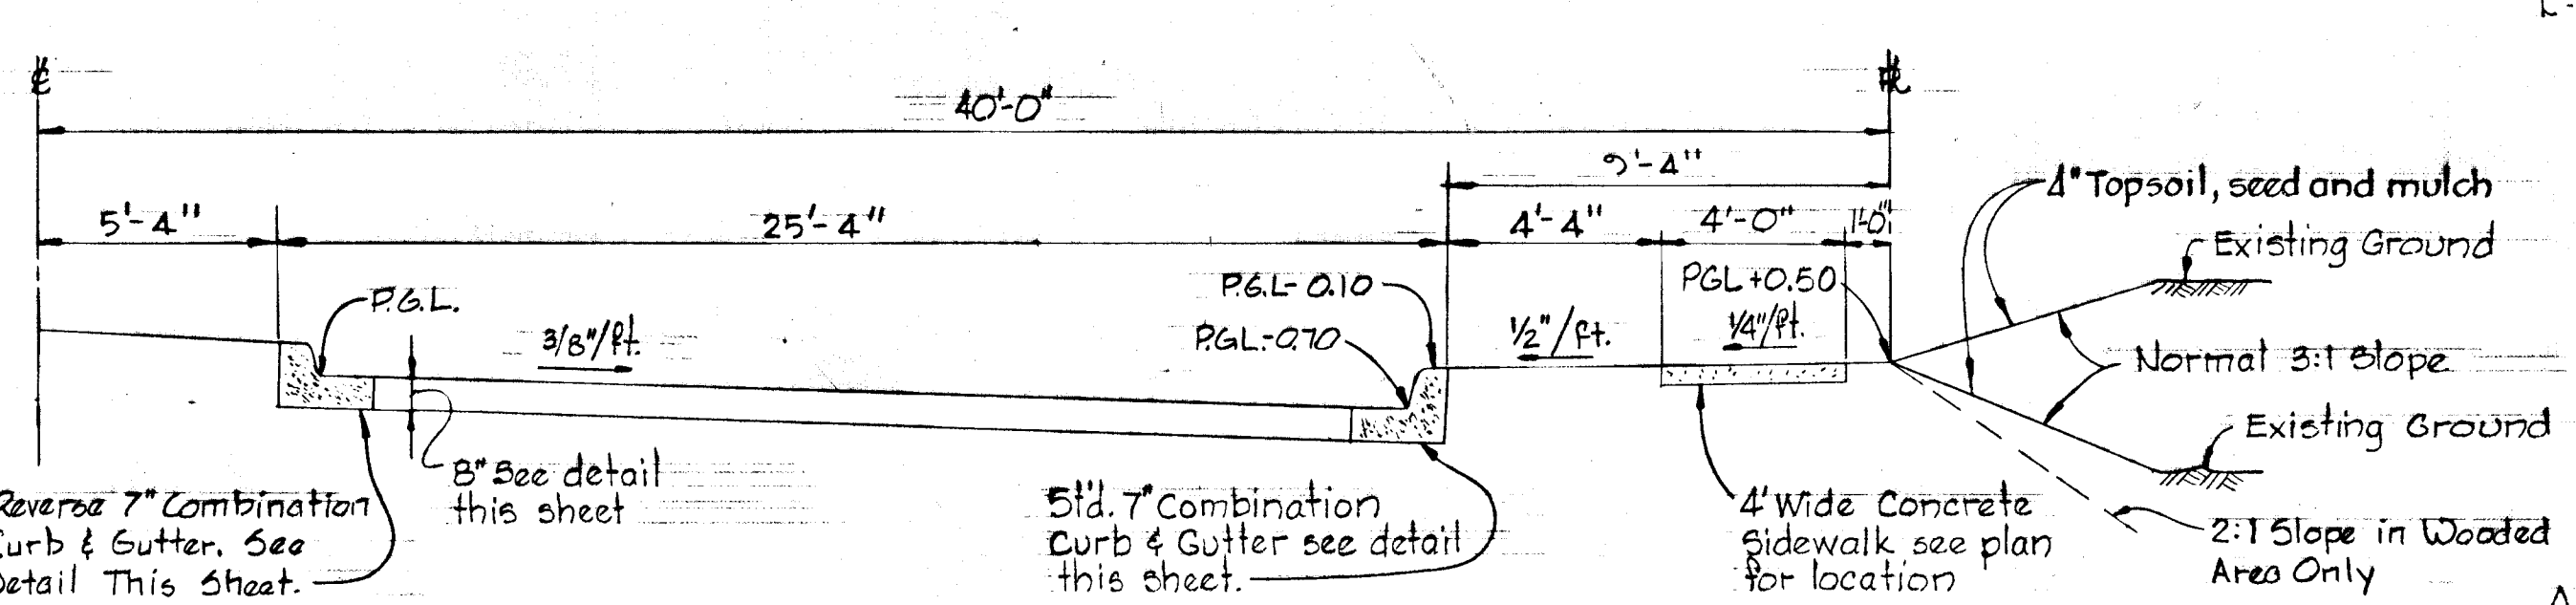


TYPICAL HALF SECTION  
 CLOKTOWER LANE (Sta. 0+55 to 3+25)  
 Scale: 1/4" = 1'-0"

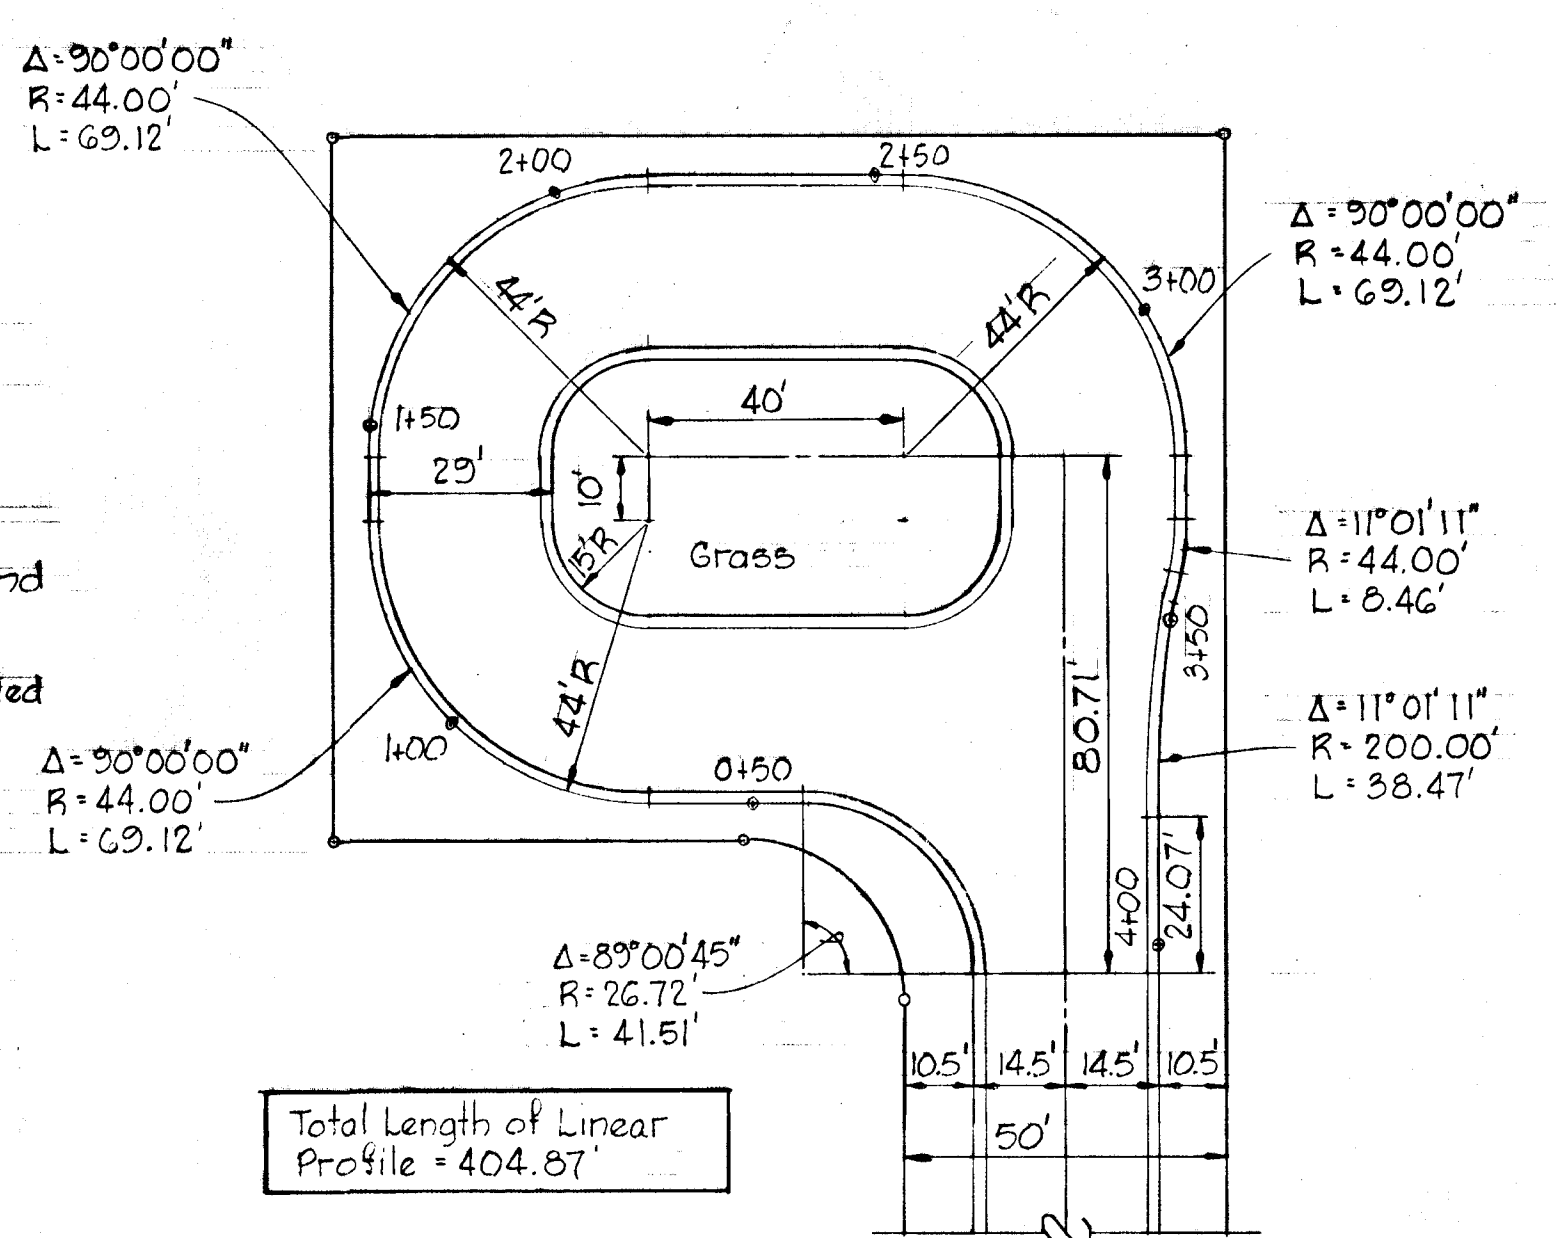


MORNING MEWS  
 Scale: 1" = 30'

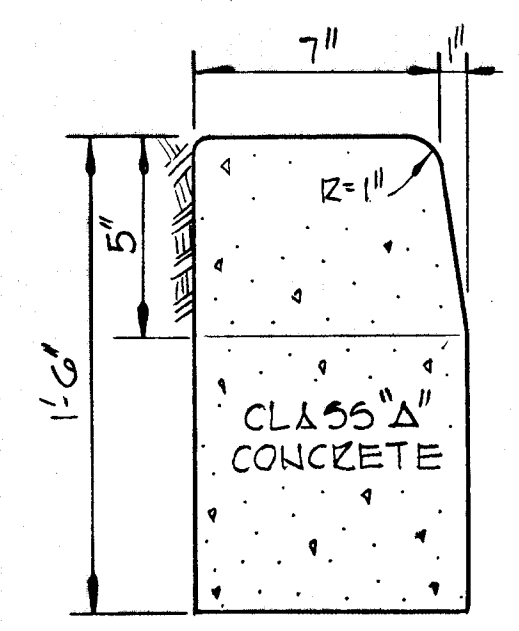

STANDARD BARRIER CURB  
 No Scale

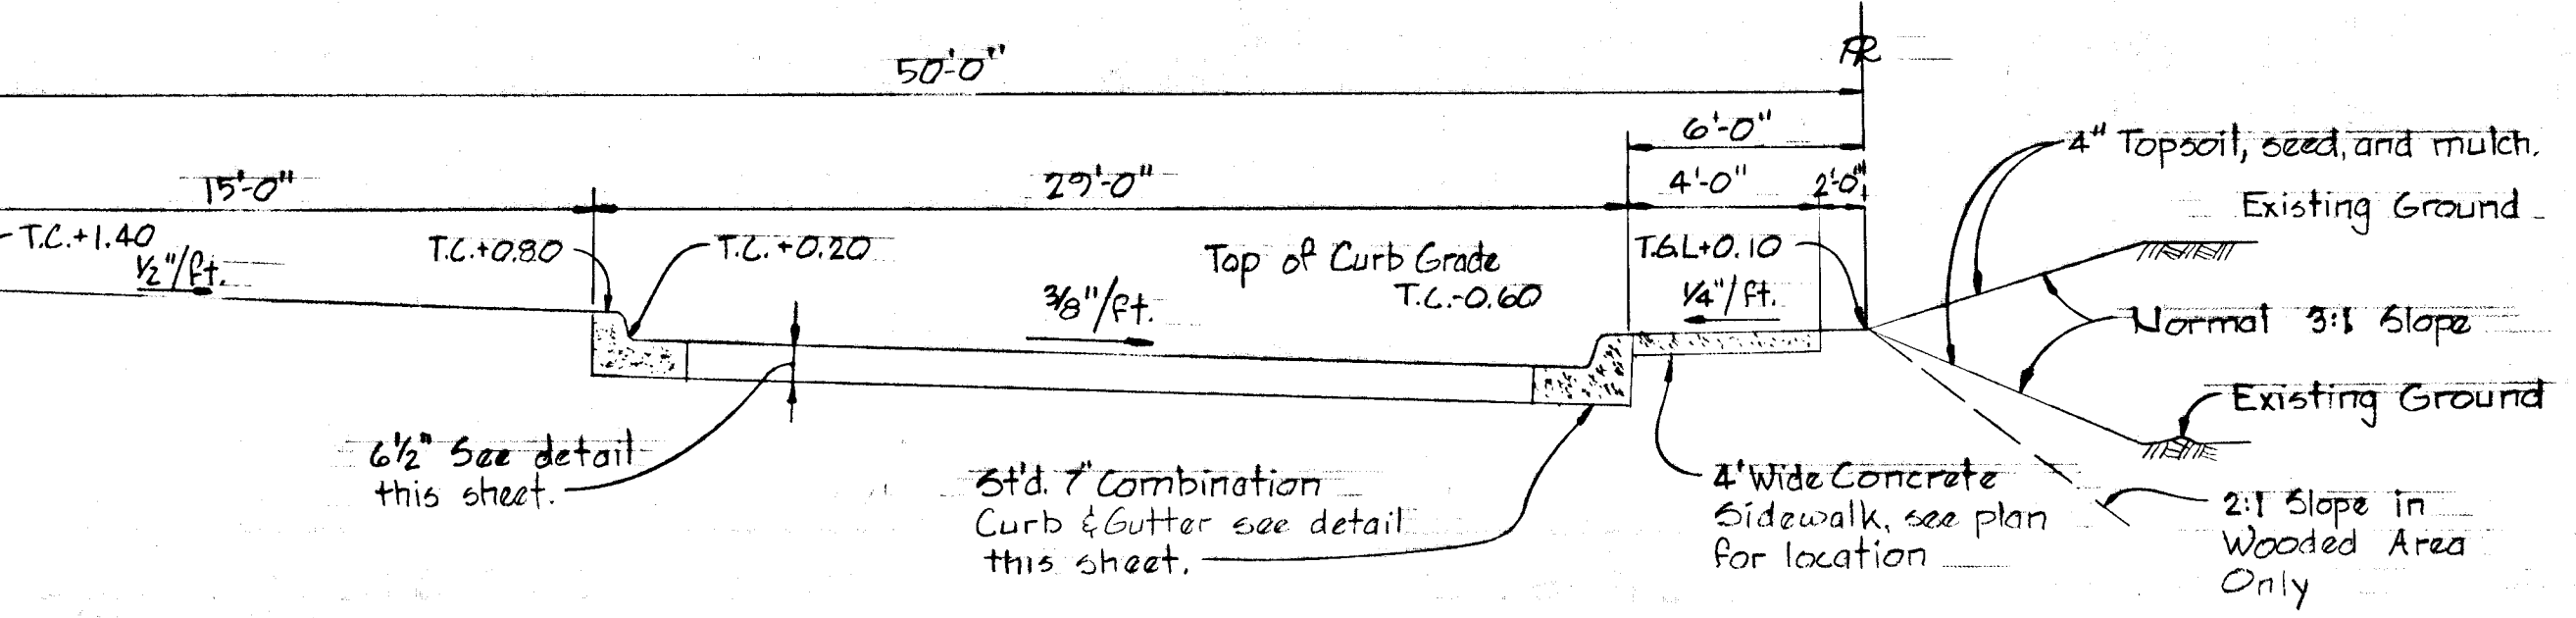

TYPICAL HALF SECTION  
 INDIGO COURT AND ARTIC FLOWER  
 No Scale

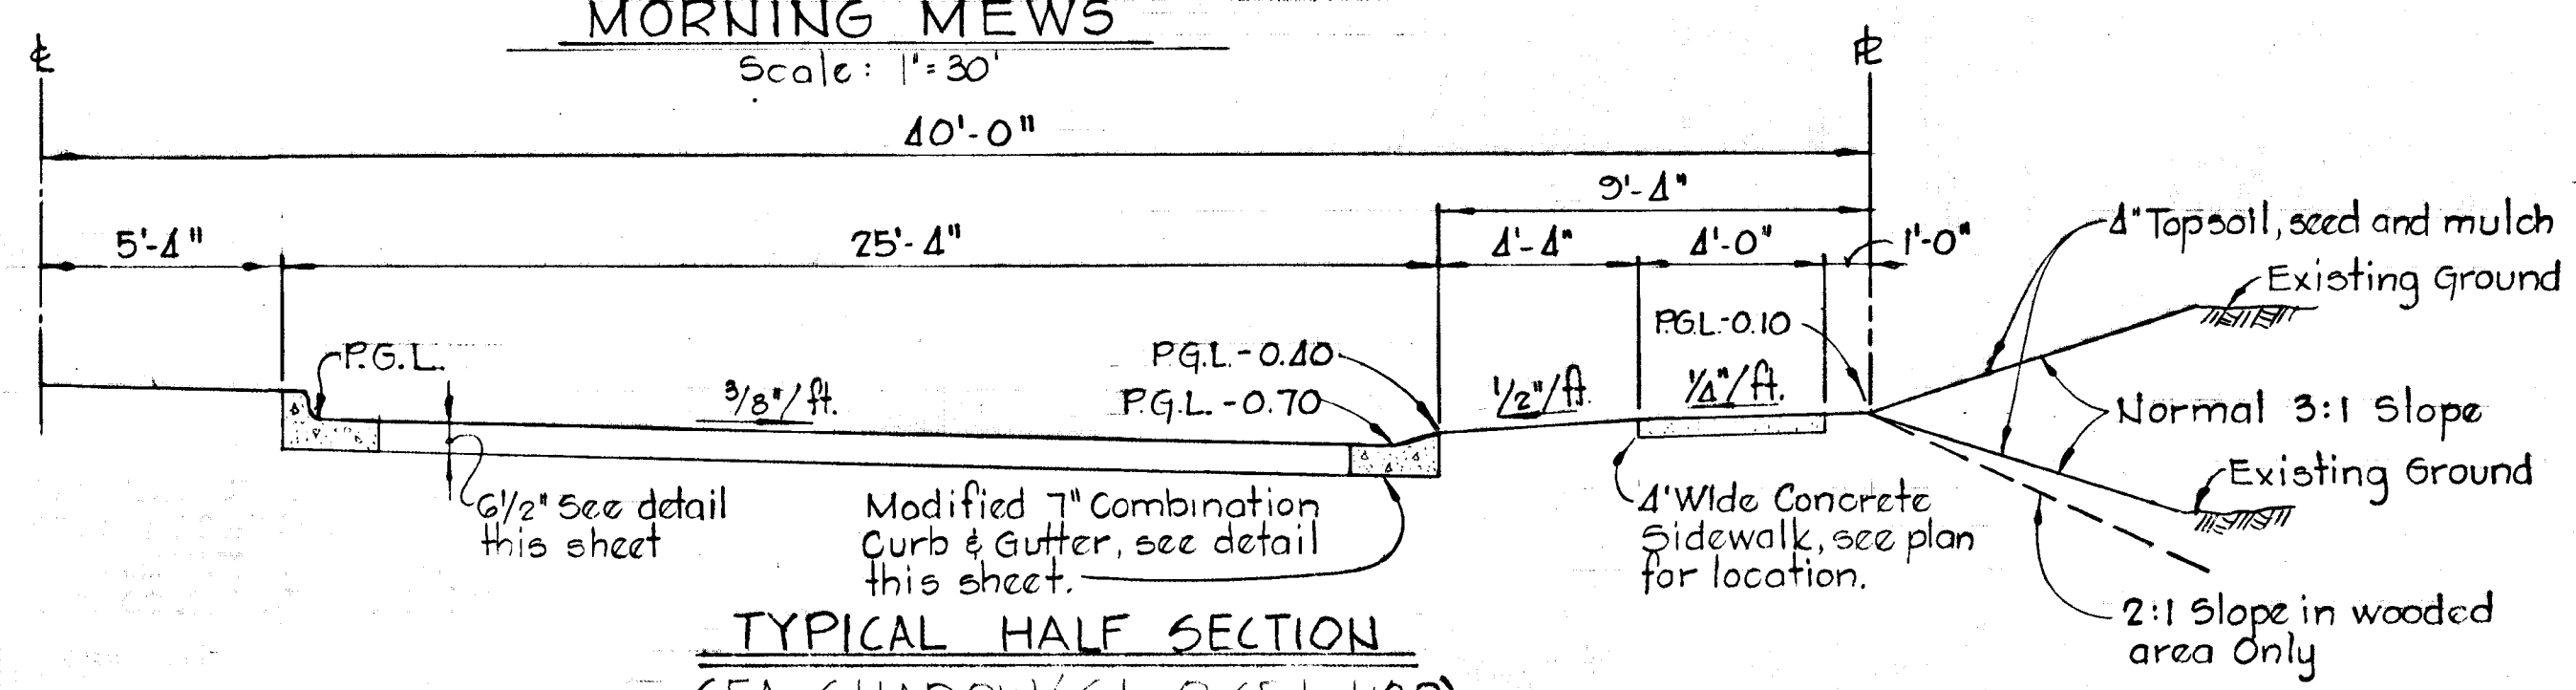

TYPICAL HALF SECTION  
 SEA SHADOW (Sta. 0+65 to 1+30)  
 WHITE SPRING WAY (Sta. 0+50 to 0+90)  
 Scale: 1/4" = 1'-0"


Rev. Date	Rev. No.	Revision Description
<b>COLUMBIA</b> 6 <sup>th</sup> ELECTION DISTRICT HOWARD COUNTY, MARYLAND		
OWNER AND DEVELOPER HOWARD RESEARCH AND DEVELOPMENT CORP.		
PROJECT AREA VILLAGE OF KINGS CONTRIVANCE SECTION 3 AREA 1		
PROJECT TITLE <b>ROADWAY DETAILS</b>		
SCALE: AS SHOWN		DATE:
WHITMAN, REQUARDT & ASSOCIATES ENGINEERS BALTIMORE, MARYLAND 21202		
<i>Kenneth A. McCord</i> KENNETH A. MCCORD Registered Engineer No. 1974		

#0000  
445




**GENERAL NOTES**


- All dimensions are to back of curb.
- See plans for sidewalk locations.
- Paving is 6 1/2" Bituminous Concrete.
- Standard 7" Combination Curb and Gutter in sumped Cul-de-Sacs only, otherwise Modified Combination Curb and Gutter.

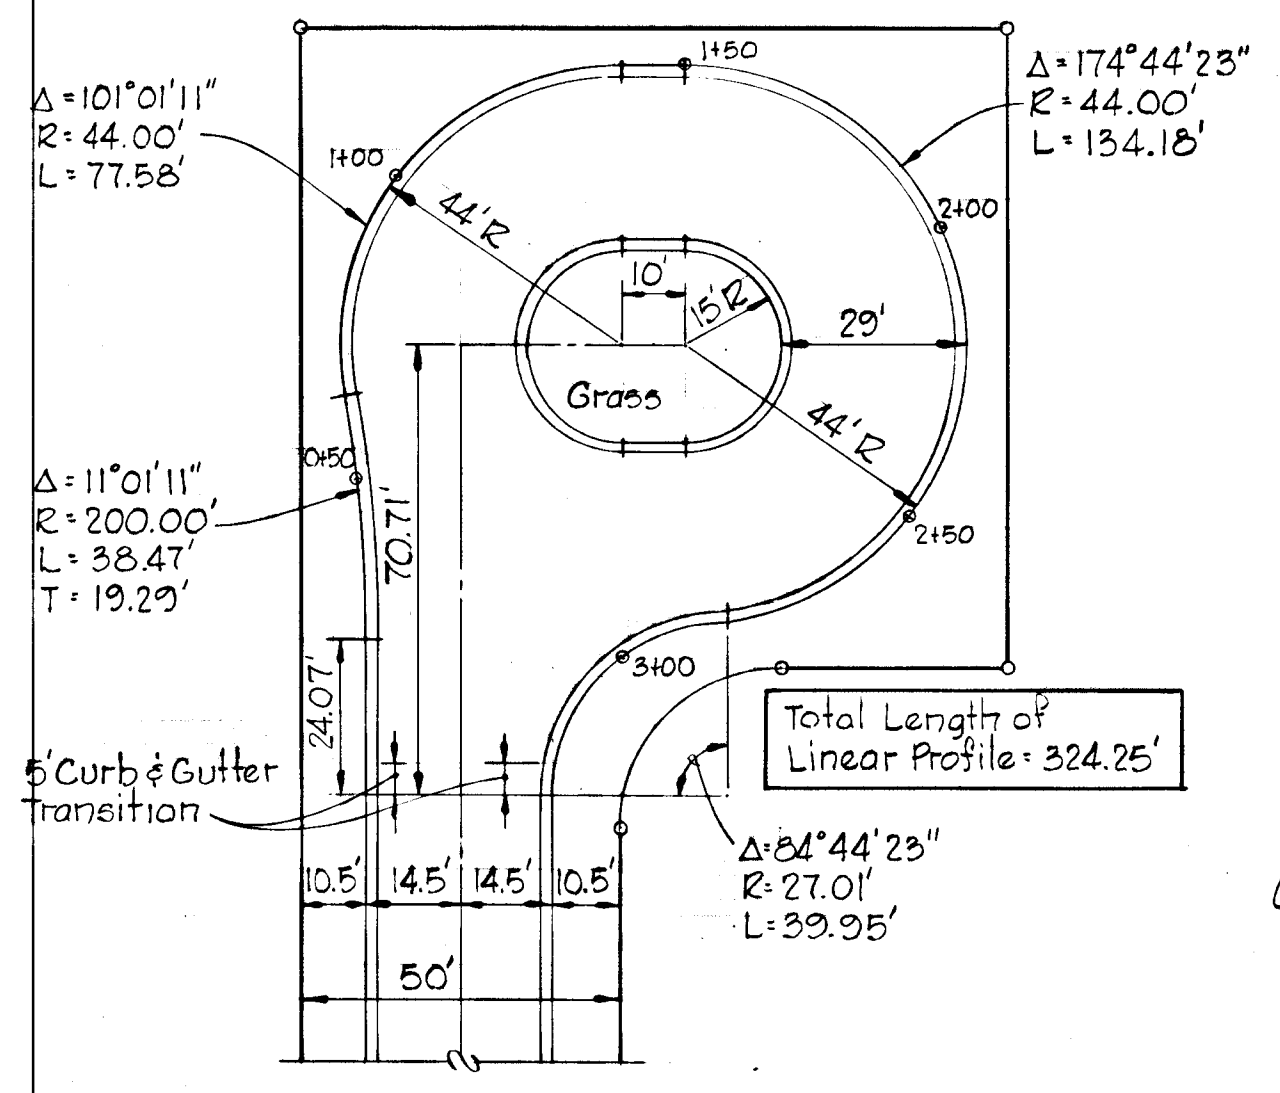


KEEPSAKE WAY  
SEA SHADOW  
WEST WINDOW WAY (OPPOSITE HAND)  
MORNING LEAP TERRACE

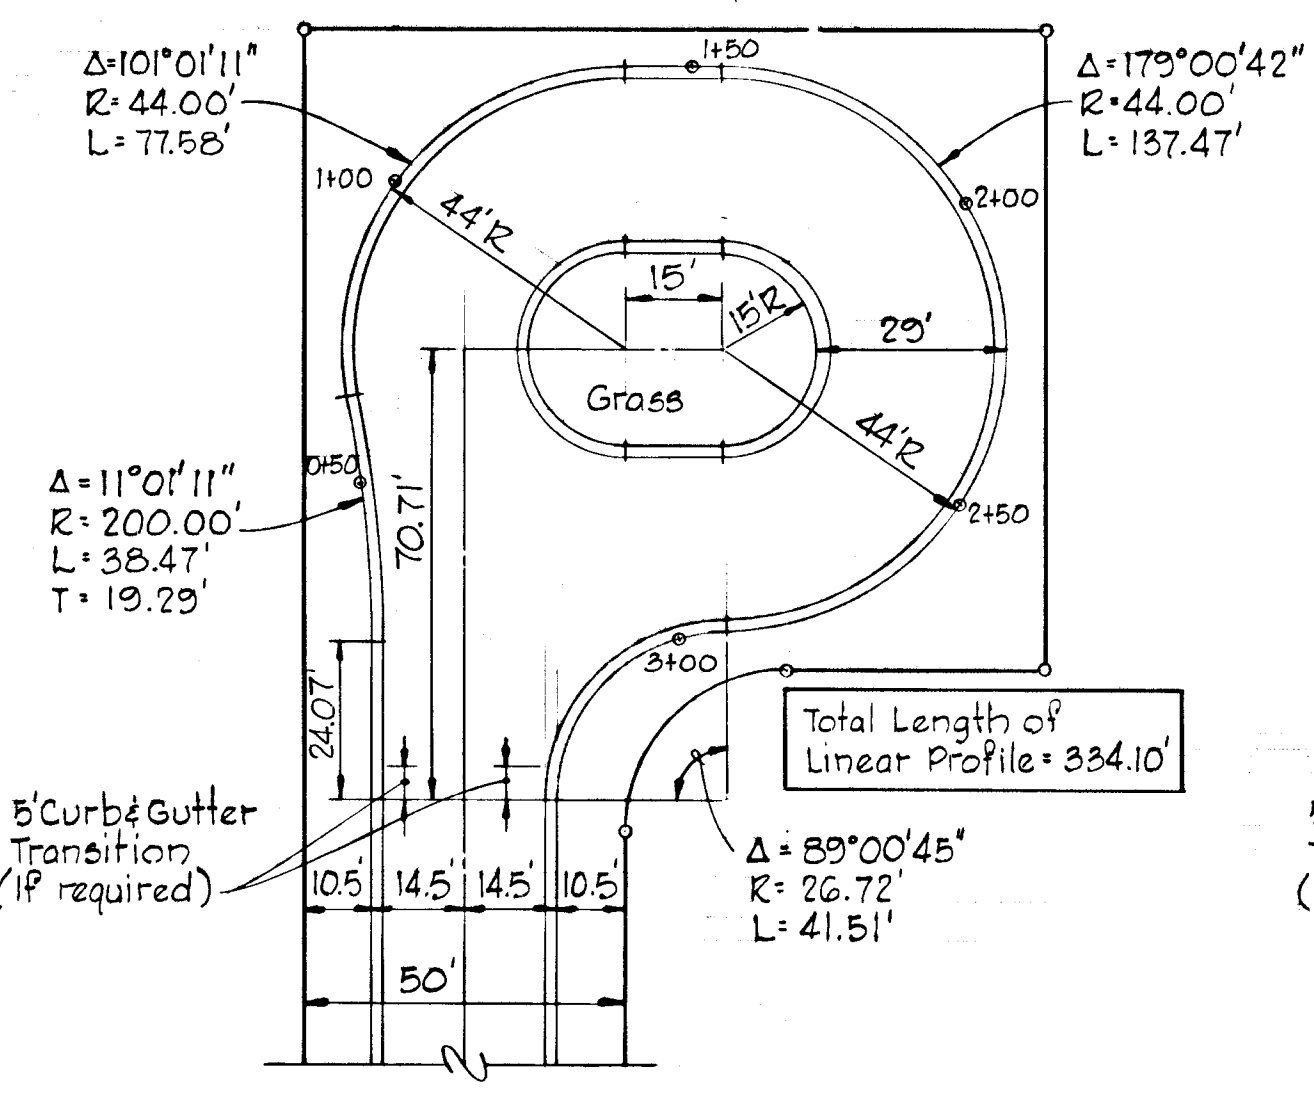


GOLDEN ROD PATH  
BLACK VELVET LANE

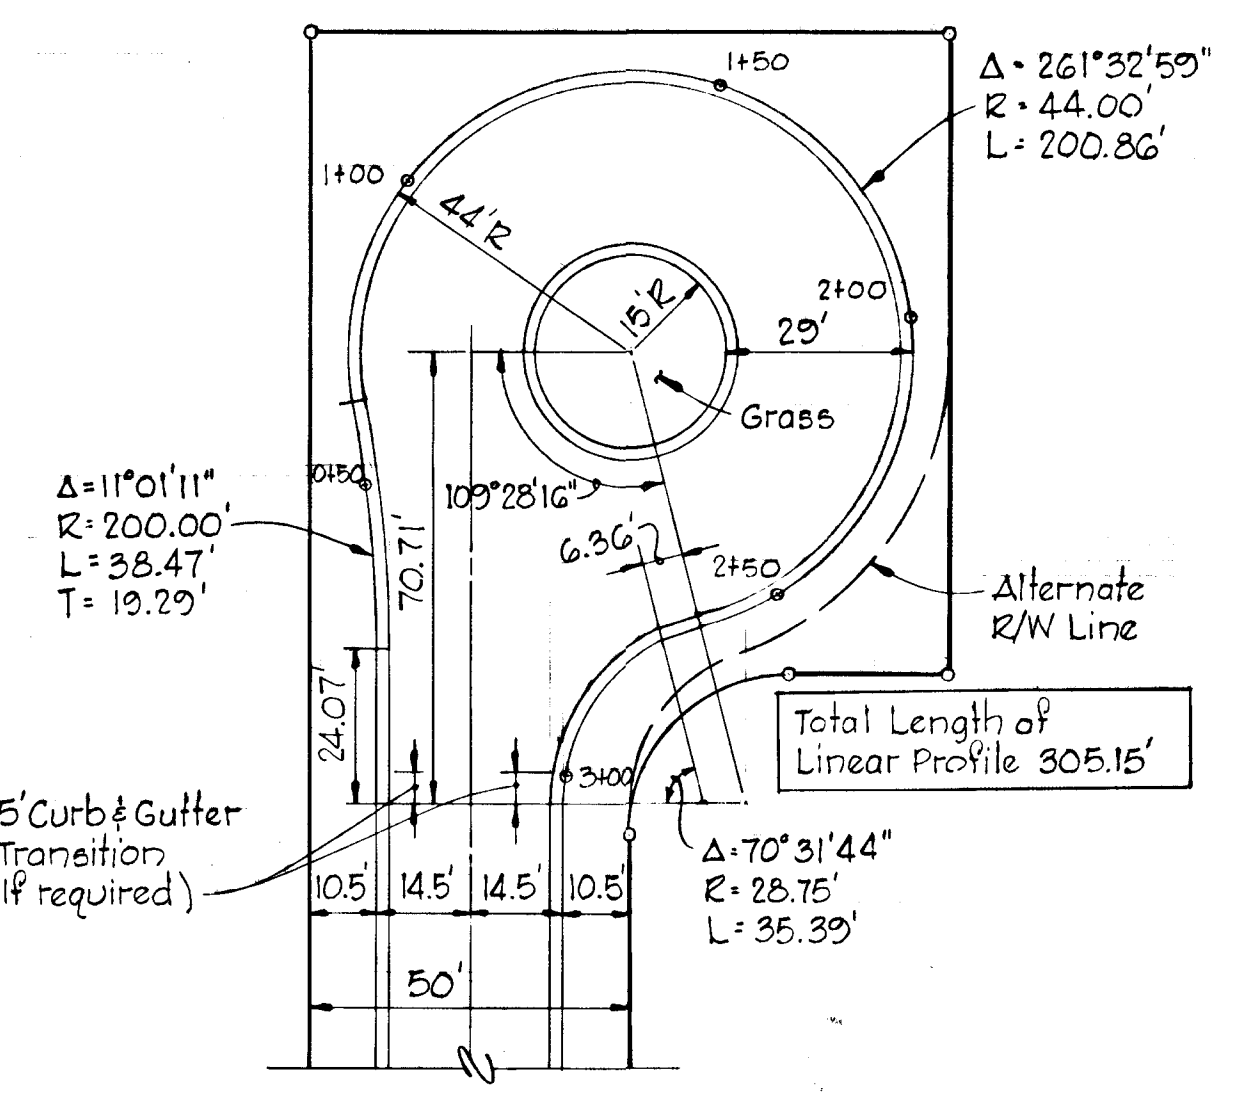


LADY BUG ROW  
COLD STAR COURT  
SWEET GRASS RIDGE  
SINGLE BIRD LANE (OPPOSITE HAND)  
DRAGONCLAW (OPPOSITE HAND)  
GREEN MOON PATH (OPPOSITE HAND)

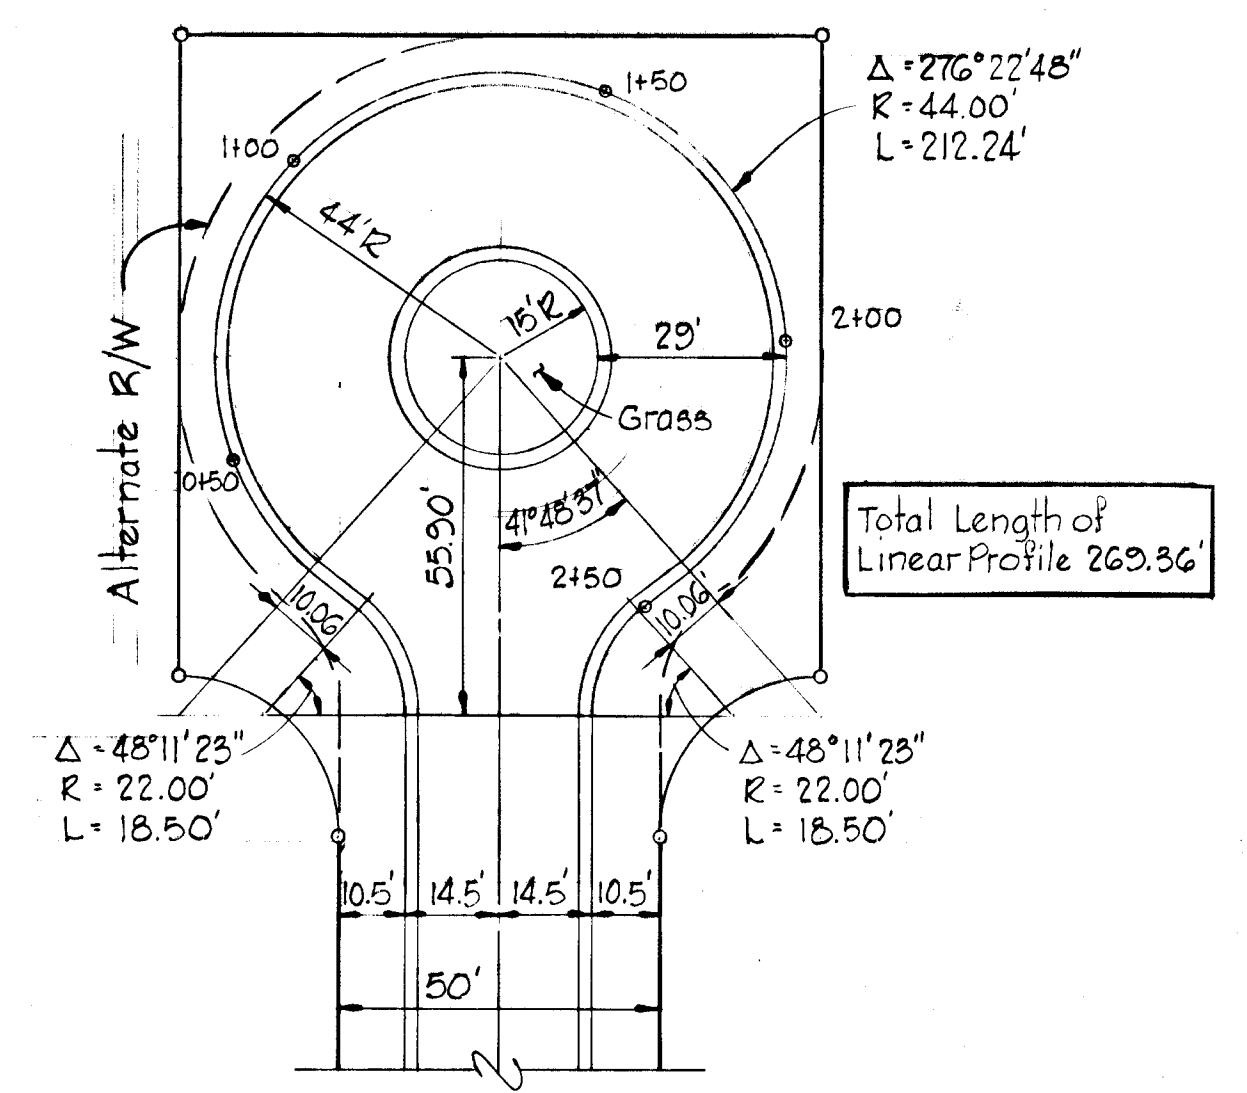


SLOW RAIN WAY  
GRAY MOUSE WAY

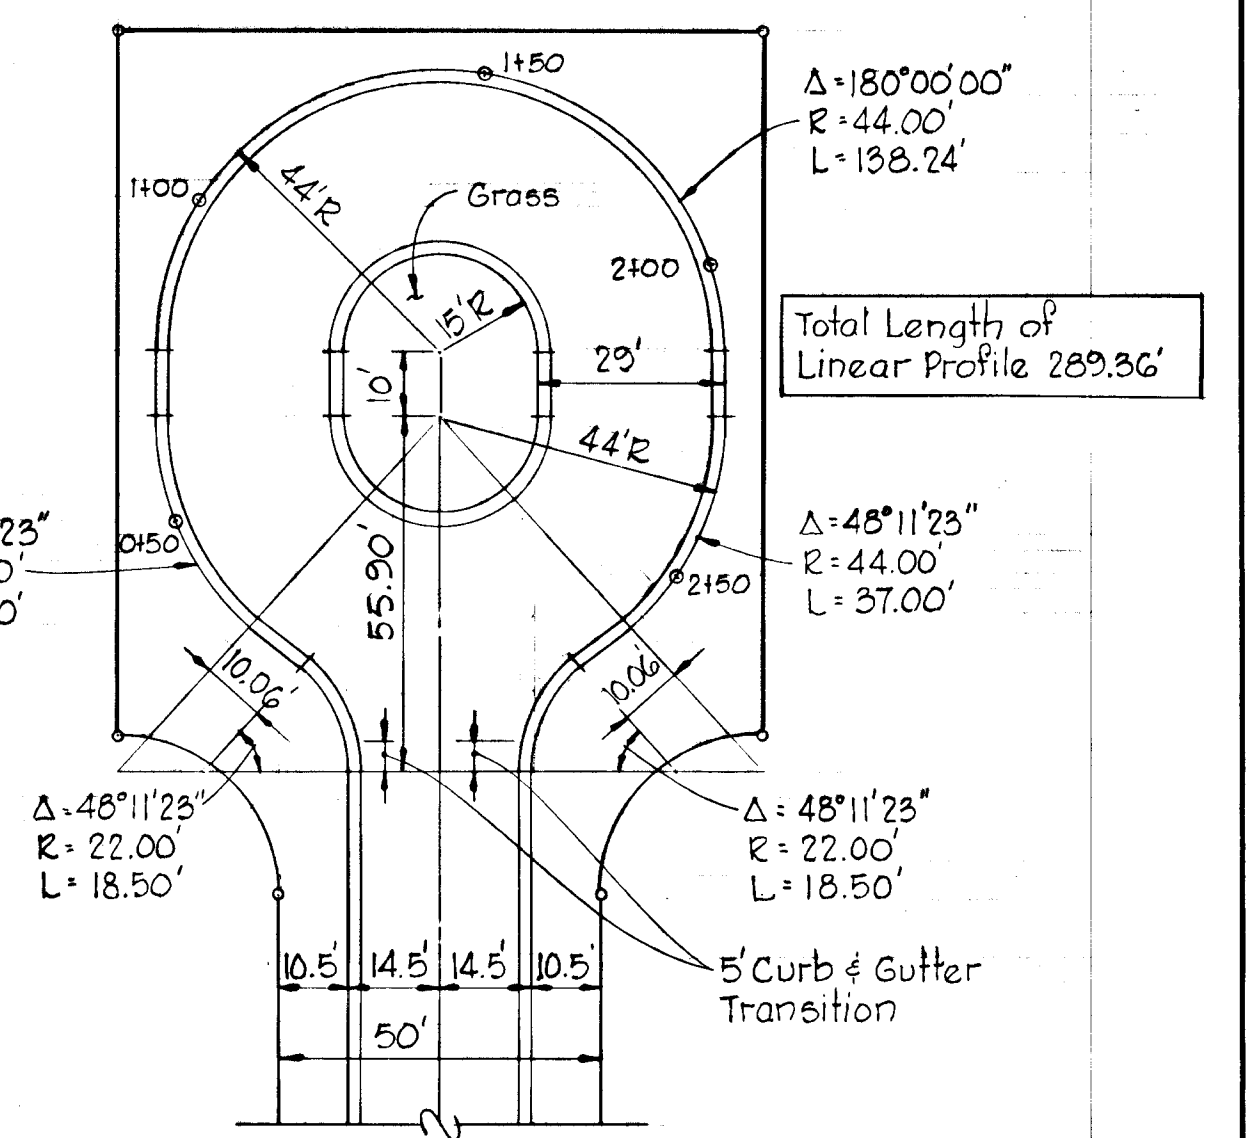


SANDLIGHT COURT

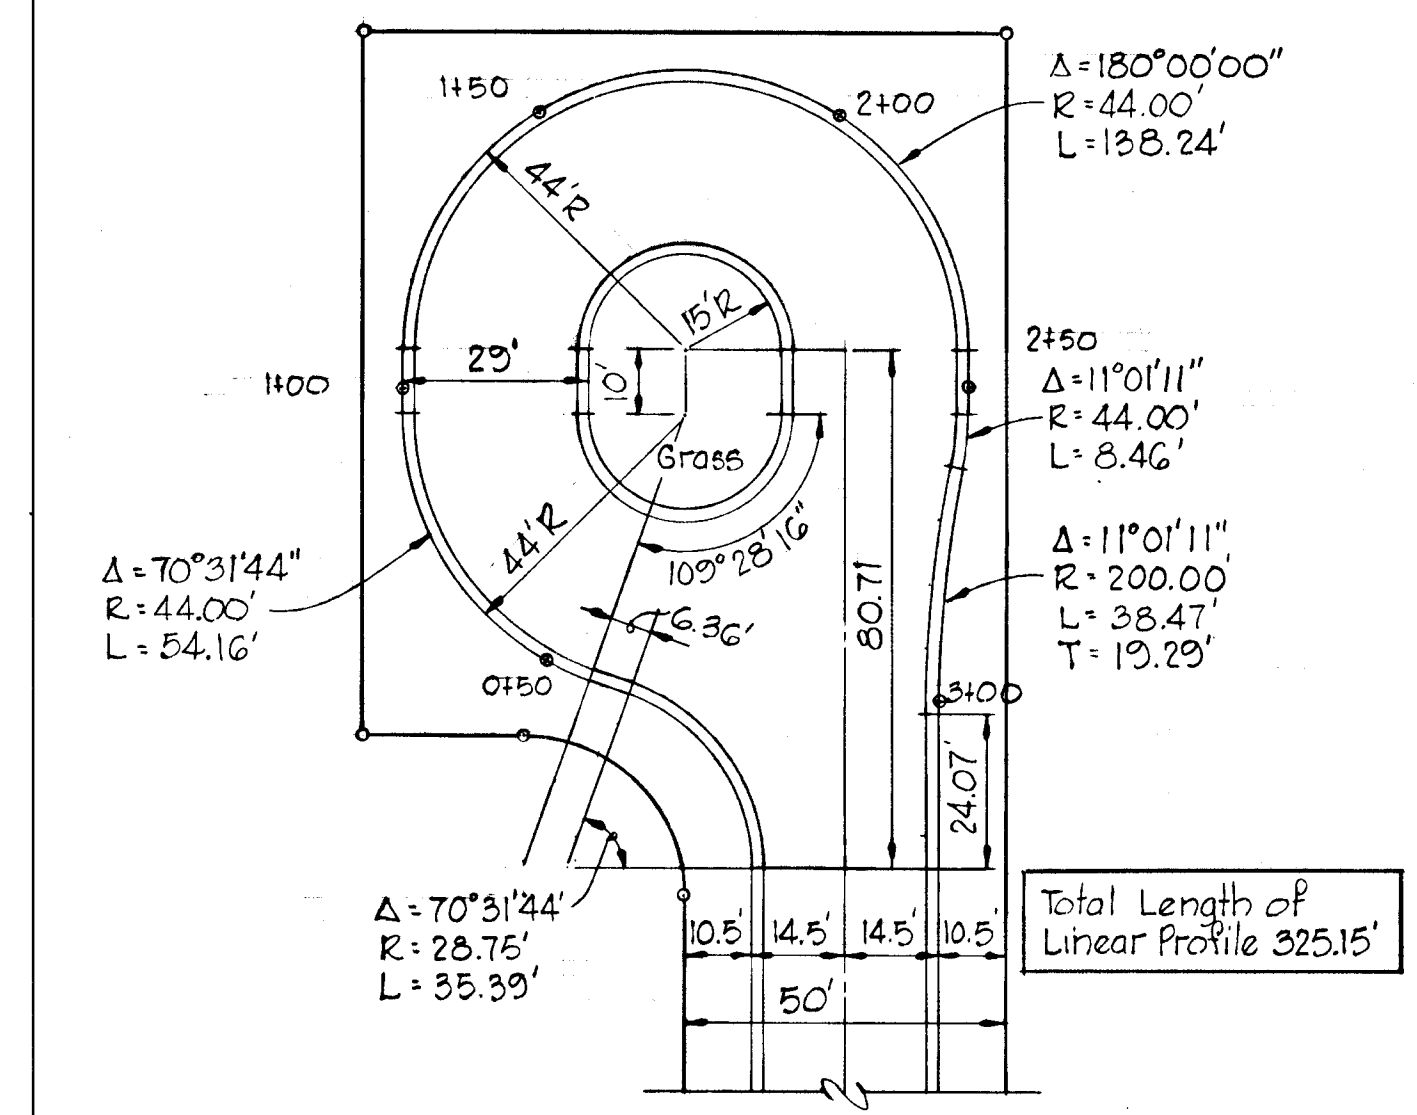


CORN TASSEL COURT

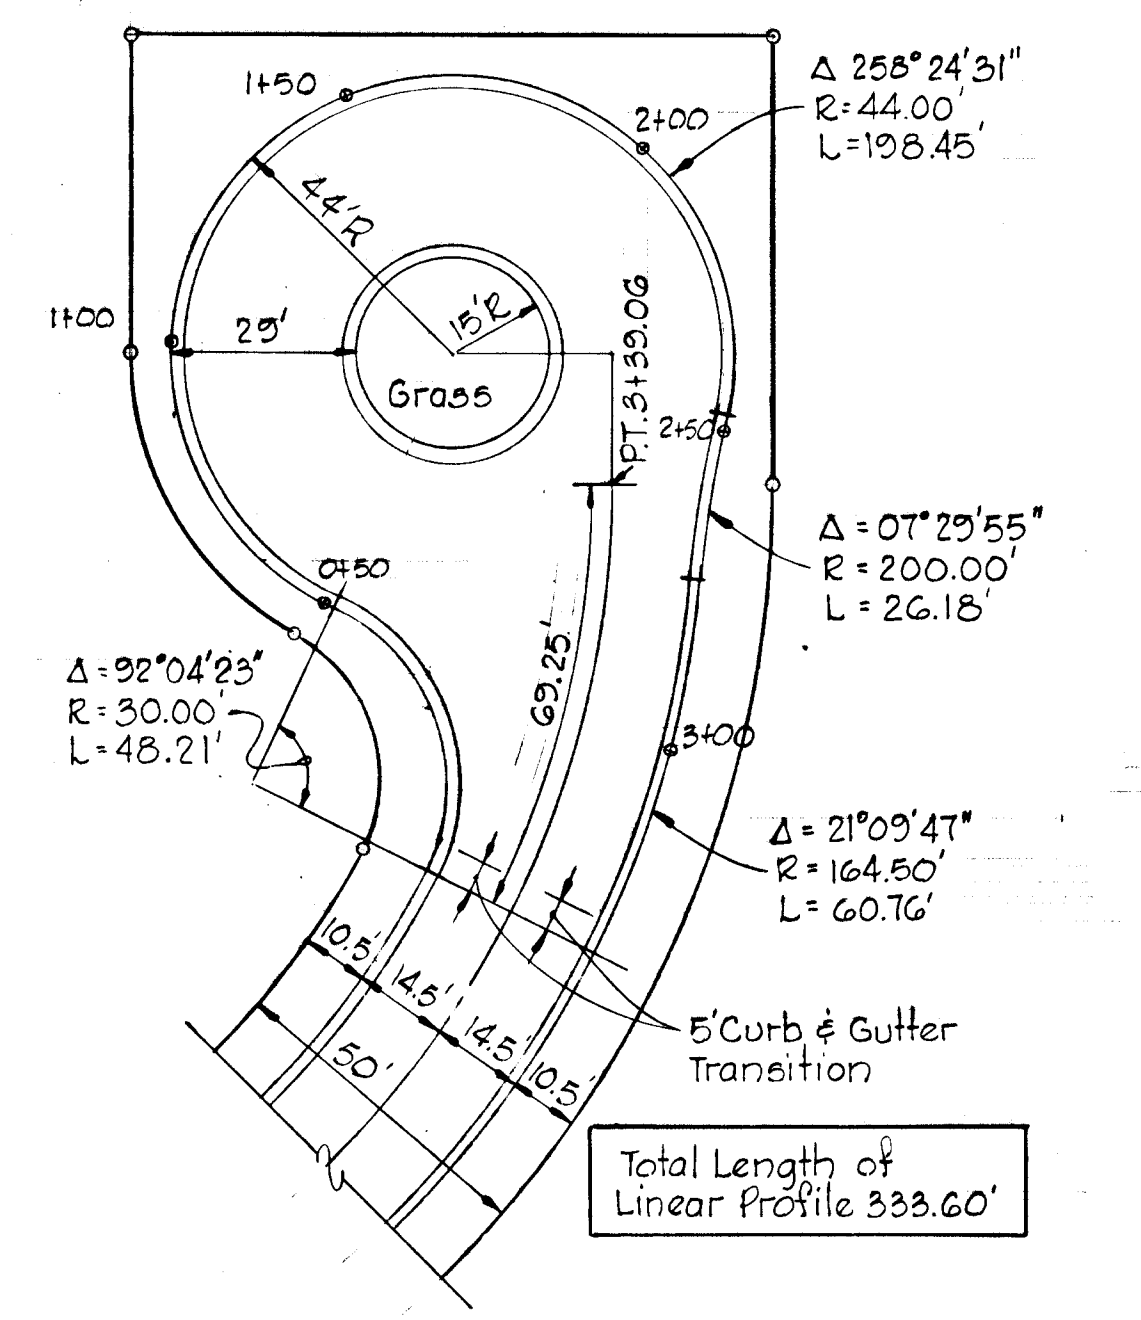

HUNDRED DRUMS ROW

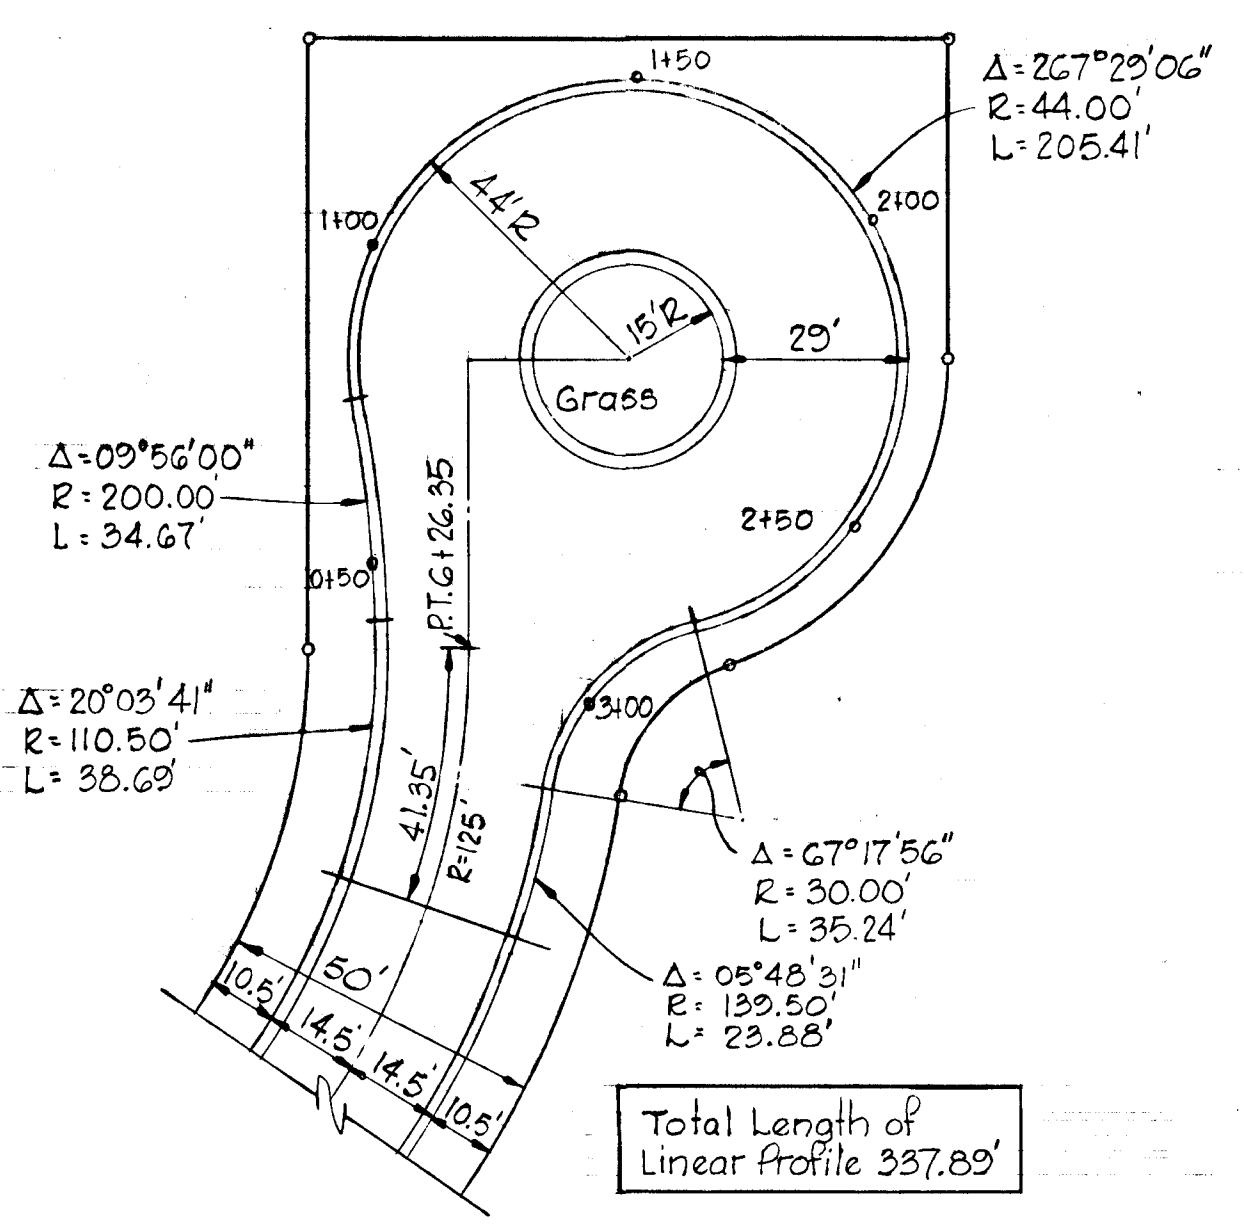

DEERFOOT WAY

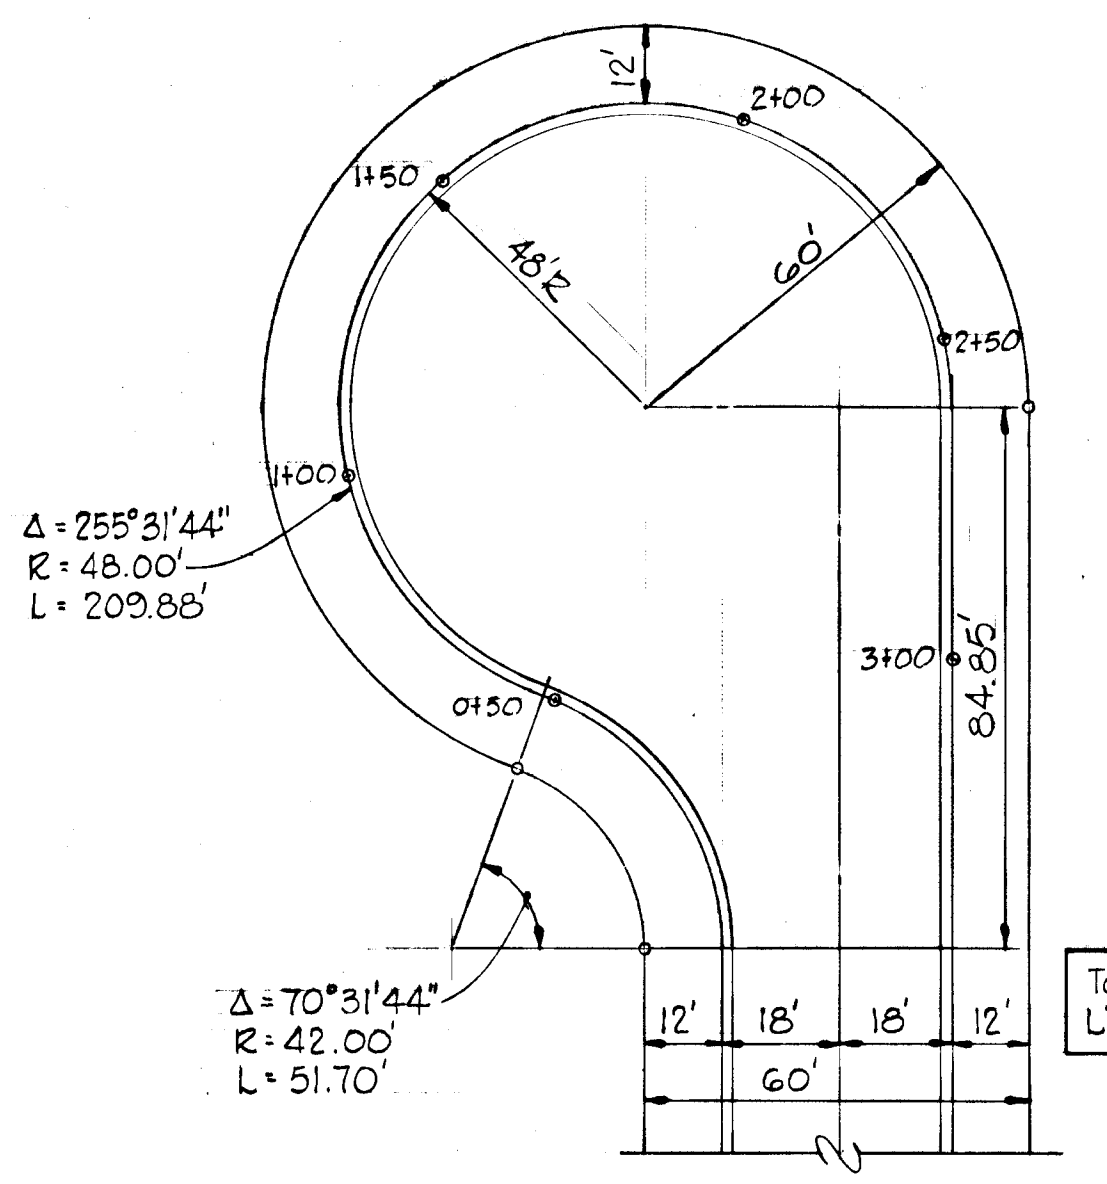


CLOCKTOWER LANE

CUL-DE-SAC DETAILS  
 Scale 1"=30'

Rev. Date	Rev. No.	Revision Description
<b>COLUMBIA</b> 8 <sup>th</sup> ELECTION DISTRICT HOWARD COUNTY, MARYLAND		
OWNER AND DEVELOPER HOWARD RESEARCH AND DEVELOPMENT CORP.		
PROJECT AREA VILLAGE OF KING'S CONTRIVANCE SECTION 3 AREA 1		
PROJECT TITLE ROADWAY DETAILS		
SCALE: AS SHOWN		DATE:
WHITMAN, REQUARDT & ASSOCIATES ENGINEERS BALTIMORE, MARYLAND 21202		
<i>Kenneth A. McCord</i> KENNETH A. McCORD Registered Engineer No. 1974		



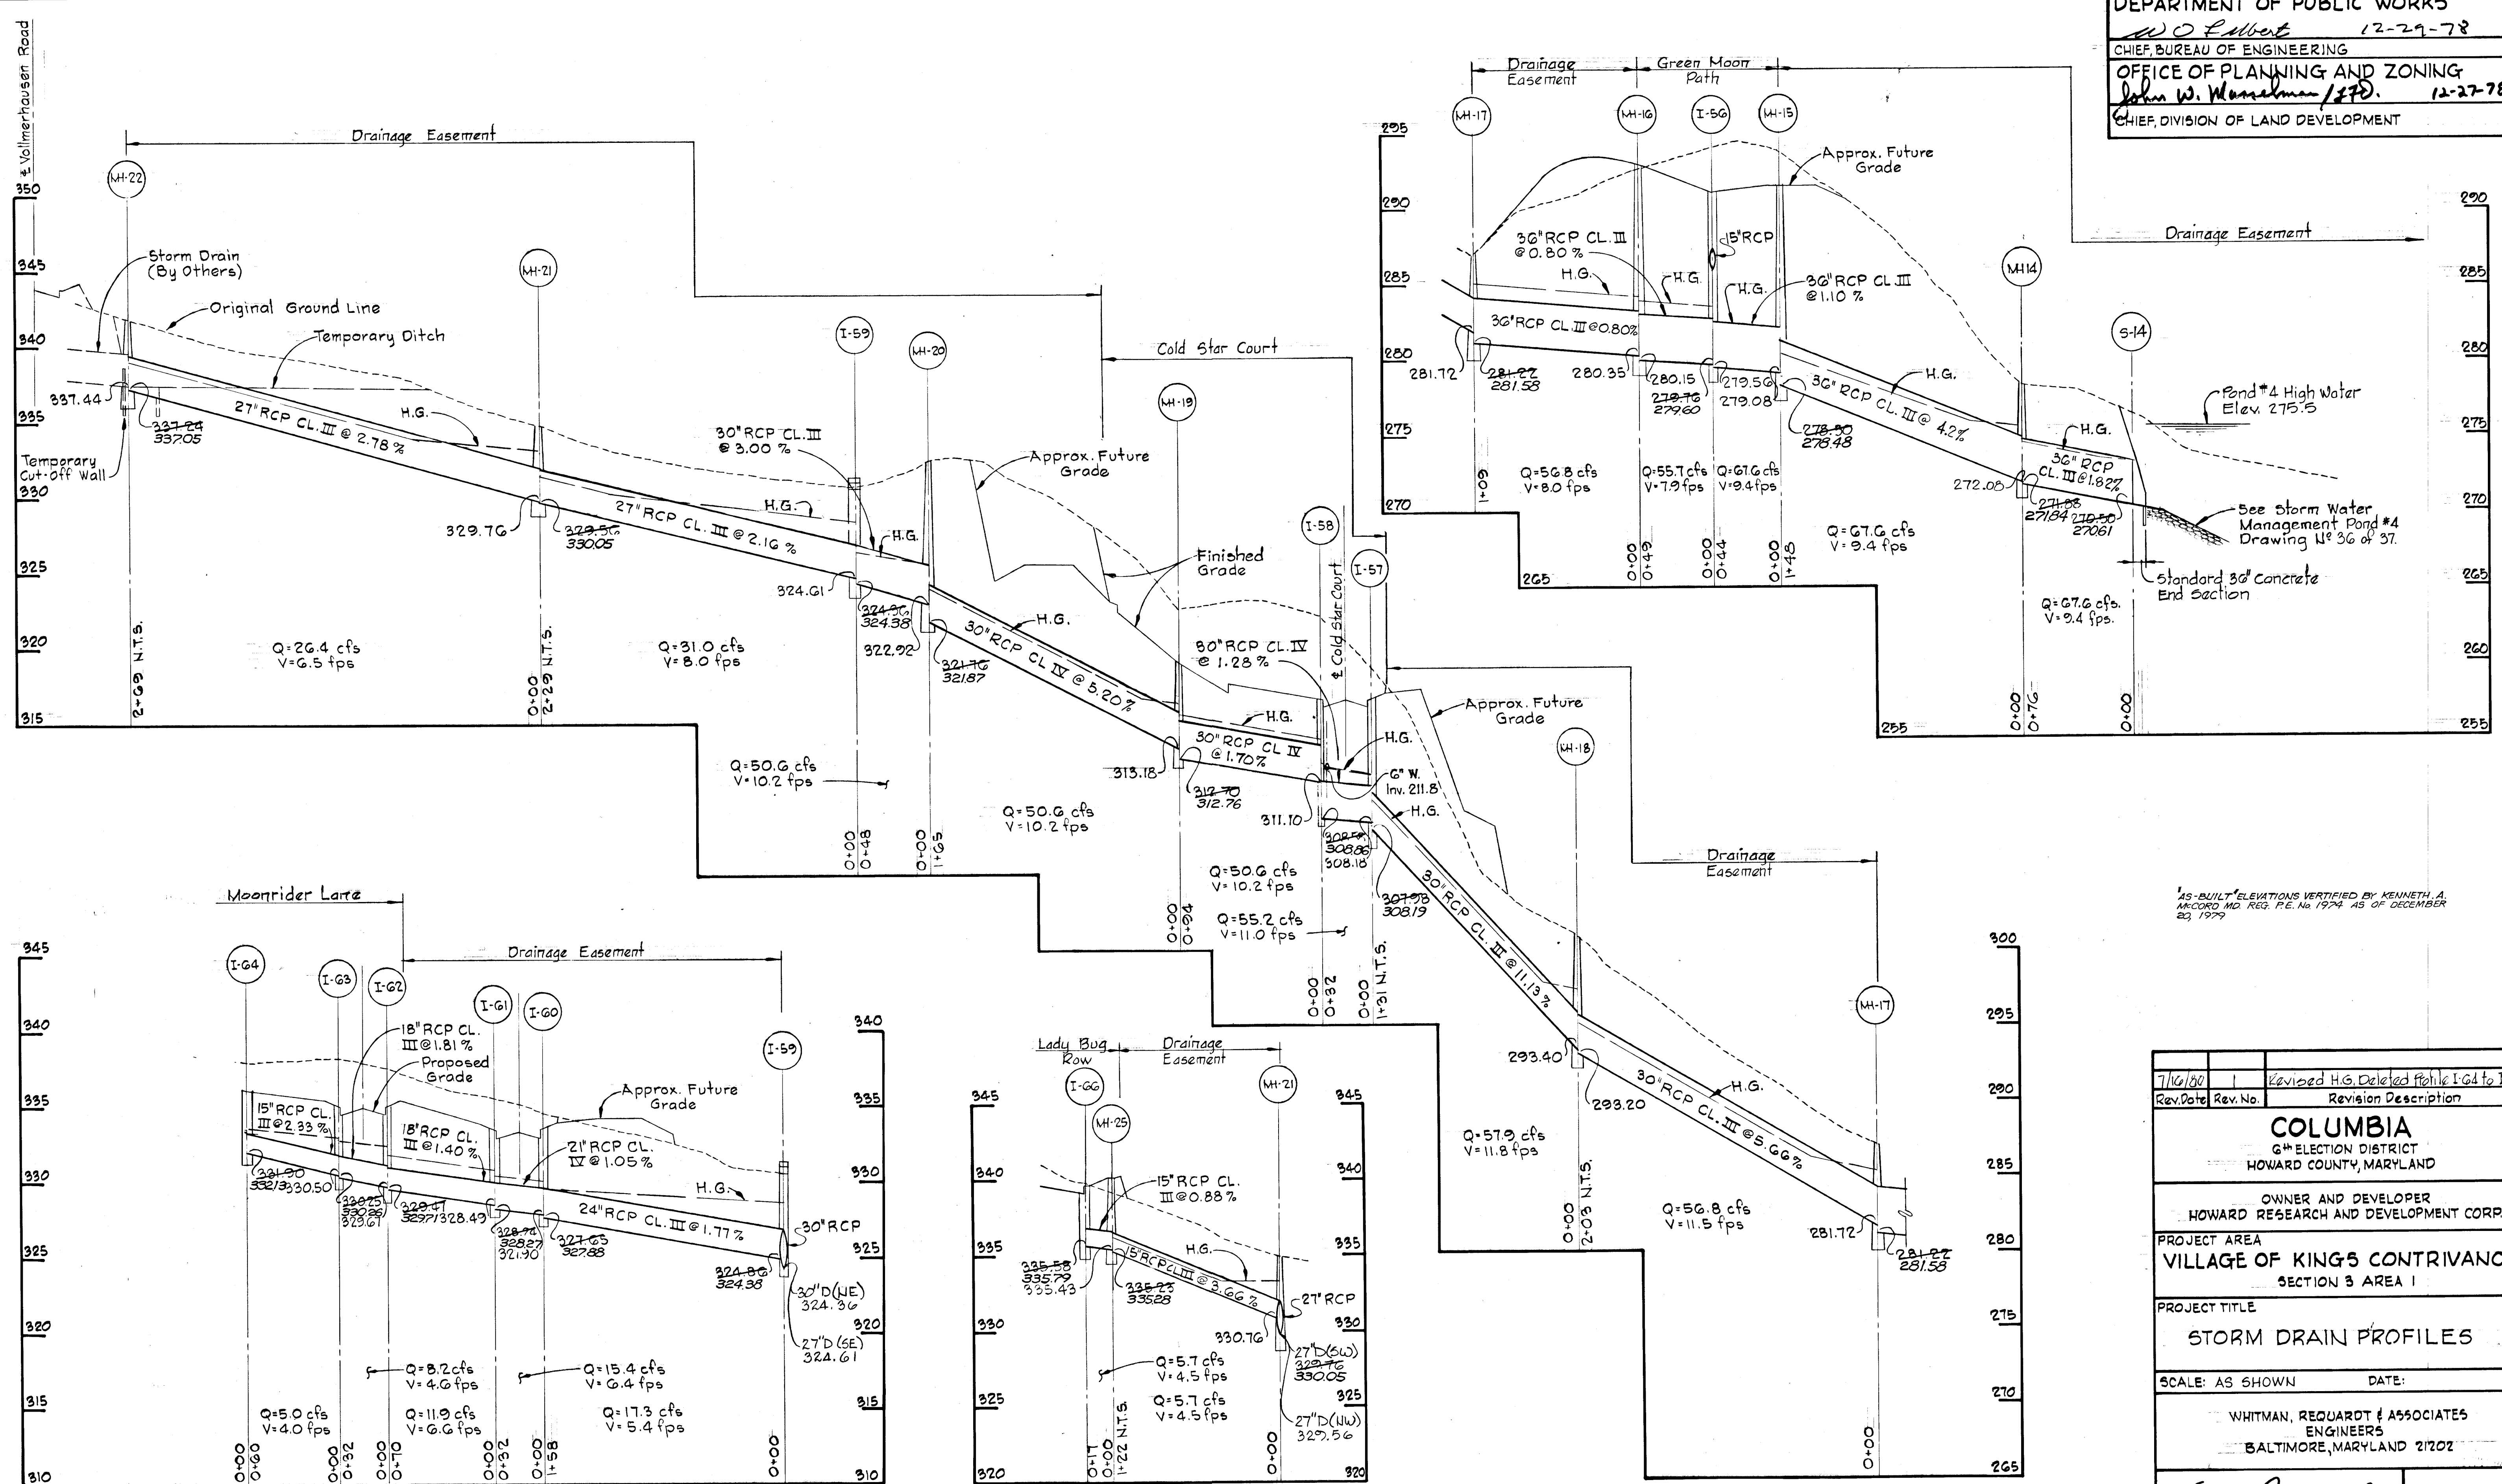

PROFILES  
 Horiz. 1"=50'  
 Vert. 1"=5'

Rev. No.	Rev. Date	Revision Description
1	7/16/80	Revised H.G. Deleted from I-64 to I-65

**COLUMBIA**  
 6<sup>th</sup> ELECTION DISTRICT  
 HOWARD COUNTY, MARYLAND

OWNER AND DEVELOPER  
 HOWARD RESEARCH AND DEVELOPMENT CORP.

PROJECT AREA  
**VILLAGE OF KING'S CONTRIVANCE**  
 SECTION 3 AREA 1



PROJECT TITLE  
**STORM DRAIN PROFILES**

SCALE: AS SHOWN      DATE:



WHITMAN, REQUARDT & ASSOCIATES  
 ENGINEERS  
 BALTIMORE, MARYLAND 21202

*Kenneth A. McCord*  
 KENNETH A. McCORD  
 Registered Engineer  
 No. 1974



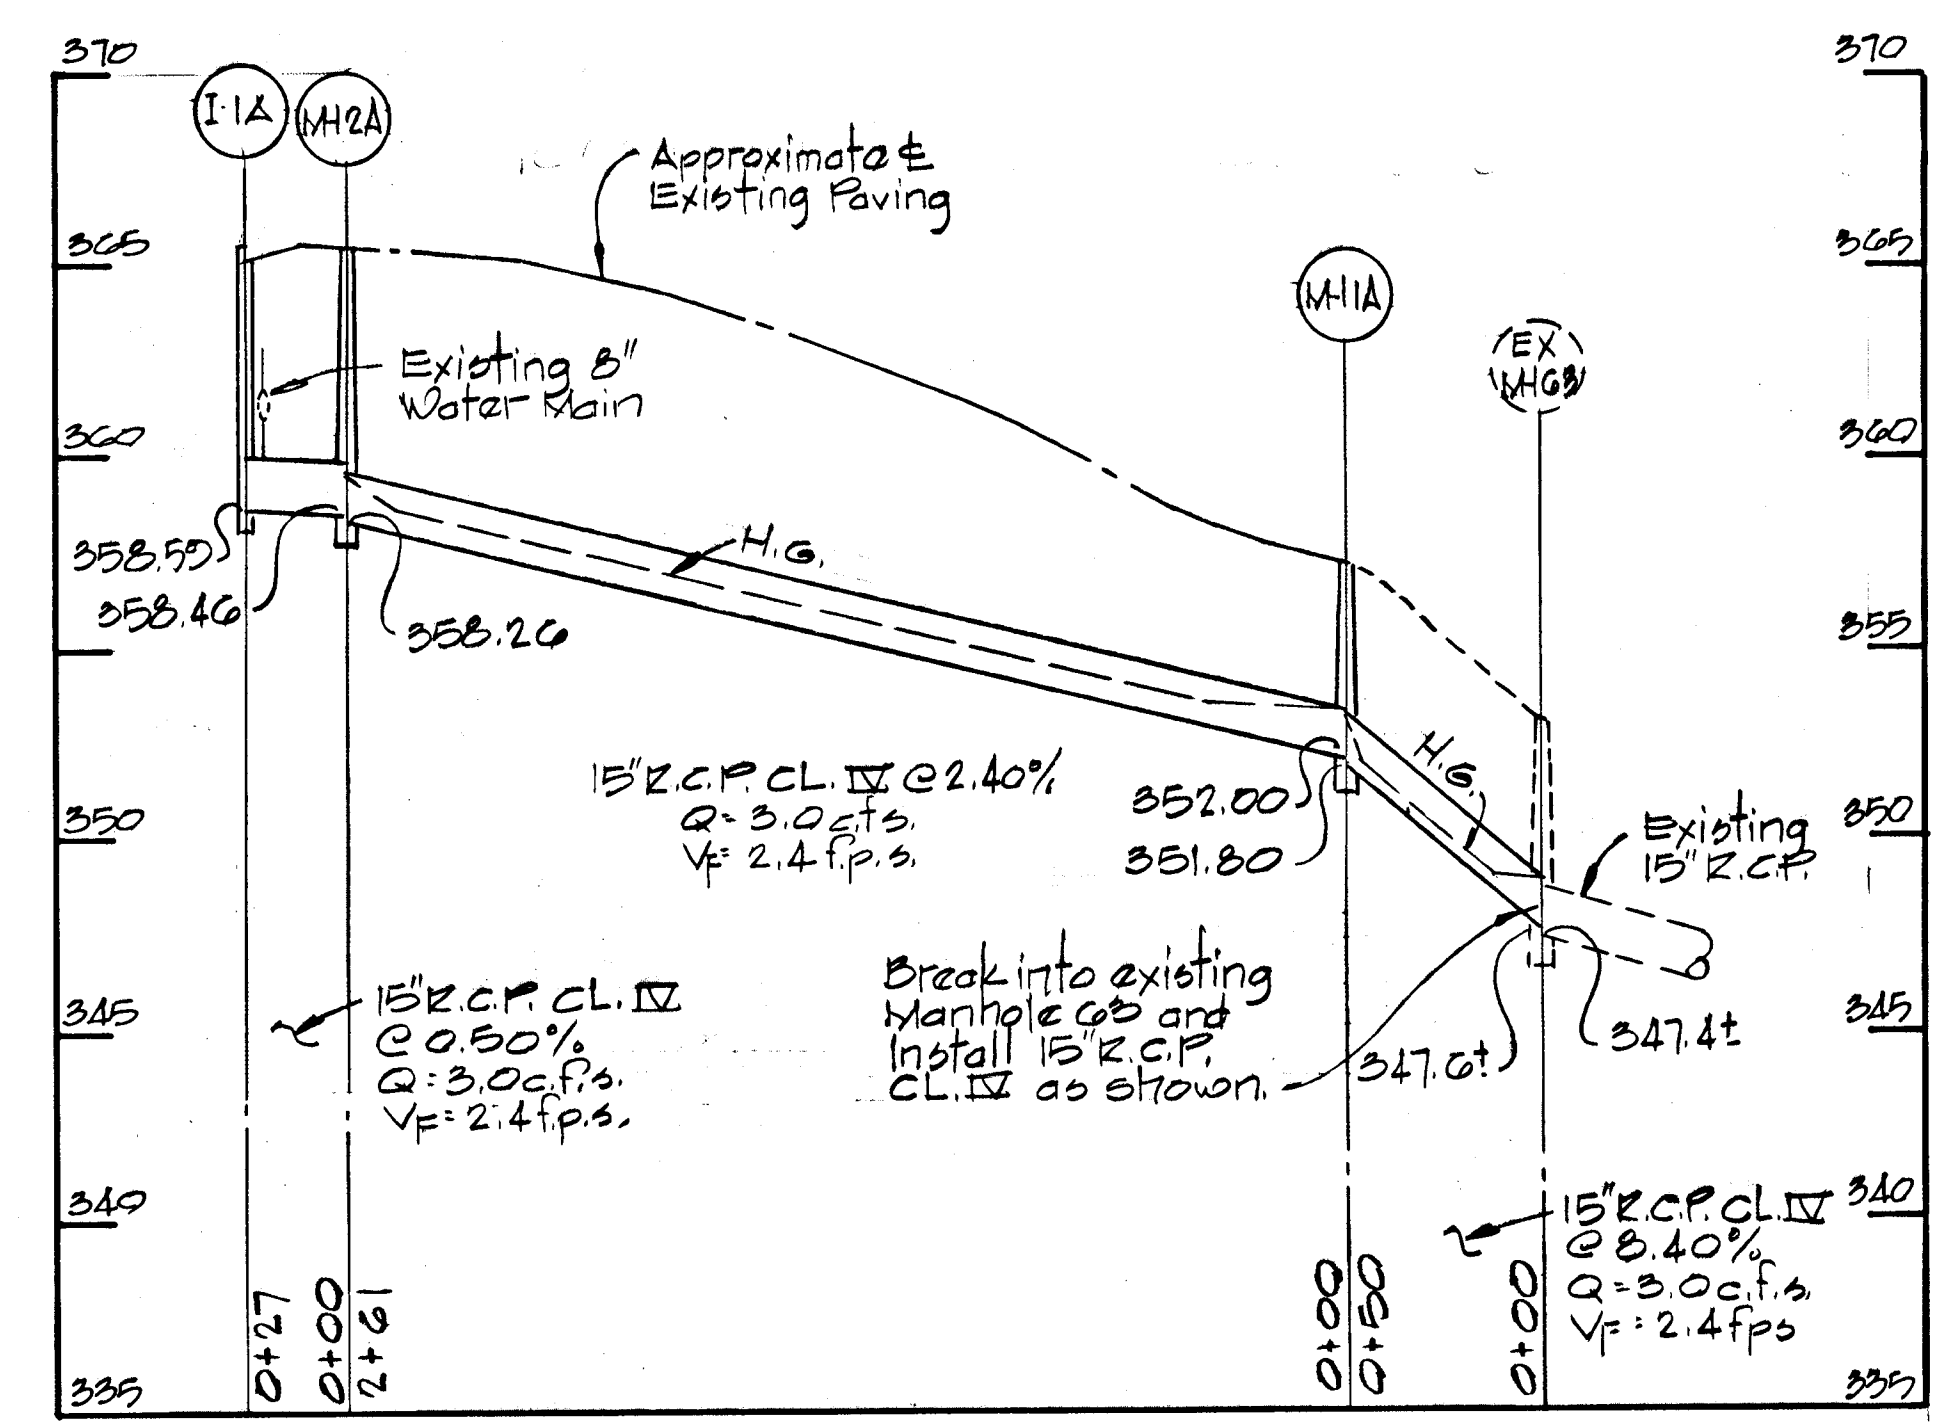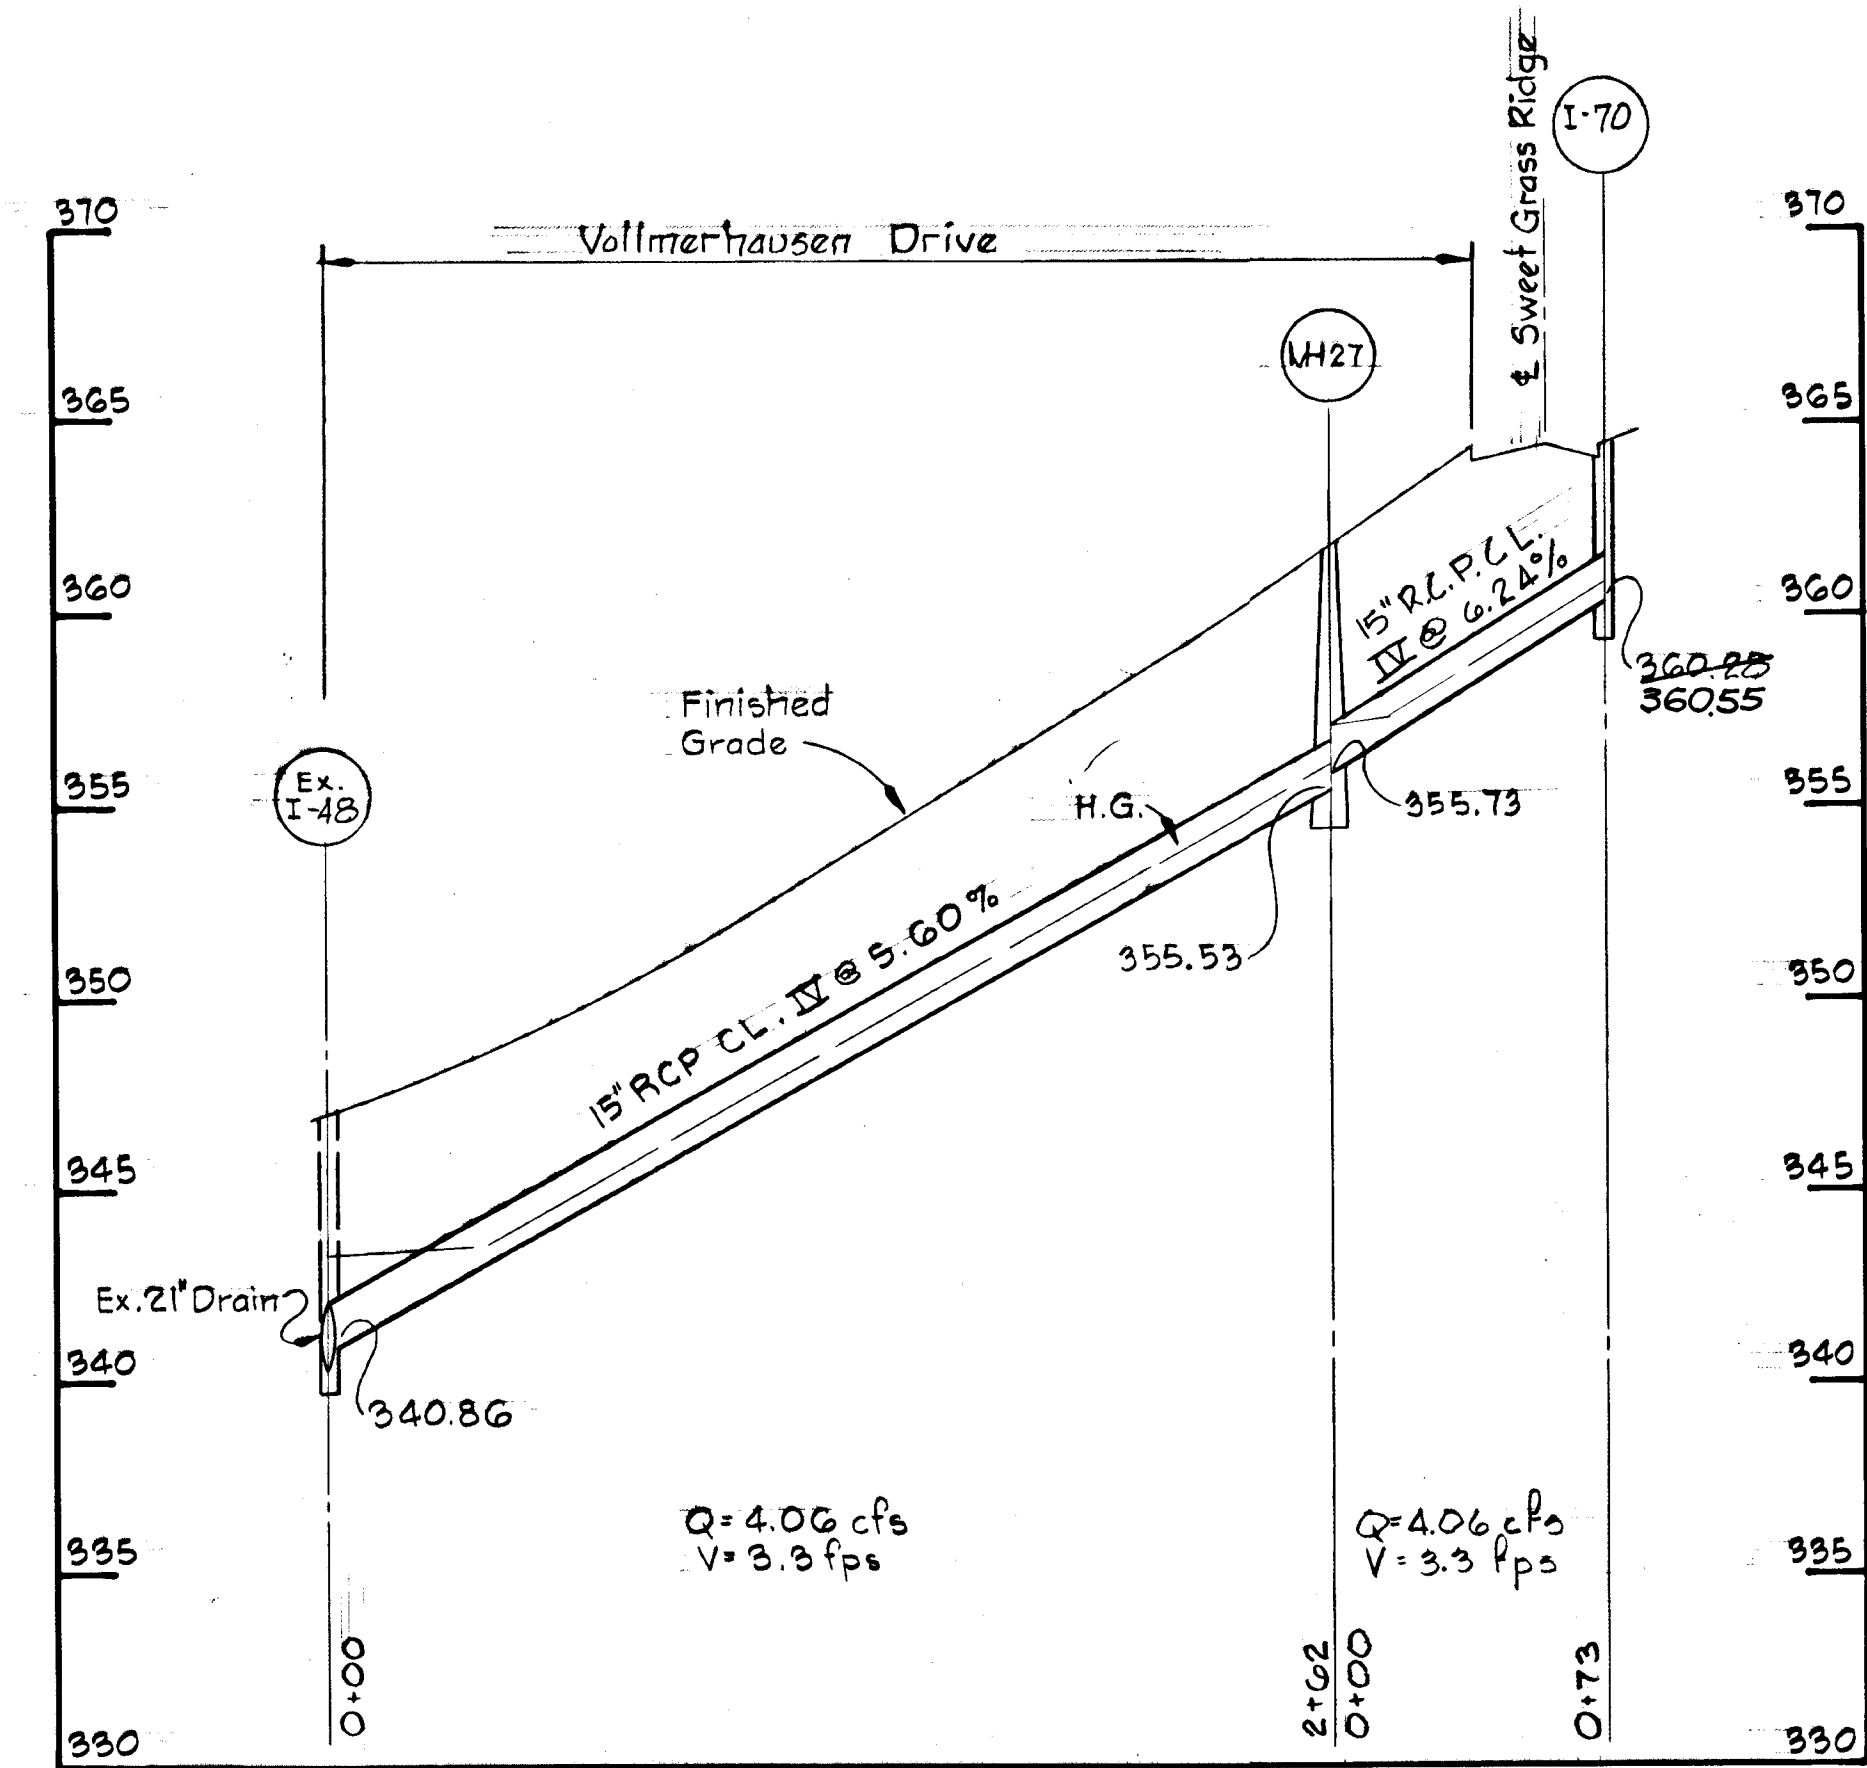

PROFILES  
 Scale: Horz. 1"=50'  
 Vert. 1"=5'

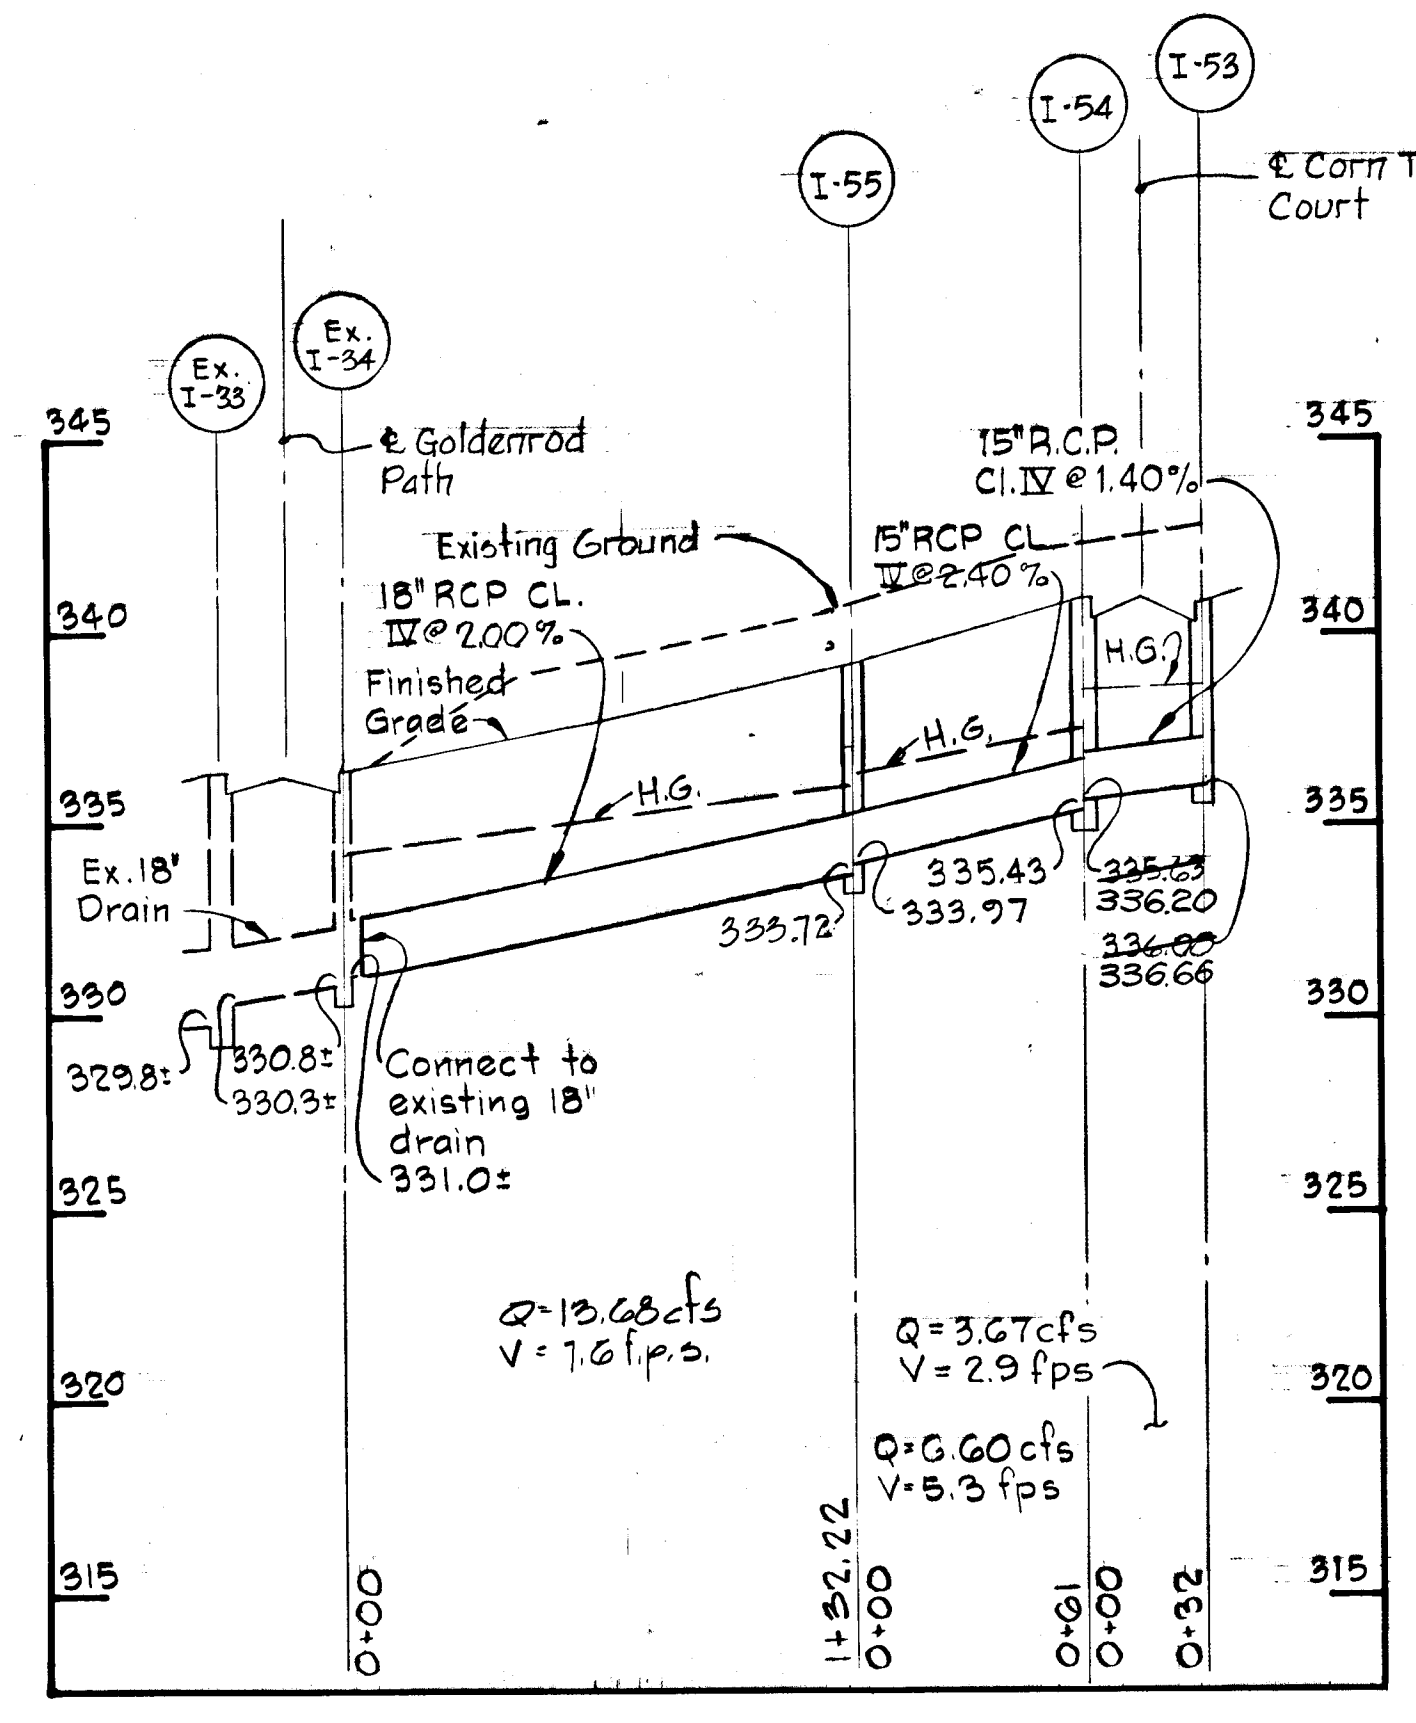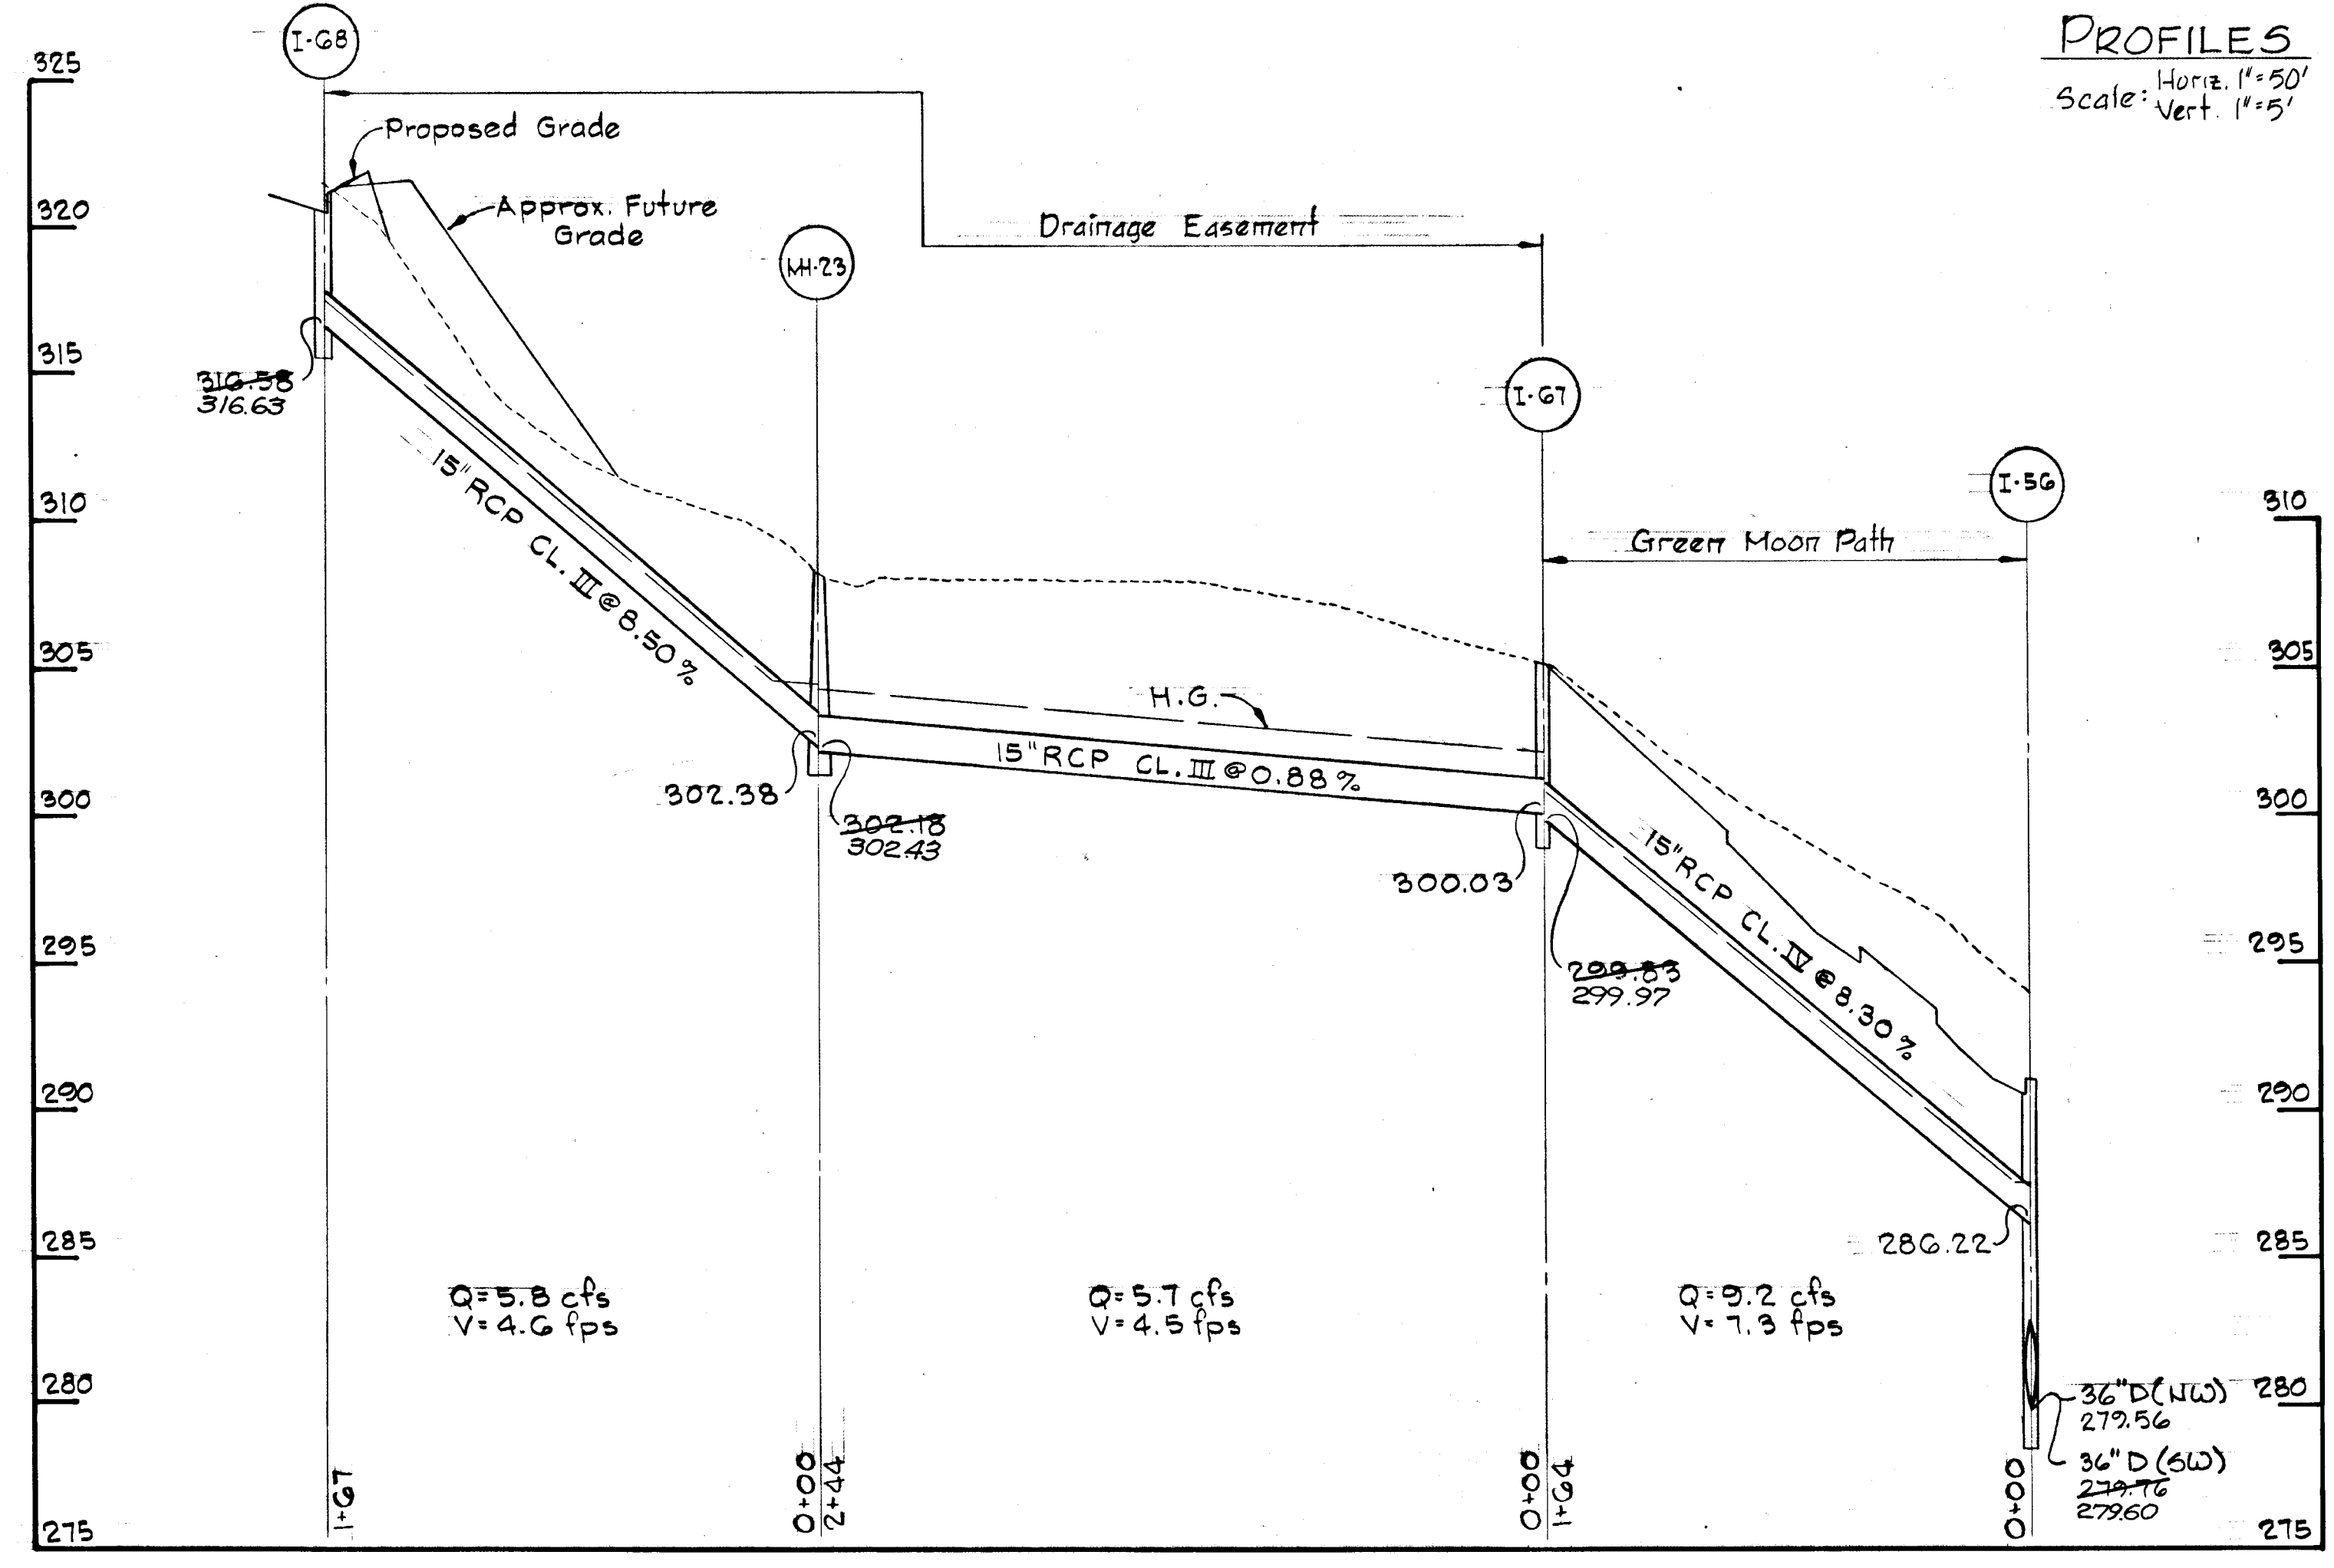

NOTE  
 AS-BUILT ELEVATIONS VERIFIED BY KENNETH A. McCORD MD REG. PE No. 1974 AS OF DECEMBER 22, 1979

Rev. Date	Rev. No.	Revision Description
7/12/81	2	Added Profile between MH23 & I-61
7/16/81	1	Revised H.G., Deleted Profile I-41 to I-63, Deleted Profile MH28 to I-101

**COLUMBIA**  
 6th ELECTION DISTRICT  
 HOWARD COUNTY, MARYLAND

OWNER AND DEVELOPER  
 HOWARD RESEARCH AND DEVELOPMENT CORP.

PROJECT AREA  
 VILLAGE OF KINGS CONTRIVANCE  
 SECTION 3 AREA 1







PROJECT TITLE  
 STORM DRAIN PROFILES

SCALE: AS SHOWN DATE:

WHITMAN, REQUARDT & ASSOCIATES  
 ENGINEERS  
 BALTIMORE, MARYLAND 21202

*Kenneth A. McCord*  
 KENNETH A. McCord  
 Registered Engineer  
 No. 1974



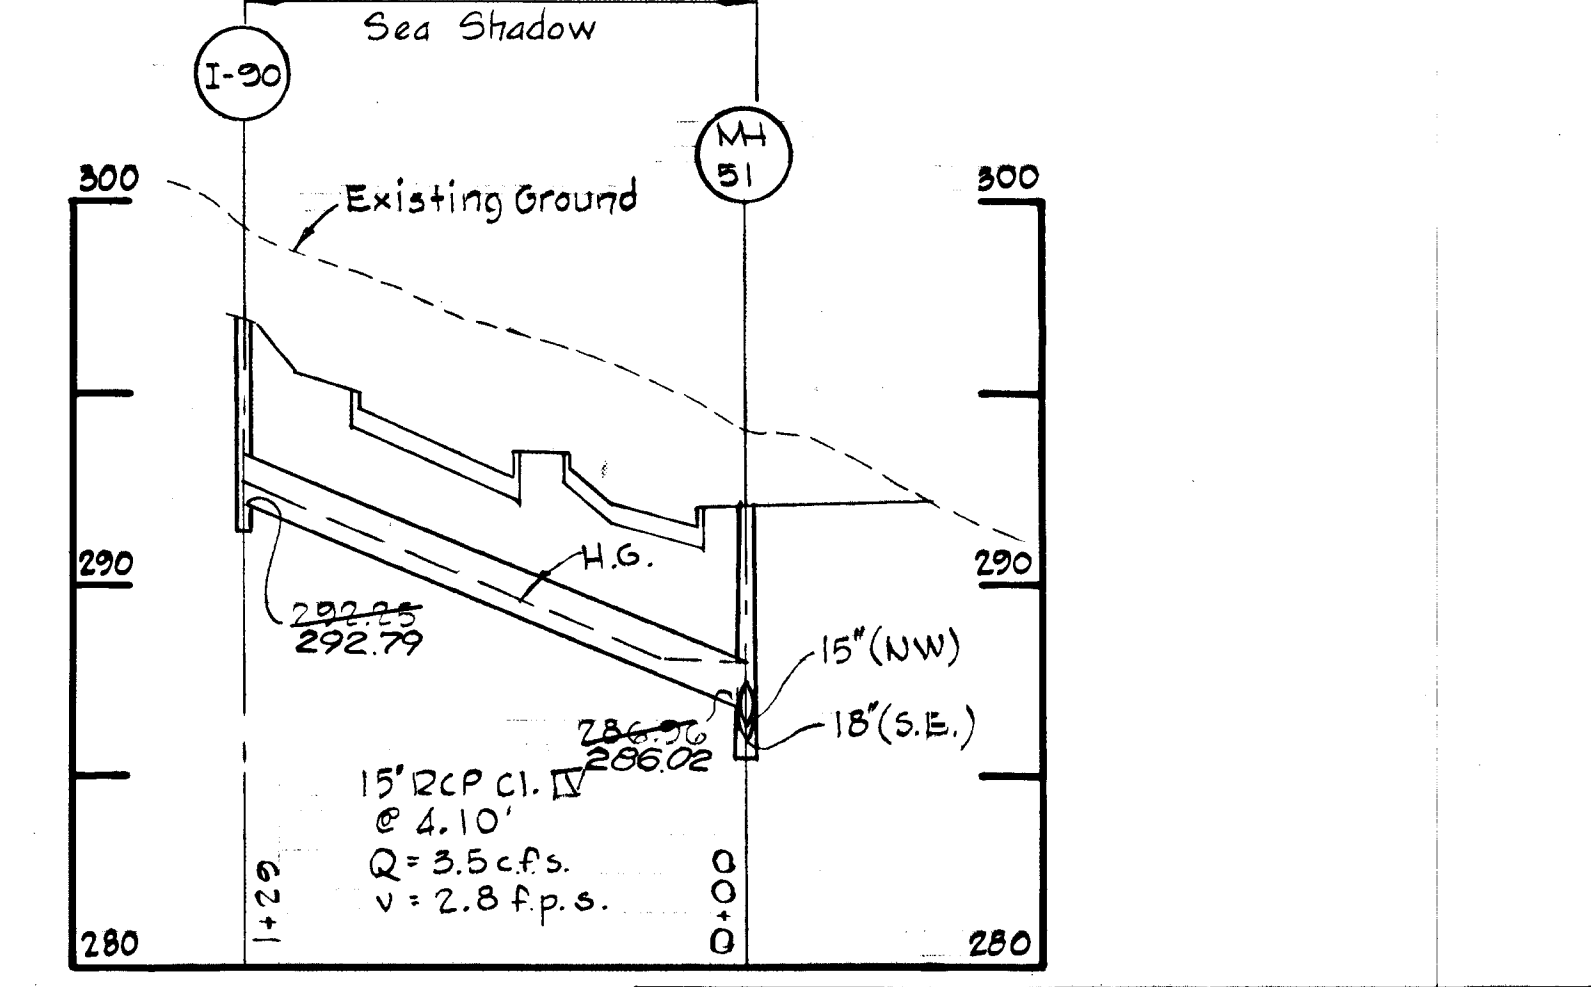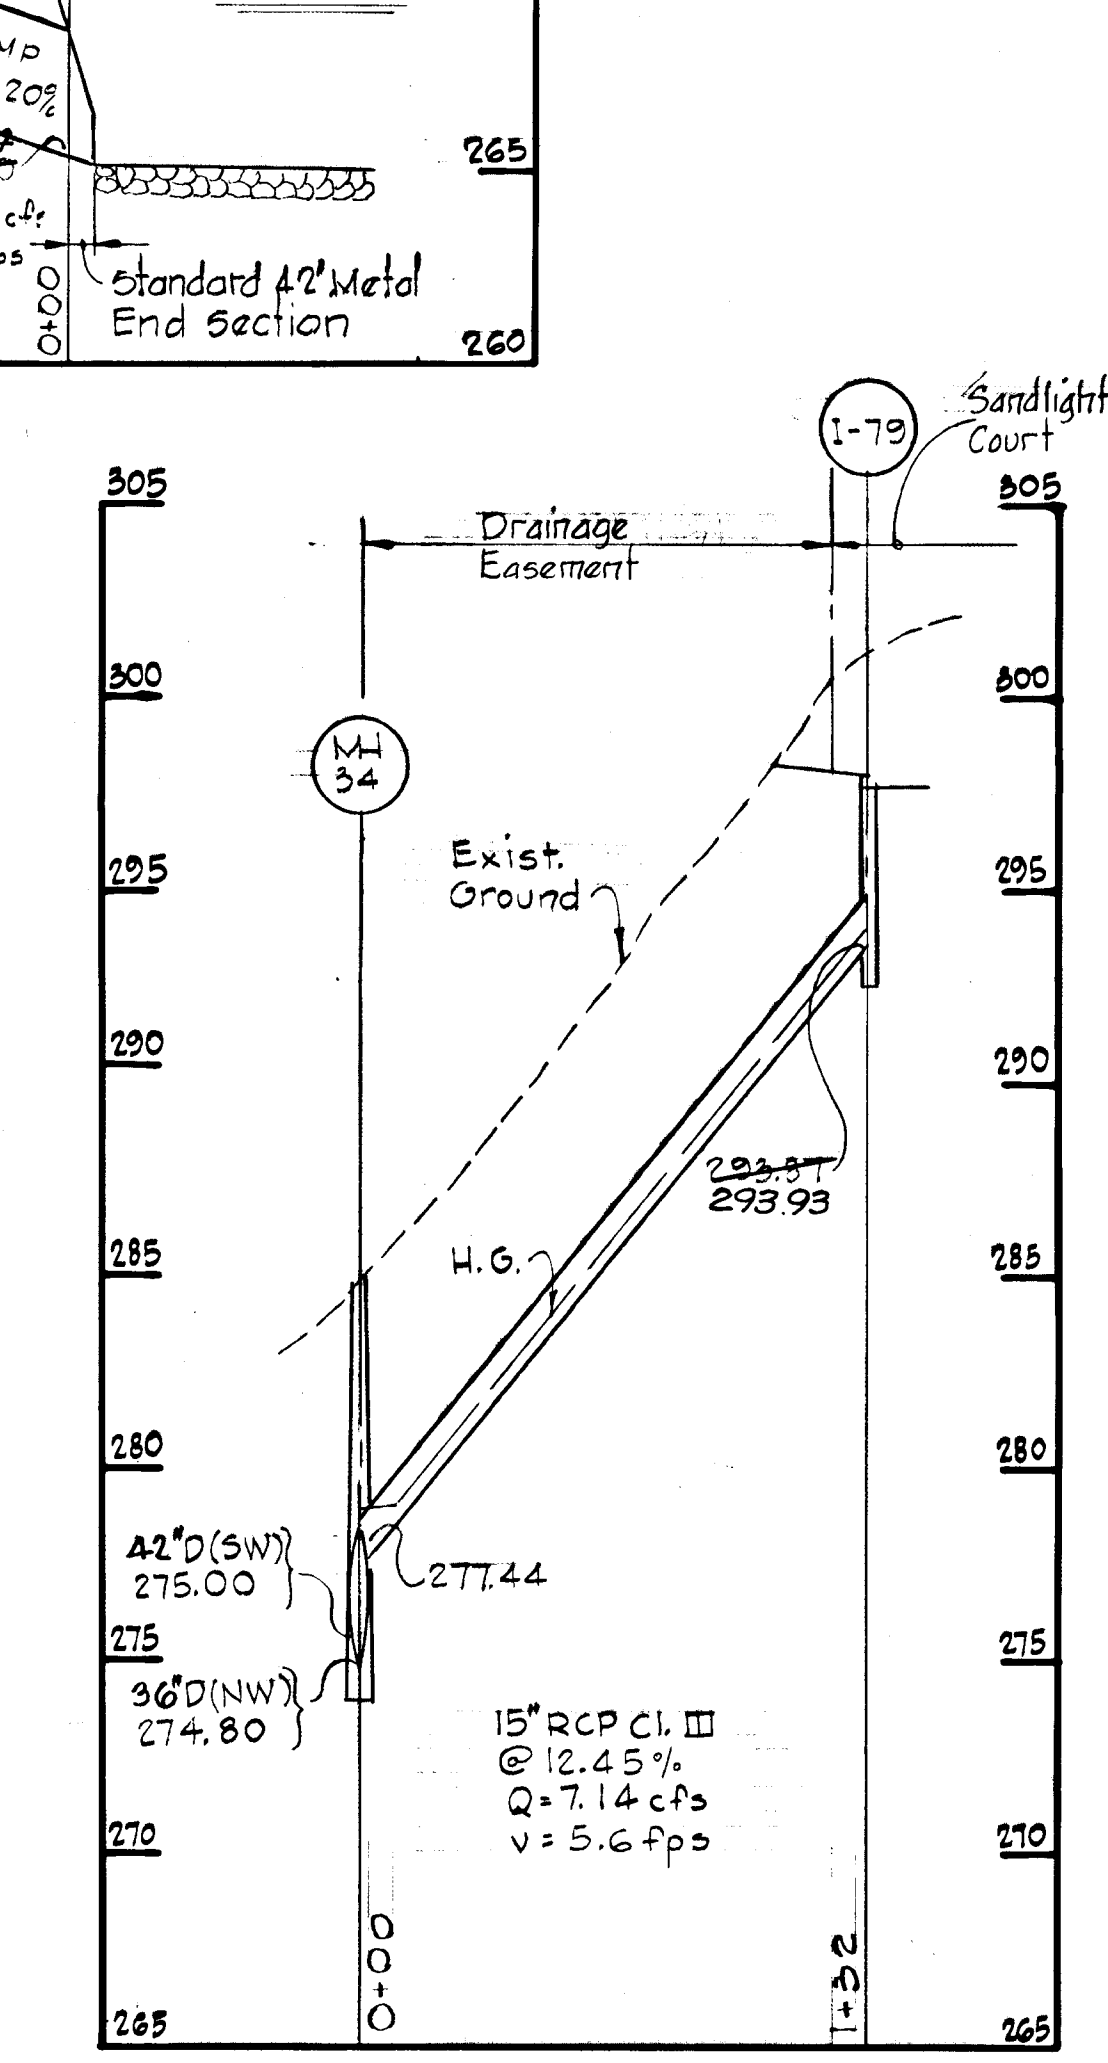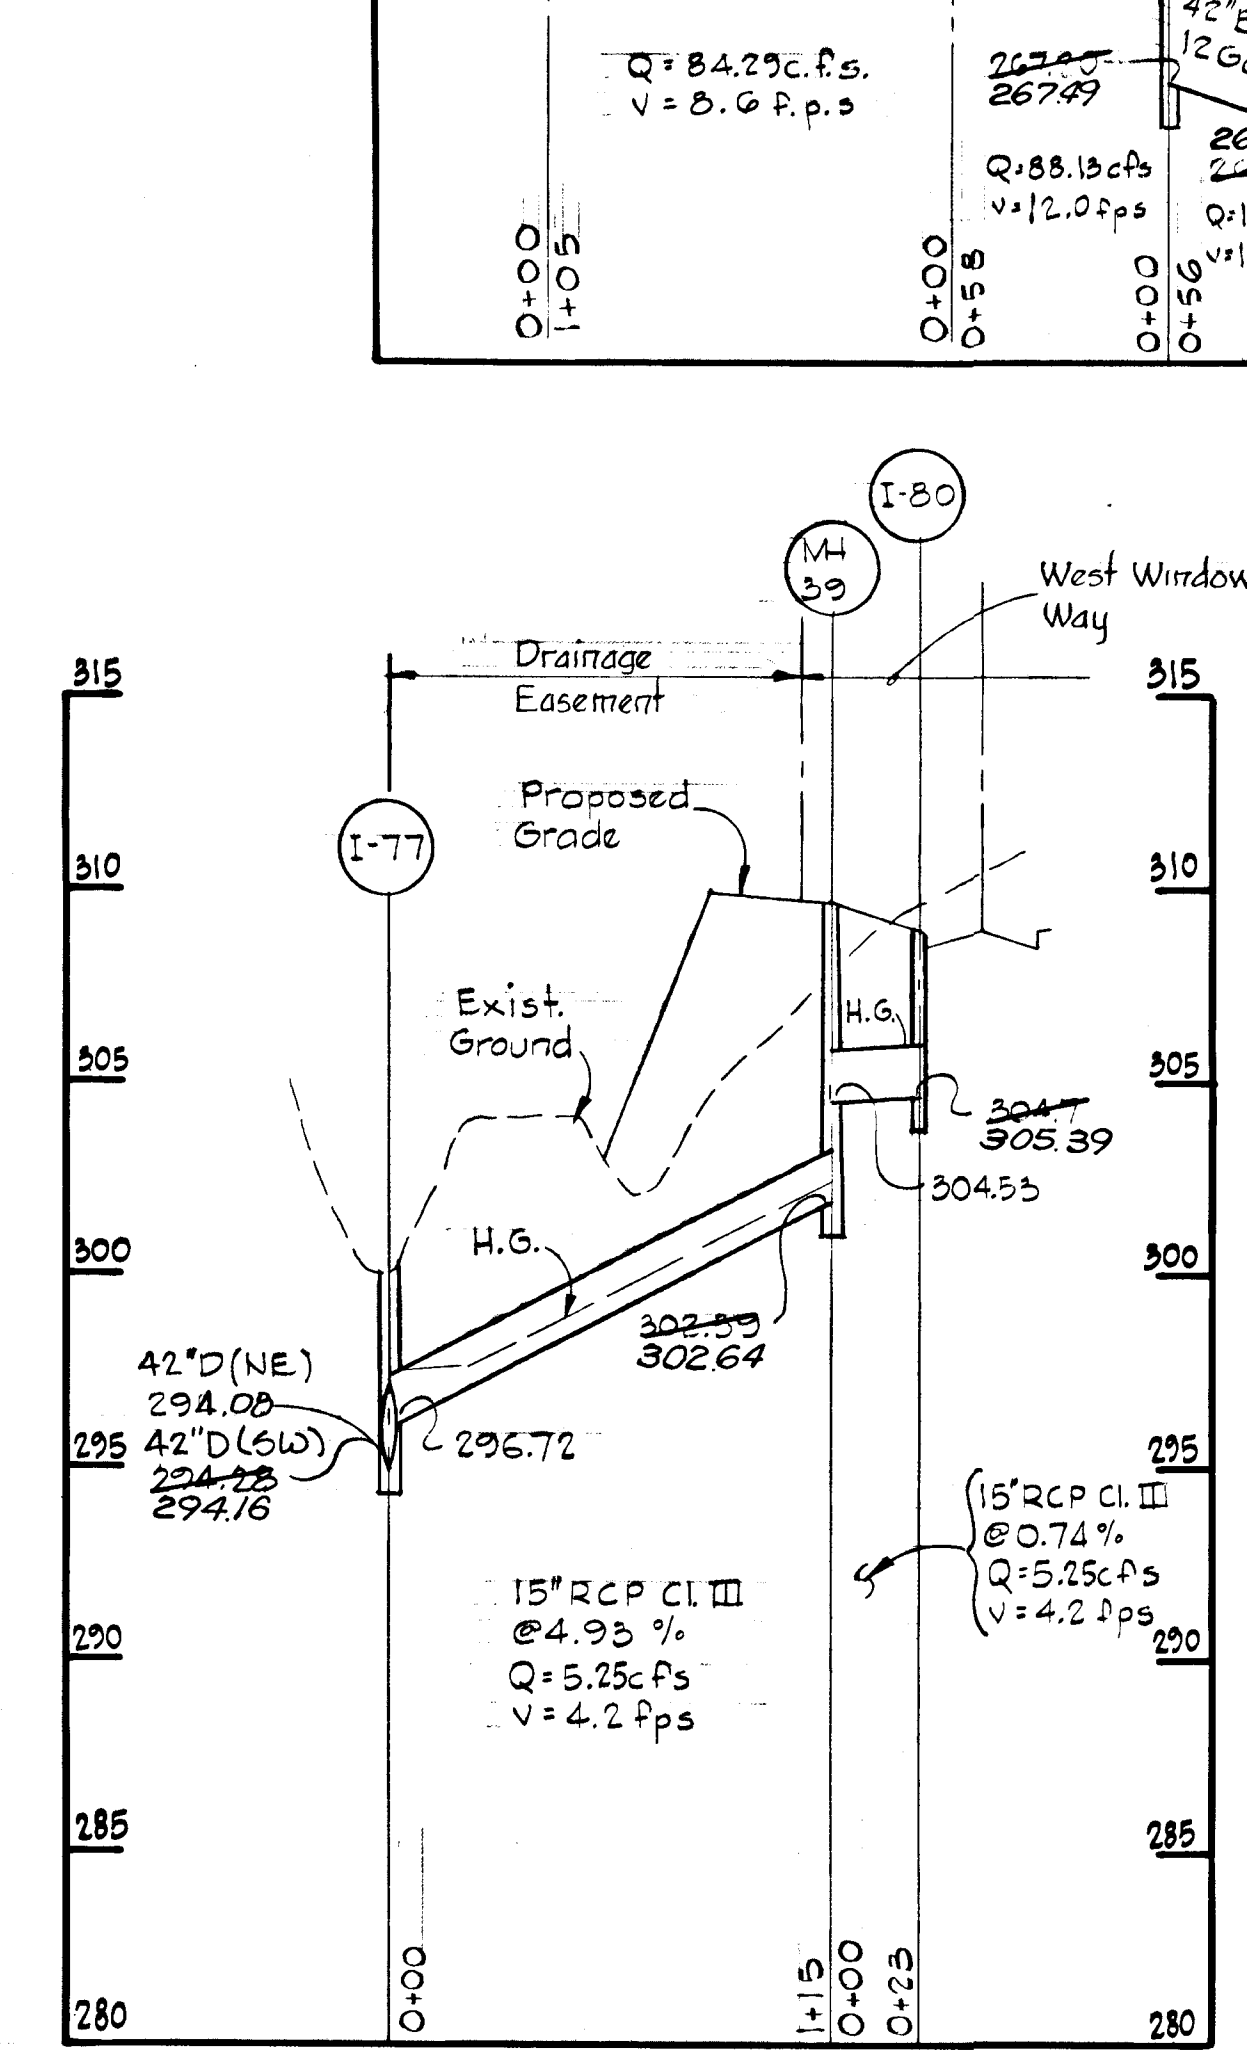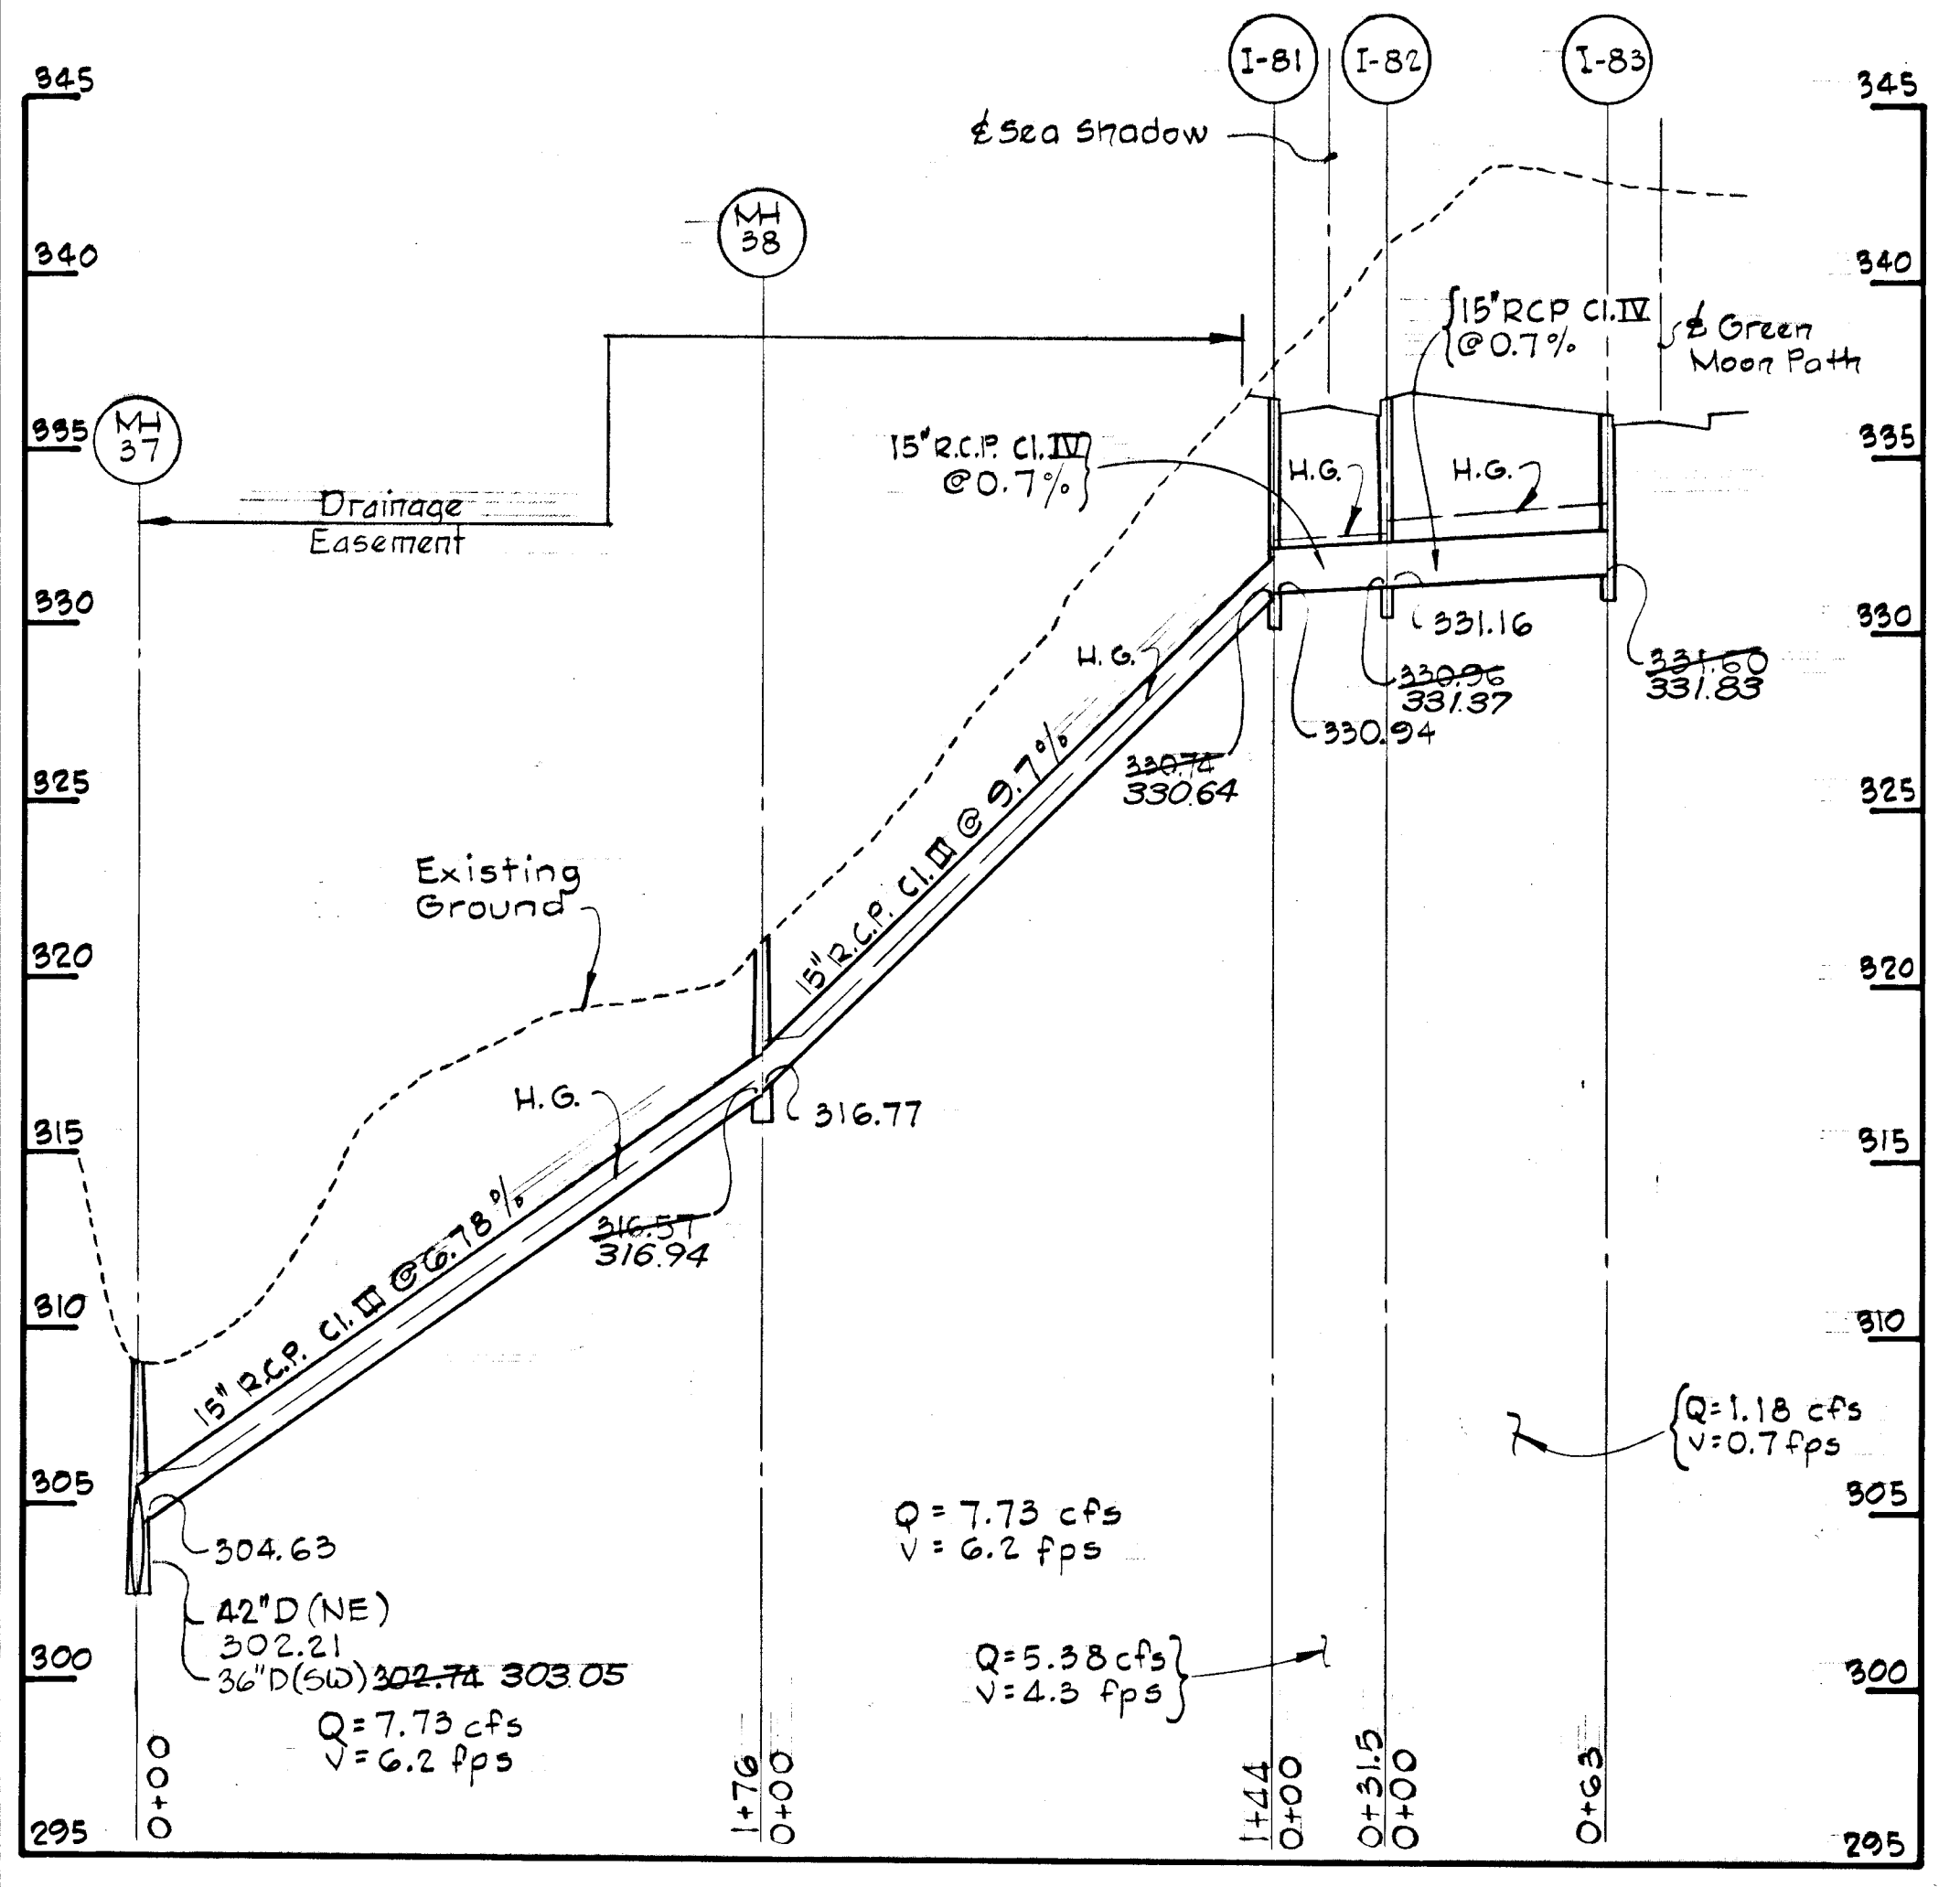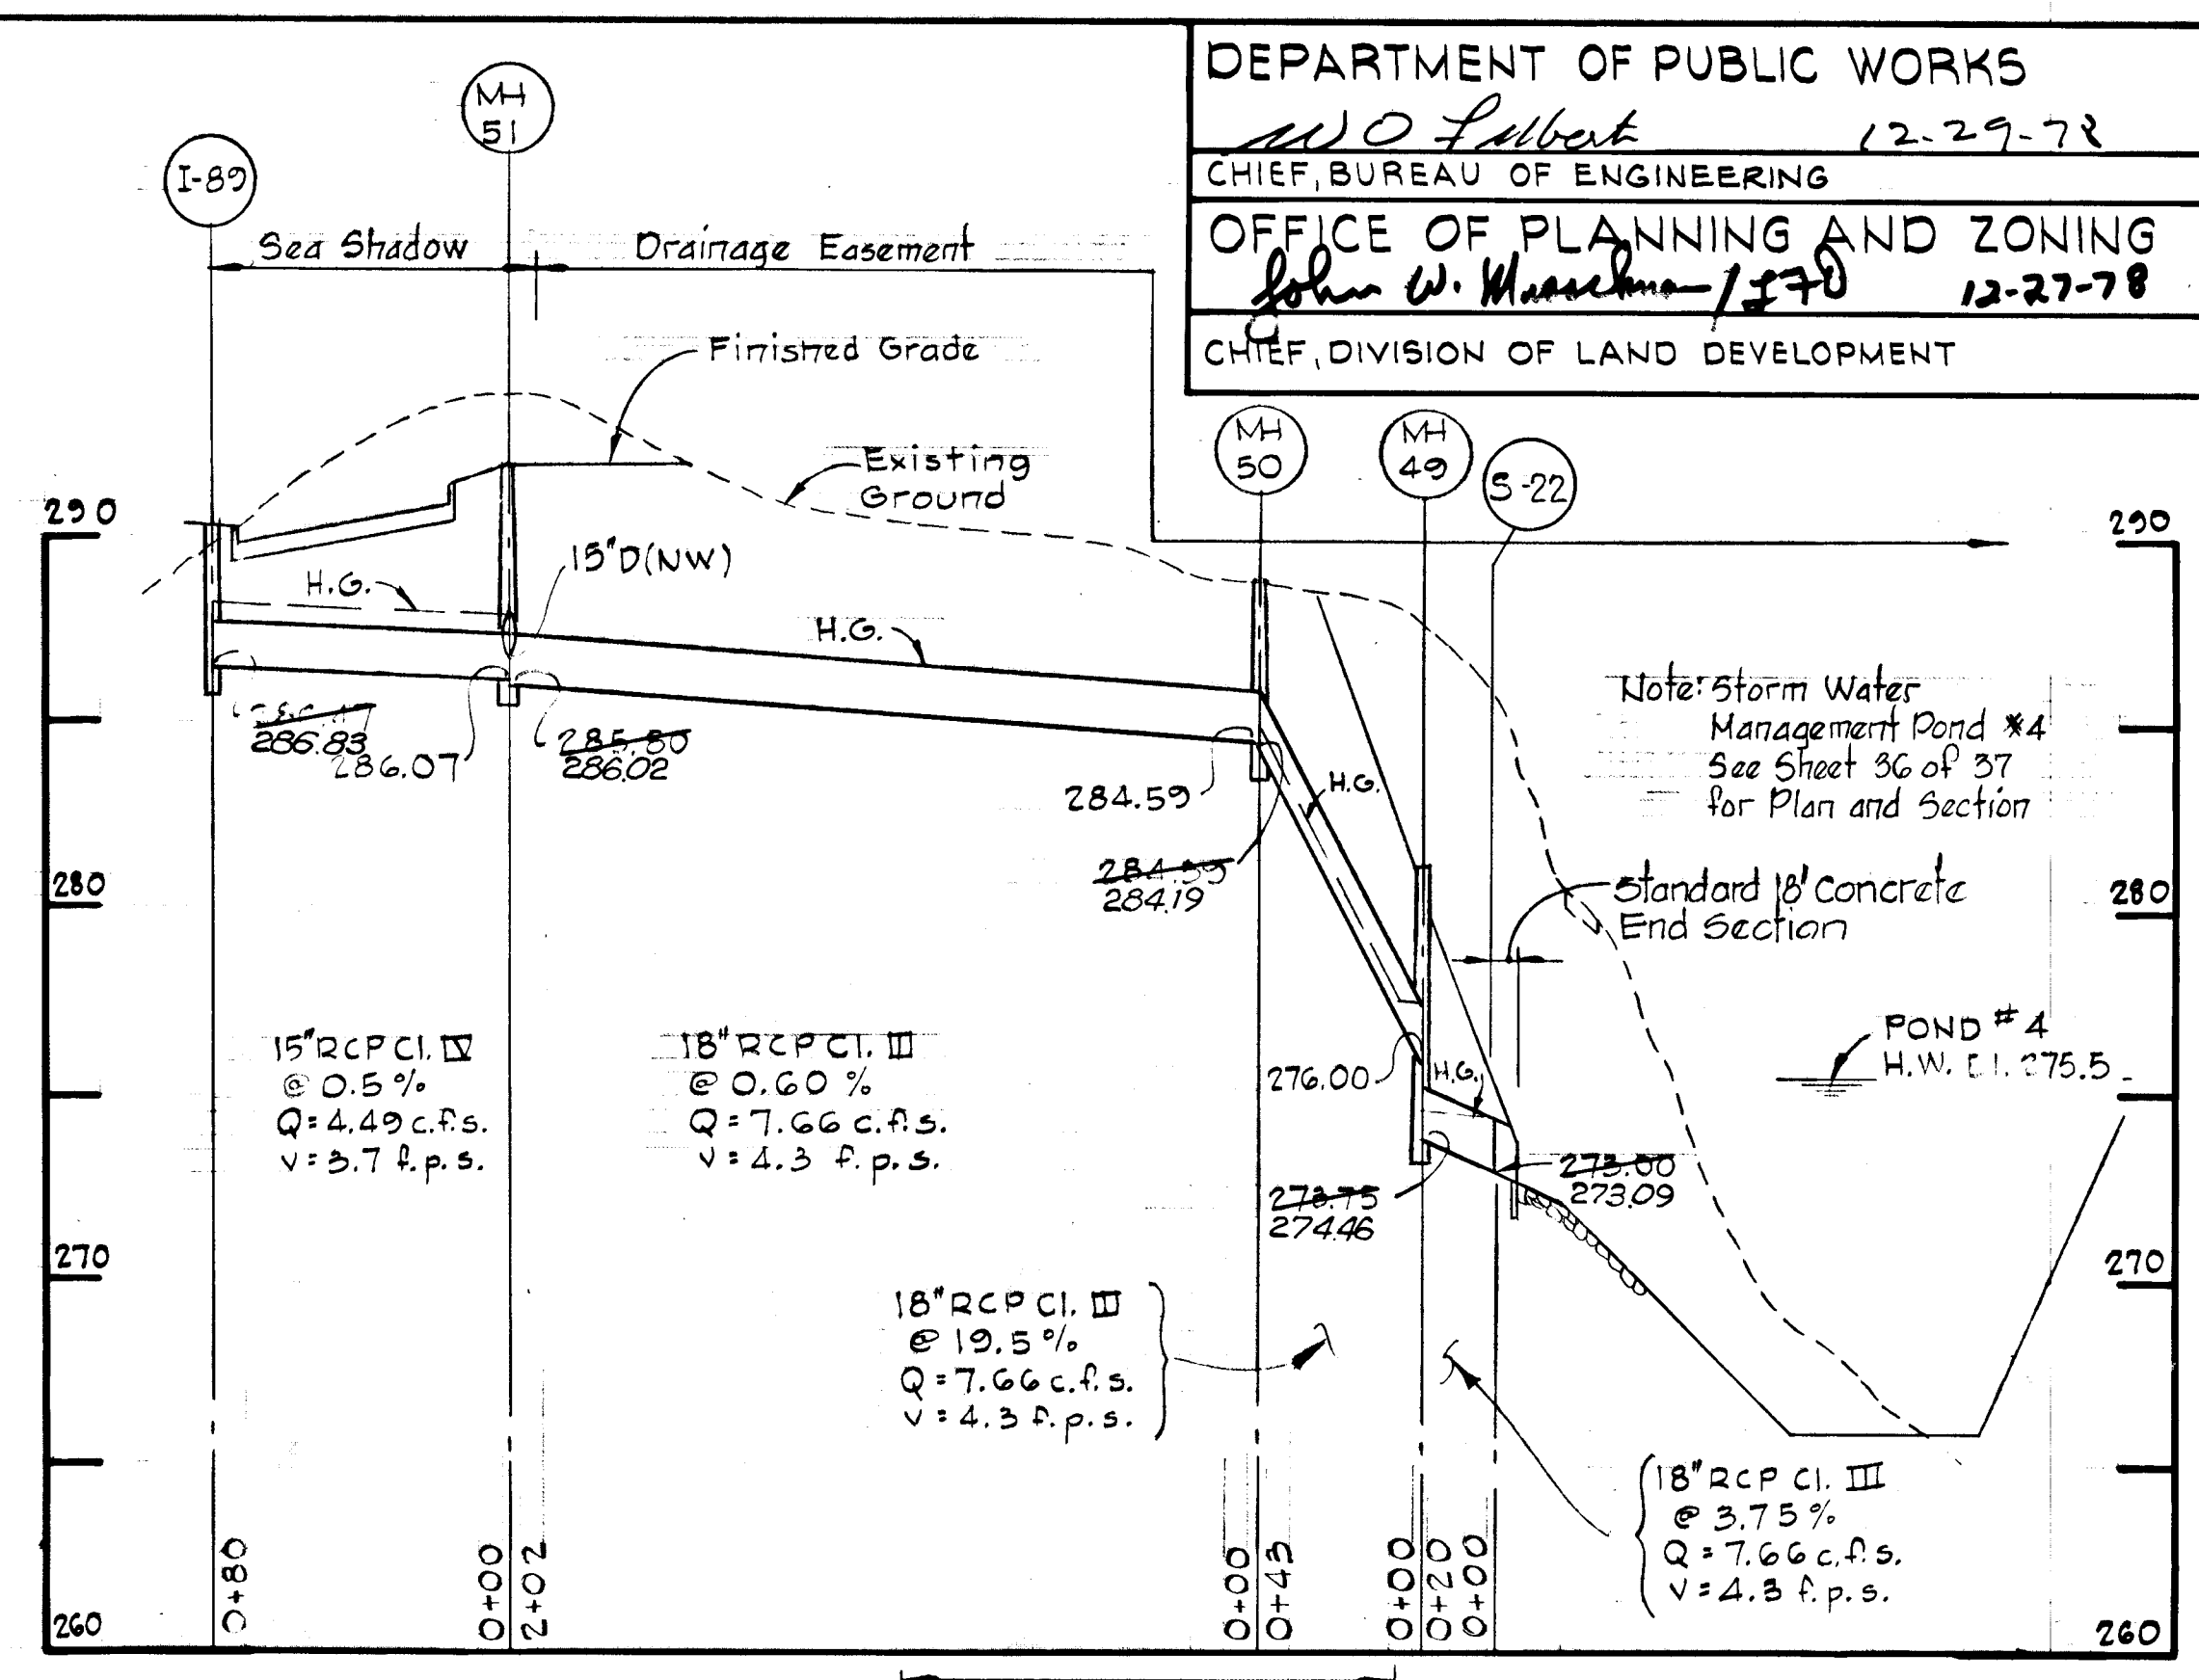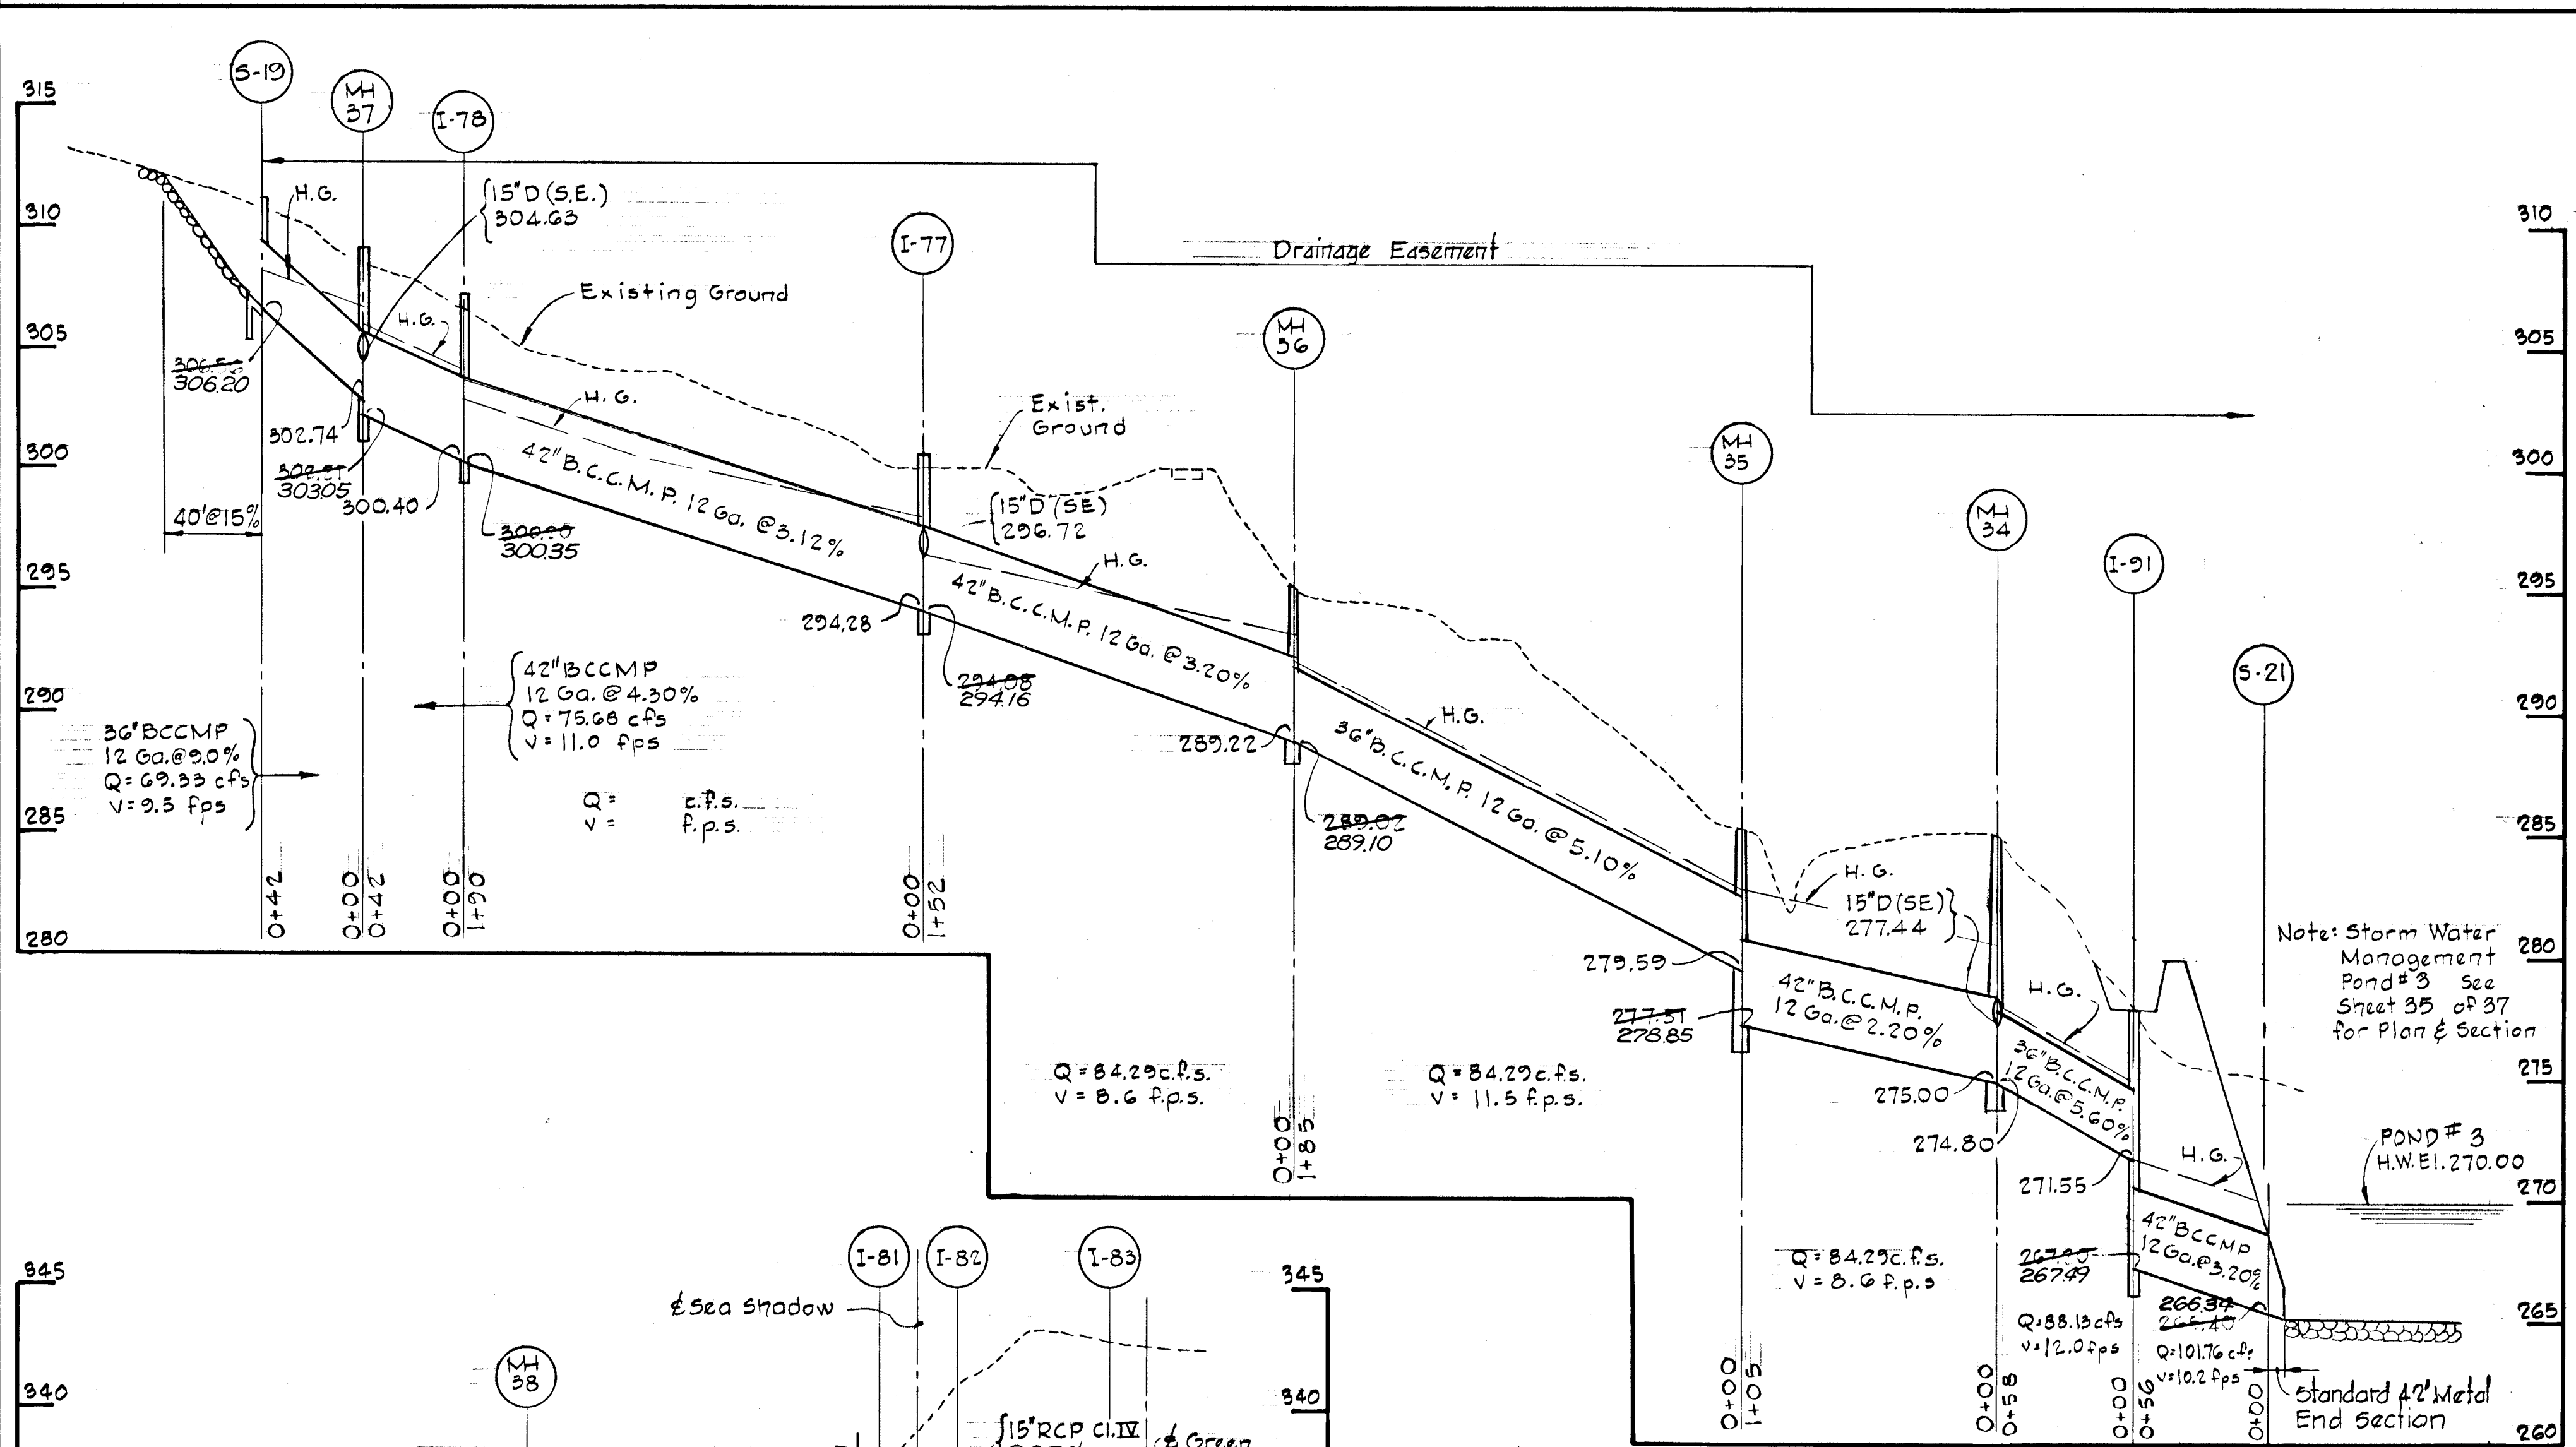


PROFILES  
 Scale: Horiz. 1"=50'  
 Vert. 1"=5'

NOTE  
 \*AS-BUILT ELEVATIONS VERIFIED BY KENNETH A. MCCORD MD. REG. P.E. No. 1974 AS OF DECEMBER 20, 1979

Rev. Date	Rev. No.	Revision Description
<b>COLUMBIA</b> 6 <sup>th</sup> ELECTION DISTRICT HOWARD COUNTY, MARYLAND OWNER AND DEVELOPER HOWARD RESEARCH AND DEVELOPMENT CORP. PROJECT AREA <b>VILLAGE OF KINGS CONTRIVANCE</b> SECTION 3 AREA 1 PROJECT TITLE <b>STORM DRAIN PROFILES</b> SCALE: AS SHOWN DATE: _____ WHITMAN, REQUARDT & ASSOCIATES ENGINEERS BALTIMORE, MARYLAND 21202 <i>Kenneth A. McCord</i> KENNETH A. MCCORD Registered Engineer No. 1974		








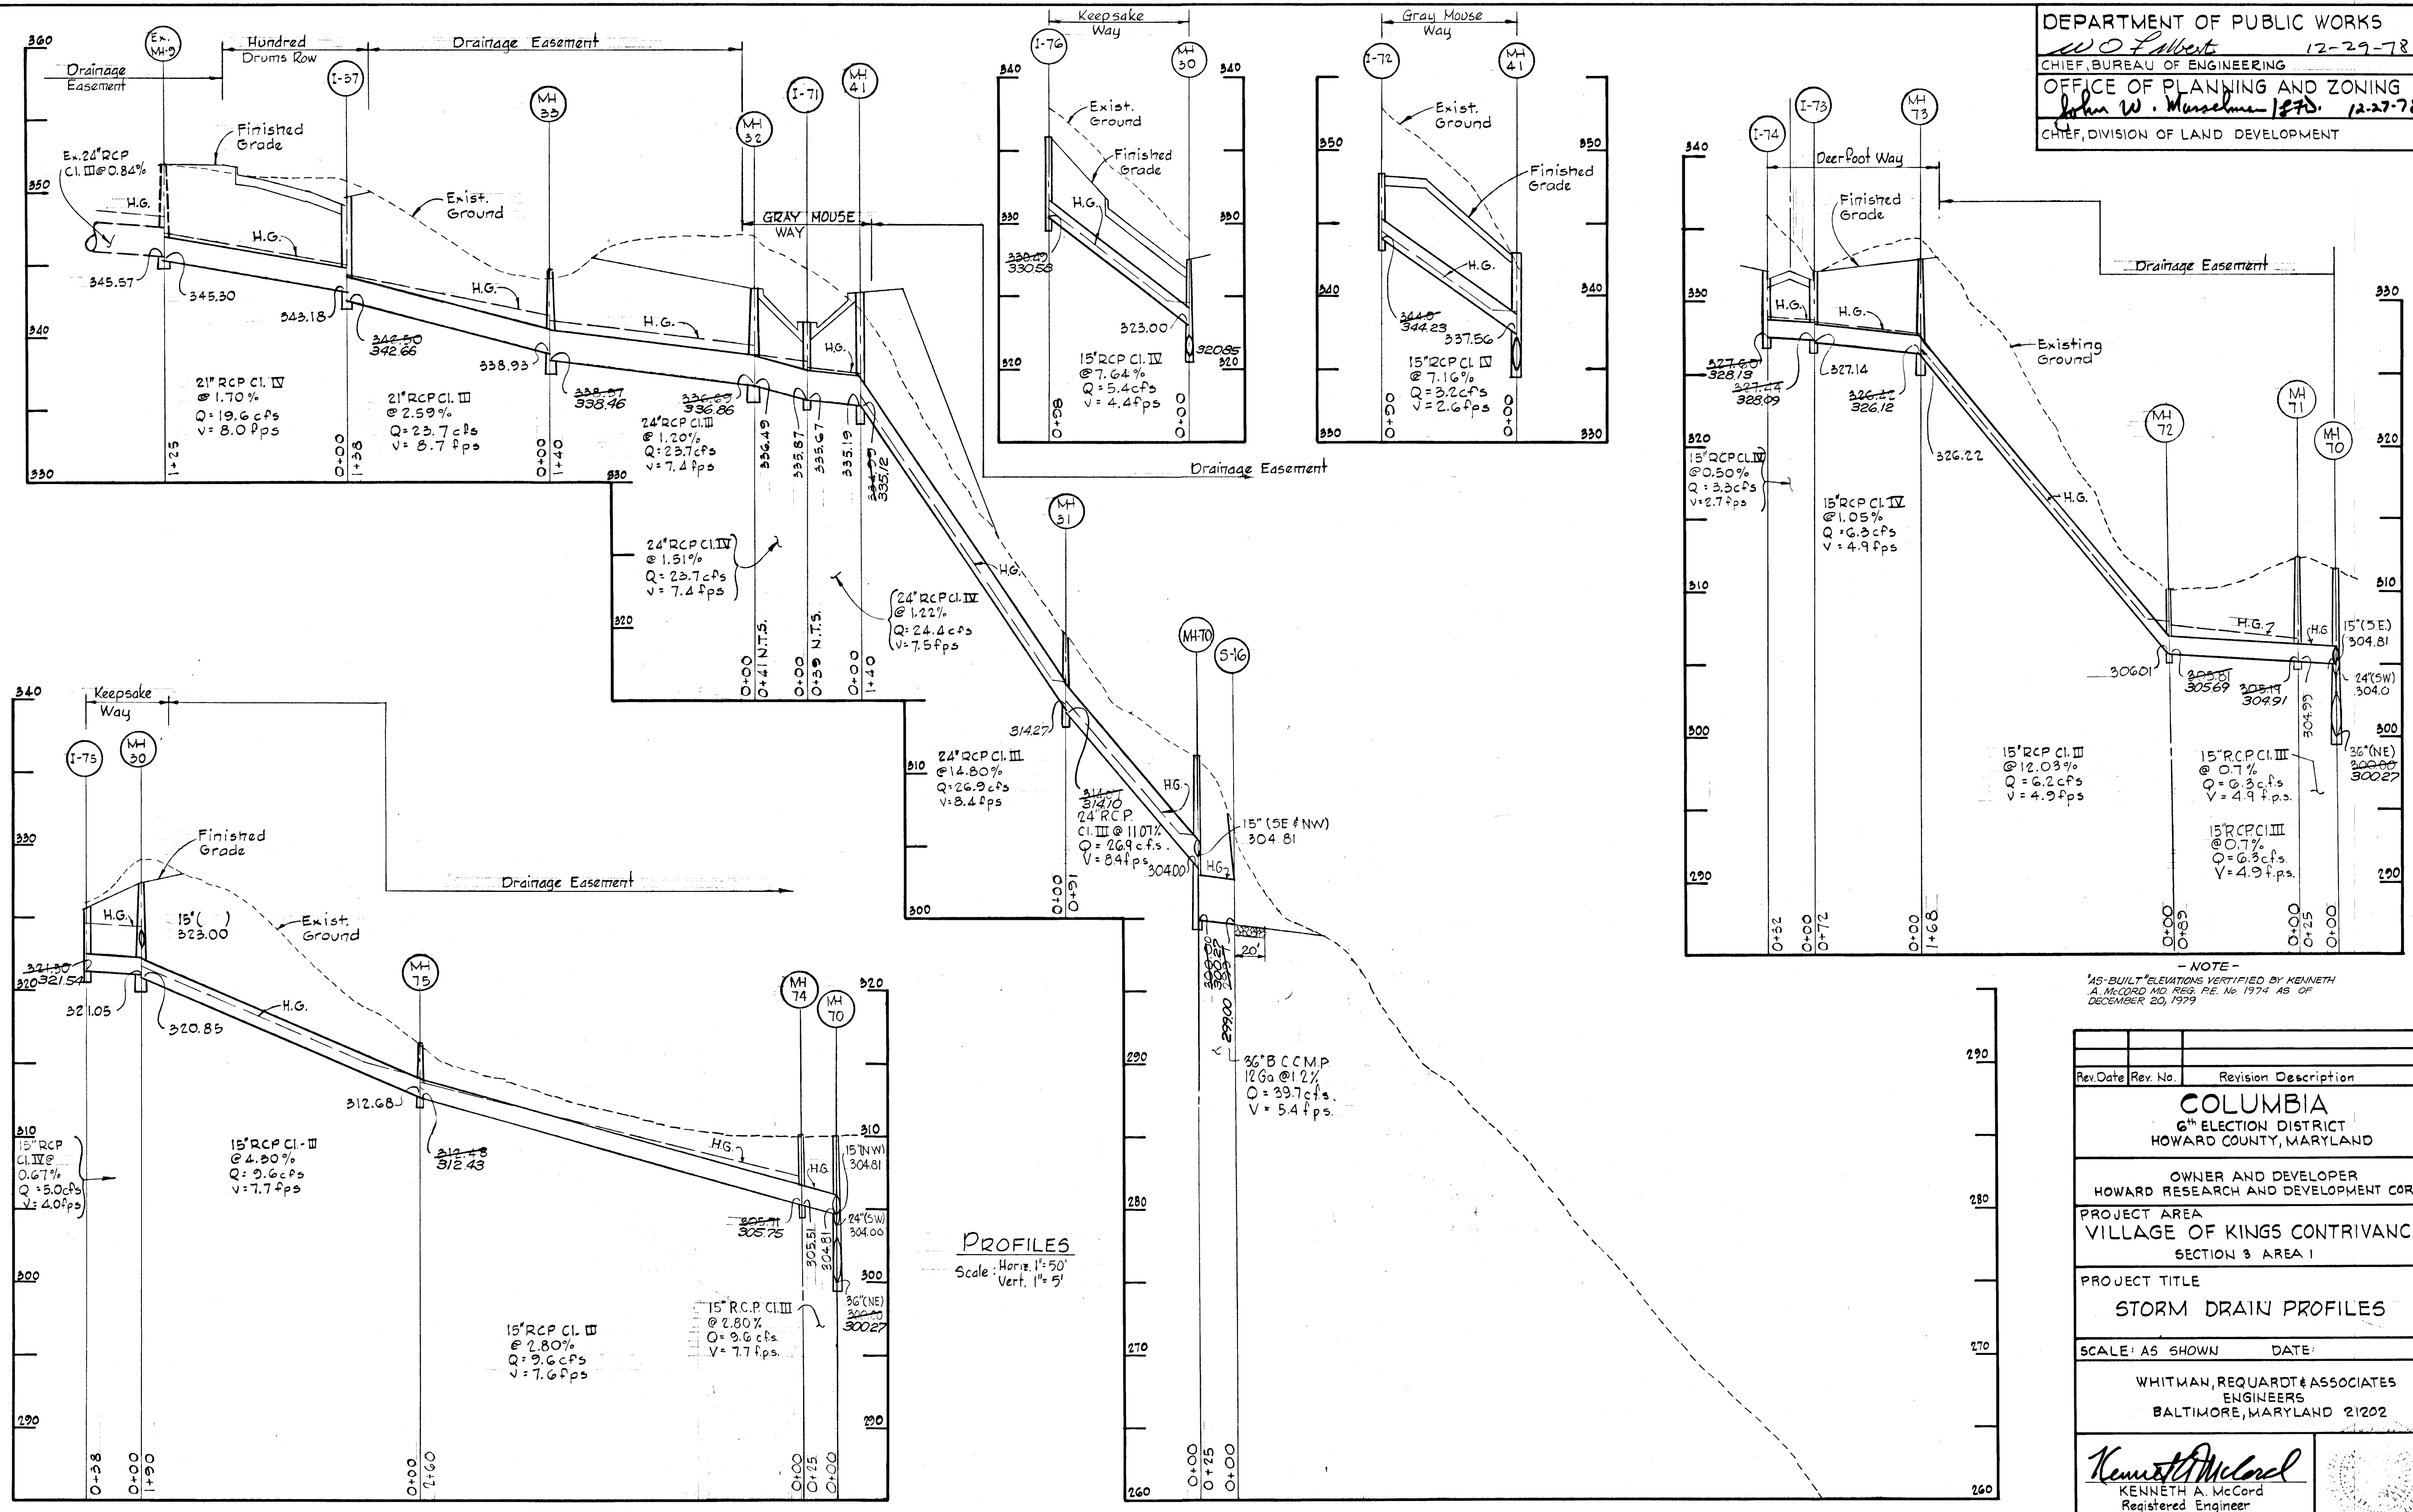


- NOTE -  
 "AS-BUILT" ELEVATIONS VERIFIED BY KENNETH A. McCORD MD REG. P.E. No. 1974 AS OF DECEMBER 20, 1979

Rev. Date	Rev. No.	Revision Description
<b>COLUMBIA</b> 6 <sup>th</sup> ELECTION DISTRICT HOWARD COUNTY, MARYLAND		
OWNER AND DEVELOPER HOWARD RESEARCH AND DEVELOPMENT CORP.		
PROJECT AREA VILLAGE OF KINGS CONTRIVANCE SECTION 3 AREA 1		
PROJECT TITLE STORM DRAIN PROFILES		
SCALE: AS SHOWN		DATE:
WHITMAN, REQUARDT & ASSOCIATES ENGINEERS BALTIMORE, MARYLAND 21202		
<i>Kenneth A. McCord</i> KENNETH A. McCord Registered Engineer No. 1974		



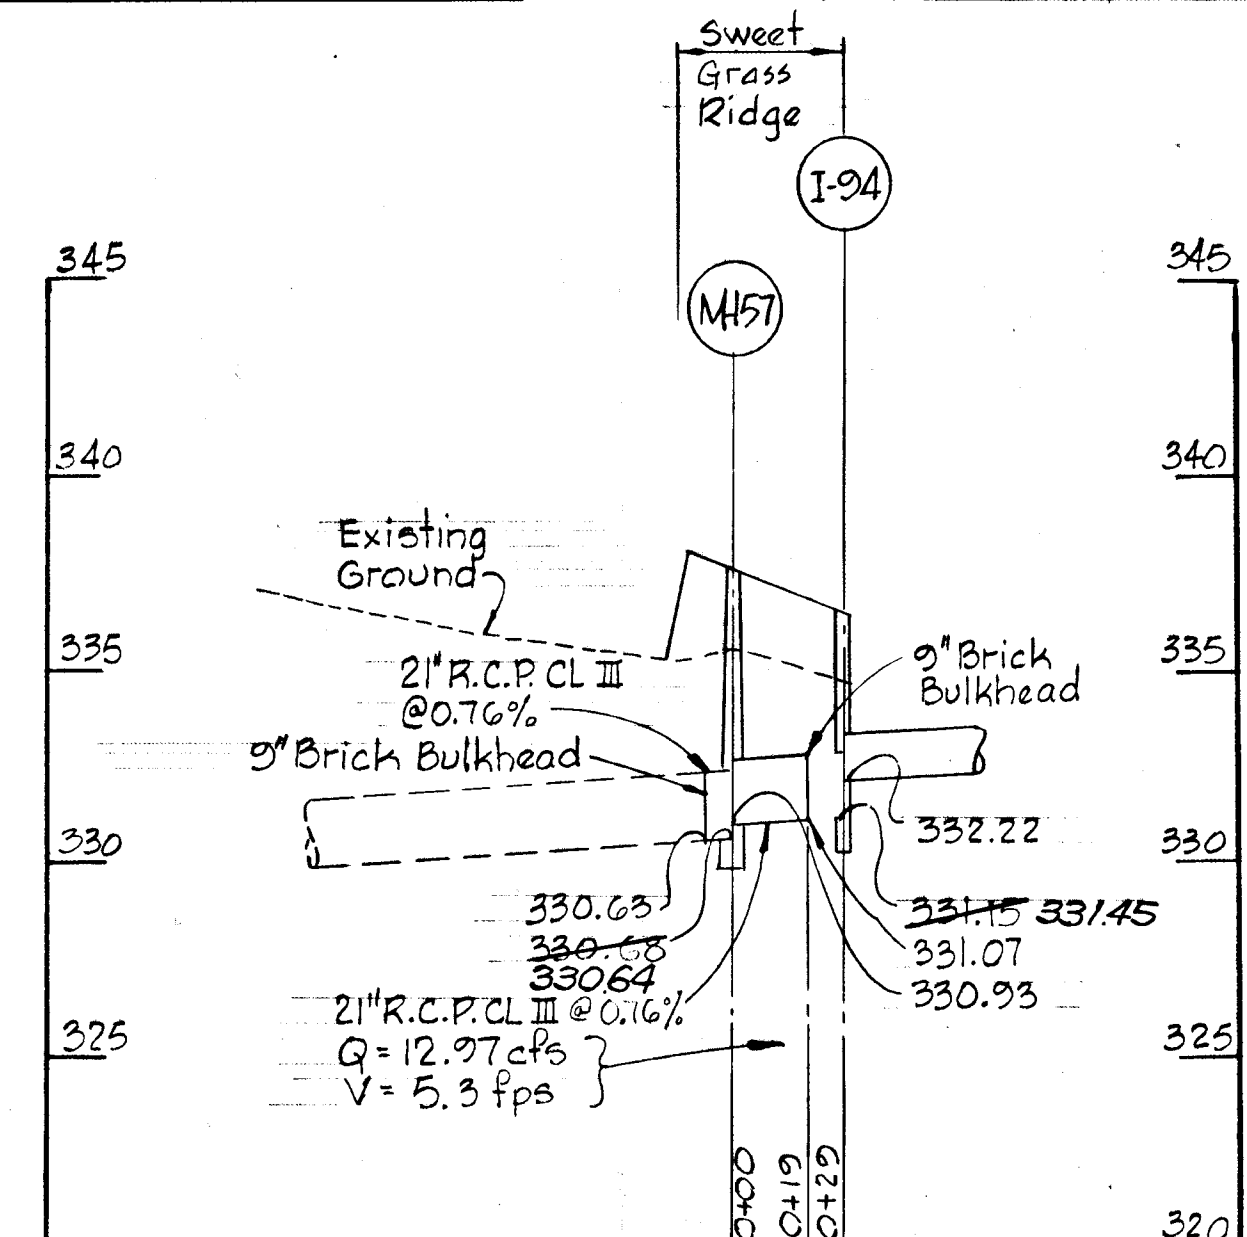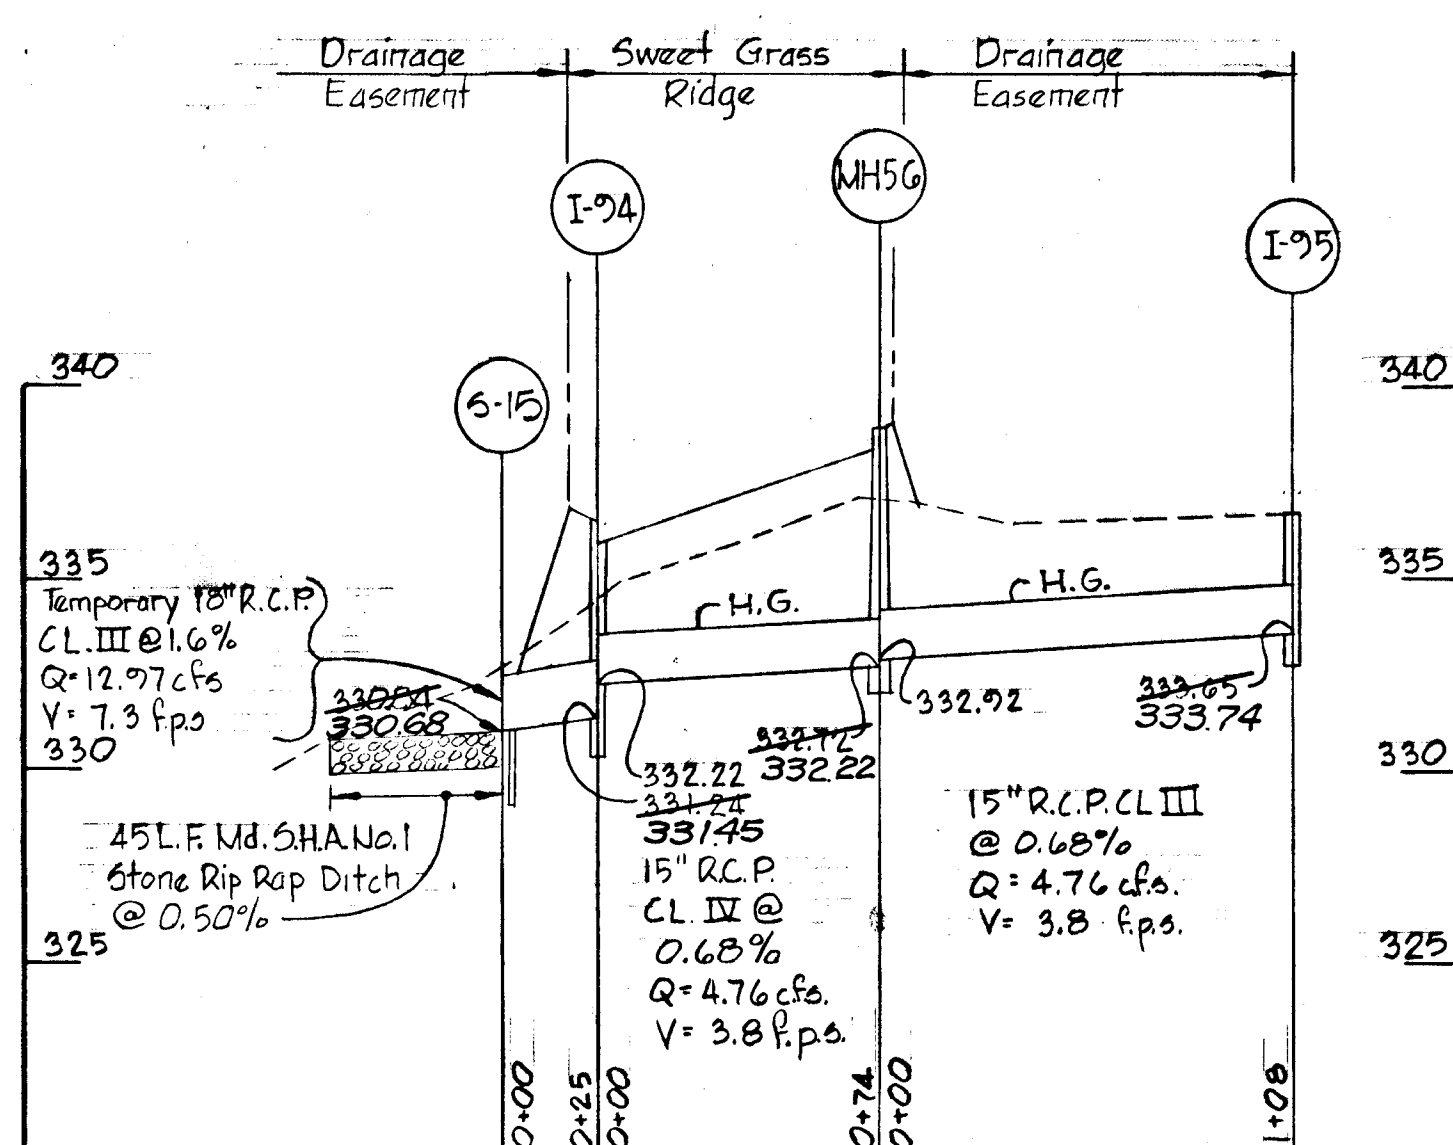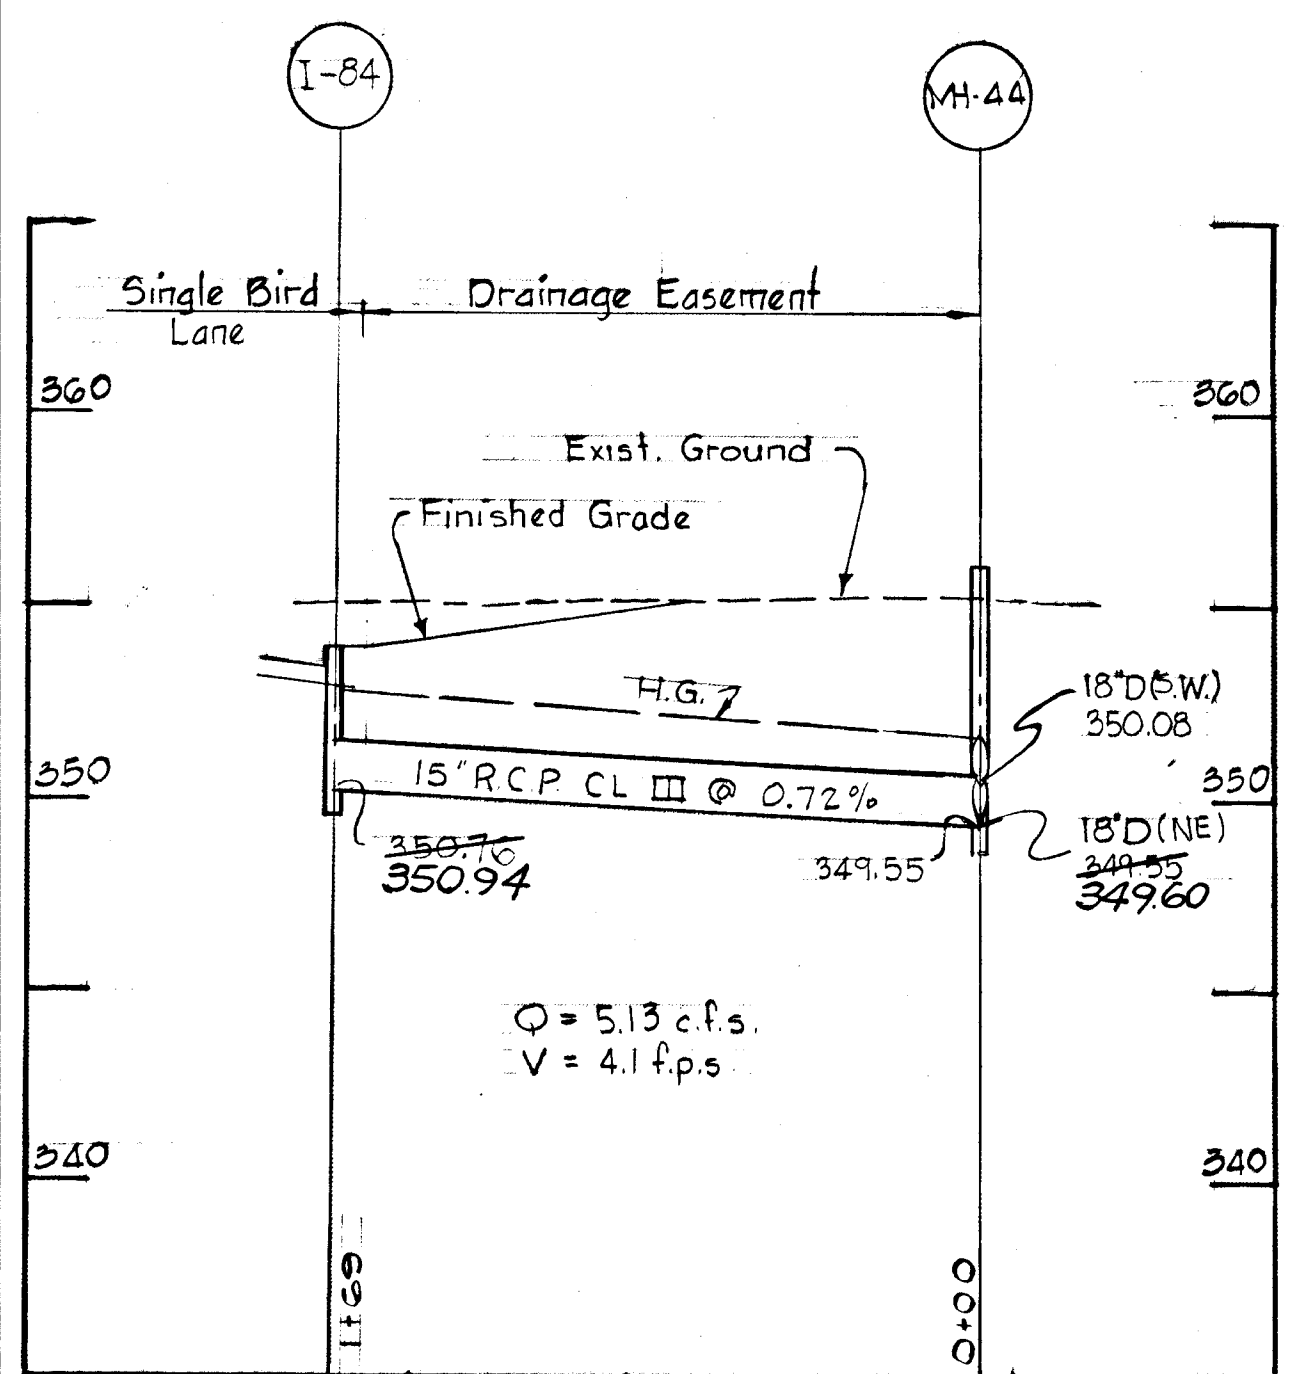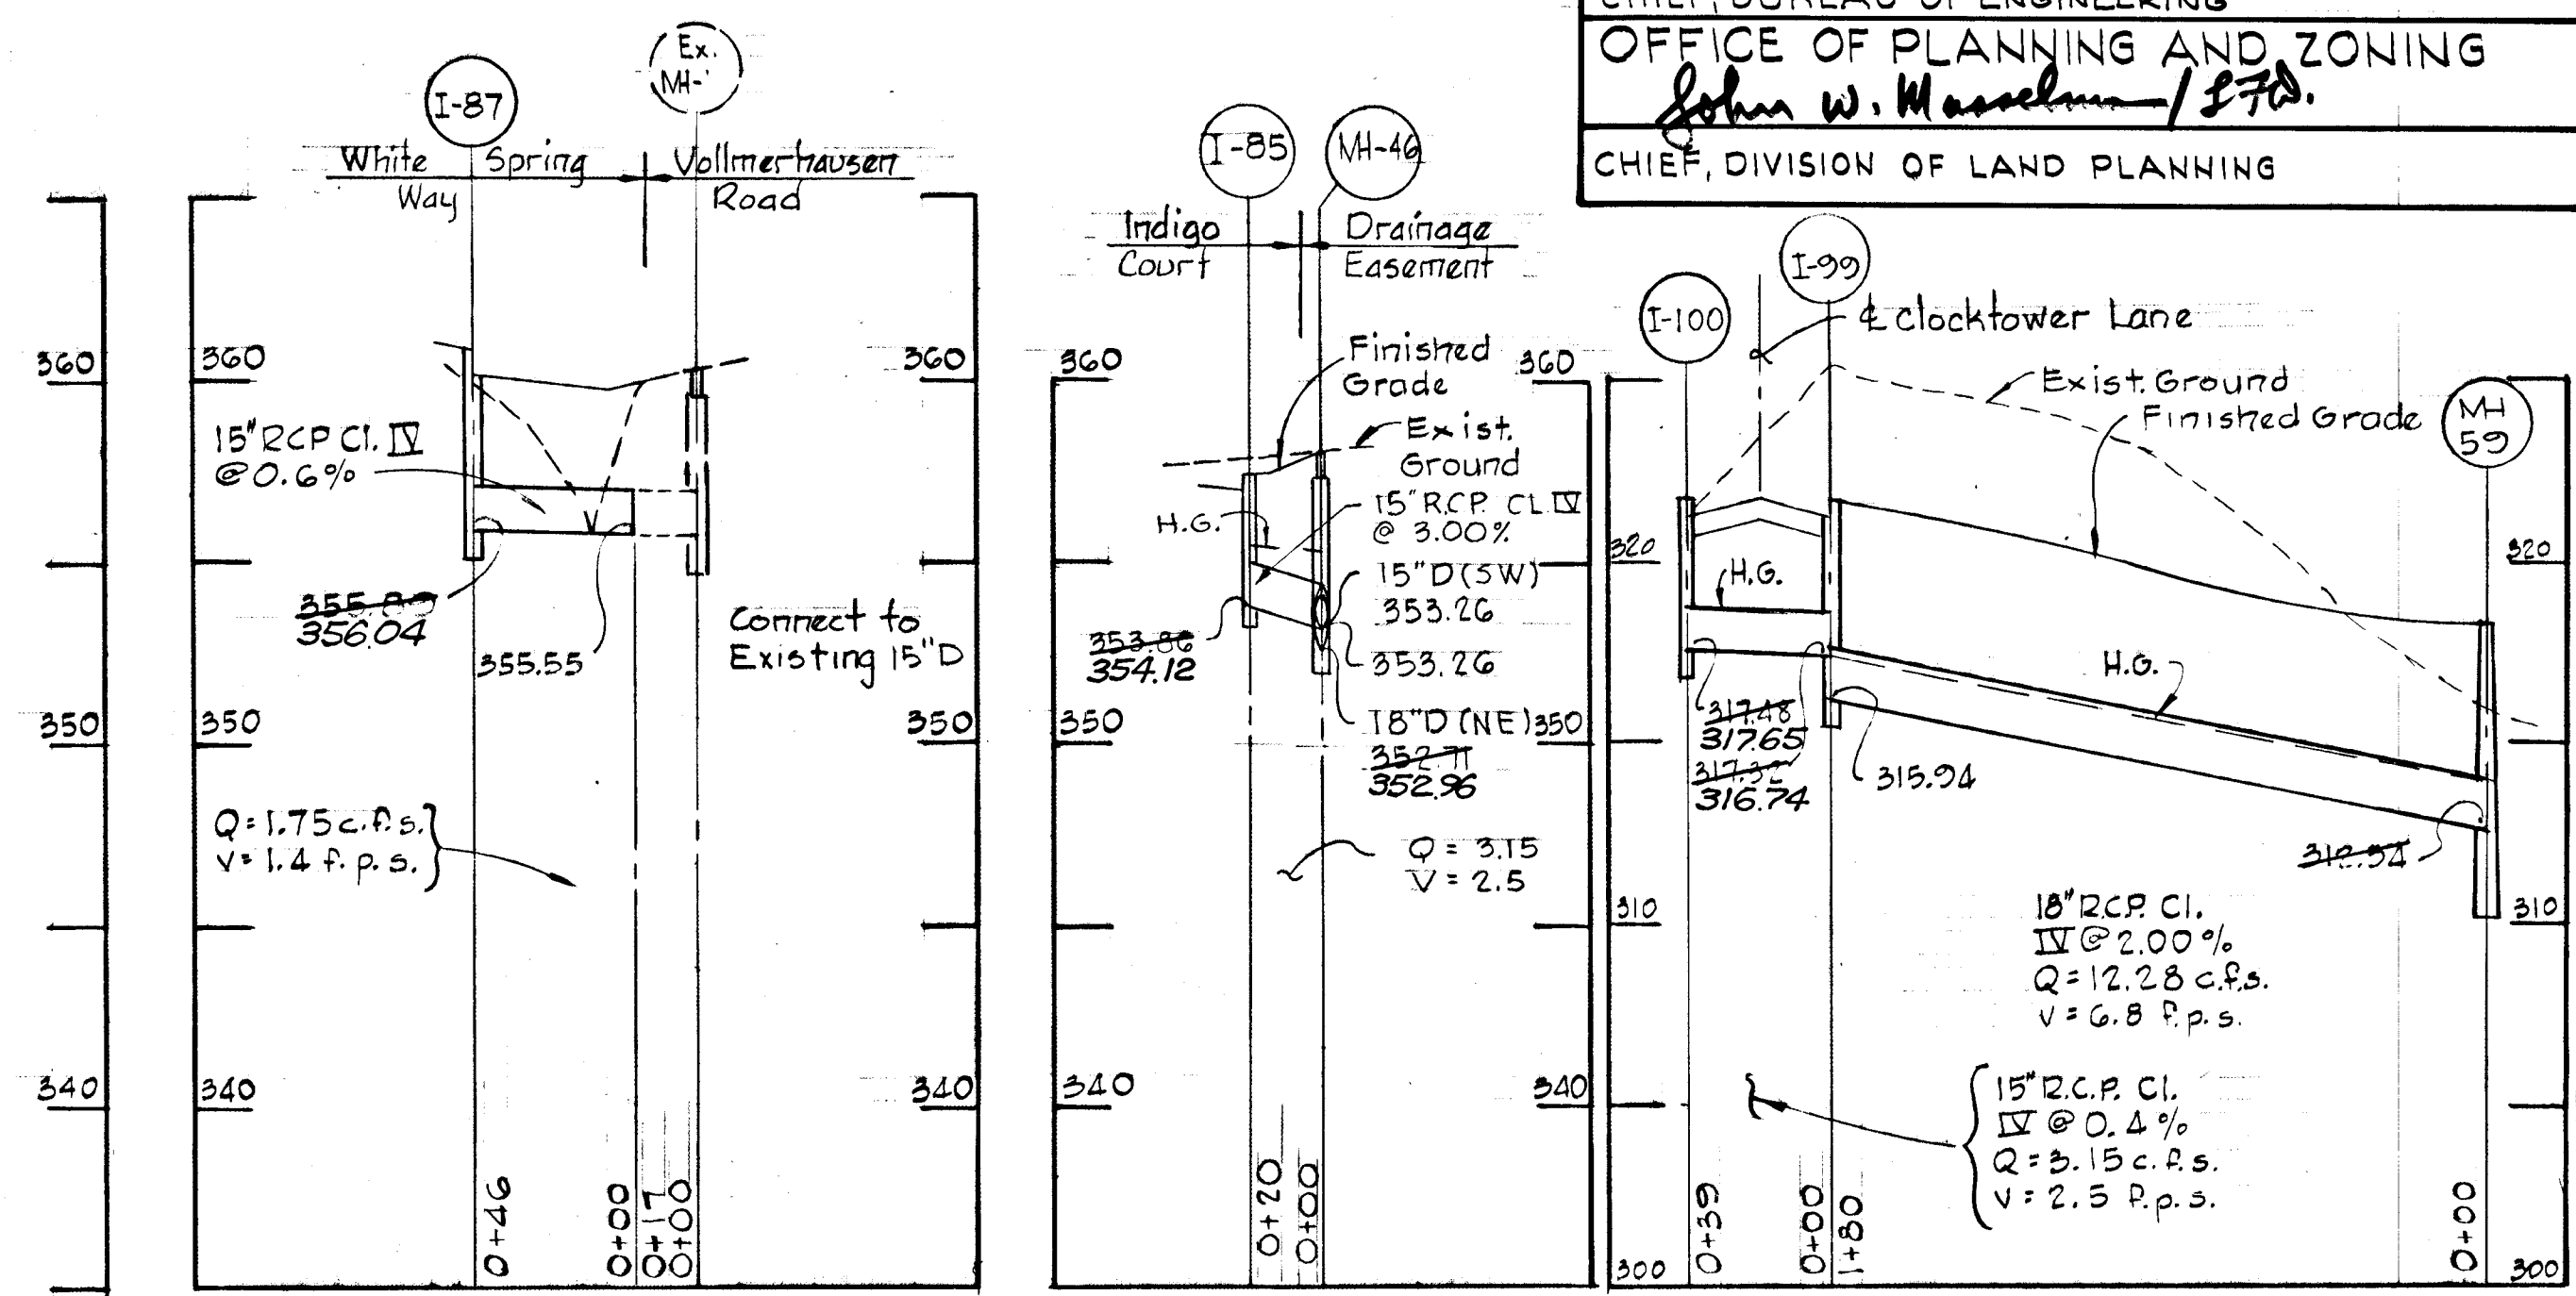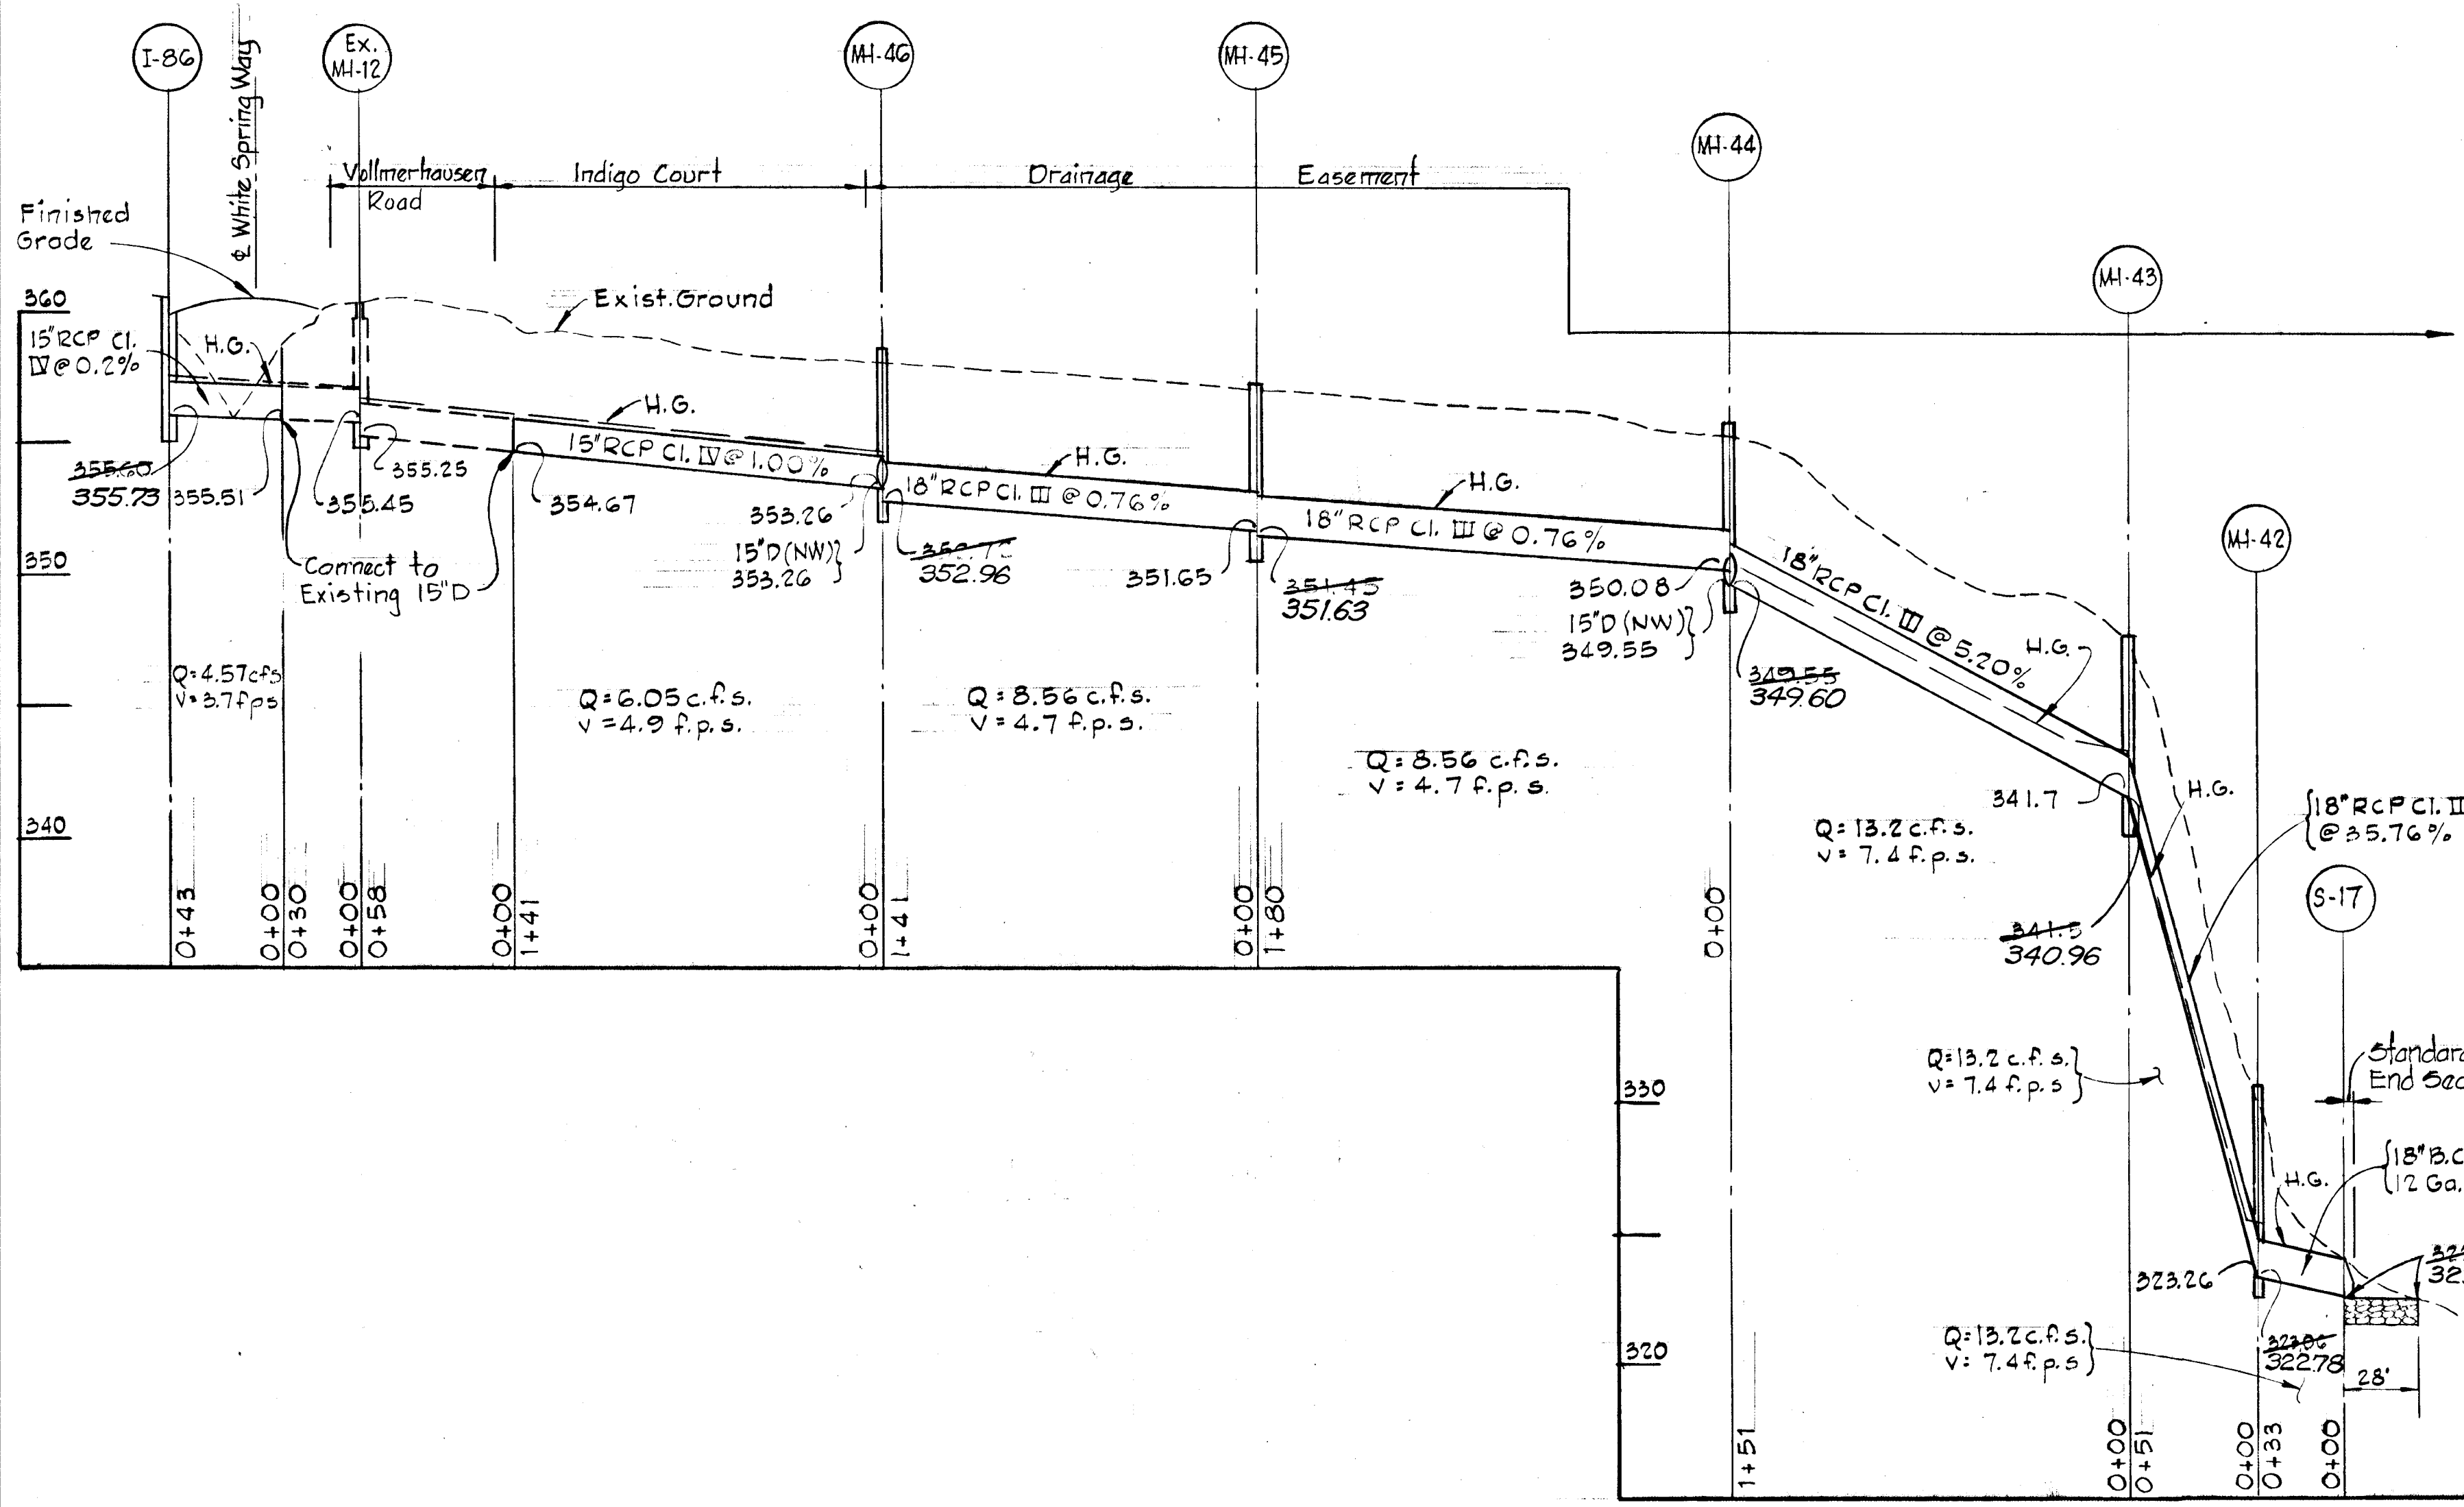

PROFILES  
 Scale: Horiz. 1"=50'  
 Vert. 1"=5'

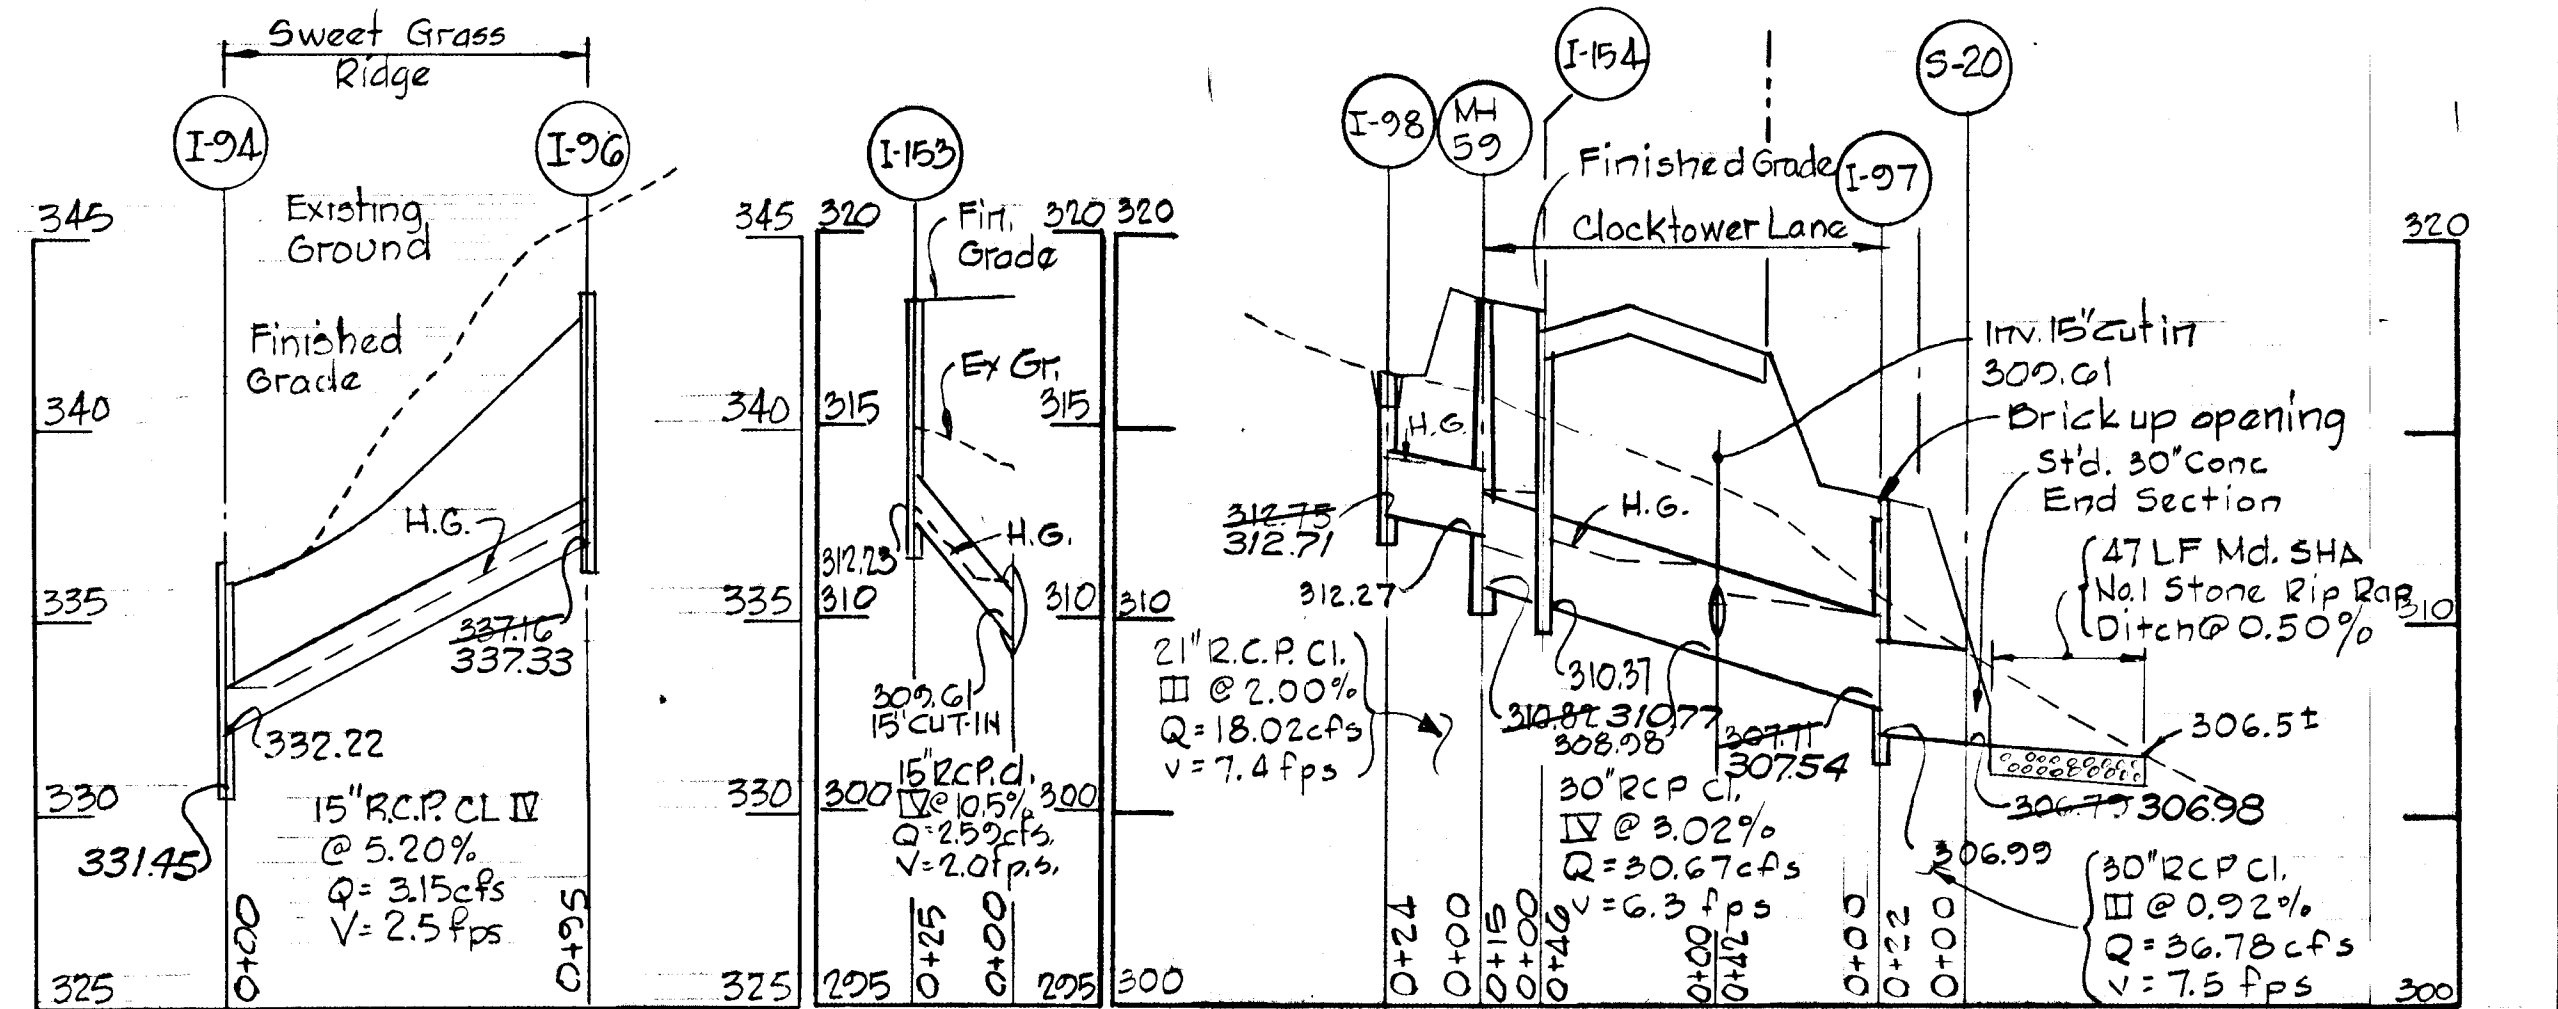

-NOTE-  
 AS-BUILT ELEVATIONS VERIFIED BY KENNETH A. McCORD MD REG. P.E. No. 1974 AS OF DECEMBER 29, 1979

Rev. No.	Rev. Date	Revision Description
1	9/26/80	Added I-153 & I-154

**COLUMBIA**  
 6<sup>th</sup> ELECTION DISTRICT  
 HOWARD COUNTY, MARYLAND

OWNER AND DEVELOPER  
 HOWARD RESEARCH AND DEVELOPMENT CORP.

PROJECT AREA  
**VILLAGE OF KINGS CONTRIVANCE**  
 SECTION 3 AREA 1


PROJECT TITLE  
**STORM DRAIN PROFILES**

SCALE: AS SHOWN DATE:

WHITMAN, REQUARDT & ASSOCIATES  
 ENGINEERS  
 BALTIMORE, MARYLAND 21202

*Kenneth A. McCord*  
 KENNETH A. McCORD  
 Registered Engineer  
 No. 1974



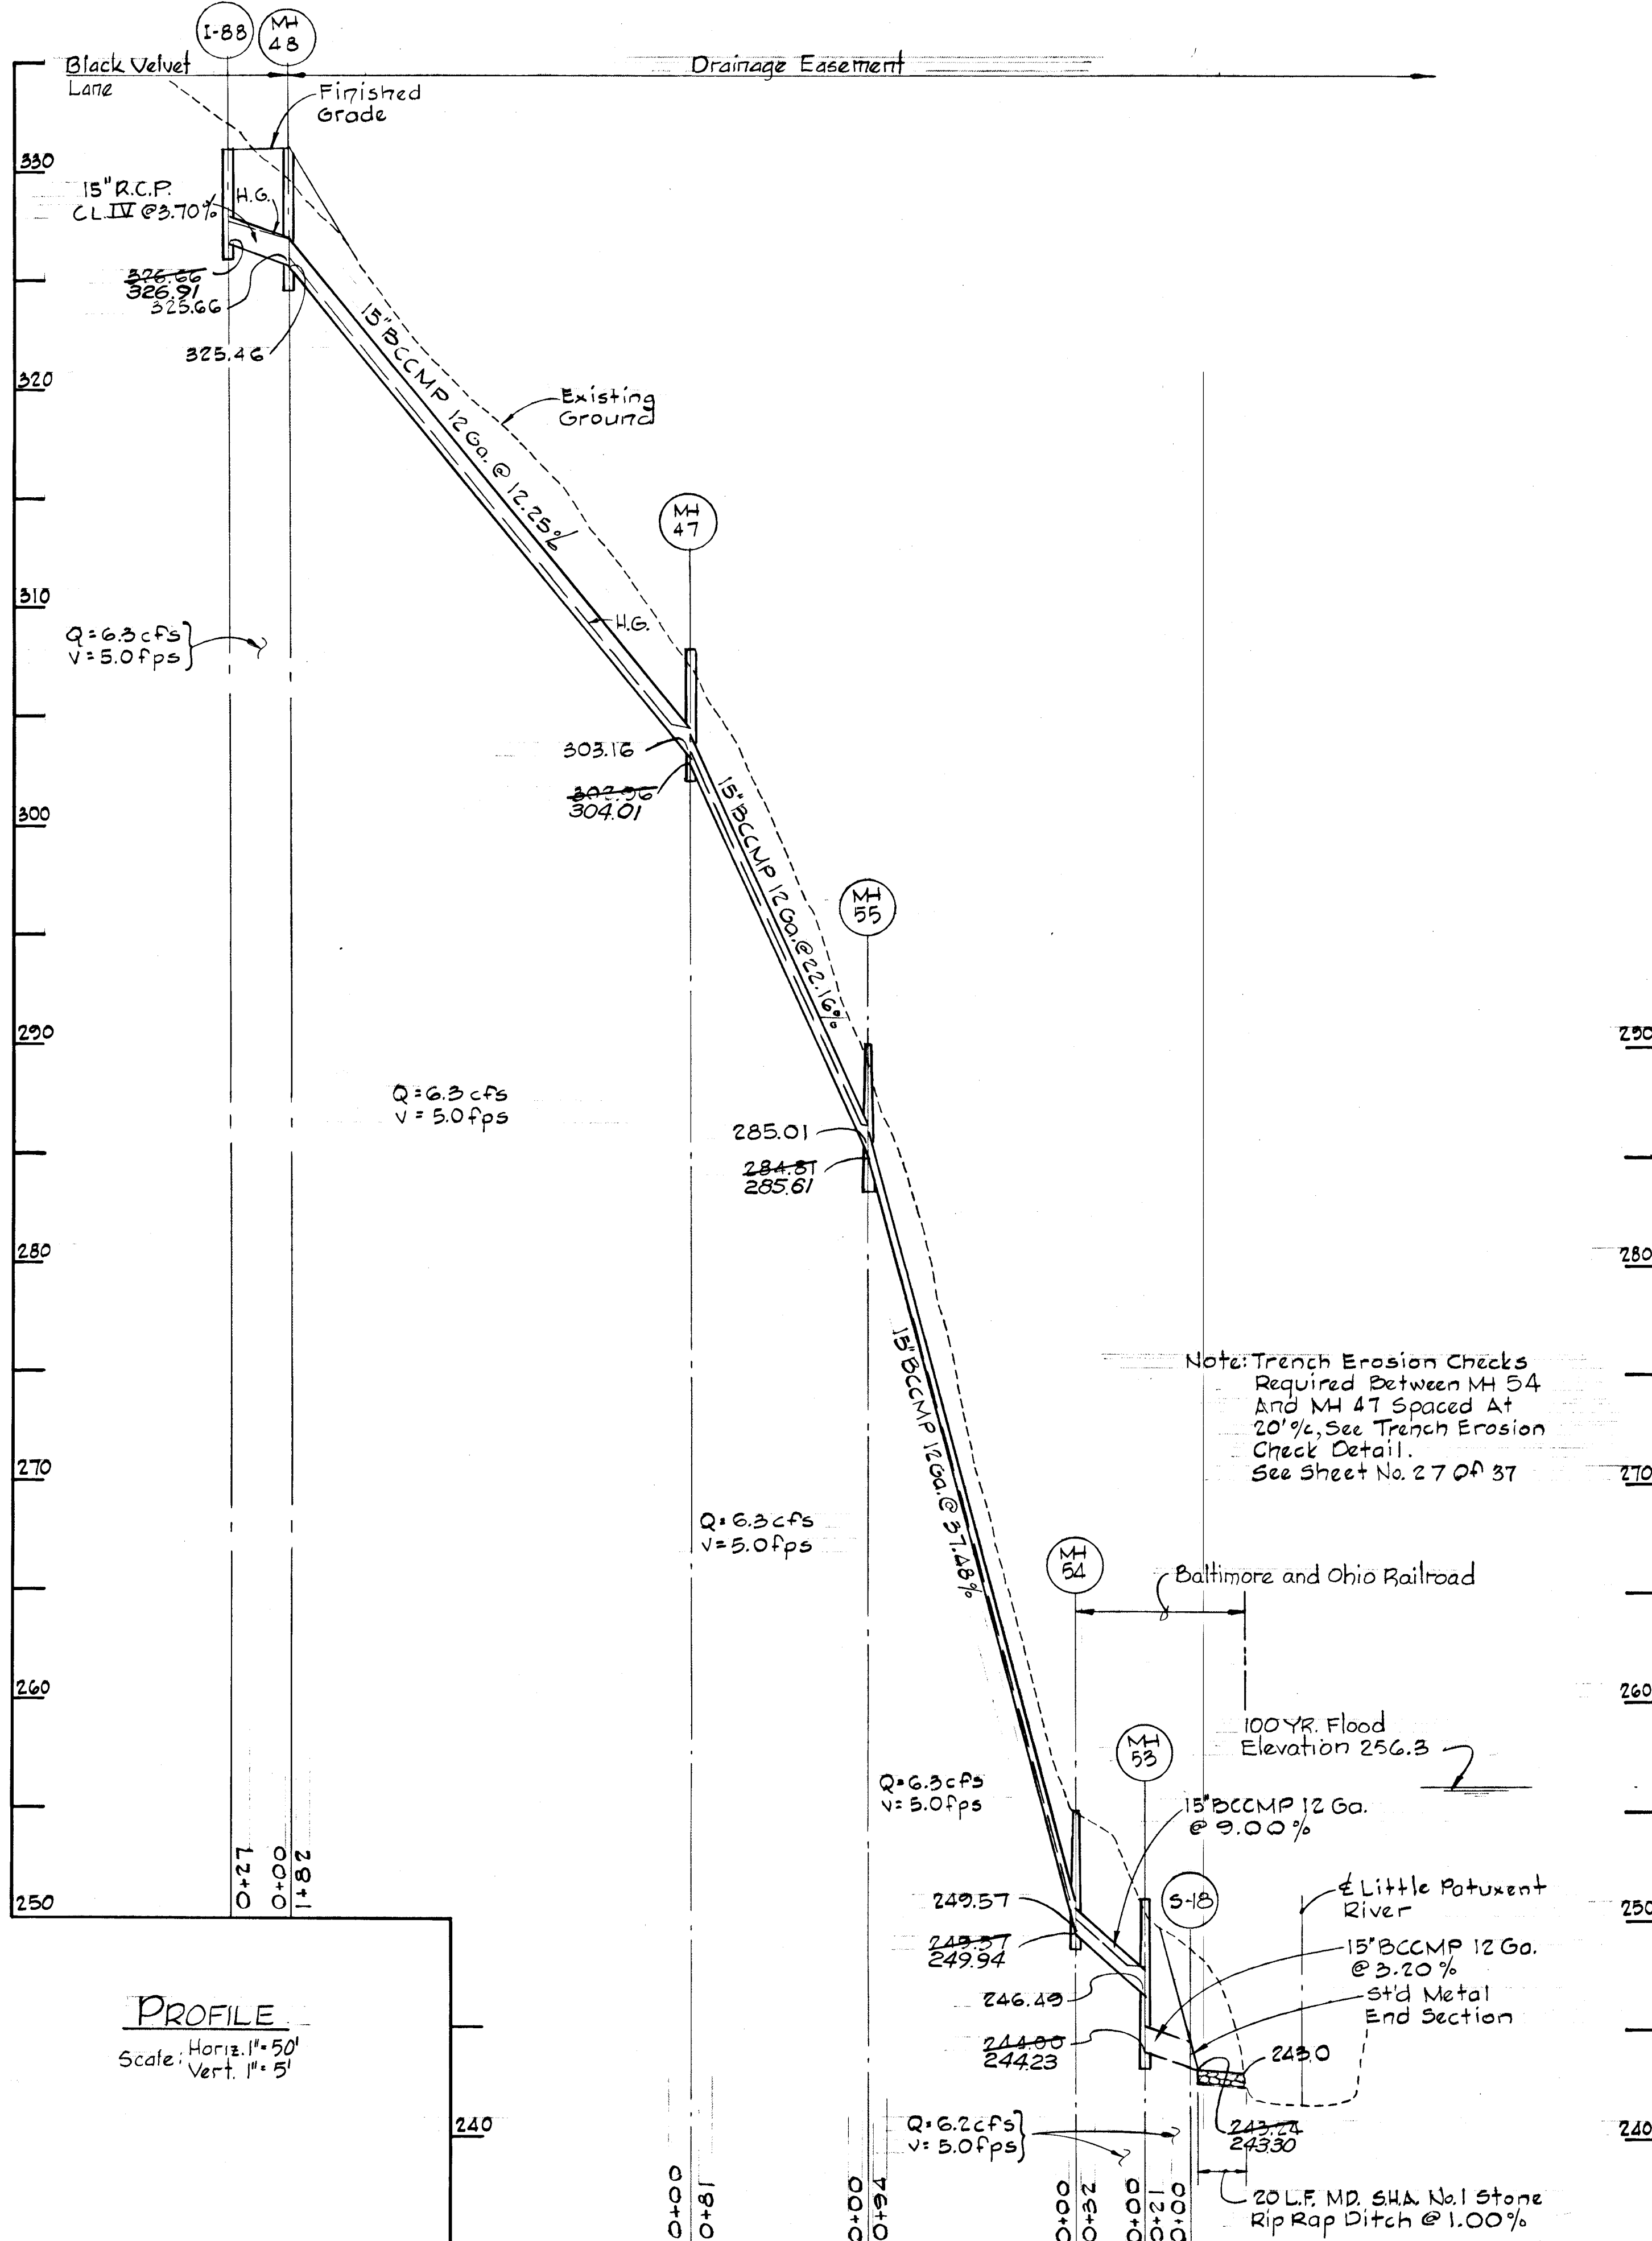


**-NOTE-**  
 AS-BUILT ELEVATIONS VERIFIED BY KENNETH A. McCORD MD REG. PE. No. 1974, AS OF DECEMBER 20, 1979

Rev. Date	Rev. No.	Revision Description
<b>COLUMBIA</b> 6 <sup>th</sup> ELECTION DISTRICT HOWARD COUNTY, MARYLAND		
OWNER AND DEVELOPER HOWARD RESEARCH AND DEVELOPMENT CORP.		
PROJECT AREA VILLAGE OF KINGS CONTRIVANCE SECTION 3 AREA 1		
PROJECT TITLE STORM DRAIN PROFILE		
SCALE: AS SHOWN		DATE:
WHITMAN, REQUARDT & ASSOCIATES ENGINEERS BALTIMORE, MARYLAND 21202		
<i>Kenneth A. McCord</i> KENNETH A. McCORD Registered Engineer No. 1974		



Note:  
 For Storm Drain Profile,  
 See Sheet 23 of 37.

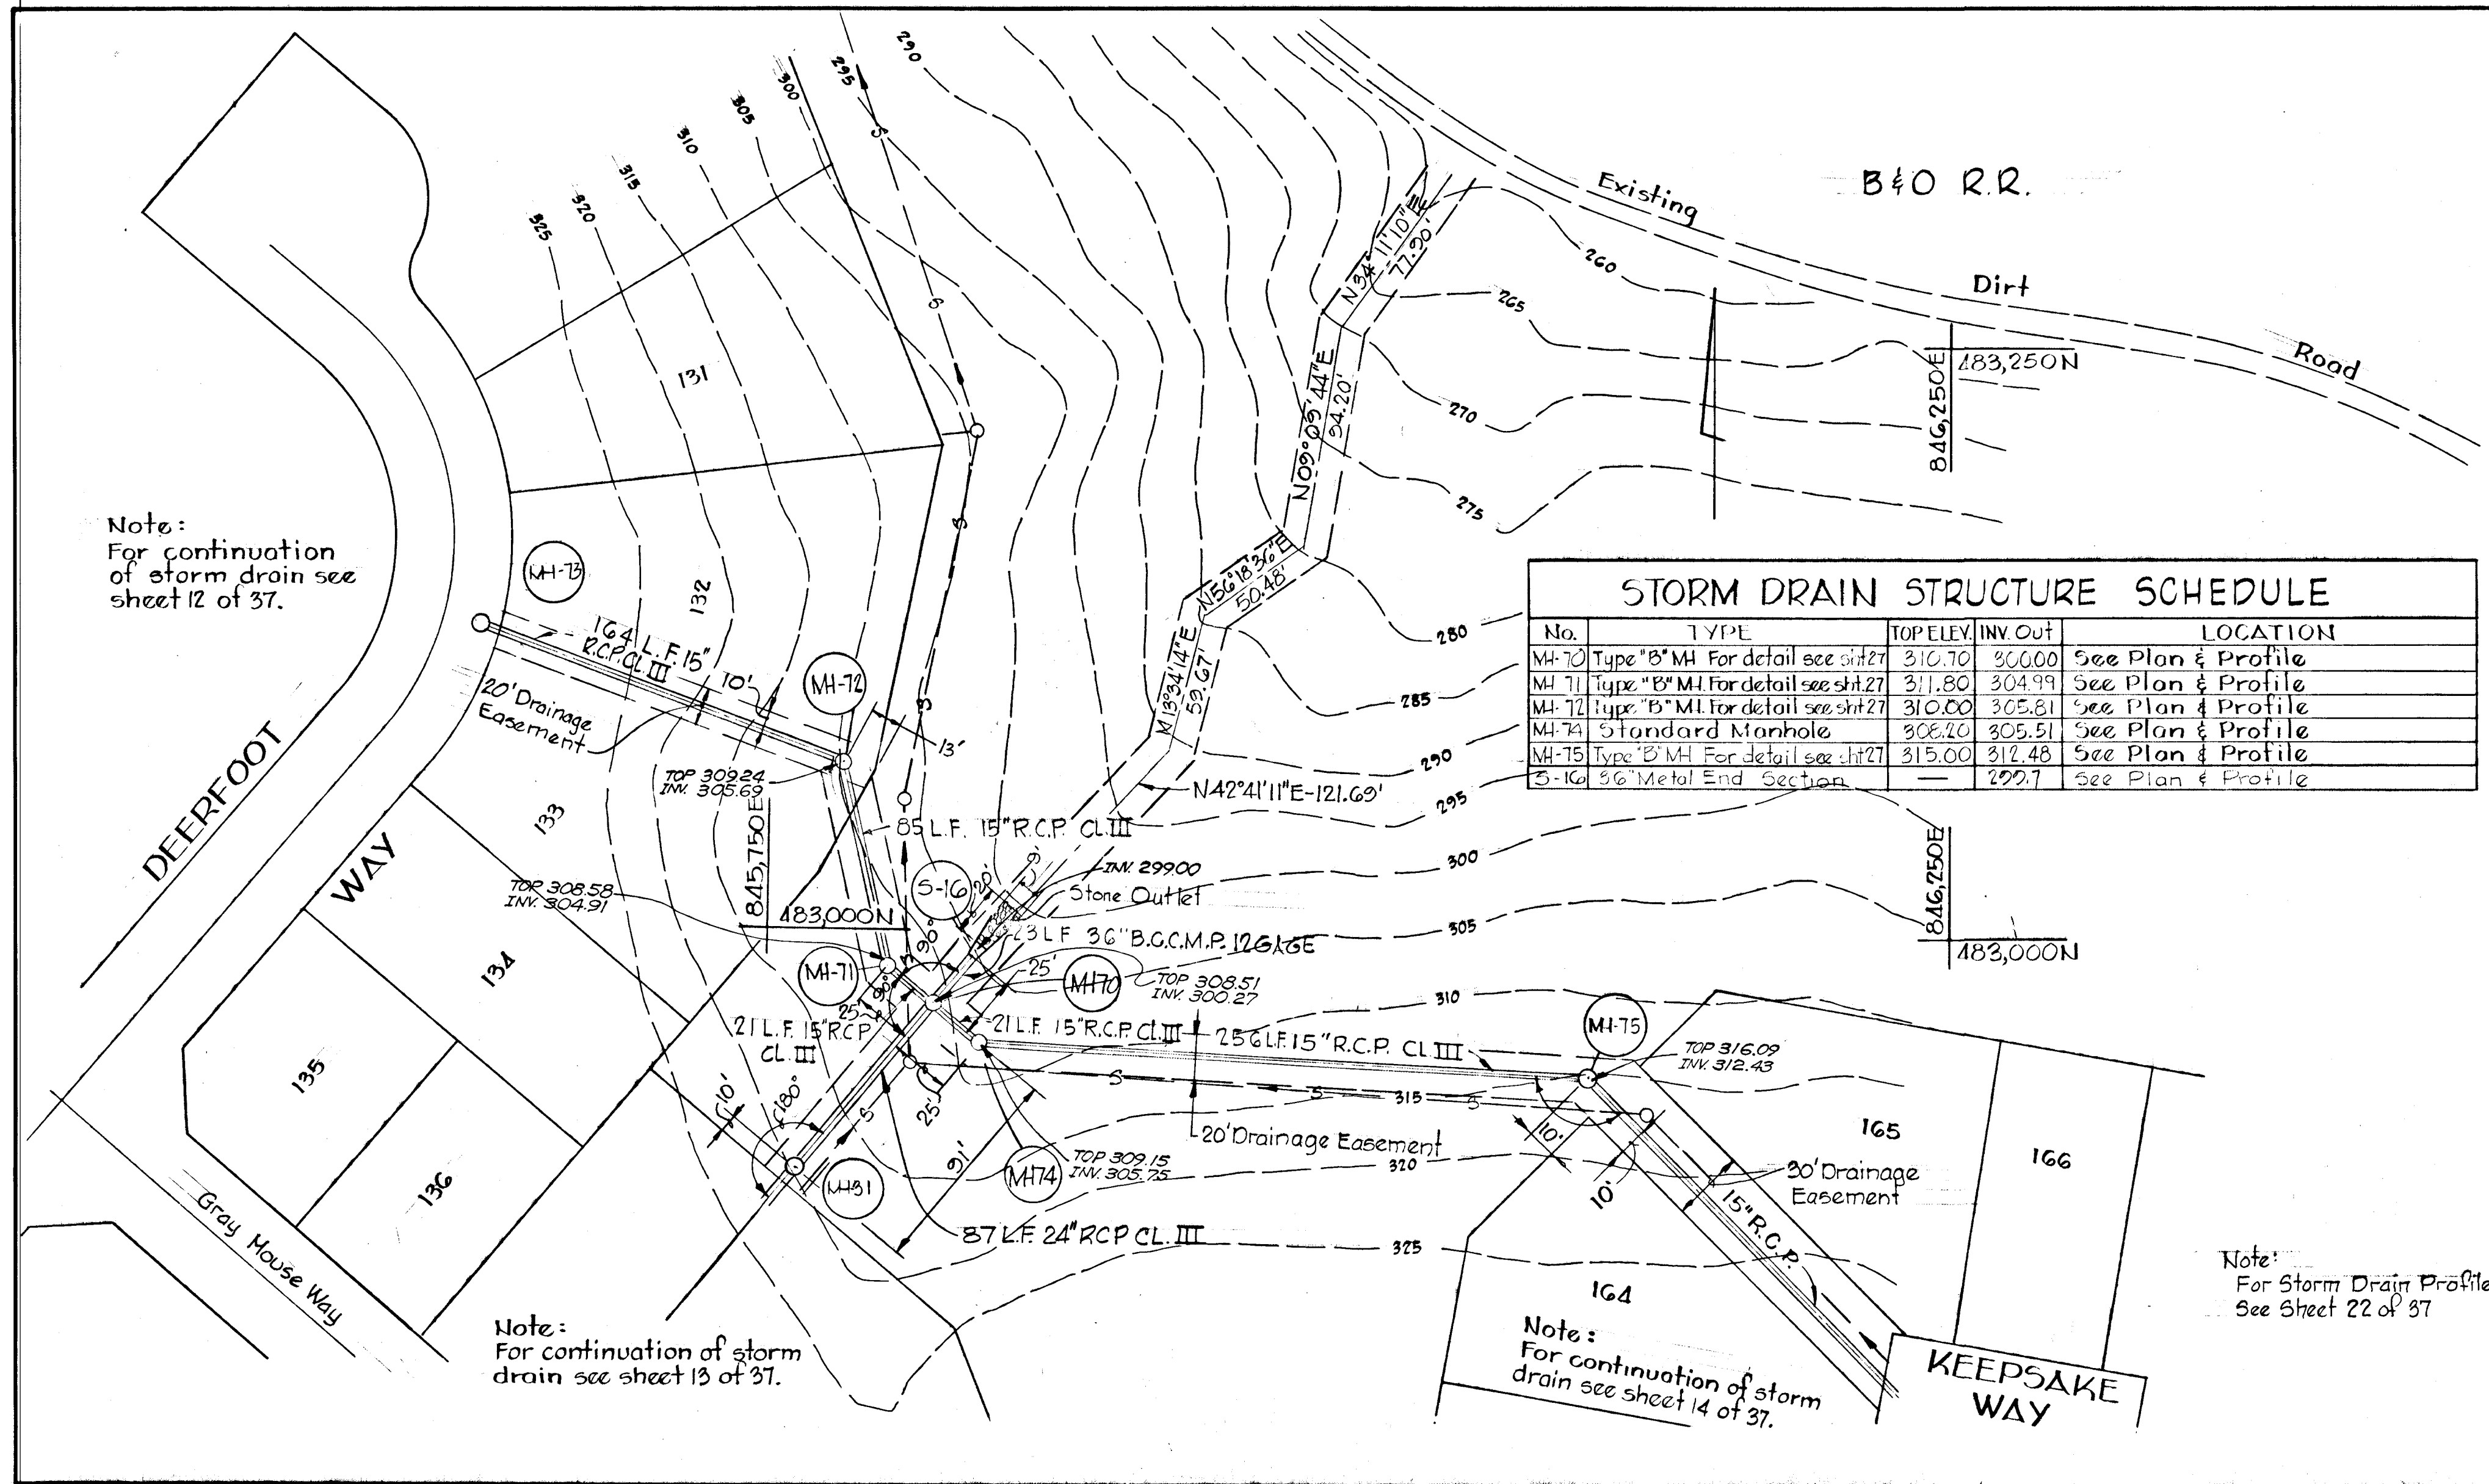


Note:  
 For continuation  
 of storm drain see  
 sheet 12 of 37.

Note:  
 For continuation of storm  
 drain see sheet 13 of 37.

Note:  
 For continuation of storm  
 drain see sheet 14 of 37.

Note:  
 For Storm Drain Profiles,  
 See Sheet 22 of 37

STORM DRAIN STRUCTURE SCHEDULE					
No.	TYPE	TOP ELEV.	INV. OUT.	LOCATION	
MH-70	Type "B" MH For detail see sheet 27	310.70	306.00	See Plan & Profile	
MH-71	Type "B" MH For detail see sheet 27	311.80	304.99	See Plan & Profile	
MH-72	Type "B" MH For detail see sheet 27	310.00	305.81	See Plan & Profile	
MH-74	Standard Manhole	306.20	305.21	See Plan & Profile	
MH-75	Type "B" MH For detail see sheet 27	315.00	312.48	See Plan & Profile	
S-16	5' Metal End Section	—	299.7	See Plan & Profile	

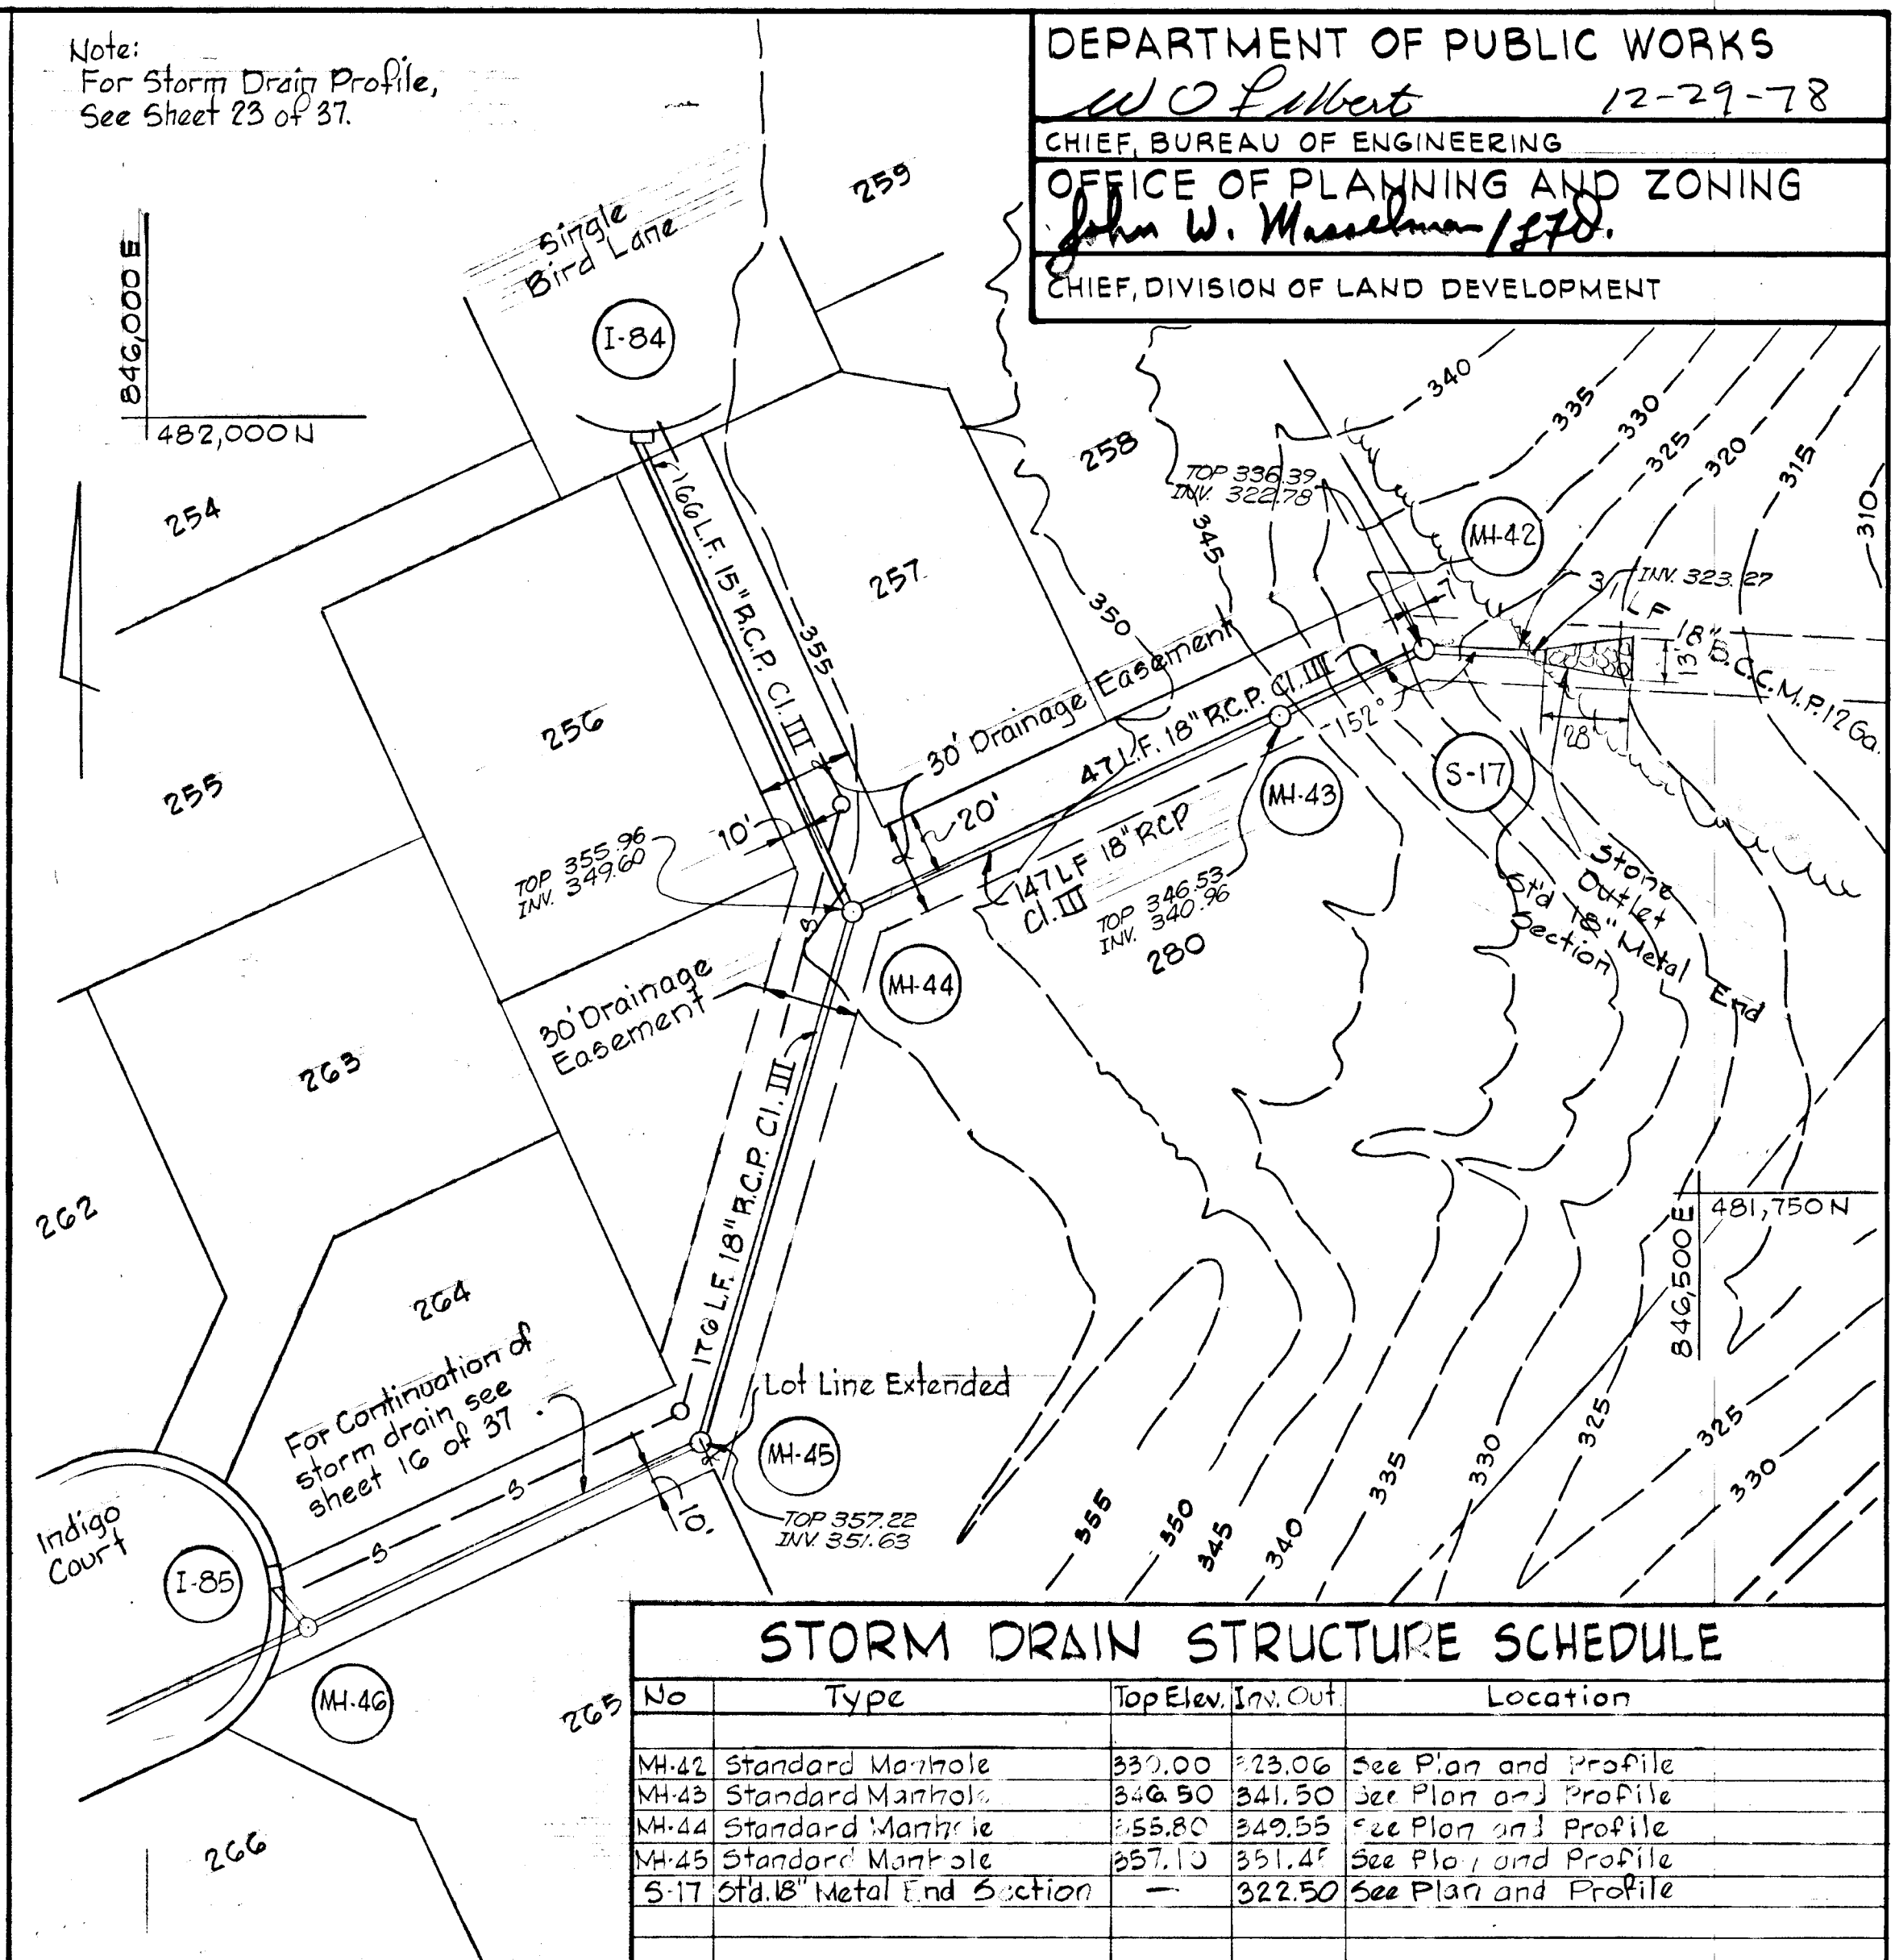


STORM DRAIN STRUCTURE SCHEDULE					
No.	Type	TOP ELEV.	INV. OUT.	LOCATION	
MH-42	Standard Manhole	337.00	323.06	See Plan and Profile	
MH-43	Standard Manhole	346.50	341.50	See Plan and Profile	
MH-44	Standard Manhole	353.80	349.55	See Plan and Profile	
MH-45	Standard Manhole	357.10	351.47	See Plan and Profile	
S-17	5' Metal End Section	—	322.50	See Plan and Profile	

PLAN  
 Scale: 1"=50'

PLAN  
 Scale: 1"=50'











-NOTE-  
 AS-BUILT ELEVATIONS VERIFIED BY KENNETH  
 A. McCORD MD, REG. P.E. No. 1974 AS OF  
 DECEMBER 20, 1979

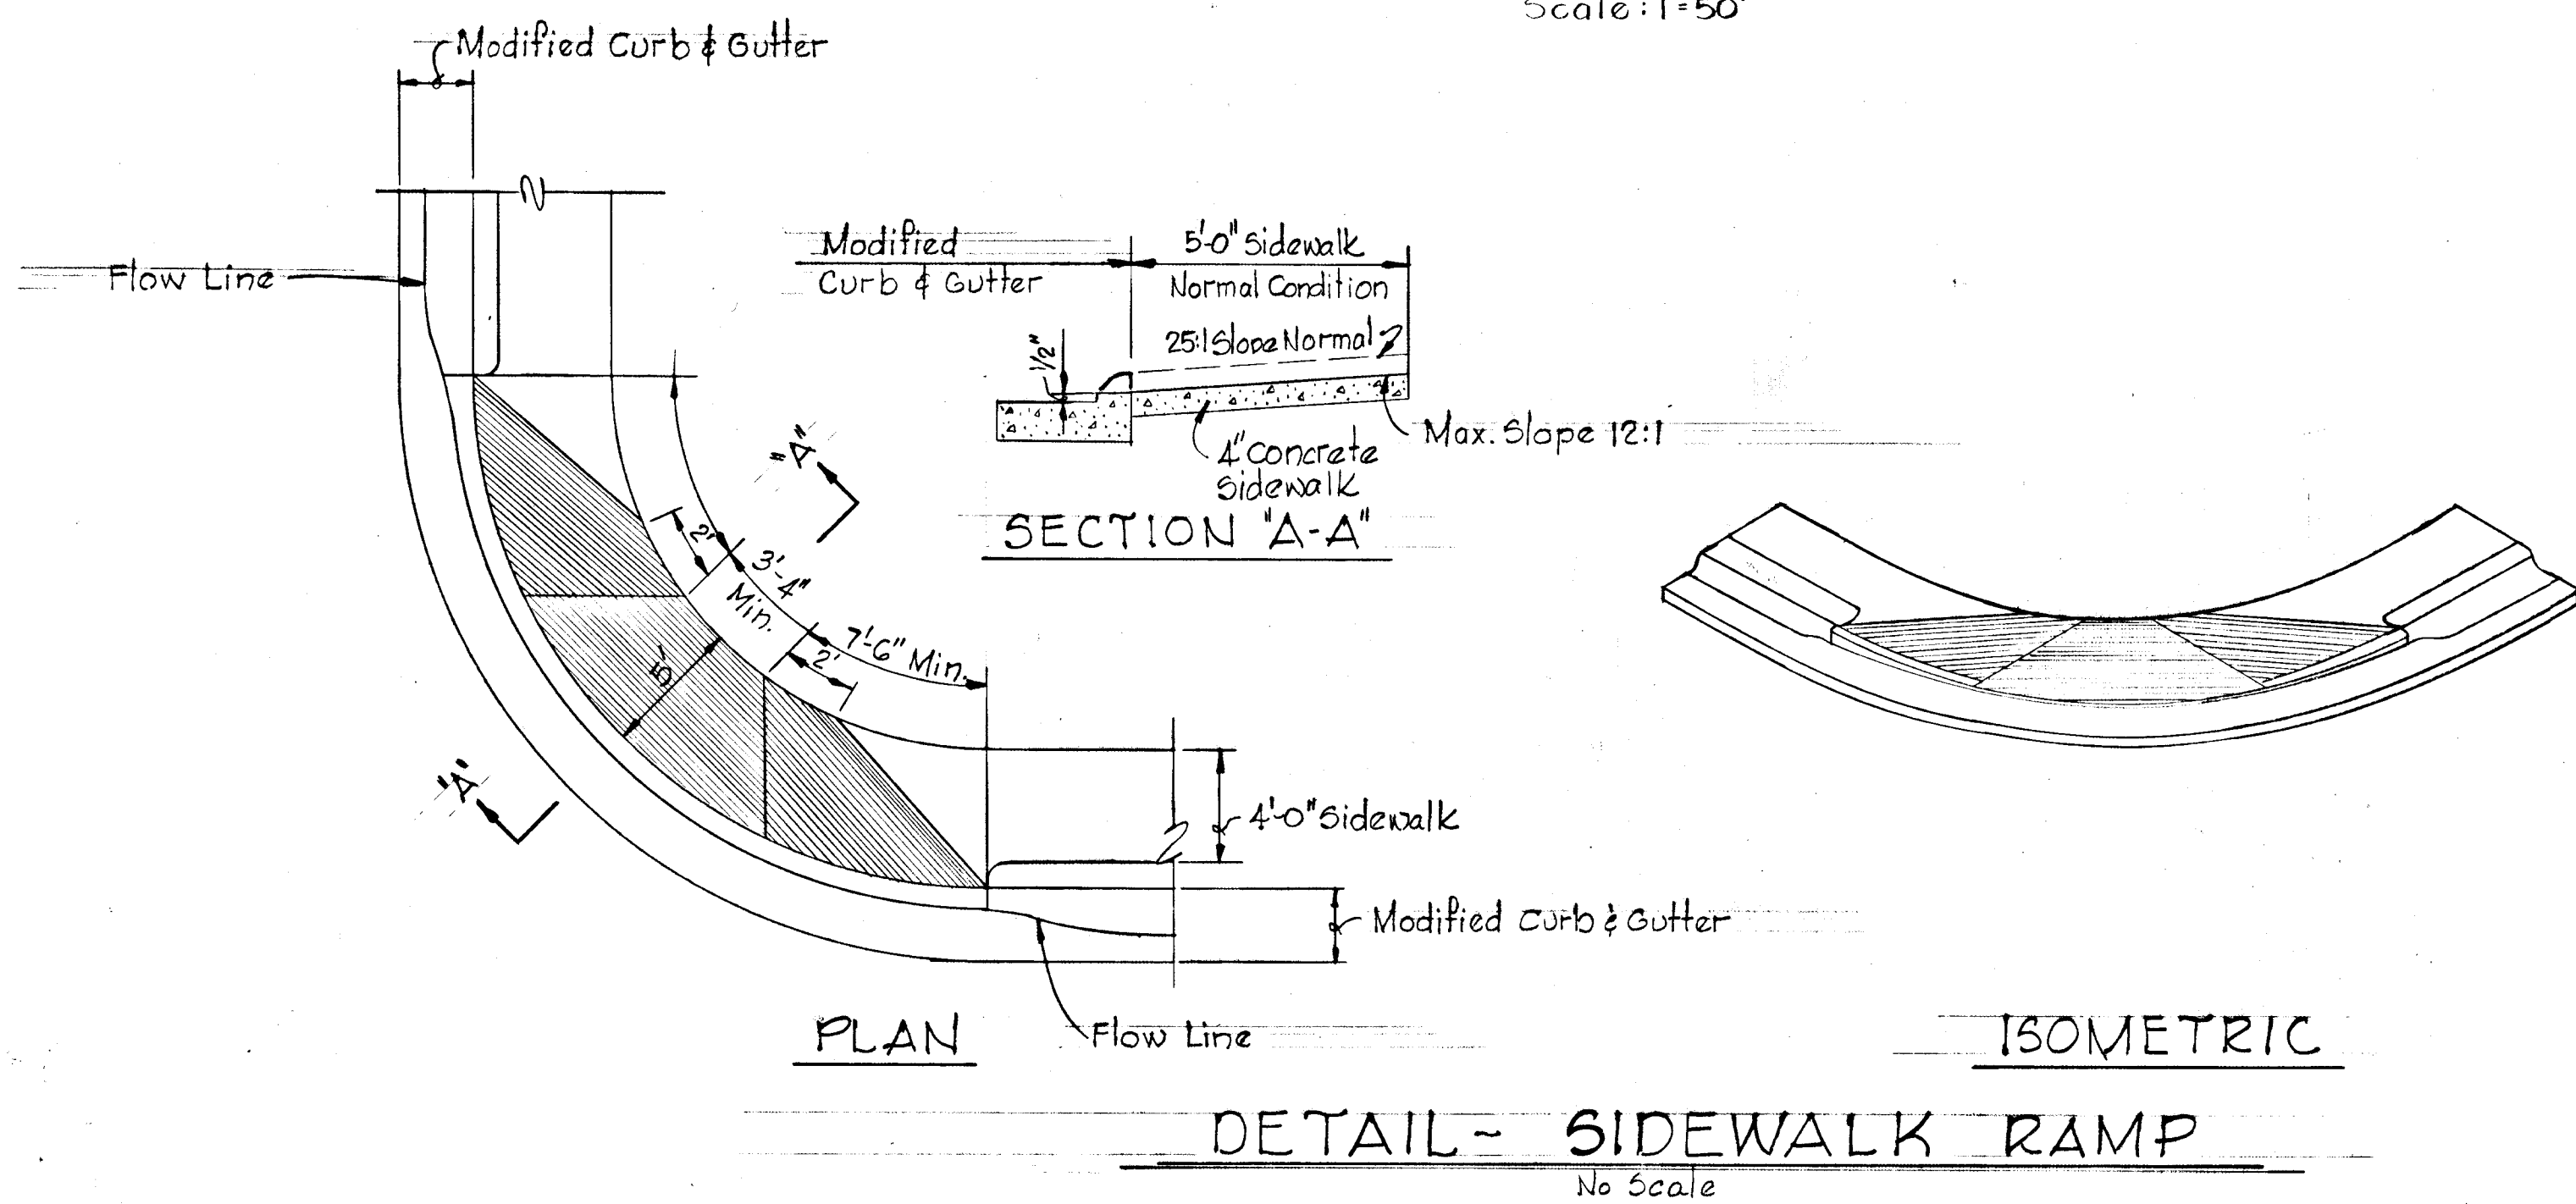



DETAIL - SIDEWALK RAMP  
 No Scale

Rev. Date	Rev. No.	Revision Description
<b>COLUMBIA</b> 6 <sup>th</sup> ELECTION DISTRICT HOWARD COUNTY, MARYLAND OWNER AND DEVELOPER HOWARD RESEARCH AND DEVELOPMENT CORP. PROJECT AREA <b>VILLAGE OF KINGS CONTRIVANCE</b> SECTION 9 AREA 1 PROJECT TITLE <b>STORM DRAIN PLANS</b> SCALE: AS SHOWN DATE: WHITMAN, REQUARDT & ASSOCIATES ENGINEERS BALTIMORE, MARYLAND 21202 <i>Kenneth A. McCord</i> KENNETH A. McCORD Registered Engineer No. 1974		







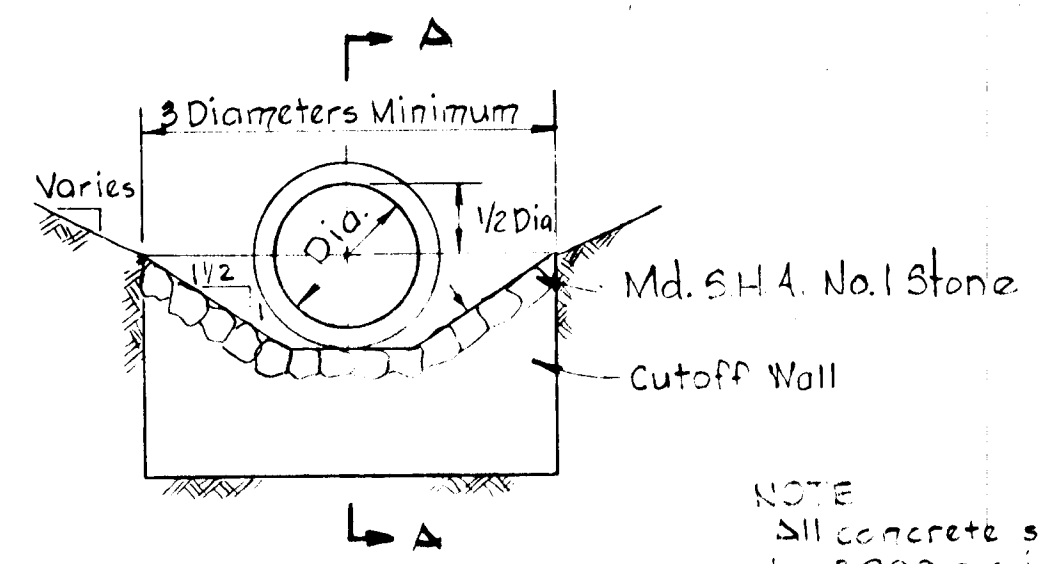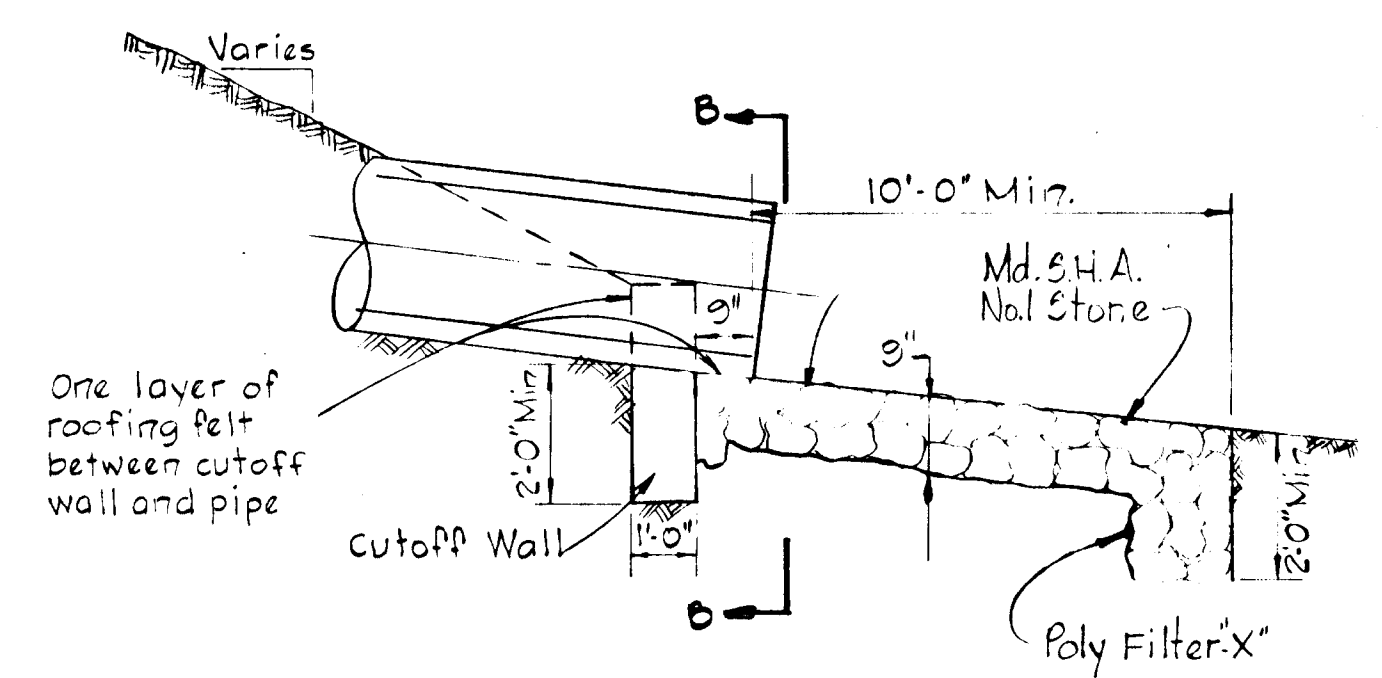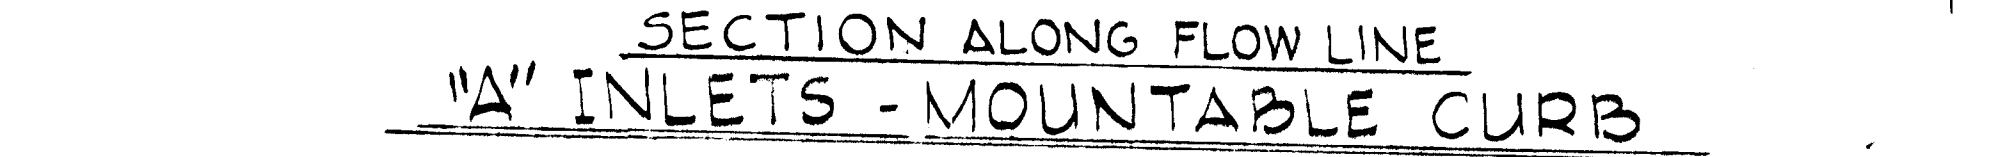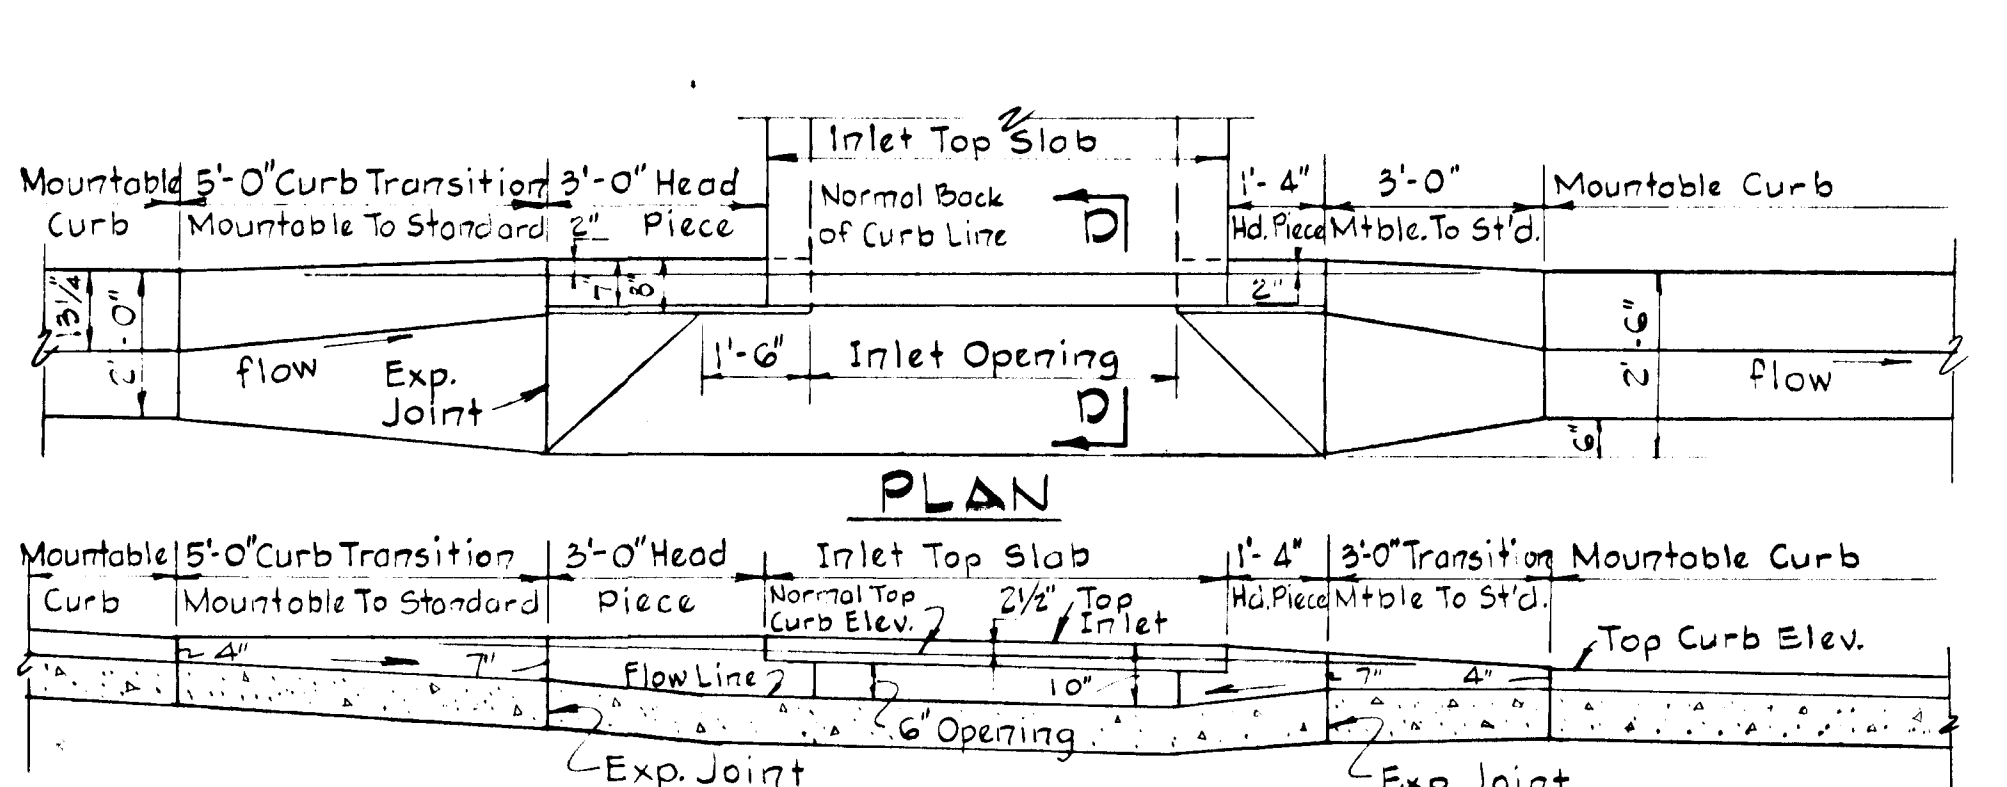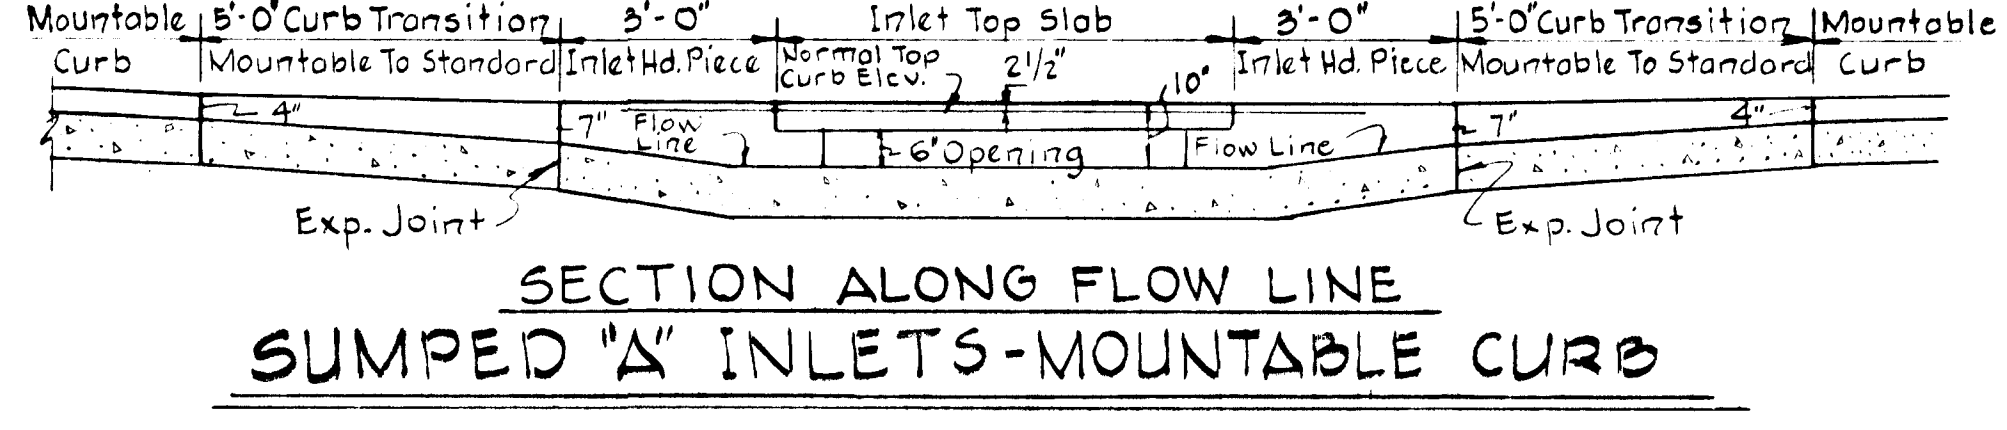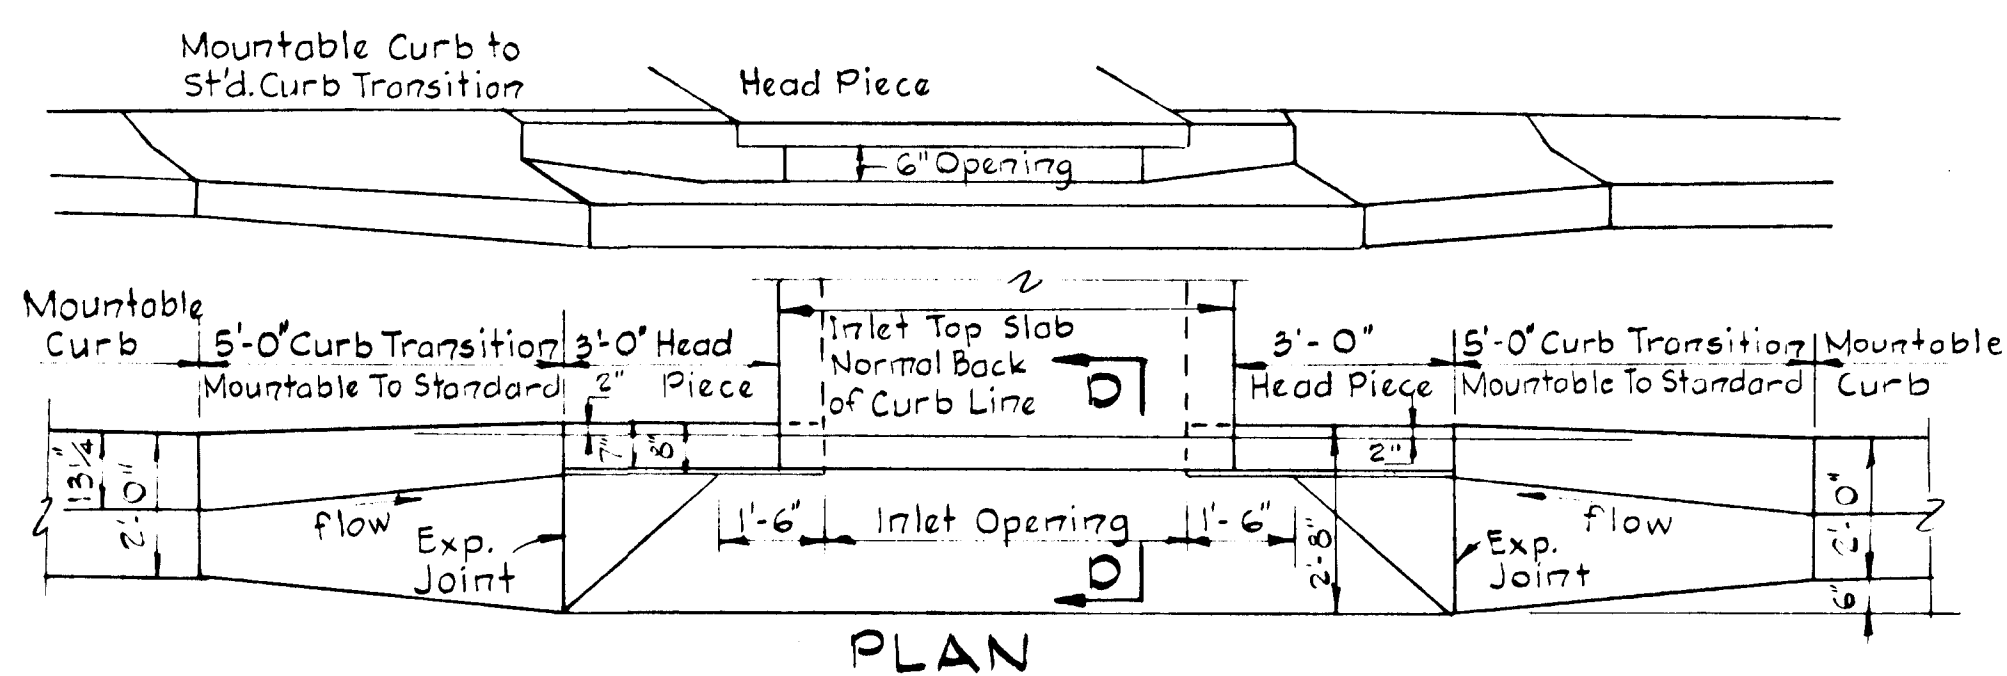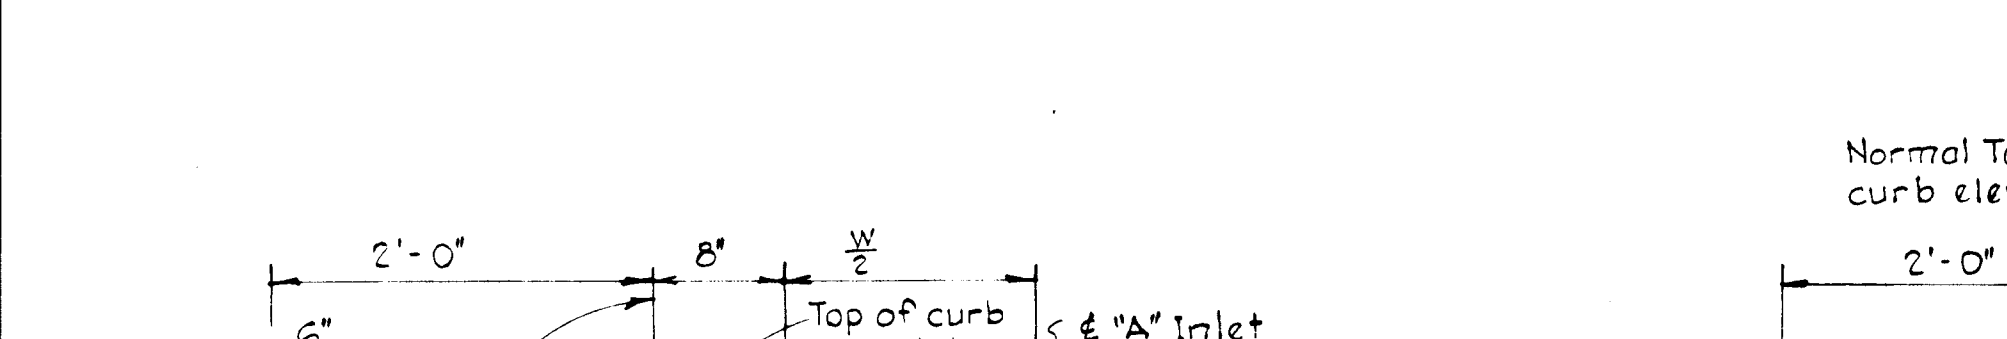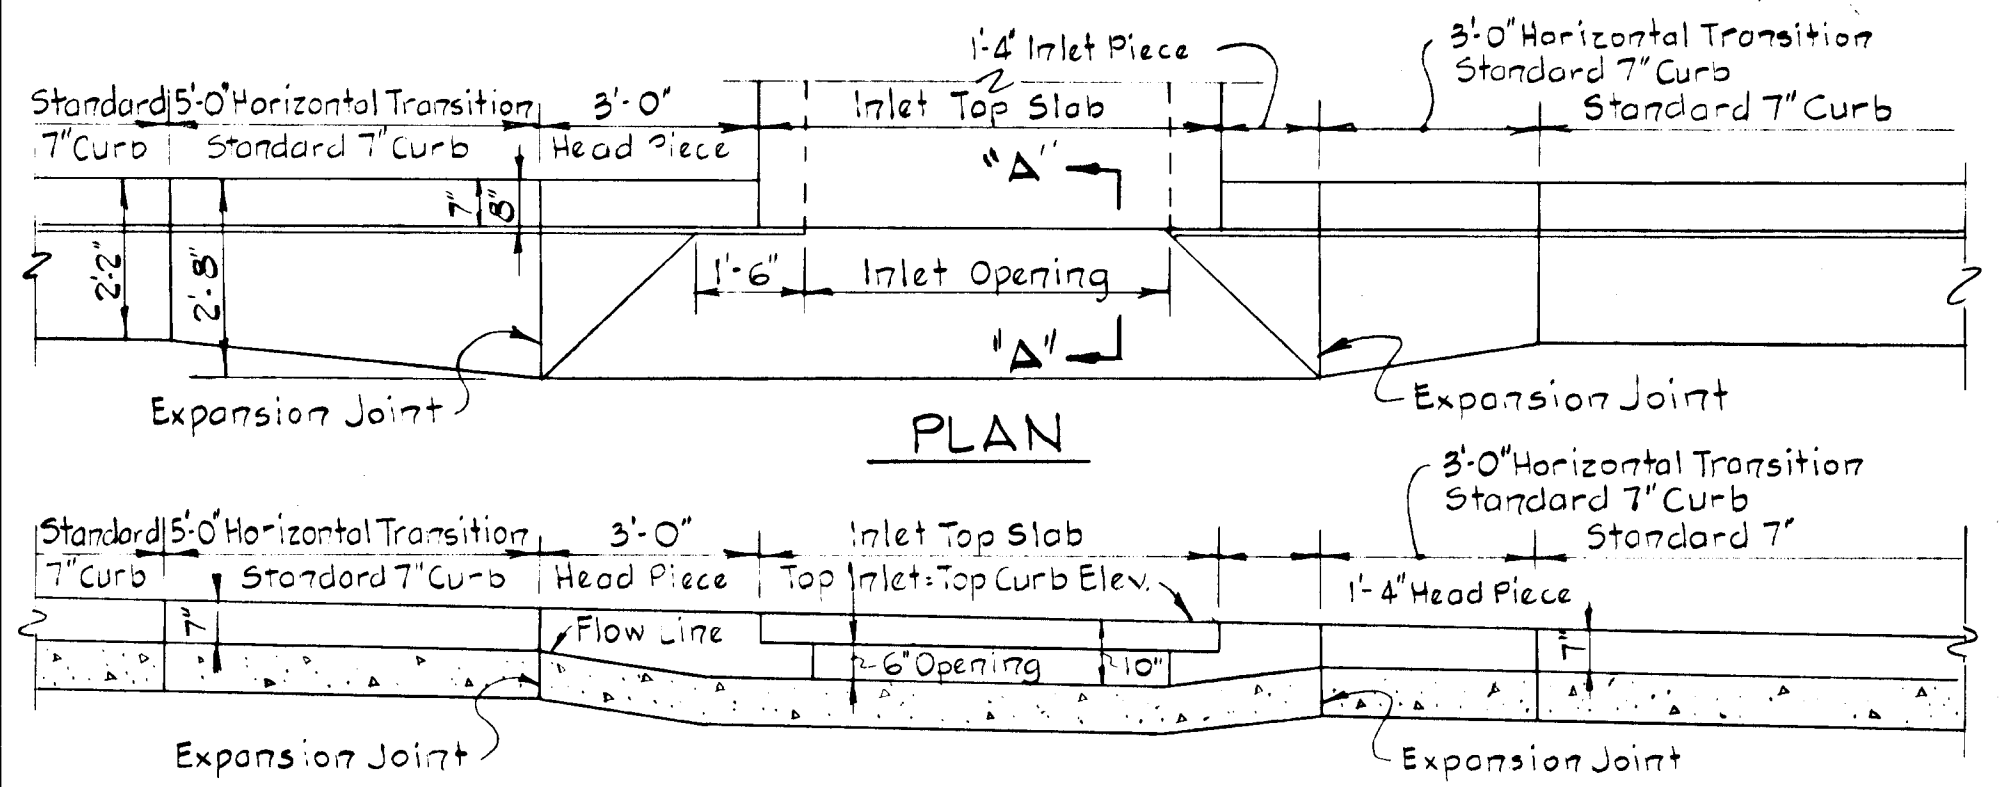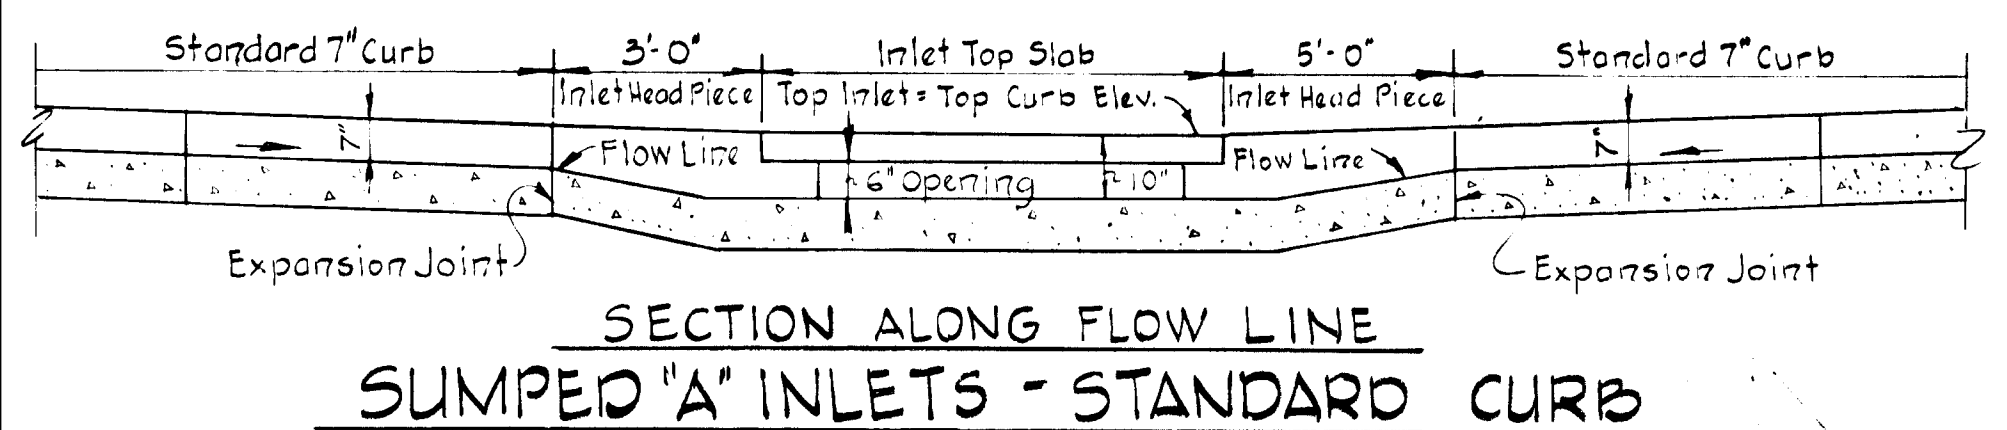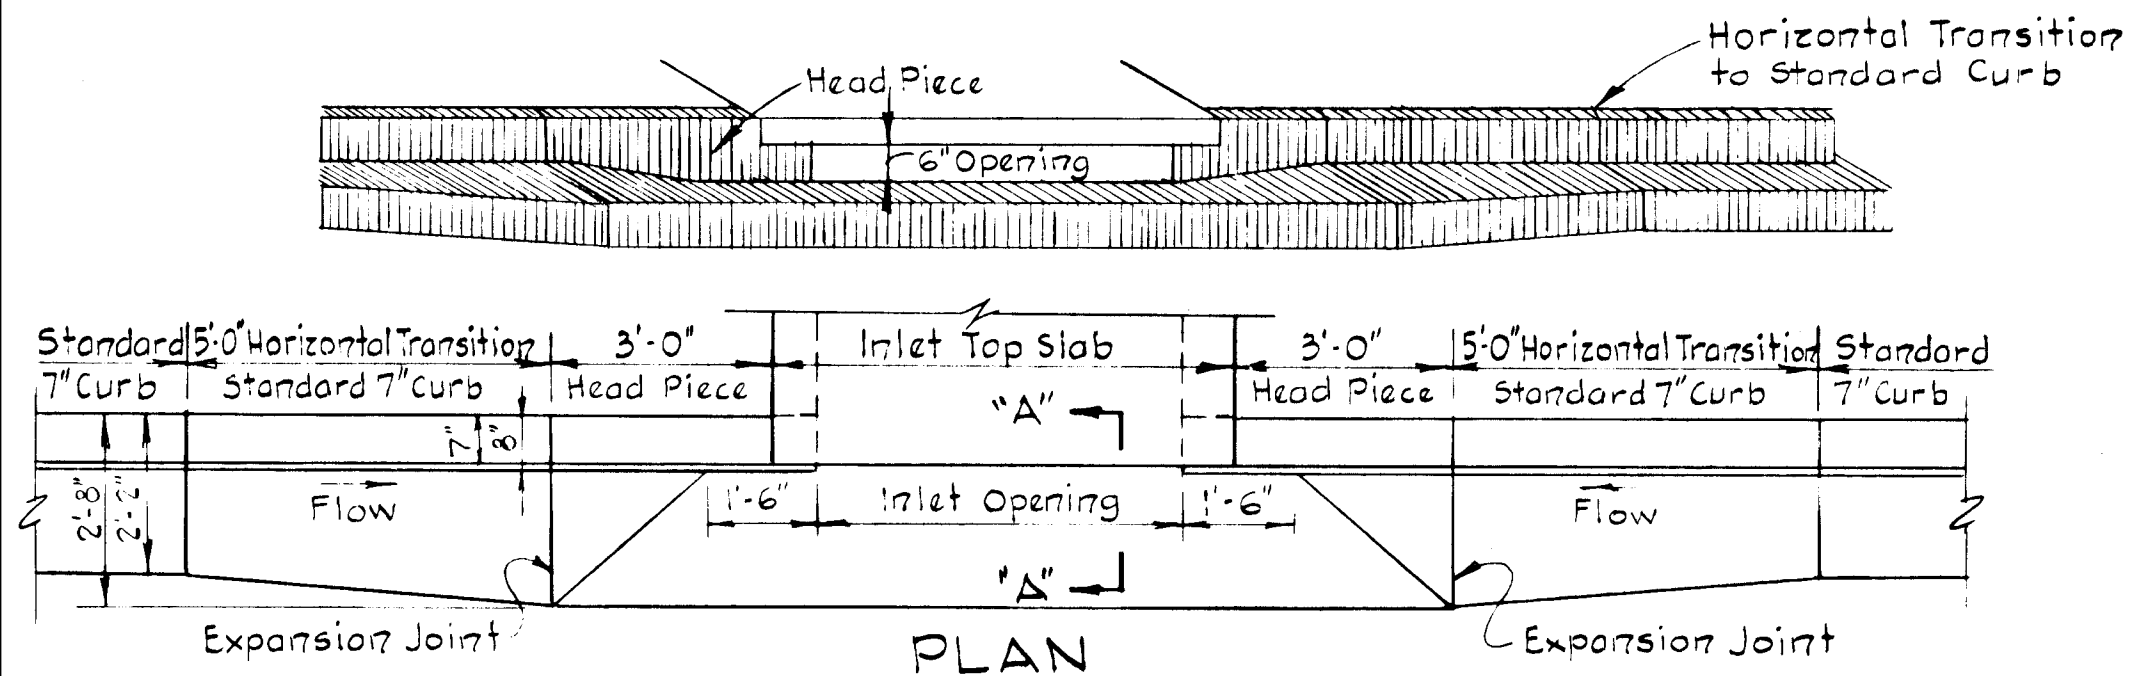

**DETAIL - CUTOFF WALL AND OUTLET PAVING**  
 No Scale

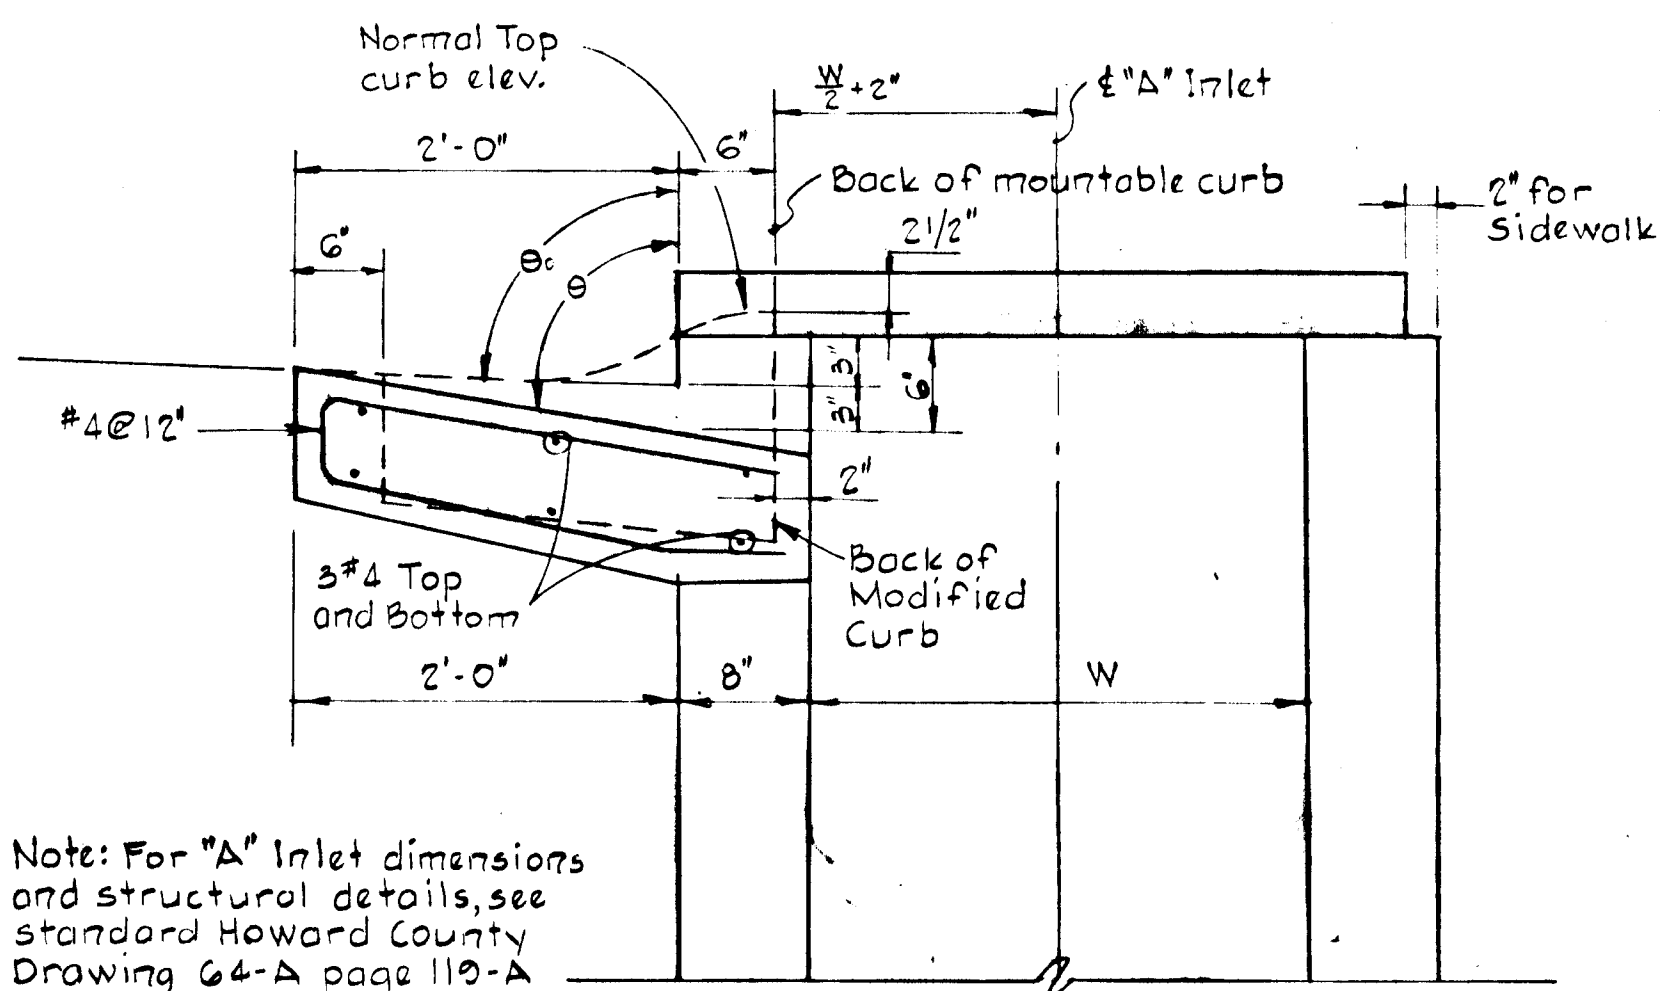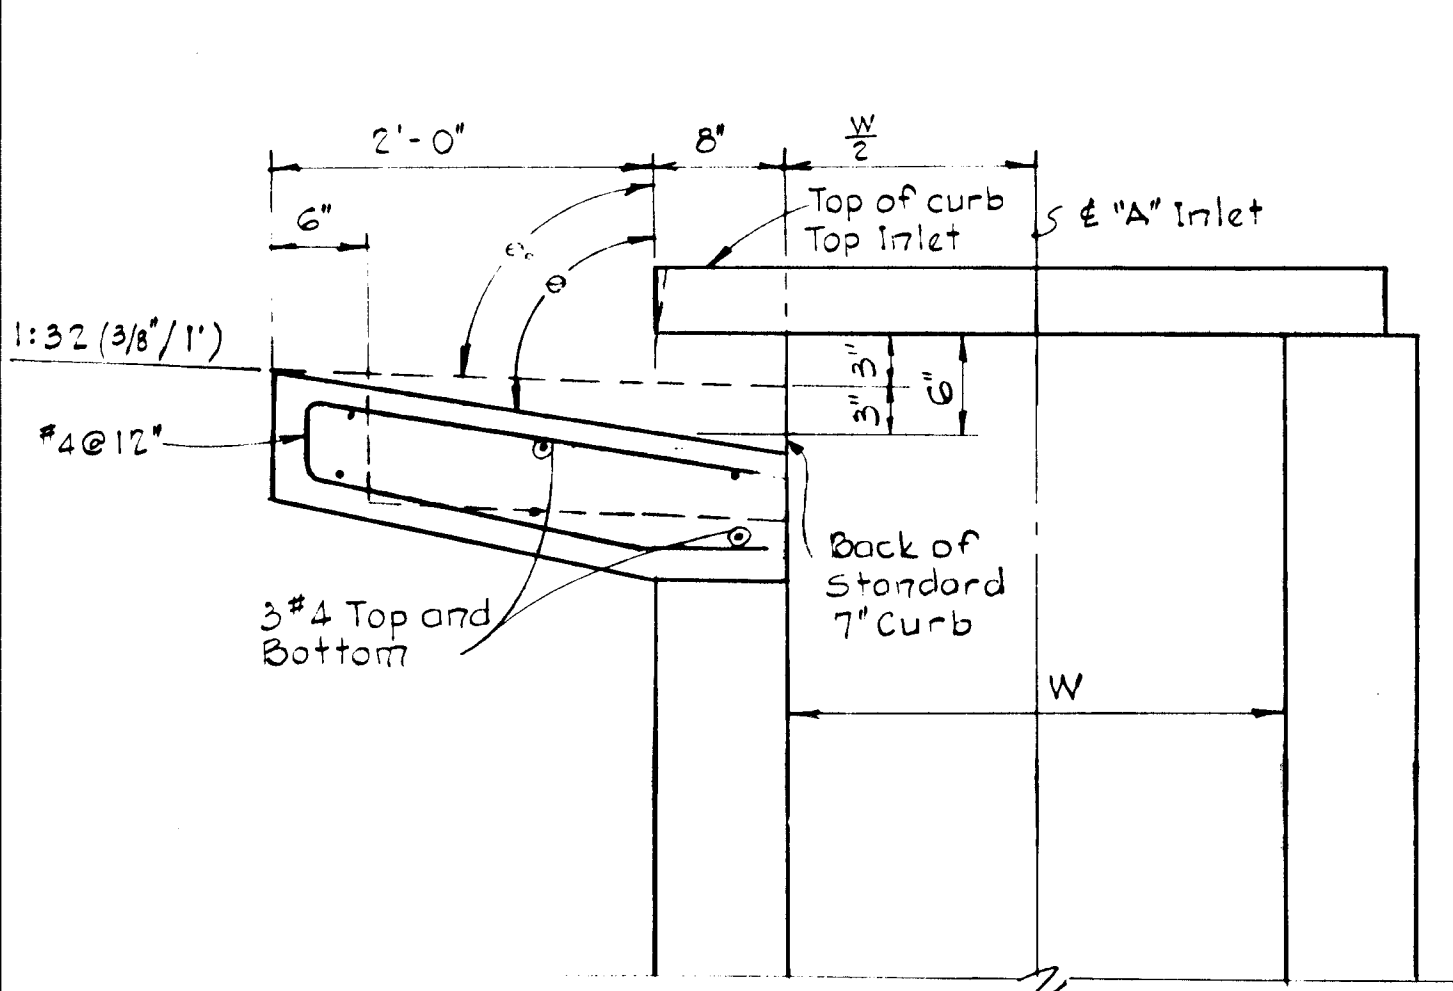

Note: For "A" Inlet dimensions and structural details, see standard Howard County Drawing G4-A page 113-A

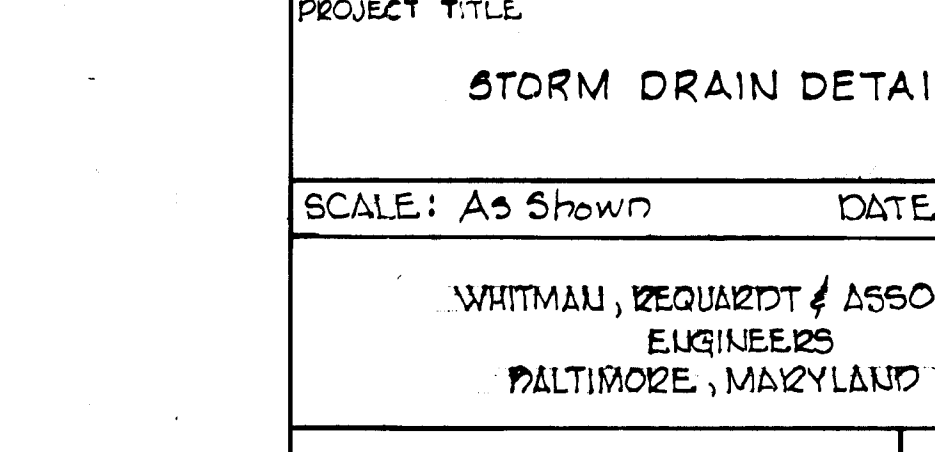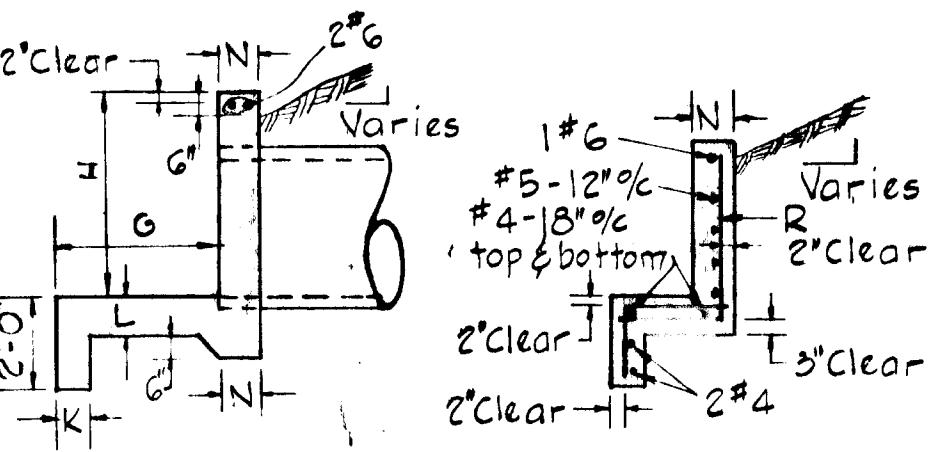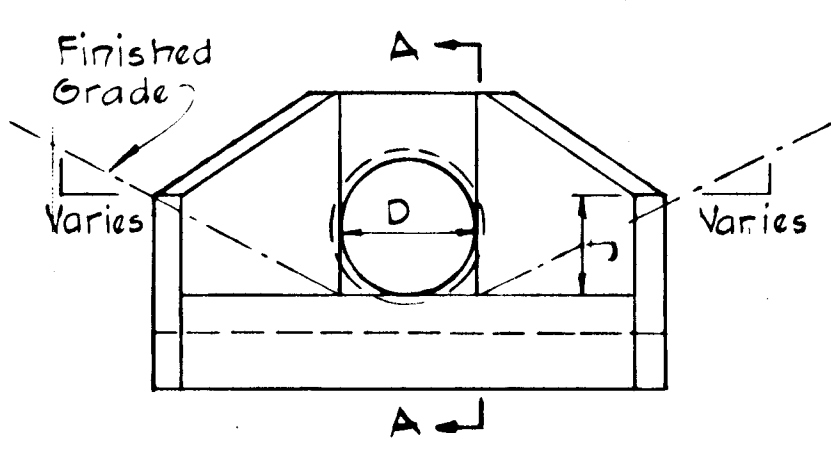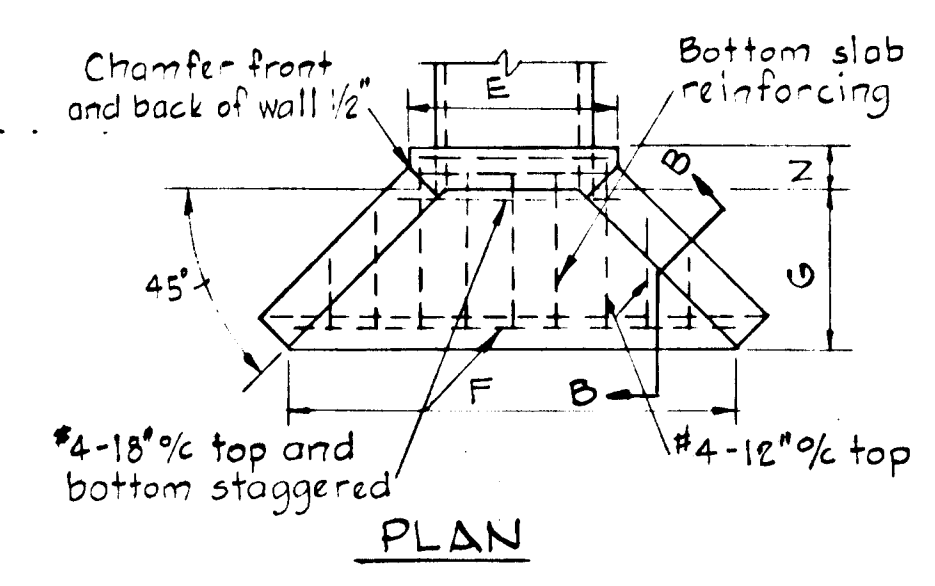

NOTES:  
 1. Exposed edges shall be chamfered 1"x1".  
 2. All concrete shall be 3000 psi.

**DETAIL - TYPE "A" HEADWALL**  
 No Scale

D	E	F	G	H	I	J	K	L	N	R
18"	3'-0"	7'-6"	3'-0"	3'-0"	3'-0"	8'	8'	8'	8'	#5-12" @ 6"
21"	3'-4"	7'-9"	3'-0"	3'-0"	3'-0"	8'	8'	8'	8'	#5-12" @ 6"
24"	3'-8"	8'-3"	3'-0"	3'-0"	3'-0"	8'	8'	8'	8'	#5-12" @ 6"
27"	4'-2"	8'-7"	3'-0"	3'-0"	3'-0"	8'	8'	8'	8'	#5-12" @ 6"
30"	4'-6"	9'-1"	3'-0"	3'-0"	3'-0"	8'	8'	8'	8'	#5-12" @ 6"
36"	4'-8"	10'-0"	3'-0"	3'-0"	3'-0"	8'	8'	8'	8'	#5-12" @ 6"
42"	5'-3"	11'-6"	3'-0"	3'-0"	3'-0"	8'	8'	8'	8'	#5-12" @ 6"
48"	5'-10"	13'-0"	3'-0"	3'-0"	3'-0"	8'	8'	8'	8'	#5-12" @ 6"
54"	6'-5"	14'-6"	3'-0"	3'-0"	3'-0"	8'	8'	8'	8'	#6-8" @ 6"
60"	7'-3"	16'-0"	3'-0"	3'-0"	3'-0"	8'	8'	8'	8'	#6-8" @ 6"
66"	7'-7"	17'-6"	3'-0"	3'-0"	3'-0"	8'	8'	8'	8'	#6-8" @ 6"
72"	8'-2"	19'-0"	3'-0"	3'-0"	3'-0"	8'	8'	8'	8'	#6-8" @ 6"


Rev. Date	Rev. No.	Revision Description
<b>COLUMBIA</b> 6th SELECTION DISTRICT HOWARD COUNTY, MARYLAND OWNER AND DEVELOPER: HOWARD RESEARCH AND DEVELOPMENT CORP. PROJECT AREA: <b>VILLAGE OF KINGS CONTRIVANCE</b> SECTION B AREA 1 PROJECT TITLE: <b>STORM DRAIN DETAILS</b> SCALE: As Shown DATE:		
WHITMAN, REQUARDT & ASSOCIATES ENGINEERS BALTIMORE, MARYLAND 21202		
<i>Kenneth A. McCord</i> KENNETH A. MCCORD Registered Engineer No. 1974		







DEPARTMENT OF PUBLIC WORKS  
*W. O. F. Smet* 12-29-78  
 CHIEF BUREAU OF ENGINEERING  
 OFFICE OF PLANNING AND ZONING  
*John W. Marshall* / *JFD*  
 CHIEF, DIVISION OF LAND DEVELOPMENT

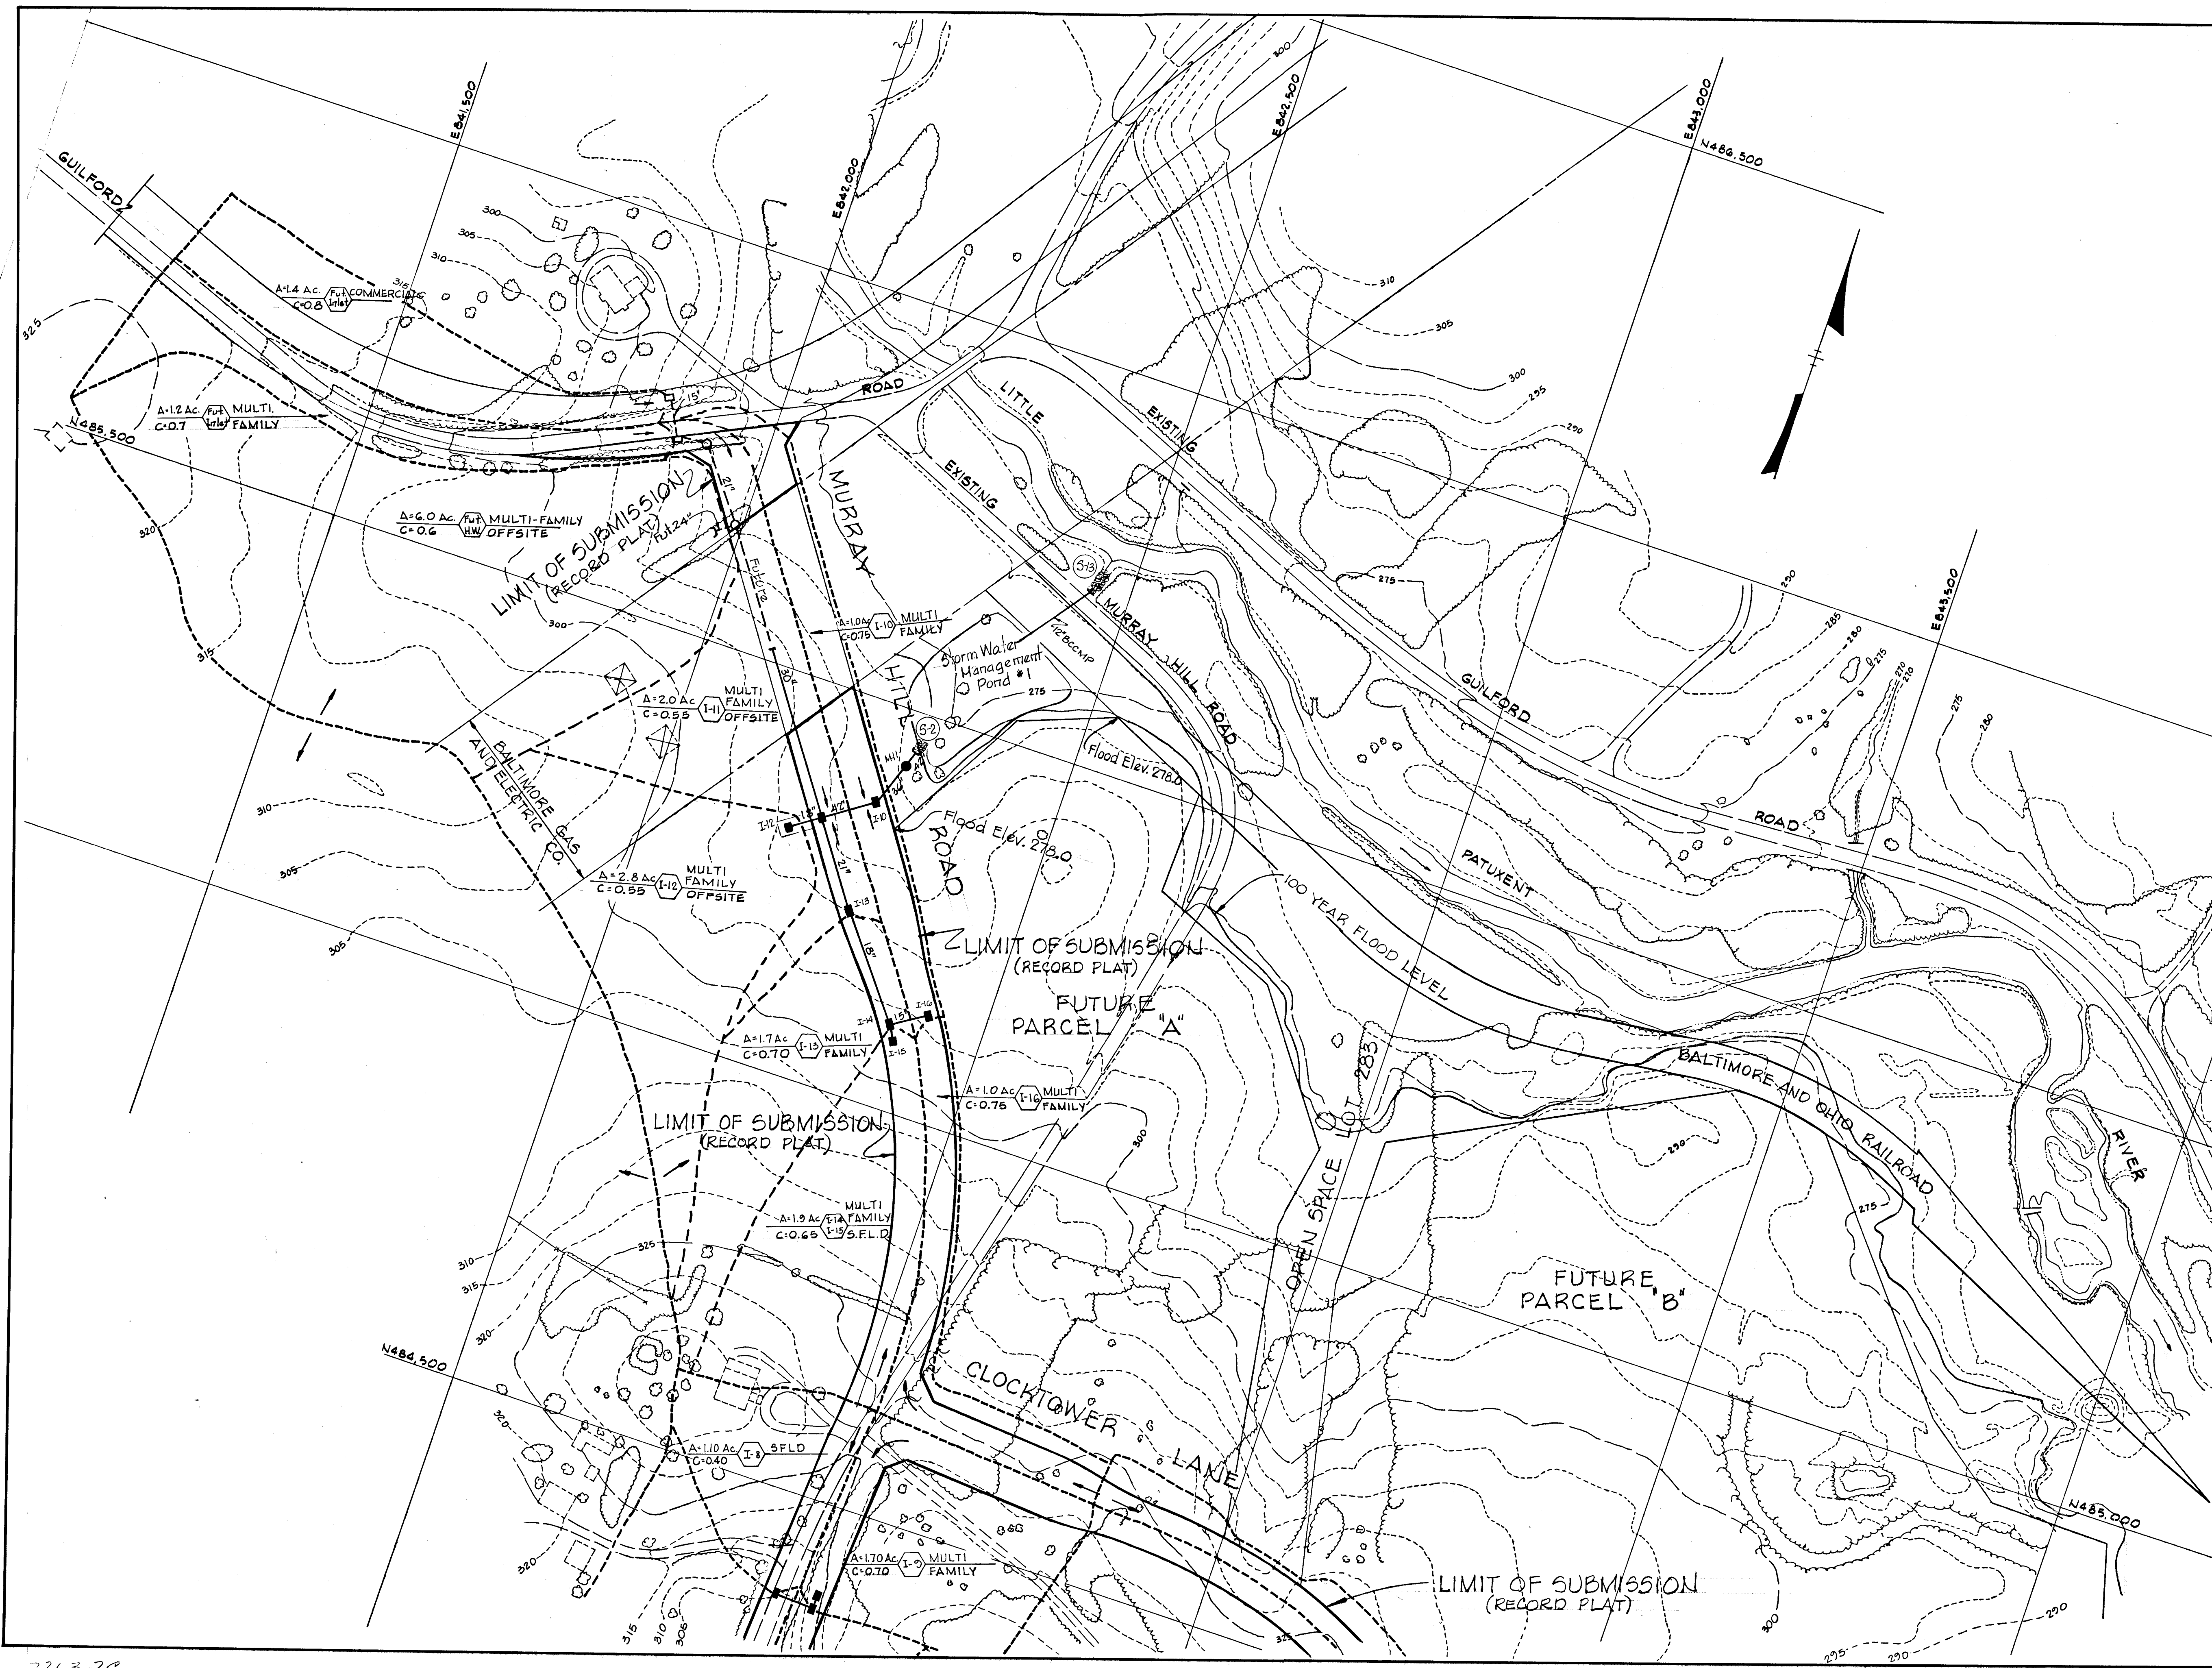

Rev. Date	Rev. No.	Revision Description
<b>COLUMBIA</b> 6th ELECTION DISTRICT HOWARD COUNTY, MARYLAND		
OWNER AND DEVELOPER HOWARD RESEARCH AND DEVELOPMENT CORP.		
PROJECT AREA VILLAGE OF KING'S CONTRIVANCE SECTION 3 AREA 1		
PROJECT TITLE DRAINAGE AREA MAP		
SCALE: 1"=100'		DATE:
WHITMAN, REQUARDT & ASSOCIATES ENGINEERS BALTIMORE, MARYLAND 21202		
<i>Kenneth A. McCord</i> KENNETH A. McCORD Registered Engineer No. 1974		


7263-2C

F-29-44c

11/31/78 SHEET 28 OF 37



DEPARTMENT OF PUBLIC WORKS  
*W. O. Albert* 12-29-78  
 CHIEF BUREAU OF ENGINEERING  
 OFFICE OF PLANNING AND ZONING  
*John W. Musselman* (P.E.)  
 CHIEF, DIVISION OF LAND DEVELOPMENT

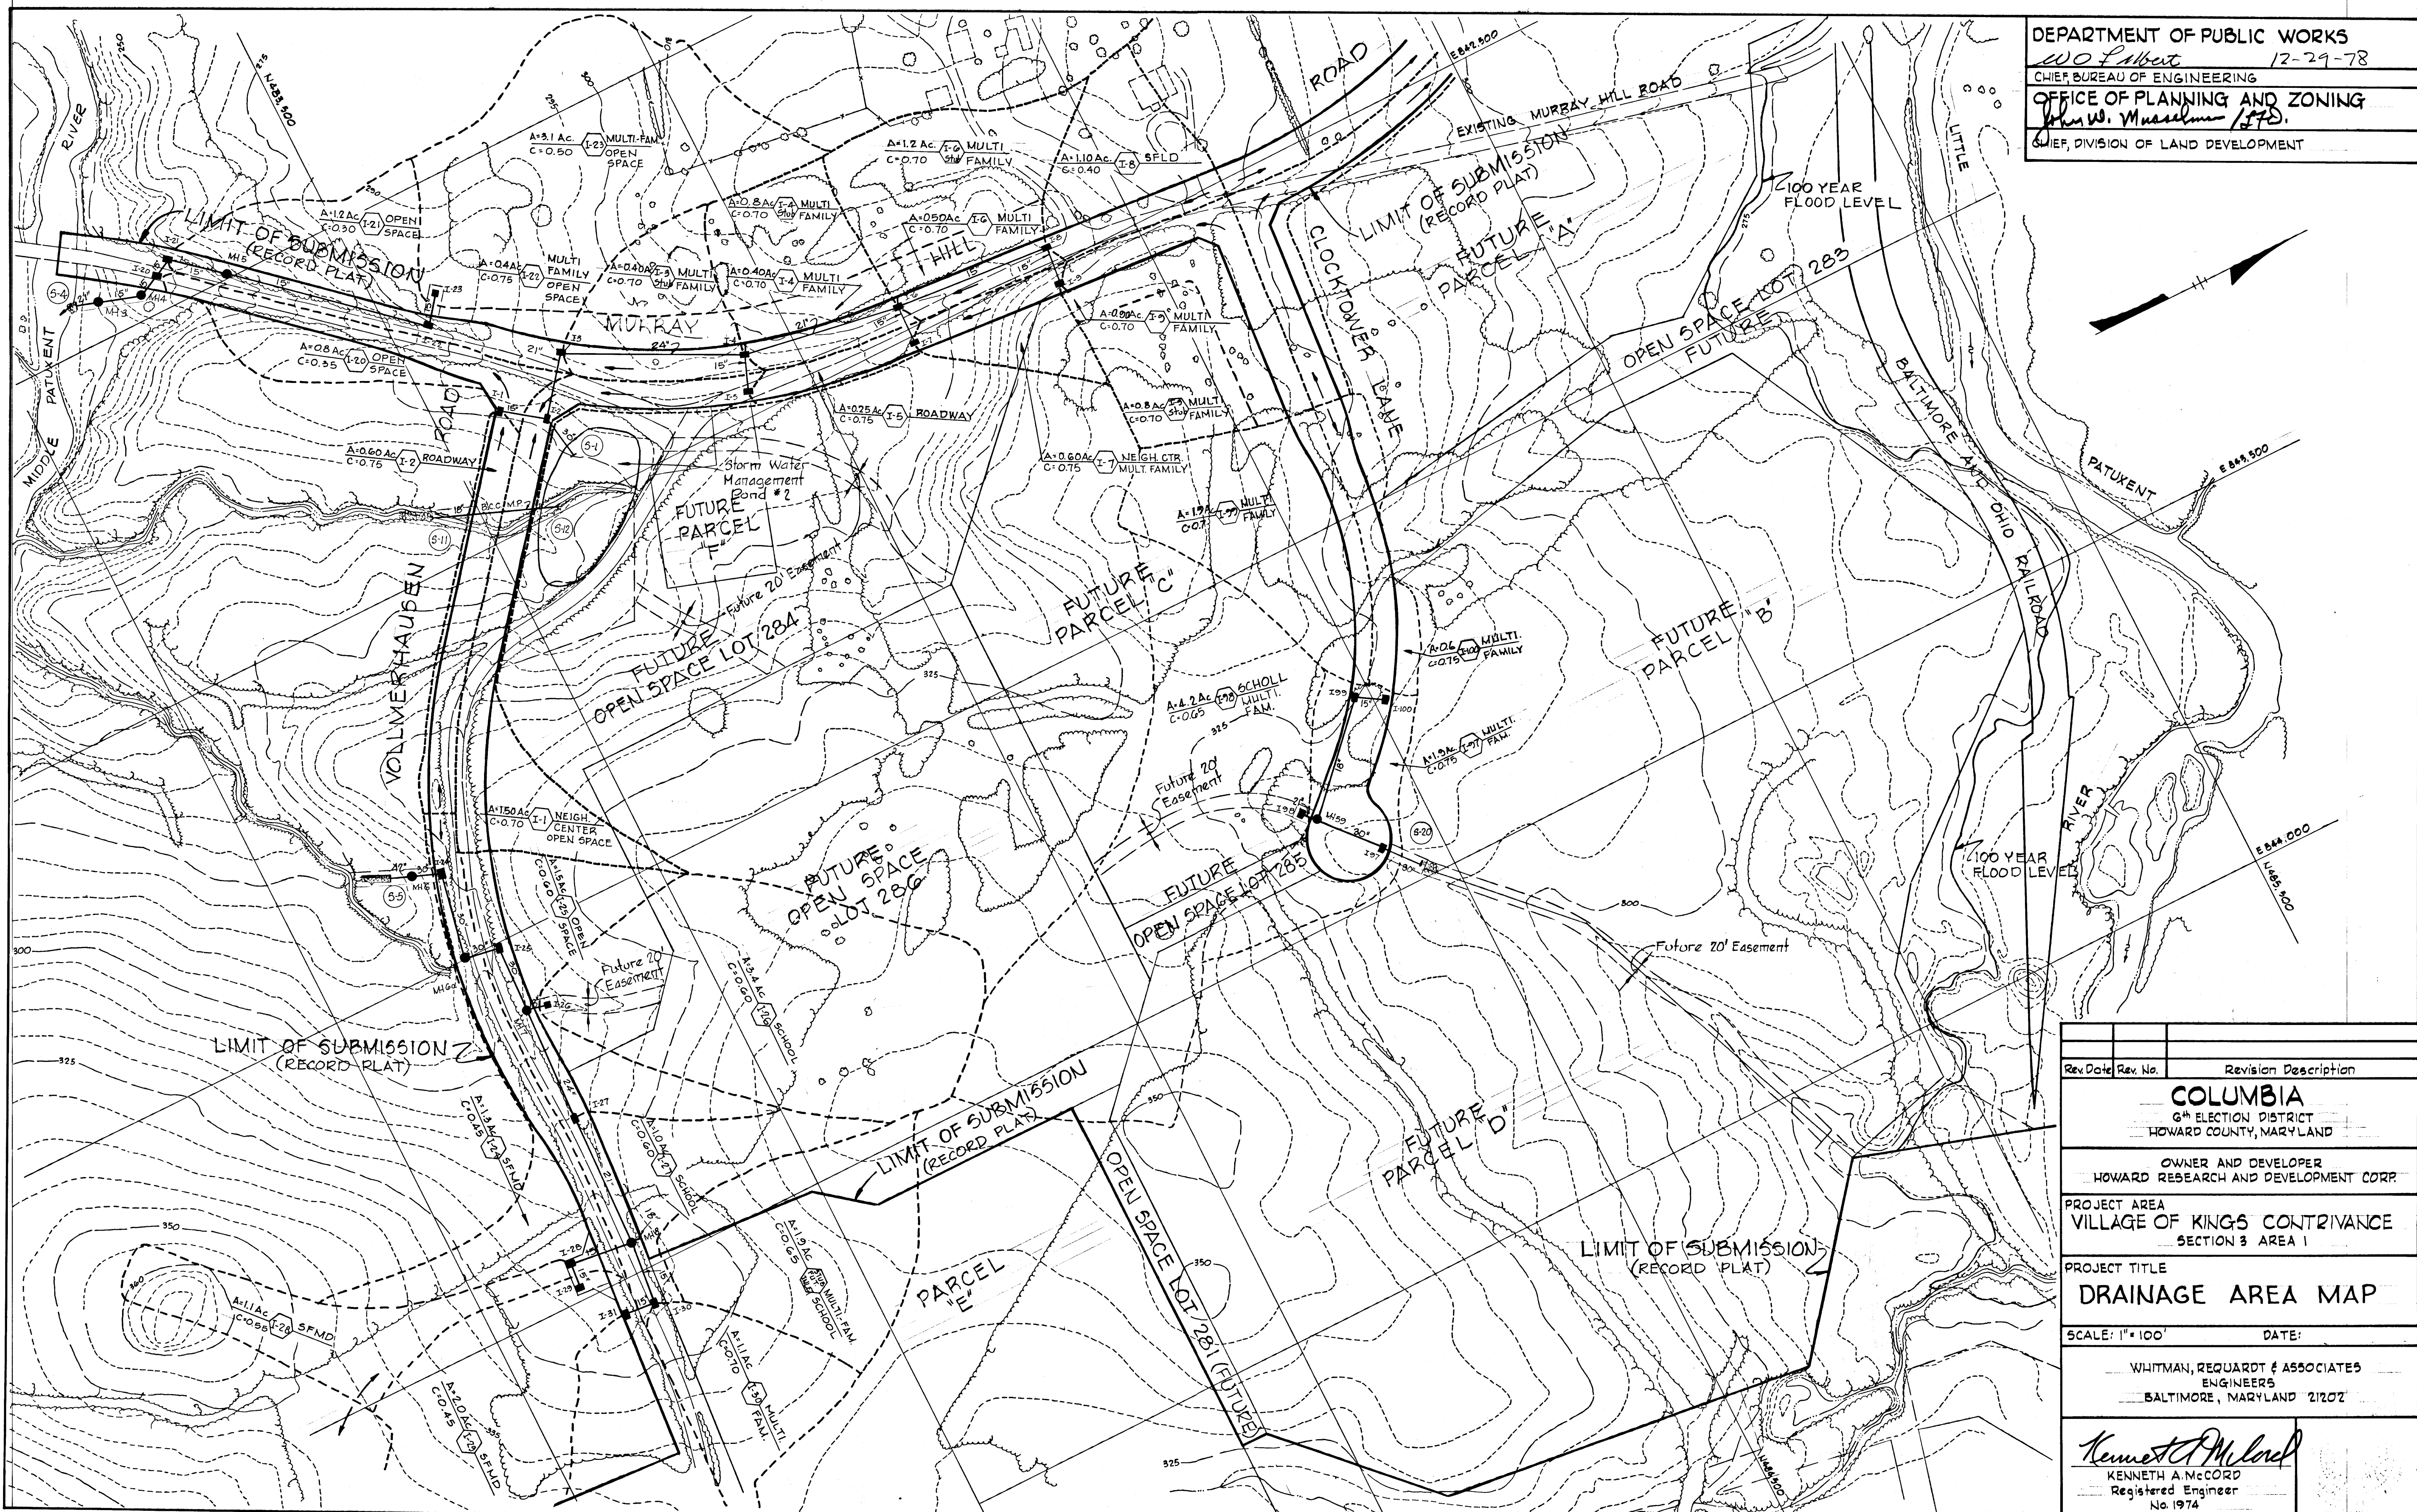


Rev. Date	Rev. No.	Revision Description
<b>COLUMBIA</b> 6th ELECTION DISTRICT HOWARD COUNTY, MARYLAND		
OWNER AND DEVELOPER HOWARD RESEARCH AND DEVELOPMENT CORP.		
PROJECT AREA VILLAGE OF KINGS CONTRIVANCE SECTION 3 AREA 1		
PROJECT TITLE <b>DRAINAGE AREA MAP</b>		
SCALE: 1" = 100'		DATE:
WHITMAN, REQUARDT & ASSOCIATES ENGINEERS BALTIMORE, MARYLAND 21202		
<i>Kenneth A. McCord</i> KENNETH A. MCCORD Registered Engineer No. 1974		

445  
28




DEPARTMENT OF PUBLIC WORKS  
*W. Lubat* 12-29-78  
 CHIEF, BUREAU OF ENGINEERING  
 OFFICE OF PLANNING AND ZONING  
*John W. Muscatello / J.W.M.*  
 CHIEF, DIVISION OF LAND DEVELOPMENT

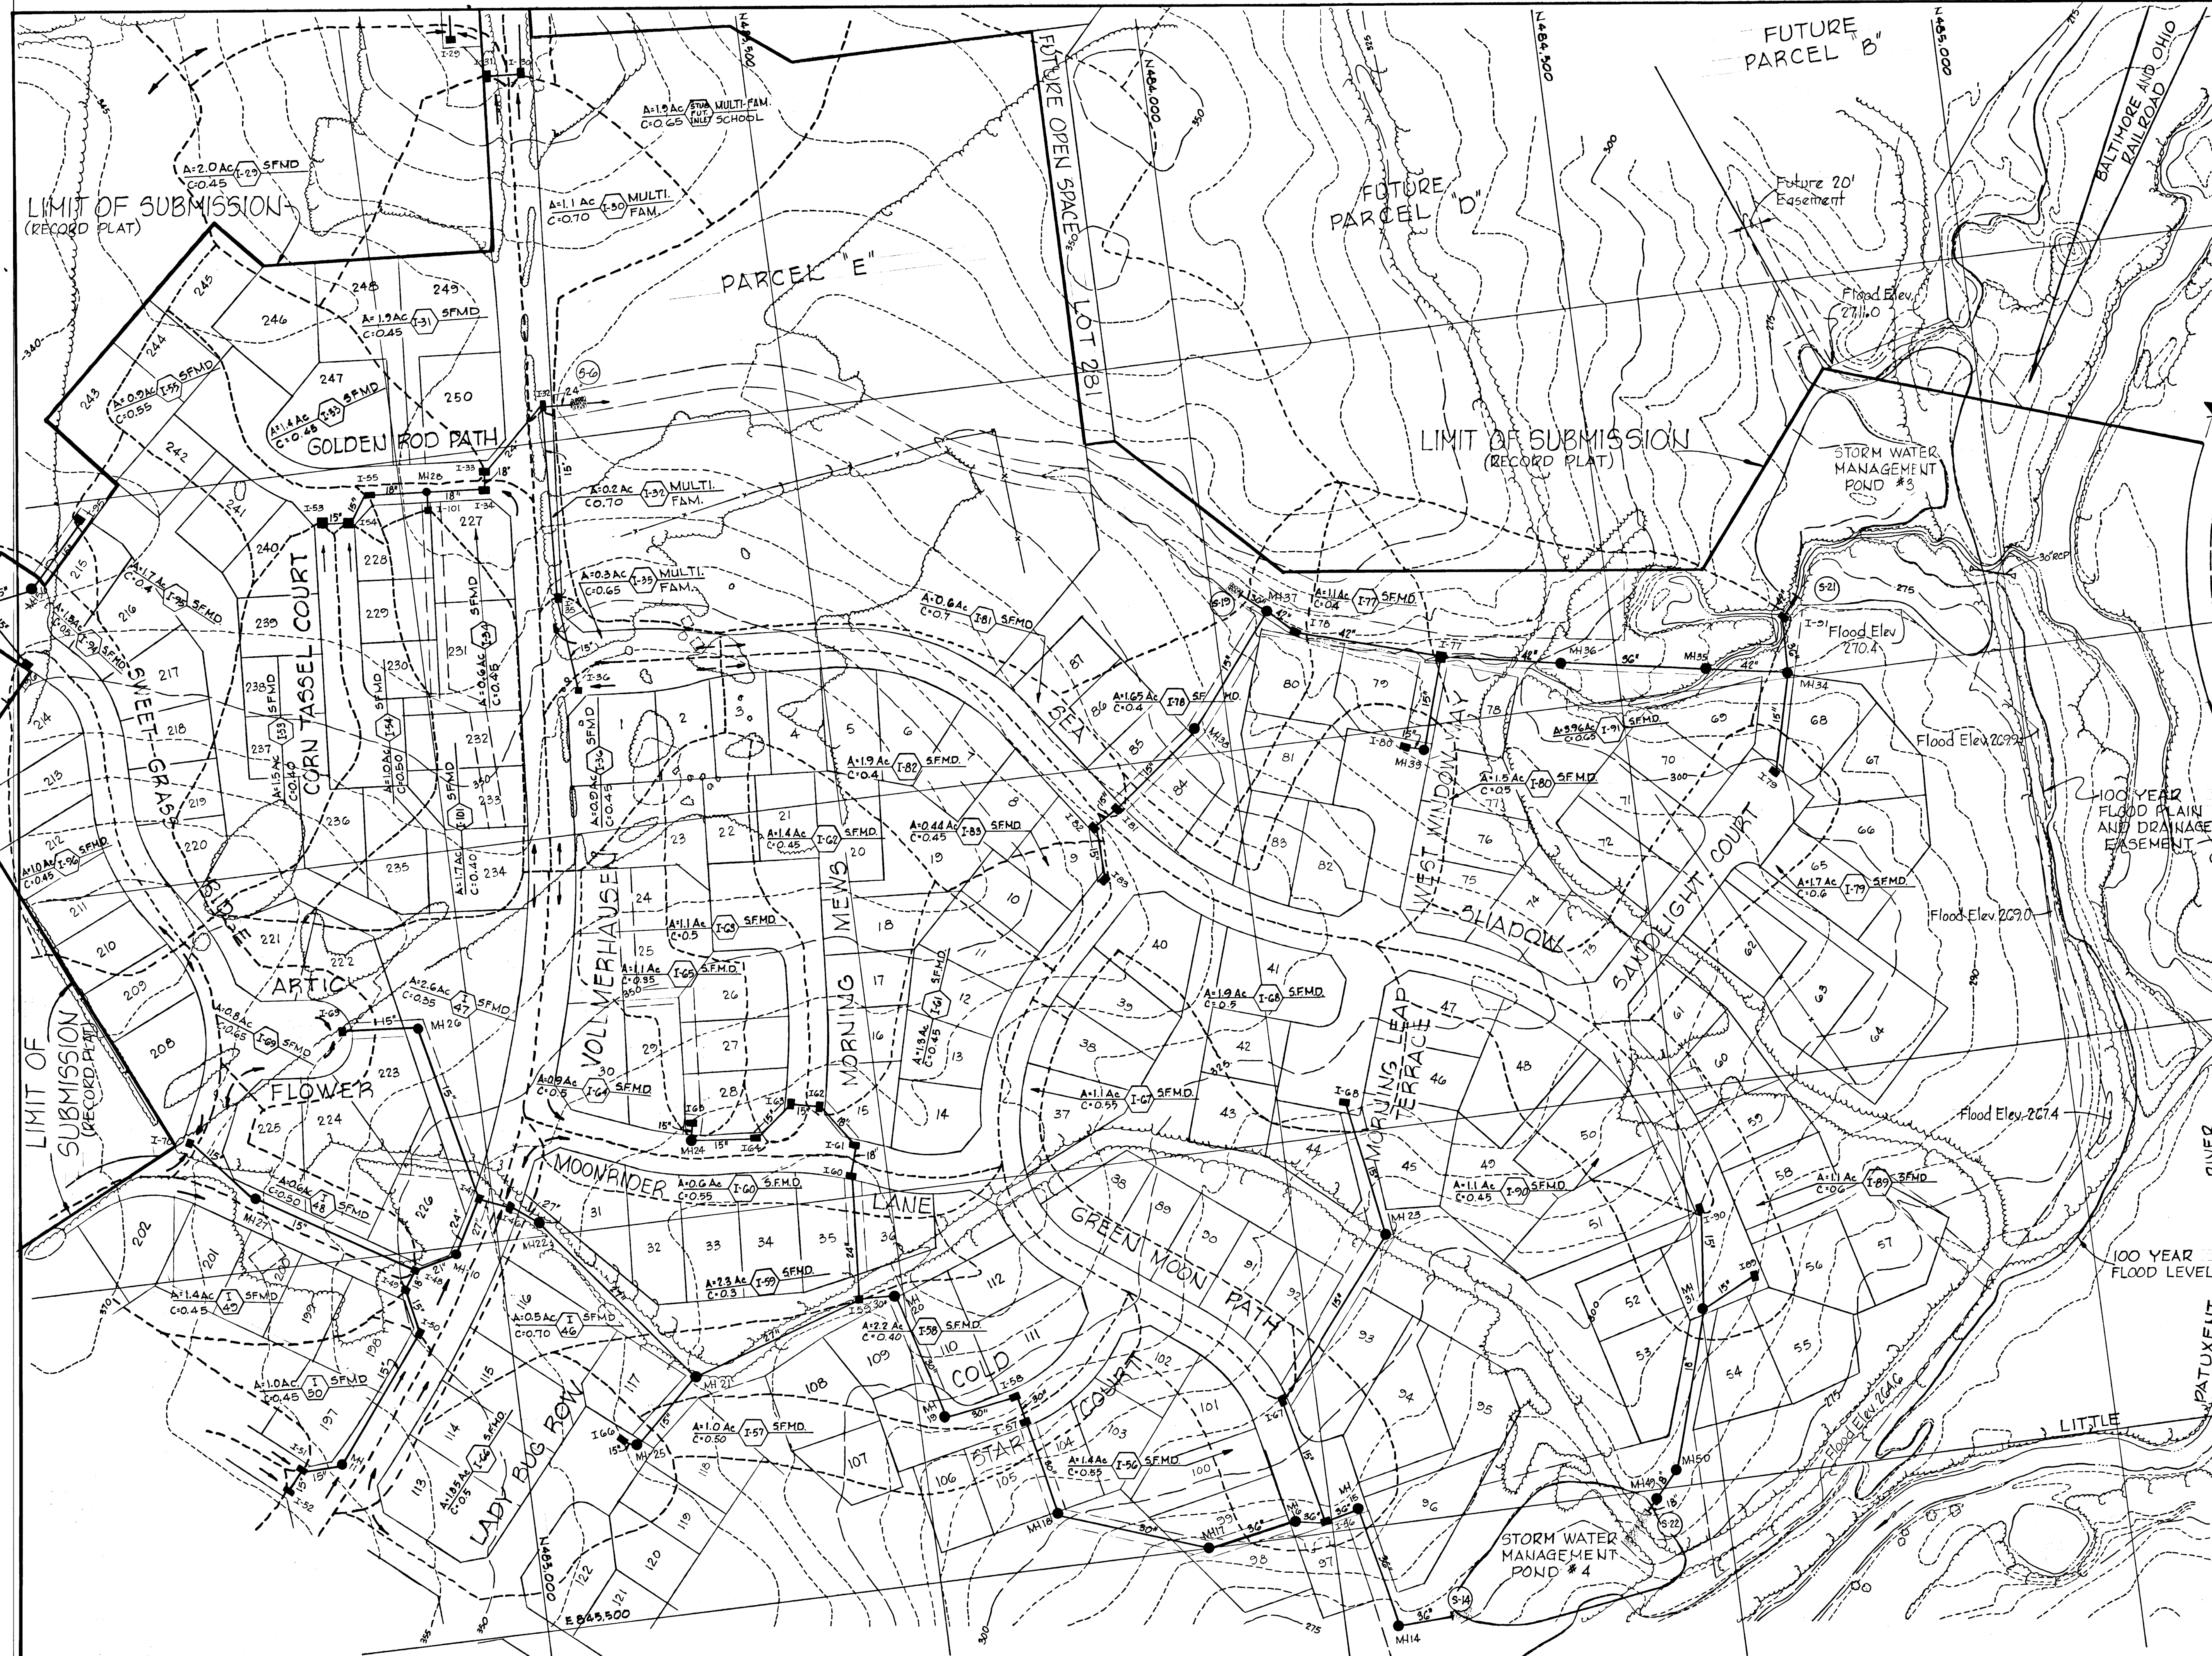

Rev. Date	Rev. No.	Revision Description
<b>COLUMBIA</b>		
6th ELECTION DISTRICT HOWARD COUNTY, MARYLAND		
OWNER AND DEVELOPER HOWARD RESEARCH AND DEVELOPMENT CORP.		
PROJECT AREA <b>VILLAGE OF KING'S CONTRIVANCE</b> SECTION 3 AREA I		
PROJECT TITLE <b>DRAINAGE AREA MAP</b>		
SCALE: 1" = 100'		DATE:
WHITMAN, REQUARDT & ASSOCIATES ENGINEERS BALTIMORE, MARYLAND 21202		
<i>Kenneth A. McCord</i> KENNETH A. MCCORD Registered Engineer No. 1974		

#445



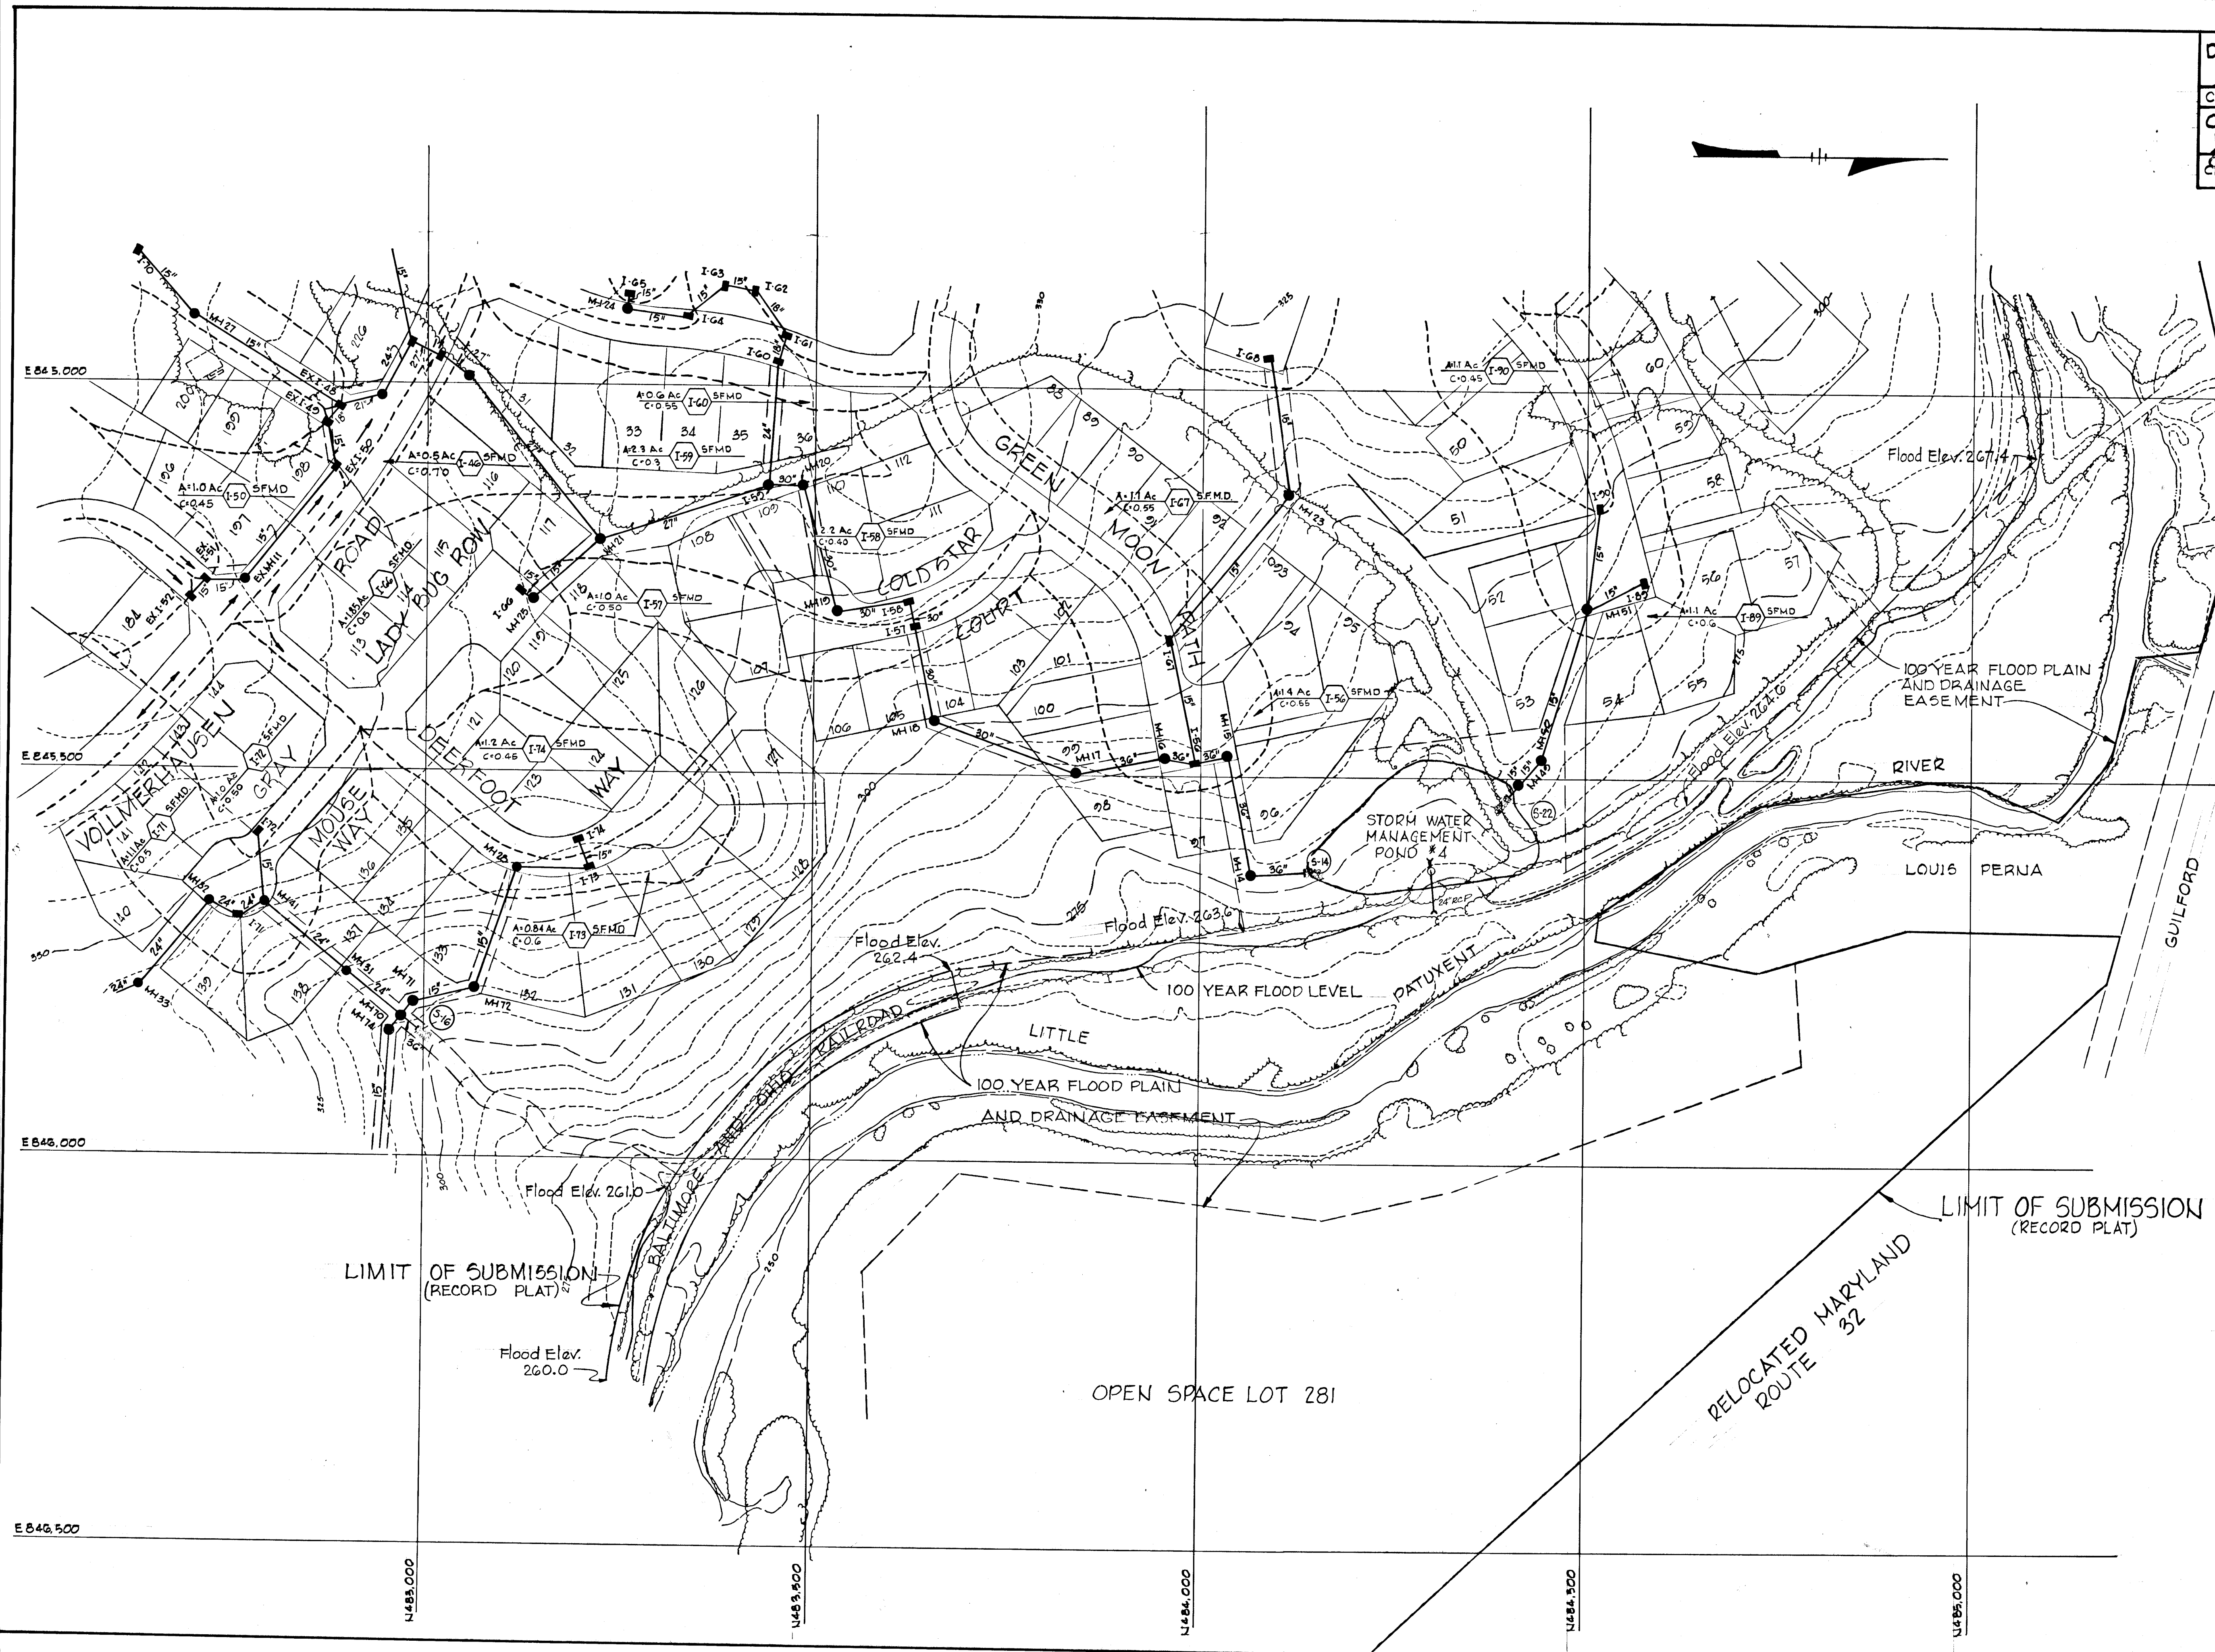

— LIMIT OF SUBMISSION (RECORD PLAT)

100 YEAR FLOOD PLAIN AND DRAINAGE EASEMENT

LOUIS PERNA RIVER

LOUIS PERNA RIVER

100 YEAR FLOOD LEVEL

100 YEAR FLOOD PLAIN AND DRAINAGE EASEMENT

— LIMIT OF SUBMISSION (RECORD PLAT)

— LIMIT OF SUBMISSION (RECORD PLAT)

OPEN SPACE LOT 281


RELOCATED MARYLAND ROUTE 32

Rev. Date	Rev. No.	Revision Description
<b>COLUMBIA</b> 6th ELECTION DISTRICT HOWARD COUNTY, MARYLAND		
OWNER AND DEVELOPER HOWARD RESEARCH AND DEVELOPMENT CORP.		
PROJECT AREA <b>VILLAGE OF KINGS CONTRIVANCE</b> SECTION 3 AREA 1		
PROJECT TITLE <b>DRAINAGE AREA MAP</b>		
SCALE: 1" = 100'		DATE:
WHITMAN, REQUARDT & ASSOCIATES ENGINEERS BALTIMORE, MARYLAND 21202		
<i>Kenneth A. McCord</i> KENNETH A. MCCORD Registered Engineer No. 1974		

445  
 000



DEPARTMENT OF PUBLIC WORKS  
*W O Lubert* 12-29-78  
 CHIEF, BUREAU OF ENGINEERING  
 OFFICE OF PLANNING AND ZONING  
*John W. Musselman* / 1278  
 CHIEF, DIVISION OF LAND DEVELOPMENT

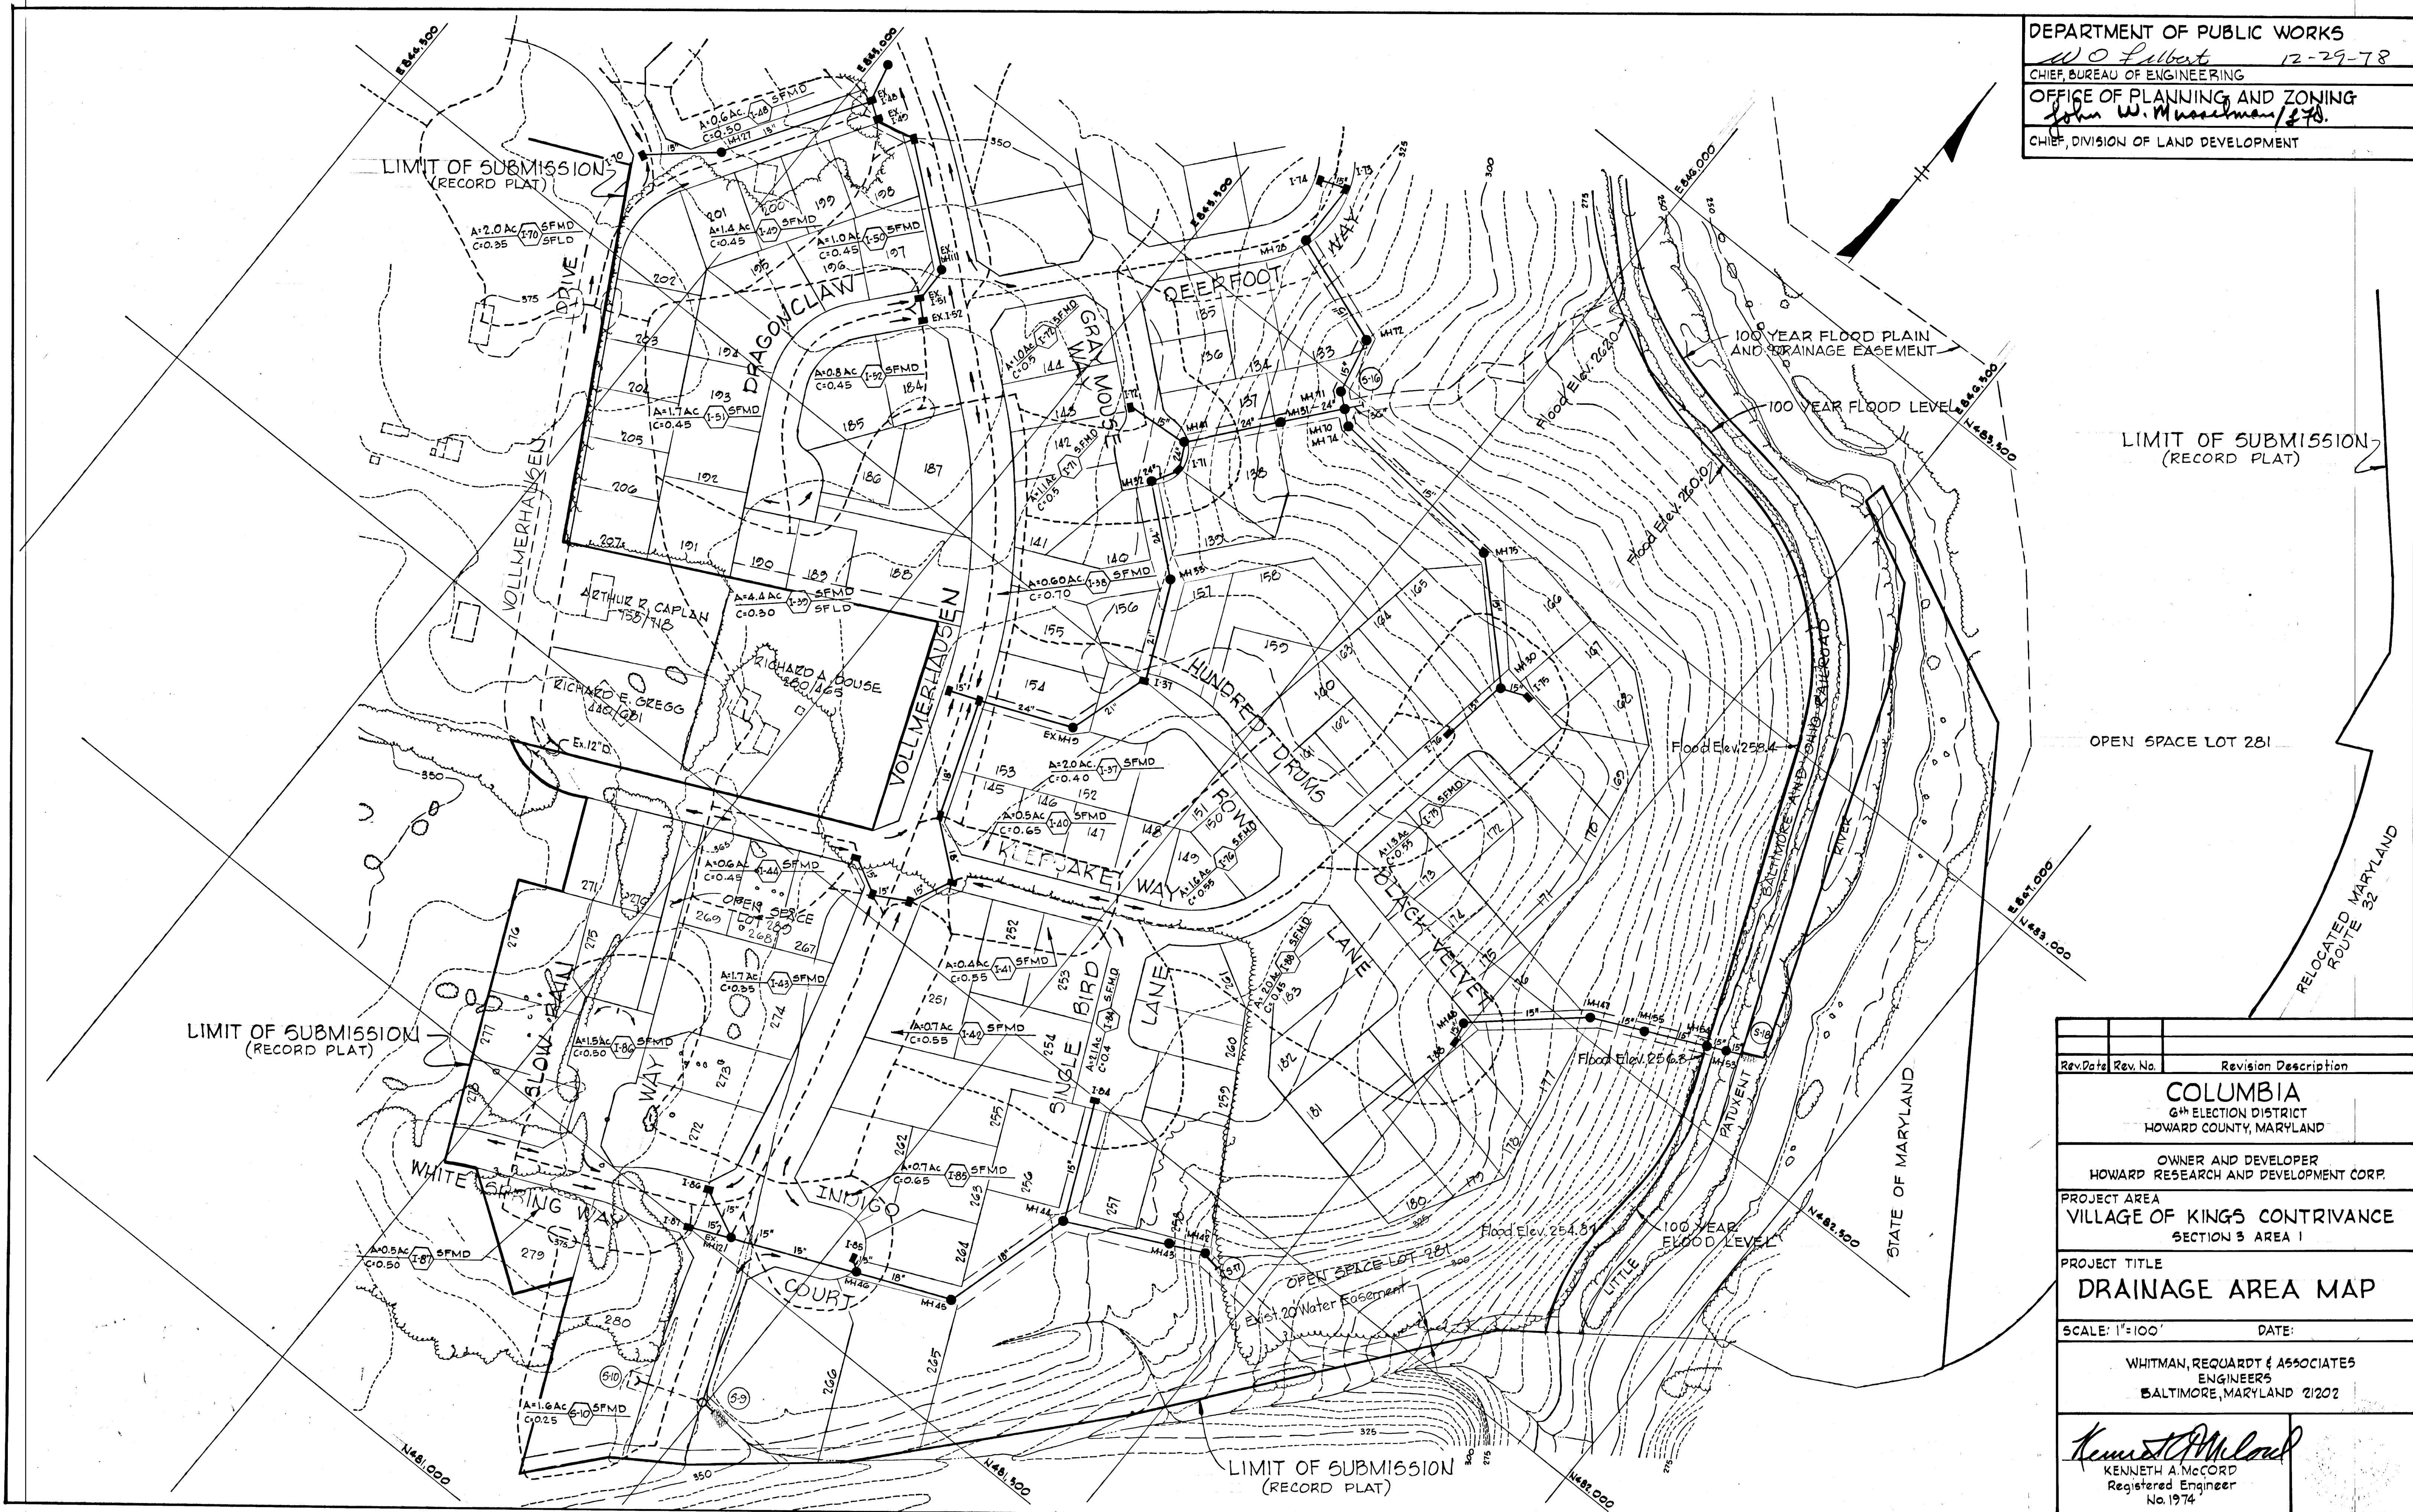

LIMIT OF SUBMISSION  
(RECORD PLAT)










OPEN SPACE LOT 281

LIMIT OF SUBMISSION  
(RECORD PLAT)



Rev. Date	Rev. No.	Revision Description
<b>COLUMBIA</b> 6th ELECTION DISTRICT HOWARD COUNTY, MARYLAND		
OWNER AND DEVELOPER HOWARD RESEARCH AND DEVELOPMENT CORP.		
PROJECT AREA VILLAGE OF KINGS CONTRIVANCE SECTION 3 AREA 1		
PROJECT TITLE <b>DRAINAGE AREA MAP</b>		
SCALE: 1"=100'		DATE:
WHITMAN, REQUARDT & ASSOCIATES ENGINEERS BALTIMORE, MARYLAND 21202		
<i>Kenneth A. McCord</i> KENNETH A. MCCORD Registered Engineer No. 1974		

445



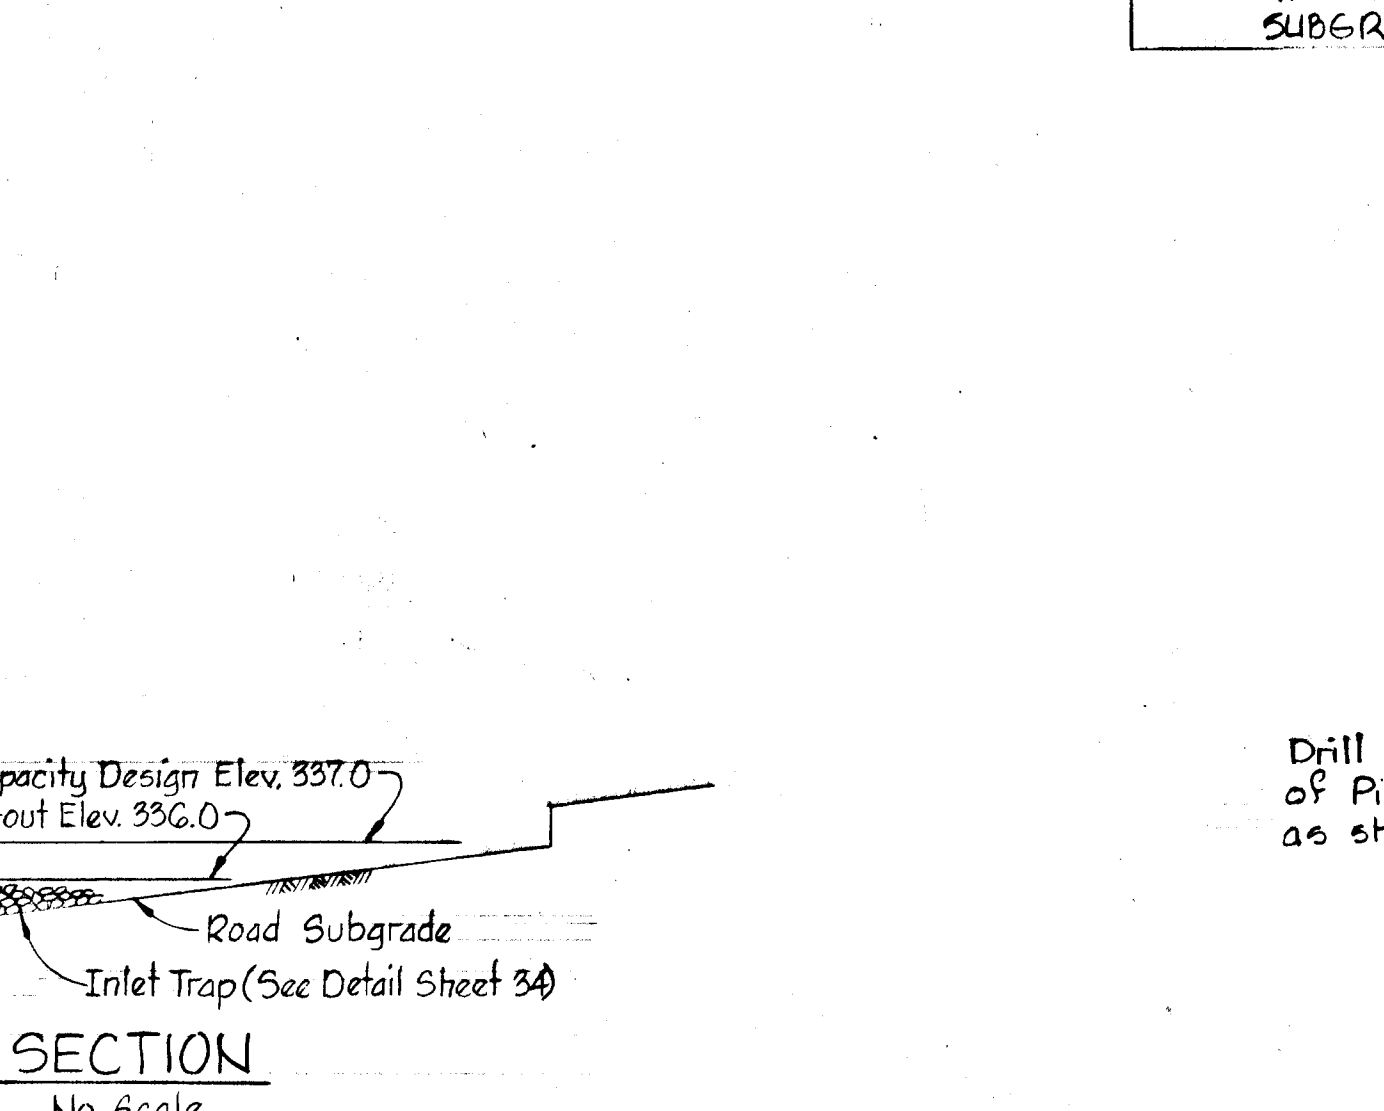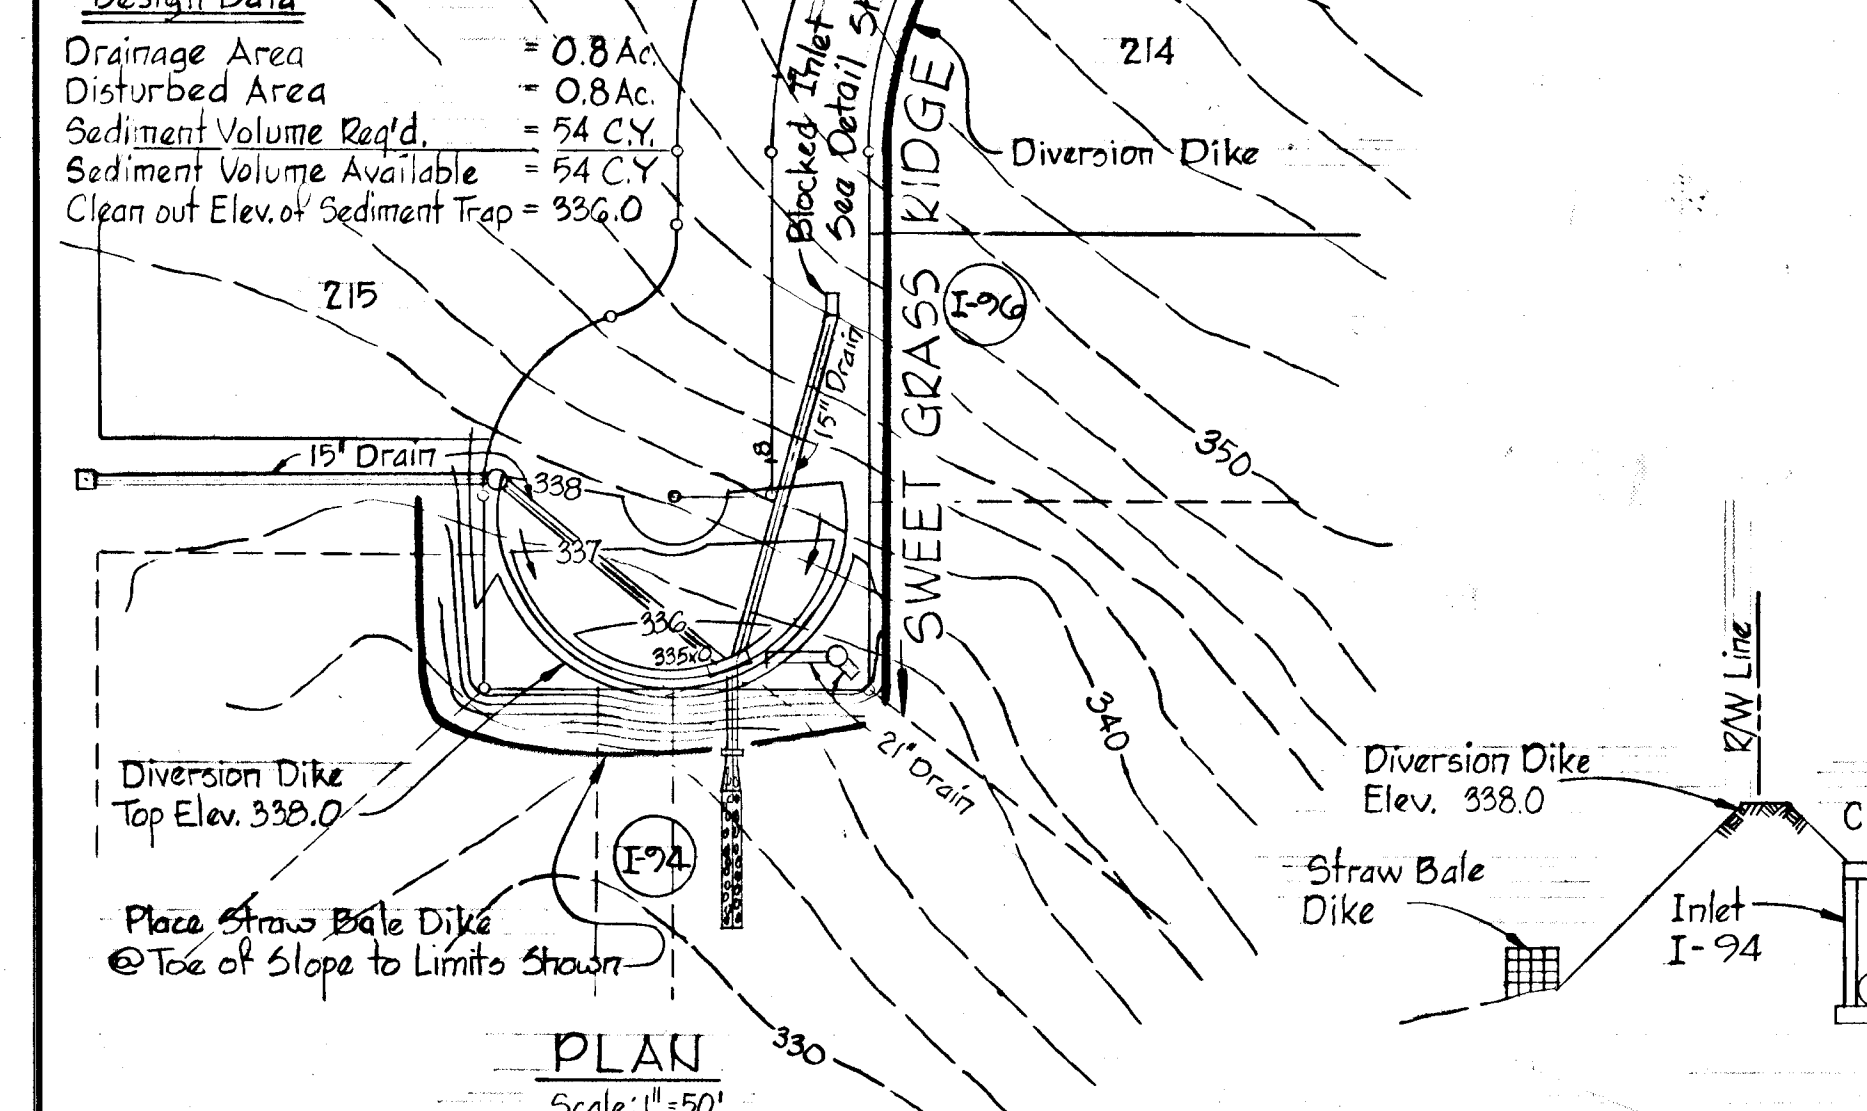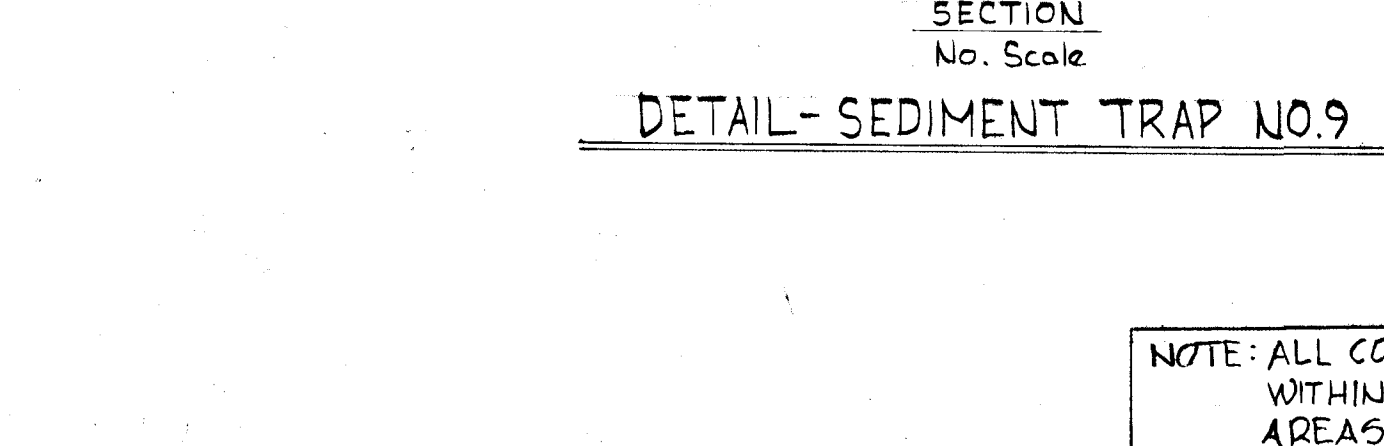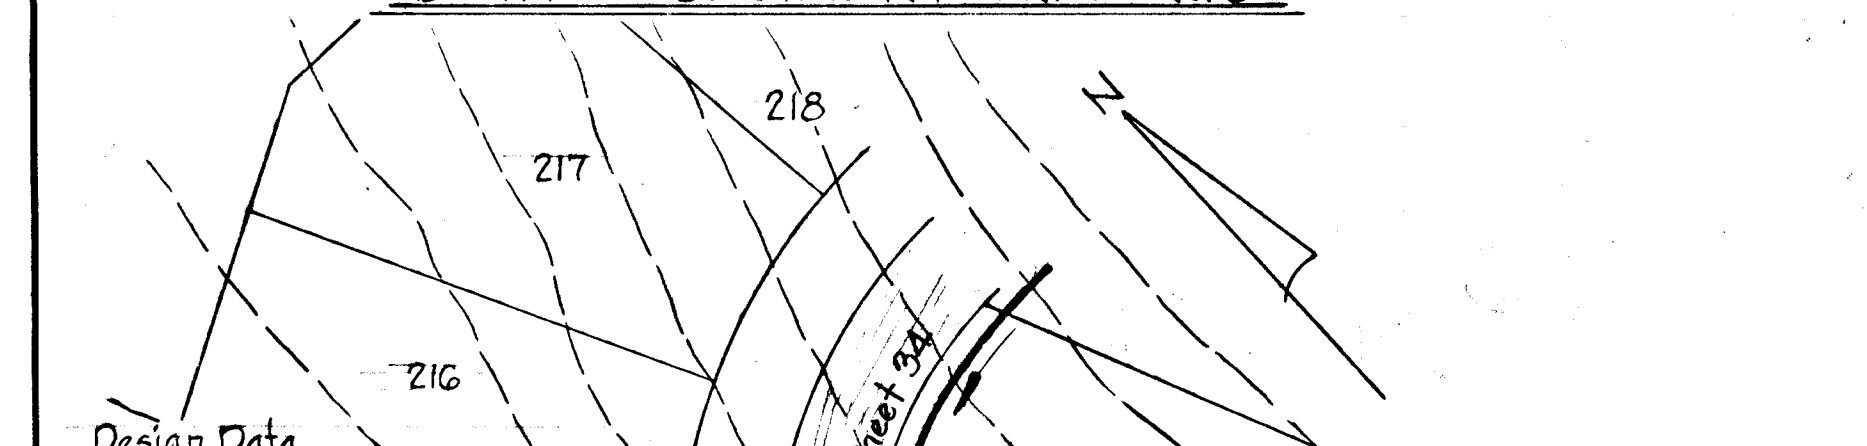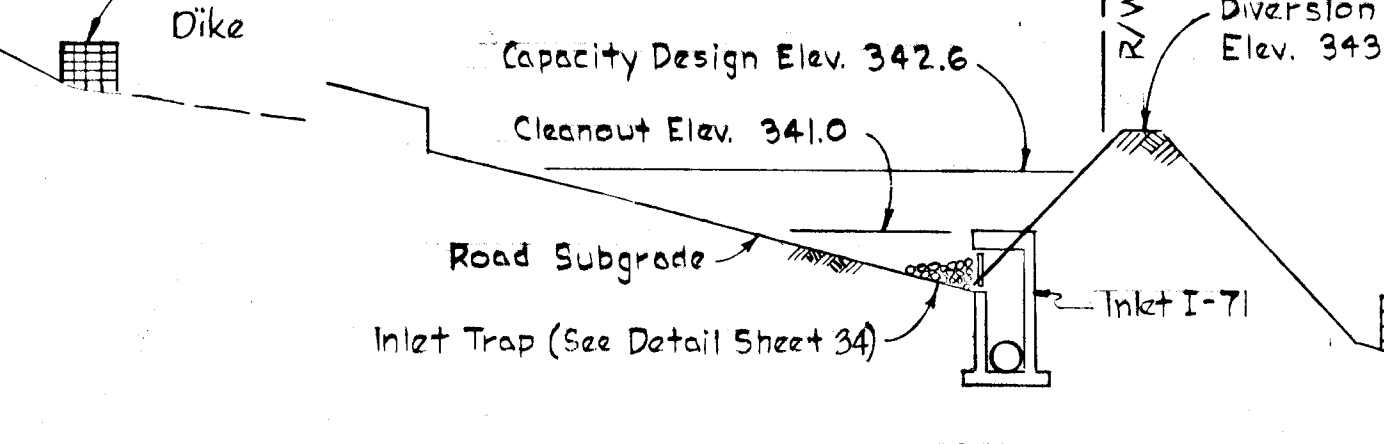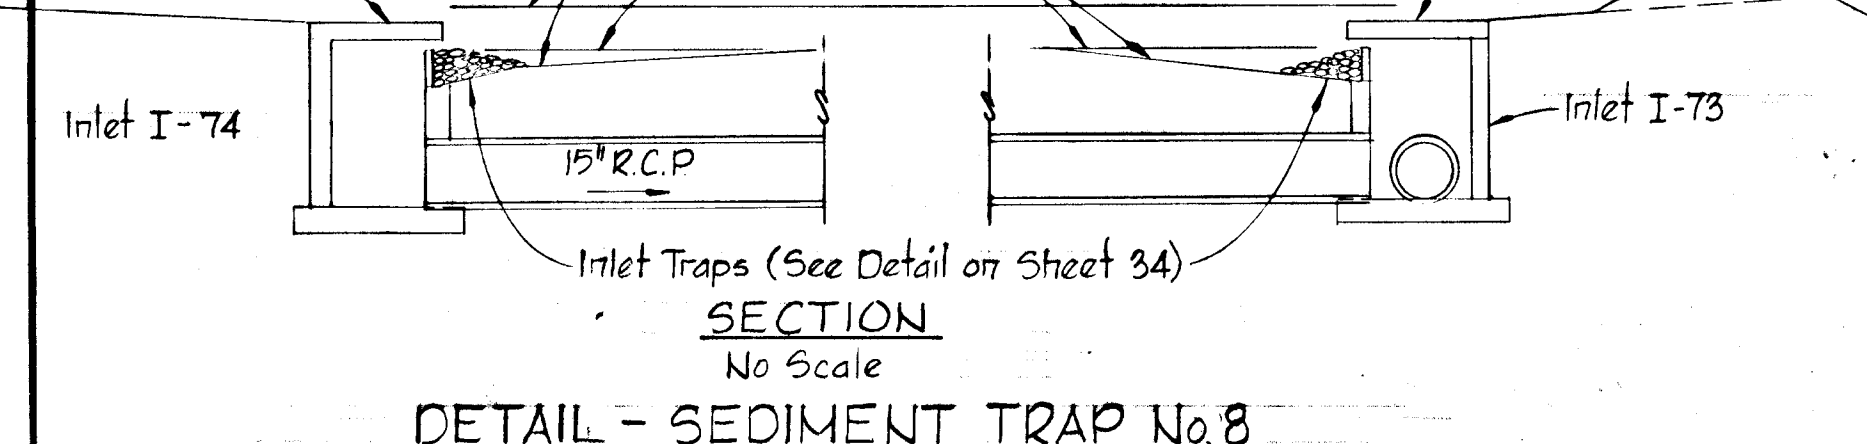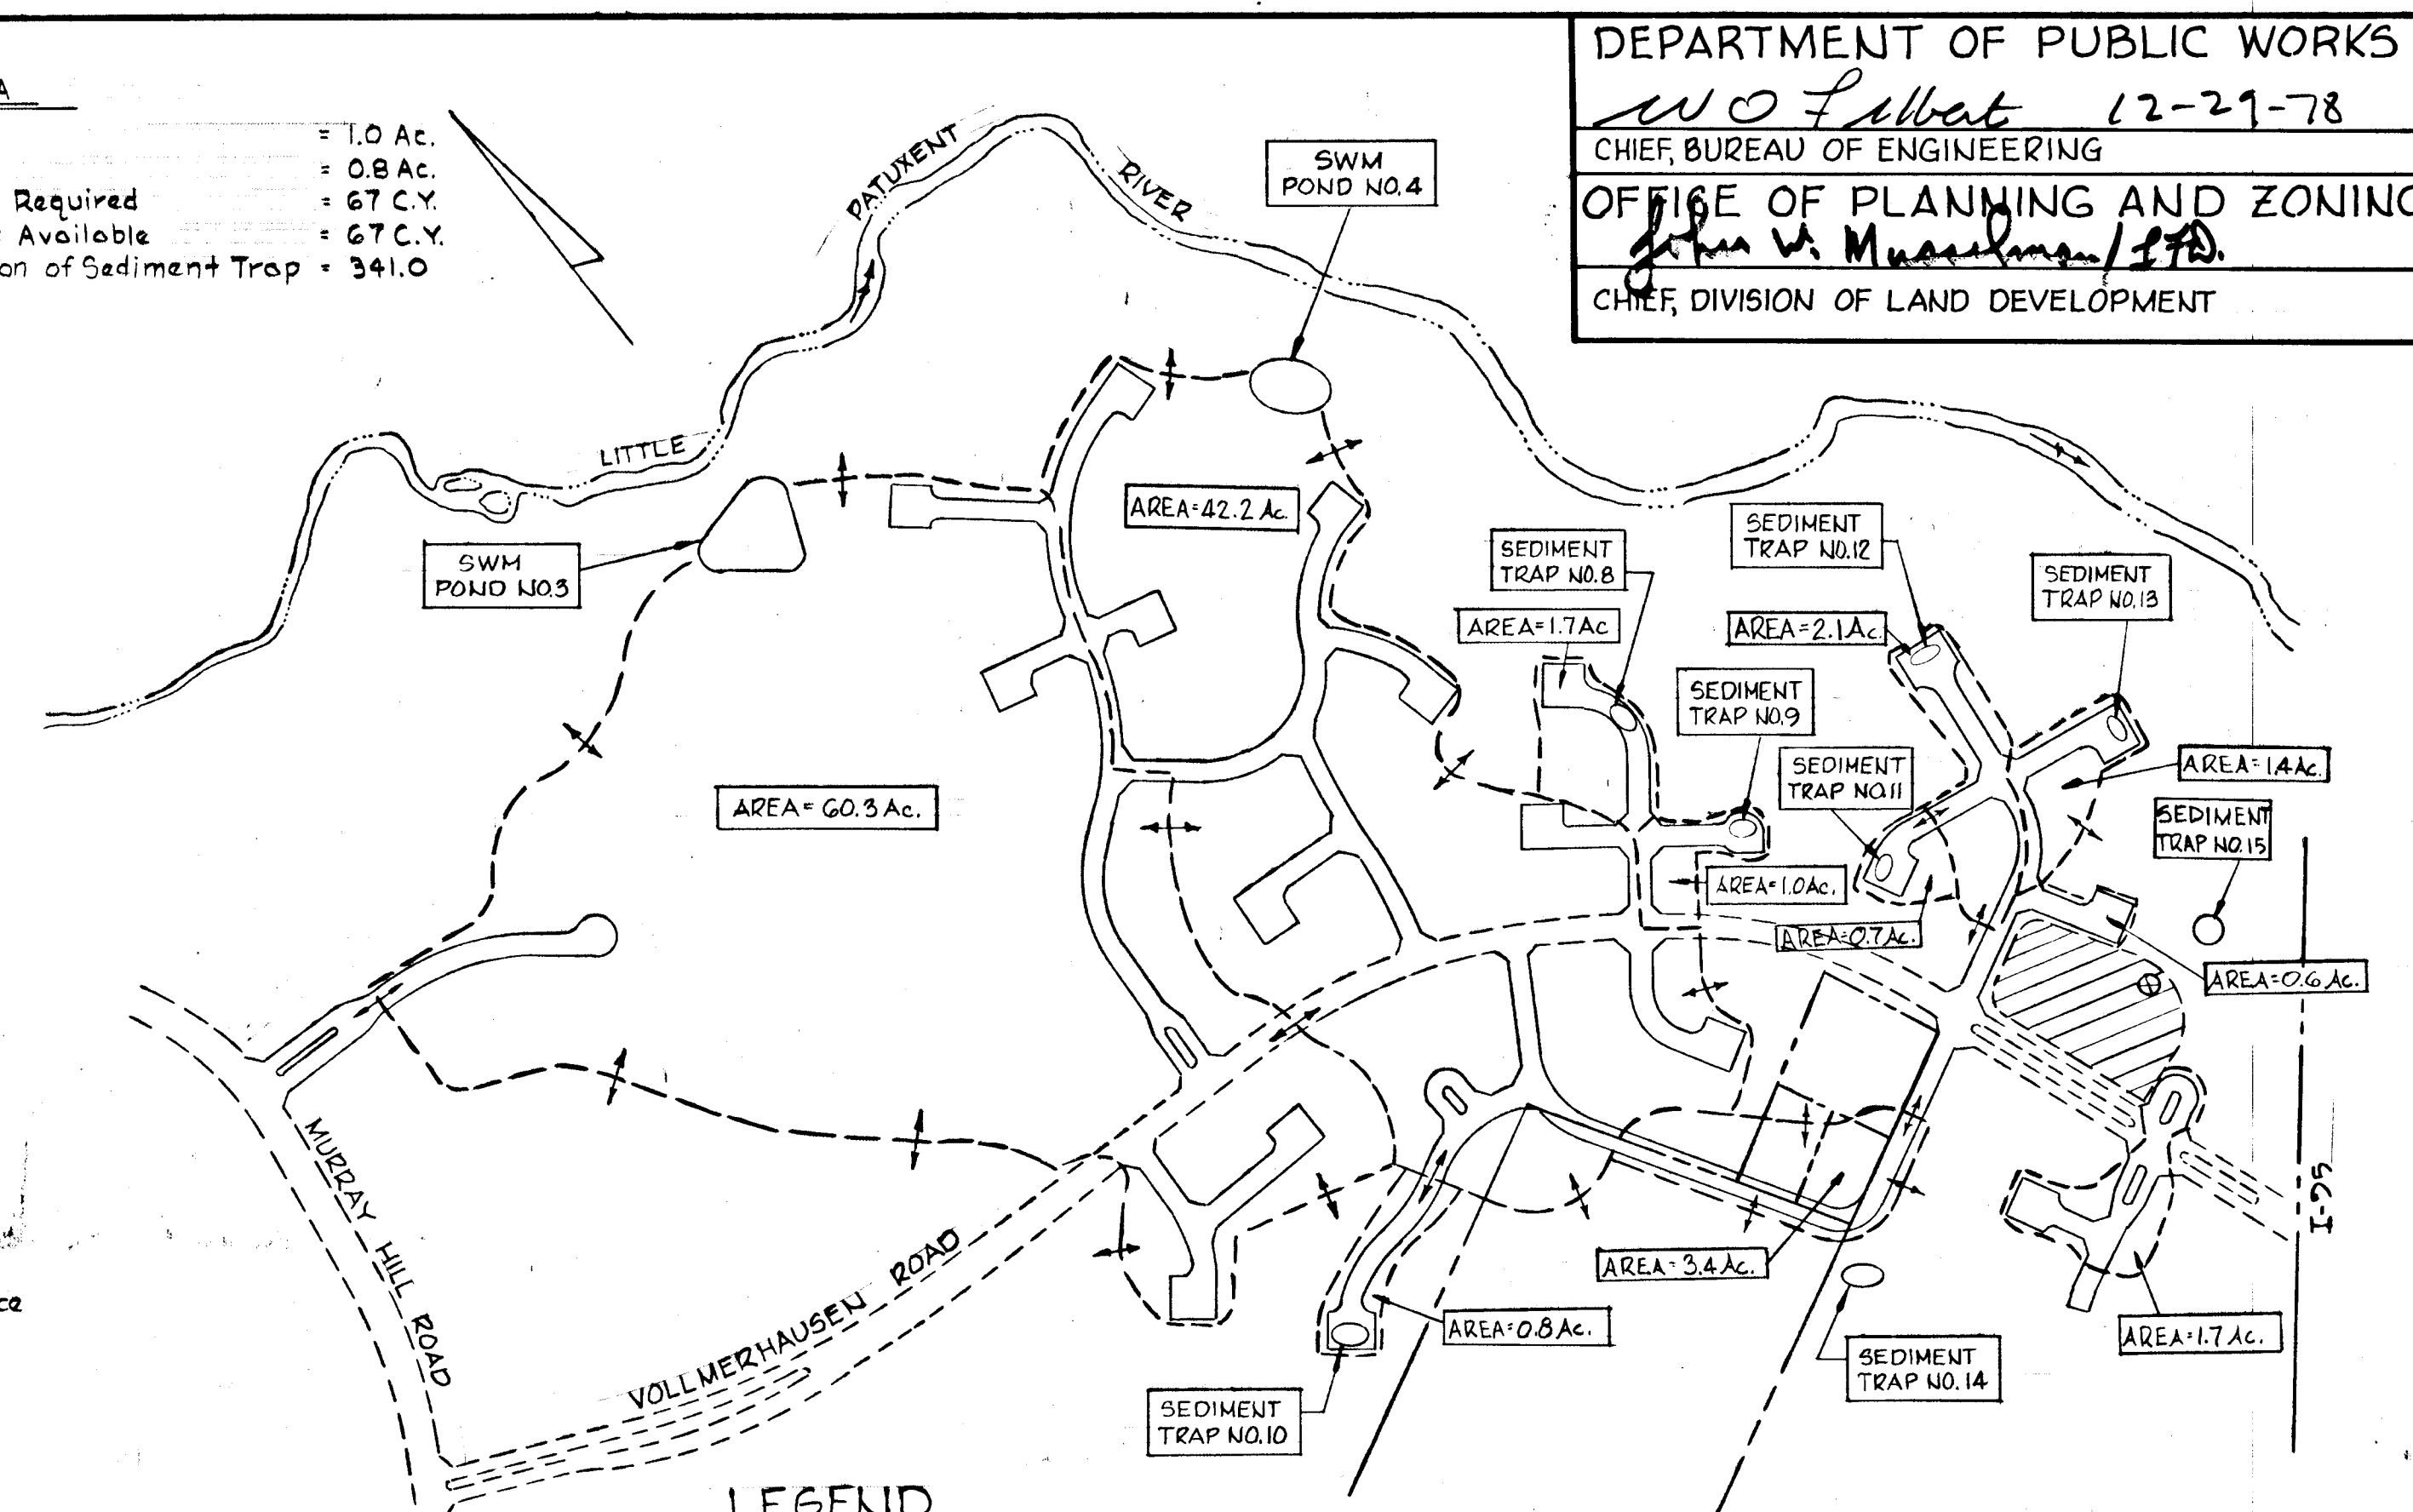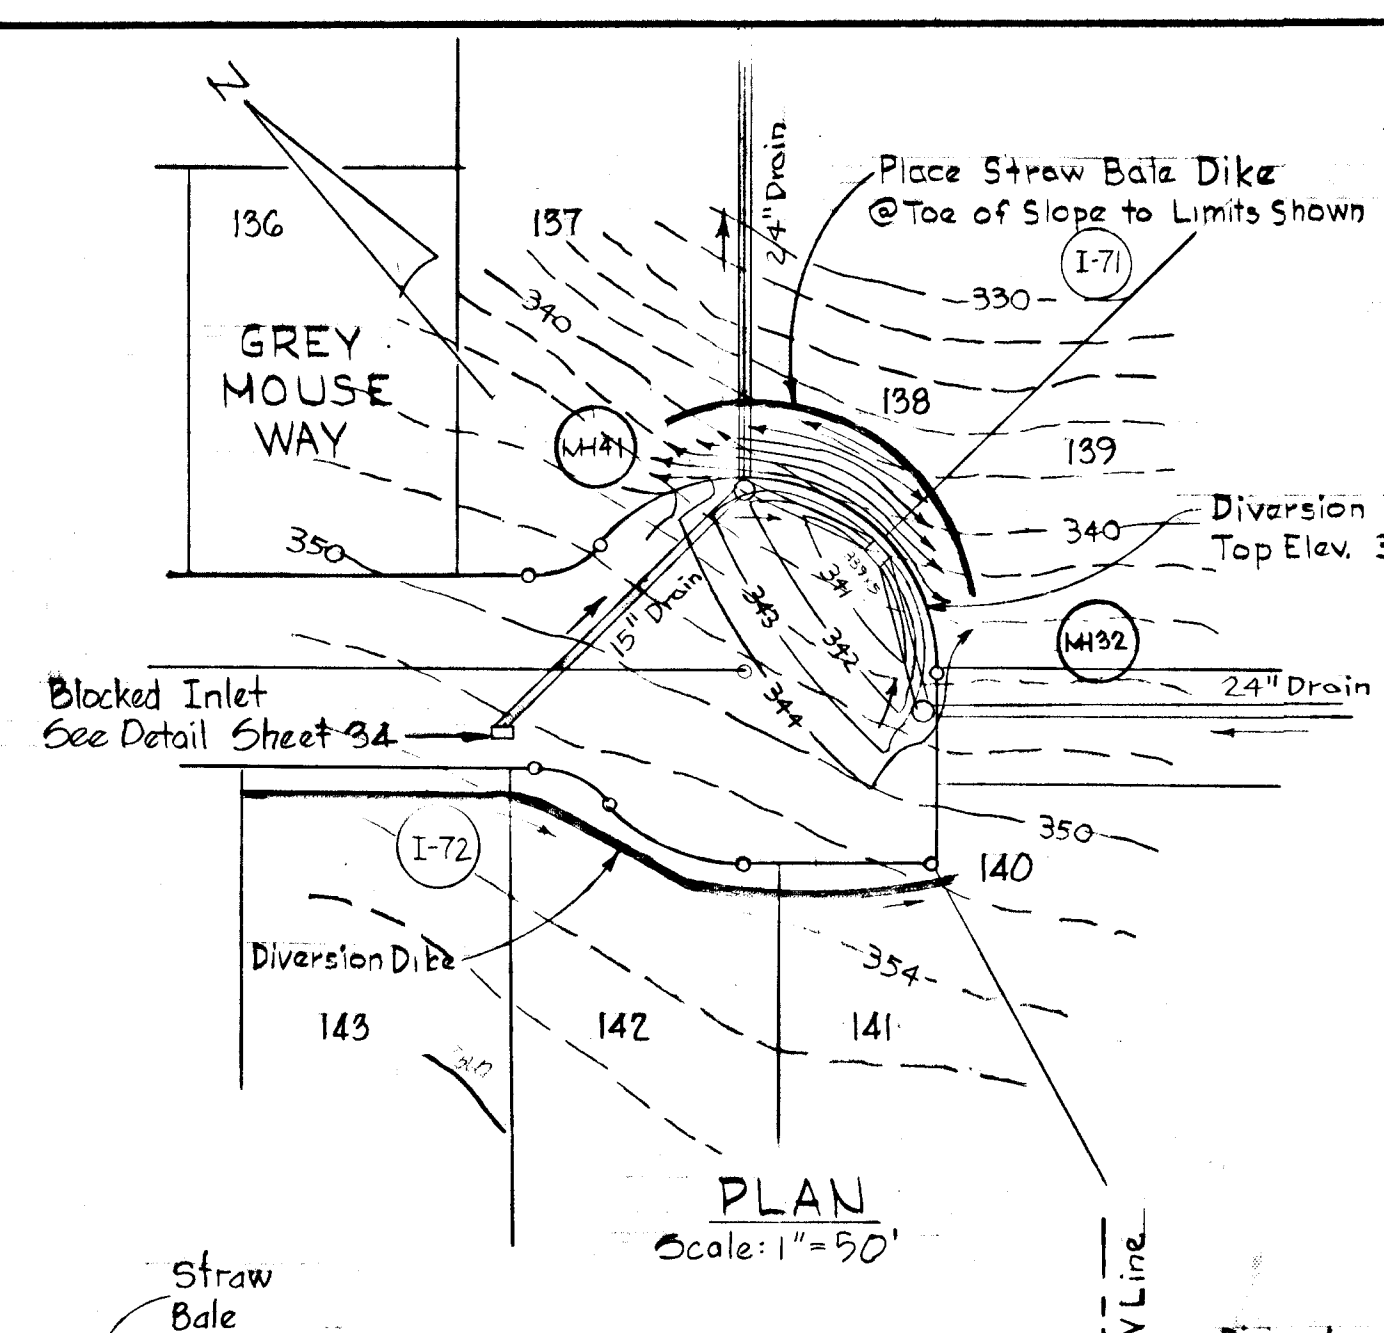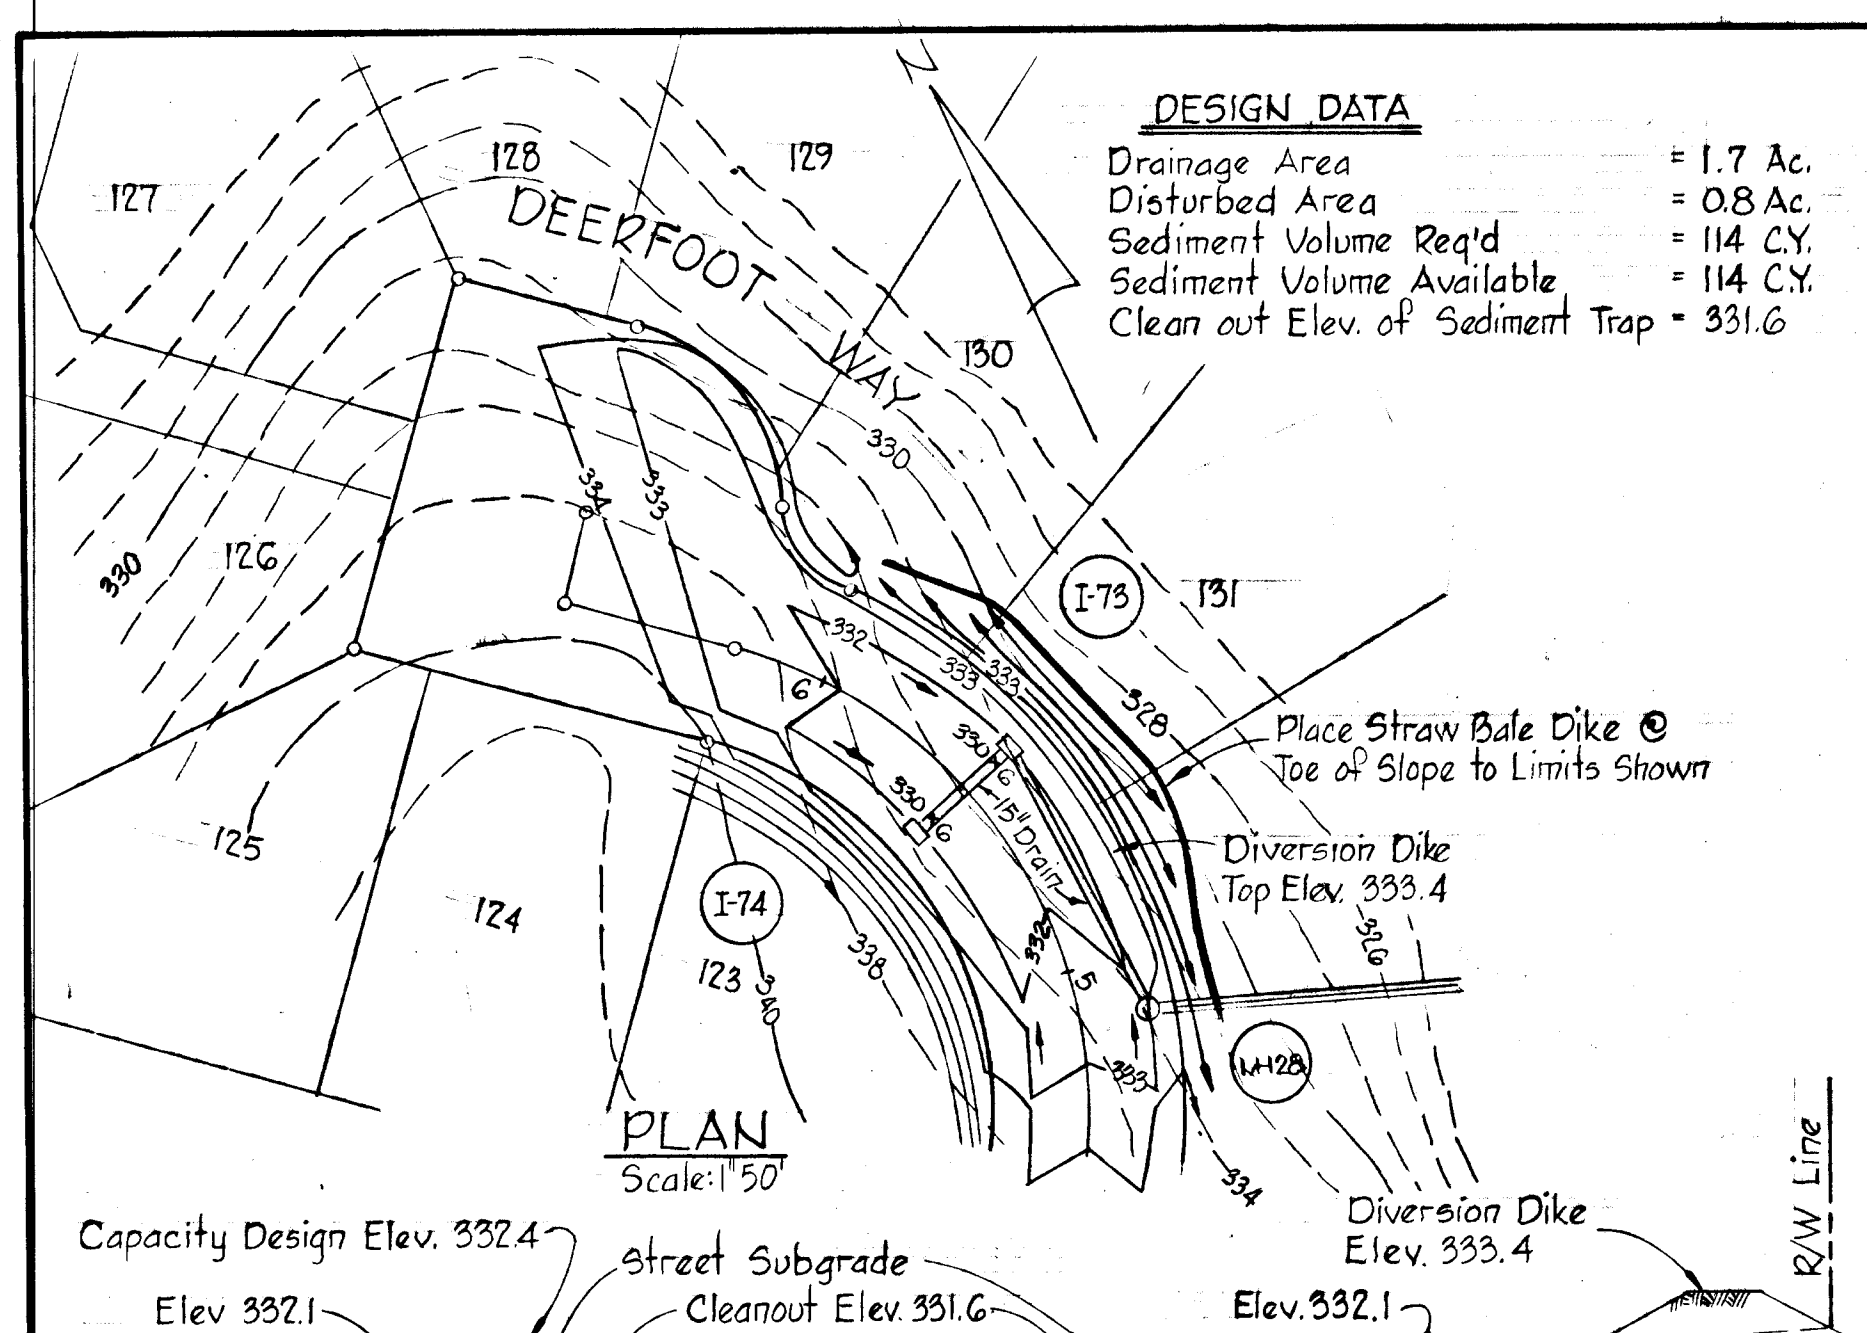

NOTE: ALL CONTOURS SHOWN WITHIN STREET PAVING AREAS DENOTE SUBGRADES

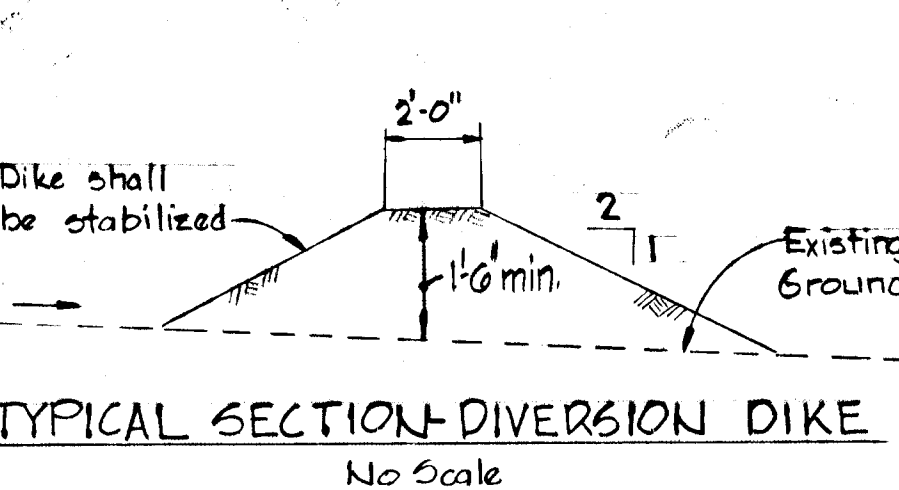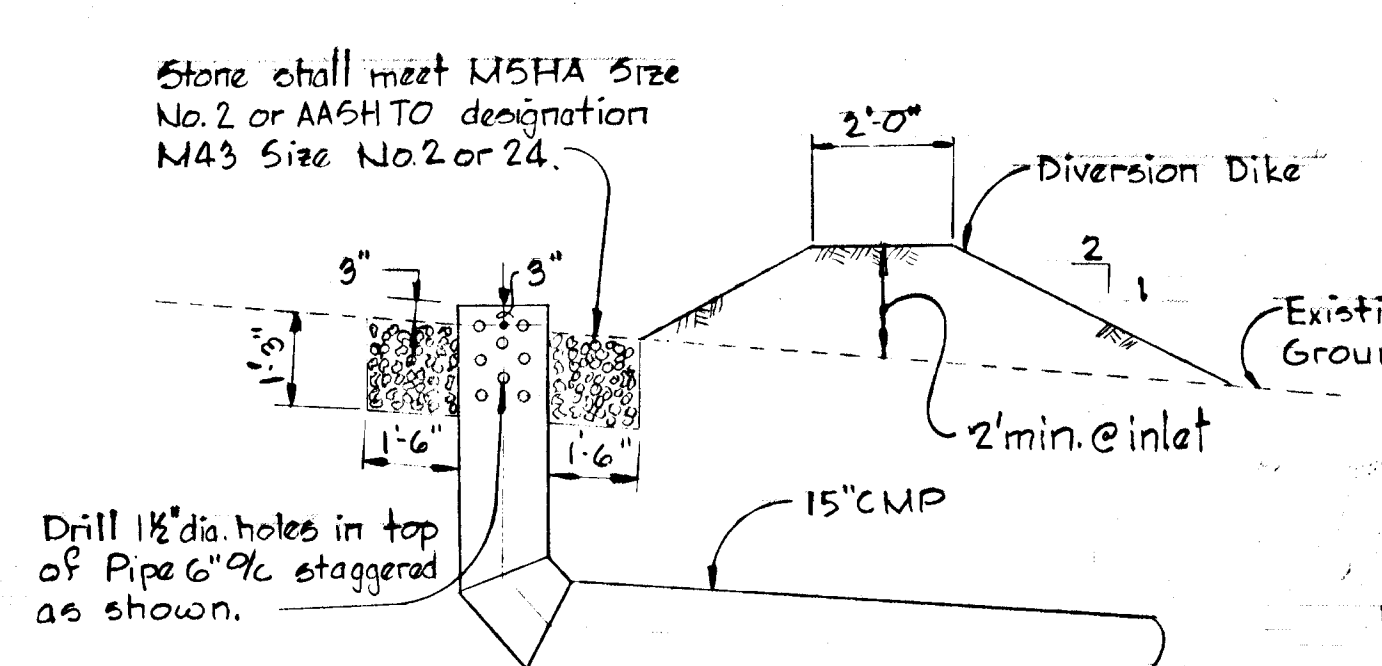

CLEAN WATER INLET Scale: 3/8"=1'-0"

TYPICAL SECTION - DIVERSION DIKE No Scale

**GENERAL NOTES**

1. See "Sequence of Construction" on Sheet 1.
2. Prior to starting any work, the Contractor shall notify the Howard Soil Conservation District at least 24 hours in advance of notice to begin.
3. The sediment control measures shall be constructed as shown on these drawings.
4. The storm water management ponds No. 3 and No. 4 are initially sediment basins. See sheets 35, 36 and 37 for details and specifications.
5. All diversion dikes shall be seeded as specified in notes 6 and 7. All other surfaces to be seeded shall be permanently seeded. See specifications on sheet 37.
6. The diversion dikes shall be hydroseeded as follows:
  - a. ground limestone - (50#/1000#), one ton/acre
  - b. fertilizer - 10-10-10 (25#/1000#), 1/2 ton/acre
  - c. Seed - Italian Ryegrass 40#/acre
7. Mulch with straw at the rate of 50#/1000# or one ton per acre. or mulch with asphalt at the rate of 400 gallons/acre.
8. Silt Fences may be substituted for straw bale dikes.

**CERTIFICATION BY THE DEVELOPER**

"I CERTIFY THAT ALL DEVELOPMENT AND OR CONSTRUCTION WILL BE DONE ACCORDING TO THIS PLAN OF DEVELOPMENT AND PLAN FOR EROSION AND SEDIMENT CONTROL, AND I ALSO AUTHORIZE PERIODIC ON-SITE INSPECTION BY THE HOWARD SOIL CONSERVATION DISTRICT OR THEIR AUTHORIZED AGENTS AS ARE DEEMED NECESSARY. DEVIATION FROM THIS PLAN WILL NOT BE MADE UNLESS AUTHORIZED BY THE HOWARD SOIL CONSERVATION DISTRICT."

*White Woodford* 9-2-78  
 SIGNATURE OF DEVELOPER DATE:

**CERTIFICATION BY THE ENGINEER**

"I CERTIFY THAT THIS PLAN FOR EROSION AND SEDIMENT CONTROL REPRESENTS A PRACTICAL AND WORKABLE PLAN BASED ON MY PERSONAL KNOWLEDGE OF THE SITE CONDITIONS AND THAT IT WAS PREPARED IN ACCORDANCE WITH THE REQUIREMENTS OF THE HOWARD SOIL CONSERVATION DISTRICT."

*Kenneth A. McCord* 9-2-78  
 KENNETH A. McCORD P.E. 1974 DATE:

THIS PLAN HAS BEEN REVIEWED BY THE HOWARD SOIL CONSERVATION DISTRICT AND MEETS THE TECHNICAL REQUIREMENTS FOR SOIL EROSION AND SEDIMENT CONTROL.










*C. Wayne Ray* 12/21/78  
 U.S. SOIL CONSERVATION DISTRICT DATE:

THIS PLAN FOR SOIL EROSION AND SEDIMENT CONTROL MEETS THE REQUIREMENTS OF THE HOWARD SOIL CONSERVATION DISTRICT.

*Howard S. G.D.* 12/21/78  
 APPROVED: HOWARD S.G.D. DATE:  
 PLAN NUMBER

REV. DATE	REV. NO.	REVISION DESCRIPTION
<b>COLUMBIA</b>		
8TH. ELECTION DISTRICT HOWARD COUNTY, MARYLAND		
OWNER AND DEVELOPER HOWARD RESEARCH AND DEVELOPMENT CORP.		
PROJECT AREA VILLAGE OF KINGS CONTRIVANCE		
SECTION 3 AREA 1		
PROJECT TITLE TEMPORARY SEDIMENT TRAPS NO. 8 THRU NO. 10 AND DETAILS		
SCALE: As Shown		DATE:
WHITMAN, REQUARDT & ASSOCIATES ENGINEERS BALTIMORE, MARYLAND 21202		
<i>Kenneth A. McCord</i> KENNETH A. McCORD REGISTERED ENGINEER NO. 1974		






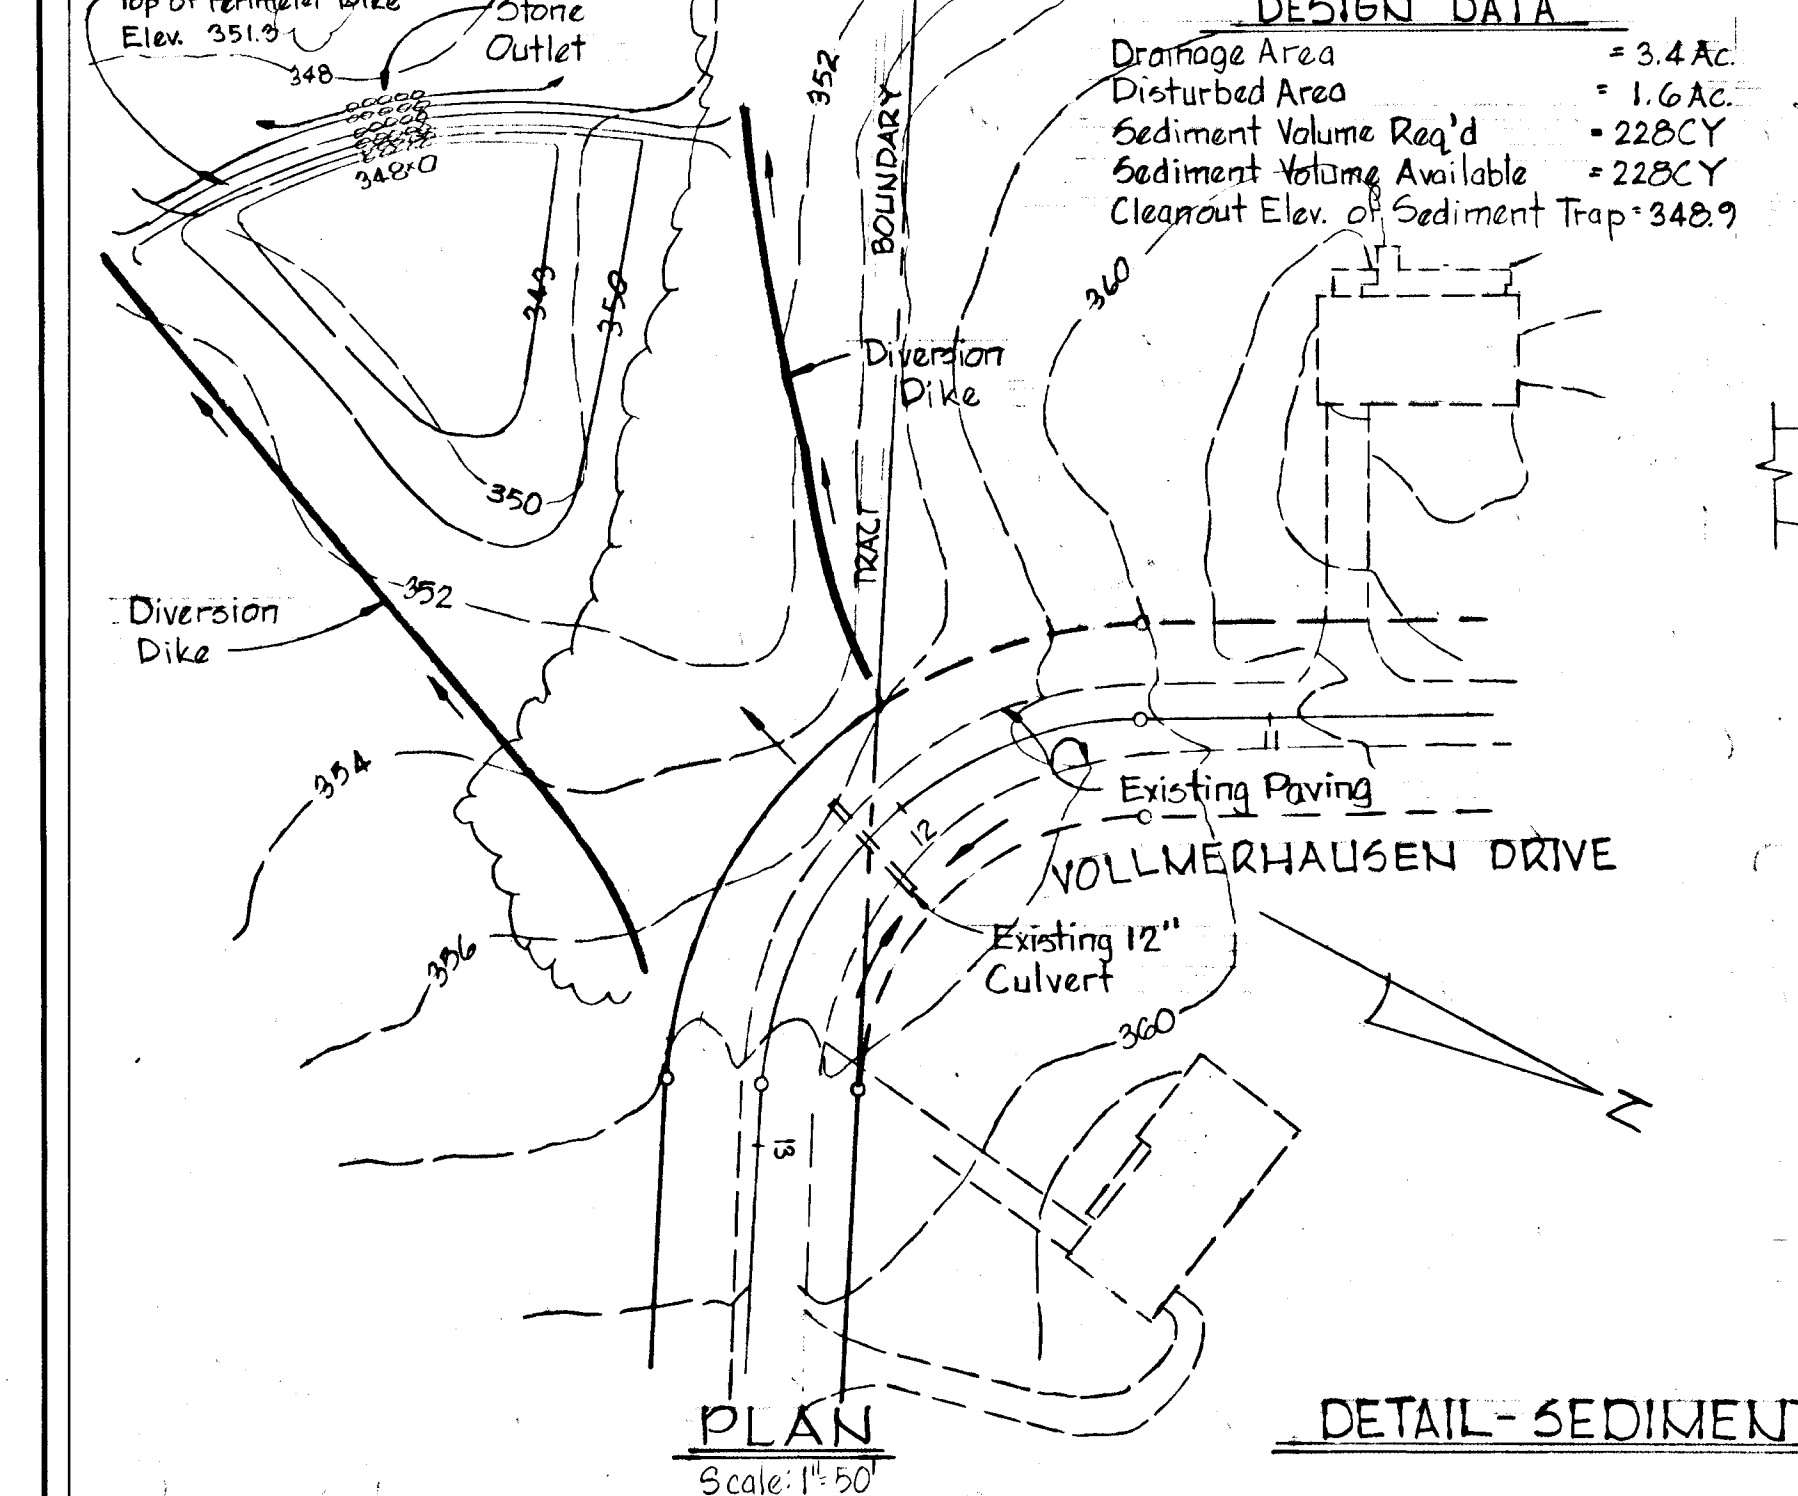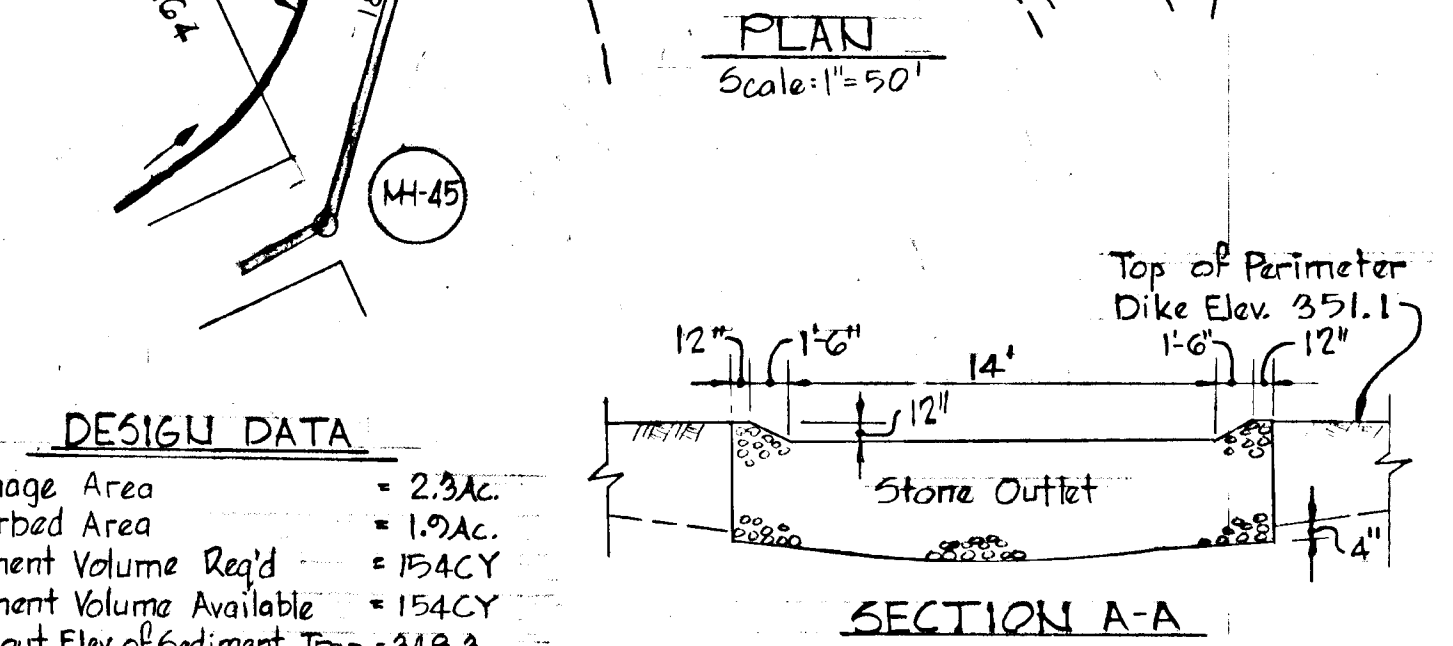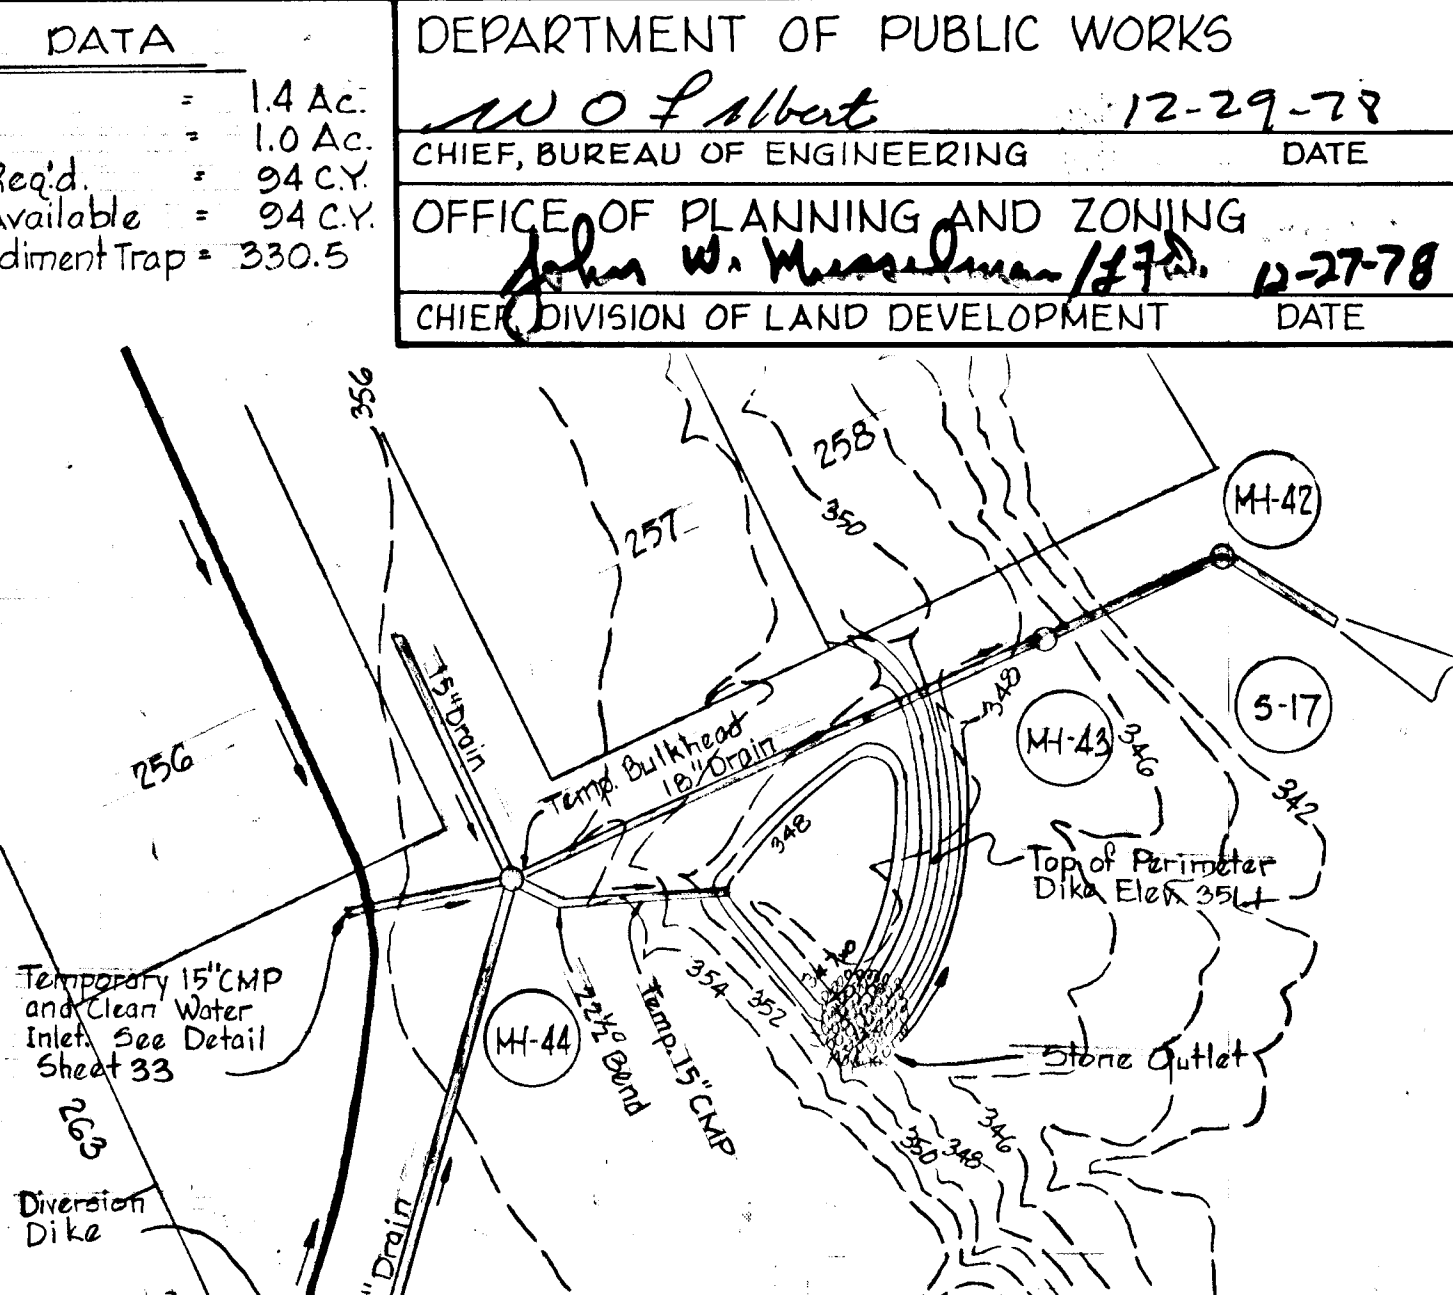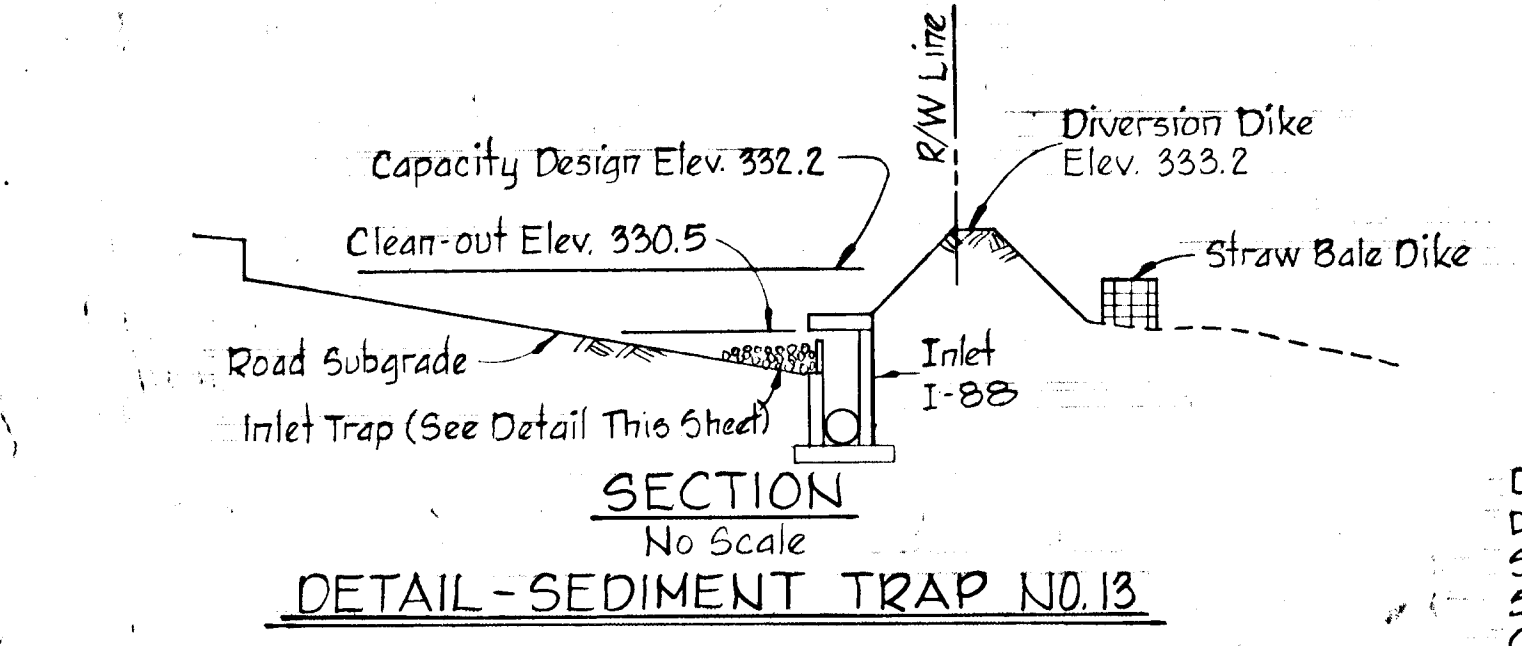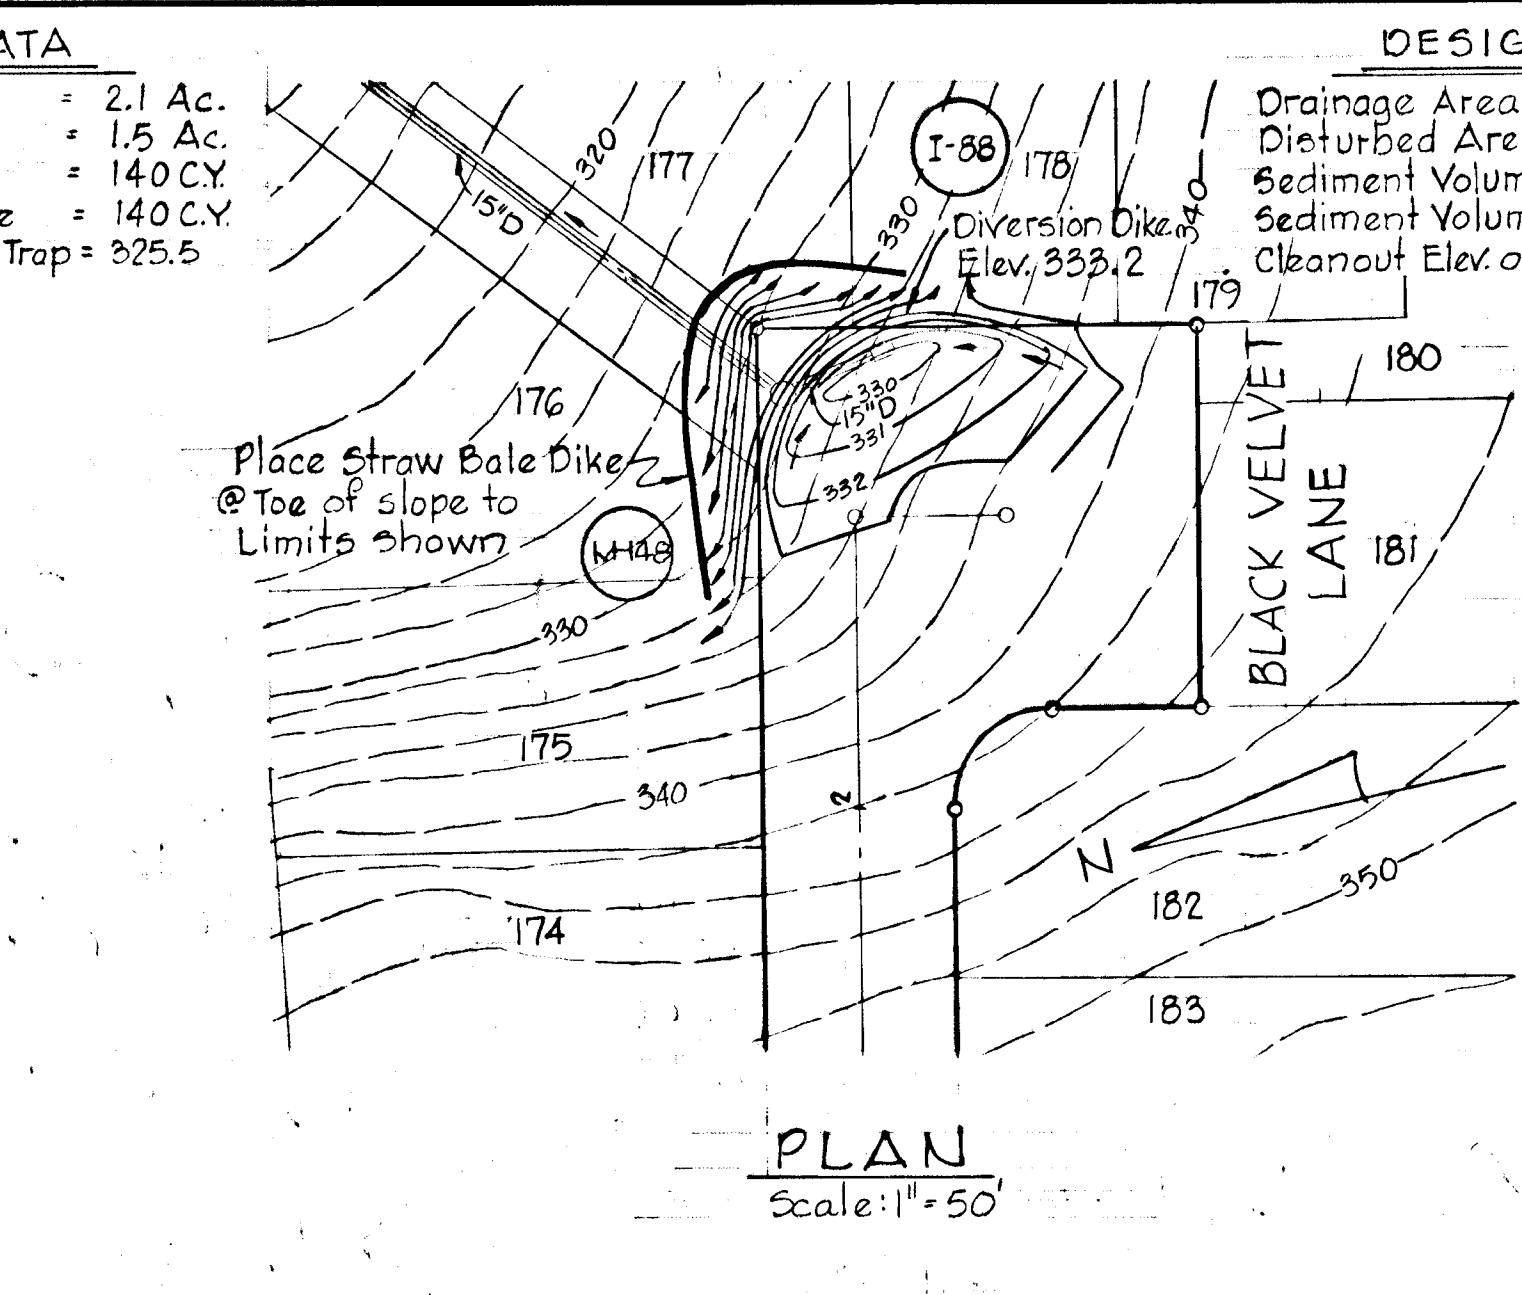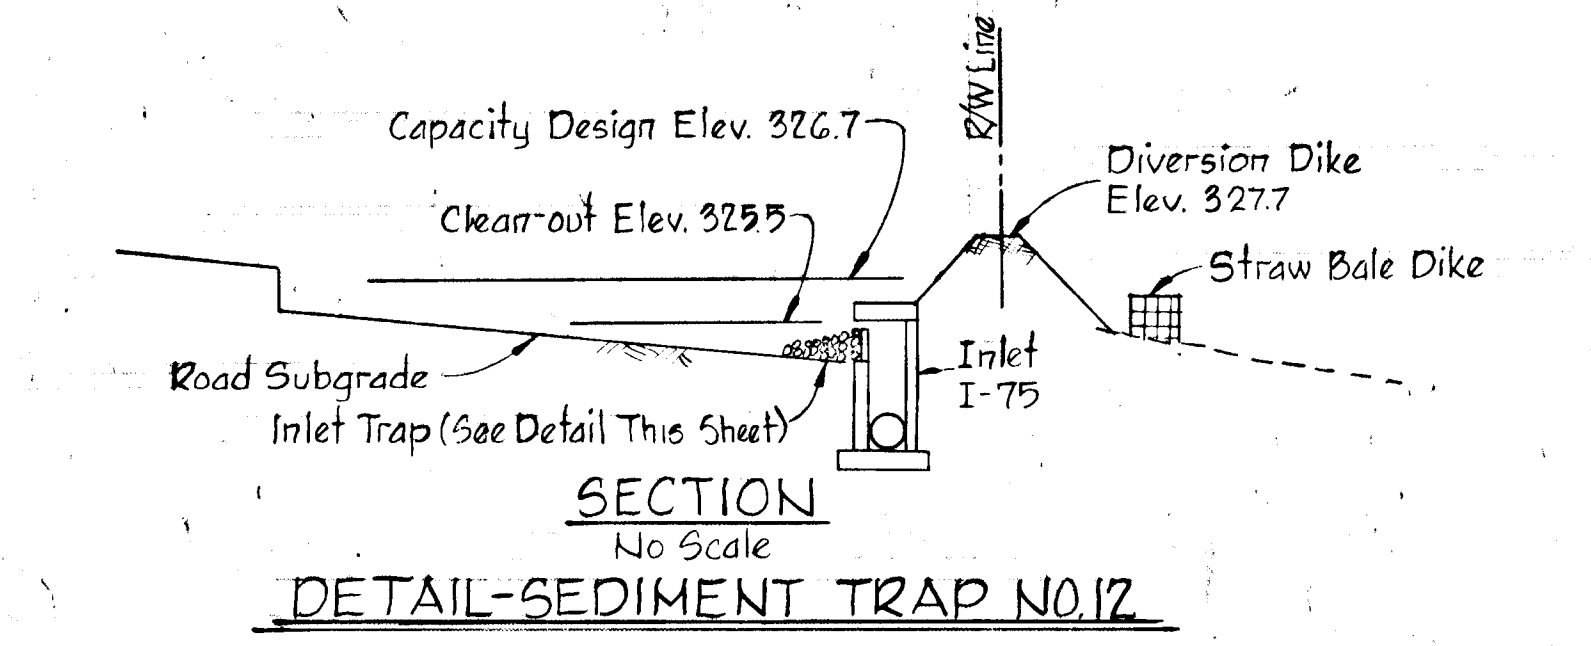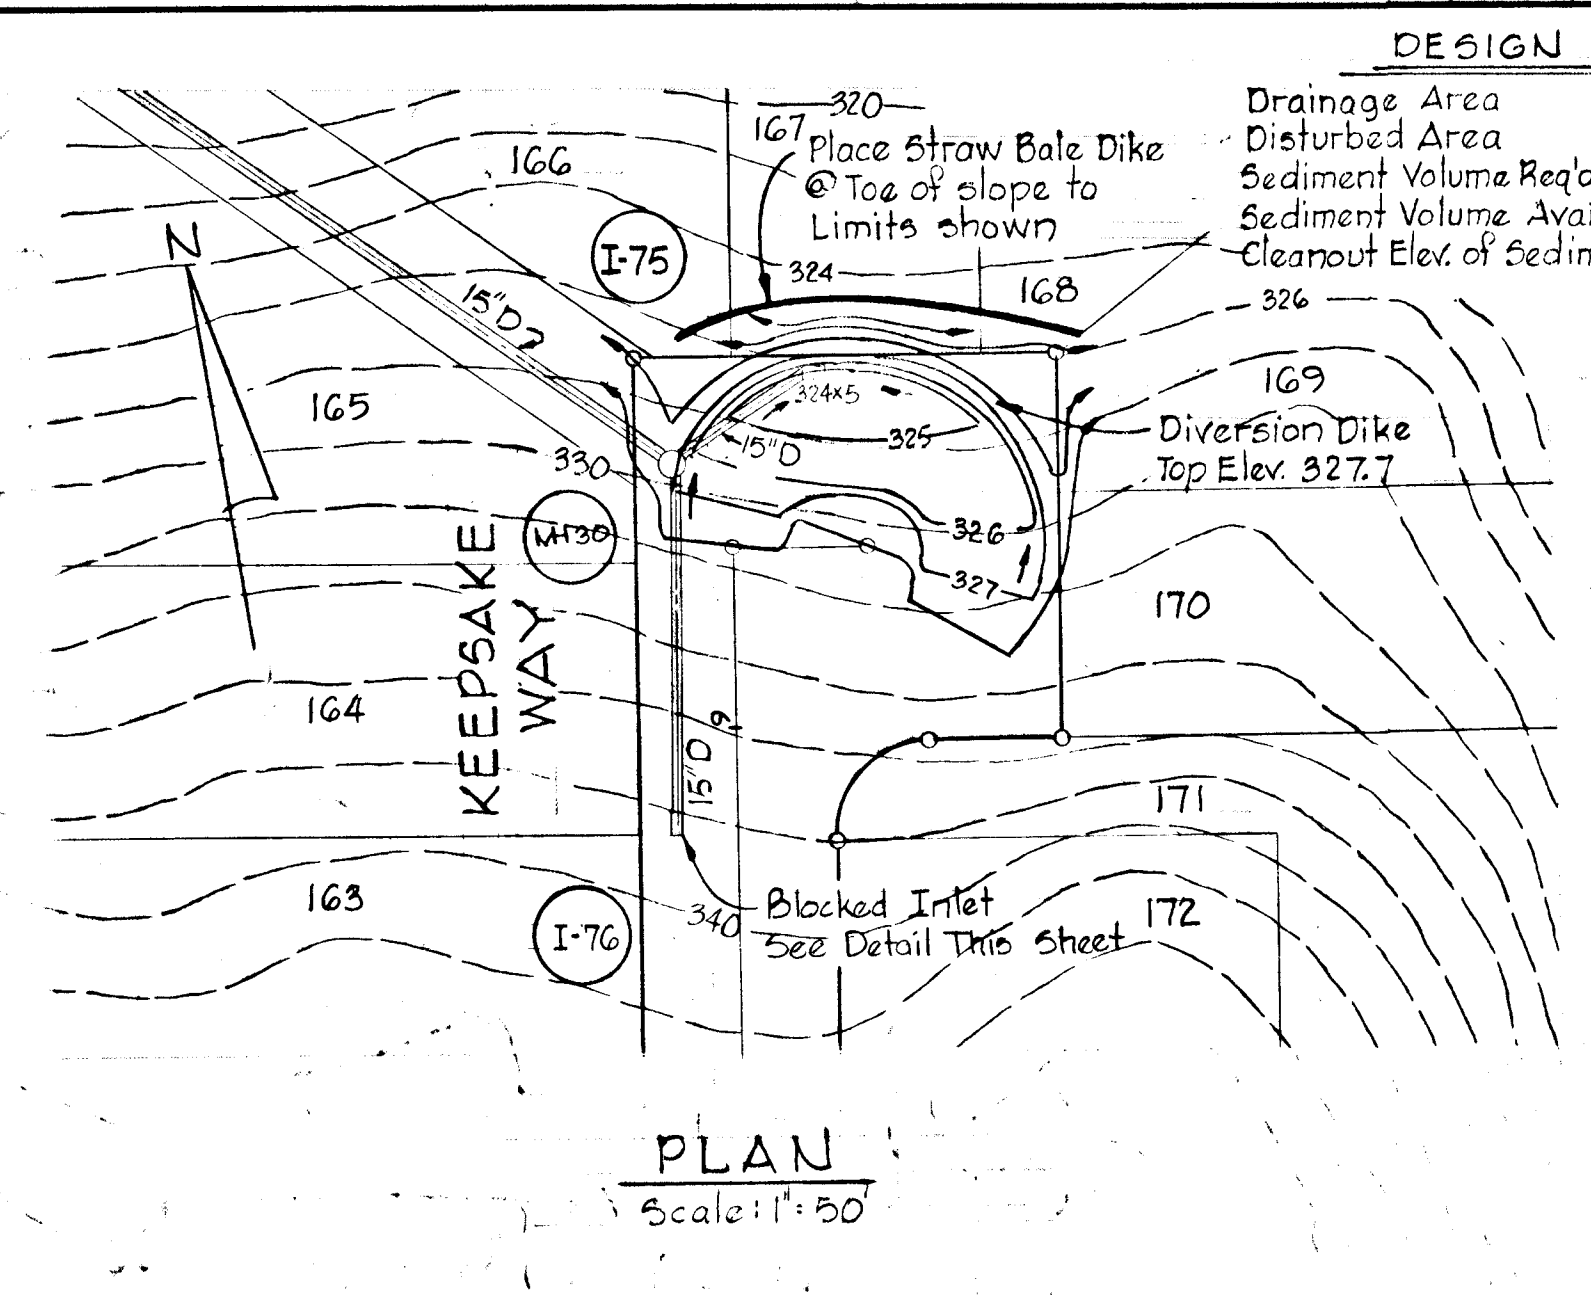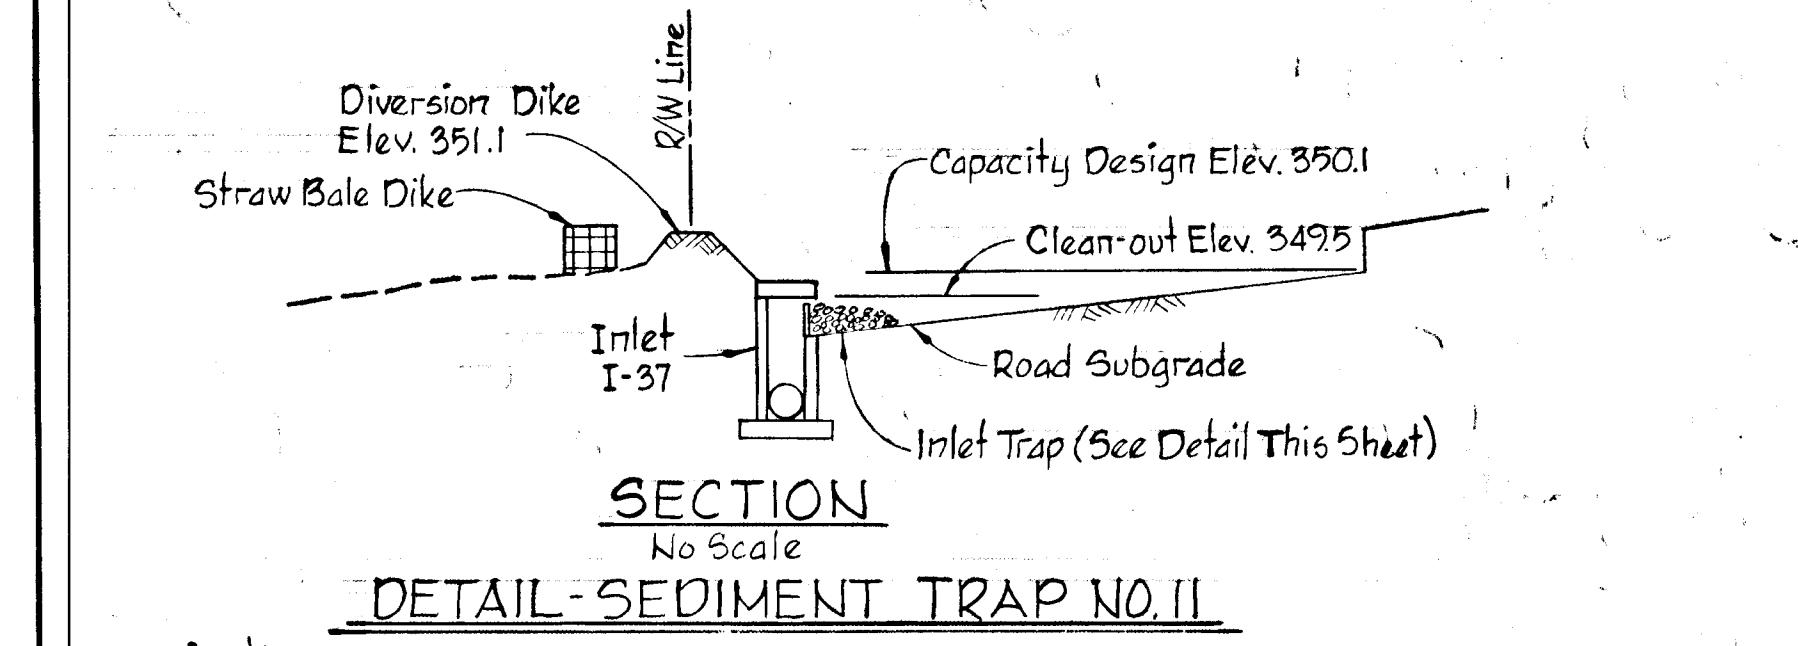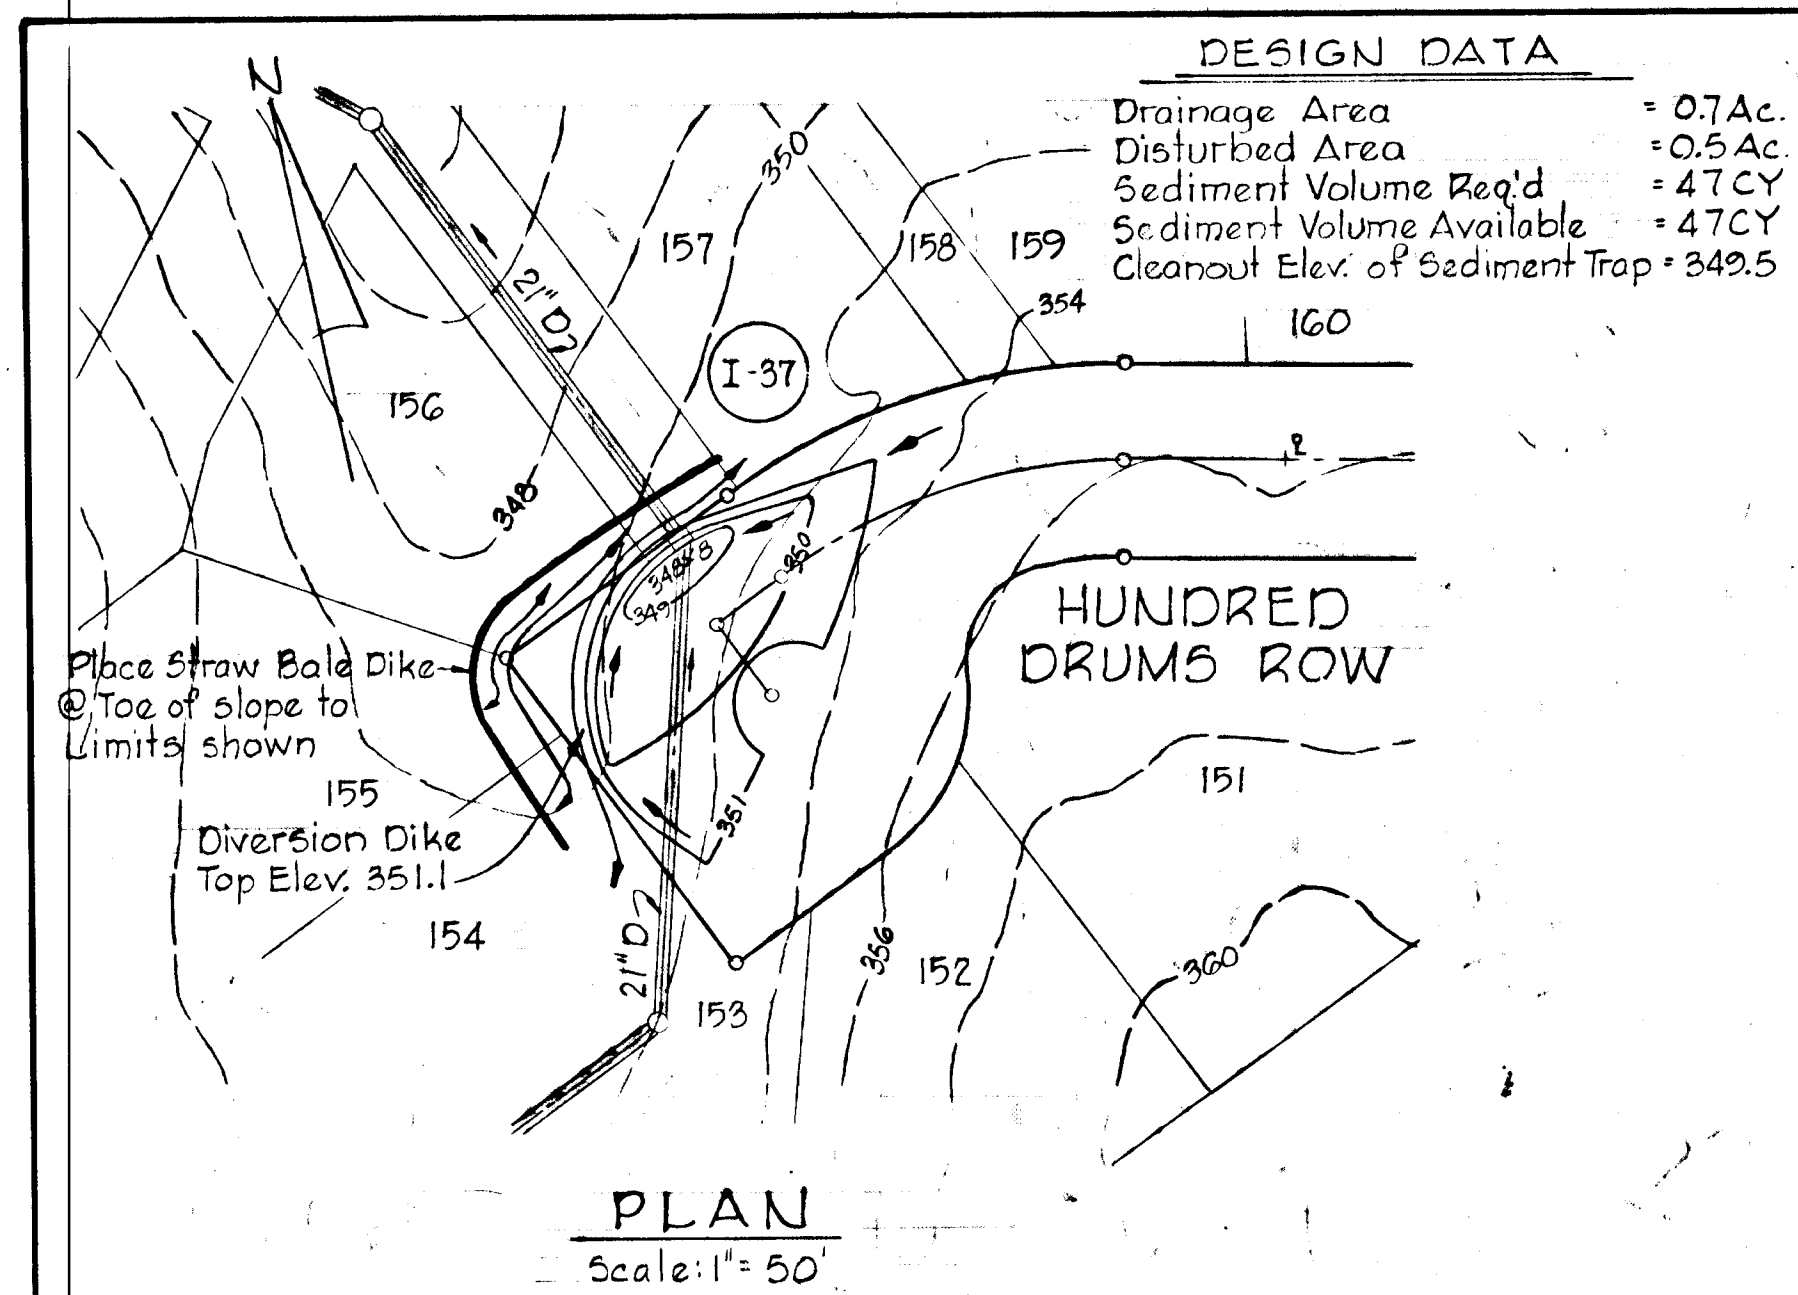

**CERTIFICATION BY THE DEVELOPER**


"I CERTIFY THAT ALL DEVELOPMENT AND OR CONSTRUCTION WILL BE DONE ACCORDING TO THIS PLAN OF DEVELOPMENT AND PLAN FOR EROSION AND SEDIMENT CONTROL, AND I ALSO AUTHORIZE PERIODIC ON-SITE INSPECTION BY THE HOWARD SOIL CONSERVATION DISTRICT OR THEIR AUTHORIZED AGENTS AS ARE DEEMED NECESSARY. DEVIATION FROM THIS PLAN WILL NOT BE MADE UNLESS AUTHORIZED BY THE HOWARD SOIL CONSERVATION DISTRICT."

*W.E. Wood* 9-2-78  
 SIGNATURE OF DEVELOPER DATE:

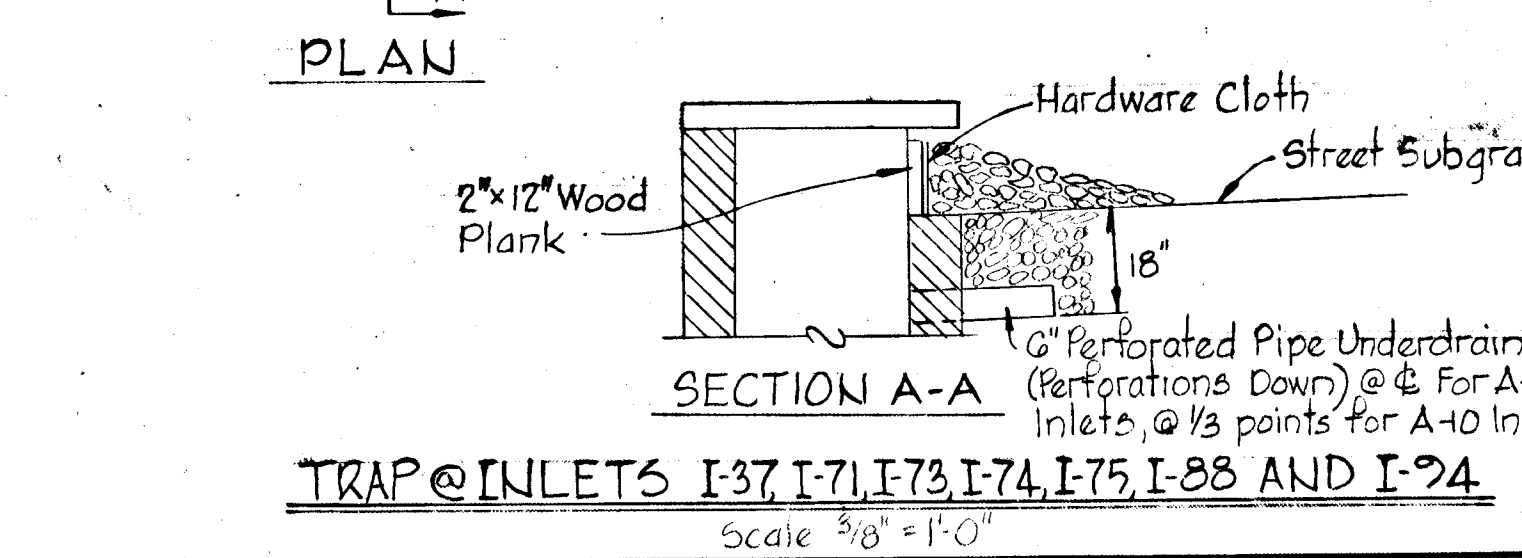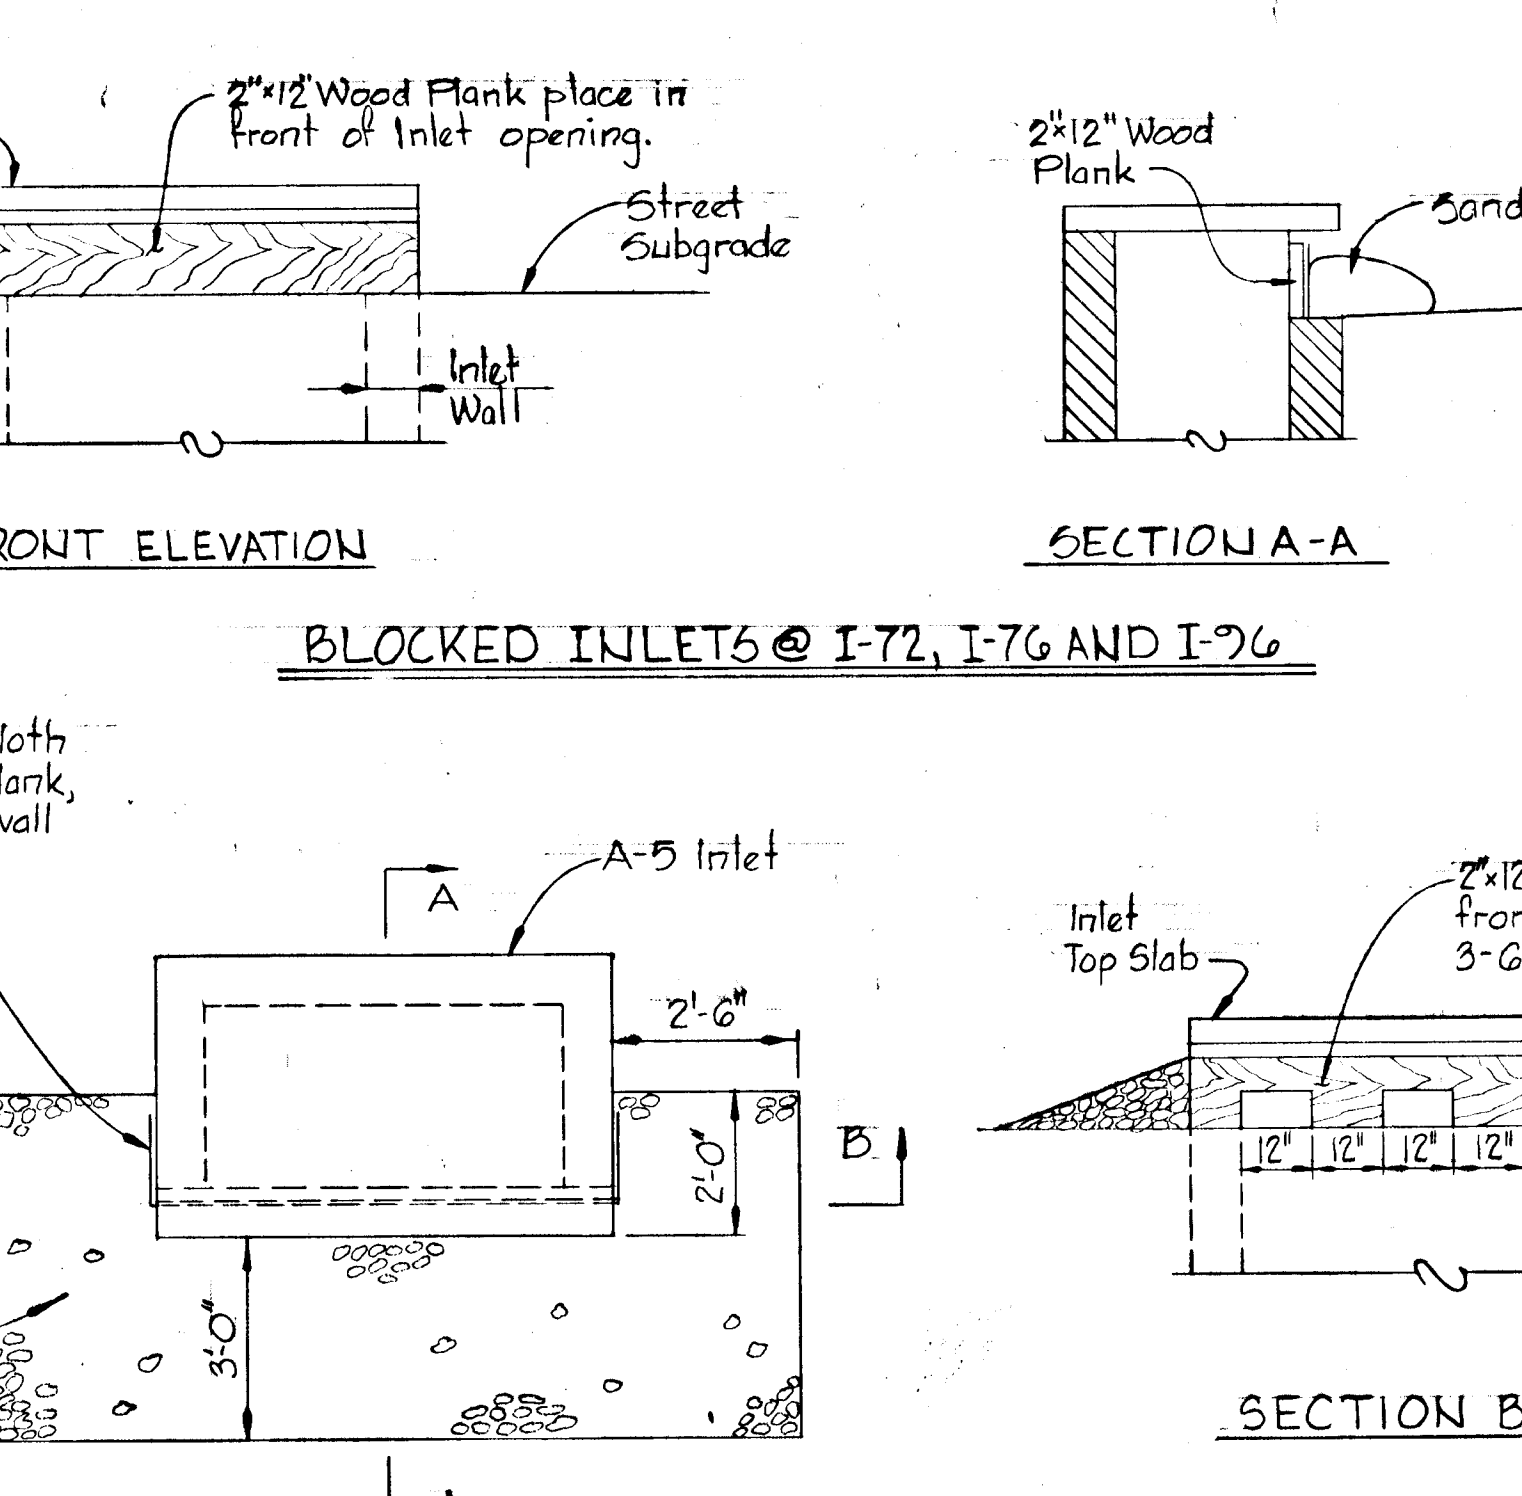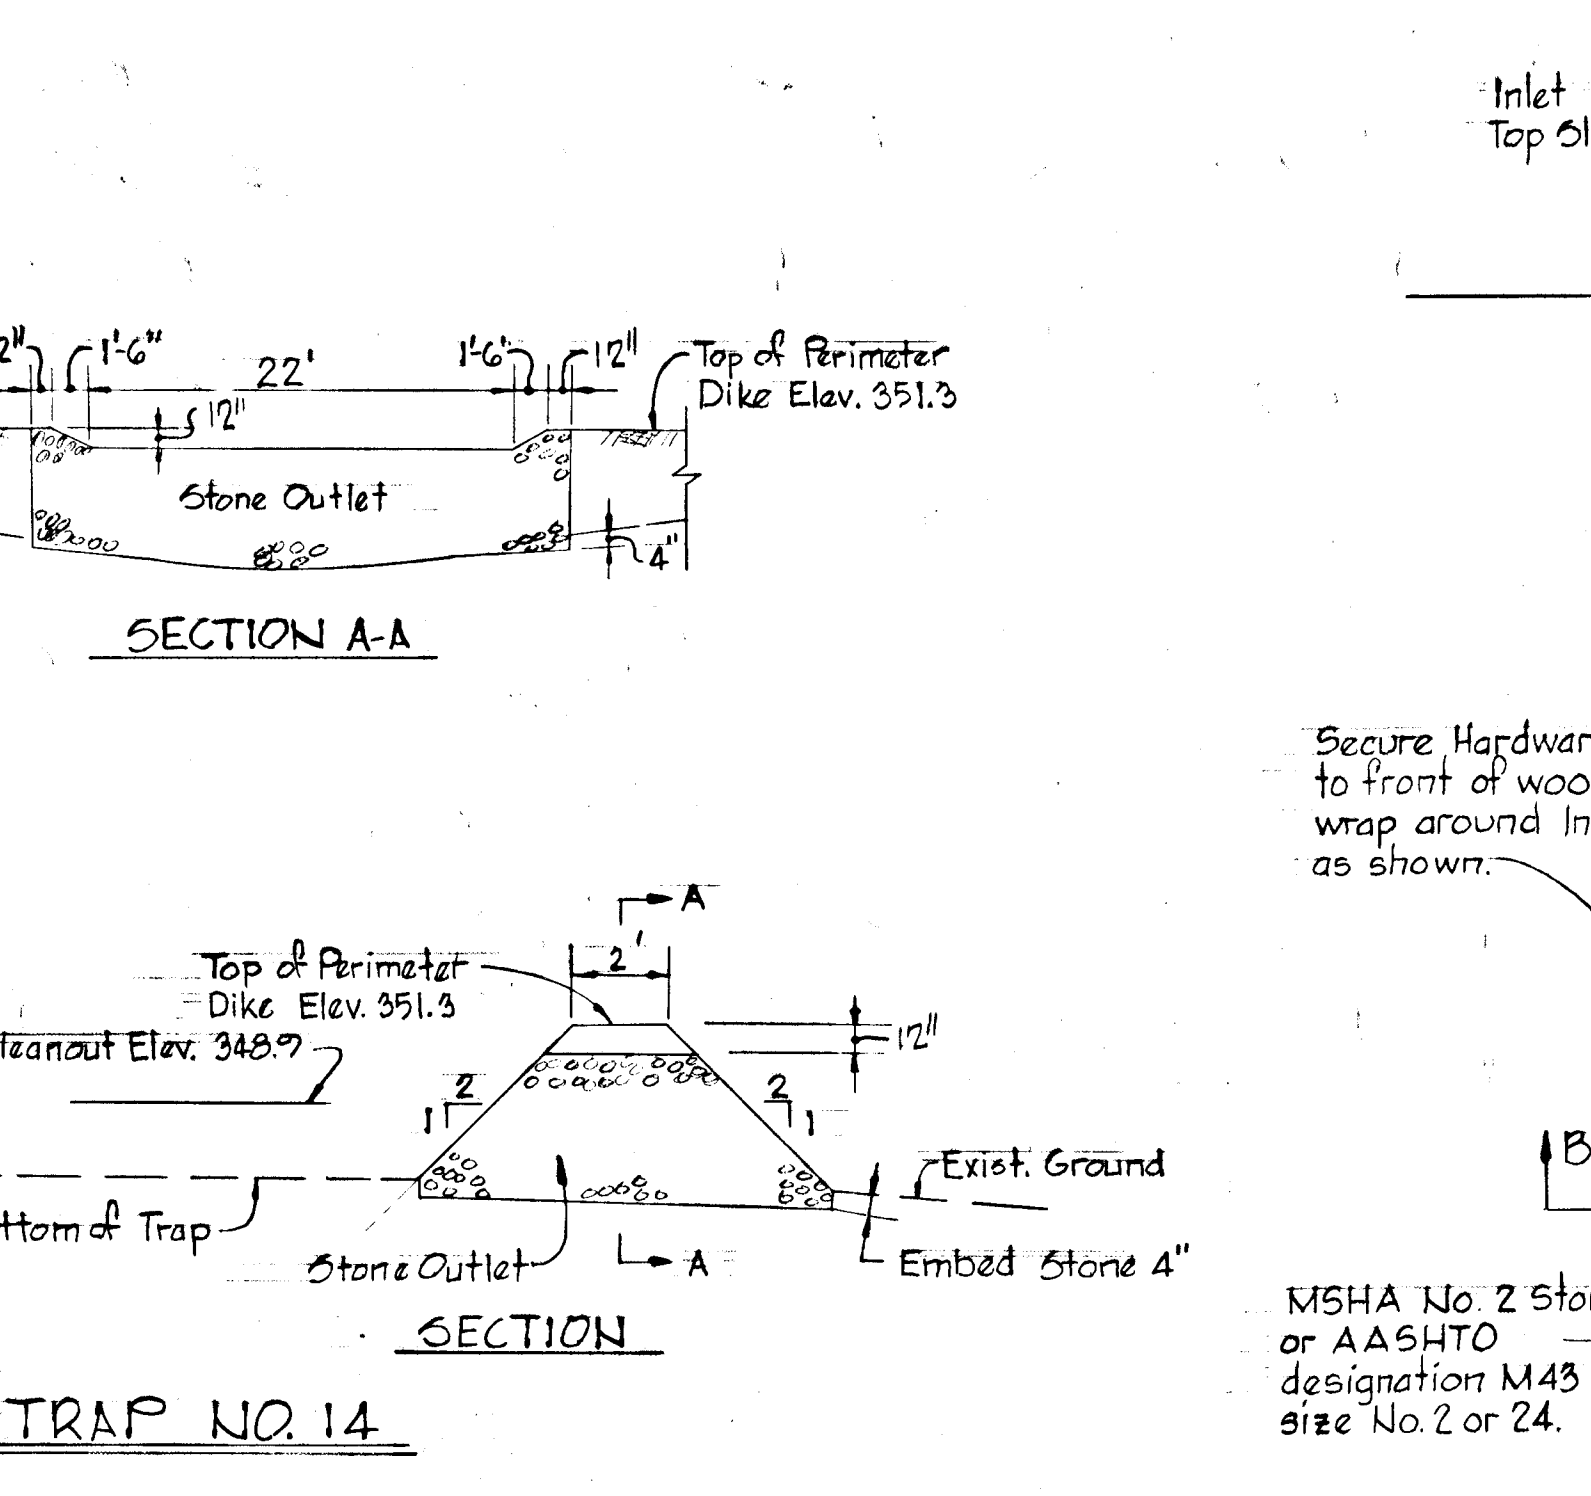

REV. DATE	REV. NO.	REVISION DESCRIPTION
<b>COLUMBIA</b>		
8TH ELECTION DISTRICT HOWARD COUNTY, MARYLAND		
OWNER AND DEVELOPER HOWARD RESEARCH AND DEVELOPMENT CORP.		
PROJECT AREA VILLAGE OF KINGS CONTRIVANCE SECTION 3 AREA 1		
PROJECT TITLE TEMPORARY SEDIMENT TRAPS NO. 11 THRU NO. 15 AND DETAILS		
SCALE: AS SHOWN		DATE:
WHITMAN REQUARDT & ASSOCIATES ENGINEERS BALTIMORE, MARYLAND 21202		
<i>Kenneth A. McCord</i> KENNETH A. MCCORD REGISTERED ENGINEER NO. 1974		



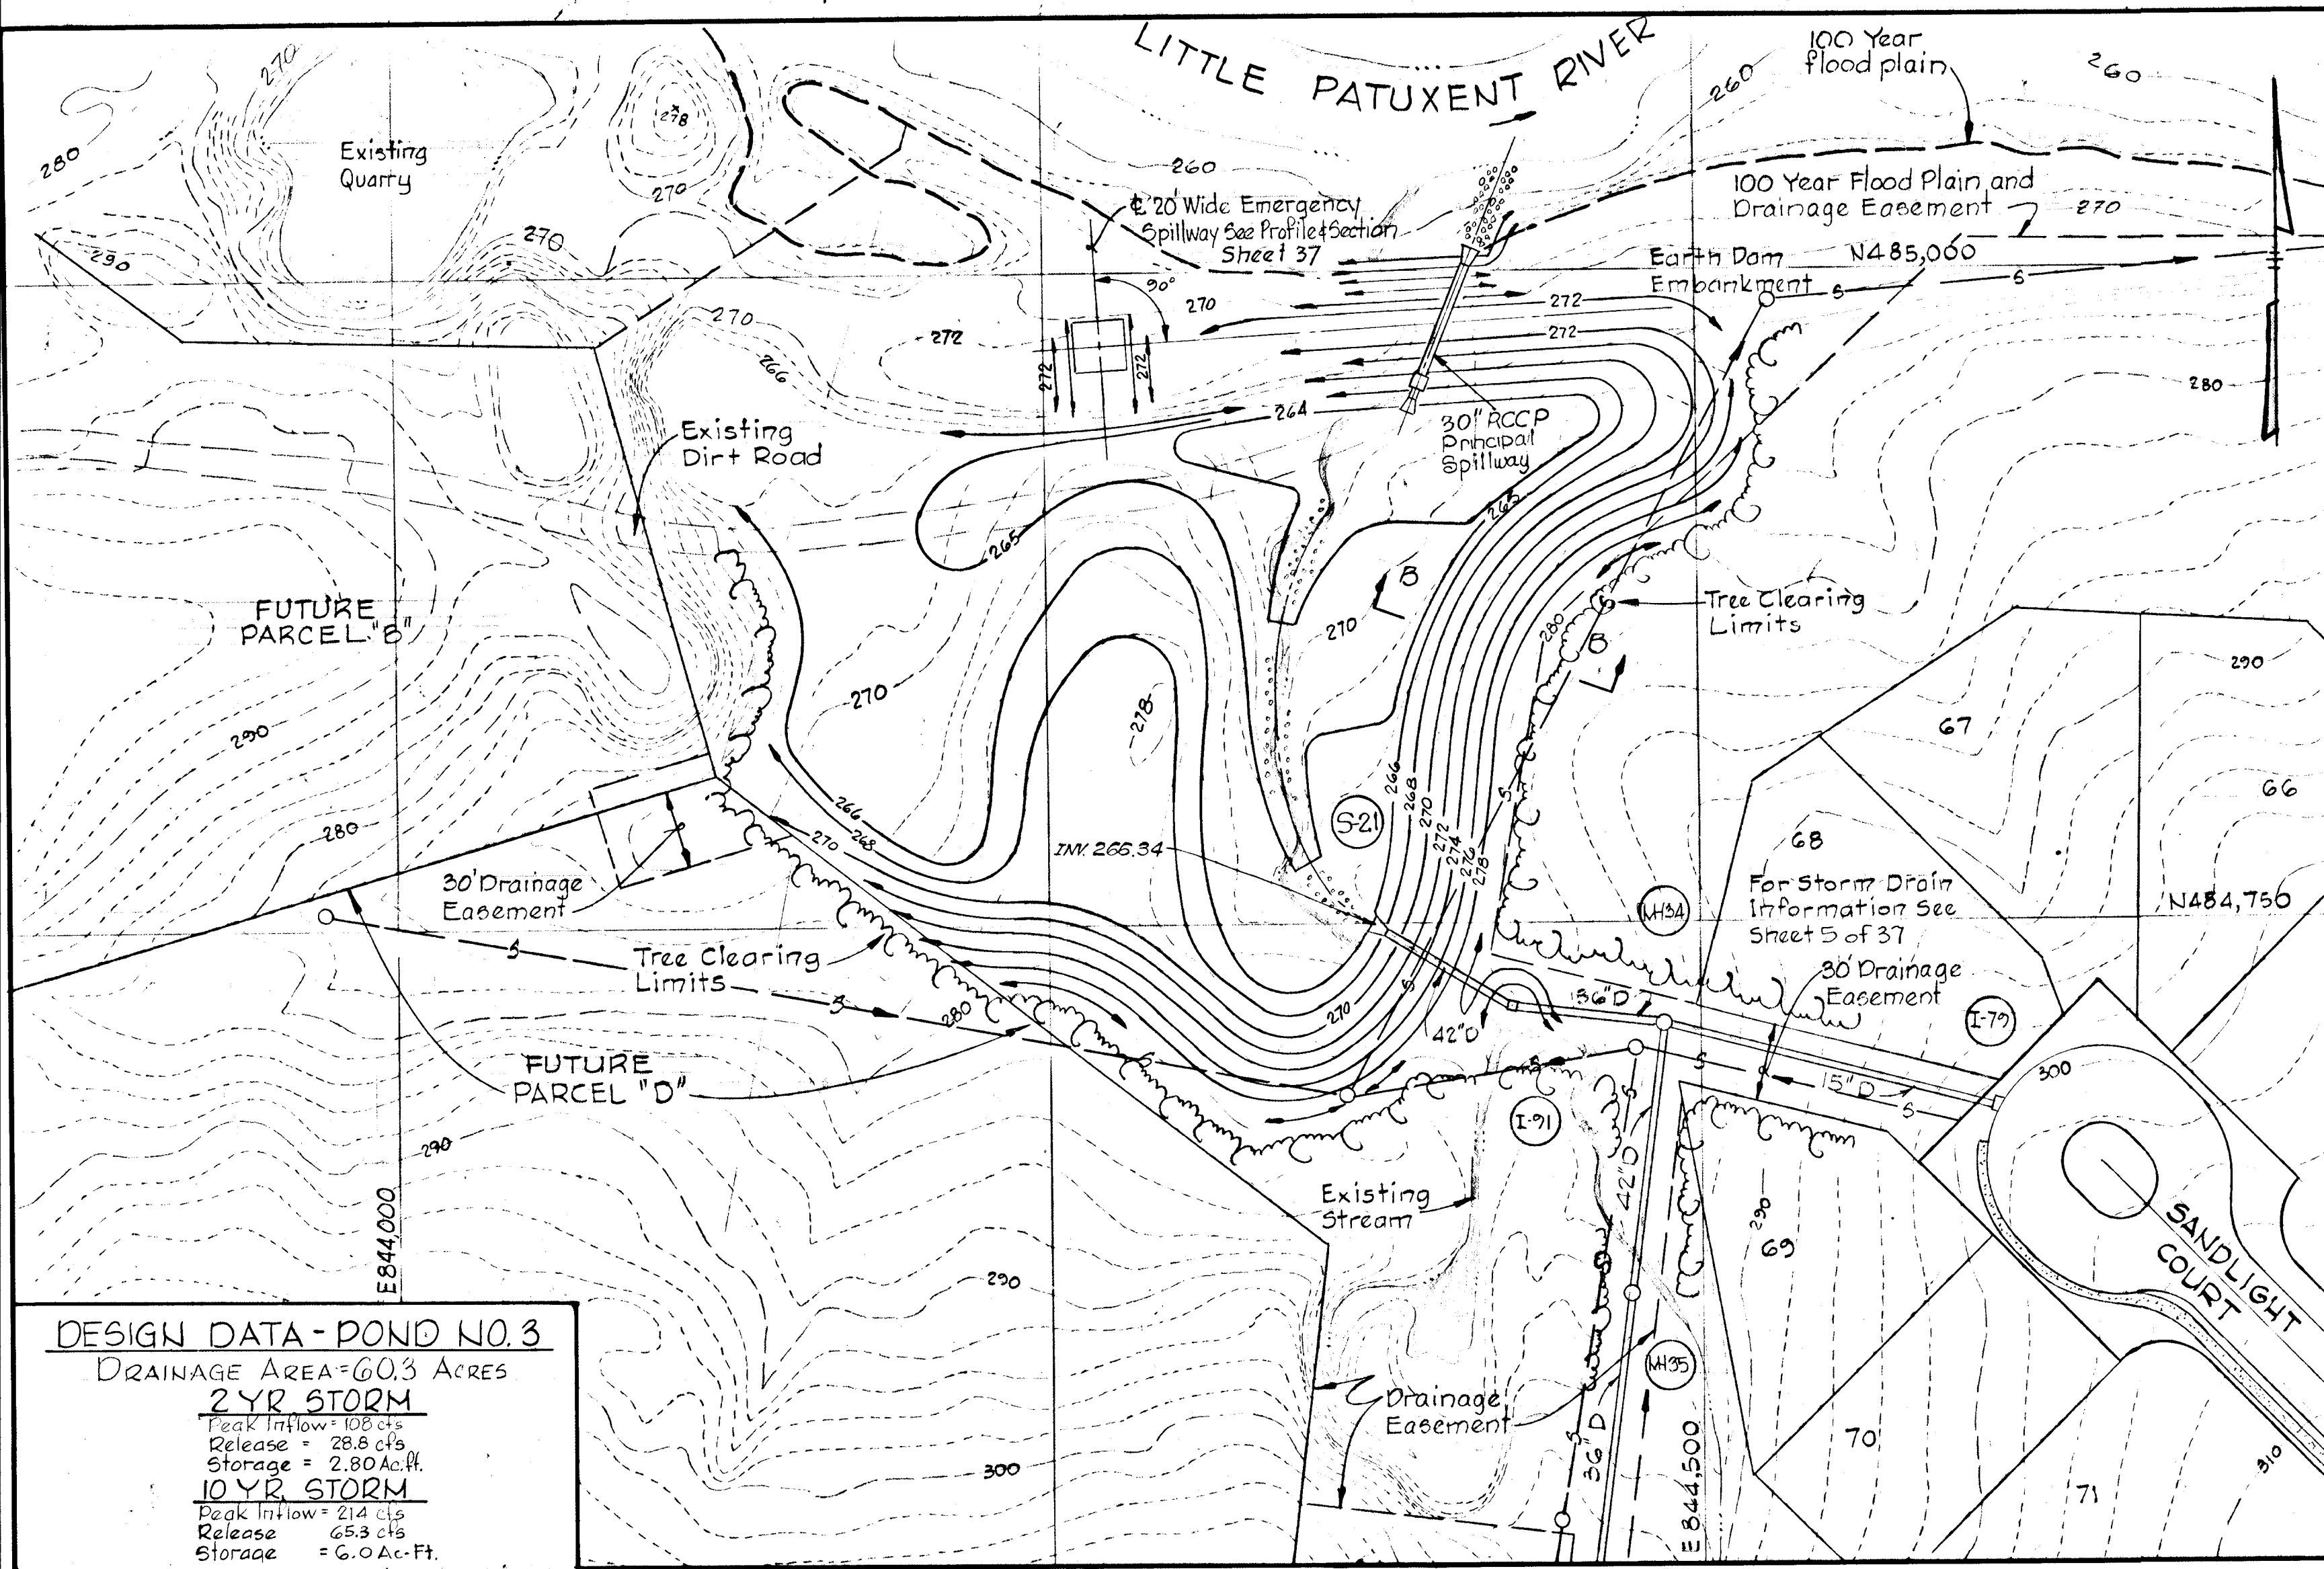


**DESIGN DATA - POND NO. 3**  
 DRAINAGE AREA = 60.3 ACRES

**2 YR STORM**  
 Peak Inflow = 108 cfs  
 Release = 28.8 cfs  
 Storage = 2.80 Ac.-ft.

**10 YR STORM**  
 Peak Inflow = 214 cfs  
 Release = 65.3 cfs  
 Storage = 6.0 Ac.-ft.

**50 YR STORM**  
 Peak Inflow = 282 cfs  
 Release = 112 cfs  
 Storage = 7.5 Ac.-ft.

**SITE PLAN - POND NO. 3**  
 Scale: 1" = 50'

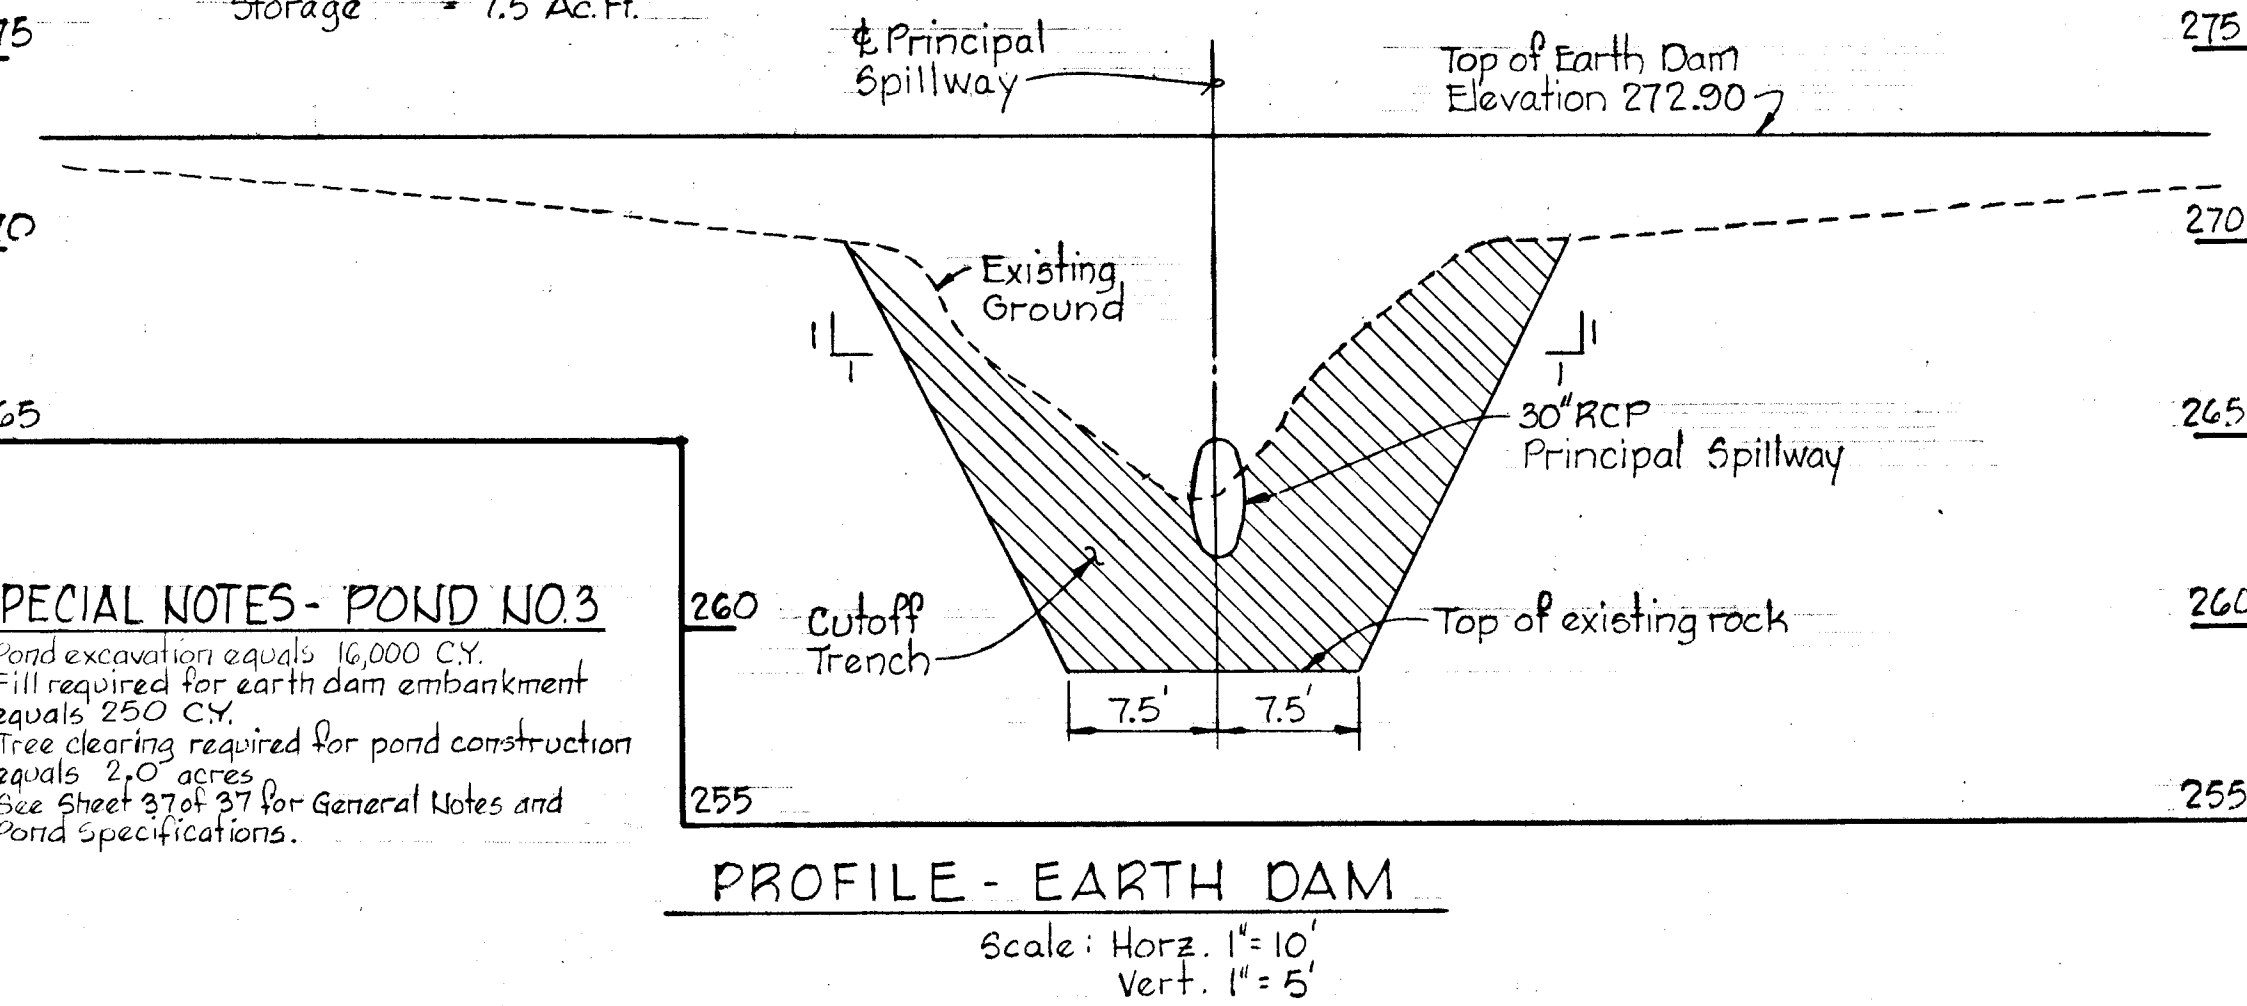


**PROFILE - EARTH DAM**  
 Scale: Horiz. 1" = 10', Vert. 1" = 5'

**CERTIFICATION BY THE DEVELOPER**  
 "I certify that all development and or construction of this pond will be done according to this plan.  
 I also authorize permanent on-site inspection by the Howard Soil Conservation District or their authorized agents as are deemed necessary. Deviation from this plan will not be made unless authorized by the Howard Soil Conservation District. I will authorize a registered professional engineer to supply the Howard Soil Conservation District office with an as-built plan of this pond within 30 days of the ponds completion.  
*Walter E. Woodford, Jr.* 9-2-78  
 Date


**CERTIFICATION BY THE ENGINEER**  
 "I certify that this plan for small pond construction represents a practical and workable plan based on my personal knowledge of the site conditions and that it was prepared in accordance with the requirements of the Howard Soil Conservation District."  
*Kenneth A. McCord* 9-2-78  
 Kenneth A. McCord P.E. 1974 Date

THIS PLAN HAS BEEN REVIEWED BY THE HOWARD SOIL CONSERVATION DISTRICT AND MEETS THE TECHNICAL REQUIREMENTS FOR SMALL POND CONSTRUCTION  
*Wendell B. Smith* 12-21-78  
 U.S. SOIL CONSERVATION DISTRICT DATE


THIS PLAN FOR SMALL POND CONSTRUCTION MEETS THE REQUIREMENTS OF THE HOWARD SOIL CONSERVATION DISTRICT  
 APPROVED *Robert J. Selman* 12-21-78  
 HOWARD S.C.D. DATE  
 PLAN NUMBER

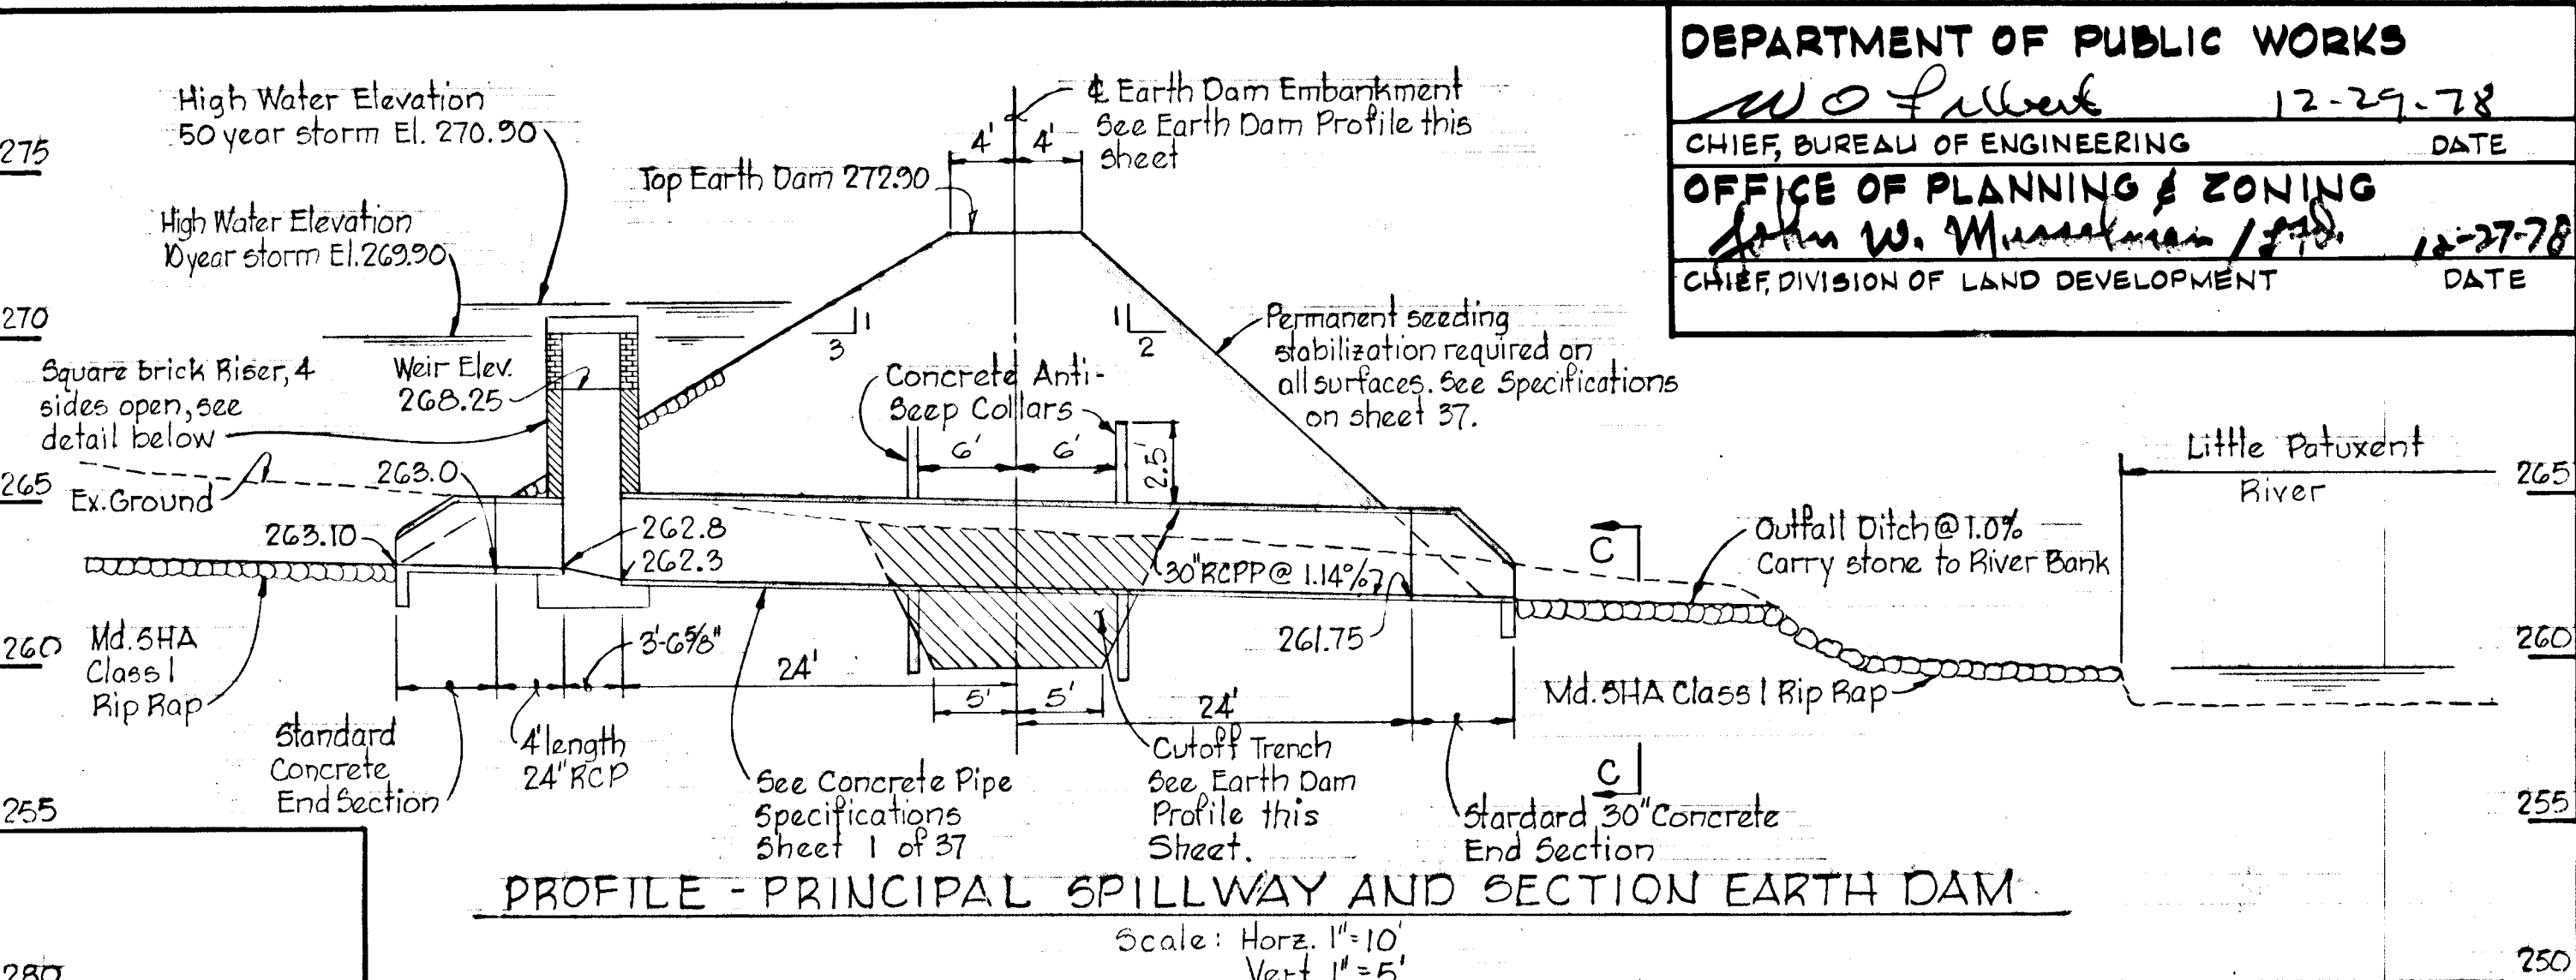

**PROFILE - PRINCIPAL SPILLWAY AND SECTION EARTH DAM**  
 Scale: Horiz. 1" = 10', Vert. 1" = 5'

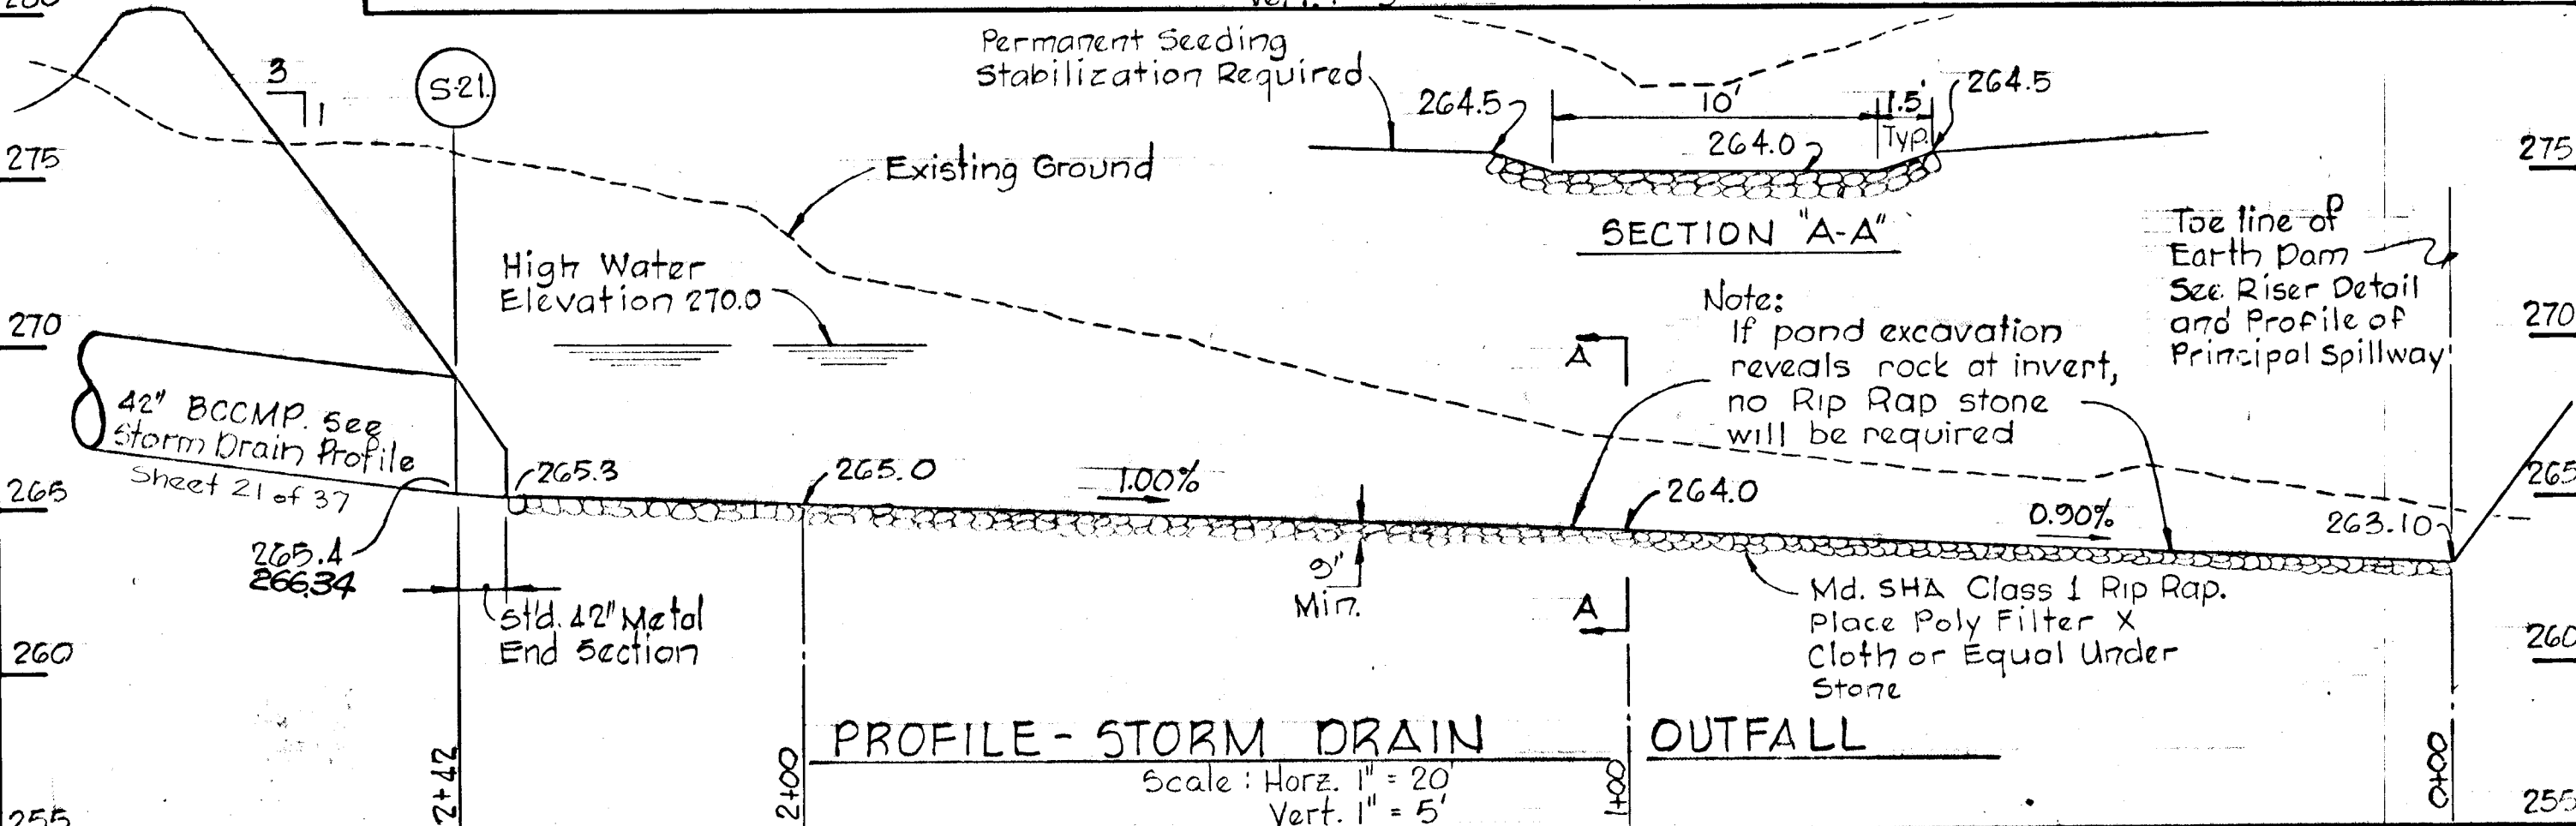

**PROFILE - STORM DRAIN**  
 Scale: Horiz. 1" = 20', Vert. 1" = 5'

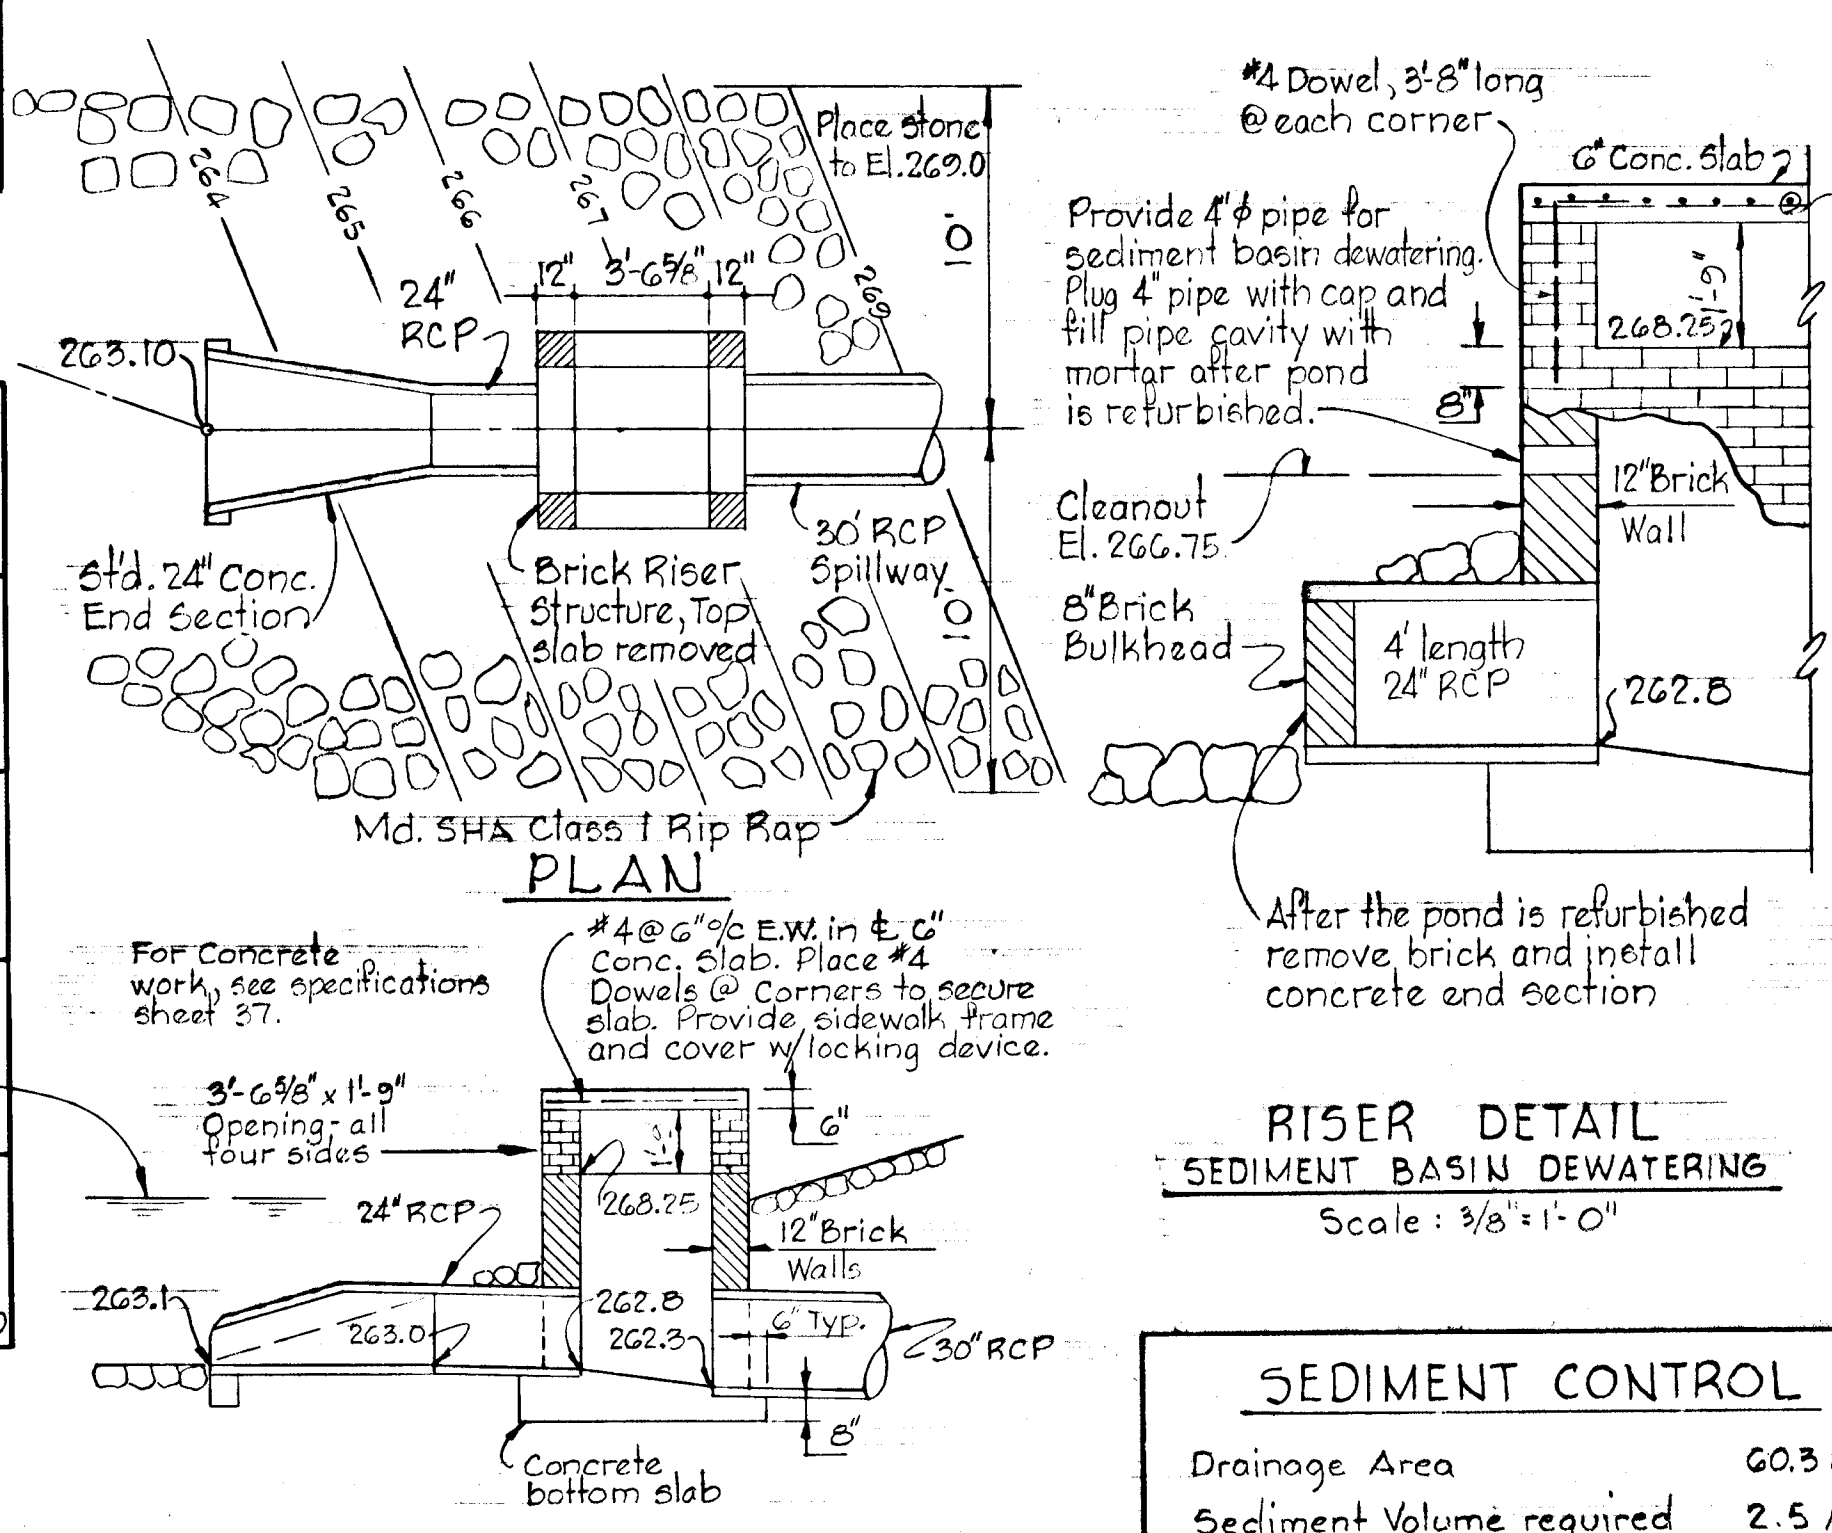


**SECTION B-B**  
 Scale: Horiz. 1" = 20', Vert. 1" = 5'

**RISER DETAIL**  
 Scale: 3/8" = 1'-0"

**SEDIMENT CONTROL**

Drainage Area	60.3 acres
Sediment Volume required	2.5 Ac.-ft.
Sediment volume available	4.0 Ac.-ft.
Cleanout elevation	267.25









**NOTE -**  
 AS-BUILT ELEVATIONS VERIFIED BY KENNETH A. MCCORD MD. REG. P.E. No. 1974 AS OF DECEMBER 29 1979

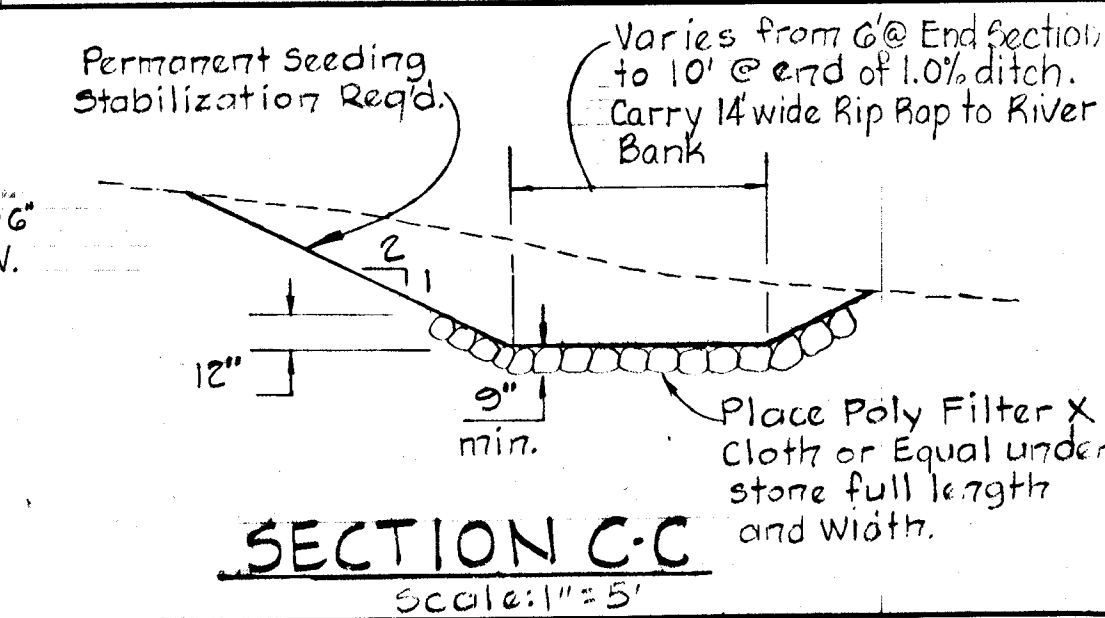

**SECTION C-C**  
 Scale: 1" = 5'

Rev. Date	Rev. No.	Revision Description
<b>COLUMBIA</b>		
6 <sup>TH</sup> ELECTION DISTRICT HOWARD COUNTY, MARYLAND		
OWNER AND DEVELOPER HOWARD RESEARCH AND DEVELOPMENT CORP.		
PROJECT AREA <b>VILLAGE OF KINGS CONTRIVANCE</b> SECTION 3 AREA 1		
PROJECT TITLE STORM WATER MANAGEMENT POND NO. 3 AND DETAILS		
SCALE: AS SHOWN		DATE
WHITMAN, REQUARDT & ASSOCIATES ENGINEERS BALTIMORE MARYLAND 21202		
<i>Kenneth A. McCord</i> KENNETH A. MCCORD Registered Engineer No. 1974		



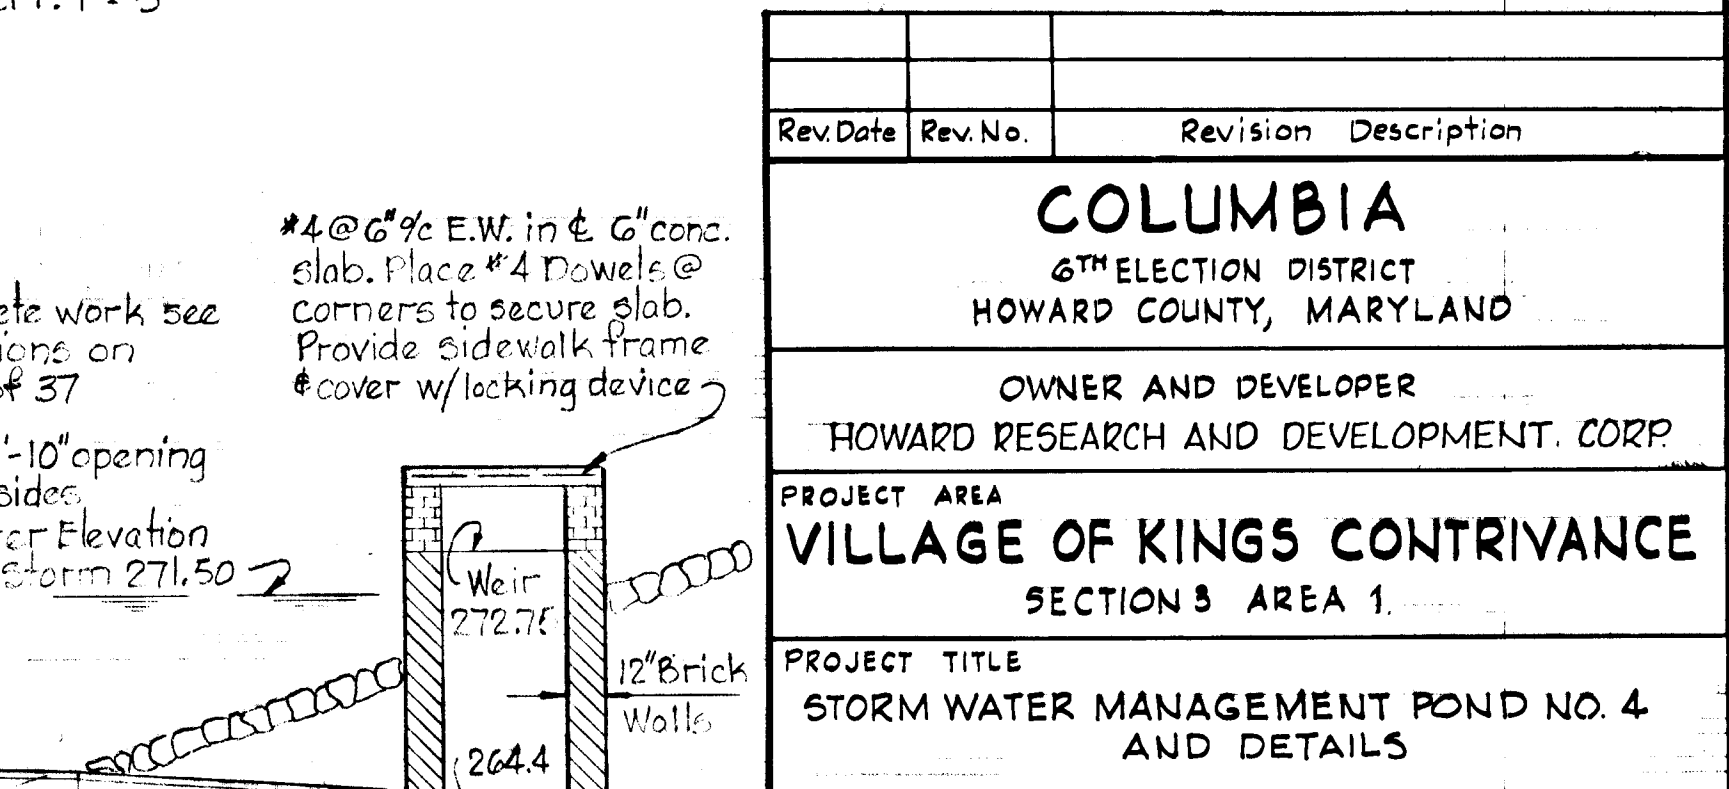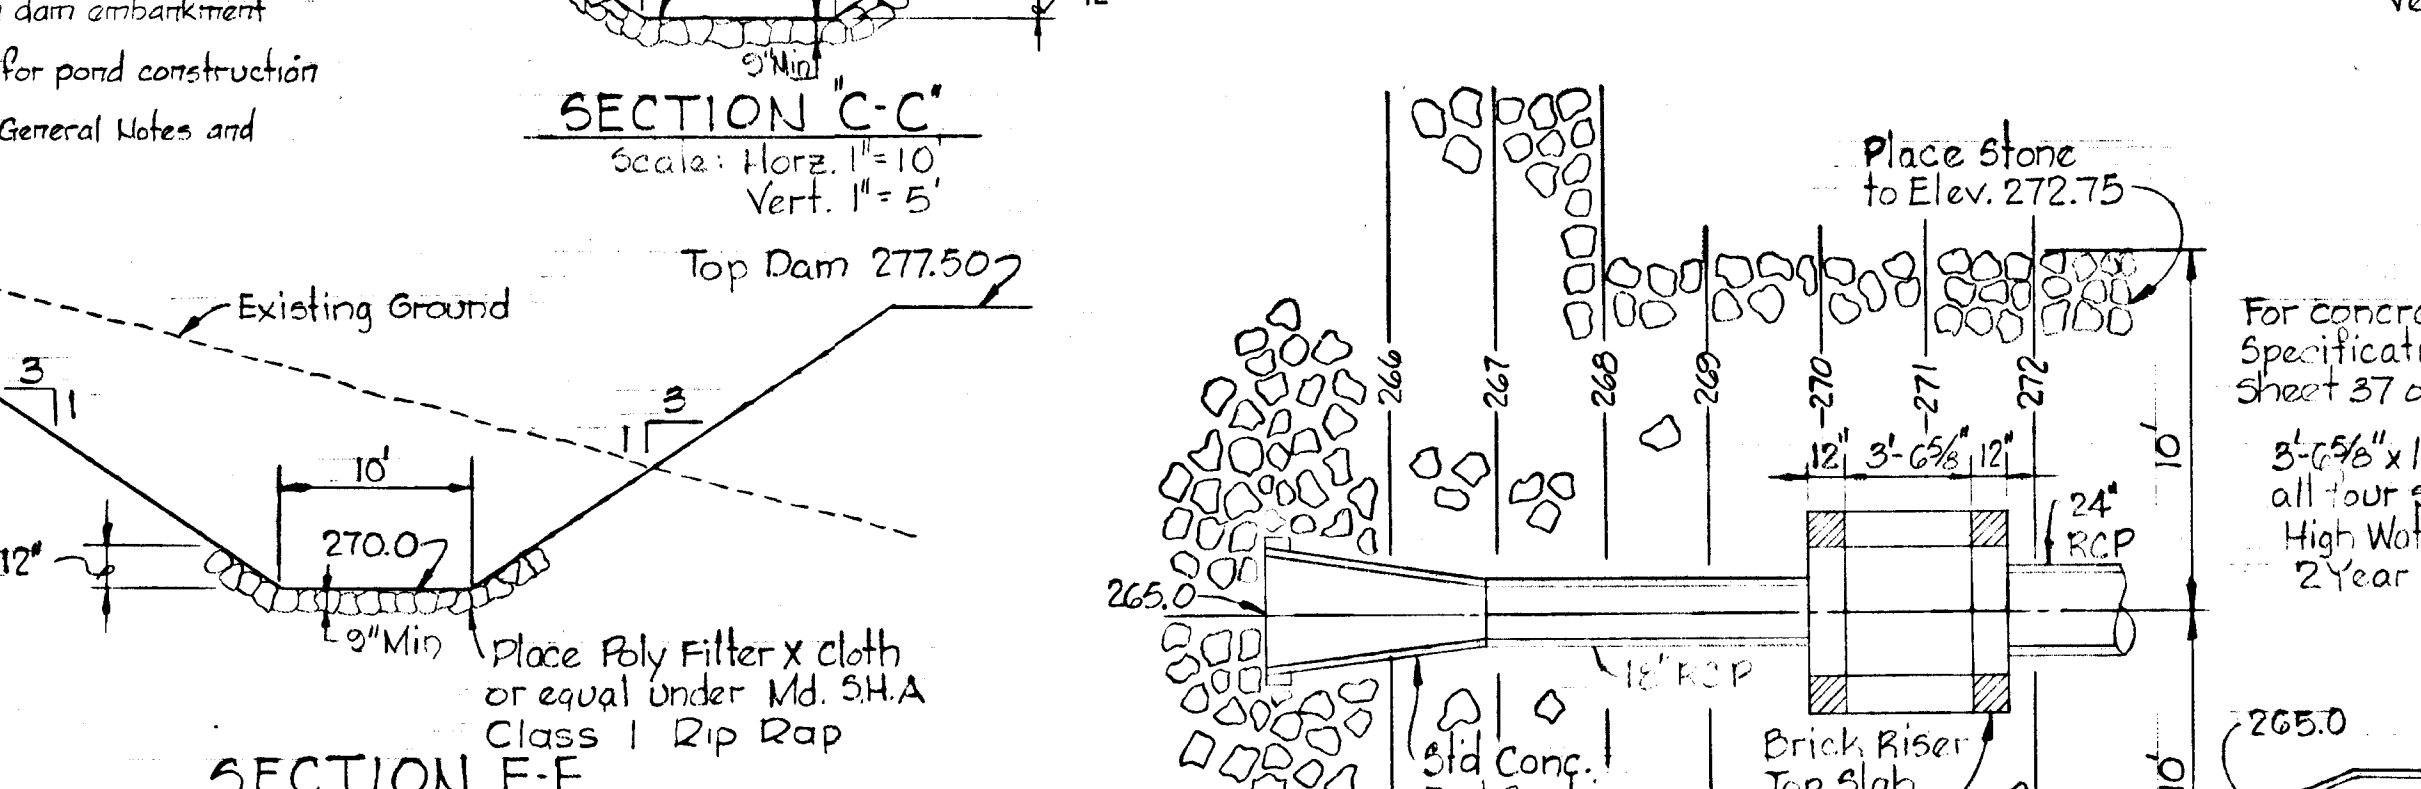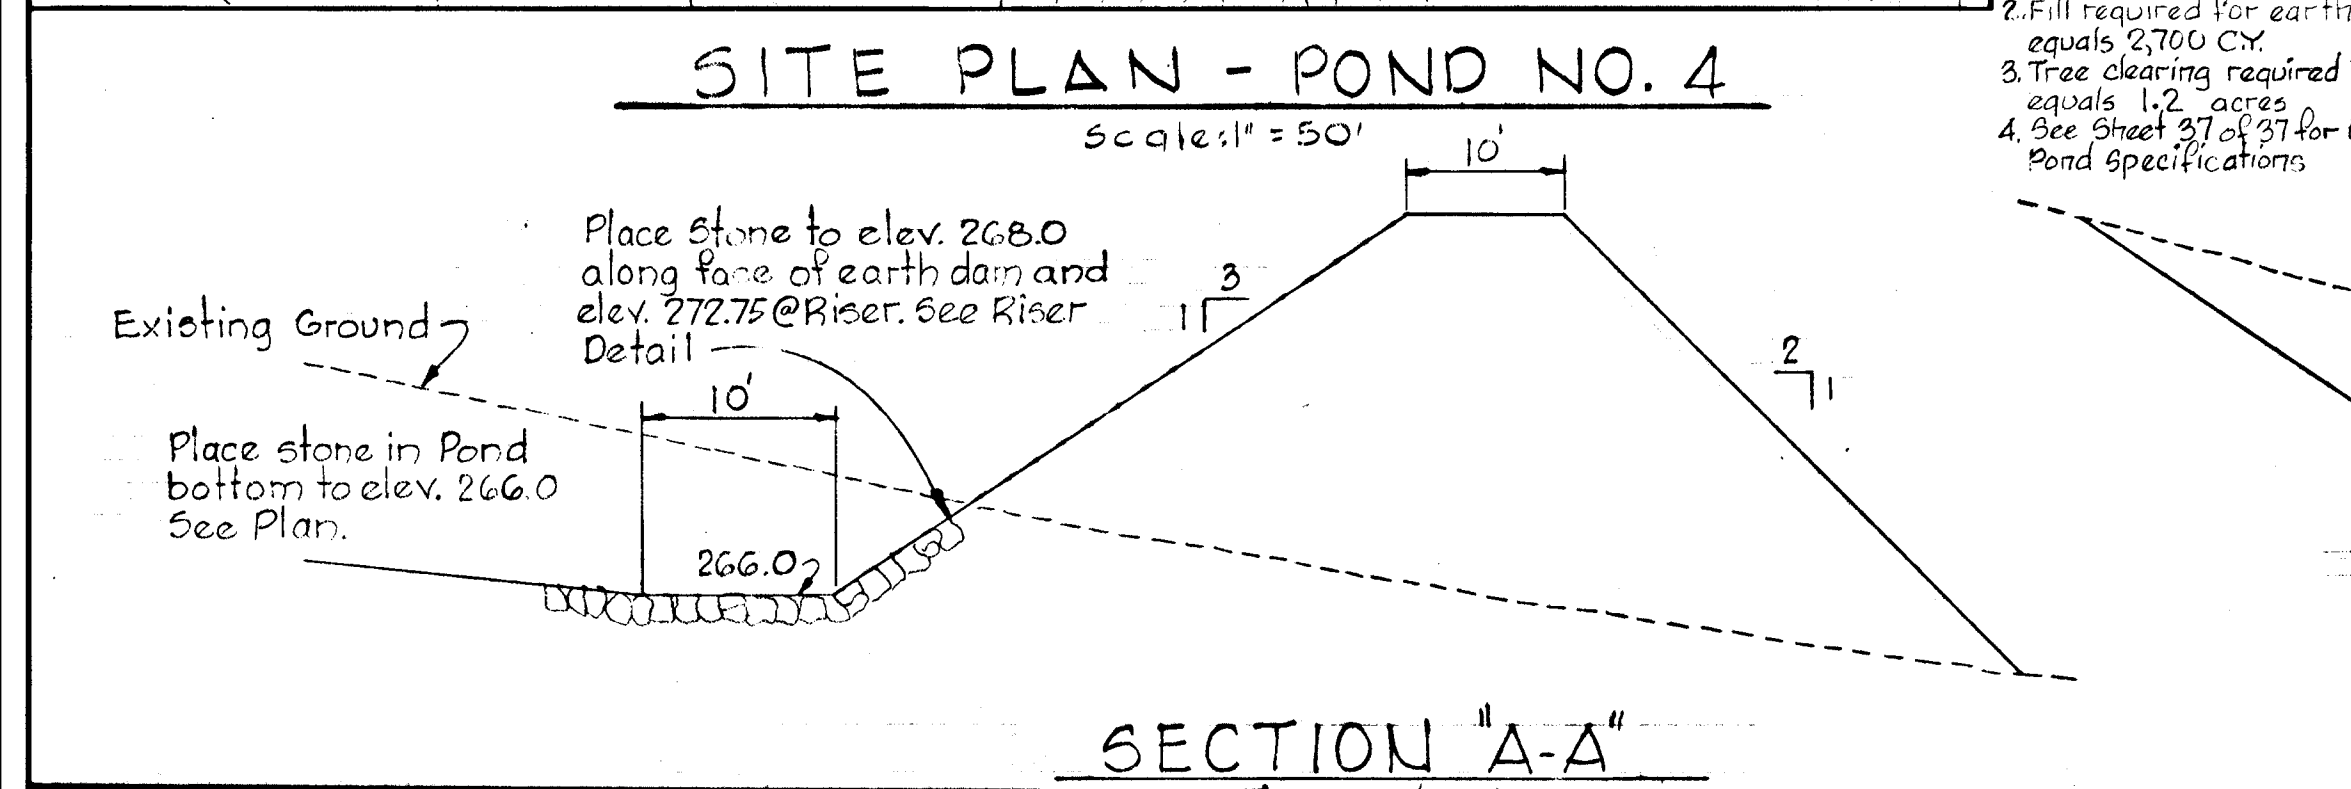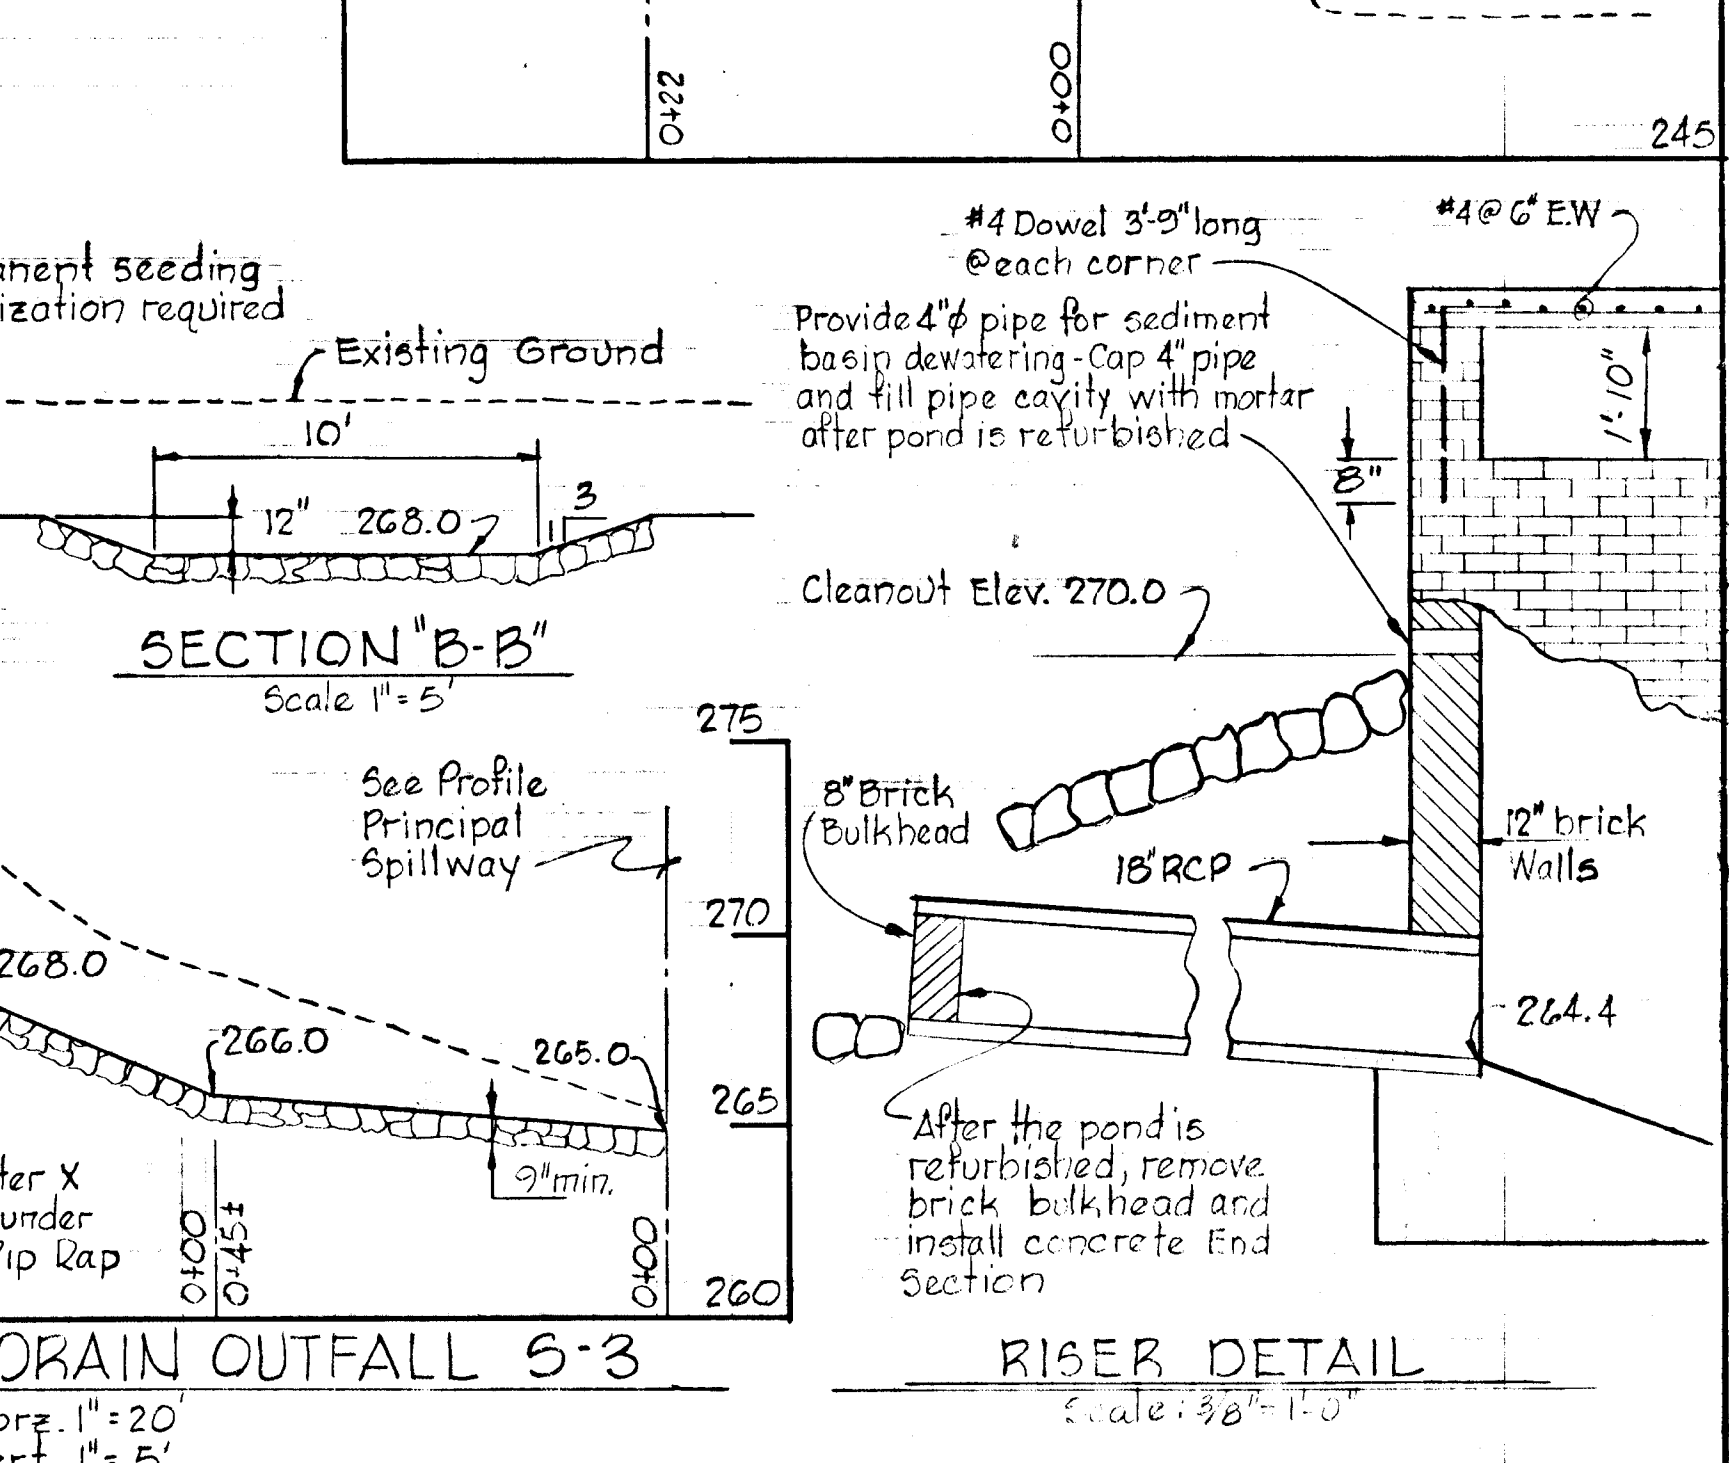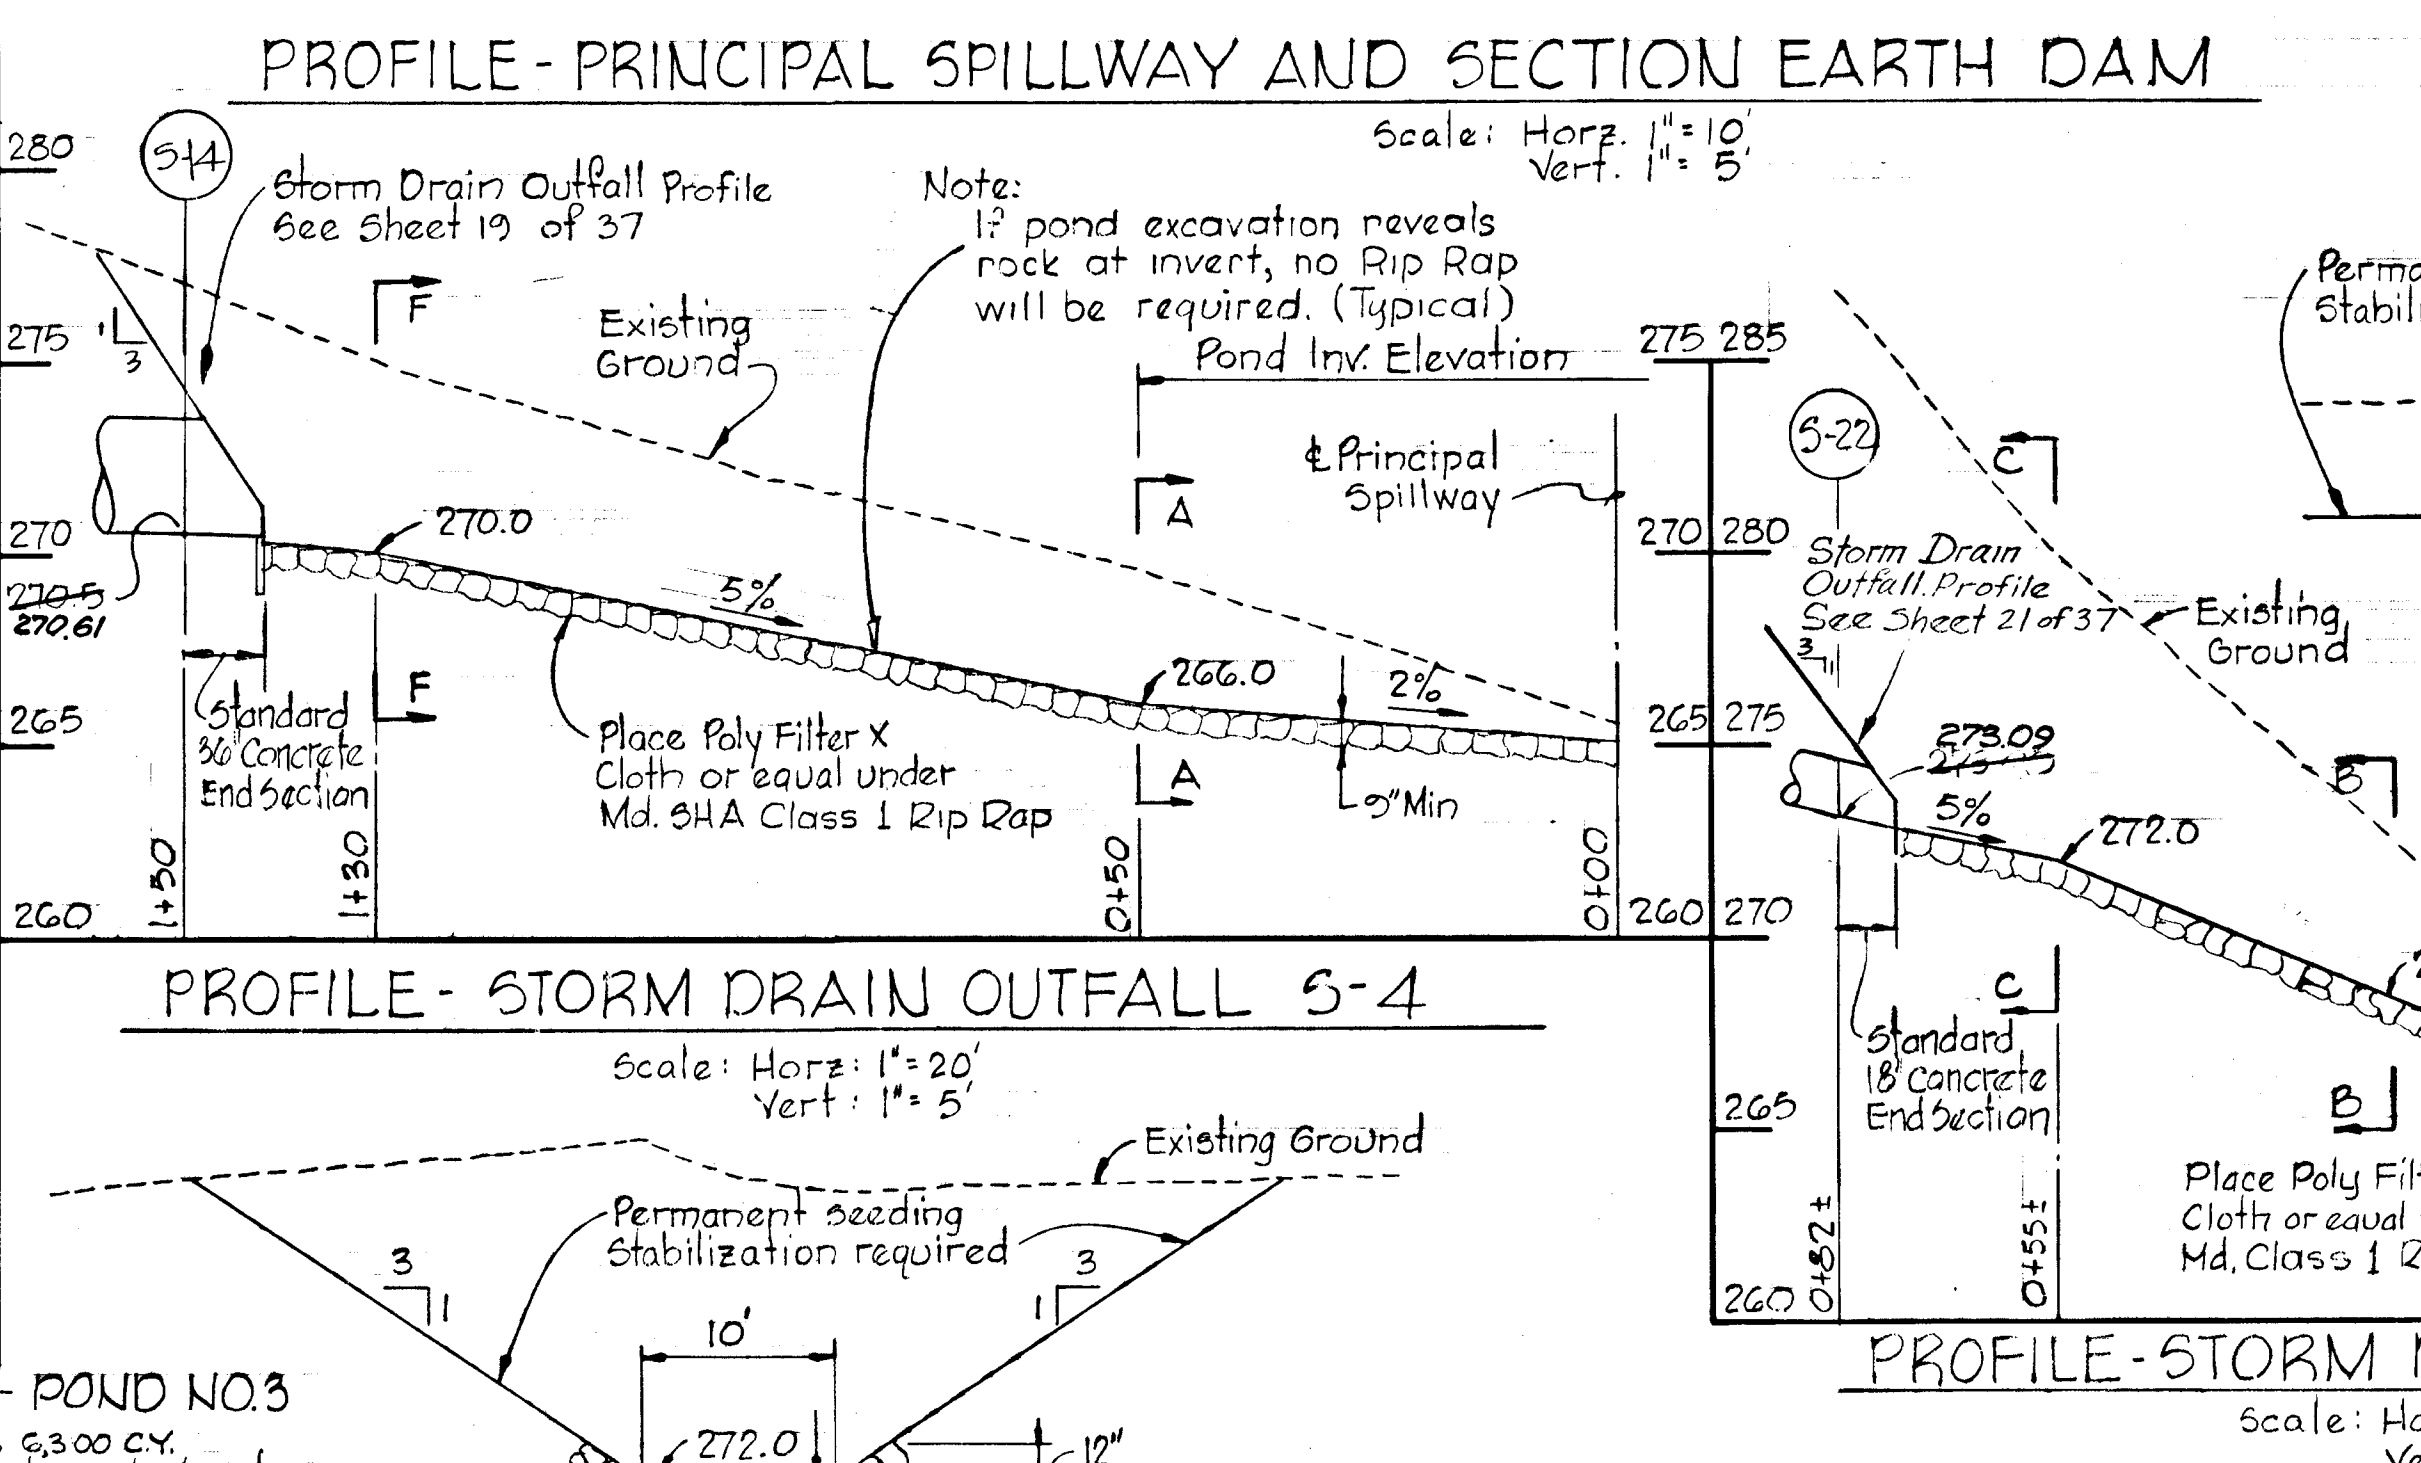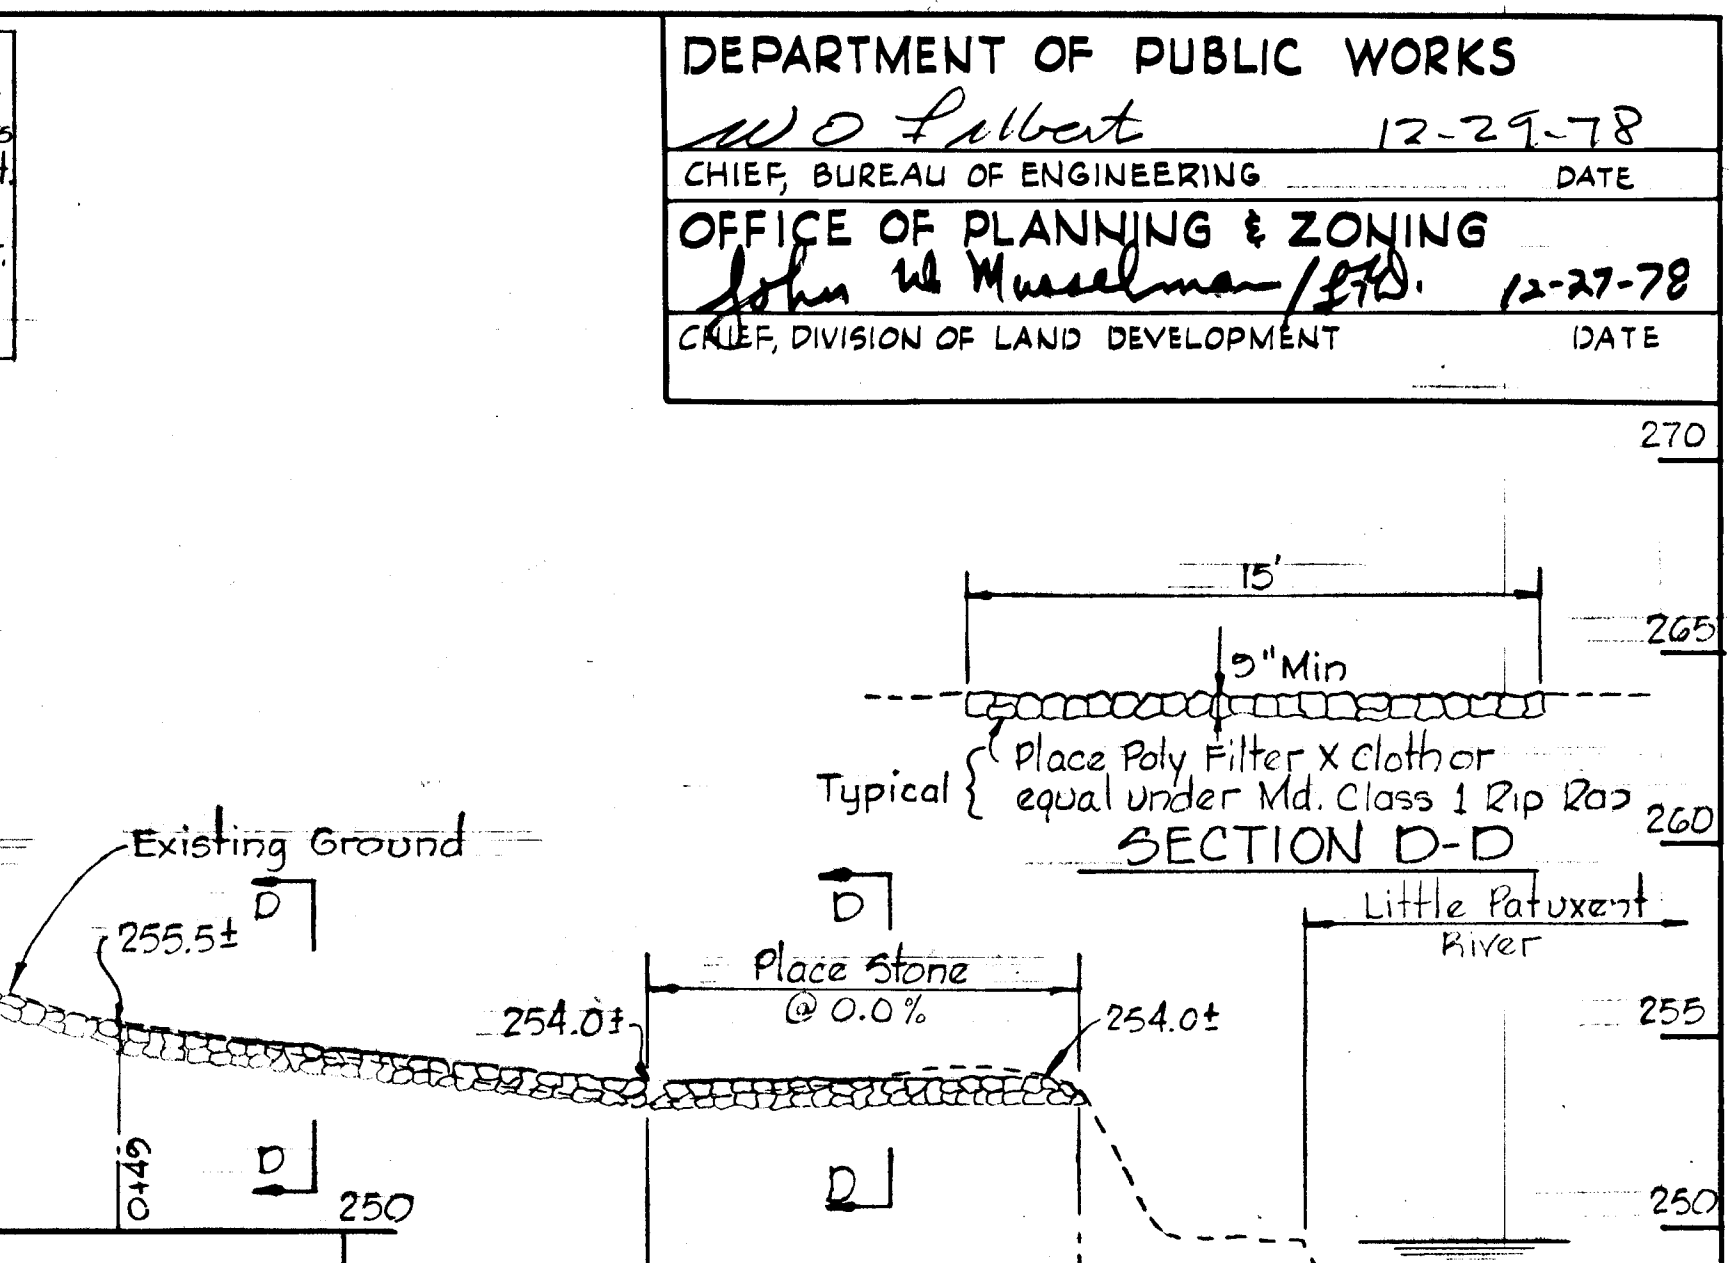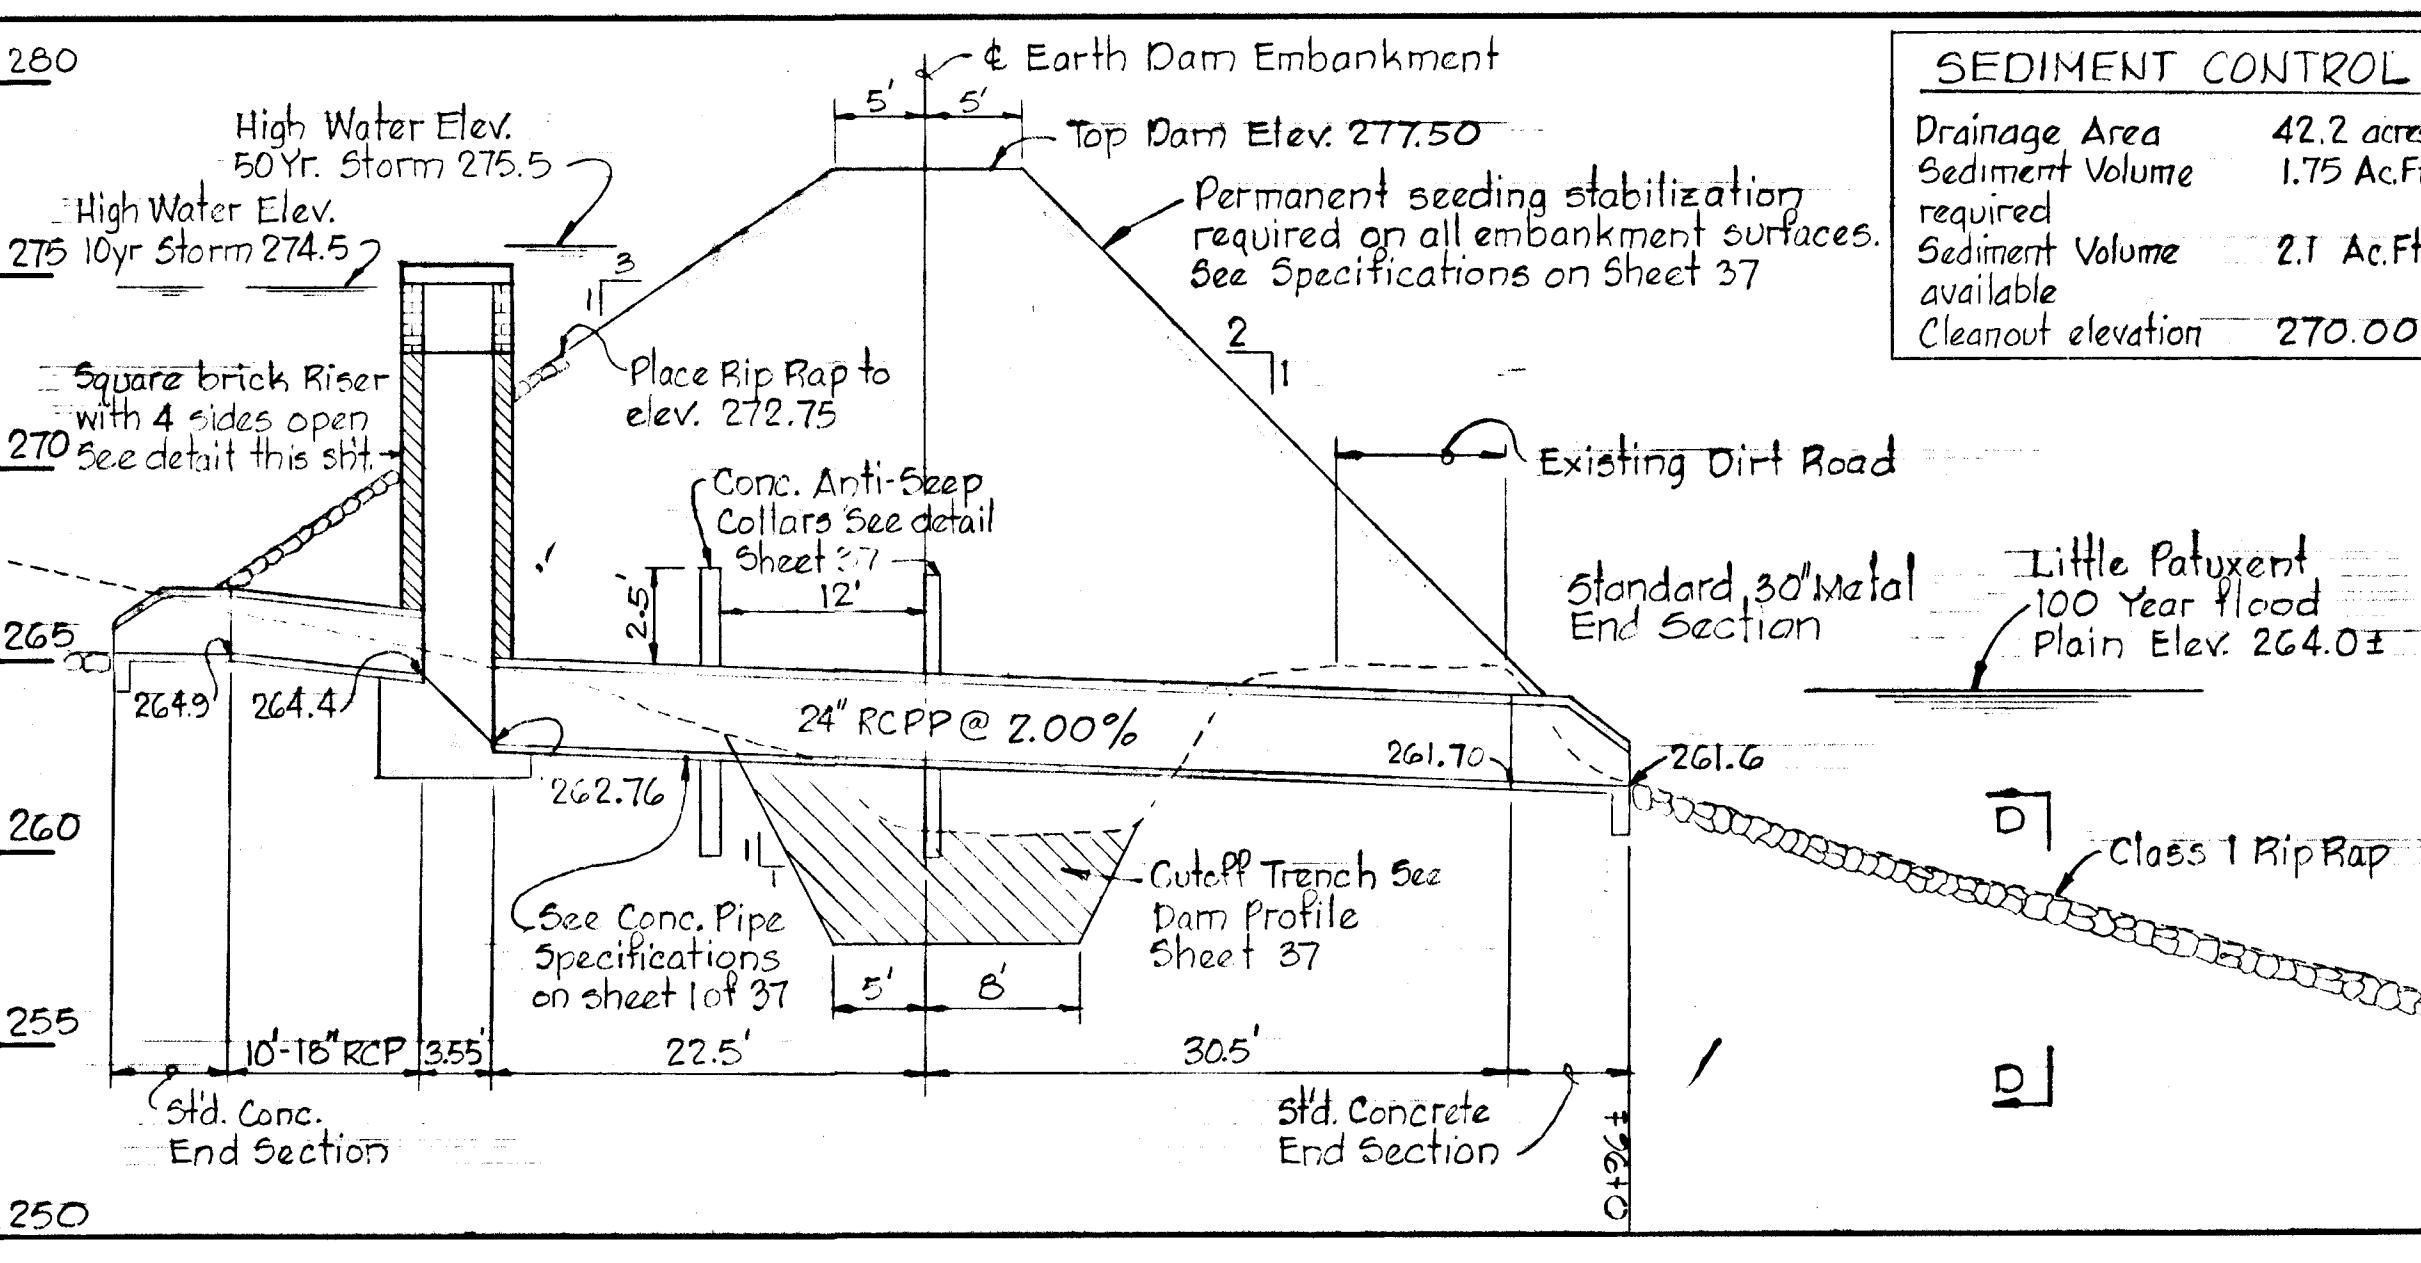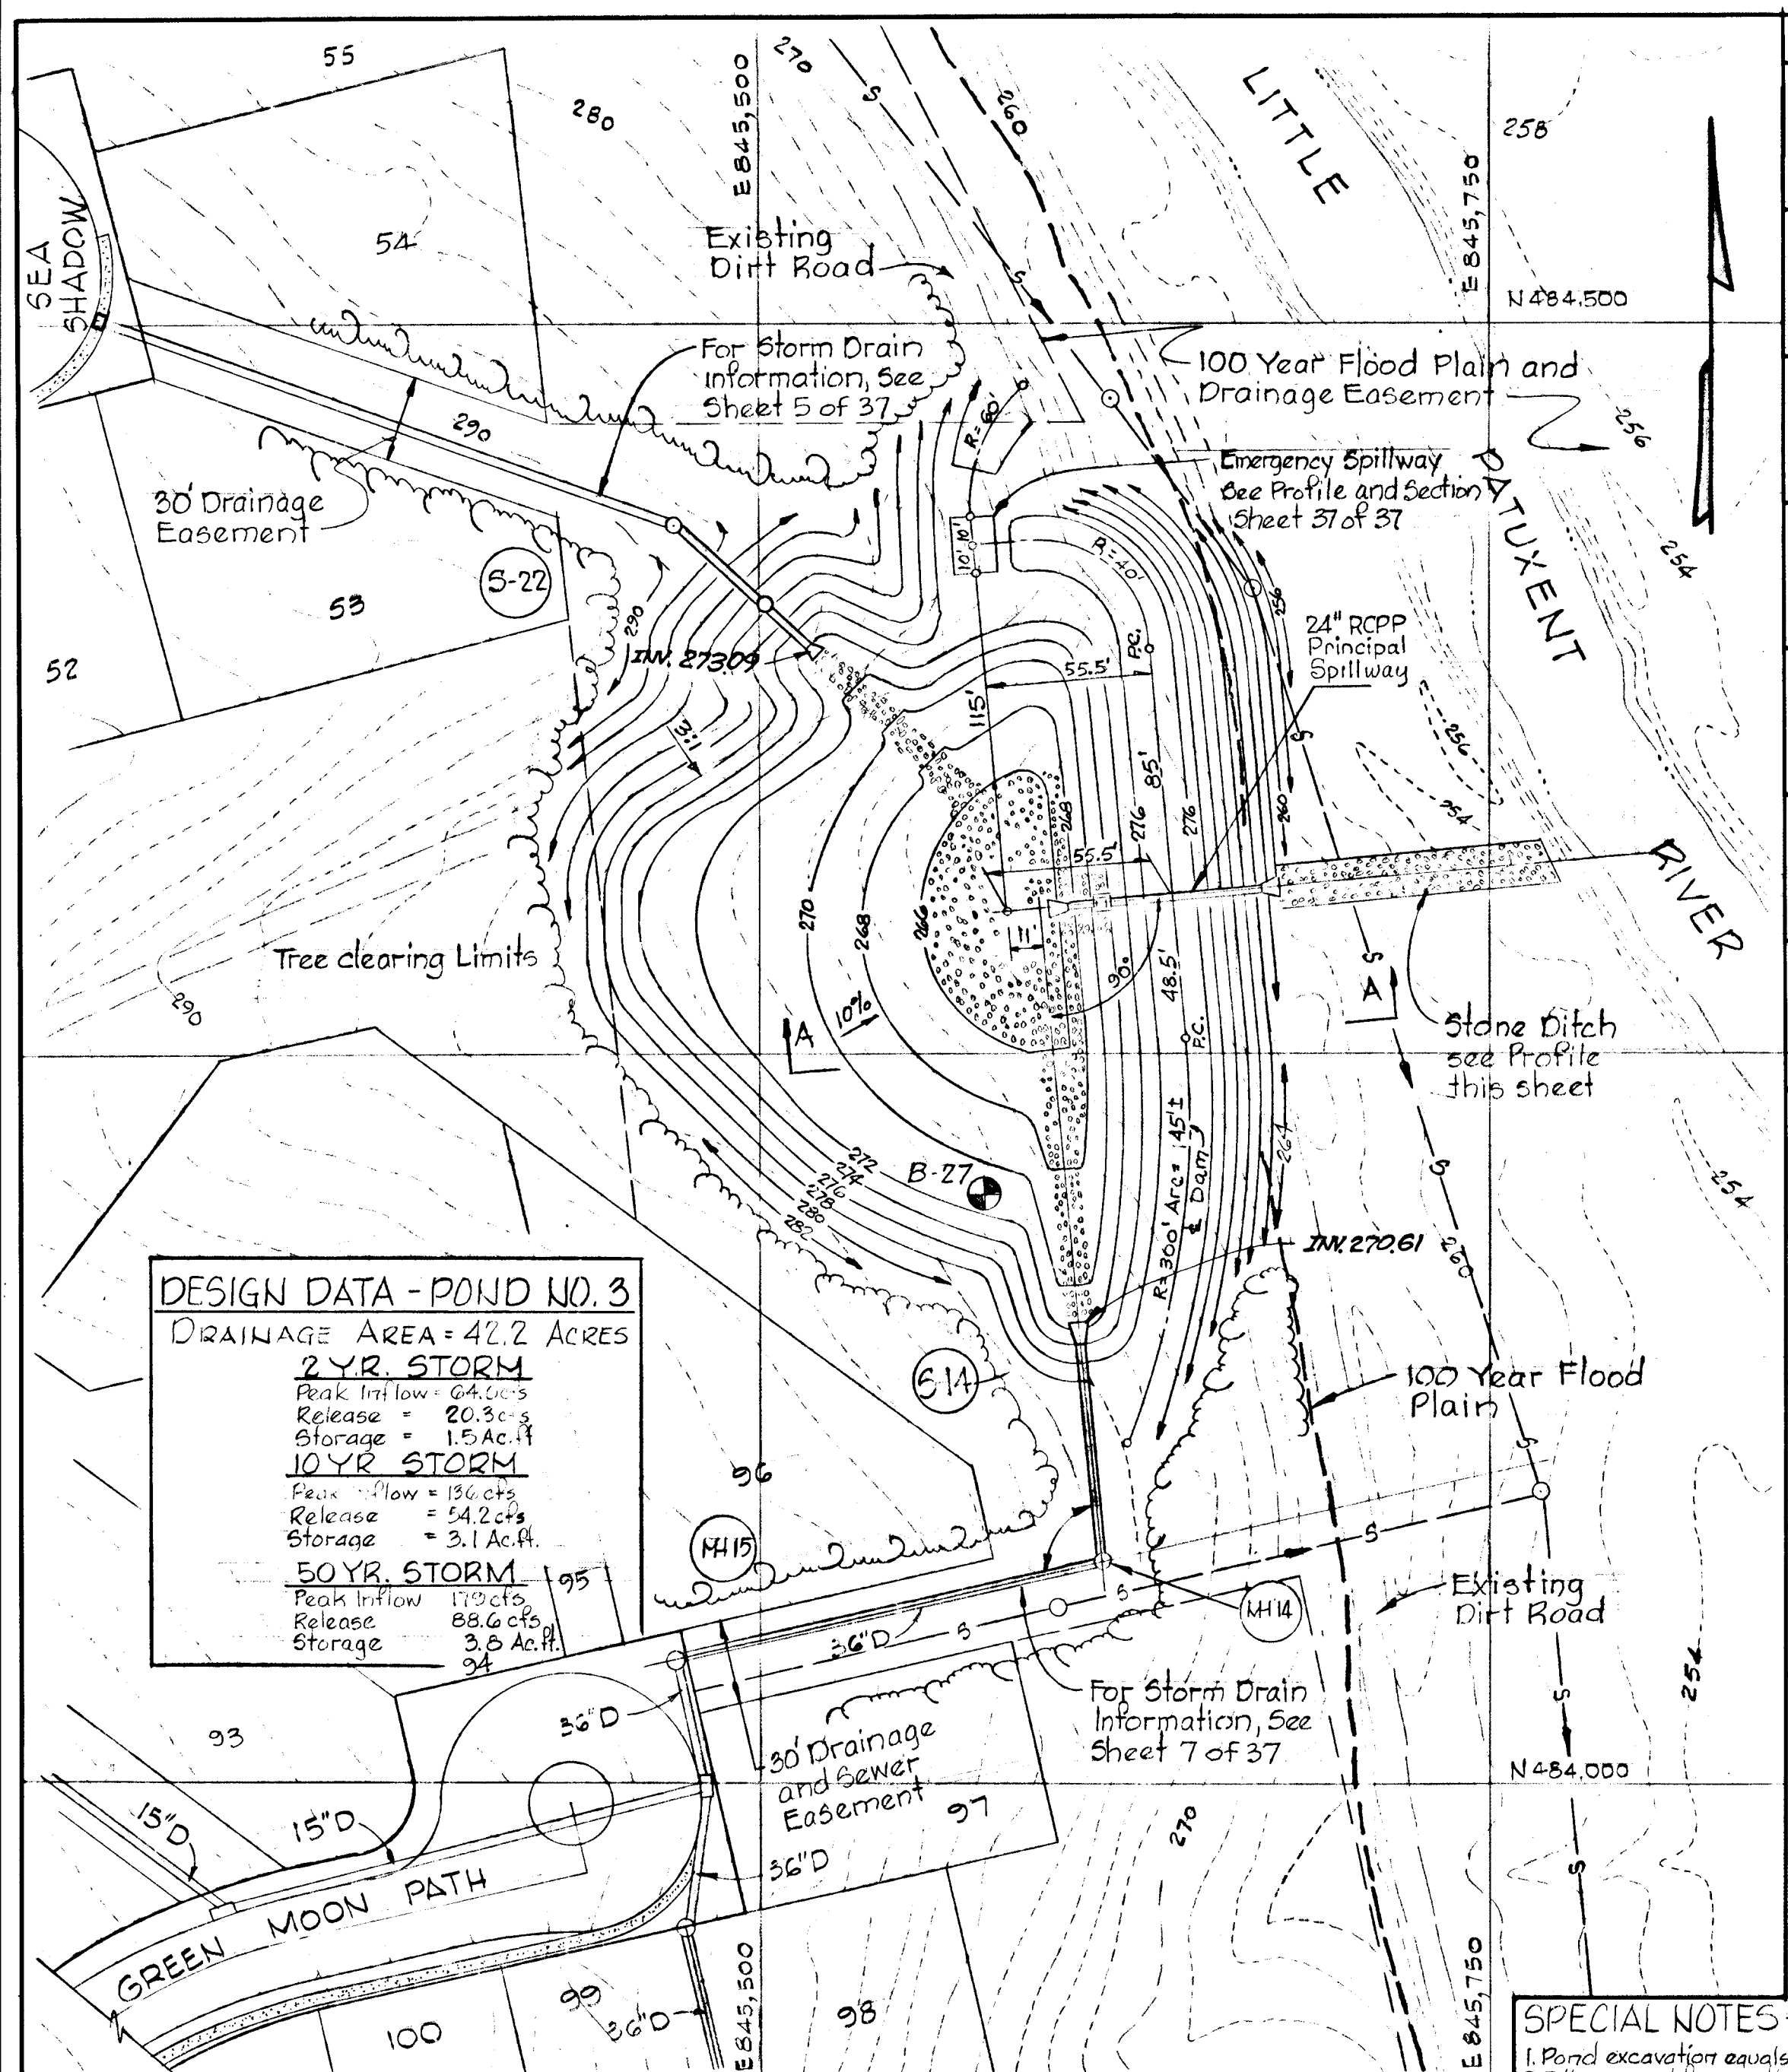

**CERTIFICATION BY THE DEVELOPER**  
 I certify that all development and/or construction of this pond will be done according to this plan.  
 I also authorize periodic on-site inspection by the Howard Soil Conservation District or their authorized agents as are deemed necessary. Deviation from this plan will not be made unless authorized by the Howard Soil Conservation District. I will authorize a registered professional engineer to supply the Howard Soil Conservation District office with an as-built plan of this pond within 90 days of the ponds completion.  
 Walter E. Woodford, Jr. 9-2-78 Date

**CERTIFICATION BY THE ENGINEER**  
 I certify that this plan for small pond construction represents a practical and workable plan based on my personal knowledge of the site conditions and that it was prepared in accordance with the requirements of the Howard Soil Conservation District.  
 Kenneth A. McCord 9-2-78 Date  
 Kenneth A. McCord P.E. 1974

THIS PLAN HAS BEEN REVIEWED BY THE HOWARD SOIL CONSERVATION DISTRICT AND MEETS THE TECHNICAL REQUIREMENTS FOR SMALL POND CONSTRUCTION.  
 U.S. SOIL CONSERVATION DISTRICT

THIS PLAN FOR SMALL POND CONSTRUCTION MEETS THE REQUIREMENT OF THE HOWARD SOIL CONSERVATION DISTRICT.  
 APPROVED Robert J. Zehner 12/21/78  
 HOWARD S.C.D. Date  
 PLAN NUMBER

DEPARTMENT OF PUBLIC WORKS  
 W.O. Silbert 12-29-78  
 CHIEF, BUREAU OF ENGINEERING DATE  
 OFFICE OF PLANNING & ZONING  
 John W. Muselman, Jr. 12-27-78  
 CHIEF, DIVISION OF LAND DEVELOPMENT DATE

Rev. Date	Rev. No.	Revision Description
<b>COLUMBIA</b> 6TH ELECTION DISTRICT HOWARD COUNTY, MARYLAND		
OWNER AND DEVELOPER HOWARD RESEARCH AND DEVELOPMENT CORP.		
PROJECT AREA <b>VILLAGE OF KINGS CONTRIVANCE</b> SECTION 3 AREA 1.		
PROJECT TITLE STORM WATER MANAGEMENT POND NO. 4 AND DETAILS		
SCALE AS SHOWN DATE		
WHITMAN, REQUARDT & ASSOCIATES ENGINEERS BALTIMORE MARYLAND 21207		
Kenneth A. McCord KENNETH A. McCORD Registered Engineer No. 1974		



**POND SPECIFICATIONS**

DEPARTMENT OF PUBLIC WORKS  
*W. J. Lambert* 12-29-78  
 CHIEF BUREAU OF ENGINEERING  
 OFFICE OF PLANNING AND ZONING  
*John W. Musickum* 1/79  
 CHIEF, DIVISION OF LAND DEVELOPMENT

**PERMANENT SEEDING** (See General Notes)

- LIME = 2 Tons/acre agricultural ground limestone
- FERTILIZER = 100 lbs./acre (10-10-10)
- SEEDING = 100 lbs./acre of the following:
  - 20% Kentucky Blue Grass
  - 20% Merion Blue Grass
  - 55% Creeping Red Fescue
  - 5% Redtop

Mulch Required - Mulch area with straw at the rate of 75 lbs./1000 s.f. or 1.5 tons/acre.  
 Anchor with asphalt at the rate of 480 gallons/acre.  
 Stabilization of slopes steeper than 3:1 shall be planted with crownvetch including 15 lbs./acres (0.34 lbs./1000 s.f.) Kentucky 31 Tall Fescue 40 lbs./acres (1 lb./1000 s.f.)

**EARTH DAM EMBANKMENT**

1. Suitable material from the pond excavation may be used for the embankment.
2. Suitable material shall be placed in 8" loose layers and compacted to 90% of ASSHTO T-180.
3. Moisture content of the suitable material shall be within the range of 2% below optimum moisture to 2% above optimum moisture.
4. Area under the embankment shall be cleared and grubbed to remove all trees, vegetation, roots or other objectionable material and topsoil stripped.
5. The fill material shall be free from roots, stumps, wood rubbish, oversize stones, frozen or other objectionable material. The fill height all along the length of the embankment shall be increased by 10%.
6. Fill materials shall be placed in 8" maximum thickness (before compaction) layers which are to be continuous over the entire length of the fill. The most porous material shall be placed in the downstream portions of the embankment.
7. Compaction shall be by multiple wheel pneumatic tired roller, vibratory roller or other types of acceptable rollers. Rolling of each layer shall be continuous over its entire area and the roller shall sufficient coverages to insure that the required density has been obtained.

**PRINCIPLE SPILLWAYS (24" AND 30")**

1. Backfill around the RCP Spillways shall be placed in horizontal layers not to exceed 4 inches in thickness and compacted by hand tampers or other compaction equipment. At no time during the backfilling operation, shall construction equipment be allowed to operate closer than 4 feet to any part of the RCP Spillways. Under no circumstances shall the contractor drive equipment over any part of the RCP Spillways unless there is a compacted fill to a depth of 24" inches or greater over the pipes.
2. The RCP Spillway shall be firmly and uniformly bedded throughout its entire length. Where rock or other unsuitable soil is encountered under the pipe, all such material shall be removed and replaced with suitable earth compacted to provide adequate support.
3. Reinforced concrete pressure pipe shall have a rubber gasket joint and shall equal or exceed AWWA Standard C302.
4. Bell and Spigot pipe shall be placed with the bell end upstream. Joints shall be made in accordance with recommendations of the manufacturer of the material. After the joints are sealed on the entire line, the bedding shall be placed so that all spaces under the pipe are filled.

**CONCRETE**








1. Concrete shall have a minimum of 6 bags of cement per cubic yard and water content not to exceed 6 gallons per bag of cement. Slump shall range 3"-4". All concrete shall be transit mix.

**CUT OFF TRENCH**

1. The backfill material for the Cut Off Trench shall be the most impervious material available from the pond excavation. The material shall be placed in 8" loose layers and compacted to 90% of ASSHTO T-180. Moisture content of the suitable material shall be within the range of 2% below optimum moisture to 2% above optimum moisture.

**GENERAL NOTES - PONDS NO.3 AND NO.4**

1. Ponds No.3 and No.4 shall function initially as SEDIMENT BASINS. Both Ponds shall be constructed prior to any construction work intended within their drainage areas. See drainage area map on sheet 33 of 37.
2. Initial construction shall include all the work as shown except Pond invert seeding and the 18" and 24" Concrete End Sections. (Upstream ends)
3. Permanent seeding is required for all the graded surfaces within the limits where permanent seeding is required. Initial permanent seeding shall be applied to all cut and fill embankments from toe to top of slope and top elevation at the earth dam construction. The invert of the Ponds shall be permanently seeded after the ponds are refurbished. Refurbishing of the ponds shall be done after all construction is completed and grass is established within the pond drainage areas. Refurbishing of the ponds shall include the removal of all sediment; the restoration of the ponds to the lines and grades as shown on the Plans; the replacement of all filter cloth and rip rap stone where necessary; installation of the metal end sections; permanent reseeding of all the disturbed graded surfaces and the cleaning of the principal spillways and outfall ditches.
4. After the Ponds are completely refurbished the owner shall submit "As Built" drawings to the Howard County Soil Conservation District.
5. Poly Filter-X cloth (CARTHAGE MILLS INCORPORATED) or equal, shall be placed under all rip-rap construction, full length and width of rip-rap.
6. Stone shall be Maryland S.H.A. Class 1 medium Rip-Rap. Stone from onsite rock excavation may be substituted for the Maryland S.H.A. Class 1 medium Rip-Rap.

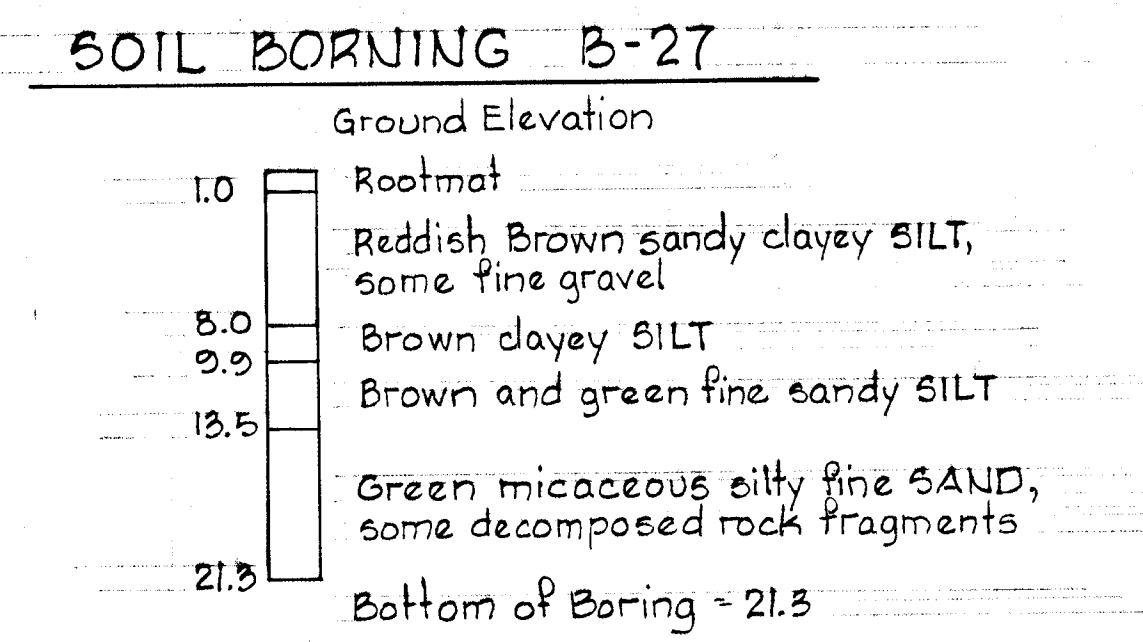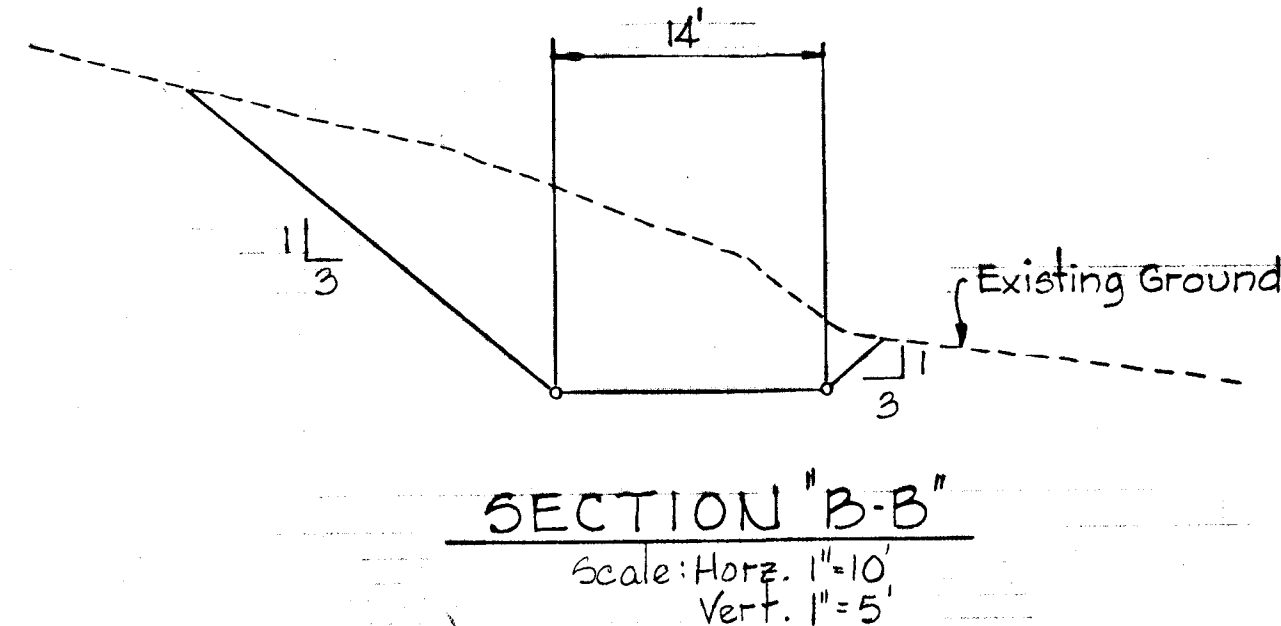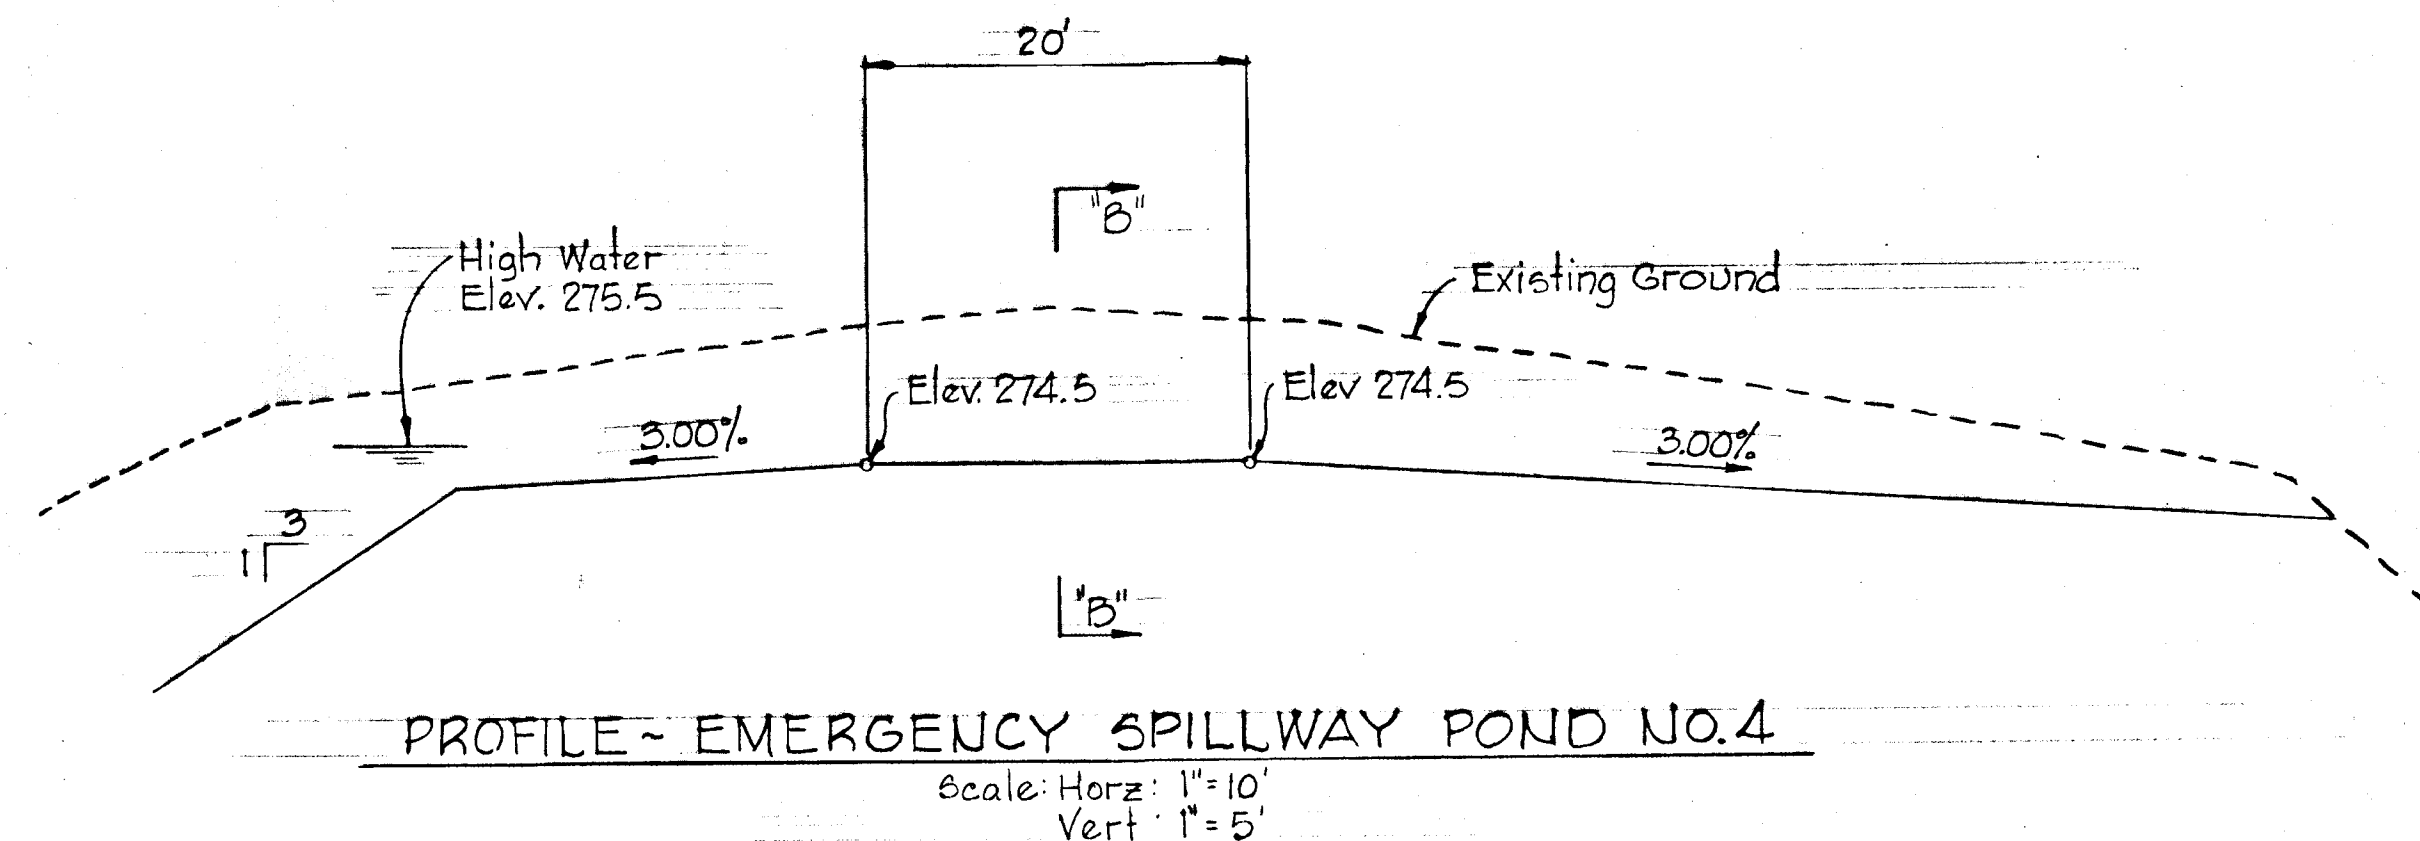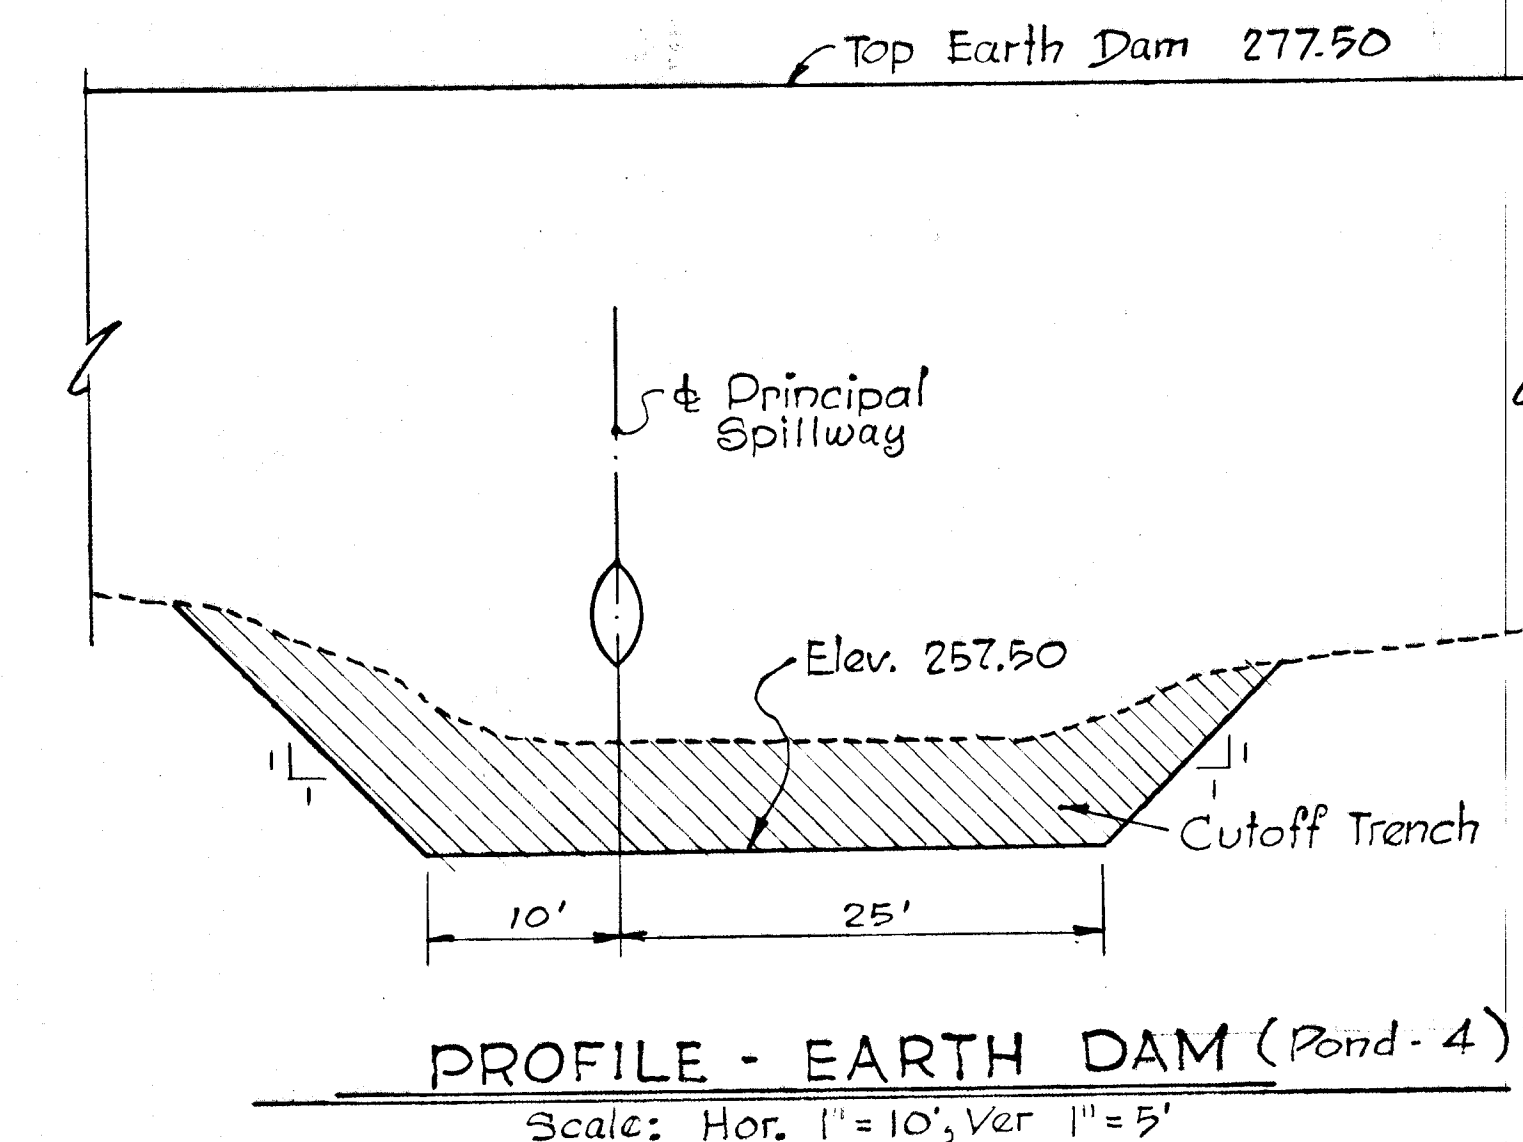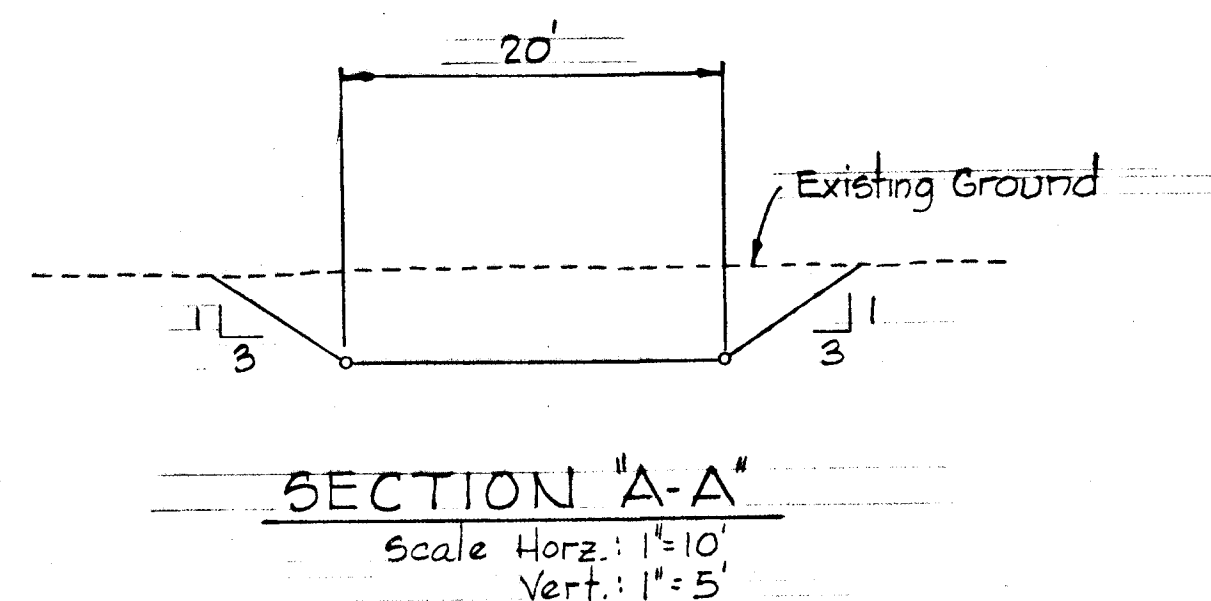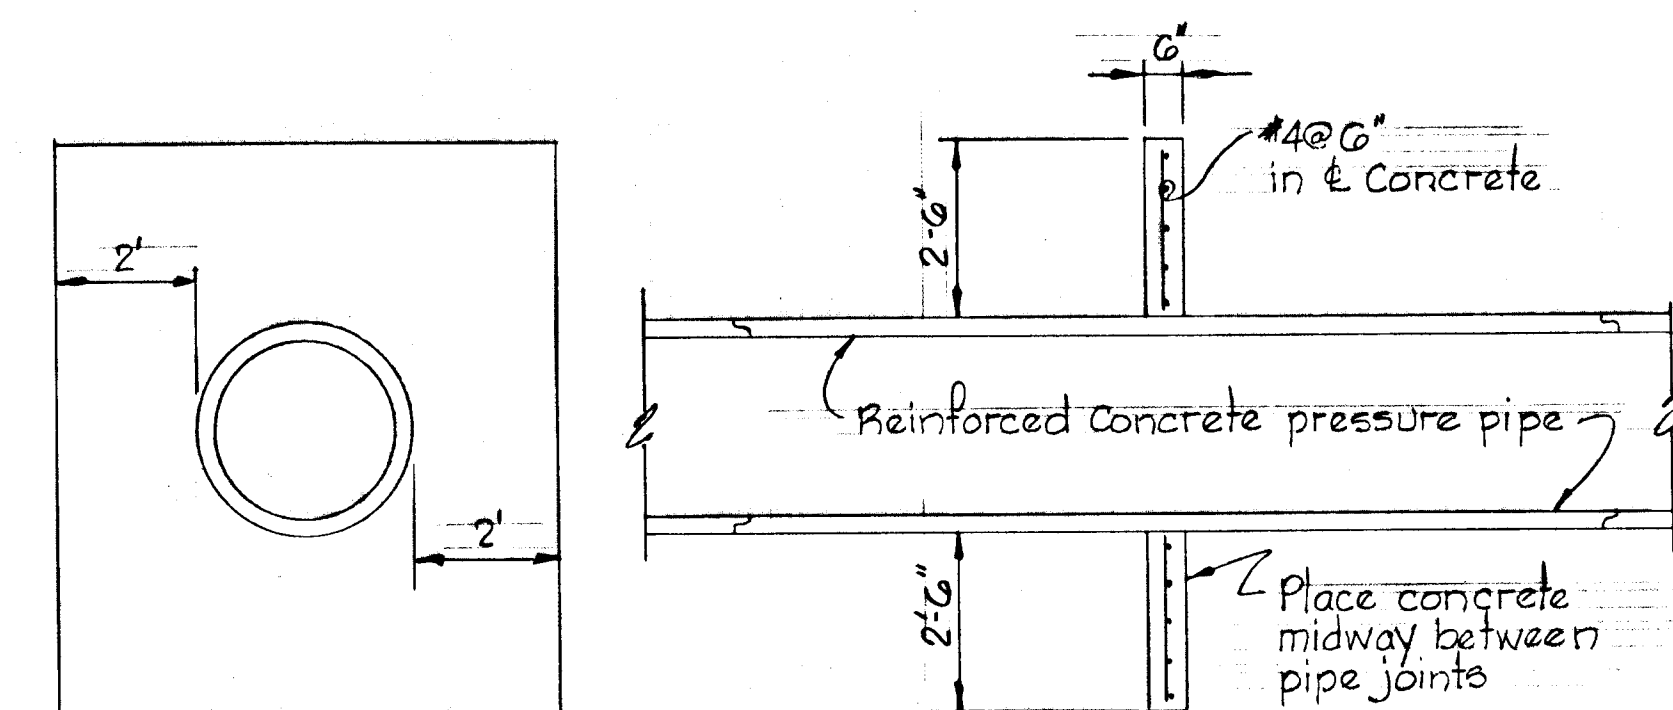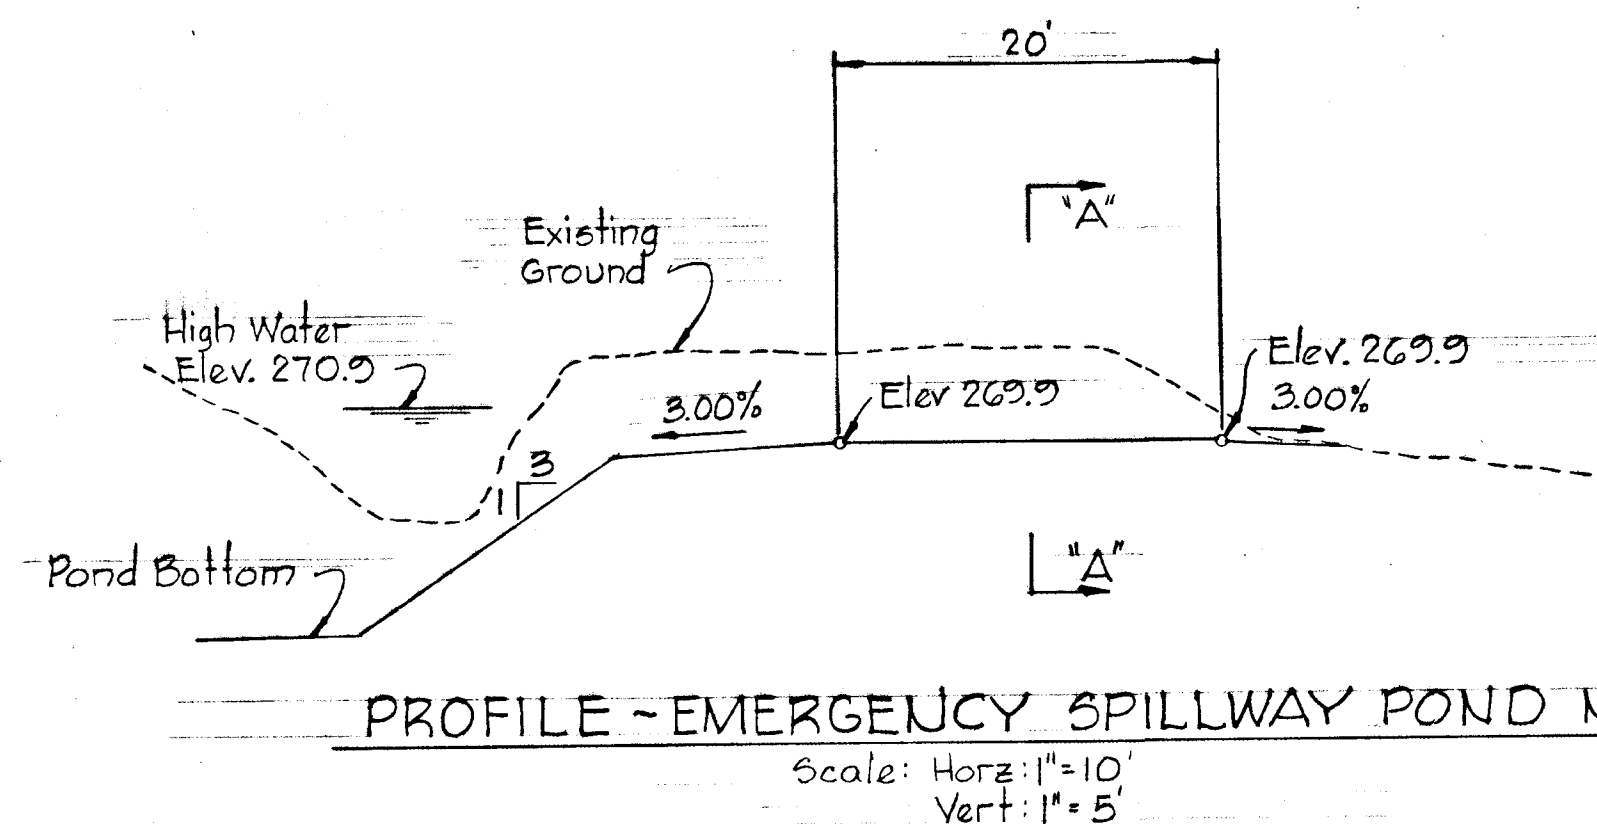

**CERTIFICATION BY THE DEVELOPER**

I certify that all development and/or construction of this pond will be done according to this plan.  
 I also authorize periodic on-site inspection by the Howard Soil Conservation District or their authorized agents as are deemed necessary. Deviation from this plan will not be made unless authorized by the Howard Soil Conservation District. I will authorize a registered professional engineer to supply the Howard Soil Conservation District office with an as-built plan of this pond within 30 days of the ponds completion.  
*Robert Woodbury* 9-2-78  
 Signature of Developer Date

**CERTIFICATION BY THE ENGINEER**

I certify that this plan for small pond construction represents a practical and workable plan based on my personal knowledge of the site conditions and that it was prepared in accordance with the requirements of the Howard Soil Conservation District.  
*Kenneth A. McCord* 9-2-78  
 Kenneth A. McCord PE, 1974 Date

THIS PLAN HAS BEEN REVIEWED BY THE HOWARD SOIL CONSERVATION DISTRICT AND MEETS THE TECHNICAL REQUIREMENTS FOR SOIL EROSION AND SEDIMENT CONTROL.  
*C. Wayne Reed* 12/21/78  
 U.S. SOIL CONSERVATION DISTRICT SERVICE Date

THIS PLAN FOR SMALL POND CONSTRUCTION MEETS THE REQUIREMENTS OF THE HOWARD SOIL CONSERVATION DISTRICT  
 APPROVED: *Robert W. Zeman* 12/21/78  
 HOWARD SOIL CONSERVATION DISTRICT Date  
 PLAN NUMBER

Rev. Date	Rev. No.	Revision Description
<b>COLUMBIA</b> 6 <sup>th</sup> ELECTION DISTRICT HOWARD COUNTY, MARYLAND		
OWNER AND DEVELOPER HOWARD RESEARCH AND DEVELOPMENT CORP.		
PROJECT AREA VILLAGE OF KINGS CONTRIVANCE SECTION 3 AREA 1		
PROJECT TITLE STORM WATER MANAGEMENT POND NO.3 AND POND NO.4 DETAILS AND SPECIFICATIONS		
SCALE: As Shown		DATE:
WHITMAN, REQUART & ASSOCIATES ENGINEERS BALTIMORE, MARYLAND 21202		
<i>Kenneth A. McCord</i> KENNETH A. MCCORD Registered Engineer No. 1974		