


DATE: _____
 BY: _____
 SURVYD. _____
 PHOTO. _____
 CHECKED BY: _____
 NO. _____




DATE: _____
 BY: _____
 SURVYD. _____
 PHOTO. _____
 CHECKED BY: _____
 NO. _____

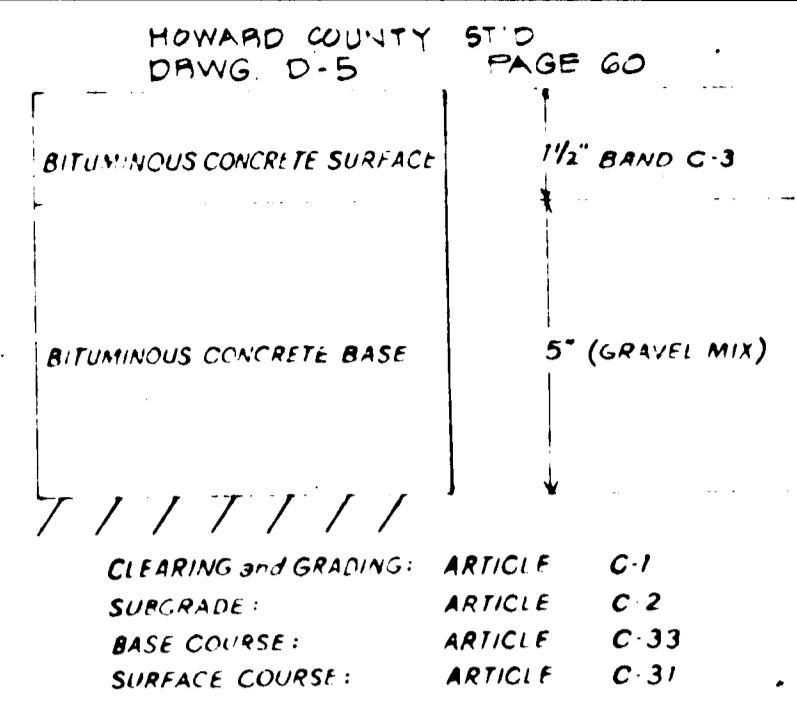

- ALL CONSTRUCTION TO BE CONSTRUCTED IN ACCORDANCE WITH THE HOWARD COUNTY ROAD CONSTRUCTION CODE AND SPECIFICATIONS, 1961.
1. THE PAVEMENT SHALL BE CONSTRUCTED IN ACCORDANCE WITH SECTION C-30.3 AS PROVIDED IN THE HOWARD COUNTY ROAD CONSTRUCTION CODE AND STANDARD SPECIFICATIONS.
 2. A TACK COAT IS REQUIRED IN ACCORDANCE WITH SECTION C-3.4 OF THE HOWARD COUNTY ROAD CONSTRUCTION CODE AND STANDARD SPECIFICATIONS.
 3. OAKLAND MILLS ROAD IS AN EXISTING ROAD.

CLEARING AND GRADING: ARTICLE C-1
 SURGRADE: ARTICLE C-2
 BASE COURSE: ARTICLE C-33
 SURFACE COURSE: ARTICLE C-31

NOTE: PROPOSED CURB & GUTTER ADDITION TO OAKLAND MILLS RD IS TO MATCH THE EXISTING EDGE OF ROAD FOR GRADE.

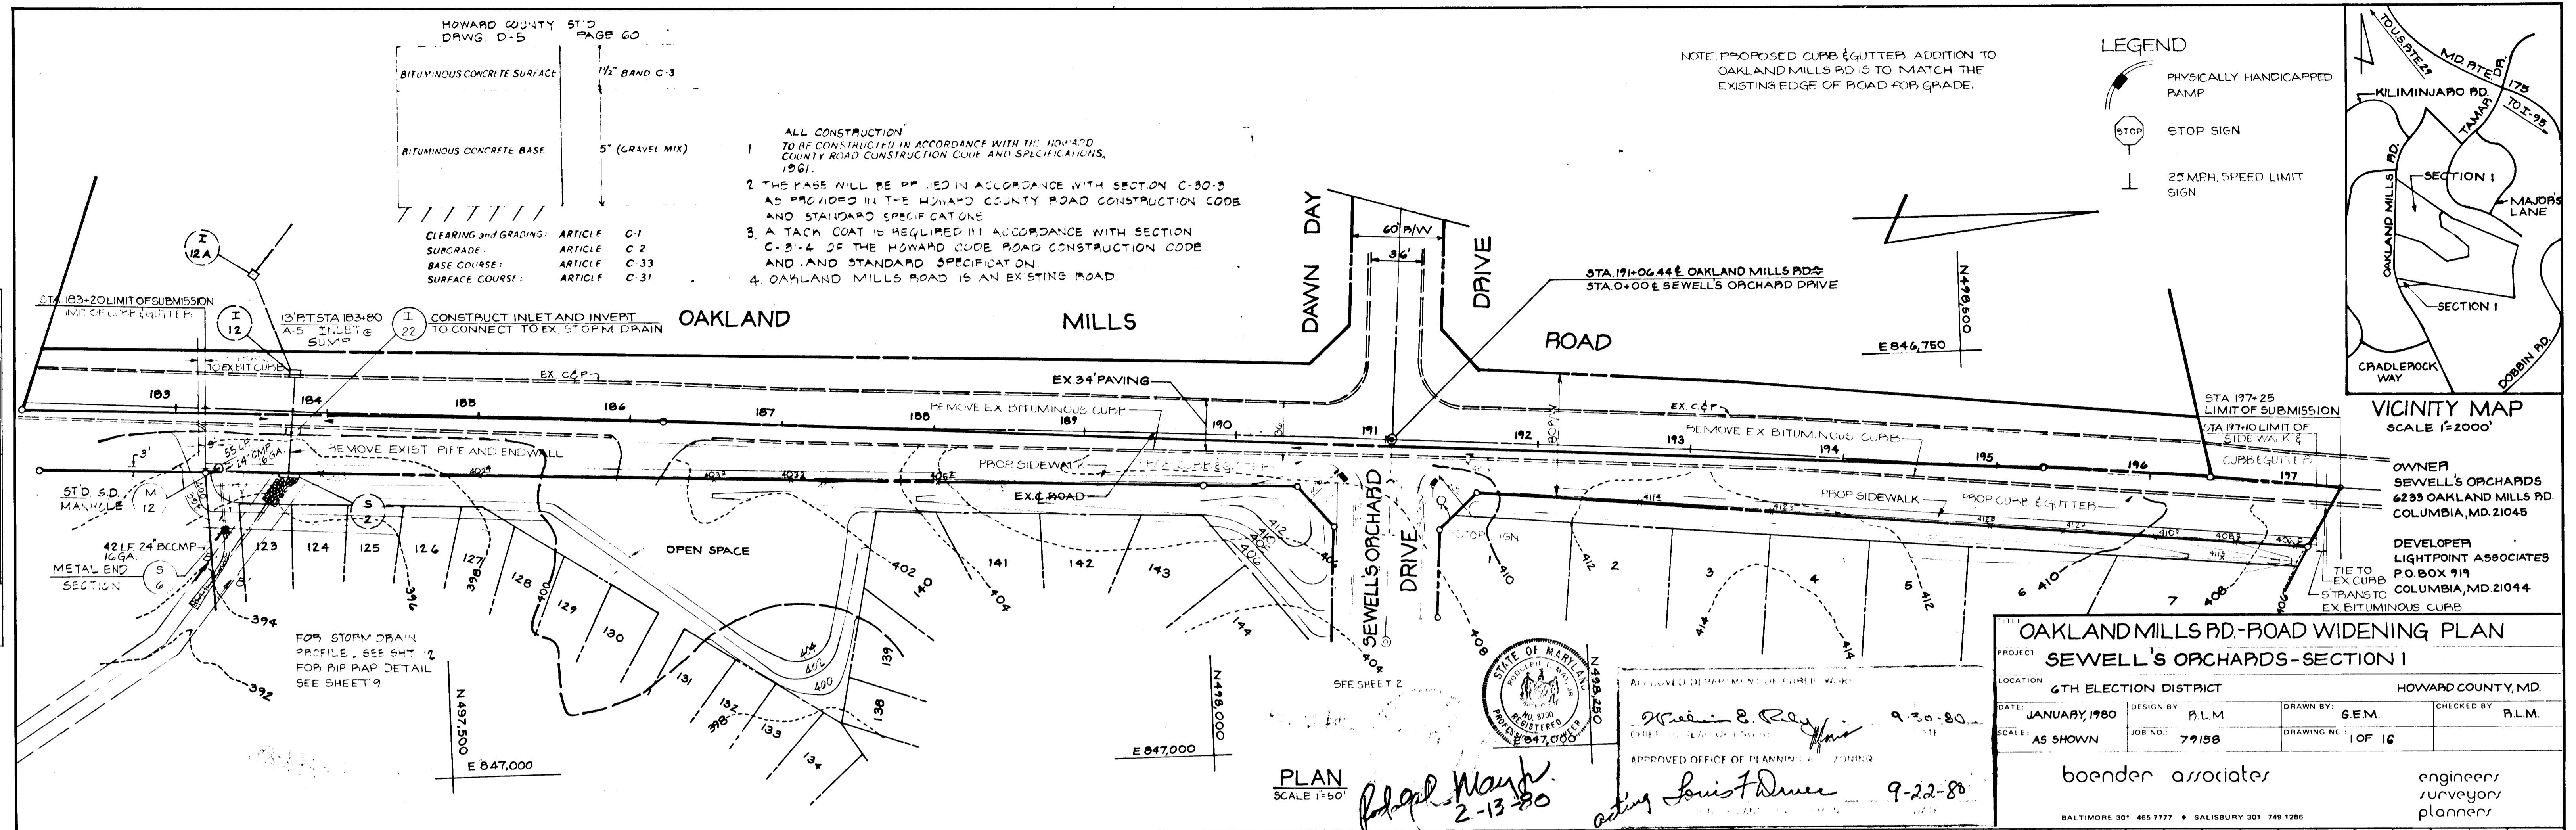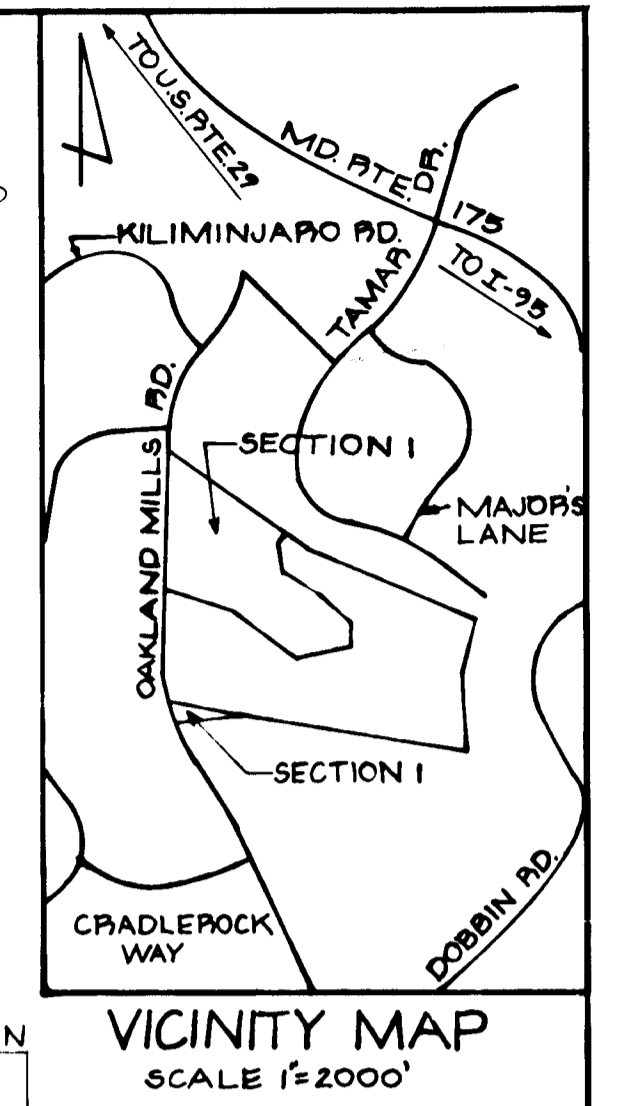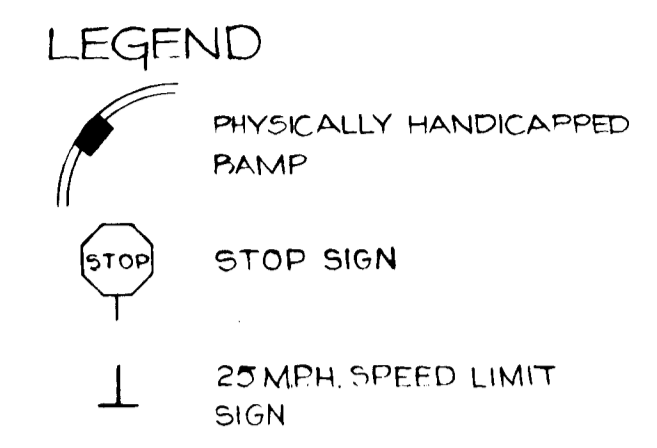

OAKLAND MILLS RD. ROAD WIDENING PLAN
SEWELL'S ORCHARDS - SECTION I


PROJECT LOCATION: 6TH ELECTION DISTRICT, HOWARD COUNTY, MD.

DATE: JANUARY, 1980 DESIGN BY: R.L.M. DRAWN BY: G.E.M. CHECKED BY: R.L.M.

SCALE: AS SHOWN JOB NO.: 79158 DRAWING NO.: 1 OF 16


boender associates engineers/surveyors/planners

BALTIMORE 301 465 7377 SALISBURY 301 749 1286

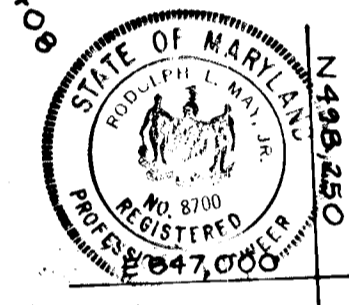

Robert E. Ray
 2-13-80

Louis F. Diner
 9-22-80


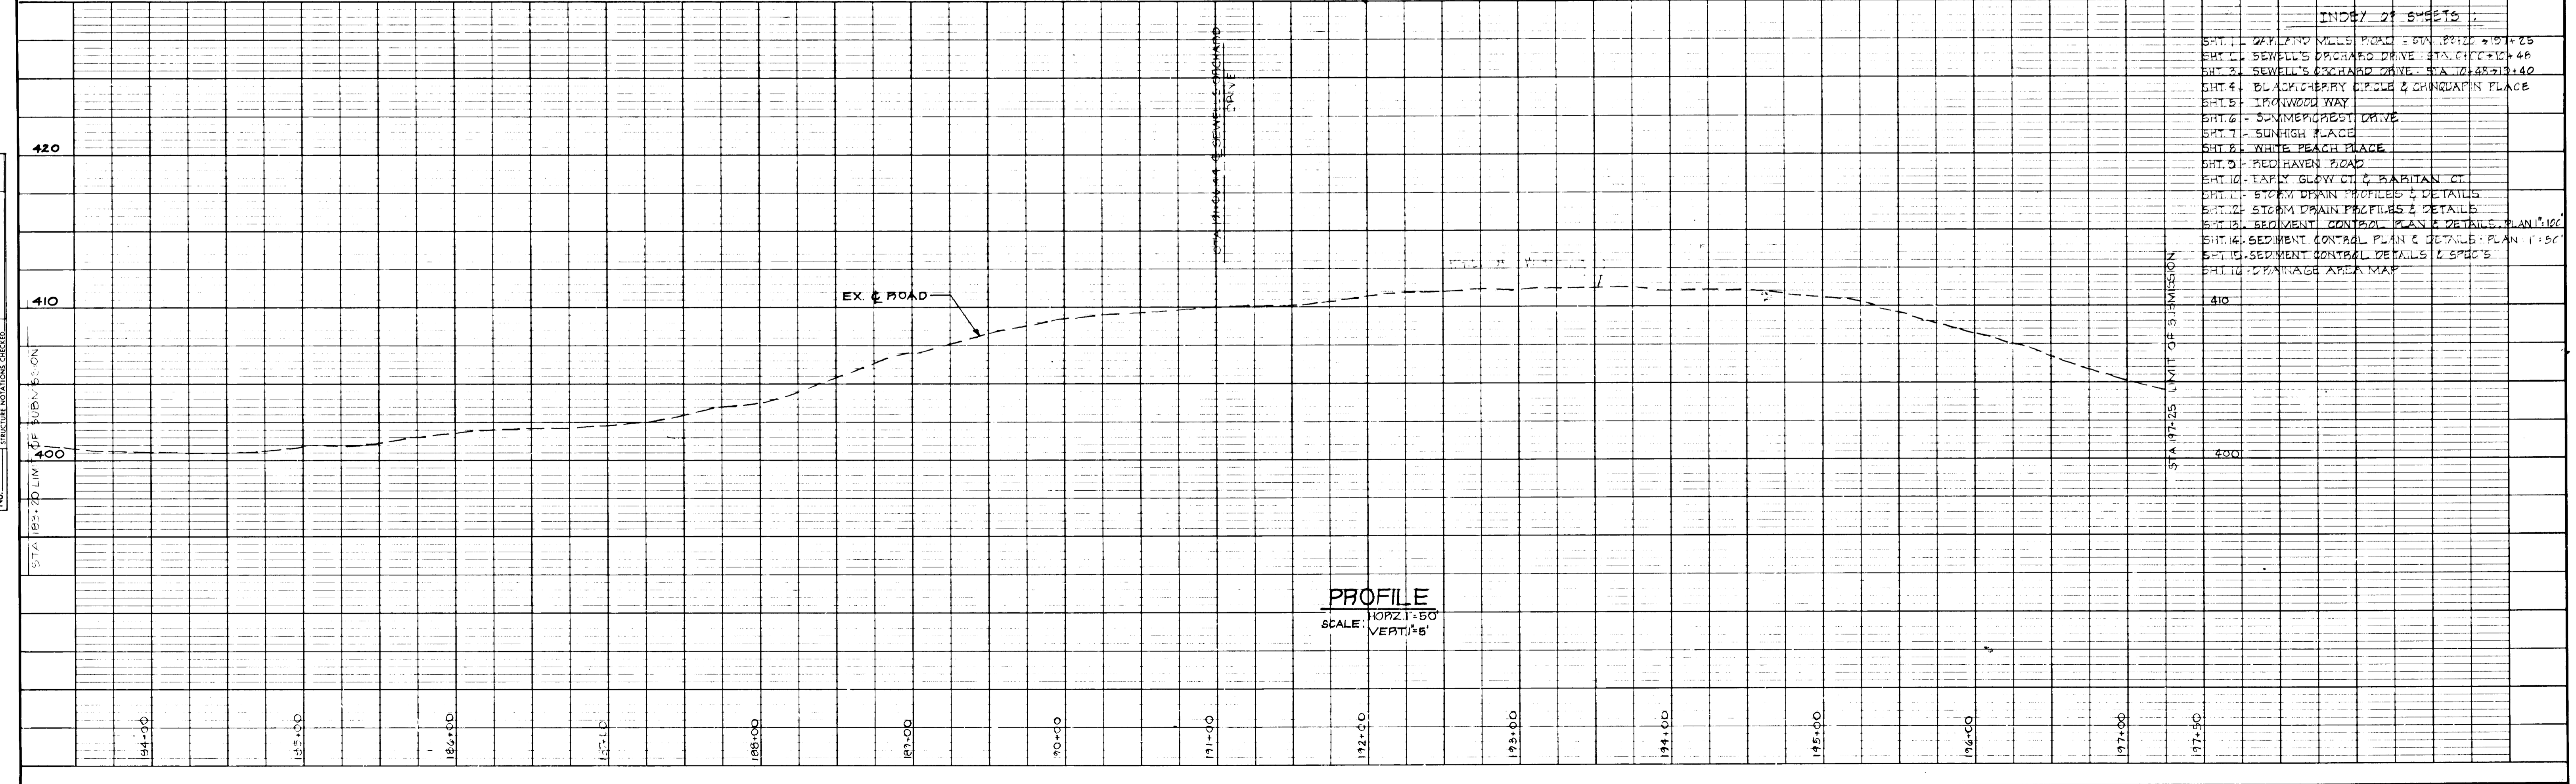


INDEX OF SHEETS

SHT. 1	OAKLAND MILLS ROAD - STA. 183+00 TO 197+25
SHT. 2	SEWELL'S ORCHARDS DRIVE - STA. 197+00 TO 197+40
SHT. 3	SEWELL'S ORCHARDS DRIVE - STA. 197+40 TO 198+00
SHT. 4	BLACKBERRY CIRCLE & CHINA PIN PLACE
SHT. 5	IRONWOOD WAY
SHT. 6	SUMMERBROOK DRIVE
SHT. 7	SUNHIGH PLACE
SHT. 8	WHITE PEACH PLACE
SHT. 9	RED HAVEN ROAD
SHT. 10	EAPY GLOW CT. & BABY TAN CT.
SHT. 11	STORM DRAIN PROFILES & DETAILS
SHT. 12	STORM DRAIN PROFILES & DETAILS
SHT. 13	SEDIMENT CONTROL PLAN & DETAILS - PLAN 1/8\"/>

DATE	
BY	
NO.	
PLAN	
NO.	
DATE	
BY	
NO.	
PROFILE	
NO.	
DATE	
BY	
NO.	

DATE	
BY	
NO.	
PROFILE	
NO.	
DATE	
BY	
NO.	

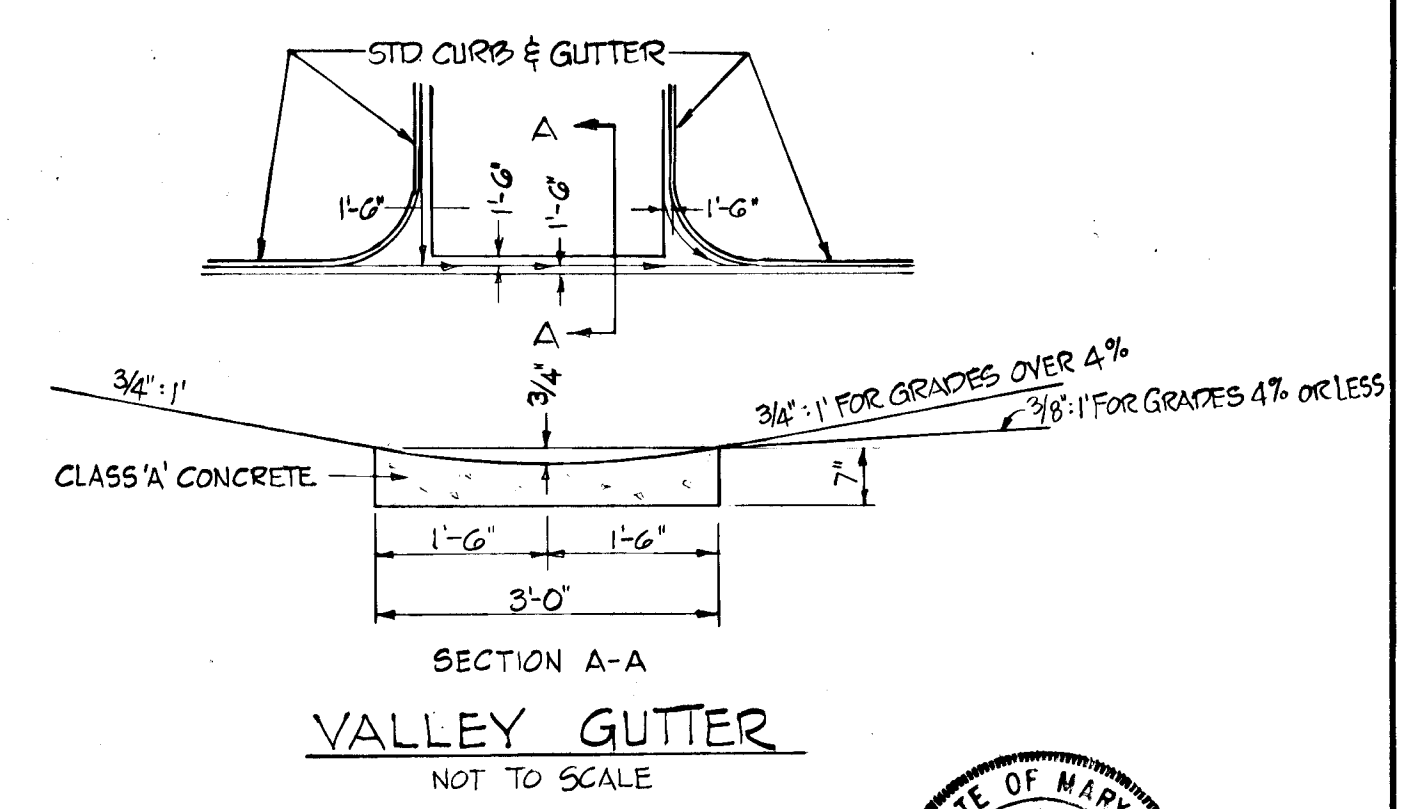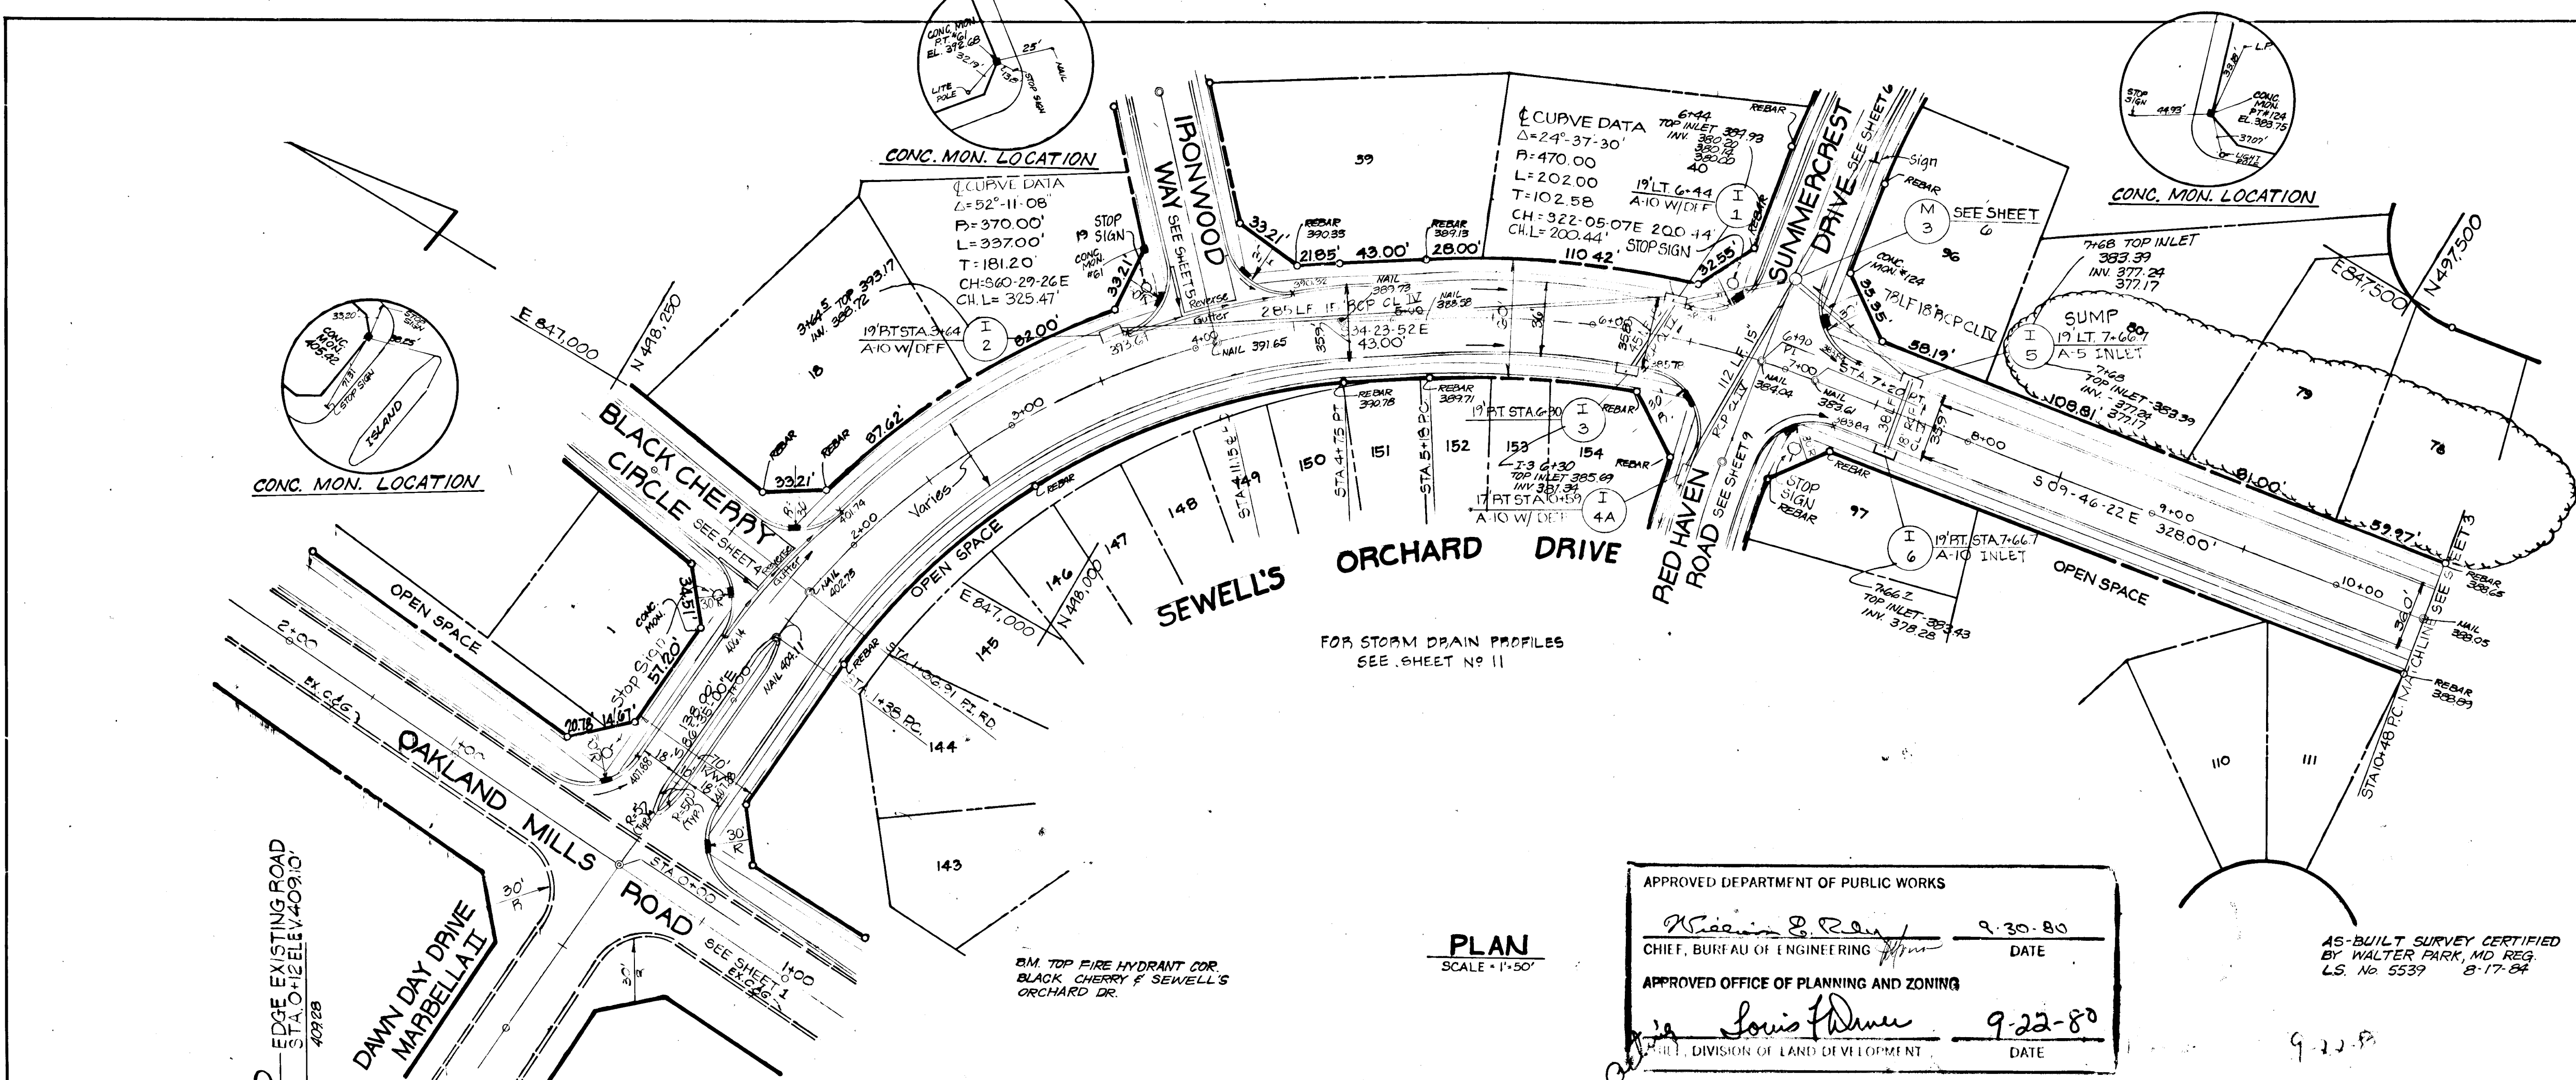

PLAN
SCALE = 1"=50'


APPROVED DEPARTMENT OF PUBLIC WORKS
William B. Ryan 9-30-80
 CHIEF, BUREAU OF ENGINEERING
 DATE
 APPROVED OFFICE OF PLANNING AND ZONING
Louis F. Dwyer 9-22-80
 DIVISION OF LAND DEVELOPMENT
 DATE

TITLE: SEWELL'S ORCHARDS DRIVE STA. 0+00 TO 10+48			
PROJECT: SEWELL'S ORCHARDS SECTION I			
LOCATION: 6TH ELECTION DISTRICT		HOWARD COUNTY, MD.	
DATE: JANUARY, 1980	DESIGN BY: W.H.N.	DRAWN BY: G.E.M./W.C.L.	CHECKED BY: P.L.M.
SCALE: AS SHOWN	JOB NO.: 79158	DRAWING NO.: 2 OF 16	
boender associates		engineers surveyors planners	
BALTIMORE 301-465-7777 • SALISBURY 301-749-1286			

STATE OF MARYLAND
 PROFESSIONAL ENGINEER
Robert May Jr.
 2-13-80

OWNER
 SEWELL'S ORCHARDS
 6233 OAKLAND MILLS RD.
 COLUMBIA, MD 21045


DEVELOPER
 LIGHTPOINT ASSOC.
 PO BOX 919
 COLUMBIA, MD 21044

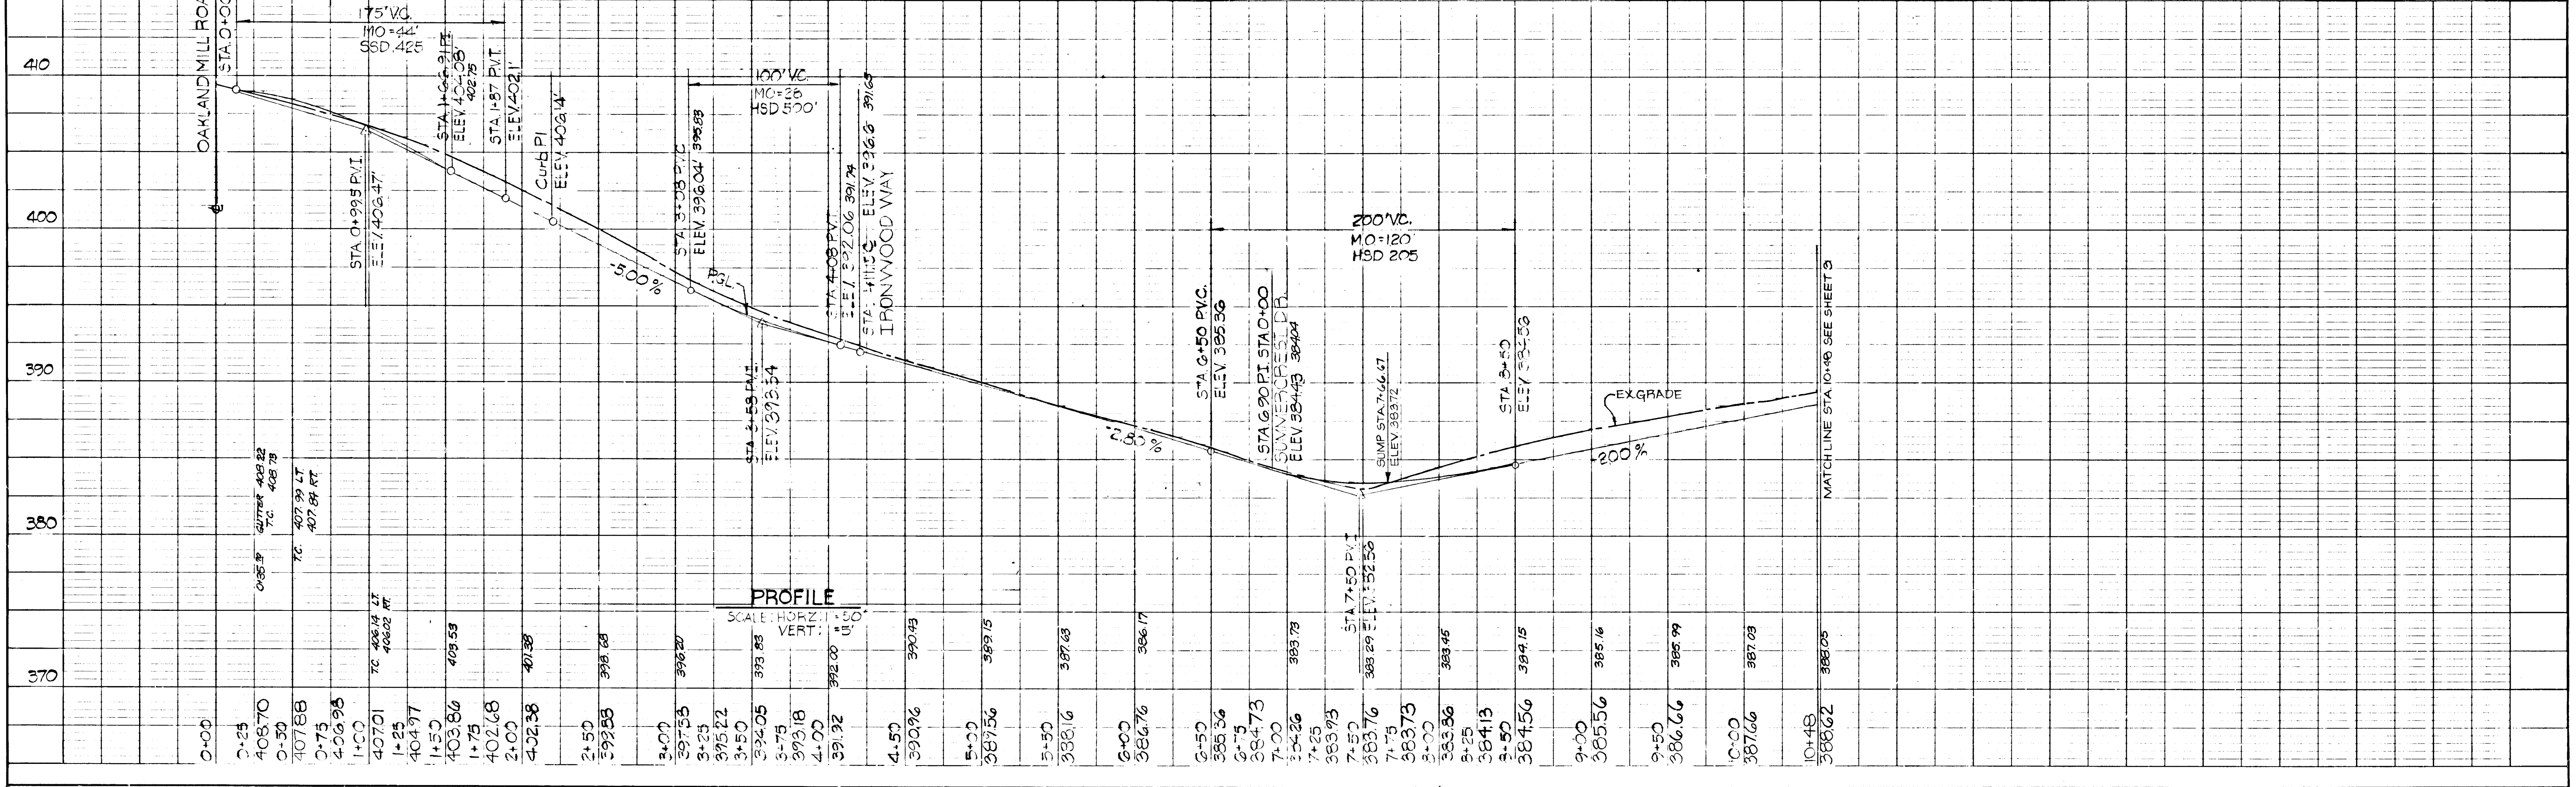

PROFILE
 SCALE: HORIZ. 1"=50'
 VERT. 1"=10'

DATE	
BY	
REVISIONS	
NO.	
PLAN	
NOTE BOOK	
ALIGNED CHECKED	
BY	
DATE	
NO.	

DATE	
BY	
REVISIONS	
NO.	
PROFILE	
NOTE BOOK	
GRADES CHECKED	
BY	
DATE	
NO.	

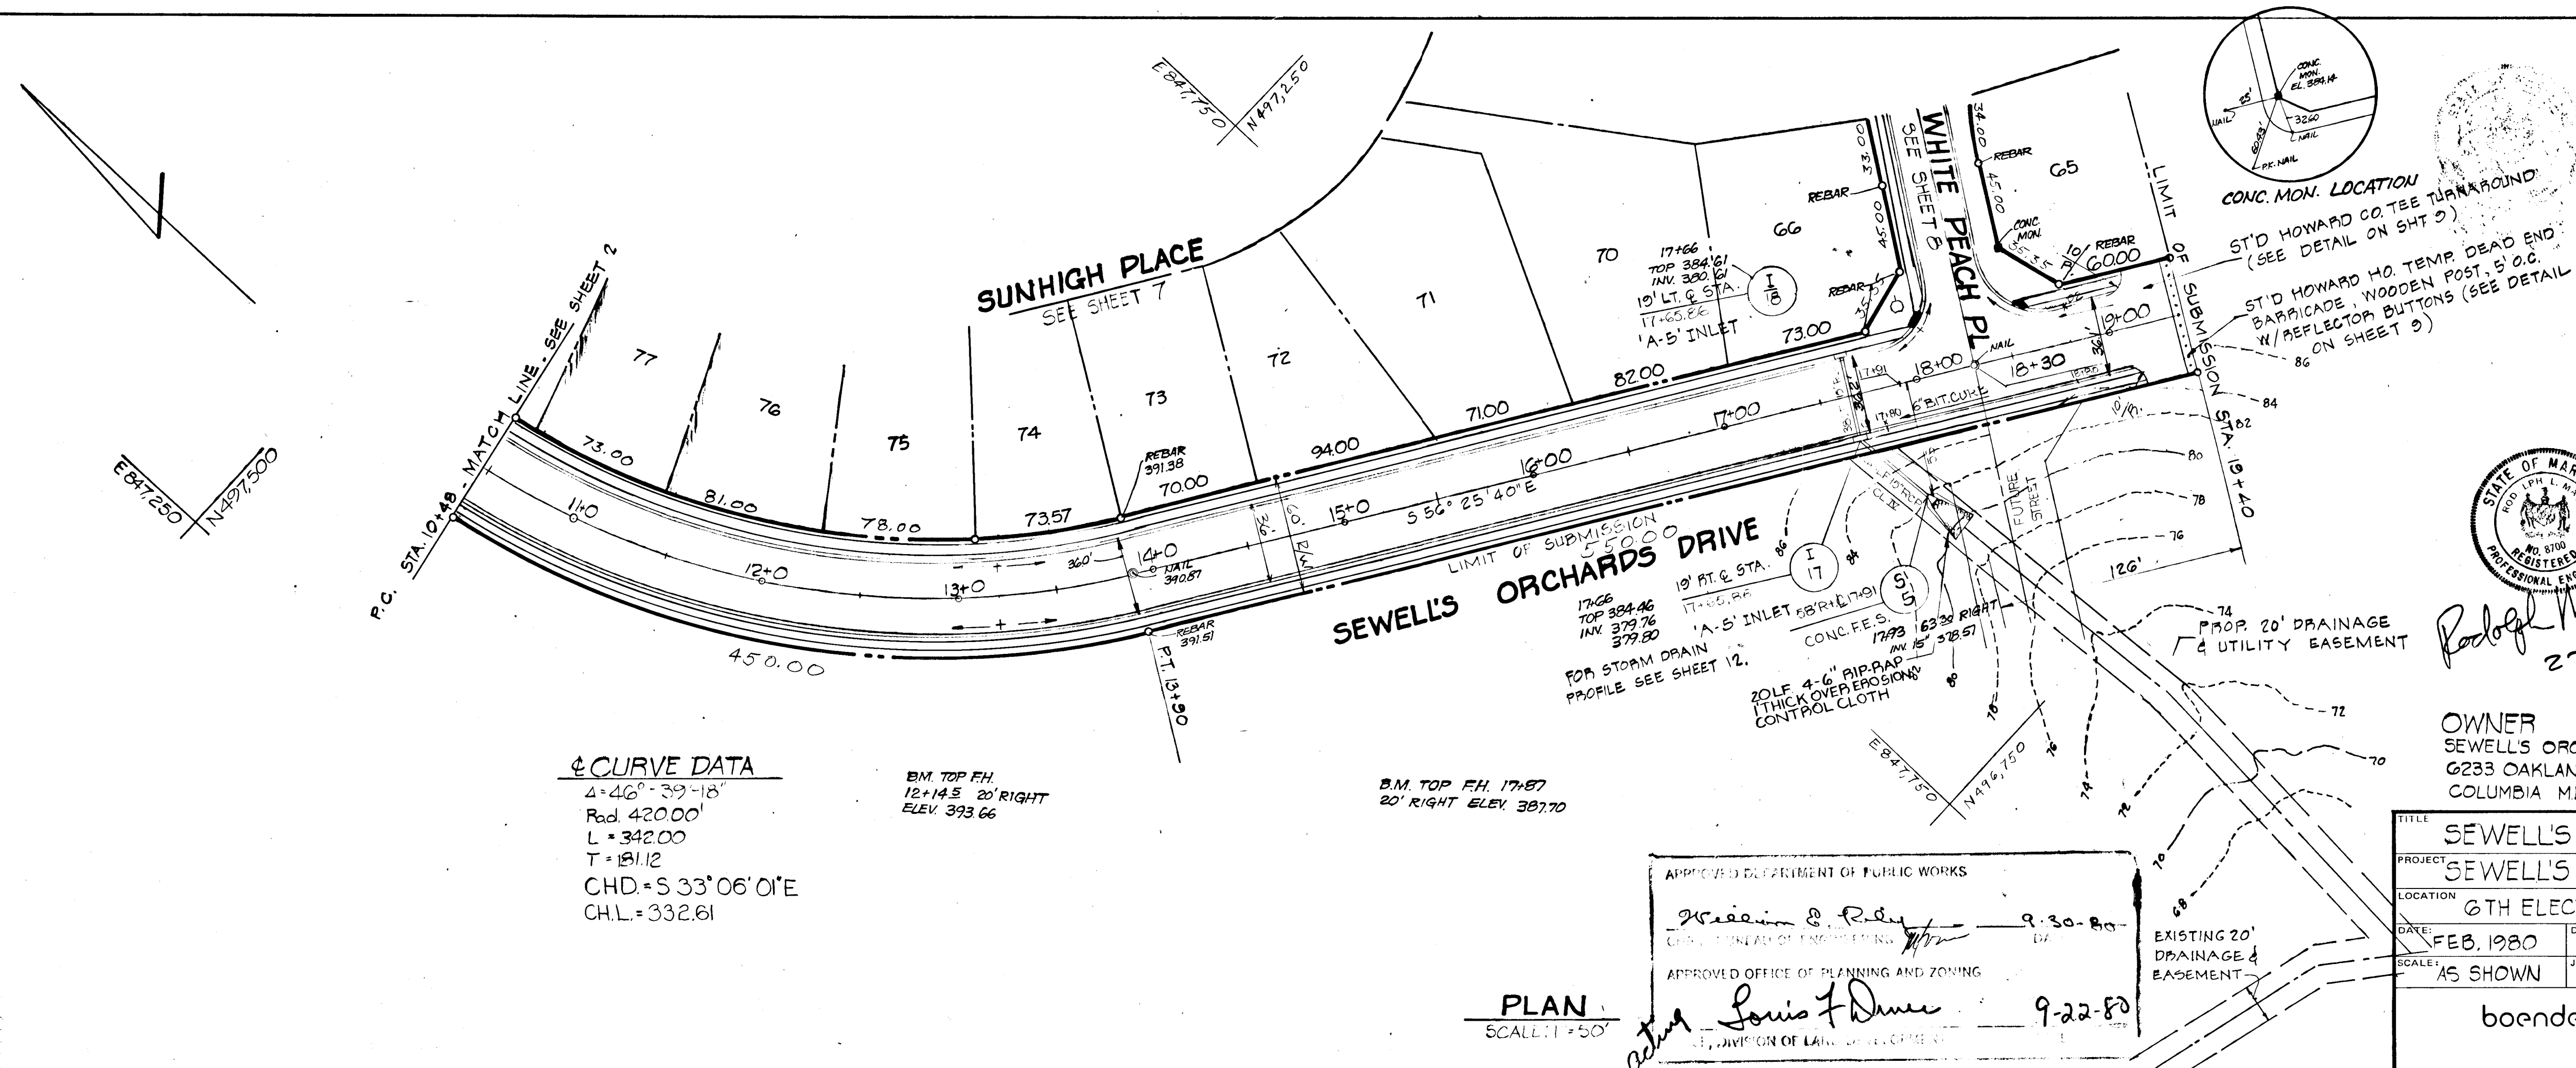

STATE OF MARYLAND
 REGISTERED PROFESSIONAL ENGINEER
 Rodolph May Jr.
 2-13-80

OWNER
 SEWELL'S ORCHARDS
 6233 OAKLAND MILLS RD
 COLUMBIA MD 21045

DEVELOPER
 LIGHTPOINT ASSOC.
 PO BOX 919
 COLUMBIA, MD 21044

APPROVED DEPARTMENT OF PUBLIC WORKS
 Approved Office of Planning and Zoning
 APPROVED OFFICE OF PLANNING AND ZONING
 DIVISION OF LAND AND DEVELOPMENT


DATE: FEB. 1980
 SCALE: AS SHOWN

DESIGN BY: R.L.M.
 JOB NO.: 79158

DRAWN BY: W.C.L.
 DRAWING NO.: 3 OF 16

CHECKED BY:


boender associates
 engineers/surveyors/planners
 BALTIMORE 301-465-7777 • SALISBURY 301-749-1286

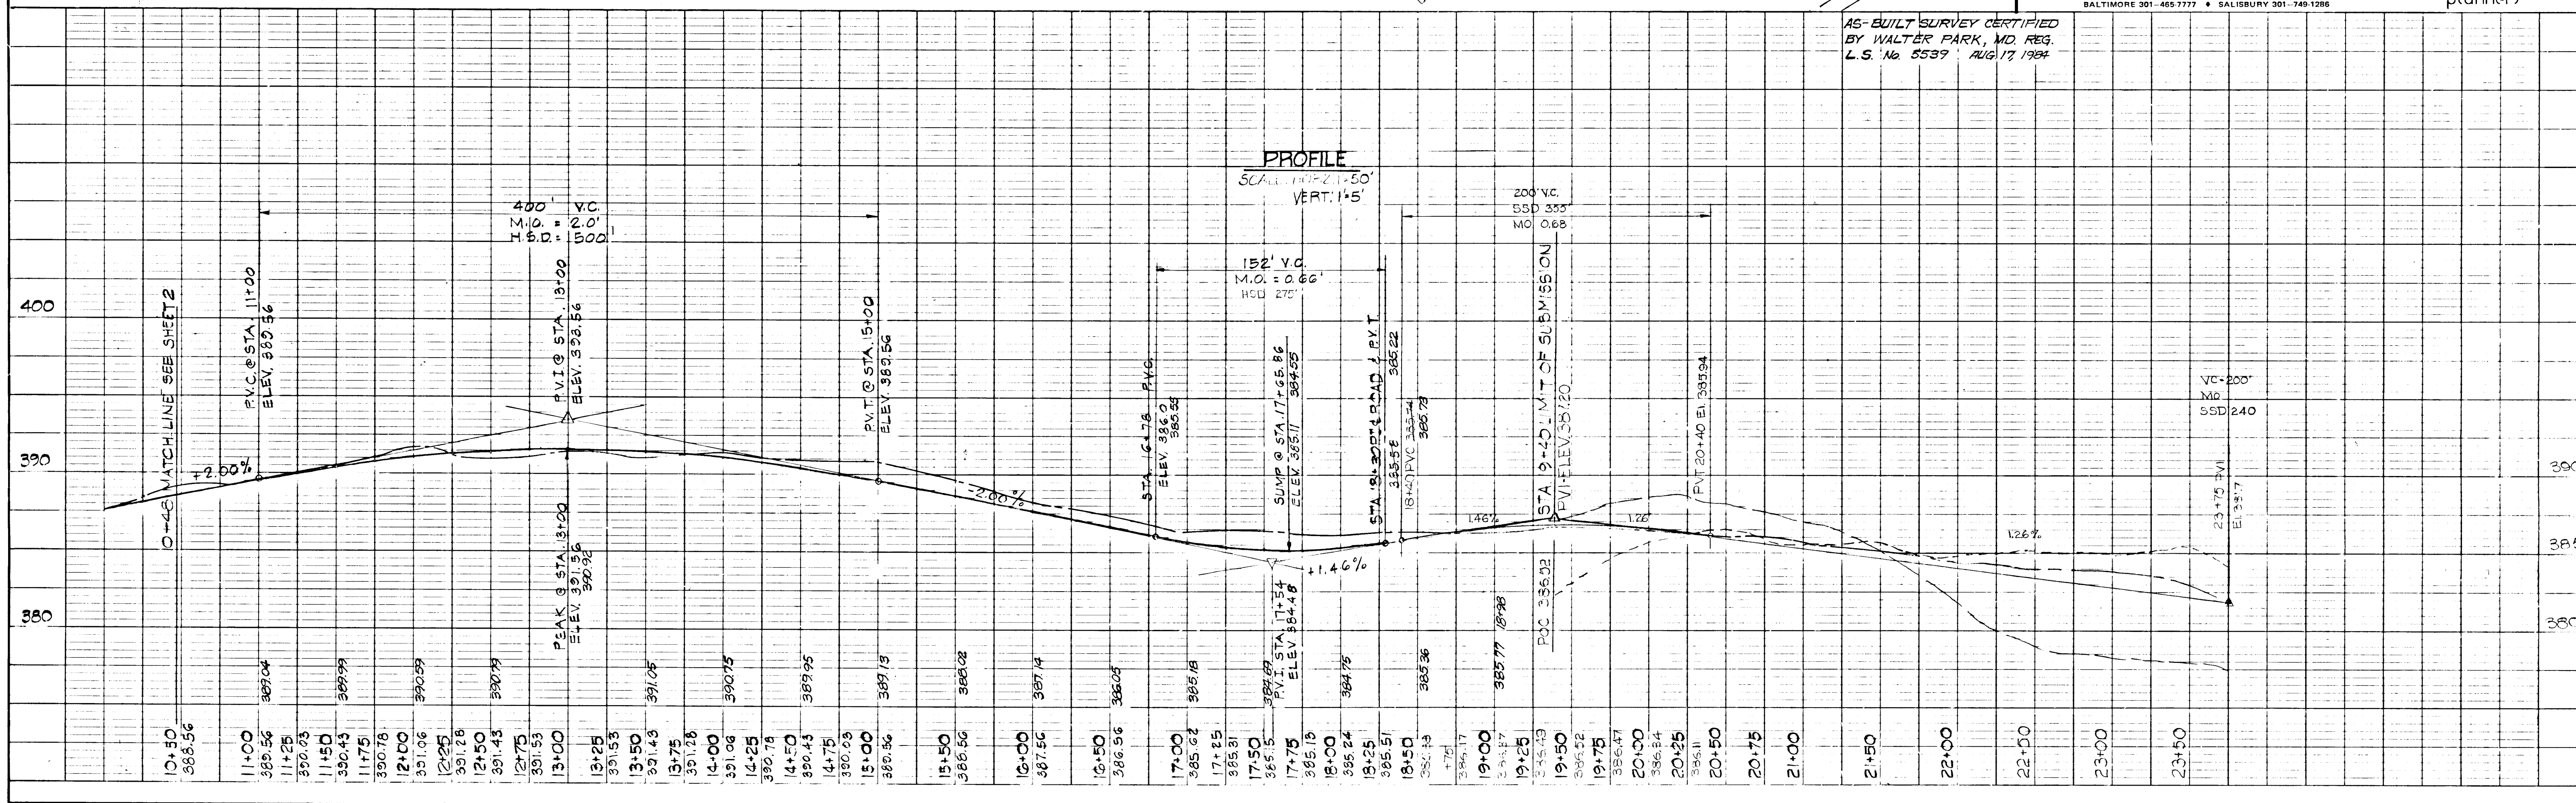

DATE: _____
 BY: _____
 SURVEYED: _____
 NOTE BOOK: _____
 ALIGNMENT CHECKED: _____
 R.C. OF WAY CHECKED: _____
 No. _____

DATE: _____
 BY: _____
 SURVEYED: _____
 NOTE BOOK: _____
 R.W. NOTES: _____
 STRUCTURE NOTATIONS CHECKED: _____
 No. _____

850

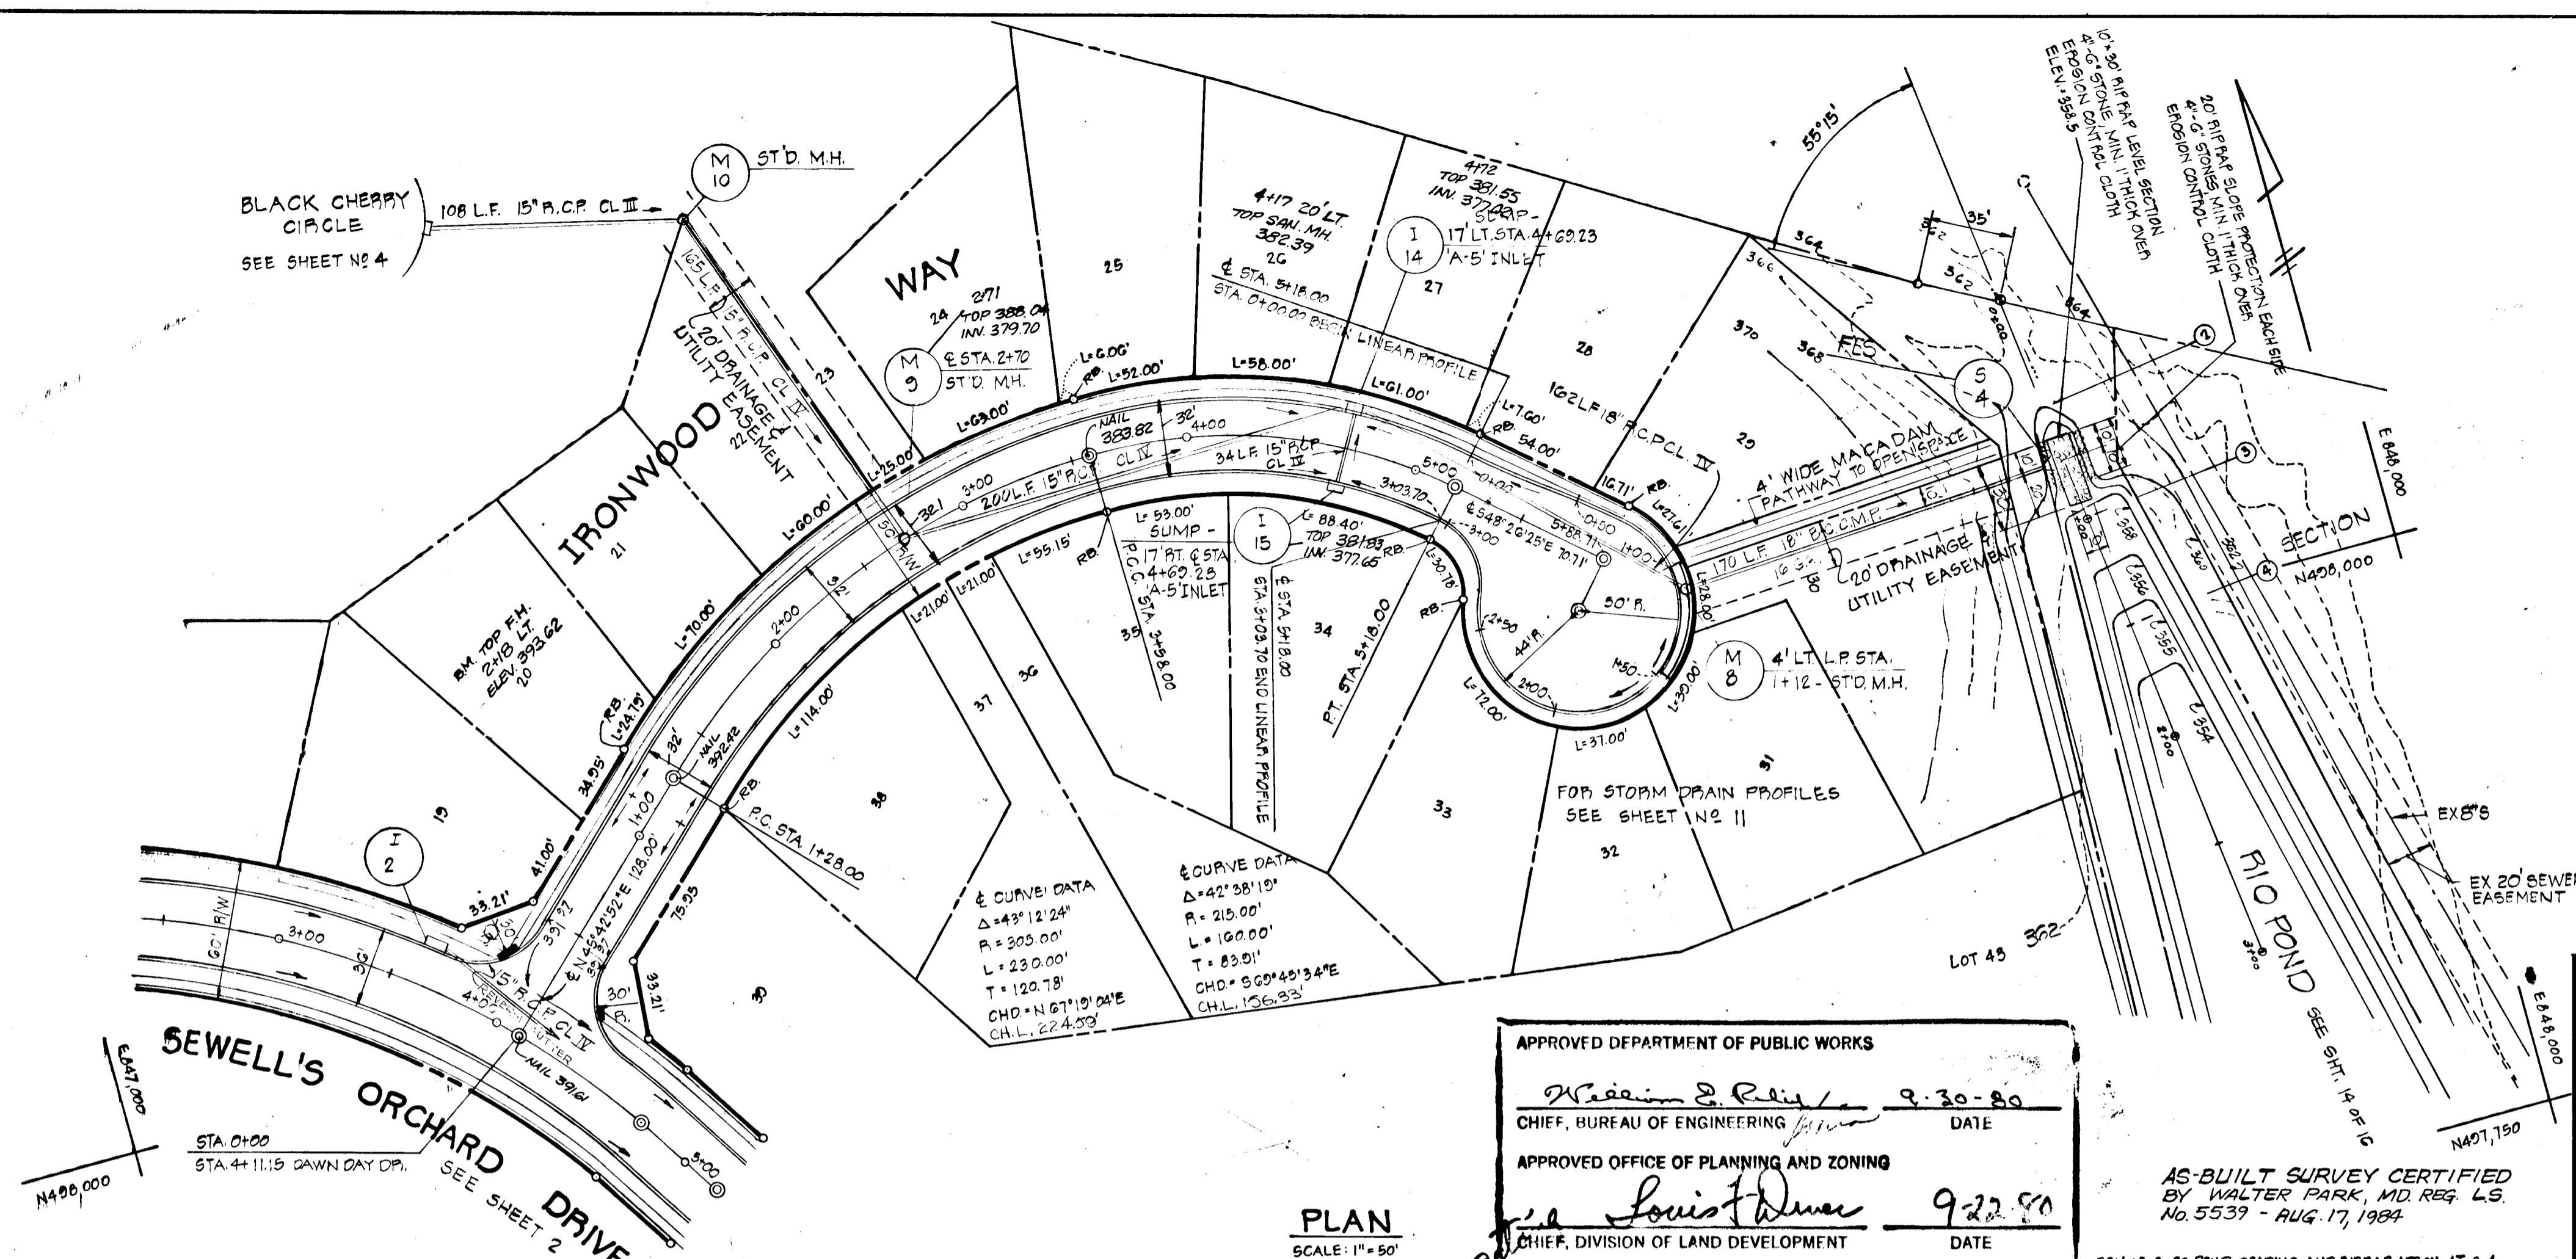

PLAN
 SCALE: 1"=50'


APPROVED DEPARTMENT OF PUBLIC WORKS
William D. Riley 9-30-80
 CHIEF, BUREAU OF ENGINEERING DATE
 APPROVED OFFICE OF PLANNING AND ZONING
Louis J. Dumas 9-22-80
 CHIEF, DIVISION OF LAND DEVELOPMENT DATE

AS-BUILT SURVEY CERTIFIED
 BY WALTER PARK, MD REG. L.S.
 No. 5539 - AUG. 17, 1984
 REV. 3-3-80 POND GRADING AND PIPERAP AT 3-4

PROJECT: ROAD CONSTRUCTION PLAN - IRONWOOD WAY			
SECTION: SEWELL'S ORCHARDS SECTION 1			
LOCATION: 6TH ELECTION DISTRICT		HOWARD COUNTY, MD	
DATE: FEB., 1980	DESIGN BY: W.H.N./P.L.M.	DRAWN BY: J.J.B./W.H.N.	CHECKED BY: P.L.M.
SCALE: AS SHOWN	JOB NO.: 79158	DRAWING NO.: 5 OF 10	

boender associates
 engineers/surveyors/planners
 BALTIMORE 301-465-7777 • SALISBURY 301-749-1286

STATE OF MARYLAND
 REGISTERED PROFESSIONAL ENGINEER
Robert M. Hart
 2-13-80
 OWNER: SEWELL'S ORCHARDS
 6233 OAKLAND MILLS ROAD
 COLUMBIA, MD. 21043
 DEVELOPER: LIGHTPOINT ASSOCIATES
 P.O. BOX 919
 COLUMBIA, MD. 21044

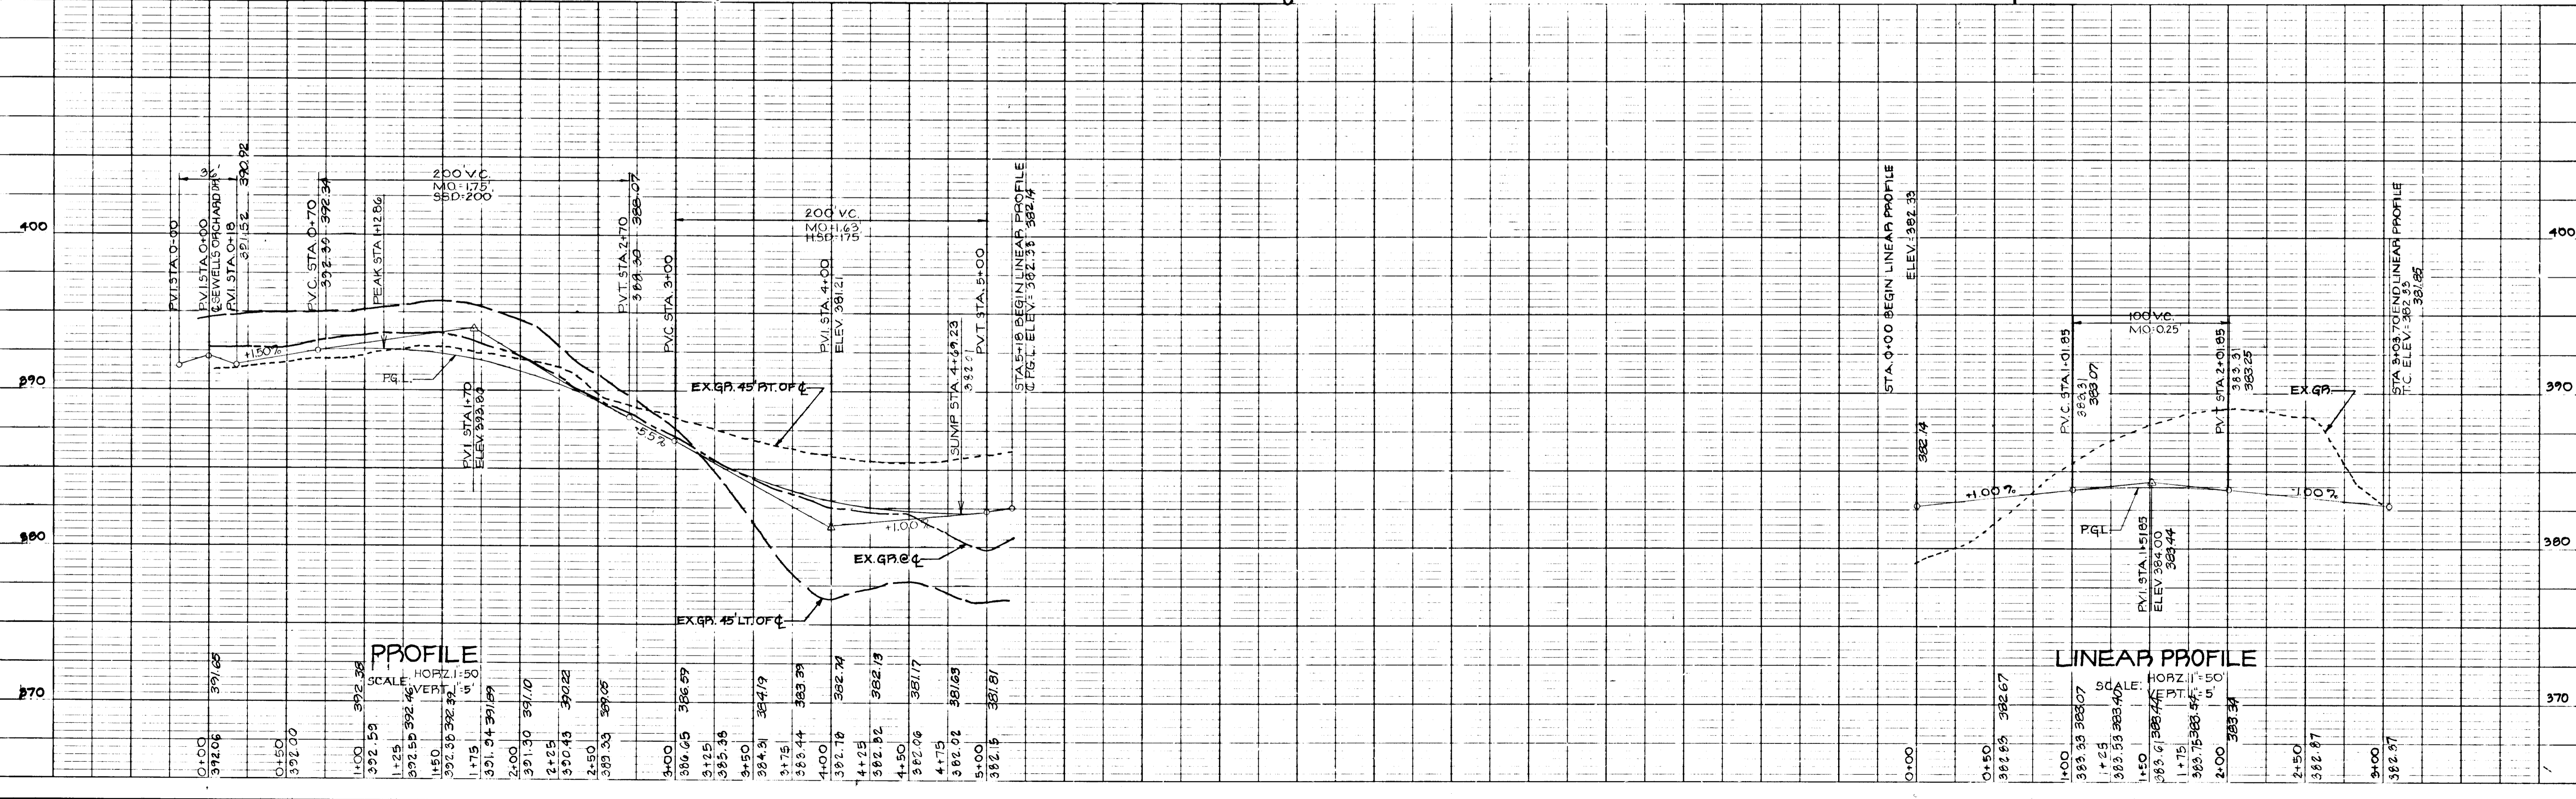


PROFILE
 SCALE: HORIZ: 1"=50'
 VERT: 1"=5'

LINEAR PROFILE
 SCALE: HORIZ: 1"=50'
 VERT: 1"=5'

DATE: _____ BY: _____
 SURVEYED: _____
 NOTE BOOK: _____
 NO. _____
 ALIGNMENT CHECKED: _____
 BY: _____
 NO. _____
 BY: _____
 NO. _____


DATE: _____ BY: _____
 SURVEYED: _____
 NOTE BOOK: _____
 NO. _____
 ALIGNMENT CHECKED: _____
 BY: _____
 NO. _____
 BY: _____
 NO. _____

APPROVED DEPARTMENT OF PUBLIC WORKS
William E. Ray 2-30-80
 CHIEF, BUREAU OF ENGINEERING DATE
 APPROVED OFFICE OF PLANNING AND ZONING
John J. ... 9-22-80
 CHIEF, DIVISION OF LAND DEVELOPMENT DATE

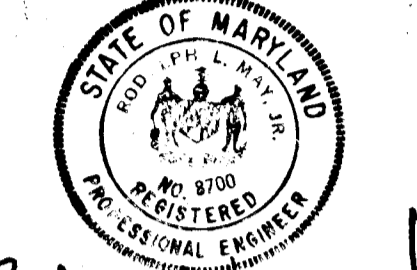


Robert M. ...
 2-13-80

OWNER: SEWELL'S ORCHARDS
 6233 OAKLAND MILLS RD.
 COLUMBIA, MD. 21045
 DEVELOPER: LIGHTPOINT ASSOC.
 P.O. BOX 319
 COLUMBIA, MD. 21044

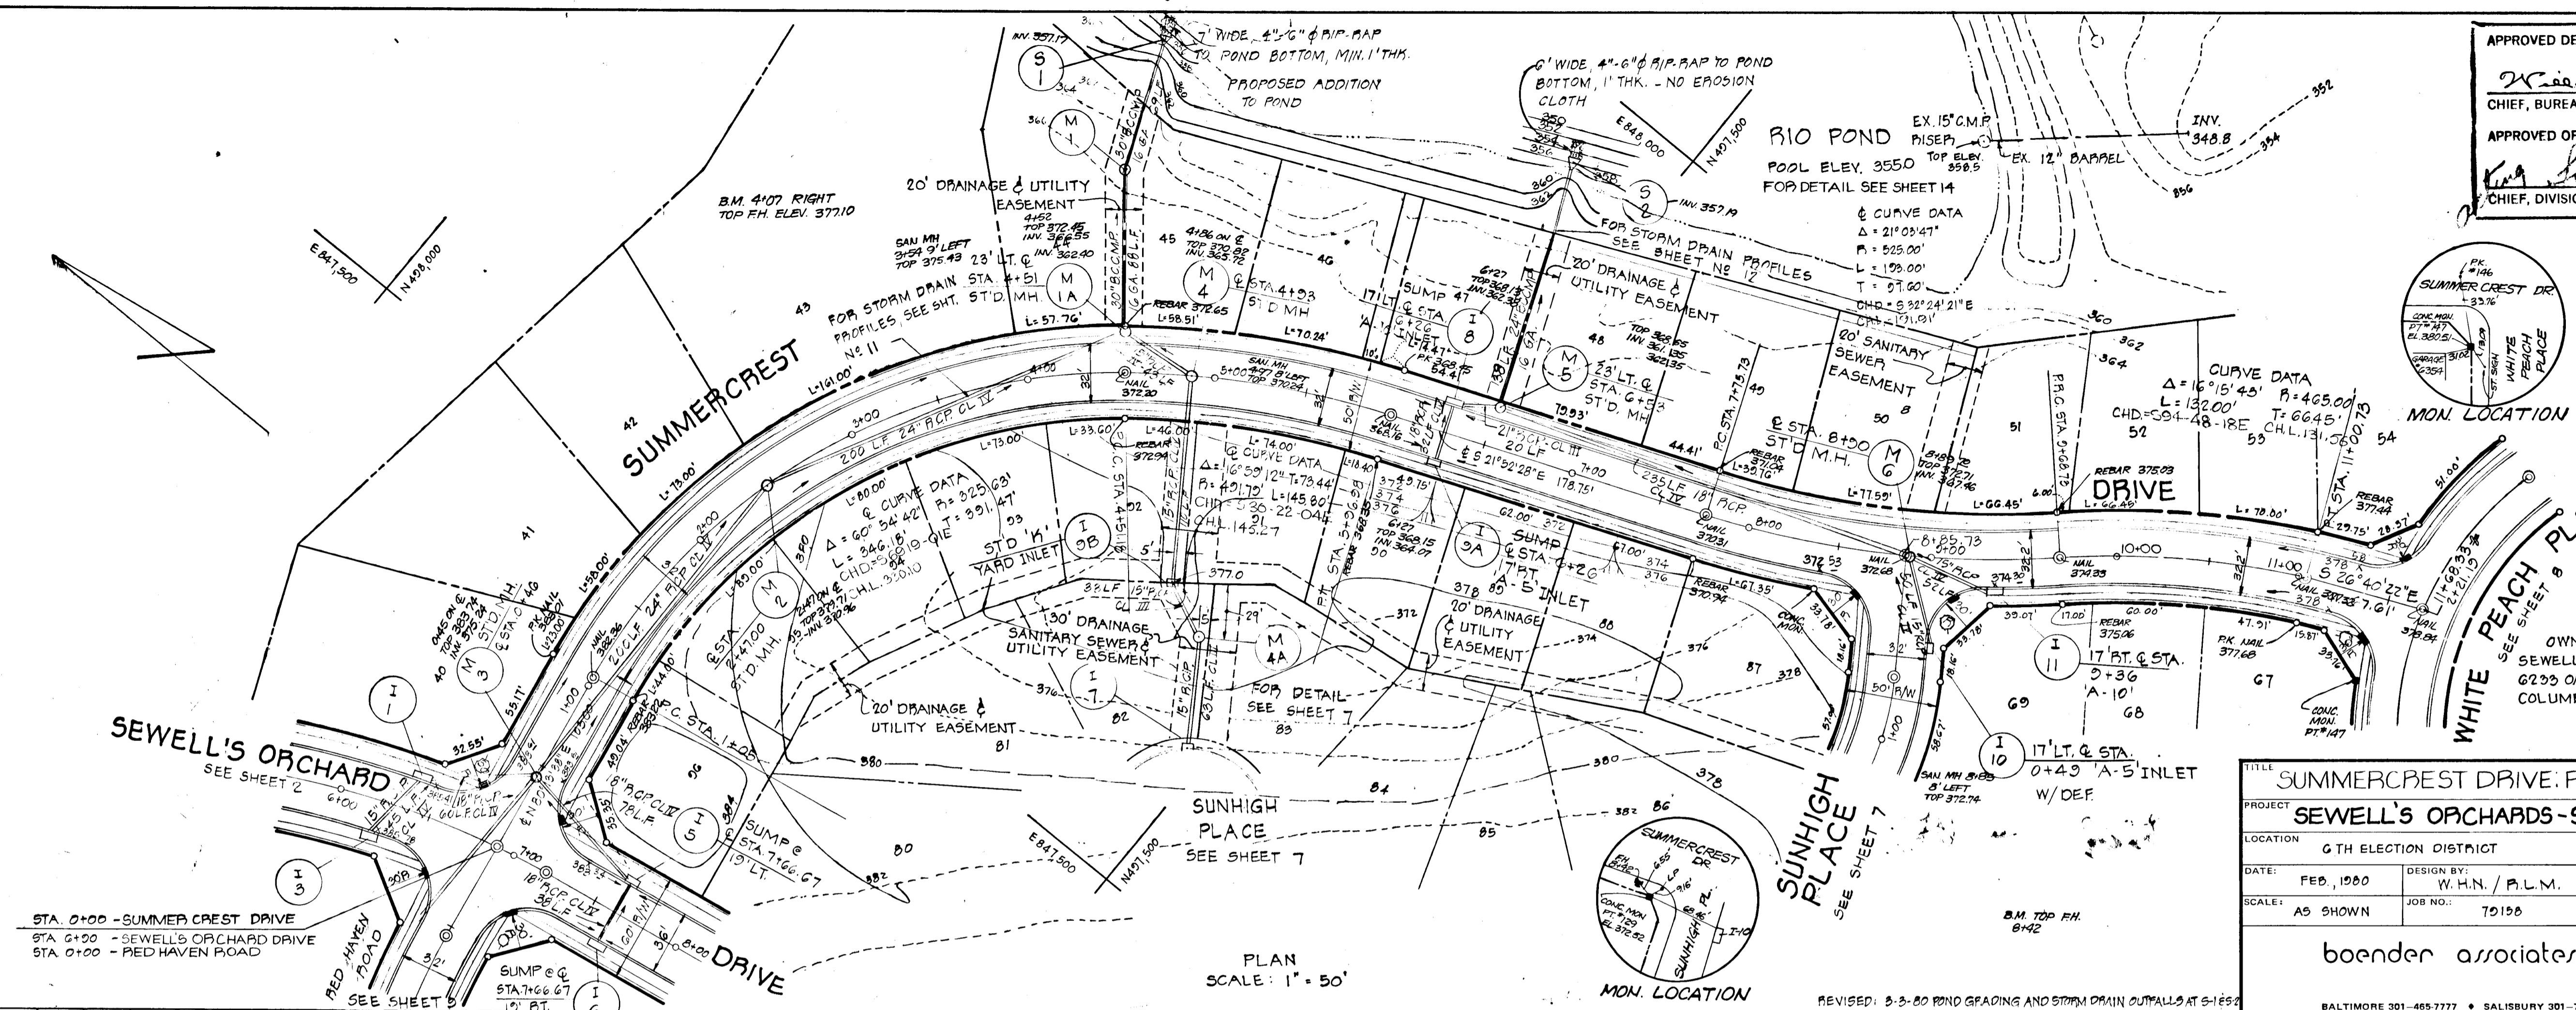

TITLE: SUMMERCREST DRIVE ROAD CONSTRUCTION PLAN			
PROJECT: SEWELL'S ORCHARDS-SECTION 1			
LOCATION: GTH ELECTION DISTRICT	HOWARD COUNTY, MD.		
DATE: FEB, 1980	DESIGN BY: W.H.N. / P.L.M.	DRAWN BY: G.E.M. / W.H.N.	CHECKED BY: P.L.M.
SCALE: AS SHOWN	JOB NO.: 75156	DRAWING NO.: 6 OF 16	

boender associates engineers/surveyors/planners
 BALTIMORE 301-465-7377 • SALISBURY 301-749-1286

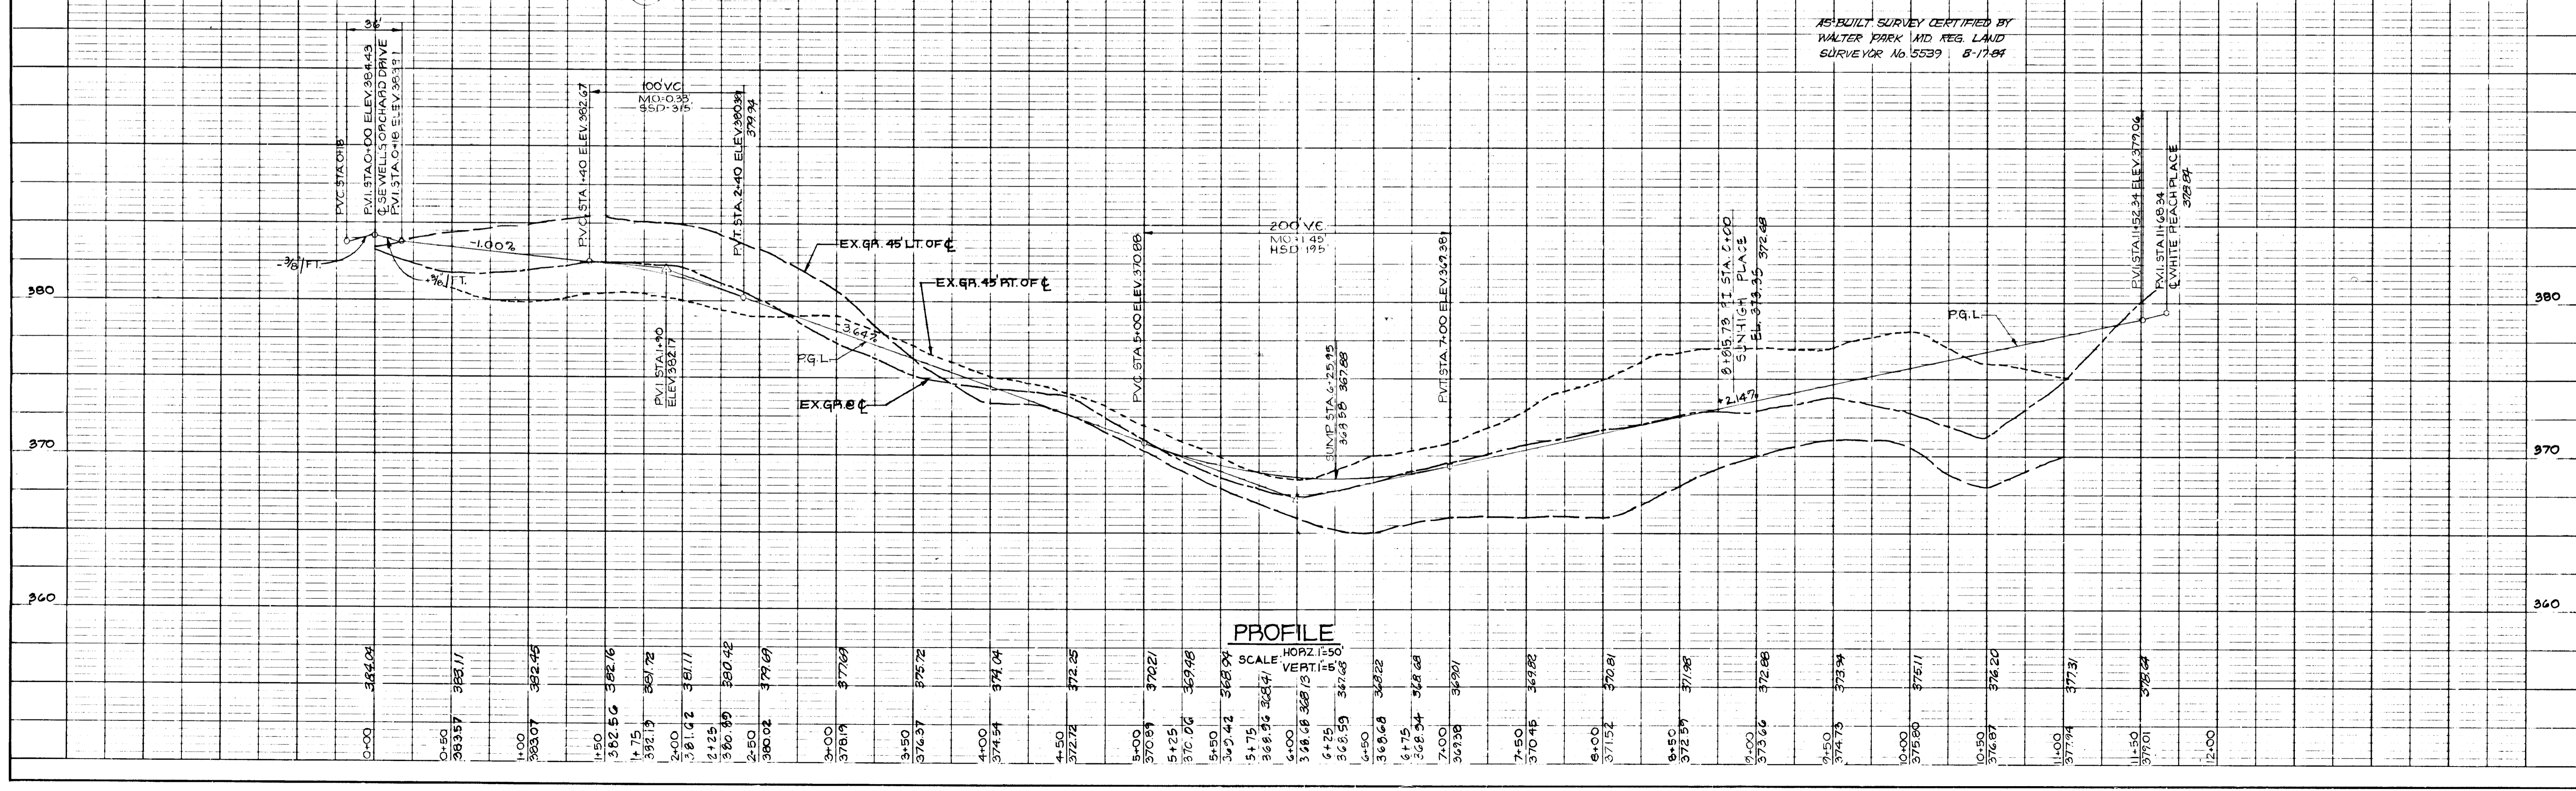


PROFILE SCALE: HORIZ 1"=50' VERT 1"=5'

PLAN	DATE
NO.	
BY	
DATE	
NO.	
BY	
DATE	
NO.	
BY	
DATE	
NO.	

APPROVED DEPARTMENT OF PUBLIC WORKS
William E. Klein 9-30-80
 CHIEF, BUREAU OF ENGINEERING DATE

APPROVED OFFICE OF PLANNING AND ZONING
John Louis Johnson 9-22-80
 CHIEF, DIVISION OF LAND DEVELOPMENT DATE

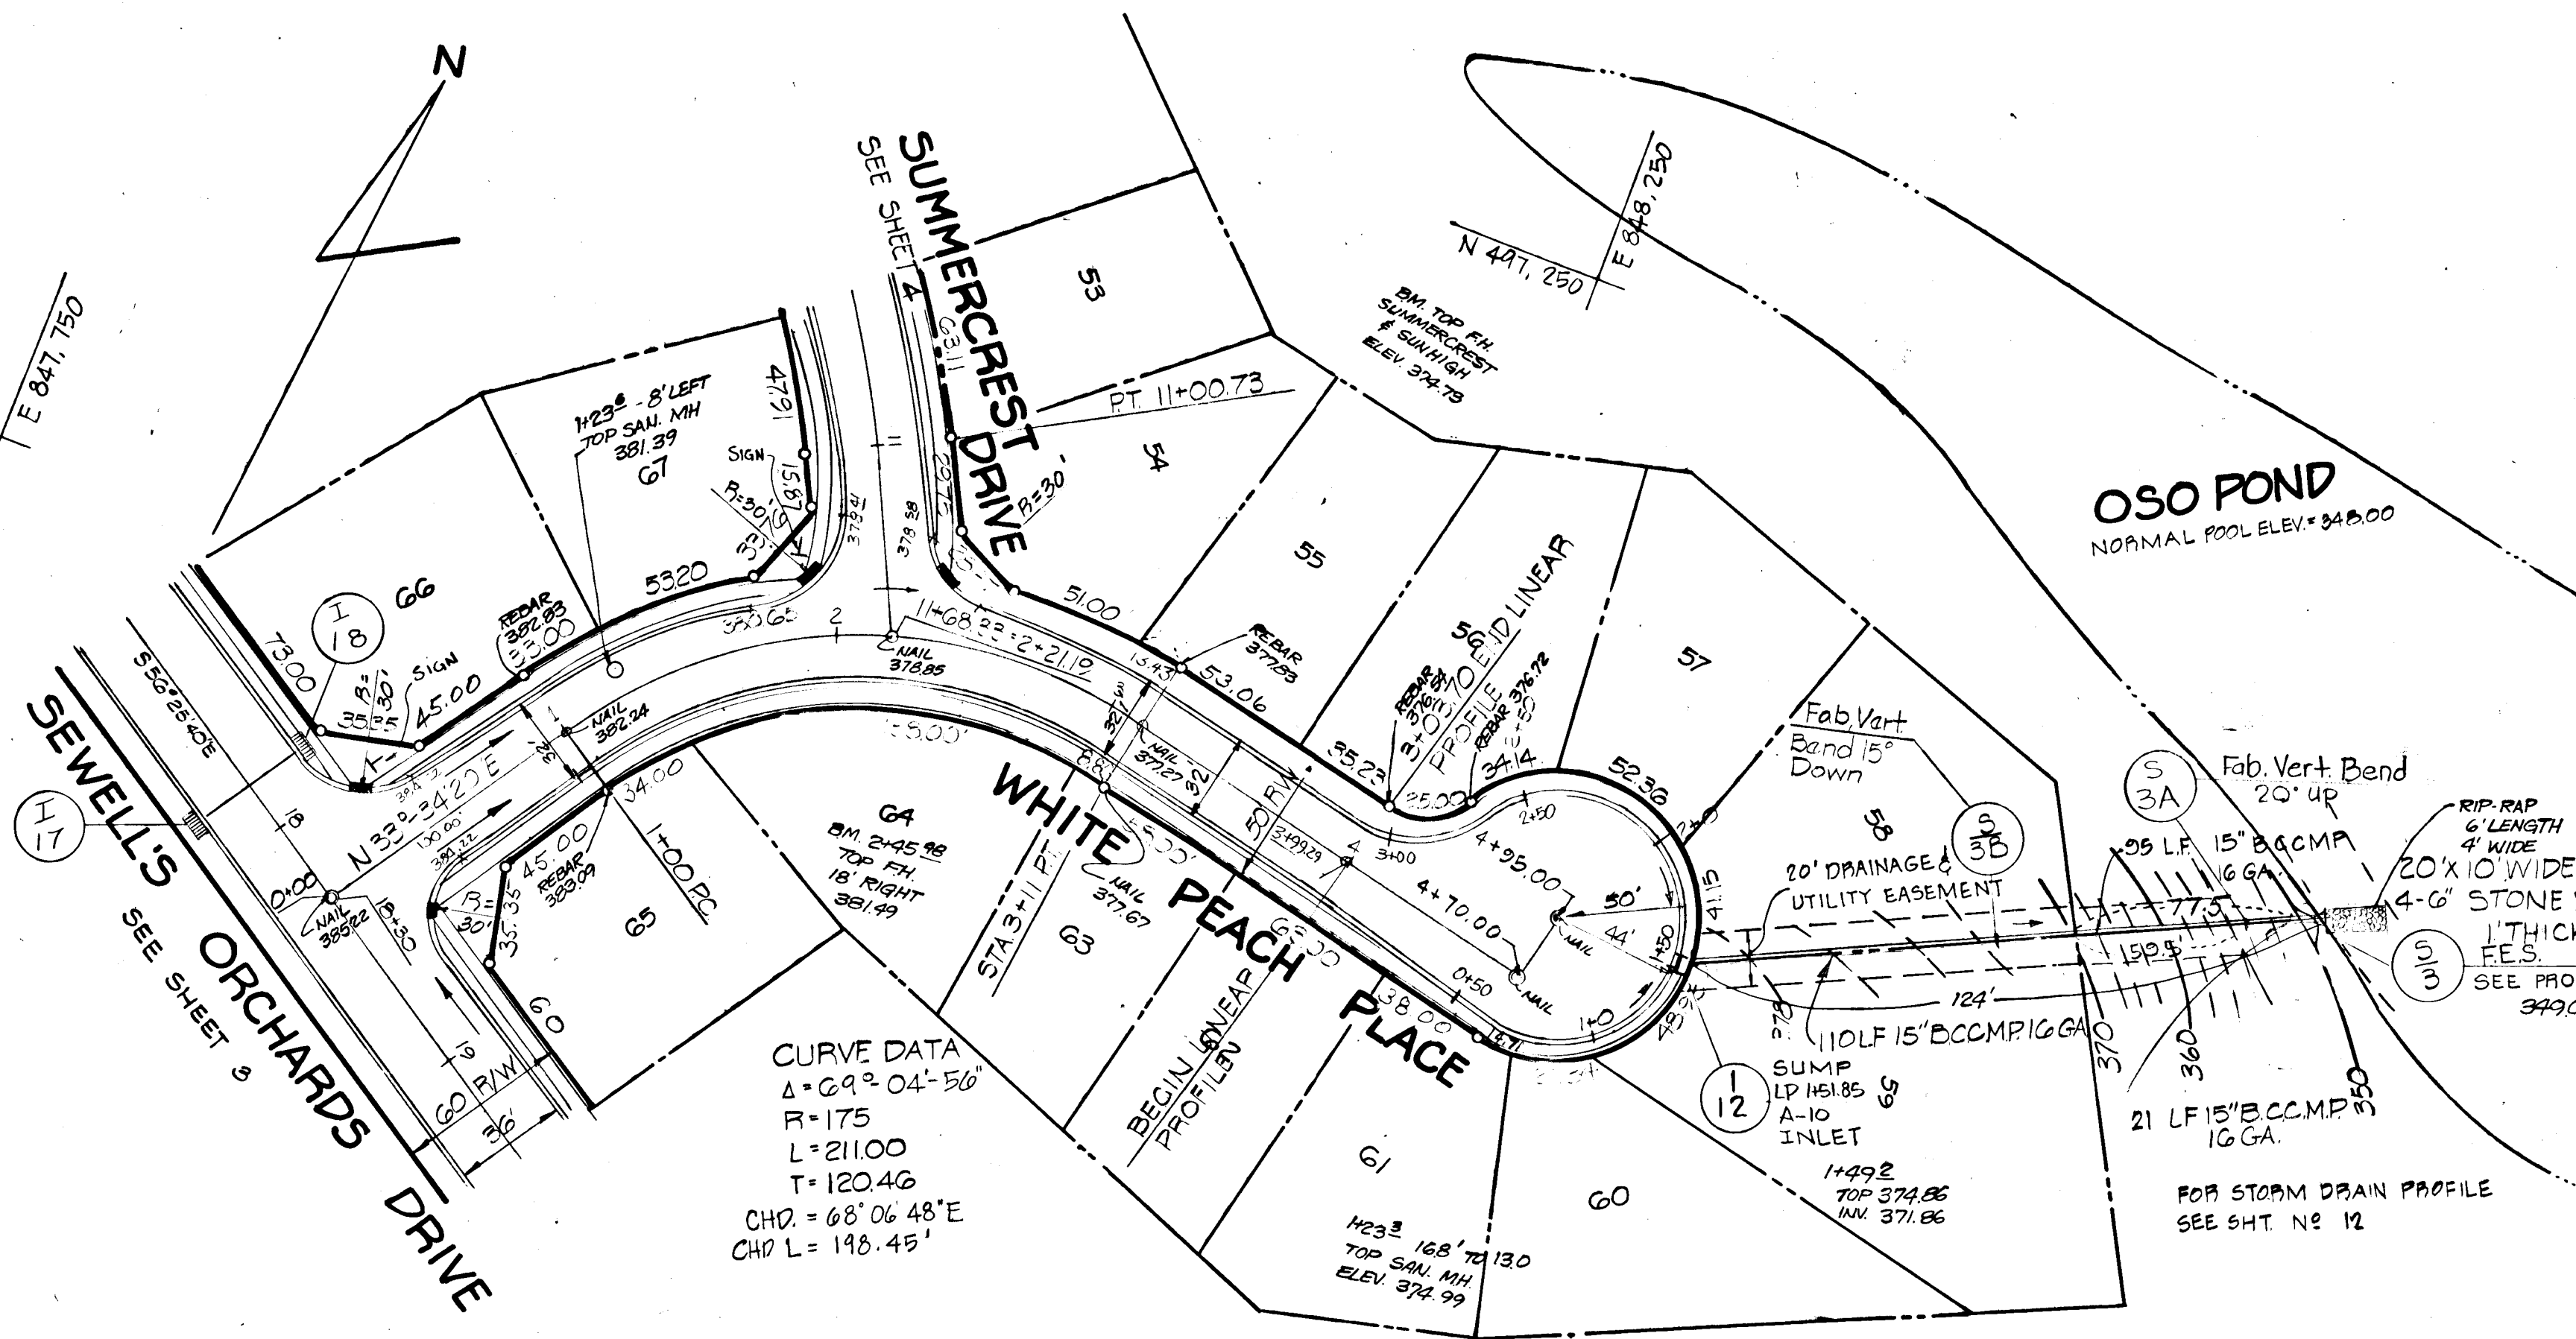

PLAN
 SCALE: 1" = 50'

TITLE	WHITE PEACH PLACE		
PROJECT	SEWELL'S ORCHARDS SECTION 1		
LOCATION	6TH ELECTION DISTRICT	HOWARD COUNTY MD	
DATE:	FEB, 1980	DESIGN BY:	RL.M.
SCALE:	AS SHOWN	JOB NO.:	79158
		DRAWN BY:	WCL
		CHECKED BY:	RL.M.
		DRAWING NO.:	8 OF 16

boender associates
 engineers
 surveyors
 planners


BALTIMORE 301-465-7777 SALISBURY 301-749-1286

AS-BUILT SURVEY CERTIFIED BY
 WALTER PARK, MD. REG. LAND
 SURVEYOR No. 5539 - AUG. 17, 1984


PROFILE	DATE
NO.	
BY	
DATE	
NO.	
BY	
DATE	
NO.	

PROFILE 'F'
 SCALE: HORIZ. 1" = 50'
 VERT. 1" = 5'


LINEAR PROFILE
 SCALE: HORIZ. 1" = 50'
 VERT. 1" = 5'

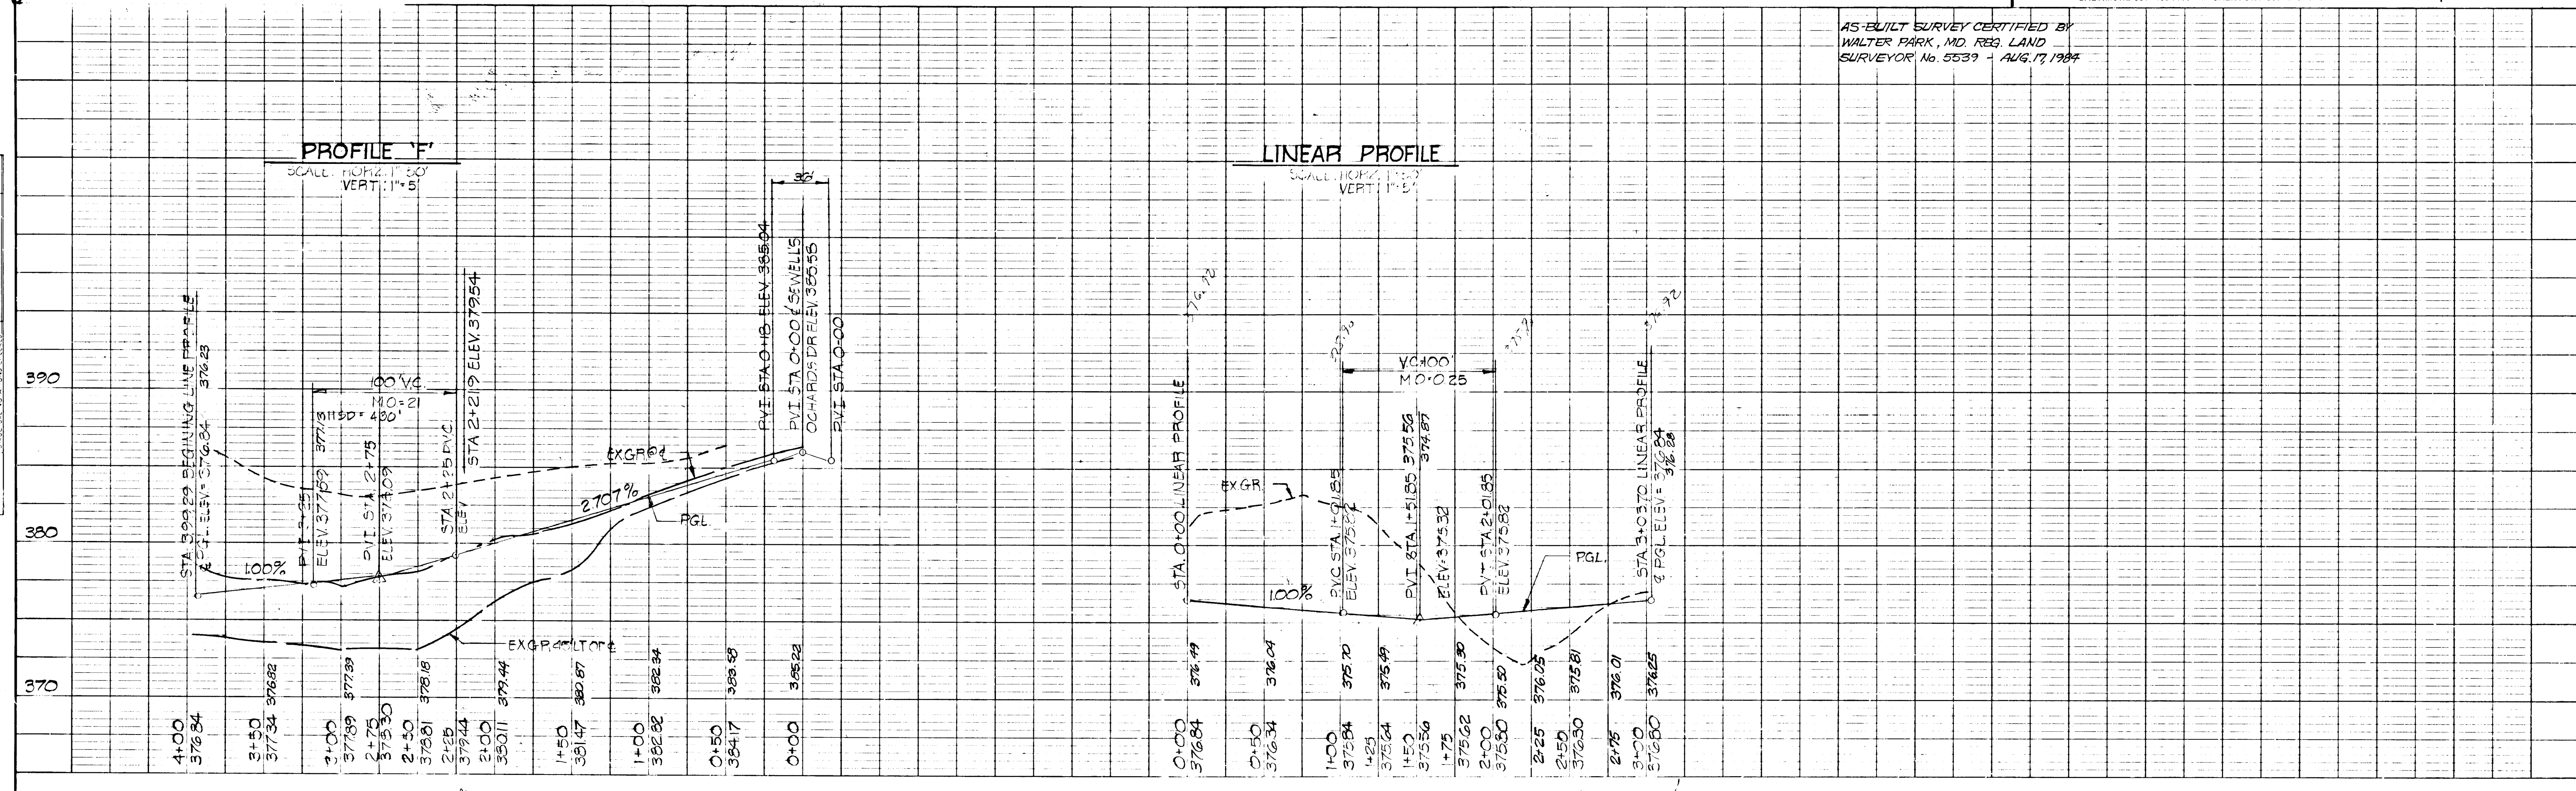


DATE: _____ BY: _____
 SURVEYED: _____
 NOTE BOOK: _____
 ALIGNMENT CHECKED: _____
 GRADES CHECKED: _____
 NO. _____

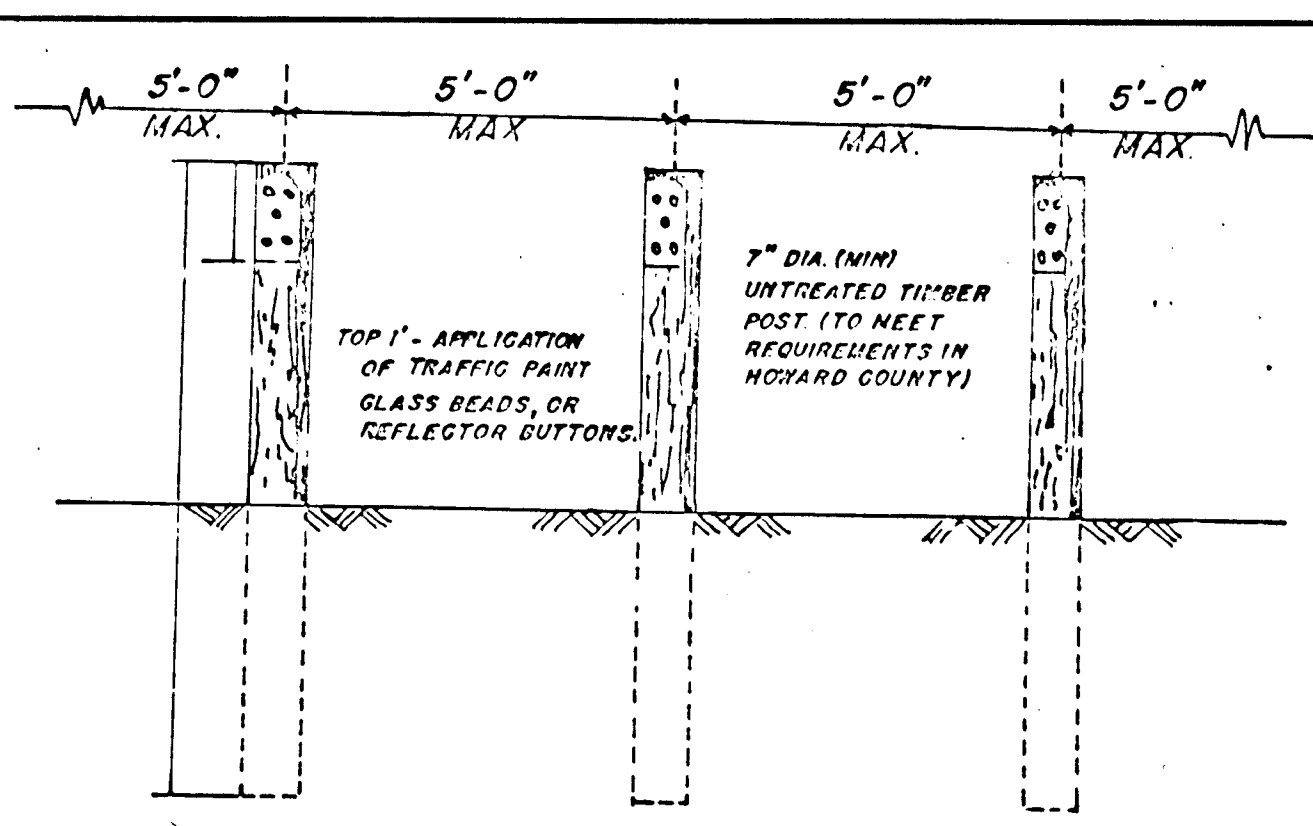

Temporary Dead End Barricade.
 DRAWING D-109 Page 164

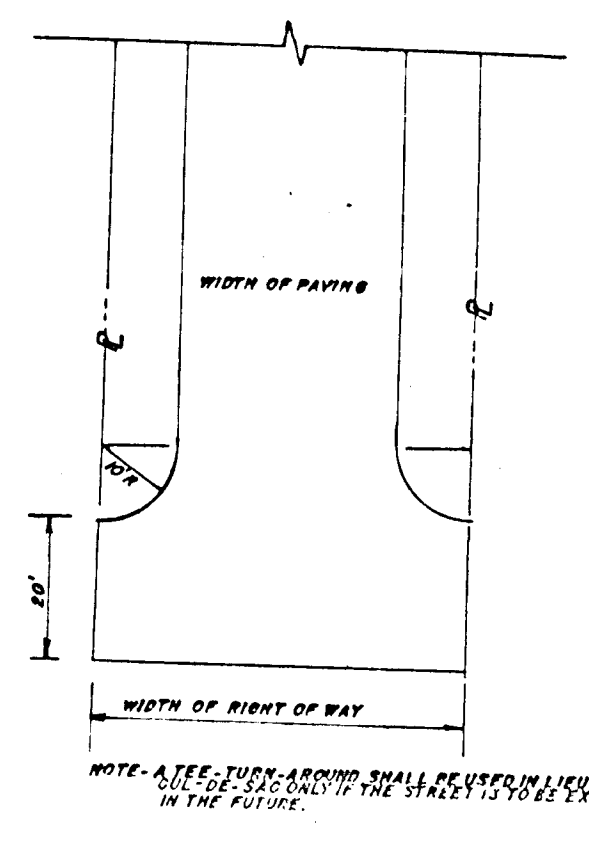

TEE TURN AROUND
 DRAWING D-33 PAGE 88

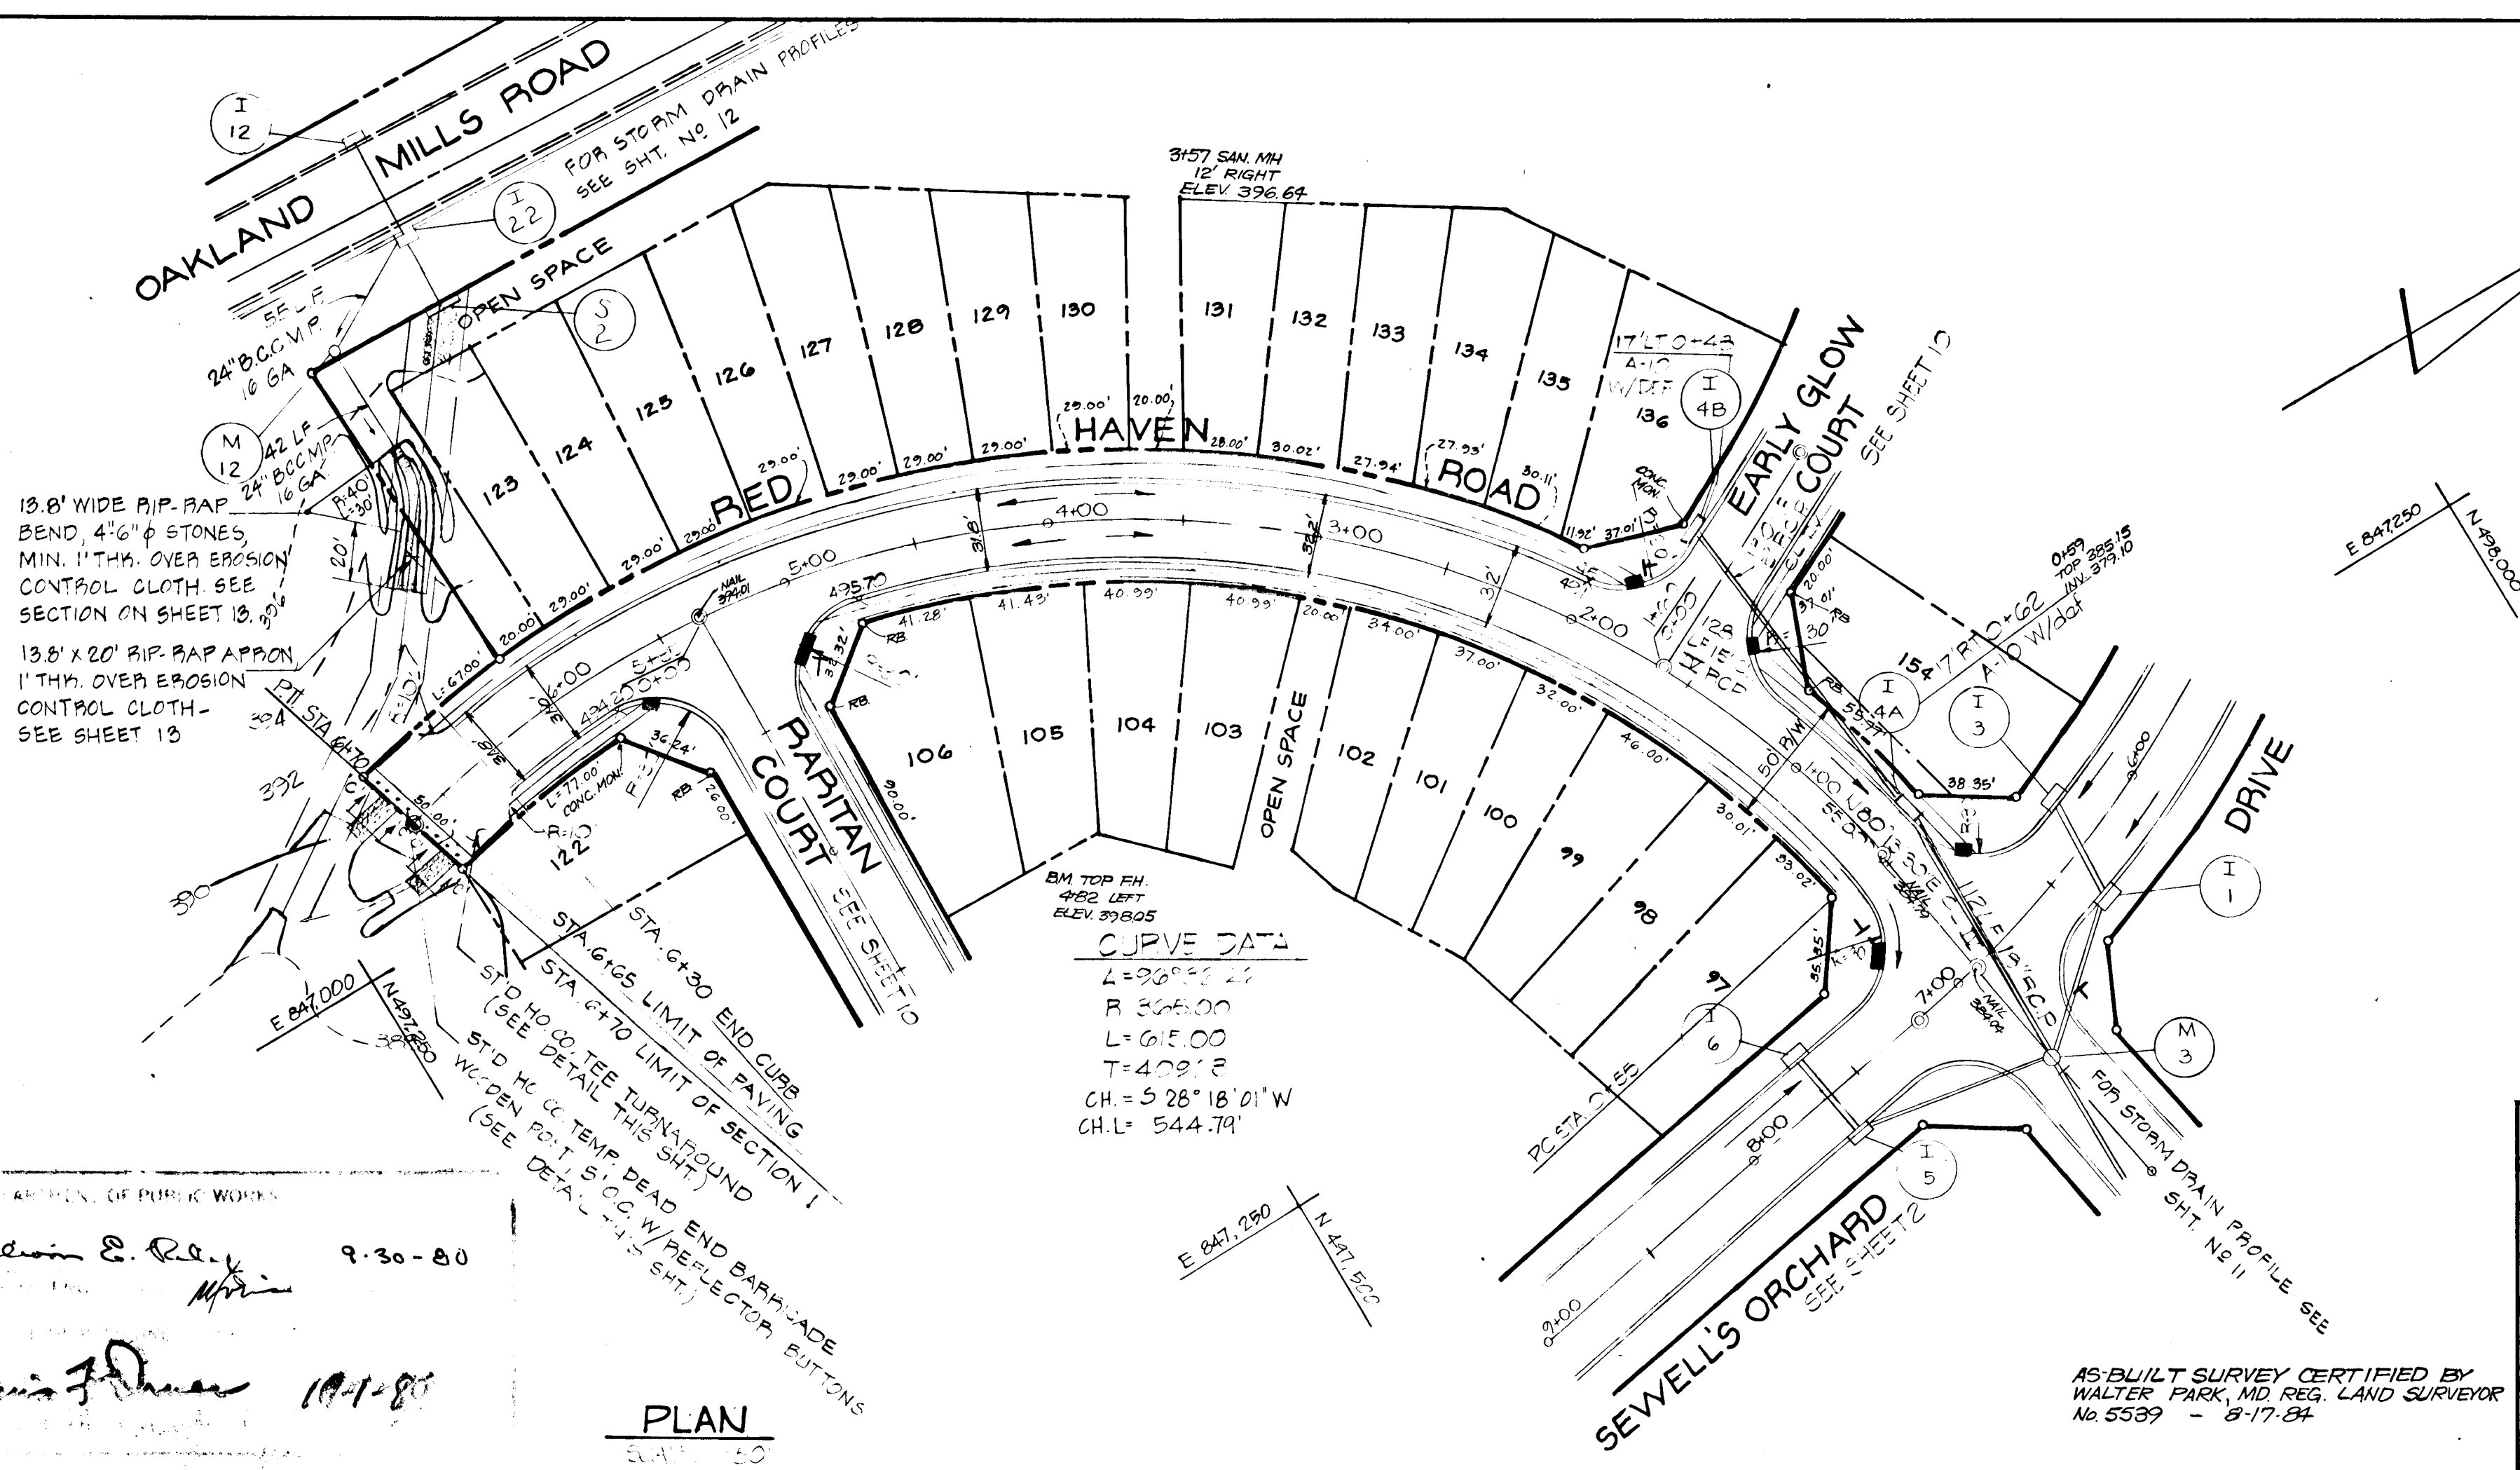

PLAN
 SCALE: 1"=40'




OWNER
 SEWELL'S ORCHARDS
 6239 OAKLAND MILLS RD.
 COLUMBIA, MD 21045

DEVELOPER
 LIGHTPOINT ASSOCIATES
 P.O. BOX 919
 COLUMBIA, MD 21044

PROJECT: RED HAVEN ROAD ROAD CONSTRUCTION PLAN			
PROJECT: SEWELL'S ORCHARDS- SECTION 1			
LOCATION: 6TH ELECTION DISTRICT		HOWARD COUNTY, MD	
DATE: FEB, 1980	DESIGN BY: P.L.M./W.H.N.	DRAWN BY: G.E.M.	CHECKED BY: P.L.M.
SCALE: AS SHOWN	JOB NO.: 7915B	DRAWING NO.: 90F 16	
boender associates		engineers surveyors planners	

DATE: _____ BY: _____
 SURVEYED: _____
 NOTE BOOK: _____
 GRADES CHECKED: _____
 NO. _____


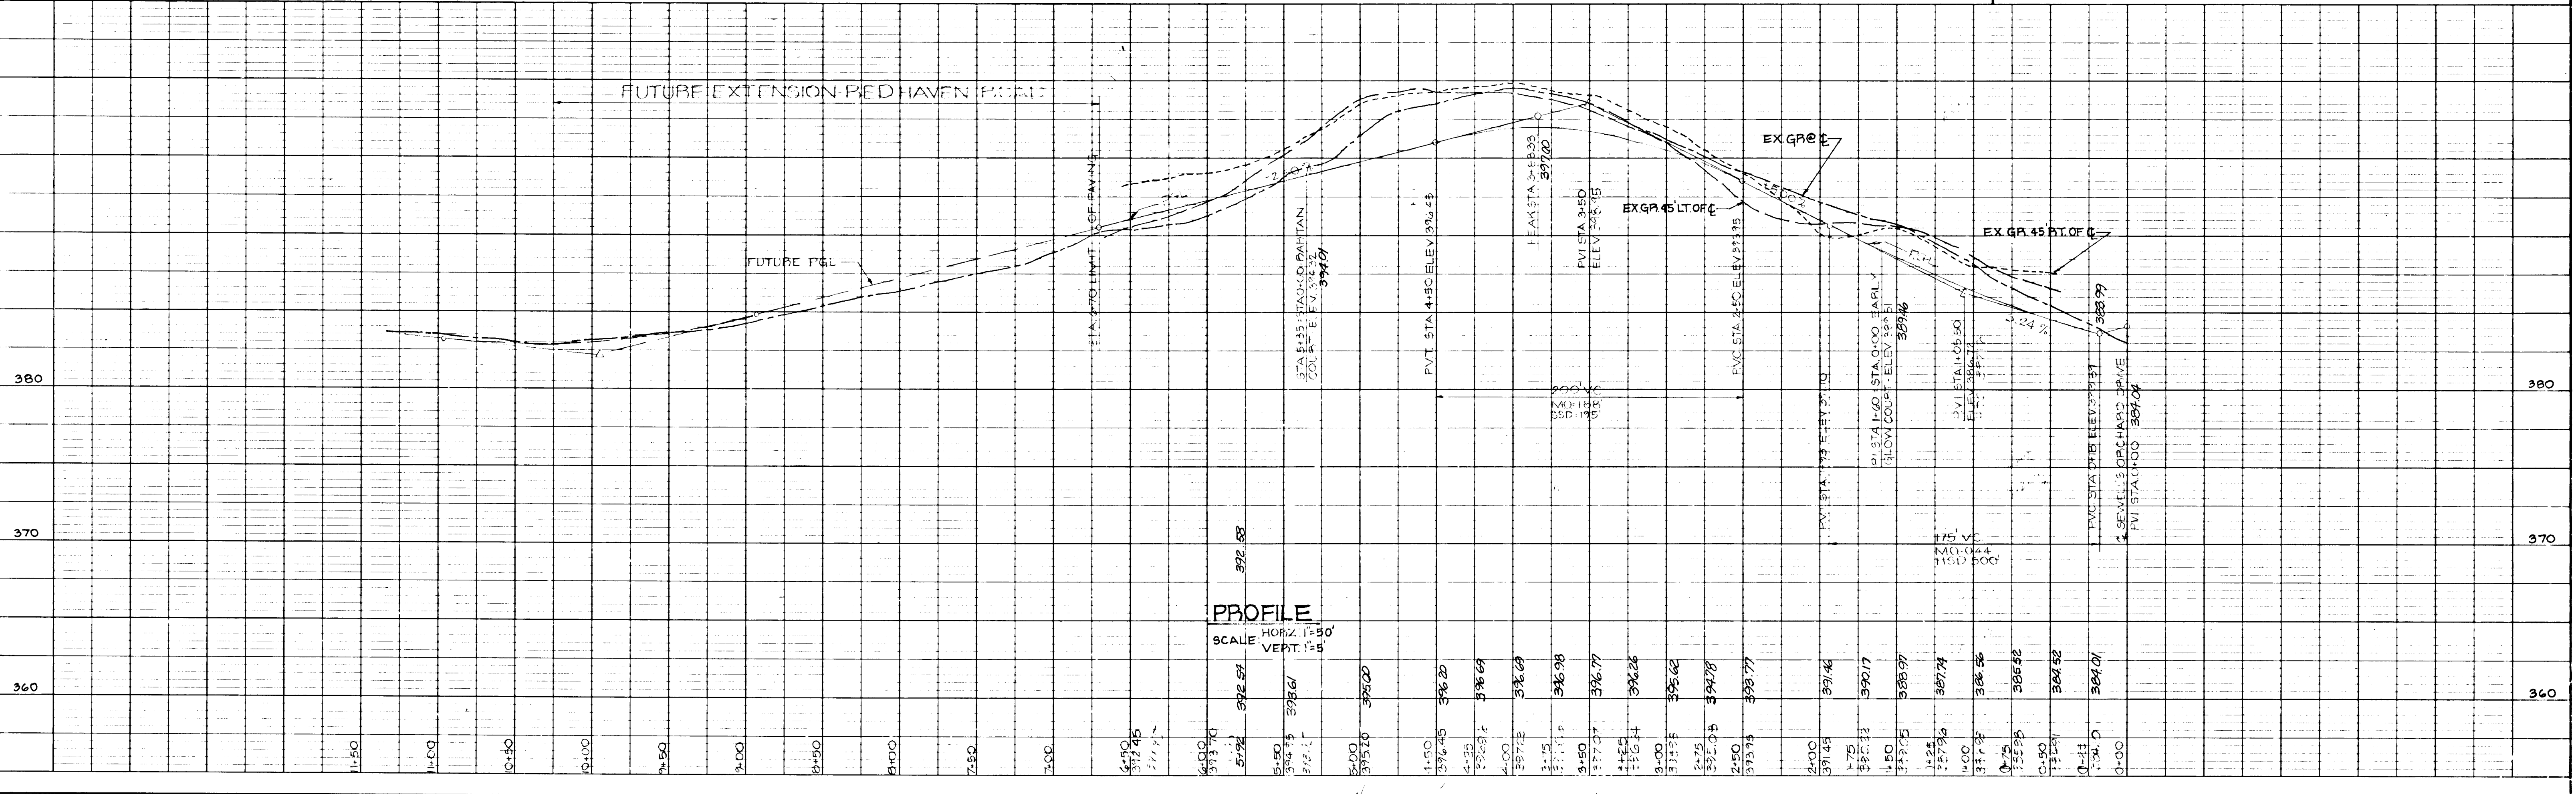


PROFILE
 SCALE: HORIZ. 1"=50'
 VERT. 1"=5'


850

DATE	
BY	
REVISIONS	
NO. DATE	
1	
2	
3	
DATE	
BY	
REVISIONS	
NO. DATE	
1	
2	
3	
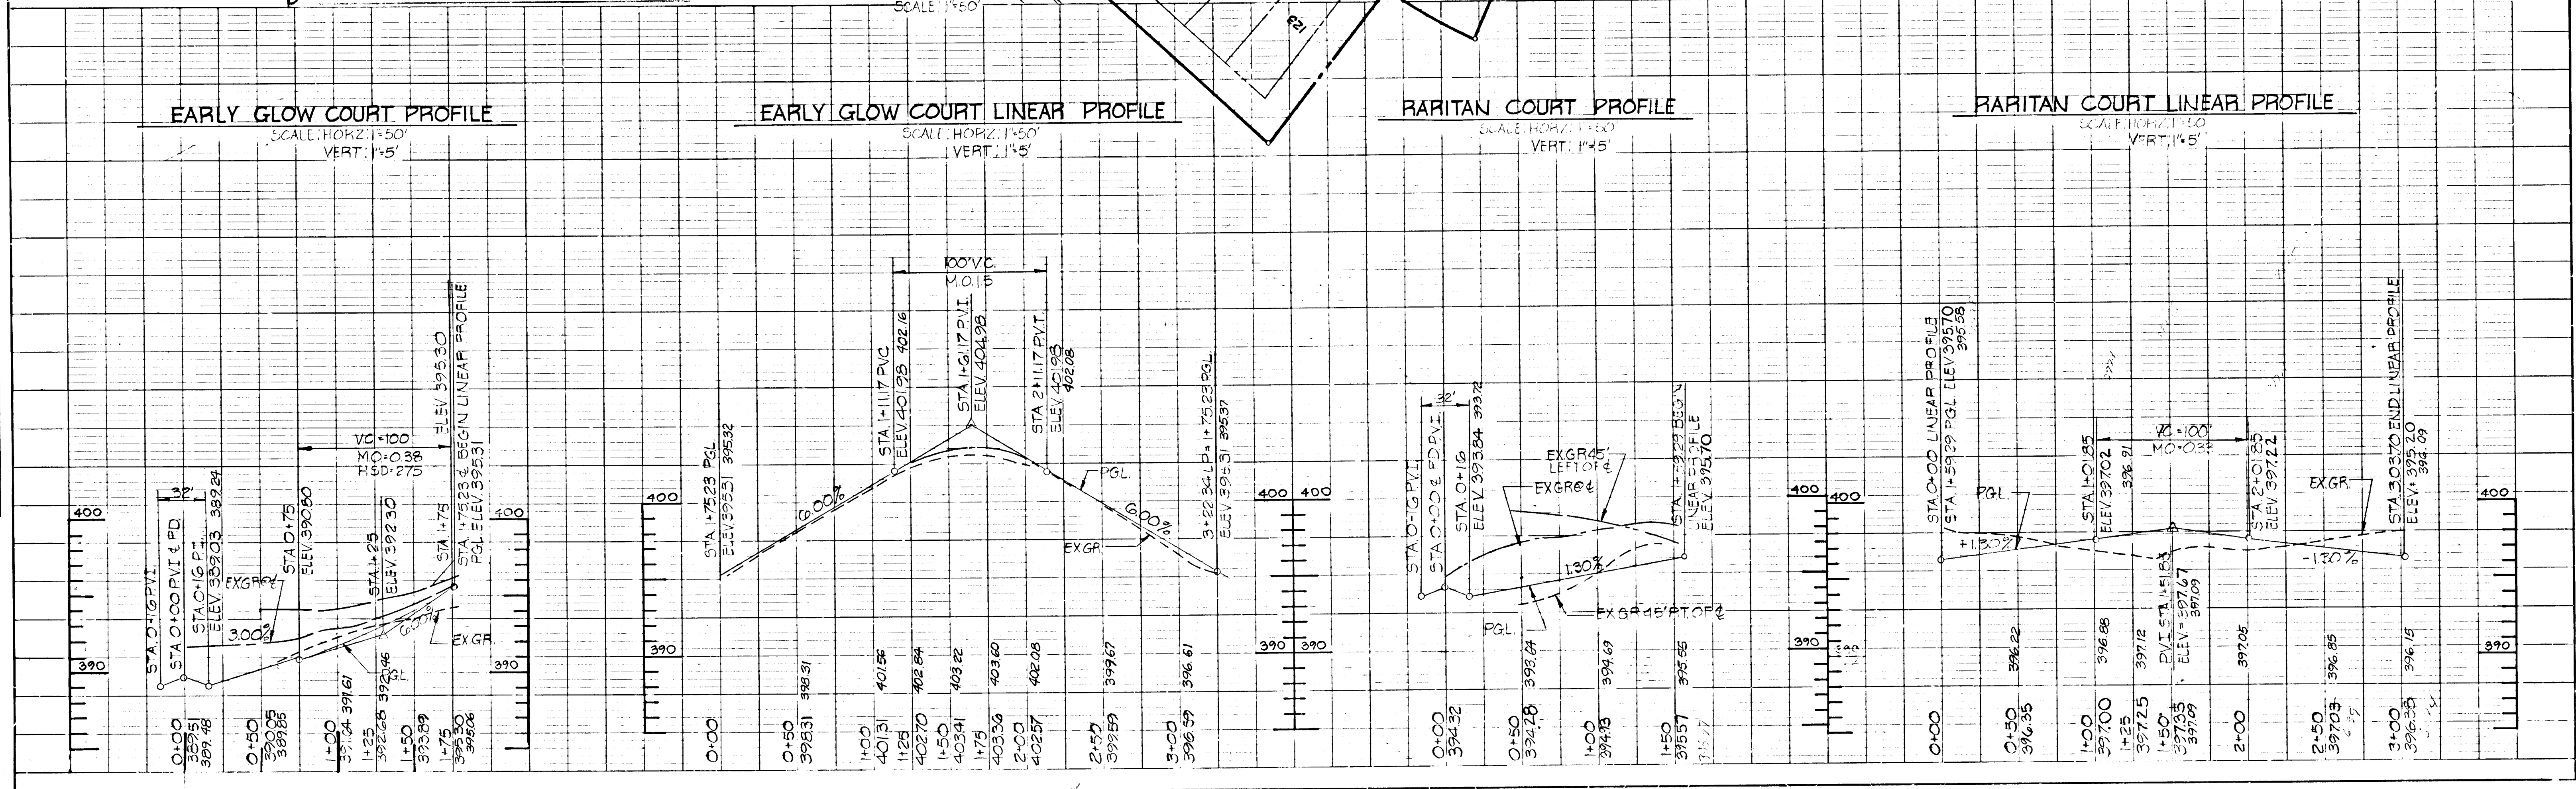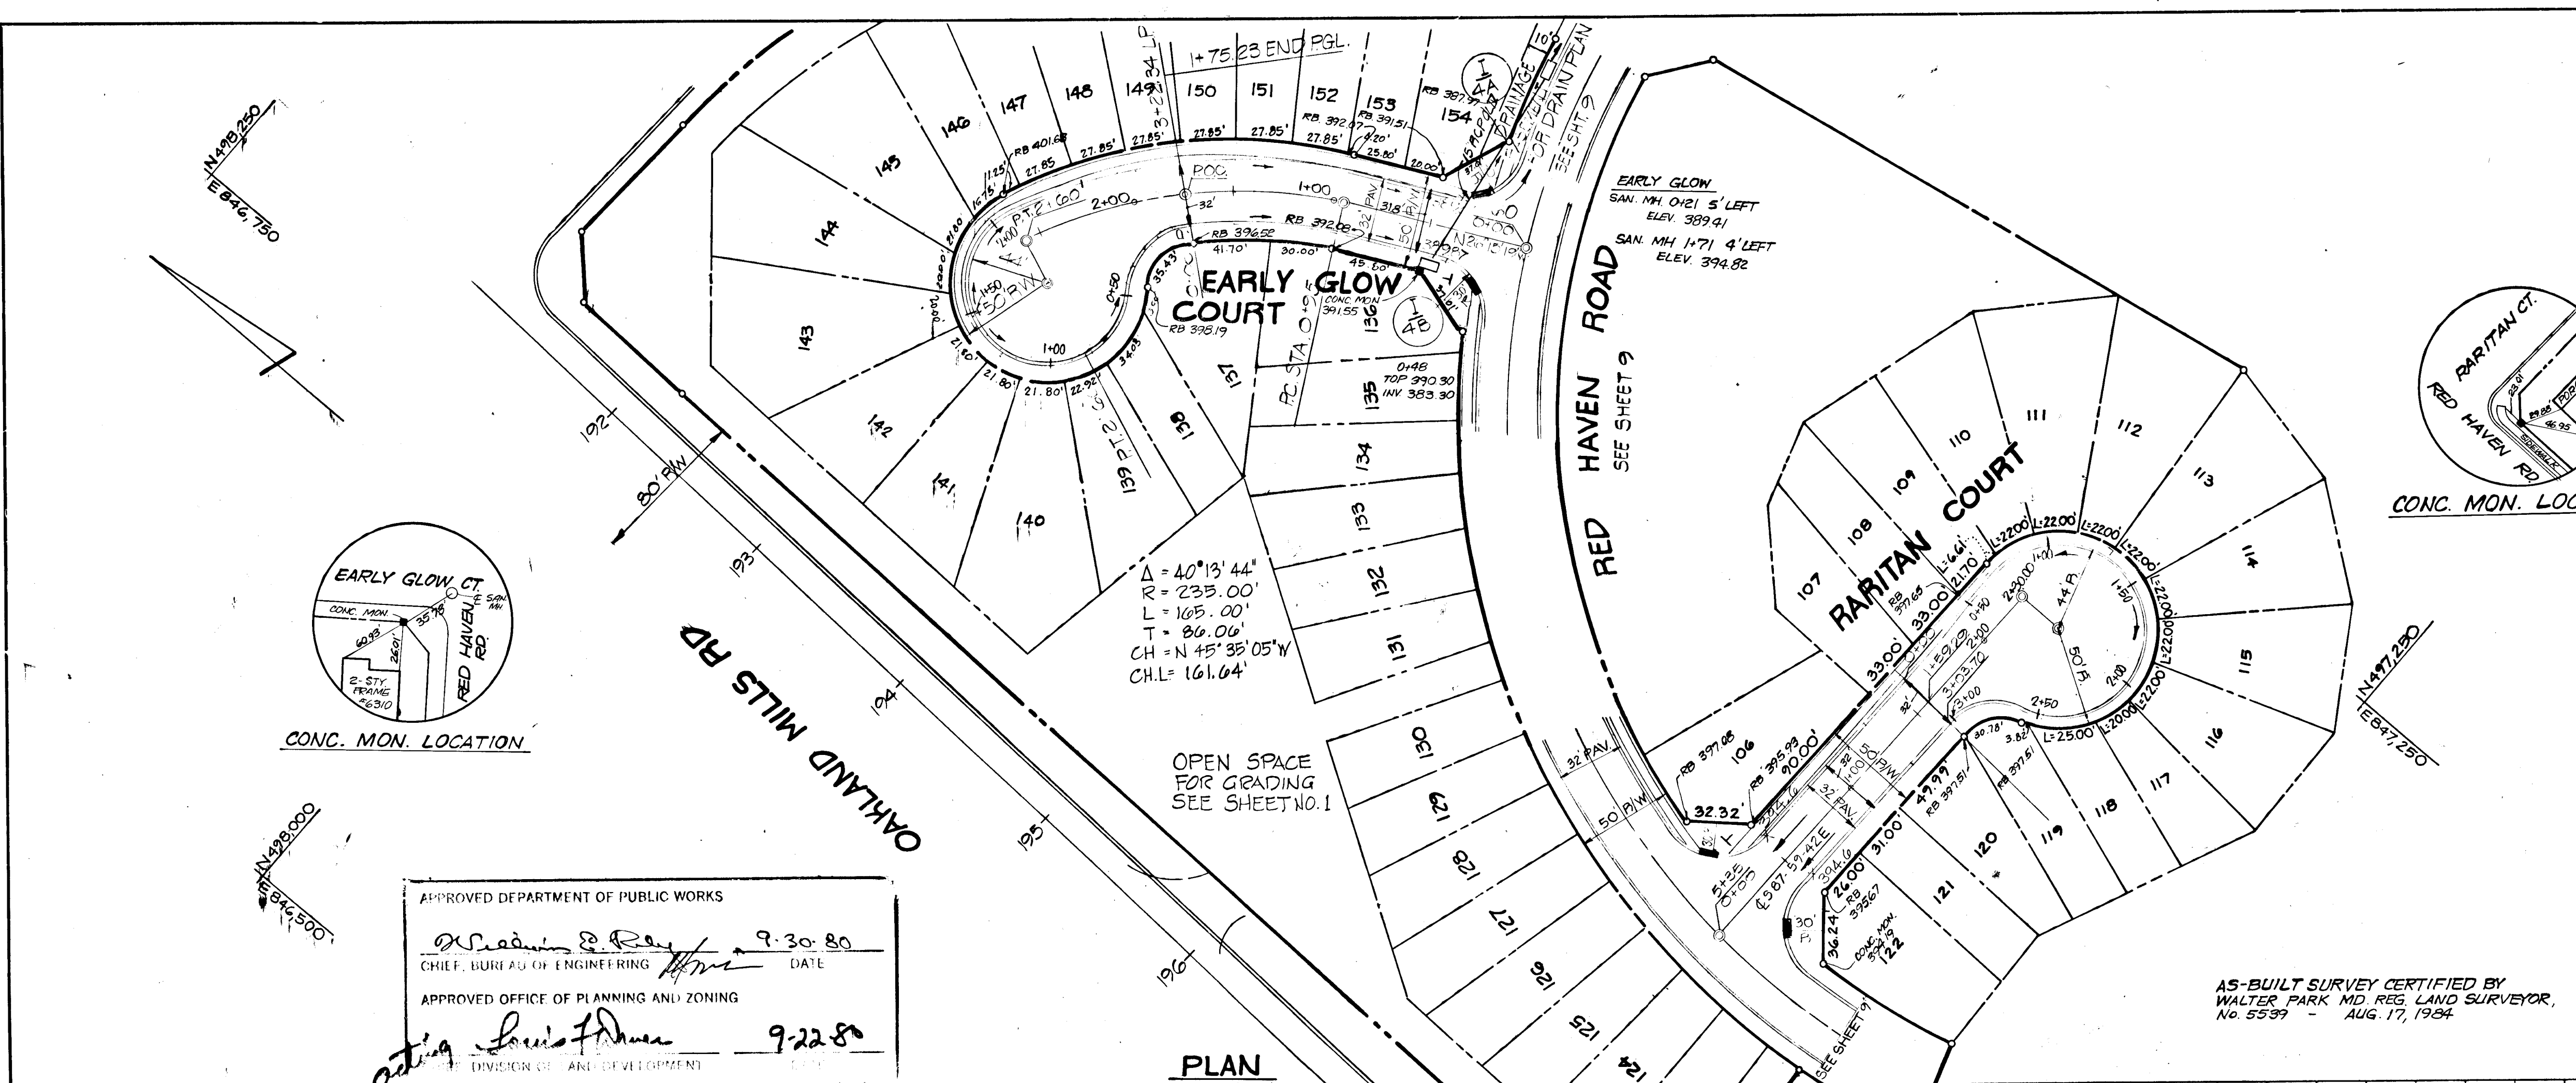




850

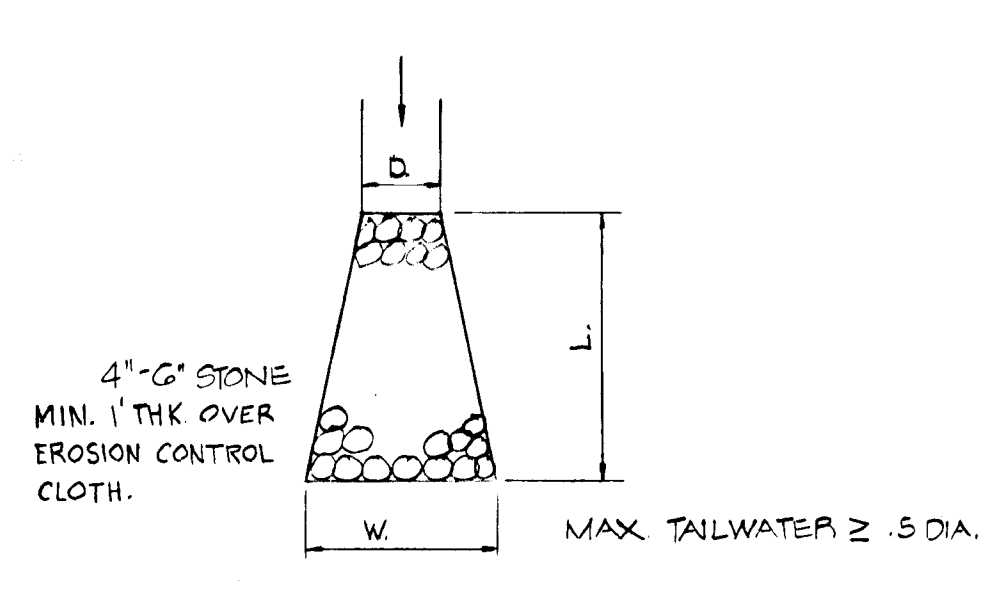






RIPRAP @ OUTFALL
S-5

NOT TO SCALE
USDA - SCS
38.00

(SEE MSHA CHART)
1031 3-3

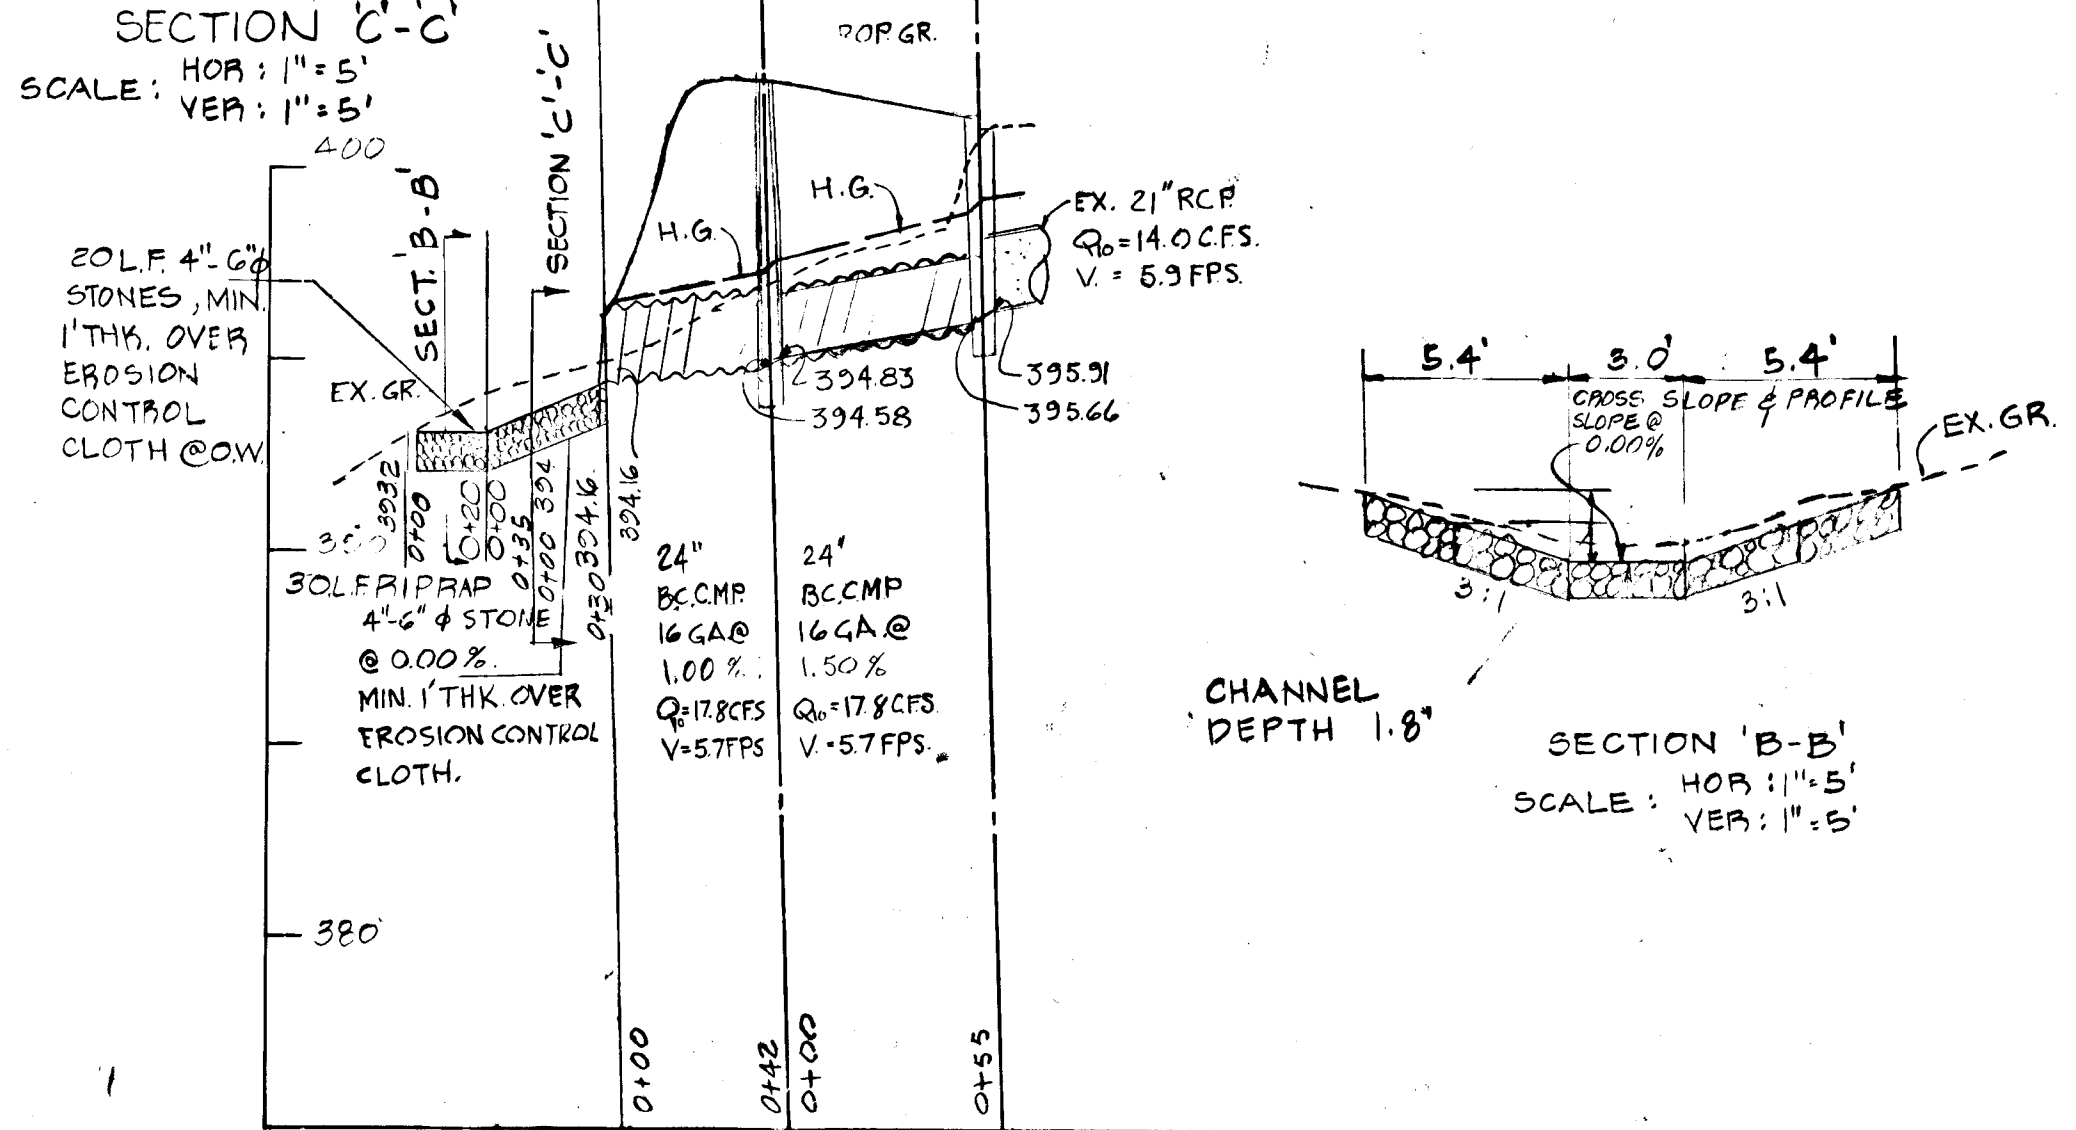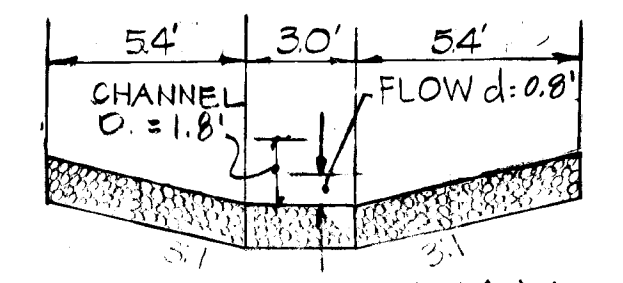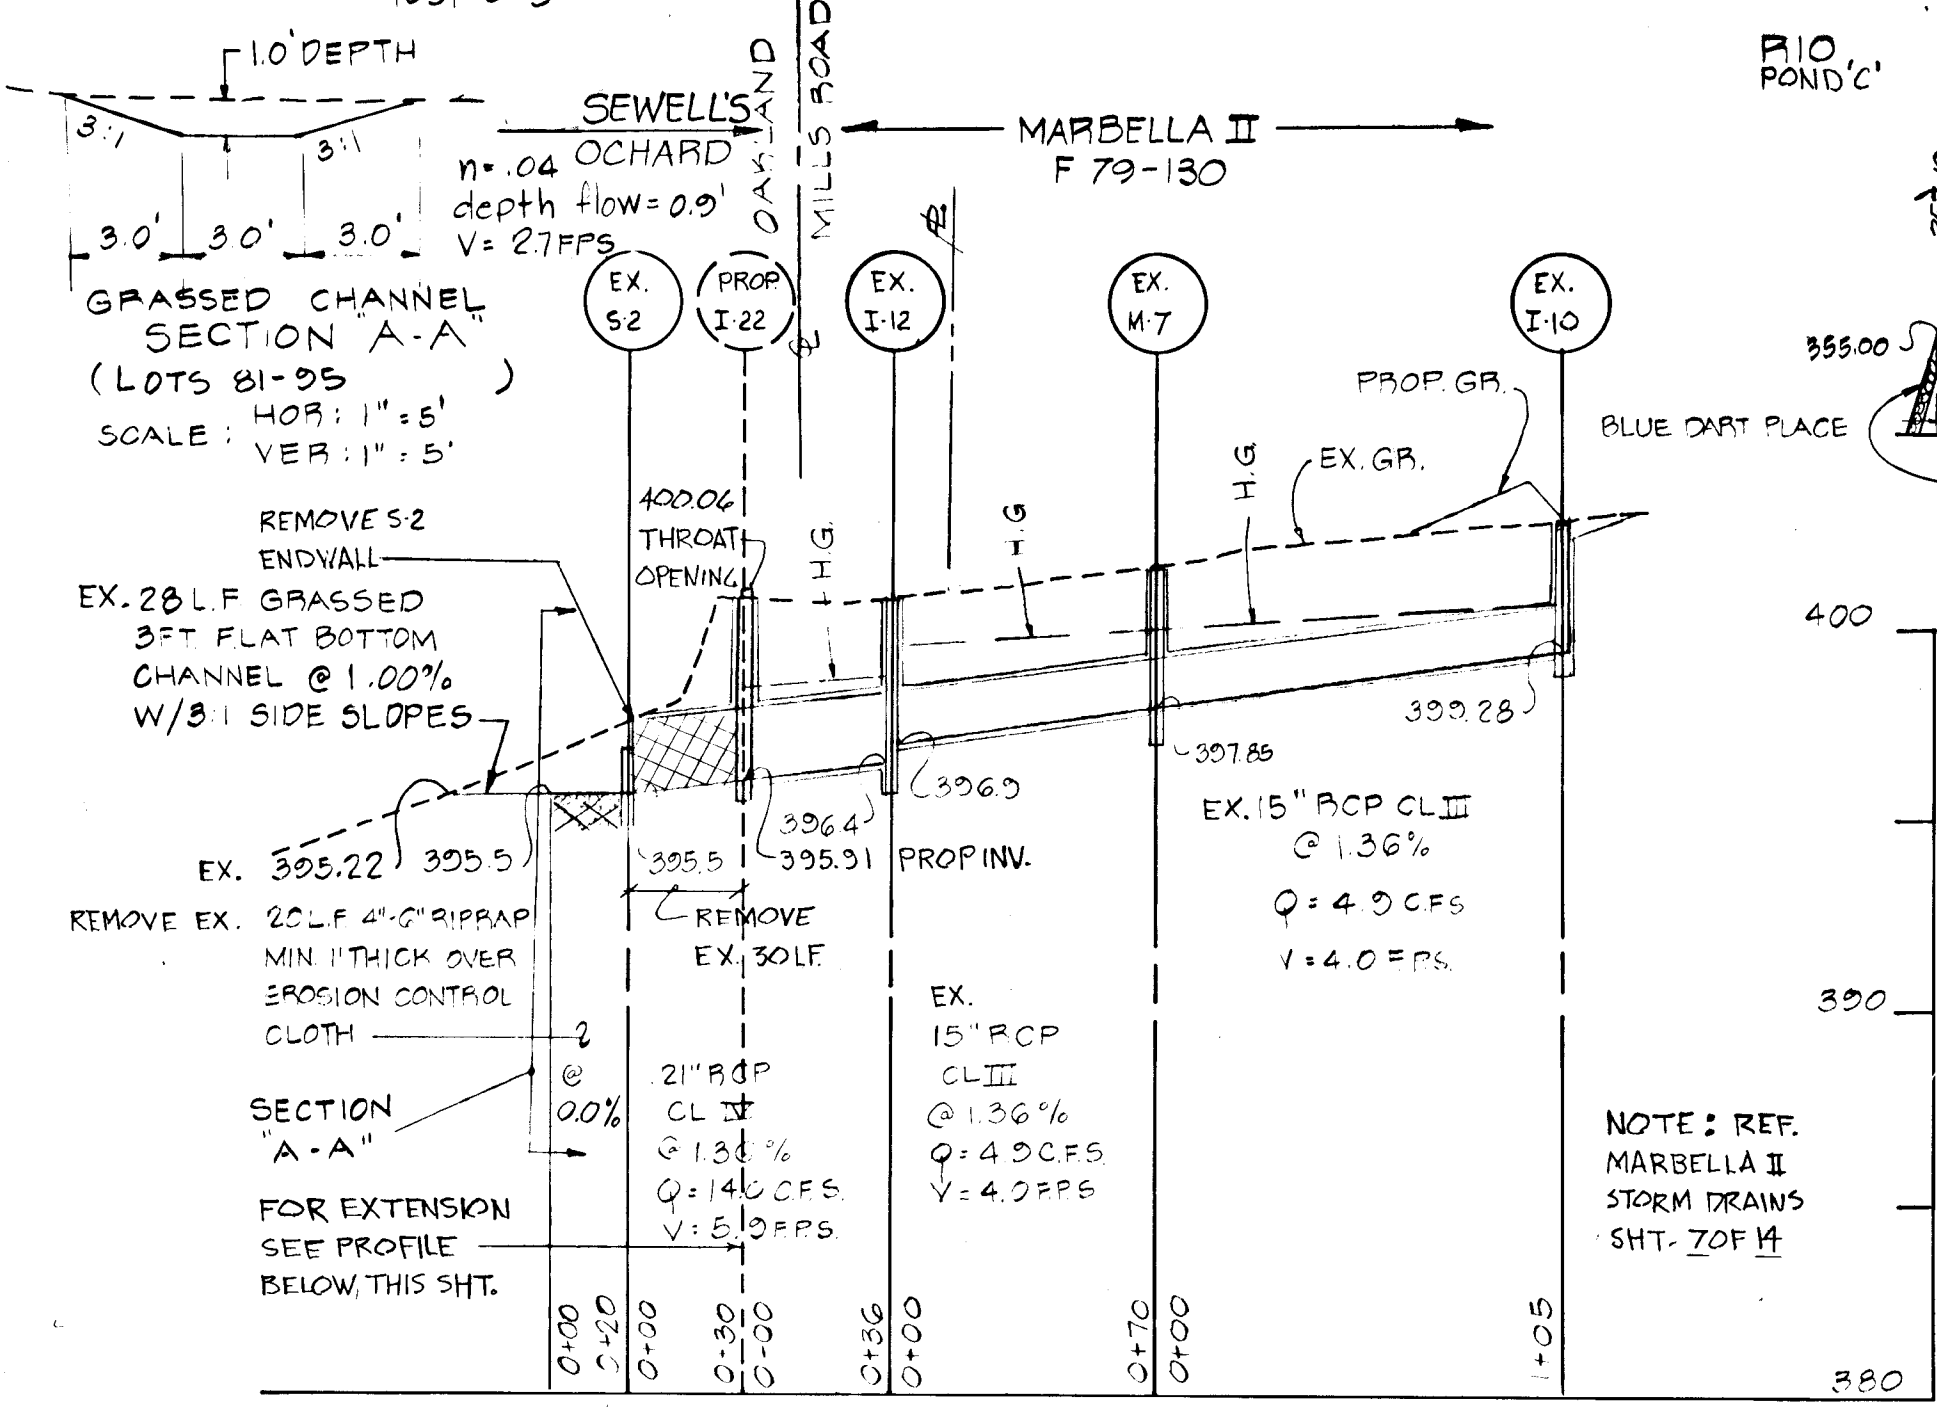

#850

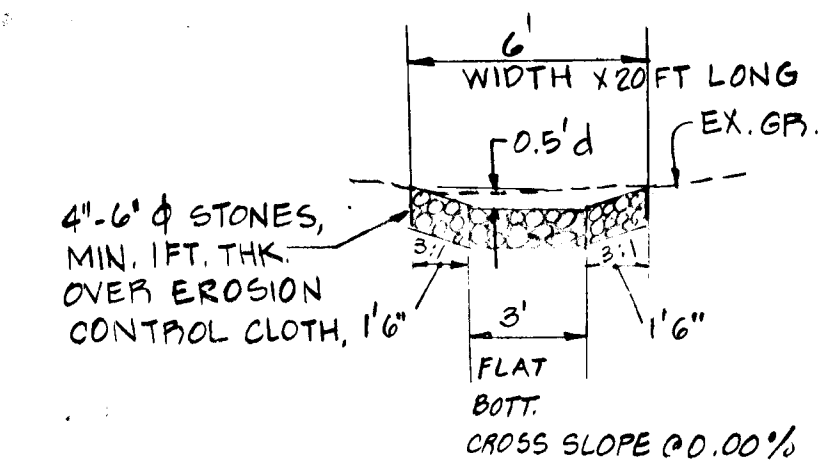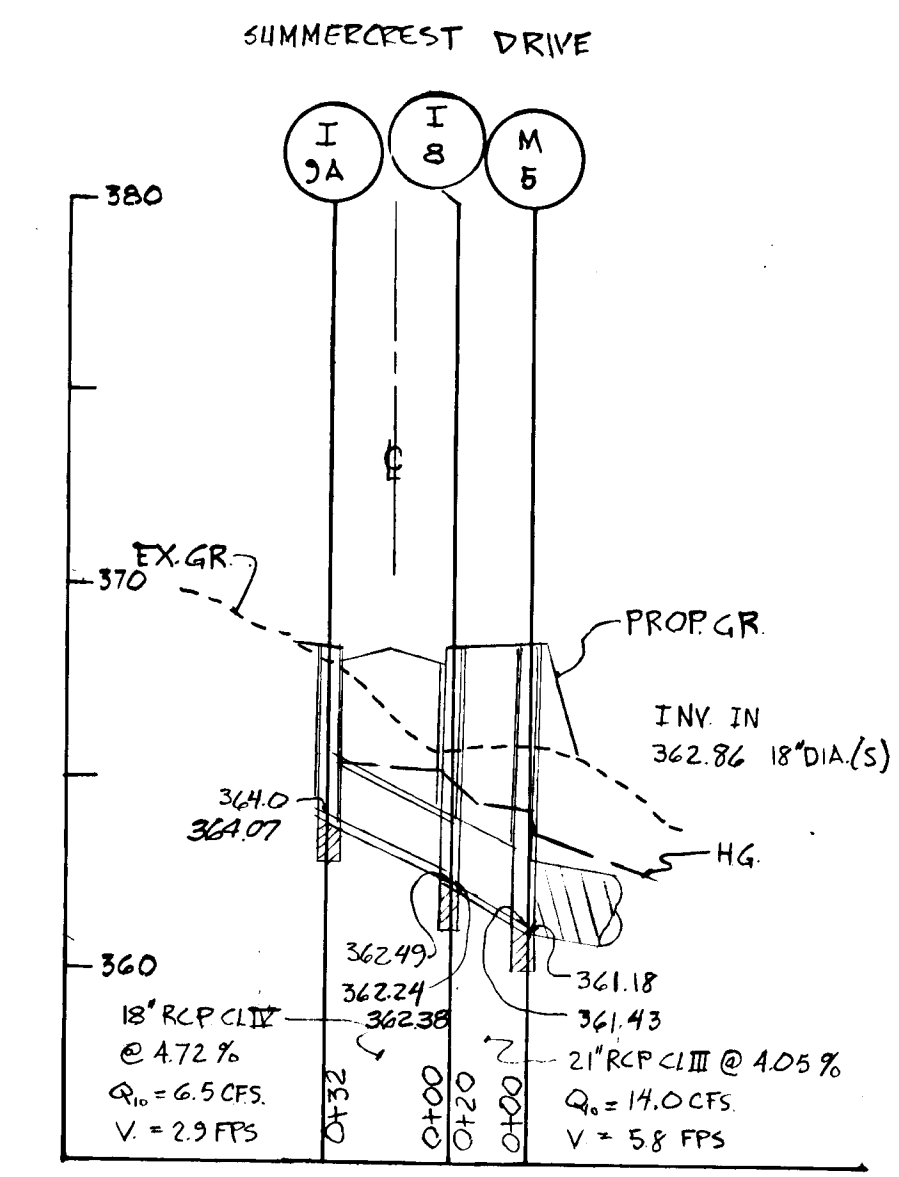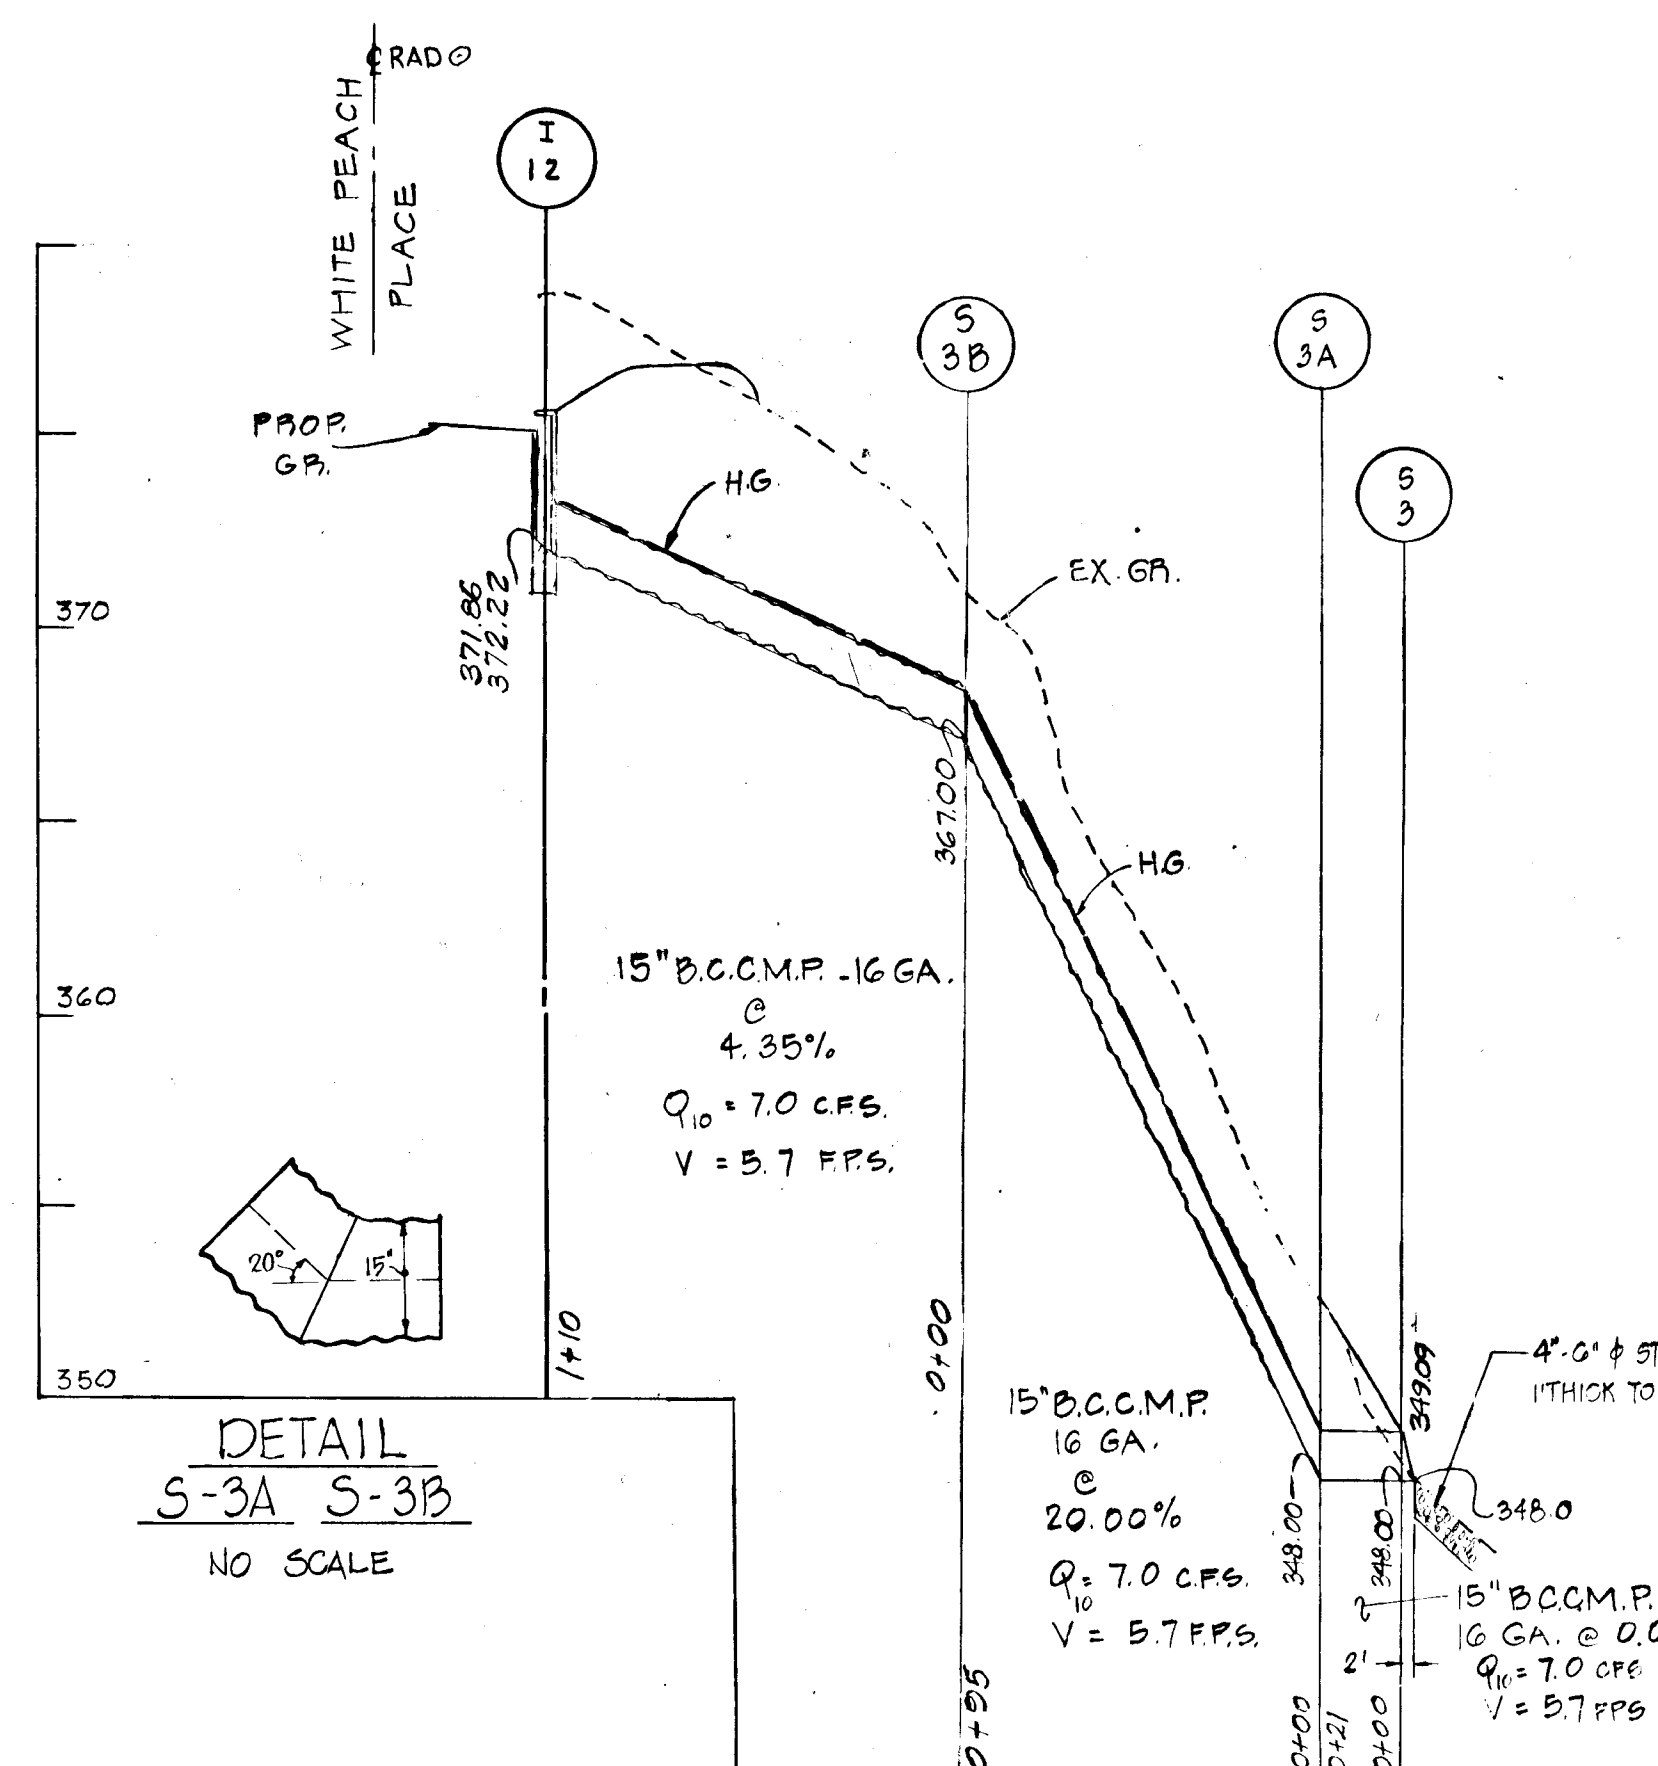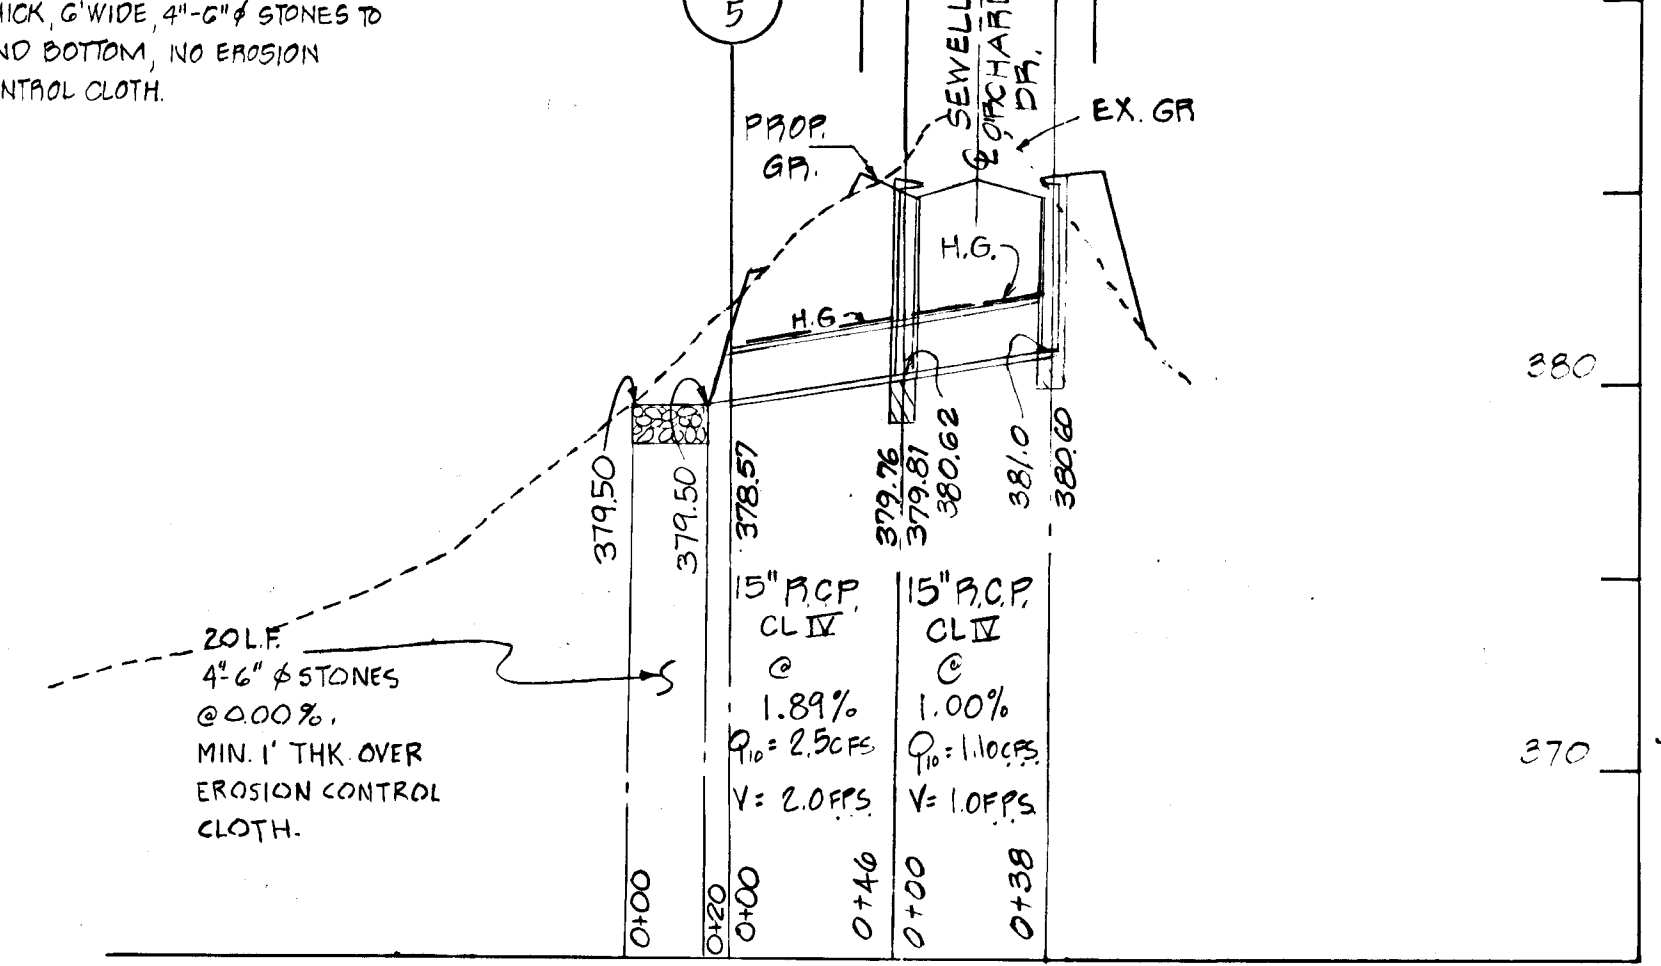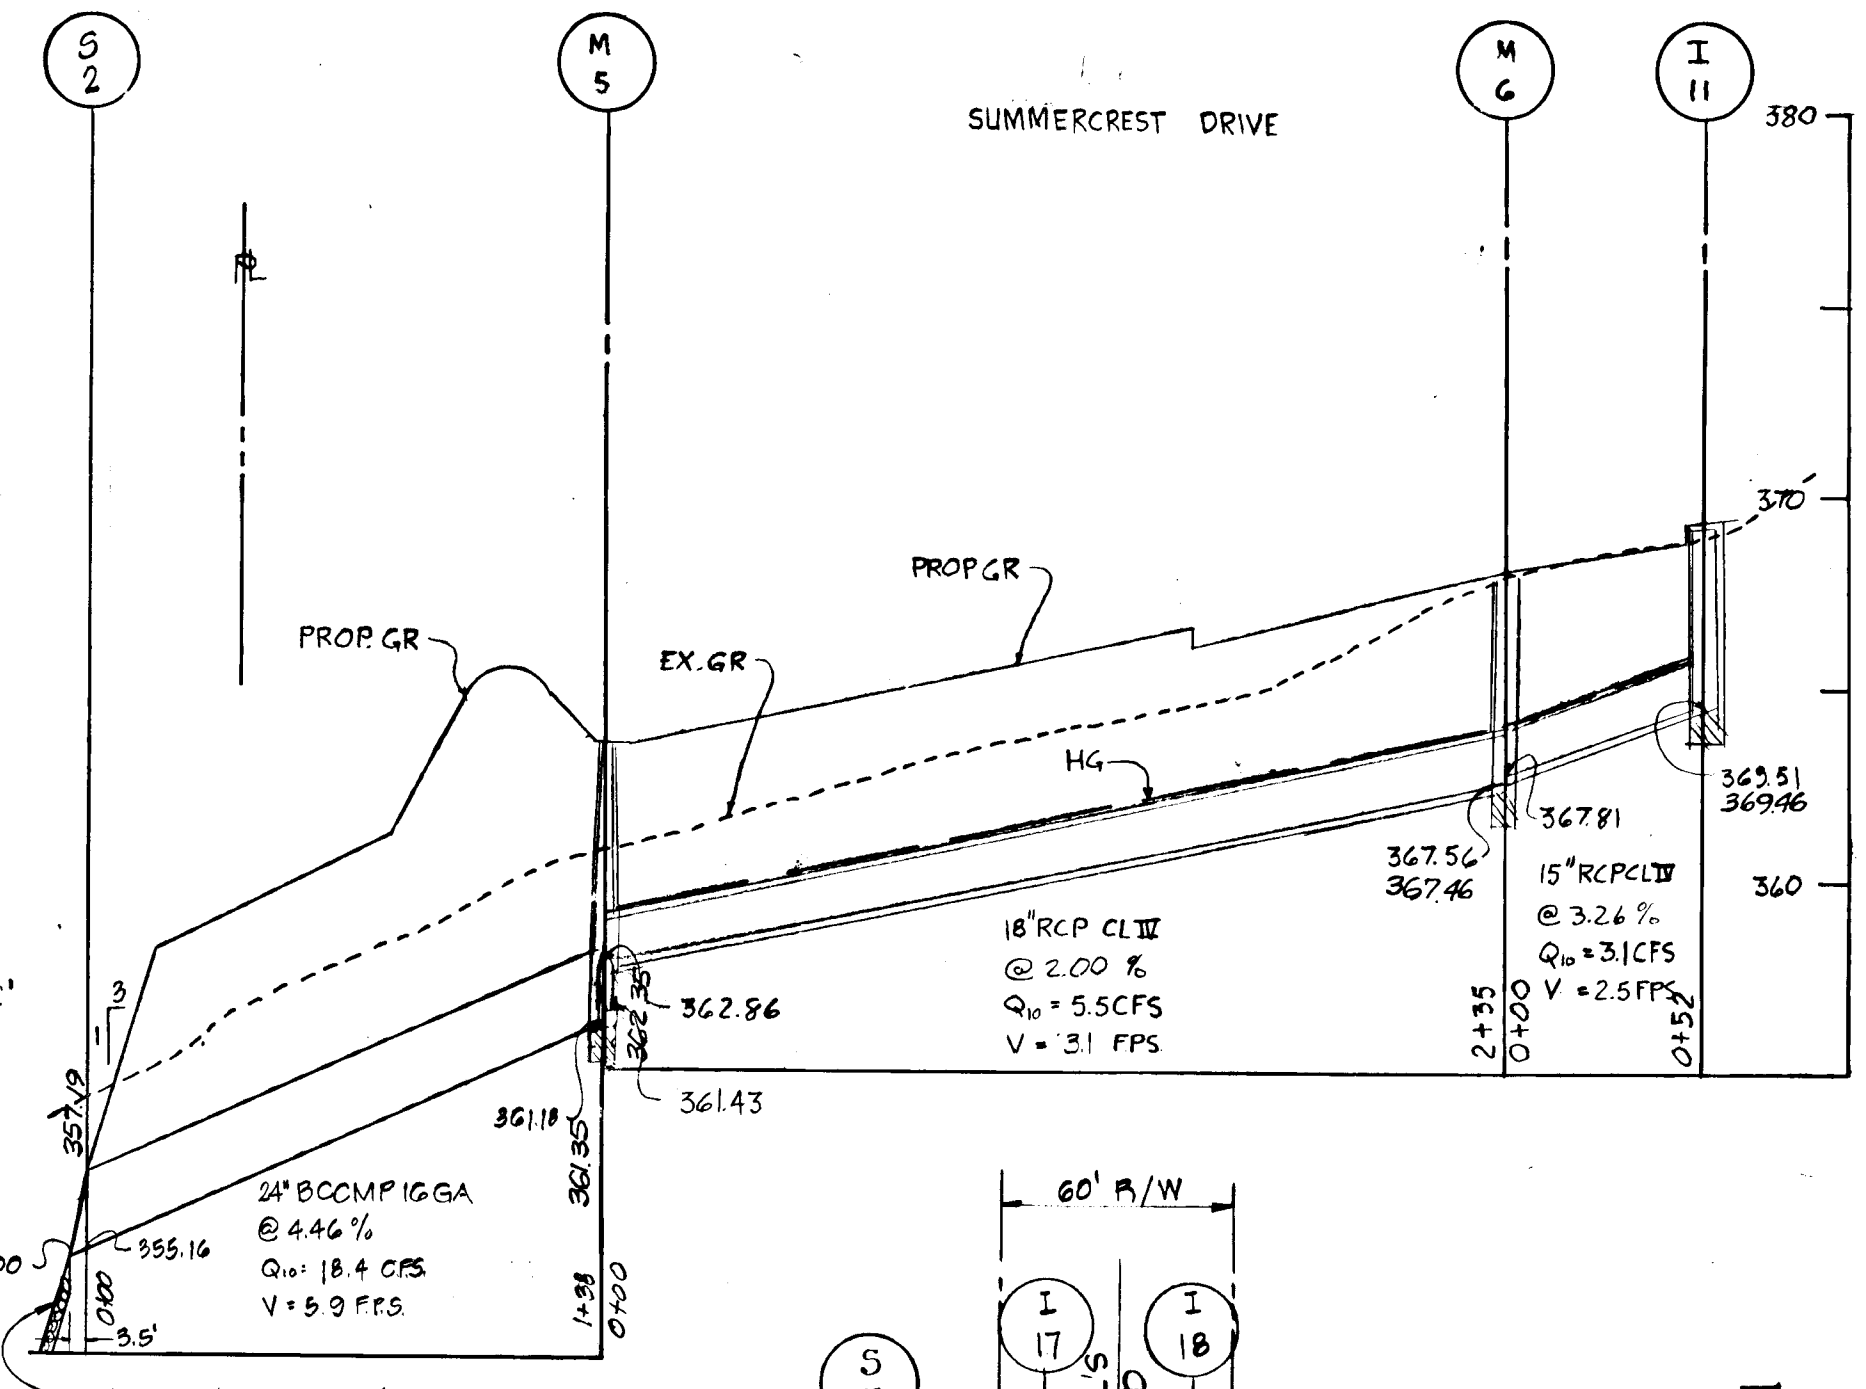

AS-BUILT SURVEY CERTIFIED
BY WALTER PARK, MD. REG.
LAND SURVEYOR No. 5539 -
AUG. 17, 1984

PROPOSED STRUCTURE SCHEDULE					
NO.	TYPE	INV. IN	INV. OUT	TOP ELEV.	REMARKS
I-10	HO. CO. STD. CLASS A-5 INLET	-	368.50	372.83	SEE HO. CO. DRWG. 64-A PG. 10A
I-11	" " " " A-10 "	-	369.50	374.80	" " " " " " " " " " " "
I-2	HO. CO. STD. CLASS A-10 INLET	-	372.22	375.56	SEE HO. CO. DRWG. 64-A PG. 10A
I-8	HO. CO. STD. CLASS A-10 INLET	362.49	362.49	368.88/10	SEE HO. CO. DRWG. 64-A PG. 10A
I-9A	HO. CO. STD. CLASS A-5 INLET	-	364.09	368.88/15	SEE HO. CO. DRWG. 64-A PG. 10A
I-7	HO. CO. STD. CLASS A-5 INLET	380.62	380.37	385.11	SEE HO. CO. DRWG. 64-A PG. 10A
I-8	HO. CO. STD. CLASS A-5 INLET	-	381.00	385.11	SEE HO. CO. DRWG. 64-A PG. 10A
M-2	HO. CO. STD. MANHOLE	374.83	374.58	420.0	SEE HO. CO. DRWG. 0-103 PG. 38
M-5	HO. CO. STD. MANHOLE	361.43	361.18	368.90	SEE HO. CO. DRWG. 0-103 PG. 38
S-6	MD STD. METAL END SECTION	-	354.16	356.16	SEE MD STD. DRWG. - 370.01, SHT. 16
S-5	MD STD. CONC. END SECTION	-	370.50	380.75	SEE MD STD. DRWG. - 368.01
S-3	MD STD. METAL END SECTION	-	348.00	349.25	SEE MD STD. DRWG. - 370.01, SHT. 16
S-2	" " " " " " " " " " " "	-	355.00	357.00	SEE MD STD. DRWG. - 370.01, SHT. 16
I-22	HO. CO. STD. CLASS A-5 INLET	355.91	355.66	401.10	SEE HO. CO. DRWG. 64-A PG. 10A
M-6	HO. CO. STD. MANHOLE	367.81	367.56	372.25	SEE HO. CO. DRWG. 64-A PG. 10A
S-8A	FABRICATED 20" VERTICAL BEND	349.0	349.00	350.25	15" BCCMP - 16 GA.
S-8B	FABRICATED 20" VERTICAL BEND	367.0	367.0	368.25	15" B.C.C.M.P. - 16 GA.

* DENOTES INLET TO BE INSTALLED WITH A DEFLECTOR

OWNER
SEWELL'S ORCHARD
6223 OAKLAND MILLS ROAD
COLUMBIA, MARYLAND 21045

DEVELOPER
LIGHTFOOT & ASSOCIATES
P.O. BOX 919
COLUMBIA, MD 21044

CERTIFICATION BY THE ENGINEER

I CERTIFY THAT THIS PLAN FOR A POND REPRESENTS A PRACTICAL AND WORKABLE PLAN BASED ON MY PERSONAL KNOWLEDGE OF THE SITE CONDITIONS AND THAT IT WAS PREPARED IN ACCORDANCE WITH THE REQUIREMENTS OF THE HOWARD COUNTY SOIL CONSERVATION DISTRICT.

Rudolph May Jr. 2-13-80
RODOLPH L. MAY, JR.
REGISTERED PROFESSIONAL ENGINEER

CERTIFICATION BY THE DEVELOPER

I CERTIFY THAT ALL DEVELOPMENT AND CONSTRUCTION WILL BE DONE ACCORDING TO THESE PLANS OF DEVELOPMENT AND PLANS FOR A POND AND I ALSO AUTHORIZE PERIODIC ON-SITE INSPECTION BY THE HOWARD COUNTY SOIL CONSERVATION DISTRICT OR THEIR AUTHORIZED AGENTS AS APPLICABLE NECESSARY. DEVIATIONS FROM THESE PLANS WILL NOT BE MADE UNLESS AUTHORIZED BY THE HOWARD COUNTY SOIL CONSERVATION DISTRICT.

L. Earl Carmiger GENERAL PARTNER 2/10/80
DEVELOPER - L. EARL CARMIGER DATE

THESE PLANS FOR SMALL POND CONSTRUCTION MEET THE REQUIREMENTS OF THE HOWARD COUNTY SOIL CONSERVATION DISTRICT.

Robert Zeichner 9-17-80
APPROVED HO. CO. S.C.D. DATE

THESE PLANS HAVE BEEN REVIEWED FOR THE HOWARD COUNTY SOIL CONSERVATION DISTRICT AND MEET THE TECHNICAL REQUIREMENTS FOR SMALL POND CONSTRUCTION.

James M. Helm 9-17-80
U.S. SOIL CONSERVATION SERVICE DATE

APPROVED DEPARTMENT OF PUBLIC WORKS
Walter Park 9-30-80
CHIEF, BUREAU OF ENGINEERING

APPROVED OFFICE OF PLANNING AND ZONING
John Louis F. Demers 9-22-80
CHIEF, DIVISION OF LAND DEVELOPMENT

REVISED: 3-30-80 OUTFALLS AT S-2 AND S-3

STORM DRAIN PROFILES & DETAILS
SEWELL'S ORCHARD SECT. 1

PROJECT: 6TH ELECTION DISTRICT HOWARD COUNTY, MARYLAND

DATE: JAN. 1980 DESIGN BY: W.H.N. DRAWN BY: G.M./W.N. CHECKED BY: S.L.M.

SCALE: HOR: 1" = 50' VER: 1" = 5'

JOB NO.: 7915B DRAWING NO.: 12 OF 16

boender associates
SUITE 102-107 TOWN & COUNTRY PROFESSIONAL BUILDING
ELLCOTT CITY, MARYLAND 21043
BALTIMORE 301-465-7777 SALEM 301-748-1288

engineers
surveyors
planners

DEVELOPER'S CERTIFICATE

I CERTIFY THAT ALL DEVELOPMENT AND/OR CONSTRUCTION WILL BE ACCORDING TO THIS PLAN OF DEVELOPMENT AND PLAN FOR EROSION AND SEDIMENT CONTROL AND I ALSO AUTHORIZE PERIODIC ON-SITE INSPECTION BY THE HOWARD SOIL CONSERVATION DISTRICT OF THEIR AUTHORIZED AGENTS AS ARE DEEMED NECESSARY. DEVIATION FROM THIS PLAN WILL NOT BE MADE UNLESS AUTHORIZED BY THE HOWARD SOIL CONSERVATION DISTRICT.

L. Carl Armiger
DEVELOPER L. CARL ARMIGER DATE 2/8/80


ENGINEER'S CERTIFICATE

I CERTIFY THAT THIS PLAN FOR EROSION AND SEDIMENT CONTROL REPRESENTS A PRACTICAL AND WORKABLE PLAN BASED ON PERSONAL KNOWLEDGE OF THE SITE CONDITIONS AND THAT IT WAS PREPARED IN ACCORDANCE WITH THE REQUIREMENTS OF THE HOWARD SOIL CONSERVATION DISTRICT.

Rodolph L. May Jr.
ENGINEER RODOLPH L. MAY JR. DATE 2-8-80

SEDIMENT TRAP SCHEDULE

No.	D.A.	VOL. REQ'D	VOL. PROV.	BOTT. DIMEN.'S	DEPTH	BOTT. EL.	C.O. EL.	LEN. ELEV.	EMER. SP.
1	4.0 AC.	7200 C.F.	2000 C.F.	60" X 40"	3'	386.0	387.5	24' 380.0	
2	1.0 AC.	1800 C.F.	250 C.F.	20" X 45"	2'	374.0	375.0	6' 376.0	

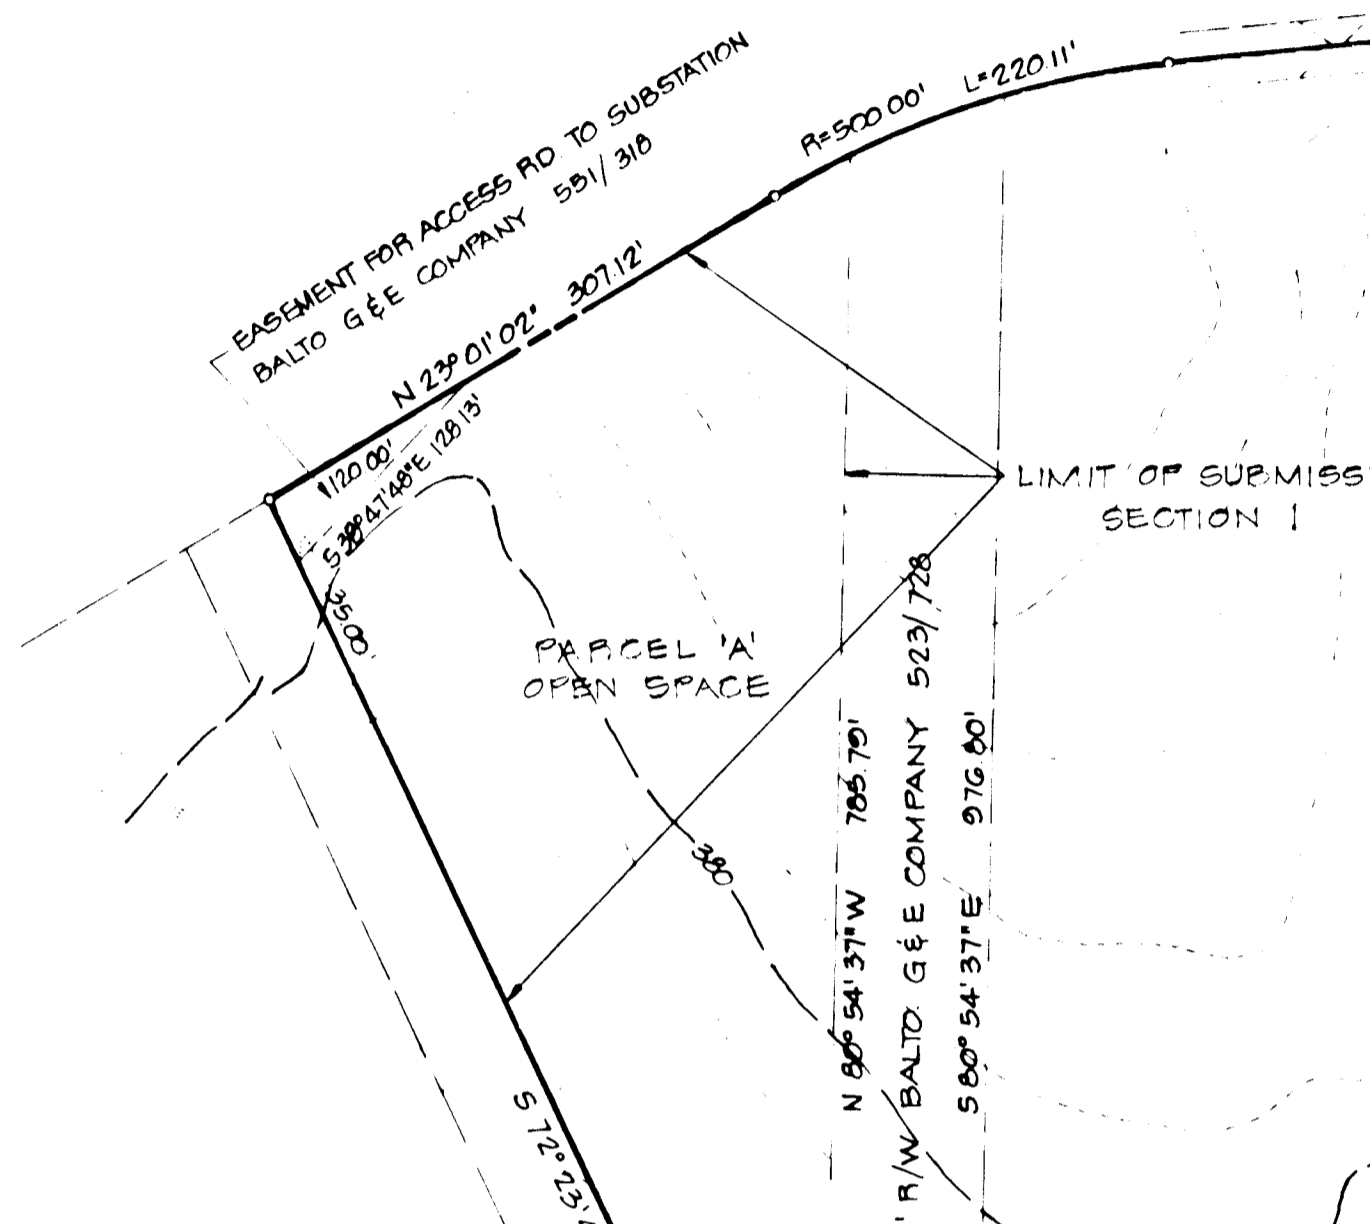

Reviewed for **Howard** S.C.D.
and posts Technical Requirements
J. Nelson Date 2-18-80
U.S. Soil Conservation Service

THIS DEVELOPMENT PLAN IS APPROVED FOR SOIL EROSION AND SEDIMENT CONTROL BY THE HOWARD SOIL CONSERVATION DISTRICT.
Approved *Wm. Rowe* Date 2-12-80
Howard S.C.D.

EARTHWORK TABULATION

EXCAVATION LOCATION	CUT C.Y.'S	FILL C.Y.'S	COMPACT. (@ 25%)	TOTAL FILL C.Y.'S
ALL ROADS	10770	8415	2104	10,519
ROADWAY STRIPPING	19,929	-	-	-
POND "C" ENLARGEMENT	5,749	2,024	656	9,280
POND "C" EARTH DAM	-	464	116	579
POND "B"	-	456	121	607
TOTAL	36,442	-	-	14,985 C.Y.'S
EXCESS MATERIAL	21,487 C.Y.'S	-	-	-



PRIMARY DISPOSAL AREAS

LOCATION	C.Y.'S	15% SETTLEMENT ALLOW.	TOTAL C.Y.'S
EARTH BERM ADJACENT TO OAKLAND MILLS RD	1479	222	1701
SIGN BERM @ ENTRANCE	389	58	447
LOTS 46-63 CUT: 2667 C.Y.'S FILL: 16,129 C.Y.'S (INCLUDES 15% ALLOW.)	-	-	7,356
LOTS 78-96 CUT: 2743 C.Y.'S FILL: 22,276 C.Y.'S (INCLUDES 15% ALLOW.)	-	-	15,870
TOTALS	22,064 C.Y.'S	3,310 C.Y.'S	25,374 C.Y.'S

SECONDARY DISPOSAL AREAS

LOCATION	FILL	15% Allow. Settlement	TOTAL FILL
PARCEL "B"	805	121	926
PARCEL "C"	1081	162	1,243
TOTAL	1,886	283	2,169 C.Y.'S

850

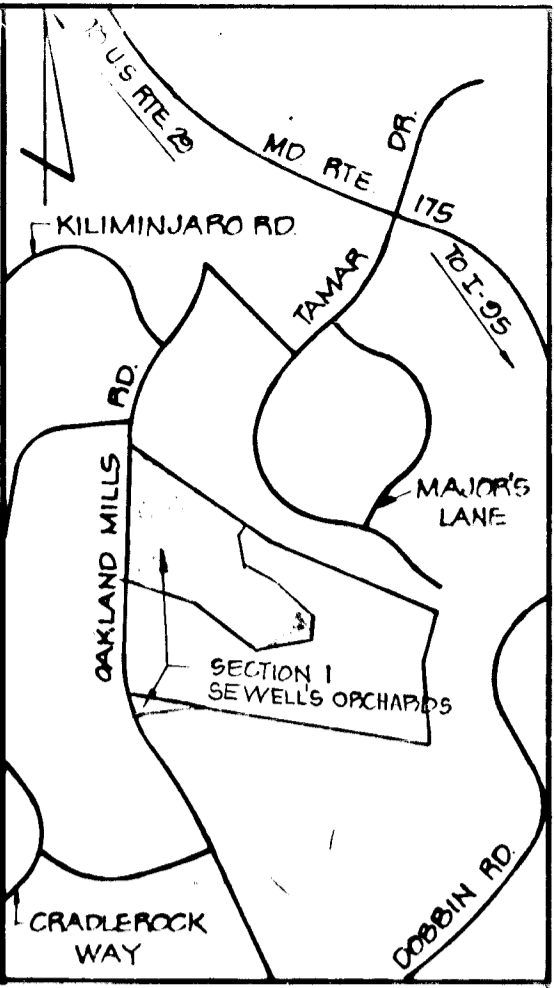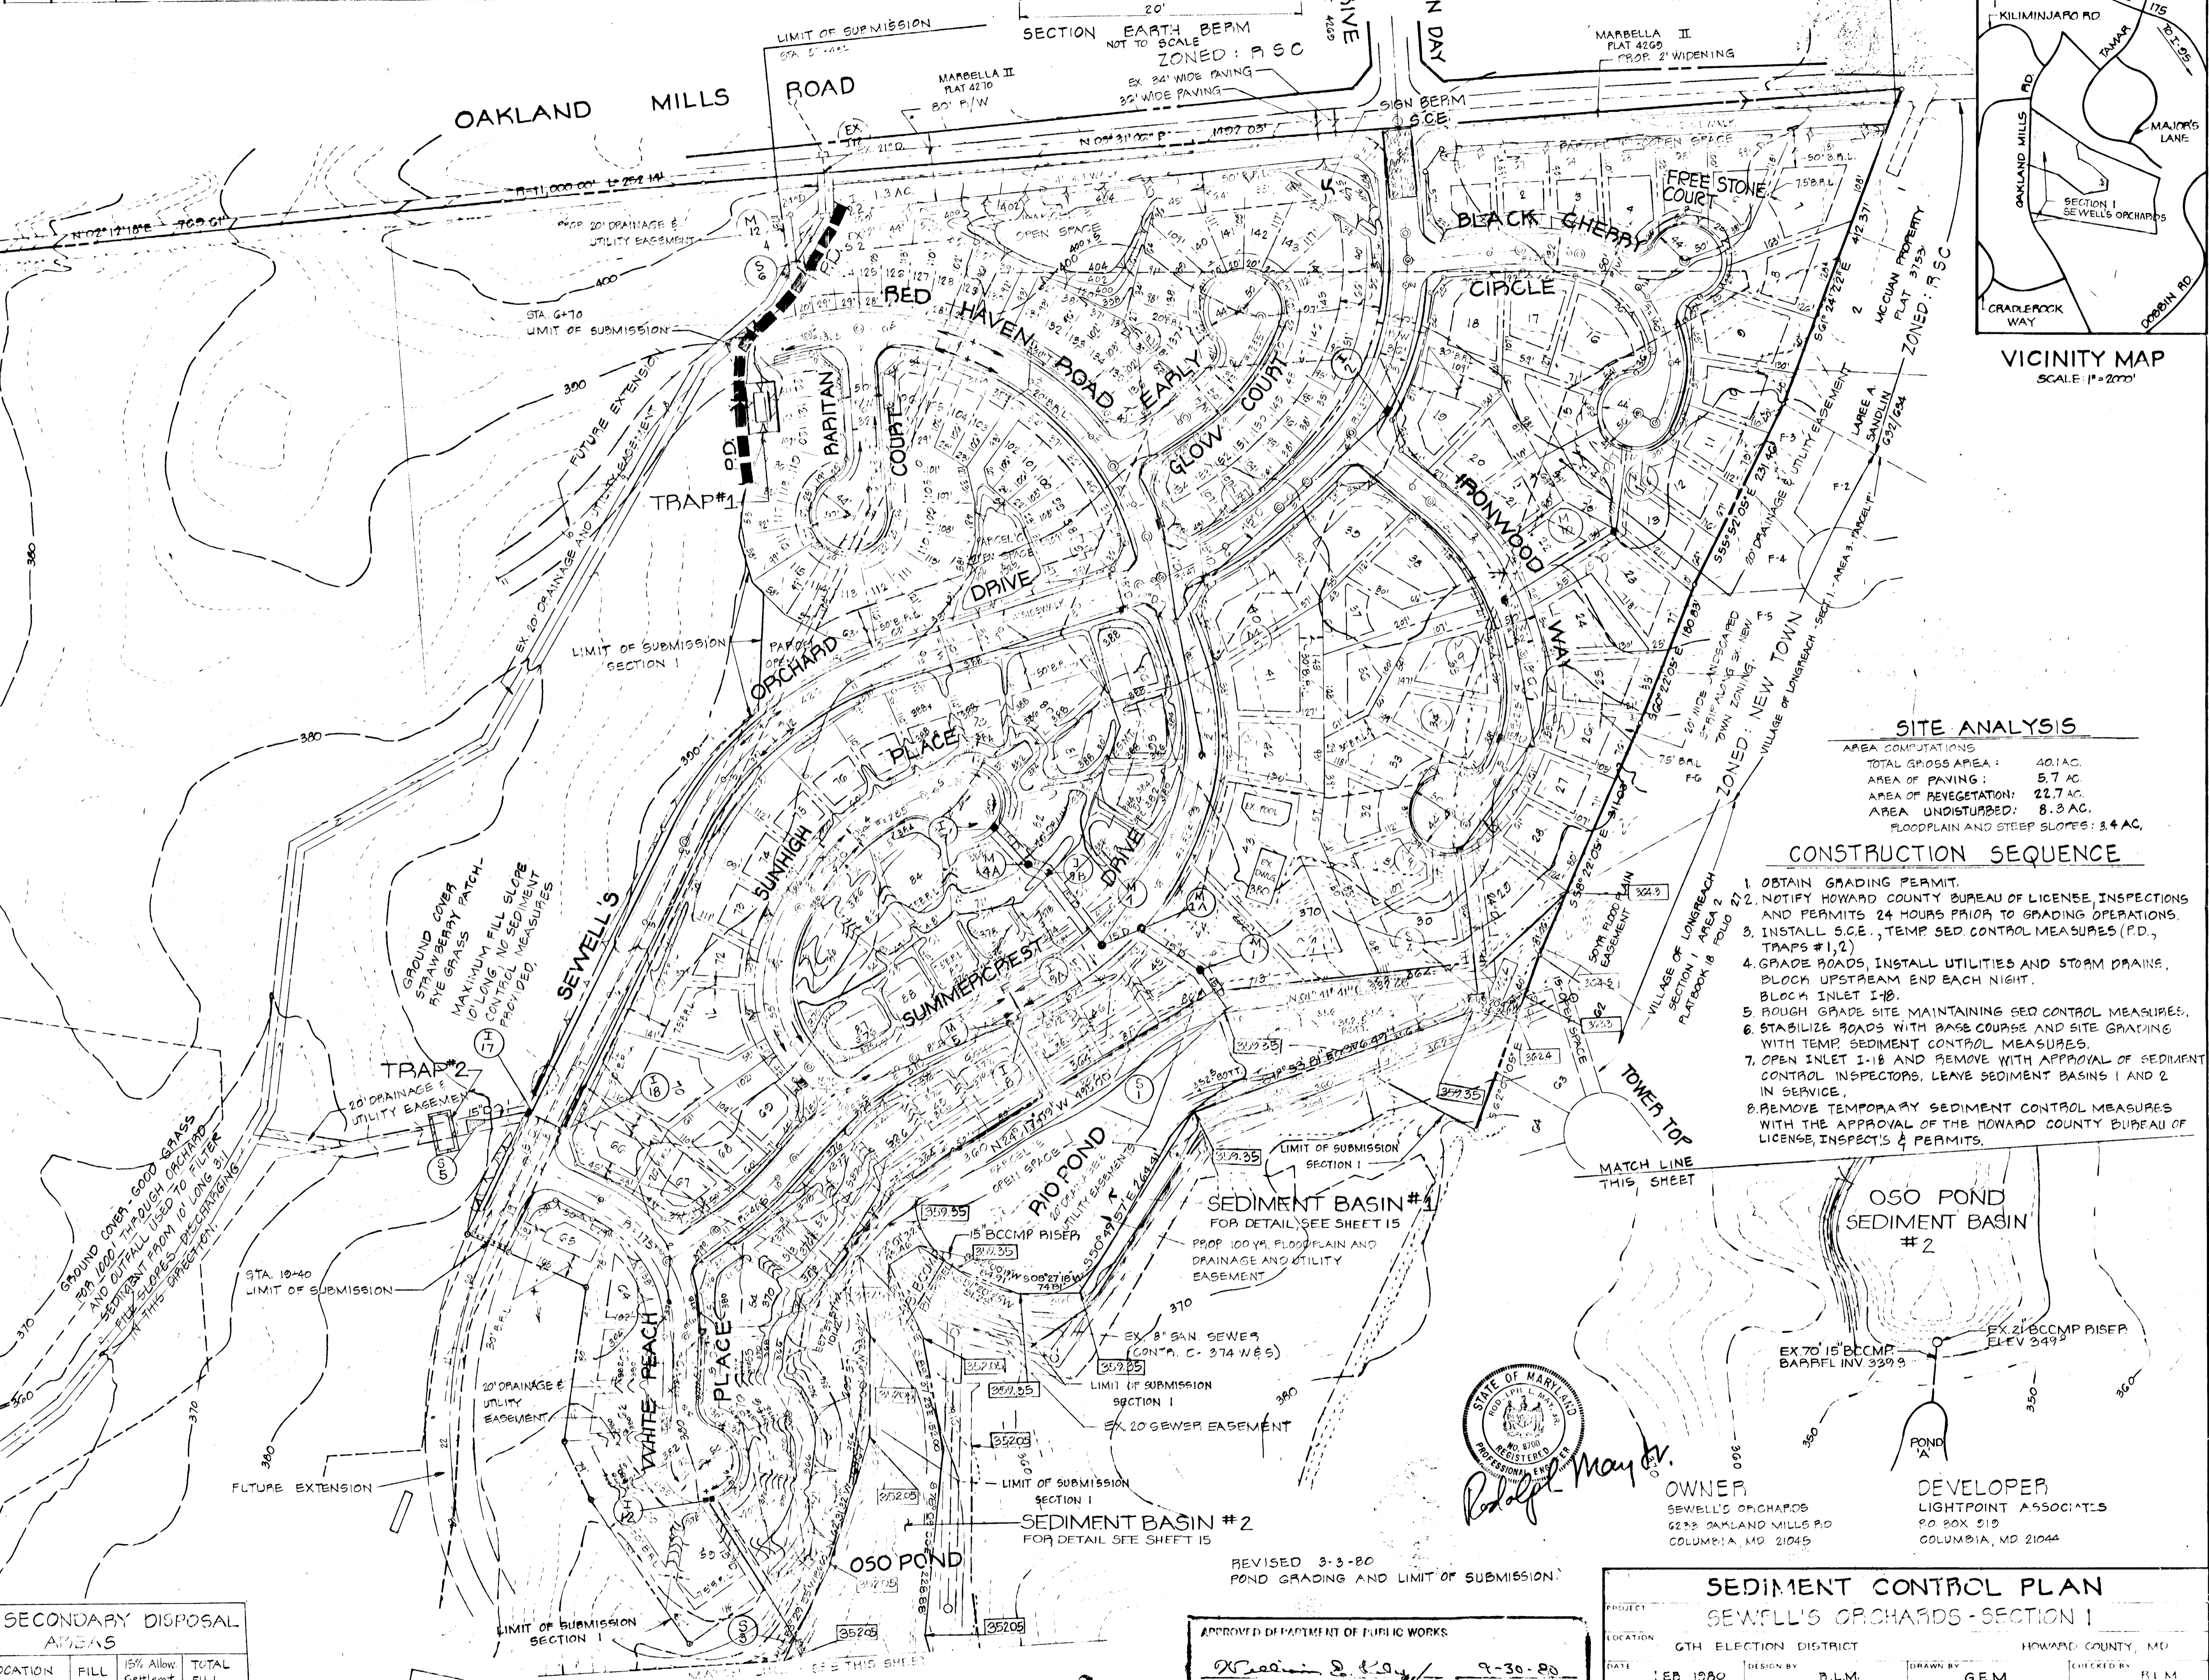


SITE ANALYSIS

AREA COMPUTATIONS

TOTAL GROSS AREA:	40.1 AC.
AREA OF PAVING:	5.7 AC.
AREA OF REVEGETATION:	22.7 AC.
AREA UNDISTURBED:	8.3 AC.
FLOODPLAIN AND STEEP SLOPES:	3.4 AC.

CONSTRUCTION SEQUENCE

1. OBTAIN GRADING PERMIT.
2. NOTIFY HOWARD COUNTY BUREAU OF LICENSE, INSPECTIONS AND PERMITS 24 HOURS PRIOR TO GRADING OPERATIONS.
3. INSTALL S.C.E., TEMP SED CONTROL MEASURES (P.D., TRAPS #1,2)
4. GRADE ROADS, INSTALL UTILITIES AND STORM DRAINS, BLOCK UPSTREAM END EACH NIGHT.
5. ROUGH GRADE SITE MAINTAINING SED CONTROL MEASURES.
6. STABILIZE ROADS WITH BASE COURSE AND SITE GRADING WITH TEMP. SEDIMENT CONTROL MEASURES.
7. OPEN INLET 1-1B AND REMOVE WITH APPROVAL OF SEDIMENT CONTROL INSPECTORS. LEAVE SEDIMENT BASINS 1 AND 2 IN SERVICE.
8. REMOVE TEMPORARY SEDIMENT CONTROL MEASURES WITH THE APPROVAL OF THE HOWARD COUNTY BUREAU OF LICENSE, INSPECT'S & PERMITS.

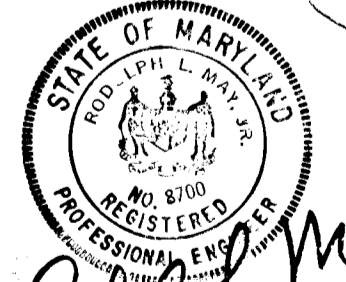

OWNER
SEWELL'S ORCHARDS
6228 OAKLAND MILLS RD
COLUMBIA, MD 21045

DEVELOPER
LIGHTPOINT ASSOCIATES
P.O. BOX 519
COLUMBIA, MD 21044

APPROVED DEPARTMENT OF PUBLIC WORKS
Richard S. Co. 9-30-80
CHIEF, E.P.D. DATE

APPROVED OFFICE OF PLANNING AND ZONING
John J. Linn 9-22-80
THURSDAY, DEPT. OF PLANNING AND ZONING DATE

SEDIMENT CONTROL PLAN
SEWELL'S ORCHARDS - SECTION I


PROJECT LOCATION: GTH ELECTION DISTRICT HOWARD COUNTY, MD

DATE: FEB 1980 DESIGN BY: R.L.M. DRAWN BY: G.E.M. CHECKED BY: R.L.M.

SCALE: 1"=100' JOB NO: 79158 DRAWING NO: 30216

boender associates
SUITE 102 107 TOWN & COUNTRY PROFESSIONAL BUILDING
ELLETT CITY, MARYLAND 21043
BALTIMORE 301 468 7377 SALES/INQUIRY: 301 740 1286

engineers/surveyors/planners

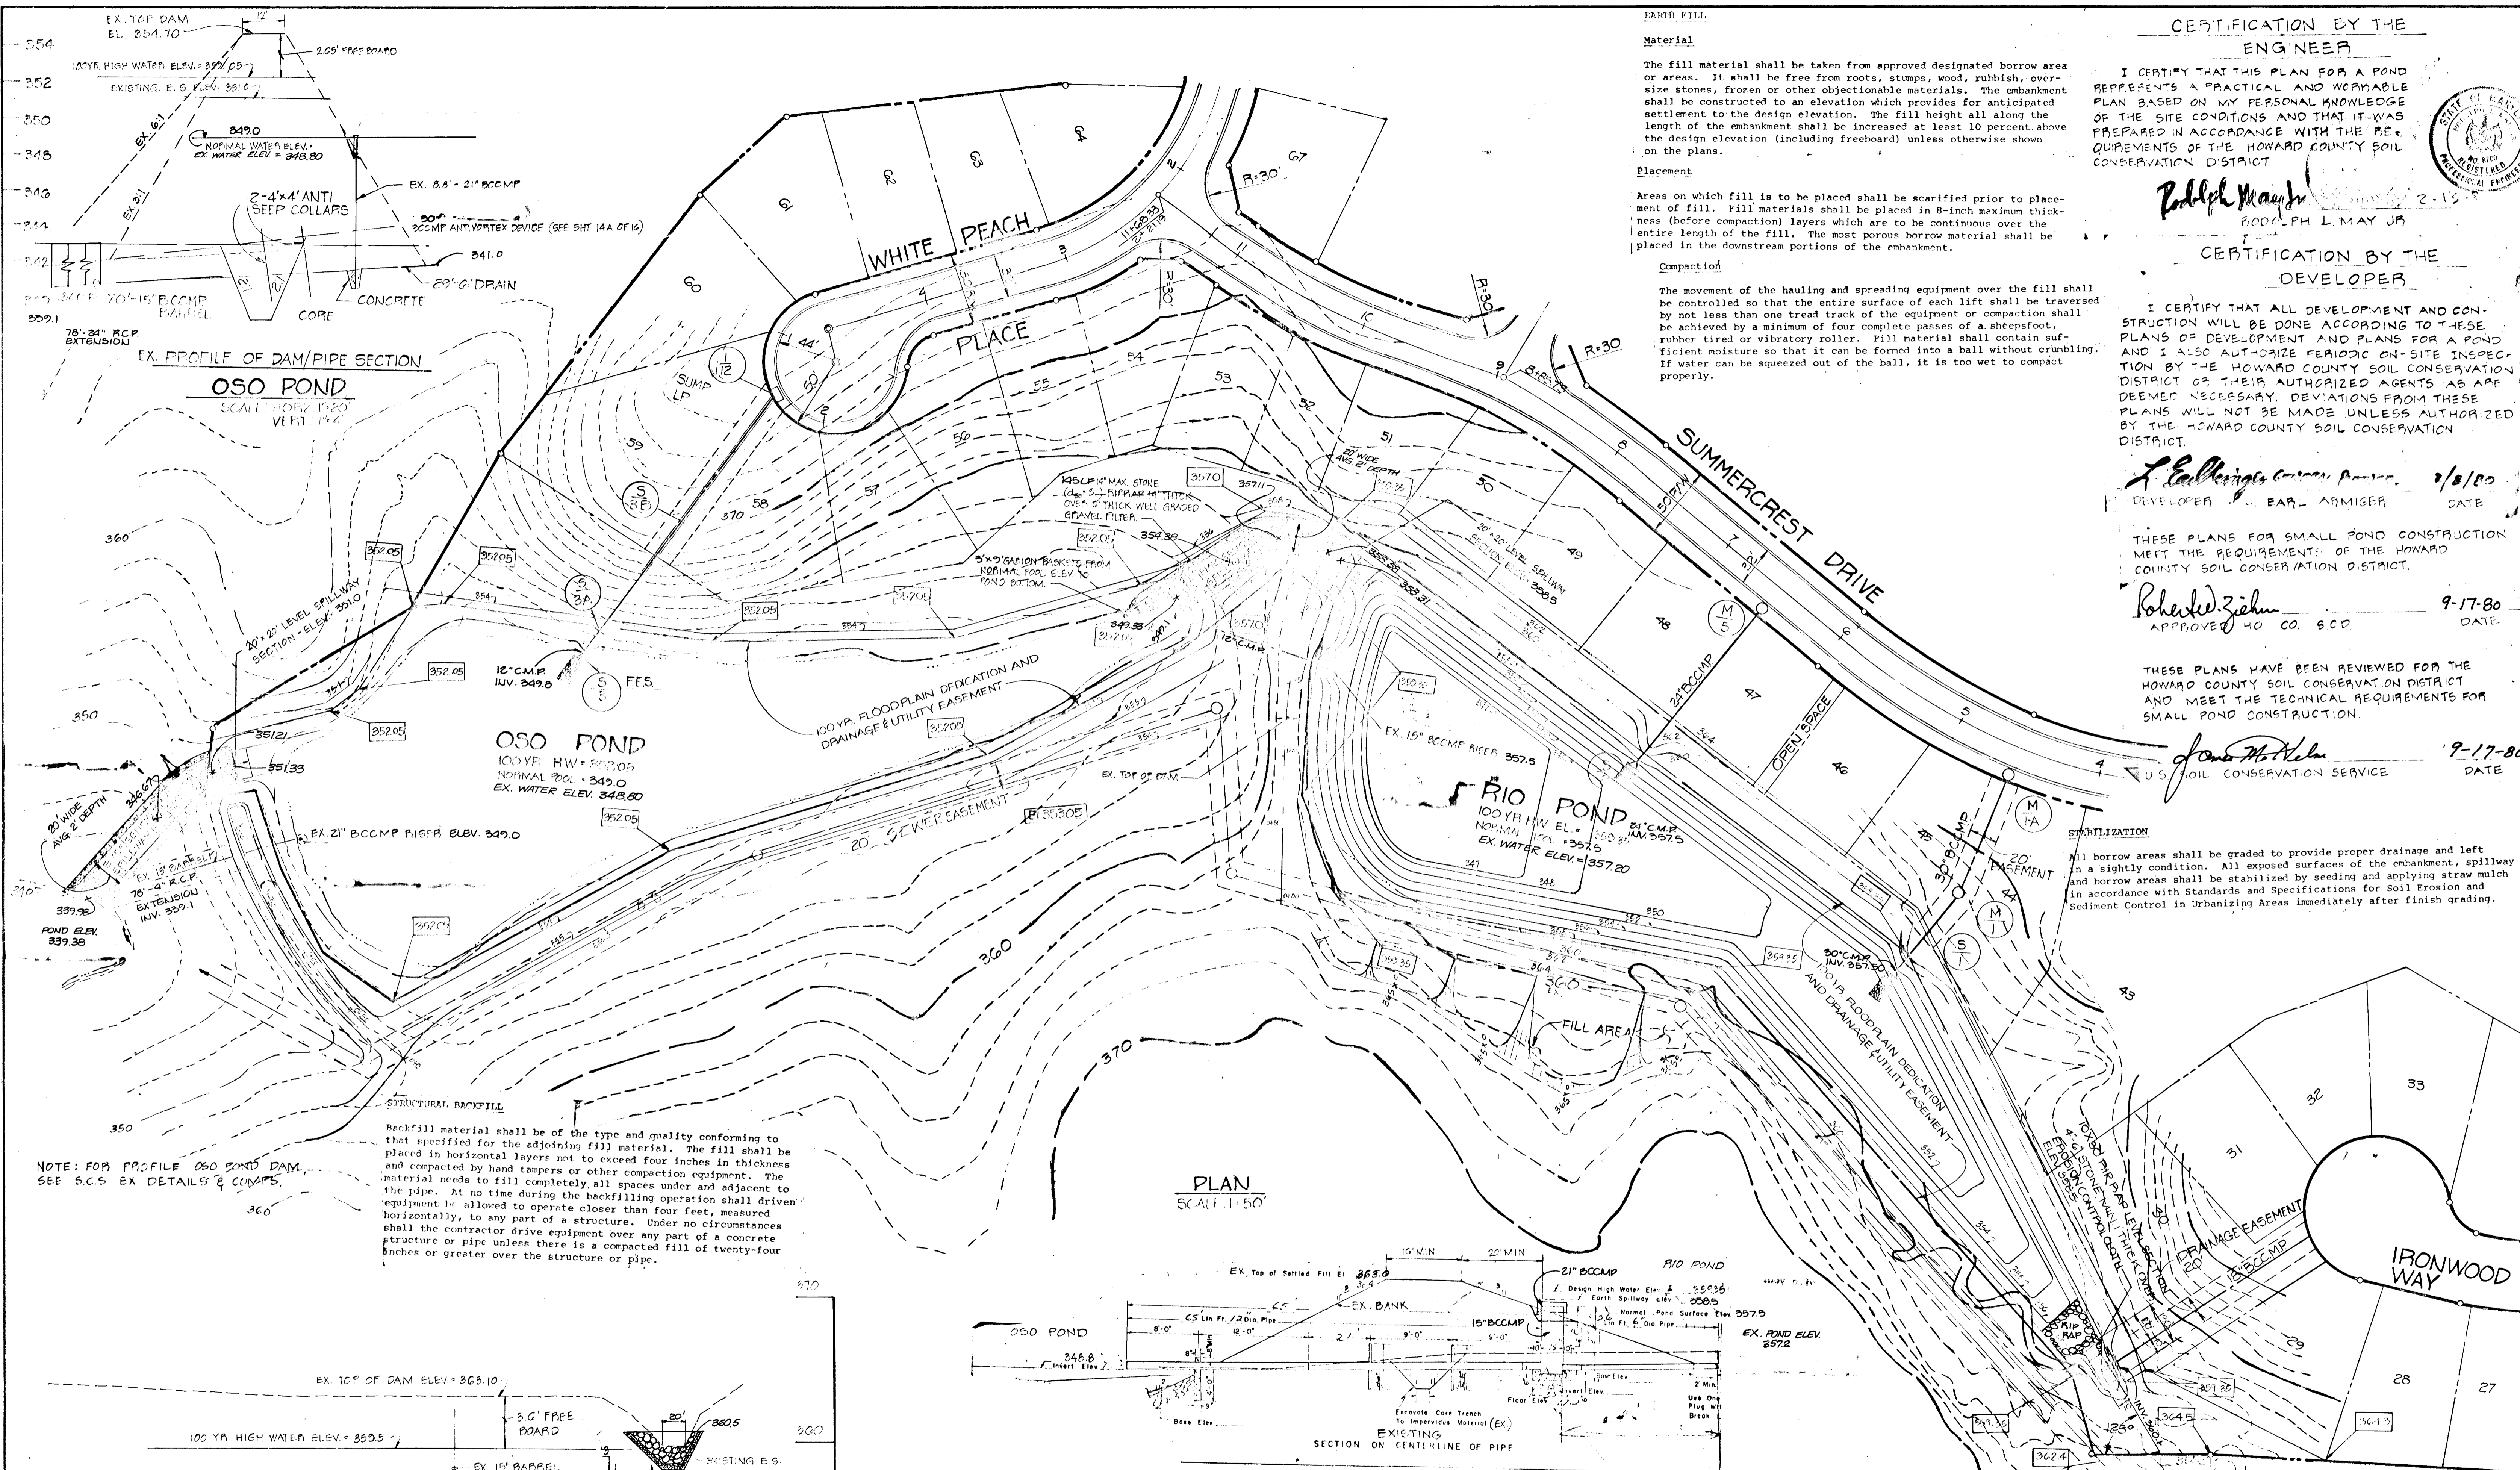

FILL
Material
 The fill material shall be taken from approved designated borrow area or areas. It shall be free from roots, stumps, wood, rubbish, over-size stones, frozen or other objectionable materials. The embankment shall be constructed to an elevation which provides for anticipated settlement to the design elevation. The fill height all along the length of the embankment shall be increased at least 10 percent above the design elevation (including freeboard) unless otherwise shown on the plans.

Placement
 Areas on which fill is to be placed shall be scarified prior to placement of fill. Fill materials shall be placed in 8-inch maximum thickness (before compaction) layers which are to be continuous over the entire length of the fill. The most porous borrow material shall be placed in the downstream portions of the embankment.

Compaction
 The movement of the hauling and spreading equipment over the fill shall be controlled so that the entire surface of each lift shall be traversed by not less than one tread track of the equipment or compaction shall be achieved by a minimum of four complete passes of a sheepsfoot, rubber tired or vibratory roller. Fill material shall contain sufficient moisture so that it can be formed into a ball without crumbling. If water can be squeezed out of the ball, it is too wet to compact properly.



CERTIFICATION BY THE ENGINEER
 I CERTIFY THAT THIS PLAN FOR A POND REPRESENTS A PRACTICAL AND WORKABLE PLAN BASED ON MY PERSONAL KNOWLEDGE OF THE SITE CONDITIONS AND THAT IT WAS PREPARED IN ACCORDANCE WITH THE REQUIREMENTS OF THE HOWARD COUNTY SOIL CONSERVATION DISTRICT.
Rodolph L. May Jr.
 RODOLPH L. MAY JR.
 2-15

CERTIFICATION BY THE DEVELOPER
 I CERTIFY THAT ALL DEVELOPMENT AND CONSTRUCTION WILL BE DONE ACCORDING TO THESE PLANS OF DEVELOPMENT AND PLANS FOR A POND AND I ALSO AUTHORIZE PERIODIC ON-SITE INSPECTION BY THE HOWARD COUNTY SOIL CONSERVATION DISTRICT OR THEIR AUTHORIZED AGENTS AS APPROPRIATE NECESSARY. DEVIATIONS FROM THESE PLANS WILL NOT BE MADE UNLESS AUTHORIZED BY THE HOWARD COUNTY SOIL CONSERVATION DISTRICT.
R. Earl Armiger
 DEVELOPER R. EARL ARMIGER DATE 2/8/80

THESE PLANS FOR SMALL POND CONSTRUCTION MEET THE REQUIREMENTS OF THE HOWARD COUNTY SOIL CONSERVATION DISTRICT.
Robert J. Zehn
 APPROVED HO. CO. SCD DATE 9-17-80

THESE PLANS HAVE BEEN REVIEWED FOR THE HOWARD COUNTY SOIL CONSERVATION DISTRICT AND MEET THE TECHNICAL REQUIREMENTS FOR SMALL POND CONSTRUCTION.
James M. Williams
 U.S. SOIL CONSERVATION SERVICE DATE 9-17-80

NOTE: FOR PROFILE OSO POND DAM, SEE S.C.S. EX. DETAILS & COMPS.
 Backfill material shall be of the type and quality conforming to that specified for the adjoining fill material. The fill shall be placed in horizontal layers not to exceed four inches in thickness and compacted by hand tampers or other compaction equipment. The material needs to fill completely all spaces under and adjacent to the pipe. At no time during the backfilling operation shall driven equipment be allowed to operate closer than four feet, measured horizontally, to any part of a structure. Under no circumstances shall the contractor drive equipment over any part of a concrete structure or pipe unless there is a compacted fill of twenty-four inches or greater over the structure or pipe.

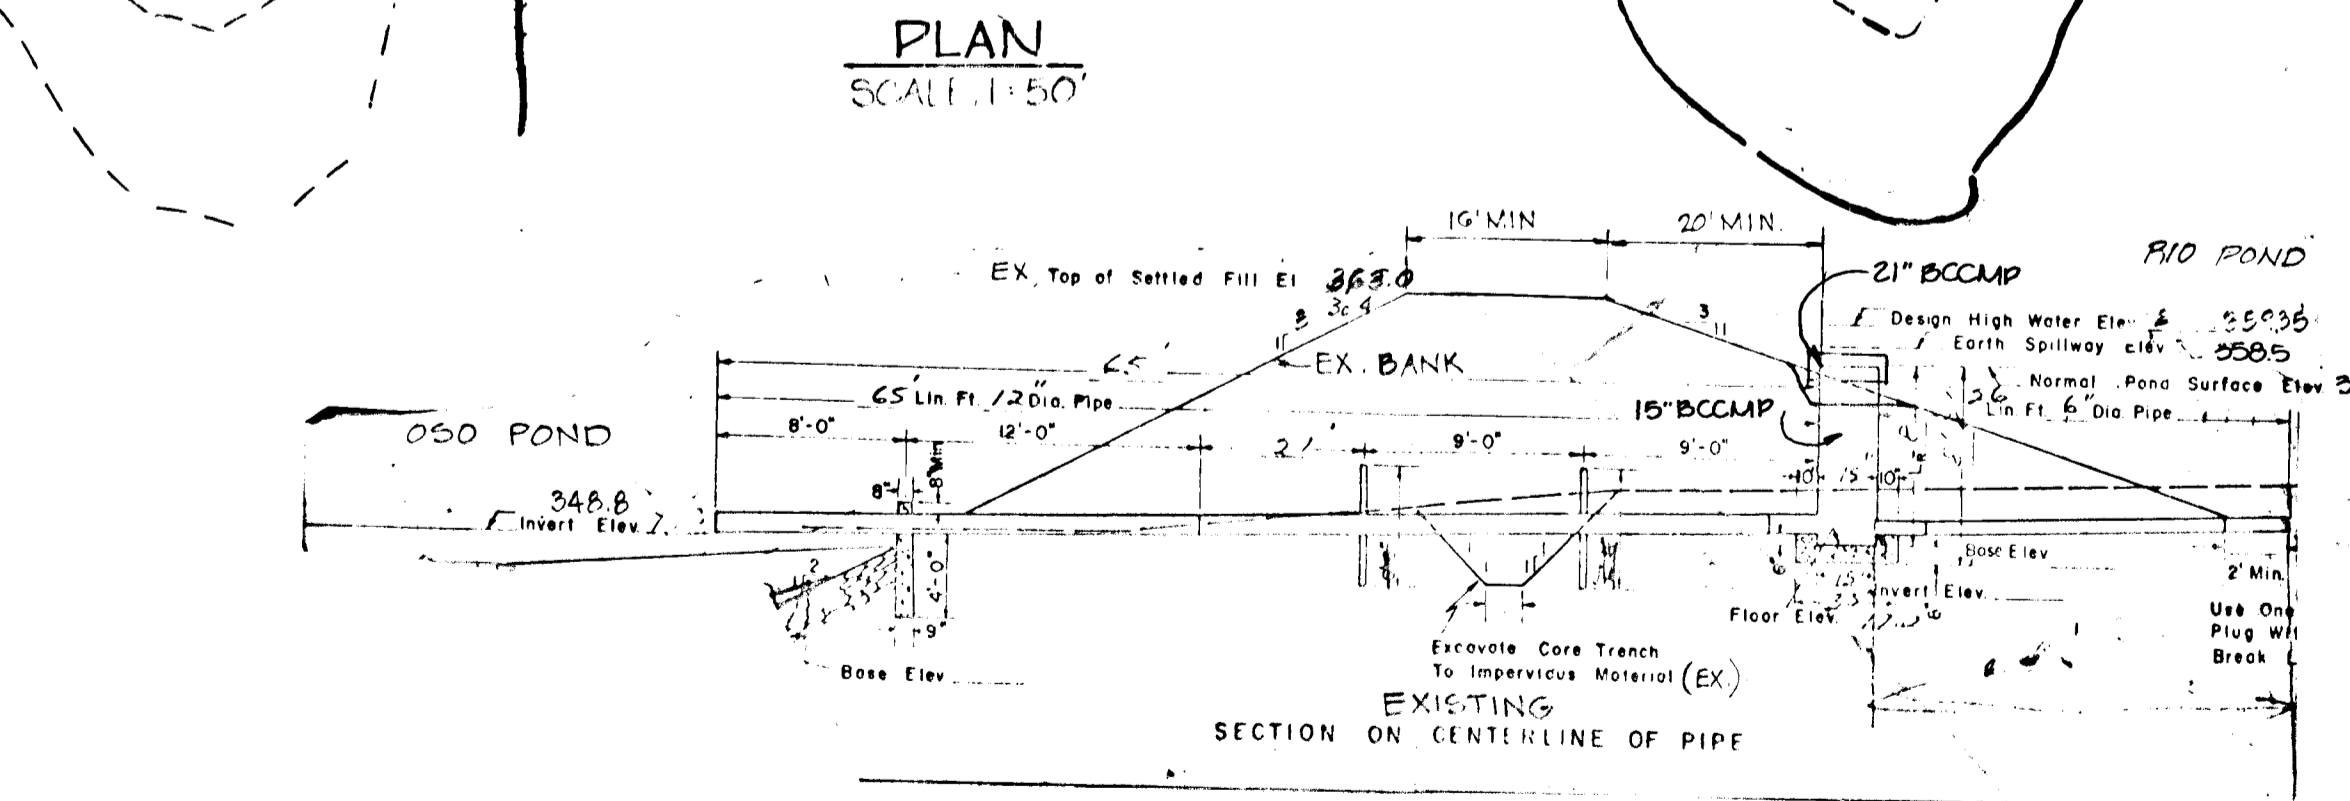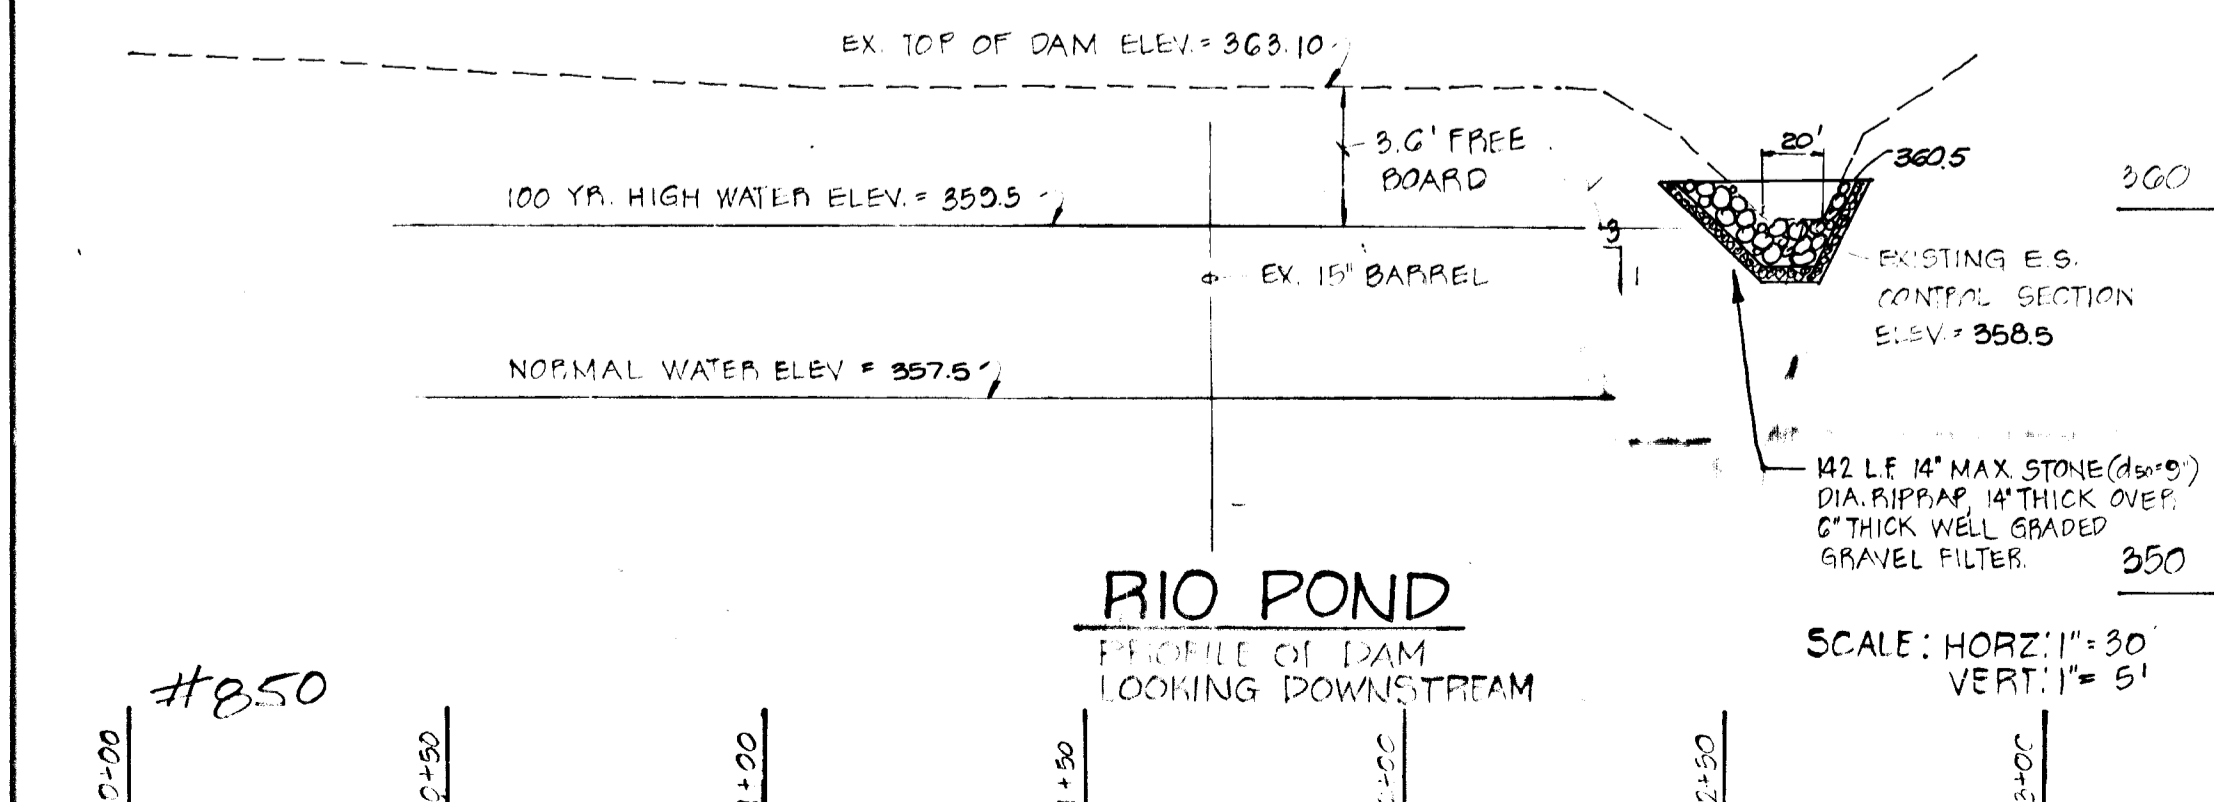


AS-BUILT SURVEY CERTIFYS THAT THE STORM WATER MANAGEMENT WAS CONSTRUCTED TO MEETS THE APPROVED MINIMUM STANDARDS AND SPECIFICATIONS.
 AS-BUILT CERTIFICATION BY RODOLPH L. MAY JR.
 MD. REG. ENGINEER NO. 8700 ON SEPT. 5, 1984.
Rodolph L. May Jr.
 REVISIONS: 7-6-84 PER POND REV. P-80-105 (6-20-84)
 9-22-80
 9-30-80

OWNER
 SEWELLS ORCHARDS
 6233 OAKLAND MILLS RD.
 COLUMBIA MD 21045

DEVELOPER
 LIGHTPOINT ASSOC.
 PO BOX 919
 COLUMBIA MD 21044


TITLE SEWELLS ORCHARDS POND PLAN			
PROJECT SEWELLS ORCHARDS - SECTION 1			
LOCATION 6TH ELECTION DISTRICT		HOWARD COUNTY MD	
DATE FEB. 1980	DESIGN BY RLM	DRAWN BY WCL	CHECKED BY RLM
SCALE AS SHOWN	JOB NO. 79158	DRAWING NO. 14 OF 16	
boender associates SUITE 102-107 TOWN & COUNTRY PROFESSIONAL BUILDING ELLCOTT CITY, MARYLAND 21043 BALTIMORE 301-466-7777 SALISBURY 301-748-1288			engineers surveyors planners

AS-BUILT SEPT. 5, 1984 F-80-105

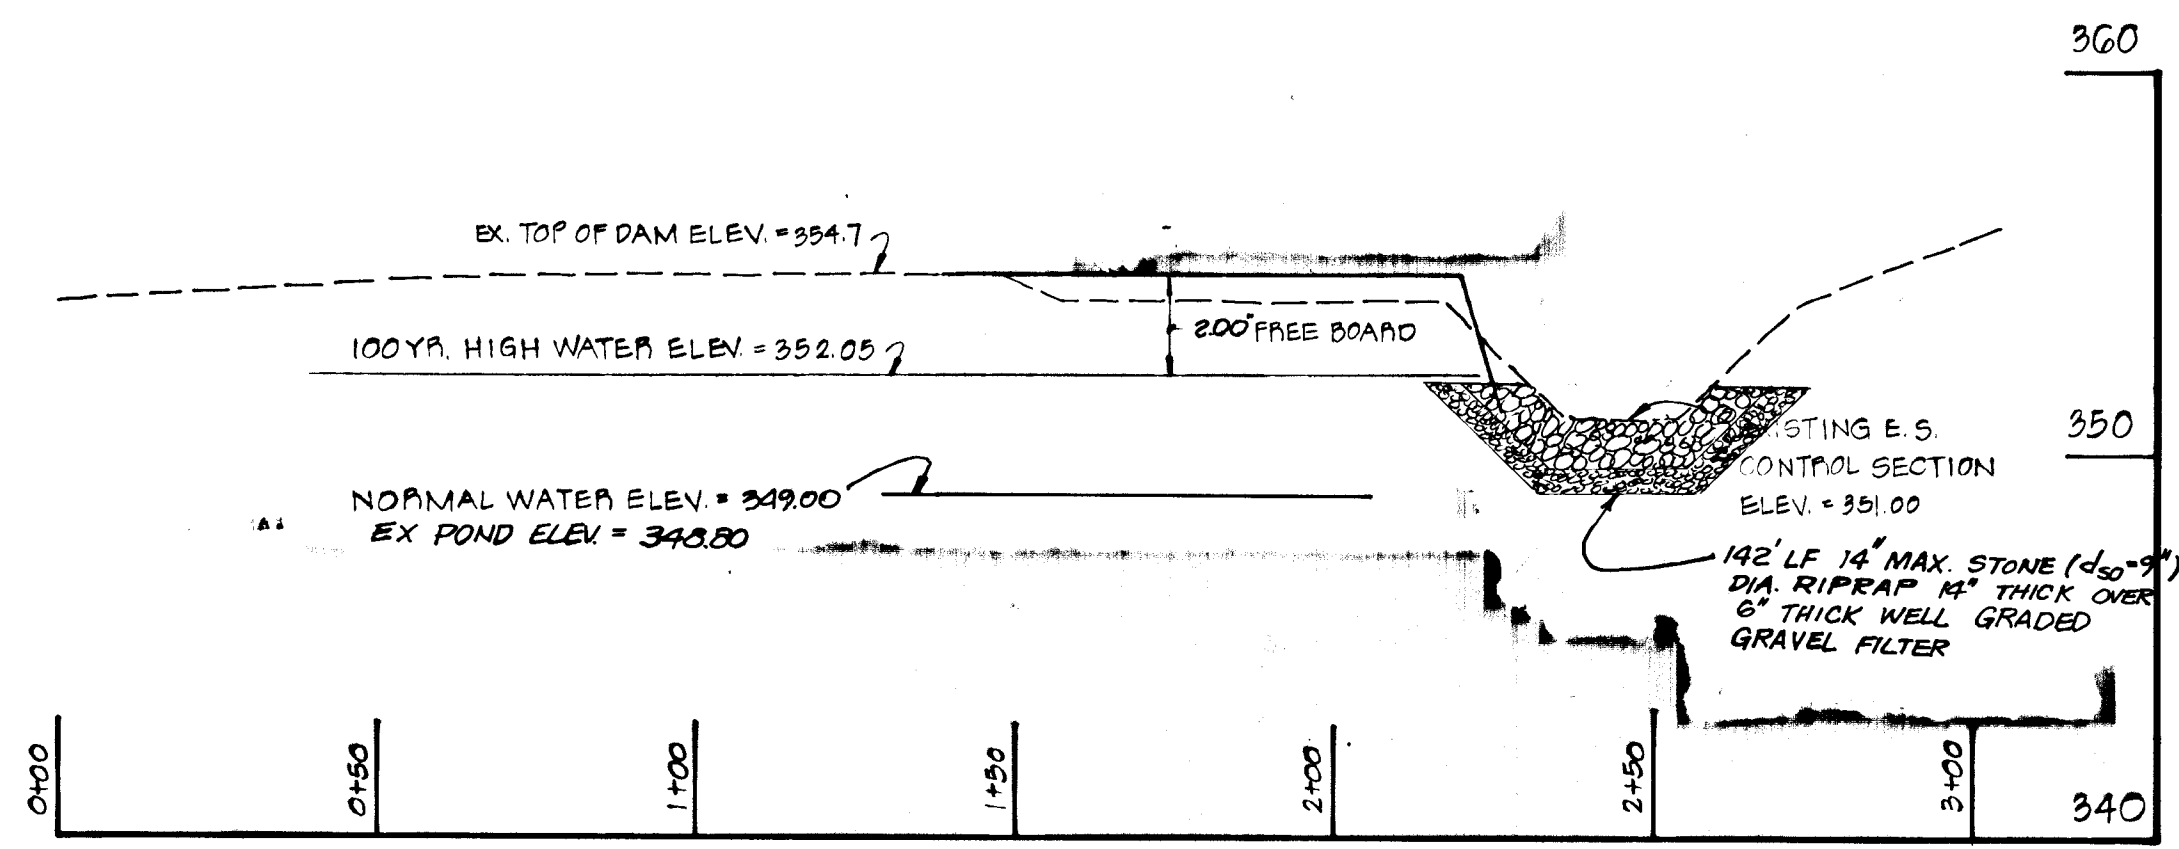


OSO POND

DAM PROFILE
LOOKING DOWNSTREAM
SCALE: HORIZ. 1" = 30'
VERT. 1" = 5'

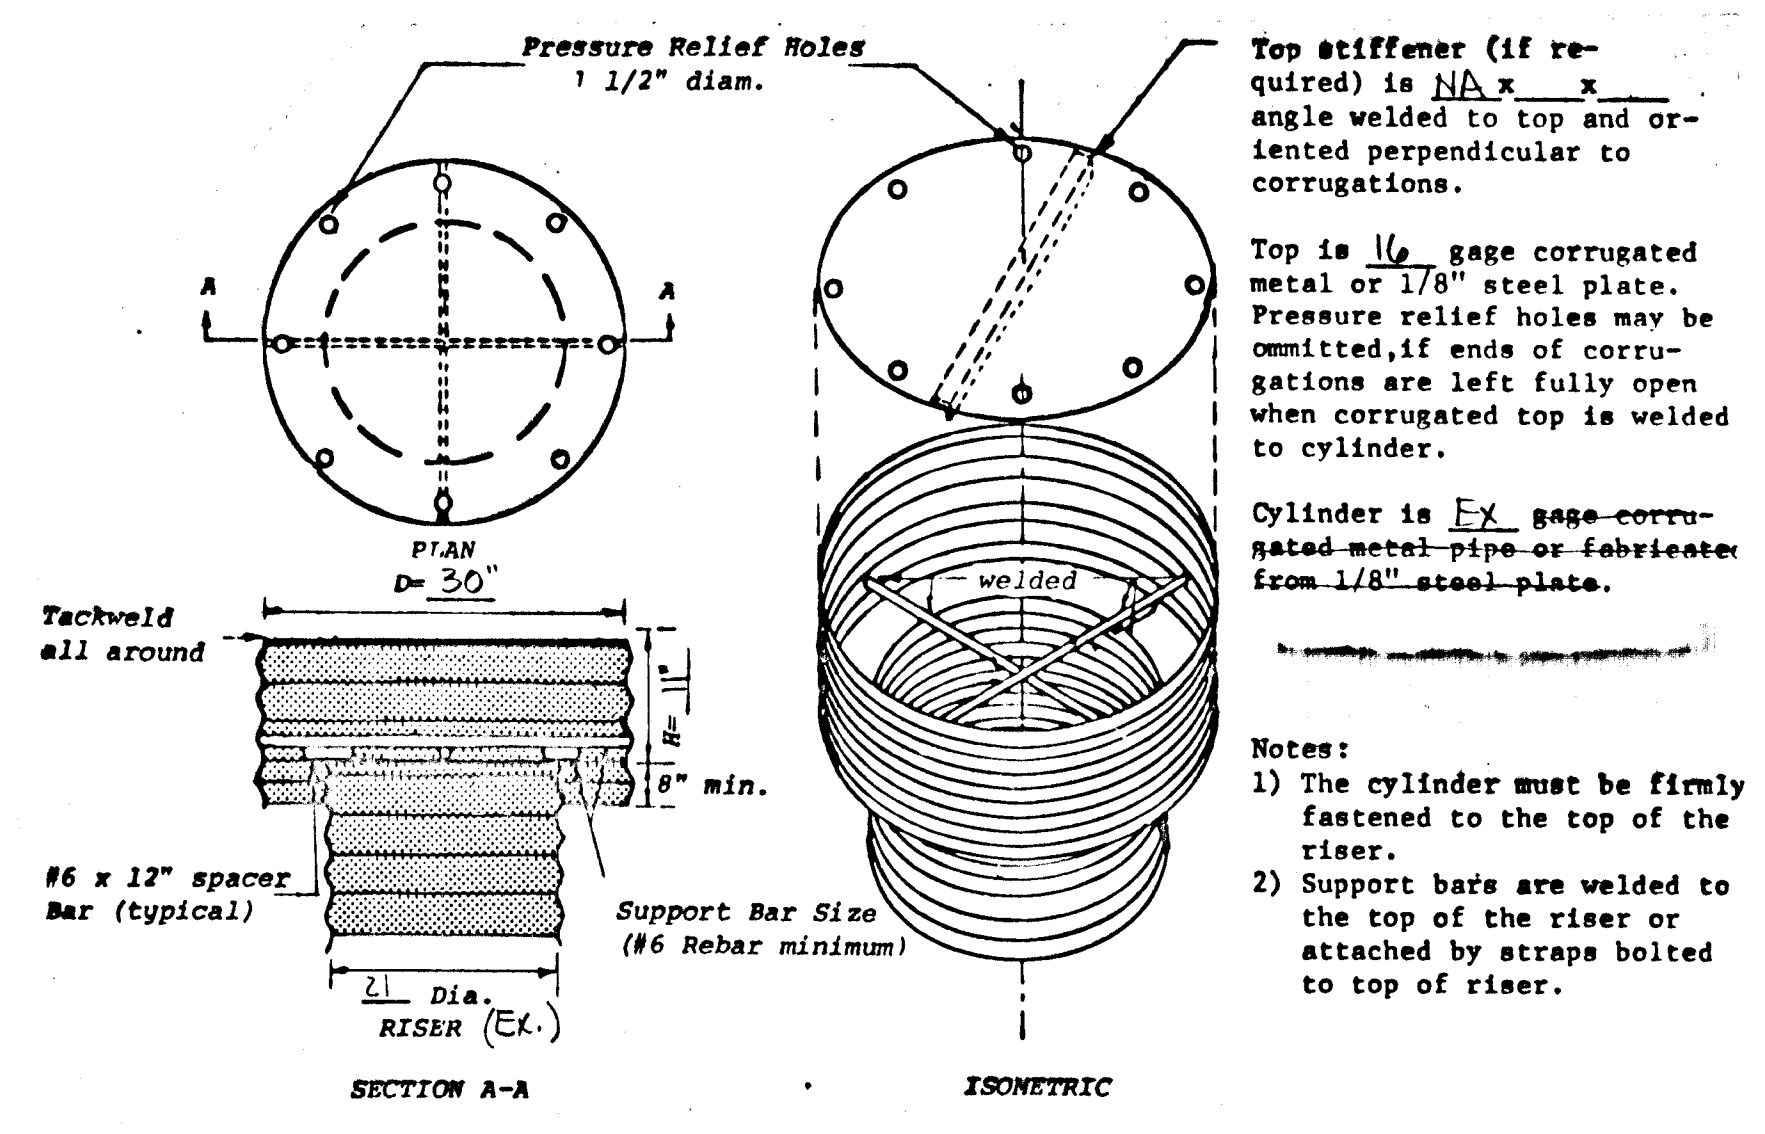


OSO POND REVISED

CONCENTRIC TRASH RACK AND ANTI-VORTEX DEVICE
(not to scale)

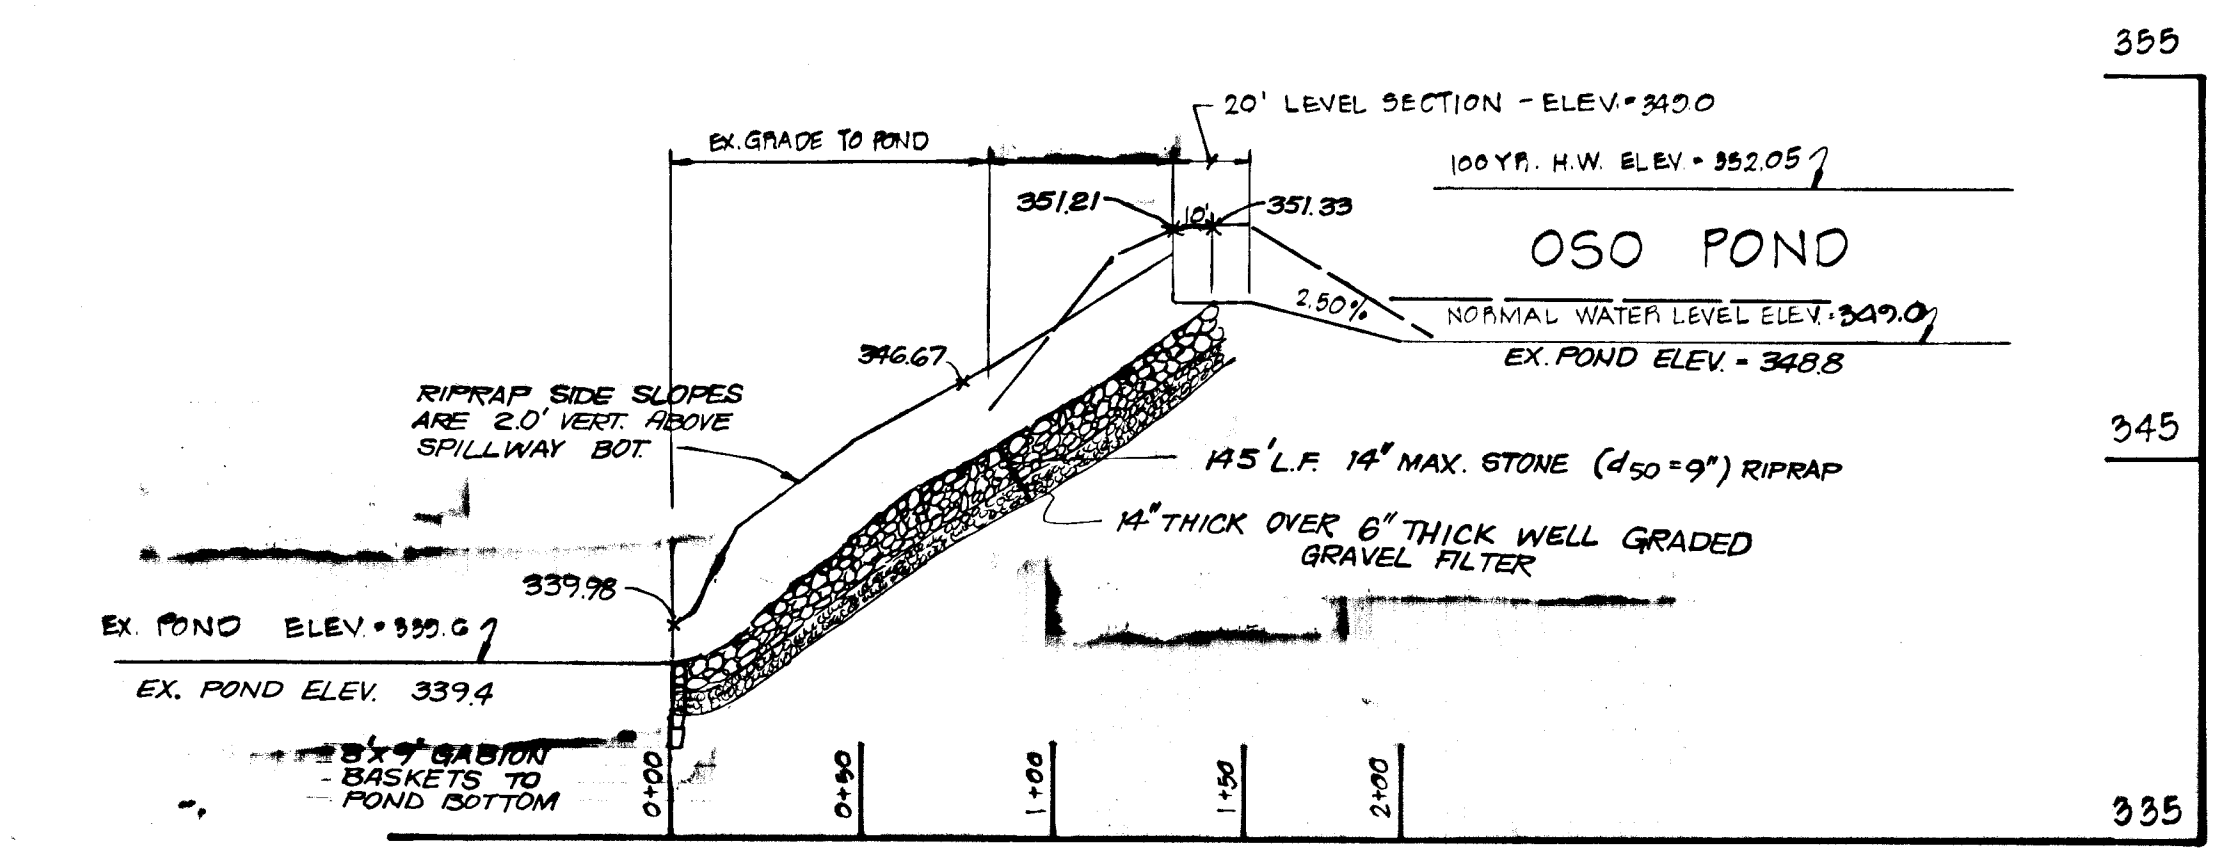


PROFILE: EMERGENCY SPILLWAY

SCALE: HORIZ. 1" = 50'
VERT. 1" = 5'

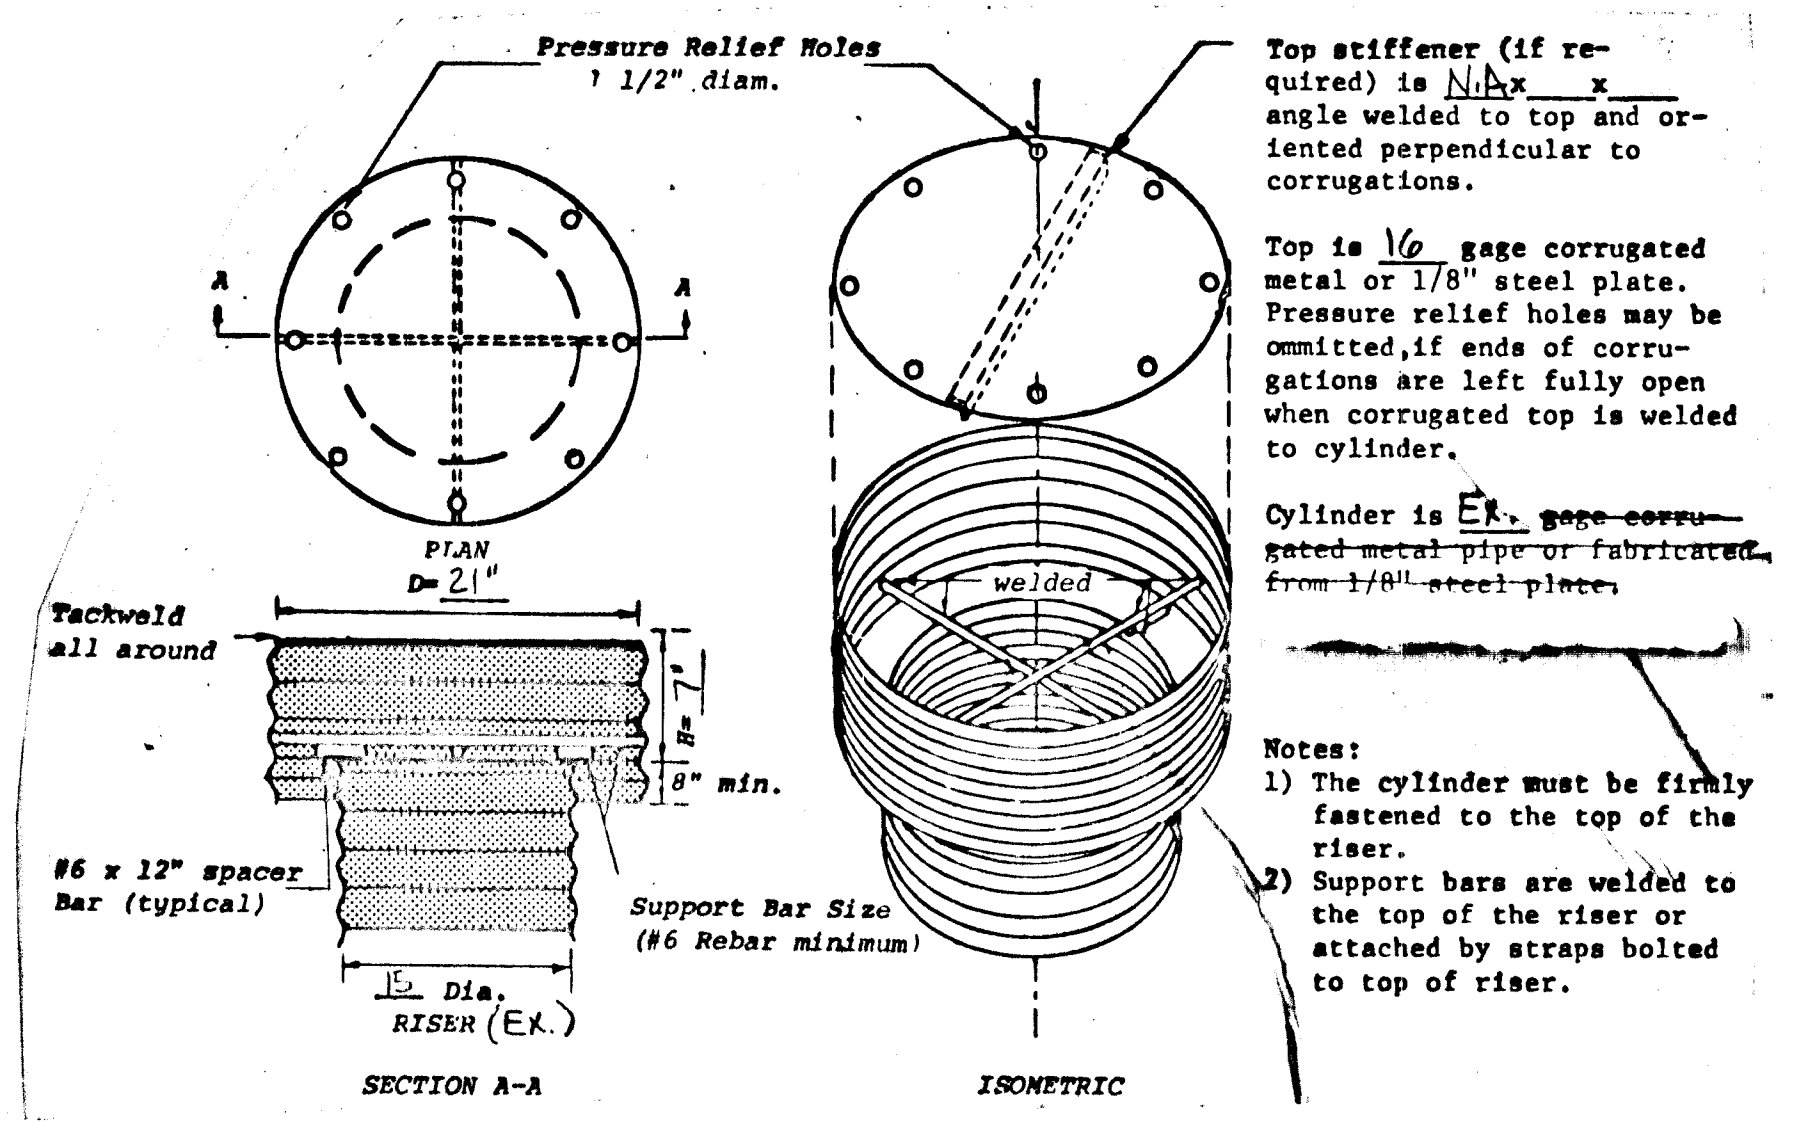

RIO POND REVISED

CONCENTRIC TRASH RACK AND ANTI-VORTEX DEVICE
(not to scale)

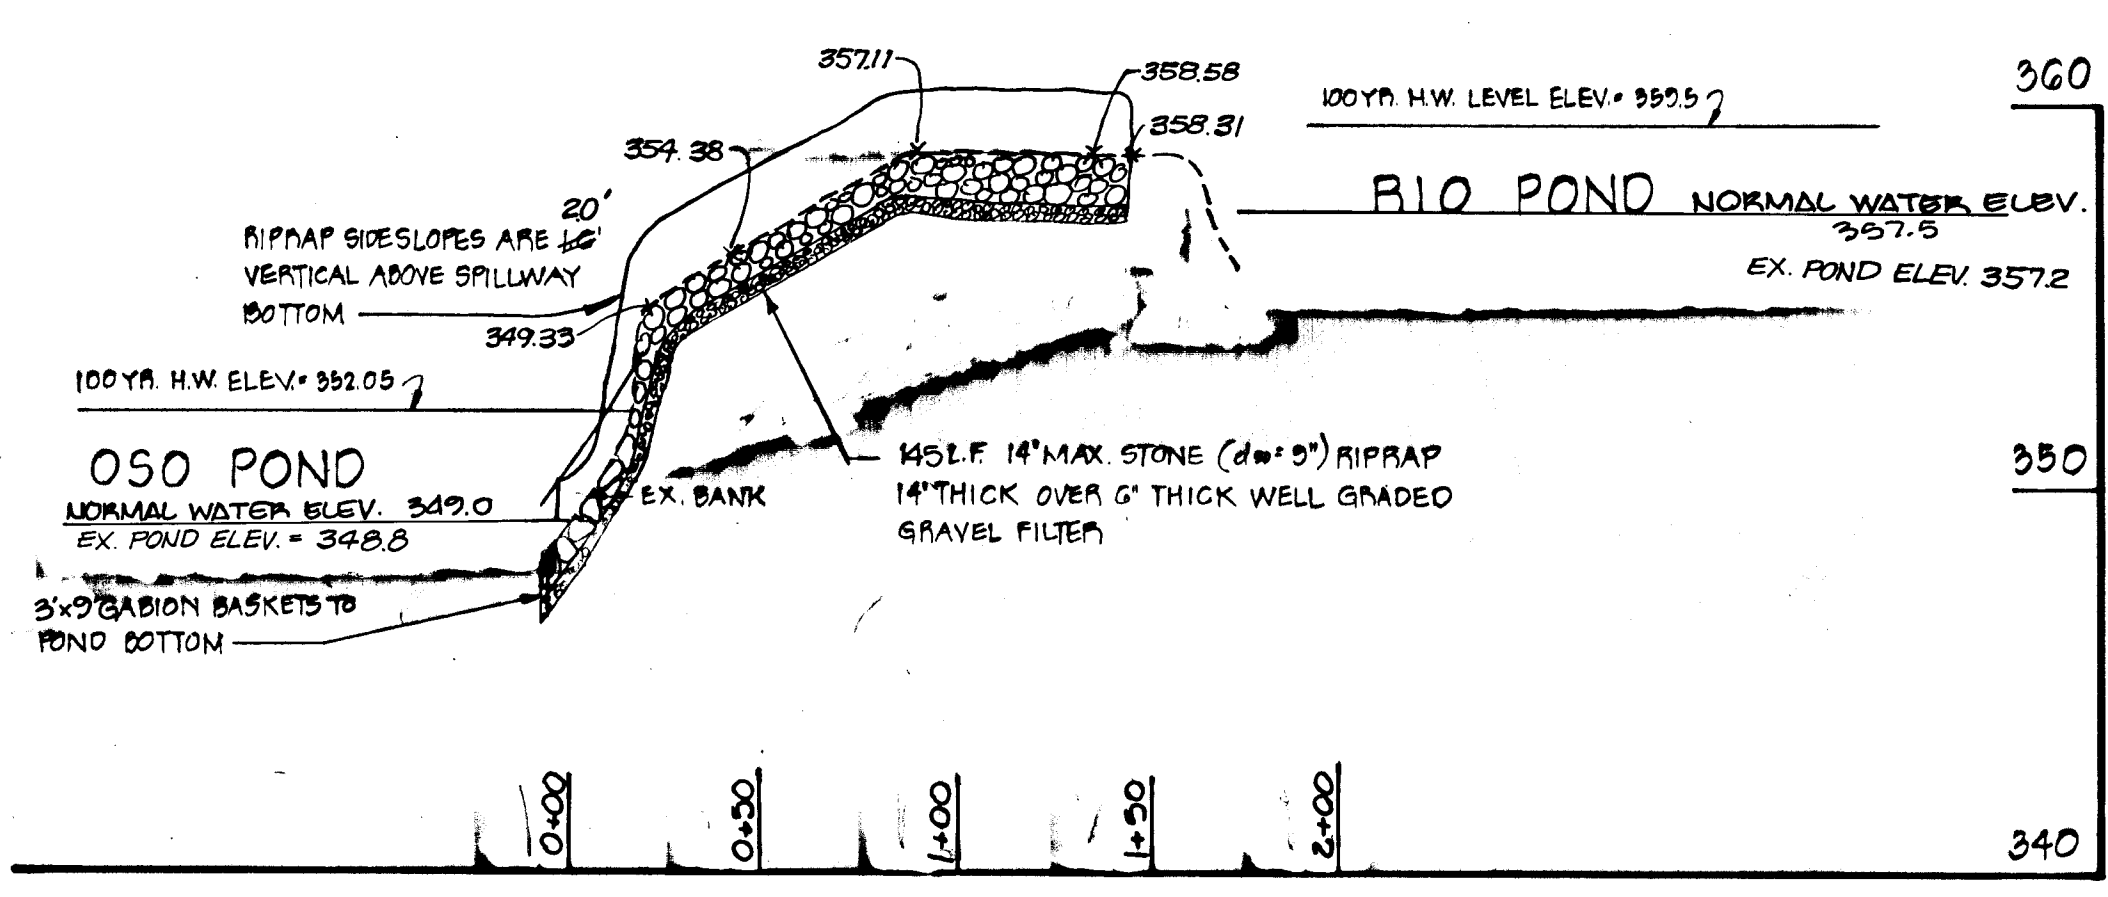

PROFILE: EMERGENCY SPILLWAY

SCALE: HORIZ. 1" = 50'
VERT. 1" = 5'

CERTIFICATION BY THE ENGINEER

I CERTIFY THAT THIS PLAN FOR A POND REPRESENTS A PRACTICAL AND WORKABLE PLAN BASED ON MY PERSONAL KNOWLEDGE OF THE SITE CONDITIONS AND THAT IT WAS PREPARED IN ACCORDANCE WITH THE REQUIREMENTS OF THE HOWARD COUNTY SOIL CONSERVATION DISTRICT.

Rudolph E. May Jr.
RUDOLPH E. MAY, JR.
3-3-80
DATE

CERTIFICATION BY THE DEVELOPER

I CERTIFY THAT ALL DEVELOPMENT AND CONSTRUCTION WILL BE DONE ACCORDING TO THESE PLANS OF DEVELOPMENT AND PLANS FOR A POND AND I ALSO AUTHORIZE PERIODIC ON-SITE INSPECTION BY THE HOWARD COUNTY SOIL CONSERVATION DISTRICT OR THEIR AUTHORIZED AGENTS AS ARE DEEMED NECESSARY. DEVIATIONS FROM THESE PLANS WILL NOT BE MADE UNLESS AUTHORIZED BY THE HOWARD COUNTY SOIL CONSERVATION DISTRICT.

L. Chalinger
DEVELOPER - L. CHALINGER
3-3-80
DATE

THESE PLANS FOR SMALL POND CONSTRUCTION MEET THE REQUIREMENTS OF THE HOWARD COUNTY SOIL CONSERVATION DISTRICT.

Robert W. Ziehm
APPROVED - H.O. CO. S.C.D.
9-17-80
DATE

THESE PLANS HAVE BEEN REVIEWED FOR THE HOWARD COUNTY SOIL CONSERVATION DISTRICT AND MEET THE TECHNICAL REQUIREMENTS FOR SMALL POND CONSTRUCTION.

John H. Helm
H.O. SOIL CONSERVATION SERVICE
9-17-80
DATE

OWNER: SEWELLS ORCHARD, 6233 OAKLAND MILLS RD., COLUMBIA, MD 21044

DEVELOPER: LIGHTPOINT ASSOCIATES, P.O. BOX 313, COLUMBIA, MD 21044

ADDED: 3-3-80

PROJECT: SEWELLS ORCHARD SECTION 1			
LOCATION: GTH ELECTION DISTRICT		HOWARD COUNTY, MD.	
DATE: MARCH, 1980	DESIGN BY: J.J.D.	DRAWN BY: J.J.D.	CHECKED BY: R.L.M.
SCALE: AS SHOWN	JOB NO.: 72158	DRAWING NO.: 14 A OF 16	
boender associates SUITE 102-107 TOW: & COUNTRY PROFESSIONAL BUILDING ELLCOTT CITY, MARYLAND 21043 BALTIMORE 301-488-7377 SALISBURY 301-748-1388			
engineers		surveyors	
planners			

AS-BUILT SURVEY CERTIFYS THAT THE STORM WATER MANAGEMENT WAS CONSTRUCTED TO MEET THE APPROVED MINIMUM STANDARDS AND SPECIFICATIONS.
BY RUDOLPH L. MAY JR., MD. REG. ENGINEER
No. 5700 ON SEPT. 5, 1984.

APPROVED DEPARTMENT OF PUBLIC WORKS

William E. Riley
CHIEF, BUREAU OF ENGINEERING
9-30-80
DATE


APPROVED OFFICE OF PLANNING AND ZONING

Louis Farmer
CHIEF, DIVISION OF LAND DEVELOPMENT
9-22-80
DATE

Rudolph E. May Jr.

#850

- Construction Specifications**
- Area under embankment shall be cleared, grubbed and stripped of any vegetation and root mat. The pool area shall be cleared.
 - The fill material for the embankment shall be free of roots or other woody vegetation as well as over sized stones, rocks, organic material or other objectionable material. The embankment shall be compacted by traversing with equipment while it is being constructed.
 - Sediment shall be removed and trap restored to its original dimensions when the sediment has accumulated to 1/2 the design depth of the trap. Removed sediment shall be deposited in a suitable area and in such a manner that it will not erode.
 - The structure shall be inspected after each rain and repairs made as needed.
 - Construction operations shall be carried out in such a manner that erosion and water pollution is minimized.
 - The structure shall be removed and the area stabilized when the drainage area has been properly stabilized.
 - All cut and fill slopes shall be 2:1 or flatter.
 - The crushed stone used in the outlet shall meet ASTM designation M3, Size No. 2 or 24 or its equivalent such as MSHA No. 2. Gravel, meeting the above gradation, may be used if crushed stone is not available. Crusher run is not acceptable.

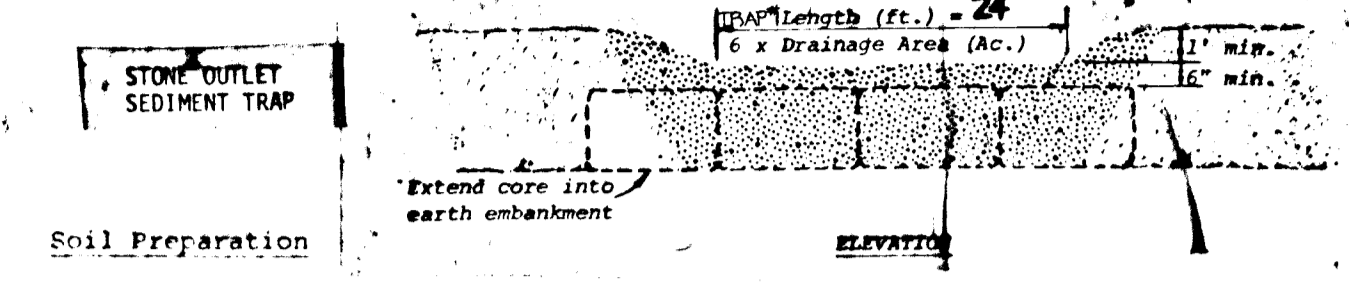

Soil Preparation

For short slopes, small areas, and mass plantings with close spacings, apply a commercial granular fertilizer such as 5-10-10 and organic supplement such as composted cow manure, peat or well-rotted sawdust, and work into the soil prior to planting. Fertilizer rate - 3 to 5 lbs. per 100 sq. ft. The organic material needed will depend upon the soil and plant being used. Plants such as pachysandra require a high rate of organic material, about a 2-inch layer worked into the root zone. Depending on the soil type and steepness of slope, the depth of soil working will vary from 4 to 6 inches.

For steep slopes and large area plantings, working up the entire planting area would be impractical and would probably induce erosion. Center hole planting, a hole dug for each plant, would be more desirable. If the soil on the slope is poorly suited to the species being planted, incorporate organic material into the planting hole. Whether organic material is needed or not, fertilize each plant at the rate of one ounce per plant of some complete fertilizer such as 10-10-10. Mix fertilizer with soil below the roots of the plants.

Another alternative is to add to the planting hole a sandy loam soil mixed with peat, composted cow manure and cocoa shells, or well-rotted sawdust at the rate of 1:1 or 2:1.

The entire planted slope shall be covered with a protective mulch such as excelsior, wood chips, straw or wood pulp fiber to conserve moisture and control erosion. Weeds shall be controlled by pulling or other acceptable means. Where fresh sawdust, wood shavings or sawdust are used as mulches or to add organic material to planting hole, a slow release fertilizer such as 7-40-6, 36-0-0 or organic forms should be used.


Where erosion hazard is very high, heavy jute matting stapled to the slope will provide excellent erosion control, as will landscape mats of excelsior or fiber glass.

Where individual plants are planted, a temporary cover crop of annuals will be used for erosion control until planted materials offer protective cover. (See standards and specifications for temporary seeding).

Maintenance

Some watering, re-mulching and fertilizing may be required of a new planting during the period of establishment. Cultivation is not recommended. This will encourage erosion and cause root injury. Competing weeds will be controlled.


If a controlled release fertilizer was used at time of planting, additional fertilizing may not be necessary for several years. Otherwise, fertilize plantings during the growing of the second growing season and thereafter as needed, using 2 to 3 pounds of a granulated commercial fertilizer such as 5-10-10 per 100 square feet.

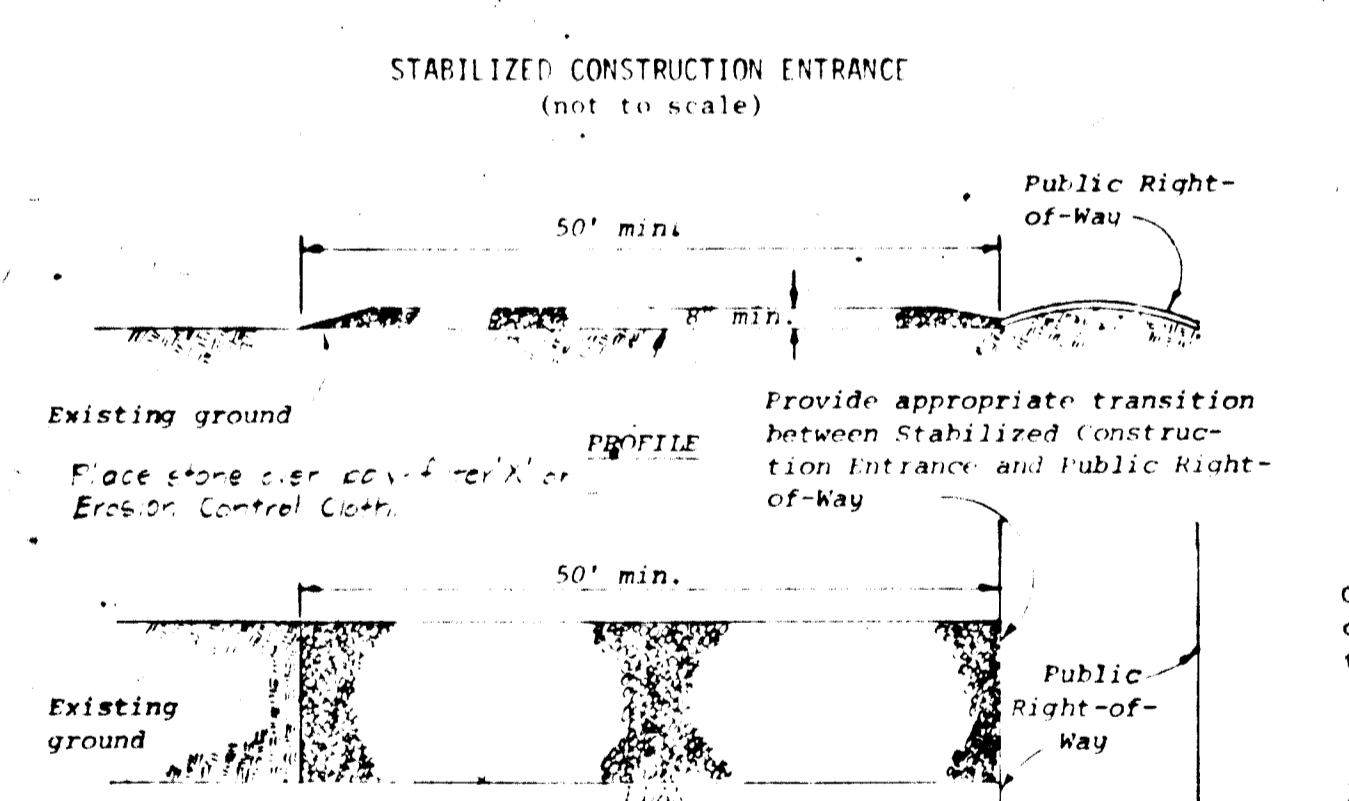

- Construction Specifications**
- Stone size - Use MSHA size No. 2 (2-1/2" to 1") or AASHTO designation M3, size No. 2 (2-1/2" to 1-1/2"). Use crushed stone.
 - length - As effective, but not less than 50 feet.
 - Thickness - Not less than eight (8) inches.
 - Width - Not less than full width of all points of ingress or egress.
 - Washing - When necessary, wheels shall be cleaned to remove sediment prior to entrance onto public right-of-way. When washing is required, it shall be done on an area stabilized with crushed stone which drains into an approved sediment trap or sediment basin. All sediment shall be prevented from entering any storm drain, ditch, or watercourse through use of sand bags, gravel, boards or other approved methods.
 - Maintenance - The entrance shall be maintained in a condition which will prevent tracking or flowing of sediment onto public right-of-way. This may require periodic top dressing with additional stone as conditions demand and repair and/or cleanup of any measures used to trap sediment. All sediment spilled, dropped, washed or tracked onto public rights-of-way must be removed immediately.

Standard Symbol SCE

#850

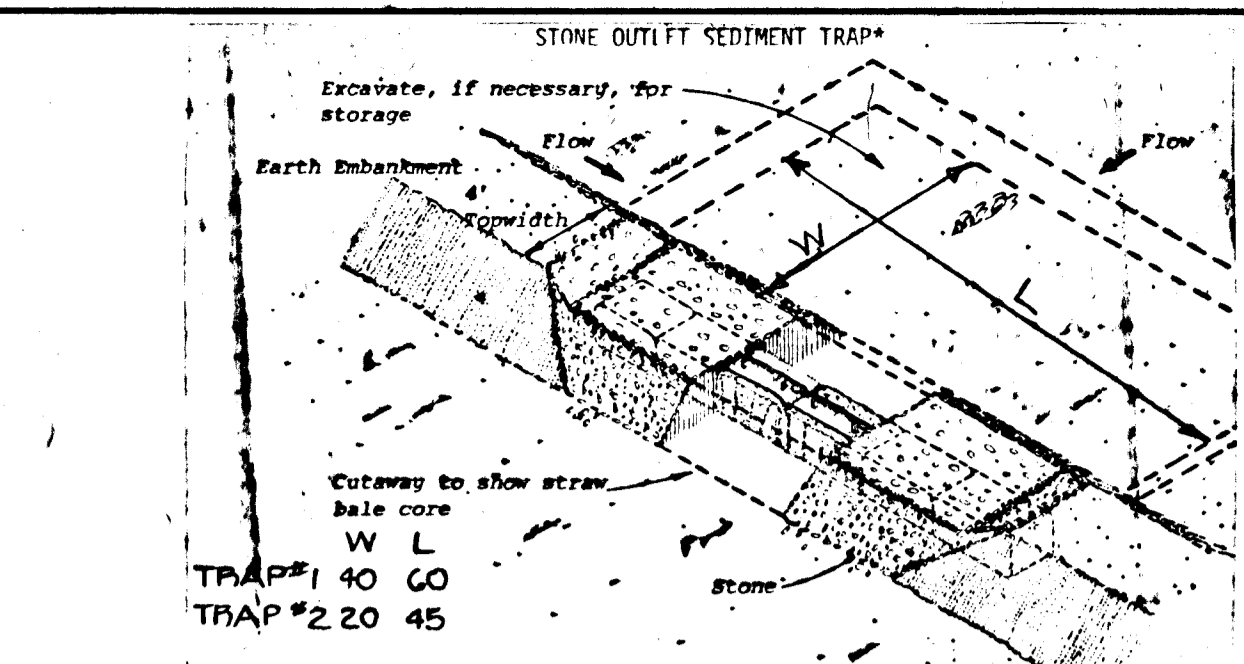

Specifications for Sodding

Fertilizer and lime application rates shall be determined by soil tests. Under unusual circumstances where there is insufficient time for a complete soil test and the contracting officer agrees, fertilizer and lime materials may be applied in amounts shown under B. and C. below.

- Prior to sodding, the surface shall be cleared of all trash, debris, and of all roots, brush, wire, grade stakes and other objects that would interfere with planting, fertilizing or maintenance operations.
- Where the soil is acid or composed of heavy clays, ground limestone shall be spread at the rate of 100 pounds per 1,000 square feet. In all soils 30 pounds of 5-10-5, or equivalent, per 1,000 square feet shall be uniformly applied and mixed into the top 3 inches of soil with the required lime.
- Slow release nitrogen at the rate of 3.5 lbs. N/1000 square feet shall be applied to the prepared soil just prior to sod installation. This material shall be approximately 1/3 immediately available and 2/3 water insoluble nitrogen. Urea formaldehyde (UF) and isobutylidene urea (IBDU) meet these standards.

II. Sod Installation

- During periods of excessively high temperature the soil shall be lightly irrigated immediately prior to laying the sod.
- The first row of sod shall be laid in a straight line with subsequent rows placed parallel to and tightly wedged against each other. Lateral joints shall be staggered to promote more uniform growth and strength. Insure that sod is not stretched or overlapped and that all joints are butted tight in order to prevent voids which would cause air drying of the roots.
- On sloping areas where erosion may be a problem, sod shall be laid with the long edges parallel to the contour and with staggered joints. Secure the sod by tamping and pegging or other approved methods.
- As sodding is completed in any one section, the entire area shall be rolled or tamped to insure solid contact of roots with the soil surface. Sod shall be watered immediately after rolling or tamping and the underside of the new sod pad and soil surface below the sod are thoroughly wet. The operations of laying, tamping and irrigating for any piece of sod shall be completed within eight hours.

III. Sod Maintenance

- In the absence of adequate rainfall, watering shall be performed daily or as often as deemed necessary by the inspector during the first week and in sufficient quantities to maintain moist soil to a depth of 4 inches. Watering should be done during the heat of the day to help prevent wilting.
- After the first week, sod shall be watered as necessary to maintain adequate moisture and insure establishment.
- First mowing should not be attempted until sod is firmly rooted. No more than 1/3 of the grass leaf shall be removed by the initial cutting or subsequent cuttings. Grass height shall be maintained between 2 and 3 inches unless otherwise specified.
- Maintenance of established sod should follow specifications outlined in table 54-1.

On exposed soils that have a potential for causing off-site environmental damage where a quick vegetative cover is desired; on sites which can be maintained with ground equipment. (2:1 or flatter slopes)

Specifications

- Class of turfgrass sod shall be Maryland or Virginia State Certified, or Maryland or Virginia State approved sod.
- Sod shall be machine cut at a uniform soil thickness of 3/4 inch, plus or minus 1/4 inch, at the time of cutting. Measurement for thickness shall exclude top growth and thatch.
- Standard size sections of sod shall be strong enough to support their own weight and retain their size and shape when suspended vertically from a firm grasp on the upper 10% of the section.
- Individual pieces of sod shall be cut to the suppliers width and length. Maximum allowable deviation from standard widths and lengths shall be 5%. Broken pads and torn or uneven ends will not be acceptable.
- Sod shall not be harvested or transplanted when moisture content (excessively dry or wet) may adversely affect its survival.
- Sod shall be harvested, delivered and installed within a period of 36 hours. Sod not transplanted within this period shall be inspected and approved by the contracting officer or his designated representative prior to its installation.

Specifications for Seeding

- Site Preparation**
 - Install needed erosion control practices such as interceptor dikes, berms and spreaders, contour ripping, erosion stops, channel liners and sediment basins.
 - Grade as needed and feasible to permit the use of conventional equipment for seeded preparation, seeding, mulch application, anchoring and maintenance.

II. Seeded Preparation

Flat areas and slopes up to 3 to 1 grade shall be loose and friable to a depth of at least 3 inches. The top layer of soil shall be loosened by raking, discing or other acceptable means before seeding.

Slopes steeper than 3 to 1 shall have the top 1-3 inches of soil loose and friable before seeding.

III. Soil Amendments

Lime and fertilizer according to soil tests. Lime and fertilizer needs can be determined by a soil testing laboratory, such as the University of Maryland's Soil Testing Laboratory.

In lieu of soil test results, apply 2 tons dolomitic limestone and 600 pounds 0-20-20, or equivalent per acre before seeding. Harrow or disc lime and 0-20-20, or equivalent fertilizer uniformly into the soil to minimum depth of 3 inches on slopes flatter than 3 to 1. On slopes of greater than 3 to 1 grade, the lime and fertilizer shall be worked in as directed by the contracting officer. On sloping land, the final harrowing or discing operation should be on the contour wherever feasible. No attempt should be made to drag any disced area to make the soil surface very smooth after discing. At time of seeding, apply 400 pounds 38-0-0 urea-form fertilizer and 500 pounds 10-20-20, or equivalent fertilizer per acre. For mixtures containing perennial legumes, the 500 pounds of 10-20-20 may be omitted.

IV. Seeding

- Select a mixture from table 51-1.
- Apply seed uniformly with a cyclone seeder, drill, cultipacker seeder or hydroseeder (slurry includes seed and fertilizer) on a firm, moist seedbed. Maximum seeding depth should be 1/4 inch on clayey soils and 1/2 inch on sandy soils, when using other than hydroseeder method of application.

V. Mulching

A. Materials and Amounts

- Straw - Straw shall be unrotted small grain straw applied at the rate of 1-1/2 to 2 tons per acre, or 70 to 90 pounds per 1,000 sq. ft. Mulch materials shall be relatively free of all kinds of weeds and shall be free of prohibited noxious weeds which are: Canada thistle, Johnsongrass and quackgrass.
- Wood-chip or paper-fiber mulch at the rate of 1,500 pounds per acre or 35 pounds per 1,000 sq. ft. may be applied by hydro-seeding. Use is limited to < 34 and < 150° length of slope and during optimum seeding periods in spring and fall.
- Mulch nettings such as jute or excelsior blanket may be used. Staple to surface in waterways and on steep slopes. Lighter materials of paper, plastic and cotton mulch nettings may be used where erosion hazard is not severe. If area is to be mowed, do not use metal staples.
- Wood chips at the rate of approximately 6 tons per acre or 275 lbs. per 1,000 sq. ft. may be used when available and when feasible to use. Particularly well-suited for utility and road rights-of-way.


B. Mulch Anchoring

- Mulch anchoring shall be accomplished immediately after mulch placement to minimize loss by wind or water. This may be done by one of the following methods, depending upon size of area, erosion hazard, and cost. On sloping land, practice No. 3 below, should be done on the contour wherever possible. Applies to all straw and to wood chips or more critical sites, except "tracking" should be done up and down the slope with 1-1/2 inch cleat marks running across the slope.
- Peg and Twine - Drive 8 to 10-inch wooden pegs to within 2 to 3 inches of the soil surface every 4 feet in all directions. Stakes may be driven before or after applying mulch. Secure mulch to soil surface by stretching twine between pegs in a criss-cross within a square pattern. Secure twine around each peg with two or more round turns.
- Mulch Nettings - Staple lightweight biodegradable paper, plastic or cotton nettings over the mulch according to manufacturer's recommendations. Nettings is usually available in rolls 4 feet wide and up to 300 feet long.

Approved Office of Planning and Zoning
 William V. Rowe
 9-30-80
 9-22-80


Owner: Sewell's Orchards
 6233 Oakland Mills Rd. P.O. Box 319
 Columbia, Md. 21045

Developer: Light Point Associates
 Columbia, Md 21045

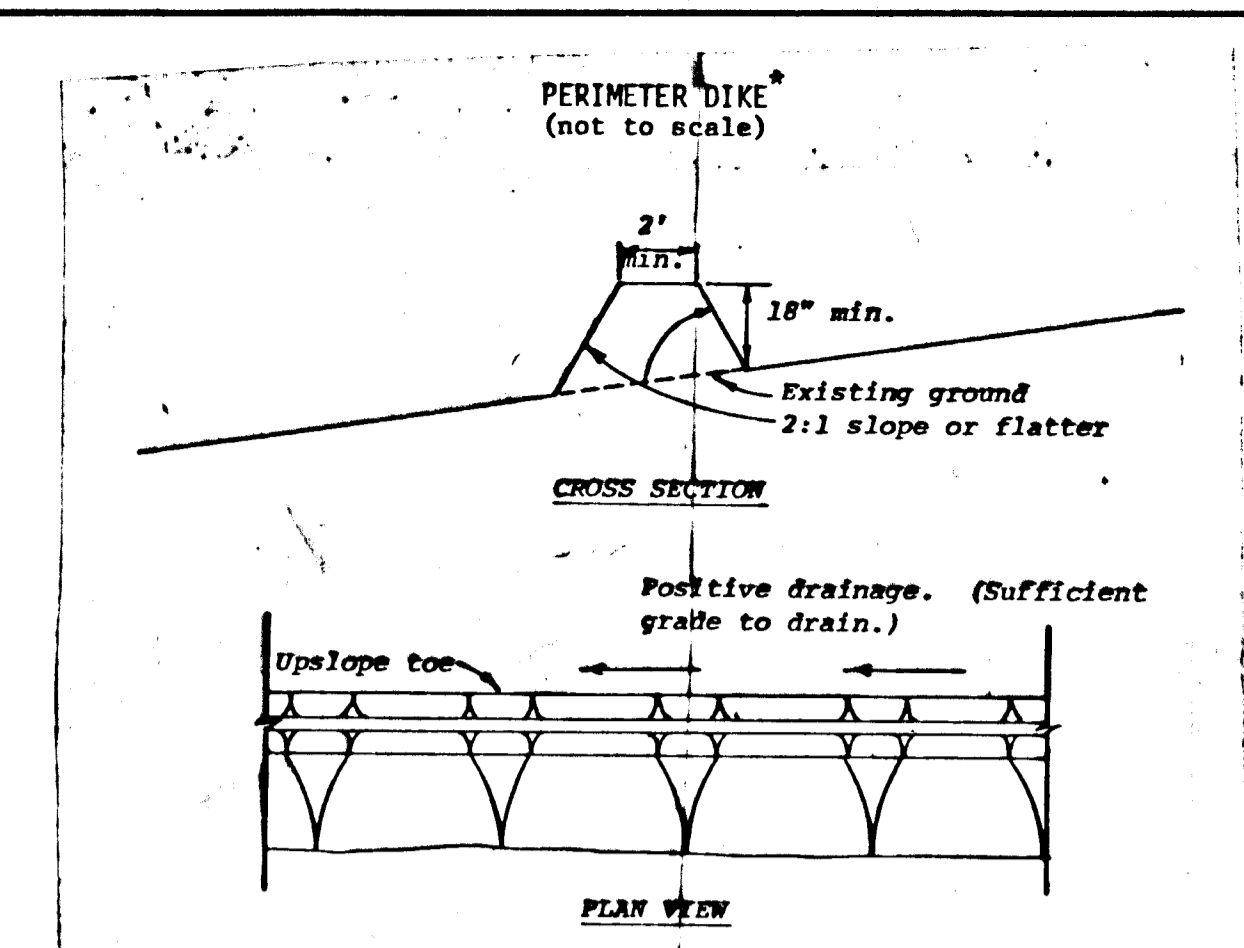

Construction Specifications

- All dikes shall be machine compacted.
- All perimeter dikes shall have positive drainage to an outlet.
 - Diverted runoff from a protected or stabilized upland area shall outlet directly onto an undisturbed stabilized area or into a level spreader or grade stabilization structure.
 - Diverted runoff from a disturbed or exposed upland area shall be conveyed to a sediment trapping device such as sediment trap or a sediment basin or to an area protected by any of these practices.
- Stabilization, when required, shall be done in accordance with Standard and Specifications for Grassed Waterway. The minimum area to be stabilized shall be the channel flow area.
- Periodic inspection and required maintenance shall be provided.

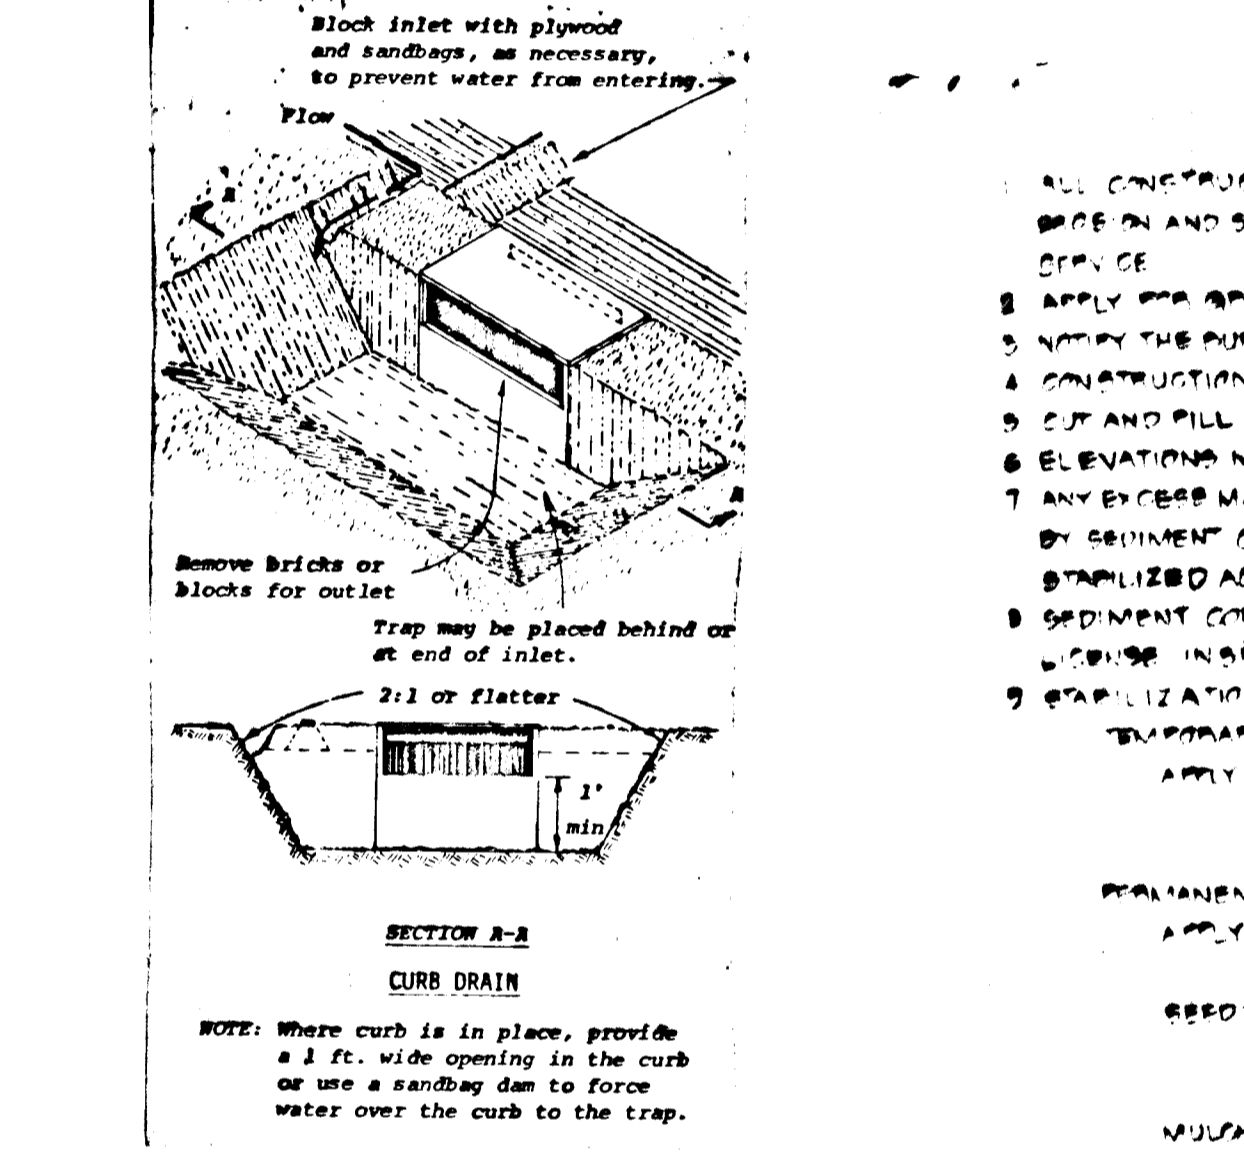

Construction Specifications

- Sediment shall be removed and trap restored to its original dimensions when the sediment has accumulated to 1/2 the design depth of the trap. Removed sediment shall be deposited in a suitable area and in such a manner that it will not erode.
- The structure shall be inspected after each rain and repairs made as needed.
- Construction operations shall be carried out in such a manner that erosion and water pollution shall be minimized.
- The sediment trap shall be removed and area stabilized when the remaining drainage area has been properly stabilized.
- All cut and fill slopes shall be 2:1 or flatter.

Professional Engineer
 Rodolph L. May Jr.
 2-13-80

Reviewed for Howard S.C.D. and Meets Technical Requirements.
 James M. Helm
 9-17-80

William V. Rowe
 9-17-80

Fills and Grading

- All graded or disturbed areas including slopes shall be protected during clearing and construction in accordance with the approved sediment control plan until they are permanently stabilized.
- All sediment control practices and measures shall be constructed, applied and maintained in accordance with the approved sediment control plan and the "Standards and Specifications for Soil Erosion and Sediment Control in Developing Areas"
- Topsoil required for the establishment of vegetation shall be stockpiled in amount necessary to complete finished grading of all exposed areas.
- Areas to be filled shall be cleared, grubbed and stripped of topsoil to remove trees, vegetation, roots or other objectionable material.
- Areas which are to be topsoiled shall be scarified to a minimum depth of three inches prior to placement of topsoil.
- All fills shall be compacted as required to reduce erosion, slippage, settlement, subsidence or other related problems. Fill intended to support buildings, structures and conduits, etc., shall be compacted in accordance with HOWARD COUNTY STANDARD SPECIFICATIONS.
- All fill shall be placed and compacted in layers not to exceed 8 inches in thickness.
 - Fill material shall be free of brush, rubbish, rocks, logs, stumps, building debris and other objectionable materials that would interfere with or prevent construction of satisfactory fills.
- Frozen material or soft, mucy or highly compressible materials shall not be incorporated into fills.
- Fill shall not be placed on a frozen foundation.
- Seeps or springs encountered during construction shall be handled in accordance with the Standard and Specifications for Subsurface Drain or other approved methods.

SEDIMENT CONTROL NOTES


- ALL CONSTRUCTION SHALL BE IN ACCORDANCE WITH STANDARDS AND SPECIFICATIONS FOR SOIL EROSION AND SEDIMENT CONTROL IN DEVELOPING AREAS PREPARED BY THE U.S.D.A. SOIL CONSERVATION SERVICE.
- APPLY FOR GRADING PERMIT.
- NOTIFY THE BUREAU OF LICENSE, INSPECTIONS AND PERMITS 24 HOURS PRIOR TO GRADING OPERATIONS.
- CONSTRUCTION SHALL ADHERE TO THE CONSTRUCTION SEQUENCE.
- CUT AND FILL SLOPES SHALL BE 2:1 MAXIMUM.
- ELEVATIONS MARKED THIS (C) SHALL BE IN SHED GRADE.
- ANY EXCESS MATERIAL SHALL BE STOCKPILED IN A CLEAR LOCATION ON SITE WHICH SHALL BE PROTECTED BY SEDIMENT CONTROL MEASURES. MAXIMUM FILL SLOPE SHALL BE 3:1. STOCKPILED MATERIAL SHALL BE STABILIZED ACCORDING TO SEEDING SPECIFICATIONS BELOW.
- SEDIMENT CONTROL STRUCTURES SHALL BE REMOVED ONLY WITH PERMISSION OF THE BUREAU OF LICENSE INSPECTIONS AND PERMITS.
- STABILIZATION MEASURES:
 - TEMPORARY STABILIZATION:
 - APPLY 1000 LBS/AC OR 45 LBS/100 SQ FT OF POLYMERIZED DOLOMITIC LIMESTONE
 - 400 LBS/AC OR 18 LBS/100 SQ FT OF 10-10-10 FERTILIZER
 - PLANT WITH TURFGRASS AT 10 LBS/AC MULCH ALL DISTURBED AREAS IMMEDIATELY AFTER GRADING
 - PERMANENT STABILIZATION:
 - APPLY 1000 LBS/AC OF POLYMERIZED DOLOMITIC LIMESTONE
 - 500 LBS/AC OF 10-10-10 FERTILIZER
 - SEED 45 LBS/AC OF KENTUCKY BLUE GRASS
 - 40 LBS/AC OF KENTUCKY BLUE GRASS
 - 10 LBS/AC OF ANNUAL TURFGRASS
 - MULCH 100 LBS/AC OF UNPOLLUTATED WHEATSTRAW OR MULCH DOWN WITH 1/2 GAL/AC OF LIQUID ASPHALT

DEVELOPER'S CERTIFICATE
 L. Earl Amiger
 2/13/80

Professional Engineer
 Rodolph L. May Jr.
 2-13-80




- Construction Specifications**
- The stone shall be crushed stone. Gravel may be used if crushed stone is not available. The stone shall meet MSHA Size No. 2 or AASHTO designation M3 Size No. 2 or 24.
 - The crest of the stone dike shall be at least six inches lower than the lowest elevation of the top of the earth dike and shall be level.
 - The stone outlet structure shall be embedded into the soil a minimum of four feet.
 - The minimum length, in feet, of the crest of the stone outlet structure shall be equal to six times the number of acres of contributing drainage area.
 - The stone outlet structure shall be inspected after each rain, and the stone shall be replaced when the structure ceases to function as intended due to silt accumulation among the stone, washout, construction traffic damage, etc.

SEDIMENT CONTROL DETAIL SHEET
 PROJECT: SEWELL'S ORCHARD - SECTION 1
 LOCATION: G.T.H. ELECTION DISTRICT HOWARD COUNTY, MD.
 DATE: JAN. 1980 DESIGN BY: WHM DRAWN BY: GEM CHECKED BY: RLM
 SCALE: NONE JOB NO.: 72158 DRAWING NO.: 15 OF 16
 boender associates engineers/surveyors/planners
 SUITE 102 107 TOWN & COUNTRY PROFESSIONAL BUILDING
 ELLICOTT CITY, MARYLAND 21042
 BALTIMORE 301-468-7777 SALISBURY 301-749-1288

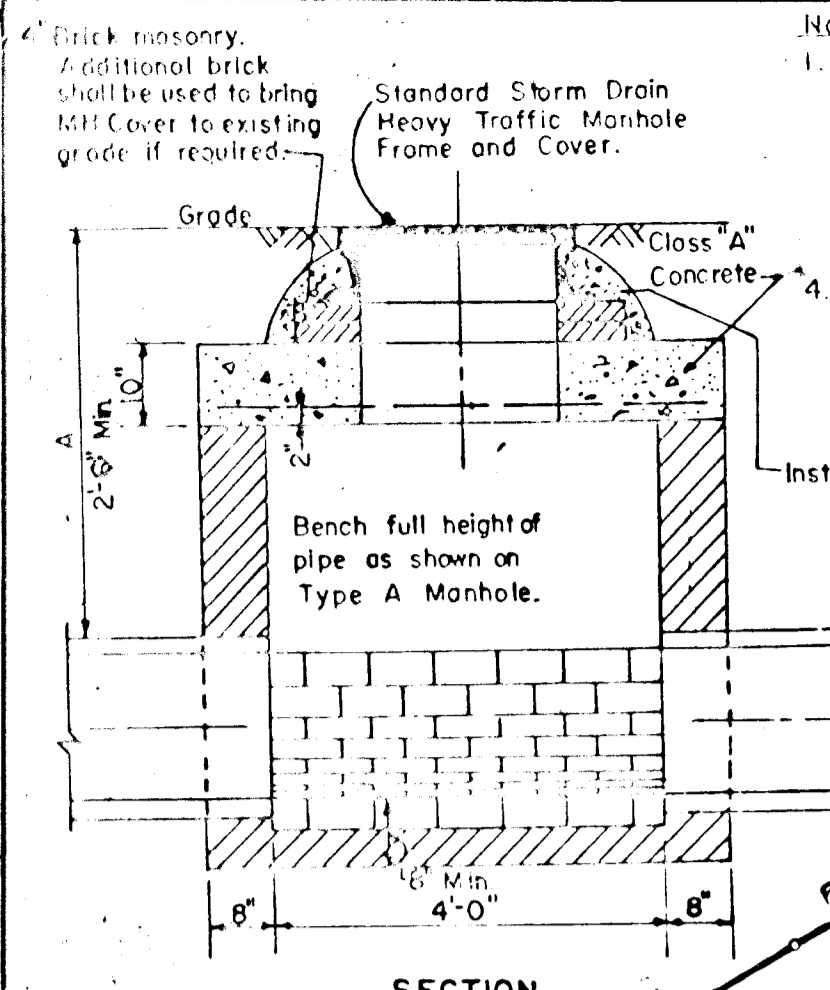

Notes:
1. Walls, bottom slab and invert shall be brick.
2. Heavy Traffic Manhole Frame and Cover.
3. Apply two coats of a Waterproof Bitumastic Compound over cement mortar.
4. Install Frame, then mortar.

STANDARD STORM DRAINAGE DETAILS
TYPE "B" MANHOLE (SHALLOW)
M1 AND M4

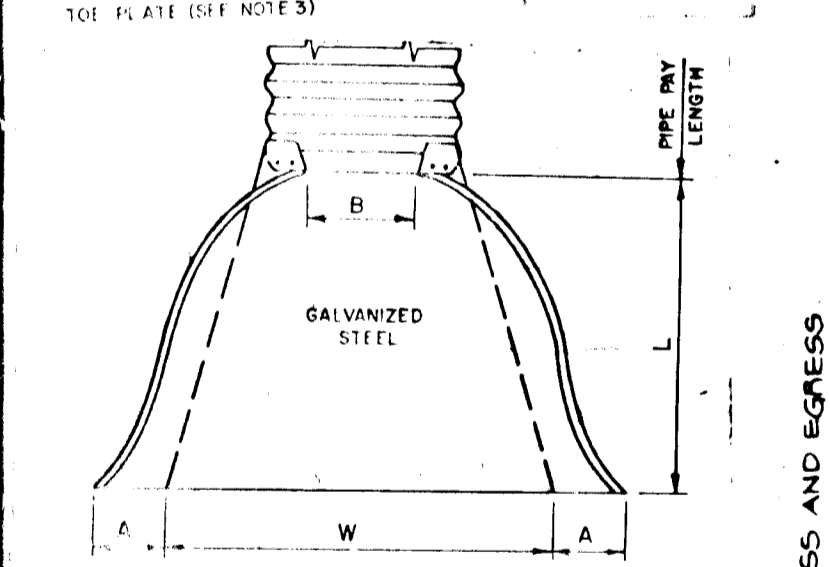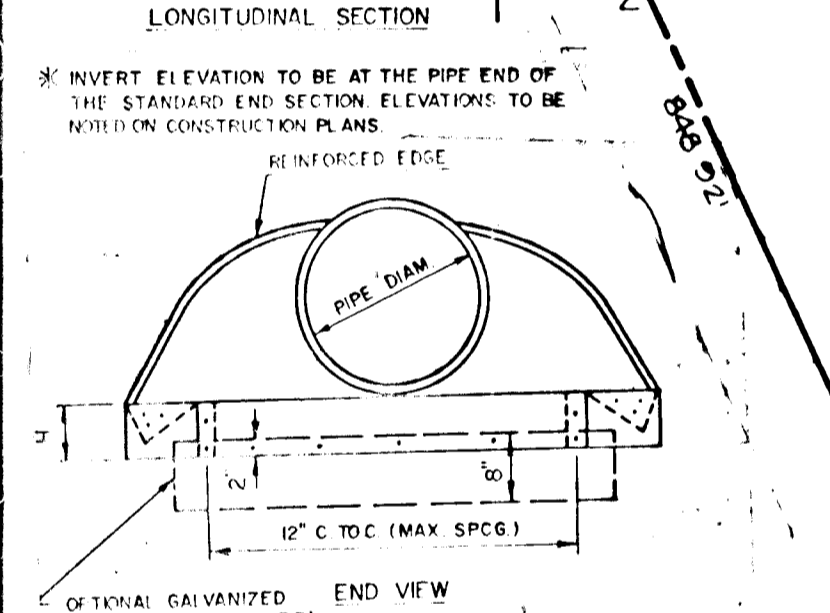
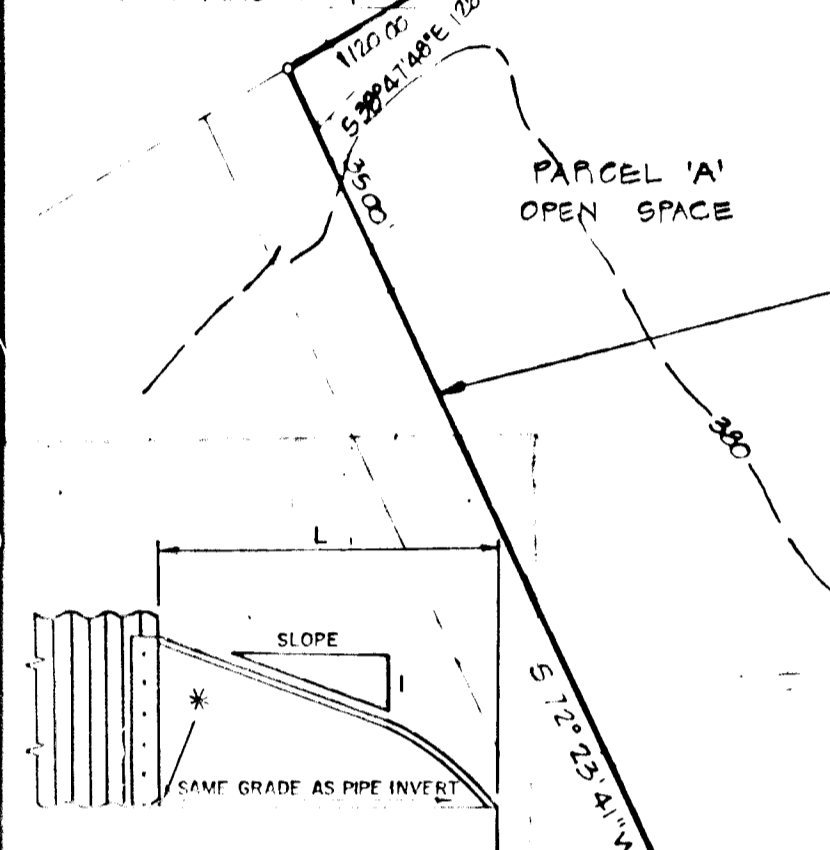


NOTES:
1. ALL 3" PIPE RODS TO HAVE 12 GA SIDES AND 10 GA CENTER RINGS. WIDTH OF CENTER PANELS TO BE GREATER THAN 20% OF THE PIPE PERIPHERY. MULTIPLE PANEL RODS TO HAVE LAP SEAMS WHICH ARE TO BE TIGHTLY JOINED BY 3" GALVANIZED RINGS OR BOLTS.
2. 1/2" 60" THRU 84" SIZES, REINFORCED EDGES TO BE SUPPLEMENTED WITH GALVANIZED STIFFENING ANGLES THE ANGLES WILL BE 2" X 2" X 1/4" FOR 60" THRU 72" DIAMETER AND 2" X 2" X 1/4" FOR 72" AND 84" DIAMETER THE ANGLES TO BE ATTACHED BY 3/8" GALVANIZED BOLTS 2" ON CENTER.
3. 1/2" PLATE SHALL BE USED WHEN SPECIFIED ON THE PLANS. COST OF 1/2" PLATE TO BE INCLUDED IN BID PRICE PER EACH OF METAL END SECTION.

PIPE DIAM.	GA.	A	B	H	L	W	APPROX. SLOPE	BODY
16"	7"	6"	6"	26"	30"	2 1/2"	1/2"	IPC
18"	8"	6"	6"	30"	36"	2 1/2"	1/2"	IPC
24"	9"	12"	6"	36"	42"	2 1/2"	1/2"	IPC
30"	10"	15"	6"	42"	48"	2 1/2"	1/2"	IPC
36"	12"	18"	6"	54"	60"	2 1/2"	1/2"	IPC

STATE OF MARYLAND
DEPARTMENT OF TRANSPORTATION
STATE HIGHWAY ADMINISTRATION
STANDARDS FOR HIGHWAYS AND INCIDENTAL STRUCTURES
STANDARD METAL END SECTION
ROUND METAL PIPE
STANDARD NO. MD-370.01

#1850

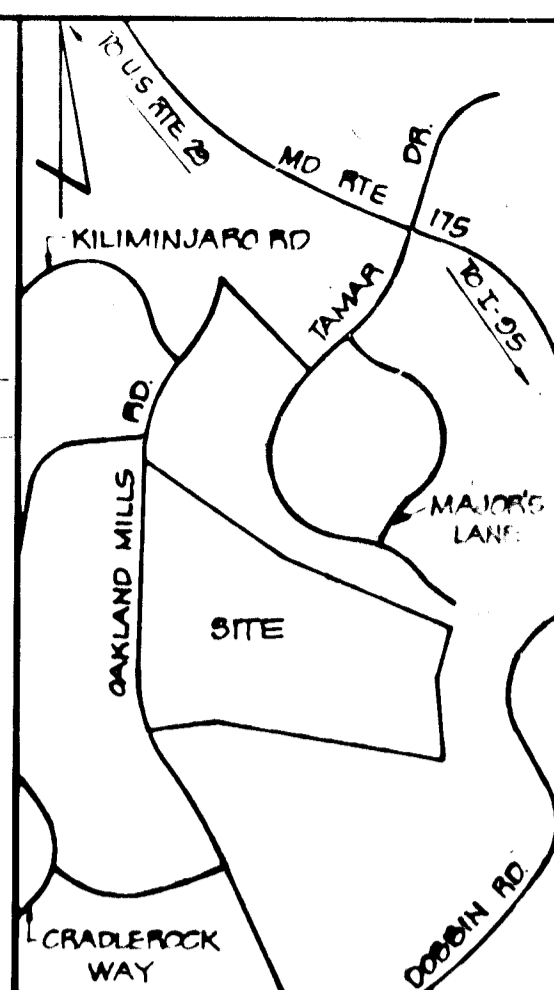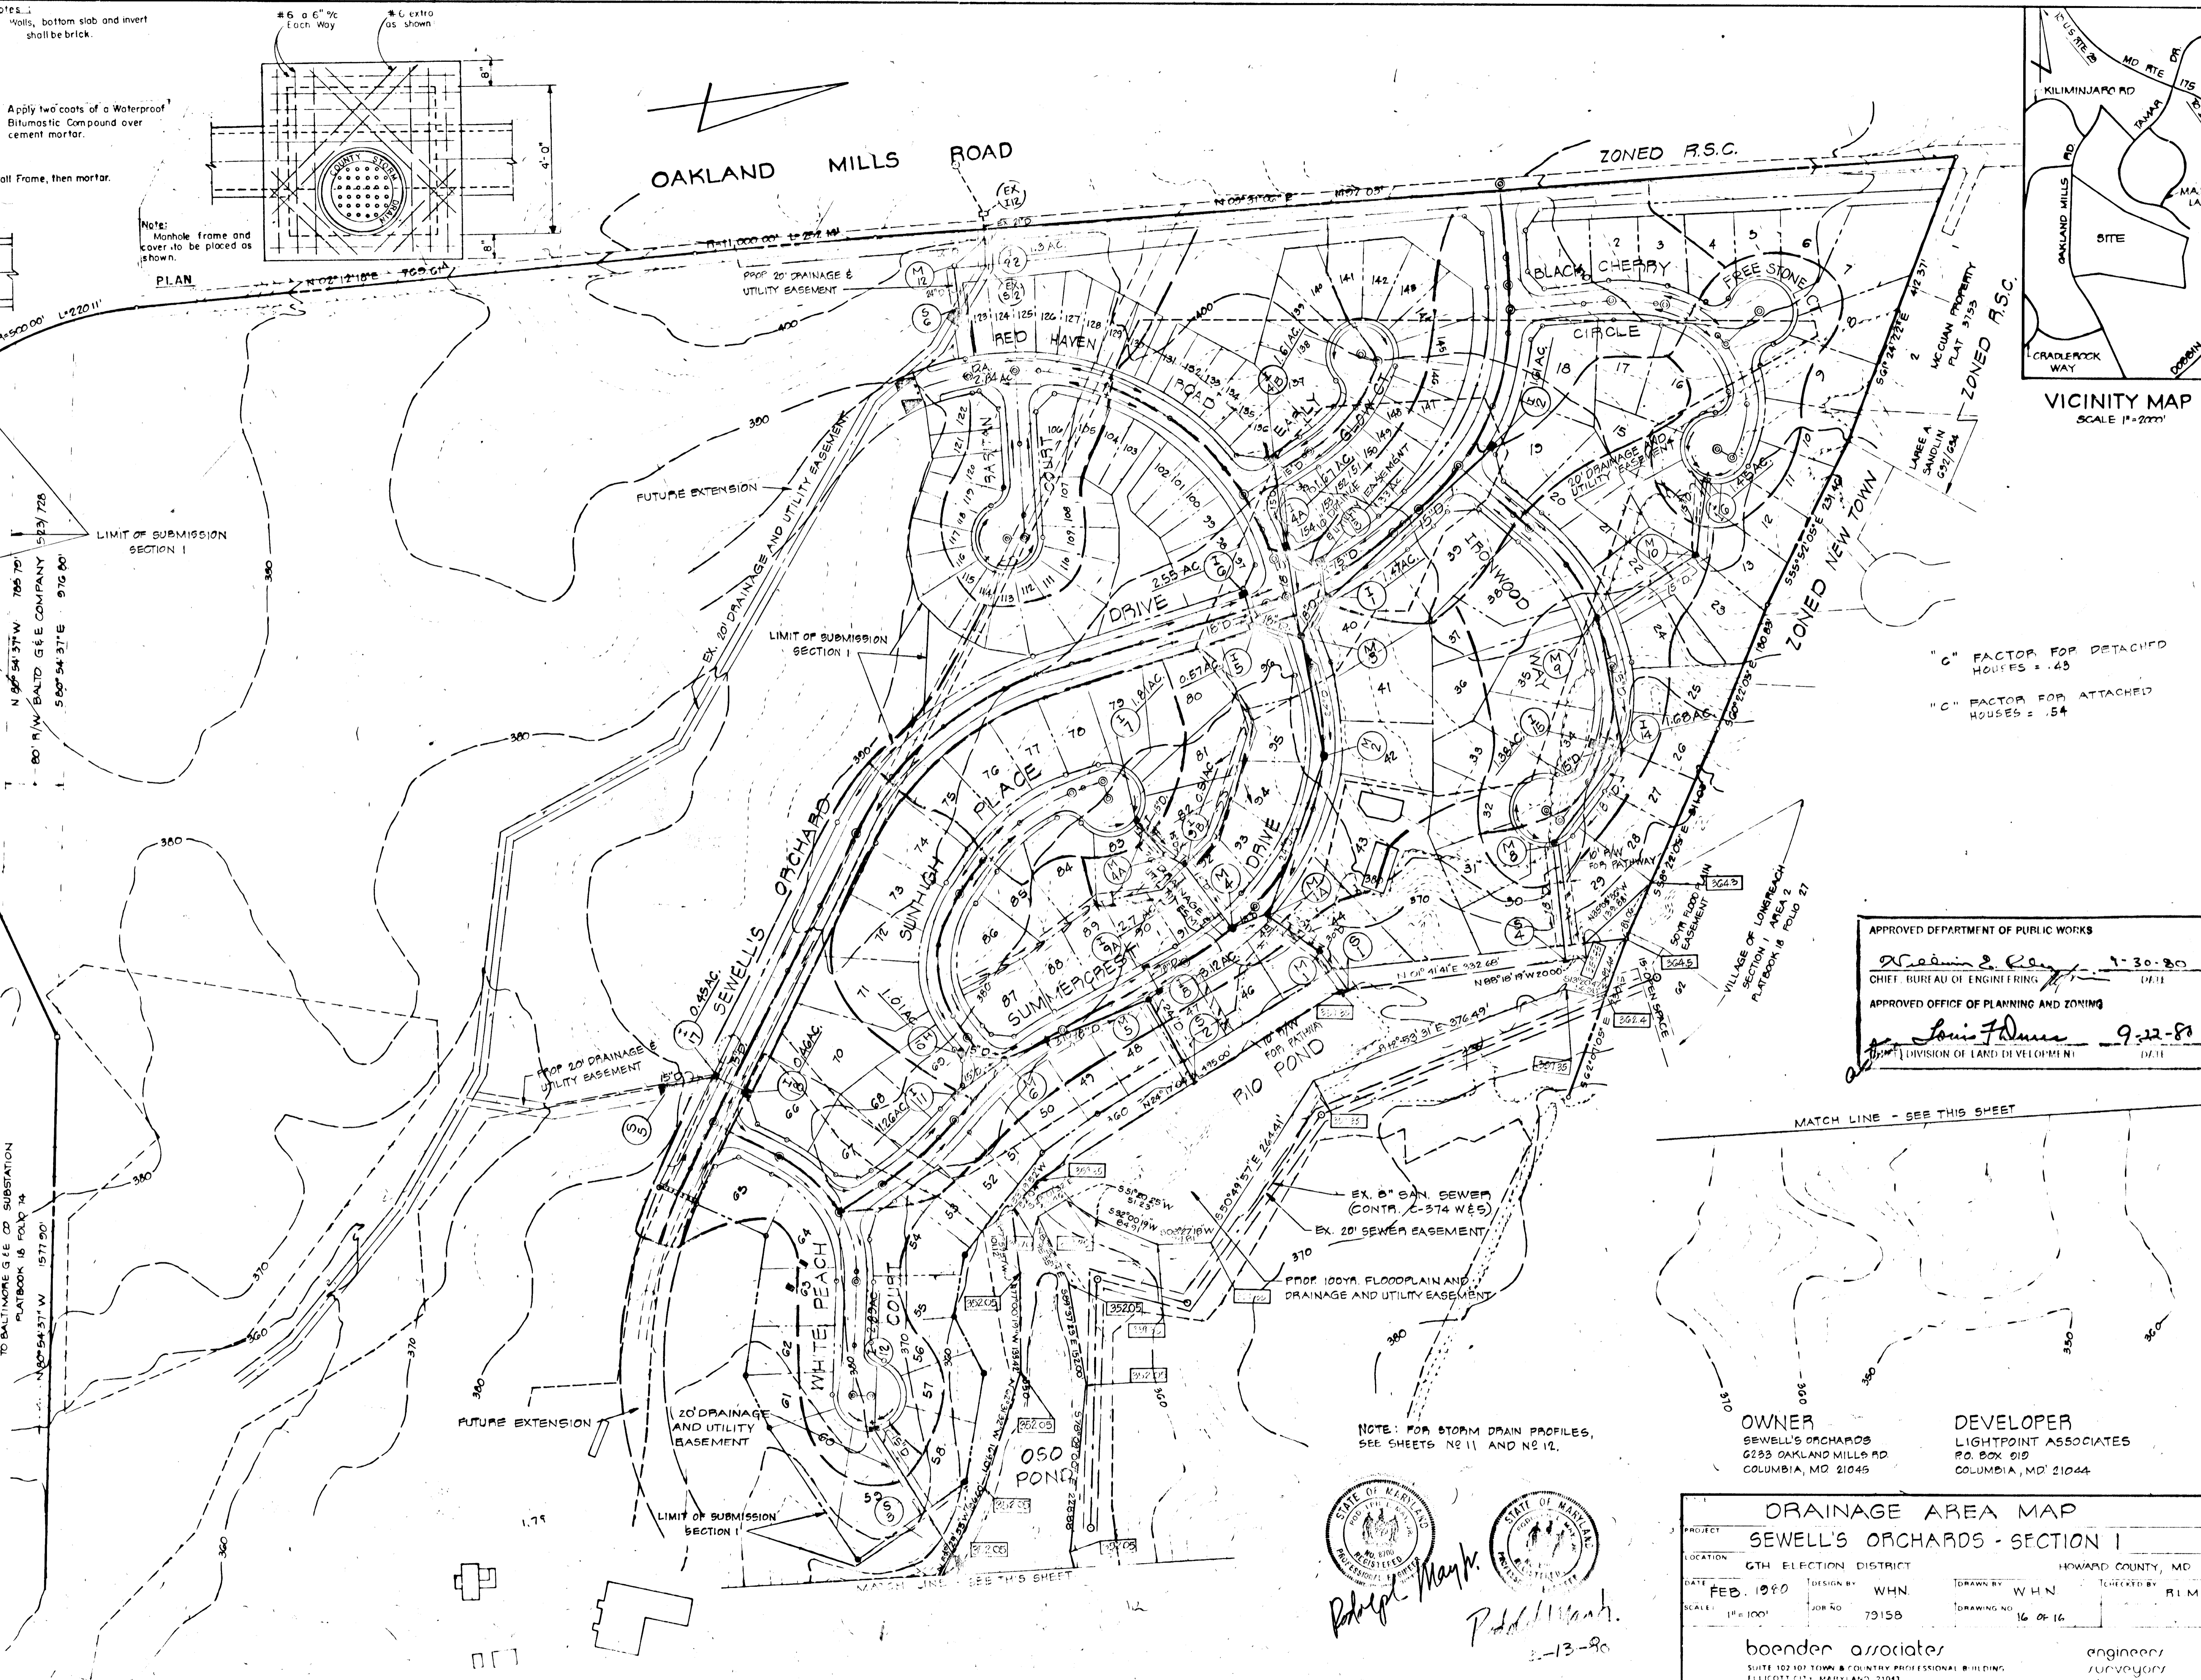

APPROVED DEPARTMENT OF PUBLIC WORKS
William S. Ray 1-30-80
CHIEF, BUREAU OF ENGINEERING
APPROVED OFFICE OF PLANNING AND ZONING
Louis F. Dumas 9-22-80
DIVISION OF LAND DEVELOPMENT

MATCH LINE - SEE THIS SHEET

OWNER
SEWELL'S ORCHARDS
6283 OAKLAND MILLS RD
COLUMBIA, MD 21045

DEVELOPER
LIGHTPOINT ASSOCIATES
P.O. BOX 919
COLUMBIA, MD 21044

NOTE: FOR STORM DRAIN PROFILES, SEE SHEETS NO 11 AND NO 12.

STATE OF MARYLAND
REGISTERED PROFESSIONAL ENGINEER
Robert Mayhew

STATE OF MARYLAND
REGISTERED PROFESSIONAL SURVEYOR
Robert Mayhew

2-13-80

DRAINAGE AREA MAP
SEWELL'S ORCHARDS - SECTION I

PROJECT: GTH ELECTION DISTRICT
LOCATION: HOWARD COUNTY, MD
DATE: FEB. 1980
SCALE: 1"=100'

DESIGN BY: WHN
DRAWN BY: WHN
CHECKED BY: RLM

JOBS NO: 79158
DRAWING NO: 16 OF 16

boender associates
SUITE 102 101 TOWN & COUNTRY PROFESSIONAL BUILDING
ELICOTT CITY, MARYLAND 21043
BALTIMORE 301 488 7777 SALISBURY 301 748 1288

engineers/surveyors/planners

REVISED: 5-8-80 POND GRADING AND FLOODPLAIN LIMITS

AS-BUILT 9-5-84 T-80-105