


**BENCH MARKS:**  
 BM#1: 12" Spike Set in 12" Poplar  
 BM#2: 12" Spike Set in 12" Maple  
 Origin of Coordinates and Bench Marks:  
 Howard County Geodetic Control Points No.  
 2243001-12 And 2142003-12


- KEY:**
- ① PROFILE GRADE LINE (PGL)
  - ② MODIFIED CONCRETE CURB & GUTTER (12-3.01)
  - ③ HOWARD COUNTY STANDARD PAVING SECTION R2 (12-2.01)
  - ④ PLACE 2" TOPSOIL SEED AND MULCH (12-3.05)
  - ⑤ 4" CONCRETE SIDEWALK

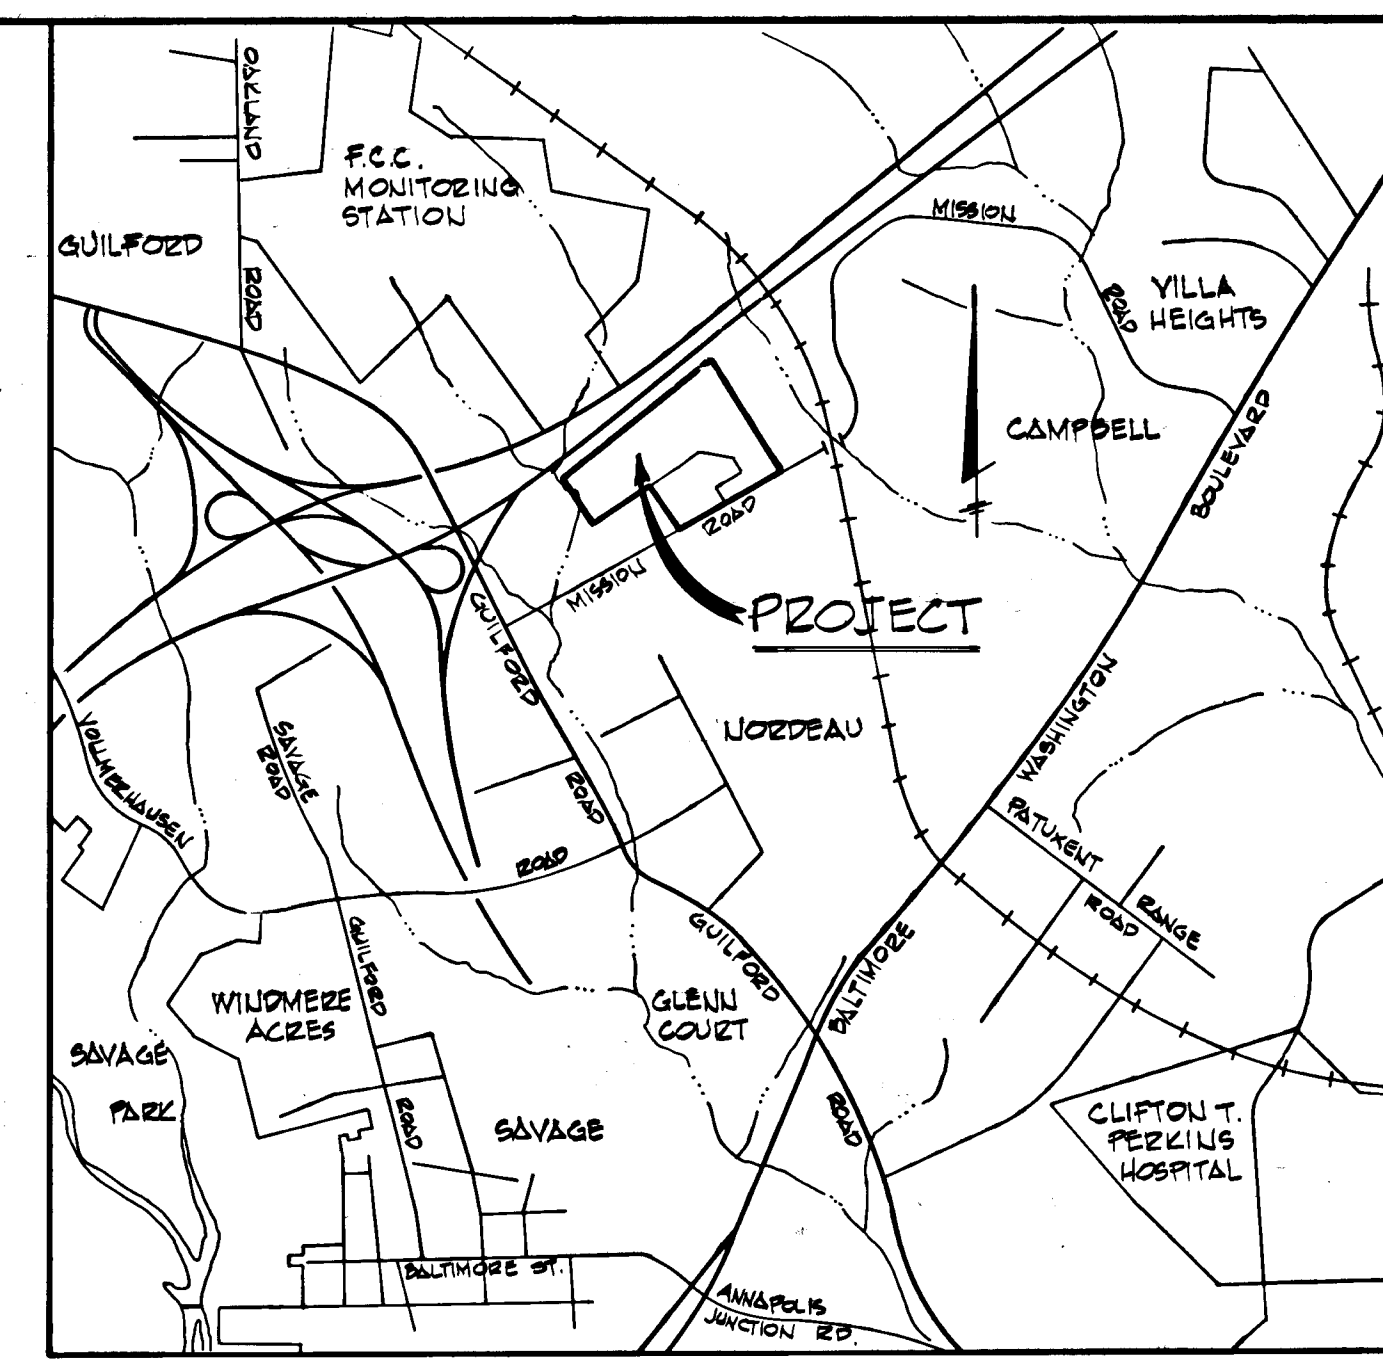

**VICINITY MAP**  
 Scale: 1" = 2,000'  
**GENERAL NOTES**


- 1) Construction shown hereon shall be in accordance with the Howard County Standard Specifications and Details.
- 2) Page and Drawing No.'s referenced hereon are taken from the "Standard Specifications and Details".
- 3) Elevations shown hereon are based on the Howard County Vertical Control Datum.
- 4) See Sheet 6 of B and B of b for Sediment Control Plan & Details.
- 5) Traffic Control Signs shall be in accordance with the State of Maryland Manual on Uniform Traffic Control Devices.
- 6) Street Lights shall be 175 Watt Modern Mercury Vapor Lamp Post Top Fixtures Mounted on 14" Embedded Fiberglass Pole.

HOWARD COUNTY GEODETIC SURVEY MONUMENT  
 NOS. 2243001 AND 2243002 WERE USED  
 FOR HORIZONTAL AND VERTICAL CONTROLS.

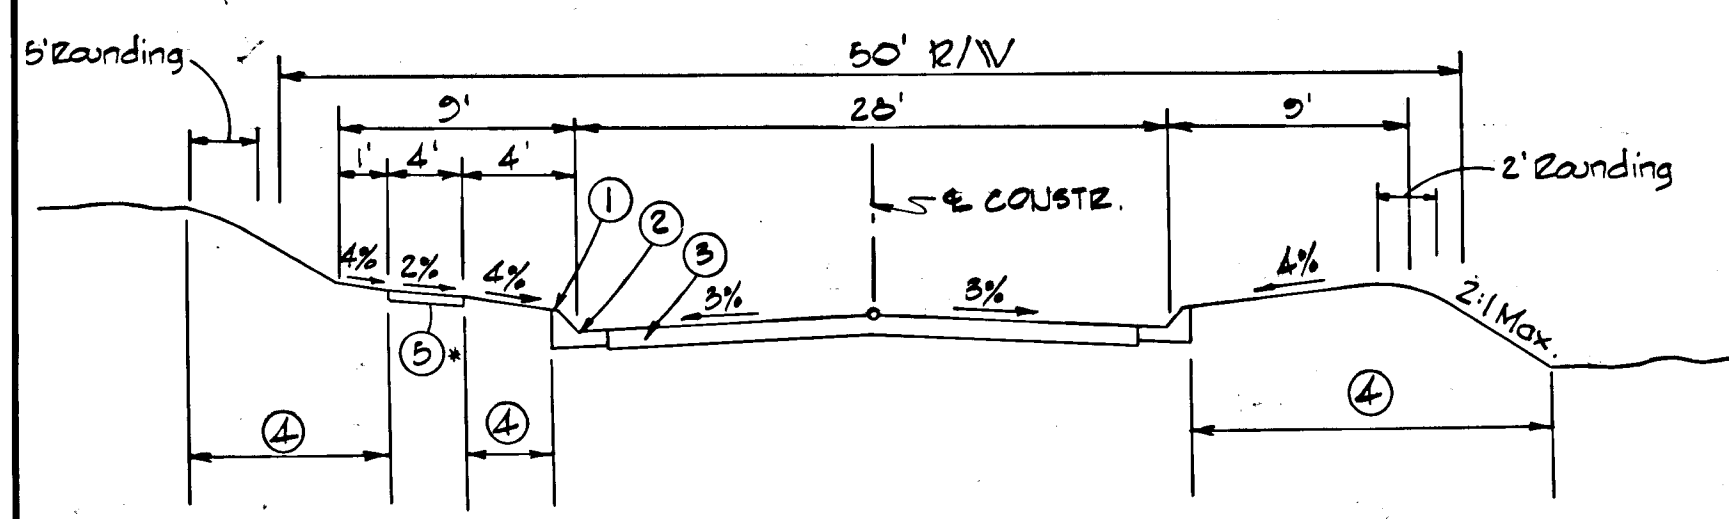


**TYPICAL SECTION**

REDONDO WAY - STA. 5+06.39 TO CUL-DE-SAC  
 CHESHIRE COURT - STA. 3+32.75 WEST TO CUL-DE-SAC  
 SMITHFIELD PLACE - STA. 2+74.57 TO CUL-DE-SAC  
 FAIRHAVEN PLACE  
 CUL-DE-SAC STREET  
 ZONING R-5C  
 DESIGN SPEED - 15/1A  
 \*Note: No sidewalk on Redondo Way

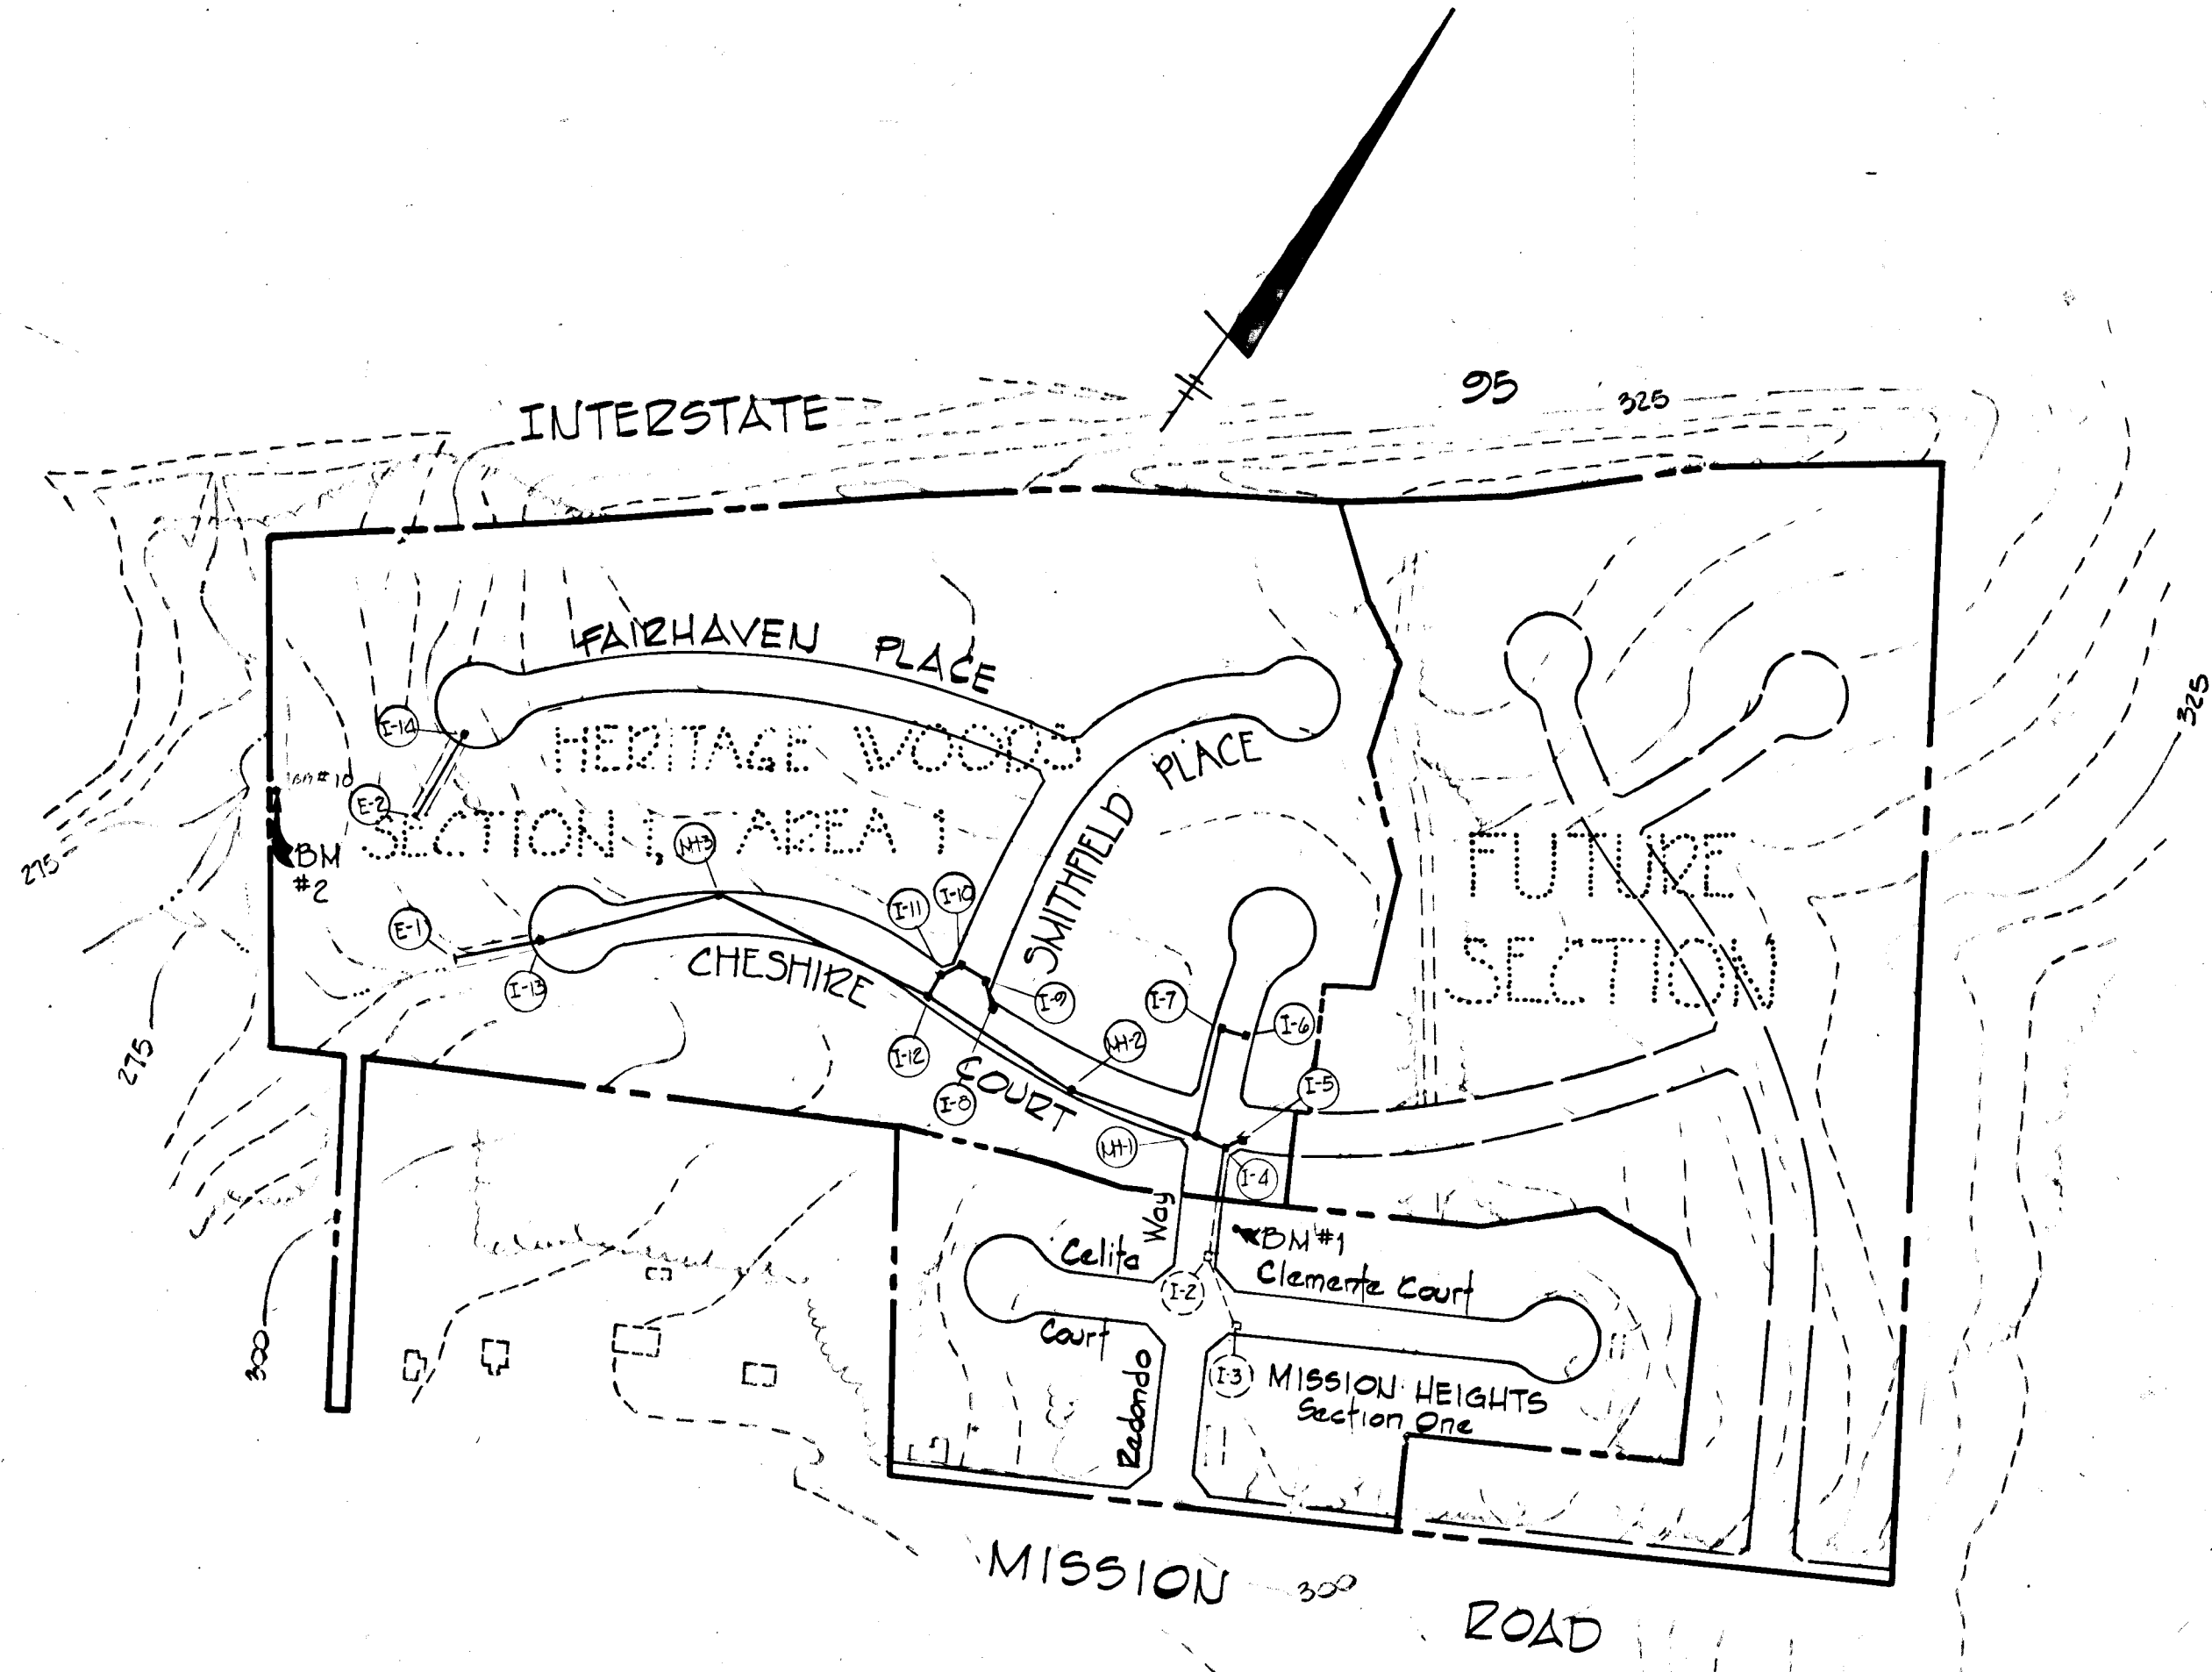

**PLAN**  
 Scale: 1" = 200'

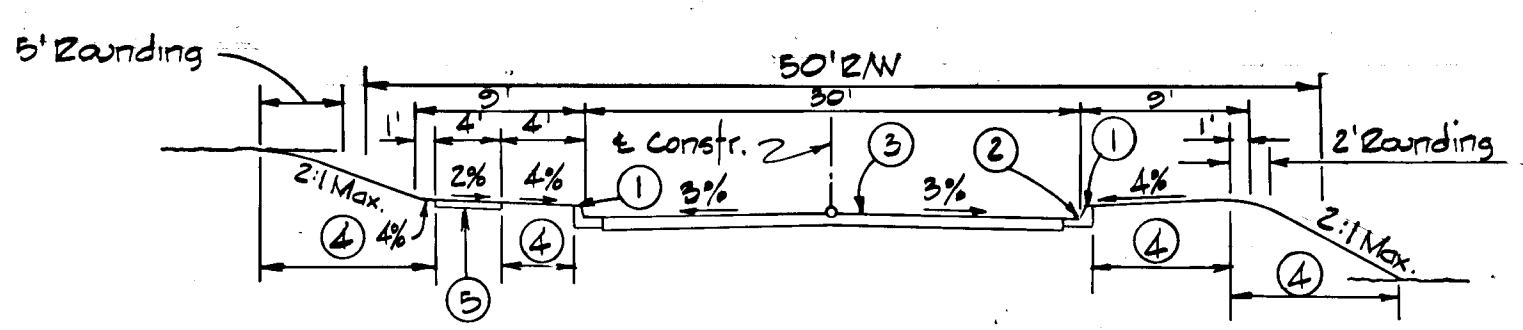

**TYPICAL SECTION**

REDONDO WAY - STA. 3+80.49 TO STA. 5+06.39  
 CHESHIRE COURT - STA. 0+00 TO STA. 3+32.75 WEST  
 STA. 0+00 TO STA. 1+03. EAST  
 SMITHFIELD PLACE - STA. 0+00 TO STA. 2+74.57  
 LOCAL STREET  
 ZONING R-5C  
 DESIGN SPEED - 30MPH

**OWNER & DEVELOPER**  
 SECURITY DEVELOPMENT CORPORATION  
 P.O. Box 417  
 Ellicott City, Maryland 21045

INDEX OF DRAWINGS	
SHEET NO.	DESCRIPTION
1	INDEX OF DRAWINGS - TYPICAL ROAD SECTIONS
2	ROAD PLAN & PROFILE - REDONDO WAY AND SMITHFIELD PLACE
3	" " " CHESHIRE COURT
4	" " " FAIRHAVEN PLACE
5	STORM DRAIN PROFILES AND DETAILS
6	GRADING & SEDIMENT CONTROL PLAN - DRAINAGE AREA MAP
7	STORMWATER MANAGEMENT DETAILS
8	EROSION & SEDIMENT CONTROL DETAILS - CONSTRUCTION SEQUENCE

This Development Plan is Approved for Soil Erosion and Sediment Control by the Howard Soil Conservation District.  
 Reviewed for Howard Soil Conservation District and Meets Technical Requirements.  
 APPROVED: Robert Zieher 7/28/82  
 Howard Soil Conservation District Date  
Thomas M. Helm 7/28/82  
 Signature Date  
 U.S. Soil Conservation District

**PURDUM & JESCHKE**  
 CONSULTING ENGINEERS  
 LAND SURVEYORS  
 1023 North Calvert Street  
 Baltimore, Maryland 21202 301/837-0194

APPROVED: Howard County Department of Public Works.  
Richard E. Reddy 10-1-82  
 Chief, Bureau of Engineering Date

APPROVED: Howard County Office of Planning and Zoning.  
Arline L. Jones 9-29-82  
 Chief, Division of Land Development and Zoning Administration Date

**DEVELOPER'S CERTIFICATION:**  
 I Certify that All Development and/or Construction will be done in accordance to this Plan of Development and Plan of Erosion and Sediment Control and I also Authorized Periodic Onsite Inspection by the Howard Soil Conservation District or their Authorized Agents as Deemed Necessary.  
William G. Rasch II 7/23/82

**ENGINEER'S CERTIFICATIONS:**  
 I Certify that this Plan for Erosion and Sediment Control Represents a Practical and Workable Plan Based on My Personal Knowledge of the Site Conditions and that it was prepared in accordance with the Requirements of the Howard Soil Conservation District.  
William G. Rasch II 7/23/82  
 Date





TYPICAL ROAD SECTIONS - INDEX OF DWGS  
**HERITAGE WOODS**  
 SECTION ONE - AREA ONE  
 6TH ELECTION DISTRICT  
 HOWARD COUNTY, MARYLAND  
 TAX MAP 42, PARCELS 371 294 & 77  
 SEPT. 1982 SCALE AS SHOWN

SHEET 1 OF 8  
 DES: DE  
 DZW: BAZ  
 CHK: DE

967



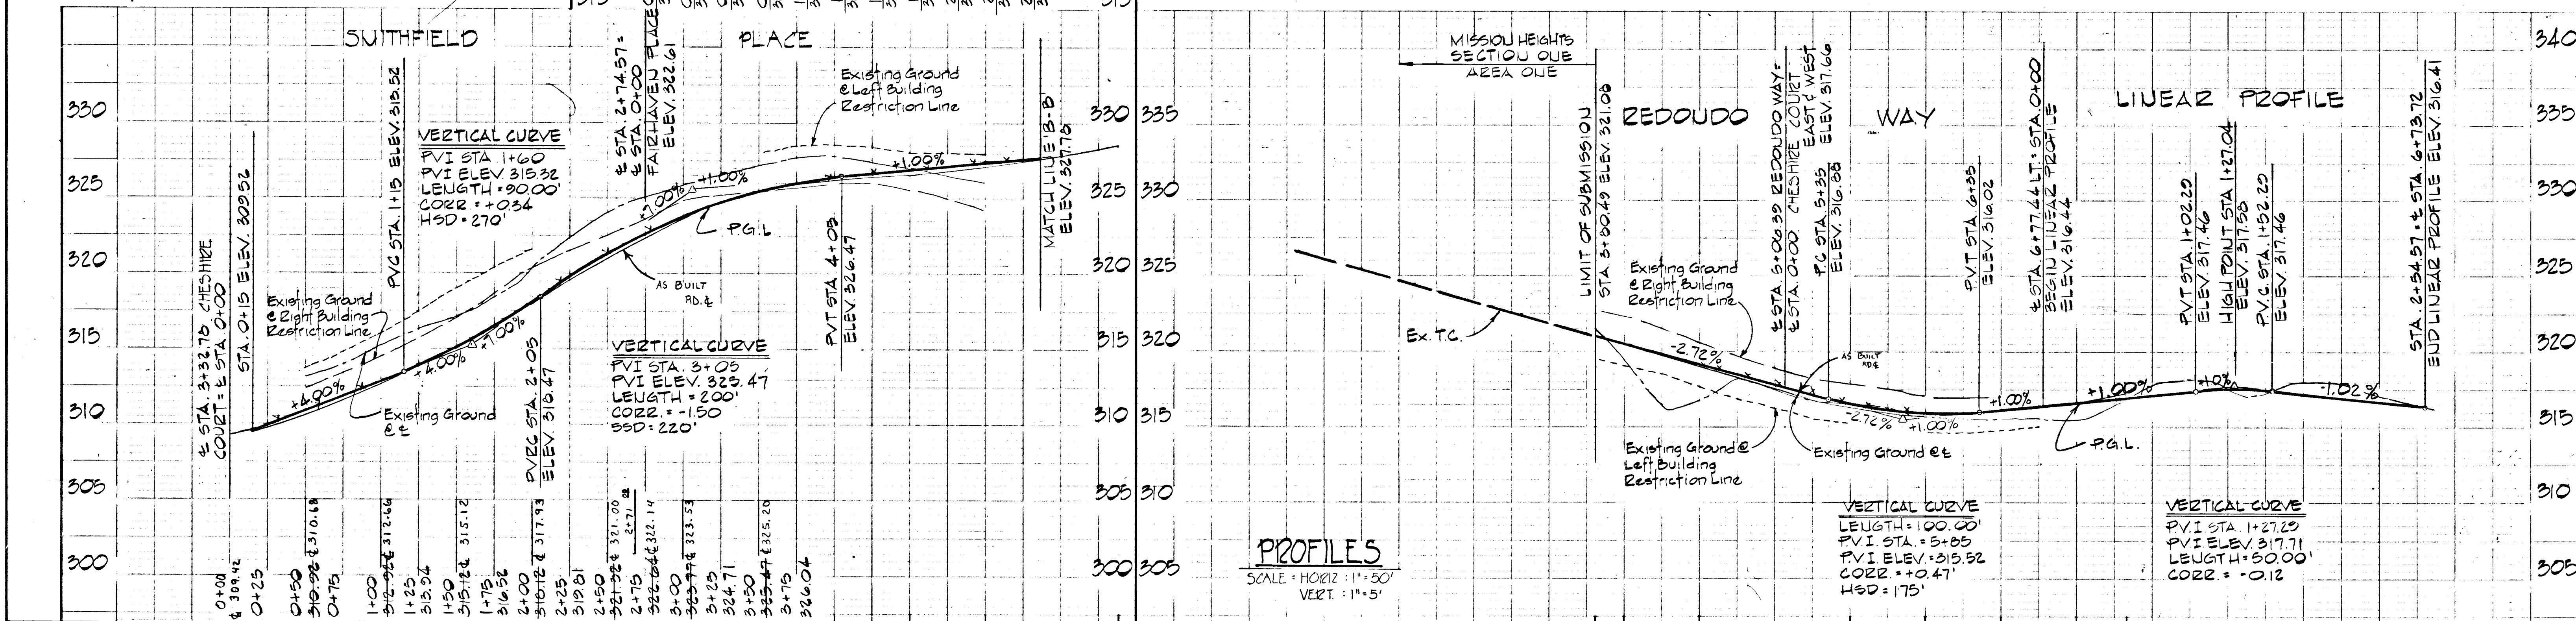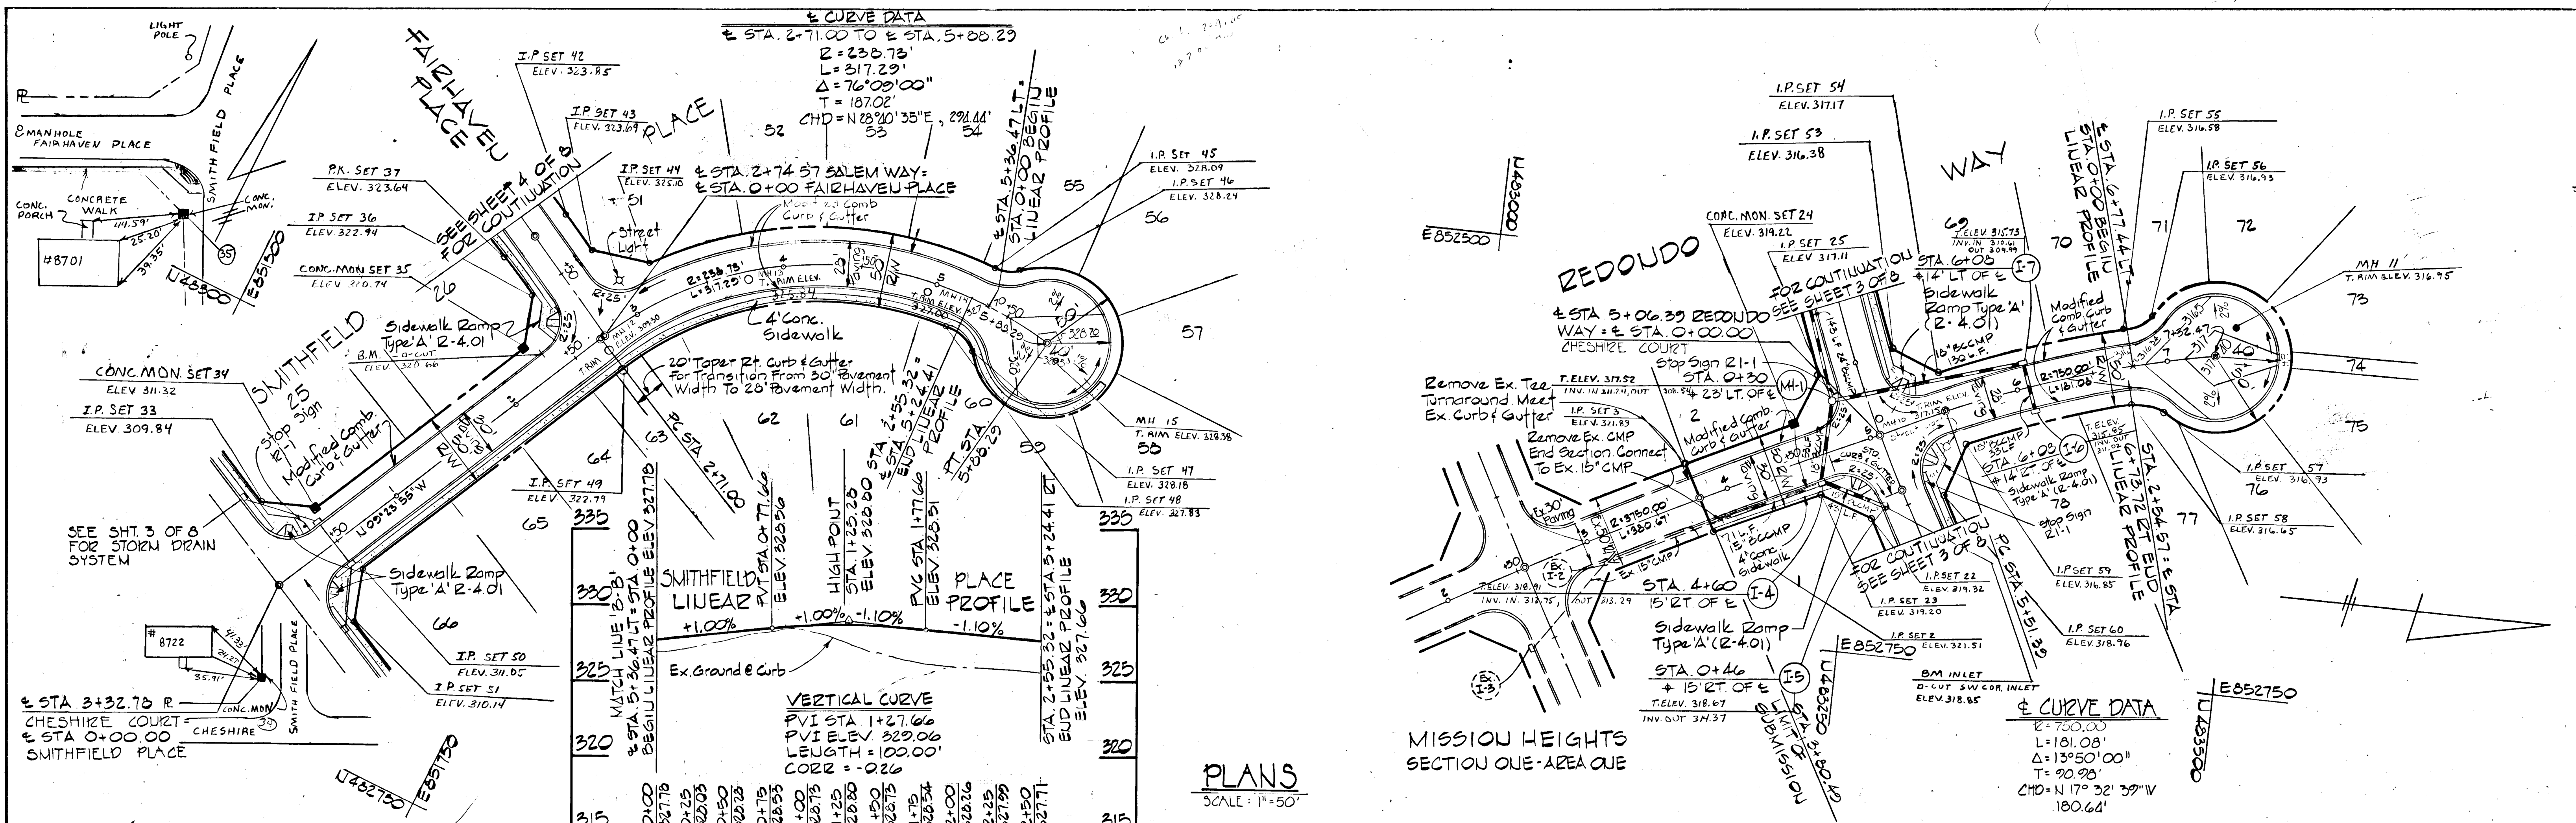

This Development Plan is Approved For Soil Erosion And Sediment Control By The Howard Soil Conservation District.

Reviewed For Howard Soil Conservation District And Meets Technical Requirements.

APPROVED: *Robert W. Zickler* 9-28-82  
 Howard Soil Conservation District Date

Signature: *James M. Hahn* 9/28/82  
 U.S. Soil Conservation District Date

APPROVED: Howard County Department of Public Works.

APPROVED: Howard County Office of Planning and Zoning

DEVELOPER'S CERTIFICATE  
 I Certify That All Development And/Or Construction Will Be Done In Accordance To This Plan Of Development And Plan Of Erosion And Sediment Control And I Also Authorized Periodic On-Site Inspection By The Howard Soil Conservation District Or Their Authorized Agents As Deemed Necessary.  
 Date: 1/25/92

ENGINEER'S CERTIFICATE  
 I Certify That This Plan For Erosion And Sediment Control Represents A Practical And Workable Plan Based On My Personal Knowledge Of The Site Conditions And That It Was Prepared In Accordance With The Requirements Of The Howard Soil Conservation District.  
 William G. Rosch II 7/22/87  
 Date

**PURDUM & JESCHKE CONSULTING ENGINEERS LAND SURVEYORS**  
 1023 North Calvert Street  
 Baltimore, Maryland 21202 301/637-0194

**APPROVED: Howard County Department of Public Works.**  
 Chief, Bureau of Engineering  
 Date: 10-1-82

**APPROVED: Howard County Office of Planning and Zoning**  
 Planning Director  
 Date: 9-29-82

**DEVELOPER'S CERTIFICATE**  
 I Certify That All Development And/Or Construction Will Be Done In Accordance To This Plan Of Development And Plan Of Erosion And Sediment Control And I Also Authorized Periodic On-Site Inspection By The Howard Soil Conservation District Or Their Authorized Agents As Deemed Necessary.  
 Date: 1/25/92

**ENGINEER'S CERTIFICATE**  
 I Certify That This Plan For Erosion And Sediment Control Represents A Practical And Workable Plan Based On My Personal Knowledge Of The Site Conditions And That It Was Prepared In Accordance With The Requirements Of The Howard Soil Conservation District.  
 William G. Rosch II 7/22/87  
 Date

**ROAD PLAN AND PROFILE**  
 SMITHFIELD PLACE - REDOUDO WAY  
**HERITAGE WOODS**  
 SECTION ONE - AREA ONE  
 6TH ELECTION DISTRICT  
 HOWARD COUNTY, MARYLAND  
 TAX MAP 42, PARCELS 371, 294, 477  
 SEPT. 10, 1982 SCALE AS SHOWN


SHEET 2 OF 8  
 DES: DE  
 DRW: RAZ  
 CHK: DE

AS-BUILT 12-29-87 F-63-05



CURVE DATA  
 ± STA. 0+00 TO STA. 2+18.78 WEST  
 R = 750.00'  
 L = 218.78'  
 Δ = 16°12'19"  
 T = 110.17'  
 CHD = S 72°14'11"W  
 218.00'

CURVE DATA  
 ± STA. 0+00 TO STA. 0+39.53 EAST  
 R = 750.00'  
 L = 39.53'  
 Δ = 03°01'12"  
 T = 19.77'  
 CHD = N 62°22'41"E  
 39.53'

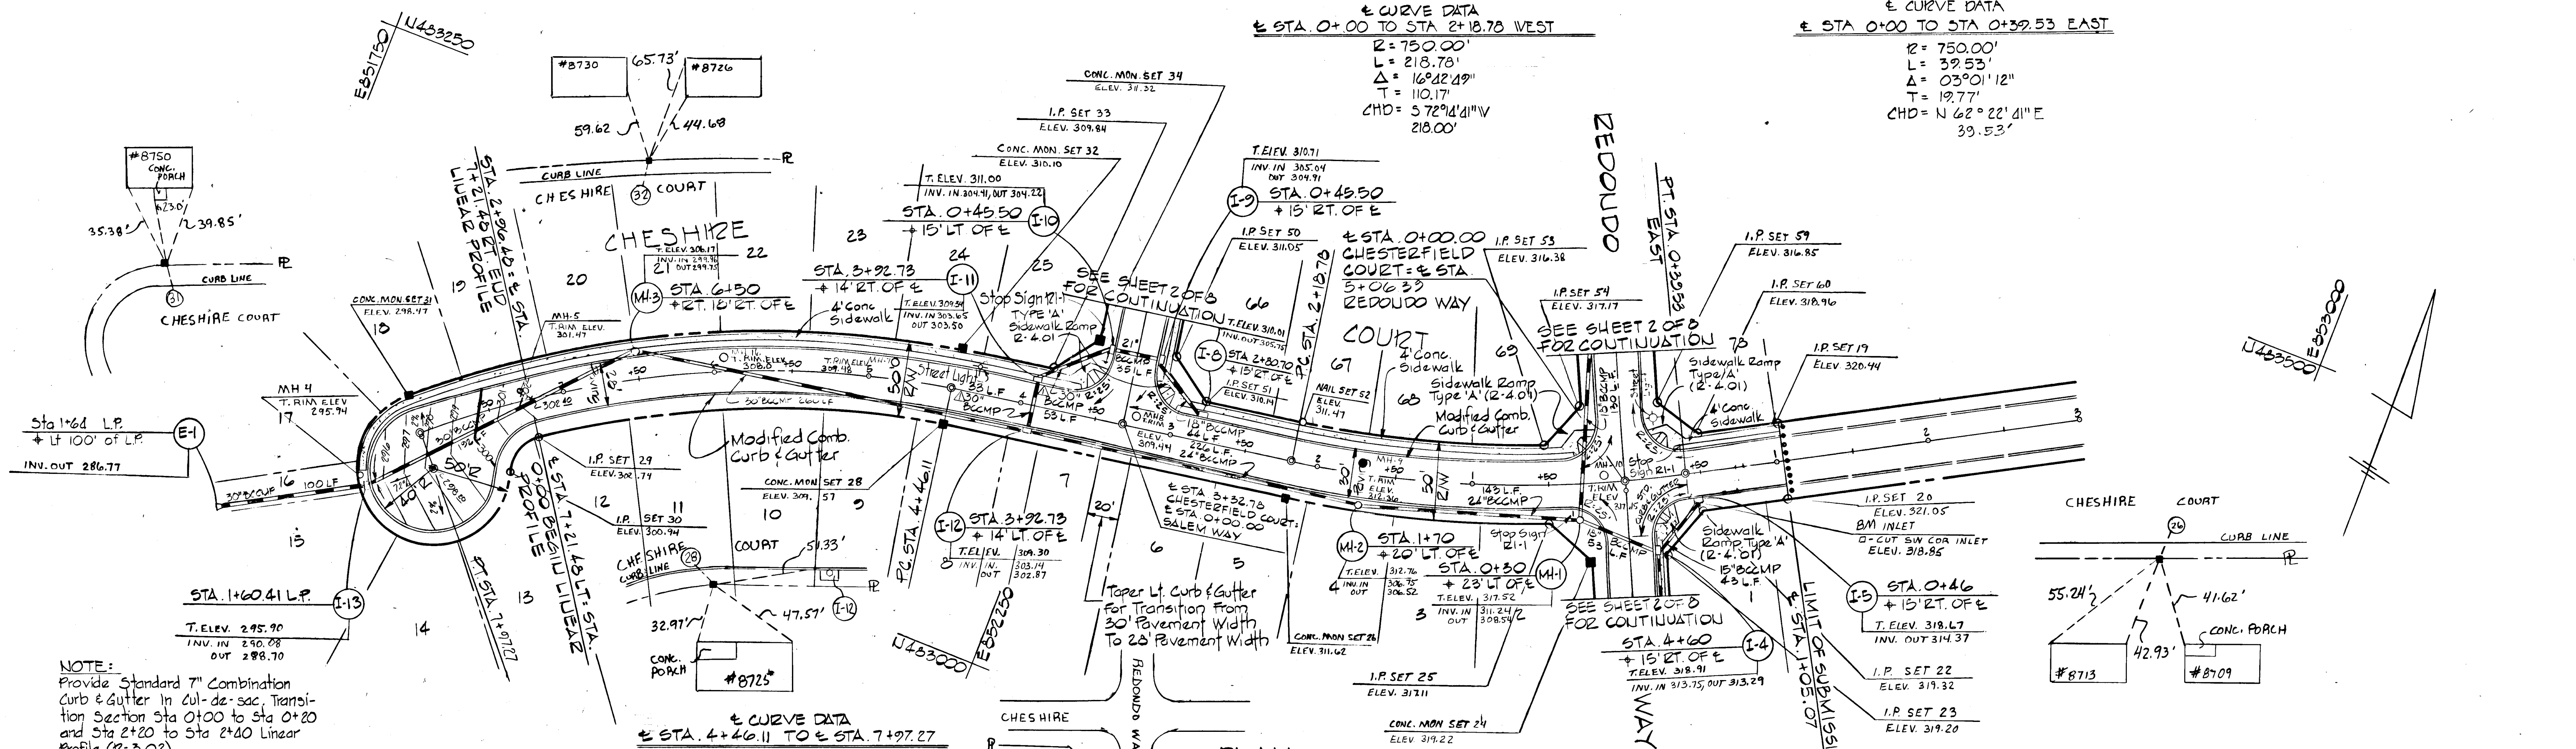


NOTE:  
 Provide Standard 7" Combination  
 Curb & Gutter In Cul-de-sac, Transition  
 Section Sta 0+00 to Sta 0+20  
 and Sta 2+20 to Sta 2+40 Linear  
 Profile (R=3.02).

CURVE DATA  
 ± STA. 4+46.11 TO ± STA. 7+97.27  
 R = 600.00'  
 L = 351.16'  
 Δ = 33°32'00"  
 T = 180.77'  
 CHD = S 63°50'05"W 346.17'

PLAN  
 SCALE 1"=50'

REVISIONS	
1	REVISIONS TO TEE TURN AROUND.

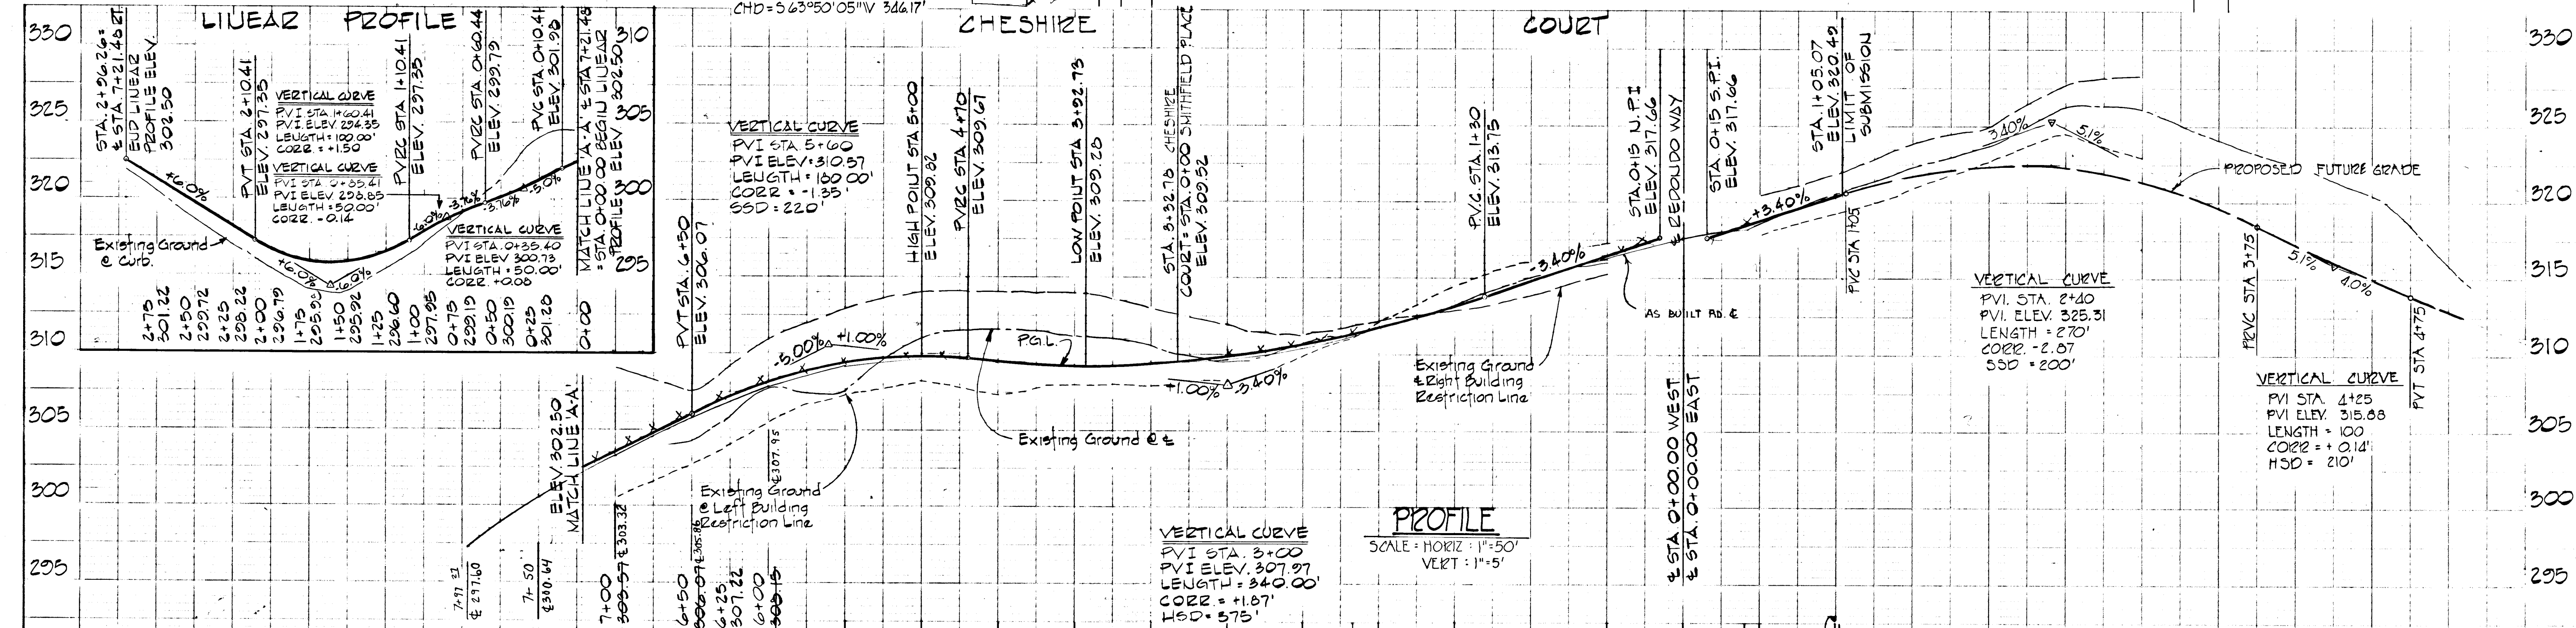

PROFILE  
 SCALE: HORIZ: 1"=50'  
 VERT: 1"=5'

This Development Plan is Approved For Soil Erosion And  
 Sediment Control By The Howard Soil Conservation District.  
 APPROVED: *Robert J. Zehn* 9-28-82  
 Howard Soil Conservation District Date

Reviewed For Howard Soil Conservation District  
 And Meets Technical Requirements.  
 APPROVED: *James M. Nelson* 9/28/82  
 Signature Date  
 U.S. Soil Conservation District

APPROVED: Howard County Department  
 Of Public Works.  
 Planning Director Date  
 APPROVED: *Louis J. ...* 9-28-82  
 Chief, Division Of Land Development  
 And Zoning Administration Date

DEVELOPER'S CERTIFICATE  
 I Certify That All Development And/Or Construction Will  
 Be In Done In Accordance To This Plan Of Development  
 And Plan Of Erosion And Sediment Control And I  
 Also Authorized Periodic Onsite Inspection By The  
 Howard Soil Conservation District Or Their  
 Authorized Agents As Deemed Necessary.  
 APPROVED: *William G. Rasch II* 7/23/82

ENGINEER'S CERTIFICATE  
 I Certify That This Plan For Erosion And Sediment  
 Control Represents A Practical And Workable Plan  
 Based On My Personal Knowledge Of The Site  
 Conditions And That It Was Prepared In Accordance  
 With The Requirements Of The Howard Soil  
 Conservation District.  
 APPROVED: *William G. Rasch II* 7/23/82  
 Date



**PURDUM & JEACHIE**  
**CONSULTING ENGINEERS**  
**LAND SURVEYORS**  
 1023 North Calvert Street  
 Baltimore, Maryland 21202 301/837-0184

APPROVED: *William G. Rasch II* 10-1-82  
 Chief, Bureau Of Engineering

APPROVED: Howard County Office of  
 Planning And Zoning.  
 Planning Director Date  
 APPROVED: *Louis J. ...* 9-28-82  
 Chief, Division Of Land Development  
 And Zoning Administration Date

DEVELOPER'S CERTIFICATE  
 I Certify That All Development And/Or Construction Will  
 Be In Done In Accordance To This Plan Of Development  
 And Plan Of Erosion And Sediment Control And I  
 Also Authorized Periodic Onsite Inspection By The  
 Howard Soil Conservation District Or Their  
 Authorized Agents As Deemed Necessary.  
 APPROVED: *William G. Rasch II* 7/23/82

ENGINEER'S CERTIFICATE  
 I Certify That This Plan For Erosion And Sediment  
 Control Represents A Practical And Workable Plan  
 Based On My Personal Knowledge Of The Site  
 Conditions And That It Was Prepared In Accordance  
 With The Requirements Of The Howard Soil  
 Conservation District.  
 APPROVED: *William G. Rasch II* 7/23/82  
 Date




ROAD PLAN & PROFILE  
**CHESHIRE COURT**  
**HERITAGE WOODS**  
 SECTION ONE - AREA ONE  
 6TH ELECTION DISTRICT  
 HOWARD COUNTY, MARYLAND  
 TAX MAP 42, PARCELS 371, 294 & 77  
 SEPT. 10, 1982 SCALE AS SHOWN  
 SHEET 3 OF 8  
 DES: BE.  
 DRW: RAZ.  
 CHK: DE.  
 REVISE FILE: 5/22/87

AS-BUILT 12-29-87

F-83-05



NOTE:  
Provide Standard 7" Combination  
Concrete Curb & Gutter in Cut-de-sac.  
Transition Sta. 0+00 to Sta. 0+20  
and Sta. 2+54 to Sta. 2+54  
Linear Profile (R=3.02)

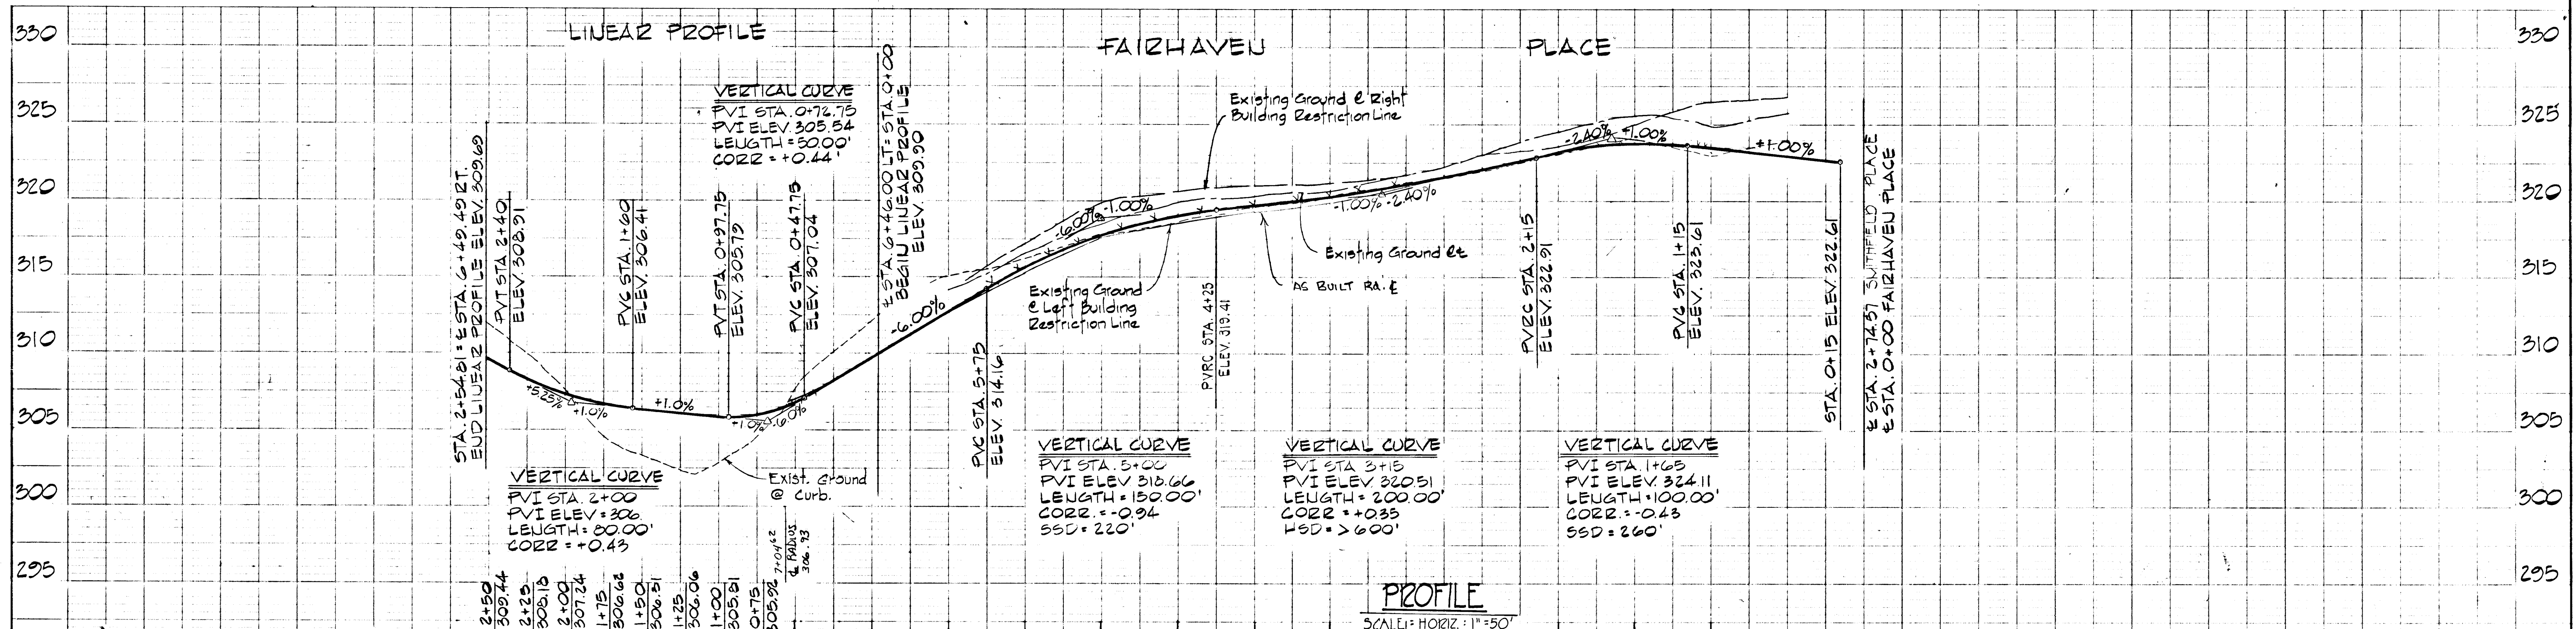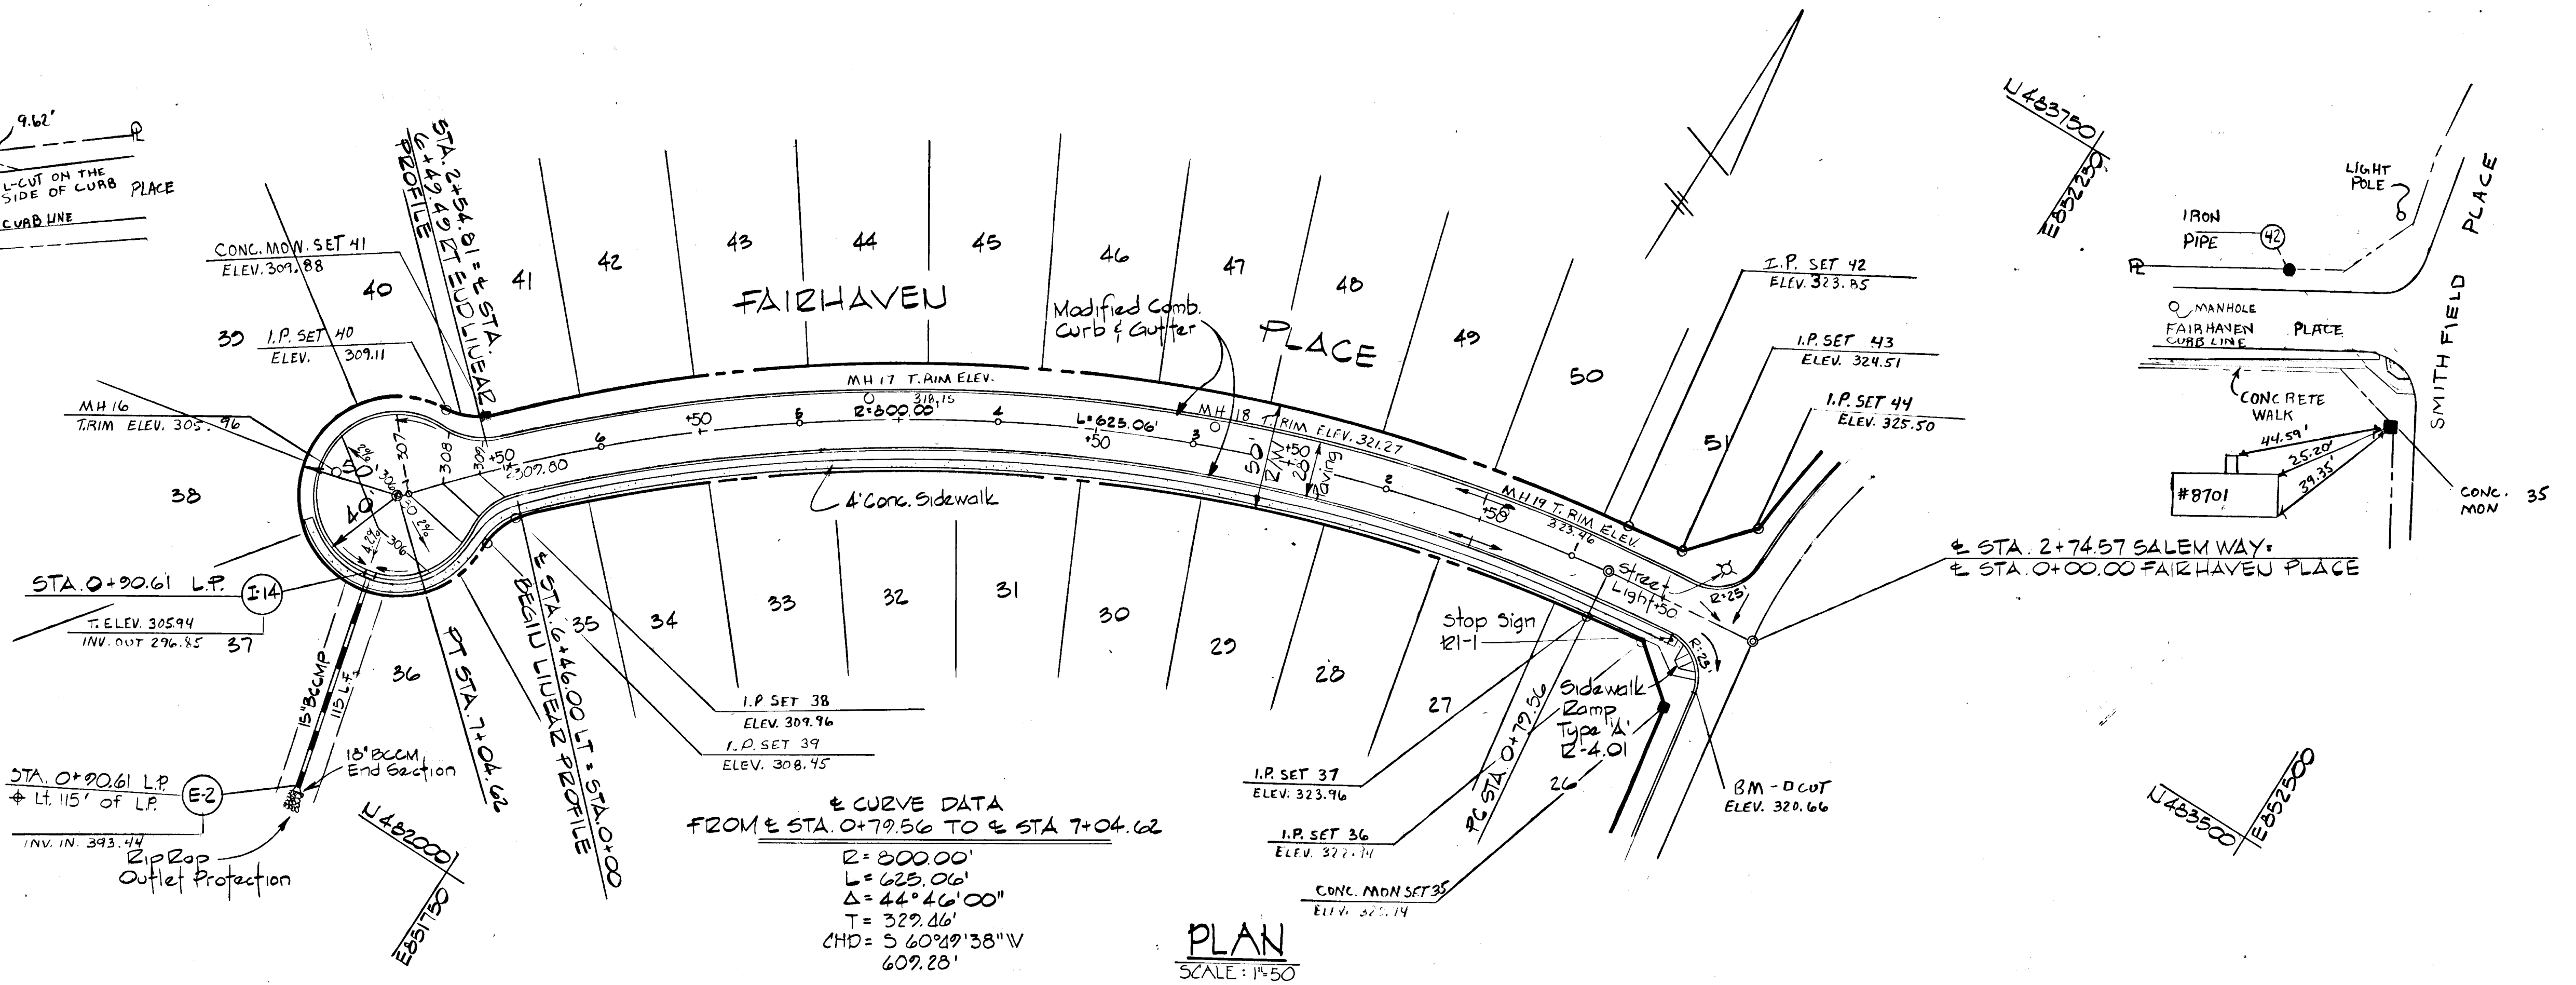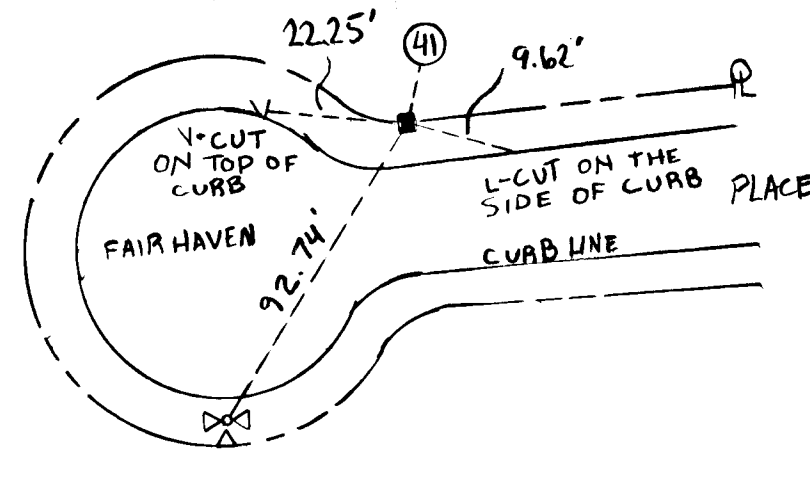

This Development Plan Is Approved For Soil Erosion And Sediment Control By The Howard Soil Conservation District.  
APPROVED: Robert W. Ziehm, 9-28-82, Howard Soil Conservation District

Reviewed For Howard Soil Conservation District And Meets Technical Requirements.  
Signature: James M. Klein, 9/28/82, U.S. Soil Conservation District

APPROVED: Howard County Department Of Public Works.  
Signature: [Blank], 10-1-82, Chief, Bureau Of Engineering

APPROVED: Howard County Office of Planning And Zoning.  
Signature: Louis [Blank], 9-29-82, Chief, Division Of Land Development And Zoning Administration

DEVELOPER'S CERTIFICATE:  
I Certify That All Development And/Or Construction Will Be In Accordance To This Plan Of Development, And Plan Of Erosion And Sediment Control And I Also Authorized Periodic Onsite Inspection By The Howard Soil Conservation District Or Their Authorized Agents As Deemed Necessary.  
Signature: [Blank], 12/29/82

ENGINEER'S CERTIFICATE:  
I Certify That This Plan For Erosion And Sediment Control Represents A Practical And Workable Plan Based On My Personal Knowledge Of The Site Conditions And That It Was Prepared In Accordance With The Requirements Of The Howard Soil Conservation District.  
Signature: William G. Jeschke II, 7/22/82

ROAD PLAN & PROFILE  
FAIRHAVEN PLACE  
HERITAGE WOODS  
SECTION ONE - AREA ONE  
6TH ELECTION DISTRICT  
HOWARD COUNTY, MARYLAND  
TAX MAP 42, PARCEL 371, 204177  
SEPT. 10, 1982 SCALE AS SHOWN  
SHEET 4 OF 8  
DES: B.E.  
DEW: KAZ.  
CHK: B.E.

**FURDUM & JESCHKE**  
CONSULTING ENGINEERS  
LAND SURVEYORS  
1023 North Calvert Street  
Baltimore, Maryland 21202 301/837-0194

APPROVED: Howard County Department Of Public Works.  
Signature: [Blank], 10-1-82, Chief, Bureau Of Engineering

APPROVED: Howard County Office of Planning And Zoning.  
Signature: [Blank], 9-29-82, Chief, Division Of Land Development And Zoning Administration


DEVELOPER'S CERTIFICATE:  
I Certify That All Development And/Or Construction Will Be In Accordance To This Plan Of Development, And Plan Of Erosion And Sediment Control And I Also Authorized Periodic Onsite Inspection By The Howard Soil Conservation District Or Their Authorized Agents As Deemed Necessary.  
Signature: [Blank], 12/29/82

ENGINEER'S CERTIFICATE:  
I Certify That This Plan For Erosion And Sediment Control Represents A Practical And Workable Plan Based On My Personal Knowledge Of The Site Conditions And That It Was Prepared In Accordance With The Requirements Of The Howard Soil Conservation District.  
Signature: William G. Jeschke II, 7/22/82






ROAD PLAN & PROFILE  
FAIRHAVEN PLACE  
HERITAGE WOODS  
SECTION ONE - AREA ONE  
6TH ELECTION DISTRICT  
HOWARD COUNTY, MARYLAND  
TAX MAP 42, PARCEL 371, 204177  
SEPT. 10, 1982 SCALE AS SHOWN  
SHEET 4 OF 8  
DES: B.E.  
DEW: KAZ.  
CHK: B.E.

AS-BUILT 12-29-87  
F-83-05

STRUCTURE SCHEDULE					
STRUCT. No.	TYPE	STANDARD DETAIL	TOP ELEV.	INV. IN	INV. OUT
E-1	MT'L END SECT	SD-5.61	-	257.05	257.05
I-13	A-10	SD-4.02	295.05/1	290.49/08	288.45/70
M-3	5' STD. MH	G-5.13/G-5.02	306.17	299.96	299.76/25
I-12	A-5	SD-4.02	300.23/30	303.14/E	302.55/87
M-2	4' STD. MH	G-5.01/G-5.12	312.85/76	306.89/75	307.08/4
M-1	"	"	317.55/53	311.21/E	309.09/4
I-4	A-5 W/DEFL	SD-4.01/SD-4.03	318.92/71	313.75/E	313.20/29
I-11	A-5	SD-4.01	309.28/39	303.79/2	303.50/4
I-10	A-10 W/DEFL	SD-4.02/SD-4.03	317.39/11	304.71/11	303.92/1
I-9	A-5 W/DEFL	SD-4.01/SD-4.03	310.99/11	305.24/11	304.89/11
I-8	A-10	SD-4.02	310.09/11	-	305.68/37
I-7	A-5	SD-4.01	315.89/73	310.74/61	310.54/4
I-6	"	"	315.89/85	-	311.00/02
I-5	A-10 W/DEFL	SD-4.02/SD-4.03	318.71/67	-	314.50/37
E-2	MT'L END SECT	SD-5.61	-	292.95	-
I-14	A-5	SD-4.01	305.74/64	-	296.41/85

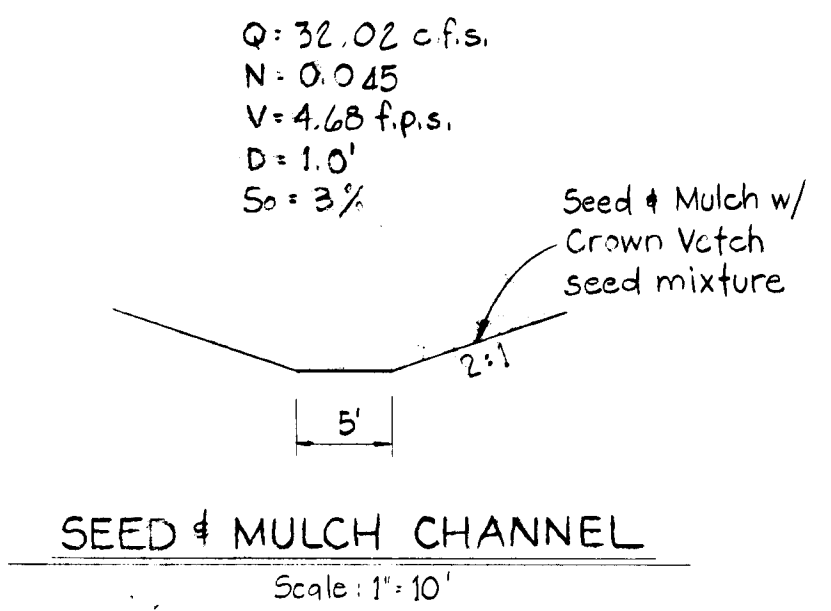

NOTE: BEDDING FOR STORM DRAINS SHALL BE TYPE C BEDDING.

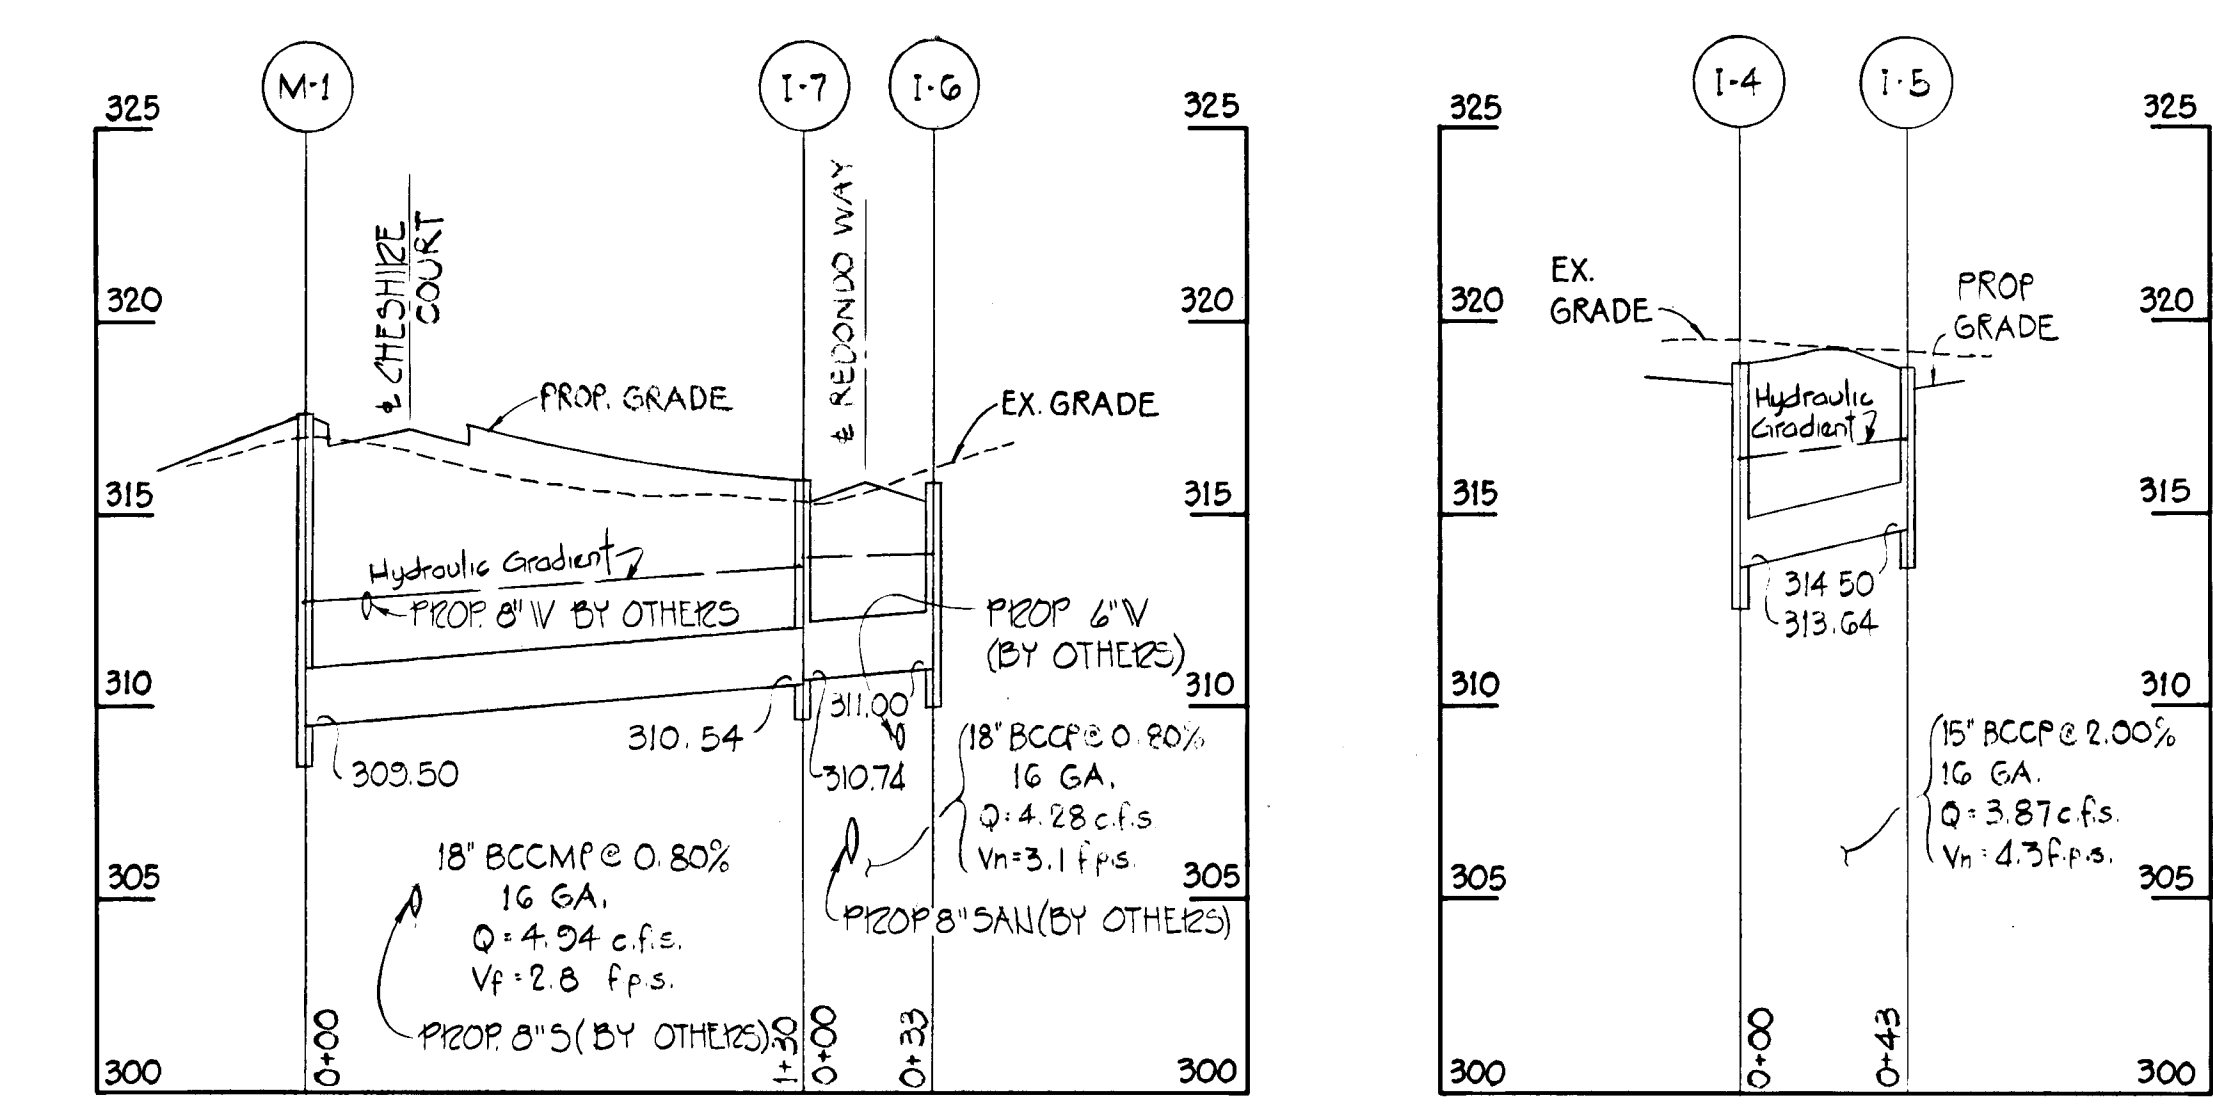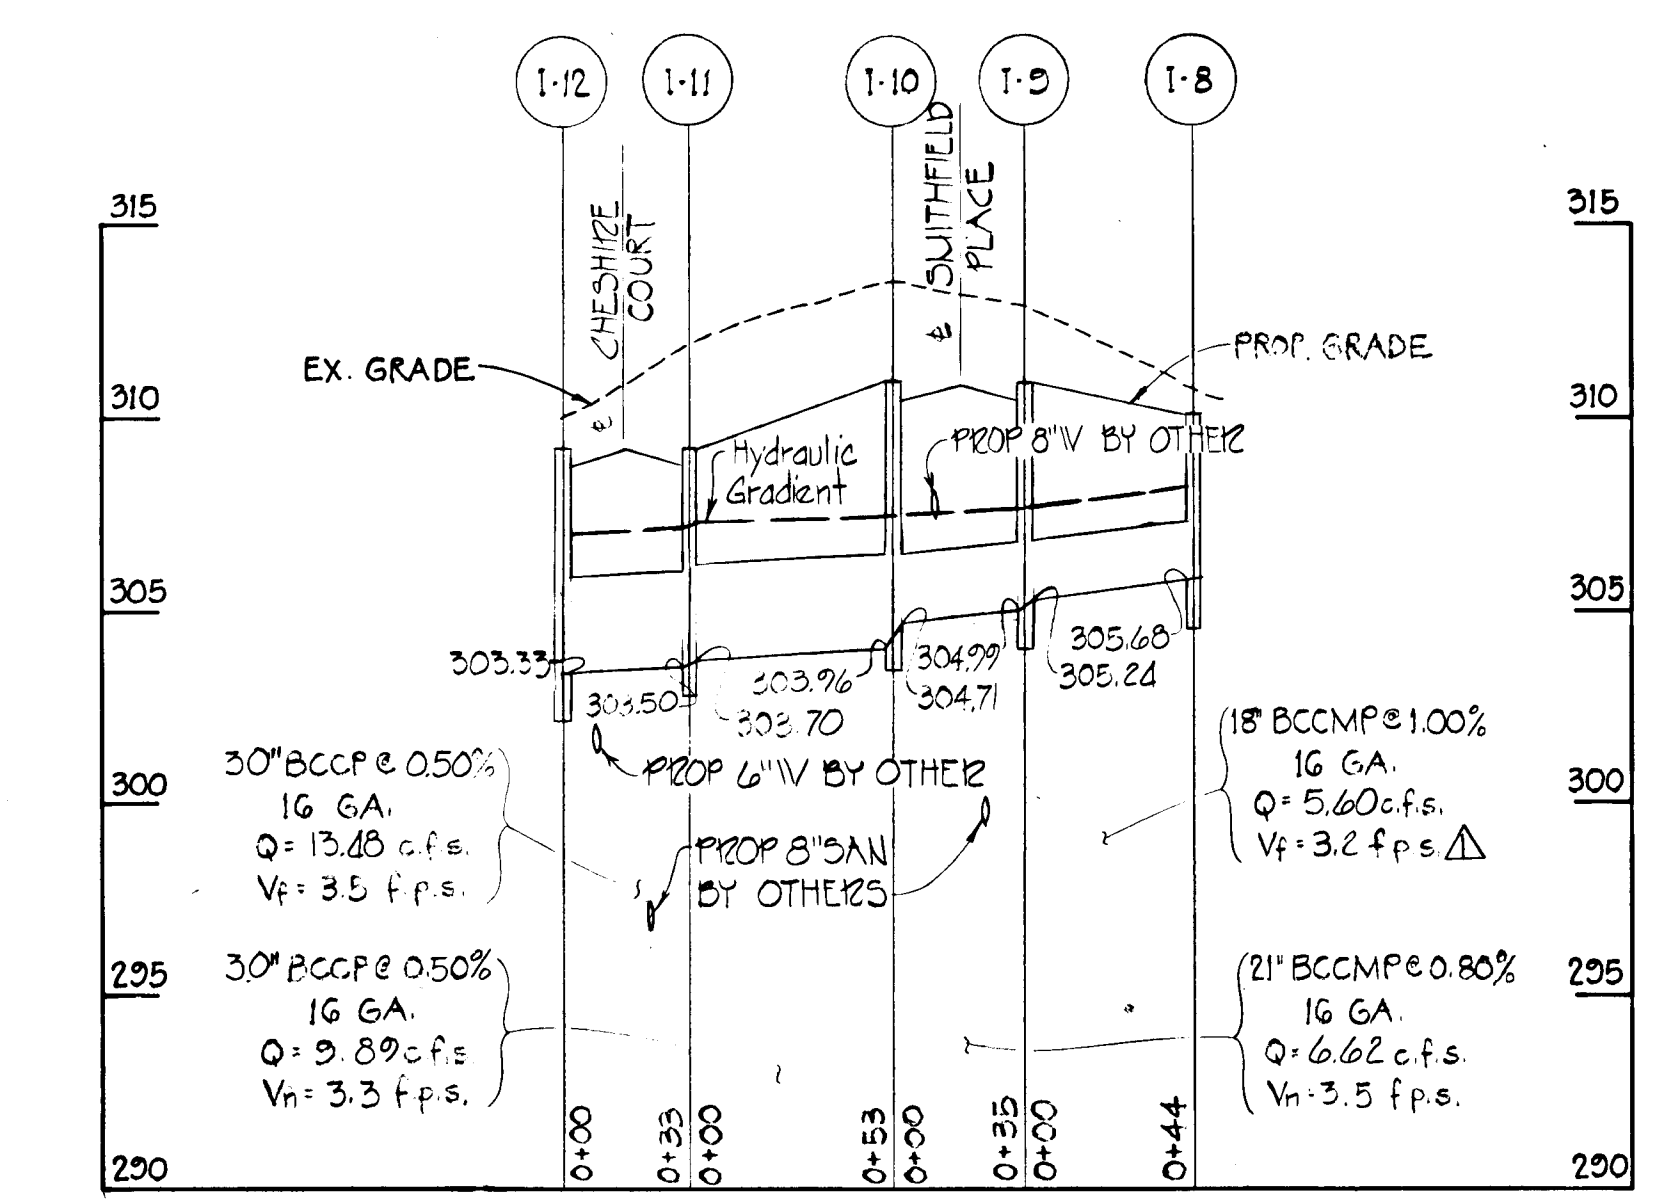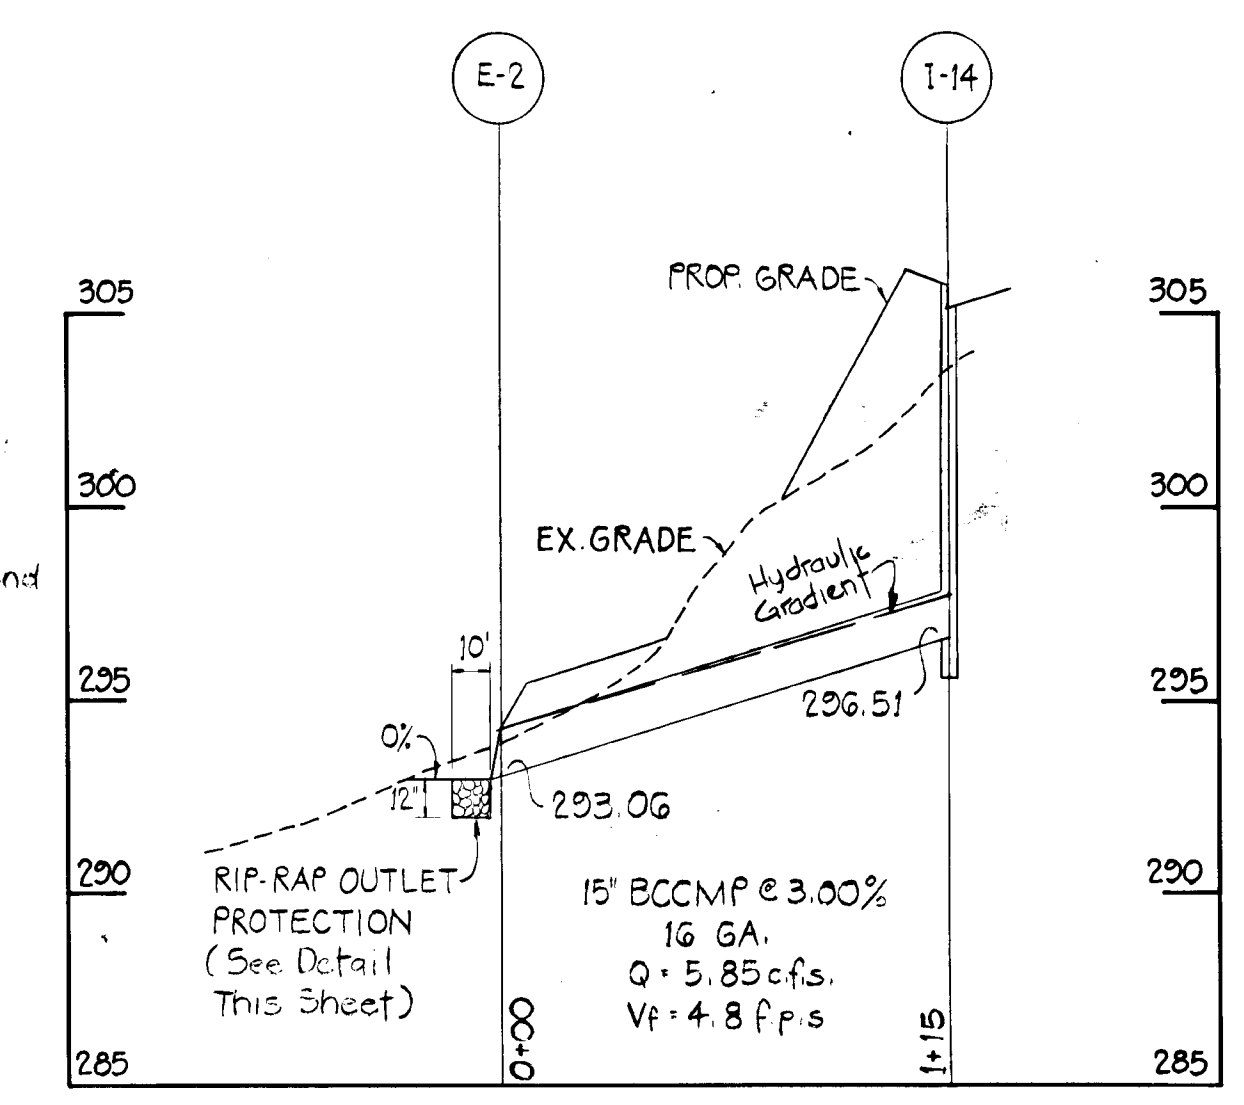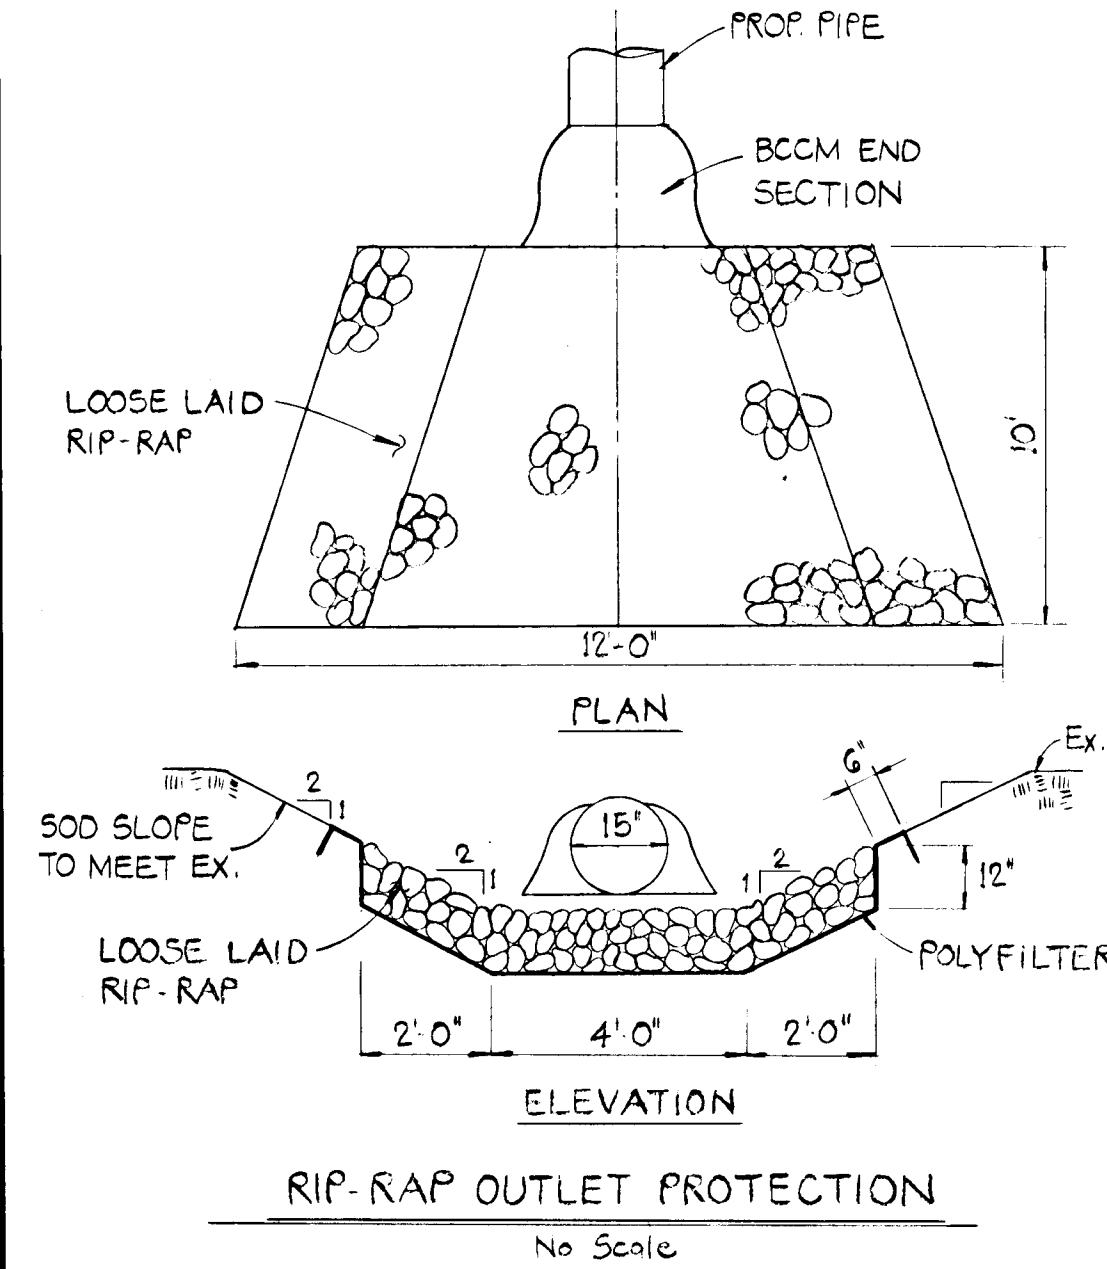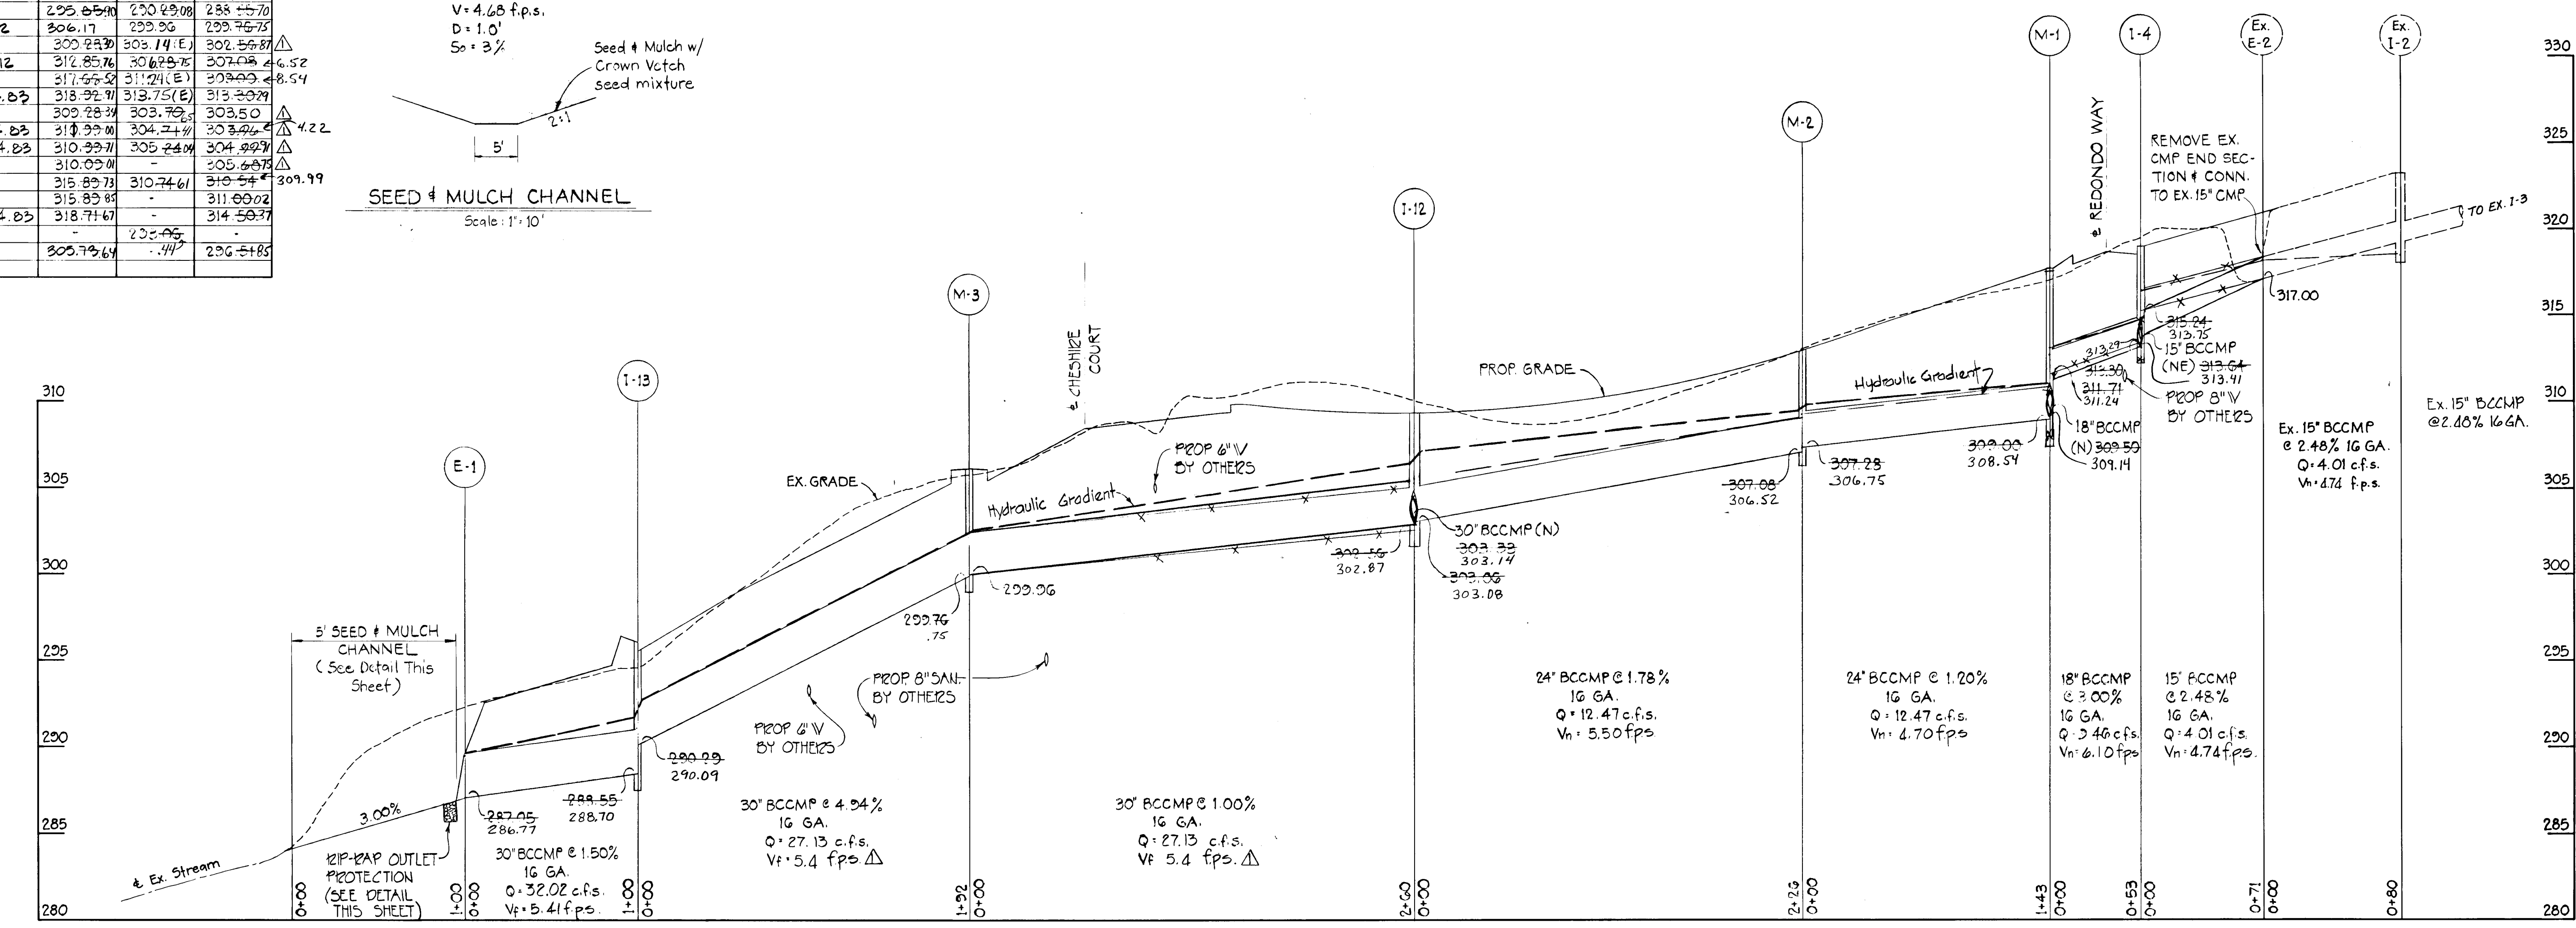

**PROFILES**

Scale: Horiz. 1"=50'  
Vert. 1"=5'

This Development Plan is Approved For Soil Erosion And Sediment Control By the Howard Soil Conservation District.  
APPROVED Robert Zielman 9-28-82  
Howard Soil Conservation District Date

Reviewed For Howard Soil Conservation District And Meets Technical Requirements.  
James Mitchell 9-28-82  
Signature Date  
W.B. Soil Conservation District

APPROVED: Howard County Department of Public Works.  
William G. Reich II 10-1-82  
Chief, Bureau Of Engineering Date

APPROVED: Howard County Office of Planning And Zoning.  
Planning Director Date  
Louis Fomen 9-29-82  
Chief, Division Of Land Development And Zoning Administration Date

DEVELOPER'S CERTIFICATE:  
I Certify That All Development And/Or Construction Will Be Done In Accordance To This Plan Of Development And Plan Of Erosion And Sediment Control And I Also Authorized Periodic On-Site Inspection By The Howard Soil Conservation District Or Their Authorized Agents As Deemed Necessary.  
William G. Reich II 7/23/82

ENGINEER'S CERTIFICATE:  
I Certify That This Plan For Erosion And Sediment Control Represents A Practical And Workable Plan Based On My Personal Knowledge Of The Site Conditions And That It Was Prepared In Accordance With The Requirements Of The Howard Soil Conservation District.  
William G. Reich II 7/22/82  
William G. Reich II Date



STORM DRAIN PROFILES & DETAILS  
**HERITAGE WOODS**  
SECTION ONE - AREA ONE  
6TH ELECTION DISTRICT  
HOWARD COUNTY, MARYLAND  
TAX MAP 42, PARCELS 371, 254 & 77  
SEPT. 10, 1982 SCALE AS SHOWN


SHEETS OF 8  
DES. E.L.B., DE  
DRW. R.E.C.  
CHK. B.E.  
P.L.V. LOCITIES, STRUCTURE SCHEDULE 12/29/82

967

BRUNING AVE IM32

**PURDUM & JESCHKE**  
CONSULTING ENGINEERS  
LAND SURVEYORS  
1023 North Calvert Street  
Baltimore, Maryland 21202 301/837-0194



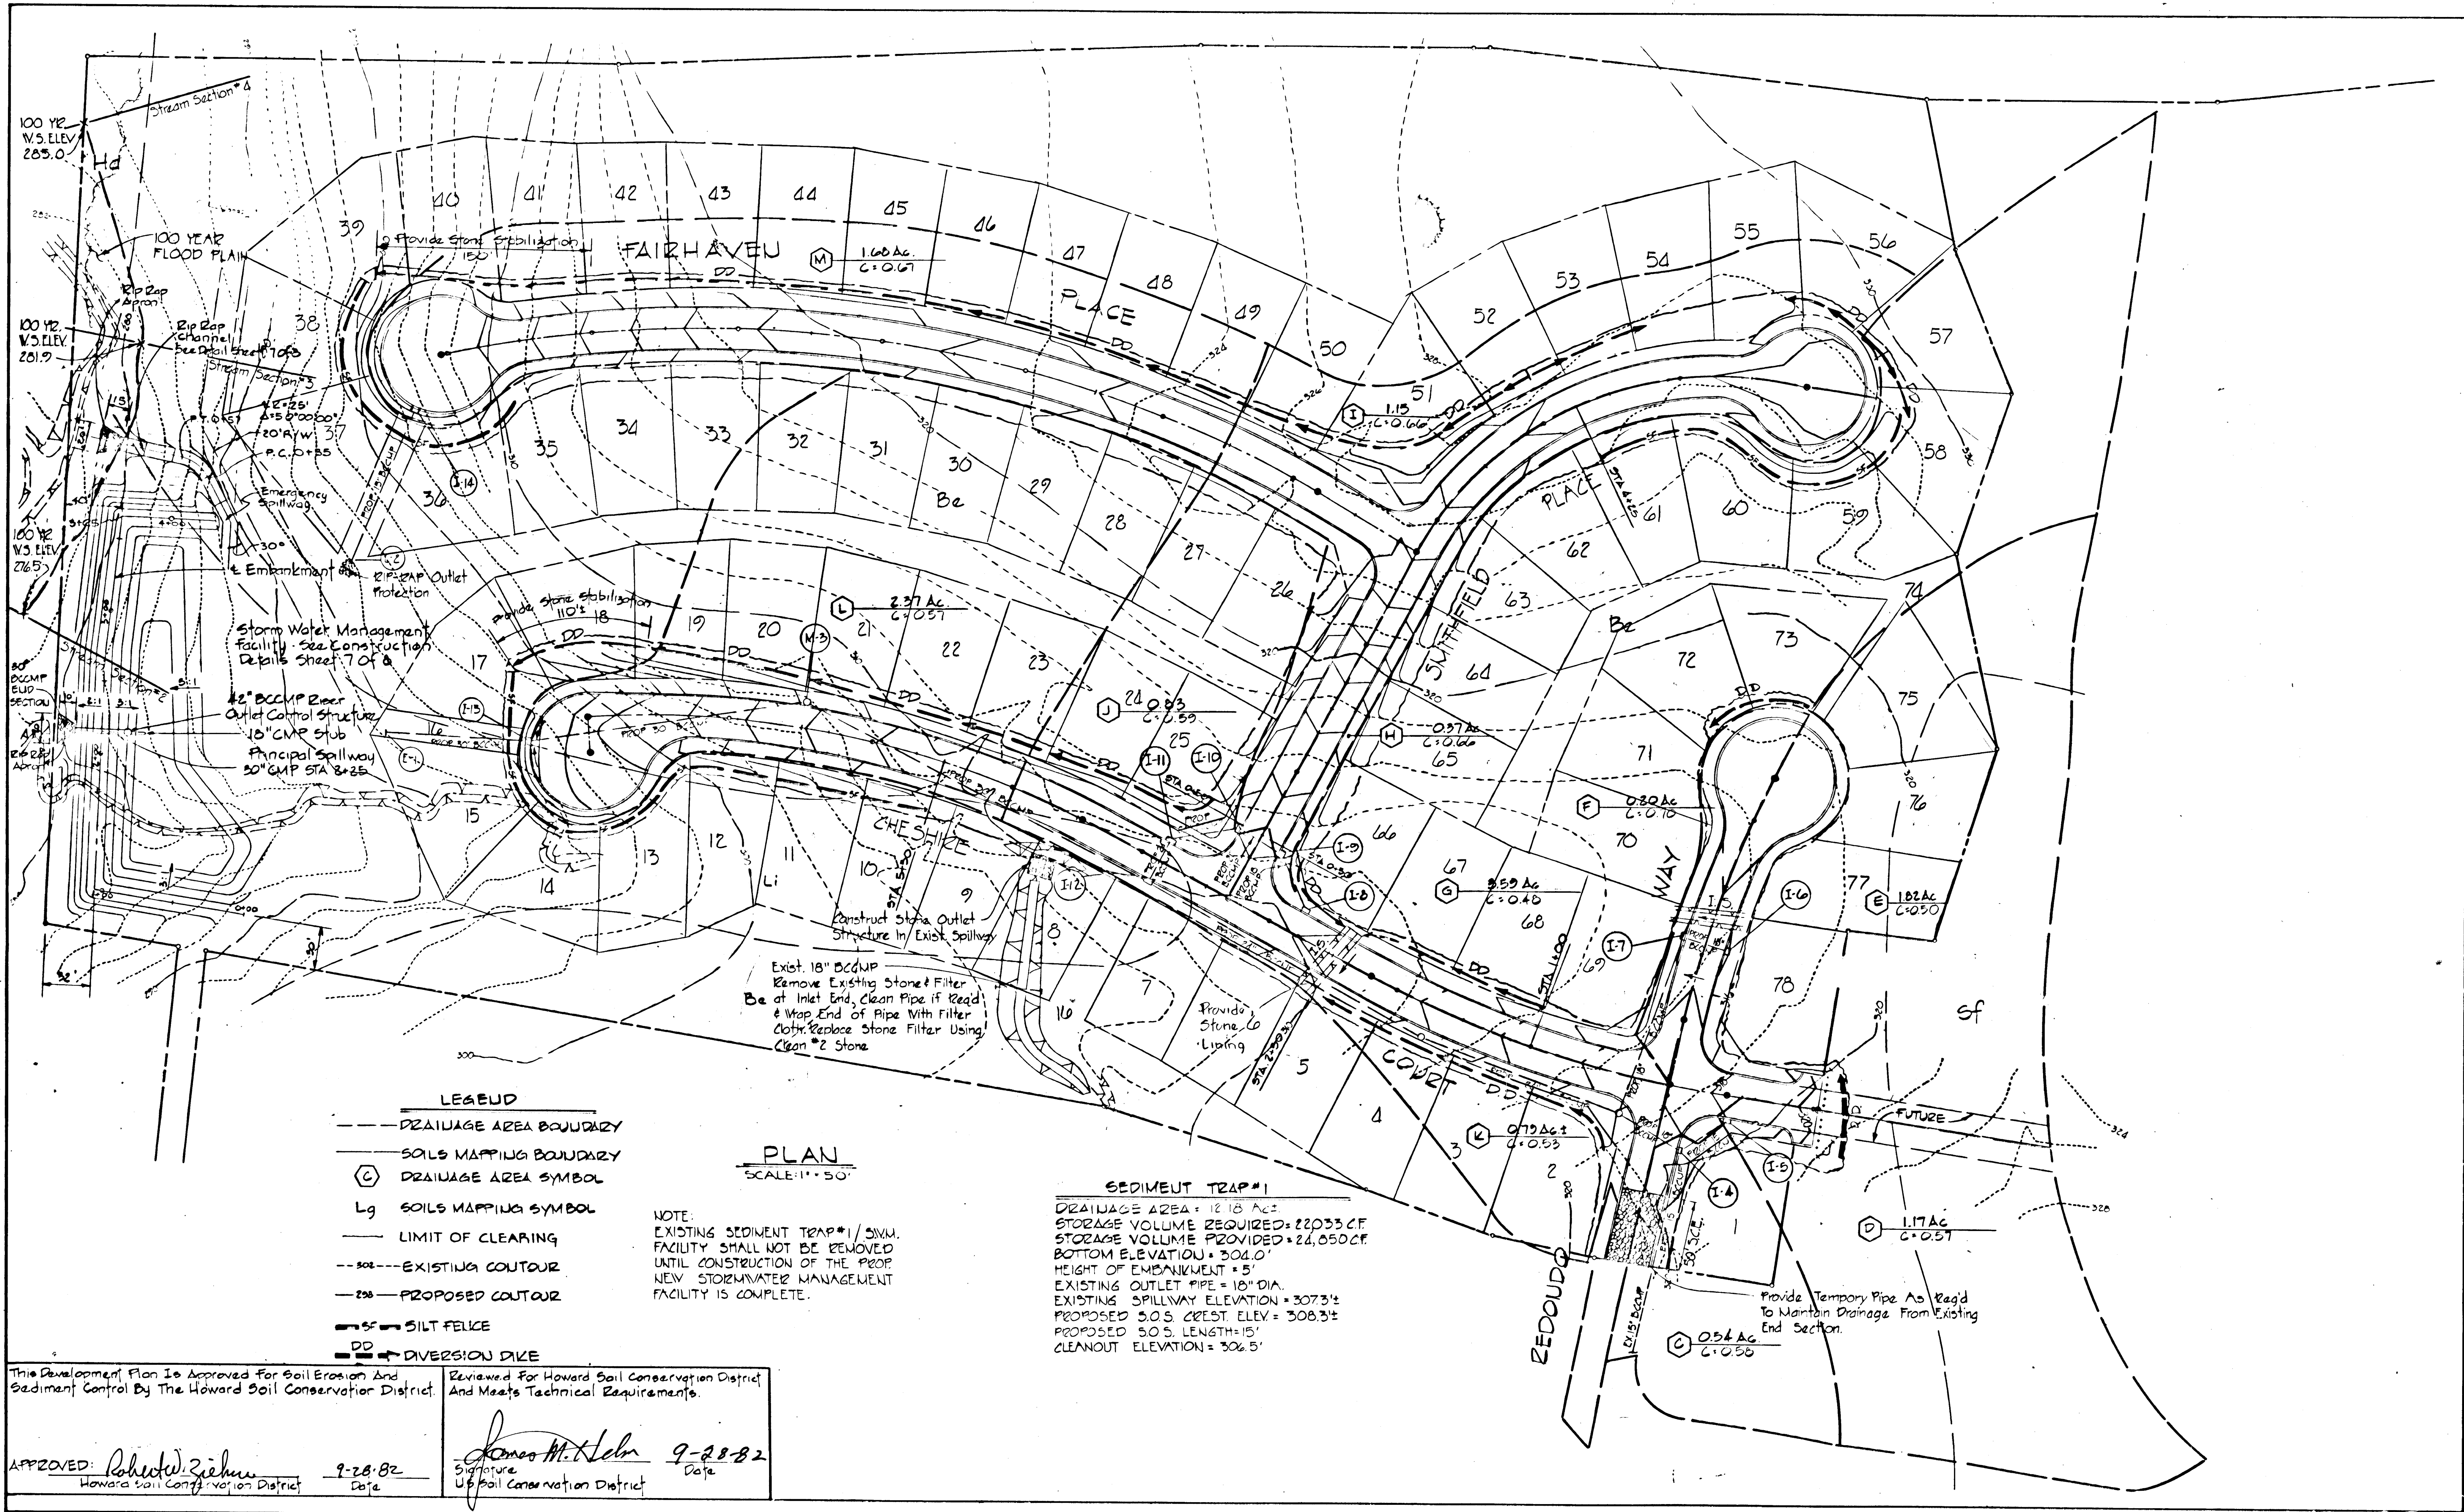

- LEGEND**
- DRAINAGE AREA BOUNDARY
  - SOILS MAPPING BOUNDARY
  - (C) DRAINAGE AREA SYMBOL
  - Lg SOILS MAPPING SYMBOL
  - LIMIT OF CLEARING
  - 50' --- EXISTING COUTOUR
  - 20' --- PROPOSED COUTOUR
  - SF --- SILT FELCE
  - DD --- DIVERSION DIKE

**PLAN**  
SCALE: 1" = 50'

NOTE:  
EXISTING SEDIMENT TRAP #1 / SWM FACILITY SHALL NOT BE REMOVED UNTIL CONSTRUCTION OF THE PROP. NEW STORMWATER MANAGEMENT FACILITY IS COMPLETE.

**SEDIMENT TRAP #1**  
DRAINAGE AREA = 12.18 AC.  
STORAGE VOLUME REQUIRED = 22,033 CF  
STORAGE VOLUME PROVIDED = 24,050 CF  
BOTTOM ELEVATION = 304.0'  
HEIGHT OF EMBANKMENT = 5'  
EXISTING OUTLET PIPE = 18" DIA.  
EXISTING SPILLWAY ELEVATION = 307.3'  
PROPOSED S.O.S. CREST ELEV. = 308.3'  
PROPOSED S.O.S. LENGTH = 15'  
CLEANOUT ELEVATION = 306.5'

This Development Plan Is Approved For Soil Erosion And Sediment Control By The Howard Soil Conservation District. Reviewed For Howard Soil Conservation District And Meets Technical Requirements.

APPROVED: Robert W. Ziehm 9-28-82  
Howard Soil Conservation District Date

Signature: James M. Klein 9-28-82  
UP Soil Conservation District Date

**PURDUM & JESCHKE**  
CONSULTING ENGINEERS  
LAND SURVEYORS  
1023 North Calvert Street  
Baltimore, Maryland 21202 301/677-0194

APPROVED: Howard County Department of Public Works.  
Date: 10-1-82  
Chief, Bureau of Engineering

APPROVED: Howard County Office of Planning And Zoning.  
Date: 9-29-82  
Acting Planning Director: Louis F. Dumas

**DEVELOPER'S CERTIFICATION**  
I Certify That All Development And/Or Construction Will Be Done In Accordance To This Plan Of Development And Plan Of Erosion And Sediment Control And I Also Authorized Periodic Onsite Inspection By The Howard Soil Conservation District Or Their Authorized Agents As Deemed Necessary.  
Date: 9/22/82

**ENGINEER'S CERTIFICATION**  
I Certify That This Plan For Erosion And Sediment Control Represents A Practical And Working Plan Based On My Personal Knowledge Of The Site Conditions And That It Was Prepared In Accordance With The Requirements Of The Howard Soil Conservation District.  
Date: 9/22/82



**EROSION & SEDIMENT CONTROL PLAN & DRAINAGE AREA MAP**  
**HERITAGE WOODS**  
SECTION ONE - AREA ONE  
6TH ELECTION DISTRICT  
TAX MAP 42 PARCELS 371, 204, 177  
SEPT 14, 1982 SCALE: 1" = 50'

SHEET 6 OF 8  
DES: DE  
DRW: RAZ  
CHK: DE  
ADD ALL LOT LINES & NOS  
12/29/82

#967



These specifications are appropriate to ponds within the scope of the Standard for practice 378.

**I. SITE PREPARATION**

Areas designated for borrow areas, embankment, and structural works shall be cleared, grubbed and stripped of topsoil. All trees, vegetation, roots and other objectionable material shall be removed. Channel banks and other breaks shall be sloped to no steeper than 1:1.

Areas to be covered by the pond or reservoir will be cleared of all trees, brush, logs, fences, rubbish and other objectionable material unless otherwise designated on the plans. Trees, brush and stumps shall be cut approximately level with the ground surface.

All cleared and grubbed material shall be disposed of outside and not the limits of the dam and reservoir as directed by the owner or his representative. When specified, a sufficient quantity of topsoil will be accepted in a suitable location for use on the embankment and other designated areas.

**II. BARTH FILL**

**Material**  
The fill material shall be taken from approved designated borrow area or areas. It shall be free of roots, stumps, wood, rubbish, oversize stones, frozen or other objectionable materials. The embankment shall be constructed to an elevation which provides for anticipated settlement to the design elevation. The fill height all along the length of the embankment shall be increased above the design elevation (including freeboard) as shown on the plans.

**Placement**  
Areas on which fill is to be placed shall be scarified prior to placement of fill. Fill materials shall be placed in 8-inch maximum thickness (before compaction) layers which are to be continuous over the entire length of the fill. The most porous borrow material shall be placed in the downstream portion of the embankment.

**Compaction**  
The movement of the hauling and spreading equipment over the fill shall be controlled so that the entire surface of each lift shall be traversed by not less than one track of the equipment or compaction shall be achieved by a minimum of two passes of the equipment. Rubber tired or vibratory roller. Fill material shall contain sufficient moisture such that the required degree of compaction can be obtained with the equipment used.

Where a minimum required density is specified, each layer of fill shall be compacted as necessary to obtain that density and is to be certified by the Engineer.

**III. STRUCTURAL BACKFILL**

Backfill material shall be of the type and quality conforming to that specified for the adjoining fill material. The fill shall be placed in horizontal layers not more than four inches in thickness and measured by the horizontal distance between the structural member and the backfill material. The side slopes of the structure shall be 1 to 1 or flatter. The backfill material for the cutoff trench shall be the most impervious material available and shall be compacted with equipment or rollers to assure maximum density and minimum permeability.

**IV. PIPE CONNECTIONS**

**A. Corrugated Metal Pipe**

1. **Materials - (Steel Pipe)** - This pipe and its appurtenances shall be galvanized and fully bituminous coated and shall conform to the requirements of ASTM Specification M-180 Type A with water tight coupling bands. Any bituminous coating damaged or otherwise impaired shall be replaced with cold applied bituminous coating compound.

2. **Connections** - All connections with pipe must be completely watertight. The drain pipe or barrel connection to the riser shall be welded all around where the pipe and riser are metallic. Watertight coupling bands or flanges shall be used at all joints. Anti-seep collars shall be connected to the pipe in such a manner as to be completely watertight. Slaple bands are not considered to be watertight.

3. **Bedding** - The pipe shall be firmly and uniformly bedded throughout its entire length. Where rock or soft, spongy or other unstable soil is encountered, all such material shall be removed and replaced with suitable earth compacted to provide adequate support.

4. **Laying pipe** - The pipe shall be placed with inside circumferential lap pointing downstream and with the longitudinal lap at the side.

5. **Backfilling** shall conform to structural backfill as shown above.


6. **Other details** (anti-seep collars, valves, etc.) shall be as shown on the drawings.

**V. STABILIZATION**


All borrow areas shall be graded to provide proper drainage and left in a slightly condition. All exposed surfaces of the embankment, spillway, spill and borrow areas, and barge shall be stabilized by seeding, liming, fertilizing and mulching (if required) in accordance with the vegetative treatment specifications or to show on the accompanying drawings.

**VI. EROSION AND SEDIMENT CONTROL**


Construction operations will be carried out in such a manner that erosion will be controlled and water and air pollution minimized. State and local laws concerning pollution abatement will be followed. Construction plans shall detail erosion and sediment control measures to be employed during the construction process.

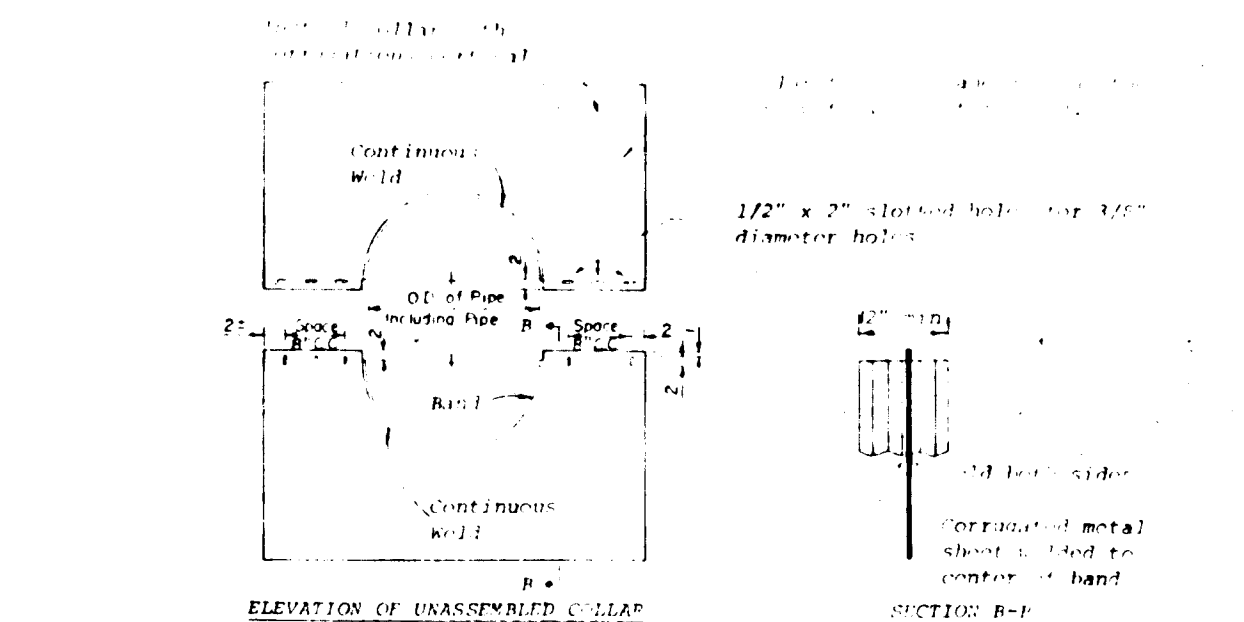


**NOTES FOR COLLARS:**  
1. All materials shall be in accordance with construction and construction material specifications.  
2. When specified on the plans, coating of collars shall be in accordance with construction and construction material specifications.  
3. Unassembled collars shall be marked by painting or tagging to identify matching pairs.  
4. The lap between the two half sections and between the pipe and connection band shall be caulked with asphalt mastic at time of installation.  
5. Each collar shall be furnished with two 1/2" diameter rods with standard hand lugs for connecting collars to pipe.

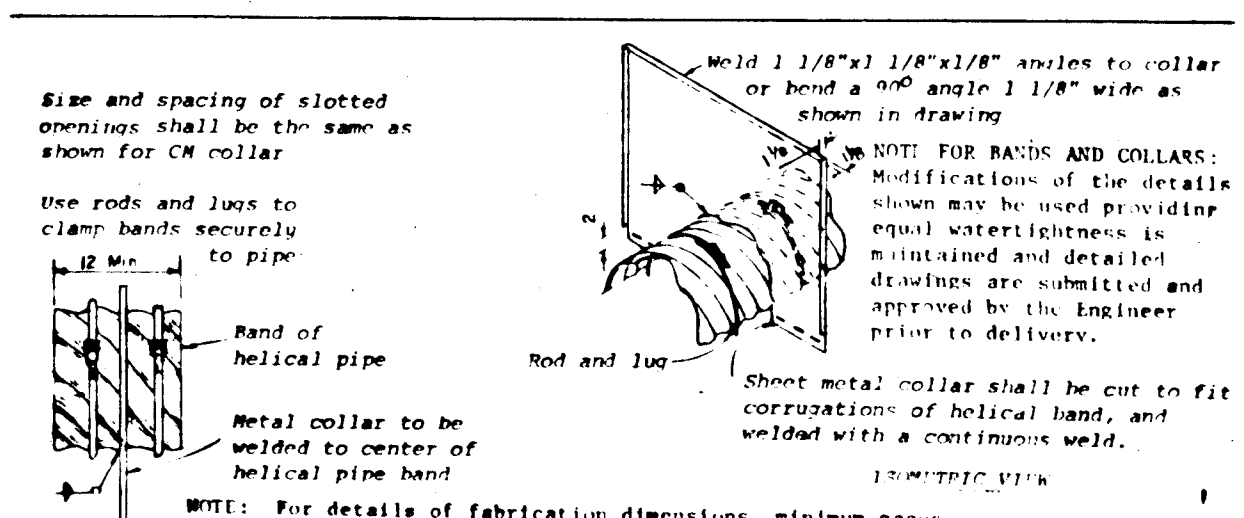


**DETAILS OF HELICAL PIPE ANTI-SEEP COLLAR**  
NOTE: Two other types of anti-seep collars are:  
1. Corrugated metal, similar to upper detail, except shop welded to a short (1 to 1.5) section of the pipe and connected with connecting bands to the pipe.  
2. Concrete, six inches thick, formed around the pipe with #3 rebar spaced 15" horizontally and vertically.

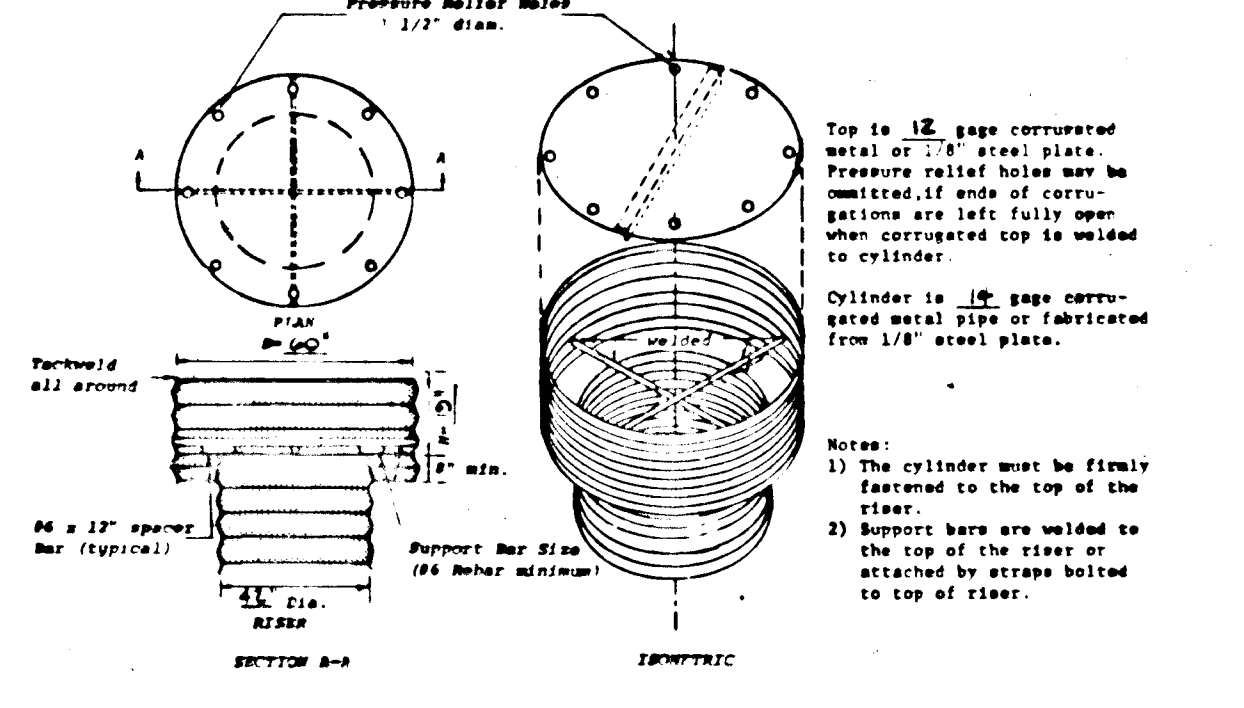


**CONCENTRIC TRASH RACK AND ANTI-VORTEX DEVICE (See to scale)**

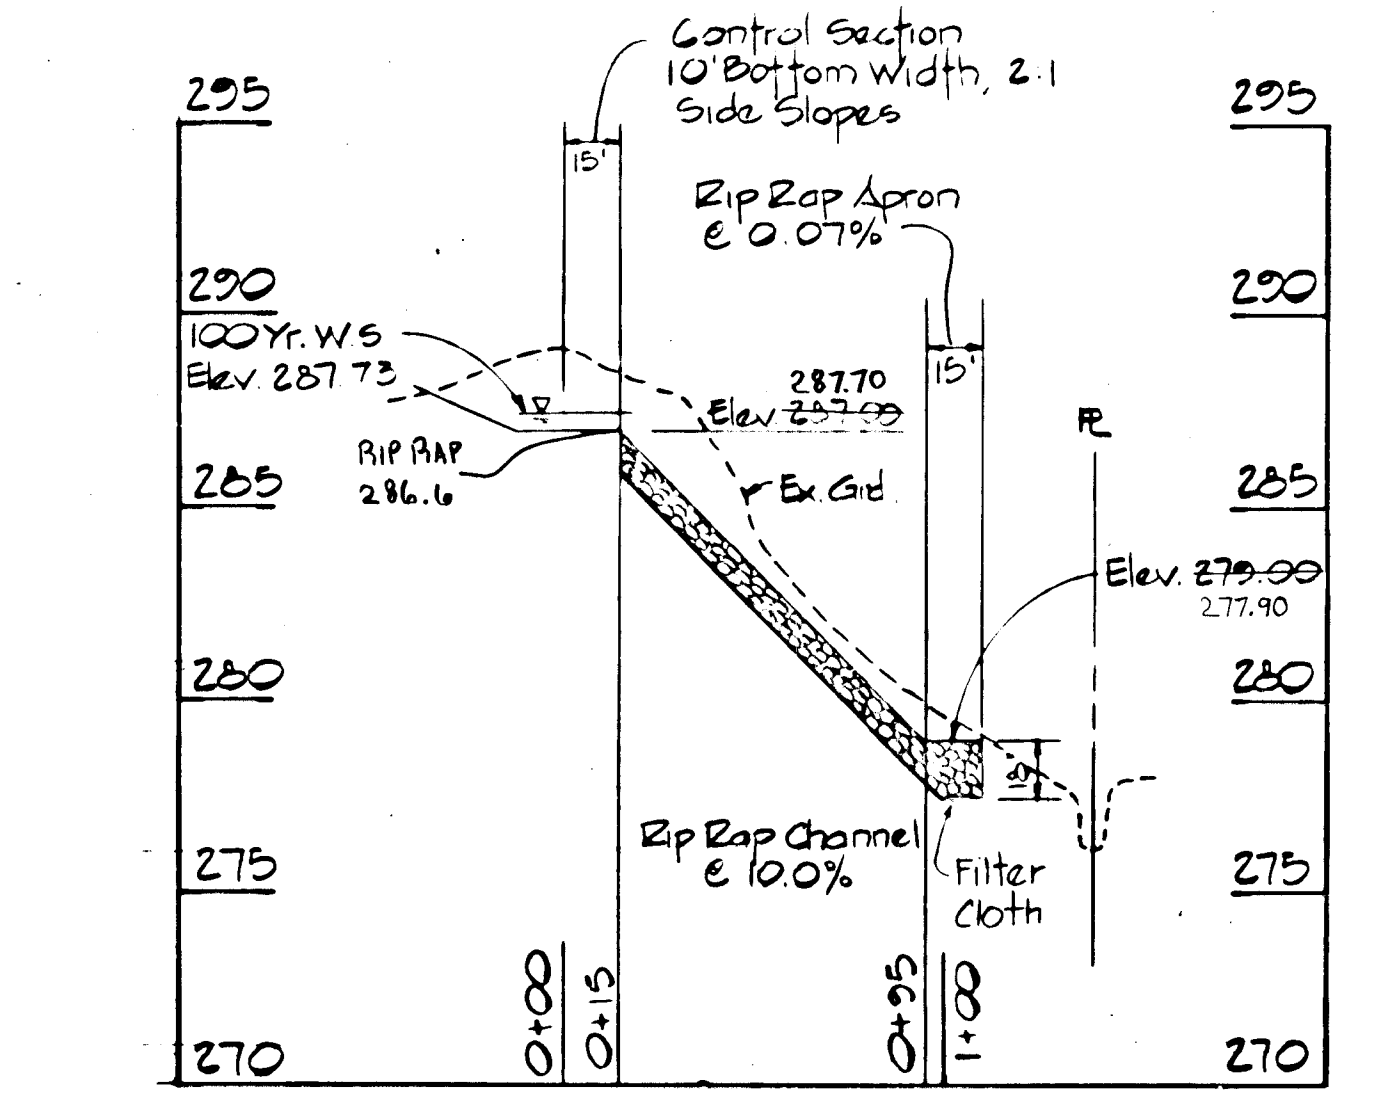


**PROFILE ALONG E EMERGENCY SPILLWAY**  
Scale: 1" = 50' Horiz.  
1" = 5' Vert.

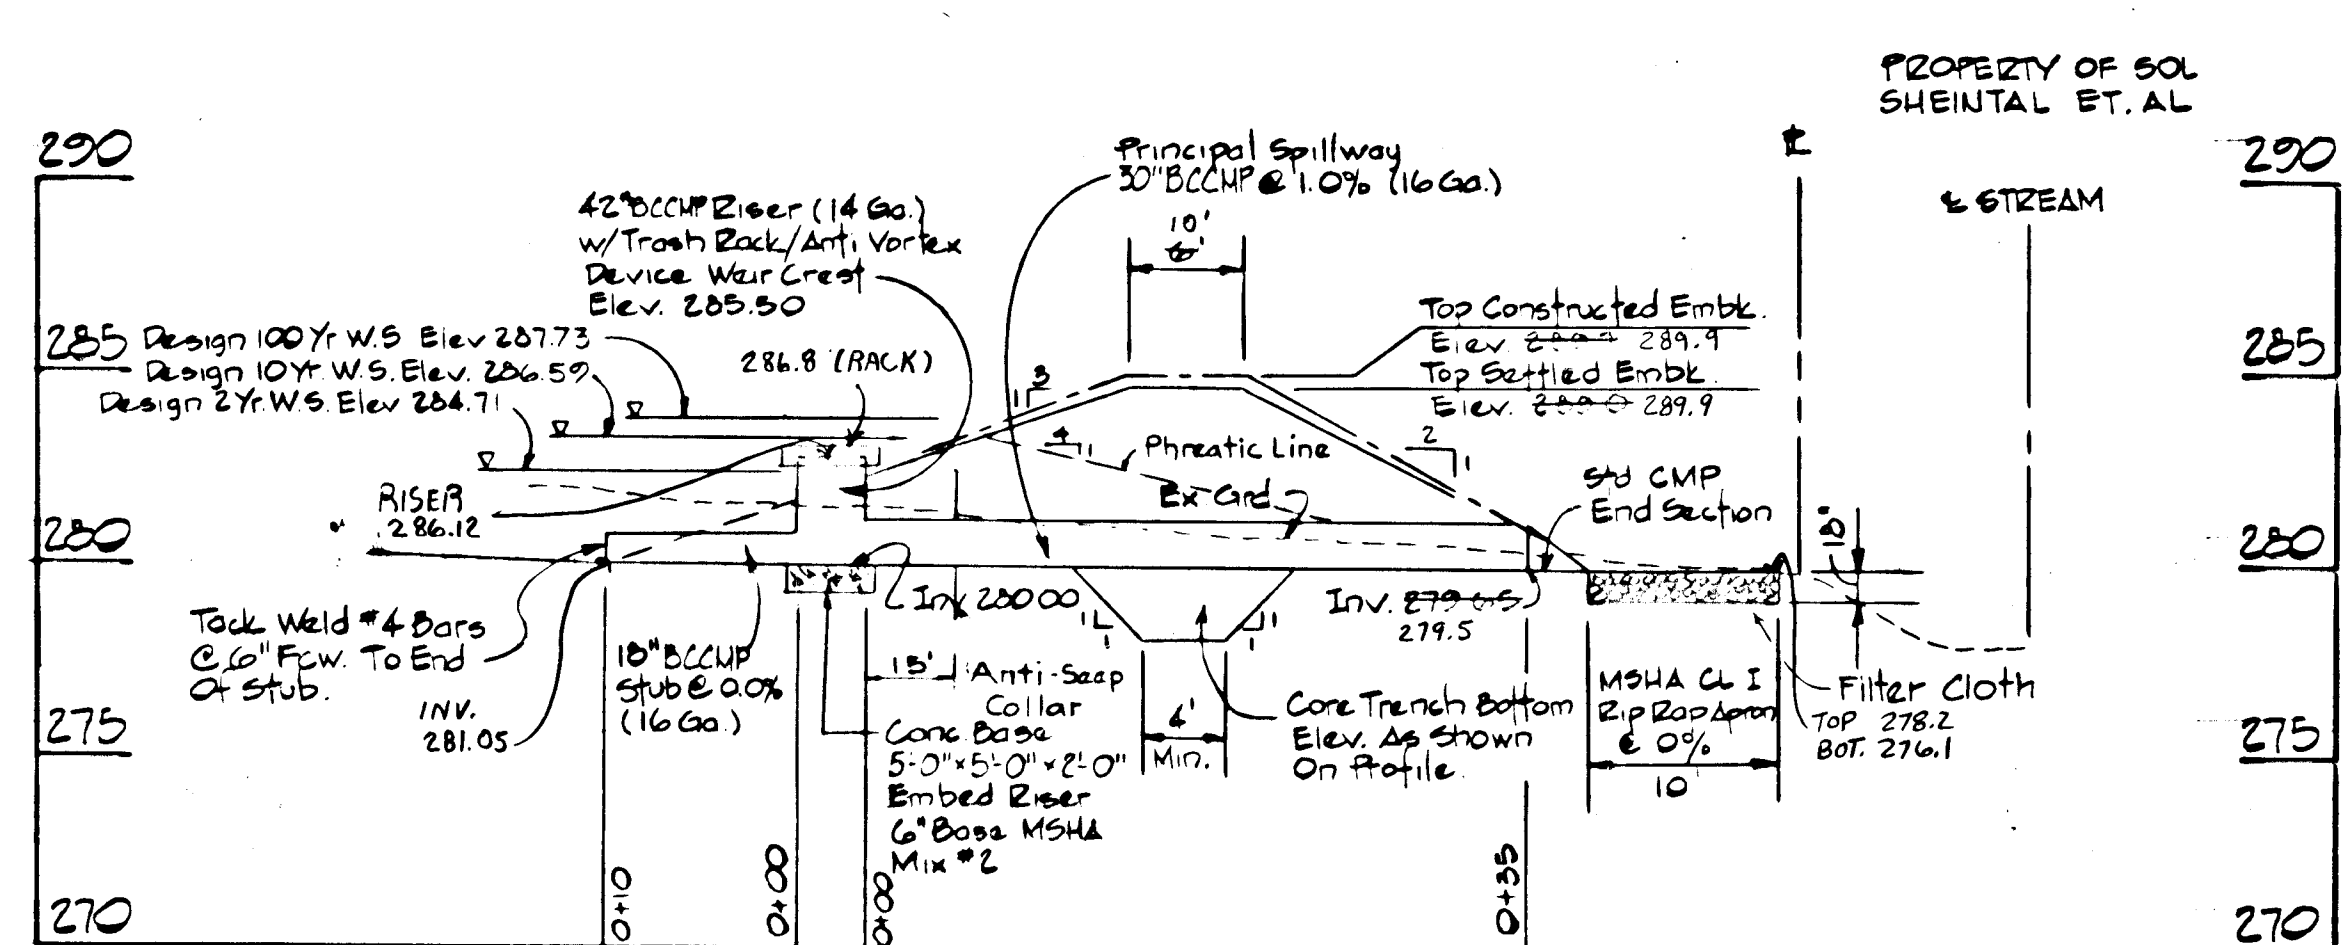


**SECTION THRU EMBANKMENT @ PRINCIPAL SPILLWAY**  
Scale: 1" = 10' Horiz.  
1" = 10' Vert.

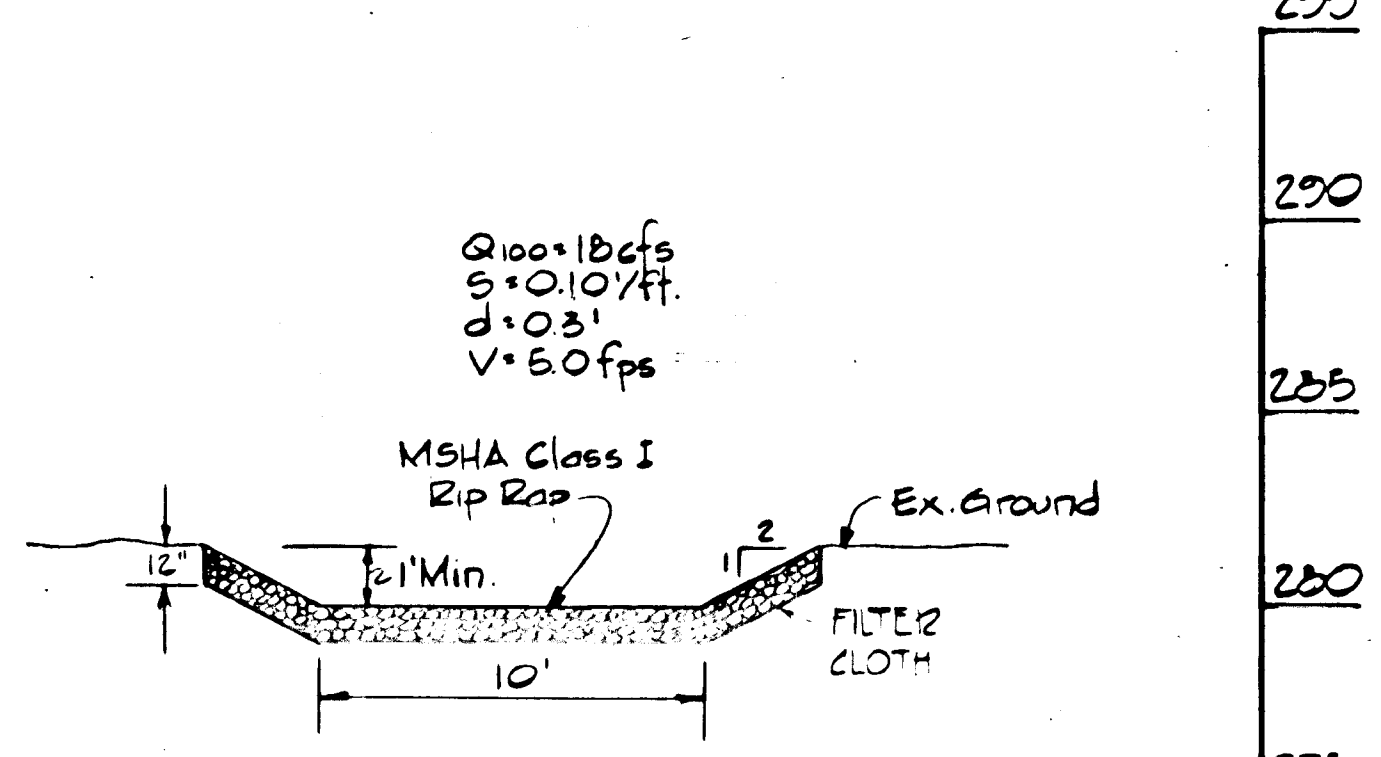

**EMERGENCY SPILLWAY OUTLET CHANNEL**  
No Scale

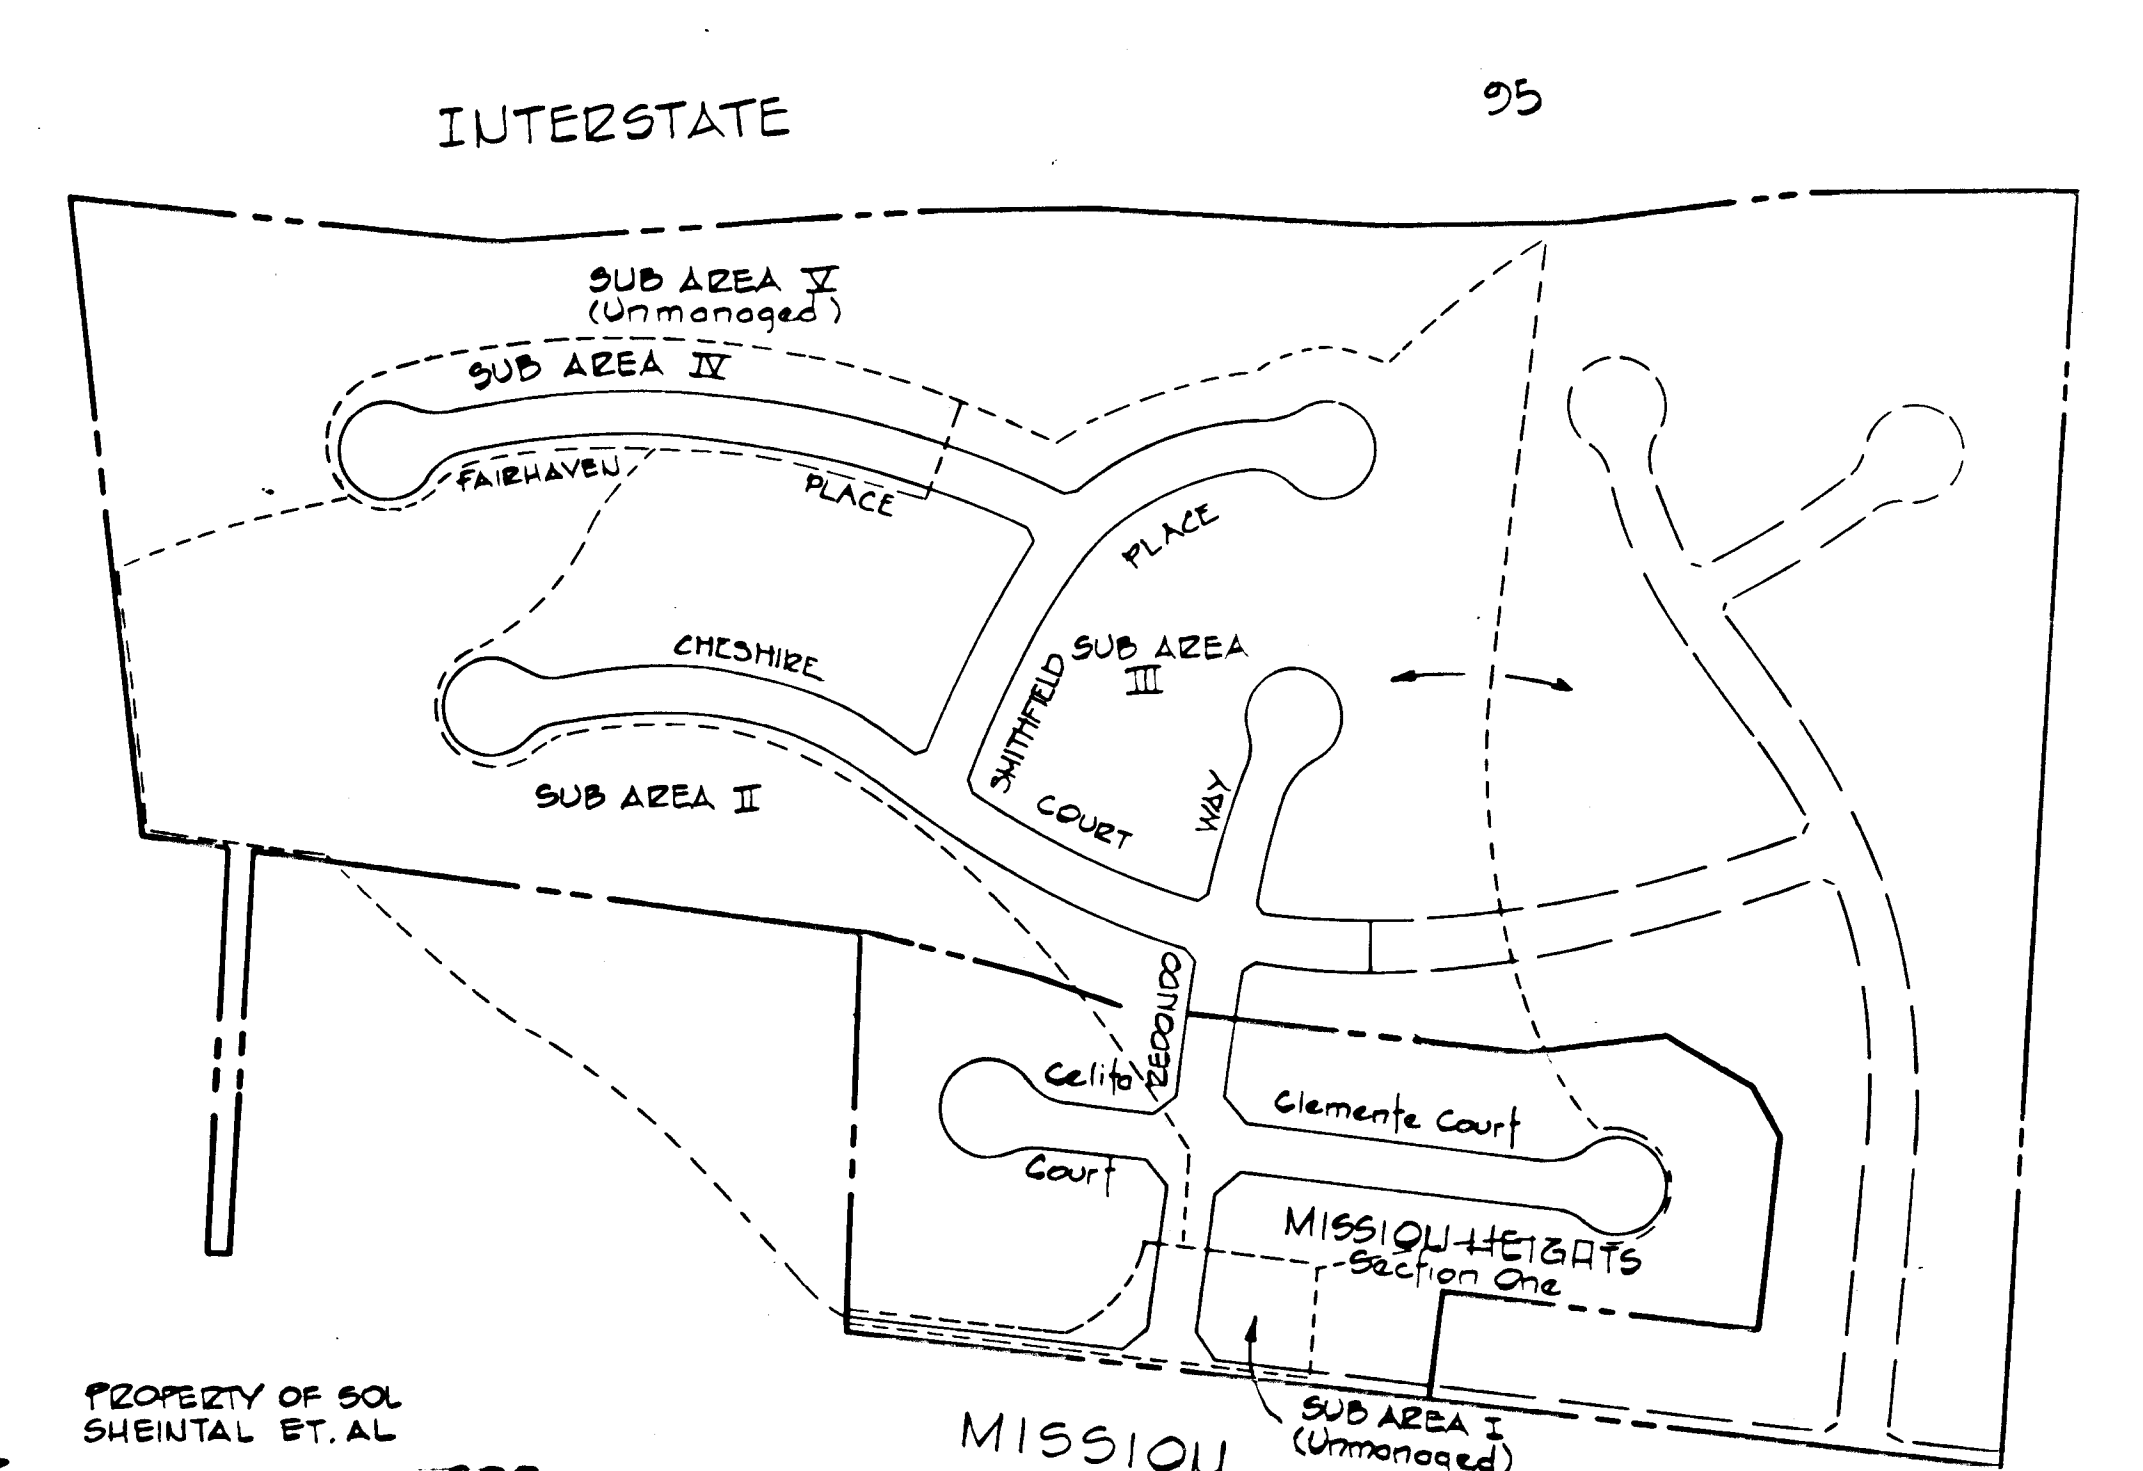

**STORMWATER MANAGEMENT WATERSHED MAP**  
Scale: 1" = 200'

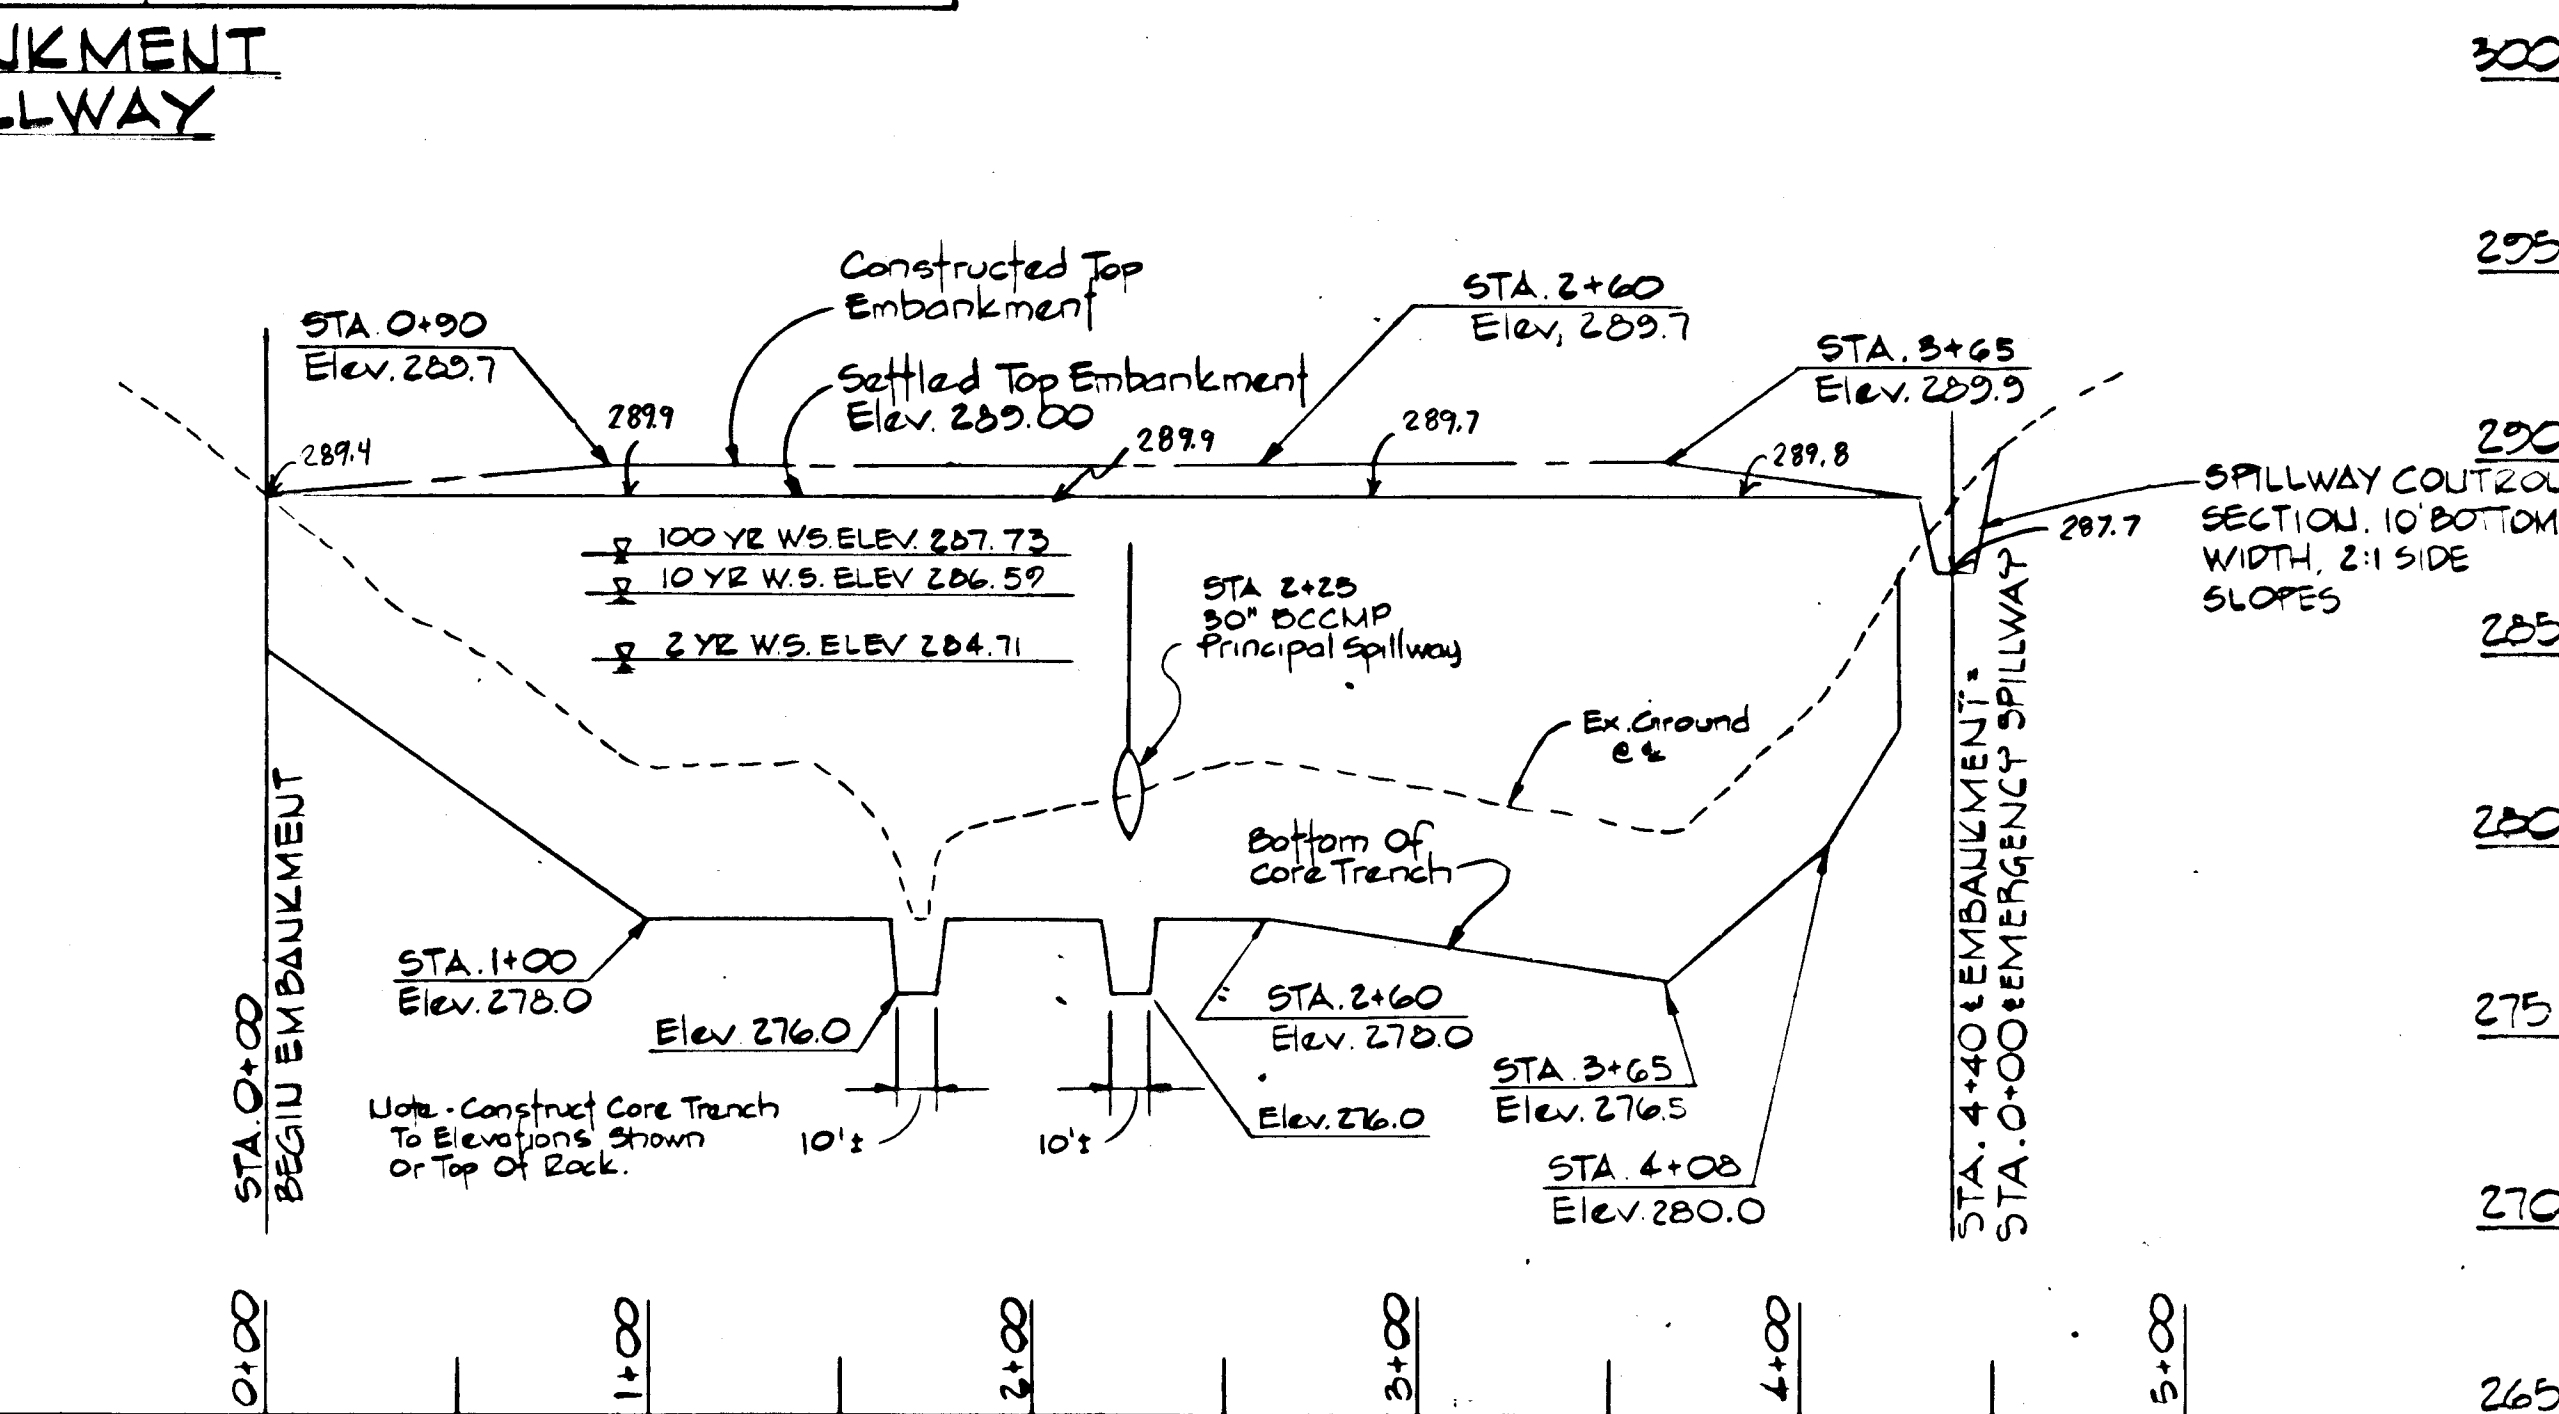

**PROFILE ALONG E EMBANKMENT**  
Scale: Horiz. 1" = 50'  
Vert. 1" = 5'

This Development Plan Is Approved For Soil Erosion And Sediment Control By The Howard Soil Conservation District.  
**APPROVED: Robert W. Ziehn** 9-28-82  
Howard Soil Conservation District Date

Reviewed For Howard Soil Conservation District And Meets Technical Requirements.  
**James M. Helm** 9-28-82  
Signature Date  
UP Soil Conservation District

**PURDUM & JESCHKE CONSULTING ENGINEERS LAND SURVEYORS**  
1023 North Calvert Street  
Baltimore, Maryland 21202 301/837-0194

**APPROVED: Howard County Department of Public Works.**  
**APPROVED: Howard County Office of Planning And Zoning.**  
Planning Director Date  
**ACTING: Louis F. Danner** 9-29-82  
Chief, Bureau of Engineering Date

**DEVELOPER'S CERTIFICATE:**  
I Certify That All Development And/Or Construction Will Be Done In Accordance To This Plan Of Development, And Plan Of Erosion And Sediment Control And I Also Authorize Periodic Onsite Inspection By The Howard Soil Conservation District Or Their Authorized Agents As Required Herein.  
**James R. Schum** 9/29/82

**ENGINEER'S CERTIFICATION:**  
I Certify That This Plan For Erosion And Sediment Control Represents A Practical And Workable Plan Based On My Personal Knowledge Of The Site Conditions And That It Was Prepared In Accordance With The Requirements Of The Howard Soil Conservation District.  
**William G. Rapp** 9/29/82

**STATE OF MARYLAND**  
DEPARTMENT OF THE ENVIRONMENT  
DIVISION OF SOIL CONSERVATION

**STORM WATER MANAGEMENT HERITAGE WOODS**  
SECTION ONE AREA ONE  
6TH ELECTION DISTRICT  
HOWARD COUNTY, MARYLAND  
TAX MAP 42, PARCELS 371, 294, 477  
SEPT. 10, 1982 SCALE AS SHOWN

BRUNING ANE 1982




SEDIMENT CONTROL NOTES

- Specifications for the Sediment Control Details shown hereon are included in the U.S.D.A. Soil Conservation Service "Standards and Specifications for Soil Erosion and Sediment Control in Developing Areas."
- The developer shall notify the Howard County Office of Inspection and Permits at least 24 hours prior to beginning any construction shown hereon (992-2435 or 992-2436).
- All sediment control structures to remain in place until permission for their removal has been obtained from the Howard County Office of Inspection and Permits (992-2435 or 992-2436).
- All graded areas shall be stabilized in accordance with the following requirements:
  - Site Preparation:
    - Harrow or disc the areas to be seeded with the following materials at the specified rate to a depth of 3":
      - Pulverized limestone at 14 tons/acre.
      - Commercial fertilizer 10-10-10 at 3/4 tons/acre.
      - Super phosphate at 600 lbs./acre.
    - Seeding:
      - Sow the following seed mixture at the specified rate with a mechanical spreader:
        - Temporary - Italian or Perennial Ryegrass (1 lb./1000 sq. ft.)
        - Permanent - (Slopes flatter than 3:1) - Common Kentucky Bluegrass 40%, Monon Bluegrass 40%, Red Fescue 20% (3 lb./1000 sq. ft.) (Slopes steeper than 3:1) - Ground Cover
      - The seeded area shall be raked with a York Rake (minimum of 2 passes), covered and compacted with a cultipacker or other approved method.
    - Mulching:
      - Seeded areas shall be uniformly mulched immediately after seeding with unweathered small grain straw at the rate of 14 to 2 tons/acre.
      - Tie mulch down with liquid asphalt at 0.1 gal./s.y. or emulsified asphalt at 0.04 gal./s.y.
    - Sodding:
      - Apply 10-10-10 fertilizer at 1000 lbs./acre. (25 lbs./1000 s.f.)
      - Apply ground agricultural limestone at 2000 lbs./acre. (50 lbs./1000 s.f.)
      - Incorporate both lime and fertilizer into soil by disking. Firm up after incorporation.
      - Lay sod to a tight fit. Roll to insure contact with underlying soil. Water as necessary for first two weeks (in summer) to ensure establishment.
  - Ground Cover:
    - Crown vetch (inoculated) at 15 lbs./acre. and Kentucky 31 Tall Fescue (certified) at 40 lbs./acre. (2:1 maximum slope)
- The contractor shall place plywood braced with sand bags at the inlet end of unfinished drain pipes at the end of each work day.
- All stockpiles shall be protected with straw bale dikes, silt fences, or other approved sediment control devices.


CONSTRUCTION SCHEDULE

- Obtain Grading Permit
- Install temporary diversion dikes and silt fence along Cheshire Court, Southfield Place and Redondo Way.
- Install existing Sediment Trap #1 as shown.
- Clear and grade roads to subgrade (except Fairhaven Place).
- Install storm drain system from E-1 to connection with existing system. Block all inlets.
- Begin construction of Stormwater Management Facility
- Install water and sewer in Redondo Way, Cheshire Court and Southfield Place. Repair sediment control devices as required after installation.
- Install sediment control devices for Fairhaven Place.
- Clear and grade Fairhaven Place to subgrade. Construct storm drain system from E-2 to I-14. Block inlet.
- Install water and sewer in Fairhaven Place. Repair sediment control devices as required after installation.
- Seed all disturbed areas outside limits of streets as grading is completed.
- Install curb and gutter. Pave streets.
- Remove temporary sediment control devices upon approval of Sediment Control Inspector after areas are stabilized.

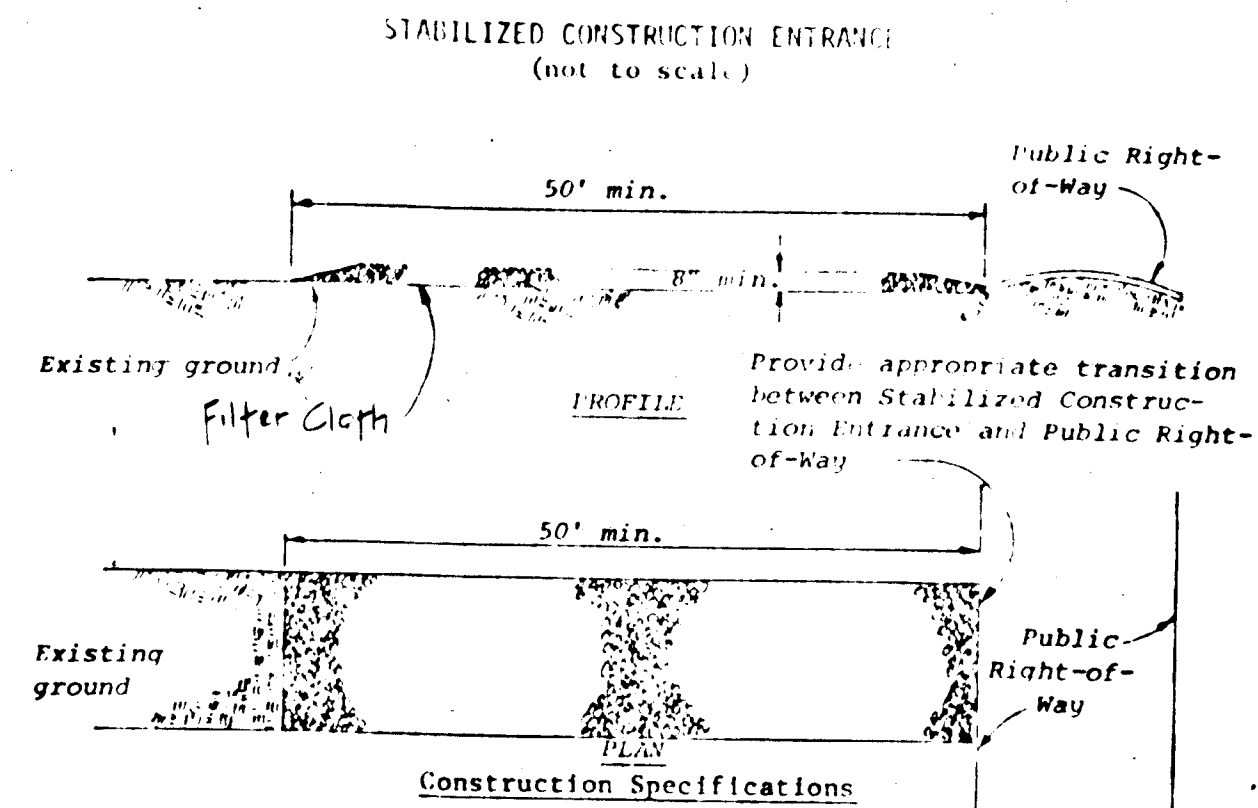

- Construction Specifications
- Stone size - Use MSHA size No. 7 (2-1/2" to 1") or AASHTO designation M43, size No. 2 (2-1/2" to 1-1/2"). Use crushed stone.
  - Length - As effective, but not less than 50 feet.
  - Thickness - Not less than eight (8) inches.
  - Width - Not less than full width of all points of ingress or egress.
  - Washing - When necessary, wheels shall be cleaned to remove sediment prior to entrance onto public right-of-way. When washing is required, it shall be done on an area stabilized with crushed stone which drains into an approved sediment trap or sediment basin. All sediment shall be prevented from entering any storm drain, ditch, or watercourse through use of sand bags, gravel boards or other approved methods.
  - Maintenance - The entrance shall be maintained in a condition which will prevent tracking or floating of sediment onto public rights-of-way. This may require periodic top dressing with additional stone as conditions demand and repair and/or cleanout of any measures used to trap sediment. All sediment spilled, dropped, washed or tracked onto public rights-of-way must be removed immediately.


Standard Symbol: [Symbol] = 2:1 or flatter

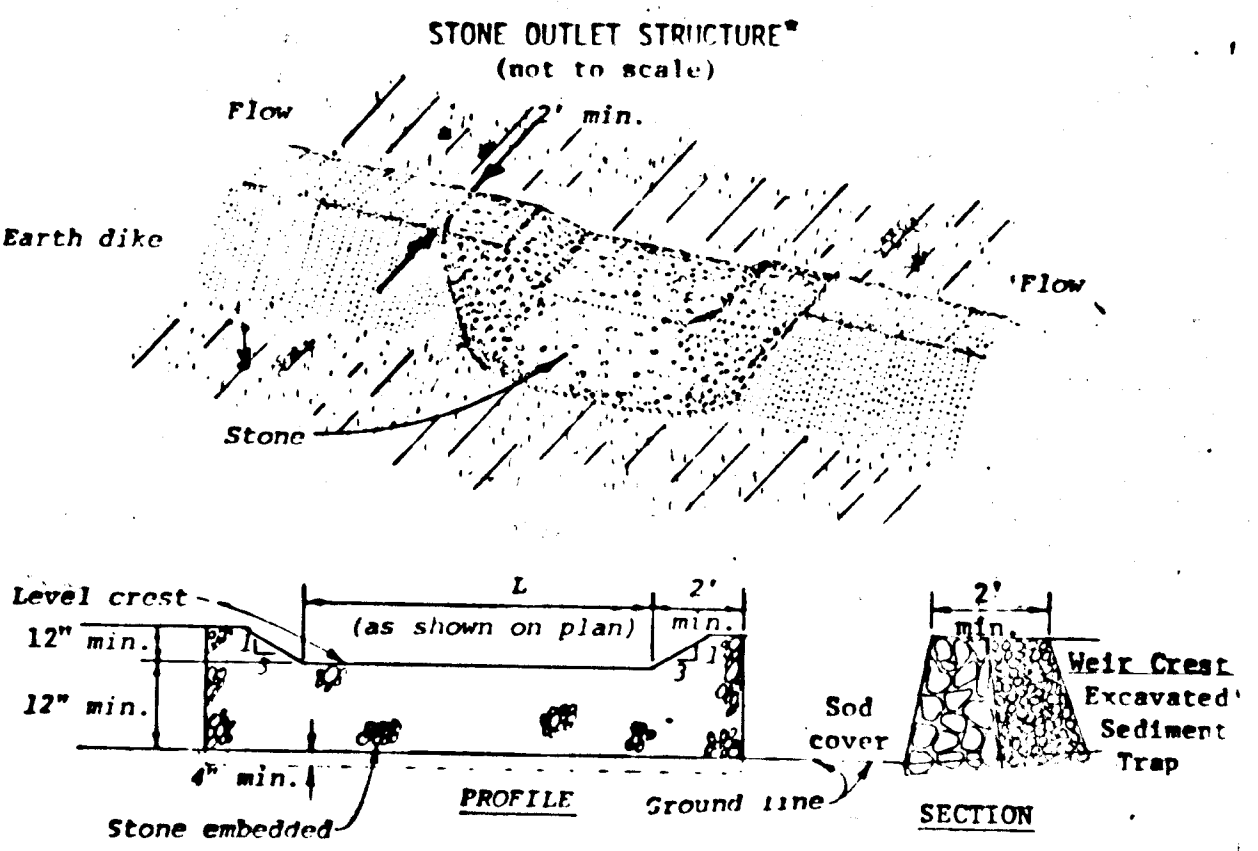


- Construction Specifications
- Area under enhancement shall be cleared, grubbed and stripped of any vegetation and root mat. The pool area shall be cleared.
  - The fill material for the enhancement shall be free of roots or other woody vegetation as well as over sized stones, rocks, organic material or other objectionable material. The enhancement shall be compacted by traversing with equipment while it is being constructed.
  - Sediment shall be removed and trap restored to its original dimensions when the sediment has accumulated to 1/2 the design depth of the trap. Removed sediment shall be deposited in a suitable area and in such a manner that it will not erode.
  - The structure shall be inspected after each rain and repairs made as needed.
  - Construction operations shall be carried out in such a manner that erosion and water pollution is minimized.
  - The structure shall be removed and the area stabilized when the drainage area has been properly stabilized.
  - All cut and fill slopes shall be 2:1 or flatter.
  - The crushed stone used in the outlet shall meet AASHTO designation M43, Size No. 2 or 24 or its equivalent such as MSHA No. 2. Gravel, meeting the above gradation, may be used if crushed stone is not available. Crusher run is not acceptable.
  - Outside half of Stone Outlet shall consist of 4" to 2" radius stone.

Standard Symbol: [Symbol] = Drainage area less than 5 acres

U.S. DEPARTMENT OF AGRICULTURE SOIL CONSERVATION SERVICE College Park, Md.

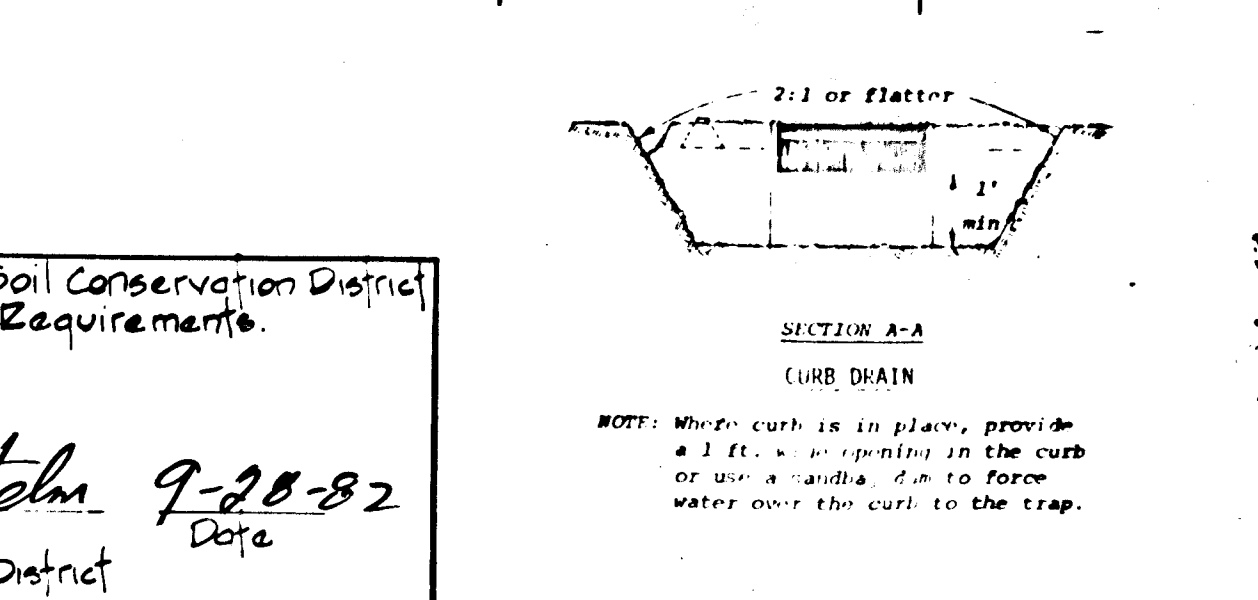


NOTE: When curb is in place, provide 1 ft. x 6" opening in the curb or use a similar 2" to 10" force water over the curb to the trap.

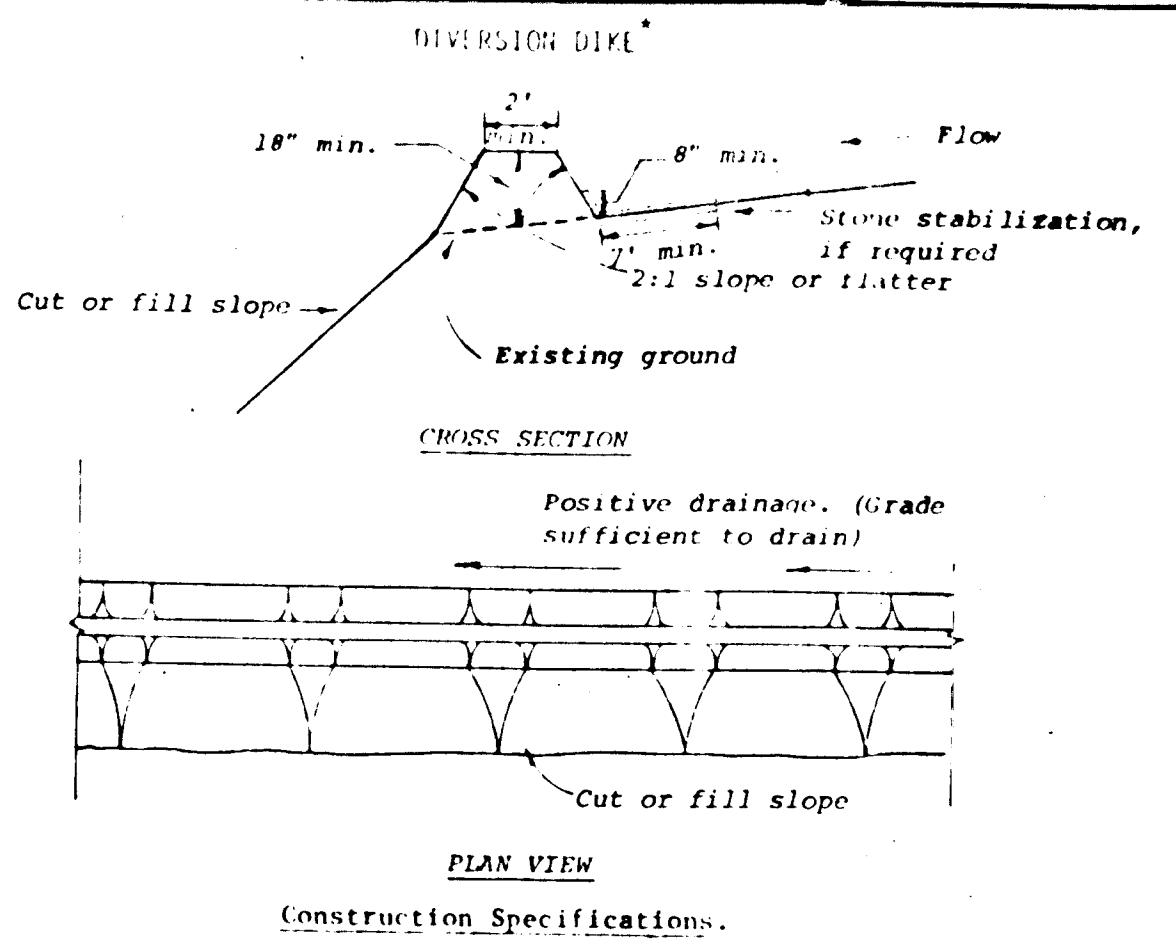


- Construction Specifications
- All dikes shall be machine compacted.
  - All diversion dikes shall have positive drainage to an outlet.
  - Diverted runoff from a protected or stabilized area shall outlet directly to an undisturbed stabilized area or into a level spreader or grade stabilization structure.
  - Diverted runoff from a disturbed or exposed upland area shall be conveyed to a sediment trapping device such as a sediment trap or a sediment basin or to an area protected by any of these practices.
  - Stabilization, as specified by the plans, shall be: (1) in accordance with Standard and Specifications for Grassed Waterway, and the area to be stabilized shall be the channel (flow area); or (2) the flow area shall be lined with stone that meets MSHA size No. 2 or AASHTO M43 size No. 2 or 24 which is placed in a 3 inch thick layer and pressed into the soil. The area covered by the stone shall be as shown on the drawing above.
  - Periodic inspection and required maintenance shall be provided.

Standard Symbol: [Symbol] = Drainage area less than 5 acres

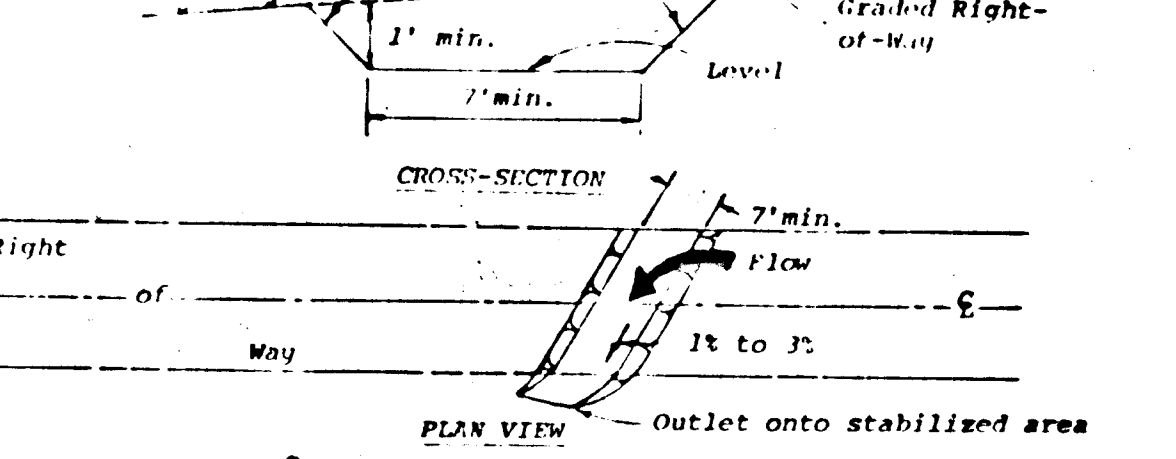


- Construction Specifications
- All trees, brush, stumps, obstructions, and other objectionable material shall be removed and disposed of so as not to interfere with the proper functioning of the swale.
  - The swale shall be excavated or shaped to line, grade, and cross section as required to meet the criteria specified herein and be free of bank projections or other irregularities which will impede normal flow.
  - Fill shall be compacted as needed to prevent unequal settlement that would cause damage in the complete swale.
  - All earth removed and not needed in construction shall be spread or disposed of so that it will not interfere with the functioning of the swale.
  - Interceptor swales shall have a minimum grade of one percent and the bottom shall be level.
  - An interceptor swale shall have an outlet that functions with a minimum of erosion.
  - Runoff shall be conveyed to a sediment trapping device such as a sediment trap or sediment basin.
  - The on-site location may need to be adjusted to meet field conditions in order to utilize the most suitable outlet.
  - Stabilization shall be: (1) in accordance with the Standard and Specifications for Grassed Waterway; or (2) by lining the flow area with stone that meets MSHA size No. 2 or AASHTO M43 size No. 2 or 24 in a layer at least 3 inches in thickness and pressed into the soil. The lining shall extend across the bottom and up both sides of the channel a height of at least 8 inches vertically above the bottom.
  - Periodic inspection and required maintenance shall be provided.

Standard Symbol: [Symbol] = Drainage area less than 5 acres

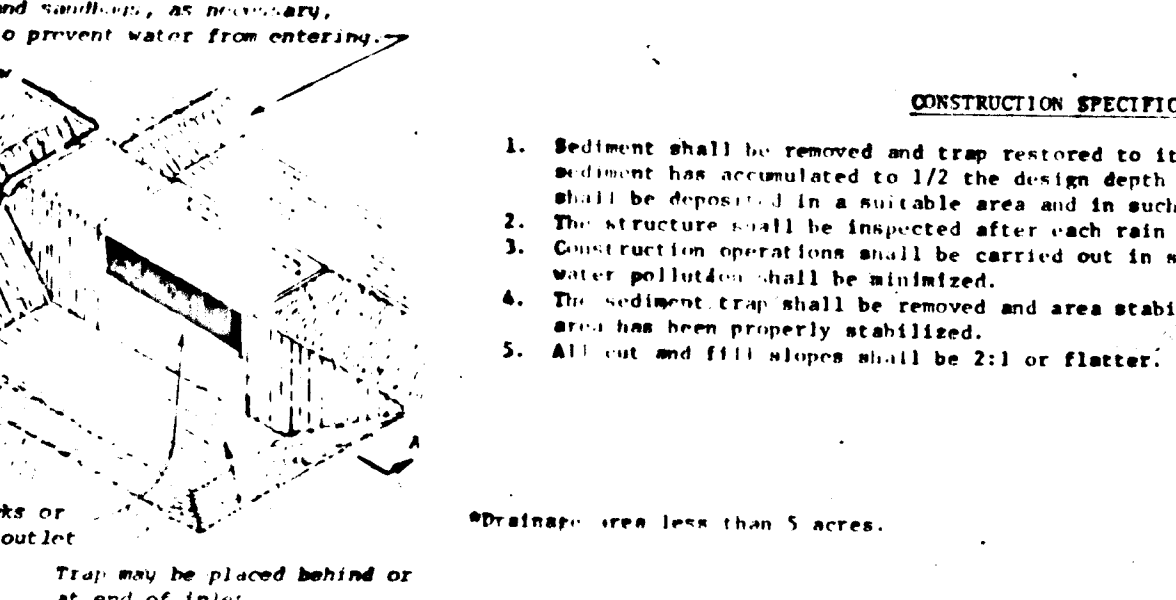


NOTE: When curb is in place, provide 1 ft. x 6" opening in the curb or use a similar 2" to 10" force water over the curb to the trap.

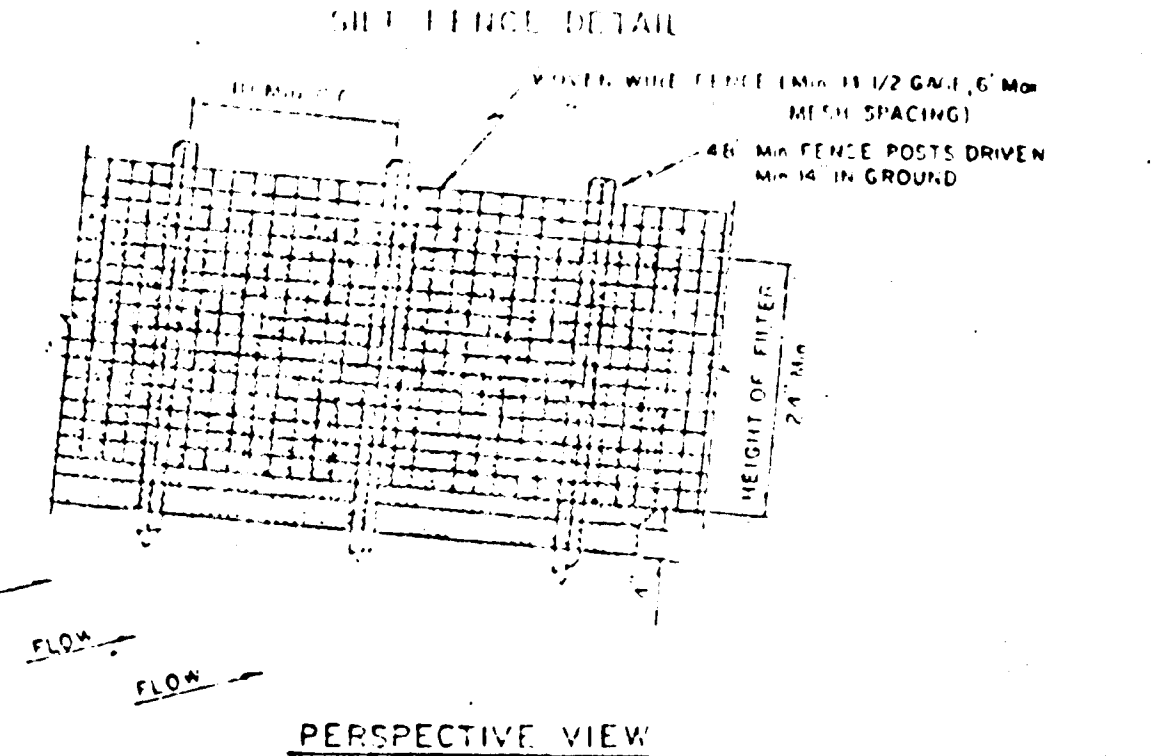

- CONSTRUCTION NOTES
- WOVEN WIRE FENCE TO BE FASTENED SECURELY TO FENCE POSTS WITH WIRE TIES OR STAPLES
  - FILTER CLOTH TO BE FASTENED SECURELY TO WOVEN WIRE FENCE WITH WIRE TIES SPACED EVERY 24" AT TOP AND MID SECTION

SECTION: W.W. FENCE 14 1/2 GA. 6' MESH SPACING WITH FILTER CLOTH COVER. 2" MIN. FIBER FILT CLOTH IN GROUND 4" MIN. POSTS: STEEL EITHER 1" OR 2" HARDWOOD. FENCE: WOVEN WIRE, 14 1/2 GA. 6" MESH OPENING. FILTER CLOTH: FILTER MESH 100 LAUREL EROSION CONTROL CLOTH BIDIM POLYFIBER X OR EQUAL.

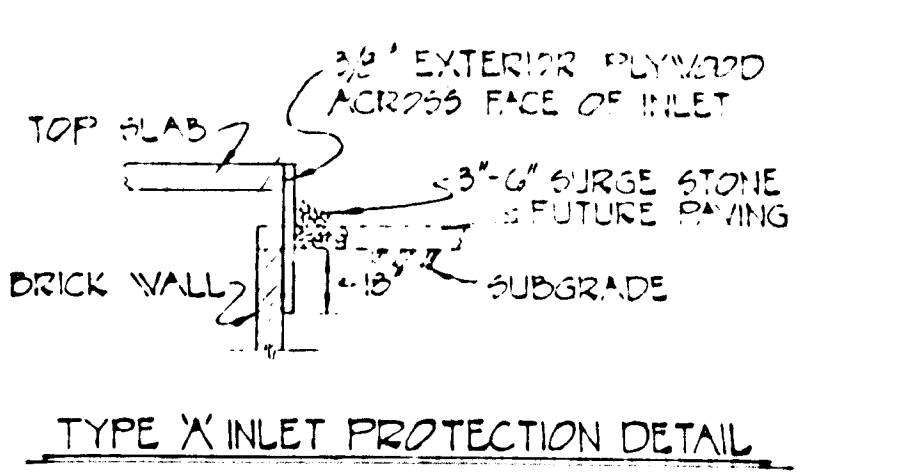

TYPE 'X' INLET PROTECTION DETAIL

This Development Plan Is Approved For Soil Erosion And Sediment Control By The Howard Soil Conservation District.

Reviewed For Howard Soil Conservation District And Meets Technical Requirements.

APPROVED: Robert W. Ziehm, Howard Soil Conservation District, 9-28-82

APPROVED: James M. Stehn, Howard Soil Conservation District, 9-28-82

APPROVED: Howard County Department of Public Works, Planning Director, 10-1-82

APPROVED: Howard County Office of Planning And Zoning, Planning Director, 9-29-82

DEVELOPER'S CERTIFICATION: I Certify That All Development And/Or Construction Will Be Done In Accordance To This Plan Of Development And Plan Of Erosion And Sediment Control And I Also Authorize Periodic Onsite Inspection By The Howard Soil Conservation District Or Their Authorized Agents As Required Herein.

ENGINEER'S CERTIFICATION: I Certify That This Plan For Erosion And Sediment Control Represents A Practical And Workable Plan Based On My Personal Knowledge Of The Site Conditions And That It Was Prepared In Accordance With The Requirements Of The Howard Soil Conservation District.



EROSION & SEDIMENT CONTROL DETAILS SHEET 8 OF 8  
HERITAGE WOODS SECTION ONE - AREA ONE  
6TH ELECTION DISTRICT  
HOWARD COUNTY, MARYLAND  
TAX MAP 42, PARCELS 371, 234 & 71  
JUNE 25, 1982 SCALE AS SHOWN

# 927