


"AS-BUILT" ELEVATIONS AS OF NOV. 19, 1984
 BY: KENNETH A. MCCORD P.E. # 1974

CURVE DATA

INT. 17+09.91	PT. 18+45.49	PC. 18+89.85	TO INT. 17+09.91
$\Delta = 07^{\circ}46'05''$	$\text{Tan} = 67.89'$	$\Delta = 18^{\circ}20'16''$	$\text{Tan} = 161.41'$
$R = 1000.00'$	$\text{Ch.} = 135.48'$	$R = 1000.00'$	$\text{Ch.} = 316.60'$
$\text{Arc} = 135.58'$	$\text{Ch. Brg.} = 587^{\circ}24'52''\text{W}$	$\text{Arc} = 320.06'$	$\text{Ch. Brg.} = 574^{\circ}21'41''\text{W}$

NOTE: FOR EXISTING HICKORY RIDGE ROAD PLAN AND PROFILE, SEE CONSTRUCTION DRAWINGS FOR VILLAGE OF CLARY'S FOREST SECTION I AREA I (F-73-79)

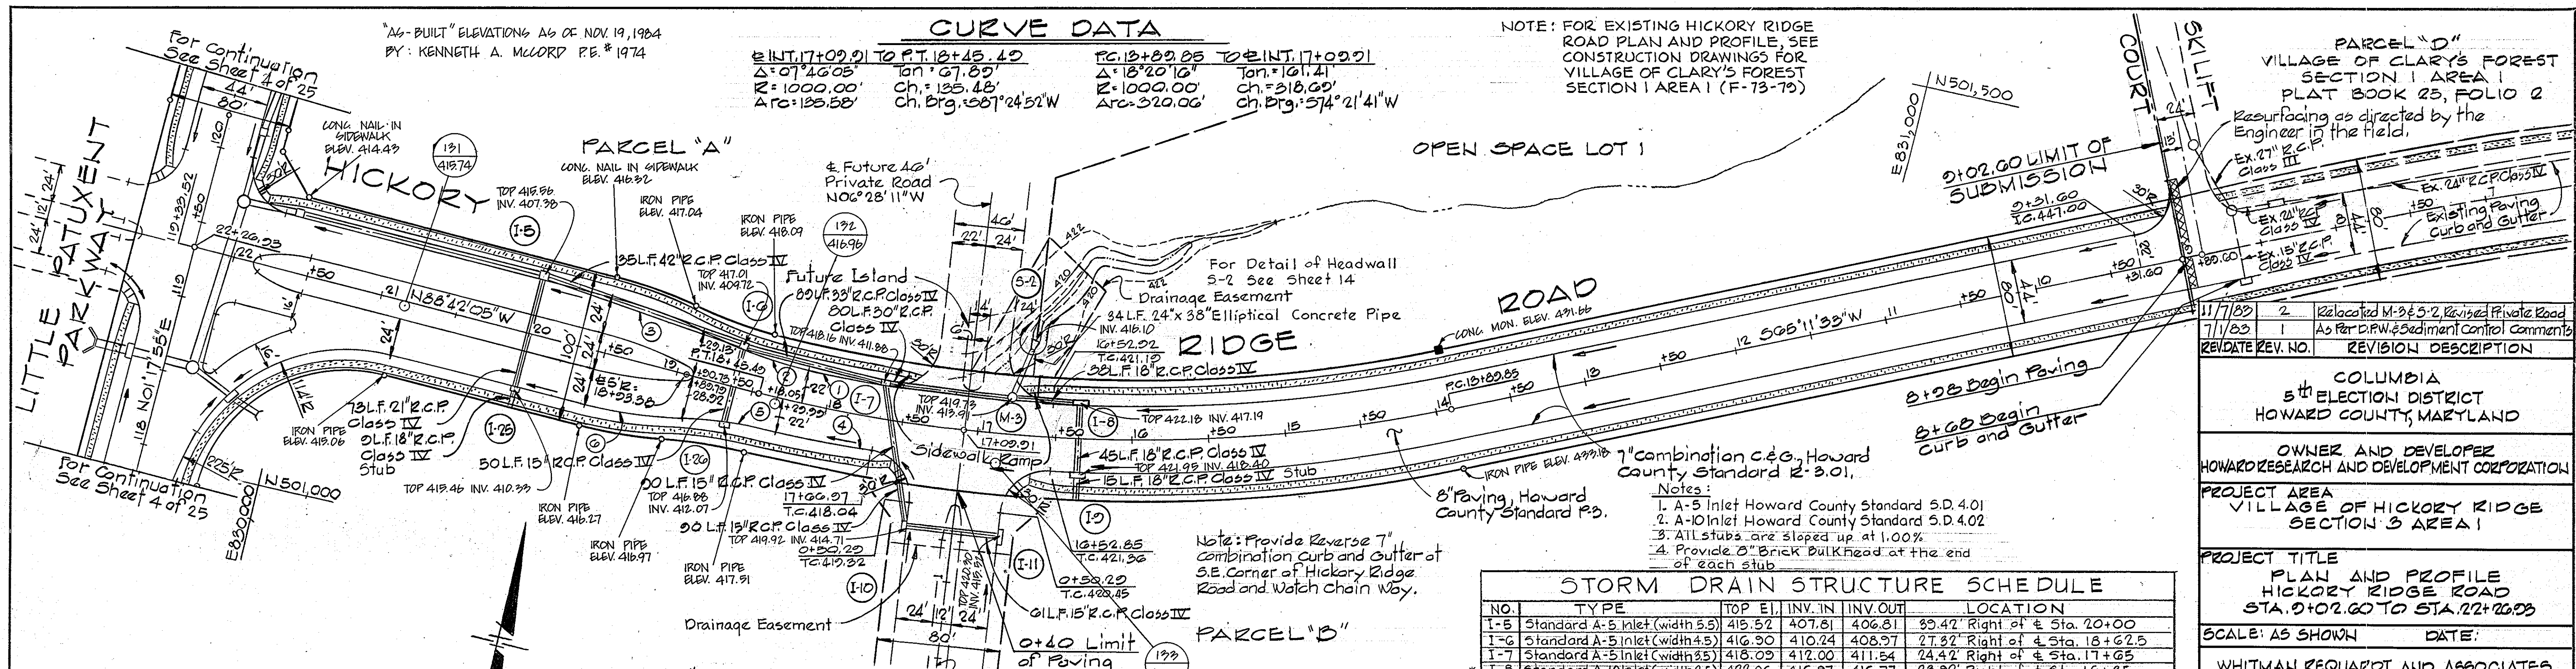

STORM DRAIN STRUCTURE SCHEDULE

NO.	TYPE	TOP EI.	INV. IN	INV. OUT	LOCATION
I-5	Standard A-5 Inlet (width 5.5)	415.52	407.81	406.81	85.42' Right of \pm Sta. 20+00
I-6	Standard A-5 Inlet (width 4.5)	416.90	410.24	408.97	27.32' Right of \pm Sta. 18+62.5
I-7	Standard A-5 Inlet (width 3.5)	418.09	412.00	411.54	24.42' Right of \pm Sta. 17+65
I-8	Standard A-10 Inlet (width 2.5)	422.06	416.97	416.77	23.92' Right of \pm Sta. 16+35
I-9	Standard A-10 Inlet (width 2.5)	422.06	418.48	418.48	23.92' Left of \pm Sta. 16+35
I-10	Standard A-5 Inlet (width 2.5)	419.83	414.78	414.58	31.92' Right of \pm Sta. 0+67
I-11	Standard A-10 Inlet (width 2.5)	422.06	415.62	415.62	31.92' Left of \pm Sta. 0+67
I-12	Standard A-5 Inlet (width 2.5)	416.90	410.58	410.58	27.92' Right of \pm Sta. 20+00
M-3	Special MH See Detail Sht. 15 of 25	419.60	414.00	413.50	23.20' Right of \pm Sta. 16+80.91
S-2	Special See Detail Sht. 14 of 25	419.50	416.00	416.00	End Pipe 52.25' Left of Sta. 16+70

REV. DATE	REV. NO.	REVISION DESCRIPTION
11/7/83	2	Relocated M-3 & S-2, Revised Private Road
7/1/83	1	As Per D.P.W. Sediment Control Comments

COLUMBIA
 5th ELECTION DISTRICT
 HOWARD COUNTY, MARYLAND

OWNER AND DEVELOPER
 HOWARD RESEARCH AND DEVELOPMENT CORPORATION

PROJECT AREA
 VILLAGE OF HICKORY RIDGE
 SECTION 3 AREA 1

PROJECT TITLE
 PLAN AND PROFILE
 HICKORY RIDGE ROAD
 STA. 0+02.60 TO STA. 22+26.23

SCALE: AS SHOWN DATE:

WHITMAN, REQUART AND ASSOCIATES
 ENGINEERS
 BALTIMORE, MARYLAND 21218

Kenneth A. McCord
 KENNETH A. MCCORD
 Registered Engineer
 No. 1974

DEPARTMENT OF PUBLIC WORKS

William S. Rubin 7-27-83
 CHIEF, BUREAU OF ENGINEERING, DATE

OFFICE OF PLANNING & ZONING

William S. Rubin 7-22-83
 CHIEF, DIVISION OF LAND DEVELOPMENT DATE
 AND ZONING ADMINISTRATION

NOTE:
 PAVING WIDTH = 44' & 2-24' LANES
 LENGTH OF ROAD = 1,907'
 3 SEWER MYS IN ROAD R/W


PLAN
 SCALE: 1"=50'

CURVE DATA FOR PAVING

STATION	PC	PT	PI	TO	PI	PT	PC
22+00	21+50	21+00	20+50	19+50	19+00	18+50	18+00
21+50	21+00	20+50	20+00	19+50	19+00	18+50	18+00
21+00	20+50	20+00	19+50	19+00	18+50	18+00	17+50
20+50	20+00	19+50	19+00	18+50	18+00	17+50	17+00
20+00	19+50	19+00	18+50	18+00	17+50	17+00	16+50
19+50	19+00	18+50	18+00	17+50	17+00	16+50	16+00
19+00	18+50	18+00	17+50	17+00	16+50	16+00	15+50
18+50	18+00	17+50	17+00	16+50	16+00	15+50	15+00
18+00	17+50	17+00	16+50	16+00	15+50	15+00	14+50
17+50	17+00	16+50	16+00	15+50	15+00	14+50	14+00
17+00	16+50	16+00	15+50	15+00	14+50	14+00	13+50
16+50	16+00	15+50	15+00	14+50	14+00	13+50	13+00
16+00	15+50	15+00	14+50	14+00	13+50	13+00	12+50
15+50	15+00	14+50	14+00	13+50	13+00	12+50	12+00
15+00	14+50	14+00	13+50	13+00	12+50	12+00	11+50
14+50	14+00	13+50	13+00	12+50	12+00	11+50	11+00
4+50	4+00	3+50	3+00	2+50	2+00	1+50	1+00
4+00	3+50	3+00	2+50	2+00	1+50	1+00	0+50
3+50	3+00	2+50	2+00	1+50	1+00	0+50	0+00
3+00	2+50	2+00	1+50	1+00	0+50	0+00	0+00

PROFILE
 SCALE: HOR. 1"=50'
 VERT. 1"=5'

HICKORY RIDGE ROAD

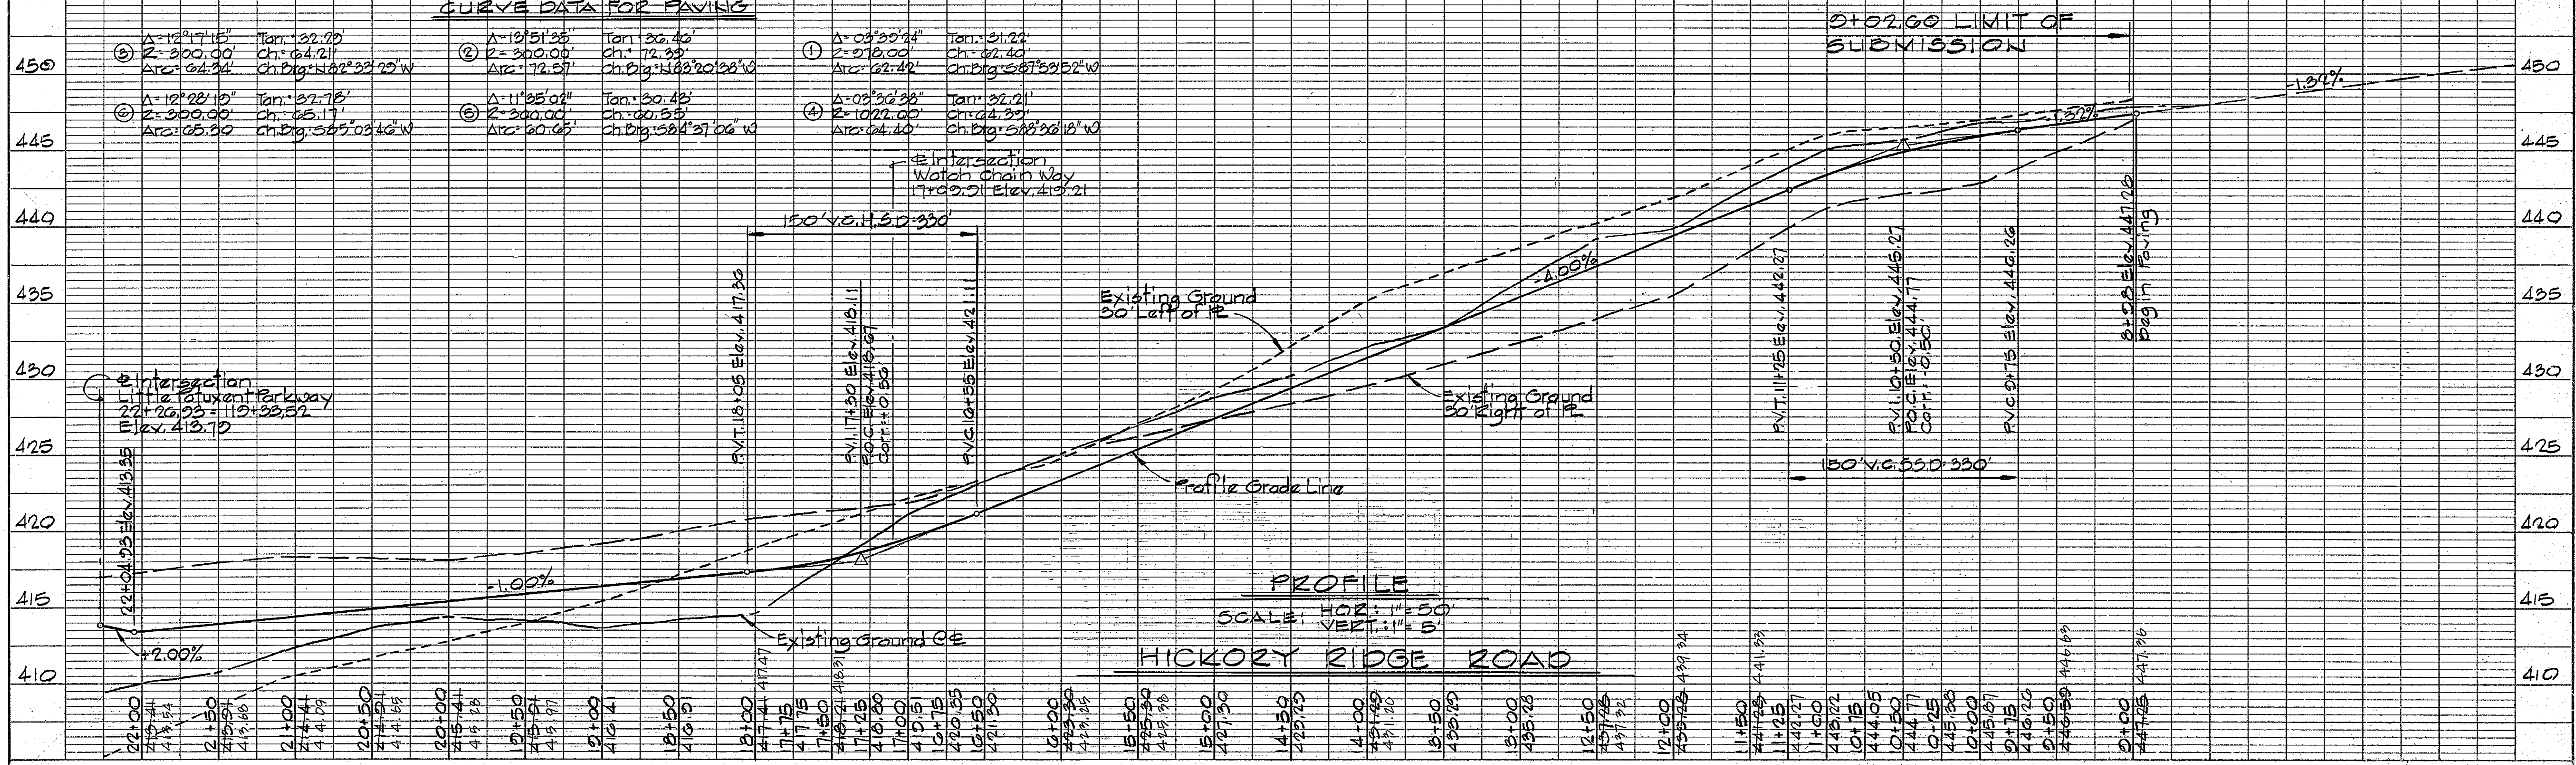

CURVE DATA
 PC: 120+23.12 to INT: 126+70.07
 Δ: 37°07'08" Tan: 335.75'
 R: 1000.00' Ch: 636.58'
 Arc: 047.85' Ch. Brg.: N10°31'20"E

INT: 126+70.07 to PT: 128+42.58
 Δ: 09°40'57" Tan: 86.02'
 R: 1000.00' Ch: 171.40'
 Arc: 171.01' Ch. Brg.: N43°20'01"E

AS-BUILT ELEVATIONS AS OF NOV. 19, 1984
 BY: KENNETH A. MCCORD P.E. #1974

SEE SHEET 7 FOR
 STAKEOUT DETAILS
 OF MEDIANS, CURB
 TRANSITIONS, ETC.

DEPARTMENT OF PUBLIC WORKS
 7-27-83
 CHIEF, BUREAU OF ENGINEERING & PLANNING
 OFFICE OF PLANNING & ZONING
 CHIEF, DIVISION OF LAND DEVELOPMENT DATE AND ZONING ADMINISTRATION


NOTE: FOR EXISTING LITTLE PATUXENT PARKWAY PLAN AND PROFILE, SEE CONSTRUCTION DRAWINGS FOR THE VILLAGE OF CLARYS FOREST, SECTION 1 AREA 1 (F-73-79)

STORM DRAIN STRUCTURE SCHEDULE

NO.	TYPE	TOP EL.	INV. IN.	INV. OUT.	LOCATION
I-13	Standard A-5 Inlet (width 36)	418.28	412.48	411.94	4 Inlet 24.42' Right & Sta. 122+31
I-14	Standard A-5 Inlet (width 36)	421.12	414.66	414.16	4 Inlet 24.42' Right & Sta. 124+20
I-15	Standard A-5 Inlet (width 36)	424.88	419.14	418.89	4 Inlet 27.78' Right & Sta. 126+10.45
I-16	Standard A-5 Inlet (width 36)	430.00	423.85	422.94	4 Inlet 40.71' Right & Sta. 127+38.29
I-17	Standard A-10 Inlet (width 25)	435.80	428.75	427.50	4 Inlet 45.92' Right & Sta. 129+50
I-18	Standard A-10 Inlet (width 25)	436.80	429.81	428.67	4 Inlet 45.92' Left & Sta. 129+50
I-19	Standard A-5 Inlet (width 25)	431.50	427.20	427.00	4 Inlet 49.77' Left & Sta. 127+85.36
I-20	Standard A-5 Inlet (width 25)	427.80	422.59	422.39	4 Inlet 37.92' Left & Sta. 48+60.75
I-21	Standard A-5 Inlet (width 25)	428.75	424.22	423.97	4 Inlet 58.55' Right & Sta. 48+79.64
I-22	Standard A-5 Inlet (width 25)	421.12	416.49	416.29	4 Inlet 23.92' Left & Sta. 124+20
I-24	Standard A-5 Inlet (width 25)	418.28	413.97	413.77	4 Inlet 23.92' Left & Sta. 122+31

Note: * Inlet with Deflectors, Howard County Standard 4.8.3

- A-5 Inlet Howard County Standard S.D. 4.01
- A-10 Inlet Howard County Standard S.D. 4.02
- All stubs are sloped up at 1.00%
- Provide 8" Brick Bulkhead at the end of each stub

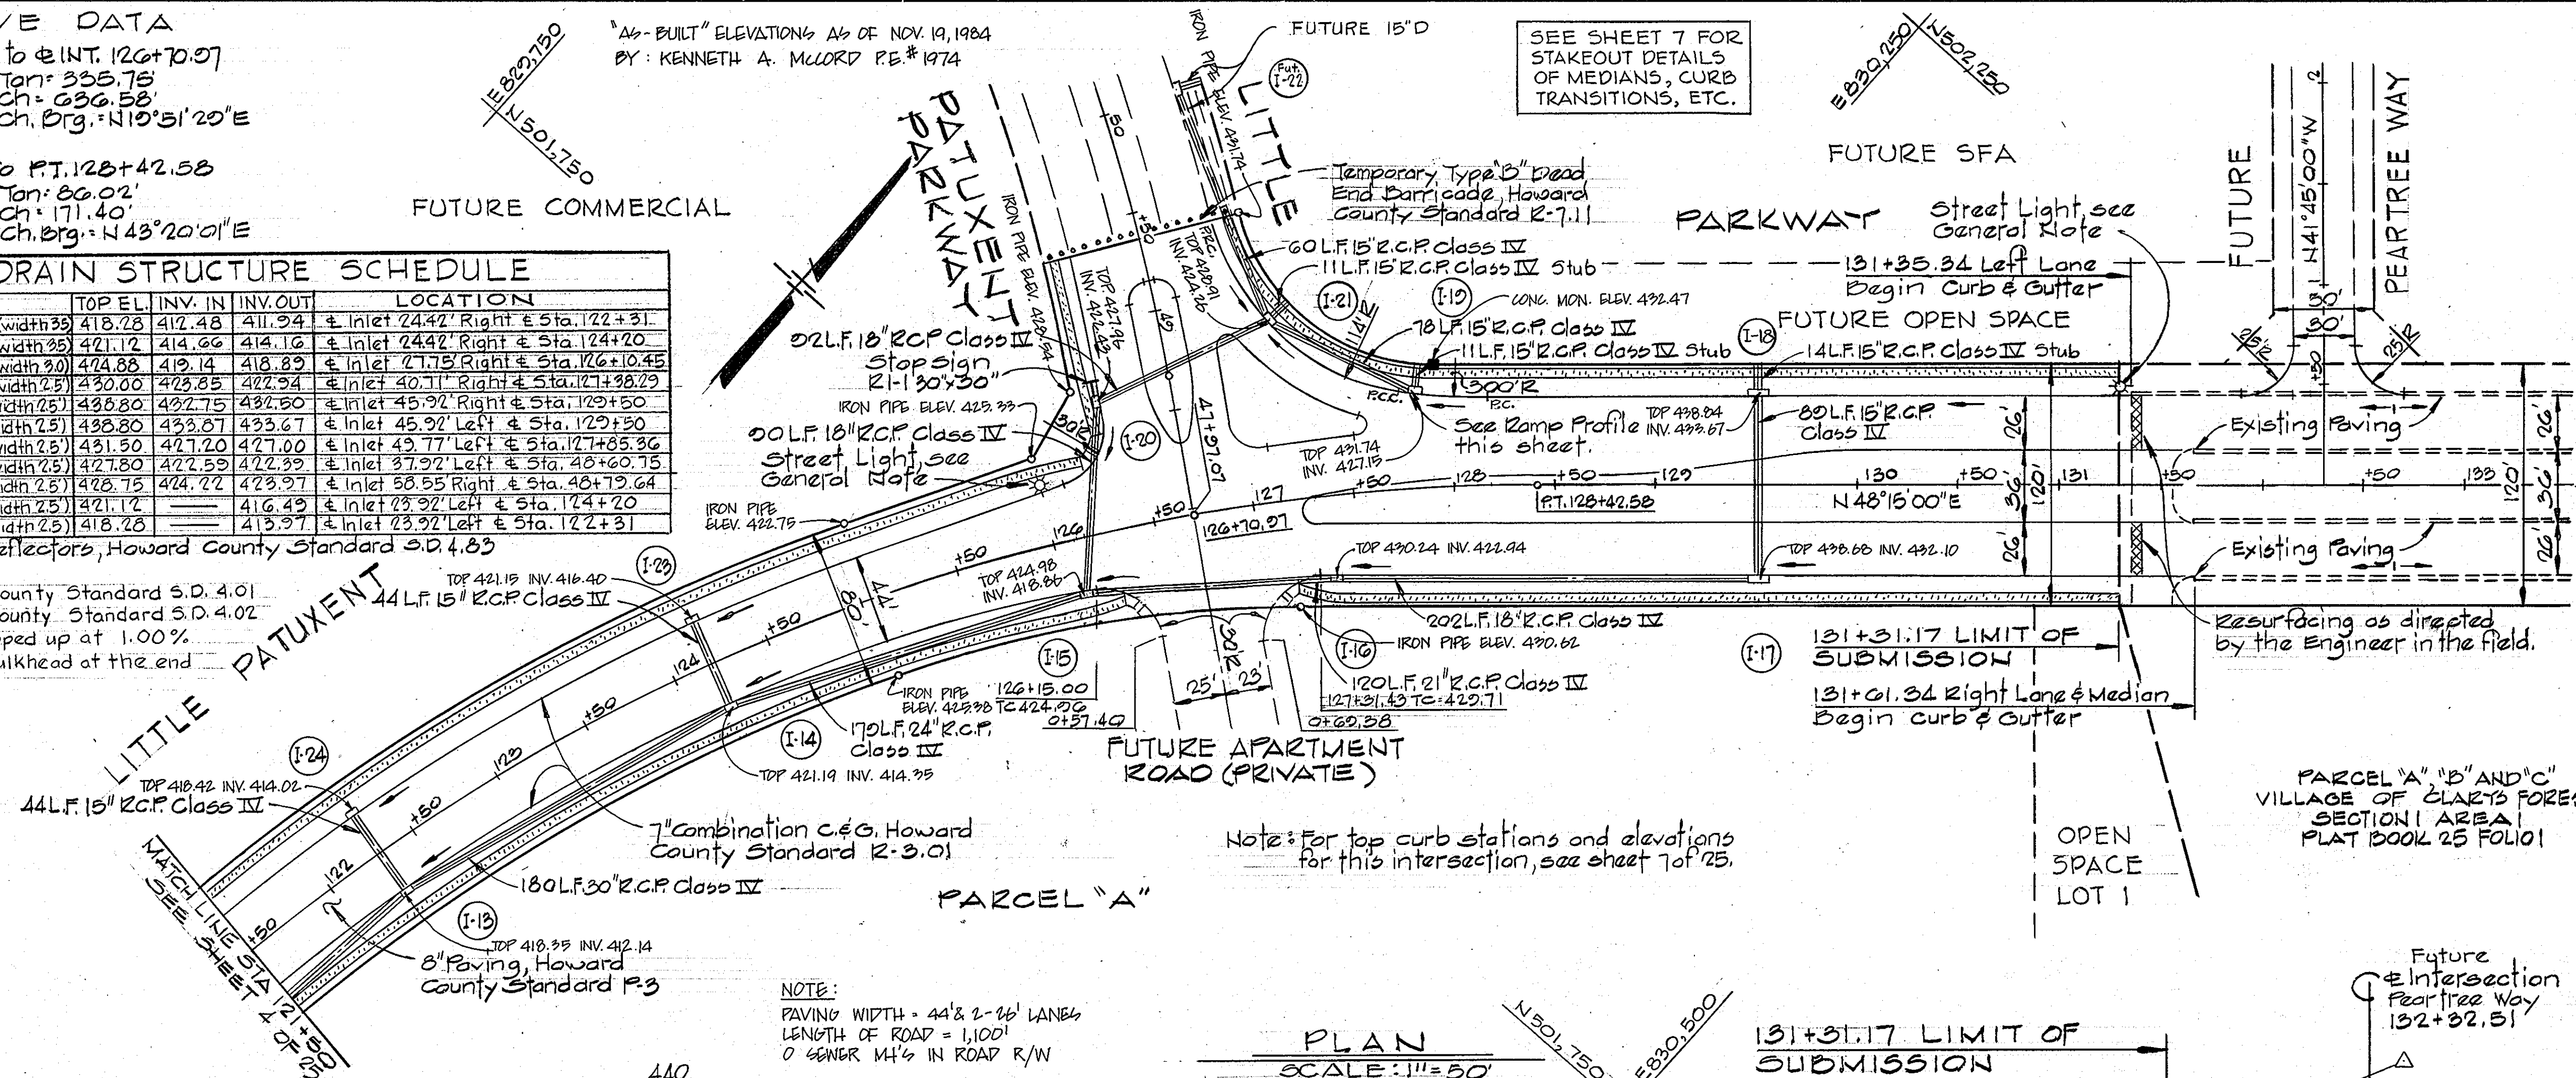

REV. DATE	REV. NO.	REVISION DESCRIPTION
11/7/83	2	Added Deflectors Removed Stubs Revised Private Road
7/1/83	1	As per DIRM & Sediment Control Comments

COLUMBIA
 5th ELECTION DISTRICT
 HOWARD COUNTY, MARYLAND

OWNER AND DEVELOPER
 HOWARD RESEARCH AND DEVELOPMENT CORPORATION


PROJECT AREA
 VILLAGE OF HICKORY RIDGE
 SECTION 3 AREA 1

PROJECT TITLE
 PLAN AND PROFILE
 LITTLE PATUXENT PARKWAY
 STA. 120+23.12 TO STA. 131+31.17

SCALE: AS SHOWN DATE:

WHITMAN, REQUAZOT AND ASSOCIATES
 ENGINEERS
 BALTIMORE, MARYLAND 21215

Kenneth A. McCord
 KENNETH A. MCCORD
 Registered Engineer
 No. 1974

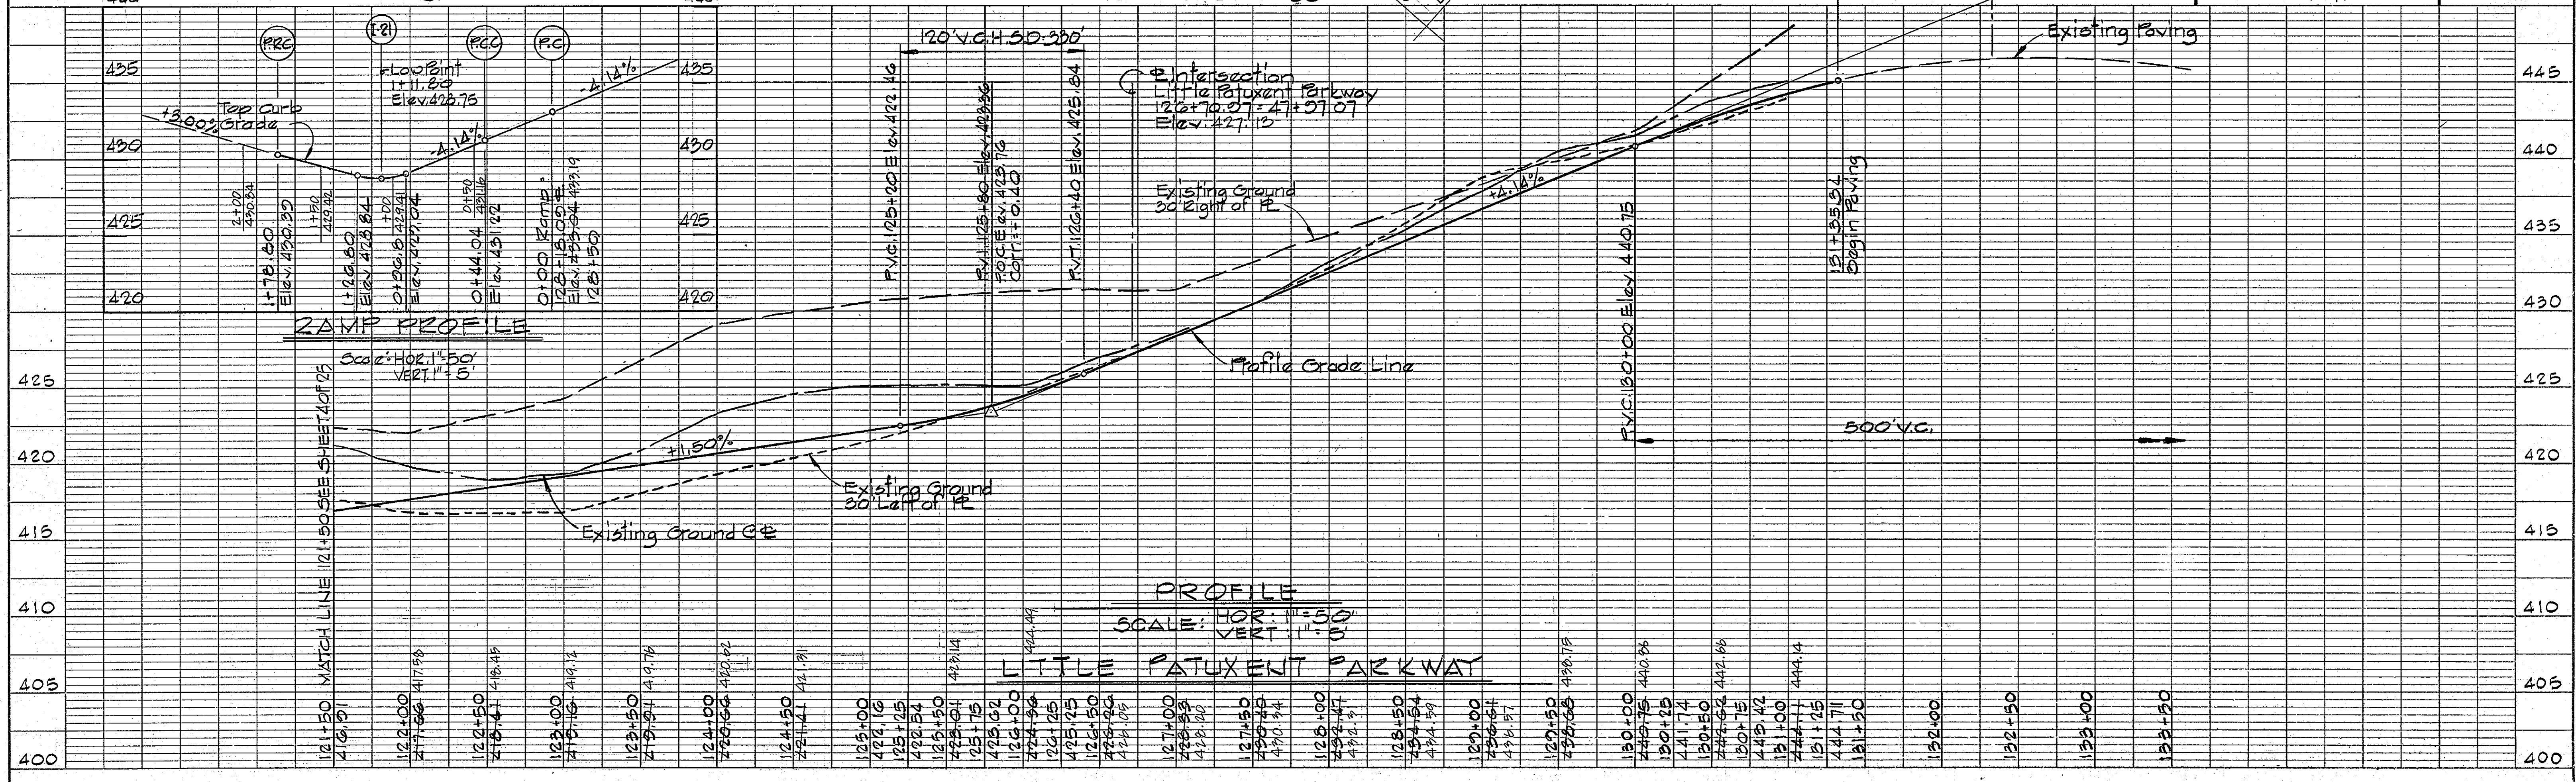

DEPARTMENT OF PUBLIC WORKS
 7-27-83
 CHIEF, BUREAU OF ENGINEERING
 OFFICE OF PLANNING & ZONING
 CHIEF, DIVISION OF LAND DEVELOPMENT, PLANNING AND ZONING ADMINISTRATION


"AS-BUILT" ELEVATIONS AS OF NOV. 19, 1984
 BY: KENNETH A. MCCORD P.E. #1974

REVISION NO.	REVISION DESCRIPTION
1/17/83 2	Removed Stub, Added Entrance Road
7/1/83 1	As Per DPW & Sediment Control Comments

COLUMBIA
 5TH ELECTION DISTRICT
 HOWARD COUNTY, MARYLAND
 OWNER AND DEVELOPER
 HOWARD RESEARCH AND DEVELOPMENT CORPORATION
 PROJECT AREA
 VILLAGE OF HICKORY RIDGE
 SECTION 3 AREA 1
 PROJECT TITLE
 PLAN AND PROFILE
 LITTLE PATUXENT PARKWAY
 STA. 111+00 TO STA. 120+25.12
 SCALE: AS SHOWN DATE:

WHITMAN, REQUIAZOT AND ASSOCIATES
 ENGINEERS
 BALTIMORE, MARYLAND 21218
 Kenneth A. McCord
 Registered Engineer
 No. 1974

CURVE DATA
 Future Open Space
 Future Village Center Entrance
 Future Commercial
 Future Parkway
 Future Hickory Ridge Road

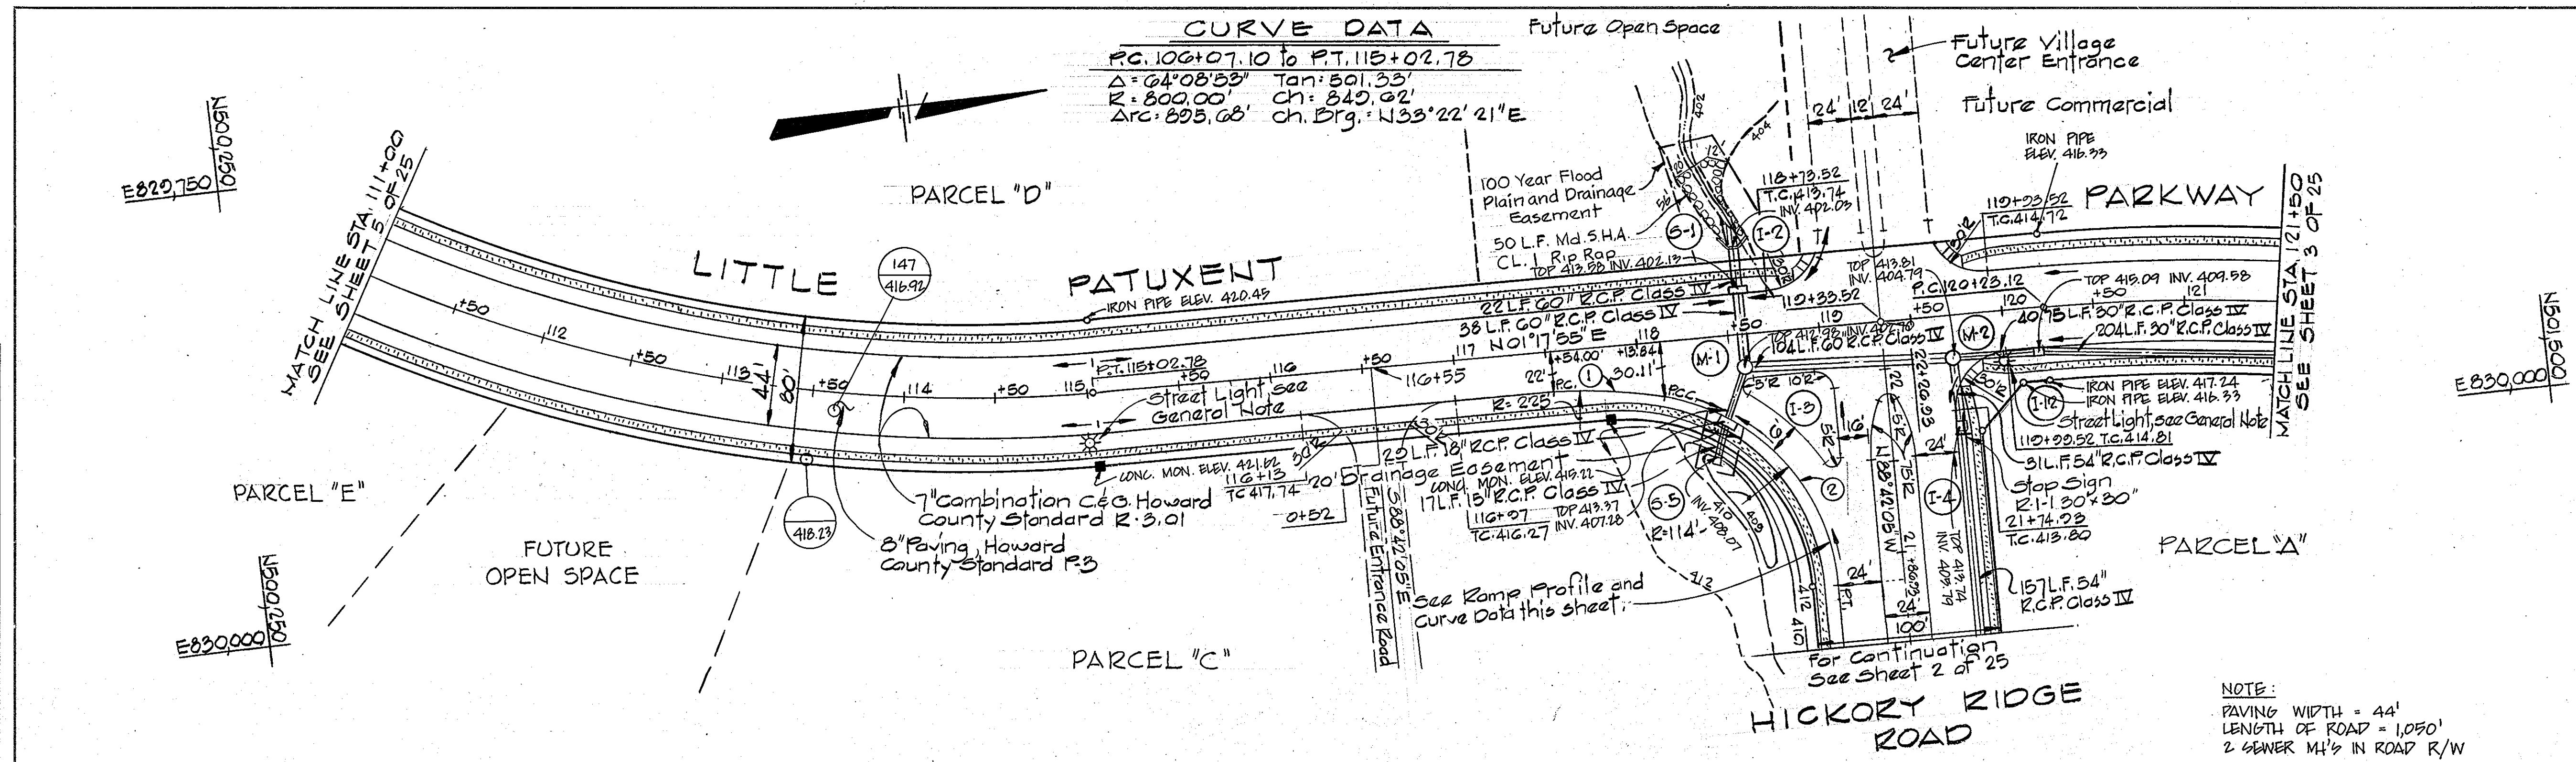


STORM DRAIN STRUCTURE SCHEDULE

NO.	TYPE	TOP EL. INV. IN	INV. OUT	LOCATION
I-2	Standard A-10 Inlet, Width 25"	413.03	402.43	Inlet 25.52' Left of Sta. 118+57
I-3	Standard A-10 Inlet, Width 25"	413.23	407.70	Inlet 46.49' Right of Sta. 118+45.3
I-4	Standard A-5 Inlet, Width 6"	413.70	405.75	Inlet 39.67' Right of Sta. 121+67
I-12	Standard A-5 Inlet, Width 4"	415.08	409.64	Inlet 24.67' Right of Sta. 120+18
M-1	Special see Detail Sheet 15	413.15	402.39	Manhole 18.0' Right of Sta. 118+57
M-2	Special see Detail Sheet 15	413.82	405.02	Manhole 23.0' Right of Sta. 119+71
S-1	Standard Type A Headwall	408.34	402.08	Headwall 47.42' Left of Sta. 118+57
S-5	Standard Conc. End Section	411.00	408.00	Outfall 63.47' Left of Sta. 118+39.32

- Notes:
- A-5 Inlet, Howard County Standard S.O. 4.01.
 - A-10 Inlet, Howard County Standard S.O. 4.02.
 - Type A Headwall, Howard County Standard
 - All stubs are sloped up at 1.00%.
 - Provide 8" Brick bulkhead at the end of each stub

CURVE DATA FOR RAMP
 ① Δ: 15°25'35" Tan: 30.47' R: 225.00' Ch. Brg.: N00°00'45"E Arc: 60.58'
 ② Δ: 74°34'24" Tan: 86.80' R: 114.00' Ch. Brg.: N54°00'42"E Arc: 146.26'

PLAN SCALE: 1" = 50'

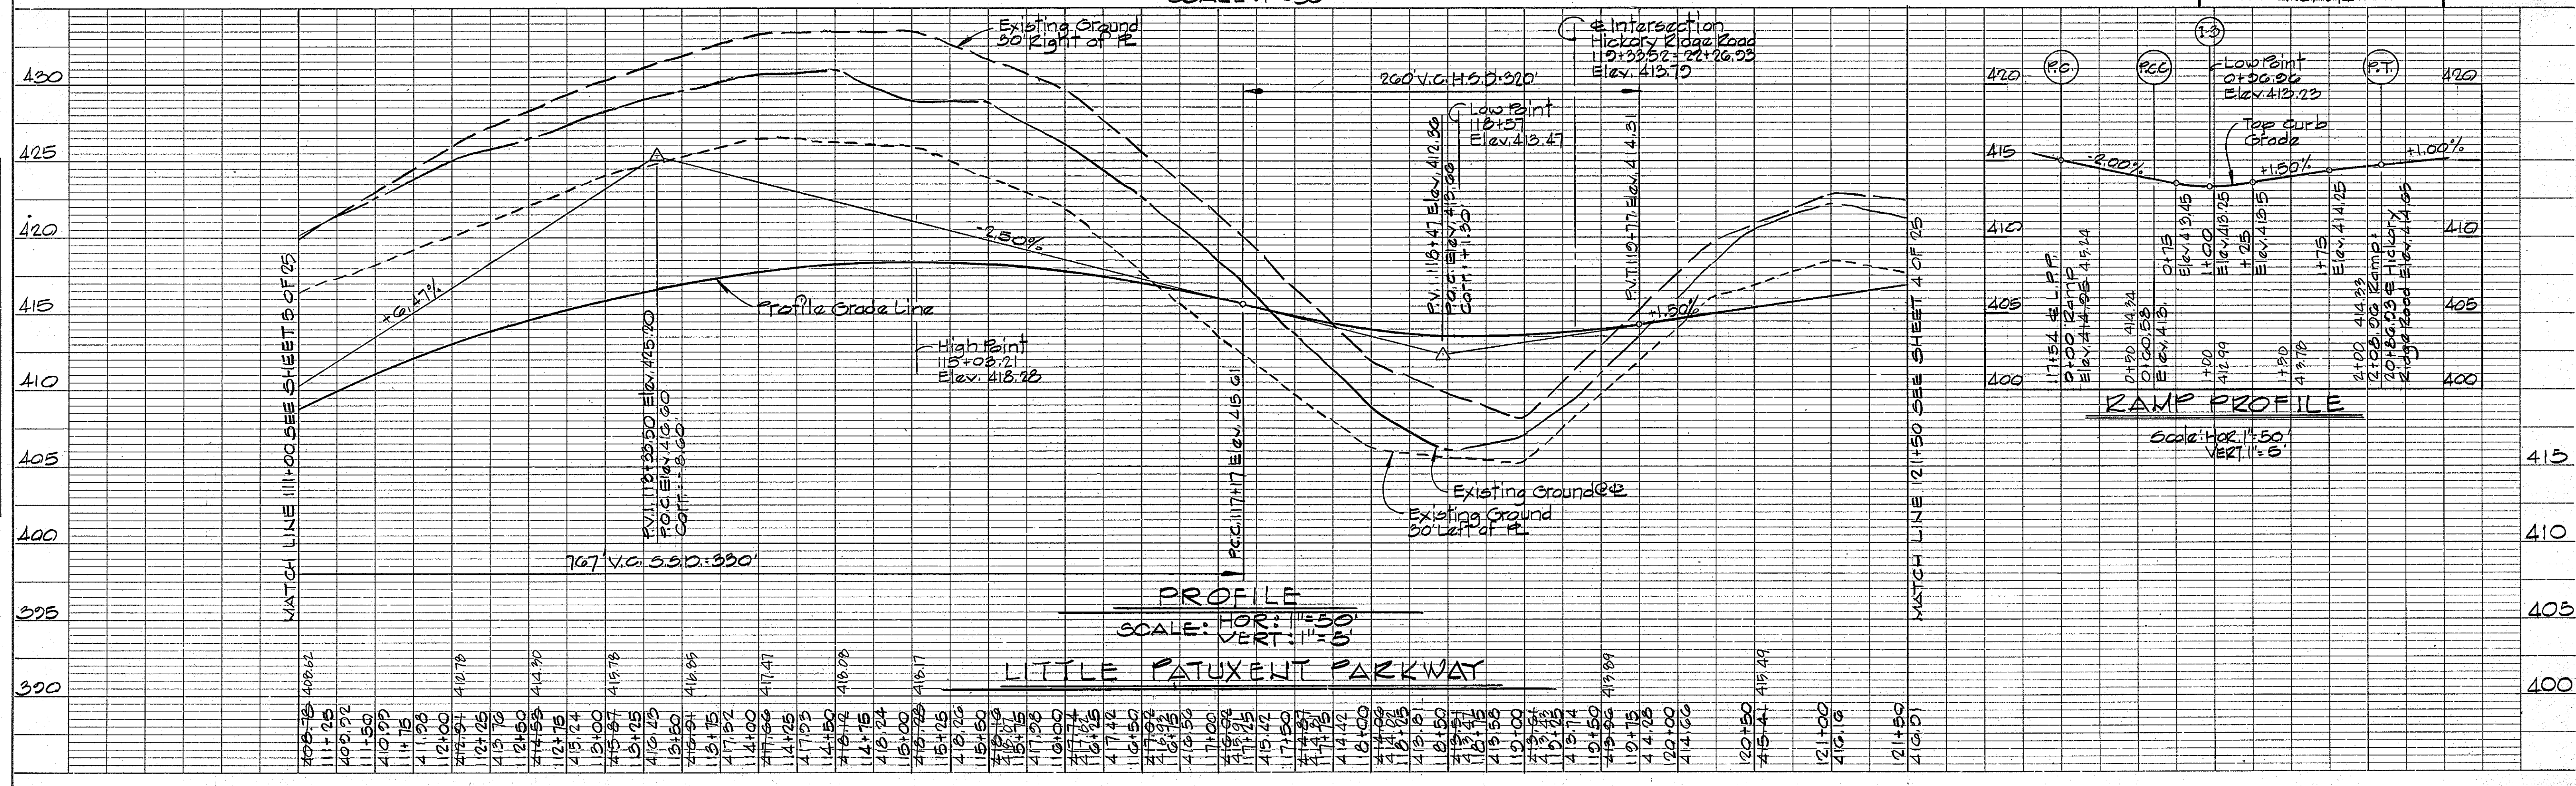

PROFILE SCALE: HOR: 1" = 50' VERT: 1" = 5'

RAMP PROFILE SCALE: HOR: 1" = 50' VERT: 1" = 6'

DATE: _____
 BY: _____
 SURVEYED: _____
 PLOTTED: _____
 CHECKED: _____
 BY: _____
 NO. _____

DATE: _____
 BY: _____
 SURVEYED: _____
 PLOTTED: _____
 CHECKED: _____
 BY: _____
 NO. _____

DATE	
BY	
REVISION	
NO.	
DATE	
BY	
REVISION	
NO.	

DATE	
BY	
REVISION	
NO.	
DATE	
BY	
REVISION	
NO.	

STORM DRAIN STRUCTURE SCHEDULE

NO.	TYPE	TOP EL.	INV. IN	INV. OUT	LOCATION
I-27	Standard A-5 Inlet, Width 23	365.75	378.36	377.38	Inlet 24.17' RT. E Sta. 104+02.54
I-28	Standard A-5 Inlet, Width 23	365.75	381.35	381.31	Inlet 23.92' LT. E Sta. 102+02.54
I-29	Standard A-10 Inlet, Width 23	367.16	381.35	380.81	Inlet 23.92' LT. E Sta. 102+50
I-30	Standard A-10 Inlet, Width 23	365.30	389.46	388.28	Inlet 23.92' LT. E Sta. 101+25
I-31	Standard A-10 Inlet, Width 23	365.30	390.07	389.52	Inlet 23.92' LT. E Sta. 101+25
I-32	Standard Type D Inlet	365.83	391.16	391.16	Inlet 23.92' LT. E Sta. 101+25
I-33	Standard A-10 Inlet, Width 23	404.75	399.70	399.50	Inlet 23.92' LT. E Sta. 99+50
I-34	Standard A-10 Inlet, Width 23	414.76	410.15	409.25	Inlet 23.92' LT. E Sta. 97+50
I-35	Standard A-10 Inlet, Width 23	414.76	410.24	410.24	Inlet 23.92' LT. E Sta. 97+50
I-36	Standard A-10 Inlet, Width 23	368.56	379.85	376.35	Inlet 23.92' LT. E Sta. 105+78
I-37	Standard A-10 Inlet, Width 23	368.27	381.44	381.44	Inlet 23.92' LT. E Sta. 106+00
I-38	Standard A-10 Inlet, Width 23	392.23	388.68	386.48	Inlet 23.92' LT. E Sta. 108+00
I-39	Standard A-10 Inlet, Width 23	401.51	398.40	398.20	Inlet 23.92' LT. E Sta. 109+25
I-40	Standard A-10 Inlet, Width 23	401.51	398.69	398.69	Inlet 23.92' LT. E Sta. 109+25
M-4	Standard Manhole	368.01	375.52	374.15	Manhole 27.00' RT. E Sta. 105+24
M-5	Shallow Manhole	321.88	385.88	385.28	Manhole 26.00' RT. E Sta. 101+28
S-3	See Detail Sheet 10		367.00	367.00	End Pipe 23.21' Right E Sta. 105+44.91
S-4	See Detail Sheet 10		368.95	368.95	End Pipe 24.91' Left E Sta. 105+54.93

Notes:
 1. A-5 Inlet, Howard County Standard S.D. 4.01
 2. A-10 Inlet, Howard County Standard S.D. 4.02
 3. Type D Inlet, Howard County Standard S.D. 4.11
 4. Standard Manhole, Howard County Standard G.S. 01
 5. Shallow Manhole, Howard County Standard G.S. 05
 6. * For Stakeout, see Plan and Profile.
 7. Reflector, Howard County Standard S.D. 4.83

NOTE:
 PAVING WIDTH = 44'
 LENGTH OF ROAD = 1,400'
 4' SEWER M/S IN ROAD R/W

DEPARTMENT OF PUBLIC WORKS
William E. Ryan 7-27-83
 CHIEF, BUREAU OF ENGINEERING
 OFFICE OF PLANNING & ZONING
John M. W. ... 7-22-83
 CHIEF, DIVISION OF LAND DEVELOPMENT
 AND ZONING ADMINISTRATION

"AS-BUILT" ELEVATIONS AS OF NOV. 19, 1984
 BY: KENNETH A. MCCORD P.E. #1974

REV. DATE	REV. NO.	REVISION DESCRIPTION
11/7/83	2	Revised I-30 & I-40, Added Deflectors Added Private Road S
7/1/83	1	After D.P.W. & Sediment Control Comments

5th COLUMBIA ELECTION DISTRICT
 HOWARD COUNTY, MARYLAND

OWNER AND DEVELOPER
 HOWARD RESEARCH AND DEVELOPMENT CORPORATION


PROJECT AREA
 VILLAGE OF HICKORY RIDGE SECTION 3 AREA 1

PROJECT TITLE
 PLAN AND PROFILE
 LITTLE PATUXENT PARKWAY
 STA. 97+00 TO STA. 111+00

SCALE: AS SHOWN DATE:


WHITMAN, REQUARDT AND ASSOCIATES ENGINEERS
 BALTIMORE, MARYLAND 21218

Kenneth A. McCord
 KENNETH A. MCCORD
 Registered Engineer
 No. 1974

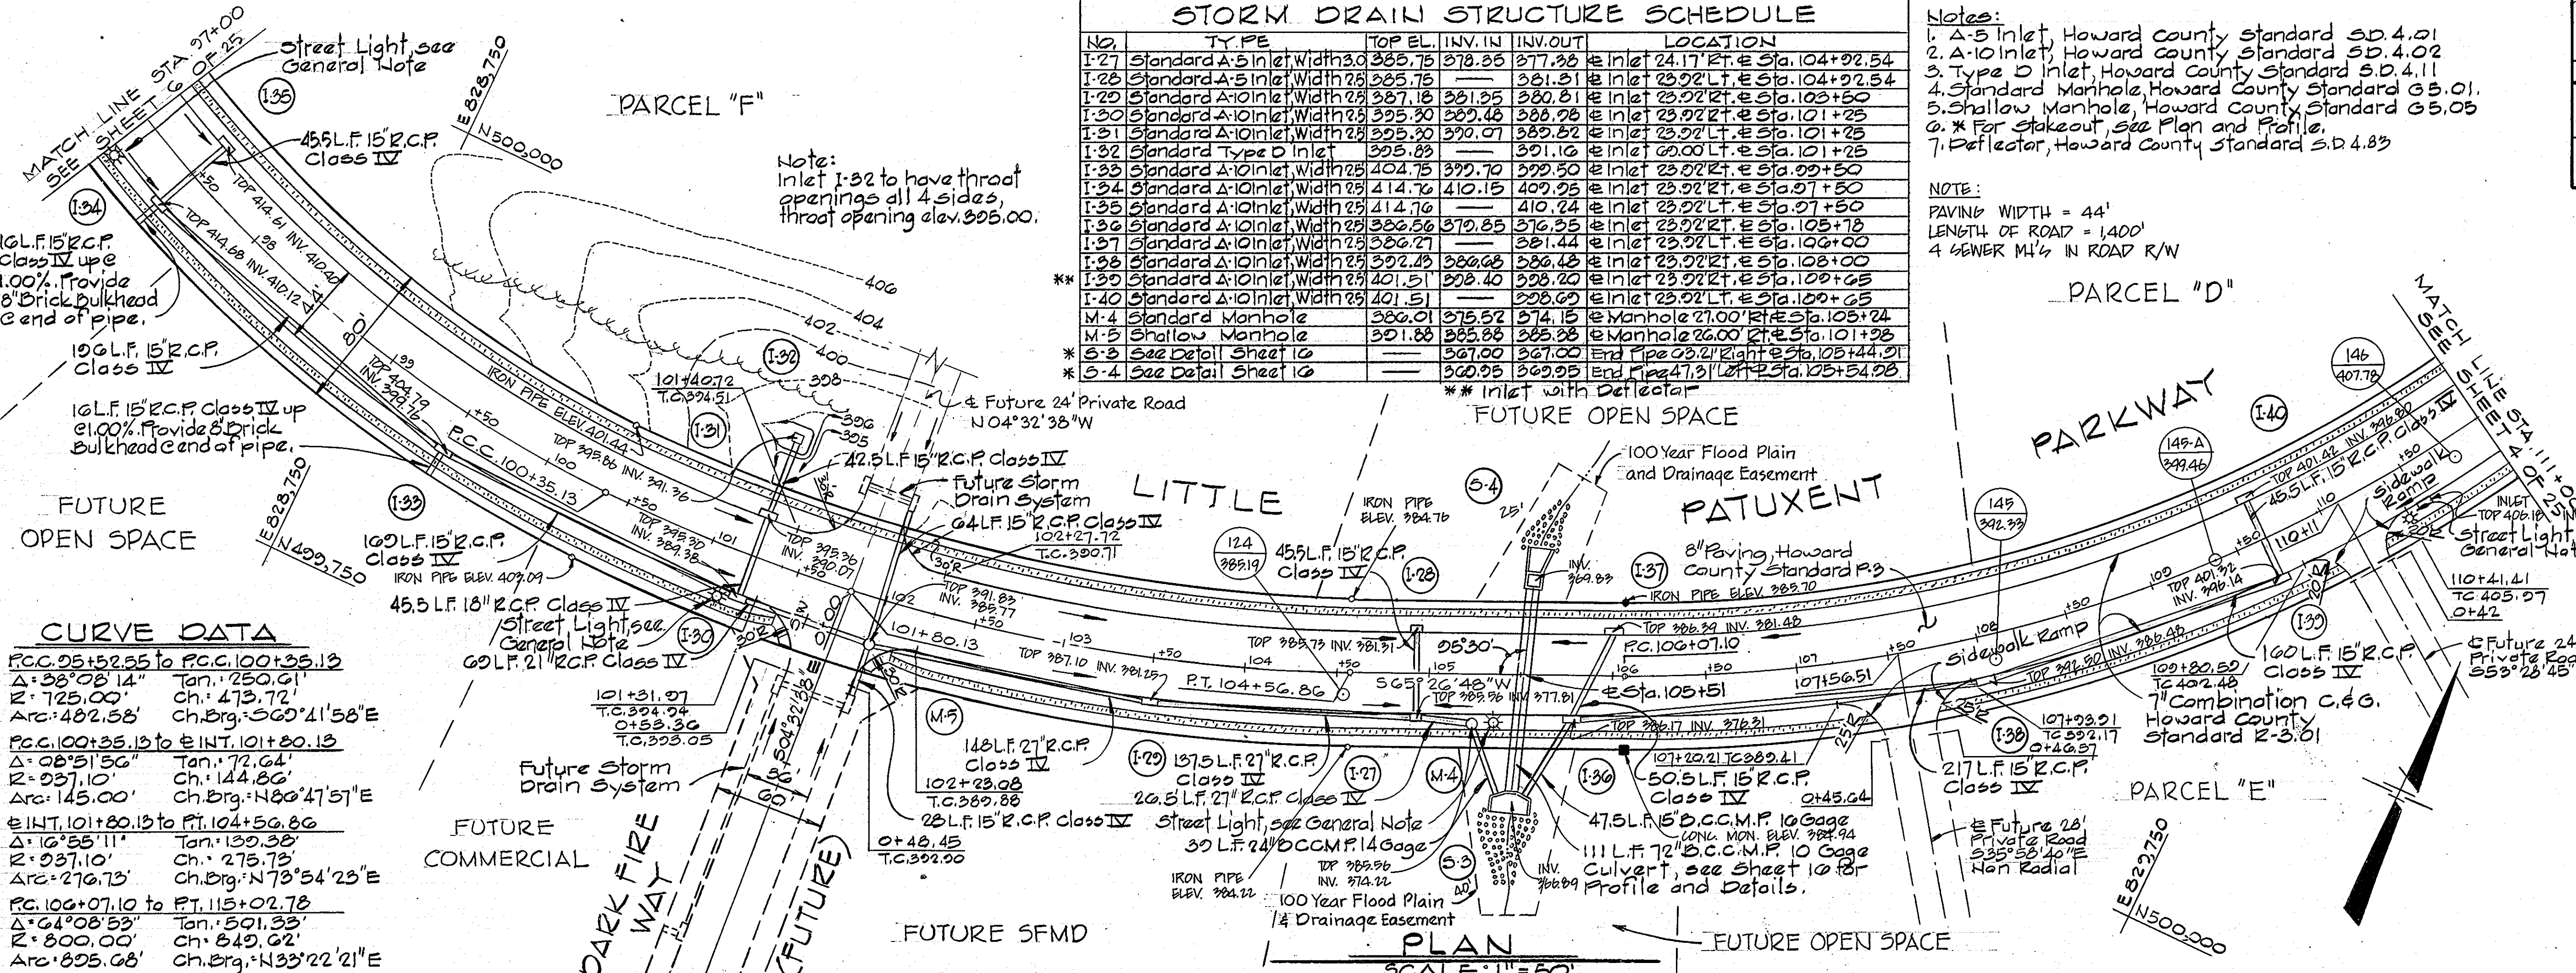

CURVE DATA


P.C.C. 95+52.55 to P.C.C. 100+35.13	Δ: 38°08'14"	Tan.: 250.61'
	R: 725.00'	Ch.: 473.72'
	Arc.: 482.58'	Ch. Brg.: S63°41'58"E
P.C.C. 100+35.13 to INT. 101+80.13	Δ: 28°51'50"	Tan.: 72.64'
	R: 237.10'	Ch.: 124.86'
	Arc.: 145.00'	Ch. Brg.: N80°47'51"E
INT. 101+80.13 to P.T. 104+56.86	Δ: 16°55'11"	Tan.: 139.38'
	R: 937.10'	Ch.: 275.78'
	Arc.: 276.73'	Ch. Brg.: N73°54'23"E
P.C. 106+07.10 to P.T. 115+02.78	Δ: 64°08'53"	Tan.: 501.33'
	R: 800.00'	Ch.: 849.62'
	Arc.: 825.68'	Ch. Brg.: N33°22'21"E

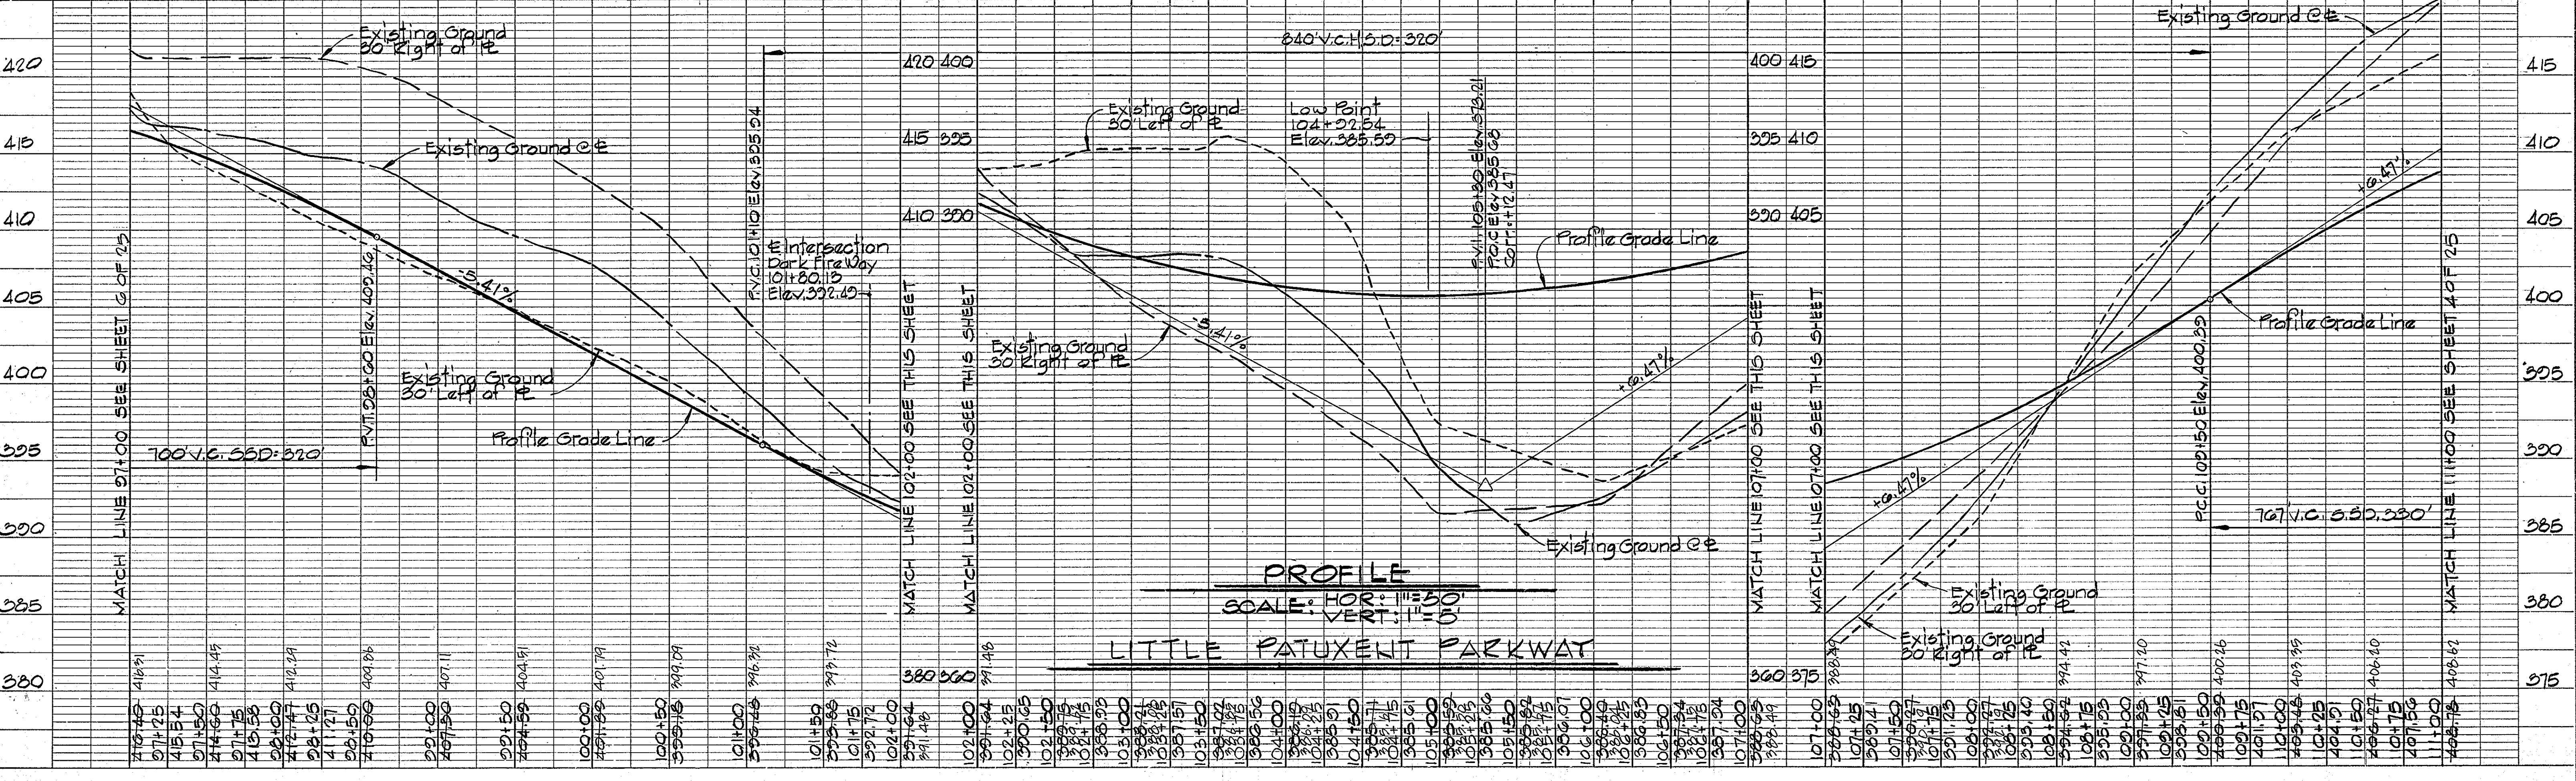

DEPARTMENT OF PUBLIC WORKS
 7-27-83
 CHIEF, BUREAU OF ENGINEERING
 OFFICE OF PLANNING & ZONING
 CHIEF, DIVISION OF LAND DEVELOPMENT AND ZONING ADMINISTRATION

"AS-BUILT" ELEVATIONS AS OF NOV. 19, 1984
 BY: KENNETH A. MCCORD P.E. # 1974

CURVE DATA	
P.C. 89+87.76 to P.I. 92+68.13	P.I. 92+68.13 to P.C.C. 95+52.55
$\Delta = 13^{\circ}08'20''$	$\Delta = 13^{\circ}19'42''$
$R = 1222.64'$	$R = 1222.64'$
$T = 140.80'$	$T = 142.85'$
$ARC = 280.37'$	$ARC = 284.42'$
$Ch. = 279.76'$	$Ch. = 283.78'$
$Ch. Brg. = N30^{\circ}43'58''W$	$Ch. Brg. = N43^{\circ}57'59''W$

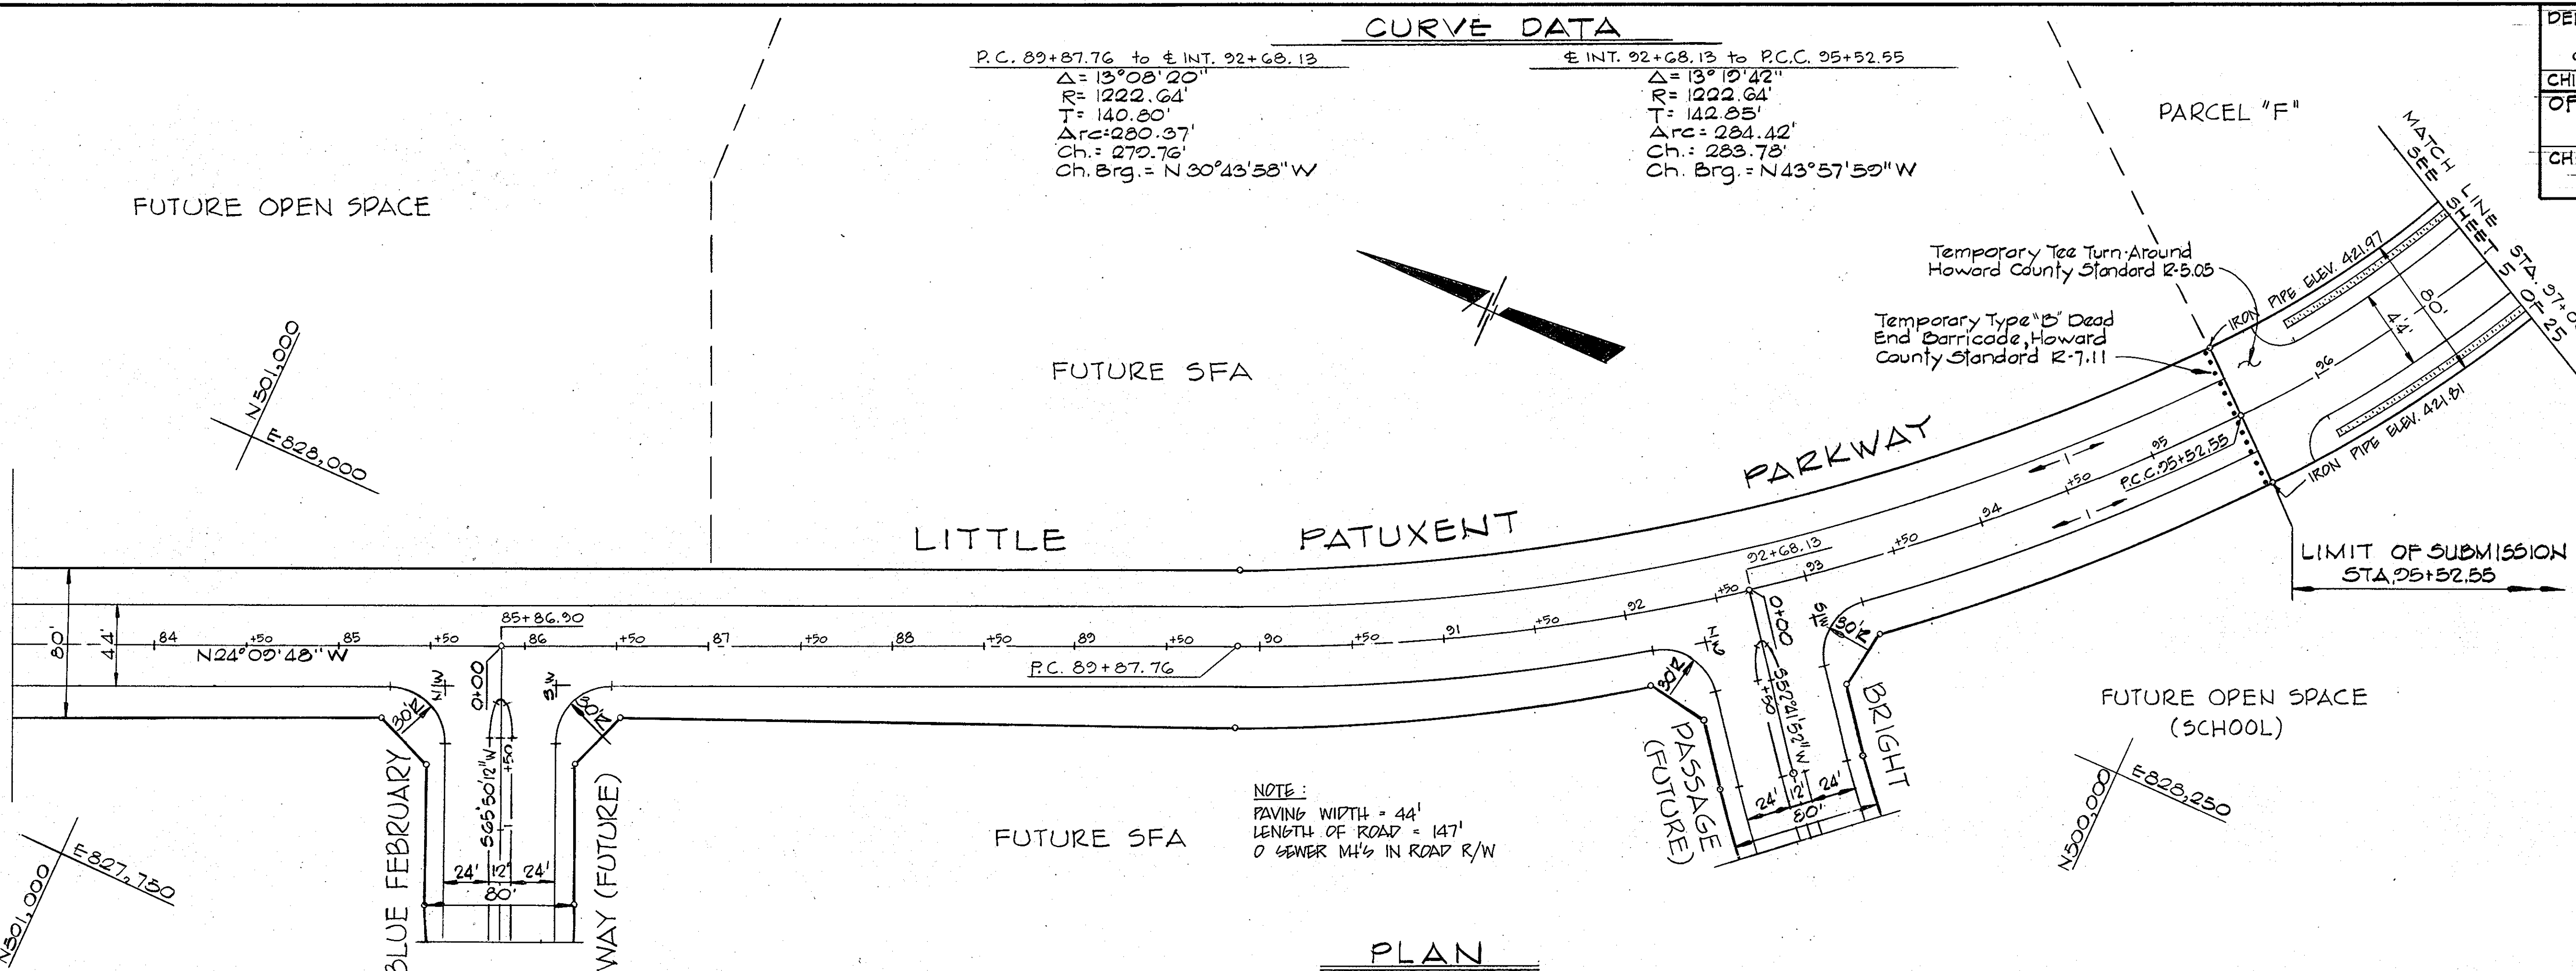

NOTE:
 PAVING WIDTH = 44'
 LENGTH OF ROAD = 147'
 0 SEWER M/S IN ROAD R/W

REV. DATE	REV. NO.	REVISION DESCRIPTION
7/1/83	1	As Per DPW Sediment Control Comments

COLUMBIA
 5th ELECTION DISTRICT
 HOWARD COUNTY, MARYLAND

OWNER AND DEVELOPER
 HOWARD RESEARCH AND DEVELOPMENT CORPORATION


PROJECT AREA
 VILLAGE OF HICKORY RIDGE
 SECTION 3 AREA 1

PROJECT TITLE
 PLAN AND PROFILE
 LITTLE PATUXENT PARKWAY
 STA. 95+52.55 TO STA. 97+00

SCALE: AS SHOWN DATE:

WHITMAN, REARDT AND ASSOCIATES
 ENGINEERS
 BALTIMORE, MARYLAND 21218

Kenneth A. McCord
 Registered Engineer
 No. 1974

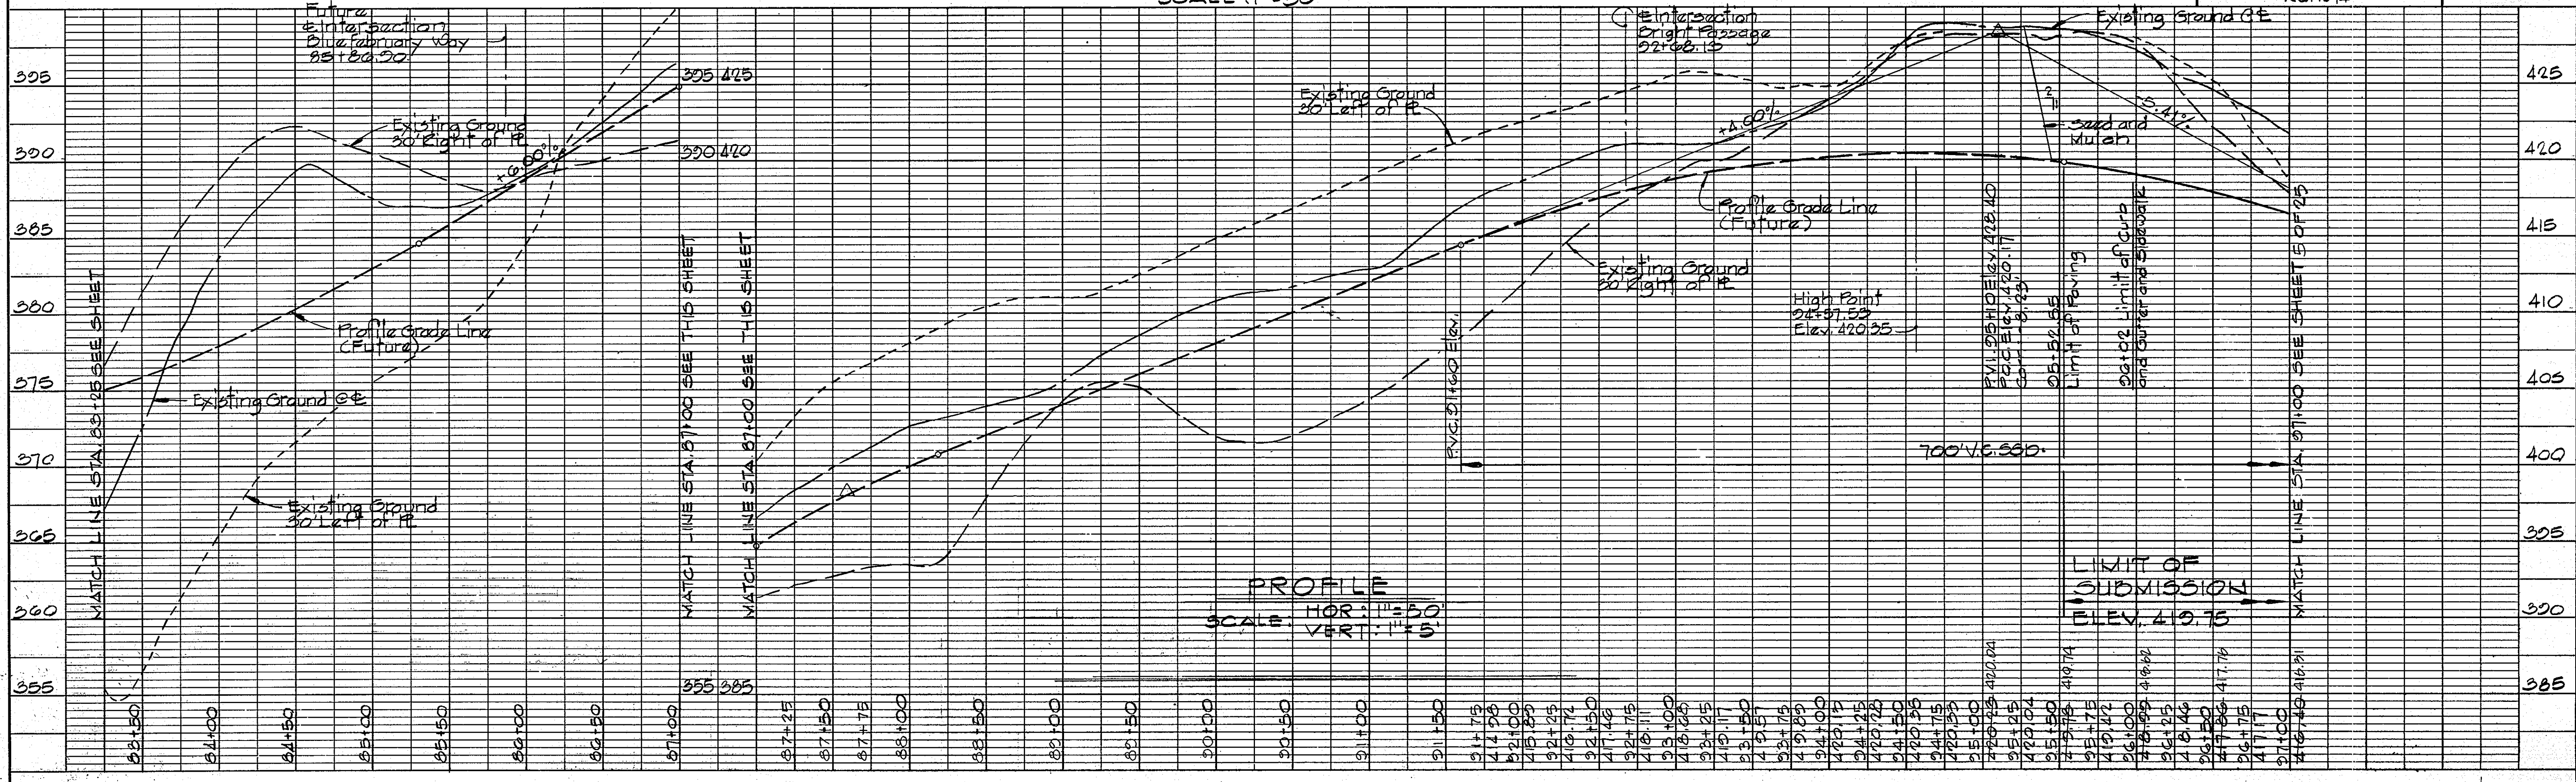

PLAN

DATE	
BY	
REVISIONS	
NO. 1	
NO. 2	
NO. 3	
NO. 4	
NO. 5	
NO. 6	
NO. 7	
NO. 8	
NO. 9	
NO. 10	


PROFILE

DATE	
BY	
REVISIONS	
NO. 1	
NO. 2	
NO. 3	
NO. 4	
NO. 5	
NO. 6	
NO. 7	
NO. 8	
NO. 9	
NO. 10	

7-27-83
DATE



7-27-83
DATE

NOTE: FOR EXISTING LITTLE PATUXENT PARKWAY PLAN AND PROFILE SEE CONSTRUCTION DRAWINGS FOR VILLAGE OF CLARY'S FOREST SECTION 1, AREA 1 (F-73-70C)

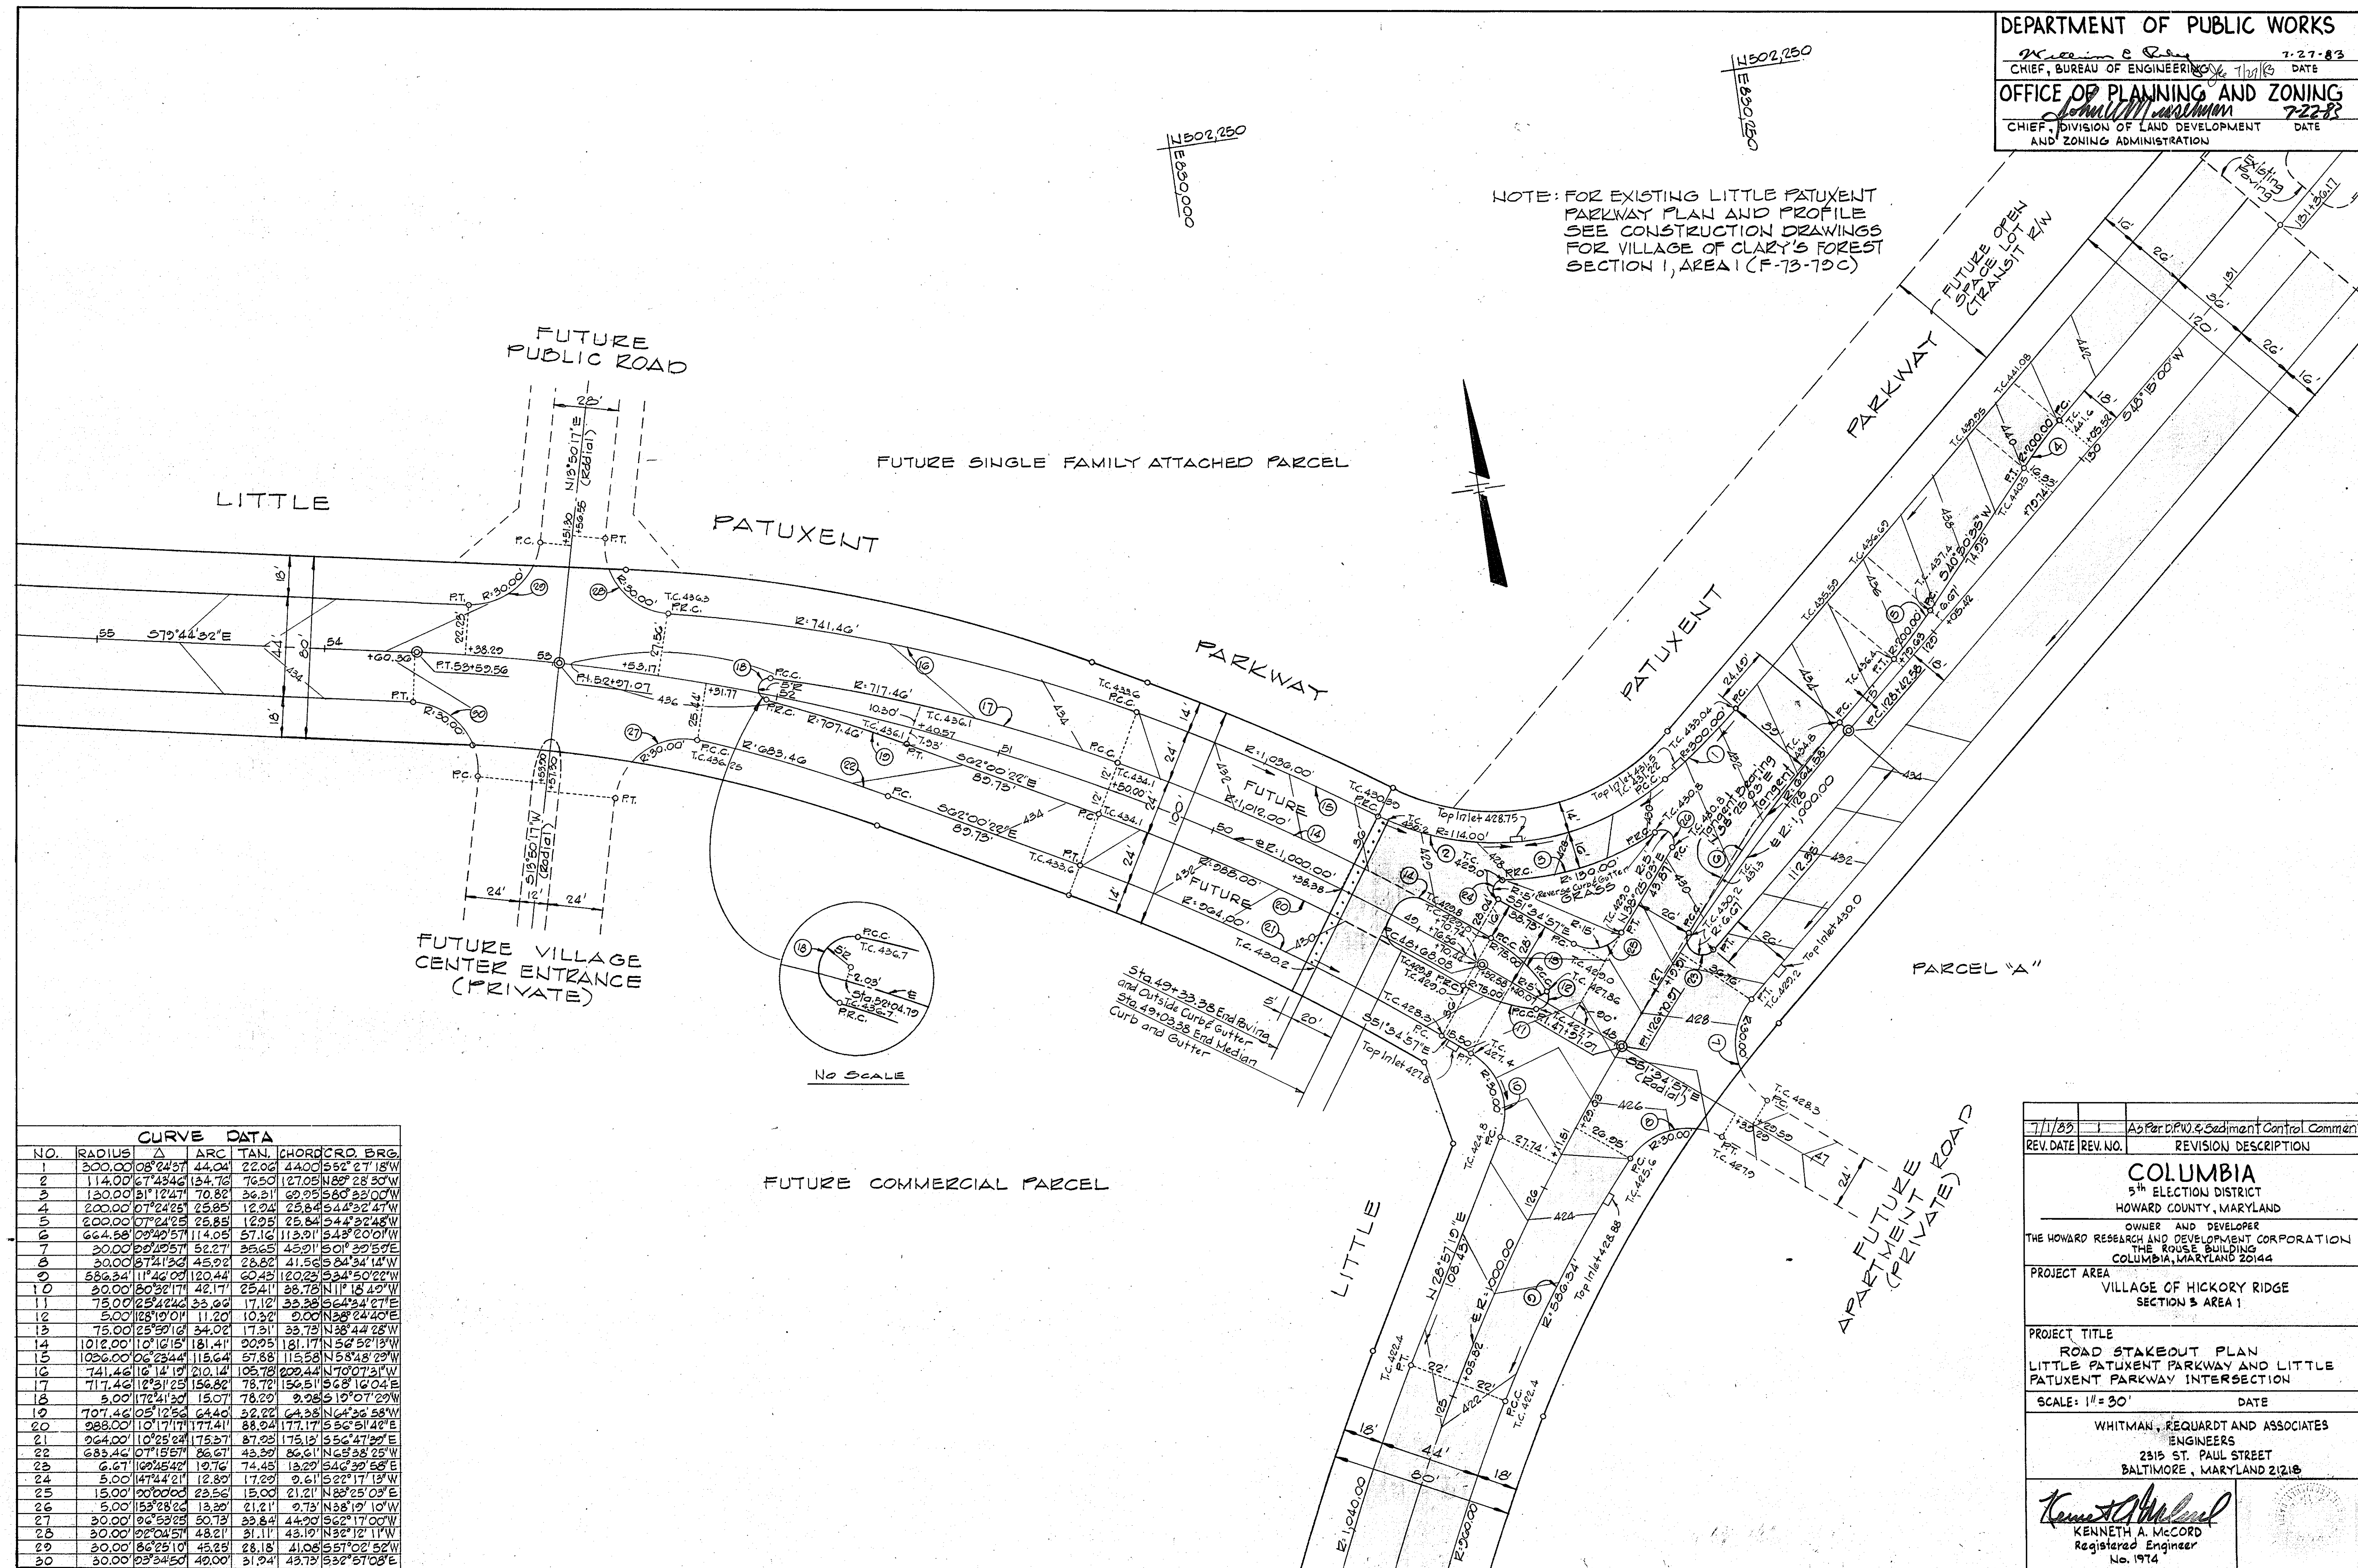





NO.	RADIUS	Δ	ARC	TAN.	CHORD	CRD. BRG.
1	300.00	08°24'37"	44.04	22.06	44.00	S52°27'18"W
2	114.00	07°43'46"	134.78	76.50	127.05	N88°28'30"W
3	120.00	31°12'47"	70.82	36.31	62.25	S68°23'00"W
4	200.00	07°24'25"	25.85	12.24	25.84	S44°32'47"W
5	200.00	07°24'25"	25.85	12.25	25.84	S44°32'48"W
6	664.58	09°20'57"	114.03	57.16	113.91	S43°20'01"W
7	200.00	09°20'57"	52.27	25.65	45.21	S01°29'59"W
8	300.00	07°14'23"	45.92	23.82	41.56	S84°34'14"W
9	586.34	11°46'09"	120.44	60.43	120.23	S34°50'22"W
10	300.00	08°32'17"	42.17	25.41	38.78	N11°18'42"W
11	75.00	05°42'42"	33.66	17.10	33.39	S64°34'07"E
12	5.00	128°19'01"	11.20	10.32	9.09	N38°24'40"E
13	75.00	25°59'16"	34.02	17.31	33.73	N38°44'28"W
14	1012.00	10°16'15"	181.41	90.95	181.17	N56°52'13"W
15	1026.00	06°23'44"	115.64	57.88	115.53	N58°48'29"W
16	741.46	16°14'10"	210.14	105.78	209.44	N70°07'31"W
17	717.46	12°31'25"	156.82	78.72	156.51	S68°16'04"E
18	5.00	172°41'30"	15.07	78.29	9.28	S19°07'29"W
19	707.46	05°12'56"	64.40	32.22	64.38	N64°26'58"W
20	288.00	10°17'17"	177.41	88.94	177.17	S56°51'40"E
21	264.00	10°25'24"	175.37	87.23	175.12	S56°47'20"E
22	683.46	07°15'57"	86.67	43.39	86.61	N63°38'25"W
23	6.67	102°45'42"	12.76	74.45	13.29	S46°32'58"E
24	5.00	147°44'21"	12.89	17.29	9.61	S22°17'13"W
25	15.00	20°00'00"	23.56	15.00	21.21	N88°25'03"E
26	5.00	53°28'22"	13.39	21.21	9.73	N38°19'10"W
27	30.00	06°53'25"	50.73	25.84	44.90	S62°17'00"W
28	30.00	02°04'51"	48.21	21.11	45.19	N32°12'11"W
29	30.00	06°25'10"	45.25	28.18	41.08	S57°02'52"W
30	30.00	09°34'50"	40.00	31.94	43.73	S52°57'03"E

7/1/83	1	As Per D.P.W. & Sediment Control Comments
REV. DATE	REV. NO.	REVISION DESCRIPTION
COLUMBIA 5th ELECTION DISTRICT HOWARD COUNTY, MARYLAND OWNER AND DEVELOPER THE HOWARD RESEARCH AND DEVELOPMENT CORPORATION THE ROUSE BUILDING COLUMBIA, MARYLAND 21044		
PROJECT AREA VILLAGE OF HICKORY RIDGE SECTION 3 AREA 1		
PROJECT TITLE ROAD STAKEOUT PLAN LITTLE PATUXENT PARKWAY AND LITTLE PATUXENT PARKWAY INTERSECTION		
SCALE: 1" = 30'		DATE
WHITMAN, REQUARDT AND ASSOCIATES ENGINEERS 2315 ST. PAUL STREET BALTIMORE, MARYLAND 21218		
Kenneth A. McCord Registered Engineer No. 1974		

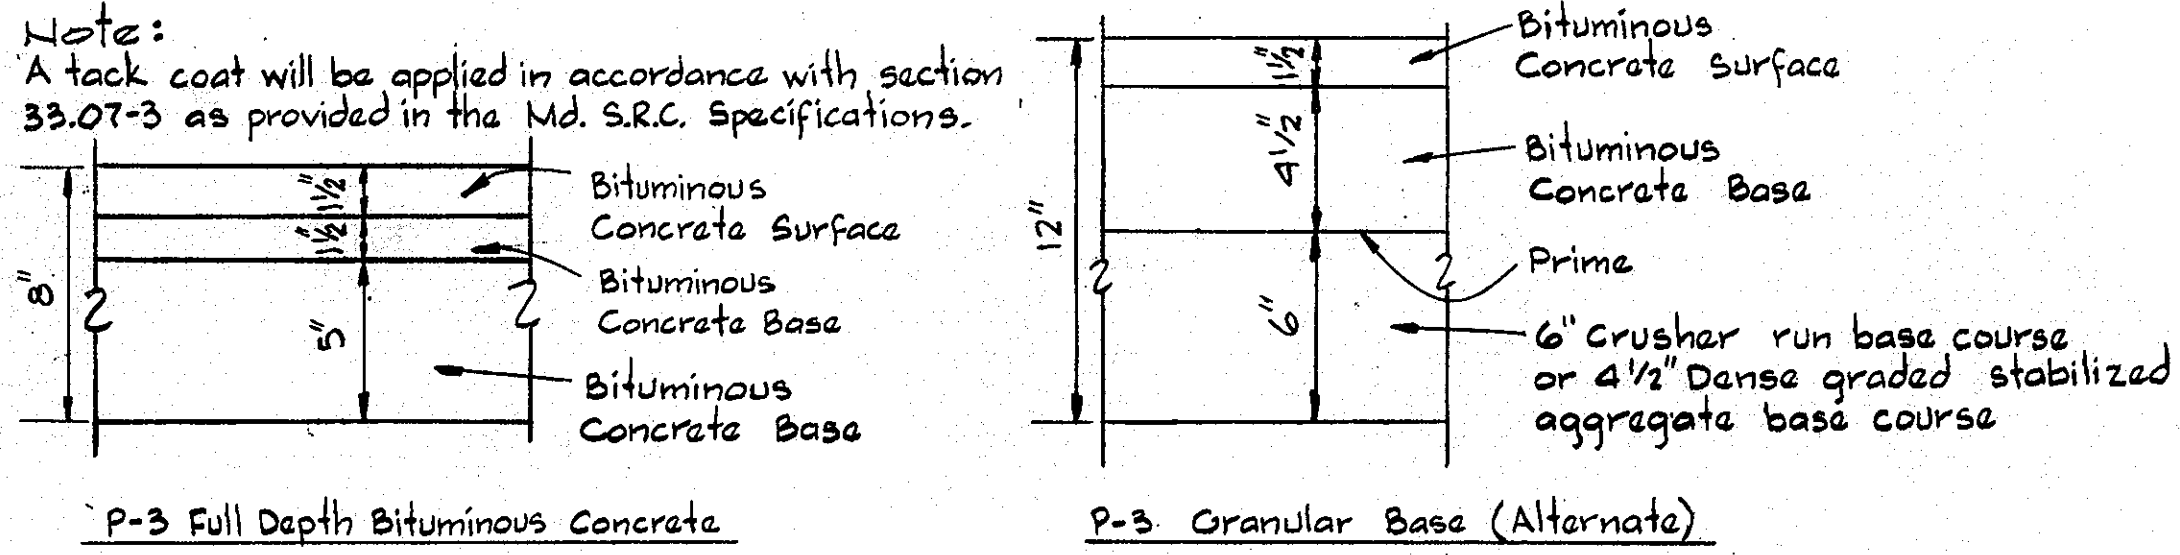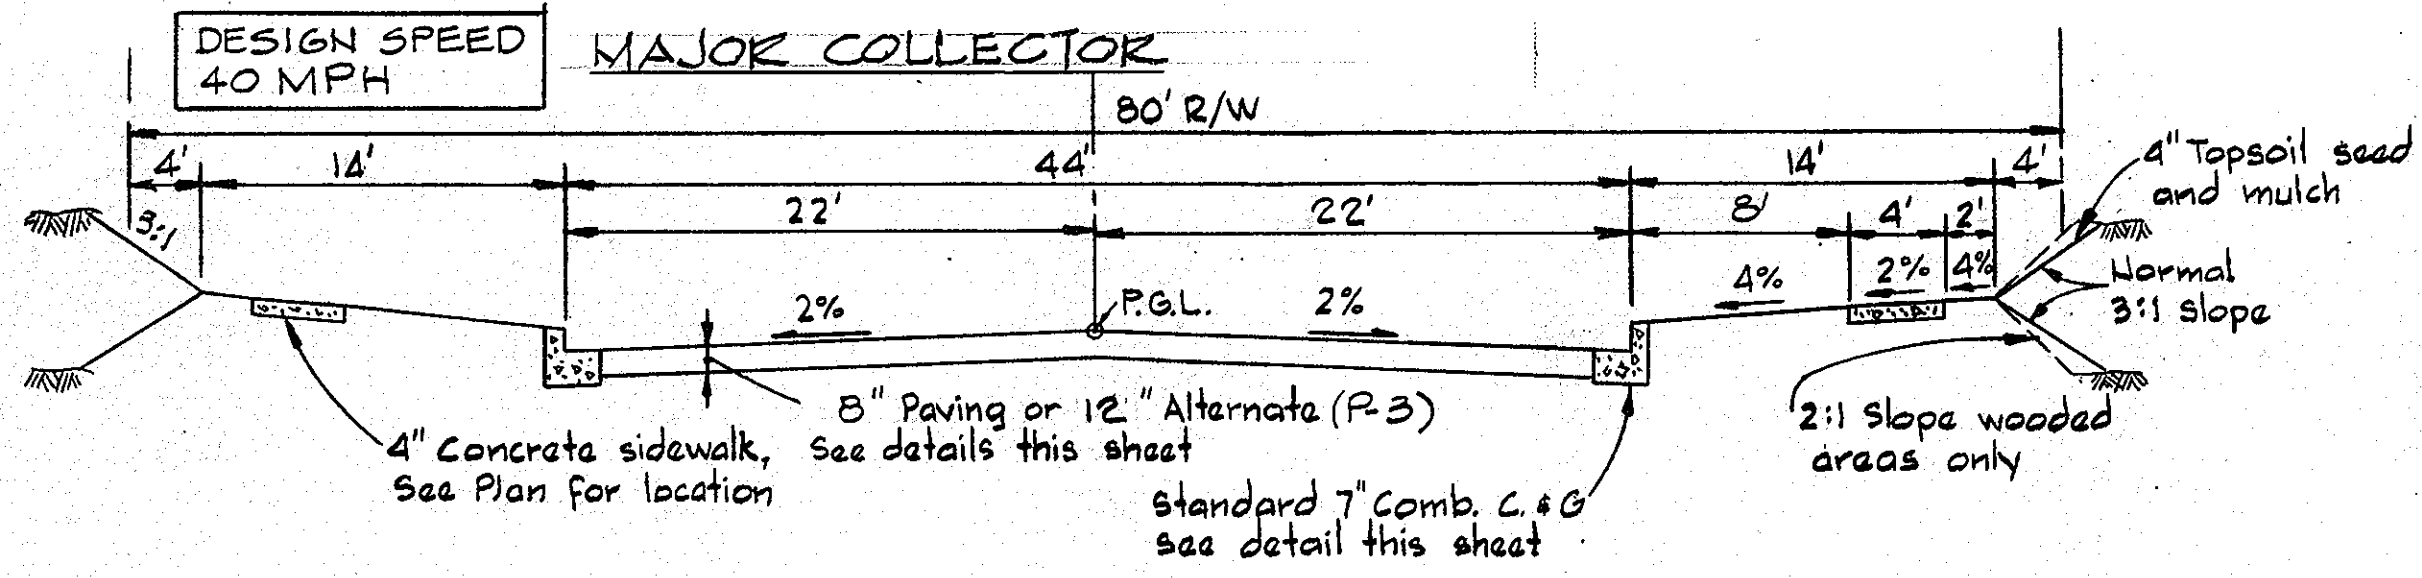




STA. 8+98 TO STA. 18+40
 HICKORY RIDGE ROAD
 STA. 96+00 TO STA. 125+05.82
 LITTLE PATUXENT PARKWAY

TYPICAL PAVING SECTION
 No Scale

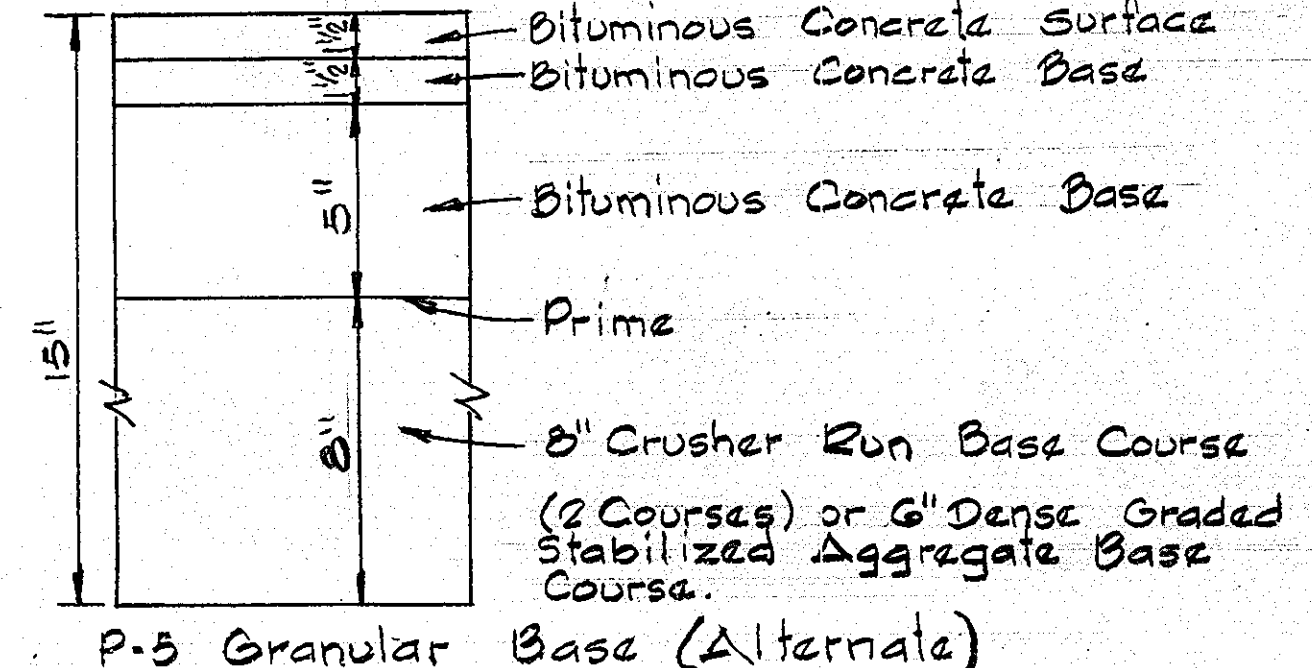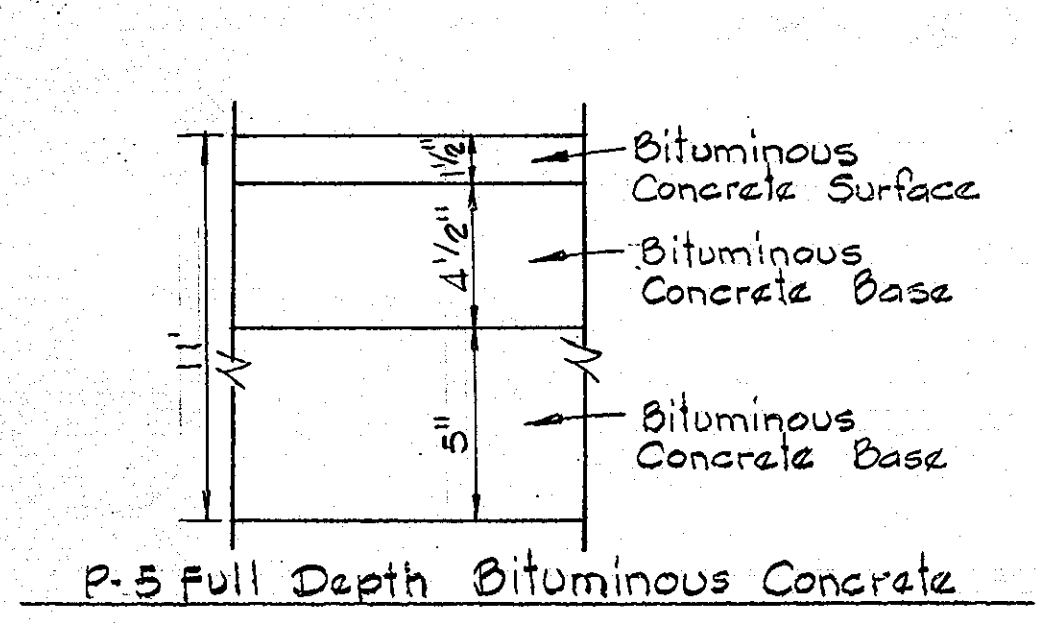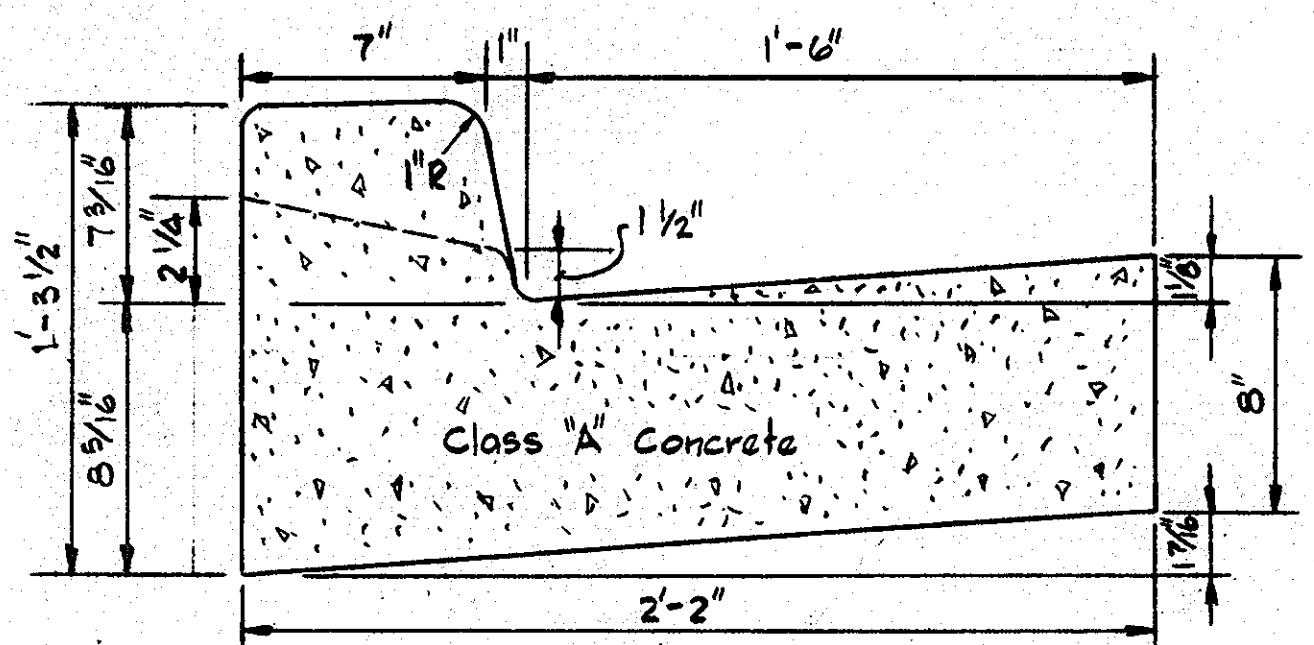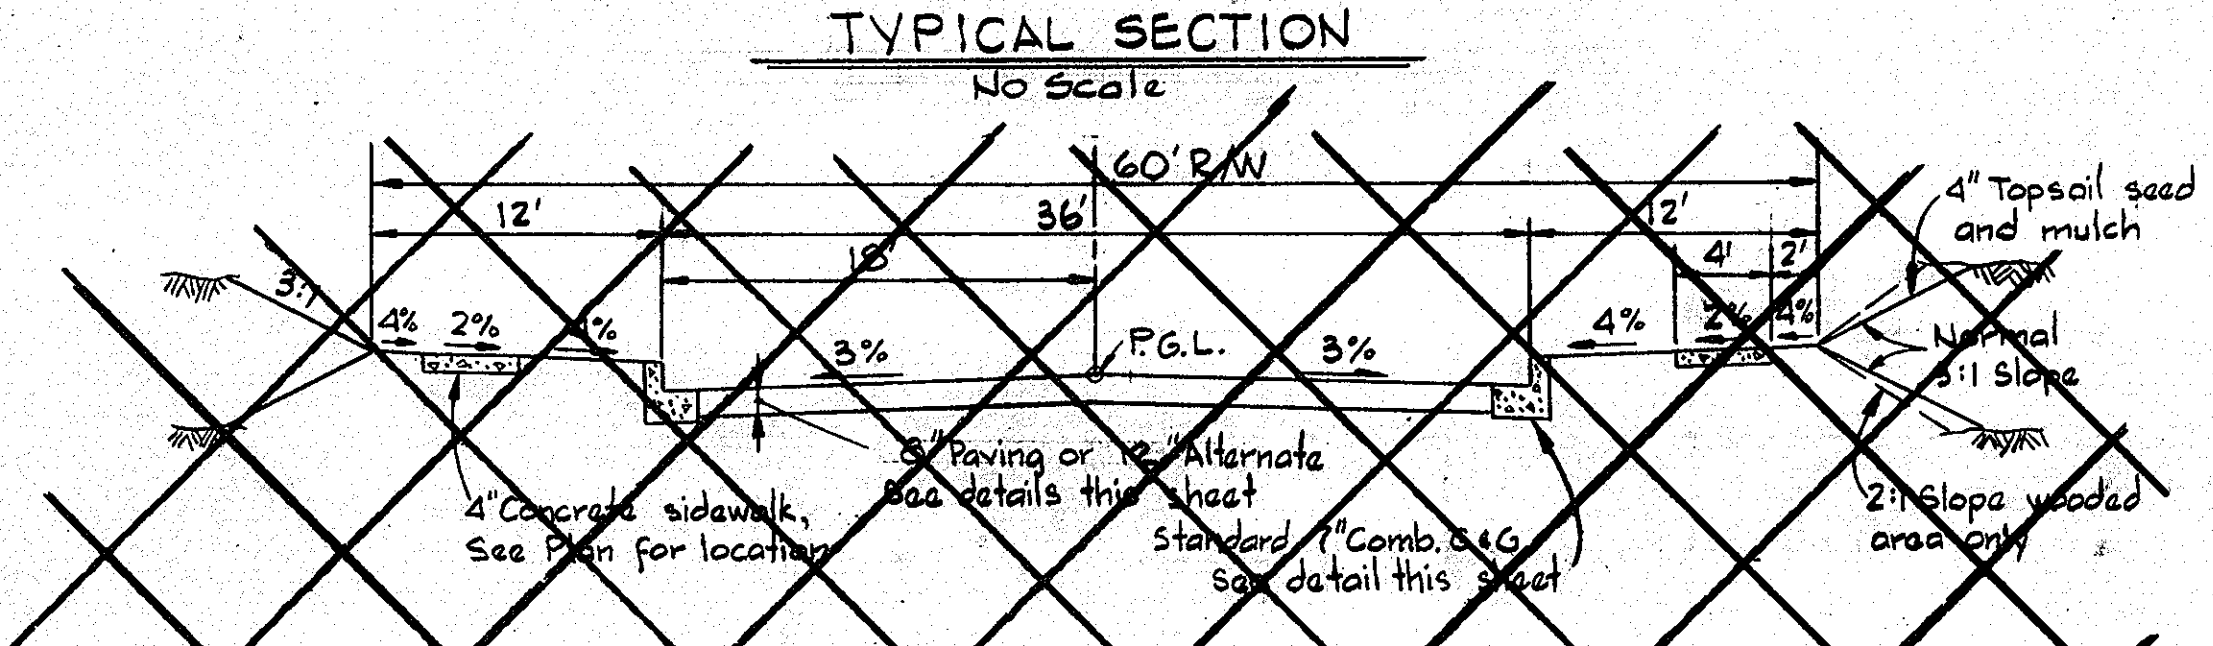



STANDARD 7" COMBINATION CURB & GUTTER
 No Scale

TYPICAL PAVING SECTION
 No Scale

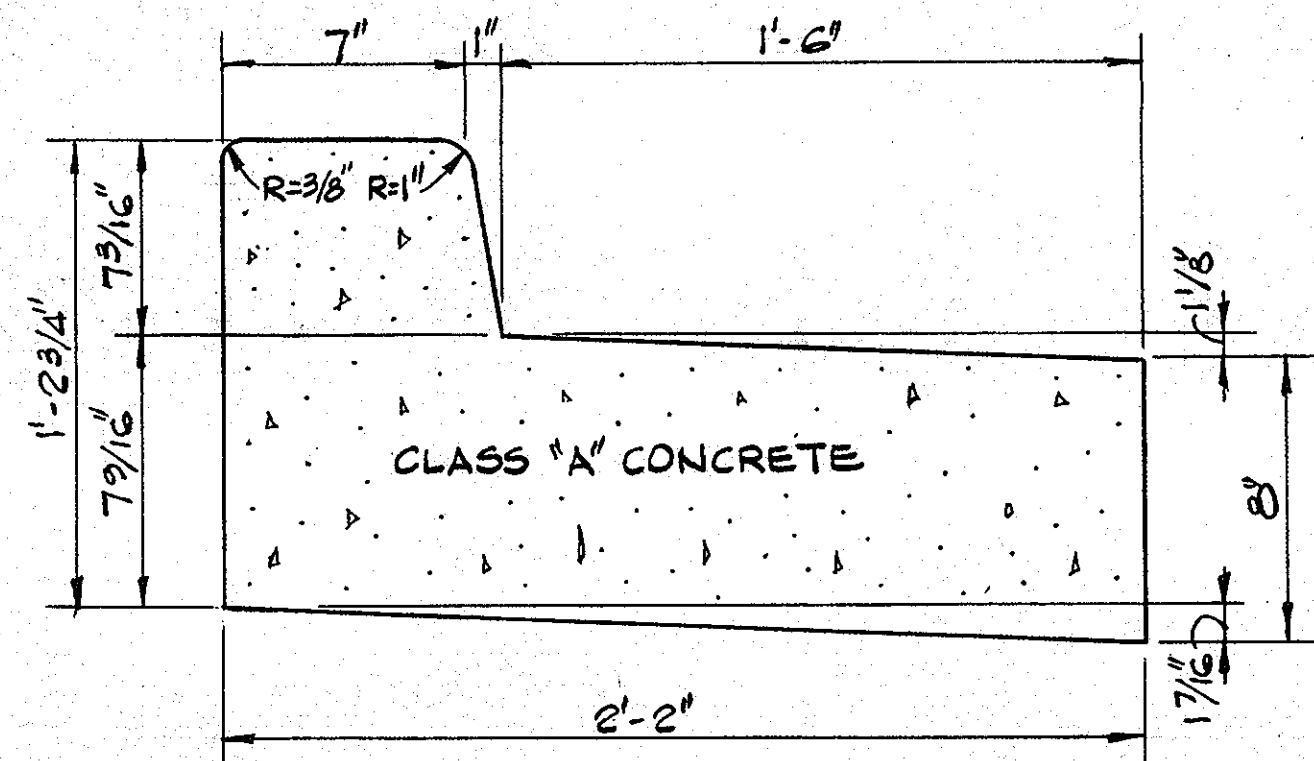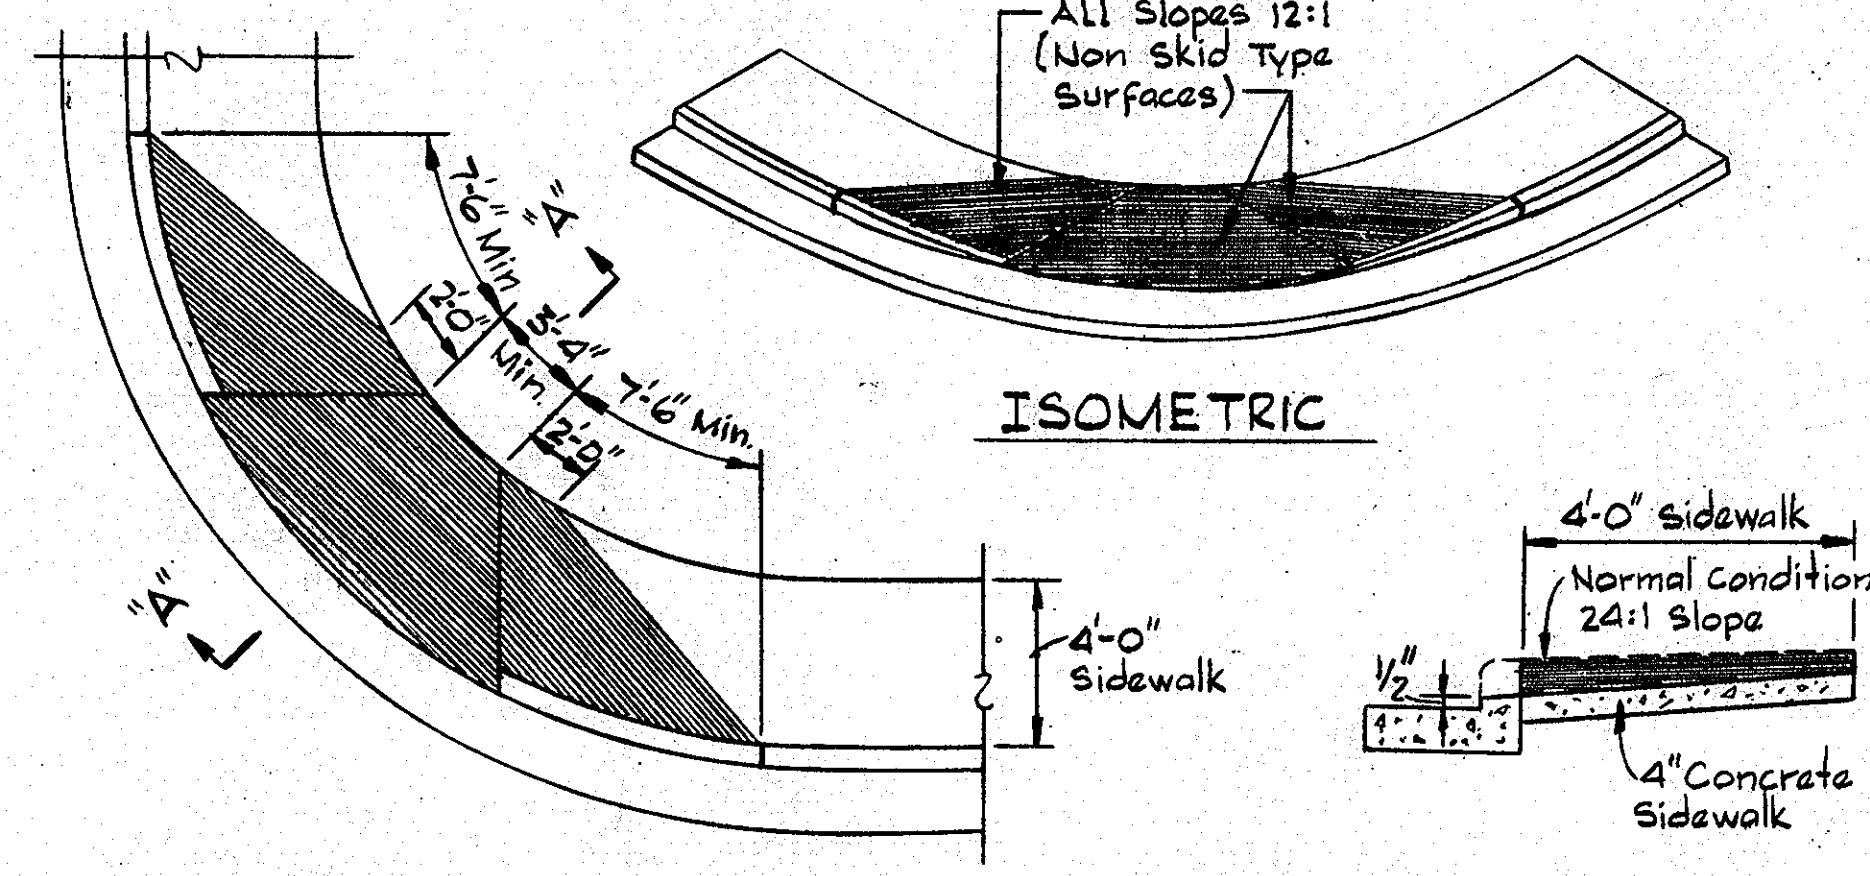
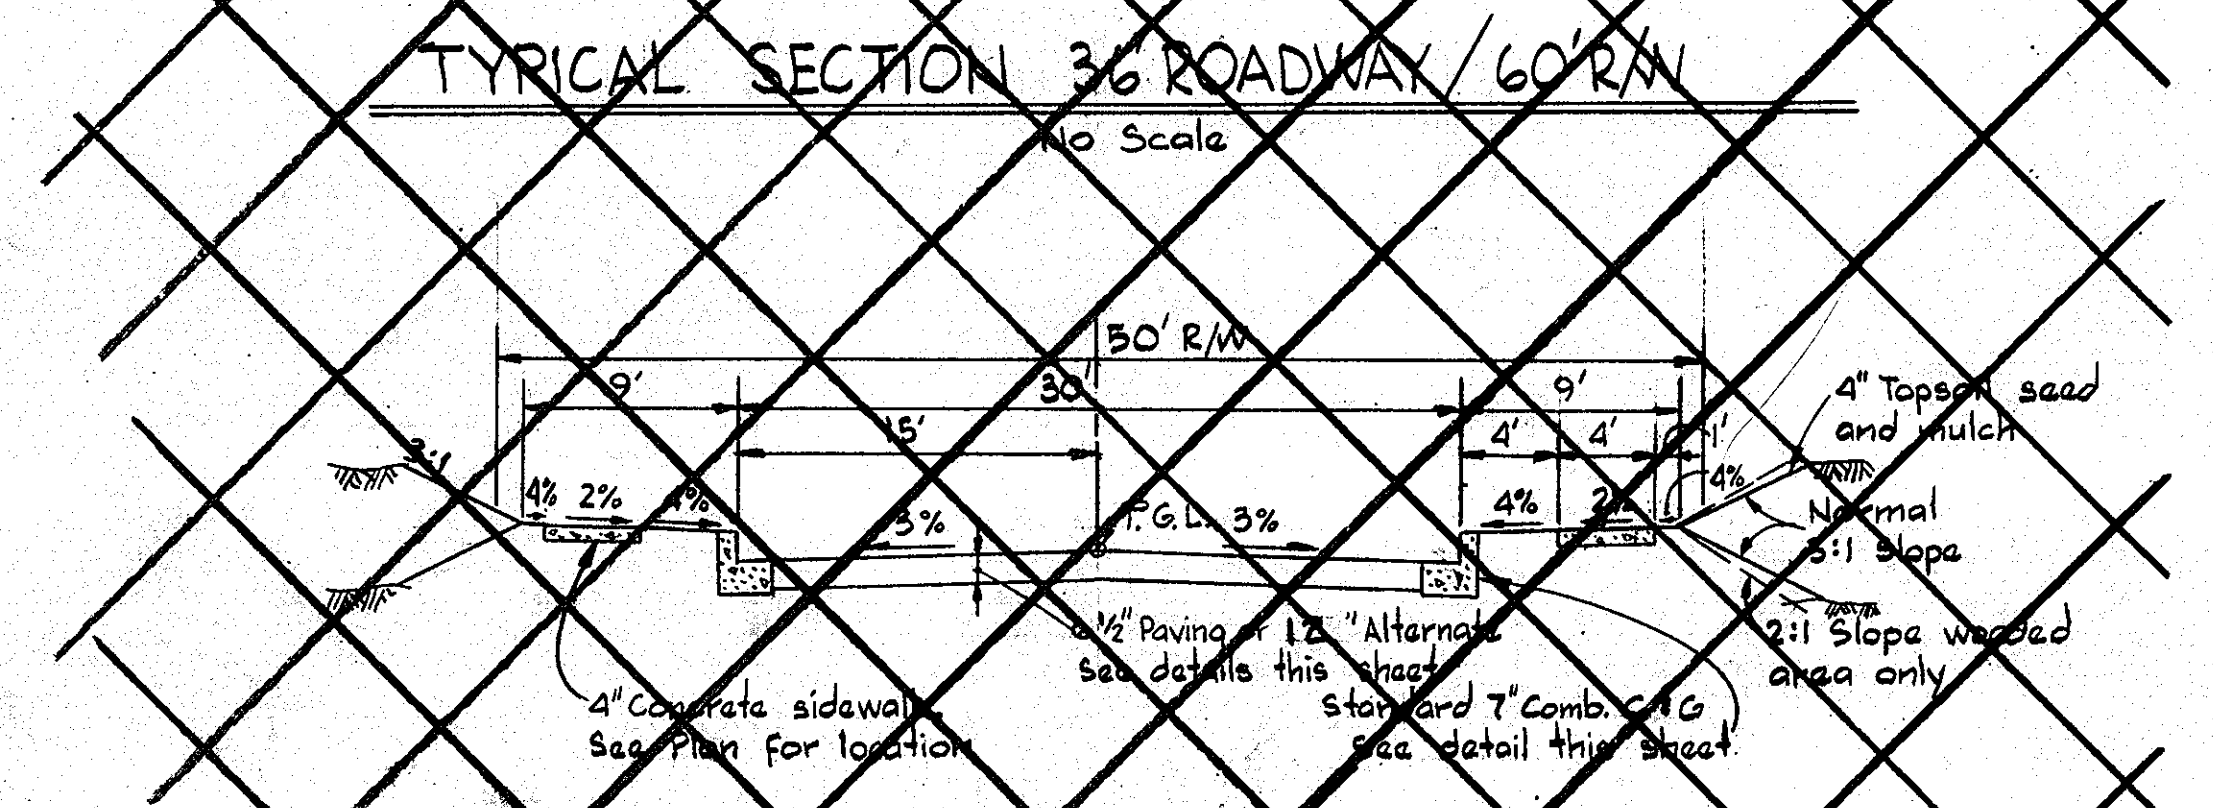


WHEEL CHAIR RAMP DETAIL
 No Scale

REVERSE 7" COMBINATION CURB & GUTTER
 No Scale

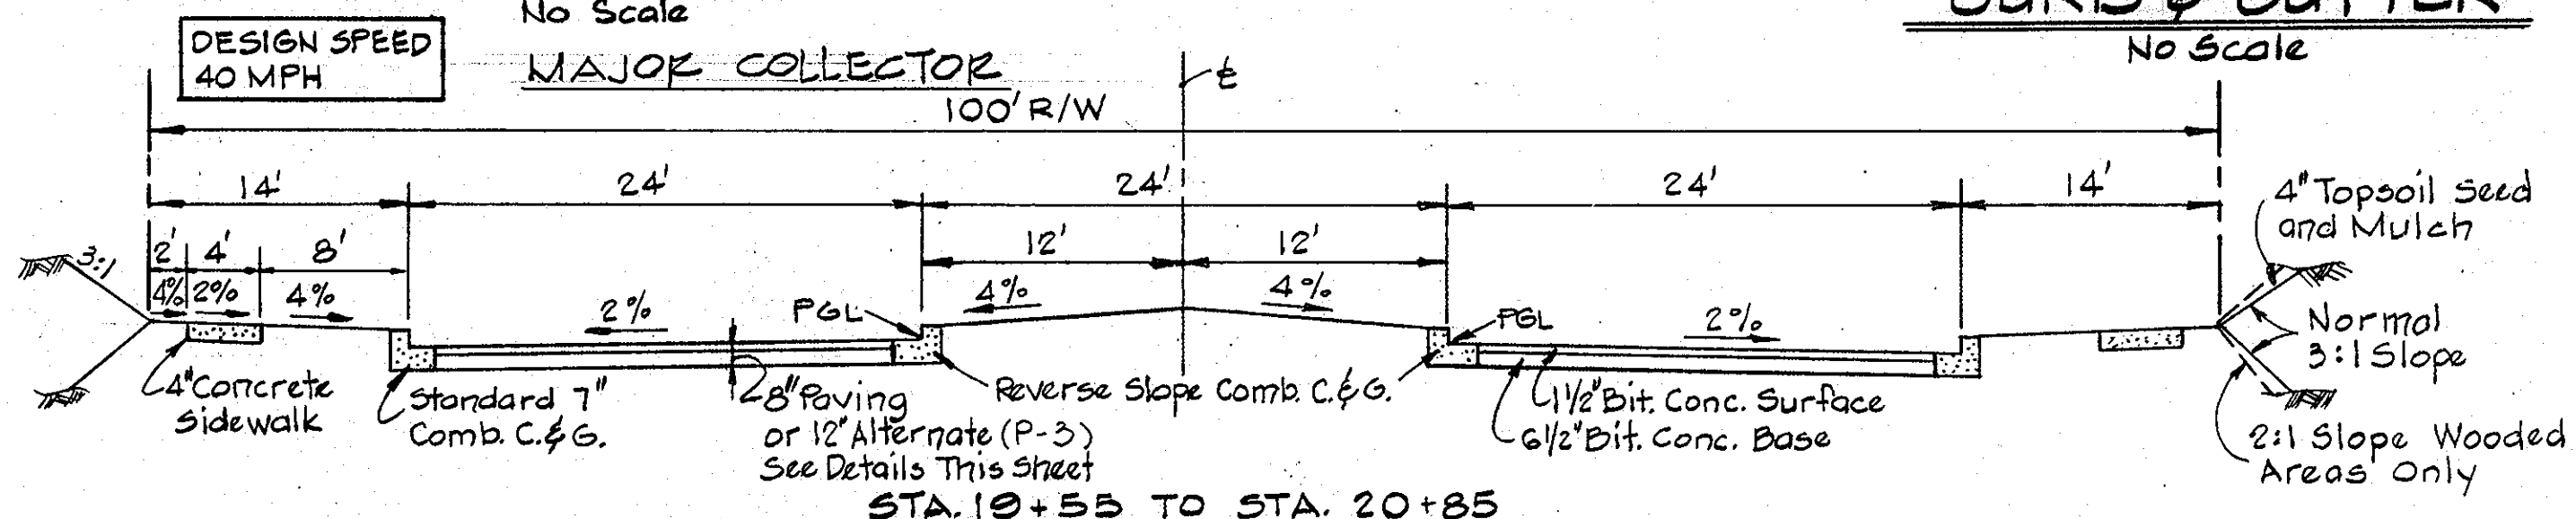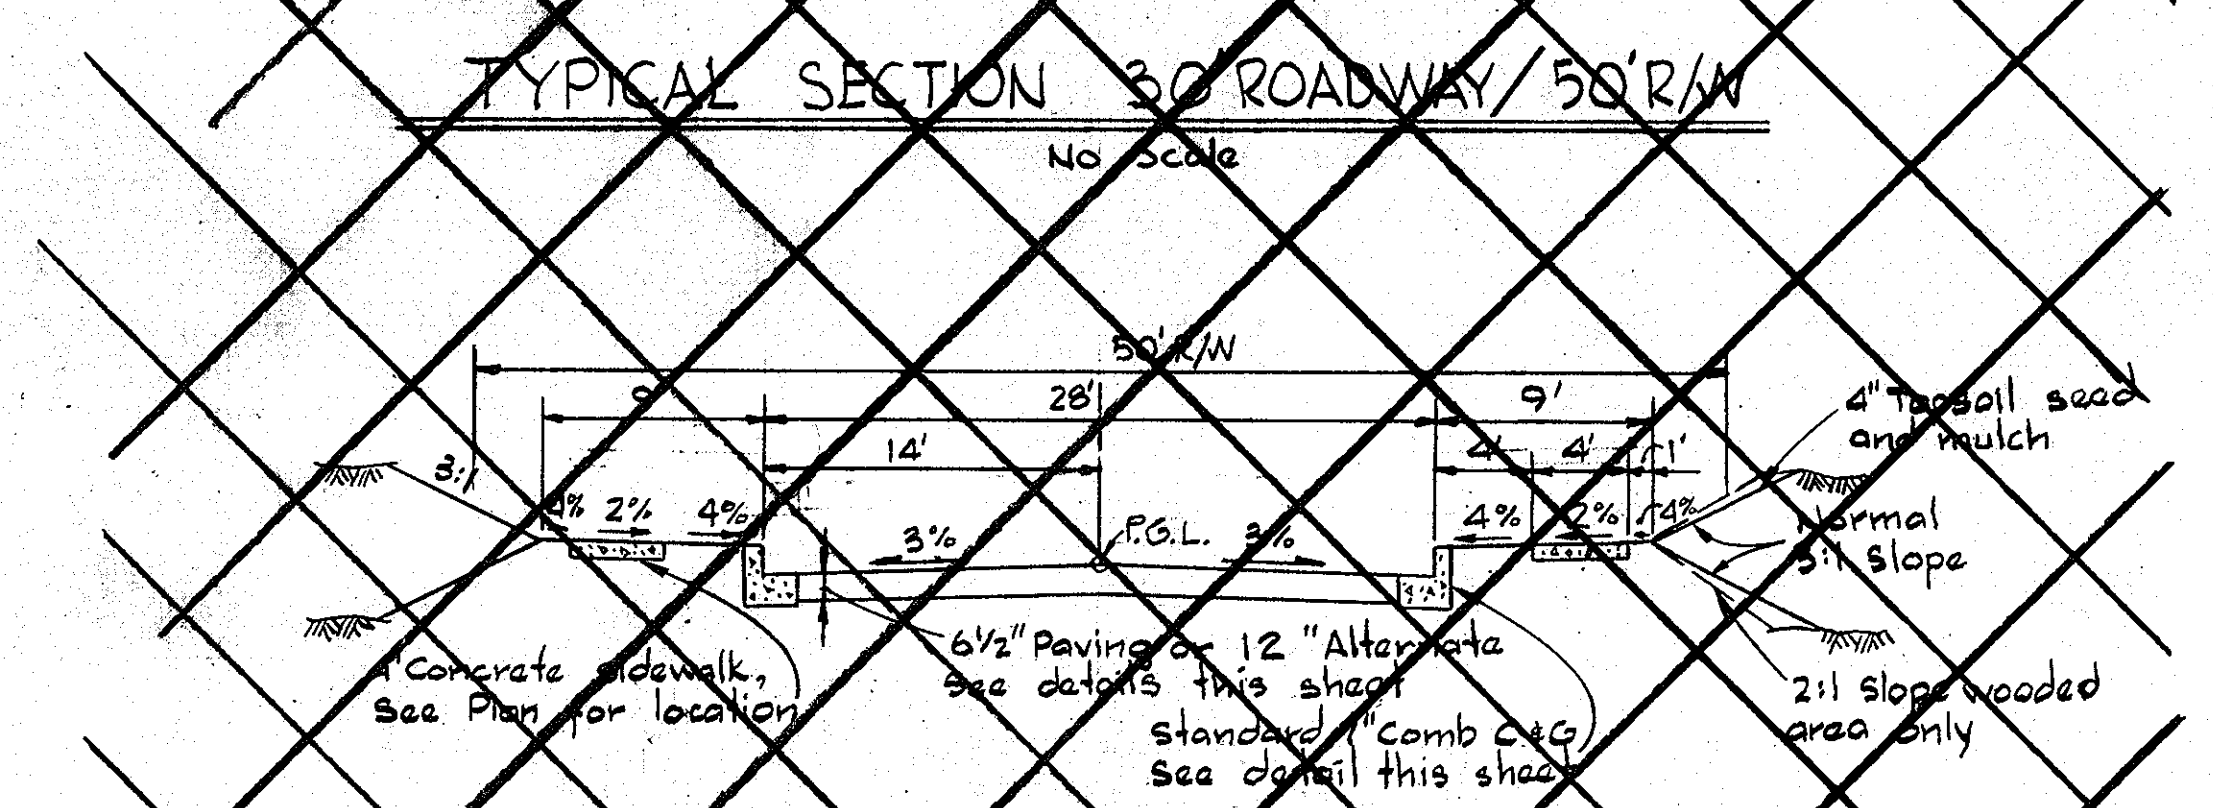

TYPICAL SECTION - HICKORY RIDGE ROAD
 No Scale

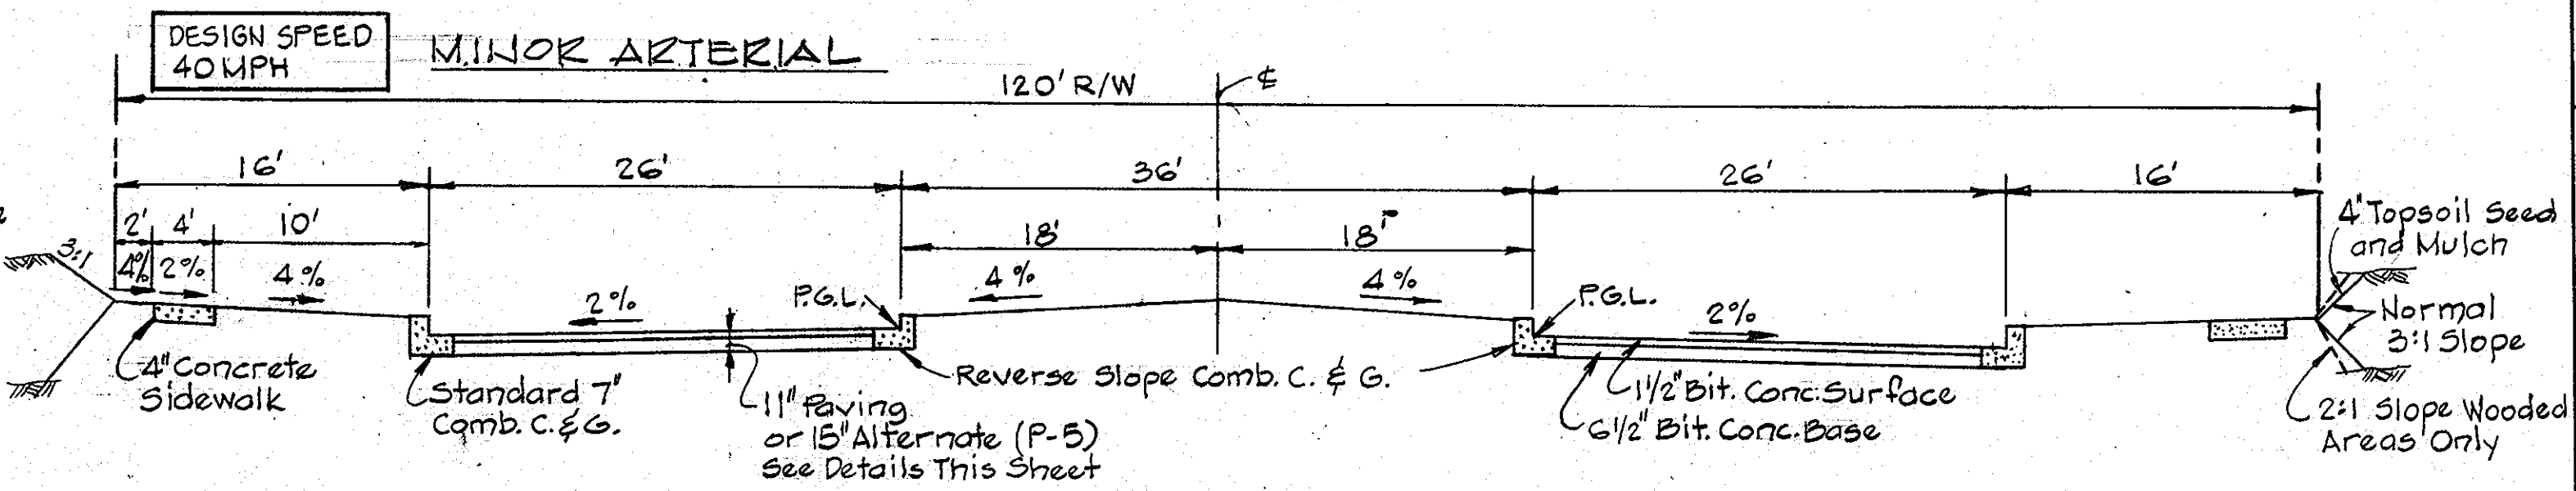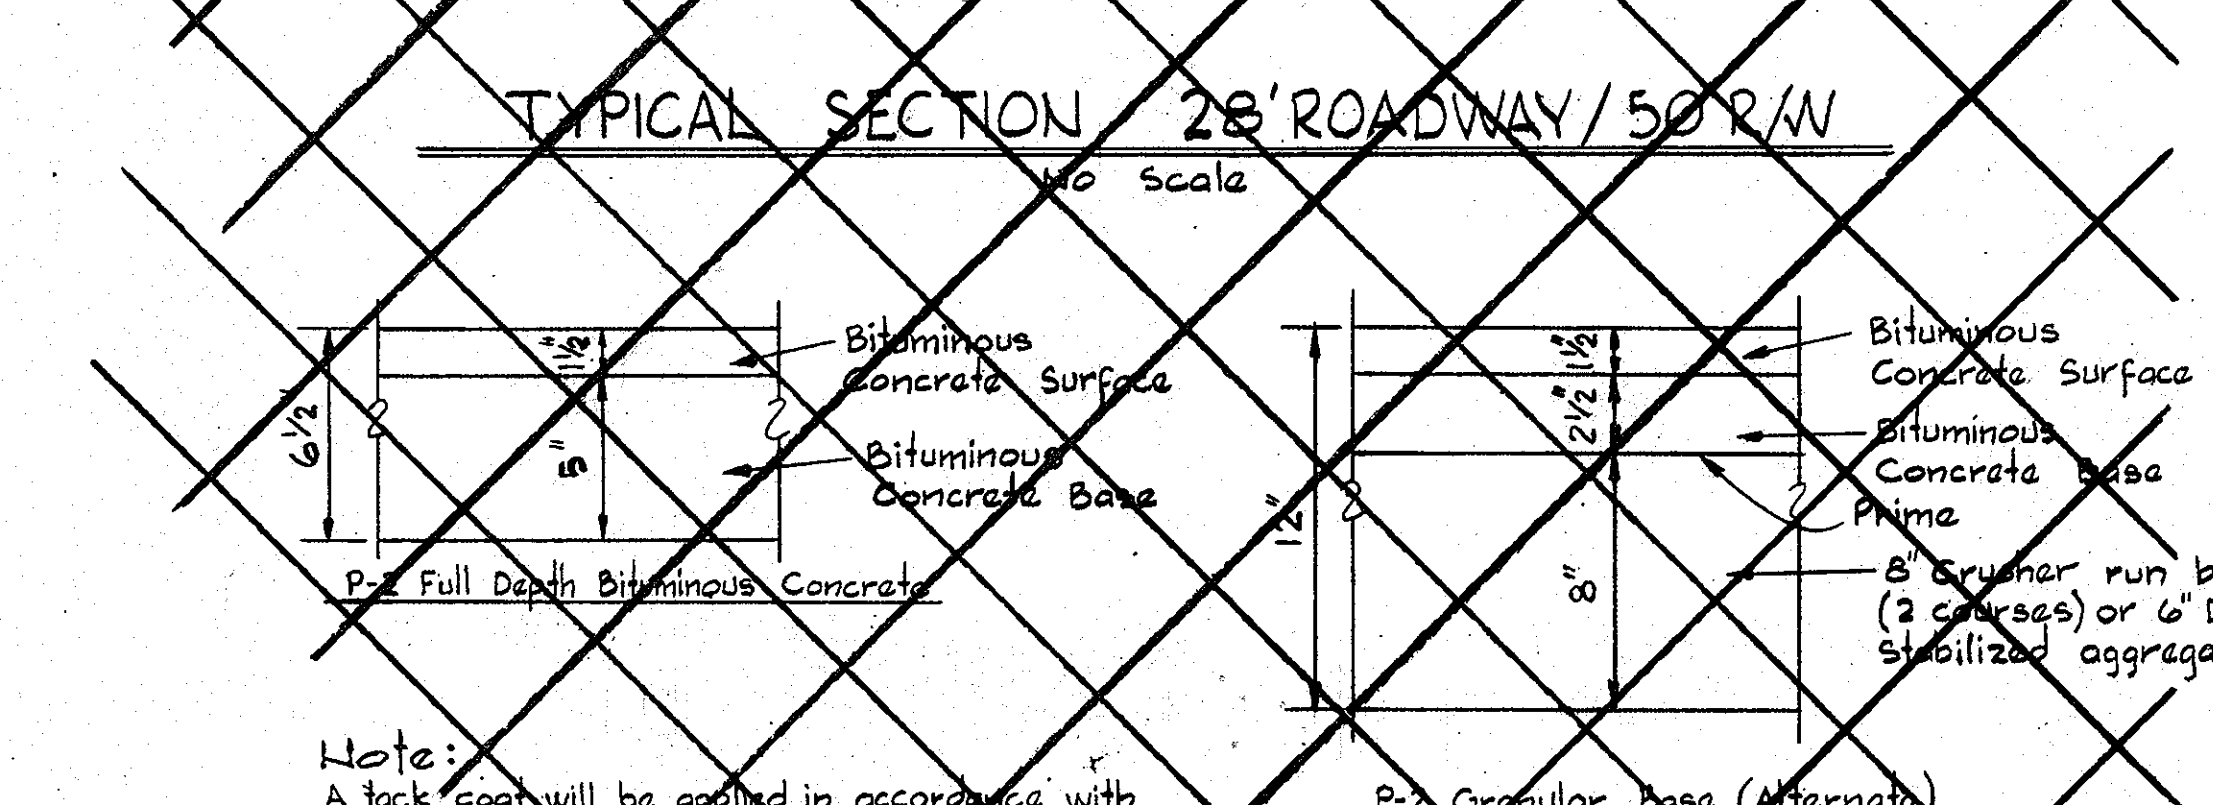


TYPICAL SECTION - LITTLE PATUXENT PARKWAY
 No Scale

Note:
 A tack coat will be applied in accordance with section 33.07-3 as provided in the Md. S.R.C. specifications.

TYPICAL PAVING SECTION
 No Scale

7/1/84	1	As Per D.P.W. & Sediment Control Comments
REV. DATE	REV. NO.	REVISION DESCRIPTION
COLUMBIA 5th ELECTION DISTRICT HOWARD COUNTY, MARYLAND OWNER AND DEVELOPER THE HOWARD RESEARCH AND DEVELOPMENT CORPORATION THE ROUSE BUILDING COLUMBIA, MARYLAND 21044		
PROJECT AREA VILLAGE OF HICKORY RIDGE SECTION 3 AREA 1		
PROJECT TITLE ROADWAY DETAILS		
SCALE: AS SHOWN	DATE	
WHITMAN, REQUARDT AND ASSOCIATES ENGINEERS 2315 ST. PAUL STREET BALTIMORE, MARYLAND 21218		
Kenneth A. McCord Registered Engineer No. 1974		

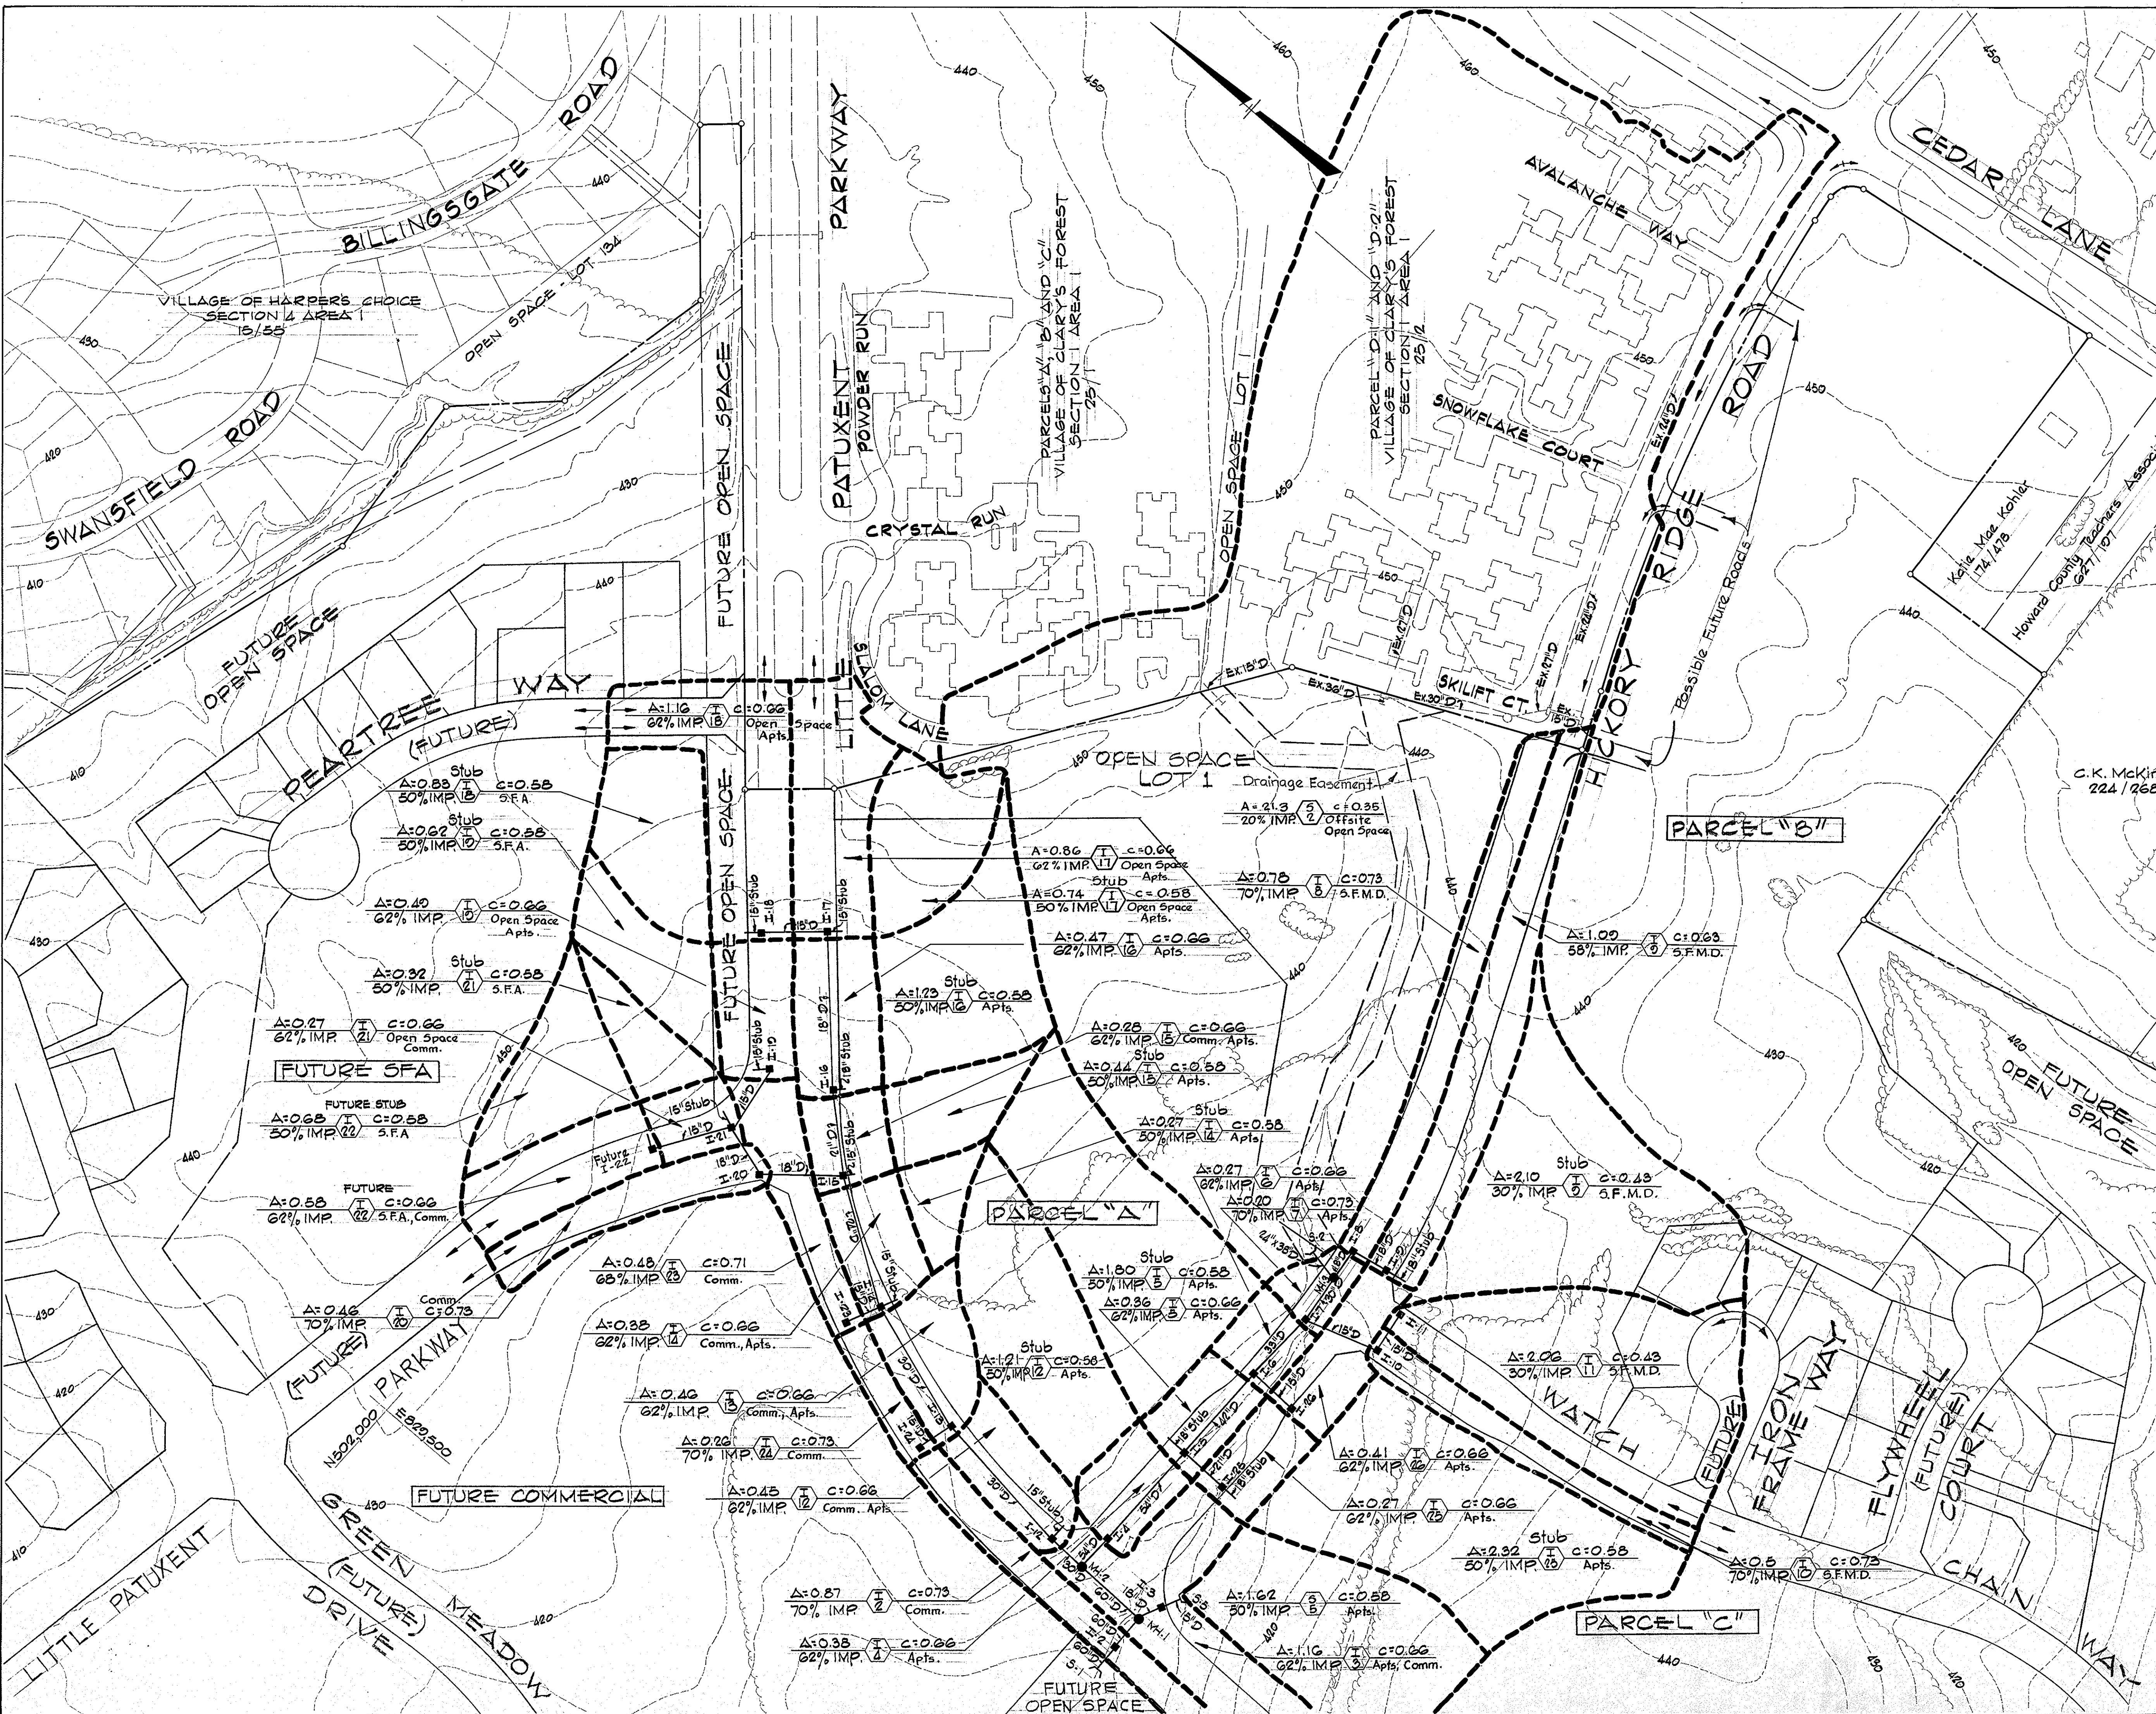

Rev/Date	Rev.No	Revision Description
7/1/83	1	As per DPW Comments

COLUMBIA
 5th ELECTION DISTRICT
 HOWARD COUNTY, MARYLAND
 OWNER AND DEVELOPER
 HOWARD RESEARCH AND DEVELOPMENT CORPORATION

PROJECT AREA
 VILLAGE OF HICKORY RIDGE
 SECTION 3 AREA 1

PROJECT TITLE
 DRAINAGE AREA MAP


SCALE: 1"=100' **DATE:**

WHITMAN, REQUARDT AND ASSOCIATES
 ENGINEERS
 7315 ST. PAUL STREET
 BALTIMORE, MARYLAND 21218

Kenneth A. McCord
 KENNETH A. MCCORD
 Registered Engineer
 No. 1974

LEGEND

El. 3600 - 100 Year Flood Plain Elevation

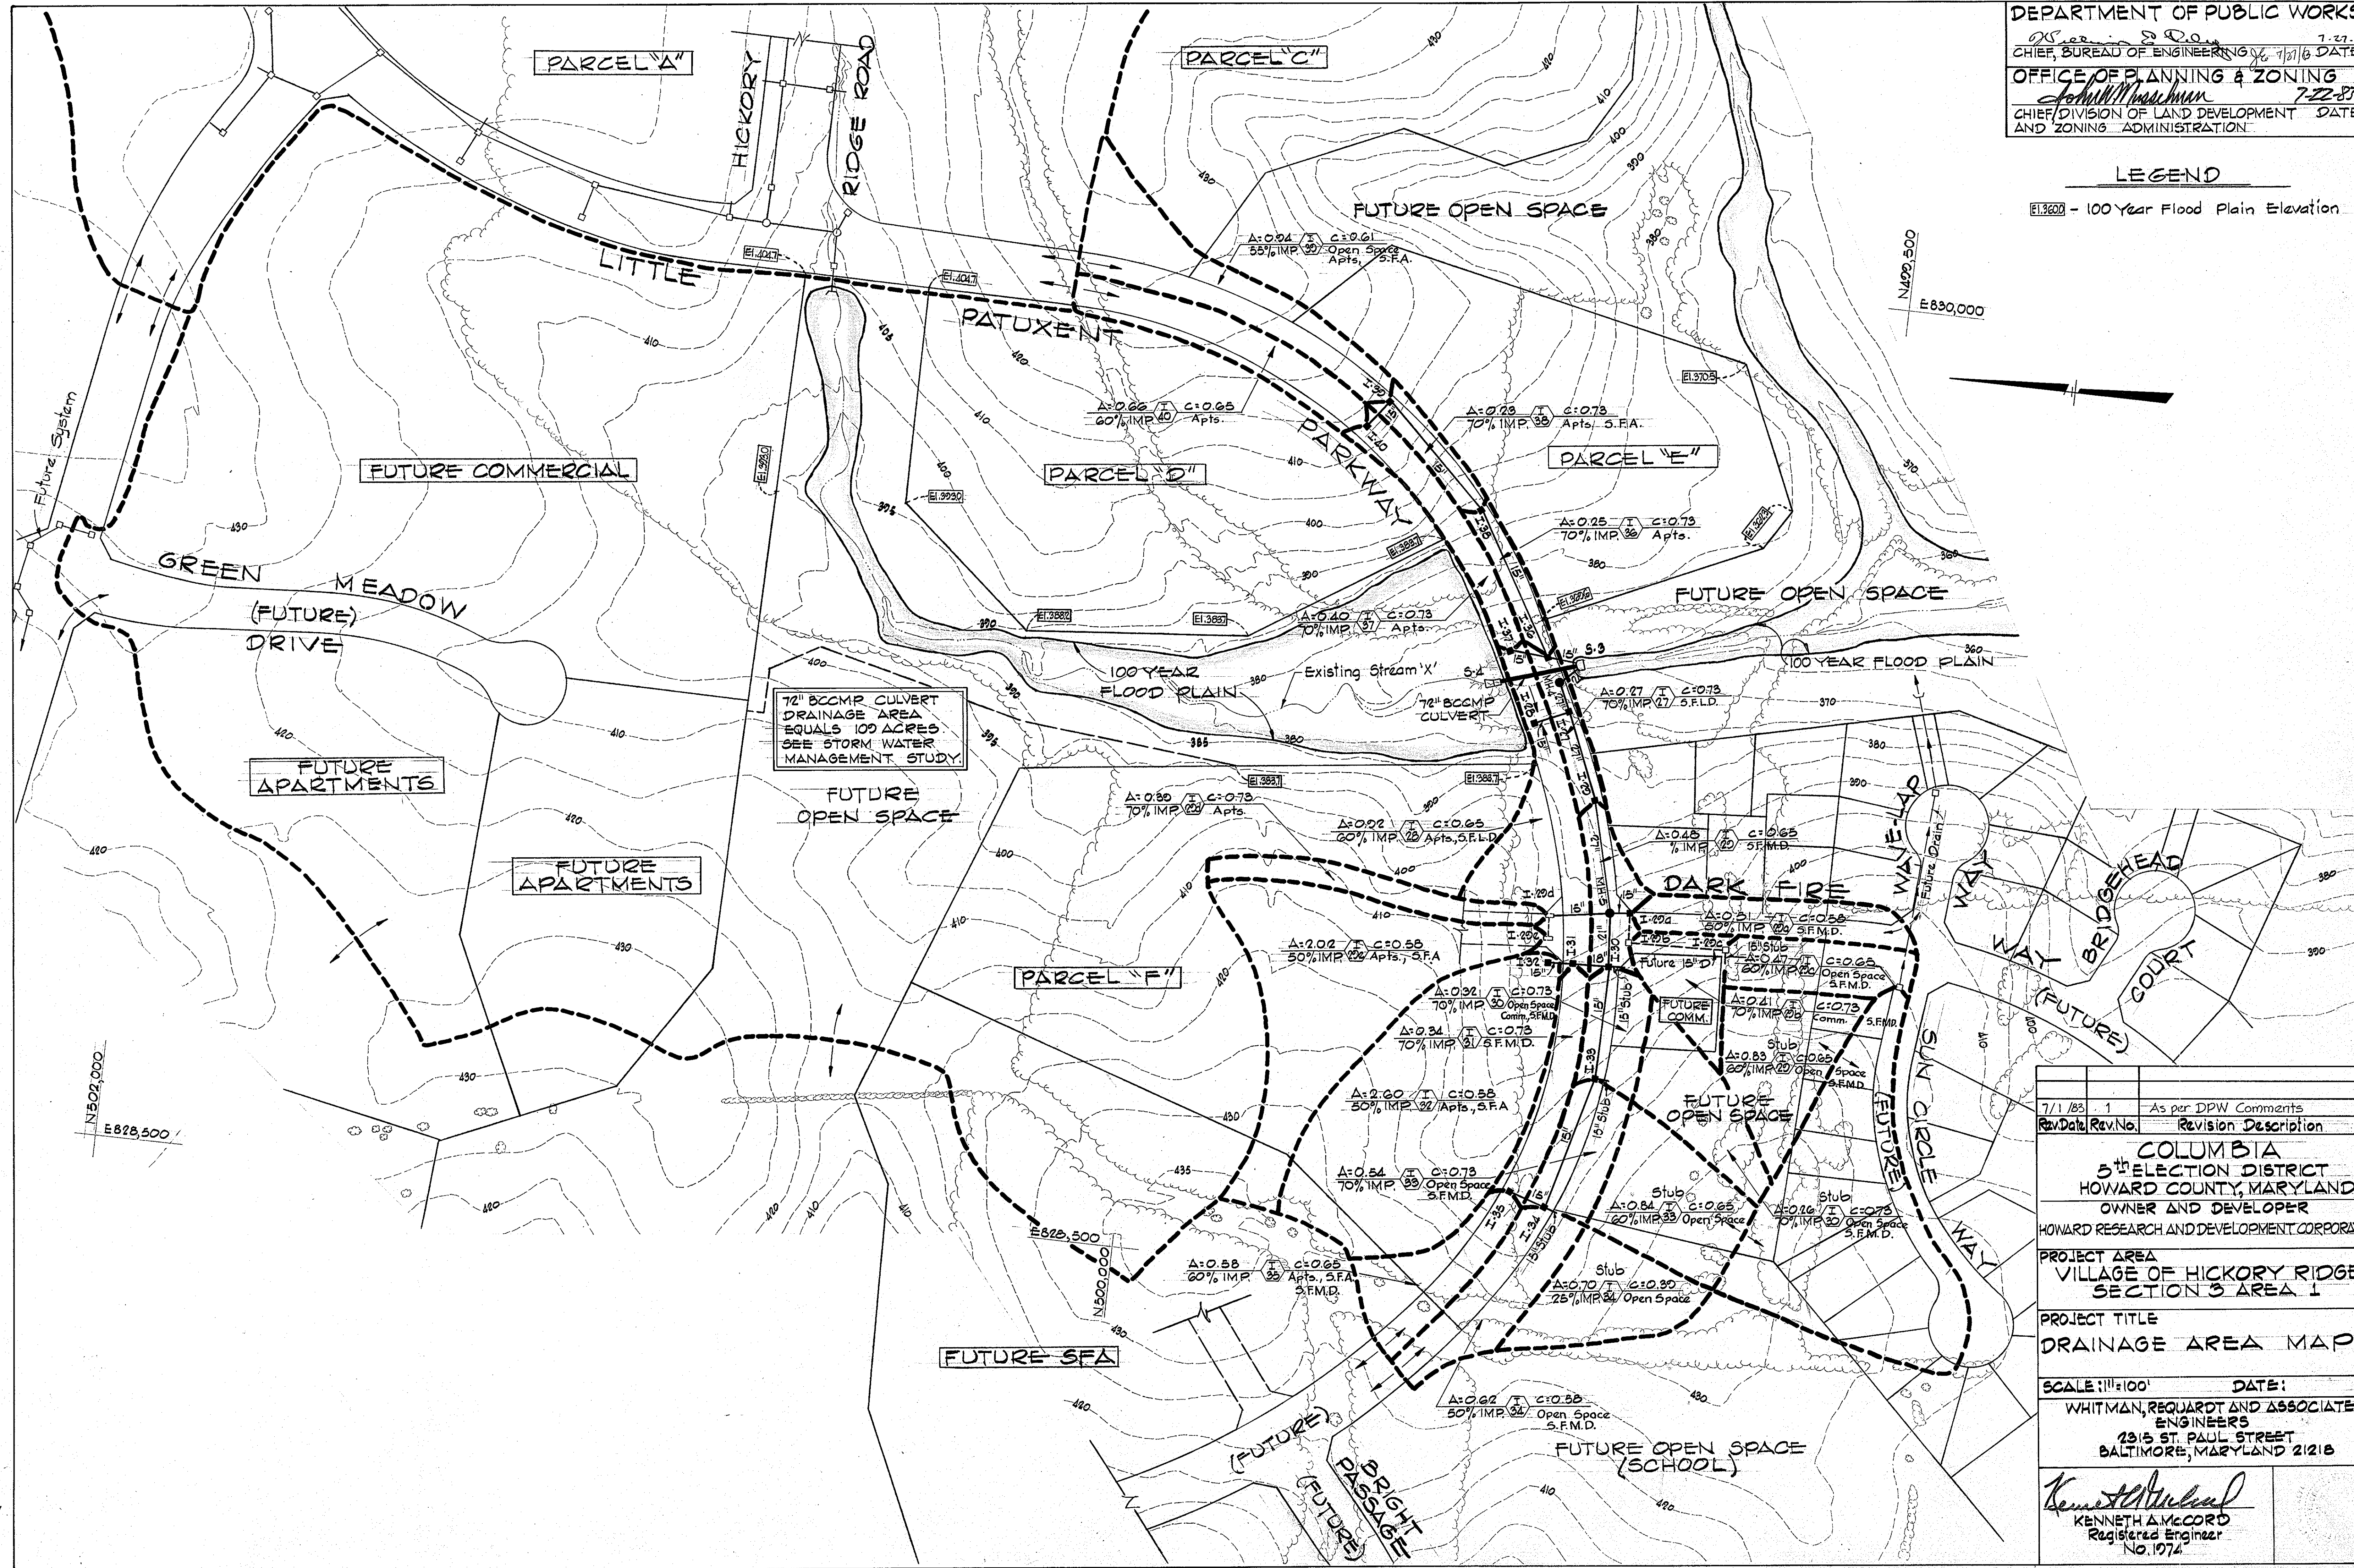

Rev. No.	Date	Revision Description
1	7/1/83	As per DPW Comments

COLUMBIA
 5th ELECTION DISTRICT
 HOWARD COUNTY, MARYLAND
 OWNER AND DEVELOPER
 HOWARD RESEARCH AND DEVELOPMENT CORPORATION

PROJECT AREA
 VILLAGE OF HICKORY RIDGE
 SECTION 3 AREA 1








PROJECT TITLE
 DRAINAGE AREA MAP

SCALE: 1"=100' DATE:
 WHITMAN, REQUARD AND ASSOCIATES
 ENGINEERS
 2315 ST. PAUL STREET
 BALTIMORE, MARYLAND 21218

Kenneth A. McCord
 KENNETH A. MCCORD
 Registered Engineer
 No. 1974

"AS-BUILT" ELEVATIONS AS OF NOV. 19, 1984
 BY: KENNETH A. McCORD P.E. # 1974

DEPARTMENT OF PUBLIC WORKS
 Chief, Bureau of Engineering 7-27-83
 DATE 11/13/83
 OFFICE OF PLANNING & ZONING
 Chief, Division of Land Development Date 7-22-87
 AND ZONING ADMINISTRATION

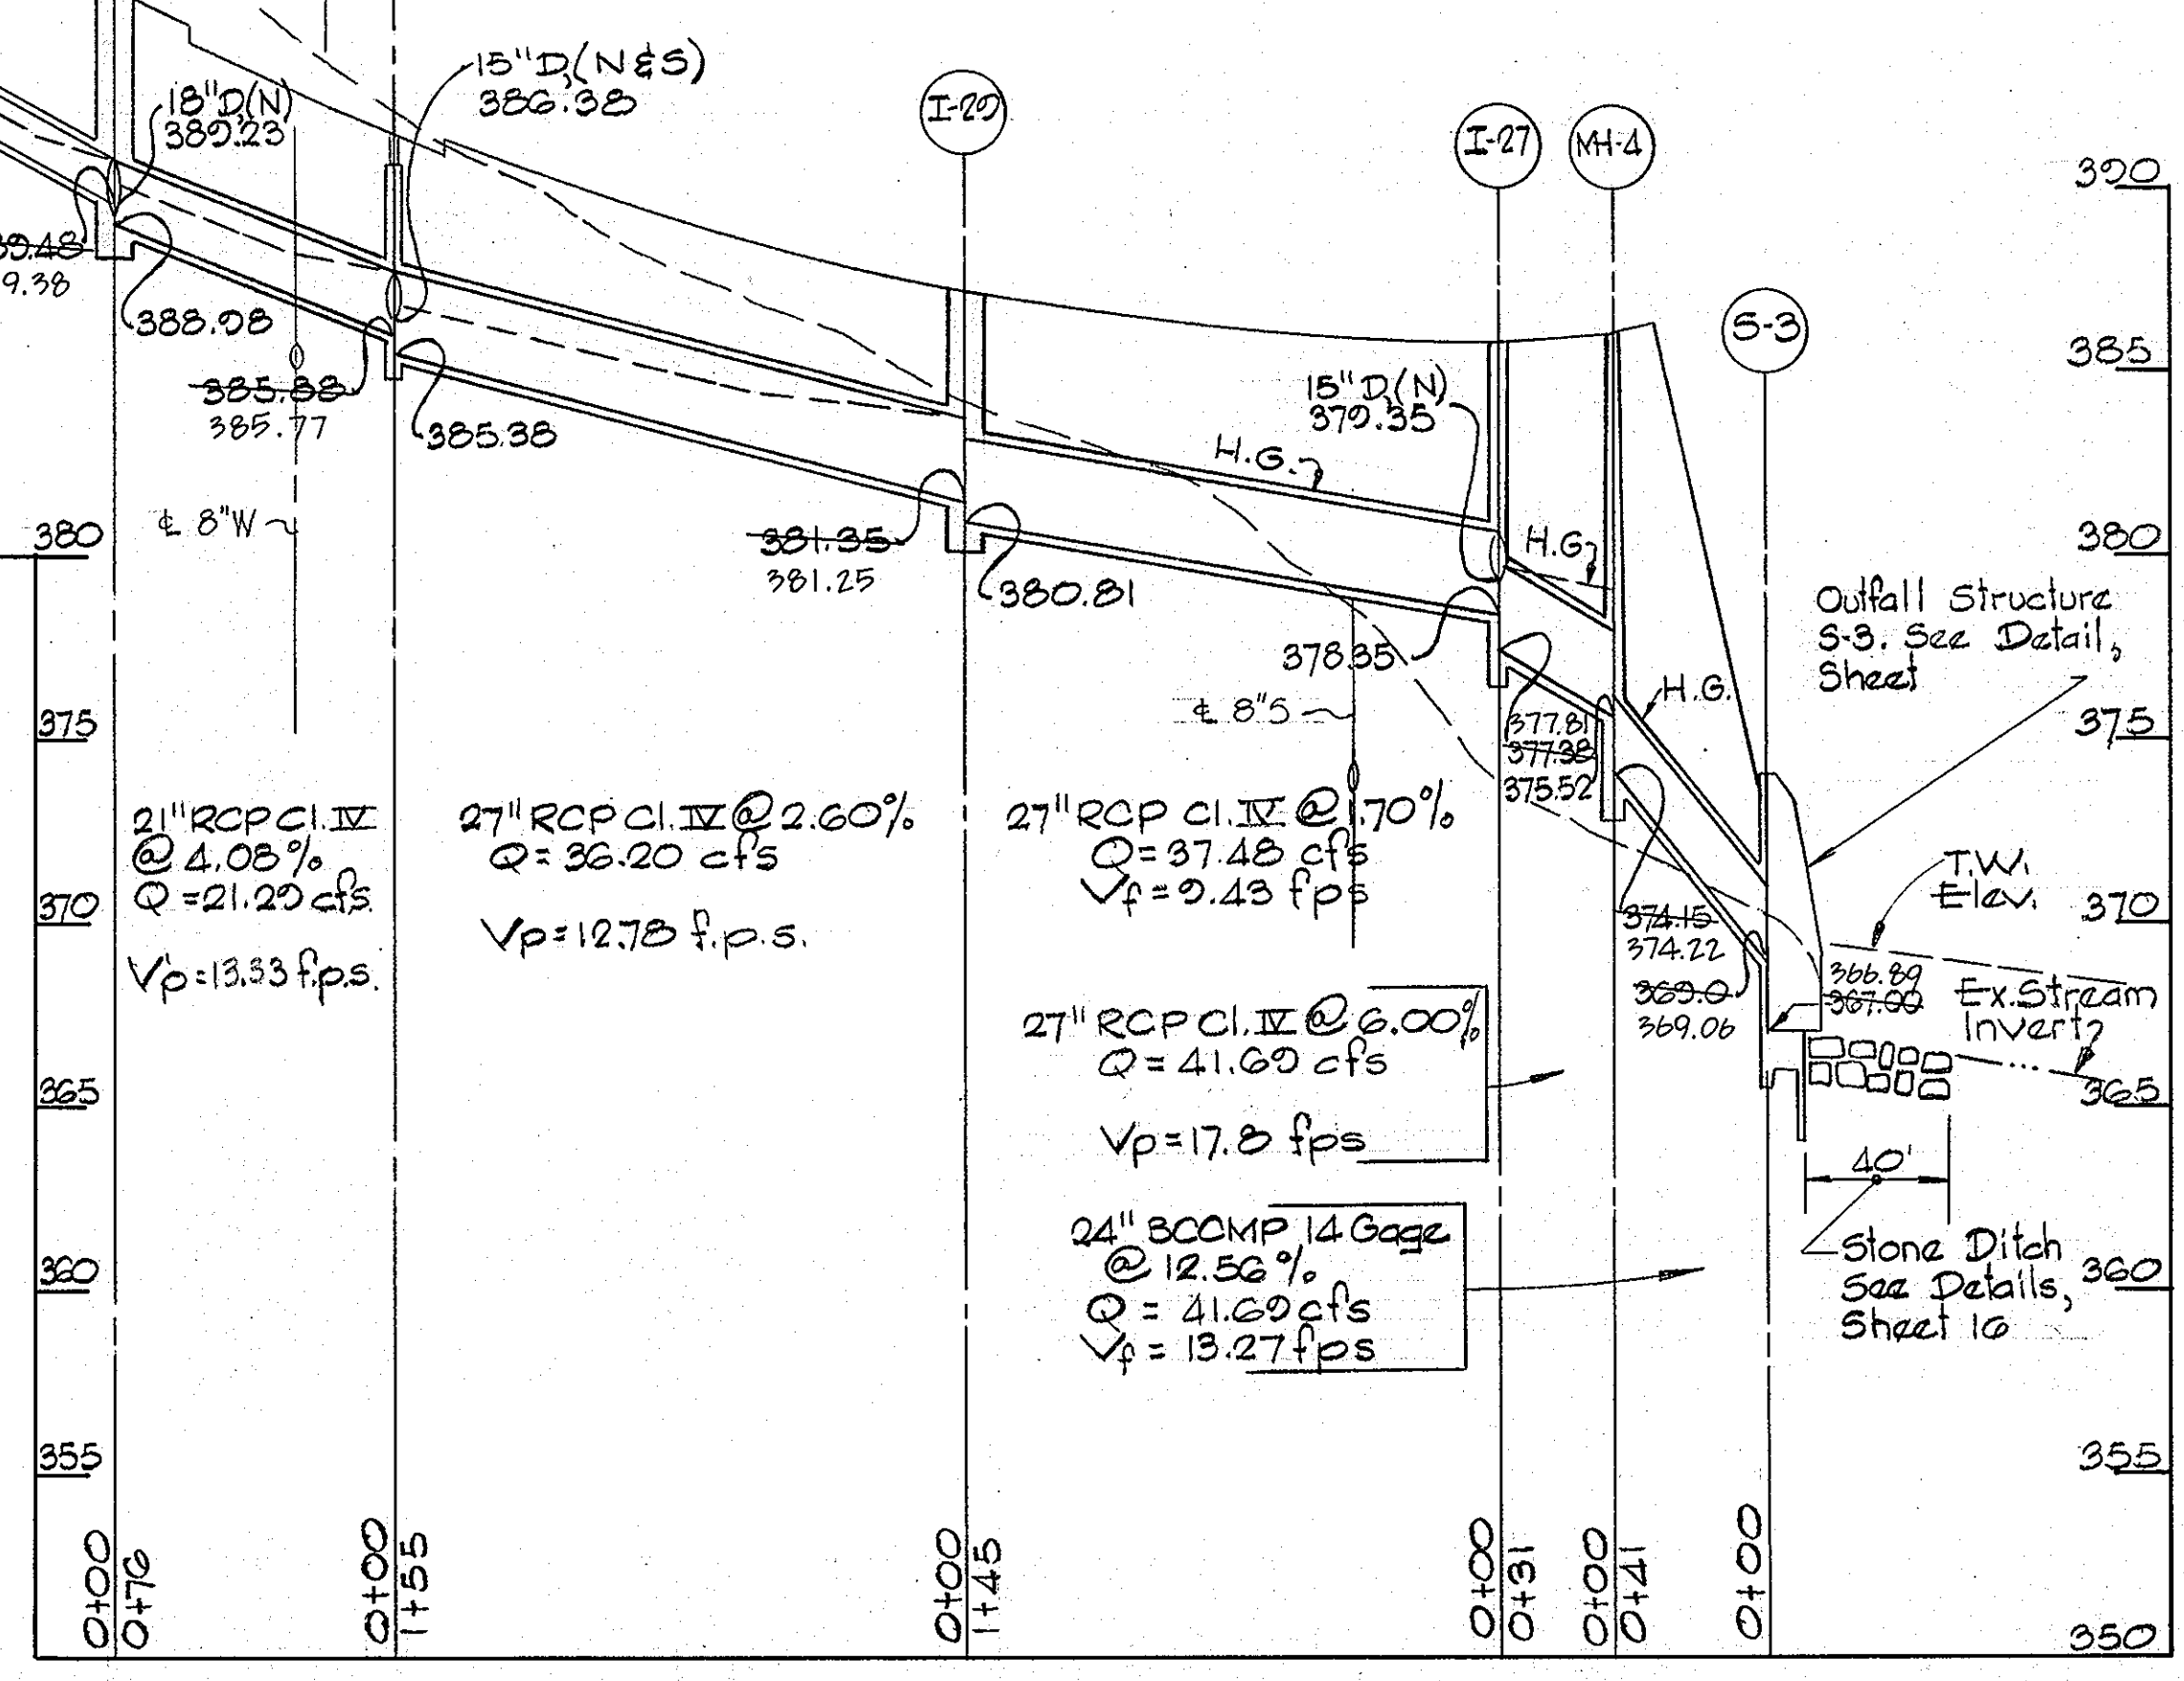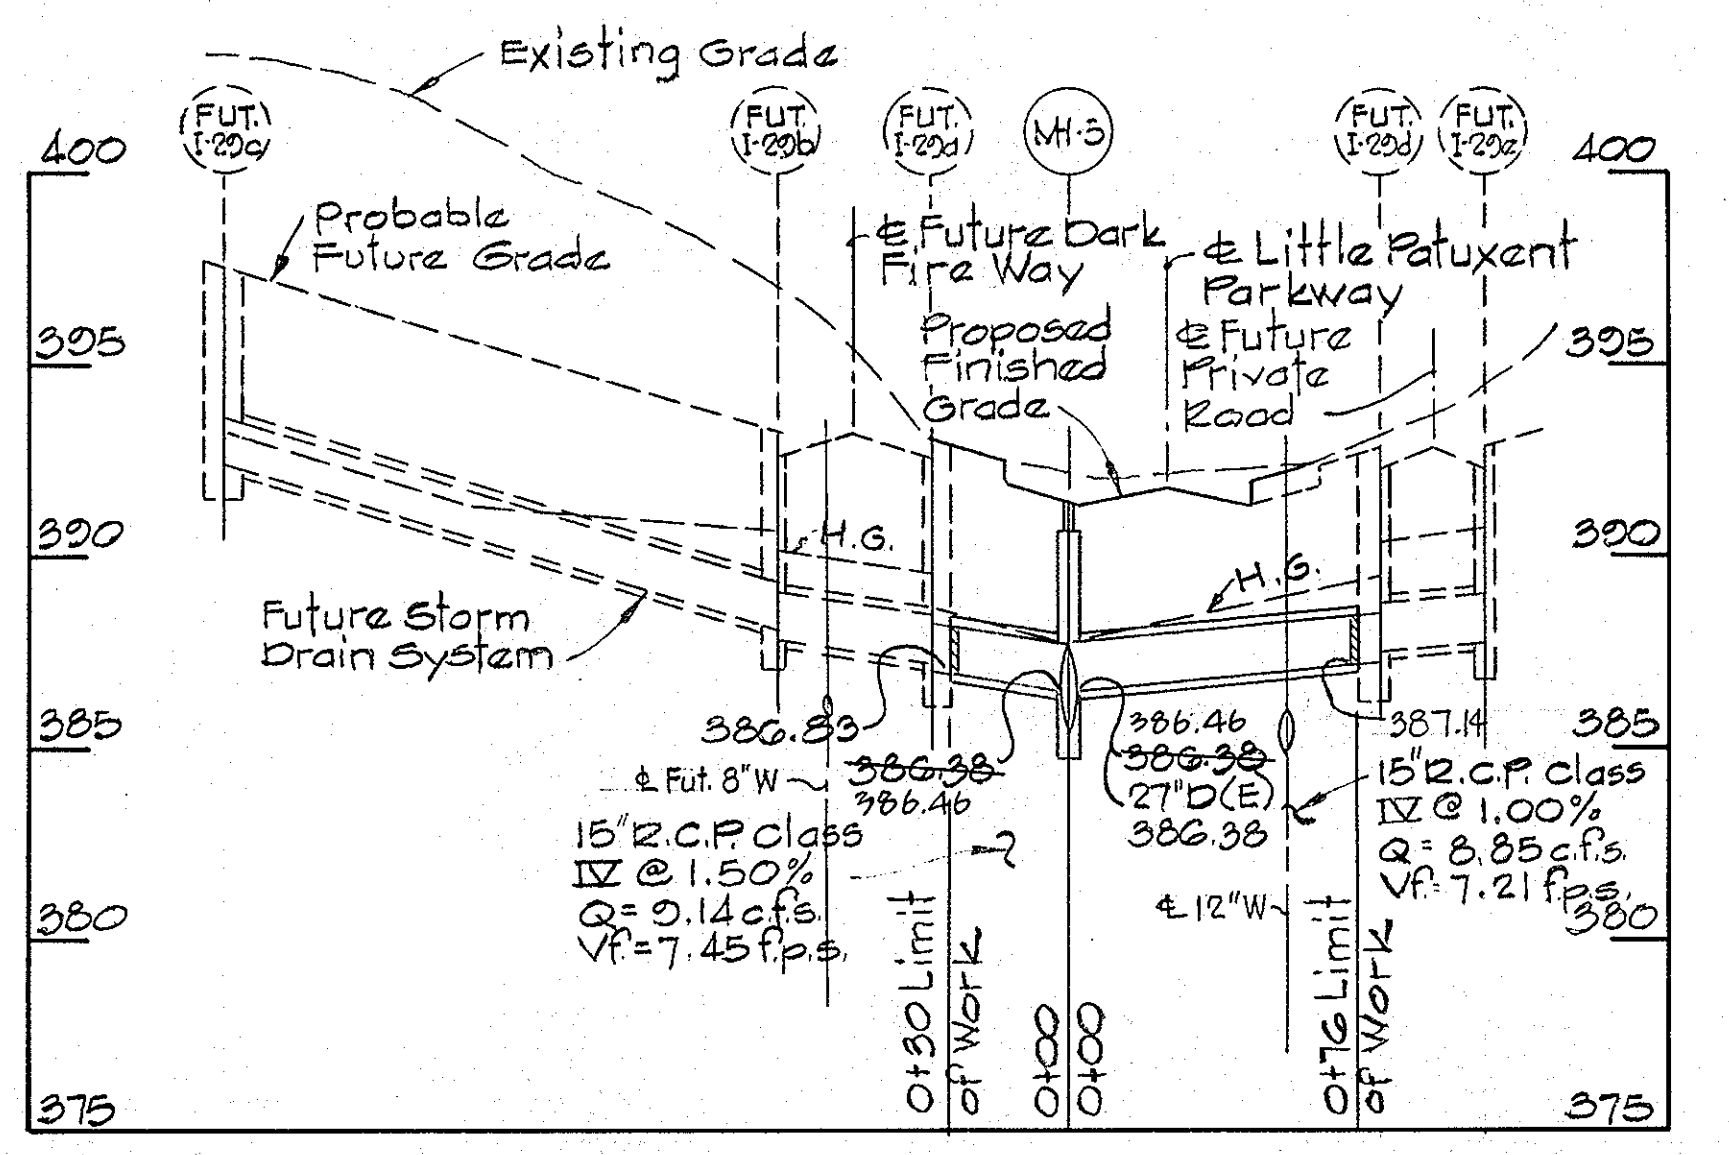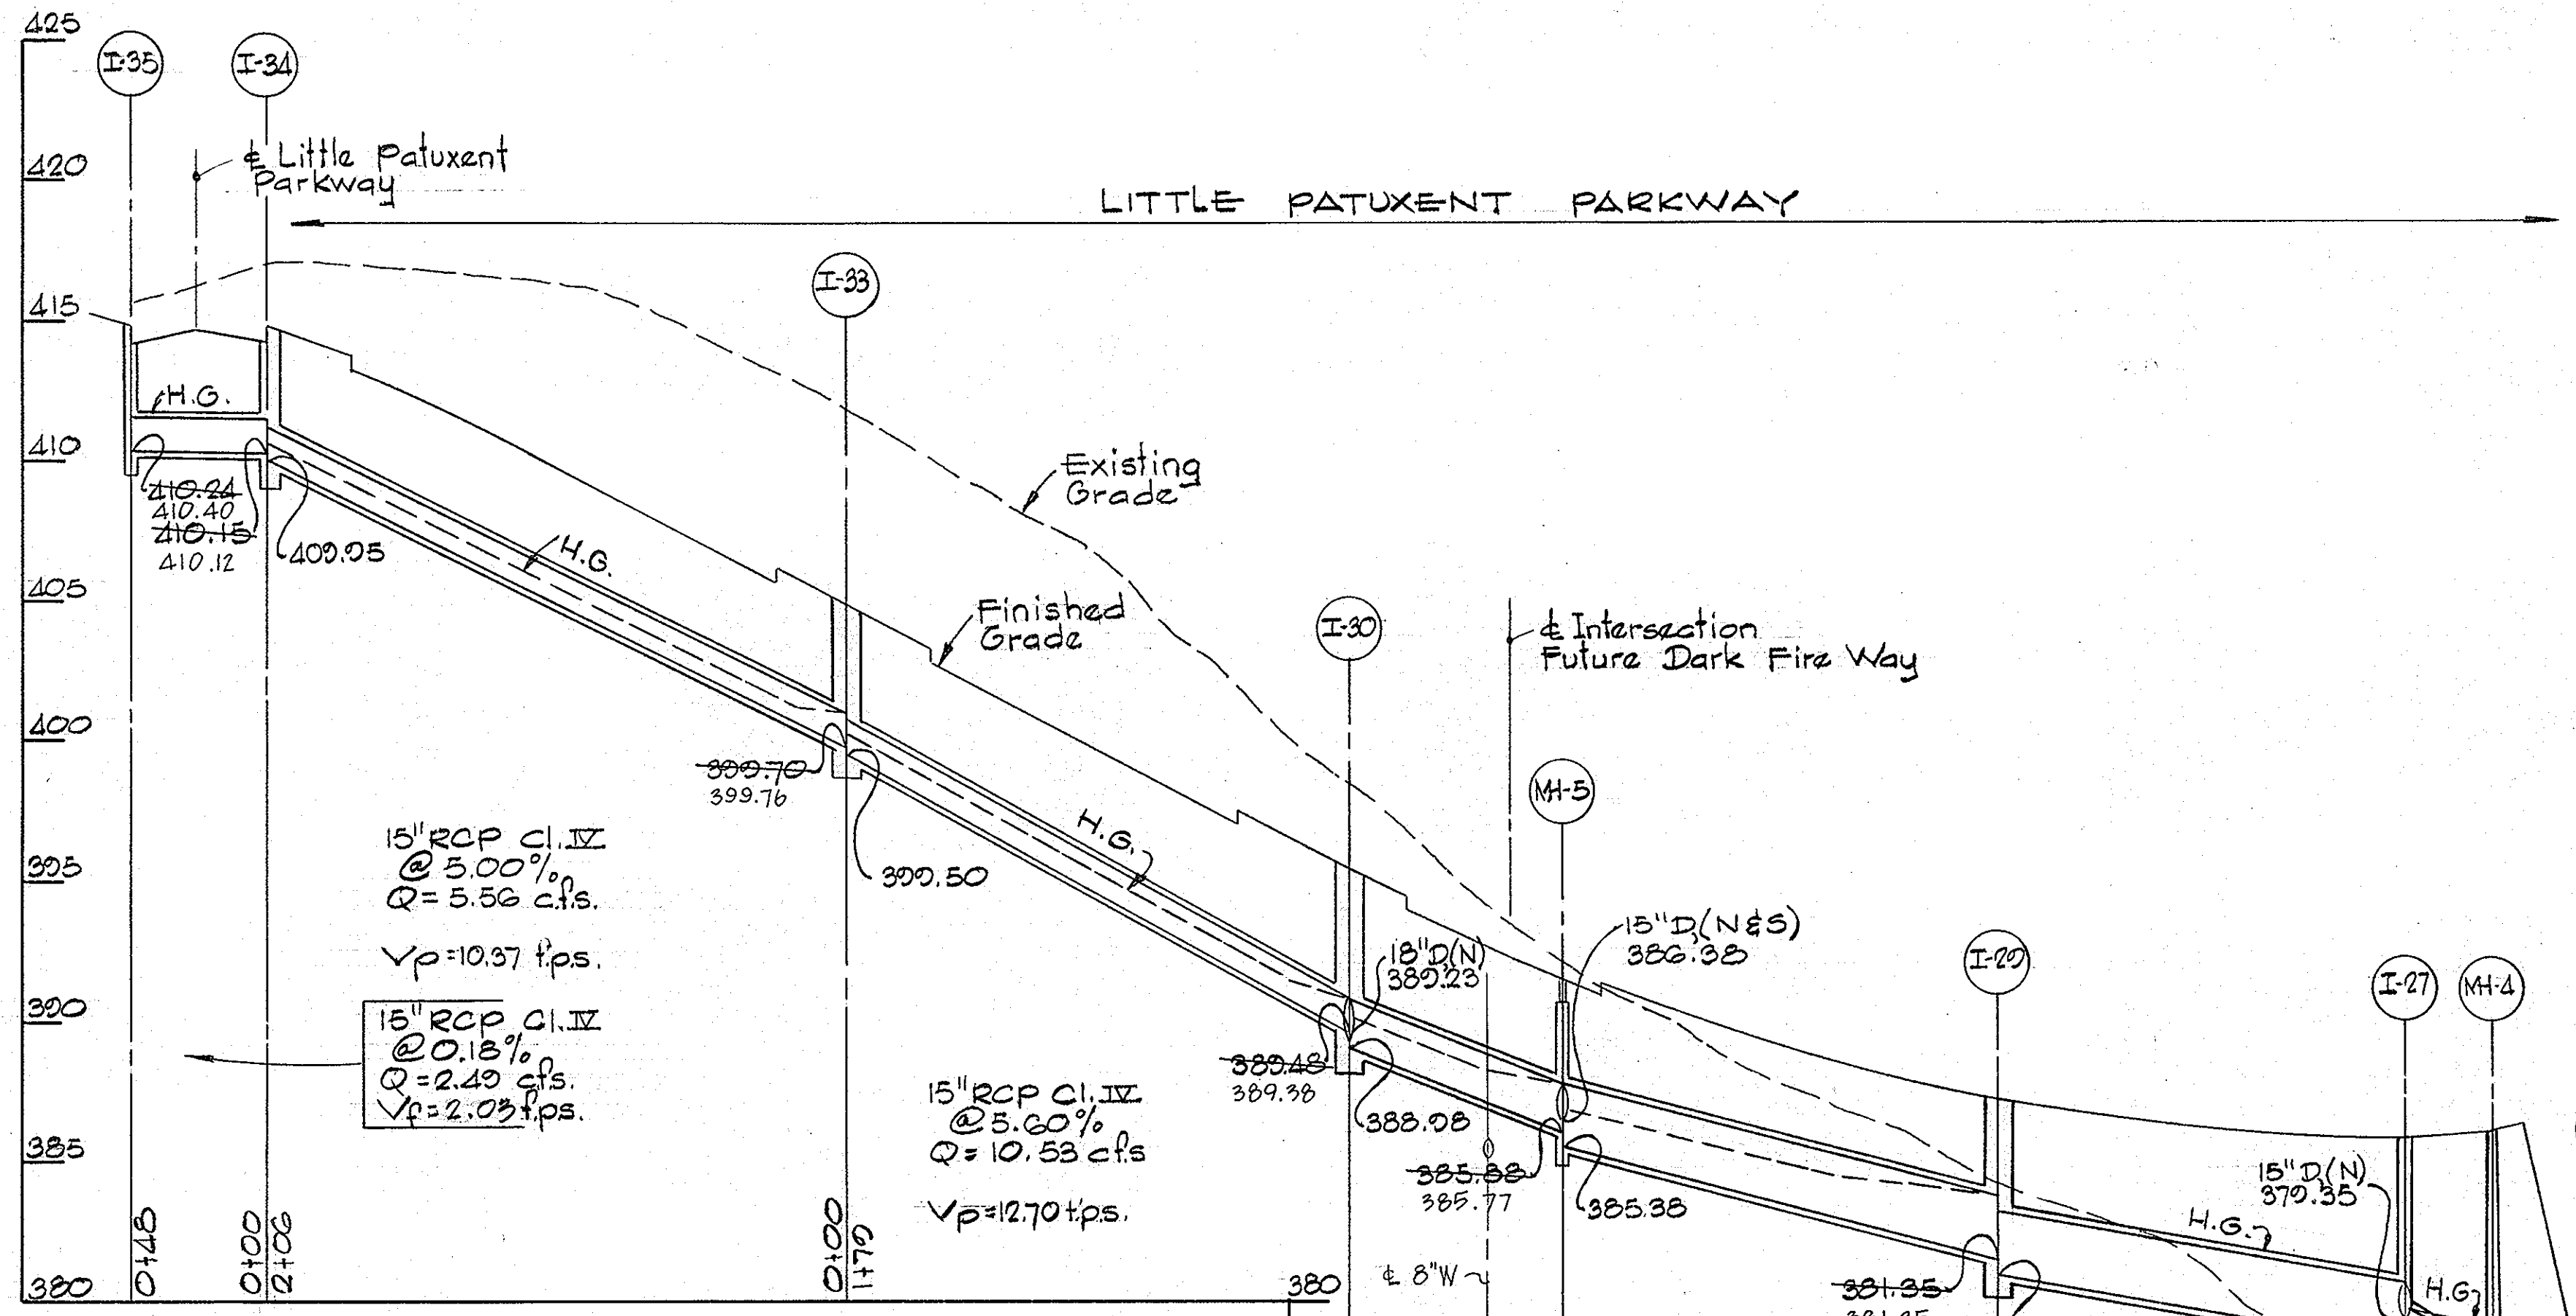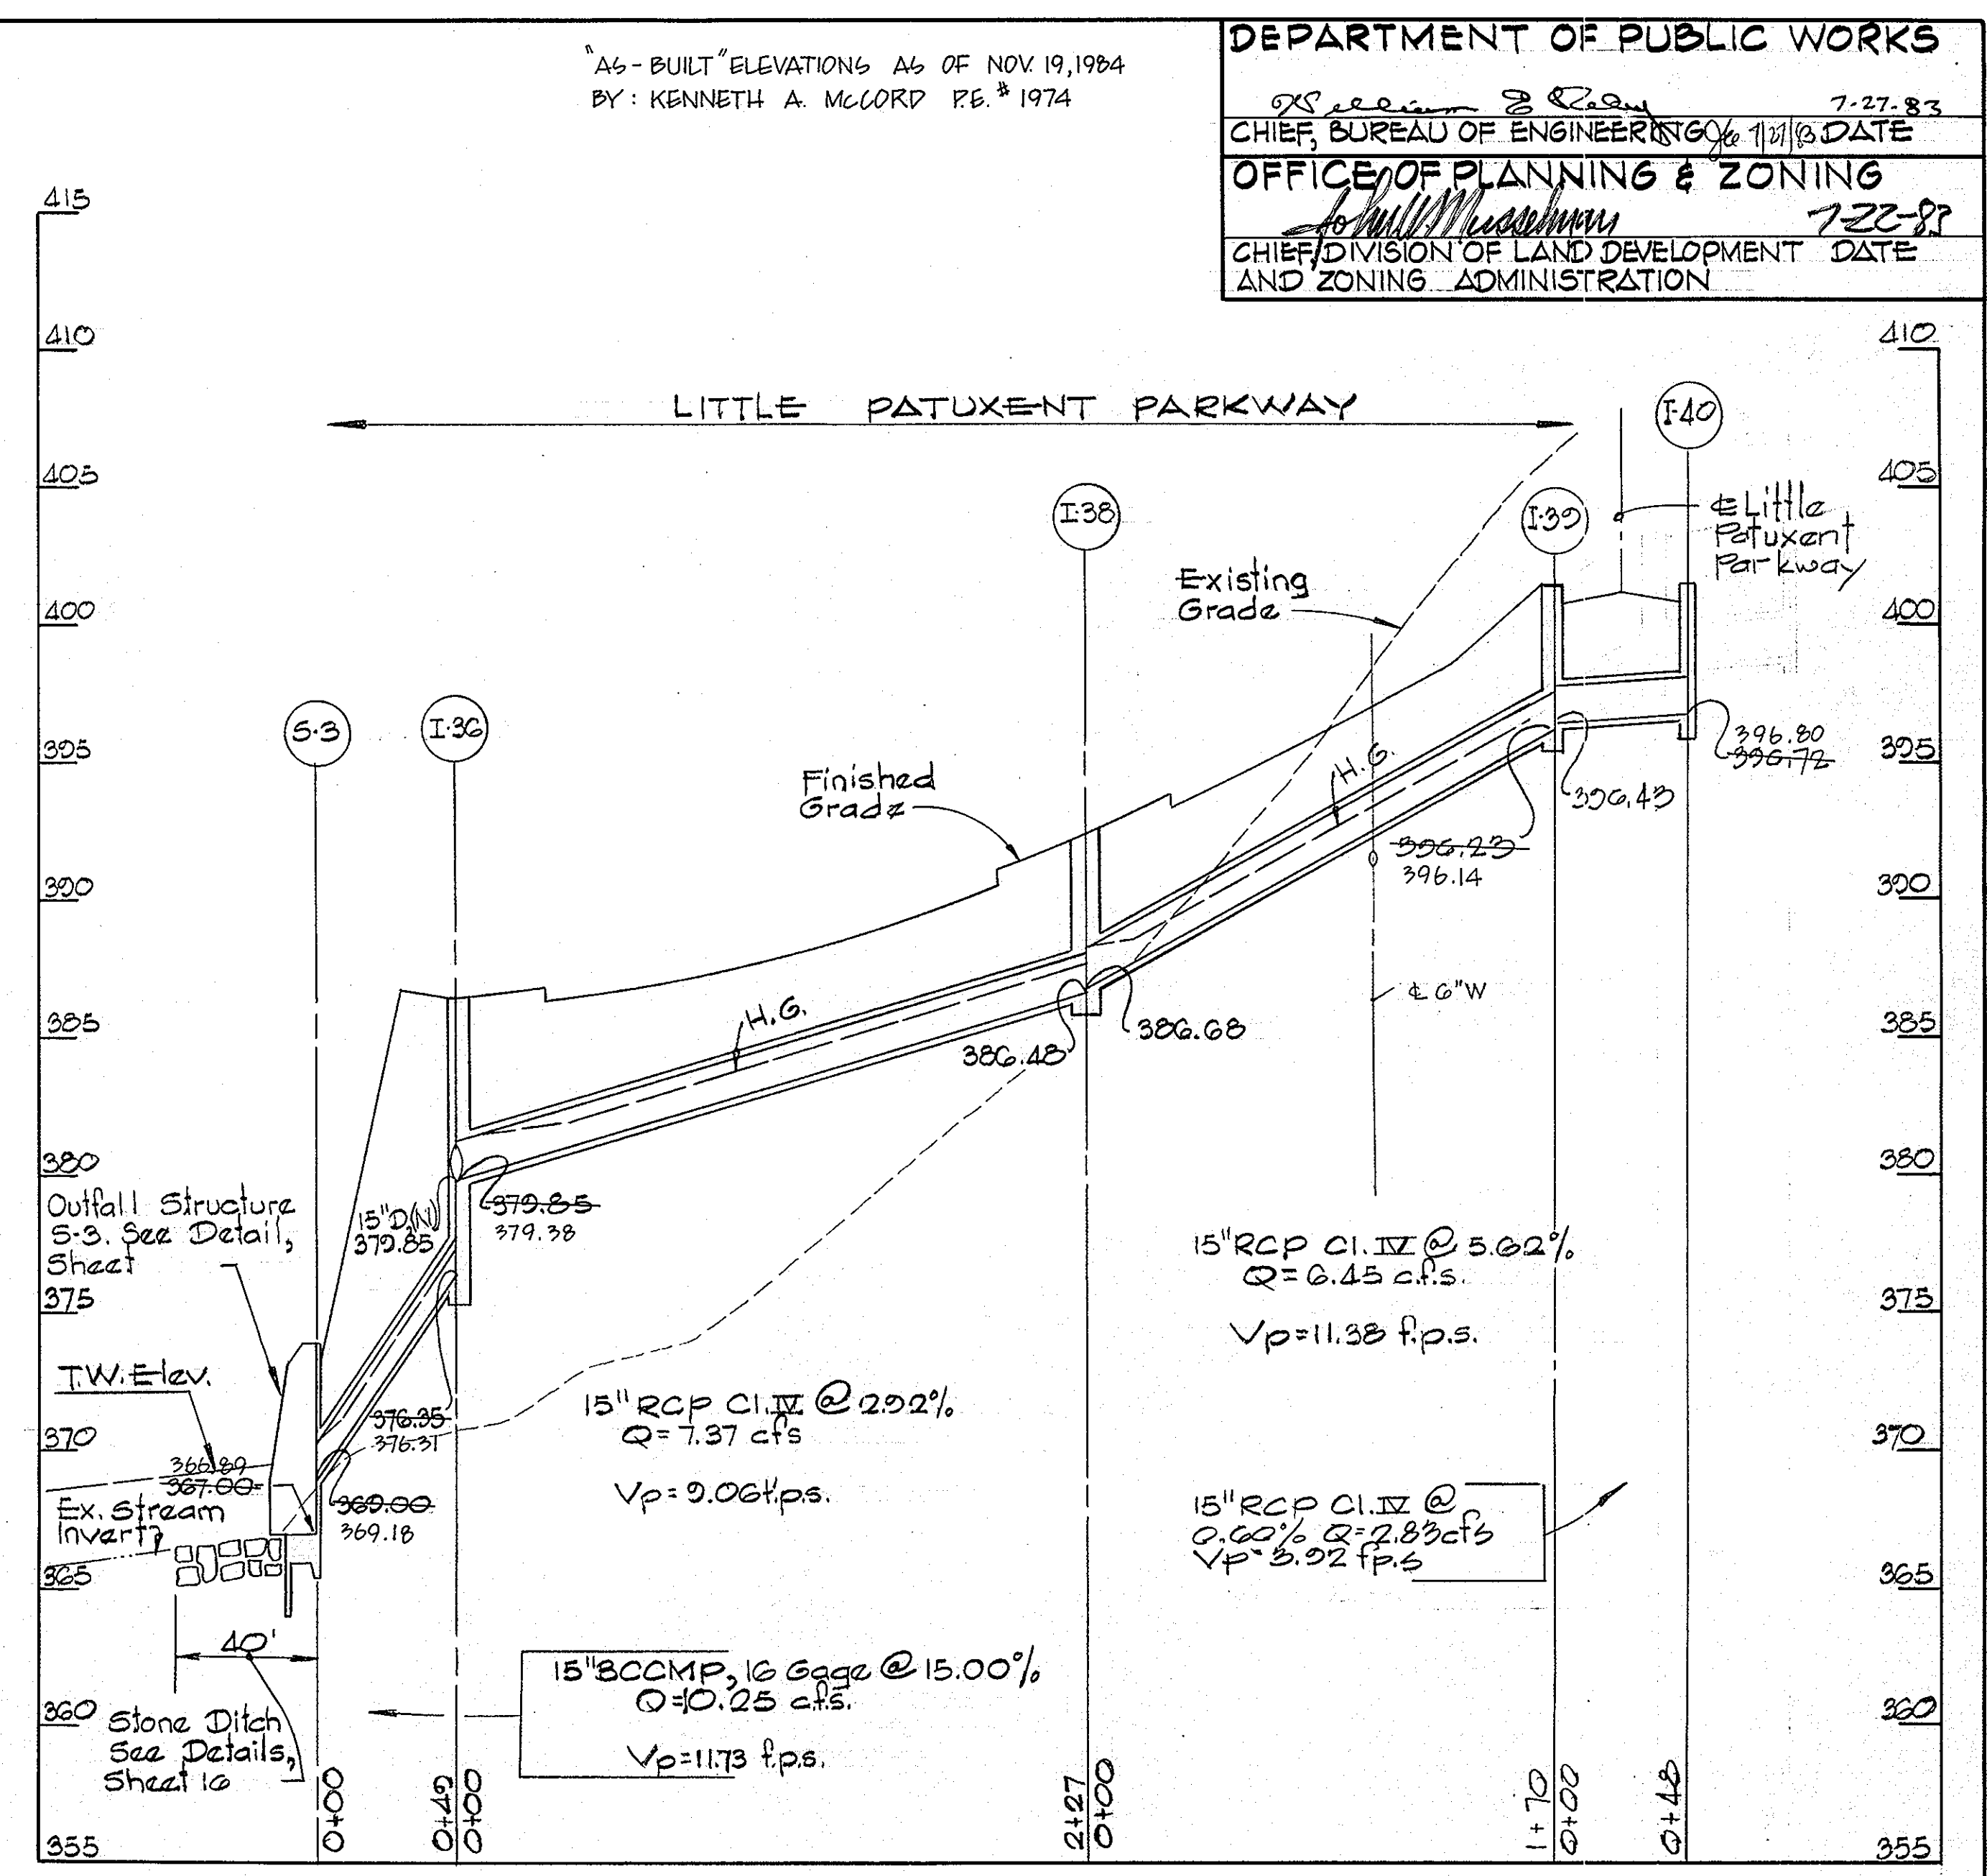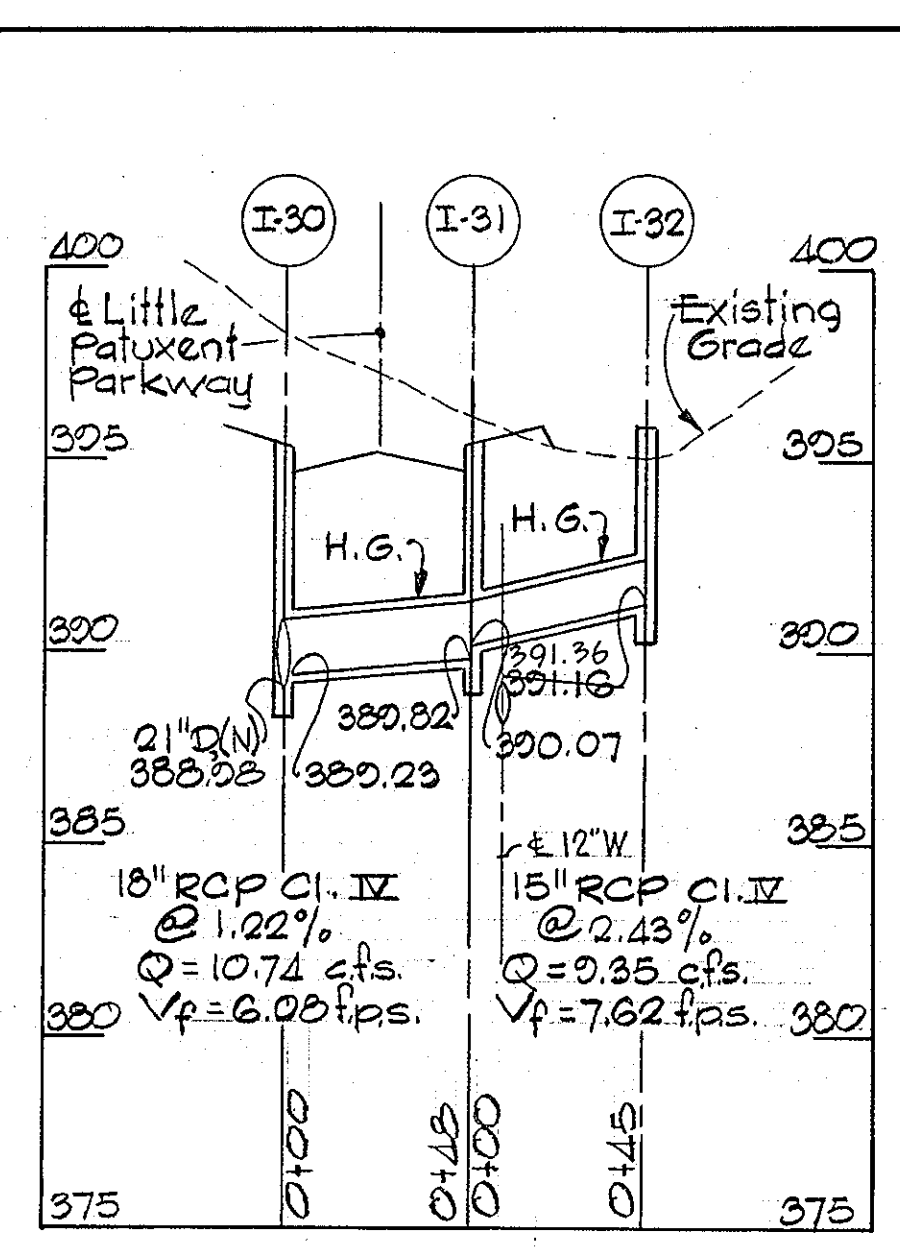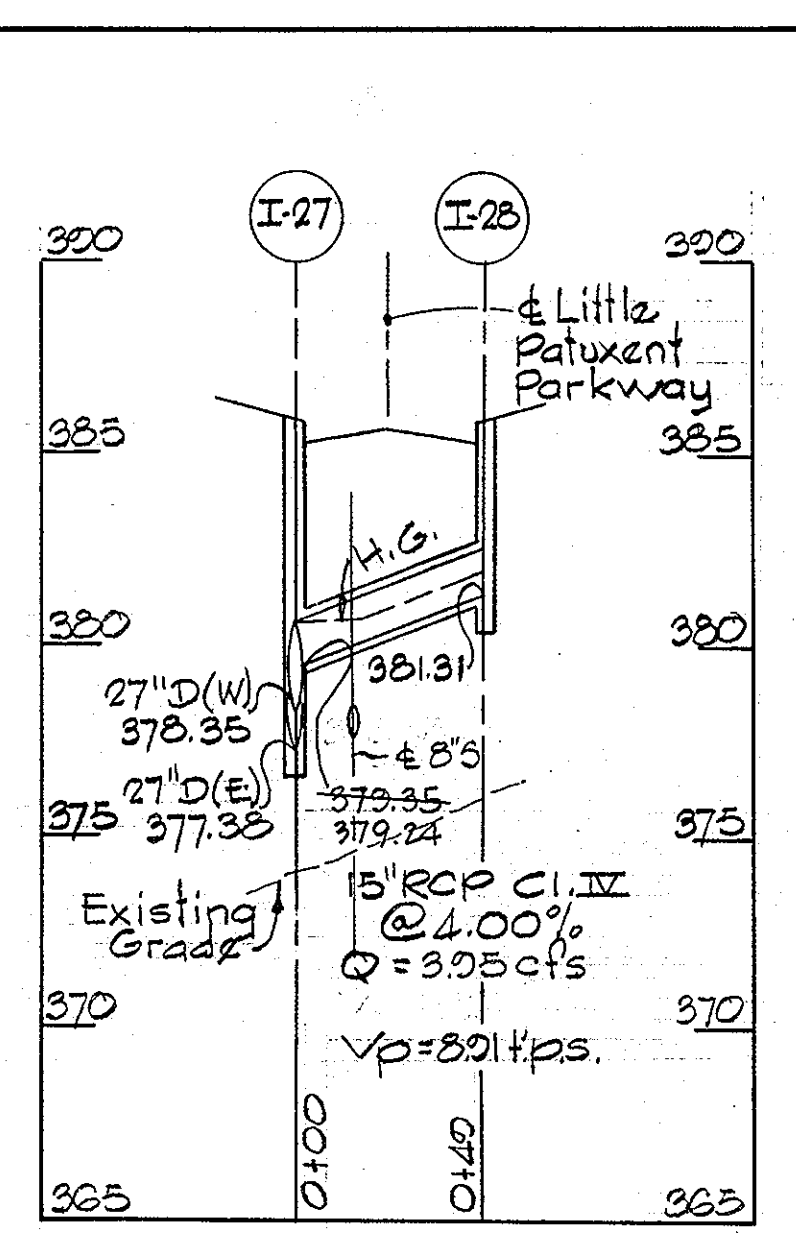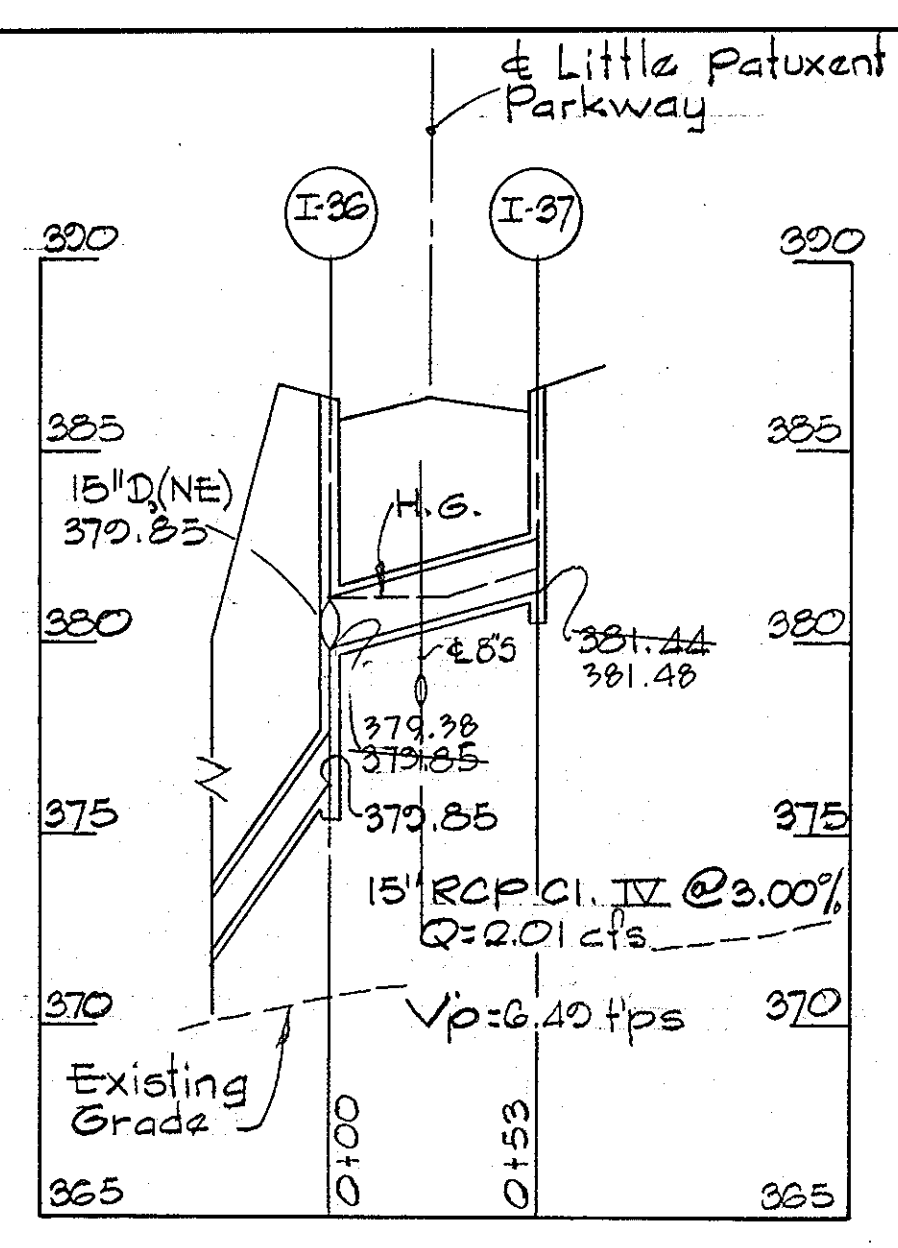

Note:
 The type of bedding used for storm drain pipe shall be Class C, shaped subgrade. If rock is encountered, the trench invert should be overexcavated 6 inches and the overexcavation of 6 inches refilled with granular material.

REVISION DATE	REV. NO.	REVISION DESCRIPTION
11/7/83	4	Revised I-29 & I-40
10/18/83	3	As Per Health Dept. Comments
8/31/83	2	Revised Note
7/1/83	1	As Per DPW & Sediment Control Comments

COLUMBIA
 5th ELECTION DISTRICT
 HOWARD COUNTY, MARYLAND

OWNER AND DEVELOPER
 HOWARD RESEARCH AND DEVELOPMENT CORPORATION

PROJECT AREA
 VILLAGE OF HICKORY RIDGE
 SECTION 3 AREA 1




PROJECT TITLE
STORM DRAIN PROFILES

SCALE: Hor. 1"=50', Vert. 1"=5' DATE:



WHITMAN, REQUARDT AND ASSOCIATES
 ENGINEERS
 BALTIMORE, MARYLAND 21218

Kenneth A. McCord
 KENNETH A. McCORD
 Registered Engineer
 No. 1974

"AS-BUILT" ELEVATIONS AS OF NOV. 19, 1984
 BY: KENNETH A. MCCORD P.E. *1974

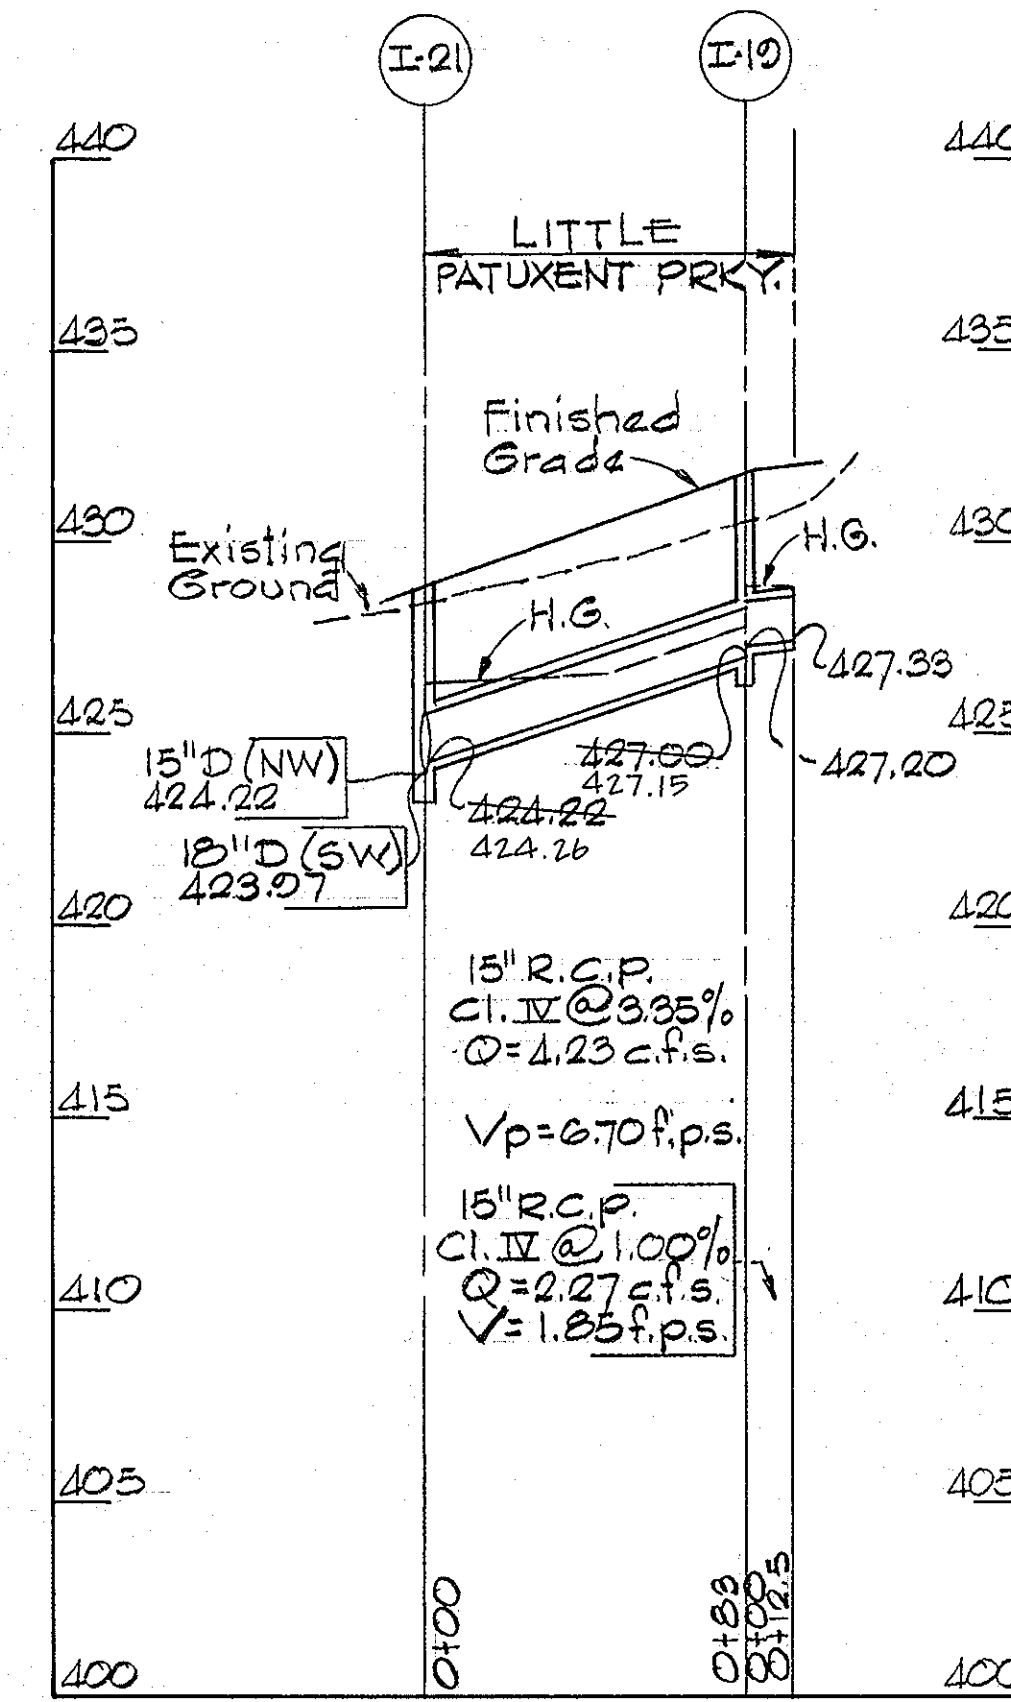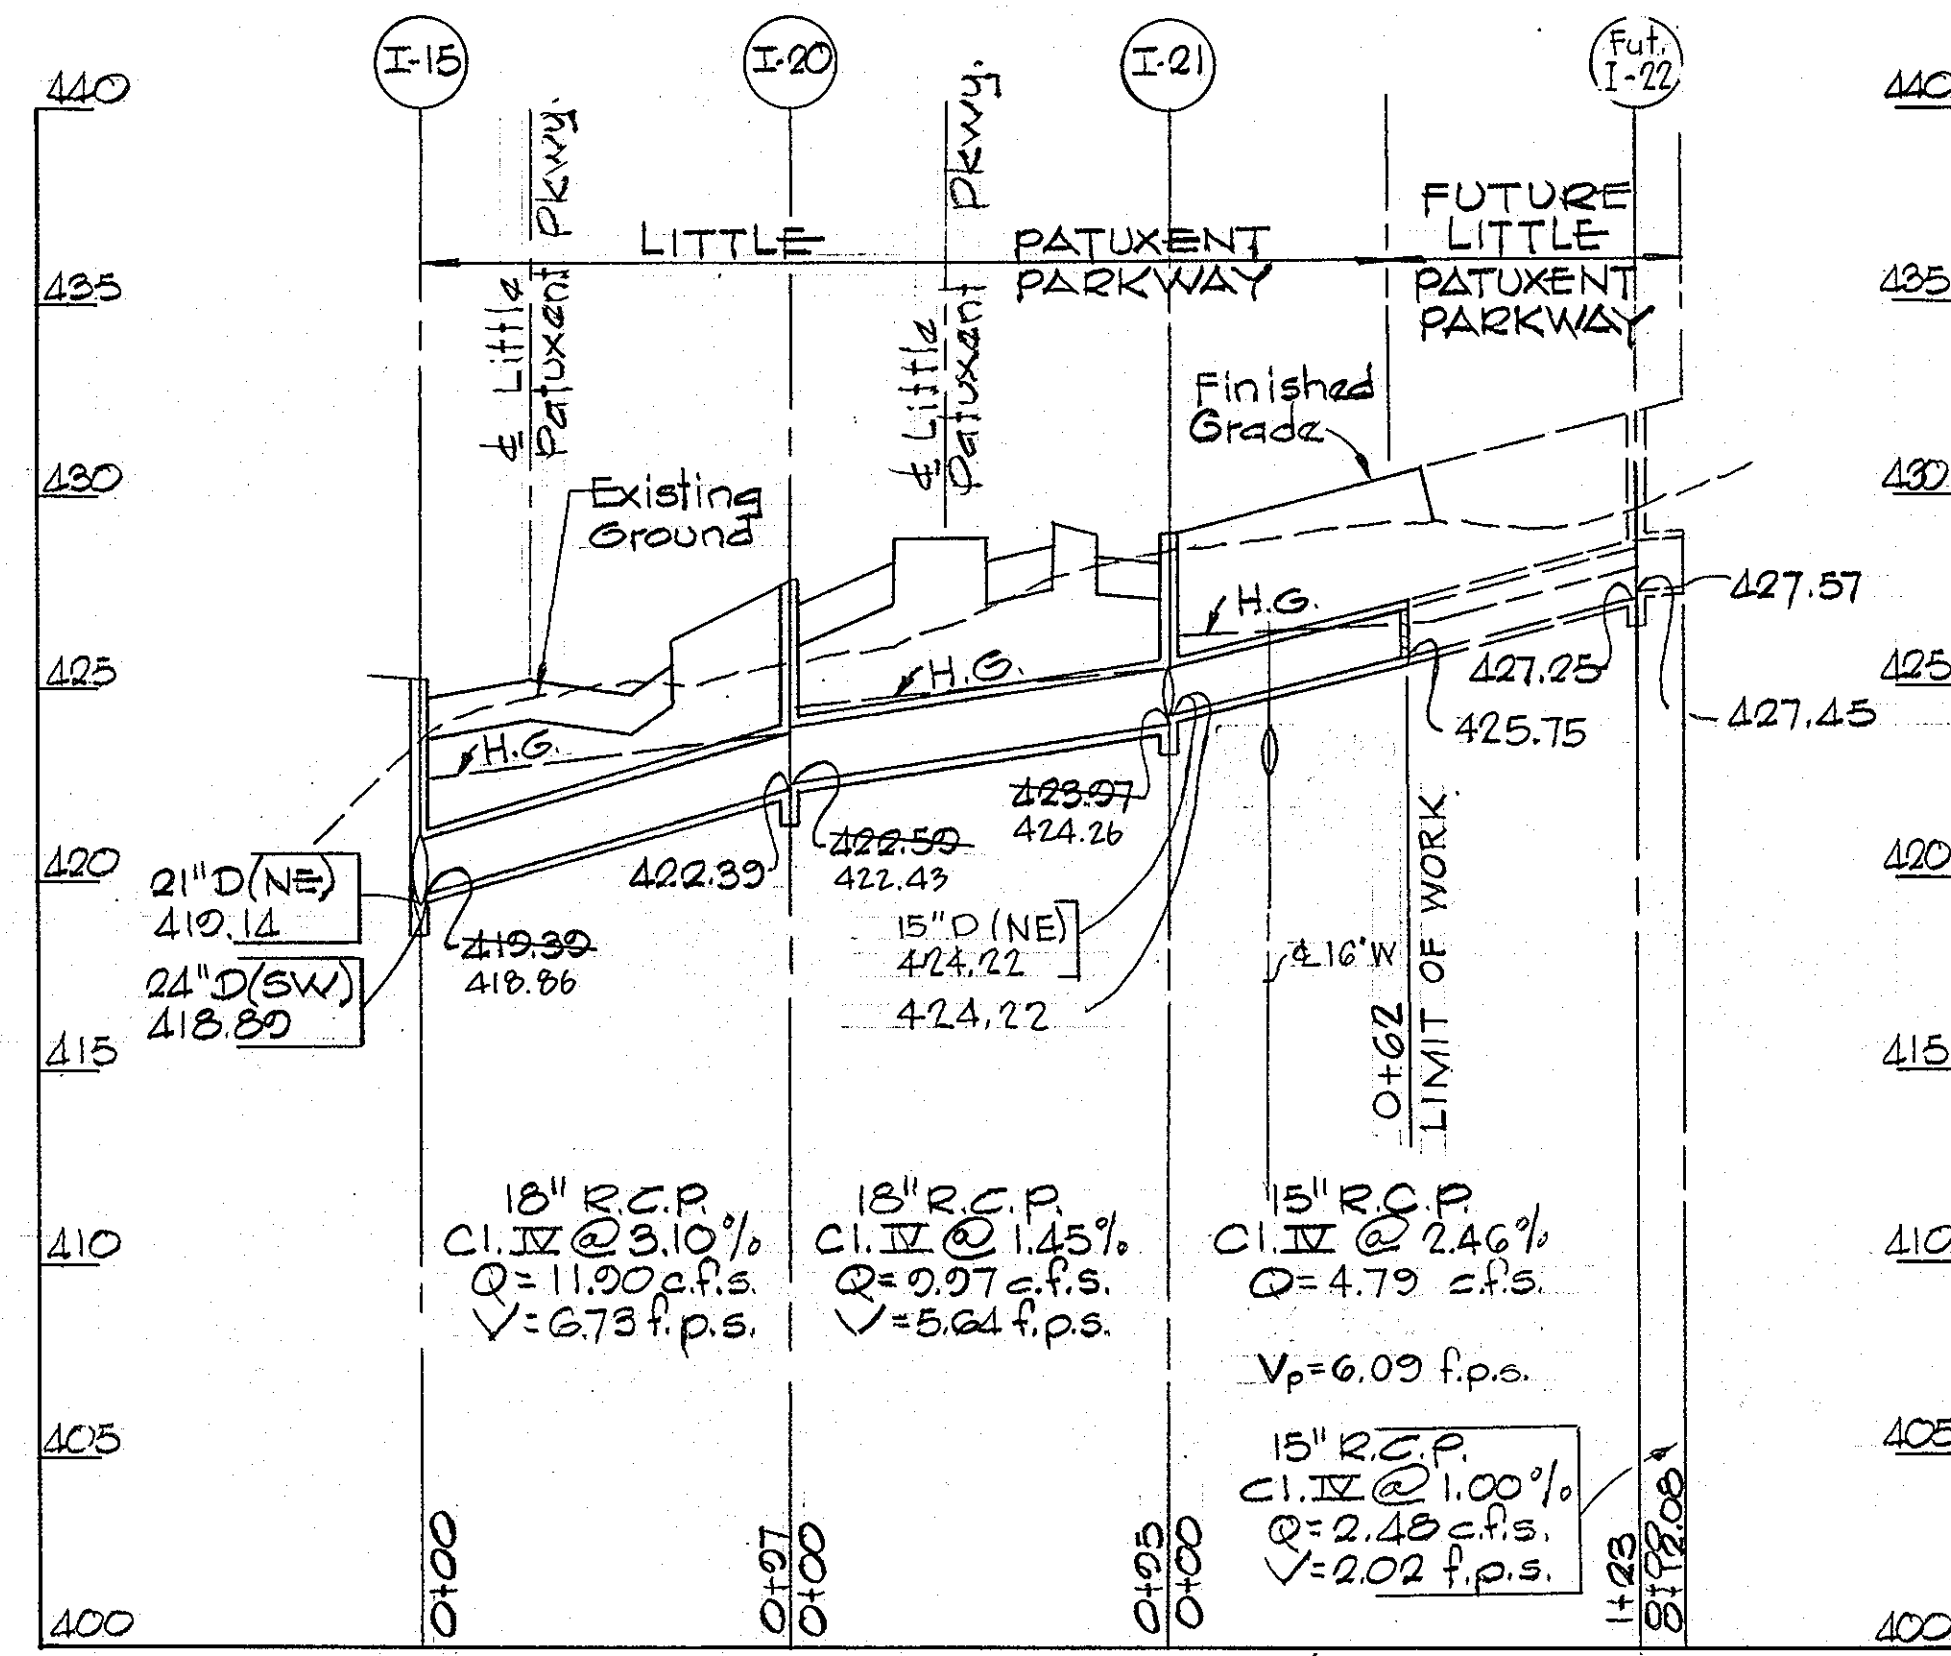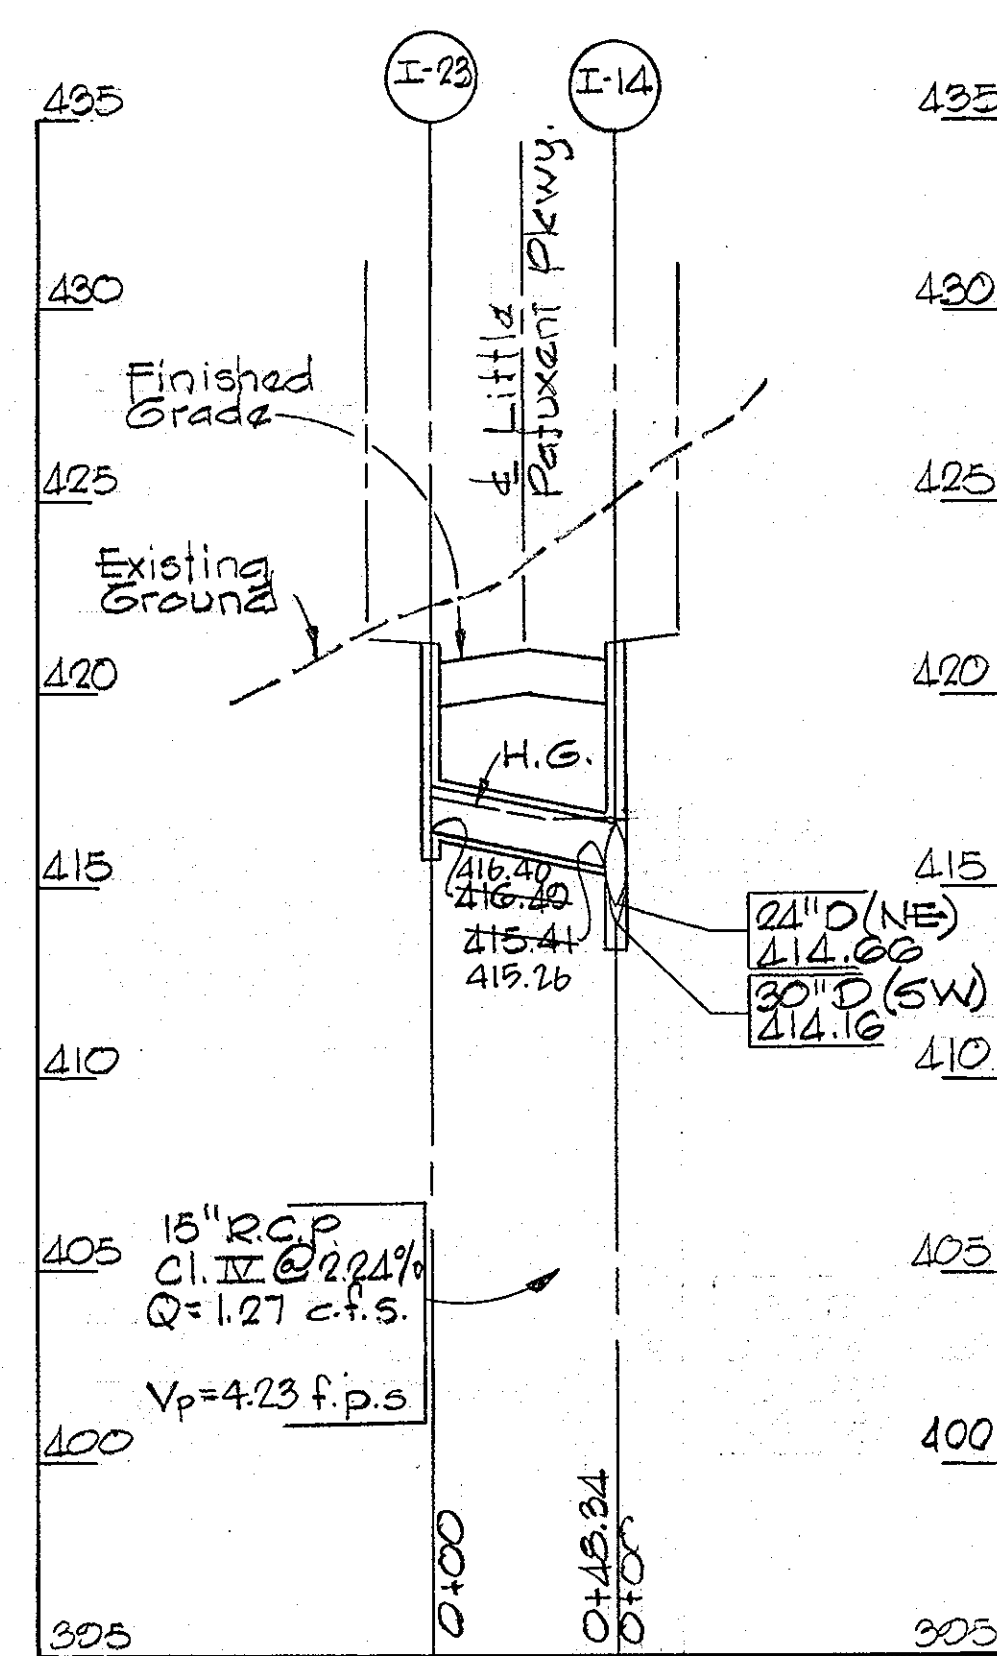

Note:
 The type of bedding used for storm drain pipe shall be class C, shaped subgrade. If rock is encountered, the trench invert should be overexcavated 6 inches and the overexcavation of 6 inches refilled with granular material.

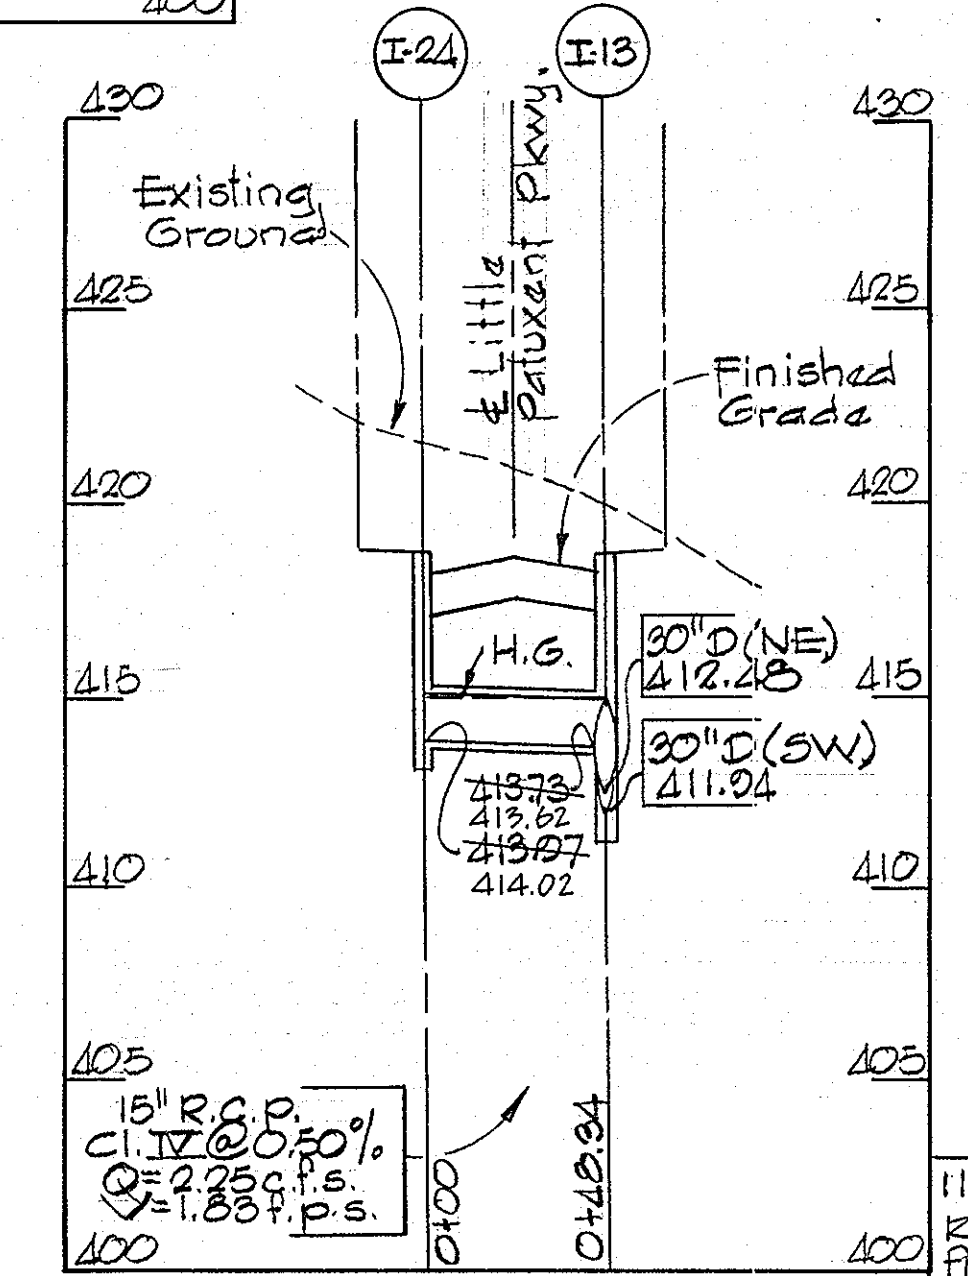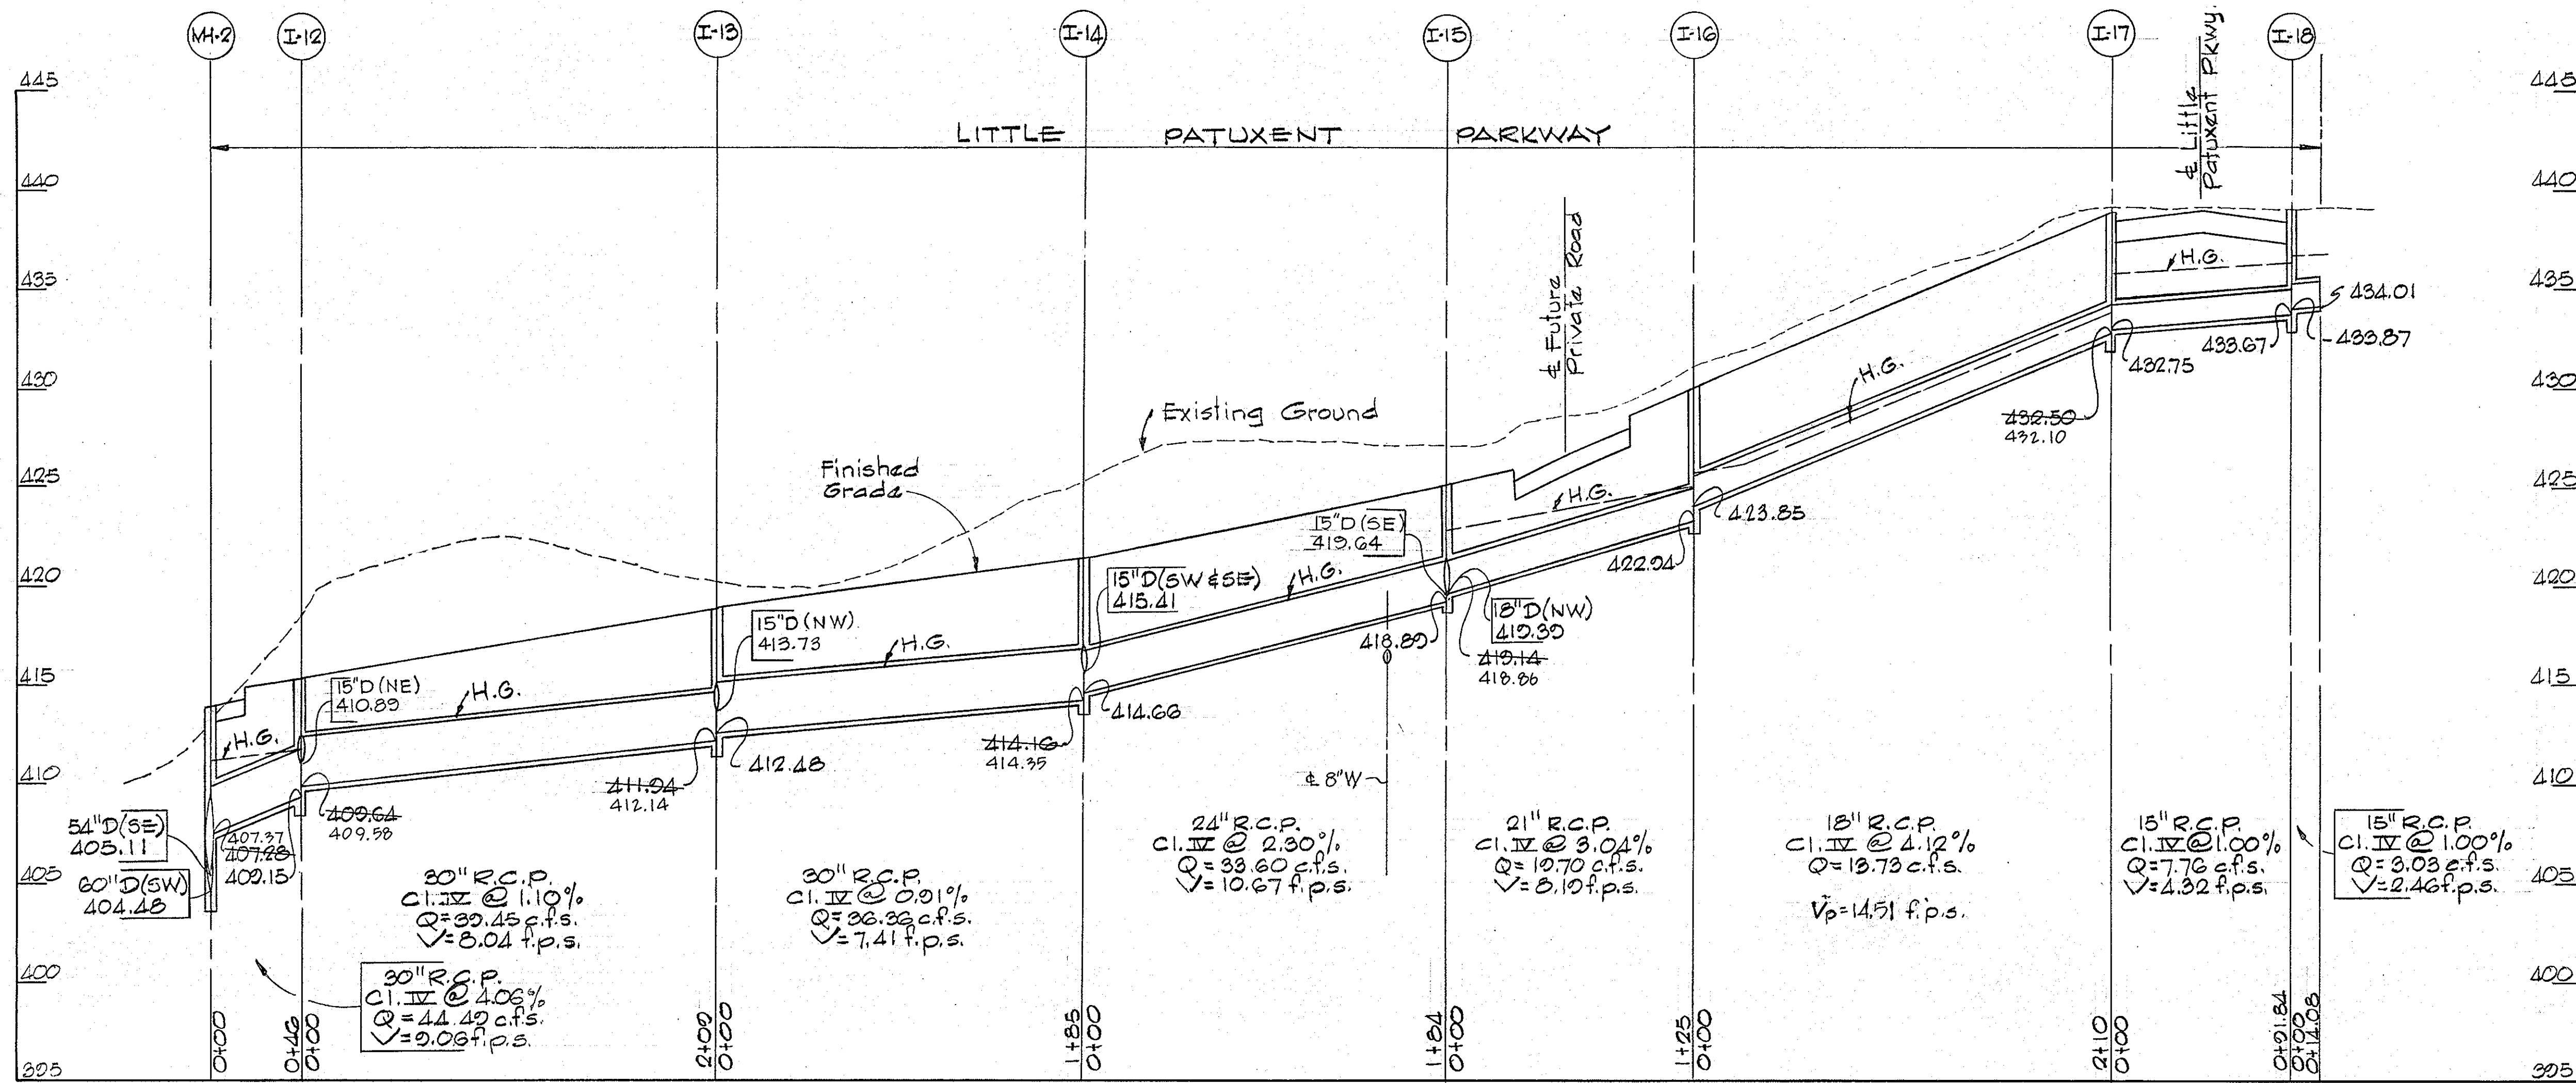








Rev. Date	Rev. No.	Revision Description
8/18/83	1	As Per Health Dept. Comments
8/21/83	2	Revised Note
7/1/83	1	As Per DEP & Sediment Control Comments

COLUMBIA
 5TH ELECTION DISTRICT
 HOWARD COUNTY, MARYLAND
 OWNER AND DEVELOPER
 HOWARD RESEARCH AND DEVELOPMENT CORPORATION
 PROJECT AREA
 VILLAGE OF HICKORY RIDGE
 SECTION 3 AREA 1

PROJECT TITLE
STORM DRAIN PROFILES

SCALE: Hor. 1"=50', Vert. 1"=5' DATE:
 WHITMAN, REQUARDT AND ASSOCIATES
 ENGINEERS
 7315 ST. PAUL STREET
 BALTIMORE, MARYLAND 21218

Kenneth A. McCord
 KENNETH A. MCCORD
 Registered Engineer
 No. 1974

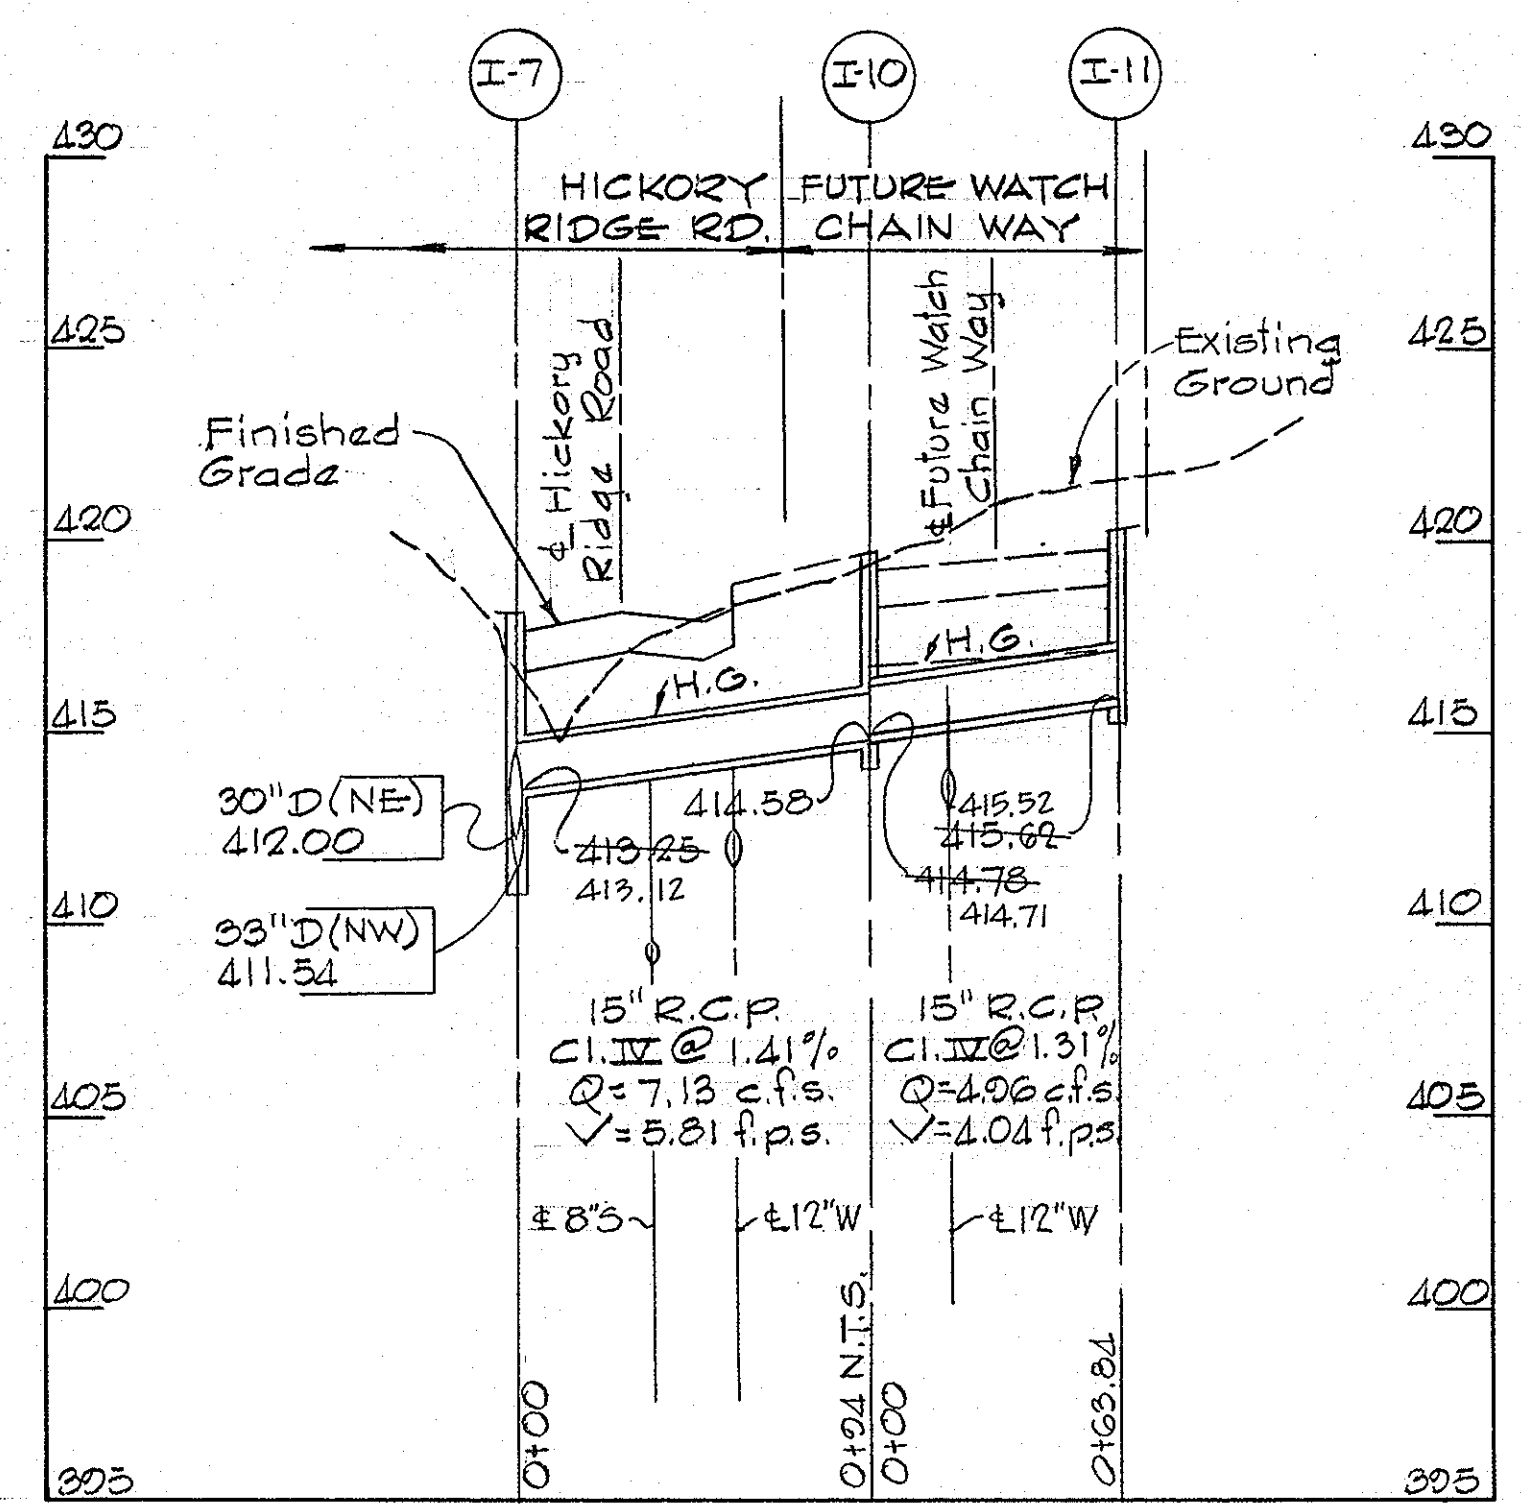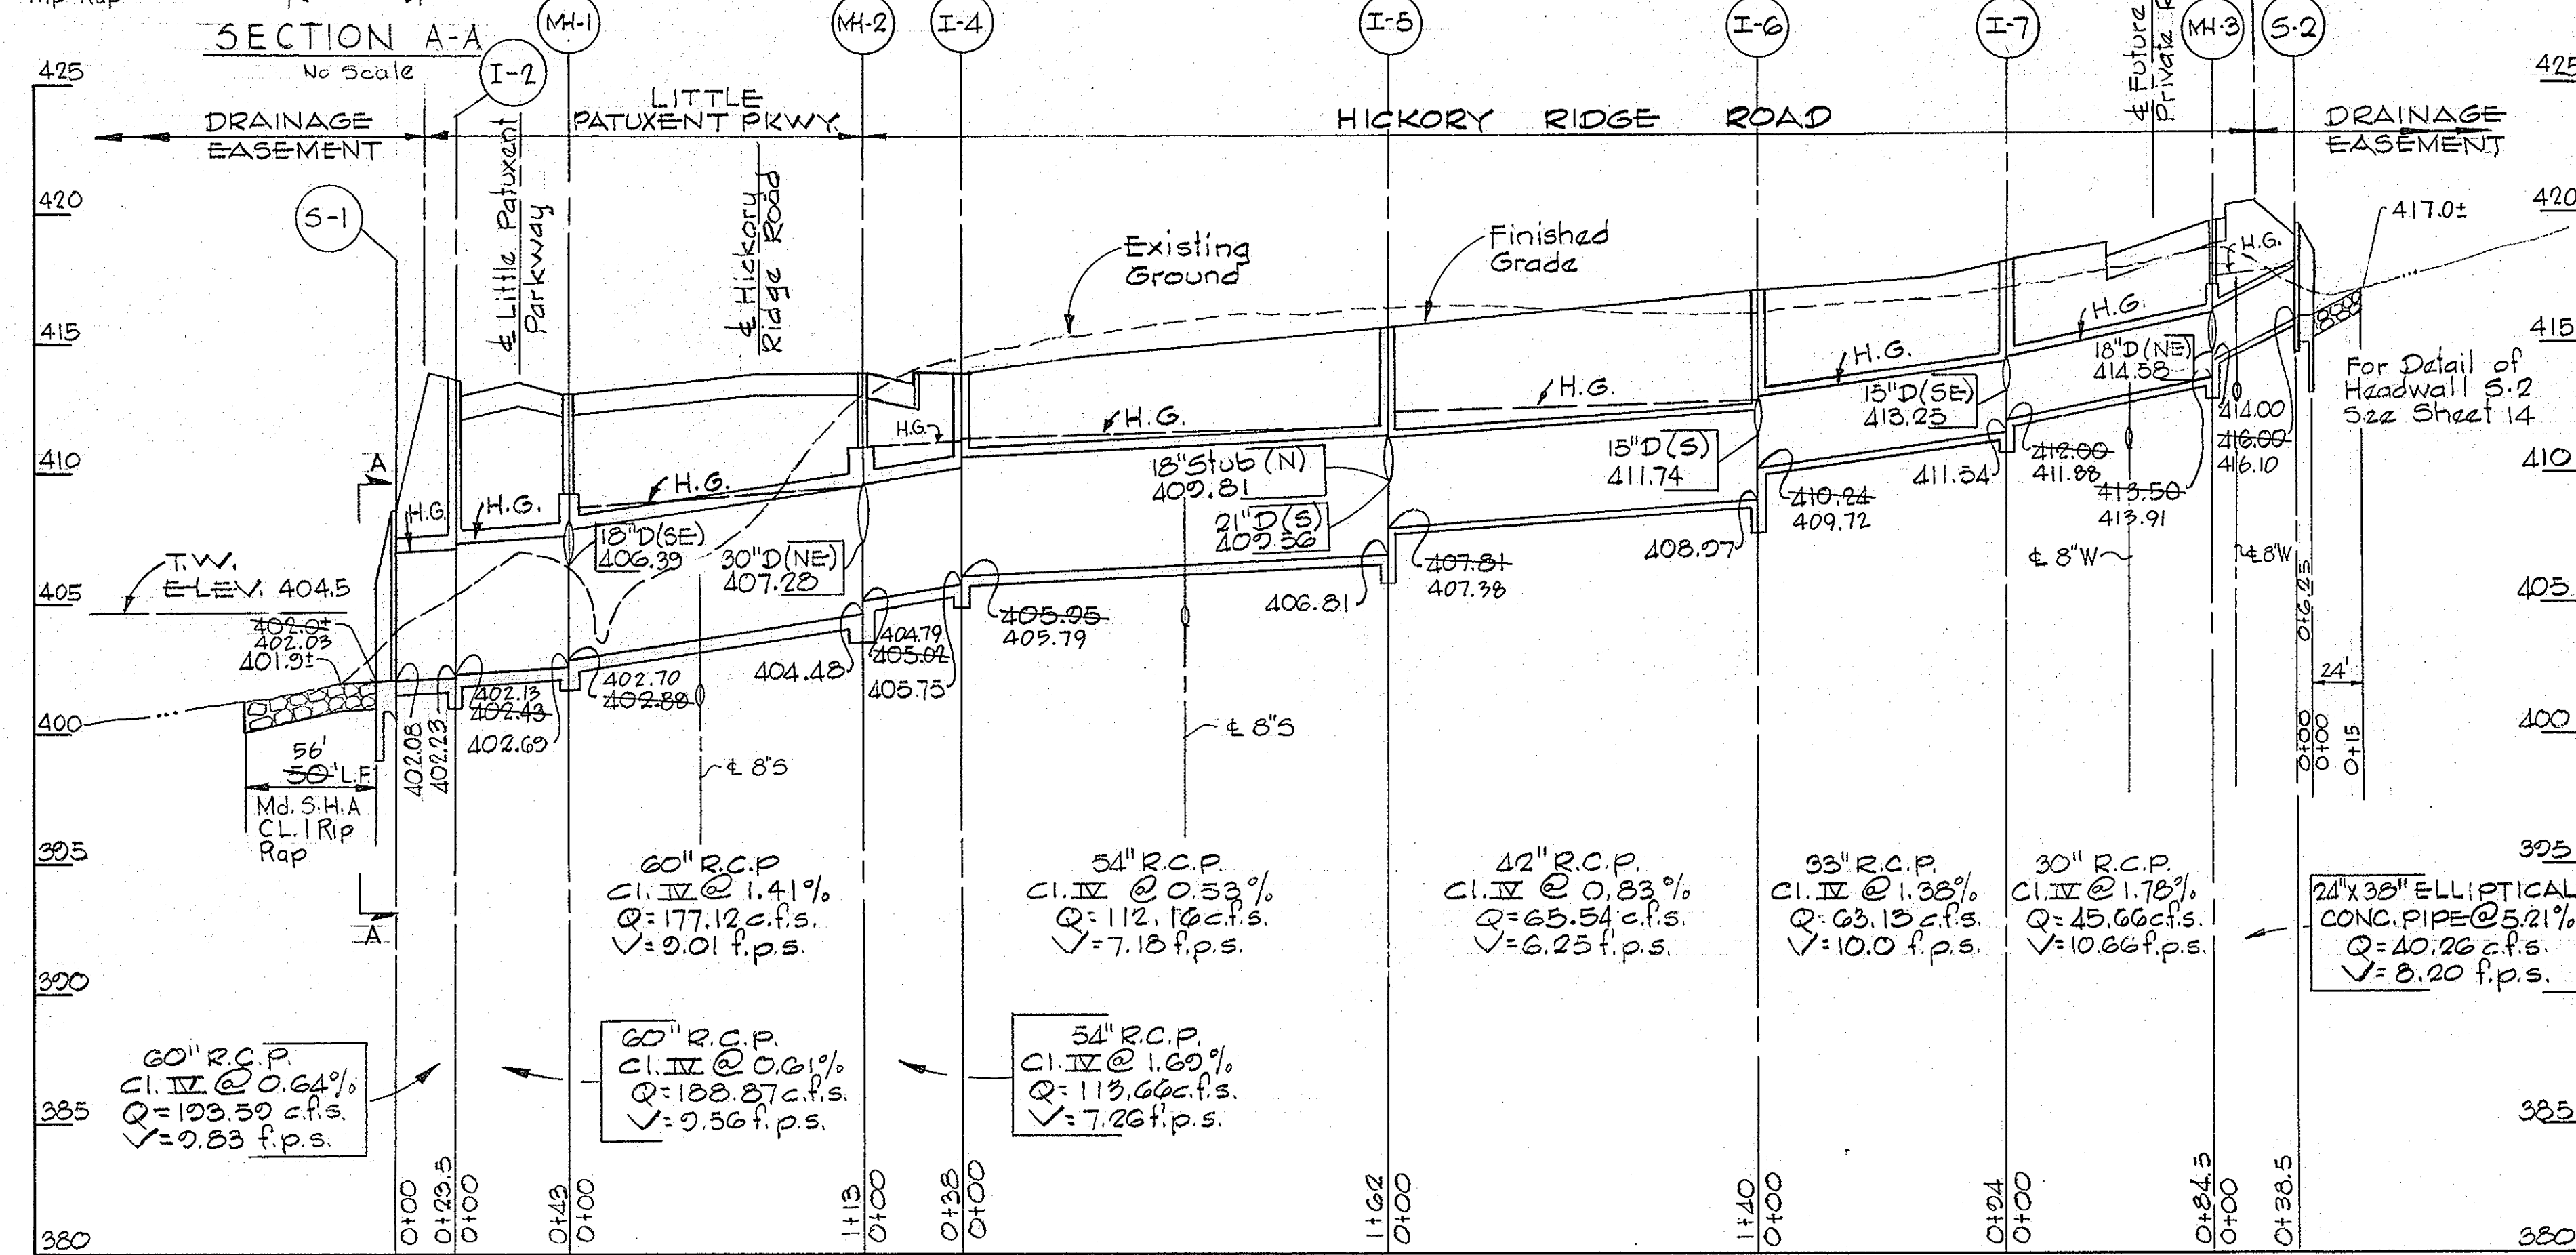
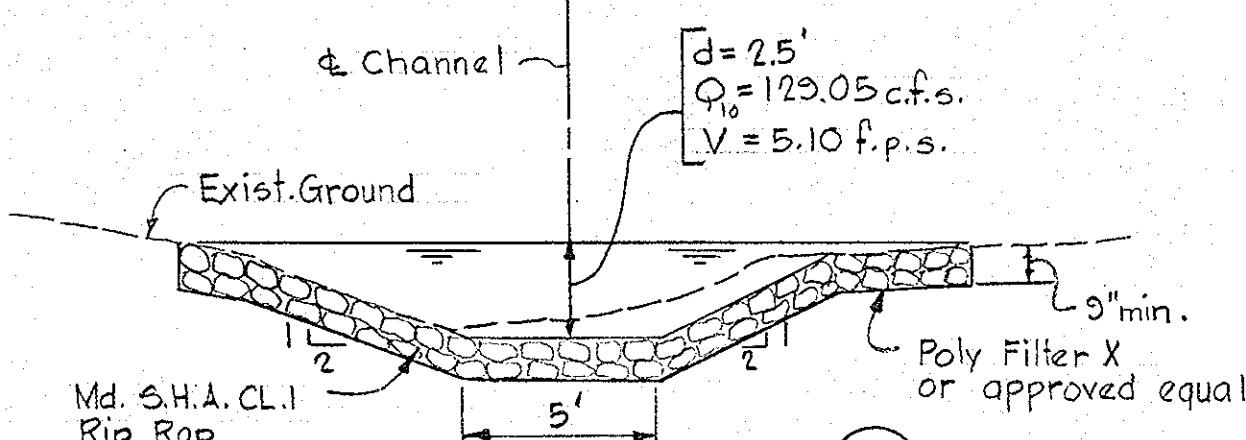
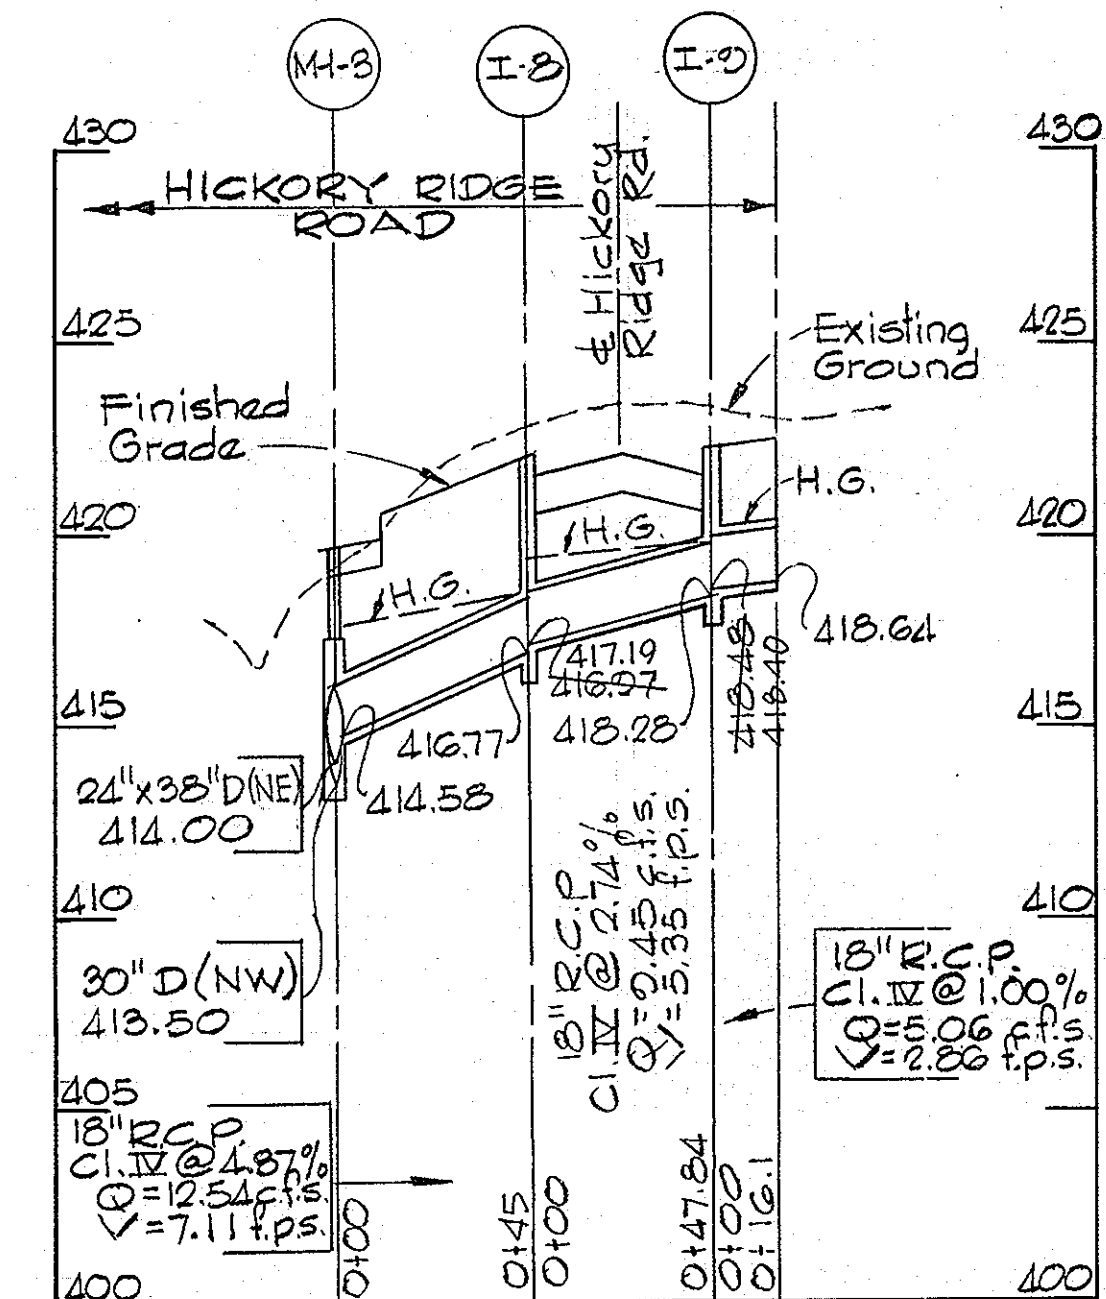
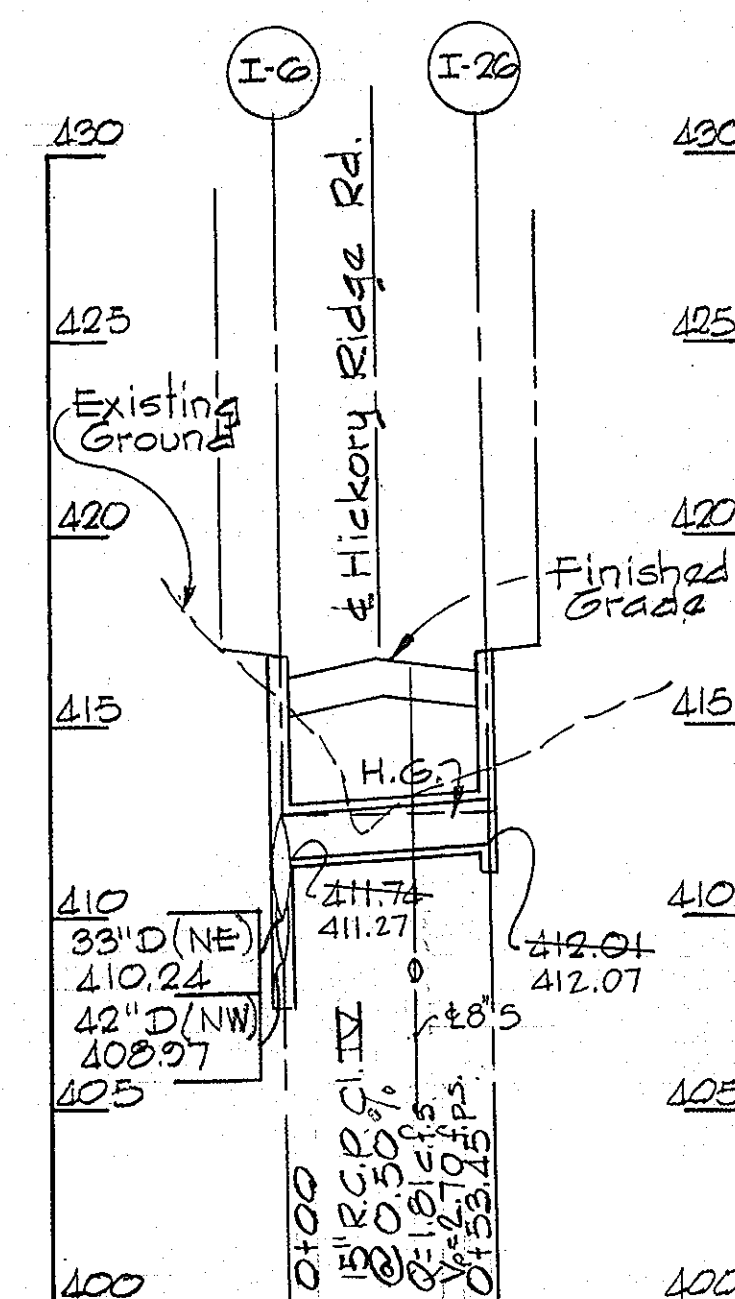
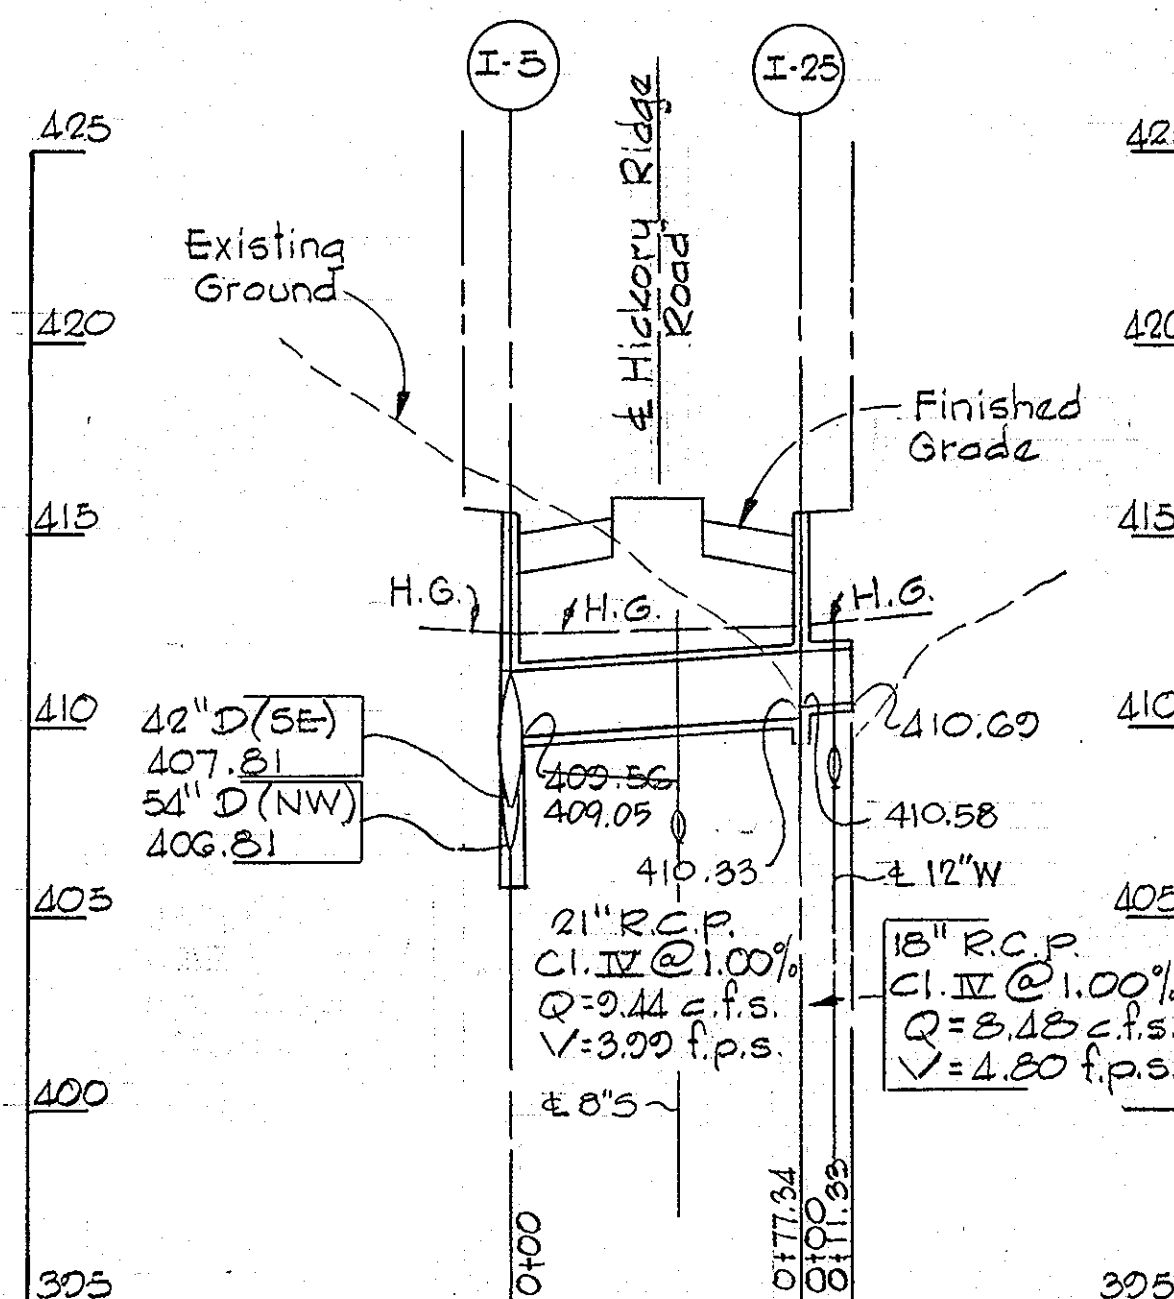
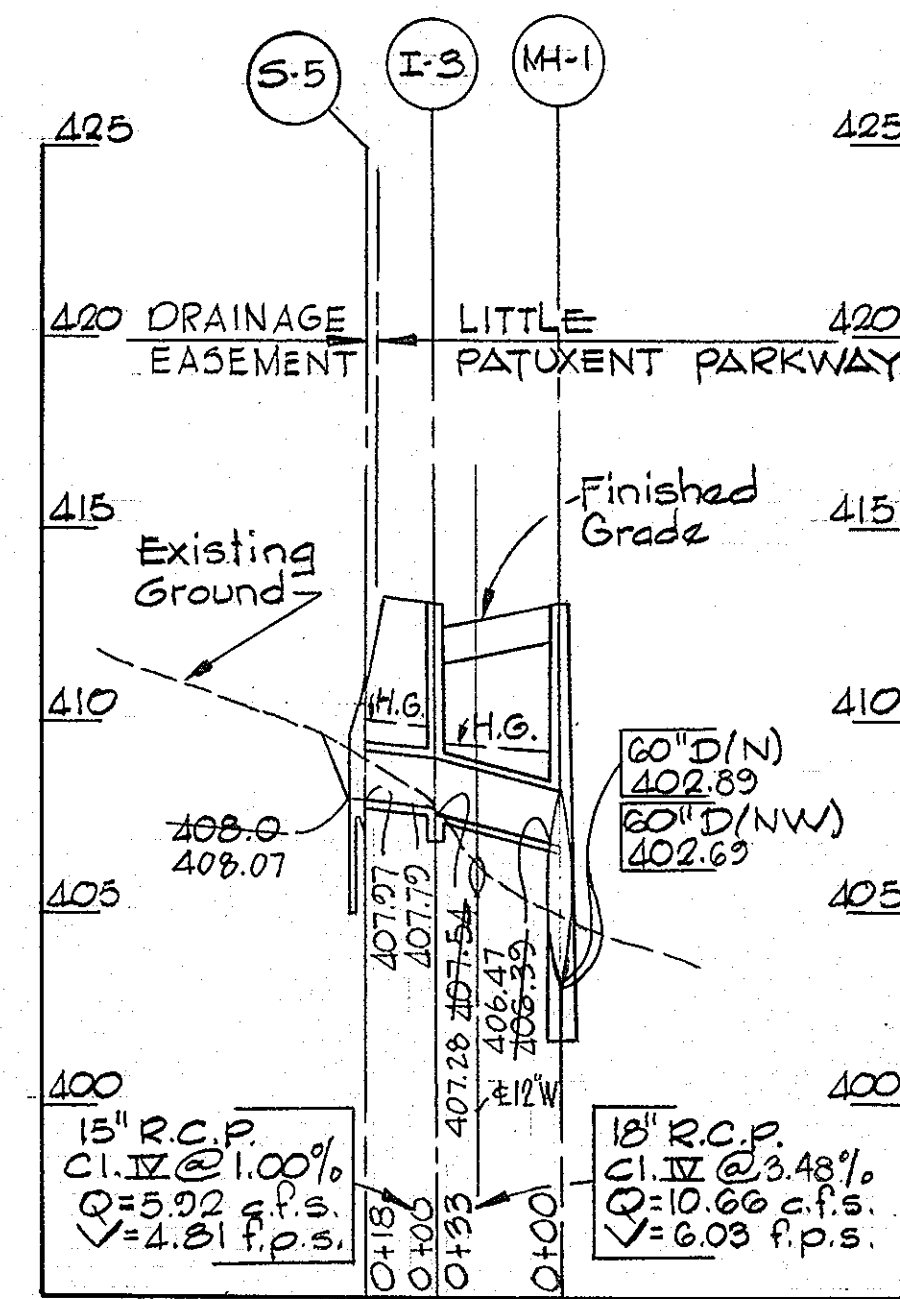


Note:
 The type of bedding used for storm drain pipe shall be Class C, shaped subgrade. If rock is encountered, the trench invert should be overexcavated 6 inches and the overexcavation of 6 inches refilled with granular material.






Rev. Date	Rev. No.	Revision Description
11/7/83	2	Removed Stub, Revised Distances, %&Q's
8/31/83	2	Added Note
7/11/83	1	As per D.P.N. & Sediment Control Comments

COLUMBIA
 5th ELECTION DISTRICT
 HOWARD COUNTY, MARYLAND
 OWNER AND DEVELOPER
 HOWARD RESEARCH AND DEVELOPMENT CORPORATION
 PROJECT AREA
 VILLAGE OF HICKORY RIDGE
 SECTION 3 AREA 1
 PROJECT TITLE
 STORM DRAIN PROFILES
 SCALE 1/4" = 5', Vert. 1" = 5' DATE:
 WHITMAN, REQUARDT AND ASSOCIATES
 ENGINEERS
 2315 ST. PAUL STREET
 BALTIMORE, MARYLAND 21218

Kenneth A. McCord
 KENNETH A. MCCORD
 Registered Engineer
 No. 1974

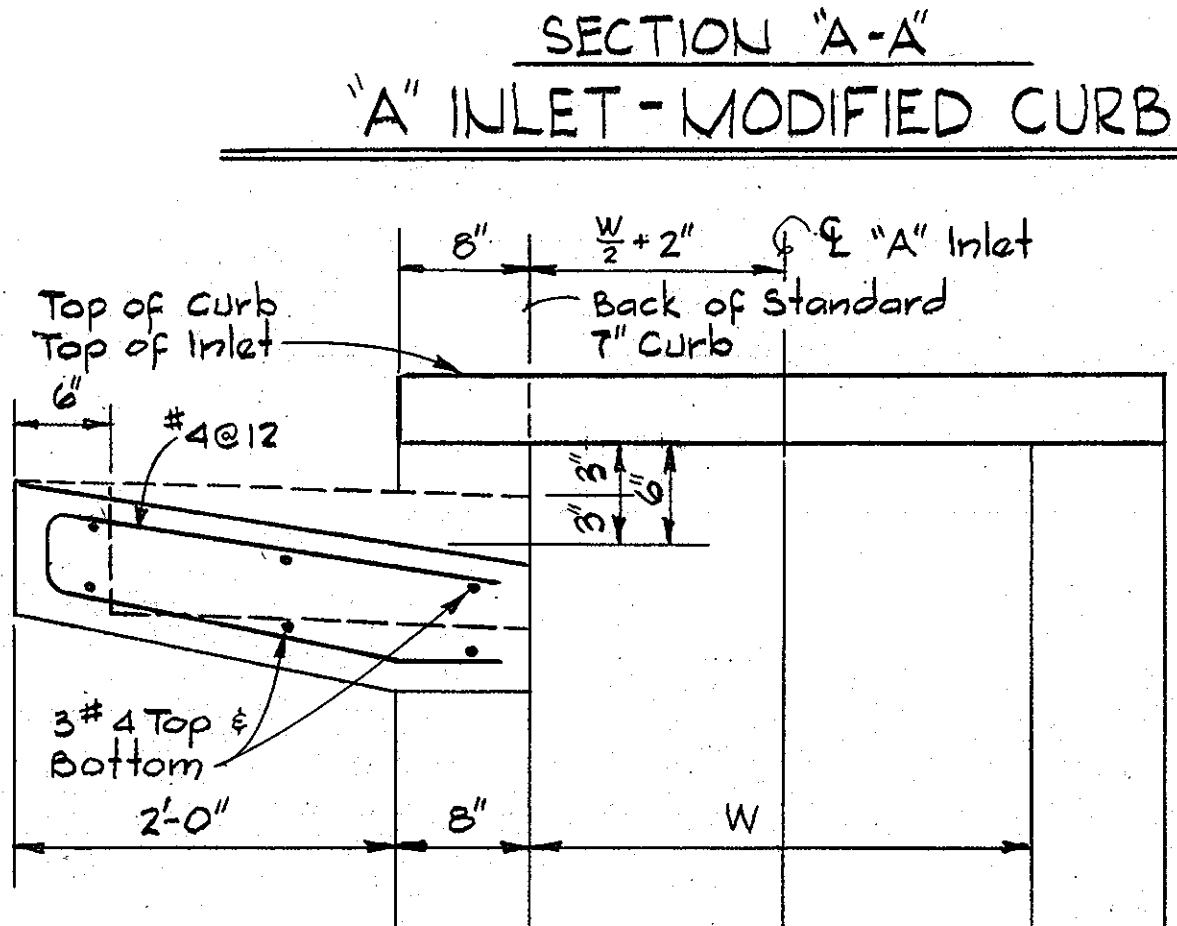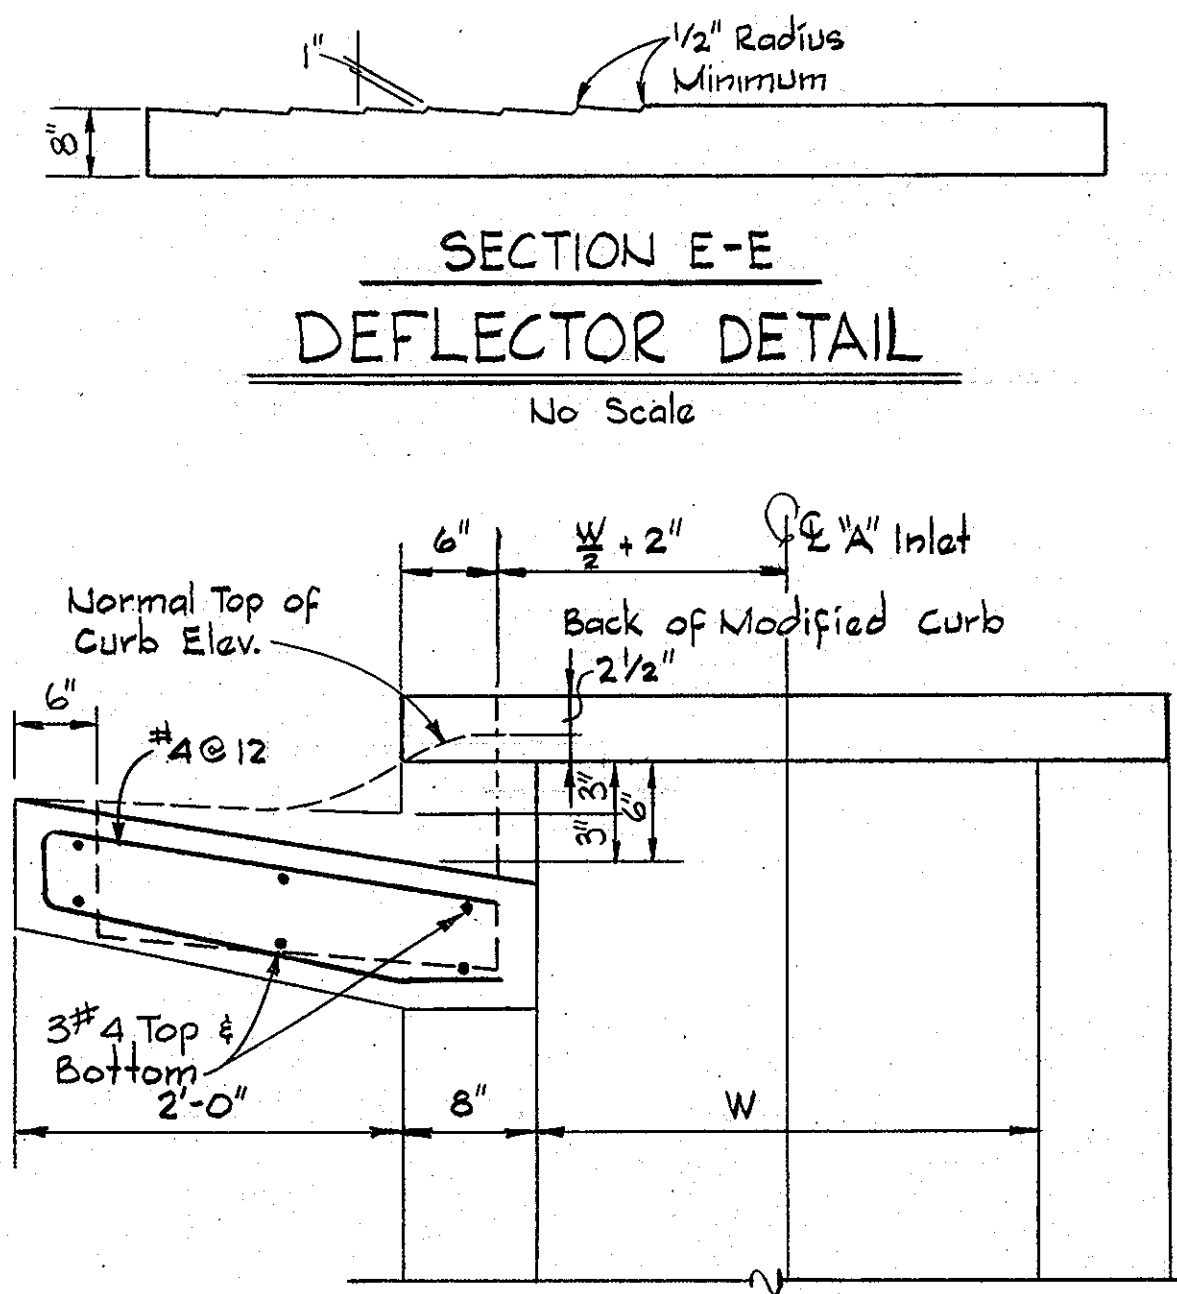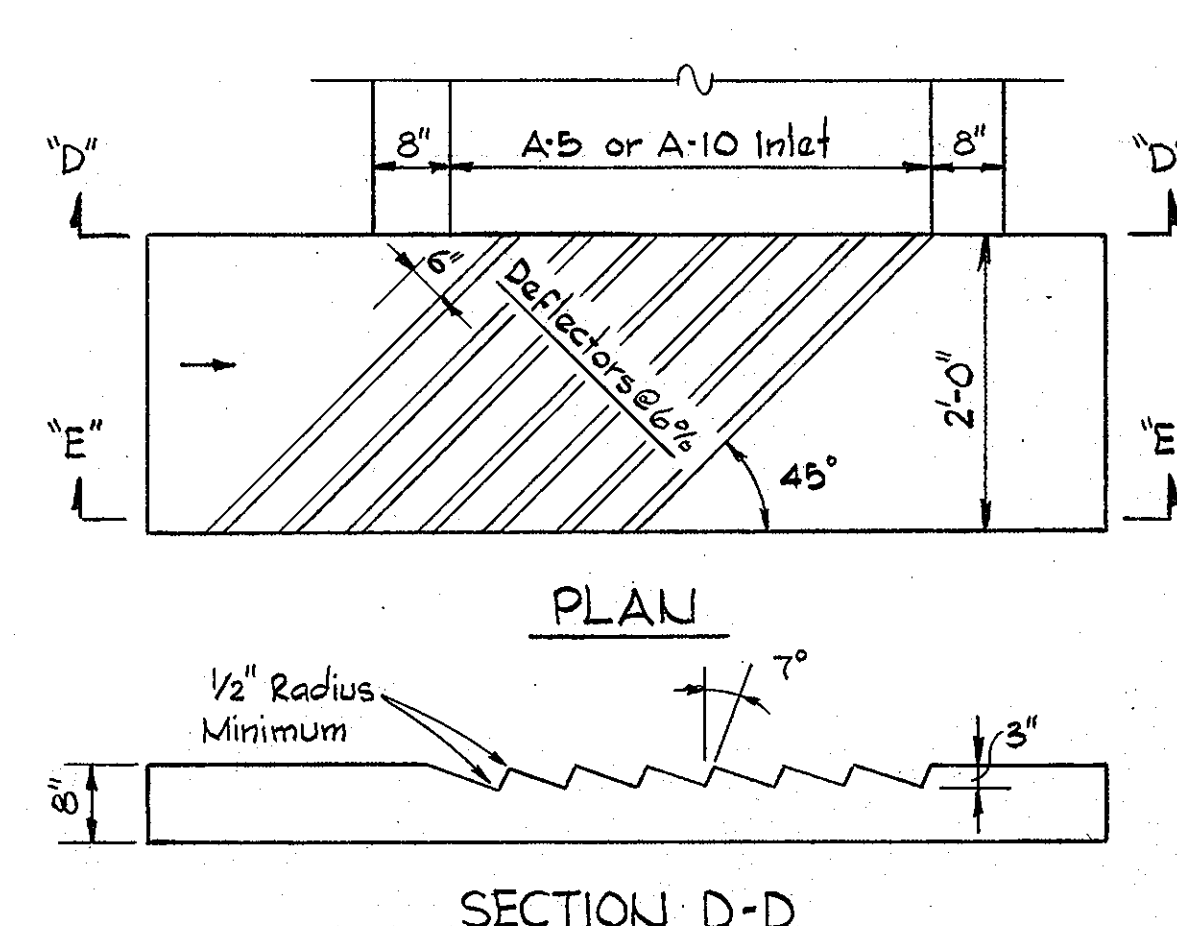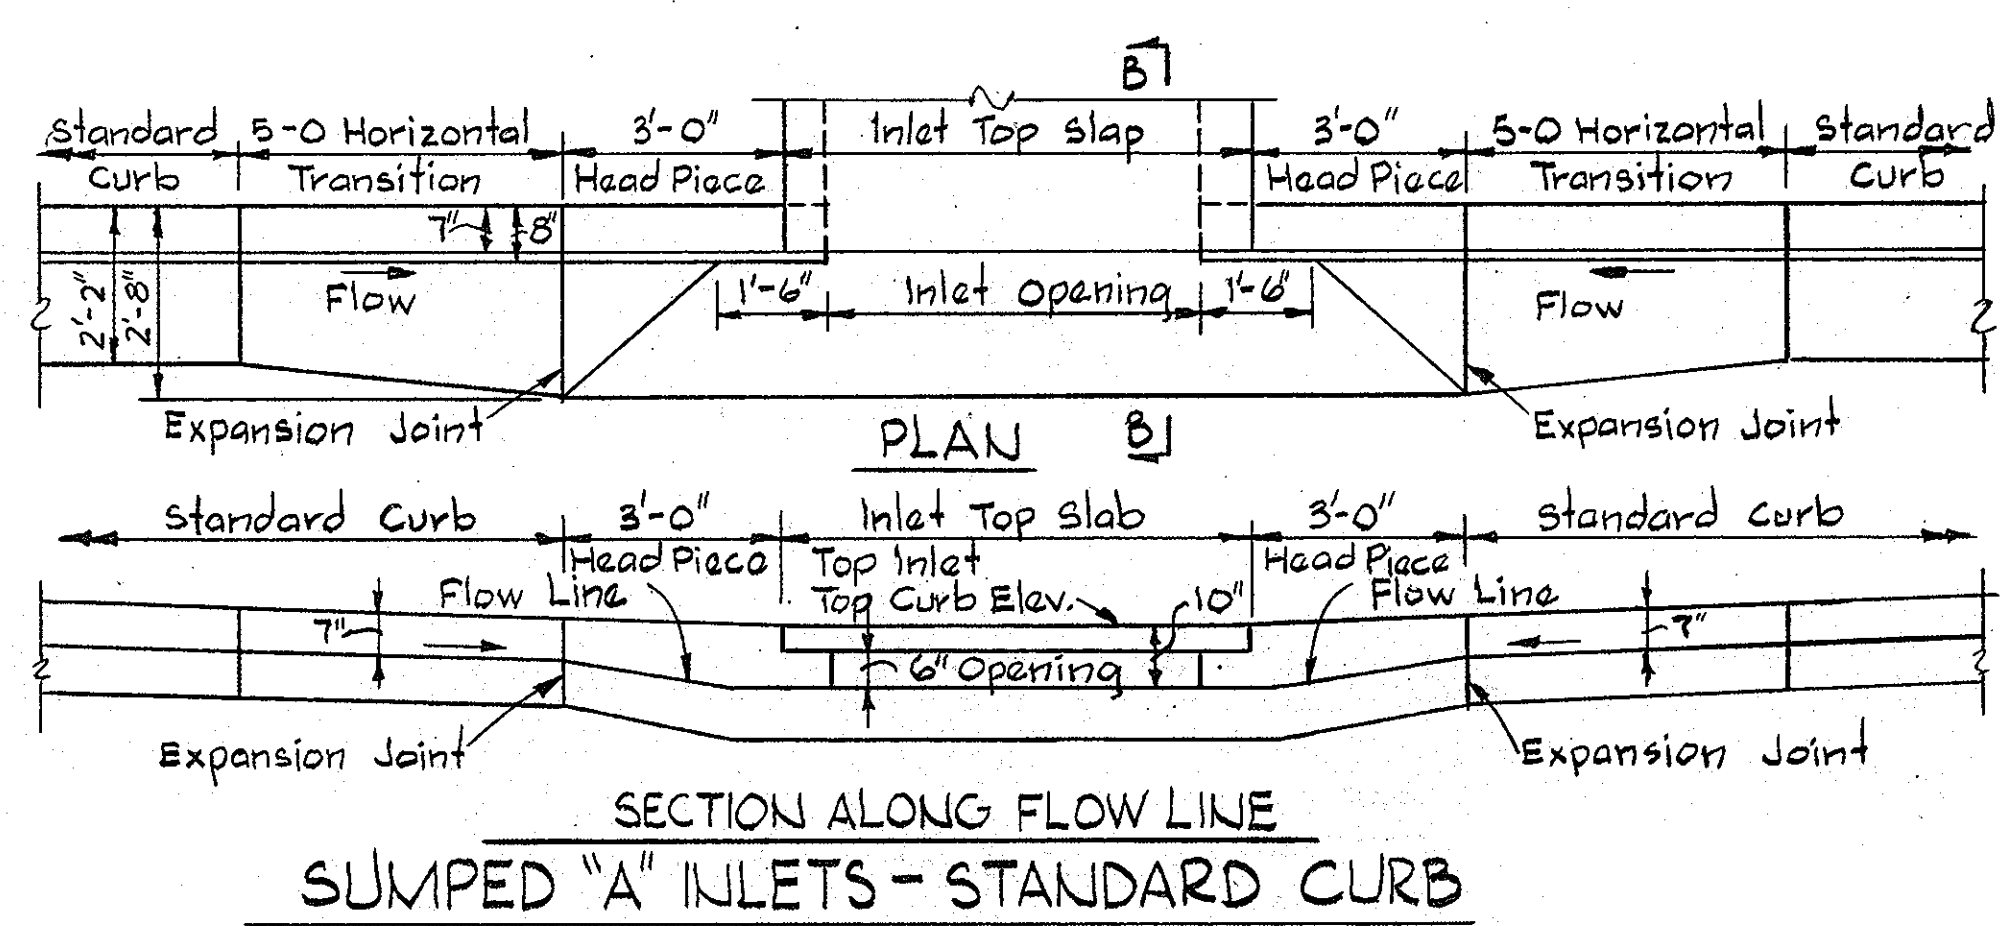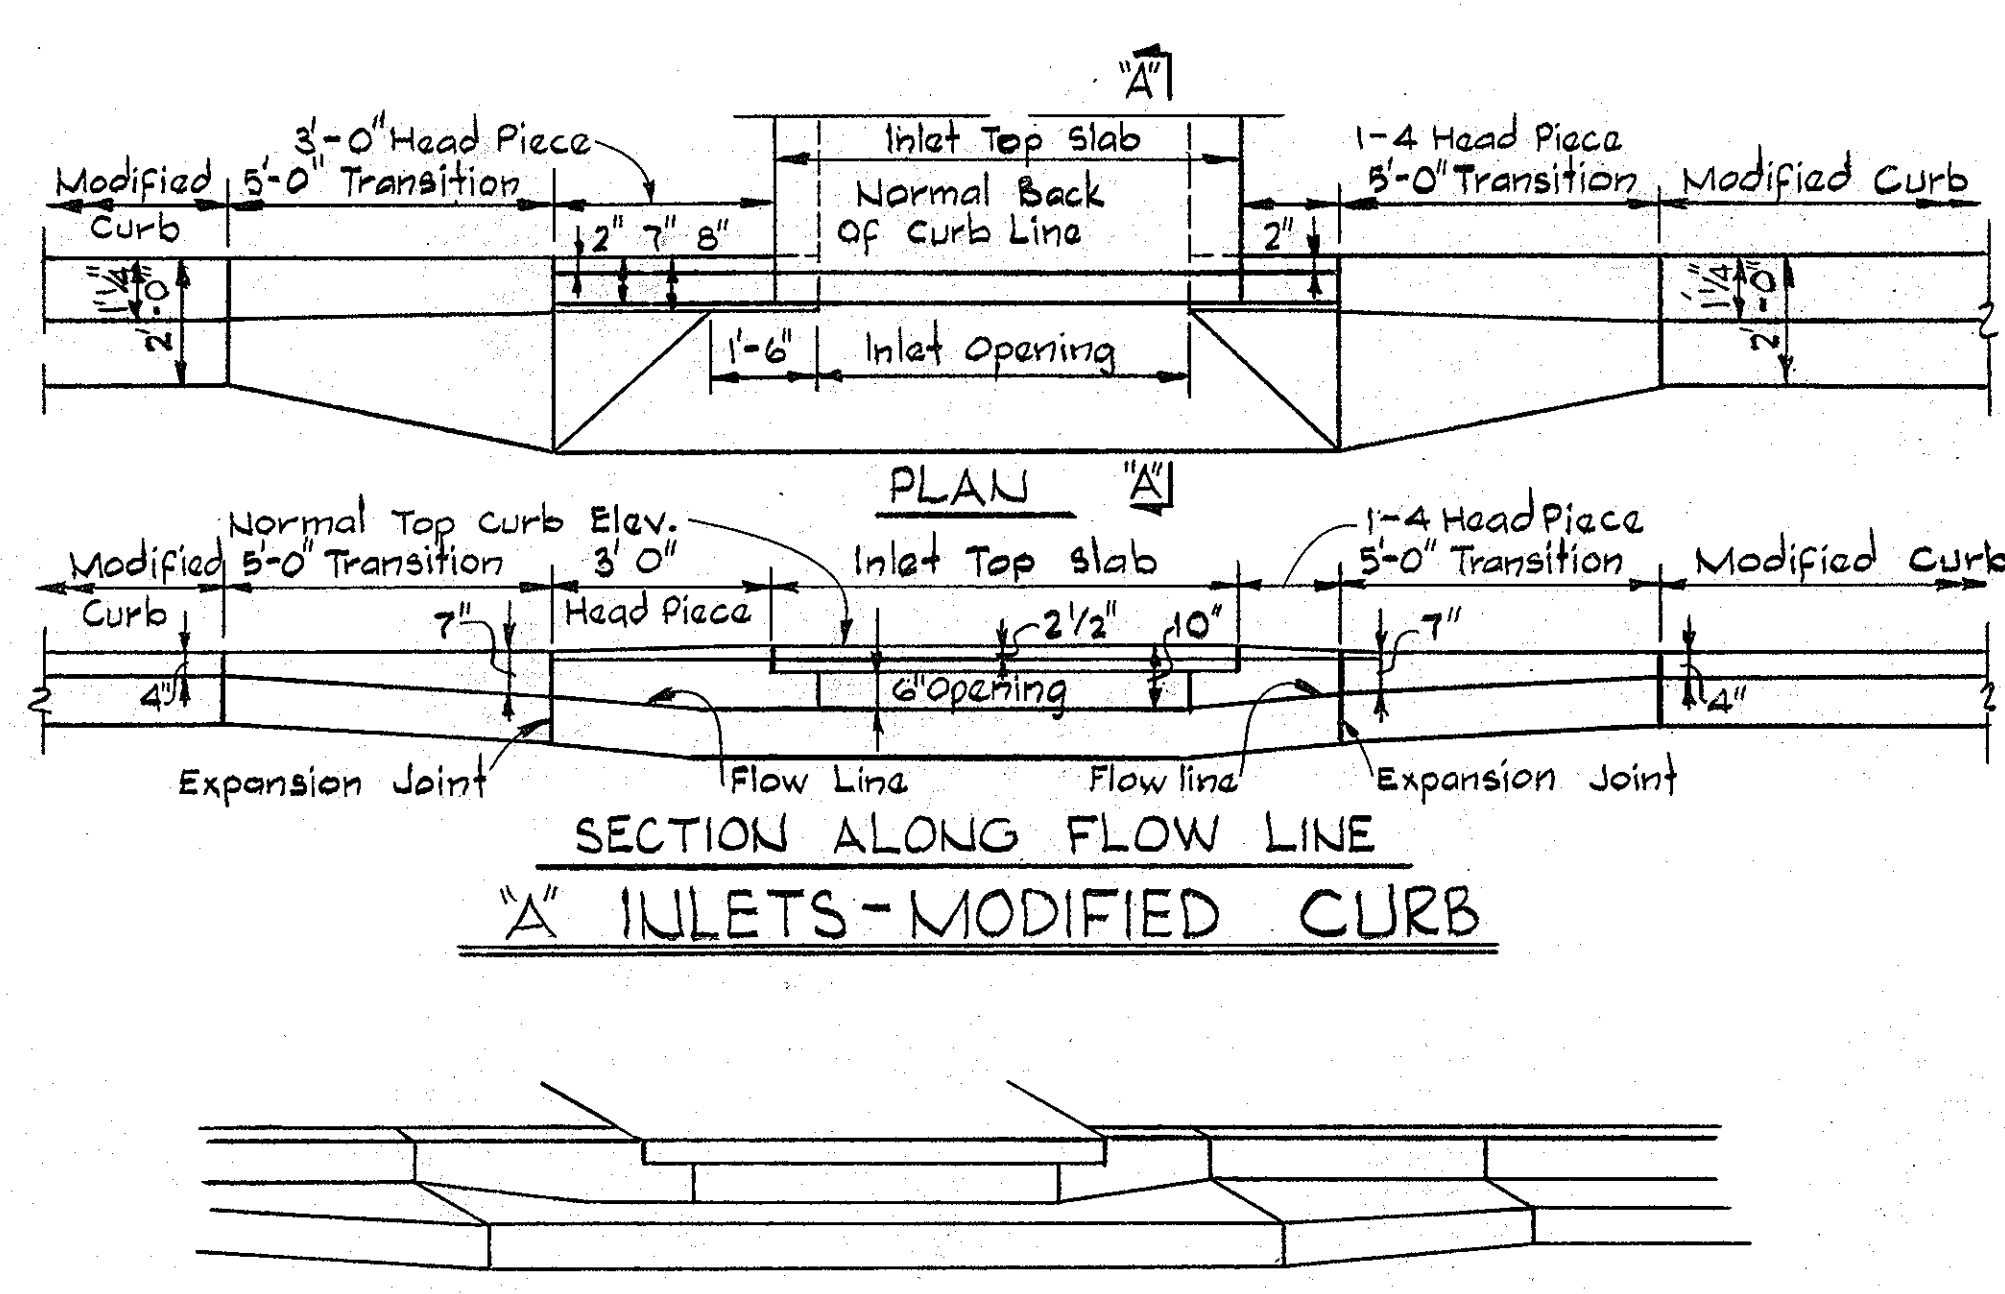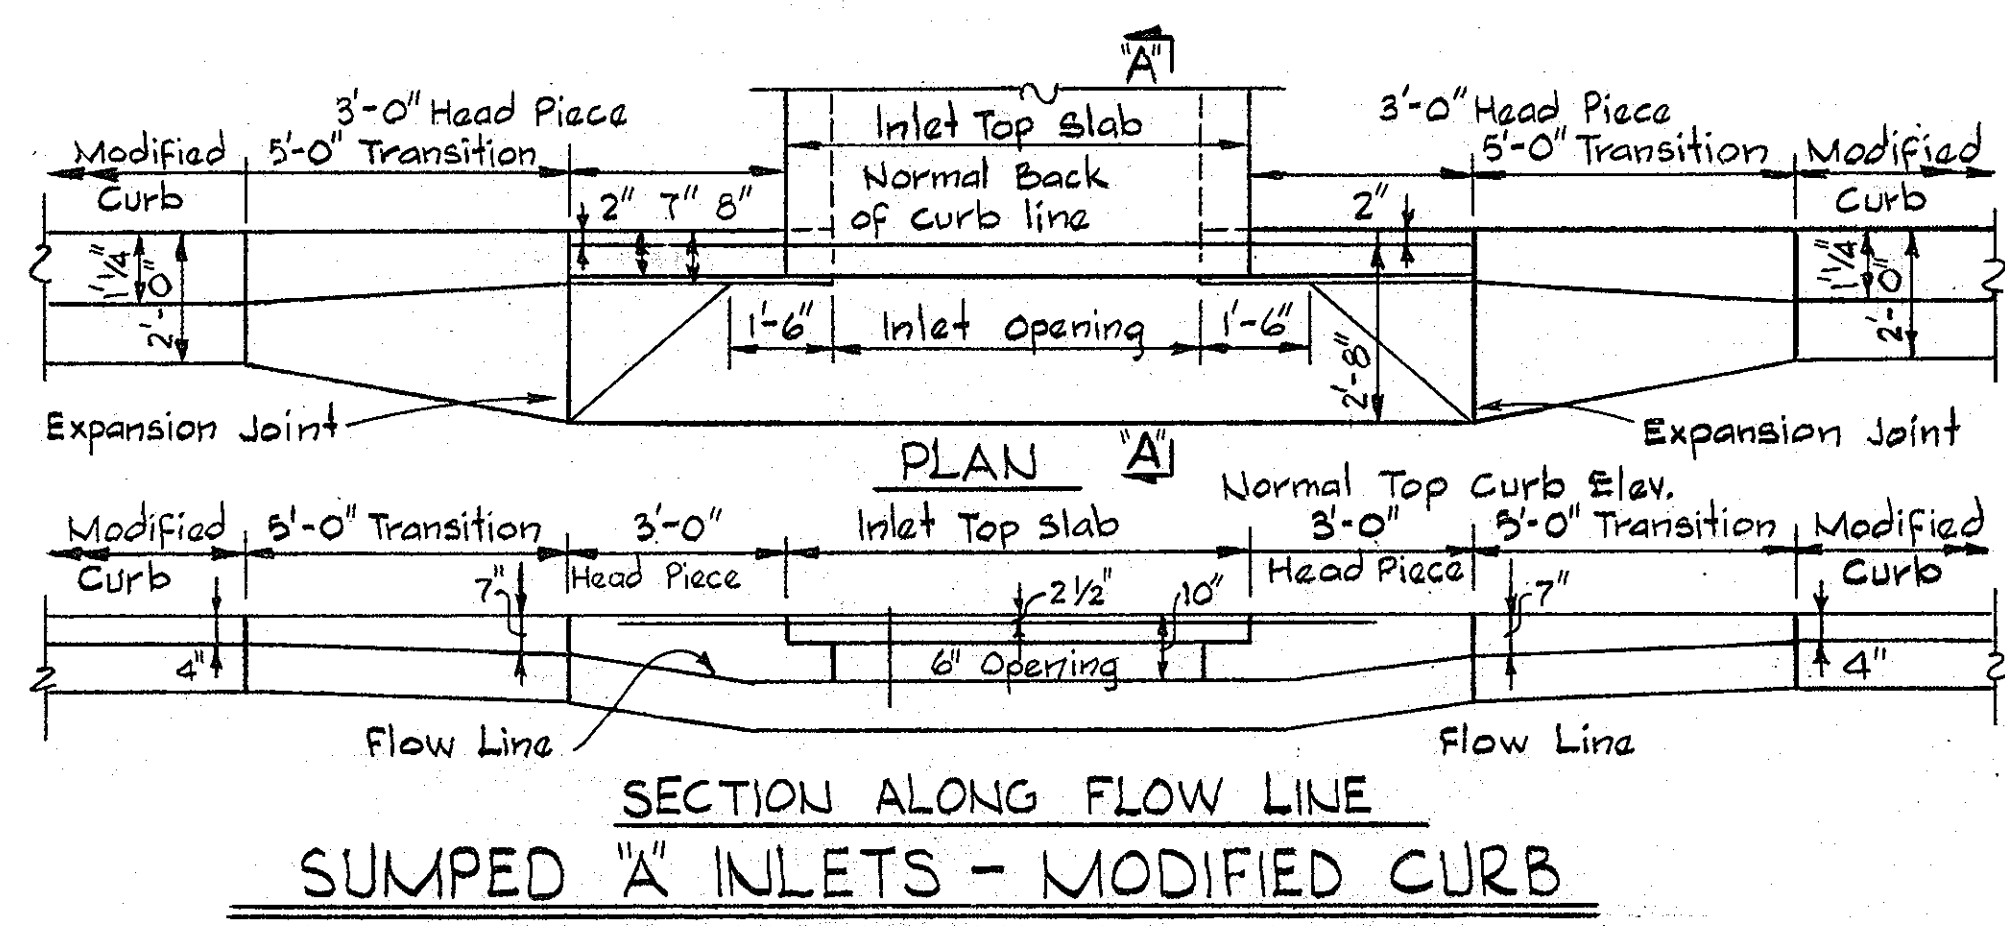

Note: For "A" Inlet dimensions and structural details see standard Howard County Drawing 64A page 119A

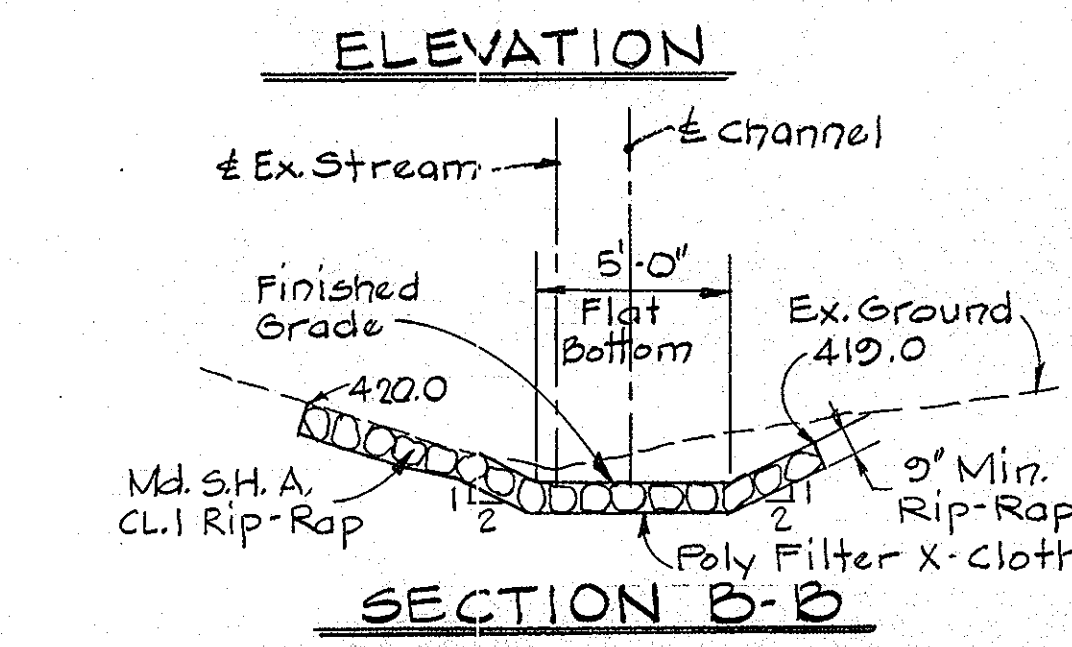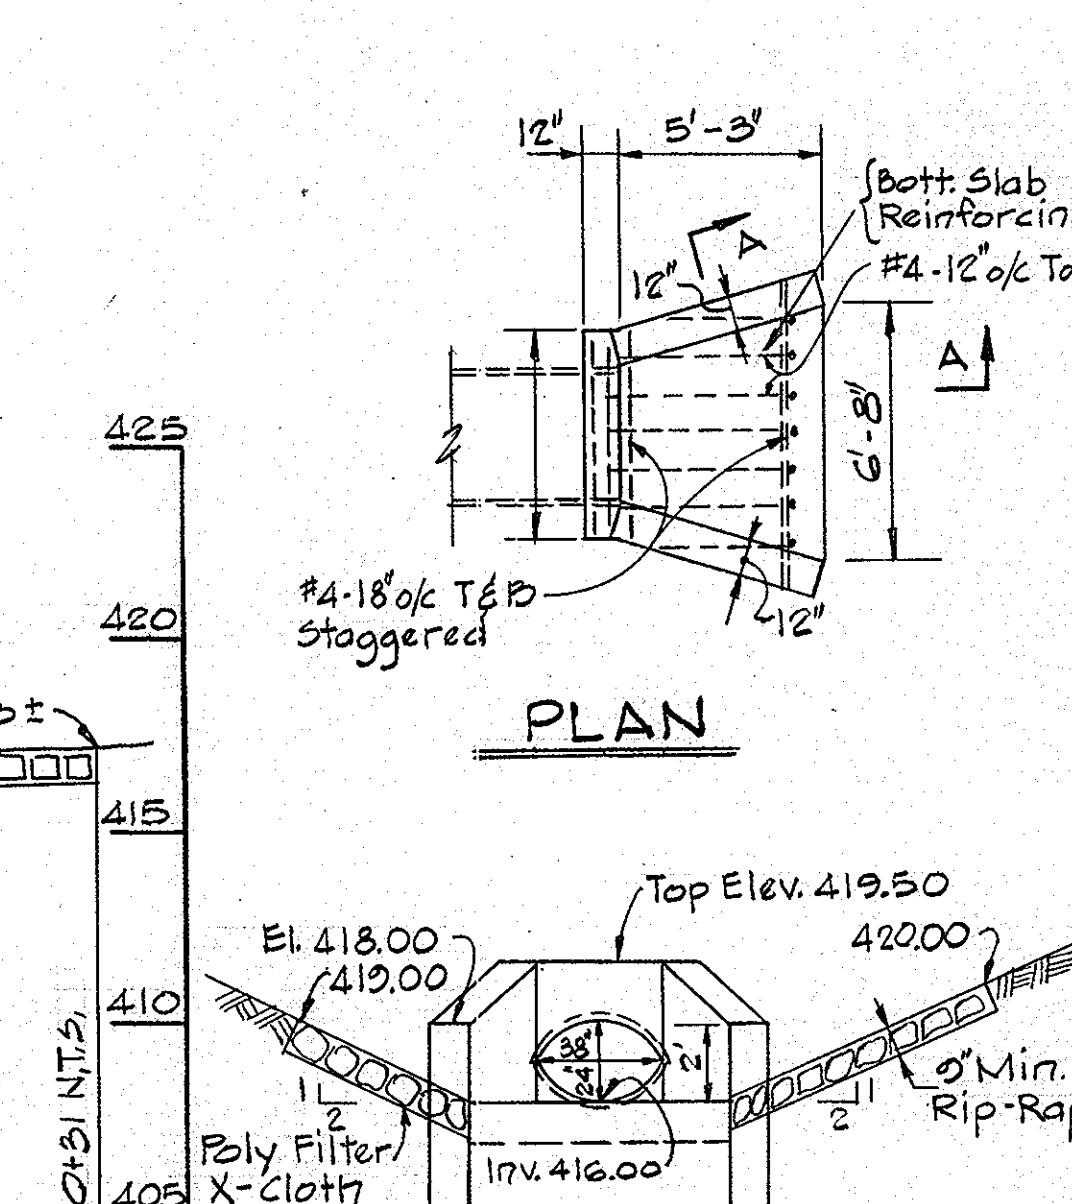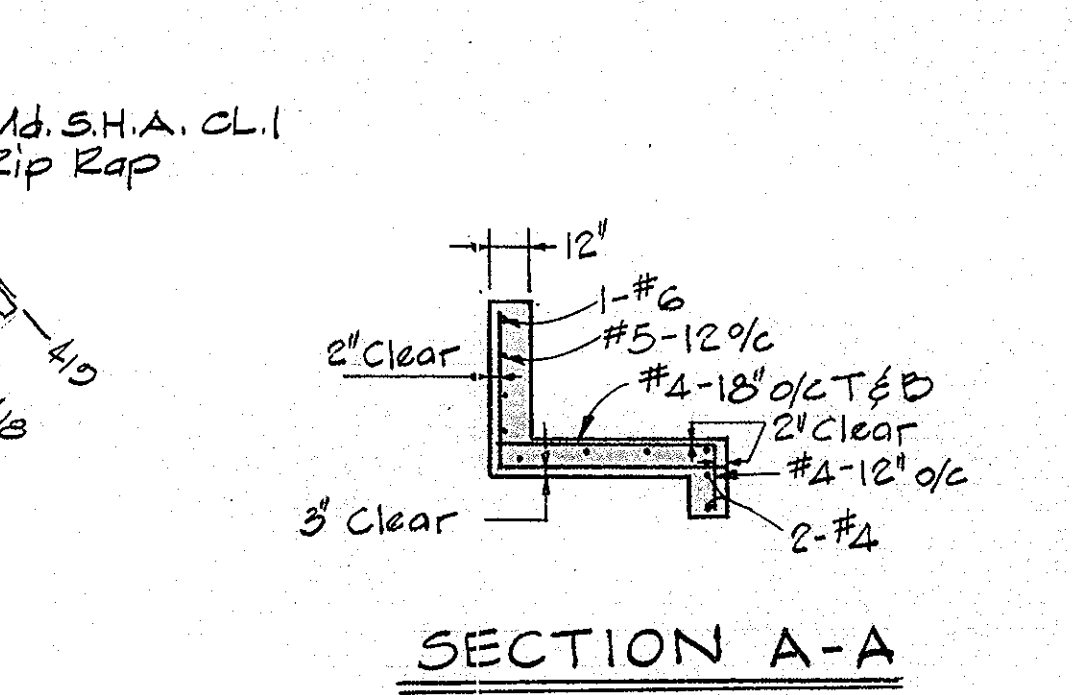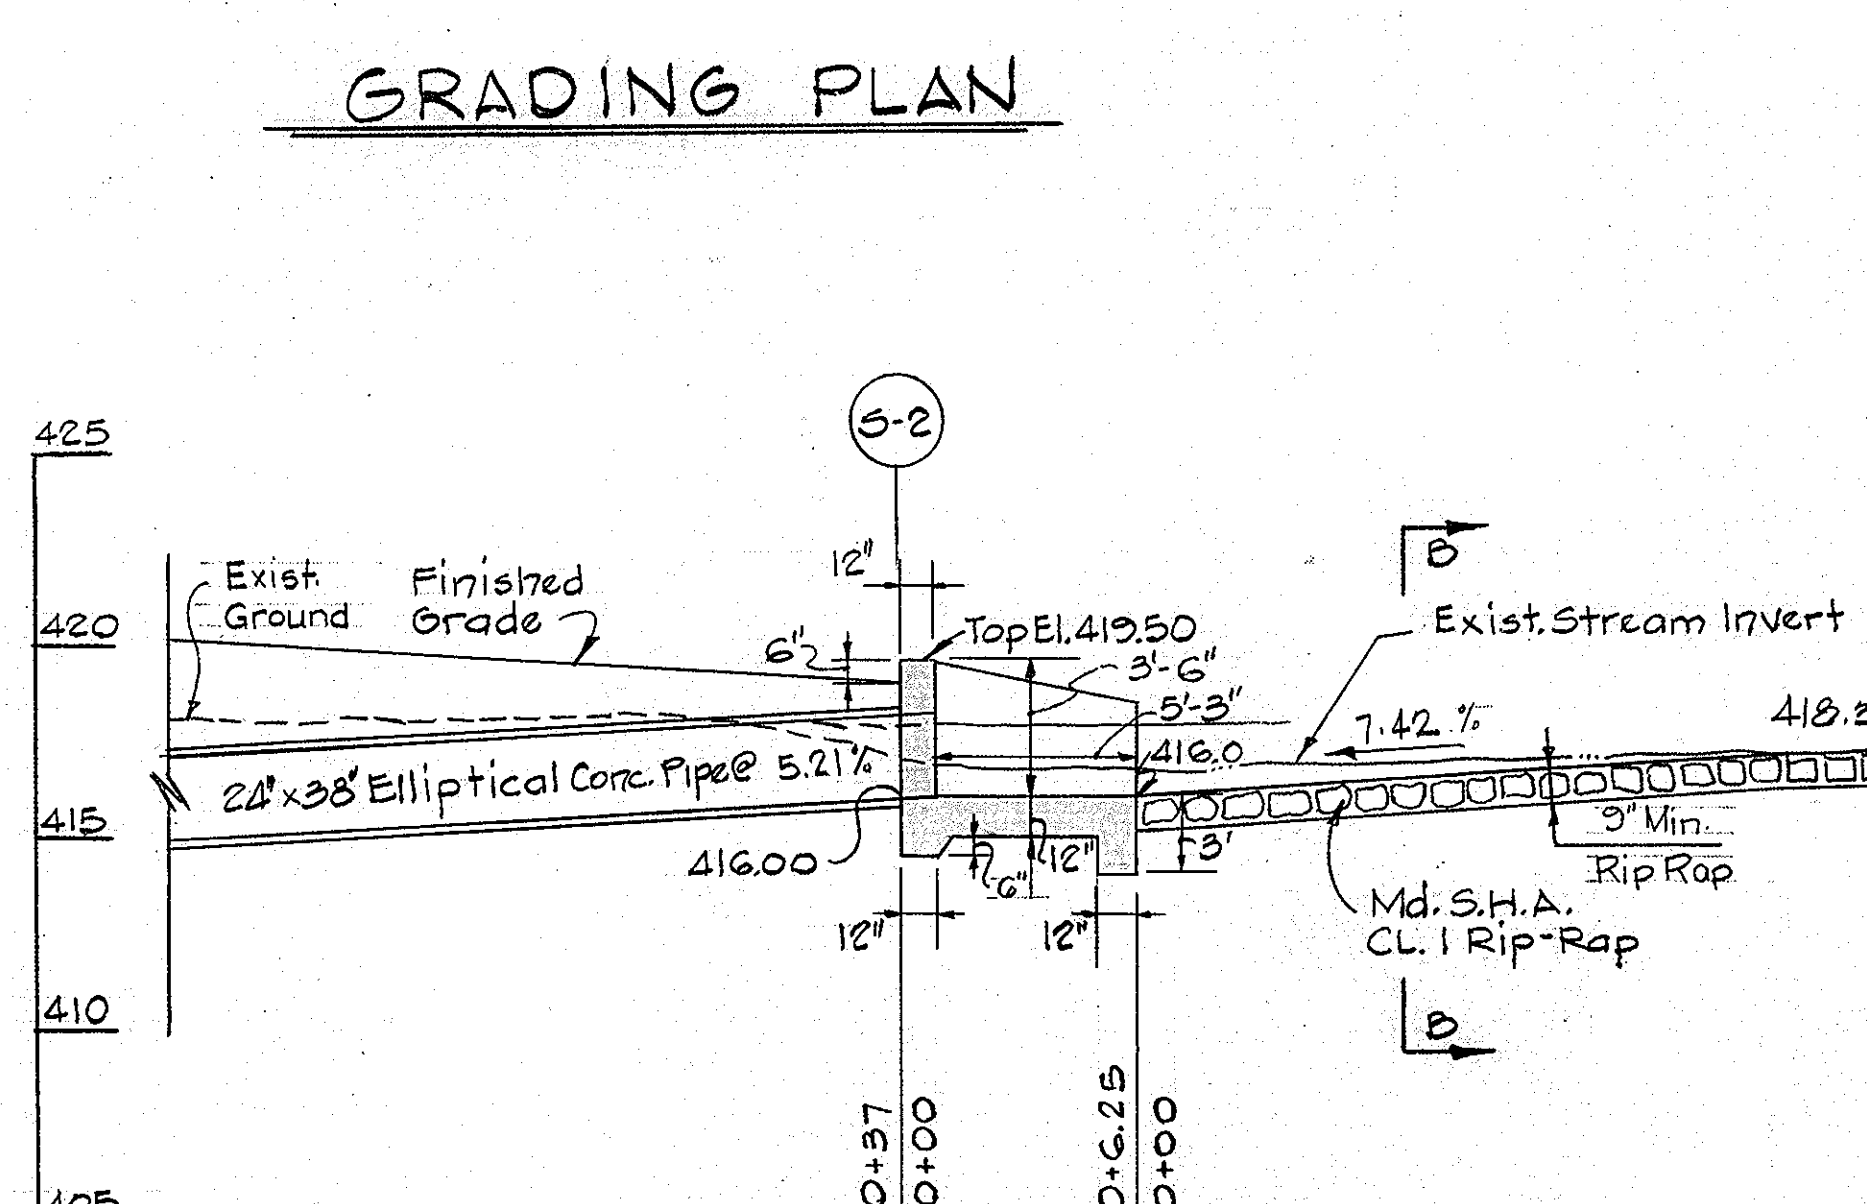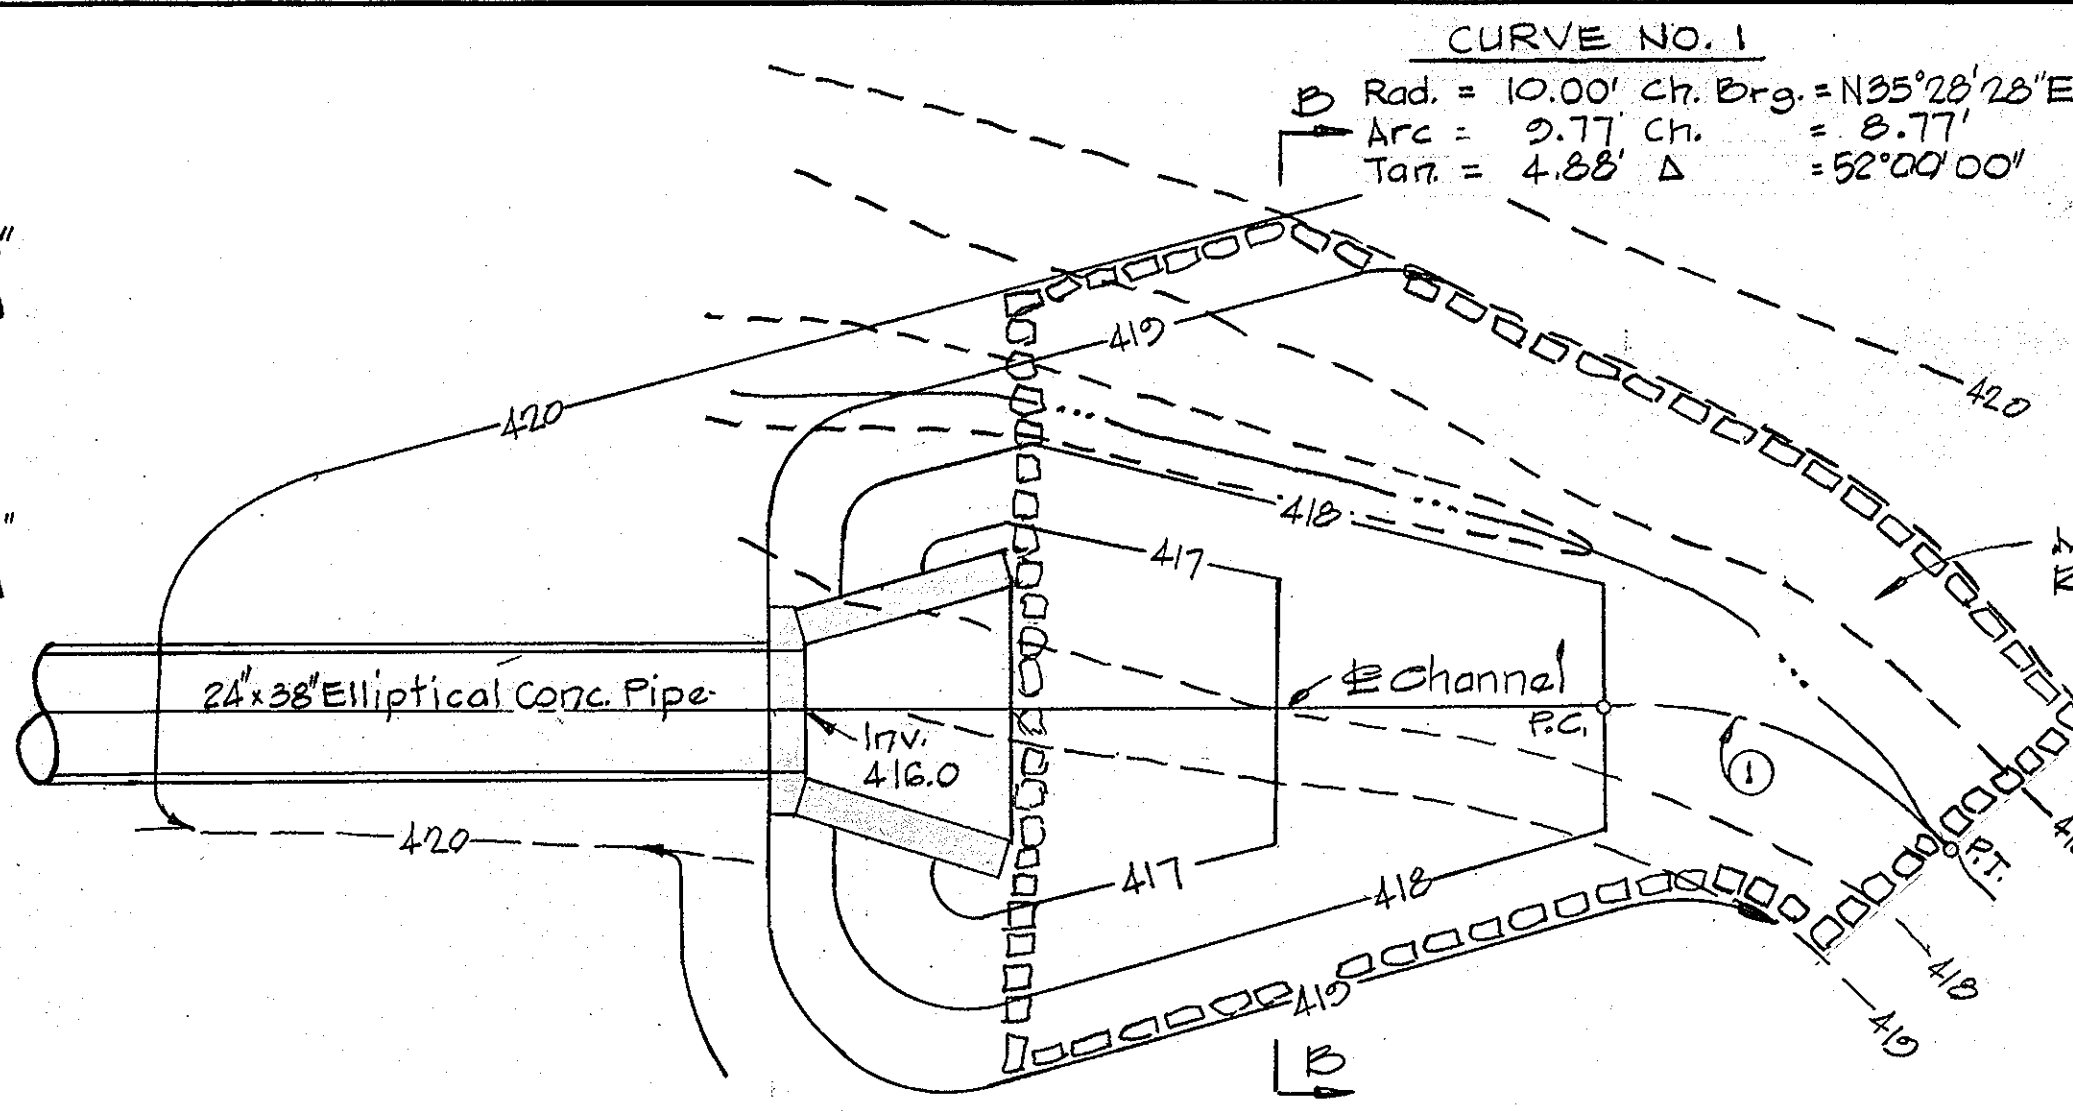

REV. DATE	REV. NO.	REVISION DESCRIPTION
11/7/83	2	Revised Structure 5-2 Details
7/1/83	1	As Per D.P.W. Sediment Control Comments

COLUMBIA
 5th ELECTION DISTRICT
 HOWARD COUNTY, MARYLAND

OWNER AND DEVELOPER
 THE HOWARD RESEARCH AND DEVELOPMENT CORPORATION
 THE ROUSE BUILDING
 COLUMBIA, MARYLAND 21044



PROJECT AREA
 VILLAGE OF HICKORY RIDGE
 SECTION 3 AREA 1

PROJECT TITLE
STORM DRAIN DETAILS



SCALE: AS SHOWN DATE

WHITMAN, REQUARDT AND ASSOCIATES
 ENGINEERS
 2315 ST. PAUL STREET
 BALTIMORE, MARYLAND 21218



Kenneth A. McCord
 KENNETH A. MCCORD
 Registered Engineer
 No. 1974

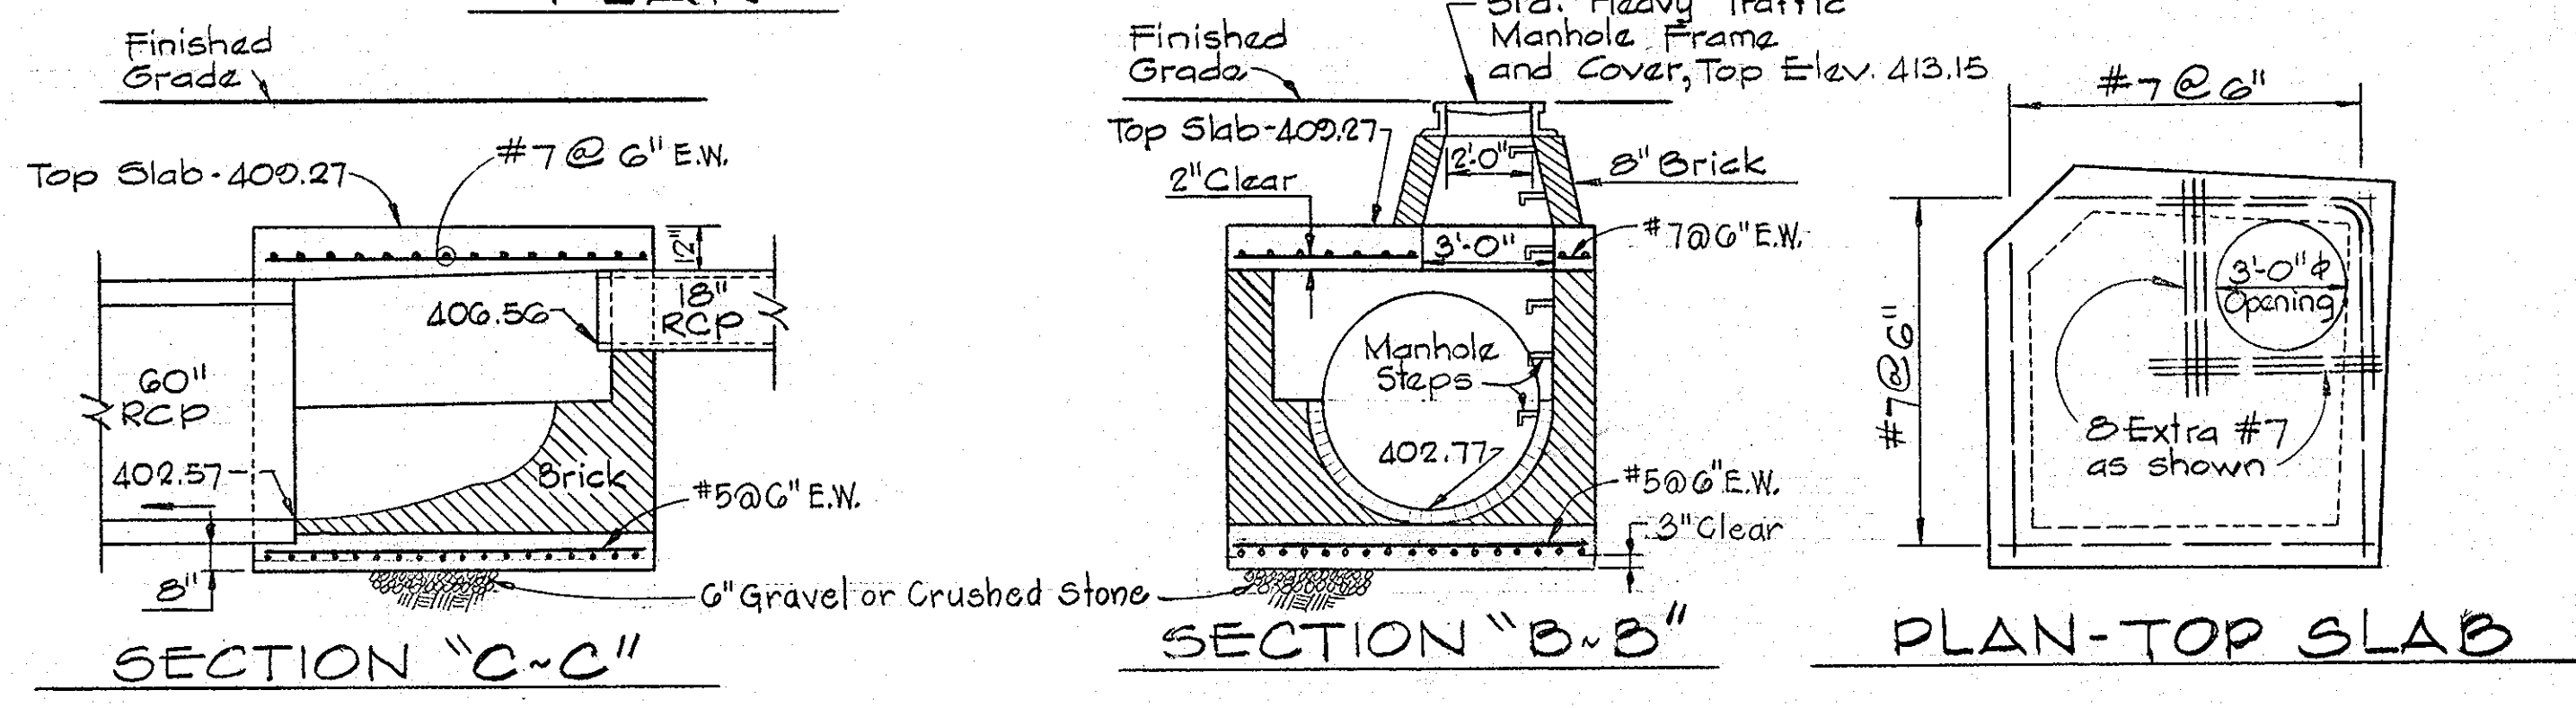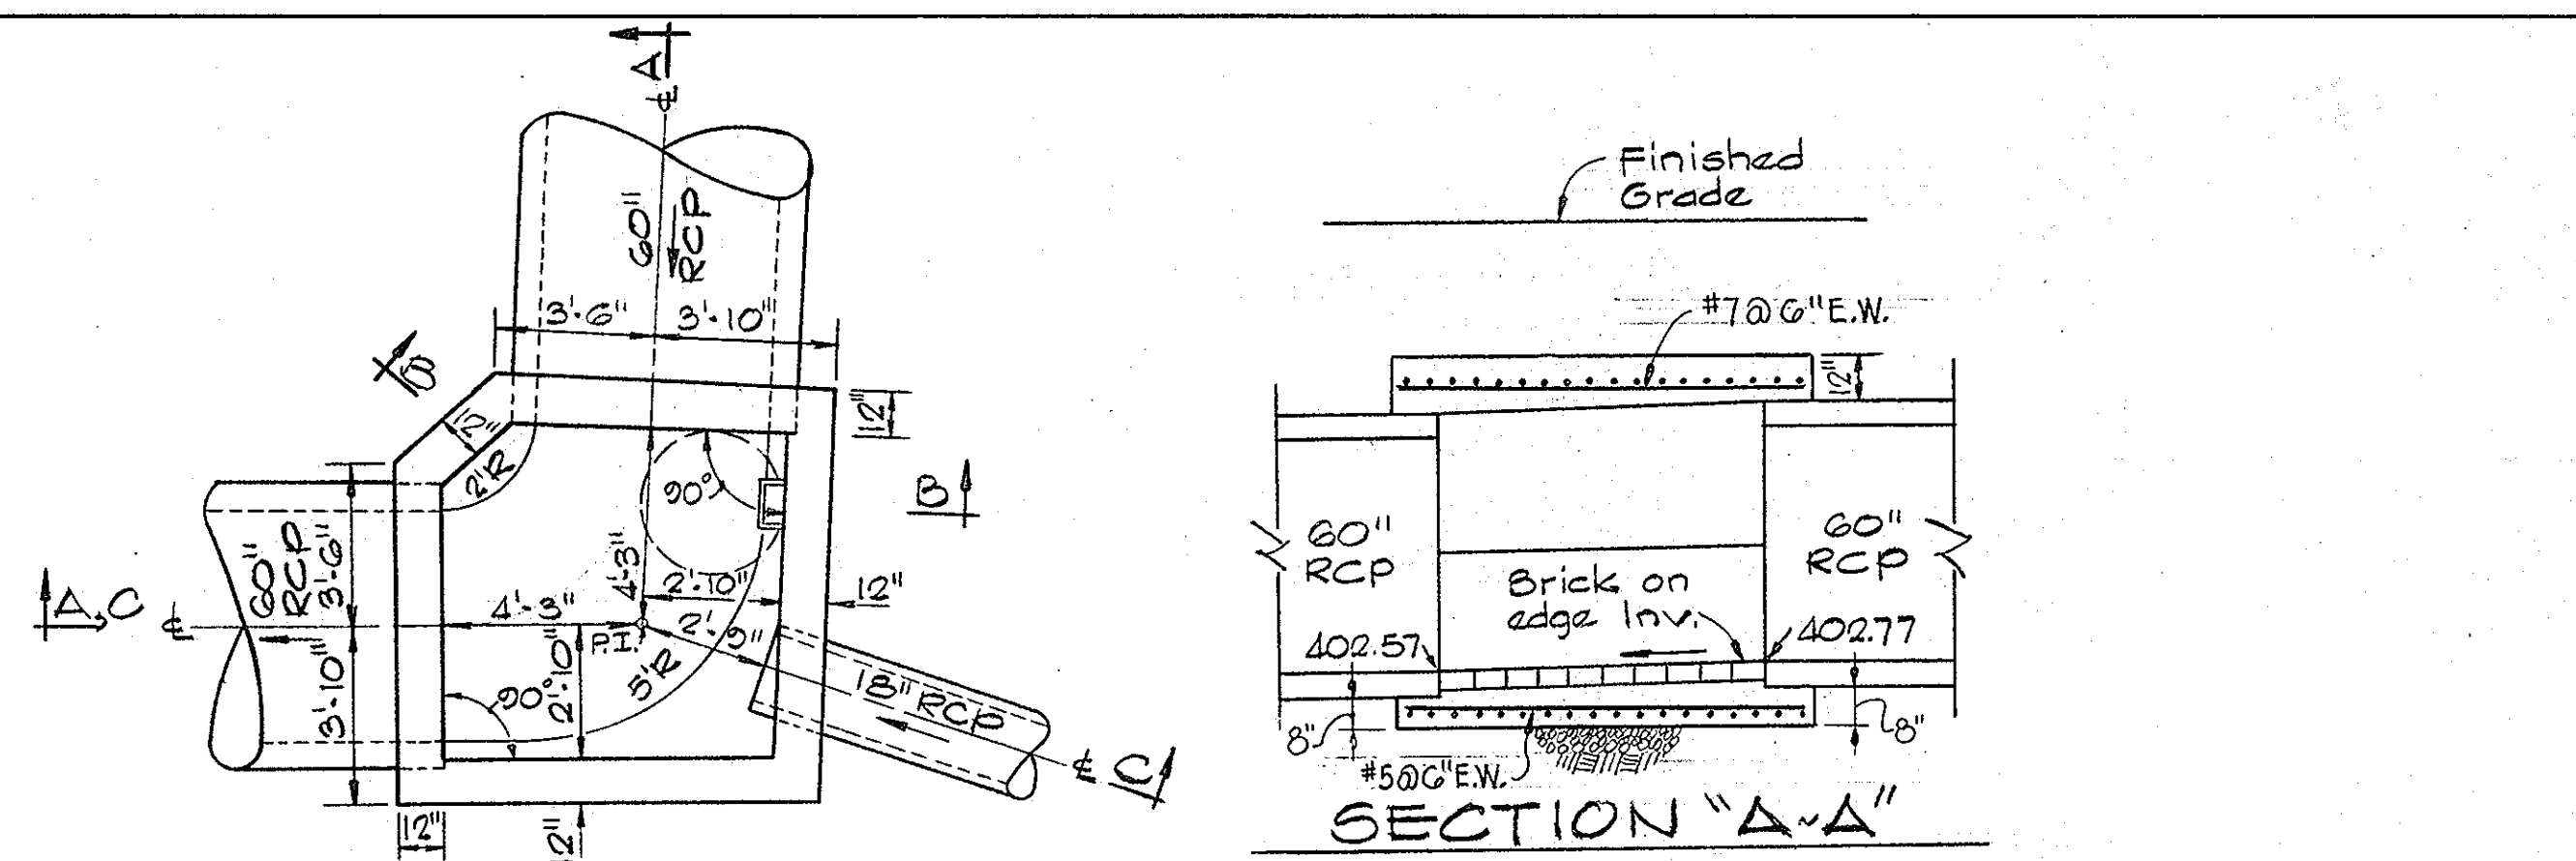

SPECIAL MANHOLE #1
 Scale: 1/4" = 1'-0"

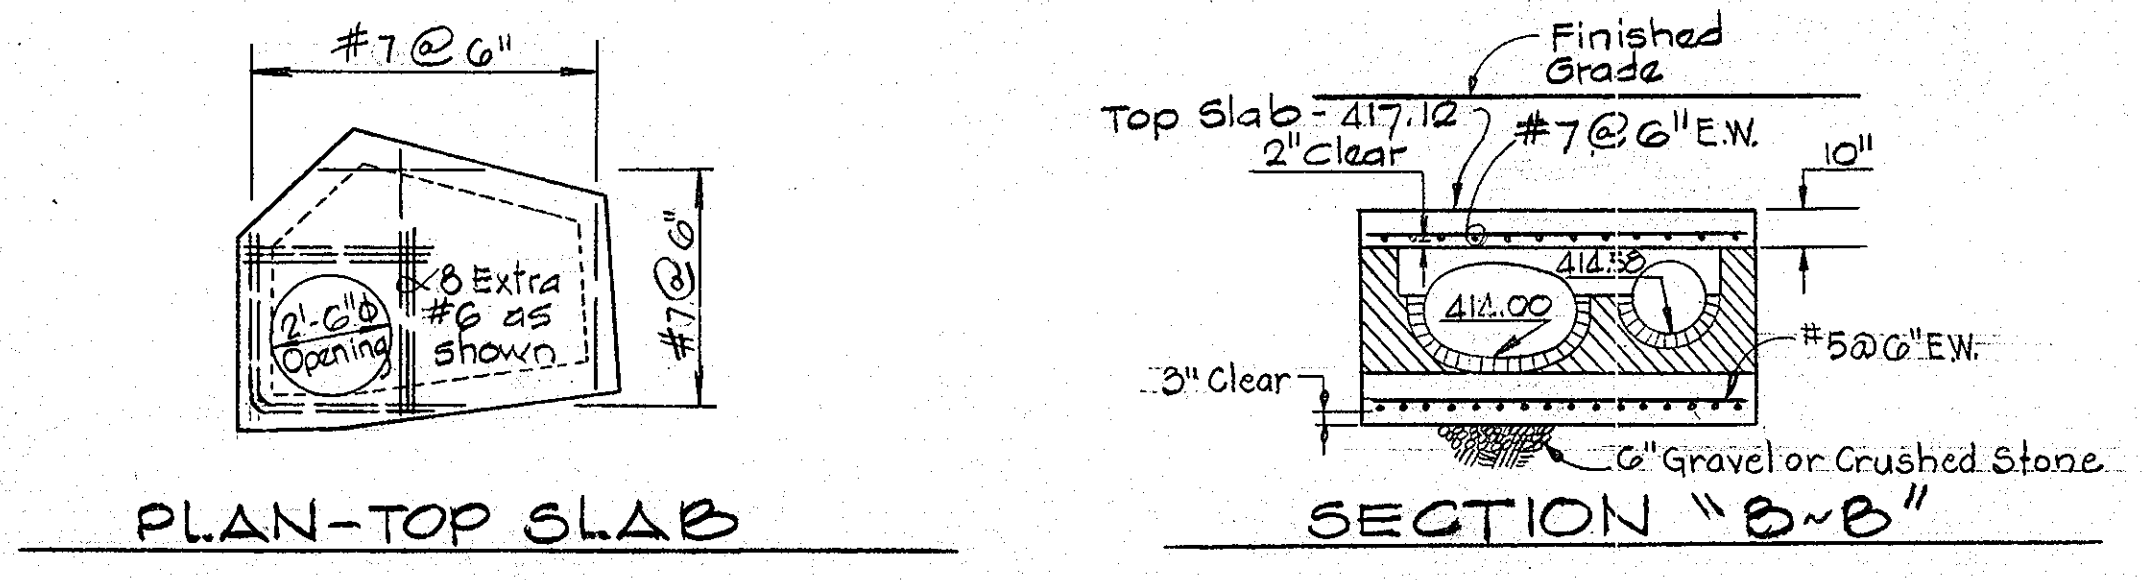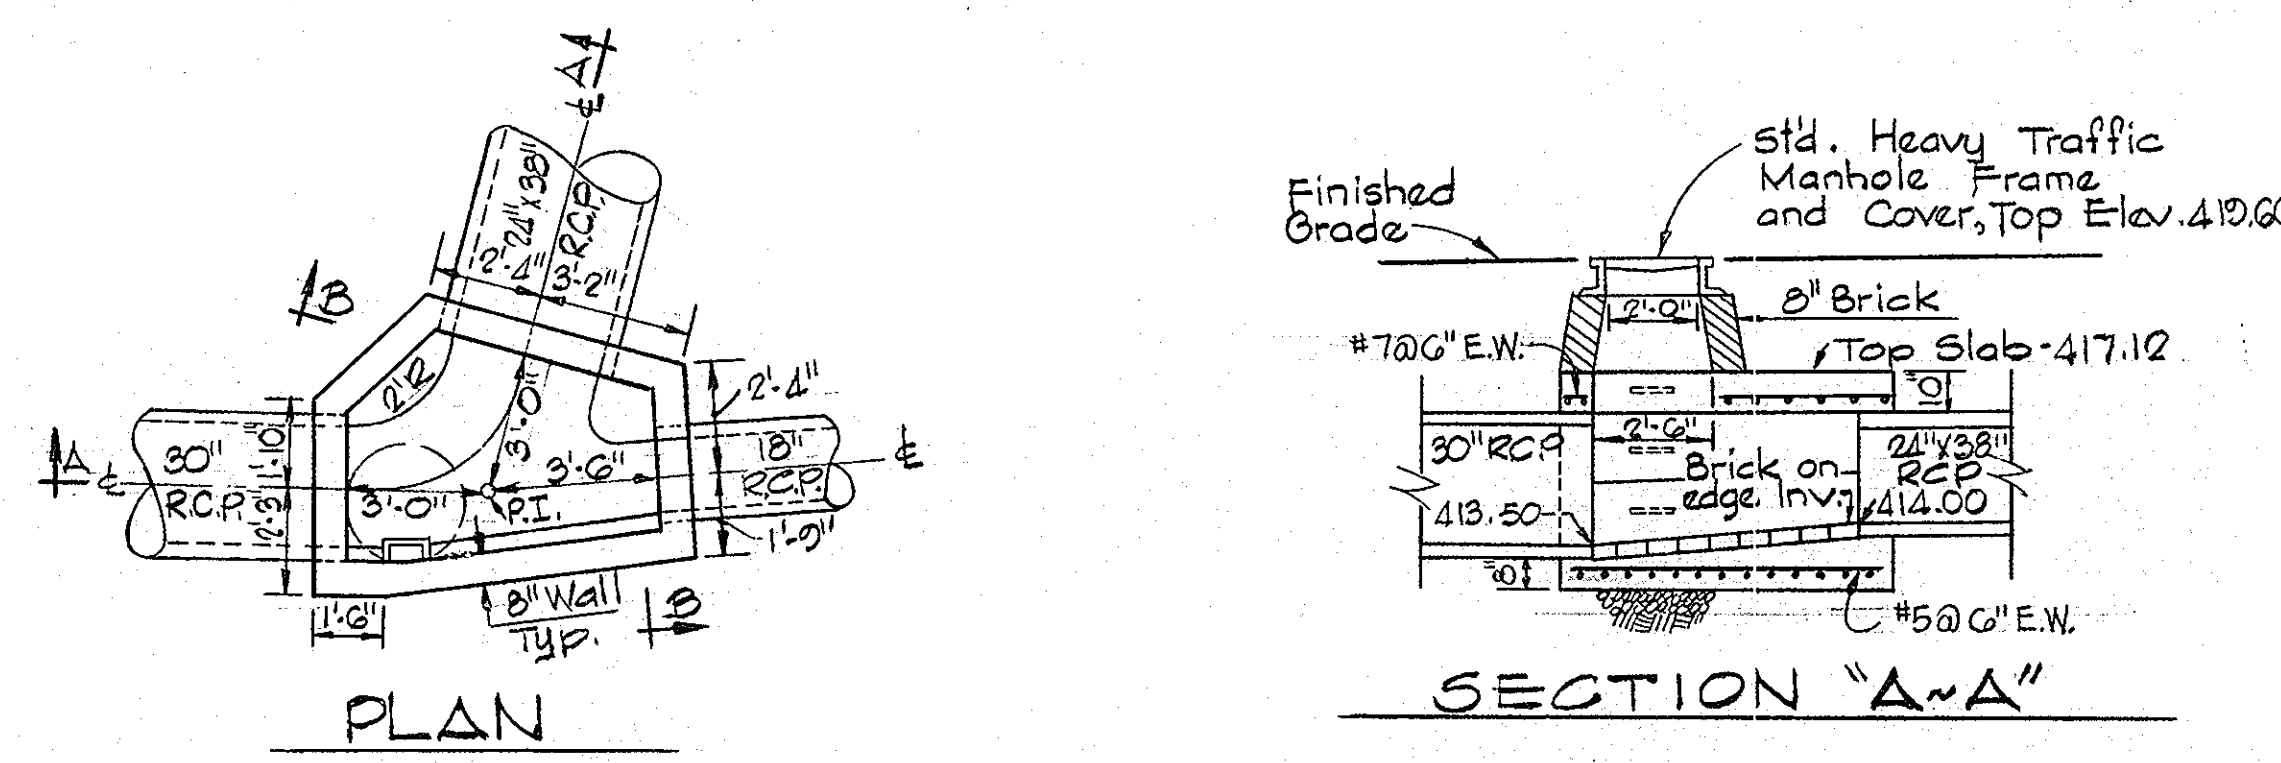

SPECIAL MANHOLE #3
 Scale: 1/4" = 1'-0"

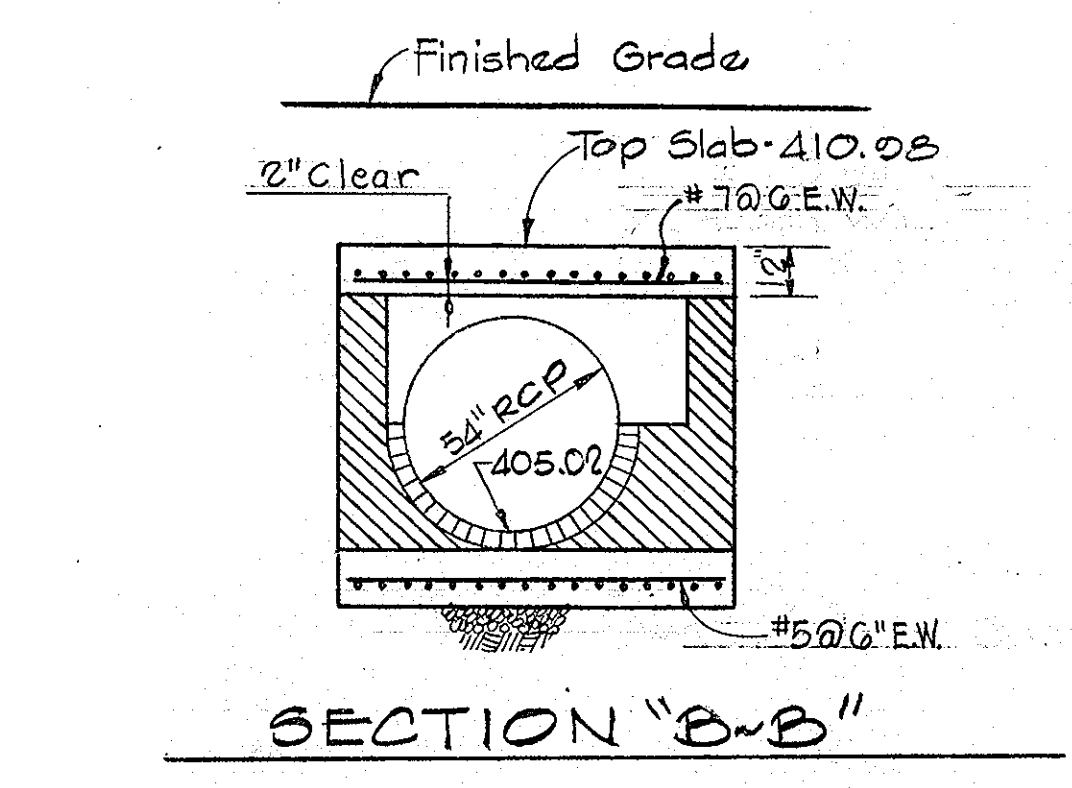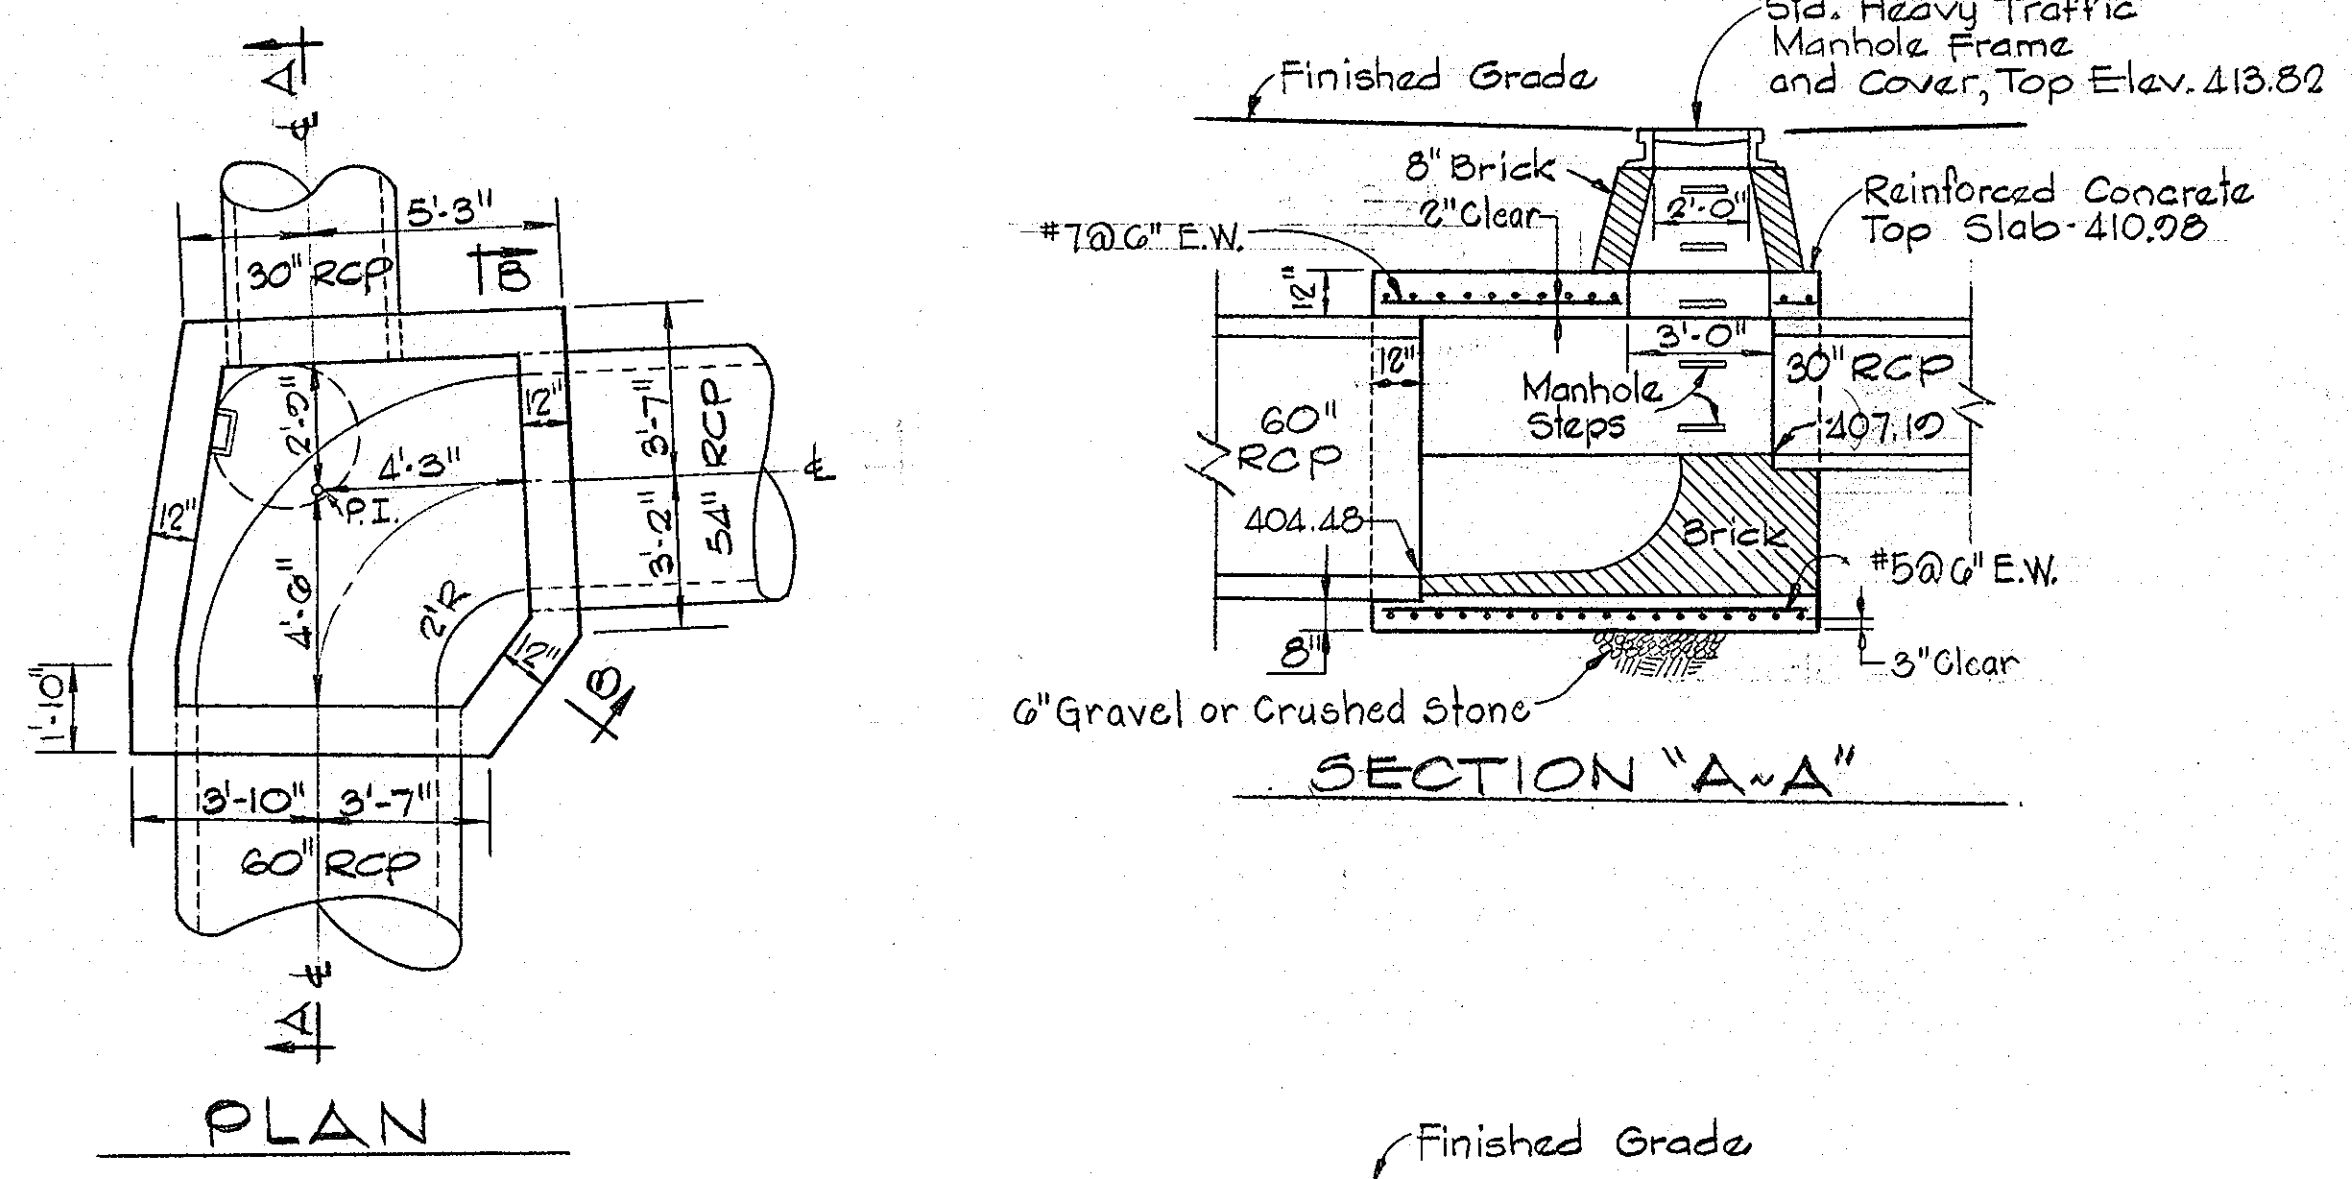

SPECIAL MANHOLE #2
 Scale: 1/4" = 1'-0"

Rev. Date	Rev. No.	Revision Description
7/1/83	1	As per DPW & Sediment Control Comments

COLUMBIA
5th ELECTION DISTRICT
HOWARD COUNTY, MARYLAND
 OWNER AND DEVELOPER
 HOWARD RESEARCH AND DEVELOPMENT CORPORATION


PROJECT AREA
VILLAGE OF HICKORY RIDGE
SECTION 3 AREA 1

PROJECT TITLE
STORM DRAIN DETAILS

SCALE: As Shown DATE:
 WHITMAN, REQUARDT AND ASSOCIATES
 ENGINEERS
 2315 ST. PAUL STREET
 BALTIMORE, MARYLAND 21218



Kenneth A. McCord
 KENNETH A. MCCORD
 Registered Engineer
 No. 1974

AS-BUILT NOV. 19, 1984


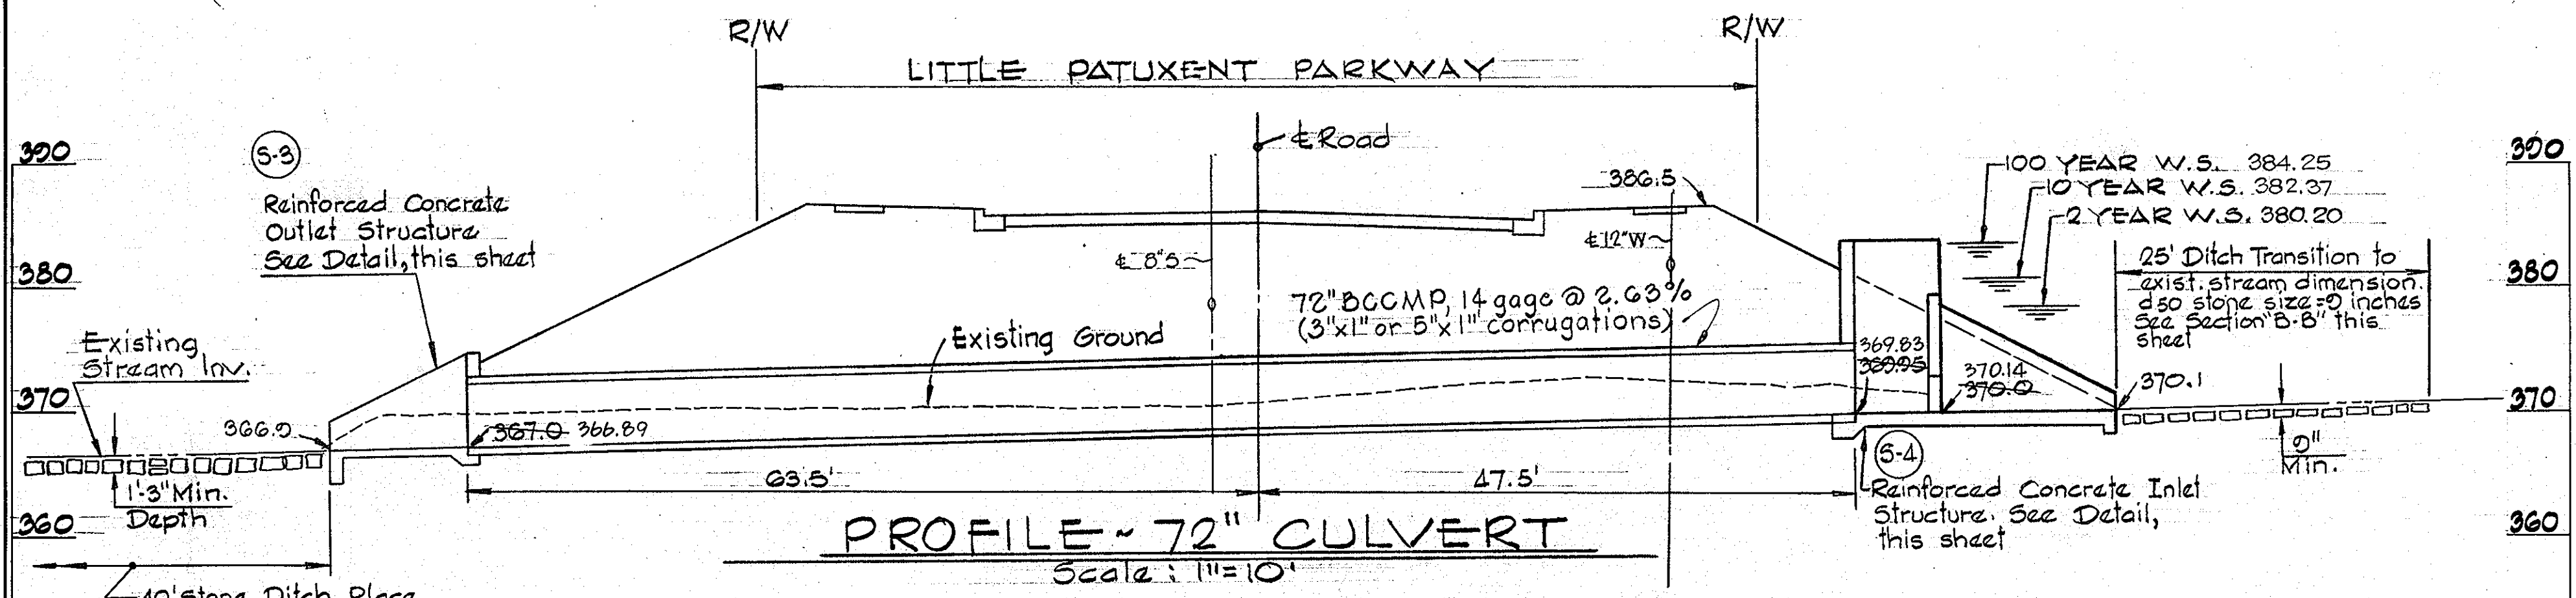


HYDRAULICS - 72" CULVERT (Ultimate Land Use)

FREQUENCY FLOOD EVENT	PEAK INFLOW CFS	PEAK OUTFLOW CFS	STORAGE AC. FT.
2 YEAR	140	24	5.7
10 YEAR	295	134	9.9
100 YEAR	474	284	14.7

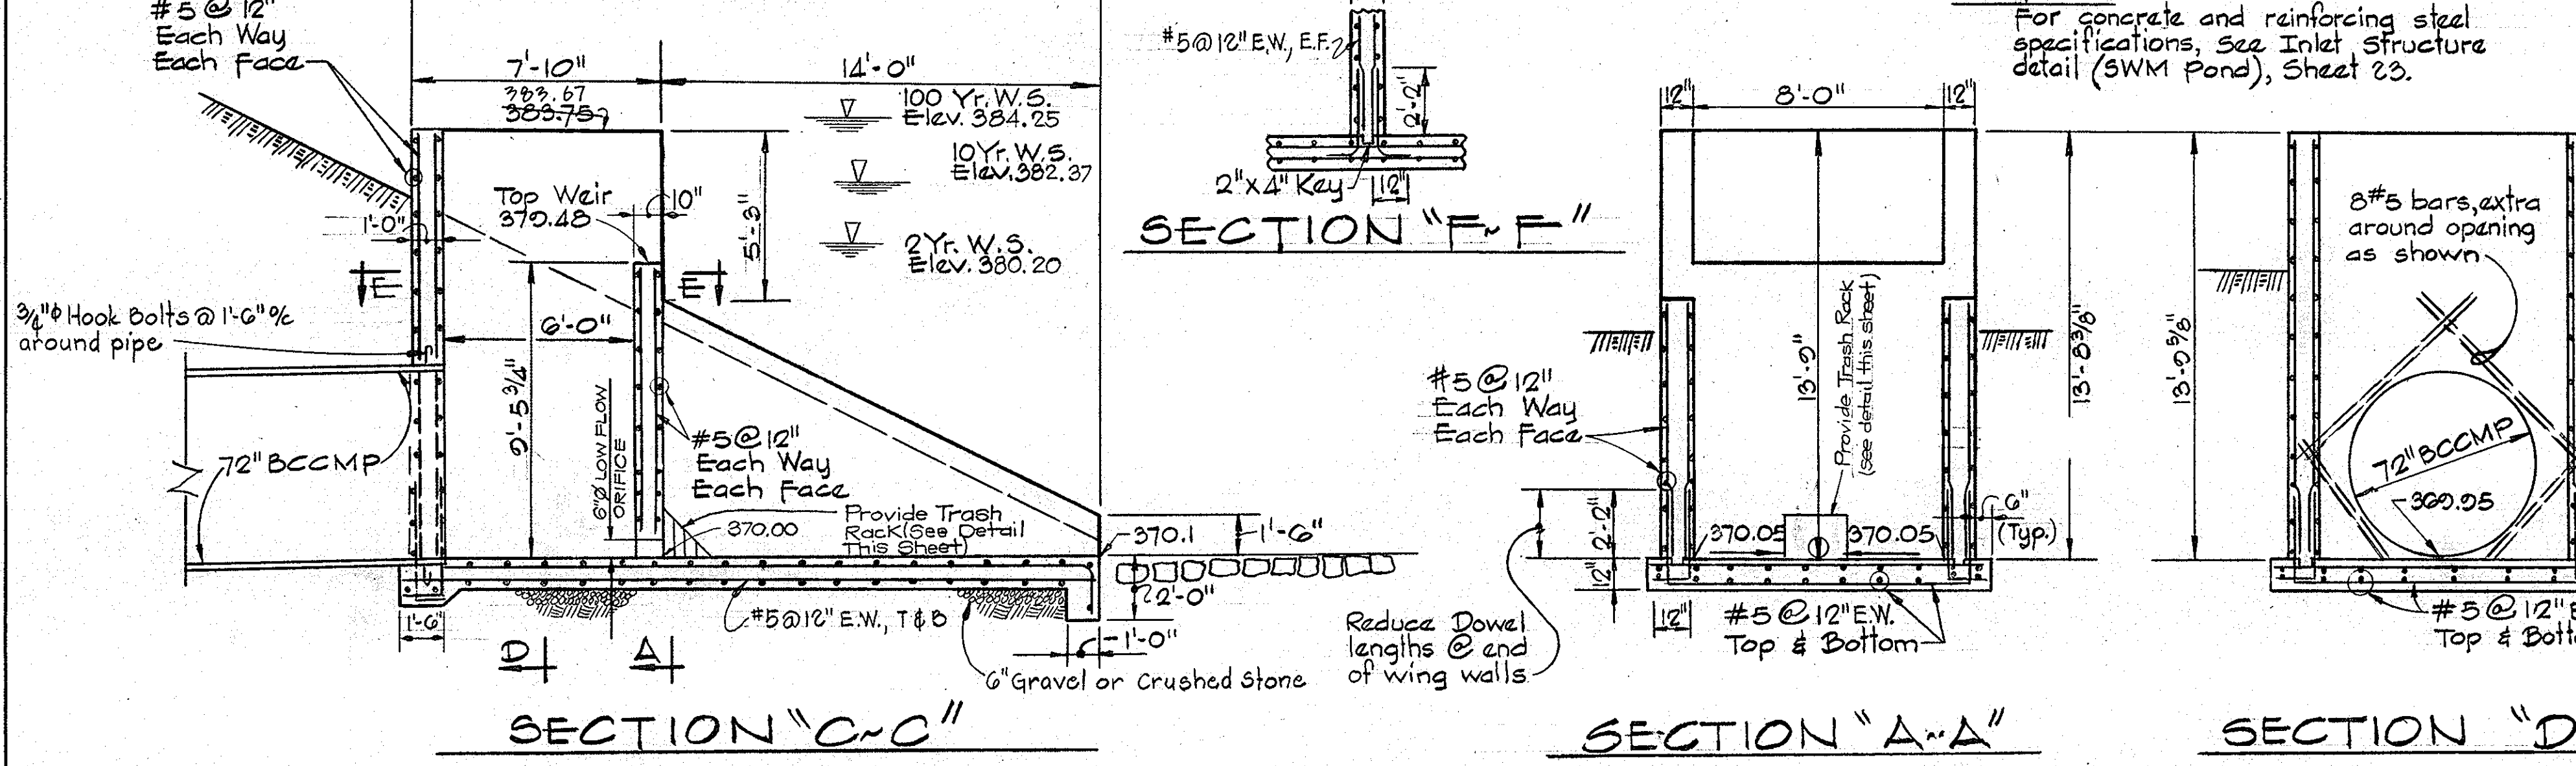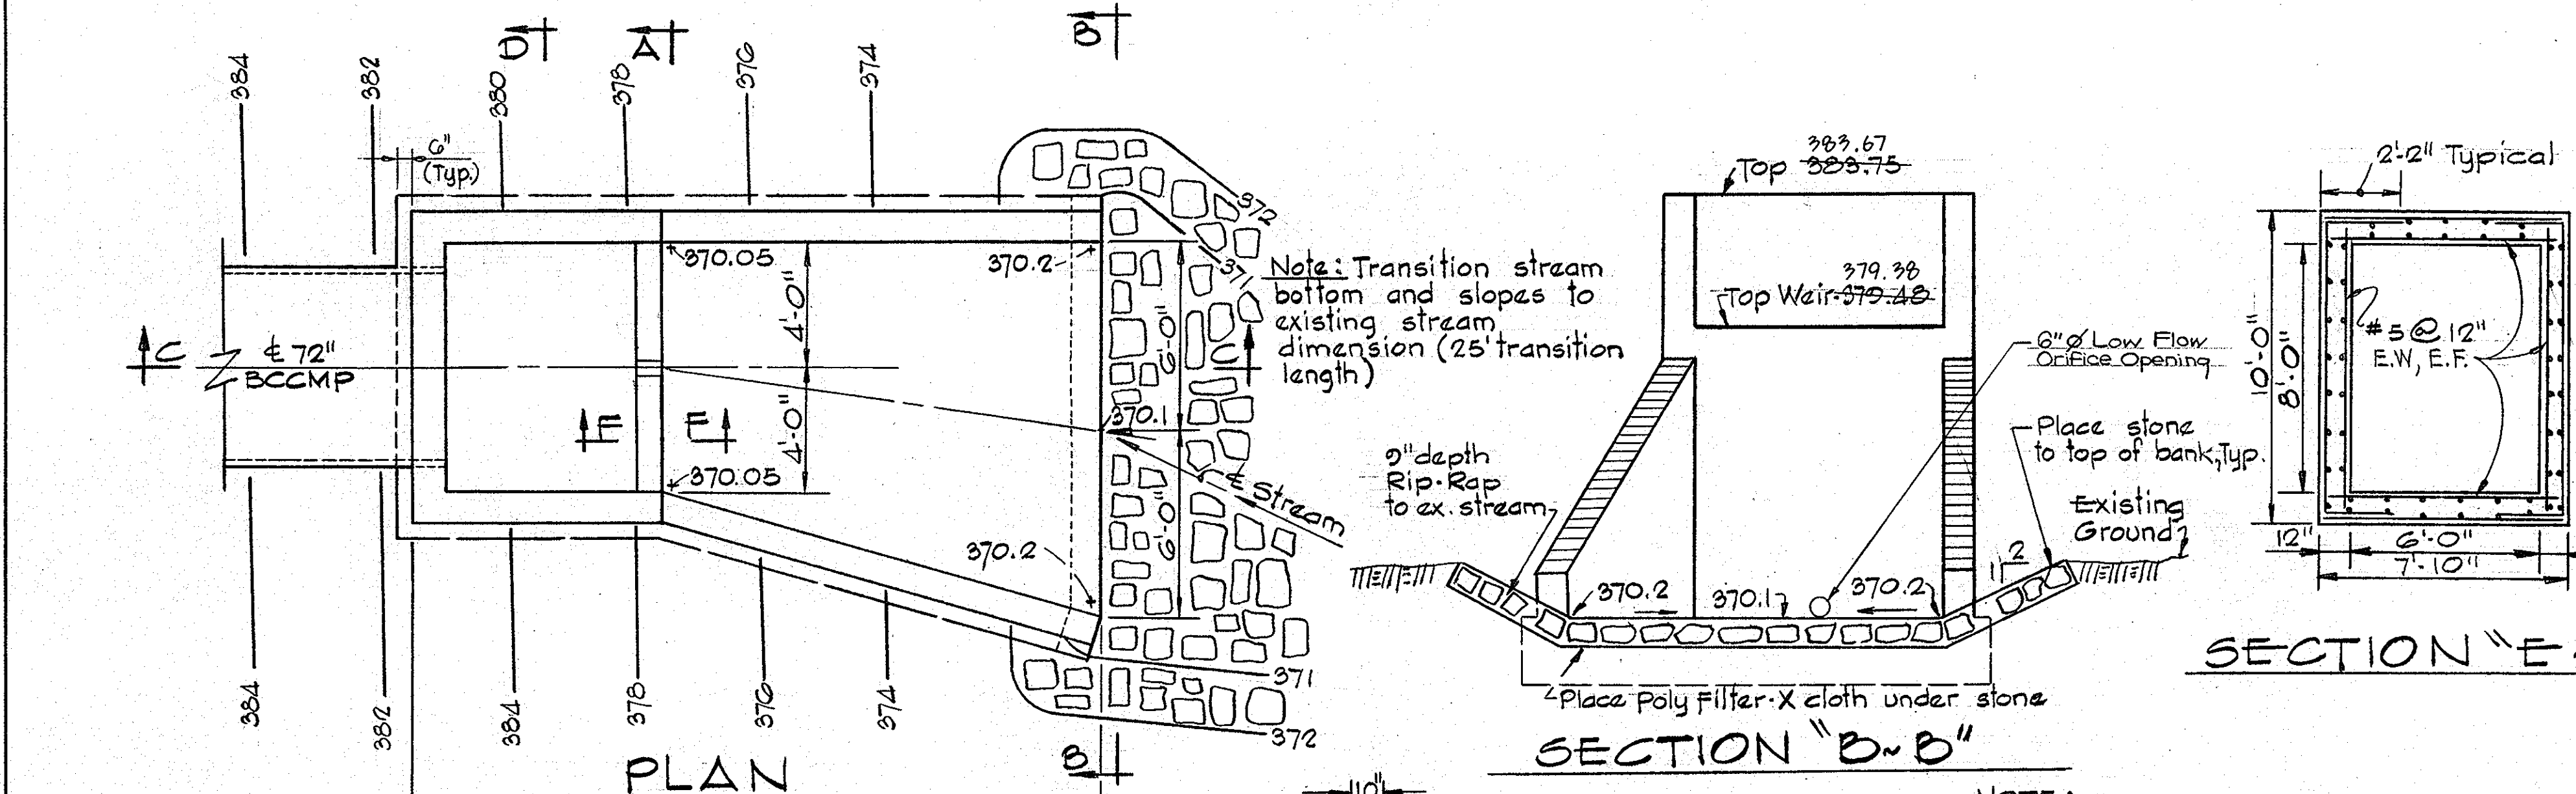


INLET STRUCTURE - 72" CULVERT (S-4)
 Scale: 1/4" = 1'-0"

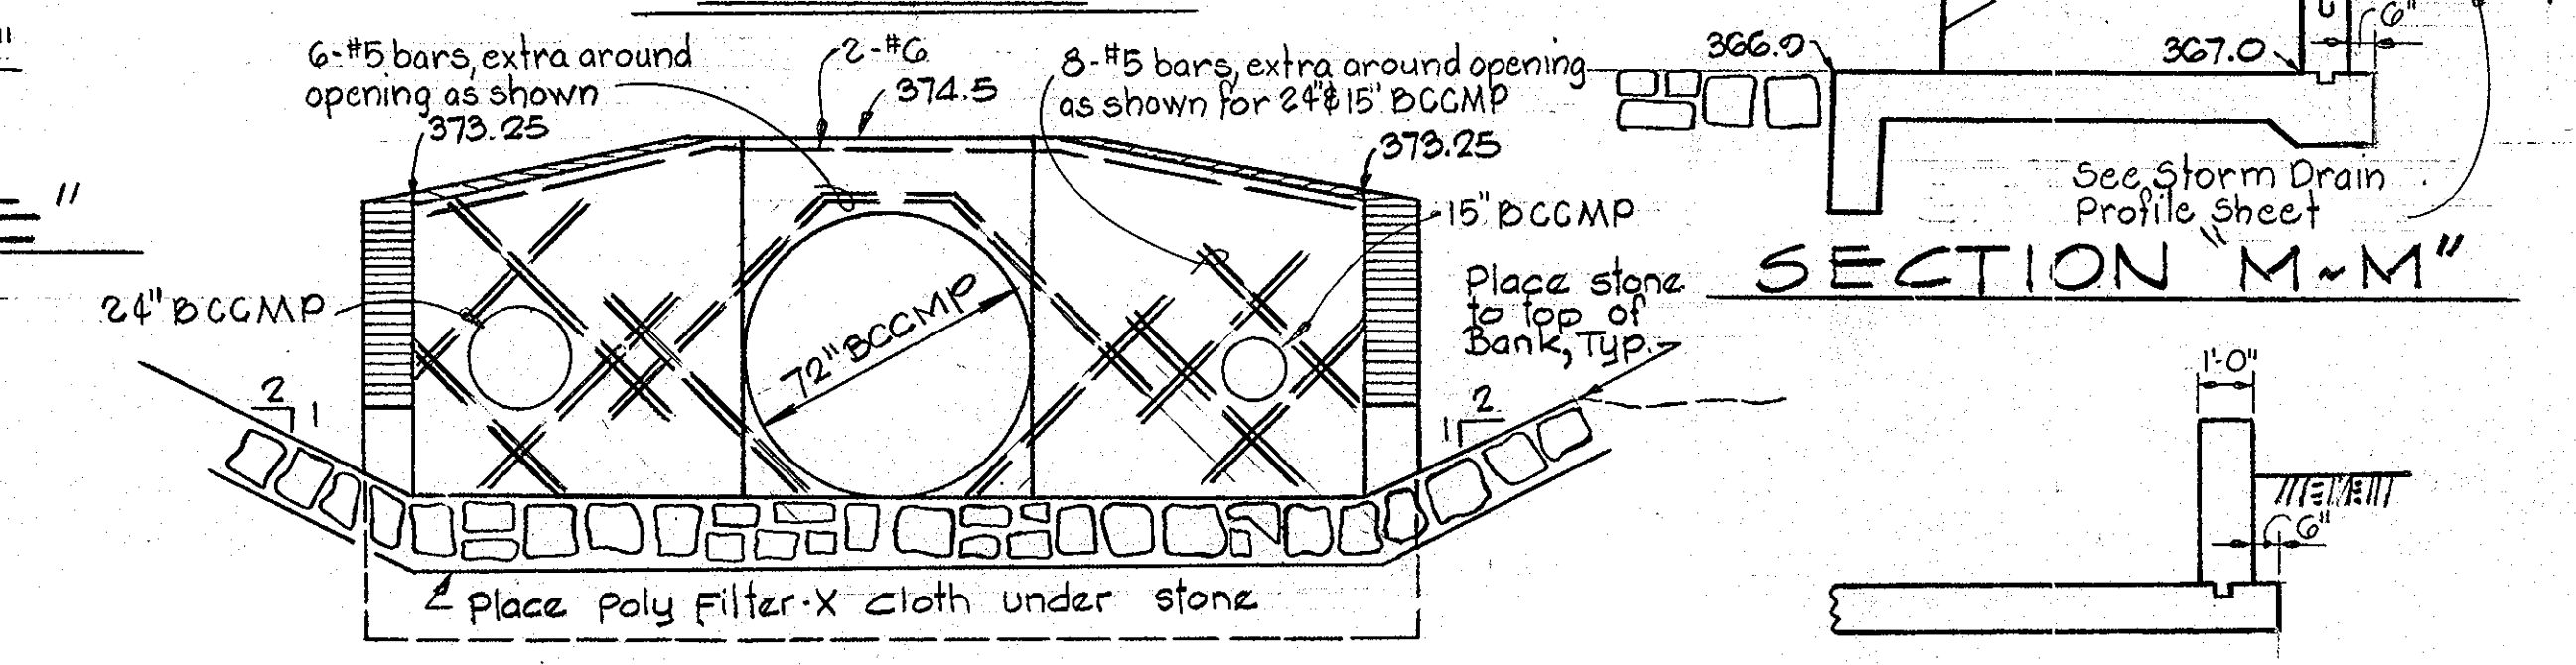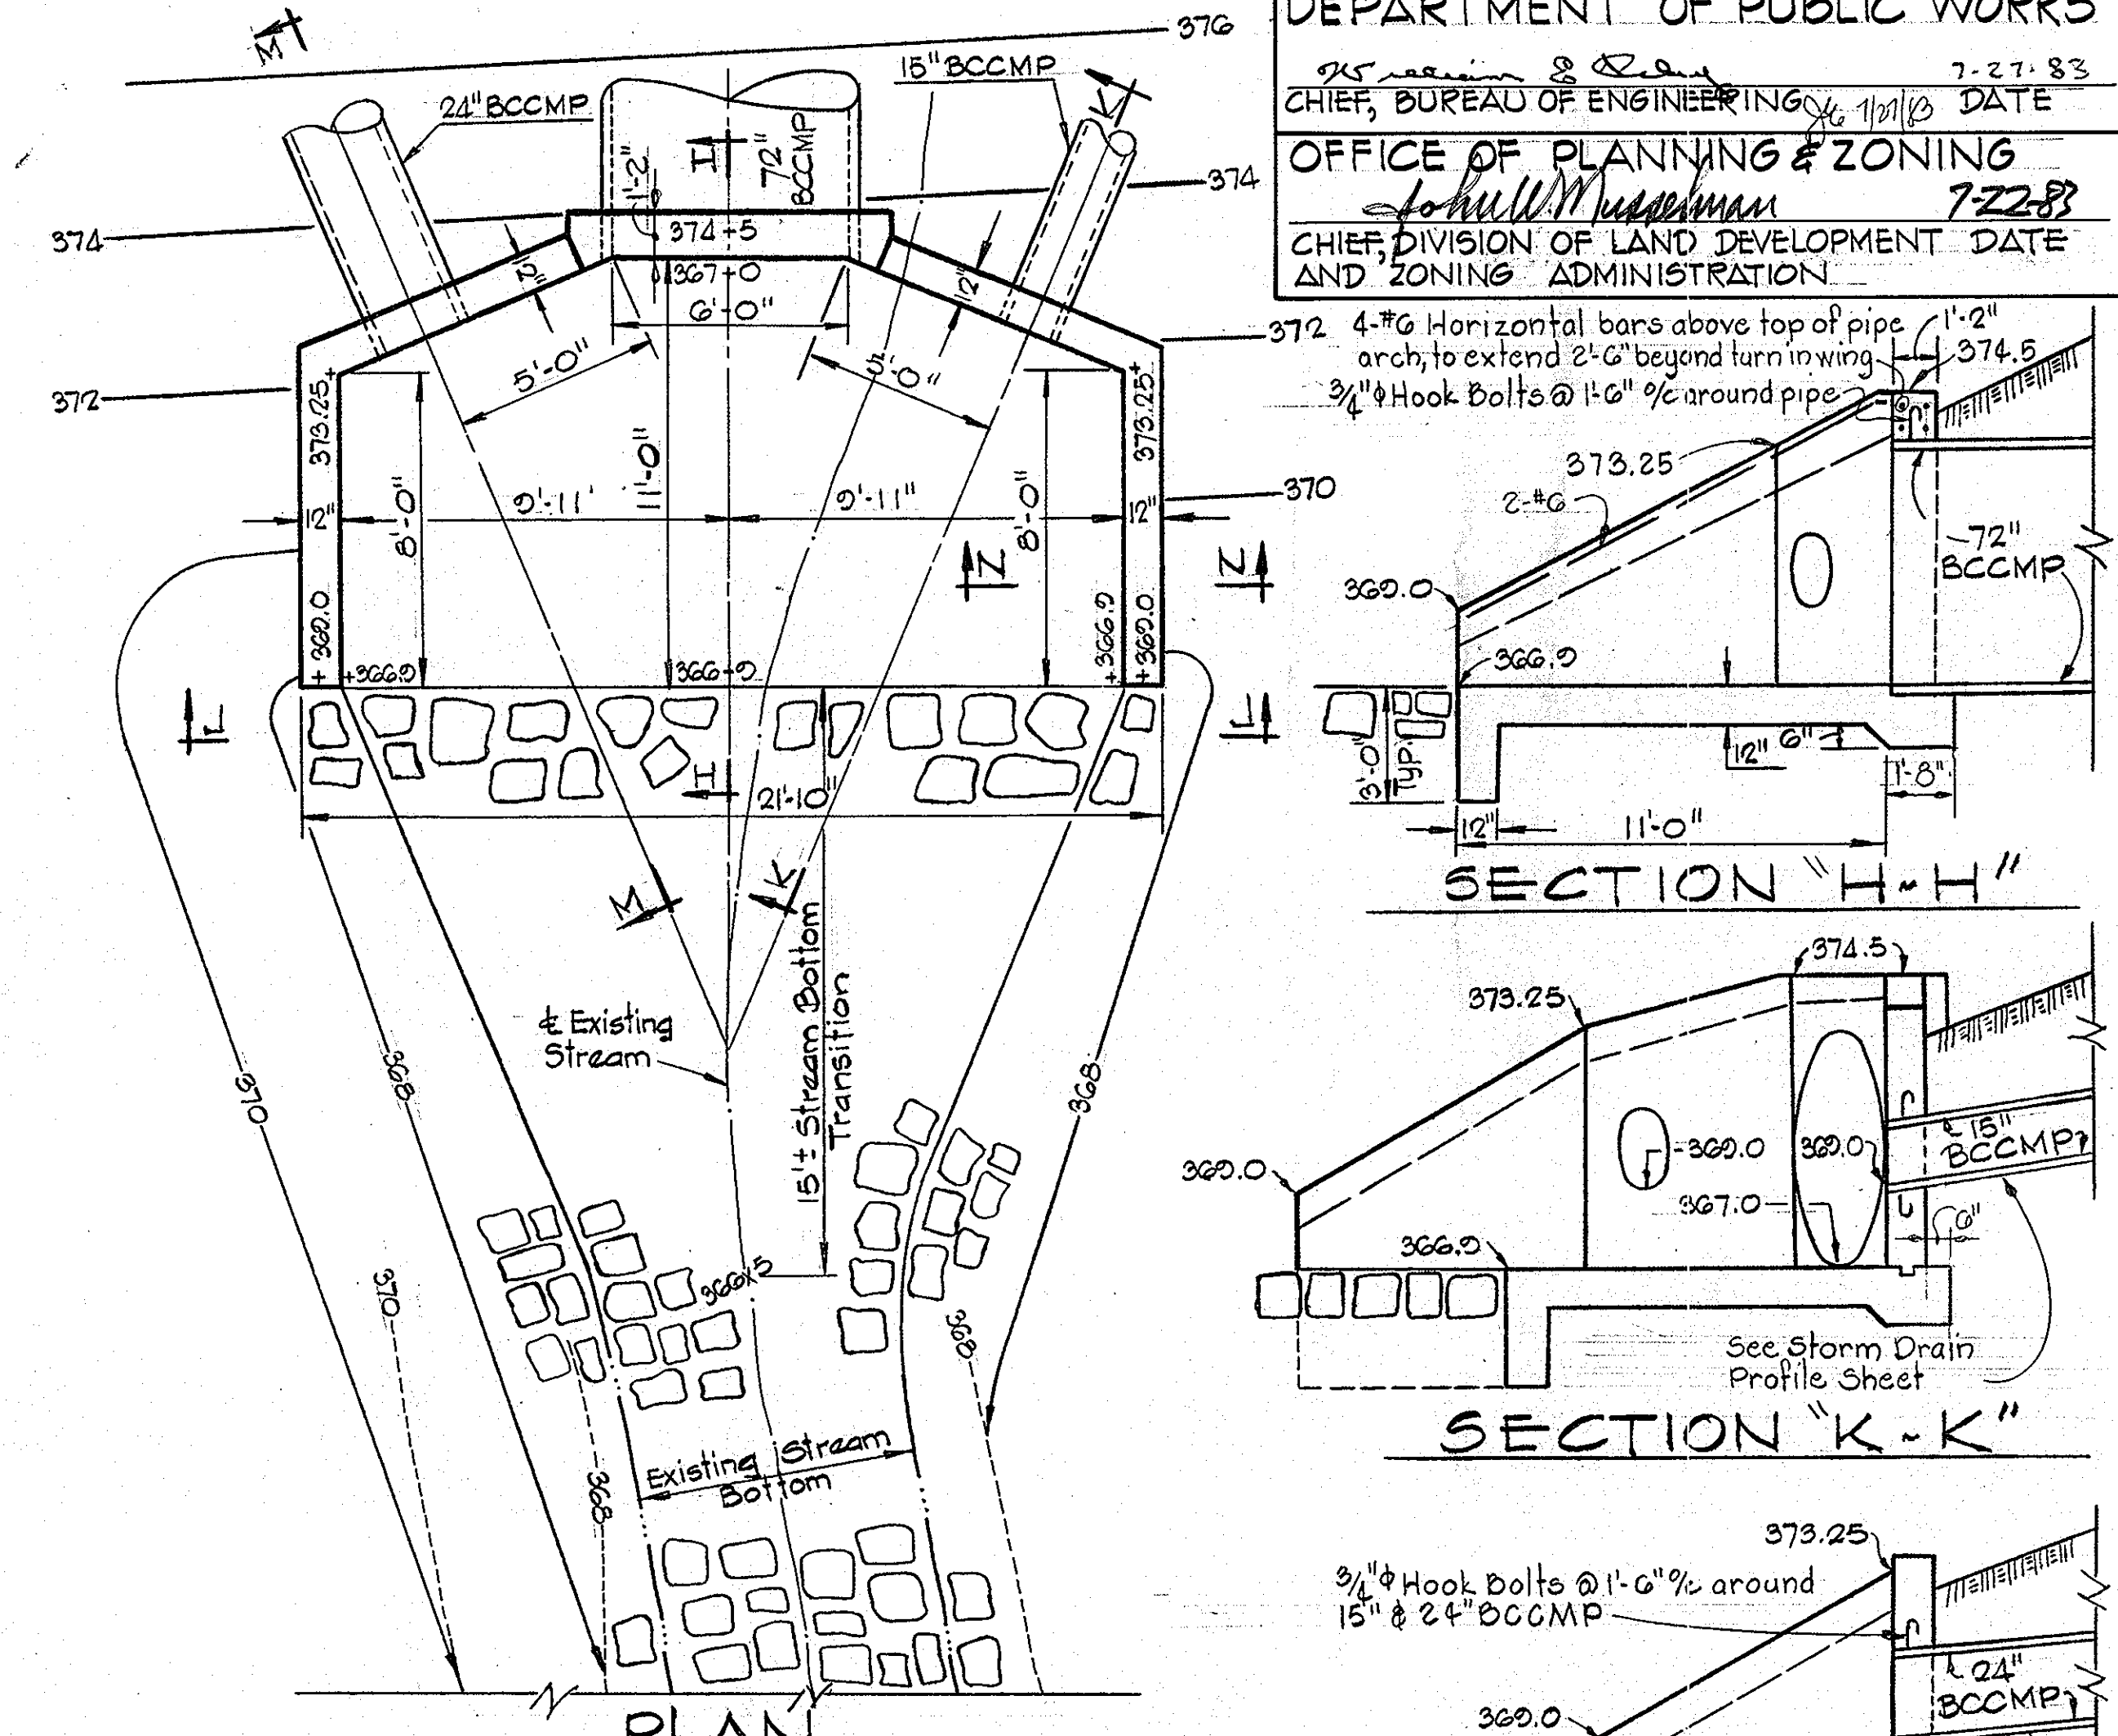

OUTLET STRUCTURE - 72" CULVERT (S-3)
 Scale: 1/4" = 1'-0"

Notes for Outlet Structure:
 1. For reinforcing steel see Howard County Department of Public Works Standards, Type 'A' Headwall.
 2. Strut 72" BCCMP while pouring concrete.

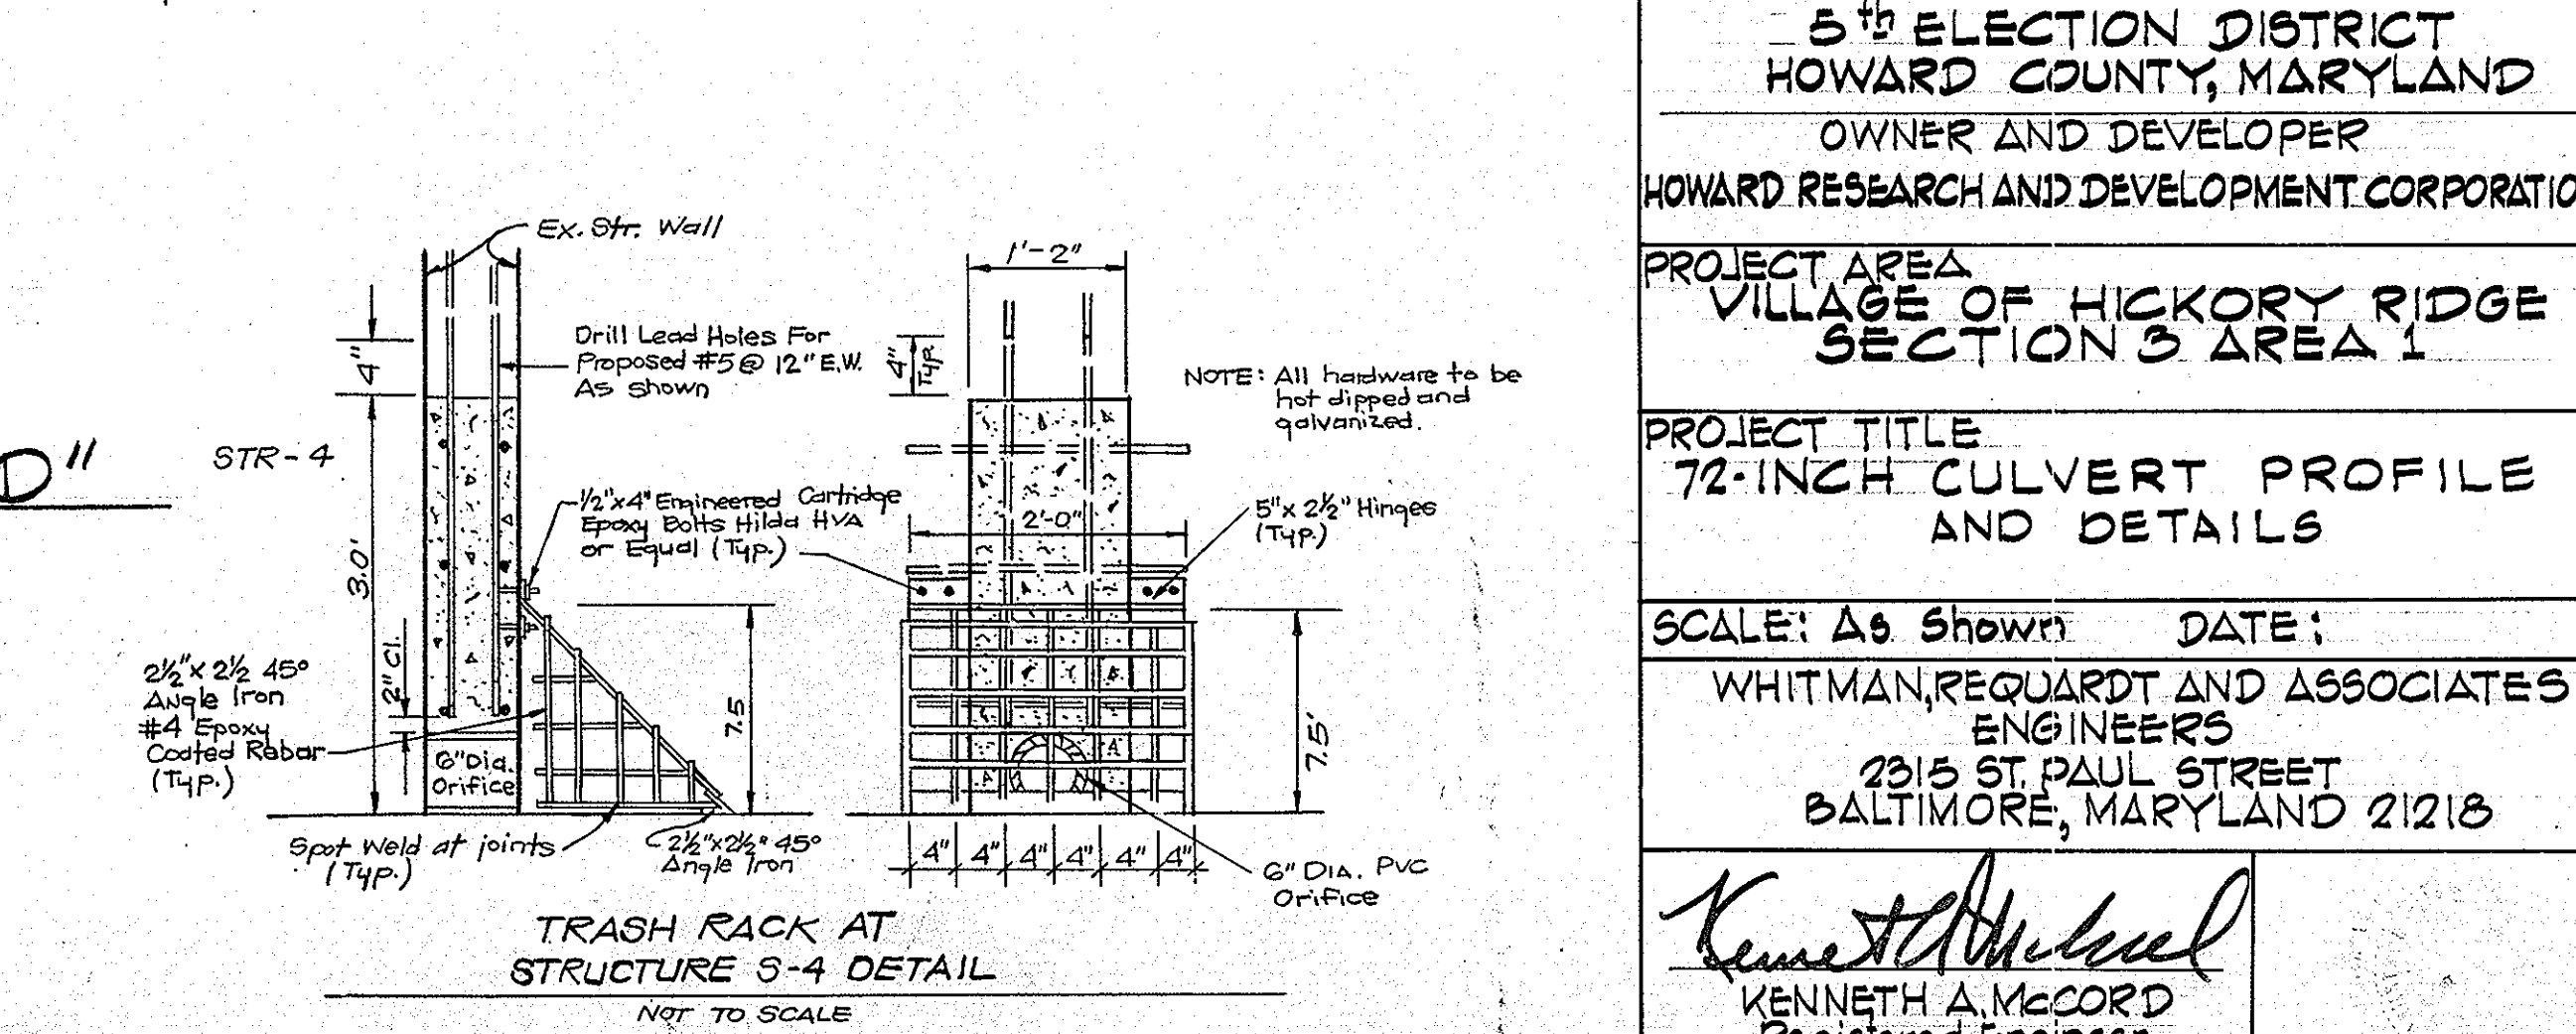


Rev. Date	Rev. No.	Revision Description
7/12/83	2	Rev. Low Flow Orifice Str. S-4 and Trash Rack Detail
7/1/83	1	As per PWD Sediment Control Comments

COLUMBIA
 5th ELECTION DISTRICT
 HOWARD COUNTY, MARYLAND
 OWNER AND DEVELOPER
 HOWARD RESEARCH AND DEVELOPMENT CORPORATION
 PROJECT AREA
 VILLAGE OF HICKORY RIDGE
 SECTION 3 AREA 1
 PROJECT TITLE
 72-INCH CULVERT PROFILE AND DETAILS
 SCALE: As Shown DATE:
 WHITMAN, REQUARDT AND ASSOCIATES
 ENGINEERS
 2315 ST. PAUL STREET
 BALTIMORE, MARYLAND 21218
 Kenneth A. McCord
 Registered Engineer
 No. 1974



"As-BUILT" ELEVATIONS AS OF NOV. 19, 1984
 BY: KENNETH A. MCCORD P.E. #1974

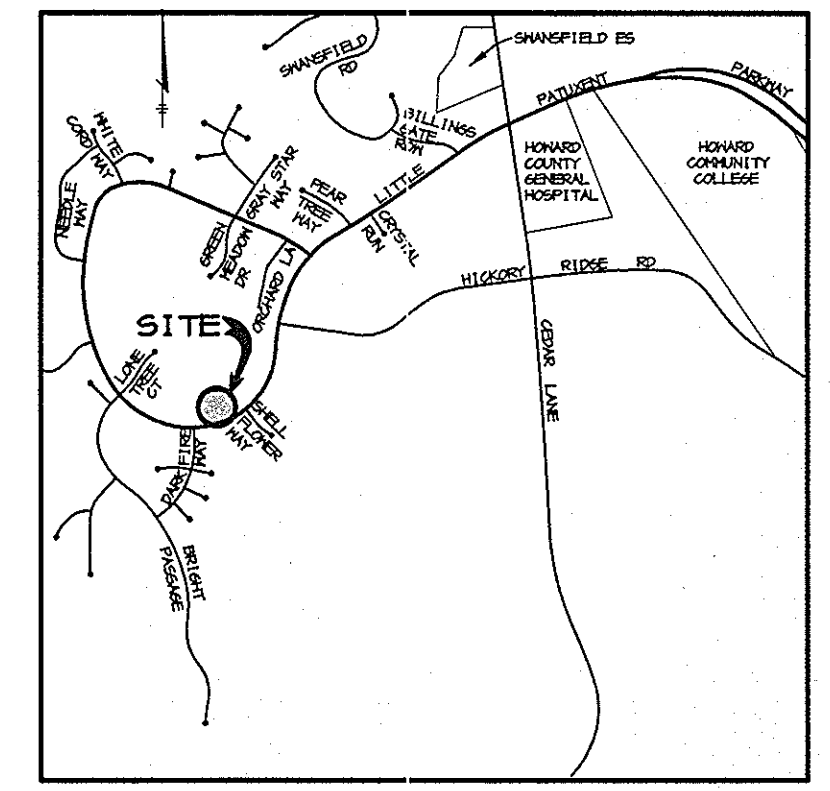


VICINITY MAP
SCALE: 1"=2000'

SEQUENCE OF CONSTRUCTION


1. CONTRACTOR SHALL OBTAIN NECESSARY PERMITS FOR THIS PROJECT.
2. USING SANDBAGS, REMOVABLE PUMPING STATION AND AN ADEQUATELY SIZED PUMP, CONTRACTOR SHALL BLOCK STREAM TO 2' HEIGHT AND PUMP WATER TO THE 12" CMP.
3. AT THE END OF EACH WORKING DAY, THE WORK AREA SHALL BE STABILIZED TO PREVENT EROSION AND A PORTION OF THE SANDBAGS SHALL BE REMOVED. NO OVERNIGHT PUMPING IS ALLOWED.

GENERAL NOTES


1. THE CONTRACTOR SHALL NOTIFY THE HOWARD CO. DEPARTMENT OF PUBLIC WORKS / BUREAU OF ENGINEERING CONSTRUCTION INSPECTION DIVISION AT 410-313-1880 AND MISS UTILITY AT 1-800-257-7777 AT LEAST (5) FIVE WORKING DAYS BEFORE STARTING WORK.
2. SUBJECT PROPERTY AND THE COMMUNITY IS ZONED NT PER THE 10-18-93 COMPREHENSIVE ZONING PLAN.
3. ALL ELEVATIONS SHOWN ARE BASED ON THE U.S.C. AND G.S. MEAN SEA LEVEL DATUM, 1929.
4. ALL CONSTRUCTION SHALL BE IN ACCORDANCE WITH THE LATEST STANDARDS AND SPECIFICATIONS OF HOWARD COUNTY.
5. ALL WORK SHALL COMPLY WITH ALL APPLICABLE PROVISIONS OF THE "1994 MARYLAND STANDARDS AND SPECIFICATIONS FOR SOIL EROSION AND SEDIMENT CONTROL" ISSUED BY THE WATER RESOURCES ADMINISTRATION AND THE NATURAL RESOURCES CONSERVATION SERVICE.
6. TOPOGRAPHY WAS FIELD SURVEYED BY RIEMER MUEGGE & ASSOCIATES, INC. IN OCTOBER, 1997.
7. SHOULD THE CONTRACTOR DISCOVER DISCREPANCIES BETWEEN THE PLANS AND FIELD CONDITIONS, THE ENGINEER IS TO BE NOTIFIED IMMEDIATELY TO RESOLVE THE SITUATION. SHOULD THE CONTRACTOR MAKE FIELD CORRECTIONS OR ADJUSTMENTS WITHOUT NOTIFYING THE ENGINEER, THEN THE CONTRACTOR ASSUMES ALL RESPONSIBILITY FOR THOSE CHANGES.
8. CONTRACTOR IS SOLELY RESPONSIBLE FOR CONSTRUCTION MEANS, METHODS, TECHNIQUES, SEQUENCES, PROCEDURES AND SAFETY PRECAUTIONS AND PROGRAMS.
9. APPROXIMATE UTILITIES ARE SHOWN FROM AVAILABLE RECORDS. THE CONTRACTOR SHALL TAKE ALL NECESSARY PRECAUTIONS TO PROTECT THE EXISTING UTILITIES AND MAINTAIN UNINTERRUPTED SERVICE. ANY DAMAGE INCURRED DUE TO CONTRACTOR'S OPERATION SHALL BE REPAIRED IMMEDIATELY AT THE CONTRACTOR'S EXPENSE.
10. ALL PIPE ELEVATIONS SHOWN ARE INVERT \odot ELEVATIONS.

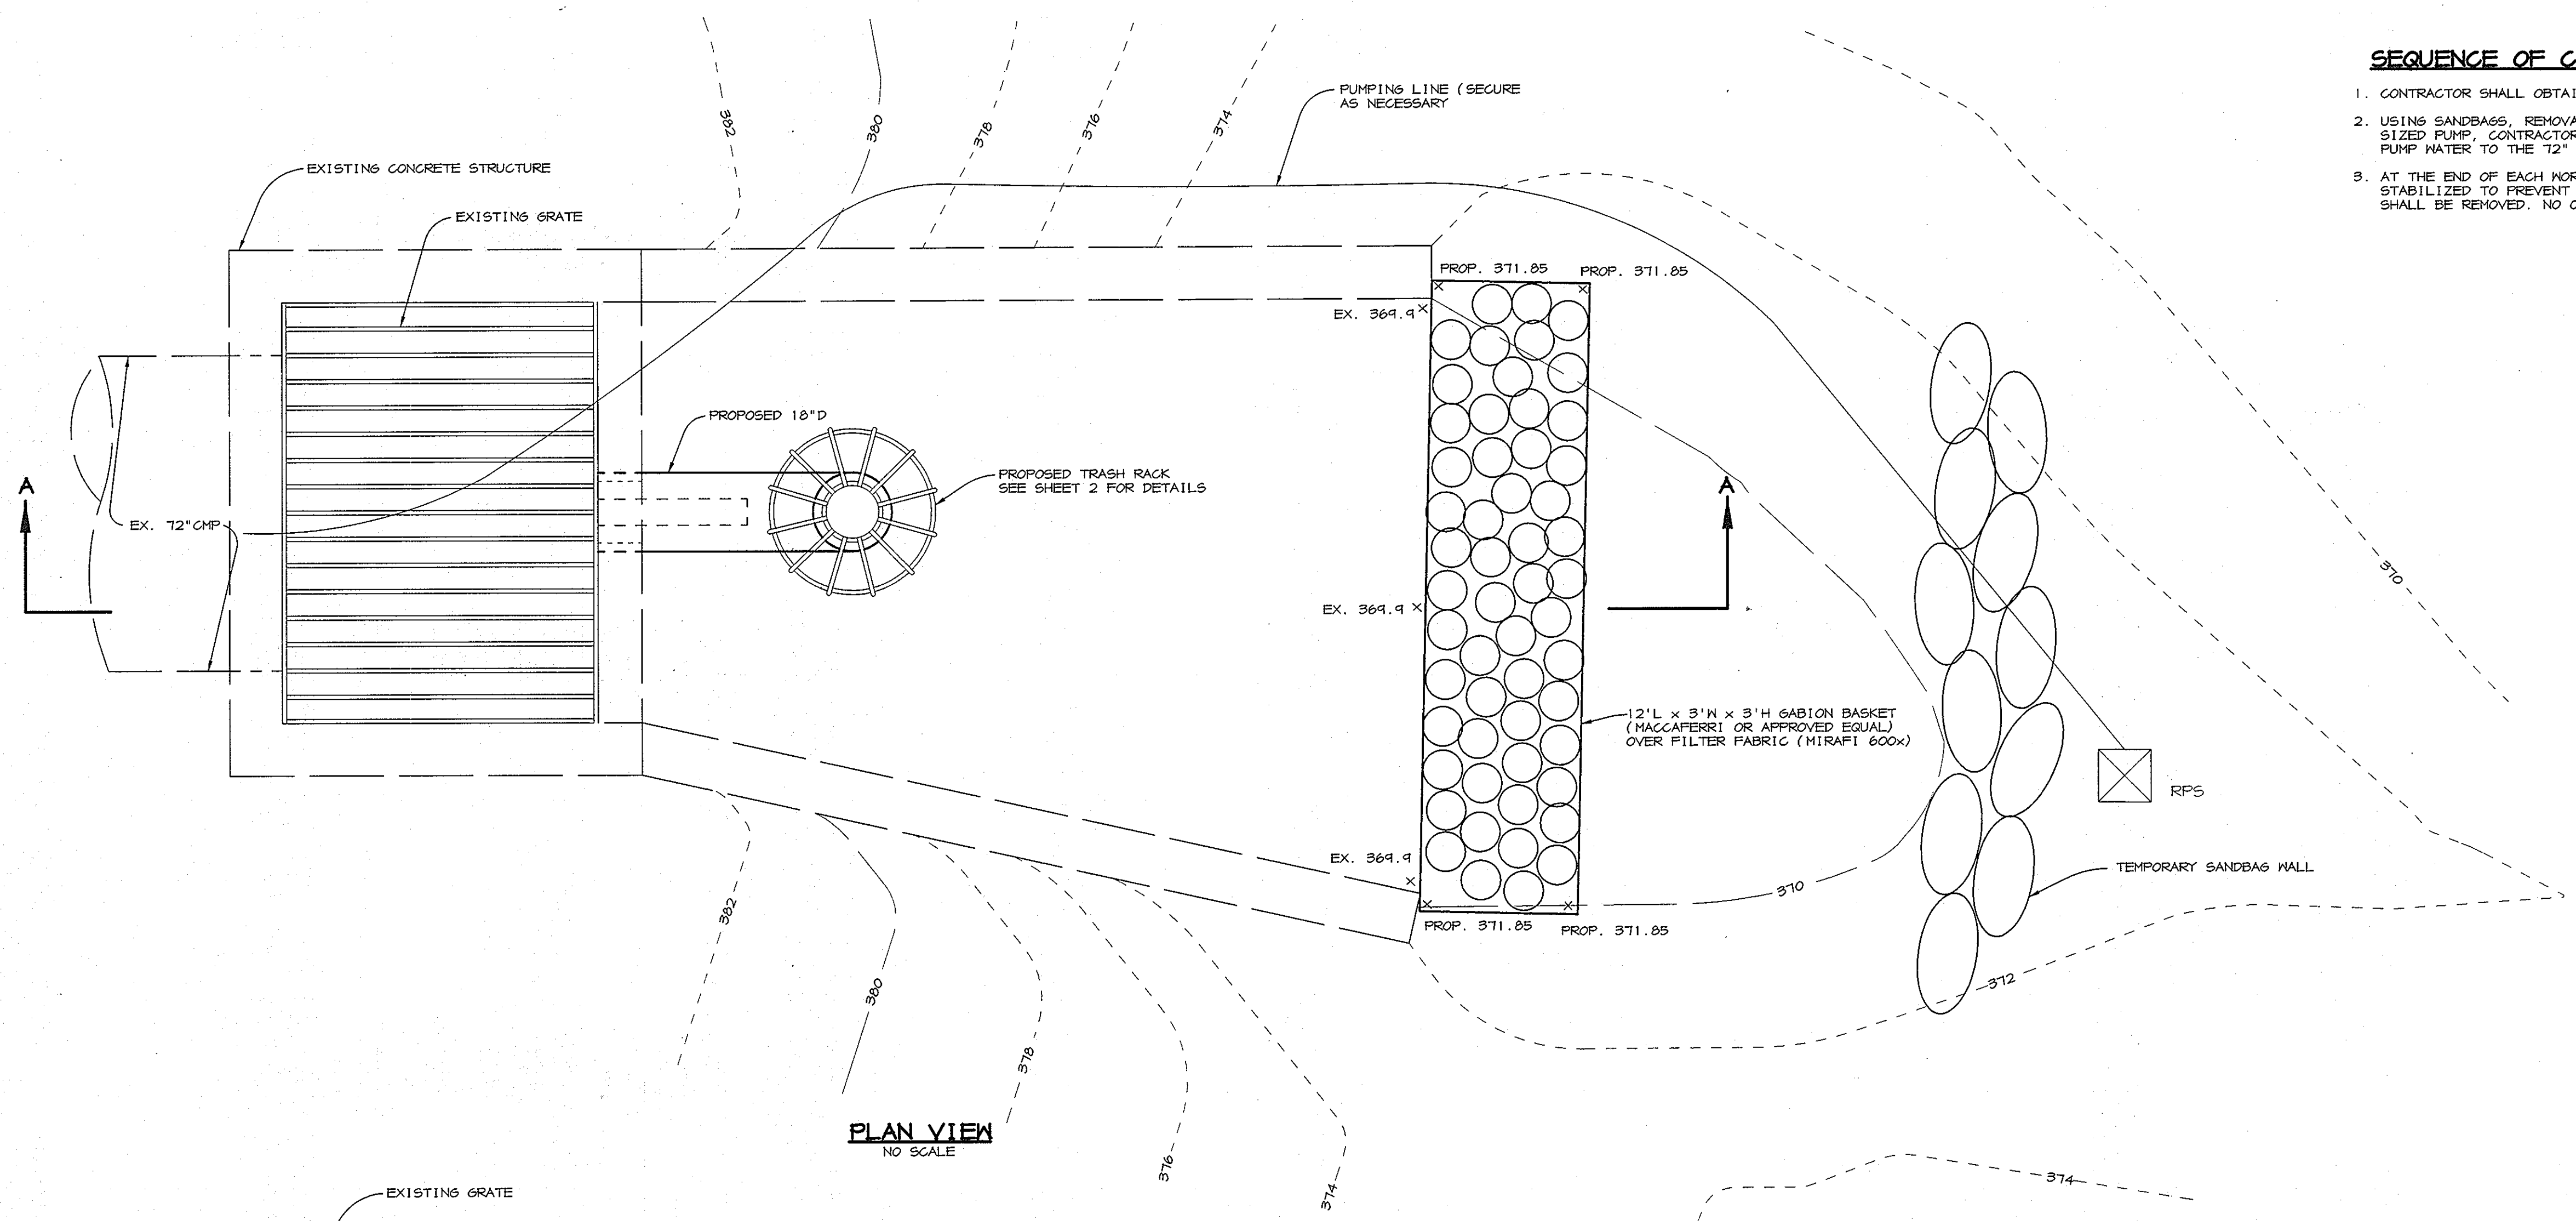

PLAN VIEW
NO SCALE

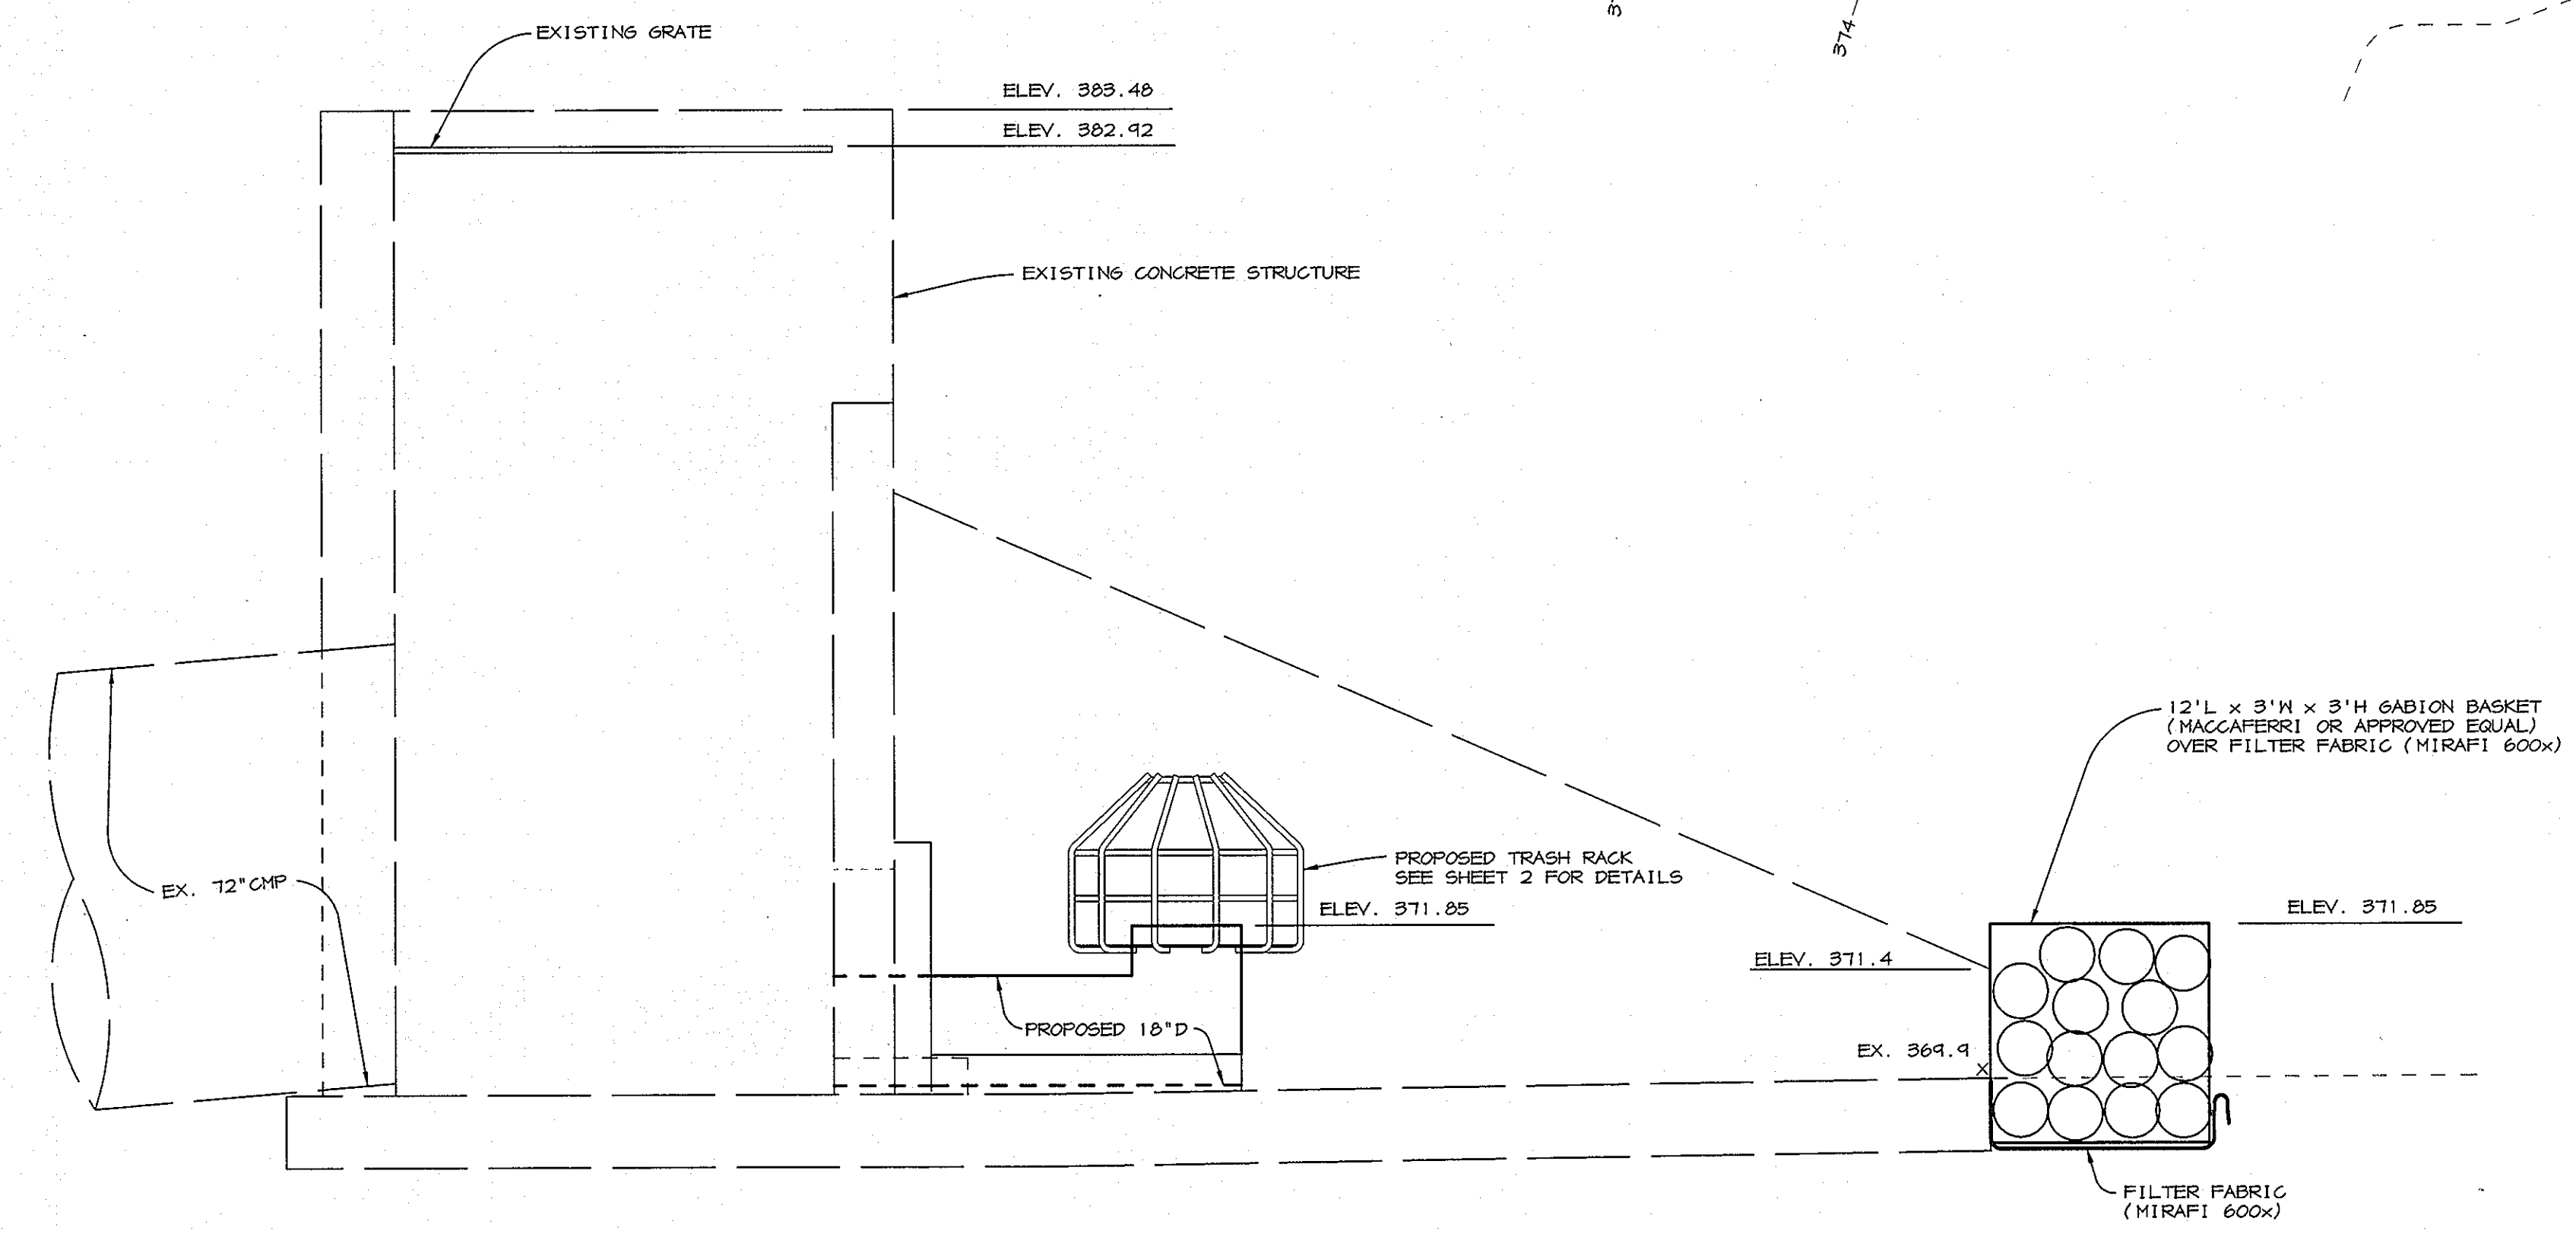


SECTION A-A
NO SCALE

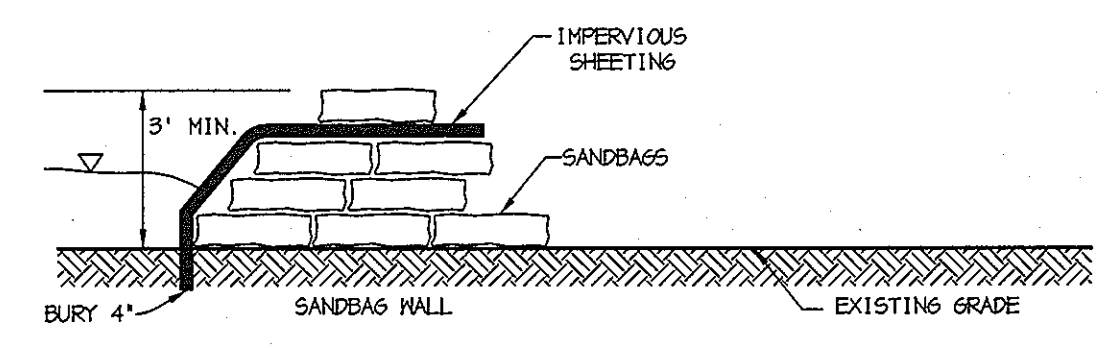

- DESCRIPTION**
THE WORK SHALL CONSIST OF INSTALLING A FLOW DIVERSION STRUCTURE WHEN CONSTRUCTION ACTIVITIES TAKE PLACE WITHIN THE STREAM CHANNEL SUCH AS GULVERT CONSTRUCTION OR STORM DRAIN CONSTRUCTION.
- MATERIAL SPECIFICATIONS**
1. SANDBAGS: SANDBAGS SHALL CONSIST OF MATERIALS WHICH ARE RESISTANT TO ULTRA-VIOLET RADIATION, TEARING AND PUNCTURE AND MOVEN TIGHTLY ENOUGH TO PREVENT LEAKAGE OF FILL MATERIAL (I.E., SAND, FINE GRAVEL, ETC.).
 2. SHEETING: SHEETING SHALL CONSIST OF POLYETHYLENE OR OTHER MATERIAL WHICH IS IMPERVIOUS AND RESISTANT TO PUNCTURE AND TEARING.
- CONSTRUCTION REQUIREMENTS**
1. ALL EROSION AND SEDIMENT CONTROL DEVICES SHALL BE INSTALLED AS THE FIRST ORDER OF WORK.
 2. THE WALL STRUCTURE SHALL BE INSTALLED FROM UPSTREAM TO DOWNSTREAM.
 3. THE TOP RIM OF DIKE IS TO BE FROM 2 - 4 FEET.
 4. THE HEIGHT OF THE DIVERSION STRUCTURE SHALL BE TWO TIMES THE DIVERSION PIPE DIAMETER.
 5. ALL EXCAVATED MATERIALS SHALL BE DISPOSED OF IN A SCD APPROVED DISPOSAL AREA OUTSIDE THE 100-YEAR FLOODPLAIN UNLESS OTHERWISE APPROVED ON THE PLANS BY THE MRA.
 6. ALL DEWATERING OF THE CONSTRUCTION AREA SHALL BE PUMPED FROM A SUMP PIT PRIOR TO RE-ENTERING THE SYSTEM.
 7. SHEETING SHALL BE OVERLAPPED SUCH THAT THE UPSTREAM PORTION COVERS THE DOWNSTREAM PORTION WITH AT LEAST AN 18 - INCH OVERLAP.
 8. SEDIMENT CONTROL DEVICES ARE TO REMAIN IN PLACE UNTIL ALL DISTURBED AREAS ARE STABILIZED IN ACCORDANCE WITH AN APPROVED SEDIMENT AND EROSION CONTROL PLAN AND THE INSPECTING AUTHORITY APPROVES THE REMOVAL.

TEMPORARY SANDBAG WALL
NO SCALE

DETAIL 20A - REMOVABLE PUMPING STATION

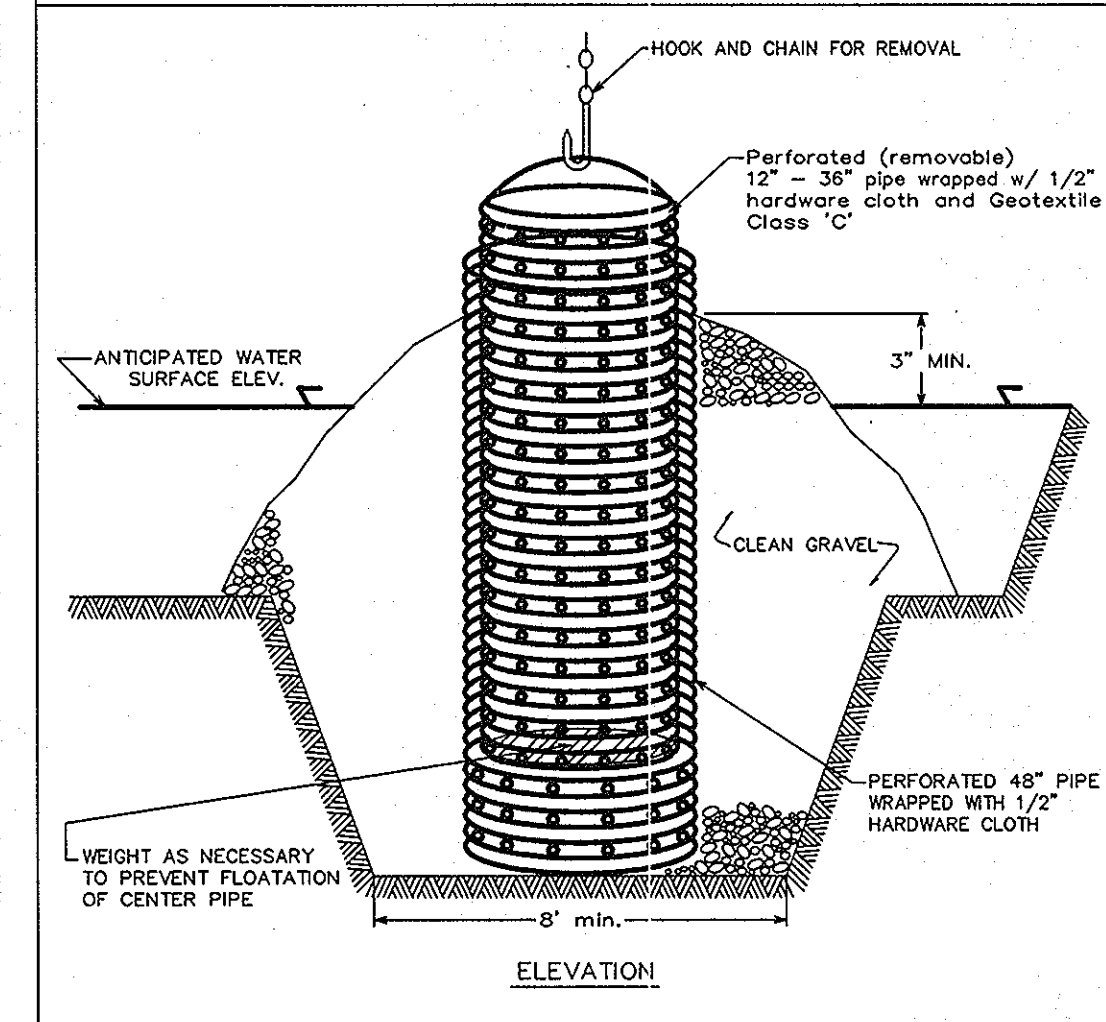

- Construction Specifications**
1. The outer pipe should be 48" dia. or shall, in any case, be at least 4" greater in diameter than the center pipe. The outer pipe shall be wrapped with 1/2" hardware cloth to prevent backfill material from entering the perforations.
 2. After installing the outer pipe, backfill around outer pipe with 2" aggregate or clean gravel.
 3. The inside stand pipe (center pipe) should be constructed by perforating a corrugated or PVC pipe between 12" and 36" in diameter. The perforations shall be 1/2" x 8" slots or 1" diameter holes 8" on center. The center pipe shall be wrapped with 1/2" hardware cloth first, then wrapped again with Geotextile Class C.
 4. The center pipe should extend 12" to 18" above the anticipated water surface elevation or riser crest elevation when dewatering a basin.

U.S. DEPARTMENT OF AGRICULTURE SOIL CONSERVATION SERVICE PAGE 8-12-4 MARYLAND DEPARTMENT OF ENVIRONMENT WATER MANAGEMENT ADMINISTRATION

DEPARTMENT OF PUBLIC WORKS
HOWARD COUNTY, MARYLAND

DIRECTOR OF PUBLIC WORKS DATE CHIEF, BUREAU OF ENVIRONMENTAL SERVICES DATE

CHIEF, BUREAU OF HIGHWAYS DATE CHIEF, STORMWATER MANAGEMENT DIVISION DATE

RIEMER MUEGGE & ASSOCIATES, INC.
ENGINEERING ENVIRONMENTAL SERVICES PLANNING SURVEYING
8818 Centre Park Drive, Columbia, Maryland 21045
tel 410.997.8900 fax 410.997.9282
41324/SHT1.DWG




DES: AAP					
DRN: MAD					
CHK: AAP					
DATE: 10/1/99	BY	NO.	REVISION	DATE	600' SCALE MAP NO. 35 BLOCK NO. 10

GABION DETAILS









LITTLE PATUXENT PARKWAY
STORMWATER MANAGEMENT RETROFIT
VILLAGE OF HICKORY RIDGE
SECTION 3, AREA 1
5th ELECTION DISTRICT
HOWARD COUNTY, MARYLAND
PROJECT No.

SCALE AS SHOWN
SHEET 16 OF 16


H. 107324/SHT1.DWG 10/1/99 RIEMER MUEGGE & ASSOCIATES, INC.

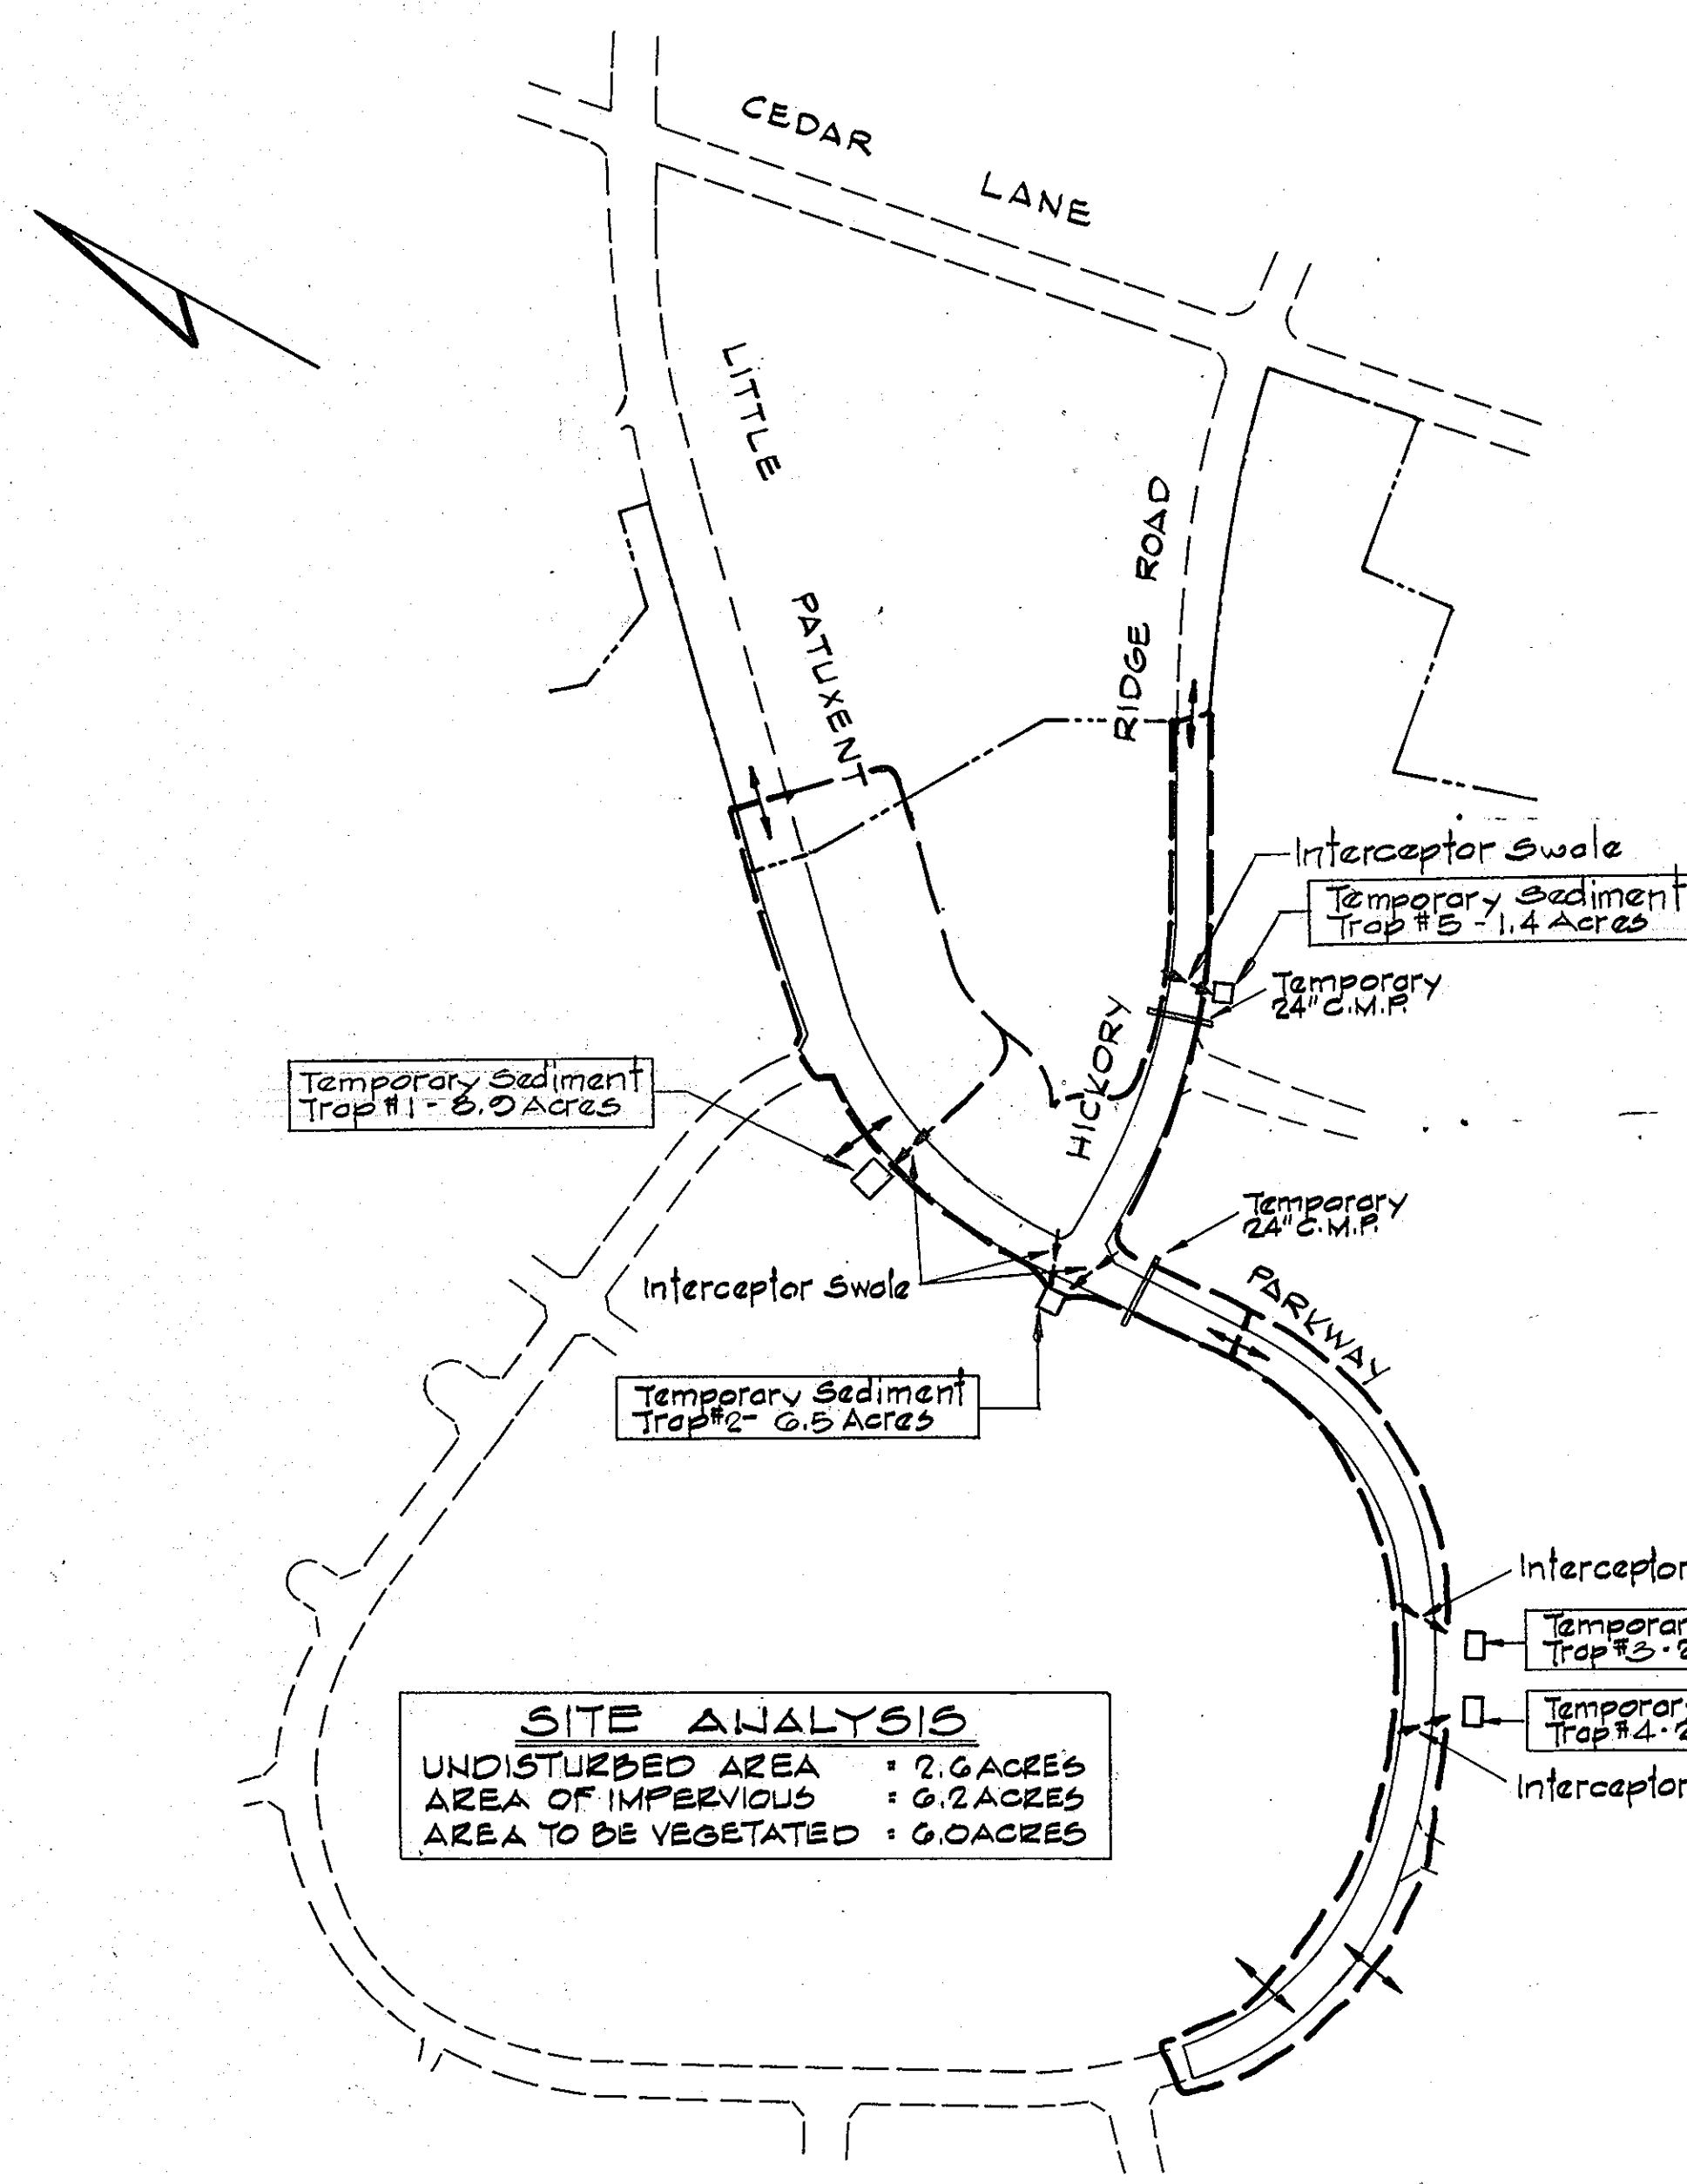

DRAINAGE AREA MAP
 Scale: 1" = 400'

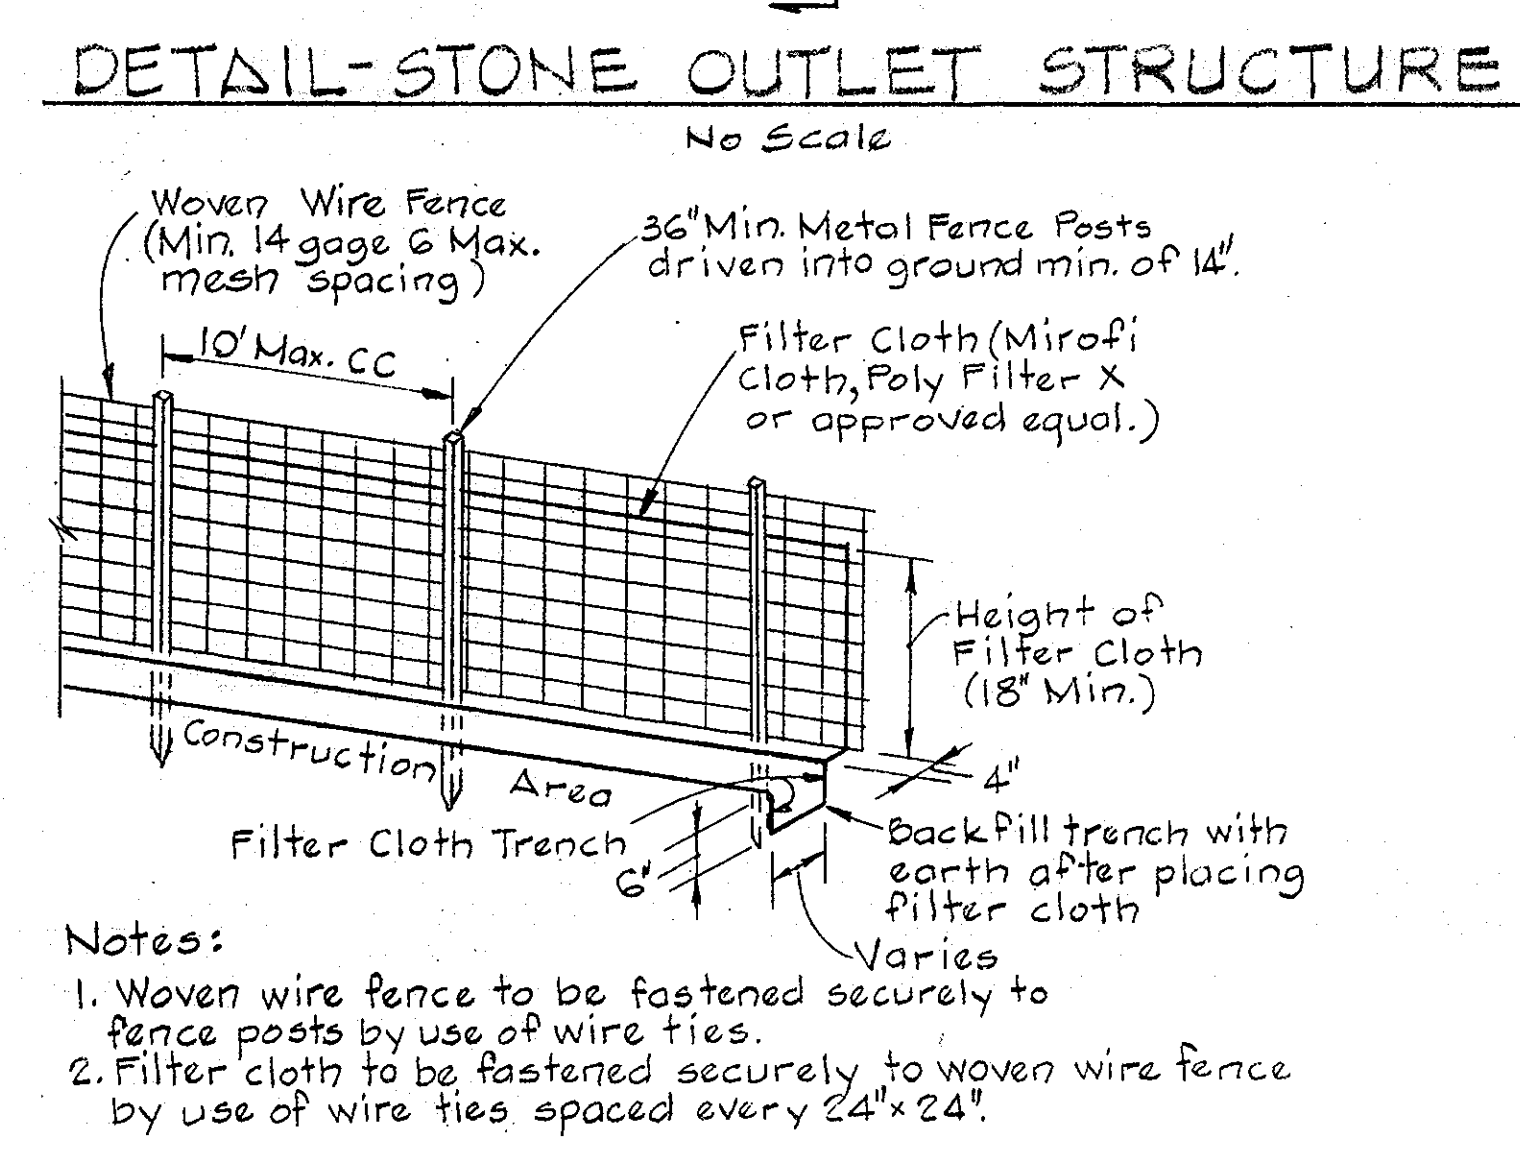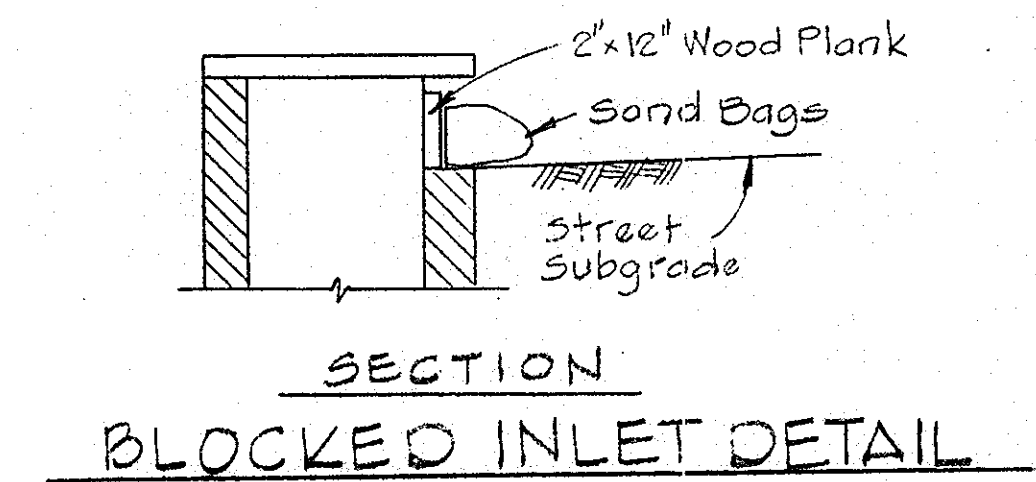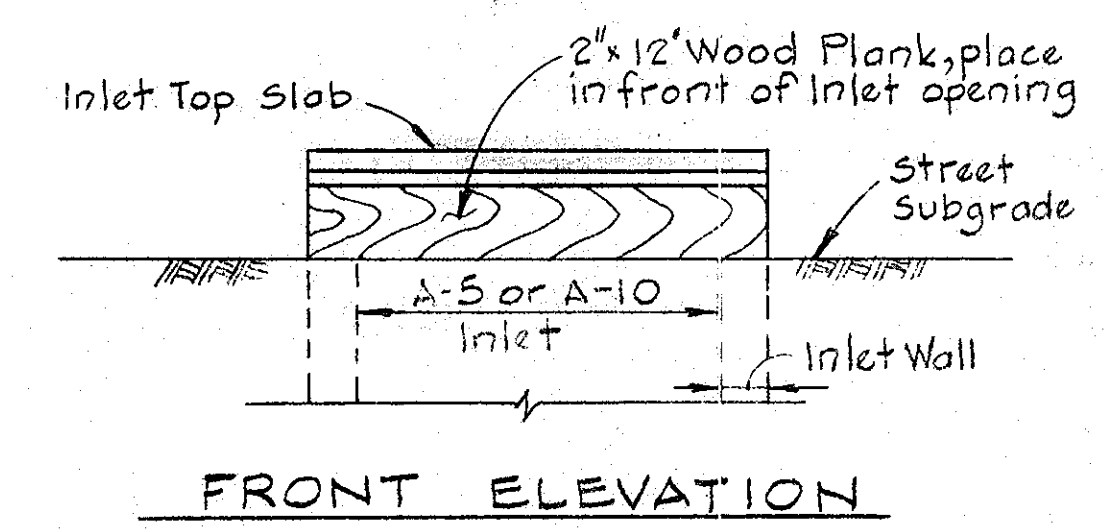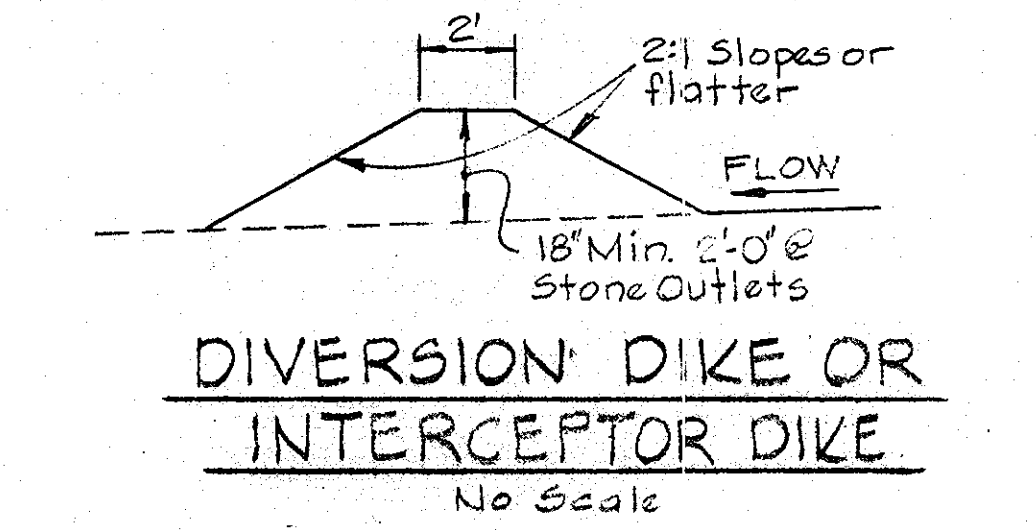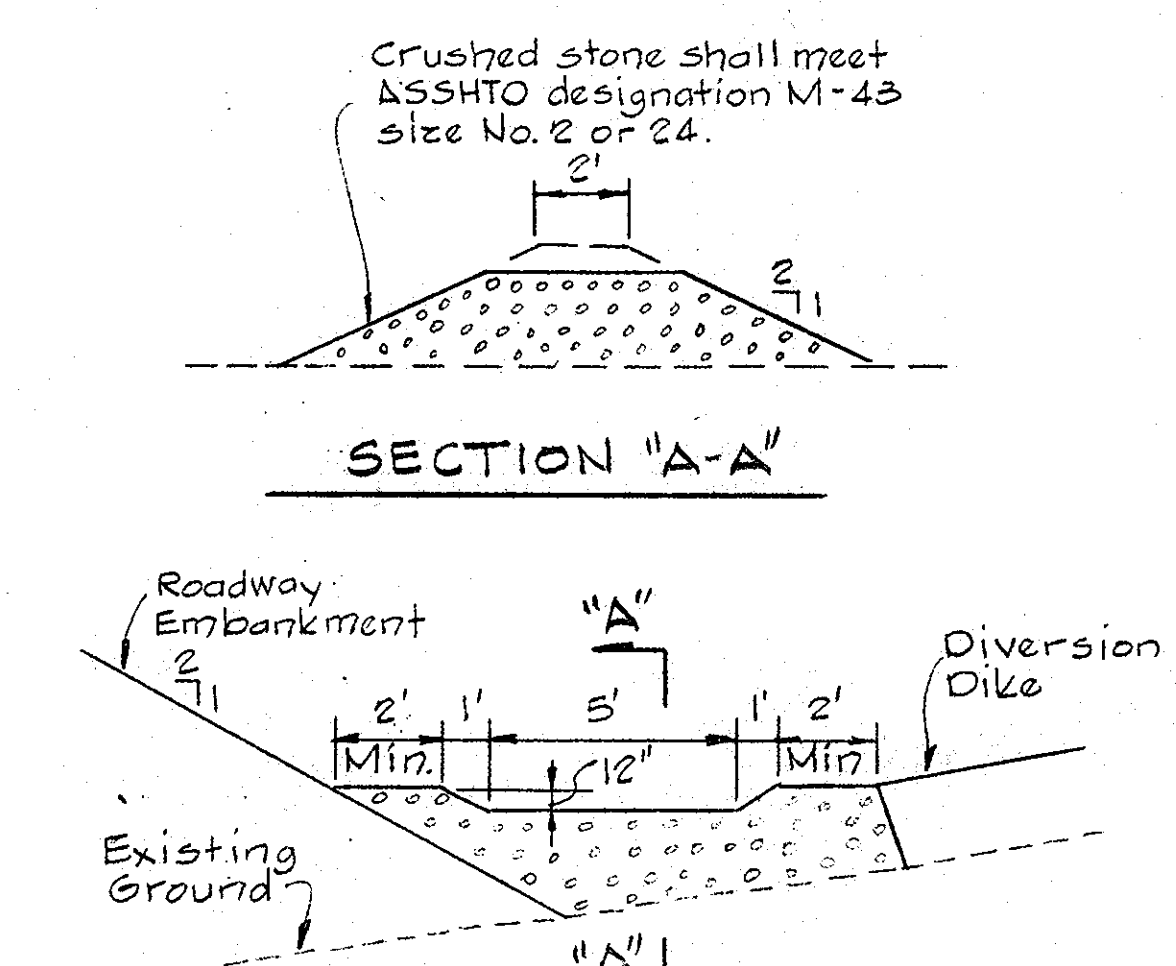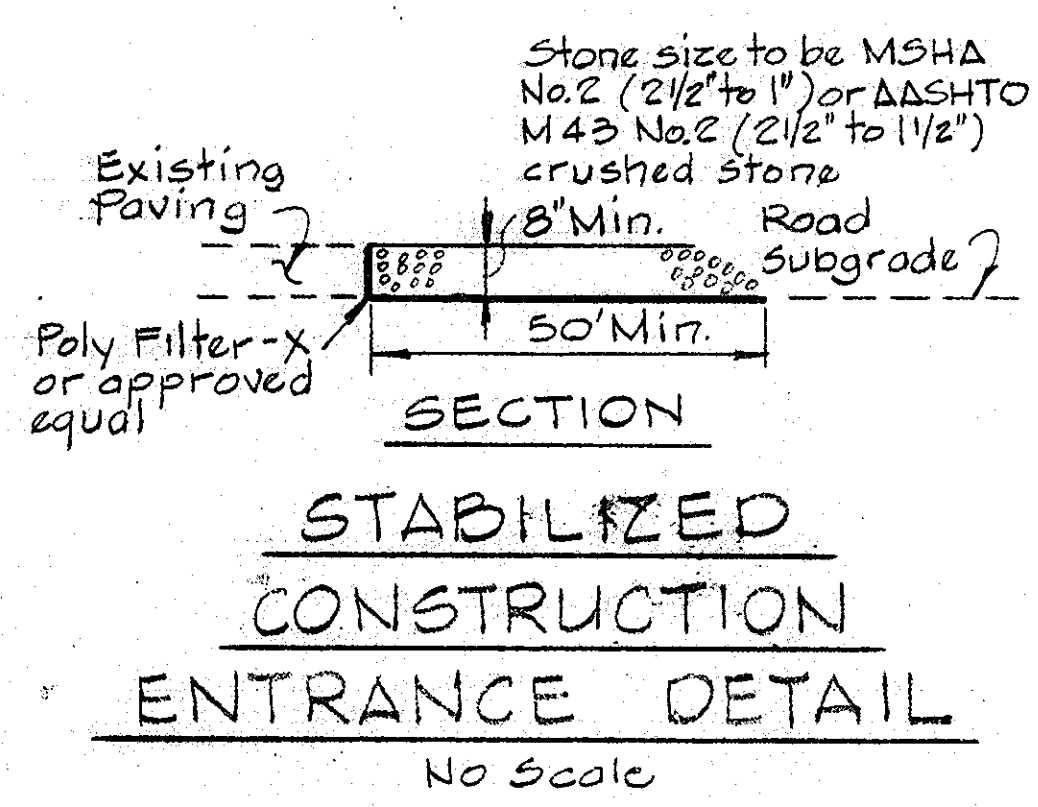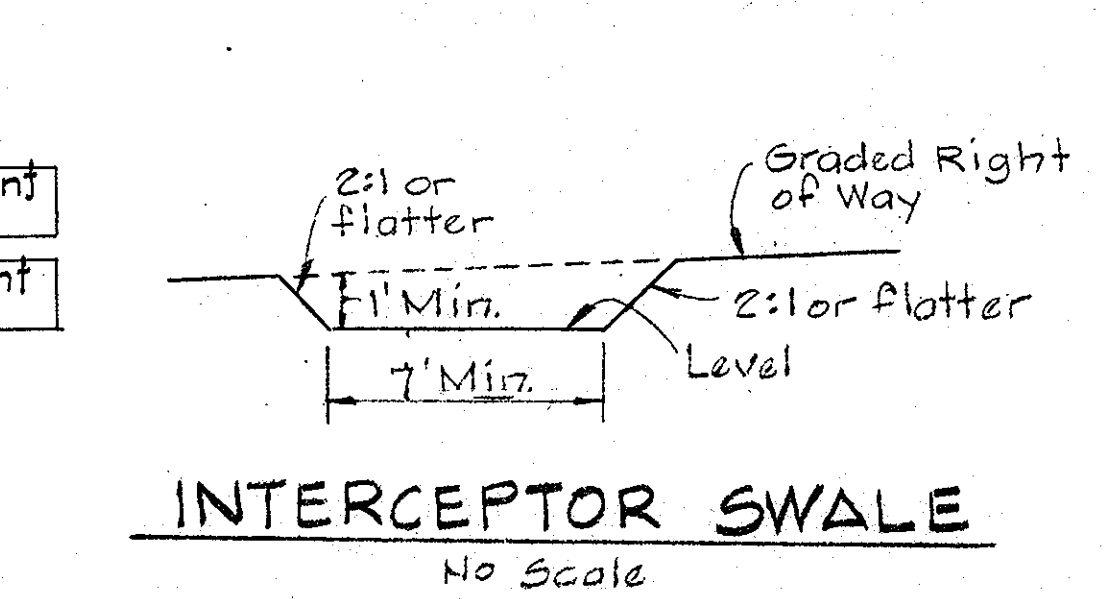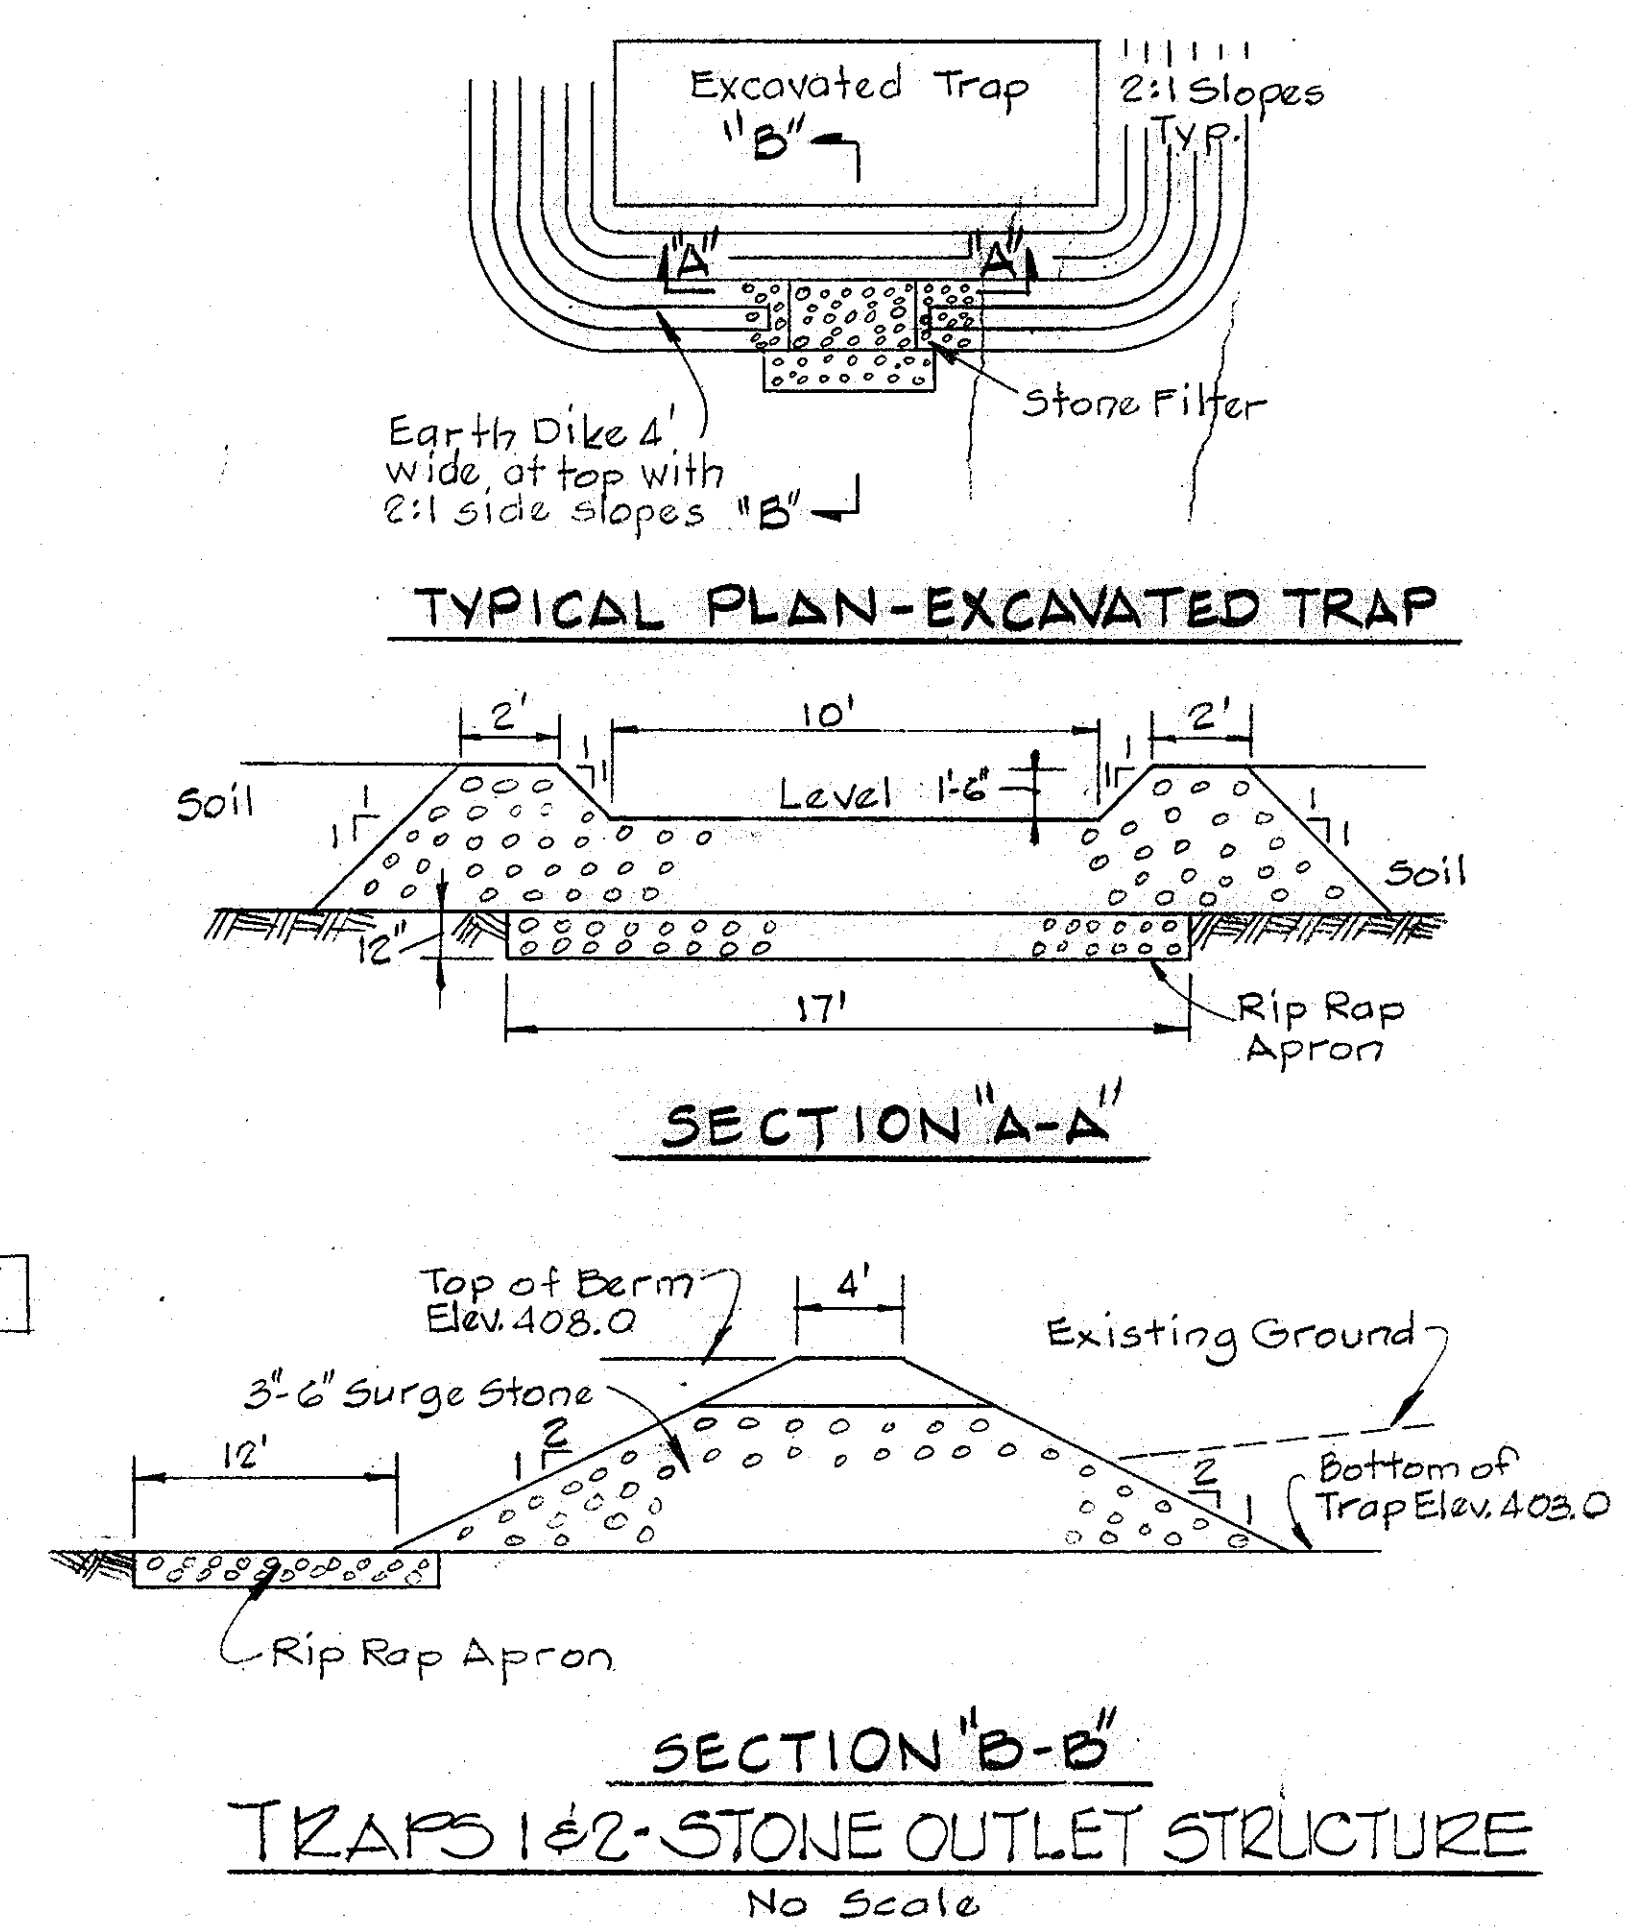

Notes:
 1. Woven wire fence to be fastened securely to fence posts by use of wire ties.
 2. Filter cloth to be fastened securely to woven wire fence by use of wire ties spaced every 24" x 24".

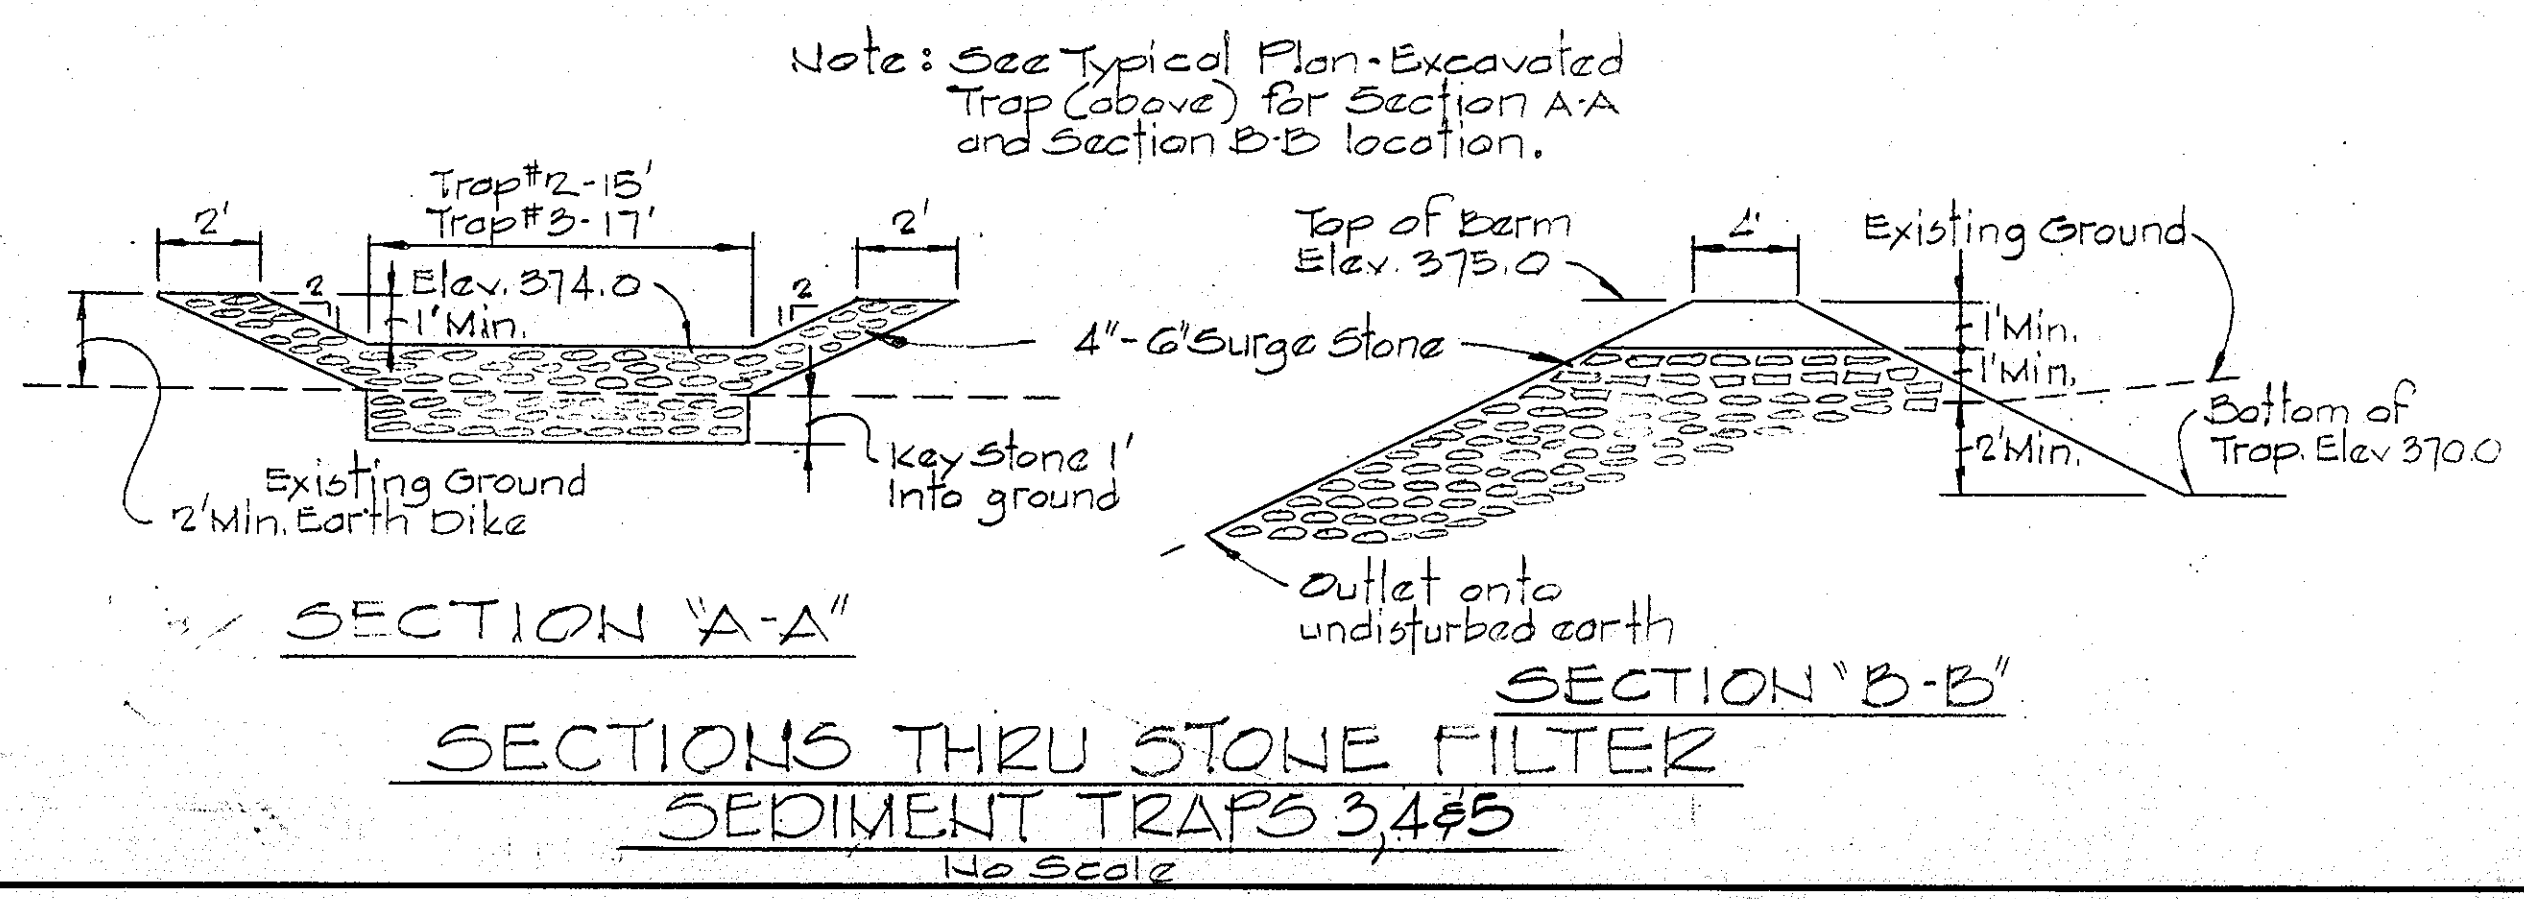

CERTIFICATION BY THE ENGINEER
 I certify that this plan for erosion and sediment control represents a practical and workable plan based on my personal knowledge of the site conditions. This plan was prepared in accordance with the requirements of the Howard Soil Conservation District. I have notified the developer that he must provide the Howard Soil Conservation District with a red-lined "as-built" of the pond within 30 days of completion.
 Kenneth A. McCord
 KENNETH A. MCCORD P.E. No. 1074
 5-4-83 Date

CERTIFICATION BY THE DEVELOPER
 I certify that all development and/or construction will be done according to these plans of development, pond construction and erosion and sediment control. I also authorize periodic on-site inspection by the Howard Soil Conservation District or their authorized agents, as are deemed necessary. Deviation from this plan will not be made unless authorized by the Howard Soil Conservation District. I will provide the Howard Soil Conservation District with a red-lined "as-built" of the pond within 30 days of completion.
 Walter Woodford
 WALTER WOODFORD
 5-10-83 Date

RESPONSIBLE PERSONNEL CERTIFICATION
 I hereby certify that any responsible personnel involved in the construction project will have a certificate of attendance at a Department of Natural Resources approved training program for the control of sediment and erosion before beginning the project.
 Walter Woodford
 WALTER WOODFORD
 5-10-83 Date

REVIEWED FOR HOWARD S.C.D. AND MEETS TECHNICAL REQUIREMENTS
 James M. Hancock 7/4/83 DATE
 U.S. SOIL CONSERVATION SERVICE
 THIS DEVELOPMENT PLAN IS APPROVED FOR SOIL EROSION AND SEDIMENT CONTROL BY THE HOWARD SOIL CONSERVATION DISTRICT.
 APPROVED [Signature] 7/21/83 DATE
 HOWARD S.C.D.

REV. DATE	REV. NO.	REVISION DESCRIPTION
7/1/83	1	As Per D.P.W. # Sediment Control Comments

COLUMBIA
 5th ELECTION DISTRICT
 HOWARD COUNTY, MARYLAND

OWNER AND DEVELOPER
 THE HOWARD RESEARCH AND DEVELOPMENT CORPORATION
 THE ROUSE BUILDING
 COLUMBIA, MARYLAND 21044

PROJECT AREA
 VILLAGE OF HICKORY RIDGE
 SECTION 3 AREA 1

PROJECT TITLE
 SEDIMENT CONTROL
 DRAINAGE AREA MAP AND DETAILS


SCALE: AS SHOWN DATE

WHITMAN, REQUARDT AND ASSOCIATES
 ENGINEERS
 2315 ST. PAUL STREET
 BALTIMORE, MARYLAND 21218

Kenneth A. McCord
 KENNETH A. MCCORD
 Registered Engineer
 No. 1074

Sediment Trap #2
See Detail Sheet 17

DEPARTMENT OF PUBLIC WORKS
Walter E. Woodford 7-21-83
 CHIEF, BUREAU OF ENGINEERING DATE
 OFFICE OF PLANNING & ZONING
Kenneth A. McCord 7-22-83
 CHIEF, DIVISION OF LAND DEVELOPMENT AND ZONING ADMINISTRATION DATE

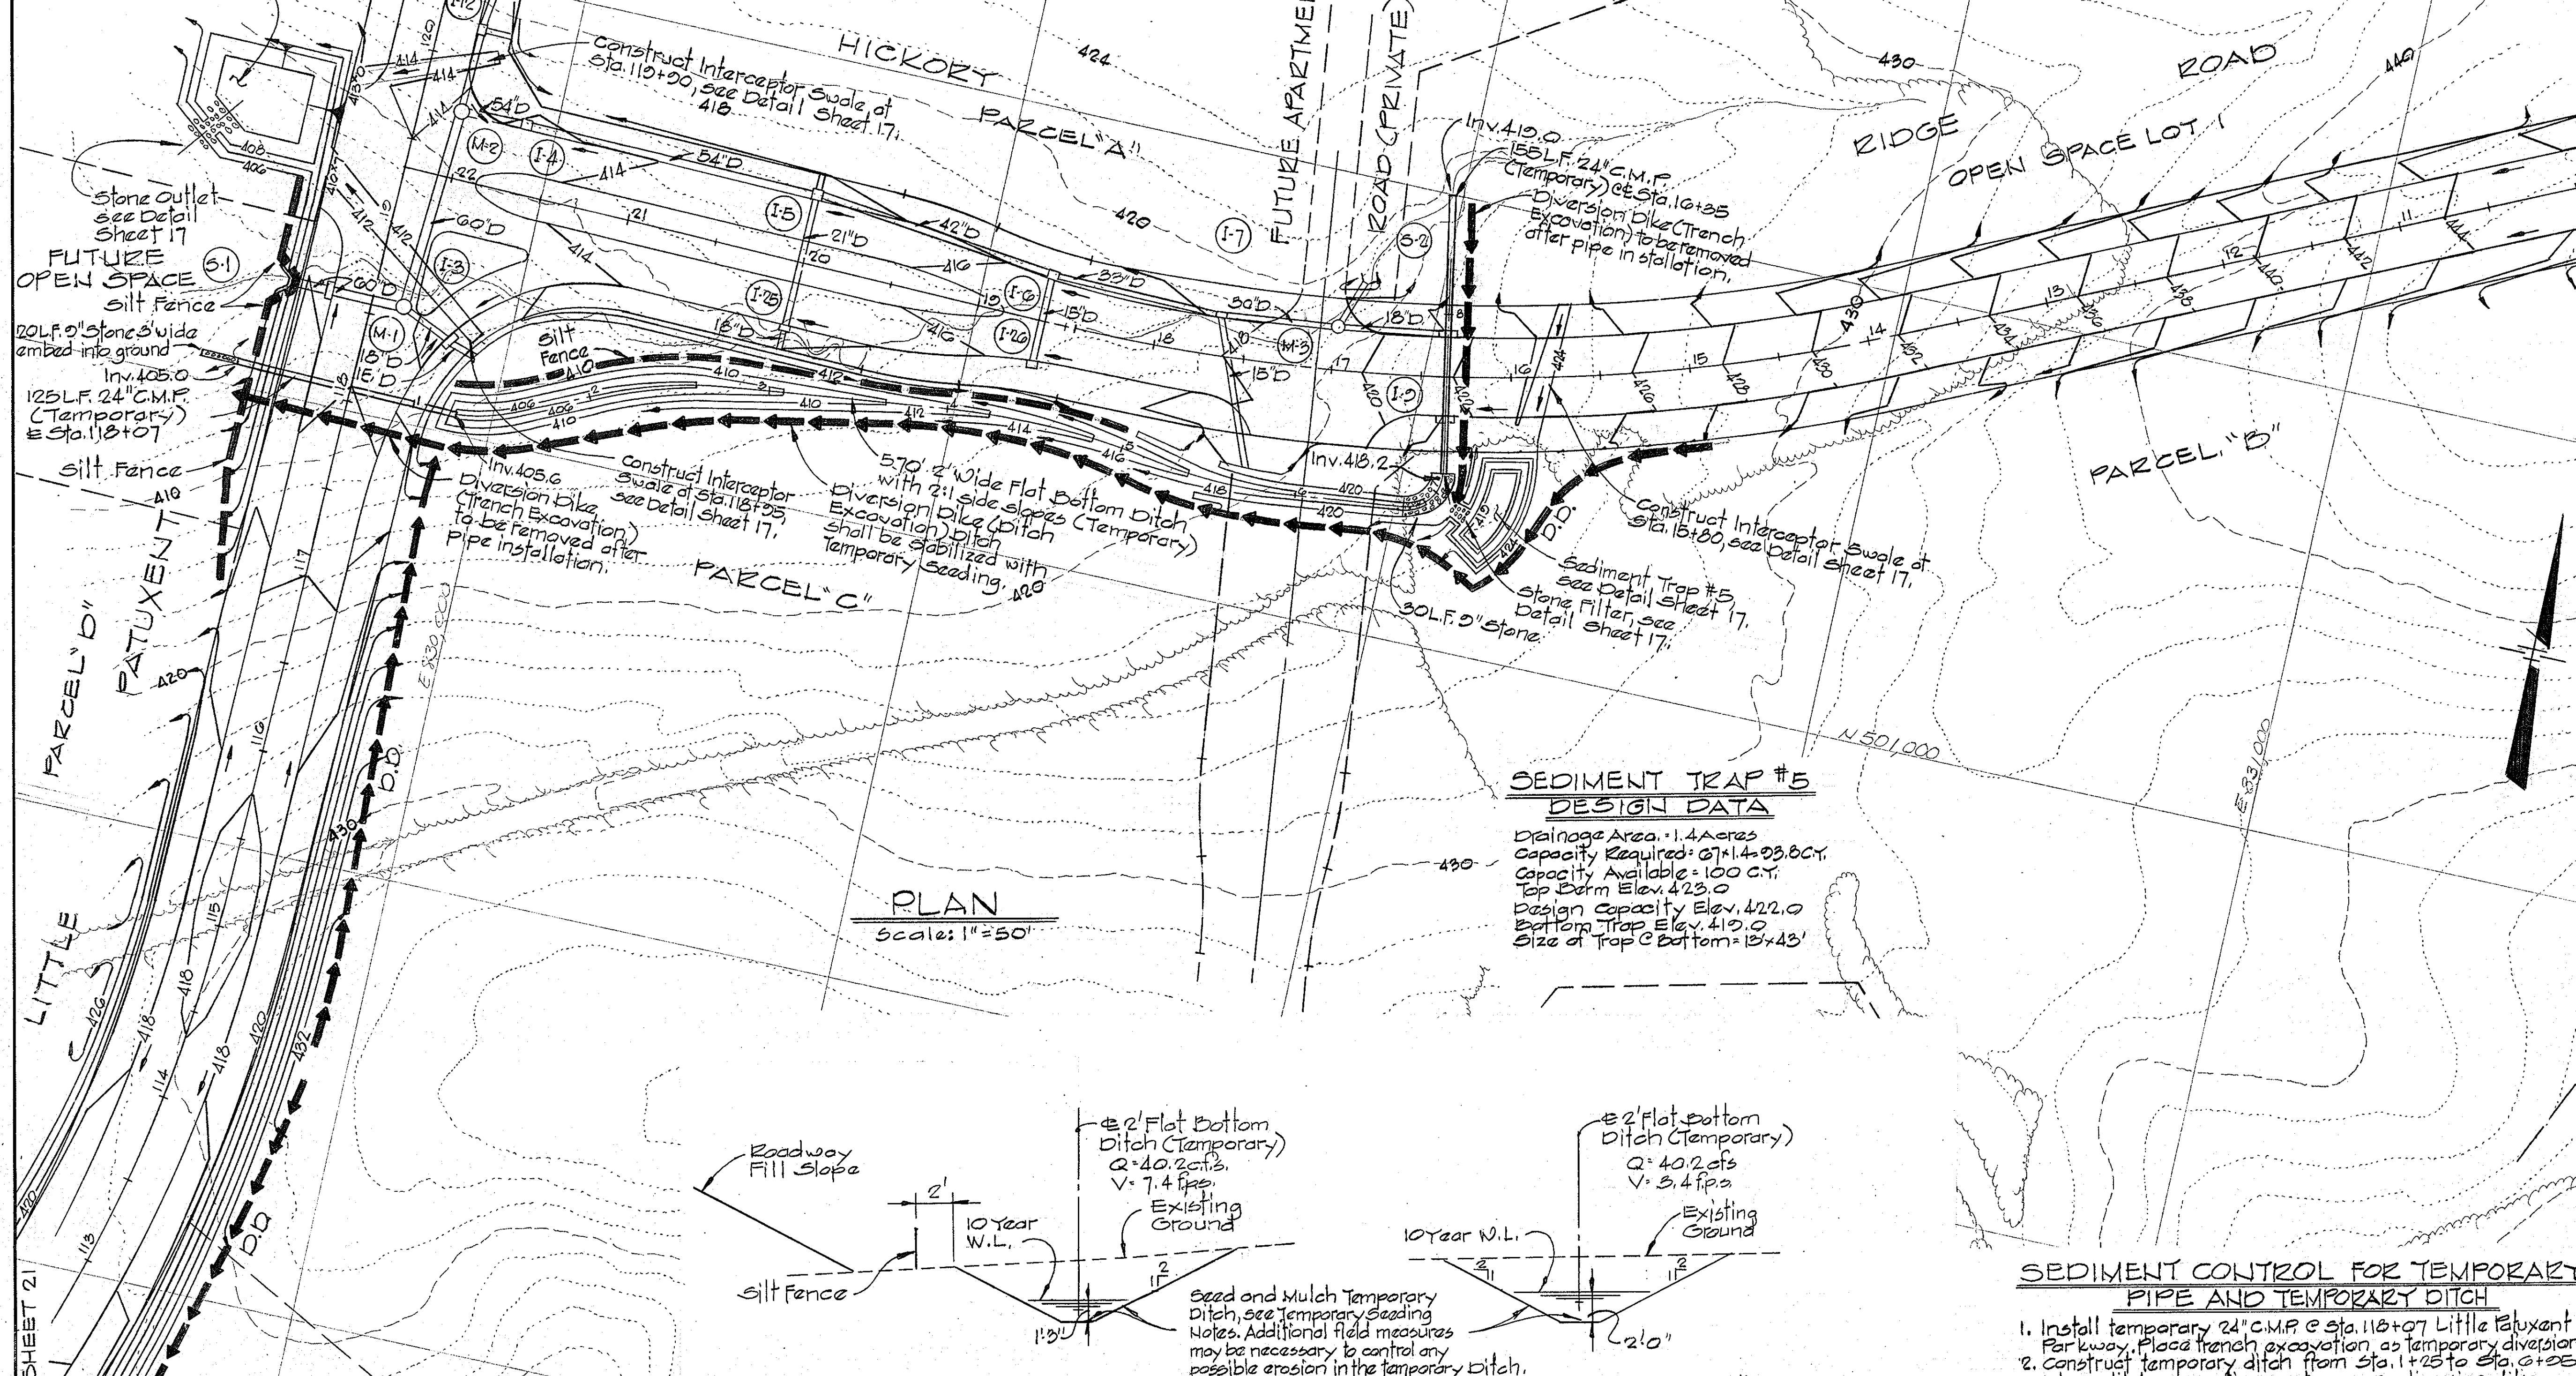

Stabilized Construction Entrance, see Detail Sheet 15.

REVIEWED FOR HOWARD S.C.D.

AND MEETS TECHNICAL REQUIREMENTS

Jane Helmer 7/21/83
DATE

U.S. SOIL CONSERVATION SERVICE


THIS DEVELOPMENT PLAN IS APPROVED FOR SOIL EROSION AND SEDIMENT CONTROL BY THE HOWARD SOIL CONSERVATION DISTRICT.

APPROVED *Howard S.C.D.* 7/21/83
HOWARD S.C.D. DATE


**SEDIMENT TRAP #5
DESIGN DATA**

Drainage Area: 1.4 Acres
 Capacity Required: 671.4 cu. yd.
 Capacity Available: 100 cu. yd.
 Top Form Elev. 423.0
 Design Capacity Elev. 422.0
 Bottom Trap Elev. 410.0
 Size of Trap C Bottom: 13'x43'

**PLAN
Scale: 1"=50'**

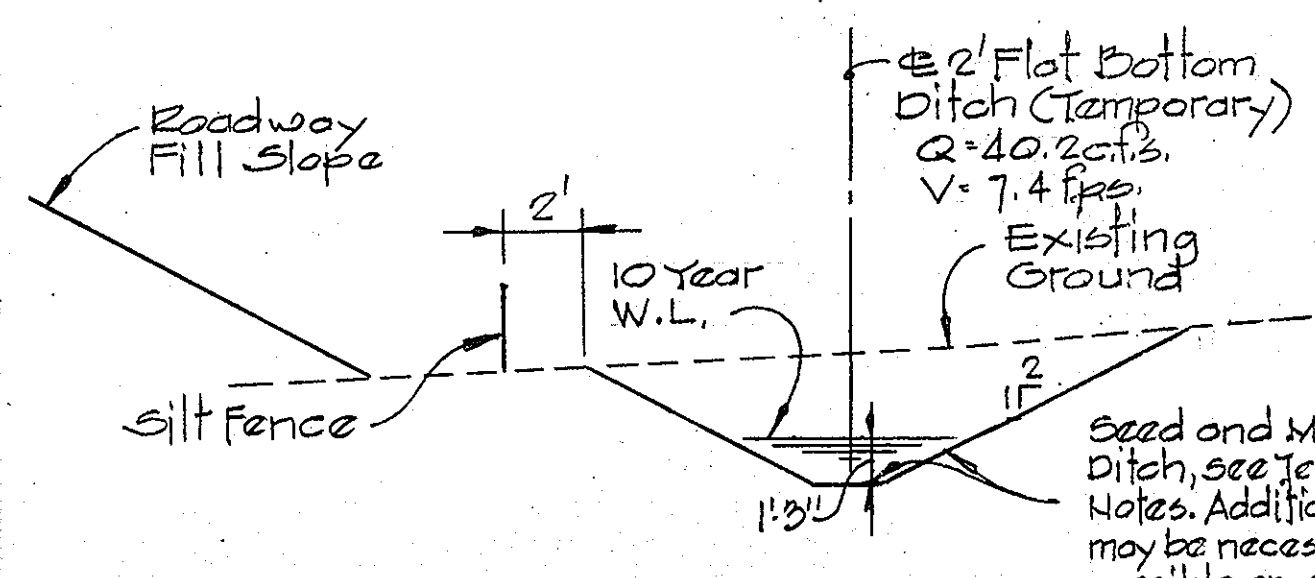

TEMPORARY DITCH SECTION
No Scale

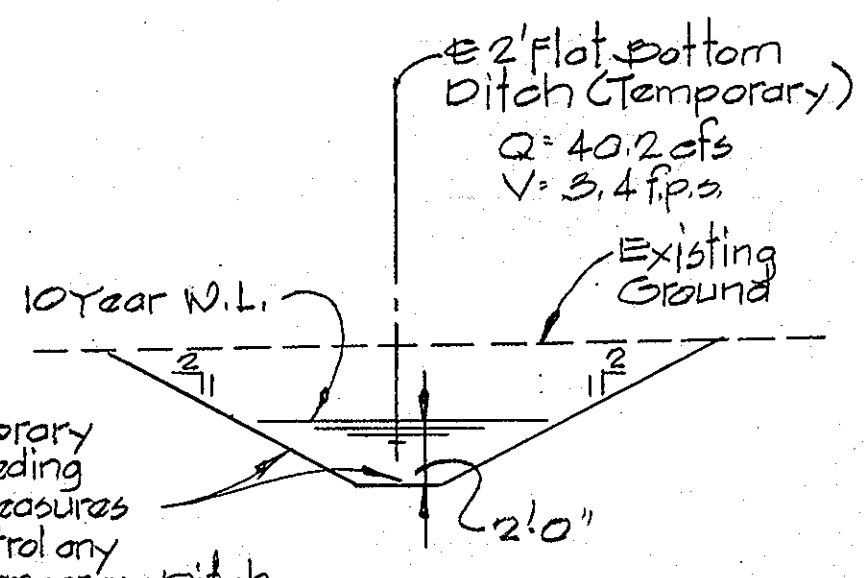

SECTION "A-A"
Scale: 1"=5' H.E.V.

SEDIMENT CONTROL FOR TEMPORARY PIPE AND TEMPORARY DITCH

1. Install temporary 24" C.M.P. @ Sta. 118+07 Little Patuxent Parkway. Place trench excavation as temporary diversion dike.
2. Construct temporary ditch from Sta. 1+25 to Sta. 0+25. Place ditch excavation as temporary diversion dike. Temporary seed ditch and diversion dike.
3. Install temporary 24" C.M.P. @ Sta. 1+25 Hickory Ridge Road. Place trench excavation as temporary diversion dike.
4. Contractor to maintain flow in existing ditch until temporary ditch is seeded and mulched.

CERTIFICATION BY THE DEVELOPER

"I/WE CERTIFY THAT ALL DEVELOPMENT AND CONSTRUCTION WILL BE DONE ACCORDING TO THIS PLAN OF DEVELOPMENT AND PLAN FOR EROSION AND SEDIMENT CONTROL AND THAT ALL RESPONSIBLE PERSONNEL INVOLVED IN THE CONSTRUCTION PROJECT WILL HAVE A CERTIFICATE OF ATTENDANCE AT A DEPT. OF NATURAL RESOURCES APPROVED TRAINING PROGRAM FOR THE CONTROL OF SEDIMENT AND EROSION BEFORE BEGINNING THE PROJECT. I ALSO AUTHORIZE PERIODIC ON-SITE INSPECTION BY THE HOWARD SOIL CONSERVATION DISTRICT OR THEIR AUTHORIZED AGENTS, AS ARE DEEMED NECESSARY."

Walter E. Woodford 5-10-83
WALTER E. WOODFORD DATE

CERTIFICATION BY THE ENGINEER

"I CERTIFY THAT THIS PLAN FOR EROSION AND SEDIMENT CONTROL REPRESENTS A PRACTICAL AND WORKABLE PLAN BASED ON MY PERSONAL KNOWLEDGE OF THE SITE CONDITIONS AND THAT IT WAS PREPARED IN ACCORDANCE WITH THE REQUIREMENTS OF THE HOWARD SOIL CONSERVATION DISTRICT."

Kenneth A. McCord 5-4-83
KENNETH A. MCCORD P.E. 1974 DATE

Rev. No.	Rev. Date	Revision Description
1	7/1/83	As Per D.P.W. Sediment Control Comments

COLUMBIA
 5TH ELECTION DISTRICT
 HOWARD COUNTY, MARYLAND
 OWNER AND DEVELOPER
 HOWARD RESEARCH AND DEVELOPMENT CORP
 PROJECT AREA
 VILLAGE OF HICKORY RIDGE
 SECTION 3 AREA 1
 PROJECT TITLE
 SEDIMENT CONTROL


SCALE: AS SHOWN DATE:
 WHITMAN, REQUARDT AND ASSOCIATES
 ENGINEERS
 2315 ST PAUL STREET
 BALTIMORE, MARYLAND 21202

Kenneth A. McCord
 KENNETH A. MCCORD
 Registered Engineer
 No. 1974

RESPONSIBLE PERSONNEL CERTIFICATION

"I hereby certify that any responsible personnel involved in the construction project will have a certificate of attendance at a Department of Natural Resources approved training program for the control of sediment and erosion before beginning the project."

Walter E. Woodford 5-10-83
 WALTER E. WOODFORD DATE

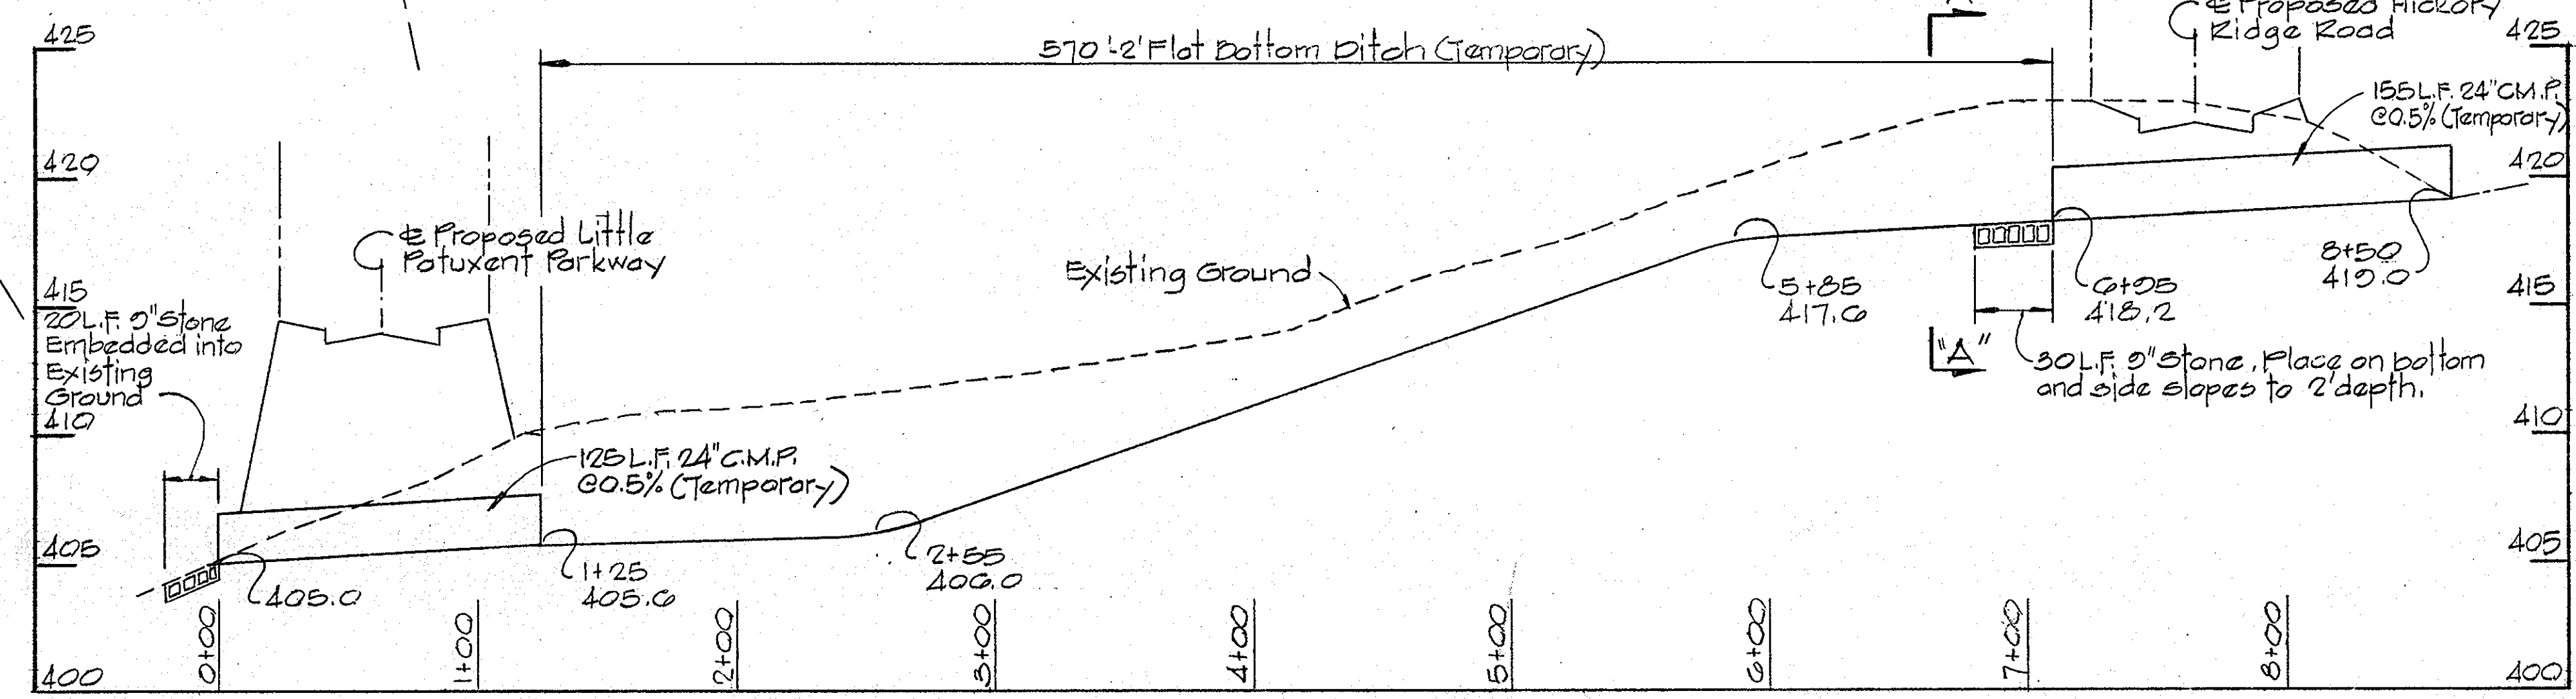

PROFILE-TEMPORARY DITCH
 Scale: Hor. 1"=50'
 Vert. 1"=5'

**SEDIMENT TRAP #2
DESIGN DATA**


Drainage Area = 0.5 Acres
Capacity Required = 67 x 0.5 = 33.5 C.Y.
Capacity Available = 450 C.Y.
Top Berm Elev. 408.0
Design Capacity = 406.5
Bottom Elev. 402.0

**SEDIMENT TRAP #1
DESIGN DATA**

Drainage Area = 8.7 Acres
Capacity Required G.M.E. = 596 C.Y.
Capacity Available = 600 C.Y.
Top Berm Elev. 410.0
Design Capacity Elev. 418.0
Bottom Elev. 413.0

DEPARTMENT OF PUBLIC WORKS

1-27-83
CHIEF, BUREAU OF ENGINEERING
OFFICE OF PLANNING & ZONING
CHIEF, DIVISION OF LAND DEVELOPMENT AND ZONING ADMINISTRATION

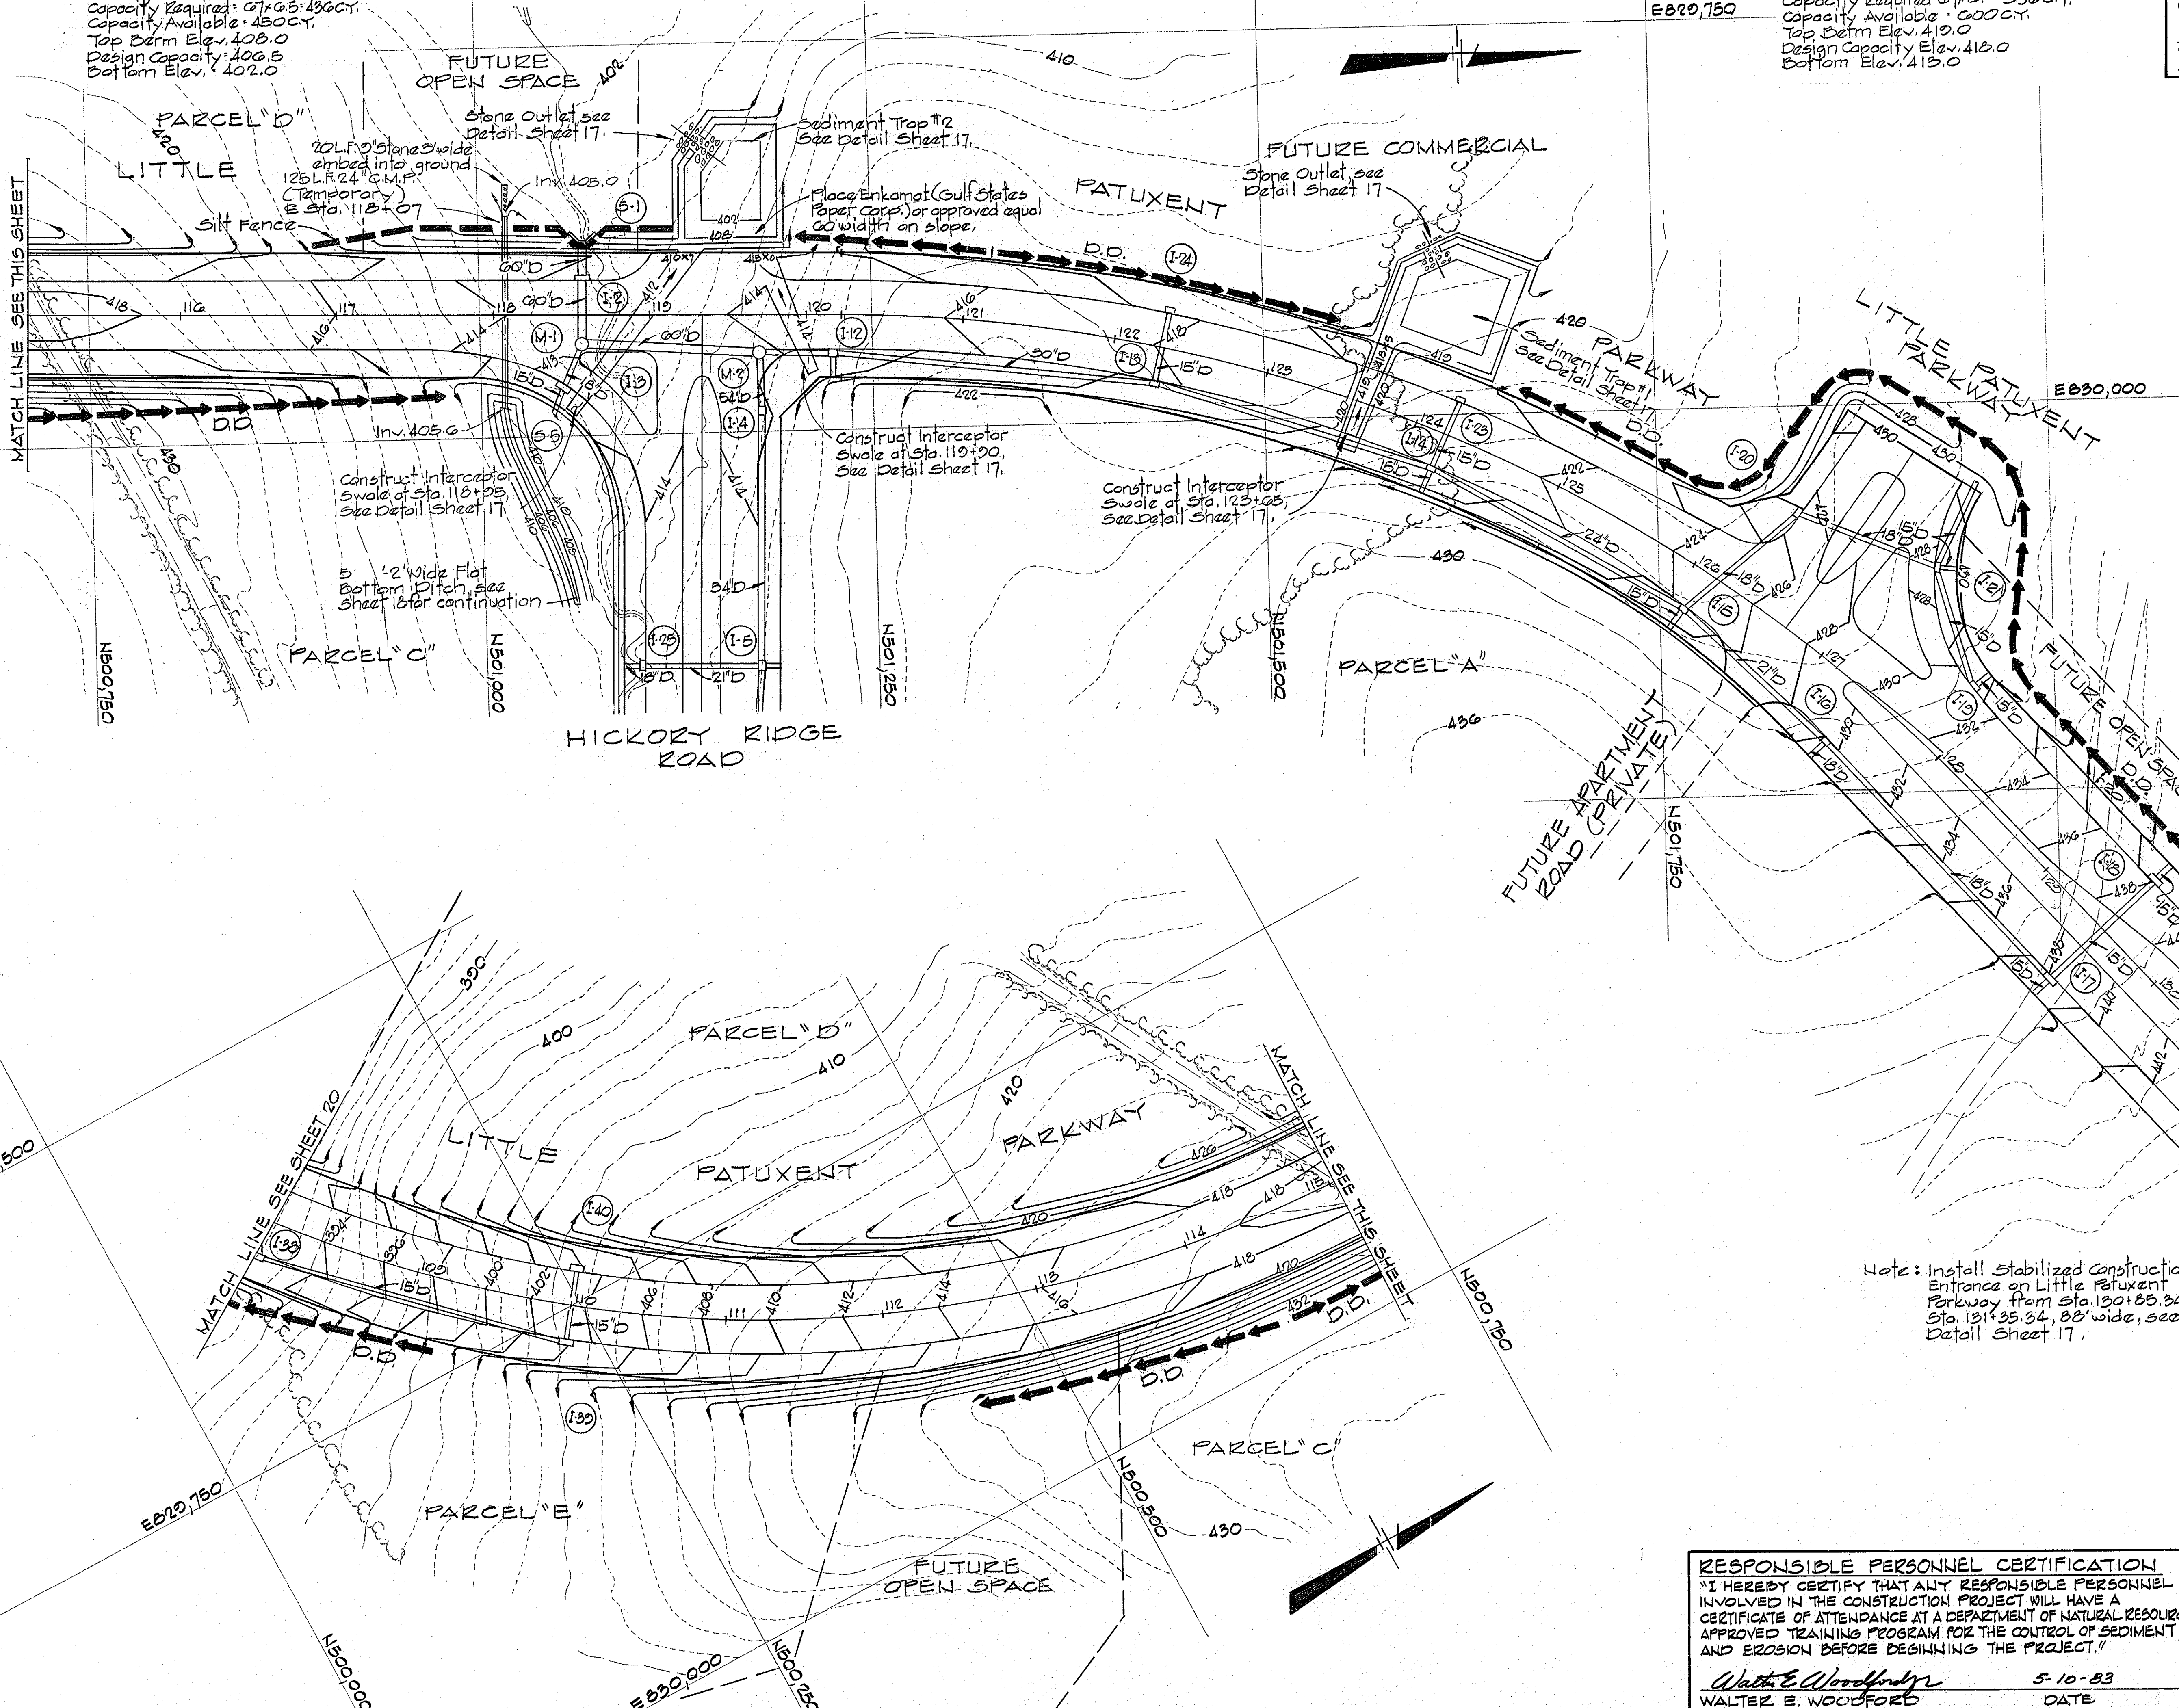

REVIEWED FOR HOWARD S.C.D.
AND MEETS TECHNICAL REQUIREMENTS
James Helm 7/1/83
DATE
U.S. SOIL CONSERVATION SERVICE
THIS DEVELOPMENT PLAN IS APPROVED FOR SOIL EROSION AND SEDIMENT CONTROL BY THE HOWARD SOIL CONSERVATION DISTRICT.
Walter E. Woodford 7/21/83
APPROVED
HOWARD S.C.D. DATE

CERTIFICATION BY THE DEVELOPER
"I HEREBY CERTIFY THAT ALL DEVELOPMENT AND CONSTRUCTION WILL BE DONE ACCORDING TO THIS PLAN OF DEVELOPMENT AND PLAN FOR EROSION AND SEDIMENT CONTROL AND THAT ALL RESPONSIBLE PERSONNEL INVOLVED IN THE CONSTRUCTION PROJECT WILL HAVE A CERTIFICATE OF ATTENDANCE AT A DEPT. OF NATURAL RESOURCES APPROVED TRAINING PROGRAM FOR THE CONTROL OF SEDIMENT AND EROSION BEFORE BEGINNING THE PROJECT. I ALSO AUTHORIZE PERIODIC ON-SITE INSPECTION BY THE HOWARD SOIL CONSERVATION DISTRICT OR THEIR AUTHORIZED AGENTS, AS ARE DEEMED NECESSARY."
Walter E. Woodford 5-10-83
WALTER E. WOODFORD DATE

CERTIFICATION BY THE ENGINEER
"I CERTIFY THAT THIS PLAN FOR EROSION AND SEDIMENT CONTROL REPRESENTS A PRACTICAL AND WORKABLE PLAN BASED ON MY PERSONAL KNOWLEDGE OF THE SITE CONDITIONS AND THAT IT WAS PREPARED IN ACCORDANCE WITH THE REQUIREMENTS OF THE HOWARD SOIL CONSERVATION DISTRICT."
Kenneth A. McCord 5-4-83
KENNETH A. MCCORD P.E. 1974 DATE

Rev. No.	Revision Description
1	As Per D.P.W. # Sediment Control Comments

COLUMBIA
5TH ELECTION DISTRICT
HOWARD COUNTY, MARYLAND
OWNER AND DEVELOPER
HOWARD RESEARCH AND DEVELOPMENT CORP.

PROJECT AREA
VILLAGE OF HICKORY RIDGE
SECTION 3 AREA 1

PROJECT TITLE
SEDIMENT CONTROL


SCALE: 1"=50' DATE:

WHITMAN, REQUARDT AND ASSOCIATES
ENGINEERS
2315 ST. PAUL STREET
BALTIMORE, MARYLAND 21202

Kenneth A. McCord
KENNETH A. MCCORD
Registered Engineer
No. 1974

RESPONSIBLE PERSONNEL CERTIFICATION
"I HEREBY CERTIFY THAT ANY RESPONSIBLE PERSONNEL INVOLVED IN THE CONSTRUCTION PROJECT WILL HAVE A CERTIFICATE OF ATTENDANCE AT A DEPARTMENT OF NATURAL RESOURCES APPROVED TRAINING PROGRAM FOR THE CONTROL OF SEDIMENT AND EROSION BEFORE BEGINNING THE PROJECT."
Walter E. Woodford 5-10-83
WALTER E. WOODFORD DATE

Note: Install stabilized construction Entrance on Little Parkway from Sta. 130+85.34 to Sta. 131+35.34, 88' wide, see Detail Sheet 17.

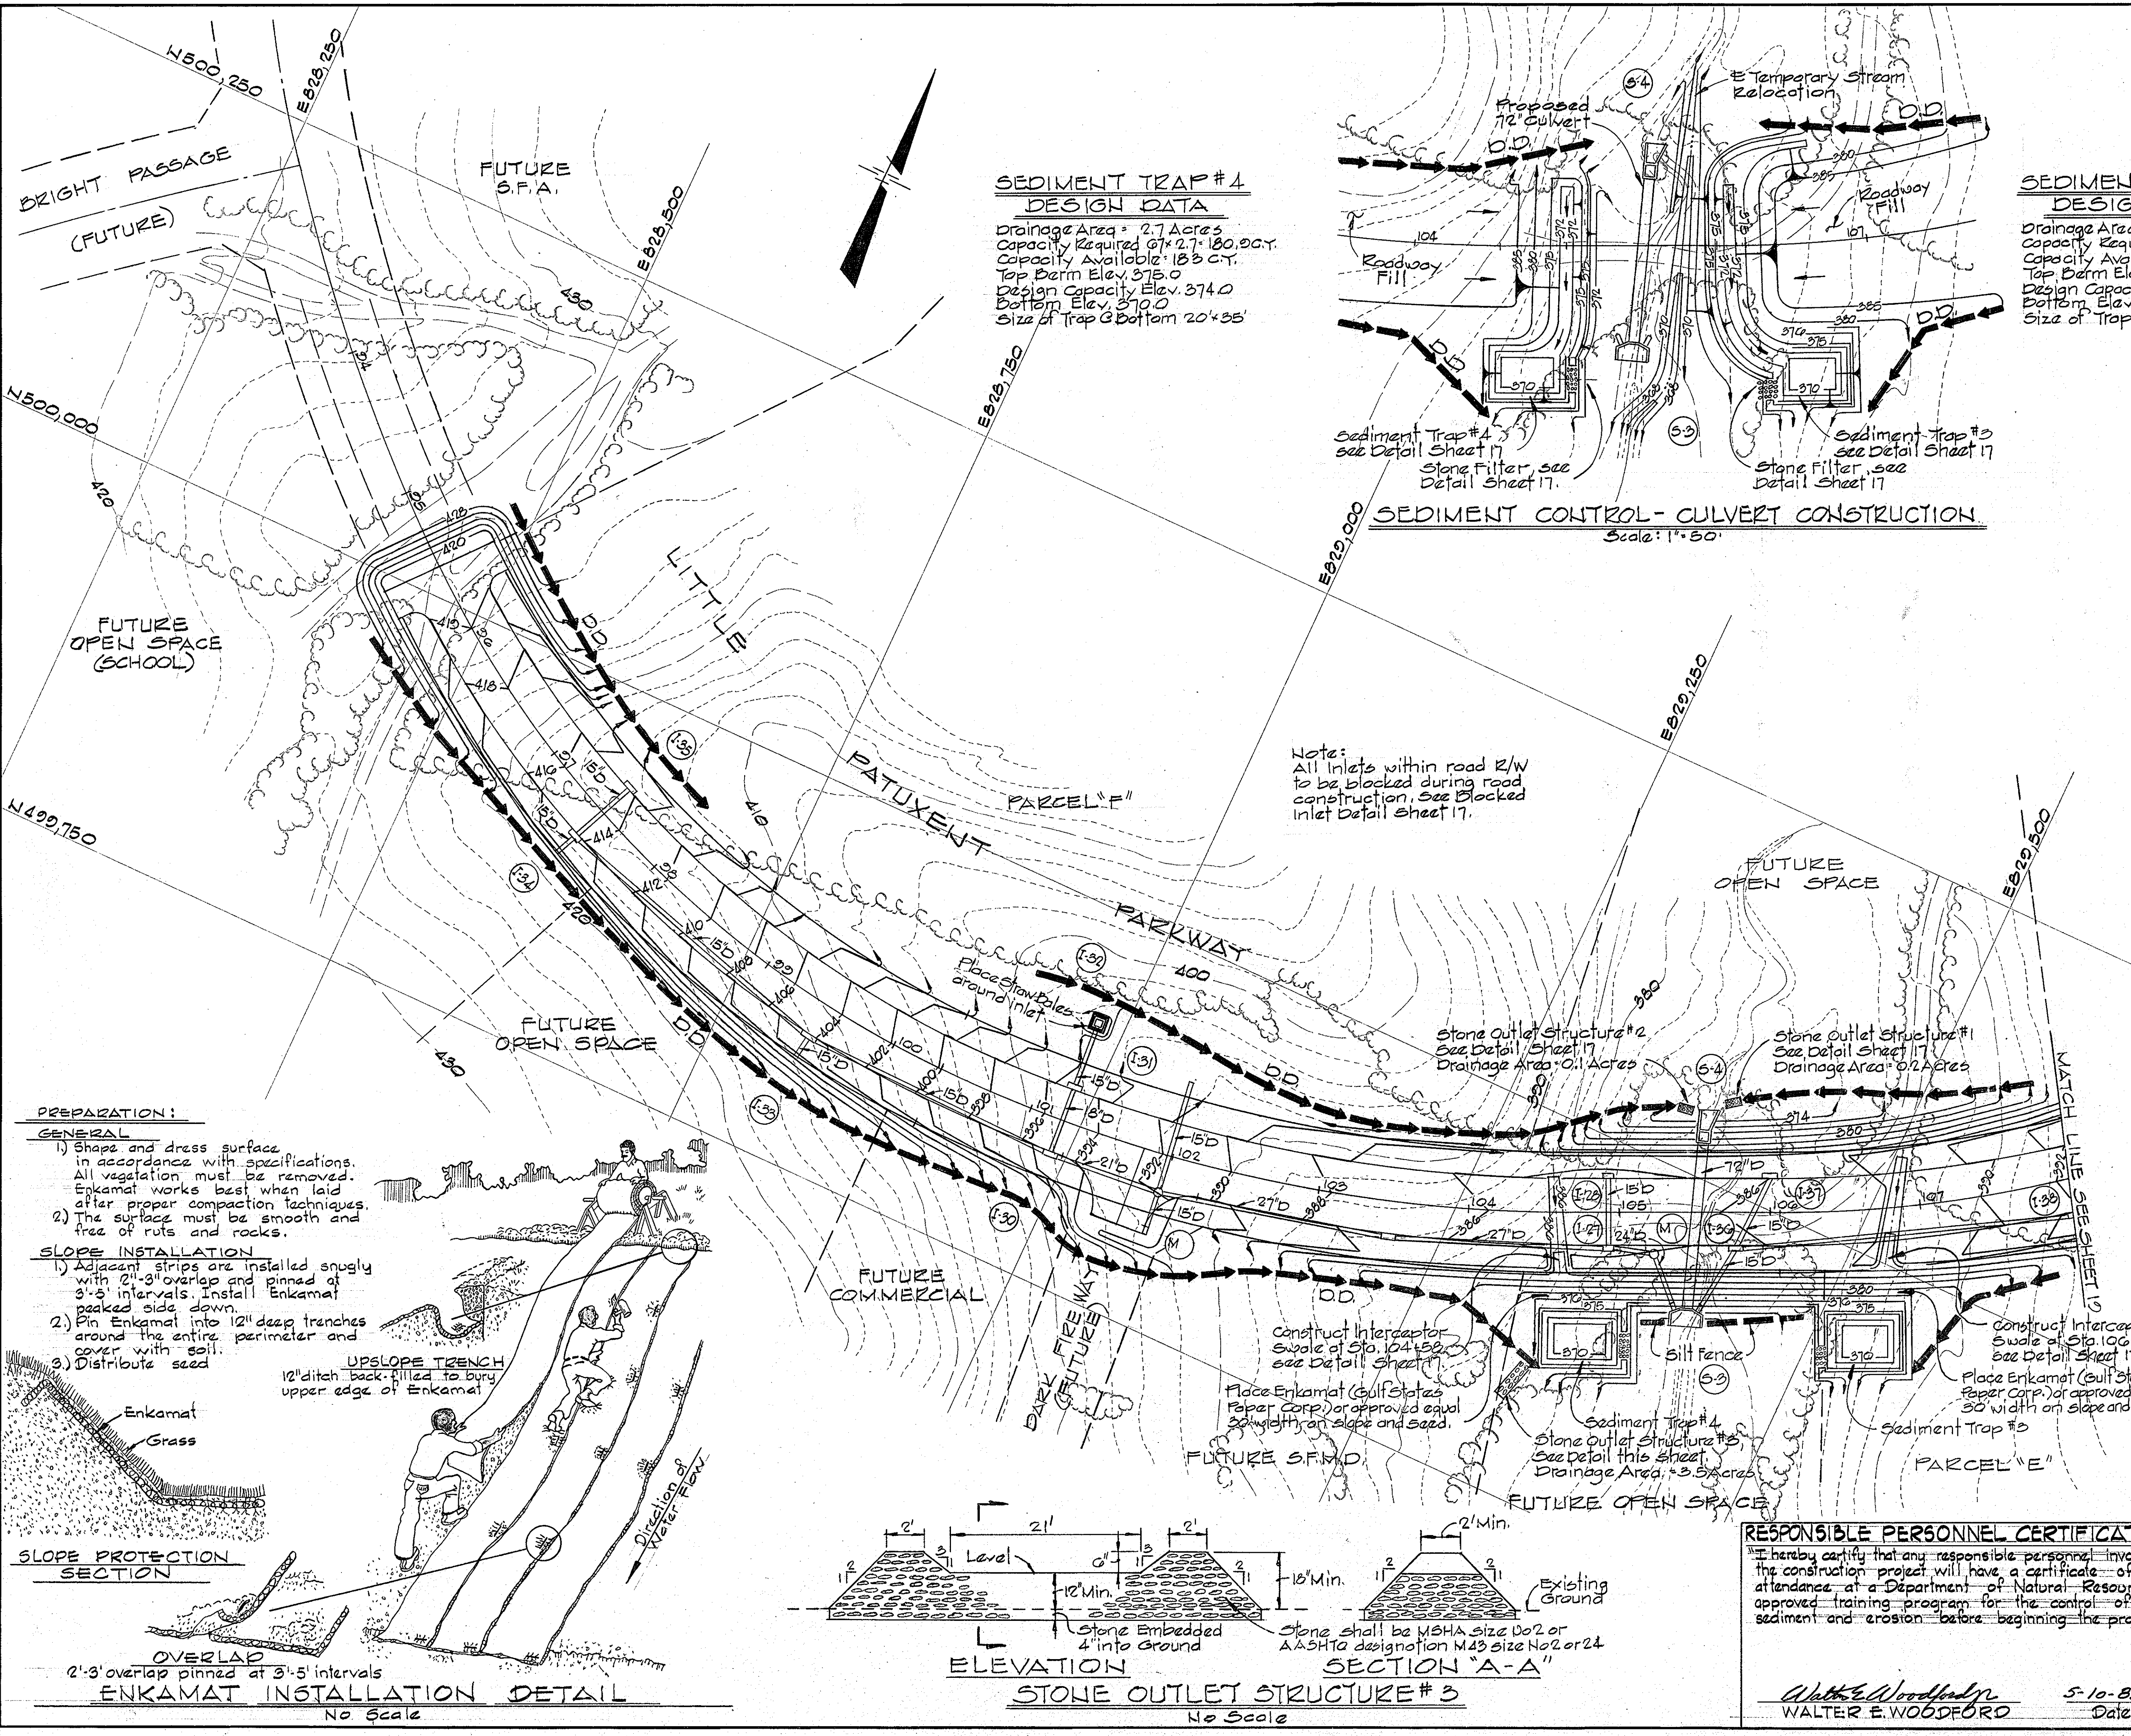

**SEDIMENT TRAP #4
 DESIGN DATA**
 Drainage Area = 2.7 Acres
 Capacity Required @ 2.7' 180 D.C.Y.
 Capacity Available: 183 C.Y.
 Top Berm Elev. 375.0
 Design Capacity Elev. 374.0
 Bottom Elev. 370.0
 Size of Trap @ Bottom 20'x35'

**SEDIMENT TRAP #3
 DESIGN DATA**
 Drainage Area = 2.4 Acres
 Capacity Required @ 2.4' 160 D.C.Y.
 Capacity Available: 162 C.Y.
 Top Berm Elev. 375.0
 Design Capacity Elev. 374.0
 Bottom Elev. 370.0
 Size of Trap @ Bottom 30'x40'

SEDIMENT CONTROL - CULVERT CONSTRUCTION
 Scale: 1"=50'

Note:
 All inlets within road R/W to be blocked during road construction, see Blocked inlet Detail sheet 17.

REVIEWED FOR HOWARD S.C.D.
 AND MEETS TECHNICAL REQUIREMENTS
 James Helmer 7/1/83 DATE
 U.S. SOIL CONSERVATION SERVICE
 THIS DEVELOPMENT PLAN IS APPROVED FOR SOIL EROSION AND SEDIMENT CONTROL BY THE HOWARD SOIL CONSERVATION DISTRICT.
 APPROVED [Signature] 7/21/83 DATE
 HOWARD S.C.D.

CERTIFICATION BY THE DEVELOPER
 I/WE CERTIFY THAT ALL DEVELOPMENT AND CONSTRUCTION WILL BE DONE ACCORDING TO THIS PLAN OF DEVELOPMENT AND PLAN FOR EROSION AND SEDIMENT CONTROL AND THAT ALL RESPONSIBLE PERSONNEL INVOLVED IN THE CONSTRUCTION PROJECT WILL HAVE A CERTIFICATE OF ATTENDANCE AT A DEPT. OF NATURAL RESOURCES APPROVED TRAINING PROGRAM FOR THE CONTROL OF SEDIMENT AND EROSION BEFORE BEGINNING THE PROJECT. I ALSO AUTHORIZE PERIODIC ON-SITE INSPECTION BY THE HOWARD SOIL CONSERVATION DISTRICT OR THEIR AUTHORIZED AGENTS, AS ARE DEEMED NECESSARY.

Walter E. Woodford 5-10-83 DATE
 WALTER E. WOODFORD

CERTIFICATION BY THE ENGINEER
 I CERTIFY THAT THIS PLAN FOR EROSION AND SEDIMENT CONTROL REPRESENTS A PRACTICAL AND WORKABLE PLAN BASED ON MY PERSONAL KNOWLEDGE OF THE SITE CONDITIONS AND THAT IT WAS PREPARED IN ACCORDANCE WITH THE REQUIREMENTS OF THE HOWARD SOIL CONSERVATION DISTRICT.

Kenneth A. McCord 5-4-83 DATE
 KENNETH A. MCCORD RE. 1974

7/1/83	1	As Per D.P.W. Sediment Control Comments
Rev. Date	Rev. No.	Revision Description

COLUMBIA
 5TH ELECTION DISTRICT
 HOWARD COUNTY, MARYLAND
 OWNER AND DEVELOPER
 HOWARD RESEARCH AND DEVELOPMENT CORP.
 PROJECT AREA
 VILLAGE OF HICKORY RIDGE
 SECTION 3 AREA 1

PROJECT TITLE
SEDIMENT CONTROL

SCALE: 1"=50' DATE:
 WHITMAN, REQUART AND ASSOCIATES
 ENGINEERS
 2315 ST PAUL STREET
 BALTIMORE, MARYLAND 21202

Kenneth A. McCord
 KENNETH A. MCCORD
 Registered Engineer
 No. 1974

RESPONSIBLE PERSONNEL CERTIFICATION
 I hereby certify that any responsible personnel involved in the construction project will have a certificate of attendance at a Department of Natural Resources approved training program for the control of sediment and erosion before beginning the project.

Walter E. Woodford 5-10-83 DATE
 WALTER E. WOODFORD


PREPARATION:

GENERAL

- 1) Shape and dress surface in accordance with specifications. All vegetation must be removed. Enkamat works best when laid after proper compaction techniques.
- 2) The surface must be smooth and free of ruts and rocks.

SLOPE INSTALLATION


- 1) Adjacent strips are installed snugly with 2'-3" overlap and pinned at 3'-5' intervals. Install Enkamat peaked side down.
- 2) Pin Enkamat into 12" deep trenches around the entire perimeter and cover with soil.
- 3) Distribute seed.

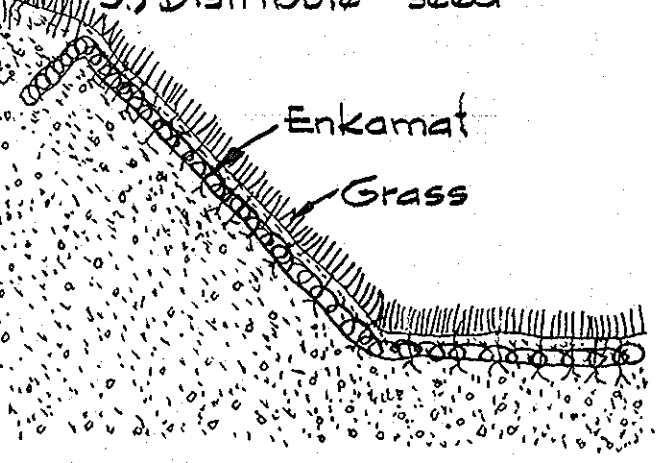

SLOPE PROTECTION SECTION

UPSLOPE TRENCH
 12" ditch back-filled to bury upper edge of Enkamat

OVERLAP ENKAMAT INSTALLATION DETAIL
 2'-3" overlap pinned at 3'-5' intervals
 No Scale

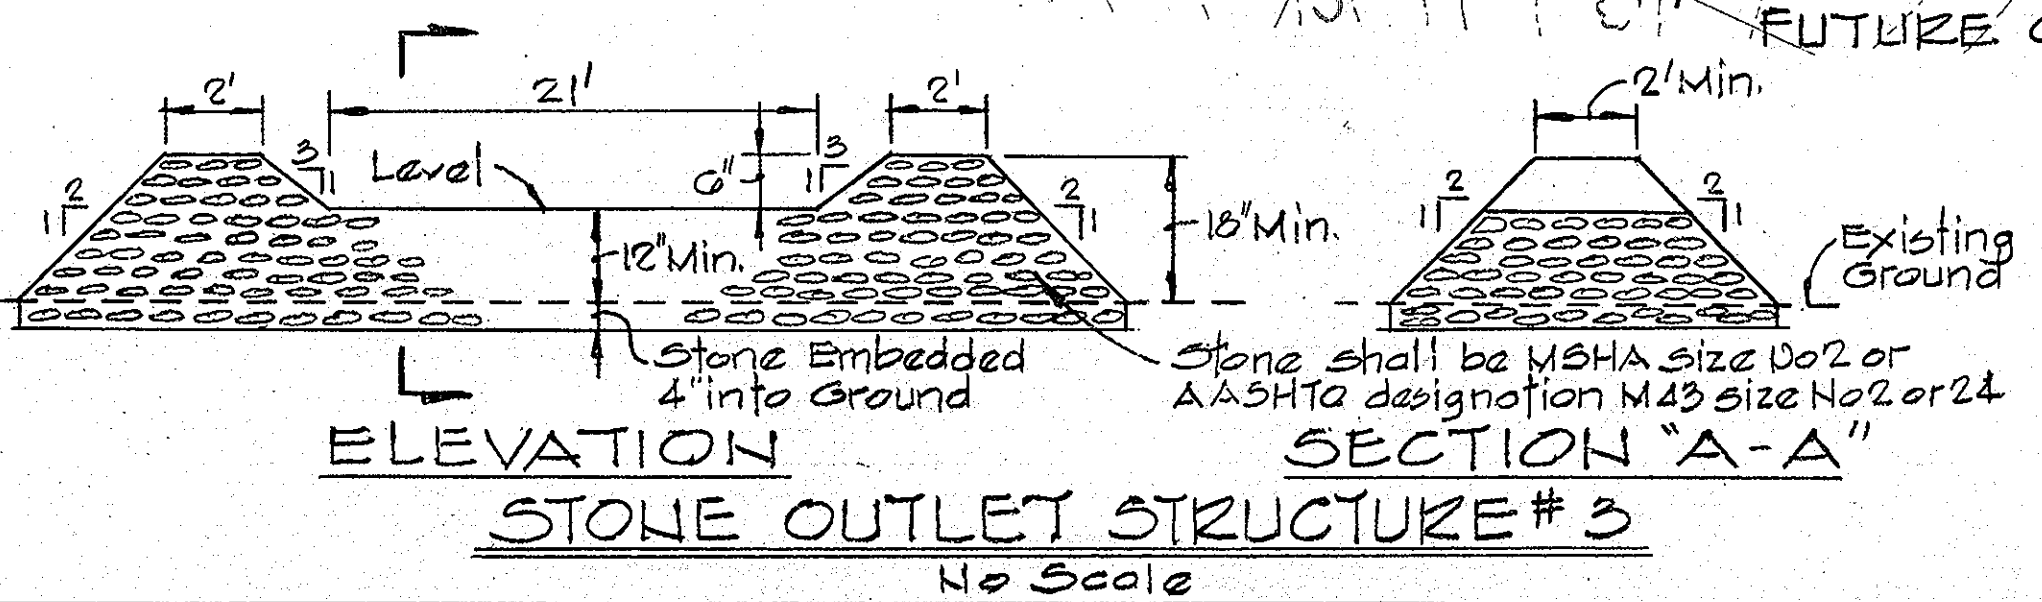

Construct Interceptor Swale of Sta. 104+58.3 see Detail Sheet 17

Place Enkamat (Gulf States Paper Corp.) or approved equal 20' width on slope and seed.


Sediment Trap #4
 Stone Outlet Structure #3
 See Detail this sheet
 Drainage Area = 3.5 Acres

Construct Interceptor Swale of Sta. 106+83, see Detail Sheet 17.

Place Enkamat (Gulf States Paper Corp.) or approved equal 30' width on slope and seed.

Sediment Trap #3

#42

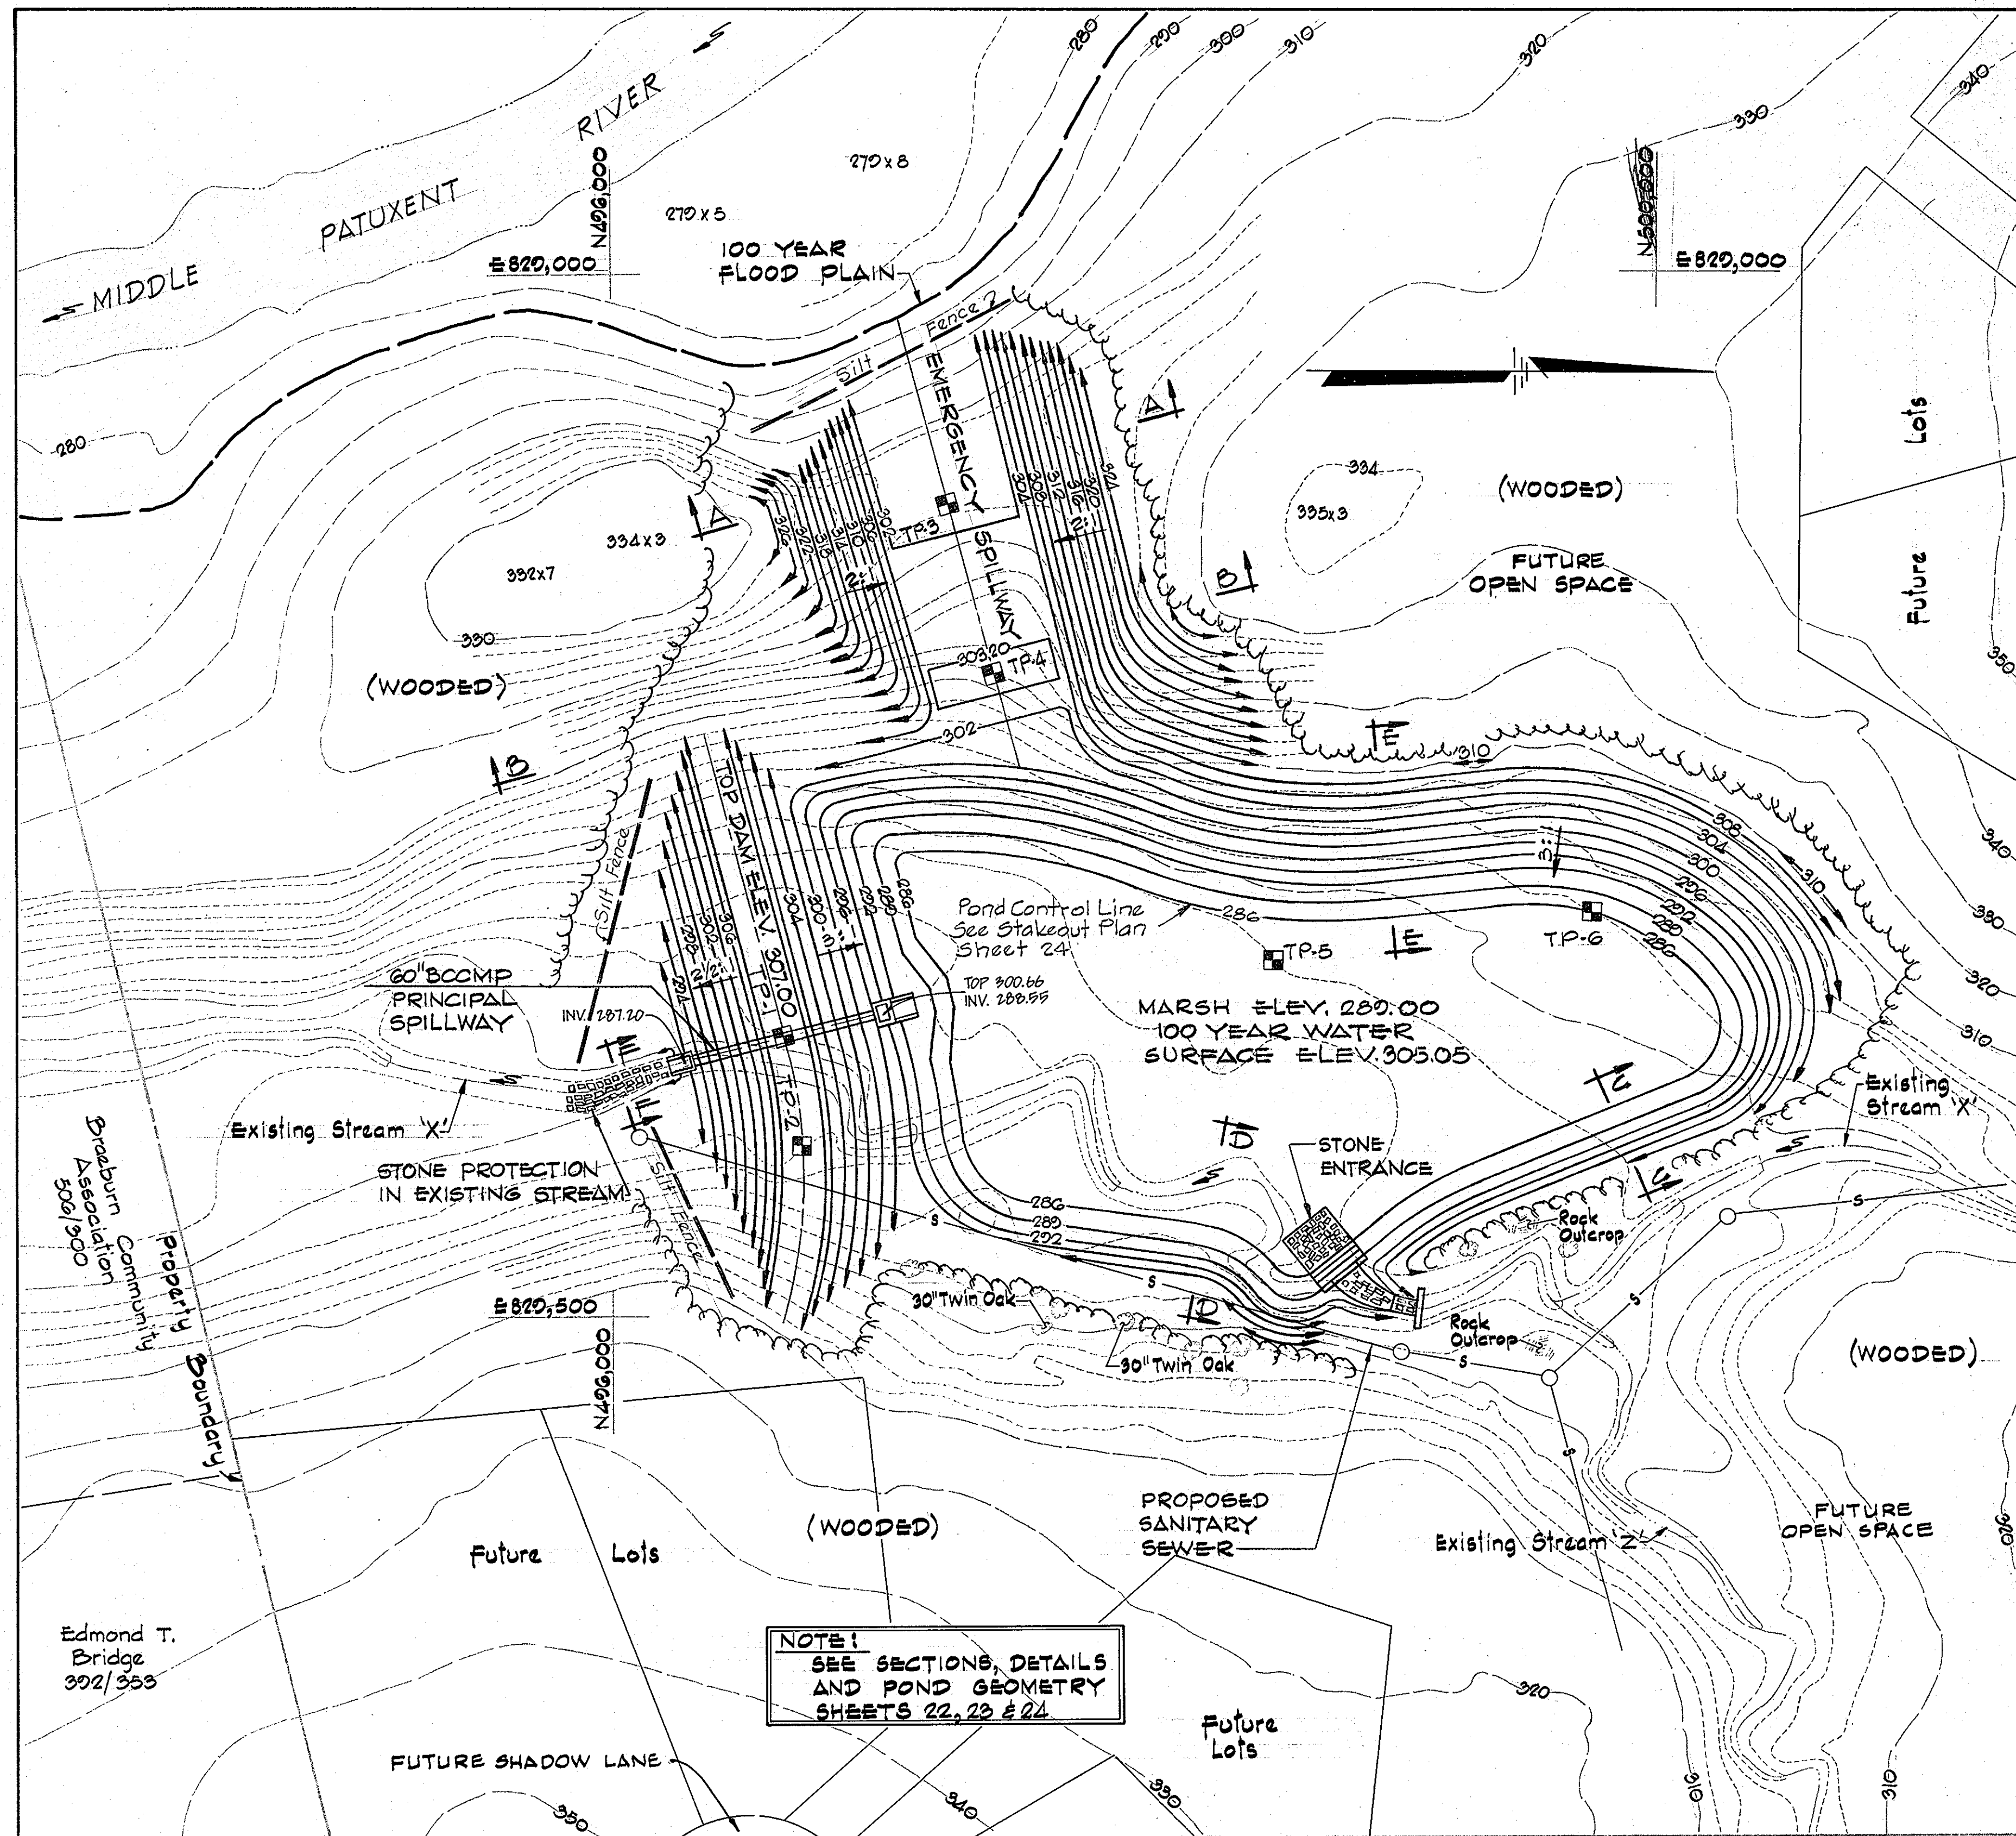

STORM WATER MANAGEMENT POND

Scale: 1"=50'

"As-Built" ELEVATIONS AS OF NOV. 19, 1984
BY: KENNETH A. McCORD PE#1974

Technical Review by Water Resources Administration Permit 83-P1-0866B
These plans have been reviewed for the Howard Soil Conservation District and meet the technical requirements for soil erosion and sediment control.
Approved: *[Signature]* 7/11/83
U.S. Soil Conservation Service Date

These plans for soil erosion and sediment control meet the requirements of the Howard Soil Conservation District.
Approved: *[Signature]* 7/2/83
Howard S.C.D. Date
F-83-120
Plan Number

CERTIFICATION BY THE ENGINEER
"I certify that this plan for pond construction, erosion, and sediment control represents a practical and workable plan based on my personal knowledge of the site conditions. This plan was prepared in accordance with the requirements of the Howard Soil Conservation District. I have notified the developer that he must provide the Howard Soil Conservation District with a red-lined "as-built" of the pond within 90 days of completion."
[Signature]
KENNETH A. McCORD PE No. 1974
5-4-83
Date

CERTIFICATION BY THE DEVELOPER
"I certify that all development and/or construction will be done according to these plans of development, pond construction and erosion and sediment control. I also authorize periodic on-site inspection by the Howard Soil Conservation District or their authorized agents, as are deemed necessary. Deviation from this plan will not be made unless authorized by the Howard Soil Conservation District. I will provide the Howard Soil Conservation District with a red-lined "as-built" of the pond within 90 days of completion."
[Signature]
WALTER WOODFORD
5-10-83
Date

RESPONSIBLE PERSONNEL CERTIFICATION
"I hereby certify that any responsible personnel involved in the construction project will have a certificate of attendance at a Department of Natural Resources approved training program for the control of sediment and erosion before beginning the project."
[Signature]
WALTER WOODFORD
5-10-83
Date

7-1-83	1	As Per D.P.W. & Sediment Control Comments
Rev. Date	Rev. No.	Revision Description
COLUMBIA 5 th ELECTION DISTRICT HOWARD COUNTY, MARYLAND OWNER AND DEVELOPER HOWARD RESEARCH AND DEVELOPMENT CORPORATION PROJECT AREA VILLAGE OF HICKORY RIDGE SECTION 3 AREA 1 PROJECT TITLE: STORM WATER MANAGEMENT POND SCALE: As Shown DATE:		
WHITMAN, REQUARD AND ASSOCIATES ENGINEERS 2315 ST. PAUL STREET BALTIMORE, MARYLAND 21218 <i>[Signature]</i> KENNETH A. McCORD Registered Engineer No. 1974		

- SPECIFICATIONS -

- GENERAL**
- For construction specifications not covered herein, the contractor shall refer to the "Soil Conservation Service of Maryland Construction Specifications for Ponds, Code 378", pages 378-14 through 378-19 dated July 1981.
- EARTH DAM EMBANKMENT**
- Suitable material from the pond excavation may be used for the embankment.
 - Suitable material shall be placed in 8" loose layers and compacted to 95% of Standard Proctor ASTM T-99.
 - Moisture content of the suitable material shall be within the range of 3% below optimum moisture to 3% above optimum moisture.
 - Area under the embankment shall be cleared and grubbed to remove all trees, vegetation, roots or other objectionable material and topsoil stripped.
 - The fill material shall be free from roots, stumps, wood, rubbish, oversize stones, frozen earth or other objectionable materials. The fill height all along the length of the embankment shall be increased by 10%.
 - Fill materials shall be placed in 8" maximum thickness (before compaction) layers which are to be continuous over the entire length of the fill. The most porous material shall be placed in the downstream portions of the embankment. Backfill for the Cutoff Trench and the upstream side of the Dam shall be the most impervious material available.
 - Compaction shall be by multiple wheel pneumatic tired roller, vibratory roller or other types of acceptable rollers. Rolling of each layer shall be continuous over its entire area and the roller shall make sufficient coverages to insure that the required density has been obtained.
- 60" BCCMP**
- Backfill around B.C.C.M.P. pipe shall be placed in horizontal layers not to exceed 4 inches in thickness and compacted by hand tampers or other compaction equipment. At no time during the back filling operation, shall construction equipment be allowed to operate closer than 4 feet to any part of the B.C.C.M.P. pipe. Under no circumstances shall the contractor drive equipment over any part of the B.C.C.M.P. pipe unless there is a compacted fill to a depth of 24 inches or greater over the B.C.C.M.P. pipe.
 - The B.C.C.M.P. pipe shall be firmly and uniformly bedded throughout its entire length. Where rock or other unsuitable soil is encountered under the pipe, all such material shall be removed and replaced with suitable earth compacted to provide adequate support.
- PERMANENT SEEDING**
- ALL DISTURBED AREAS SHALL BE STABILIZED AS FOLLOWS:
- SEED PREPARATION: Loosen upper 3 inches of soil by raking, discing or other acceptable means before seeding.
 - SOIL AMENDMENTS: Apply 2 tons per acre dolomitic limestone (92 lbs./1,000 sq. ft.) and 600 lbs. per acre 0-20 fertilizer (14 lbs./1,000 sq. ft.). Harrow or disc time and fertilizer into upper three inches of soil. At time of seeding, apply 400 lbs. per acre (9.2 lbs./1,000 sq. ft.) of 38-0-0 ureaform fertilizer and 500 lbs. per acre (11.5 lbs./1,000 sq. ft.) of 10-20-20 fertilizer.
 - SEEDING: For the periods March 1 thru April 30, and August 1 thru October 15, seed with 45 lbs. per acre (1.4 lbs./1,000 sq. ft.) of Kentucky 31 Tall Fescue. For the period May 1 thru July 31, seed with 45 lbs. Kentucky 31 Tall Fescue per acre and 2 lbs. per acre (.05 lbs./1,000 sq. ft.) of weeping lovegrass. During the period of October 16 thru February 28, protect site by: Option (1)-2 tons per acre of well anchored straw mulch and seed as soon as possible in the spring. Option (2)-use sod. Option (3)-seed with 60 lbs./acre Kentucky 31 Tall Fescue and mulch with 2 tons/acre well anchored straw.
 - EROSION CONTROL FABRIC: "Hold Gro", Gulf State Paper Corporation, P.O.B. No. 3199 Tuscaloosa, Alabama, 35404, or an approved equal. Install as recommended by the Manufacturer.
 - MAINTENANCE: Inspect all seeded areas and make needed repairs, replacements, and reseedings.
 - Add Crown Vetch leguminous seed to mixture on 2:1 slopes. Seed mixture shall be sown at the rate of 45 pound/acre with Crown Vetch sown at 15 pound/acre. Inoculant for Crown Vetch shall be at the rate of 6.7 oz. powder or liquid culture per 20 pounds Crown Vetch. Seed inoculated with liquid culture shall be sown within 24 hours after treatment; seed inoculated with powdered culture shall be sown within 48 hours after treatment. The seeding contractor may elect to apply the inoculated legume seed dry and in a separate operation prior to applying an aqueous mixture, or he may apply them in the aqueous mixture with the seed and commercial fertilizer using four times the quantity of inoculum recommended for dry leguminous seed application.

SITE HYDROLOGY

FREQUENCY FLOOD EVENT	* PRESENT LAND USE DISCHARGE - CFS	* ULTIMATE LAND USE DISCHARGE - CFS	* ULTIMATE LAND USE WITH MANAGEMENT DISCHARGE - CFS
2 YEAR	114	330	118
10 YEAR	460	843	462
100 YEAR	979	1486	1157

* DESIGN POINT CONFLUENCE OF FLOWS, MIDDLE PATUXENT RIVER AND STREAM "X"











POND HYDRAULICS (Ultimate Land Use)

FREQUENCY FLOOD EVENT	* PEAK INFLOW CFS	* PEAK OUTFLOW CFS	* STORAGE AC. FT.
2 YEAR	211	43	15.7
10 YEAR	535	261	30.4
100 YEAR	975	814	38.5

SPECIAL NOTES

STORM WATER MANAGEMENT (POND DRAINAGE AREA - 417 ACRES)
The Storm Water Management construction drawings, (Sheets 21 thru 25); Hydrologic and Hydraulic computations and a pond permit application have been submitted to the Maryland State Dept. of Natural Resources for review.

SEDIMENT CONTROL
The final pond bottom elevation is 286.00 which is several feet below existing stream invert. The pond has been designed to provide approximately 4.0 acre feet of permanent sediment storage. During construction the contractor shall provide a natural earth diversion berm along the immediate perimeter of the existing and/or redirected stream. See Detail, Sheet 24. The Contractor shall also provide a silt fence on the downstream side of the proposed earth dam embankment. See Plan this Sheet. See silt fence detail, Sheet 17.

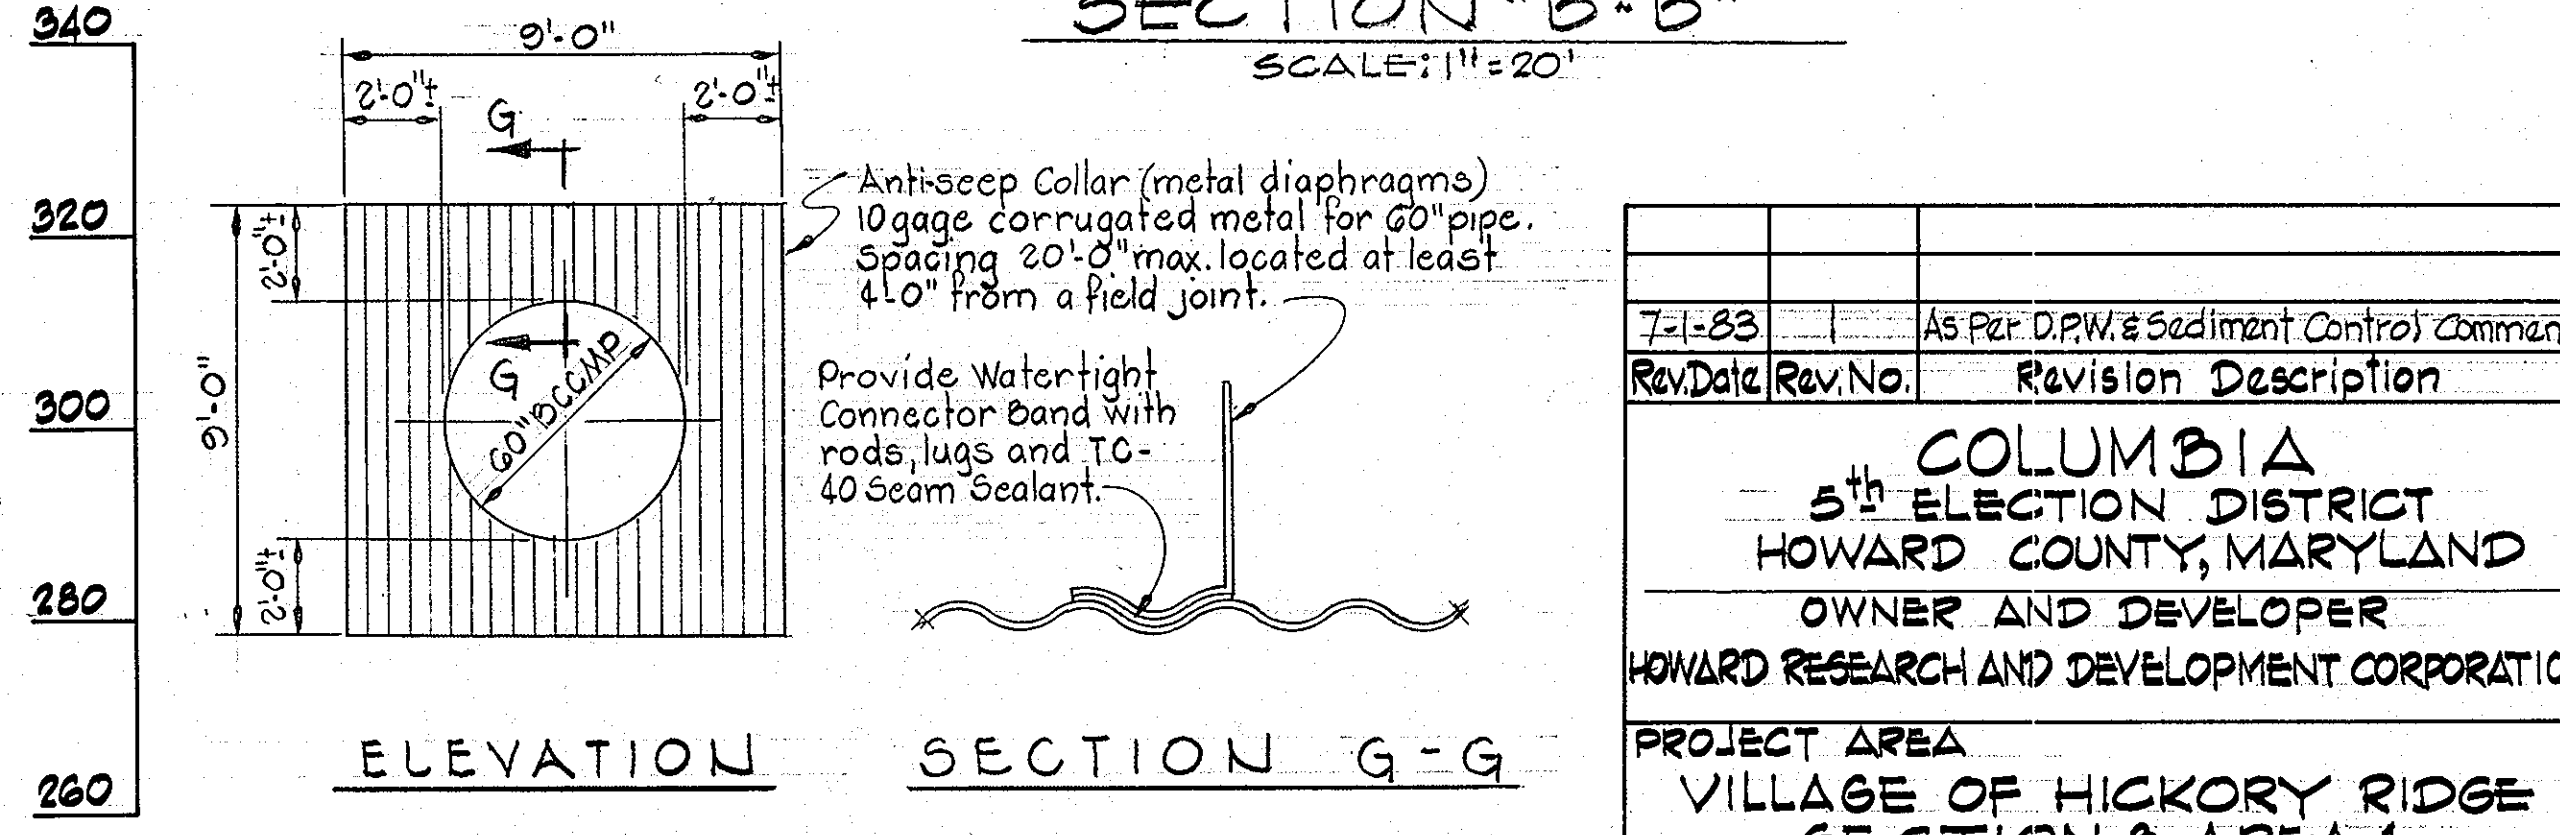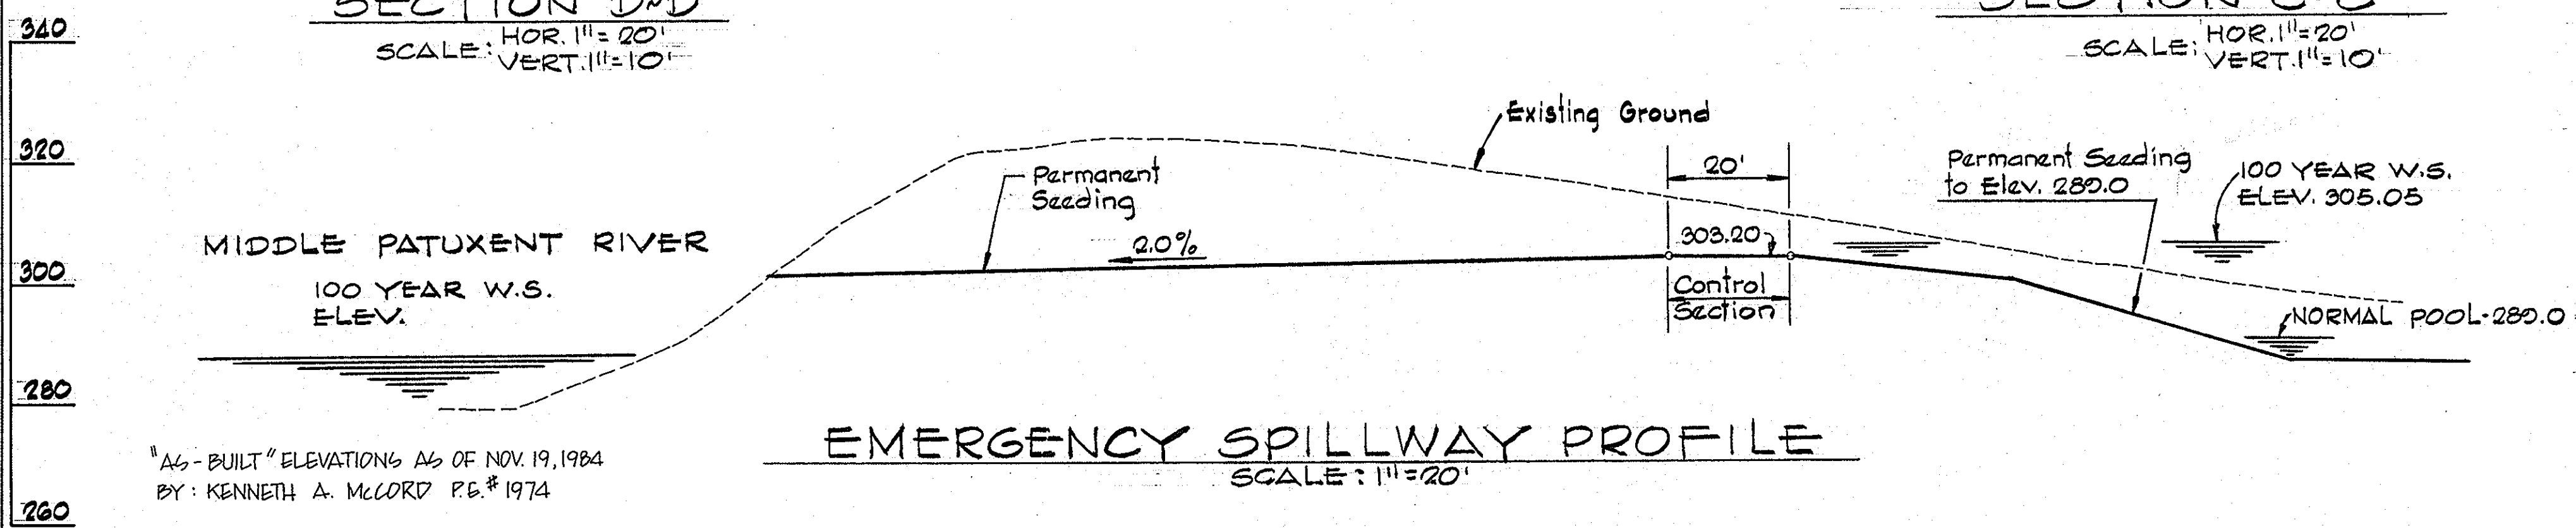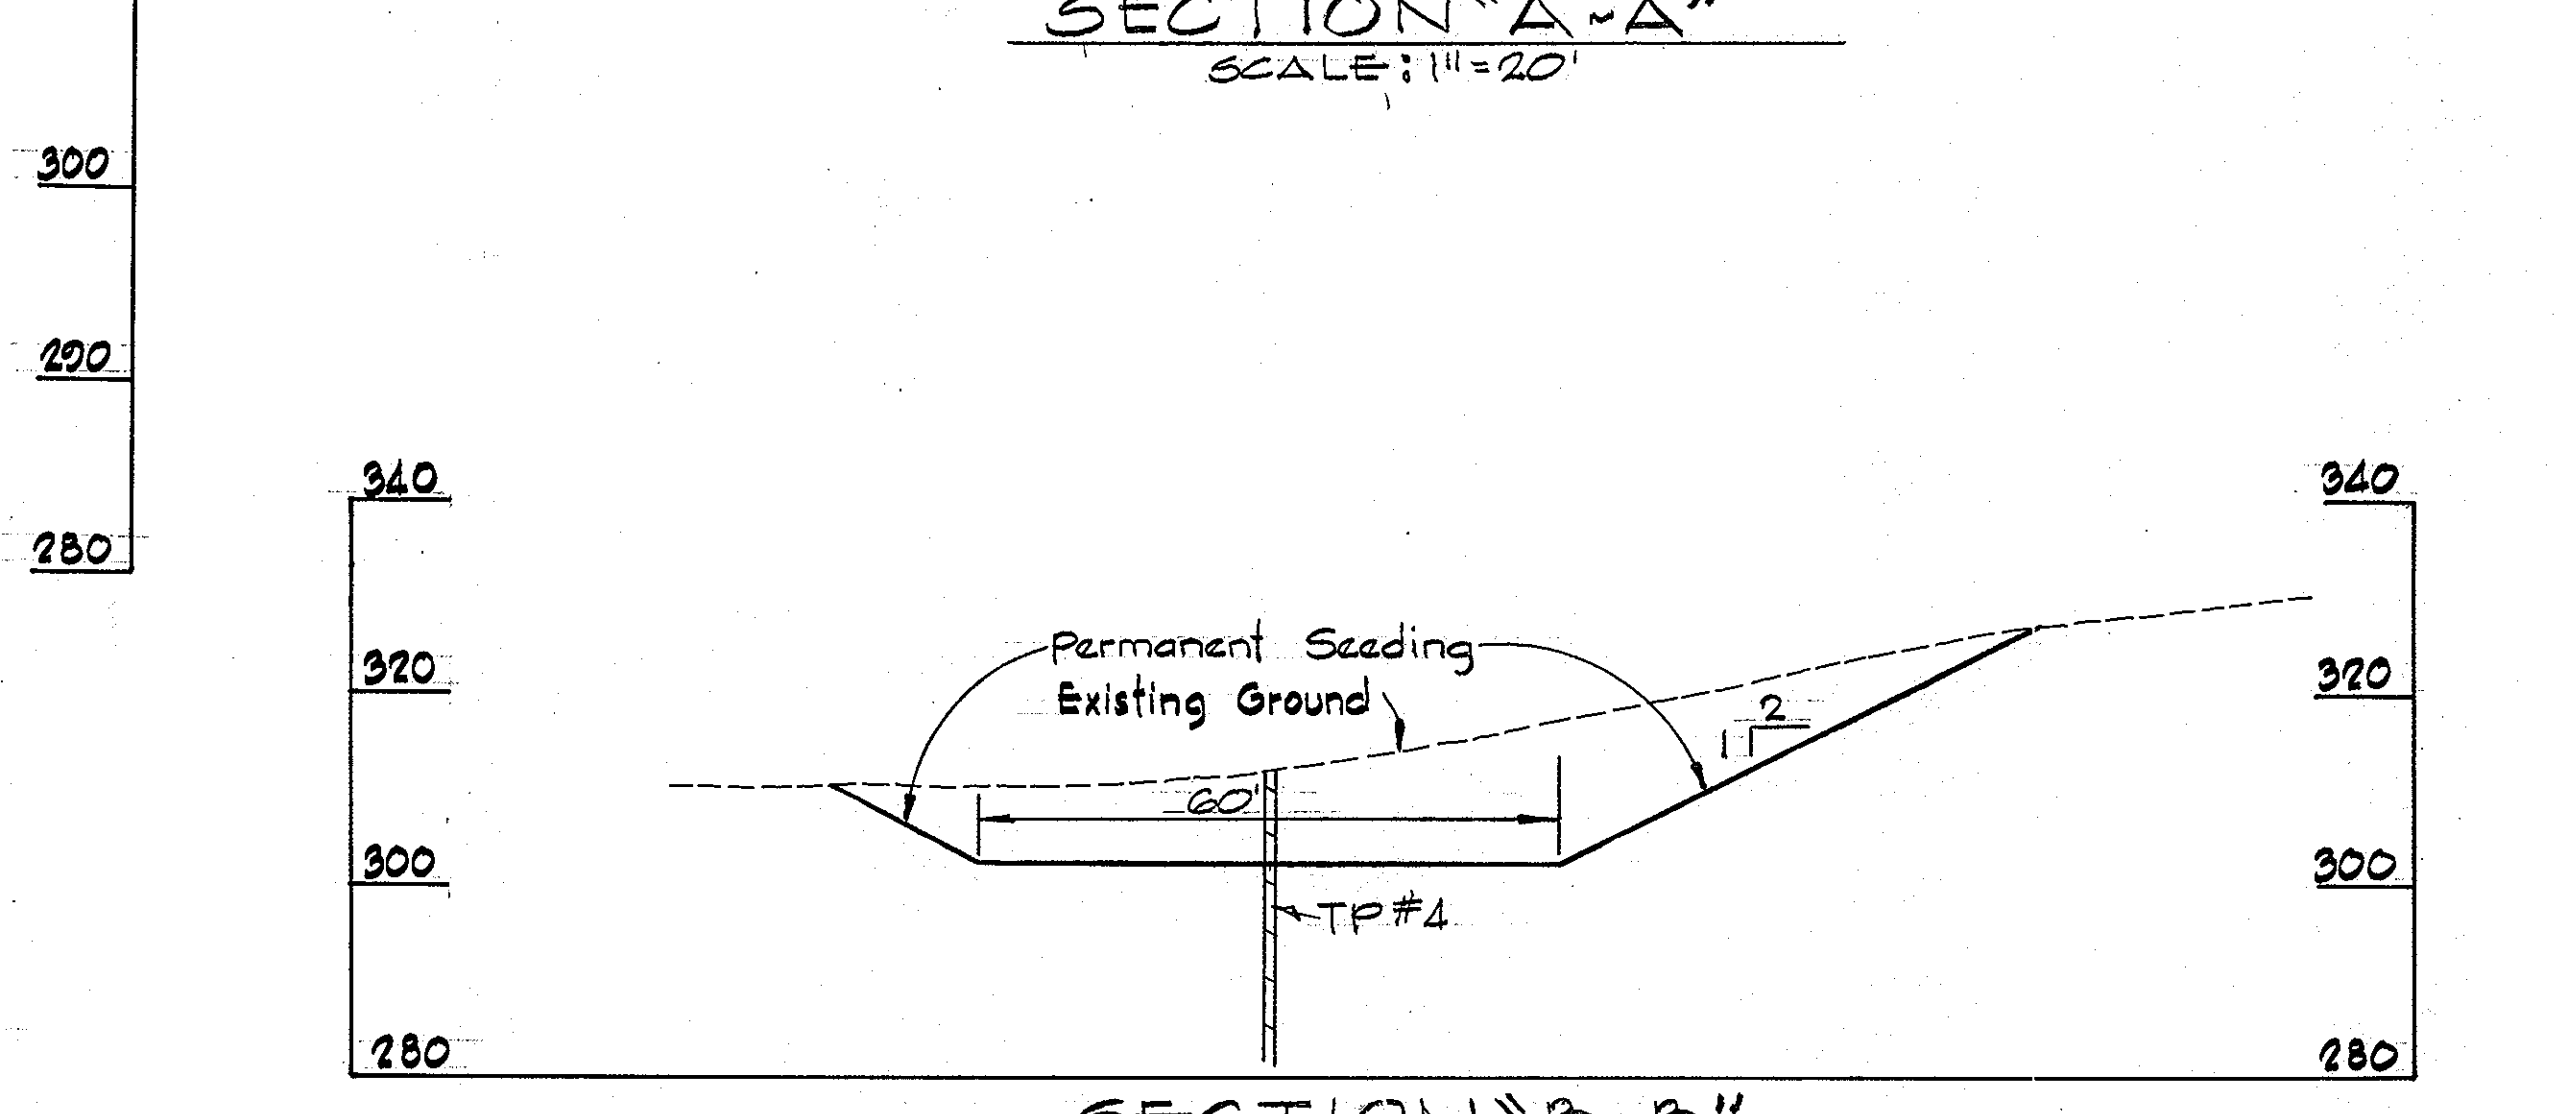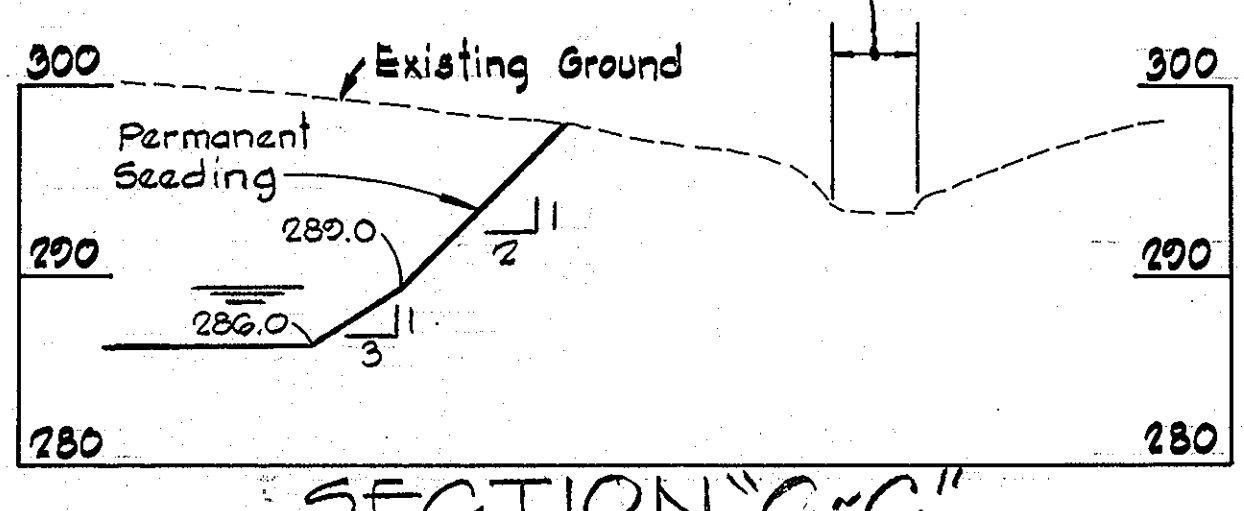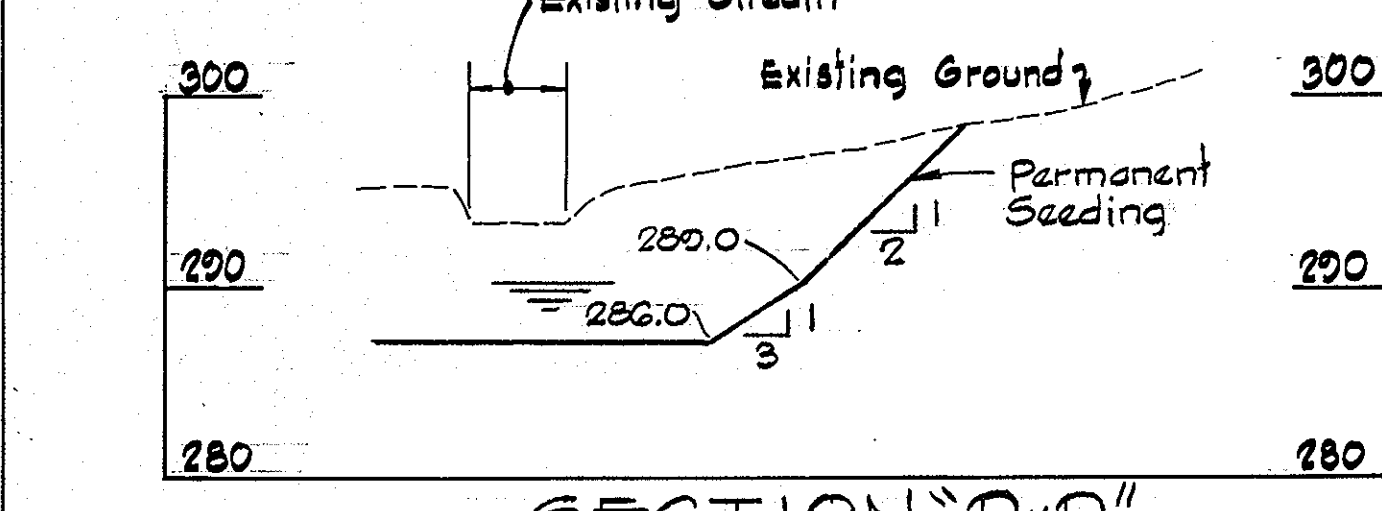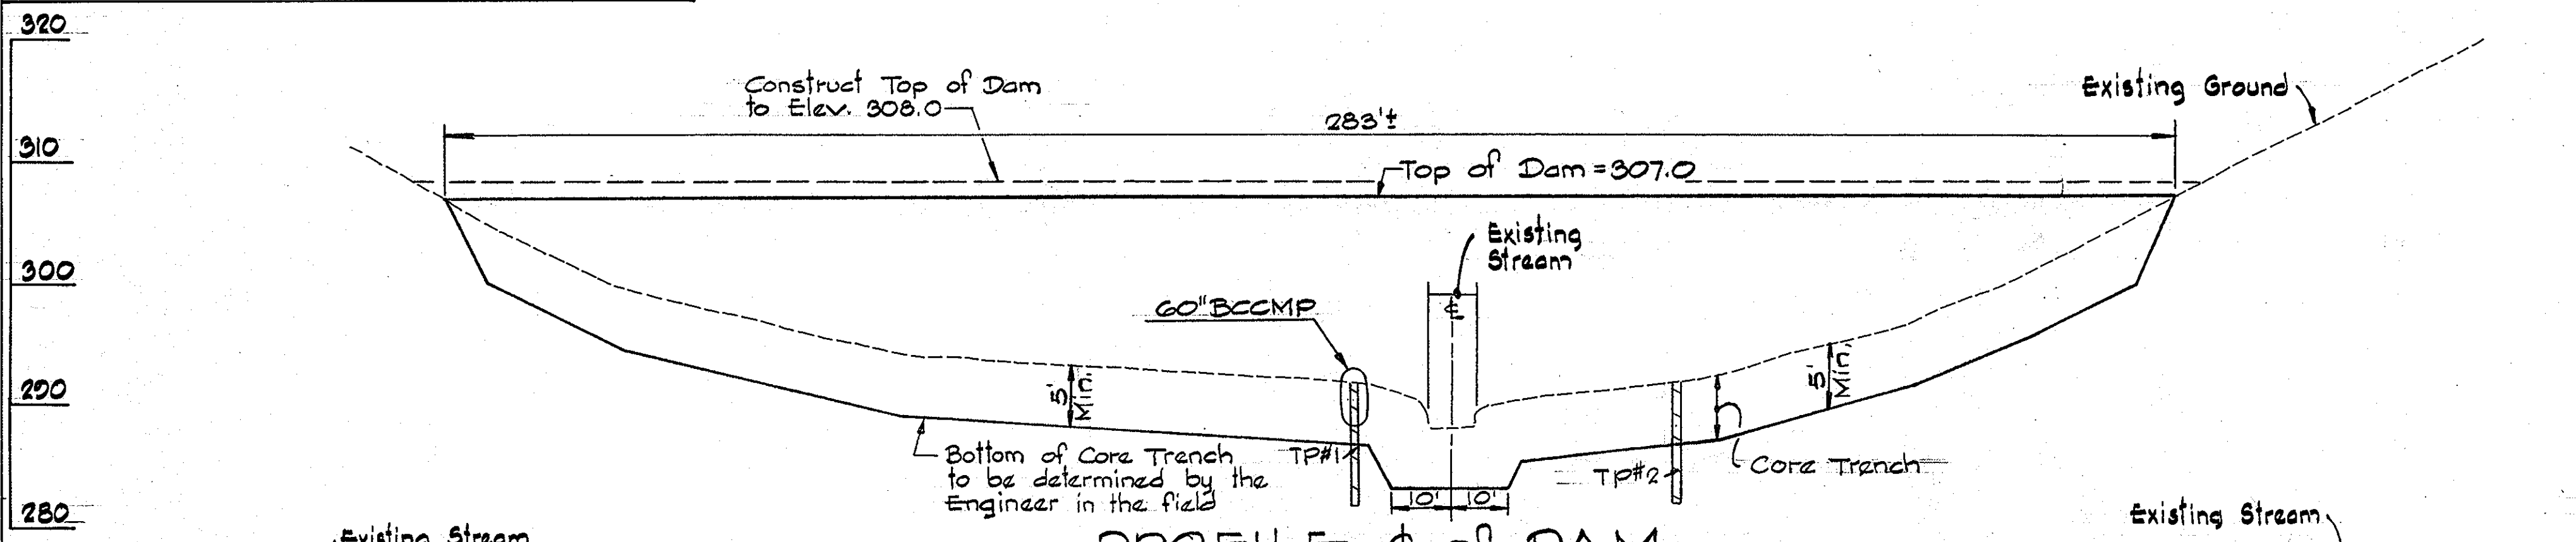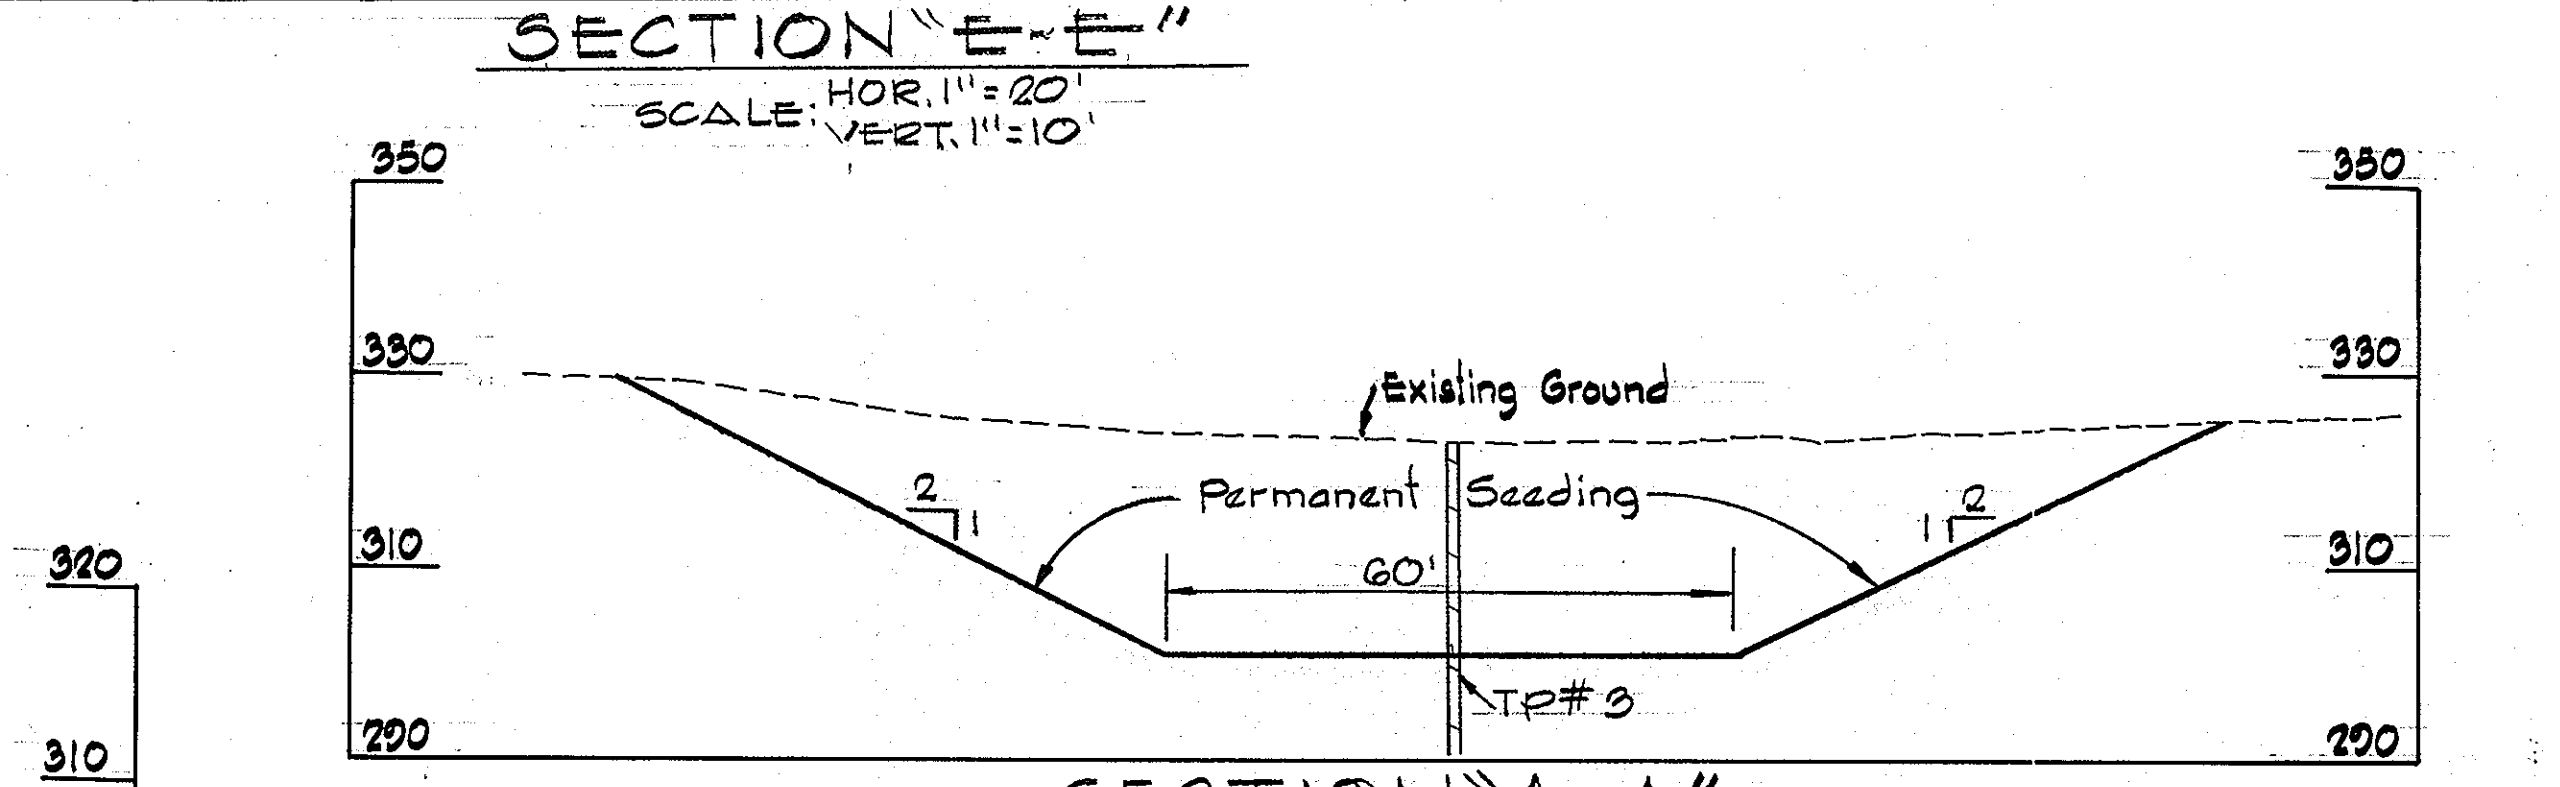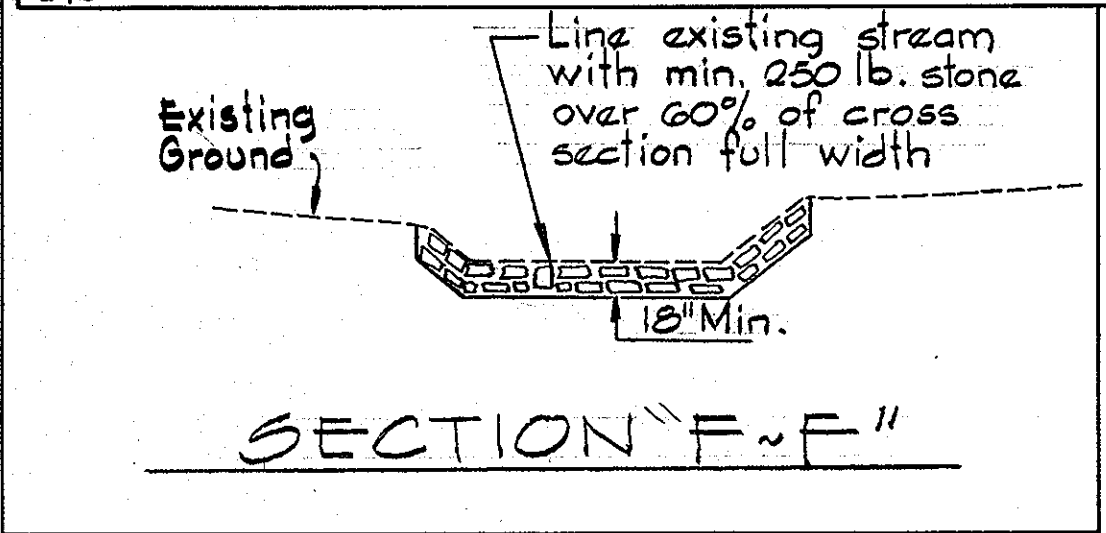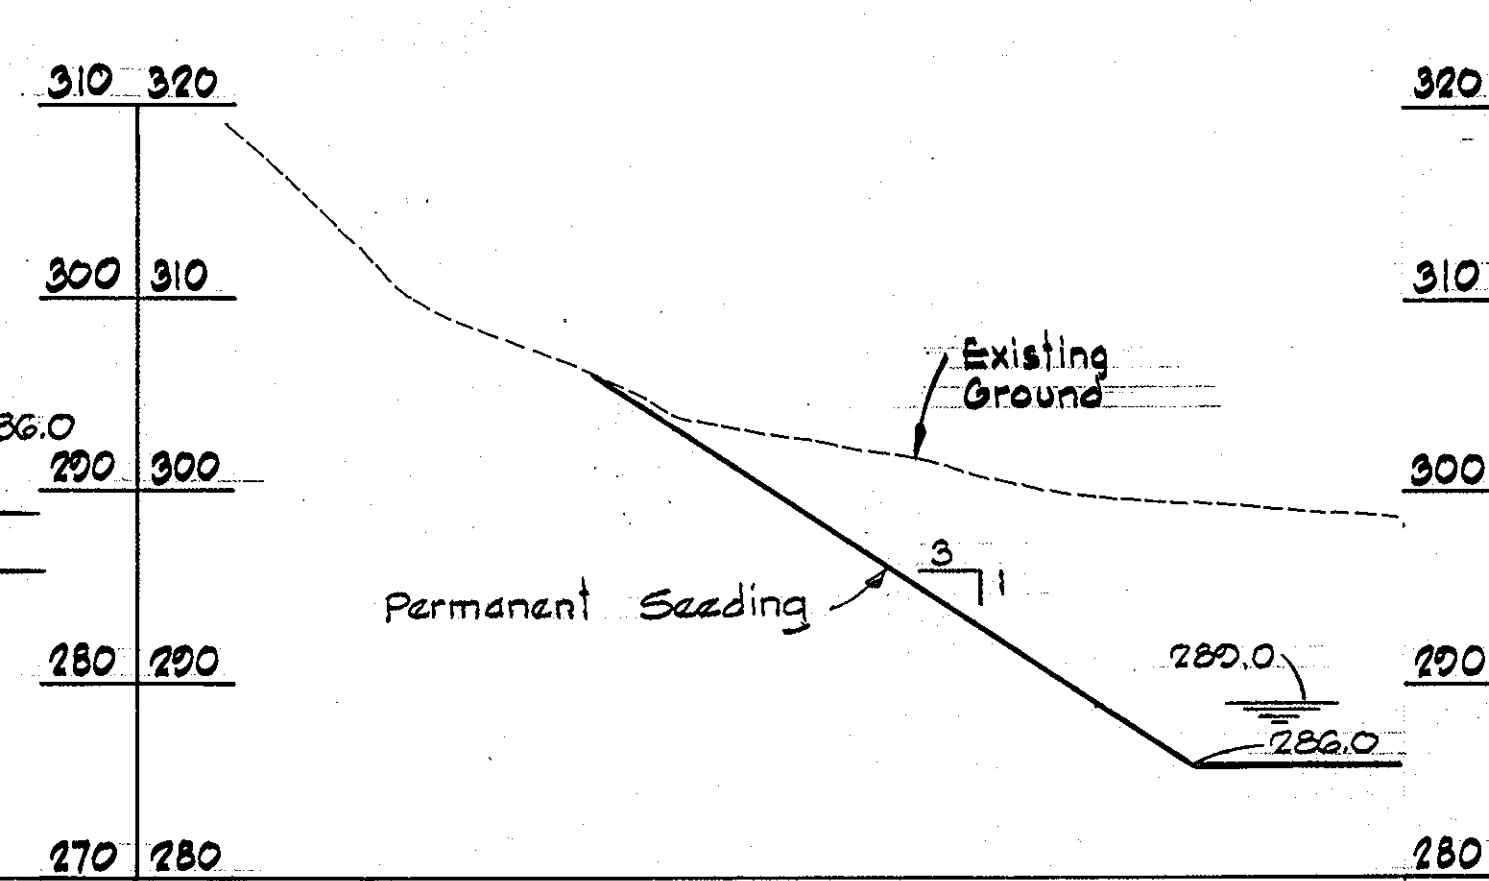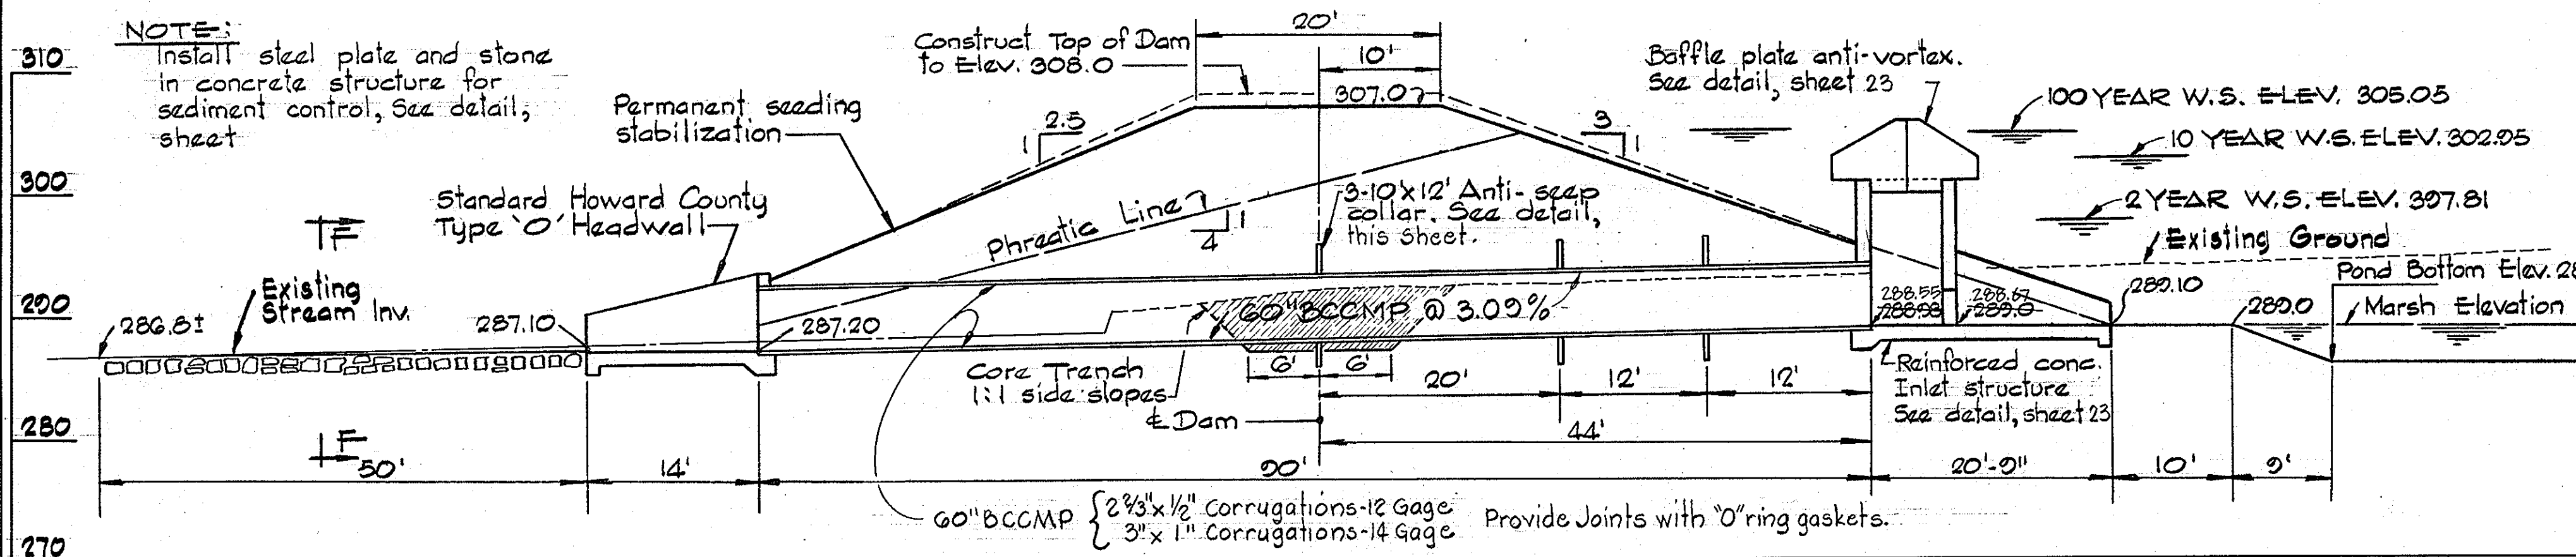

Technical Review by Water Resources Administration Permit 83-PD-0868

These plans have been reviewed for the Howard Soil Conservation District and meet the technical requirements for soil erosion and sediment control.

Approved: *James Hillman* 7/21/83
 U.S. Soil Conservation Service Date

These plans for soil erosion and sediment control meet the requirements of the Howard Soil Conservation District.

Approved: *James Hillman* 7/21/83
 Howard S.C.D. Date
 F-83-120
 Plan Number

CERTIFICATION BY THE ENGINEER

I certify that this plan for pond construction, erosion, and sediment control represents a practical and workable plan based on my personal knowledge of the site conditions. This plan was prepared in accordance with the requirements of the Howard Soil Conservation District. I have notified the developer that he must provide the Howard Soil Conservation District with a red-lined "as-built" of the pond within 30 days of completion.

Kenneth A. McCord
 KENNETH A. MCCORD P.E. No. 1974 Date

CERTIFICATION BY THE DEVELOPER

I certify that all development and/or construction will be done according to these plans of development, pond construction and erosion and sediment control. I also authorize periodic on-site inspection by the Howard Soil Conservation District or their authorized agents, as are deemed necessary. Deviation from this plan will not be made unless authorized by the Howard Soil Conservation District. I will provide the Howard Soil Conservation District with a red-lined "as-built" of the pond within 30 days of completion.







Walter Woodford
 WALTER WOODFORD Date

RESPONSIBLE PERSONNEL CERTIFICATION


I hereby certify that any responsible personnel involved in the construction project will have a certificate of attendance at a Department of Natural Resources approved training program for the control of sediment and erosion before beginning the project.

Walter Woodford
 WALTER WOODFORD Date

7-1-83	As Per D.P.W. & Sediment Control Comments
Rev. Date/Rev. No.	Revision Description
COLUMBIA 5 TH ELECTION DISTRICT HOWARD COUNTY, MARYLAND OWNER AND DEVELOPER HOWARD RESEARCH AND DEVELOPMENT CORPORATION PROJECT AREA VILLAGE OF HICKORY RIDGE SECTION 3 AREA 1 PROJECT TITLE STORM WATER MANAGEMENT POND	
SCALE: As Shown	DATE:
WHITMAN, REQUARDT AND ASSOCIATES ENGINEERS 2315 ST. PAUL STREET BALTIMORE, MARYLAND 21218 <i>Kenneth A. McCord</i> KENNETH A. MCCORD Registered Engineer No. 1974	

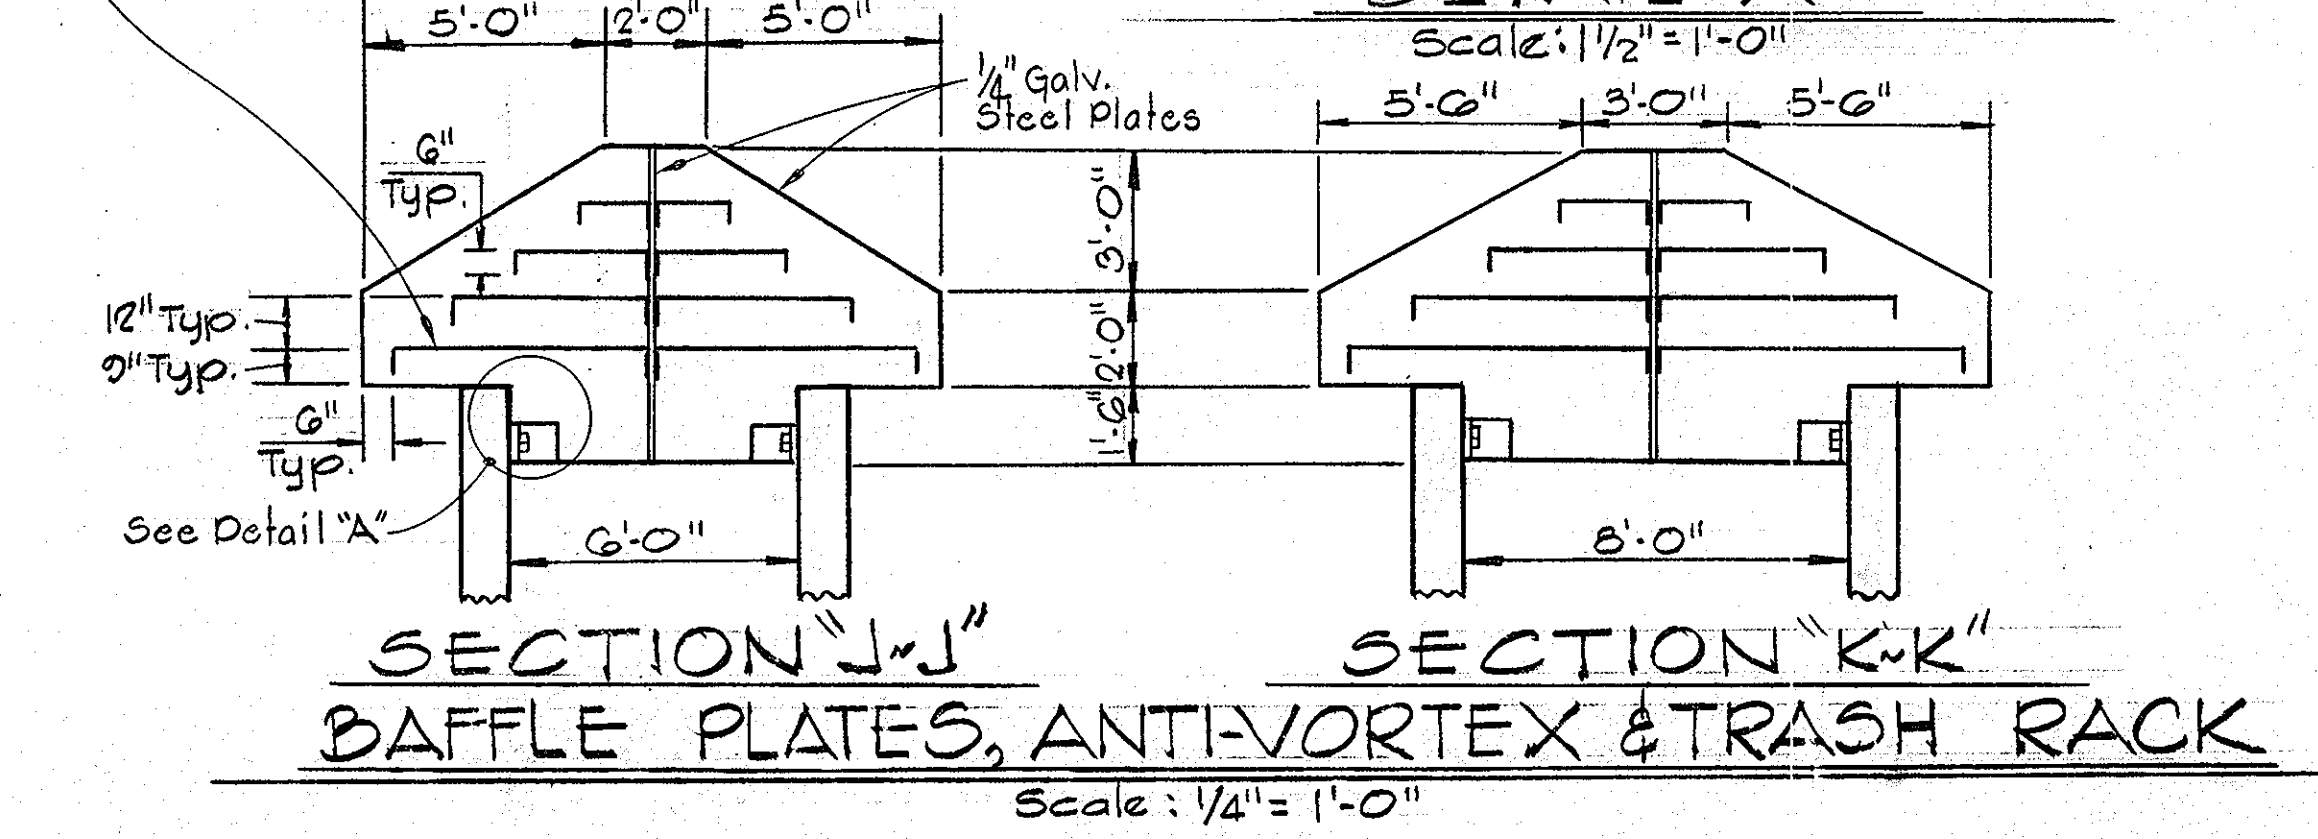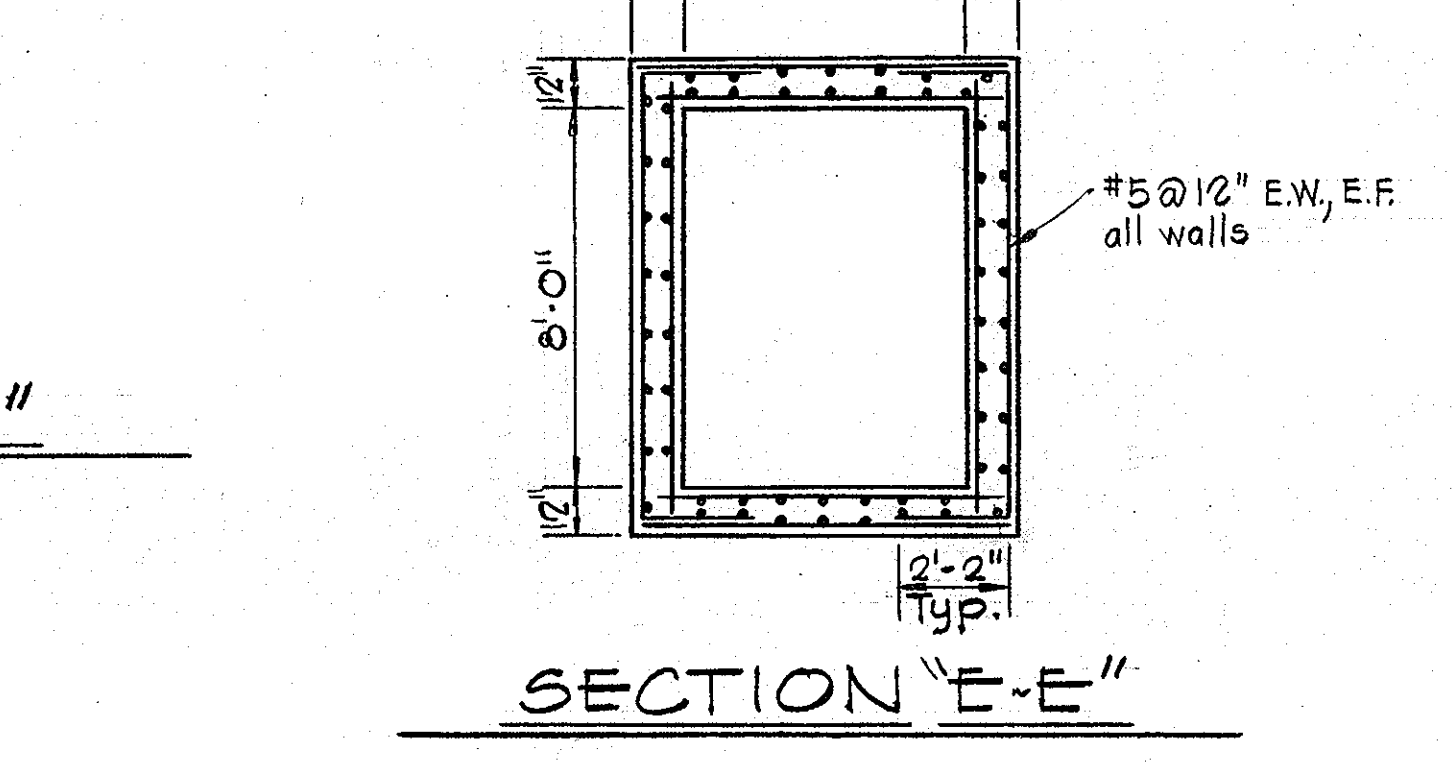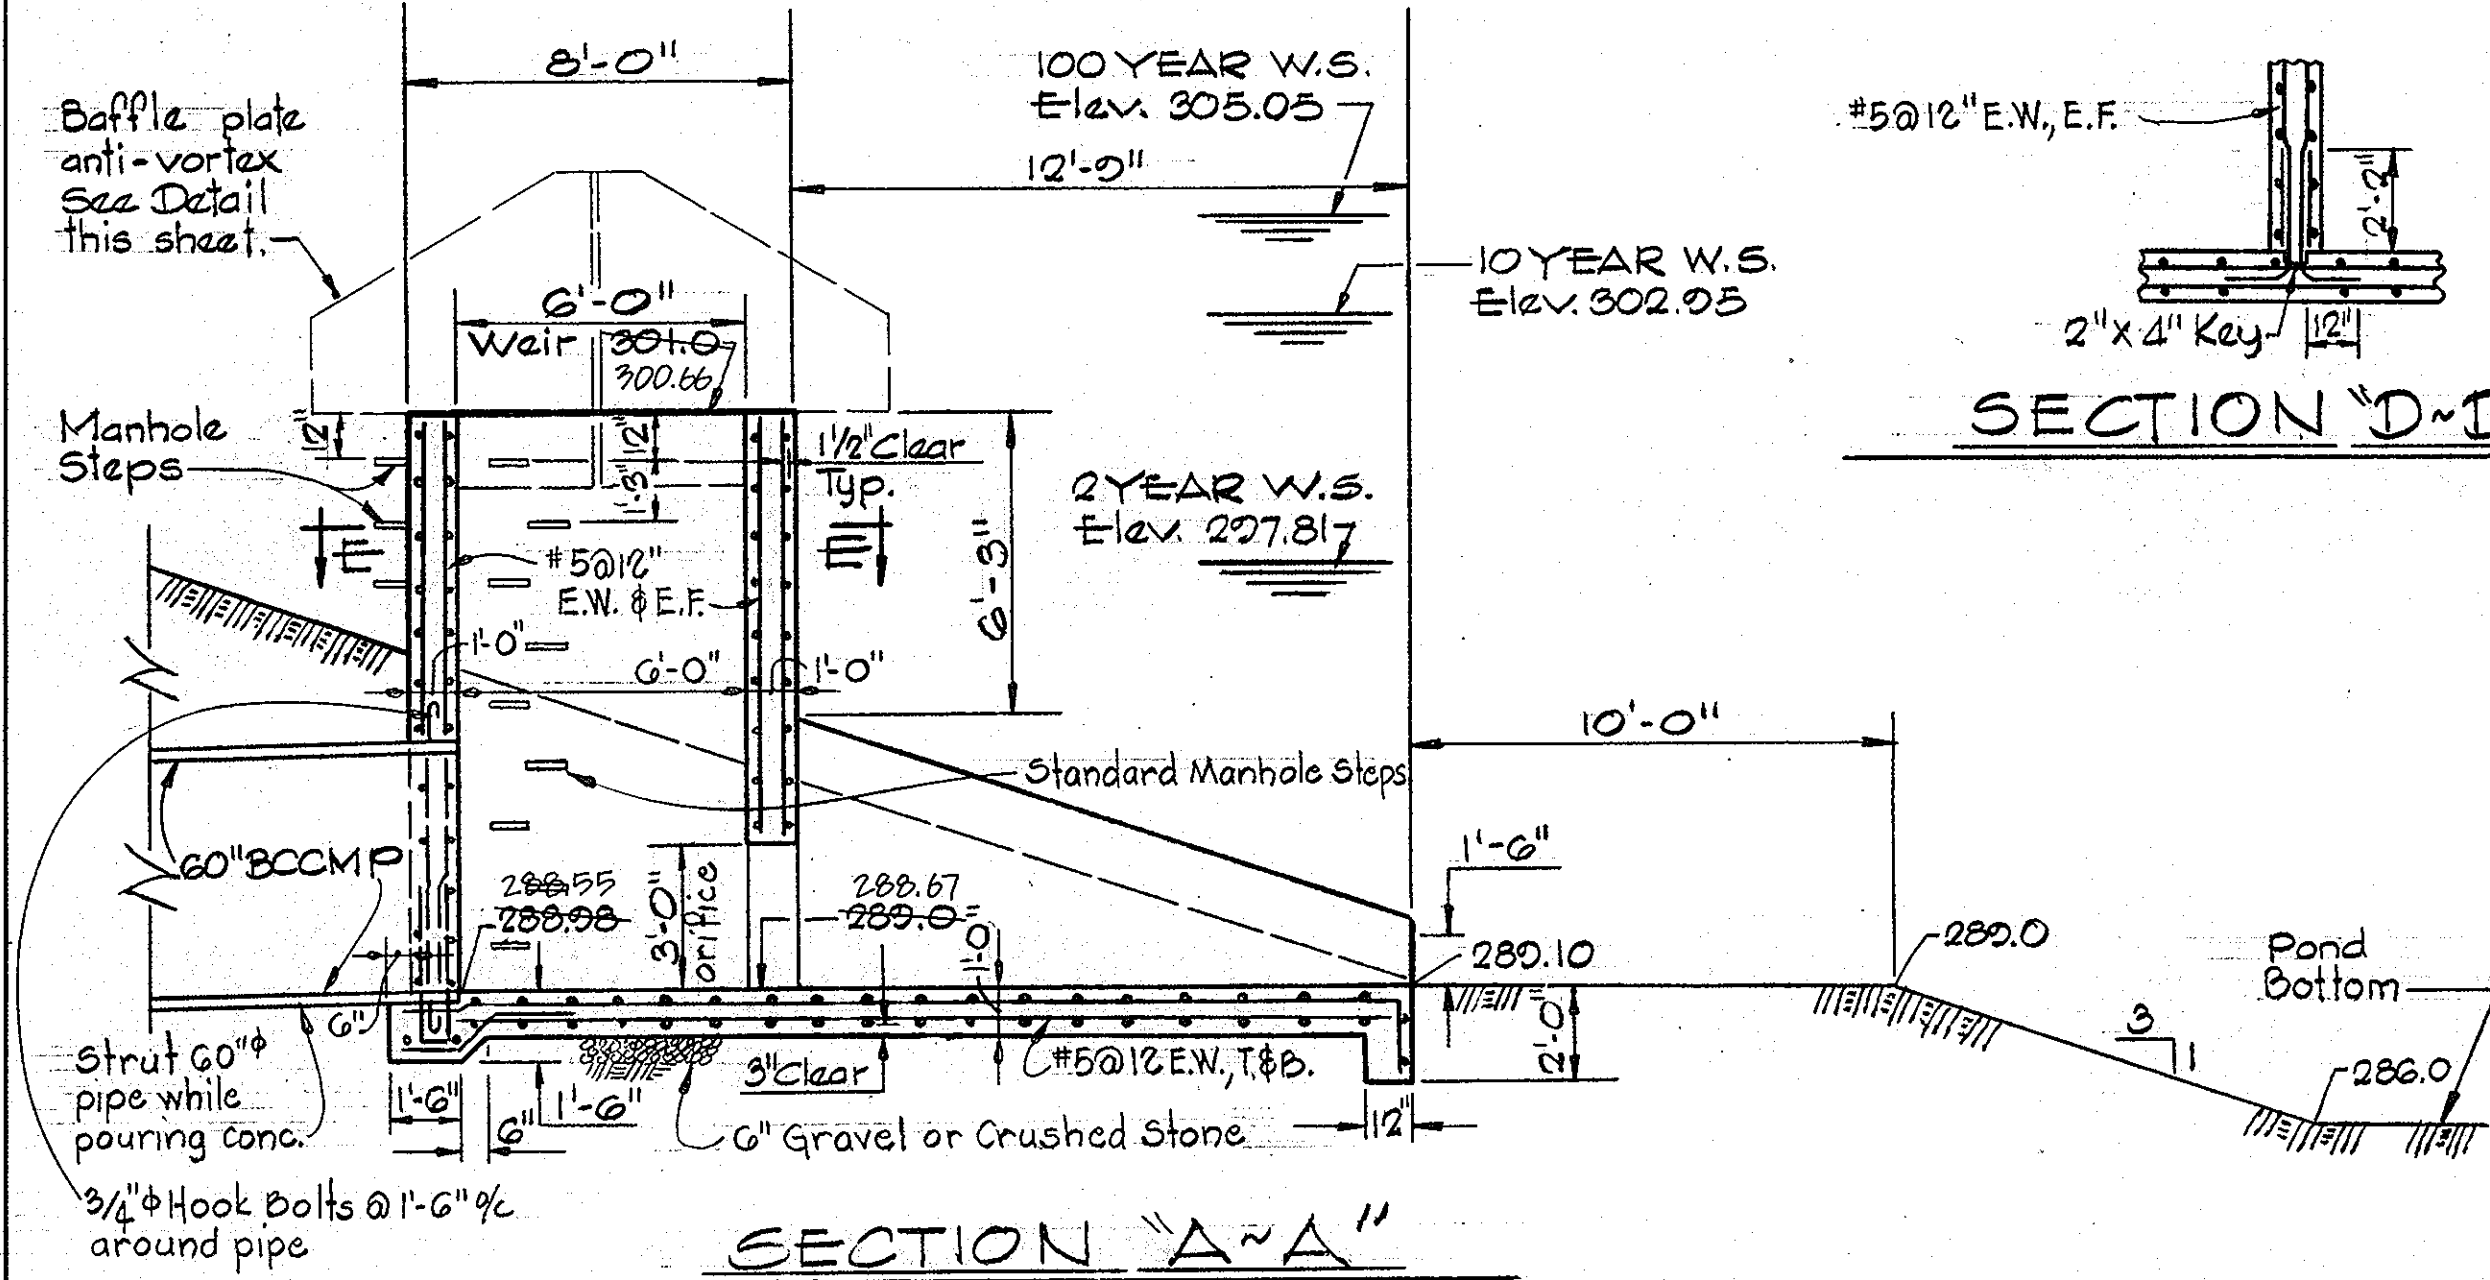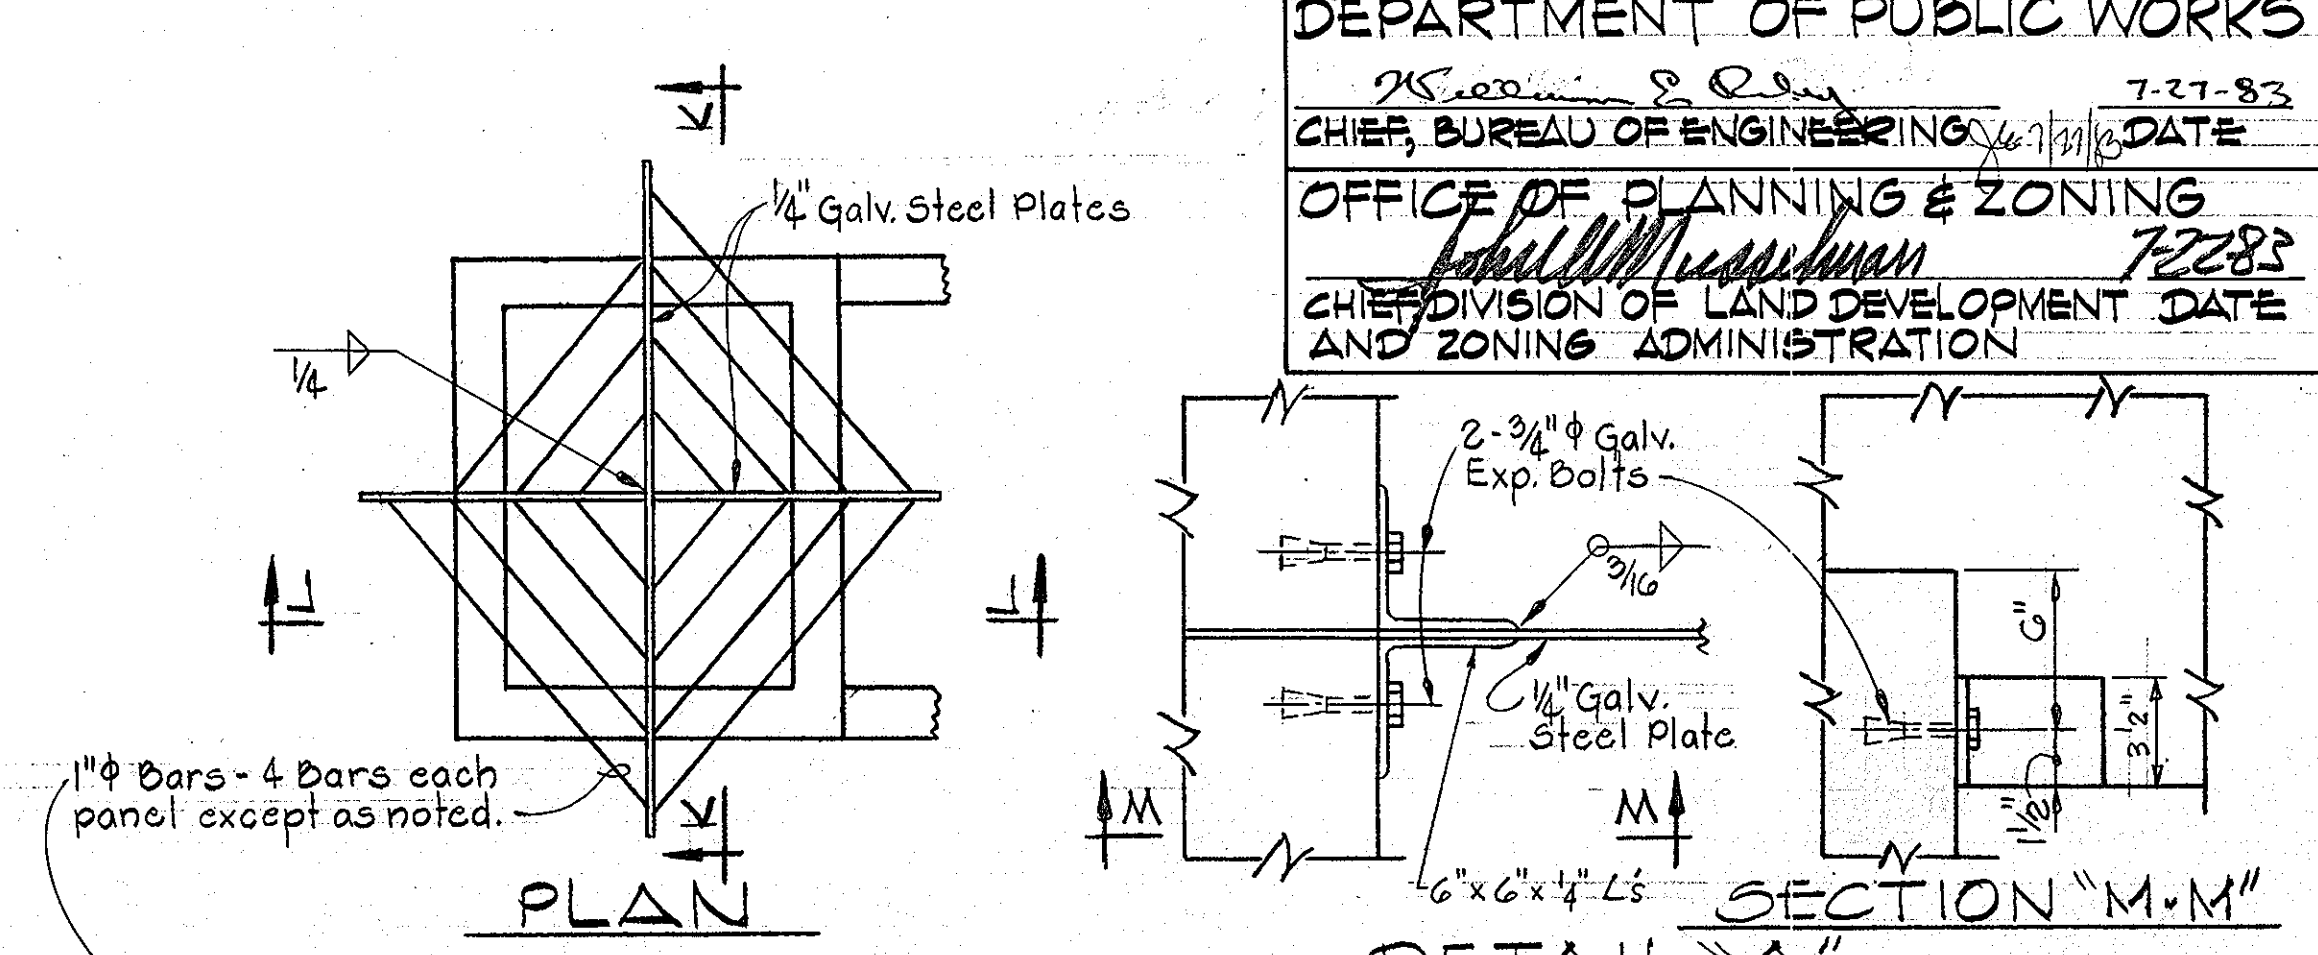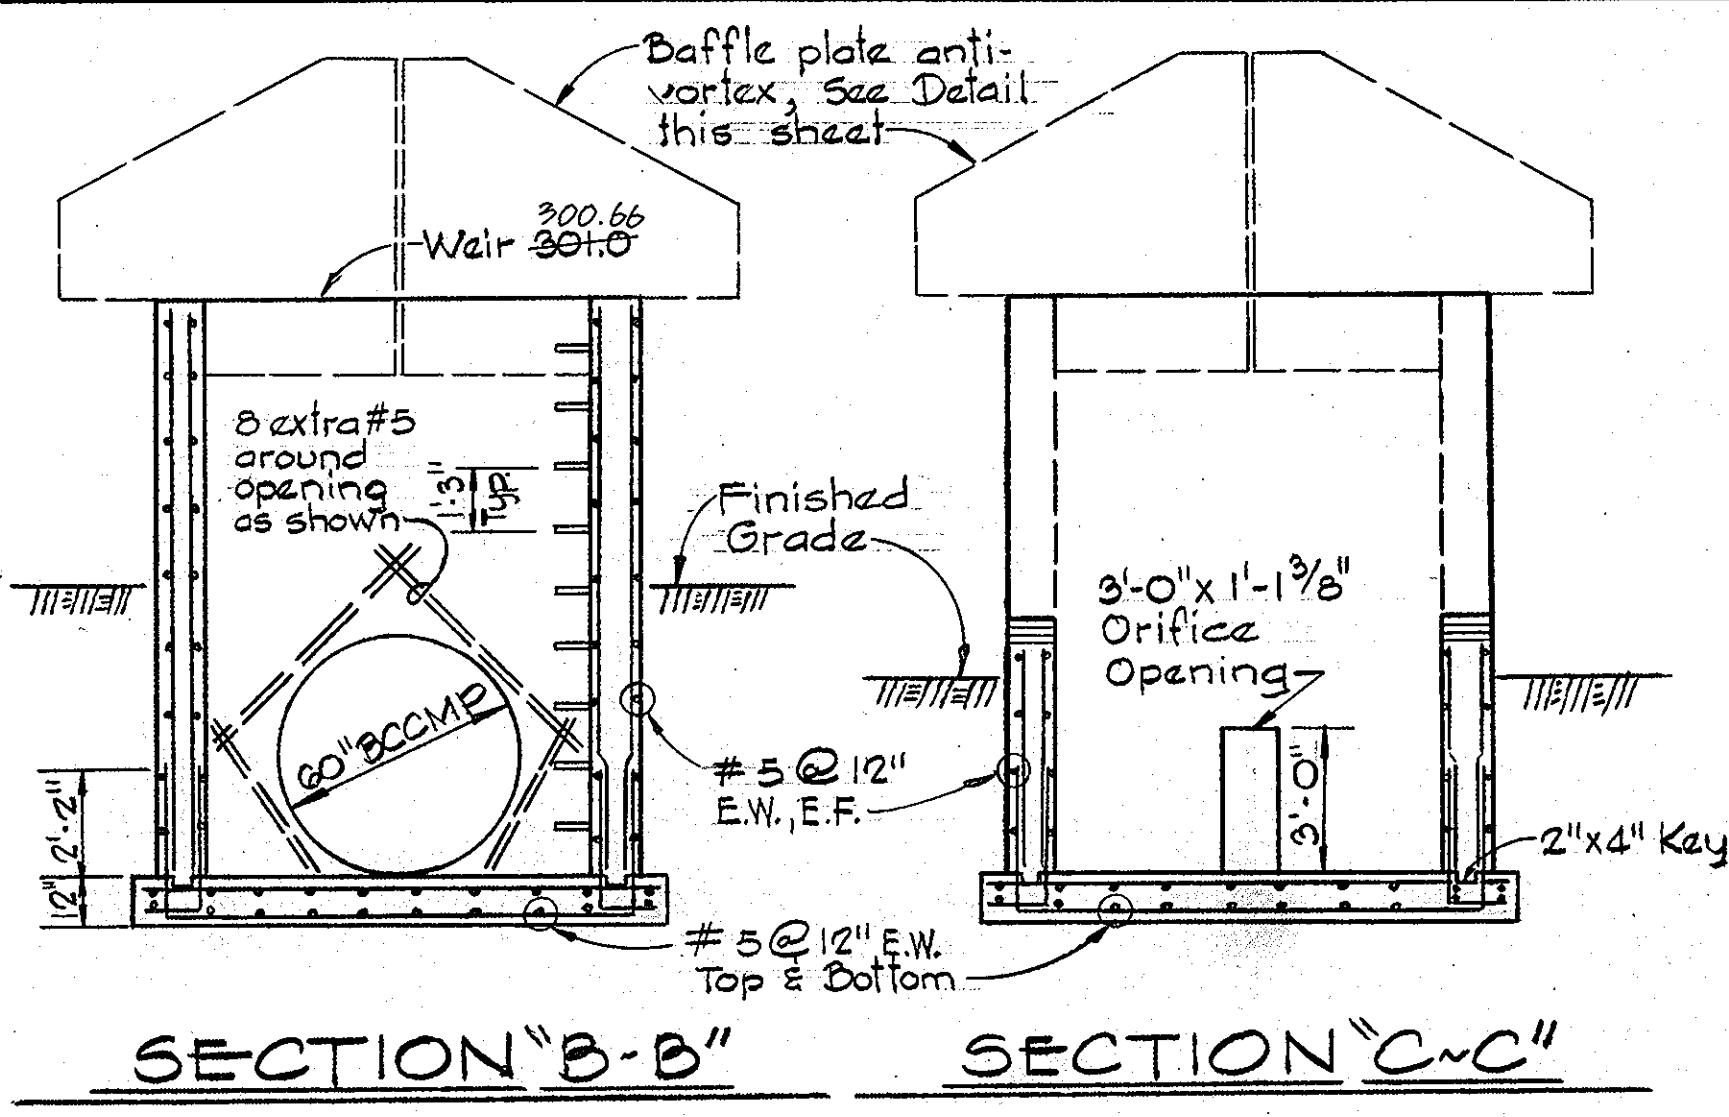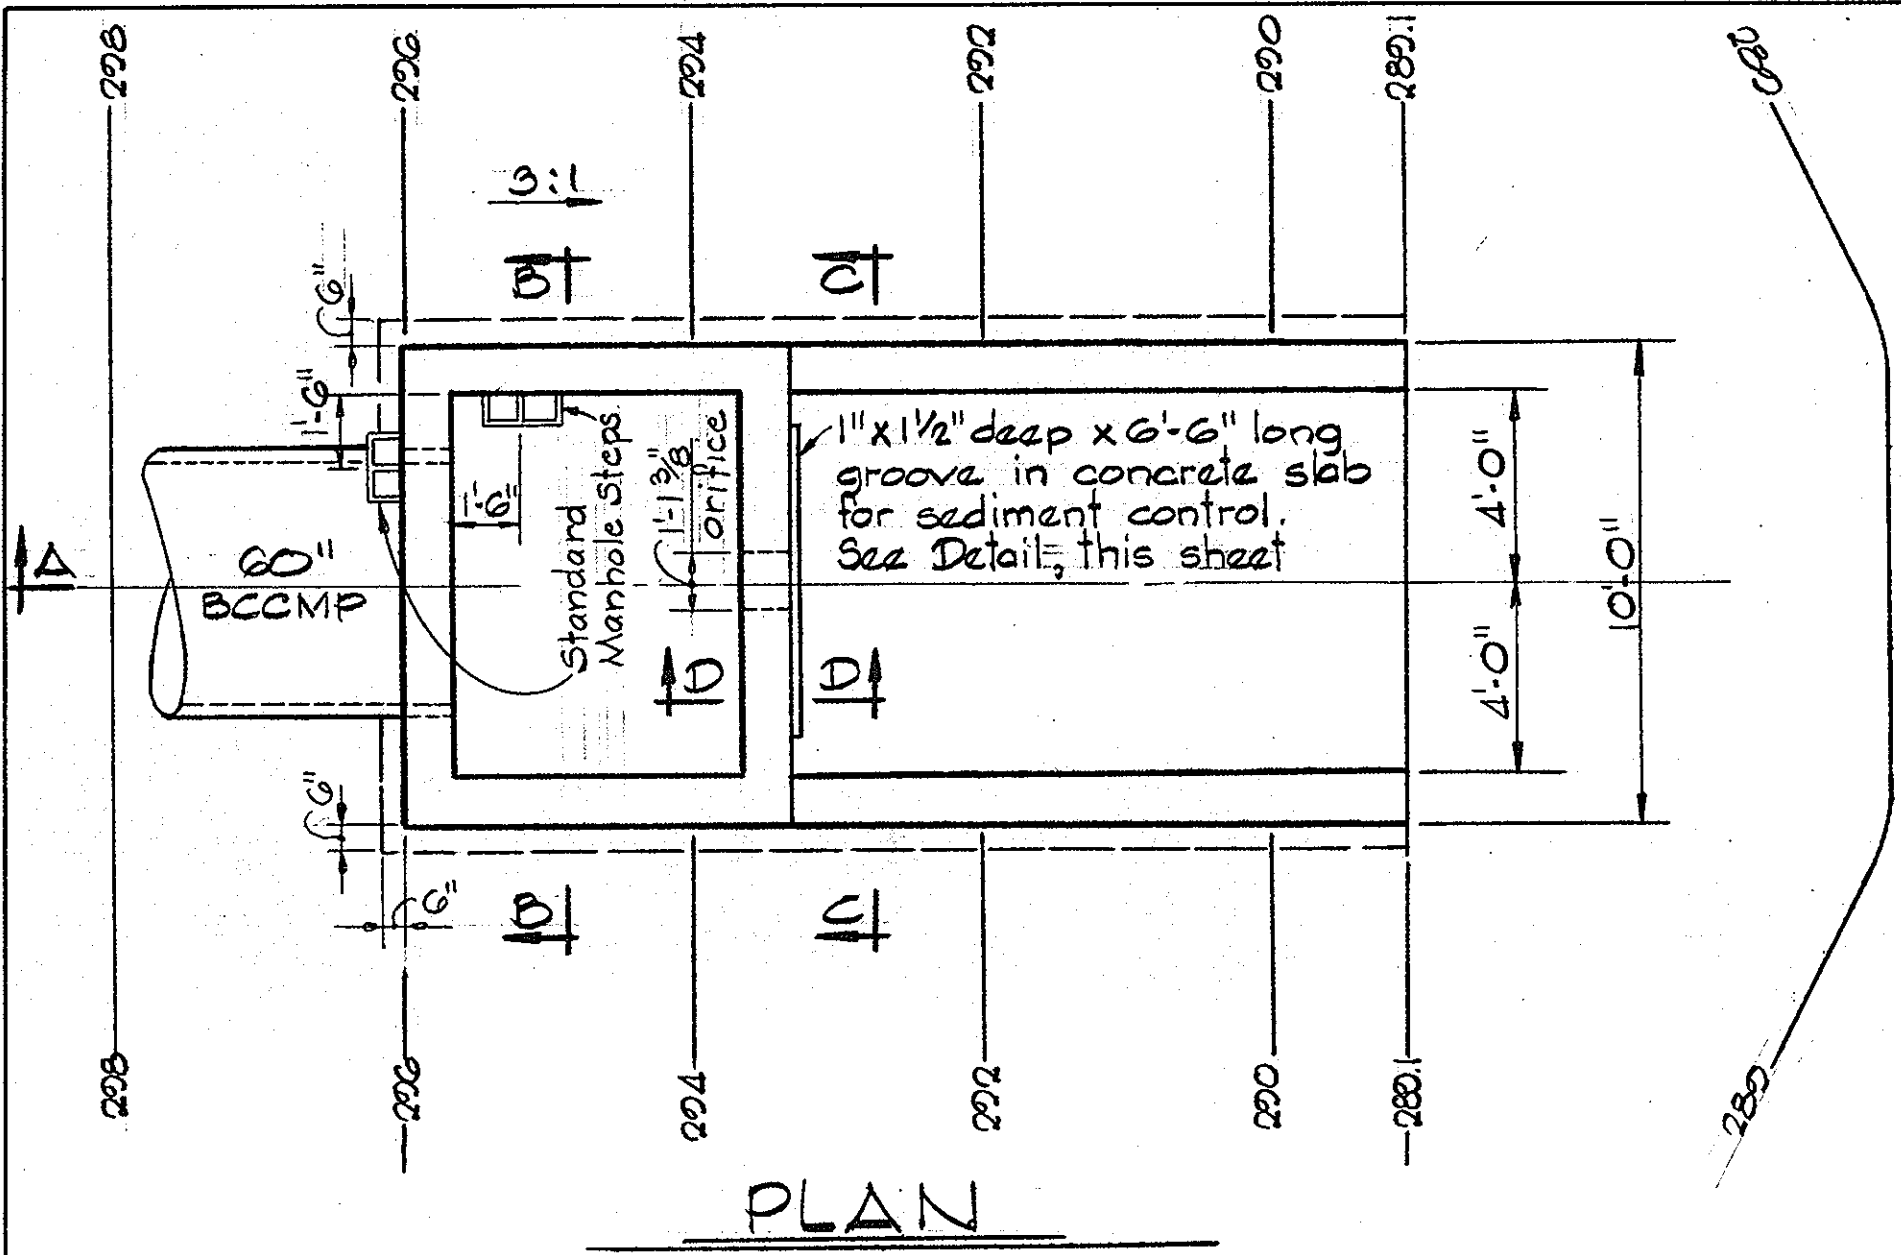

- NOTES:
- All concrete shall have a minimum compression strength of 4000 psi @ 28 days.
 - Reinforced concrete shall be constructed in accordance with current A.C.I. 301-76 (revised 81) STANDARD BUILDING CODE requirement.
 - Reinforcing steel shall be detailed in accordance with A.C.I. 315-80, A.C.I. 315R-80 & A.C.I. DETAILING MANUAL-1980.
 - All reinforcement shall conform to A.S.T.M. specification A-615-81 Grade 60.
 - All exposed concrete edges shall be chamfered 3/4".

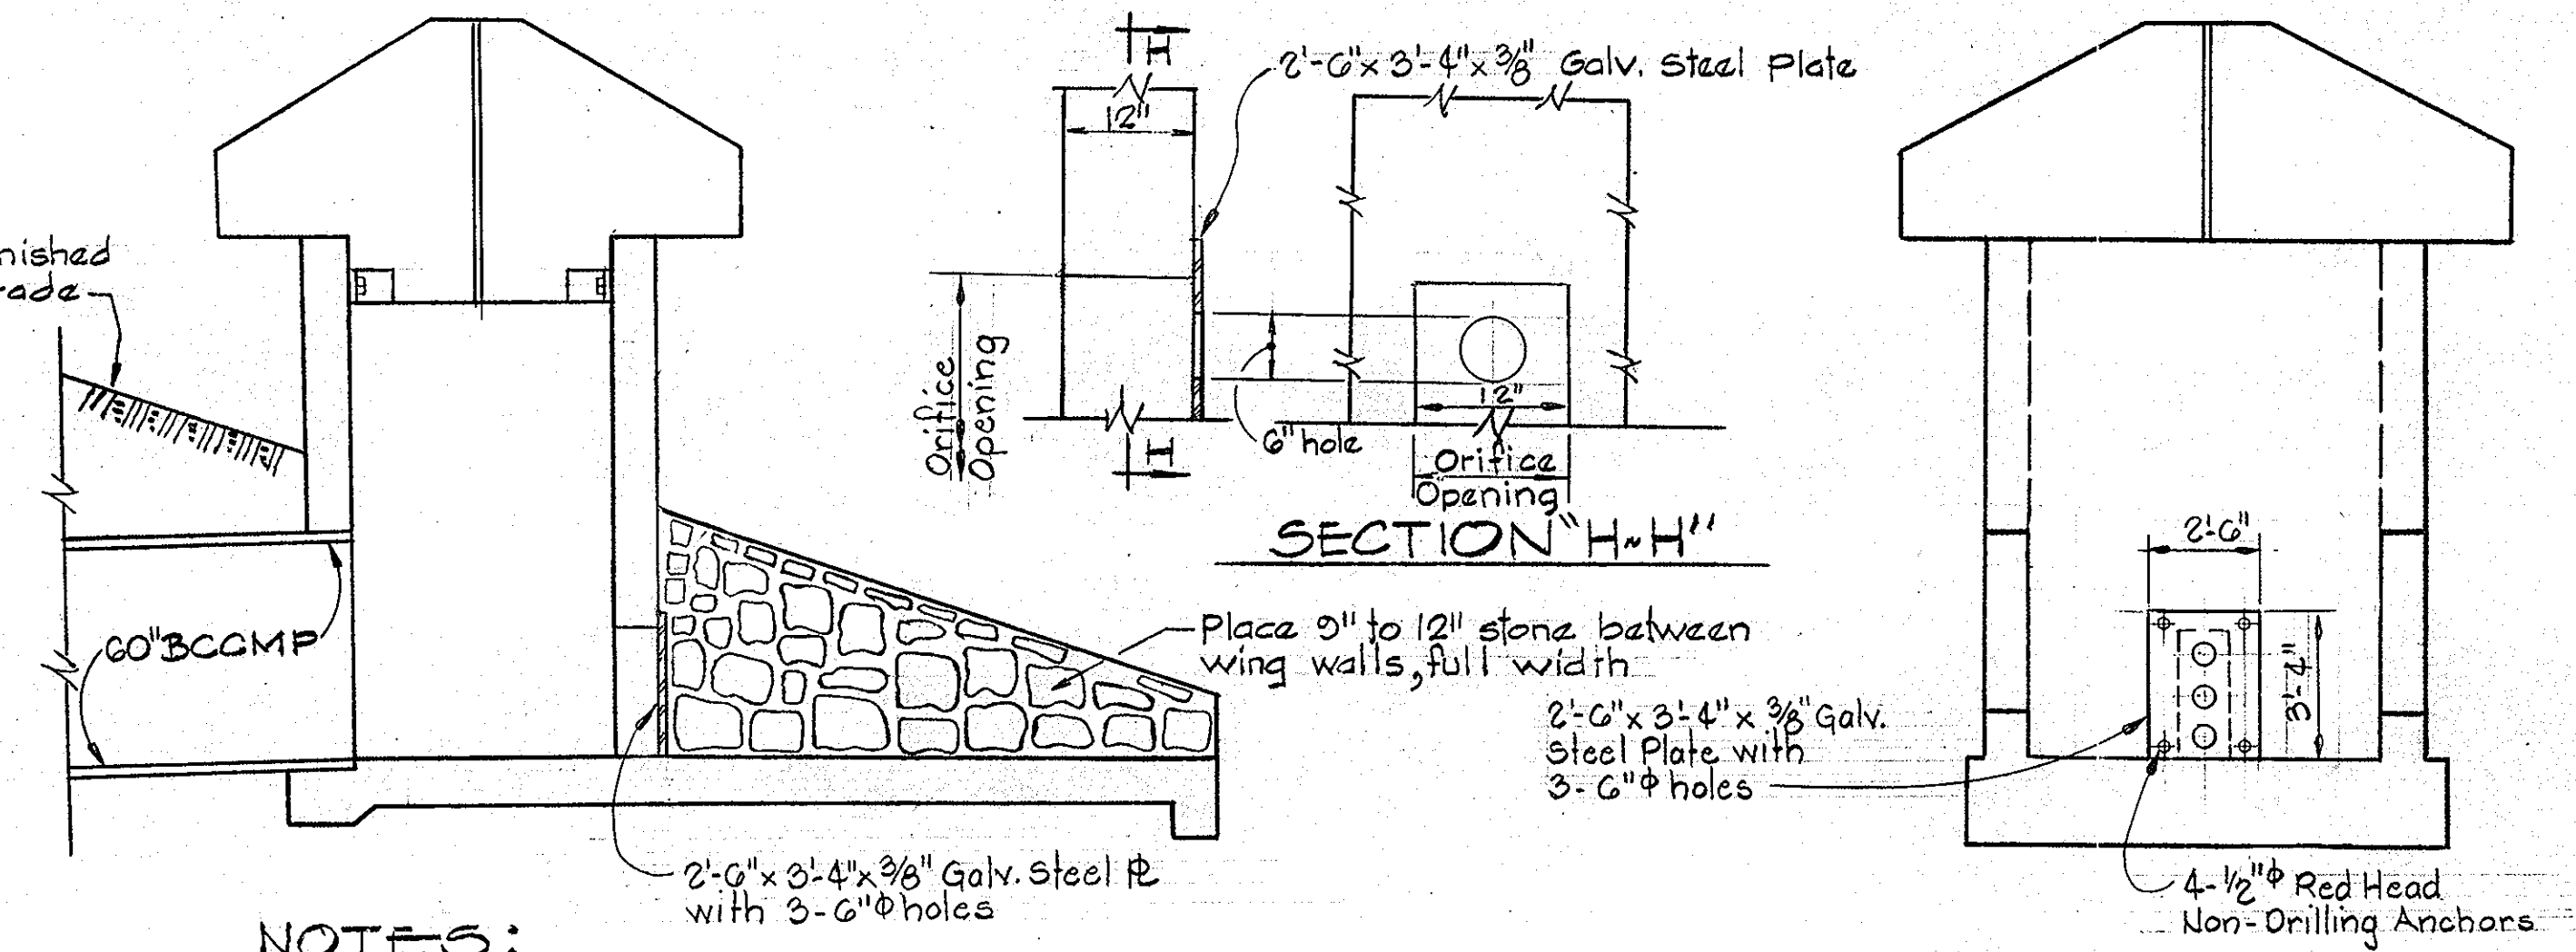

DETAIL - CONCRETE INLET STRUCTURE
 Scale: 1/4" = 1'-0"

- NOTES:
- Bolt steel plate in place as shown.
 - Place stone between wing walls.
 - After sediment control, remove stone and steel plate.

DETAIL - POND DEWATERING
 No Scale

NO. 1	NO. 2	NO. 3	NO. 4	NO. 5	NO. 6
Gr. 202.0 1.0' Topsoil	Gr. 202.0 1.5' Topsoil	Gr. 322.0 1.0' Topsoil	Gr. 312.0 1.0' Topsoil	Gr. 208.0 1.0' Topsoil	Gr. 302.0 1.5' Topsoil
Brown sand and clay with mica Very moist - (SC)	Gray clay mixed with 6" to 12" sand rock (SC-ML)	Light brown sand with silt & mica (SM)	Brown clay with sand & mica (CL) 6.0' Firm	Silty sand with 6" to 18" sand rock. (SM)	Silty sand with 6" to 18" sand rock. (SM)
10.0'	Orange sand with clay & mica (SC)	18.0'	Dark brown sand with mica (SM)	12.0'	Dark brown silty sand with mica (SM)
	10.0'		18.0'		16.0'

TEST PITS

Technical Review by Water Resources Administration Permit 83-PD-0868
 These plans have been reviewed for the Howard Soil Conservation District and meet the technical requirements for soil erosion and sediment control.
 James M. Belmont
 U.S. Soil Conservation Service
 Date: 7/6/83



These plans for soil erosion and sediment control meet the requirements of the Howard Soil Conservation District.
 Approved: [Signature]
 HOWARD S.C.D.
 Date: 7-21-83
 F-83-120
 Plan Number

CERTIFICATION BY THE ENGINEER
 I certify that this plan for pond construction, erosion, and sediment control represents a practical and workable plan based on my personal knowledge of the site conditions. This plan was prepared in accordance with the requirements of the Howard Soil Conservation District. I have notified the developer that he must provide the Howard Soil Conservation District with a red-lined "as-built" of the pond within 30 days of completion.
 Kenneth A. McCord
 Registered Engineer
 P.E. No. 1074
 Date






CERTIFICATION BY THE DEVELOPER
 I certify that all development and/or construction will be done according to these plans of development, pond construction and erosion and sediment control. I also authorize periodic on-site inspection by the Howard Soil Conservation District or their authorized agents, as are deemed necessary. Deviation from this plan will not be made unless authorized by the Howard Soil Conservation District. I will provide the Howard Soil Conservation District with a red-lined "as-built" of the pond within 30 days of completion.
 Walter Woodford
 Date

RESPONSIBLE PERSONNEL CERTIFICATION
 I hereby certify that any responsible personnel involved in the construction project will have a certificate of attendance at a Department of Natural Resources approved training program for the control of sediment and erosion before beginning the project.
 Walter Woodford
 Date

Rev. No.	Revision Description
7-1-83	As Per D.P.W. & Sediment Control Comments
COLUMBIA 5th ELECTION DISTRICT HOWARD COUNTY, MARYLAND OWNER AND DEVELOPER HOWARD RESEARCH AND DEVELOPMENT CORPORATION PROJECT AREA VILLAGE OF HICKORY RIDGE SECTION 3 AREA 1 PROJECT TITLE STORM WATER MANAGEMENT POND	
SCALE: As Shown DATE: WHITMAN, REQUARDT AND ASSOCIATES ENGINEERS 2315 ST. PAUL STREET BALTIMORE, MARYLAND 21218 Kenneth A. McCord Registered Engineer No. 1074	

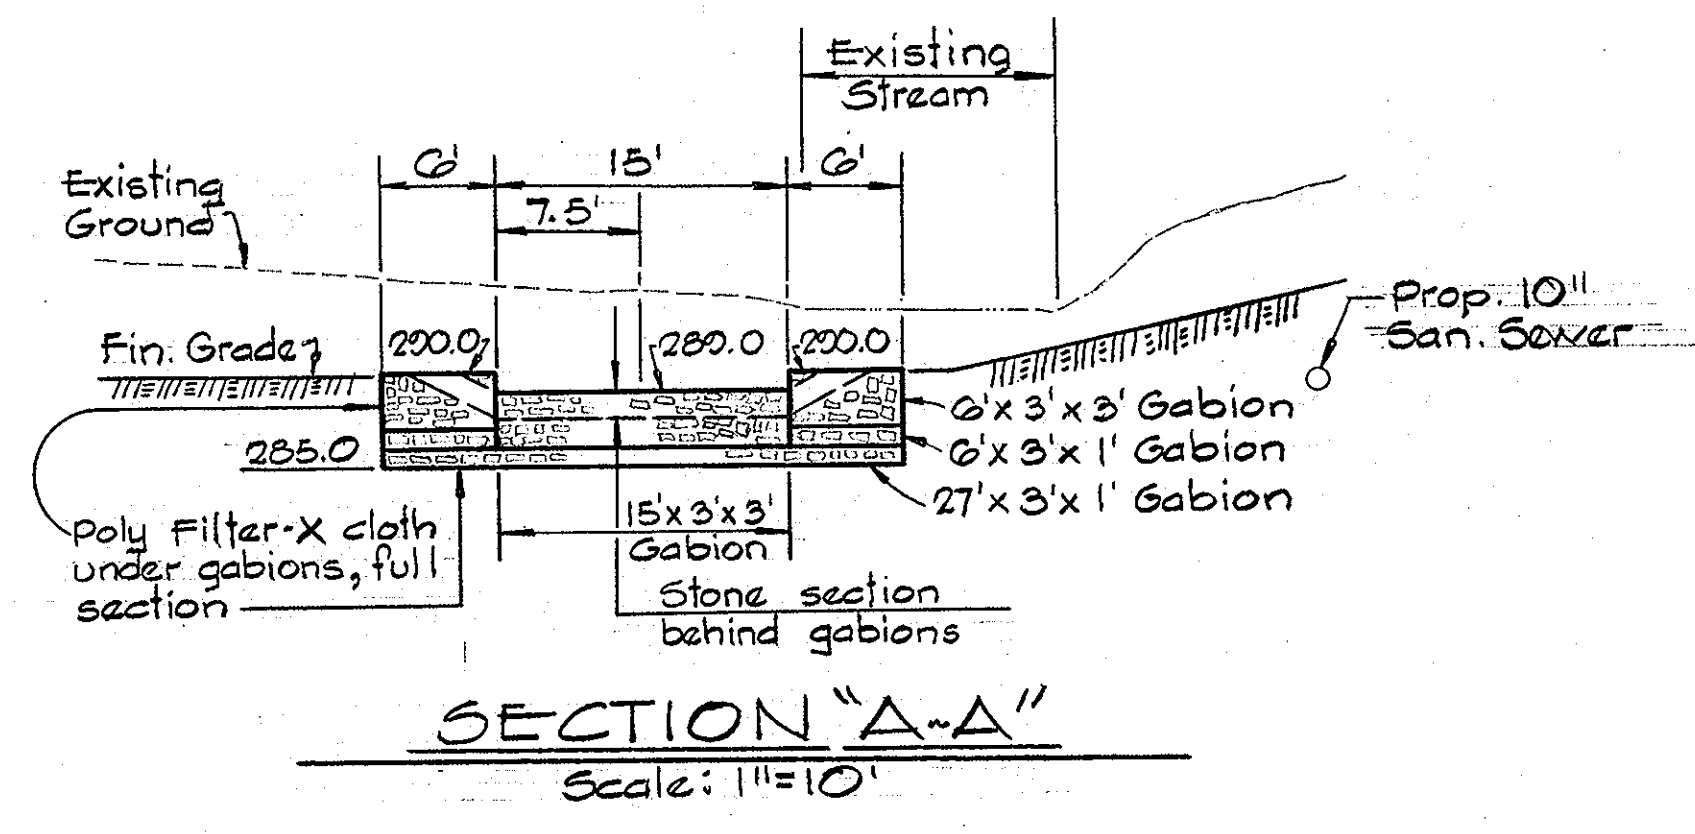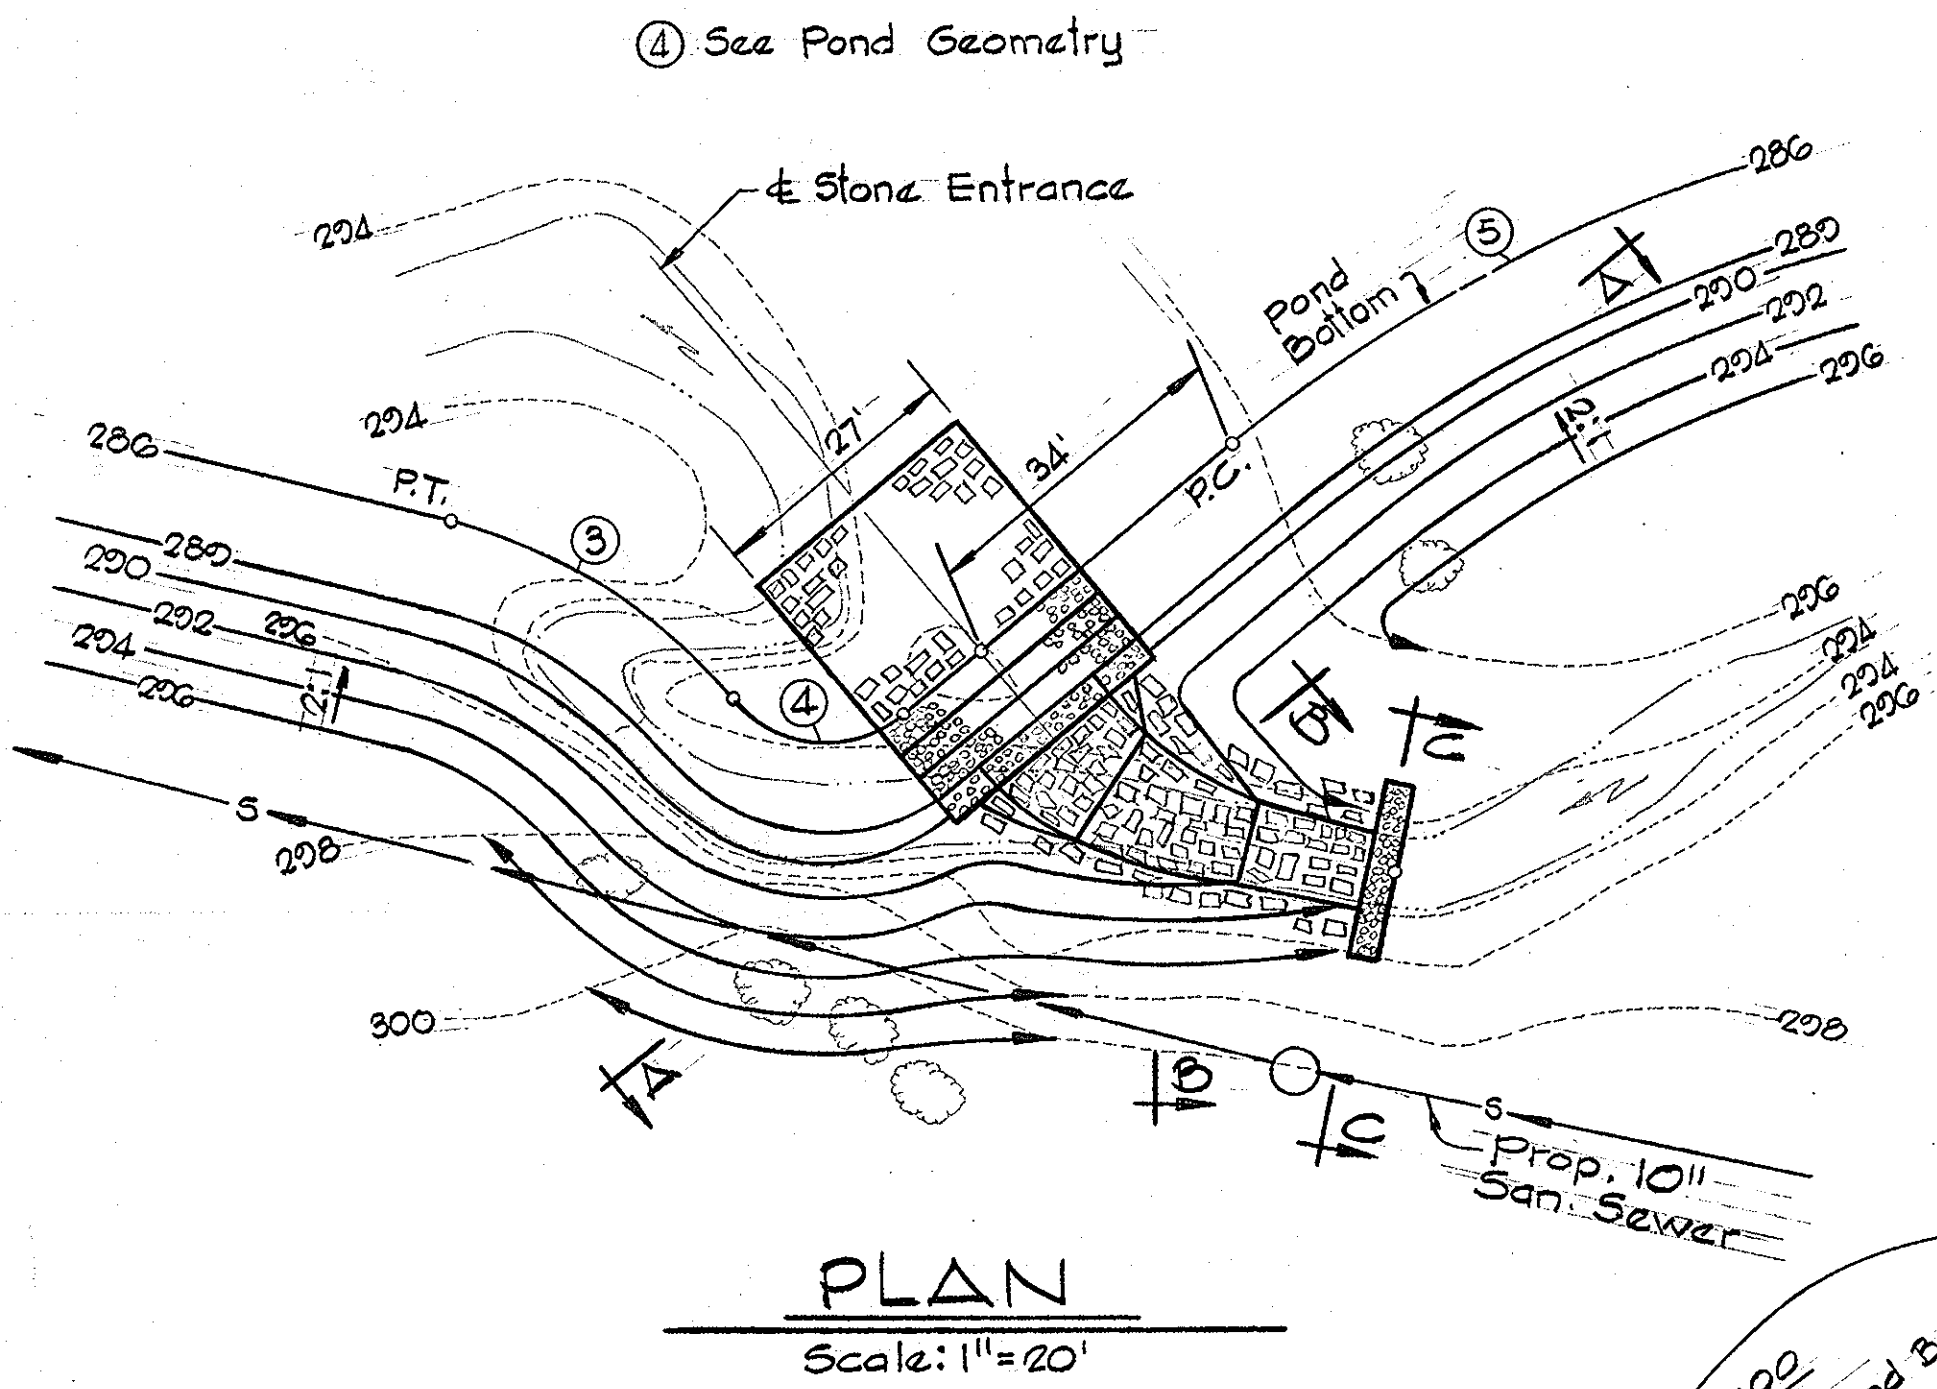

CURVE #1	CURVE #2	CURVE #3
R=400.00' Δ=07°40'00" L=59.52' Chd. Br.=N70°10'36"E Tan.=26.80' Chd. Lgth.=53.48'	R=35.50' Δ=72°55'50" L=45.22' Chd. Br.=N46°31'02"E Tan.=26.26' Chd. Lgth.=42.22'	R=55.00' Δ=36°41'40" L=35.22' Chd. Br.=S18°07'20"E Tan.=18.24' Chd. Lgth.=34.63'
CURVE #4	CURVE #5	CURVE #6
R=12.50' Δ=90°00'00" L=19.64' Chd. Br.=S05°34'00"W Tan.=12.50' Chd. Lgth.=17.68'	R=150.00' Δ=17°15'00" L=45.16' Chd. Br.=N30°48'13"W Tan.=22.75' Chd. Lgth.=44.09'	R=25.00' Δ=100°25'00" L=43.82' Chd. Br.=N72°23'13"W Tan.=30.01' Chd. Lgth.=38.42'
CURVE #7	CURVE #8	CURVE #9
R=100.00' Δ=63°45'00" L=111.27' Chd. Br.=S25°31'47"W Tan.=62.18' Chd. Lgth.=105.61'	R=250.00' Δ=26°41'18" L=116.45' Chd. Br.=S06°59'57"W Tan.=59.20' Chd. Lgth.=115.40'	R=250.00' Δ=28°30'00" L=102.54' Chd. Br.=N08°35'36"W Tan.=52.00' Chd. Lgth.=101.82'
CURVE #10	CURVE #11	
R=7.50' Δ=101°30'00" L=13.20' Chd. Br.=N53°54'24"W Tan.=9.18' Chd. Lgth.=11.62'	R=250.00' Δ=30°30'00" L=133.03' Chd. Br.=S89°24'25"E Tan.=68.16' Chd. Lgth.=131.52'	

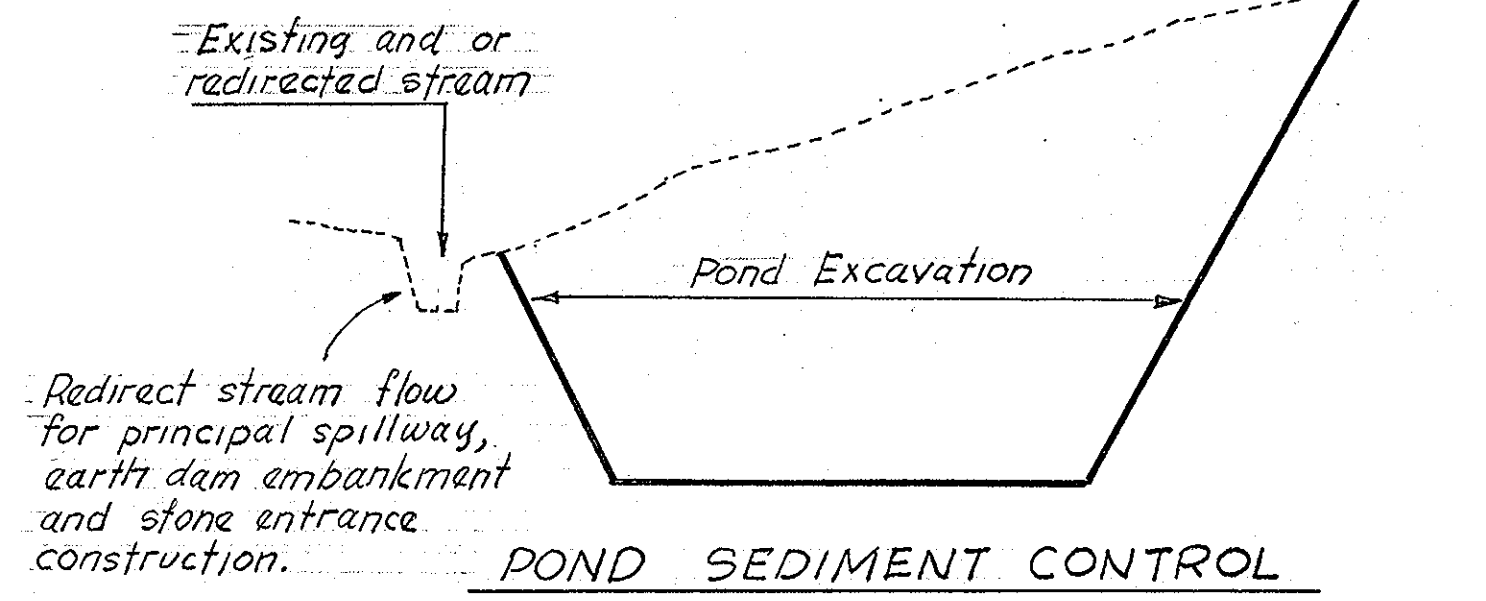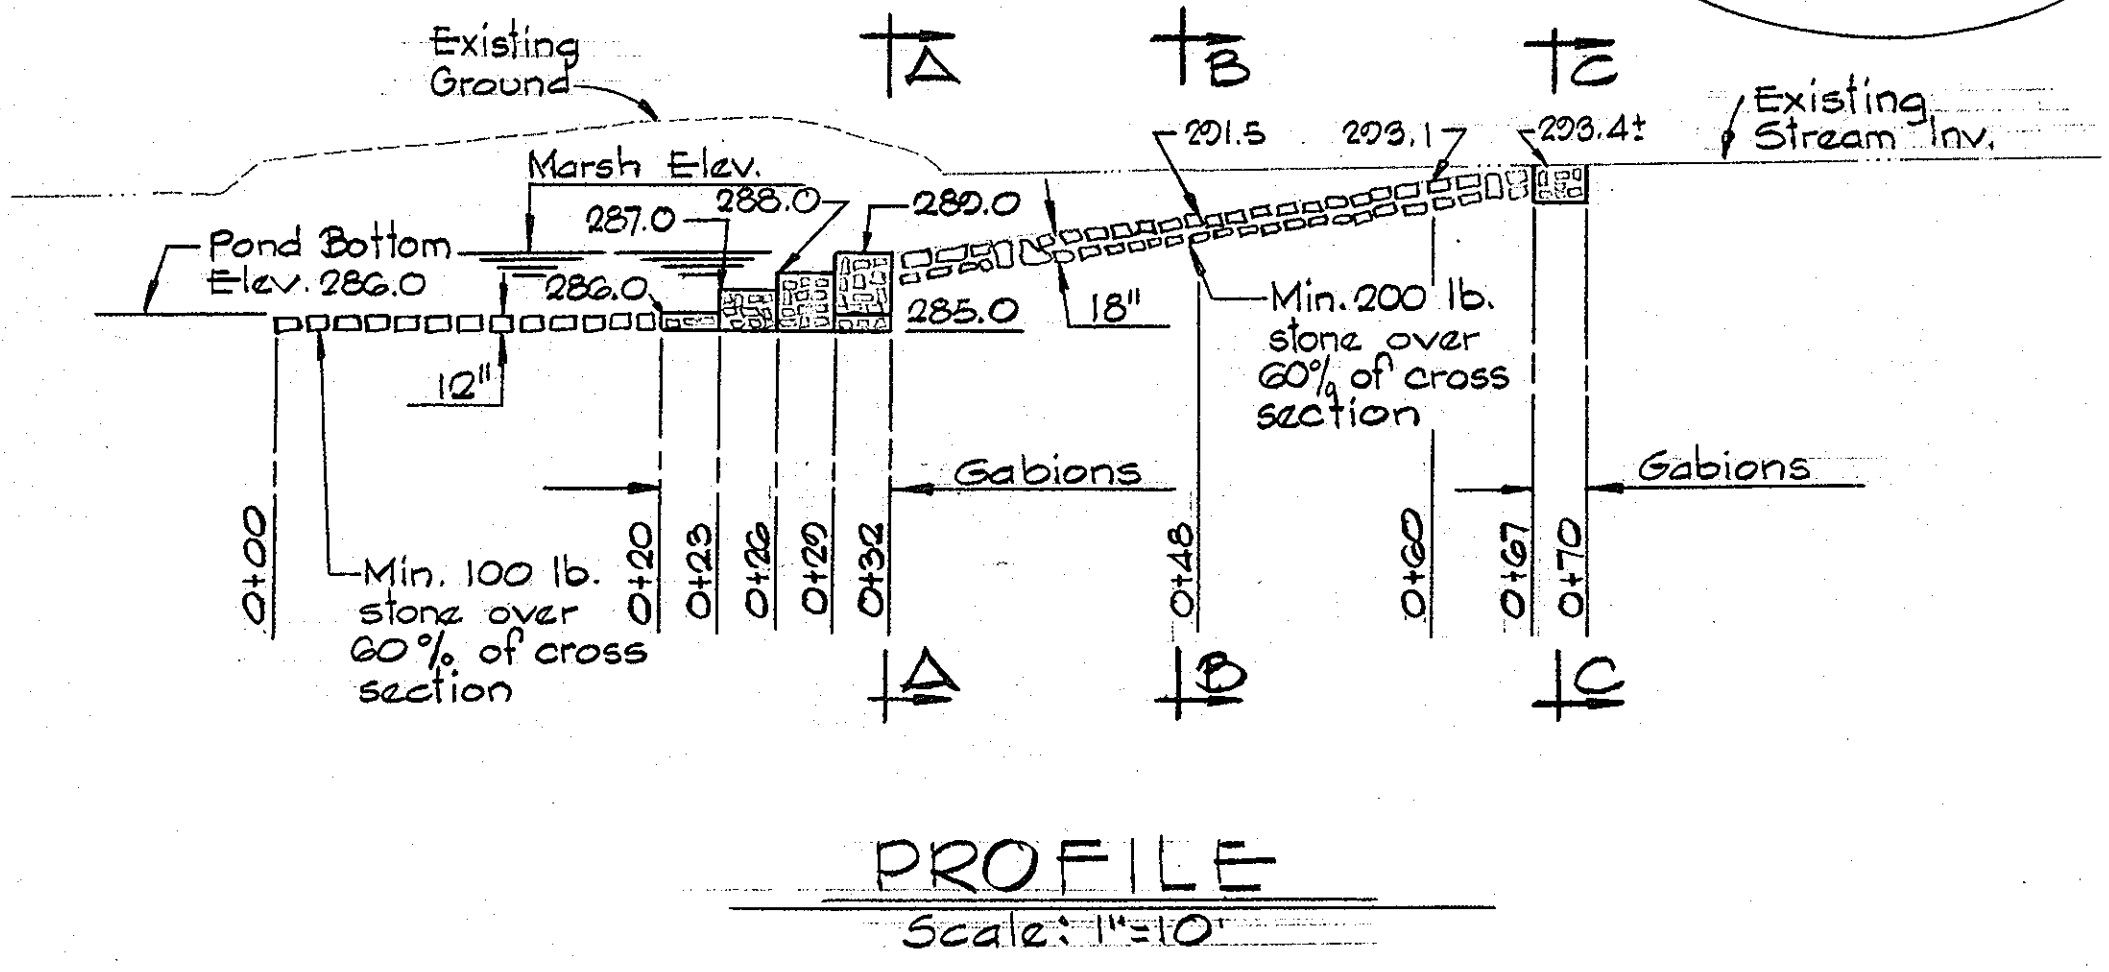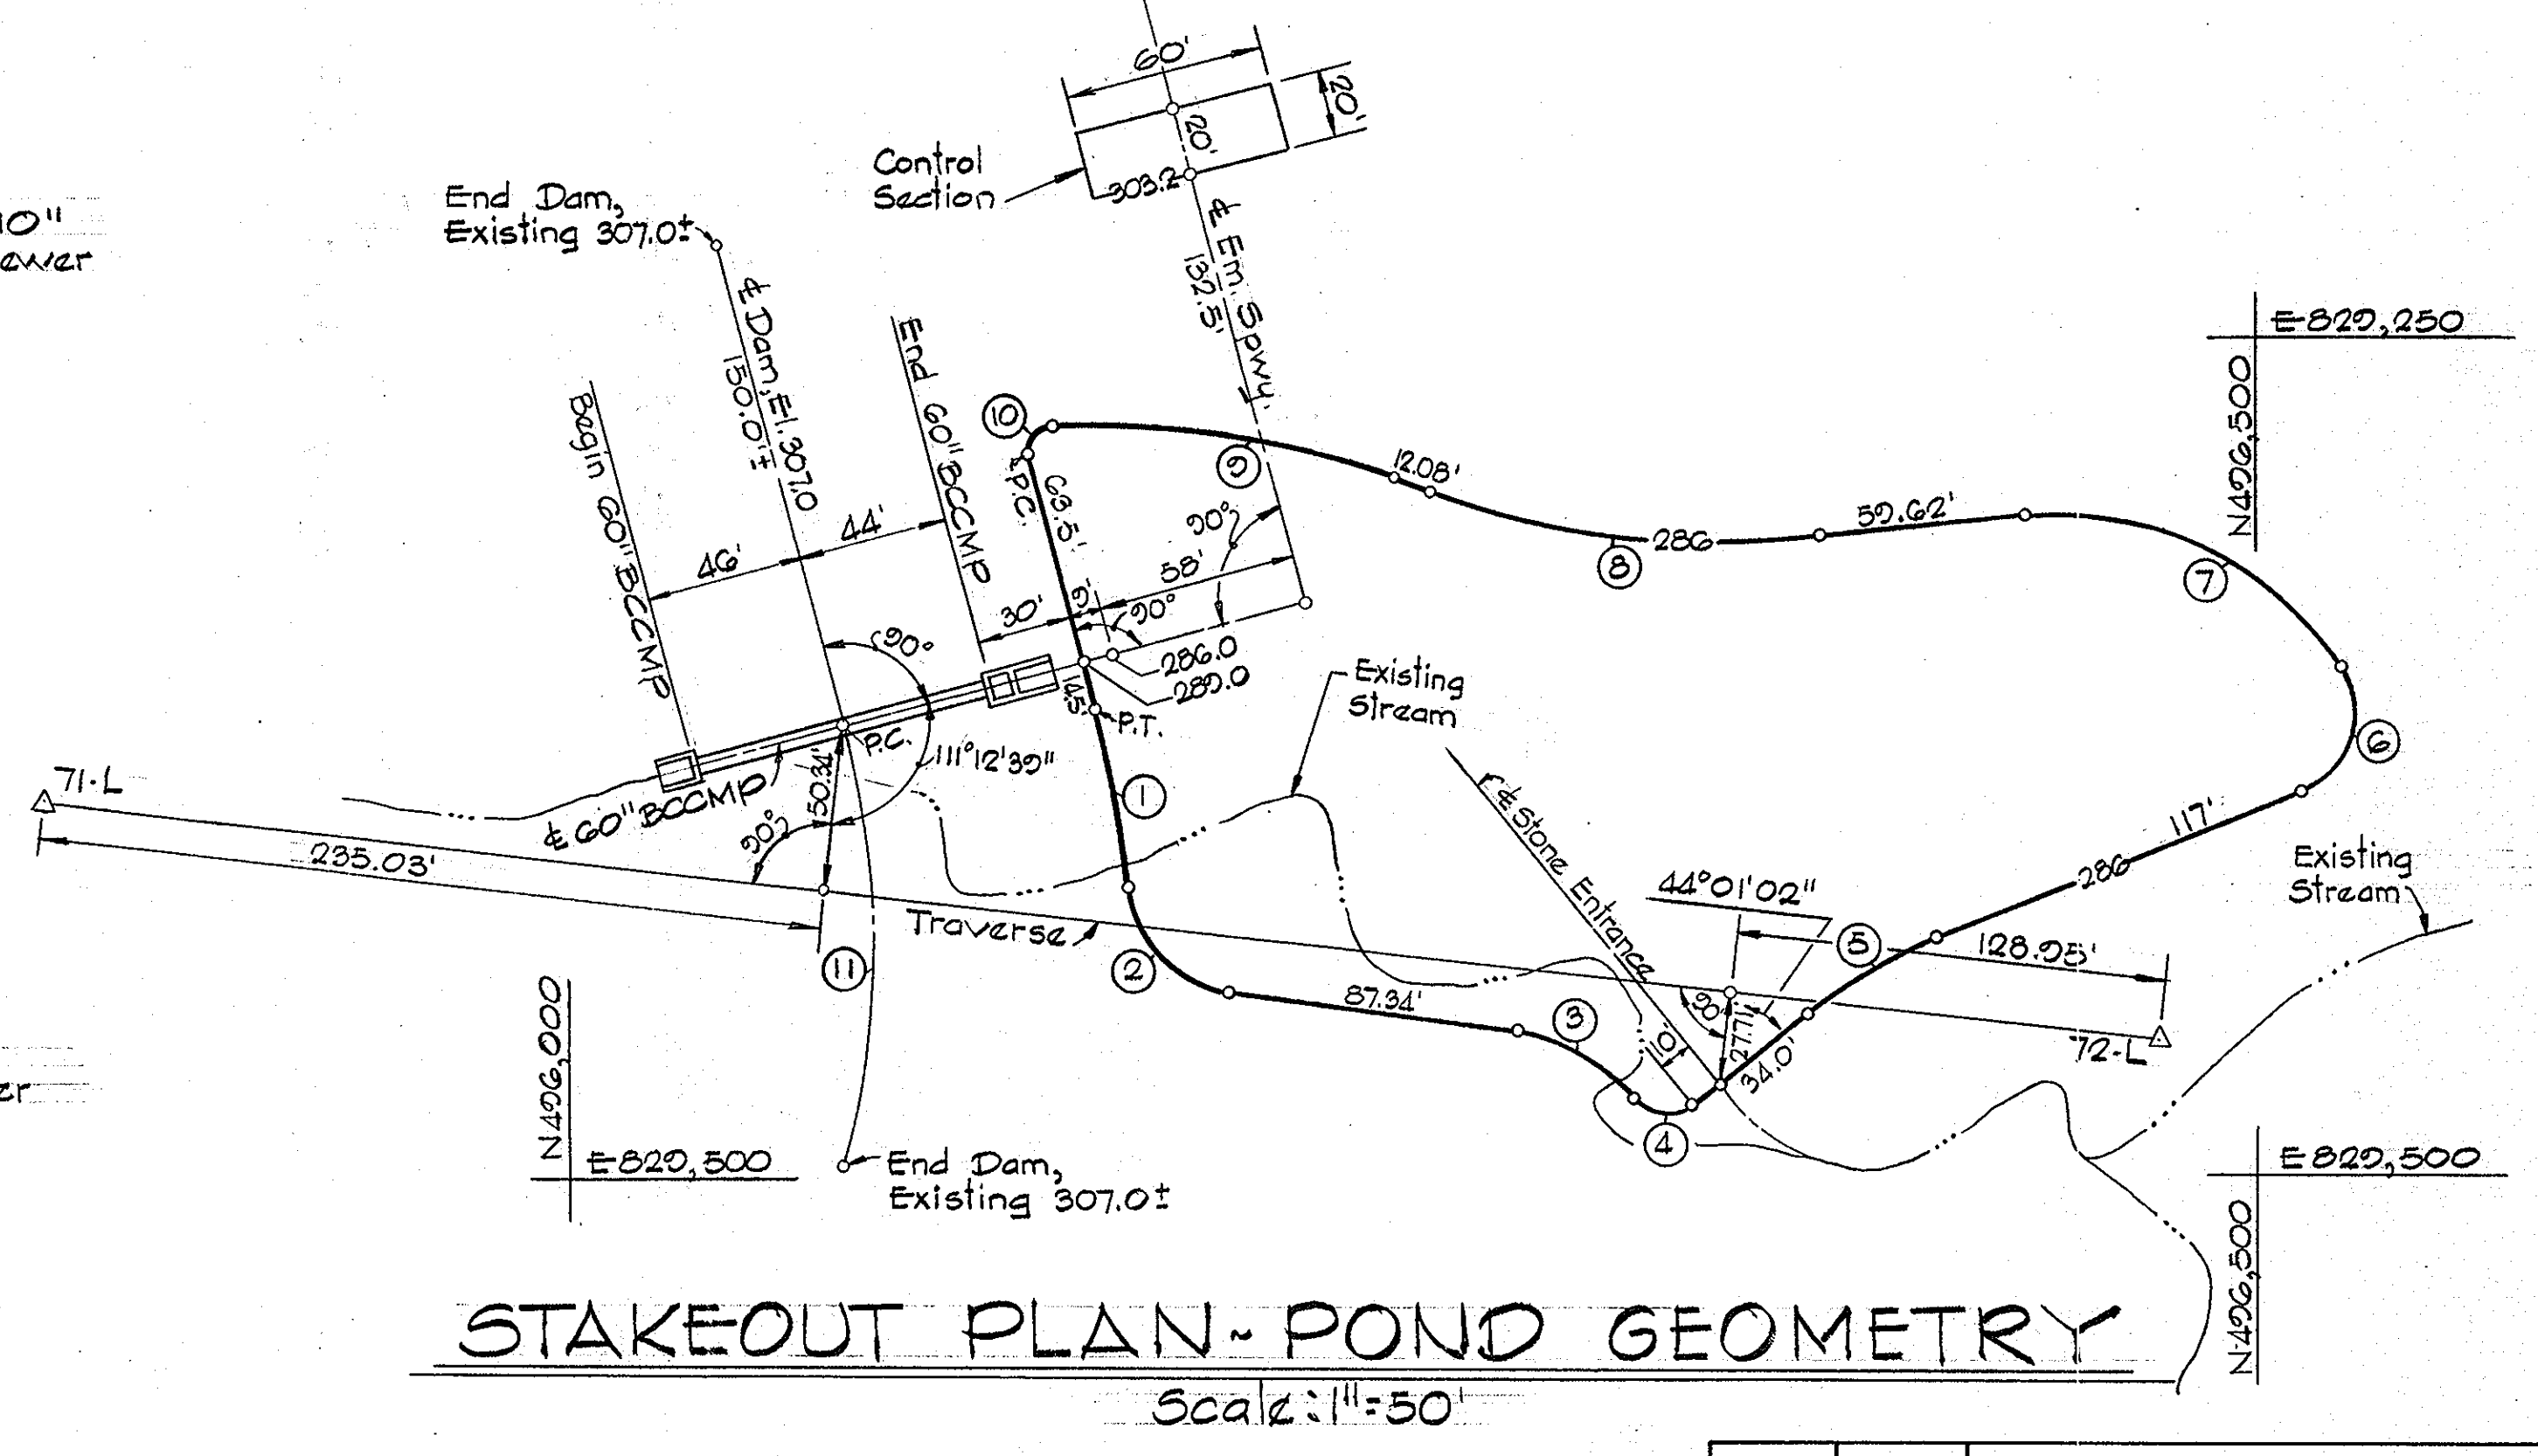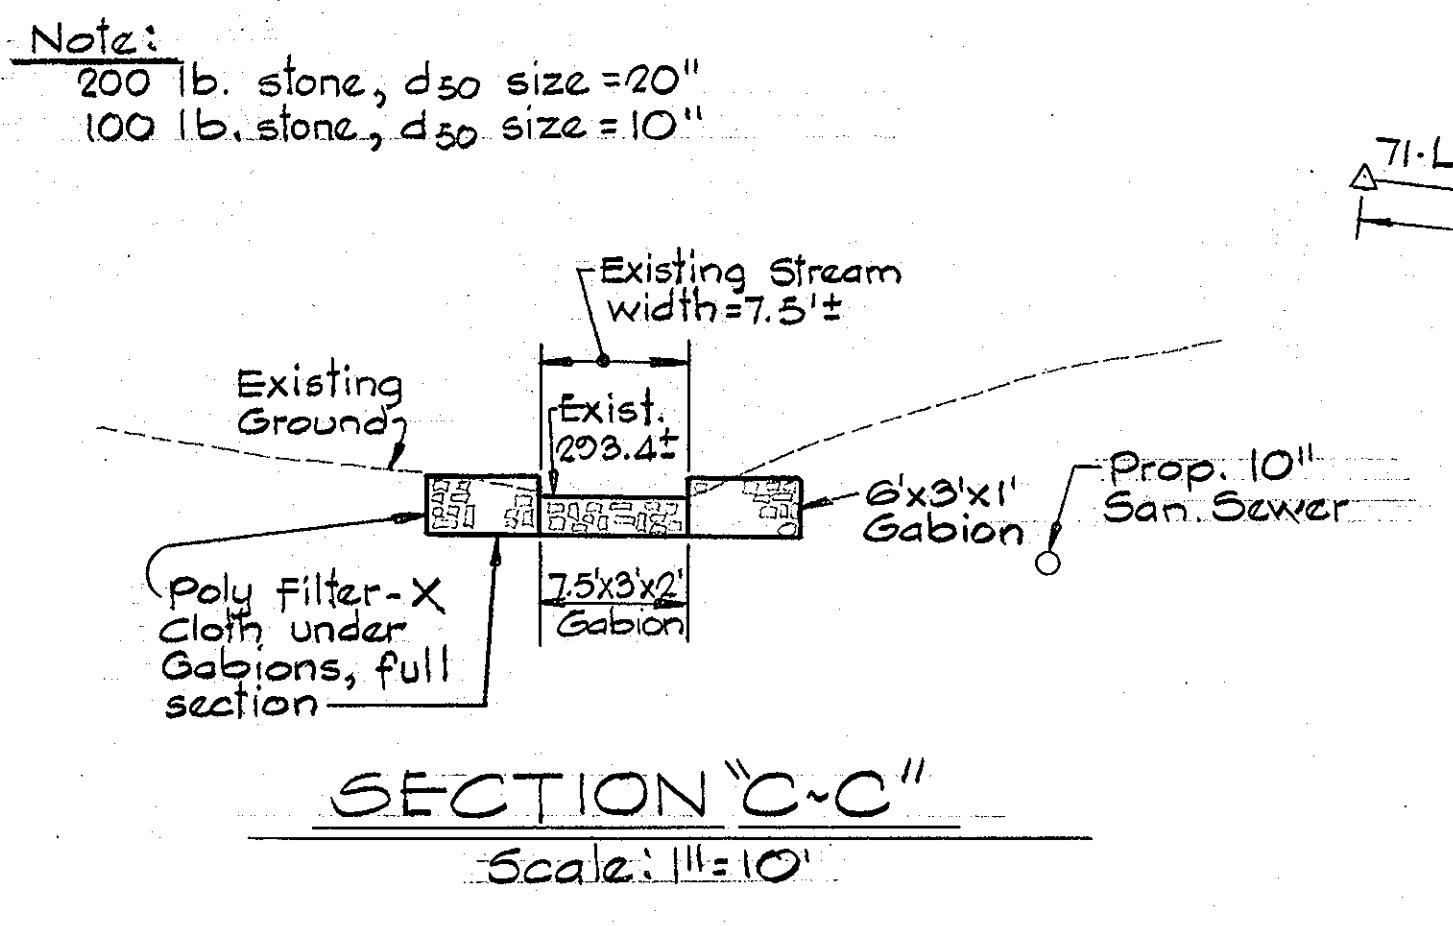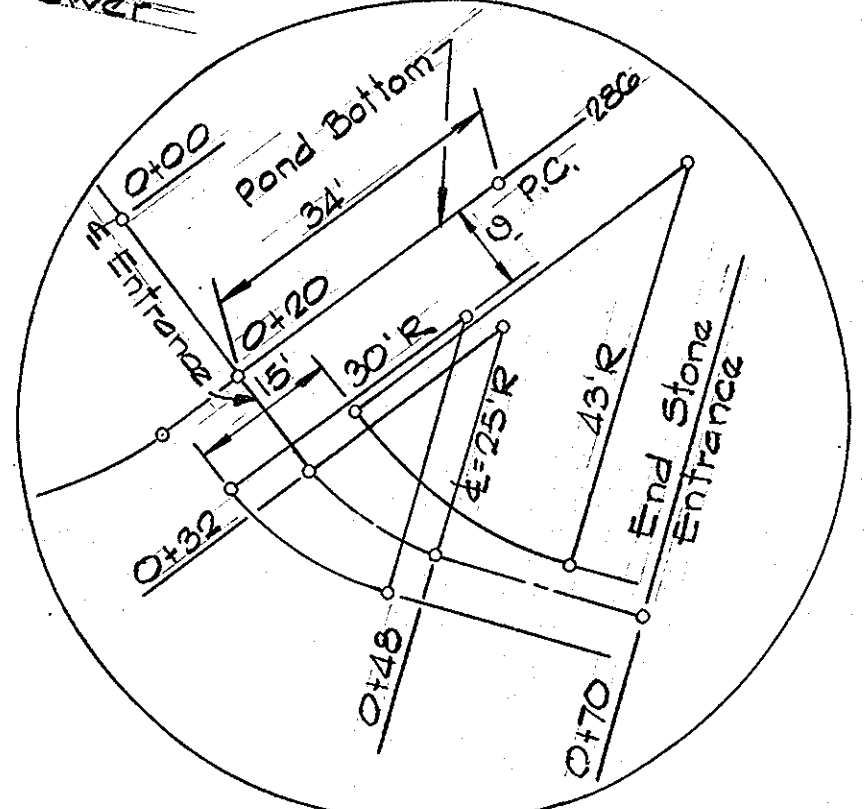

Technical Review by Water Resources Administration Permit #3-PD-0868
 These plans have been reviewed for the Howard Soil Conservation District and meet the technical requirements for soil erosion and sediment control.
 Approved: *James Helmer* 7/16/83
 U.S. Soil Conservation Service Date

These plans for soil erosion and sediment control meet the requirements of the Howard Soil Conservation District.
 Approved: *Wm. Rowe* 7-21-83
 Howard S.C.D. Date
 F-83-120
 Plan Number

CERTIFICATION BY THE ENGINEER
 I certify that this plan for pond construction, erosion, and sediment control represents a practical and workable plan based on my personal knowledge of the site conditions. This plan was prepared in accordance with the requirements of the Howard Soil Conservation District. I have notified the developer that he must provide the Howard Soil Conservation District with a red-lined "as-built" of the pond within 90 days of completion.
Kenneth A. McCord
 KENNETH A. McCORD PE No. 1074
 5-4-83 Date

CERTIFICATION BY THE DEVELOPER
 I certify that all development and/or construction will be done according to these plans of development, pond construction and erosion and sediment control. I also authorize periodic onsite inspection by the Howard Soil Conservation District or their authorized agents, as are deemed necessary. Deviation from this plan will not be made unless authorized by the Howard Soil Conservation District. I will provide the Howard Soil Conservation District with a red-lined "as-built" of the pond within 90 days of completion.
Walter Woodford
 WALTER WOODFORD
 5-10-83 Date

RESPONSIBLE PERSONNEL CERTIFICATION
 I hereby certify that any responsible personnel involved in the construction project will have a certificate of attendance at a Department of Natural Resources approved training program for the control of sediment and erosion before beginning the project.
Walter Woodford
 WALTER WOODFORD
 5-10-83 Date

Rev. No.	Revision Description
7-1-83	As per D.P.W. # Sediment Control Comments


COLUMBIA
 5th ELECTION DISTRICT
 HOWARD COUNTY, MARYLAND
 OWNER AND DEVELOPER
 HOWARD RESEARCH AND DEVELOPMENT CORPORATION

PROJECT AREA
 VILLAGE OF HICKORY RIDGE
 SECTION 3 AREA 1


PROJECT TITLE
 STORM WATER
 MANAGEMENT POND

SCALE: As Shown DATE:
 WHITMAN, REQUARD AND ASSOCIATES
 ENGINEERS
 7315 ST. PAUL STREET
 BALTIMORE, MARYLAND 21218
Kenneth A. McCord
 KENNETH A. McCORD
 Registered Engineer
 No. 1074


NOTE:
 SEE SHEET 16 FOR TABULATION
 OF 72" CULVERT HYDRAULICS
 FOR 2, 10 AND 100 YEAR STORMS

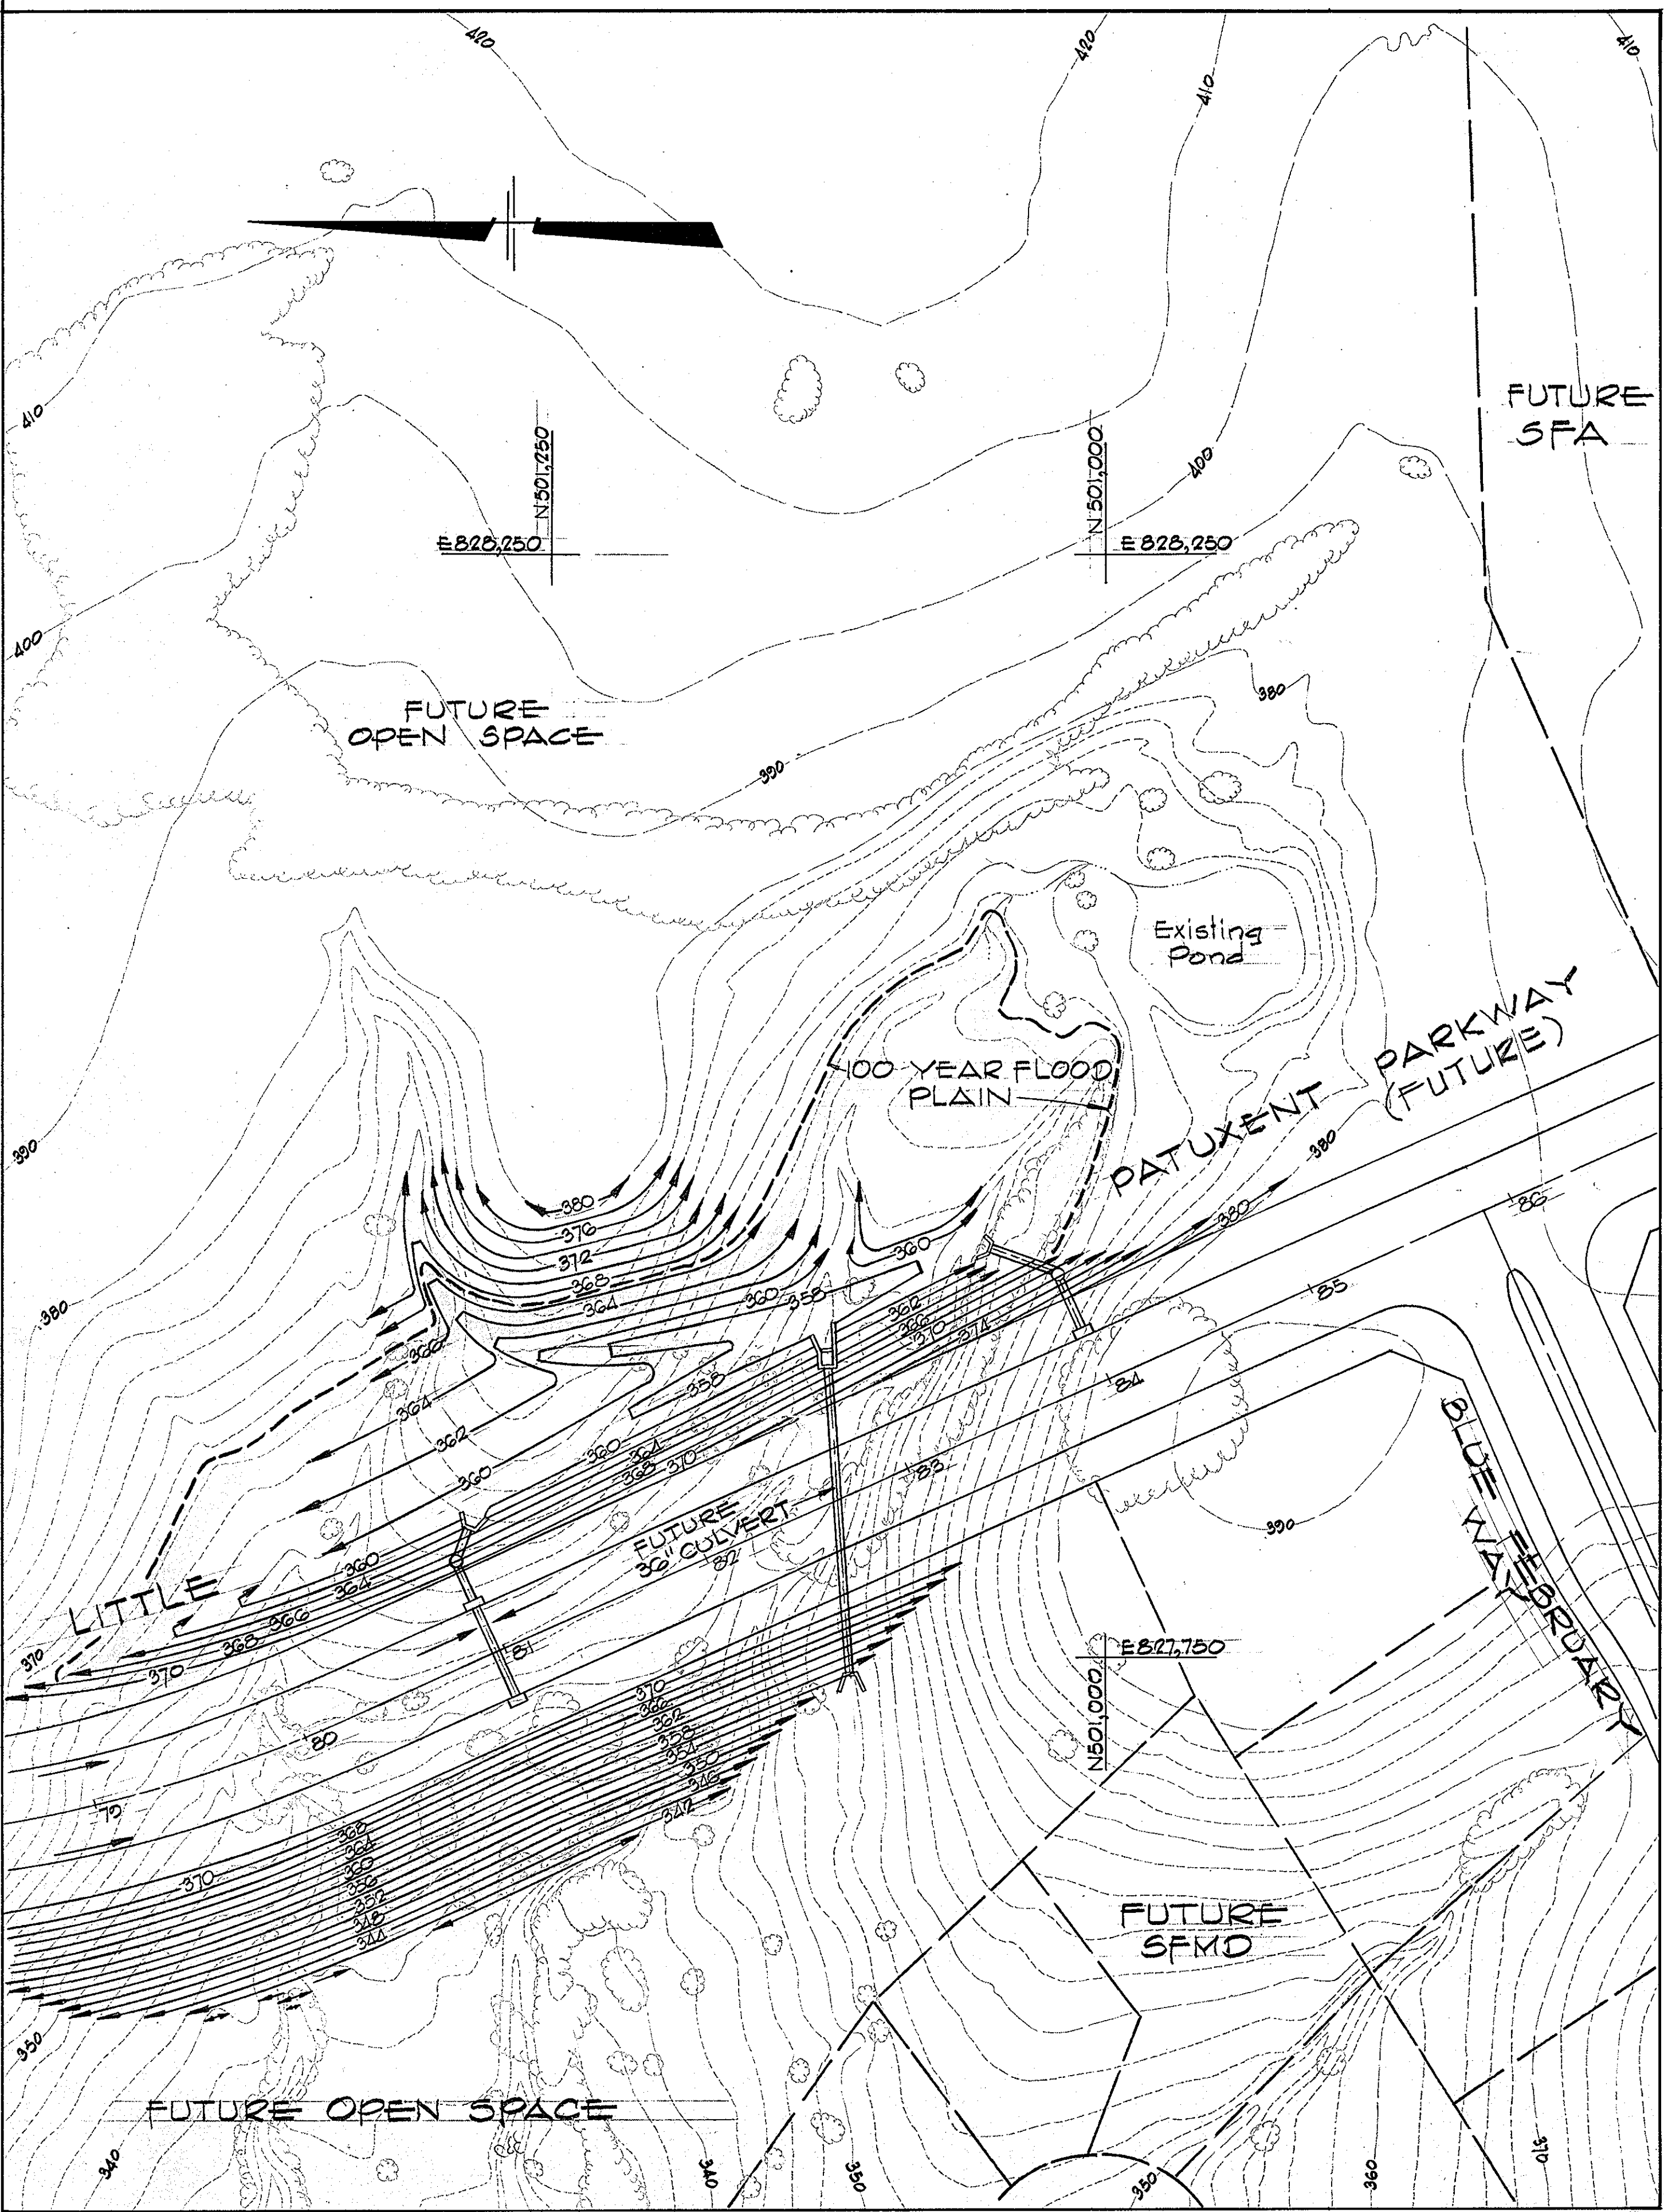

PLAN
 FUTURE 36" CULVERT RESERVOIR, 100 YEAR FLOOD PLAIN

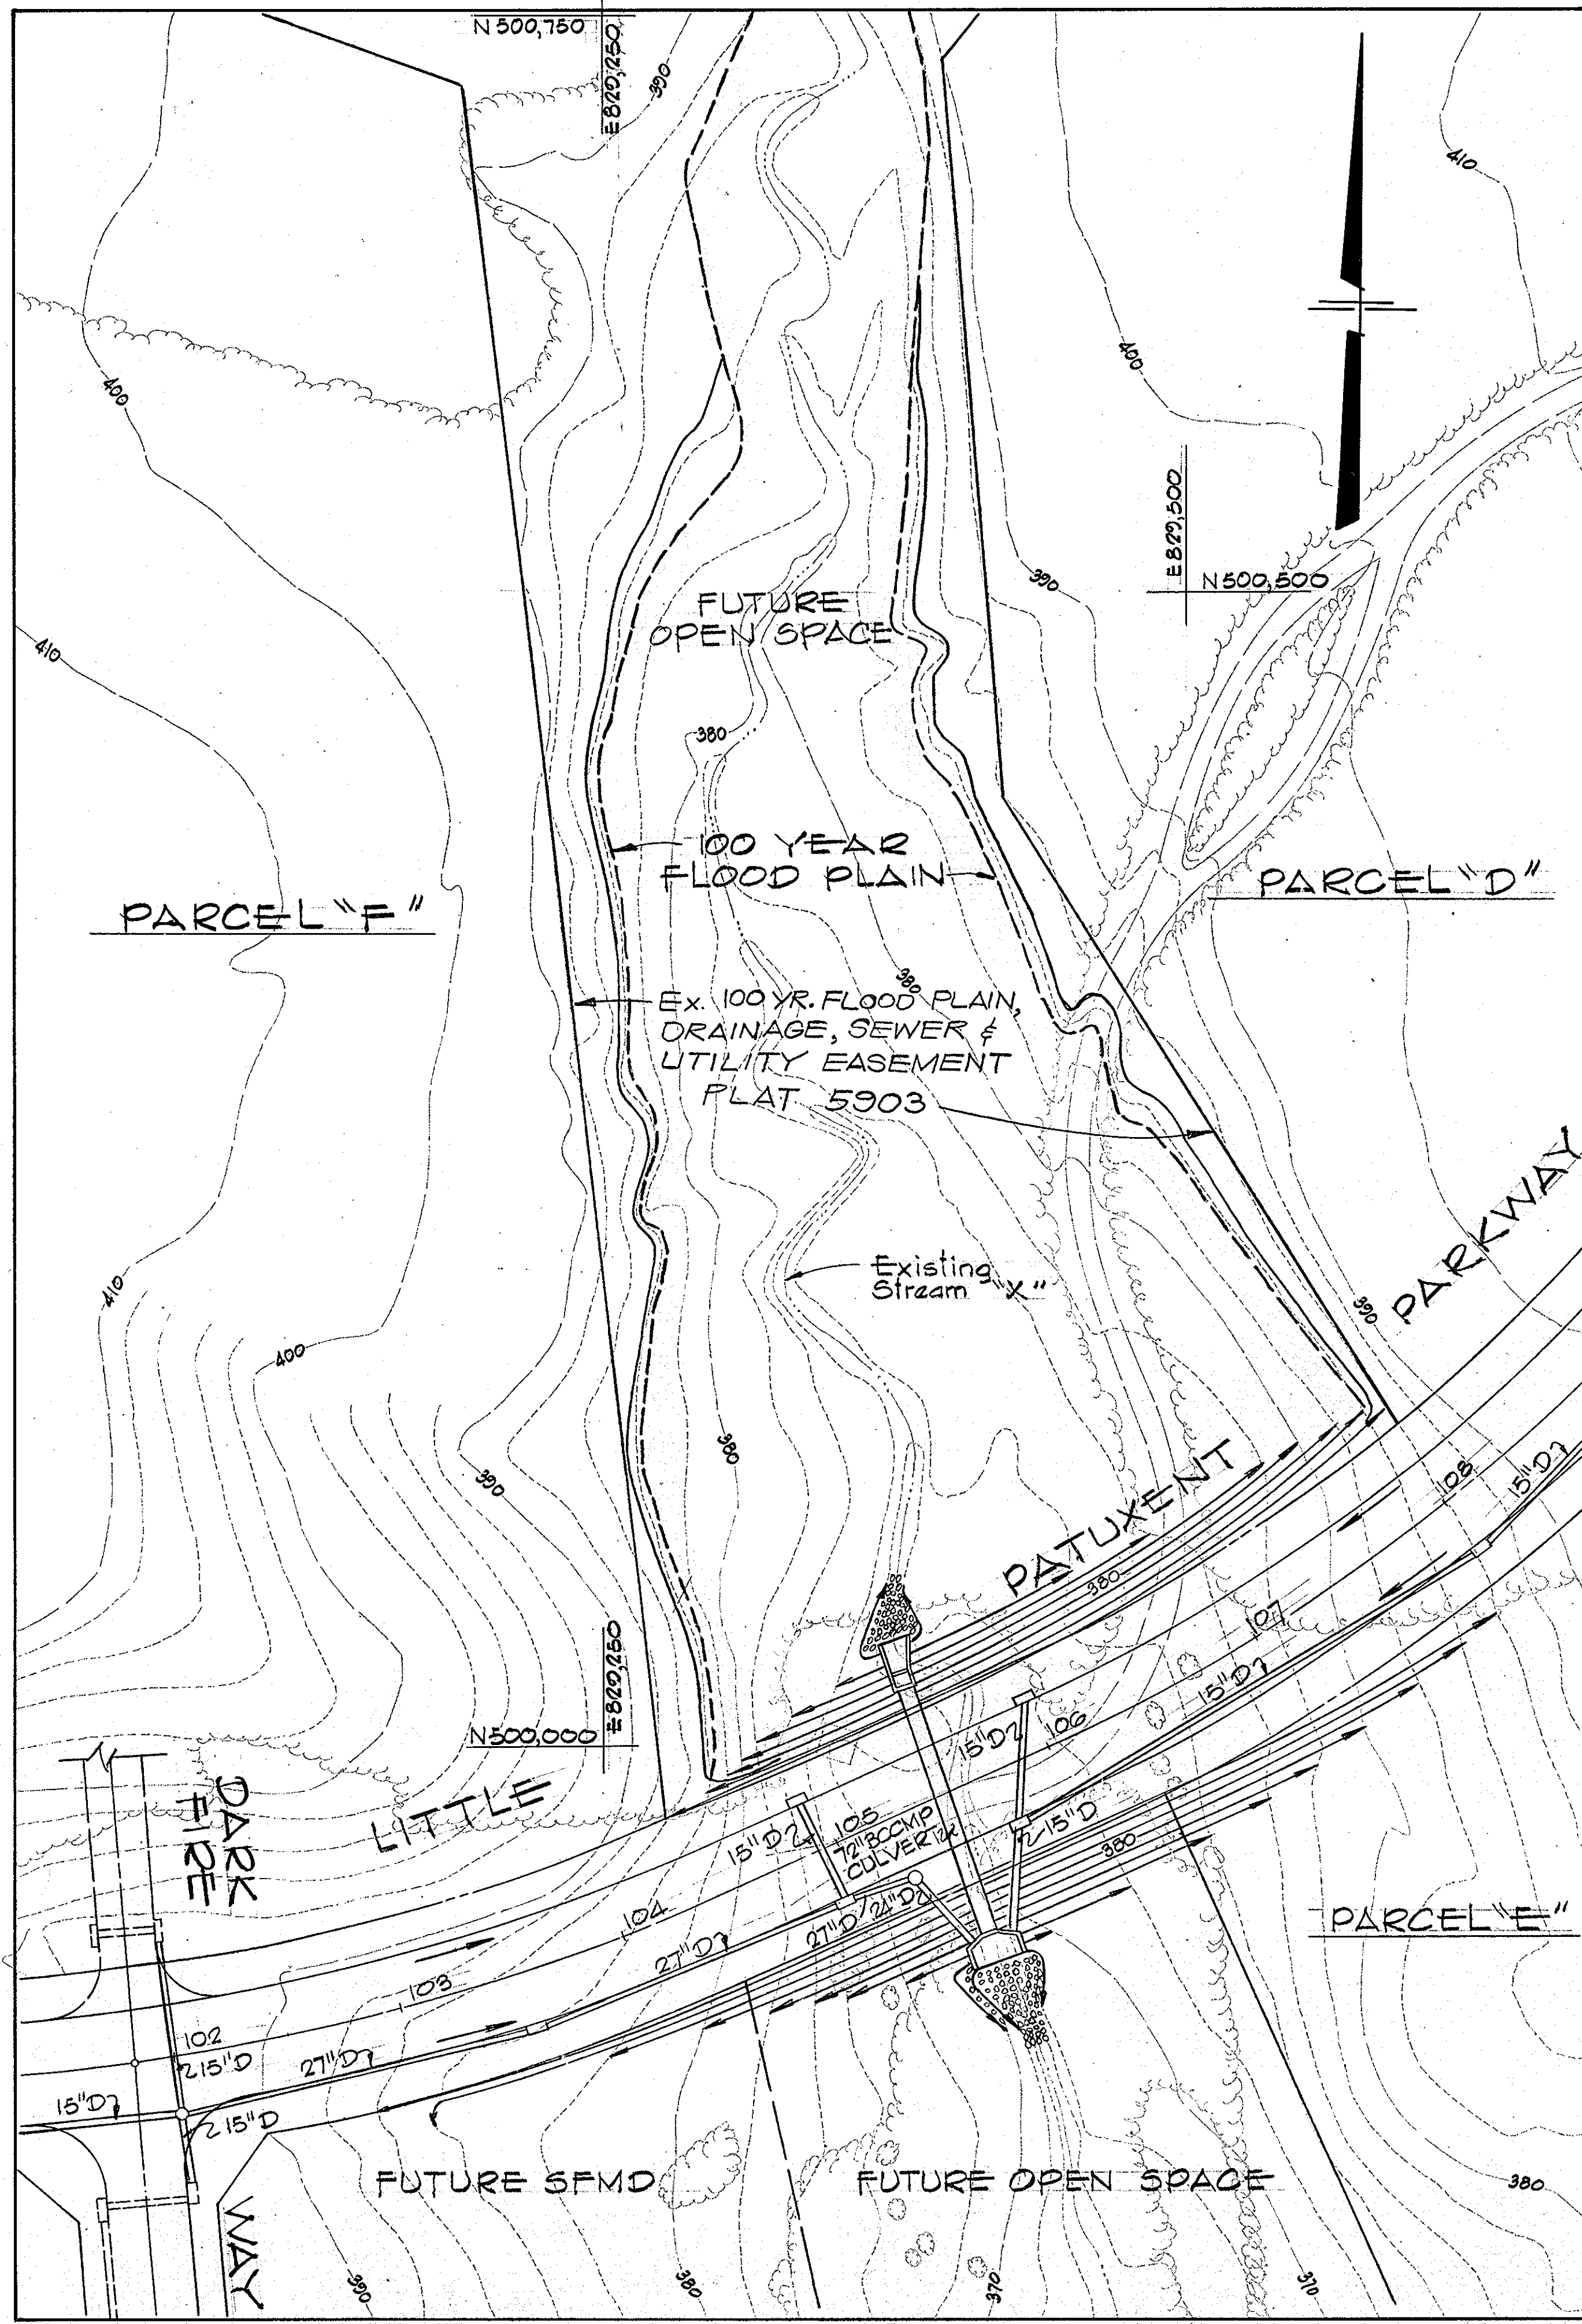

PLAN
 72" CULVERT RESERVOIR, 100 YEAR FLOOD PLAIN

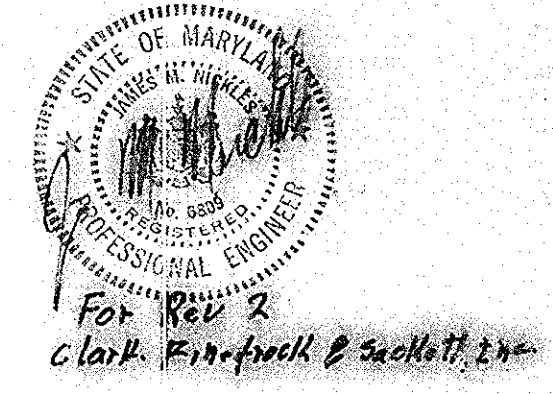

Rev. Date	Rev. No.	Revision Description
7/12/83	2	Rev. 100 Yr. Floodplain Easement
7/1/83	1	AS per DPW Comments

COLUMBIA
 5th ELECTION DISTRICT
 HOWARD COUNTY, MARYLAND
 OWNER AND DEVELOPER
 HOWARD RESEARCH AND DEVELOPMENT CORPORATION
 PROJECT AREA
 VILLAGE OF HICKORY RIDGE
 SECTION 3 AREA 1

PROJECT TITLE
 STORM WATER MANAGEMENT
 72" CULVERT - 36" CULVERT

SCALE: 1" = 50' DATE:
 WHITMAN, REQUARDT AND ASSOCIATES
 ENGINEERS
 2315 ST. PAUL STREET
 BALTIMORE, MARYLAND 21218

Kenneth A. McCord
 KENNETH A. MCCORD
 Registered Engineer
 No. 1974