


"As-Built" Elevations as of May 6, 1986
 Kenneth A. McCord P.E. #1974

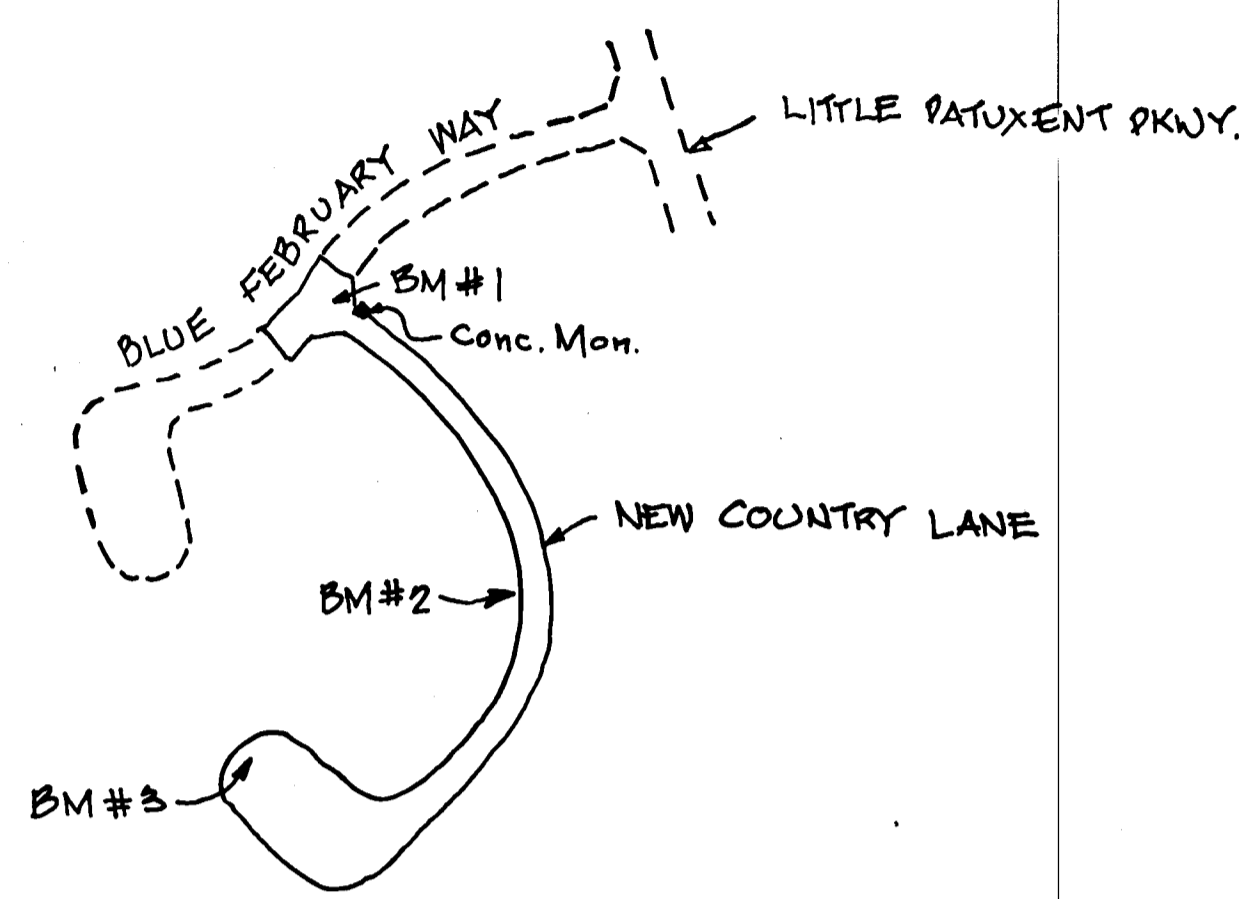


PLAN
 No Scale

COLUMBIA

HOWARD COUNTY, MARYLAND
 5TH ELECTION DISTRICT

ROAD CONSTRUCTION PLANS VILLAGE OF HICKORY RIDGE SECTION 3 AREA 6 LOTS I-1 THRU I-50

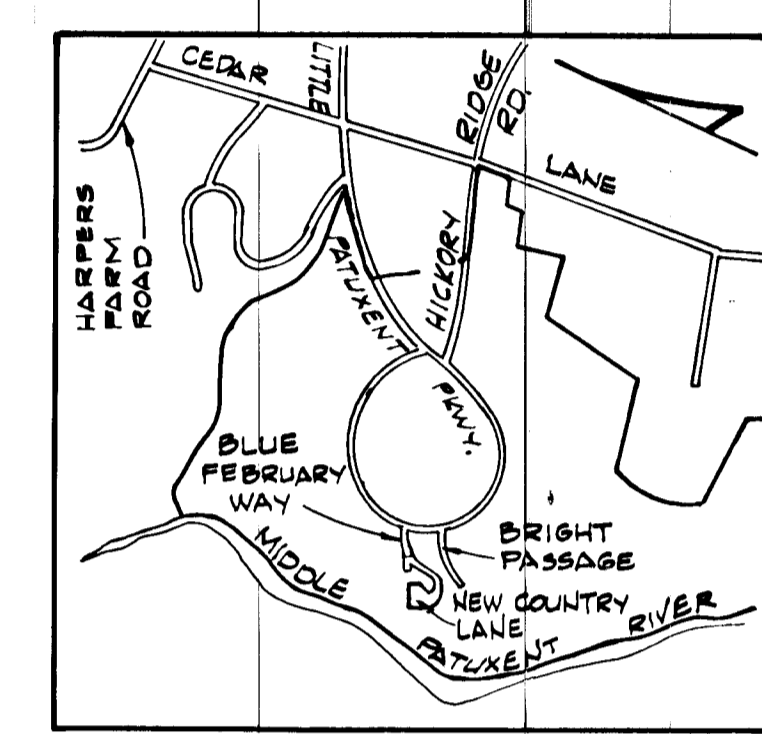

VICINITY MAP
 Scale: 1" = 2,000'


PLAN SUBJECT TO V.P.

BENCH MARK
 B.M. Hickory #54 Elev. 365.538
 R.R. Spike in Base of 30' Poplar
 155' Left of Station 85+65
 Little Patuxent Parkway

BENCH MARKS

- B.M.#1 - Square cut in top of inlet slab 32' left of Sta. 7+26 Blue February Way Elev. 380.56
- B.M.#2 - Cross cut in front flange bolt of fire hydrant 17' right of Sta. 5+95 New Country Lane Elev. 390.23
- B.M.#3 - Box cut in front corner of inlet slab 14' left of Sta. 13+35 New Country Lane Elev. 370.91

SHEET INDEX	
NO.	DESCRIPTION
1	TITLE SHEET
2	PLAN AND PROFILE-BLUE FEBRUARY WAY-STA.7+80 TO STA.9+85.00
3	PLAN AND PROFILE-NEW COUNTRY LANE
4	DRAINAGE AREA MAP
5	STANDARD DETAILS
6	STORM DRAIN PROFILES
7	SEDIMENT CONTROL PLAN
8	SEDIMENT CONTROL DETAILS

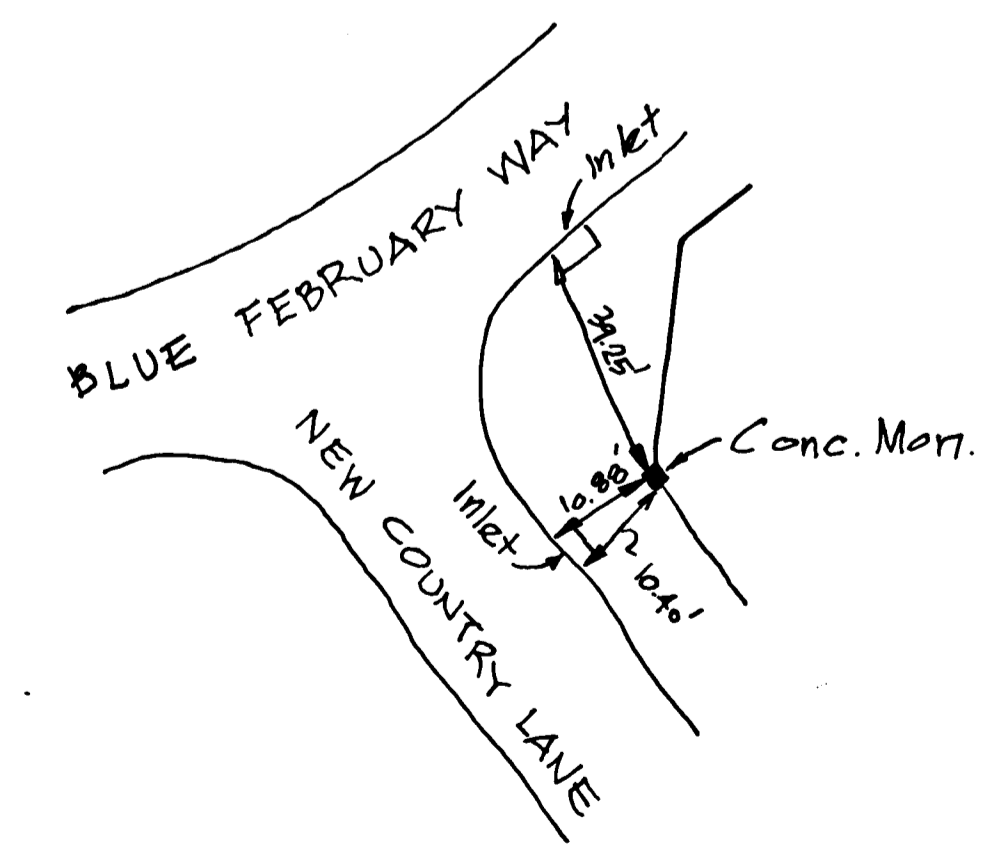

MONUMENT
 RECOVERY SKETCH
 No Scale

GENERAL NOTES:

1. All work shall be done in accordance with Howard County Standards, Specifications and Details for Construction.
2. All utility companies must be notified 24 hours in advance of any construction.
3. Local street is designed for 30 mph speed and cul-de-sac street is designed for 25 mph speed.
4. All inlets shall be Howard County standard unless otherwise shown. All "A" inlets shall be depressed.
5. Storm drain trenches within road rights-of-ways shall be backfilled and compacted in accordance with Howard County Standards, Specifications and Details for Construction.
6. Any damage to public rights-of-ways or paving will be corrected at the developer's expense.
7. Approximate location of existing utilities are shown. The contractor shall take all necessary precautions to protect existing utilities and to maintain uninterrupted service. Any damage incurred due to contractor's operations shall be repaired immediately at the contractor's expense.
8. The Contractor shall test pit existing utilities where directed by the Engineer a minimum of two weeks in advance of any construction.
9. Contractor to notify the Howard County Dept. of Inspectors and Permits at least 3 days before starting work shown on these drawings. Telephone 992-2436.
10. Provide Street Lights at the following locations:
 - a. 250-Watt pendant mounted fixture on a 25 foot bronze pole located at the western corner of Blue February Way and New Country Lane.
 - b. 175-Watt post top fixture on a 12 foot bronze pole located at station 4+00.1 right and station 8+00.1 right, New Country Lane.
11. **Street Trees (86 Total)**
 The location, type and number of trees shown on this plan are tentative and are used for bond purposes only. The final location and variety of trees may vary to accommodate field conditions and builder's landscape program. Bond release is contingent upon Section 16.31 of the Howard County Subdivision and Land Development Regulations, as approved by the Office of Planning and Zoning.

AS-BUILD SURVEY CERTIFIED BY
 KENNETH A. McCORD REG.-P.E. NO. 1974
 ON MARCH 19, 1984

REV. DATE	REV. NO.	REVISION DESCRIPTION
8/6/84	3	Revised Storm Drain M-9 to 5-2
6/25/84	2	Added Street Tree Note 11
5/10/84	1	As per D.W. and S.C.C. Comments

DEVELOPER
 THE HOWARD RESEARCH
 AND DEVELOPMENT CORPORATION
 10275 LITTLE PATUXENT PARKWAY
 COLUMBIA, MARYLAND 21044



WHITMAN, REQUARDT AND ASSOCIATES
 ENGINEERS
 2315 ST. PAUL STREET
 BALTIMORE, MARYLAND 21218

KENNETH A. McCORD
 Registered Engineer
 No. 1974

DATE	
BY	
REVISIONS	
NO.	
DATE	
BY	
REVISIONS	
NO.	
DATE	
BY	
REVISIONS	
NO.	


THE HOWARD RESEARCH AND DEVELOPMENT CORPORATION
LIBER 463, FOLIO 196

NOTE:
PAVING WIDTH = 30' VARIABLE
LENGTH OF ROAD = 595'
2 SEWER M4'S IN ROAD R/W

EDITCH CURVE DATA
A: 40'00"00 T: 10'92"
R: 30'00' Chd: 20'52'
Arc: 20'94' Chd. Drg: 35'43'10"W

Note:
Existing 8" sewer built under Contract No 54-1194-D.

DATE	
BY	
REVISIONS	
NO.	
DATE	
BY	
REVISIONS	
NO.	

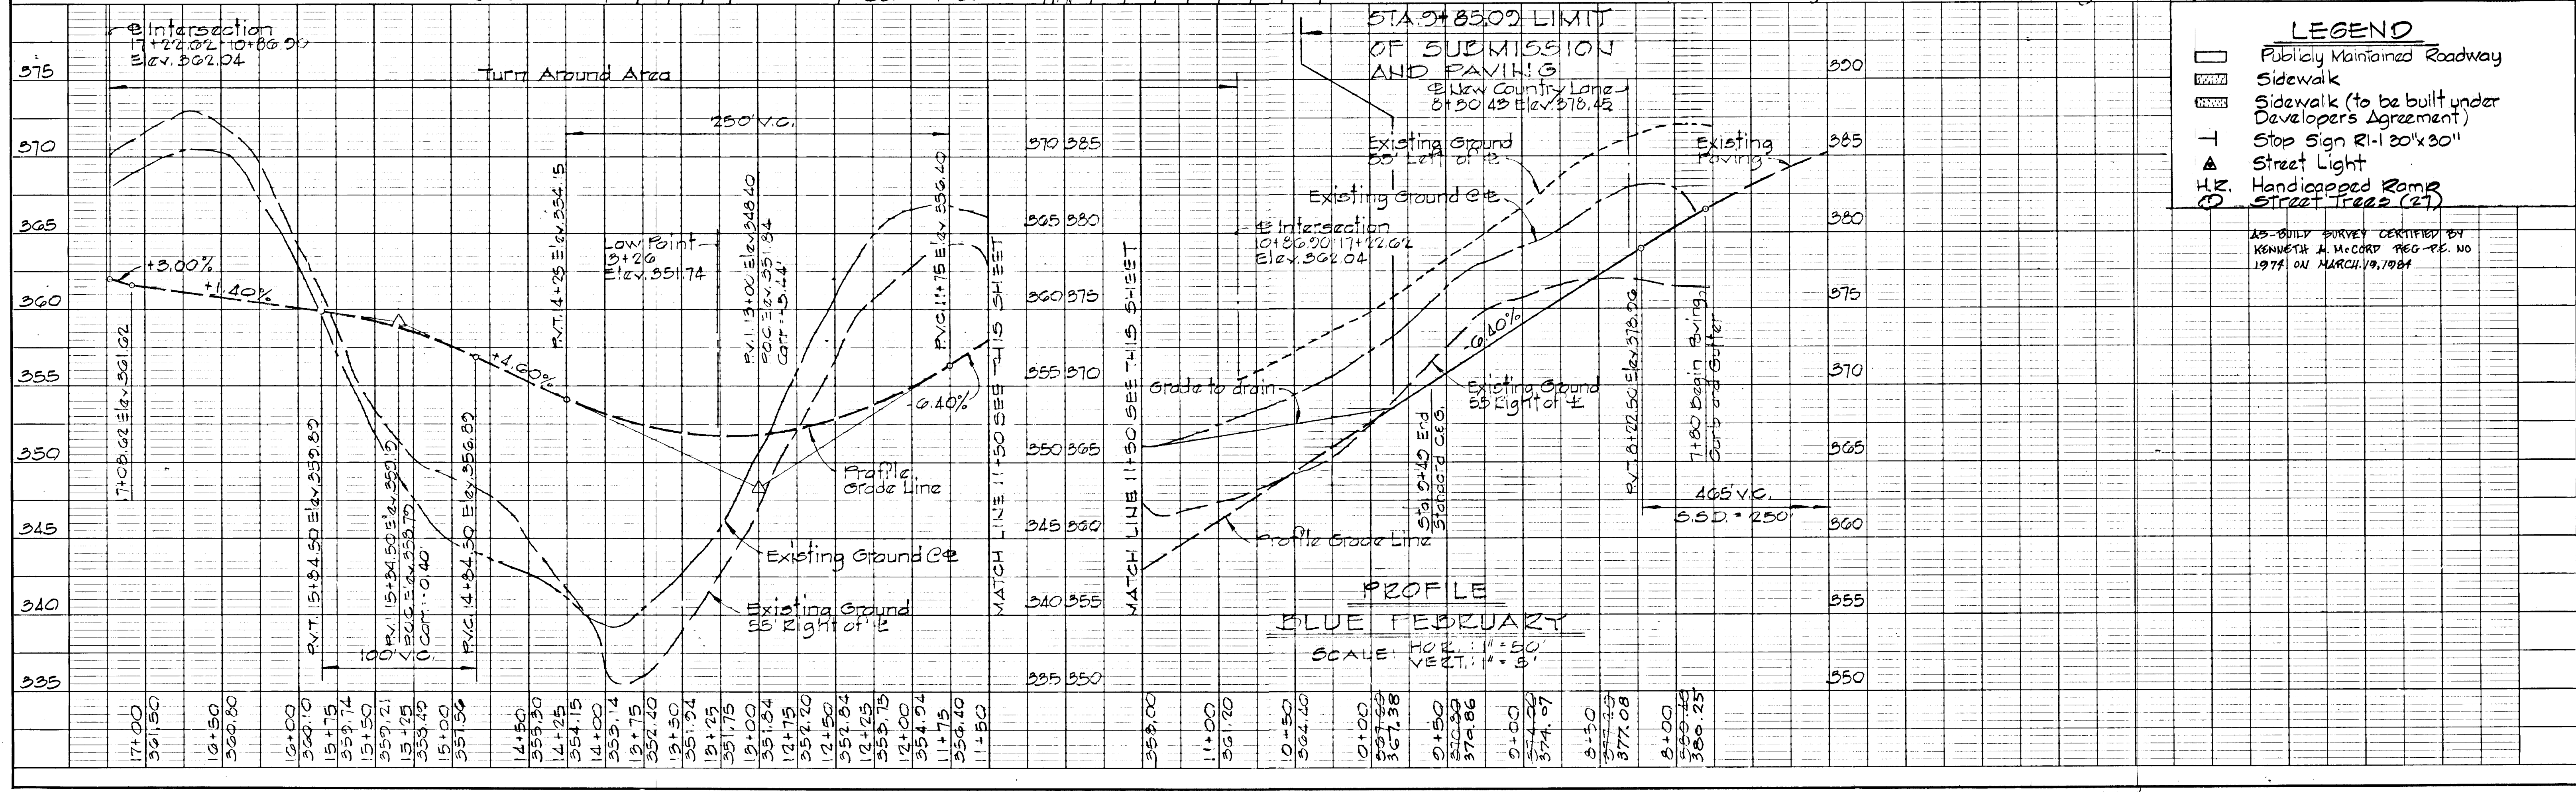

STORM DRAIN STRUCTURE SCHEDULE

NO.	TYPE	TOPEL	INV. IN	INV. OUT	LOCATION
I-1	A-10 Inlet (width 30") S.D. 4.02	351.92	349.15	342.68	inlet 16.17' Right of Sta. 13+28.80
I-2	Type "D" Inlet S.D. 4.11	356.33	350.91	350.00	See Plan & Profile
I-3	Type "D" Inlet S.D. 4.11	375.33	365.30	364.60	See Plan & Profile
I-4	A-5 Inlet (width 25") S.D. 4.01	371.60	369.50	369.00	See Plan & Profile
I-5	A-5 Inlet (width 25") S.D. 4.01	373.40	373.53	373.33	inlet 16.92' Rt. of Sta. 0+67.50
I-6	A-5 Inlet (width 25") S.D. 4.01	373.36	373.83	373.68	inlet 16.92' Lt. of Sta. 0+20.24
I-7	A-5 Inlet (width 25") S.D. 4.01	380.28	-	376.00	inlet 31.92' Lt. of Sta. 7+26.00
I-11	A-10 Inlet (width 25") S.D. 4.02	380.61	376.10	375.85	inlet 16.92' Lt. of Sta. 2+25
M-1	Standard Manhole G.5.05	385.00	228.75	367.00	See Plan & Profile
M-2	Standard Manhole G.5.01	348.50	340.54	340.92	See Plan & Profile
M-3	Standard Manhole G.5.01	371.30	348.10	347.95	inlet Manhole 3' Rt. of Sta. 15+15.78
M-4	Standard Manhole G.5.05	360.50	358.00	354.71	See Plan & Profile
S-1	Type "A" Headwall S.D. 11	330.01	326.01	326.88	See Plan & Profile

NOTE:
SEE SHEET 3 FOR NEW COUNTRY LANE PROFILE

"As-Built" Elevations as of May 6, 1986

Kenneth A. McCord P.E. #1974

CURVE DATA
BLUE FEBRUARY WAY

PC: 0+78.00 To PCC: 8+50.43 Δ: 14°25'20" T: 76.30' R: 603.00' Chd: 151.40' Arc: 151.80' Chd. Drg: 542°28'05"W	PC: 11+27.90 To PT: 11+61.46 Δ: 52°33'21" T: 61.72' R: 125.00' Chd: 110.68' Arc: 114.66' Chd. Drg: 575°59'24"W	PC: 14+52.54 To PT: 14+76.10 Δ: 90°00'00" T: 15.00' R: 15.00' Chd: 21.21' Arc: 23.56' Chd. Drg: 157°16'05"E
--	---	--

MEDIAN CURVE DATA

① Δ: 08°01'34" T: 41.88' R: 597.00' Chd: 83.56' Arc: 83.63' Chd. Drg: 539°16'08"W	② Δ: 13°54'42" T: 55.30' R: 454.00' Chd: 109.90' Arc: 110.23' Chd. Drg: 542°31'31"W
---	---

DEPARTMENT OF PUBLIC WORKS

CHIEF, BUREAU OF ENGINEERING
OFFICE OF PLANNING & ZONING
CHIEF, DIVISION OF LAND DEVELOPMENT AND ZONING ADMINISTRATION

NOTE: FOR EXISTING BLUE FEBRUARY WAY PLAN AND PROFILE SEE VILLAGE OF HICKORY RIDGE SECTION 3 AREA G (F-84-52) CONST. DWGS.

COLUMBIA 5th ELECTION DISTRICT HOWARD COUNTY, MARYLAND

OWNER AND DEVELOPER
HOWARD RESEARCH AND DEVELOPMENT CORPORATION


PROJECT AREA
VILLAGE OF HICKORY RIDGE SECTION 3 AREA G LOTS I-1 THRU I-50

PROJECT TITLE
PLAN AND PROFILE BLUE FEBRUARY WAY STA. 7+80 TO STA. 11+50

SCALE: AS SHOWN DATE:

WHITMAN, REQUARDT AND ASSOCIATES ENGINEERS BALTIMORE, MARYLAND 21218

Kenneth A. McCord Registered Engineer No. 1974

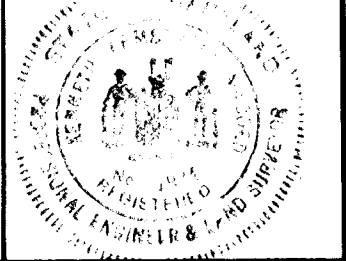

LEGEND

- Publicly Maintained Roadway
- Sidewalk
- Sidewalk (to be built under Developers Agreement)
- Stop Sign R-1 30"x30"
- Street Light
- Handicapped Ramp
- Street Tree (2")

AS-BUILT SURVEY CERTIFIED BY KENNETH A. MCCORD REG. P.E. NO. 1974 ON MARCH 19, 1984

DEPARTMENT OF PUBLIC WORKS
 GREEN & CO., INC. 02-84
 CHIEF, BUREAU OF ENGINEERING DATE
 OFFICE OF PLANNING & ZONING
 KENNETH A. MCCORD 02-84
 CHIEF, DIVISION OF LAND DEVELOPMENT DATE
 AND ZONING ADMINISTRATION




THE HOWARD RESEARCH
 AND DEVELOPMENT CORPORATION
 LIBER 463, FOLIO 100


5/10/84	1	As Per DPW and S.C.S Comments
REV/DATE	REV/NO	REVISION DESCRIPTION
COLUMBIA 5 th ELECTION DISTRICT HOWARD COUNTY, MARYLAND		
OWNER AND DEVELOPER HOWARD RESEARCH AND DEVELOPMENT CORPORATION		
PROJECT AREA VILLAGE OF HICKORY RIDGE SECTION 3 AREA C LOTS I-1 THRU I-59		
PROJECT TITLE DRAINAGE AREA MAP		
SCALE: 1" = 50'		DATE:
WHITMAN, REQUARDT AND ASSOCIATES ENGINEERS BALTIMORE, MARYLAND 21215		
Kenneth A. McCord KENNETH A. MCCORD Registered Engineer No. 1074		

ROADWAY CONSTRUCTION NOTES


- All materials and construction methods shall be in accordance with the Howard County Standard Specifications and Details for Construction.
- Standard 7" Comb. Curb and Gutter shall be in accordance with County Standard Detail R-3.01.
- Paving (5") shall be in accordance with County Detail R-2.01 (Paving Section P-1).
- Paving (6 1/2") shall be in accordance with County Standard Detail R-2.01 (Paving Section P-2).
- Sidewalks shall be in accordance with County Standard Detail R-3.05.
- Base will be primed in accordance with Article 33.04 of the Howard County Standard Specifications.
- Tack coat is required in accordance with the Howard County Standard Specifications.
- Paving (8") shall be in accordance with County Standard Detail R-2.01 (Paving Section P-3).
- Granular Base Alternates may be substituted at the option of the Developer.

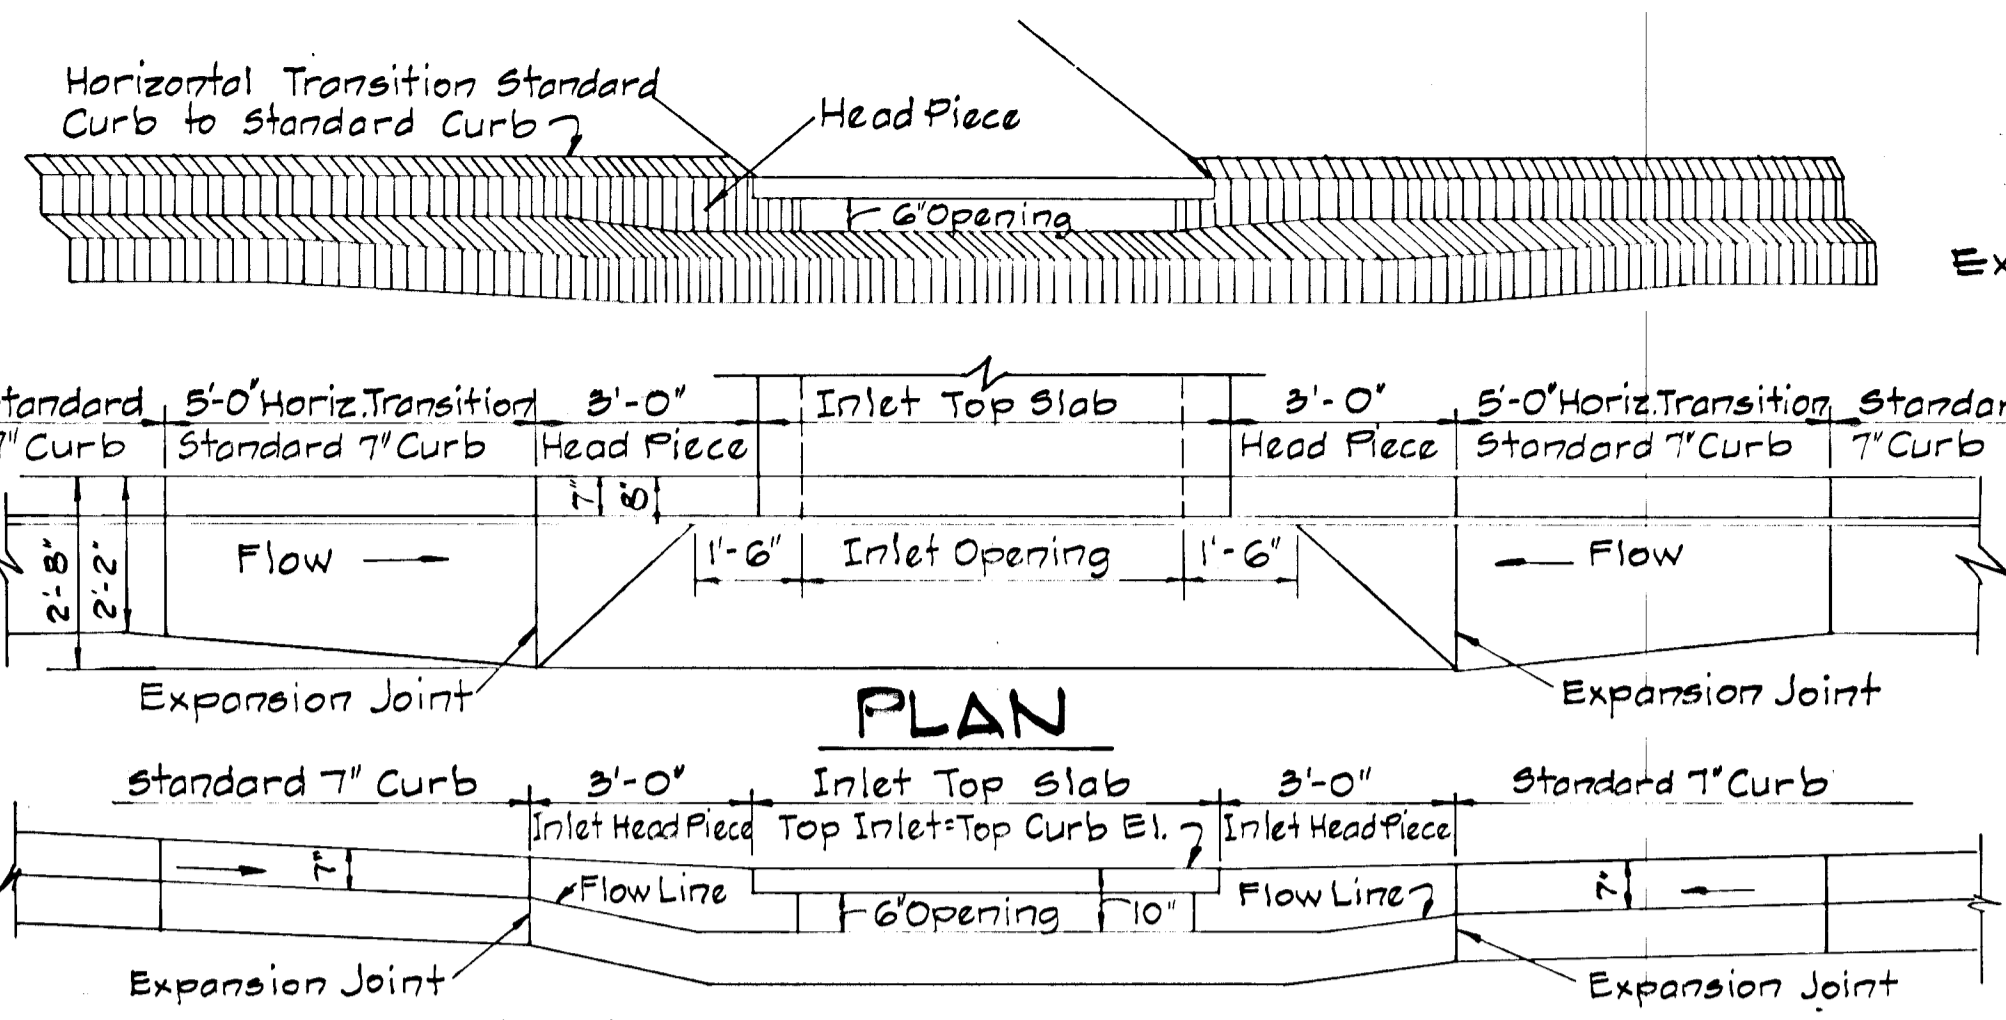


**SECTION ALONG FLOW LINE
 SUMPED "A" INLETS - STANDARD CURB**

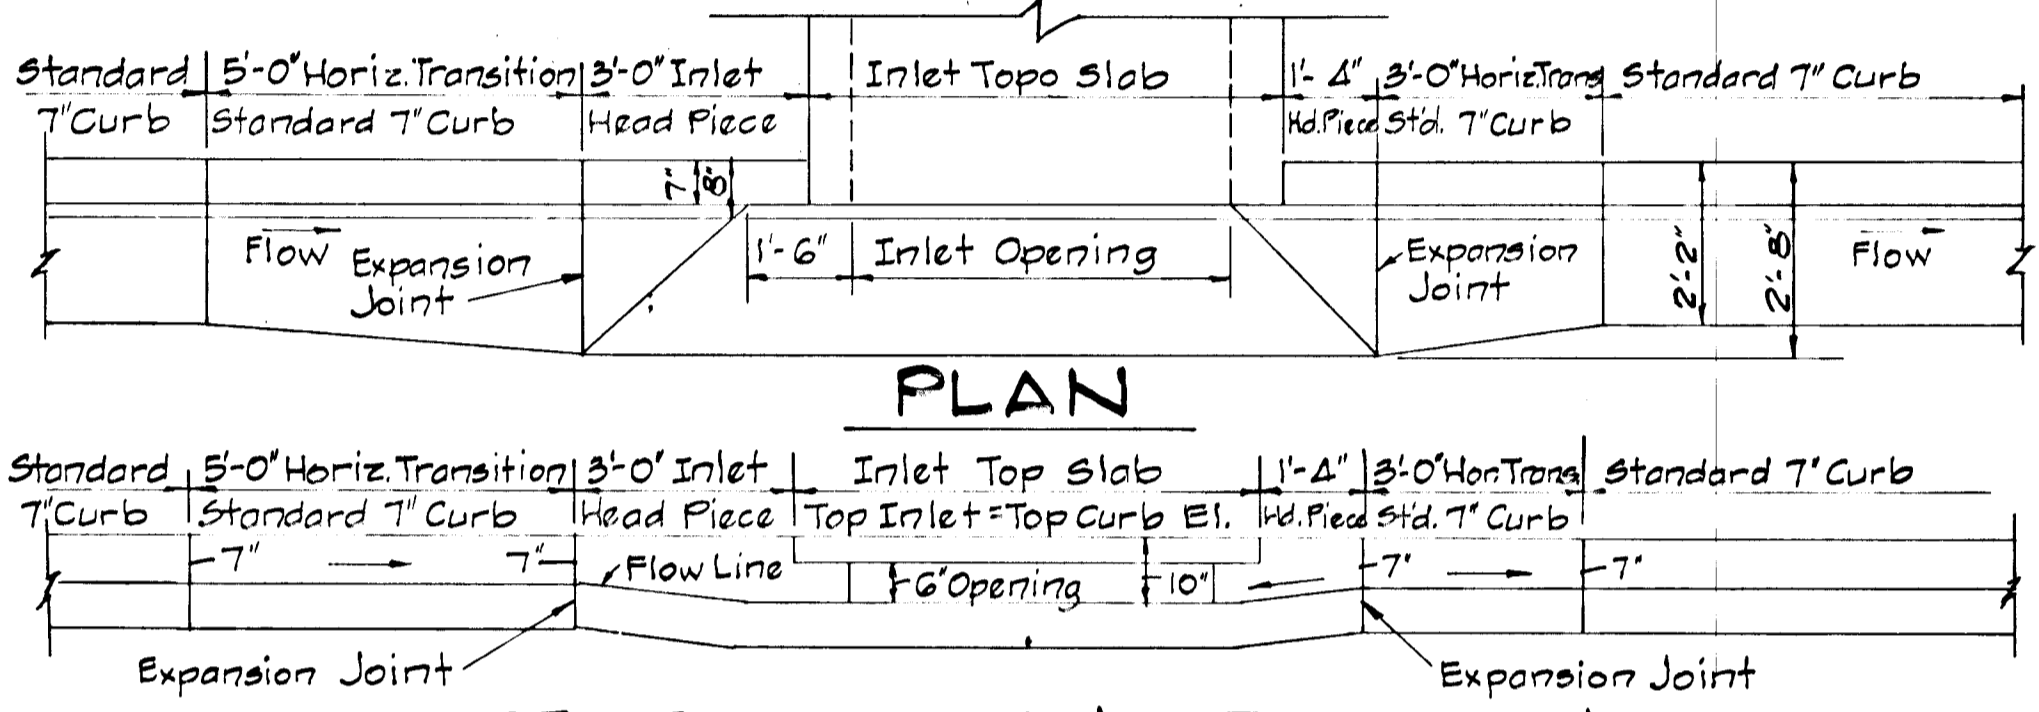









**SECTION ALONG FLOW LINE
 "A" INLETS - STANDARD CURB**

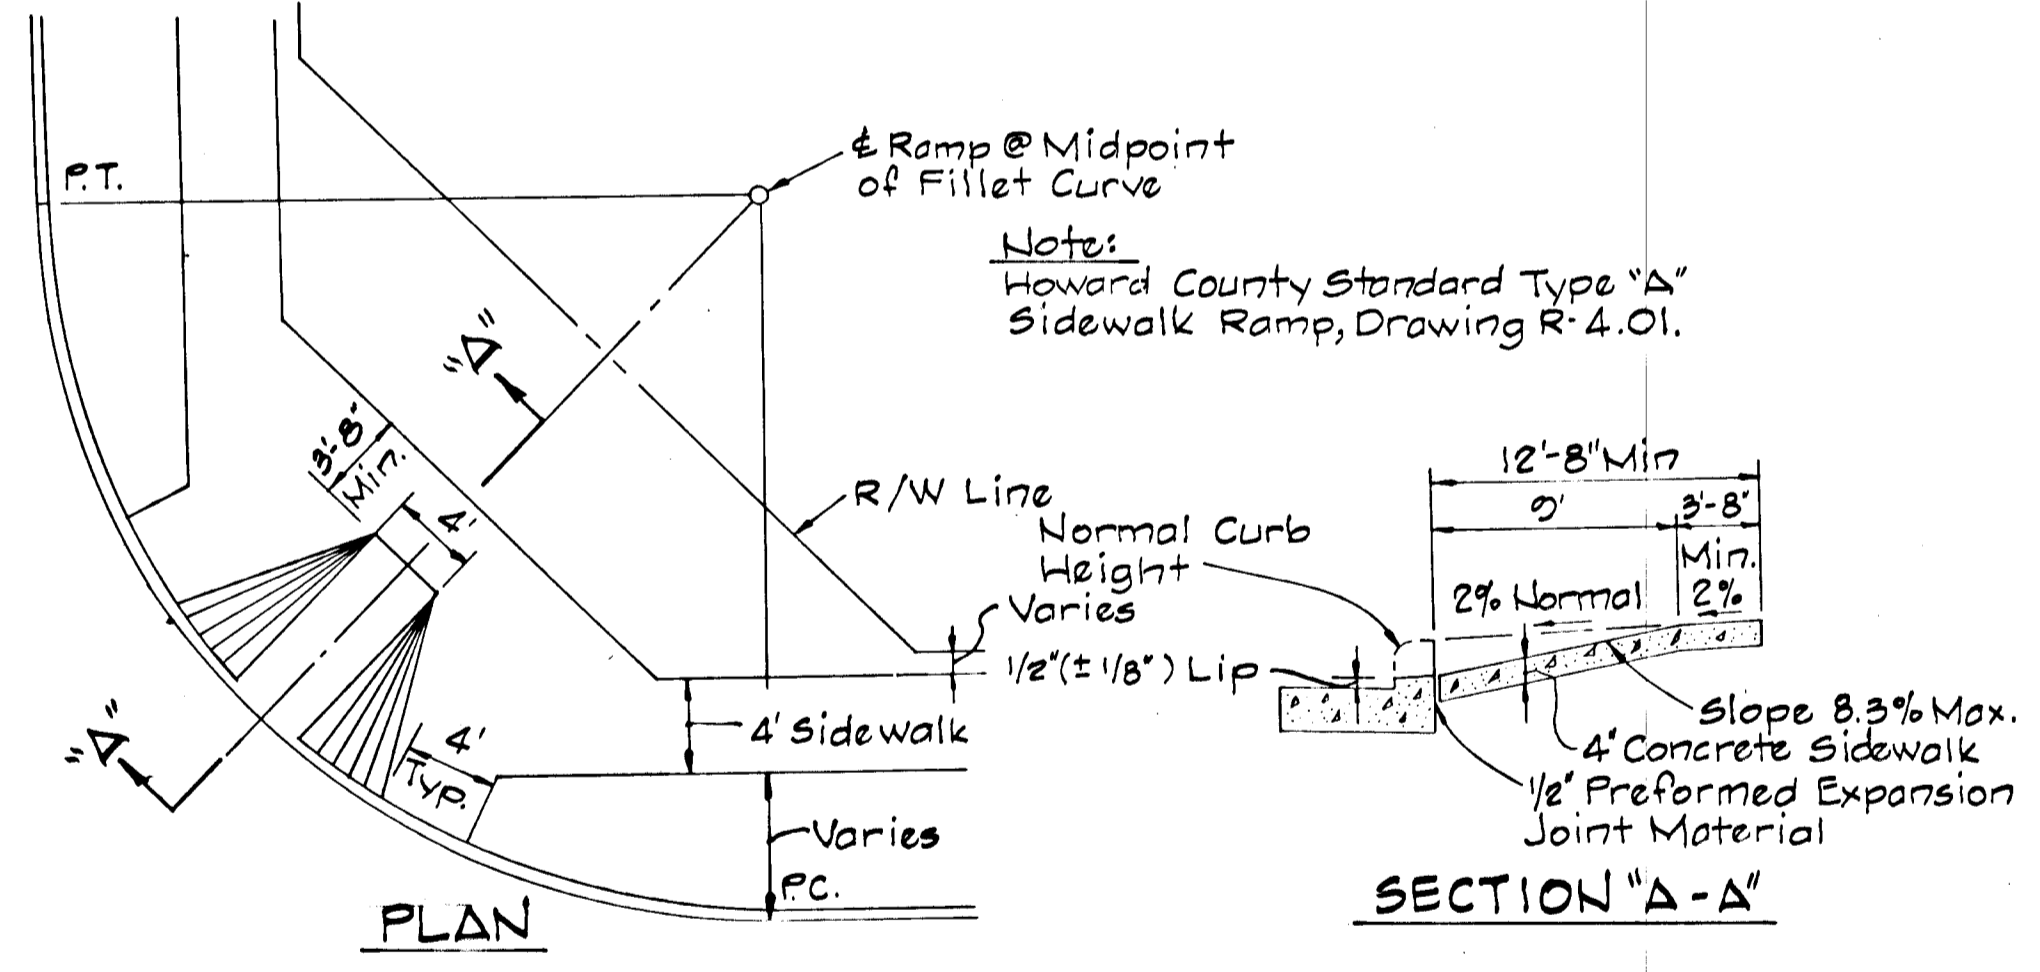


WHEEL CHAIR RAMP DETAIL

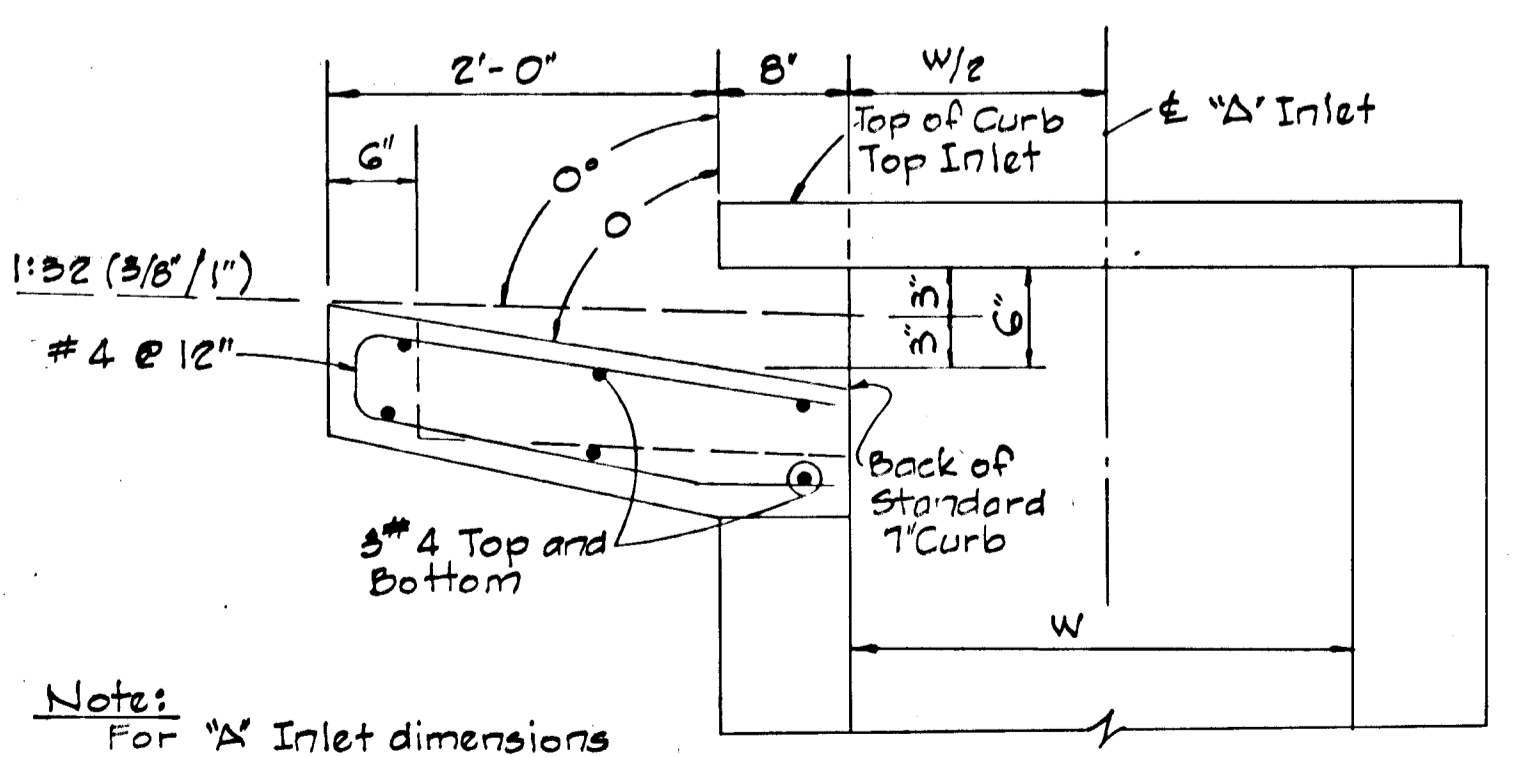

SECTION "A" INLET-STANDARD CURB

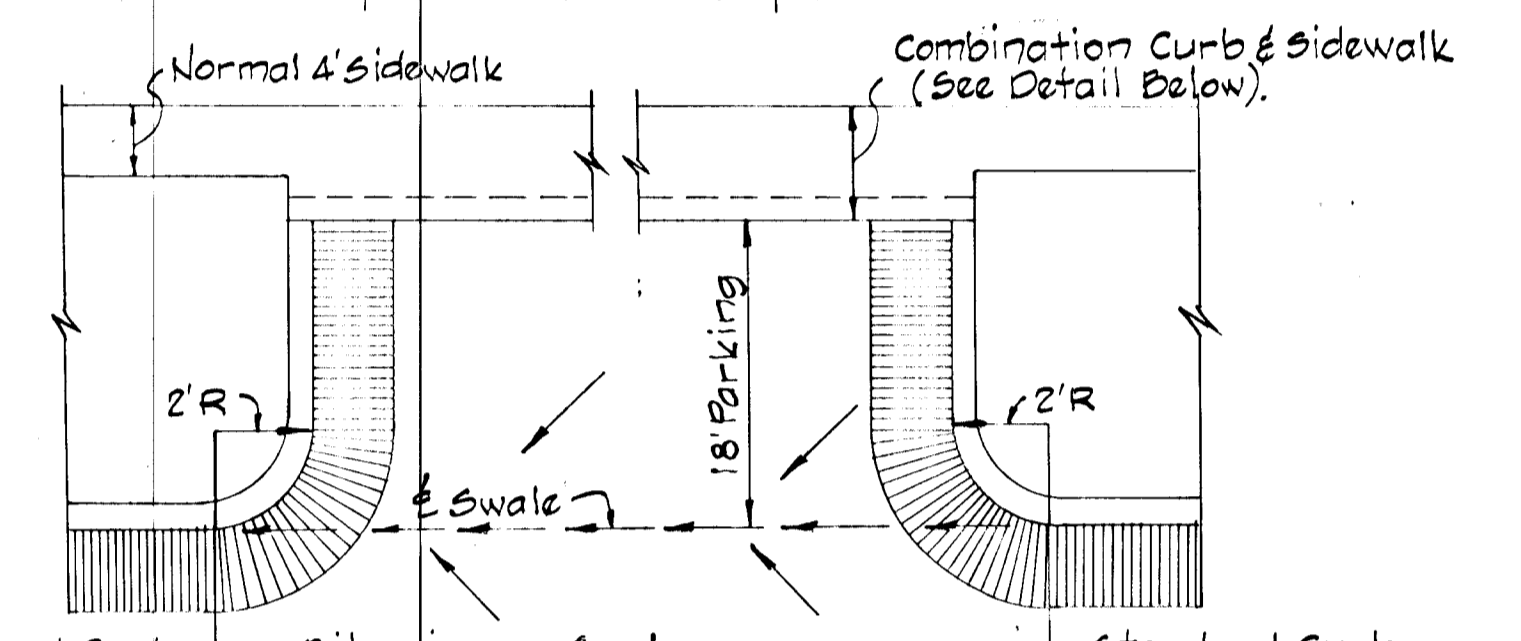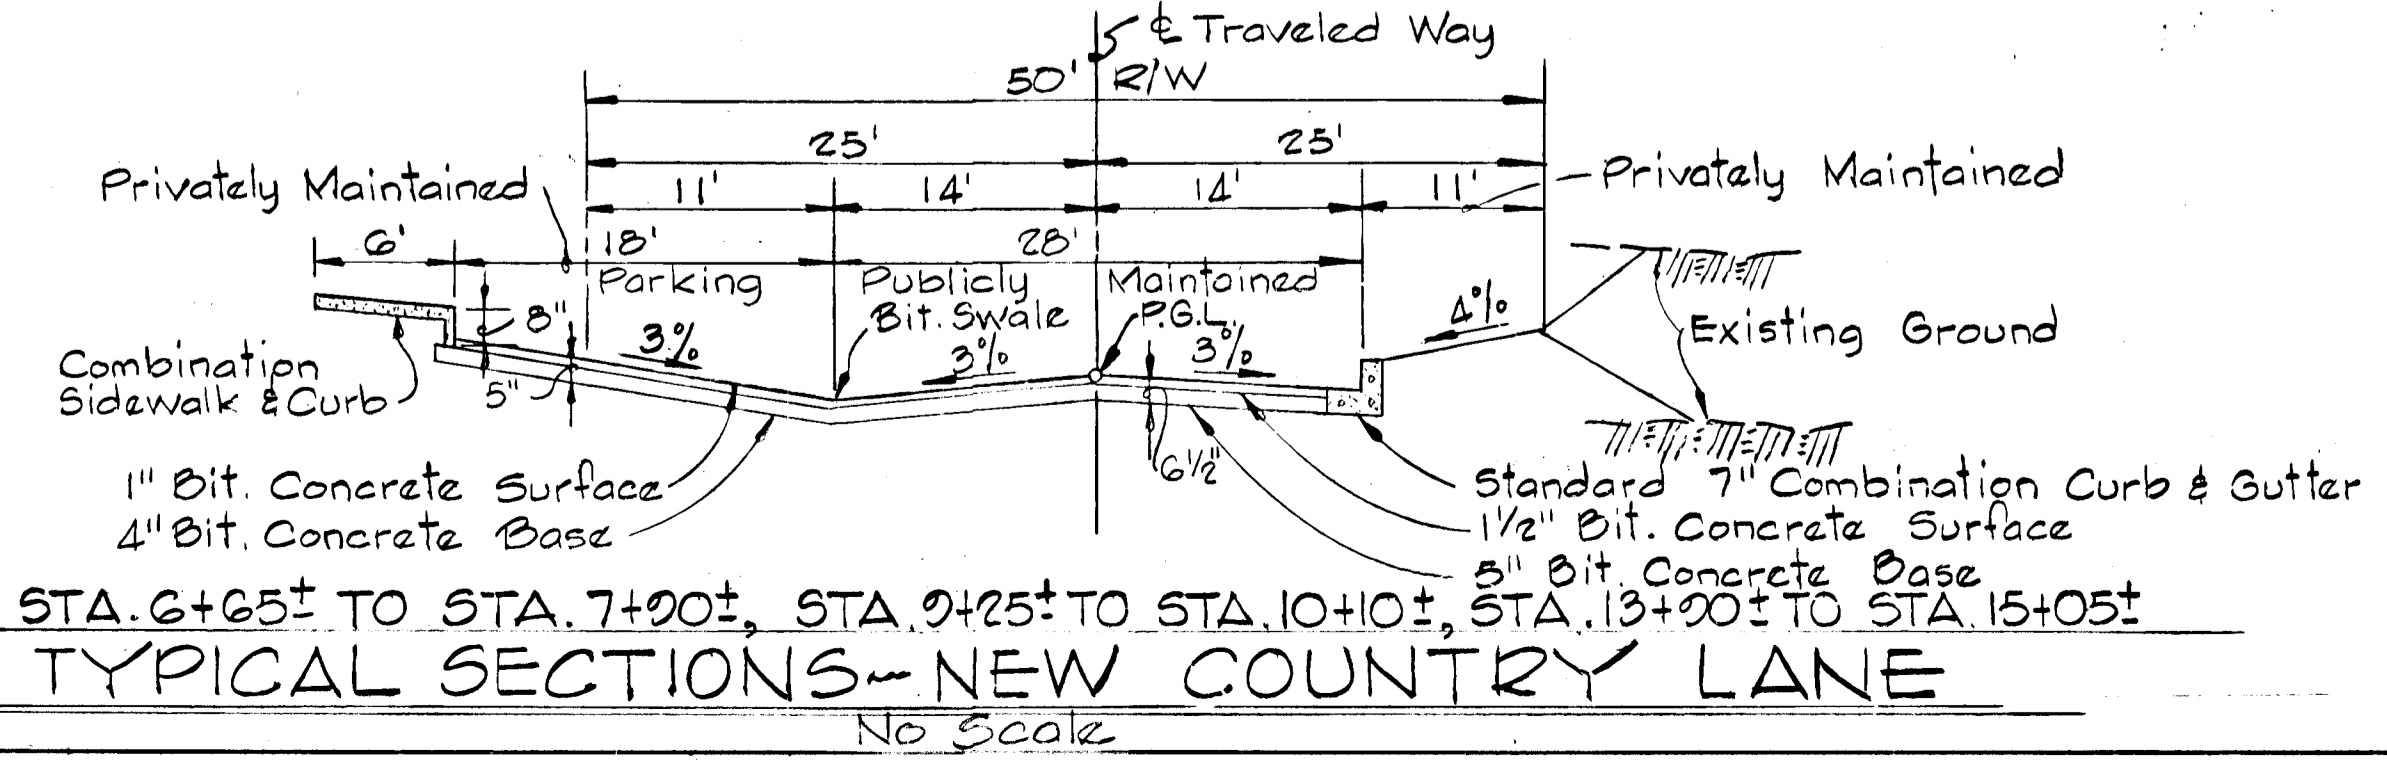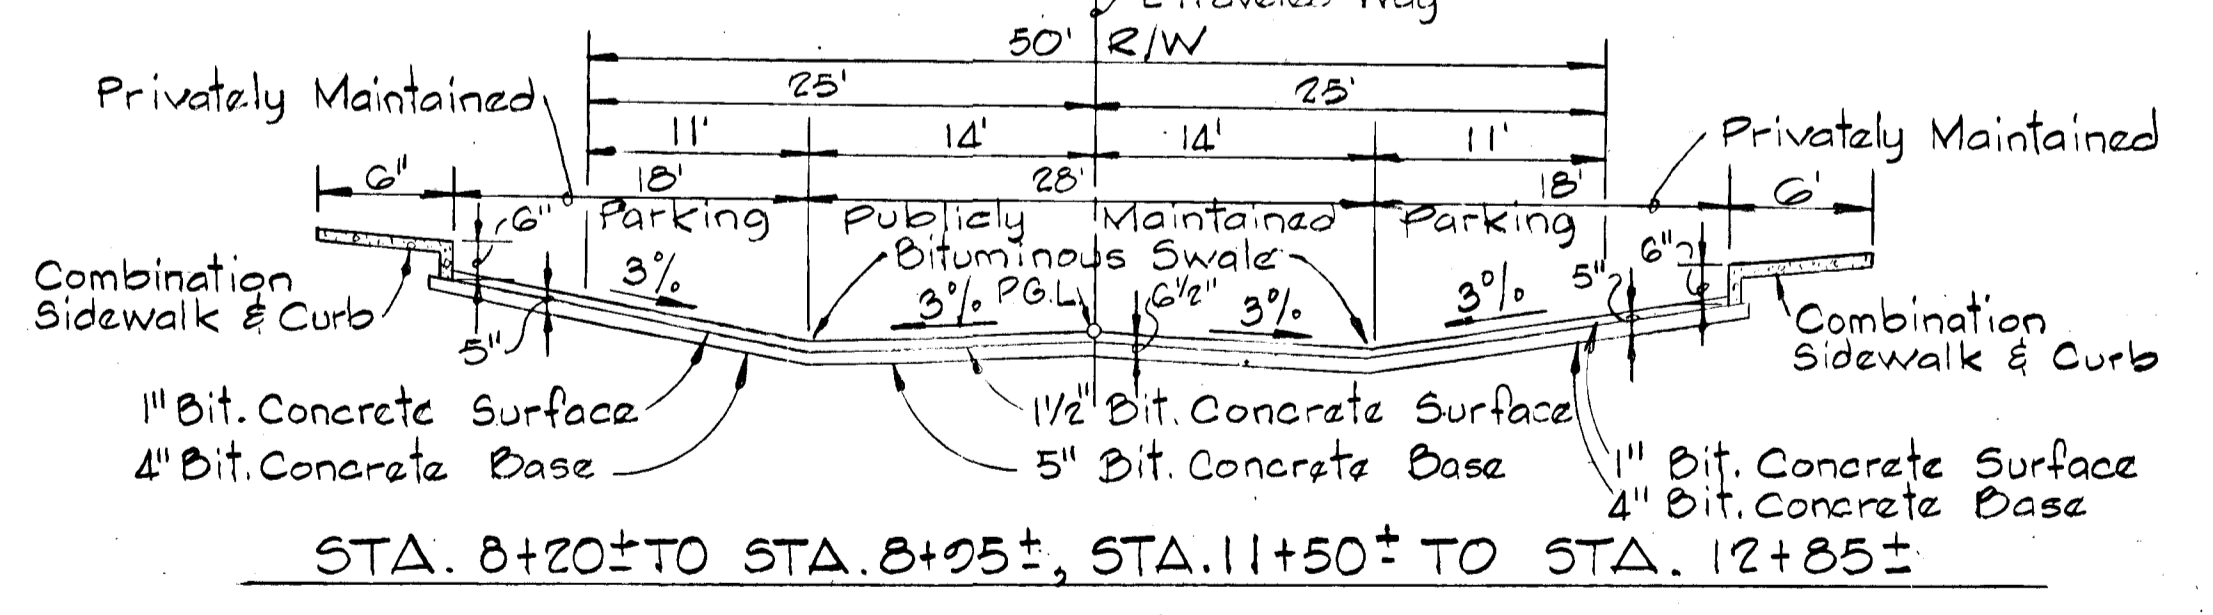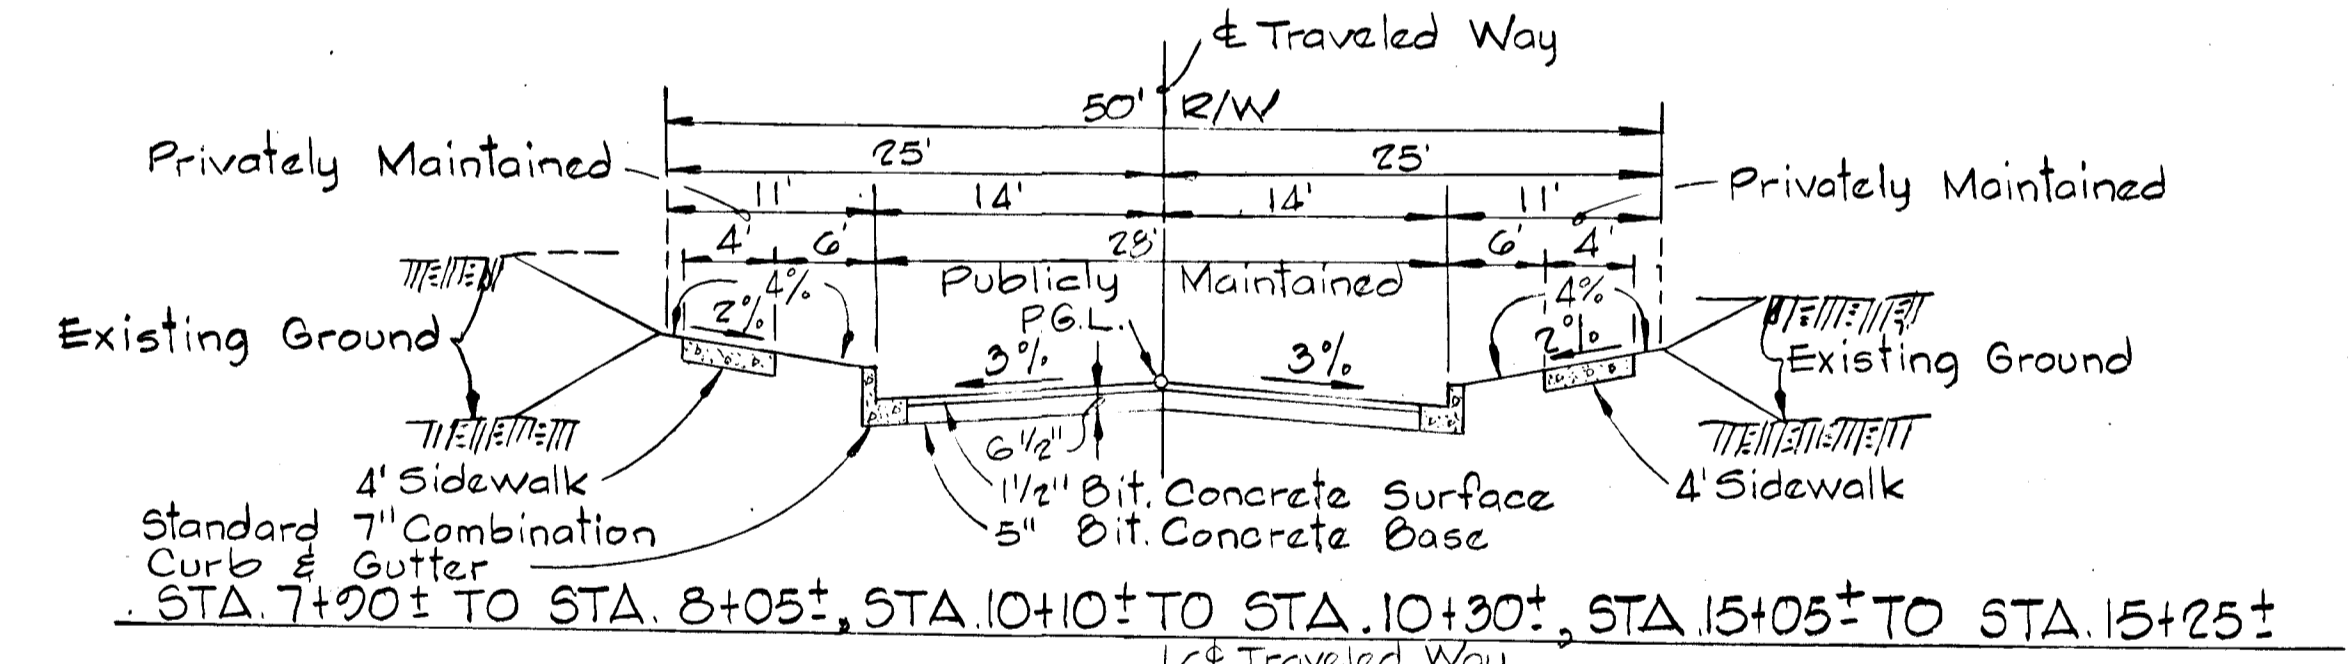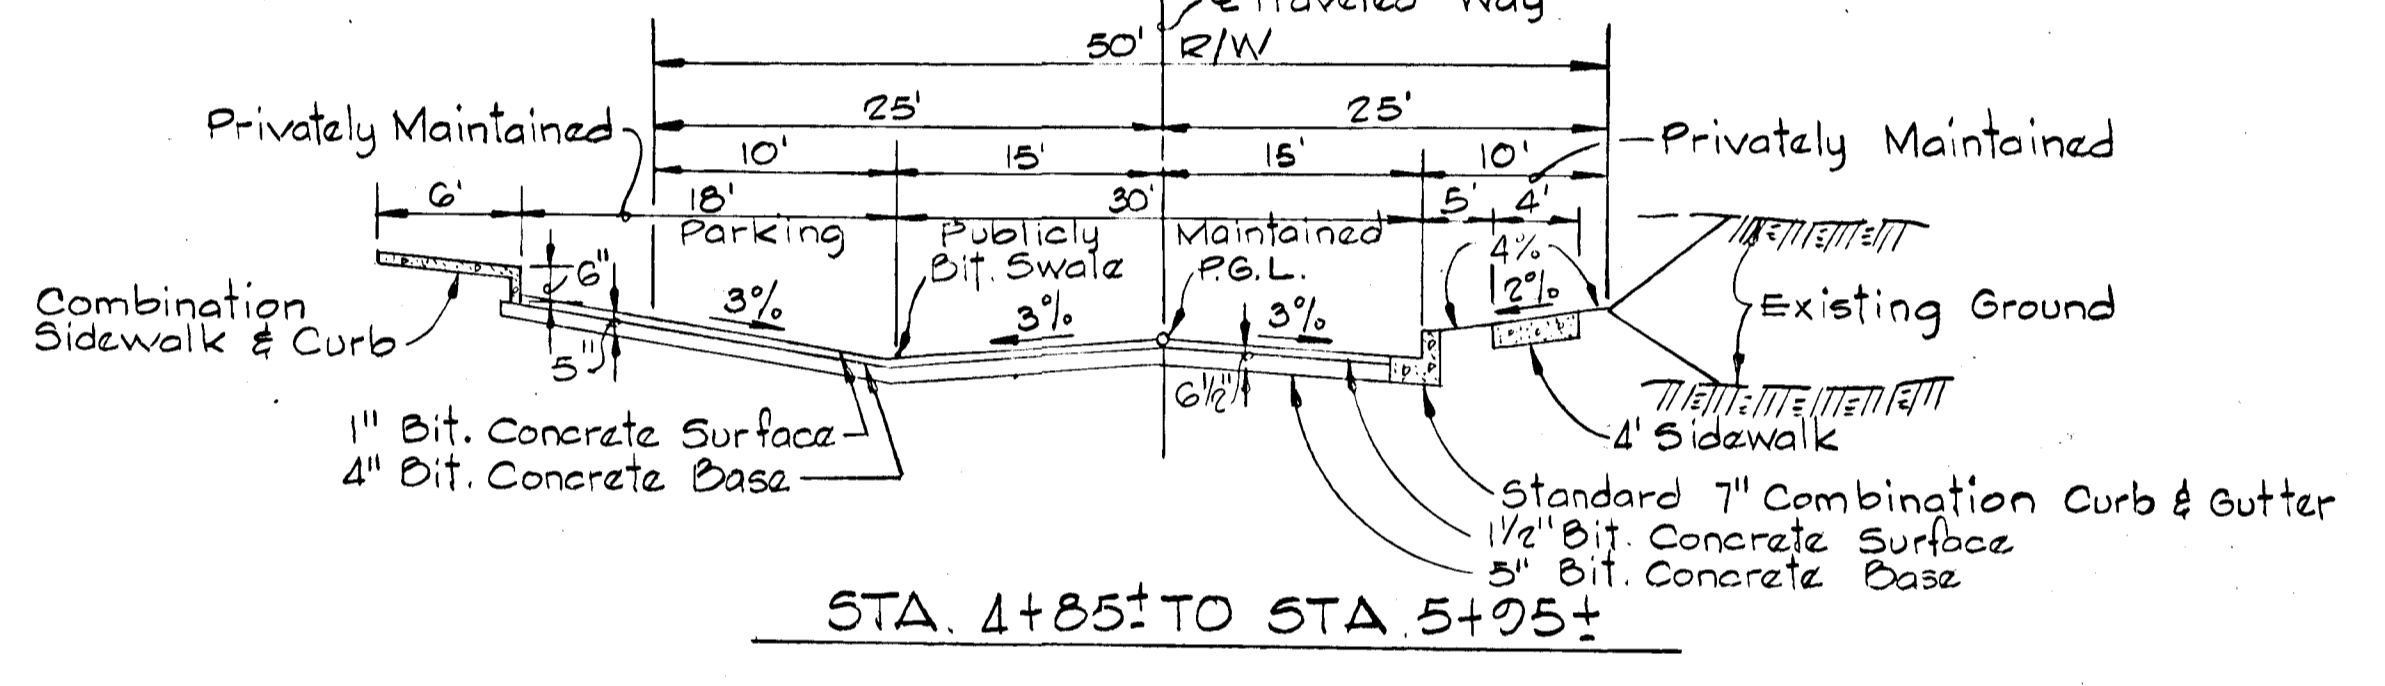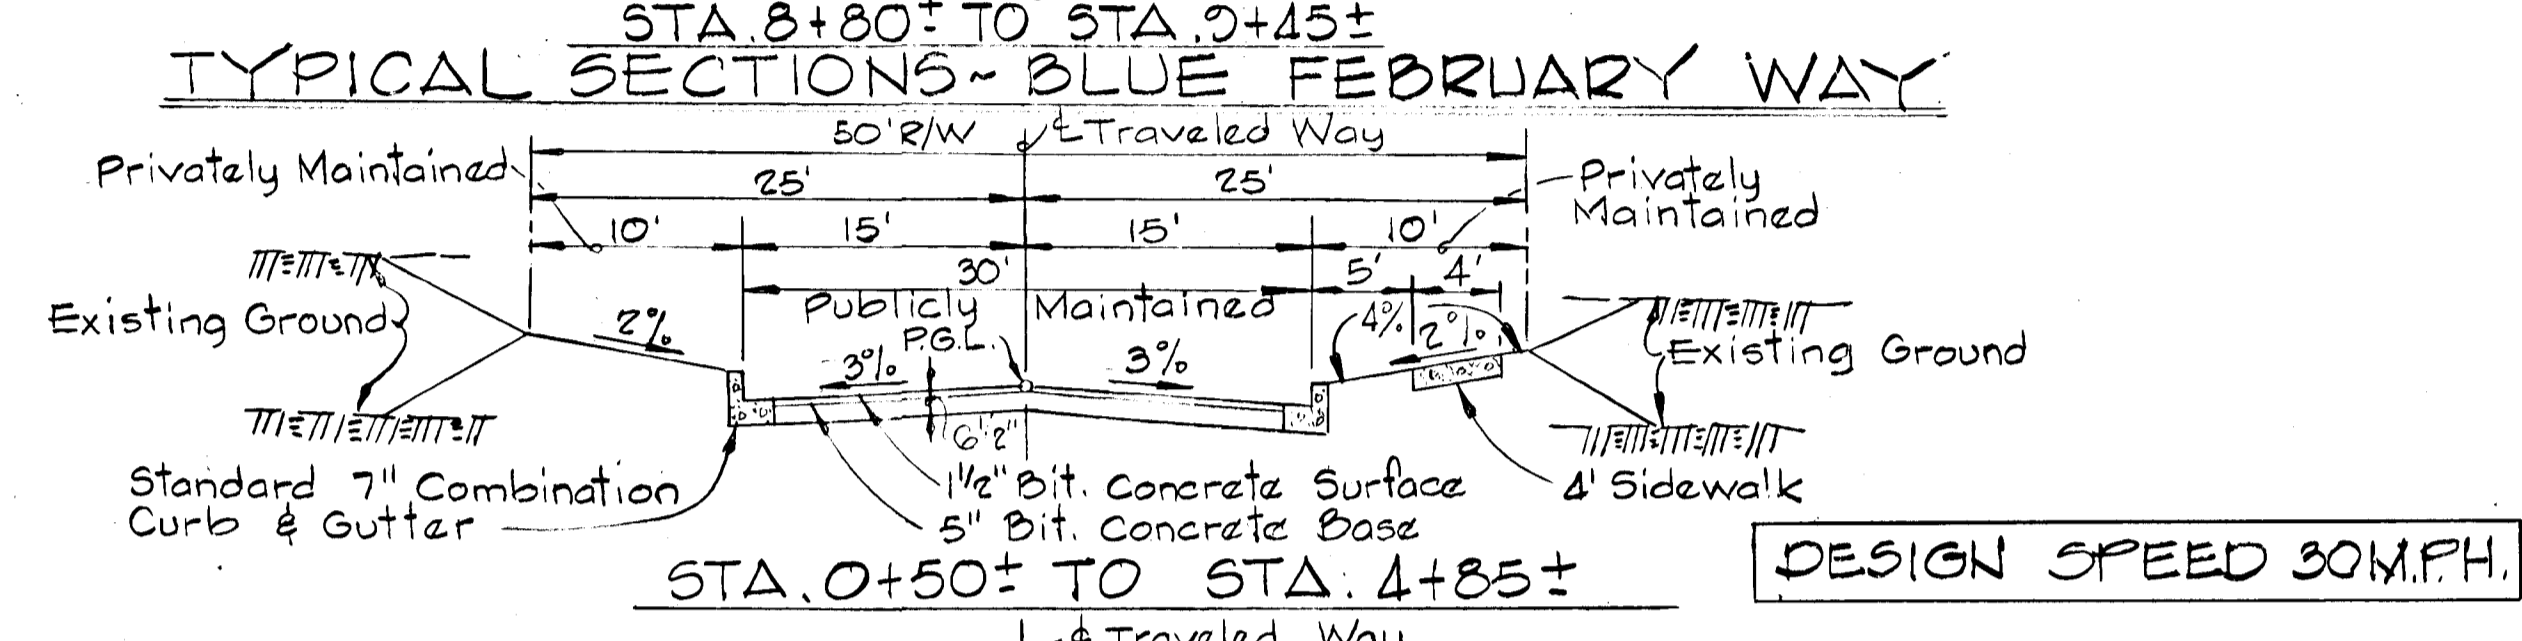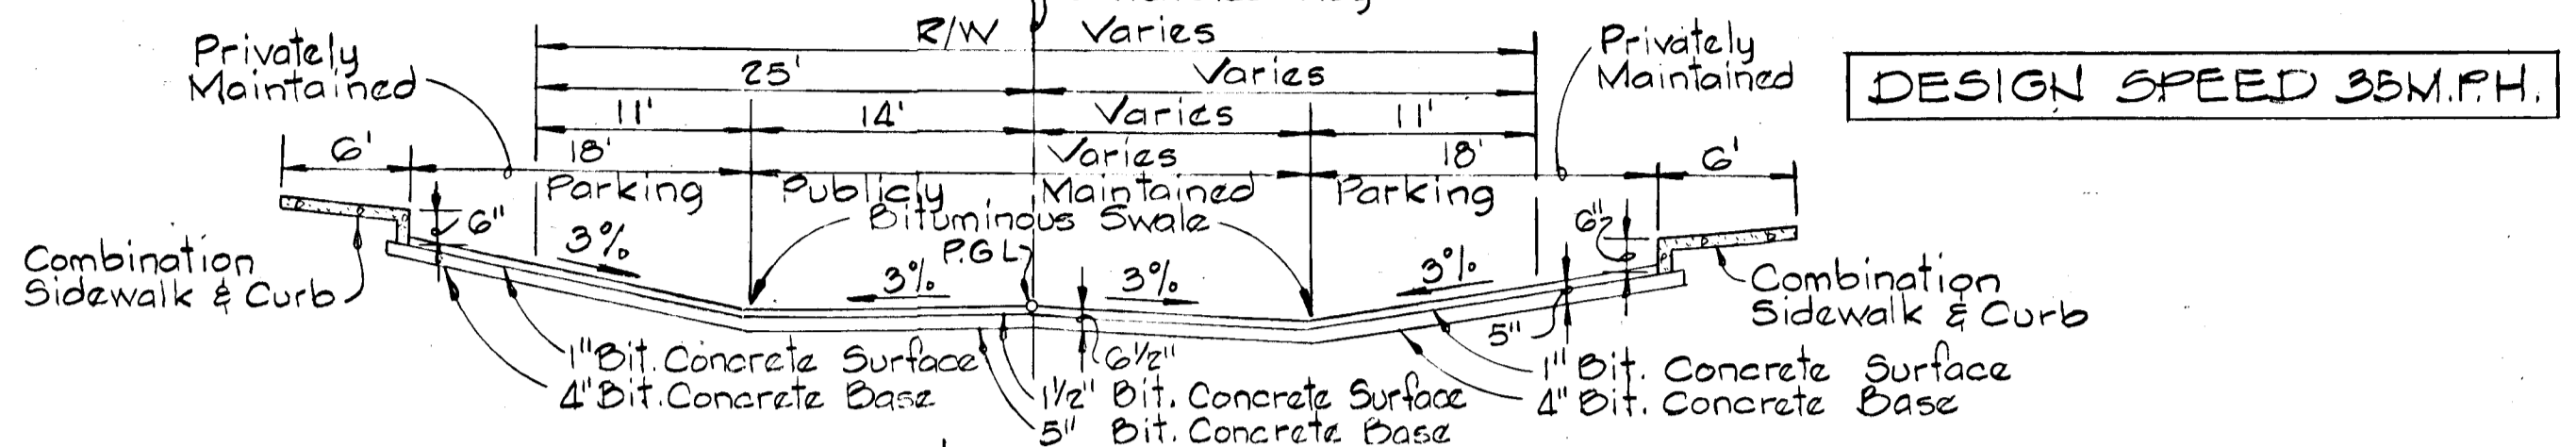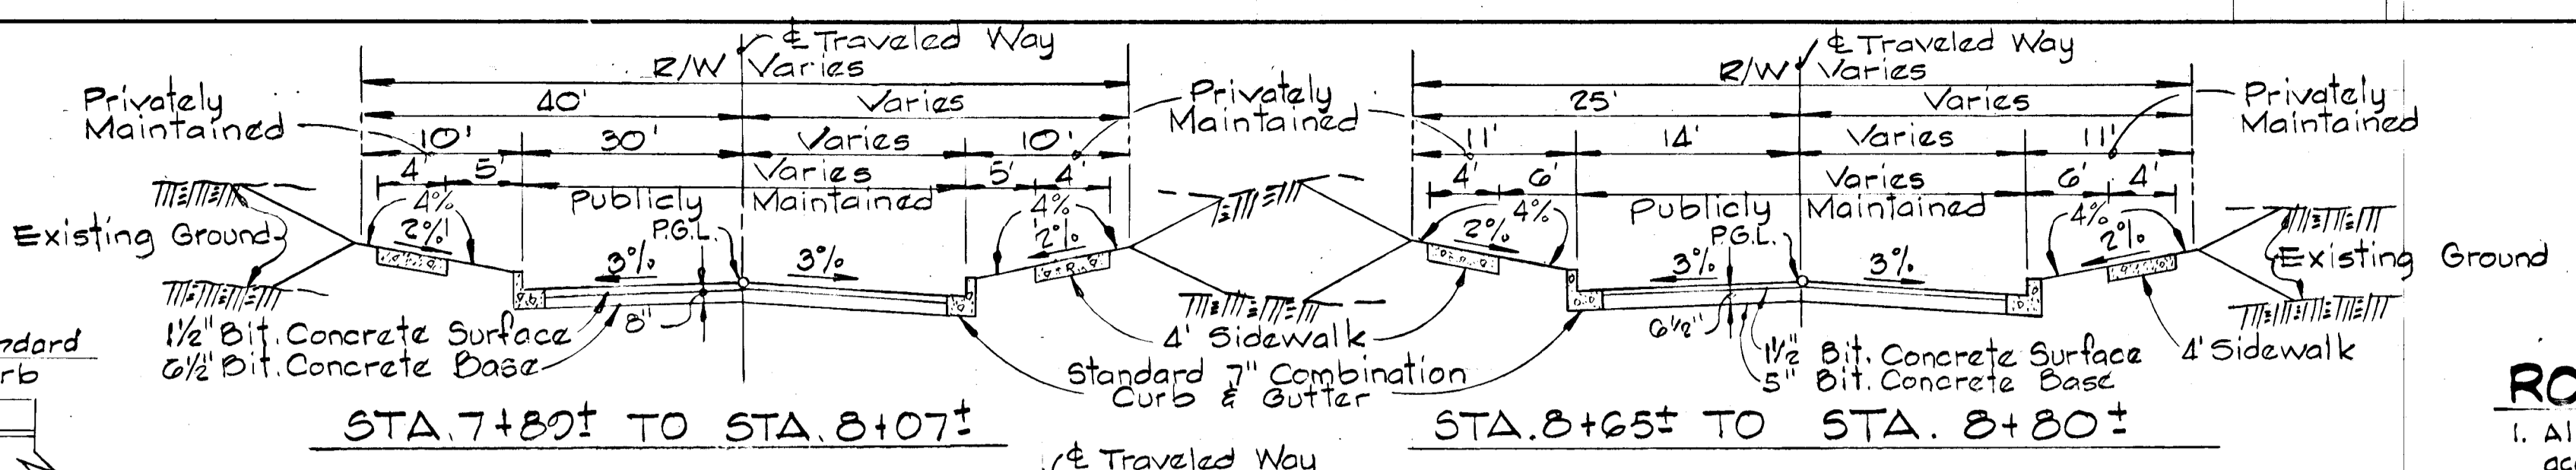

CURB GUTTER TRANSITION DETAIL

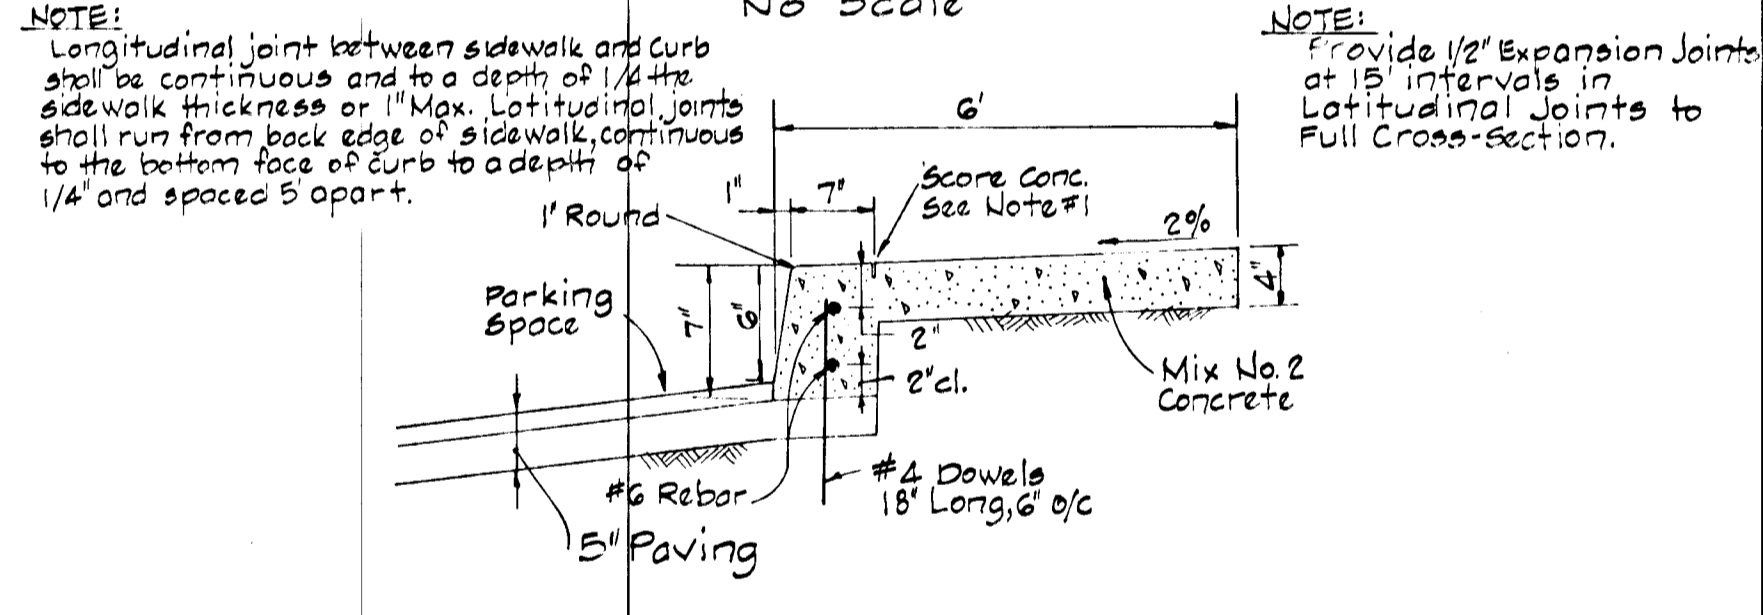

MONOLITHIC CURB & SIDEWALK PRIVATE PARKING AREA

Rev. Date	Rev. No.	Revision Description
5/10/84	1	As Per DPW, and S.C.E. Comments

COLUMBIA
 5TH ELECTION DISTRICT
 HOWARD COUNTY, MARYLAND
 OWNER AND DEVELOPER
 HOWARD RESEARCH AND DEVELOPMENT CORPORATION







PROJECT AREA
 VILLAGE OF HICKORY RIDGE
 SECTION 3 AREA 6
 LOTS I-1 THRU I-59
 PROJECT TITLE

STANDARD DETAILS

SCALE: AS SHOWN DATE:

WHITMAN, REQUART & ASSOCIATES
 ENGINEERS
 BALTIMORE, MARYLAND 21218

Kenneth A. McCord
 Registered Engineer
 No. 1974

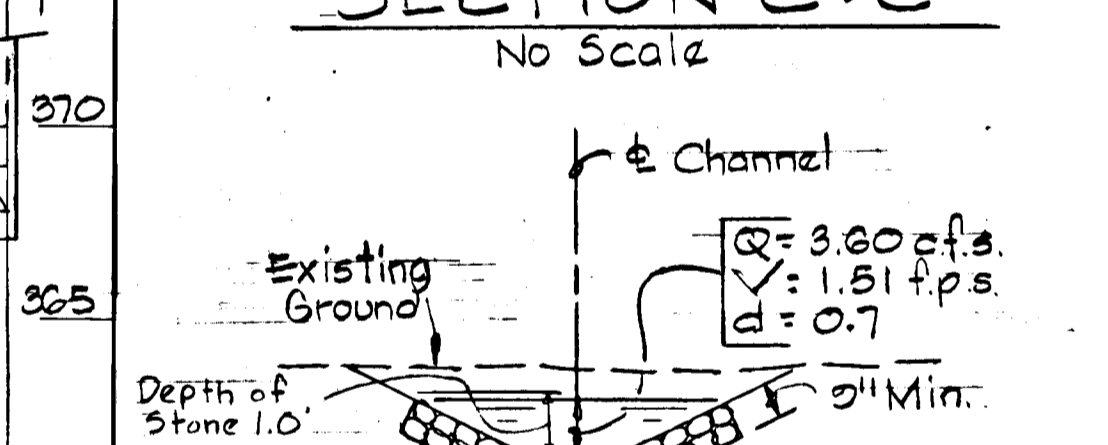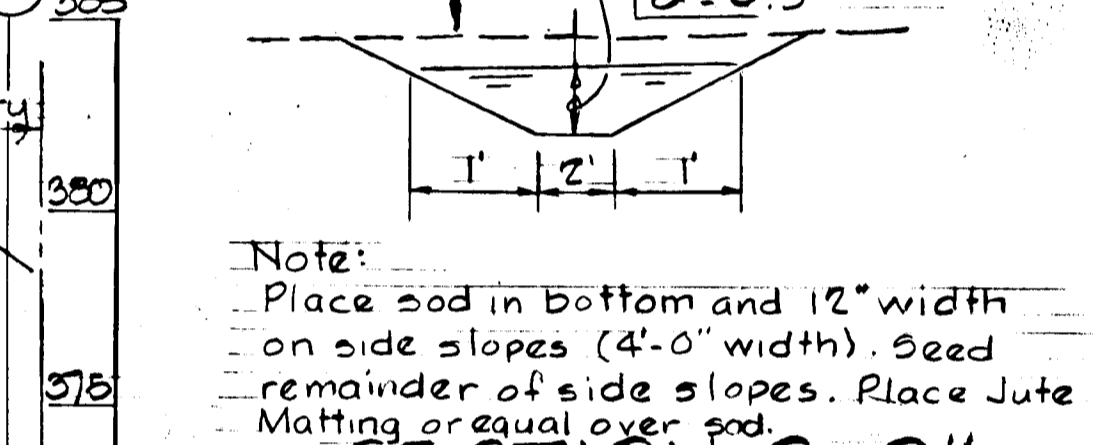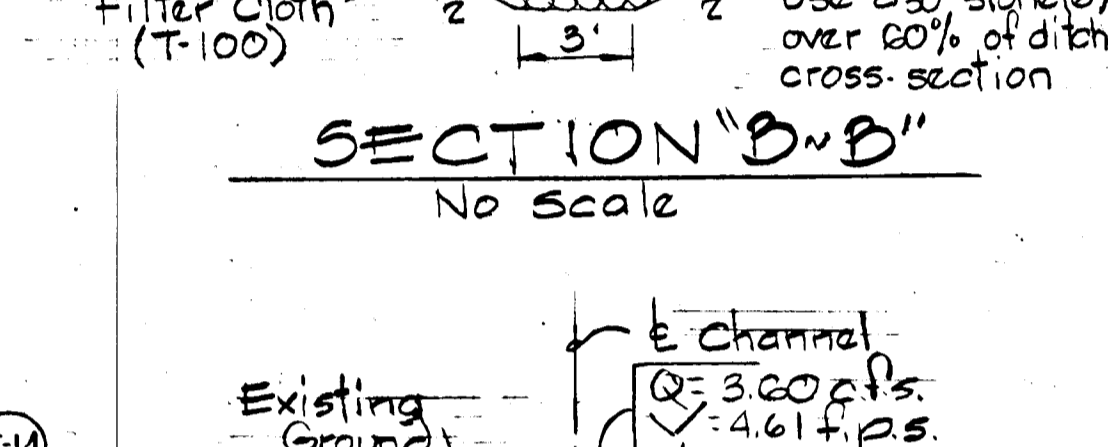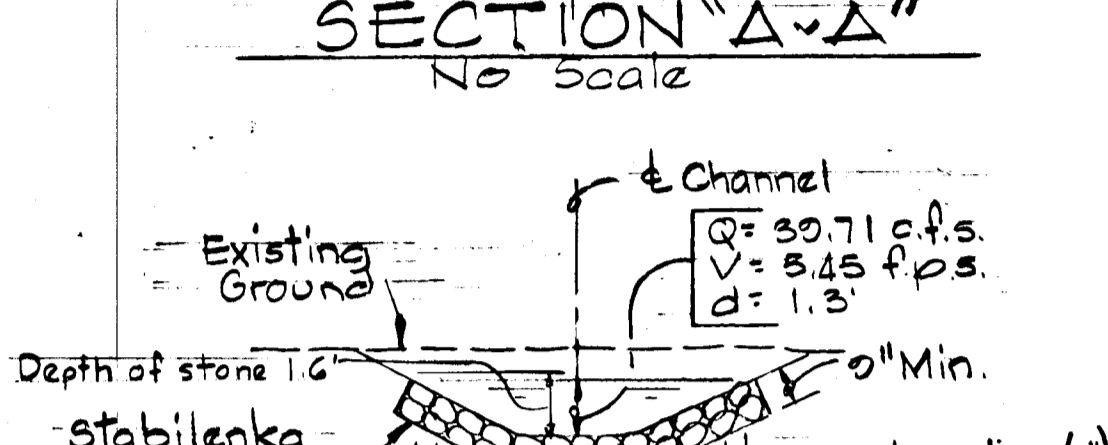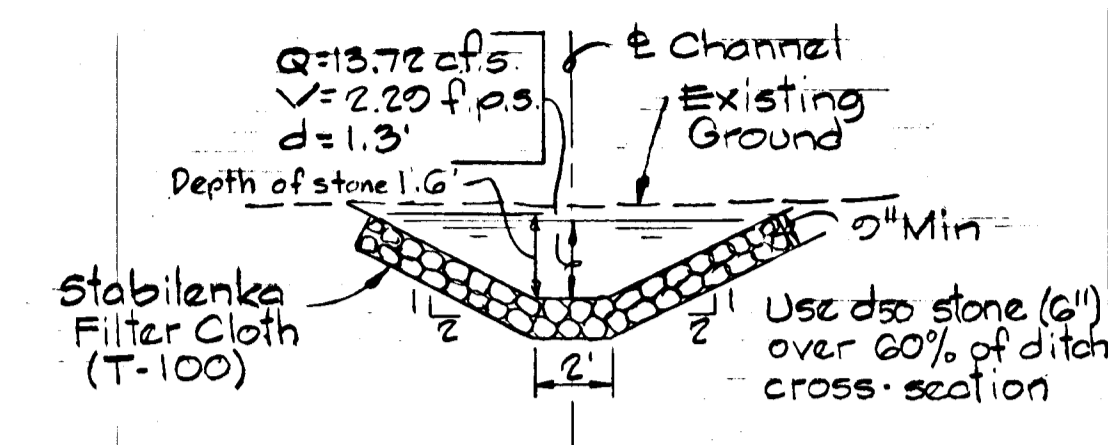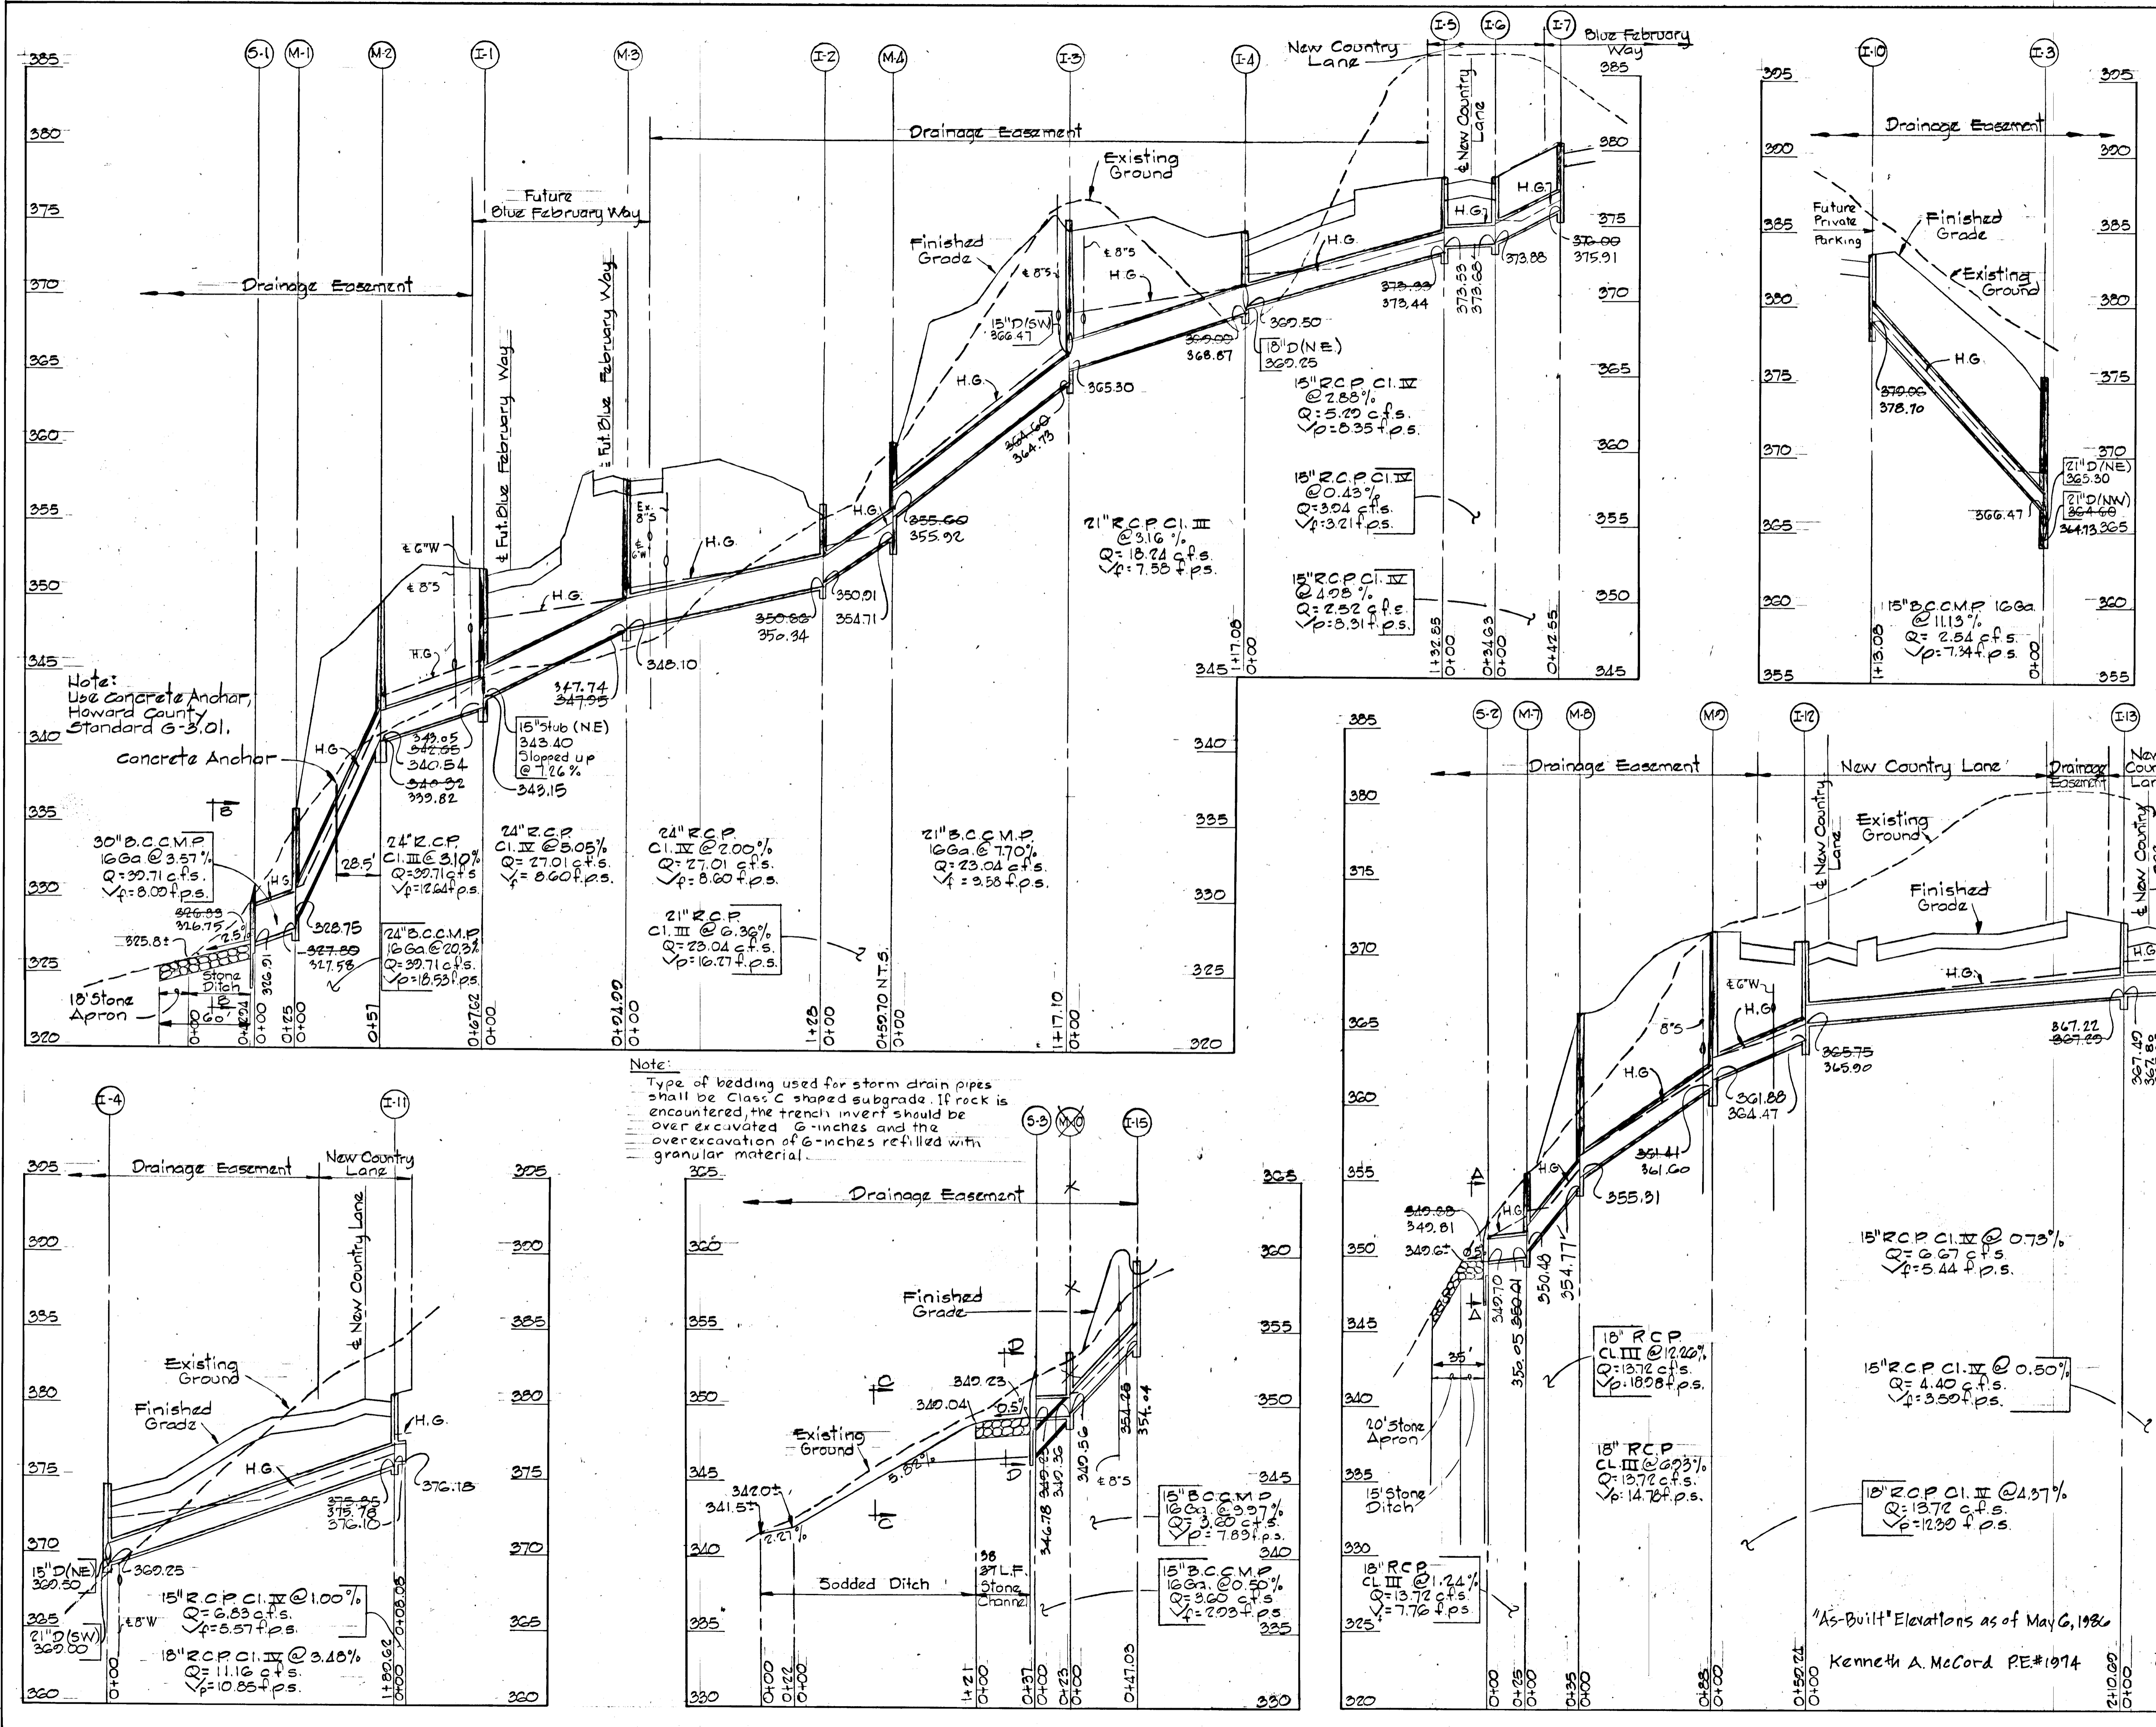

Note:
 Place sod in bottom and 12" width on side slopes (4'-0" width). Seed remainder of side slopes. Place Jute Matting or equal over sod.

Rev/Date	Rev.No.	Revision Description
2/17/84	4	Revised S.D. between M-1-M-3, M-4-M-13, M-13-M-14
8/20/84	3	Added Concrete Anchor between M-1 & M-2
8/6/84	2	Revised Storm Drain from M-3 to S-2
5/10/84	1	As Per D.F.W. and S.C.S. Comments

COLUMBIA
 5th ELECTION DISTRICT
 HOWARD COUNTY, MARYLAND

OWNER AND DEVELOPER
 HOWARD RESEARCH AND DEVELOPMENT CORPORATION

PROJECT AREA
 VILLAGE OF HICKORY RIDGE
 SECTION 3 AREA G
 LOTS I-1 THRU I-50

PROJECT TITLE
STORM DRAIN PROFILES

SCALE: As Shown DATE:
 WHITMAN, REQUARDT AND ASSOCIATES
 ENGINEERS
 2315 ST. PAUL STREET
 BALTIMORE, MARYLAND 21218

Kenneth A. McCord
 Registered Engineer
 No. 1074

Note:
 Use Concrete Anchor,
 Howard County
 Standard G-3.01.

Note:
 Type of bedding used for storm drain pipes shall be Class C shaped subgrade. If rock is encountered, the trench invert should be over excavated 6-inches and the over excavation of 6-inches refilled with granular material.

DEPARTMENT OF PUBLIC WORKS
 CHIEF, BUREAU OF ENGINEERING
 OFFICE OF PLANNING & ZONING
 CHIEF, DIVISION OF LAND DEVELOPMENT AND ZONING ADMINISTRATION

PERMANENT SEEDING NOTES
 LIME - 2 tons/acre agricultural ground limestone.
 FERTILIZER - 1000 lbs/acre (10-10-10).
 SEEDING - 100 lbs/acre of the following:
 20% Kentucky Blue Grass, 20% Marion Blue Grass, 55% Creeping Red Fescue, 5% Zedtop.
 Mulch Required - Mulch area with straw at the rate of 75 lbs/1000 \pm or 1.5 tons/acre. Anchor with asphalt at the rate of 480 gallons/acre. Stabilization of slopes steeper than 3:1 shall be planted with crown vetch at the rate of 20 lbs/acre or 0.45 lbs/1000 \pm and Kentucky 91 Tall fescue at the rate of 40 lbs/acre or 1 lb./1000 \pm .

SEDIMENT CONTROL NOTES
 1. See "Sequence of construction" this sheet.
 2. The sediment control measures shall be constructed as shown on these drawings.
 3. All temporary sediment control devices shall be seeded as specified in Notes 4 and 5. All other surfaces to be permanently seeded. See specifications this sheet.
 4. The temporary sediment control devices shall be hydroseeded as follows:
 a. Ground Limestone (50 lbs/1000 \pm)
 b. Fertilizer - 10-10-10 (25 lbs/1000 \pm)
 c. Seed - Italian Ryegrass (40 lbs/acre)
 5. Mulch with straw at the rate of 50 lbs/1000 \pm or one ton/acre. Anchor with asphalt at the rate of 480 gallons/acre.
 6. Prior to starting any work the contractor shall notify Howard County Sediment Control Division at least 24 hours in advance.

SEQUENCE OF CONSTRUCTION
 1. Obtain Grading Permit.
 2. Install stabilized Construction Entrance on Blue February Way.
 3. Construct Sediment Basin Embankment and Principal Spillway. See initial sediment basin construction details on Sheet 8 of 8. Construct Diversion Dikes, Silt Fences and Stone Outlet Structures.
 4. Stabilize Diversion Dikes with temporary seeding, see specifications this sheet.
 5. Clear and grub entire site.
 6. Strip entire site. Rough grade entire site except the three proposed buildings in and adjacent to the Sediment Basin, stockpile suitable excavation material in building areas adjacent to Sediment Basin, see Plan. During site grading the contractor shall maintain positive drainage into Sediment Basin. When storm drain is constructed (see temporary drain into basin) runoff will be directed to the basin via the storm drain.
 7. Construct temporary 24" C.M.P. and storm drain systems M-2 to I-11 and S-2 to I-14. Place stone filters at inlets I-12, I-13 and I-14.
 8. Construct utilities, housing, curb and gutter and streets for Lots I-1 thru I-50.
 9. Fine grade and construct sidewalks.
 10. Stabilize all disturbed areas with permanent seeding, see specifications this sheet.
 11. Remove Diversion Dike, Stone Outlet Structure and Silt Fence behind Lots I-31 thru I-50.

REV. DATE	REV. NO.	DESCRIPTION
4/16/84	1	As per S.C.S. Comments

COLUMBIA
 5th ELECTION DISTRICT
 HOWARD COUNTY, MARYLAND

OWNER AND DEVELOPER
 HOWARD RESEARCH AND DEVELOPMENT CORPORATION

PROJECT AREA
 VILLAGE OF HICKORY RIDGE
 SECTION 9 AREA G
 LOTS I-1 THRU I-50

PROJECT TITLE
 SEDIMENT CONTROL PLAN

SCALE: 1" = 50' DATE:

WHITMAN, REQUARDT AND ASSOCIATES
 ENGINEERS
 BALTIMORE, MARYLAND 21218

Kenneth A. McLeod
 KENNETH A. MCCOY
 Registered Engineer
 No. 1074

SITE ANALYSIS
 AREA OF IMPERVIOUS - 3.2 ACRES
 AREA TO BE VEGETATED - 11.2 ACRES
 UNDISTURBED AREA - 4.1 ACRES


CERTIFICATION BY THE DEVELOPER
 "I/WE CERTIFY THAT ALL DEVELOPMENT AND CONSTRUCTION WILL BE DONE ACCORDING TO THIS PLAN, AND THAT ANY RESPONSIBLE PERSONNEL INVOLVED IN THE CONSTRUCTION PROJECT WILL HAVE A CERTIFICATE OF ATTENDANCE AT A DEPARTMENT OF NATURAL RESOURCES APPROVED TRAINING PROGRAM FOR THE CONTROL OF SEDIMENT AND EROSION BEFORE BEGINNING THE PROJECT."
Walter E. Woodford 3.20.84
 WALTER E. WOODFORD DATE

CERTIFICATION BY THE ENGINEER
 "I CERTIFY THAT THIS PLAN FOR EROSION AND SEDIMENT CONTROL REPRESENTS A PRACTICAL AND WORKABLE PLAN BASED ON MY PERSONAL KNOWLEDGE OF THE SITE CONDITIONS AND THAT IT WAS PREPARED IN ACCORDANCE WITH THE REQUIREMENTS OF THE HOWARD SOIL CONSERVATION DISTRICT."
Kenneth A. McLeod 3.19.84
 KENNETH A. MCCOY DATE




REVIEWED FOR HOWARD S.C.D. AND MEETS TECHNICAL REQUIREMENTS
James M. Miller 6-19-84
 U.S. SOIL CONSERVATION SERVICE

THIS DEVELOPMENT PLAN IS APPROVED FOR SOIL EROSION AND SEDIMENT CONTROL BY THE HOWARD SOIL CONSERVATION DISTRICT.
 APPROVED *Richard A. Miller*
 HOWARD S.C.S. DISTRICT

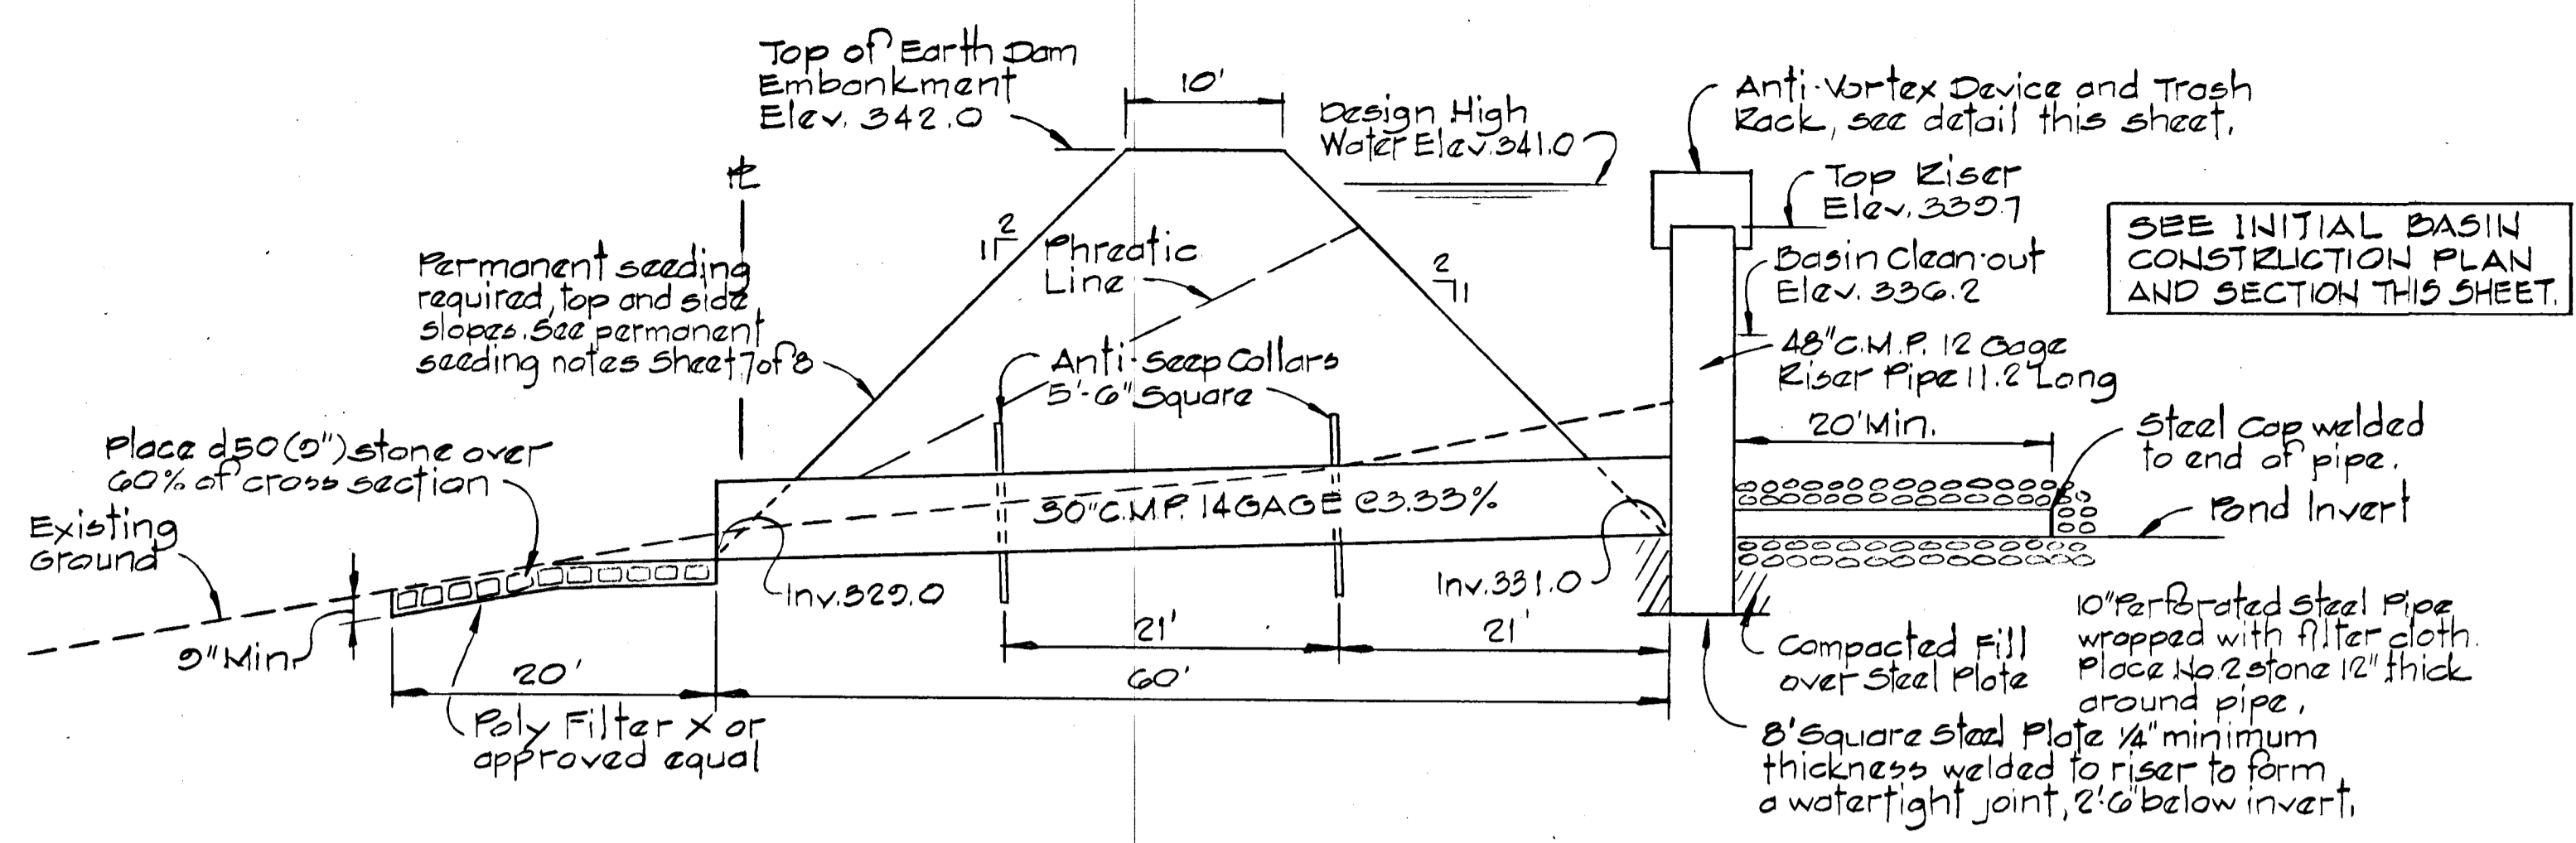


SECTION THRU DAM @ 30" C.M.P.
 No Scale

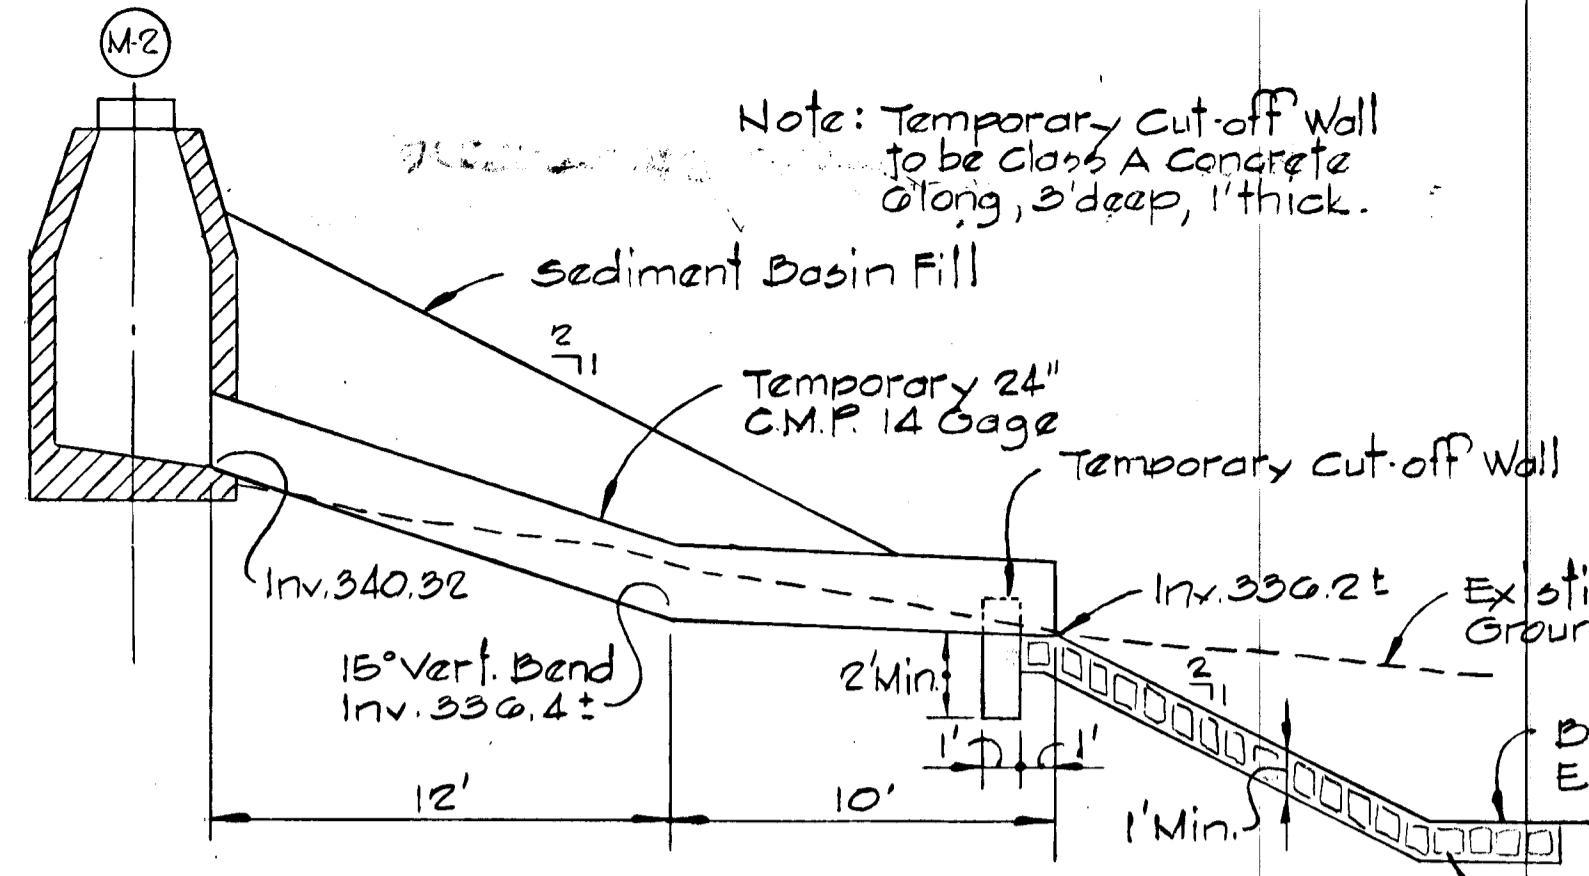


SECTION THRU TEMPORARY 24" C.M.P.
 No Scale

Carry d50(0") stone into bottom of basin.

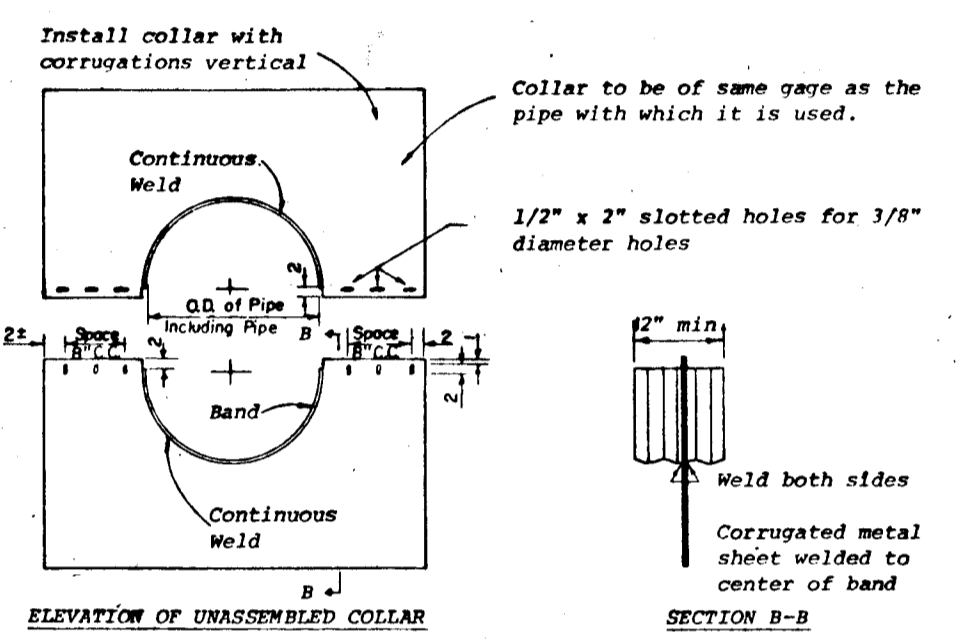


CORRUGATED METAL ANTI-SEEP COLLAR
 No Scale

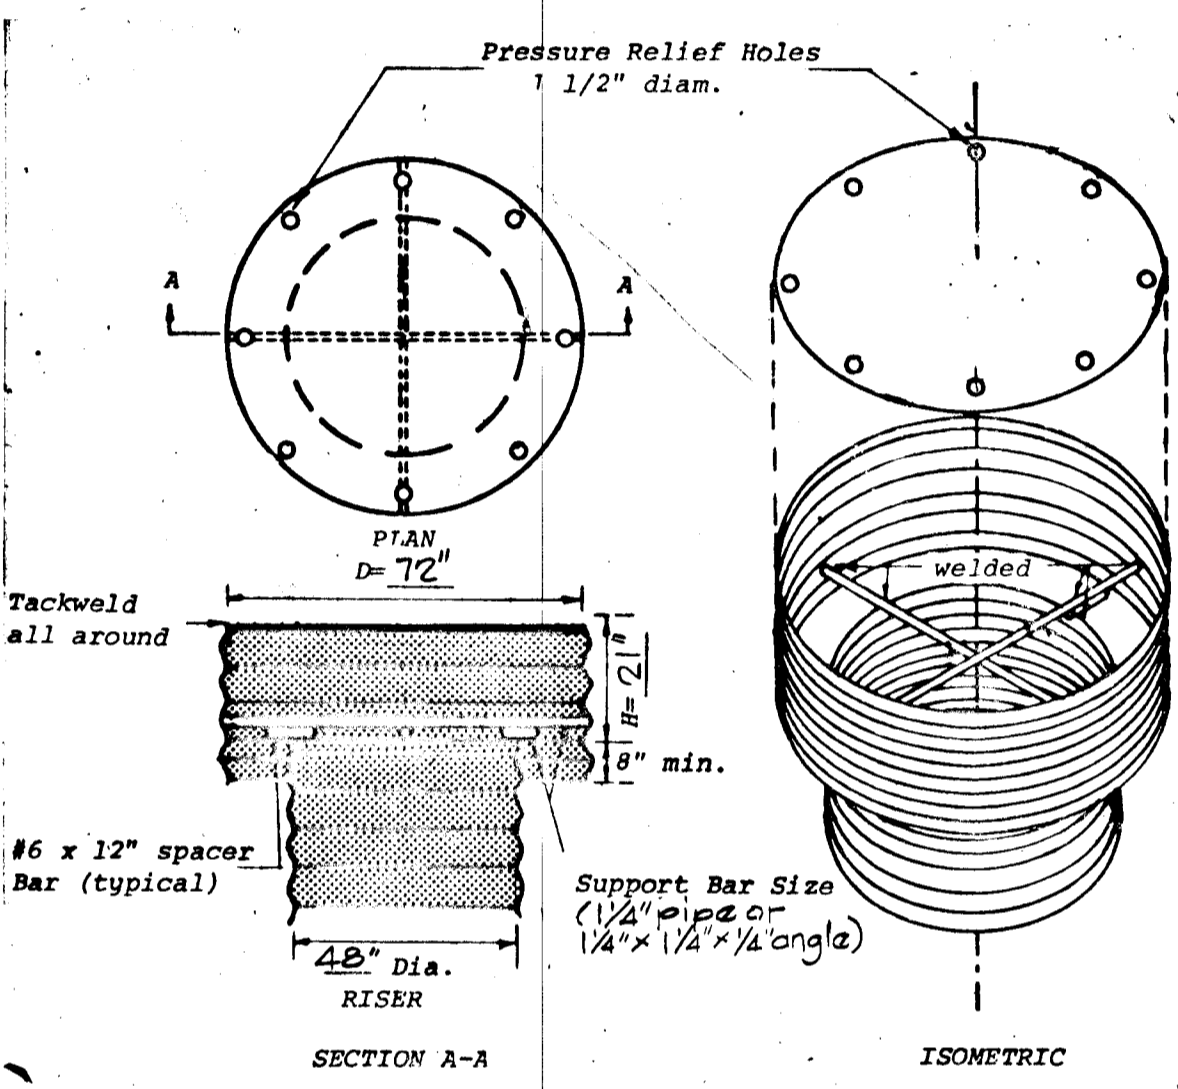

ANTI-VORTEX DEVICE AND TRASH RACK
 No Scale


- NOTES FOR COLLARS:
- All materials to be in accordance with construction and construction material specifications.
 - When specified on the plans, coating of collars shall be in accordance with construction and construction material specifications.
 - Unassembled collars shall be marked by painting or tagging to identify matching pairs.
 - The lap between the two half sections and between the pipe and connecting band shall be caulked with asphalt mastic at time of installation.
 - Each collar shall be furnished with two 1/2" diameter rods with standard tank lugs for connecting collars to pipe.

- Notes:
- The cylinder must be firmly fastened to the top of the riser.
 - Support bars are welded to the top of the riser or attached by straps bolted to top of riser.

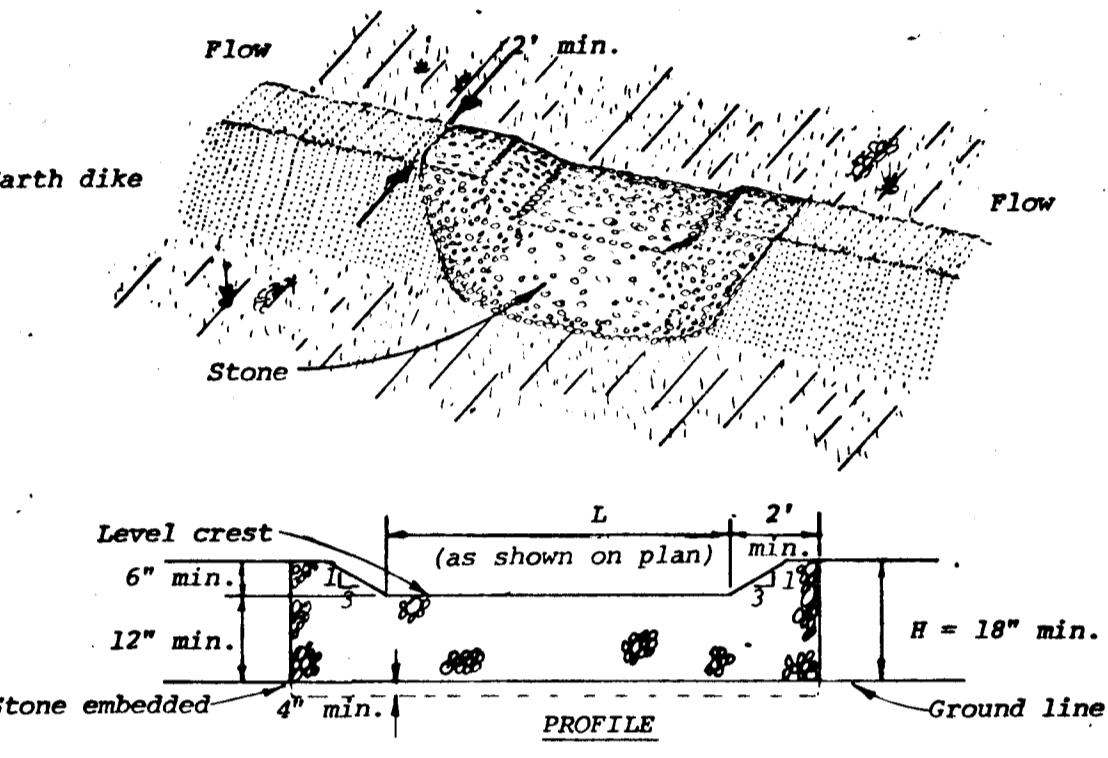


- Construction Specifications
- The stone shall be crushed stone. Gravel may be used if crushed stone is not available. The stone shall meet MSHA Size No. 2 or AASHTO designation M43 Size No. 2 or 24.
 - The crest of the stone dike shall be at least six inches lower than the lowest elevation of the top of the earth dike and shall be level.
 - The stone outlet structure shall be embedded into the soil a minimum of four inches.
 - The minimum length, in feet, of the crest of the stone outlet structure shall be equal to six times the number of acres of contributing drainage area.
 - The stone outlet structure shall be inspected after each rain, and the stone shall be replaced when the structure ceases to function as intended due to silt accumulation among the stone, washout, construction traffic damage, etc.

STONE OUTLET STRUCTURE
 No Scale

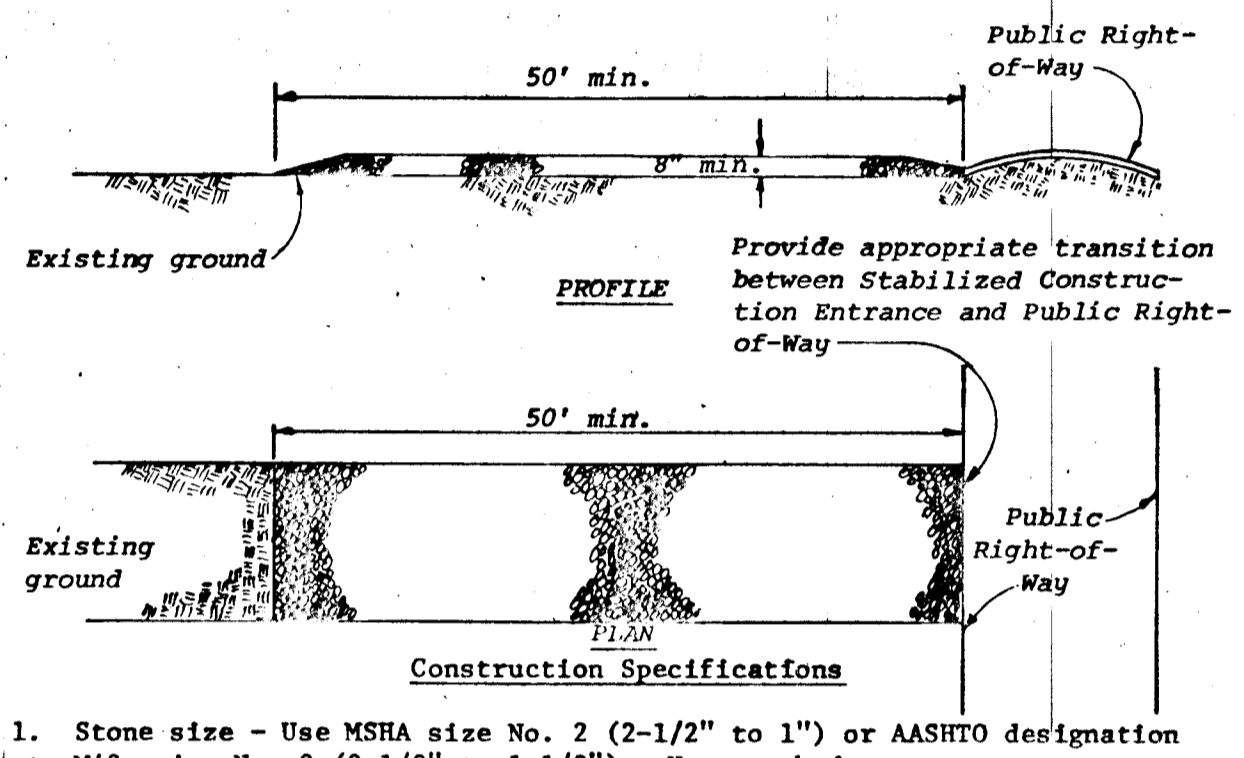


- Construction Specifications
- Stone size - Use MSHA size No. 2 (2-1/2" to 1") or AASHTO designation M43, size No. 2 (2-1/2" to 1-1/2"). Use crushed stone.
 - Length - As effective, but not less than 50 feet.
 - Thickness - Not less than eight (8) inches.
 - Width - Not less than full width of all points of ingress or egress.
 - Washing - When necessary, wheels shall be cleaned to remove sediment prior to entrance onto public right-of-way. When washing is required, it shall be done on an area stabilized with crushed stone which drains into an approved sediment trap or sediment basin. All sediment shall be prevented from entering any storm drain, ditch, or watercourse through use of sand bags, gravel, boards or other approved methods.
 - Maintenance - The entrance shall be maintained in a condition which will prevent tracking or flowing of sediment onto public rights-of-way. This may require periodic top dressing with additional stone as conditions demand and repair and/or cleanout of any measures used to trap sediment. All sediment spilled, dropped, washed or tracked onto public rights-of-way must be removed immediately.


STABILIZED CONSTRUCTION ENTRANCE
 No Scale

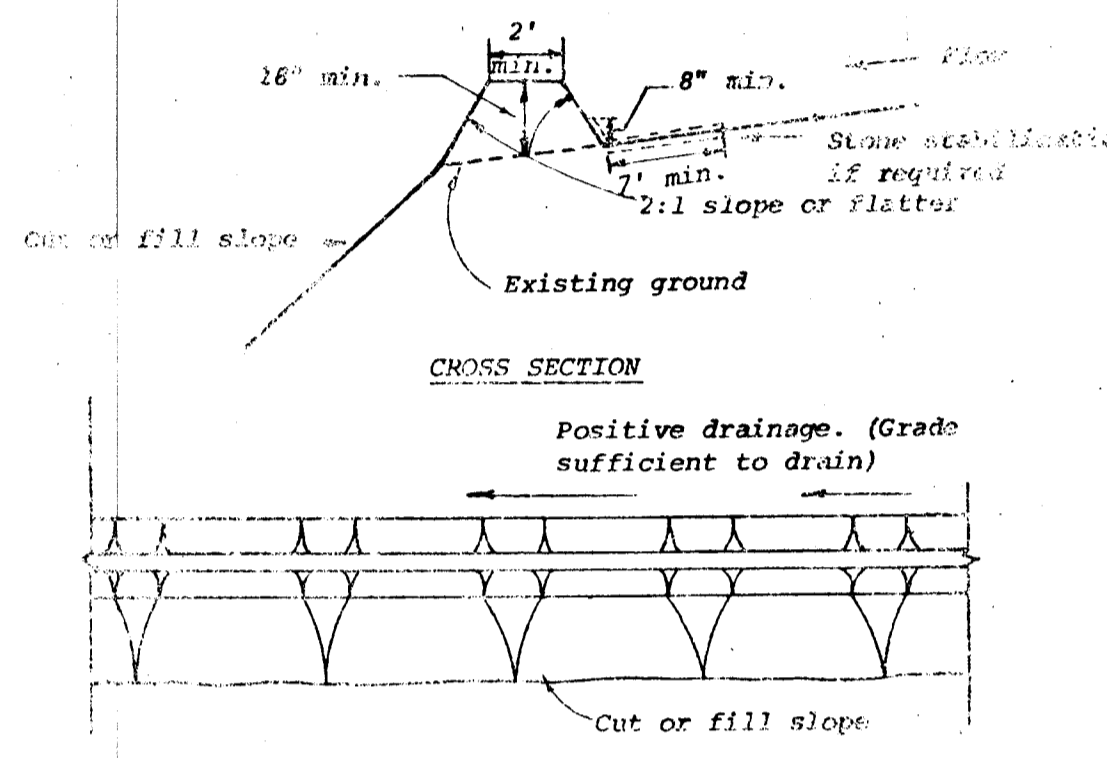


DIVERSION DIKE
 No Scale

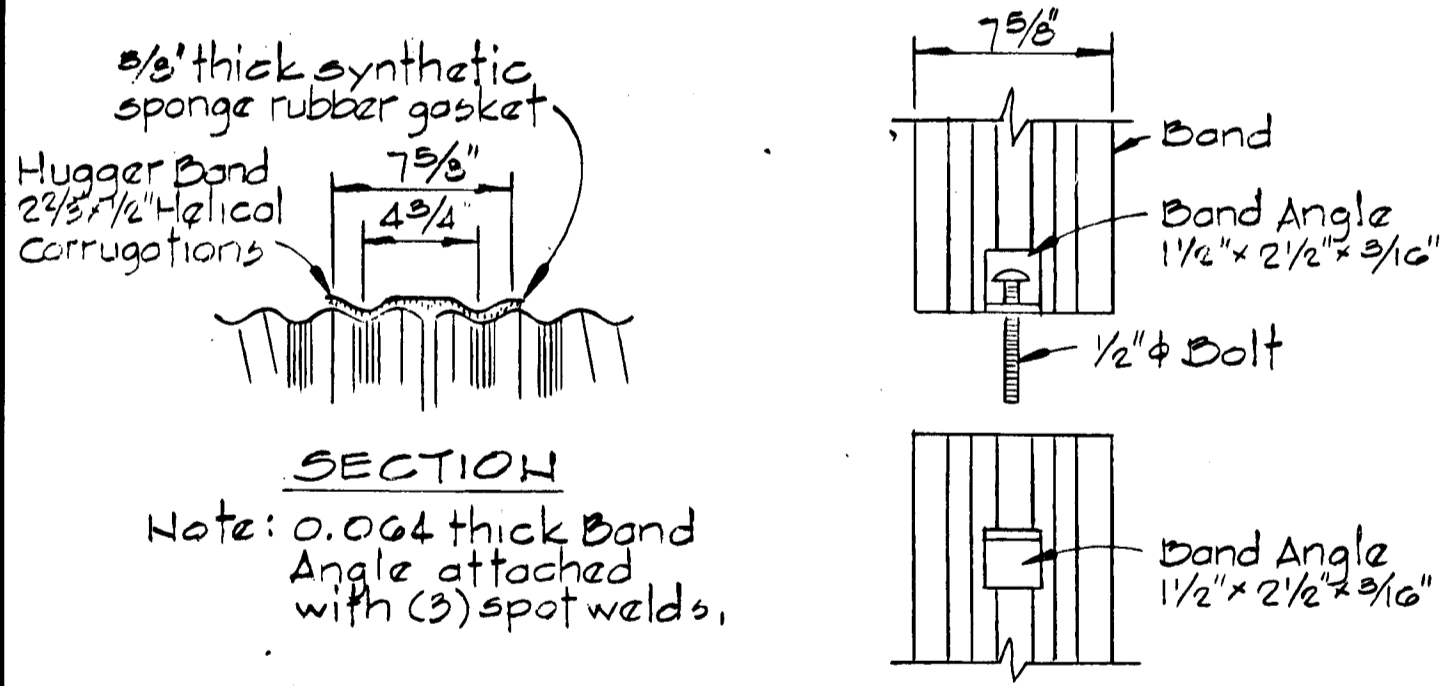


WATERTIGHT COUPLING BAND FOR 30" C.M.P.
 No Scale

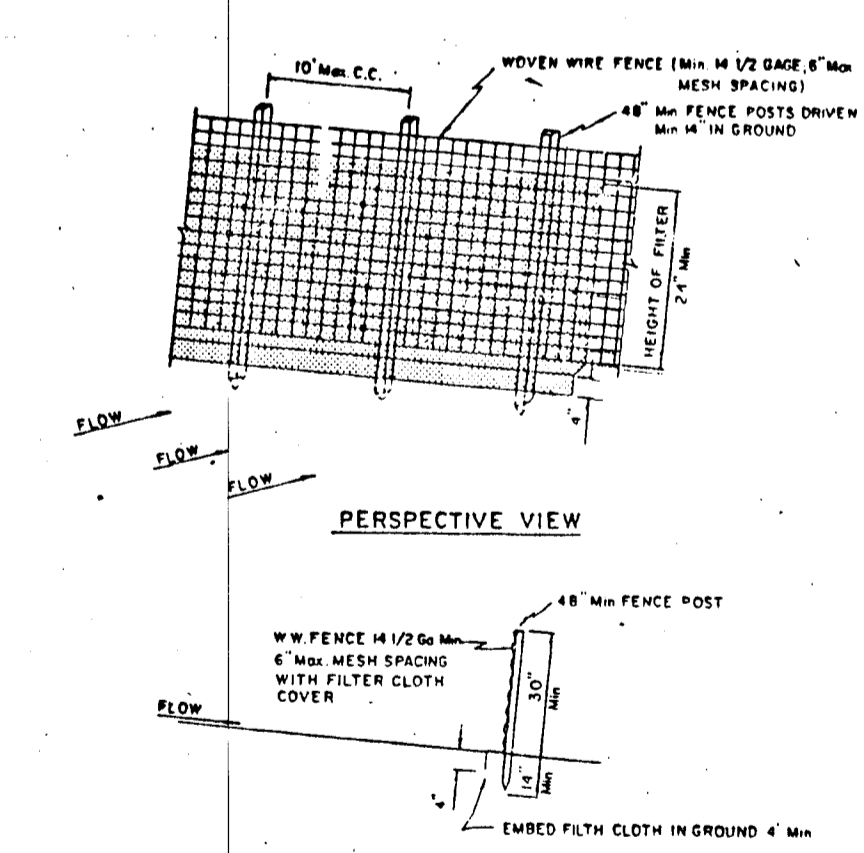

SILT FENCE
 No Scale

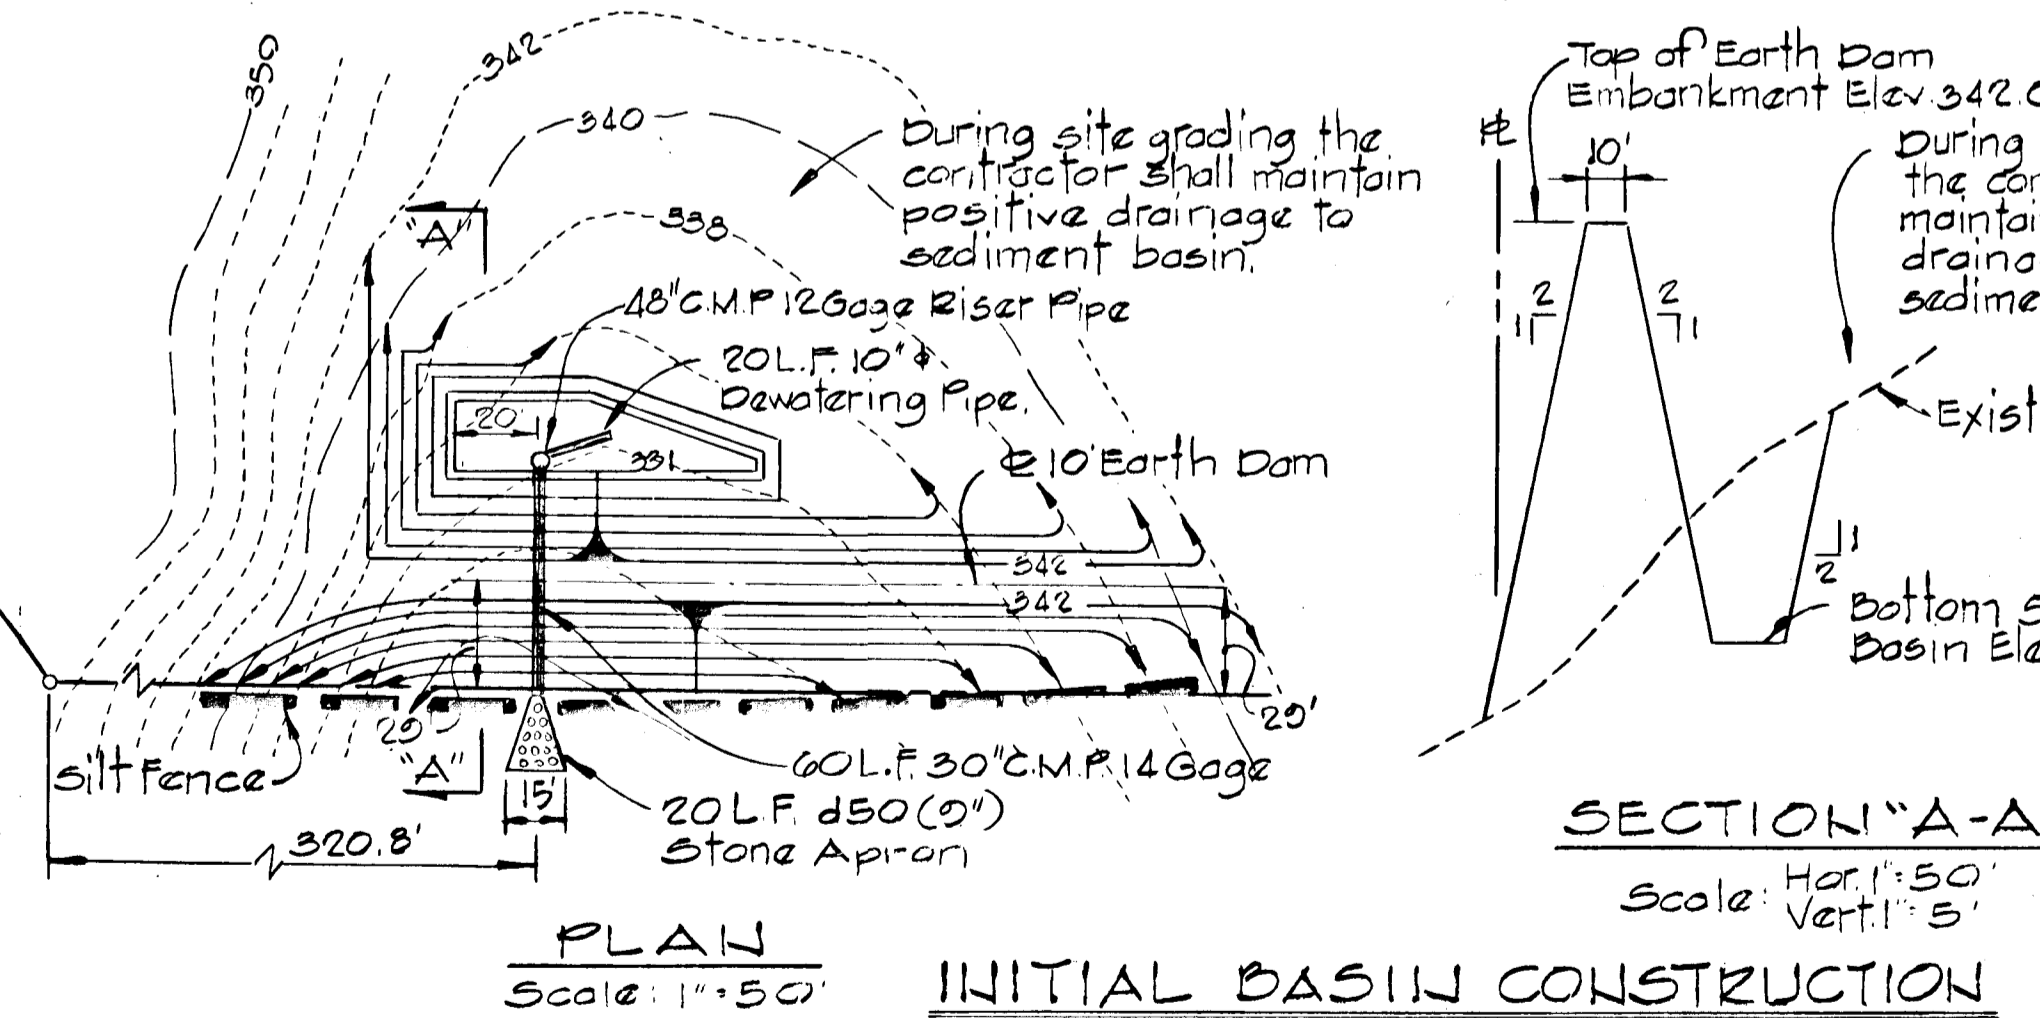

INITIAL BASIN CONSTRUCTION PLAN AND SECTION
 Scale: As Shown

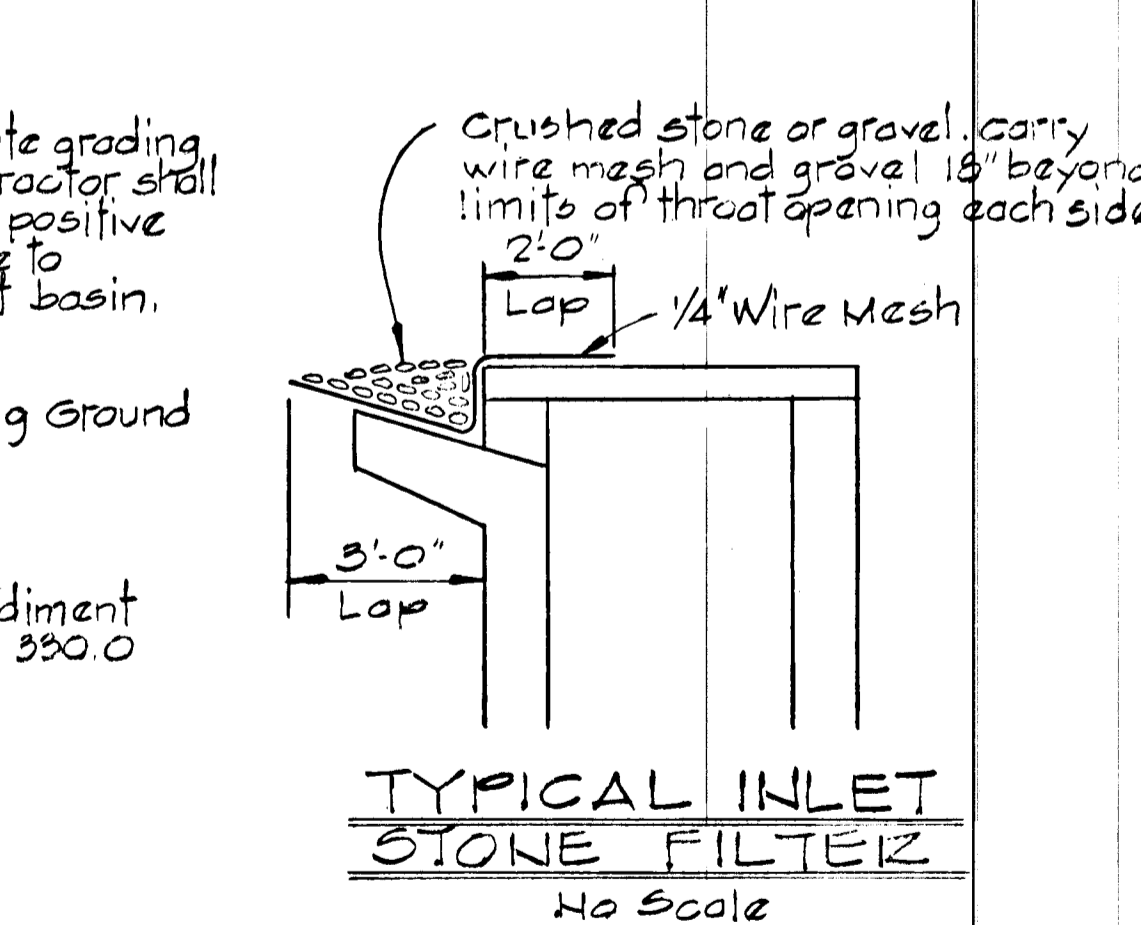

TYPICAL INLET STONE FILTER
 No Scale

REVIEWED FOR HOWARD S.C.D. AND MEETS TECHNICAL REQUIREMENTS
 James M. Helms 6-19-84
 U.S. SOIL CONSERVATION SERVICE

THIS DEVELOPMENT PLAN IS APPROVED FOR SOIL EROSION AND SEDIMENT CONTROL BY THE HOWARD SOIL CONSERVATION DISTRICT.
 APPROVED: Howard S.C.S. District

CERTIFICATION BY THE ENGINEER
 I CERTIFY THAT THIS PLAN FOR EROSION AND SEDIMENT CONTROL REPRESENTS A PRACTICAL AND WORKABLE PLAN BASED ON MY PERSONAL KNOWLEDGE OF THE SITE CONDITIONS AND THAT IT WAS PREPARED IN ACCORDANCE WITH THE REQUIREMENTS OF THE HOWARD SOIL CONSERVATION DISTRICT.
 Kenneth A. McGoird 3-19-84
 DATE

CERTIFICATION BY THE DEVELOPER
 I/WE CERTIFY THAT ALL DEVELOPMENT AND CONSTRUCTION WILL BE DONE ACCORDING TO THIS PLAN, AND THAT ANY RESPONSIBLE PERSONNEL INVOLVED IN THE CONSTRUCTION PROJECT WILL HAVE A CERTIFICATE OF ATTENDANCE AT A DEPARTMENT OF NATURAL RESOURCES APPROVED TRAINING PROGRAM FOR THE CONTROL OF SEDIMENT AND EROSION BEFORE BEGINNING THE PROJECT.
 Kenneth A. McGoird 3-20-84
 DATE

REVISION NO.	REVISION DESCRIPTION
1	As per S.C.S. Comments

COLUMBIA 5th ELECTION DISTRICT HOWARD COUNTY, MARYLAND

OWNER AND DEVELOPER
 HOWARD RESEARCH AND DEVELOPMENT CORPORATION

PROJECT AREA
 VILLAGE OF HICKORY RIDGE SECTION 3 AREA C

PROJECT TITLE
 SEDIMENT CONTROL DETAILS

SCALE: AS SHOWN DATE:

WHITMAN, REQUARDT AND ASSOCIATES ENGINEERS BALTIMORE, MARYLAND 21218

Kenneth A. McGoird Registered Engineer No. 1074