





DATE  
BY  
SURVEYED  
GRADE CHECKED  
ALIGNMENT CHECKED  
NOTE BOOK  
RT. OF WAY CHECKED  
NO.

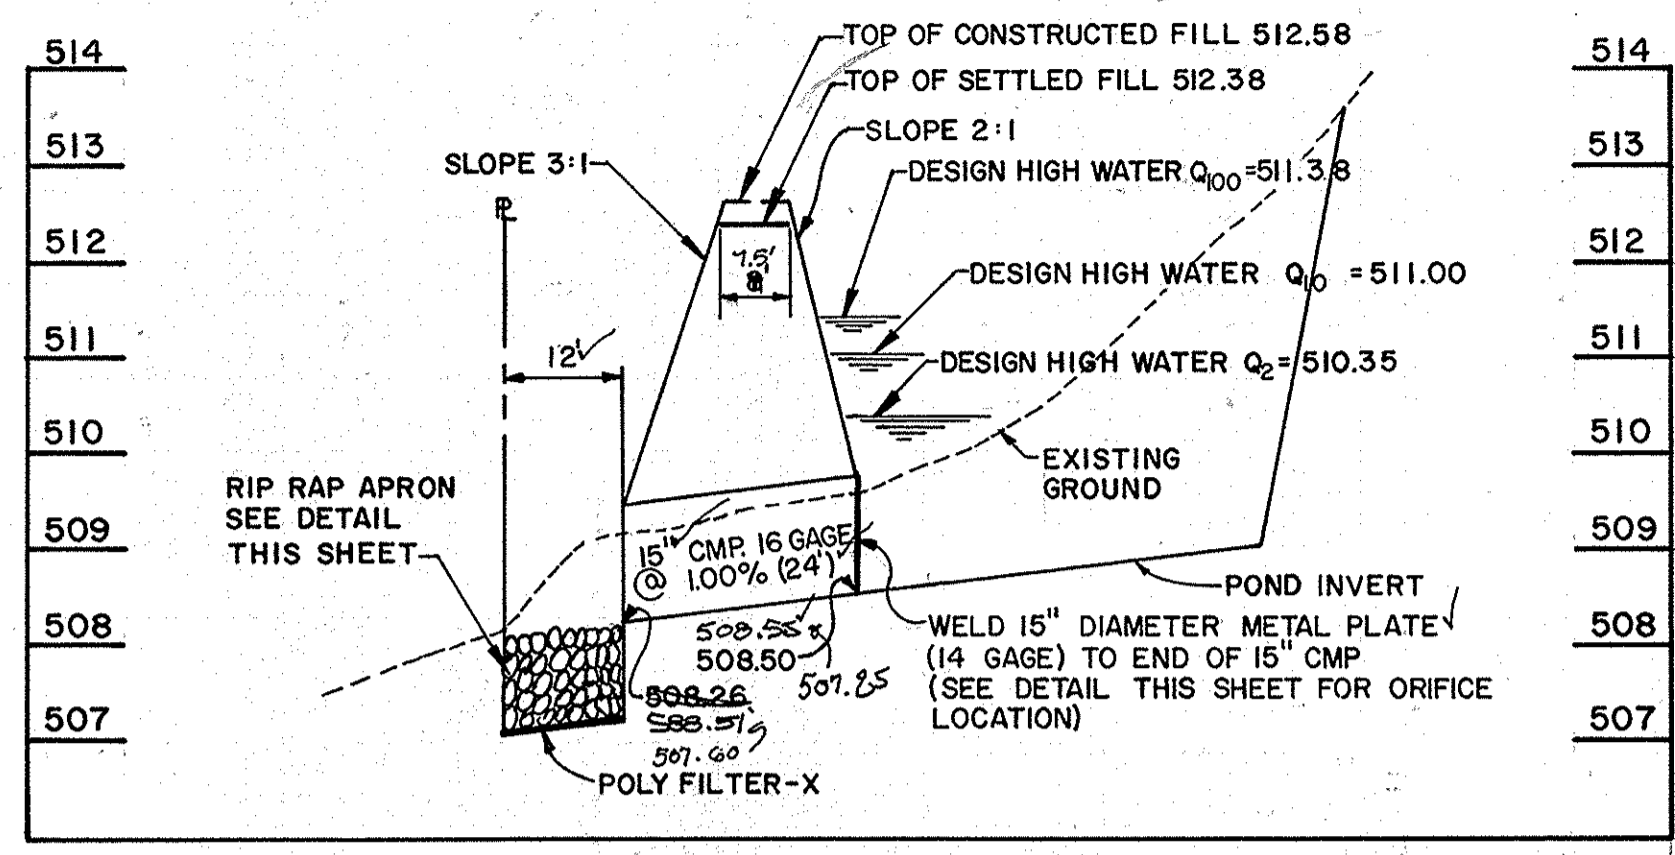

**STORM WATER MANAGEMENT PROFILE**


SCALE: 1" = 20' HOR.  
1" = 2' VERT.

NO.	TYPE	INV. IN	INV. OUT	Q STATION	Q TOP ELEVATION	REMARKS
I-1	A (S)-5	---	513.93 513.21	1+26.45 LINEAR PROFILE BARRINGTON COURT	519.79 517.29	DRWG. SD. 4.01
M-1	STANDARD MANHOLE	510.58 510.53	510.33 510.35	---	518.65	DRWG. G. 5.01
S-1	STANDARD METAL END SECTION	---	509.04 509.03	---	510.20 509.50	DRWG. SD. 5.61
I-2	DOUBLE "S" COMB. INLET WITH RE- TICULAR GRATES	---	512.02 511.77	---	515.76 515.75	DRWGS MD-37904 & MD-37908

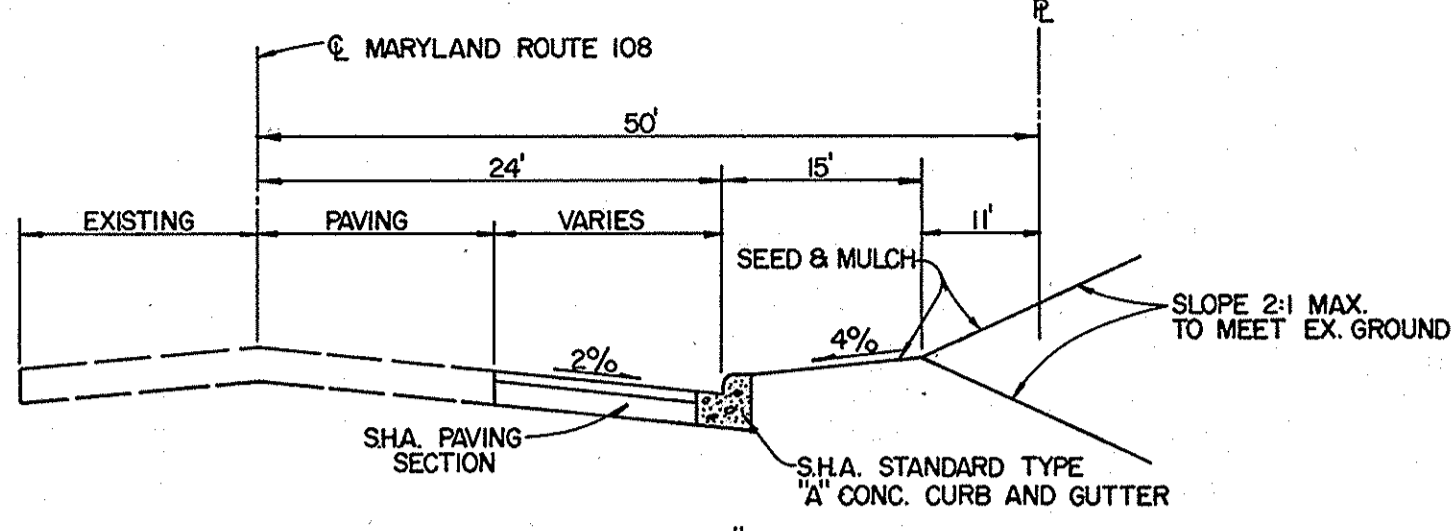


**TYPICAL WIDENING SECTION ALONG MARYLAND ROUTE 108**

NO SCALE

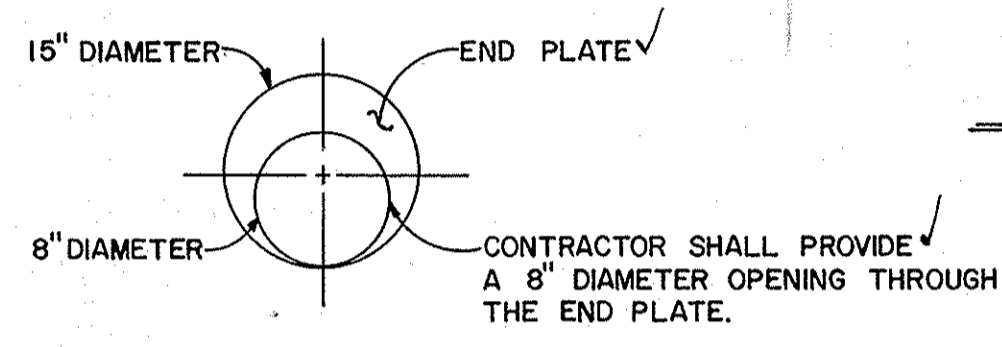


**ORIFICE DETAIL**

NO SCALE

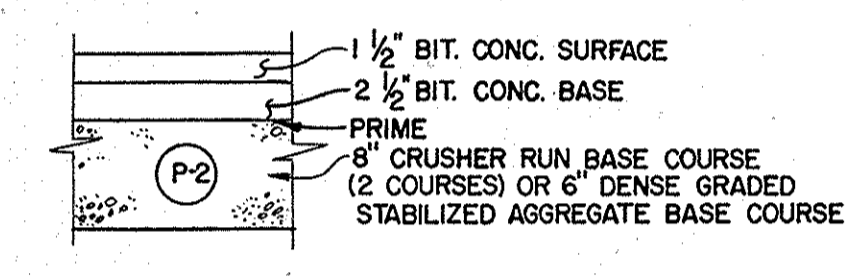


**PAVING SECTION P-2**

NO SCALE

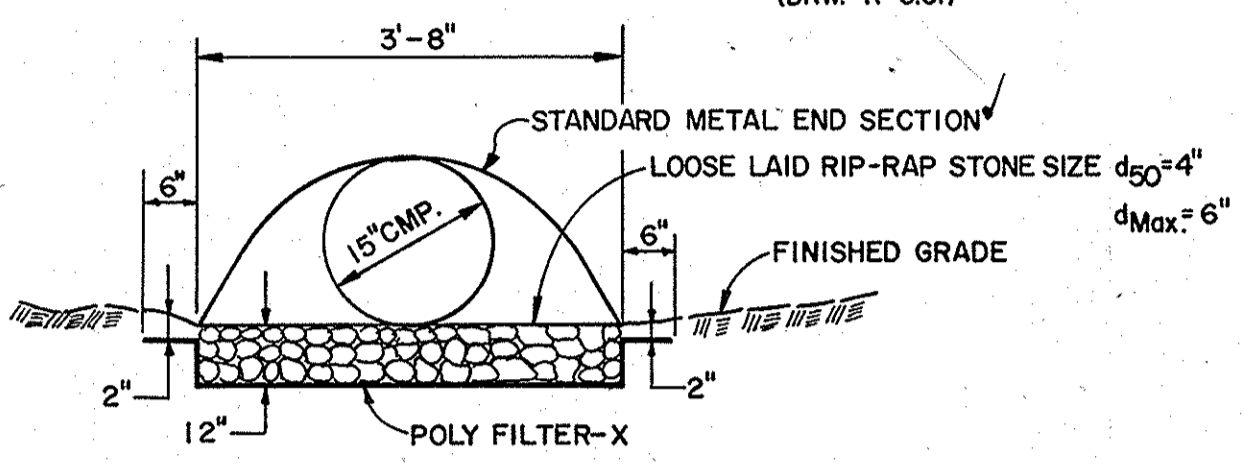


**RIP RAP APRON DETAIL @ S-1**

NO SCALE

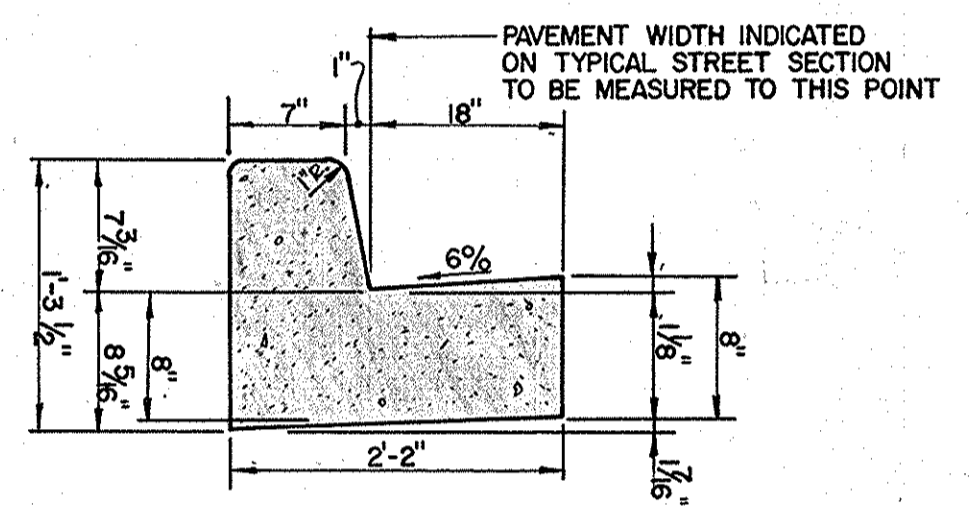

**STANDARD SLOPE 7" COMB. CONC. CURB & GUTTER**


NO SCALE

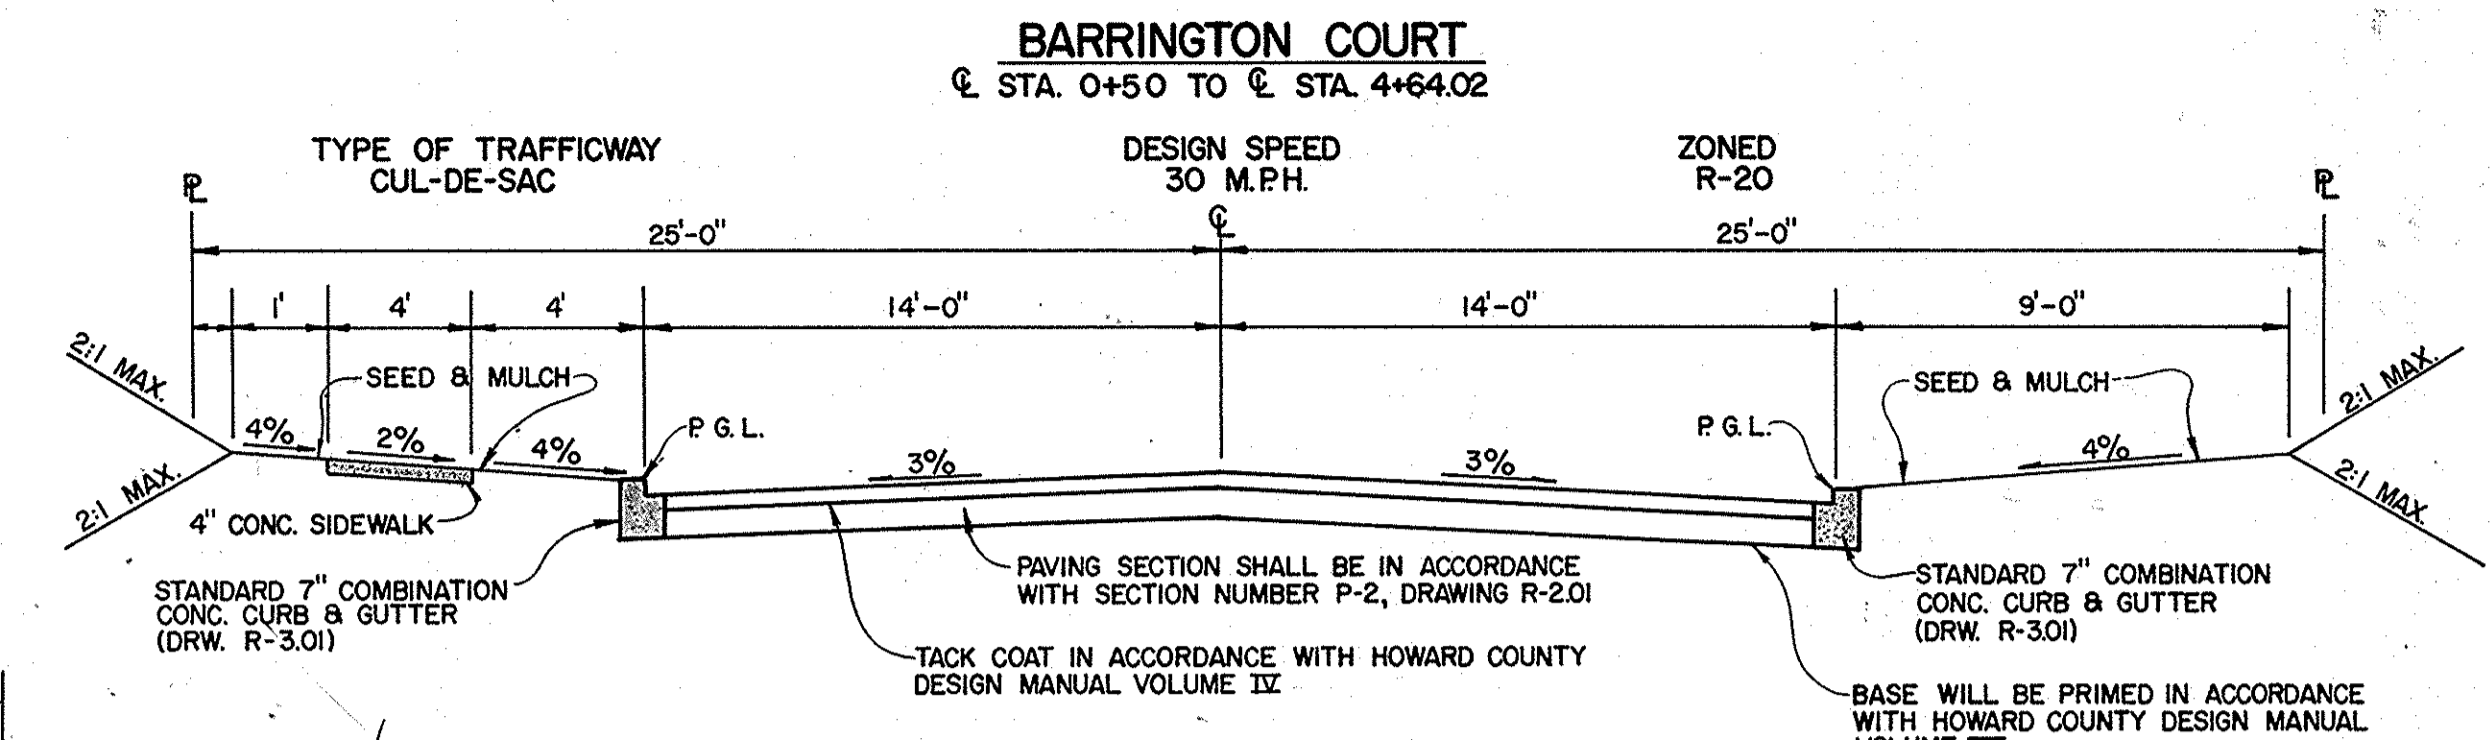

**TYPICAL ROADWAY SECTION**


NO SCALE

NOTE: ALL MATERIALS AND CONSTRUCTION SHALL BE IN ACCORDANCE WITH HOWARD COUNTY DESIGN MANUAL VOLUME III STANDARD SPECIFICATIONS AND DETAILS FOR CONSTRUCTION.

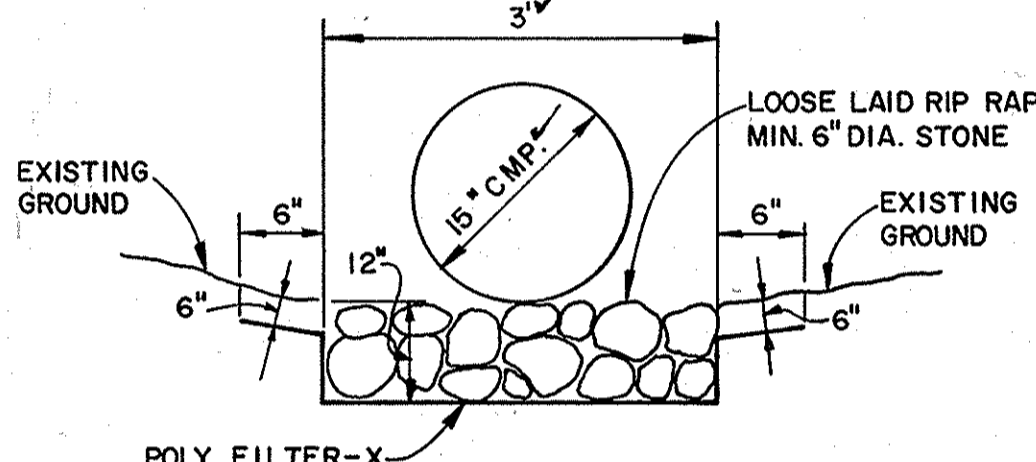

**RIP-RAP APRON DETAIL @ S.W.M. POND OUTFALL**

NO SCALE

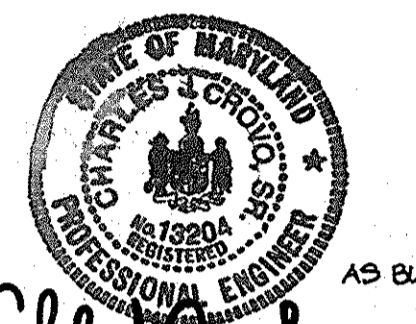

AS BUILT CERTIFICATION 7/14/86  
8/30/84  
CHARLES J. CROVO, SR. DATE


**BARRINGTON WOODS**  
LOTS 1-14  
SIXTH ELECTION DISTRICT  
HOWARD COUNTY, MARYLAND

ROAD SECTION, DETAILS,  
STORM DRAIN & STORM WATER  
MANAGEMENT PROFILES

OWNER AND DEVELOPER  
BARRINGTON WOODS LIMITED PARTNERSHIP  
SUITE 114 GORMAN PLAZA BUILDING  
COLUMBIA, MARYLAND 21045


SCALE AS SHOWN DATE AUGUST 17, 1984 DWG. NO. 2 OF 3  
DES. C. CROVO DRN. A. BOGDAN CHK. R. CARTER  
FISHER, COLLINS AND CARTER, INC.  
CIVIL ENGINEERS AND LAND SURVEYORS  
8388 COURT AVE. ELLICOTT CITY, MARYLAND 21043

APPROVED DEPARTMENT OF PUBLIC WORKS  
CHIEF, BUREAU OF ENGINEERING  
APPROVED OFFICE OF PLANNING AND ZONING  
CHIEF, DIVISION OF LAND DEVELOPMENT AND ZONING ADMINISTRATION

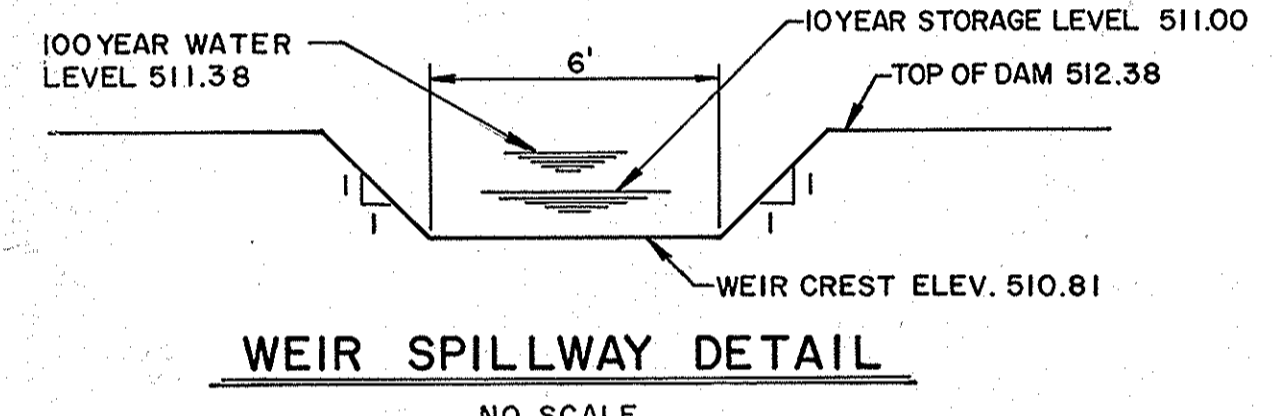

**WEIR SPILLWAY DETAIL**


NO SCALE

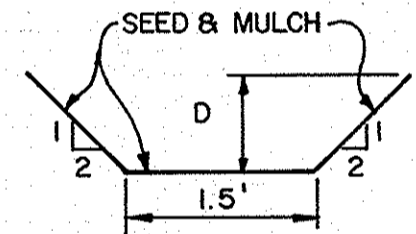

**CHANNEL DETAIL ALONG REAR OF LOTS 9-13**


NO SCALE

CHANNEL SLOPE	A	P	R	R <sup>2/3</sup>	S <sup>1/2</sup>	n	D	Q <sub>D</sub>	V <sub>D</sub>
1.00%	0.92'	3.28'	0.2805	0.4285	0.1000	0.03	0.40'	2.0 cfs.	2.12 fps.
2.90%	0.65'	2.86'	0.2273	0.3724	0.1703	0.03	0.31'	2.0 cfs.	3.14 fps.
5.00%	0.53'	2.66'	0.1992	0.3411	0.2236	0.03	0.26'	2.0 cfs.	3.78 fps.

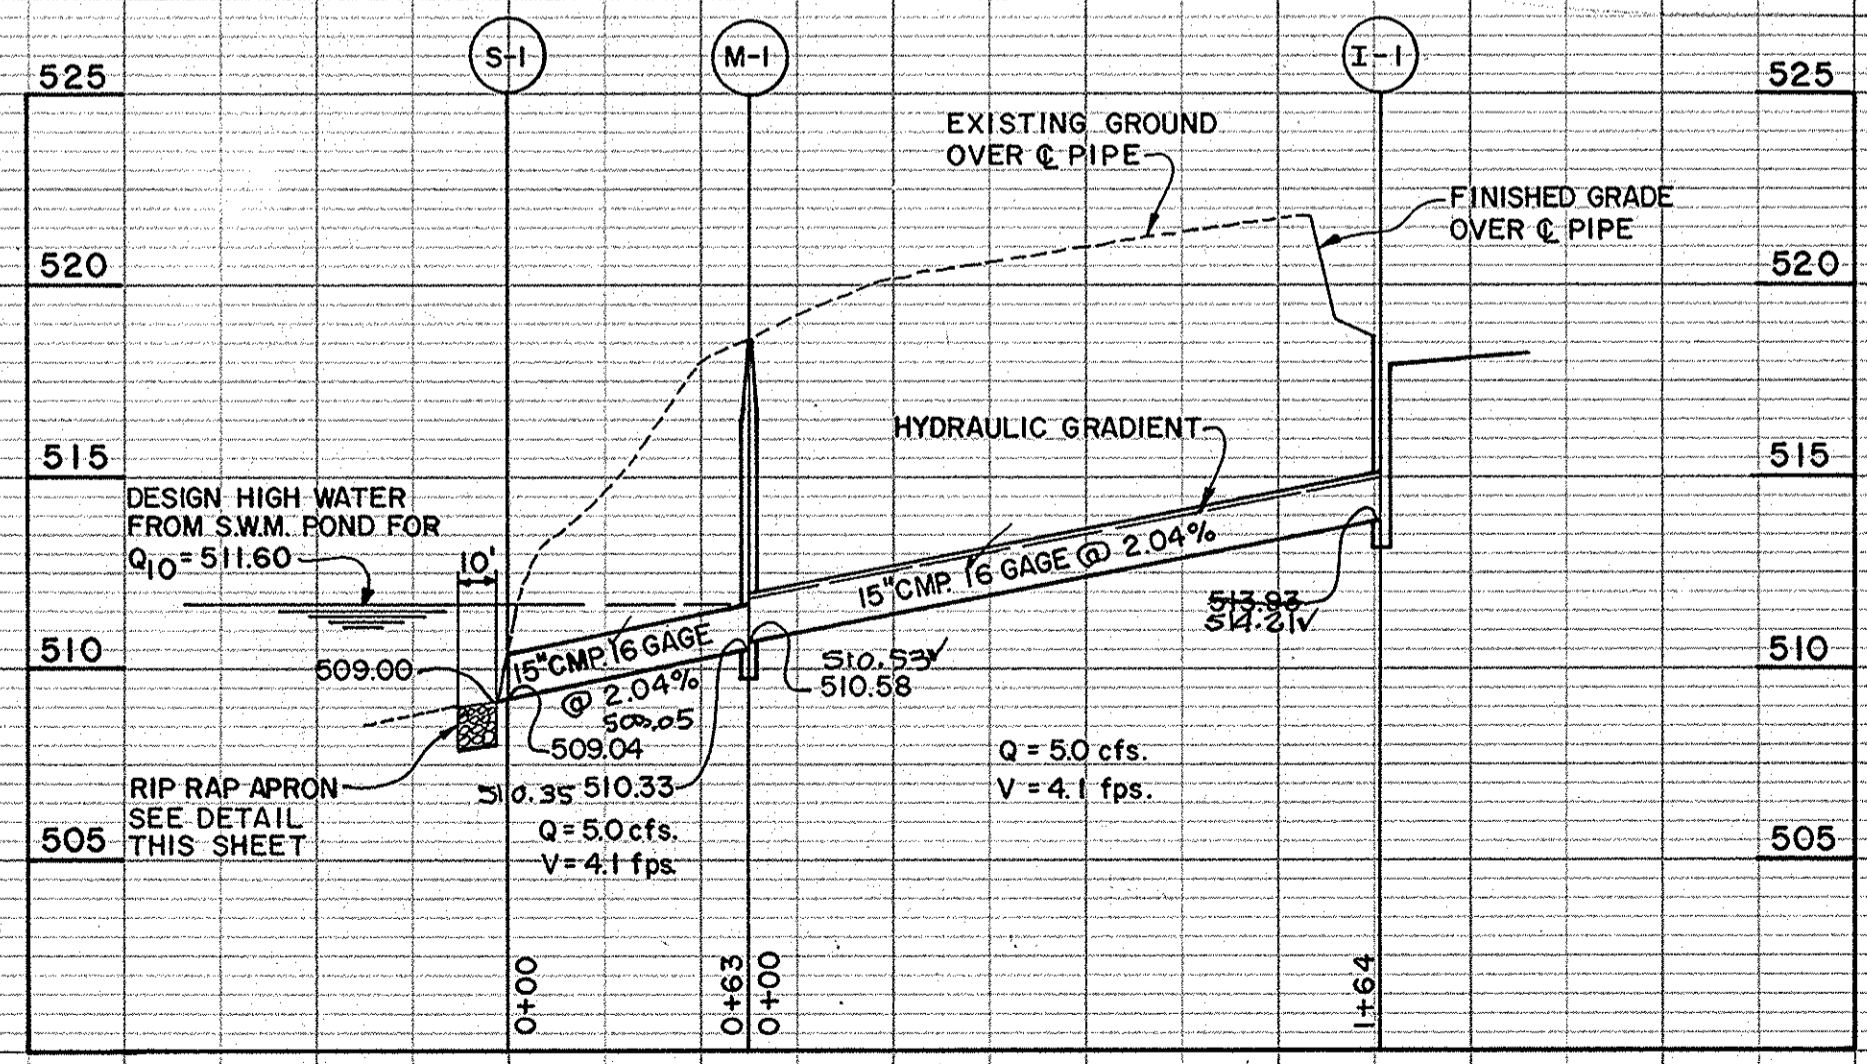

**STORM DRAIN PROFILE**

SCALE: 1" = 50' HOR.  
1" = 5' VERT.

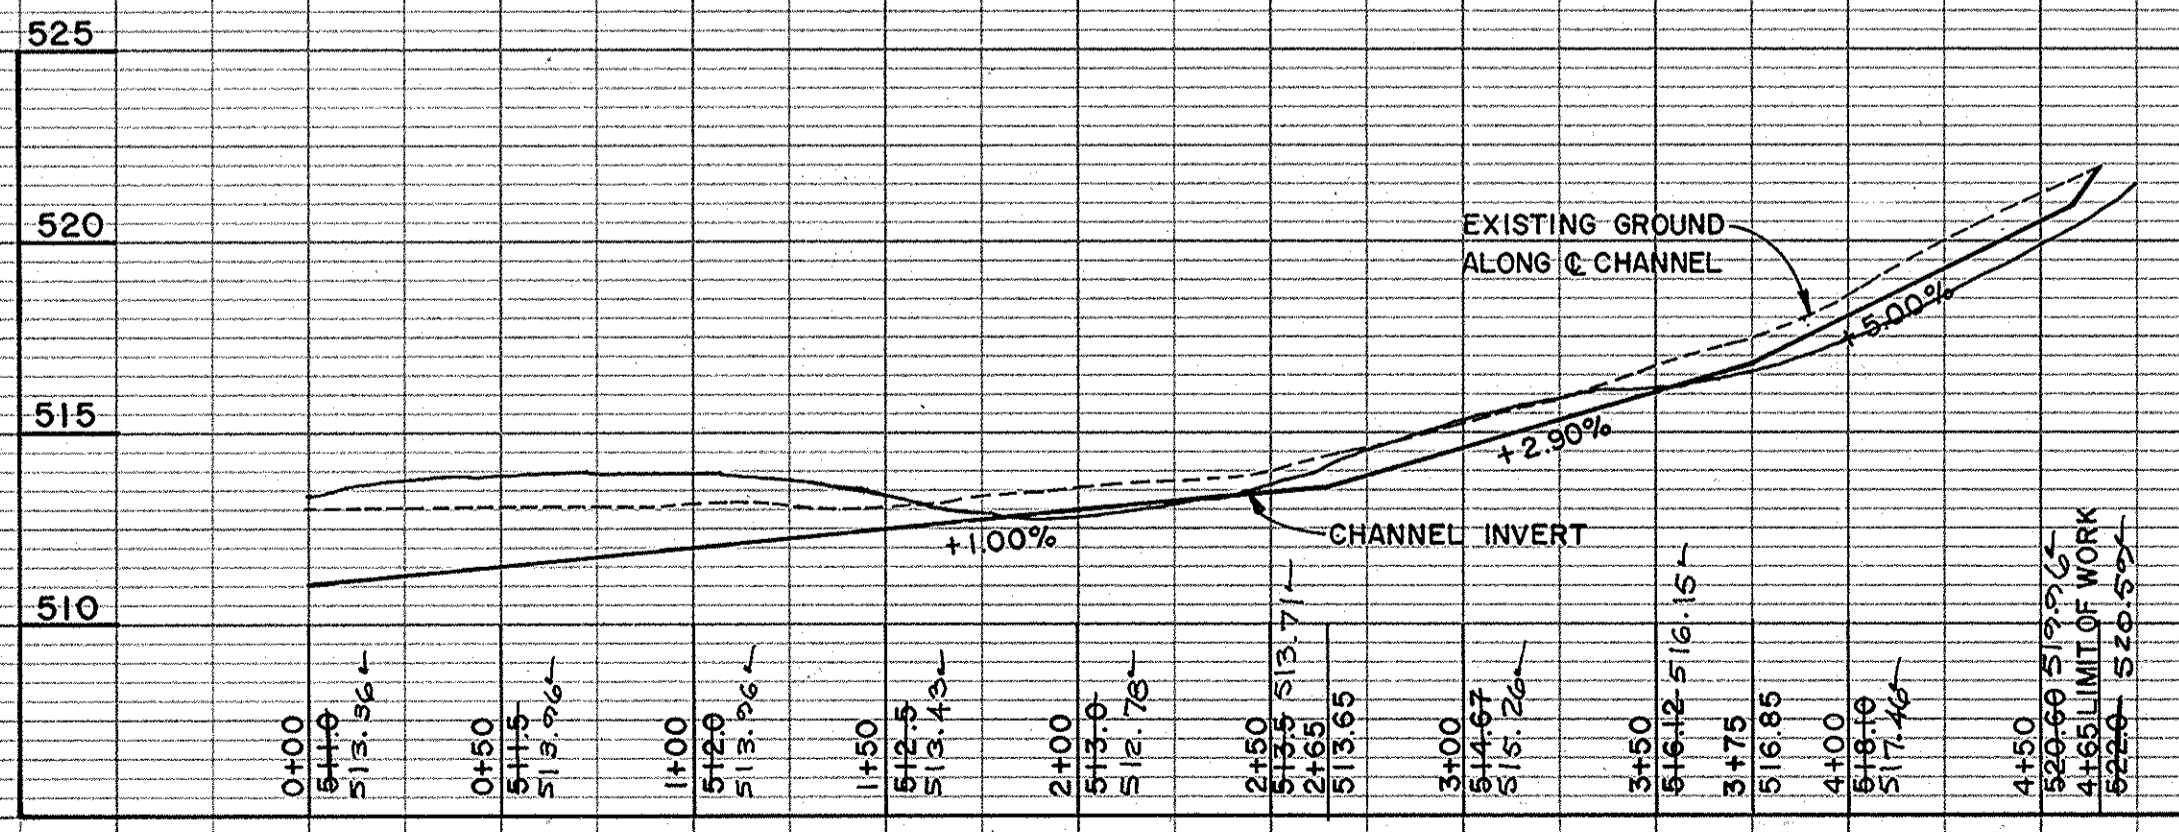

**CHANNEL PROFILE ALONG REAR OF LOTS 9-13**

SCALE: 1" = 50' HOR.  
1" = 5' VERT.

