

ENGINEER'S CERTIFICATE
 I HEREBY CERTIFY THAT THIS PLAN FOR EROSION AND SEDIMENT CONTROL REPRESENTS A WORKABLE PLAN BASED ON MY PERSONAL KNOWLEDGE OF THE SITUATION AND THAT IT WAS PREPARED IN ACCORDANCE WITH THE REQUIREMENTS OF THE HOWARD COUNTY SOIL CONSERVATION DISTRICT.

Charles J. Crovo, Sr. 1/23/86
 CENTENNIAL GROUP

DEVELOPER'S CERTIFICATE
 I CERTIFY THAT ALL DEVELOPMENT AND CONSTRUCTION WILL BE DONE ACCORDING TO THIS PLAN OF DEVELOPMENT AND PLAN FOR EROSION AND SEDIMENT CONTROL AND THAT ALL RESPONSIBLE PERSONNEL INVOLVED IN THE CONSTRUCTION PROJECT WILL HAVE A CERTIFICATE OF ATTENDANCE AT A DEPARTMENT OF NATURAL RESOURCES APPROVED TRAINING PROGRAM FOR THE CONTROL OF SEDIMENT AND EROSION BEFORE BEGINNING THE PROJECT. I ALSO AUTHORIZE PERIODIC ON-SITE INSPECTION BY THE HOWARD COUNTY SOIL CONSERVATION DISTRICT OR THEIR AUTHORIZED AGENTS AS ARE DEEMED NECESSARY.

Stephen J. Carter 4/23/86
 CENTENNIAL GROUP


REVIEWED FOR HOWARD COUNTY SOIL CONSERVATION DISTRICT AND METS TECHNICAL REQUIREMENTS.
William H. O'Brien 3-20-86
 U.S. SOIL CONSERVATION DISTRICT

THIS DEVELOPMENT PLAN IS APPROVED FOR EROSION AND SEDIMENT CONTROL BY THE HOWARD COUNTY SOIL CONSERVATION DISTRICT.
Stephen K. G. Galt 3/20/86
 HOWARD COUNTY SOIL CONSERVATION DISTRICT




- GENERAL NOTES**
- ALL WORK SHALL BE DONE IN ACCORDANCE WITH HOWARD COUNTY STANDARDS, SPECIFICATIONS, AND DETAILS FOR CONSTRUCTION.
 - ALL UTILITY COMPANIES MUST BE NOTIFIED 24 HOURS IN ADVANCE OF ANY CONSTRUCTION.
 - STORM DRAINAGE TRENCHES WITHIN ROAD RIGHTS-OF-WAY SHALL BE BACKFILLED AND COMPACTED IN ACCORDANCE WITH HOWARD COUNTY ROAD CODE.
 - ANY DAMAGE TO PUBLIC RIGHTS-OF-WAY SHALL BE AT THE CONTRACTOR'S EXPENSE.
 - CONTRACTOR TO NOTIFY THE HOWARD COUNTY INSPECTION AND SURVEY DIVISION AT LEAST 3 DAYS BEFORE STARTING WORK SHOWN ON THESE DRAWINGS - TELEPHONE = 792-7272.
 - TRAFFIC CONTROL DEVICES SHALL BE INSTALLED IN ACCORDANCE WITH THE MANUAL OF UNIFORM TRAFFIC CONTROL DEVICES, 1978 EDITION.
 - THE HORIZONTAL CONTROL IS BASED ON THE FOLLOWING STATIONS: NO. 3240004 AND NO. 3240005
 NB 326436.20 NS 26615.58
 E 33959.67 E 633251.34

APPROVED DEPARTMENT OF PUBLIC WORKS
William H. O'Brien 3-24-86
 CHIEF ENGINEER

APPROVED OFFICE OF PLANNING AND ZONING
John M. Marchman 3-26-86
 AND ZONING ADMINISTRATION

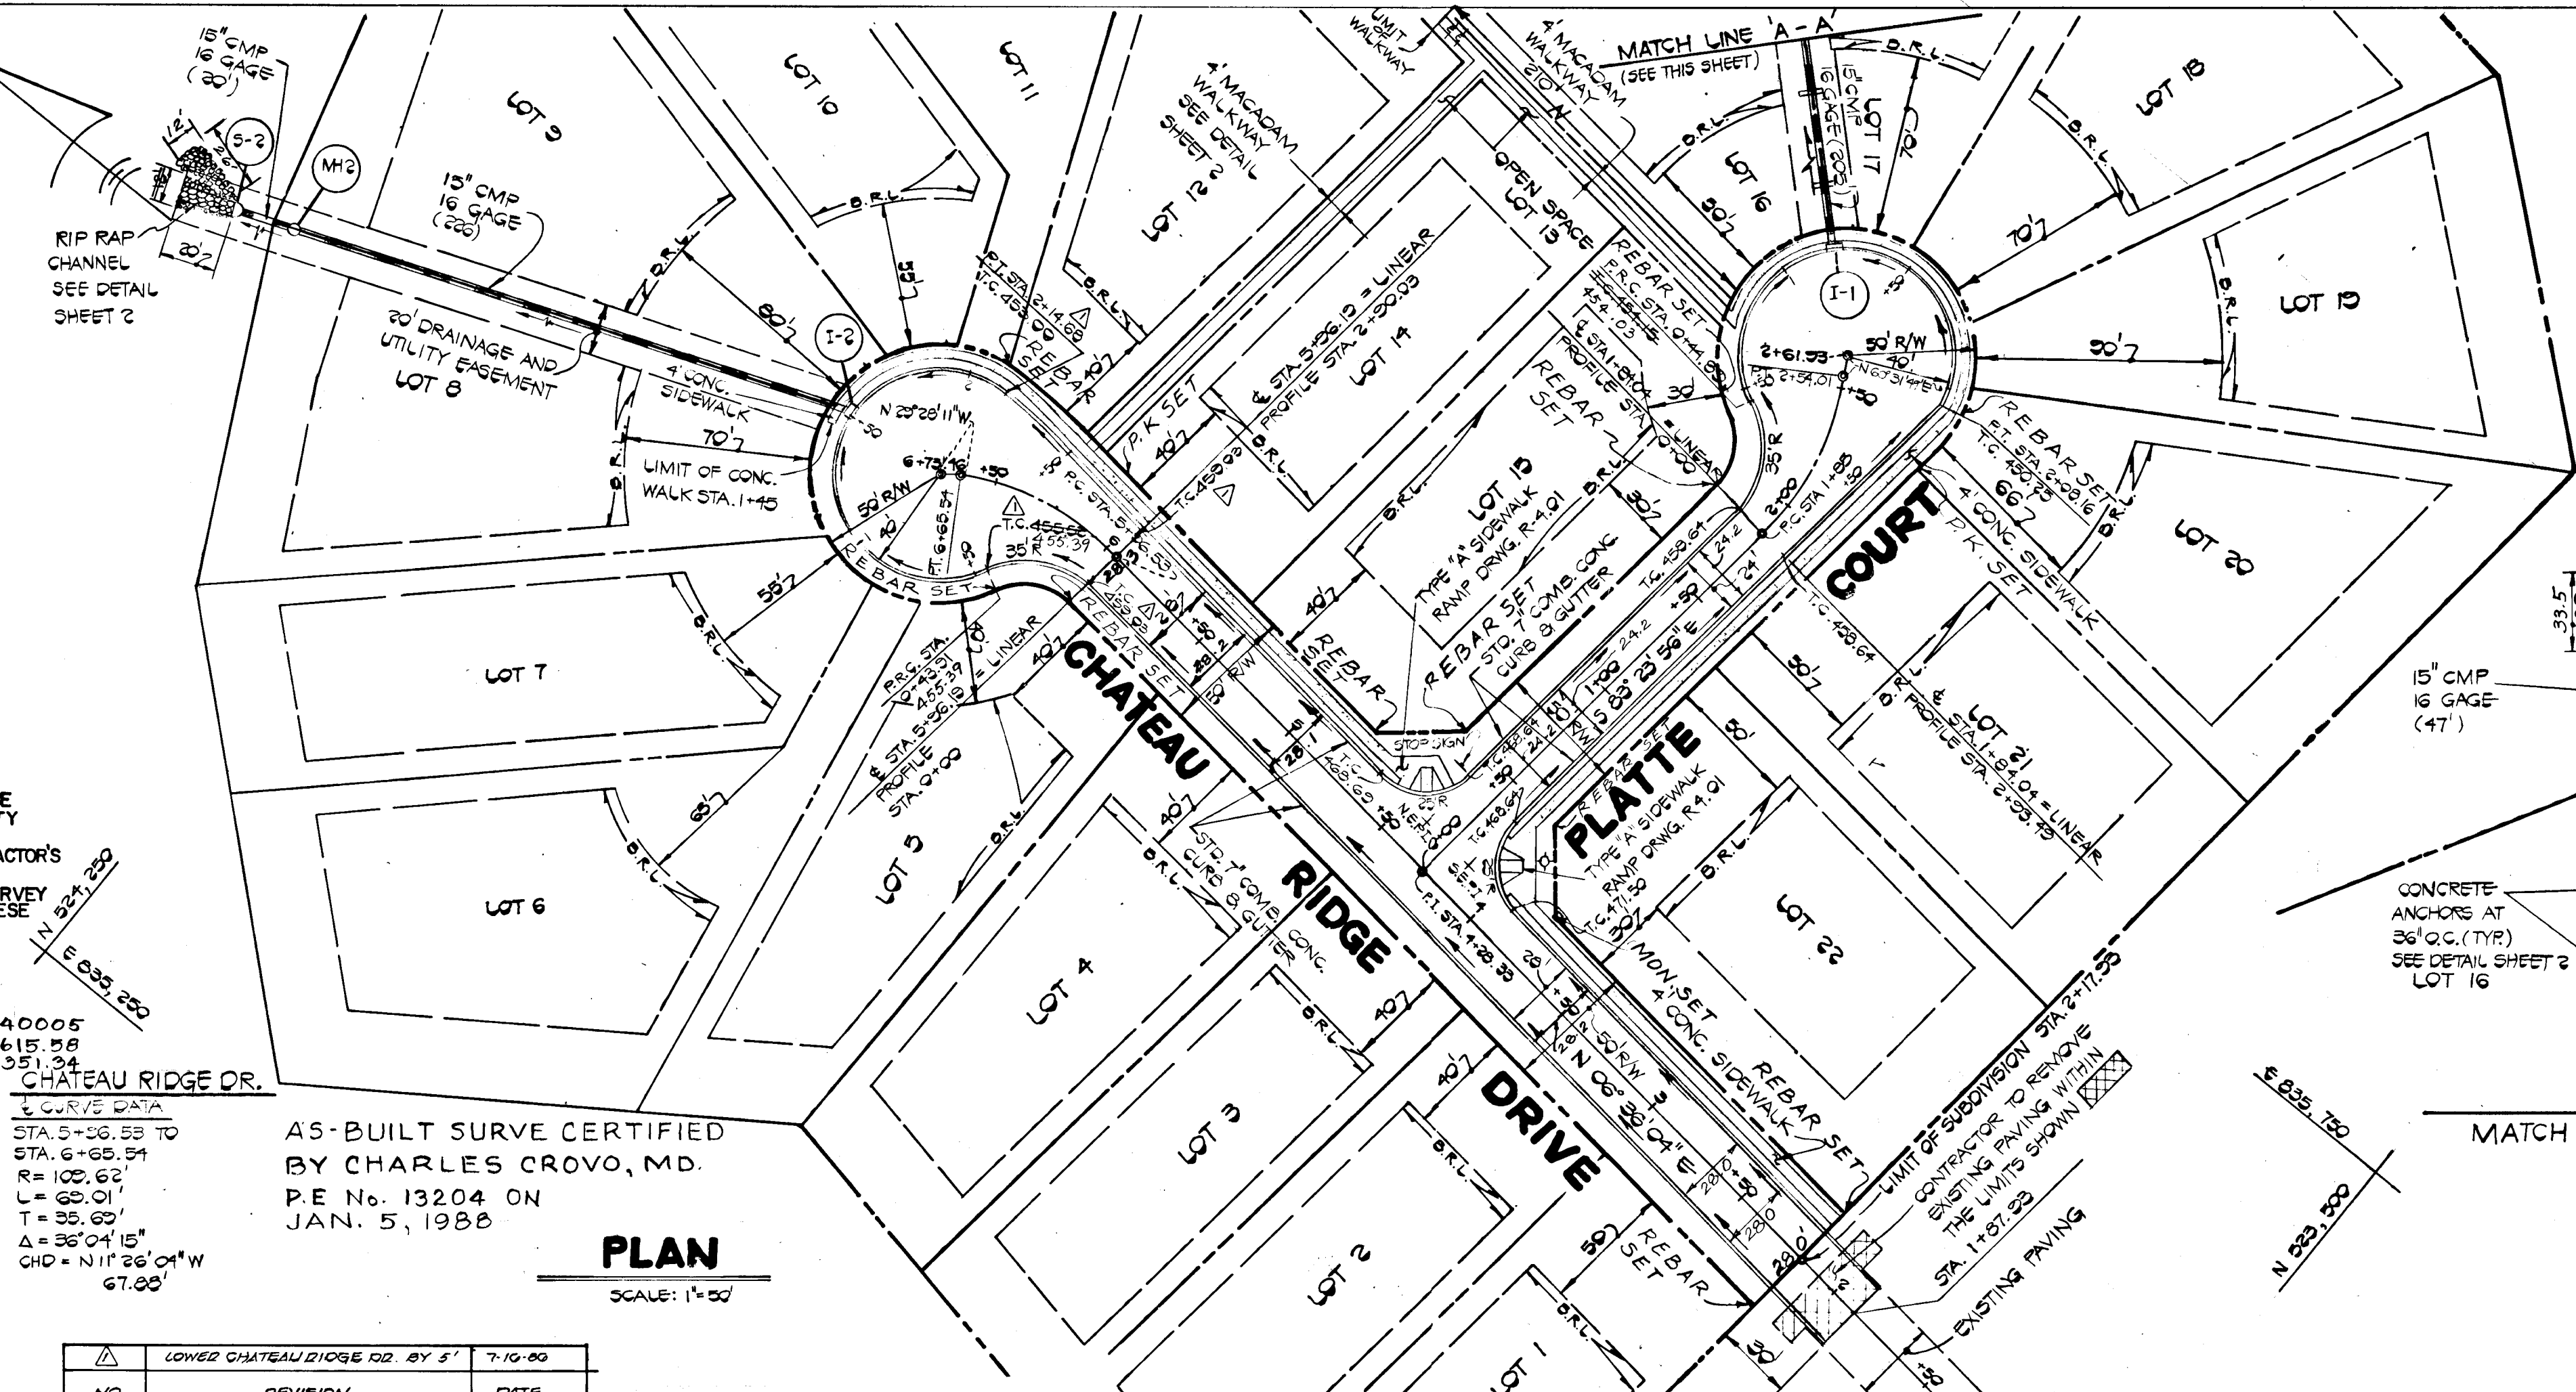

AS-BUILT SURVEY CERTIFIED BY CHARLES CROVO, MD. P.E. No. 13204 ON JAN. 5, 1988

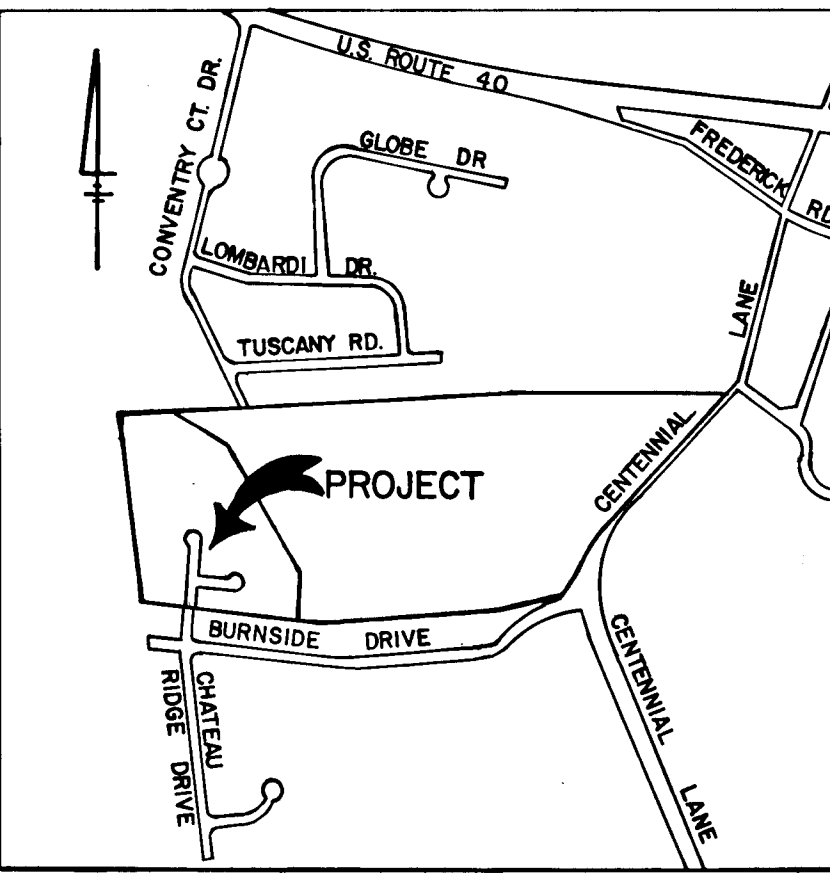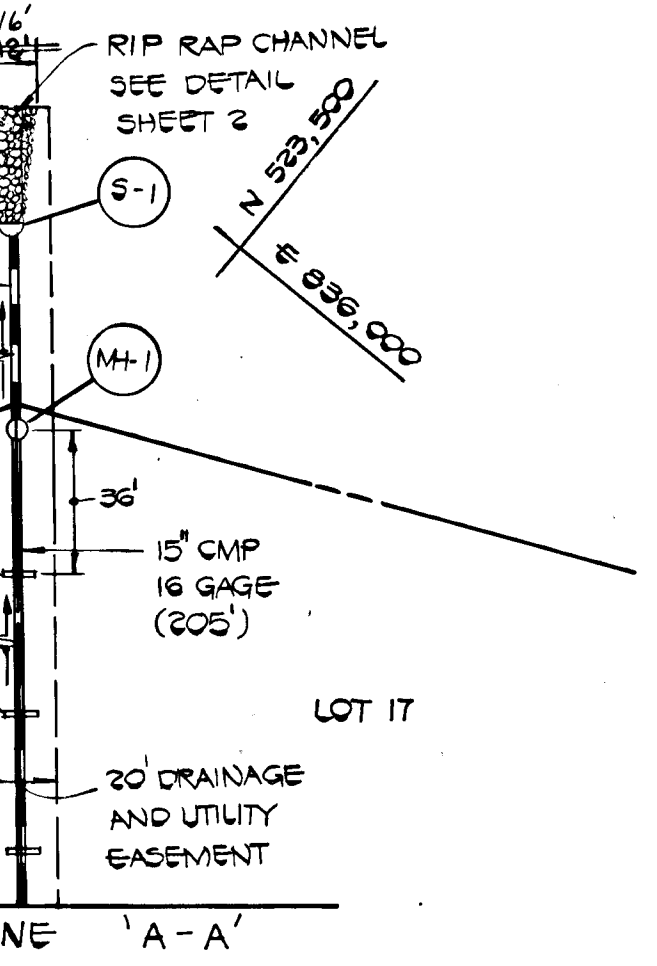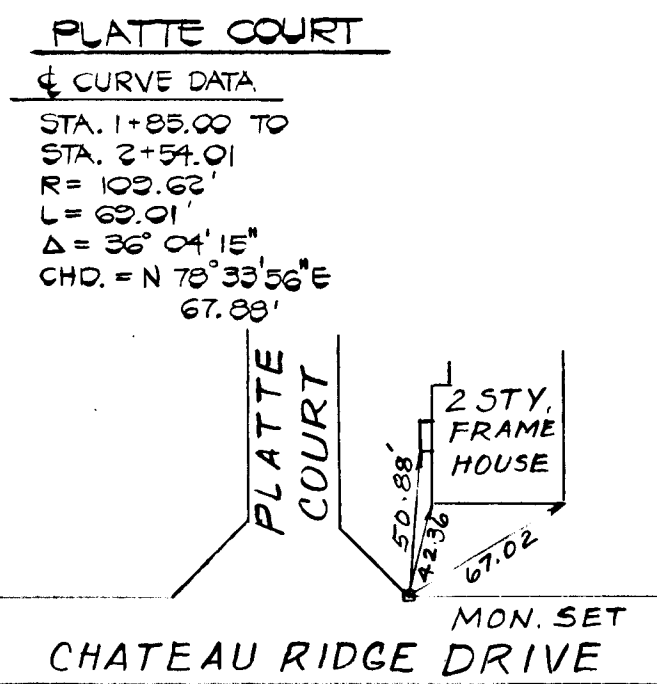

BENCH MARKS
 B.M.#1 RIM ELEVATION ON EX. SANITARY MH#2249 (CONTR.#179-S) ELEV. 399.07
 B.M.#2 RIM ELEVATION ON EX. SANITARY MH#2248 (CONTR.#179-S) ELEV. 386.52
 (SEE SHEET 3 FOR LOCATION OF BENCH MARKS)


CENTENNIAL MANOR SECTION ONE AREA ONE LOTS 1-22
 SECOND ELECTION DISTRICT HOWARD COUNTY, MARYLAND

CHATEAU RIDGE DRIVE PLAN & PROFILE
PLATTE COURT PLAN & PROFILE

OWNER AND DEVELOPER: CENTENNIAL GROUP
 620 HOWARD COUNTY LAND SERVICES 10776 BALTIMORE NATIONAL PIKE
 1076 BALTIMORE NATIONAL PIKE ELLICOTT CITY, MARYLAND 21043


SCALE AS SHOWN DATE JANUARY 24, 1986 DWG. NO. 1 OF 3
 DES. C. CROVO DRN. D. NEWTON CHK. R. B. CARTER

FISHER, COLLINS AND CARTER, INC.
 CIVIL ENGINEERS AND LAND SURVEYORS
 8388 COURT AVE. ELLICOTT CITY, MARYLAND 21043

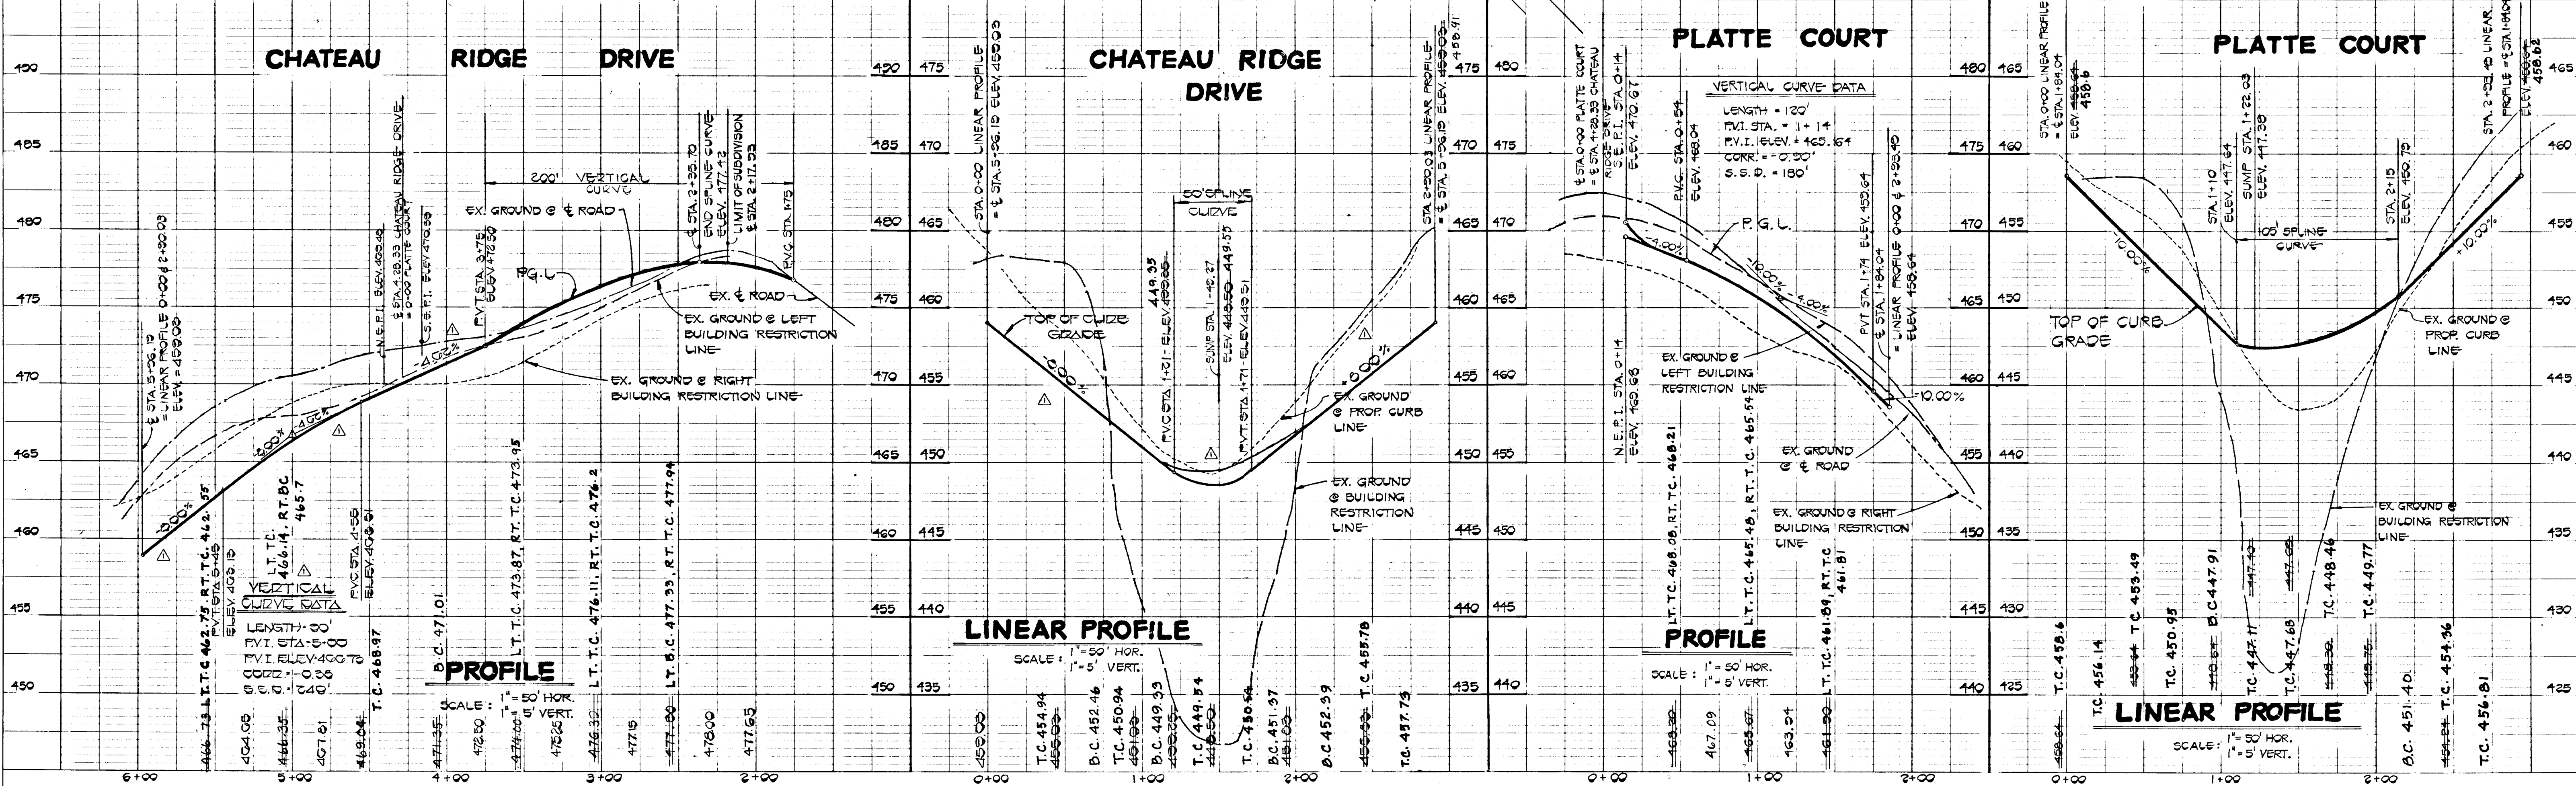


1198


ROAD NAME	CLASSIFICATION	DESIGN SPEED	ZONING	STA. LIMITS	*
CHATEAU RIDGE DRIVE	CUL DE SAC	30 M.P.H.	R-20	2+793 TO 5+96.19	28'
PLATTE COURT	CUL DE SAC	30 M.P.H.	R-20	0+00 TO 1+84.04	24'

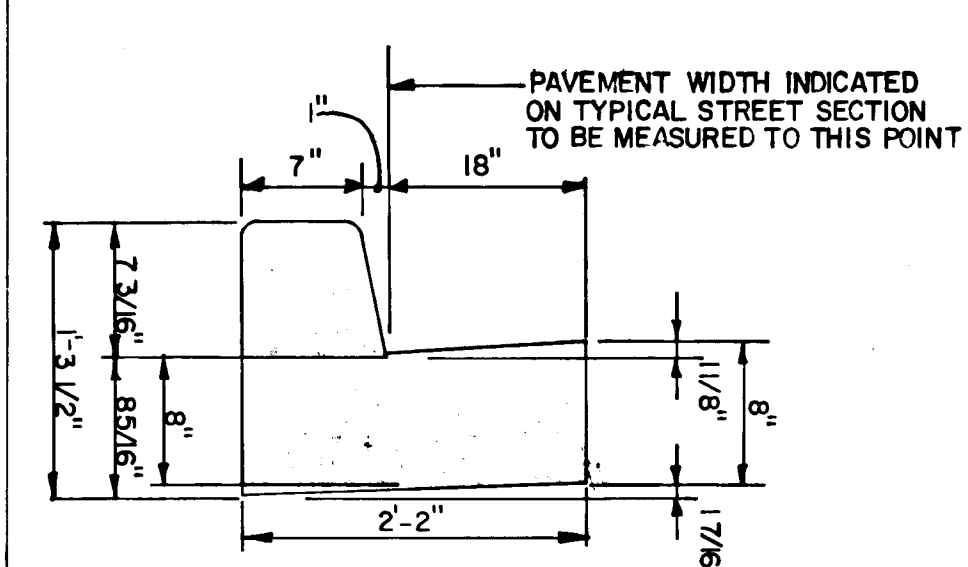


STANDARD SLOPE 7" COMB. CONC. CURB & GUTTER
NO SCALE

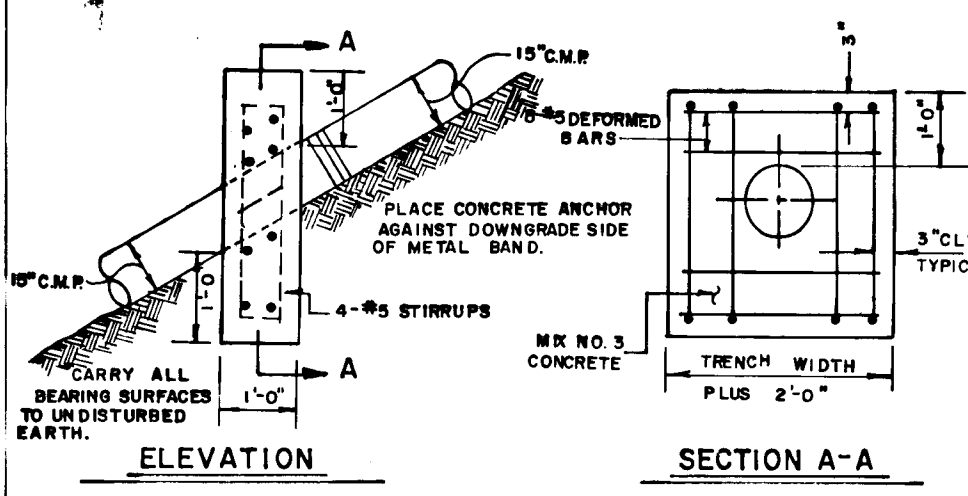


CONCRETE ANCHOR DETAIL
NO SCALE

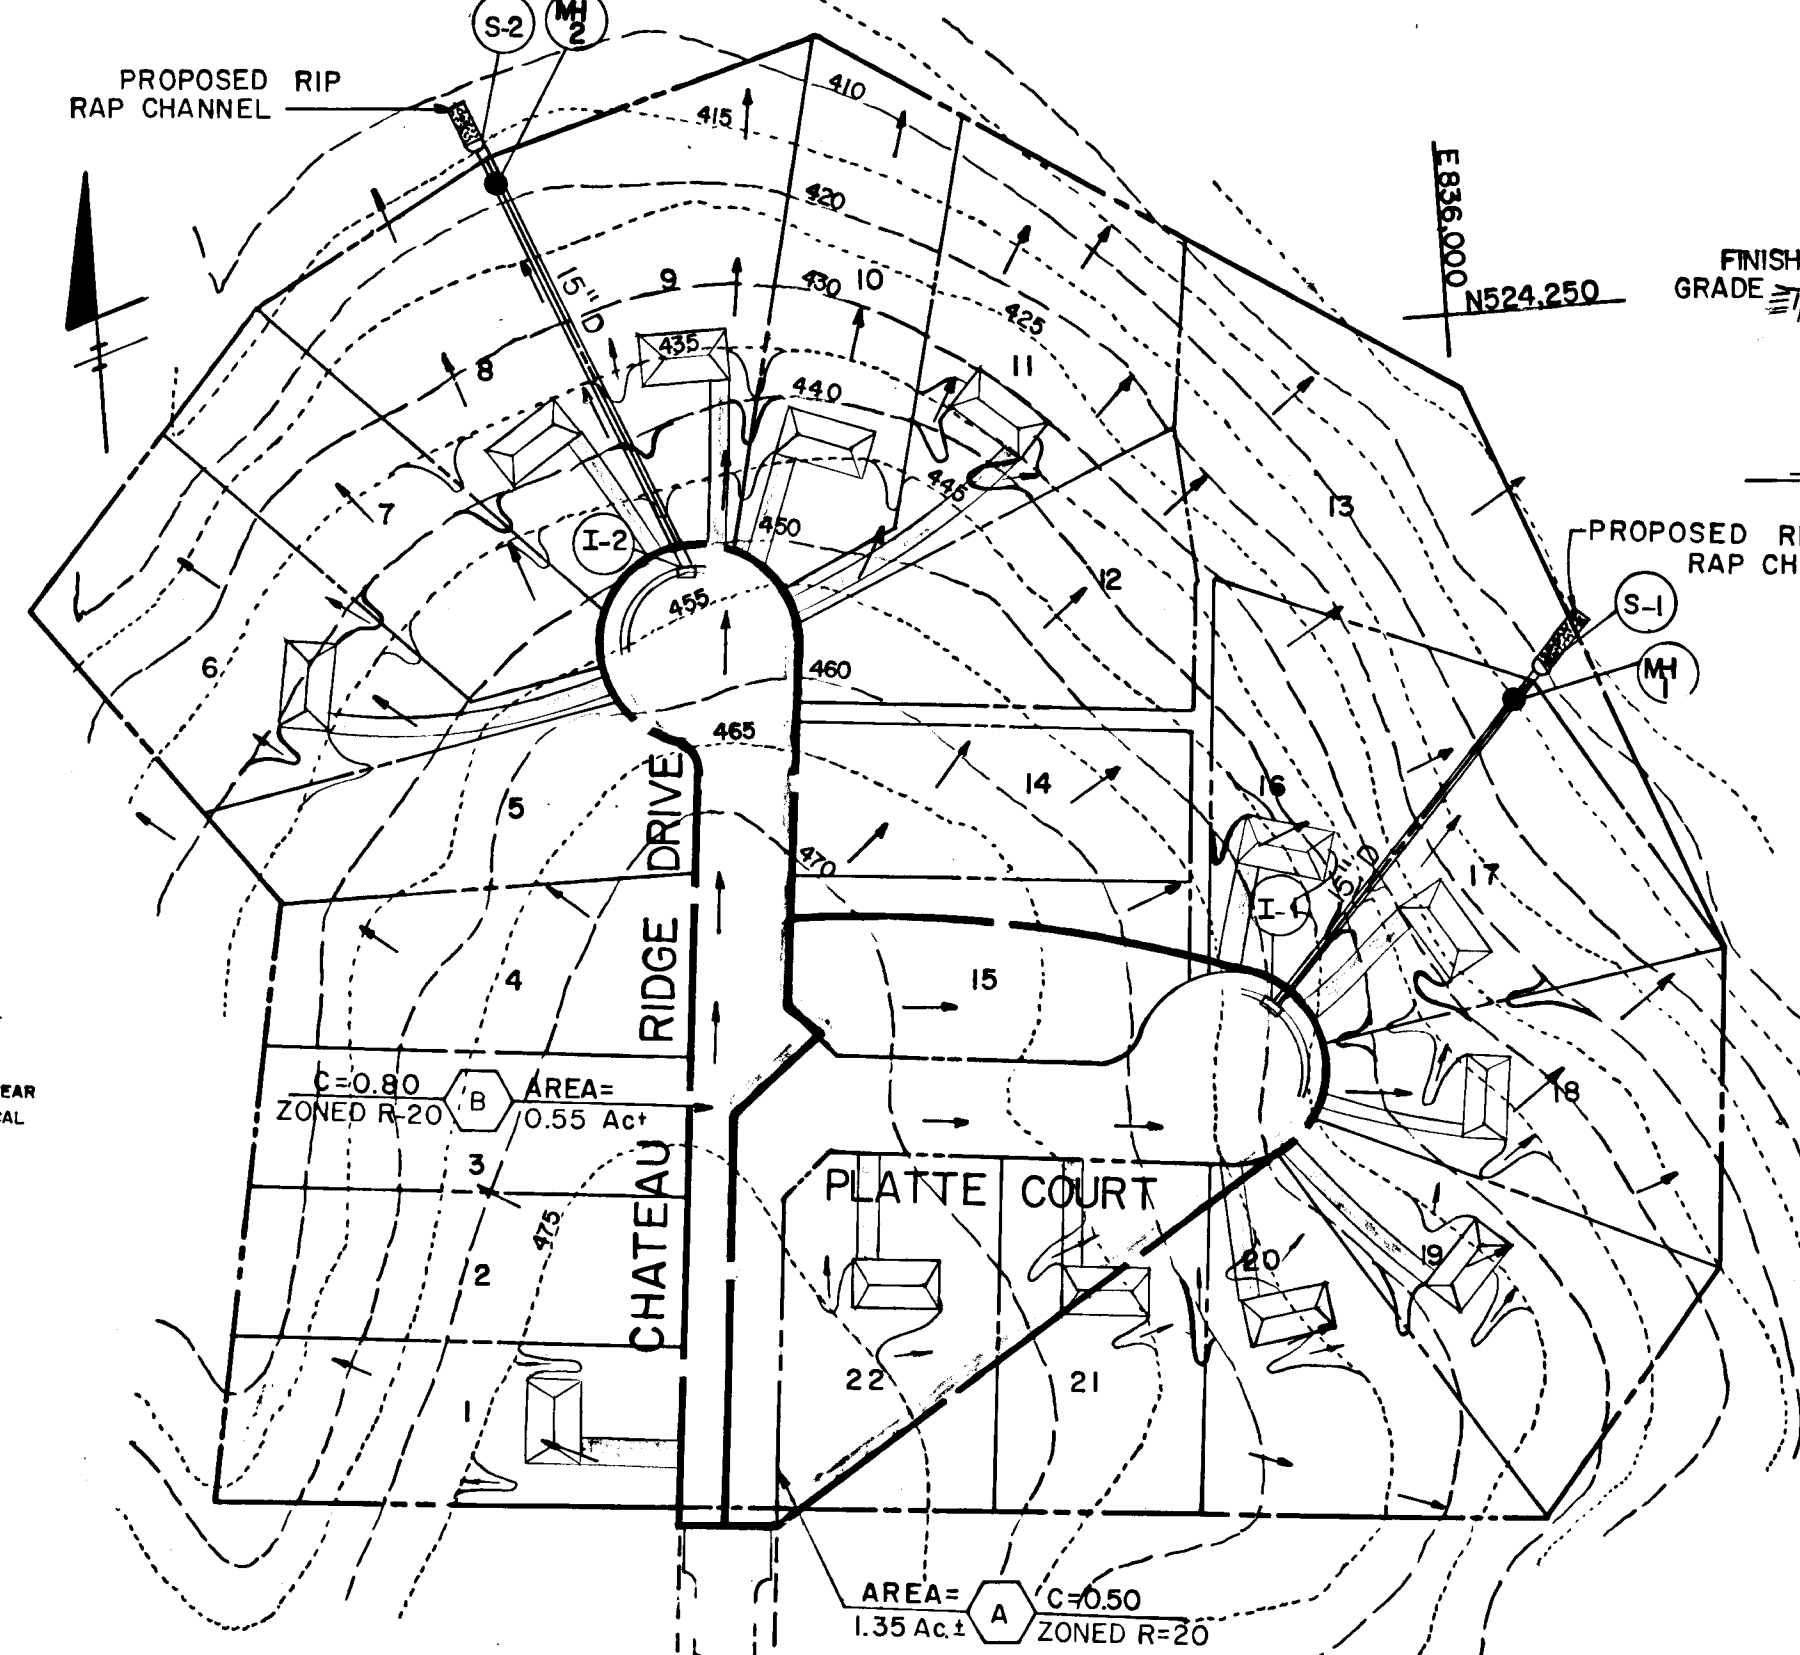

DRAINAGE AREA MAP
SCALE: 1"=100'

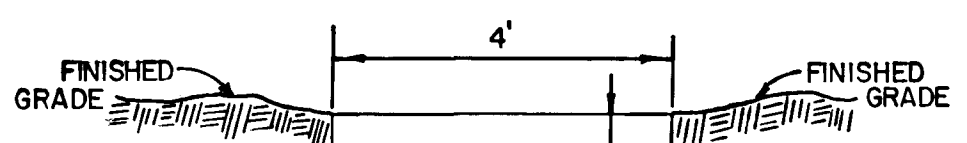


MACADAM WALKWAY DETAIL
NO SCALE

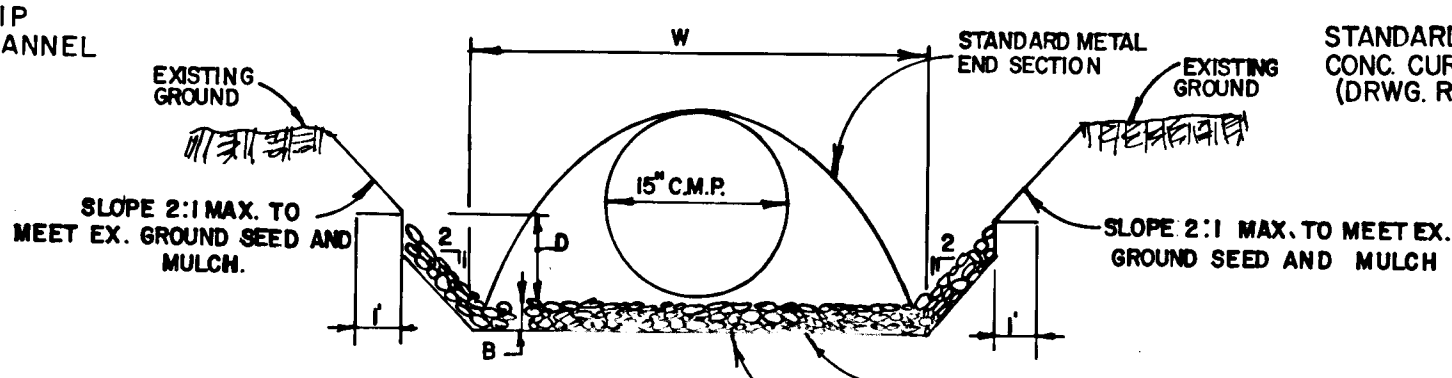


RIP RAP CHANNEL DETAIL
NO SCALE

STRUCTURE	A ²	P ¹	R	R 2/3	S	S 1/2	N	Q	V	D	W	RIP RAP SIZE	B	
S-1	2.15	5.97	.36	.50	1.00%	0.10	0.04	4.03 c.f.s.	1.87 f.p.s.	0.44'	4'	6"	9"	14"
S-2	1.95	5.79	.33	.48	1.00%	0.10	0.04	3.40 c.f.s.	1.77 f.p.s.	0.40'	4'	6"	9"	14"

NO.	TYPE	INV. IN	INV. OUT	ELF. TOP	REMARKS
I-1	A-5	443.46	443.38	443.38	LINEAR PROFILE STA. 1+22.03 PLATTE COURT
I-2	A-5	444.25	444.25	444.25	LINEAR PROFILE STA. 1+49.27 CHATEAU RIDGE DRIVE
MH-1	STANDARD MANHOLE	391.75	391.50	391.42	DWG. G. 5.01
MH-2	STANDARD MANHOLE	409.94	409.69	415.58	DWG. G. 5.01
S-1	METAL END SECTION	388.60	389.25		DWG. S. D. 5.61
S-2	METAL END SECTION	403.36	410.75		DWG. S. D. 5.61

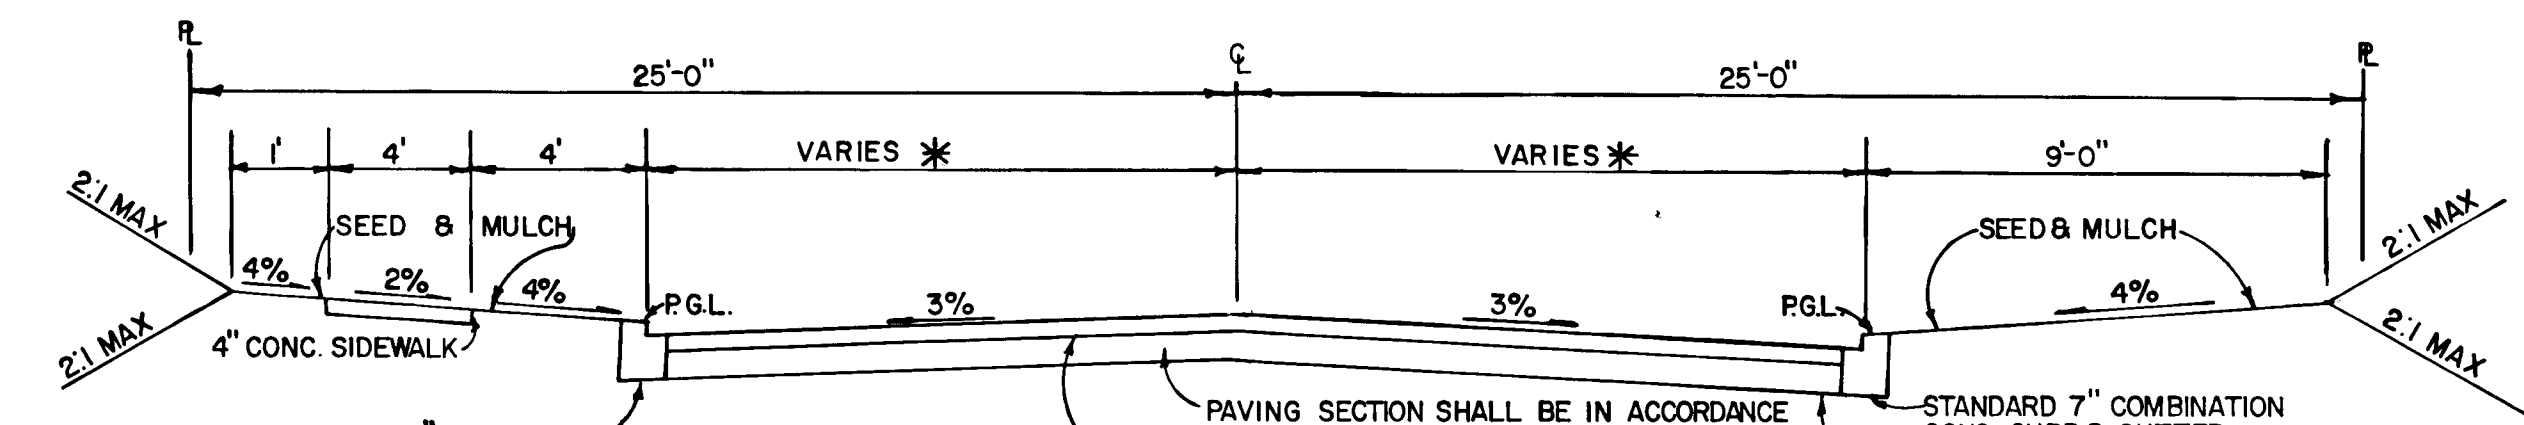

TYPICAL ROADWAY SECTION
NO SCALE

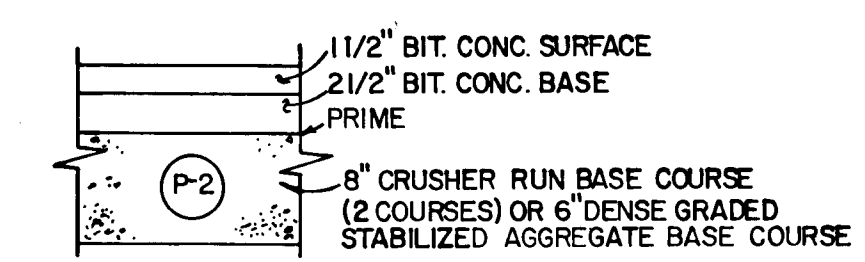

PAVING SECTION P-2
NO SCALE



AS-BUILT SURVEY CERTIFIED BY CHARLES CROVO, MD. P.E. No. 13204 ON JAN. 5, 1988


CENTENNIAL MANOR SECTION ONE AREA ONE LOTS 1-22
SECOND ELECTION DISTRICT HOWARD COUNTY, MARYLAND
DRAINAGE AREA MAP, STORM DRAIN PROFILES, ROAD SECTION, AND DETAILS

OWNER AND DEVELOPER: CENTENNIAL GROUP, 1076 BALTIMORE NATIONAL PIKE, ELLICOTT CITY, MARYLAND 21043
DESIGNER: FISHER, COLLINS AND CARTER, INC., 8388 COURT AVE., ELLICOTT CITY, MARYLAND 21043
DATE: JANUARY 24, 1986
DWG. NO.: 2 OF 3
DRN.: D. NEWTON
CHK.: R. B. CARTER

DATE: _____
BY: _____
PLAN SURVEYED, GRADES CHECKED, ALIGNMENT CHECKED, RT. OF WAY CHECKED. NOTE BOOK NO. _____

APPROVED: _____ 3-10-86
DEPARTMENT OF PUBLIC WORKS
CHIEF, BUREAU OF ENGINEERING
OFFICE OF PLANNING AND ZONING AND ZONING ADMINISTRATION
DATE: 3-26-86

DATE: _____
BY: _____
PROFILE SURVEYED, GRADES CHECKED, S.W. NOTED, STRUCTURE NOTATIONS CHECKED. NOTE BOOK NO. _____

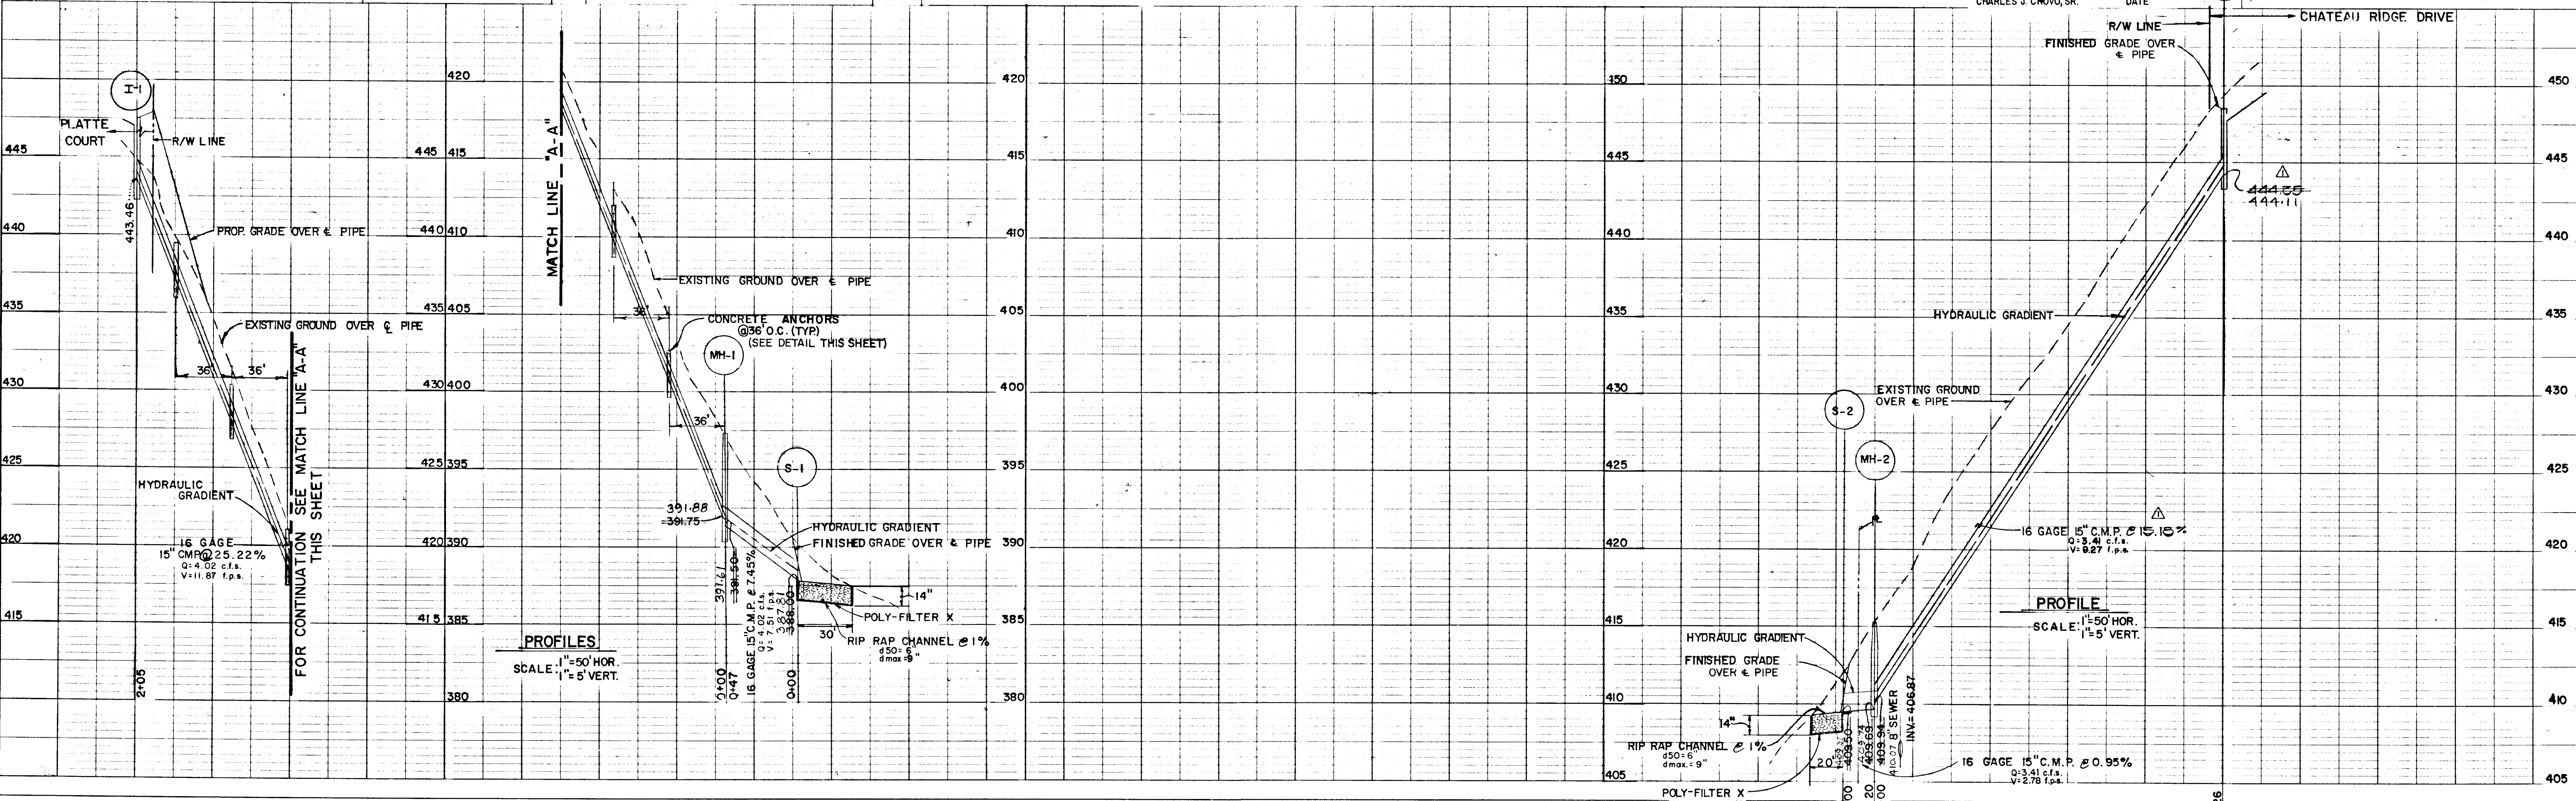

1198

PERMANENT SEEDING NOTES:
 APPLY TO GRADED OR CLEARED AREA NOT SUBJECT TO IMMEDIATE FURTHER DISTURBANCE WHERE A PERMANENT LONG-LIVED VEGETATIVE COVER IS NEEDED.
 SEEDBED PREPARATION: LOOSEN UPPER THREE-INCHES OF SOIL BY RAKING, DISCING OR OTHER ACCEPTABLE MEANS BEFORE SEEDING.
 SOIL AMENDMENTS: IN LIEU OF SOIL TEST RECOMMENDATIONS, USE ONE OF THE FOLLOWING SCHEDULES:


- 1) PREFERRED - APPLY 2 TONS PER ACRE DOLOMITIC LIMESTONE (92 LBS/1000 SQ. FT.) AND 600 LBS PER ACRE 10-10-10 FERTILIZER (14 LBS/1000 SQ. FT.) BEFORE SEEDING. HARROW OR DISC INTO UPPER THREE-INCHES OF SOIL. AT TIME OF SEEDING, APPLY 400 LBS. PER ACRE 30-0-0 UREA-FORM FERTILIZER (9 LBS/1000 SQ. FT.).
- 2) ACCEPTABLE - APPLY 2 TONS PER ACRE DOLOMITIC LIMESTONE (92 LBS/1000 SQ. FT.) AND 1000 LBS PER ACRE 10-10-10 FERTILIZER (23 LBS/1000 SQ. FT.) BEFORE SEEDING. HARROW OR DISC INTO UPPER THREE-INCHES OF SOIL.

SEEDING: FOR PERIODS MARCH 1 THRU APRIL 30, AND AUGUST 1 THRU OCTOBER 15, SEED WITH 50 LBS PER ACRE (1.4 LBS/1000 SQ. FT.) OF KENTUCKY 31 TALL FESCUE. FOR THE PERIOD MAY 1 THRU JULY 31, SEED WITH 60 LBS KENTUCKY 31 TALL FESCUE PER ACRE AND 2 LBS PER ACRE (.05 LBS/1000 SQ. FT.) OF WEEPING LOVEGRASS. DURING THE PERIOD OF OCTOBER 16 THRU FEBRUARY 28, PROTECT SITE BY OPTION (1) 2 TONS PER ACRE OF WELLS ANCHORED STRAW MULCH AND SEED AS SOON AS POSSIBLE IN THE SPRING. OPTION (2) USE SOO. OPTION (3) SEED WITH 60 LBS/ACRE KENTUCKY 31 TALL FESCUE AND MULCH WITH 2 TONS/ACRE WELLS ANCHORED STRAW MULCH.
 MULCHING: APPLY 14 TO 2 TONS PER ACRE (70 TO 90 LBS/1000 SQ. FT.) OF UNROTTED SMALL BRUSH STRAW IMMEDIATELY AFTER SEEDING. ANCHOR MULCH IMMEDIATELY AFTER APPLICATION USING MULCH ANCHORING TOOL OR 218 GALLONS PER ACRE (5 GAL/1000 SQ. FT.) OF EMULSIFIED ASPHALT ON FLAT AREAS. ON SLOPES 8 FEET OR HIGHER, USE 348 GALLONS PER ACRE (8 GAL/1000 SQ. FT.) FOR ANCHORING.
 MAINTENANCE: INSPECT ALL SEEDING AREAS AND MAKE NEEDED REPAIRS, REPLACEMENTS AND RESEEDINGS.



TEMPORARY SEEDING NOTES:
 APPLY TO GRADED OR CLEARED AREAS LIKELY TO BE REDISTURBED WHERE A SHORT-TERM VEGETATIVE COVER IS NEEDED.
 SEEDBED PREPARATION: LOOSEN UPPER THREE-INCHES OF SOIL BY RAKING, DISCING OR OTHER ACCEPTABLE MEANS BEFORE SEEDING.
 SOIL AMENDMENTS: APPLY 600 LBS PER ACRE 10-10-10 FERTILIZER (14 LBS/1000 SQ. FT.)

SEEDING: FOR PERIODS MARCH 1 THRU APRIL 30 AND FROM AUGUST 15 THRU NOVEMBER 15, SEED WITH 25 BUSHEL PER ACRE ANNUAL RYE (3.2 LBS/1000 SQ. FT.). FOR THE PERIOD MAY 1 THRU AUGUST 14, SEED WITH 3 LBS PER ACRE OF WEEPING LOVEGRASS (.07 LBS/1000 SQ. FT.). FOR THE PERIOD NOVEMBER 16 THRU FEBRUARY 28, PROTECT SITE BY APPLYING 2 TONS PER ACRE OF WELLS ANCHORED STRAW MULCH AND SEED AS SOON AS POSSIBLE IN THE SPRING, OR USE SOO.
 MULCHING: APPLY 14 TO 2 TONS PER ACRE (70 TO 90 LBS/1000 SQ. FT.) OF UNROTTED SMALL BRUSH STRAW IMMEDIATELY AFTER SEEDING. ANCHOR MULCH IMMEDIATELY AFTER APPLICATION USING MULCH ANCHORING TOOL OR 218 GAL PER ACRE (5 GAL/1000 SQ. FT.) OF EMULSIFIED ASPHALT ON FLAT AREAS. ON SLOPES, 8 FT. OR HIGHER, USE 348 GAL PER ACRE (8 GAL/1000 SQ. FT.) FOR ANCHORING.
 REFER TO THE 1983 MARYLAND STANDARDS AND SPECIFICATIONS FOR SOIL EROSION AND SEDIMENT CONTROL FOR RATE AND METHODS NOT COVERED.

STONE OUTLET SEDIMENT TRAP #2 DATA:
 DRAINAGE AREA-1.0 AC. +
 VOLUME REQUIRED-67 CU.YDS.
 VOLUME PROVIDED-67 CU.YDS.
 TOP DIMENSIONS-78' x 12'
 BOTTOM DIMENSIONS-73' x 7'
 DEPTH-2.5'
 SIDE SLOPES 1:1
 BOTTOM ELEVATION-429.0
 CLEANOUT ELEVATION-430.25
 WEIR CREST ELEVATION-432.5

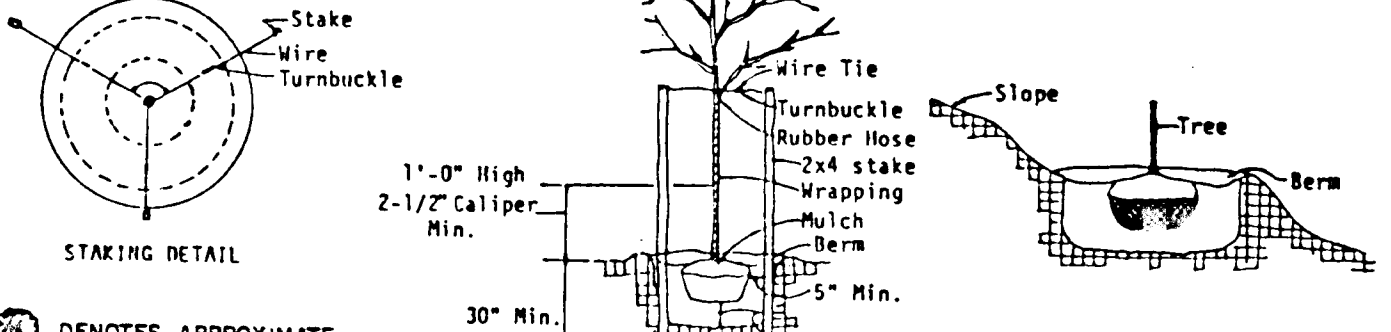



TREE PLANTING DETAIL
 NO SCALE
 NOTE: CONTRACTOR SHALL VERIFY LOCATION OF UNDERGROUND UTILITIES PRIOR TO DIGGING. FINAL LOCATIONS OF TREES MAY BE ADJUSTED SLIGHTLY TO ACCOMMODATE FIELD CONDITIONS. PLANTING PROCEDURES SHALL COMPLY WITH "LANDSCAPE SPECIFICATIONS FOR BALTIMORE-WASHINGTON METROPOLITAN AREAS". SUBSTITUTIONS TO THE ABOVE SPECIES MAY BE PERMITTED PROVIDED THE PLANTING IS IN ACCORDANCE WITH THE STREET TREE AND LANDSCAPE REQUIREMENTS AS SPECIFIED IN SECTION 16.131 OF THE HOWARD COUNTY SUBDIVISION REGULATIONS.

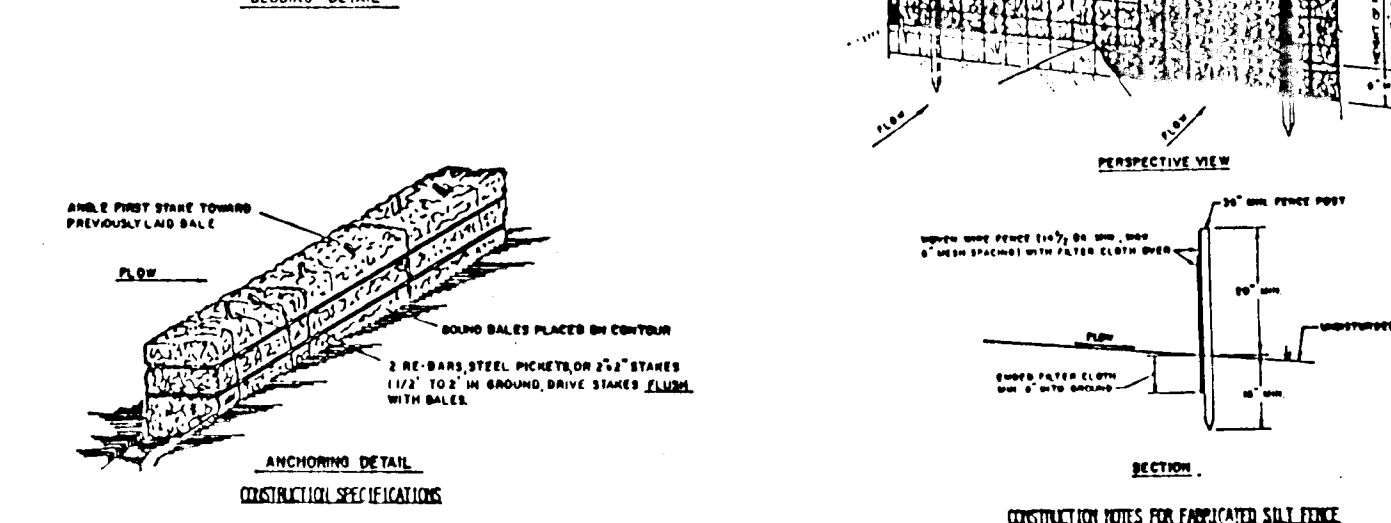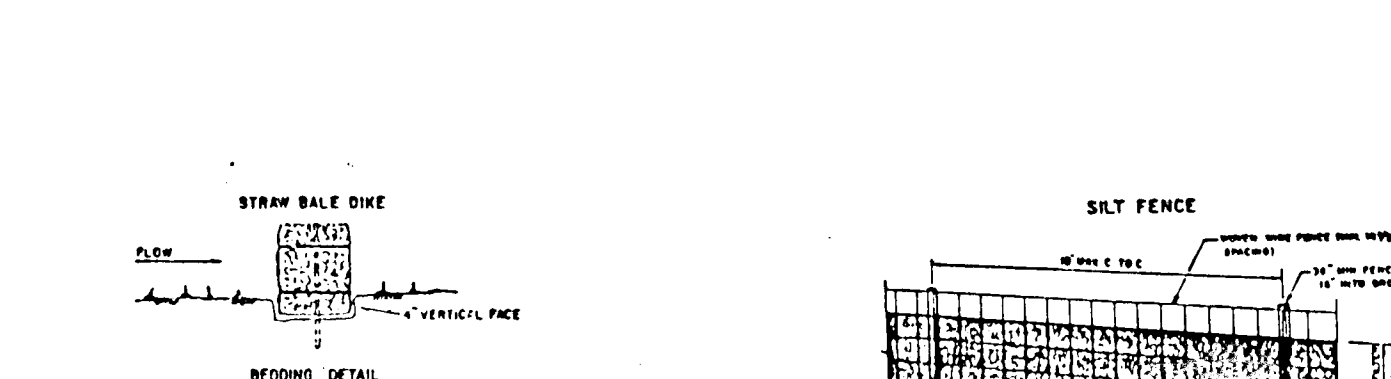

1. SAILS SHALL BE PLACED AT THE TOP OF A SLOPE OR ON THE CORNER AND IN A ROW WITH LEAST SPACING BETWEEN THE ADJACENT SAILS.
2. SAILS SHALL BE PLACED IN THE SOIL AT A SPACING OF (40) INCHES, AND PLACED ON THE ENDINGS AND HEADINGS.
3. SAILS SHALL BE WELDED TOGETHER AT THE TOP AND BOTTOM AND AT THE CORNERS. THE TOP AND BOTTOM SHALL BE WELDED TOGETHER WITH THE SAILS. SAILS SHALL BE WELDED TOGETHER WITH THE SAILS.
4. SAILS SHALL BE FREQUENTLY INSPECTED AND REPLACEMENTS SHALL BE MADE AS NECESSARY.
5. SAILS SHALL BE REMOVED WITH CARE TO PREVENT DAMAGE TO THE UNDERLYING SOIL OR TO THE SURFACE OF THE SLOPE.

AS-BUILT SURVEY CERTIFIED
 BY CHARLES CROVO, MD,
 P.E. No. 13204 ON JAN. 5, 1988

FISHER, COLLINS AND CARTER, INC.
 CONSULTING ENGINEERS AND LAND SURVEYORS
 8389 COURT AVENUE
 ELLICOTT CITY, MARYLAND 21043
 TELEPHONE: (301) 461-2855

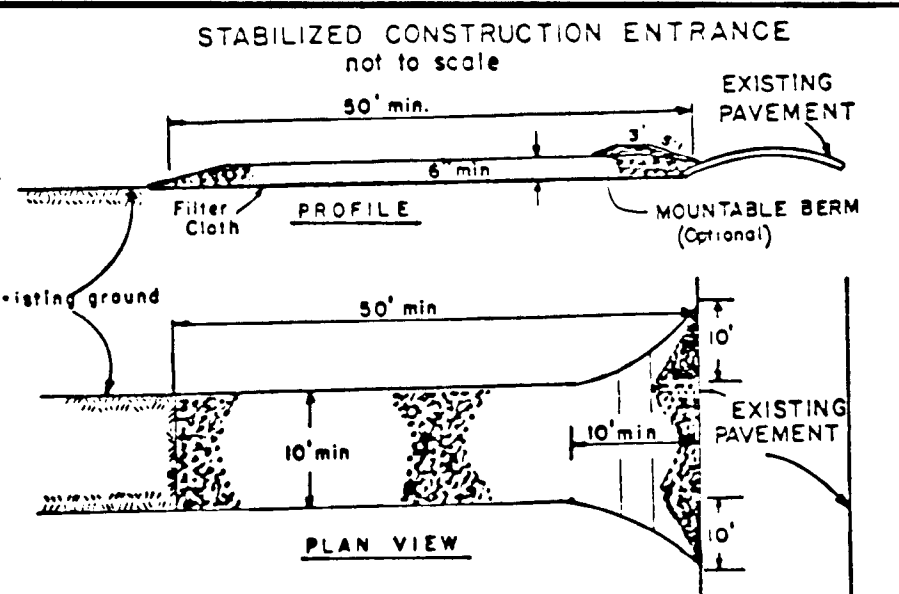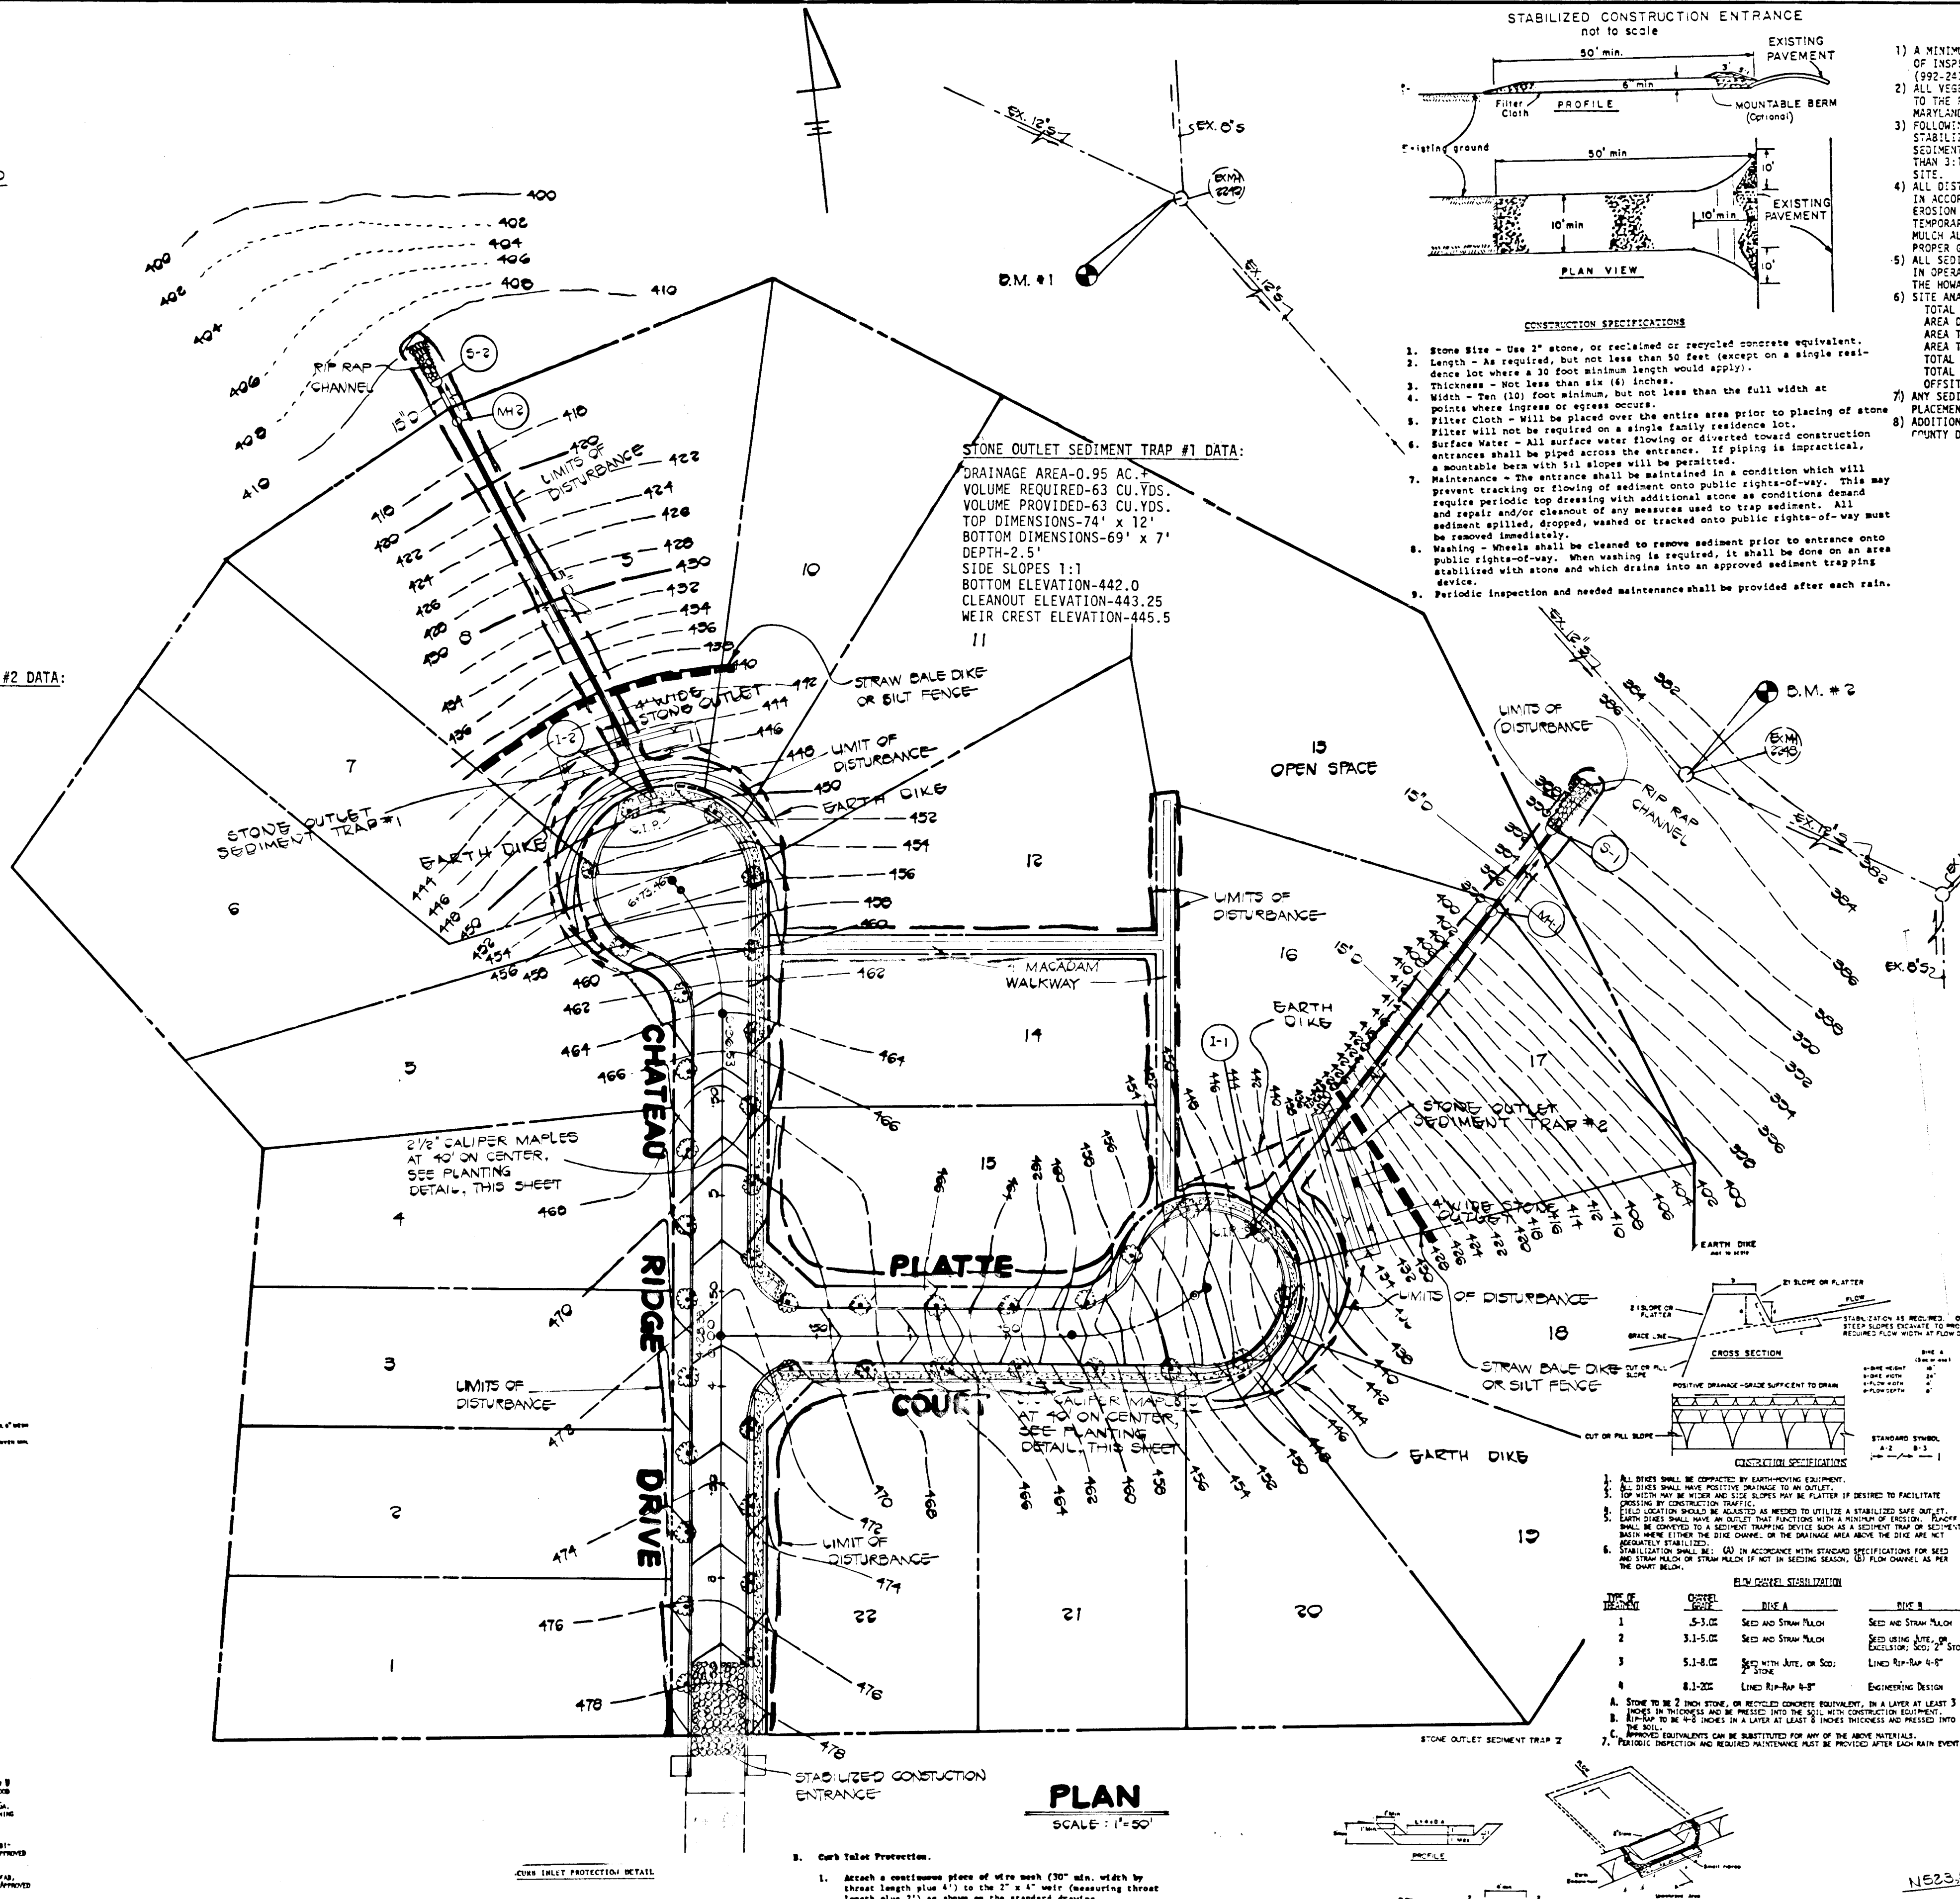

- CONSTRUCTION SPECIFICATIONS**
1. Stone Size - One (1) stone, or reclaimed or recycled concrete equivalent.
 2. Length - As required, but not less than 30 feet (except on a single residence lot where a 30 foot minimum length would apply).
 3. Thickness - Not less than six (6) inches.
 4. Width - Ten (10) foot minimum, but not less than the full width at points where ingress or egress occurs.
 5. Filter Cloth - Will be placed over the entire area prior to placing of stone. Filter cloth will not be required on a single family residence lot.
 6. Surface Water - All surface water flowing or directed toward construction entrances shall be piped across the entrance. If piping is impractical, a moundable berm with 5:1 slopes will be permitted.
 7. Maintenance - The entrance shall be maintained in a condition which will prevent tracking or flowing of sediment onto public rights-of-way. This may require periodic top dressing with additional stone as conditions demand and repair and/or cleaned, washed or tracked onto public rights-of-way must be removed immediately.
 8. Washing - Wheels shall be cleaned to remove sediment prior to entrance onto a public right-of-way. When washing is required, it shall be done on an area stabilized with stone and which drains into an approved sediment trap or device.
 9. Periodic inspection and needed maintenance shall be provided after each rain event.

- SEDIMENT CONTROL NOTES:**
- 1) A MINIMUM OF 24 HOURS NOTICE MUST BE GIVEN TO THE HOWARD COUNTY OFFICE OF INSPECTIONS AND PERMITS PRIOR TO THE START OF ANY CONSTRUCTION (892-2433)
 - 2) ALL VEGETATIVE AND STRUCTURAL PRACTICES ARE TO BE INSTALLED ACCORDING TO THE PROVISIONS OF THIS PLAN AND ARE TO BE IN CONFORMANCE WITH THE 1983 MARYLAND STANDARDS AND SPECIFICATIONS FOR SOIL EROSION AND SEDIMENT CONTROL.
 - 3) FOLLOWING INITIAL SOIL DISTURBANCE OR REDISTURBANCE, PERMANENT OR TEMPORARY STABILIZATION SHALL BE COMPLETED WITHIN: a) 7 CALENDAR DAYS FOR ALL PERIMETER SEDIMENT CONTROL STRUCTURES, DIKES, PERIMETER SLOPES AND ALL SLOPES GREATER THAN 3:1, b) 14 DAYS AS TO ALL OTHER DISTURBED OR GRADED AREAS ON THE PROJECT SITE.
 - 4) ALL DISTURBED AREAS MUST BE STABILIZED WITHIN THE TIME PERIOD SPECIFIED ABOVE IN ACCORDANCE WITH THE 1983 MARYLAND STANDARDS AND SPECIFICATIONS FOR SOIL EROSION AND SEDIMENT CONTROL FOR PERMANENT SEEDINGS (SEC. 51) SOO (SEC. 54), TEMPORARY SEEDING (SEC. 50) AND MULCHING (SEC. 52). TEMPORARY STABILIZATION WITH MULCH ALONE CAN ONLY BE DONE WHEN RECOMMENDED SEEDING DATES DO NOT ALLOW FOR PROPER GERMINATION AND ESTABLISHMENT OF GRASSES.
 - 5) ALL SEDIMENT CONTROL STRUCTURES ARE TO REMAIN IN PLACE AND ARE TO BE MAINTAINED IN OPERATIVE CONDITION UNTIL PERMISSION FOR THEIR REMOVAL HAS BEEN OBTAINED FROM THE HOWARD COUNTY SEDIMENT CONTROL INSPECTOR.
 - 6) SITE ANALYSIS:

TOTAL AREA: SITE	20.8	ACRES
AREA DISTURBED	1.7	ACRES
AREA TO BE ROOFED OR PAVED	0.75	ACRES
AREA TO BE VEGETATIVELY STABILIZED	0.86	ACRES
TOTAL CUT		CU. YDS.
TOTAL FILL		CU. YDS.
 - 7) ANY SEDIMENT CONTROL PRACTICE WHICH IS DISTURBED BY GRADING ACTIVITY FOR PLACEMENT OF UTILITIES MUST BE REPAIRED ON THE SAME DAY OF DISTURBANCE.
 - 8) ADDITIONAL SEDIMENT CONTROL MEASURES PROVIDED, IF DEEMED NECESSARY BY THE HOWARD COUNTY SEDIMENT CONTROL INSPECTOR.

ENGINEER'S CERTIFICATE
 I, Charles Crovo, P.E., hereby certify that this plan for erosion and sediment control represents a practical and workable plan based on my personal knowledge of the site conditions and that it was prepared in accordance with the requirements of the HOWARD COUNTY SOIL CONSERVATION DISTRICT.
 Signature: Charles Crovo
 Date: 1/23/88

DEVELOPER'S CERTIFICATE
 I, I/we certify that all development and construction will be done according to this plan of development and plan for erosion and sediment control and that all responsible personnel involved in the construction project will have a certificate of attendance at a department of natural resources approved training program for the control of sediment and erosion before beginning the project. I also authorize periodic on-site inspection by the HOWARD COUNTY SOIL CONSERVATION DISTRICT or their authorized agents, as are deemed necessary.
 Signature: Ronald B. Oster
 Date: 1/23/88

REVIEWED FOR HOWARD COUNTY SOIL CONSERVATION DISTRICT AND MEETS TECHNICAL REQUIREMENTS.
 Signature: John M. Smith
 Date: 3-20-86

U.S. SOIL CONSERVATION SERVICE
 APPROVED: Stephen L. Andra
 Date: 3-20-86

HOWARD COUNTY SOIL CONSERVATION DISTRICT
 APPROVED: DEPARTMENT OF PUBLIC WORKS.

Signature: William B. Reilly
 Date: 3-24-86
 CHIEF, BUREAU OF ENGINEERING

APPROVED: OFFICE OF PLANNING AND ZONING
 Signature: Jim W. Moore
 Date: 3-26-86
 CHIEF, DIVISION OF LAND DEVELOPMENT AND ZONING ADMINISTRATION

CONSTRUCTION SCHEDULE

1. OBTAIN GRADING PERMIT. 2 DAYS
2. CONSTRUCT STONE CONSTRUCTION ENTRANCE. 1 DAY
3. INSTALL STRAW BALE DIKES OR SILT FENCE AS SHOWN ON PLAN. 1 DAY
4. CONSTRUCT STONE OUTLET SEDIMENT TRAPS AND EARTH DIKES AND STABILIZE WITH TEMPORARY SEEDING. 2 DAYS
5. GRADE ROADS TO SUBGRADE STABILIZING SLOPE AREAS BETWEEN EXISTING GROUND AND BACK OF CURB USING PERMANENT SEEDING. 1 WEEK
6. CONSTRUCT STORM DRAIN SYSTEM. CONTRACTOR SHALL PLACE STRAW BALE DIKES OR SILT FENCE DOWNSTREAM OF ANY DISTURBED AREA AT THE END OF EACH WORKING DAY. 4 DAYS
7. INSTALL INLET PROTECTION DEVICES AT ALL STORM DRAIN INLETS. 1 DAY
8. CONSTRUCT CONCRETE CURB AND LAY BASE COURSE. 1 WEEK
9. UPON STABILIZATION OF GRADED AREAS, INLETS SHALL BE OPENED AND ACCUMULATED SEDIMENT SHALL BE REMOVED FROM THE STORM DRAIN SYSTEM. INSTALL RIP RAP CHANNELS. 1 DAY
10. DURING CONSTRUCTION AND AFTER EACH RAINFALL, THE CONTRACTOR SHALL SUSPECT AND PROVIDE NECESSARY MAINTENANCE ON THE SEDIMENT AND EROSION CONTROL STRUCTURES SHOWN HEREON.
11. REMOVE STONE CONSTRUCTION ENTRANCE, STONE OUTLET SEDIMENT TRAPS AND EARTH DIKES. 2 DAYS
12. CLEAN BASE COURSE: APPLY TACK COAT TO BASE COURSE AND LAY SURFACE COURSE. STABILIZE ALL SHOULDERS USING PERMANENT SEEDING.
13. ALL DISTURBED AREAS DUE TO REMOVAL OF SEDIMENT CONTROL MEASURES SHALL BE GRADED AND STABILIZED BY PERMANENT SEEDING. 1 DAY
14. FOLLOWING INITIAL SOIL DISTURBANCE OR REDISTURBANCE, PERMANENT OR TEMPORARY STABILIZATION SHALL BE COMPLETED WITHIN: a) 7 CALENDAR DAYS FOR ALL PERIMETER SEDIMENT CONTROL STRUCTURES, DIKES, SLOPES, SLOPE PERIMETER SLOPES AND ALL SLOPES GREATER THAN 3:1, b) 14 DAYS FOR ALL OTHER DISTURBED OR GRADED AREAS ON THE PROJECT SITE.

PLAN
 SCALE: 1"=50'

TYPE OF STABILIZATION	OUTLET	DIKE A	DIKE B
1	5'-3" x 3'	SEED AND STRAW MULCH	SEED AND STRAW MULCH
2	3'-1.5" x 3'	SEED AND STRAW MULCH	SEED AND STRAW MULCH
3	5'-1.5" x 3'	SEED WITH MULCH OR SOO	LINED RIP-RAP 4'-8" x 3'
4	8'-1.5" x 3'	LINED RIP-RAP 4'-8" x 3'	ENGINEERING DESIGN

- CONSTRUCTION SPECIFICATIONS FOR CURB**
1. A one foot layer of 2" stone may be placed on the upper side of the riprap in place of the unconsolidated filter cloth.
 1. A one foot layer of 2" stone may be placed on the upper side of the riprap in place of the unconsolidated filter cloth.
 2. The filter material for the subbase shall be free of roots and other woody vegetation as well as unconsolidated stones, cinders, crushed material or other unconsolidated material. The subbase shall be compacted by vibrating with equipment while it is being constructed.
 3. The stone used in the filter shall be well sorted 2" to 4" with a maximum of 2" aggregate placed on the upper side of the riprap. 2" material filter cloth shall be placed on the upper side of the riprap.
 4. The filter shall be placed and kept wet to the full depth of the subbase and shall be compacted by vibrating with equipment while it is being constructed.
 5. The filter shall be placed and kept wet to the full depth of the subbase and shall be compacted by vibrating with equipment while it is being constructed.
 6. The filter shall be placed and kept wet to the full depth of the subbase and shall be compacted by vibrating with equipment while it is being constructed.
 7. The filter shall be placed and kept wet to the full depth of the subbase and shall be compacted by vibrating with equipment while it is being constructed.
 8. The filter shall be placed and kept wet to the full depth of the subbase and shall be compacted by vibrating with equipment while it is being constructed.

AS-BUILT SURVEY CERTIFIED
 BY CHARLES CROVO, MD,
 P.E. No. 13204 ON
 JAN. 5, 1988

STREET TREE, GRADING AND
 SEDIMENT CONTROL PLAN
CENTENNIAL MANOR
 SECTION I AREA I
 2ND ELECTION DISTRICT HOWARD COUNTY, MARYLAND
 SCALE: 1"=50'
 JANUARY 24, 1986
 SHEET 3 OF 3