


SHEET INDEX	
NO.	DESCRIPTION
1	TITLE SHEET
2	PLAN & PROFILES OF HAYSHED LANE AND OPEN MEADOW WAY.
3	PLAN & PROFILE OF OPEN MEADOW WAY.
4	PLAN & PROFILES OF MEADOWSWEET CT, GOLDENSTRAW LA. & ROCKCRESS CT.
5	PLAN & PROFILE OF DAVIS RD AND STORM DRAIN PROFILES.
6	STORM DRAIN PROFILES AND ROAD DETAILS.
7	DRAINAGE AREA MAP
8	GRADING AND SEDIMENT CONTROL PLAN.
9	GRADING & SEDIMENT CONTROL PLAN AND SEDIMENT CONTROL DETAILS.
10	STORM WATER MANAGEMENT DETAILS AND NOTES.

ROADWAY, STORMDRAINS & STORM WATER MANAGEMENT

LONG MEADOW

6 TH ELECTION DISTRICT

HOWARD COUNTY, MARYLAND

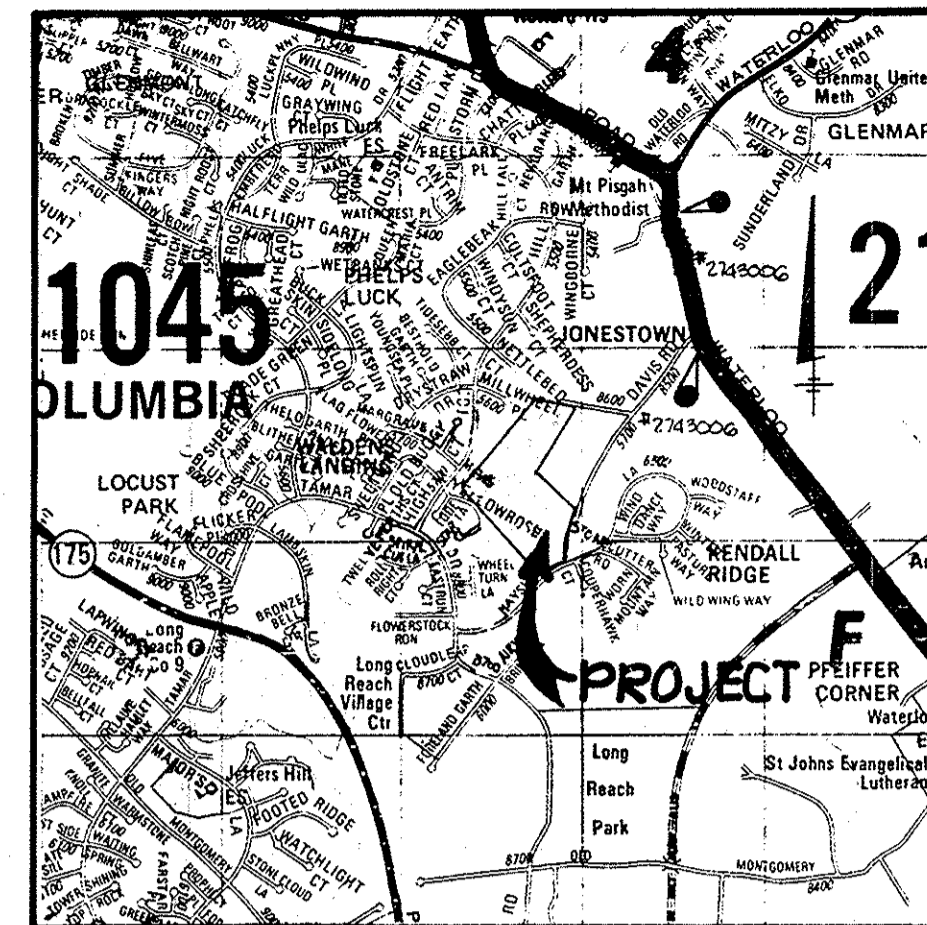

VICINITY MAP
SCALE: 1" = 200'

NOTE: 10/22/15 CAPITAL PROJECT D-1159 PRINCIPLE SPILLWAY REPAIR IN POND #1, OPEN SPACE LOT 15 BY REPLACING THE CAP ANTI-VORTEX DEVICE CONTROL STRUCTURE AND 60" CMP WITH AN RCP OUTLET CONTROL STRUCTURE AND 54" RCP.


GENERAL NOTES

- ALL WORK SHALL BE PERFORMED IN ACCORDANCE WITH THE HOWARD COUNTY DESIGN MANUAL, VOL. IV, I.E., STANDARD SPECIFICATIONS AND DETAILS FOR CONSTRUCTION.
- APPROXIMATE LOCATION OF EXISTING UTILITIES ARE SHOWN. THE CONTRACTOR SHALL TAKE ALL NECESSARY PRECAUTIONS TO PROTECT THE EXISTING UTILITIES AND MAINTAIN UNINTERRUPTED SERVICE. ANY DAMAGE INCURRED DUE TO CONTRACTOR'S OPERATION SHALL BE REPAIRED IMMEDIATELY AT THE CONTRACTOR'S EXPENSE.
- THE CONTRACTOR SHALL TEST PIT EXISTING UTILITIES AT LEAST FIVE (5) DAYS BEFORE STARTING WORK SHOWN ON THESE DRAWINGS.
- CONTRACTOR SHALL NOTIFY THE FOLLOWING UTILITIES AT LEAST FIVE (5) DAYS BEFORE STARTING WORK ON THESE DRAWINGS:

MISS UTILITY	1-800-257-7777
BELL TELEPHONE SYSTEM	393-3649
LONG DISTANCE CABLE DIVISION	393-3553 or 3554
BALTIMORE GAS AND ELECTRIC COMPANY	539-8000, ext. 691
HOWARD COUNTY BUREAU OF UTILITIES	992-2366
HOWARD COUNTY CONSTRUCTION/INSPECTION SURVEY DIVISION (24 HOURS NOTICE PRIOR TO COMMENCEMENT OF WORK)	792-7272
- ALL INLETS SHALL BE CONSTRUCTED IN ACCORDANCE WITH HOWARD COUNTY STANDARDS.
- ALL STREET CURB RETURNS SHALL HAVE 35.0' RADII UNLESS OTHERWISE NOTED.
- STORM DRAIN TRENCHES WITHIN ROAD RIGHT-OF-WAY SHALL BE BACKFILLED AND COMPACTED IN ACCORDANCE WITH HOWARD COUNTY DESIGN MANUAL, VOLUME IV, I.E., STANDARD SPECIFICATIONS AND DETAILS FOR CONSTRUCTION.
- INSTALLATION OF TRAFFIC CONTROL DEVICES, MARKING, AND SIGNING SHALL BE IN ACCORDANCE WITH THE MANUAL OF UNIFORM TRAFFIC CONTROL DEVICES 1978 EDITION.
- PIPE SHALL NOT BE INSTALLED BY THE CONTRACTOR UNTIL THE LENGTH CALLED FOR AT EACH STATION HAS BEEN APPROVED BY THE ENGINEER IN THE FIELD.
- DESIGNED TRAFFIC SPEED IN ACCORDANCE WITH THE AMERICAN ASSOCIATION OF STATE HIGHWAY OFFICIAL STANDARDS:

ALL 50' RIGHT-OF-WAYS	25 (30 M.P.H.)
-----------------------	----------------
- ALL ELEVATIONS SHOWN ARE BASED ON U.S.C. AND G.S. MEAN SEA LEVEL DATUM, 1929.
- ALL FILL AREAS WITHIN ROADWAYS AND UNDER STRUCTURES TO BE COMPACTED TO A MINIMUM OF 95% COMPACTION.
- ALL PIPE ELEVATIONS SHOWN ARE INVERT ELEVATIONS.
- PROFILE STATIONS SHALL BE ADJUSTED AS NECESSARY TO CONFORM TO PLAN DIMENSIONS.
- SUBJECT PROPERTY ZONED R-12 PER D-2-83 COMPREHENSIVE ZONING PLAN.
- TOPO TAKEN FROM FIELD RUN SURVEY DATED SEPTEMBER, 1985 BY THE RIEMER GROUP, INC.
- NO PIPE SHALL BE LAID UNTIL LINES OF EXCAVATION HAVE BEEN BROUGHT WITHIN 6" OF FINISHED GRADE.
- ALL STORM DRAIN PIPE BEDDING SHALL BE CLASS 'C' AS SHOWN IN FIG. 11.4, VOLUME I OF HOWARD COUNTY DESIGN MANUAL UNLESS OTHERWISE NOTED.
- SEE OFFICE OF PLANNING AND ZONING FILE NO'S 5 86 57 1 P 86 40
- THE EXISTING DRIVEWAY WILL BE ABANDONED WHEN OTHER PUBLIC ACCESS BECOMES AVAILABLE.

MILLWHEEL PLACE

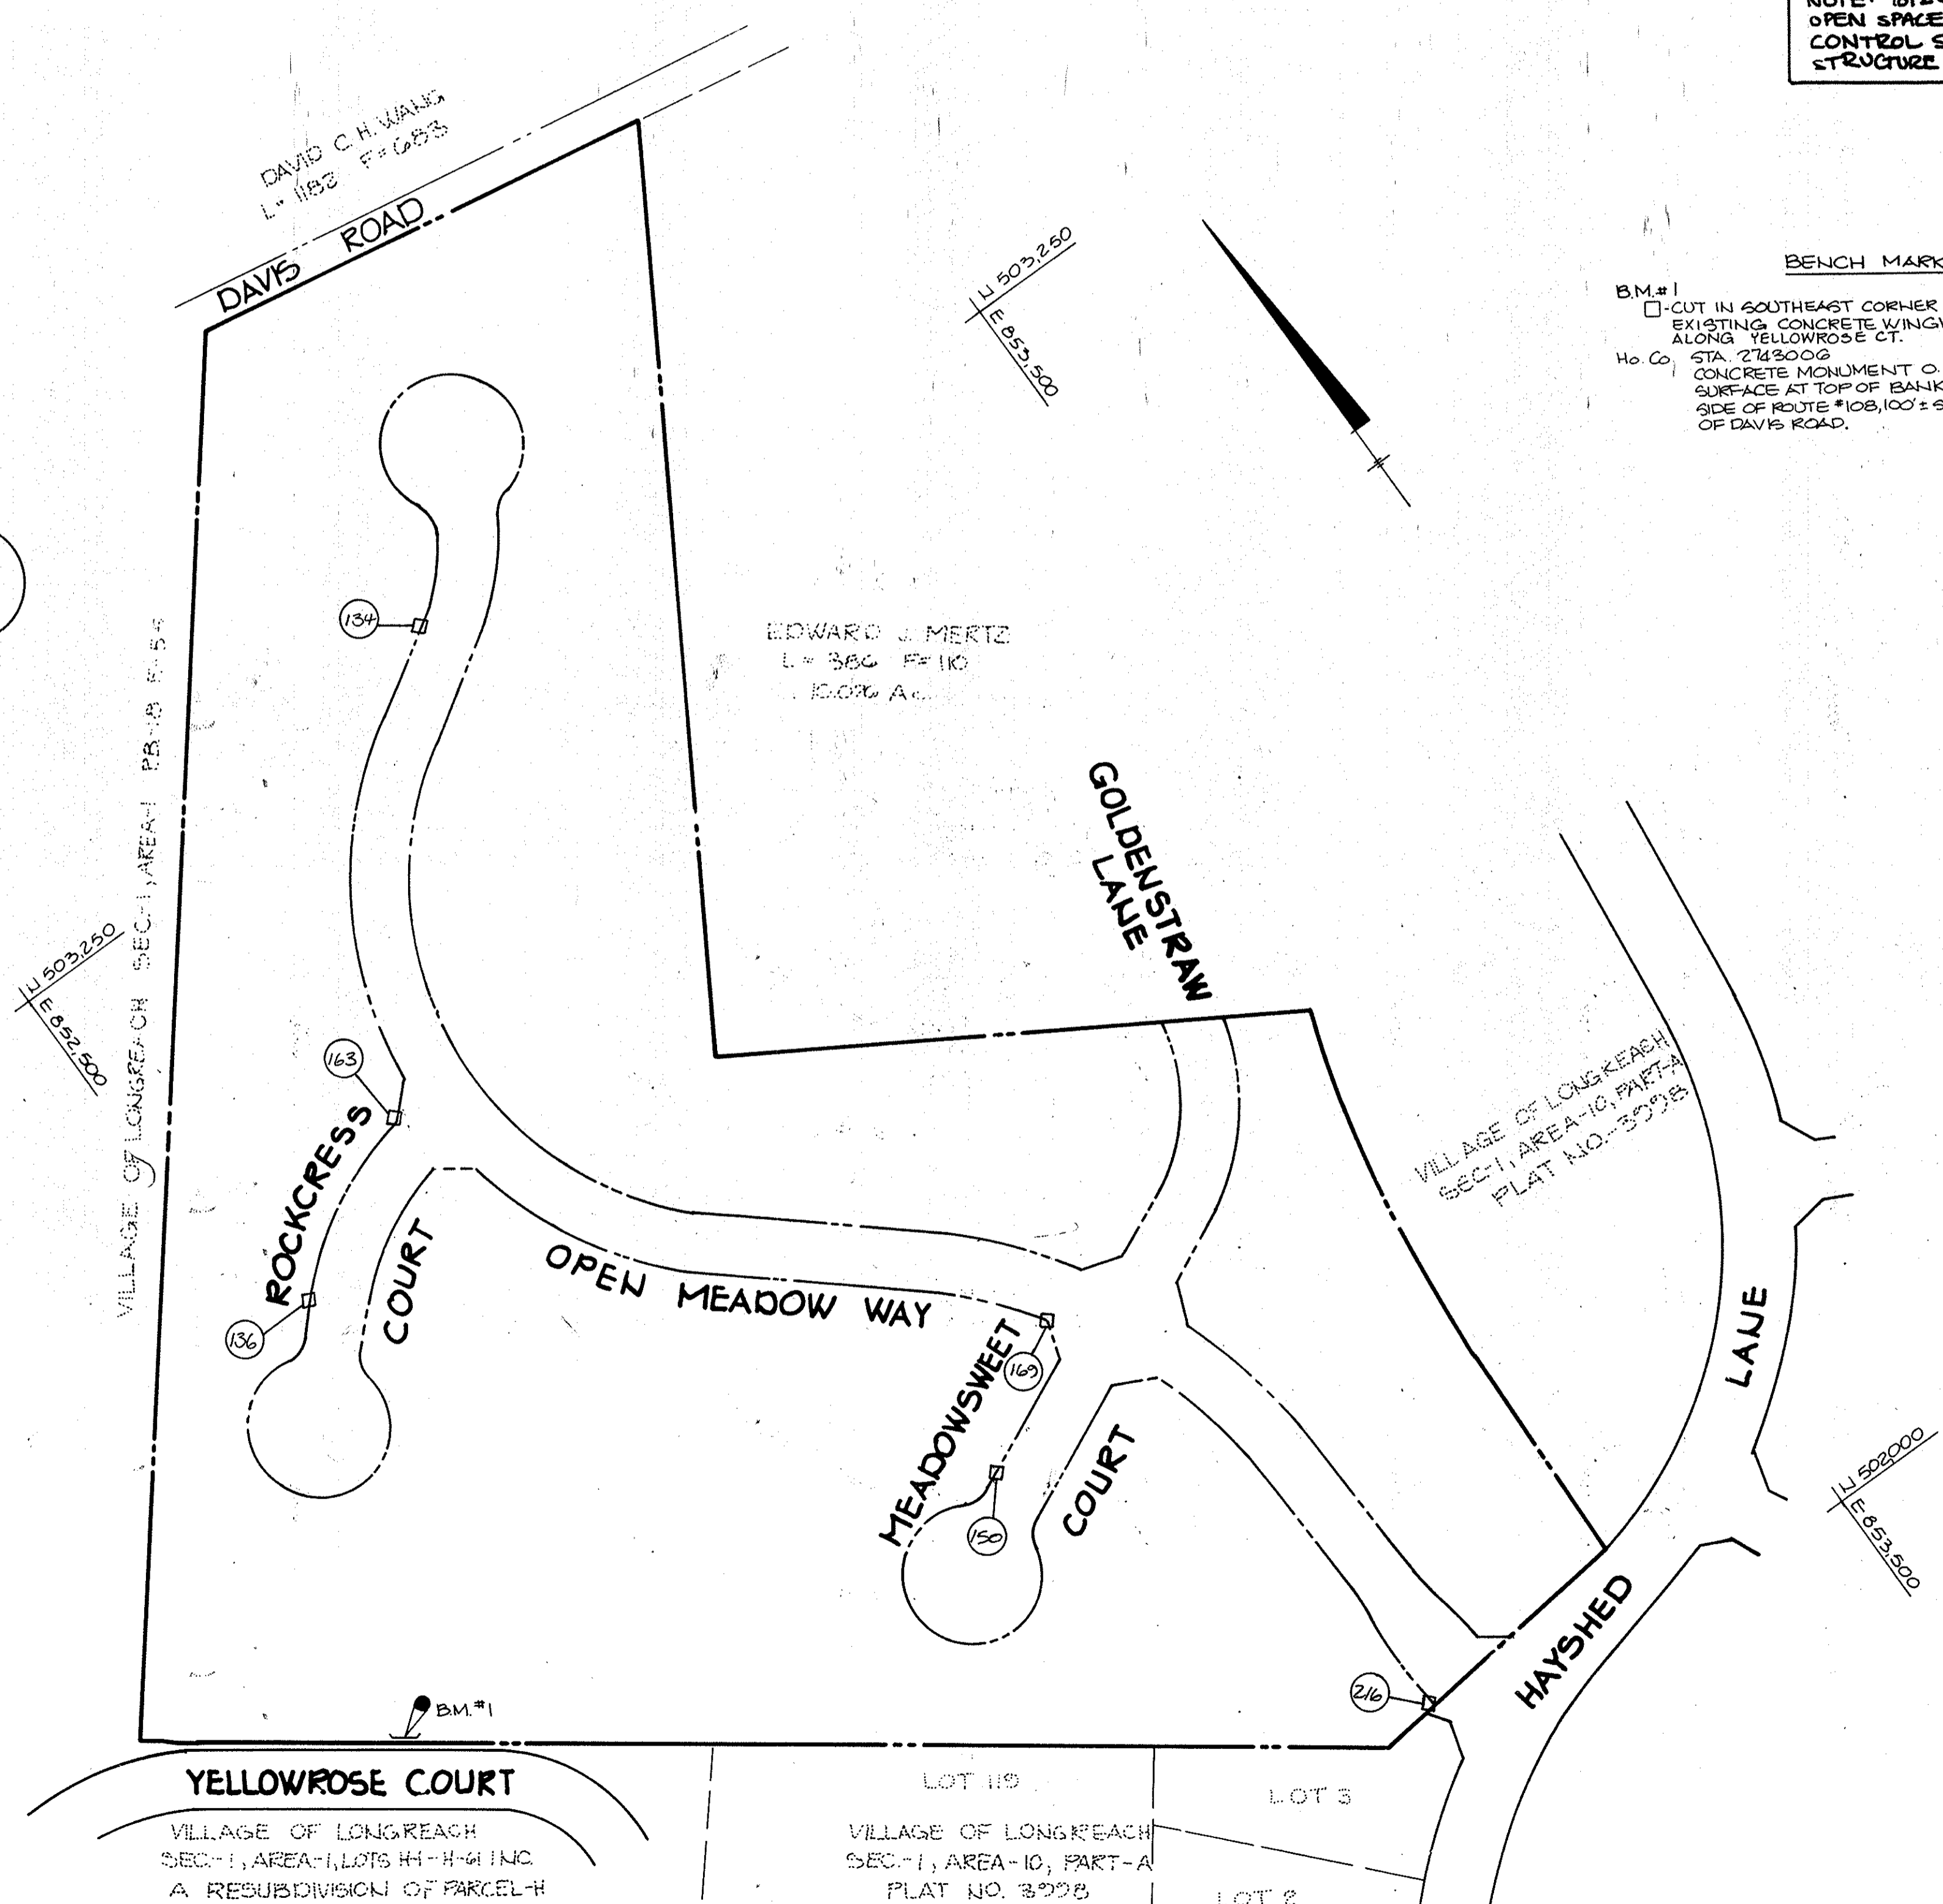

BENCH MARKS
 BM #1: CUT IN SOUTHEAST CORNER OF EXISTING CONCRETE WINGWALL ALONG YELLOWROSE CT. ELEV. 411.04
 Ho Co STA. 214200G CONCRETE MONUMENT 0.1' BELOW SURFACE AT TOP OF BANK WEST SIDE OF ROUTE #108, 100' SOUTH OF DAVIS ROAD. ELEV. 616.004
 HORIZONTAL & VERTICAL CONTROLS USED IN AS-BUILT SURVEY

LOT SIZE IN SQ. FT.	NO. OF LOTS	AREA IN ACRES	OS. REQUIRED	AREA OF OS. REQUIRED IN ACRES	AREA OF OS. PROVIDED IN ACRES
12,000 OR GREATER	17	5.67±	8%	0.46±	2.26±
10,000 - 11,999	3	0.78±	10%	0.08±	0.43±
9,000 - 10,799	18	4.16±	20%	0.83±	0.03±
8,400 - 9,599	23	4.71±	30%	1.41±	0.06±
TOTALS	61			2.77±	2.78±

DENSITY TABULATION						
GROSS AREA	FLOODPLAIN STEEP SLOPES	NET AREA	NO. OF DWELLING UNITS ALLOWED	FLOODPLAIN LOT ADJUSTMENT	TOTAL NO. OF DU. PROPOSED	TOTAL NO. OF DU. ALLOWED
21.96ac±	1.67ac±	20.29ac±	61	0	61	0
						3.00

PLAN
SCALE: 1" = 100'

APPROVED: HOWARD COUNTY OFFICE OF PLANNING AND ZONING
William E. Moran 9-9-86
 CHIEF, DIVISION OF LAND DEVELOPMENT AND ZONING ADMINISTRATION

APPROVED: HOWARD COUNTY DEPARTMENT OF PUBLIC WORKS
William E. Moran 9-9-86
 CHIEF, BUREAU OF ENGINEERING

10/22/15 1 Add Capital Project D-1159 ref.
 DATE NO. REVISION

OWNER: GEORGE C. DEERING, ROBERT M. HANJIN, ROBERT R. PRELLER, 5838 STILLMEADOW LANE, COLUMBIA, MARYLAND
 DEVELOPER: LONG MEADOW VENTURERS, ONE KNOLL NORTH DRIVE, SUITE 502, COLUMBIA, MARYLAND

PROJECT: LONG MEADOW SECTION ONE LOTS 1 THRU 65
 AREA TAX MAP NO. 36 PARCEL NO. 263
 6TH ELECTION DISTRICT HOWARD COUNTY, MARYLAND

TITLE: TITLE SHEET


THE RIEMER GROUP, INC.
 The Riemer Group, Inc. A Land Planning, Design & Civil Engineering Firm
 3106 Health Park Drive, Elkott City, Maryland 21043 (301) 461-2690

9-4-86 DATE
 DESIGNED BY: DAM
 DRAWN BY: FDM
 PROJECT NO: 23000
 DATE: JULY 31, 1986
 SCALE: AS SHOWN
 DRAWING NO. 1 OF 10

12.36

4 CURVE DATA
FROM 4 STA 0+21 TO 4 STA 0+37
Δ = 21° 46' 21"
R = 200.00
L = 76.00
T = 38.46'
Dc = 28° 38' 52"
Chd = N 12° 41' 15" W, 75.54'


NO	Δ	RAD	LEN	TAN	CHD	L.C.B
1	06° 24' 33"	211.00'	23.60'	11.81'	23.59'	N05° 03' 21" W
2	06° 24' 33"	189.00'	21.14'	10.56'	21.13'	N05° 03' 21" W
3	13° 30' 21"	185.00'	44.09'	22.15'	43.99'	N08° 40' 45" W
4	18° 28' 38"	200.00'	64.50'	32.53'	64.22'	S11° 05' 23" E
5	13° 43' 28"	200.00'	47.91'	24.07'	47.79'	S08° 42' 49" E
6	13° 13' 47"	215.00'	49.64'	24.98'	49.53'	S08° 27' 58" E
7	06° 24' 33"	189.00'	21.14'	10.56'	21.13'	S01° 21' 13" W
8	06° 24' 33"	211.00'	23.60'	11.81'	23.59'	S01° 21' 12" W

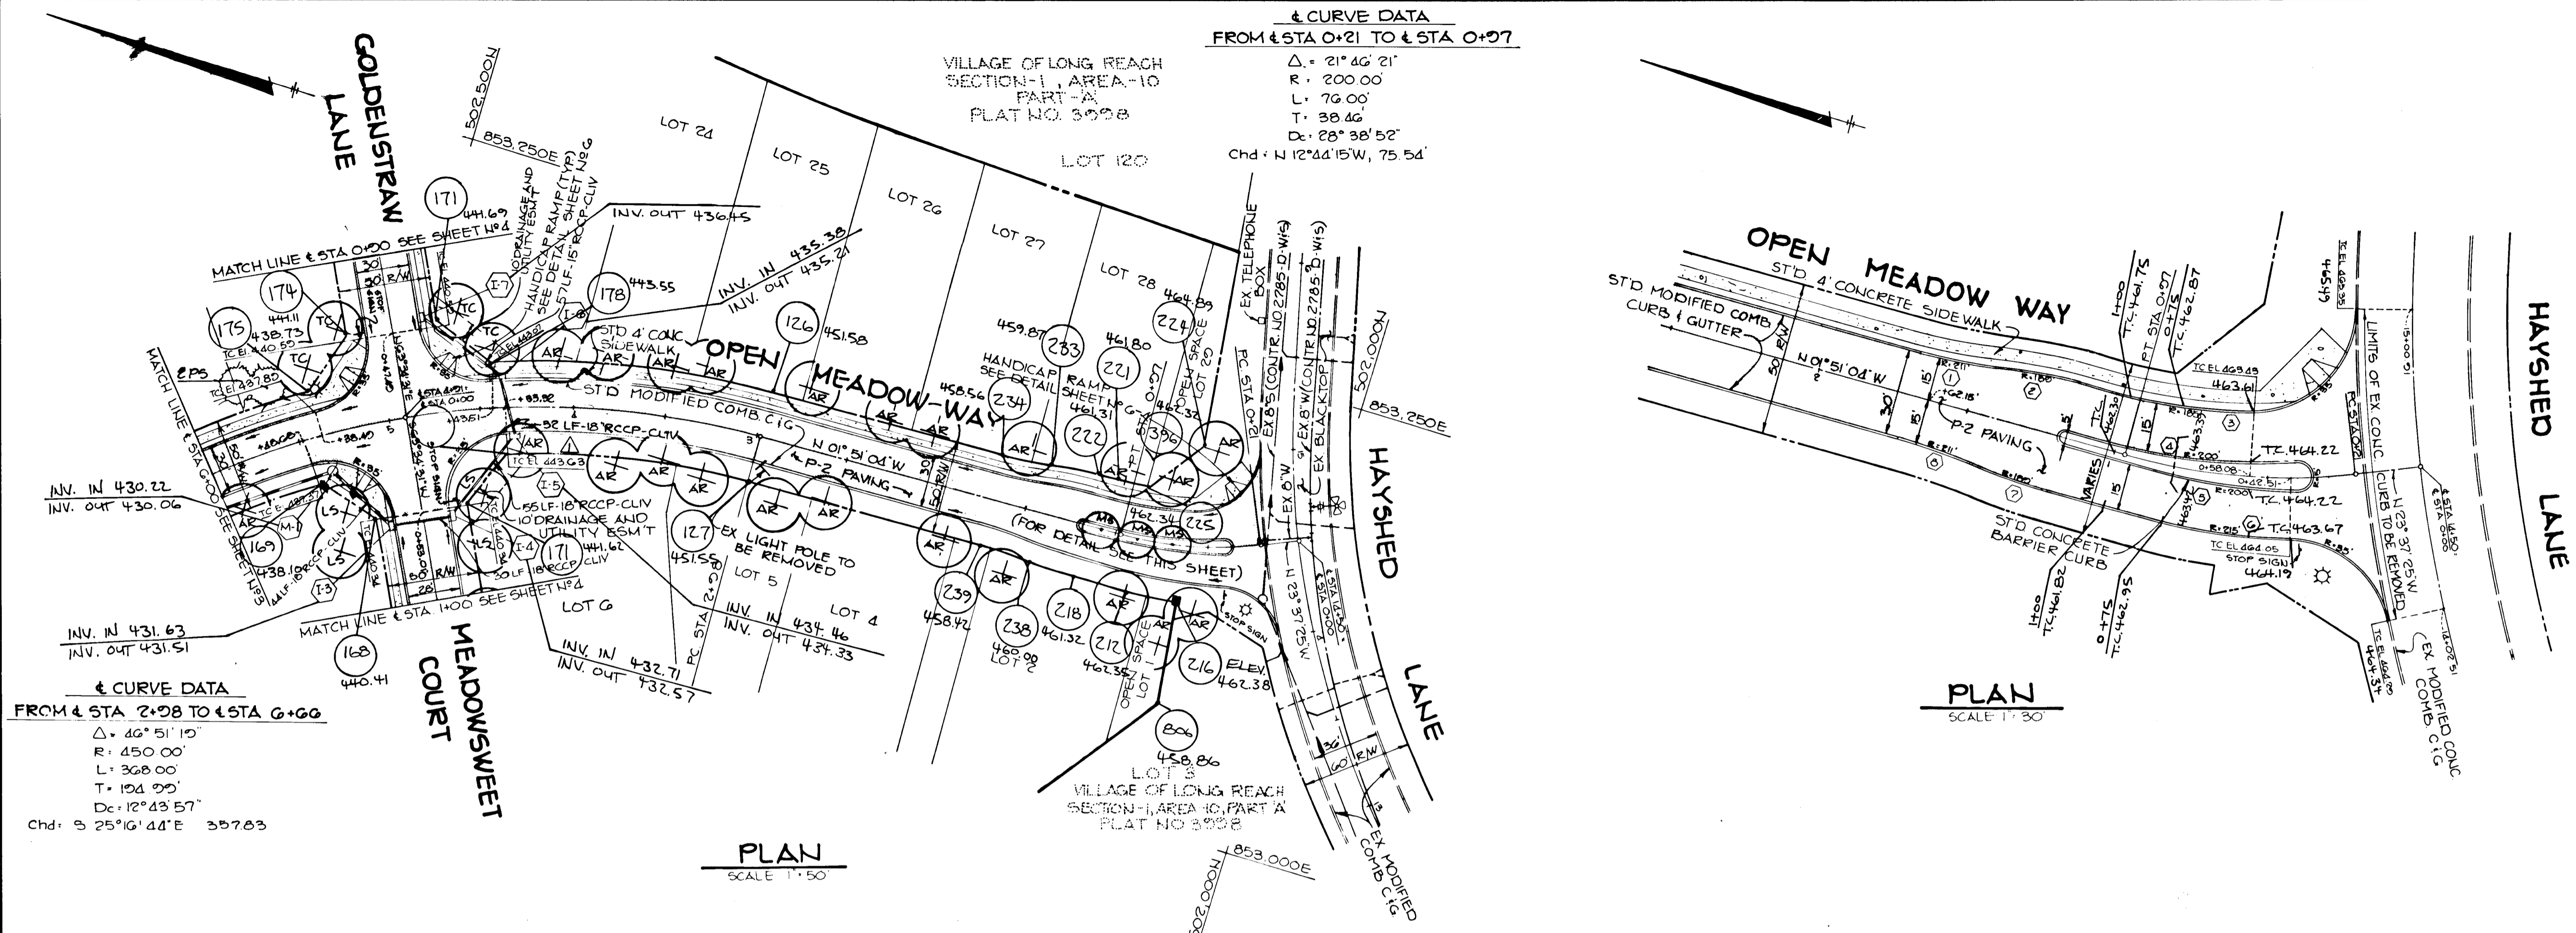


4 CURVE DATA
FROM 4 STA 2+08 TO 4 STA 6+00
Δ = 46° 51' 10"
R = 450.00'
L = 368.00'
T = 194.95'
Dc = 12° 43' 57"
Chd = S 25° 16' 44" E 357.83

PLAN
SCALE 1" = 50'


PLAN
SCALE 1" = 30'

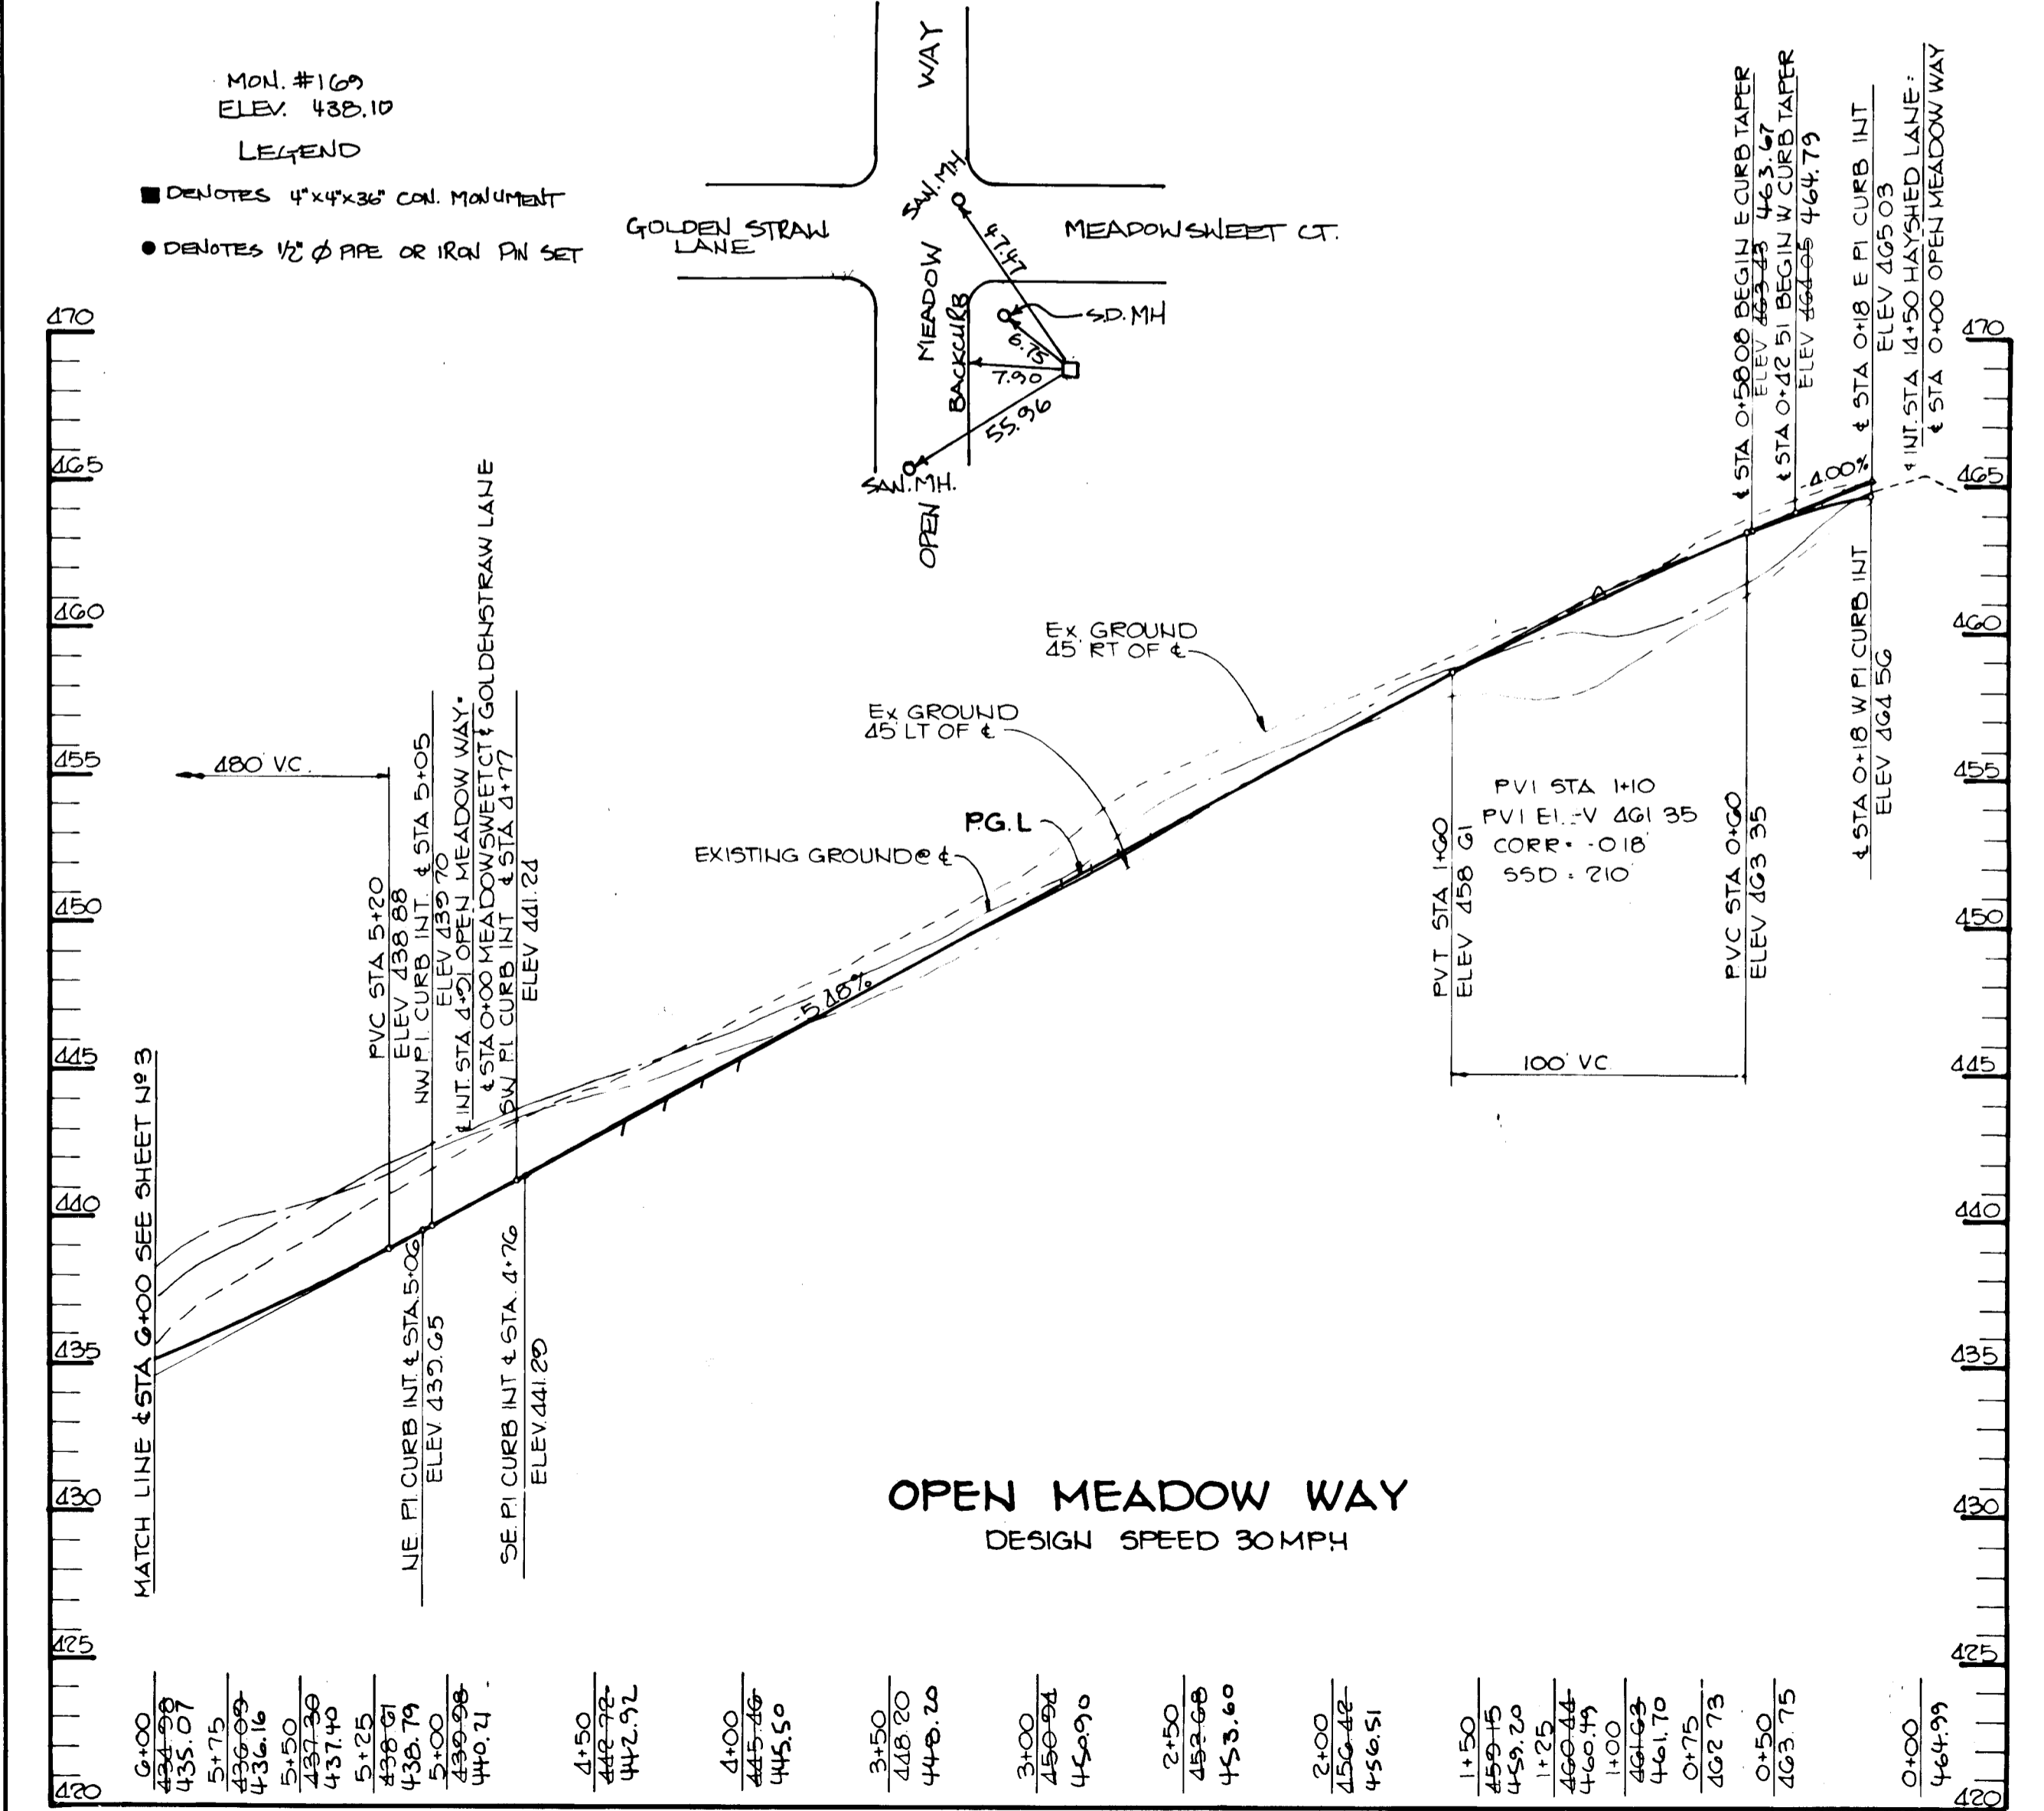

PROFILES: SCALE HORIZ 1" = 50' VERT 1" = 5'

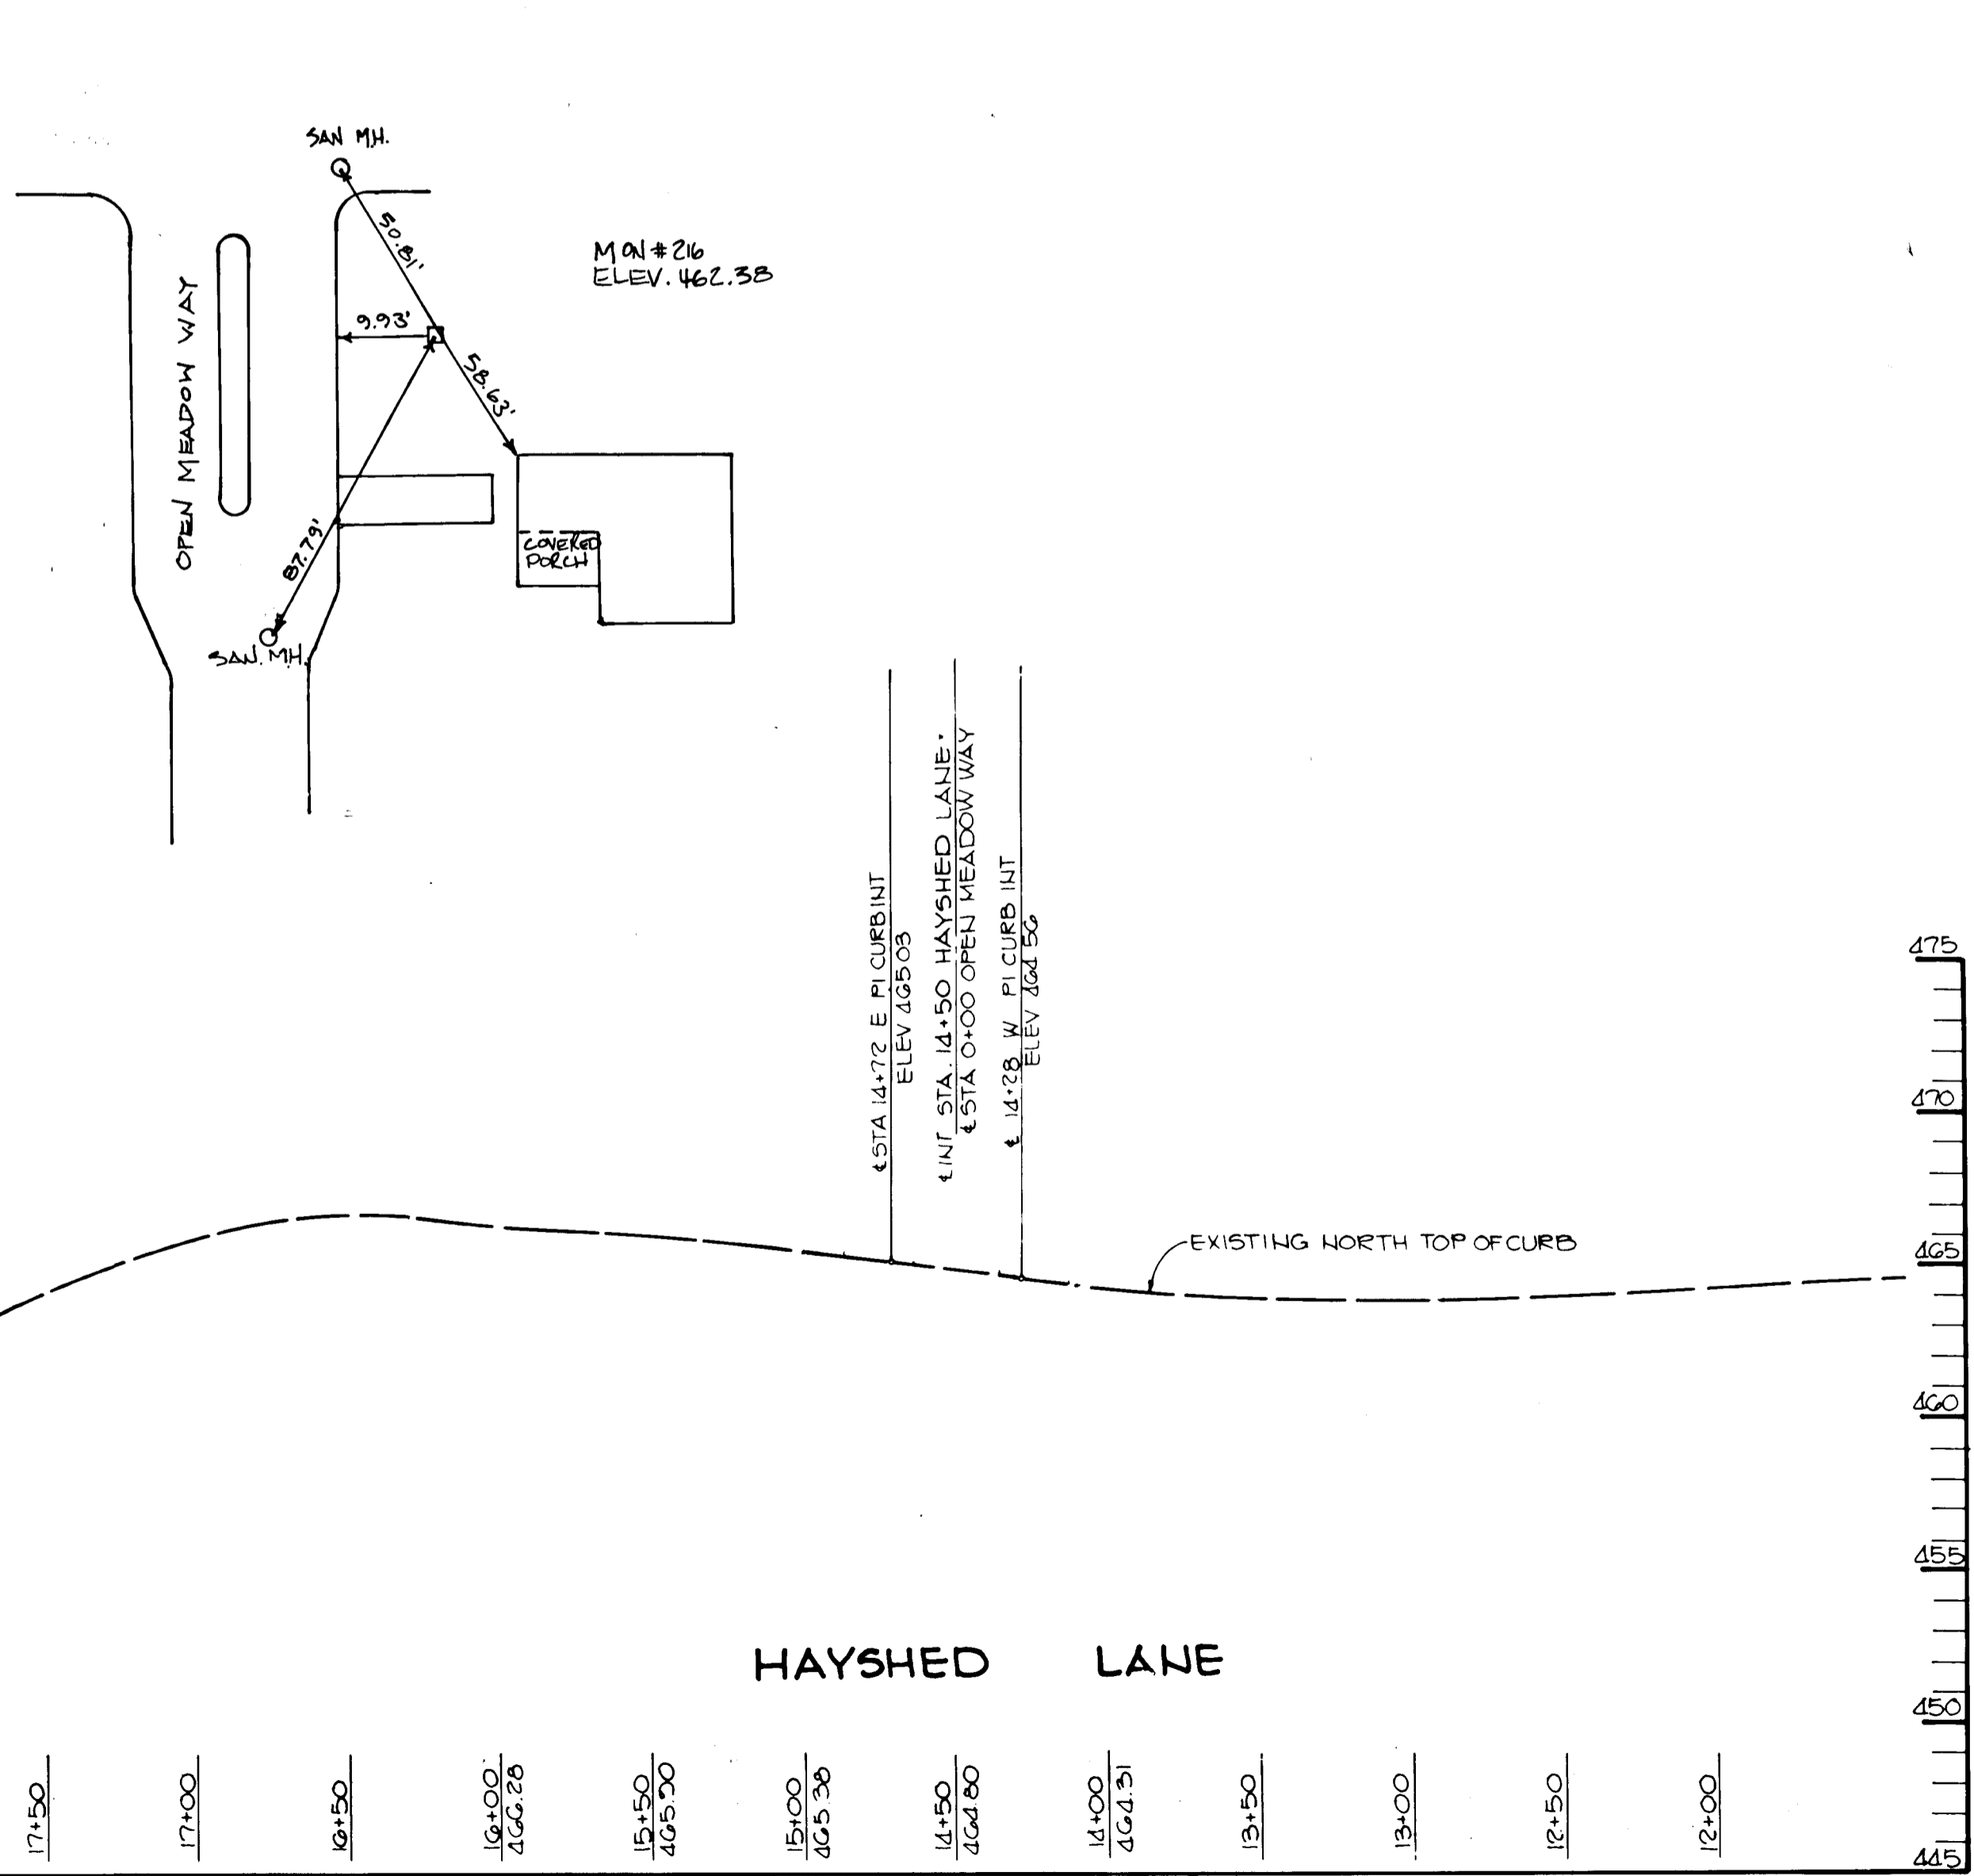

MON. #169
ELEV. 432.10
LEGEND
■ DENOTES 4" x 4" x 36" CON. MANHOLE
● DENOTES 1/2" Ø PIPE OR IRON PIN SET

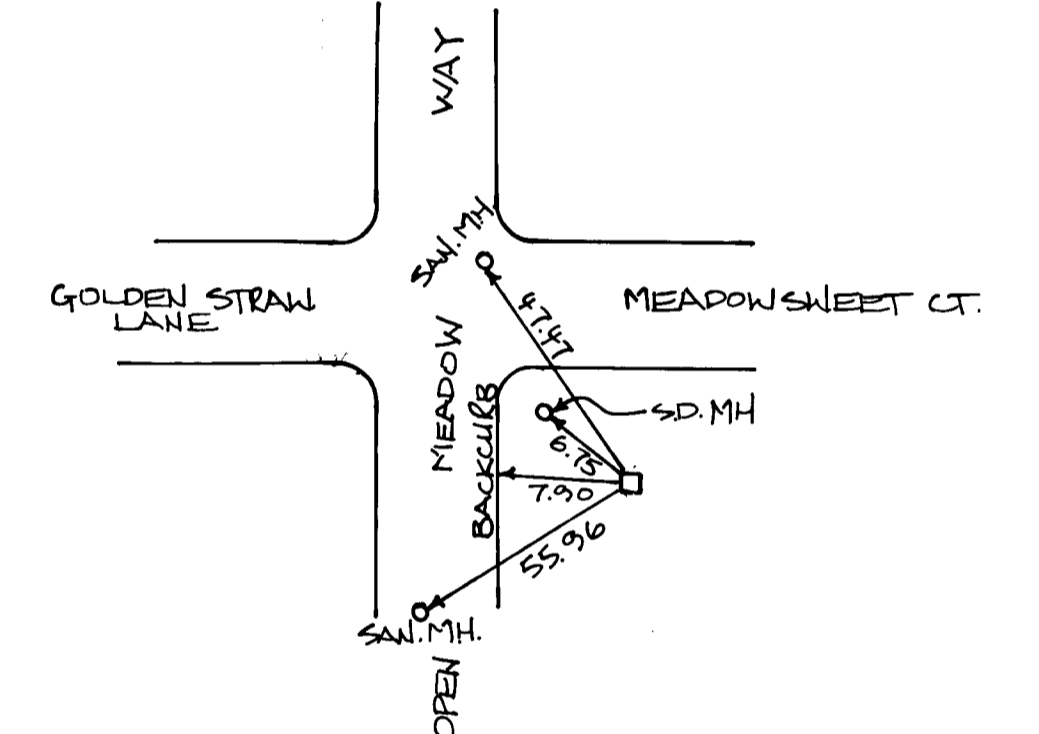

APPROVED: HOWARD COUNTY OFFICE OF PLANNING AND ZONING
John M. Muegge 9986
CHIEF, DIVISION OF LAND DEVELOPMENT AND ZONING ADMINISTRATION

APPROVED: HOWARD COUNTY DEPARTMENT OF PUBLIC WORKS
William E. Reilly 9.11.86
CHIEF, BUREAU OF ENGINEERING

DATE	NO	REVISION
10-20-86	Δ	REVISED PIPE SIZE BETWEEN I-5 & I-G

OWNER: GEORGE C DEERING, ROBERT M HANKIN, ROBERT R PRELLER, 5838 STILLMEADOW LANE, COLUMBIA, MARYLAND

DEVELOPER: LONG MEADOW VENTURERS ONE KNOLL NORTH DRIVE, SUITE 502, COLUMBIA MARYLAND

PROJECT: LONG MEADOW SECTION ONE LOTS 1 THROUGH 5

AREA: TAX MAP 14-36 PARCEL NO 203 ELECTION DISTRICT G HOWARD COUNTY, MARYLAND

TITLE: PLAN AND PROFILE OF OPEN MEADOW WAY AND HAYSHED LANE



THE RIEMER GROUP, INC.
The Riemer Group, Inc. A Land Planning, Design & Civil Engineering Firm
3105 Health Park Drive, Ellicott City, Maryland 21043 (301) 461-2890

9.9.86 DATE
DESIGNED BY: D A M
DRAWN BY: D A M
PROJECT NO: 23000
DATE: JULY 31, 1986
SCALE: AS SHOWN
DRAWING NO. 2 OF 10

Arthur E. Muegge
ARTHUR E. MUEGGE * 0707

← CURVE DATA
 FROM STA 15+29 TO STA 16+43
 Δ: 32° 32' 31"
 R: 200.00'
 L: 114.00'
 T: 58.60'
 D: 28° 36' 52"
 Chd. N 41° 25' 24" E 112.46'

← CURVE DATA
 FROM STA 8+46 TO STA 14+22
 Δ: 106° 27' 33"
 R: 310.00'
 L: 576.00'
 T: 414.83'
 D: 18° 28' 57"
 Chd. N 04° 31' 23" E 406.65'

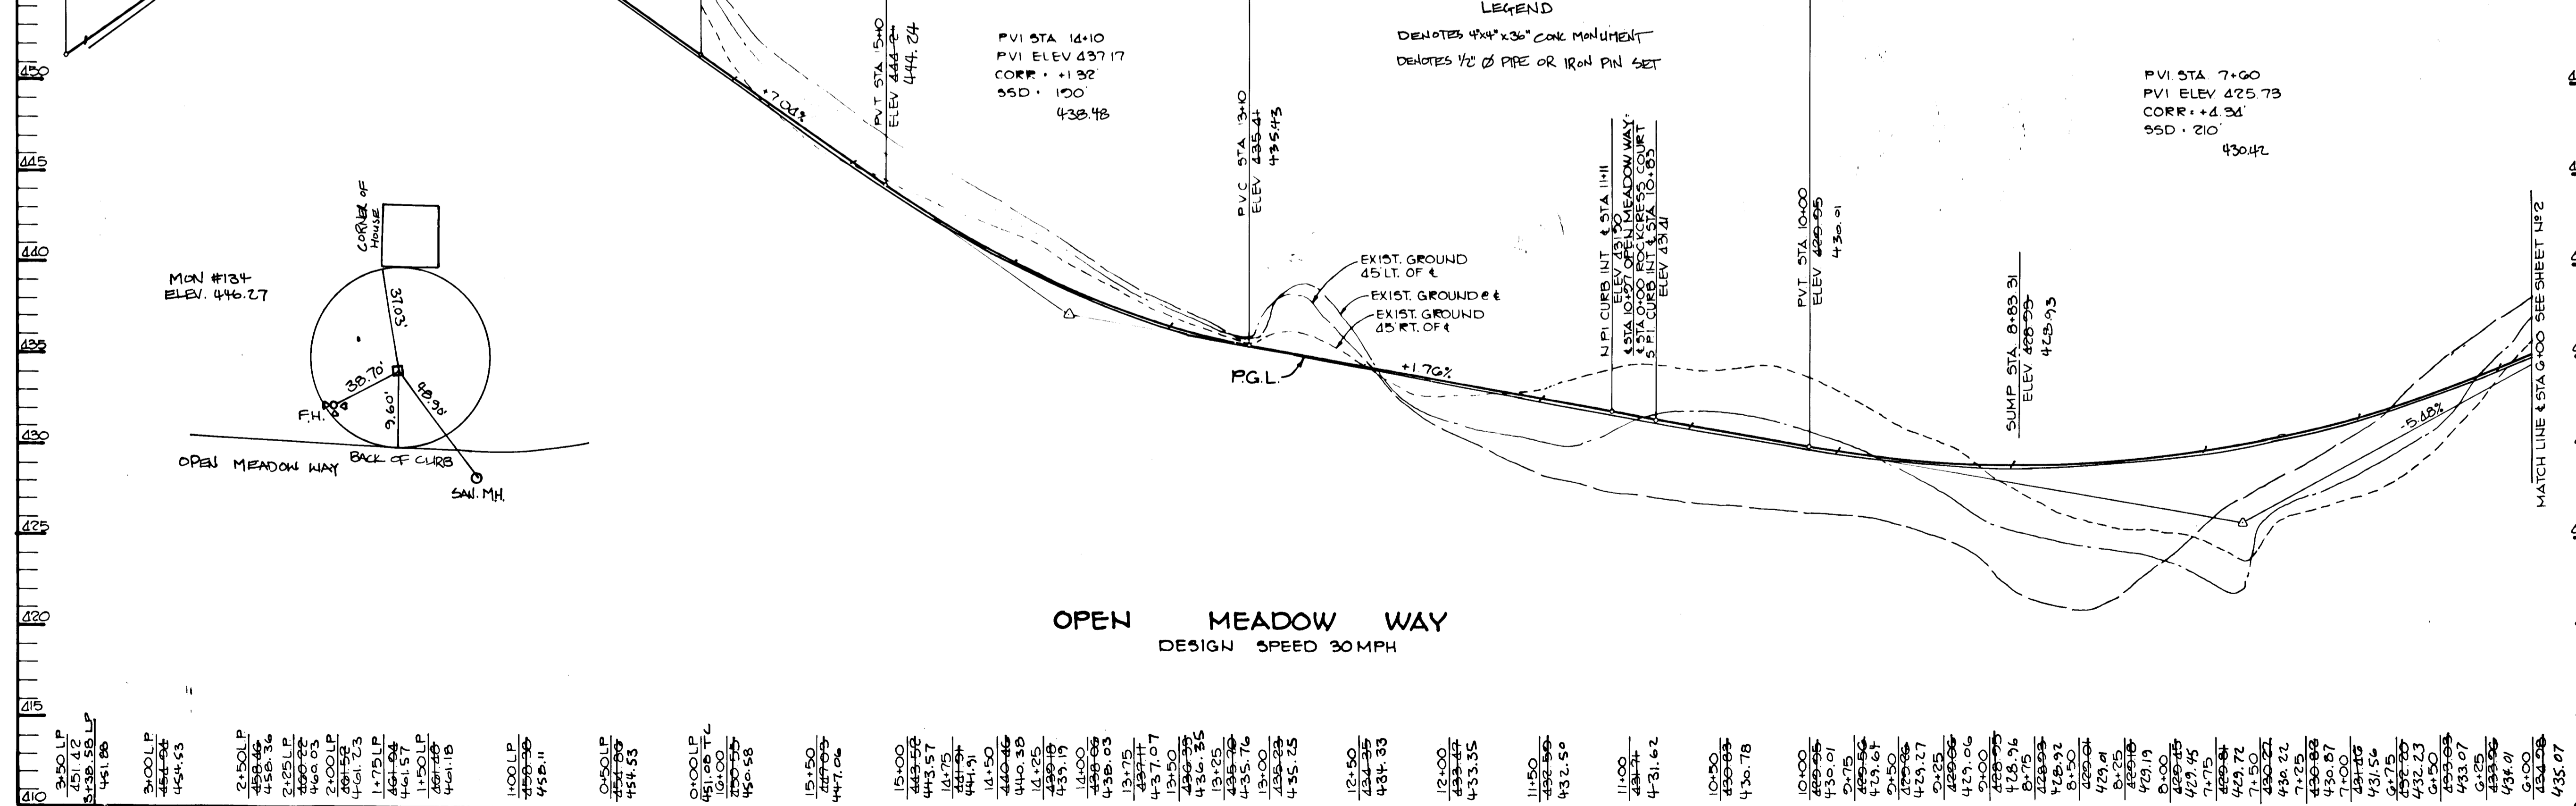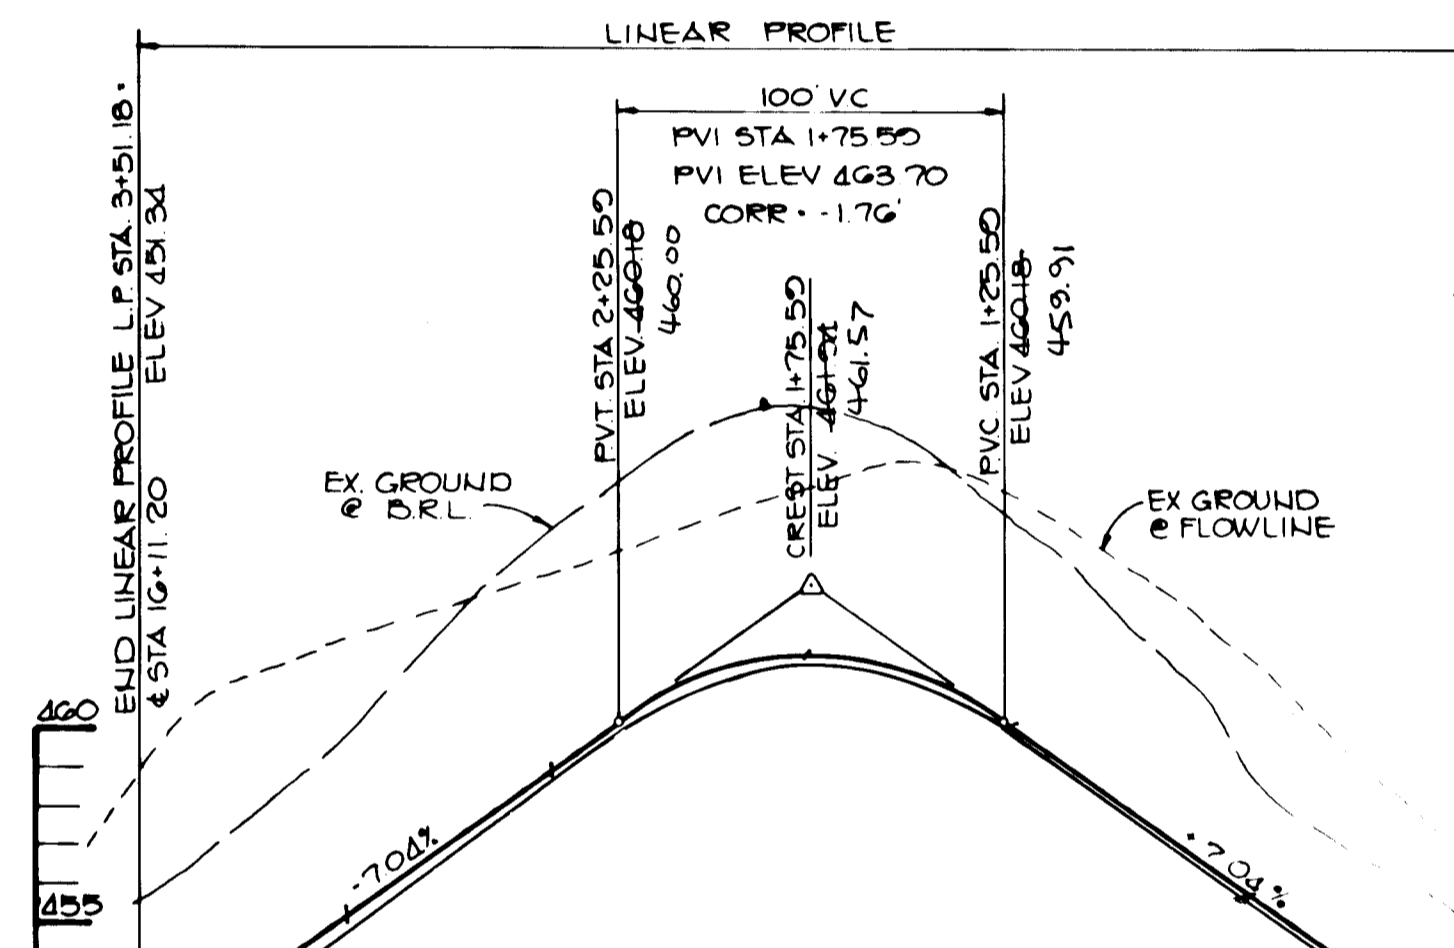

APPROVED: HOWARD COUNTY OFFICE OF PLANNING AND ZONING
Paul Muegge 9-9-86
 CHIEF, DIVISION OF LAND DEVELOPMENT AND ZONING ADMINISTRATION

APPROVED: HOWARD COUNTY DEPARTMENT OF PUBLIC WORKS
Robert M. Hankin 9-11-86
 CHIEF, BUREAU OF ENGINEERING

10-29-86
 DATE NO. REVISION
 REVISED PIPE SIZE BETWEEN I-1 & I-2

OWNER: GEORGE C. DEERING, ROBERT M. HANKIN, ROBERT R. PRELLER, 5698 STILL MEADOW WAY, COLUMBIA, MARYLAND
 DEV: LONG MEADOW VENTURES, ONE KNOLL NORTH DRIVE, SUITE 502, COLUMBIA, MARYLAND

PROJECT: LONG MEADOW SECTION ONE, LOTS 1 THRU 65

AREA: TAX MAP NO. 36, PARCEL NO. 263, ELECTION DISTRICT G, HOWARD COUNTY, MARYLAND


TITLE: PLAN AND PROFILE OF OPEN MEADOW WAY

THE RIEMER GROUP, INC.
 The Riemer Group, Inc. A Land Planning, Design & Civil Engineering Firm
 3105 Health Park Drive, Ellicott City, Maryland 21043 (301) 481-2690


DATE: 9-9-86
 DESIGNED BY: D.A.M.
 DRAWN BY: D.A.M.
 PROJECT NO: 23000
 DATE: JULY 31, 1986
 SCALE: AS SHOWN
 DRAWING NO. 3 OF 10

12360

4 CURVE DATA
 FROM STA 0+24 TO STA 1+04
 $\Delta: 40^{\circ}35'04''$
 $R: 240.00'$
 $L: 170.00'$
 $T: 88.74'$
 $Dc: 29^{\circ}52'24''$
 Chd: $3.07^{\circ}29'55''W, 108.47'$

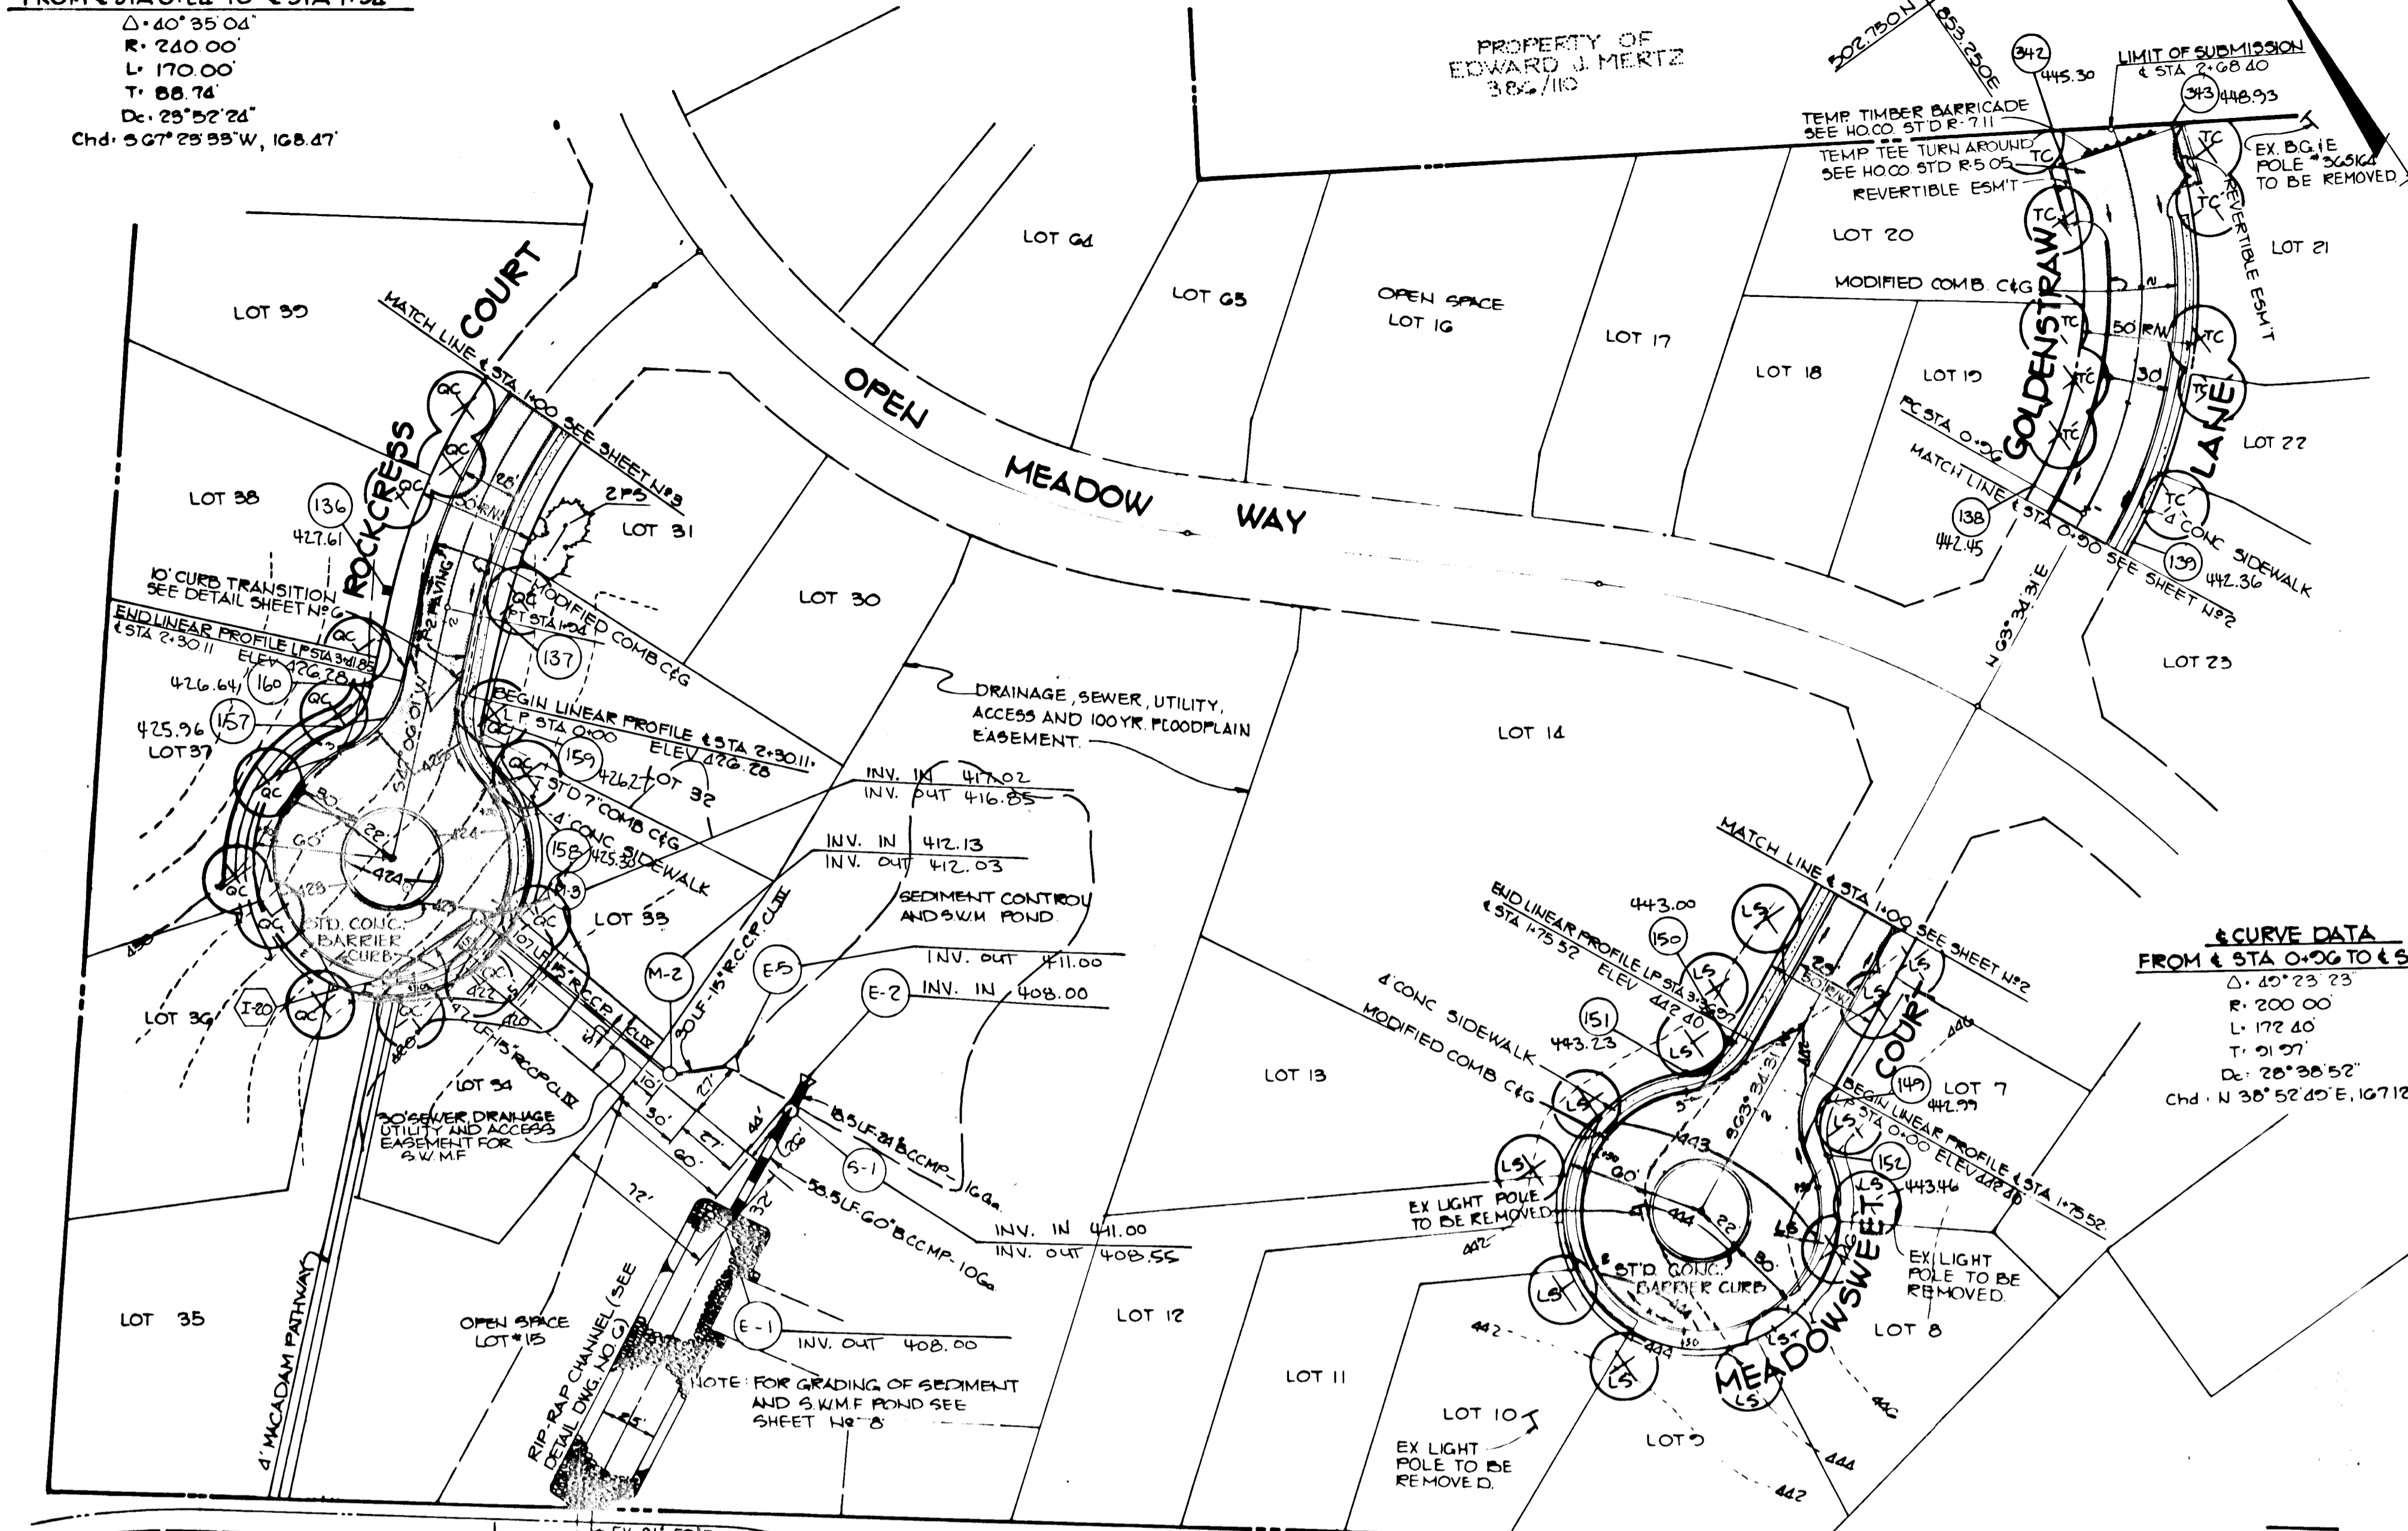

PLAN
 SCALE 1"=50'

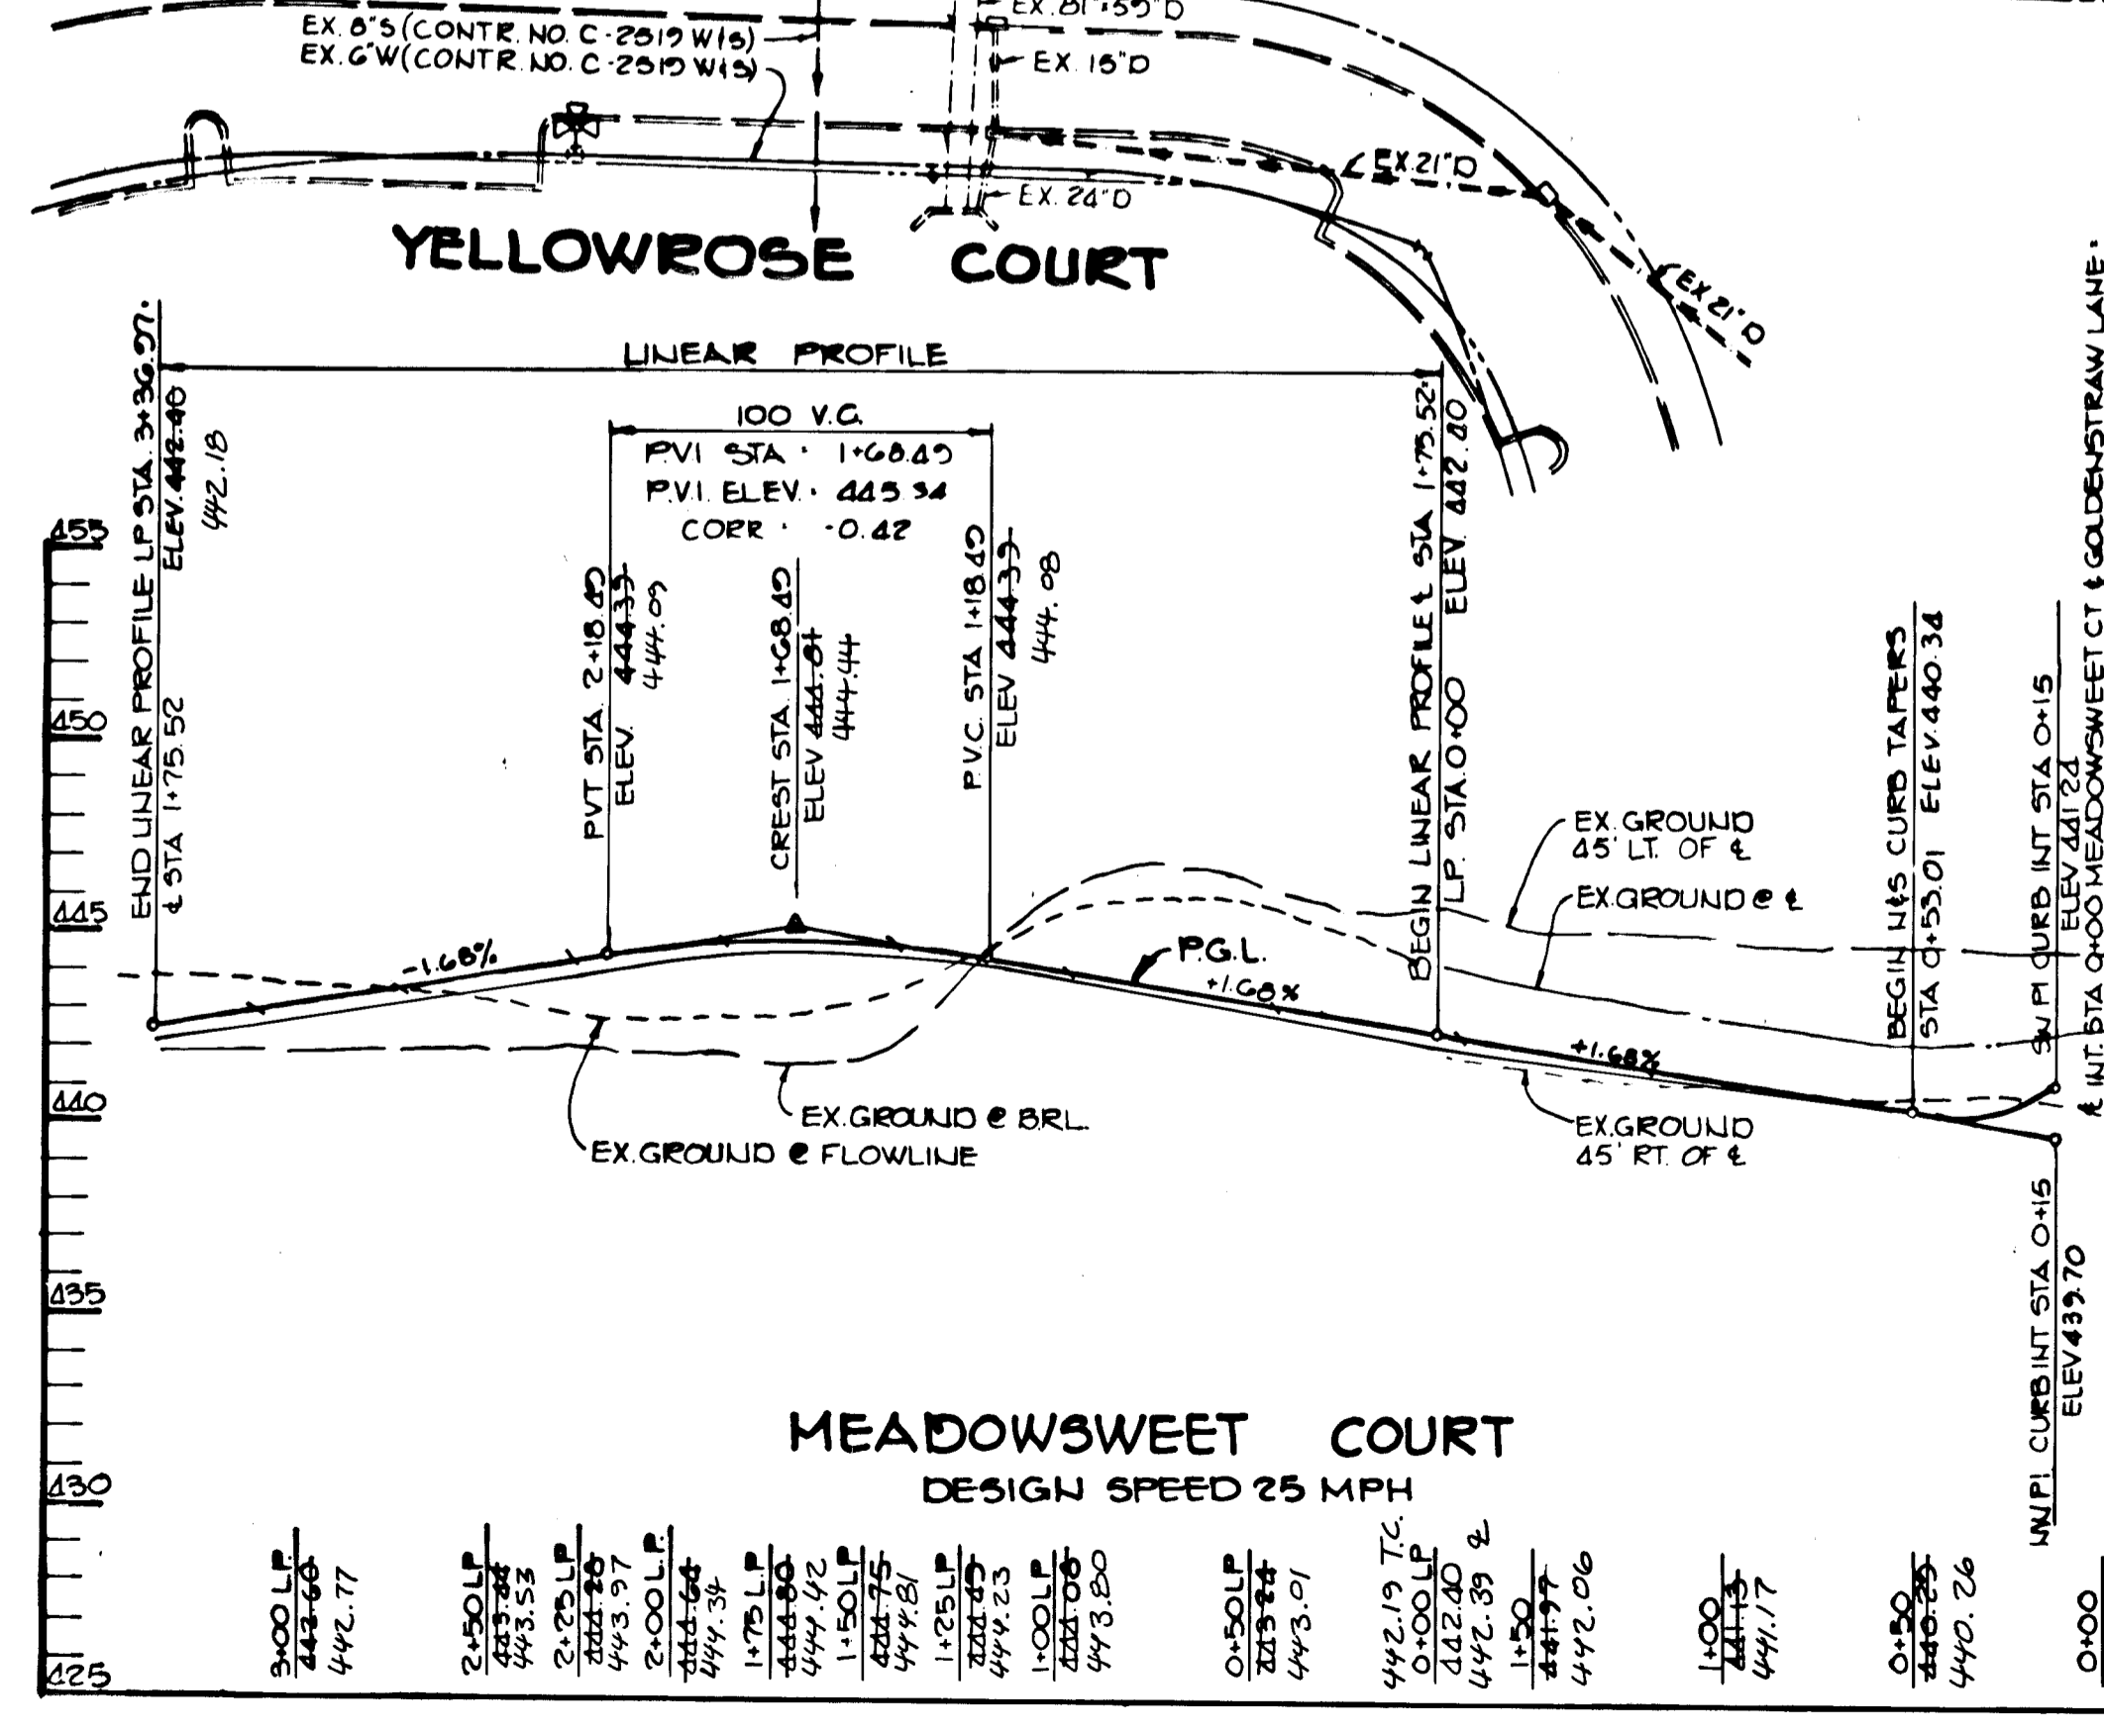


MEADOWSWEET COURT
 DESIGN SPEED 25 MPH

GOLDENSTRAW LANE
 DESIGN SPEED 30 MPH


PROFILE
 SCALE HORIZ 1"=50'
 VERT 1"=5'

PROPERTY OF
 EDWARD J. MERTZ
 382/110

4 CURVE DATA
 FROM STA 0+00 TO STA 2+08.40
 $\Delta: 40^{\circ}23'23''$
 $R: 200.00'$
 $L: 172.40'$
 $T: 91.27'$
 $Dc: 26^{\circ}30'52''$
 Chd: $N 30^{\circ}52'20'' E, 107.12'$

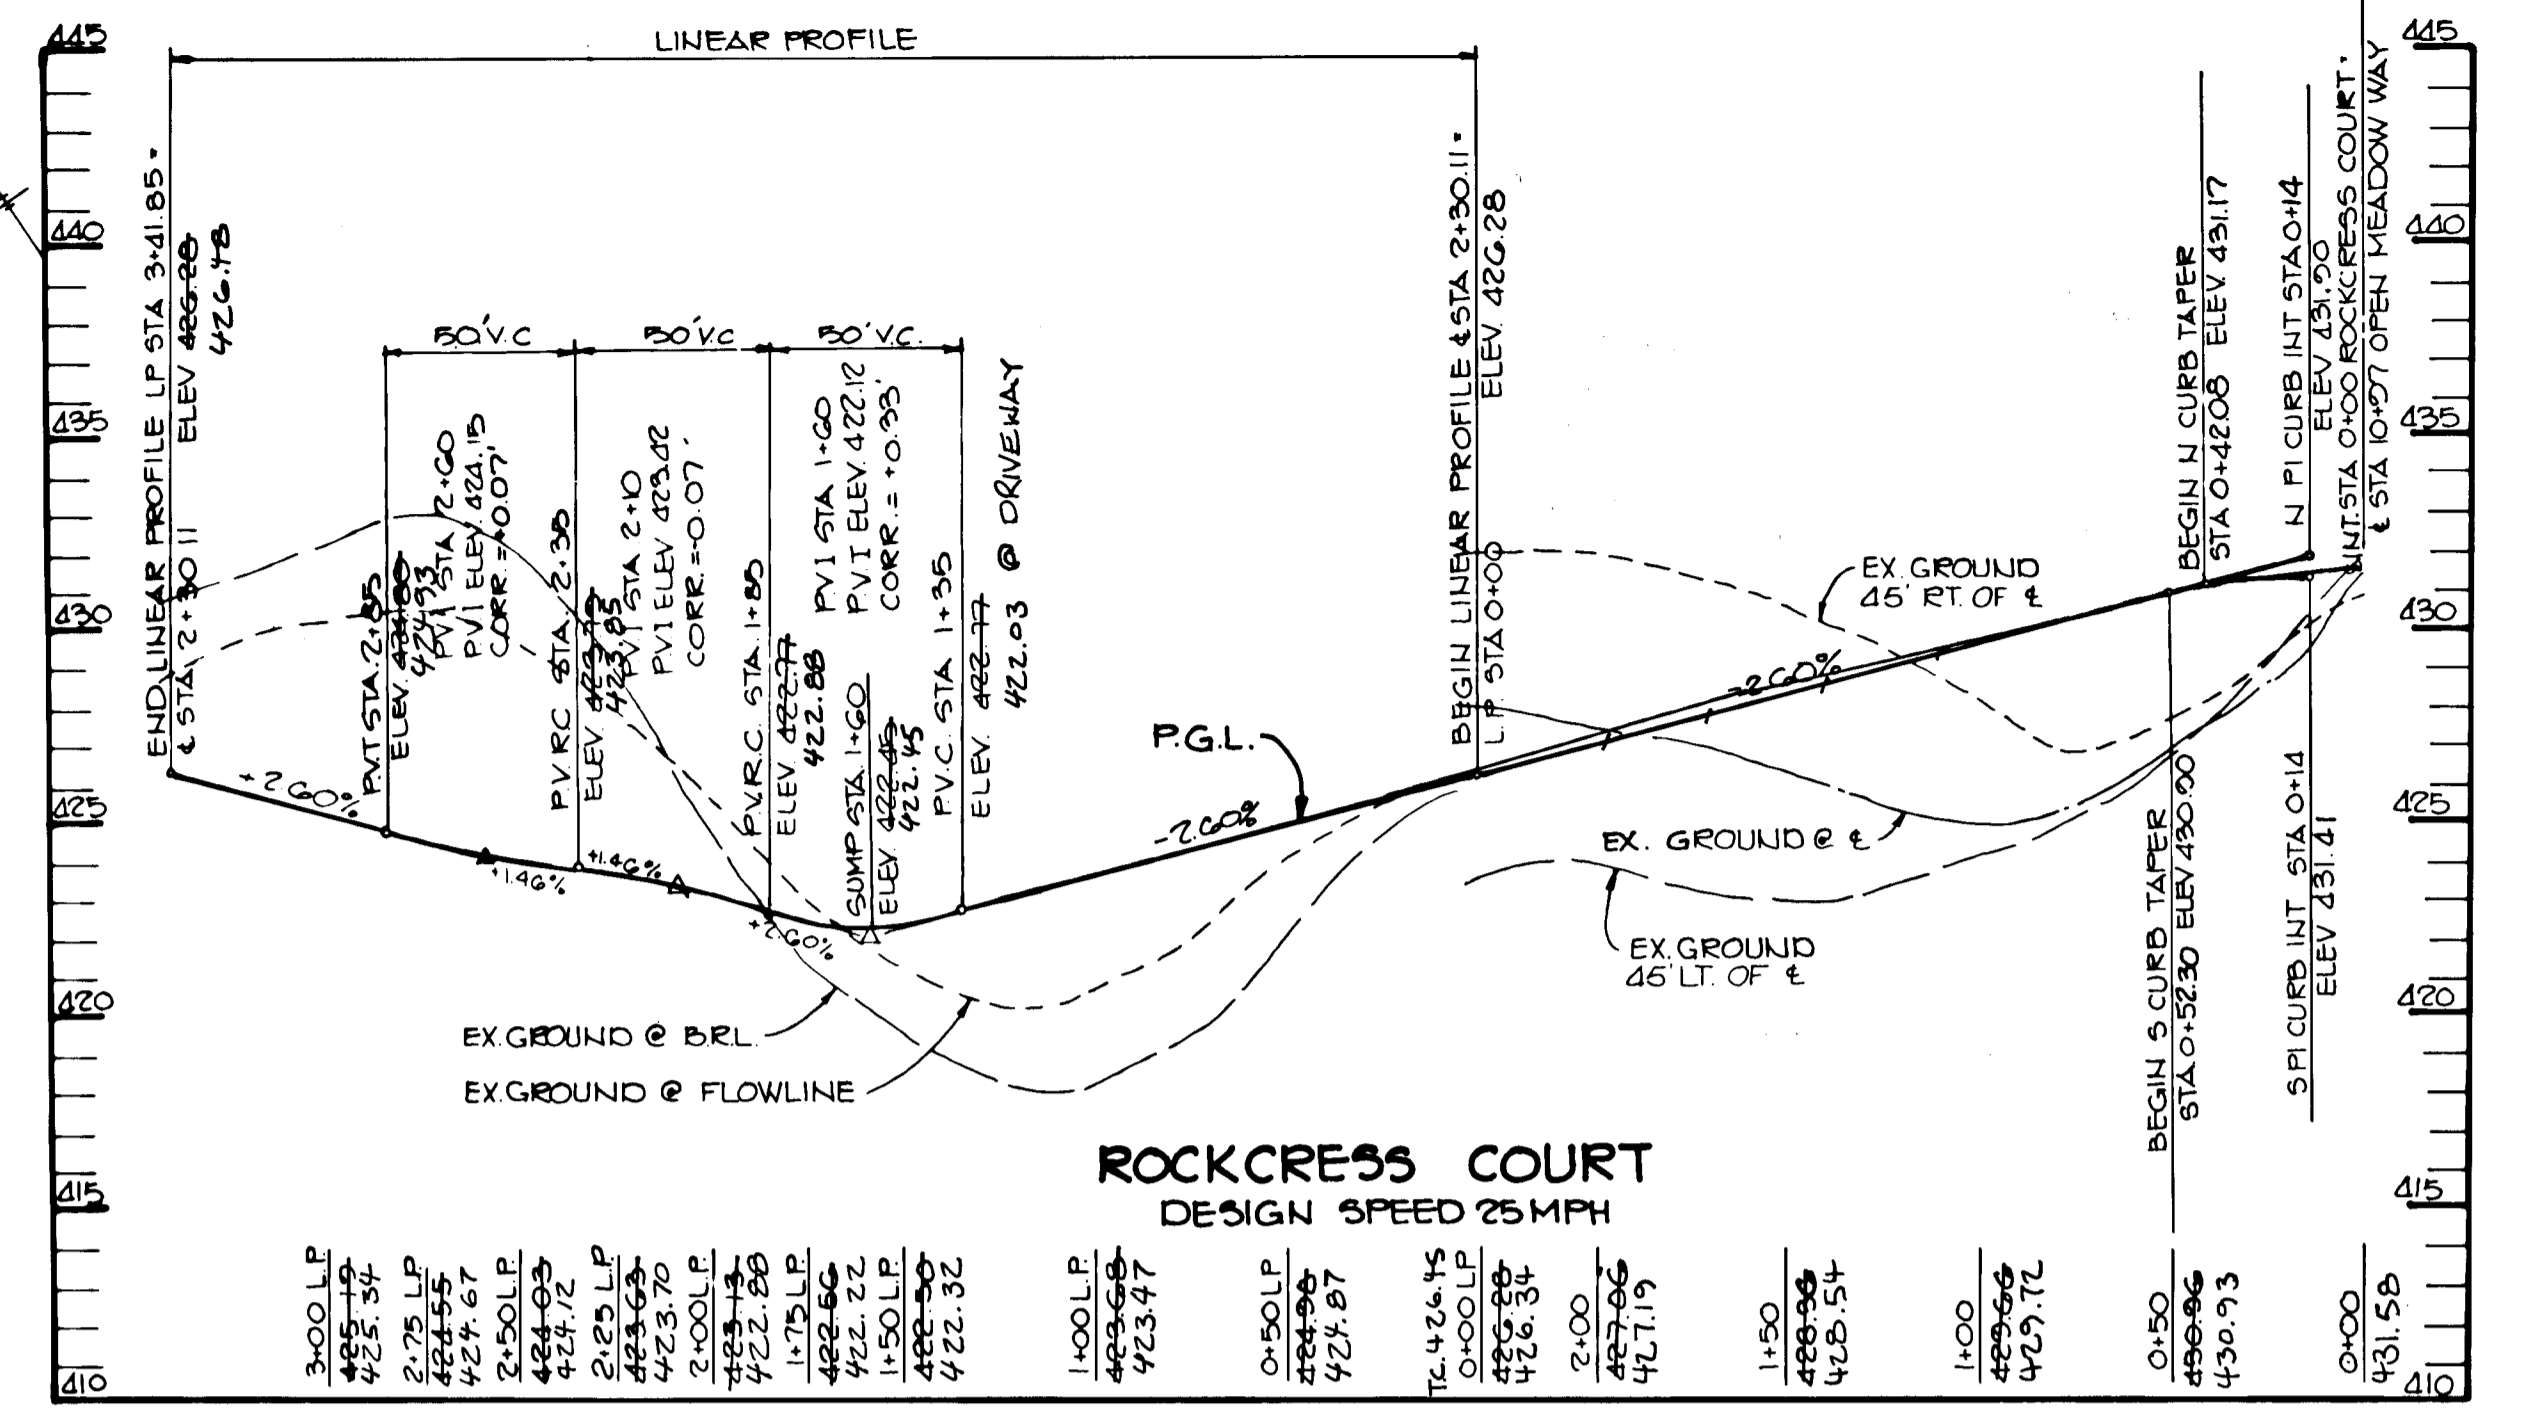

PROFILE
 SCALE HORIZ 1"=50'
 VERT 1"=5'

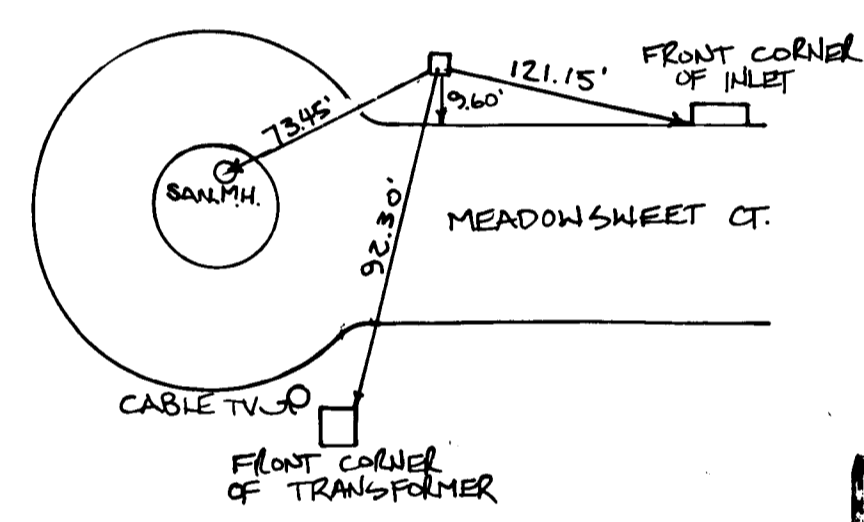

LEGEND
 ■ DENOTES 4"X4" CONCRETE MONUMENT
 ● DENOTES 1/2" PIPE OR 1/4" PIN SET

APPROVED: HOWARD COUNTY OFFICE OF PLANNING AND ZONING
John M. Mackman 9-9-86
 CHIEF, DIVISION OF LAND DEVELOPMENT AND ZONING ADMINISTRATION

APPROVED: HOWARD COUNTY DEPARTMENT OF PUBLIC WORKS
William E. Reilly 9-11-86
 CHIEF, BUREAU OF ENGINEERING

DATE NO. REVISION

OWNER: GEORGE C. DEERING, ROBERT M. HANKIN, ROBERT E. PRELLER, 5838 STILLMEADOW LANE, COLUMBIA, MARYLAND
 DEVELOPER: LONG MEADOW VENTURERS, ONE KNOLL NORTH DRIVE, SUITE 502, COLUMBIA, MARYLAND


PROJECT: LONG MEADOW SECTION ONE LOTS 1 THROUGH 5

AREA: TAX MAP NO. 36, PARCEL NO. 203, ELECTION DISTRICT G, HOWARD COUNTY, MARYLAND


TITLE: PLAN AND PROFILE OF MEADOWSWEET COURT, ROCKCROSS COURT AND GOLDENSTRAW LANE

THE RIEMER GROUP, INC.
 The Riemer Group, Inc. A Land Planning, Design & Civil Engineering Firm
 3106 Health Park Drive, Ellicott City, Maryland 21043 (301) 481-2890

DATE: 9-9-86
 DESIGNED BY: D.A.M.
 DRAWN BY: D.A.M.
 PROJECT NO: 23000
 DATE: JULY 31, 1986
 SCALE: AS SHOWN
 DRAWING NO. 4 OF 10

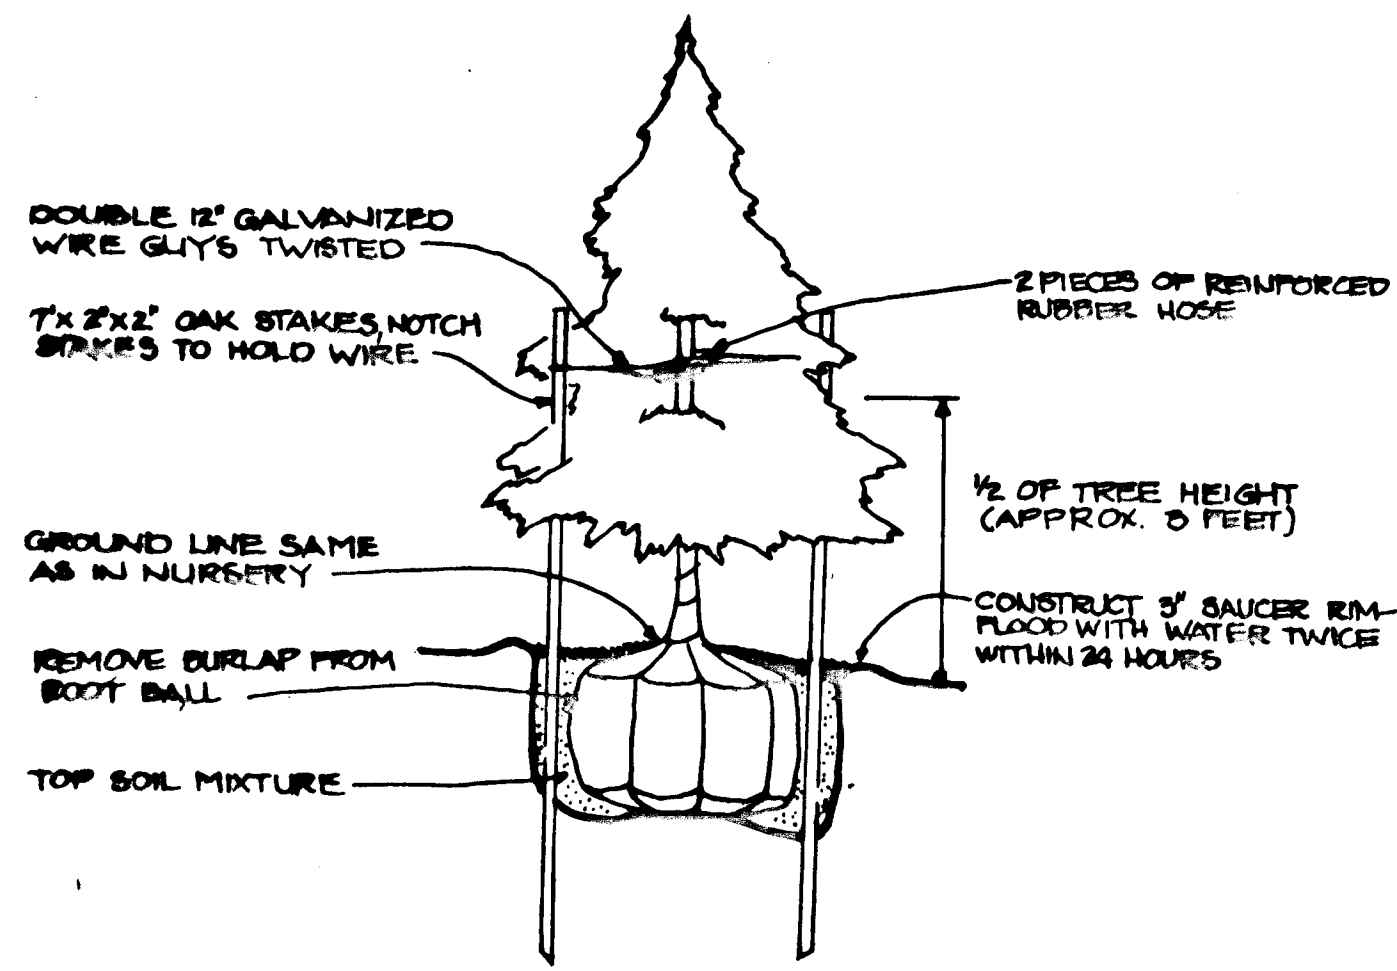

EVERGREEN PLANTING DETAIL
NO SCALE

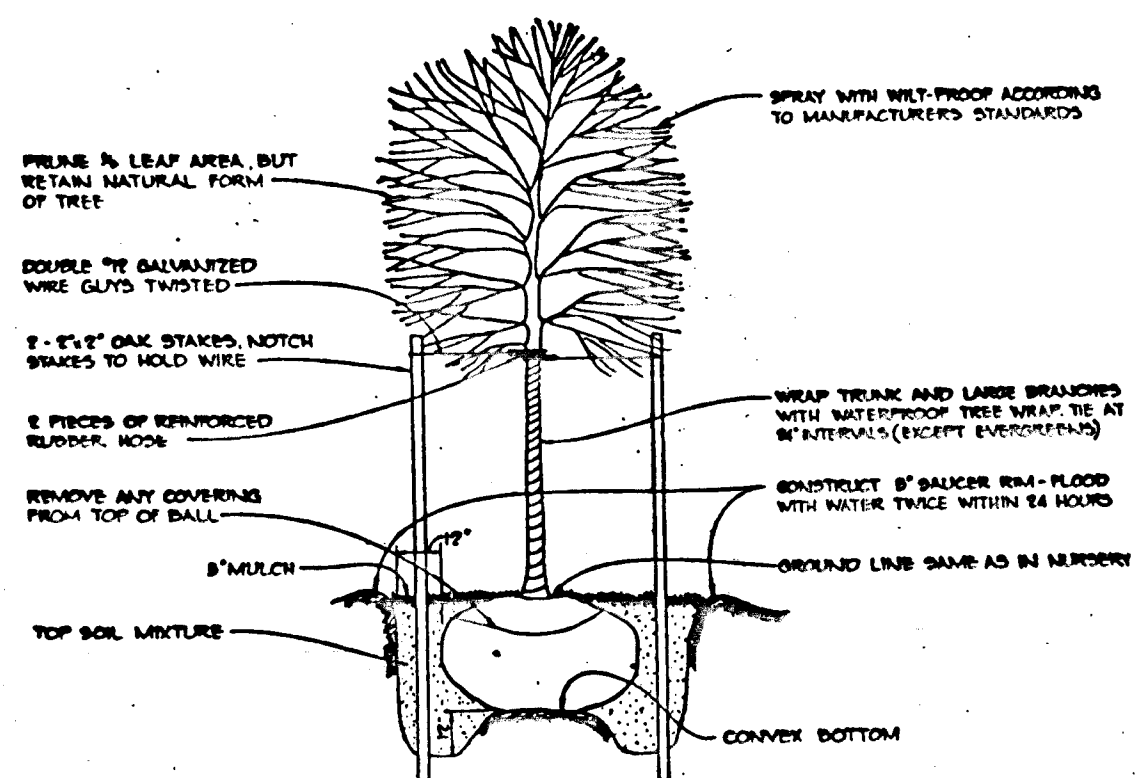

PLANTING DETAILS
NO SCALE

SHADE TREES

QTY.	ABR.	NAME	SIZE	REMARKS
75	Ar	ACER RUBRUM Red Maple	2 1/2 - 3" Cal., 13 - 15' Ht.	Full head, B & B
18	Ls	LIQUIDAMBAR STYRACIFLUA Sweet Gum	2 1/2 - 3" Cal., 12 - 14' Ht.	Full head, B & B
15	Qc	QUERCUS COCCINEA Scarlet Oak	2 1/2 - 3" Cal., 12 - 14' Ht.	Full head, B & B
28	Tc	TILIA CORDATA "GREENSPIRE" Greenspire Linden	2 1/2 - 3" Cal., 12 - 14' Ht.	Full head, B & B



PLANT LIST

EVERGREENS


13	Ps	PINUS STROBUS Eastern White Pine	8 - 10' Ht.	Full branching, B & B
----	----	-------------------------------------	-------------	--------------------------

FLOWERING TREES

3	Ms	MALUS SNOWCLOUD Snowcloud Crabapple	2 - 2 1/2" Cal., 8-9' Ht.	Full head, B & B
---	----	--	------------------------------	------------------

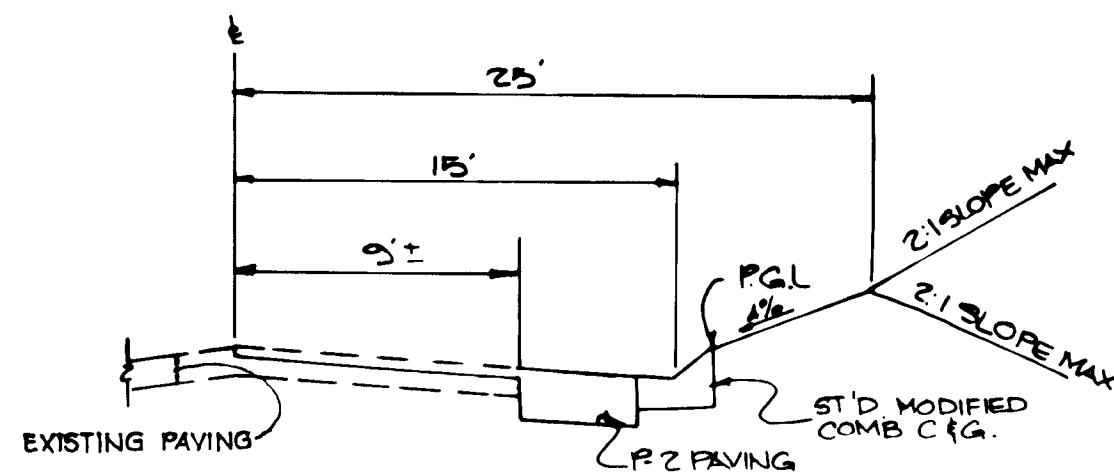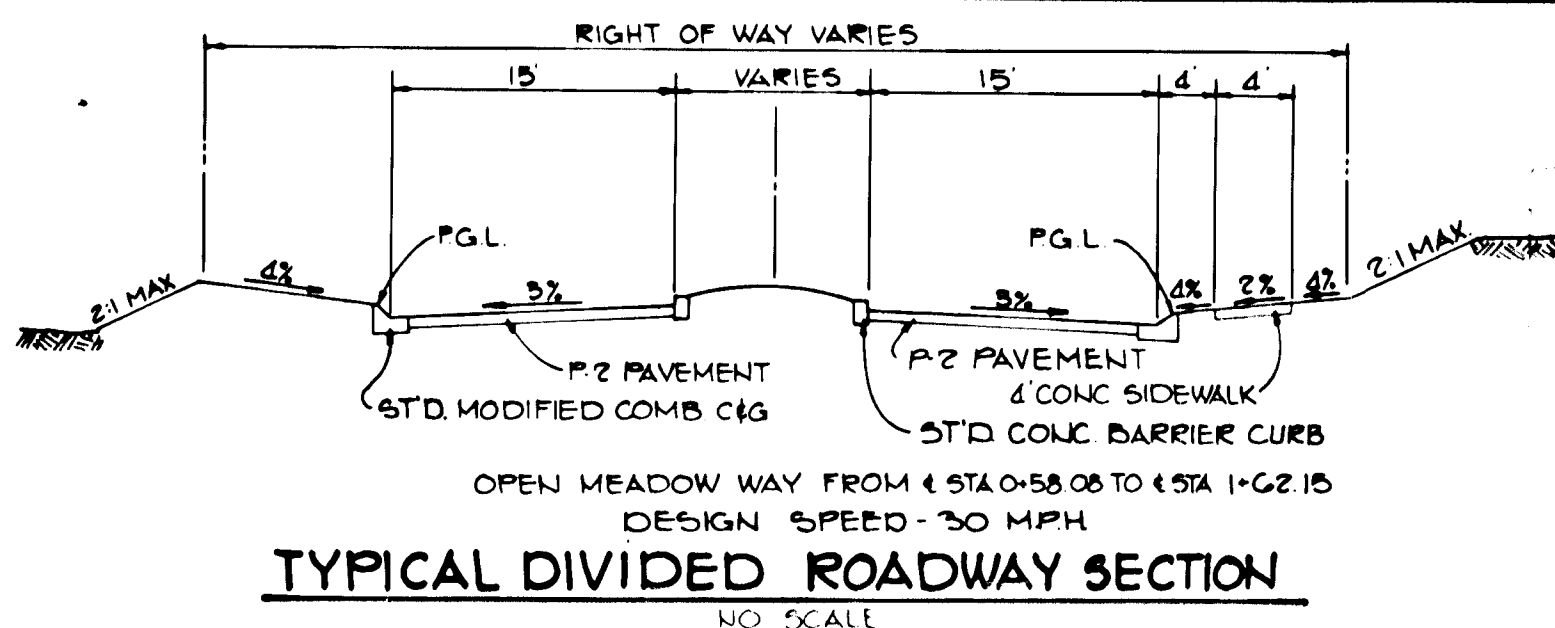


NOTE: SEE HOWARD COUNTY STANDARD DETAILS R-10.02 AND R-10.01 FOR ADDITIONAL NOTES AND DIMENSIONS
DAVIS ROAD STA. 15+24 TO STA. 15+53
DESIGN SPEED 30 MPH
DAVIS ROAD WIDENING DETAIL
NO SCALE

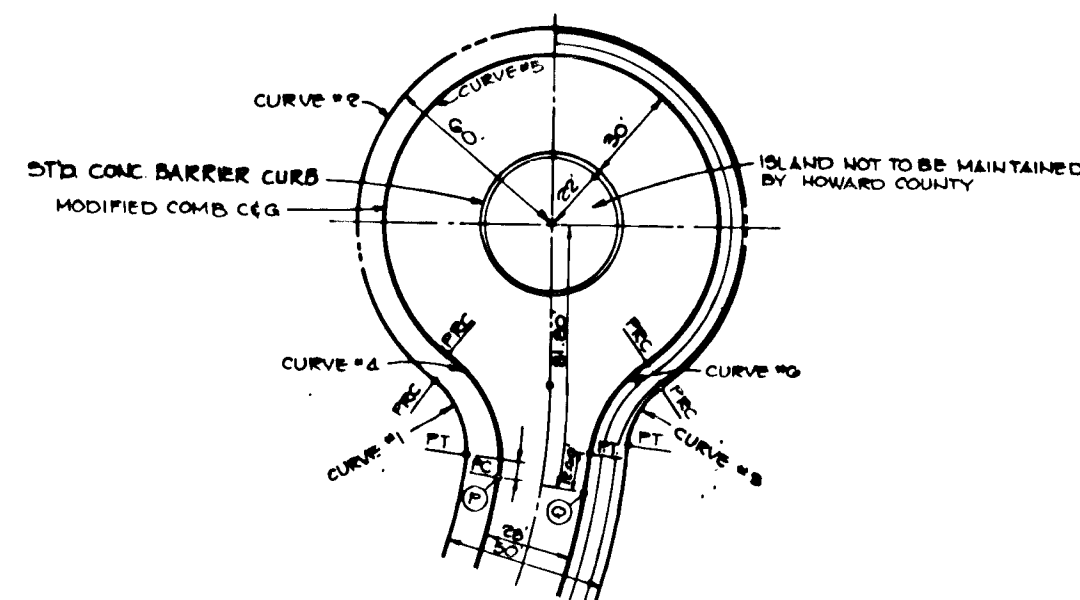

CURVE DATA		OPEN MEADOW WAY	
STATION	CURVE NO.	STATION	CURVE NO.
0+00	14	0+00	14
0+25	15	0+25	15
0+50	16	0+50	16
0+75	17	0+75	17
1+00	18	1+00	18
1+25	19	1+25	19
1+50	20	1+50	20


OPEN MEADOW WAY

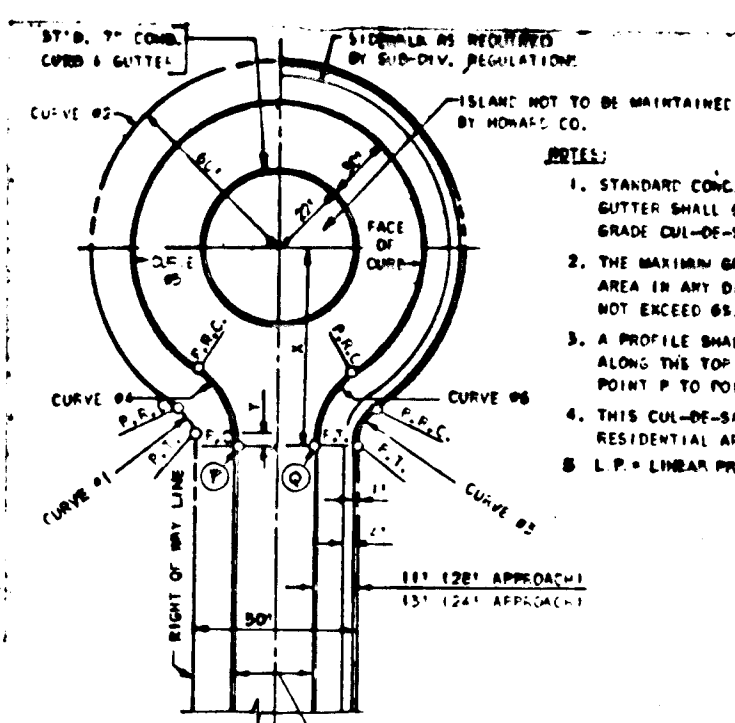

CURVE DATA		MEADOWSWEET COURT	
STATION	CURVE NO.	STATION	CURVE NO.
0+00	14	0+00	14
0+25	15	0+25	15
0+50	16	0+50	16
0+75	17	0+75	17
1+00	18	1+00	18
1+25	19	1+25	19
1+50	20	1+50	20


**MEADOWSWEET COURT
ROCKCRESS COURT
CUL-DE-SAC DETAILS**
NO SCALE

STANDARD BARRIER CURB
NO SCALE

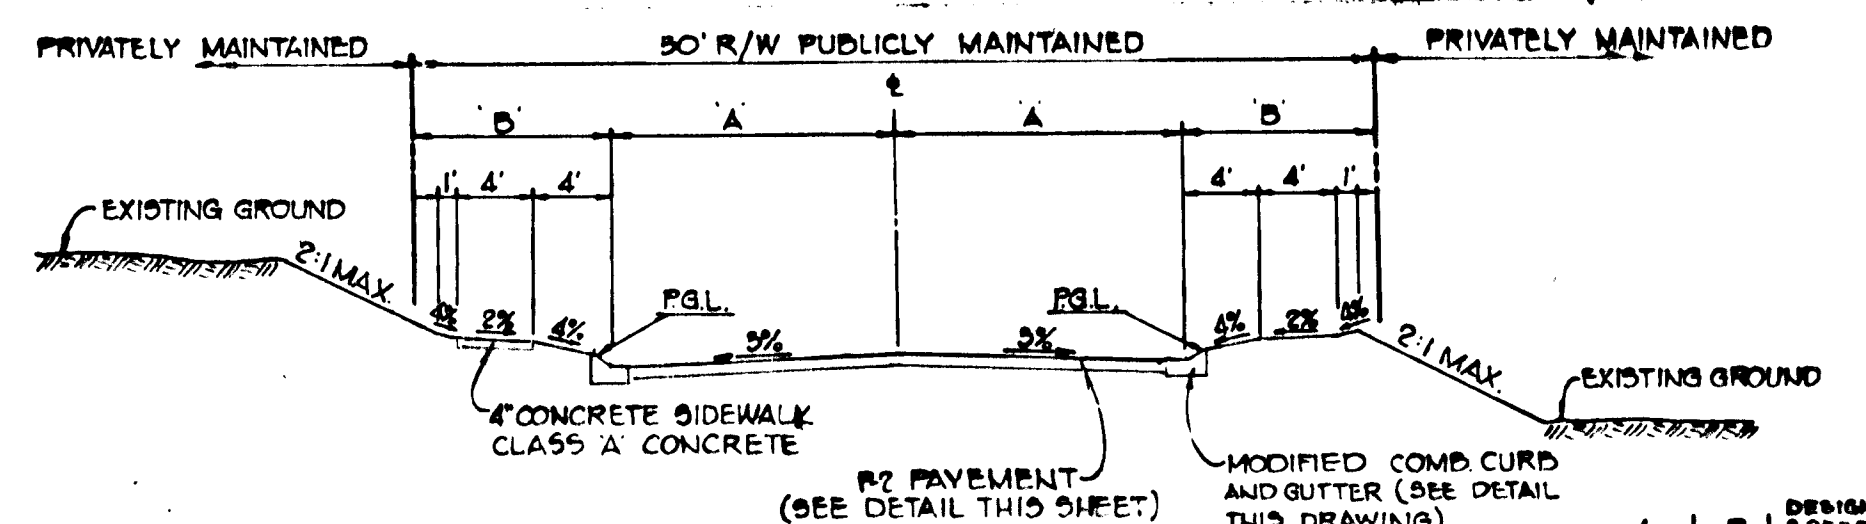


	A	B	DESIGN SPEED
OPEN MEADOW WAY FROM STA. 0+00 TO STA. 10+55.52	15'	10'	30
MEADOWSWEET COURT FROM STA. 0+51.76 TO STA. 1+75.52	14'	11'	25
ROCKCRESS COURT FROM STA. 0+51.10 TO STA. 2+50.11	14'	11'	25
GOLDENSTRAW LANE FROM STA. 0+46.50 TO STA. 2+20	15'	10'	30
OPEN MEADOW WAY FROM STA. 11+35.73 TO STA. 16+11.20	14'	11'	30


ZONED: R-12
TYPICAL SECTION FOR 30' R/W
NO SCALE

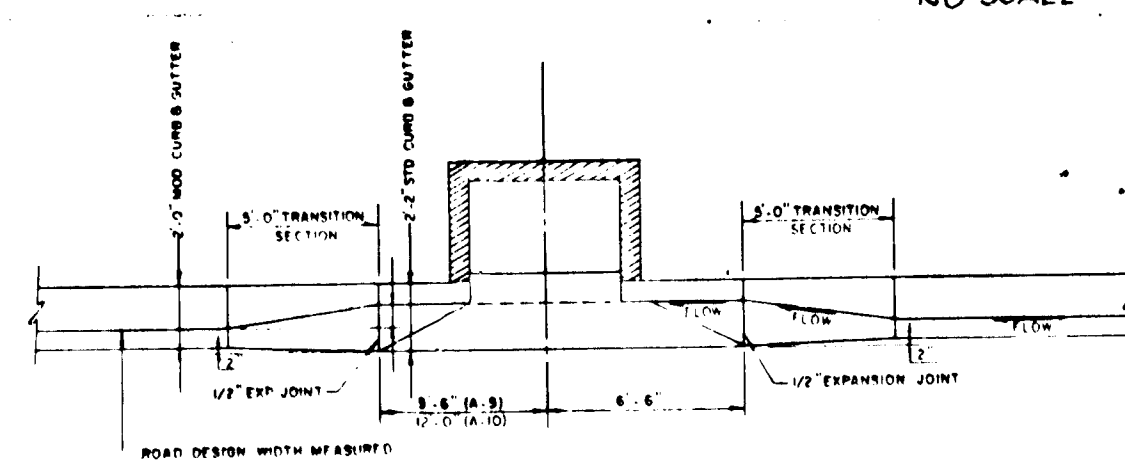


CONCRETE CURB AND GUTTER TRANSITION
NO SCALE

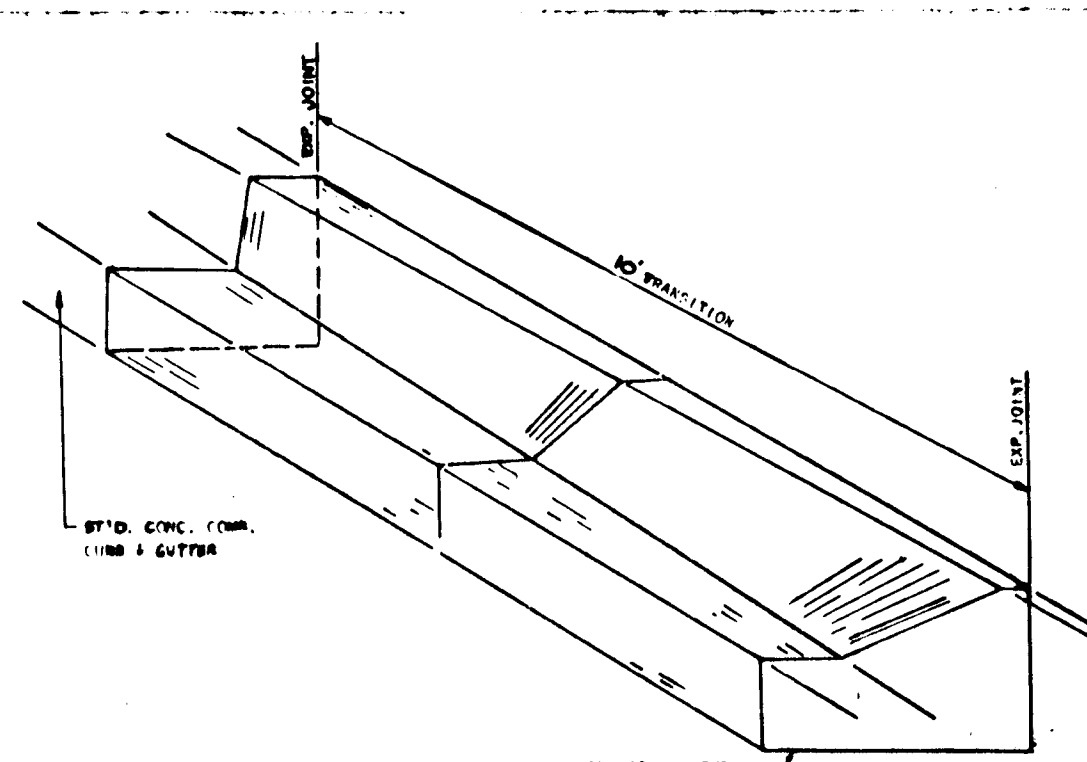


TRANSITION CURB SECTION AT 'A' TYPE INLETS
NO SCALE

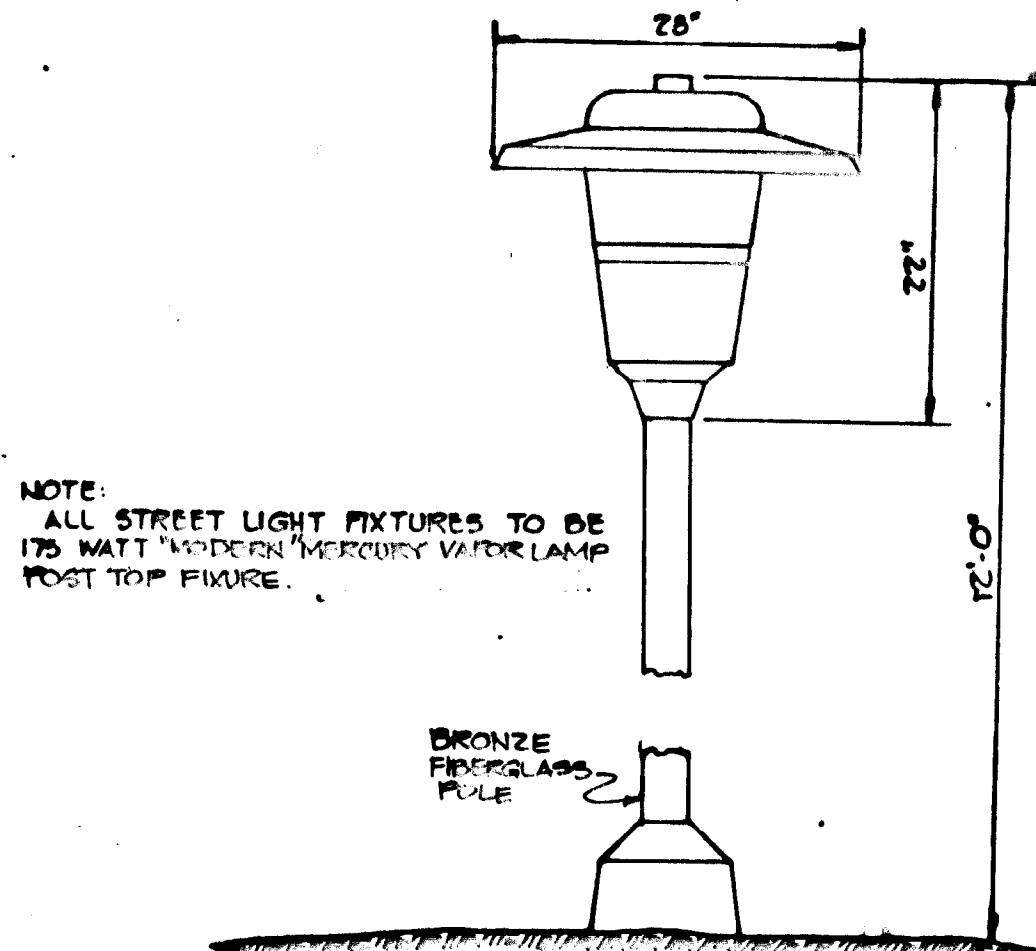


NOTE: ALL STREET LIGHT FIXTURES TO BE 175 WATT MILDENHALL MERCURY VAPOR LAMP POST TOP FIXTURE.
DETAIL - LIGHTING FIXTURE
NO SCALE

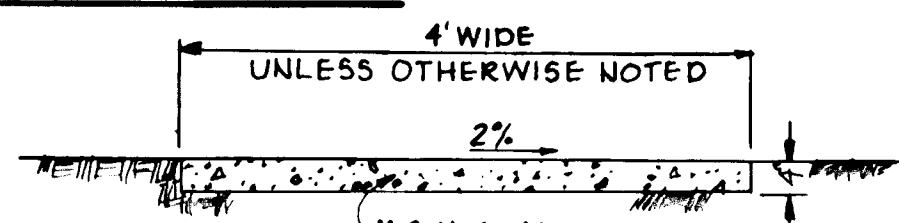



SIDEWALK DETAIL
NO SCALE

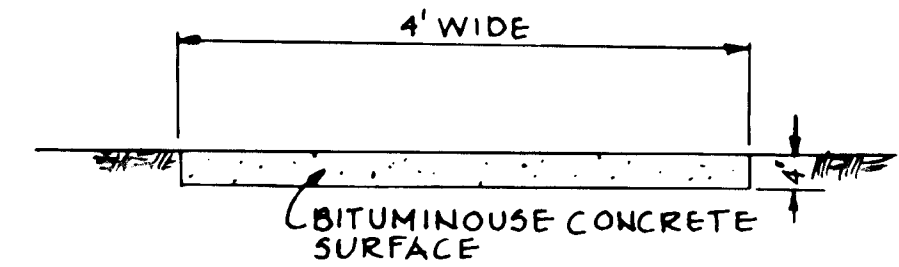


MACADAM PATHWAY DETAIL
NO SCALE

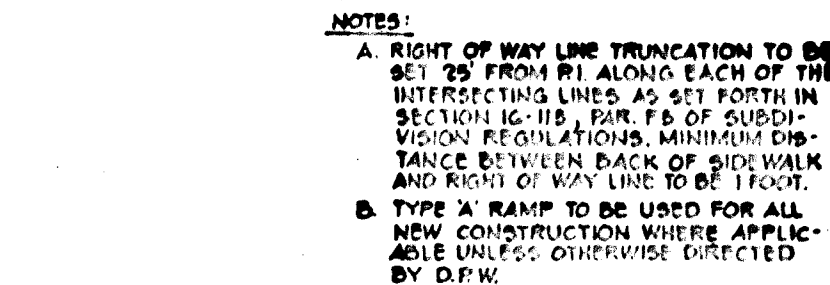

TYPICAL HANDICAP RAMP
NO SCALE

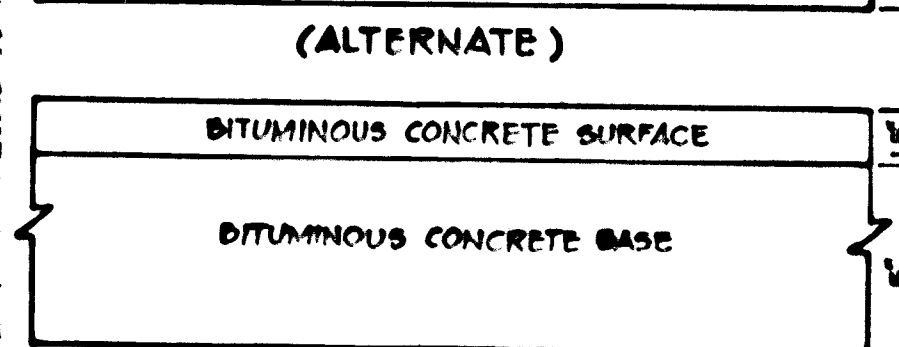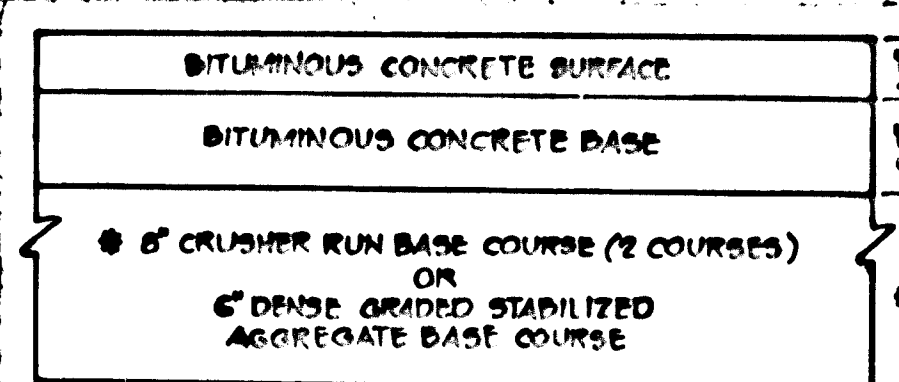


HOWARD COUNTY DESIGN MANUAL VOLUME II - STANDARD SPECIFICATIONS AND DETAILS FOR CONSTRUCTION (DRAWING R-2.01)
6" PAVING, P-2
NO SCALE

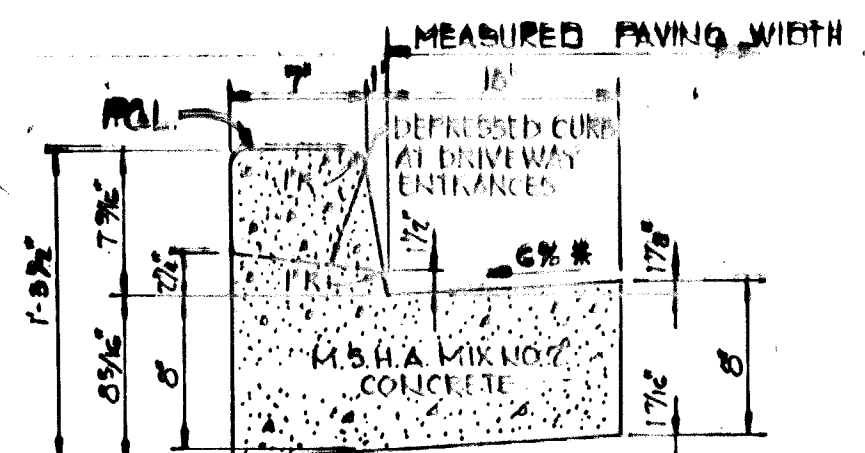

HOWARD COUNTY DESIGN MANUAL VOLUME II - STANDARD SPECIFICATIONS AND DETAILS FOR CONSTRUCTION (DRAWING R-2.01)
* GUTTER PAN AT THE MEDIAN EDGE OF INTERMEDIATE ARTERIALS OR THE HIGH SIDE OF SUPERELEVATED SECTIONS SHALL BE SLOPED AT THE SAME RATE AS THE PAVEMENT.

STANDARD 7" COMBINATION CURB AND GUTTER
NO SCALE

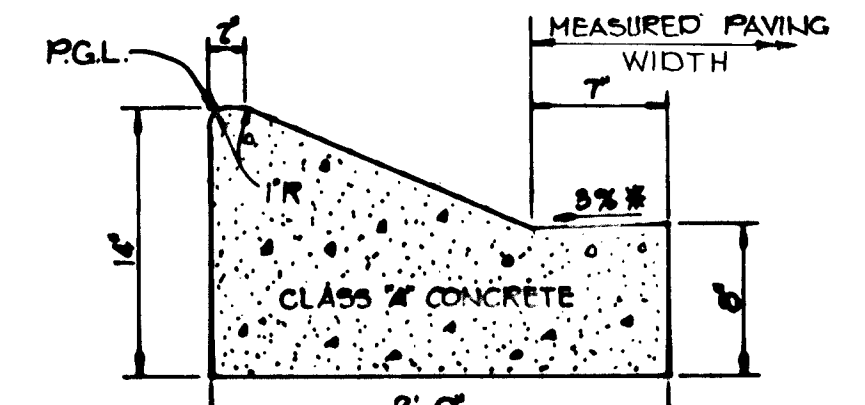

HOWARD COUNTY DESIGN MANUAL VOLUME II - STANDARD SPECIFICATIONS AND DETAILS FOR CONSTRUCTION (DRAWING R-2.01)
* GUTTER PAN AT THE MEDIAN EDGE OF INTERMEDIATE ARTERIALS OR THE HIGH SIDE OF SUPERELEVATED SECTIONS SHALL BE SLOPED AT THE SAME RATE AS THE PAVEMENT.

MODIFIED COMBINATION CURB AND GUTTER
NO SCALE

APPROVED: HOWARD COUNTY OFFICE OF PLANNING AND ZONING
John M. ... 9-9-86
CHIEF, DIVISION OF LAND DEVELOPMENT AND ZONING ADMINISTRATION

APPROVED: HOWARD COUNTY DEPARTMENT OF PUBLIC WORKS
... 9-11-86
CHIEF, BUREAU OF ENGINEERING

DATE: NO. REVISION
OWNER: GEORGE C. DEERING
ROBERT M. HANKIN
ROBERT R. PRELLER
5830 STILL MEADOW LANE
COLUMBIA, MARYLAND
DEVEL: LONG MEADOWS VENTURES
ONE KNOLL NORTH DRIVE
SUITE 502
COLUMBIA, MARYLAND
21045

PROJECT: LONG MEADOW SECTION ONE
LOTS 1 THRU 65
AREA: TAX MAP # 36 PARCEL # 263
ELECTION DISTRICT 6
HOWARD COUNTY, MARYLAND

TITLE: DETAIL SHEET


THE RIEMER GROUP, INC.

The Riemer Group, Inc. A Land Planning, Design & Civil Engineering Firm
3105 Health Park Drive, Ellicott City, Maryland 21043 (301) 461-2800

DATE: 9-9-86 (5-6-37)
DESIGNED BY: D.A.M.
DRAWN BY: K.J.B.
PROJECT NO: 23000
DATE: JULY 31, 1986
SCALE: AS SHOWN
DRAWING NO. 6 OF 10

ARTHUR E. MUEGGE #0707
F-86-203

12.36

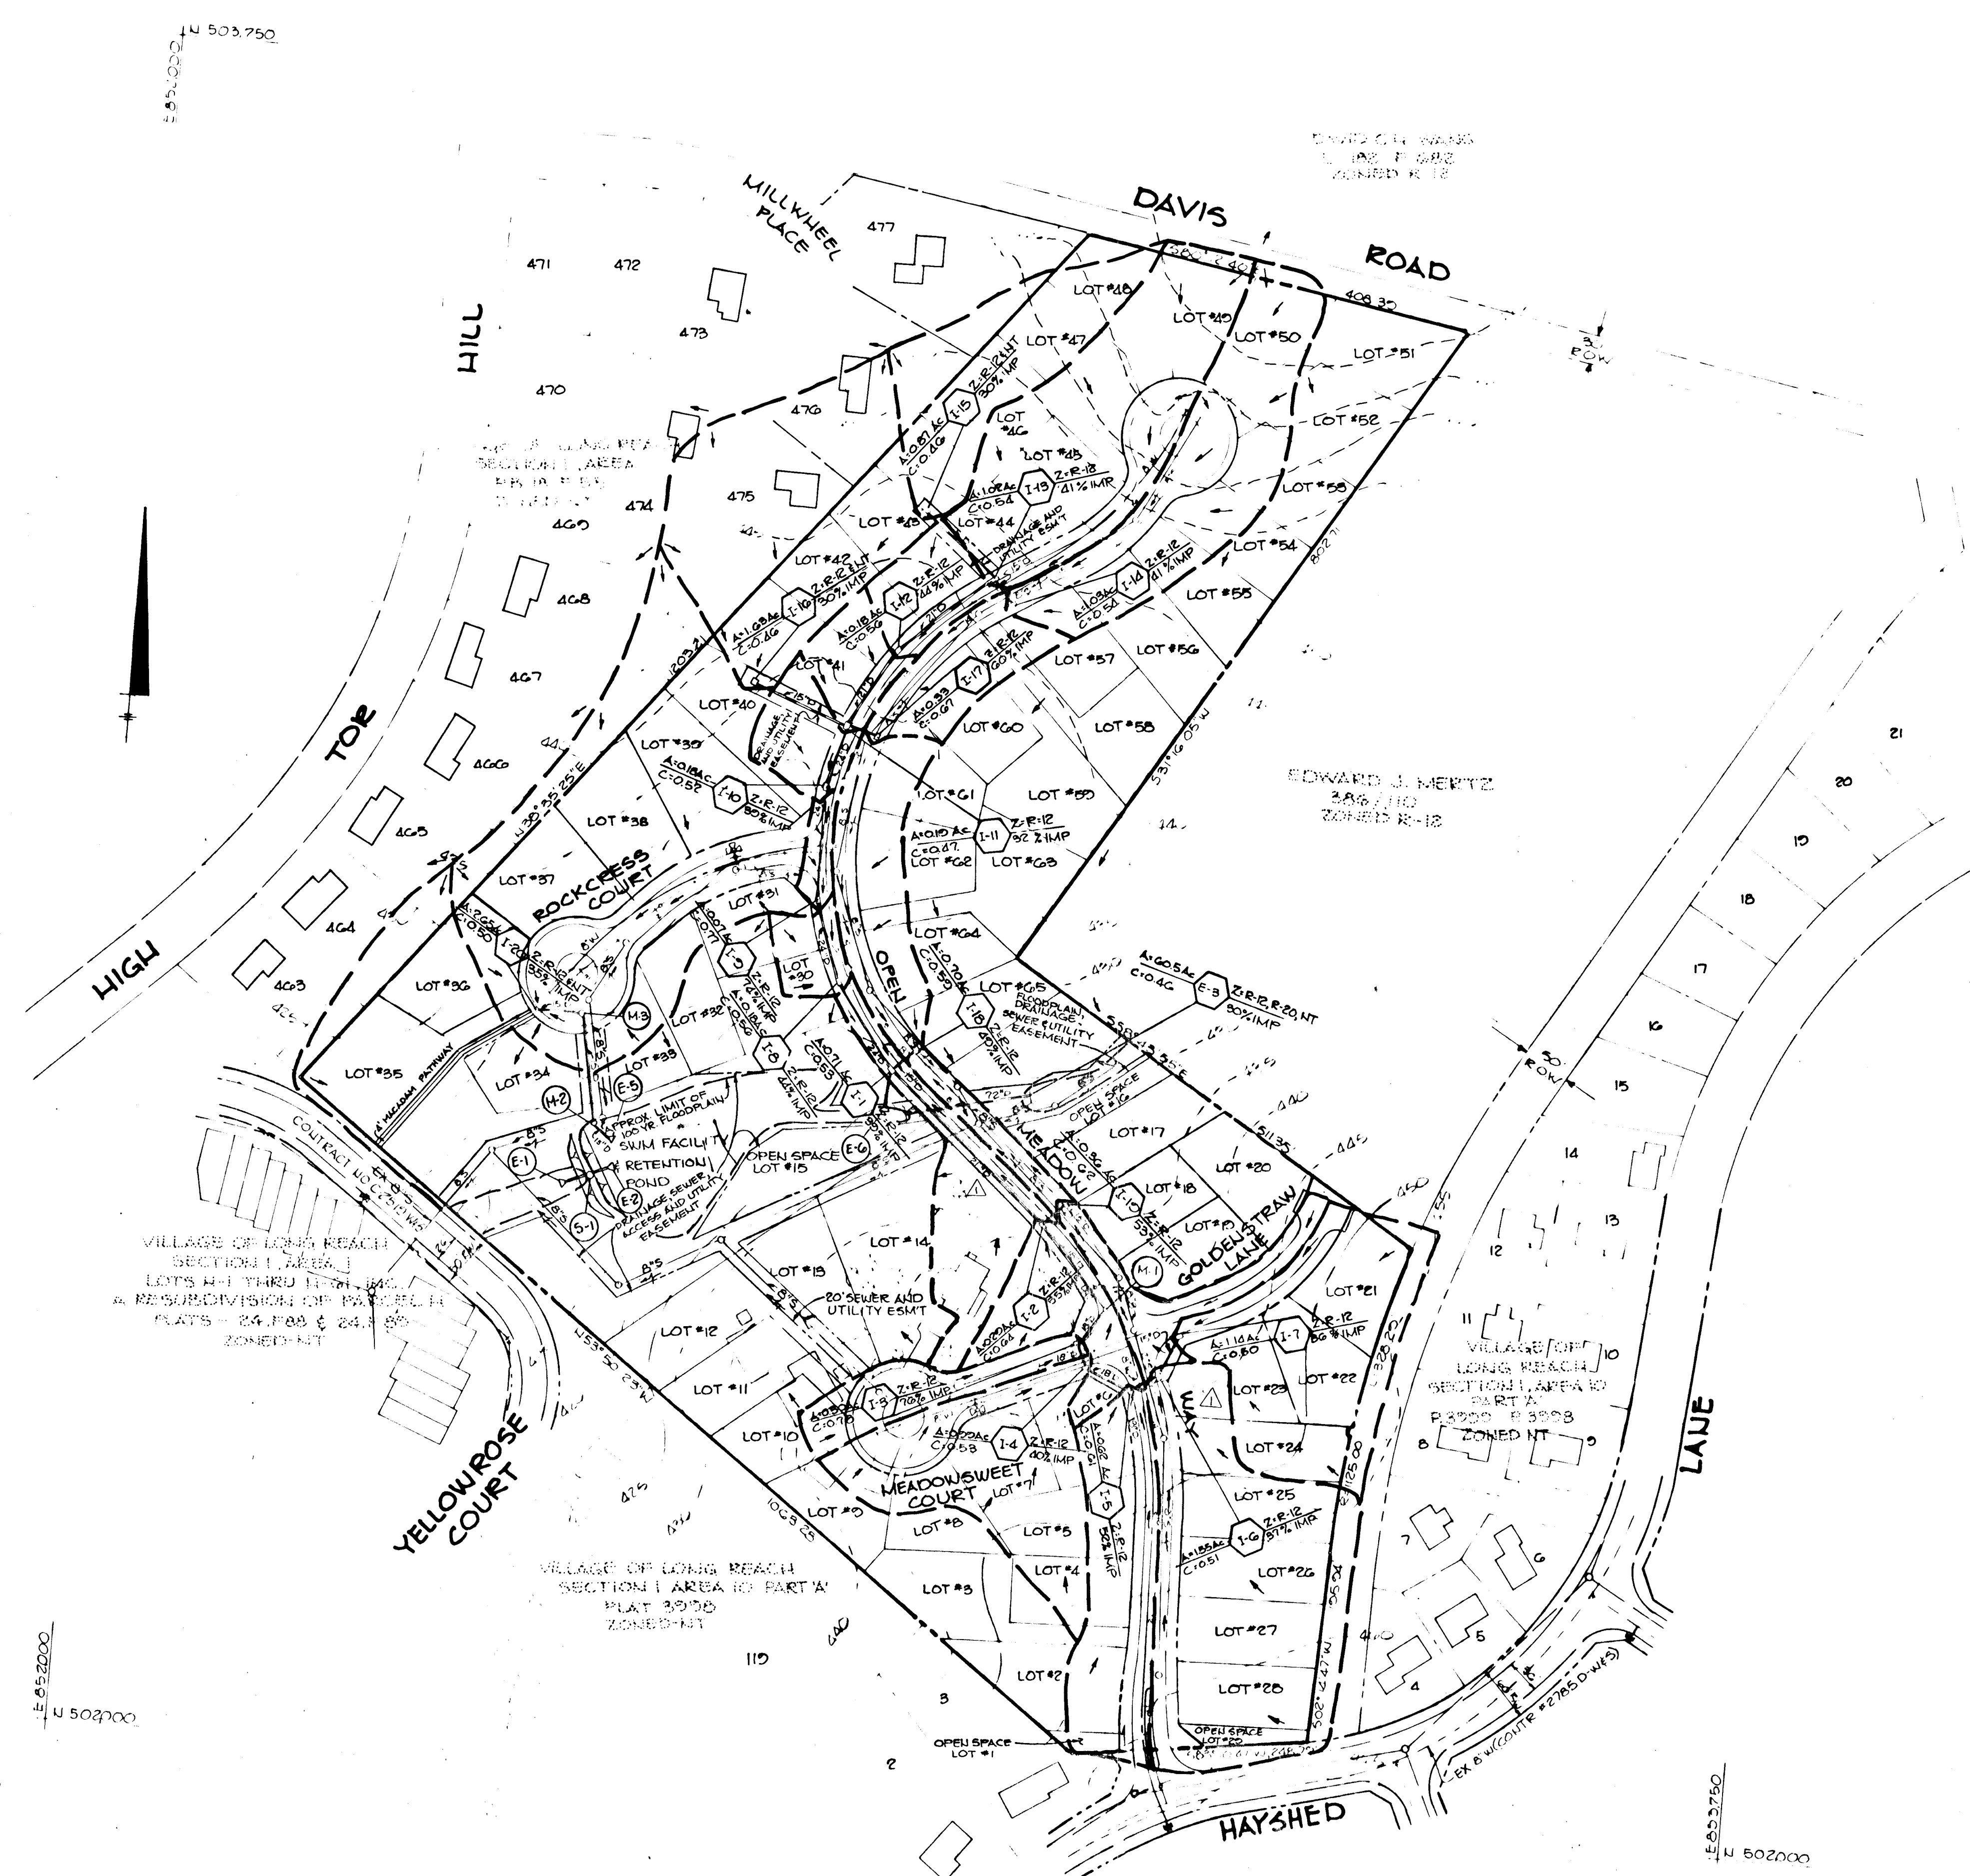

STRUCTURE SCHEDULE

No.	Type	Location	Inv. In	Inv. Out	Top Curb Elev.	Remarks
1-1	A-5	15' Lt. Centerline Sta. 8+83.31	24"(NW) 422.40	423.10	423.10	Ho. Co. Std. SD-4.01
1-2	A-5 w/ Def.	15' Lt. Centerline Sta. 6+40	15"(E) 423.40	423.25	423.25	Ho. Co. Std. SD-4.01 and SD-4.83
1-3	A-5	14' Rt. Centerline Sta. 0+58.51	18"(SE) 423.75	421.28	440.43	Ho. Co. Std. SD-4.01
1-4	A-5 w/ Def.	14' Lt. Centerline Sta. 0+58.51	431.63	431.51	440.44	Ho. Co. Std. SD-4.01 and SD-4.83
1-5	A-5 w/ Def.	15' Lt. Centerline Sta. 4+27.82	432.03	432.57	440.71	Ho. Co. Std. SD-4.01
1-6	A-10 w/ Def.	15' Rt. Centerline Sta. 4+31.51	434.22	434.55	443.99	Ho. Co. Std. SD-4.01 and SD-4.83
1-7	A-5 w/ Def.	15' Rt. Centerline Sta. 0+52.99	434.95	435.51	440.00	Ho. Co. Std. SD-4.01 and SD-4.83
1-8	A-5	15' Lt. Centerline Sta. 9+72	435.38	436.42	440.74	Ho. Co. Std. SD-4.01
1-9	A-5	15' Lt. Centerline Sta. 10+48.02	436.45	437.48	441.42	Ho. Co. Std. SD-4.01
1-10	A-5	14' Lt. Centerline Sta. 11+50	437.88	438.88	442.50	Ho. Co. Std. SD-4.01
1-11	A-5	14' Lt. Centerline Sta. 12+23	438.91	439.87	443.62	Ho. Co. Std. SD-4.01
1-12	A-5	14' Lt. Centerline Sta. 13+31	15"(E) 439.94	440.89	444.74	Ho. Co. Std. SD-4.01
1-13	A-5 w/ Def.	14' Lt. Centerline Sta. 14+32	15"(W) 439.94	440.89	444.74	Ho. Co. Std. SD-4.01 and SD-4.83
1-14	A-5 w/ Def.	14' Rt. Centerline Sta. 14+32	439.94	440.89	444.74	Ho. Co. Std. SD-4.01 and SD-4.83
1-15	'K' Inlet	See Plan	---	---	---	Ho. Co. Std. SD-4.13
1-16	'K' Inlet	See Plan	---	---	---	Ho. Co. Std. SD-4.13
1-17	A-5 w/ Def.	14' Rt. Centerline Sta. 12+23	429.25	430.24	434.98	Ho. Co. Std. SD-4.01 and SD-4.83
1-18	A-5	15' Rt. Centerline Sta. 8+83.31	429.25	429.25	434.15	Ho. Co. Std. SD-4.01
1-19	A-5 w/ Def.	15' Rt. Centerline Sta. 6+40	424.17	424.17	429.08	Ho. Co. Std. SD-4.01 and SD-4.83
I-20	A-10	Sta. 1+60 LP	---	---	---	Ho. Co. Std. SD-4.02
M-2	Std. 4'-0"	See Plan	---	---	---	Ho. Co. Std. G-5.11
H-1	20' Lt. Centerline	See Plan	---	---	---	Ho. Co. Std. G-5.11
M-3	Std. 4'-0"	See Plan	---	---	---	Ho. Co. Std. G-5.11
E-1	60" Metal End Section	See Plan	---	---	---	Ho. Co. Std. SD-5.61
E-2	24" Metal End Section	See Plan	---	---	---	Ho. Co. Std. SD-5.61
E-3	72" Metal End Section	See Plan	---	---	---	Ho. Co. Std. SD-5.61
E-4	72" Metal End Section	See Plan	---	---	---	Ho. Co. Std. SD-5.61
E-5	15" Concrete End Section	See Plan	---	---	---	Ho. Co. Std. SD-5.51
E-6	30" Concrete End Section	See Plan	---	---	---	Ho. Co. Std. SD-5.51
S-1	Special Structure	See Plan	---	---	---	See Sheet 6 of 10

* Top of rim or grate elevation

APPROVED: HOWARD COUNTY OFFICE OF PLANNING AND ZONING
John W. ... 9-9-86
 CHIEF, DIVISION OF LAND DEVELOPMENT AND ZONING ADMINISTRATION

APPROVED: HOWARD COUNTY DEPARTMENT OF PUBLIC WORKS
... 9-11-86
 CHIEF, BUREAU OF ENGINEERING

REVISIONS:
 NO. DATE REVISION
 1-27-86 REVISED INVERTS IN FOOT ON STRUCTURES 1-1, 1-2, 1-3, 1-4, 1-5, 1-6 AND 1-11. REVISED PIPE SIZES.

OWNER: GEORGE C. DEERING, ROBERT M. HANKIN, ROBERT R. PRELLER, 5833 STILLMEADOW LANE, COLUMBIA, MARYLAND

DEVEL: LONG MEADOW VENTURES, ONE KNOLL NORTH DRIVE, SUITE 502, COLUMBIA, MARYLAND

PROJECT: LONG MEADOW SECTION ONE LOTS 1 THRU 65

AREA: TAX MAP 119 266 PARCEL 119 266 ELECTION DISTRICT 6 HOWARD COUNTY, MARYLAND

TITLE: DRAINAGE AREA MAP (S-86-37)

THE RIEMER GROUP, INC.
 The Riemer Group, Inc. A Land Planning, Design & Civil Engineering Firm
 3105 Health Park Drive, Ellicott City, Maryland 21043 (301) 461-2660

DESIGNED BY LJD
 DRAWN BY DAM
 PROJECT NO 2300
 DATE JULY 31, 1986
 SCALE 1" = 100'
 DRAWING NO 7 OF 10

POND CONSTRUCTION SPECIFICATIONS

SITE PREPARATION

Areas under the borrow areas, embankment, and structural works shall be cleared, grubbed and the topsoil stripped to remove all trees, vegetation, roots or other objectionable material. Channel banks and sharp breaks shall be sloped to no steeper than 1:1.

Areas covered by the pond or reservoir will be cleared of all trees, brush, logs, fences, rubbish and other objectionable material unless otherwise designated on the plans. Trees, brush and stumps shall be cut approximately level with the ground surface.

All cleared and grubbed material shall be disposed of outside the limits of the dam and reservoir as directed by the owner or his representative. When specified, a sufficient quantity of topsoil will be stockpiled in a suitable location for use on the embankment and other designated areas.

EARTH FILL

The fill material shall be taken from approved designated borrow area or areas. It shall be free of roots, stumps, wood, rubbish, oversize stones, frozen or other objectionable materials. The embankment shall be constructed to an elevation which provides for anticipated settlement to the design elevation. The fill height all along the length of the embankment shall be increased above the design elevation (including freeboard) as shown on the plans.

Areas on which fill is to be placed shall be scarified prior to placement of fill. Fill materials shall be placed in 8-inch maximum thickness (before compaction) layers which are to be continuous over the entire length of the fill. The most porous borrow material shall be placed in the downstream portions of the embankment.

The movement of the hauling and spreading equipment over the fill shall be controlled so that the entire surface of each lift shall be traversed by not less than one tread track of the equipment or compaction shall be achieved by a minimum of four complete passes of a sheepsfoot, rubber tired or vibratory roller. Fill material shall contain sufficient moisture such that the required degree of compaction can be obtained with the equipment used.

Cutoff Trench

Where specified, a cutoff trench shall be excavated along or parallel to the centerline of the embankment as shown on the plans. The bottom width of the trench shall be governed by the equipment used for excavation, with the minimum width being four feet. The depth shall be at least four feet or as shown on the plans. The side slopes of the trench shall be 1 to 1 or flatter. The backfill material for the cutoff trench shall be the most impervious material available and shall be compacted with equipment or rollers to assure maximum density and minimum permeability.

STRUCTURAL BACKFILL

Backfill material shall be of the type and quality conforming to that specified for the adjoining fill material. The fill shall be placed in horizontal layers not to exceed four inches in thickness and compacted by hand tampers or other compaction equipment. The material needs to fill completely all spaces under and adjacent to the pipe. At no time during the backfilling operation shall driven equipment be allowed to operate closer than four feet, measured horizontally, to any part of a structure. Under no circumstances shall the contractor drive equipment over any part of a concrete structure or pipe unless there is a compacted fill of twenty-four inches or greater over the structure or pipe.

CORRUGATED METAL PIPE

(Steel Pipe)-This pipe and its appurtenances shall be galvanized and fully bituminous coated and shall conform to the requirements of AASHTO Specification M-100 Type A with watertight coupling bands. Any bituminous coating damaged or otherwise removed shall be replaced with cold applied bituminous coating compound.

Connections

All connections with pipes must be completely watertight. The drain pipe or barrel connection to the riser shall be welded all around when the pipe and riser are metal. Watertight coupling bands shall be used at all joints. Antiseep collars shall be connected to the pipe in such a manner as to be completely watertight.

Bedding

The pipe shall be firmly and uniformly bedded throughout its entire length. Where rock or soft, spongy or other unstable soil is encountered, all such material shall be removed and replaced with suitable earth compacted to provide adequate support.

Concrete

1. Cement - Normal Portland cement shall conform to the latest ASTM Specification C-150.
2. Water - The water used in concrete shall be clean, free from oil, acid, alkali, scales, organic matter or other objectionable substances.
3. Sand - The sand used in concrete shall be clean, hard, strong and durable, and shall be well graded with 100 percent passing a one-quarter inch sieve. Limestone sand shall not be used.
4. Course Aggregate - The coarse aggregate shall be clean, hard, strong and durable, and free from clay or dirt. It shall be well graded with a maximum size of one and one-half (1-1/2) inches.
5. Reinforcing Steel - The reinforcing steel shall be deformed bars of intermediate grade billet steel or rail steel conforming to ASTM Specification A-615.

Design Mix

The concrete shall be mixed in the following proportions, measured by weight. The water-cement ratio shall be 2.4 to 6 U.S. gallons of water per 94 pound bag of cement. The proportion of materials for the trial mix shall be 1:2:3.5. The combination of aggregates may be adjusted to produce a plastic and workable mix that will not produce harshness in placing or honeycombing in the structure.

Mixing

The concrete ingredients shall be mixed in batch mixers until the mixture is homogeneous and of uniform consistency. The mixing of each batch shall continue for not less than one and one-half minutes after all the ingredients, except the full amount of water, are in the mixer. The minimum mixing time is predicted on proper control of the speed of rotation of the mixer and of the introduction of the material, including water, into the mixer. Water shall be added prior to, during, and following the mixer-charging operations. Excessive overmixing requiring the addition of water to preserve the required concrete consistency shall not be permitted. Truck mixing will be allowed provided that the use of this method shall cause no violation of any applicable provisions of the specifications given here.

Placing Temperature

Concrete may not be placed at temperatures below 37° F with the temperature falling or 34° with the temperature rising.

Stabilization

All borrow areas shall be graded to provide proper drainage and left in a slightly condition. All exposed surfaces of the embankment, spillway, spoil and borrow areas, and berms shall be stabilized by seeding, fertilizing and mulching (if required) in accordance with the vegetative treatment specifications shown on or accompanying the drawings.

Forms

The forms shall have sufficient strength and rigidity to hold the concrete and to stand the necessary pressure, tamping, and vibration without deflection from the prescribed lines. They shall be mortar-tight and constructed so that they can be removed without hammering or prying against the concrete.

The inside of forms shall be oiled with a non-staining mineral oil or thoroughly wetted before concrete is placed. Forms may be removed 24 hours after the placement of concrete. All wire ties and other devices used shall be recessed from the surface of the concrete.

Reinforcing Steel

All reinforcing material shall be free of dirt, rust, scale, oil, paint or other coatings. The steel shall be accurately placed and securely tied and blocked into position so that no movement of the steel will occur during placement of concrete.

Consolidation

Concrete shall be consolidated with internal type mechanical vibrators. Vibration shall be supplemented by spading and hand tamping as necessary to insure smooth and dense concrete along form surfaces, in corners, and around embedded items.

Finishing

Defective concrete, honeycombed areas, voids left by the removal of tie rods, ridges on all concrete surfaces permanently exposed to view or exposed to water on the finished structure, shall be repaired immediately after the removal of forms. All voids shall be reamed and completely filled with dry-patching mortar.

Protection and Curing


Exposed surfaces of concrete shall be protected from the direct rays of the sun for at least the first three (3) days. All concrete shall be kept continuously moist for at least ten (10) days after being placed. Moisture may be applied by spraying or sprinkling as necessary to prevent the concrete from drying. Concrete shall not be exposed to freezing during the curing period. Curing compounds may also be used.

Placing Temperature


Concrete may not be placed at temperatures below 37° F with the temperature falling or 34° with the temperature rising.

Stabilization

All borrow areas shall be graded to provide proper drainage and left in a slightly condition. All exposed surfaces of the embankment, spillway, spoil and borrow areas, and berms shall be stabilized by seeding, fertilizing and mulching (if required) in accordance with the vegetative treatment specifications shown on or accompanying the drawings.

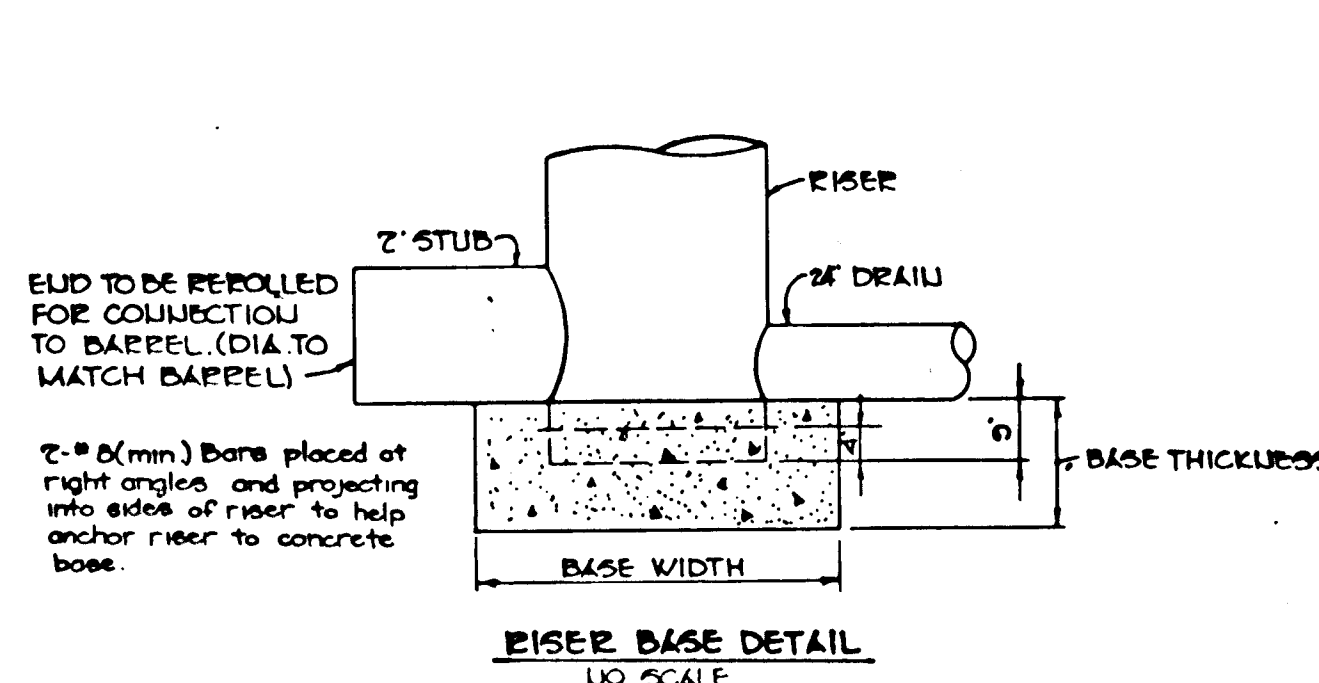


NOTE: The concrete base shall be poured in such a manner to insure that the concrete fills the bottom of the riser to the invert of the cutoff pipe to prevent the riser from breaking away from the base.

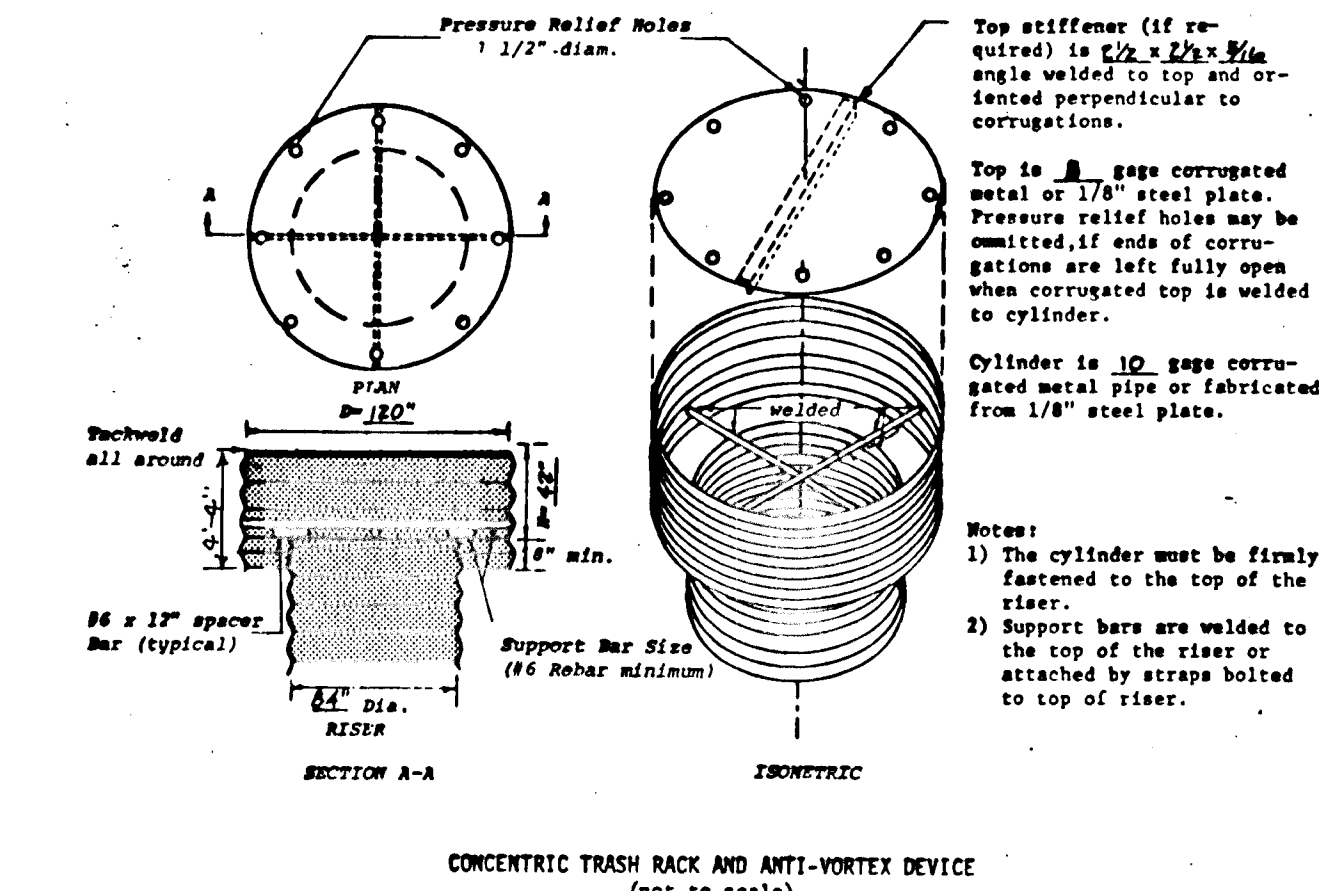

RISER DETAIL FOR SEDIMENT BASIN

NO SCALE

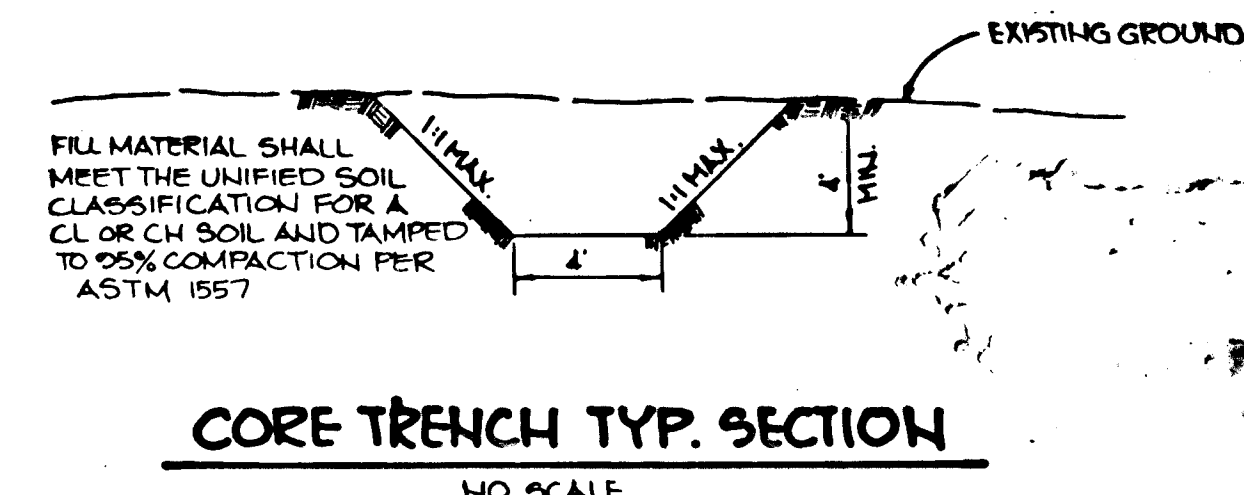

CORE TRENCH TYP. SECTION

NO SCALE

BY THE DEVELOPER:
 "I CERTIFY THAT ALL DEVELOPMENT AND/OR CONSTRUCTION WILL BE DONE ACCORDING TO THESE PLANS, AND THAT ANY RESPONSIBLE PERSONNEL INVOLVED IN THE CONSTRUCTION PROJECT WILL HAVE A CERTIFICATE OF ATTENDANCE AT A DEPARTMENT OF NATURAL RESOURCES APPROVED TRAINING PROGRAM FOR THE CONTROL OF SEDIMENT AND EROSION BEFORE BEGINNING THE PROJECT. I WILL PROVIDE THE HOWARD SOIL CONSERVATION DISTRICT WITH AN 'AS-BUILT' PLAN OF THE POND WITHIN 30 DAYS OF COMPLETION."
 DEVELOPER: *Earl Armiger* DATE: 9-4-86

BY THE ENGINEER:
 "I CERTIFY THAT THIS PLAN FOR POND CONSTRUCTION, EROSION AND SEDIMENT CONTROL REPRESENTS A PRACTICAL AND WORKABLE PLAN BASED ON MY PERSONAL KNOWLEDGE OF THE SITE CONDITIONS. THIS PLAN WAS PREPARED IN ACCORDANCE WITH THE REQUIREMENTS OF THE HOWARD SOIL CONSERVATION DISTRICT. I HAVE NOTIFIED THE DEVELOPER THAT HE MUST PROVIDE THE HOWARD SOIL CONSERVATION DISTRICT WITH AN 'AS-BUILT' PLAN OF THE POND WITHIN 30 DAYS OF COMPLETION."
 ENGINEER: *Arthur E. Muegge* DATE: 9-4-86

THESE PLANS HAVE BEEN REVIEWED FOR THE HOWARD SOIL CONSERVATION DISTRICT AND MEET THE TECHNICAL REQUIREMENTS FOR SMALL POND CONSTRUCTION, SOIL EROSION AND SEDIMENT CONTROL.

U.S. SOIL CONSERVATION SERVICE DATE: 9-9-86

THESE PLANS FOR SMALL POND CONSTRUCTION, SOIL EROSION AND SEDIMENT CONTROL MEET THE REQUIREMENTS OF THE HOWARD SOIL CONSERVATION DISTRICT.

APPROVED: *Robert W. Zuber* DATE: 9-9-86
 HOWARD S.C.D.

APPROVED: HOWARD COUNTY OFFICE OF PLANNING AND ZONING
 CHIEF, DIVISION OF LAND DEVELOPMENT AND ZONING ADMINISTRATION DATE: 9-9-86

APPROVED: HOWARD COUNTY DEPARTMENT OF PUBLIC WORKS
 CHIEF, BUREAU OF ENGINEERING DATE: 9-11-86


DATE	NO.	REVISION

PROJECT: **LONG MEADOW**
 SECTION ONE
 LOTS 1 THRU 65
 AREA TAX MAP NO 36 PARCEL NO 203
 6TH ELECTION DISTRICT
 HOWARD COUNTY, MARYLAND

TITLE: **STORM WATER MANAGEMENT DETAILS AND NOTES**

THE RIEMER GROUP, INC.
 The Riemer Group, Inc. A Land Planning, Design & Civil Engineering Firm
 3106 Heath Park Drive, Ellicott City, Maryland 21043 (301) 481-2600

DESIGNED BY: L.J.D.
 DRAWN BY: DAK
 PROJECT NO: 23000
 DATE: JULY 31, 1986
 SCALE: AS SHOWN
 DRAWING NO. 10 OF 10

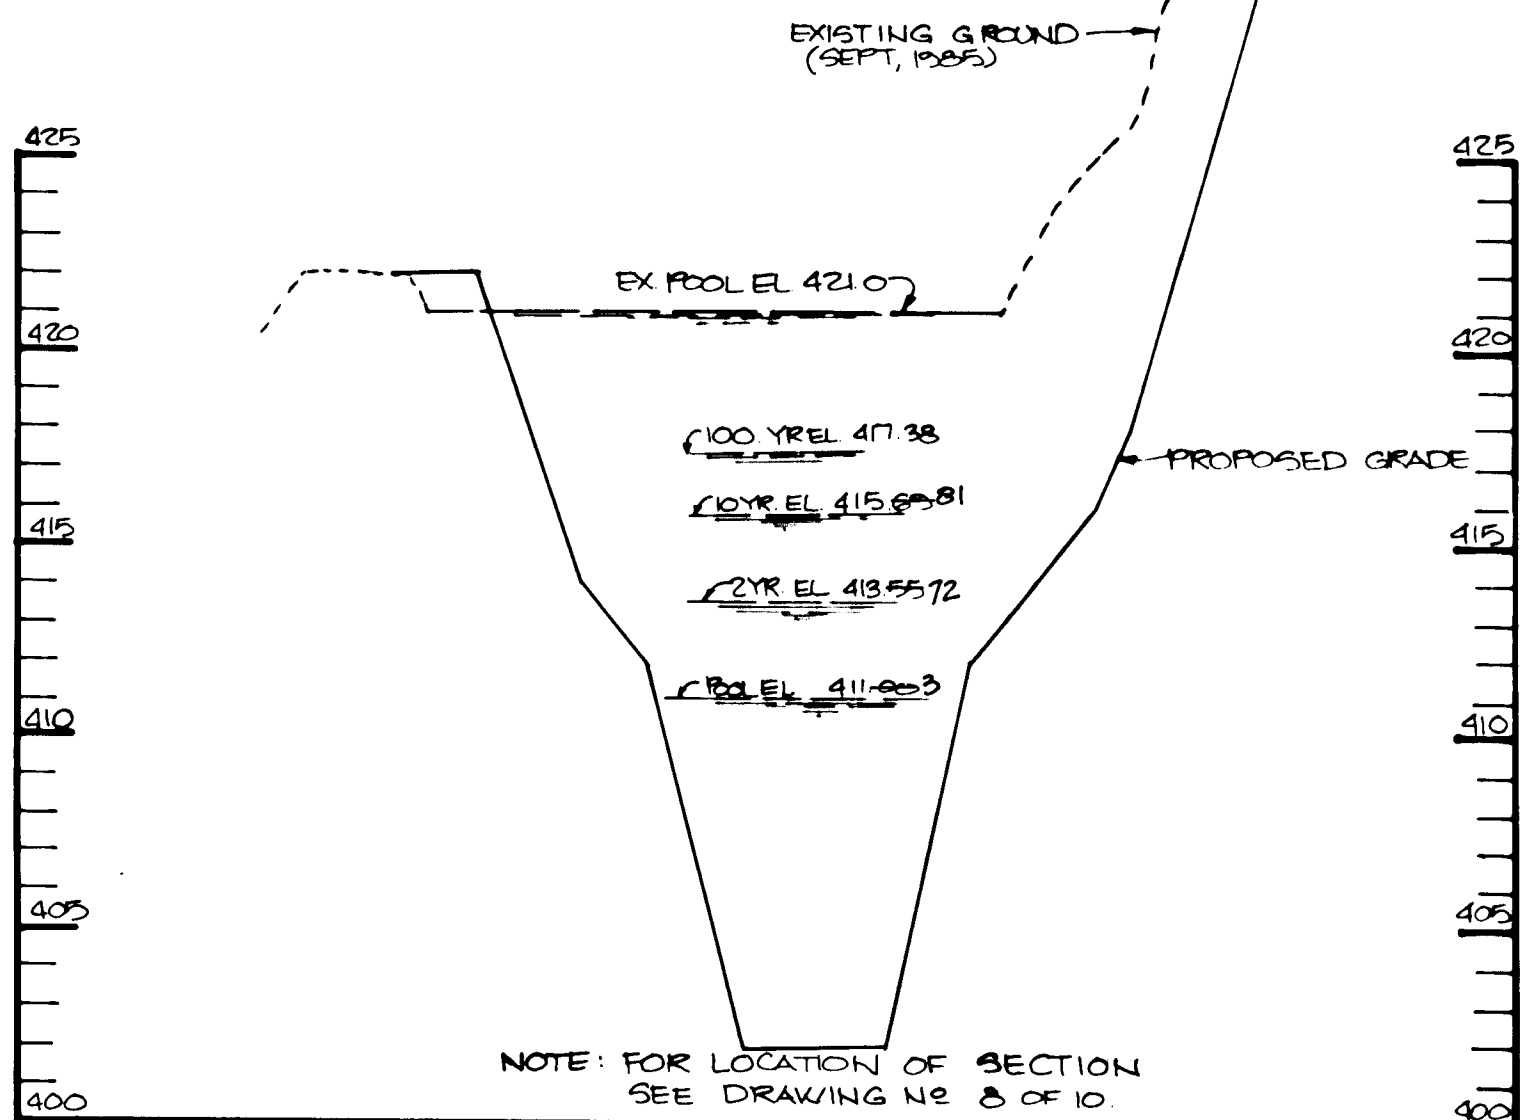


STORM WATER MANAGEMENT FACILITY SECTION A-A

HORIZ: 1"=50'
 VERT: 1"=5'

DEPTH	SOIL TYPE	DEPTH	SOIL TYPE
0	BROWN SANDY CLAYED SILT	0	GRAY SANDY CLAYEY SILT W/ GRAVEL (ML)(A)
2.0	LIGHT GRAY SANDY SILT	2.0	GRAY SILTY SAND W/ GRAVEL (SM)(A)
4.0	REDDISH BROWN SANDY SILT W/ MICA (ML)(R)	5.0	BROWN SILTY SAND (WEATHERED ROCK) (SM)(R)
14.0	BROWN/LIGHT GRAY SANDY SILT W/ MICA (ML)(R)	11.0	BORING LOG


BORING LOGS

NO SCALE

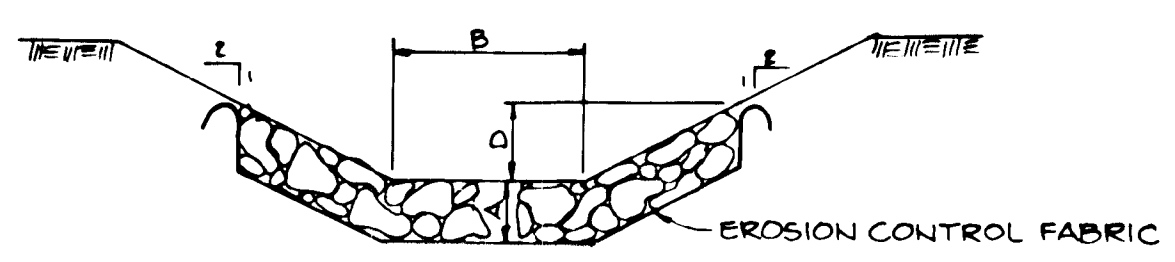


TYPICAL RIPRAP TRAPEZOIDAL CHANNEL

NO SCALE

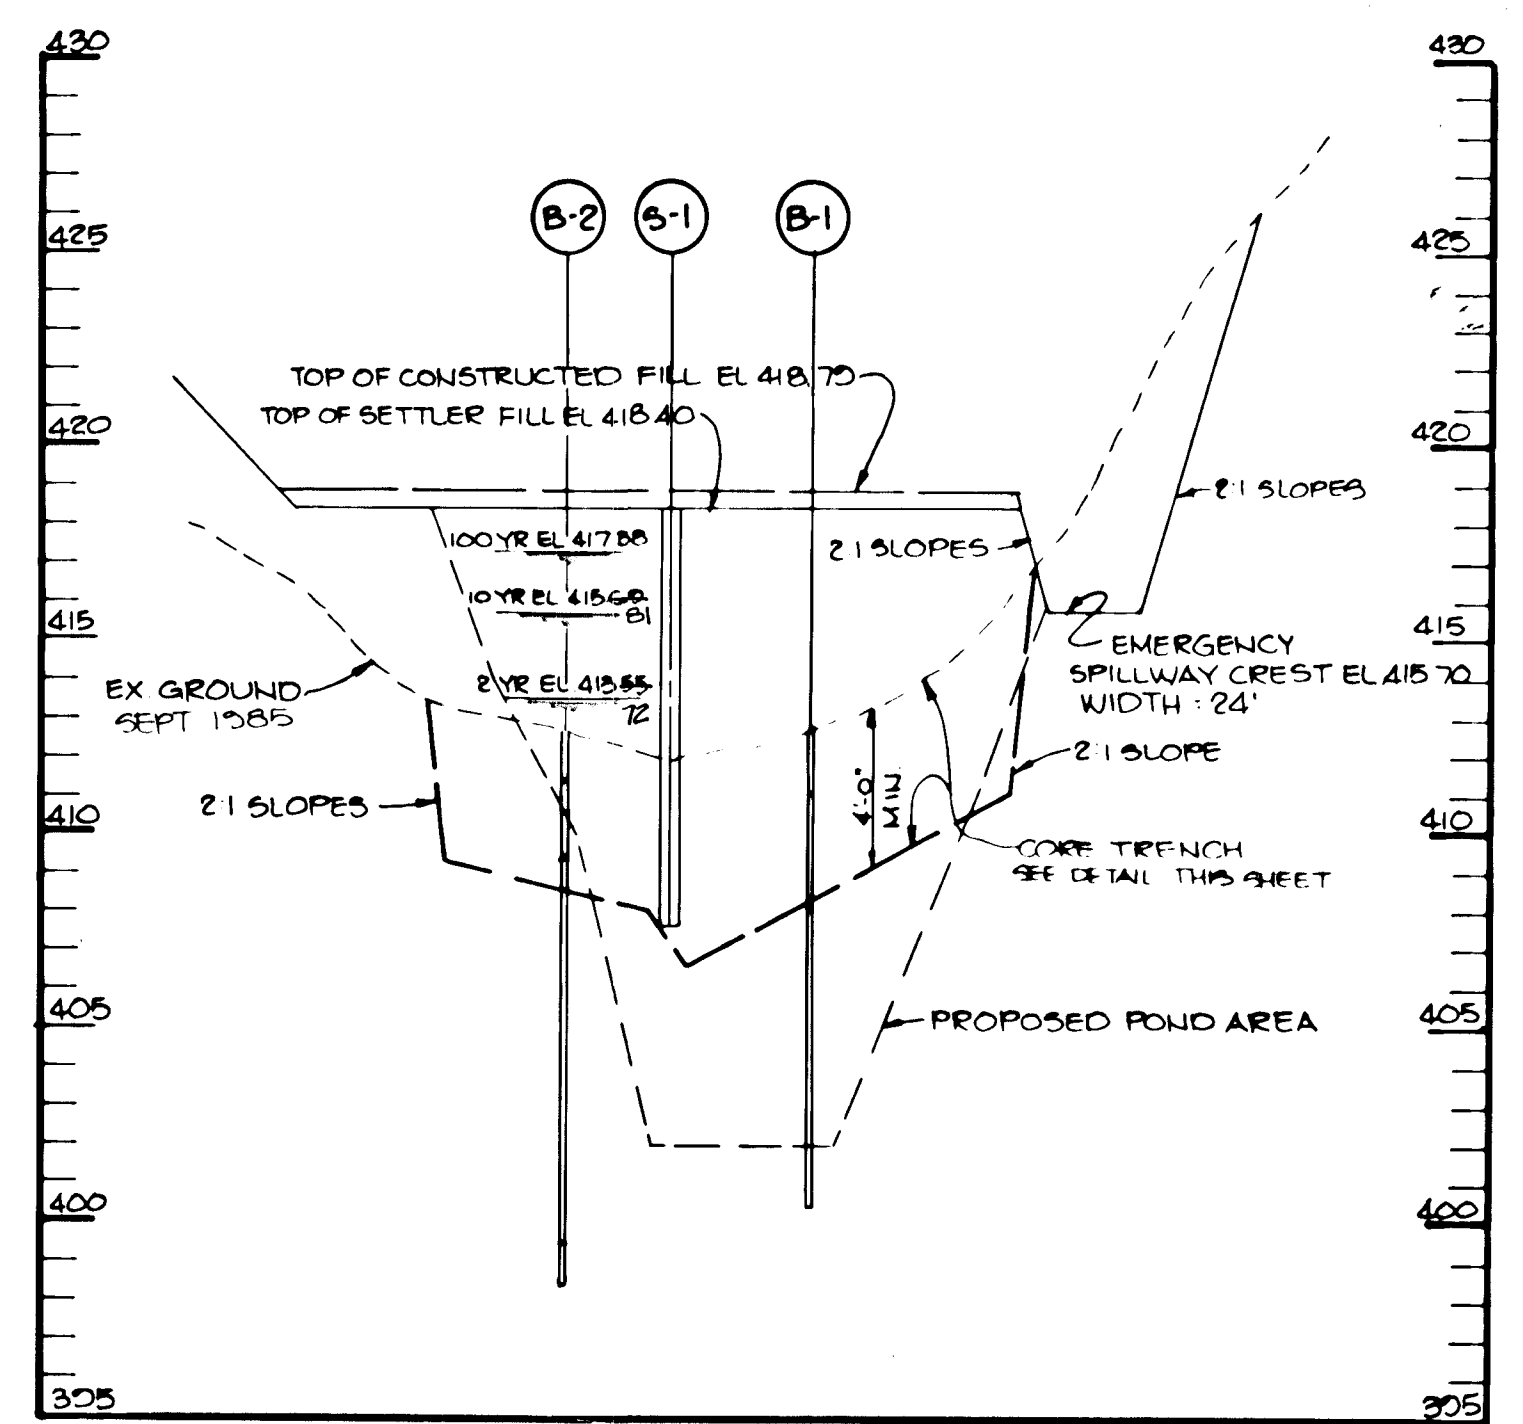


PROFILE ALONG DAM FOR SWMF

SCALE HOR: 1"=50' VERT: 1"=5'

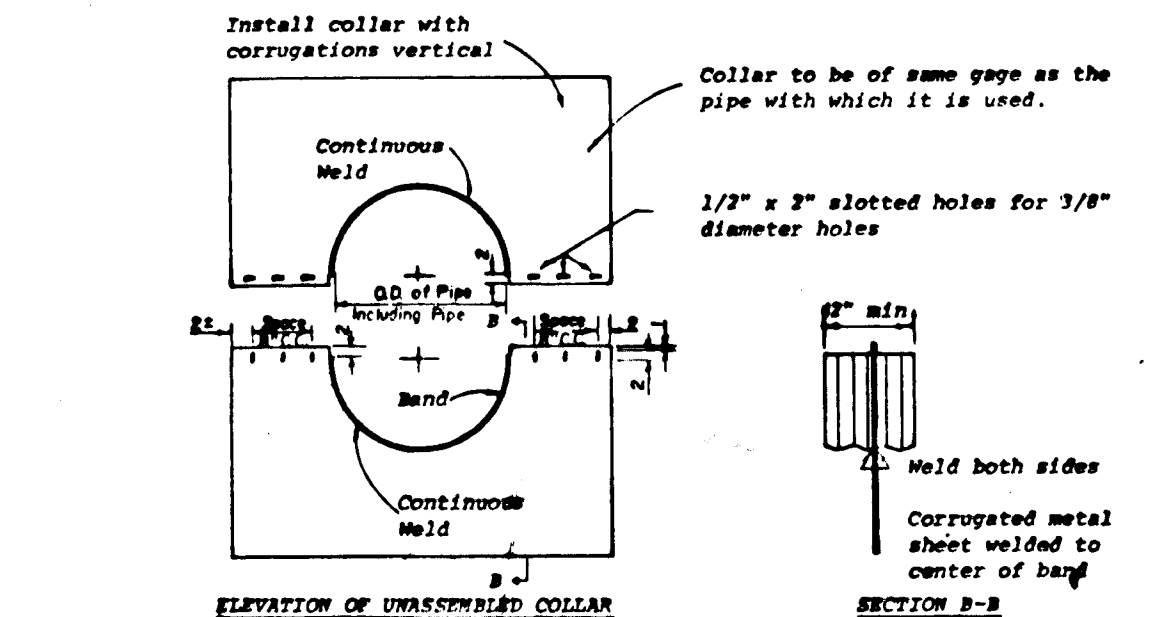

1. All materials to be in accordance with construction and construction material specifications.
2. When specified on the plans, coating of collars shall be in accordance with construction and construction material specifications.
3. Disassembled collars shall be marked by painting or tagging to identify matching pairs.
4. The lap between the two half sections and between the pipe and connecting band shall be caulked with asphalt mastic at time of installation.
5. Each collar shall be furnished with two 1/2" diameter rods with standard tank lugs for connecting collars to pipe.

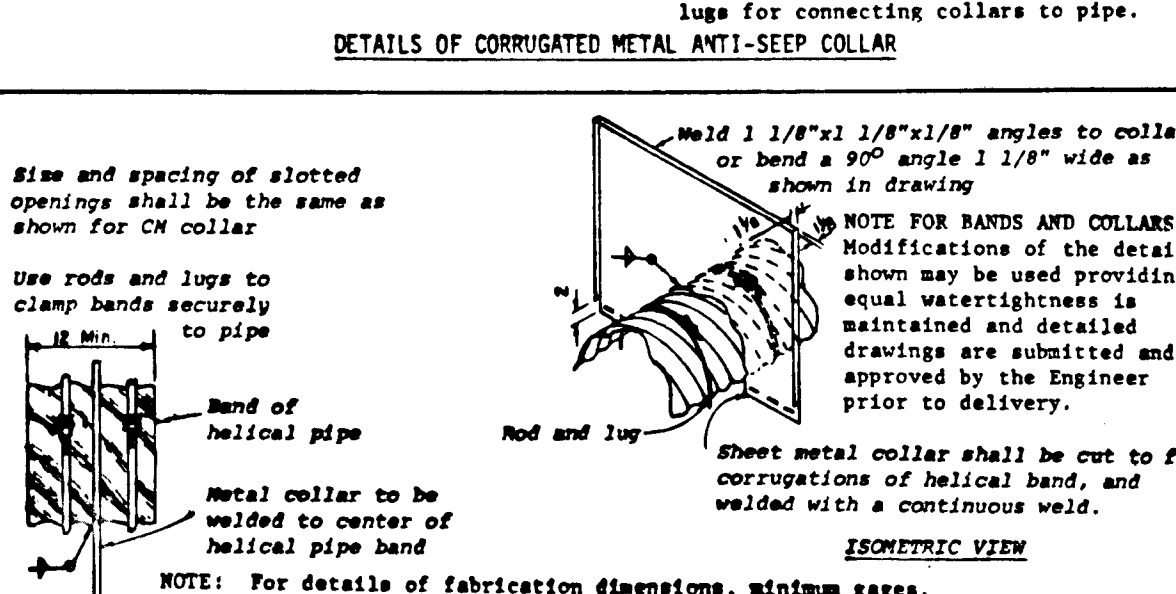

1. Corrugated metal, similar to upper detail, except shop welded to a short (4 ft.) section of the pipe and connected with connecting bands to the pipe.
2. Concrete, six inches thick formed around the pipe with #3 rebar spaced 15" horizontally and vertically.

ANTI-SEEP COLLAR

NO SCALE

12360