

SHEET INDEX	
NO.	DESCRIPTION
1	TITLE SHEET
2	PLAN OF RED APPLE LANE, LUMBERJACK ROW, RED RAIN PATH WINDBEAT WAY AND VOLLMEHHAUSEN DRIVE
3	ROAD PROFILES
4	ROAD PROFILES
5	DETAILS AND STORM DRAIN PROFILES
6	DRAINAGE AREA MAP
7	GRADING, SEDIMENT CONTROL, AND S.W.M. PLAN
8	SEDIMENT CONTROL & S.W.M. NOTES AND DETAILS
9	S.W.M. SPECIFICATIONS AND DETAILS
10	STREET TREE PLAN


# ROADWAY, STORM DRAIN & STORM WATER MANAGEMENT

# HUNTINGTON SOUTH

## SECTION 1, AREA 1

## 6TH ELECTION DISTRICT

## HOWARD COUNTY, MARYLAND

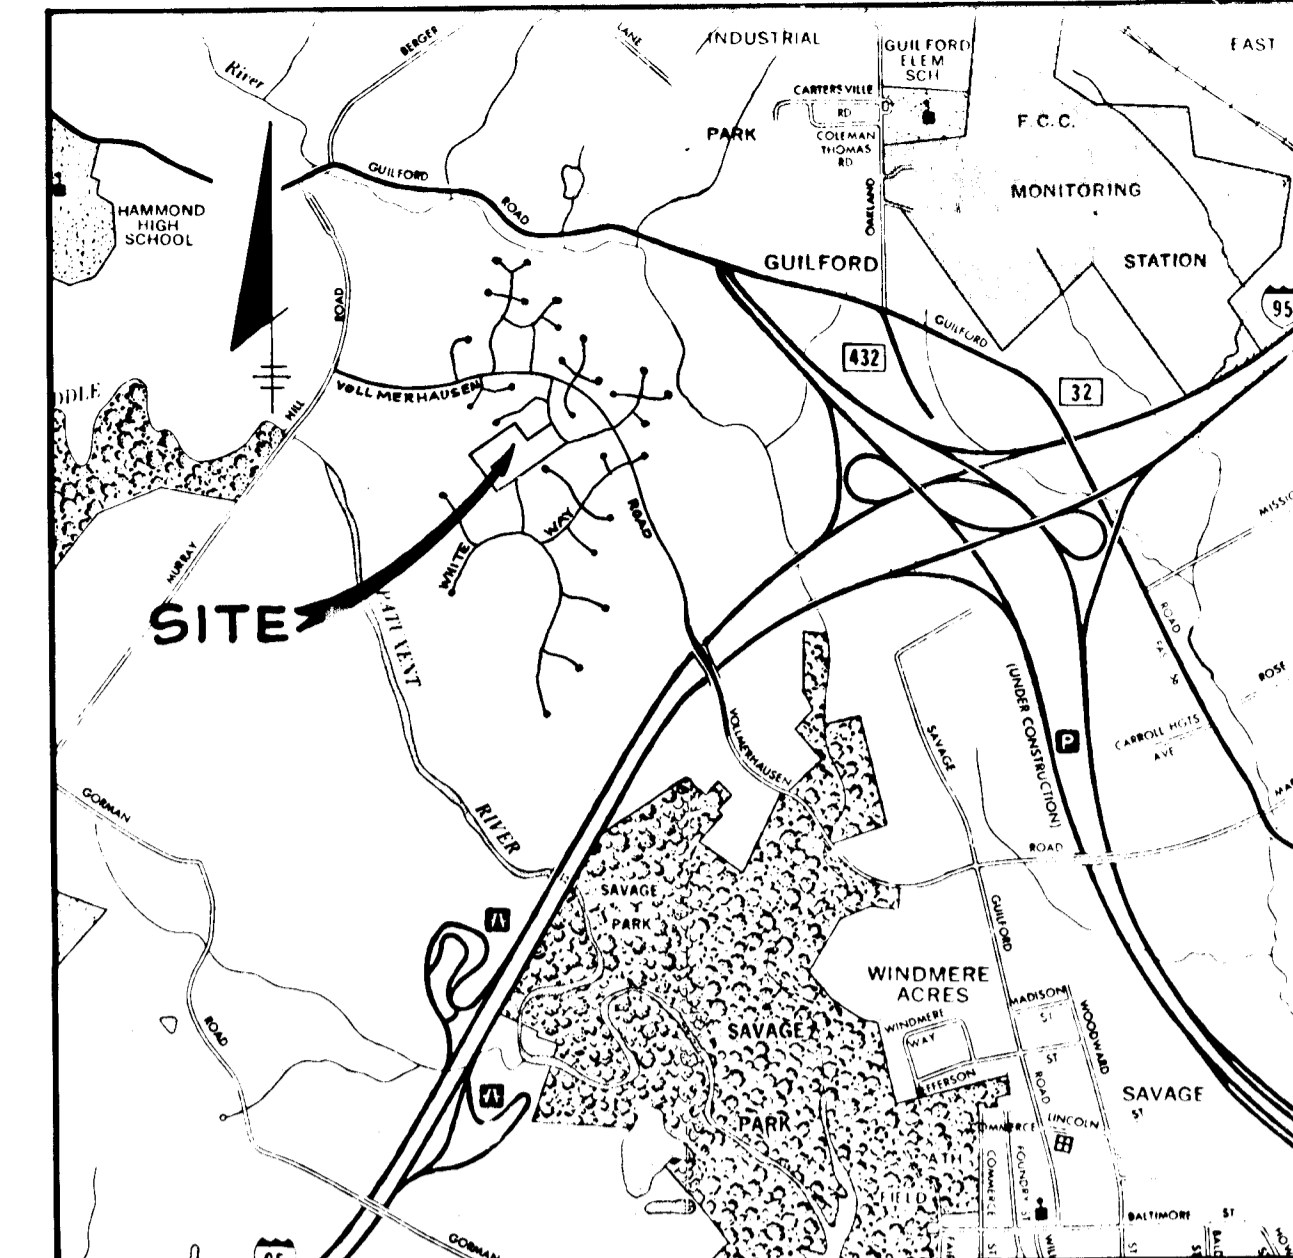


**VICINITY MAP**  
SCALE 1"=2000'

**GENERAL NOTES**

- ALL WORK SHALL BE PERFORMED IN ACCORDANCE WITH THE HOWARD COUNTY DESIGN MANUAL, VOLUME IV, STANDARD SPECIFICATIONS AND DETAILS FOR ROAD CONSTRUCTION.
- APPROXIMATE LOCATION OF EXISTING UTILITIES ARE SHOWN. THE CONTRACTOR SHALL TAKE ALL NECESSARY PRECAUTIONS TO PROTECT THE EXISTING UTILITIES AND MAINTAIN UNINTERRUPTED SERVICE. ANY DAMAGE INCURRED DUE TO CONTRACTOR'S OPERATION SHALL BE REPAIRED IMMEDIATELY AT THE CONTRACTOR'S EXPENSE.
- THE CONTRACTOR SHALL TEST PIT EXISTING UTILITIES, WHERE DIRECTED BY THE ENGINEER, A MINIMUM OF TWO WEEKS IN ADVANCE OF CONSTRUCTION OPERATIONS.
- CONTRACTOR TO NOTIFY THE FOLLOWING UTILITIES AT LEAST THREE DAYS BEFORE STARTING WORK SHOWN ON THESE DRAWINGS.

BELL TELEPHONE SYSTEM	393-3649
LONG DISTANCE CABLE DIVISION	393-3553 OR 3554
BALTIMORE GAS AND ELECTRIC	539-8000 EXT. 691
HOWARD COUNTY BUREAU OF UTILITIES	992-2366
HOWARD COUNTY CONSTRUCTION INSPECTION SURVEY DIVISION	992-2417/2418
- ALL INLETS SHALL BE CONSTRUCTED IN ACCORDANCE WITH HOWARD COUNTY STANDARDS.
- ALL STREET CURB RETURNS SHALL HAVE 20.0' RADII UNLESS OTHERWISE NOTED.
- STORM DRAIN TRENCHES WITHIN ROAD RIGHT OF WAY SHALL BE BACKFILLED AND COMPACTED IN ACCORDANCE WITH HOWARD COUNTY ROAD CODE.
- INSTALLATION OF TRAFFIC CONTROL DEVICES, MARKING AND SIGNING SHALL BE IN ACCORDANCE WITH THE MANUAL OF UNIFORM TRAFFIC CONTROL DEVICES 1978 EDITION.
- PIPE SHALL NOT BE INSTALLED BY THE CONTRACTOR UNTIL THE LENGTH CALLED FOR AT EACH STATION HAS BEEN APPROVED BY THE ENGINEER IN THE FIELD.
- DESIGNED TRAFFIC SPEED IN ACCORDANCE WITH THE AMERICAN ASSOCIATION OF STATE HIGHWAY OFFICIAL STANDARDS:  
ALL CUL-DE-SAC DESIGNED FOR 30 M.P.H., ALL LOCAL STREETS DESIGNED FOR 30 M.P.H.
- ALL ELEVATIONS SHOWN ARE BASED ON U.S.C. AND G.S. MEAN SEA LEVEL DATUM 1929.
- ALL FILL AREAS WITHIN ROADWAYS AND UNDER STRUCTURES TO BE COMPACTED TO A MINIMUM 95% OF MAXIMUM OBTAINABLE DENSITY DETERMINED BY MARSHALL PROCTOR.
- ALL PIPE ELEVATIONS SHOWN ARE INVERT ELEVATIONS.
- PROFILE STATIONS SHALL BE ADJUSTED AS NECESSARY TO CONFORM TO PLAN DIMENSIONS.
- SUBJECT PROPERTY ZONED R-SC PER 8-2-85 COMPREHENSIVE ZONING PLAN.
- ALL TOPO TAKEN FROM FIELD RUN SURVEY BY SHANABERGER AND LANE DATED JANUARY, 1986.

NOTE: ORIGIN OF COORDINATES COORDINATES SHOWN HEREON ARE BASED UPON TRAVERSE CONTROLS FOR COLUMBIA ESTABLISHED BY MAPS, INC. IN 1965 AND PURDUM AND JESCHKE IN 1966, WHICH CONTROLS WERE TIED TO THE MARYLAND BUREAU OF CONTROL SURVEY MONUMENTS AND TO U.S. COAST AND GEODETIC SURVEY MONUMENTS IN THE COLUMBIA AREA.

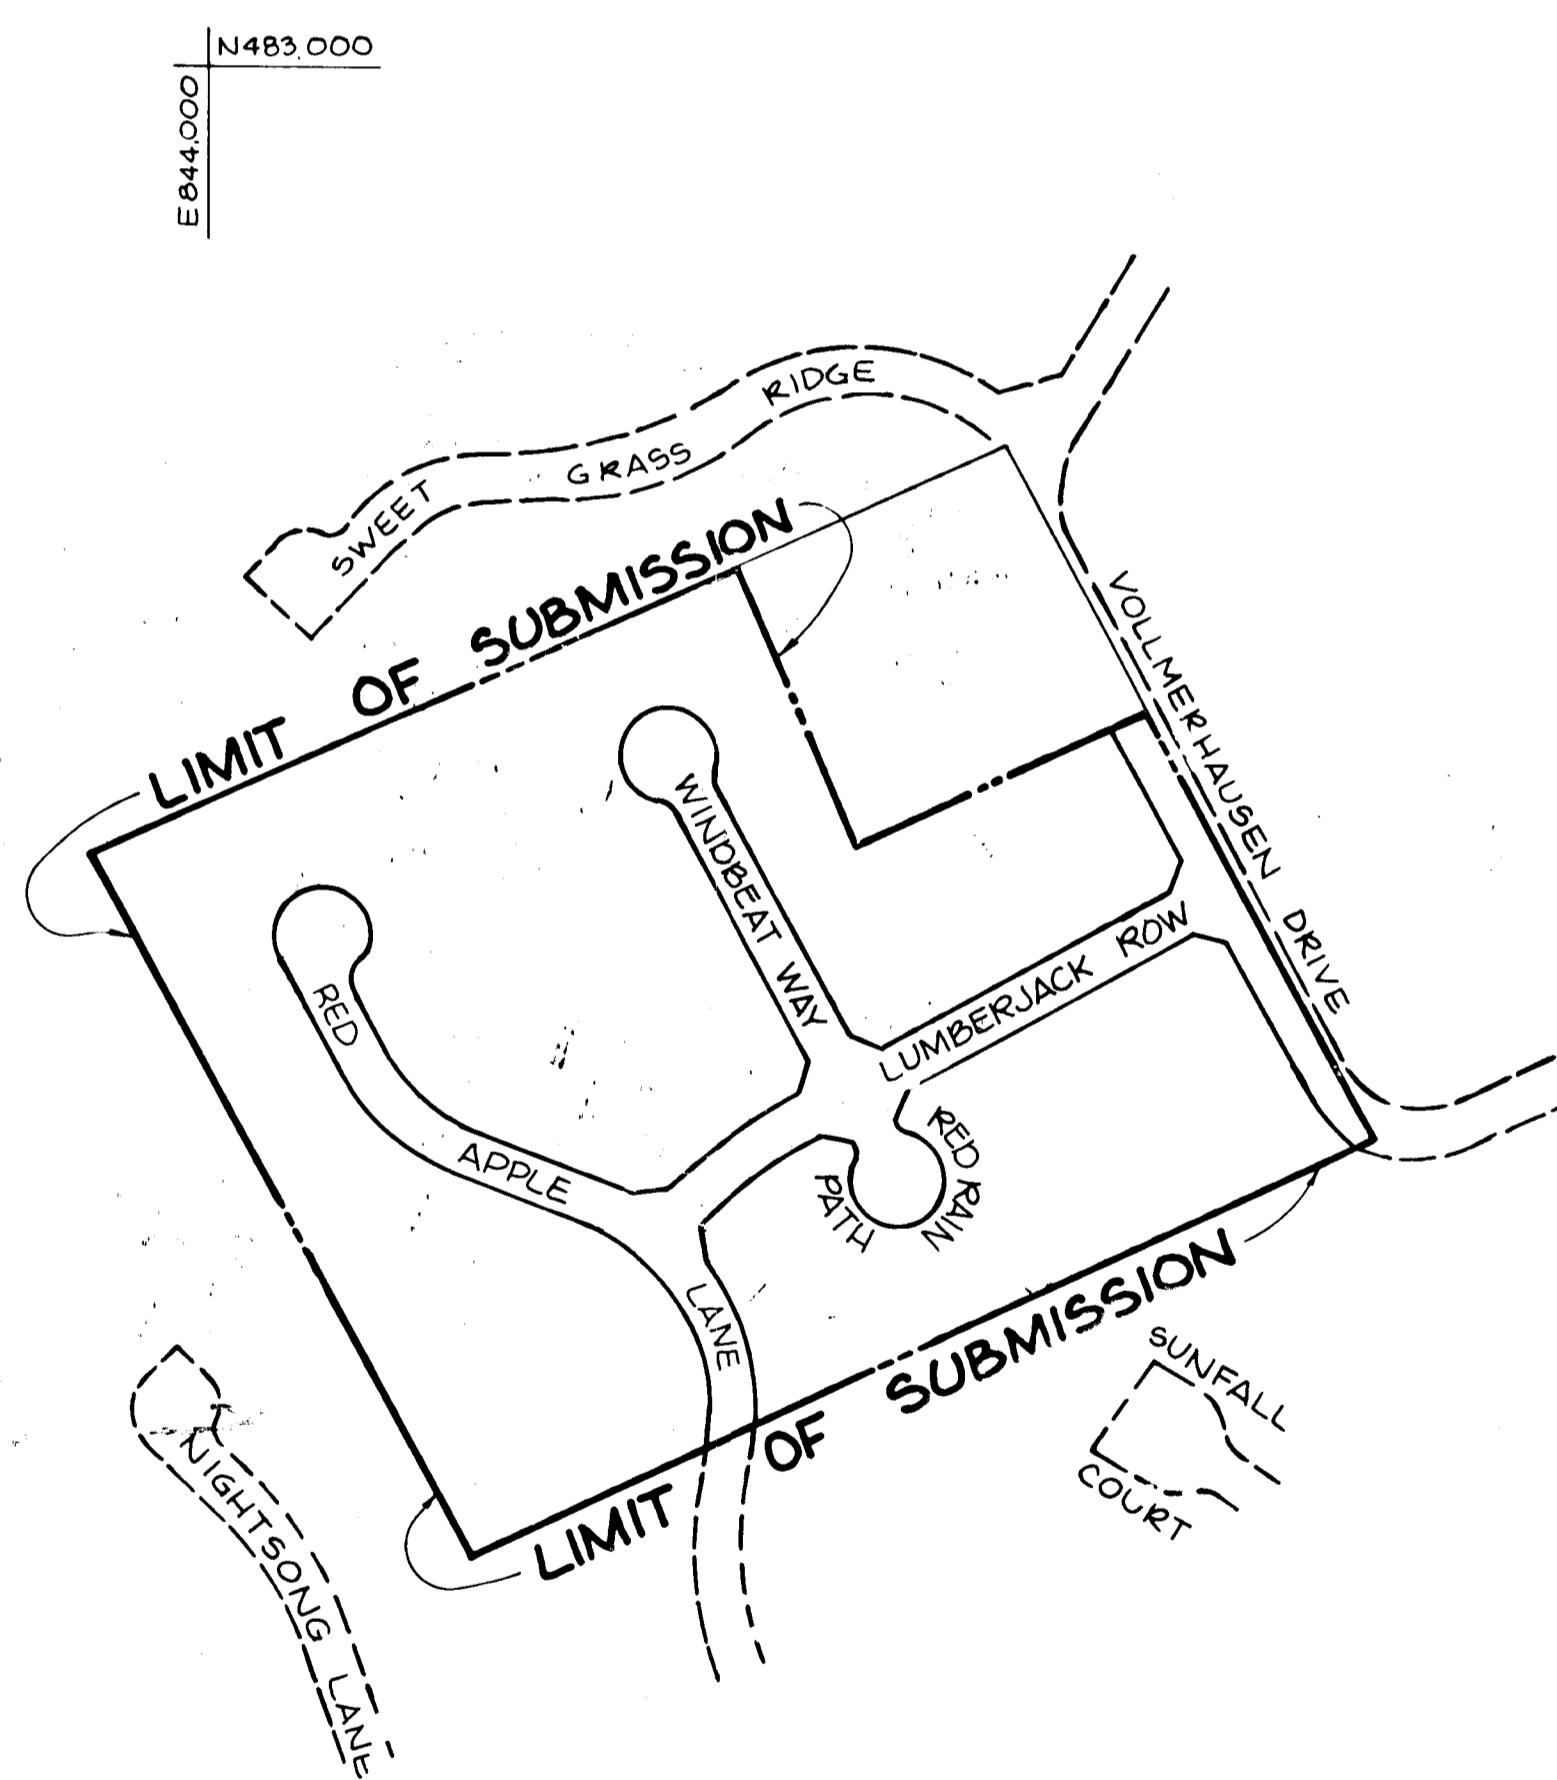


**PLAN**  
SCALE 1"=200'

APPROVED: HOWARD COUNTY OFFICE OF PLANNING AND ZONING <i>John M. ...</i> 10-23-86 CHIEF, DIVISION OF LAND DEVELOPMENT AND ZONING ADMINISTRATION DATE		
APPROVED: HOWARD COUNTY DEPARTMENT OF PUBLIC WORKS <i>...</i> 10-23-86 CHIEF, BUREAU OF ENGINEERING DATE		
NO.	DATE	REVISION
TRACY, SCHULTE & ASSOCIATES INC. planning • architecture • engineering 8450 Baltimore National Pike • Suite 34 • Ellicott City, Maryland 21043 • (301) 465-6105		
OWNER SECURITY DEVELOPMENT CORP 8450 BALTIMORE NATIONAL PIKE ELLCOTT CITY, MARYLAND 21043		PROJECT <b>HUNTINGTON SOUTH</b> SECTION 1 AREA 1 LOTS 1 THRU 66
DEVELOPER SECURITY DEVELOPMENT CORP 8450 BALTIMORE NATIONAL PIKE ELLCOTT CITY, MARYLAND 21043		LOCATION 6 <sup>TH</sup> ELECTION DISTRICT HOWARD COUNTY, MD TAX MAP NO 42 ZONING MAP NO 42 PARCEL 87
DES. R.J.W.		DRN. C.D.T.
DATE JUNE 19, 1986		PROJECT NO 8506 R&D
SCALE 1"=200'		DRAWING 1 OF 10

F-86-227 AS-BUILT 12-1-88

1235



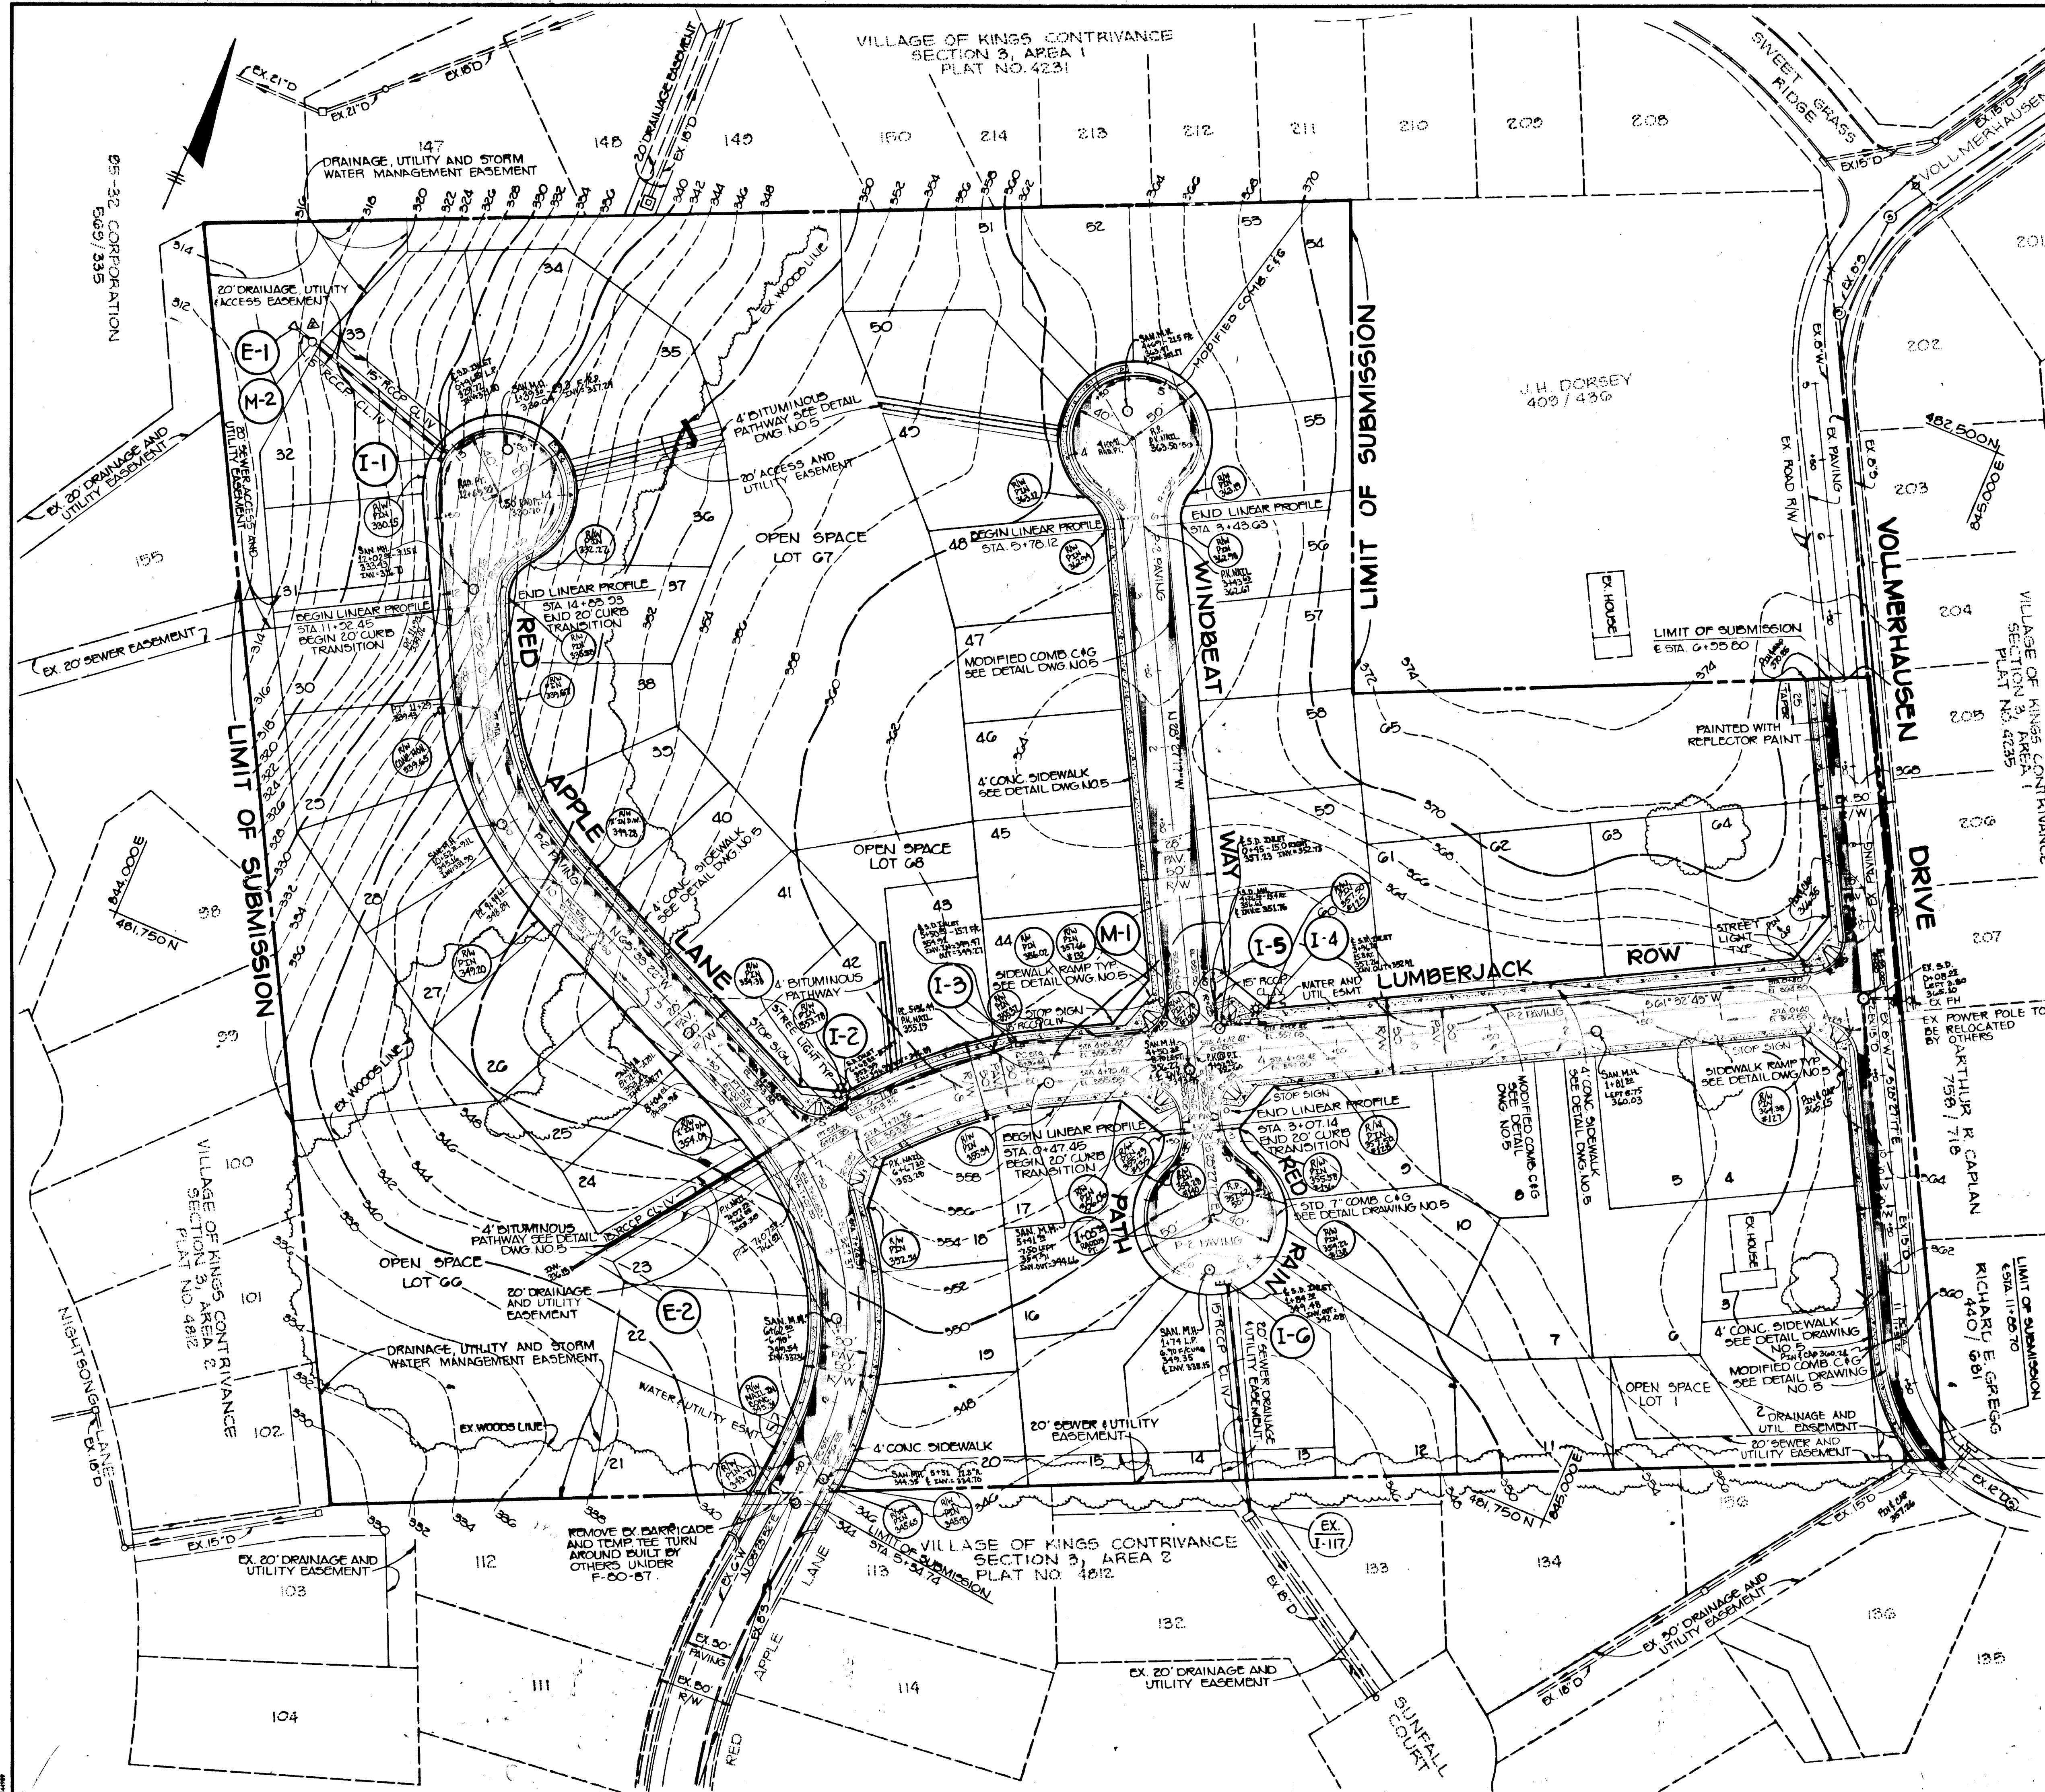


**€ CURVE DATA RED APPLE LANE**  
 € STA. 5+50.22 TO € STA. 3+04.01  
 $\Delta = 70^\circ 57' 14''$   
 $R = 200.00'$   
 $L = 247.68'$   
 $T = 142.54'$   
 $D = 28^\circ 36' 52''$   
 $Chd = N 30^\circ 04' 45'' W, 232.15'$

**€ CURVE DATA RED APPLE LANE**  
 € STA. 5+50.61 TO € STA. 11+28.48  
 $\Delta = 56^\circ 55' 12''$   
 $R = 200.00'$   
 $L = 128.08'$   
 $T = 66.77'$   
 $D = 28^\circ 36' 52''$   
 $Chd = N 47^\circ 05' 46'' W, 126.05'$

**€ CURVE DATA VOLLMERHAUSEN DRIVE**  
 € STA. 11+35.22 TO € STA. 11+65.70  
 $\Delta = 31^\circ 47' 16''$   
 $R = 100.00'$   
 $L = 55.45'$   
 $T = 28.47'$   
 $D = 57^\circ 17' 45''$   
 $Chd = S 44^\circ 20' 58'' E, 54.77'$

**€ CURVE DATA LUMBERJACK DRIVE**  
 € STA. 5+50.44 TO € STA. 0+07.20  
 $\Delta = 25^\circ 0' 55''$   
 $R = 300.00'$   
 $L = 150.55'$   
 $T = 66.65'$   
 $D = 15^\circ 05' 55''$   
 $Chd = S 45^\circ 02' 27'' W, 125.91'$

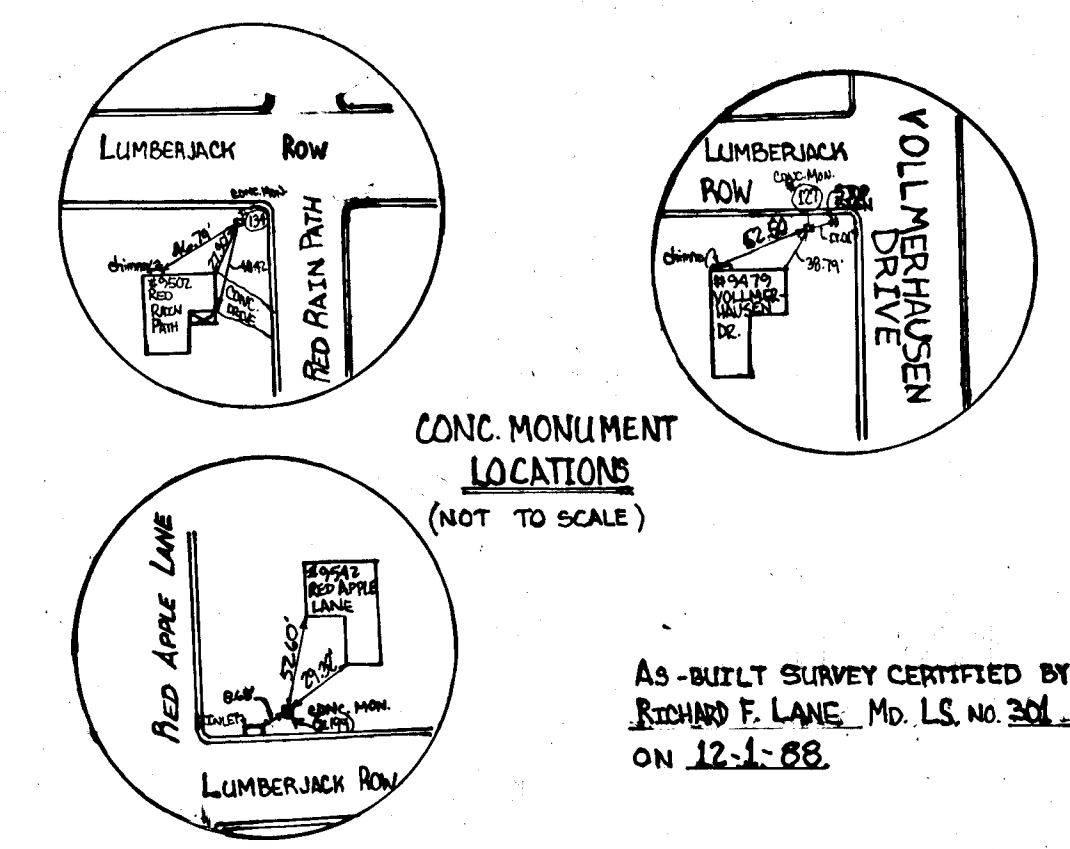

AS-BUILT SURVEY CERTIFIED BY  
 RICHARD E. LANE, Md. L.S. No. 3011  
 ON 12-1-88

STRUCTURE SCHEDULE

NO.	TYPE	LOCATION	INV IN	INV OUT	TOP ELEV	DESCRIPTION
I-1	A-10	LP STA 12+88.50 RED APPLE LANE	----	321.76	329.86	HO CO STD SD 4.02
I-2	A-5 W/DEFL	15' RT STA 6+83.58 LUMBERJACK ROW	346.84	346.84	353.39	HO CO STD SD 4.01
I-3	A-5 W/DEFL	15' RT STA 5+48.38 LUMBERJACK ROW	349.36	349.36	354.86	HO CO STD SD 4.01
I-4	A-10	15' RT STA 3+32.82 LUMBERJACK ROW	----	352.70	357.24	HO CO STD SD 4.02
I-5	A-10 W/DEFL	14' RT STA 0+45.50 WINDBEAT WAY	----	352.79	357.83	HO CO STD SD 4.02
I-6	A-5	LP STA 1+73.82 RED RAIN PATH	----	342.37	349.89	HO CO STD SD 4.01
M-1	4" DIA MANHOLE	15' RT STA 4+26.88 LUMBERJACK ROW	15"D(N)351.89 15"D(E)351.89	351.64	356.75	HO CO STD G 5.12
E-1	15" CONC END SECTION	122' LT LP STA 12+88.50 RED APPLE LANE	----	309.88	----	HO CO STD SD 5.52
E-2	18" CONC END SECTION	150' LT STA 7+77 RED APPLE LANE	----	336.08	----	HO CO STD SD 5.52
M-2	4" DIA MANHOLE	110' LT LP STA 12+88.50 RED APPLE LANE	311.76	311.56	ADJUST IN FIELD	HO CO STD G 5.12

ALL STORM DRAIN PIPE BEDDING SHALL BE CLASS 'C'

APPROVED: HOWARD COUNTY DEPARTMENT OF PUBLIC WORKS

CHIEF, BUREAU OF ENGINEERING DATE 10-23-86

APPROVED: HOWARD COUNTY OFFICE OF PLANNING AND ZONING

CHIEF, DIVISION OF LAND DEVELOPMENT AND ZONING ADMINISTRATION DATE 10-23-86

4-12-89 ADDED M-2 AND REVISED STORMDRAIN FROM I-1 TO E-1.  
 4/27/87 CHANGED CURB NOTES.

NO	DATE	REVISION
1		

TRACY, SCHULTE & ASSOCIATES INC.  
 planning • architecture • engineering

8450 Baltimore National Pike • Suite 34 • Ellicott City, Maryland 21043 • (301) 465-6105

OWNER SECURITY DEVELOPMENT CORP 8450 BALTIMORE NATIONAL PIKE ELLICOTT CITY, MARYLAND 21043	PROJECT <b>HUNTINGTON SOUTH</b> SECTION 1, AREA 1, LOTS 1 THRU 60
DEVELOPER SECURITY DEVELOPMENT CORP 8450 BALTIMORE NATIONAL PIKE ELLICOTT CITY, MARYLAND 21043	LOCATION TAX MAP NO. 42 PARCEL 87 6TH ELECTION DISTRICT HOWARD COUNTY, MARYLAND
DATE JUNE 19, 1986	TITLE PLAN OF RED APPLE LANE, RED RAIN PATH, WINDBEAT WAY, LUMBERJACK ROW AND VOLLMERHAUSEN DRIVE
DES. RJW	PROJECT NO. 8506 RSD
DRN. KMN/JLB	DATE SCALE: 1" = 50'
	DRAWING 2 OF 10


12821











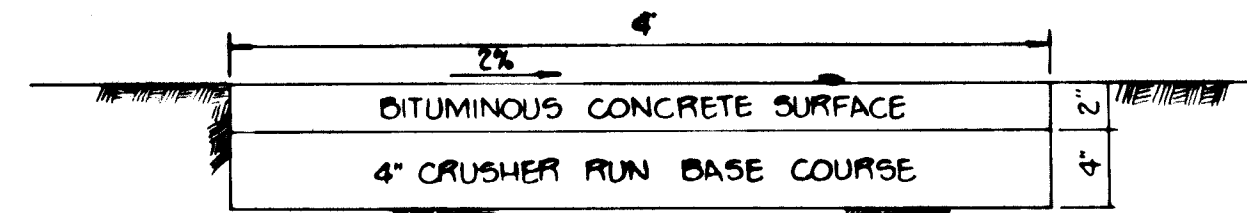

**BITUMINOUS PATHWAY DETAIL**  
NO SCALE

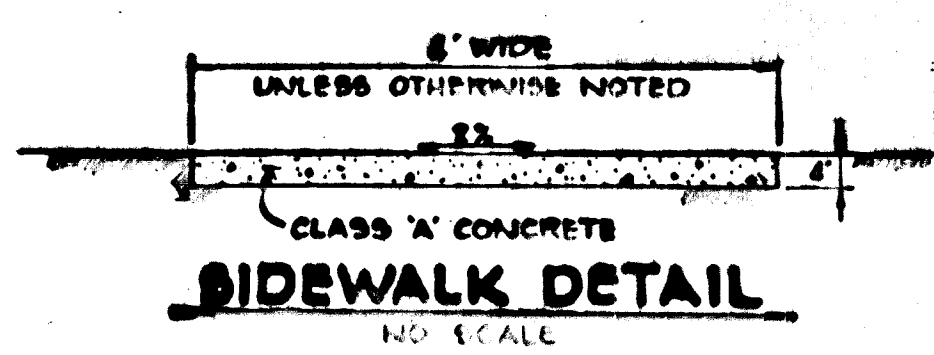


**CLASS 'A' CONCRETE SIDEWALK DETAIL**  
NO SCALE

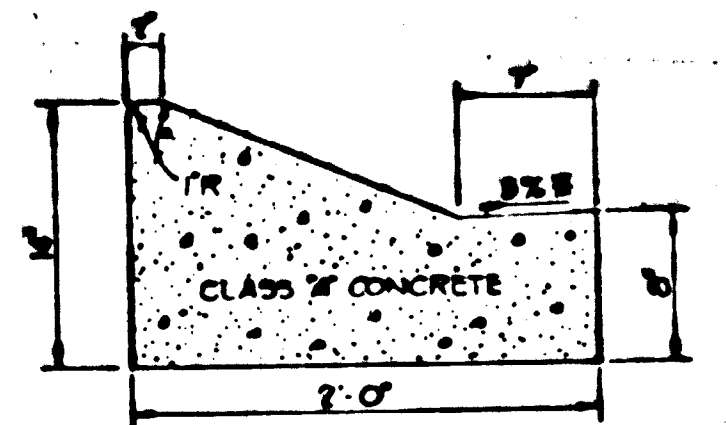


**MODIFIED COMBINATION CURB AND GUTTER**  
NO SCALE


**MODIFIED COMBINATION CURB AND GUTTER**  
No Scale

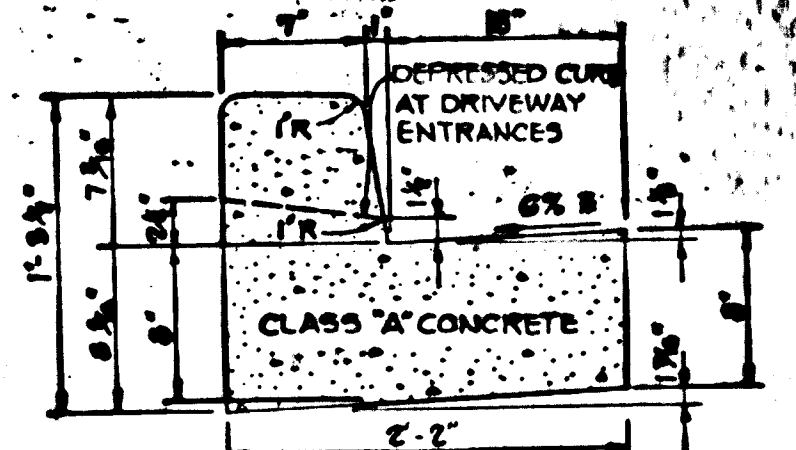


**STANDARD 7\"/>**

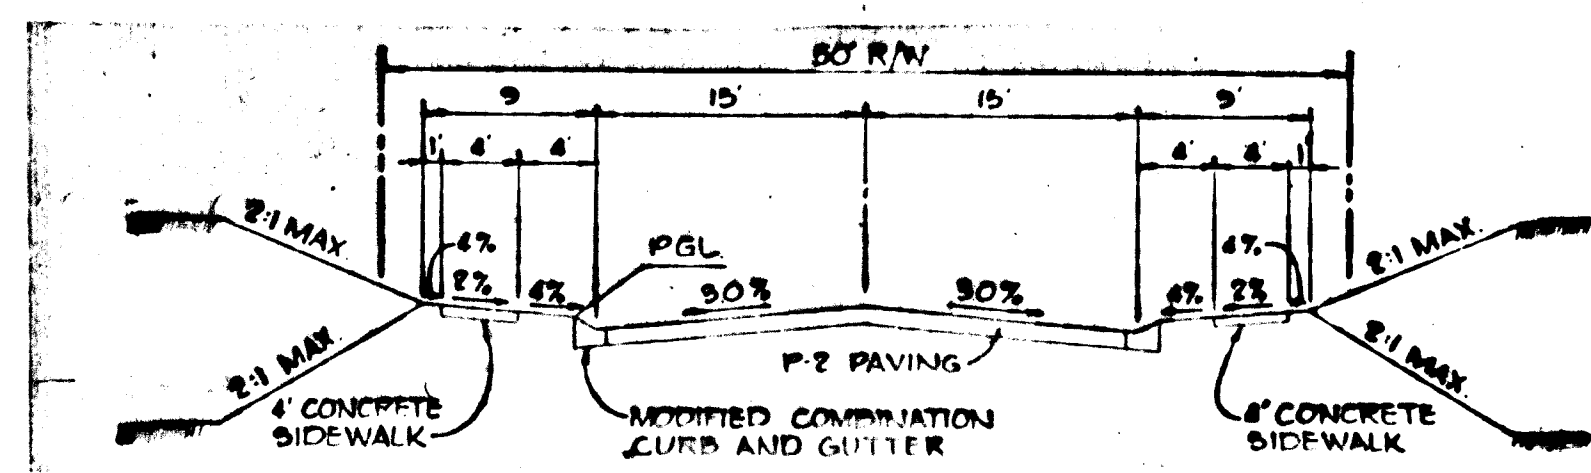



**TYPICAL SECTION**  
NO SCALE

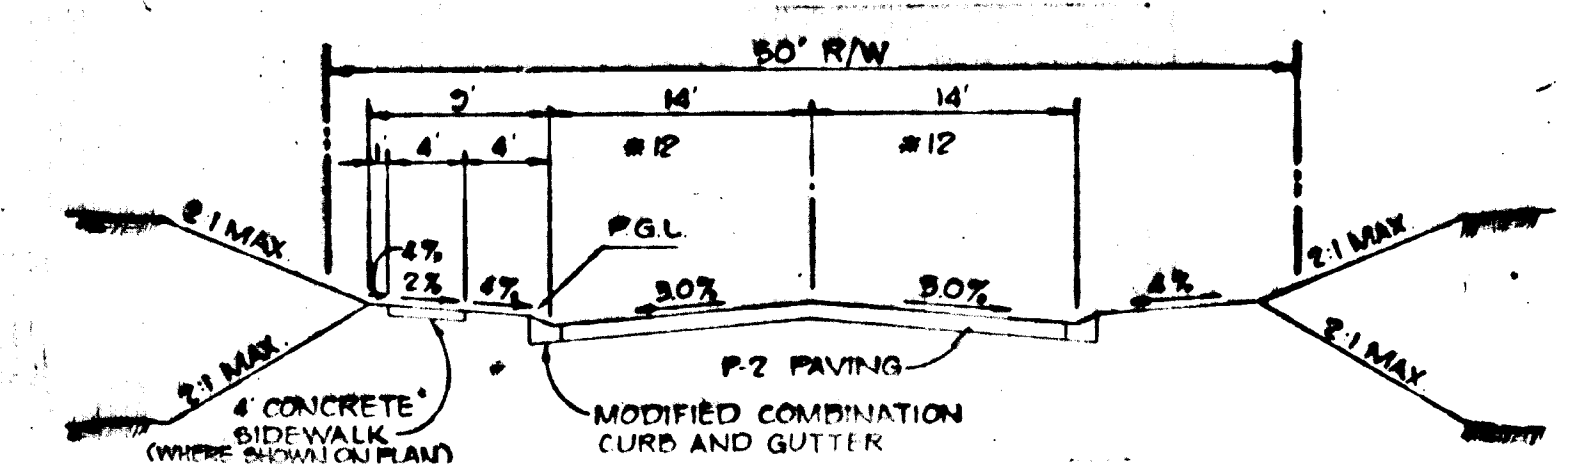

**TYPICAL SECTION**  
NO SCALE

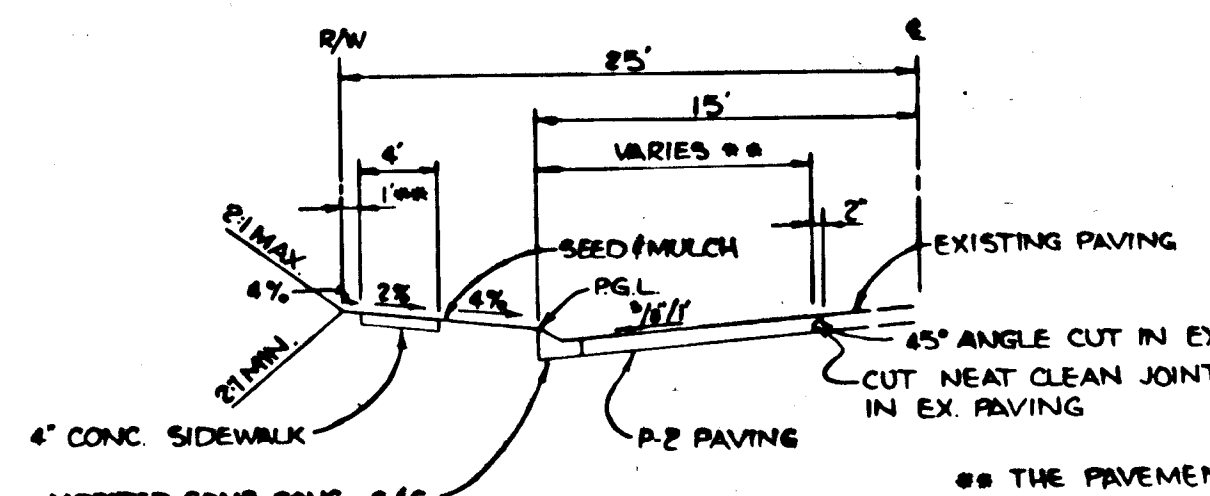




**TYPICAL HALF SECTION VOLLMERHAUSEN DRIVE**  
NO SCALE

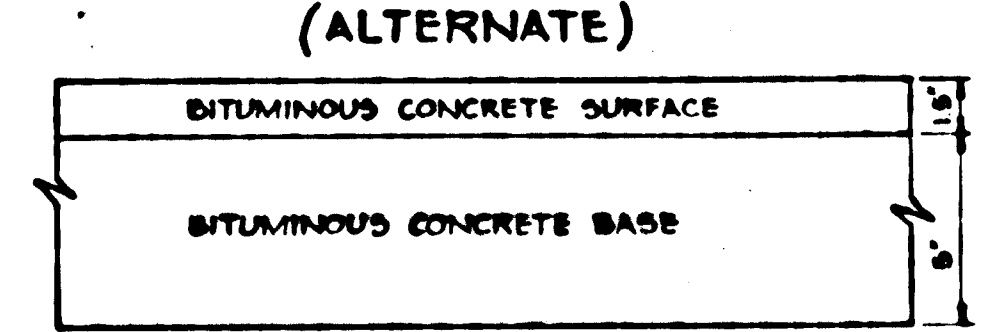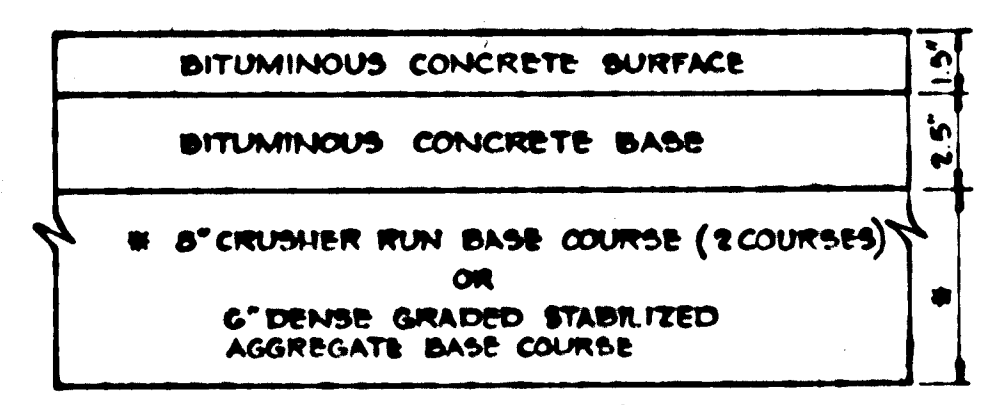

**HOWARD COUNTY DESIGN MANUAL VOLUME IV STANDARD SPECIFICATIONS AND DETAILS FOR CONSTRUCTION (DRAWING R-2.01)**


VOLLMERHAUSEN DRIVE  
LUMBERJACK ROW  
RED RAIN PATH  
WINDBEAT WAY  
RED APPLE LANE

**6 1/2\"/>**

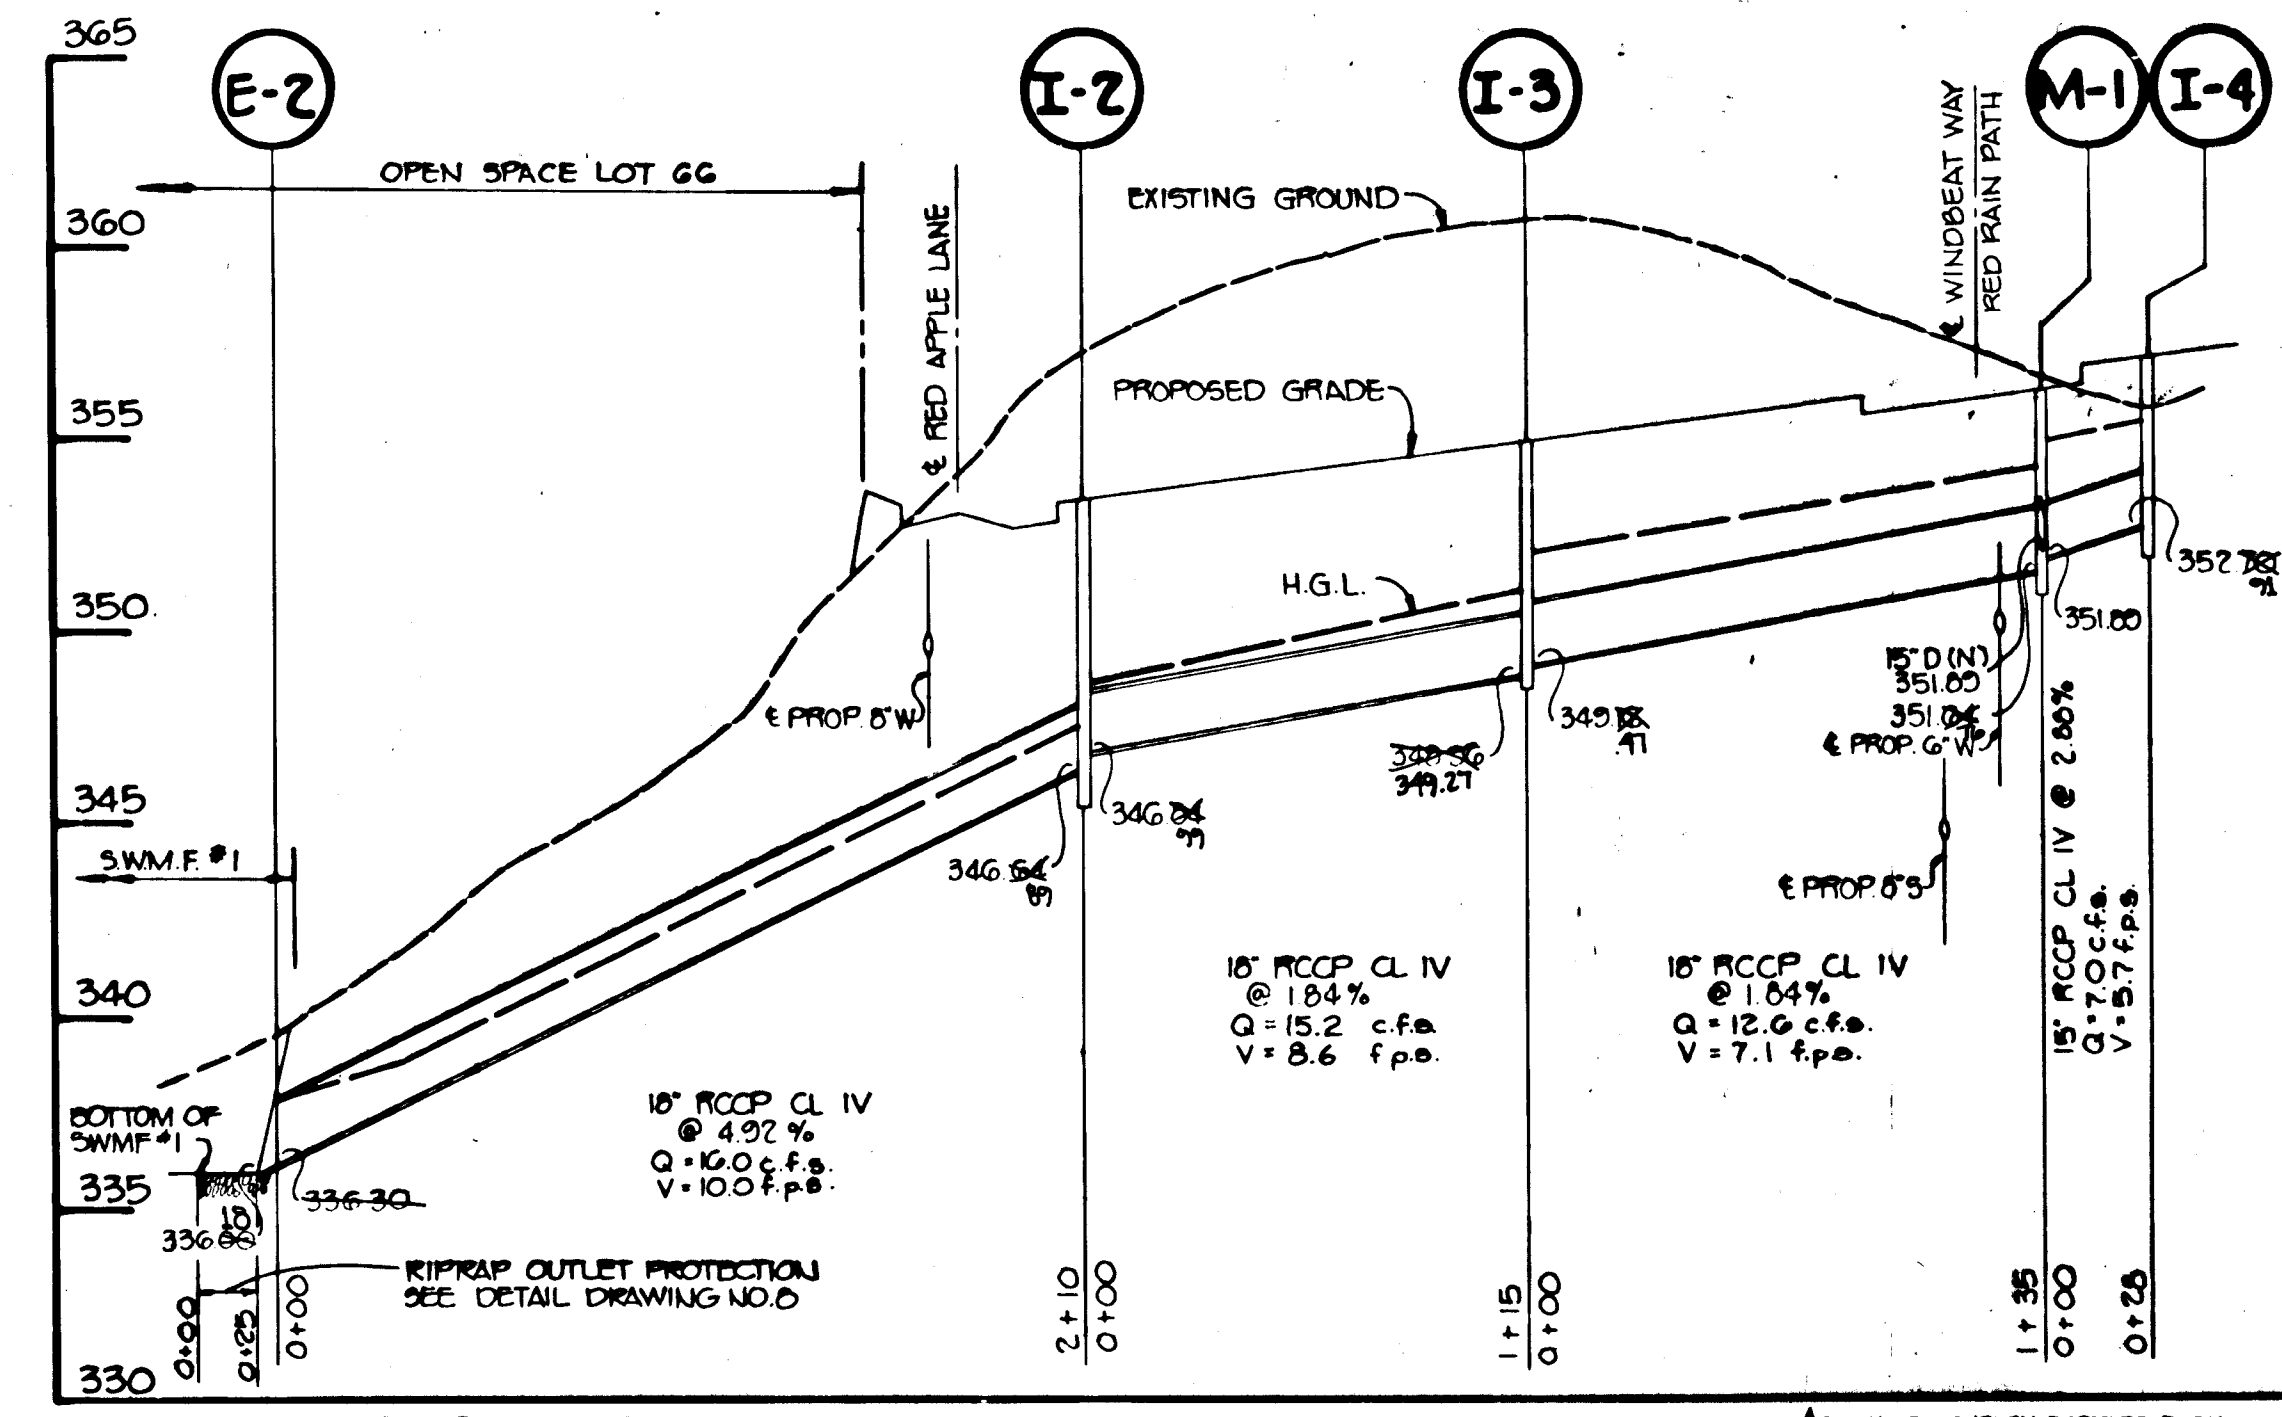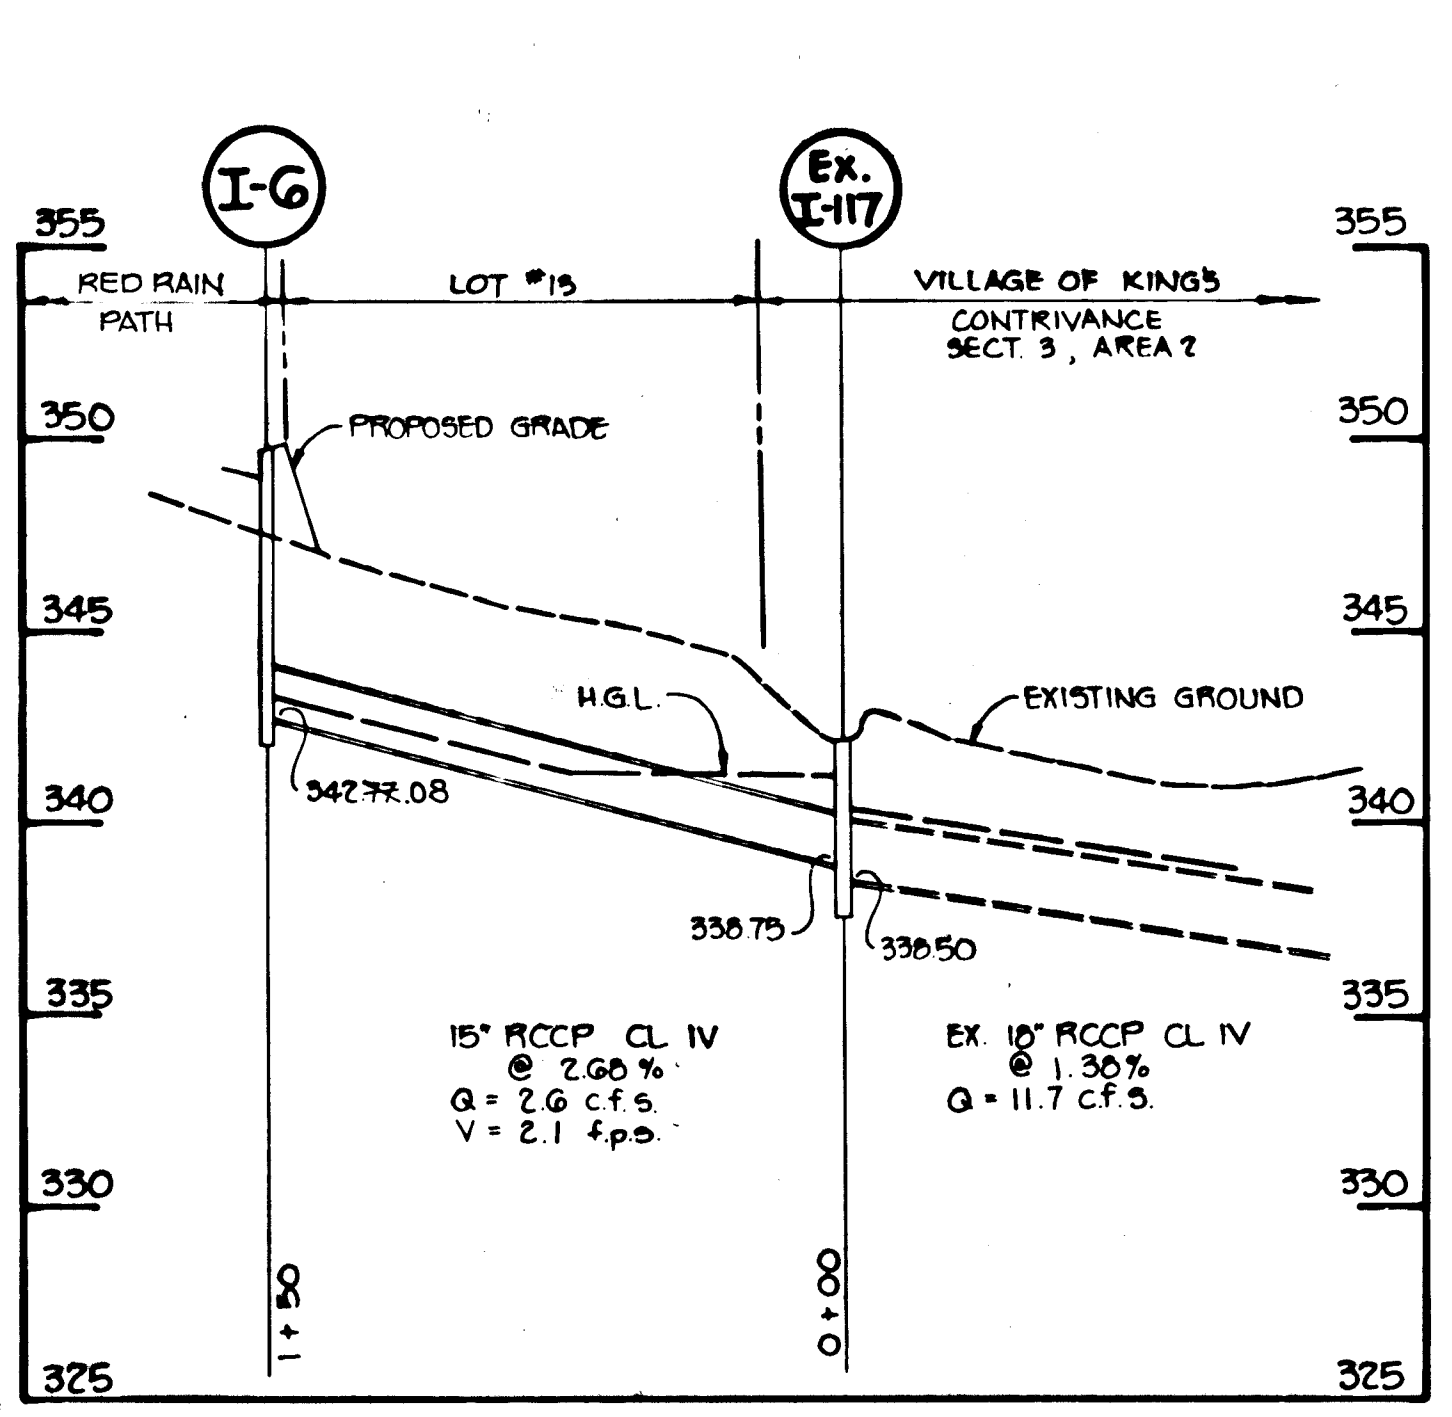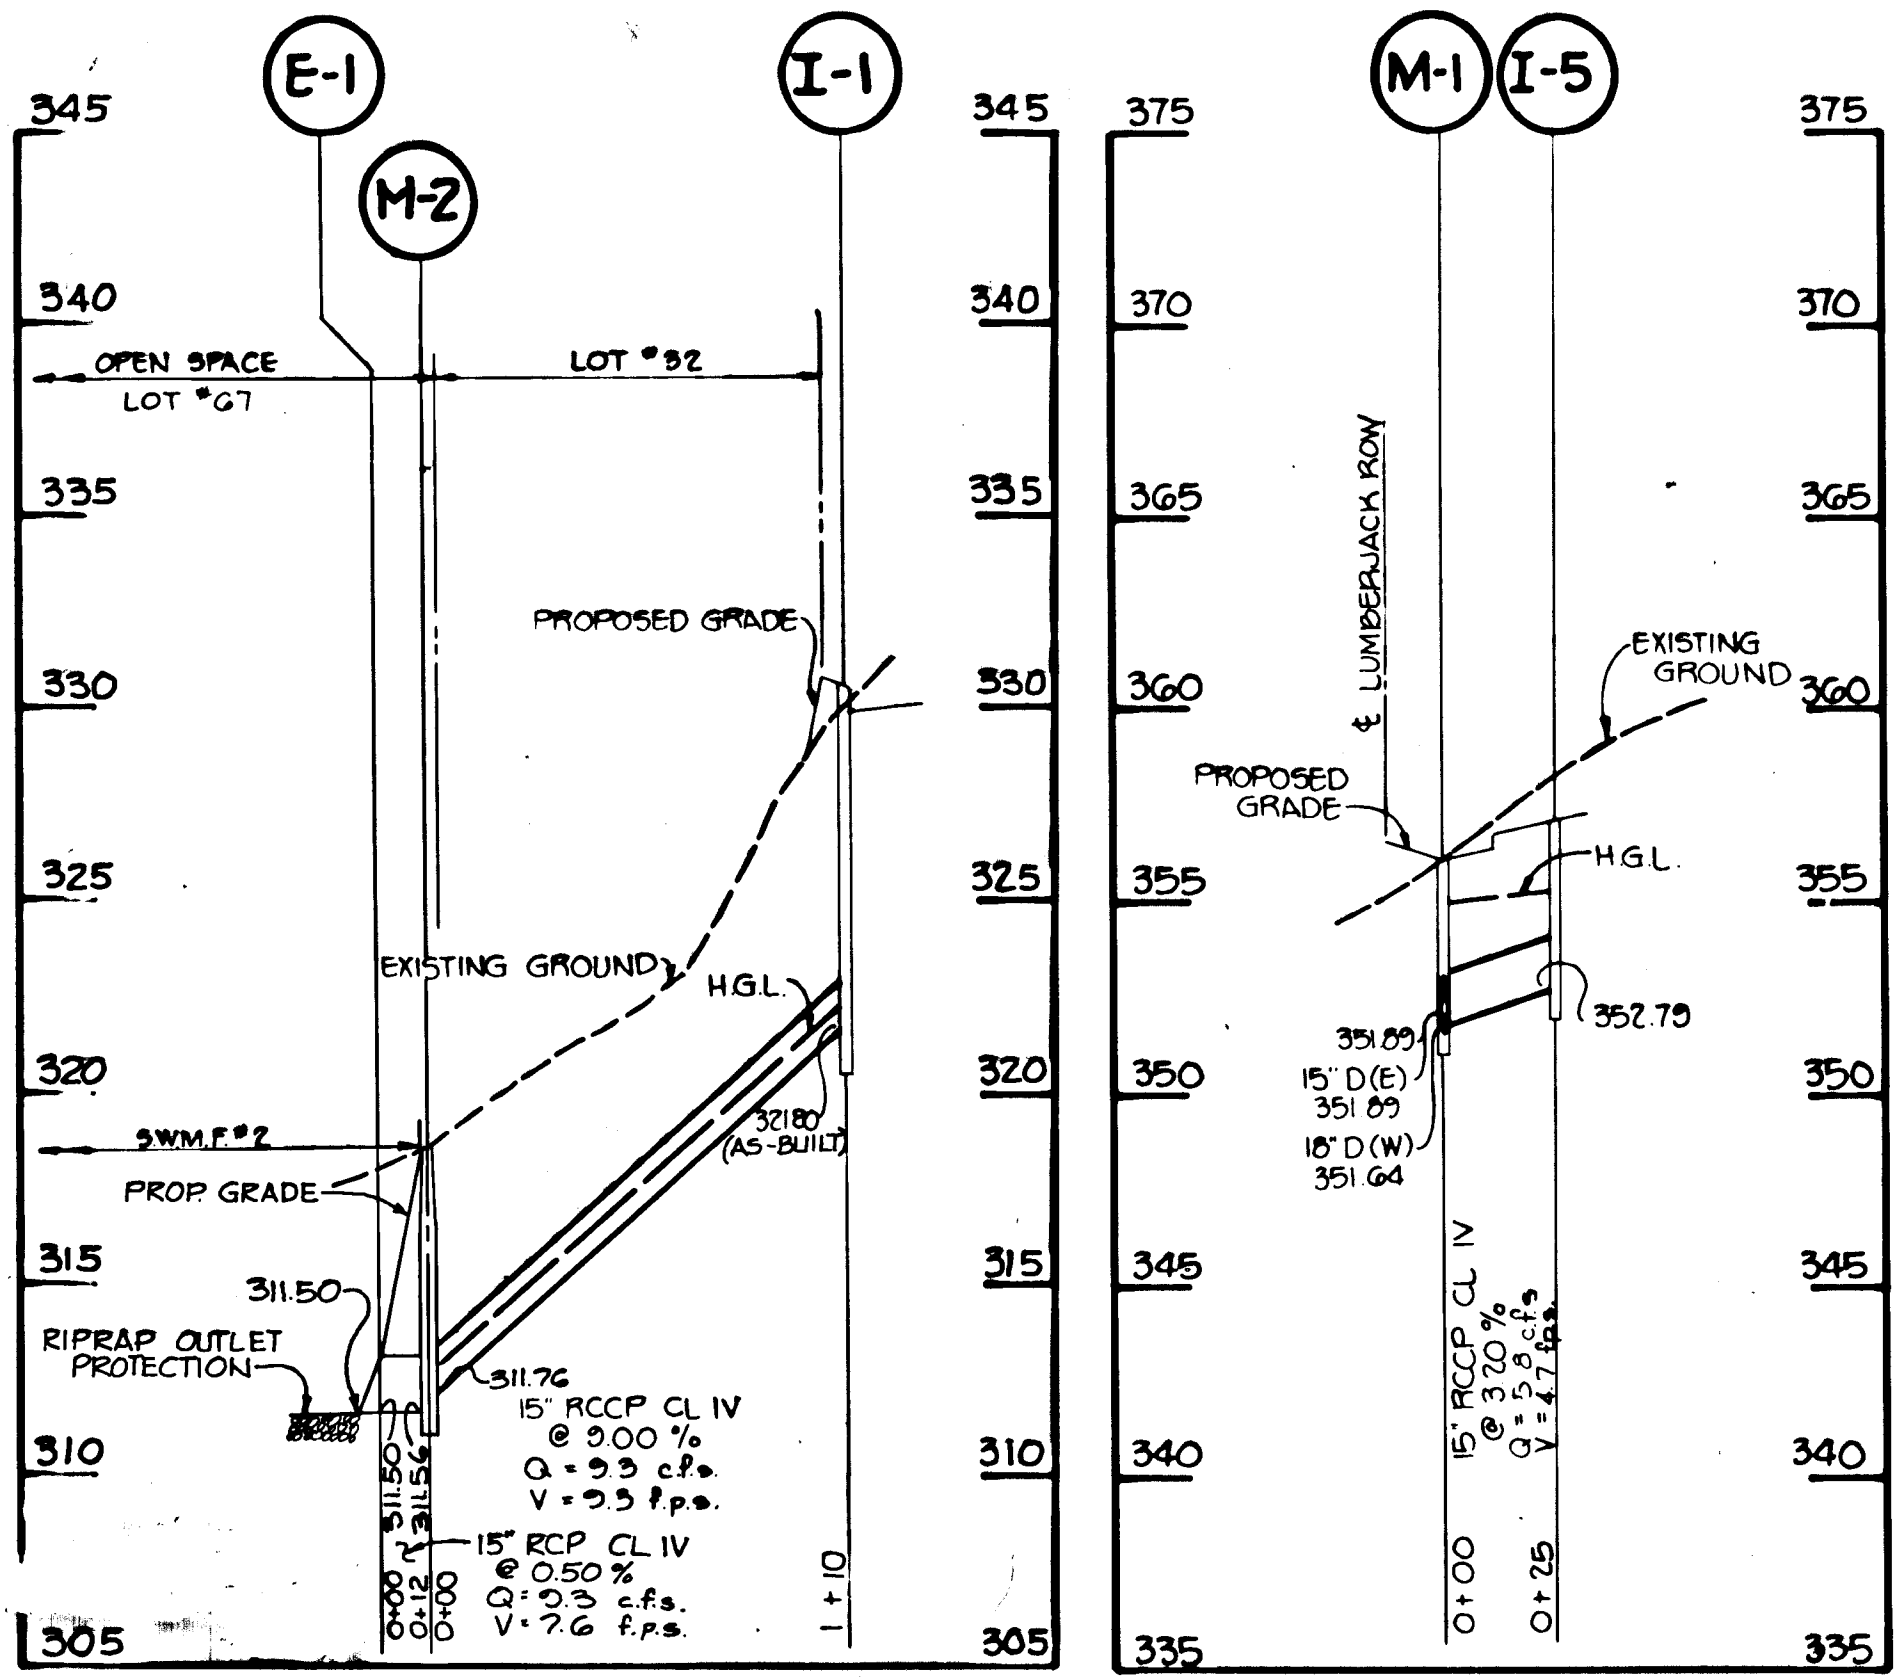


**PROFILES**  
SCALE: HORIZ. 1"=20'  
VERT. 1"=5'

AS-BUILT SURVEY CERTIFIED BY  
RICHARD F. LANE, Md. L.S. NO. 201  
ON 12-1-88

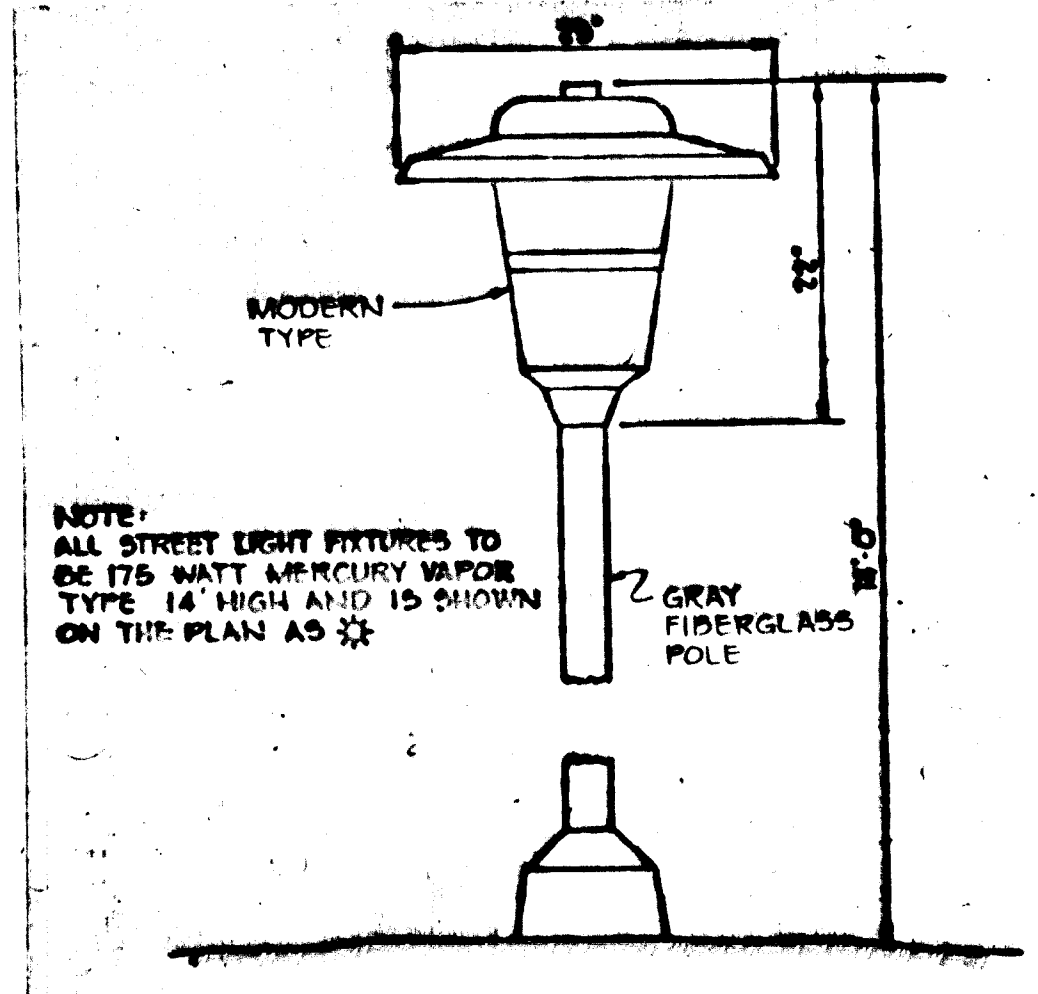

**DETAIL - LIGHTING FIXTURE**

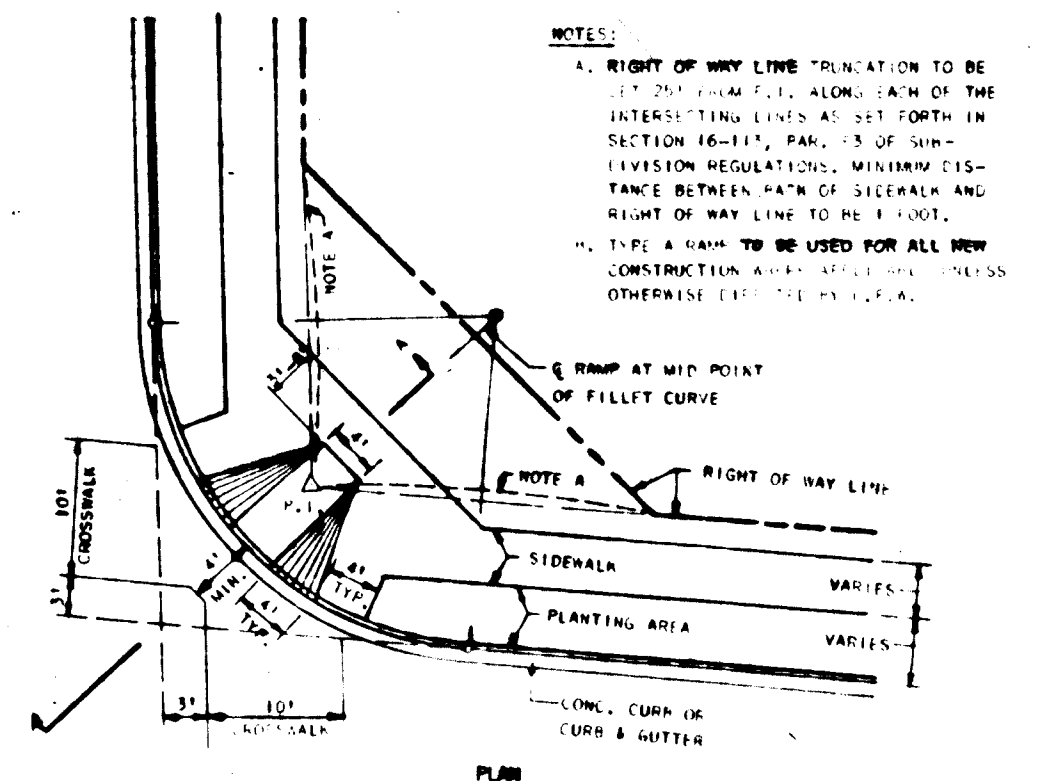


**SIDEWALK RAMP**  
NO SCALE

APPROVED: HOWARD COUNTY OFFICE OF PLANNING AND ZONING		10-23-88	
John W. M... CHIEF, DIVISION OF LAND DEVELOPMENT AND ZONING ADMINISTRATION		DATE	
APPROVED: HOWARD COUNTY DEPARTMENT OF PUBLIC WORKS		10-29-88	
Tracy Schulte & Associates Inc. CHIEF, BUREAU OF ENGINEERING		DATE	
1-4-12-89	REVISED STORM DRAIN PROFILE FROM I-1 TO E-1		
NO DATE	REVISION		
OWNER SECURITY DEVELOPMENT CORP 8450 BALTIMORE NATIONAL PIKE ELLICOTT CITY, MARYLAND 21043		PROJECT <b>HUNTINGTON SOUTH</b> SECTION 1, AREA 1 LOTS 1 THRU 68	
DEVELOPER SECURITY DEVELOPMENT CORP 8450 BALTIMORE NATIONAL PIKE ELLICOTT CITY, MD. 21043		LOCATION TAX MAP 42 PARCEL 67 G <sup>RD</sup> ELECTION DISTRICT HOWARD COUNTY, MARYLAND	
TITLE DETAILS AND STORM DRAIN PROFILES		DATE JUNE 19, 1986 PROJECT NO 8506 R5D	
DES. RJW	DRN. LRC	SCALE: NO SCALE	DRAWING 5 OF 10







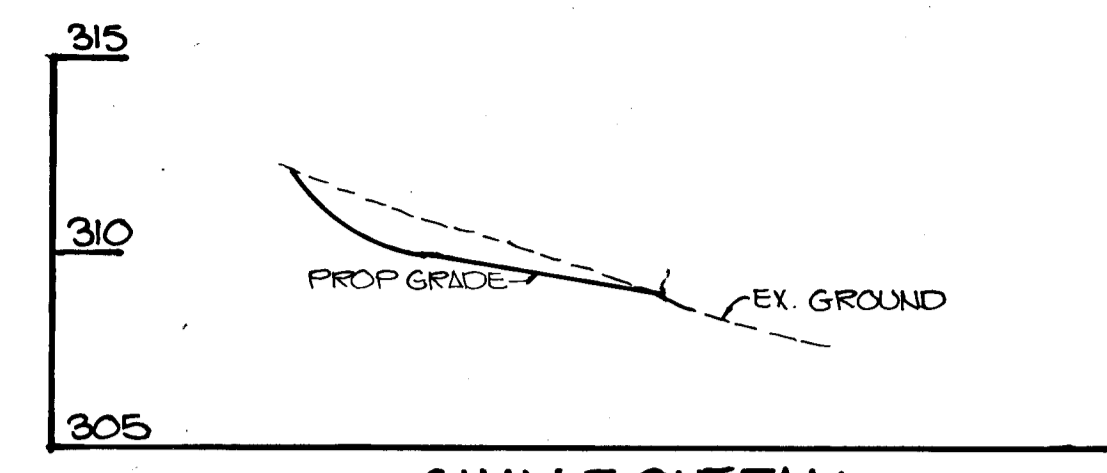

**S.W.M.F. OUTFALL**  
SCALE: HORIZ. 1"=60' VERT. 1"=6'

SEDIMENT TRAP	NO. 1	NO. 2	NO. 3
DRAINAGE AREA	3.10 AC.	3.06 AC.	3.43 AC.
DISTURBED AREA	1.76 AC.	1.41 AC.	1.43 AC.
STORAGE VOLUME			
REQUIRED	5,580 c.f.	5,508 c.f.	6,174 c.f.
PROVIDED	3,378.5 c.f.	10,300 c.f.	6,272 c.f.
CREST ELEVATION	339.04'	313.0	343.0
CLEANOUT ELEVATION	338.02	312.0	342.0
BOTTOM ELEVATION	337.0	311.0	341.0
DIMENSIONS	26' x 165' x 2.02'	80' x 95' x 110' x 2'	56' x 56' x 2'
WEIR LENGTH	N/A	13'	14'
* 100 YEAR STORM ELEVATION			

BY THE ENGINEER:  
 "I CERTIFY THAT THIS PLAN FOR POND CONSTRUCTION, EROSION AND SEDIMENT CONTROL REPRESENTS A PRACTICAL AND WORKABLE PLAN BASED ON MY PERSONAL KNOWLEDGE OF THE SITE CONDITIONS. THIS PLAN WAS PREPARED IN ACCORDANCE WITH THE REQUIREMENTS OF THE HOWARD SOIL CONSERVATION DISTRICT. I HAVE NOTIFIED THE DEVELOPER THAT HE MUST PROVIDE THE HOWARD SOIL CONSERVATION DISTRICT WITH AN "AS-BUILT" PLAN OF THE POND WITHIN 30 DAYS OF COMPLETION."  
 ENGINEER: *James K. Tracy* DATE: 6-19-86

BY THE DEVELOPER:  
 "I CERTIFY THAT ALL DEVELOPMENT AND/OR CONSTRUCTION WILL BE DONE ACCORDING TO THESE PLANS, AND THAT ANY RESPONSIBLE PERSONNEL INVOLVED IN THE CONSTRUCTION PROJECT WILL HAVE A CERTIFICATE OF ATTENDANCE AT A DEPARTMENT OF NATURAL RESOURCES APPROVED TRAINING PROGRAM FOR THE CONTROL OF SEDIMENT AND EROSION BEFORE BEGINNING THE PROJECT. I WILL PROVIDE THE HOWARD SOIL CONSERVATION DISTRICT WITH AN "AS-BUILT" PLAN OF THE POND WITHIN 30 DAYS OF COMPLETION."  
 DEVELOPER: *James R. Moxley, Jr.* DATE: 6-19-86  
 SECURITY DEVELOPMENT CORPORATION - PRESIDENT

THESE PLANS HAVE BEEN REVIEWED FOR THE HOWARD SOIL CONSERVATION DISTRICT AND MEET THE TECHNICAL REQUIREMENTS FOR SMALL POND CONSTRUCTION, SOIL EROSION AND SEDIMENT CONTROL.  
*James M. Nelson* DATE: 10-21-86  
 U. S. SOIL CONSERVATION SERVICE

THESE PLANS FOR SMALL POND CONSTRUCTION, SOIL EROSION AND SEDIMENT CONTROL MEET THE REQUIREMENTS OF THE HOWARD SOIL CONSERVATION DISTRICT.  
 APPROVED: *Robert W. Ziehm* DATE: 10-27-86  
 HOWARD S.C.D.

APPROVED: *William E. R...* DATE: 10-29-86  
 CHIEF, BUREAU OF ENGINEERING

APPROVED: *Schell M. Mueselman* DATE: 10-23-86  
 CHIEF, DIVISION OF LAND DEVELOPMENT AND ZONING ADMINISTRATION

2 4-12-88 ADDED M-2 AND REVISED STORM DRAIN FROM I-1 TO E-1.  
 11-23-88 CHANGE GRADE ON S.W.M.F. #2, ADDED A OUTFALL PROFILE  
 NO. DATE REVISION

TRACY, SCHULTE & ASSOCIATES INC.  
 planning • architecture • engineering  
 8450 Baltimore National Pike • Suite 34 • Ellicott City, Maryland 21043 • (301) 465-6105

OWNER: SECURITY DEVELOPMENT CORP  
 8450 BALTIMORE NATIONAL PIKE  
 ELLICOTT CITY, MARYLAND 21043

PROJECT: HUNTINGTON SOUTH  
 SECTION 1, AREA 1, LOTS 1 THRU 60

LOCATION: TAX MAP NO. 42  
 PARCEL 87  
 6TH ELECTION DISTRICT  
 HOWARD COUNTY, MARYLAND

DEVELOPER: SECURITY DEVELOPMENT CORP  
 8450 BALTIMORE NATIONAL PIKE  
 ELLICOTT CITY, MARYLAND 21043


TITLE: GRADING AND SEDIMENT CONTROL  
 AND STORM WATER MANAGEMENT PLAN

DATE: JUNE 19, 1986 PROJECT NO: 8506-K-10


DES: RJW DRN: KMN/JLB SCALE: 1"=50' DRAWING: 7 OF 10

1235



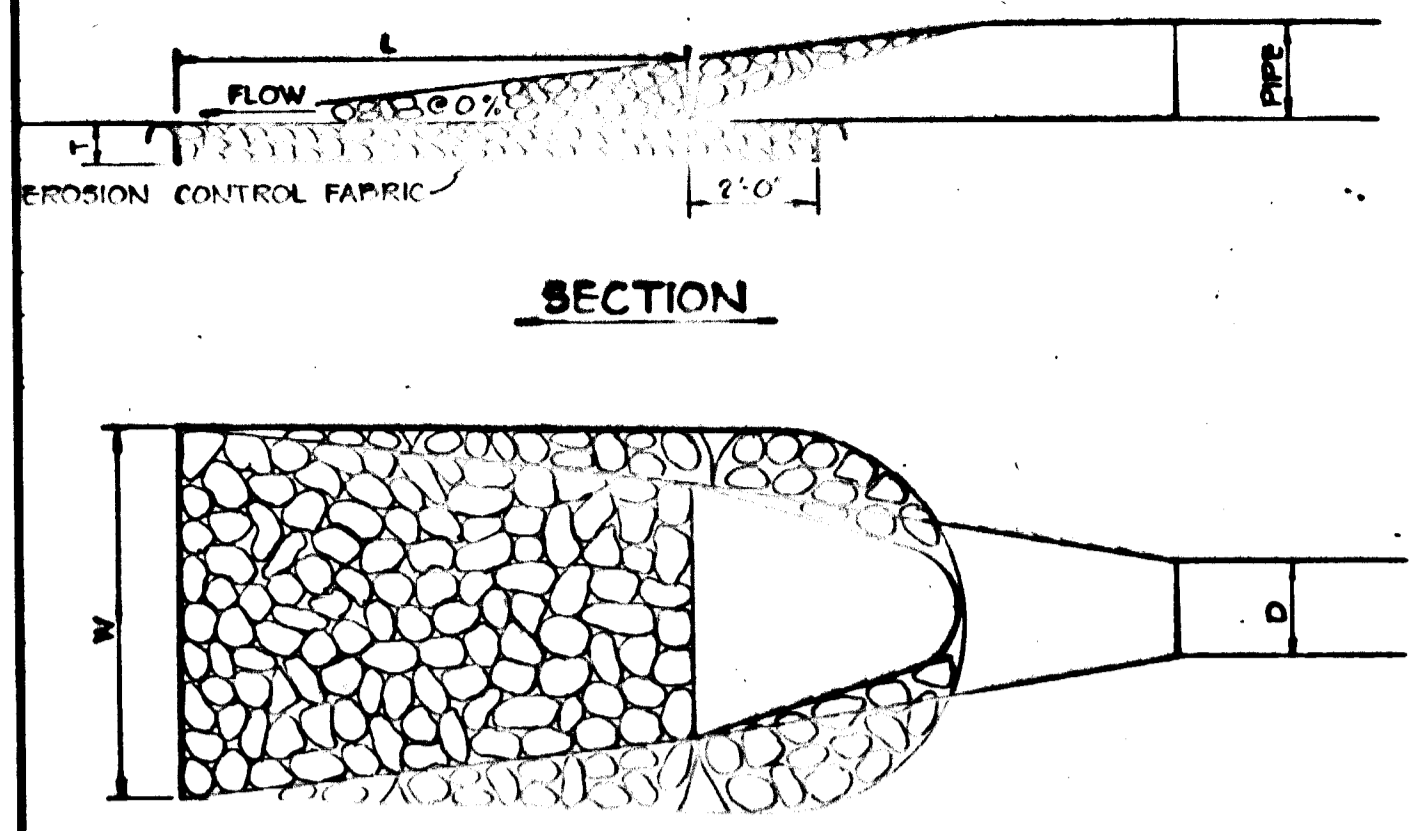


STRUCTURE	MEDIUM	LENGTH (L)	WIDTH (W)	THICKNESS (T)
E-1	6"	20'	10'	1.25"
E-2	6"	25'	12'	1.25"

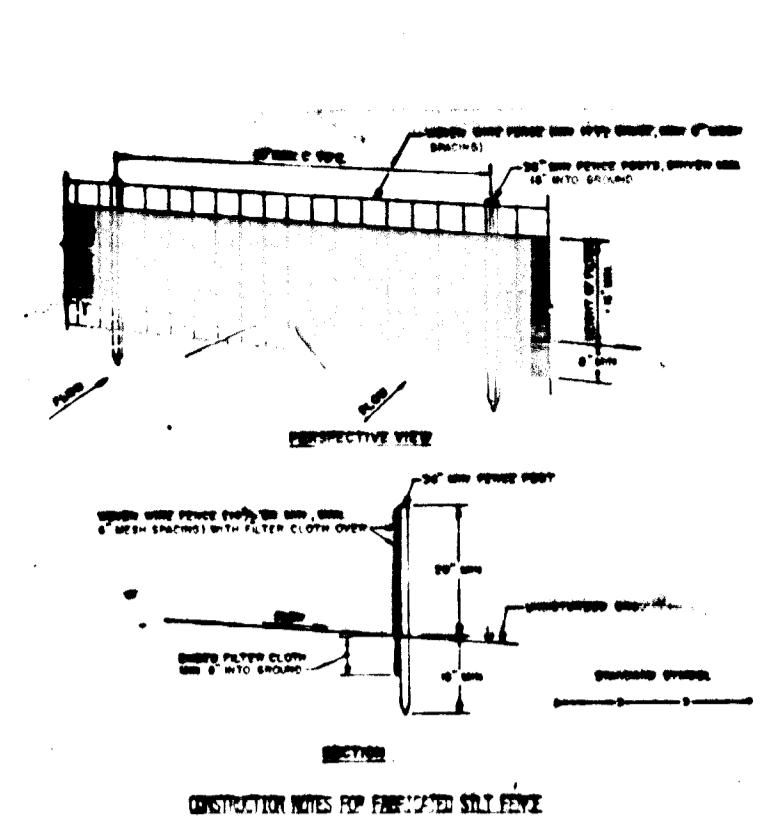

1. Silt fence shall be installed in accordance with the manufacturer's instructions.
2. Silt fence shall be installed in a straight line across the slope.
3. Silt fence shall be installed in a straight line across the slope.
4. Silt fence shall be installed in a straight line across the slope.

### SILT FENCE


NO SCALE

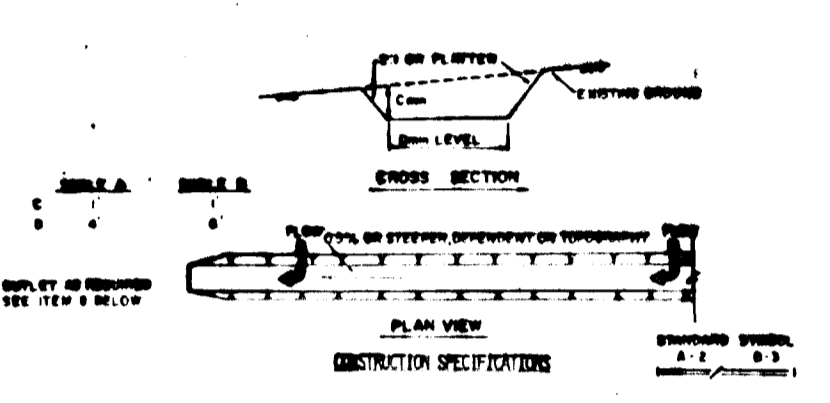

1. All temporary silt fences shall be constructed in accordance with the manufacturer's instructions.
2. Silt fence shall be installed in a straight line across the slope.
3. Silt fence shall be installed in a straight line across the slope.
4. Silt fence shall be installed in a straight line across the slope.
5. Silt fence shall be installed in a straight line across the slope.
6. Silt fence shall be installed in a straight line across the slope.
7. Silt fence shall be installed in a straight line across the slope.

### TEMPORARY SWALE


NO SCALE

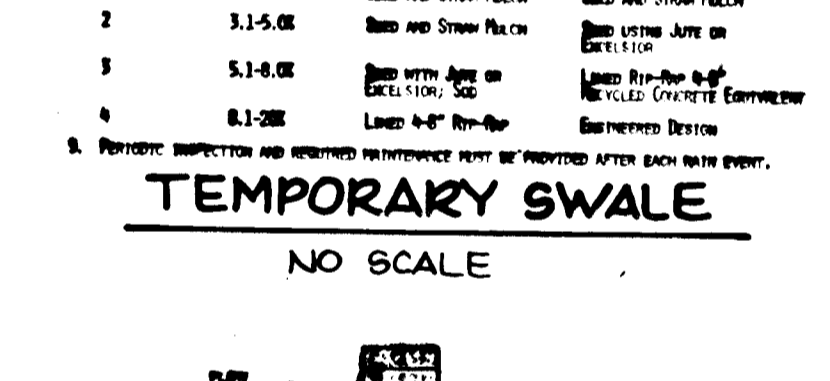

1. Swales shall be constructed in accordance with the manufacturer's instructions.
2. Swales shall be constructed in accordance with the manufacturer's instructions.
3. Swales shall be constructed in accordance with the manufacturer's instructions.
4. Swales shall be constructed in accordance with the manufacturer's instructions.
5. Swales shall be constructed in accordance with the manufacturer's instructions.
6. Swales shall be constructed in accordance with the manufacturer's instructions.
7. Swales shall be constructed in accordance with the manufacturer's instructions.

### STRAW BALE DIKE


NO SCALE

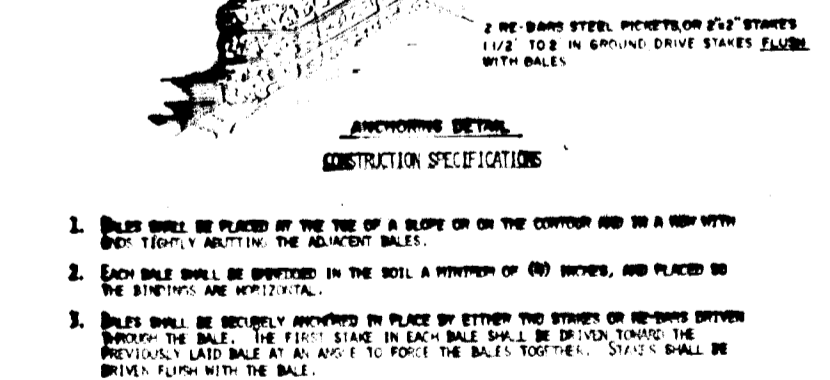


1. Straw bale dike shall be constructed in accordance with the manufacturer's instructions.
2. Straw bale dike shall be constructed in accordance with the manufacturer's instructions.
3. Straw bale dike shall be constructed in accordance with the manufacturer's instructions.
4. Straw bale dike shall be constructed in accordance with the manufacturer's instructions.
5. Straw bale dike shall be constructed in accordance with the manufacturer's instructions.
6. Straw bale dike shall be constructed in accordance with the manufacturer's instructions.
7. Straw bale dike shall be constructed in accordance with the manufacturer's instructions.

### STONE OUTLET SEDIMENT TRAP

NO SCALE

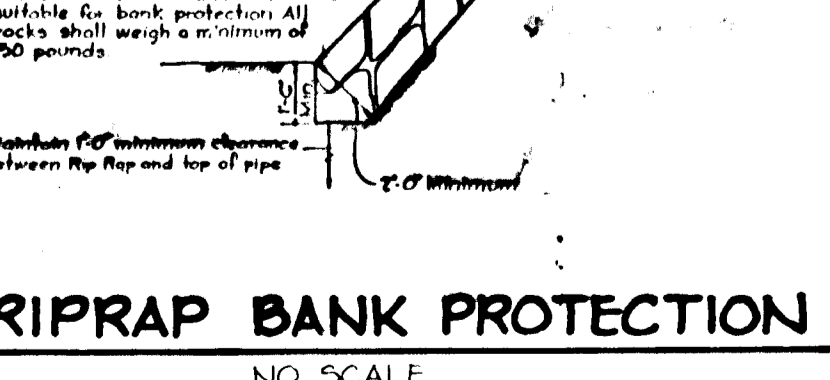


1. Stone outlet sediment trap shall be constructed in accordance with the manufacturer's instructions.
2. Stone outlet sediment trap shall be constructed in accordance with the manufacturer's instructions.
3. Stone outlet sediment trap shall be constructed in accordance with the manufacturer's instructions.
4. Stone outlet sediment trap shall be constructed in accordance with the manufacturer's instructions.
5. Stone outlet sediment trap shall be constructed in accordance with the manufacturer's instructions.
6. Stone outlet sediment trap shall be constructed in accordance with the manufacturer's instructions.
7. Stone outlet sediment trap shall be constructed in accordance with the manufacturer's instructions.

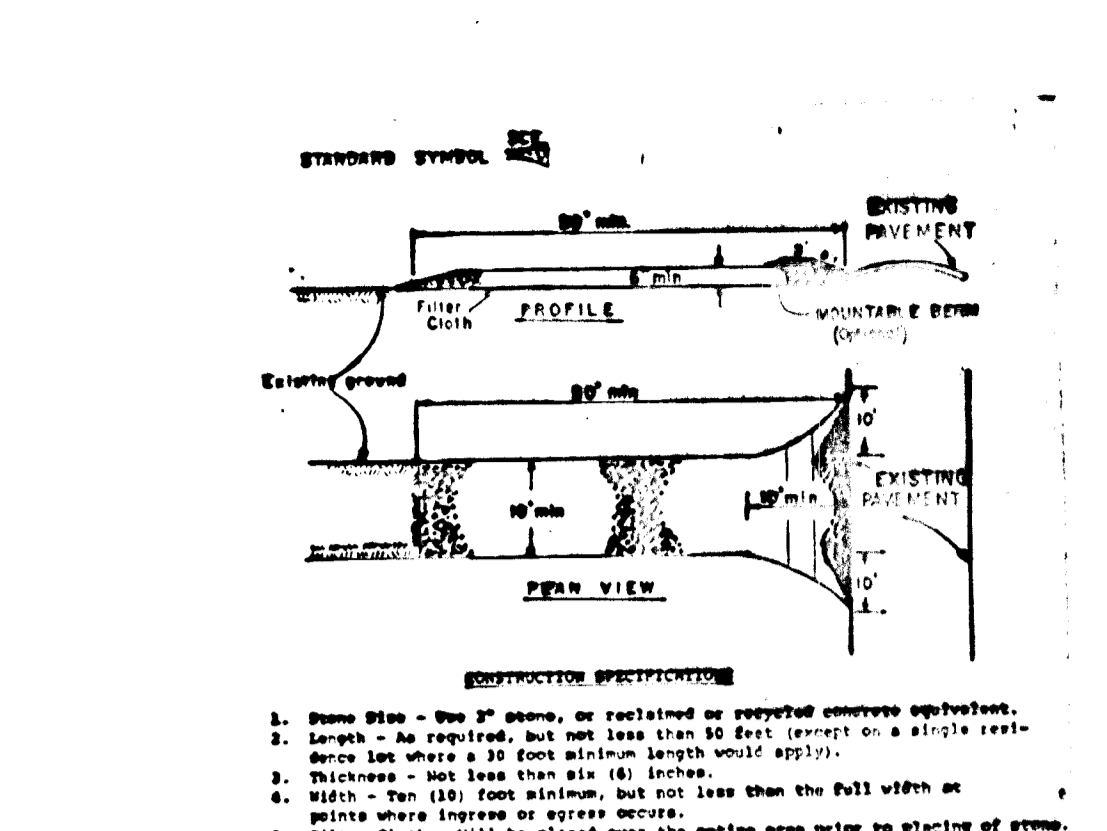

1. Stabilized construction entrance shall be constructed in accordance with the manufacturer's instructions.
2. Stabilized construction entrance shall be constructed in accordance with the manufacturer's instructions.
3. Stabilized construction entrance shall be constructed in accordance with the manufacturer's instructions.
4. Stabilized construction entrance shall be constructed in accordance with the manufacturer's instructions.
5. Stabilized construction entrance shall be constructed in accordance with the manufacturer's instructions.
6. Stabilized construction entrance shall be constructed in accordance with the manufacturer's instructions.
7. Stabilized construction entrance shall be constructed in accordance with the manufacturer's instructions.

### STABILIZED CONSTRUCTION ENTRANCE


NO SCALE

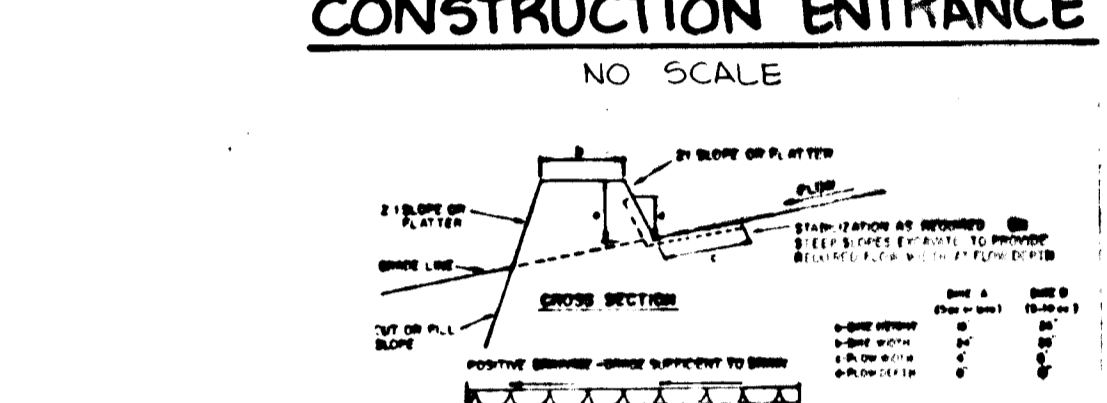

1. Earth dike shall be constructed in accordance with the manufacturer's instructions.
2. Earth dike shall be constructed in accordance with the manufacturer's instructions.
3. Earth dike shall be constructed in accordance with the manufacturer's instructions.
4. Earth dike shall be constructed in accordance with the manufacturer's instructions.
5. Earth dike shall be constructed in accordance with the manufacturer's instructions.
6. Earth dike shall be constructed in accordance with the manufacturer's instructions.
7. Earth dike shall be constructed in accordance with the manufacturer's instructions.

### EARTH DIKE


NO SCALE

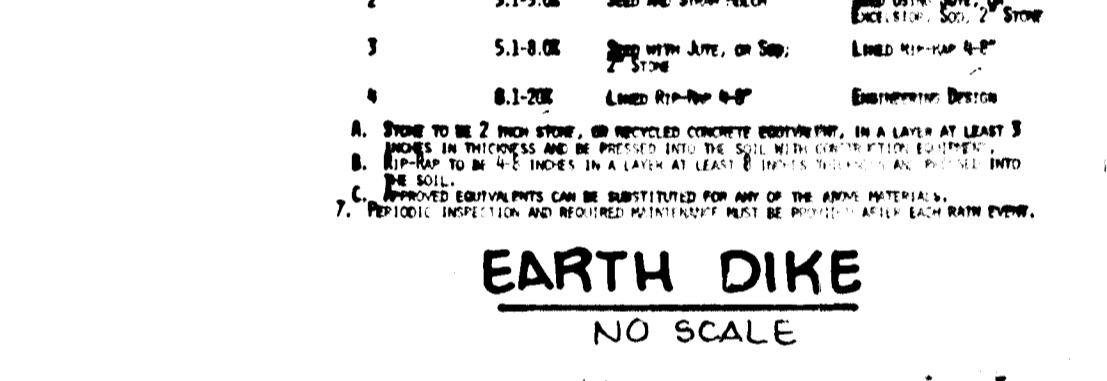

1. Riprap outlet sediment trap shall be constructed in accordance with the manufacturer's instructions.
2. Riprap outlet sediment trap shall be constructed in accordance with the manufacturer's instructions.
3. Riprap outlet sediment trap shall be constructed in accordance with the manufacturer's instructions.
4. Riprap outlet sediment trap shall be constructed in accordance with the manufacturer's instructions.
5. Riprap outlet sediment trap shall be constructed in accordance with the manufacturer's instructions.
6. Riprap outlet sediment trap shall be constructed in accordance with the manufacturer's instructions.
7. Riprap outlet sediment trap shall be constructed in accordance with the manufacturer's instructions.

### RIPRAP OUTLET SEDIMENT TRAP


NO SCALE

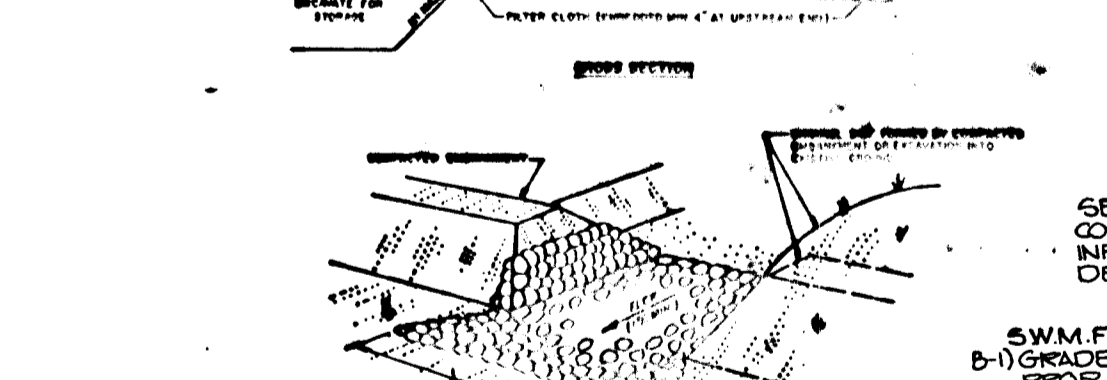


1. Riprap bank protection shall be constructed in accordance with the manufacturer's instructions.
2. Riprap bank protection shall be constructed in accordance with the manufacturer's instructions.
3. Riprap bank protection shall be constructed in accordance with the manufacturer's instructions.
4. Riprap bank protection shall be constructed in accordance with the manufacturer's instructions.
5. Riprap bank protection shall be constructed in accordance with the manufacturer's instructions.
6. Riprap bank protection shall be constructed in accordance with the manufacturer's instructions.
7. Riprap bank protection shall be constructed in accordance with the manufacturer's instructions.

### RIPRAP BANK PROTECTION

NO SCALE

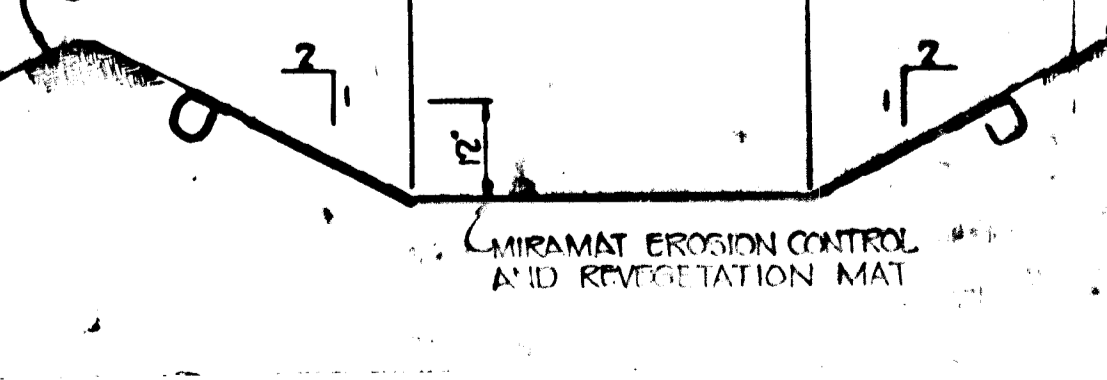


1. 4'-0" Miramat lined channel shall be constructed in accordance with the manufacturer's instructions.
2. 4'-0" Miramat lined channel shall be constructed in accordance with the manufacturer's instructions.
3. 4'-0" Miramat lined channel shall be constructed in accordance with the manufacturer's instructions.
4. 4'-0" Miramat lined channel shall be constructed in accordance with the manufacturer's instructions.
5. 4'-0" Miramat lined channel shall be constructed in accordance with the manufacturer's instructions.
6. 4'-0" Miramat lined channel shall be constructed in accordance with the manufacturer's instructions.
7. 4'-0" Miramat lined channel shall be constructed in accordance with the manufacturer's instructions.

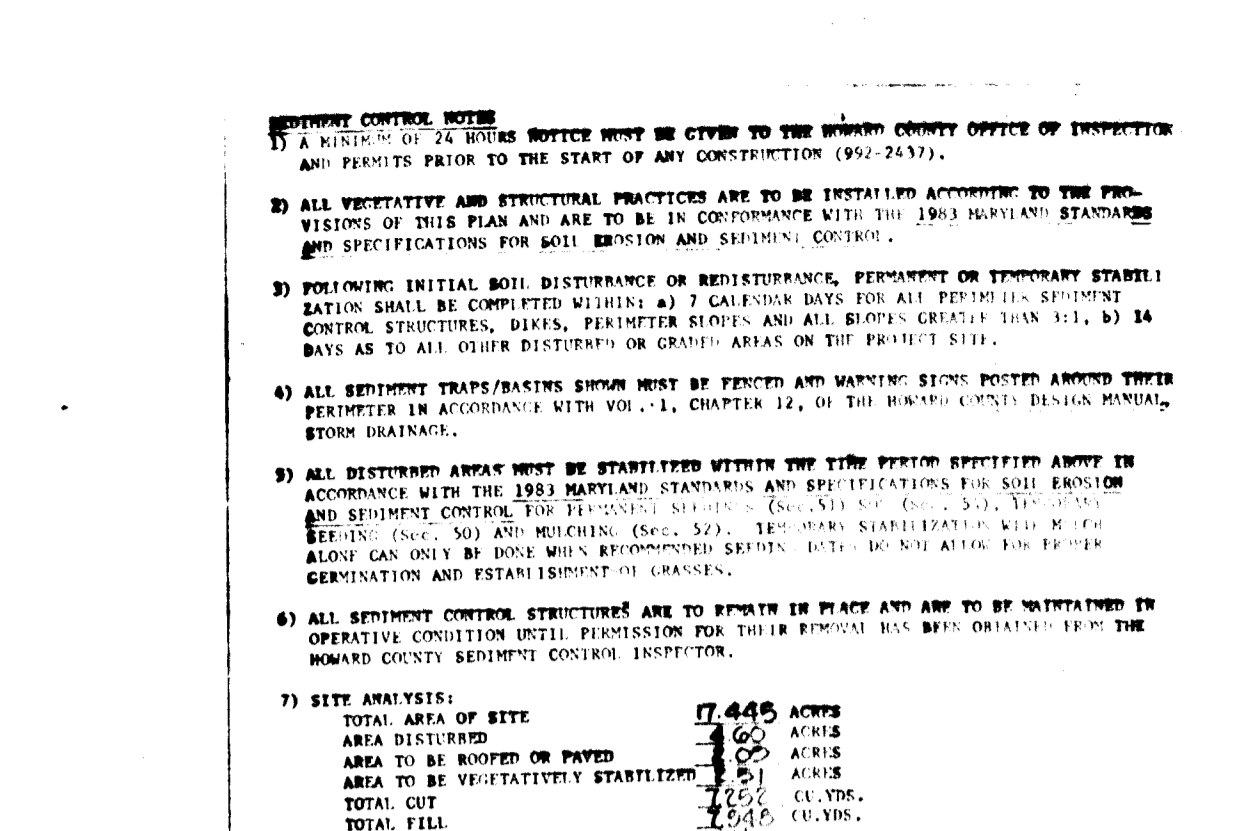

1. Outlet protection detail shall be constructed in accordance with the manufacturer's instructions.
2. Outlet protection detail shall be constructed in accordance with the manufacturer's instructions.
3. Outlet protection detail shall be constructed in accordance with the manufacturer's instructions.
4. Outlet protection detail shall be constructed in accordance with the manufacturer's instructions.
5. Outlet protection detail shall be constructed in accordance with the manufacturer's instructions.
6. Outlet protection detail shall be constructed in accordance with the manufacturer's instructions.
7. Outlet protection detail shall be constructed in accordance with the manufacturer's instructions.

### OUTLET PROTECTION DETAIL


NO SCALE

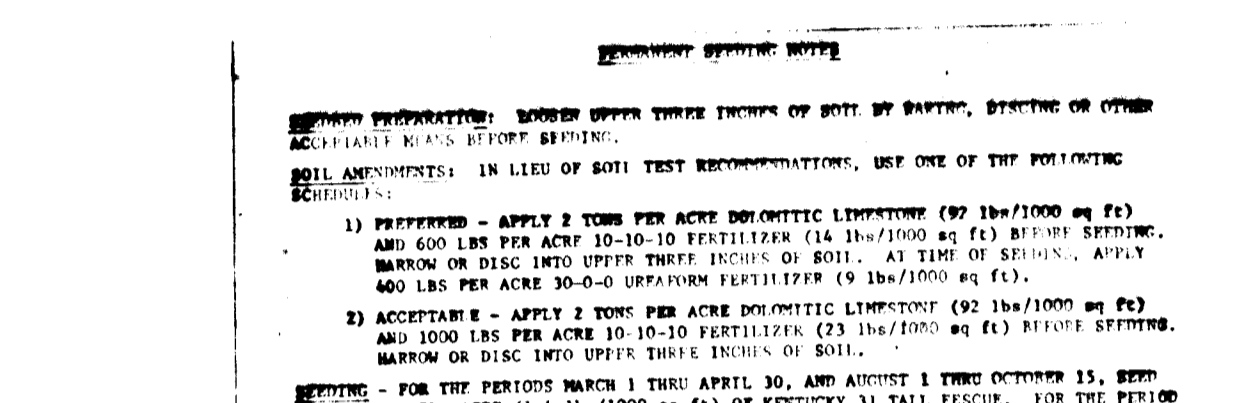

1. Grassed outlet sediment trap detail shall be constructed in accordance with the manufacturer's instructions.
2. Grassed outlet sediment trap detail shall be constructed in accordance with the manufacturer's instructions.
3. Grassed outlet sediment trap detail shall be constructed in accordance with the manufacturer's instructions.
4. Grassed outlet sediment trap detail shall be constructed in accordance with the manufacturer's instructions.
5. Grassed outlet sediment trap detail shall be constructed in accordance with the manufacturer's instructions.
6. Grassed outlet sediment trap detail shall be constructed in accordance with the manufacturer's instructions.
7. Grassed outlet sediment trap detail shall be constructed in accordance with the manufacturer's instructions.

### GRASSED OUTLET SEDIMENT TRAP DETAIL


NO SCALE

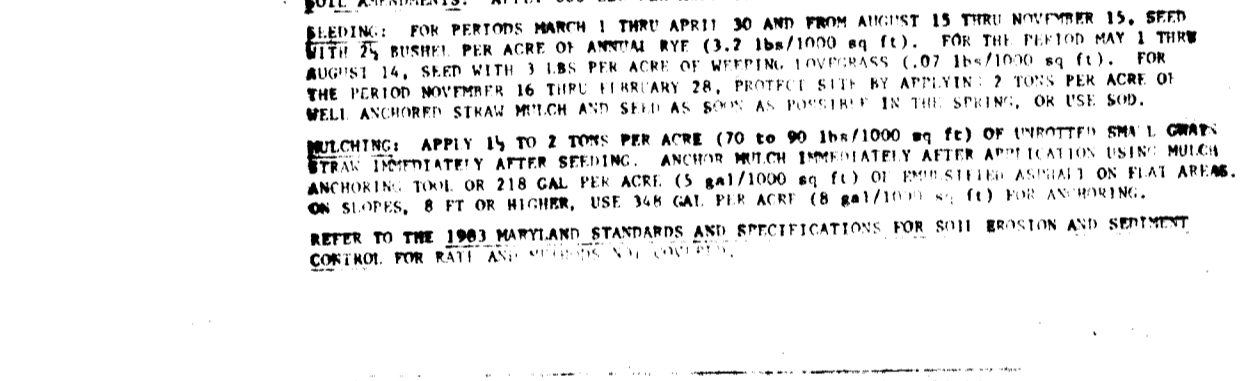

1. Stone outlet sediment trap shall be constructed in accordance with the manufacturer's instructions.
2. Stone outlet sediment trap shall be constructed in accordance with the manufacturer's instructions.
3. Stone outlet sediment trap shall be constructed in accordance with the manufacturer's instructions.
4. Stone outlet sediment trap shall be constructed in accordance with the manufacturer's instructions.
5. Stone outlet sediment trap shall be constructed in accordance with the manufacturer's instructions.
6. Stone outlet sediment trap shall be constructed in accordance with the manufacturer's instructions.
7. Stone outlet sediment trap shall be constructed in accordance with the manufacturer's instructions.

### STONE OUTLET SEDIMENT TRAP


NO SCALE

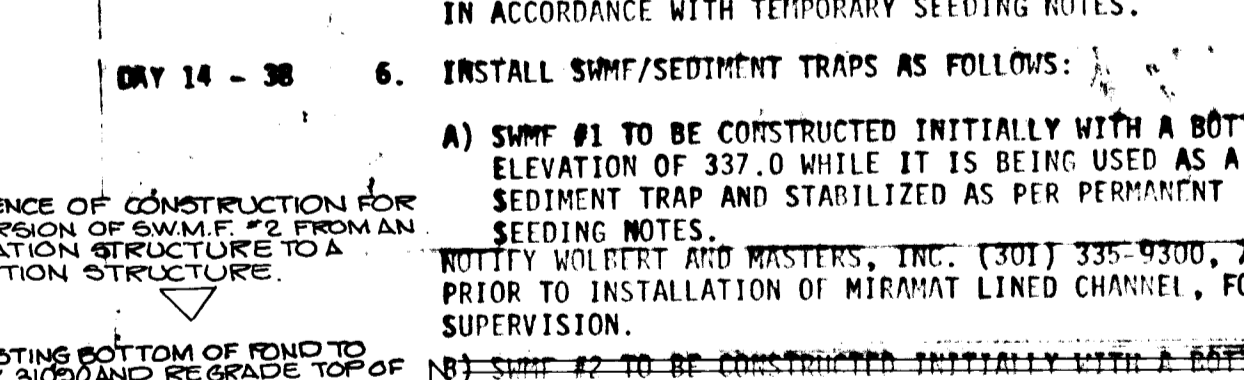


1. Riprap bank protection shall be constructed in accordance with the manufacturer's instructions.
2. Riprap bank protection shall be constructed in accordance with the manufacturer's instructions.
3. Riprap bank protection shall be constructed in accordance with the manufacturer's instructions.
4. Riprap bank protection shall be constructed in accordance with the manufacturer's instructions.
5. Riprap bank protection shall be constructed in accordance with the manufacturer's instructions.
6. Riprap bank protection shall be constructed in accordance with the manufacturer's instructions.
7. Riprap bank protection shall be constructed in accordance with the manufacturer's instructions.

### RIPRAP BANK PROTECTION

NO SCALE

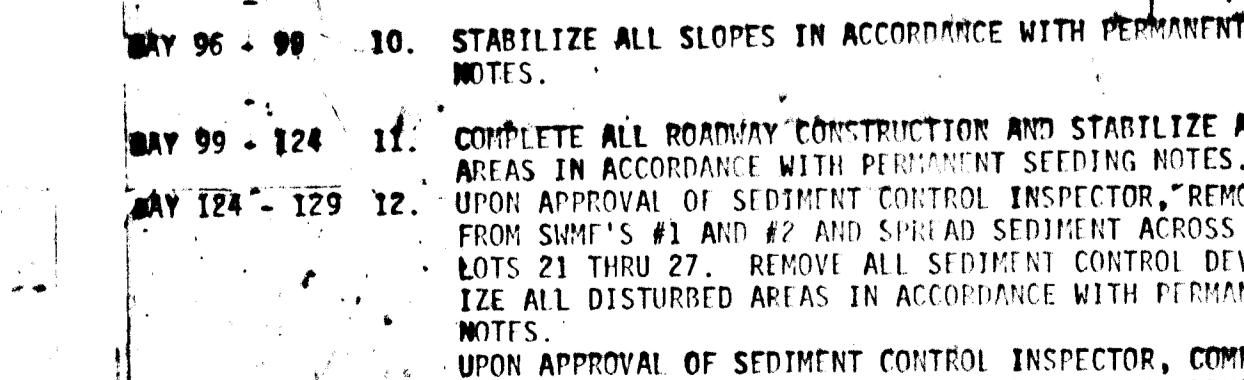


1. 4'-0" Miramat lined channel shall be constructed in accordance with the manufacturer's instructions.
2. 4'-0" Miramat lined channel shall be constructed in accordance with the manufacturer's instructions.
3. 4'-0" Miramat lined channel shall be constructed in accordance with the manufacturer's instructions.
4. 4'-0" Miramat lined channel shall be constructed in accordance with the manufacturer's instructions.
5. 4'-0" Miramat lined channel shall be constructed in accordance with the manufacturer's instructions.
6. 4'-0" Miramat lined channel shall be constructed in accordance with the manufacturer's instructions.
7. 4'-0" Miramat lined channel shall be constructed in accordance with the manufacturer's instructions.

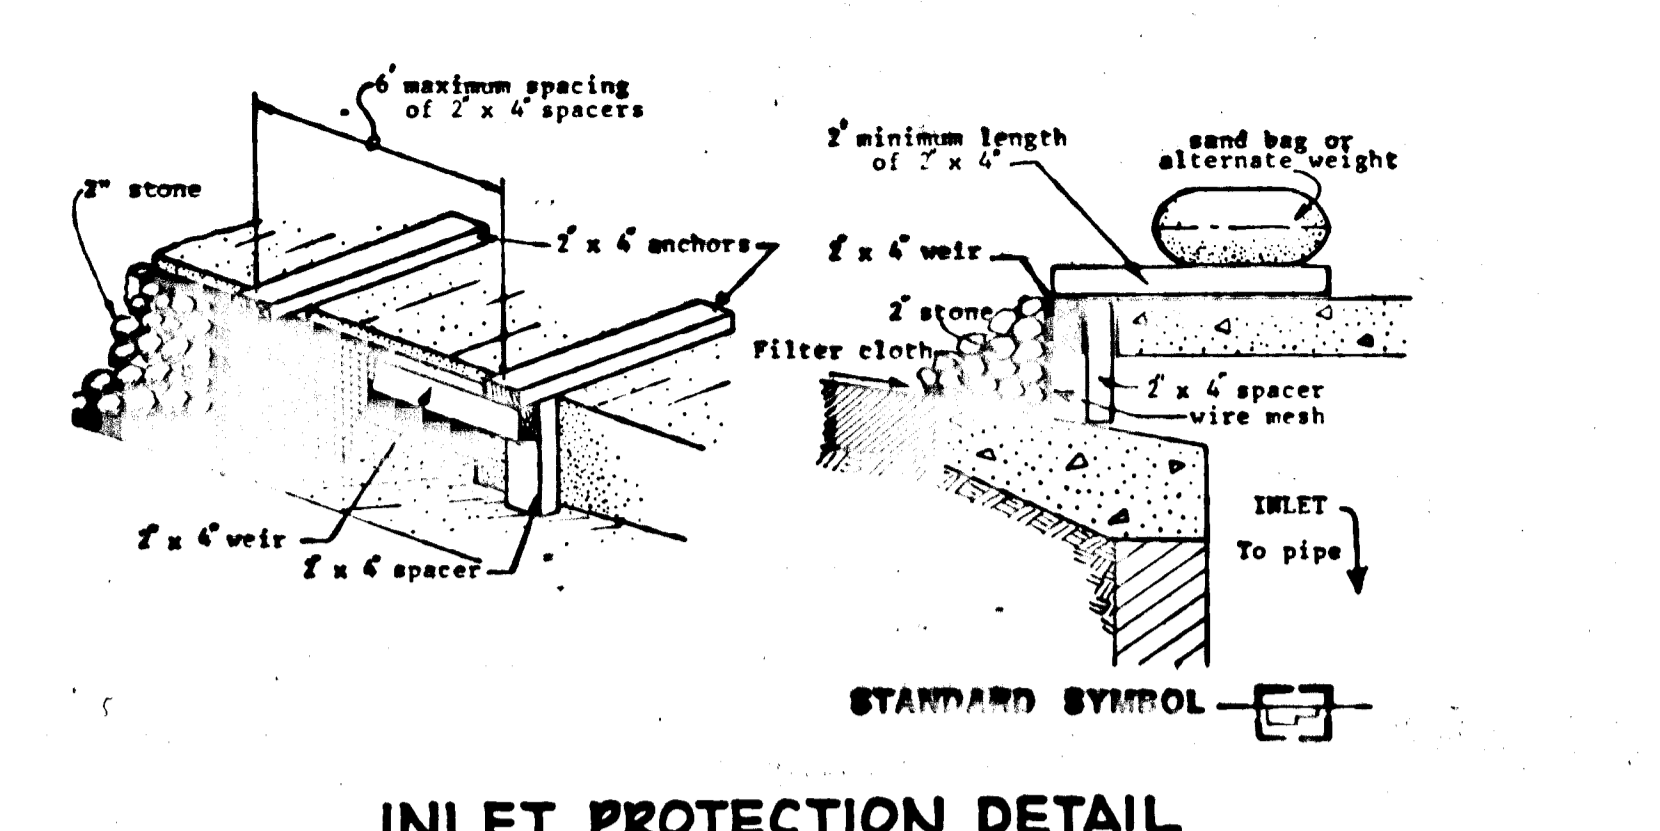

1. Inlet protection detail shall be constructed in accordance with the manufacturer's instructions.
2. Inlet protection detail shall be constructed in accordance with the manufacturer's instructions.
3. Inlet protection detail shall be constructed in accordance with the manufacturer's instructions.
4. Inlet protection detail shall be constructed in accordance with the manufacturer's instructions.
5. Inlet protection detail shall be constructed in accordance with the manufacturer's instructions.
6. Inlet protection detail shall be constructed in accordance with the manufacturer's instructions.
7. Inlet protection detail shall be constructed in accordance with the manufacturer's instructions.

### INLET PROTECTION DETAIL


NO SCALE

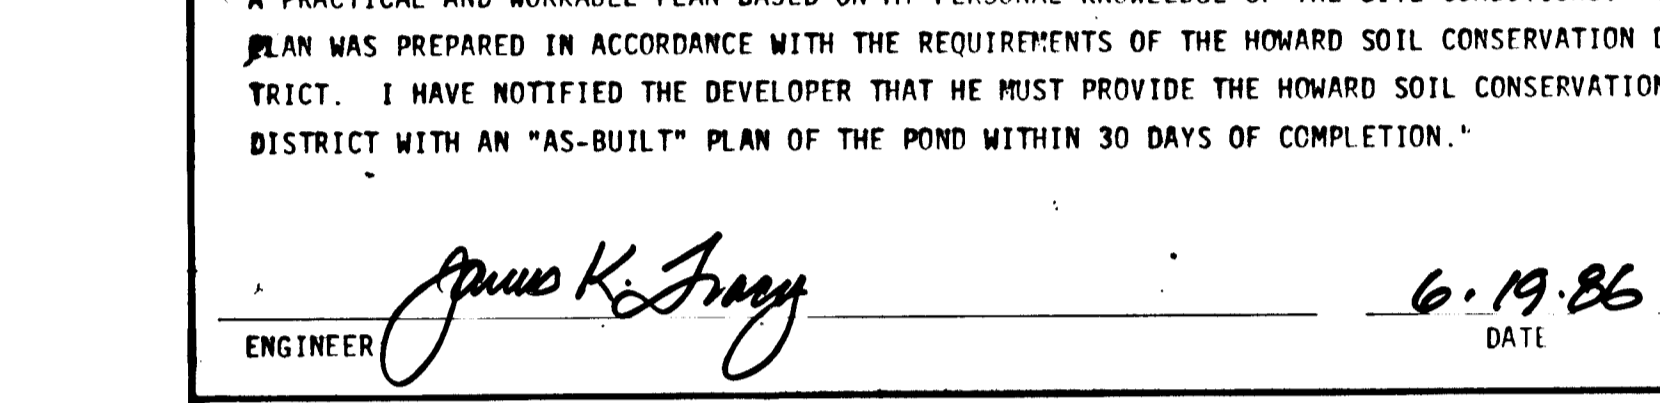

1. Stabilized construction entrance shall be constructed in accordance with the manufacturer's instructions.
2. Stabilized construction entrance shall be constructed in accordance with the manufacturer's instructions.
3. Stabilized construction entrance shall be constructed in accordance with the manufacturer's instructions.
4. Stabilized construction entrance shall be constructed in accordance with the manufacturer's instructions.
5. Stabilized construction entrance shall be constructed in accordance with the manufacturer's instructions.
6. Stabilized construction entrance shall be constructed in accordance with the manufacturer's instructions.
7. Stabilized construction entrance shall be constructed in accordance with the manufacturer's instructions.

### STABILIZED CONSTRUCTION ENTRANCE


NO SCALE

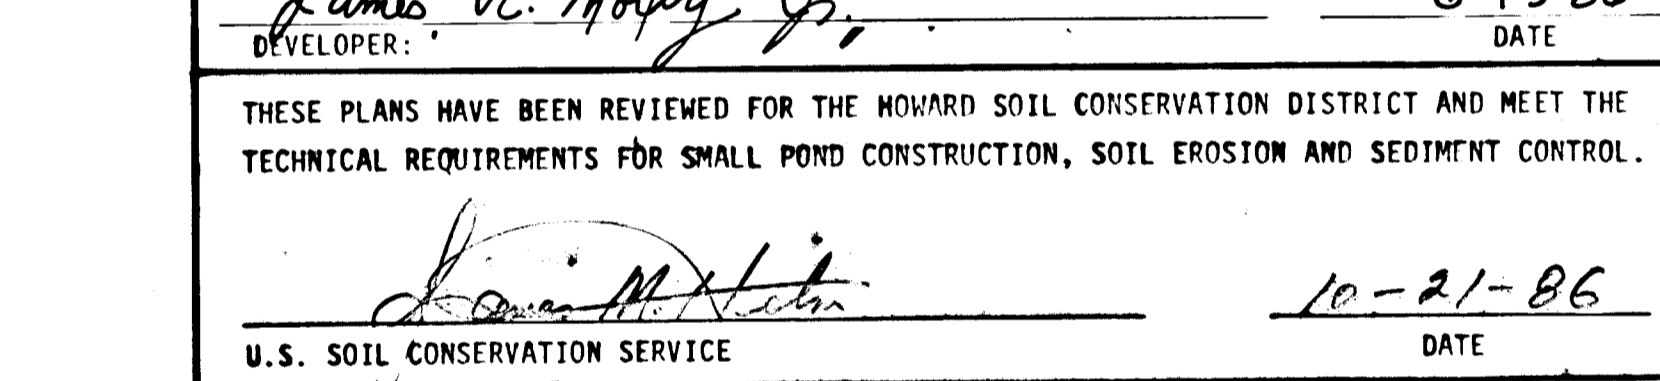

1. Earth dike shall be constructed in accordance with the manufacturer's instructions.
2. Earth dike shall be constructed in accordance with the manufacturer's instructions.
3. Earth dike shall be constructed in accordance with the manufacturer's instructions.
4. Earth dike shall be constructed in accordance with the manufacturer's instructions.
5. Earth dike shall be constructed in accordance with the manufacturer's instructions.
6. Earth dike shall be constructed in accordance with the manufacturer's instructions.
7. Earth dike shall be constructed in accordance with the manufacturer's instructions.

### EARTH DIKE


NO SCALE

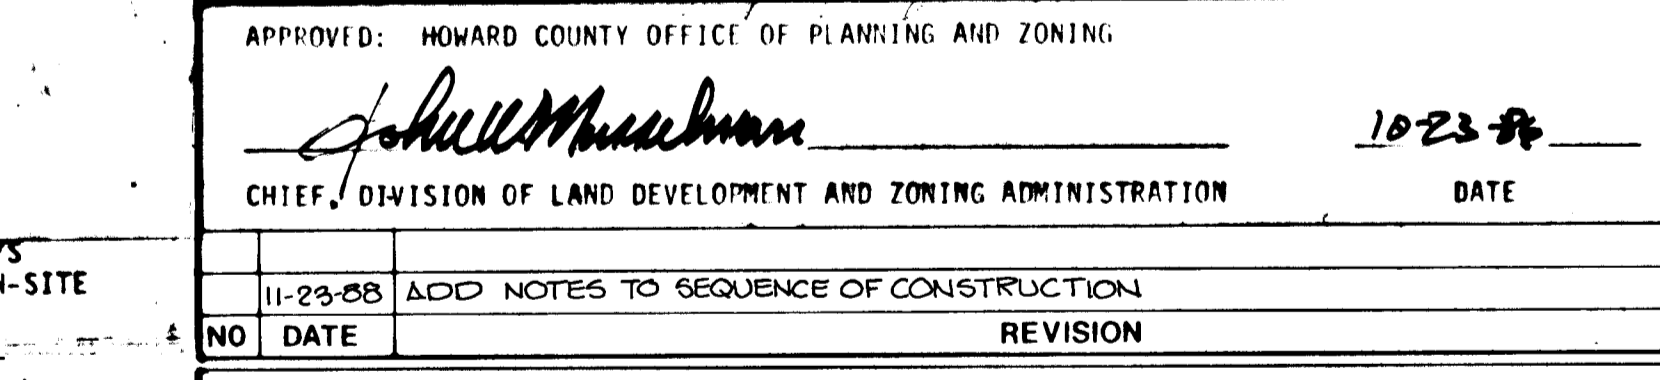

1. Riprap outlet sediment trap shall be constructed in accordance with the manufacturer's instructions.
2. Riprap outlet sediment trap shall be constructed in accordance with the manufacturer's instructions.
3. Riprap outlet sediment trap shall be constructed in accordance with the manufacturer's instructions.
4. Riprap outlet sediment trap shall be constructed in accordance with the manufacturer's instructions.
5. Riprap outlet sediment trap shall be constructed in accordance with the manufacturer's instructions.
6. Riprap outlet sediment trap shall be constructed in accordance with the manufacturer's instructions.
7. Riprap outlet sediment trap shall be constructed in accordance with the manufacturer's instructions.

### RIPRAP OUTLET SEDIMENT TRAP


NO SCALE

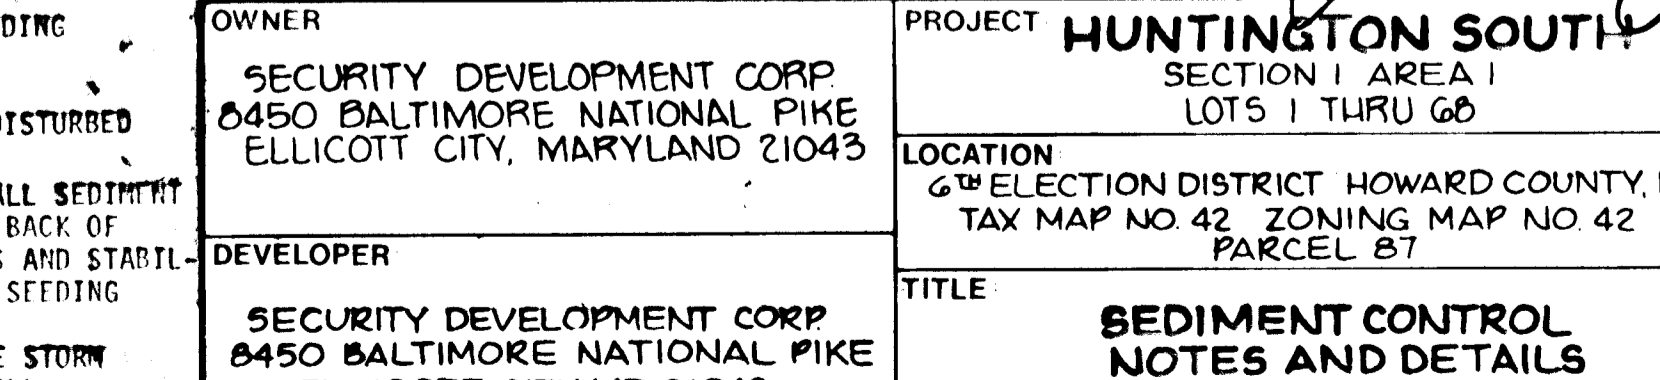

1. Riprap bank protection shall be constructed in accordance with the manufacturer's instructions.
2. Riprap bank protection shall be constructed in accordance with the manufacturer's instructions.
3. Riprap bank protection shall be constructed in accordance with the manufacturer's instructions.
4. Riprap bank protection shall be constructed in accordance with the manufacturer's instructions.
5. Riprap bank protection shall be constructed in accordance with the manufacturer's instructions.
6. Riprap bank protection shall be constructed in accordance with the manufacturer's instructions.
7. Riprap bank protection shall be constructed in accordance with the manufacturer's instructions.

### RIPRAP BANK PROTECTION

NO SCALE

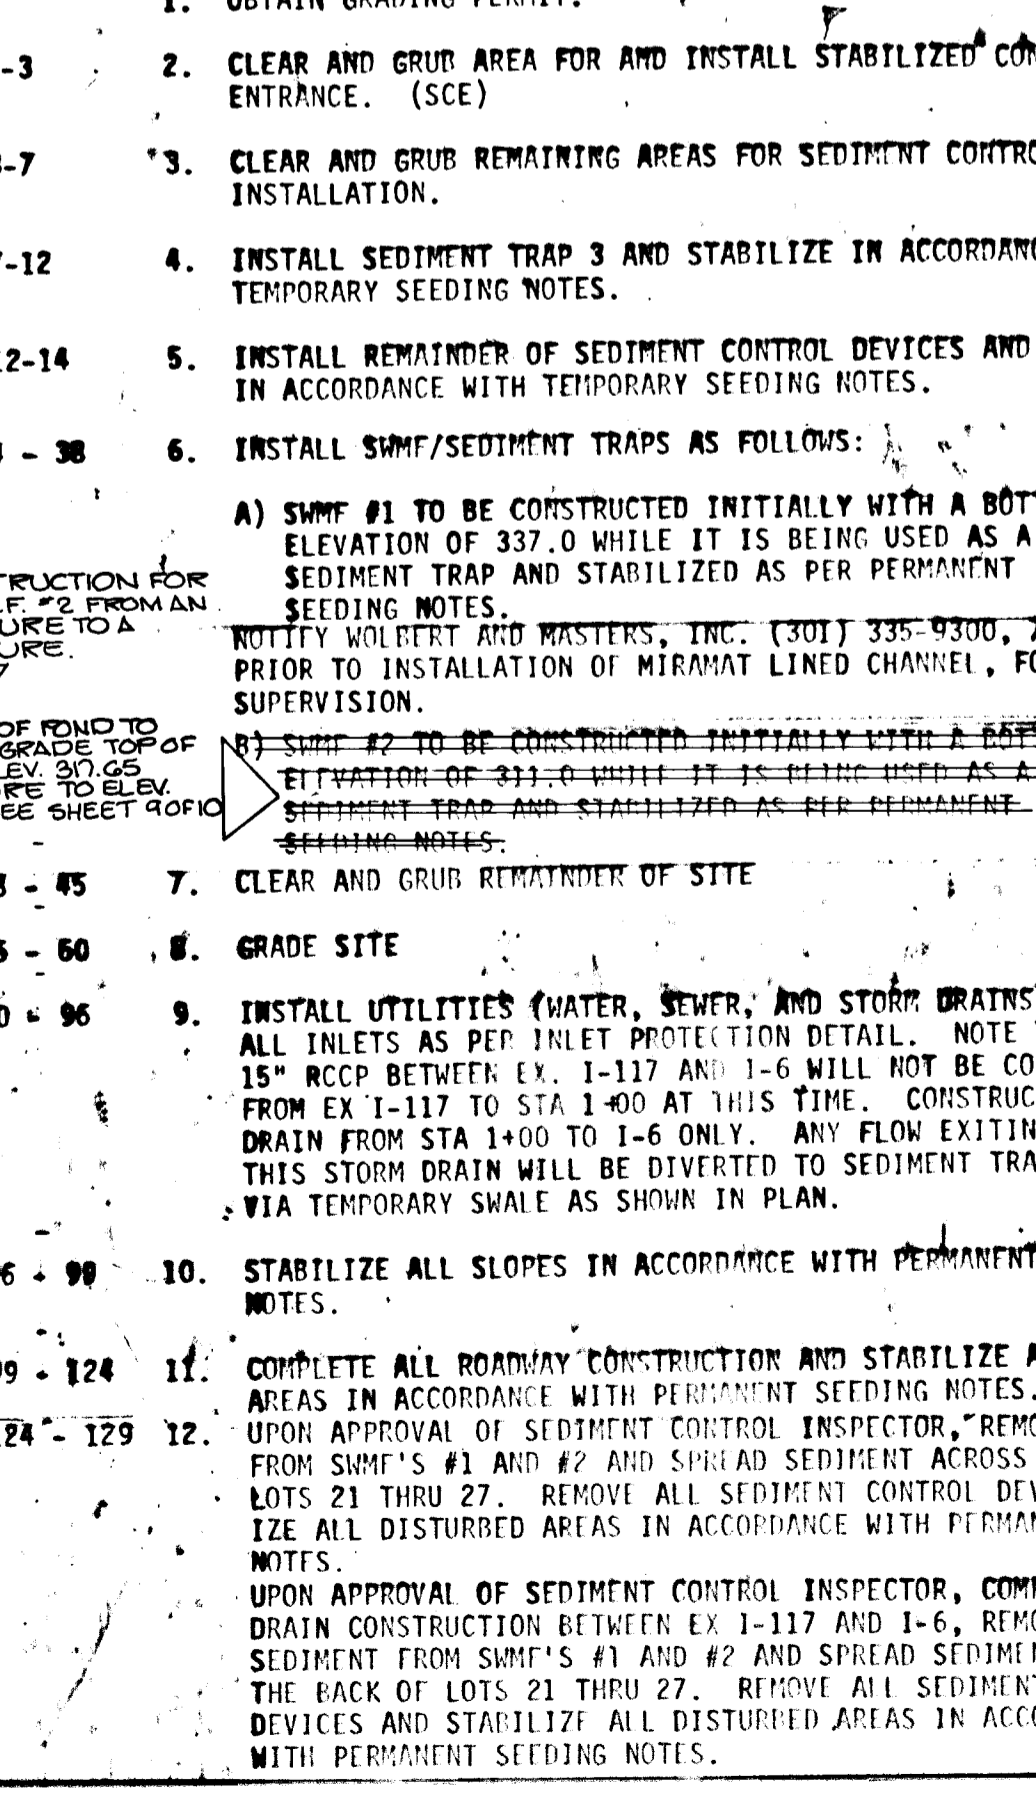

BY THE ENGINEER:

"I CERTIFY THAT THIS PLAN FOR POND CONSTRUCTION, EROSION AND SEDIMENT CONTROL REPRESENTS A PRACTICAL AND WORKABLE PLAN BASED ON MY PERSONAL KNOWLEDGE OF THE SITE CONDITIONS. THIS PLAN WAS PREPARED IN ACCORDANCE WITH THE REQUIREMENTS OF THE HOWARD SOIL CONSERVATION DISTRICT. I HAVE NOTIFIED THE DEVELOPER THAT HE MUST PROVIDE THE HOWARD SOIL CONSERVATION DISTRICT WITH AN "AS-BUILT" PLAN OF THE POND WITHIN 30 DAYS OF COMPLETION."

James K. Jorgy  
ENGINEER  
6-19-86  
DATE

BY THE DEVELOPER:

"I CERTIFY THAT ALL DEVELOPMENT AND/OR CONSTRUCTION WILL BE DONE ACCORDING TO THESE PLANS. AND THAT ANY RESPONSIBLE PERSONNEL INVOLVED IN THE CONSTRUCTION PROJECT WILL HAVE A CERTIFICATE OF ATTENDANCE AT A DEPARTMENT OF NATURAL RESOURCES APPROVED TRAINING PROGRAM FOR THE CONTROL OF SEDIMENT AND EROSION BEFORE BEGINNING THE PROJECT. I WILL PROVIDE THE HOWARD SOIL CONSERVATION DISTRICT WITH AN "AS-BUILT" PLAN OF THE POND WITHIN 30 DAYS OF COMPLETION."

James R. Morley Jr.  
DEVELOPER  
6-19-86  
DATE

THESE PLANS HAVE BEEN REVIEWED FOR THE HOWARD SOIL CONSERVATION DISTRICT AND MEET THE TECHNICAL REQUIREMENTS FOR SMALL POND CONSTRUCTION, SOIL EROSION AND SEDIMENT CONTROL.

James M. Hester  
U.S. SOIL CONSERVATION SERVICE  
10-21-86  
DATE

THESE PLANS FOR SMALL POND CONSTRUCTION, SOIL EROSION AND SEDIMENT CONTROL MEET THE REQUIREMENTS OF THE HOWARD SOIL CONSERVATION DISTRICT.

APPROVED: HOWARD COUNTY DEPARTMENT OF PUBLIC WORKS  
HOWARD S.C.D.  
DATE

APPROVED: HOWARD COUNTY OFFICE OF PLANNING AND ZONING  
John M. Hester  
CHIEF, DIVISION OF LAND DEVELOPMENT AND ZONING ADMINISTRATION  
10-23-86  
DATE

NO	DATE	REVISION
1	11-23-88	ADD NOTES TO SEQUENCE OF CONSTRUCTION

TRACY, SCHULTE & ASSOCIATES INC.  
planning • architecture • engineering  
8450 Baltimore National Pike • Suite 34 • Ellicott City, Maryland 21043 • (301) 465-6105

OWNER: SECURITY DEVELOPMENT CORP  
6450 BALTIMORE NATIONAL PIKE  
ELLICOTT CITY, MARYLAND 21043

PROJECT: HUNTINGTON SOUTH  
SECTION I AREA I  
LOTS 1 THRU 60

LOCATION: 6th ELECTION DISTRICT HOWARD COUNTY, MD  
TAX MAP NO. 42 ZONING MAP NO. 42  
PARCEL 87

DEVELOPER: SECURITY DEVELOPMENT CORP  
6450 BALTIMORE NATIONAL PIKE  
ELLICOTT CITY, MD 21043

TITLE: SEDIMENT CONTROL  
NOTES AND DETAILS

DATE: JUNE 19, 1986 PROJECT NO: 8506 RSD

DES: R.J.W. DRN: C.D.T. SCALE: AS SHOWN DRAWING 8 OF 10

AS-BUILT 12-1-88 F-86-227

1235



I. SITE PREPARATION

Areas designated for borrow areas, embankment, and structural work shall be cleared, grubbed and stripped of topsoil. All trees, vegetation, roots and other objectionable material shall be removed. Channel banks and sharp breaks shall be sloped to no steeper than 1:1.

Areas to be covered by the pond or reservoir will be cleared of all trees, brush, logs, fences, rubbish and other objectionable material unless otherwise designated on the plans. Trees, brush and stumps shall be cut approximately level with the ground surface.

All cleared and grubbed material shall be disposed of outside and below the limits of the dam and reservoir as directed by the owner or his representative. When specified, a sufficient quantity of topsoil will be stockpiled in a suitable location for use on the embankment and other designated areas.

II. EARTH FILL

The fill material shall be taken from approved designated borrow area or areas. It shall be free of roots, stumps, wood, rubbish, oversize stones, frozen or other objectionable materials. The embankment shall be constructed to an elevation which provides for anticipated settlement to the design elevation. The fill height all along the length of the embankment shall be increased above the design elevation (including freeboard) as shown on the plans.

Placement

Areas on which fill to be placed shall be scarified prior to placement of fill. Fill materials shall be placed in 8-inch maximum thickness (before compaction) layers which are to be continuous over the entire length of the fill. The most porous borrow material shall be placed in the downstream portions of the embankment.

Compaction

The movement of the hauling and spreading equipment over the fill shall be controlled so that the entire surface of each lift shall be traversed by not less than one tread track of the equipment or compaction shall be achieved by a minimum of four complete passes of a sheepsfoot, rubber tired or vibratory roller. Fill material shall contain sufficient moisture such that the required degree of compaction can be obtained with the equipment used.

Where a minimum required density is specified, each layer of fill shall be compacted as necessary to obtain that density and is to be certified by the Engineer.

Cutoff Trench

Where specified, a cutoff trench shall be excavated along or parallel to the centerline of the embankment as shown on the plans. The bottom width of the trench shall be as shown on the drawings, with the minimum width being four feet. The depth shall be at least four feet or as shown on the plans. The side slopes of the trench shall be 1 to 1 or flatter. The backfill material for the cutoff trench shall be the most impervious material available and shall be compacted with equipment or rollers to assure maximum density and minimum permeability.

III. STRUCTURAL BACKFILL

Backfill material shall be of the type and quality conforming to that specified for the adjoining fill material. The fill shall be placed in horizontal layers not to exceed four inches in thickness and compacted by hand tampers or other compaction equipment. The material needs to fill the backfilling operation shall driven equipment be allowed to operate closer than four feet, measured horizontally, to any part of a structure. Under no circumstances shall equipment be driven over any part of a concrete structure or pipe unless there is a compacted fill of twenty-four inches or greater over the structure or pipe.

IV. PIPE CONDUITS

All pipes shall be circular in cross section.

A. Corrugated Metal Pipe

1. Materials - (Steel Pipe) - This pipe and its appurtenances shall be galvanized and fully bituminous coated and shall conform to the requirements of AASHTO Specifications M-190 Type A with watertight coupling bands. Any bituminous coating damaged or otherwise removed shall be replaced with cold applied bituminous coating compound.

Steel pipes with polymeric coatings shall have a minimum coating thickness of 0.01 inch (10 mil) on both sides of the pipe. The following coatings are commercially available: Newon Plast-Cote, Blac-Klad, and Beth-Cu-Loy. Coated corrugated steel pipe shall meet the requirements of AASHTO M-245 and M-246.

Materials - (Aluminized Steel Pipe) - This pipe and its appurtenances shall conform to the requirements of AASHTO Specification M-274-791 with watertight coupling bands or flanges.

Materials - (Aluminum Pipe) - This pipe and its appurtenances shall conform to the requirements of AASHTO Specification M-196 or M-211 with watertight coupling bands or flanges. Coupling bands, anti-seep collars, end sections, etc. must be composed of the same material as the pipe. Metals must be insulated from dissimilar materials with use of rubber or plastic insulating materials at least 24 mils in thickness. Aluminum surfaces that are to be in contact with concrete shall be painted with one coat of zinc chromate primer. Hot dip galvanized bolts may be used for connections. The pH of the surrounding soils shall be less than 9 and greater than 4.

2. Connections - All connections with pipes must be completely watertight. The drain pipe or barrel connection to the riser shall be welded all around when the pipe and riser are metal. Watertight coupling bands or flanges shall be used at all joints. Anti-seep collars shall be connected to the pipe in such a manner as to the completely watertight. Dimple bands are not considered to be watertight.

3. Bedding - The pipe shall be firmly and uniformly bedded throughout its entire length. Where rock or soft, spongy or other unstable soil is encountered, all such material shall be removed and replaced with suitable earth compacted to provide adequate support.

4. Laying pipe - The pipe shall be placed with inside circumferential laps pointing downstream and with the longitudinal laps at the sides.

5. Backfilling shall conform to structural backfill as shown above.

6. Other details (anti-seep collars, valves, etc.) shall be as shown on the drawings.

B. Reinforced Concrete Pipe

1. Materials - Reinforced concrete pipe shall have a rubber gasket joint and shall equal or exceed ASTM Specification C-361. An approved equivalent is AWWA Specification C-301.

2. Bedding - All reinforced concrete pipe conduits shall be laid in a concrete bedding for their entire length. This bedding shall consist of high slump concrete placed under the pipe and up the sides of the pipe at least 10% of its outside diameter with a minimum thickness of 3", or as shown on the drawings.

3. Laying pipe - Bell and spigot pipe shall be placed with the bell end upstream. Joints shall be made in accordance with recommendations of the manufacturer of the material. After the joints are sealed for the entire line, the bedding shall be placed so that all spaces under the pipe are filled. Care shall be exercised to prevent any deviation from the original line and grade of the pipe.

4. Backfilling shall conform to structural backfill as shown above.

5. Other details (anti-seep collars, valves, etc.) shall be as shown on the drawings.

C. For pipes of other materials, specific specifications shall be shown on the drawings.

V. CONCRETE

1. Materials

a. Cement - Normal Portland cement shall conform to the latest ASTM Specification C-150.

b. Water - The water used in concrete shall be clean, free from oil, acid, alkali, scales, organic matter or other objectionable substances.

c. Sand - The sand used in concrete shall be clean, hard, strong and durable, and shall be well graded with 100 percent passing a one-quarter inch sieve. Limestone sand shall not be used.

d. Coarse Aggregate - The coarse aggregate shall be clean, hard, strong and durable, and free from clay or dirt. It shall be well graded with a maximum size of one and one-half (1-1/2) inches.

e. Reinforcing Steel - The reinforcing steel shall be deformed bars of intermediate grade billet steel conforming to ASTM Specification A-615.

2. Design Mix - The concrete shall be mixed in the following proportions, measured by weight. The water-cement ratio shall be 3-4 to 6 U.S. Gallons of water per 94 pound bag of cement. The proportion of materials for the trial mix shall be 1:2:3-4. The combination of aggregates may be adjusted to produce a plastic and workable mix that will not produce harshness in placing or honeycombing in the structure.

3. Mixing - The concrete ingredients shall be mixed in batch mixers until the mixture is homogeneous and of uniform consistency. The mixing of each batch shall continue for not less than one and one-half minutes after all the ingredients, except the full amount of water, are in the mixer. The minimum mixing time is predicted on proper control of the speed of rotation of the mixer and of the introduction of the materials, including water, into the mixer. Water shall be added prior to, during, and following the mixer-charging operations. Excessive overmixing requiring the addition of water to preserve the required concrete consistency shall not be permitted. Truck mixing will be allowed provided that the use of this method shall cause no violation of any applicable provisions of the specifications given here.

4. Forms - The forms shall have sufficient strength and rigidity to hold the concrete and to withstand the necessary pressure, tamping, and vibration without deflection from the prescribed lines. They shall be mortar-tight and constructed so that they can be removed without hammering or prying against the concrete.

The inside of forms shall be oiled with a non-staining mineral oil or thoroughly wetted before concrete is placed.

Forms may be removed 24 hours after the placement of concrete. All wire ties and other devices used shall be recessed from the surface of the concrete.

5. Reinforcing Steel - All reinforcing material shall be free of dirt, rust, scale, oil, paint or any other coatings. The steel shall be accurately placed and securely tied and blocked into position so that no movement of the steel will occur during placement of concrete.

6. Consolidating - Concrete shall be consolidated with internal type mechanical vibrators. Vibration shall be supplemented by spading and hand tamping as necessary to insure smooth and dense concrete along form surfaces, in corners, and around embedded items.

7. Finishing - Defective concrete, honeycombed areas, voids left by the removal of tie rods, ridges on all concrete surfaces permanently exposed to view or exposed to water on the finished structure, shall be repaired immediately after the removal of forms. All voids shall be reamed and completely filled with dry-patching mortar.

8. Protection and Curing - Exposed surfaces of concrete shall be protected from the direct rays of the sun for at least the first three (3) days. All concrete shall be kept continuously moist for at least ten (10) days after being placed. Moisture may be applied by spraying or sprinkling as necessary to prevent the concrete from drying. Concrete shall not be exposed to freezing during the curing period. Curing compounds may also be used.








9. Placing Temperature - Concrete may not be placed at temperatures below 37°F with the temperature falling, or 34° with the temperature rising.

VI. STABILIZATION

All borrow areas shall be graded to provide proper drainage and left in a slightly condition. All exposed surfaces of the embankment, spillway, spoil and borrow areas, and berms shall be stabilized by seeding, liming, fertilizing and mulching (if required) in accordance with the vegetative treatment specifications or as shown on the accompanying drawings.

VII. EROSION AND SEDIMENT CONTROL

Construction operations will be carried out in such a manner that erosion will be controlled and water and air pollution minimized. State and local laws concerning pollution abatement will be followed. Construction plans shall detail erosion and sediment control measures to be employed during the construction process.

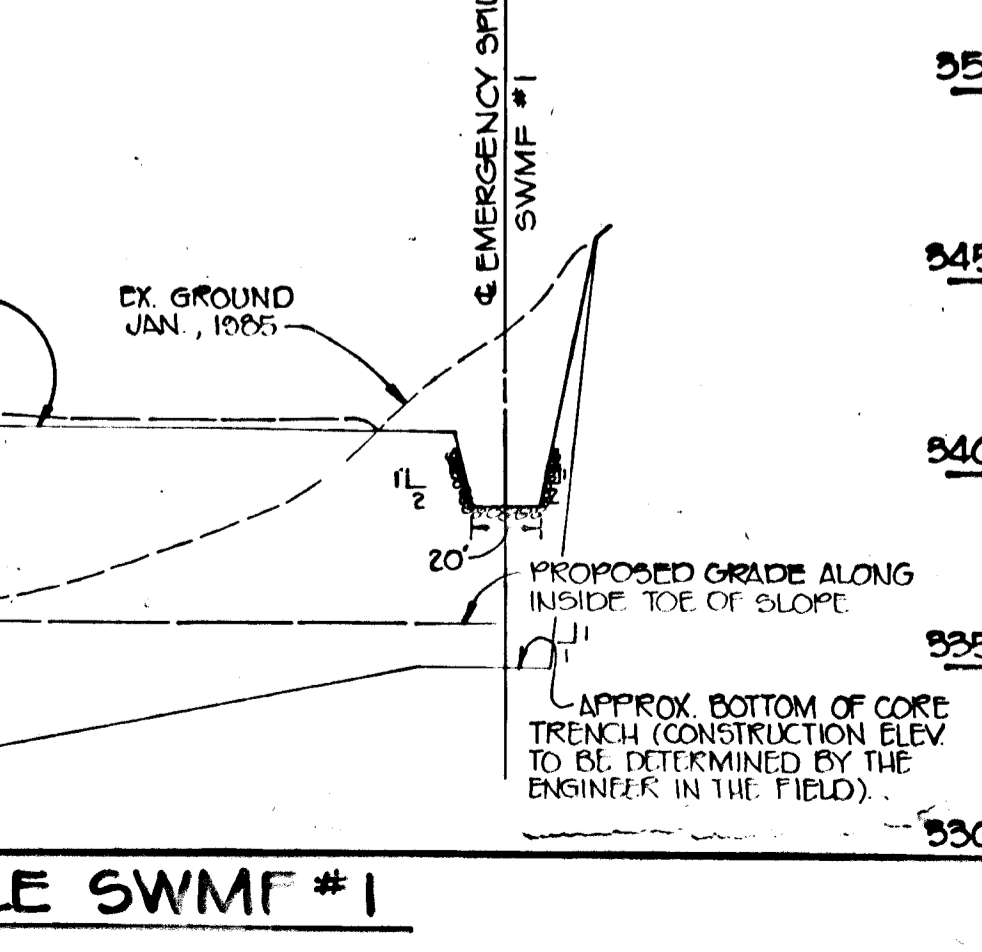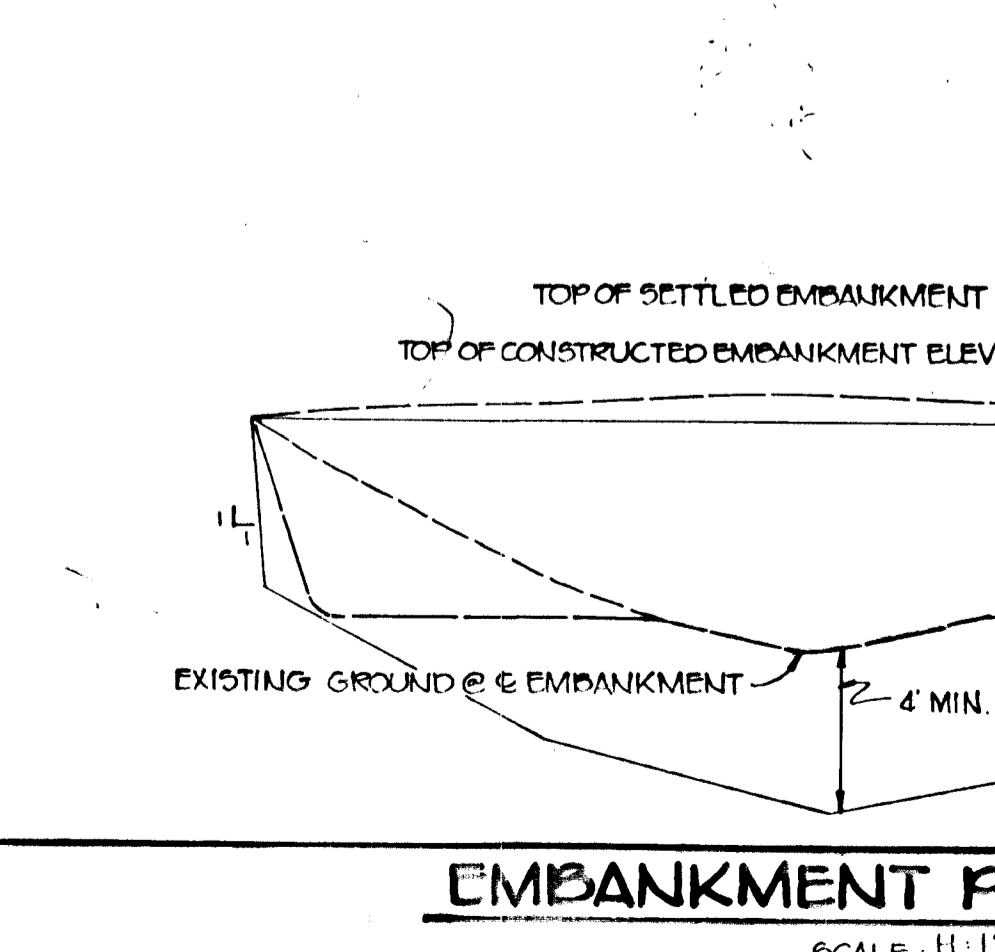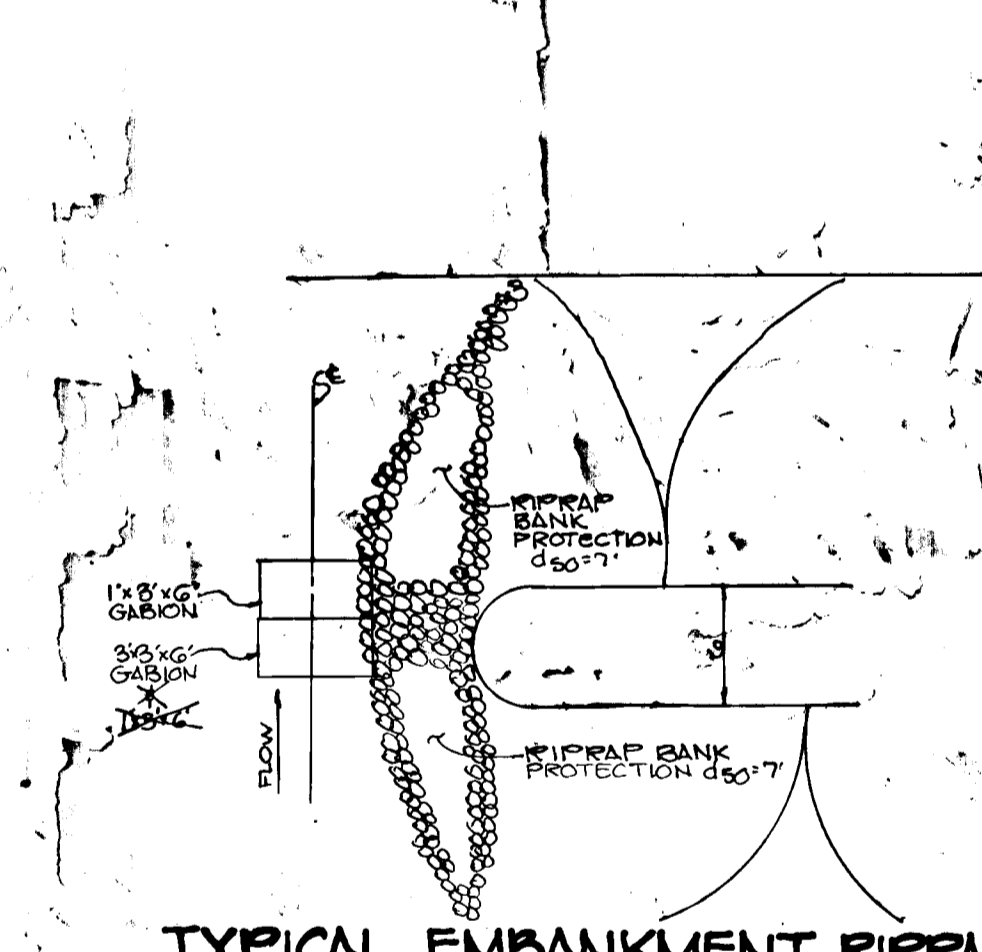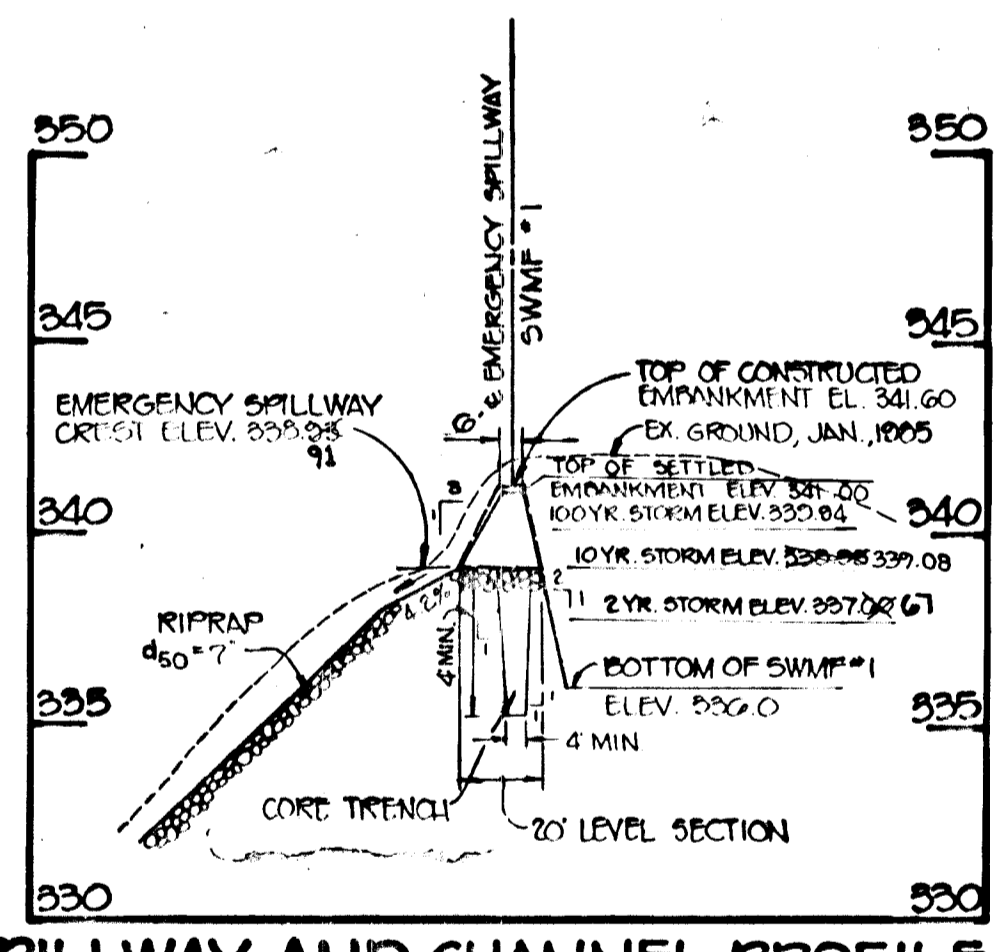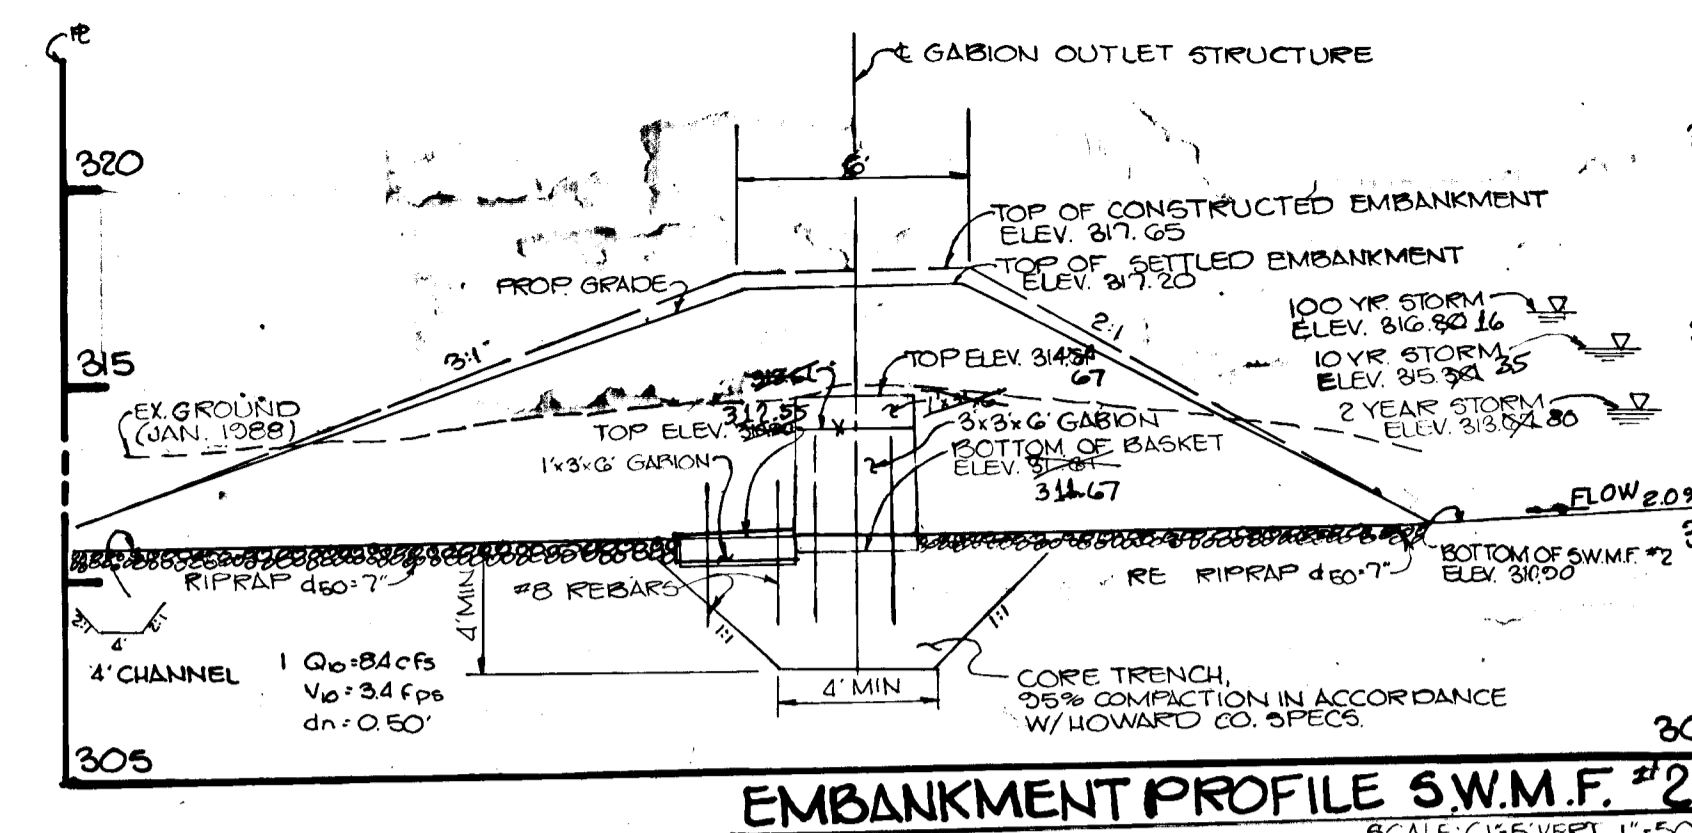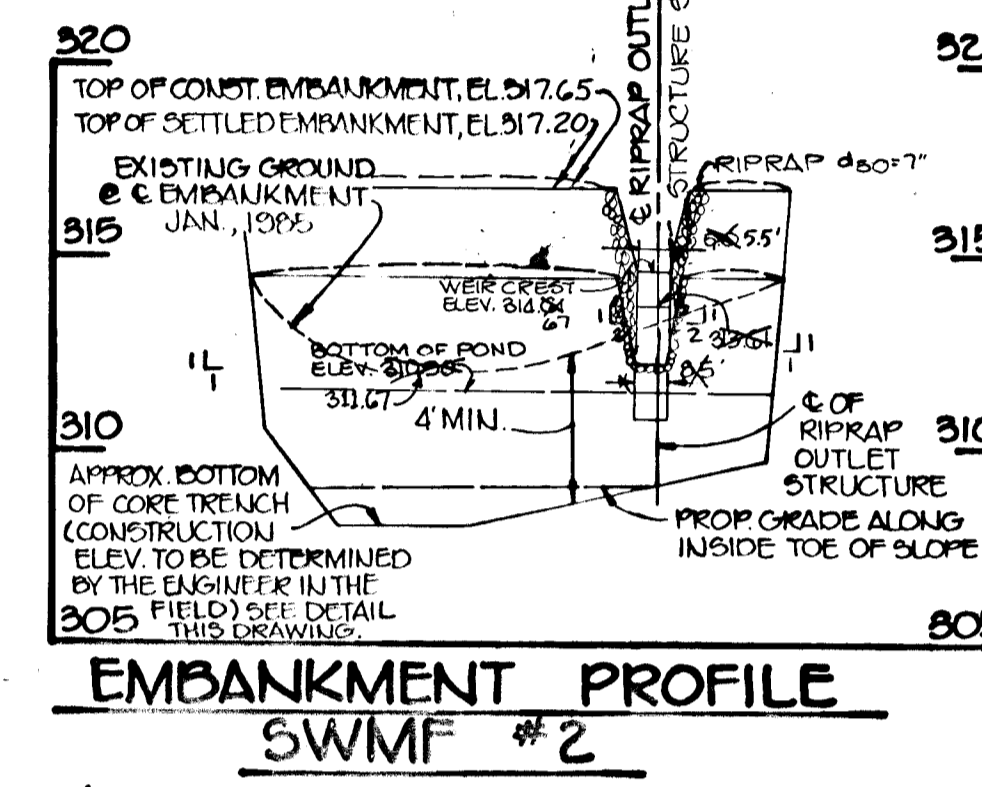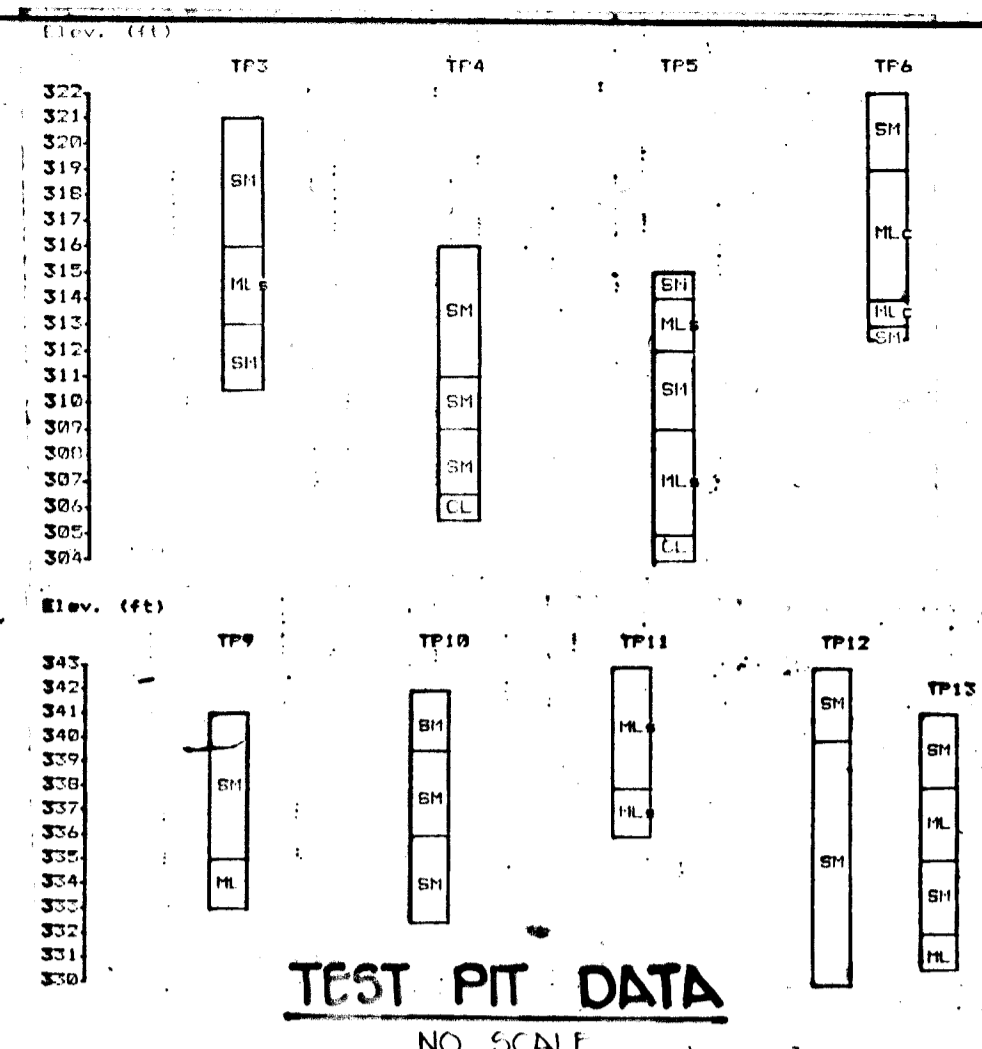

BY THE ENGINEER:  
 I CERTIFY THAT THIS PLAN FOR POND CONSTRUCTION, EROSION AND SEDIMENT CONTROL REPRESENTS A PRACTICAL AND WORKABLE PLAN BASED ON MY PERSONAL KNOWLEDGE OF THE SITE CONDITIONS. THIS PLAN WAS PREPARED IN ACCORDANCE WITH THE REQUIREMENTS OF THE HOWARD SOIL CONSERVATION DISTRICT. I HAVE NOTIFIED THE DEVELOPER THAT HE MUST PROVIDE THE HOWARD SOIL CONSERVATION DISTRICT WITH AN "AS-BUILT" PLAN OF THE POND WITHIN 30 DAYS OF COMPLETION.  
 James K. Tracy  
 ENGINEER JAMES K. TRACY  
 6-19-86  
 DATE

BY THE DEVELOPER:  
 I CERTIFY THAT ALL DEVELOPMENT AND/OR CONSTRUCTION WILL BE DONE ACCORDING TO THESE PLANS, AND THAT ANY RESPONSIBLE PERSONNEL INVOLVED IN THE CONSTRUCTION PROJECT WILL HAVE A CERTIFICATE OF ATTENDANCE AT A DEPARTMENT OF NATURAL RESOURCES APPROVED TRAINING PROGRAM FOR THE CONTROL OF SEDIMENT AND EROSION BEFORE BEGINNING THE PROJECT. I WILL PROVIDE THE HOWARD SOIL CONSERVATION DISTRICT WITH AN "AS-BUILT" PLAN OF THE POND WITHIN 30 DAYS OF COMPLETION.  
 James R. Malley Jr.  
 SECURITY DEVELOPMENT CORPORATION - PRESIDENT  
 6-19-86  
 DATE

THESE PLANS HAVE BEEN REVIEWED FOR THE HOWARD SOIL CONSERVATION DISTRICT AND MEET THE TECHNICAL REQUIREMENTS FOR SMALL POND CONSTRUCTION, SOIL EROSION AND SEDIMENT CONTROL.  
 James M. Hatten  
 U.S. SOIL CONSERVATION SERVICE  
 10-21-86  
 DATE

APPROVED Robert W. Zehn  
 HOWARD S.C.D.  
 10-27-86  
 DATE

APPROVED: HOWARD COUNTY OFFICE OF PLANNING AND ZONING  
 John M. Murchman  
 CHIEF, DIVISION OF LAND DEVELOPMENT AND ZONING ADMINISTRATION  
 10-23-86  
 DATE

APPROVED: HOWARD COUNTY DEPARTMENT OF PUBLIC WORKS  
 William E. Reig  
 CHIEF, BUREAU OF ENGINEERING  
 10-24-86  
 DATE

4-12-89	REVISED EMBANKMENT PROFILE AND SPILLWAY
11-23-88	PUR EMBANKMENT PROFILE AND SPILLWAY
NO	DATE REVISION

TRACY, SCHULTE & ASSOCIATES INC.  
 planning • architecture • engineering  
 8450 Baltimore National Pike • Suite 34 • Ellicott City, Maryland 21043 • (301) 465-6105

OWNER: SECURITY DEVELOPMENT CORP. 8450 BALTIMORE NATIONAL PIKE ELLICOTT CITY, MARYLAND 21043  
 PROJECT: HUNTINGTON SOUTH SECTION ONE, AREA ONE LOTS 11131-168 LOCATION G 7<sup>TH</sup> ELECTION DISTRICT, HOWARD COUNTY, MD TAX MAP NO. 42 ZONING MAP NO. 42 PARCEL 87  
 DEVELOPER: SECURITY DEVELOPMENT CORP. 8450 BALTIMORE NATIONAL PIKE ELLICOTT CITY, MARYLAND 21043  
 TITLE: S.W.M. SPECIFICATIONS AND DETAILS  
 DATE: JUNE 1986 PROJECT NO: 85006 R50  
 DES: J.K.T. DRN: K.A.M./J.L.B. SCALE: AS SHOWN DRAWING 29 OF 10

1235



