

SHEET INDEX	
NO	DESCRIPTION
1	TITLE SHEET
2	PLAN OF PIRATES COVE, HIDDEN COVE AND PRIVATE DRIVE
3	PROFILES OF PIRATES COVE, HIDDEN COVE, AND PRIVATE DRIVE
4	PROFILES OF OAKLAND MILLS RD AND PRIVATE DRIVE
5	DETAILS
6	DRAINAGE AREA MAP AND DETAILS
7	GRADING AND SEDIMENT CONTROL PLAN
8	SEDIMENT CONTROL NOTES AND DETAILS
9	STORM WATER MANAGEMENT SPECIFICATIONS AND DETAILS
10	STREET TREE PLAN


# ROADWAY, STORM DRAIN & STORM WATER MANAGEMENT

## CARTER'S COVE

### SECTION 1, AREA 1

### 6TH ELECTION DISTRICT

## HOWARD COUNTY, MARYLAND

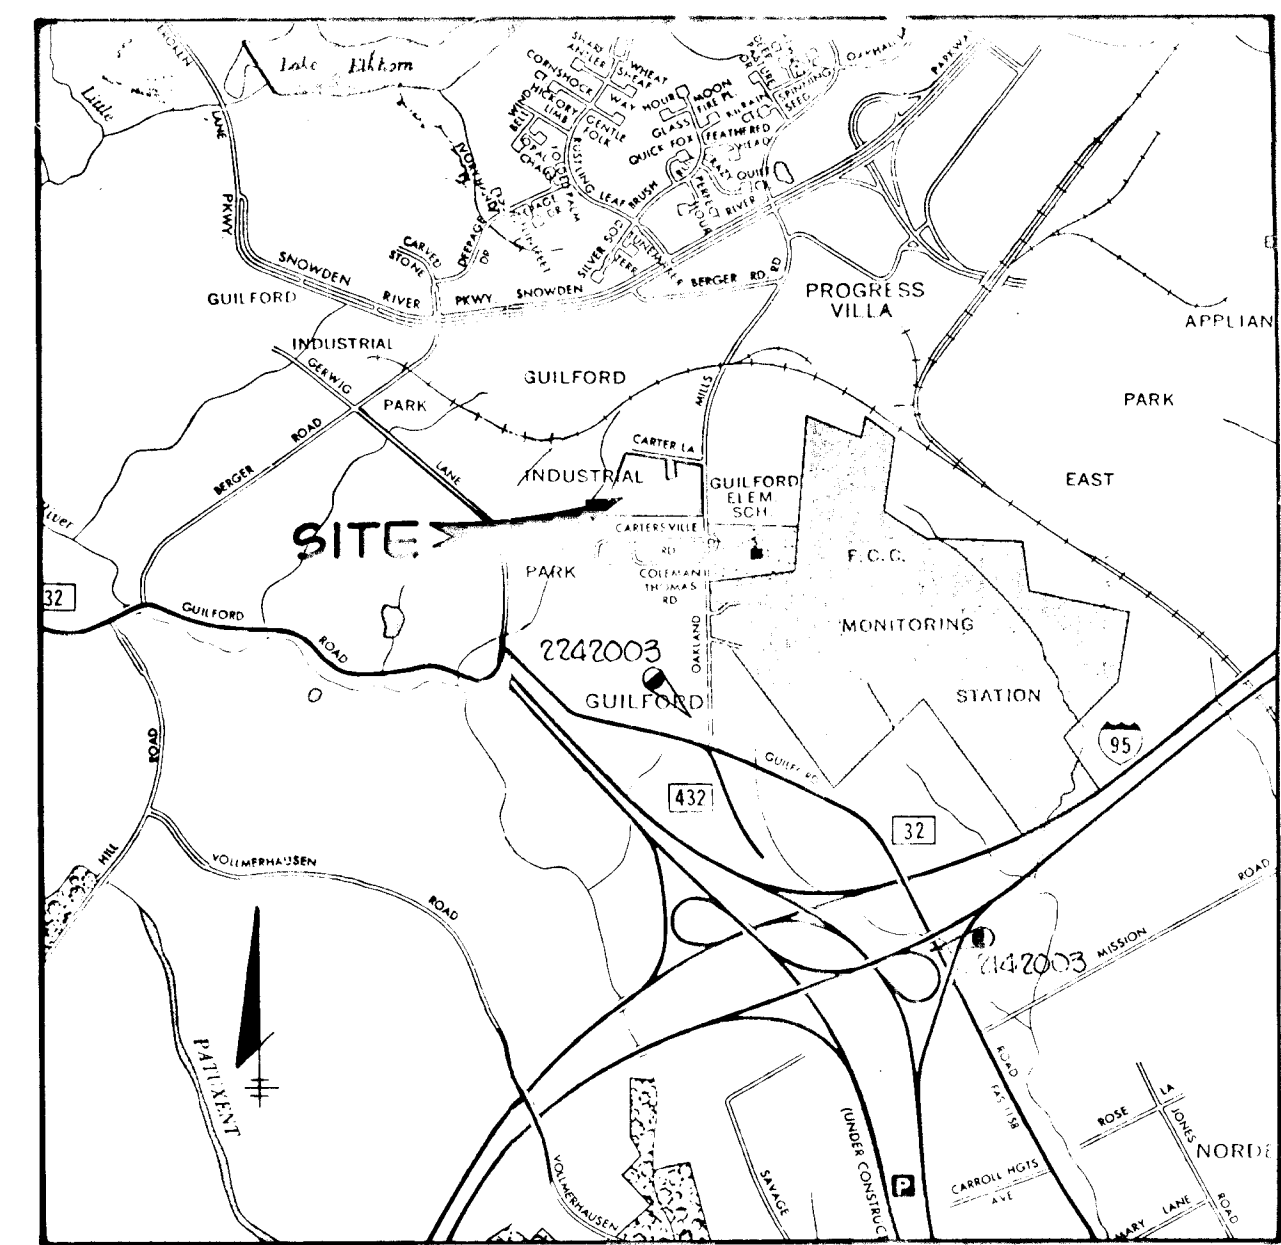

**VICINITY MAP**  
SCALE 1"=2000'

**BENCH MARK DESCRIPTIONS**


BM #2242003 ELEV 374.228'  
CONCRETE MONUMENT SET FLUSH WITH GROUND AT NORTHWEST CORNER OF INTERSECTION OF OAKLAND MILLS ROAD OLD ROUTE #32.

BM #2142003 ELEV 328.746'  
CONCRETE MONUMENT 6' EAST OF END CONCRETE CURB OF ROUTE #25 NORTHBOUND LANE 0.1' BELOW SURFACE.

**GENERAL NOTES**

- ALL WORK SHALL BE PERFORMED IN ACCORDANCE WITH THE HOWARD COUNTY DESIGN MANUAL, VOLUME IV STANDARD SPECIFICATIONS AND DETAILS FOR ROAD CONSTRUCTION.
- APPROXIMATE LOCATION OF EXISTING UTILITIES ARE SHOWN. THE CONTRACTOR SHALL TAKE ALL NECESSARY PRECAUTIONS TO PROTECT THE EXISTING UTILITIES AND MAINTAIN UNINTERRUPTED SERVICE. ANY DAMAGE INCURRED DUE TO CONTRACTOR'S OPERATION SHALL BE REPAIRED IMMEDIATELY AT THE CONTRACTOR'S EXPENSE.
- THE CONTRACTOR SHALL TEST PIT EXISTING UTILITIES, WHERE DIRECTED BY THE ENGINEER, A MINIMUM OF TWO WEEKS IN ADVANCE OF CONSTRUCTION OPERATIONS.
- CONTRACTOR TO NOTIFY THE FOLLOWING UTILITIES AT LEAST THREE DAYS BEFORE STARTING WORK SHOWN ON THESE DRAWINGS.
 

BELL TELEPHONE SYSTEM	393-3649
LONG DISTANCE CABLE DIVISION	393-3553 OR 3554
BALTIMORE GAS AND ELECTRIC	539-8000 EXT. 691
HOWARD COUNTY BUREAU OF UTILITIES	992-2366
HOWARD COUNTY CONSTRUCTION INSPECTION SURVEY DIVISION	992-2417/2418
- ALL INLETS SHALL BE CONSTRUCTED IN ACCORDANCE WITH HOWARD COUNTY STANDARDS.
- ALL STREET CURB RETURNS SHALL HAVE 20.0' RADIUS UNLESS OTHERWISE NOTED.
- STORM DRAIN TRENCHES WITHIN ROAD RIGHT OF WAY SHALL BE BACKFILLED AND COMPACTED IN ACCORDANCE WITH HOWARD COUNTY ROAD CODE.
- INSTALLATION OF TRAFFIC CONTROL DEVICES, MARKING AND SIGNING SHALL BE IN ACCORDANCE WITH THE MANUAL OF UNIFORM TRAFFIC CONTROL DEVICES 1973 EDITION.
- PIPE SHALL NOT BE INSTALLED BY THE CONTRACTOR UNTIL THE LENGTH CALLED FOR AT EACH STATION HAS BEEN APPROVED BY THE ENGINEER IN THE FIELD.
- DESIGNED TRAFFIC SPEED IN ACCORDANCE WITH THE AMERICAN ASSOCIATION OF STATE HIGHWAY OFFICIAL STANDARDS:
  - ALL CUL-DE-SAC DESIGNED FOR 30 M.P.H., ALL LOCAL STREETS DESIGNED FOR 30 M.P.H.
- ALL ELEVATIONS SHOWN ARE BASED ON U.S.C. AND G.S. MEAN SEA LEVEL DATUM 1929.
- ALL FILL AREAS WITHIN ROADWAYS AND UNDER STRUCTURES TO BE COMPACTED TO A MINIMUM 95% OF MAXIMUM OBTAINABLE DENSITY DETERMINED BY MARSHALL PROCTOR.
- ALL PIPE ELEVATIONS SHOWN ARE INVERT ELEVATIONS.
- PROFILE STATIONS SHALL BE ADJUSTED AS NECESSARY TO CONFORM TO PLAN DIMENSIONS.
- SUBJECT PROPERTY ZONED R-SA PER B-7-85 COMPREHENSIVE ZONING PLAN.
- INFO TAKEN FROM FIELD SURVEY BY TRACY, SCHULTE & ASSOC. DATED JUNE, 1986.

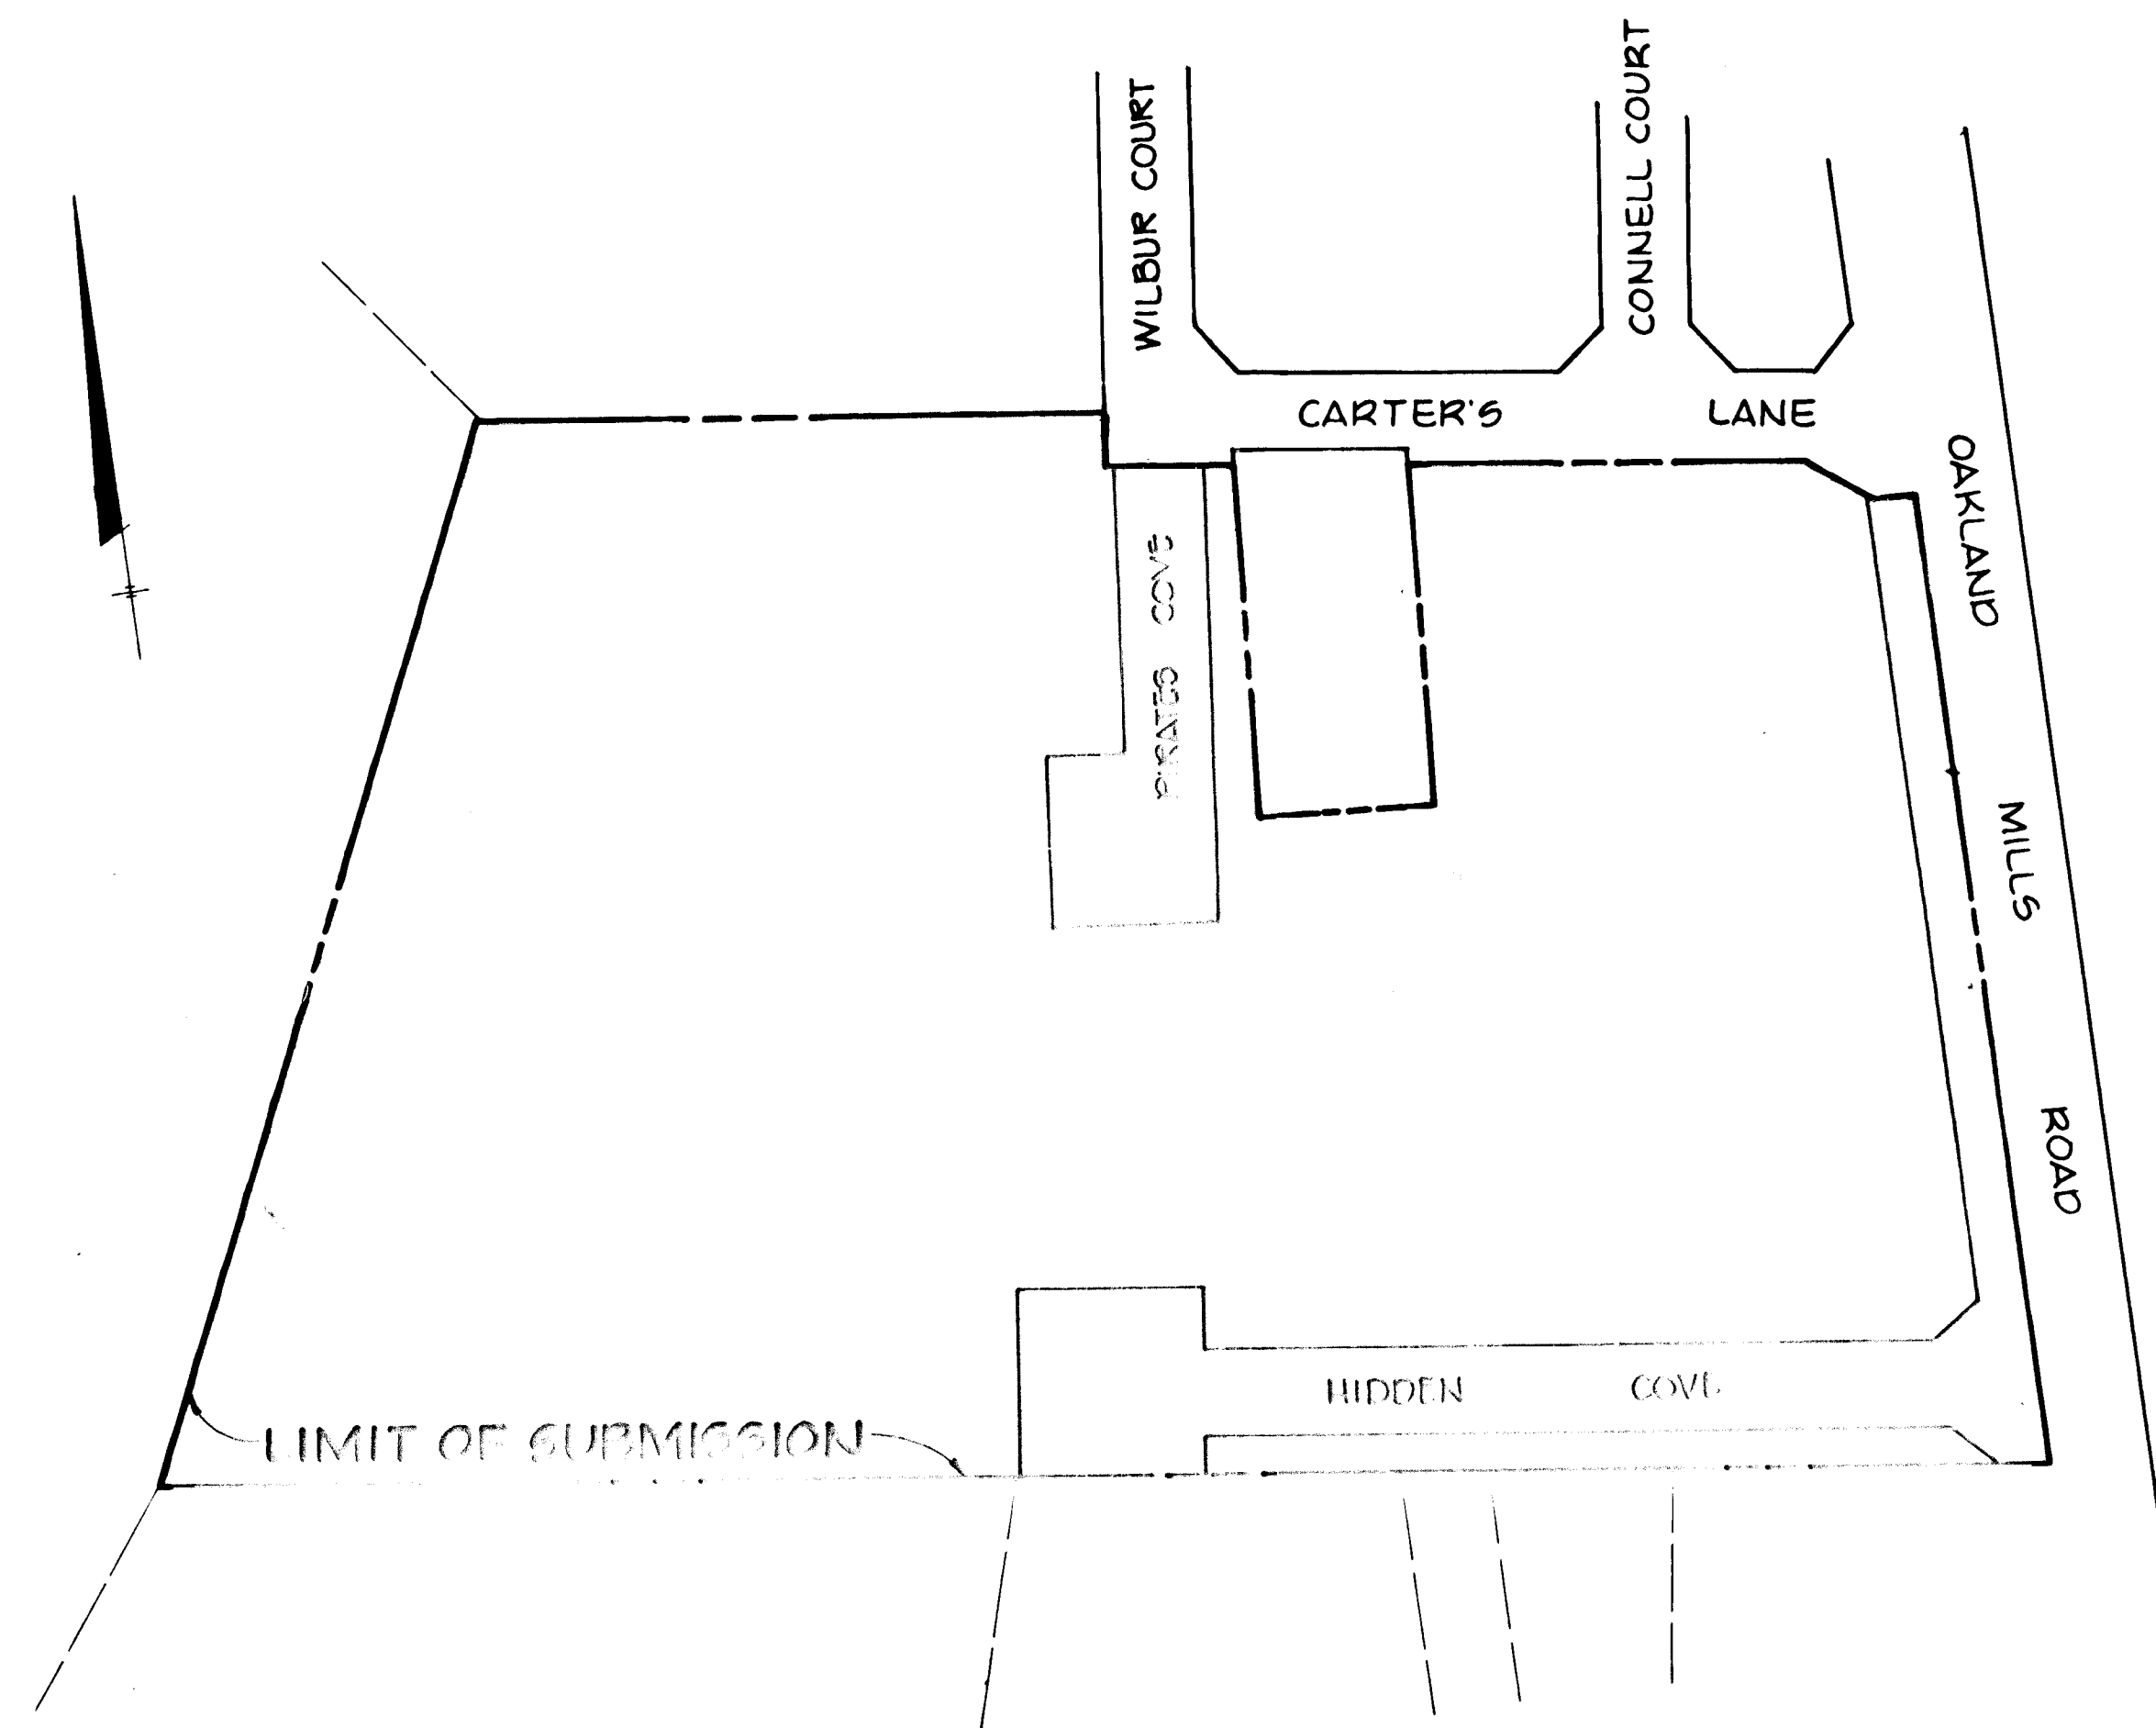

**PLAN**  
SCALE 1"=100'

\* VERTICAL CONTROL USED FOR AS-BUILT IS BASED ON HOWARD COUNTY CONTROL MONUMENT (PATTERSON E & F) #2242003 ELEV. = 374.228'

APPROVED: HOWARD COUNTY OFFICE OF PLANNING AND ZONING  
*John W. ...* 2-15-87  
CHIEF, DIVISION OF LAND DEVELOPMENT AND ZONING ADMINISTRATION DATE

APPROVED: HOWARD COUNTY DEPARTMENT OF PUBLIC WORKS  
*William E. ...* 2-18-87  
CHIEF, BUREAU OF ENGINEERING DATE

NO	DATE	REVISION

**TRACY, SCHULTE & ASSOCIATES INC.**  
planning • architecture • engineering

8480 Baltimore National Pike • Ellicott City, Maryland 21043 • (301) 465 6105

OWNER SECURITY DEVELOPMENT CORP 8480 BALTIMORE NATIONAL PIKE ELLICOTT CITY, MARYLAND 21043	PROJECT <b>CARTER'S COVE</b> SECTION 1, AREA 1 LOTS 1 THRU 100
DEVELOPER SECURITY DEVELOPMENT CORP 8480 BALTIMORE NATIONAL PIKE ELLICOTT CITY MARYLAND 21043	LOCATION TAX MAP NO. 42 PARCEL NO. 27 & 253 6TH ELECTION DISTRICT HOWARD COUNTY, MARYLAND
TITLE <b>TITLE SHEET</b>	
DATE FEB. 6, 1987	PROJECT NO 8523
DES DAM	DRN CDT
SCALE AS SHOWN	DRAWING 1 OF 10

¢ CURVE DATA - DRIVEWAY TO GUILFORD PLACE  
 ¢ STA 0+51.40 TO 1+00.30  
 Δ 32° 36' 11"  
 R 100.00'  
 L 56.90'  
 T 29.24'  
 D 57° 20' 58"


¢ CURVE DATA - PRIVATE DRIVE 'A'  
 ¢ STA 1+67.2 TO ¢ STA 3+25.43  
 Δ 90° 25' 05"  
 R 100.00'  
 L 157.91'  
 T 100.73'  
 D 57° 20' 58"

No.	DATE	REVISION
3	11-24-88	ADD 3 PARKING SPACES TO HIDDEN COVE; REMOVE ISLAND AND ADD 4 PARKING SPACES TO PIRATES COVE; ADD ENTRANCE TO PIRATES COVE.

STRUCTURE SCHEDULE						
NO.	TYPE	LOCATION	INV IN	INV OUT	TOP ELEV	DESCRIPTION
I-1	A-5	21.50 RT LP STA 6+60.00 HIDDEN COVE	---	353.85	356.80	HO CO STD SD 4.01
I-2	'D' INLET OPEN ON ONE SIDE	SEE PLAN	---	350.48	353.73	HO CO STD SD 4.11
I-3	A-5 W/ 2 OPENINGS	21.7' LEFT OF L.P. STA 4+4 SEE PLAN PIRATES COVE	15"D 352.38 21"D 351.84	351.68	357.87 WEST 357.21 EAST	HO CO STD SD 4.01
I-4	A-5	23.2' LEFT OF L.P. STA 2+40.2 SEE PLAN PIRATES COVE	---	356.41	361.17	HO CO STD SD 4.01
M-1	STD 4'-0" DIA MANHOLE	SEE PLAN	15"D 349.40 24"D 349.07	346.84	355.28	HO CO STD G 5.12
E-1	15" METAL END SECTION	SEE PLAN	353.38	353.38	---	HO CO STD SD 5.61
E-2	24" METAL END SECTION	SEE PLAN	345.43	345.43	---	HO CO STD SD 5.61
E-3	36" METAL END SECTION	SEE PLAN	335.60	335.86	---	HO CO STD SD 5.61
E-4	42" METAL END SECTION	SEE PLAN	336.68	336.68	---	HO CO STD SD 5.61
S-1	MODIFIED MANHOLE	SEE PLAN	335.91	335.91	337.08	SEE DETAIL DRAWG 9

ALL STORM DRAIN PIPE BEDDING SHALL BE CLASS 'C'

NOTES  
 1 ALL CURB AND GUTTER TO BE STANDARD 7" COMBINATION CURB AND GUTTER WITH REVERSE GUTTER PAN UNLESS OTHERWISE NOTED

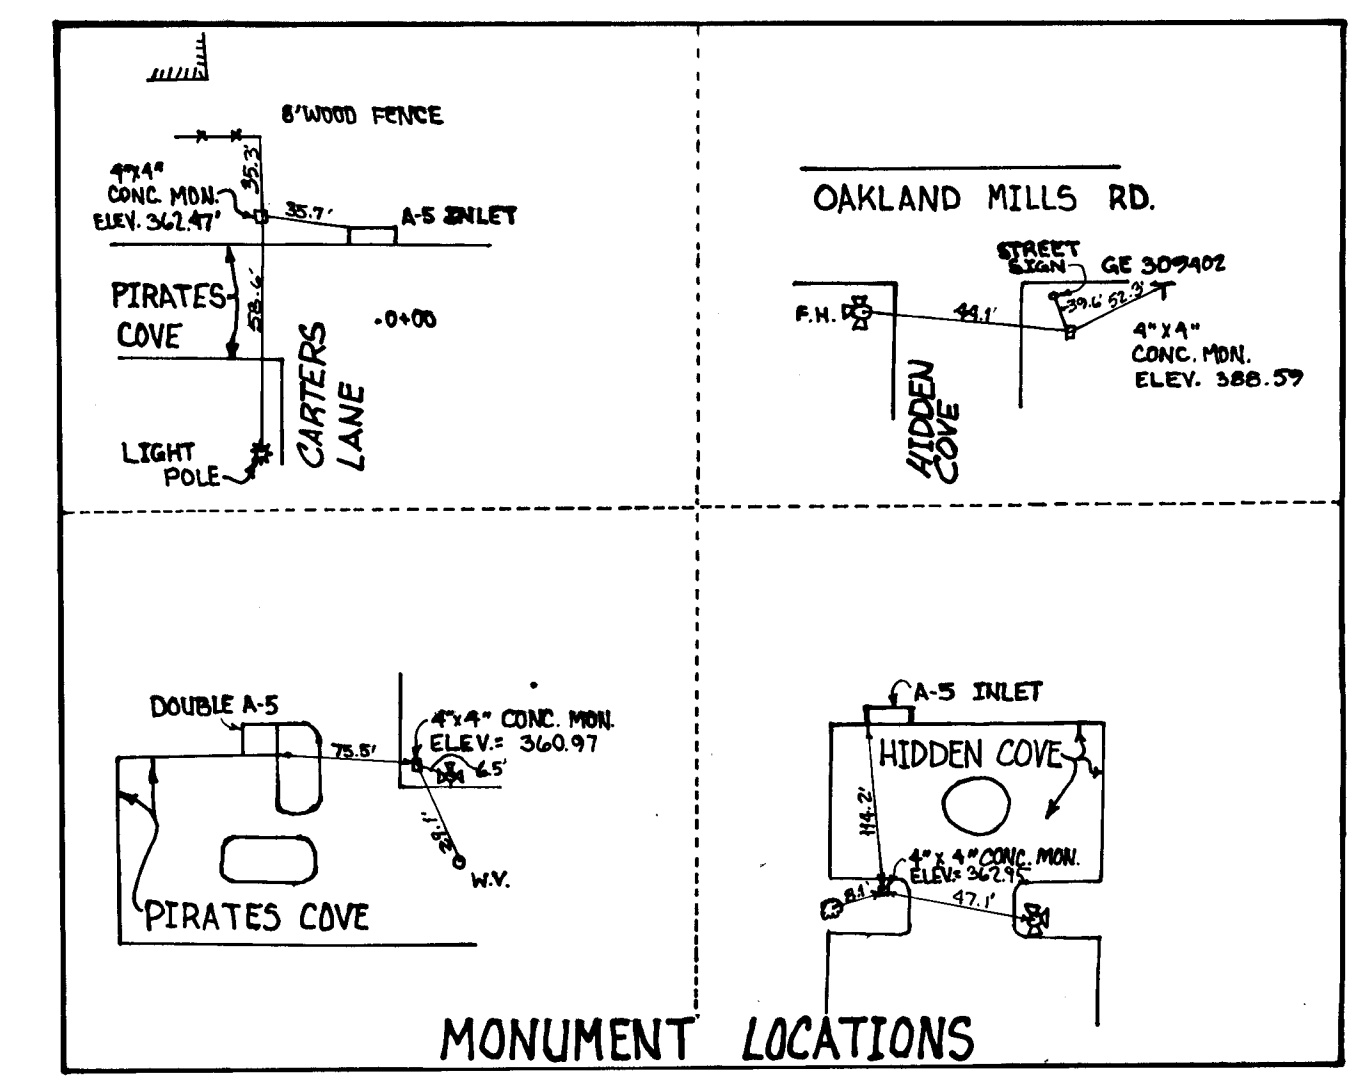

AS-BUILT SURVEY CERTIFIED BY  
 WILLIAM G. RASCH III, Md. L.S./P.E.  
 NO. 4575 ON 11-18-88

APPROVED: HOWARD COUNTY DEPARTMENT OF PUBLIC WORKS	DATE: 2-18-87
CHIEF, BUREAU OF ENGINEERING	DATE: 2-13-87
APPROVED: HOWARD COUNTY OFFICE OF PLANNING AND ZONING	DATE: 2-13-87
CITY ENGINEER, DIVISION OF LAND DEVELOPMENT AND ZONING ADMINISTRATION	DATE: 2-13-87
REVISION: 10/21/87 REVISED PARKING IN HIDDEN COVE	
REVISION: 7/28/88 REVISE GRADING IN STORMWATER MANAGEMENT FACILITY	

**TRACY, SCHULTE & ASSOCIATES INC.**  
 planning • architecture • engineering  
 8480 Baltimore National Pike • Ellicott City, Maryland 21043 • (301) 465-6105

Professional Engineer Seal for James K. Ruddy, No. 10000, State of Maryland.

OWNER SECURITY DEVELOPMENT CORP 8480 BALTIMORE NATIONAL PIKE ELLICOTT CITY, MARYLAND 21043	PROJECT <b>CARTER'S COVE</b> SECTION 1, AREA 1, LOTS 1 THRU 100 LOCATION TAX MAP NO. 42 PARCEL NOS. ST 4 253 6TH ELECTION DISTRICT HOWARD COUNTY, MARYLAND
DEVELOPER SECURITY DEVELOPMENT CORP 8480 BALTIMORE NATIONAL PIKE ELLICOTT CITY, MARYLAND 21043	TITLE PLAN OF PIRATE'S COVE, HIDDEN COVE AND PRIVATE DRIVES
DATE FEB 6, 1987	PROJECT NO 8529 RSD
DES R.J.W.	DRN K.M.N./C.D.T.
SCALE 1" = 50'	DRAWING 2 OF 10




467.750 N  
 347.000 E

ALL C&G TO BE STANDARD  
 7" COMB C&G WITH REVERSE  
 GUTTER PAN UNLESS  
 OTHERWISE NOTED

EGU SECTION 2, AREA 3  
 PARCEL I  
 ZONED NT

NOTE:  
 EXISTING POND TO BE DRAINED PRIOR  
 TO CONSTRUCTION OF PROPOSED STORM  
 WATER MANAGEMENT FACILITY.

1250

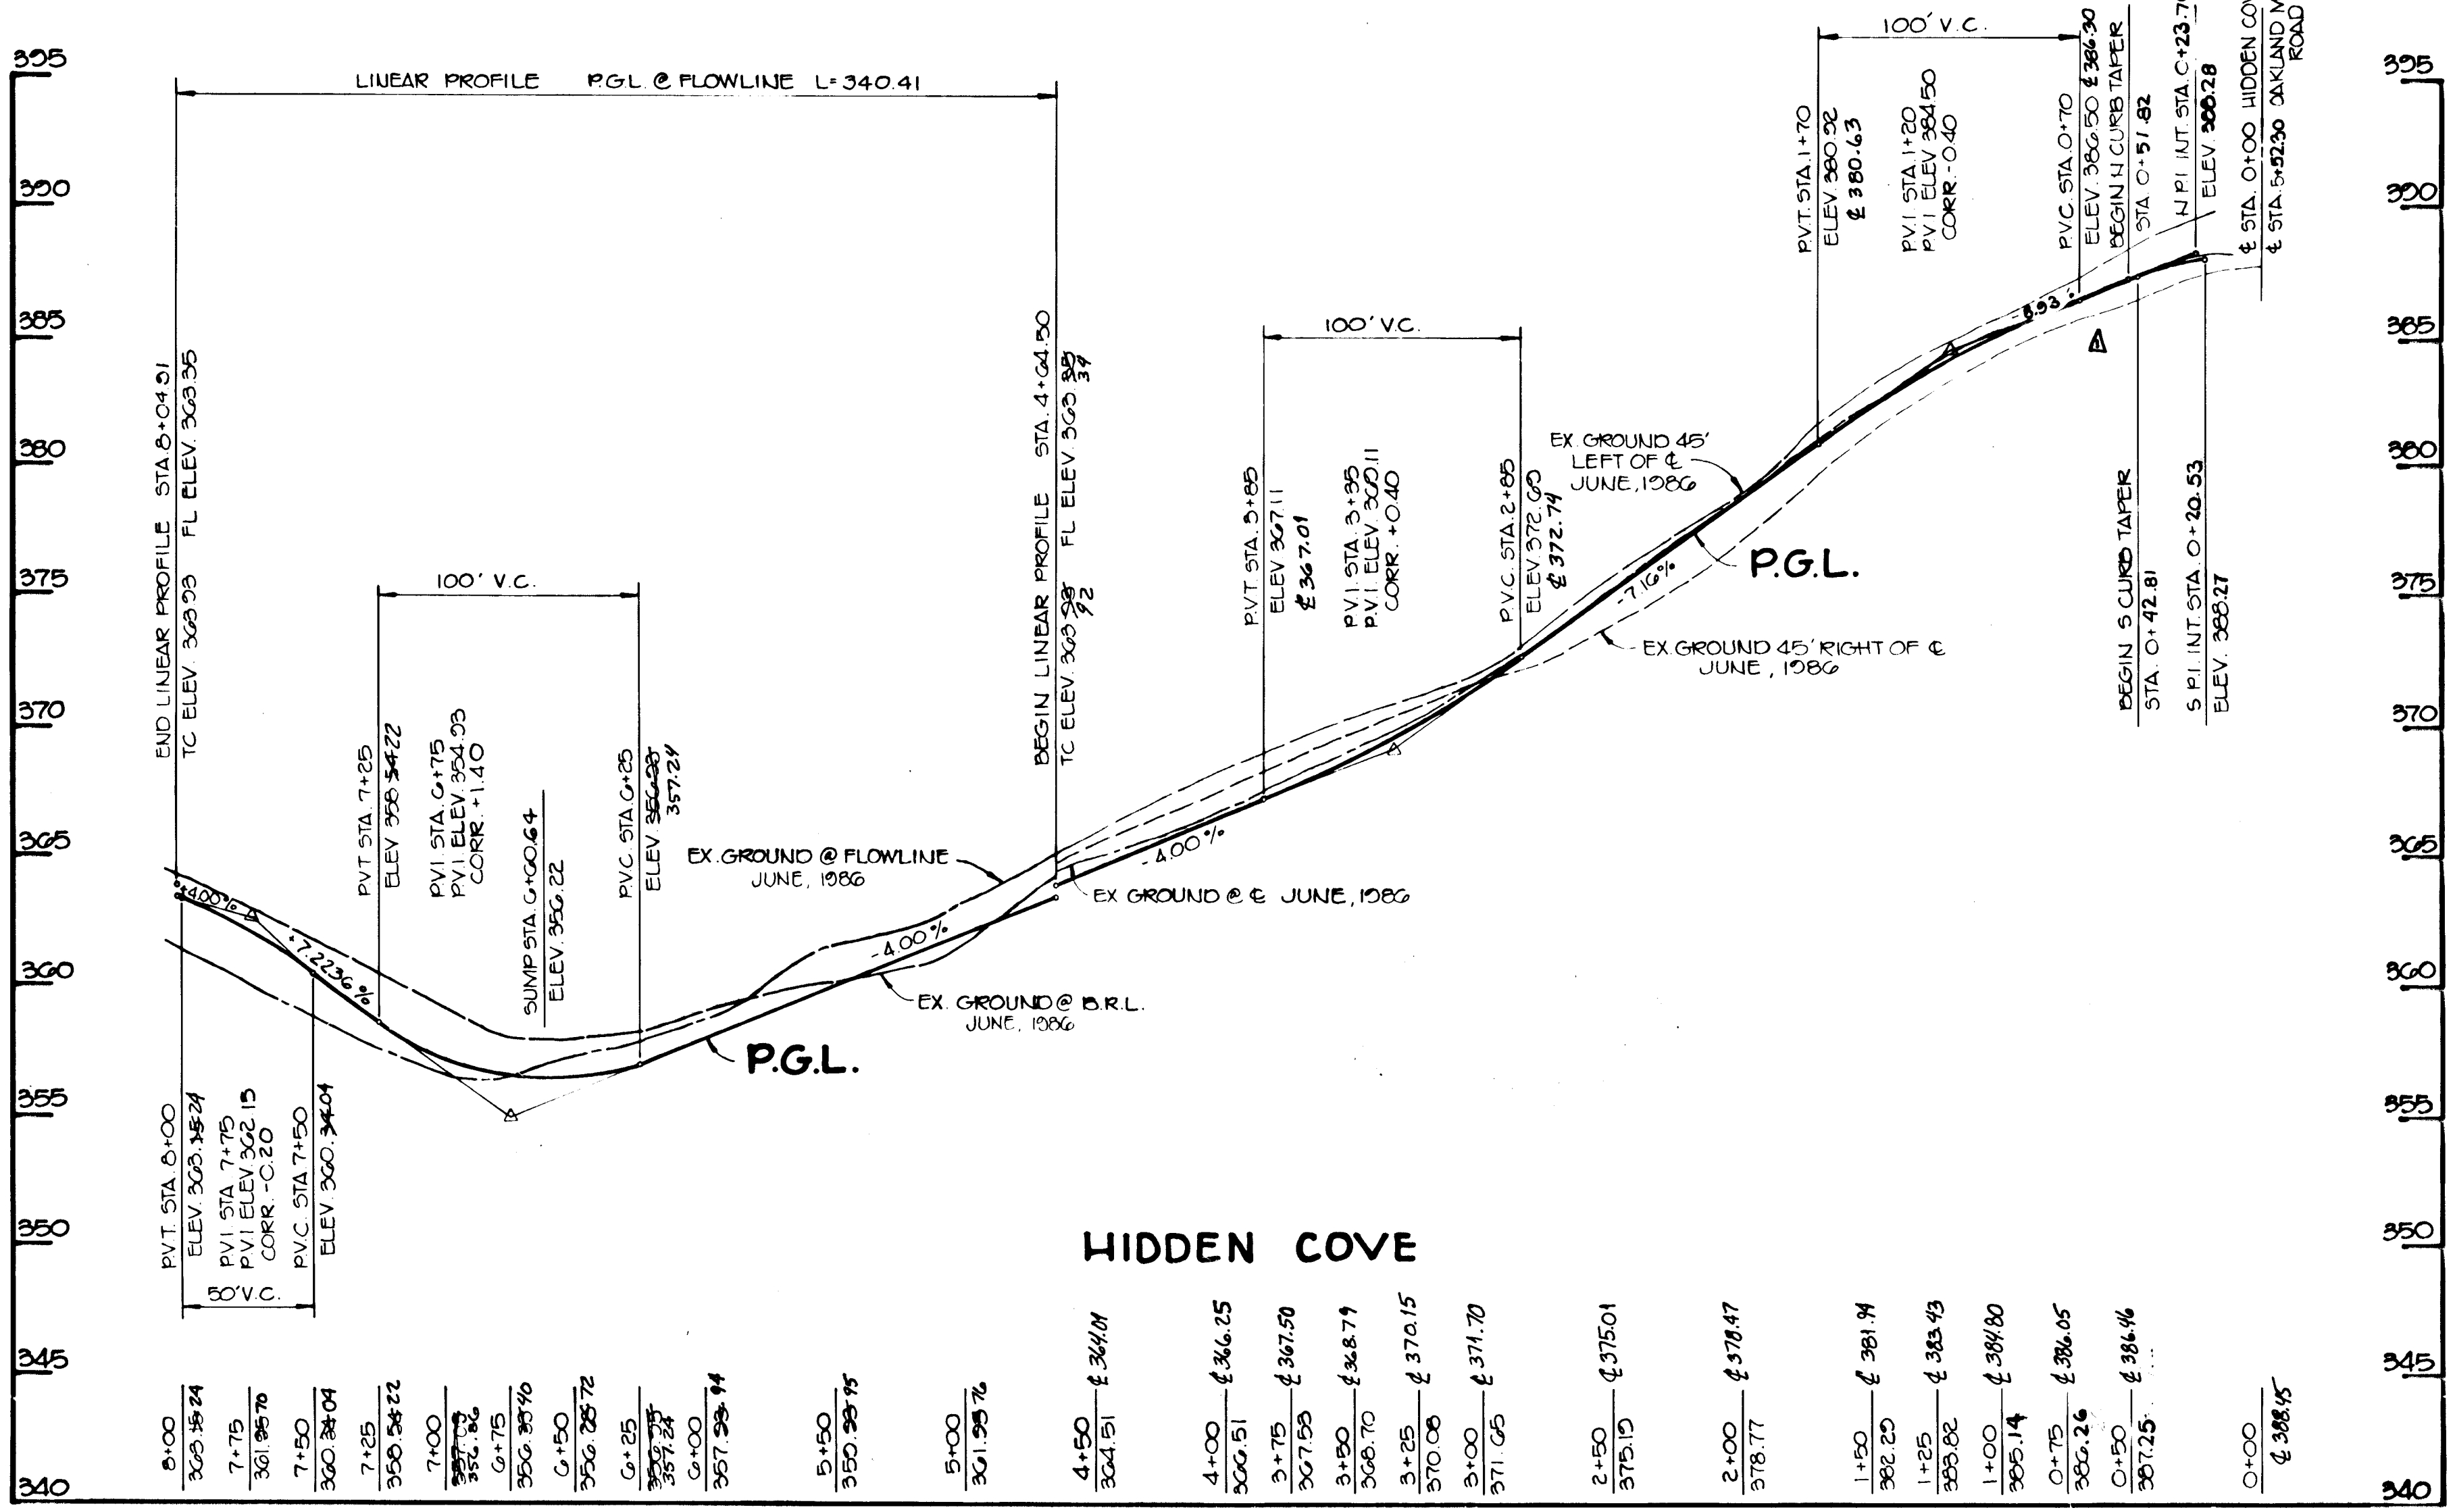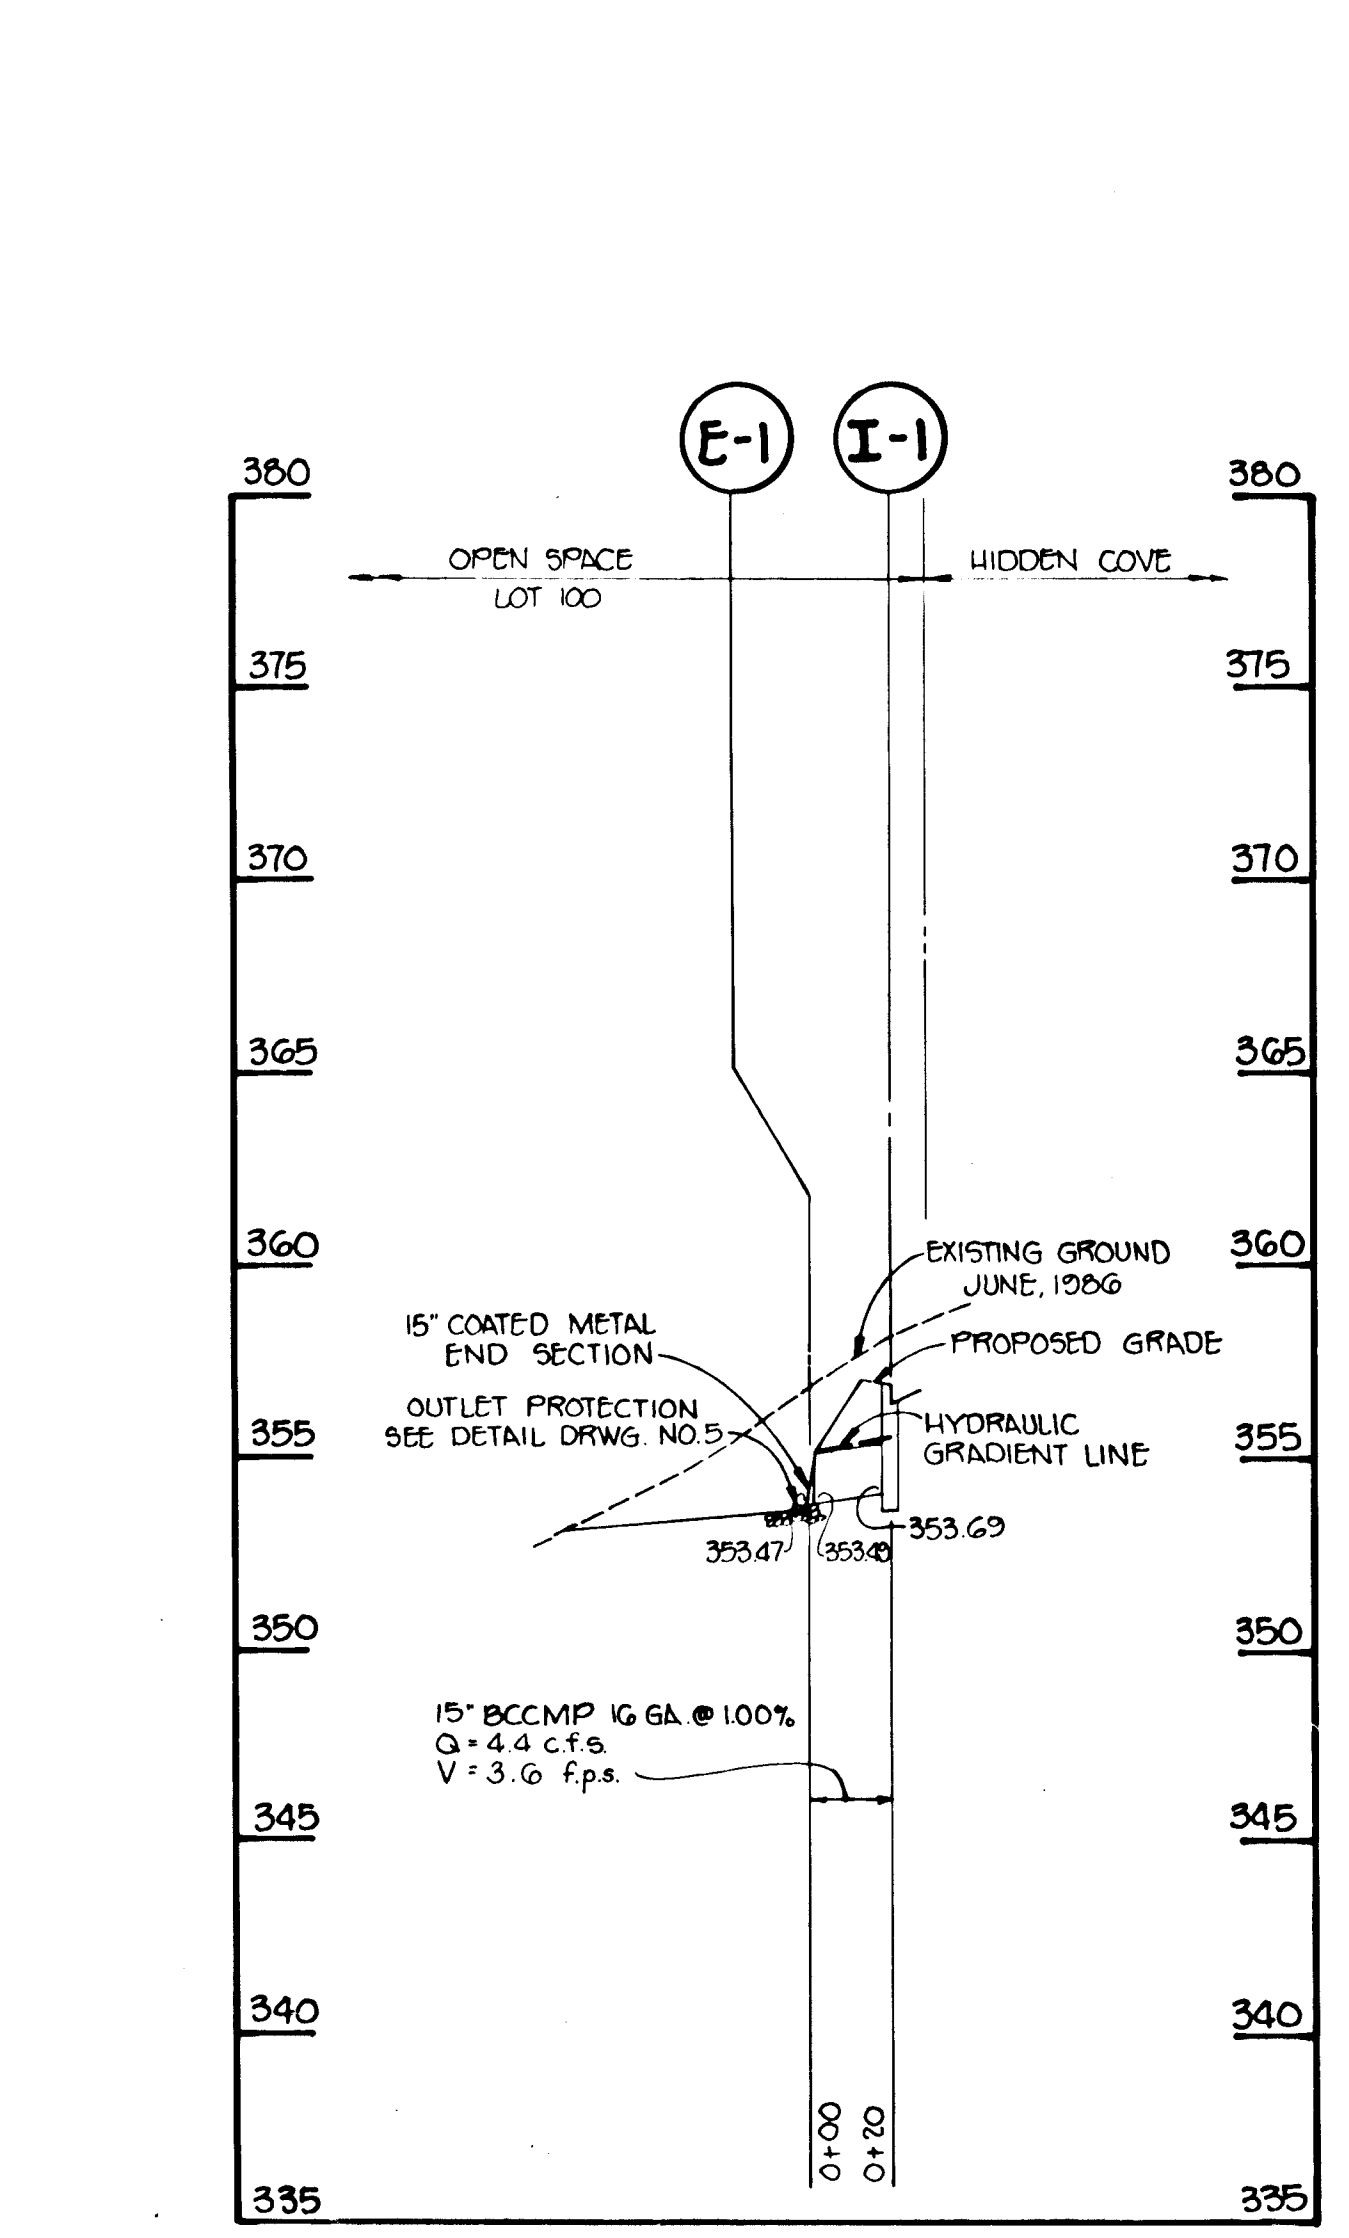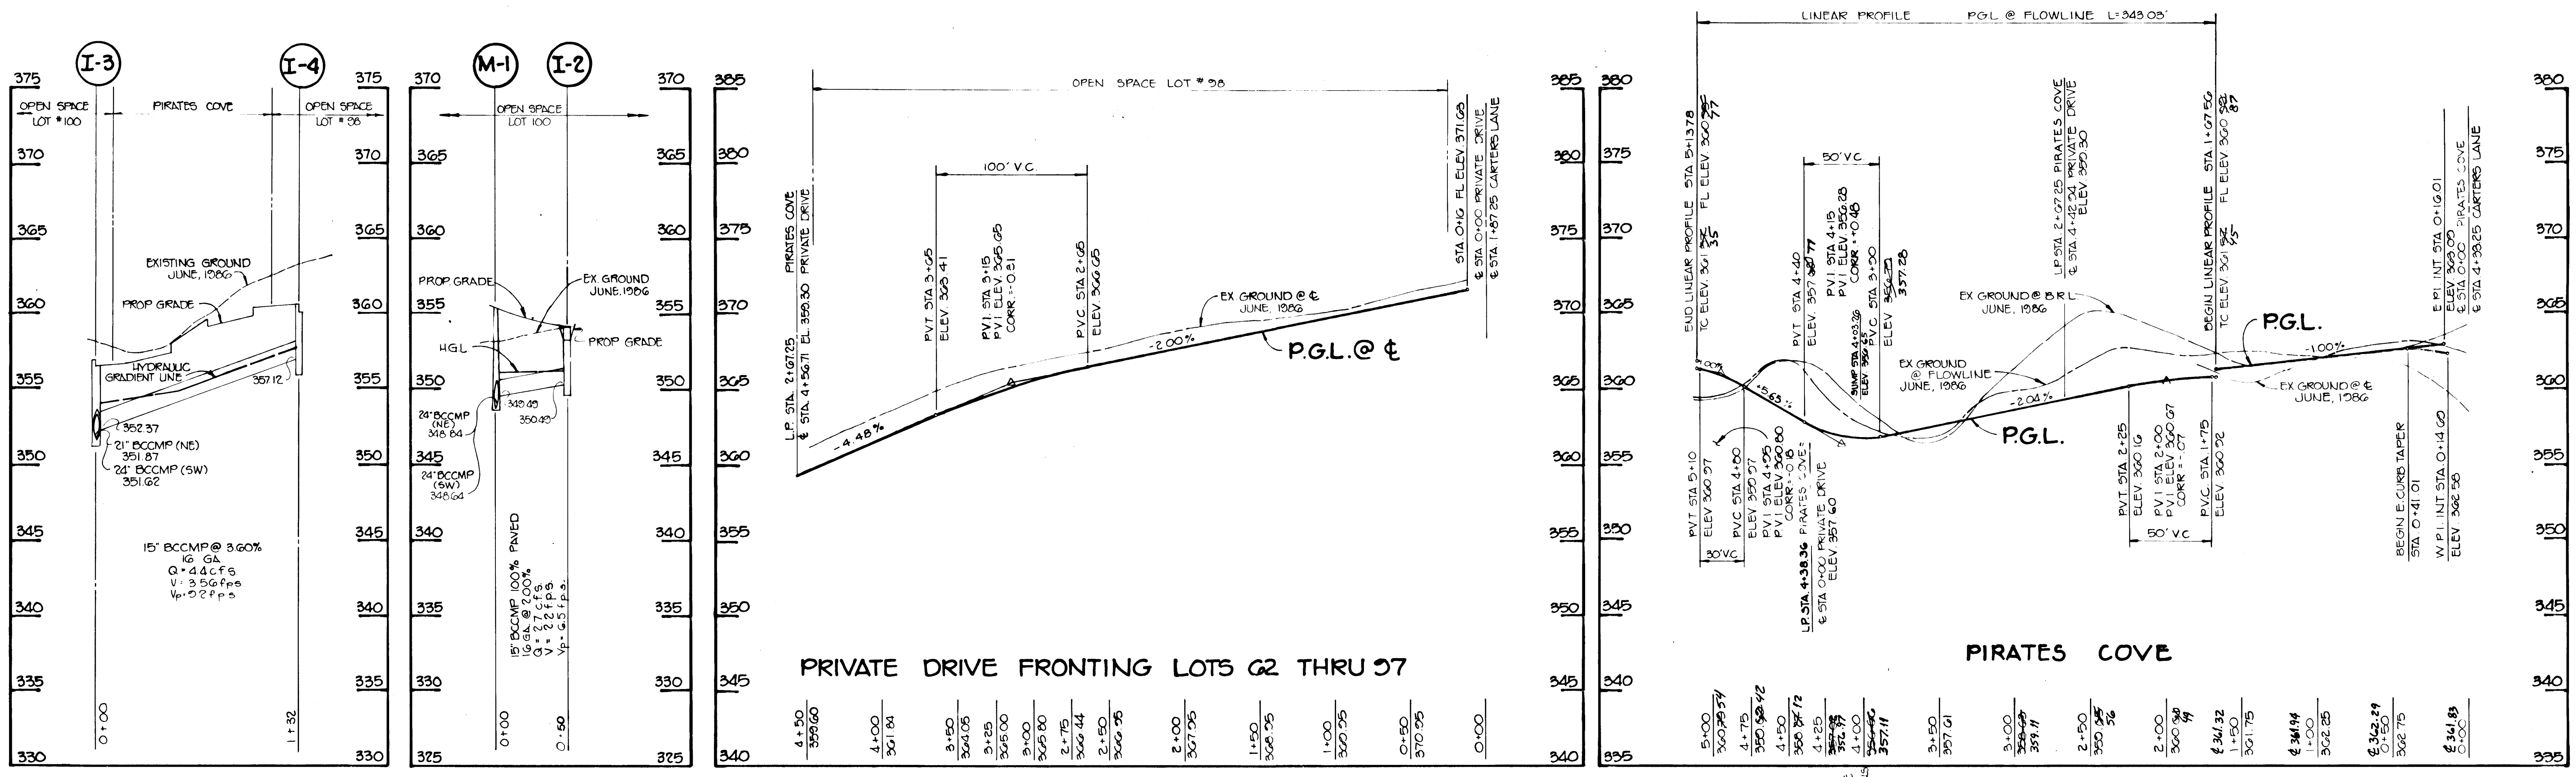

AS-BUILT SURVEY CERTIFIED BY  
WILLIAM G. RASCH, II, Md. P.E./L.S. No.  
4575, on 11-18-88.

APPROVED: HOWARD COUNTY DEPARTMENT OF PUBLIC WORKS  
*William G. Rasch, II* 2-18-87  
CHIEF, BUREAU OF ENGINEERING DATE

APPROVED: HOWARD COUNTY OFFICE OF PLANNING AND ZONING  
*John M. Mansueti* 2-13-87  
CHIEF, DIVISION OF LAND DEVELOPMENT AND ZONING ADMINISTRATION DATE

NO. DATE REVISION

TRACY, SCHULTE & ASSOCIATES INC.  
planning • architecture • engineering  
8480 Baltimore National Pike • Ellicott City, Maryland 21043 • (301) 465-6105

OWNER: SECURITY DEVELOPMENT CORP.  
8480 BALTIMORE NATIONAL PIKE  
ELLICOTT CITY, MARYLAND 21043

PROJECT: CARTER'S COVE  
SECTION 1, AREA 1 LOTS 1 THRU 100  
LOCATION: TAX MAP NO. 42  
PARCEL NOS. 37 & 253  
CITY ELECTION DISTRICT  
HOWARD COUNTY, MARYLAND




DEVELOPER: SECURITY DEVELOPMENT CORP.  
8480 BALTIMORE NATIONAL PIKE  
ELLICOTT CITY, MARYLAND 21043

TITLE: PROFILES

DATE: FEB. 6, 1987 PROJECT NO: 8529


DES: D.A.M. DRN: J.L.B. SCALE: H: 1"=50' V: 1"=5' DRAWING: 3 OF 10

1250

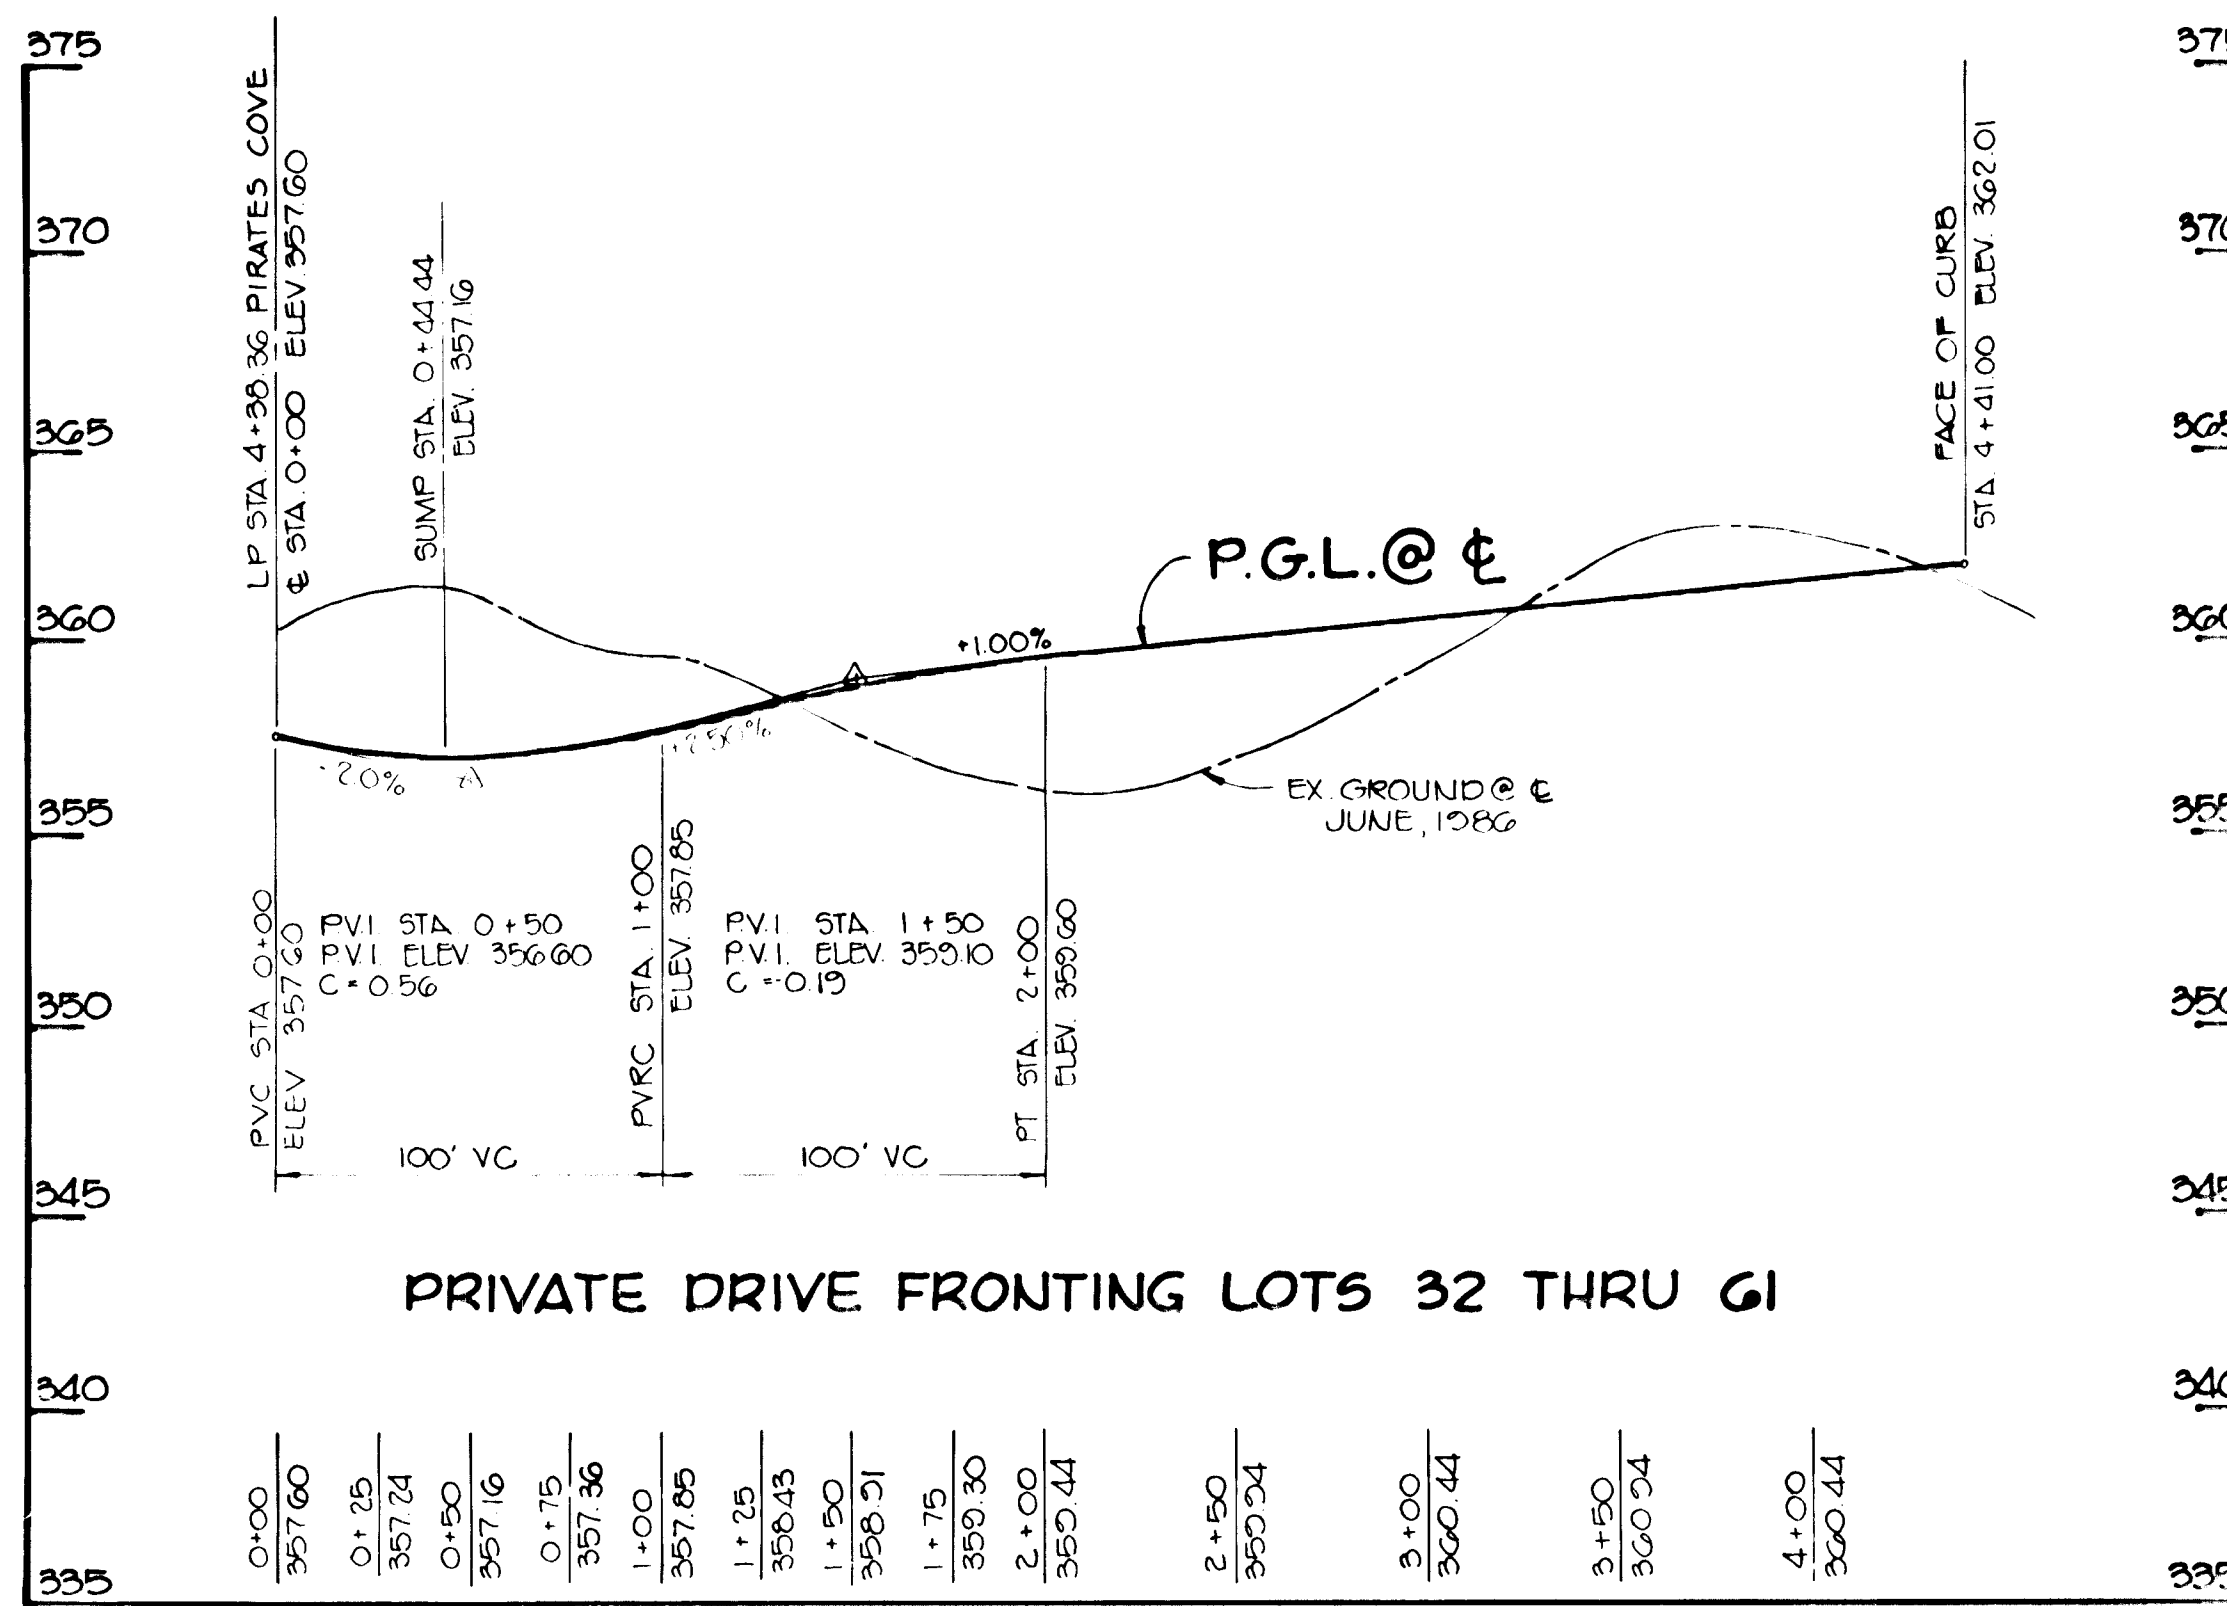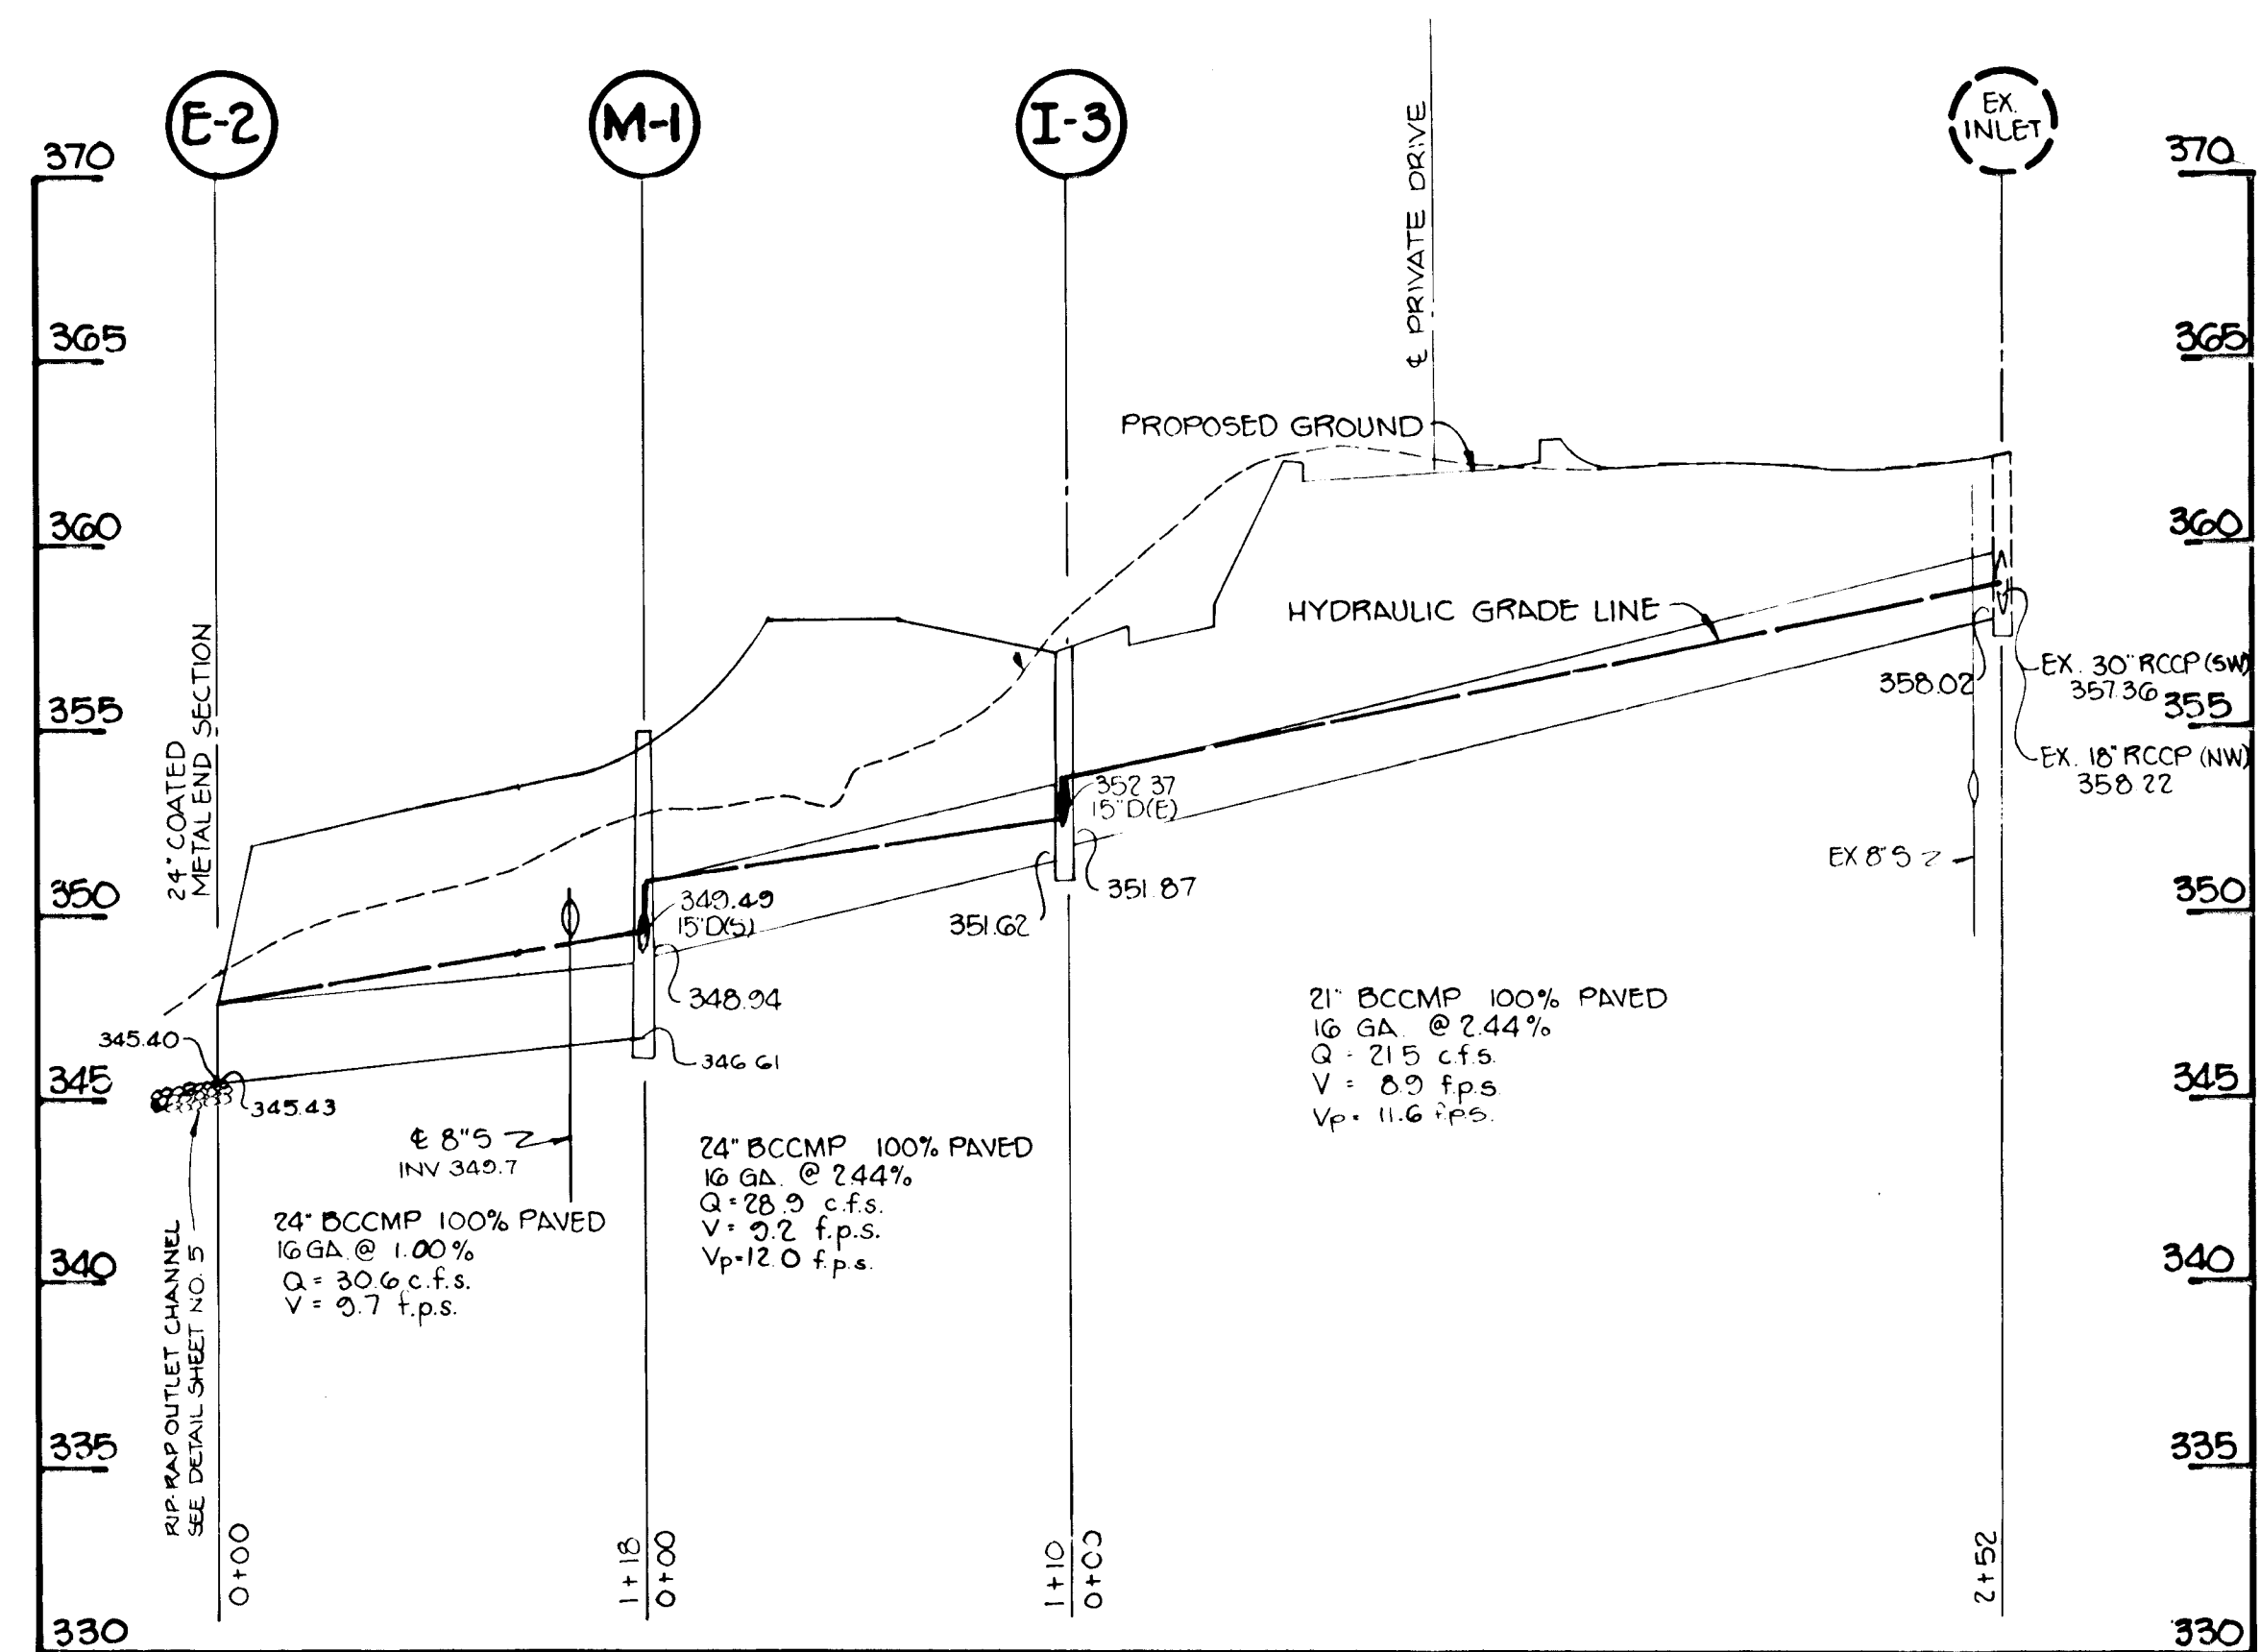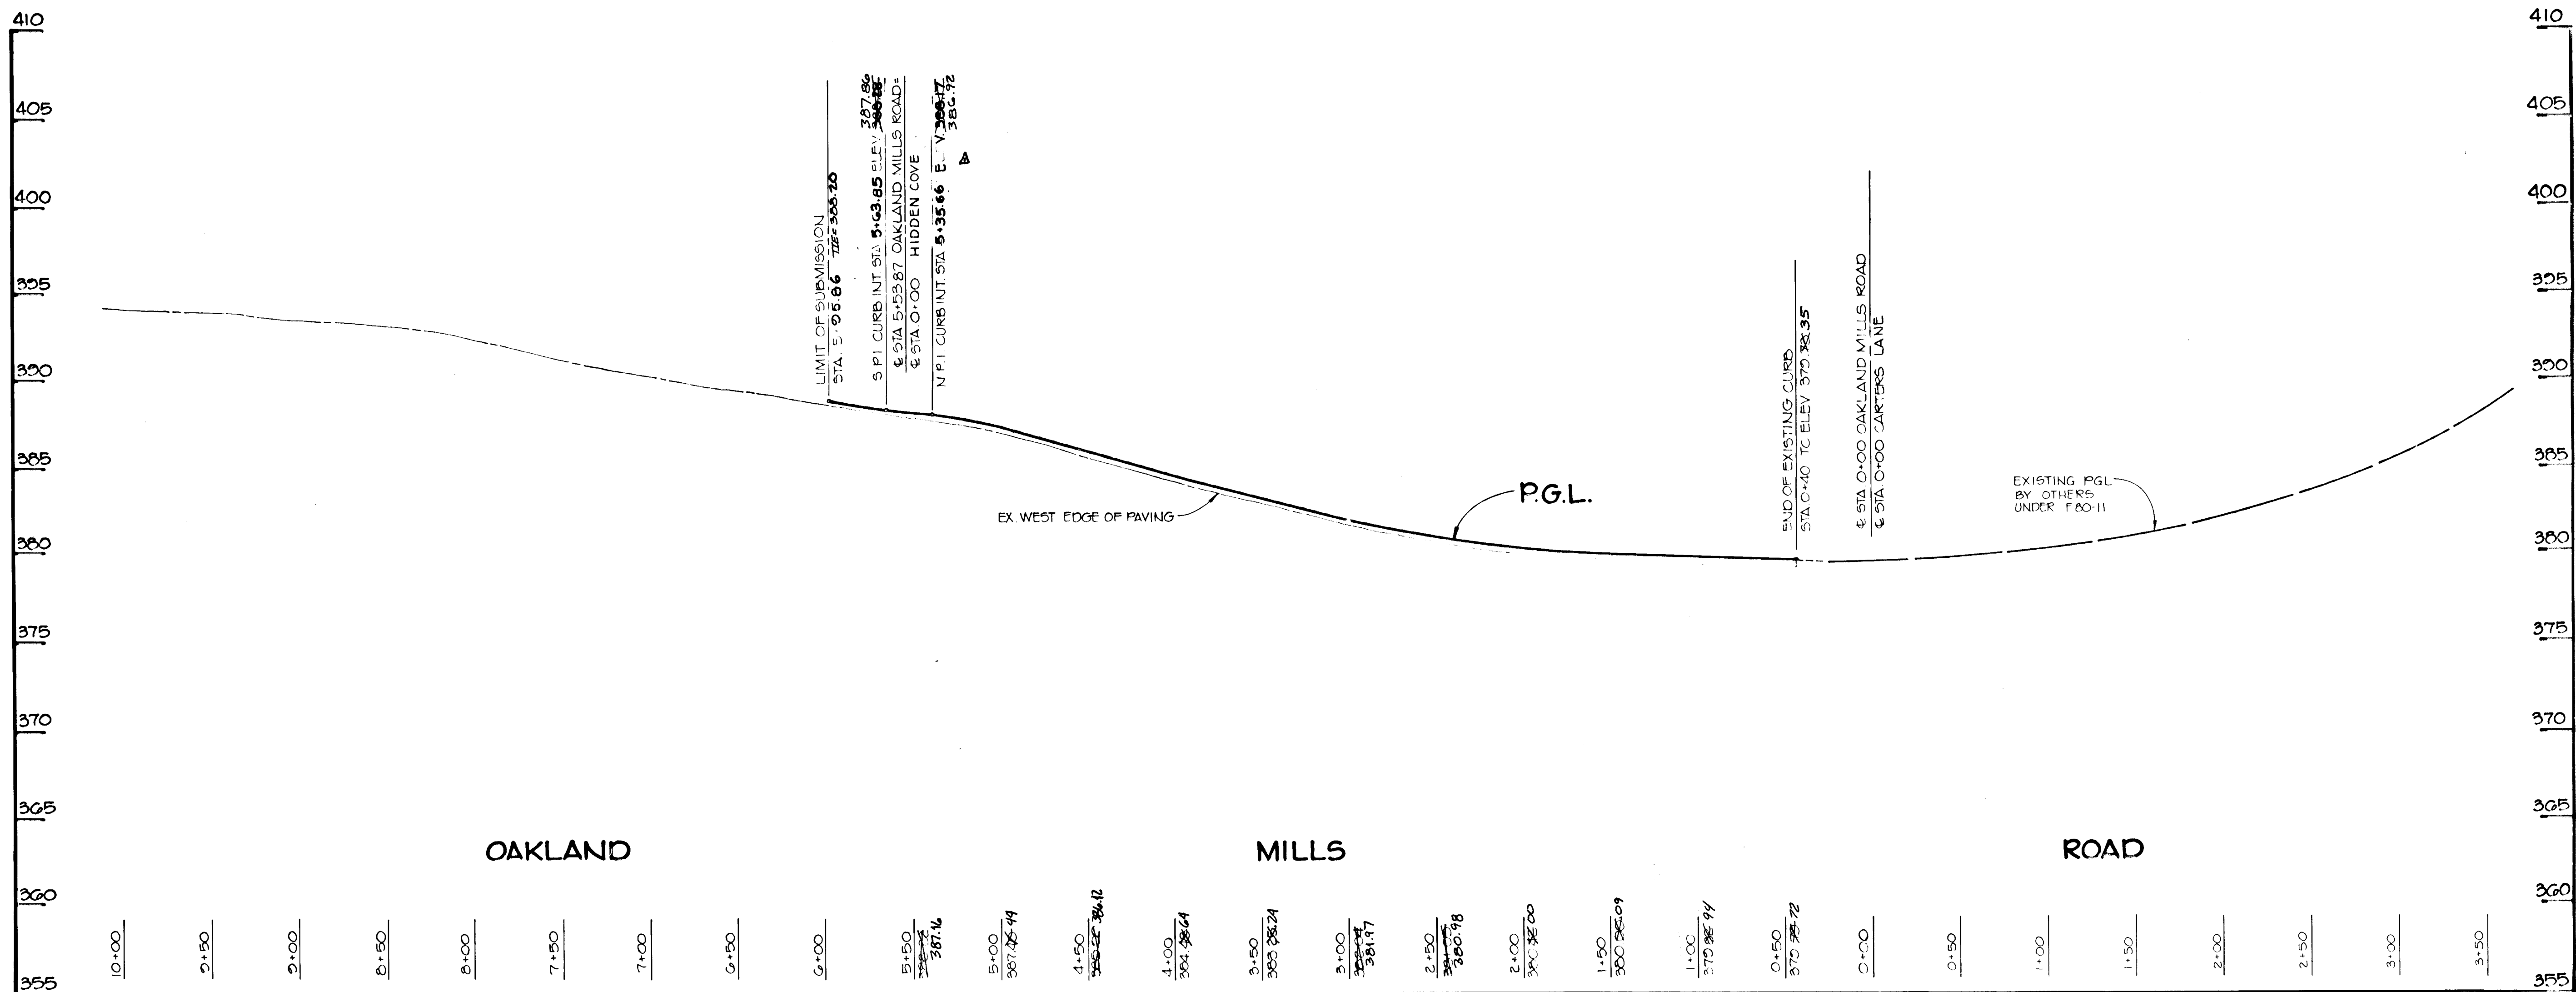


AS-BUILT SURVEY CERTIFIED BY  
WILLIAM G. RASCH, II, MD, P.E./L.S.  
NO. 4575 ON 11-18-88.

APPROVED: HOWARD COUNTY DEPARTMENT OF PUBLIC WORKS		2-18-87
<i>William G. Rasch, II</i> CHIEF, BUREAU OF ENGINEERING		DATE
APPROVED: HOWARD COUNTY OFFICE OF PLANNING AND ZONING		2-13-87
<i>John W. M... ..</i> CHIEF, DIVISION OF LAND DEVELOPMENT AND ZONING ADMINISTRATION		DATE
10/21/87 REVISED OAKLAND MILLS ROAD PROFILE		
NO.	DATE	REVISION
<b>TRACY, SCHULTE &amp; ASSOCIATES INC.</b> planning • architecture • engineering 8480 Baltimore National Pike • Ellicott City, Maryland 21043 • (301) 465-6105		
OWNER: SECURITY DEVELOPMENT CORP. 8480 BALTIMORE NATIONAL PIKE ELLICOTT CITY, MARYLAND 21043		PROJECT: <b>CARTER'S COVE</b> SECTION I, AREA I LOTS 1 THRU 100 LOCATION: TAX MAP NO. 42 PARCEL NOS. 37 & 253 6 <sup>TH</sup> ELECTION DISTRICT HOWARD COUNTY, MARYLAND
DEVELOPER: SECURITY DEVELOPMENT CORP. 8480 BALTIMORE NATIONAL PIKE ELLICOTT CITY, MARYLAND 21043		TITLE: <b>PROFILES</b>
DES. D.A.M.	DRN J.L.B.	DATE FEB 0, 1987 SCALE H 1"=50' V 1"=5' PROJECT NO. 0520 DRAWING 4 OF 10

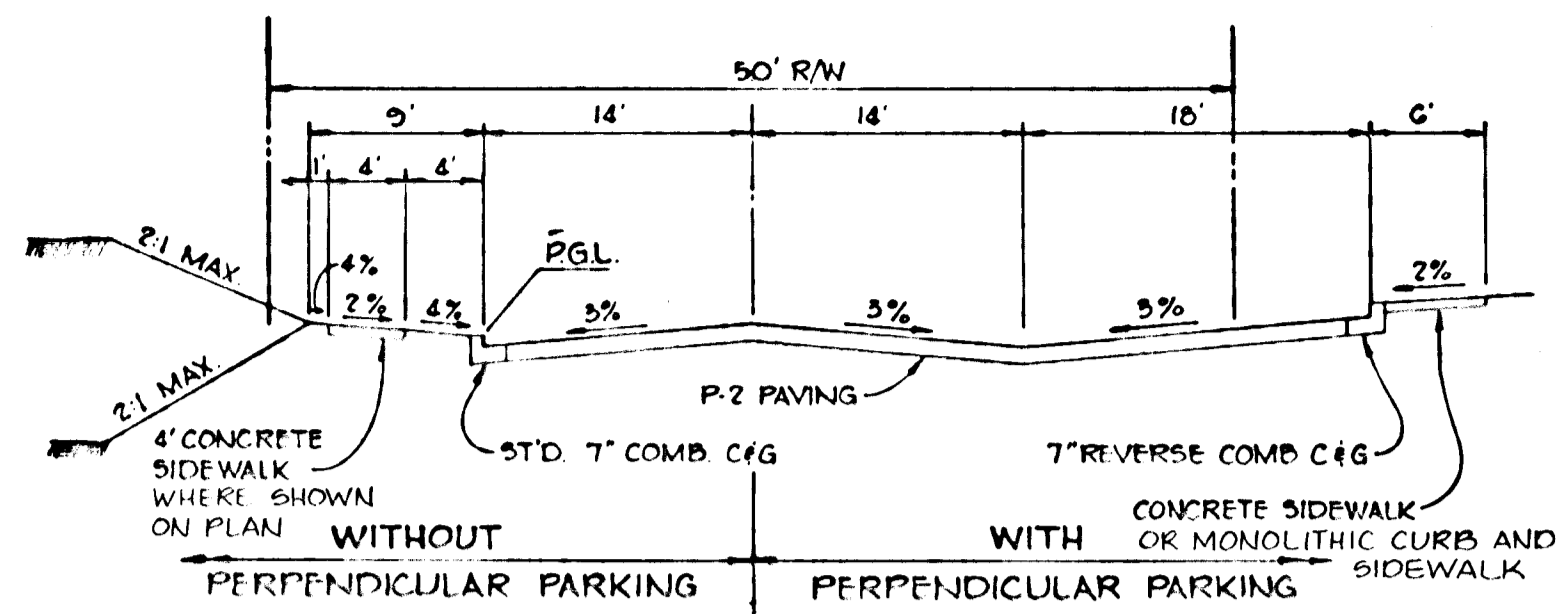


CLASSIFICATION - CUL-DE-SAC  
(ZONED - R-5C)  
DESIGN SPEED - 30 MPH  
PIRATES COVE FROM STA 0+00 TO STA 1+67.5G  
HIDDEN COVE FROM STA 0+00 TO STA 4+64.50

TYPICAL SECTION  
NO SCALE

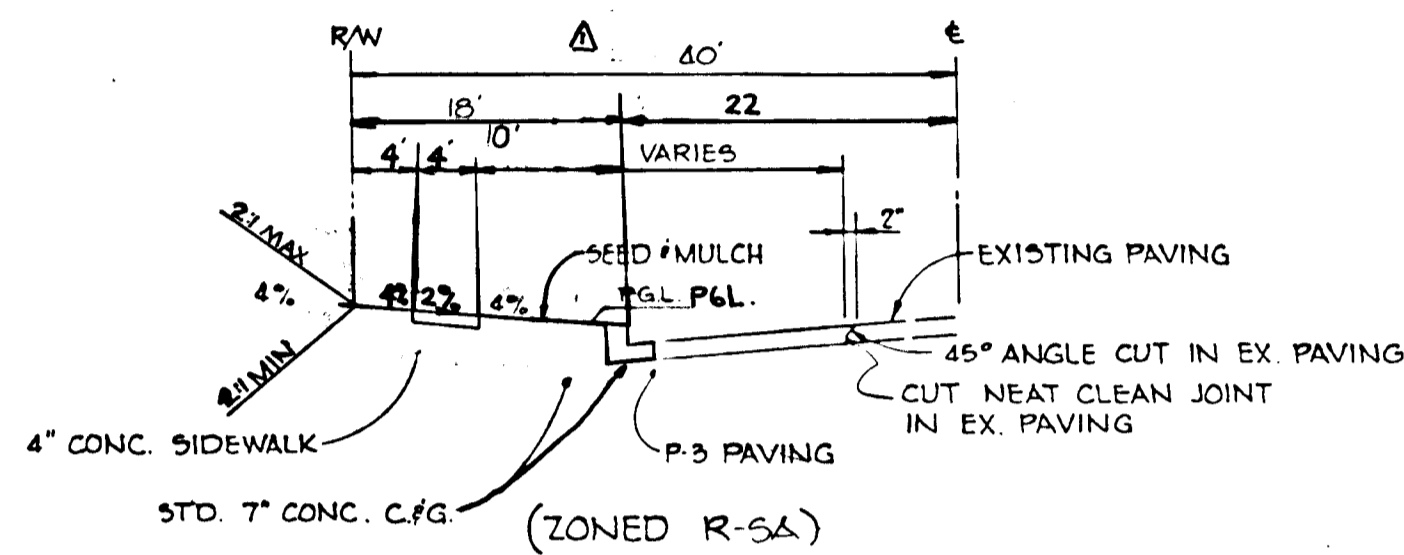


OAKLAND MILLS ROAD FROM STA 0+40 TO STA 5+07.30  
CLASSIFICATION - MAJOR COLLECTOR


TYPICAL HALF SECTION  
NO SCALE

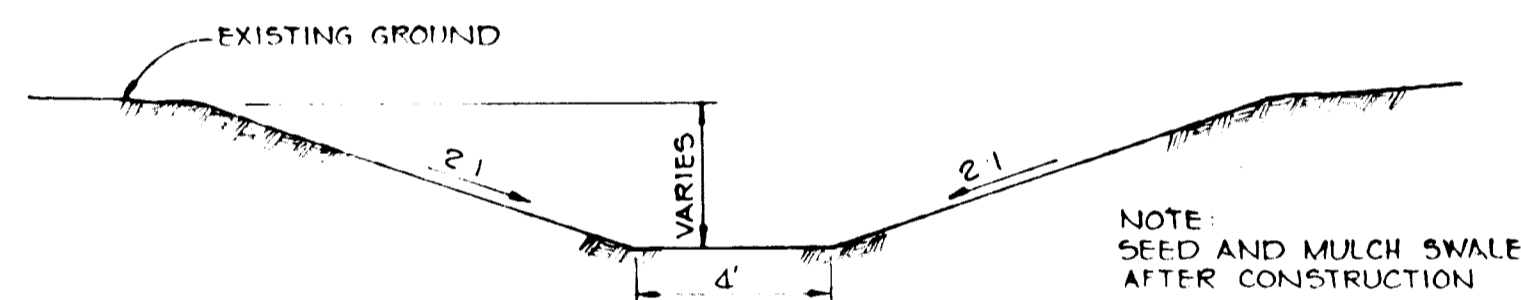


GRASSED SWALE  
NO SCALE

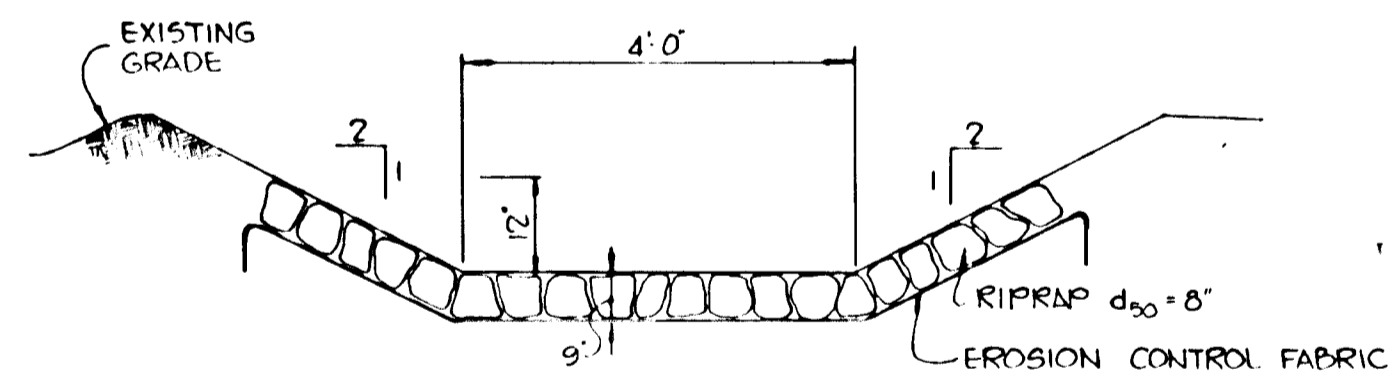

TRAPEZOIDAL RIP RAP CHANNEL  
TYPICAL SECTION  
NO SCALE

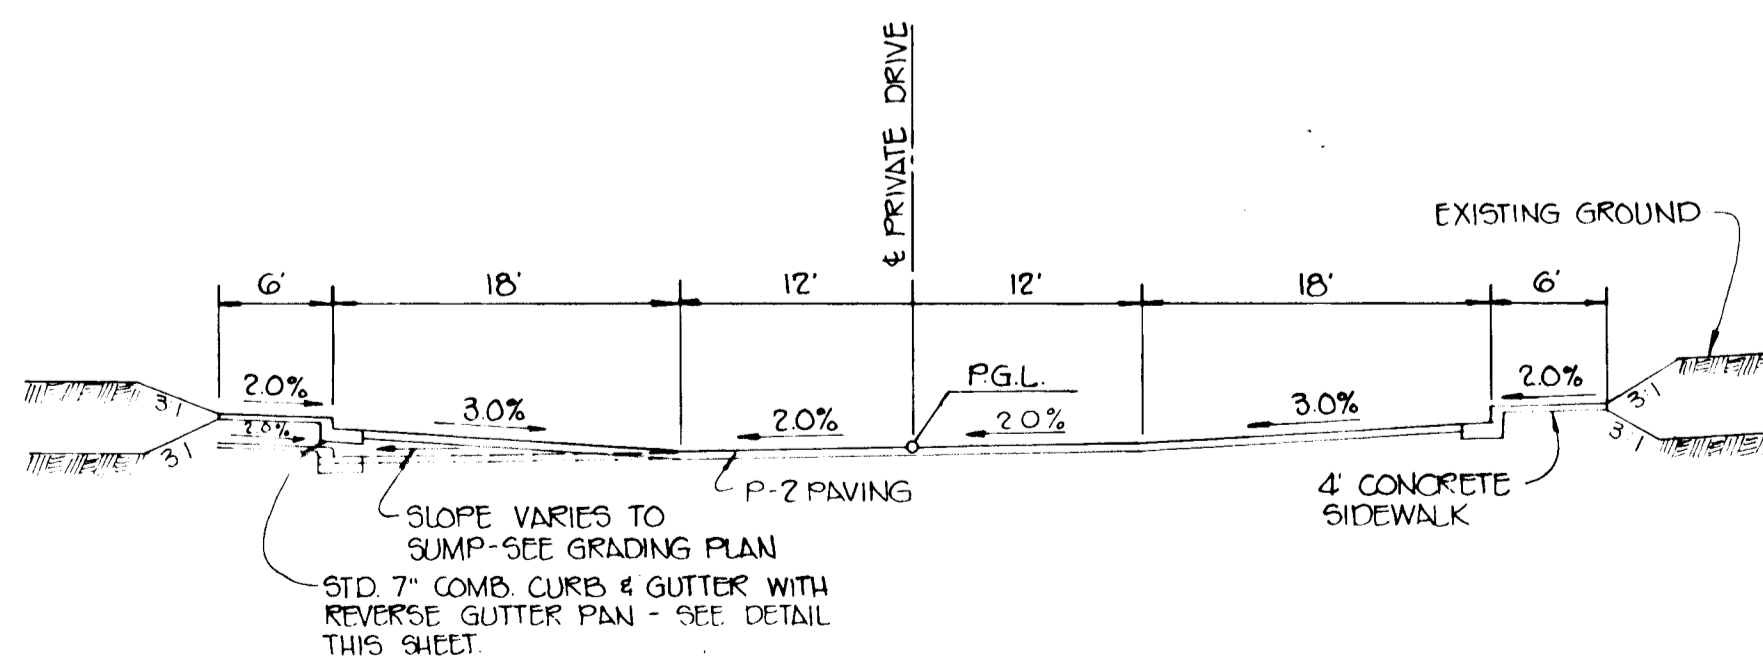

TYPICAL SECTION - PRIVATE DRIVES  
NO SCALE

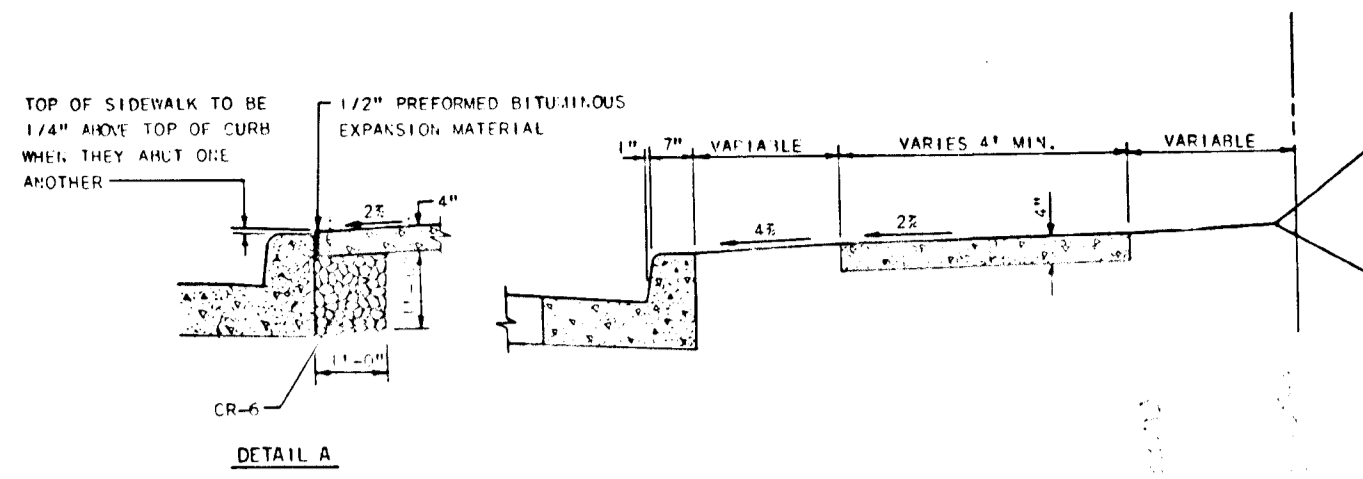


- NOTES:
1. SIDEWALK TO BE SCURED IN 5' MAXIMUM SQUARES.
  2. EXPANSION JOINTS ACROSS THE SIDEWALK NOT TO BE MORE THAN 10' APART.
  3. 1/2" PREFORMED BITUMINOUS EXPANSION MATERIAL IN EXPANSION JOINTS TO BE KEPT 1/4" BELOW SURFACE OF SIDEWALK.
  4. CONCRETE TO BE MIX NO. 2.
  5. WHEN SIDEWALK ADJUTS CURB, WALK SHALL BE 1/4" ABOVE CURB WITH 1/2" PREFORMED BITUMINOUS EXPANSION MATERIAL BETWEEN SIDEWALK AND CURB AND RESTING ON A COMPACTED CRUSHER STOLE BASE. SEE DETAIL A THIS SHEET.
  6. ON LONGITUDINAL SIDEWALK GRADES OF 3% OR GREATER, A CONCRETE HEADER, 6" THICK AND 6" DEEP BELOW THE NORMAL 4" SIDEWALK THICKNESS SHALL BE CONSTRUCTED FOR THE FULL WIDTH OF THE SIDEWALK AT INTERVALS OF 40 FEET. THE HEADERS SHALL BE PLACED AT APPROXIMATE 20' INTERVALS AND SHALL BE MONOLITHIC WITH THE SIDEWALK.

CONCRETE SIDEWALK


NO SCALE

- NOTES:
1. LONGITUDINAL JOINT BETWEEN SIDEWALK AND CURB SHALL BE CONTINUOUS AND TO A DEPTH OF 1/4 THE SIDEWALK THICKNESS OR 1" MAX. LATITUDINAL JOINTS SHALL RUN FROM BACK EDGE OF SIDEWALK, CONTINUOUS TO THE BOTTOM FACE OF CURB TO A DEPTH OF 1/4" AND SPACED 5' APART.
  2. PROVIDE 1/2" EXPANSION JOINTS AT 15' INTERVALS IN LATITUDINAL JOINTS TO FULL CROSS-SECTION.

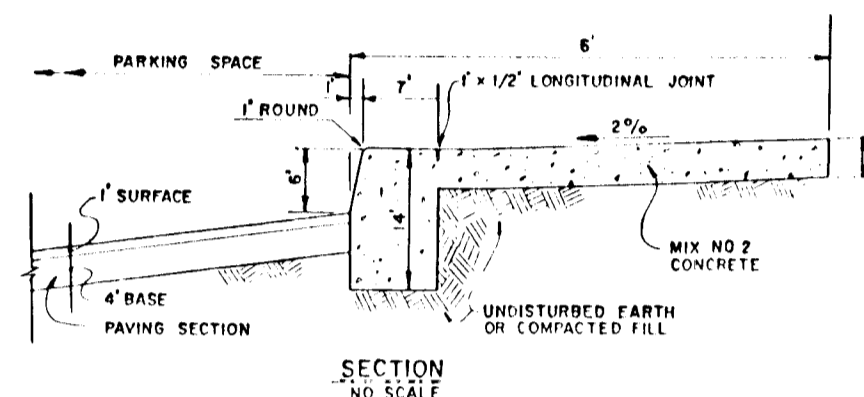


MONOLITHIC CURB & SIDEWALK

NO SCALE

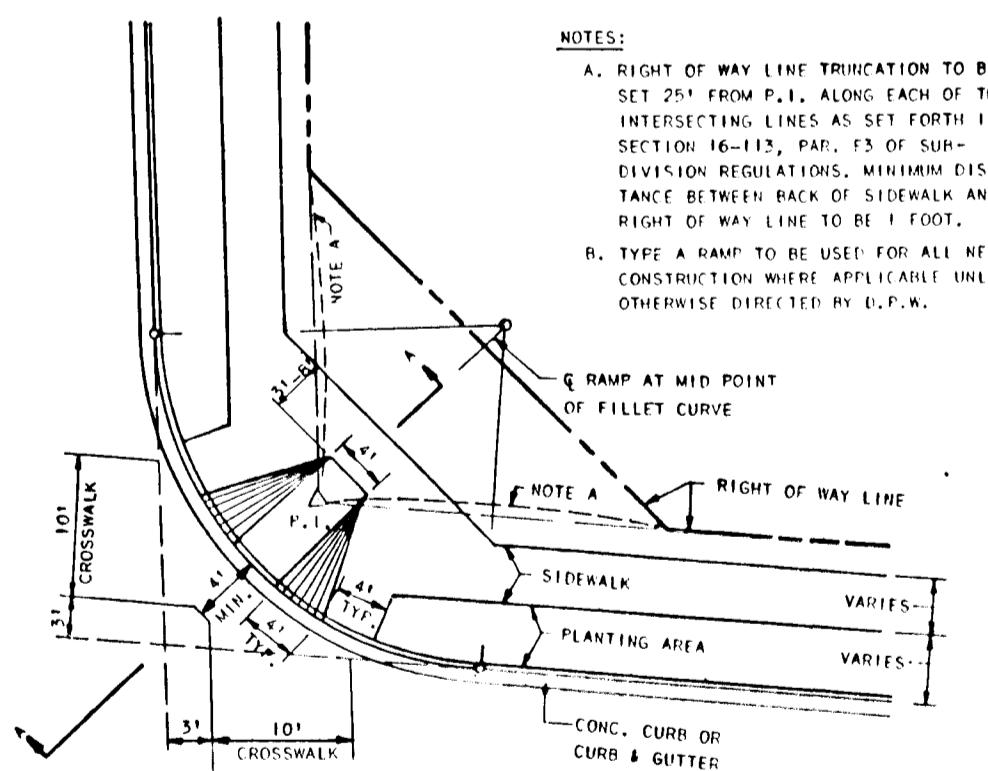


SIDEWALK RAMP

NO SCALE

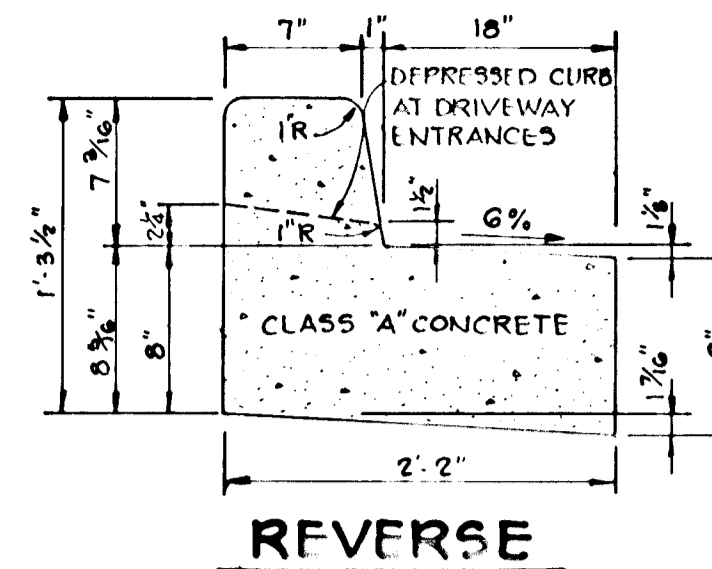


REVERSE

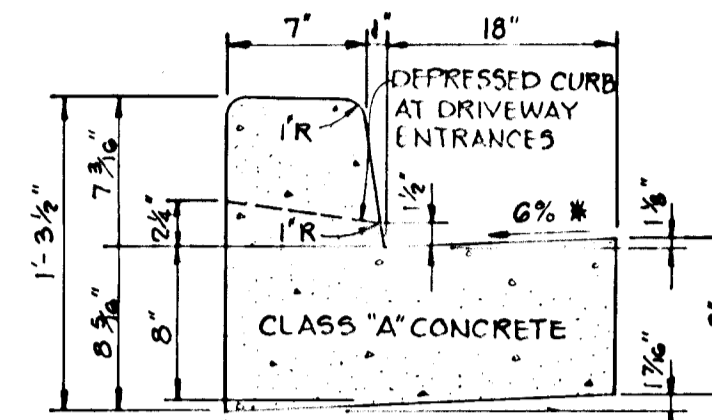


STANDARD 7" COMBINATION CURB AND GUTTER

NO SCALE

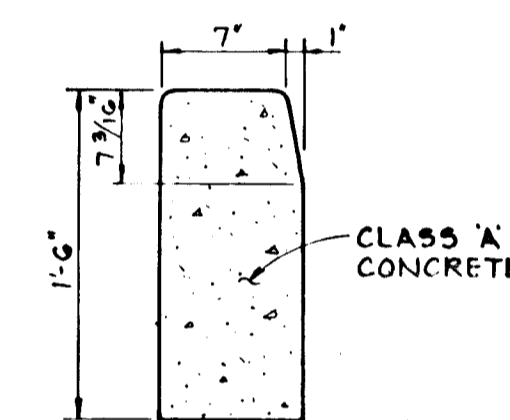


STANDARD BARRIER CURB

NO SCALE

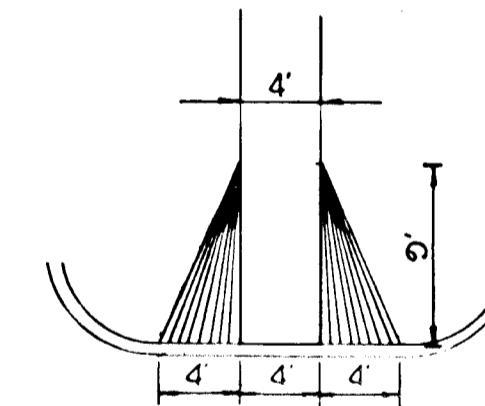

HANDICAP RAMP


NO SCALE

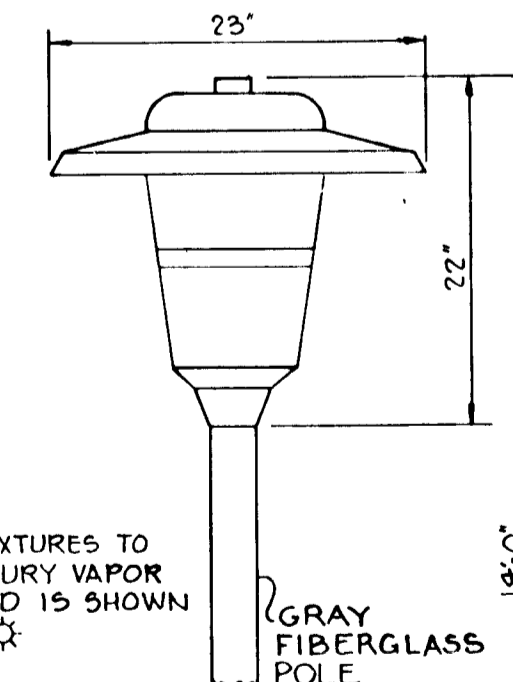


DETAIL - LIGHTING FIXTURE

NO SCALE

- NOTES:
1. THIS LIGHT FIXTURE TO BE USED AT THE INTERSECTION OF CARTER'S LANE AND PIRATES COVE.
  2. THE LIGHT FIXTURE AT THE INTERSECTION OF OAKLAND MILLS ROAD AND HIDDEN COVE TO BE PENDANT TYPE 30 WATT ON 30' GALVANIZED PIPE.

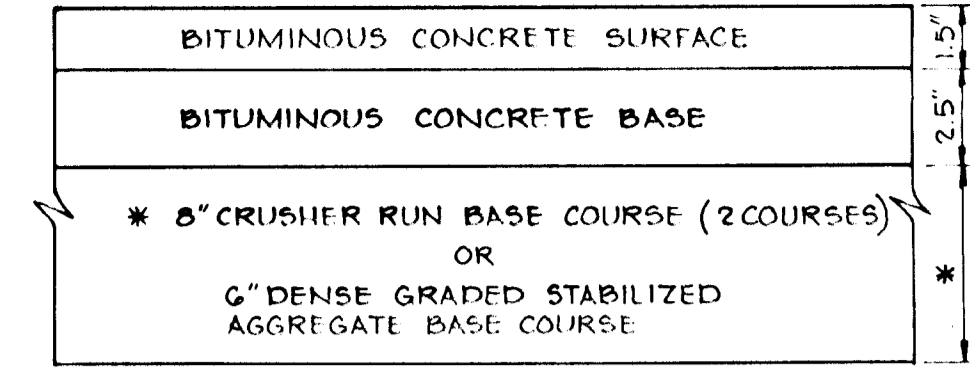

(ALTERNATE)

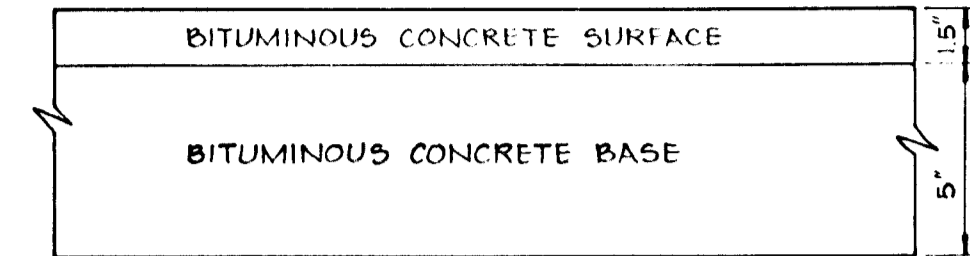


HOWARD COUNTY DESIGN MANUAL VOLUME IV  
STANDARD SPECIFICATIONS AND DETAILS FOR  
CONSTRUCTION (DRAWING R-201)


6 1/2" PAVING, P-2

NO SCALE

PIRATES COVE  
HIDDEN COVE  
ALL PRIVATE DRIVES

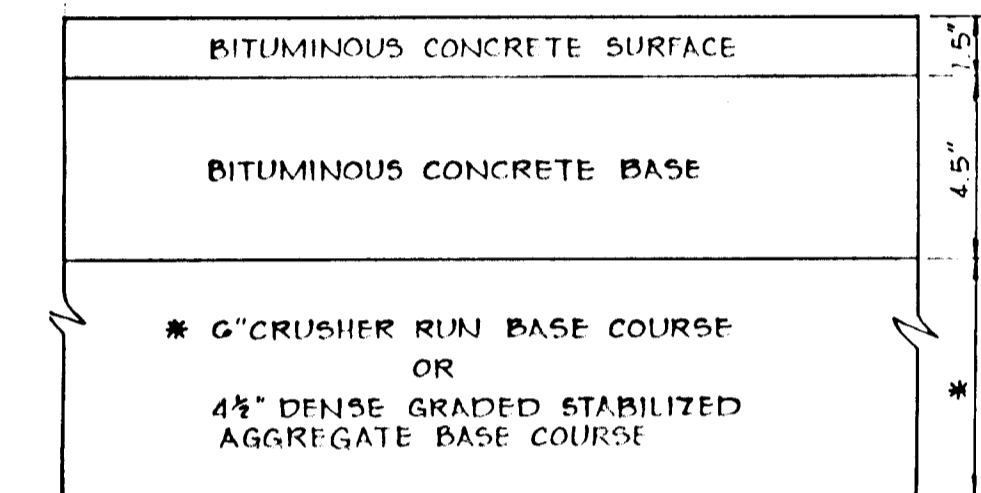

(ALTERNATE)

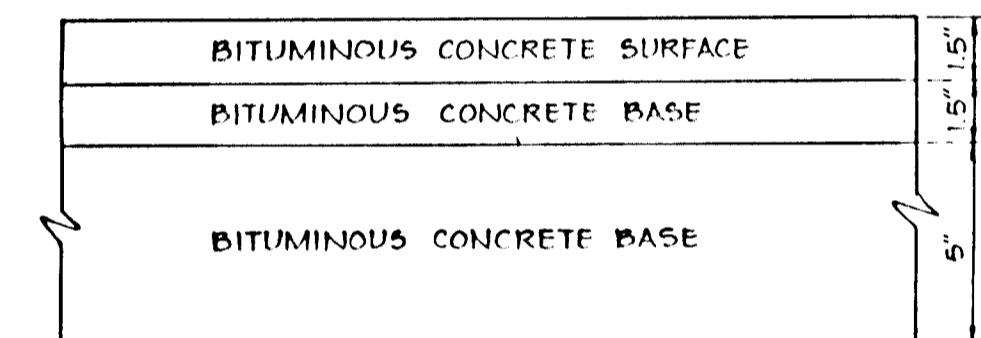

HOWARD COUNTY DESIGN MANUAL VOLUME IV  
STANDARD SPECIFICATIONS AND DETAILS FOR  
CONSTRUCTION (DRAWING R-201)

8" PAVING, P-3

NO SCALE

OAKLAND MILLS ROAD

APPROVED: HOWARD COUNTY DEPARTMENT OF PUBLIC WORKS  
2-18-87  
DATE

APPROVED: HOWARD COUNTY OFFICE OF PLANNING AND ZONING  
2-18-87  
DATE



NO DATE REVISION

TRACY, SCHULTE & ASSOCIATES INC.  
planning • architecture • engineering  
8480 Baltimore National Pike • Ellicott City, Maryland 21043 • (301) 465 6105

OWNER: SECURITY DEVELOPMENT CORP  
8480 BALTIMORE NATIONAL PIKE  
ELLICOTT CITY, MARYLAND 21043  
PROJECT: CARTER'S COVE  
SECTION I AREA I LOTS I THRU 100  
LOCATION: TAX MAP NO. 42  
PARCEL NOS. 37 & 253  
6TH ELECTION DISTRICT  
HOWARD COUNTY, MARYLAND  
DEVELOPER: SECURITY DEVELOPMENT CORP  
8480 BALTIMORE NATIONAL PIKE  
ELLICOTT CITY, MARYLAND 21043  
TITLE: DETAILS  
DATE: FEB. 6, 1987  
PROJECT NO: 8529 R6D  
DES: RJW  
DRN: CDT  
SCALE: AS SHOWN  
DRAWING: 5 OF 10

& CURVE DATA - PRIVATE DRIVE 'A'  
 & STA 1+67.62 TO & STA 3+25.43  
 Δ 90° 25' 05"  
 R 100.00'  
 L 157.01'  
 T 100.73'  
 D 51° 23' 58"

No.	DATE	REVISION
3	11-24-88	ADD 3 PARKING SPACES TO HIDDEN COVE; REMOVE ISLAND AND ADD 4 PARKING SPACES TO PIRATES COVE; ADD ENTRANCE TO PIRATES COVE.

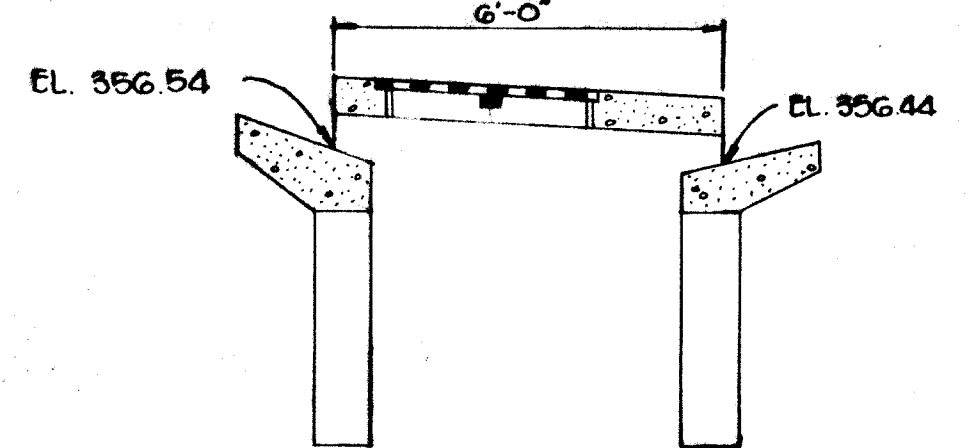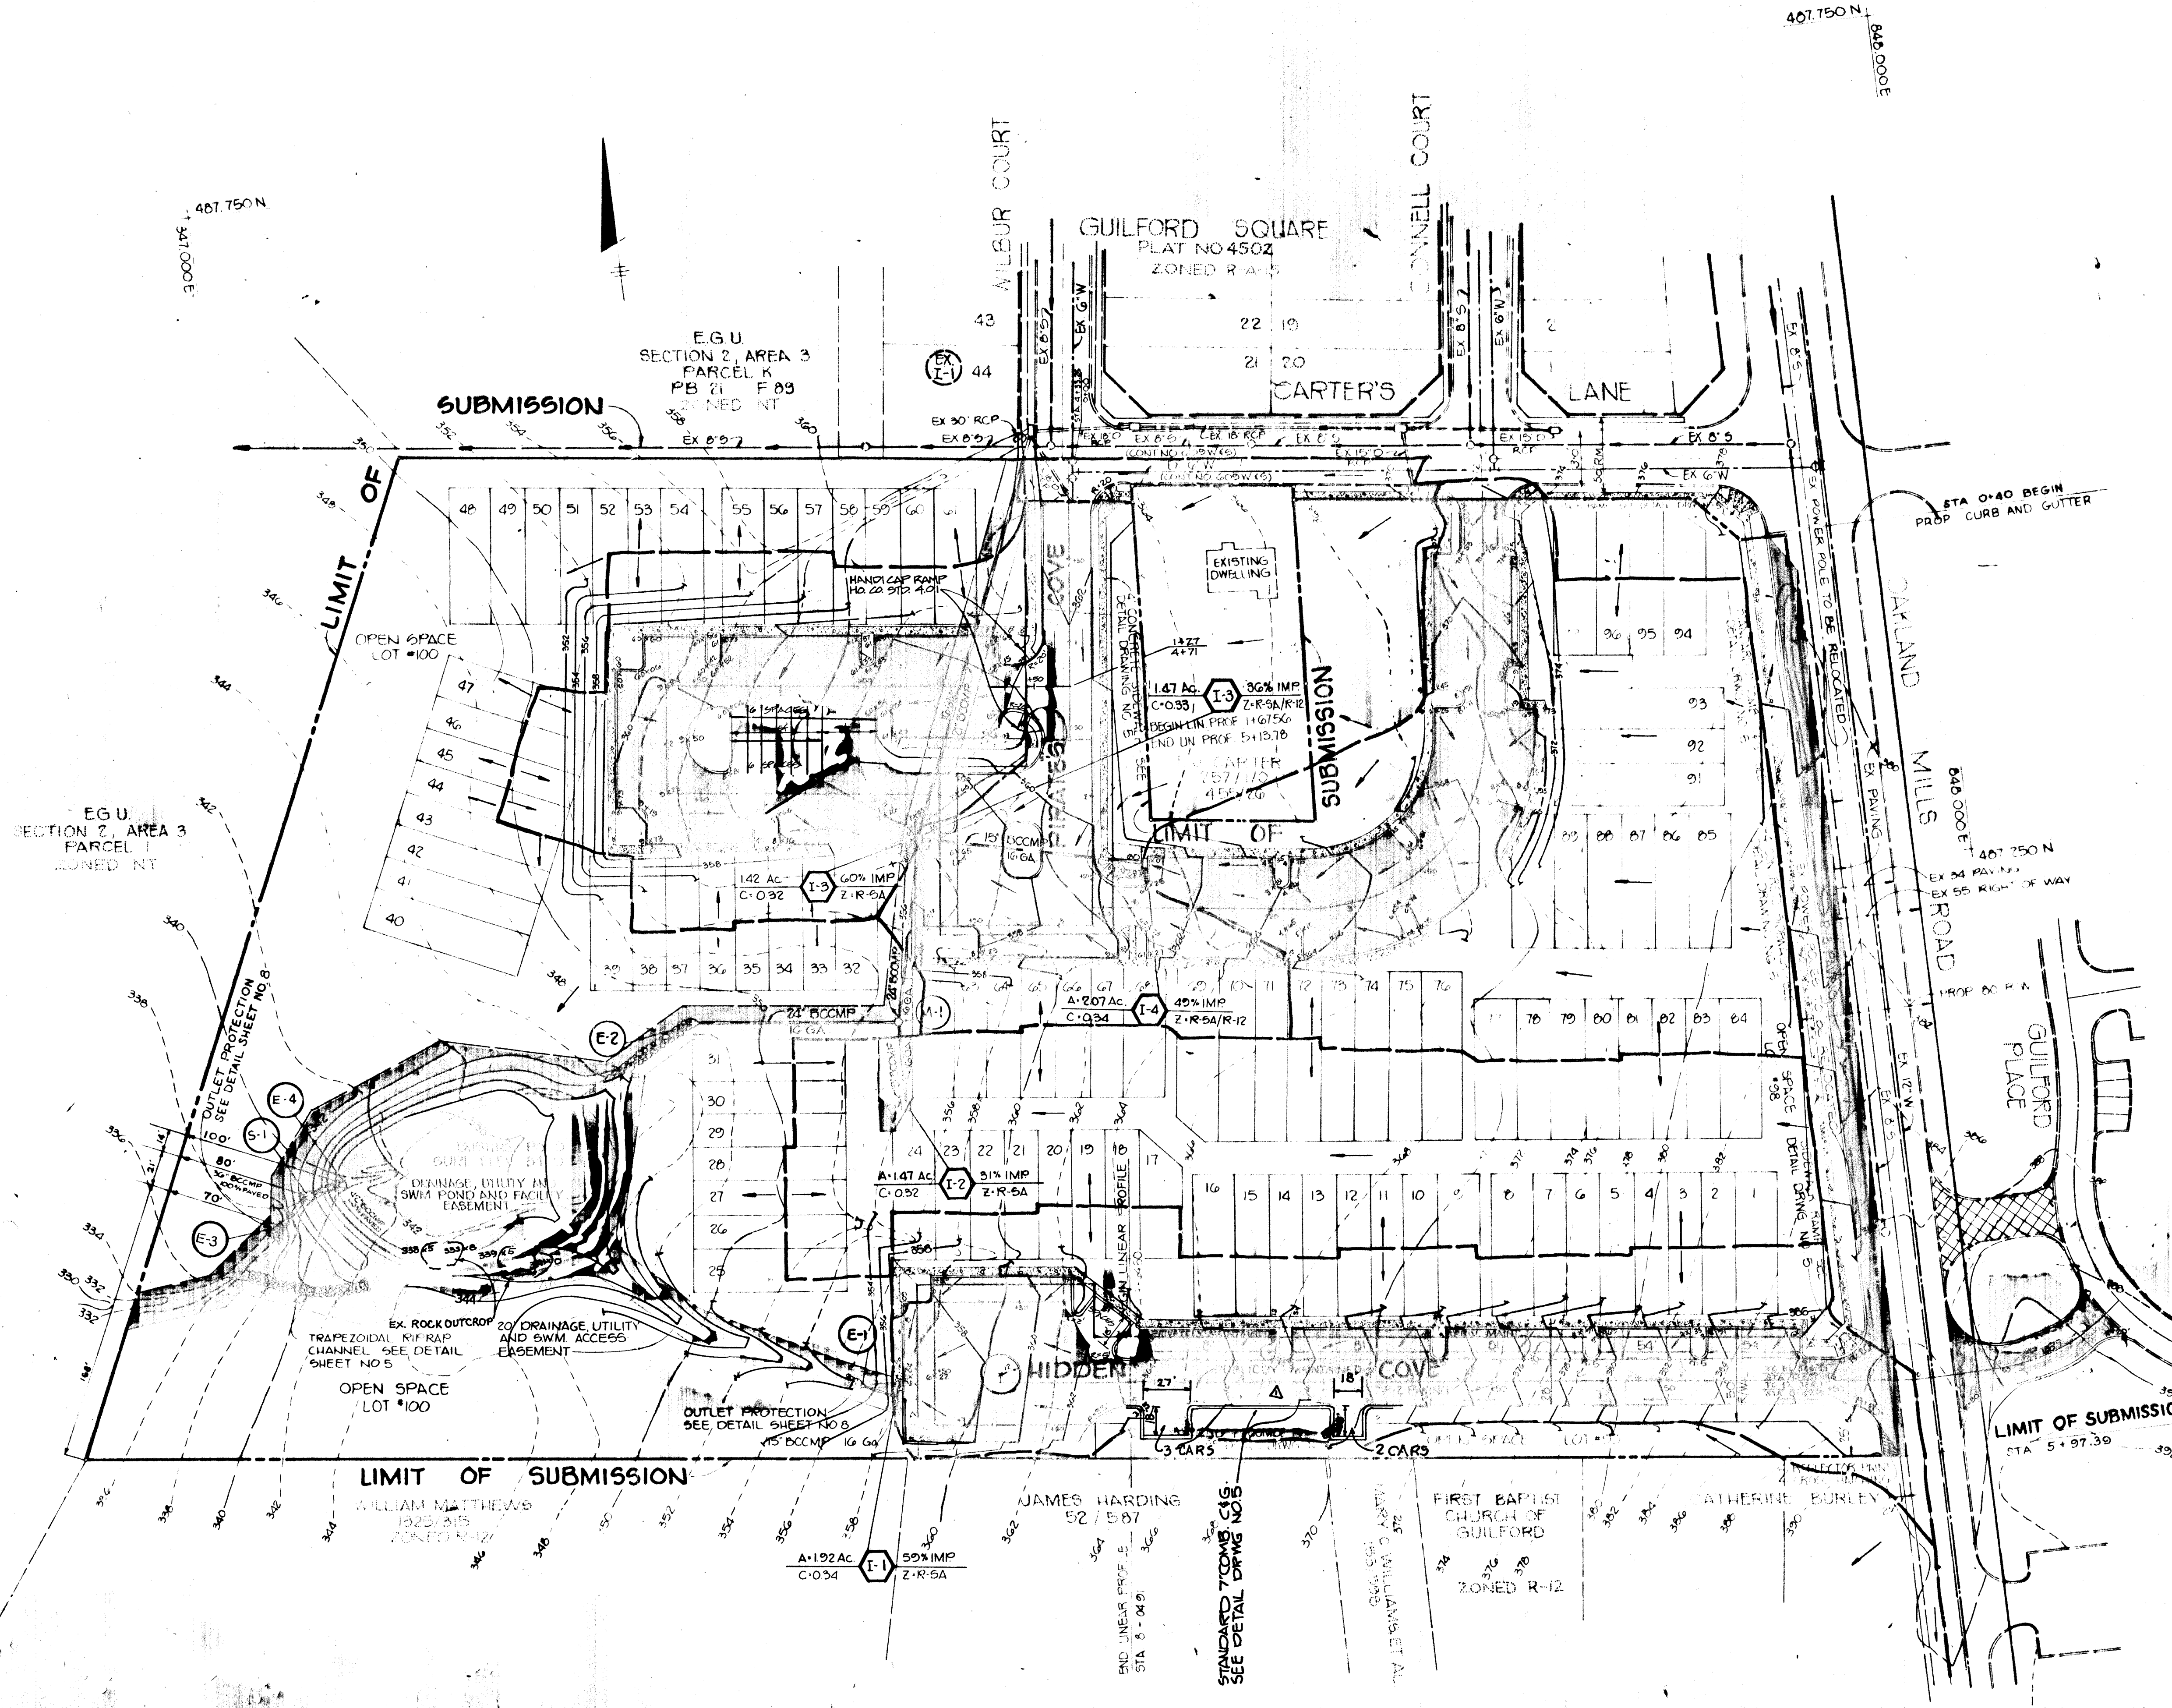

**SPECIAL DOUBLE THROAT INLET I-3**  
 NO SCALE

APPROVED: HOWARD COUNTY DEPARTMENT OF PUBLIC WORKS	
<i>William E. Re...</i> CHIEF, BUREAU OF ENGINEERING	2-18-87 DATE
APPROVED: HOWARD COUNTY DEPT. OF PLANNING AND ZONING	
<i>John M. ...</i> CHIEF, DIVISION OF LAND DEVELOPMENT AND ZONING ADMINISTRATION	2-18-87 DATE
Δ 10/21/87 REVISED PARKING - HIDDEN COVE	
Δ 7/28/88 REVISE GRADING IN STORMWATER MANAGEMENT FACILITY	
NO. DATE	REVISION

**TRACY, SCHULTE & ASSOCIATES INC.**  
 planning • architecture • engineering  
 8480 Baltimore National Pike • Ellicott City, Maryland 21043 • (301) 465-6105


*James K. Fry*

OWNER SECURITY DEVELOPMENT CORP 8480 BALTIMORE NATIONAL PIKE ELLICOTT CITY, MARYLAND 21043	PROJECT <b>CARTER'S COVE</b> SECTION 1, AREA 1, LOTS 1 THRU 100
DEVELOPER SECURITY DEVELOPMENT CORP 8480 BALTIMORE NATIONAL PIKE ELLICOTT CITY, MARYLAND 21043	LOCATION TAX MAP NO. 42 PARCEL NOS. 37 & 253 6TH ELECTION DISTRICT HOWARD COUNTY, MARYLAND
TITLE <b>DRAINAGE AREA MAP AND DETAILS</b>	DATE: FEB 4, 1987 PROJECT NO: 8529 RSD
DES: RJW DRN: KMN/CDT	SCALE: 1" = 50' DRAWING: 6 OF 10

1750

<b>KIRPAP OUTLET SEDIMENT TRAP</b>	<b>NO 1</b>
DRAINAGE AREA	11.27 AC
DISTURBED AREA	10.60 AC
STORAGE VOLUME REQUIRED	20,286 C.F.
PROVIDED	60,500 C.F.
CREST ELEVATION	342.55
CLEANOUT ELEVATION	339.77
BOTTOM ELEVATION	337.00
DIMENSIONS	APPROX 130' x 160'
WEIR LENGTH	14.0'

NOTE: ALL CONTOURS SHOWN WITHIN PAVED AREAS ARE TO SURGRADE ONLY ALLOWING FOR P.2 PAVING

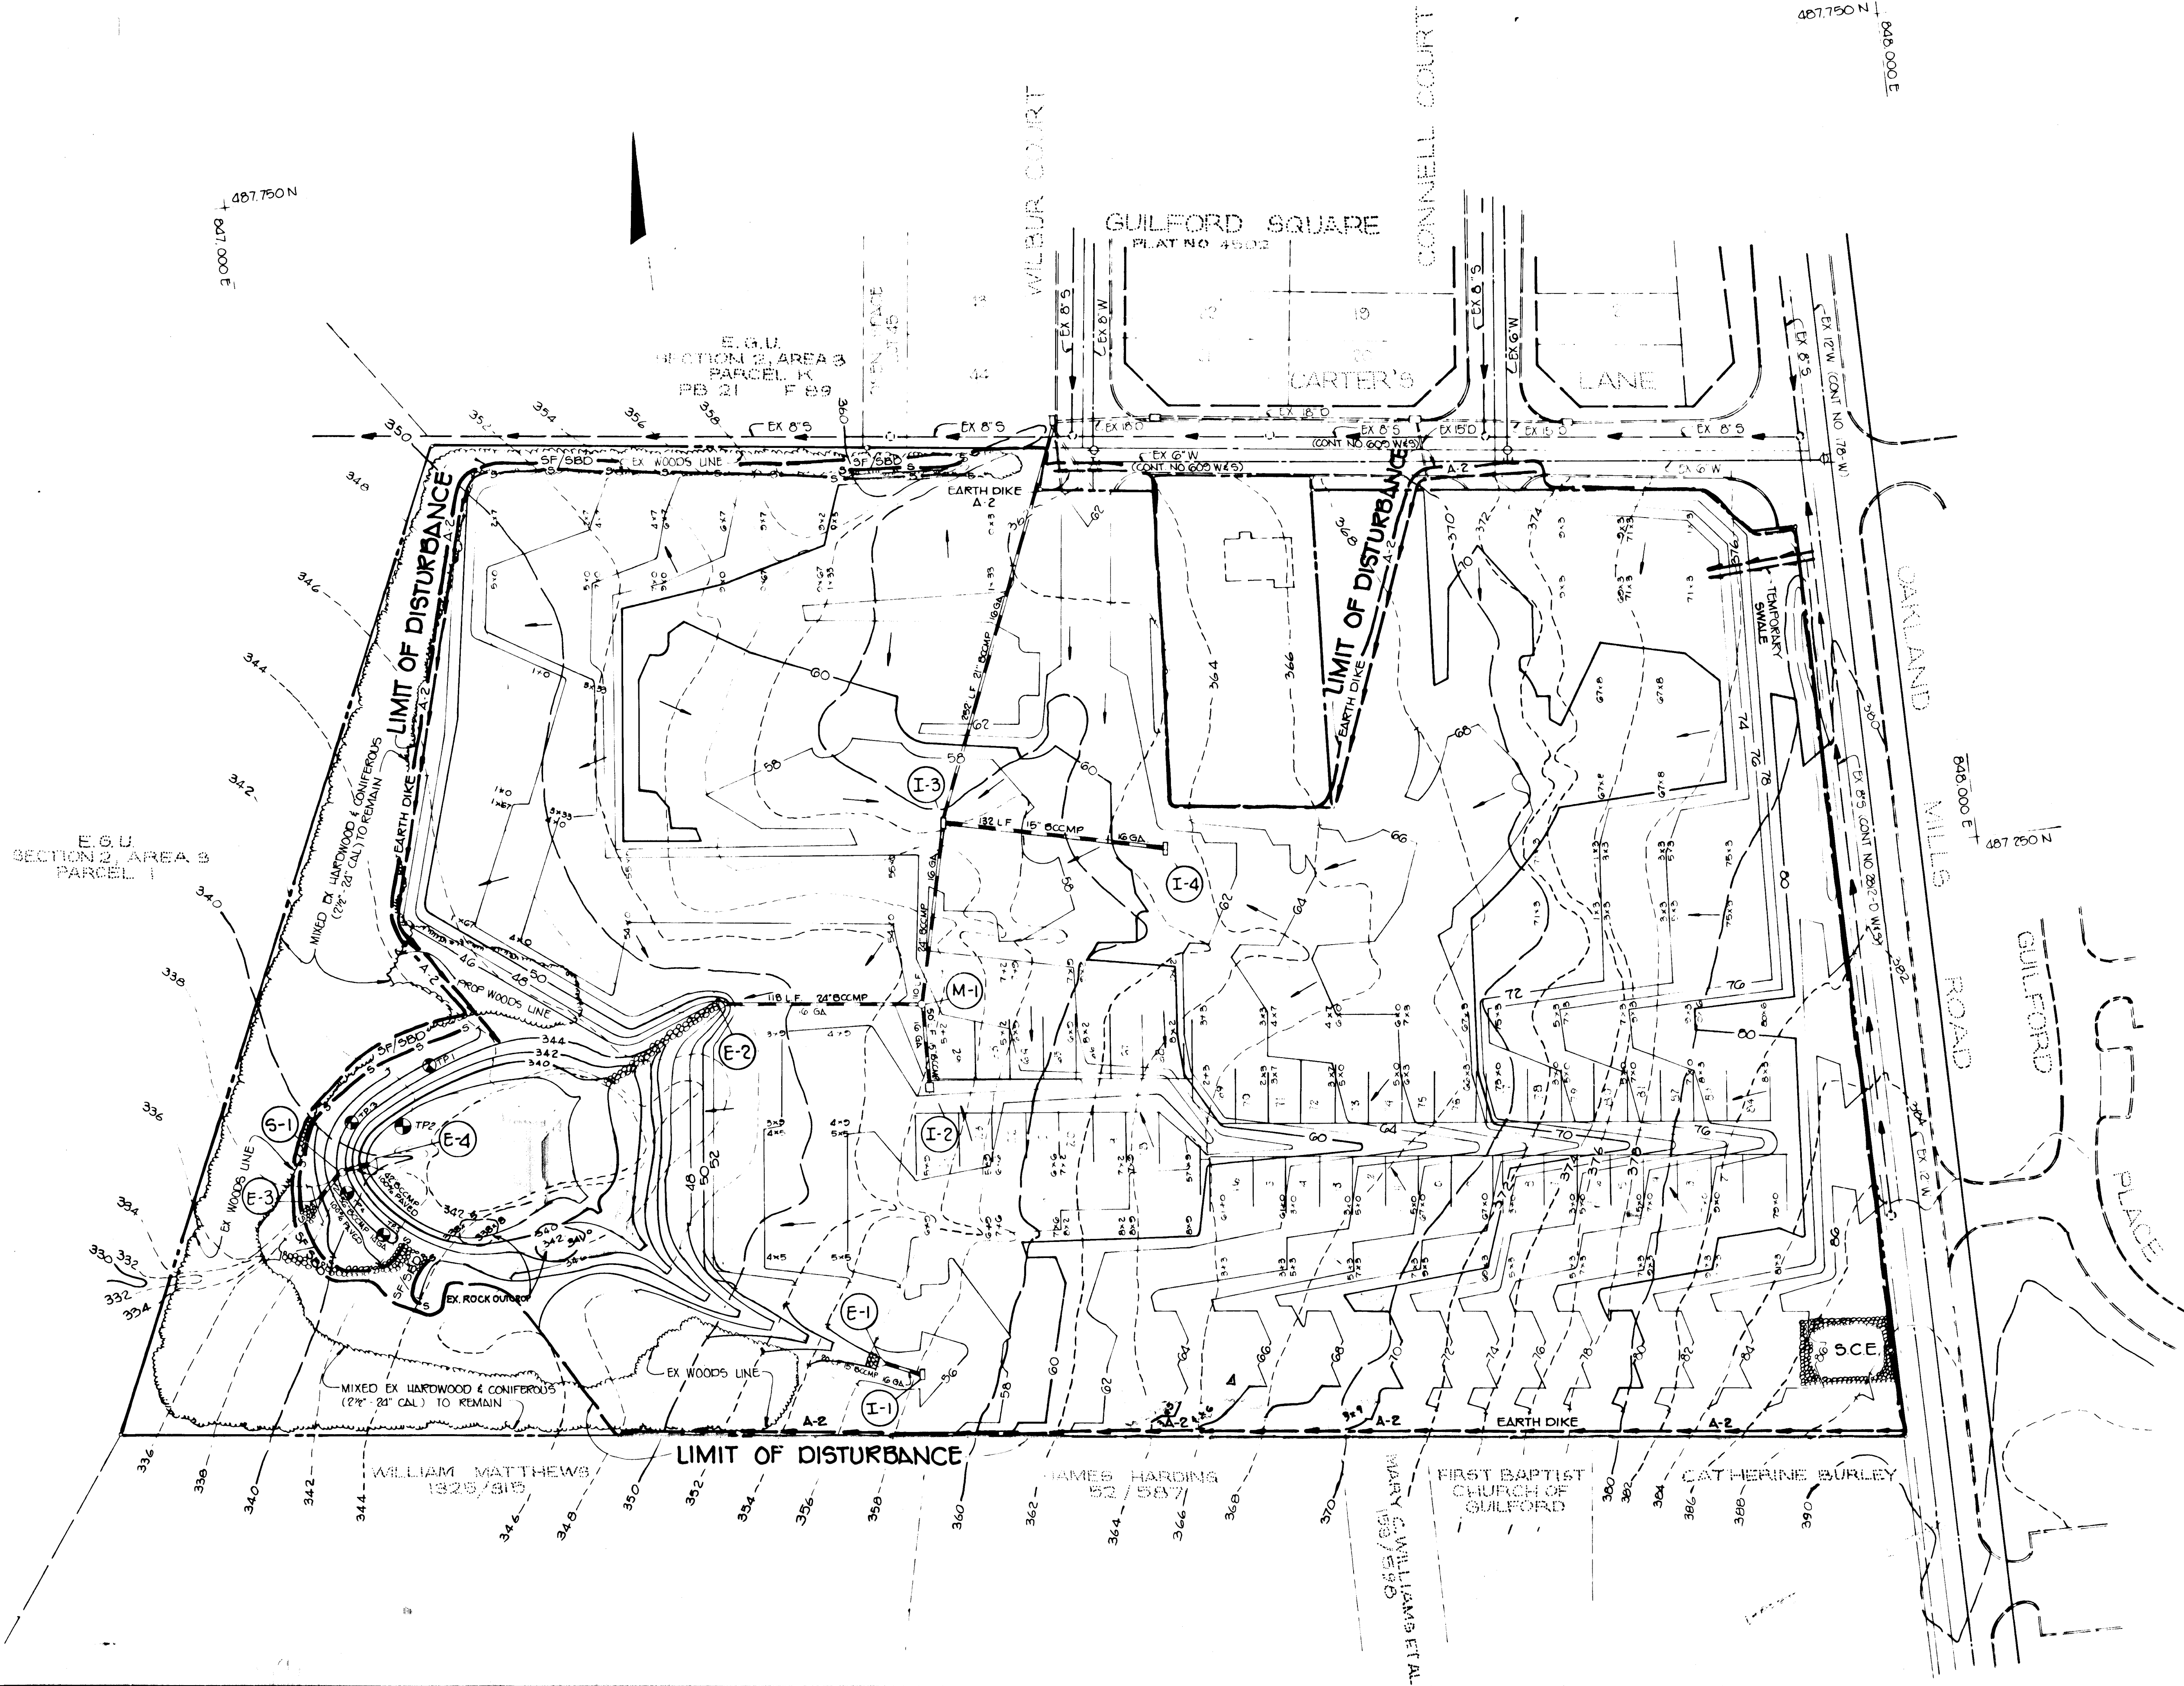

BY THE ENGINEER:	
"I CERTIFY THAT THIS PLAN FOR POND CONSTRUCTION, EROSION AND SEDIMENT CONTROL REPRESENTS A PRACTICAL AND WORKABLE PLAN BASED ON MY PERSONAL KNOWLEDGE OF THE SITE CONDITIONS. THIS PLAN WAS PREPARED IN ACCORDANCE WITH THE REQUIREMENTS OF THE HOWARD SOIL CONSERVATION DISTRICT. I HAVE NOTIFIED THE DEVELOPER THAT HE MUST PROVIDE THE HOWARD SOIL CONSERVATION DISTRICT WITH AN "AS-BUILT" PLAN OF THE POND WITHIN 30 DAYS OF COMPLETION."	
<i>James K. Tracy</i> ENGINEER: JAMES K. TRACY (EIT) # 9566	12.10.86 DATE
BY THE DEVELOPER:	
"I CERTIFY THAT ALL DEVELOPMENT AND/OR CONSTRUCTION WILL BE DONE ACCORDING TO THESE PLANS, AND THAT ANY RESPONSIBLE PERSONNEL INVOLVED IN THE CONSTRUCTION PROJECT WILL HAVE A CERTIFICATE OF ATTENDANCE AT A DEPARTMENT OF NATURAL RESOURCES APPROVED TRAINING PROGRAM FOR THE CONTROL OF SEDIMENT AND EROSION BEFORE BEGINNING THE PROJECT. I WILL PROVIDE THE HOWARD SOIL CONSERVATION DISTRICT WITH AN "AS-BUILT" PLAN OF THE POND WITHIN 30 DAYS OF COMPLETION. I ALSO AUTHORIZE PERIODIC ON-SITE INSPECTION BY THE HOWARD SOIL CONSERVATION DISTRICT."	
<i>James R. Mosley Jr.</i> DEVELOPER: JAMES R. MOSLEY JR. PRESIDENT - SECURITY DEVELOPMENT CORP.	12.10.86 DATE
THESE PLANS HAVE BEEN REVIEWED FOR THE HOWARD SOIL CONSERVATION DISTRICT AND MEET THE TECHNICAL REQUIREMENTS FOR SMALL POND CONSTRUCTION, SOIL EROSION, AND SEDIMENT CONTROL.	
<i>James M. Helm</i> U.S. SOIL CONSERVATION SERVICE	2-10-87 DATE
THESE PLANS FOR SMALL POND CONSTRUCTION, SOIL EROSION, AND SEDIMENT CONTROL MEET THE REQUIREMENTS OF THE HOWARD SOIL CONSERVATION DISTRICT.	
APPROVED: <i>Robert J. Ziebel</i> HOWARD S.C.D.	2-10-87 DATE
APPROVED: HOWARD COUNTY DEPARTMENT OF PUBLIC WORKS	
<i>William E. Ray</i> CHIEF, BUREAU OF ENGINEERING	2-12-87 DATE
APPROVED: HOWARD COUNTY OFFICE OF PLANNING AND ZONING	
<i>John W. Washburn</i> CHIEF, DIVISION OF LAND DEVELOPMENT AND ZONING ADMINISTRATION	2-13-87 DATE
▲ 10/21/87 REVISED GRADING HIDDEN COVE ▲ 7/28/88 REVISE GRADING IN STORMWATER MANAGEMENT FACILITY NO. DATE REVISION	
<b>TRACY, SCHULTE &amp; ASSOCIATES INC.</b> planning • architecture • engineering 14801 Baltimore National Pike • Ellicott City, Maryland 21041 • (301) 465-6105	
OWNER	PROJECT
SECURITY DEVELOPMENT CORP. 8480 BALTIMORE NATIONAL PIKE ELLICOTT CITY, MARYLAND 21043	<b>CARTER'S COVE</b> SECTION 1, AREA 1, LOTS 1 THRU 100
DEVELOPER	LOCATION
SECURITY DEVELOPMENT CORP. 8480 BALTIMORE NATIONAL PIKE ELLICOTT CITY, MARYLAND 21043	TAX MAP NO. 42 PARCEL NOS. 37 & 259 6 <sup>th</sup> ELECTION DISTRICT HOWARD COUNTY, MARYLAND
TITLE	DATE
<b>GRADING AND SEDIMENT CONTROL PLAN</b>	SEP. 6, 1987
DES: RJW	PROJECT NO. 8529 RSD
DRN: JH/JR	SCALE: 1" = 50'
	DRAWING: 7 OF 10

1250





I. SITE PREPARATION

Areas designated for borrow areas, embankment, and structural works shall be cleared, grubbed and stripped of topsoil. All trees, vegetation, roots and other objectionable material shall be removed. Channel banks and sharp breaks shall be sloped to no steeper than 1:1.

Areas to be covered by the pond or reservoir will be cleared of all trees, brush, logs, fences, rubbish and other objectionable material unless otherwise designated on the plans. Trees, brush and stumps shall be cut approximately level with the ground surface.

All cleared and grubbed material shall be disposed of outside and below the limits of the dam or reservoir as directed by the owner or his representative. When specified, a sufficient quantity of topsoil will be stockpiled in a suitable location for use on the embankment and other designated areas.

II. EARTH FILL

The fill material shall be taken from approved designated borrow areas or areas. It shall be free of roots, stumps, wood, rocks, frozen or other objectionable materials. The embankment shall be constructed to an elevation which provides for anticipated settlement to the design elevation. The fill height all along the length of the embankment shall be increased above the design elevation (including freeboard) as shown on the plans.

Placement

Areas on which fill to be placed shall be scarified prior to placement of fill. Fill materials shall be placed in 8-inch maximum thickness (before compaction) layers which are to be continuous over the entire length of the fill. The most porous borrow material shall be placed in the downstream portions of the embankment.

Compaction

The movement of the hauling and spreading equipment over the fill shall be controlled so that the entire surface of each lift shall be traversed by not less than one tread track of the equipment or compaction shall be achieved by a minimum of four complete passes of a sheepfoot, rubber tired or vibratory roller. Fill material shall contain sufficient moisture such that the required degree of compaction can be obtained with the equipment used.

Where a minimum required density is specified, each layer of fill shall be compacted as necessary to obtain that density and is to be certified by the Engineer.

Cutoff Trench

Where specified, a cutoff trench shall be excavated along or parallel to the centerline of the embankment as shown on the plans. The bottom width of the trench shall be as shown on the drawings, with the minimum width being four feet. The depth shall be at least four feet or as shown on the plans. The side slopes of the trench shall be 1 to 1 or flatter. The backfill material for the cutoff trench shall be the most impervious material available and shall be compacted with equipment or rollers to assure maximum density and minimum permeability.

III. STRUCTURAL BACKFILL

Backfill material shall be of the type and quality conforming to that specified for the adjoining fill material. The fill shall be placed in horizontal layers not to exceed four inches in thickness and compacted by hand tampers or other compaction equipment. The material needs to fill the backfilling operation shall driven equipment be allowed to operate closer than four feet, measured horizontally, to any part of a structure. Under no circumstances shall equipment be driven over any part of a concrete structure or pipe unless there is a compacted fill of twenty-four inches or greater over the structure or pipe.

IV. PIPE CONDUITS

All pipes shall be circular in cross section.

A. Corrugated Metal Pipe

1. Materials - (Steel Pipe) - This pipe and its appurtenances shall be galvanized and fully bituminous coated and shall conform to the requirements of AASHTO Specifications M-190 Type A with watertight coupling bands. Any bituminous coating damaged or otherwise removed shall be replaced with cold applied bituminous coating compound.

Steel pipes with polymeric coatings shall have a minimum coating thickness of 0.01 inch (10 mil) on both sides of the pipe. The following coatings are commercially available: Nexon, Plasti-Cote, Blac-Klad, and Beth-Cu-Loy. Coated corrugated steel pipe shall meet the requirements of AASHTO M-245 and M-246.

Materials - (Aluminized Steel Pipe) - This pipe and its appurtenances shall conform to the requirements of AASHTO Specification M-274-791 with watertight coupling bands or flanges.

Materials - (Aluminum Pipe) - This pipe and its appurtenances shall conform to the requirements of AASHTO Specification M-196 or M-211 with watertight coupling bands or flanges. Coupling bands, anti-seep collars, end sections, etc. must be composed of the same material as the pipe. Metals must be insulated from dissimilar materials with use of rubber or plastic insulating materials at least 24 mils in thickness. Aluminum surfaces that are to be in contact with concrete shall be painted with one coat of zinc chromate primer. Hot dip galvanized bolts may be used for connections. The pH of the surrounding soils shall be less than 9 and greater than 4.

2. Connections - All connections with-pipes must be completely watertight. The drain pipe or barrel connection to the riser shall be welded all around when the pipe and riser are metal. Watertight coupling bands or flanges shall be used at all joints. Anti-seep collars shall be connected to the pipe in such a manner as to be completely watertight. Dimple bands are not considered to be watertight.

3. Bedding - The pipe shall be firmly and uniformly bedded throughout its entire length. Where rock or soft, spongy or other unstable soil is encountered, all such material shall be removed and replaced with suitable earth compacted to provide adequate support.

4. Laying pipe - The pipe shall be placed with inside circumferential laps pointing downstream and with the longitudinal laps at the sides.

5. Backfilling shall conform to structural backfill as shown above.

6. Other details (anti-seep collars, valves, etc.) shall be as shown on the drawings.

B. Reinforced Concrete Pipe

1. Materials - Reinforced concrete pipe shall have a rubber gasket joint and shall equal or exceed ASTM Specification C-361. An approved equivalent is AWWA Specification C-301.

2. Bedding - All reinforced concrete pipe conduits shall be laid in a concrete bedding for their entire length. This bedding shall consist of high slump concrete placed under the pipe and up the sides of the pipe at least 10% of its outside diameter with a minimum thickness of 3", or as shown on the drawings.

3. Laying pipe - Bell and spigot pipe shall be placed with the bell end upstream. Joints shall be made in accordance with recommendations of the manufacturer of the material. After the joints are sealed for the entire line, the bedding shall be placed so that all spaces under the pipe are filled. Care shall be exercised to prevent any deviation from the original line and grade of the pipe.

4. Backfilling shall conform to structural backfill as shown above.

5. Other details (anti-seep collars, valves, etc.) shall be as shown on the drawings.

C. For pipes of other materials, specific specifications shall be shown on the drawings.

V. CONCRETE

1. Materials

- a. Cement - Normal Portland cement shall conform to the latest ASTM Specification C-150.
b. Water - The water used in concrete shall be clean, free from oil, acid, alkali, scales, organic matter or other objectionable substances.
c. Sand - The sand used in concrete shall be clean, hard, strong and durable, and shall be well graded with 100 percent passing a one-quarter inch sieve. Limestone sand shall not be used.
d. Coarse Aggregate - The coarse aggregate shall be clean, hard, strong and durable, and free from clay or dirt. It shall be well graded with a maximum size of one and one-half (1-1/2) inches.
e. Reinforcing Steel - The reinforcing steel shall be deformed bars of intermediate grade billet steel conforming to ASTM Specification A-615.

2. Design Mix - The concrete shall be mixed in the following proportions, measured by weight. The water-cement ratio shall be 5-3 to 6 U.S. Gallons of water per 94 pound bag of cement. The proportion of materials for the trial mix shall be 1:2:3-1/2. The combination of aggregates may be adjusted to produce a plastic and workable mix that will not produce harshness in placing or honeycombing in the structure.

3. Mixing - The concrete ingredients shall be mixed in batch mixers until the mixture is homogeneous and of uniform consistency. The mixing of each batch shall continue for not less than one and one-half minutes after all the ingredients, except the full amount of water, are in the mixer. The minimum mixing time is predicted on proper control of the speed of rotation of the mixer and of the introduction of the materials, including water, into the mixer. Water shall be added prior to, during, and following the mixer-charging operations. Excessive overmixing requiring the addition of water to preserve the required concrete consistency shall not be permitted. Truck mixing will be allowed provided that the use of this method shall cause no violation of any applicable provisions of the specifications given here.

4. Forms - The forms shall have sufficient strength and rigidity to hold the concrete and to withstand the necessary pressure, tamping, and vibration without deflection from the prescribed lines. They shall be mortar-tight and constructed so that they can be removed without hammering or prying against the concrete.

The inside of forms shall be oiled with a non-staining mineral oil or thoroughly wetted before concrete is placed.

Forms may be removed 24 hours after the placement of concrete. All wire ties and other devices used shall be recessed from the surface of the concrete.

5. Reinforcing Steel - All reinforcing material shall be free of dirt, rust, scale, oil, paint or any other coatings. The steel shall be accurately placed and securely tied and blocked into position so that no movement of the steel will occur during placement of concrete.

6. Consolidating - Concrete shall be consolidated with internal type mechanical vibrators. Vibration shall be supplemented by spading and hand tamping as necessary to insure smooth and dense concrete along form surfaces, in corners, and around embedded items.

7. Finishing - Defective concrete, honeycombed areas, voids left by the removal of tie rods, ridges on all concrete surfaces permanently exposed to view or exposed to water on the finished structure, shall be repaired immediately after the removal of forms. All voids shall be reamed and completely filled with dry-patching mortar.

8. Protection and Curing - Exposed surfaces of concrete shall be protected from the direct rays of the sun for at least the first three (3) days. All concrete shall be kept continuously moist for at least ten (10) days after being placed. Moisture may be applied by spraying or sprinkling as necessary to prevent the concrete from drying. Concrete shall not be exposed to freezing during the curing period. Curing compounds may also be used.








9. Placing Temperature - Concrete may not be placed at temperatures below 37°F with the temperature falling, or 34° with the temperature rising.

VI. STABILIZATION

All borrow areas shall be graded to provide proper drainage and left in a slightly condition. All exposed surfaces of the embankment, spillway, spoil and borrow areas, and berms shall be stabilized by seeding, liming, fertilizing and mulching (if required) in accordance with the vegetative treatment specifications or as shown on the accompanying drawings.

VII. EROSION AND SEDIMENT CONTROL.

Construction operations will be carried out in such a manner that erosion will be controlled and water and air pollution minimized. State and local laws concerning pollution abatement will be followed. Construction plans shall detail erosion and sediment control measures to be employed during the construction process.

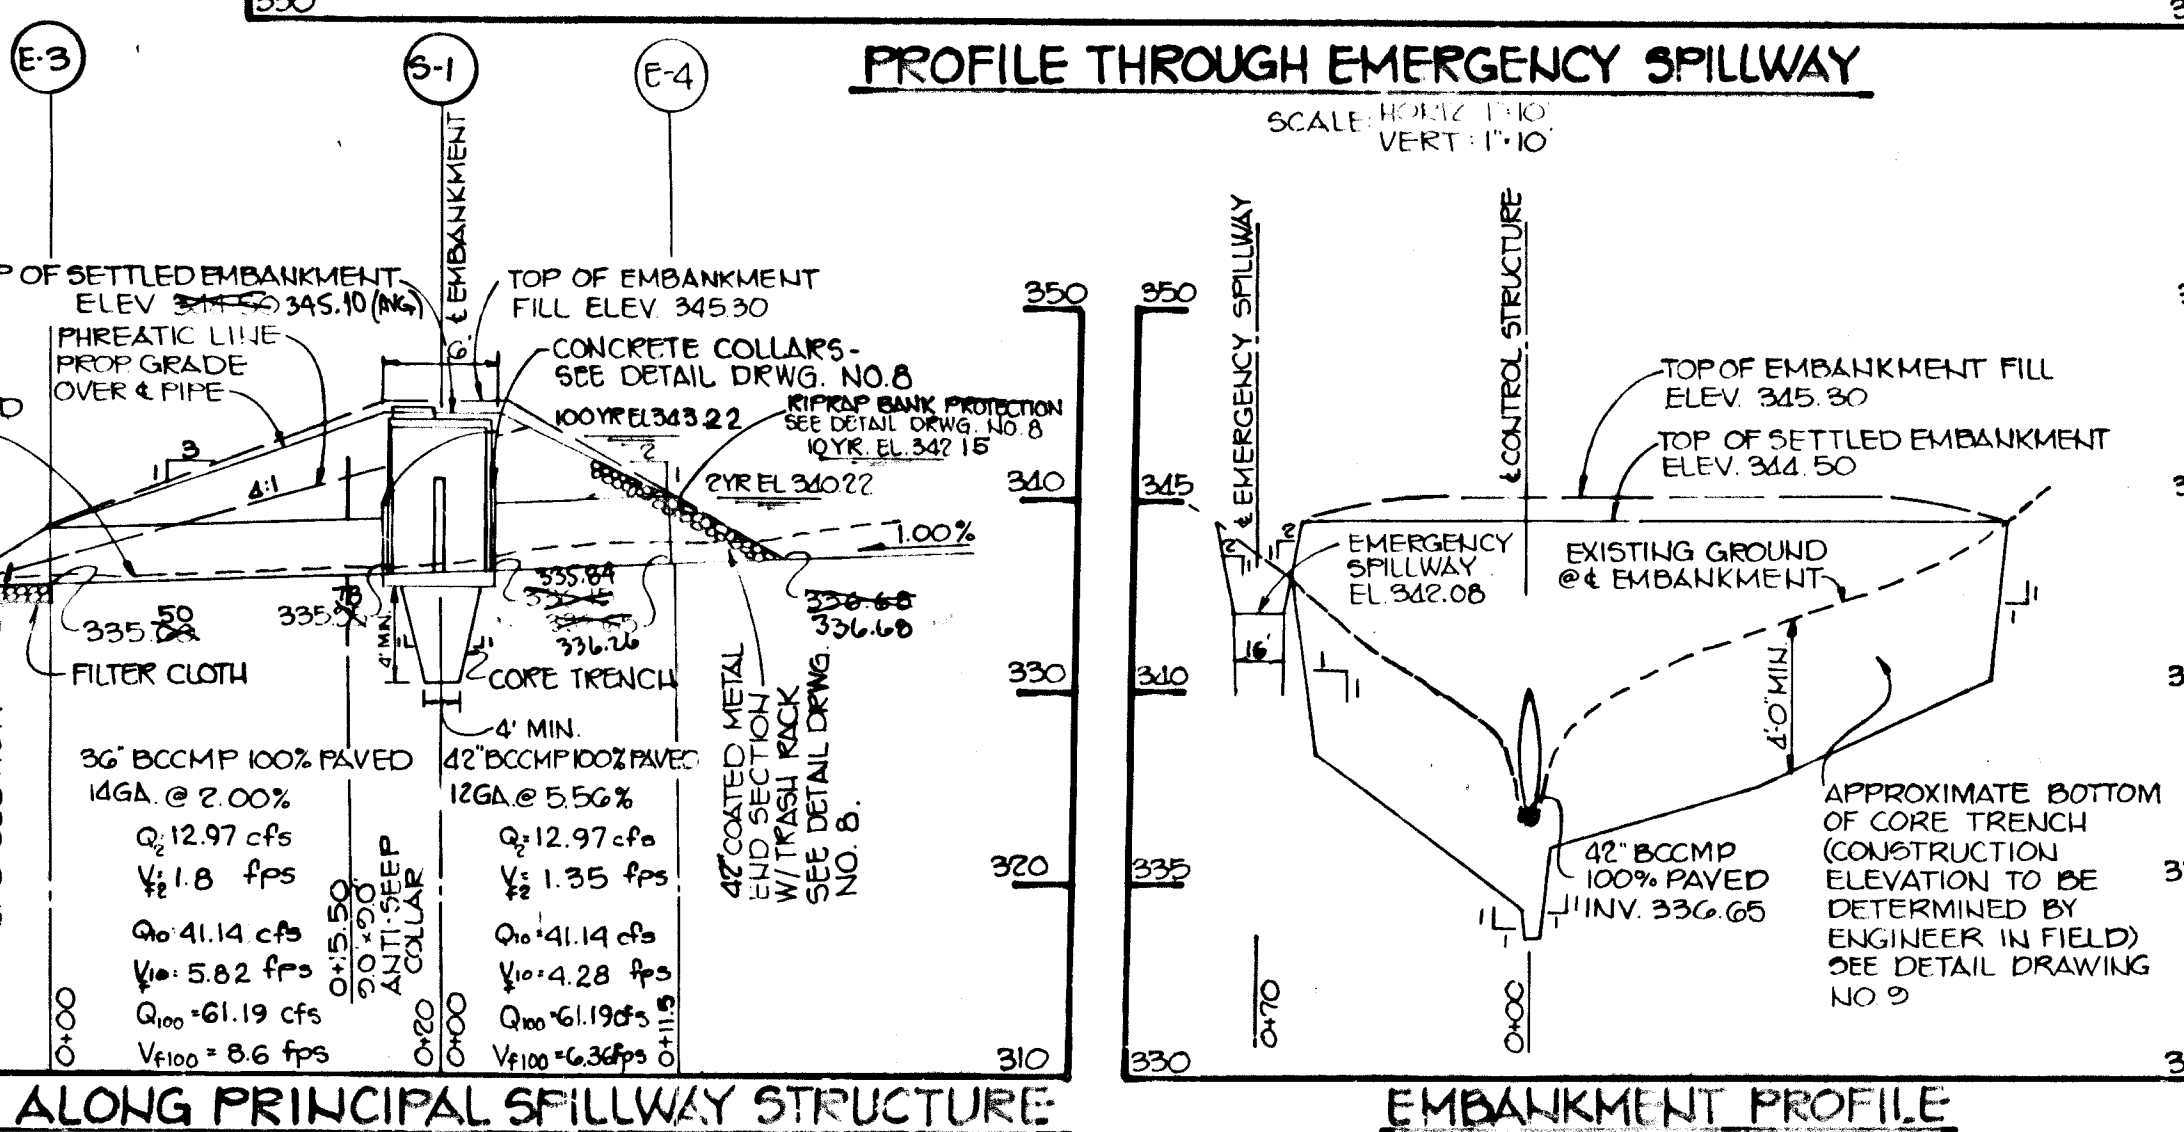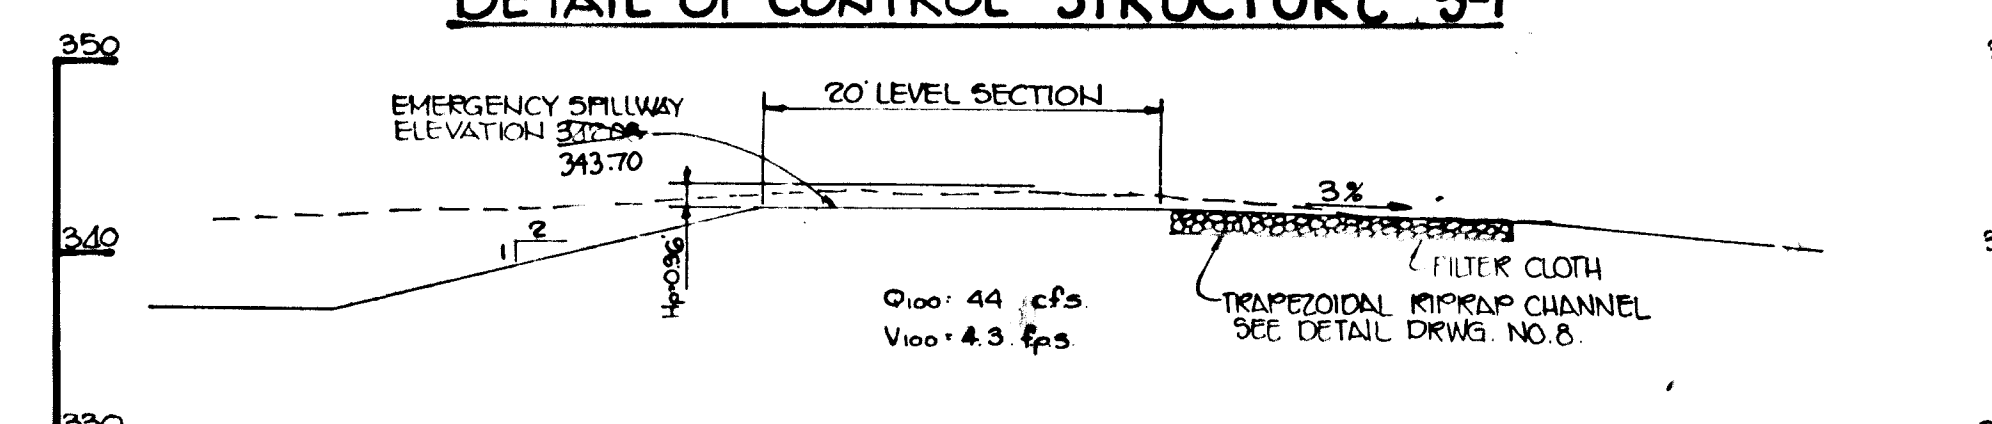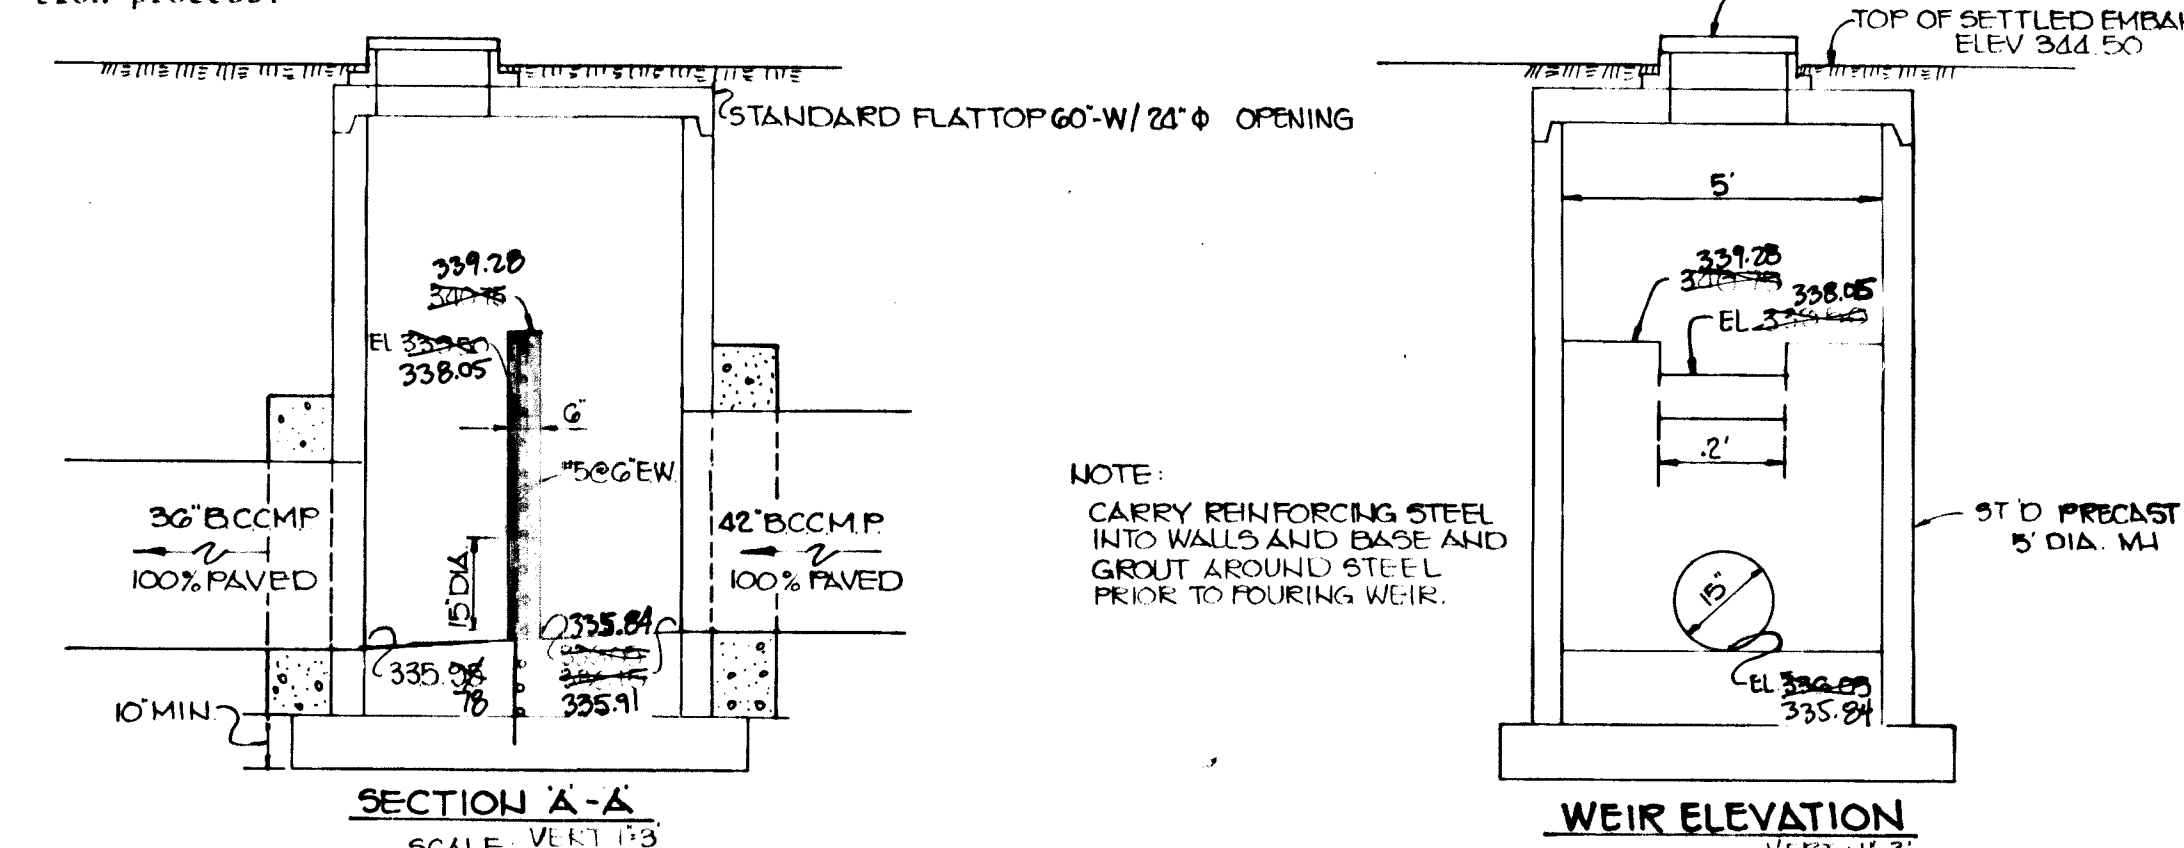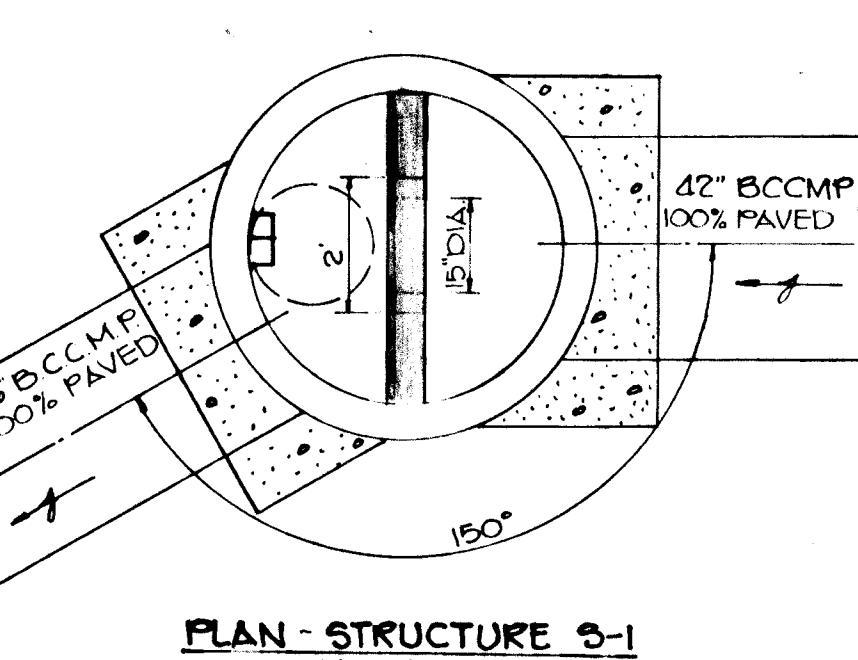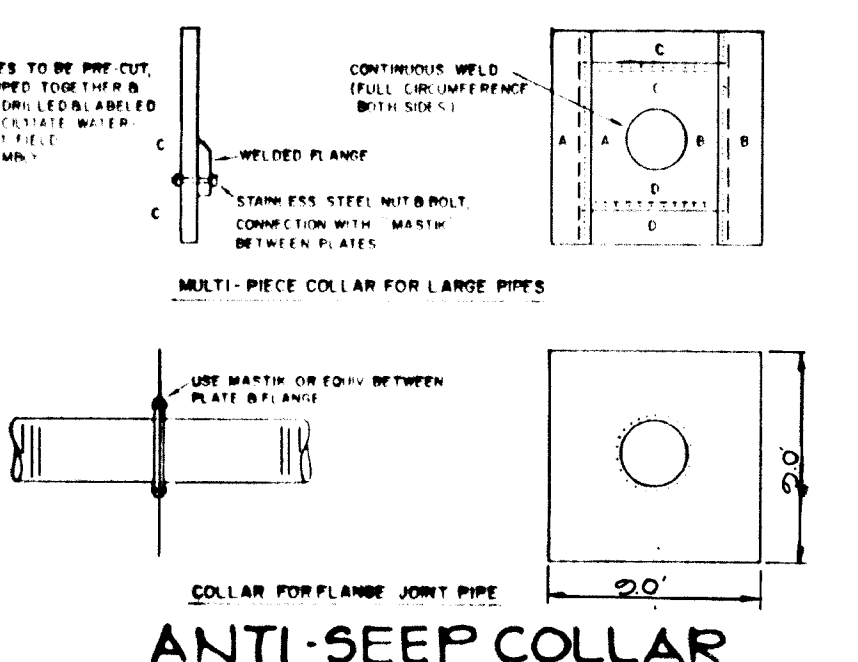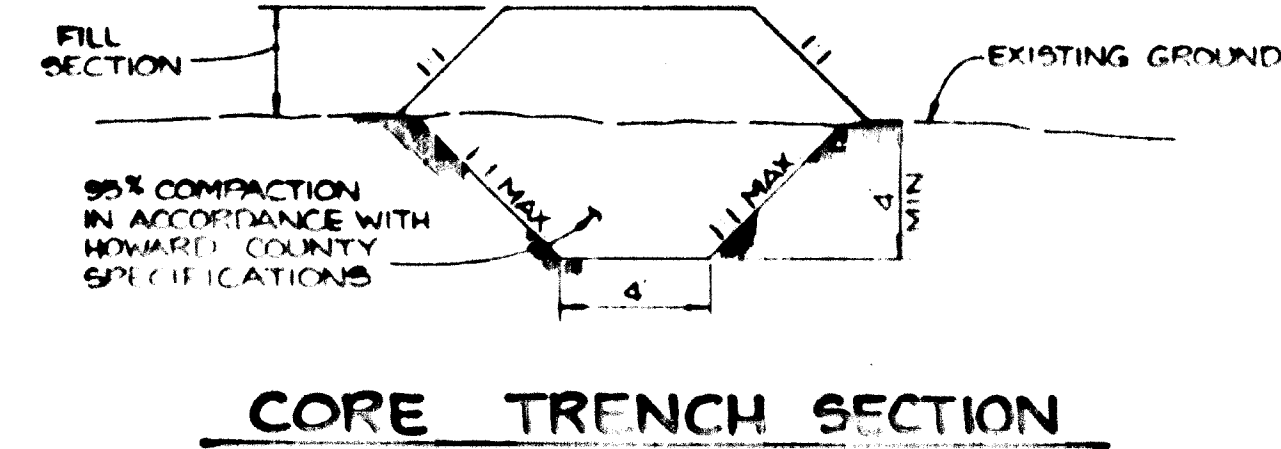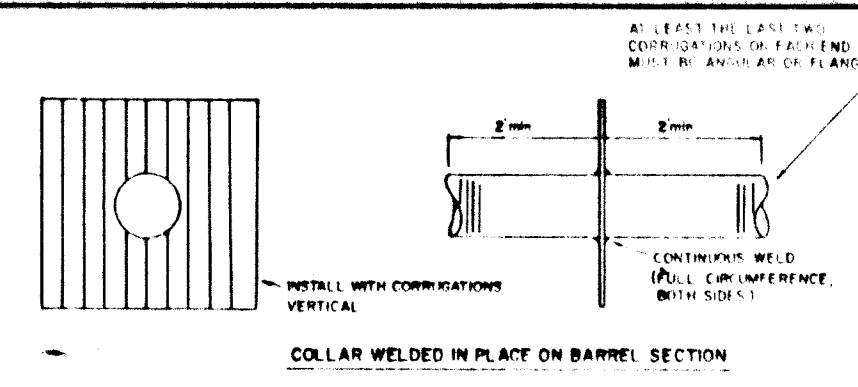

AS-BUILT SURVEY CERTIFIED BY WILLIAM G. RASCH, II, MD. P.E./S. NO. 4575 ON 11-18-88.

Professional engineering stamps and certification blocks. Includes signatures of James K. Tracy (12-10-86), James B. Maffey Jr. (12-10-86), Robert Zielow (2-10-87), and John W. Mueschler (2-10-87). Also includes a stamp from the State of Maryland Professional Engineer and project information for Carter's Cove.

1250



± CURVE DATA - PRIVATE DRIVE 'A'  
 ± STA 1+00.00 TO ± STA 3+25.43  
 I = 67.62  
 Δ 90° 25' 09"  
 R 100.00  
 L 157.81  
 T 100.73  
 D 51° 29' 58"

No	DATE	REVISION
3	11-24-78	ADD 3 PARKING SPACES TO HIDDEN COVE AND REVISE TREE LOCATION; REMOVE ISLAND AND ADD 4 PARKING SPACES TO PIRATES COVE; ADD ENTRANCE TO PIRATES COVE.

PLANT LIST			
SYMBOL	QUANTITY	NAME	REMARKS
○	10	ACER RUBRUM Red Maple	2 1/2 Min. Cal. B & B Full Head
○	9	QUERCUS PALUSTRIS Pin Oak	
○	10	QUERCUS BOREALIS Rtd Oak	
○	9	PYRUS CALLERYANA Bradford Callery Pear	
TOTAL	38	44 TOTAL TREES PLANTED	

**STREET TREE TABULATIONS**

± LENGTH OAKLAND MILLS ROAD	= 597.99 LF + 80 = 747
± LENGTH CARTER'S LANE	= 433.25 LF + 80 = 542
± LENGTH PIRATE'S COVE	= 167.56 LF + 40 = 419
± LENGTH HIDDEN COVE	= 464.50 LF + 40 = 1161
LINEAR PROFILE PIRATE'S COVE	= 346.22 LF + 80 = 433
LINEAR PROFILE HIDDEN COVE	= 340.41 LF + 80 = 426
TOTAL REQUIRED	= 3728
TOTAL PROVIDED	= 38

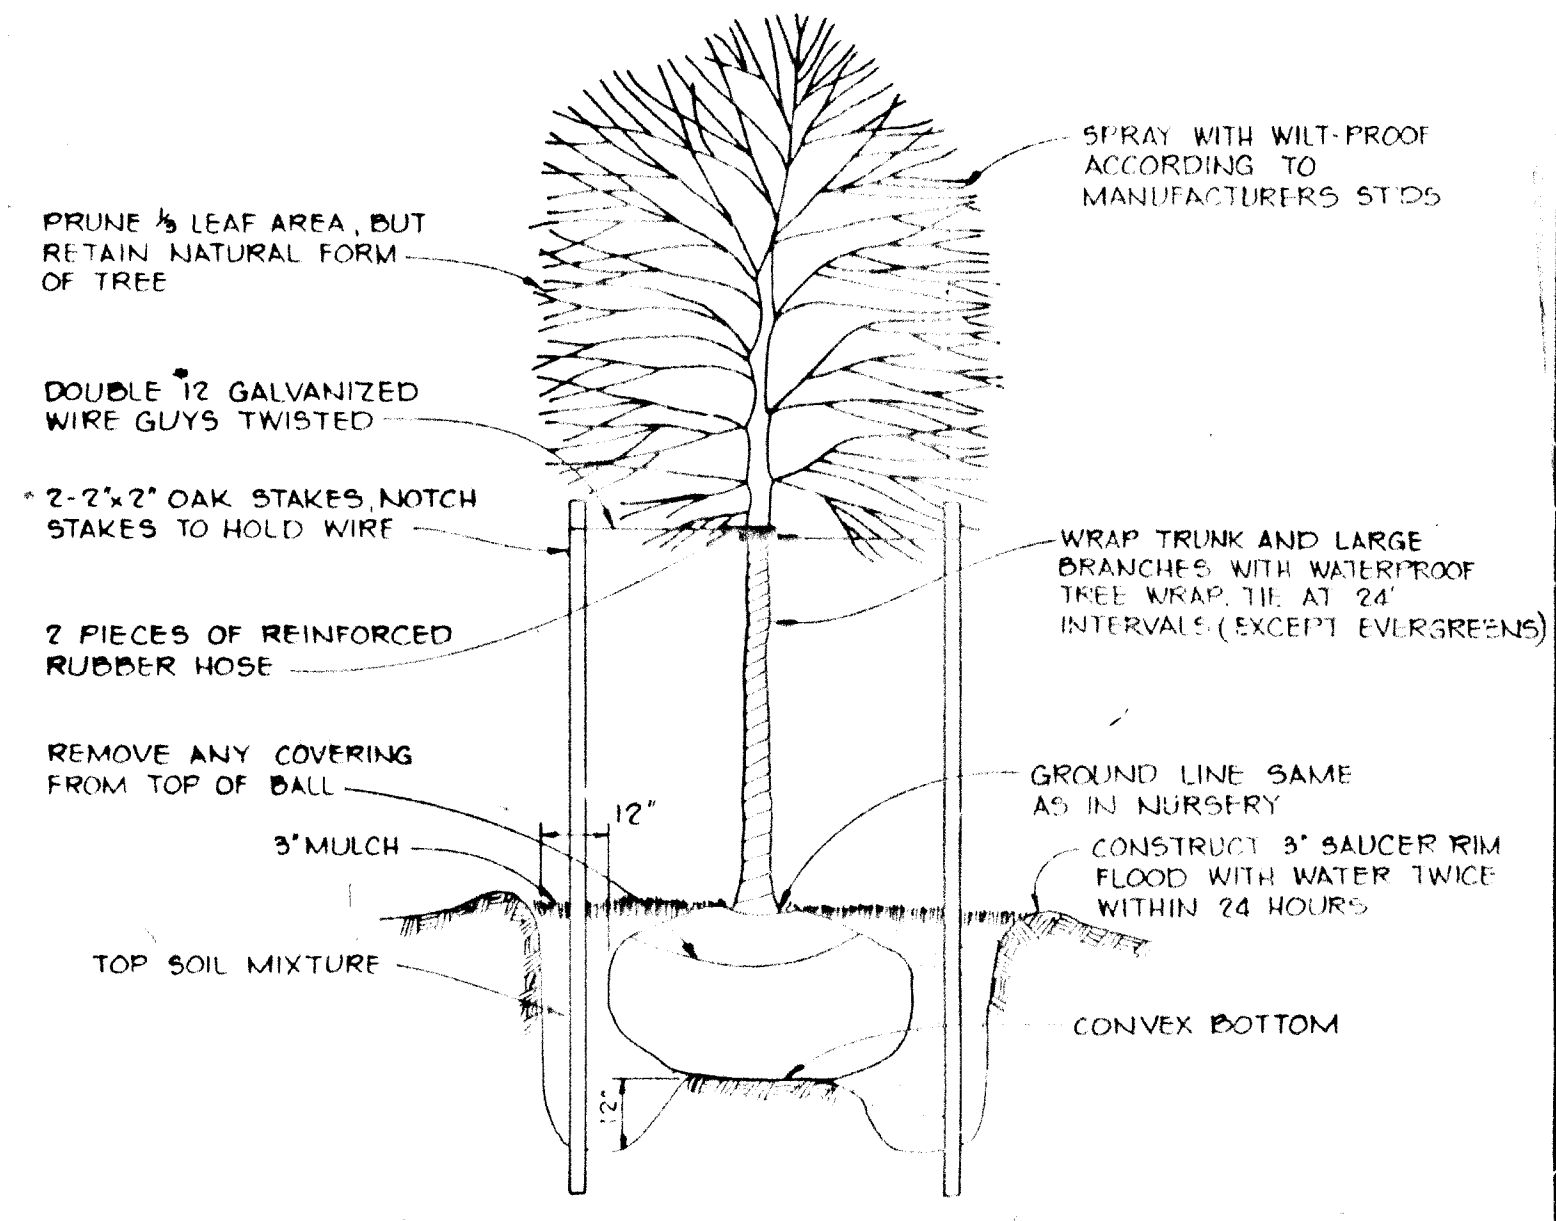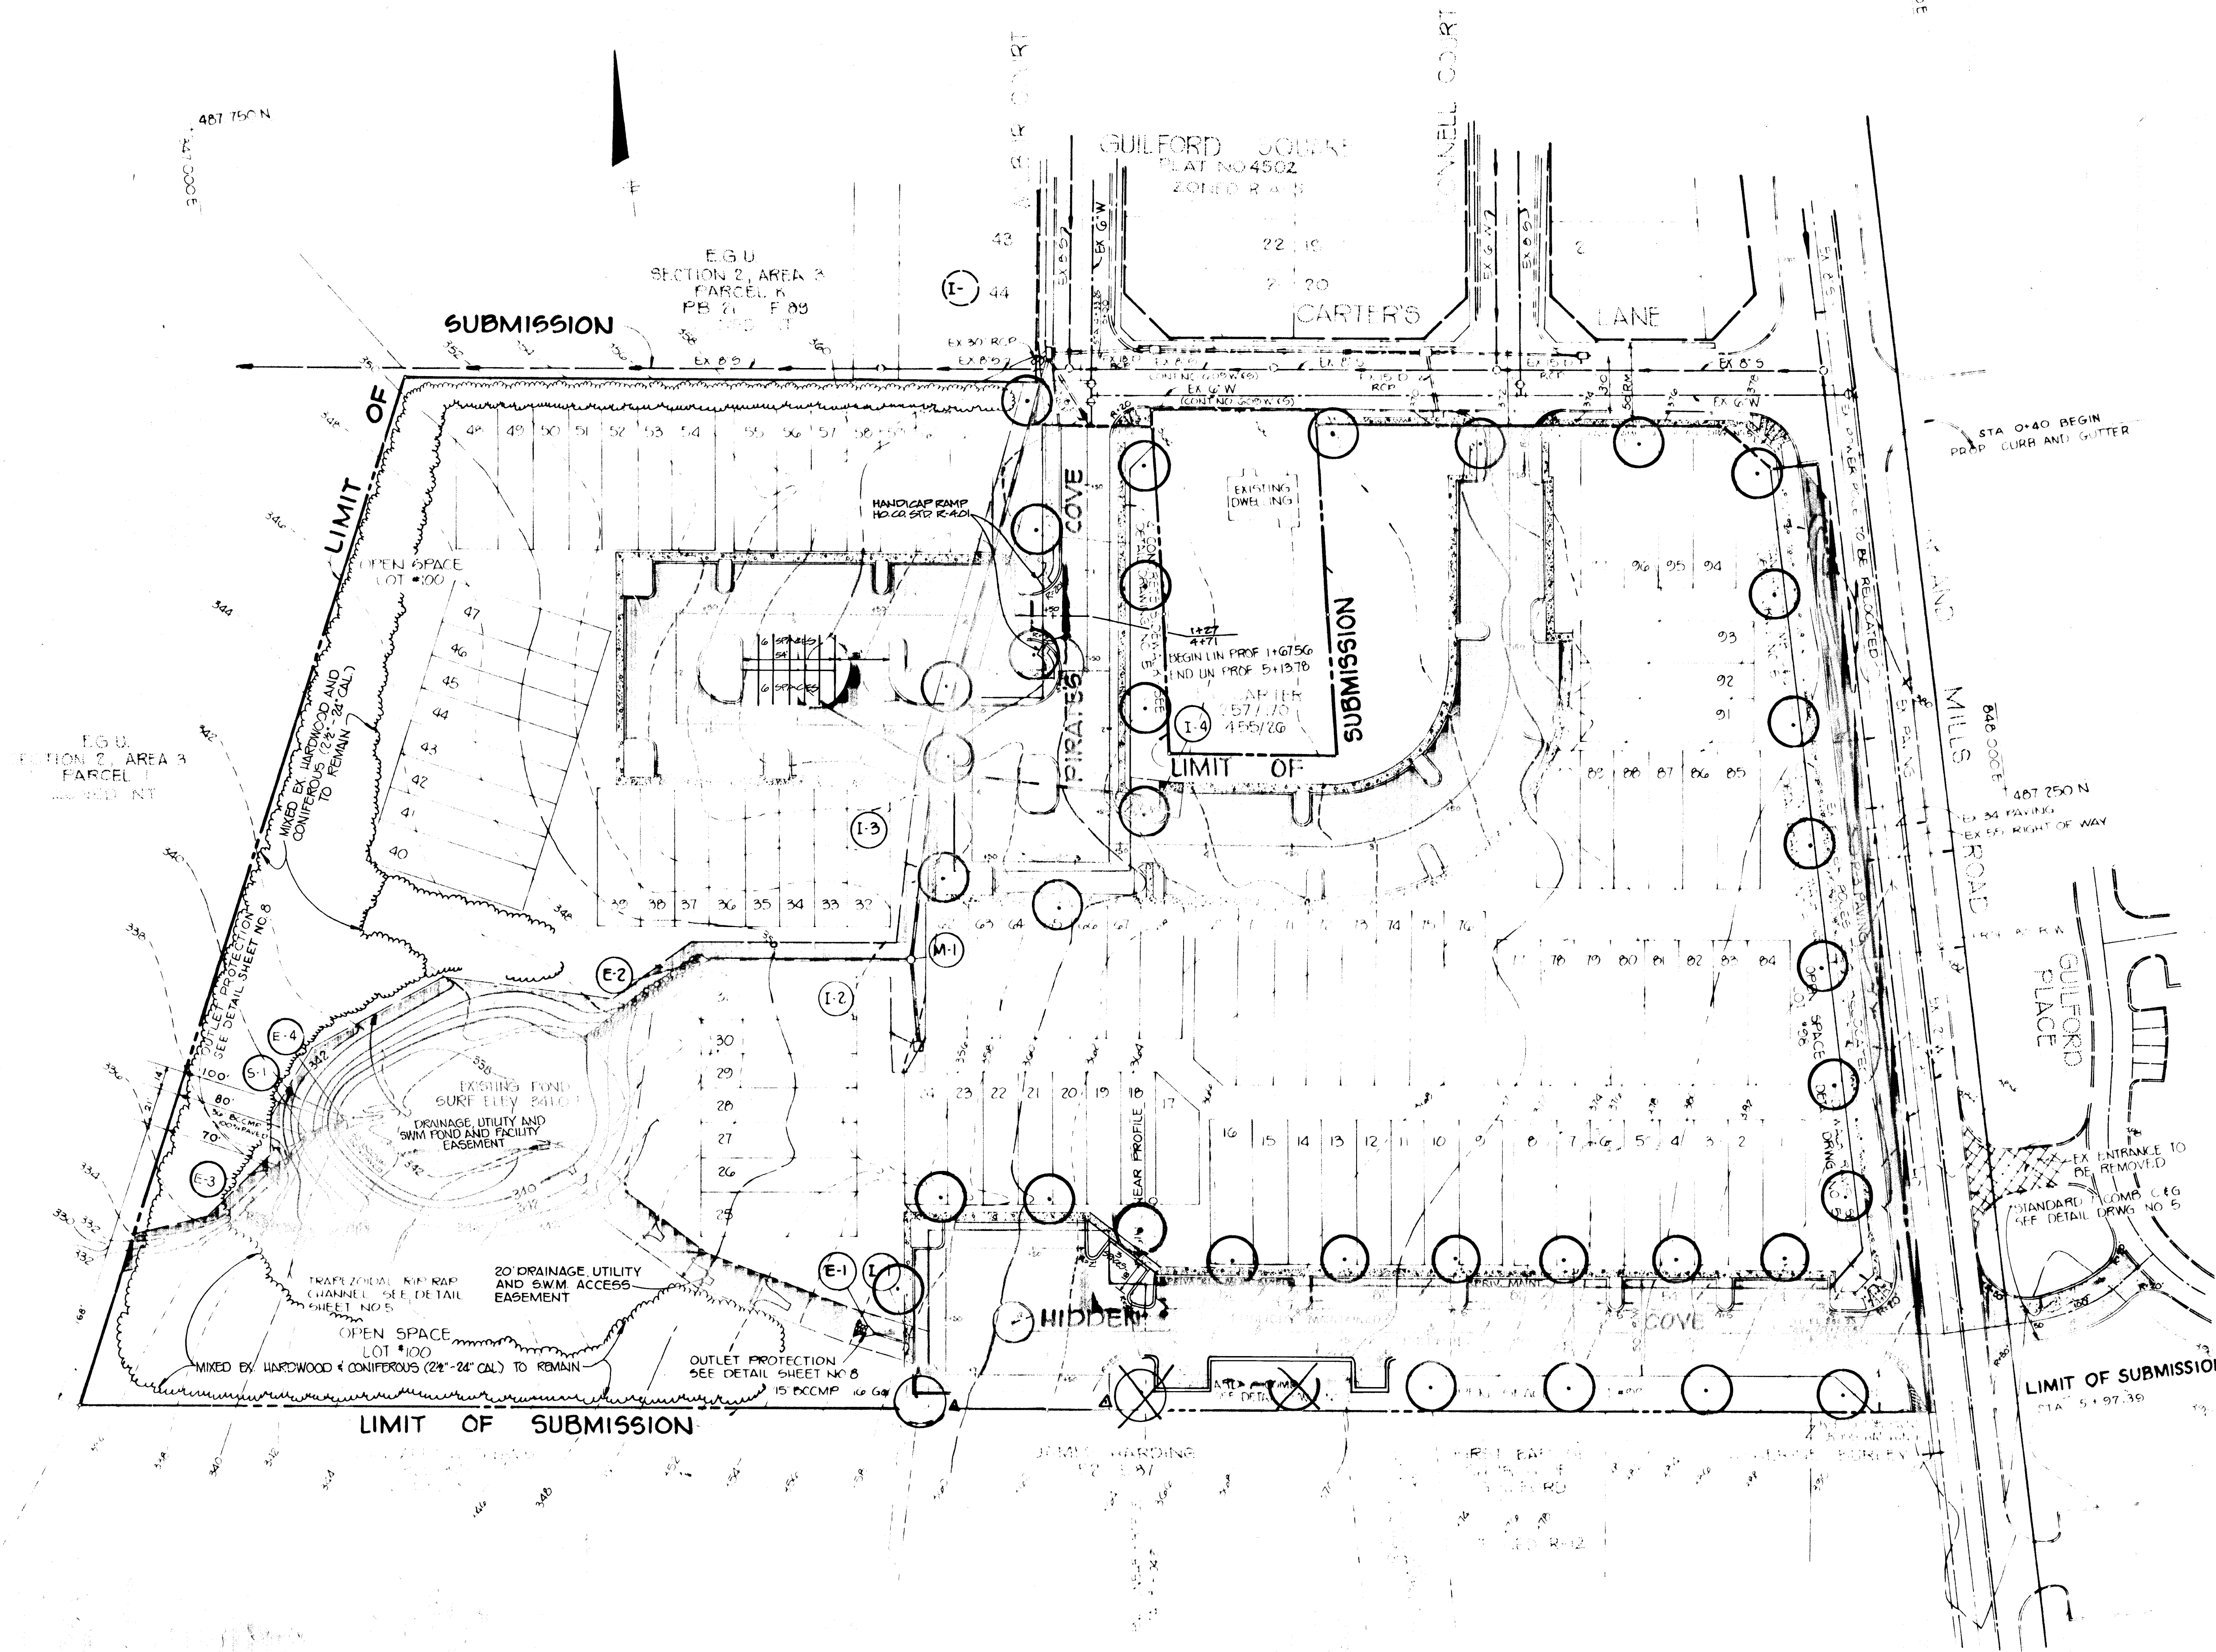

**TREE PLANTING DETAIL**

AS-BUILT SURVEY CERTIFIED BY  
 WILLIAM G. PASCHKE, PE/LS  
 NO. 4575, ON 11-18-88

William G. Paschke CHIEF, CIVIL ENGINEERING 2-18-87	2-18-87 DATE
[Signature] PROJECT MANAGER 2-13-87	2-13-87 DATE
10/21/87 MOVED TREES AND REVISED PARKING - HIDDEN COVE	
NO. DATE	REVISION

**TRACY, SCHULTE & ASSOCIATES INC.**  
 planning • architecture • engineering  
 8480 Baltimore National Pike • Ellicott City, Maryland 21043 • (301) 465-6105

<b>OWNER</b> SECURITY DEVELOPMENT CORP 8480 BALTIMORE NATIONAL PIKE ELICOTT CITY, MARYLAND 21043	<b>PROJECT</b> CARTER'S COVE SECTION 2, AREA 3, LOTS 1-100 LOCATION TAX MAP NO. 47 PARCEL NOS. 37 & 253 6th ELECTION DISTRICT HOWARD COUNTY, MARYLAND
<b>DEVELOPER</b> SECURITY DEVELOPMENT CORP 8480 BALTIMORE NATIONAL PIKE ELICOTT CITY, MARYLAND 21043	<b>TITLE</b> STREET TREE PLAN
DATE: FEB. 6, 1987 SCALE: 1" = 50' DES: RJW DRN: KMN/CDT	PROJECT NO: 8520 RSD DRAWING 10 OF 10

1250