



SHEET INDEX	
NO.	DESCRIPTION
1	PLAN AND PROFILE OF LARK BROWN ROAD
2	PLAN AND PROFILE OF PAINTED ROCK ROAD AND STAIRTOP CURB
3	DRAINAGE AREA AND SOILS MAP
4	DETAILS AND STORM DRAIN PROFILES
5	STORM WATER MANAGEMENT SPECIFICATIONS AND DETAILS
6	GRADING AND SEDIMENT CONTROL PLAN
7	SEDIMENT CONTROL NOTES AND DETAILS

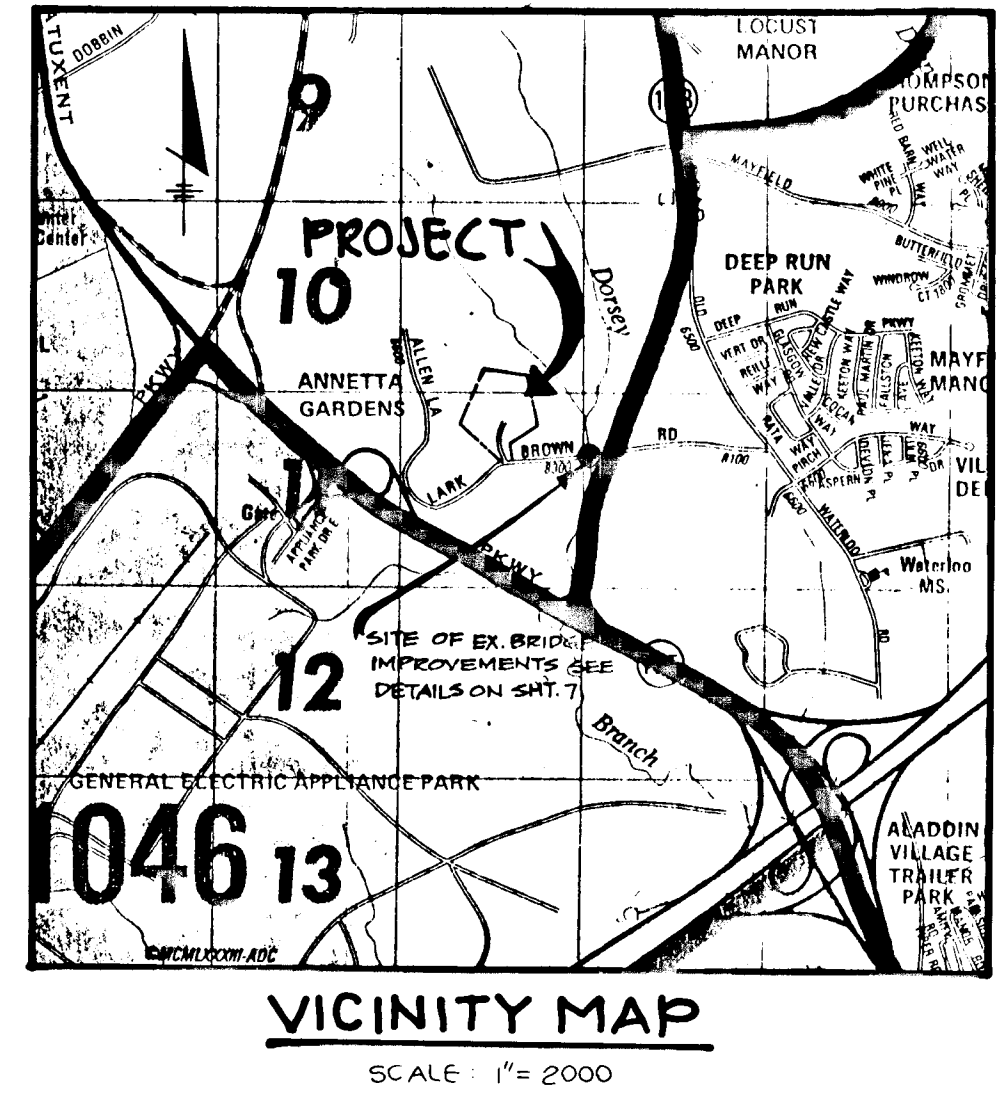

BENCHMARKS


1) HO. CO. STA. 2343001 ELEV. 288.241
 1/4" x 1/2" SET 3" BELOW SURFACE OF GROUND IN THE NORTHEAST CORNER OF ISLAND OF ROUTE # 108 AND ROUTE # 175 STANDARD CONCRETE MONUMENT
 2) HO. CO. MONUMENT 2443001 ELEV. 291.400
 SET 2" BELOW SURFACE OF GROUND IN THE NORTHWEST CORNER OF THE INTERSECTION OF ROUTE # 108 AND LARK BROWN ROAD.

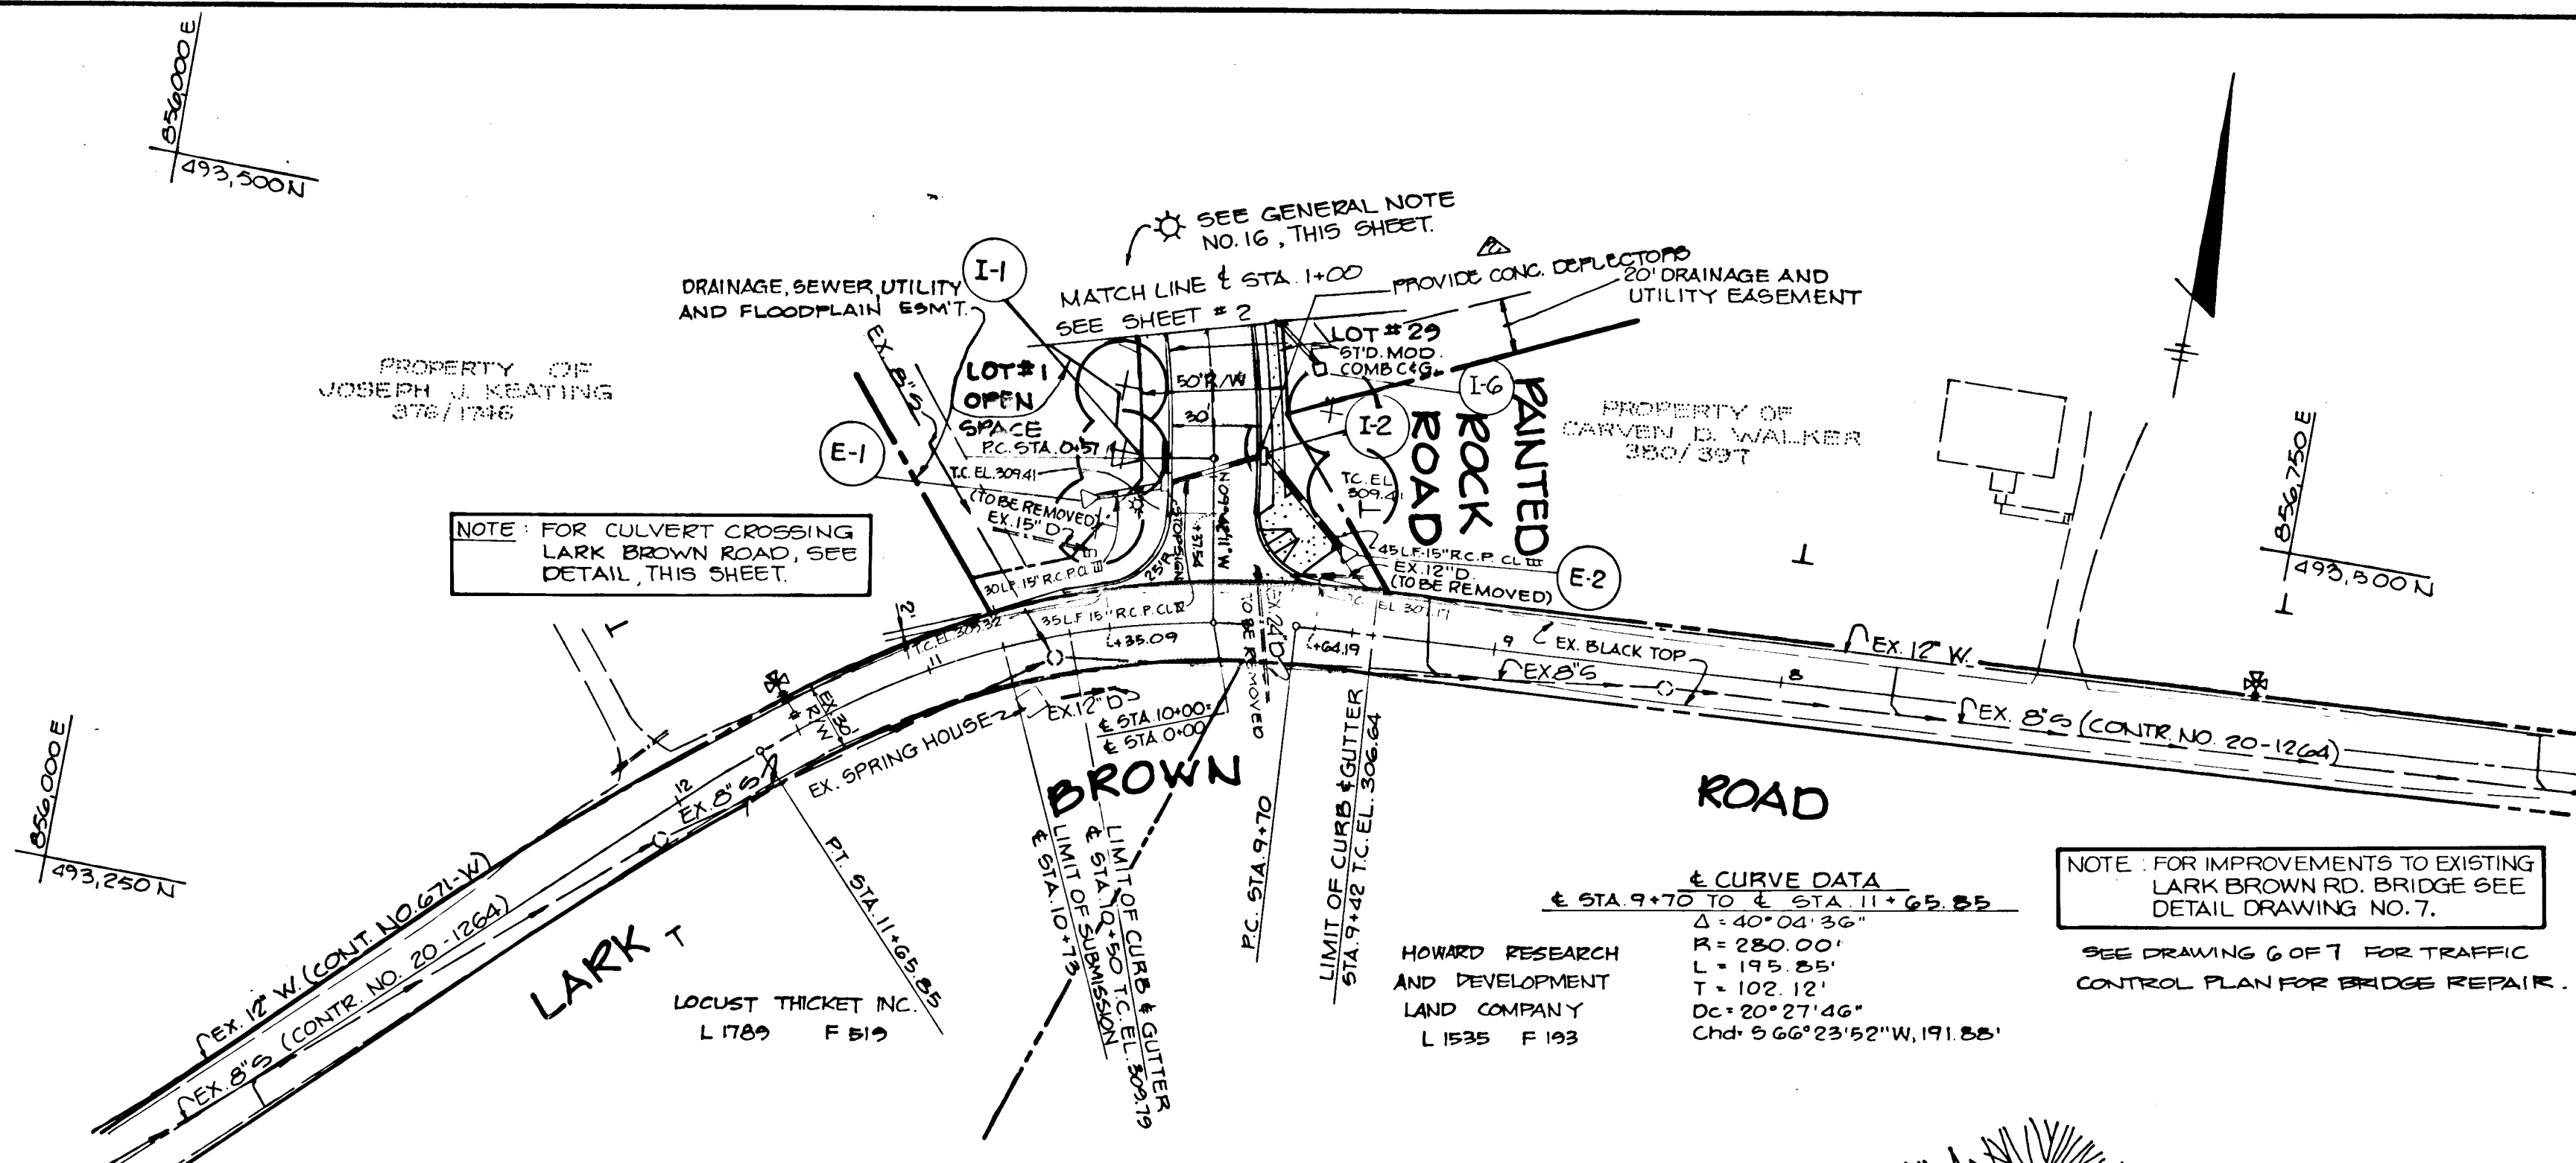


NOTE: FOR IMPROVEMENTS TO EXISTING LARK BROWN RD. BRIDGE SEE DETAIL DRAWING NO. 7.
 SEE DRAWING 6 OF 7 FOR TRAFFIC CONTROL PLAN FOR BRIDGE REPAIR.

PLANT LIST

Qty	Symbol	Name	Size	Remarks
52	(Symbol)	SHADE TREE ACER PLATANOIDES 'SUMMERSHANE' Summershade Norway Maple	2 1/2" - 3" Cal., 12' - 14' Ht.	R&B, Full Head
6	(Symbol)	EVERGREEN TREE PINUS STROBILIS Eastern White Pine	2 1/2" - 3" Cal., 7' - 8' Ht.	R&B, Unsheared

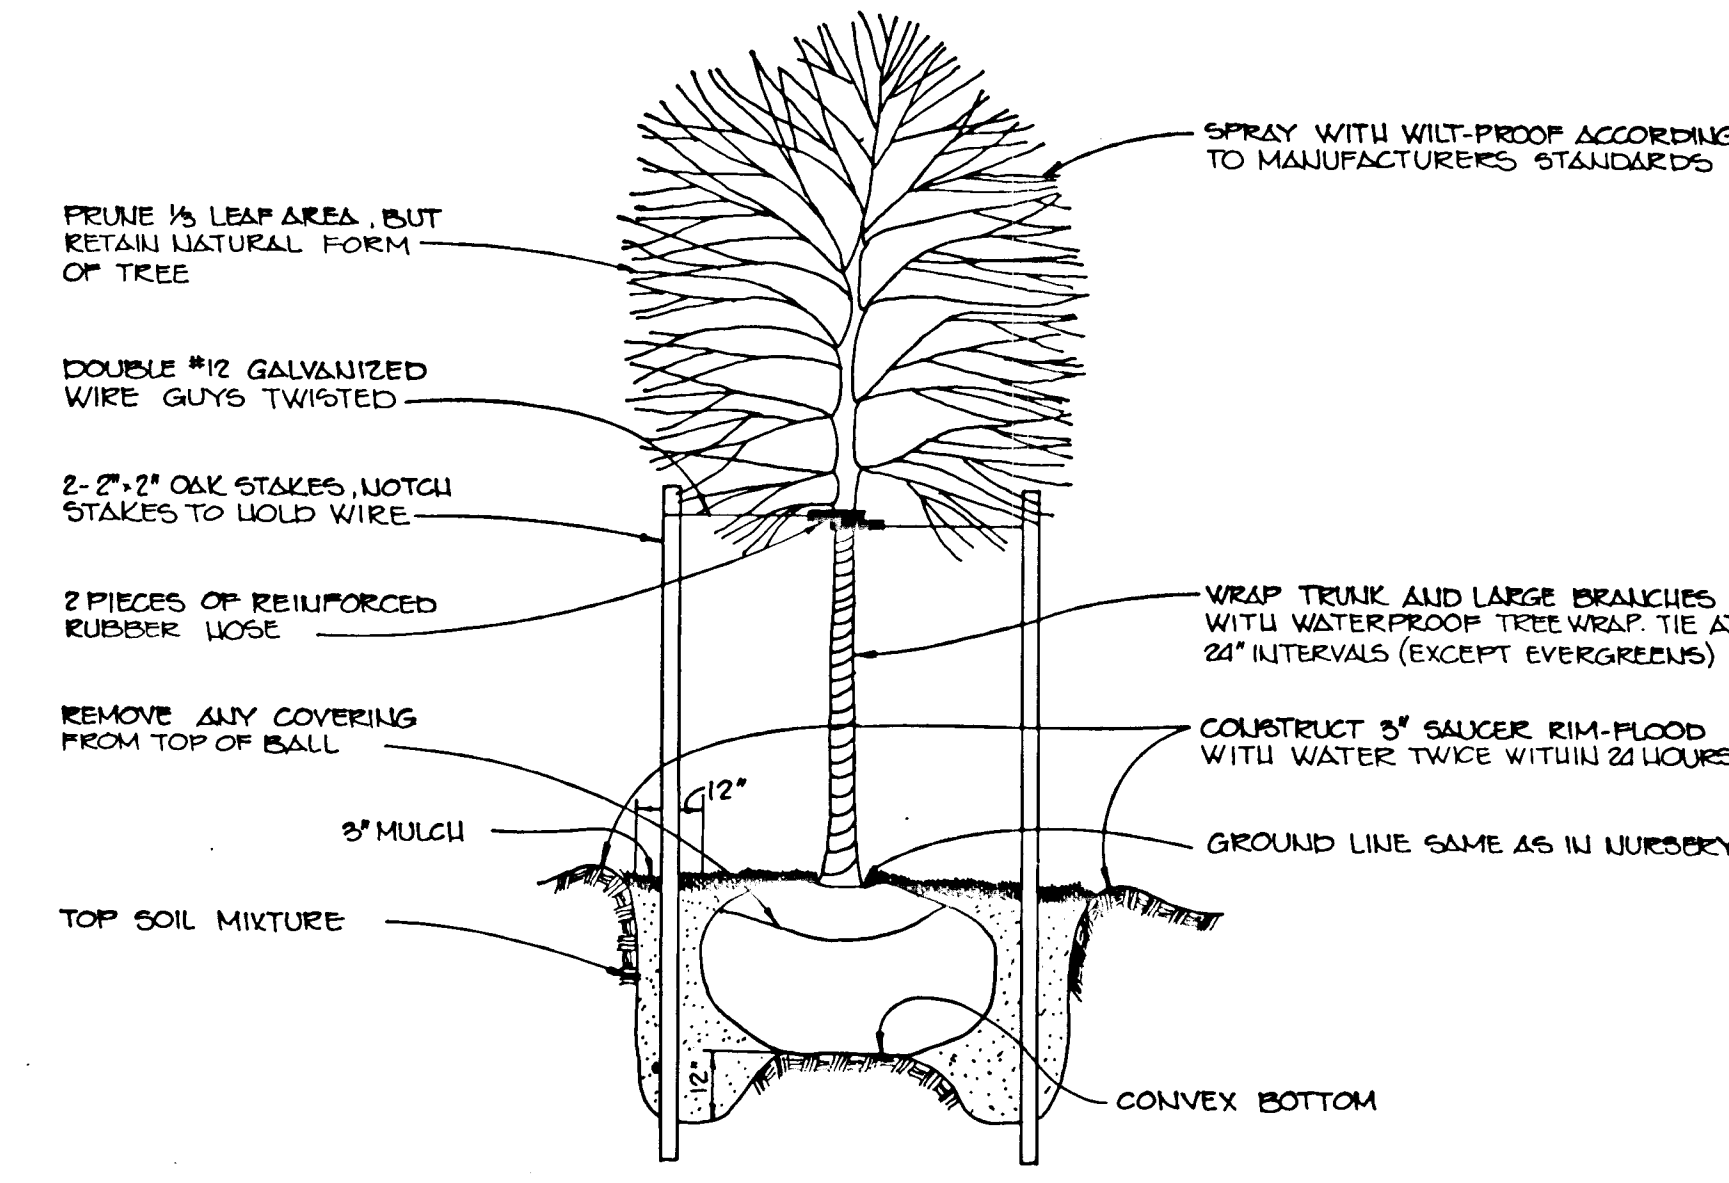

TREE PLANTING DETAIL
NO SCALE

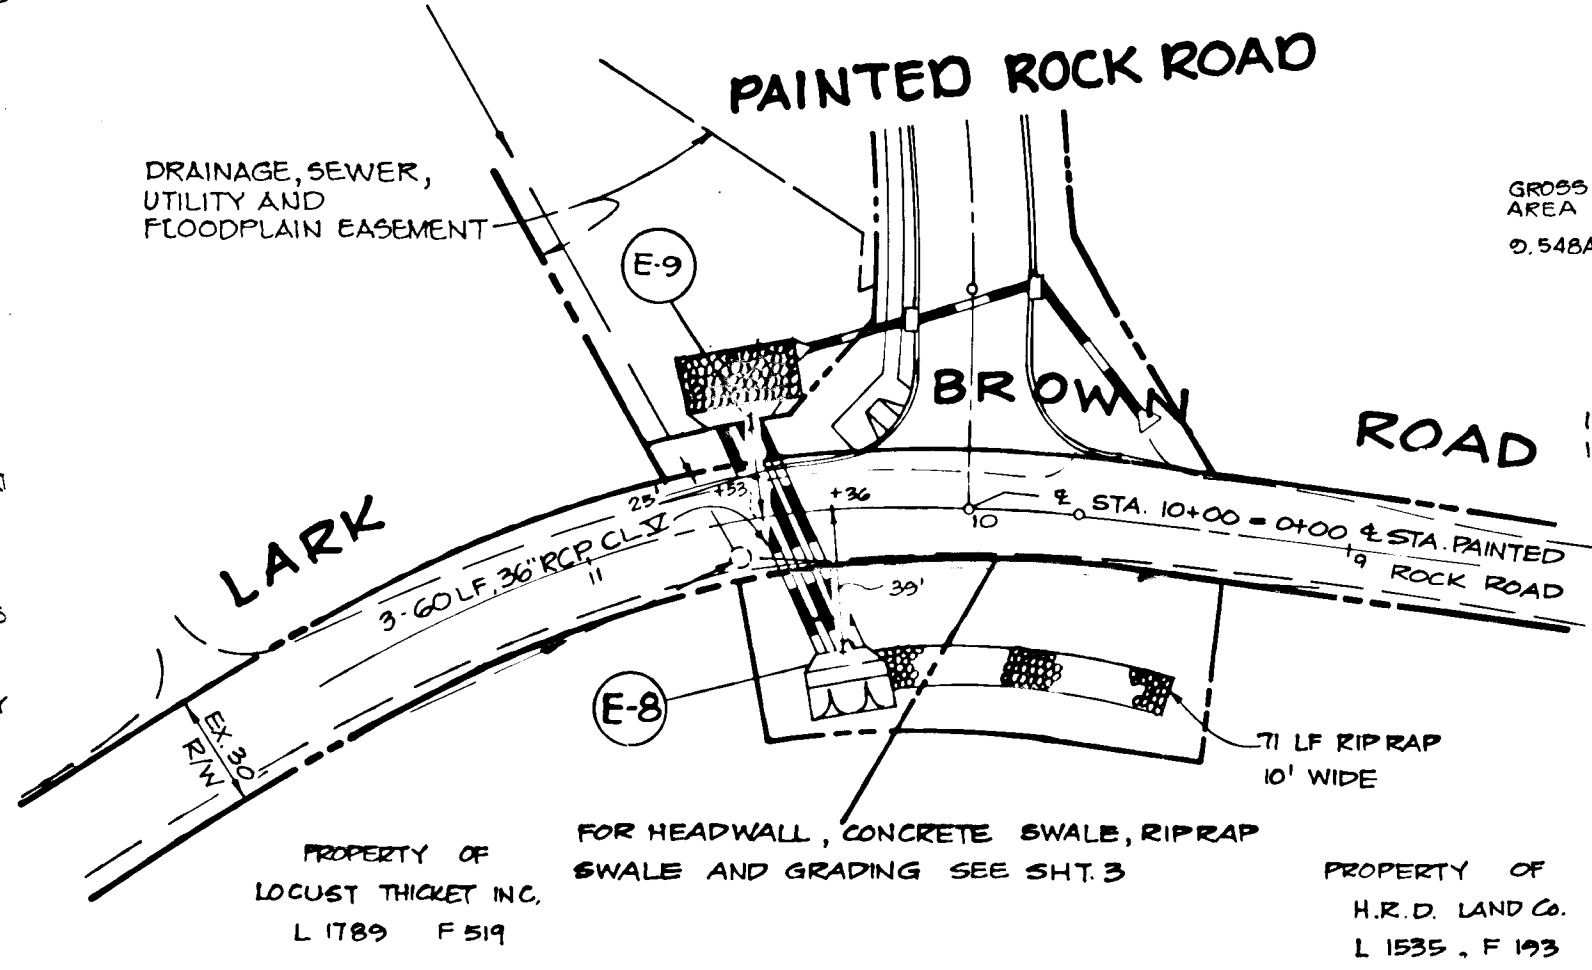

DETAIL CULVERT CROSSING LARK BROWN ROAD
SCALE: 1" = 50'

DENSITY TABULATION

GROSS AREA	FLOODPLAIN AREA	NET AREA	TOTAL LOTS	ALLOWED	DENSITY
0.548Ac	0.157Ac	0.391Ac	28	27	2.87

OPEN SPACE TABULATION


LOT SIZE	NO OF LOTS	AREA OF LOTS	MANDATORY OPEN SPACE	REQUIRED OPEN SPACE	PROVIDED OPEN SPACE
12,000+ LARGER	1	0.501	8%	0.024	1.496Ac
10,800+ - 11,999#	3	0.778	10%	0.078	0.199Ac
9,600+ - 10,799#	8	1.855	20%	0.371	0.340Ac
8,400+ - 9,599#	15	3.005	30%	0.901	-
TOTALS	27	5.935	30%	1.374	1.936Ac

APPROVED: HOWARD COUNTY OFFICE OF PLANNING AND ZONING
Frank J. DeAngelis 12-2-88
 CHIEF, DIVISION OF COMMUNITY PLANNING AND LAND DEVELOPMENT

APPROVED: HOWARD COUNTY DEPARTMENT OF PUBLIC WORKS
Donald J. Spang 10/27/88
 Chief, Land Development Division

Francis W. Wehlauf 11/2/88
 Chief, Bureau of Highways

William E. Muegge 11-16-88
 Chief, Bureau of Engineering

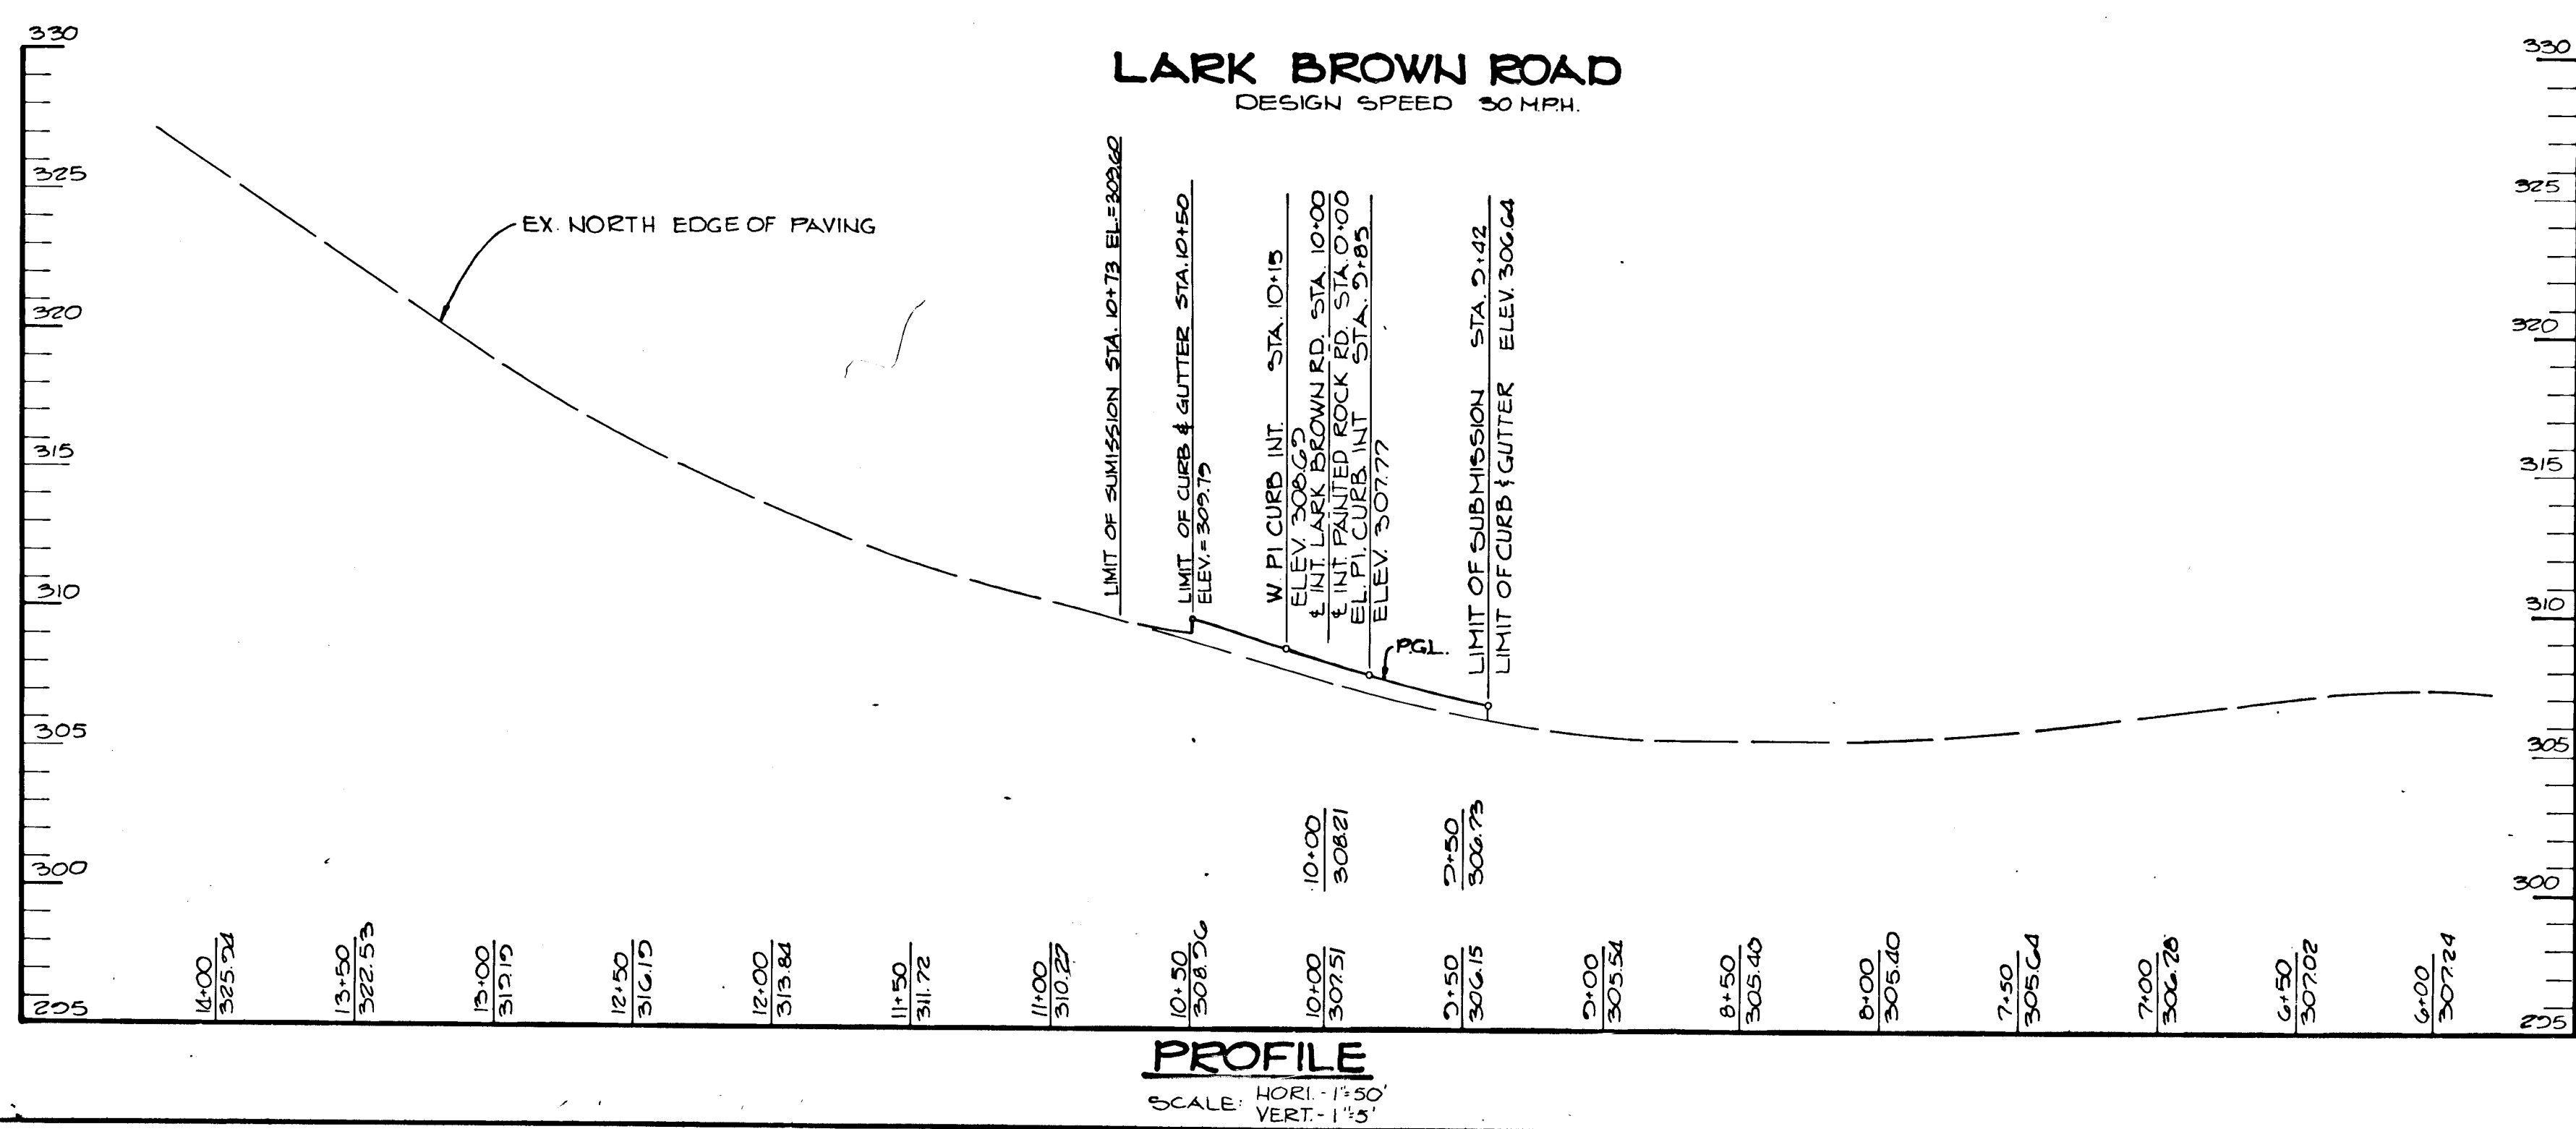

- GENERAL NOTES**
- ALL WORK SHALL BE PERFORMED IN ACCORDANCE WITH THE HOWARD COUNTY DESIGN MANUAL, VOL. IV, I.E., STANDARD SPECIFICATIONS AND DETAILS FOR CONSTRUCTION.
 - APPROXIMATE LOCATION OF EXISTING UTILITIES ARE SHOWN. THE CONTRACTOR SHALL TAKE ALL NECESSARY PRECAUTIONS TO PROTECT THE EXISTING UTILITIES AND MAINTAIN UNINTERRUPTED SERVICE. ANY DAMAGE INCURRED DUE TO CONTRACTOR'S OPERATION SHALL BE REPAIRED IMMEDIATELY AT THE CONTRACTOR'S EXPENSE.
 - THE CONTRACTOR SHALL TEST PIT EXISTING UTILITIES AT LEAST FIVE (5) DAYS BEFORE STARTING WORK SHOWN ON THESE DRAWINGS TO VERIFY THEIR LOCATION AND ELEVATION. THE CONTRACTOR SHALL NOTIFY THE ENGINEER IMMEDIATELY IF LOCATION OF UTILITIES IS OTHER THAN SHOWN. CONTRACTOR SHALL NOTIFY THE FOLLOWING UTILITIES AT LEAST FIVE (5) DAYS BEFORE STARTING WORK ON THESE DRAWINGS:
 - MISS UTILITY 1-800-257-7777
 - CAP TELEPHONE COMPANY 725-9976
 - AT&T CABLE LOCATION DIVISION 393-3553
 - BALTIMORE GAS AND ELECTRIC COMPANY 685-0123
 - STATE HIGHWAY ADMINISTRATION 531-5533
 - HOWARD COUNTY CONSTRUCTION INSPECTION SURVEY DIVISION (24 HOURS NOTICE PRIOR TO COMMENCEMENT OF WORK) 792-7272
 - ALL INLETS SHALL BE CONSTRUCTED IN ACCORDANCE WITH HOWARD COUNTY DESIGN MANUAL, VOL. IV, I.E., STANDARD SPECIFICATIONS AND DETAILS.
 - STORM DRAIN BACKFILL WITHIN ROADWAYS, UNDER STRUCTURES AND FOR STORM DRAIN TRENCHES SHALL BE COMPACTED TO A MINIMUM OF 95% COMPACTION OF MAXIMUM DRY DENSITY AS DETERMINED BY ASTM 1557.
 - NO PIPE SHALL BE LAID UNTIL LINES OF EXCAVATION HAVE BEEN BROUGHT WITHIN 6" OF FINISHED GRADE.
 - ALL STORM DRAIN PIPE BEDDING SHALL BE AS SHOWN IN DETAIL G2.01 (TRENCH IN ROCK OR TRENCH IN EARTH AS DETERMINED BY FIELD CONDITIONS) IN VOL. IV OF HOWARD COUNTY DESIGN MANUAL UNLESS OTHERWISE DIRECTED BY THE ENGINEER OR AS SHOWN ON THE DRAWINGS.
 - ALL STREET CURB RETURNS SHALL HAVE 35.0' RADII UNLESS OTHERWISE NOTED.
 - ALL ELEVATIONS SHOWN ARE BASED ON U.S.G.S. MEAN SEA LEVEL DATUM, 1929.
 - ALL PIPE ELEVATIONS SHOWN ARE INVERT ELEVATIONS.
 - TOPO TAKEN FROM FIELD RUN SURVEY DATED OCTOBER, 1985.
 - SUBJECT PROPERTY ZONED R-12 PER 8.2.85 COMPREHENSIVE ZONING PLAN.
 - INSTALLATION OF TRAFFIC CONTROL DEVICES, MARKING, AND SIGNING SHALL BE IN ACCORDANCE WITH THE MANUAL OF UNIFORM TRAFFIC CONTROL DEVICES 1978 EDITION.
 - DESIGNED TRAFFIC SPEED IN ACCORDANCE WITH THE AMERICAN ASSOCIATION OF STATE HIGHWAY OFFICIAL STANDARDS.
 - 1.6 DENOTES 1 1/2" WATTED MODERN MERCURY VAPOR LAMP POST TOP FIXTURES ON A 14 FOOT GRAY FIBERGLASS POLE LOCATED 2-10 FEET FROM BACK OF CURB.

1-15-91 ADD DEFLECTORS AT I-2

DATE NO REVISION

OWNER/DEVELOPER:
H&A CONSTRUCTION CO. INC.
13C STREET
LAUREL, MARYLAND 20707

PROJECT:
PAINTER'S HILL SECTION ONE

AREA TAX MAP NO. 37 PARCEL 007
GTH ELECTION DISTRICT P. 86.55
HOWARD COUNTY, MARYLAND S. 86.15

TITLE:
PLAN AND PROFILE OF LARK BROWN ROAD




THE RIEMER GROUP, INC.
The Riemer Group, Inc. A Land Planning, Design & Civil Engineering Firm
3105 Heath Park Drive, Ellicott City, Maryland 21043 (301) 461-2690

5-31-88 DATE
DESIGNED BY: L.J.D.
DRAWN BY: F.D.M.
PROJECT NO: 22200
DATE: OCTOBER 2, 1987
SCALE: AS SHOWN
DRAWING NO. 1 OF 7

ARTHUR E. MUEGGE 7/8/87

NOTE: PROVIDE 4' HIGH CHAIN LINK FENCE FROM & STA. 1+50 LEFT TO 1' OFF PROPERTY LINE FOR LOT 2 AND ALONG SIDE PROPERTY LINE OF LOT 2 TO THE REAR PROPERTY LINE, MAINTAINING 1' OFF PROPERTY LINE.

NOTE: PROVIDE HO. CO. STD GUARDRAIL FROM & STA. 1+50, LEFT TO & STA. 3+48, LEFT.

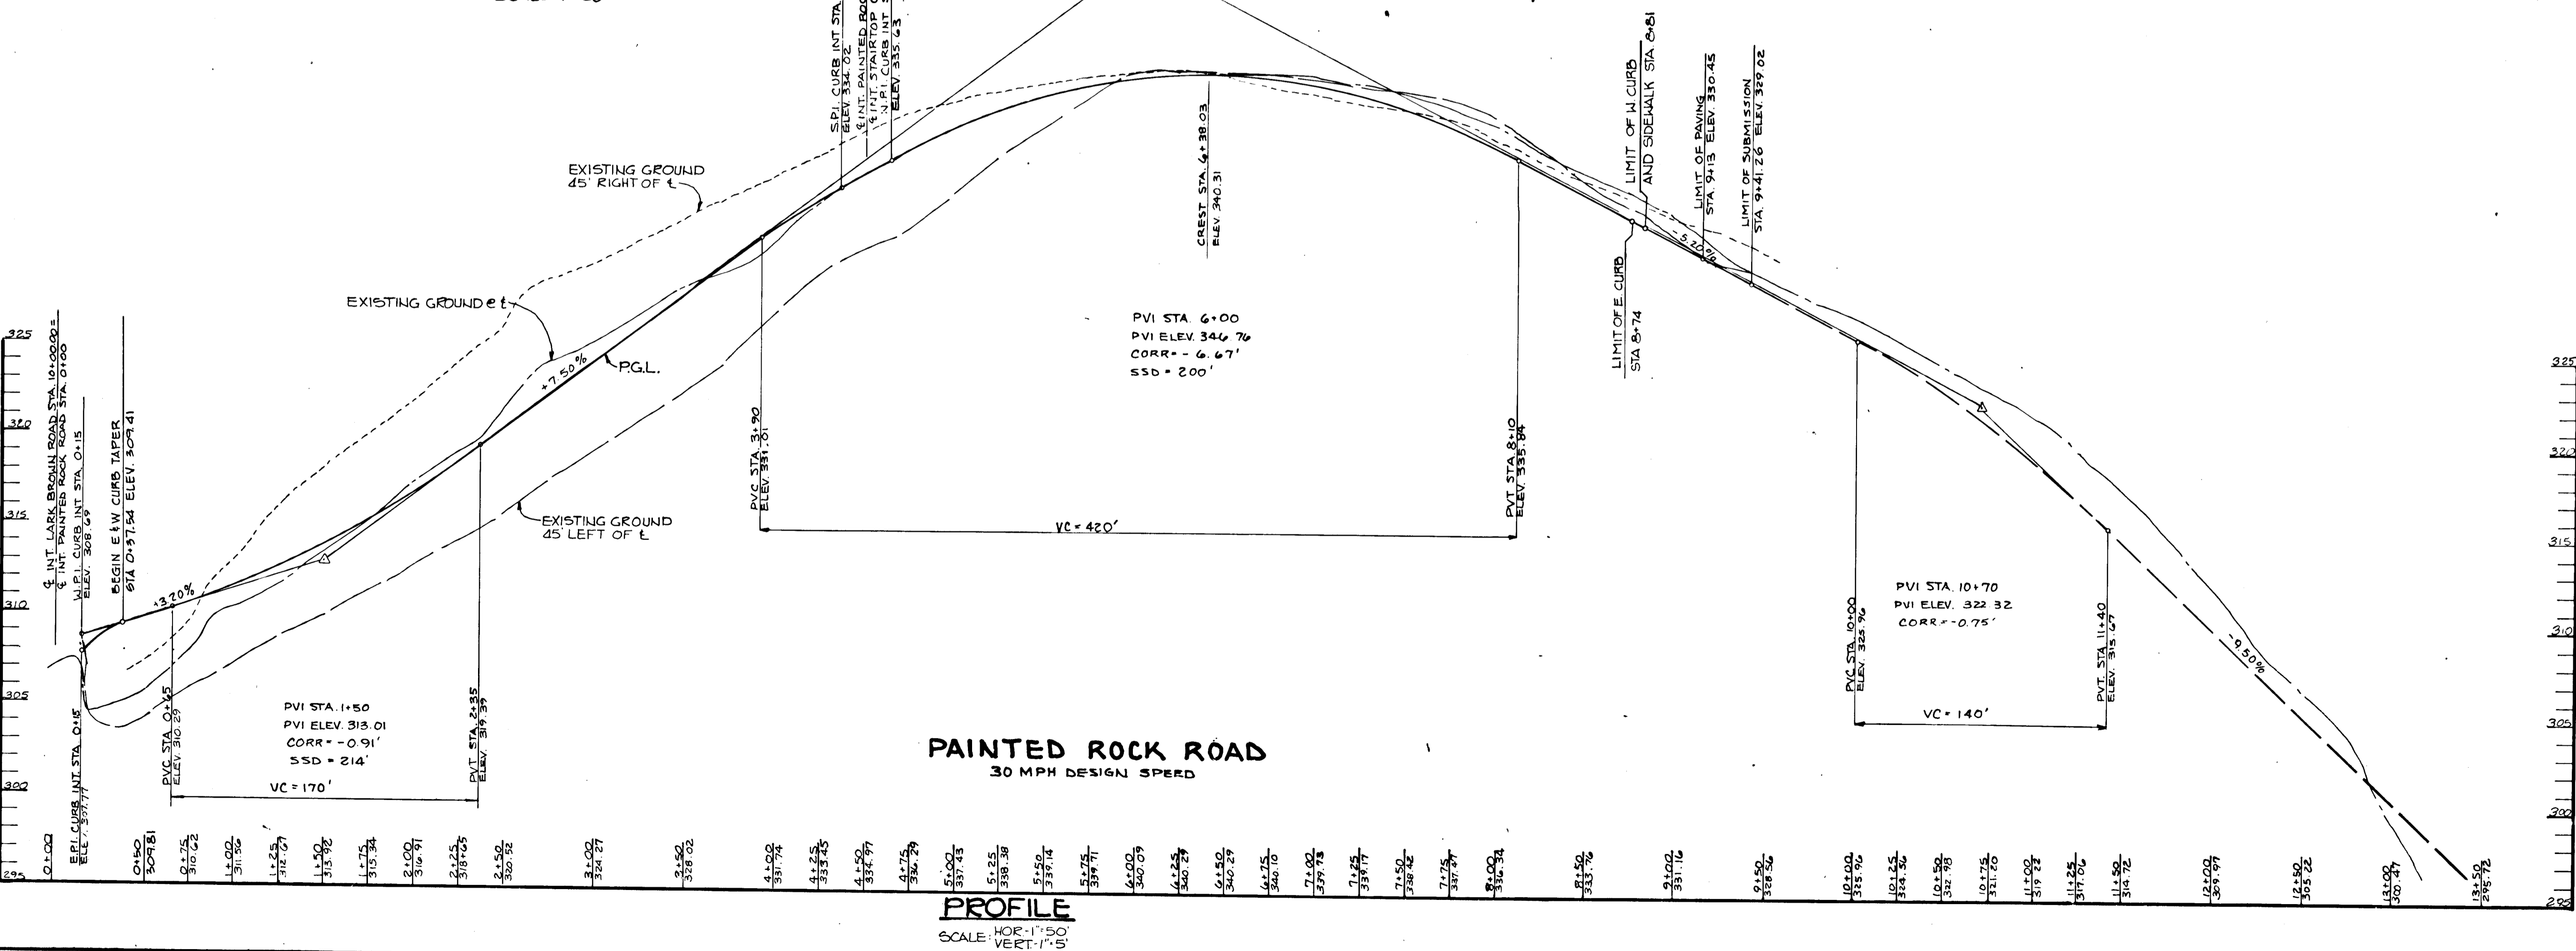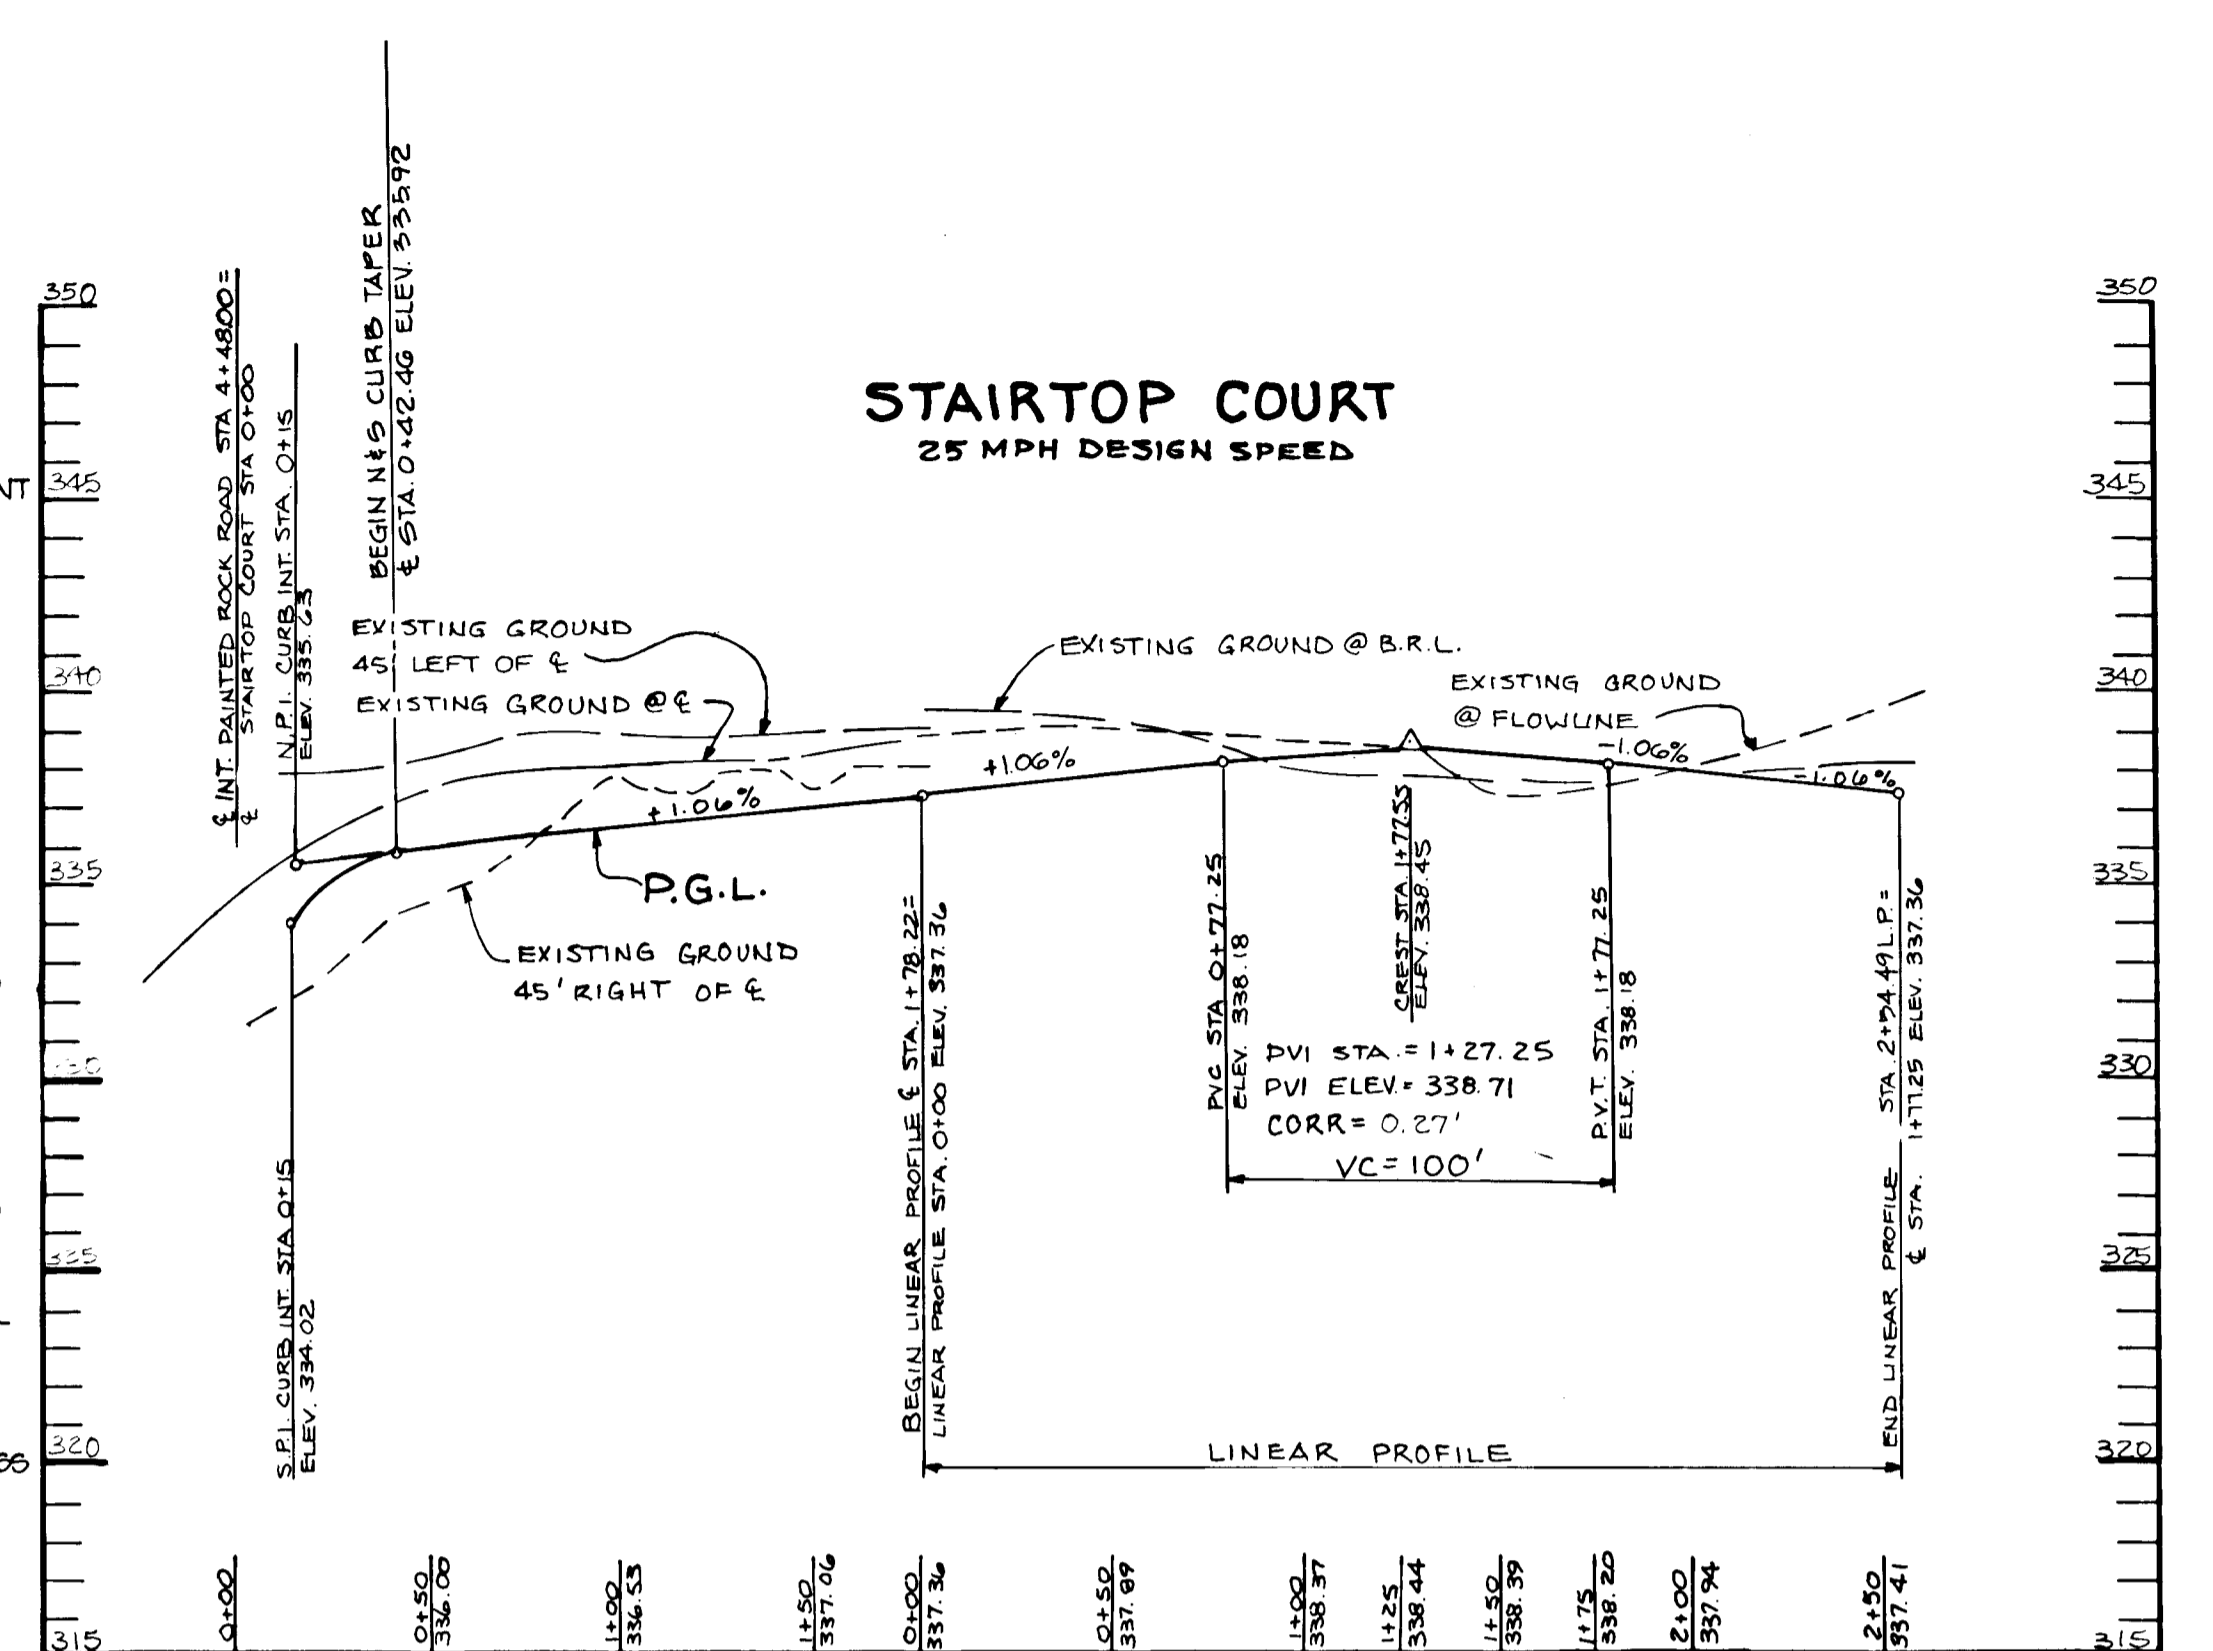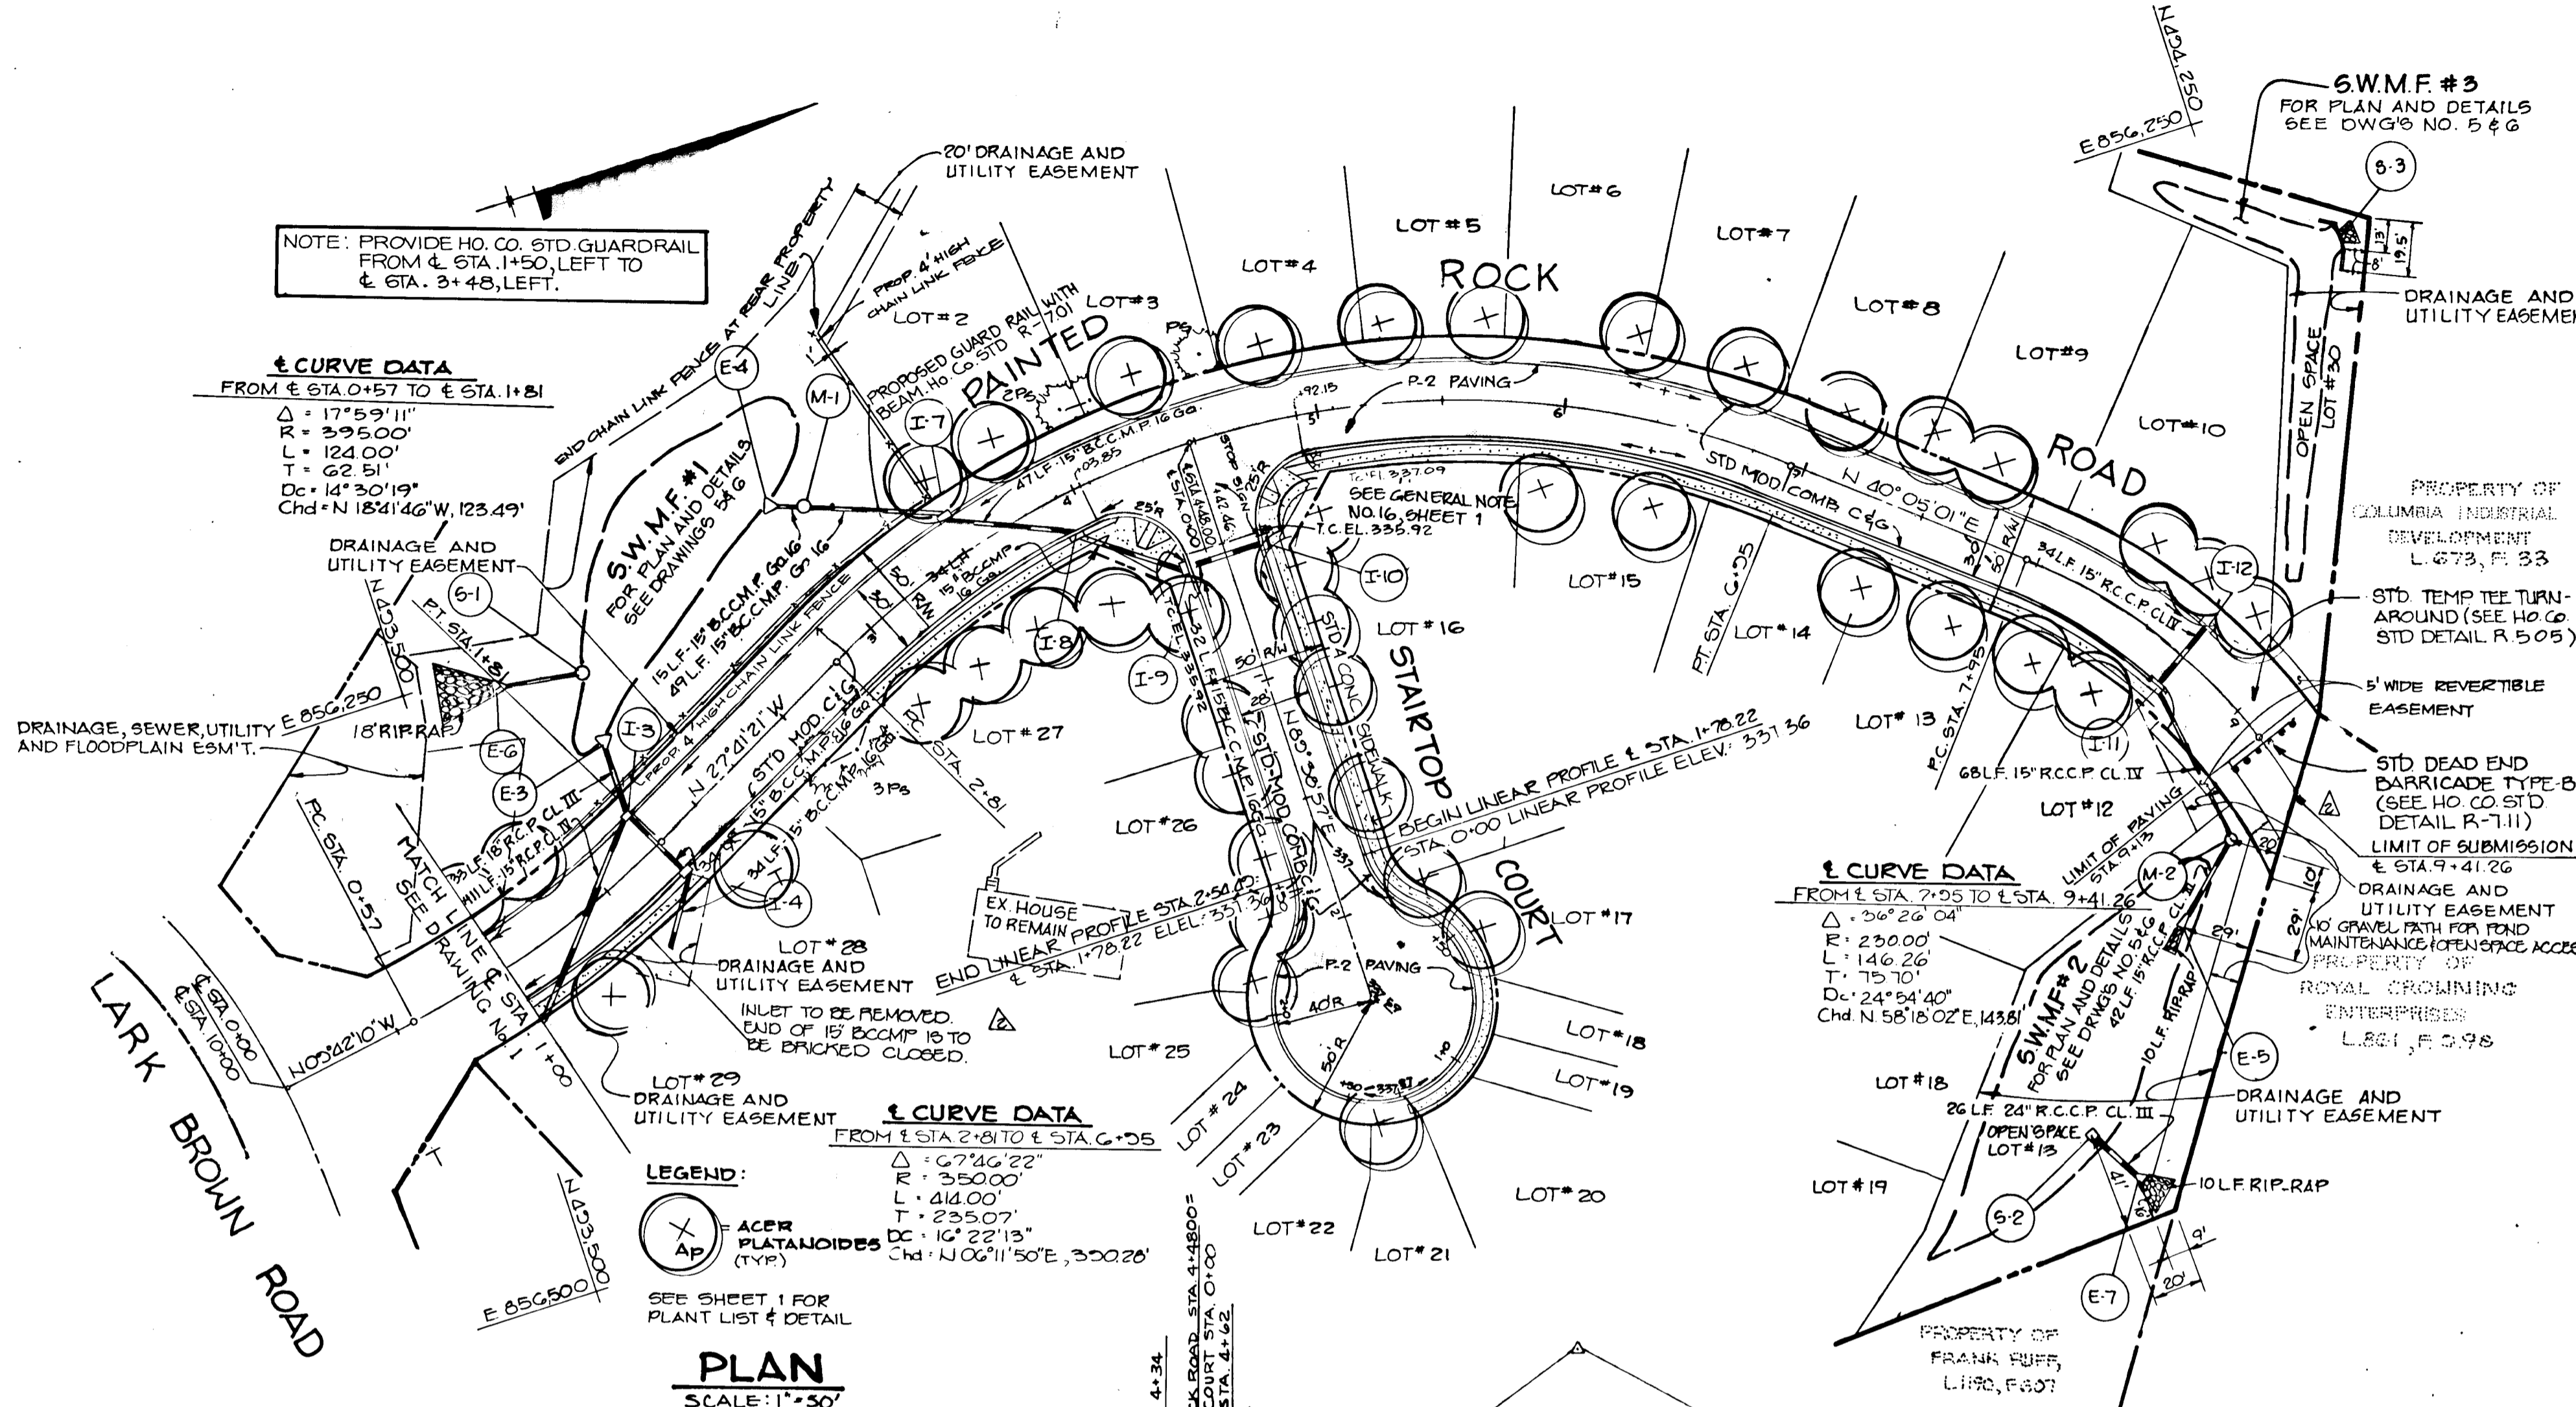

APPROVED: HOWARD COUNTY OFFICE OF PLANNING AND ZONING
Frank J. Langley 12-7-88
 CHIEF, DIVISION OF COMMUNITY PLANNING AND LAND DEVELOPMENT

APPROVED: HOWARD COUNTY DEPARTMENT OF PUBLIC WORKS
Paul M. Johnson 10/27/88
 CHIEF, Land Development Division

Granville W. McAlena 11/02/88
 CHIEF, Bureau of Highways

W. William B. Ray 11-16-88
 CHIEF, Bureau of Engineering

DATE	NO.	REVISION
1-15-91	1	REMOVE I-5, ADD GRAVEL PATHS FOR POND MAINTENANCE & OPEN SPACE ACCESS

OWNER/DEVELOPER:
 H & A CONSTRUCTION CO. INC.
 13 C STREET
 LAUREL, MARYLAND 20707

PROJECT:
PAINTER'S HILL
 SECTION ONE



AREA TAX MAP NO. 37 PARCEL 467
 GTH ELECTION DISTRICT P. 26-53
 HOWARD COUNTY MARYLAND S. 06-15

TITLE:
PLAN AND PROFILES OF PAINTED ROCK ROAD AND STAIRTOP COURT

THE RIEMER GROUP, INC.
 The Riemer Group, Inc. A Land Planning, Design & Civil Engineering Firm
 3105 Health Park Drive, Ellicott City, Maryland 21043 (301) 481-2880

DATE: 5-31-85
 DESIGNED BY: LJD
 DRAWN BY: FDM
 PROJECT NO: 22200
 DATE: OCTOBER 2, 1987
 SCALE: AS SHOWN
 DRAWING NO. 2 OF 7

1302

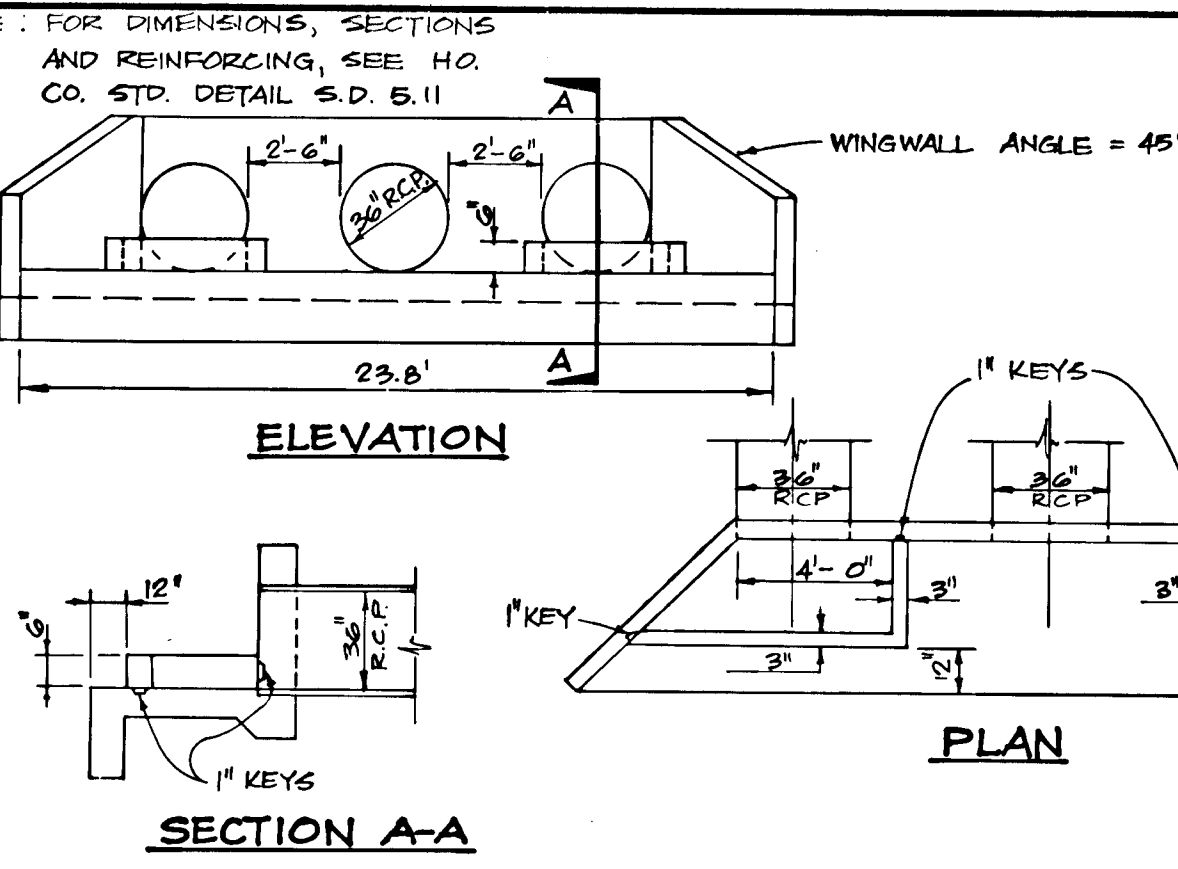
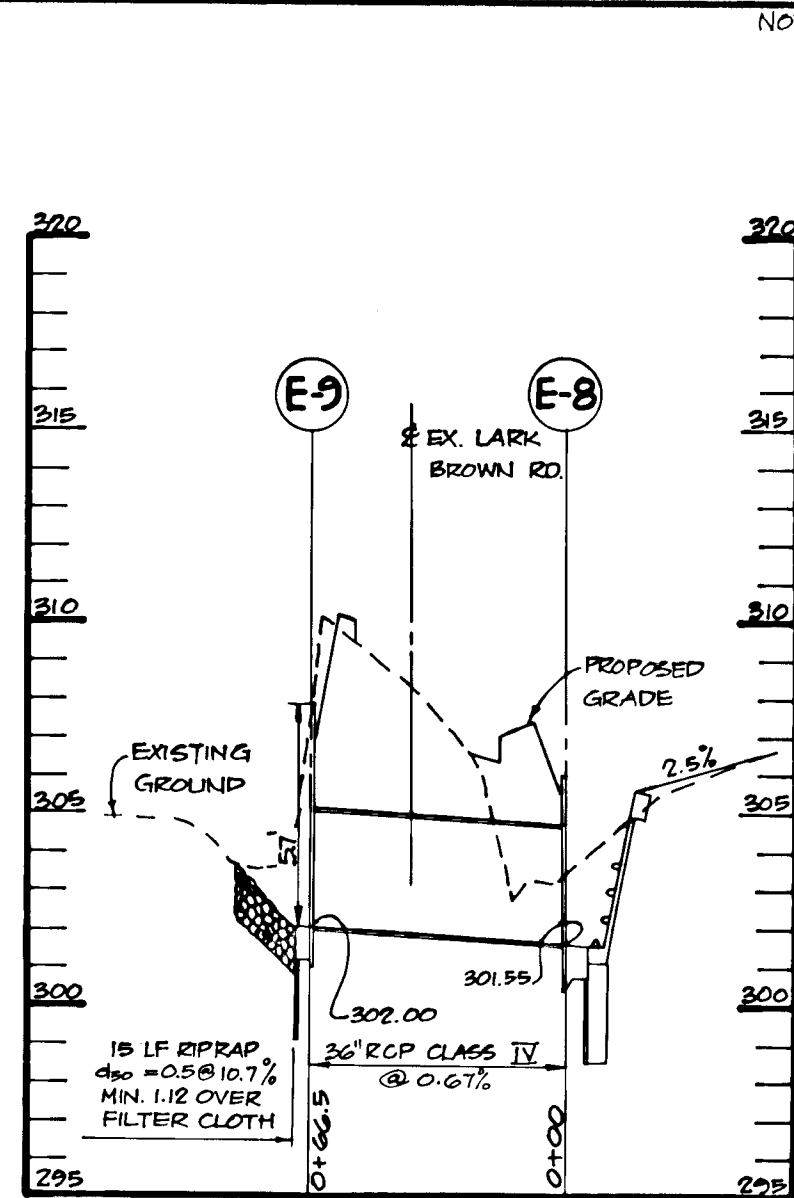


LOW FLOW DIVERTER AT E-9
NO SCALE



PROFILE
SCALE: HOR. 1" = 50'
VERT. 1" = 5'

STRUCTURE SCHEDULE

NO.	TYPE	DETAIL	LOCATION	INV. IN	INV. OUT	TOP OF CURB OR RIM ELEVATION
I-1	A-5	SD 4.01	15' LT C/L STA 0+48	304.20	304.00	309.74
I-2	A-5 w/ Def.	SD 4.01	15' RT C/L STA 0+57	305.10	304.90	310.03
I-3	A-5 w/ Def.	SD 4.01	15' LT C/L STA 1+77.5	311.06	307.17	315.69
I-4	A-5 w/ Def.	SD 4.01	15' RT C/L STA 1+77.5	311.60	311.40	315.69
I-6	D Inlet	SD 4.11	38' RT C/L STA 0+84	311.50	308.23	312.33*
I-7	A-5 w/ Def.	SD 4.01	15' LT C/L STA 3+52	320.71	320.17	328.17
I-8	A-5 w/ Def.	SD 4.01	15' RT C/L STA 3+97.35	325.61	325.41	331.55
I-9	A-5	SD 4.01	14' RT C/L STA 0+47.96	328.67	328.47	335.98
I-10	A-5	SD 4.01	14' LT C/L STA 0+47.96	330.85	330.65	335.98
I-11	A-5 w/ Def.	SD 4.01	15' RT C/L STA 8+69	327.95	327.75	332.77
I-12	A-5 w/ Def.	SD 4.01	15' RT C/L STA 8+69	328.12	328.12	332.77
M-1	4" Brick MI	G 5.01	62 LT C/L STA 3+25	310.96	308.06	315.60*
M-2	Shallow MI	G 5.05	See Plan	327.41	327.21	330.70
E-1	Cone. End Section	SD 5.51	46' LT STA 0+41	---	303.40	---
E-2	Cone. End Section	SD 5.51	47' RT STA 0+23	---	306.00	---
E-3	Cone. End Section	SD 5.51	46' LT STA 1+84	---	307.00	---
E-4	Metal End Section	SD 5.61	70' LT STA 3+20	---	327.00	---
E-5	Cone. End Section	SD 5.51	See Plan	---	325.00	---
E-6	Metal End Section	SD 5.61	86' LT STA 1+77	---	325.00	---
E-7	Cone. End Section	SD 5.51	See Plan	---	325.75	---
S-1	Outlet Control Str.	Sheet #5	65' LT STA 2+05	---	306.20	---
S-2	Outlet Control Str.	Sheet #5	See Plan	---	325.75	---
S-3	Outlet Control Str.	Sheet #5	See Plan	---	330.00	---
E-8	Mod. Type 'A' Headwall	Sheet #3	25' RT STA 10+54	302.00	301.65	---
E-9	Mod. Type 'A' Headwall	Sheet #3	25' RT STA 10+54	302.00	301.65	---
*			Denotes top of frame elevation.			

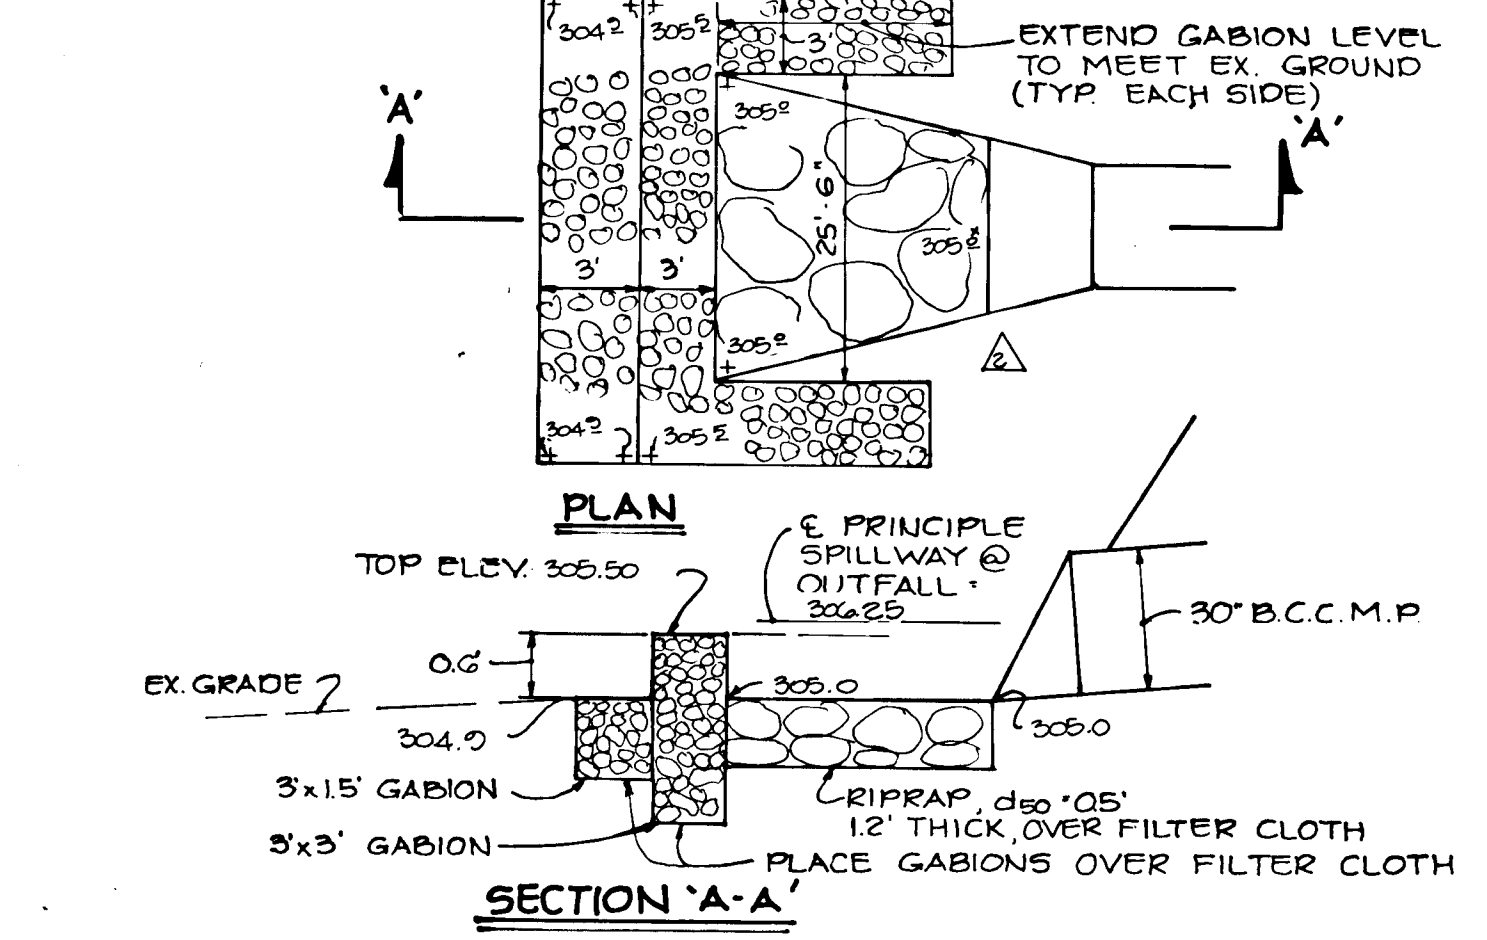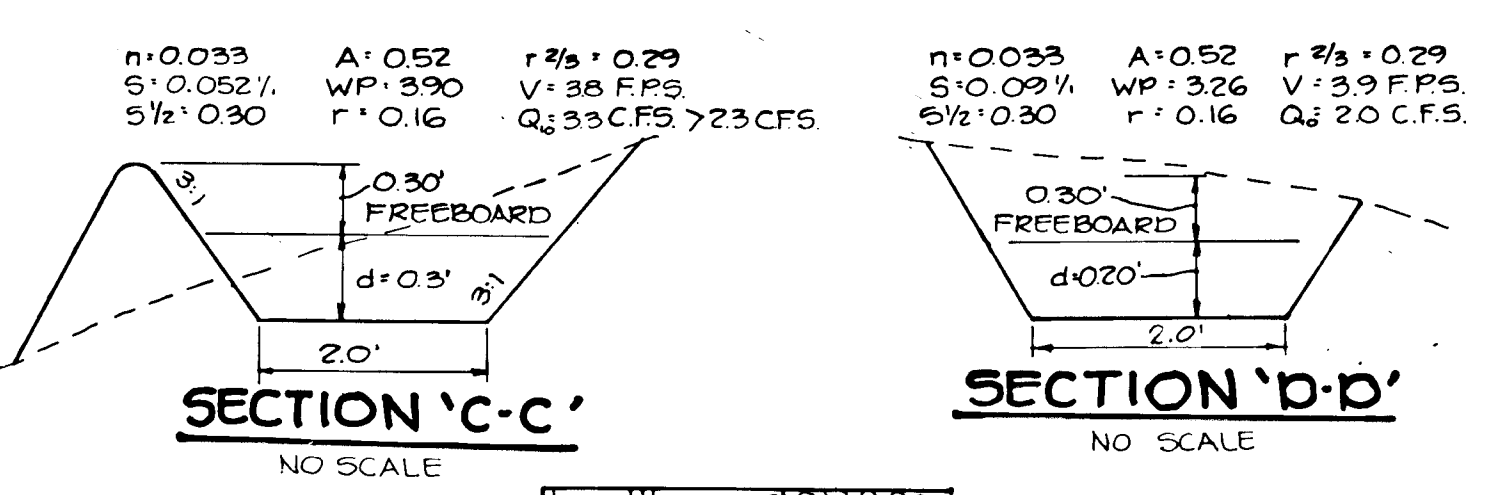


DETAIL GABION LOW FLOW ENERGY DISSIPATER AT E-6
NO SCALE

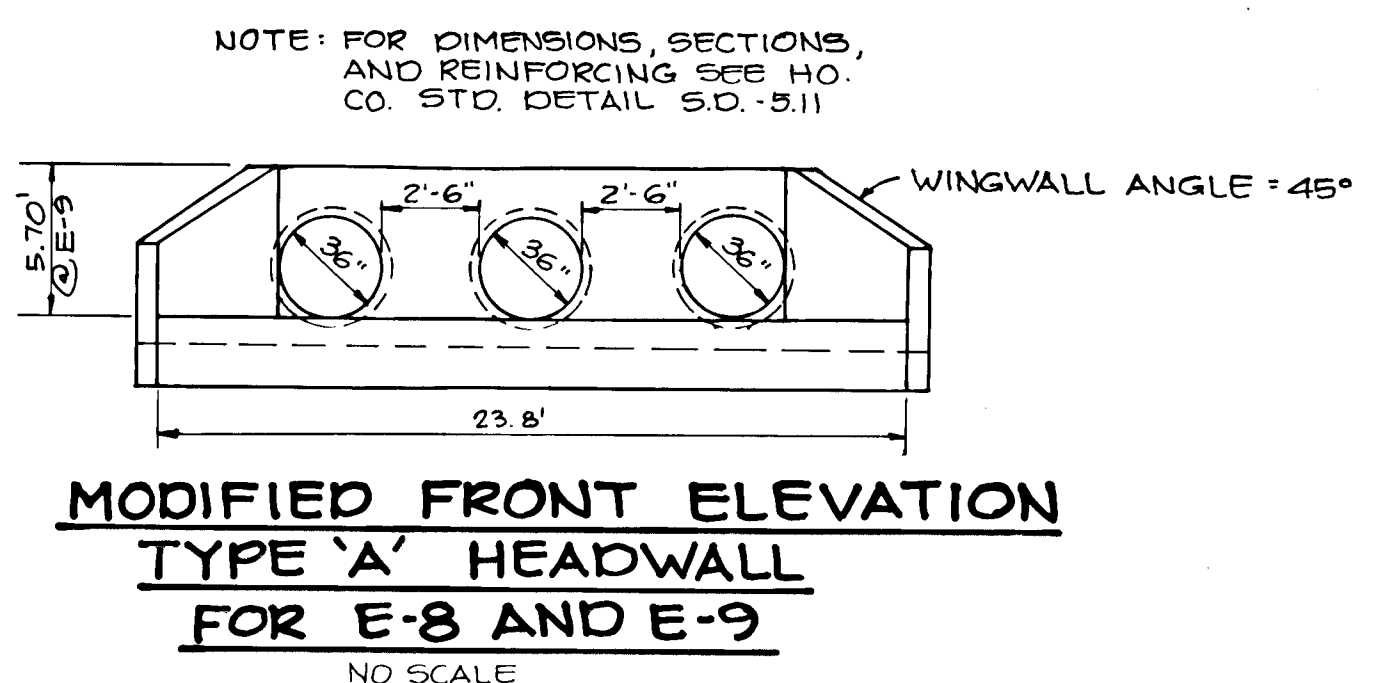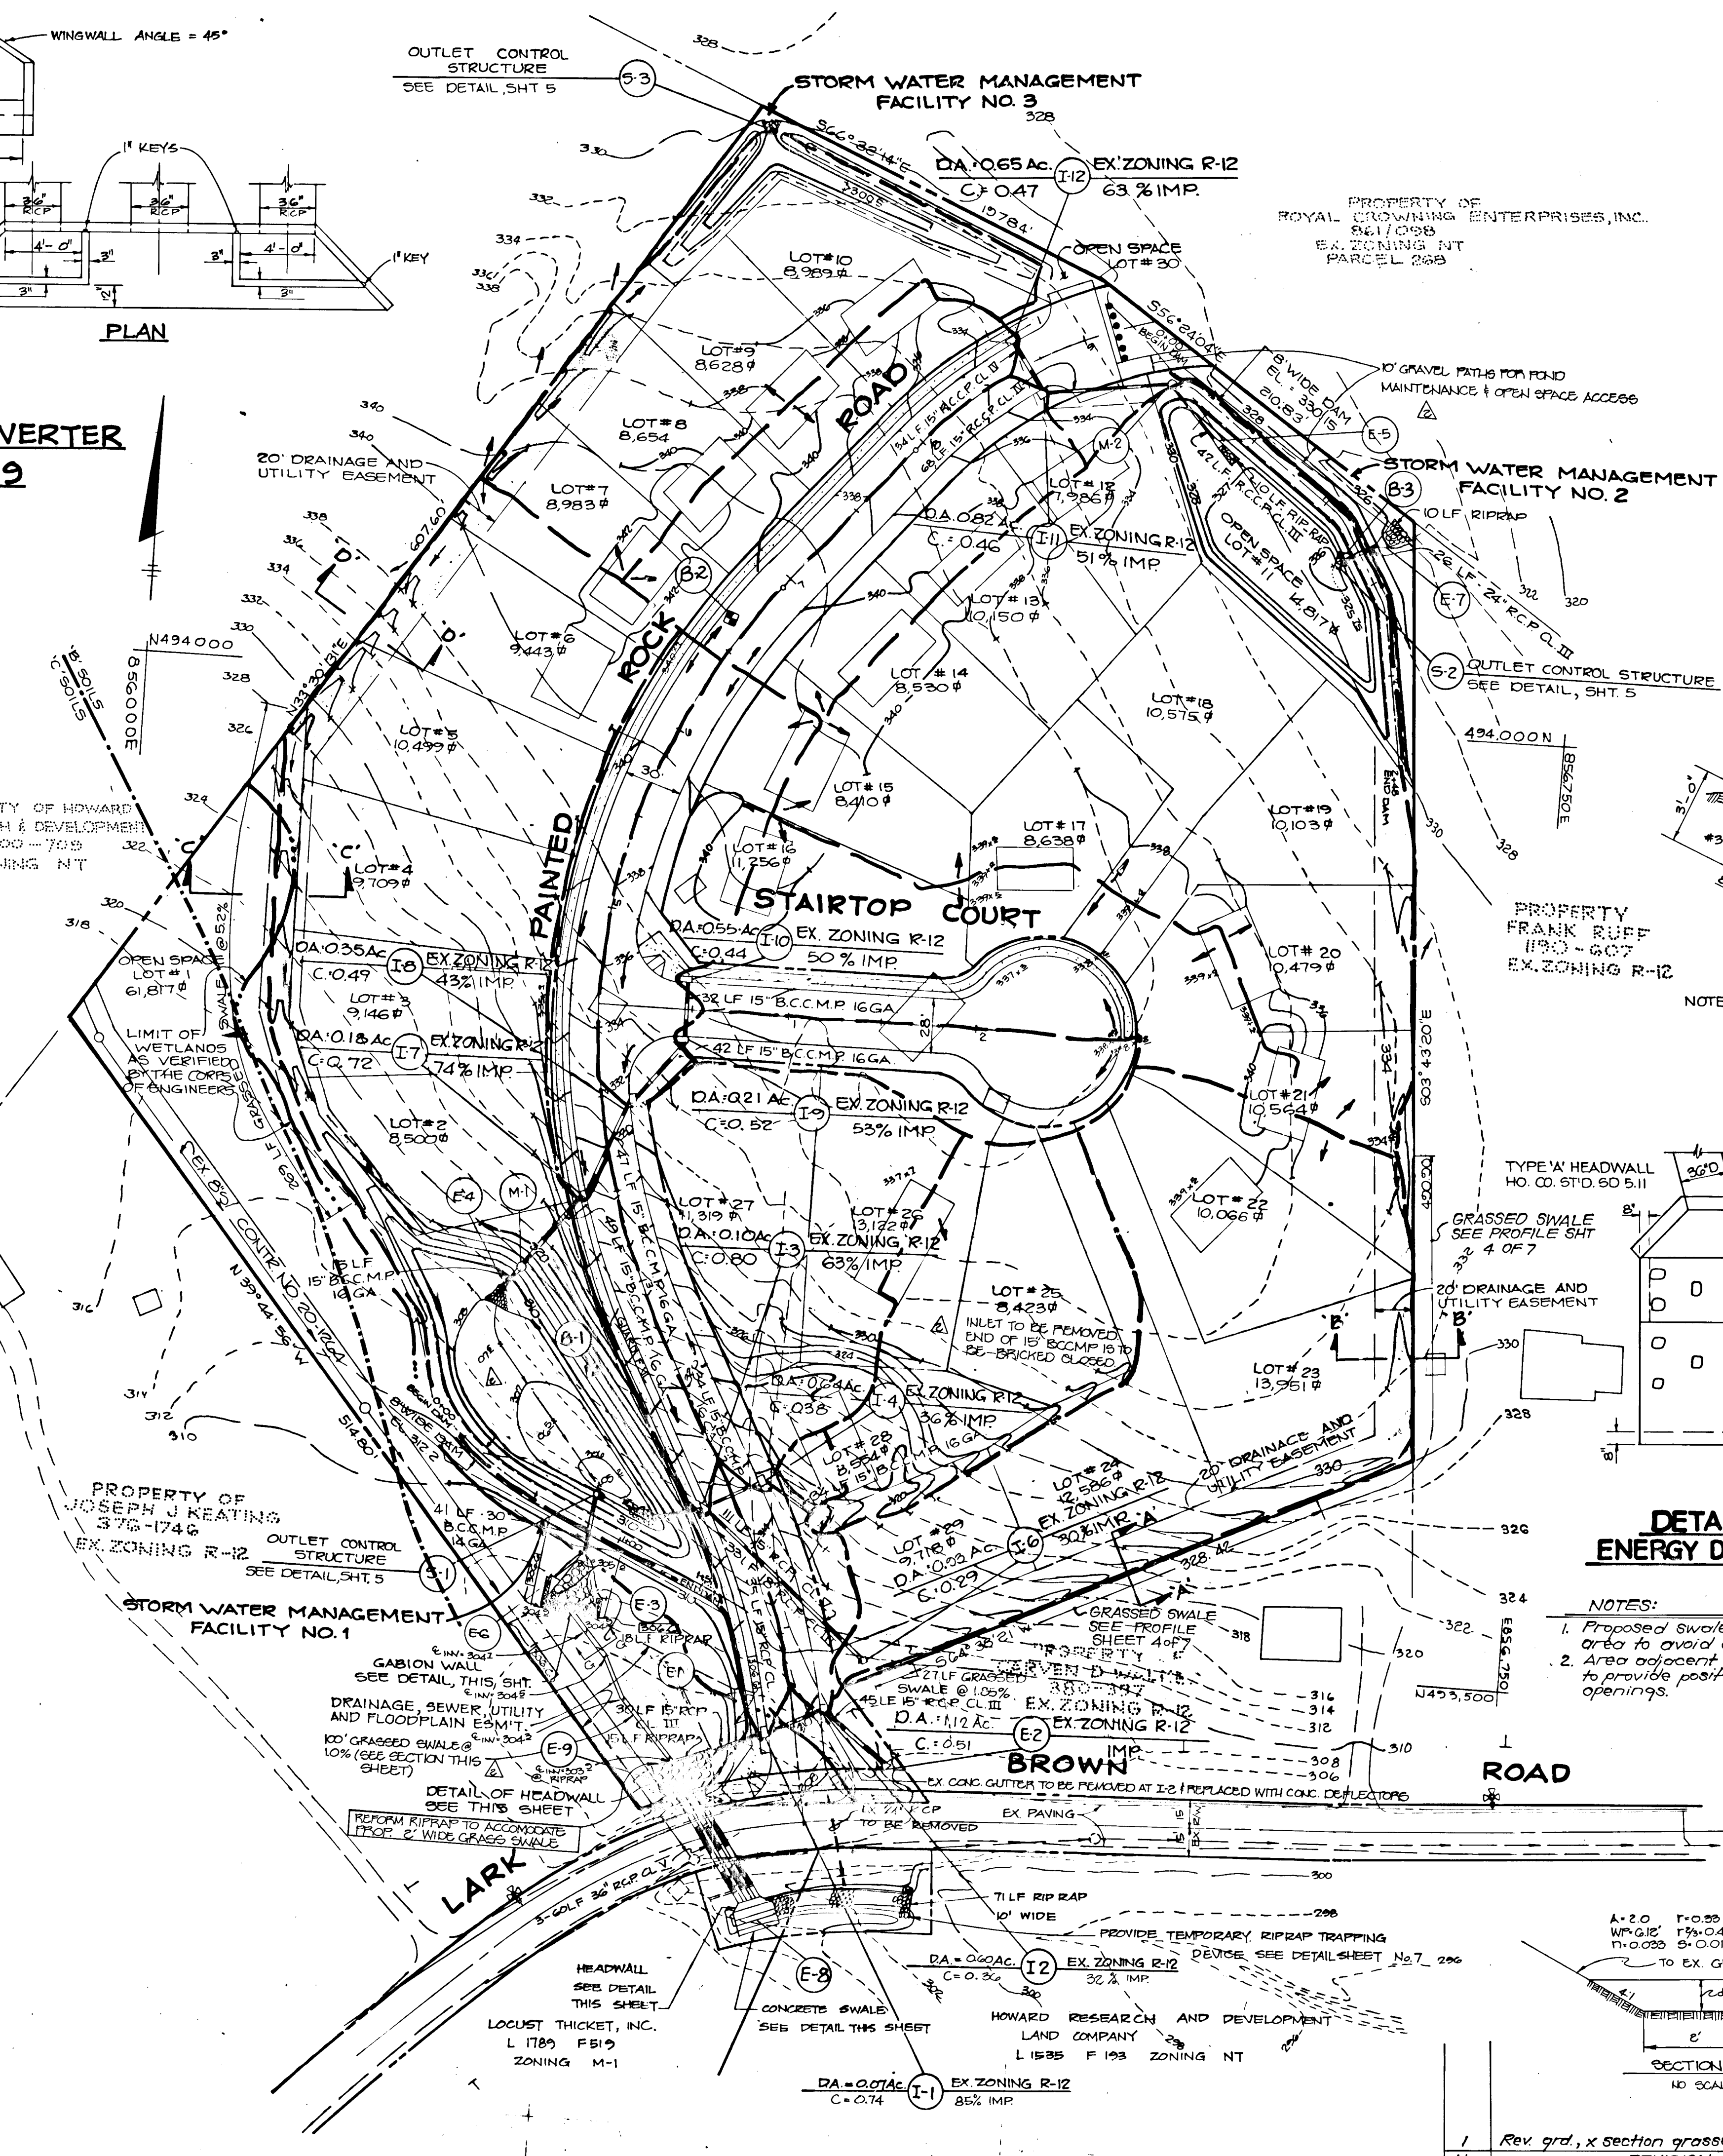


MODIFIED FRONT ELEVATION TYPE 'A' HEADWALL FOR E-8 AND E-9
NO SCALE

STRUCTURE	MEDIUM STONE DIA.	LENGTH (L)	WIDTH (W)	THICKNESS (T)
E-6	0.5'	23'	25.5'	1.2'
E-5	0.5'	10'	9.25'	1.2'
E-7	0.5'	10'	12.0'	1.2'
E-4	0.5'	10'	11.25'	1.2'
E-3	0.5'	10'	11.50'	1.2'

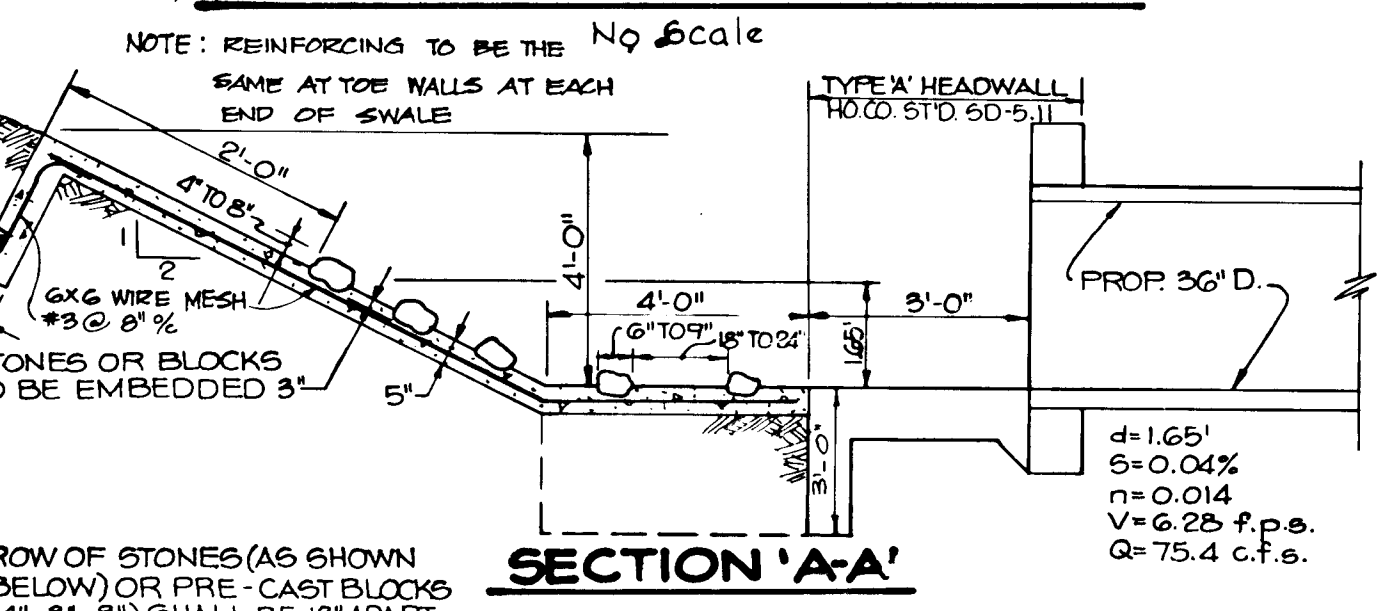

OUTLET PROTECTION DETAIL
NO SCALE

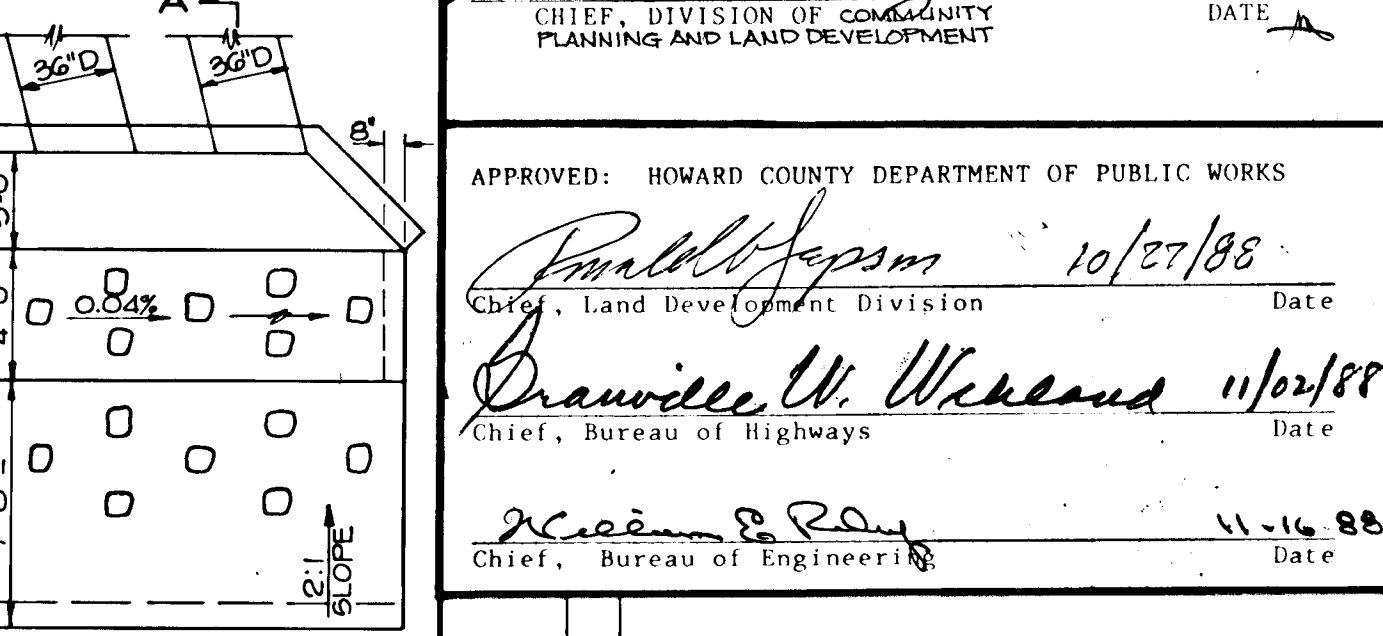

PLAN DETAIL OF 5' CONCRETE ENERGY DISSIPATING SWALE
NO SCALE

NOTES:
1. Proposed swale to be installed in cut area to avoid erosion.
2. Area adjacent to I-6 shall be graded to provide positive drainage to inlet openings.

APPROVED: HOWARD COUNTY OFFICE OF PLANNING AND ZONING
Mark J. ... 12-2-88
 CHIEF, DIVISION OF COMMUNITY PLANNING AND LAND DEVELOPMENT
 APPROVED: HOWARD COUNTY DEPARTMENT OF PUBLIC WORKS
Paul ... 10/27/88
 Chief, Land Development Division
David W. ... 11/02/88
 Chief, Bureau of Highways
William ... 11-16-88
 Chief, Bureau of Engineering

DATE	NO.	REVISION
1-19-91	1	REMOVE I-6, REVEAL FLOOD OUTLET STRUCTURE, ADD GRAVEL PATHS FOR FLOOD MAINTENANCE & OPEN SPACE ACCESS

OWNER/DEVELOPER:
H&A CONSTRUCTION CO., INC.
13 C STREET
LAUREL, MARYLAND 20707

PROJECT:
PAINTER'S HILL SECTION ONE

AREA TAX MAP 37 PARCEL 467
6TH ELECTION DISTRICT P-86-53
HOWARD COUNTY, MARYLAND S-26-15


TITLE:
DRAINAGE AREA & SOILS MAP

THE RIEMER GROUP, INC.
 The Riemer Group, Inc. A Land Planning, Design & Civil Engineering Firm
 3105 Health Park Drive, Ellicott City, Maryland 21043 (301) 461-2890


DATE: 5-21-88
 DESIGNED BY:
 DRAWN BY: JVP
 PROJECT NO: 22700
 DATE: OCTOBER 2, 1987
 SCALE: 1" = 50'
 DRAWING NO. 3 OF 7

ARTHUR E. MUEGGEL, P.E.
 PROFESSIONAL ENGINEER

1393

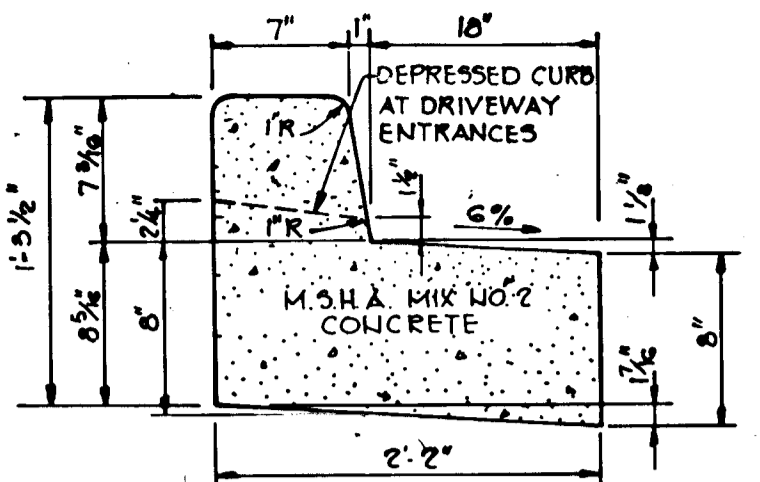


REVERSE 7" COMBINATION CURB AND GUTTER
No Scale

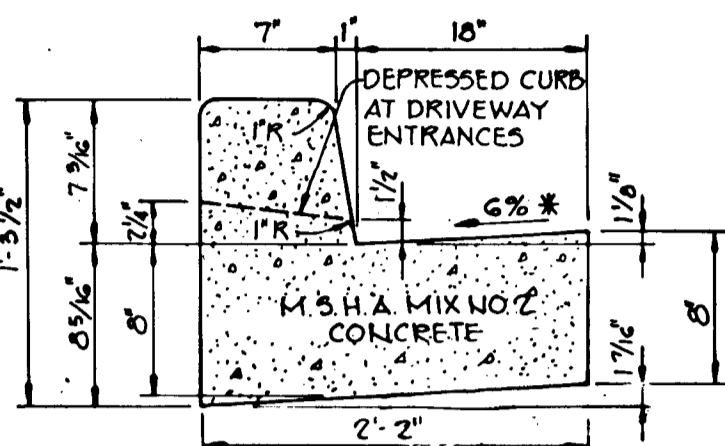


STANDARD 7" COMBINATION CURB AND GUTTER
No Scale

MODIFIED COMBINATION CURB AND GUTTER
No Scale

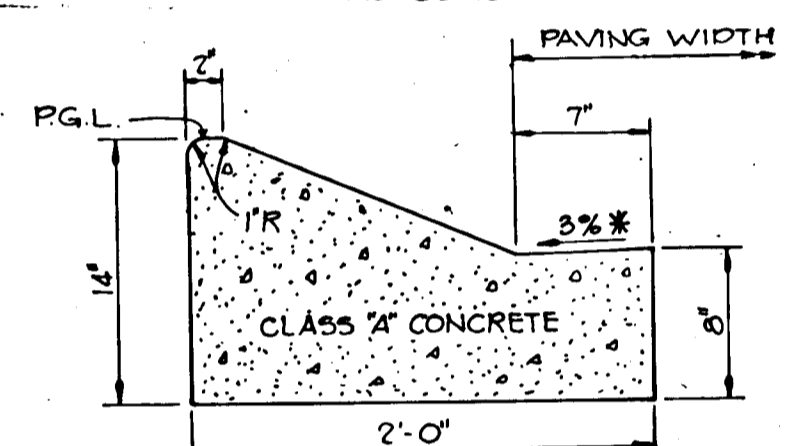


CONCRETE CURB AND GUTTER TRANSITION
NO SCALE


SIDEWALK DETAIL
No Scale

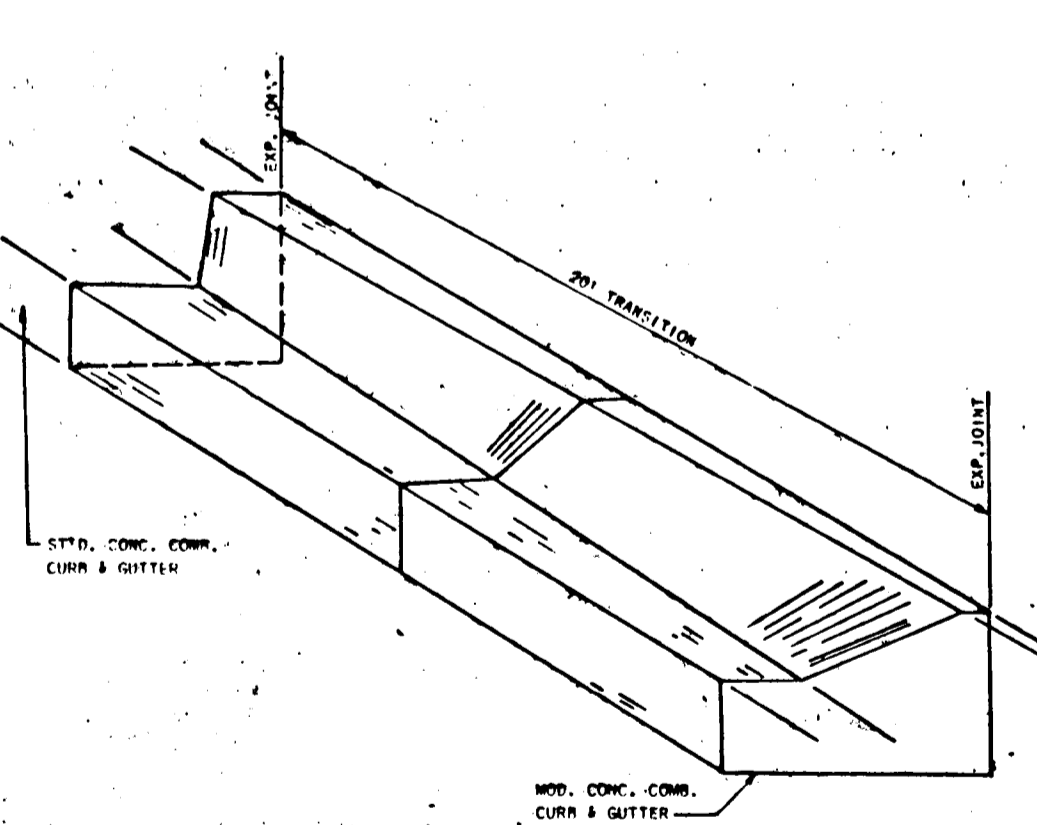


CONCRETE CURB AND GUTTER TRANSITION
NO SCALE

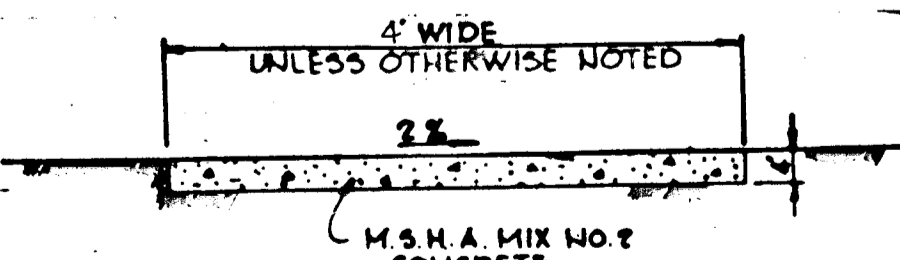


SIDEWALK DETAIL
No Scale

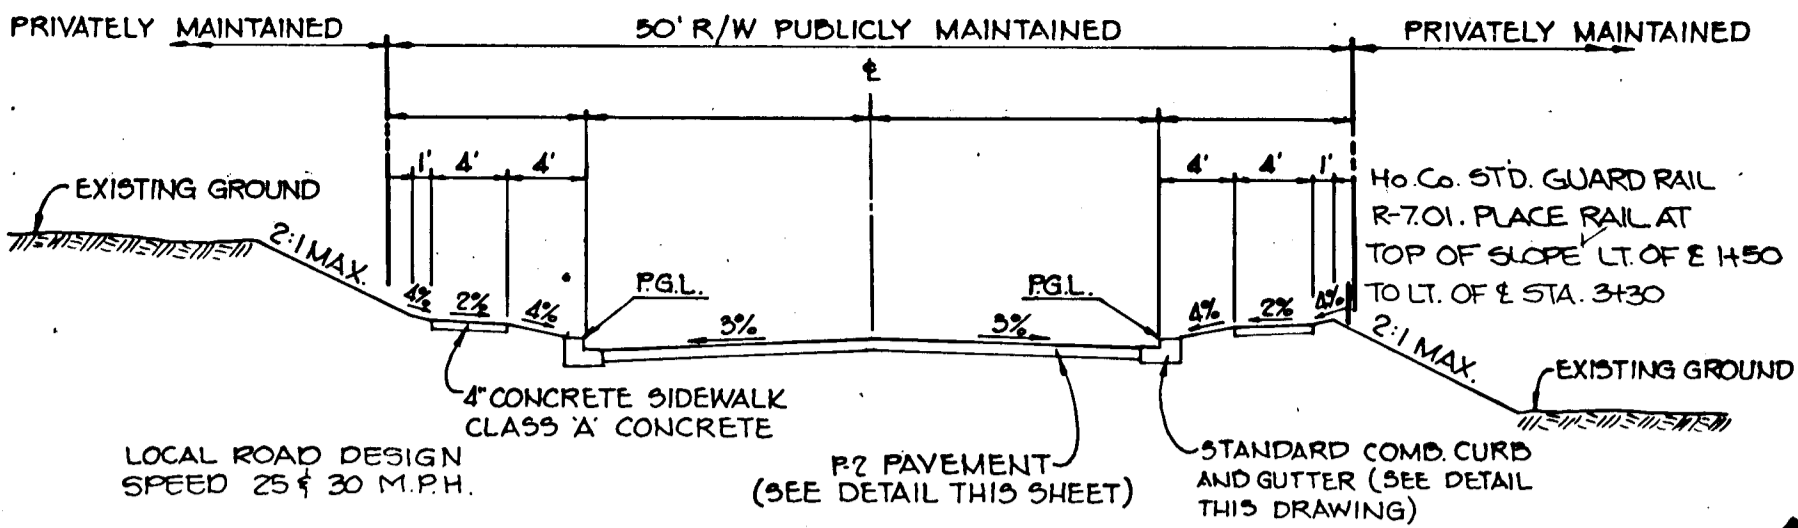


TYPICAL SECTION FOR 50' R/W
NO SCALE

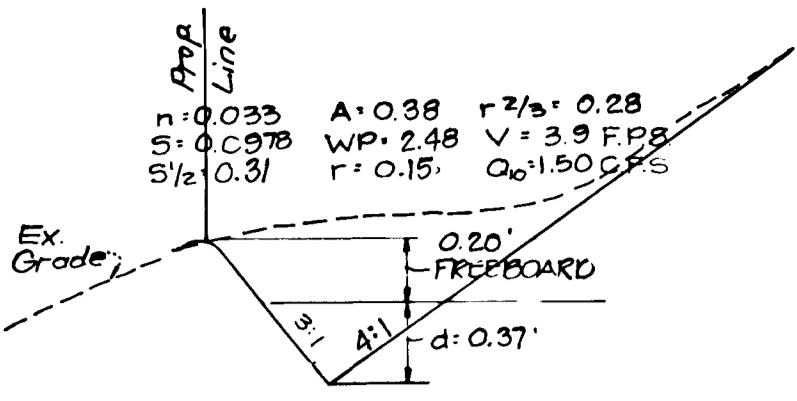


SECTION 'A-A'
NO SCALE

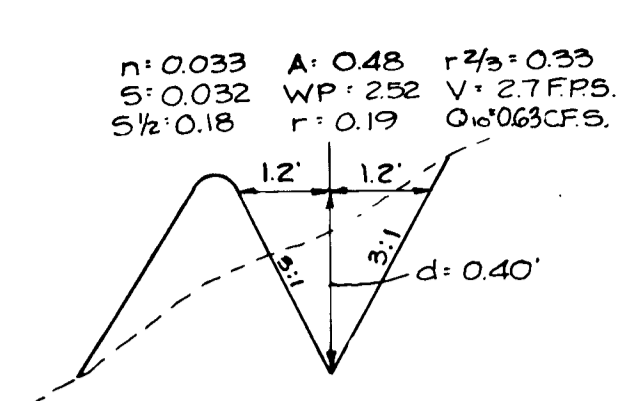


SECTION 'B-B'
NO SCALE

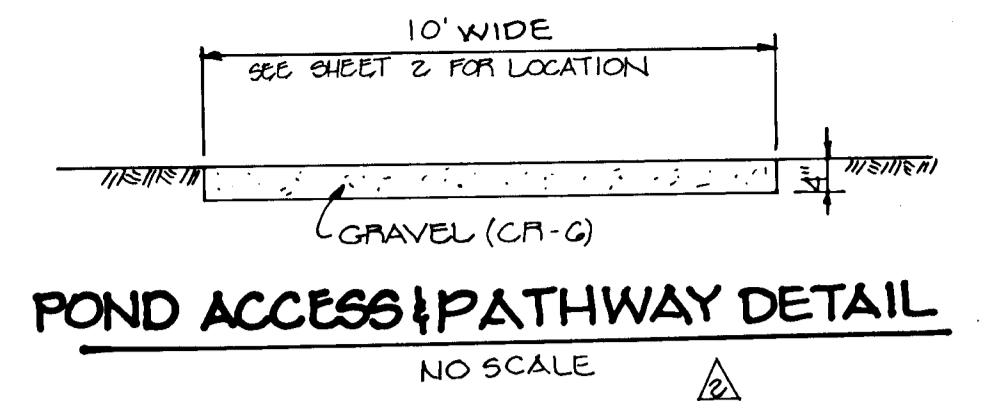



POND ACCESS PATHWAY DETAIL
NO SCALE

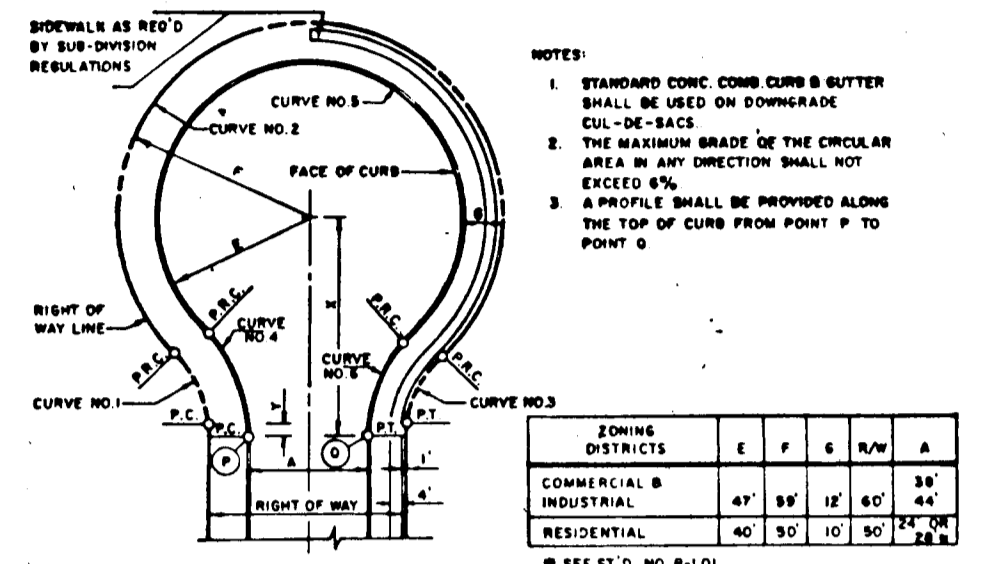


TYPICAL CUL-DE-SAC
NO SCALE

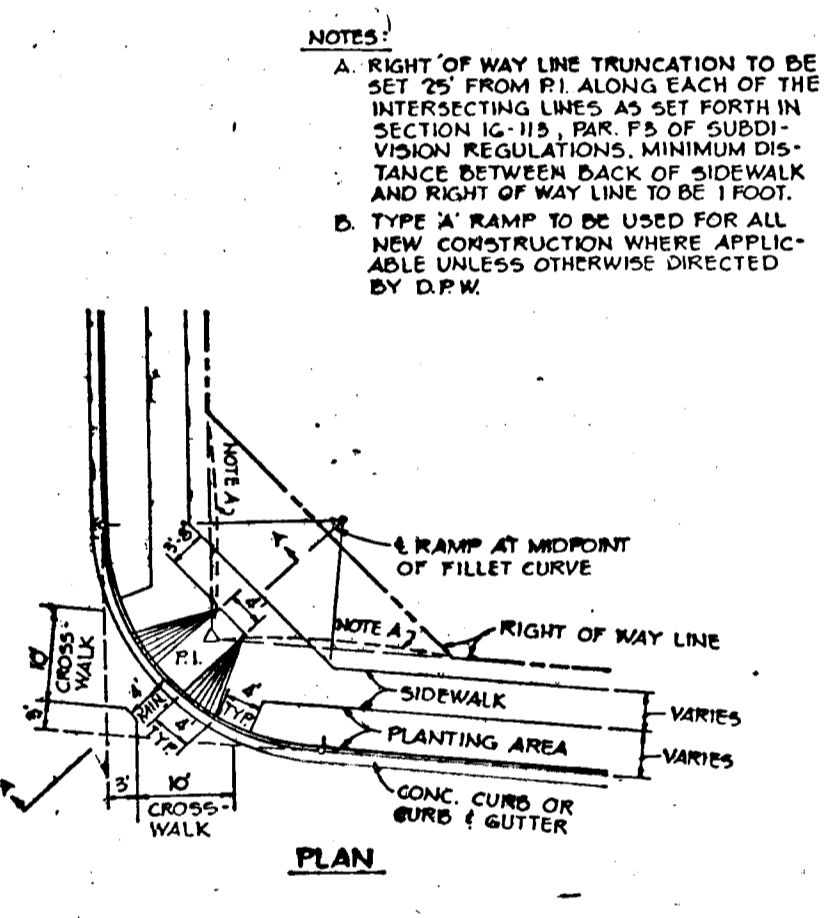


TYPICAL HANDICAP RAMP
NO SCALE

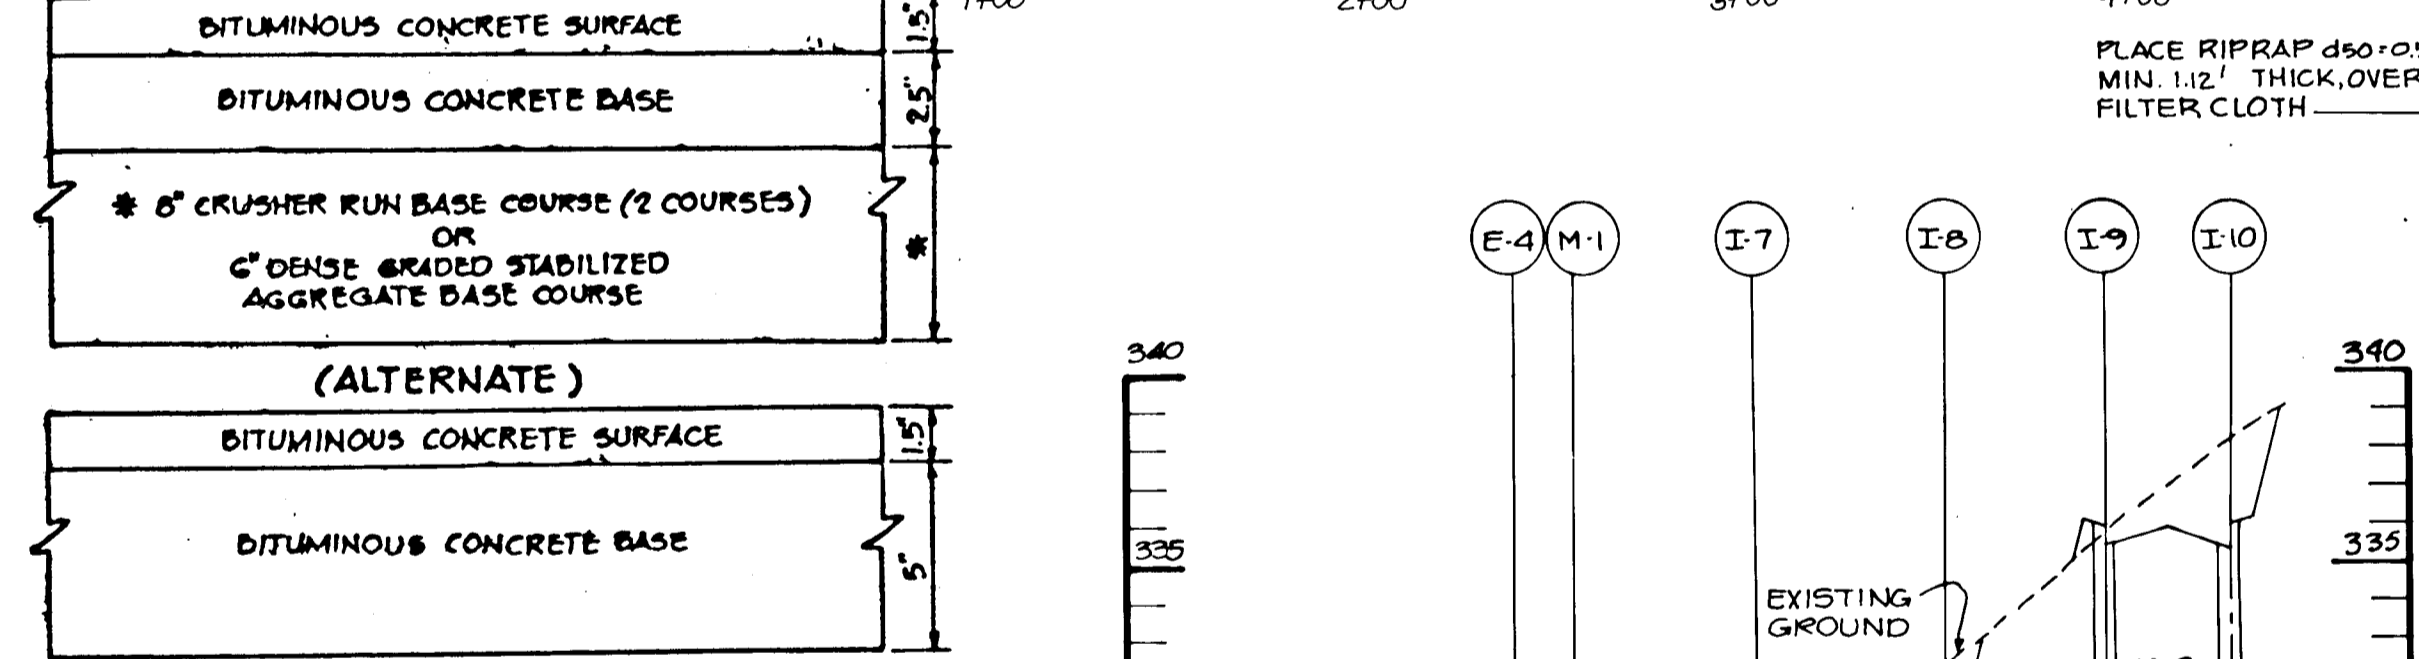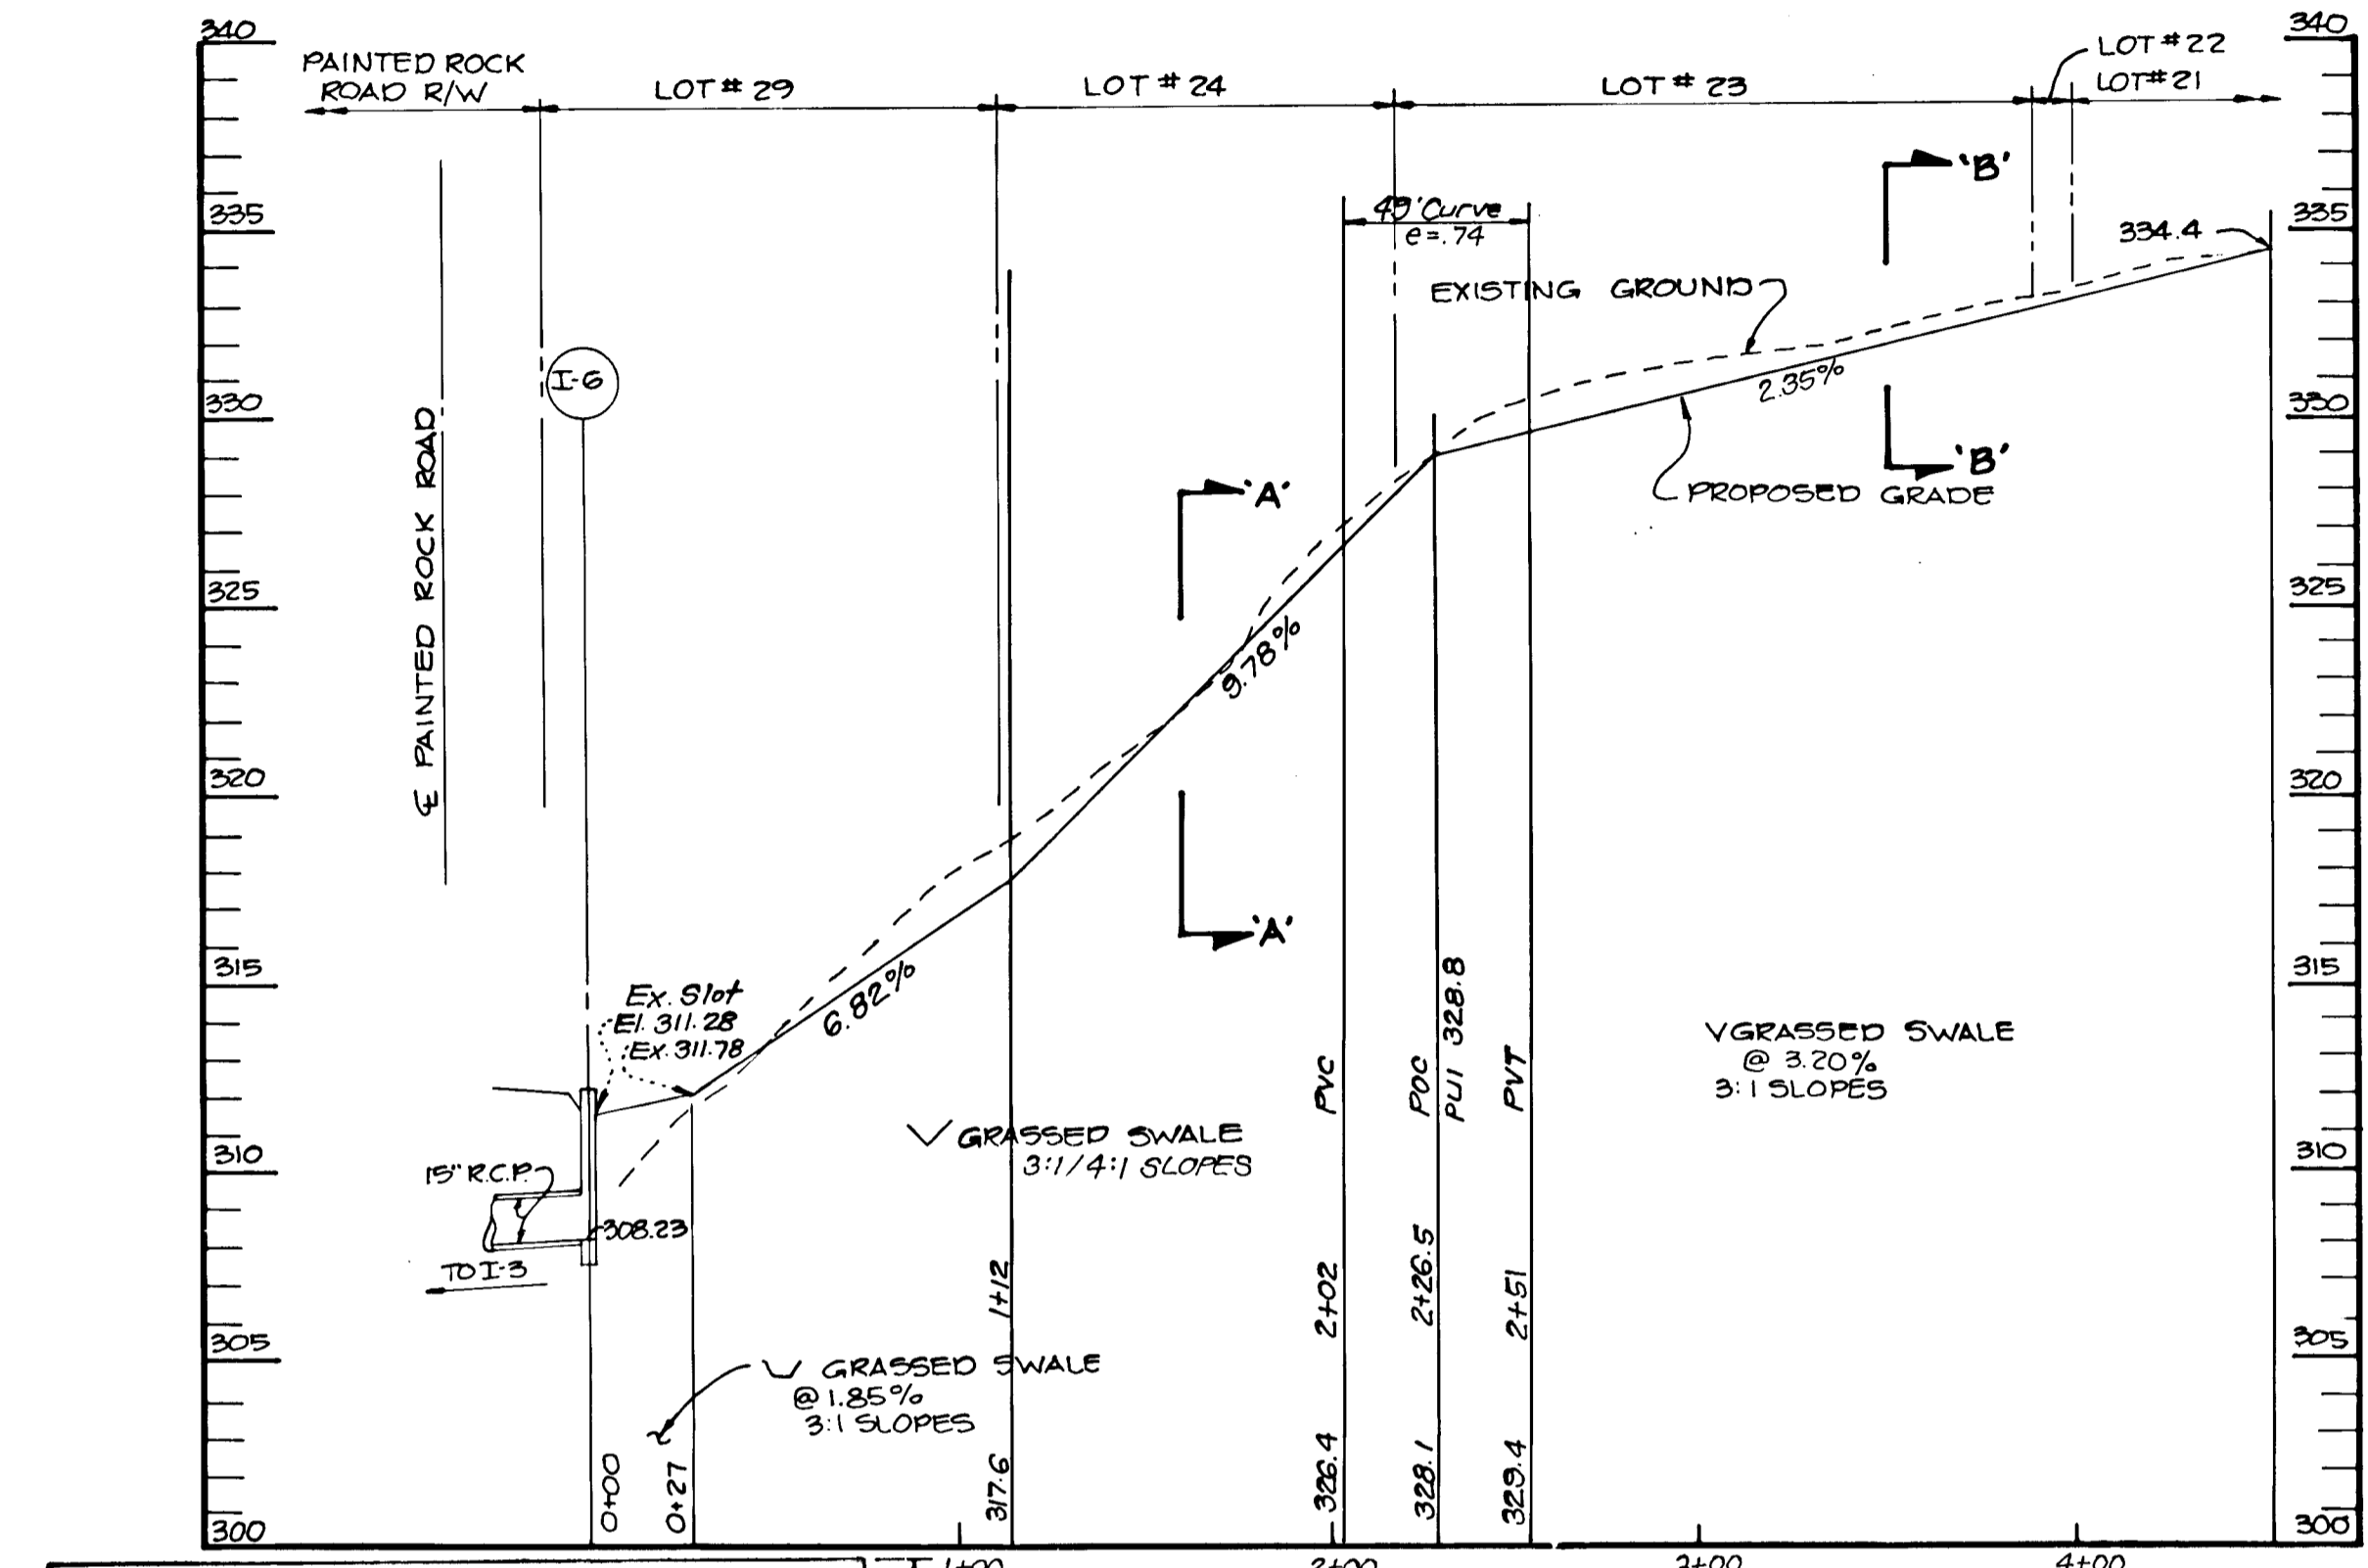


P-2 PAVING SECTION
NO SCALE

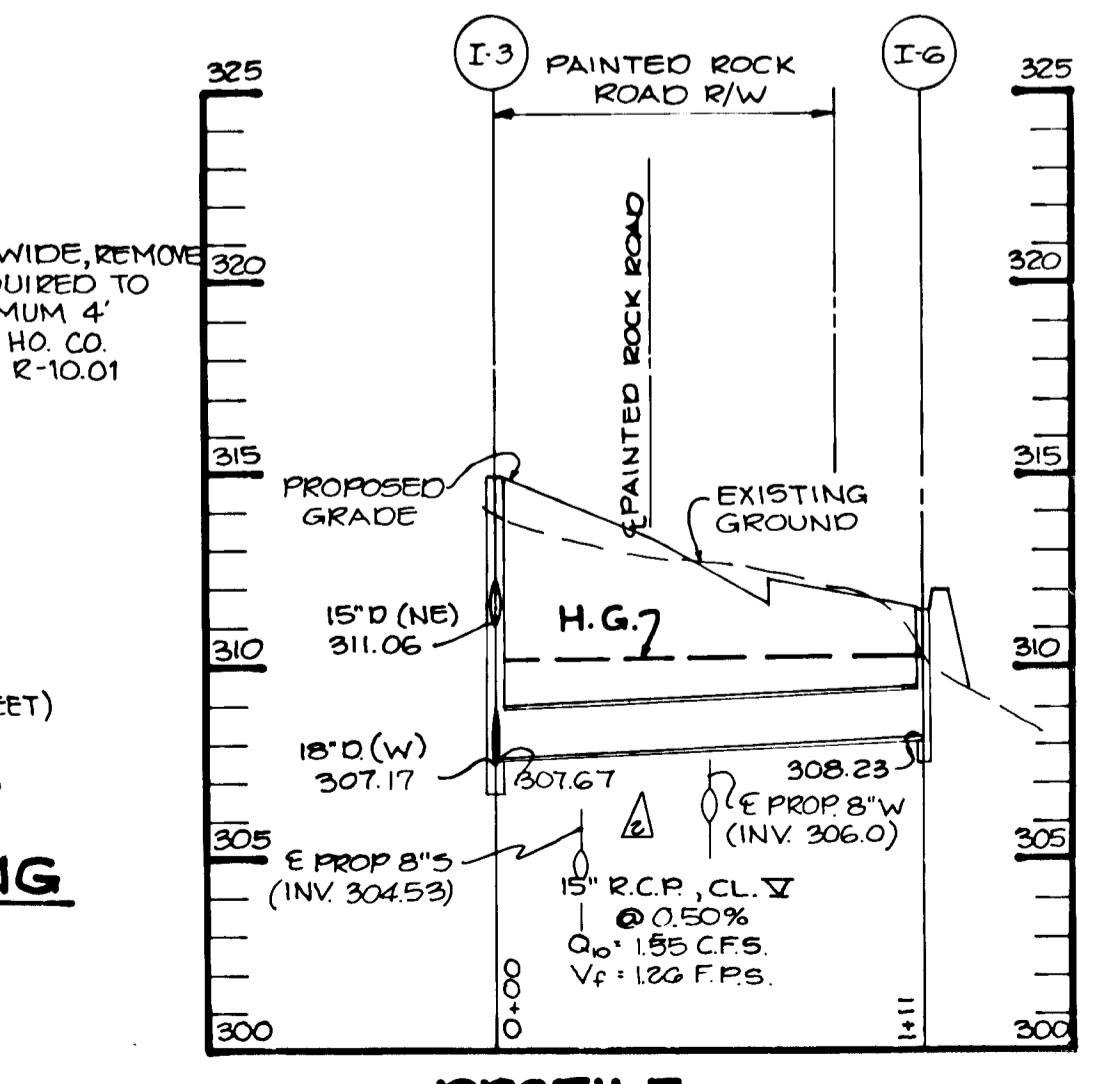


PROFILE
SCALE: HORIZ 1"=50' VERT 1"=5'

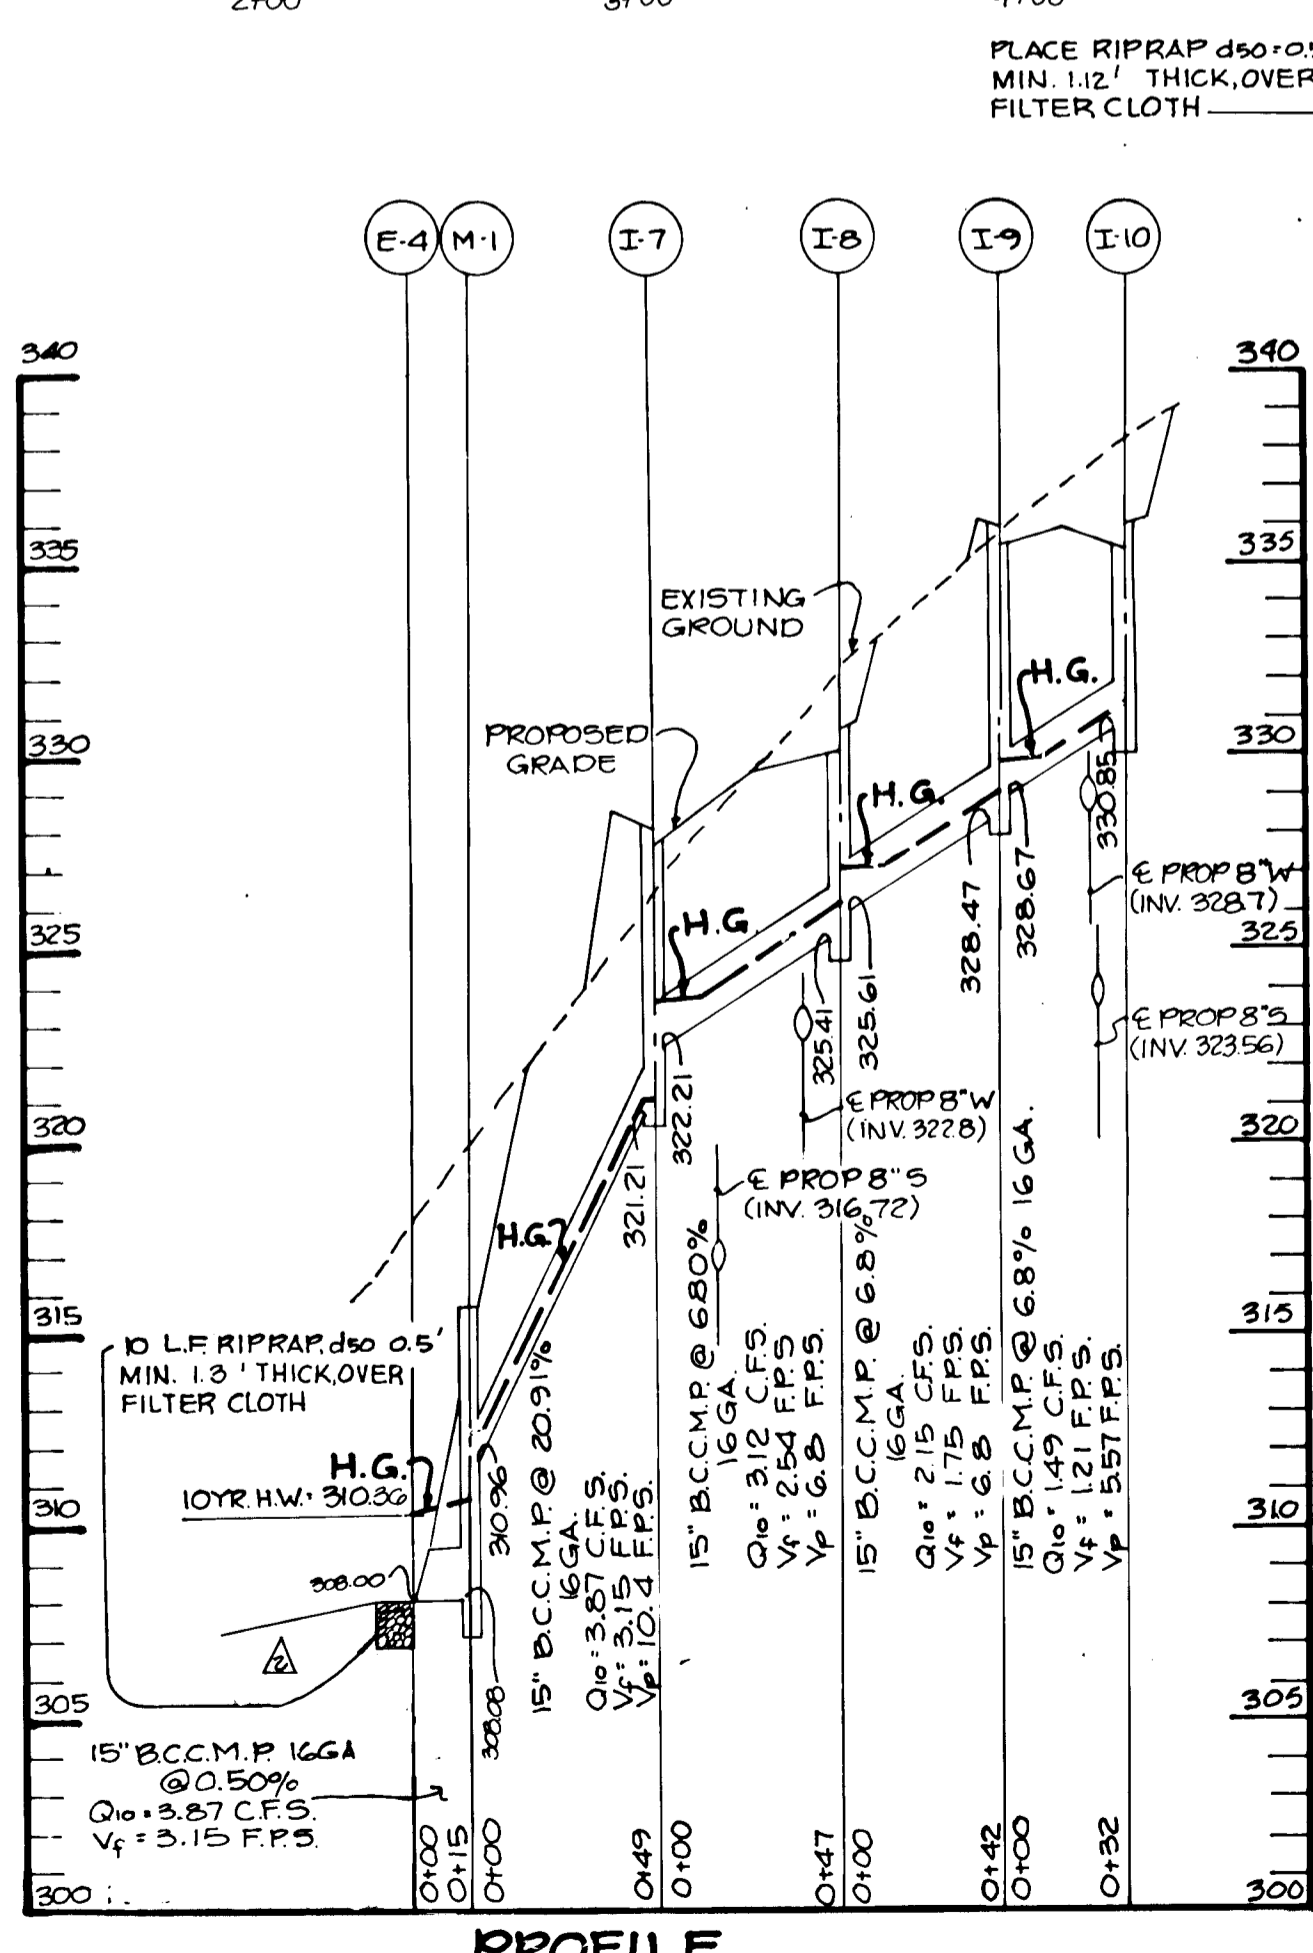


PROFILE
SCALE: HORIZ 1"=50' VERT 1"=5'

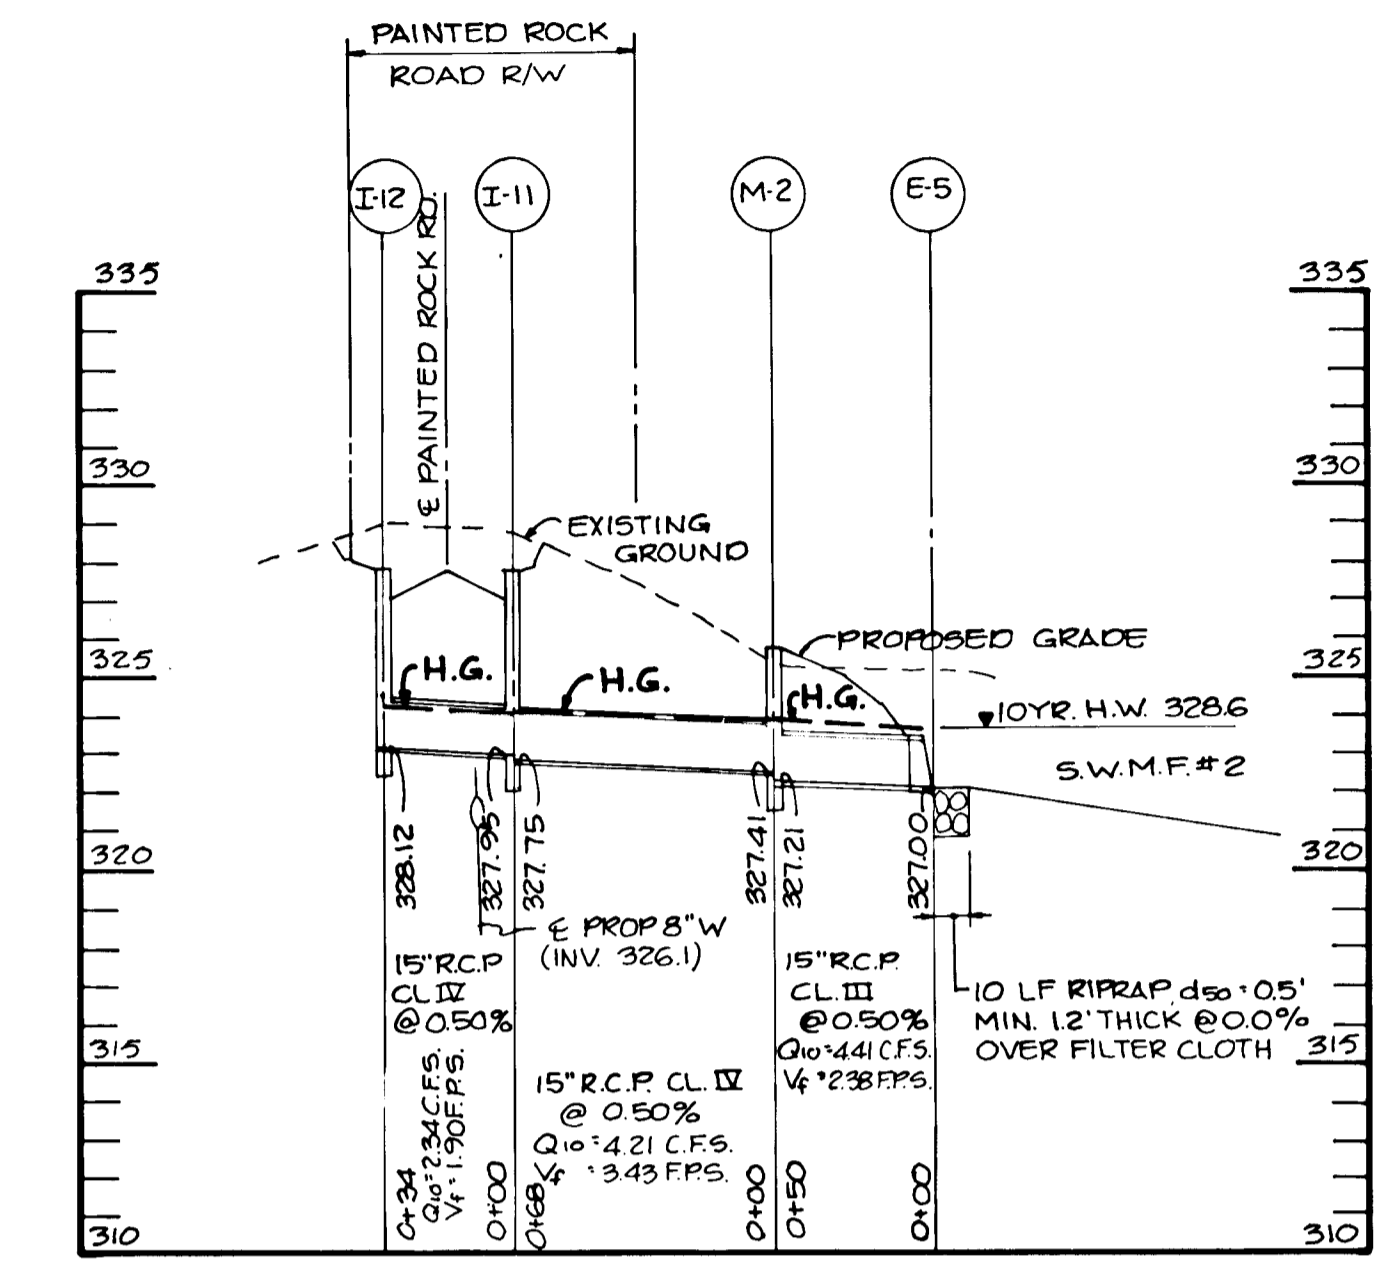

PROFILE
SCALE: HORIZ 1"=50' VERT 1"=5'

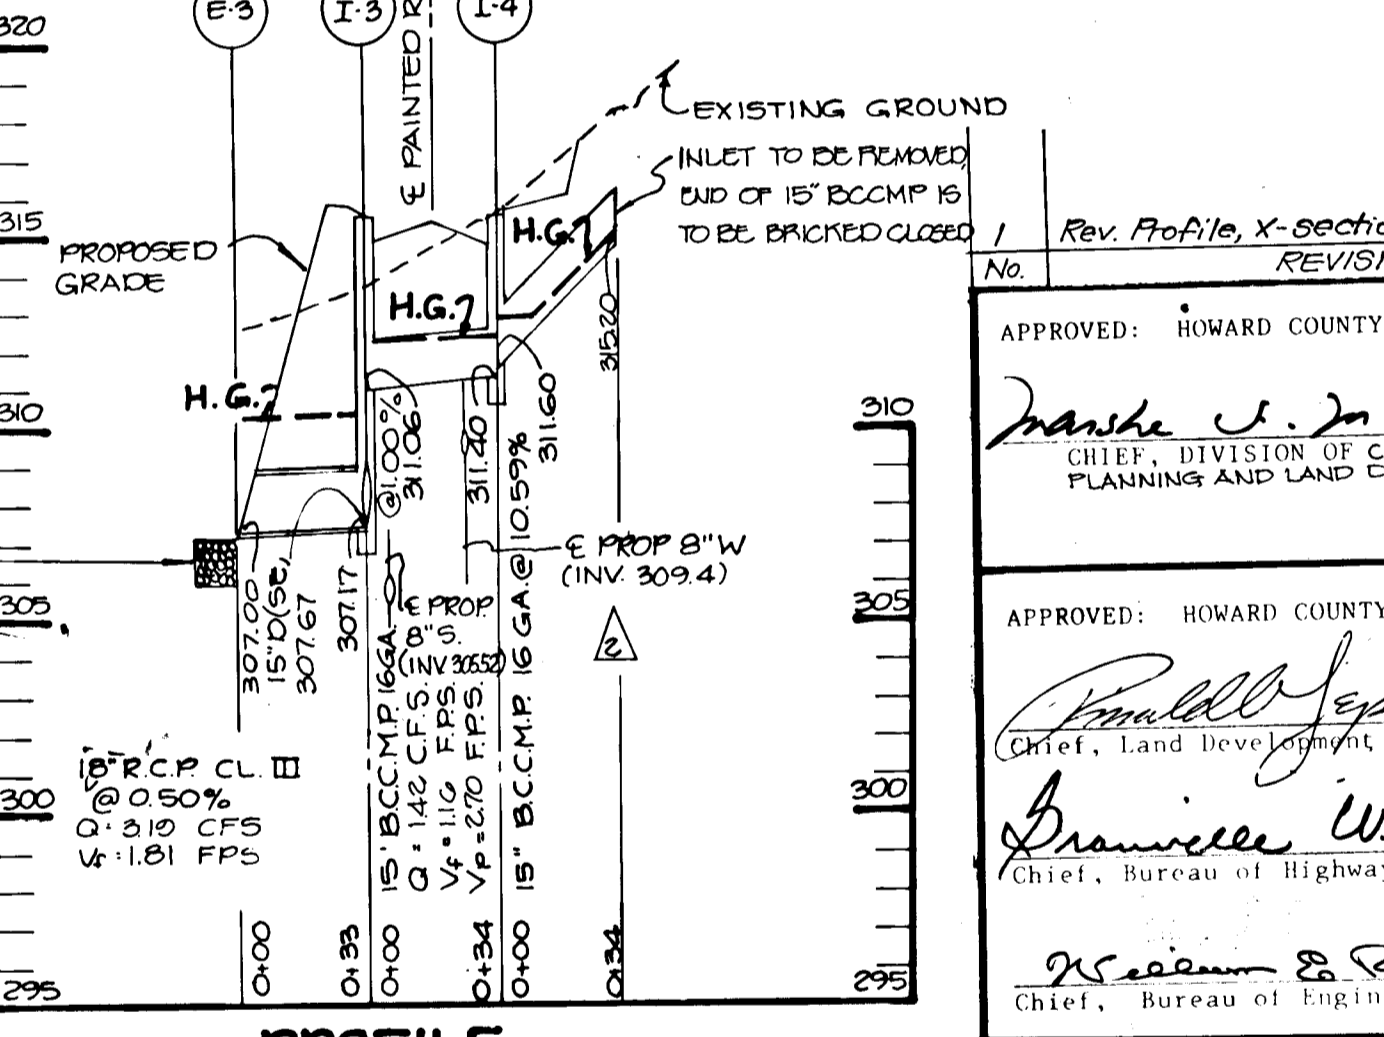

PROFILE
SCALE: HORIZ 1"=50' VERT 1"=5'

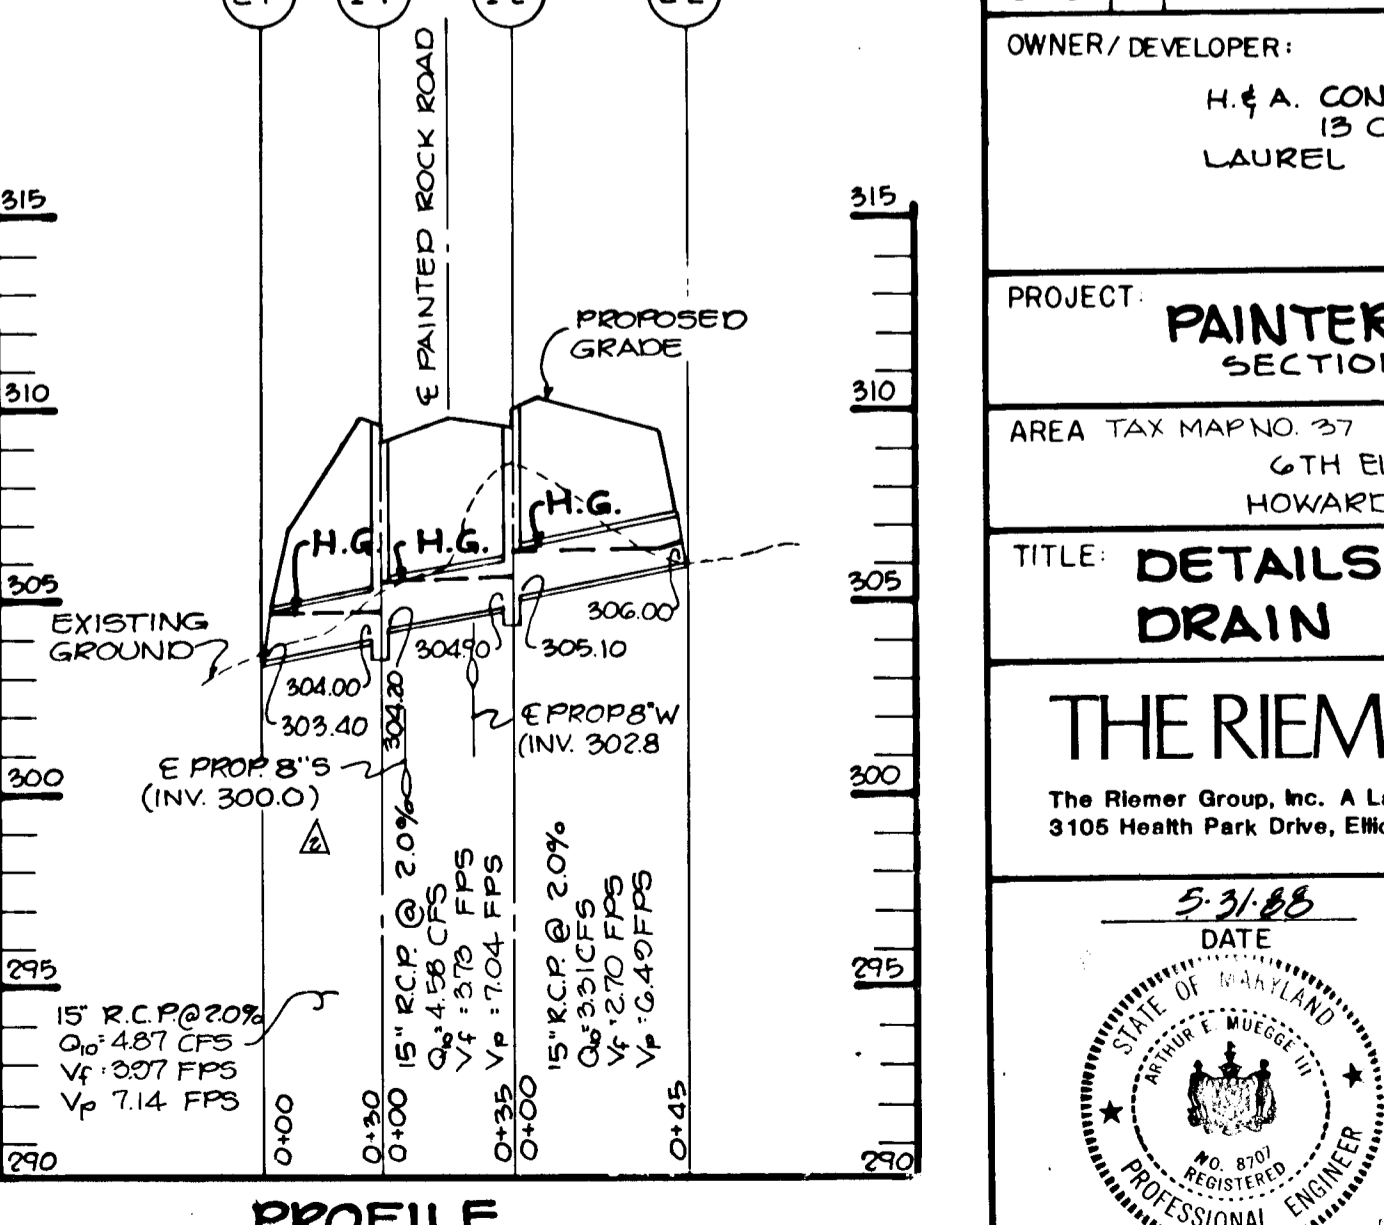

PROFILE
SCALE: HORIZ 1"=50' VERT 1"=5'

Rev. Profile, X-section of grassed swale by C.F.S. 10/19/90

APPROVED: HOWARD COUNTY OFFICE OF PLANNING AND ZONING
Martha J. J. J. 12-2-99 DATE

APPROVED: HOWARD COUNTY DEPARTMENT OF PUBLIC WORKS
Paul J. J. 10/07/03 DATE

Gravies W. W. 4/02/88 DATE
 Chief, Bureau of Highways

William E. R. 11-16-88 DATE
 Chief, Bureau of Engineering

OWNER/DEVELOPER:
 H & A CONSTRUCTION CO., INC.
 15 C STREET
 LAUREL, MARYLAND 20707

PROJECT: **PAINTER'S HILL SECTION ONE**

AREA TAX MAP NO 37 PARCEL 467
 6TH ELECTION DISTRICT PAGE 53
 HOWARD COUNTY, MARYLAND 5-80-15

TITLE: **DETAILS & STORM DRAIN PROFILES**

THE RIEMER GROUP, INC.
 The Riemer Group, Inc. A Land Planning, Design & Civil Engineering Firm
 3105 Health Park Drive, Ellicott City, Maryland 21043 (301) 461-2880

DATE: 5/31/88
 DESIGNED BY: L.J.D.
 DRAWN BY: M.A.D.
 PROJECT NO: 22200
 DATE: OCTOBER 2, 1987
 SCALE: AS SHOWN
 DRAWING NO. 4 OF 7

1302

S.W.M. SPECIFICATIONS

I. SITE PREPARATION

Areas under the borrow areas, embankment, and structural works shall be cleared, grubbed and the topsoil stripped to remove all trees, vegetation, roots or other objectionable material. Channel banks and sharp breaks shall be sloped to no steeper than 1:1.

Areas covered by the pond or reservoir will be cleared of all trees, brush, logs, fences, rubbish and other objectionable material unless otherwise designated on the plans. Trees, brush and stumps shall be cut approximately level with the ground surface.

All cleared and grubbed material shall be disposed of outside the limits of the dam and reservoir as directed by the owner or his representative. A sufficient quantity of topsoil shall be stockpiled in a suitable location for use on the embankment and other designated areas.

II. EARTH FILL

The fill material shall be taken from approved designated borrow area or areas. It shall be free of roots, stumps, wood, rubbish, oversize stones, frozen or other objectionable materials. The embankment shall be constructed to an elevation which provides for anticipated settlement to the design elevation. The fill height all along the length of the embankment shall be increased above the design elevation (including freeboard) as shown on the plans.

Placement:
Areas on which fill is to be placed shall be scarified prior to placement of fill. Fill materials shall be placed in 8-inch maximum thickness (before compaction) layers which are to be continuous over the entire length of the fill. The most porous borrow material shall be placed in the downstream portions of the embankment.

Compaction:
The movement of the hauling and spreading equipment over the fill shall be controlled so that the entire surface of each lift shall be traversed by not less than one track wheel of the equipment or compaction shall be achieved by a minimum of four complete passes shall consist of rubber tired or vibratory roller. Fill material of compacted sufficient moisture such that the required degree of compaction can be obtained with the equipment used.

Cutoff Trench:
Where specified, a cutoff trench shall be excavated along or parallel to the centerline of the embankment as shown on the plans. The bottom width of the trench shall be governed by the equipment used for excavation, with the minimum width being four feet. The depth shall be at least four feet or as shown on the plans. The side slopes of the trench shall be 1 to 1 or flatter. The backfill material for the cutoff trench shall be the most impervious material available and shall be compacted with equipment or rollers to assure maximum density and minimum permeability.

III. STRUCTURAL BACKFILL

Backfill material shall be of the type and quality conforming to that specified for the adjoining fill material. The fill shall be placed in horizontal layers not to exceed four inches in thickness and compacted by hand tamper or other compaction equipment. The material needs to fill completely all spaces under and adjacent to the pipe. At no time during the backfilling operation shall driven equipment be allowed to operate closer than four feet, measured horizontally, to any part of a structure. Under no circumstances shall the contractor drive equipment over any part of a concrete structure or pipe unless there is a compacted fill of twenty-four inches or greater over the structure or pipe.

IV. CORRUGATED METAL PIPE

Material:
(Steel Pipe)-This pipe and its appurtenances shall be galvanized and fully bituminous coated and shall conform to the requirements of ASTM Specification M-190 Type A with watertight coupling bands. Any bituminous coating damaged or otherwise removed shall be replaced with cold applied bituminous coating compound.

Connections:
All connections with pipes must be completely watertight. The drain pipe or barrel connection to the riser shall be welded all around when the pipe and riser are metal. Watertight coupling bands shall be used at all joints. Antiseep collars shall be connected to the pipe in such a manner as to be completely watertight.

bedding:
The pipe shall be firmly and uniformly bedded throughout its entire length. Where rock or soft, spongy or other unstable soil is encountered, all such material shall be removed and replaced with suitable earth compacted to provide adequate support.

V. CONCRETE

1. Cement - Normal Portland cement shall conform to the latest ASTM Specification C-150.
2. Water - The water used in concrete shall be clean, free from oil, acid, alkali, scales, organic matter or other objectionable substances.
3. Sand - The sand used in concrete shall be clean, hard, strong and durable, and shall be well graded with 100 percent passing a one-quarter inch sieve. Limestone sand shall not be used.
4. Course Aggregate - The coarse aggregate shall be clean, hard, strong and durable, and free from clay or dirt. It shall be well graded with a maximum size of one and one-half (1-1/2) inches.
5. Reinforcing Steel - The reinforcing steel shall be deformed to ASTM Specification A-615.

Design Mix:
The concrete shall be mixed in the following proportions, measured by weight. The water-cement ratio shall be 3-3/4 to 6 U.S. gallons of water per 94 pound bag of cement. The proportion of materials for the trial mix shall be 1:2:3-1/2. The combination of aggregate not produce harshness in placing or honeycombing in the structure.

Mixing:
The concrete ingredients shall be mixed in batch mixers until the mixture is homogeneous and of uniform consistency. The mixing of each batch shall continue for not less than one and one-half minutes after all the ingredients, except the full amount of water, are in the mixer. The minimum mixing time is predicted on proper control of the speed of rotation of the mixer and of the introduction of the material, including water, into the mixer. Water shall be added prior to, during, and following the mixer-charging operations. Excessive oversizing requiring the additions of water to preserve the required concrete consistency shall not be permitted. Truck mixing will be allowed provided that the use of this method shall cause no violation of any applicable provisions of the specifications given here.

Forms:
The forms shall have sufficient strength and rigidity to hold the concrete and to withstand the necessary pressure, tamping, and the mortar-rigidity and constructed so that they can be removed without hammering or prying against the concrete.

The inside of forms shall be oiled with a non-staining mineral oil or thoroughly wetted before concrete is placed.

Forms may be removed 24 hours after the placement of concrete. All wire ties and other devices used shall be recessed from the surface of the concrete.

Reinforcing Steel:
All reinforcing material shall be free of dirt, rust, scale, oil, paint or other coatings. The steel shall be accurately placed and securely tied and blocked into position so that no movement of the steel will occur during placement of concrete.

Consolidating:
Concrete shall be consolidated with internal type mechanical vibrator. Vibration shall be supplemented by spading and hand tamping in corners, and around embedded items.



Finishing:
Defective concrete, honeycombed areas, voids left by the removal of the rods, ridges on all concrete surfaces permanently exposed to view or exposed to water on the finished structure, shall be repaired immediately after the removal of forms. All voids shall be reamed and completely filled with dry-patching mortar.

Protection and Curing:
Exposed surfaces of concrete shall be protected from the direct rays of the sun for at least the first three (3) days. All concrete shall be kept continuously moist for at least ten (10) days after being placed. Moisture may be applied by spraying or sprinkling as necessary to prevent the concrete from drying. Concrete shall not be exposed to freezing during the curing period. Curing compounds may also be used.





Placing Temperature:
Concrete may not be placed at temperatures below 33° F with the temperature falling or 34° with the temperature rising.

STABILIZATION
All borrow areas shall be graded to provide proper drainage and left in a slightly condition. All exposed surfaces of the embankment, spillway, spill and borrow areas, and berms shall be stabilized by seeding, fertilizing, and mulching (if required) in accordance with the vegetative treatment specifications shown on or accompanying the drawings.



NOTE: WEIR OPENINGS ON ALL FOUR SIDES.

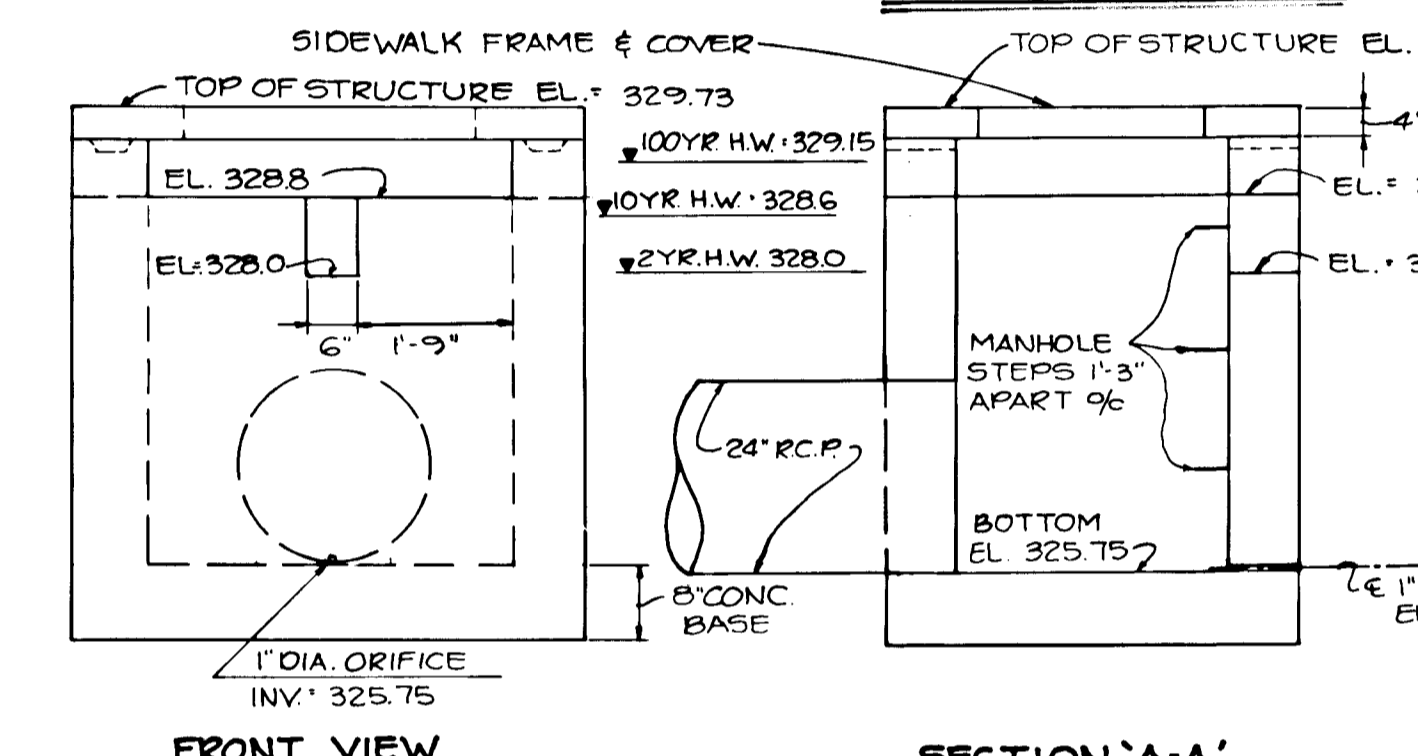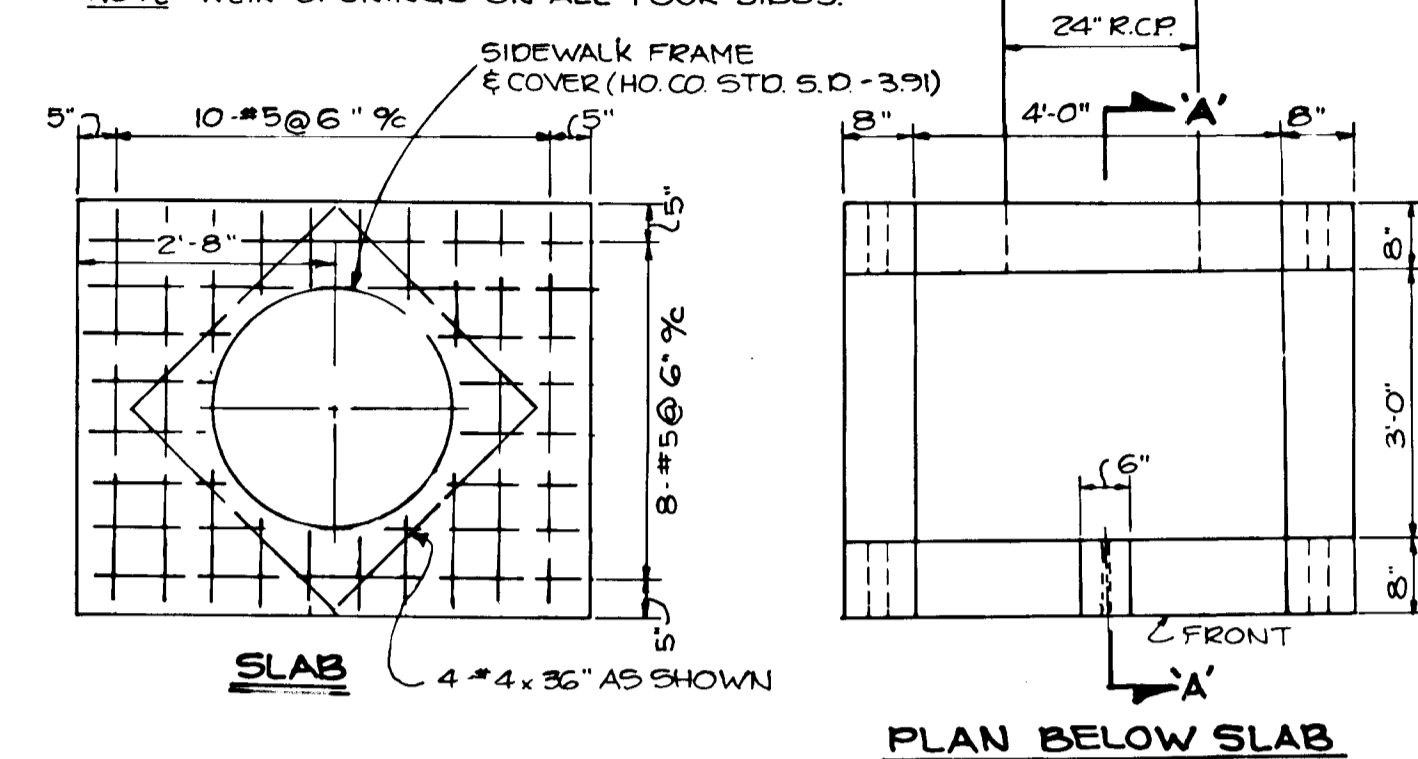



5-2 OUTLET CONTROL STRUCTURE - S.W.M.F. #2

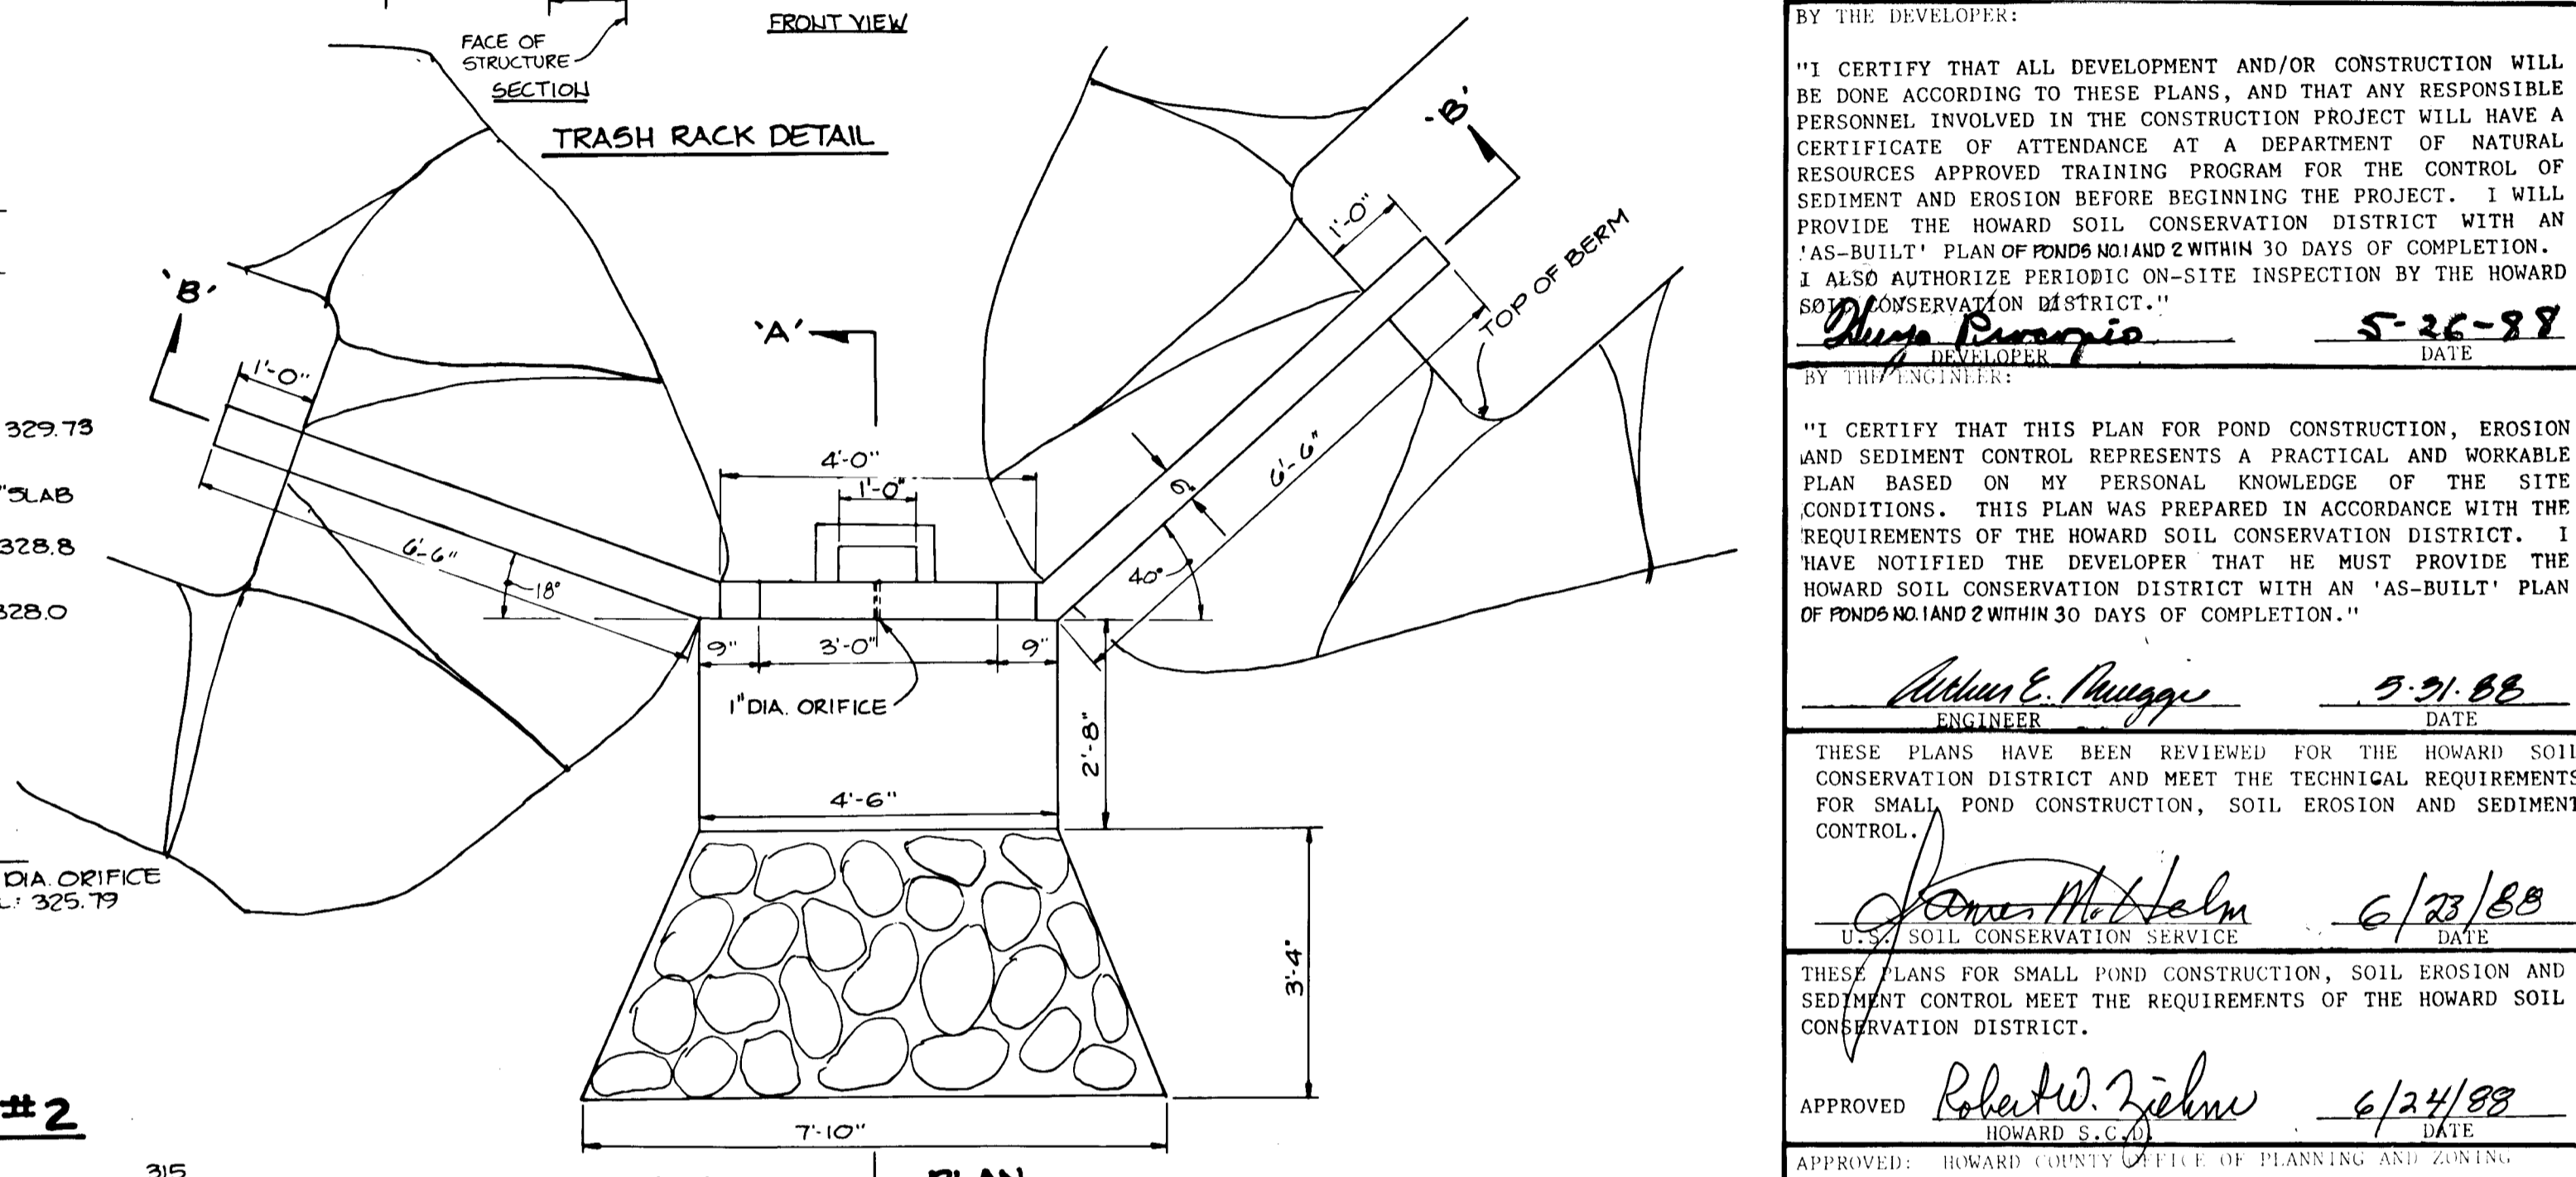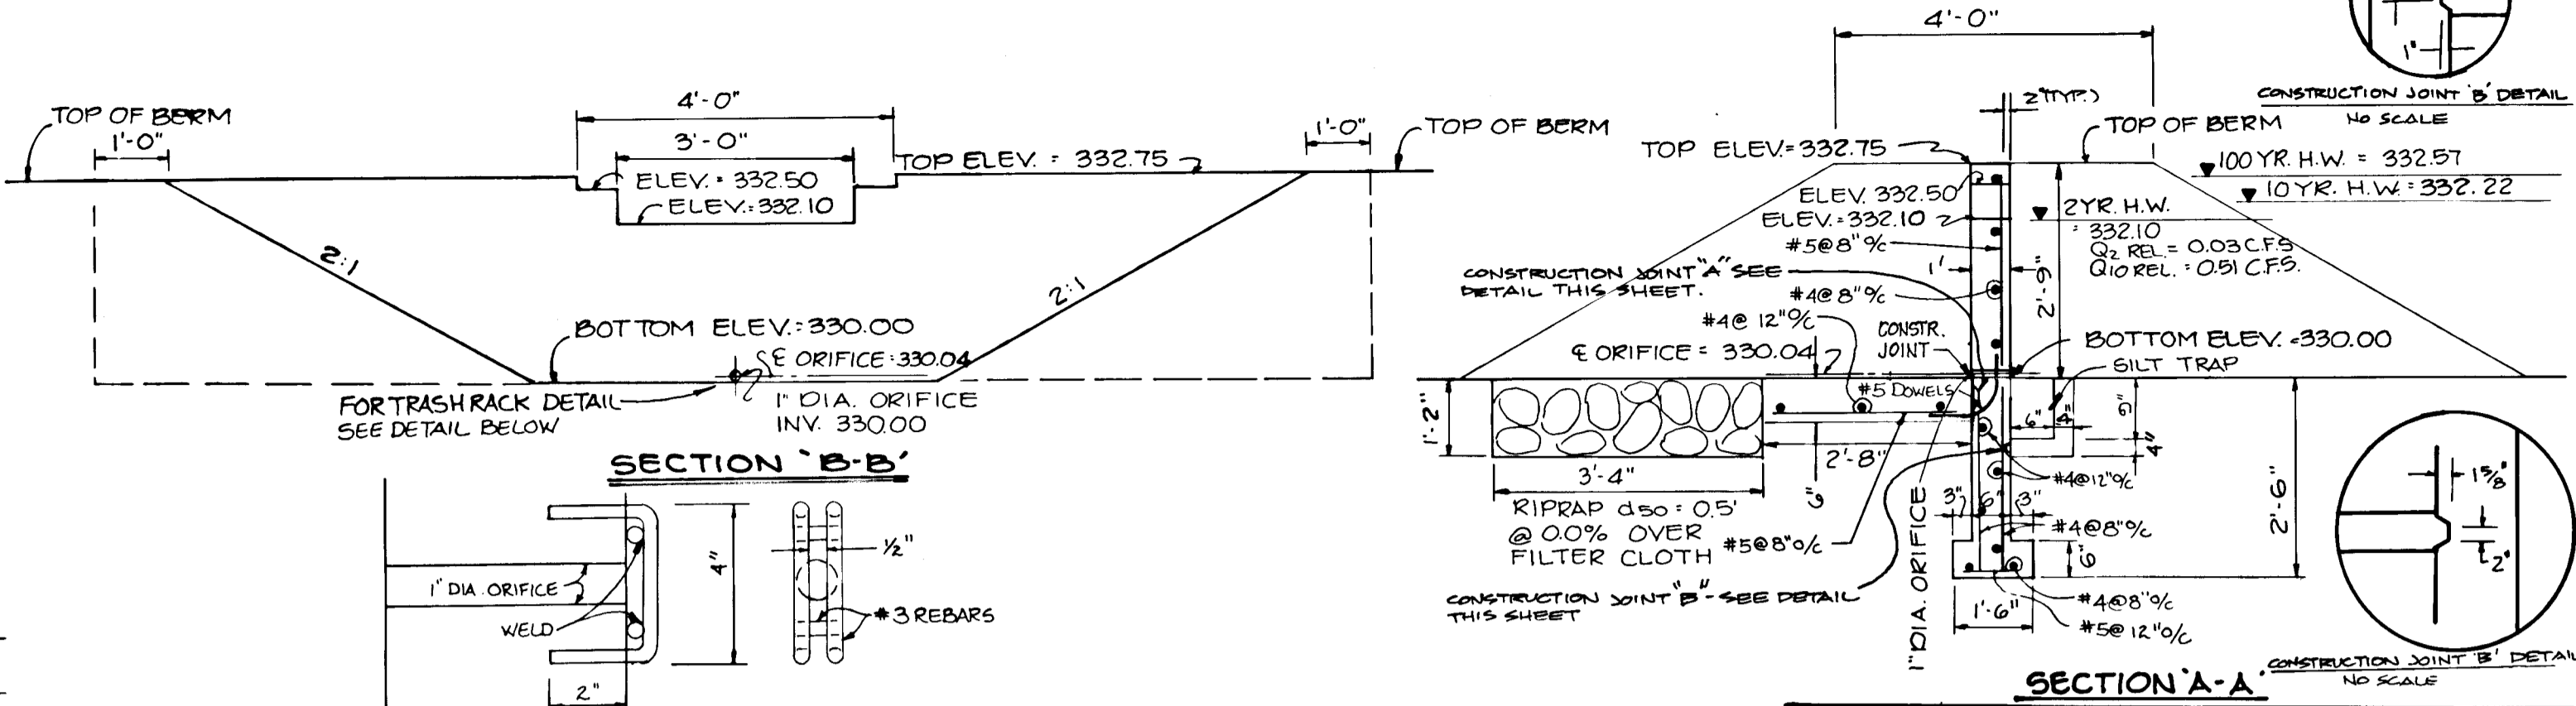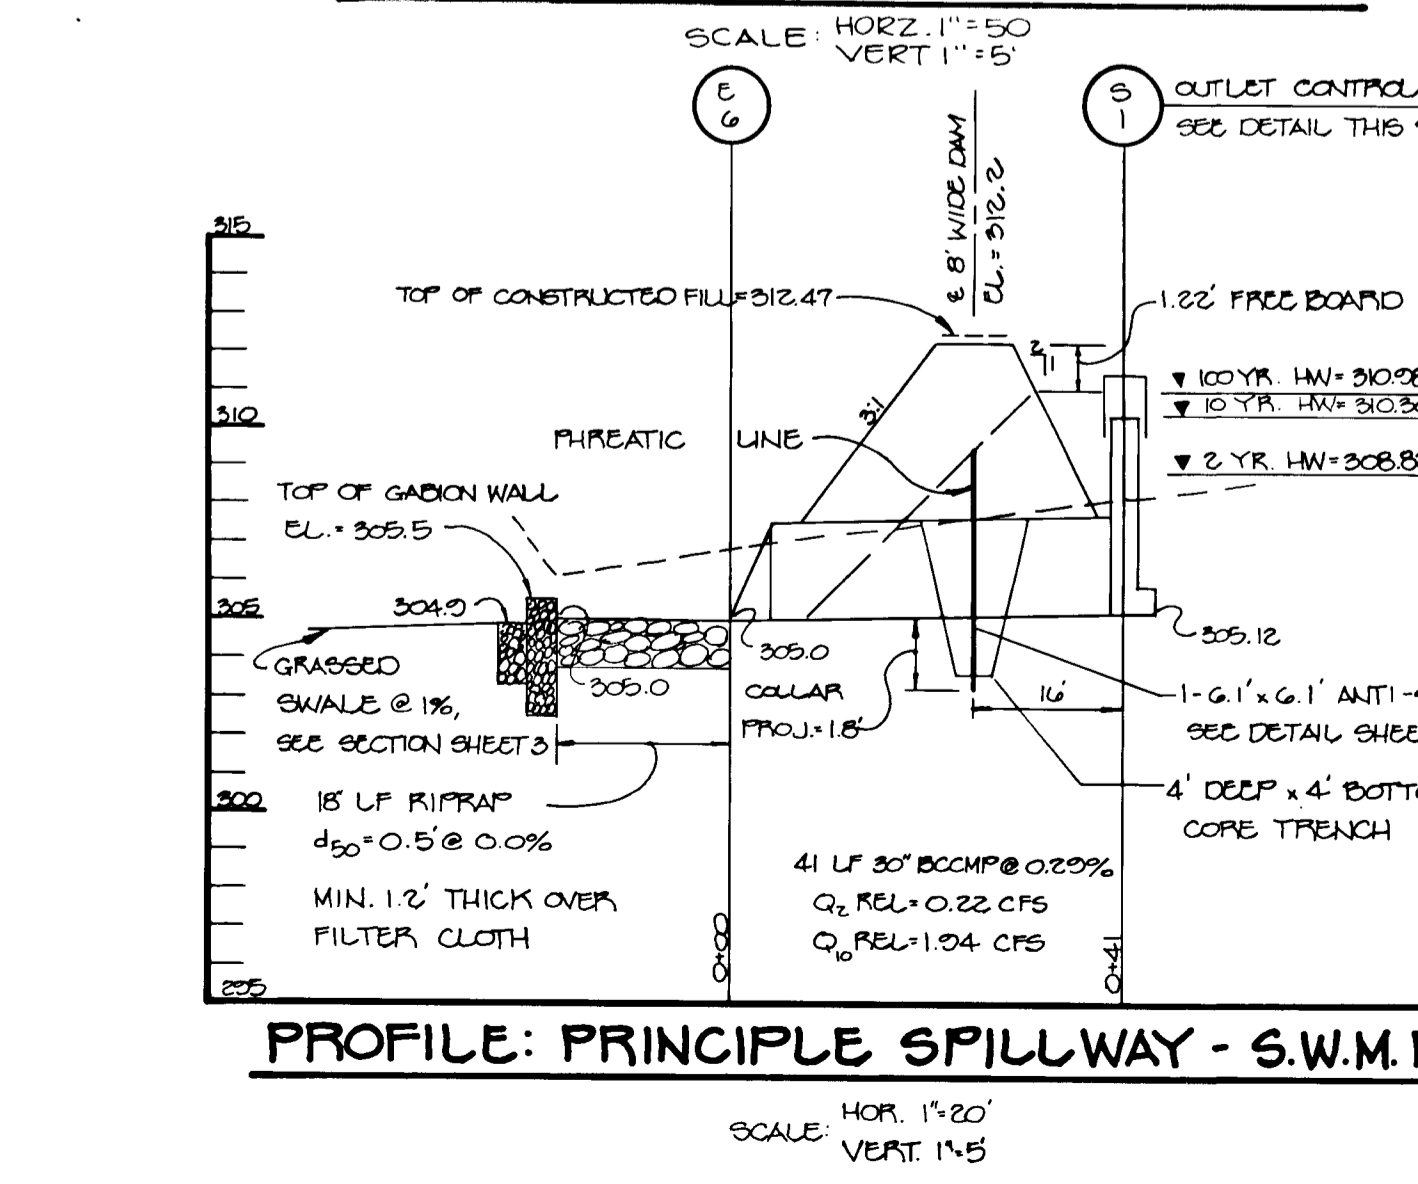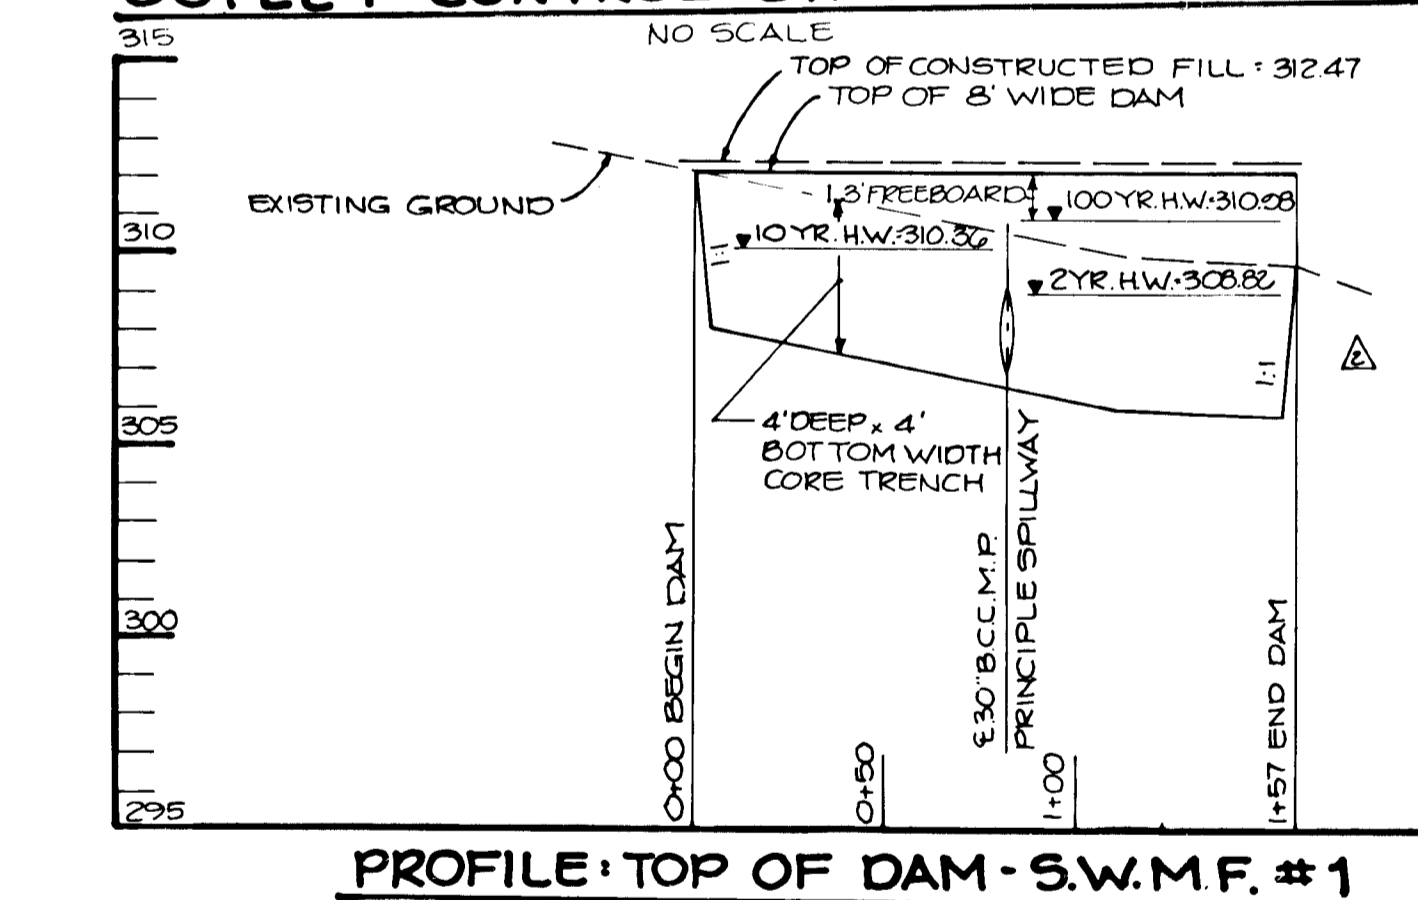

5-3 OUTLET CONTROL STRUCTURE S.W.M.F. #3

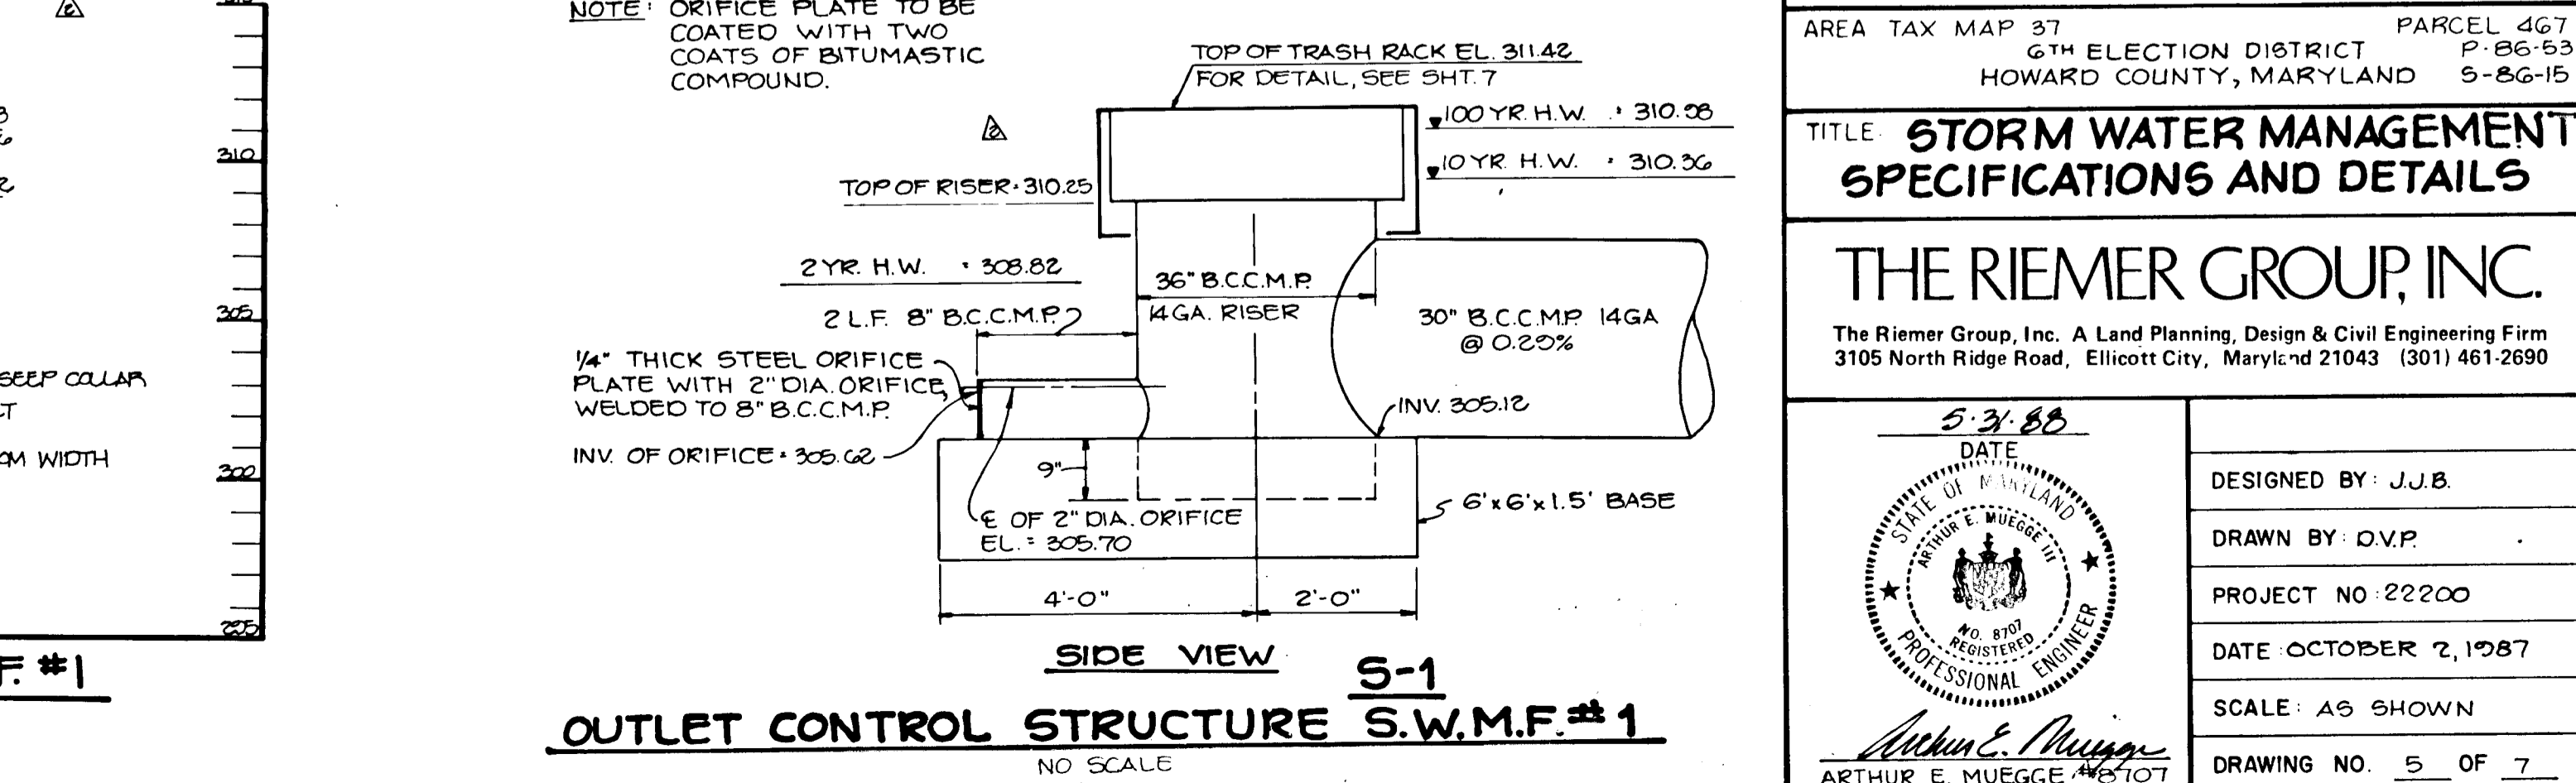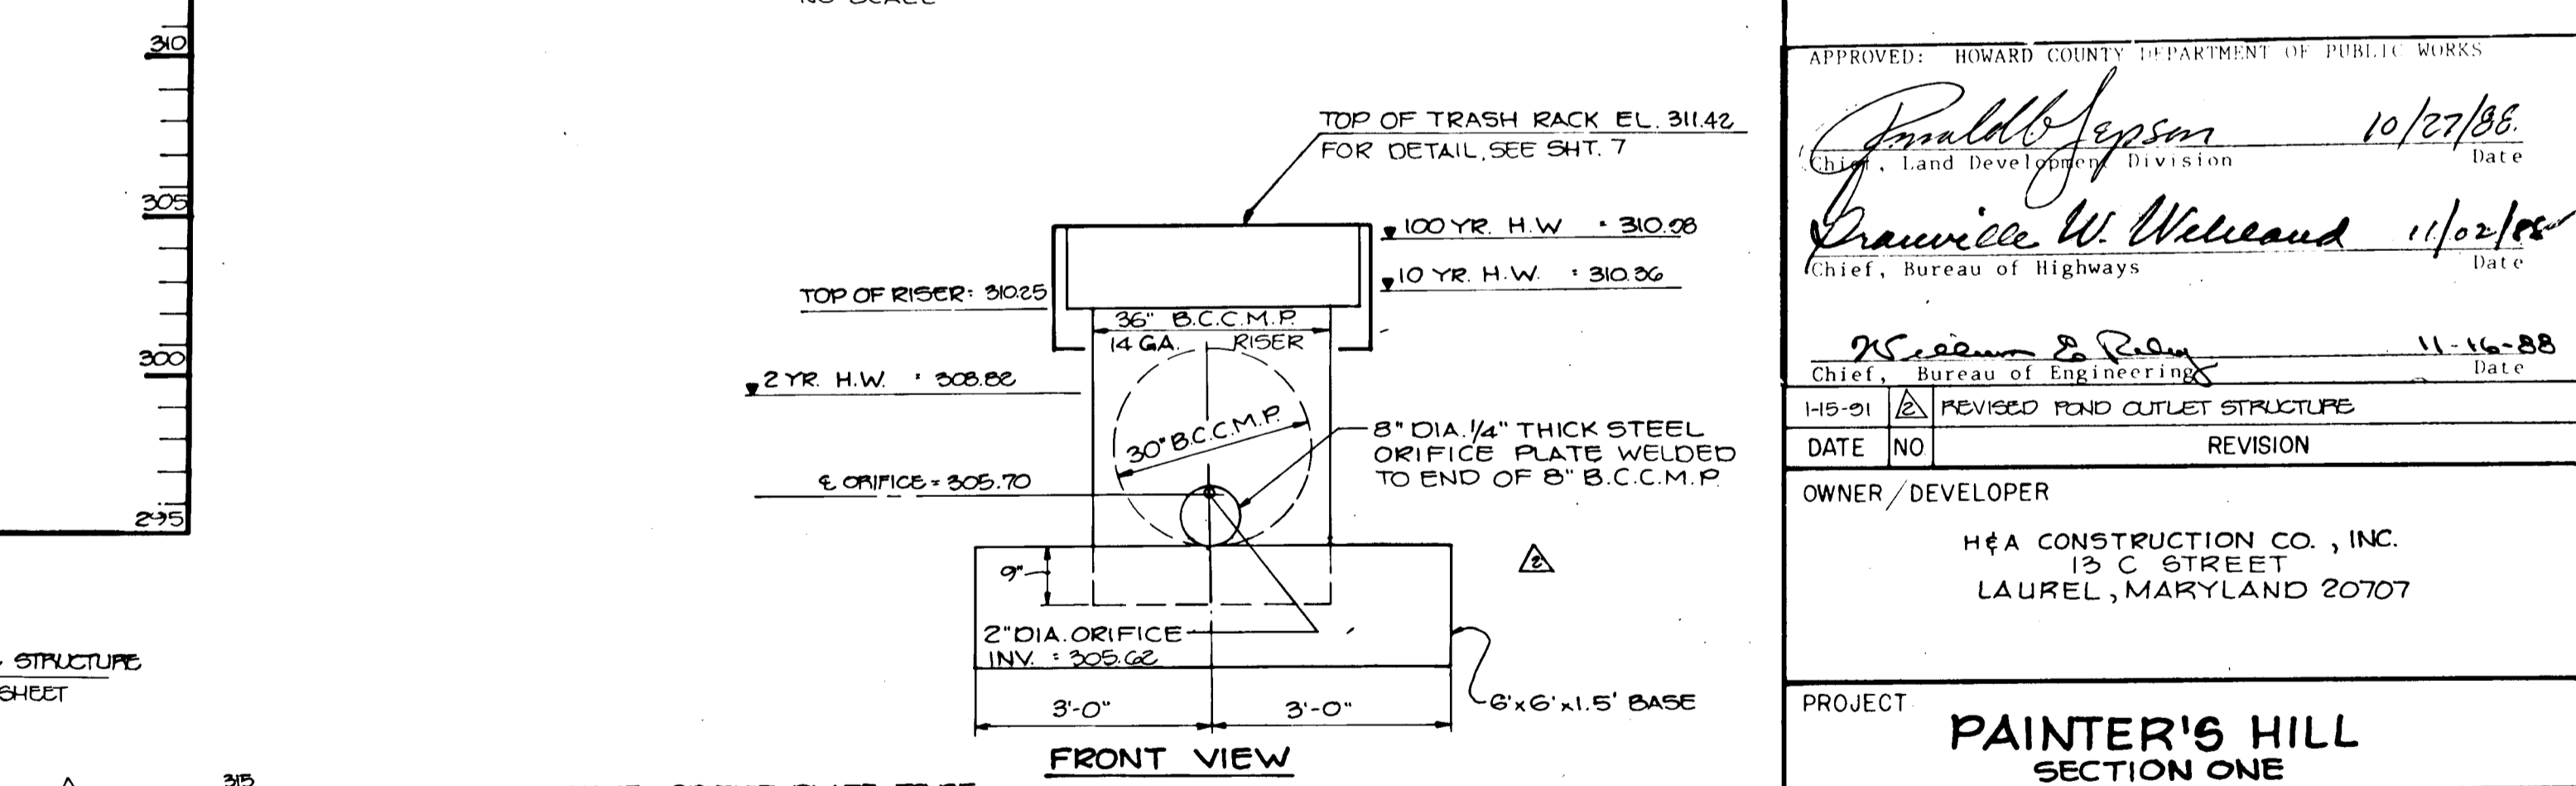

5-1 OUTLET CONTROL STRUCTURE S.W.M.F. #1

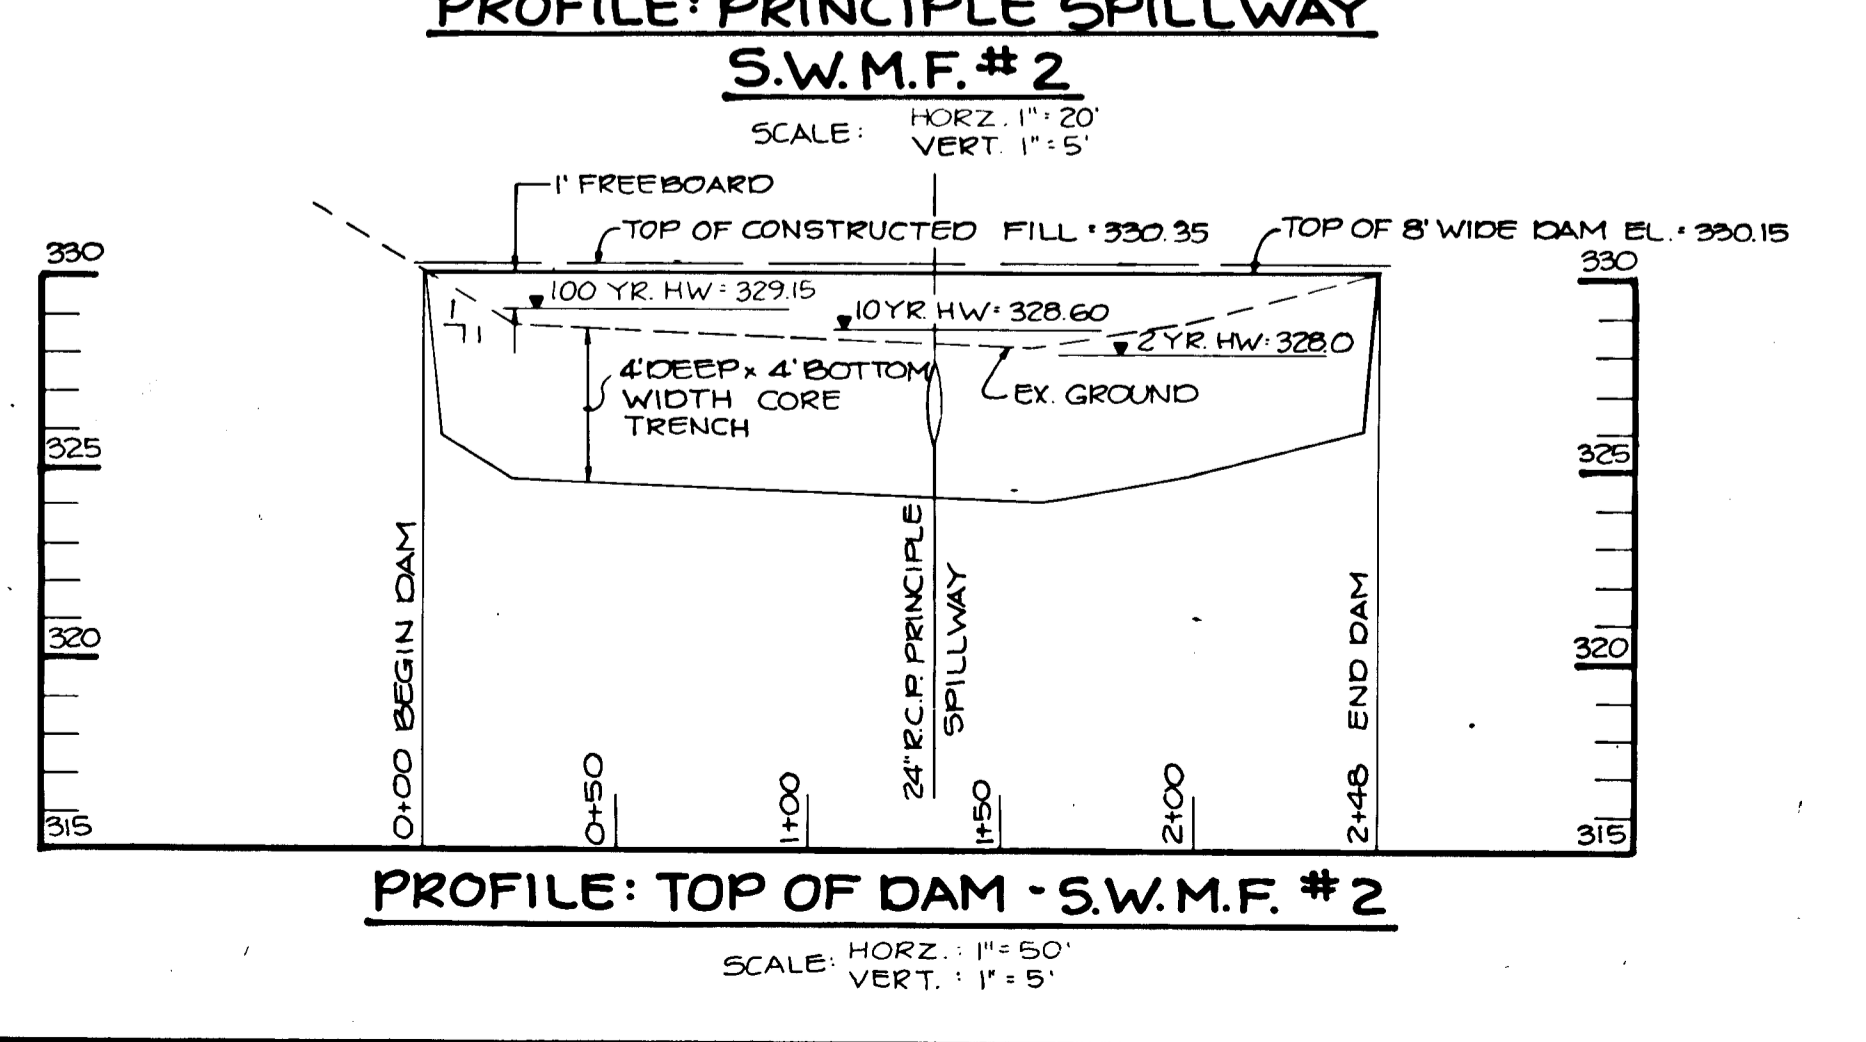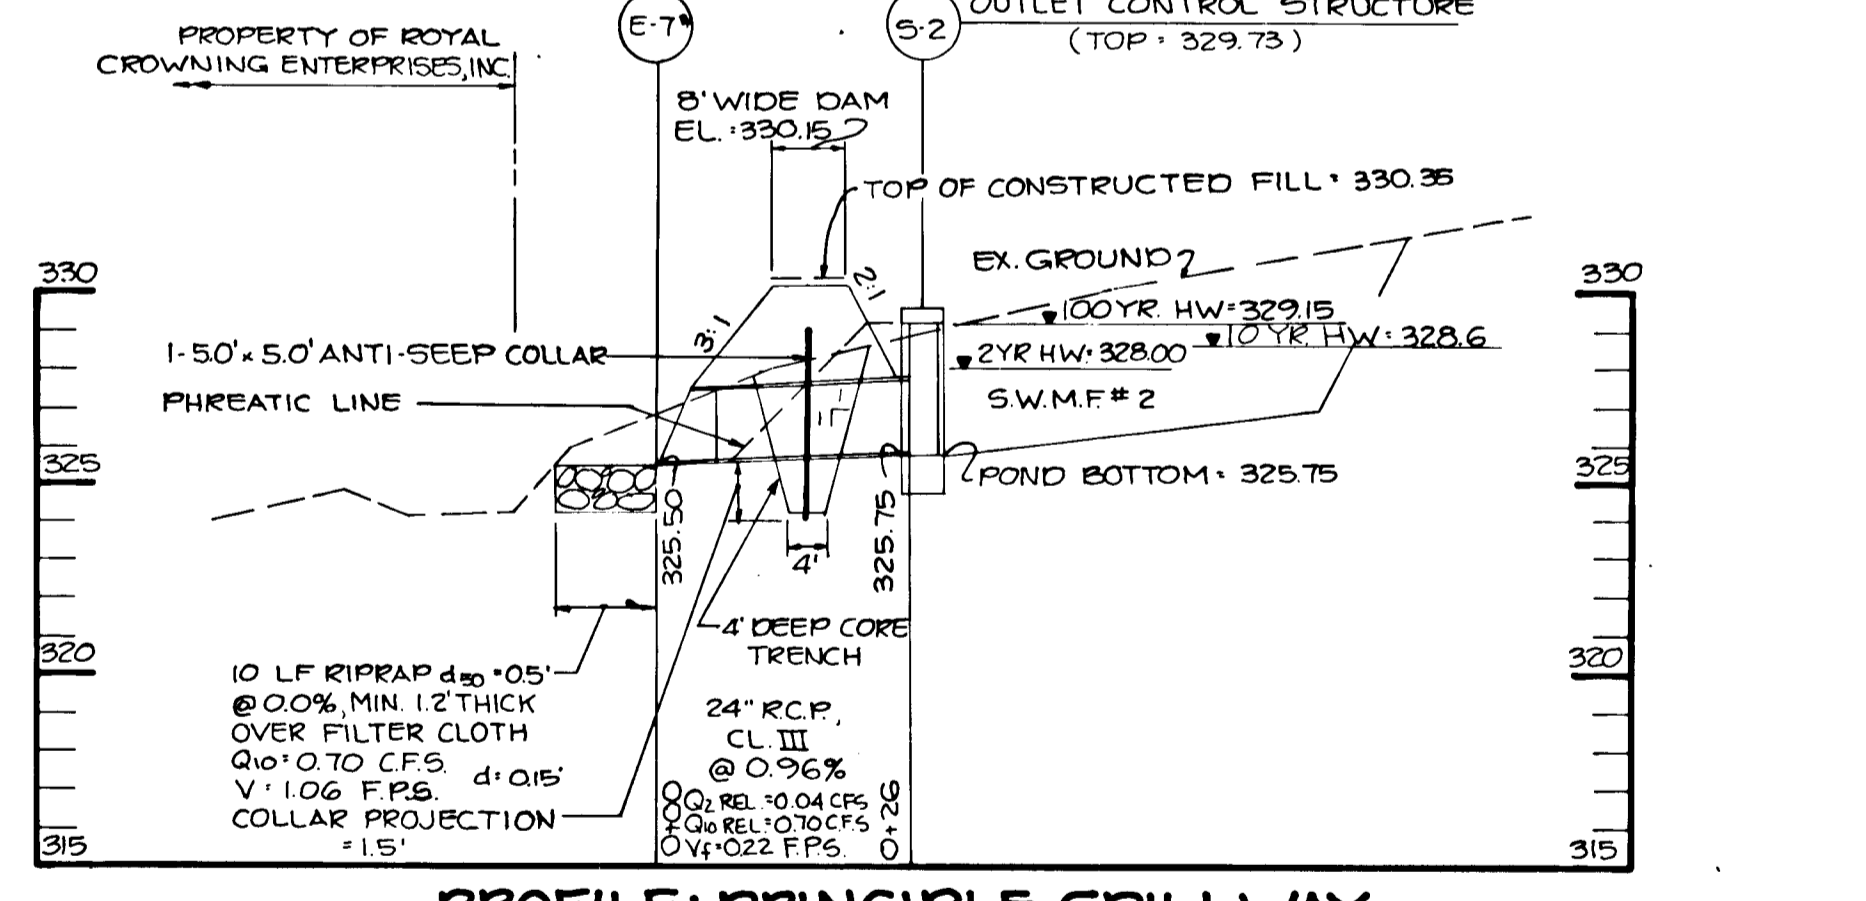

BY THE DEVELOPER:
"I CERTIFY THAT ALL DEVELOPMENT AND/OR CONSTRUCTION WILL BE DONE ACCORDING TO THESE PLANS, AND THAT ANY RESPONSIBLE PERSONNEL INVOLVED IN THE CONSTRUCTION PROJECT WILL HAVE A CERTIFICATE OF ATTENDANCE AT A DEPARTMENT OF NATURAL RESOURCES APPROVED TRAINING PROGRAM FOR THE CONTROL OF SEDIMENT AND EROSION BEFORE BEGINNING THE PROJECT. I WILL PROVIDE THE HOWARD SOIL CONSERVATION DISTRICT WITH AN 'AS-BUILT' PLAN OF FOUNDS NO. 1 AND 2 WITHIN 30 DAYS OF COMPLETION. I ALSO AUTHORIZE PERIODIC ON-SITE INSPECTION BY THE HOWARD SOIL CONSERVATION DISTRICT."
Arthur E. Muegge 5-26-88
ENGINEER DATE

BY THE ENGINEER:
"I CERTIFY THAT THIS PLAN FOR POND CONSTRUCTION, EROSION AND SEDIMENT CONTROL REPRESENTS A PRACTICAL AND WORKABLE PLAN BASED ON MY PERSONAL KNOWLEDGE OF THE SITE CONDITIONS. THIS PLAN WAS PREPARED IN ACCORDANCE WITH THE REQUIREMENTS OF THE HOWARD SOIL CONSERVATION DISTRICT. I HAVE NOTIFIED THE DEVELOPER THAT HE MUST PROVIDE THE HOWARD SOIL CONSERVATION DISTRICT WITH AN 'AS-BUILT' PLAN OF FOUNDS NO. 1 AND 2 WITHIN 30 DAYS OF COMPLETION."
Arthur E. Muegge 5-21-88
ENGINEER DATE

THESE PLANS HAVE BEEN REVIEWED FOR THE HOWARD SOIL CONSERVATION DISTRICT AND MEET THE TECHNICAL REQUIREMENTS FOR SMALL POND CONSTRUCTION, SOIL EROSION AND SEDIMENT CONTROL.
James McHelm 6/23/88
U.S. SOIL CONSERVATION SERVICE DATE

THESE PLANS FOR SMALL POND CONSTRUCTION, SOIL EROSION AND SEDIMENT CONTROL MEET THE REQUIREMENTS OF THE HOWARD SOIL CONSERVATION DISTRICT.
APPROVED *Robert W. Zehm* 6/24/88
HOWARD COUNTY DATE

APPROVED: HOWARD COUNTY DEPARTMENT OF PLANNING AND ZONING.
Marsha J. Campbell 12-2-88
CHIEF, DIVISION OF COMMUNITY PLANNING AND LAND DEVELOPMENT DATE

APPROVED: HOWARD COUNTY DEPARTMENT OF PUBLIC WORKS
Donald B. Jepsen 10/27/88
Chief, Land Development Division DATE

Lawrence W. Wilcox 11/20/88
Chief, Bureau of Highways DATE

W. S. ... 11-16-88
Chief, Bureau of Engineering DATE


OWNER/DEVELOPER
H&A CONSTRUCTION CO., INC.
13 C STREET
LAUREL, MARYLAND 20707

PROJECT
PAINTER'S HILL SECTION ONE
AREA TAX MAP 87 ELECTION DISTRICT PARCEL 467 P 85-53 HOWARD COUNTY, MARYLAND 5-86-15


TITLE
STORM WATER MANAGEMENT SPECIFICATIONS AND DETAILS

THE RIEMER GROUP, INC.
The Riemer Group, Inc. A Land Planning, Design & Civil Engineering Firm
3105 North Ridge Road, Ellicott City, Maryland 21043 (301) 461-2690

DATE 5-31-88
DESIGNED BY: J.J.B.
DRAWN BY: D.V.P.
PROJECT NO: 22200
DATE OCTOBER 2, 1987
SCALE: AS SHOWN
DRAWING NO. 5 OF 7

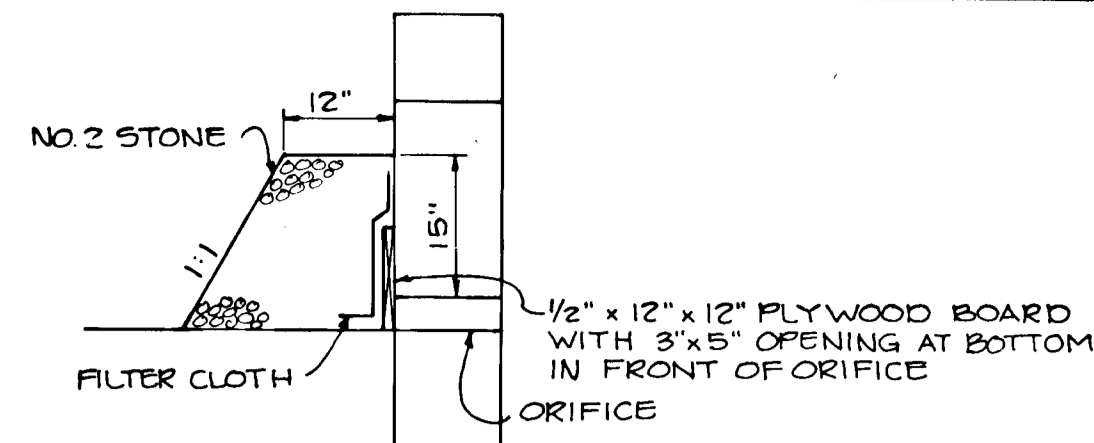


LOW FLOW ORIFICE BLOCKING DETAIL @ S-3
NO SCALE

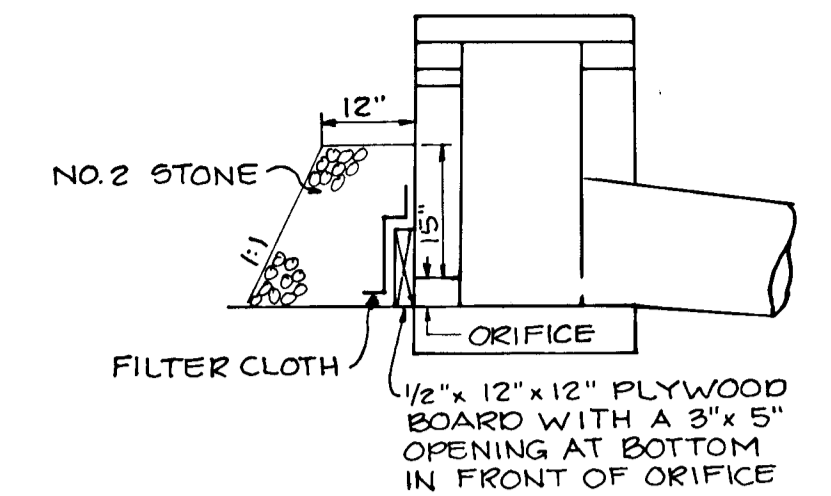


LOW FLOW ORIFICE BLOCKING DETAIL @ S-2
NO SCALE

SEQUENCE OF CONSTRUCTION

1. OBTAIN A GRADING PERMIT.
2. INSTALL STABILIZED CONSTRUCTION ENTRANCE, EARTH DIKES, AND SILT FENCE. INSTALL STORM WATER MANAGEMENT FACILITIES, BLOCKING LOW FLOW ORIFICES. (5 DAYS)
3. CLEAR AND GRUB AREA WITHIN LIMITS OF DISTURBANCE (5 DAYS)
4. GRADE SITE, STABILIZE PER TEMPORARY SEEDING NOTES. (6 DAYS)
5. INSTALL UTILITIES AND STABILIZE DISTURBED AREAS PER TEMPORARY SEEDING NOTES. (2 WEEKS)
6. INSTALL CURB AND GUTTER AND PAVE ROADS. (10 DAYS)
7. FINE GRADE AS NEEDED, STABILIZE ALL DISTURBED AREAS PER PERMANENT SEEDING NOTES. (3 DAYS)
8. AFTER OBTAINING PERMISSION FROM THE HOWARD COUNTY SEDIMENT CONTROL INSPECTOR REMOVE TEMPORARY SEDIMENT CONTROL MEASURES AND RESTORE TEMPORARY TRAPS INTO SWM FACILITIES BY:
 - A. PUMP STANDING WATER ONTO A STABILIZED OUTFALL.
 - B. REMOVE SEDIMENT AND DEPOSIT ON A SITE WITH APPROVED SEDIMENT CONTROL.
 - C. REMOVE LOW FLOW ORIFICE BLOCKING, RESTORE GRADES TO DESIGN ELEVATIONS AND STABILIZE IN ACCORDANCE WITH PERMANENT SEEDING NOTES.
 - D. REMOVE REMAINING SEDIMENT CONTROL MEASURES AND STABILIZE ANY DISTURBED AREAS IN ACCORDANCE WITH PERMANENT SEEDING NOTES.

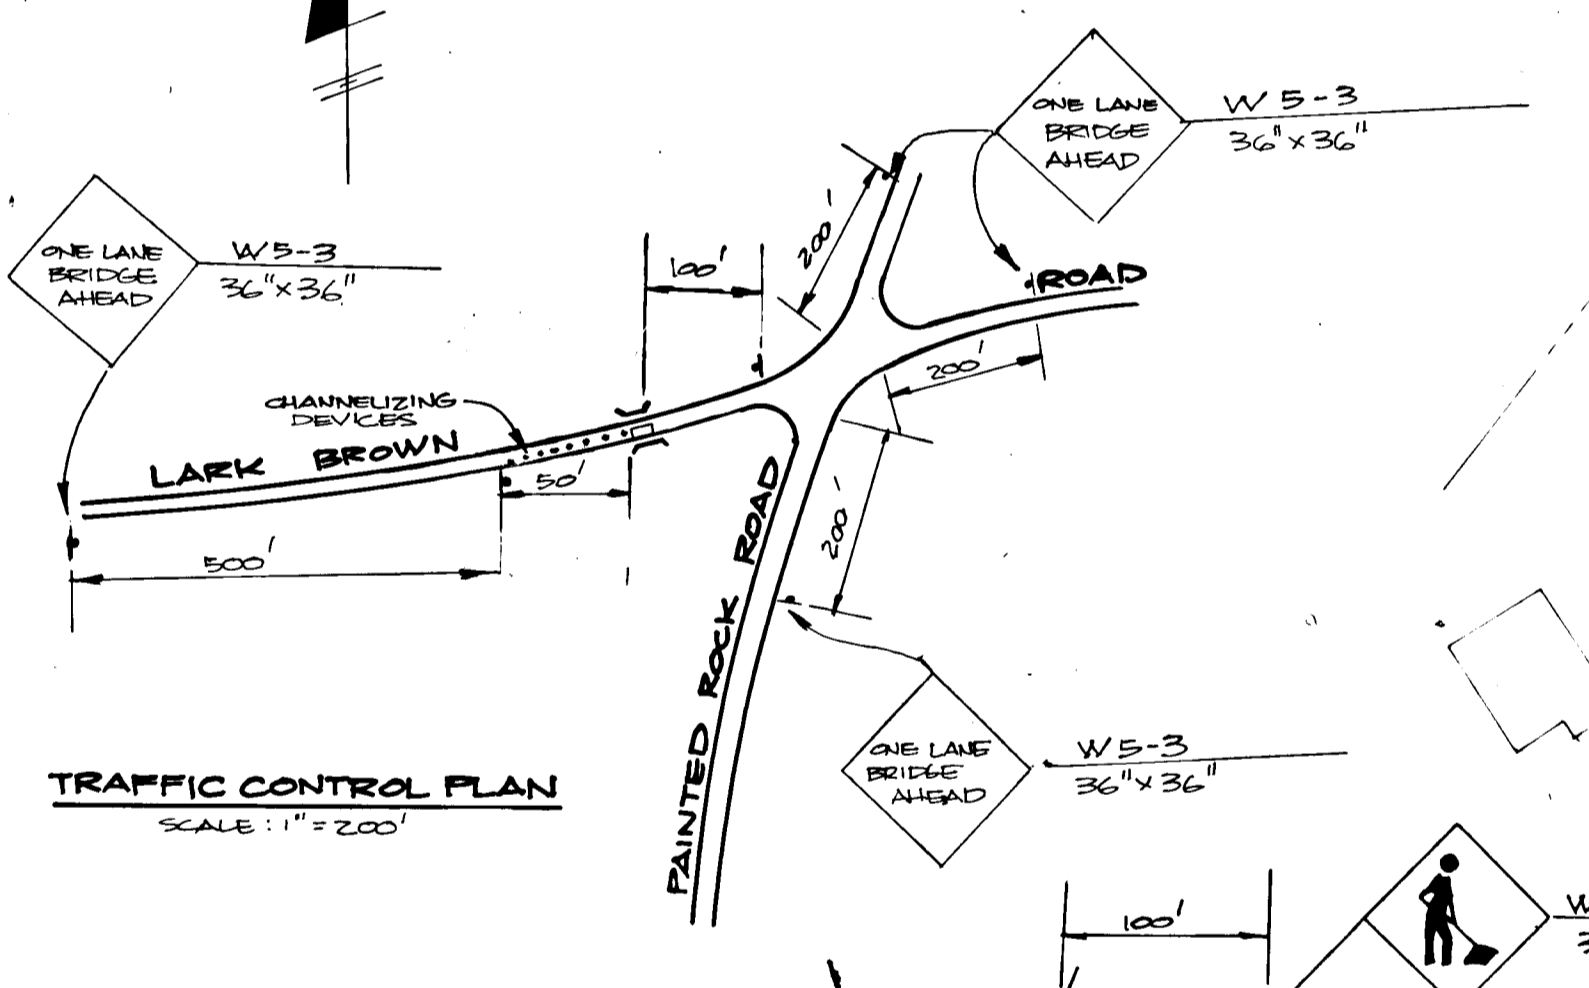


TRAFFIC CONTROL PLAN
SCALE 1" = 200'

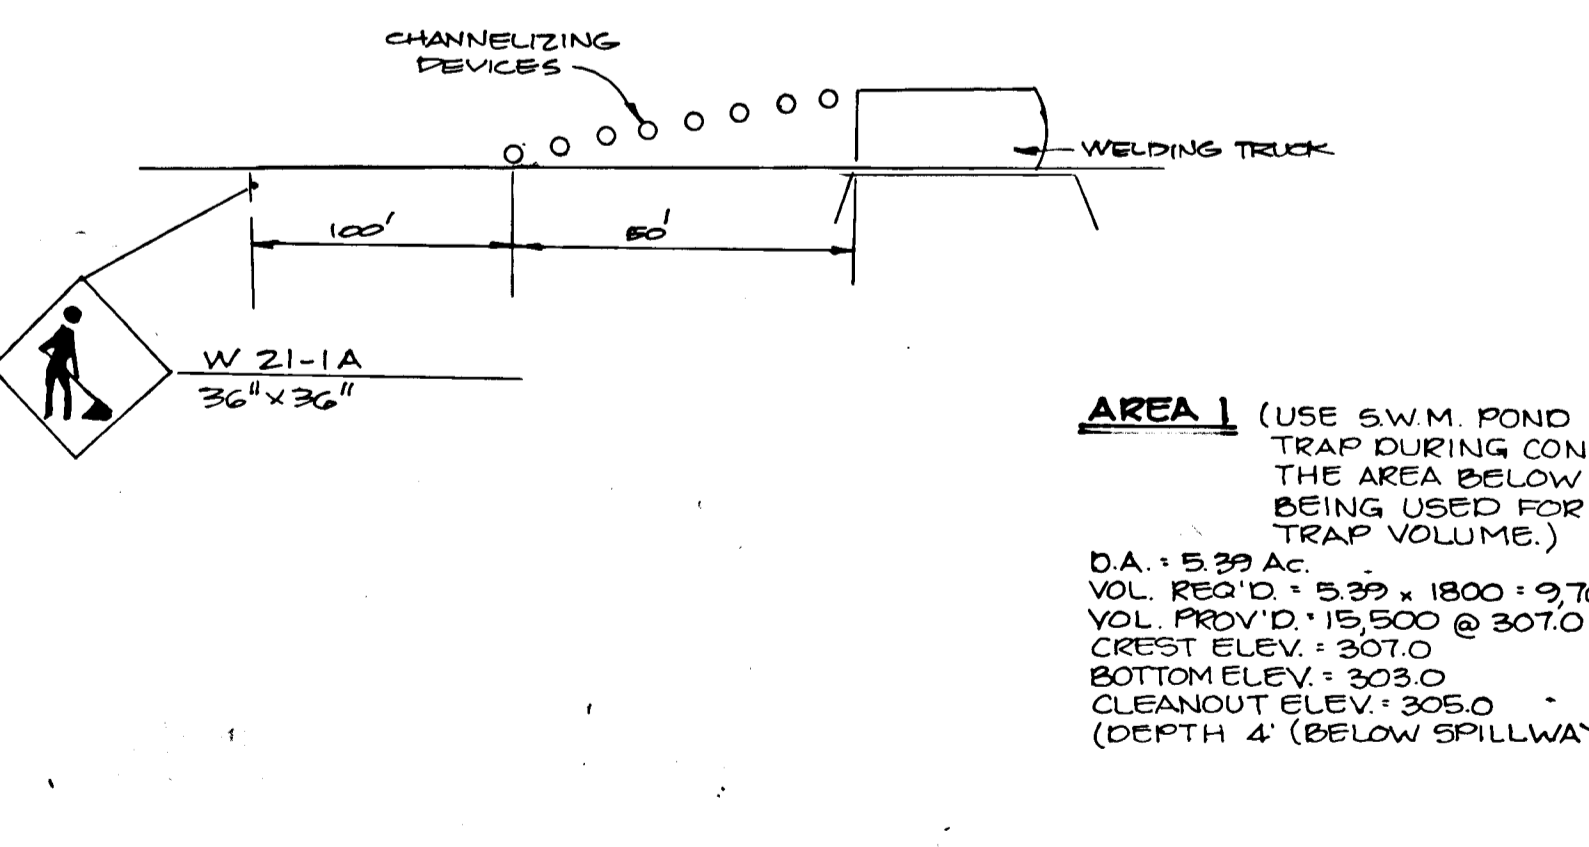

AREA 1 (USE SWM POND AS SEDIMENT TRAP DURING CONSTRUCTION WITH THE AREA BELOW NORMAL POOL BEING USED FOR SEDIMENT TRAP VOLUME.)
D.A. = 5.39 AC.
VOL. REQ'D = 5,329 x 1800 = 9,702 C.F.
VOL. PROVIDED = 15,500 @ 307.0 (NORMAL POOL)
CREST ELEV. = 307.0
BOTTOM ELEV. = 303.0
CLEANOUT ELEV. = 305.0
(DEPTH 4' BELOW SPILLWAY)

AREA 3 (STONE OUTLET SEDIMENT TRAP MODIFIED, USE OUTLET CONTROL STRUCTURE FOR SPILLWAY - SEE DETAIL, SHT. 5)
D.A. = 0.85 AC.
VOL. REQ'D = 0.85 x 1800 = 1530 C.F.
VOL. PROVIDED = 2,530 C.F. @ CREST
CREST ELEV. = 332.1
BOTTOM ELEV. = 320.0
CLEANOUT ELEV. = 331.0
DEPTH = 2.1' (BELOW SPILLWAY)
SPILLWAY WIDTH = 3' (WEIR 1) AND 4' (WEIR 2)

AREA 2 (PIPE OUTLET SEDIMENT TRAP MODIFIED, USE OF OUTLET CONTROL STRUCTURE FOR SPILLWAY - SEE DETAIL, SHT. 5)
D.A. = 2.82 AC.
VOL. REQ'D = 2.82 x 1,800 = 5,076 C.F.
VOL. PROVIDED = 8,356 C.F. @ CREST
CREST ELEV. = 328.0
BOTTOM ELEV. = 325.75
CLEANOUT ELEV. = 326.5
DEPTH = 2.25' (BELOW SPILLWAY)
SPILLWAY WIDTH = 0.5' (WEIR 1) AND 14' (WEIR 2)

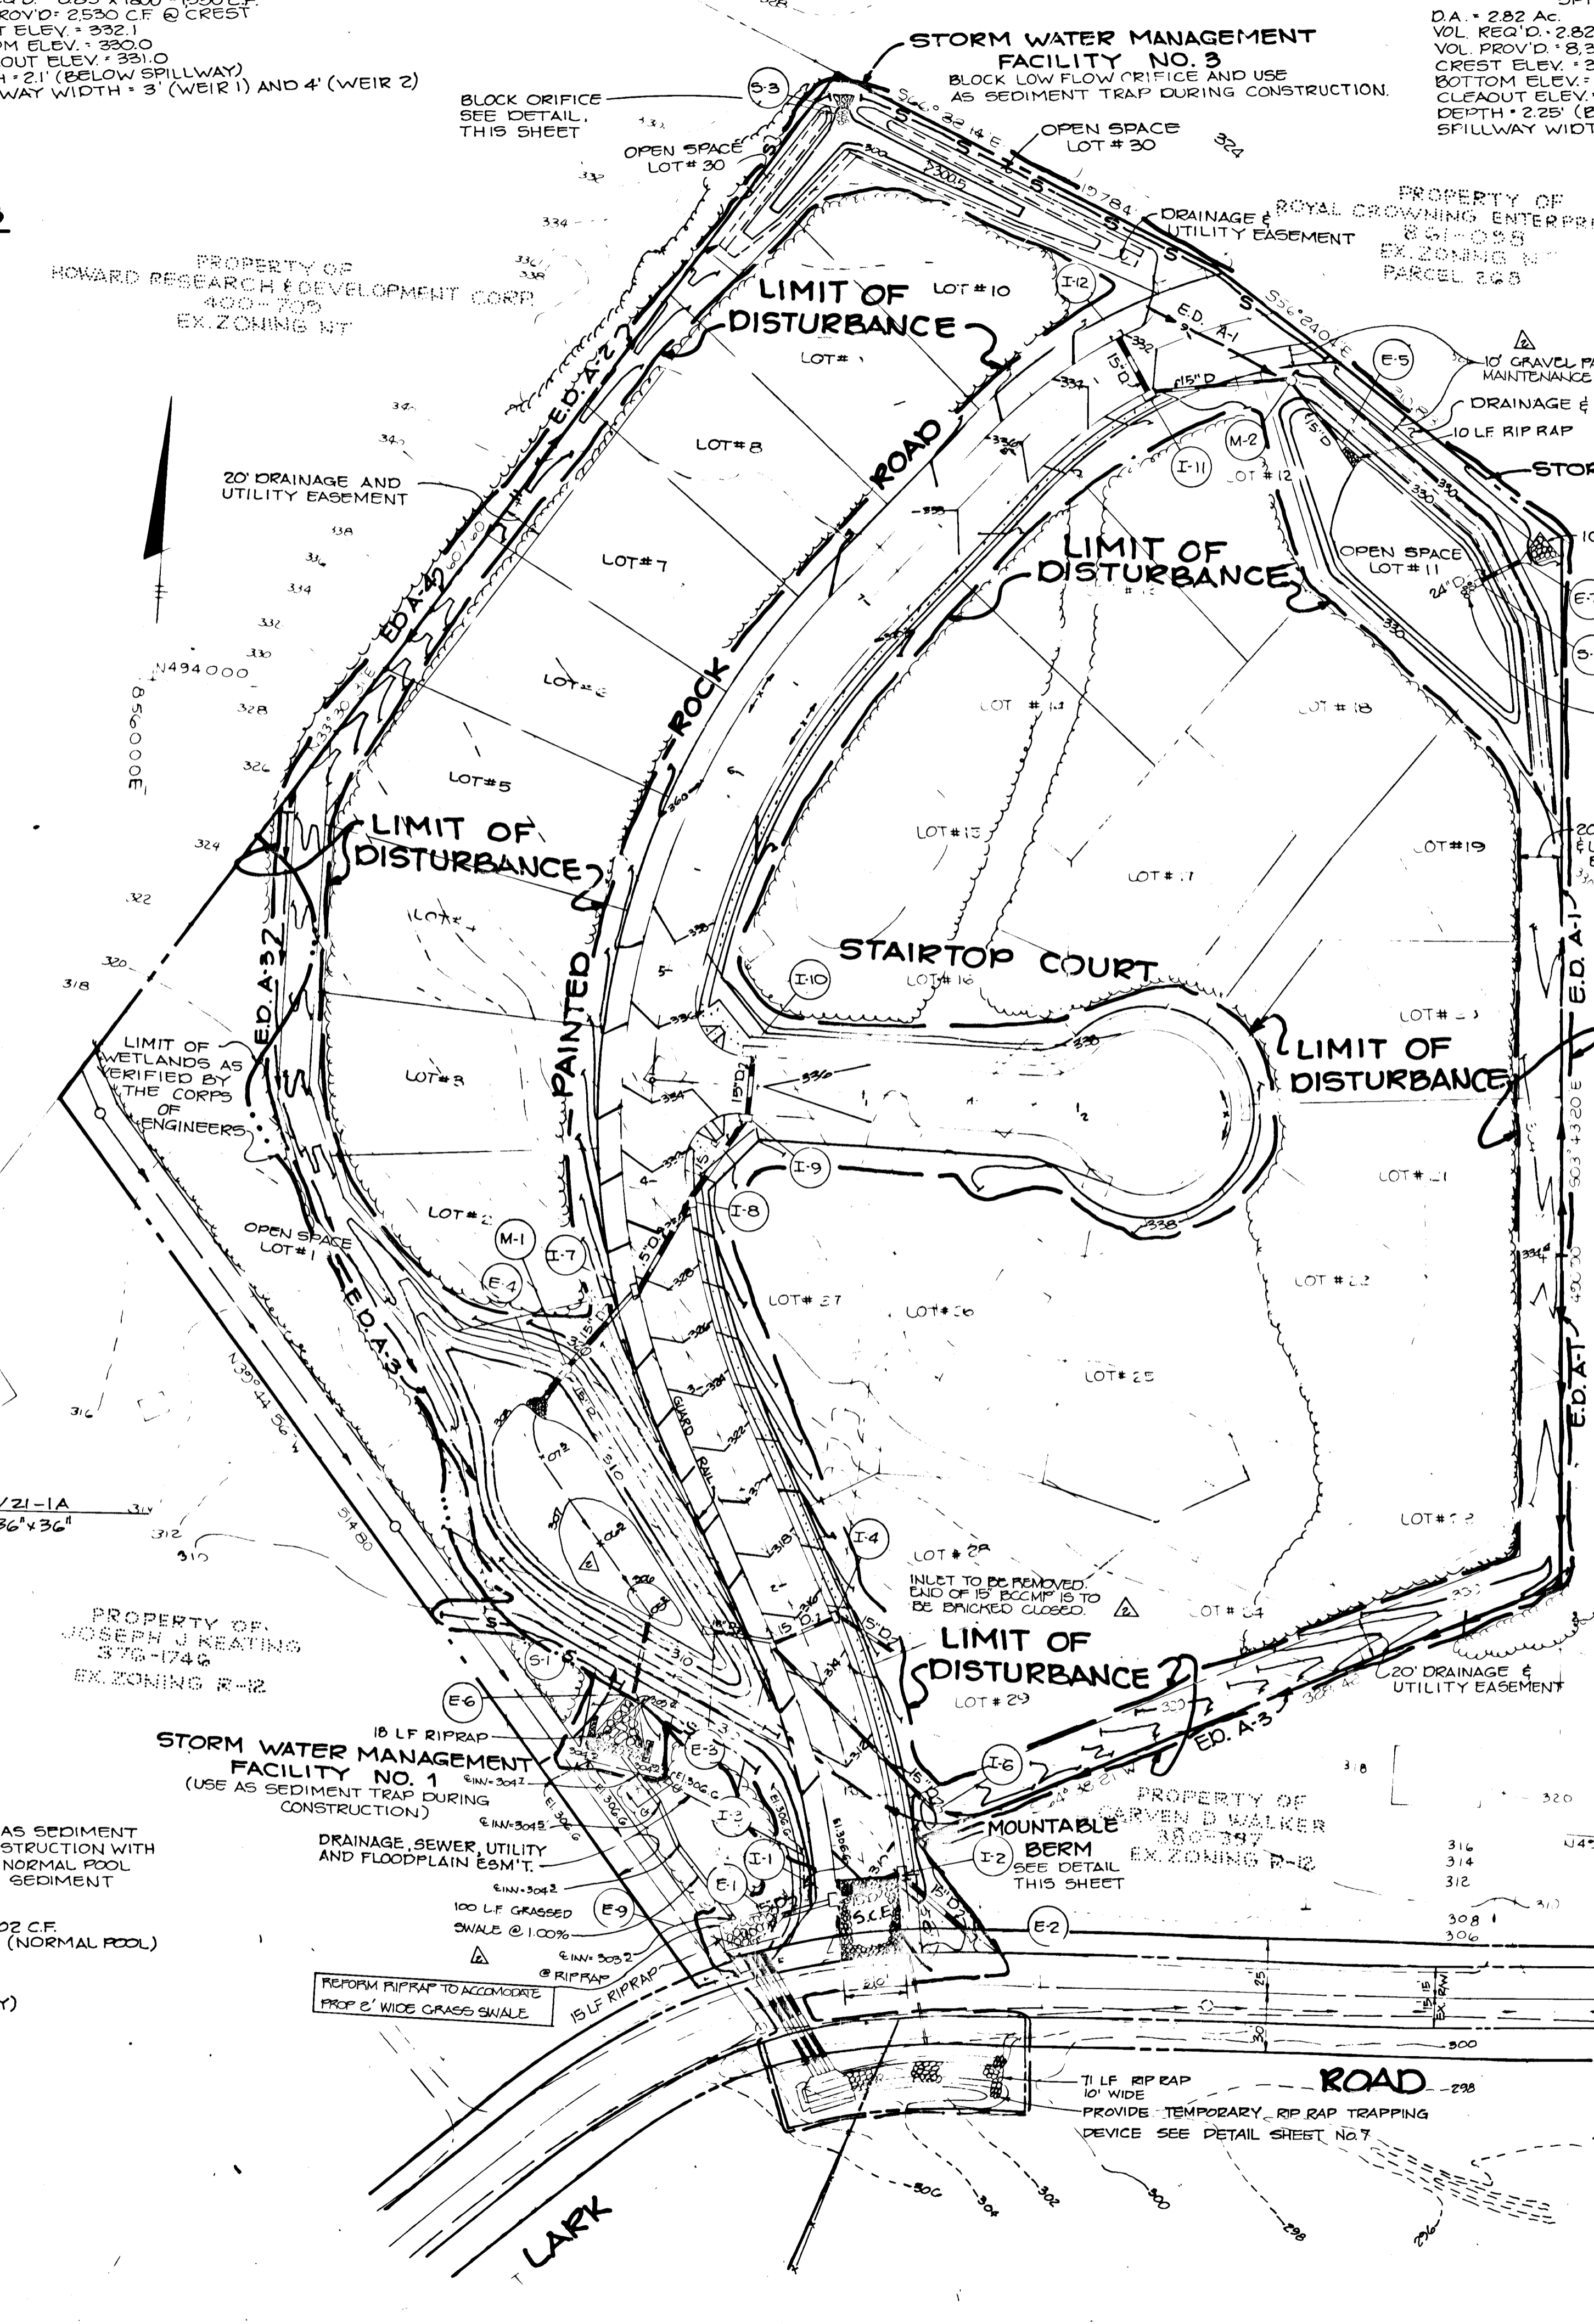

MOUNTABLE BERM
NO SCALE

BY THE DEVELOPER:
"I CERTIFY THAT ALL DEVELOPMENT AND/OR CONSTRUCTION WILL BE DONE ACCORDING TO THESE PLANS, AND THAT ANY RESPONSIBLE PERSONNEL INVOLVED IN THE CONSTRUCTION PROJECT WILL HAVE A CERTIFICATE OF ATTENDANCE AT A DEPARTMENT OF NATURAL RESOURCES APPROVED TRAINING PROGRAM FOR THE CONTROL OF SEDIMENT AND EROSION BEFORE BEGINNING THE PROJECT. I WILL PROVIDE THE HOWARD SOIL CONSERVATION DISTRICT WITH AN 'AS-BUILT' PLAN OF POND NO. 1 AND 2 WITHIN 30 DAYS OF COMPLETION. I ALSO AUTHORIZE PERIODIC ON-SITE INSPECTION BY THE HOWARD SOIL CONSERVATION DISTRICT."
Thyges Rasmussen 5-26-88
DEVELOPER DATE

BY THE ENGINEER:
"I CERTIFY THAT THIS PLAN FOR POND CONSTRUCTION, EROSION AND SEDIMENT CONTROL REPRESENTS A PRACTICAL AND WORKABLE PLAN BASED ON MY PERSONAL KNOWLEDGE OF THE SITE CONDITIONS. THIS PLAN WAS PREPARED IN ACCORDANCE WITH THE REQUIREMENTS OF THE HOWARD SOIL CONSERVATION DISTRICT. I HAVE NOTIFIED THE DEVELOPER THAT HE MUST PROVIDE THE HOWARD SOIL CONSERVATION DISTRICT WITH AN 'AS-BUILT' PLAN OF POND NO. 1 AND 2 WITHIN 30 DAYS OF COMPLETION."
Arthur E. Muegge 5-31-88
ENGINEER DATE

THESE PLANS HAVE BEEN REVIEWED FOR THE HOWARD SOIL CONSERVATION DISTRICT AND MEET THE TECHNICAL REQUIREMENTS FOR SMALL POND CONSTRUCTION, SOIL EROSION AND SEDIMENT CONTROL.
James M. Dehn 6/23/88
U.S. SOIL CONSERVATION SERVICE DATE

THESE PLANS FOR SMALL POND CONSTRUCTION, SOIL EROSION AND SEDIMENT CONTROL MEET THE REQUIREMENTS OF THE HOWARD SOIL CONSERVATION DISTRICT.
APPROVED *Robert J. Johns* 6/24/88
HOWARD S.C.D. DATE

115-01	REMOVE IS-5 POND OUTLET STRUCTURE, ADD GRAVEL PATHS FOR ROAD MAINTENANCE & OPEN SPACE ACCESS
DATE	NO REVISION
OWNER/DEVELOPER	
H.A. CONSTRUCTION CO. INC. 13 C STREET LAUREL, MARYLAND 20707	

PROJECT **PAINTER'S HILL SECTION ONE**

AREA TAX MAP 57 PAR E 1400
6TH ELECTION DISTRICT P-86-53
HOWARD COUNTY, MARYLAND S-86-15


TITLE **GRADING AND SEDIMENT CONTROL PLAN**

THE RIEMER GROUP, INC.
The Riemer Group, Inc. A Land Planning, Design & Civil Engineering Firm
3105 Heath Park Drive, Ellicott City, Maryland 21043 (301) 461-2690

5-31-88	DATE
DESIGNED BY LJD	
DRAWN BY DVP	
PROJECT NO 22200	
DATE OCTOBER 2, 1987	
SCALE 1" = 30'	
DRAWING NO. 6 OF 7	

APPROVED: HOWARD COUNTY OFFICE OF PLANNING AND ZONING
Janice S. D'Angelo 12-7-87
CHIEF, DIVISION OF COMMUNITY PLANNING AND LAND DEVELOPMENT DATE

APPROVED: HOWARD COUNTY DEPARTMENT OF PUBLIC WORKS
Donald J. Sporn 10/27/88
Chief, Land Development Division Date
Branville W. Wean 11/02/89
Chief, Bureau of Highways Date
Arthur E. Muegge 11-16-88
Chief, Bureau of Engineering Date

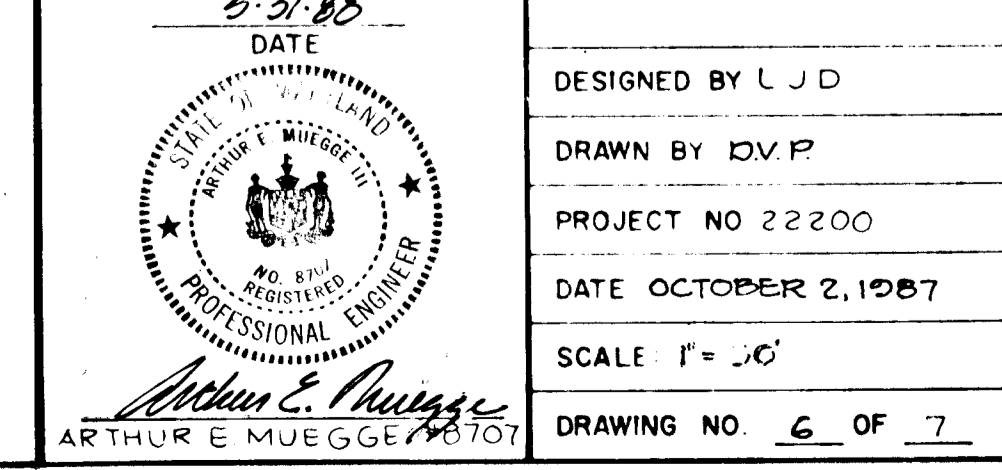

sediment control specifications

PERMANENT SEEDING

Seeded Preparation: Flat areas and slopes up to 3:1 slope shall be loose and friable to a depth of at least 3 inches. The top layer of soil shall be loosened by raking, discing or other acceptable means before seeding. Slopes steeper than 3:1 shall have the top 1 to 3 inches of soil loose and friable before seeding.

Soil Amendments: Use one of the following schedules.

Line and fertilizer according to soil tests. Line and fertilizer needs can be determined by a soil testing laboratory, such as the University of Maryland's Soil Testing Laboratory. In lieu of soil test results, use one of the following schedules.

- 1) Preferred - Apply 2 tons per acre dolomitic limestone (92 LBS./1000 SF) and 600 LBS. per acre 10-10-10 fertilizer (14 LBS./1000 SF) before seeding. Harrow or disc into upper three inches of soil. At time of seeding, apply 400 LBS. per acre 30-0-0 ureaform fertilizer (91 LBS./1000 SF).
2) Acceptable - Apply 2 tons per acre dolomitic limestone (92 LBS./1000 SF) and 1000 LBS. per acre 10-10-10 fertilizer (23 LBS./1000 SF) before seeding. Harrow or disc into upper three inches of soil.

On slopes steeper than 3:1 slope, the line and fertilizer shall be worked the best way possible. On sloping land, the final harrowing or discing operation should be on the contour wherever feasible. No attempt should be made to drag any disced area to make the soil surface smooth after discing.

Seeding:

For the periods March 1 thru April 30, and August 1 thru October 15. Seed with 60 LBS. per acre (1.4 LBS./1000 SF) of Kentucky 31 Tall Fescue.

For the period May 1 thru July 31. Seed with 60 LBS. Kentucky 31 Tall Fescue per acre and 2 LBS. per acre (.05 LBS./1000 SF) of Weeping Lovegrass.

For the period October 16 thru February 28, protect site by: Option (1) 2 tons per acre of well anchored straw mulch and seed as soon as possible in the spring.

- Option (2) Use sod.
Option (3) Seed with 60 LBS./acre (1.4 LBS./1000 SF) Kentucky 31 Tall Fescue and mulch with 2 tons per acre well-anchored straw.

Apply seed uniformly with a cyclone seeder, drill, cultipacker seeder or hydroseeder (slurry includes seed and fertilizer) on a firm, moist seedbed. Maximum seeding depth should be 1/4 inch on clayey soils and 1/2 inch on sandy soils, when using other than hydroseeder method of application. Note: If hydroseeding is used and the seed and fertilizer is mixed, they shall be mixed on site and the seeding shall be immediate without interruption.

Mulching: See Mulching Specification.

Irrigation:

If soil moisture is deficient, supply new seedlings with adequate water for plant growth until they are firmly established, if feasible. This is especially true when seedlings are made late in the planting season, in abnormally dry or hot seasons, or on adverse sites.

Maintenance:

Irrigation - If soil moisture becomes deficient, irrigate to prevent loss of stand of protective vegetation, if feasible.

Repairs - Inspect all seeded areas for failures and make necessary repairs, replacements, and reseeding within the planting season, if possible.

- 1) If stand is inadequate for erosion control, overseed and fertilize using half of the rates originally applied.
2) If stand is over 50% damaged, reestablish following original line, fertilizer, seeded preparation and seeding recommendations.

TEMPORARY SEEDING

Seeded Preparation:

When the area to be seeded has been recently loosened to the extent that an adequate seedbed exists, no additional treatment is required. However, when the area to be seeded is packed, crusted, and hard, the top 3 inches of soil shall be loosened by discing, raking or other acceptable means before seeding.

Soil Amendments:

For temporary seedings, fertilizer shall be applied at the rate of 600 LBS. per acre (15 LBS./1000 SF), using 10-10-10 or equivalent. Soils which are highly acid should be limed.

Seeding:

For periods March 1 thru April 30 and August 15 thru November 15. Seed with 2 1/2 BU. per acre (3.2 LBS./1000 SF) of annual rye.

For the period May 1 thru August 14. Seed with 3 LBS. per acre (.07 LBS./1000 SF) of Weeping Lovegrass.

For the period November 16 thru February 28, protect site by: Applying 2 tons per acre of well anchored straw mulch and seed as soon as possible in the spring, or sod.

Apply seed uniformly with a cyclone seeder, drill, cultipacker seeder or hydroseeder (slurry includes seed and fertilizer).

Mulching: See Mulching Specification.

SOD

Sod shall be Kentucky 31 Tall Fescue or Kentucky Bluegrass/Red Fescue mixture, or approved equal. All sod shall be Maryland or Virginia State Certified or Maryland or Virginia State approved sod.

Site Preparation:

Fertilizer and lime application rates shall be determined by soil tests. Under unusual circumstances where there is insufficient time for a complete soil test, fertilizer and lime materials may be applied in amounts shown under B, below.

- A) Prior to sodding, the surface shall be cleared of all trash, debris, and of all roots, brush, wire, grade stakes and other objects that would interfere with planting, fertilizing or maintenance operations.
B) Where the soil is acid or composed of heavy clays, ground limestone shall be spread at the rate of 2 tons per acre (100 LBS./1000 SF). In all soils 1000 LBS. per acre (25 LBS./1000 SF) of 10-10-10 fertilizer or equivalent shall be uniformly applied and mixed into the top 3 inches of soil with the required lime.
C) All areas receiving sod shall be uniformly fine graded. Hard-packed earth shall be scarified prior to placement of sod.

BRIDGE CONSTRUCTION NOTES

ALL WELDING WORK WILL BE DONE BY A WELDER CERTIFIED IN THE STATE OF MARYLAND. ALL WORK ON BRIDGE SHOULD BE IN ACCORDANCE WITH HOWARD COUNTY, AA-5HT AND STATE ROAD SPECIFICATIONS, LATEST EDITION. THE DEVELOPER WILL NOTIFY THE BUREAU OF HIGHWAYS FIVE DAYS BEFORE STARTING WORK ON THE BRIDGE. THE DEVELOPER WILL BE RESPONSIBLE FOR THE BRIDGE DURING THE PERIOD OF TIME THE PROPOSED WORK IS BEING DONE. ANY DAMAGE TO THE BRIDGE DURING OR AS A RESULT OF THE DEVELOPERS MODIFICATION TO THE BRIDGE SHALL BE CORRECTED AT THE DEVELOPERS EXPENSE. CONTRACTOR SHALL NOTIFY THE BUREAU OF HIGHWAYS AND ARRANGE FOR WELD INSPECTION PRIOR TO LEAVING CONSTRUCTION SITE.

Sod Installation:

During periods of excessively high temperature the soil shall be lightly irrigated immediately prior to laying the sod.

The first row of sod shall be laid in a straight line with subsequent rows placed parallel to and tightly wedged against each other. Lateral joints shall be staggered to promote uniform growth and strength. Insure that sod is not stretched or overlapped and that all joints are butted tight in order to prevent voids which would cause air drying of the soils.

On sloping areas where erosion may be a problem, sod shall be laid with the long edges parallel to the contour and with staggered joints. Secure the sod by tamping and pegging or other approved methods.

As sodding is completed in any one section, the entire area shall be rolled or tamped to insure solid contact of roots with the soil surface. Sod shall be watered immediately after rolling or tamping until the underside of the new sod pad and soil surface below the sod are thoroughly wet. The operations of laying, tamping and irrigating for any piece of sod shall be completed within eight hours.

Sod Maintenance:

In the absence of adequate rainfall, watering shall be performed daily or as often as necessary during the first week and in sufficient quantities to maintain moist soil to a depth of 4 inches. Watering should be done during the heat of the day to prevent wilting.

After the first week, sod shall be watered as necessary to maintain adequate moisture and insure establishment.

First mowing should not be attempted until sod is firmly rooted. No more than 1/3 of the grass leaf shall be removed by the initial cutting or subsequent cuttings. Grass height shall be maintained between 2 and 3 inches unless otherwise specified.

MULCHING

Materials and Amounts:

- 1) Straw - Straw shall be unworted small grain applied at the rate of 1 1/2 to 2 tons per acre (70 to 90 LBS./1000 SF). Mulch materials shall be relatively free of all kinds of weeds and shall be free of prohibited noxious weeds such as: thistles, Johnsongrass and quackgrass. Spread uniformly by hand or mechanically. For uniform distribution of hand spread mulch, divide area into approximately 1000 SF sections and place 70 to 90 LBS. (two bales) of mulch in each section.
2) Asphalt emulsion or cutback asphalt at 600 to 1200 GALS. per acre (15 to 30 GALS./1000 SF). This is suitable for a limited period of time where travel by people, animals or machines is not a problem.
3) Synthetic soil stabilizers may be used according to manufacturer's recommendations, under suitable conditions.
4) Mulch matings such as jute or excelsior blanket shall be stapled to the surface in wet areas and on steep slopes. Lighter materials of paper, plastic and cotton mulch matings may be used where erosion hazard is not severe. If area is to be mowed, do not use metal staples.
5) Wood chips at the rate of approximately 6 tons per acre (275 LBS./1000 SF) may be used when available and when feasible to use.
6) Crushed rock, stones, gravel or shale blankets. Apply at rate of 20 to 100 tons per acre (900 to 4500 LBS./1000 SF) with coarsest material applied at the highest rate.

Mulch Anchoring


 












Mulch anchoring shall be accomplished immediately after mulch placement to minimize loss by wind or water. This may be done by one of the following methods, (listed by preference) depending upon size of area, erosion hazard, and cost. On sloping land, practice No. 1 below, should be done on the contour wherever possible, except "tracking" should be done up and down the slope with 1 1/2 inch clear marks running across the slope.

- 1) Mulch Anchoring Tool and Tracking. A mulch anchoring tool is a tractor drawn implement designed to punch and anchor mulch into the surface two (2) inches or less. This practice affords maximum erosion control but is limited to flatter slopes where equipment can operate safely - primarily used on flatter than 3:1 cut and fill slopes to cut the mulch into the soil. "Tracking" is used primarily on slopes steeper than 3:1 cut and fill slopes to cut the mulch into the soil with cleared tracks.
2) Mulch Matting. Staple lightweight biodegradable paper, plastic or cotton netting over the mulch according to manufacturer's recommendations.
3) Liquid Mulch Binders. Applications of liquid binder should be heavier at edges where wind catches mulch, in valleys and at crests of banks. The remainder of the area should be uniform in appearance. Caution should be used with asphalt in residential and similar areas.
a. Cutback asphalt - rapid curing (RC-70, RC-250 and RC-800) or medium curing (MC-250 or MC-800). Apply at the rate of 200 gallons per acre (5 GAL./1000 SF) on flat areas and on slopes and on slopes less than 8 feet high. On slopes 8 feet or more high, apply at the rate of 348 gallons per acre (8 GAL./1000 SF).
b. Emulsified asphalt - (SS-1, CSS-1, CMS-2, MS-2, RS-1, RS-2, CS-1, and CS-2). Apply at the rate of 200 gallons per acre (5 GAL./1000 SF) on flat areas and on slopes less than 8 feet high. On slopes 8 feet or more high, apply at the rate of 348 gallons per acre (8 GAL./1000 SF).
All asphalt designations are from the Asphalt Institute Specifications.
c. Synthetic binders such as Acrylic DLA (Agr-Tac), DCA-70, Petroset or Terra Tac may be used at rates recommended by the manufacturer to anchor mulch material.

- 4) Wood Cellulose Fiber Binder. The fiber binder shall be applied at a net dry weight of 750 LBS. per acre. The wood cellulose fiber shall be mixed with water, and the mixture shall contain a maximum of 50 LBS. of wood cellulose fiber per 100 gallons.
5) Peg and Twine. Drive 8 to 10 inch wooden pegs to within 2 to 3 inches of the soil surface every 4 feet in all directions. Stakes may be driven before or after applying mulch. Secure mulch to soil surface by stretching twine between pegs in a criss-cross within a square pattern. Secure twine around each peg with two or more round turns.

SEDIMENT CONTROL NOTES

- 1. A minimum of 24 hours notice must be given to the Howard County Office of Inspection and Permits prior to the start of any construction (992-2423)
2. All vegetative and structural practices are to be installed according to the provisions of this plan and are to be in conformance with the 1983 MARYLAND STANDARDS AND SPECIFICATIONS FOR SOIL EROSION AND SEDIMENT CONTROL.
3. Following initial soil disturbance or redistribution, permanent or temporary stabilization shall be completed within: a) 7 calendar days for all perimeter sediment control structures, dikes, perimeter slopes and all slopes greater than 3:1, b) 14 days as to all other disturbed or graded areas on the project site.
4. All sediment traps/basins shall be fenced and warning signs posted around their perimeter in accordance with Vol. 1, Chapter 12, of the HOWARD COUNTY DESIGN MANUAL, Storm Drainage.
5. All disturbed areas must be stabilized within the time period specified above in accordance with the 1983 MARYLAND STANDARDS AND SPECIFICATIONS FOR SOIL EROSION AND SEDIMENT CONTROL for permanent seedings (Sec. 51) and (Sec. 54), temporary seedings (Sec. 52) and mulching (Sec. 52). Temporary stabilization with mulch alone can only be done when recommended seedings do not allow for proper germination and establishment of grasses.
6. All sediment control structures are to remain in place and are to be maintained in operation until permission for their removal has been obtained from the Howard County Sediment Control Inspector.
7. Site Analysis:
Total Area of Site: 7.5 acres
Area Disturbed: 2.0 acres
Area to be roofed or paved: 0.5 acres
Area to be vegetatively stabilized: 5.0 acres
Total Cut: 1.5 Cu. yds.
Total Fill: 250 Cu. yds.
8. Any sediment control practice which is disturbed by grading activity for placement of utilities must be repaired on the same day of disturbance.
9. Additional sediment controls must be provided, if deemed necessary by the Howard County DPW sediment control inspector.
10. Site grading will begin only after all perimeter sediment control measures have been installed and are in a functioning condition.
11. Sediment will be removed from traps when its depth reaches the clean out elevation shown on the plans.

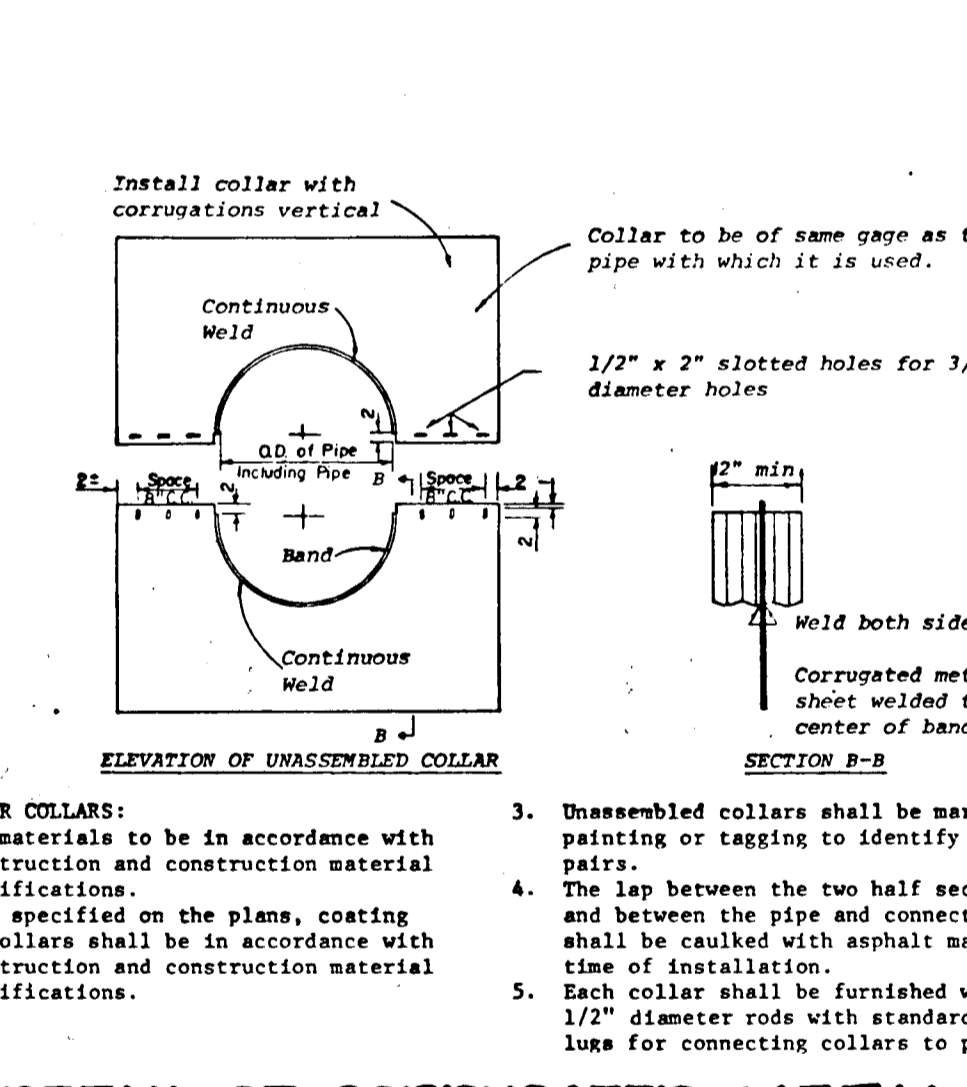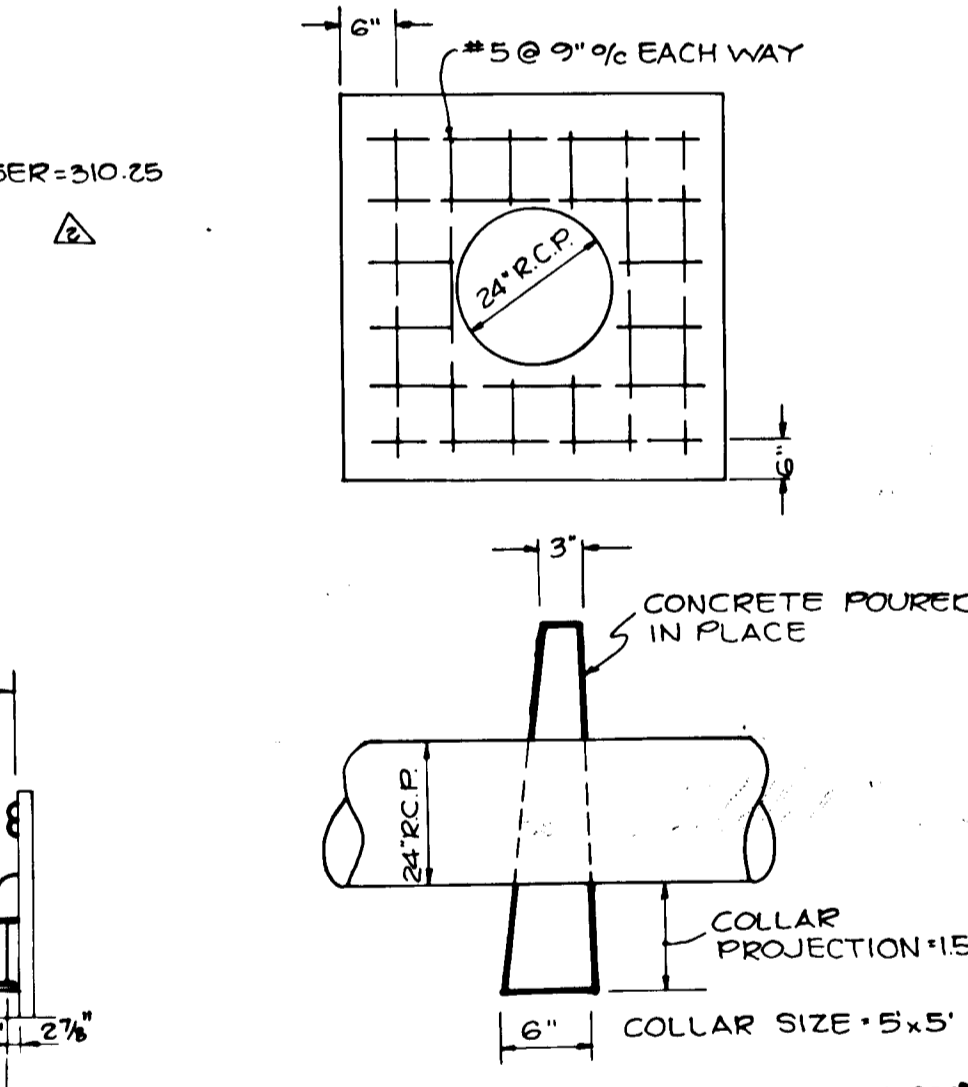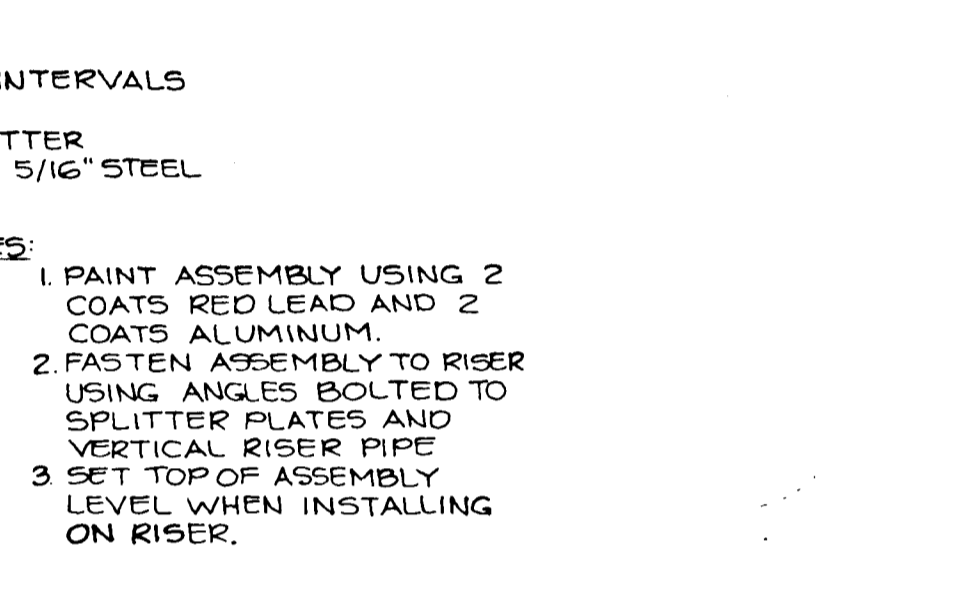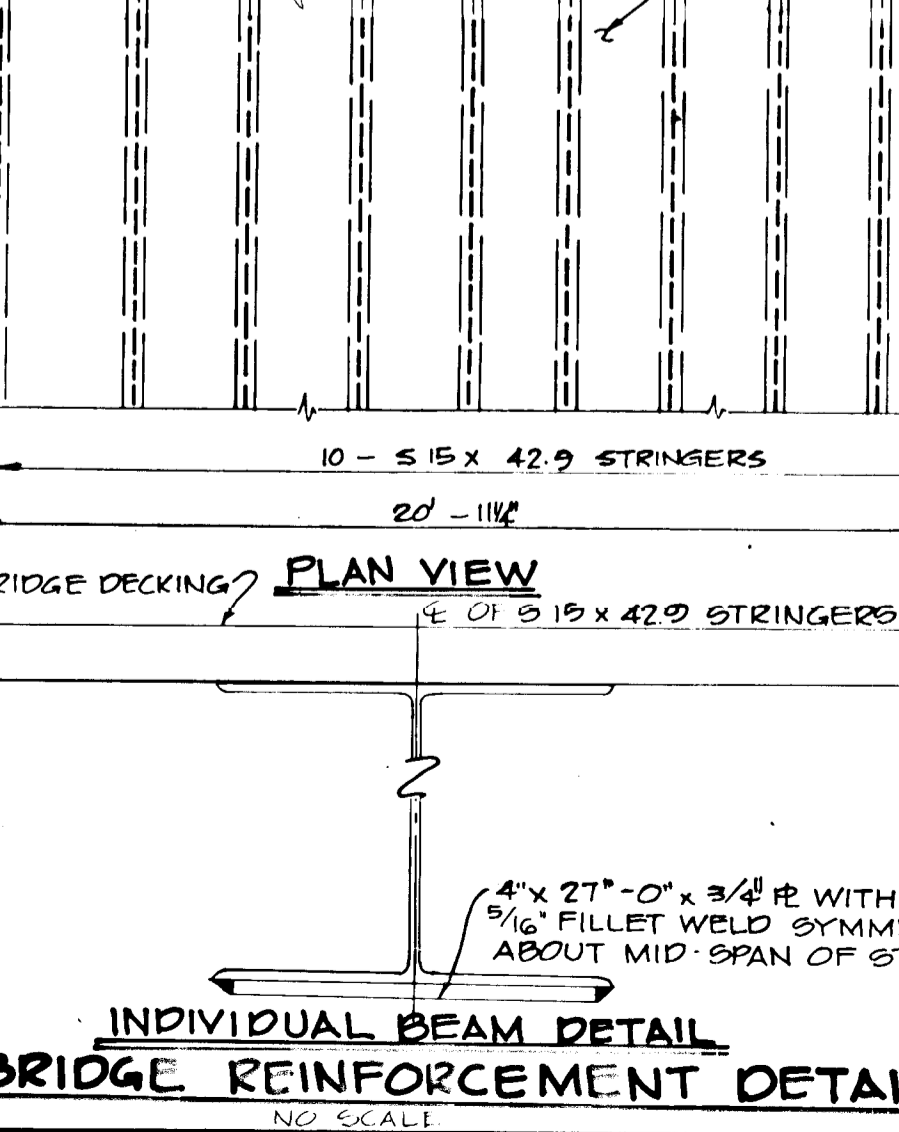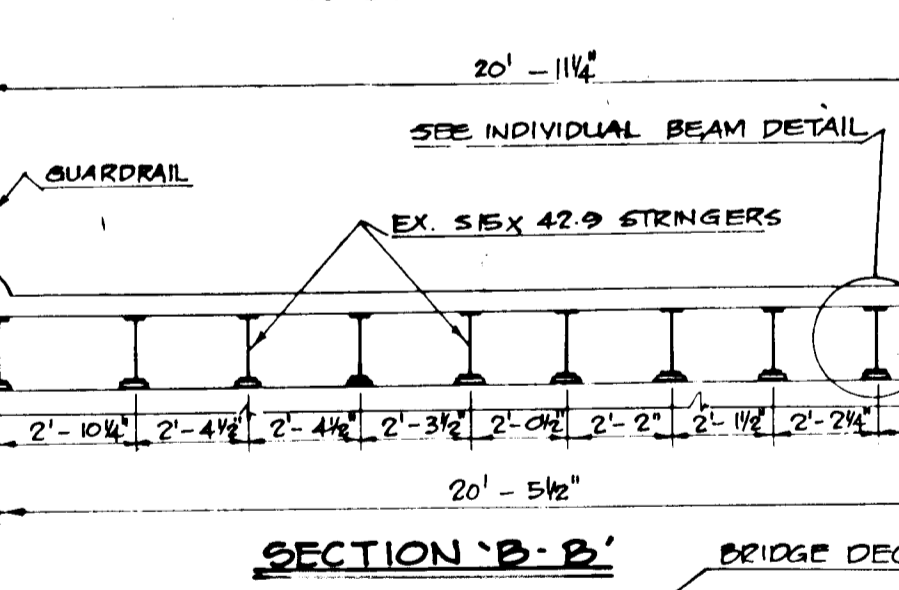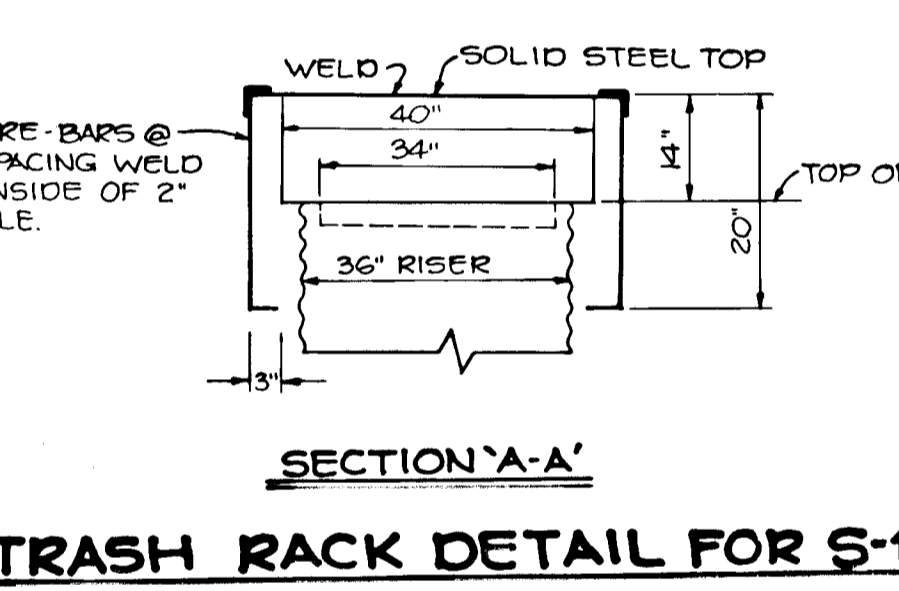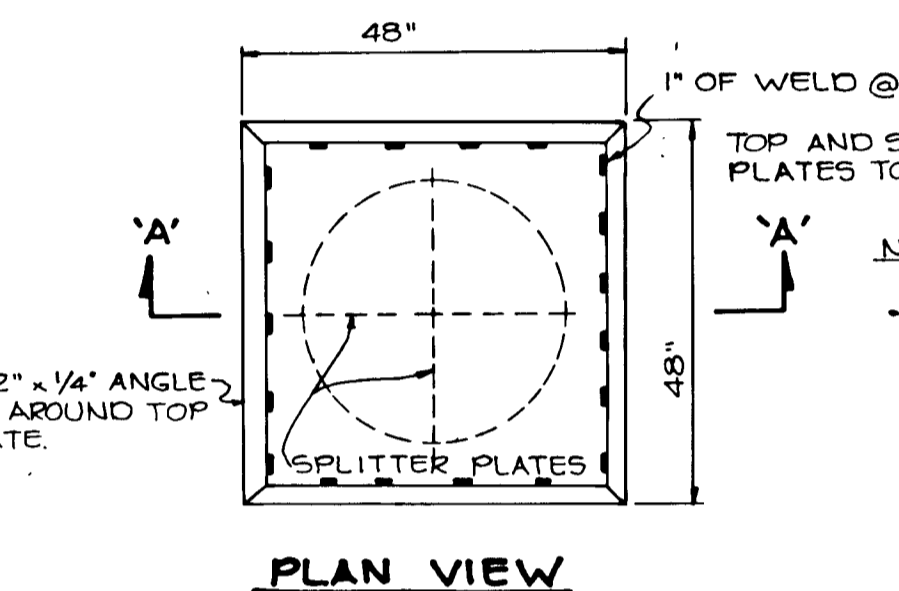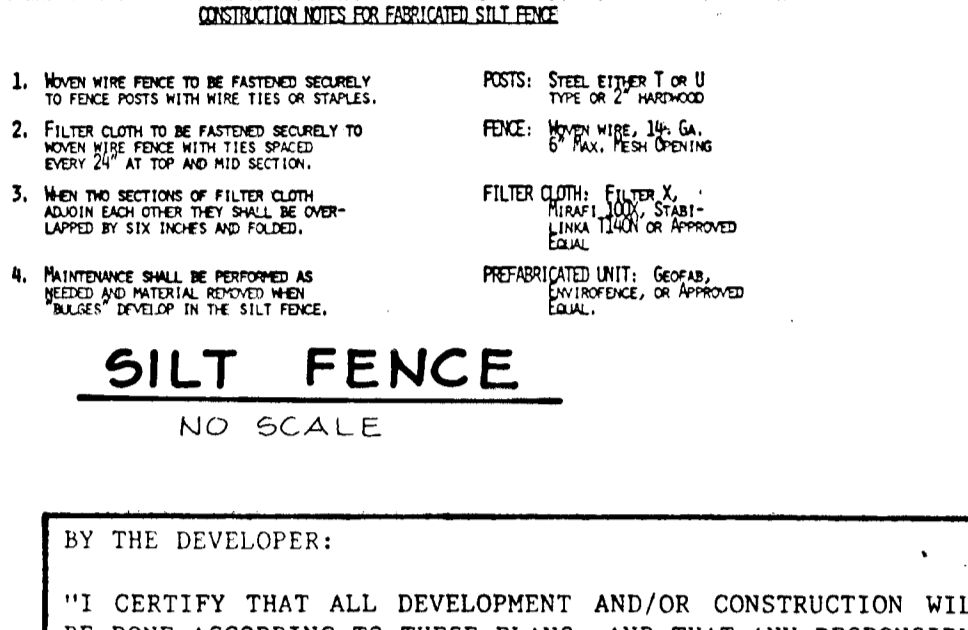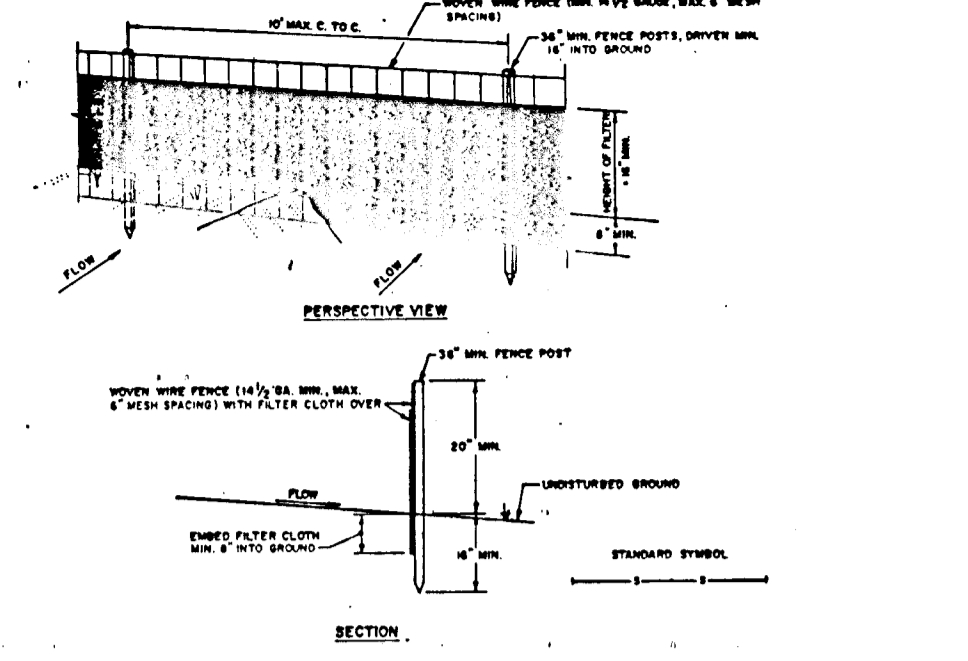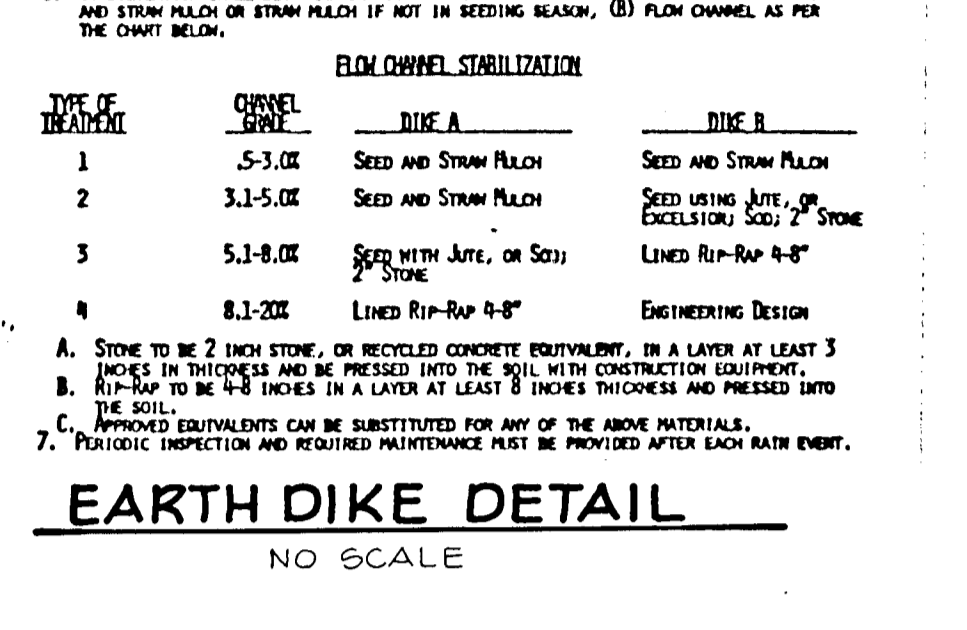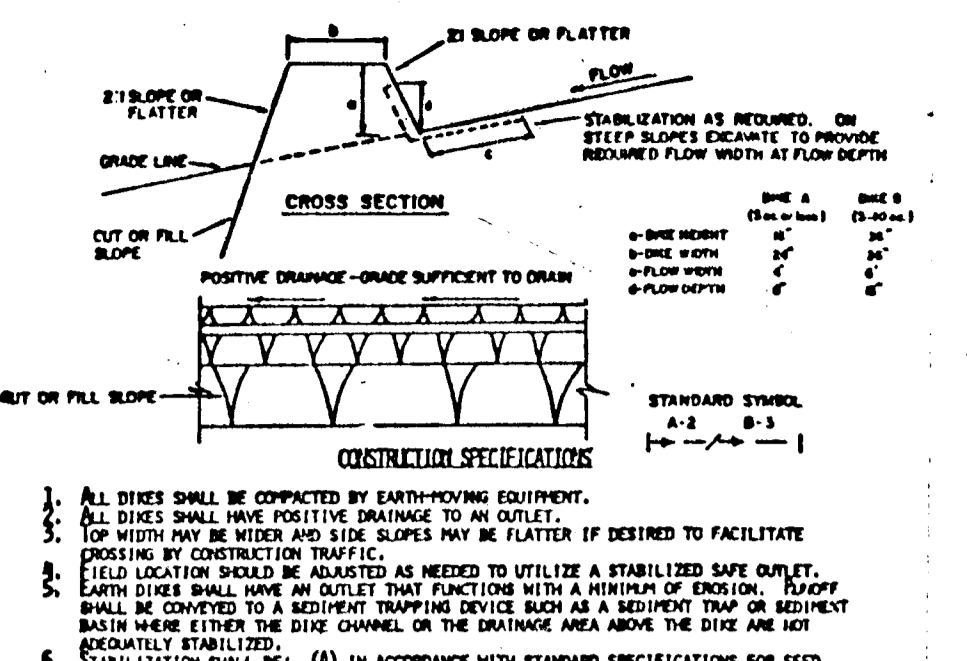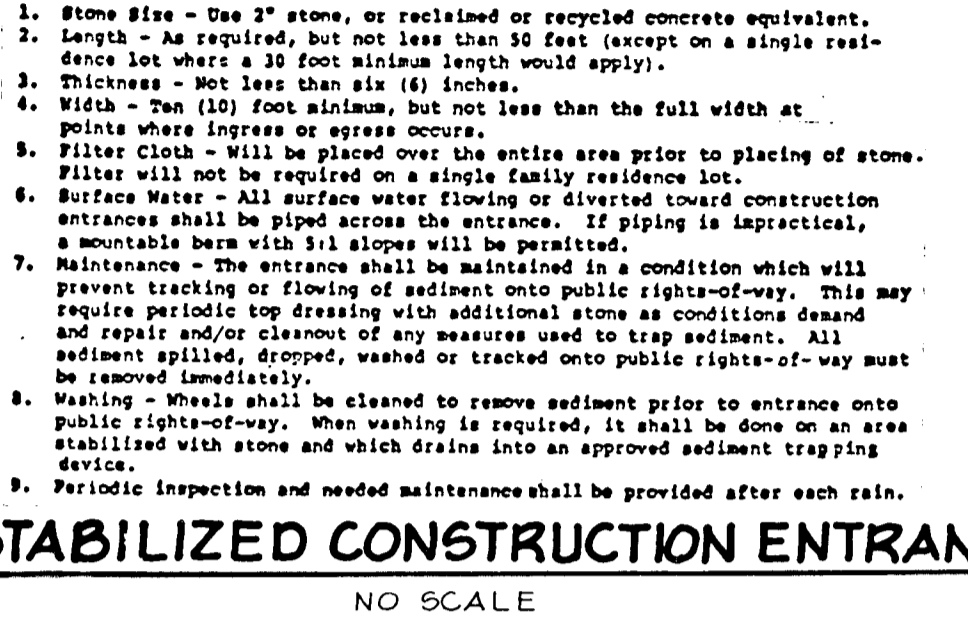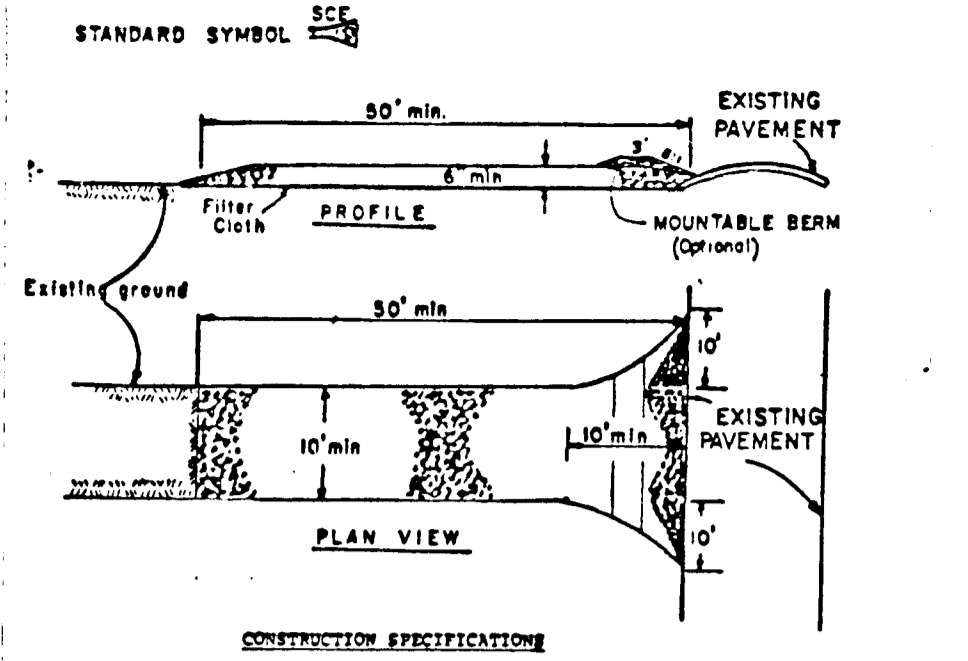

BY THE DEVELOPER: [Signature] DATE: 5-26-88

BY THE ENGINEER: [Signature] DATE: 5-31-88

APPROVED: [Signature] DATE: 6/24/88

OWNER/DEVELOPER: H A CONSTRUCTION CO. INC. 1201 S.E. LAUREL, MARYLAND 20707
PROJECT: PAINTER'S HILL SECTION ONE
AREA TAX MAP: 6TH ELECTION DISTRICT PARCEL 467 P 86-153 HOWARD COUNTY, MARYLAND 6-82-15
TITLE: SEDIMENT CONTROL NOTES AND DETAILS
THE RIEMER GROUP, INC. The Rierner Group, Inc. A Land Planning, Design & Civil Engineering Firm 3105 North Ridge Road, Ellicott City, Maryland 21043 (301) 461-2690
DATE: 5-26-88
DESIGNED BY: L.J.D.
DRAWN BY: J.C.R.
PROJECT NO: 22200
DATE: OCTOBER 2, 1987
SCALE: AS SHOWN
DRAWING NO. 7 OF 7
F-88-13