







DATE: \_\_\_\_\_ BY: \_\_\_\_\_  
 SURVEYED: \_\_\_\_\_  
 NOTE BOOK: \_\_\_\_\_  
 NO. \_\_\_\_\_  
 CHECKED: \_\_\_\_\_  
 DATE: \_\_\_\_\_

DATE: \_\_\_\_\_ BY: \_\_\_\_\_  
 SURVEYED: \_\_\_\_\_  
 NOTE BOOK: \_\_\_\_\_  
 NO. \_\_\_\_\_  
 CHECKED: \_\_\_\_\_  
 DATE: \_\_\_\_\_


### STORM DRAIN STRUCTURE SCHEDULE

No.	TYPE	TOP EL.	INV. IN	INV. OUT	LOCATION
I-30	A-5 Inlet, width 25 (S.D. 4.0)	343.92	338.02	335.27	Inlet 23.92 Lt. & Sta. 22+65.84
I-31	A-5 Inlet, width 25 (S.D. 4.0)	343.92	338.02	335.28	Inlet 23.92 Rt. & Sta. 22+65.84
S-15	Type 'A' Headwall (S.D. 5.1)	337.81	334.81	334.78	See Plan and Profile
M-25	Standard Manhole (S. 5.03)	342.41	339.72	339.32	BM 33.26 Lt. & Sta. 21+00.07
S-2	Special (See Sheet 7 of 11)	342.75	332.25	332.15	See Plan and Profile
S-3	Special (See Sheet 7 of 11)	342.40	333.96	333.20	See Plan and Profile


LOCAL ROAD - DESIGN SPEED 30 MPH - ZONING POK  
 MINOR COLLECTOR - DESIGN SPEED 35 MPH - ZONING POR

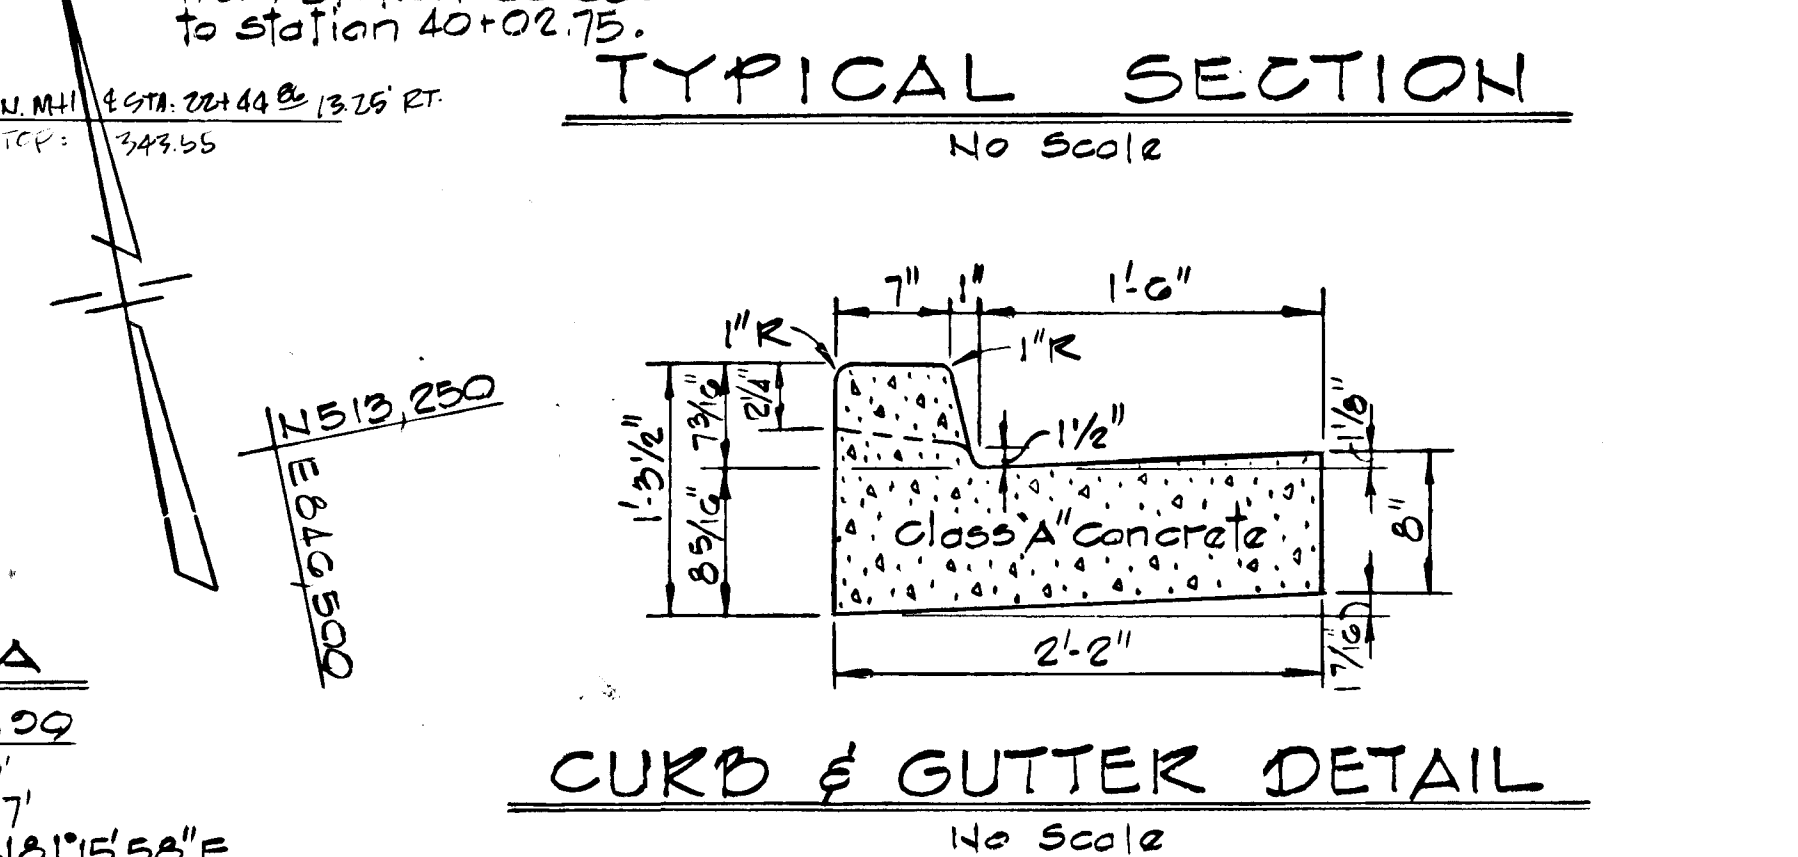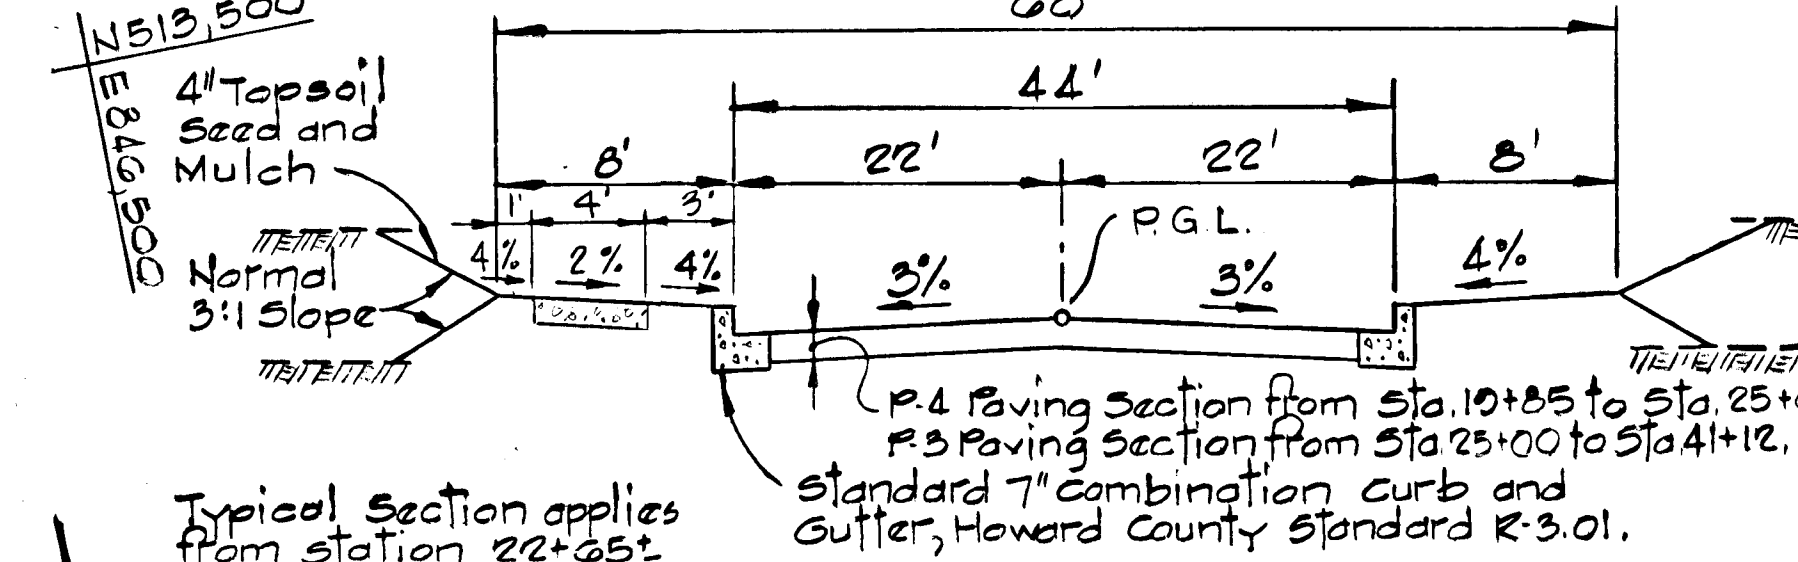


NOTE:  
 FOR EXISTING DORSEY HALL  
 ROAD CONSTRUCTION DRAWINGS  
 SEE SECTION 2 AREA 3 (F87-143).

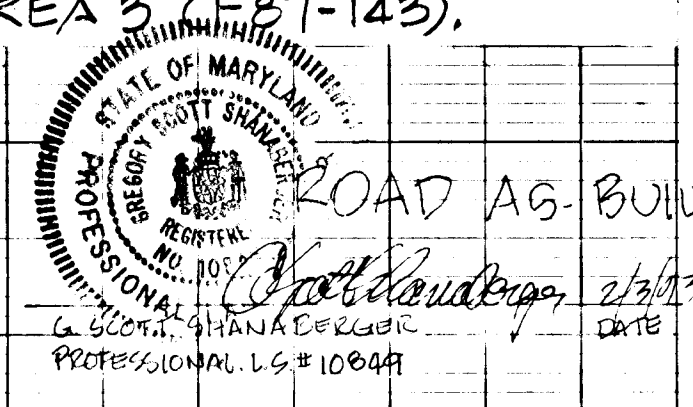


SHANBERGER & LANE  
 8726 TOWN & COUNTRY BLVD.  
 SUITE 104  
 ELLICOTT CITY, MARYLAND 21103

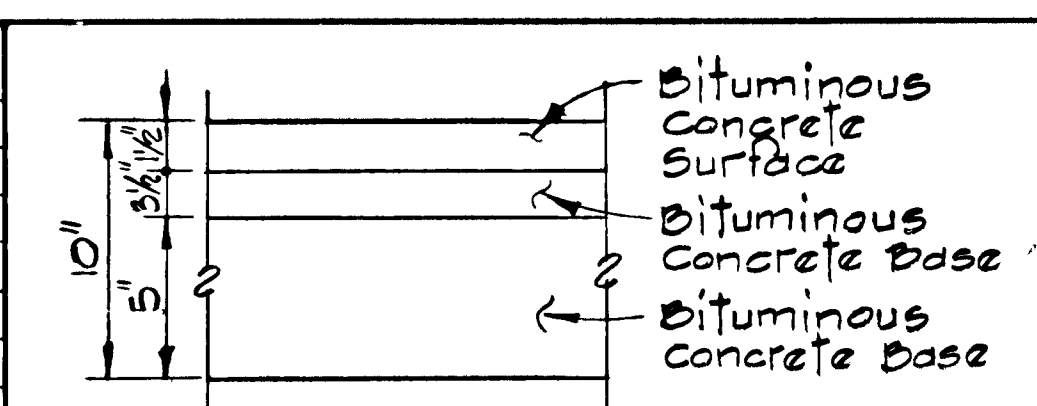


NOTES:  
 1. Base will be primed in accordance with Article 33.03 as provided in The Md. S.R.C. Specifications.  
 2. A tack coat will be applied in accordance with Section 33.07-3 as provided in The Md. S.R.C. Specifications.

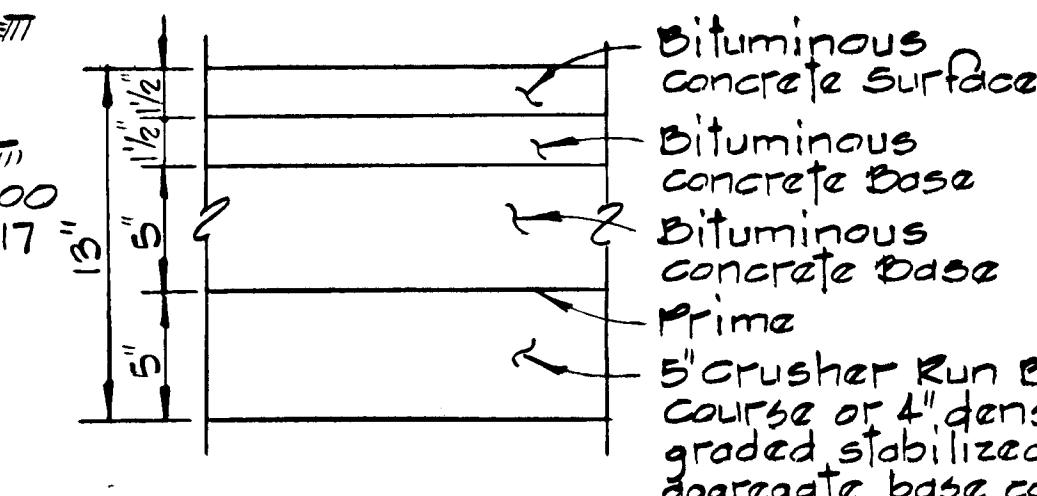

NOTES:  
 1. Base will be primed in accordance with Article 33.03 as provided in The Md. S.R.C. Specifications.  
 2. A tack coat will be applied in accordance with Section 33.07-3 as provided in The Md. S.R.C. Specifications.

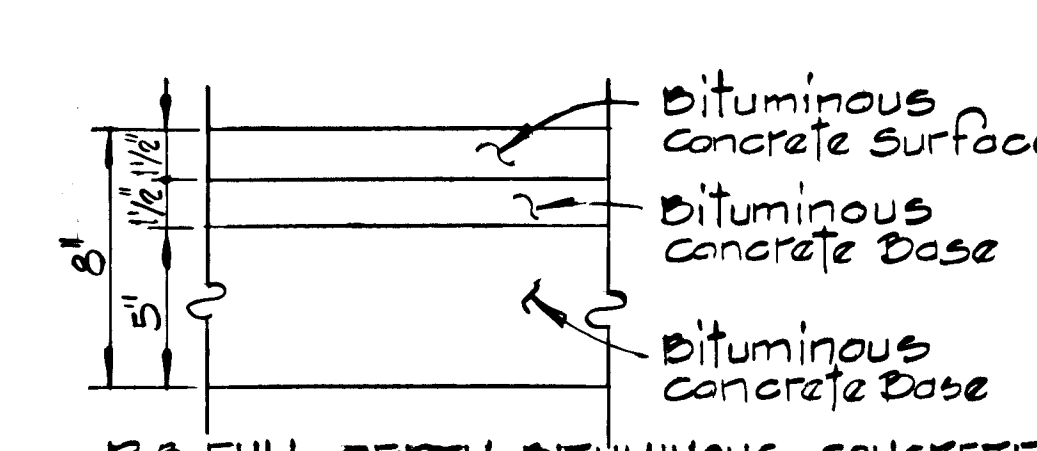

NOTES:  
 1. Base will be primed in accordance with Article 33.03 as provided in The Md. S.R.C. Specifications.  
 2. A tack coat will be applied in accordance with Section 33.07-3 as provided in The Md. S.R.C. Specifications.

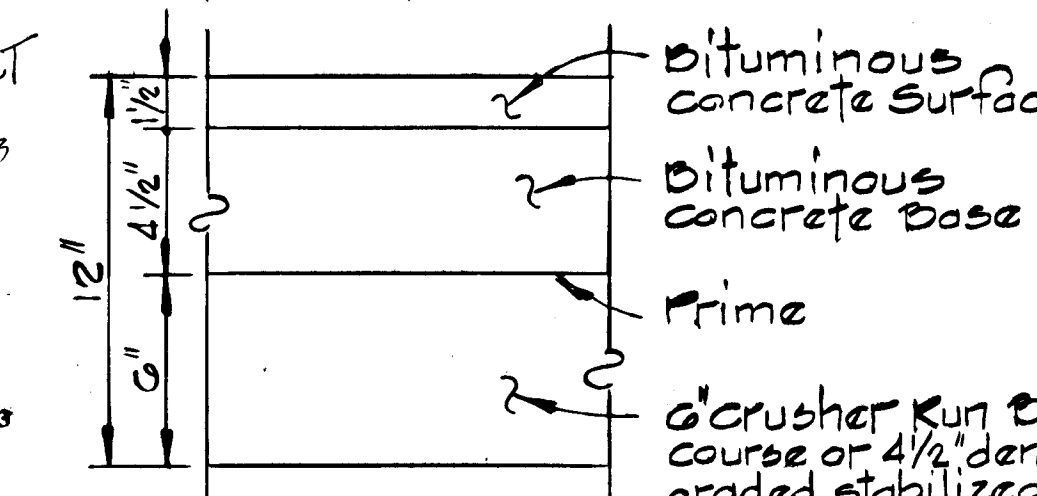

NOTES:  
 1. Base will be primed in accordance with Article 33.03 as provided in The Md. S.R.C. Specifications.  
 2. A tack coat will be applied in accordance with Section 33.07-3 as provided in The Md. S.R.C. Specifications.

APPROVED: HOWARD COUNTY DEPARTMENT OF PUBLIC WORKS  
 Date: 12/23/87  
 Chief, Land Development Division  
 Approved: OFFICE OF PLANNING AND ZONING  
 Date: 12/23/87  
 Chief, Division of Land Development and Zoning Administration

REV. NO.	REVISION DESCRIPTION
1	As Per Planning, DP W = SC-5 Curve 7/8
2	Revised Culvert

DORSEY HALL  
 2<sup>ND</sup> ELECTION DISTRICT  
 HOWARD COUNTY, MARYLAND

OWNER AND DEVELOPER  
 THE HOWARD RESEARCH AND DEVELOPMENT LAND COMPANY


PROJECT AREA  
 SECTION 2 AREA 5  
 PARCELS N AND O

PROJECT TITLE  
 PLAN, PROFILE AND DETAILS  
 DORSEY HALL DRIVE  
 STATION 10+85 TO STATION 24+00



SCALE: AS SHOWN DATE:

WHITMAN, REQUARDT AND ASSOCIATES  
 ENGINEERS  
 BALTIMORE, MARYLAND 21218

Kenneth A. McCord  
 REGISTERED ENGINEER  
 NO. 1974

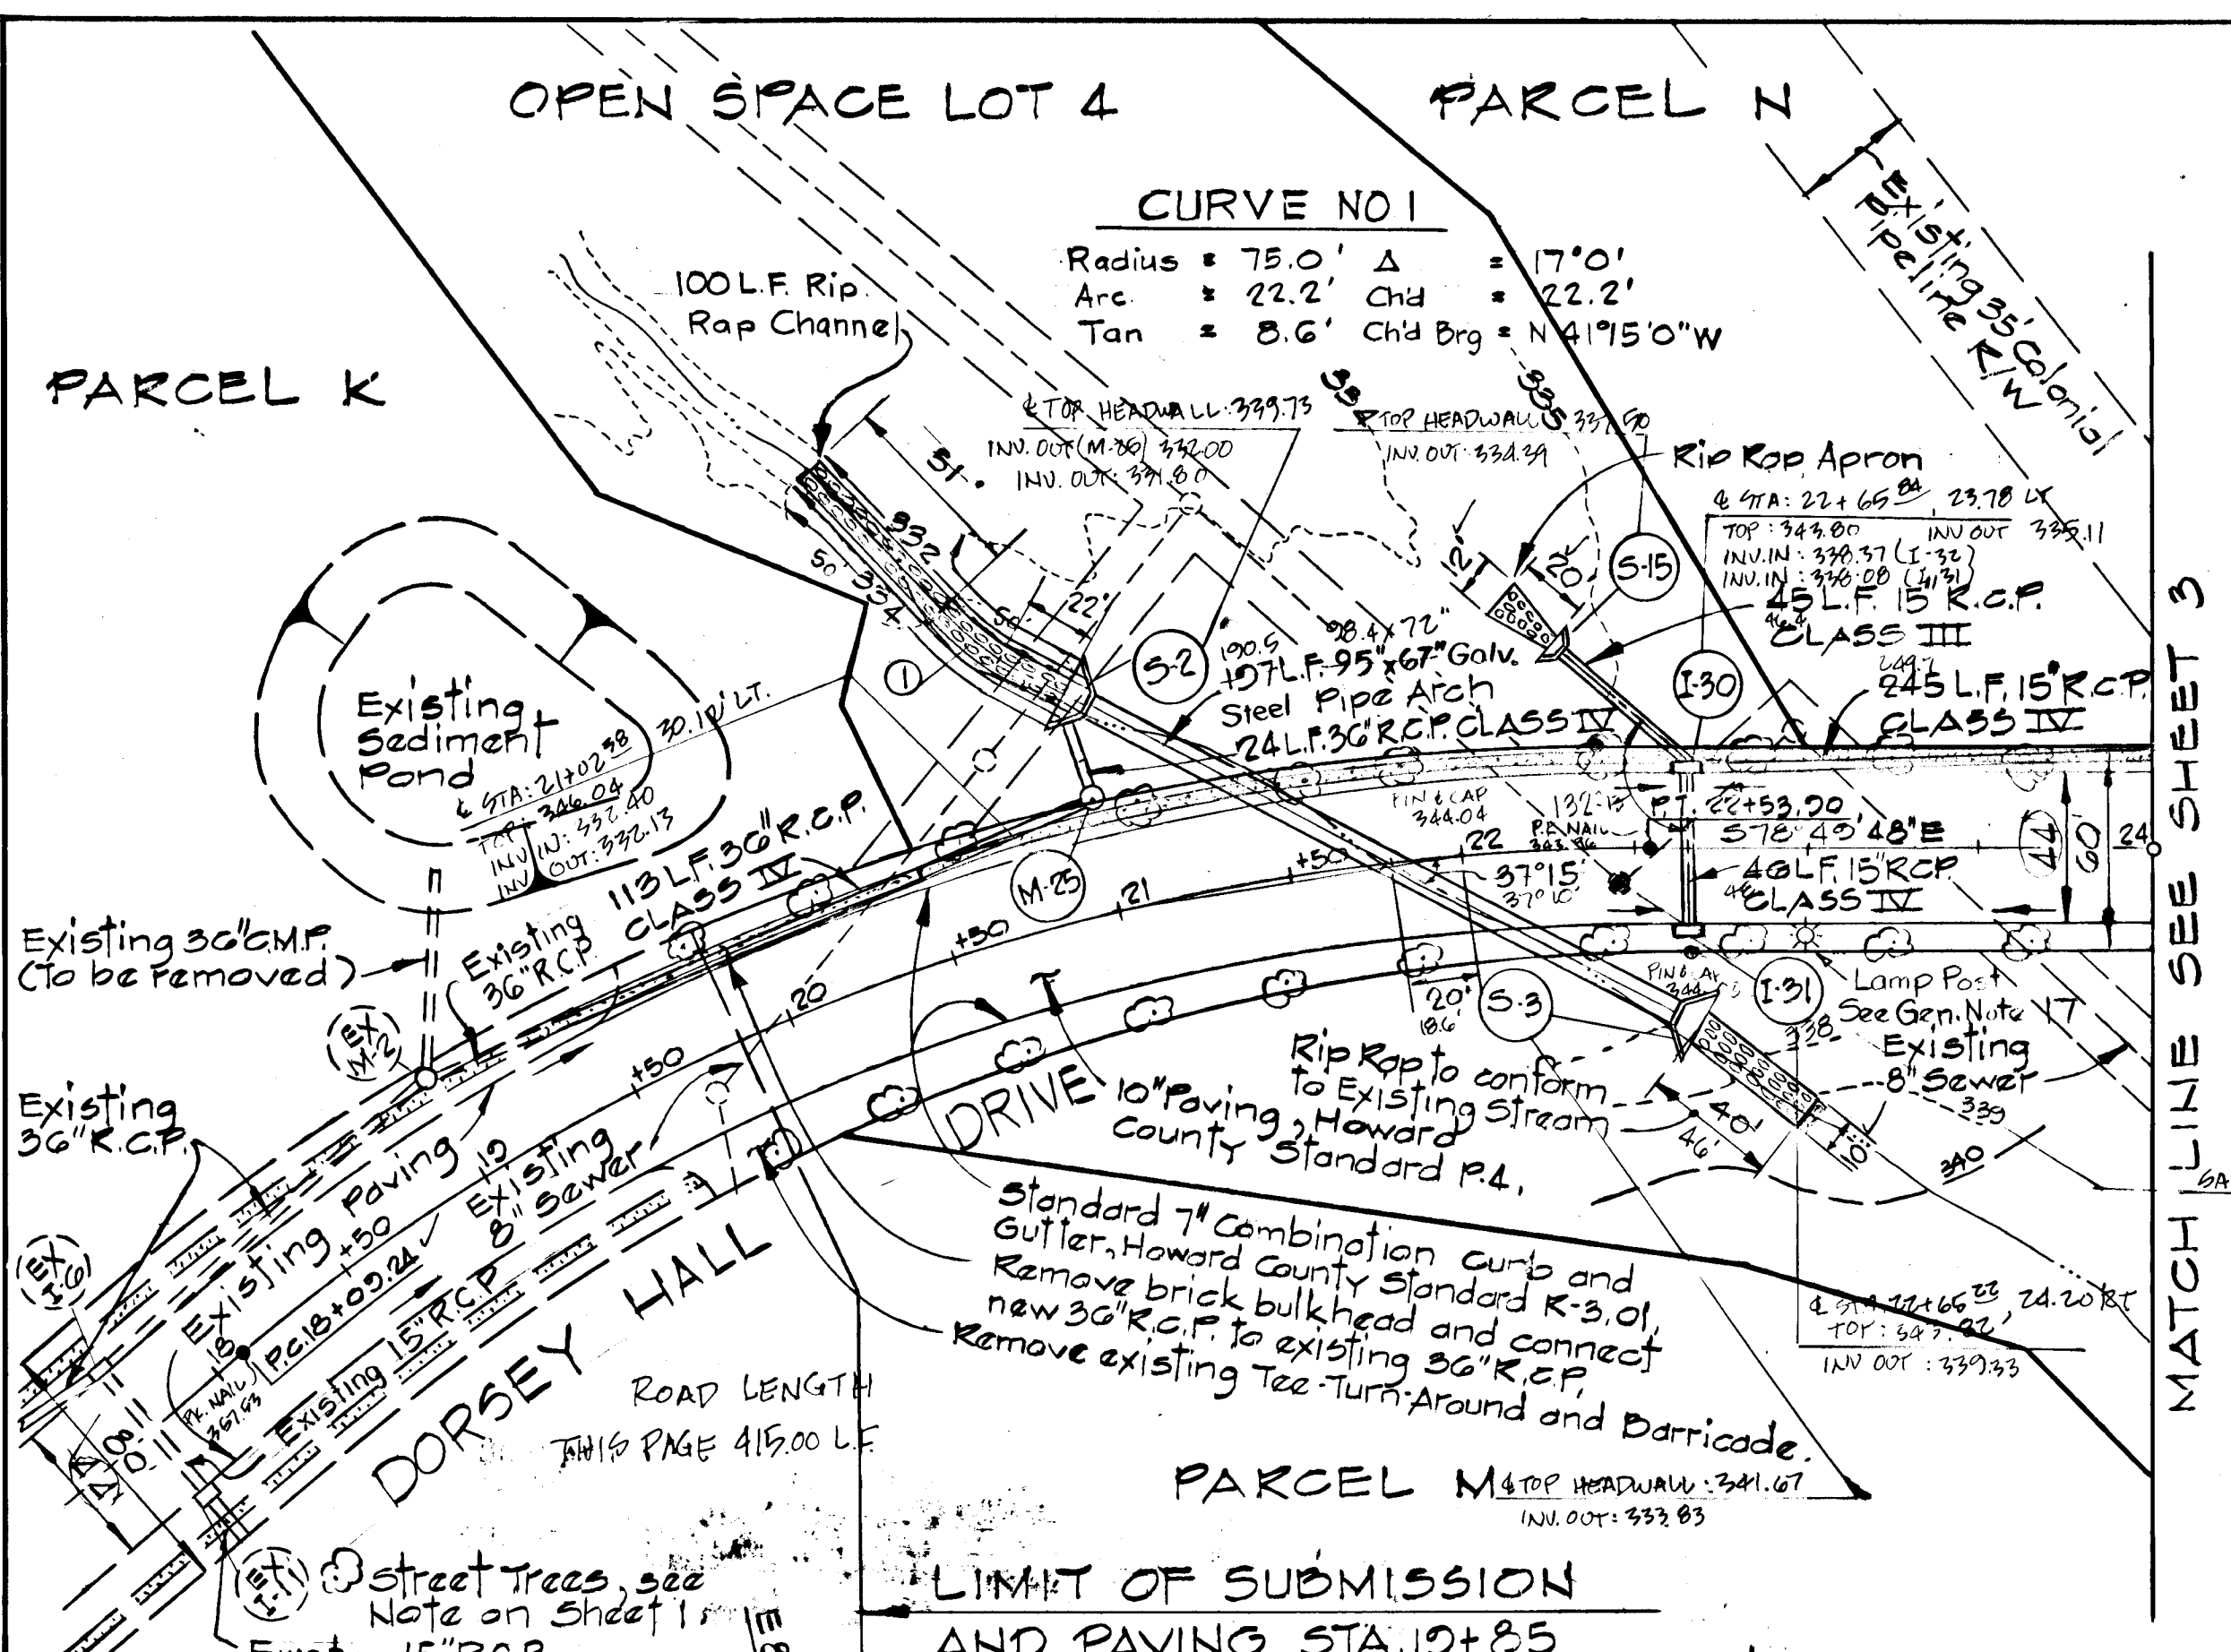

**CURVE DATA**  
 PC: 18+00.24 TO PT: 22+50.00  
 Δ: 30° 46' 28" TAN: 231.73'  
 R: 640.00' CH'D BRO: 435.77'  
 ARC: 444.00' CH'D BRO: N81°15'58"E

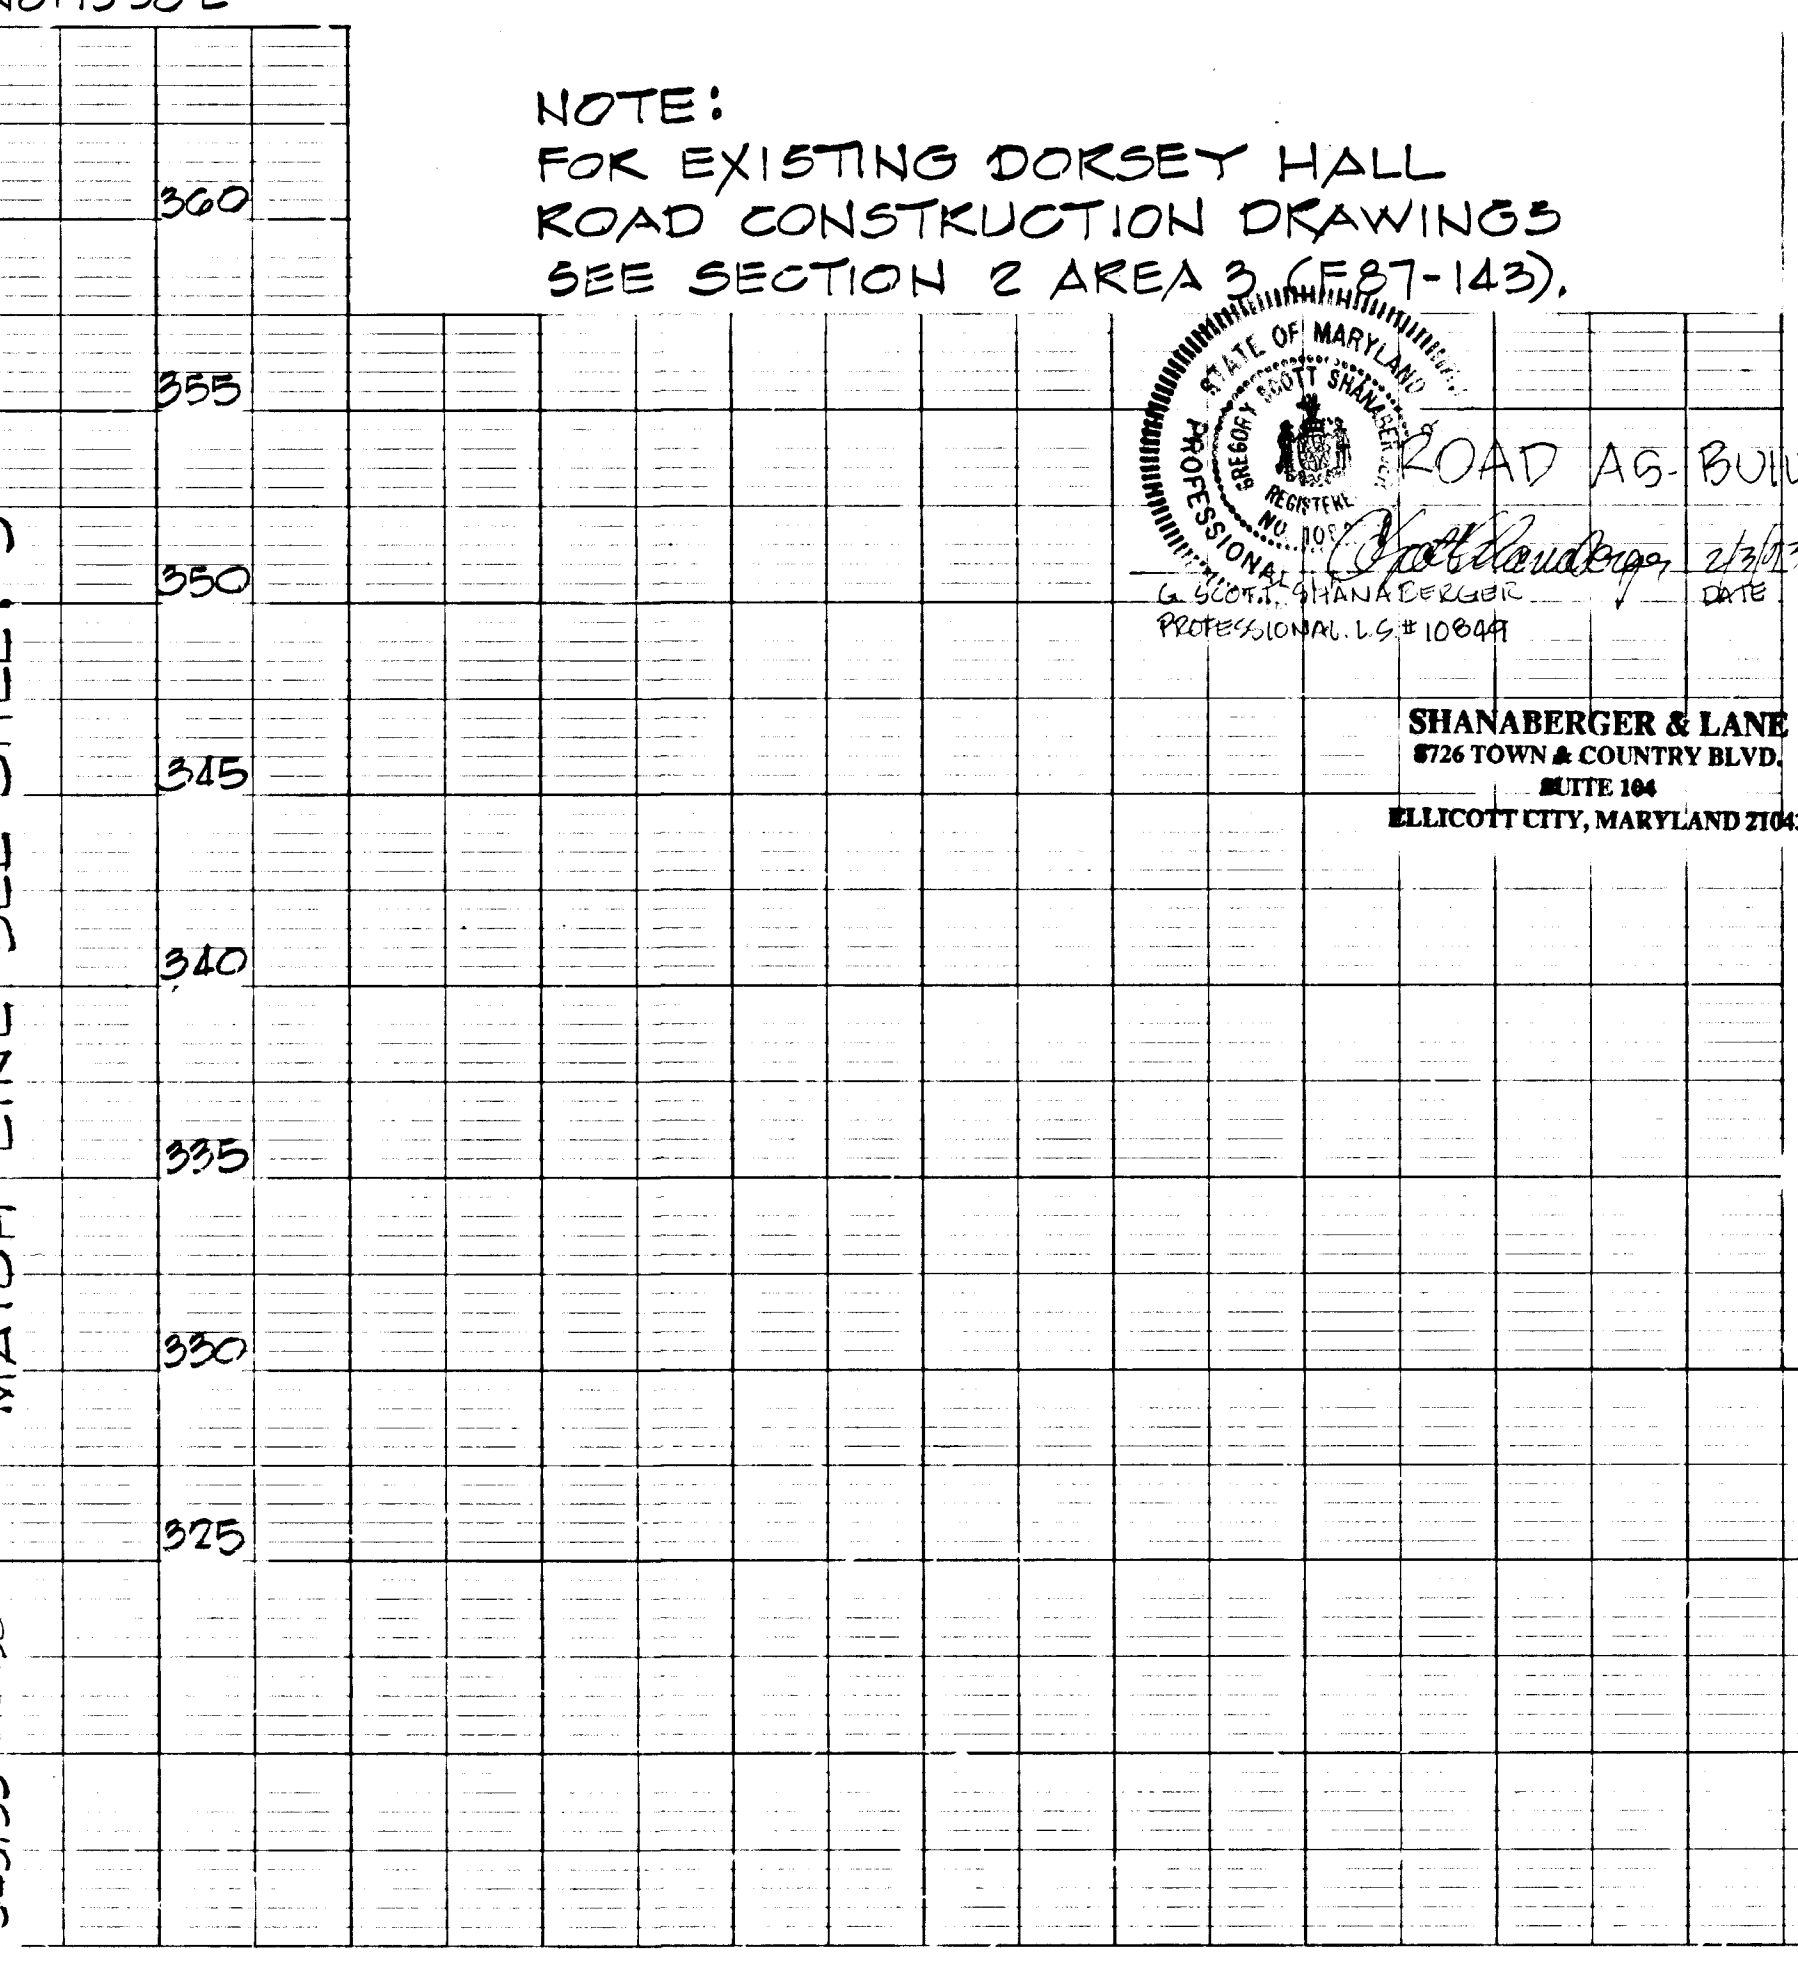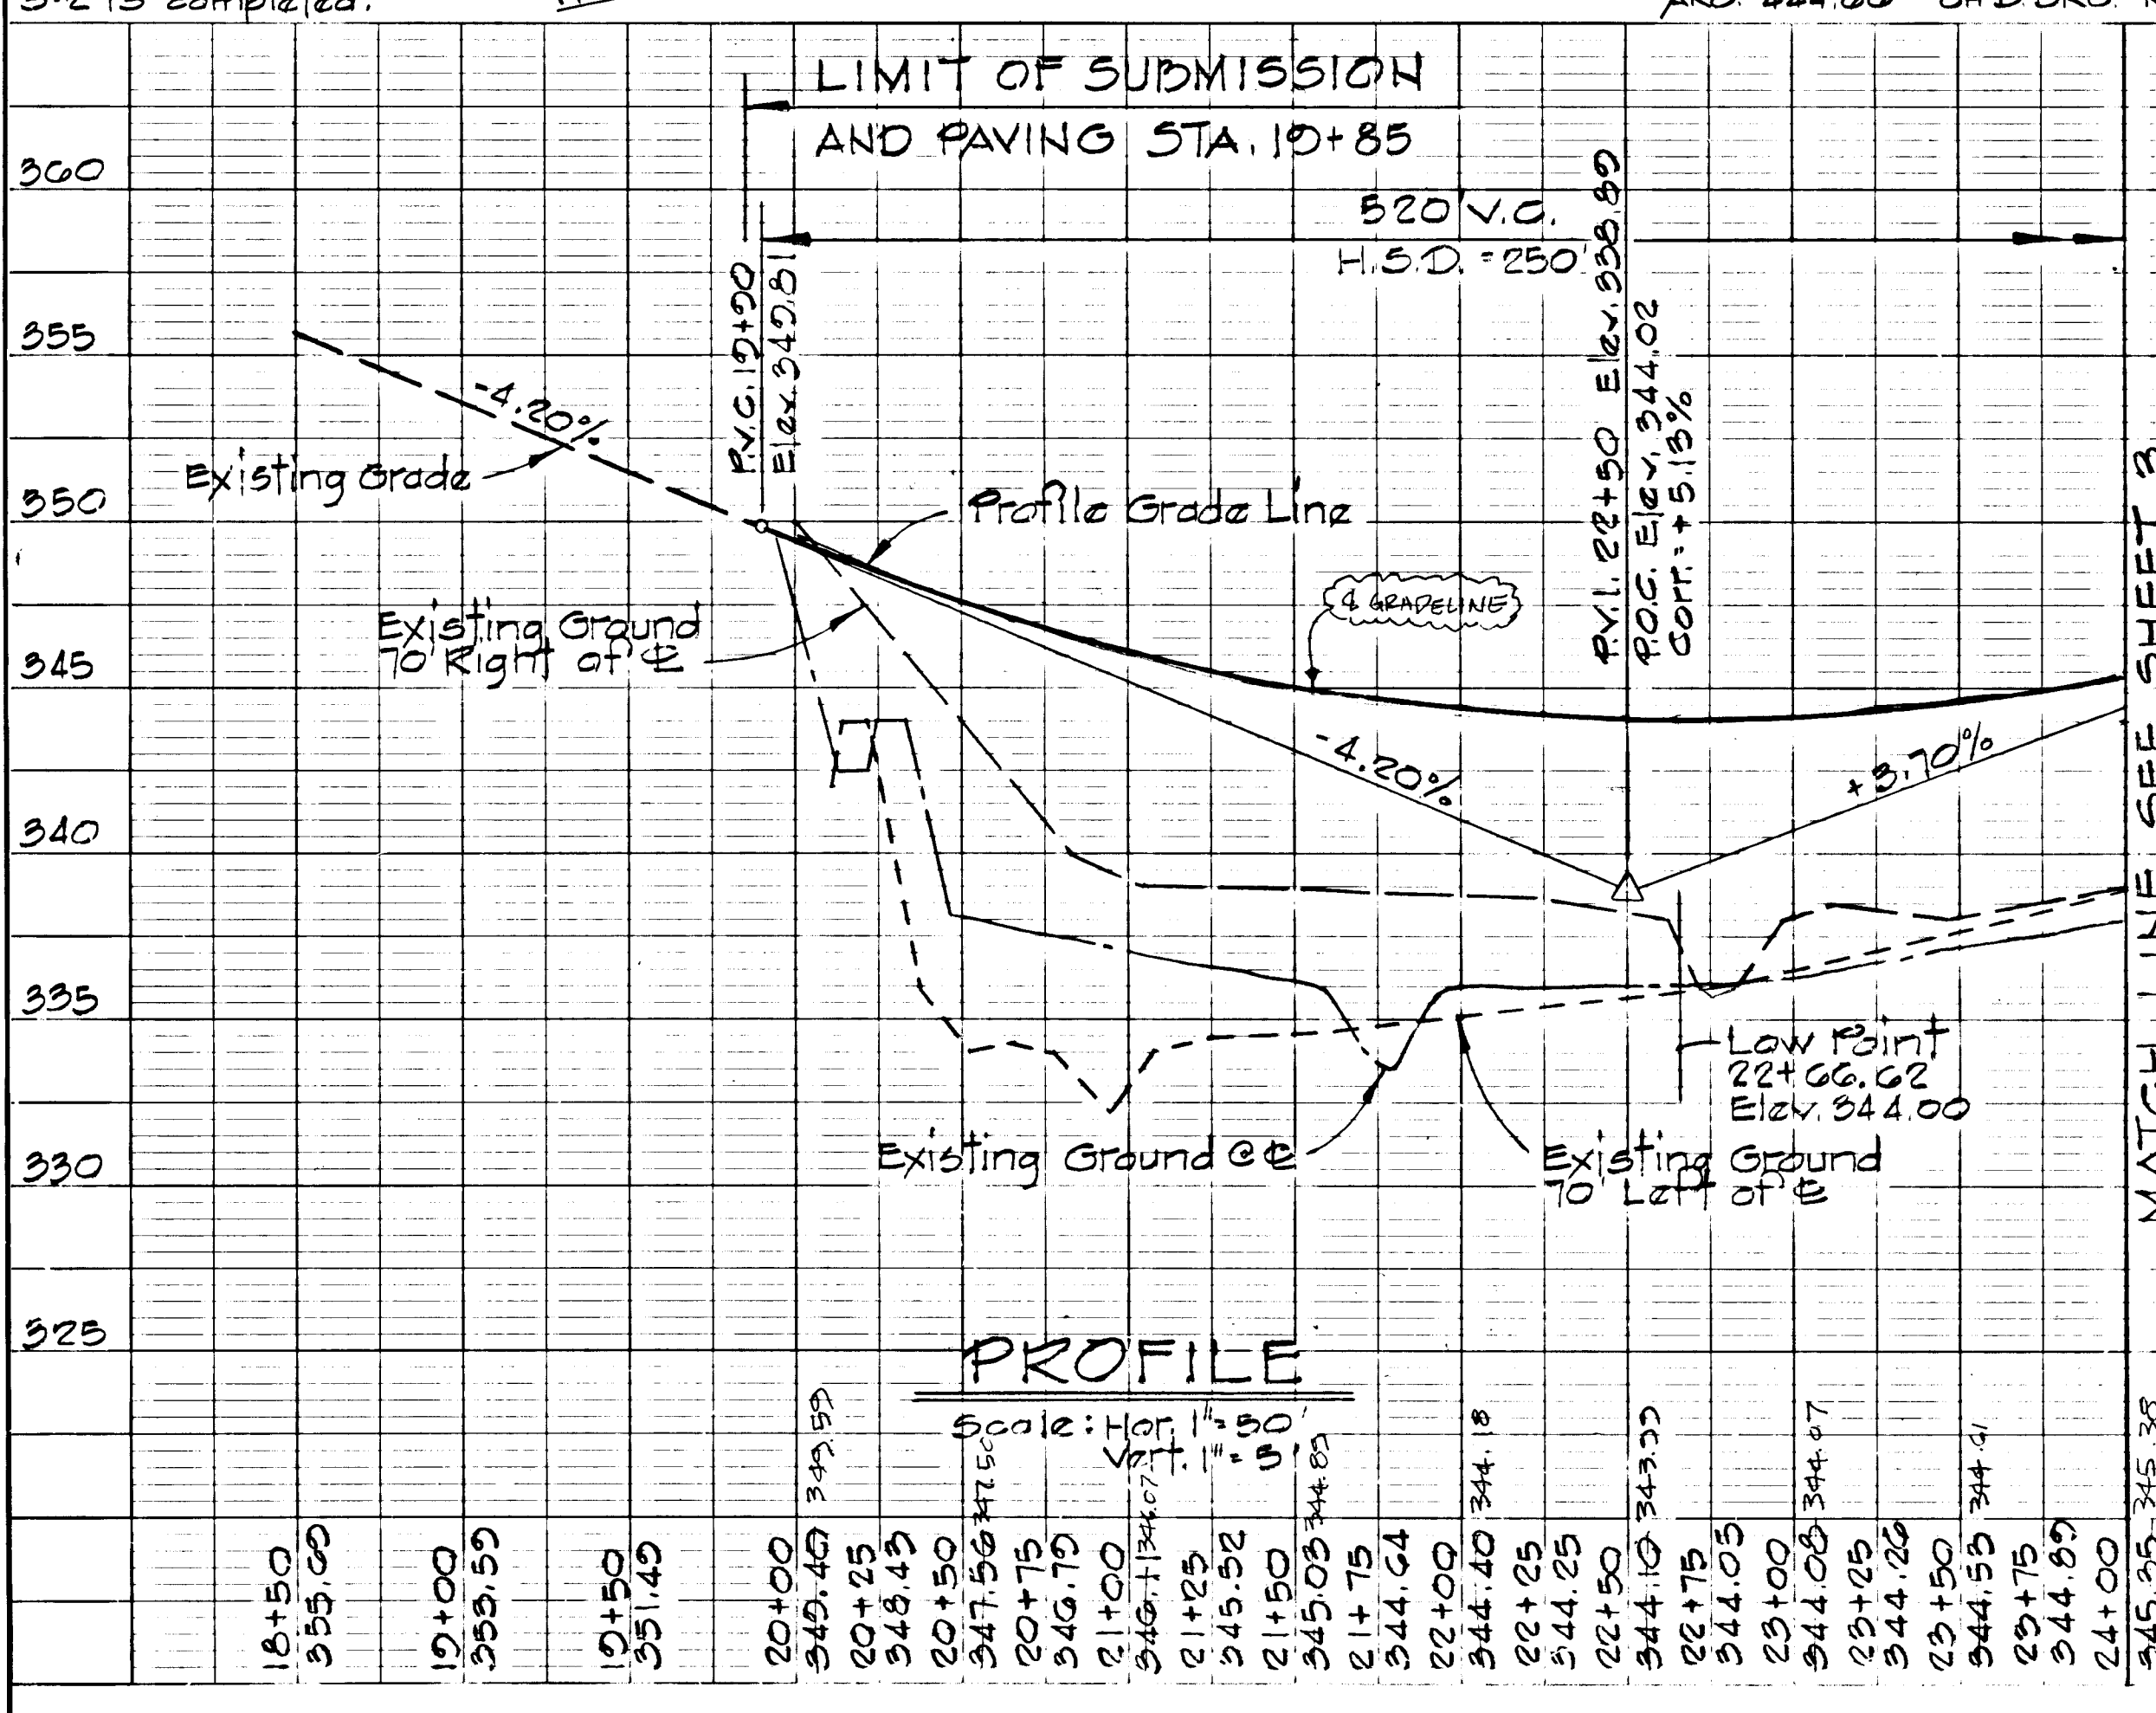

777



**STORM DRAIN STRUCTURE SCHEDULE**

NO.	TYPE	TOP EL.	INV. IN.	INV. OUT.	LOCATION
I-36	A-5 Inlet width 2.5'(S.D.R.4)	343.07	343.00	342.80	± Inlet 23.92' Left ± Sta. 33+85.63
I-37	A-5 Inlet width 2.5'(S.D.R.4)	343.07	343.00	342.71	± Inlet 23.92' Right ± Sta. 33+85.63
I-38	Modified S.H.A. Type "K" (See Sht. 8)	342.65	342.90	342.75	See Plan & Profile
S-6	Type "A" Headwall (S.D.S.11)	342.75	341.75	341.73	See Plan & Profile
S-7	Type "A" Headwall (S.D.S.11)	342.50	342.50	341.44	See Plan & Profile
I-32	A-5 Inlet width 2.5'(S.D.R.4)	343.79	343.76	343.56	± Inlet 23.92' Left ± Sta. 25+20.0
I-33	A-5 Inlet width 2.5'(S.D.R.4)	343.79	343.79	343.00	± Inlet 23.92' Right ± Sta. 25+20.0

\* Inlets with deflectors

**CURVE NO. 3**  
 Rad = 185.0' Chd = 91.08'  
 Arc = 91.97' Chd Brg = N87°15'0"W  
 Tan = 46.98' Δ = 28°30'

**CURVE NO. 2**  
 Rad = 40.0' Chd = 37.87'  
 Arc = 39.42' Chd Brg = N22°15'0"W  
 Tan = 21.43' Δ = 56°30'

**CURVE NO. 1**  
 Rad = 25.0' Chd = 22.80'  
 Arc = 23.76' Chd Brg = N19°30'0"W  
 Tan = 12.87' Δ = 54°30'

Note:  
 For Pond removal, grading and  
 new channel, see Sheet 3.  
 For removal sequence see sheet 11

APPROVED: HOWARD COUNTY DEPARTMENT  
 OF PUBLIC WORKS  
 Chief, Land Development Division  
*Druid W. Welton* 12/23/87  
 Chief, Bureau of Highways  
*William E. Ray* 12/23/87  
 Chief, Bureau of Engineering  
*James R. Foster* 12/23/87  
 APPROVED: OFFICE OF PLANNING AND ZONING  
 Chief, Division of Land Development  
 and Zoning Administration  
 12/23/87

REVISION	REV. NO.	REVISION DESCRIPTION
12/2/87	2	As per SCS Comments
10/19/87	1	As Per Planning, DFW # SCS Comments

**DORSEY HALL**  
 2<sup>ND</sup> ELECTION DISTRICT  
 HOWARD COUNTY, MARYLAND

OWNER AND DEVELOPER  
 THE HOWARD RESEARCH AND  
 DEVELOPMENT LAND COMPANY


PROJECT AREA  
 SECTION 2 AREA 5  
 PARCELS N AND O

PROJECT TITLE  
 PLAN AND PROFILE  
 DORSEY HALL DRIVE  
 STATION 24+00 TO STATION 37+50

SCALE AS SHOWN DATE:

WHITMAN, REGUARDT AND ASSOCIATES  
 ENGINEERS  
 BALTIMORE, MARYLAND 21218

*Kenneth A. McCord*  
 KENNETH A. MCCORD  
 REGISTERED ENGINEER  
 NO. 1074

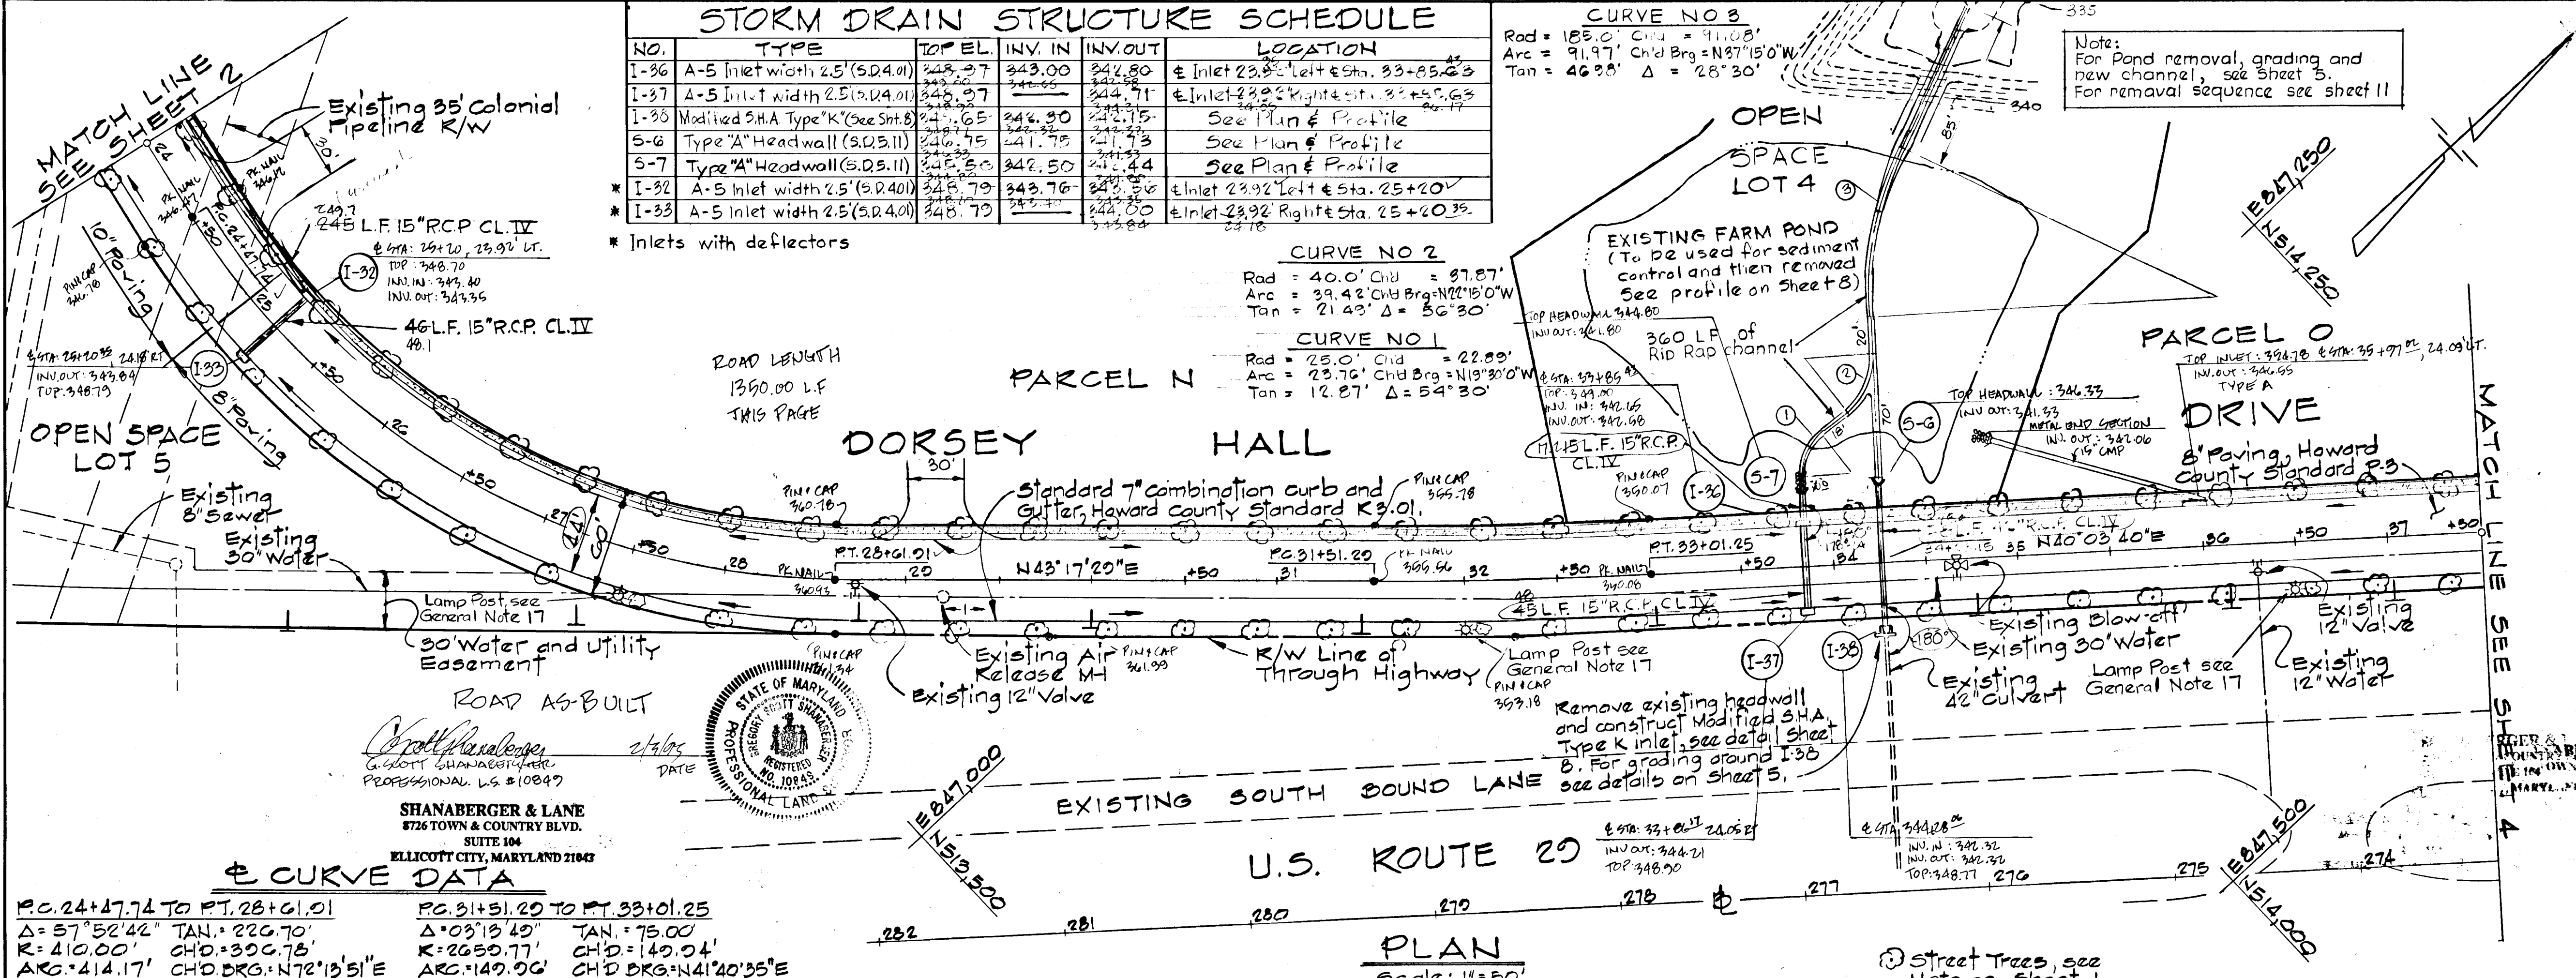


DATE: \_\_\_\_\_  
 BY: \_\_\_\_\_  
 SURVEYED: \_\_\_\_\_  
 PLANNED: \_\_\_\_\_  
 NOTE BOOK: \_\_\_\_\_  
 NO. \_\_\_\_\_

DATE: \_\_\_\_\_  
 BY: \_\_\_\_\_  
 SURVEYED: \_\_\_\_\_  
 PROFILED: \_\_\_\_\_  
 NOTE BOOK: \_\_\_\_\_  
 NO. \_\_\_\_\_

771

**± CURVE DATA**

PC	PT	Δ	TAN	R	CHD	CHD BRG
PC. 24+47.74	PT. 28+01.01	57°52'42"	226.70'	410.00'	300.78'	N72°15'51"E
PC. 31+51.20	PT. 33+01.25	09°15'40"	75.00'	2650.77'	140.04'	N41°40'35"E

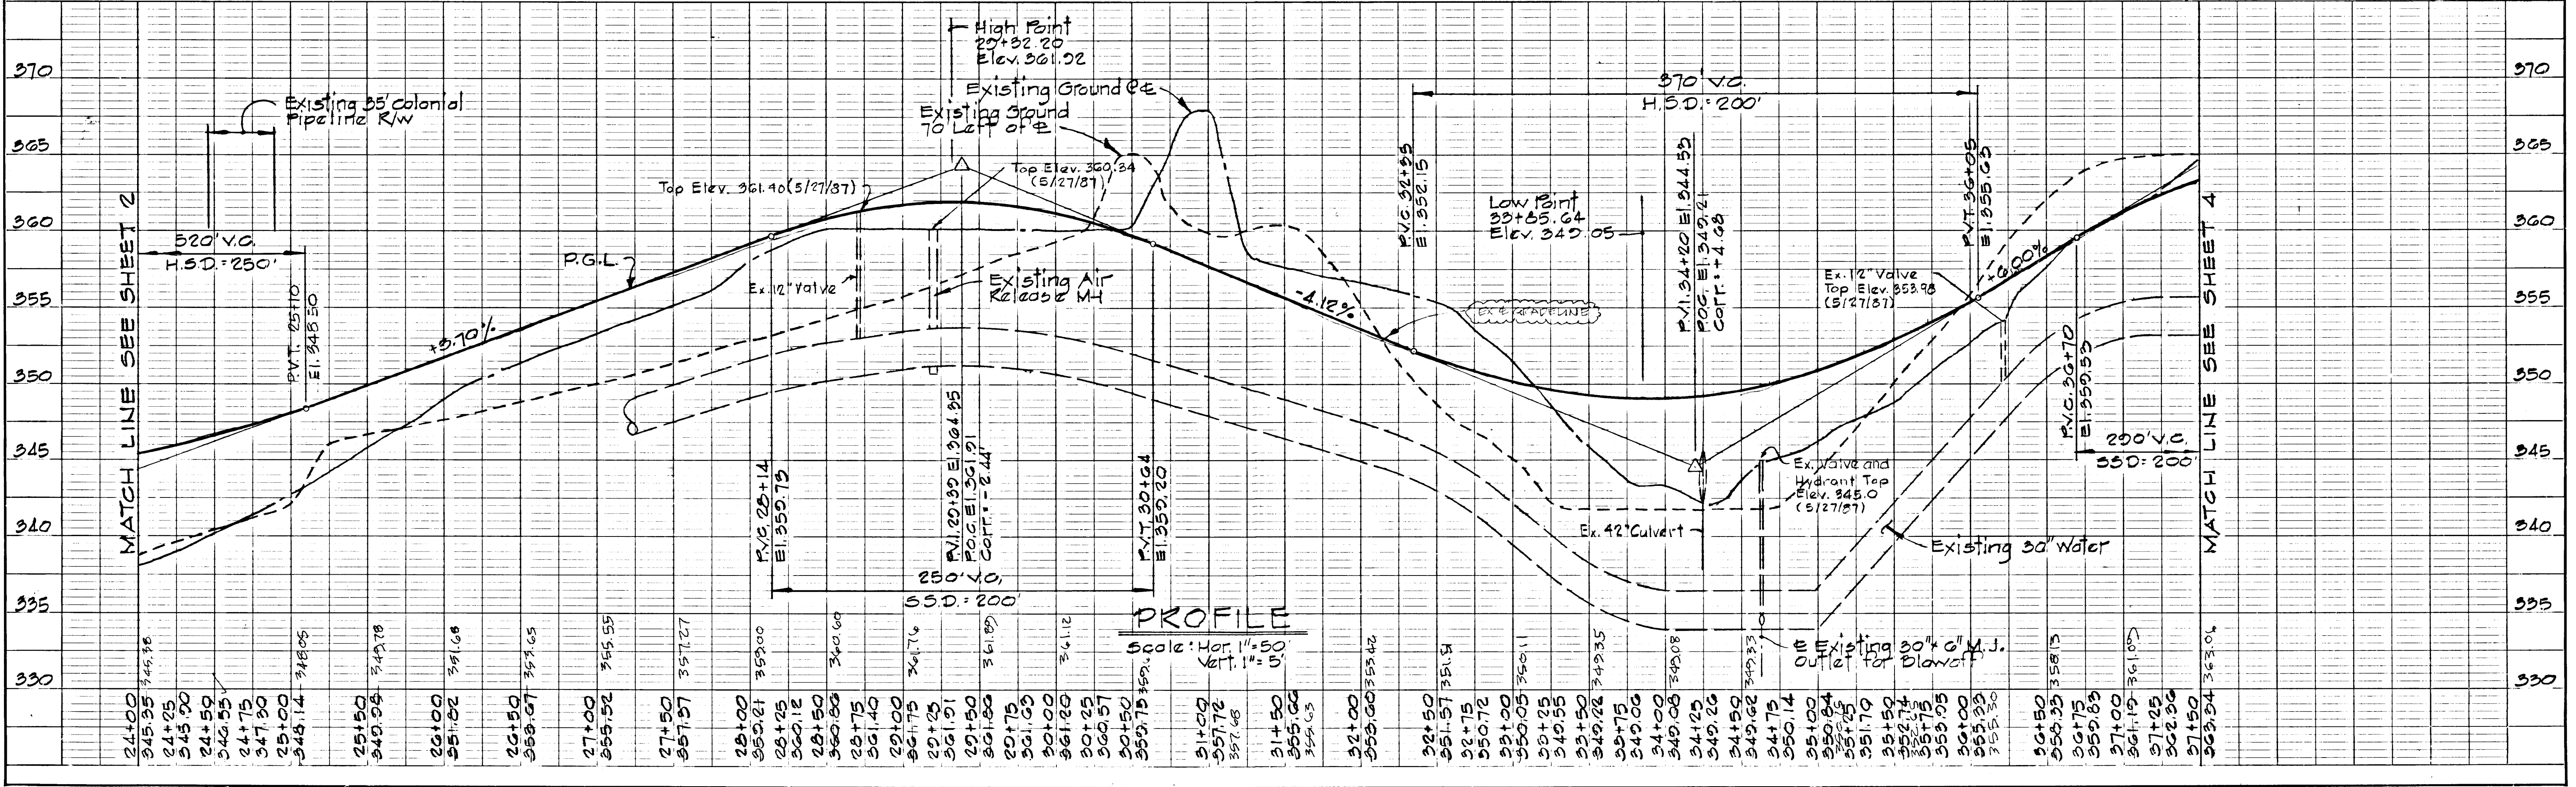




**☉ CURVE DATA**

PC.40+03.05 TO 41+12.17  
 Δ: 43°36'18" TAN: 57.36'  
 R: 145.38' CHD: 100.50'  
 ARC: 100.12' CHD BKG: N18°15'30"E

**STORM DRAIN STRUCTURE SCHEDULE**

NO.	TYPE	TOP EL.	INV. IN	INV. OUT	LOCATION
I-35	A-5 Inlet 2.5 width (S.D. 4.0)	358.95		354.75	Inlet 1.02' back L.P. Sta. 2+54.12
M-26	Standard Manhole (S. 5.0)	353.20	342.50	339.60	See Plan and Profile
M-27	Standard Manhole (S. 5.0)	356.25	350.90	349.25	See Plan and Profile
S-5	Type A Headwall (S.D. 5.1)	342.51	339.51	339.50	See Plan and Profile

APPROVED: HOWARD COUNTY DEPARTMENT OF PUBLIC WORKS  
 Chief, Land Development Division Date 12/23/87  
 Chief, Bureau of Highways Date 12-23-87  
 Chief, Bureau of Engineering Date 12-23-87  
 APPROVED: OFFICE OF PLANNING AND ZONING  
 Chief, Division of Land Development and Zoning Administration Date 12/23/87

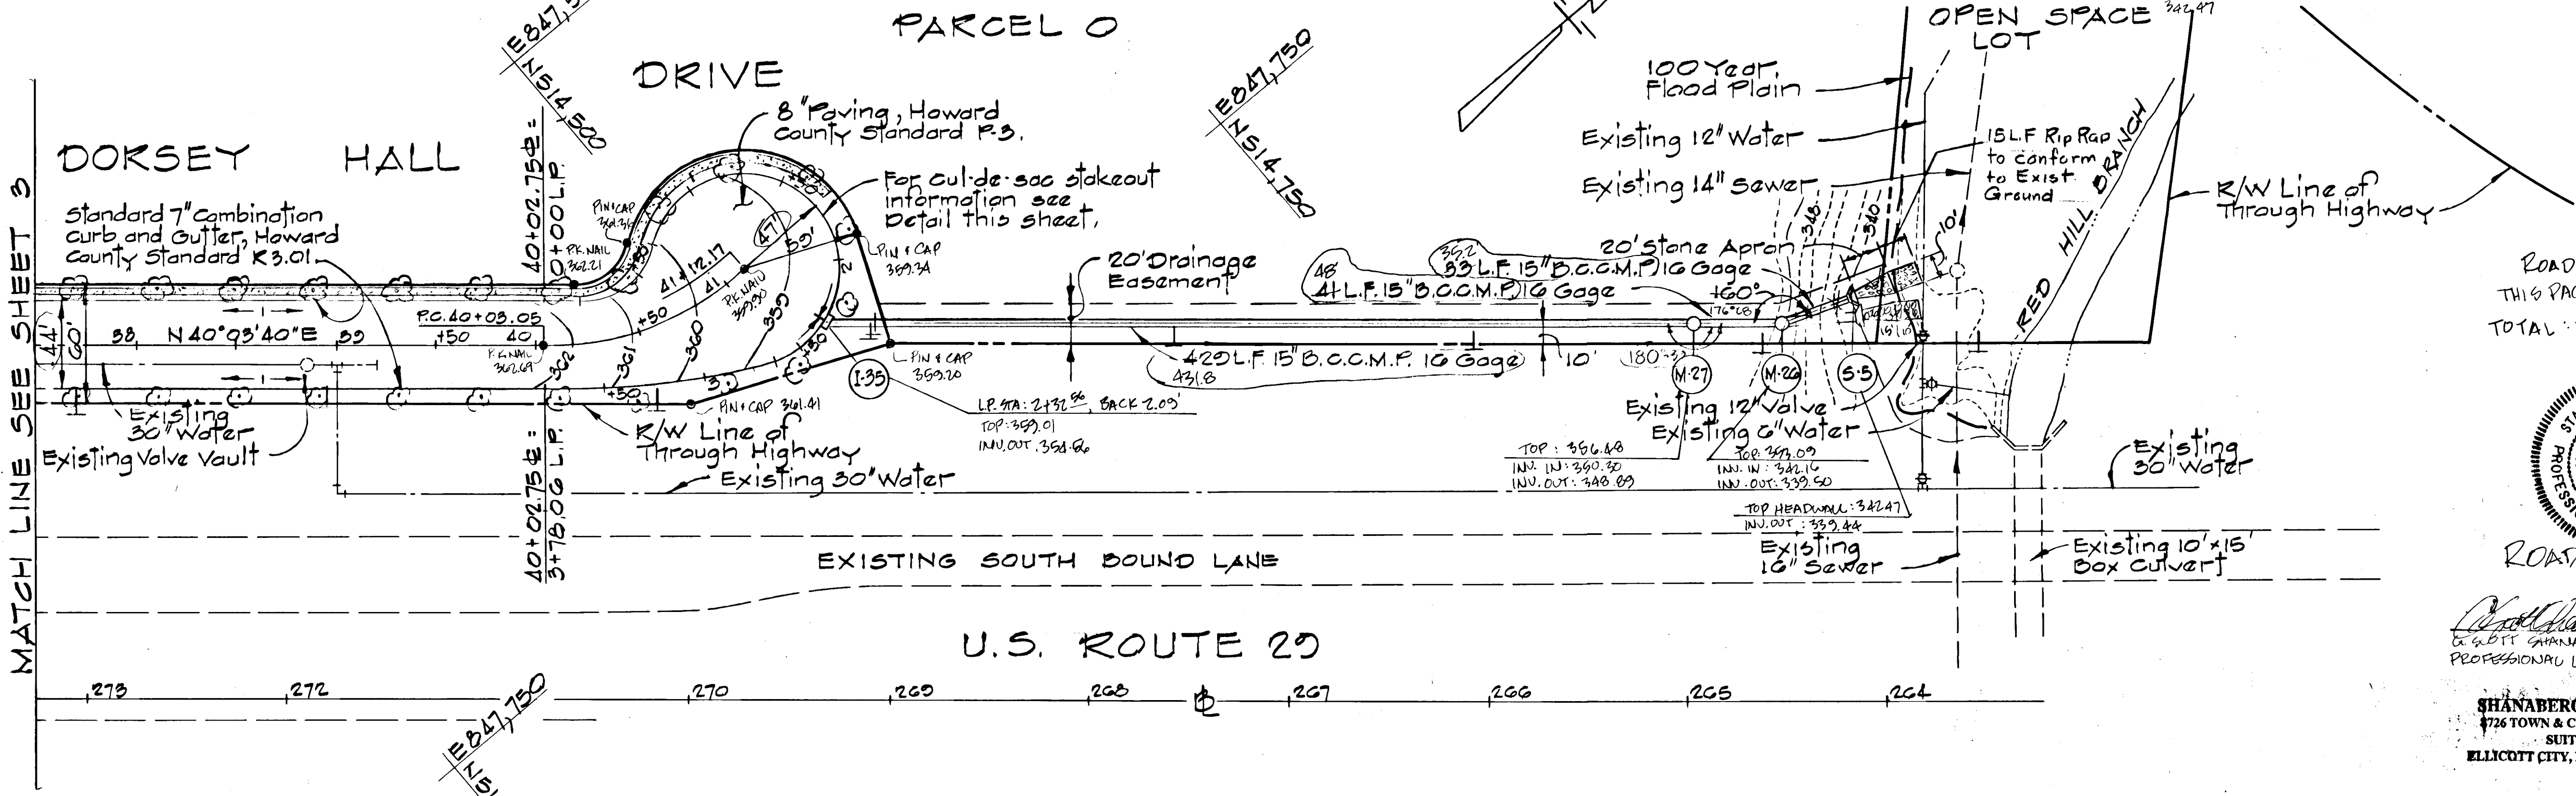

ROAD LENGTH THIS PAGE: 342.17 LF  
 TOTAL: 2127.17 LF



SHANBERGER & LANE  
 1726 TOWN & COUNTRY BLVD.  
 SUITE 104  
 ELLICOTT CITY, MARYLAND 21103

REV. DATE	REV. NO.	REVISION DESCRIPTION
10/19/87	1	As Per Planning, RPWES.CS Comments



**DORSEY HALL**  
 2<sup>ND</sup> ELECTION DISTRICT  
 HOWARD COUNTY, MARYLAND  
 OWNER AND DEVELOPER  
 THE HOWARD RESEARCH AND DEVELOPMENT LAND COMPANY  
 PROJECT AREA  
 SECTION 2, AREA 5  
 PARCELS N AND O  
 PROJECT TITLE  
 PLAN AND PROFILE  
 DORSEY HALL DRIVE  
 STATION 37+50 TO STATION 41+12.17  
 SCALE: AS SHOWN DATE:  
 WHITMAN, REQUARDT AND ASSOCIATES  
 ENGINEERS  
 BALTIMORE, MARYLAND 21218

**PLAN**  
 Scale: 1"=50'

Street Trees, see Note on sheet 1.

**CURVE DATA**

NO.	Δ	RAD.	ARC.	TAN	CH'D	CH'D BKG.
1	76°37'01"	57.00'	49.48'	29.23'	45.87'	N01°45'10"E
2	235°55'03"	47.00'	196.80'	—	—	—
3	16°41'58"	392.17'	114.30'	57.56'	113.90'	S31°42'41"W

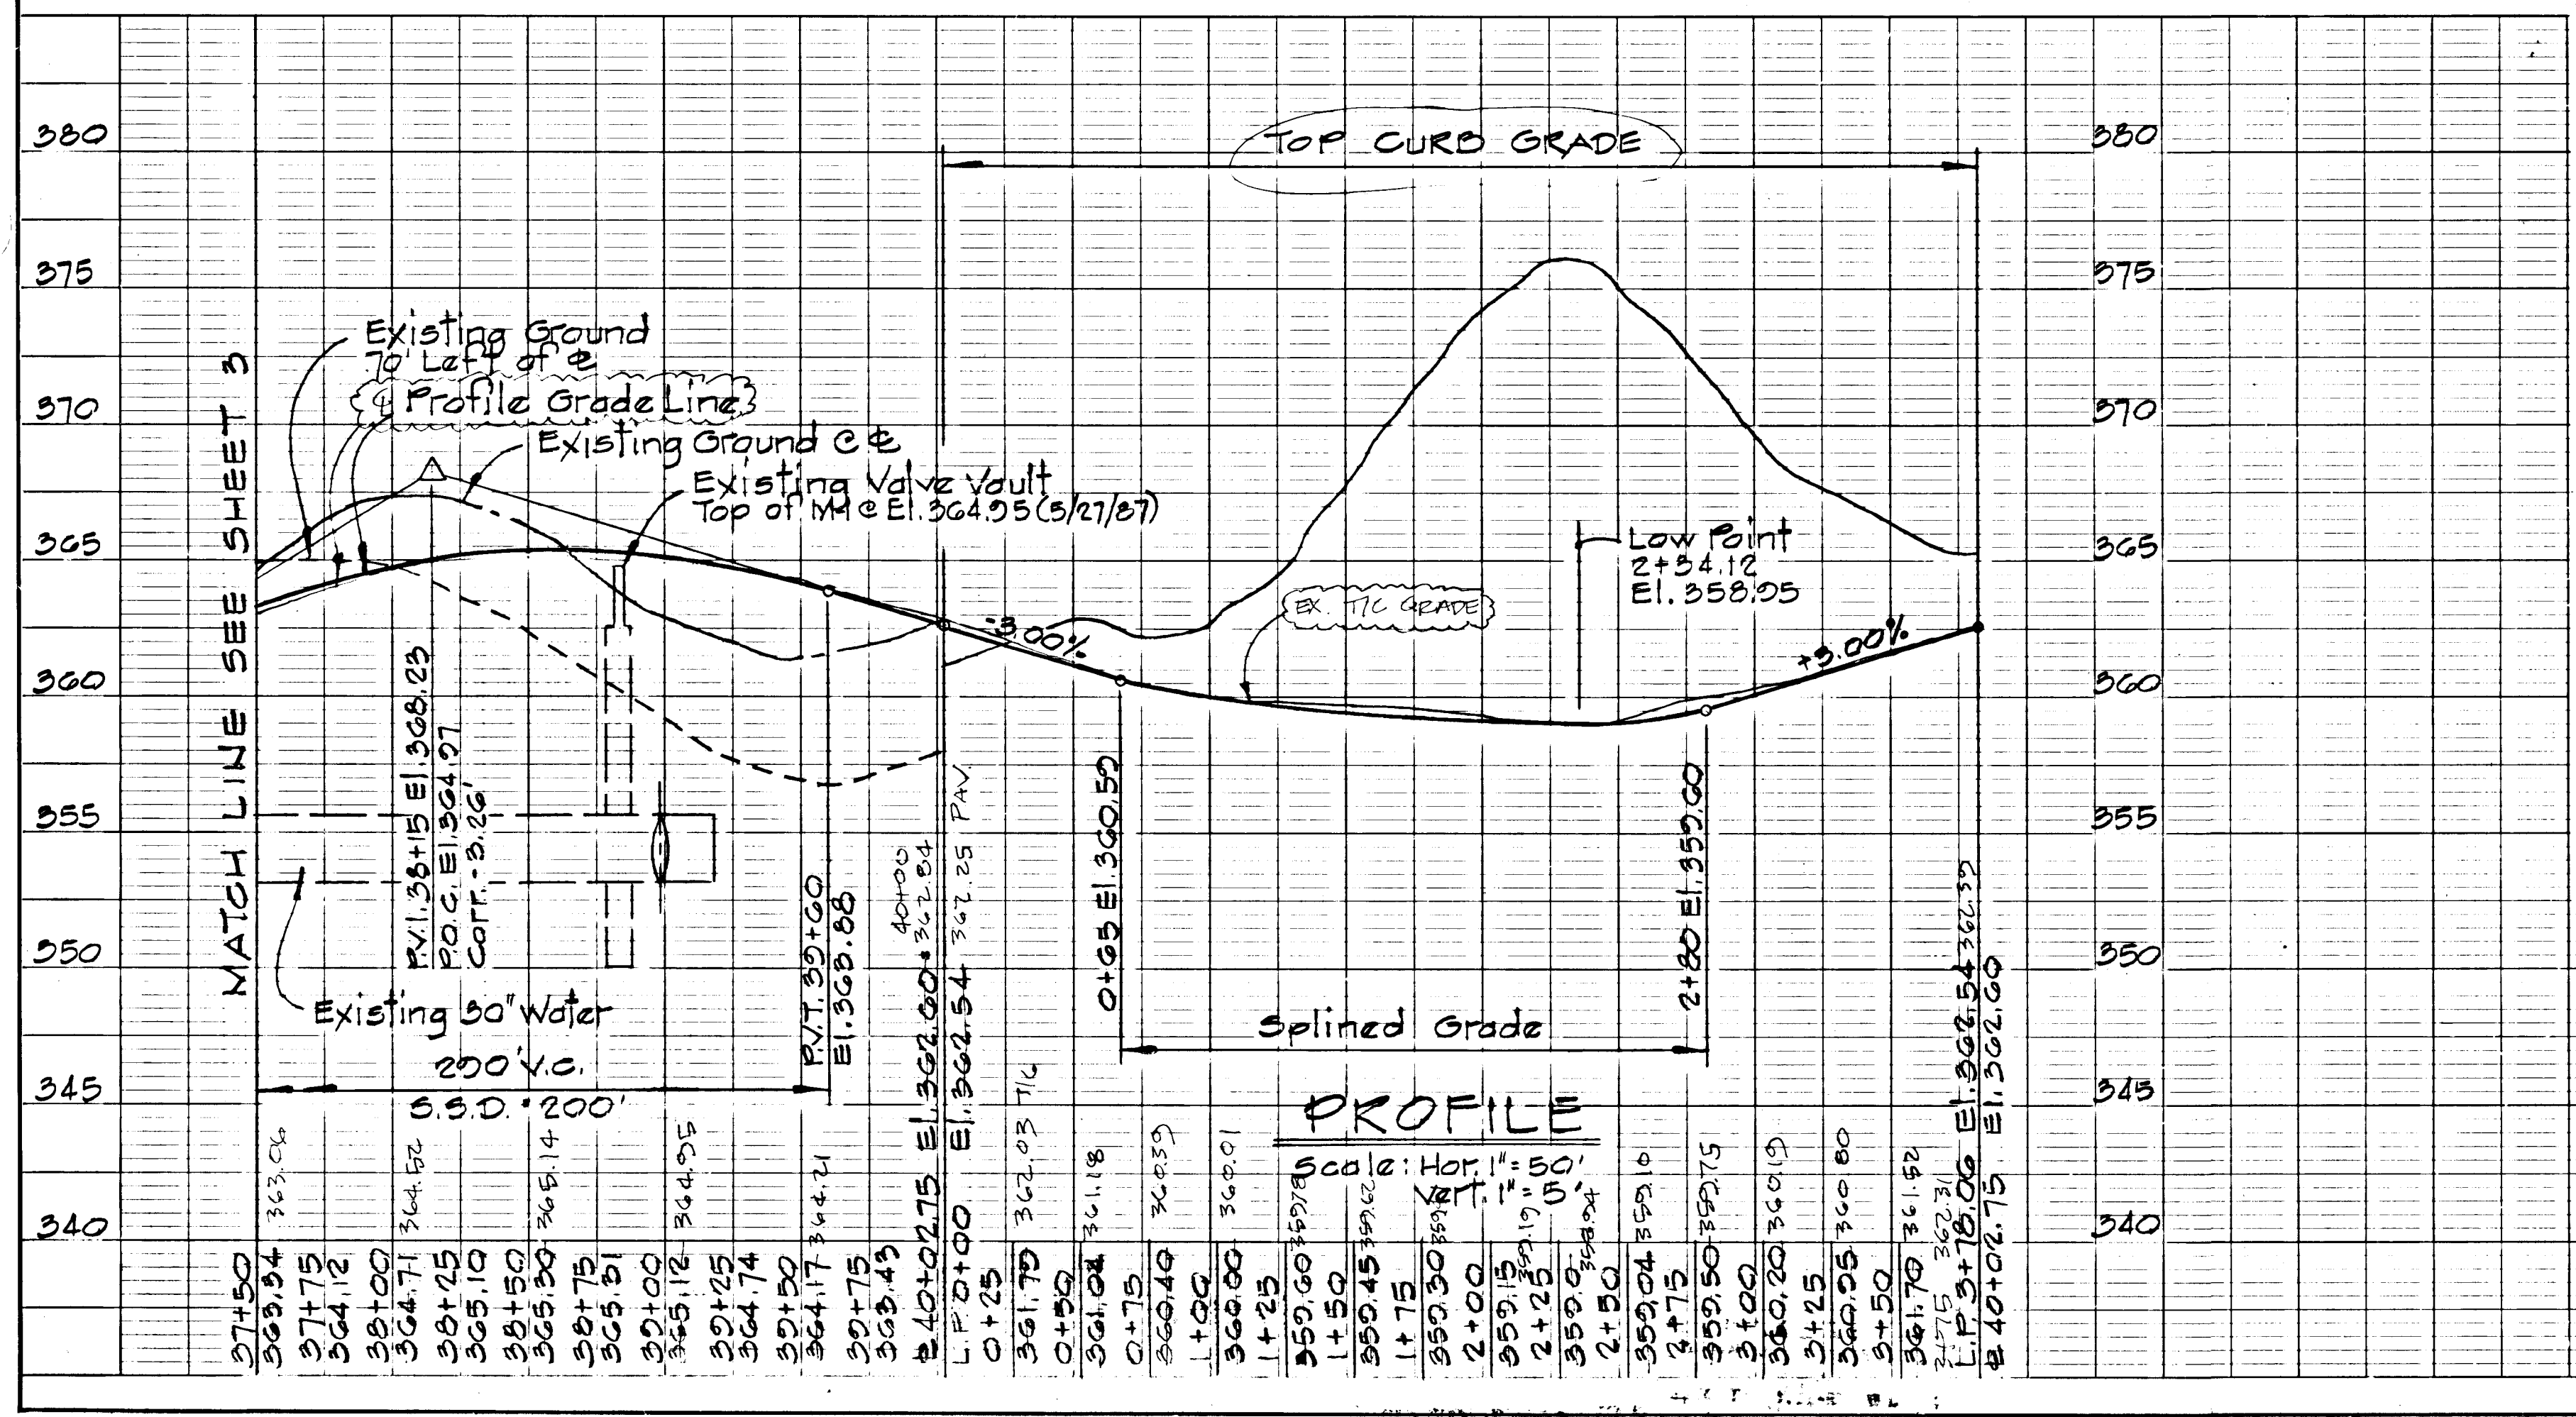
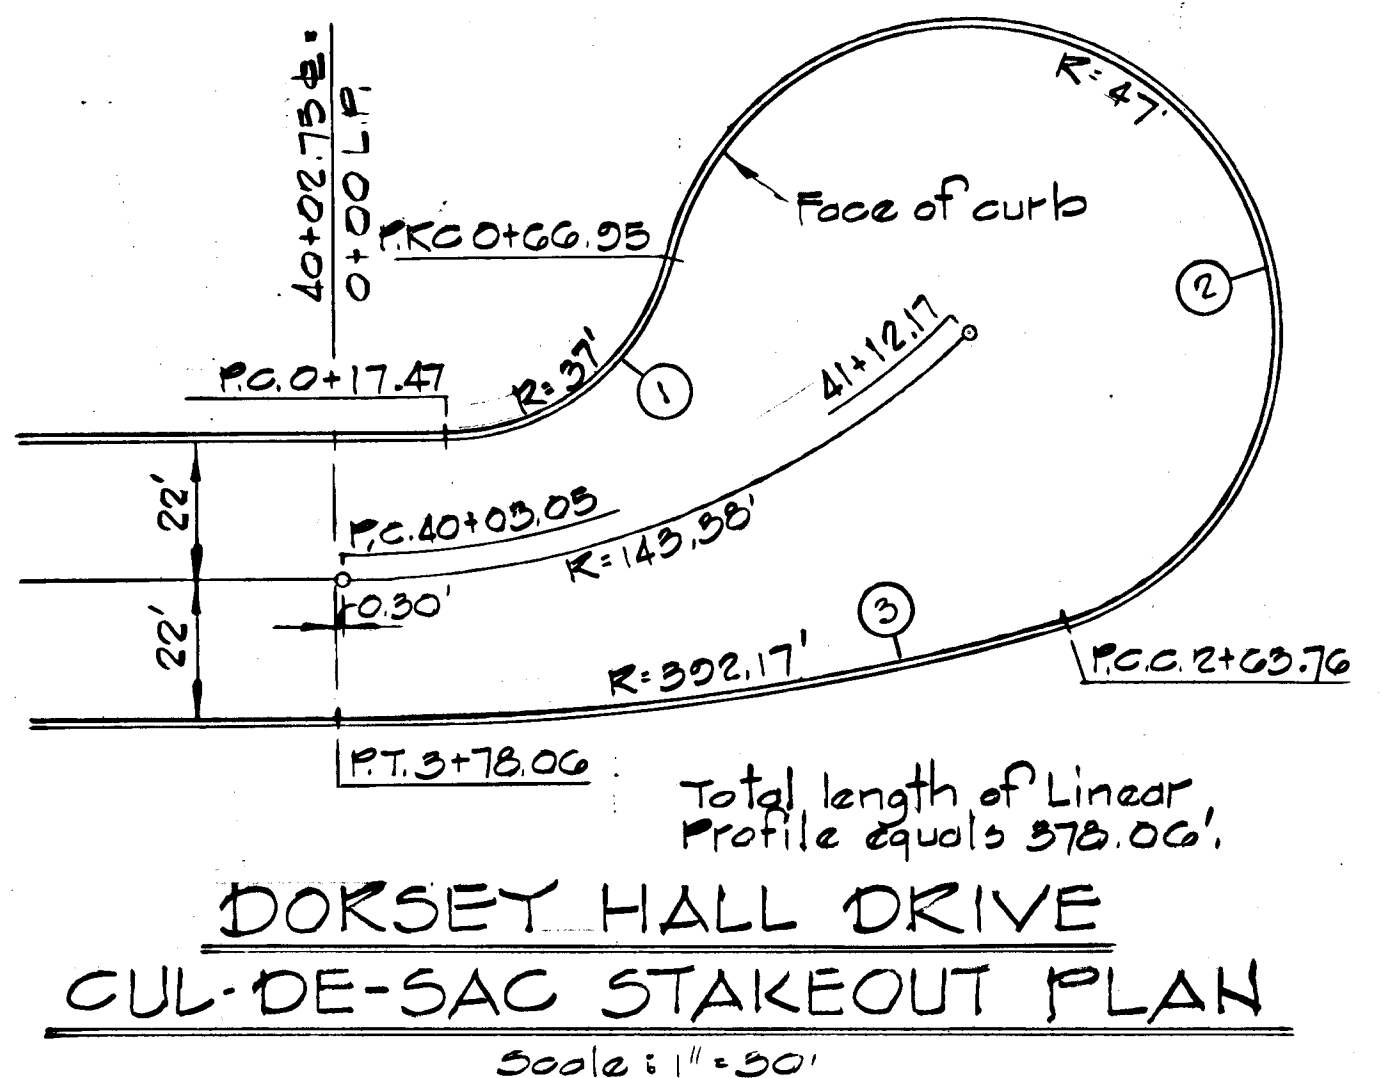






APPROVED: HOWARD COUNTY DEPARTMENT OF PUBLIC WORKS  
 Chief, Land Development Division  
 Chief, Bureau of Highways  
 Chief, Bureau of Engineering

APPROVED: OFFICE OF PLANNING AND ZONING  
 Chief, Division of Land Development and Zoning Administration

12/23/87  
 12/23/87  
 12/23/87

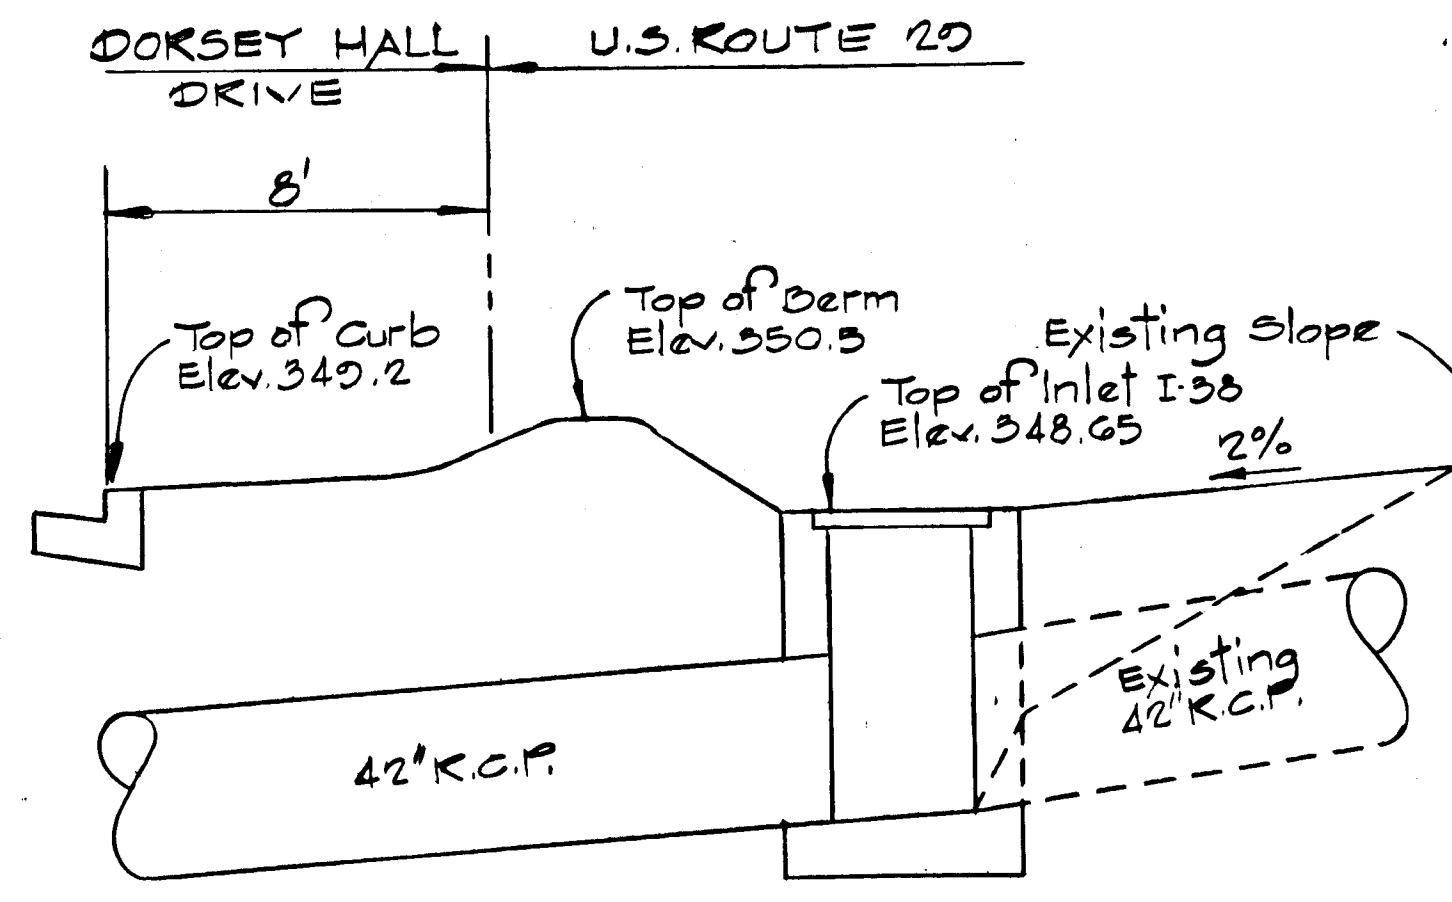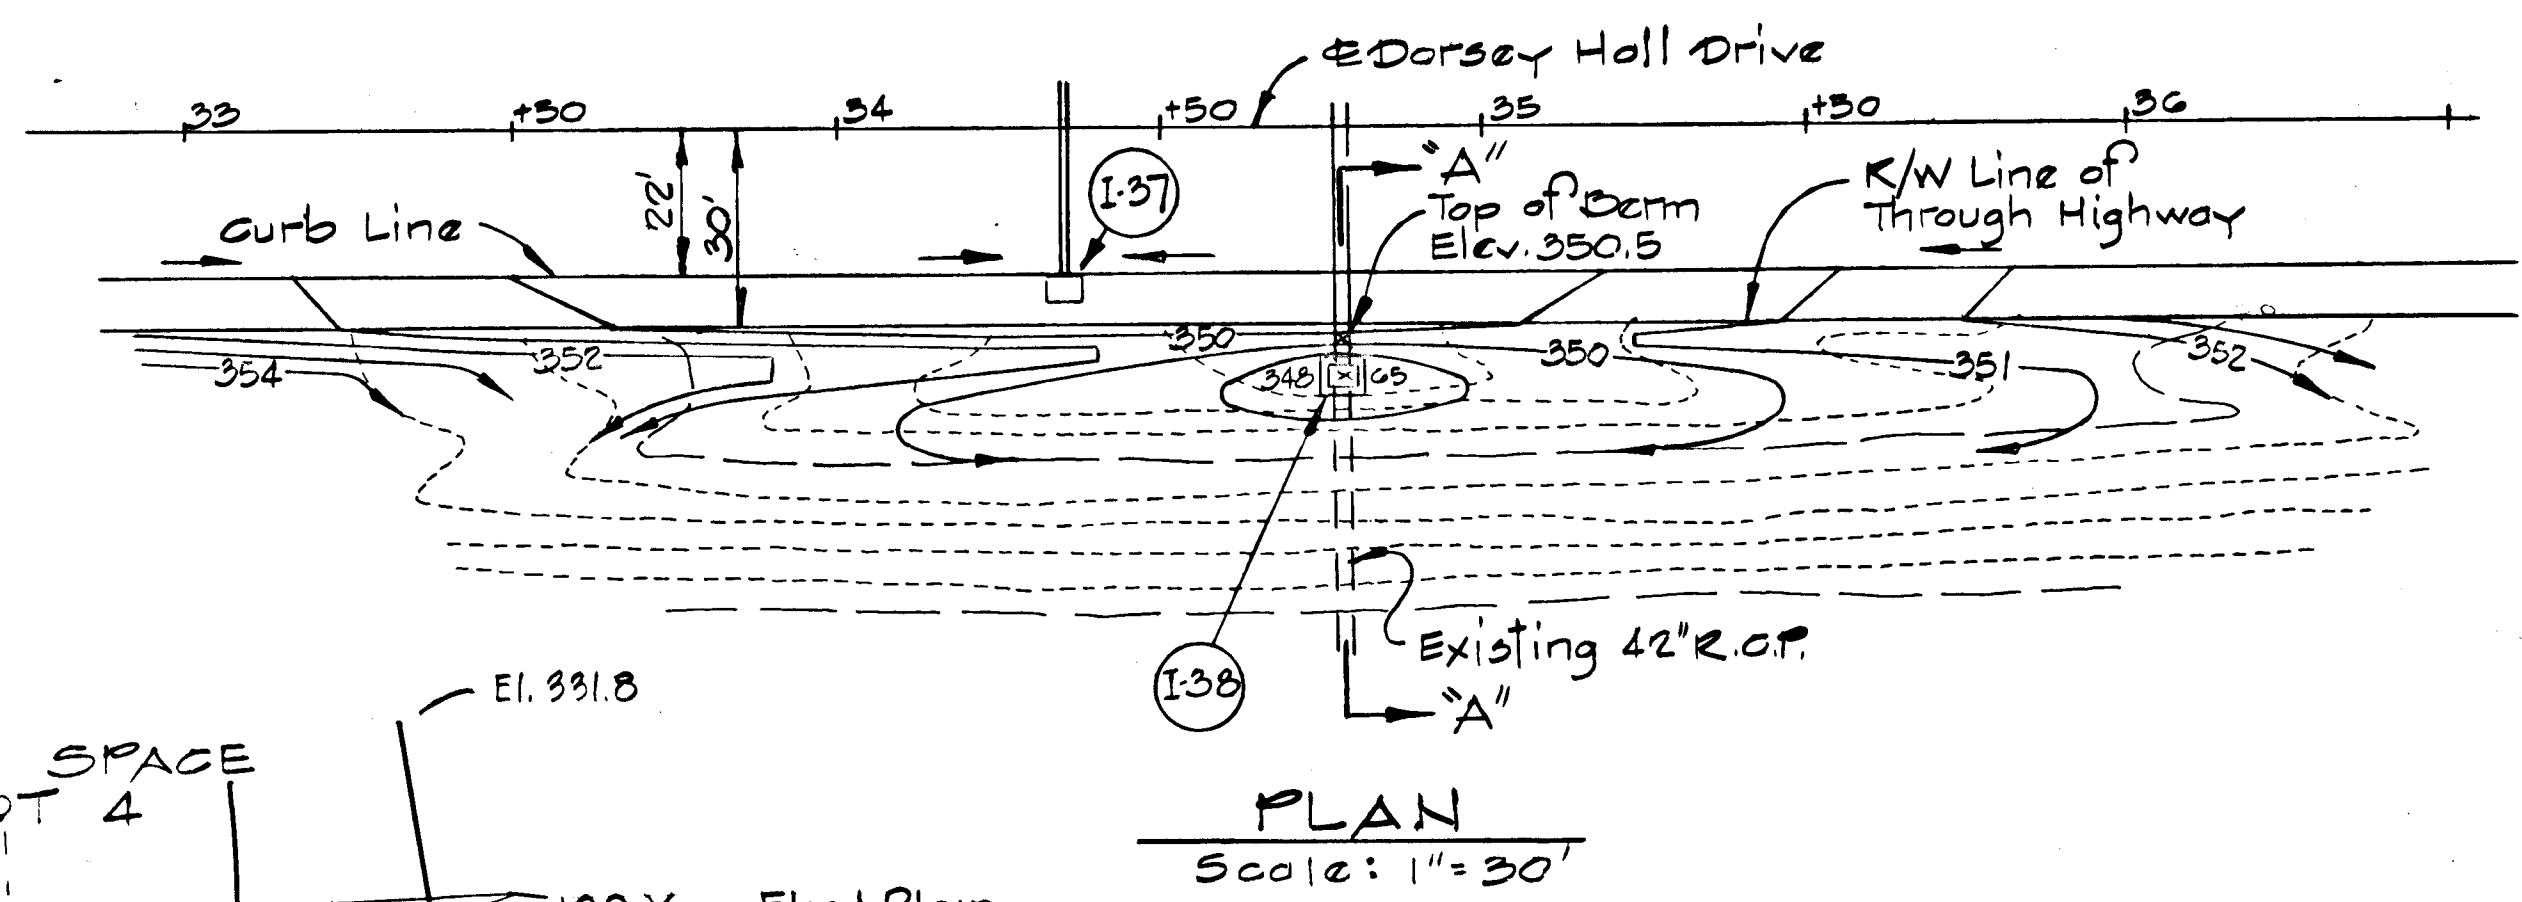

DETAILS OF GRADING AROUND INLET I-38

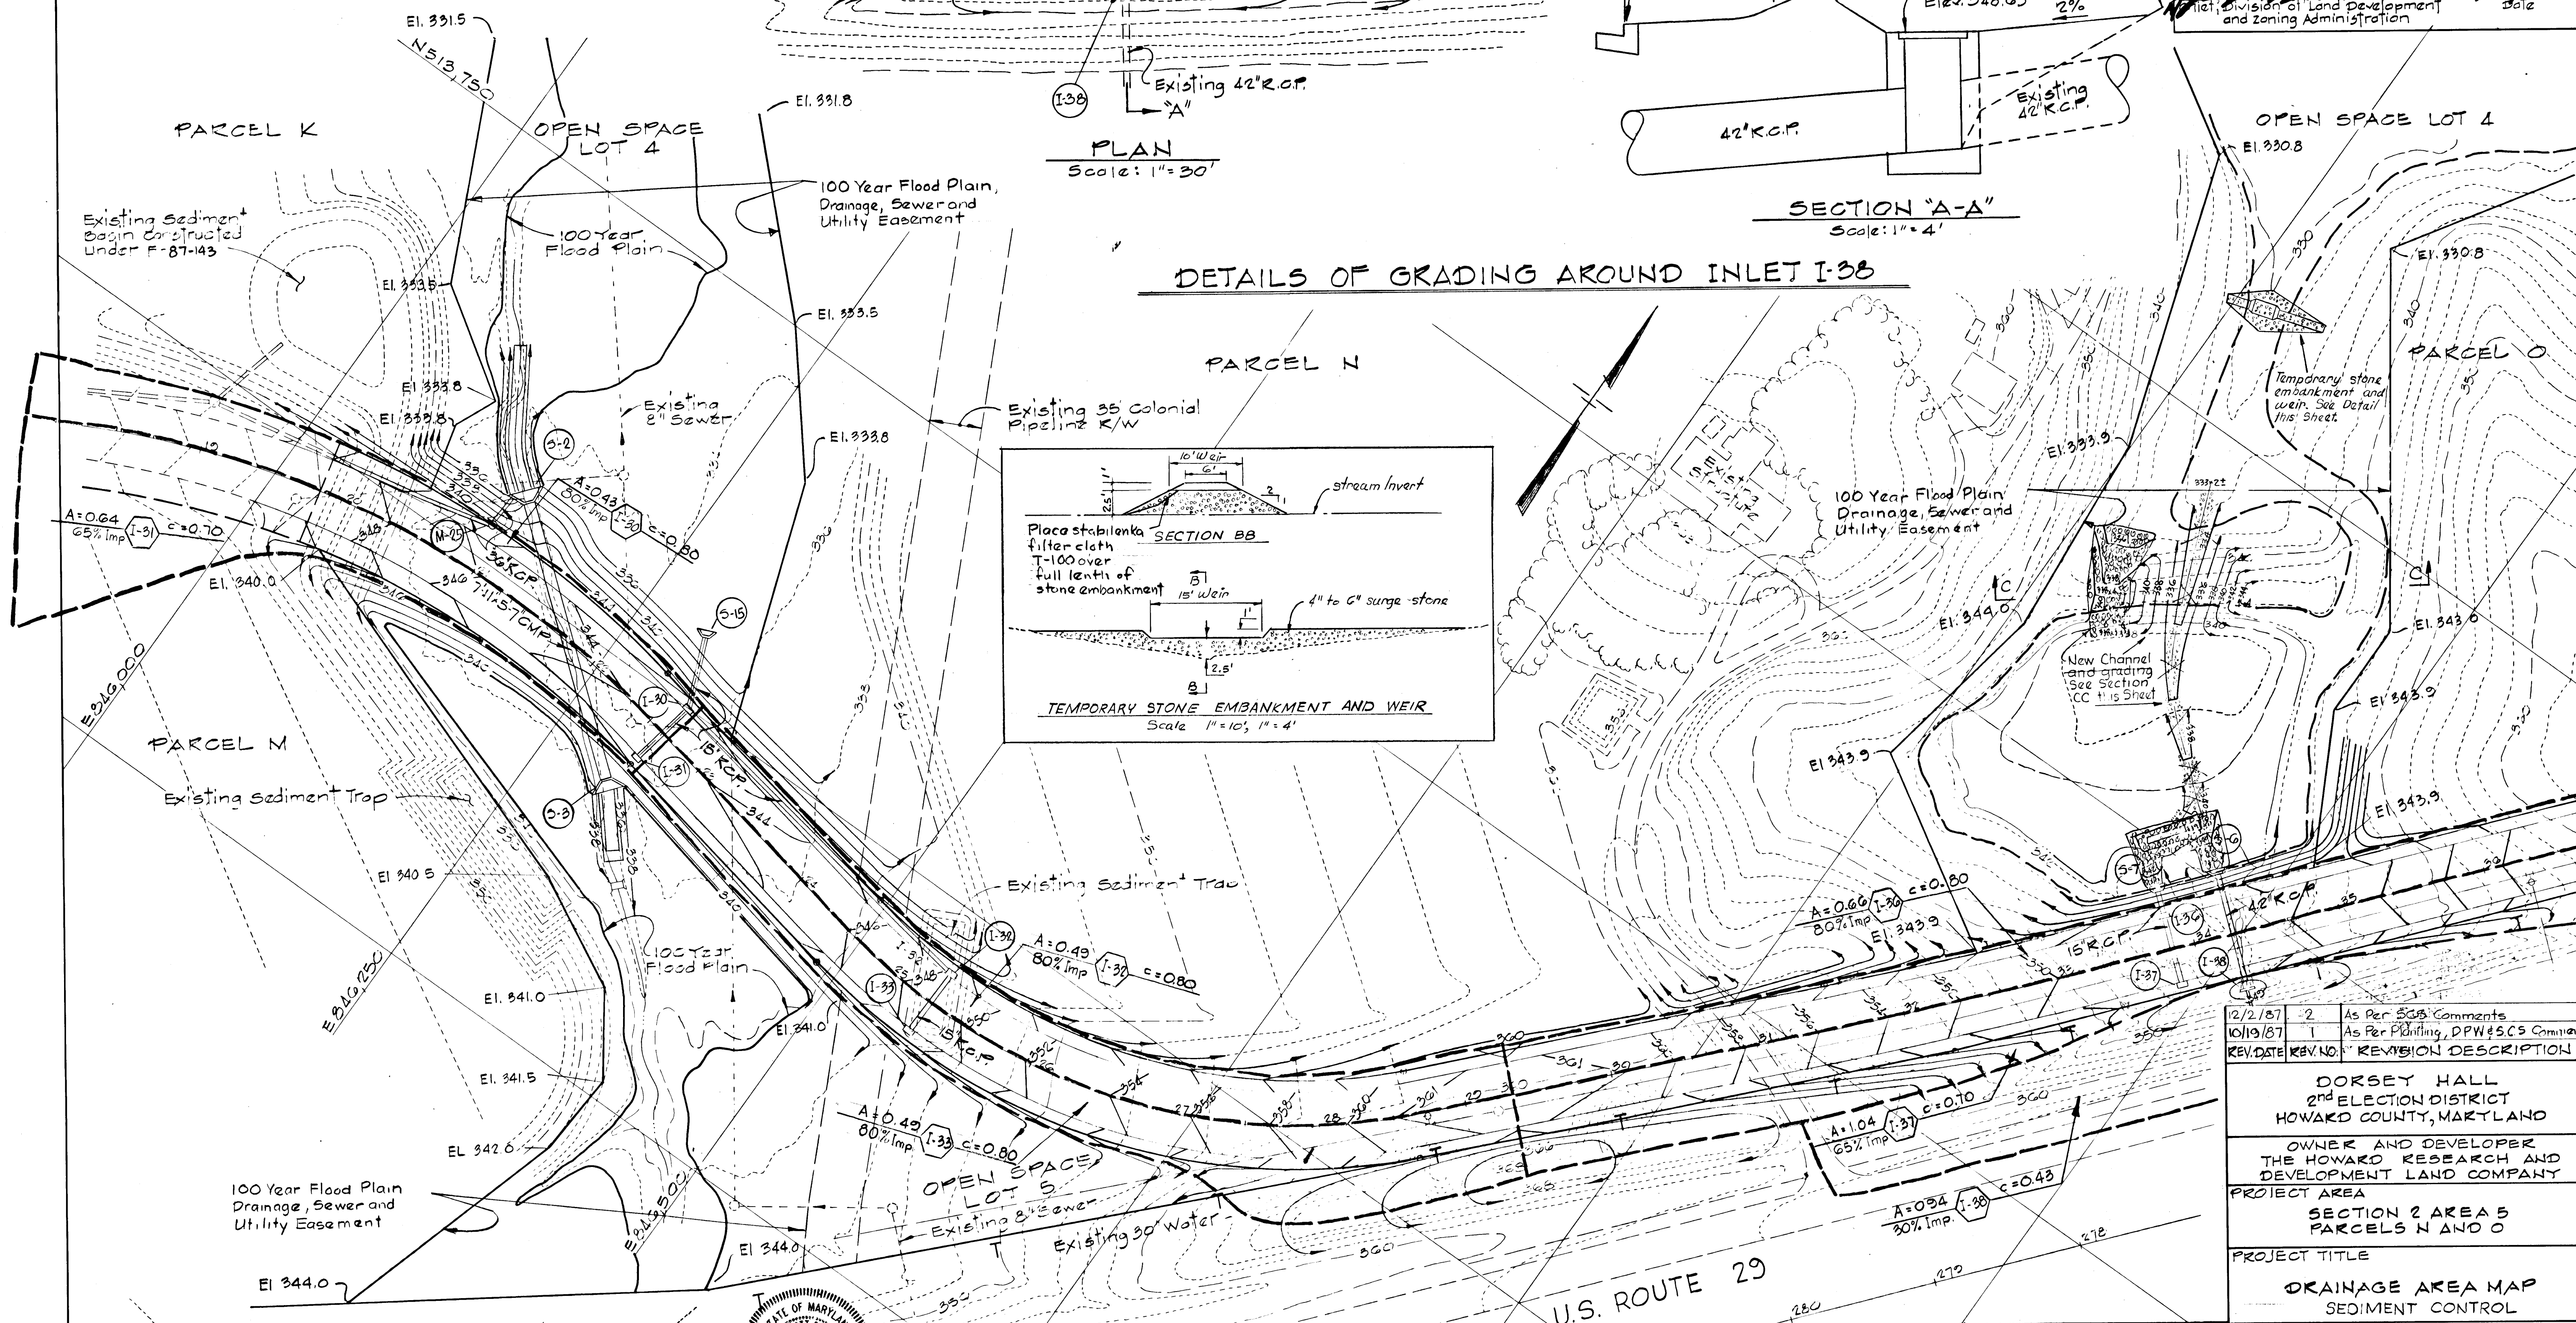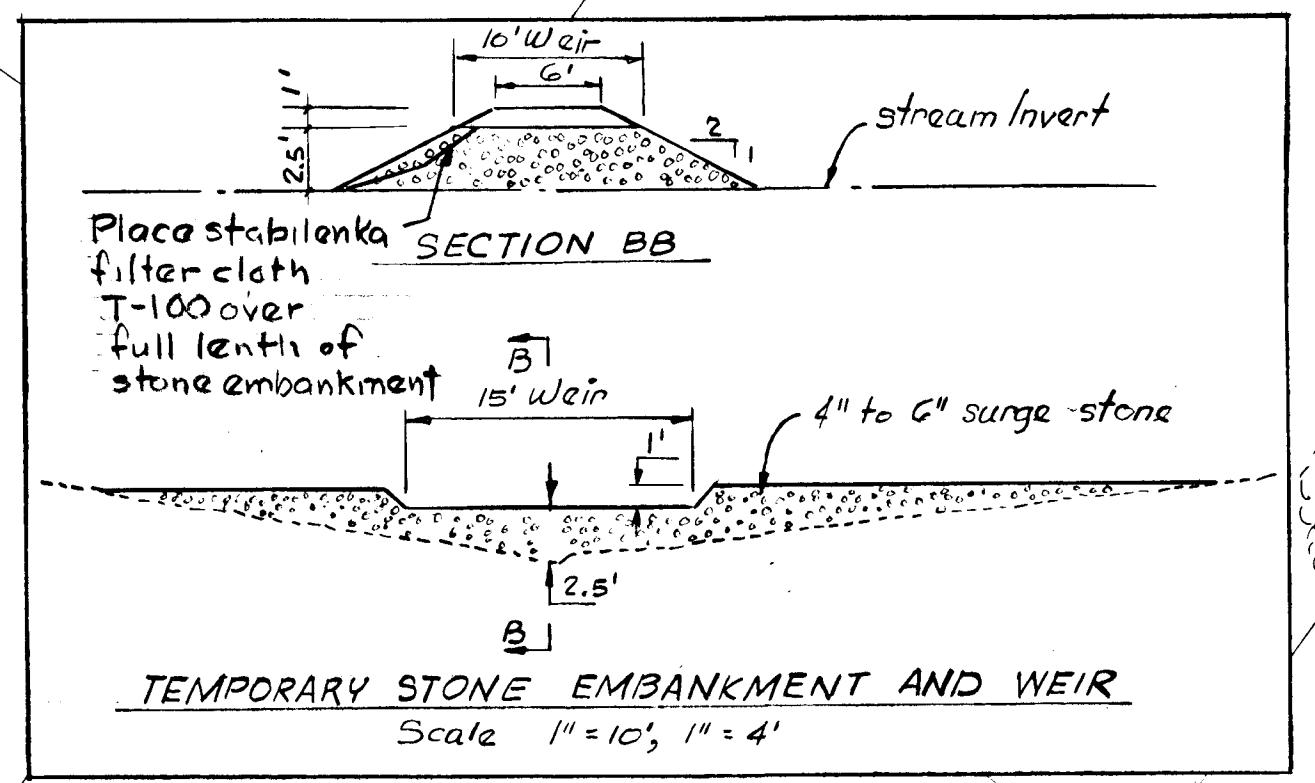



REV. DATE	REV. NO.	REVISION DESCRIPTION
12/2/87	-2	As Per SCS Comments
10/19/87	1	As Per Planning, DPW & SCS Comments

DORSEY HALL  
 2nd ELECTION DISTRICT  
 HOWARD COUNTY, MARYLAND

OWNER AND DEVELOPER  
 THE HOWARD RESEARCH AND  
 DEVELOPMENT LAND COMPANY

PROJECT AREA  
 SECTION 2 AREA 5  
 PARCELS N AND O

PROJECT TITLE  
 DRAINAGE AREA MAP  
 SEDIMENT CONTROL

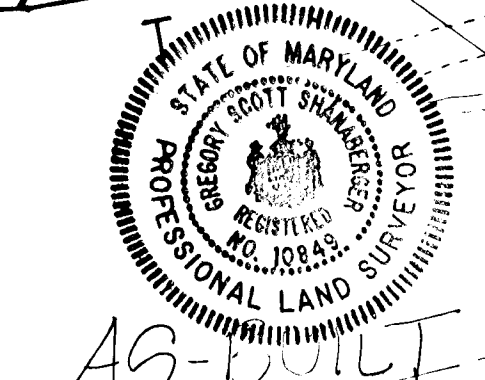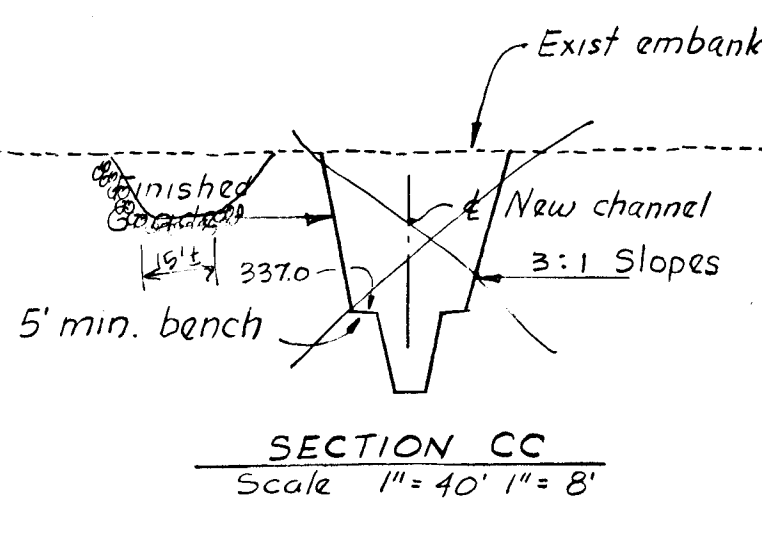

SHANABERGER & LANE  
 8726 TOWN & COUNTRY BLVD.  
 SUITE 104  
 ELLICOTT CITY, MARYLAND 21043

12/4/87  
 VME

By the Engineer:  
 "I certify that this plan for erosion and sediment control represents a practical and workable plan based on my personal knowledge of the site conditions and that it was prepared in accordance with the requirements of the Howard Soil Conservation District."  
 Kenneth A. McCord  
 8-4-87  
 Date

By the Developer:  
 "I/We certify that all development and construction will be done according to this plan, and that any responsible personnel involved in the construction project will have a Certificate of Attendance at a Department of Natural Resources Approved Training Program for the Control of Sediment and Erosion before beginning the project. I also authorize periodic on-site inspection by the Howard Soil Conservation District."  
 Gregory R. Stan  
 8-4-87  
 Date

Reviewed for HOWARD S.C.D. and meets Technical Requirements  
 U.S. Soil Conservation Service  
 Date  
 THIS DEVELOPMENT PLAN IS APPROVED FOR SOIL EROSION AND SEDIMENT CONTROL BY THE HOWARD SOIL CONSERVATION DISTRICT  
 Stephen L. Fisher  
 12/14/87  
 Date  
 Howard S.C.D.


SCALE: 1" = 50' DATE:  
 WHITMAN, REQUART AND ASSOCIATES  
 ENGINEERS  
 BALTIMORE, MARYLAND 21218

Kenneth A. McCord  
 REGISTERED ENGINEER  
 NO. 1974



Chief, Land Development Division Date  
*Draville W. Vaneau* 12/23/87  
 Chief, Bureau of Highways Date  
*William S. Powell* 12/23/87  
 Chief, Bureau of Engineering Date

Chief, Division of Land Development and Zoning Administration Date  
*James Smith* 12/23/87

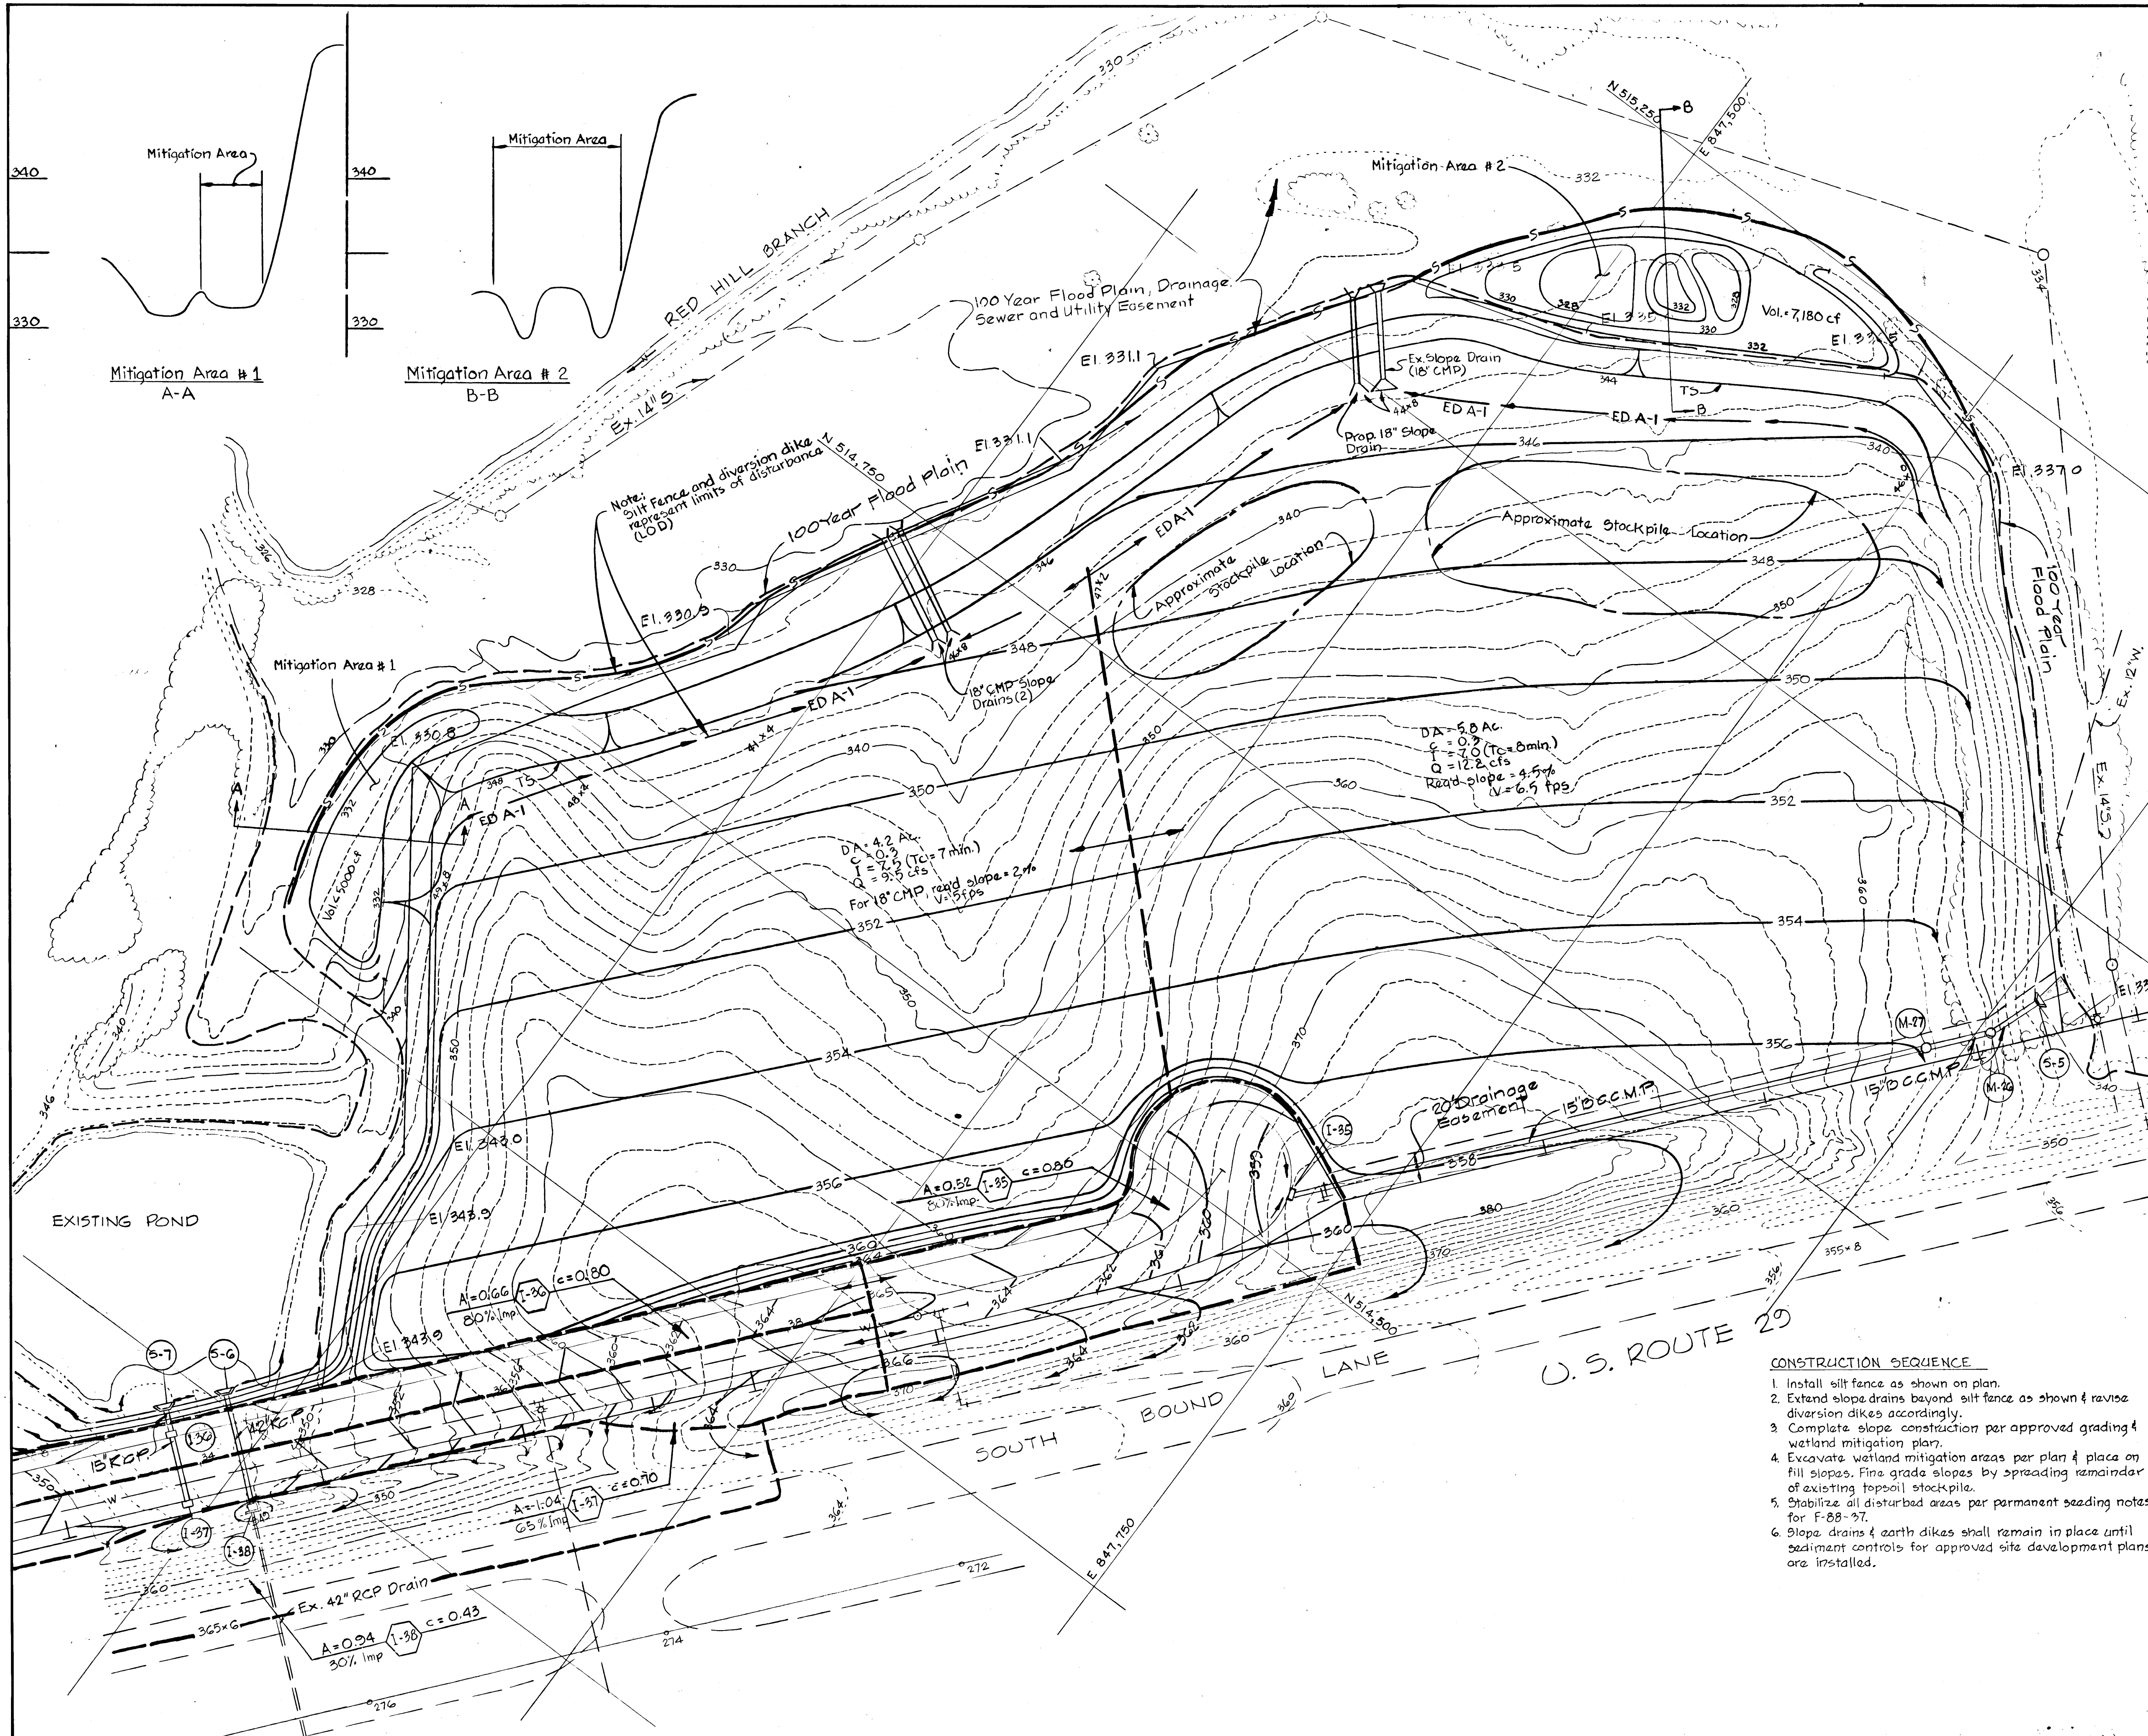

- CONSTRUCTION SEQUENCE**
1. Install silt fence as shown on plan.
  2. Extend slope drains beyond silt fence as shown & revise diversion dikes accordingly.
  3. Complete slope construction per approved grading & wetland mitigation plan.
  4. Excavate wetland mitigation areas per plan & place on fill slopes. Fine grade slopes by spreading remainder of existing topsoil stockpile.
  5. Stabilize all disturbed areas per permanent seeding notes for F-88-87.
  6. Slope drains & earth dikes shall remain in place until sediment controls for approved site development plans are installed.

7/6/89	2	As Per D.P.W. Comments (5/24/89)
10/19/87	1	As Per Planning, D.P.W. & S.C.S. Comments
REV. DATE	REV. NO.	REVISION DESCRIPTION

DORSEY HALL  
 2<sup>ND</sup> ELECTION DISTRICT  
 HOWARD COUNTY, MARYLAND

OWNER AND DEVELOPER  
 THE HOWARD RESEARCH AND  
 DEVELOPMENT LAND COMPANY

PROJECT AREA  
 SECTION 2 AREAS  
 PARCELS N AND O

PROJECT TITLE  
 DRAINAGE AREA MAP

SCALE: 1" = 50' DATE:






WHITMAN, REQUARDT AND ASSOCIATES  
 ENGINEERS  
 BALTIMORE, MARYLAND 21218

*Kenneth A. McCord*  
 KENNETH A. MCCORD  
 Registered Engineer  
 No. 1974











APPROVED: HOWARD COUNTY DEPARTMENT OF PUBLIC WORKS  
 Chief, Land Development Division  
 Date: 12/24/87  
 Drawn: W. Welton 12/23/87  
 Chief, Bureau of Highways  
 Date: 12-23-87  
 Approved: OFFICE OF PLANNING AND ZONING  
 Chief, Division of Land Development and Zoning Administration  
 Date: 12/23/87

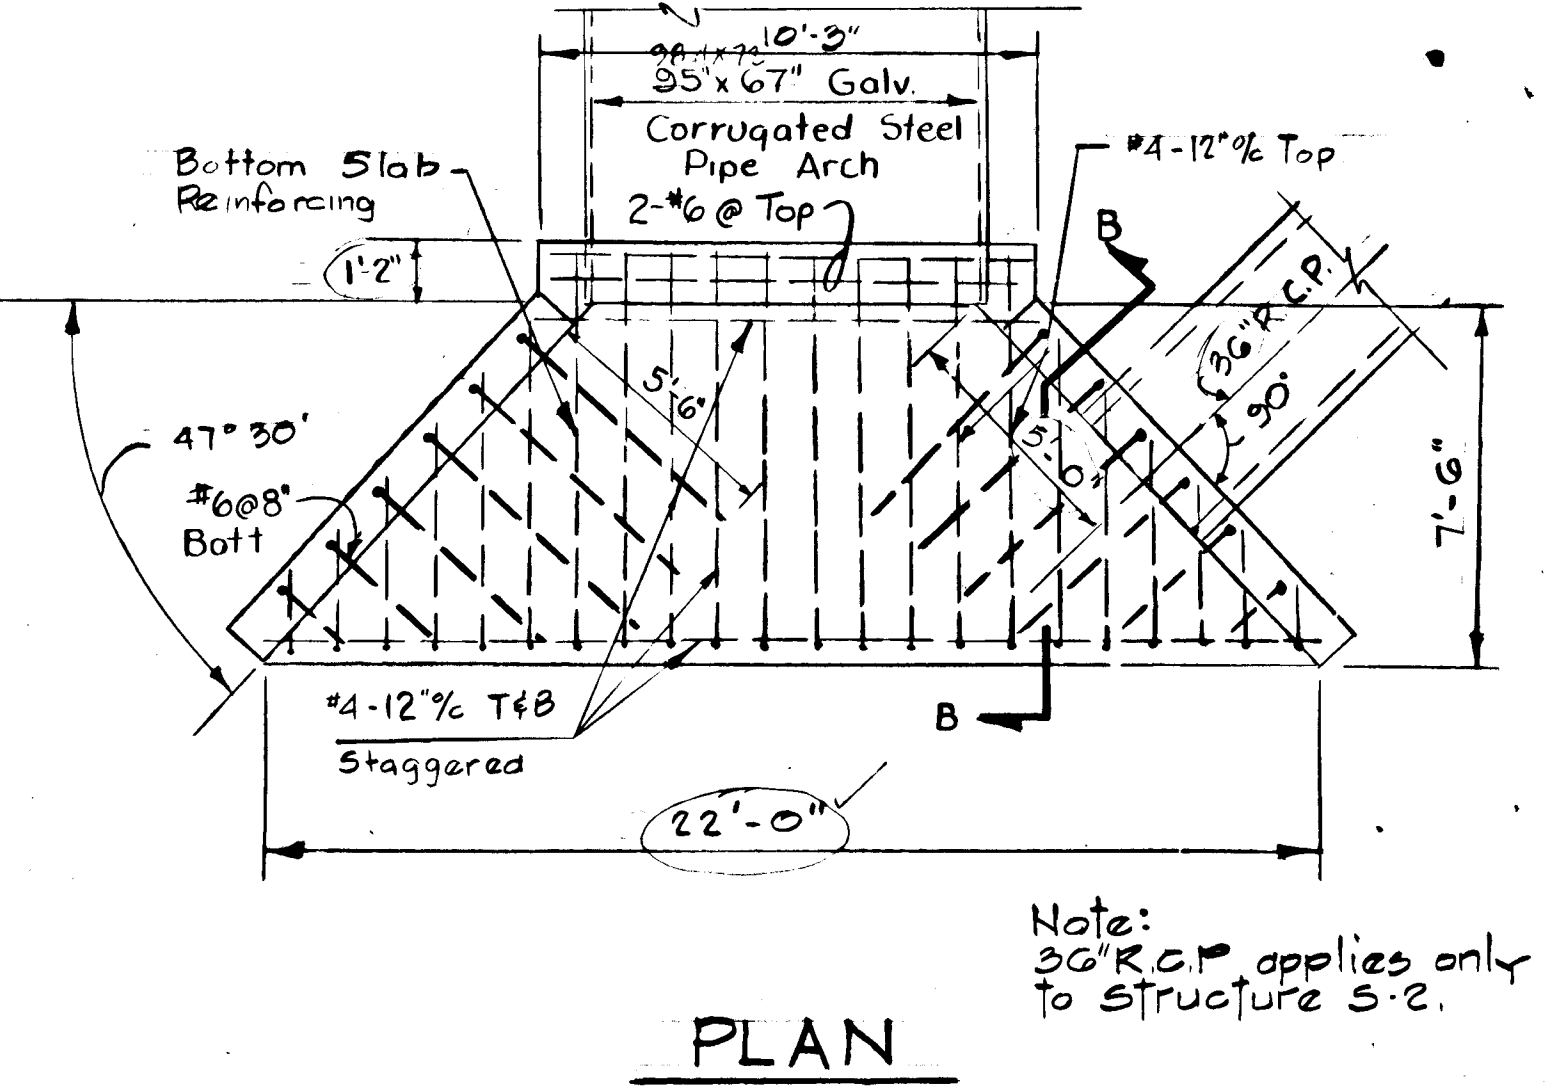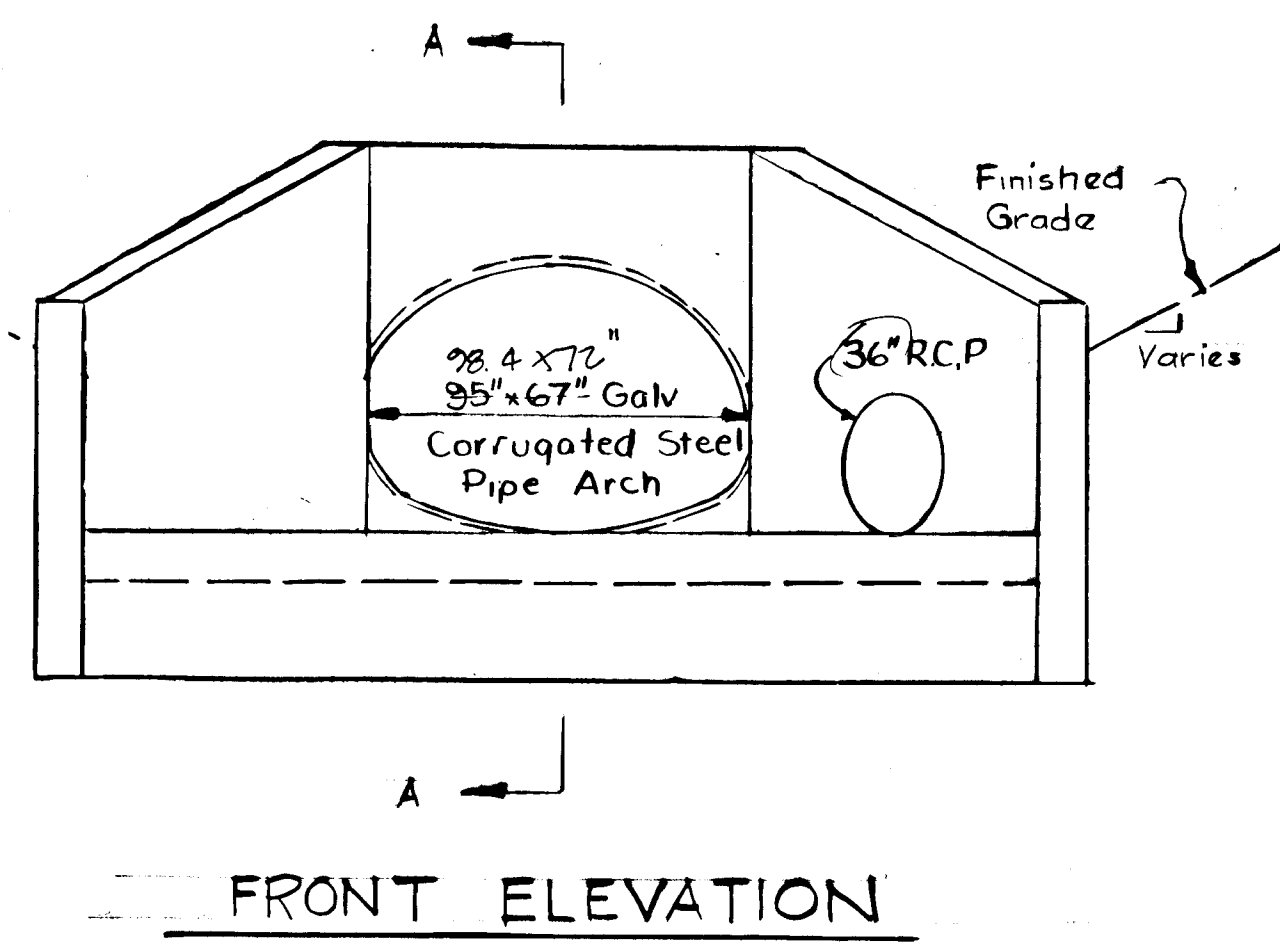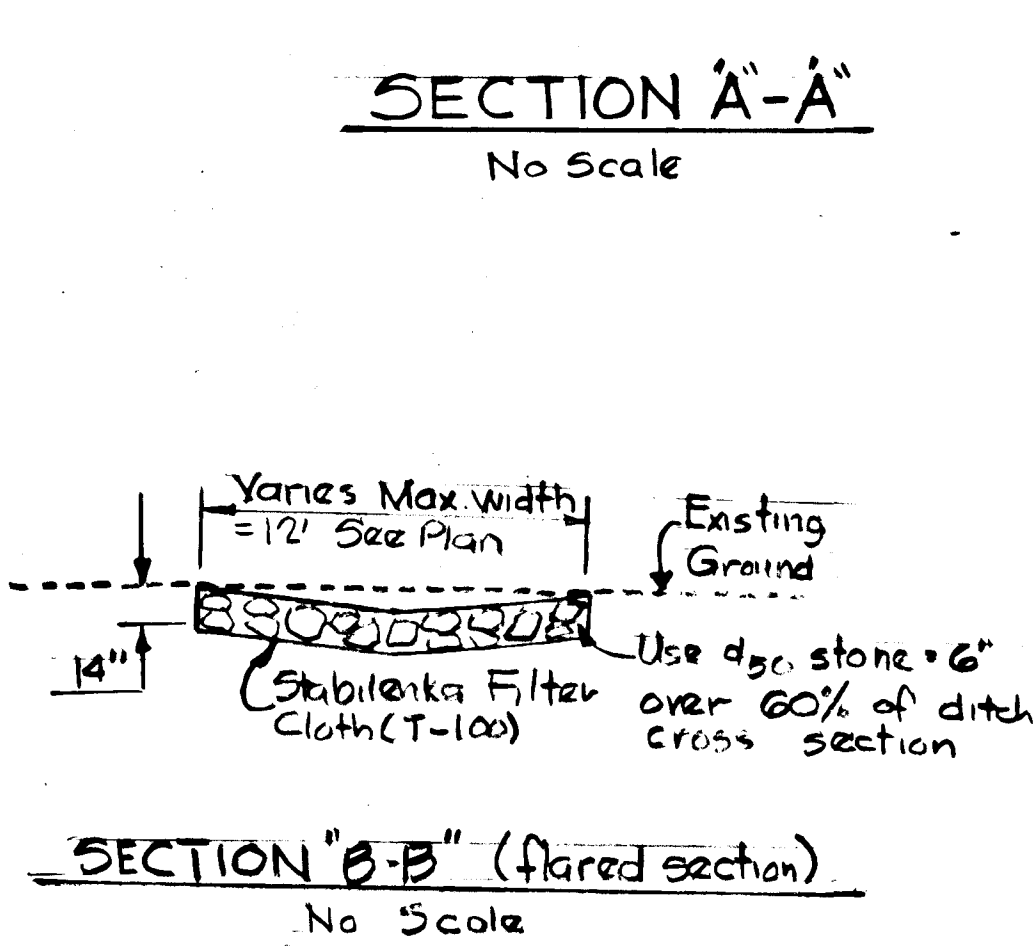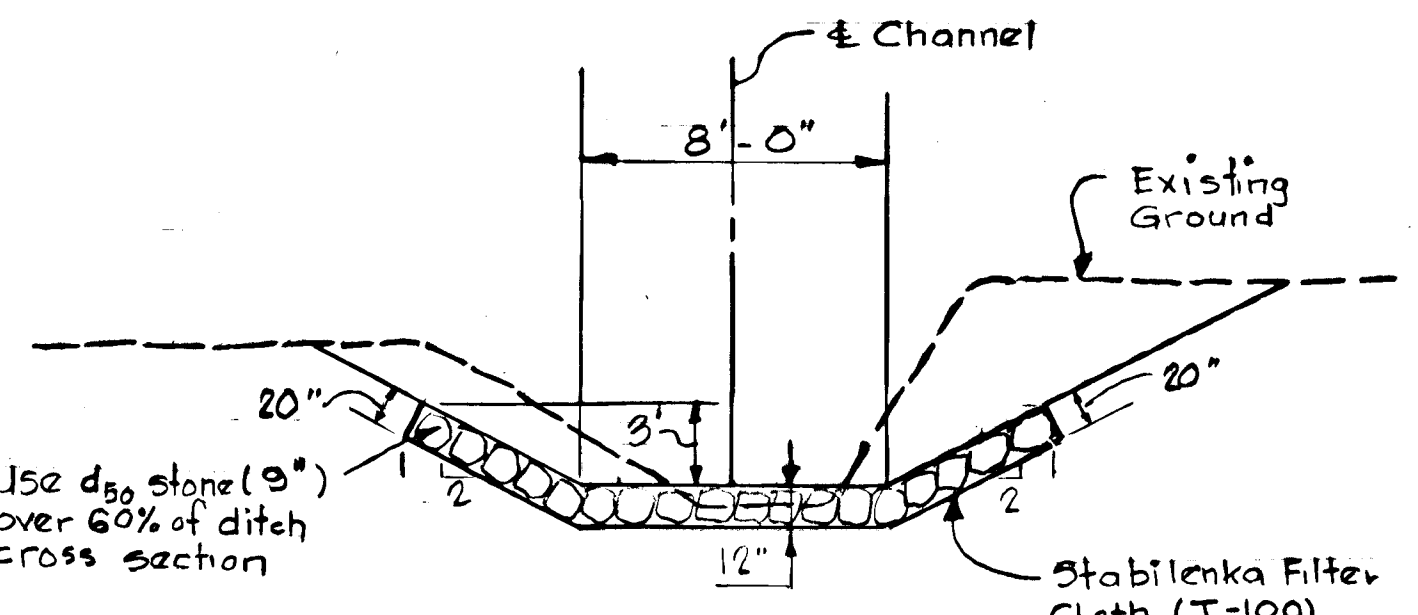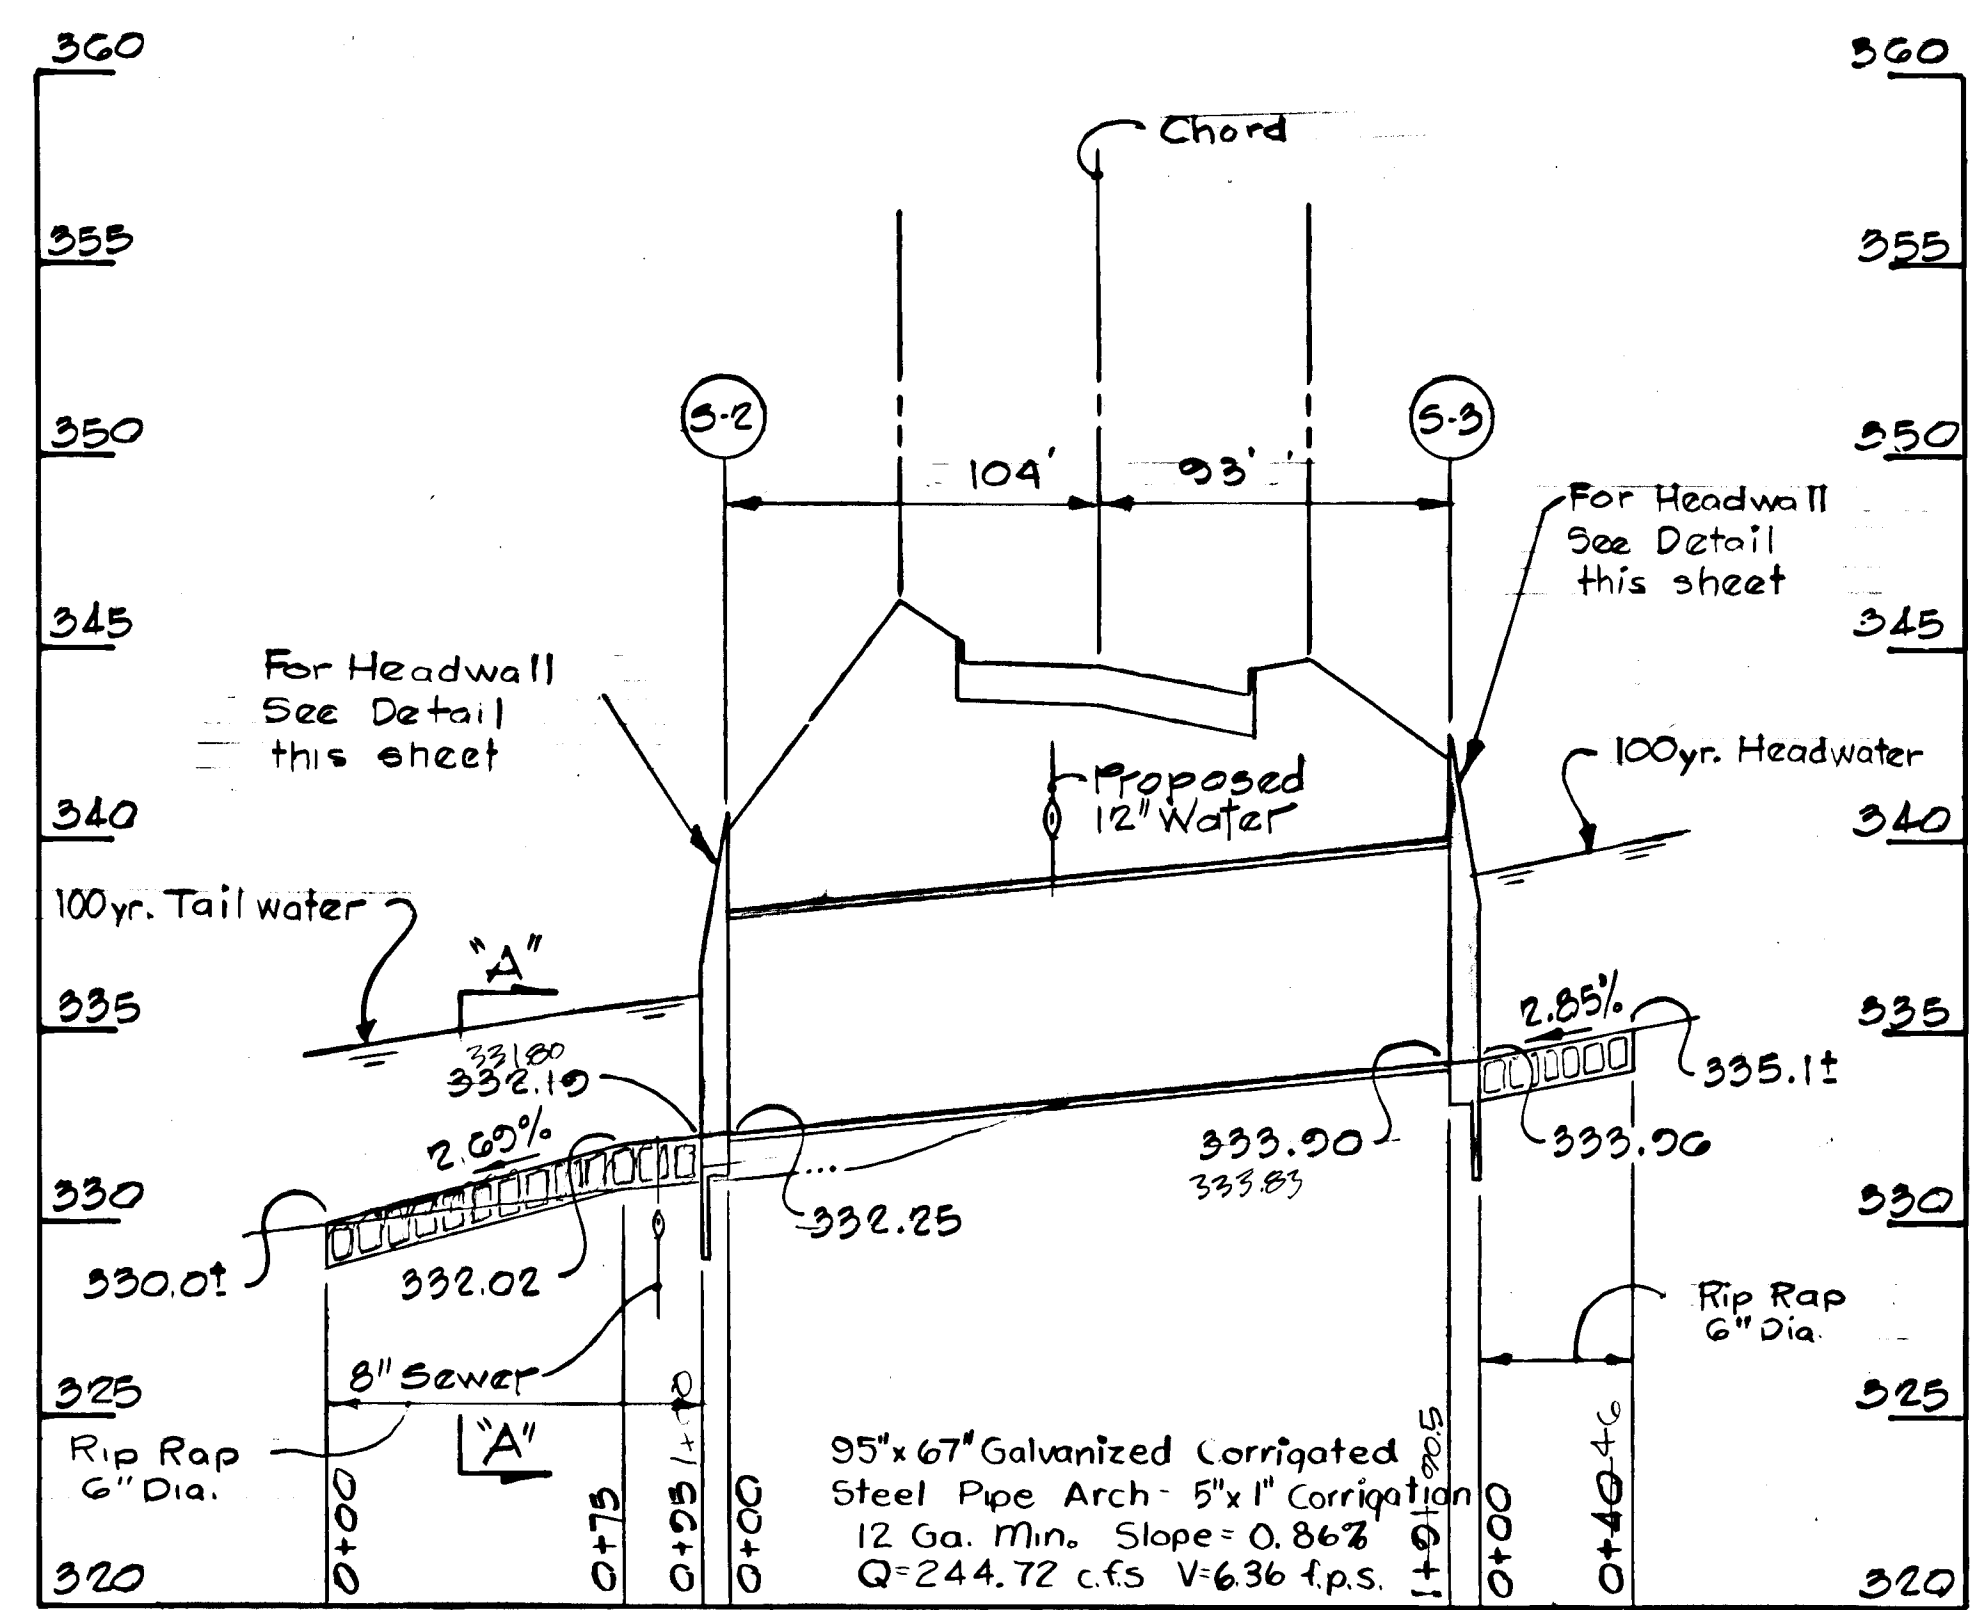

Note: 36" R.C.P. applies only to Structure 5-2.

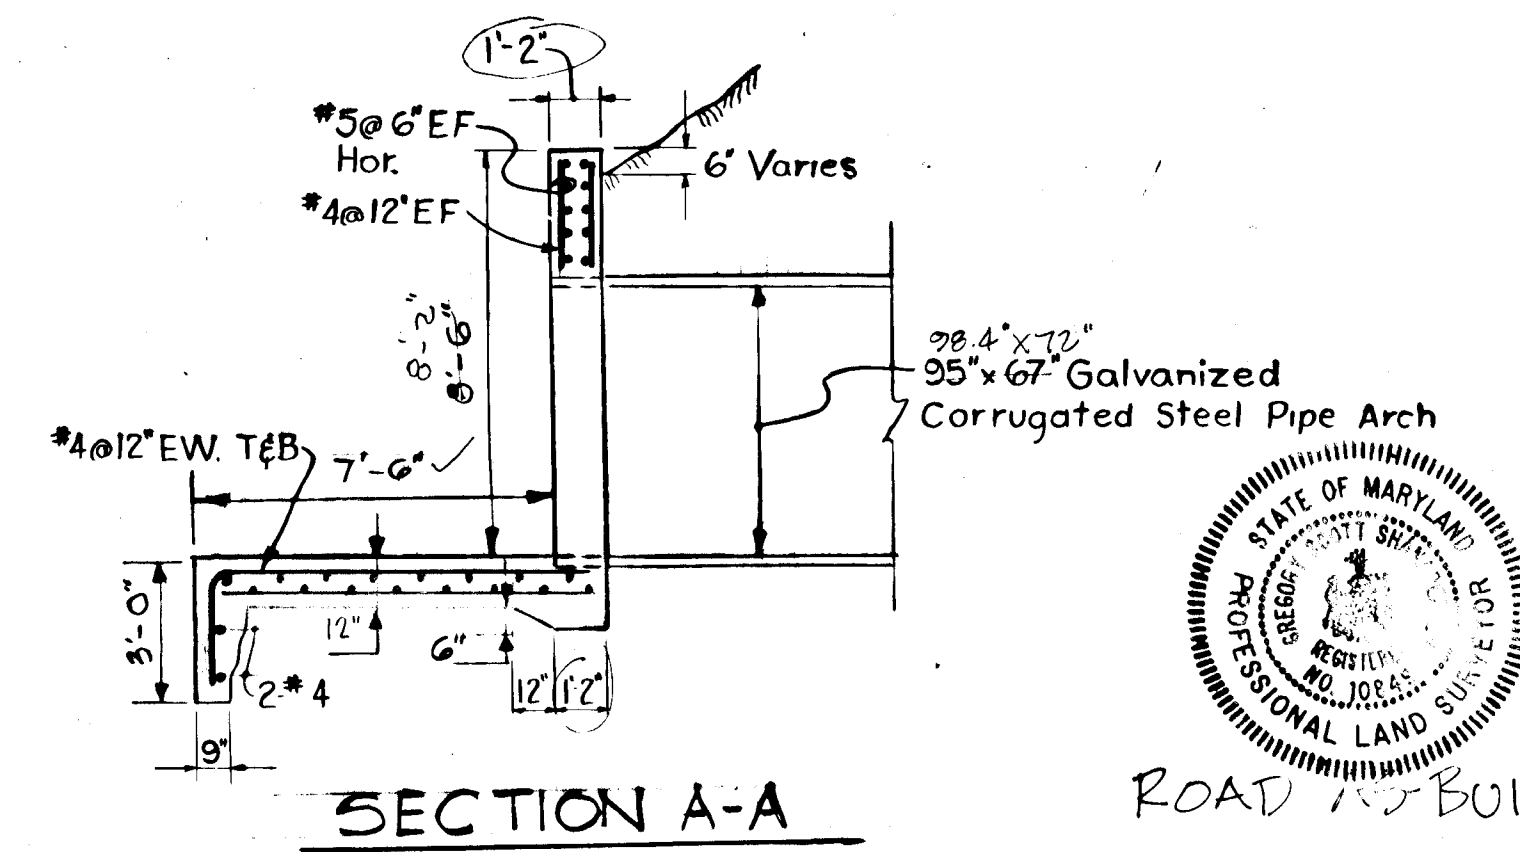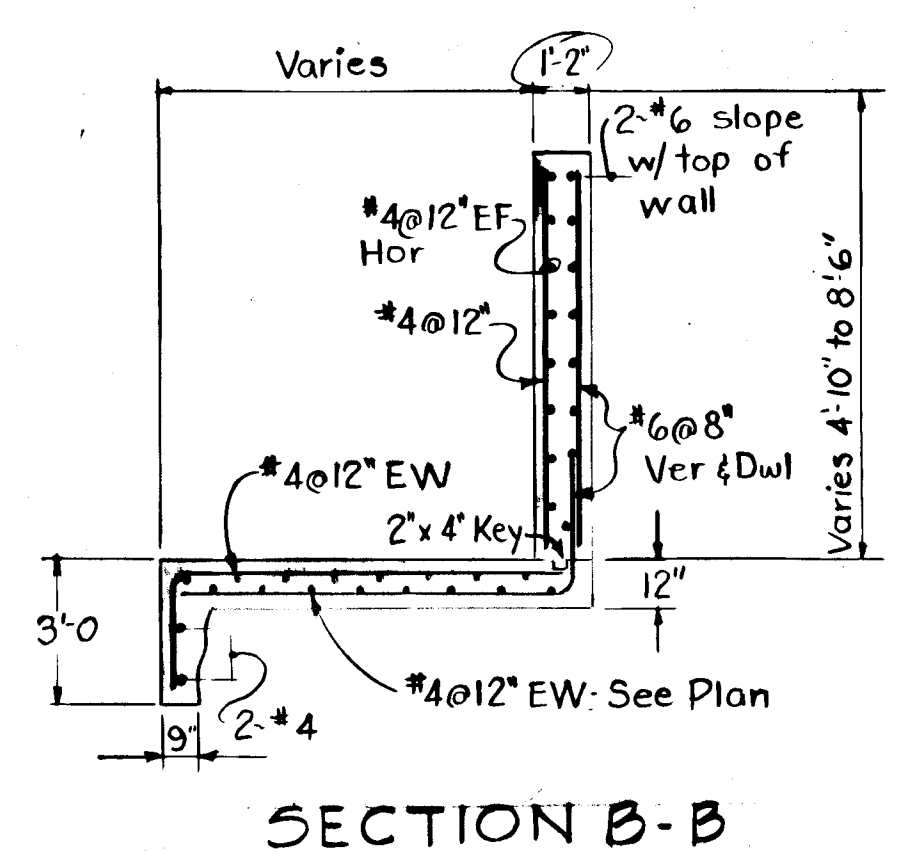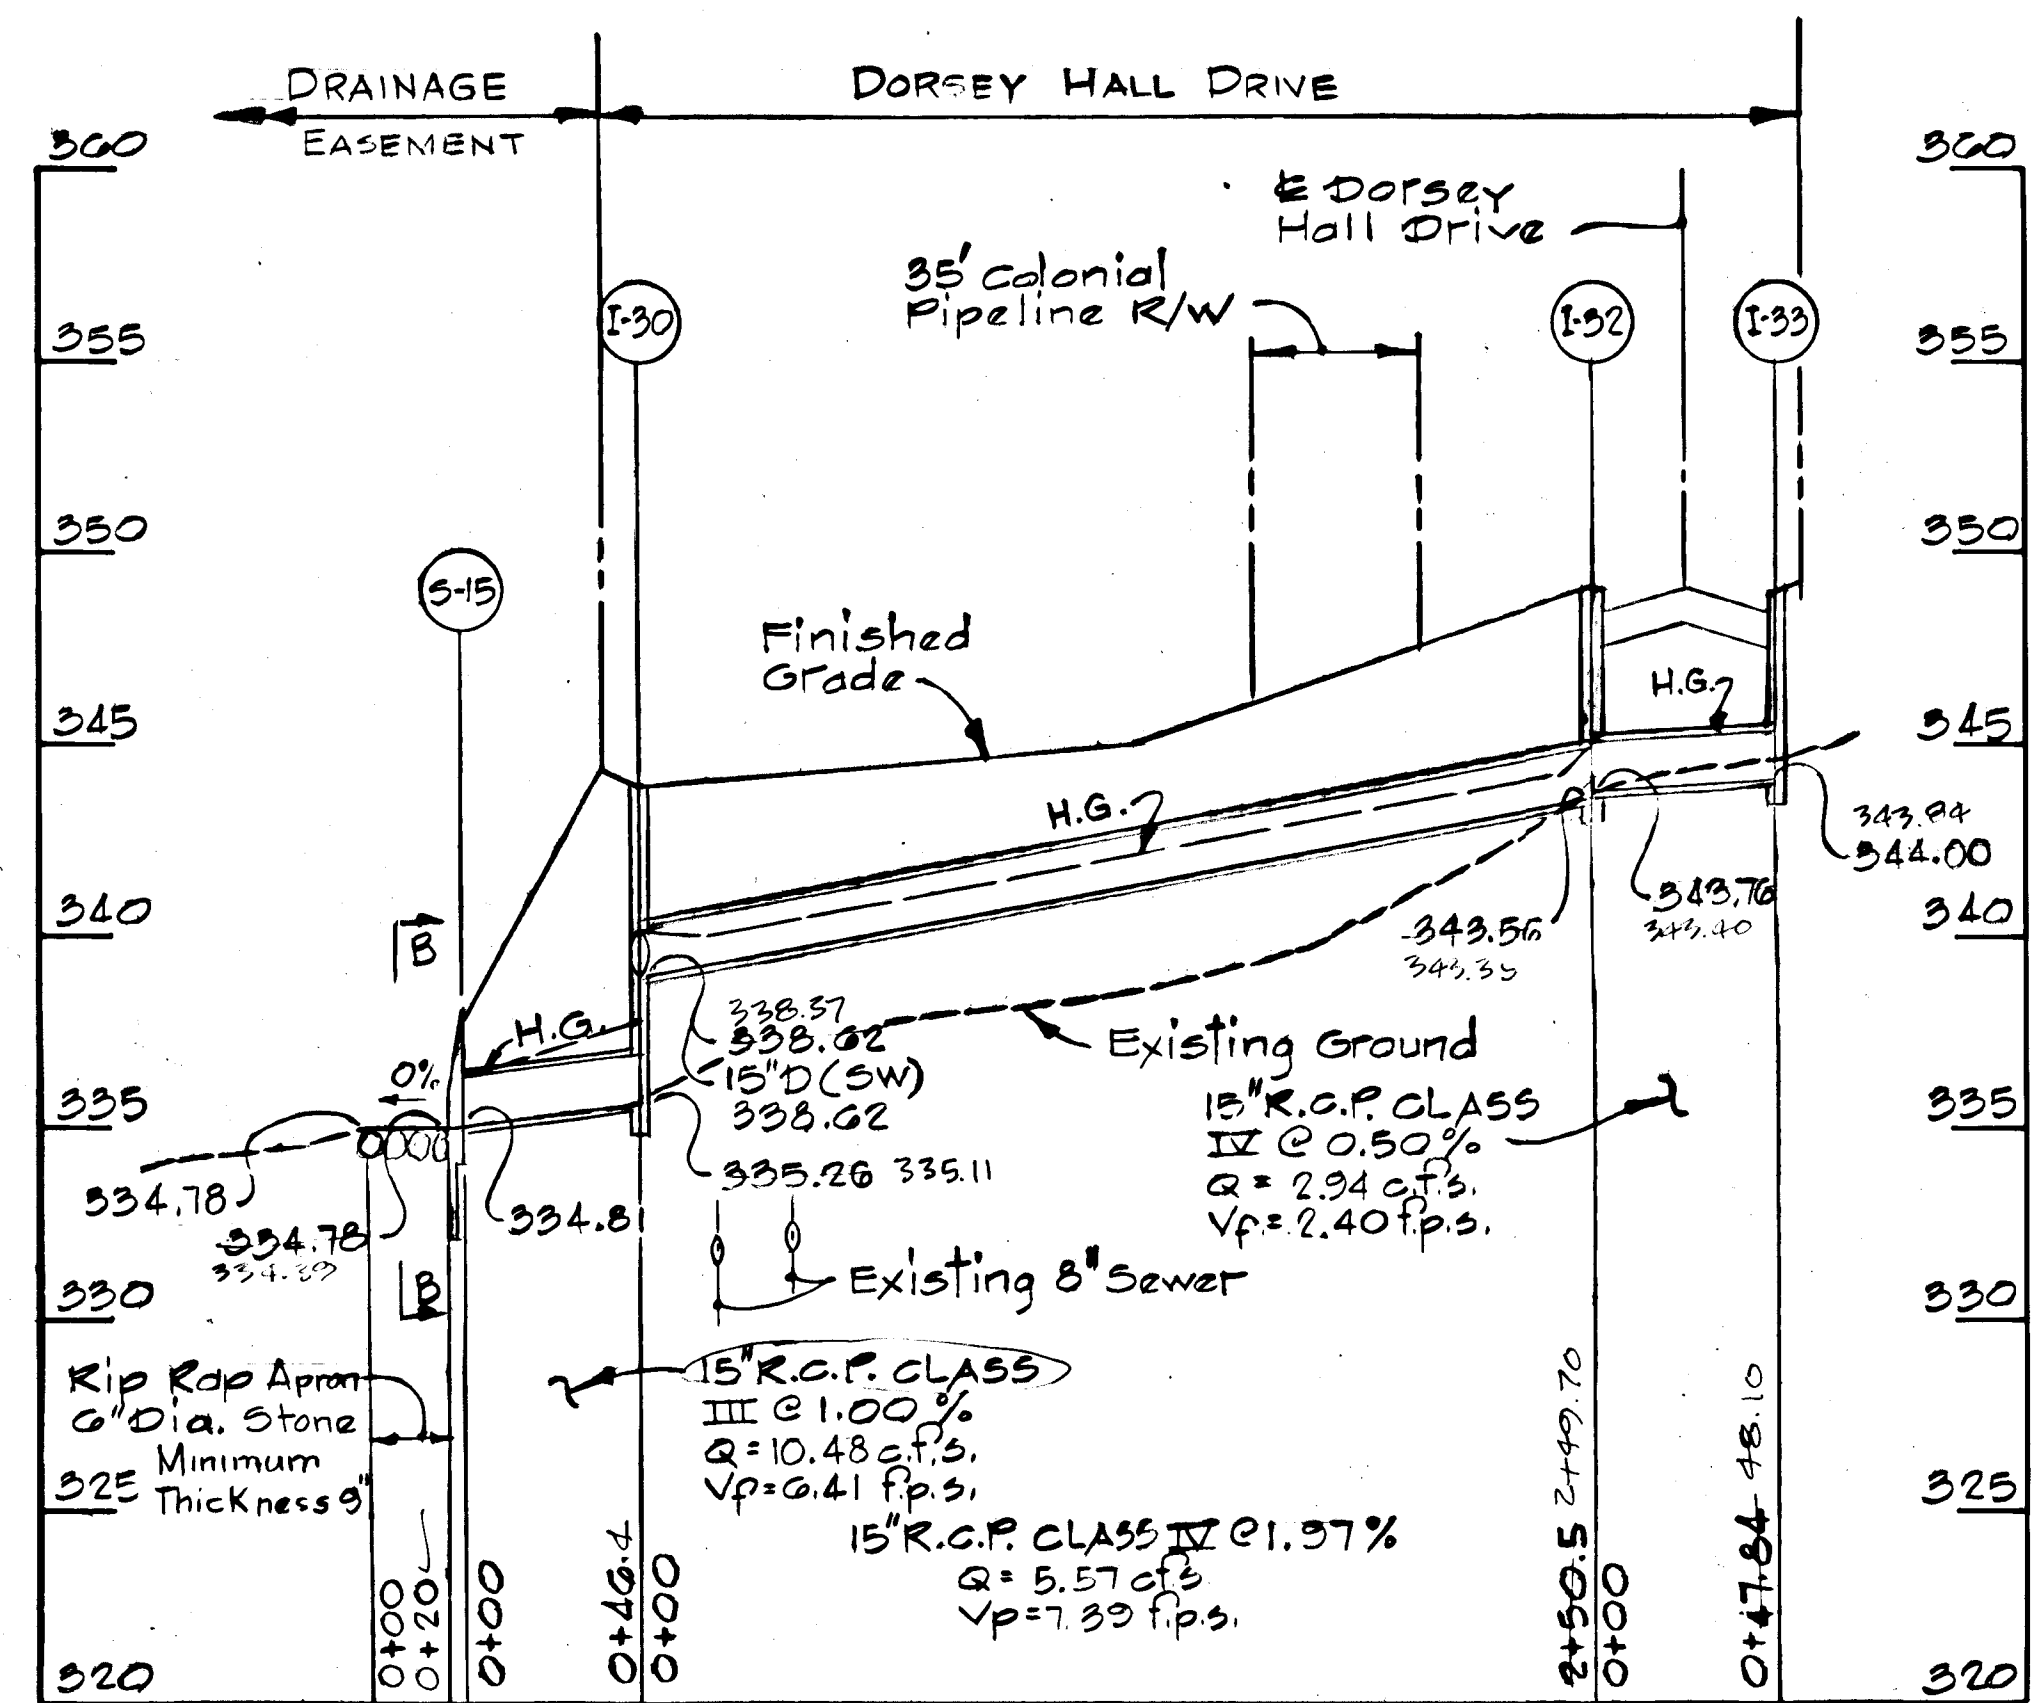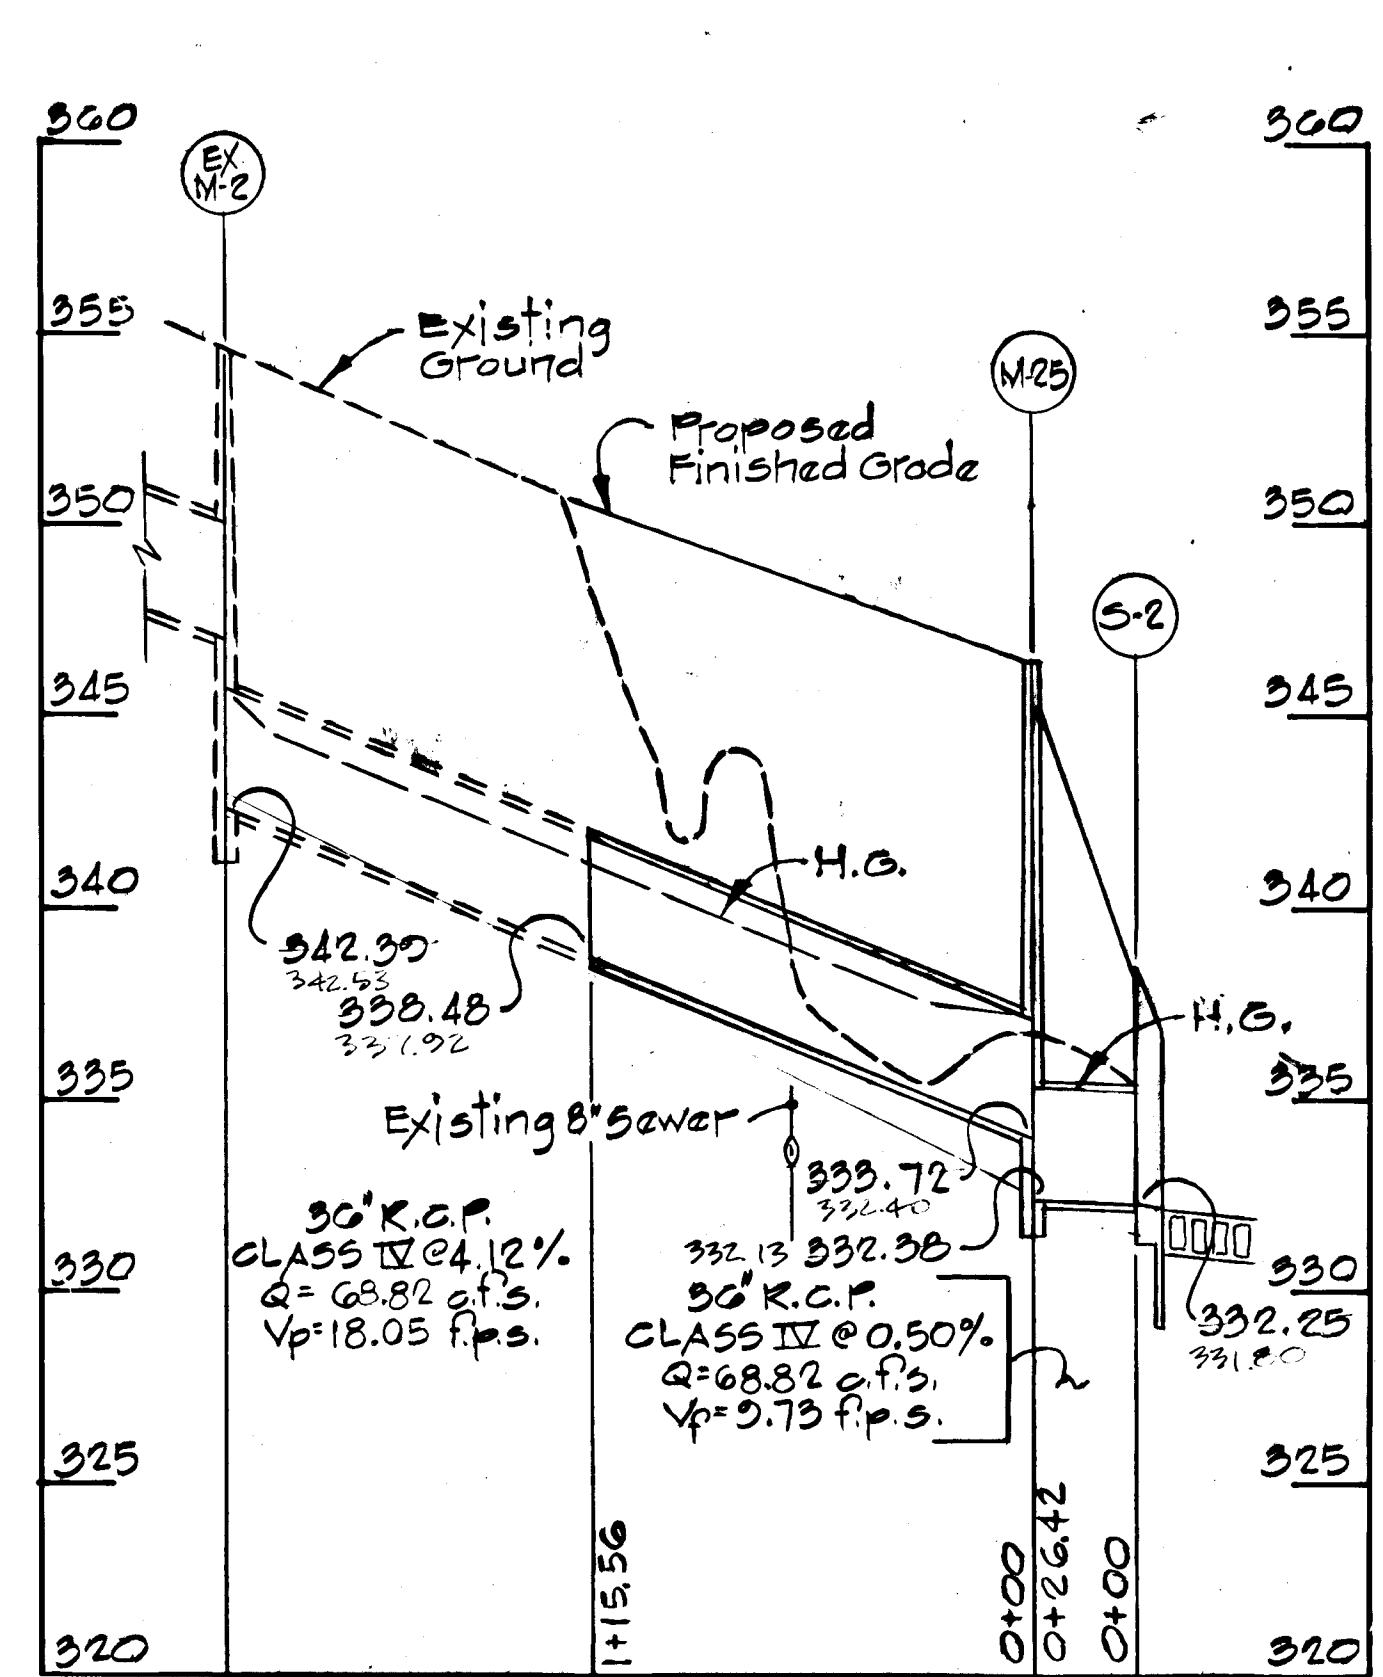

DETAIL STRUCTURES 5-2 & 5-3  
 Scale 1/4" = 1'-0"

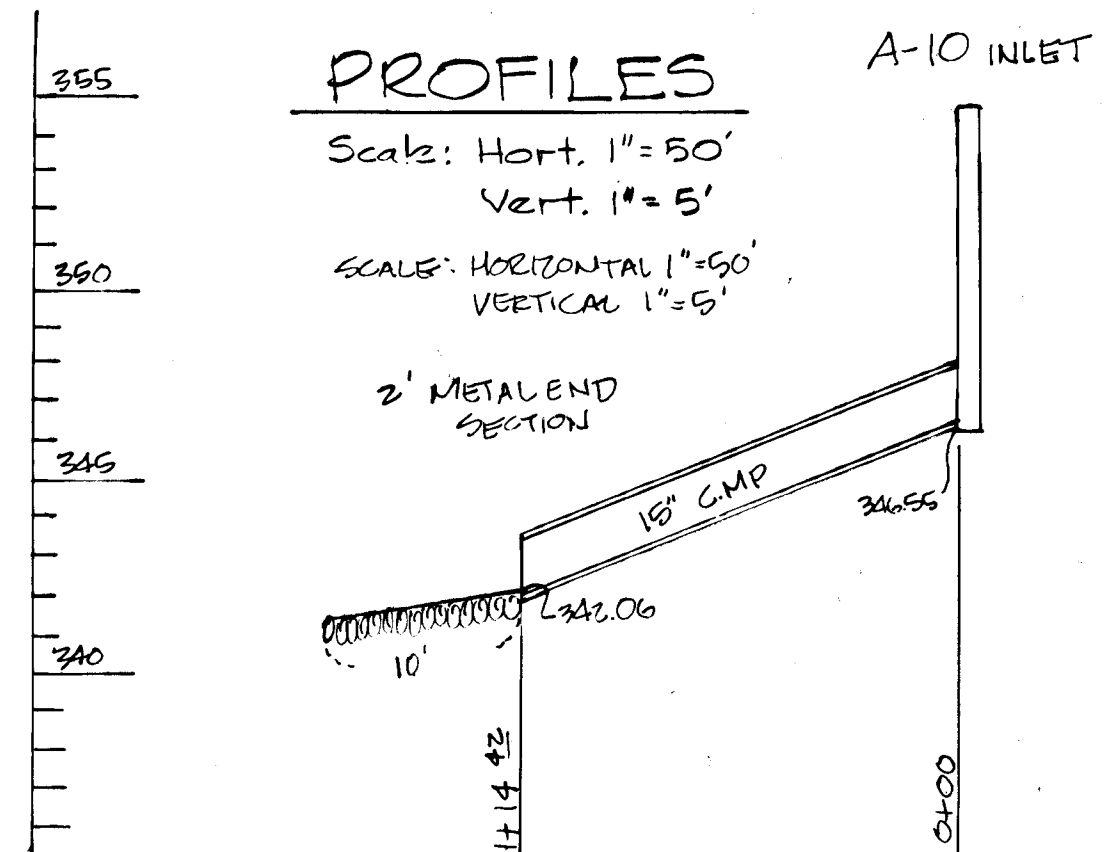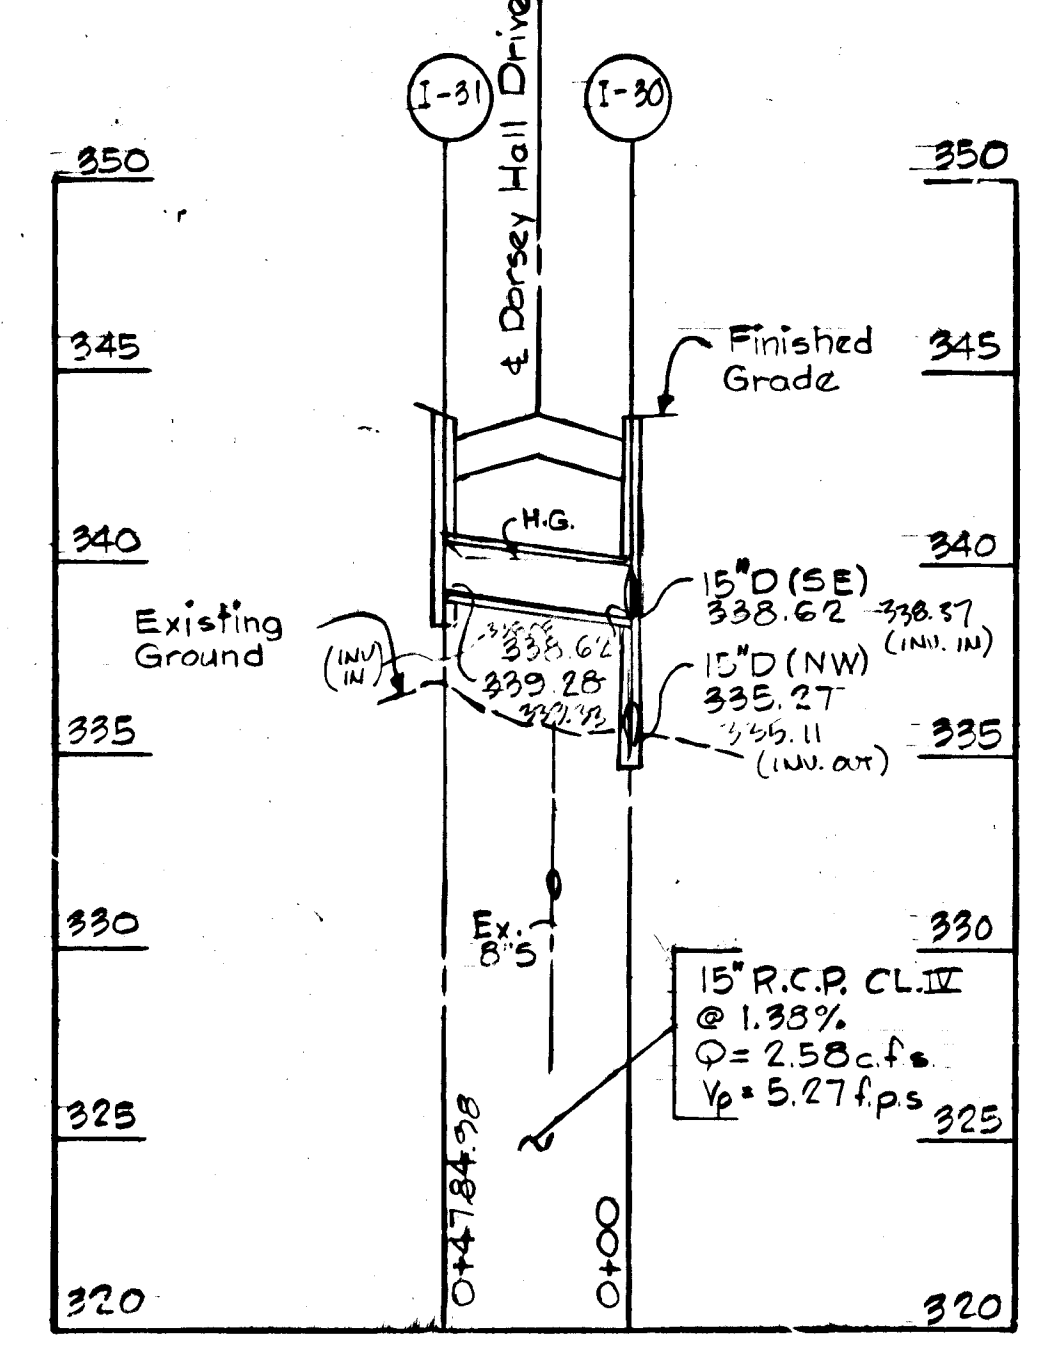

Note: Type of bedding used for storm drain pipes shall be class "C" shaped subgrade. If rock is encountered the trench invert should be overexcavated 6 inches and the overexcavation of 6 inches refilled with granular material.








SHANBERGER & LANE  
 8126 TOWN & COUNTRY BLVD.  
 SUITE 104  
 BETHESDA, MARYLAND 20814

REVDATE	REV. NO.	REVISION DESCRIPTION
12/2/87	2	As Per SCS Comments
10/19/87	1	As Per Planning, D.P.W. & S.C. Comments

DORSEY HALL 2 <sup>ND</sup> ELECTION DISTRICT HOWARD COUNTY, MARYLAND	
OWNER AND DEVELOPER THE HOWARD RESEARCH AND DEVELOPMENT LAND COMPANY	
PROJECT AREA SECTION 2 AREA 5 PARCELS N AND O	
PROJECT TITLE STORM DRAIN PROFILES AND DETAILS	
SCALE: AS SHOWN	DATE:
WHITMAN, REQUARDT AND ASSOCIATES ENGINEERS BALTIMORE, MARYLAND 21218	
Kenneth A. McCord KENNETH A. MCCORD REGISTERED ENGINEER NO. 1974	

APPROVED: HOWARD COUNTY DEPARTMENT OF PUBLIC WORKS  
 Chief, Land Development Division  
 Chief, Bureau of Highways  
 Chief, Bureau of Engineering  
 APPROVED: OFFICE OF PLANNING AND ZONING  
 Chief, Division of Land Development and Zoning Administration

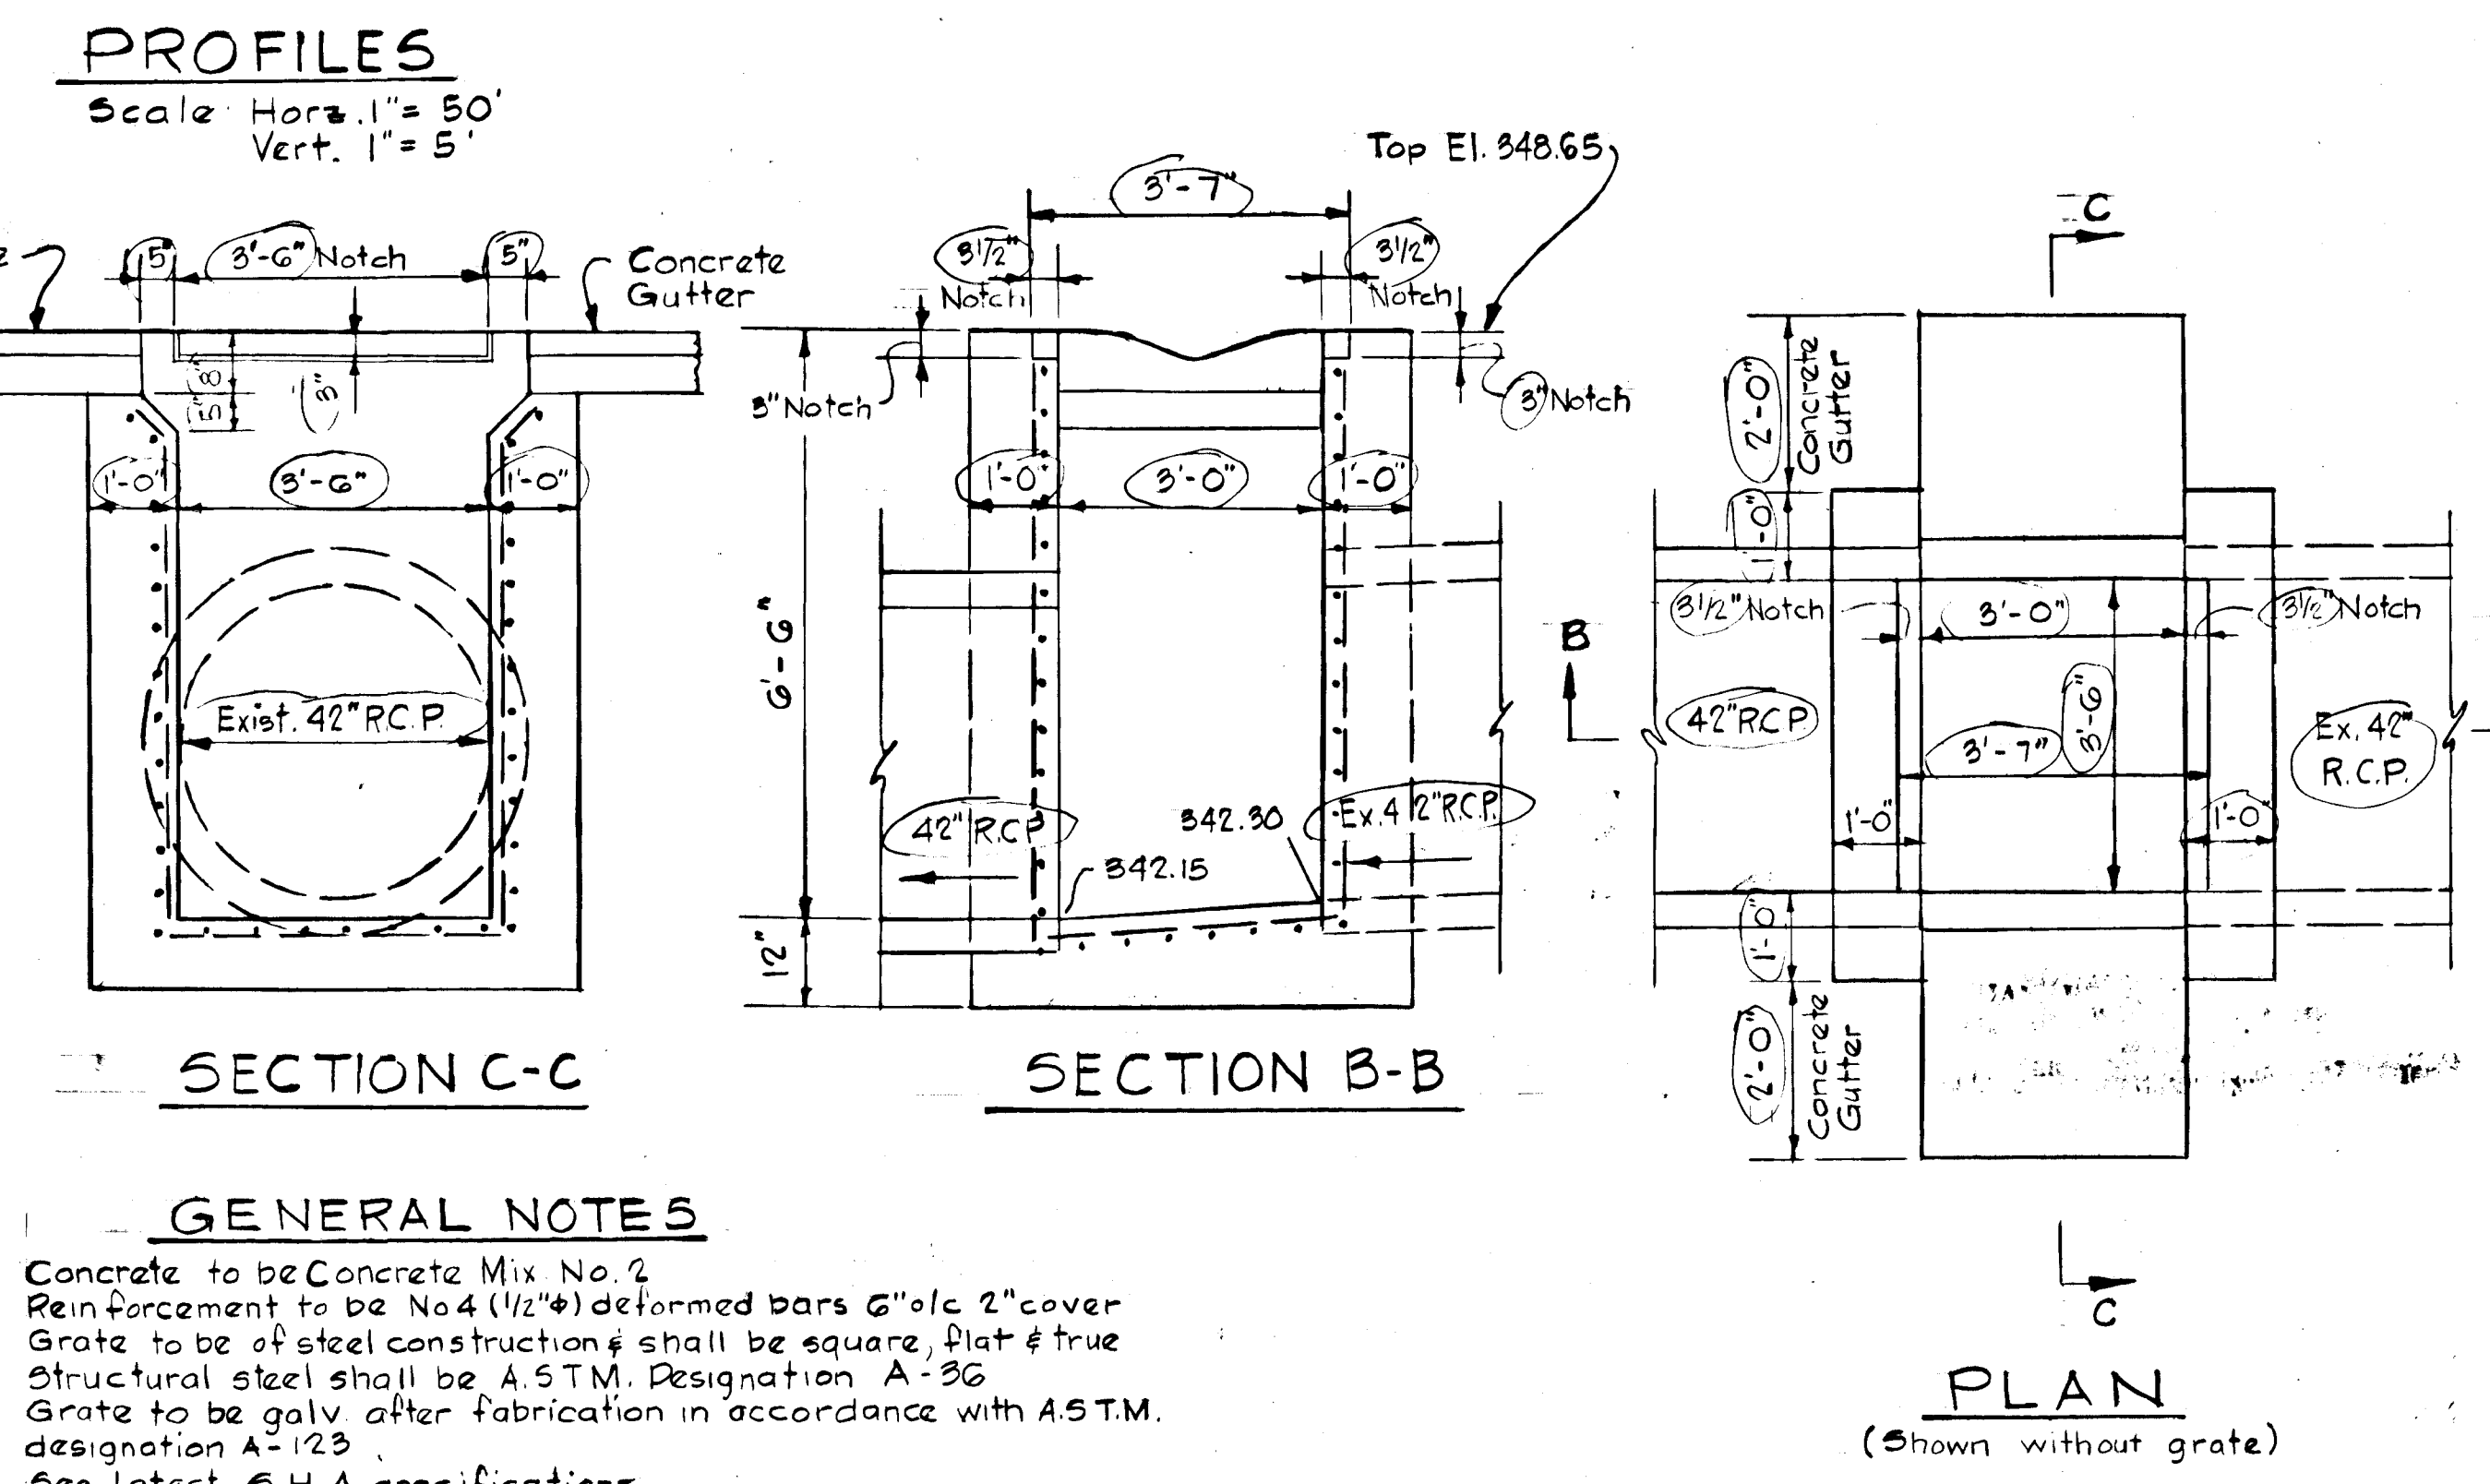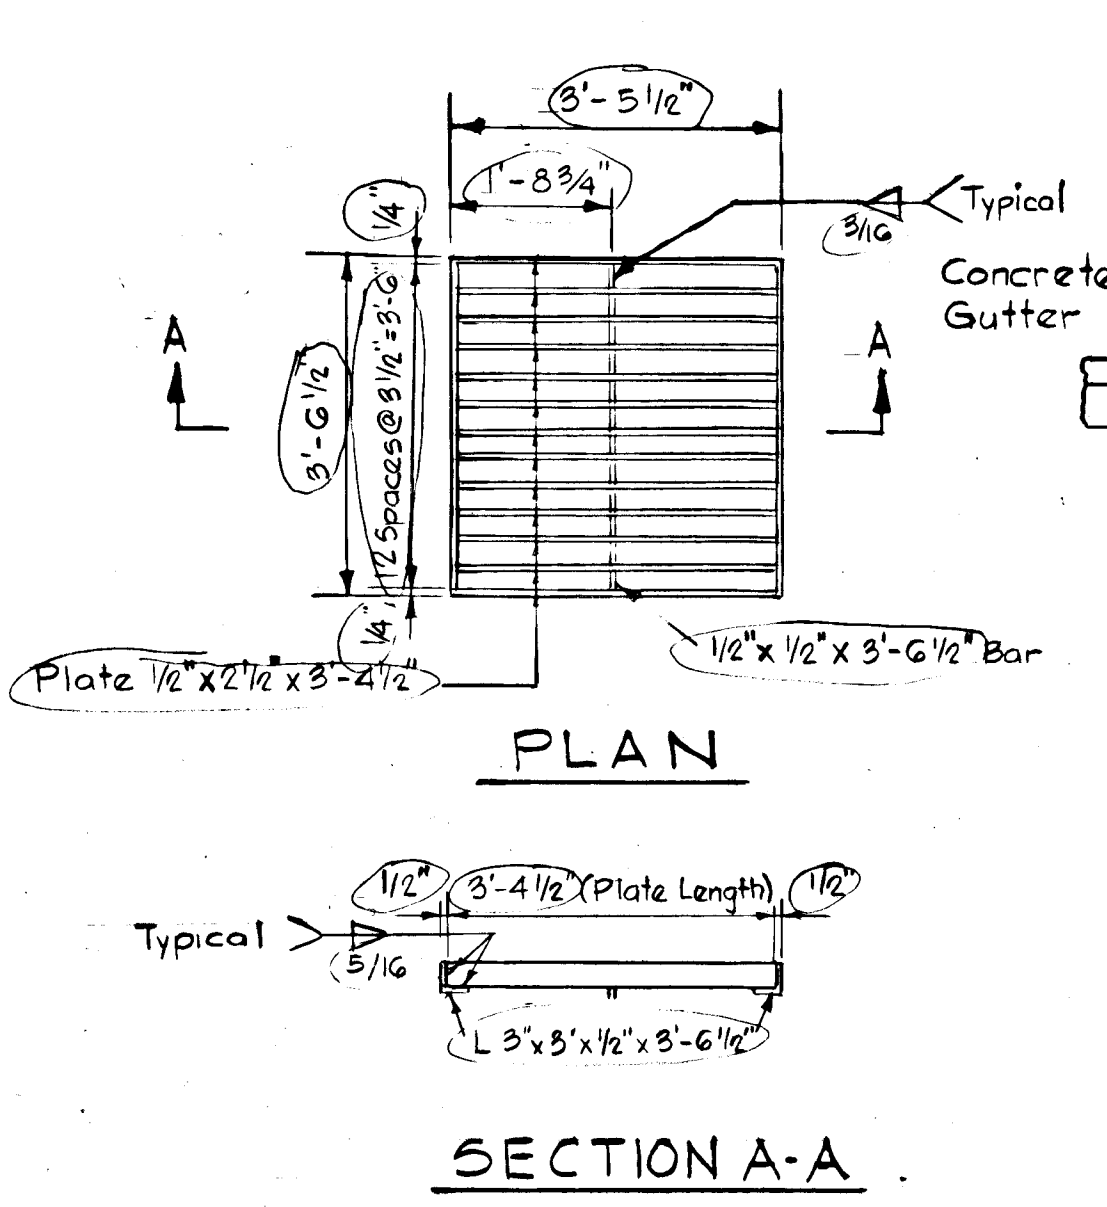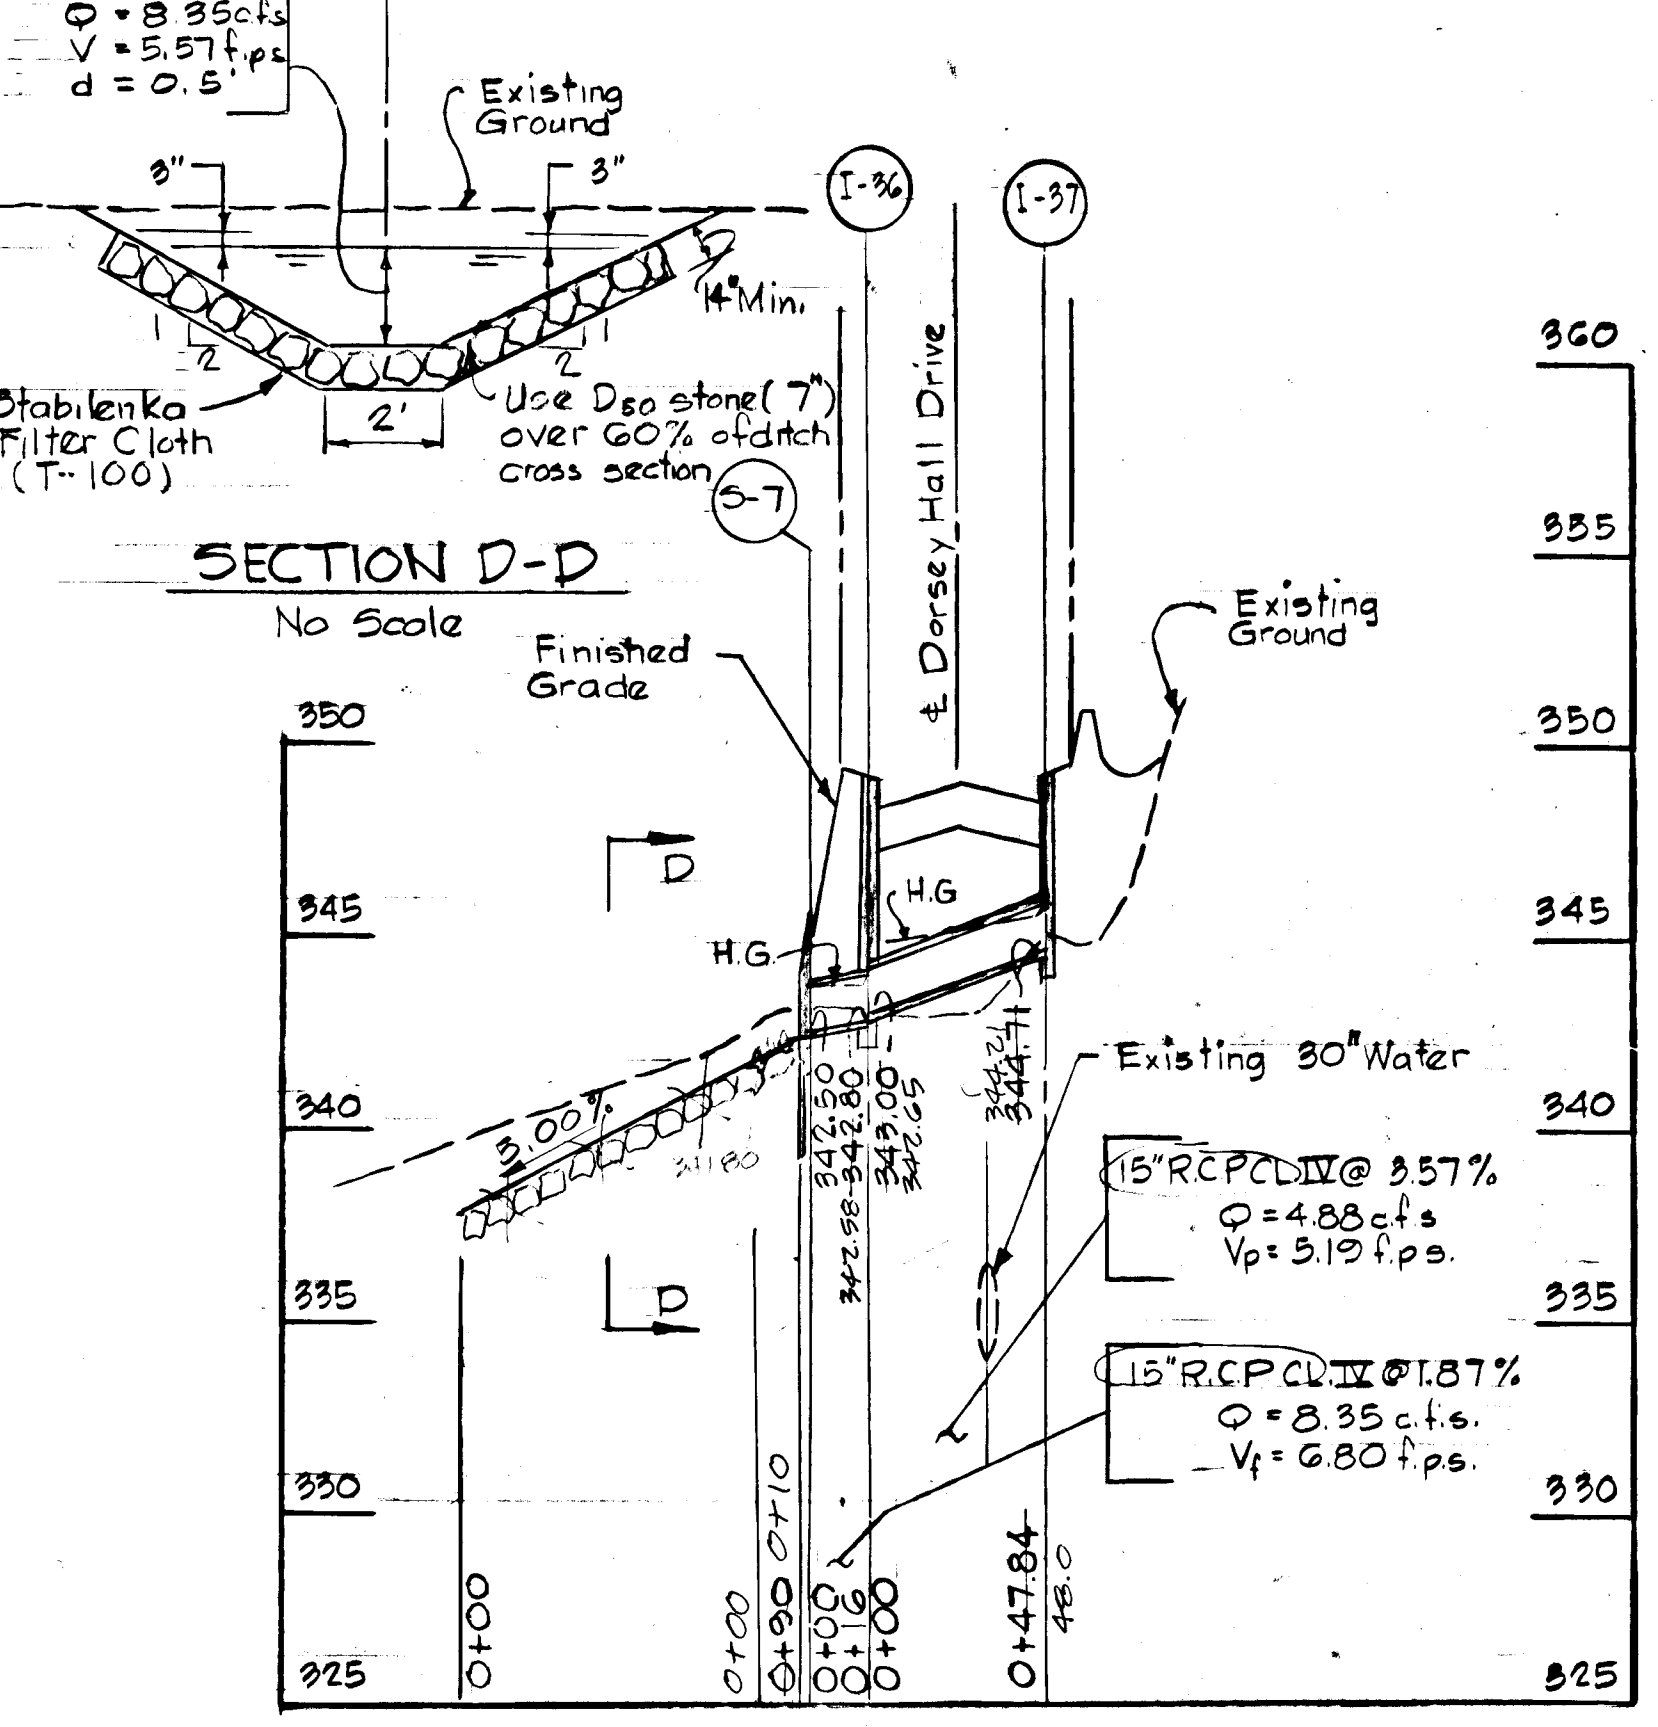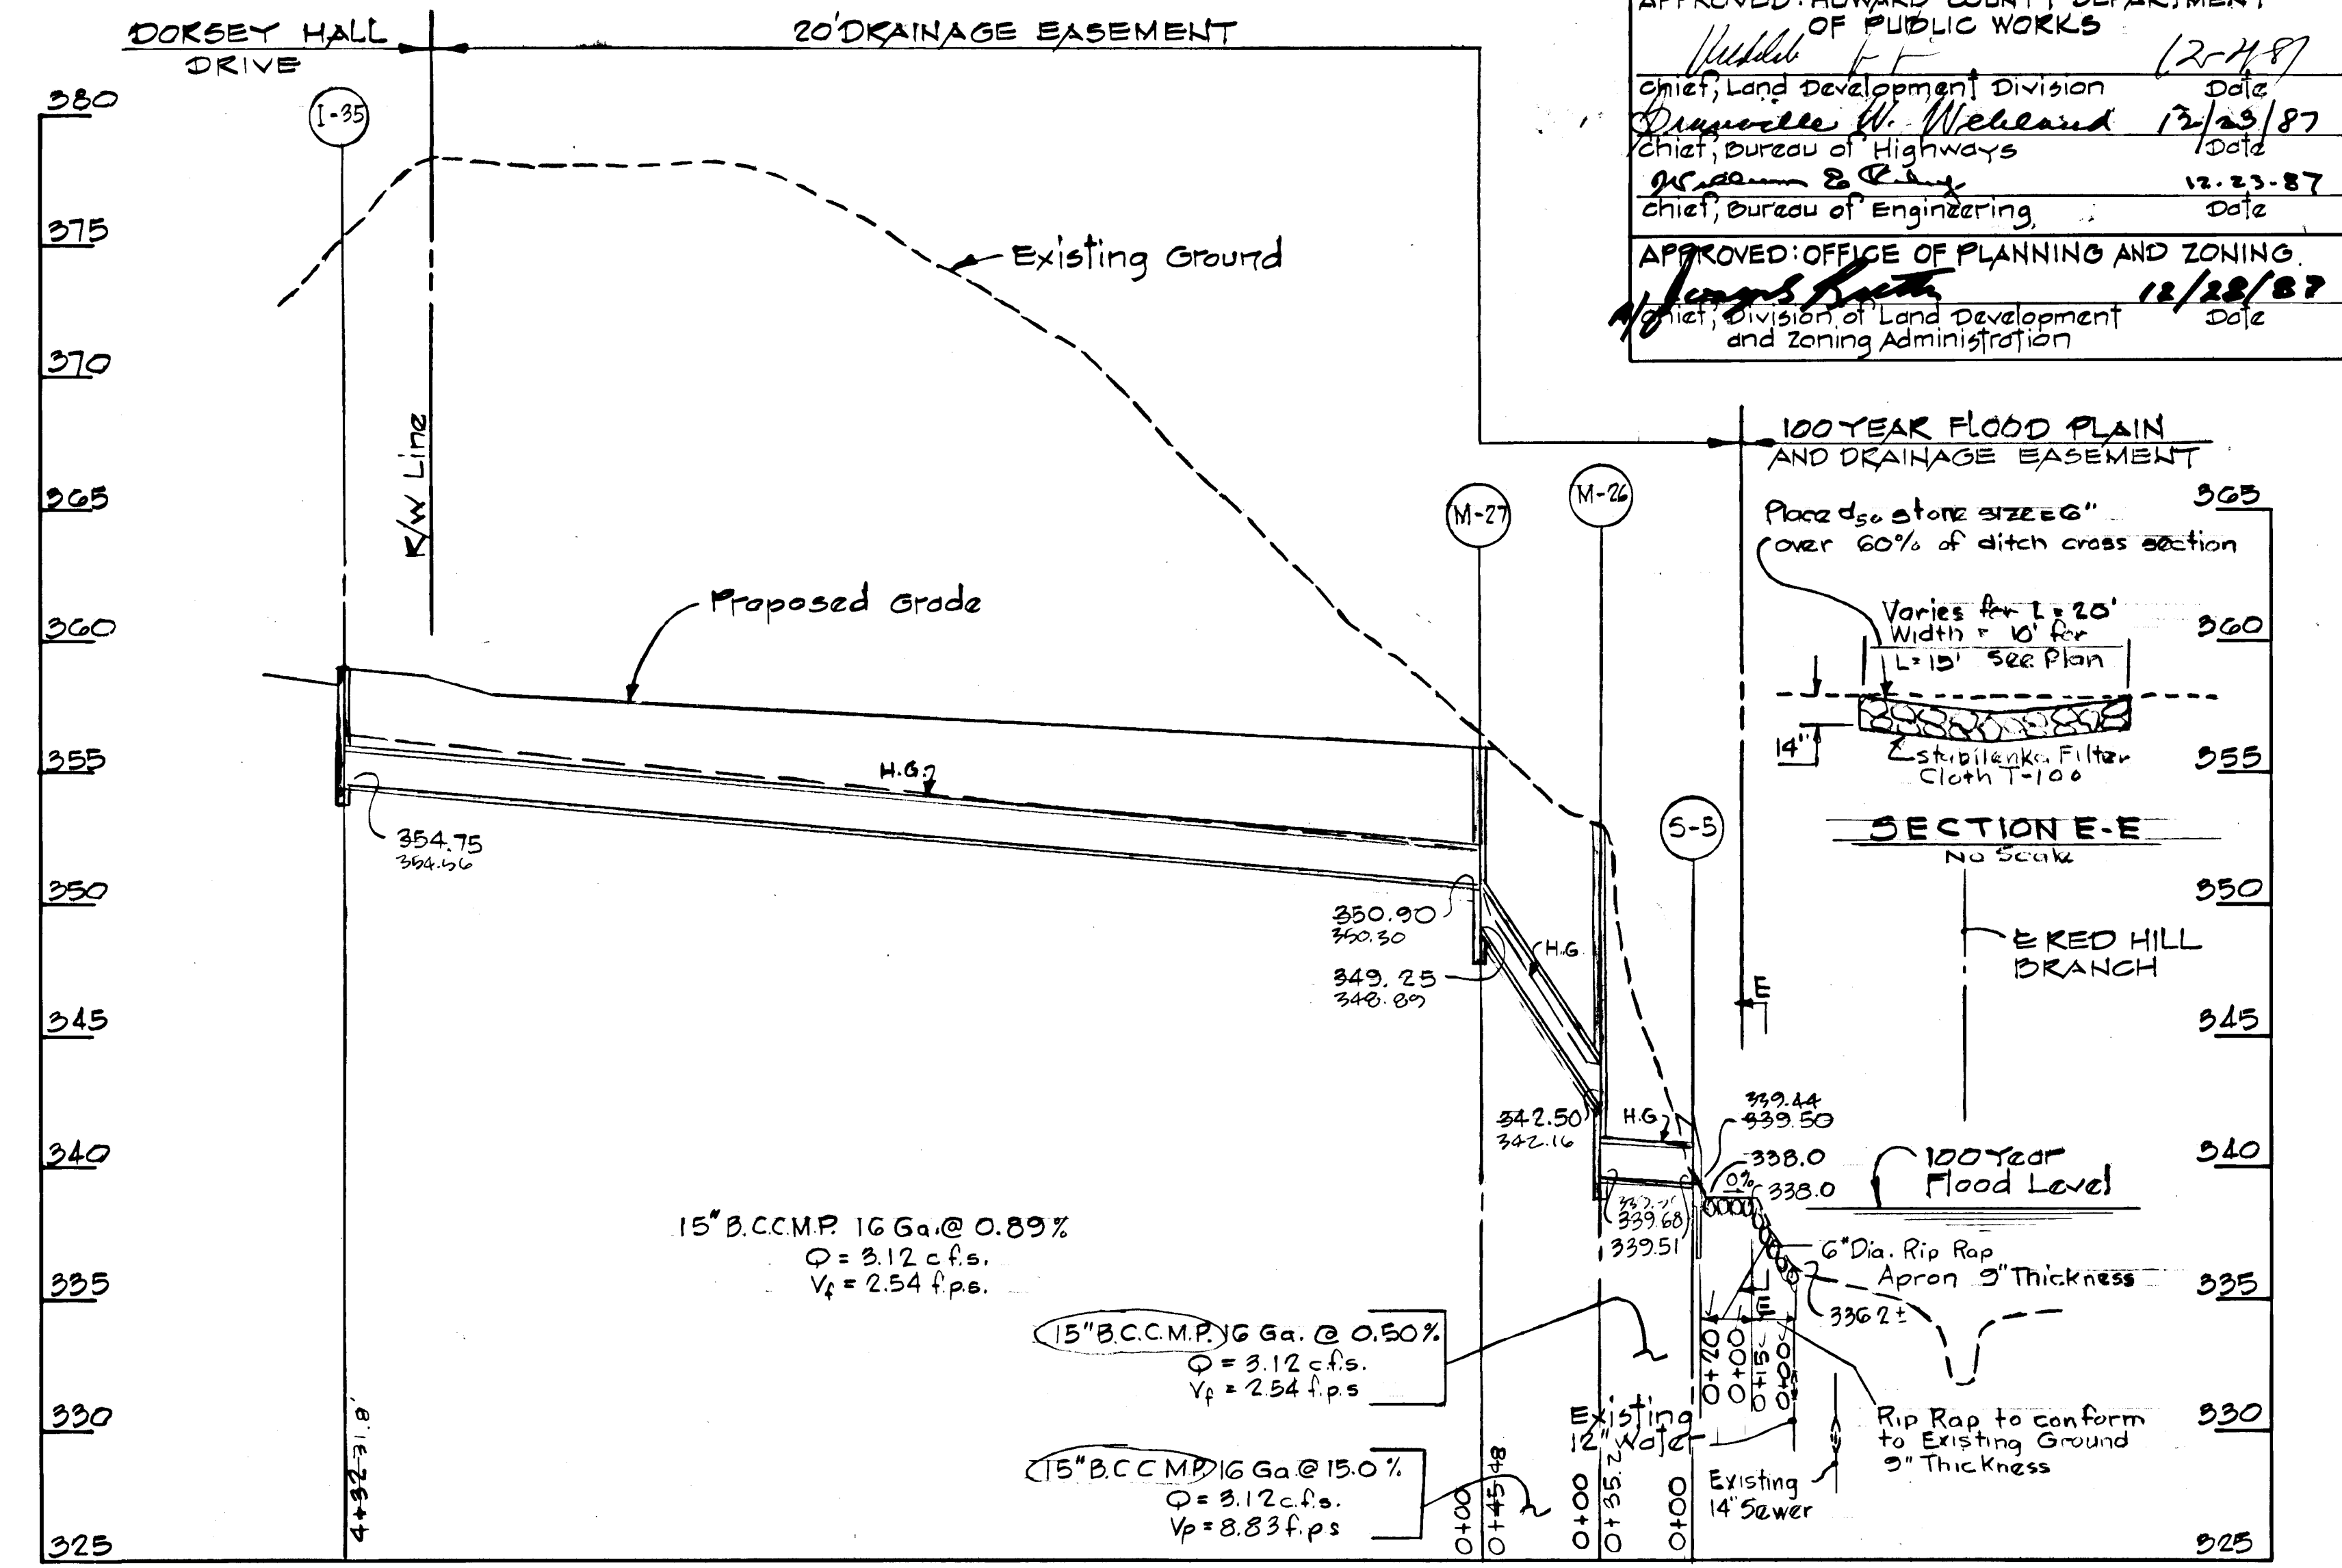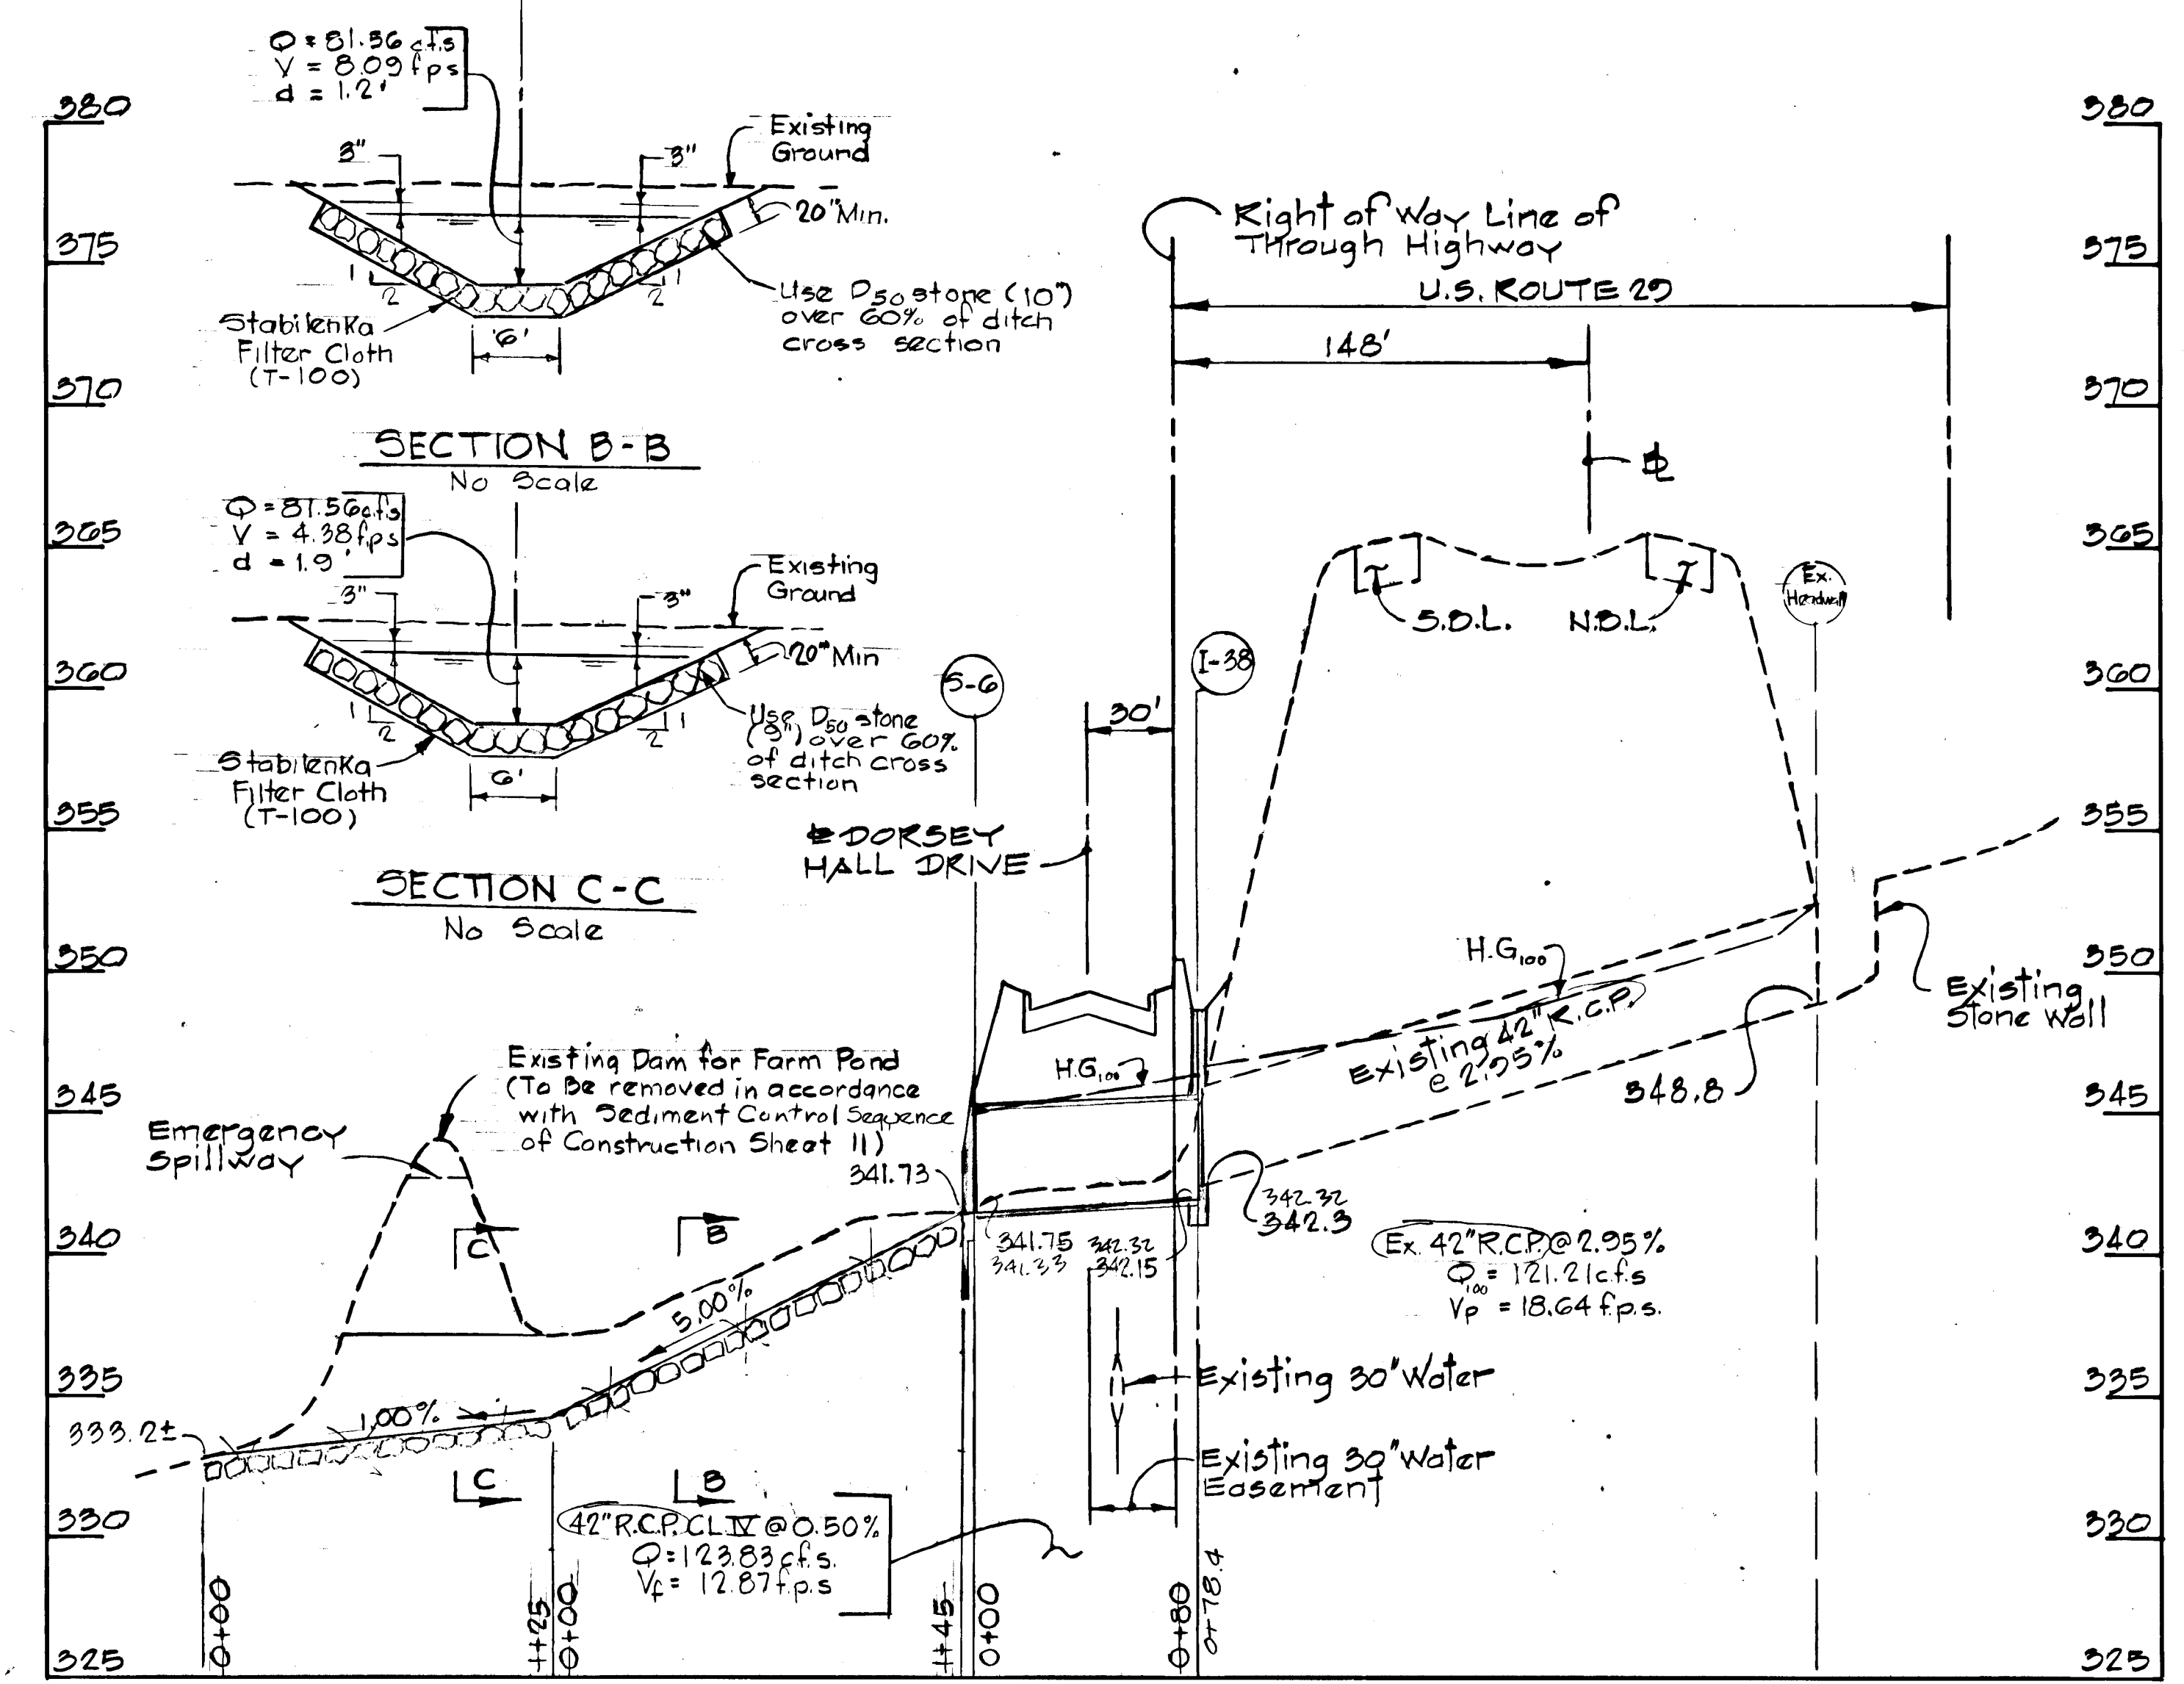

**GENERAL NOTES**

- Concrete to be Concrete Mix No. 2
- Reinforcement to be No. 4 (1/2") deformed bars 6" o/c 2" cover
- Grate to be of steel construction & shall be square, flat & true
- Structural steel shall be A 57M, Designation A-36
- Grate to be galv. after fabrication in accordance with A 57M, designation A-123
- See latest S.H.A. specifications.

**DETAIL INLET I-38**  
 MODIFIED S.H.A. STANDARD TYPE "K"  
 Scale 1/2" = 1'-0"

Note:  
 Type of bedding used for storm drain pipes shall be Class 'C' shaped subgrade. If rock is encountered the trench invert should be overexcavated 6 inches and the overexcavation of 6 inches refilled with granular material.

STATE OF MARYLAND  
 PROFESSIONAL LAND SURVEYOR  
 ROAD AS-BUILT

SHANABGER & LANE  
 8726 TOWN & COUNTRY BLVD.  
 SUITE 104  
 ELICOTT CITY, MARYLAND 21038

REV. DATE	REV. NO.	REVISION DESCRIPTION
12/2/87	2	As Per SCS Comments
10/14/87	1	As Per Planning, DWE SCS Comment

**DORSEY HALL**  
 2<sup>ND</sup> ELECTION DISTRICT  
 HOWARD COUNTY, MARYLAND

OWNER AND DEVELOPER  
 THE HOWARD RESEARCH AND  
 DEVELOPMENT LAND COMPANY  
 PROJECT AREA  
 SECTION 2 AREA 5  
 PARCELS N AND O

PROJECT TITLE  
 STORM DRAIN PROFILES  
 AND DETAILS

SCALE: AS SHOWN DATE:



WHITMAN, REQUARDT AND ASSOCIATES  
 ENGINEERS  
 BALTIMORE, MARYLAND 21218

Kenneth A. McCord  
 REGISTERED ENGINEER  
 No. 1974



**DESIGN DATA FOR  
SEDIMENT TRAP NO. 1**  
 DRAINAGE AREA = 2.8 ACRES  
 DISTURBED AREA = 2.8 ACRES  
 VOLUME REQUIRED = 2.8 x 67 = 187.6 CT.  
 VOLUME AVAILABLE = 204 CT.  
 TOP DECK ELEVATION = 335.5  
 WEIR CREST ELEVATION = 334.2  
 LENGTH OF WEIR = 12'  
 STORAGE ELEVATION = 333.0  
 BOTTOM ELEVATION = 330.0

APPROVED: HOWARD COUNTY DEPARTMENT OF PUBLIC WORKS  
 Chief, Land Development Division  
 Chief, Bureau of Highways  
 Chief, Bureau of Engineering  
 APPROVED: OFFICE OF PLANNING AND ZONING  
 Chief, Division of Land Development and Zoning Administration

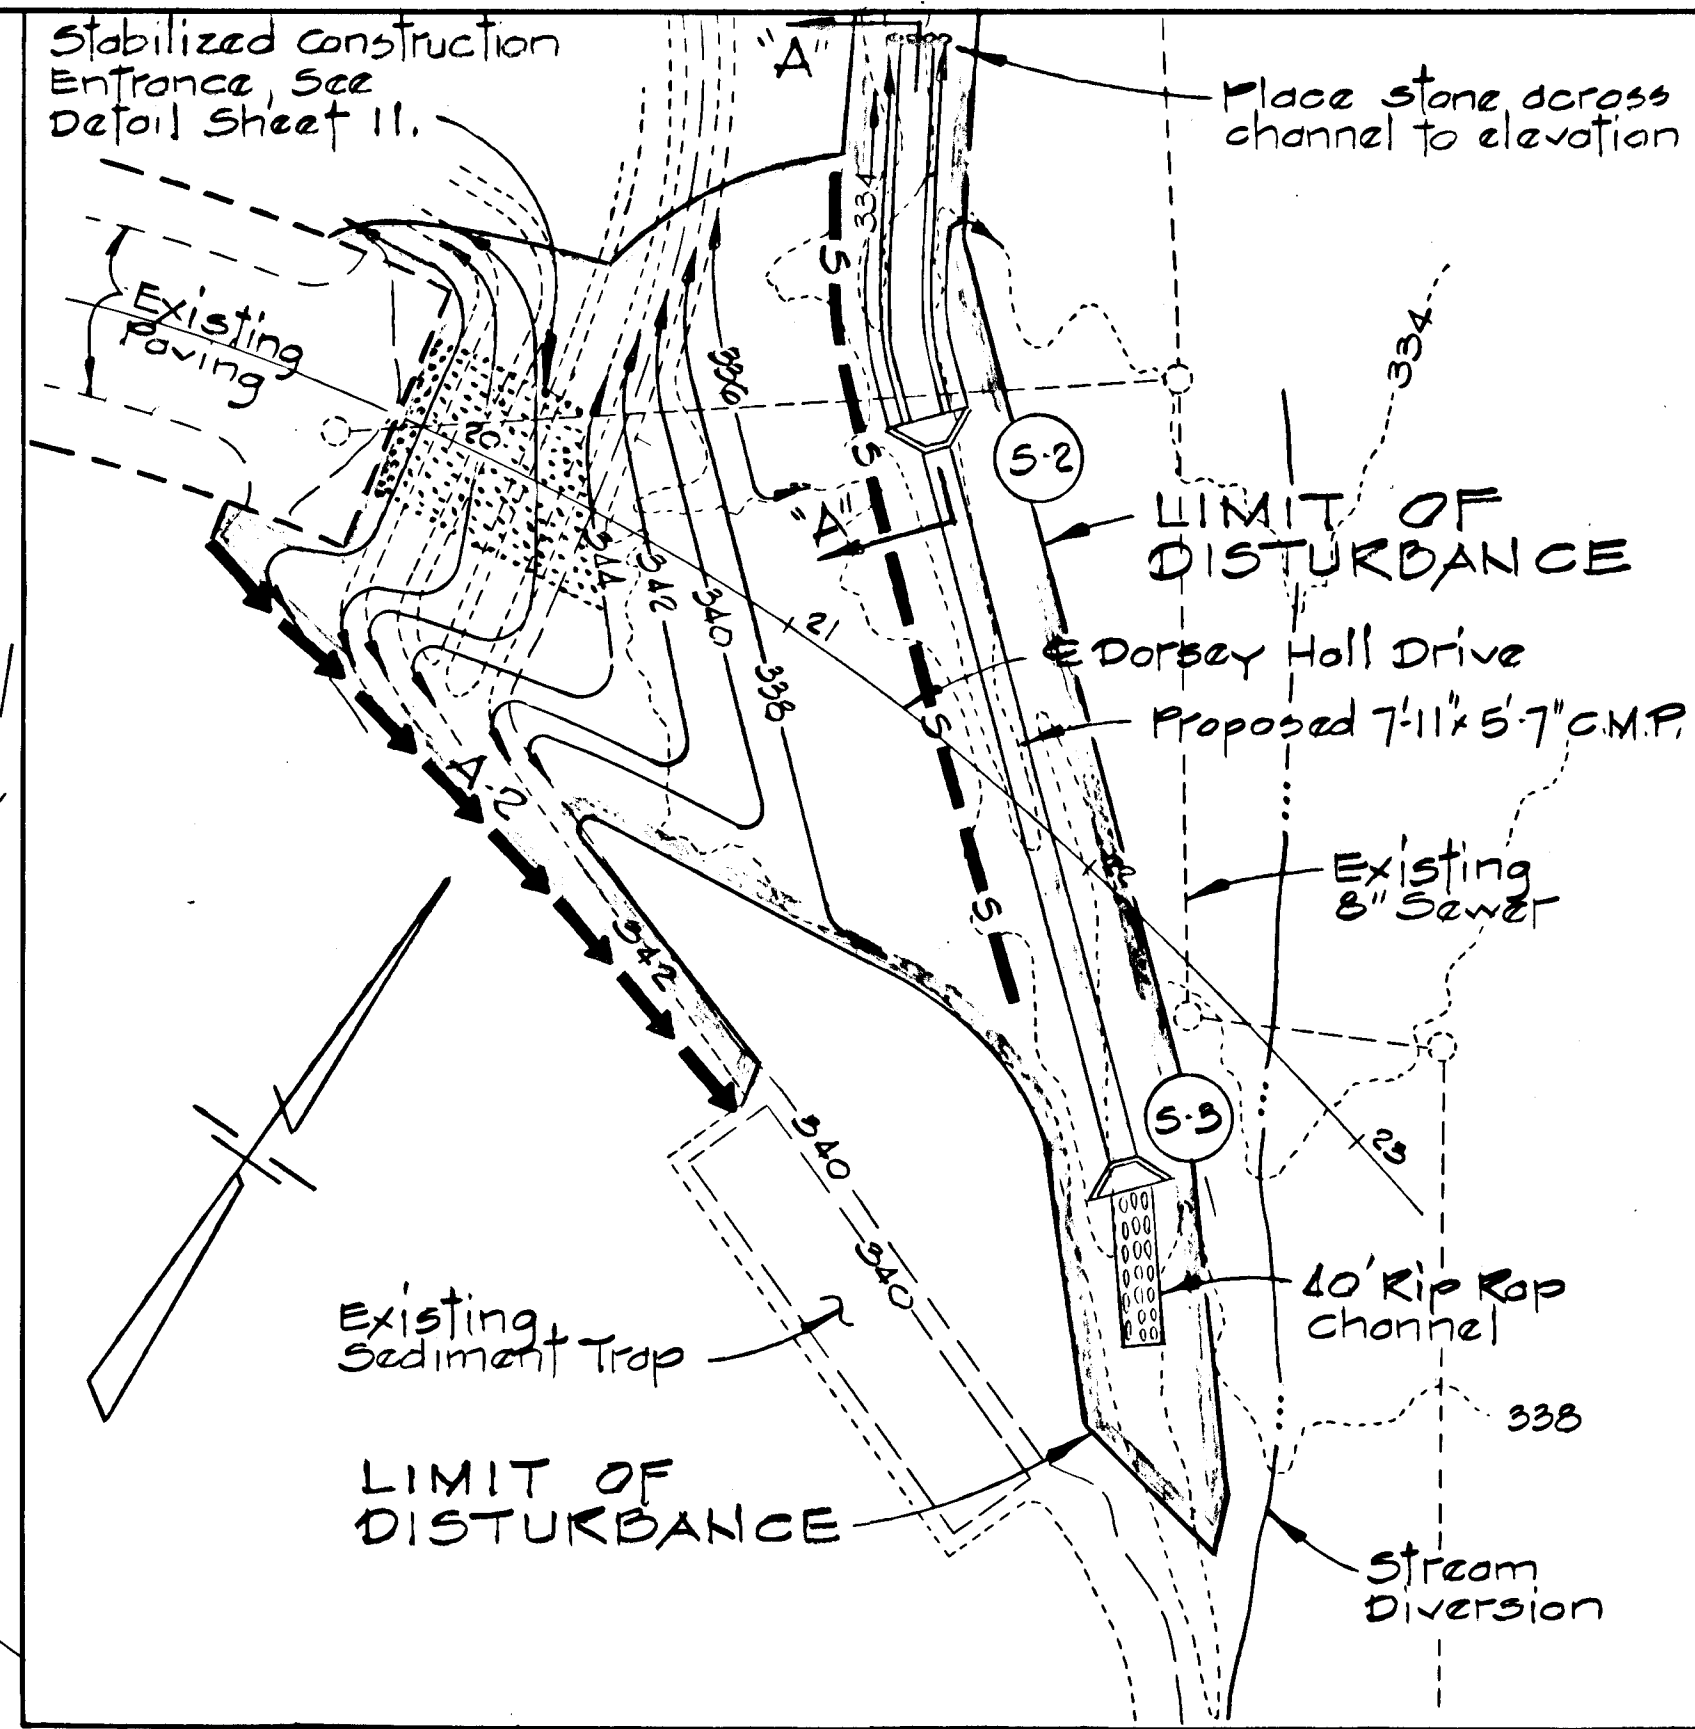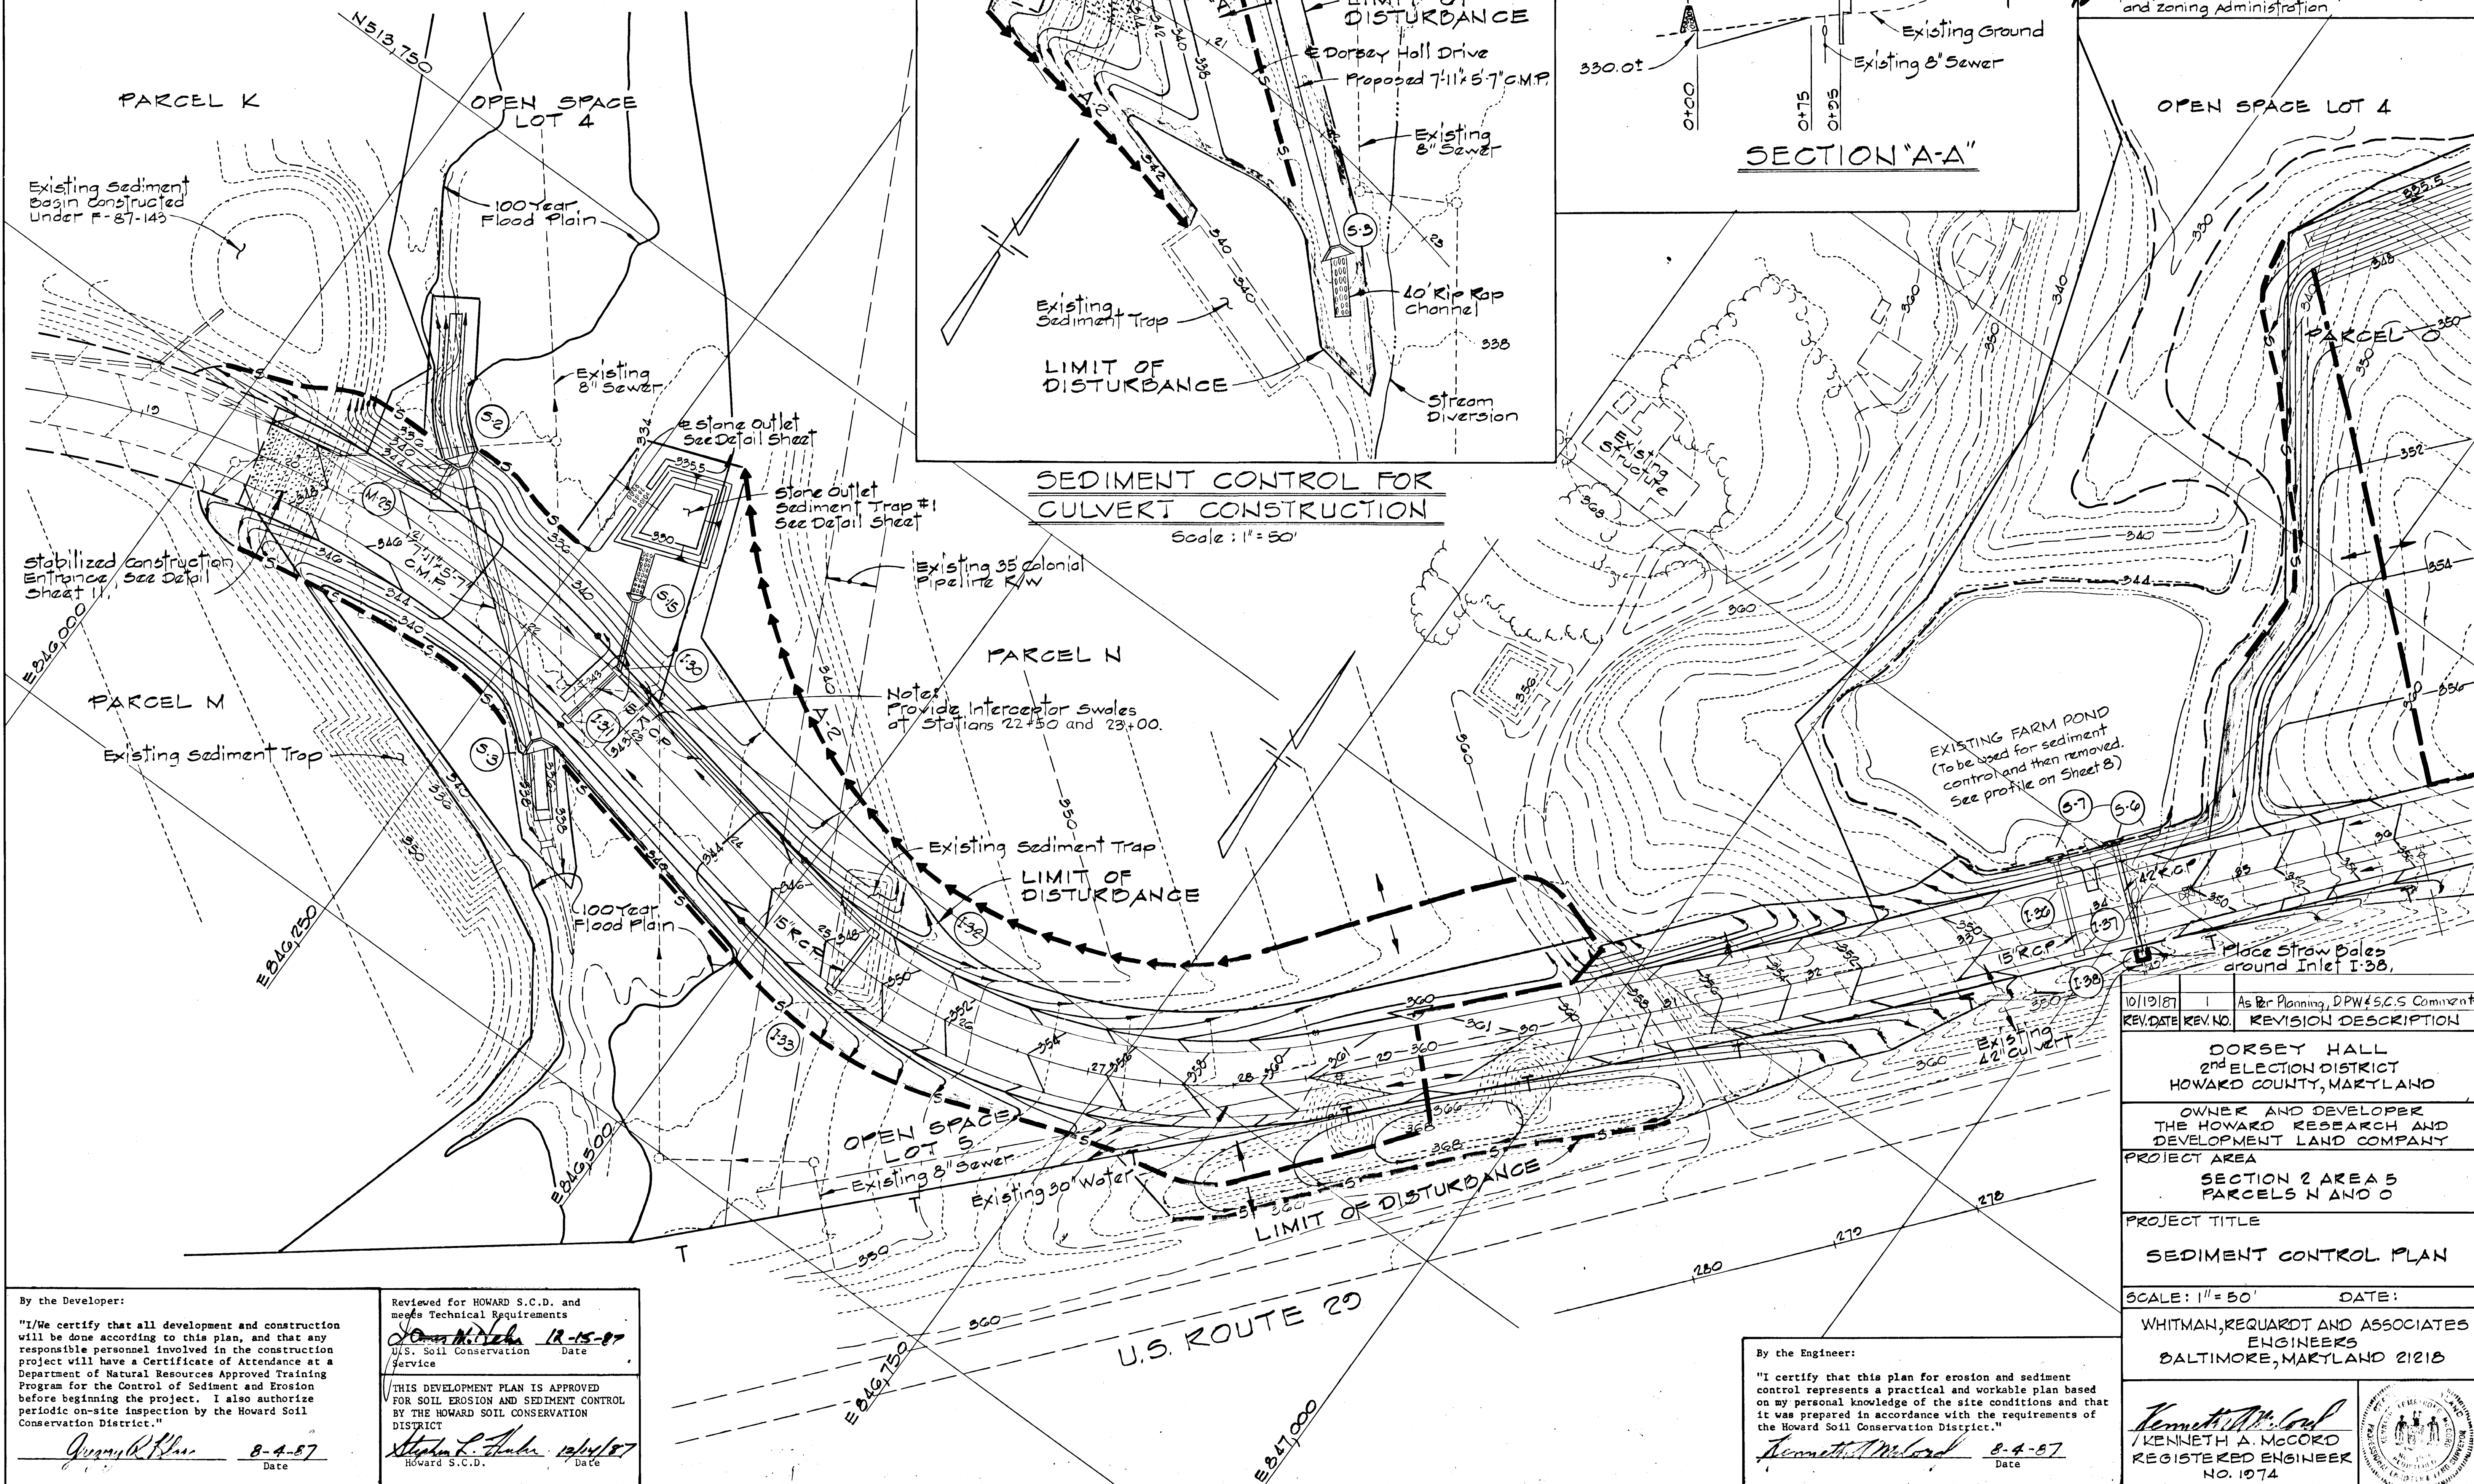

**SEDIMENT CONTROL FOR  
CULVERT CONSTRUCTION**  
 Scale: 1" = 50'

REV. DATE	REV. NO.	REVISION DESCRIPTION
10/19/87	1	As Per Planning, DPW & S.C.S. Comments

DORSEY HALL  
 2<sup>ND</sup> ELECTION DISTRICT  
 HOWARD COUNTY, MARYLAND

OWNER AND DEVELOPER  
 THE HOWARD RESEARCH AND  
 DEVELOPMENT LAND COMPANY

PROJECT AREA  
 SECTION 2 AREA 5  
 PARCELS N AND O

PROJECT TITLE  
 SEDIMENT CONTROL PLAN

SCALE: 1" = 50' DATE:

WHITMAN, REQUARDT AND ASSOCIATES  
 ENGINEERS  
 BALTIMORE, MARYLAND 21218

By the Developer:  
 "I/We certify that all development and construction will be done according to this plan, and that any responsible personnel involved in the construction project will have a Certificate of Attendance at a Department of Natural Resources Approved Training Program for the Control of Sediment and Erosion before beginning the project. I also authorize periodic on-site inspection by the Howard Soil Conservation District."  
*Gregory R. Blair* 8-4-87  
 Date

Reviewed for HOWARD S.C.D. and meets Technical Requirements  
*Donna M. DeLoach* 12-15-87  
 U.S. Soil Conservation Service Date  
 THIS DEVELOPMENT PLAN IS APPROVED FOR SOIL EROSION AND SEDIMENT CONTROL BY THE HOWARD SOIL CONSERVATION DISTRICT  
*Stephen L. Fisher* 12/14/87  
 Howard S.C.D. Date


By the Engineer:  
 "I certify that this plan for erosion and sediment control represents a practical and workable plan based on my personal knowledge of the site conditions and that it was prepared in accordance with the requirements of the Howard Soil Conservation District."  
*Kenneth A. McCord* 8-4-87  
 Date

*Kenneth A. McCord*  
 KENNETH A. MCCORD  
 REGISTERED ENGINEER  
 NO. 1974



**DESIGN DATA FOR  
SEDIMENT TRAP #2**  
 DRAINAGE AREA = 12.3 ACRES  
 DISTURBED AREA = 12.3 ACRES  
 VOLUME REQUIRED = 123,671.024.107  
 VOLUME AVAILABLE = 845 CT.  
 TOP BERM ELEVATION = 335.5  
 WEIR CREST ELEVATION = 331.5  
 LENGTH OF WEIR = 14'  
 STORAGE ELEVATION = 330.5  
 BOTTOM ELEVATION = 326.0

APPROVED: HOWARD COUNTY DEPARTMENT  
OF PUBLIC WORKS  
*Robert W. ...* 12-11-87  
 Chief, Land Development Division Date  
*Orville W. ...* 12-13-87  
 Chief, Bureau of Highways Date  
*Gregory B. ...* 12-23-87  
 Chief, Bureau of Engineering Date  
 APPROVED: OFFICE OF PLANNING AND ZONING  
*James ...* 12/20/87  
 Chief, Division of Land Development and Zoning Administration Date

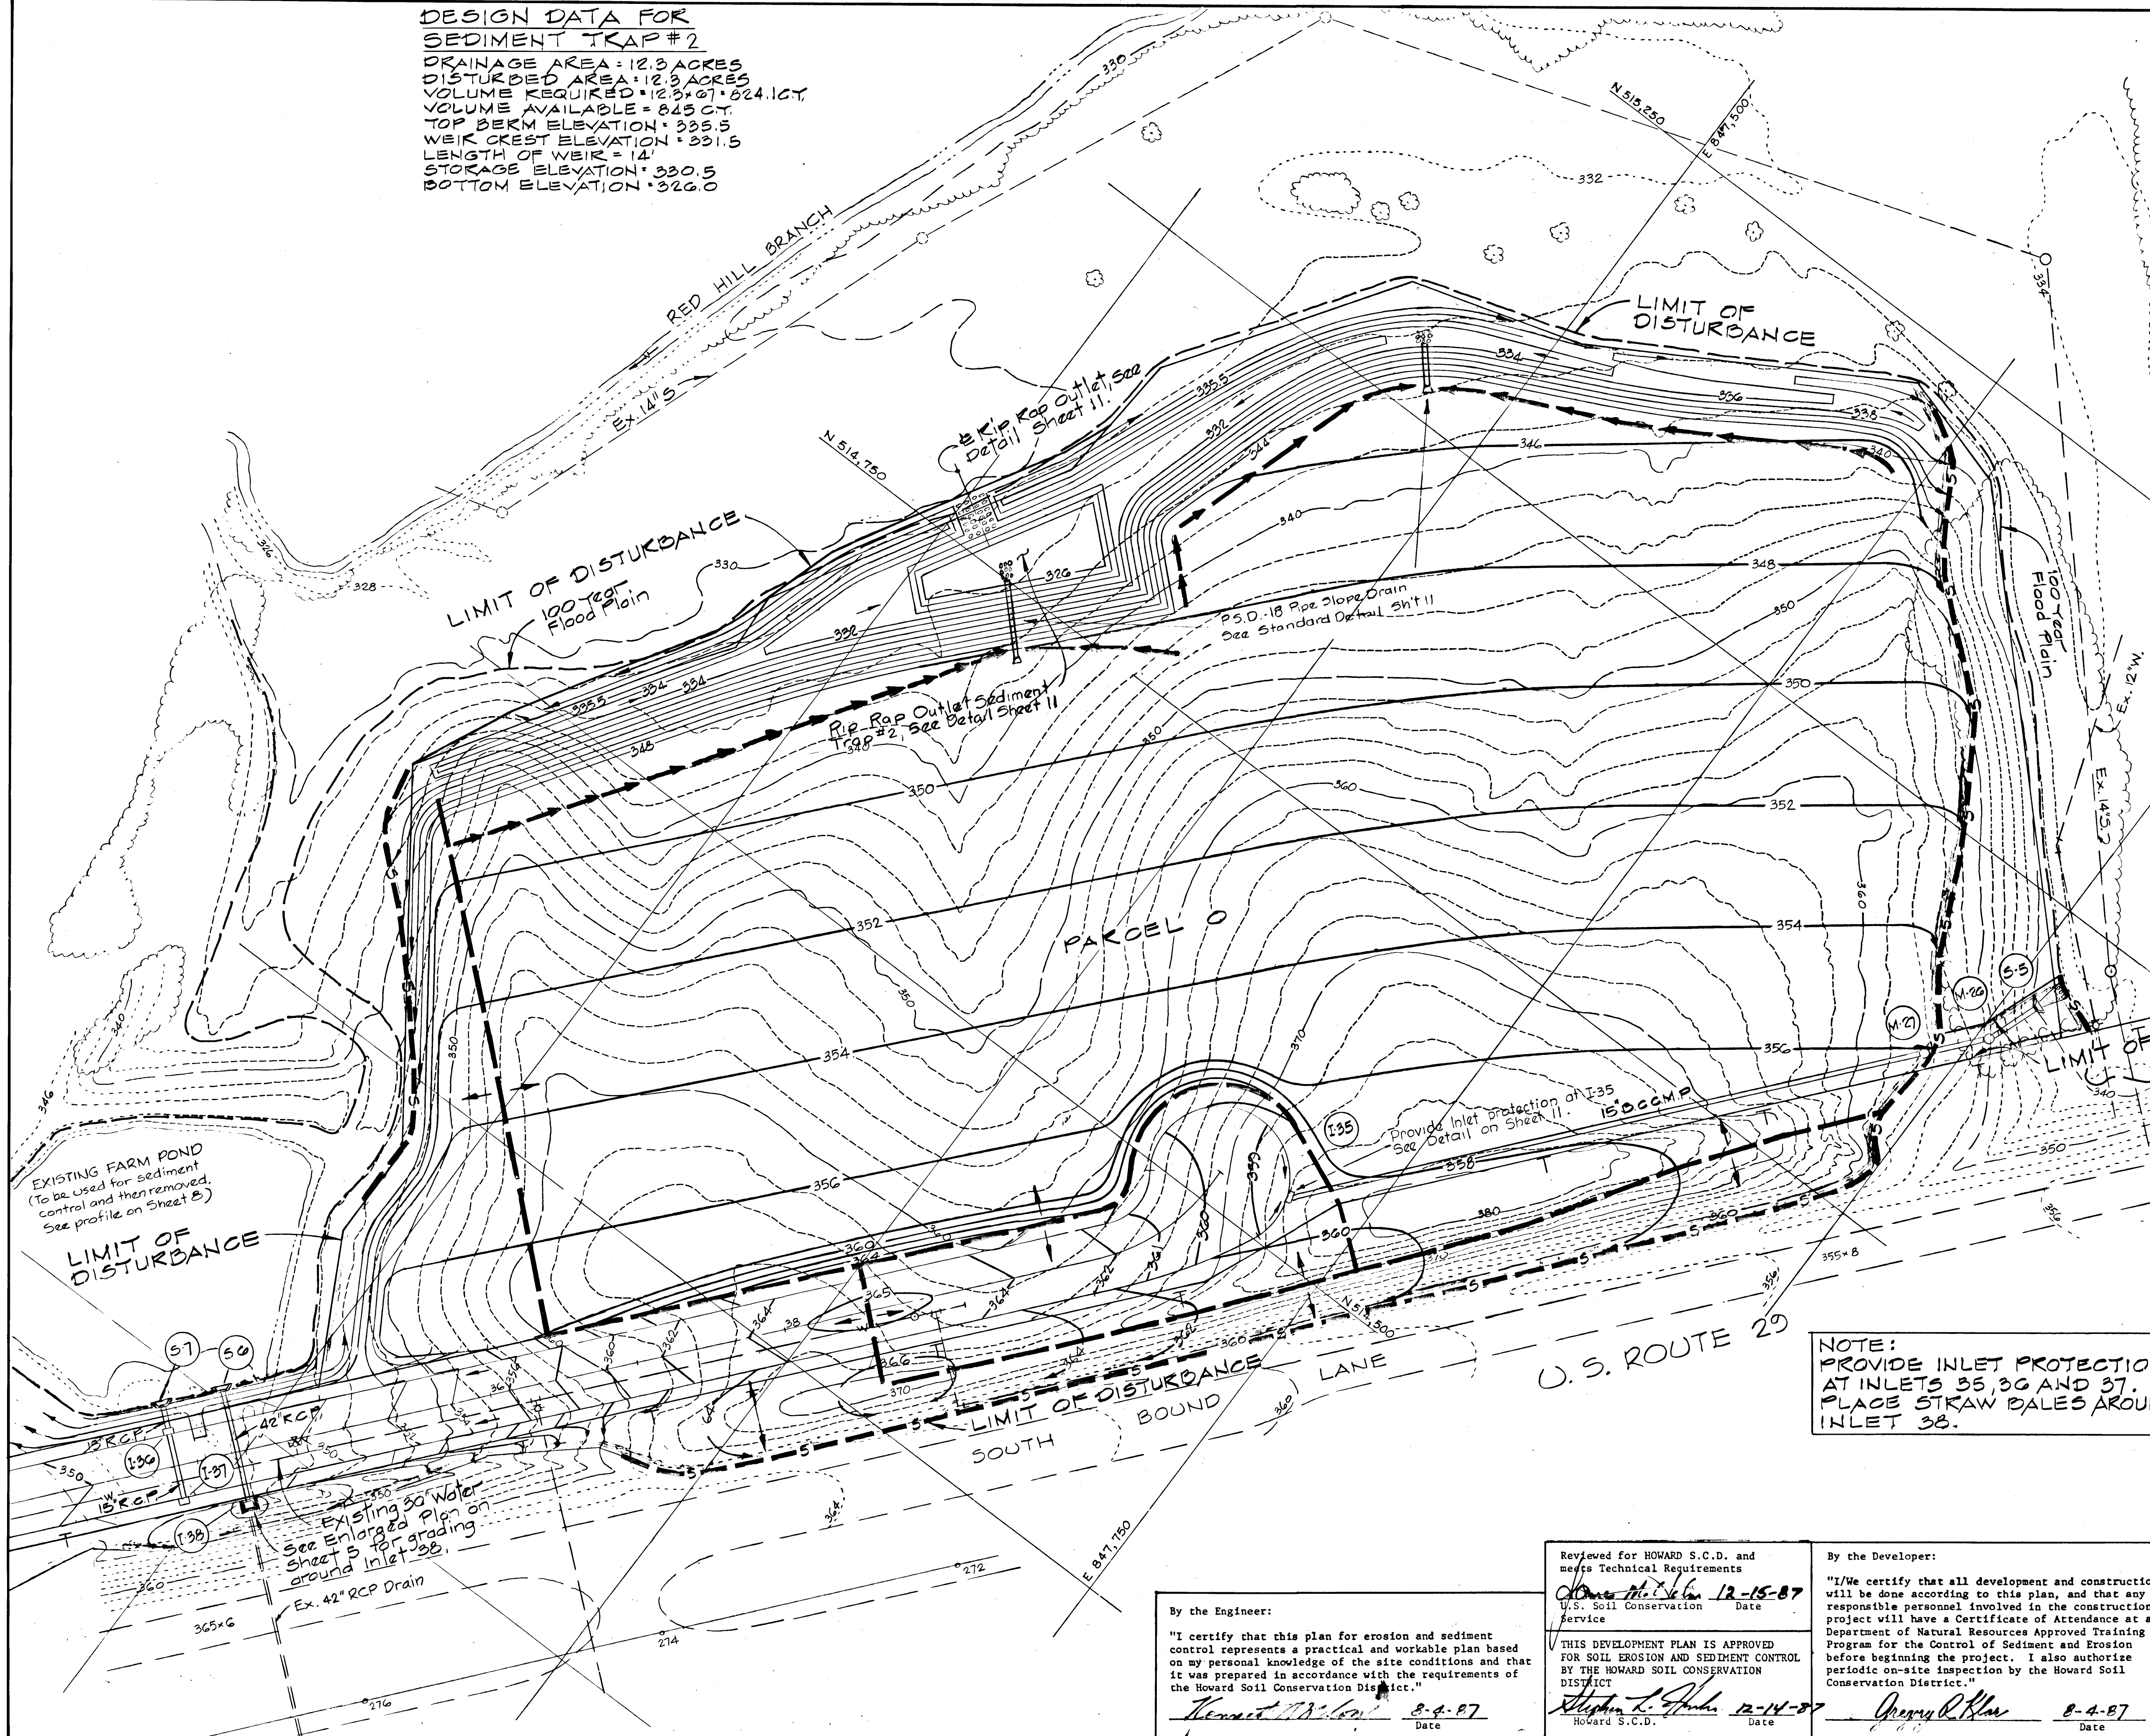

**NOTE:**  
 PROVIDE INLET PROTECTION  
 AT INLETS 35, 36 AND 37.  
 PLACE STRAW BALES AROUND  
 INLET 38.

12/2/87	2	As Per SCS Comments
10/1/87	1	As Per Planning, DPW & SCS Comments
REV. DATE	REV. NO	REVISION DESCRIPTION

DORSEY HALL  
 2<sup>ND</sup> ELECTION DISTRICT  
 HOWARD COUNTY, MARYLAND  
 OWNER AND DEVELOPER  
 THE HOWARD RESEARCH AND  
 DEVELOPMENT LAND COMPANY  
 PROJECT AREA  
 SECTION 2 AREA 5  
 PARCELS N AND O  
 PROJECT TITLE  
 SEDIMENT CONTROL PLAN

SCALE: 1" = 50' DATE:  
 WHITMAN, REQUARDT AND ASSOCIATES  
 ENGINEERS  
 BALTIMORE, MARYLAND 21218  
*Kenneth A. McCord*  
 KENNETH A. MCCORD  
 Registered Engineer  
 No. 1974

By the Engineer:  
 "I certify that this plan for erosion and sediment control represents a practical and workable plan based on my personal knowledge of the site conditions and that it was prepared in accordance with the requirements of the Howard Soil Conservation District."  
*Kenneth A. McCord* 8-4-87  
 Date

Reviewed for HOWARD S.C.D. and meets Technical Requirements  
*Orville W. ...* 12-15-87  
 U.S. Soil Conservation Date  
 Service  
 THIS DEVELOPMENT PLAN IS APPROVED FOR SOIL EROSION AND SEDIMENT CONTROL BY THE HOWARD SOIL CONSERVATION DISTRICT  
*Stephen L. ...* 12-14-87  
 Howard S.C.D. Date

By the Developer:  
 "I/We certify that all development and construction will be done according to this plan, and that any responsible personnel involved in the construction project will have a Certificate of Attendance at a Department of Natural Resources Approved Training Program for the Control of Sediment and Erosion before beginning the project. I also authorize periodic on-site inspection by the Howard Soil Conservation District."  
*Gregory B. ...* 8-4-87  
 Date



**SEDIMENT CONTROL NOTES**

- A minimum of 24 hours notice must be given to the Howard County Office of Inspection and Permits prior to the start of any construction. (293.23)
- All vegetative and structural practices are to be installed according to the provisions of this plan and are to be in conformance with the 1983 MARYLAND STANDARDS AND SPECIFICATIONS FOR SOIL EROSION AND SEDIMENT CONTROL.
- Following initial soil disturbance or re-disturbance, permanent or temporary stabilization shall be completed within a 7 calendar days for all perimeter sediment control structures, dikes, perimeter slopes and all slopes greater than 3:1, b) 14 days as to all other disturbed or graded areas on the project sites.
- All sediment traps/basins shall be fenced and warning signs posted around their perimeter in accordance with Vol. 1, Chapter 12, of the HOWARD COUNTY DESIGN MANUAL, Storm Drainage.
- All disturbed areas must be stabilized within the time period specified above in accordance with the 1983 MARYLAND STANDARDS AND SPECIFICATIONS FOR SOIL EROSION AND SEDIMENT CONTROL for permanent seedings (Sec. 31) sod (Sec. 54), temporary seeding (Sec. 50) and mulching (Sec. 52). Temporary stabilization with mulch alone can only be done when recommended seeding dates do not allow for proper germination and establishment of grasses.
- All sediment control structures are to remain in place and are to be maintained in operating condition until permission for their removal has been obtained from the Howard County Sediment Control Inspector.
- Site Analysis:
 

Total Area of Site	17.4 Acres
Area Disturbed	17.4 Acres
Area to be roofed or paved	0.2 Acres
Area to be vegetatively stabilized	15.2 Acres
Total Cut	0.00 cu. yds
Total Fill	25,000 cu. yds
Office waste/borrow area location	
- Any sediment control practice which is disturbed by grading activity for placement of utilities must be repaired on the same day of disturbance.
- Additional sediment controls must be provided, if deemed necessary by the Howard County DPM sediment control inspector.
- On all sites with disturbed areas in excess of 2 acres, approval of the inspection agency shall be requested upon completion of installation of perimeter erosion and sediment controls, but before proceeding with any other earth disturbance or grading. Other building or grading inspection approvals may not be authorized until this initial approval by the inspection agency is made.

**CONSTRUCTION SPECIFICATIONS FOR ST-1**

- The area under embankment shall be cleared, grubbed and stripped of any vegetation and root mat. The pool area shall be cleared.
- The fill material for the embankment shall be free of roots or other woody vegetation as well as over-sized stones, rocks, organic material or other objectionable material. The embankment shall be compacted by traversing with equipment while it is being constructed. Maximum height of embankment shall be five (5) feet, measured at centerline of embankment.
- All fill slopes shall be 2:1 or flatter; cut slopes 1:1 or flatter.
- Elevation of the top of any dike directing water into trap must equal or exceed the height of embankment.
- Storage area provided shall be figured by computing the volume available behind the outlet channel up to an elevation of one (1) foot below the level weir crest.
- Filter cloth shall be placed over the bottom and sides of the outlet channel prior to placement of stone. Sections of fabric must overlap at least one (1) foot with section nearest the entrance placed on top. Fabric shall be embedded at least six (6) inches into existing ground at entrance of outlet channel.
- Stone used in the outlet channel shall be four (4) to eight (8) inches (triangular) to provide a filtering effect, a layer of filter cloth shall be embedded one (1) foot back into the upstream face of the outlet stone or a one (1) foot thick layer of two (2) inch or finer aggregate shall be placed on the upstream face of the outlet.
- Sediment shall be removed and trap restored to its original dimensions when the sediment has accumulated to 1/2 the design depth of the trap. Removed sediment shall be deposited in a suitable area and in such a manner that it will not erode.
- The structure shall be inspected after each rain and repaired as needed.
- Construction operations shall be carried out in such a manner that erosion and water pollution are minimized.
- The structure shall be removed and the area stabilized when the drainage area has been properly stabilized.
- Drainage area for this practice is limited to 15 acres or less.

**PERMANENT SEEDING NOTES**

Apply to graded or cleared areas not subject to immediate further disturbance where a permanent long-lived vegetative cover is needed.

**Seedbed Preparation:** Loosen upper three inches of soil by raking, disking or other acceptable means before seeding.

**Soil Amendments:** In lieu of soil test recommendations, use one of the following schedules:

- Preferred - Apply 2 tons per acre dolomitic limestone (92 lbs/1000 sq ft) and 600 lbs per acre 10-10-10 fertilizer (14 lbs/1000 sq ft) before seeding. Narrow or disc into upper three inches of soil. At time of seeding, apply 400 lbs per acre 30-0-0 urea-form fertilizer (9 lbs/1000 sq ft).
- Acceptable - Apply 2 tons per acre dolomitic limestone (92 lbs/1000 sq ft) and 1000 lbs per acre 10-10-10 fertilizer (23 lbs/1000 sq ft) before seeding. Narrow or disc into upper three inches of soil.

**Seeding:** For the periods March 1 thru April 30, and August 1 thru October 15, seed with 60 lbs per acre (1.4 lbs/1000 sq ft) of Kentucky 31 Tall Fescue. For the period May 1 thru July 31, seed with 60 lbs Kentucky 31 Tall Fescue per acre and 2 lbs per acre (.05 lbs/1000 sq ft) of seeding lovegrass. During the period of October 16 thru February 28, protect site by: Option (1) 2 tons per acre of well anchored straw mulch and seed as soon as possible in the spring. Option (2) Use sod. Option (3) Seed with 60 lbs/acre Kentucky 31 Tall Fescue and mulch with 2 tons/acre well anchored straw.

**Mulching:** Apply 1 1/2 to 2 tons per acre (70 to 90 lbs/1000 sq ft) of unrotted small grain straw immediately after seeding. Anchor mulch immediately after application using mulch anchoring tool or 218 gallons per acre (5 gal/1000 sq ft) of emulsified asphalt on flat areas. On slopes 8 feet or higher, use 348 gallons per acre (8 gal/1000 sq ft) for anchoring.

**Maintenance:** Inspect all seeded areas and make needed repairs, replacements and touchings.

Apply to graded or cleared areas likely to be re-disturbed where a short-term vegetative cover is needed.

**Seedbed Preparation:** Loosen upper three inches of soil by raking, disking or other acceptable means before seeding.


**Soil Amendments:** Apply 600 lbs per acre 10-10-10 Fertilizer (14 lbs/1000 sq ft)

**Seeding:** For periods March 1 thru April 30 and from August 15 thru November 15, seed with 75 bushels per acre of annual ryegrass (3.2 lbs/1000 sq ft). For the period May 1 thru August 14, seed with 3 lbs per acre of weeping lovegrass (.07 lbs/1000 sq ft). For the period November 16 thru February 28, protect site by applying 2 tons per acre of well anchored straw mulch and seed as soon as possible in the spring, or use sod.


**Mulching:** Apply 1 1/2 to 2 tons per acre (70 to 90 lbs/1000 sq ft) of unrotted small grain straw immediately after seeding. Anchor mulch immediately after application using mulch anchoring tool or 218 gal per acre (5 gal/1000 sq ft) of emulsified asphalt on flat areas. On slopes, 8 ft or higher, use 348 gal per acre (8 gal/1000 sq ft) for anchoring.

Refer to the 1983 MARYLAND STANDARDS AND SPECIFICATIONS FOR SOIL EROSION AND SEDIMENT CONTROL for rate and methods not covered.

**RIPRAP OUTLET SEDIMENT TRAP ST-1**

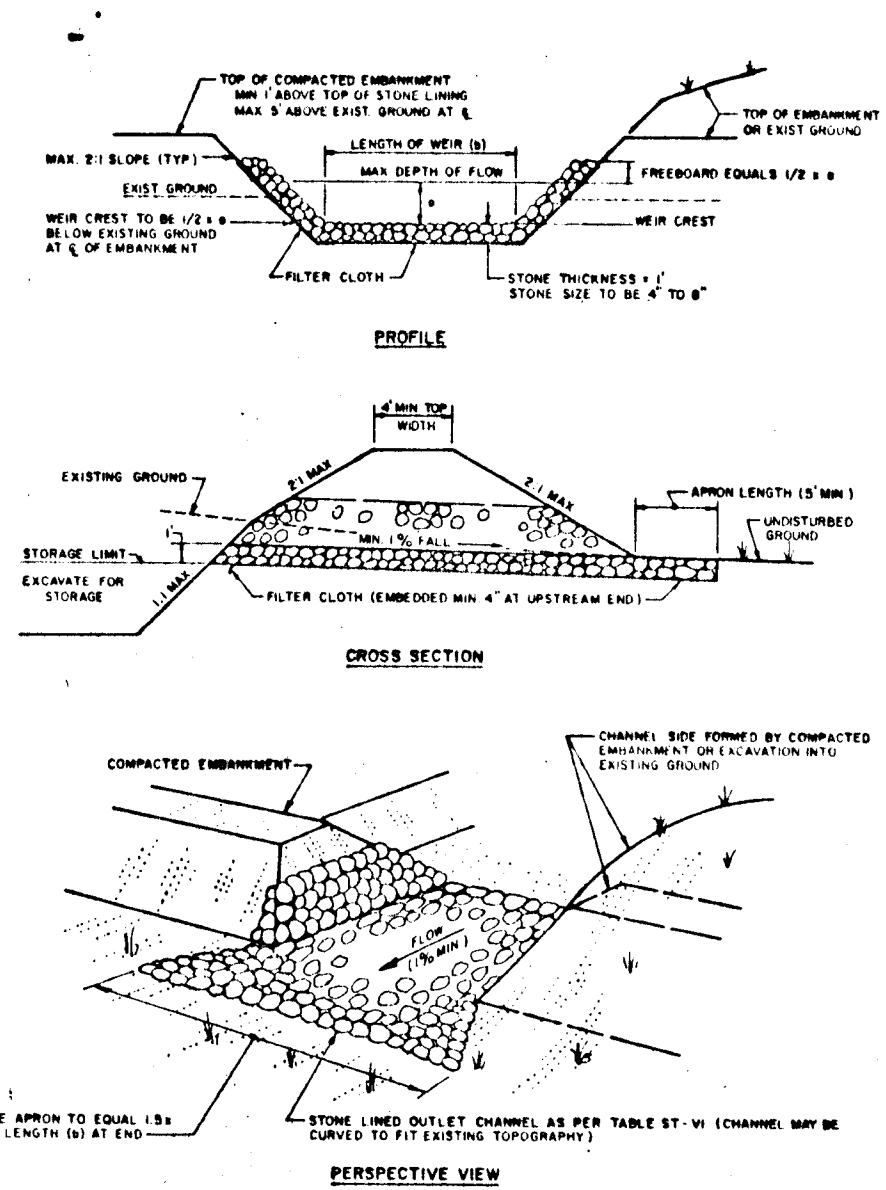


**STABILIZED CONSTRUCTION ENTRANCE**  
not to scale

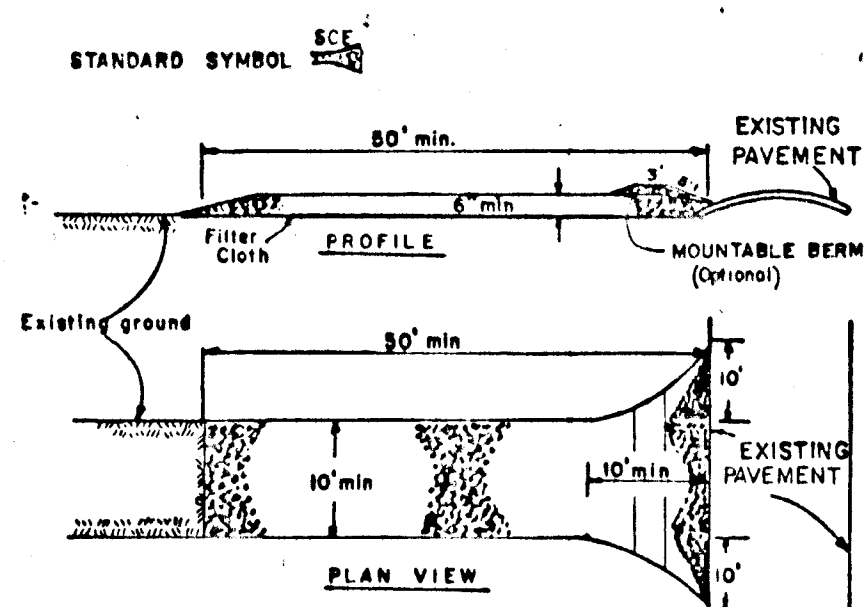


**CONSTRUCTION SPECIFICATIONS**

- Stone Size - One 3" stone, or equivalent or recycled concrete equivalent.
- Length - As required, but not less than 50 feet (except on a single residence lot where a 30 foot minimum length would apply).
- Thickness - Not less than six (6) inches.
- Width - Ten (10) foot minimum, but not less than the full width at points where ingress or egress occurs.
- Filter Cloth - Will be placed over the entire area prior to placing of stone. Filter will not be required on a single family residence lot.
- Surface Water - All surface water flowing or diverted toward construction entrances shall be piped across the entrance. If piping is impractical, a mounded berm with 5:1 slopes will be permitted.
- Maintenance - The entrance shall be maintained in a condition which will prevent tracking or flowing of sediments onto public rights-of-way. It may require periodic top dressing with additional stone as conditions demand and repair and/or cleanup of any measures used to trap sediment. All sediments spilled, dropped, washed or tracked onto public rights-of-way must be removed immediately.
- Washing - Wheels shall be cleaned to remove sediment prior to entrance onto public rights-of-way. When washing is required, it shall be done on an area stabilized with stone and which drains into an approved sediment trapping device.
- Periodic inspection and required maintenance must be provided after each rain.

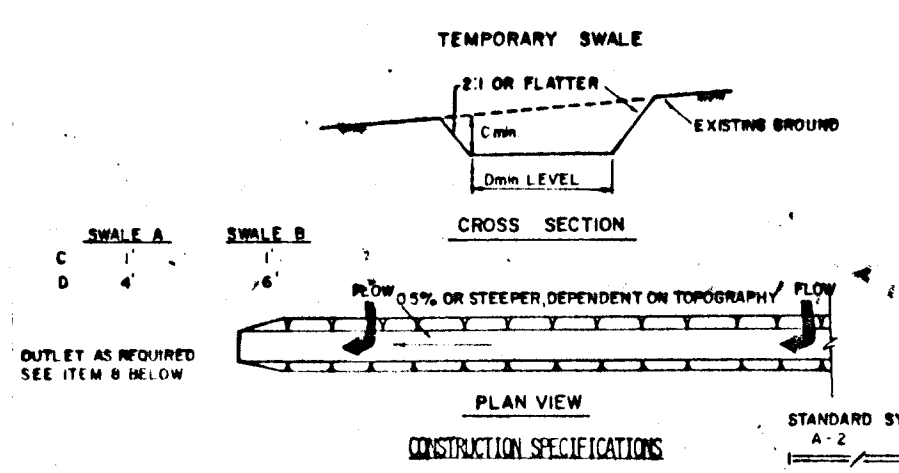

**CONSTRUCTION SPECIFICATIONS**


- All temporary swales shall have uninterrupted positive grade to an outlet.
  - Diverted runoff from a disturbed area shall be conveyed to a sediment trapping device.
  - Diverted runoff from an undisturbed area shall divert directly into an undisturbed stabilized area at non-erosive velocity.
  - All trees, brush, stumps, obstructions, and other objectionable material shall be removed and disposed of so as not to interfere with the proper functioning of the swale.
  - The swale shall be excavated or topped to line, grade, and cross section as required to meet the criteria specified herein and be free of bank projections or other irregularities which will impede normal flow.
  - Fills shall be compacted by earth moving equipment.
  - All earth removal and not needed on construction shall be placed so that it will not interfere with the functioning of the swale.
  - Stabilization shall be as per the chart below:
- | TYPE OF DISTURBANCE | CHANNEL SIZE    | A (5 AC OR LESS)                | B (5 AC - 10 AC)                 |
|---------------------|-----------------|---------------------------------|----------------------------------|
| 1                   | 1-5'-0"         | SEED AND STRAW MULCH            | SEED AND STRAW MULCH             |
| 2                   | 5.1-8'-0"       | SEED AND STRAW MULCH            | SEED USING JUTE OR CORKSLIPS, SO |
| 3                   | 8.1-12'-0"      | SEED WITH JUTE OR CORKSLIPS, SO | LINED WITH 4-8" RIP-RAP          |
| 4                   | 12'-0" AND OVER | LINED 4-8" RIP-RAP              | ENGINEERED DESIGN                |

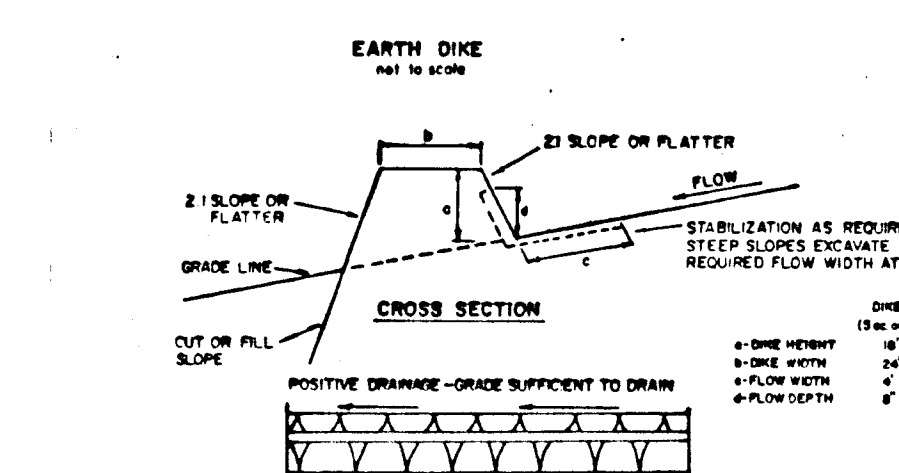


**CONSTRUCTION SPECIFICATIONS**

- All dikes shall be compacted by earthmoving equipment.
  - All dikes shall have positive drainage to an outlet.
  - Top width may be wider and side slopes may be flatter if desired to facilitate crossing by construction traffic.
  - Field location shall be adjusted as needed to utilize a stabilized bare outlet.
  - Earth dikes shall have an outlet that functions with a minimum of erosion. Dikes shall be covered up to a sediment trapping device such as a sediment trap or sediment basin where either the dike channel or the drainage area above the dike are not adequately stabilized.
  - Stabilization shall be: (A) IN ACCORDANCE WITH STANDARD SPECIFICATIONS FOR SEED AND STRAW MULCH OR STRAW MULCH IF NOT IN SEEDING SEASON, (B) FLOW CHANNEL AS PER THE CHART BELOW.
- | TYPE OF DISTURBANCE | CHANNEL SIZE    | DIKE A                         | DIKE B                                     |
|---------------------|-----------------|--------------------------------|--|
| 1                   | 1-5'-0"         | SEED AND STRAW MULCH           | SEED AND STRAW MULCH                       |
| 2                   | 5.1-8'-0"       | SEED AND STRAW MULCH           | SEED USING JUTE OR CORKSLIPS, SO, 2" STONE |
| 3                   | 8.1-12'-0"      | SEED WITH JUTE OR SO, 2" STONE | LINED RIP-RAP 4-8"                         |
| 4                   | 12'-0" AND OVER | LINED RIP-RAP 4-8"             | ENGINEERED DESIGN                          |
- A. STONE TO BE 2 INCH STONE, OR RECYCLED CONCRETE EQUIVALENT, IN A LAYER AT LEAST 3 INCHES IN THICKNESS AND BE PRESSED INTO THE SOIL WITH CONSTRUCTION EQUIPMENT.  
B. RIP-RAP TO BE 2 INCH TO 4 INCH STONE.  
C. JUTE OR CORKSLIPS EQUIVALENTS CAN BE SUBSTITUTED FOR ANY OF THE ABOVE MATERIALS.  
7. PERIODIC INSPECTION AND REQUIRED MAINTENANCE MUST BE PROVIDED AFTER EACH RAIN EVENT.

APPROVED: HOWARD COUNTY DEPARTMENT OF PUBLIC WORKS  
 Chief, Land Development Division  
 Date: 12/23/87  
 Chief, Bureau of Highways  
 Date: 12/23/87  
 Chief, Bureau of Engineering  
 Date: 12/23/87  
 APPROVED: OFFICE OF PLANNING AND ZONING  
 Chief, Division of Land Development and Zoning Administration  
 Date: 12/28/87

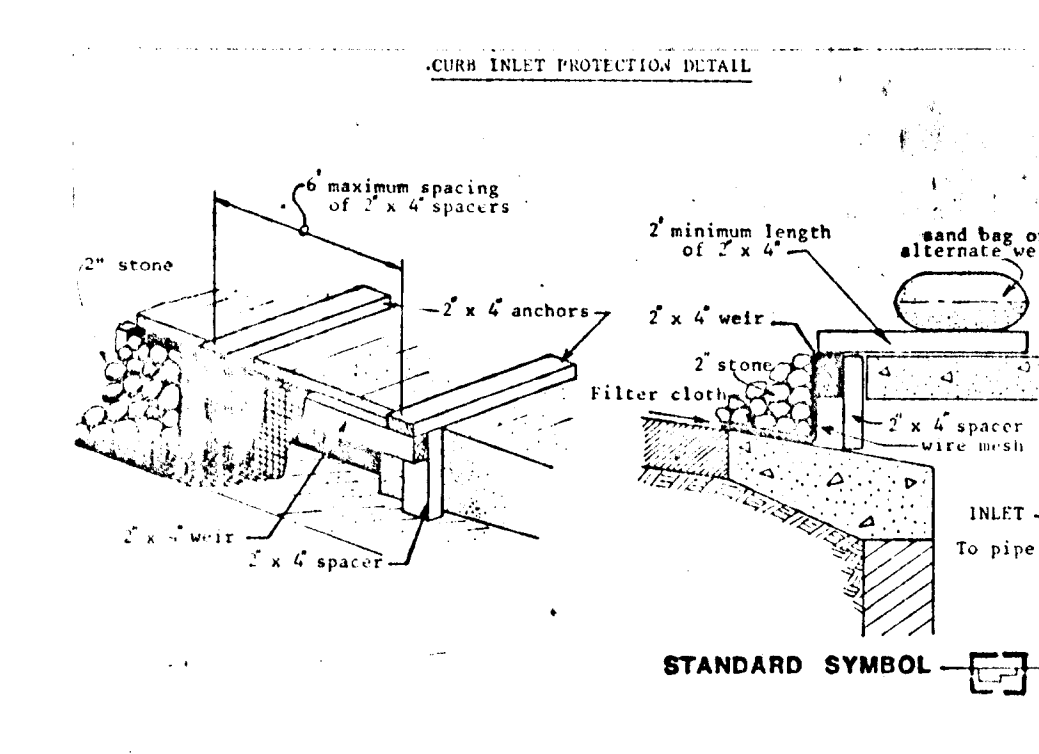

**SILT FENCE**

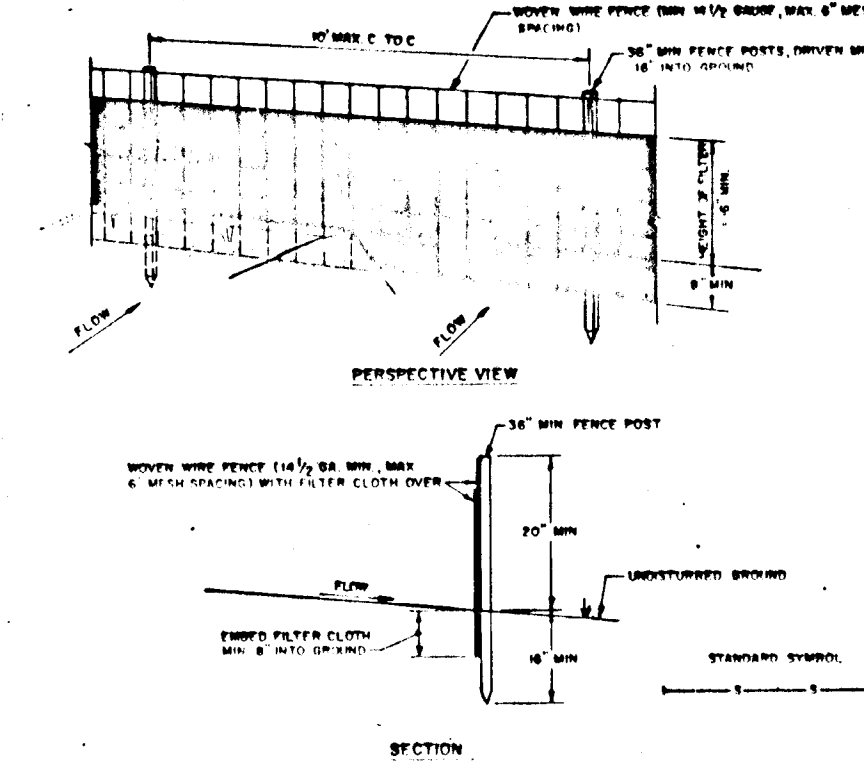

**CONSTRUCTION NOTES FOR PERFORATED SILT FENCE**


- When wire fence to be fastened securely to fence posts with wire ties or staples.
  - Filter cloth to be fastened securely to posts with wire ties or staples.
  - When two sections of filter cloth along each other they shall be overlapped by six inches and folded.
  - Maintenance shall be performed as needed and material removed when it becomes unusable or soiled.
- POSTS: STEEL TIEPS TO U TYPE OR 2\"/>

FENCE: WOODEN 1 1/2\"/>

FILTER CLOTH: FILTER Y, 1\"/>

PREFABRICATED UNITS: GEORGE, 1\"/>


**STRAW BALE DIKE**

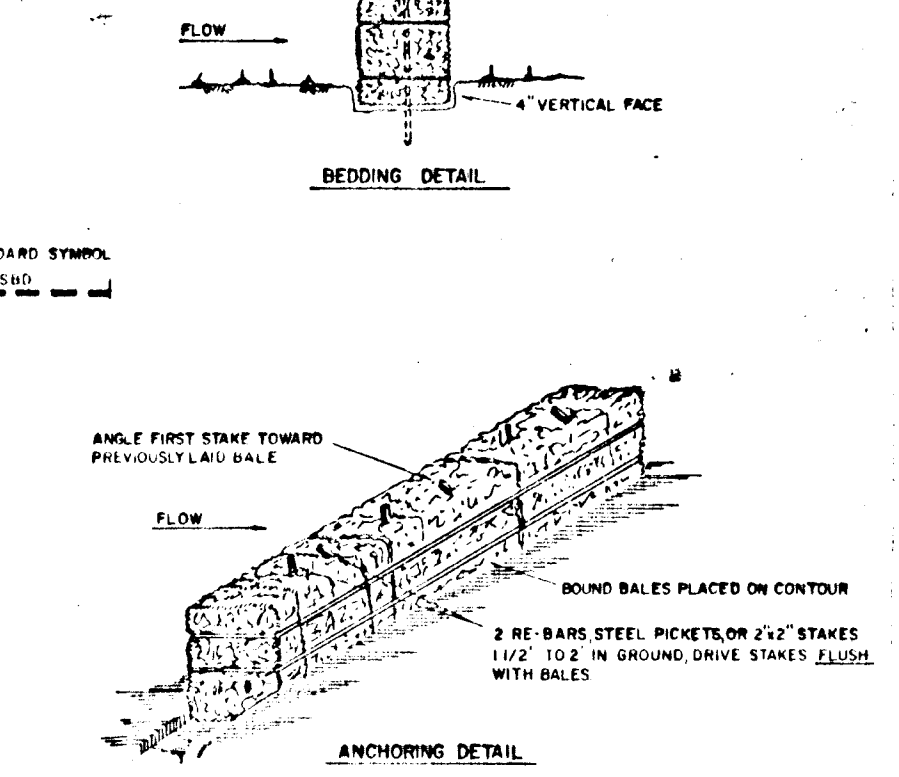

**CONSTRUCTION SPECIFICATIONS**

- Bales shall be placed at the toe of a slope or on the contour and in a row with each bale tightly abutting the adjacent bales.
- Each bale shall be embedded in the soil a minimum of (4) inches, and placed so the bales are horizontal.
- Bales shall be securely anchored in place by either two stakes or re-bar driven through the bale. The first stake in each bale shall be driven through the previously laid bale at an angle to force the bales together. Stakes shall be driven flush with the bale.
- Inspection shall be frequent and repair replacement shall be made promptly as needed.
- Bales shall be removed when they have served their usefulness so as not to block or impede storm flow or drainage.


**STONE OUTLET SEDIMENT TRAP ST-2**

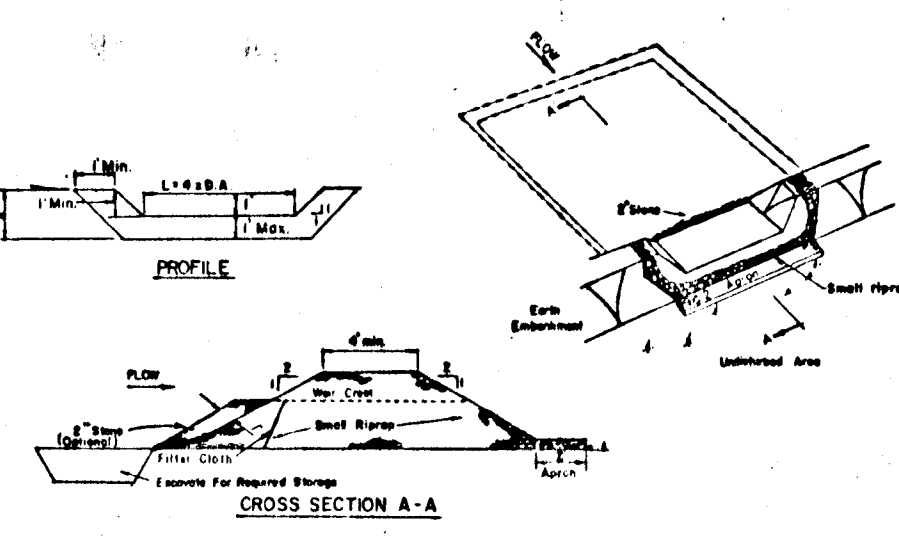

**CONSTRUCTION SPECIFICATIONS FOR ST-2**

- Area under embankment shall be cleared, grubbed and stripped of any vegetation and root mat. The pool area shall be cleared.
- The fill material for the embankment shall be free of roots and other woody vegetation as well as over-sized stones, rocks, organic material or other objectionable material. The embankment shall be compacted by traversing with equipment while it is being constructed. Maximum height of embankment shall be five (5) feet, measured at centerline of embankment.
- All fill slopes shall be 2:1 or flatter.
- The stone used in the outlet shall be small riprap 4-8" along with a 1" thickness of #3 aggregate placed on the upstream side of the small riprap and embedded filter cloth in the riprap.
- Sediment shall be removed and trap restored to its original dimensions when the sediment has accumulated to 1/2 the design depth of the trap.
- The structure shall be inspected after each rain and repaired as needed.
- Construction operations shall be carried out in such a manner that erosion and water pollution are minimized.
- The structure shall be removed and the area stabilized when the drainage area has been properly stabilized.

**PIPE SLOPE TRAP (FLEXIBLE)**

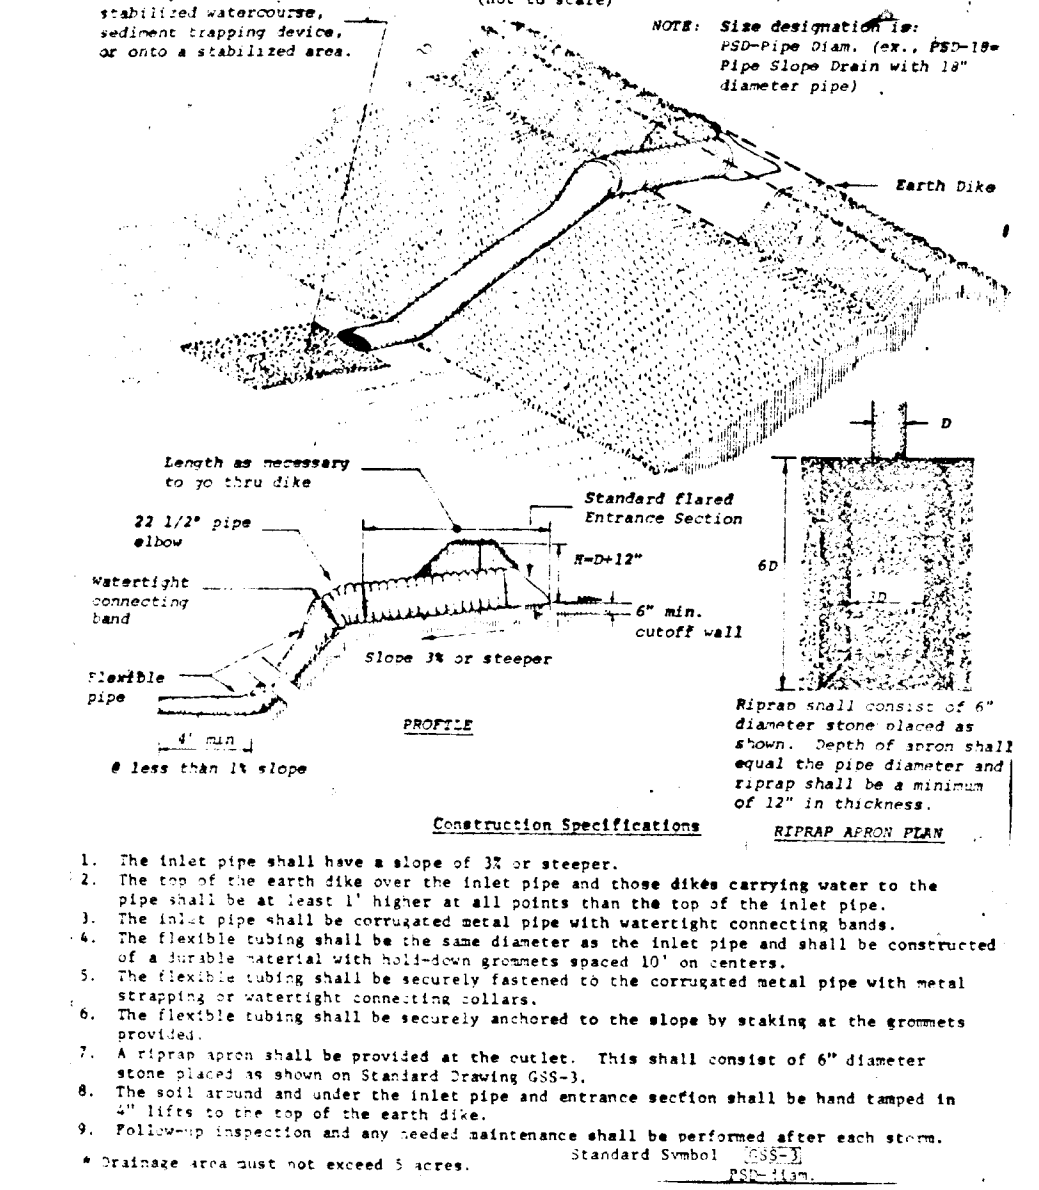

**CONSTRUCTION SPECIFICATIONS**

- Area under embankment shall be cleared, grubbed and stripped of any vegetation and root mat. The pool area shall be cleared.
- The fill material for the embankment shall be free of roots and other woody vegetation as well as over-sized stones, rocks, organic material or other objectionable material. The embankment shall be compacted by traversing with equipment while it is being constructed. Maximum height of embankment shall be five (5) feet, measured at centerline of embankment.
- All fill slopes shall be 2:1 or flatter.
- The stone used in the outlet shall be small riprap 4-8" along with a 1" thickness of #3 aggregate placed on the upstream side of the small riprap and embedded filter cloth in the riprap.
- Sediment shall be removed and trap restored to its original dimensions when the sediment has accumulated to 1/2 the design depth of the trap.
- The structure shall be inspected after each rain and repaired as needed.
- Construction operations shall be carried out in such a manner that erosion and water pollution are minimized.
- The structure shall be removed and the area stabilized when the drainage area has been properly stabilized.

**\*\* POND REMOVAL (See Sheet 5 for plan and details)**

- Remove water from existing pond by pumping. It is estimated that the pond can be drained in approximately 24 hours using a 4-inch or 5-inch pump, (400 gpm rating).
- Construct temporary stone embankment and weir 200 feet downstream of the earth dam embankment.
- Excavate earth dam embankment to elev. 337.0
- Construct temporary one foot deep ditch to outfalls 5-6 and 5-7. Allow several days for pond bottom to dry.
- Construct rip rap channel to outfalls 5-6 and 5-7.
- Stabilize all graded surfaces with permanent seeding.
- After the area is stabilized, remove temporary stone embankment and weir.

Reviewed for HOWARD S.C.D. and meets Technical Requirements  
 [Signature] R-15-87  
 S. Soil Conservation Date  
 Service

THIS DEVELOPMENT PLAN IS APPROVED FOR SOIL EROSION AND SEDIMENT CONTROL BY THE HOWARD SOIL CONSERVATION DISTRICT  
 [Signature] 12-14-87  
 Howard S.C.D. Date

By the Developer:  
 "I/We certify that all development and construction will be done according to this plan, and that any responsible personnel involved in the construction project will have a Certificate of Attendance at a Department of Natural Resources Approved Training Program for the Control of Sediment and Erosion before beginning the project. I also authorize periodic on-site inspection by the Howard Soil Conservation District."  
 [Signature] 8-4-87  
 Date

By the Engineer:  
 "I certify that this plan for erosion and sediment control represents a practical and workable plan based on my personal knowledge of the site conditions and that it was prepared in accordance with the requirements of the Howard Soil Conservation District."  
 [Signature] 8-4-87  
 Date

**SEQUENCE OF CONSTRUCTION**

- CULVERT CONSTRUCTION**
- OBTAIN GRADING PERMIT.
  - CLEAR AND GRUB AREAS FOR SEDIMENT CONTROL FACILITIES FOR CULVERT CONSTRUCTION ONLY.
  - INSTALL STABILIZED CONSTRUCTION ENTRANCE.
  - DIVERT EXISTING STREAM AND INSTALL SILT FENCE AND EARTH DIKE.
  - CONSTRUCT CULVERT, STRUCTURES S-2 AND S-3 AND RIP RAP CHANNELS.
  - REMOVE EARTH DIKE AND SILT FENCE.

- ROADWAY CONSTRUCTION AND PARCEL O ROUGH GRADING**
- CLEAR AND GRUB AREAS FOR SEDIMENT CONTROL FACILITIES.
  - MODIFY STABILIZED CONSTRUCTION ENTRANCE AS REQUIRED.
  - CONSTRUCT SEDIMENT TRAPS 1 AND 2, EARTH DIKES, SILT FENCE AND SWALES TO TRAP NO. 2.
  - STABILIZE EARTH DIKES WITH TEMPORARY SEEDING, SEE SPECIFICATIONS ON SHEET 11.
  - STRIP AND ROUGH GRADE LIMITS OF CONSTRUCTION AND PROVIDE INTERCEPTOR SWALE AT STATIONS 23+00 AND 24+00.
  - ROUGH GRADE PARCEL O AND STABILIZE WITH TEMPORARY SEEDING (SECS ON SH.11) CONSTRUCT DIVERSION DIKES TO TRAP 4 AND CONSTRUCT PIPE SLOPE DRAINS.
  - CONSTRUCT ALL UTILITIES.
  - PROVIDE INLET PROTECTION AT INLETS 35, 36 AND 37. PLACE STRAW BALES AROUND INLET 38.
  - PAVE ROAD.
  - WITH PERMISSION OF SEDIMENT CONTROL INSPECTOR REMOVE ALL SEDIMENT CONTROL FACILITIES AFTER GRASS IS ESTABLISHED IN THE CONTRIBUTING DRAINAGE AREAS.

\* Existing farm pond to also be used for sediment control.

REV. DATE	REV. NO.	REVISION DESCRIPTION
12/2/87	2	As Per SCS Comments
11/13/87	1	As Per Planning, DPWF SCS Comments

**DORSEY HALL**  
 2ND ELECTION DISTRICT  
 HOWARD COUNTY, MARYLAND

OWNER AND DEVELOPER  
 THE HOWARD RESEARCH AND DEVELOPMENT LAND COMPANY

PROJECT AREA  
 SECTION 2 AREA 5  
 PARCELS N AND O

PROJECT TITLE  
 SEDIMENT CONTROL DETAILS

SCALE: DATE:  
 WHITMAN, REQUARDT AND ASSOCIATES  
 ENGINEERS  
 BALTIMORE, MARYLAND 21218

[Signature]  
 KENNETH A. McCORD  
 REGISTERED ENGINEER  
 NO. 1074