


GENERAL NOTES

- 1) ALL WORK SHALL BE DONE IN ACCORDANCE WITH HOWARD COUNTY STANDARDS, SPECIFICATIONS, AND DETAILS FOR CONSTRUCTION.
- 2) ALL UTILITY COMPANIES MUST BE NOTIFIED 24 HOURS IN ADVANCE OF ANY CONSTRUCTION.
- 3) ALL INLETS SHALL BE HOWARD COUNTY STANDARDS UNLESS OTHERWISE SHOWN. ALL "A" INLETS SHALL BE DEPRESSED.
- 4) STORM DRAIN TRENCHES WITHIN ROAD RIGHTS-OF-WAYS SHALL BE BACKFILLED AND COMPACTED IN ACCORDANCE WITH HOWARD COUNTY ROAD CODE.
- 5) ANY DAMAGE TO PUBLIC RIGHTS-OF-WAYS OR PAVING WILL BE CORRECTED AT THE CONTRACTOR'S EXPENSE.
- 6) CONTRACTOR TO NOTIFY THE HOWARD COUNTY DEPT. OF INSPECTION AT LEAST 3 DAYS BEFORE STARTING WORK SHOWN ON THESE DRAWINGS.
TELEPHONE 792-7272
- 7) ALL TRAFFIC CONTROL DEVICES SHALL BE INSTALLED IN COMPLIANCE WITH THE MANUAL OF UNIFORM TRAFFIC CONTROL DEVICES, 1978 EDITION.
- 8) DESIGN SHOWN HEREON IS BASED ON 1" AERIAL TOPOGRAPHY PREPARED BY MAPS INC.
- 9) WATER AND SEWER SEDIMENT CONTROL SHOWN ON SHEETS 15, 16, AND 17 IS FOR INFORMATIONAL PURPOSES ONLY. SEE WATER AND SEWER CONTRACT #24-1758 D FOR WATER AND SEWER SEDIMENT CONTROL.

◆ DENOTES STREET LIGHT 250 WATT ON 30' POLE 2 TOTAL
 ○ DENOTES STREET LIGHT 175 WATT ON 12' POLE 6 TOTAL

BENCH MARKS

- BM # 1** ELEV = 374.31
 P.K. NAIL SET IN C&P # 5, 40' ± SOUTHEAST OF P.I. "H-2"
 *SEE SHEET 2 FOR LOCATION.
- BM # 2** ELEV = 315.72
 P.K. NAIL SET IN 30" OAK TREE BETWEEN TRAV. STA. H-9 & H-10; 150' SOUTH OF H-9
 *SEE SHEET 7 FOR LOCATION.

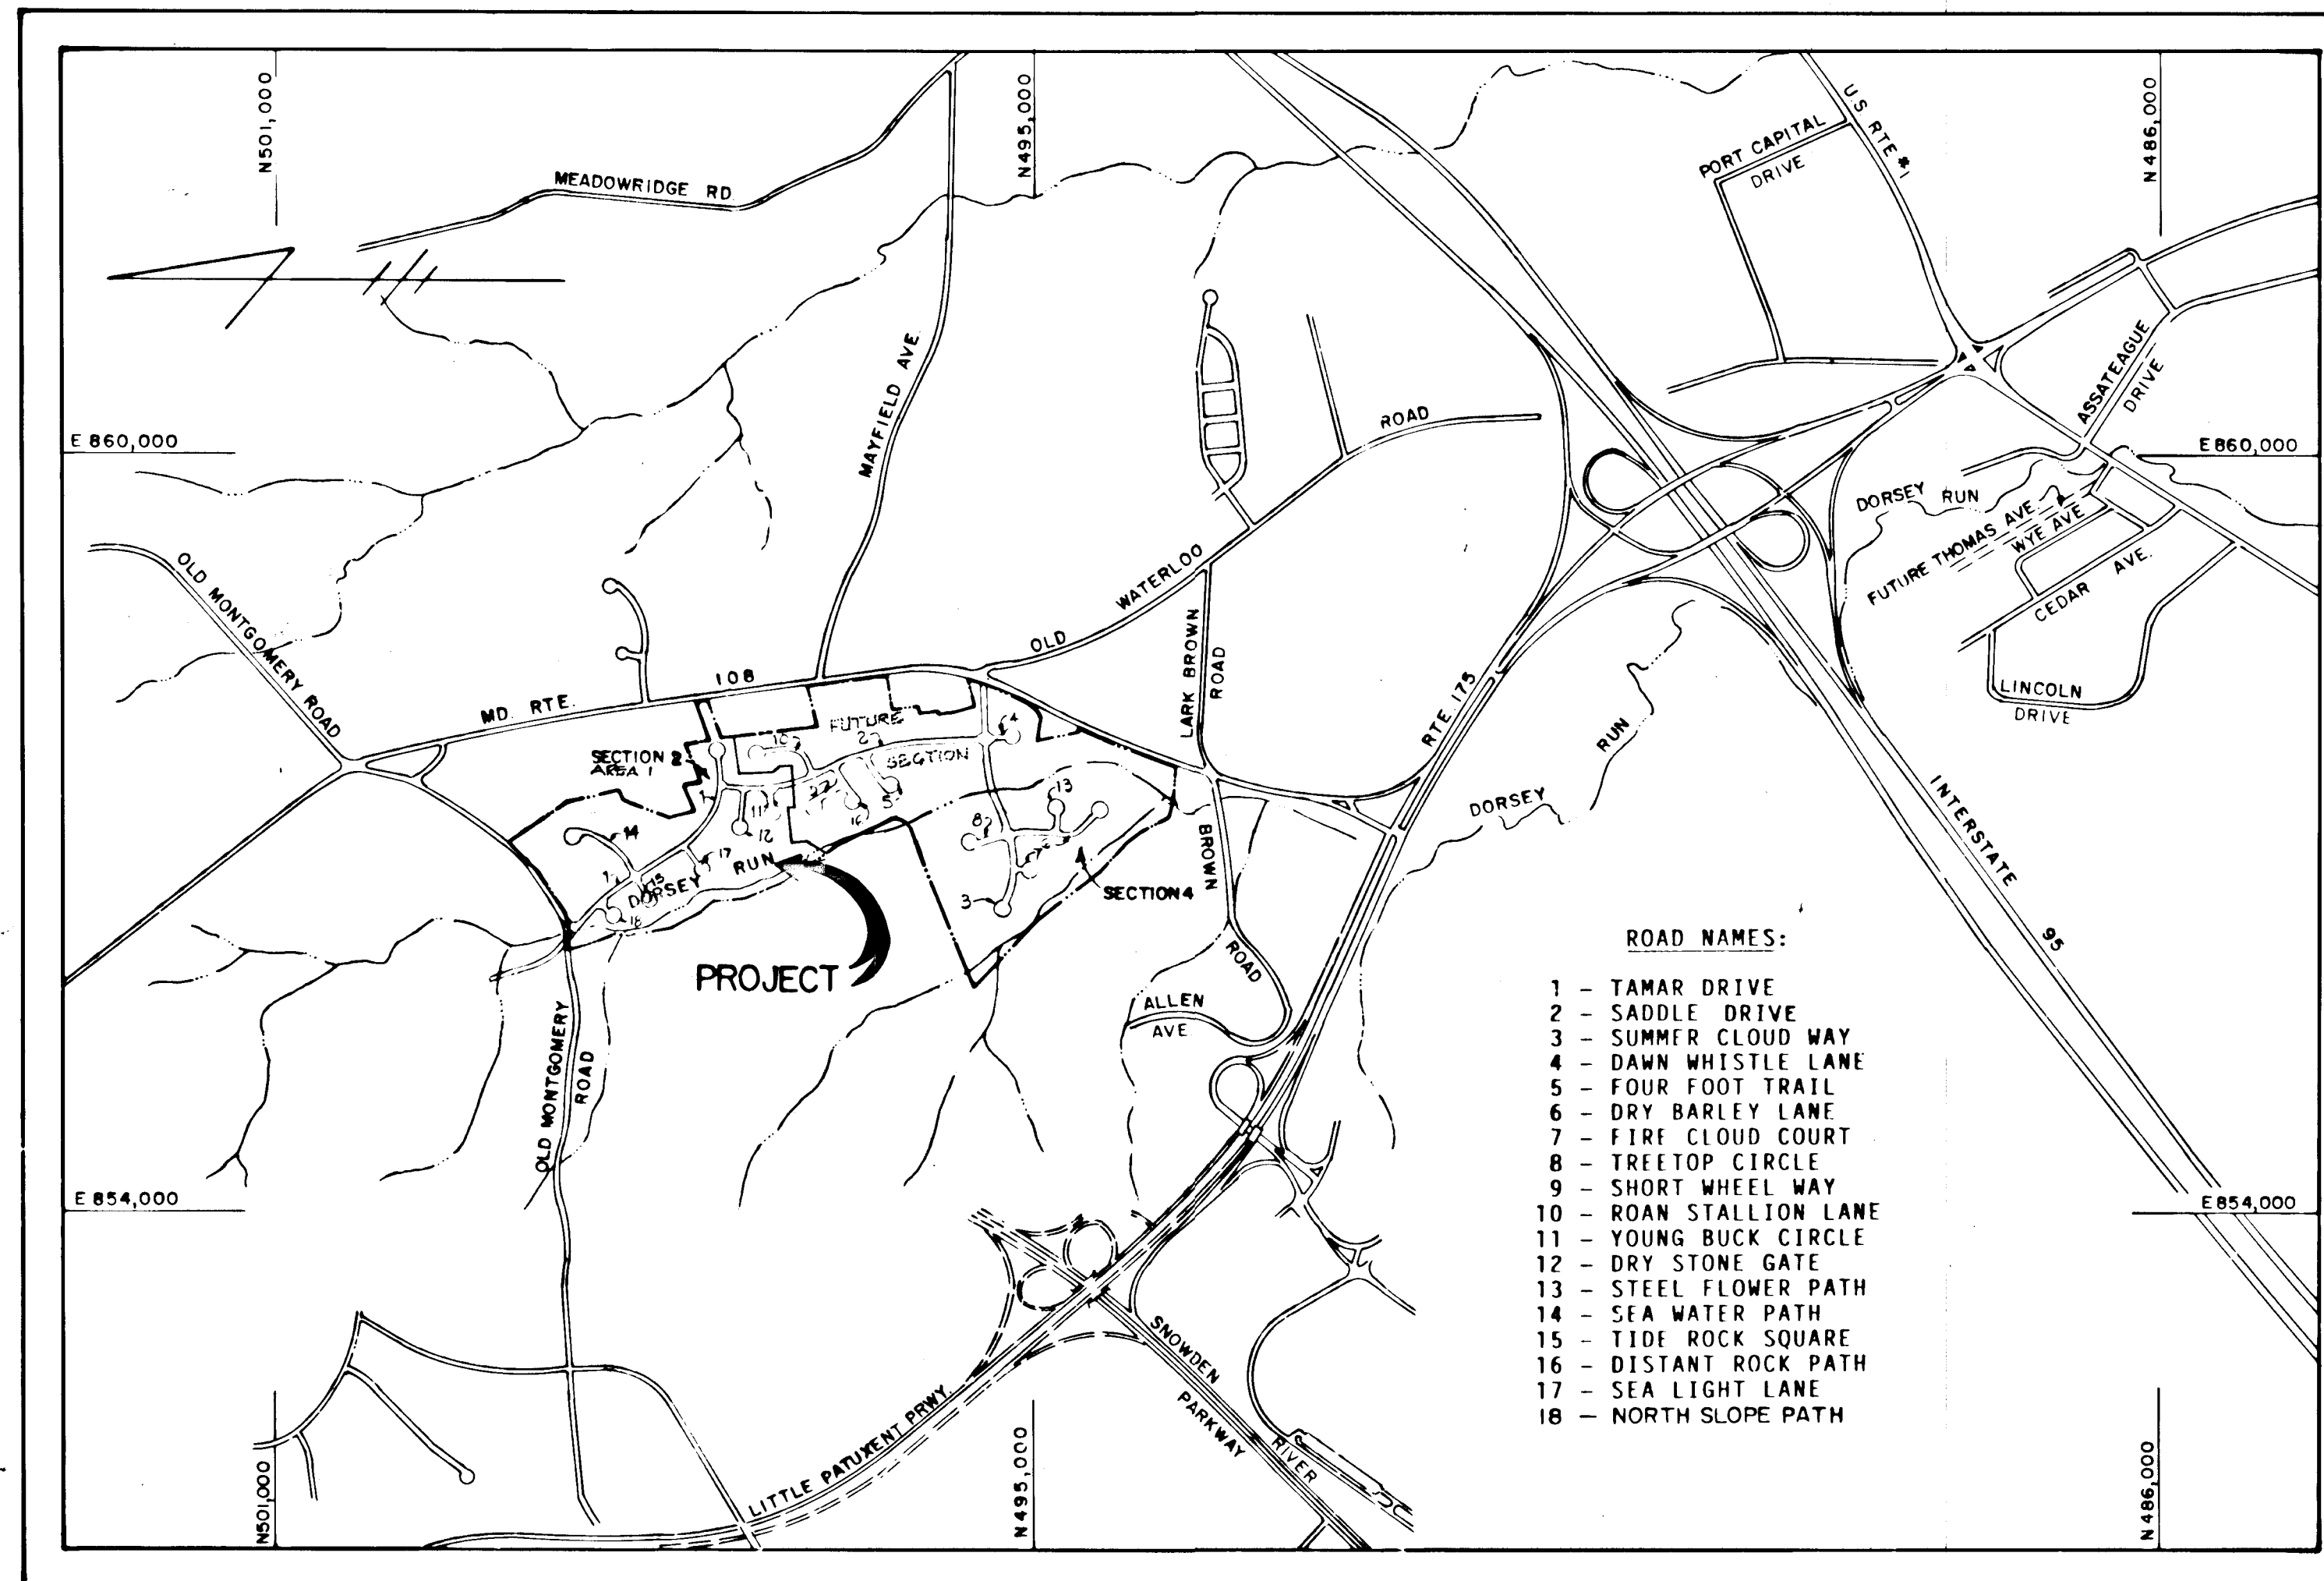

SCALE: 1" = 1200'

COLUMBIA VILLAGE OF LONGREACH

SECTION 2 AREA 1

SIXTH ELECTION DISTRICT HOWARD COUNTY, MARYLAND

APPROVED DEPARTMENT OF PUBLIC WORKS
[Signature] 1/22/88
 CHIEF, BUREAU OF HIGHWAYS DATE

APPROVED DEPARTMENT OF PUBLIC WORKS
[Signature] 1/21/88
 CHIEF, BUREAU OF HIGHWAYS DATE

APPROVED OFFICE OF PLANNING AND ZONING
[Signature] 1/26/88
 CHIEF, DIVISION OF COMMUNITY PLANNING AND LAND DEVELOPMENT DATE

APPROVED DEPARTMENT OF PUBLIC WORKS
[Signature] 1-21-88
 CHIEF LAND DEVELOPMENT DIVISION DATE

INDEX OF SHEETS

- 1) TITLE SHEET
- 2) OLD MONTGOMERY ROAD - PLAN AND PROFILE
- 3) TAMAR DRIVE - PLAN AND PROFILE
- 4) TAMAR DRIVE - PLAN AND PROFILE
- 5) NORTH SLOPE PATH - PLAN AND PROFILE
- 6) SEA WATER PATH - PLAN AND PROFILE, TIDE ROCK SQUARE - PLAN AND PROFILE
- 7) TIDE ROCK SQUARE - PLAN AND PROFILE, SEA LIGHT LANE - PLAN AND PROFILE
- 8) TAMAR DRIVE - PLAN AND PROFILE, SADDLE DRIVE - PLAN AND PROFILE
- 9) DRY STONE GATE - PLAN AND PROFILE, YOUNG BUCK CIRCLE - PLAN AND PROFILE
- 10) SADDLE DRIVE - PLAN AND PROFILE
- 11) ROADWAY SECTION, NOTES AND DETAILS
- 12) DRAINAGE AREA MAP
- 13) STORM DRAIN PROFILES
- 14) STORM DRAIN PROFILES
- 15) STREET TREE, GRADING, AND SEDIMENT CONTROL PLAN
- 16) STREET TREE, GRADING, AND SEDIMENT CONTROL PLAN
- 17) STREET TREE, GRADING, AND SEDIMENT CONTROL PLAN
- 18) STREET TREE, GRADING, AND SEDIMENT CONTROL NOTES AND DETAILS


100

FISHER, COLLINS & CARTER, INC.
 CIVIL ENGINEERS, ARCHITECTS AND SURVEYORS
 8788 COLLEGE AVENUE
 ELLESMERE, MARYLAND 21042




OWNER & DEVELOPER
 THE HOWARD RESEARCH AND
 DEVELOPMENT LAND COMPANY
 102751 LITTLE PATUXENT PARKWAY
 COLUMBIA, MARYLAND 21044
 587-39 887-60

AS-BUILT JAN 15 1988

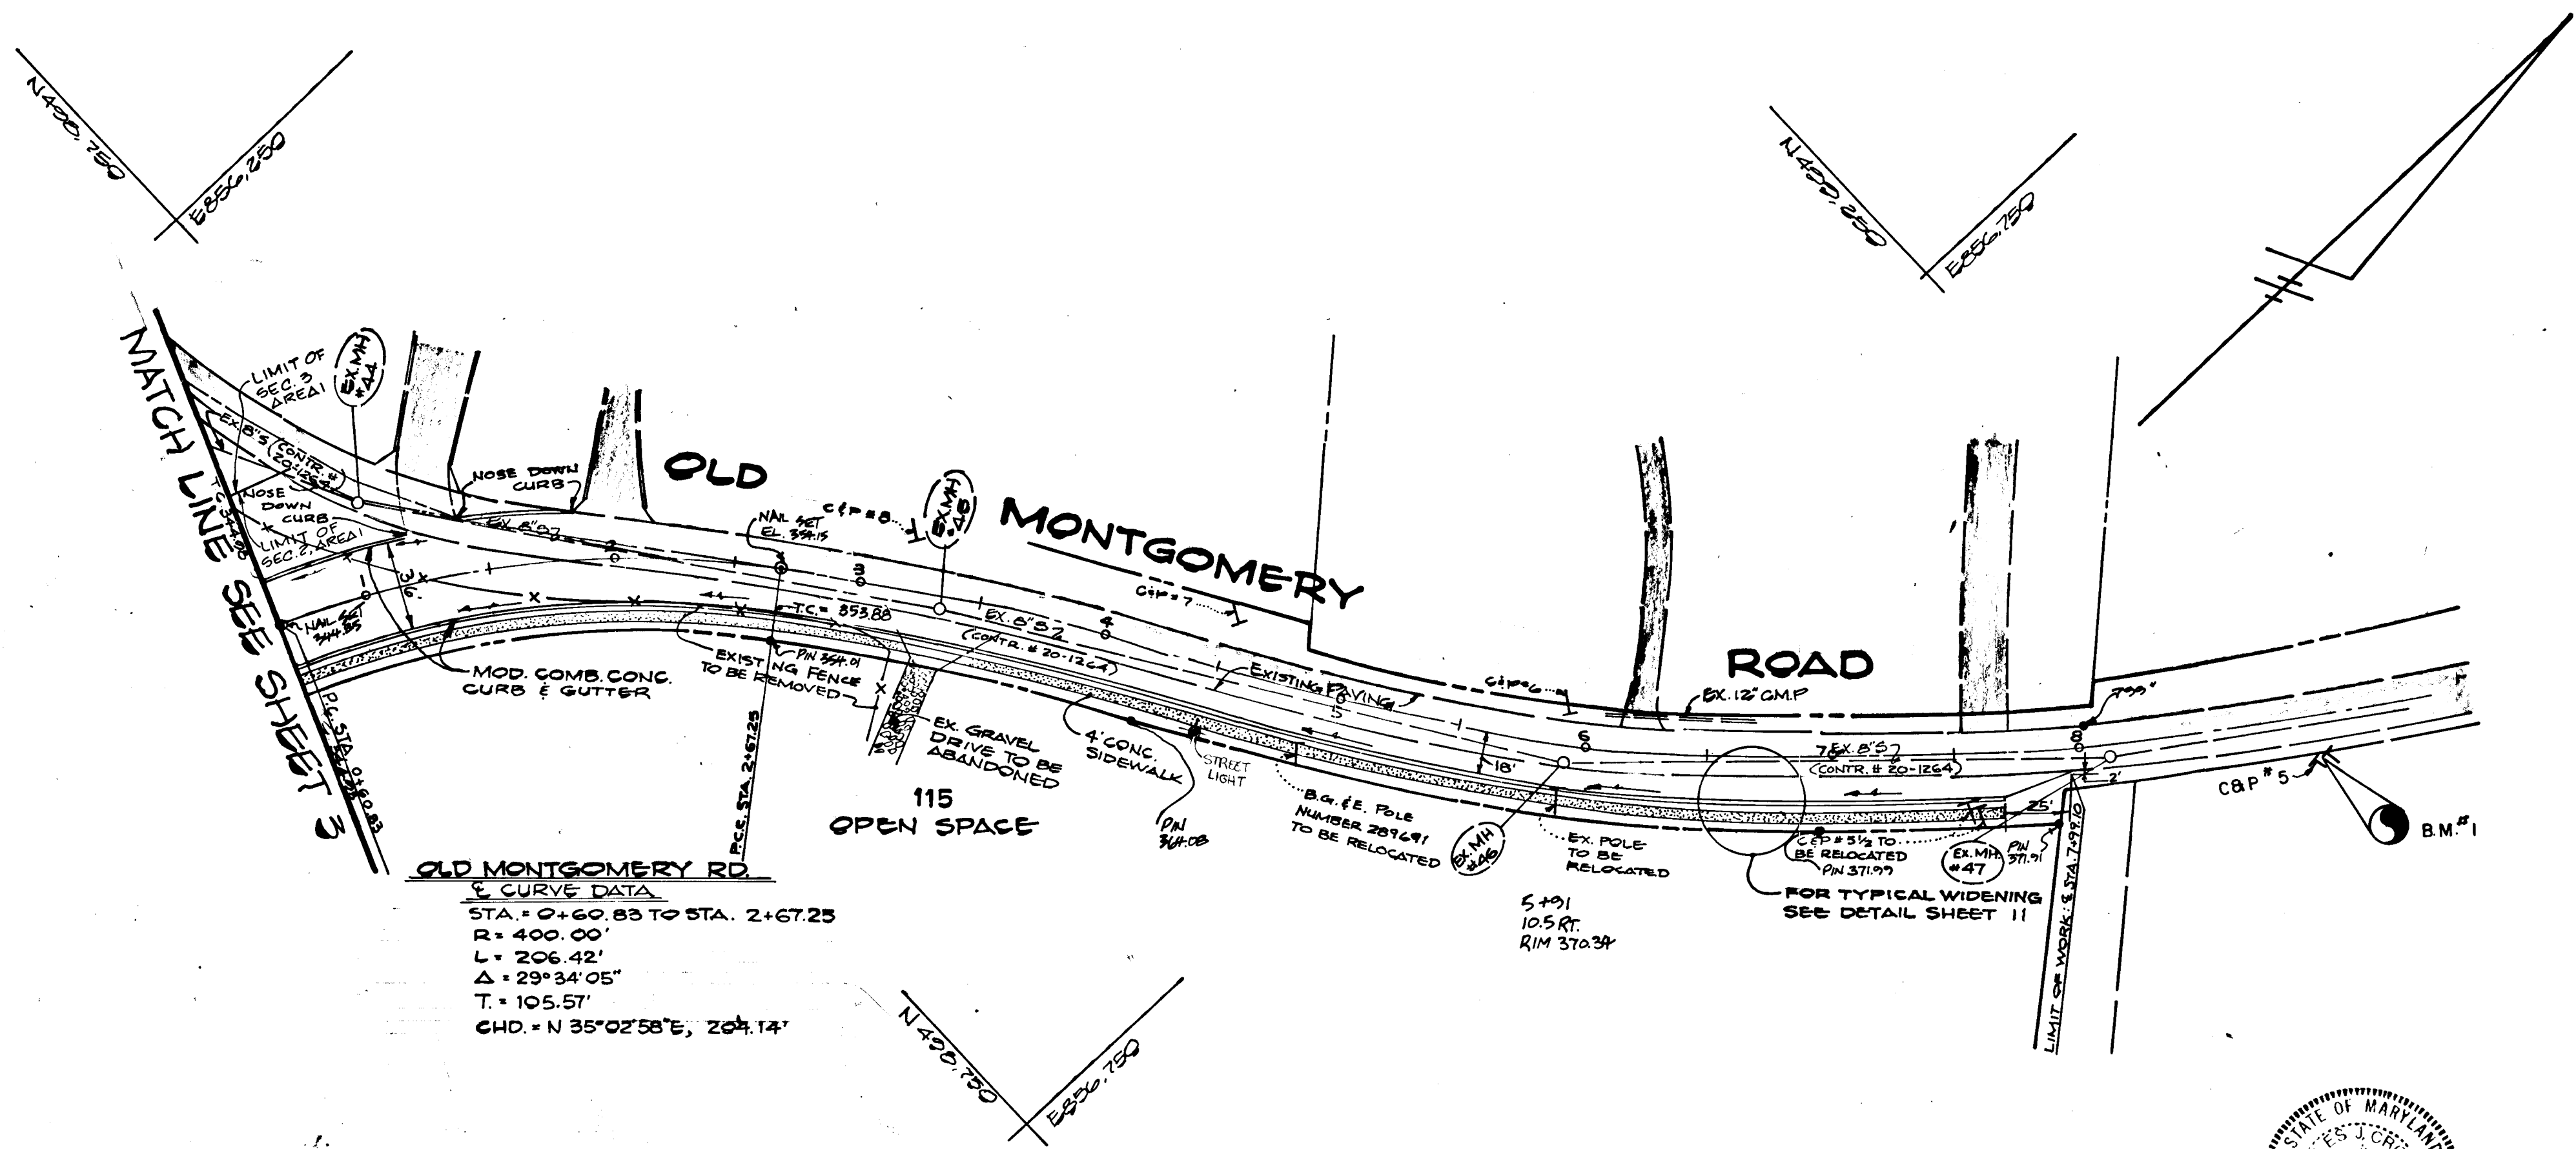

OLD MONTGOMERY RD. CURVE DATA
 STA. 0+00.00 TO STA. 2+67.25
 R = 400.00'
 L = 206.42'
 Δ = 29°34'05"
 T = 105.57'
 CHD. = N 35°02'58"E, 204.14'

PLAN
 SCALE: 1"=50'

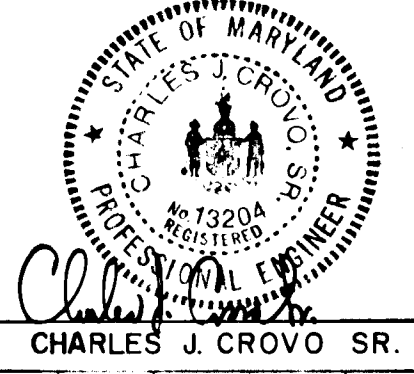

REVISION	DATE
Changed Top Of Curb & Ex. Ground Elevation	4-28-88

VILLAGE OF LONGREACH
 SECTION 2 AREA I
 LOTS 1-117
 6TH ELECTION DISTRICT
 HOWARD COUNTY, MARYLAND

OLD MONTGOMERY ROAD
 PLAN & PROFILE

OWNER AND DEVELOPER
THE HOWARD RESEARCH AND DEVELOPMENT LAND COMPANY
 10275 LITTLE PATUXENT PARKWAY
 COLUMBIA, MARYLAND 21044


SCALE AS SHOWN	DATE	DWG. NO.	OF
DF R. ISA ACS	SEPT. 24, 1987	NO. 2	OF 18

CHK. C.J. CROVO

FISHER, COLLINS AND CARTER, INC.
 CIVIL ENGINEERS AND LAND SURVEYORS
 8388 COURT AVE. ELLICOTT CITY, MARYLAND 21043

APPROVED	DEPARTMENT OF PUBLIC WORKS	DATE
<i>M. H. ...</i>	CHIEF, LAND DEVELOPMENT DIVISION	11-21-88
APPROVED	DEPARTMENT OF PUBLIC WORKS	DATE
<i>Francisco W. Williams</i>	CHIEF, BUREAU OF HIGHWAYS	1/21/88
APPROVED	DEPARTMENT OF PUBLIC WORKS	DATE
<i>William S. ...</i>	CHIEF, BUREAU OF ENGINEERING	1-22-88
APPROVED	OFFICE OF PLANNING AND ZONING	DATE
<i>Joseph ...</i>	COMMUNITY PLANNING AND LAND DEVELOPMENT	1/24/88

OLD MONTGOMERY ROAD

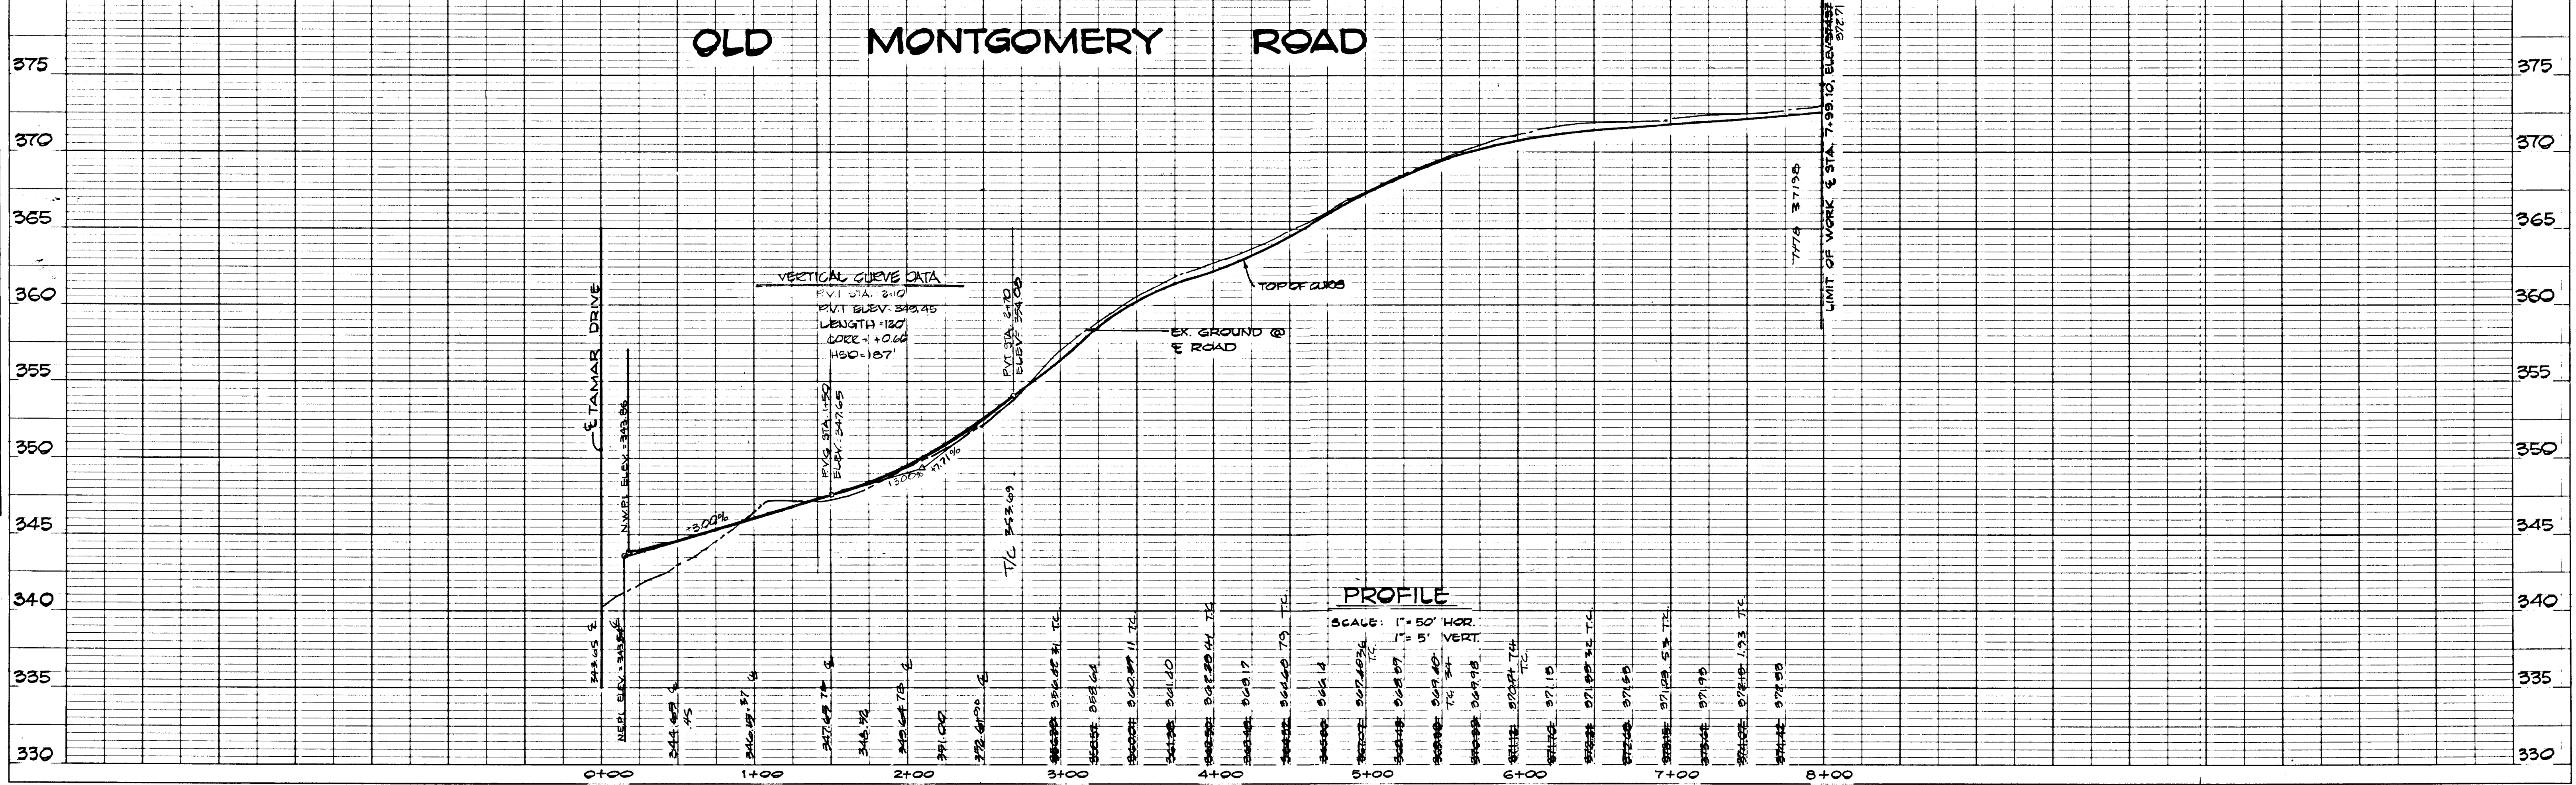

PROFILE



SCALE: 1"=50' HOR.
 1"=5' VERT.

DATE	BY

DATE	BY

DATE
BY
SURVEYED
ALIGNED
CHECKED
RT. OF WAY CHECKED
NO. DATE

DATE
BY
SURVEYED
GRADES CHECKED
B.M. NOTED
STRUCTURE NOTATION CHECKED
NO. DATE

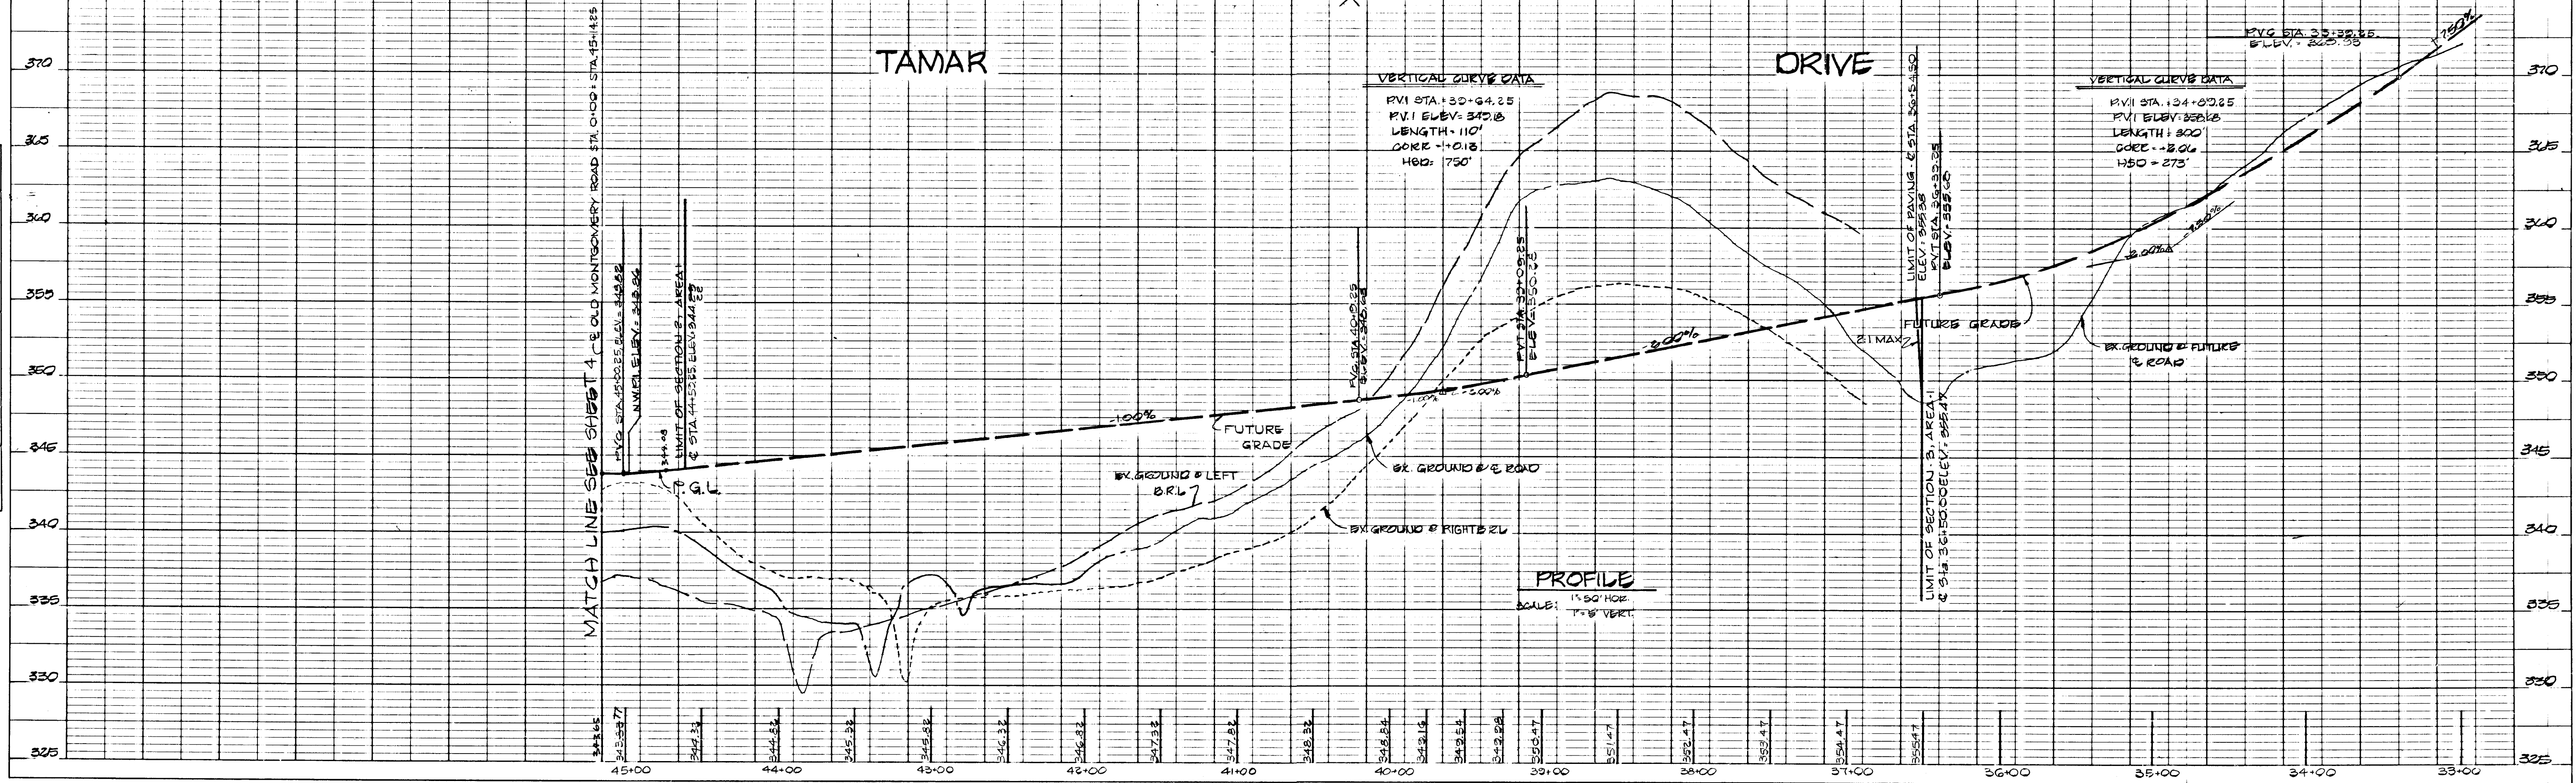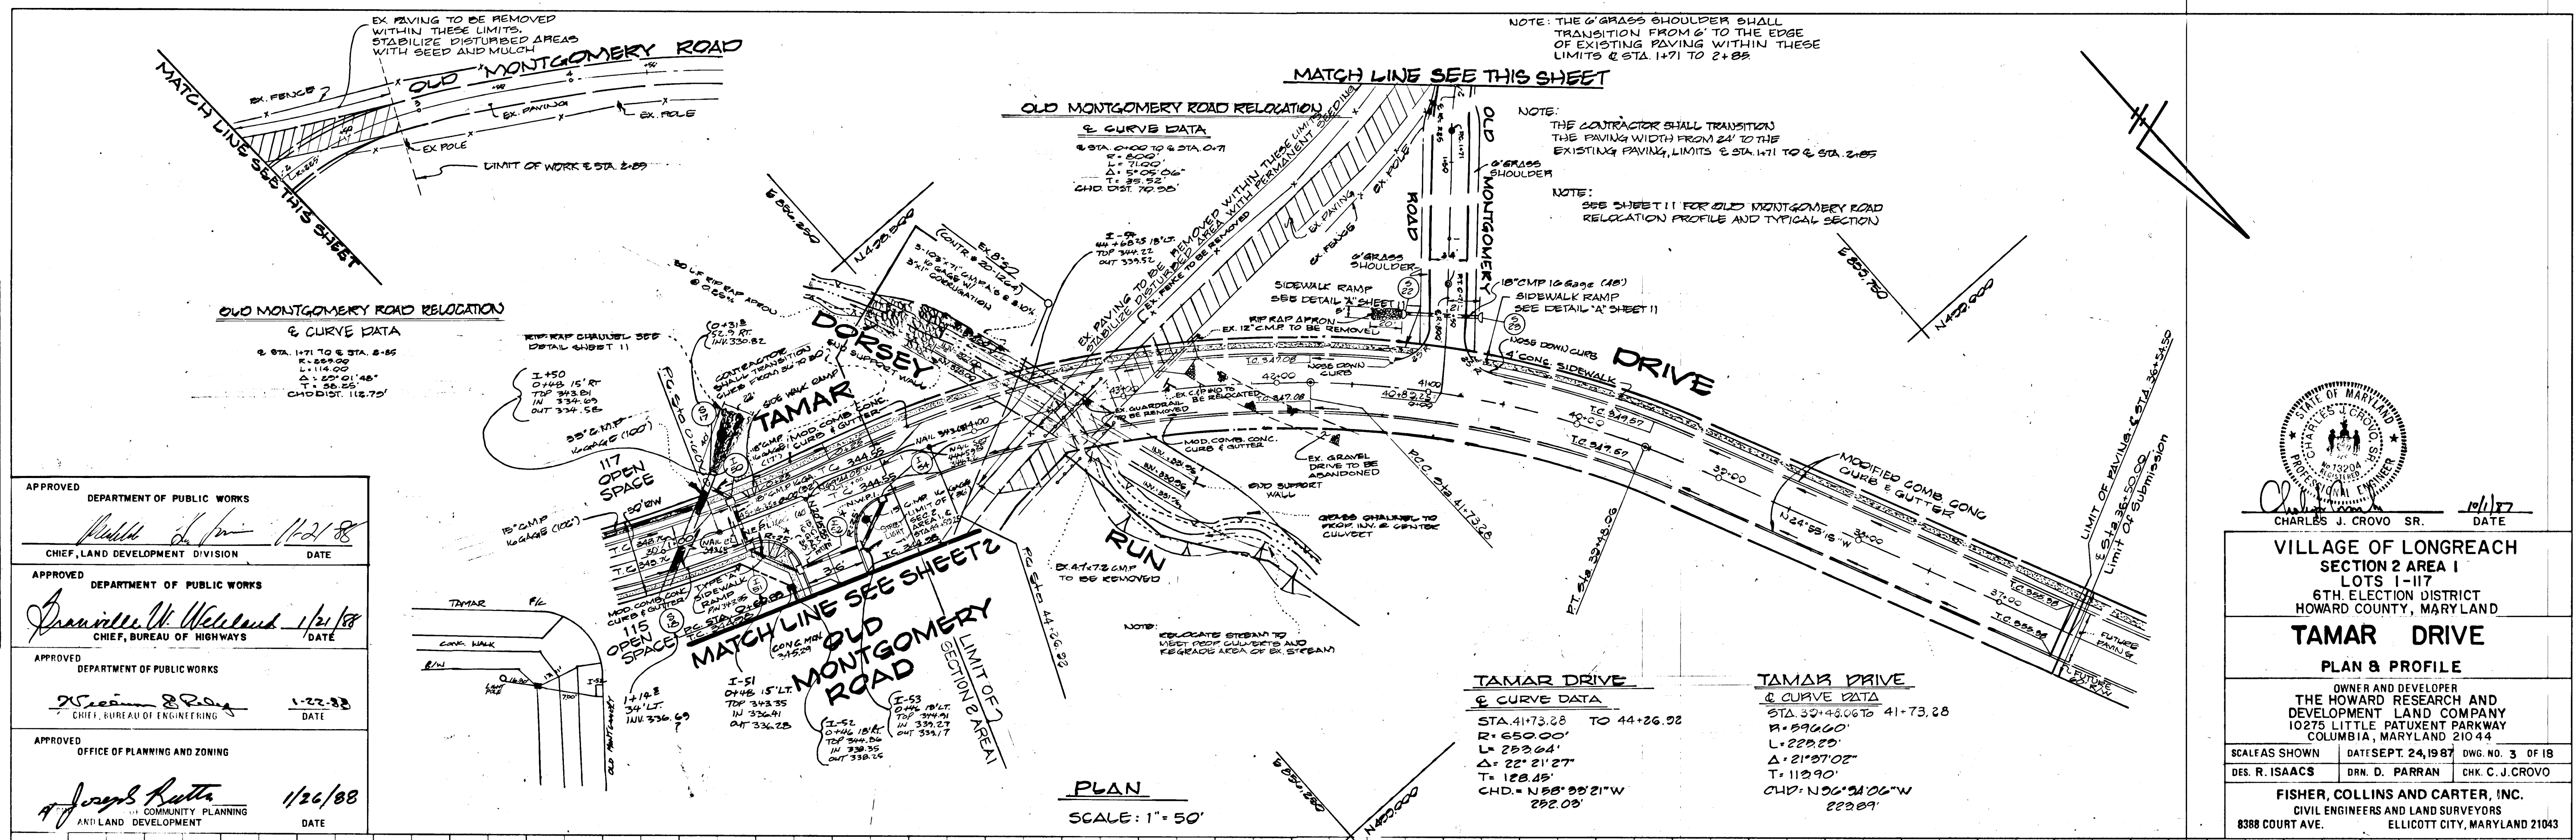

APPROVED DEPARTMENT OF PUBLIC WORKS
 Chief, Land Development Division
 DATE 1/21/88



APPROVED DEPARTMENT OF PUBLIC WORKS
 Chief, Bureau of Highways
 DATE 1/21/88

APPROVED DEPARTMENT OF PUBLIC WORKS
 Chief, Bureau of Engineering
 DATE 1-22-88

APPROVED OFFICE OF PLANNING AND ZONING
 Community Planning and Land Development
 DATE 1/26/88

DESIGNED BY: R. ISAACS
 DRAWN BY: D. PARRAN
 CHECKED BY: C. J. CROVO

FISHER, COLLINS AND CARTER, INC.
 CIVIL ENGINEERS AND LAND SURVEYORS
 8388 COURT AVE.
 ELLICOTT CITY, MARYLAND 21043

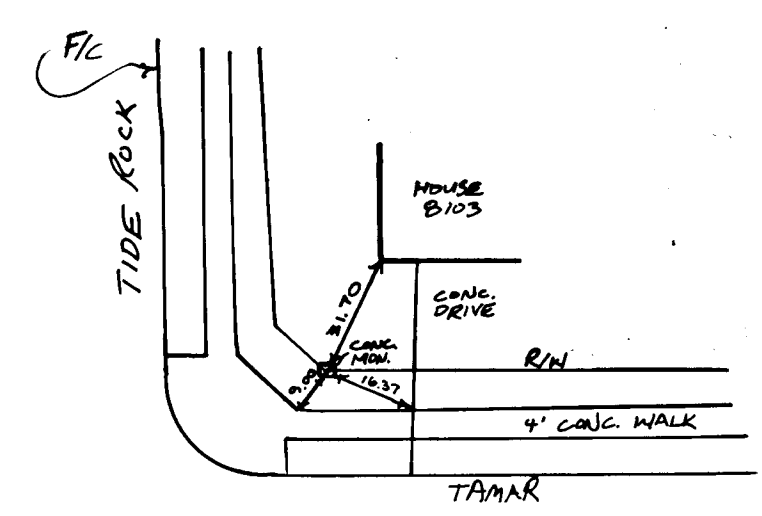
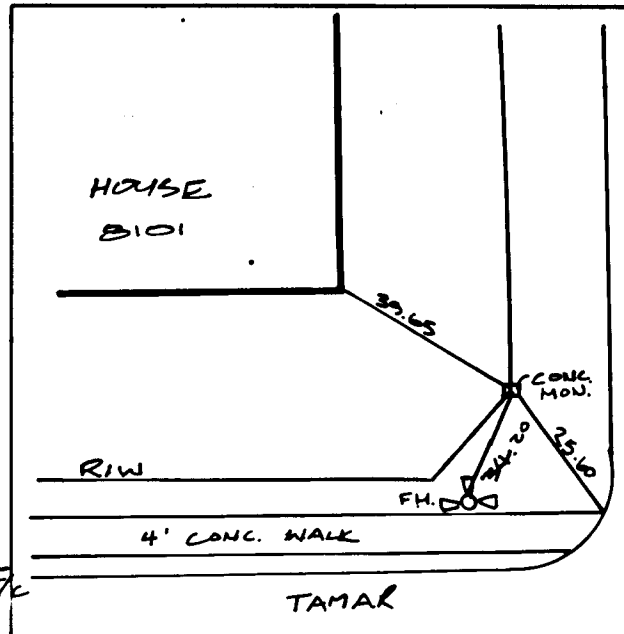


TAMAR DRIVE
 E CURVE DATA
 STA. 0+00.00 TO STA. 2+20.00
 R = 600.00'
 L = 160.00'
 Δ = 15° 03' 11"
 T = 204.6'
 CHD = S 62° 12' 29" E
 159.54'

DATE	BY

APPROVED	DEPARTMENT OF PUBLIC WORKS
<i>Robert L. F.</i>	1/24/88
CHIEF, LAND DEVELOPMENT DIVISION	DATE
APPROVED	DEPARTMENT OF PUBLIC WORKS
<i>Francis W. Wallace</i>	1/25/88
CHIEF, BUREAU OF HIGHWAYS	DATE
APPROVED	DEPARTMENT OF PUBLIC WORKS
<i>William B. Kelly</i>	1-22-88
CHIEF, BUREAU OF ENGINEERING	DATE
APPROVED	OFFICE OF PLANNING AND ZONING
<i>Joseph R. Keith</i>	1/26/88
CHIEF, COMMUNITY PLANNING AND LAND DEVELOPMENT	DATE

DATE	BY

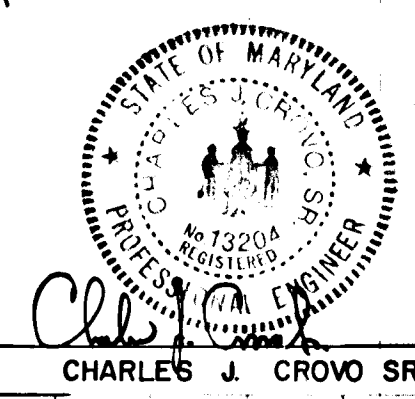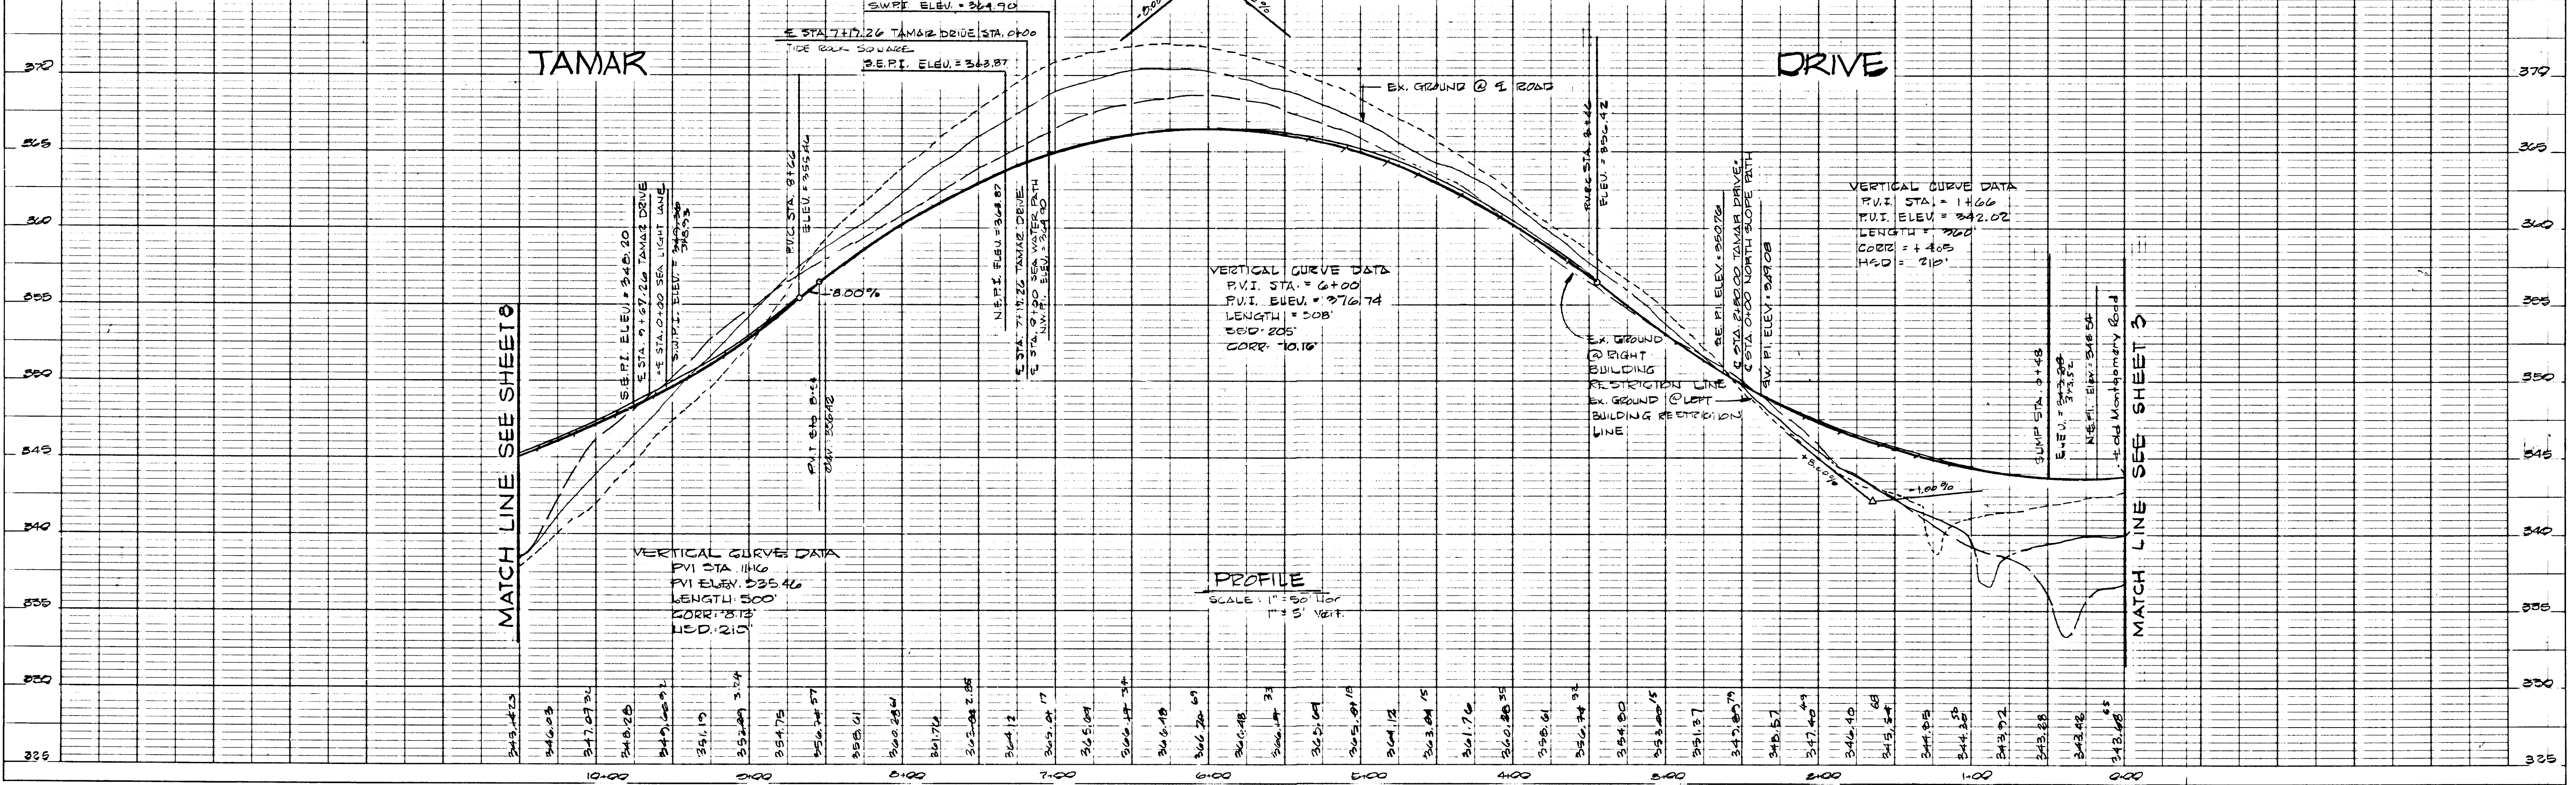

CHARLES J. CROVO SR. DATE 10/1/87

VILLAGE OF LONGREACH
 SECTION 2 AREA 1
 LOTS 1-117
 6TH ELECTION DISTRICT
 HOWARD COUNTY, MARYLAND
TAMAR DRIVE
 PLAN & PROFILE

OWNER AND DEVELOPER:
 THE HOWARD RESEARCH AND
 DEVELOPMENT LAND COMPANY
 10275 LITTLE PATUXENT PARKWAY
 COLUMBIA, MARYLAND 21044

SCALE AS SHOWN DATE: SEPT. 24, 1987 DWG. NO. 4 OF 18
 DES. R. ISAACS DRN. D. PARRAN CHK. C. J. CROVO

FISHER, COLLINS AND CARTER, INC.
 CIVIL ENGINEERS AND LAND SURVEYORS
 8388 COURT AVE. ELLICOTT CITY, MARYLAND 21043

DATE
BY
SURVEYED
NOTE BOOK
ALIGNMENT CHECKED
RT. OF WAY CHECKED


DATE
BY
SURVEYED
NOTE BOOK
GRADES CHECKED
B.M. NOTED
STRUCTURE NOTATIONS CHECKED

APPROVED DEPARTMENT OF PUBLIC WORKS
David L. F. 1-14-88
 CHIEF, LAND DEVELOPMENT DIVISION DATE

APPROVED DEPARTMENT OF PUBLIC WORKS
Aurice W. McLeod 1/21/88
 CHIEF, BUREAU OF HIGHWAYS DATE


APPROVED DEPARTMENT OF PUBLIC WORKS
William E. R. 1-22-88
 CHIEF, BUREAU OF ENGINEERING DATE

APPROVED OFFICE OF PLANNING AND ZONING
Joseph R. 1/26/88
 COMMUNITY PLANNING AND LAND DEVELOPMENT DATE

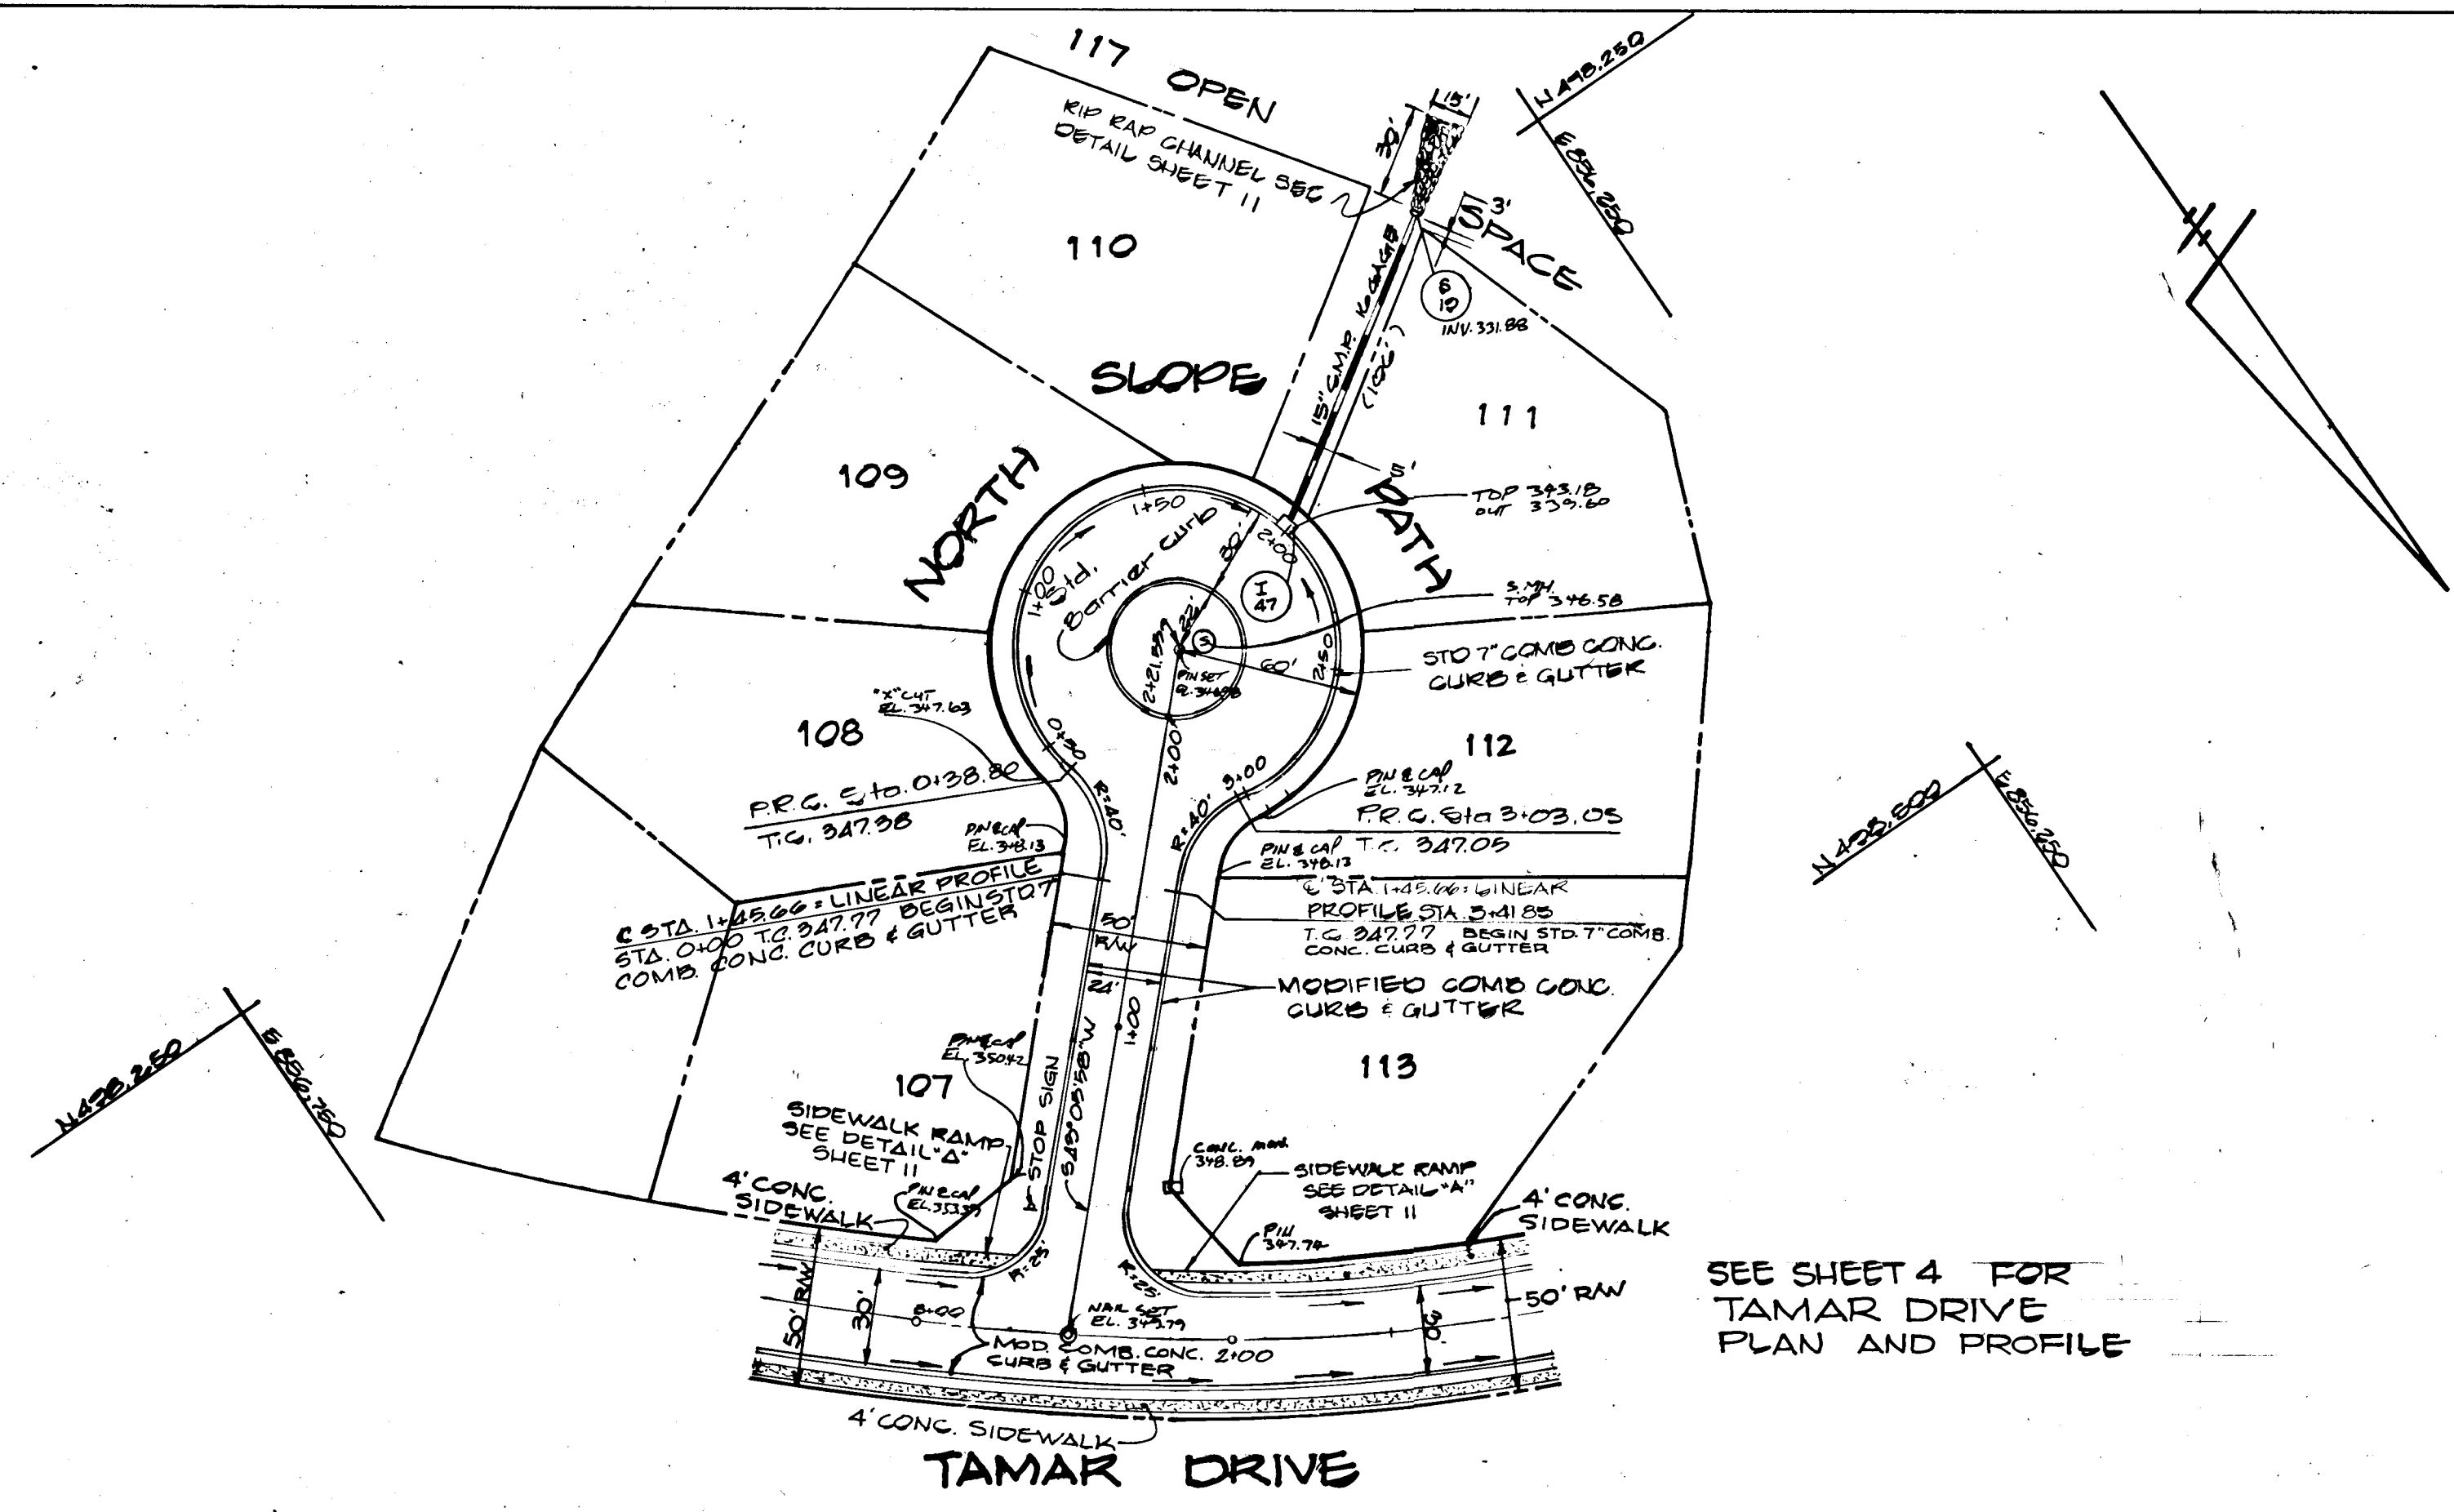

SEE SHEET 4 FOR TAMAR DRIVE PLAN AND PROFILE

PLAN
Scale: 1" = 50'

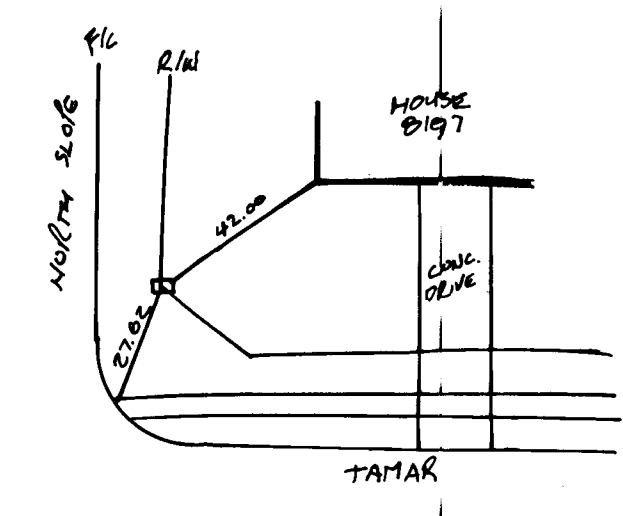

VILLAGE OF LONGREACH
 SECTION 2 AREA I
 LOTS 1-117
 6TH ELECTION DISTRICT
 HOWARD COUNTY, MARYLAND


NORTH SLOPE PATH
 PLAN & PROFILE

OWNER AND DEVELOPER
 THE HOWARD RESEARCH AND
 DEVELOPMENT LAND COMPANY
 10275 LITTLE PATUXENT PARKWAY
 COLUMBIA, MARYLAND 21044

SCALE AS SHOWN DATE SEPT. 24, 1987 DWG. NO. 5 OF 18
 DES. R. ISAACS DRN. D. PARRAN CHK. C. J. CROVO

FISHER, COLLINS AND CARTER, INC.
 CIVIL ENGINEERS AND LAND SURVEYORS
 8388 COURT AVE. ELLICOTT CITY, MARYLAND 21043

STATE OF MARYLAND
 CHARLES J. CROVO, JR.
 PROFESSIONAL ENGINEER
 LICENSE NO. 13204
 REGISTERED PROFESSIONAL ENGINEER
 CHARLES J. CROVO SR. DATE 10/1/87

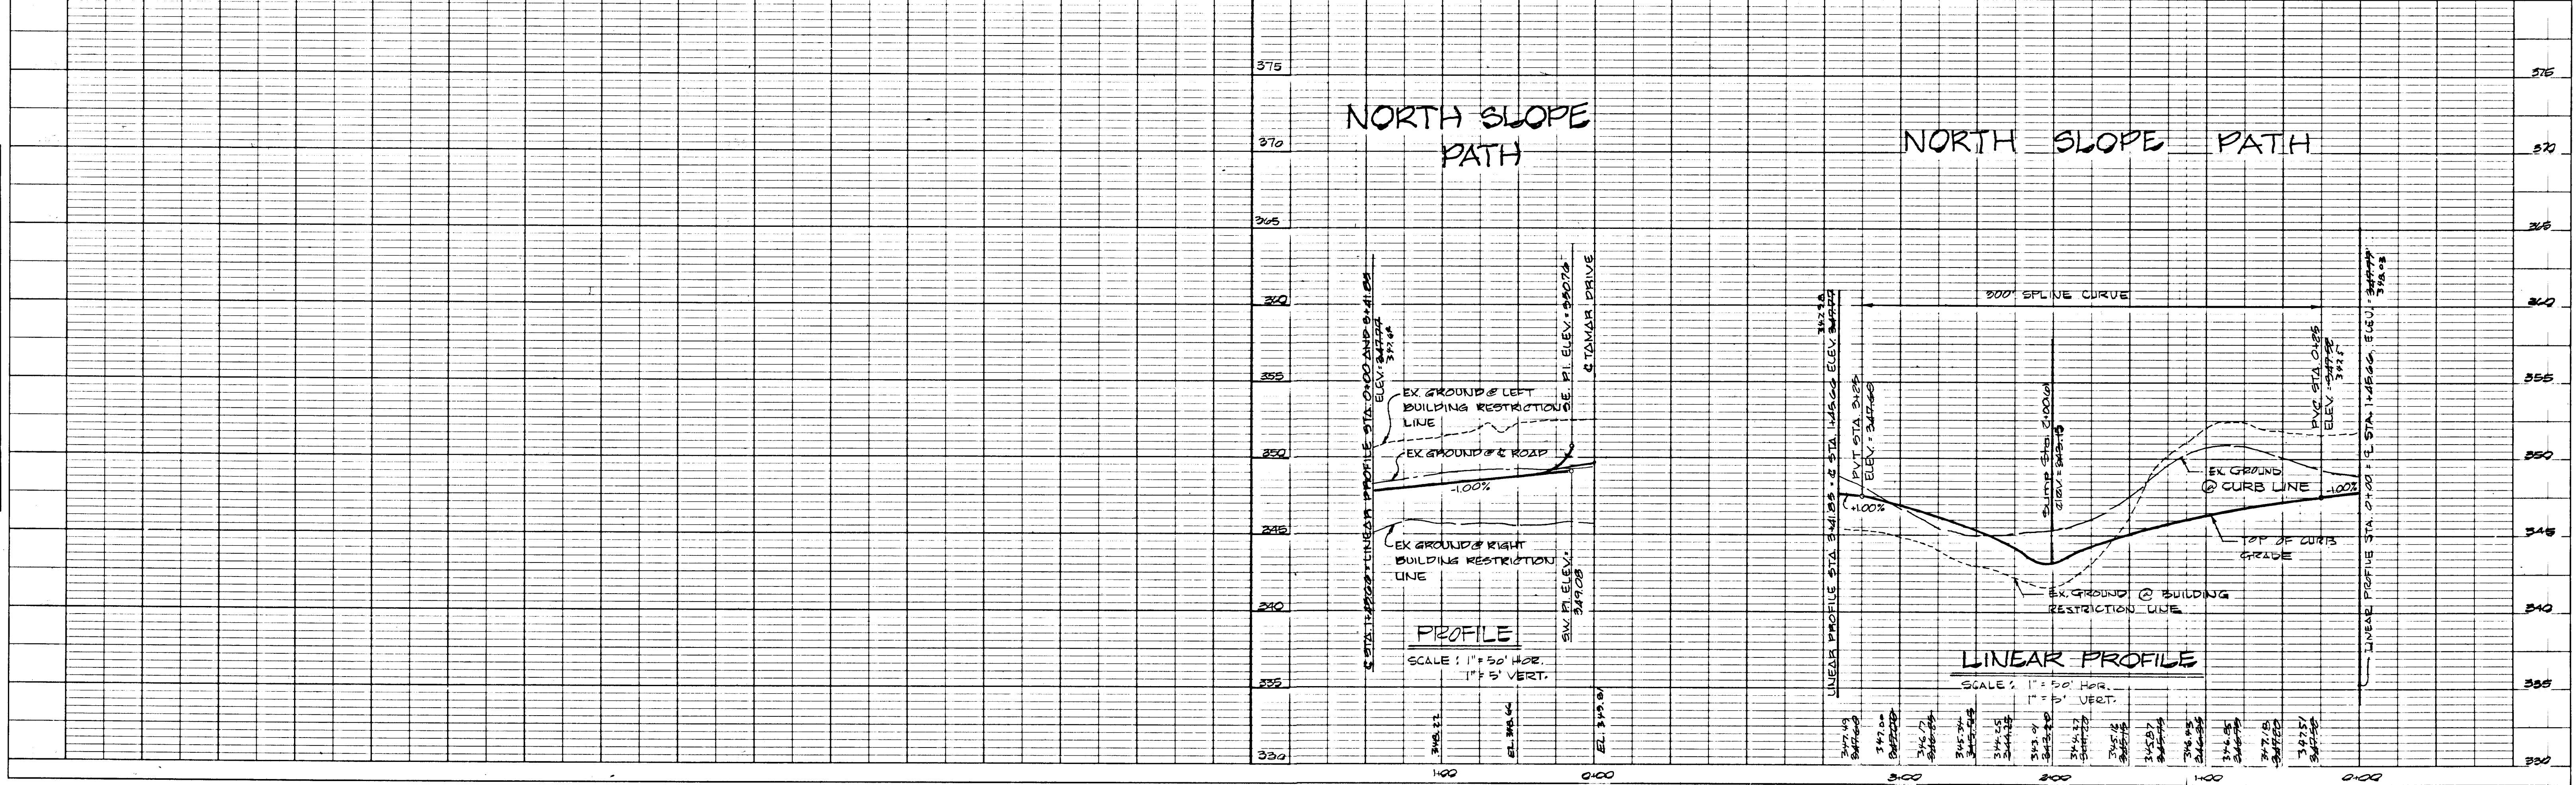

100


DATE
BY
PLAN
SURVEYED
PLOTTED
ALIGNMENT CHECKED
RT. OF WAY CHECKED
NOTE BOOK NO.

APPROVED DEPARTMENT OF PUBLIC WORKS
CHIEF, LAND DEVELOPMENT DIVISION
DATE 1/22/88

APPROVED DEPARTMENT OF PUBLIC WORKS
CHIEF, BUREAU OF HIGHWAYS
DATE 1/22/88

APPROVED DEPARTMENT OF PUBLIC WORKS
CHIEF, BUREAU OF ENGINEERING
DATE 1-22-88

APPROVED OFFICE OF PLANNING AND ZONING
DATE 1/26/88

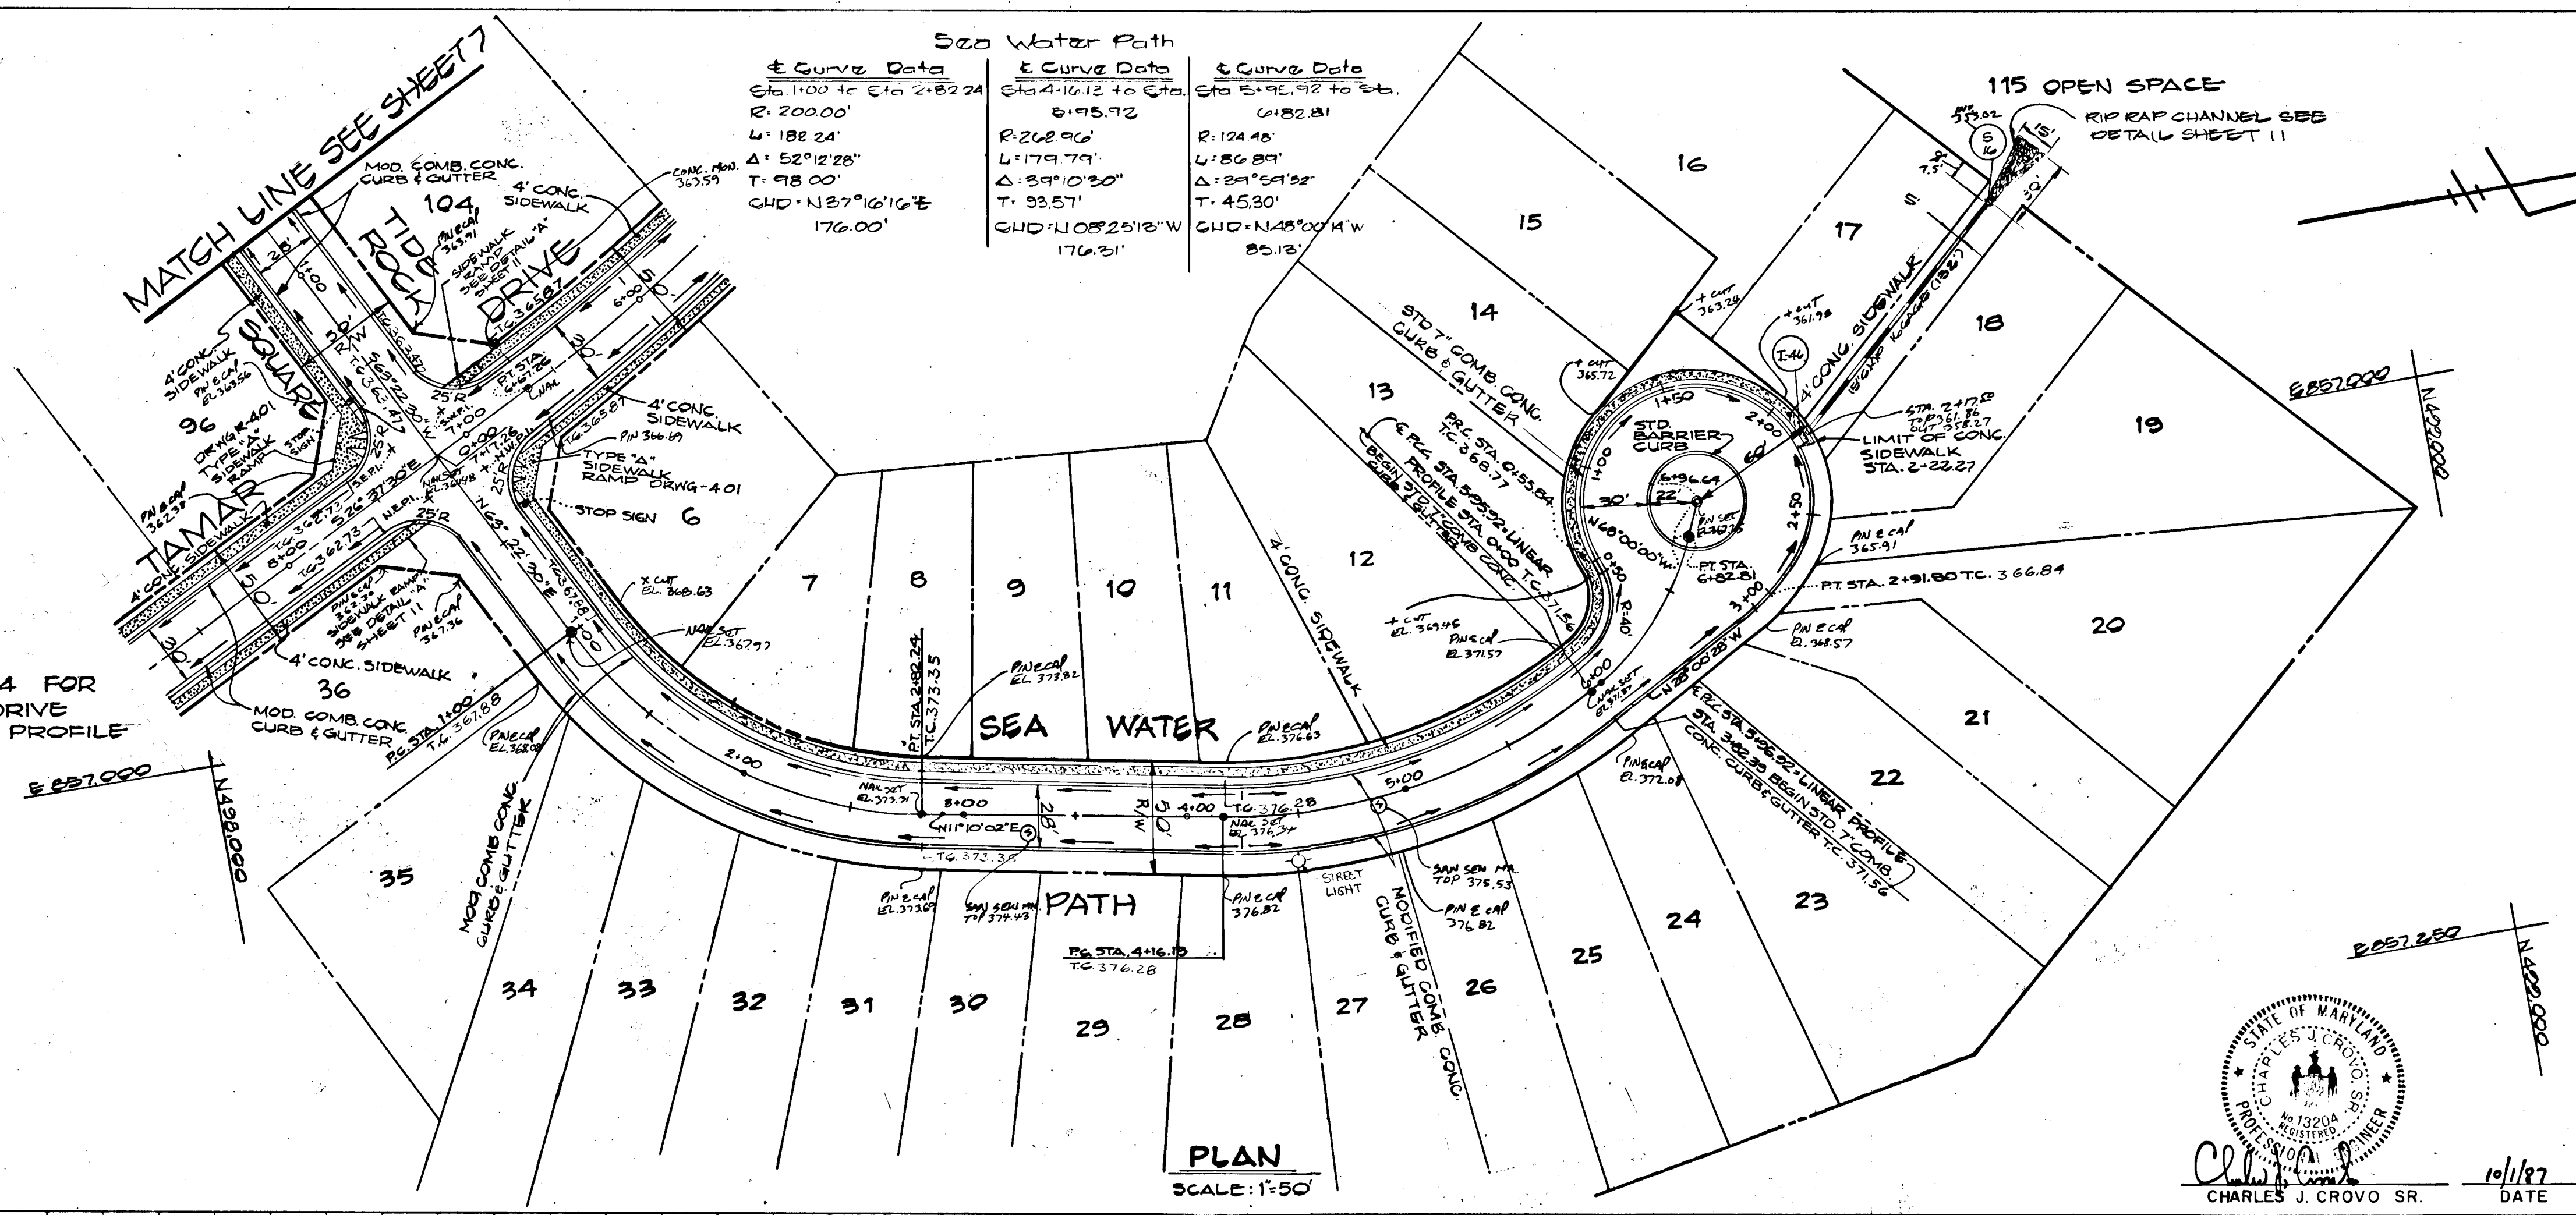

VILLAGE OF LONGREACH
SECTION 2 AREA 1
LOTS 1-117
6TH ELECTION DISTRICT
HOWARD COUNTY, MARYLAND


SEA WATER PATH PLAN & PROFILE

TIDE ROCK SQUARE PLAN


OWNER AND DEVELOPER
THE HOWARD RESEARCH AND DEVELOPMENT LAND COMPANY
10275 LITTLE PATUXENT PARKWAY
COLUMBIA, MARYLAND 21044

SCALE AS SHOWN DATE SEPT. 24, 1987 DWG. NO. 6 OF 18
DES. R. ISAACS DRN. D. PARRAN CHK. C. J. CROVO

FISHER, COLLINS AND CARTER, INC.
CIVIL ENGINEERS AND LAND SURVEYORS
8388 COURT AVE. ELLICOTT CITY, MARYLAND 21043

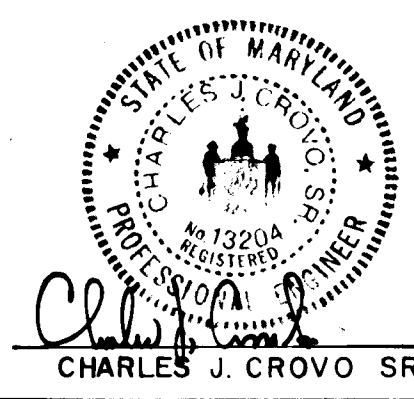

DATE
BY
PROFILE
SURVEYED
GRADES CHECKED
E.M. NOTED
STATIONING NOTATIONS CHKD
NOTE BOOK NO.

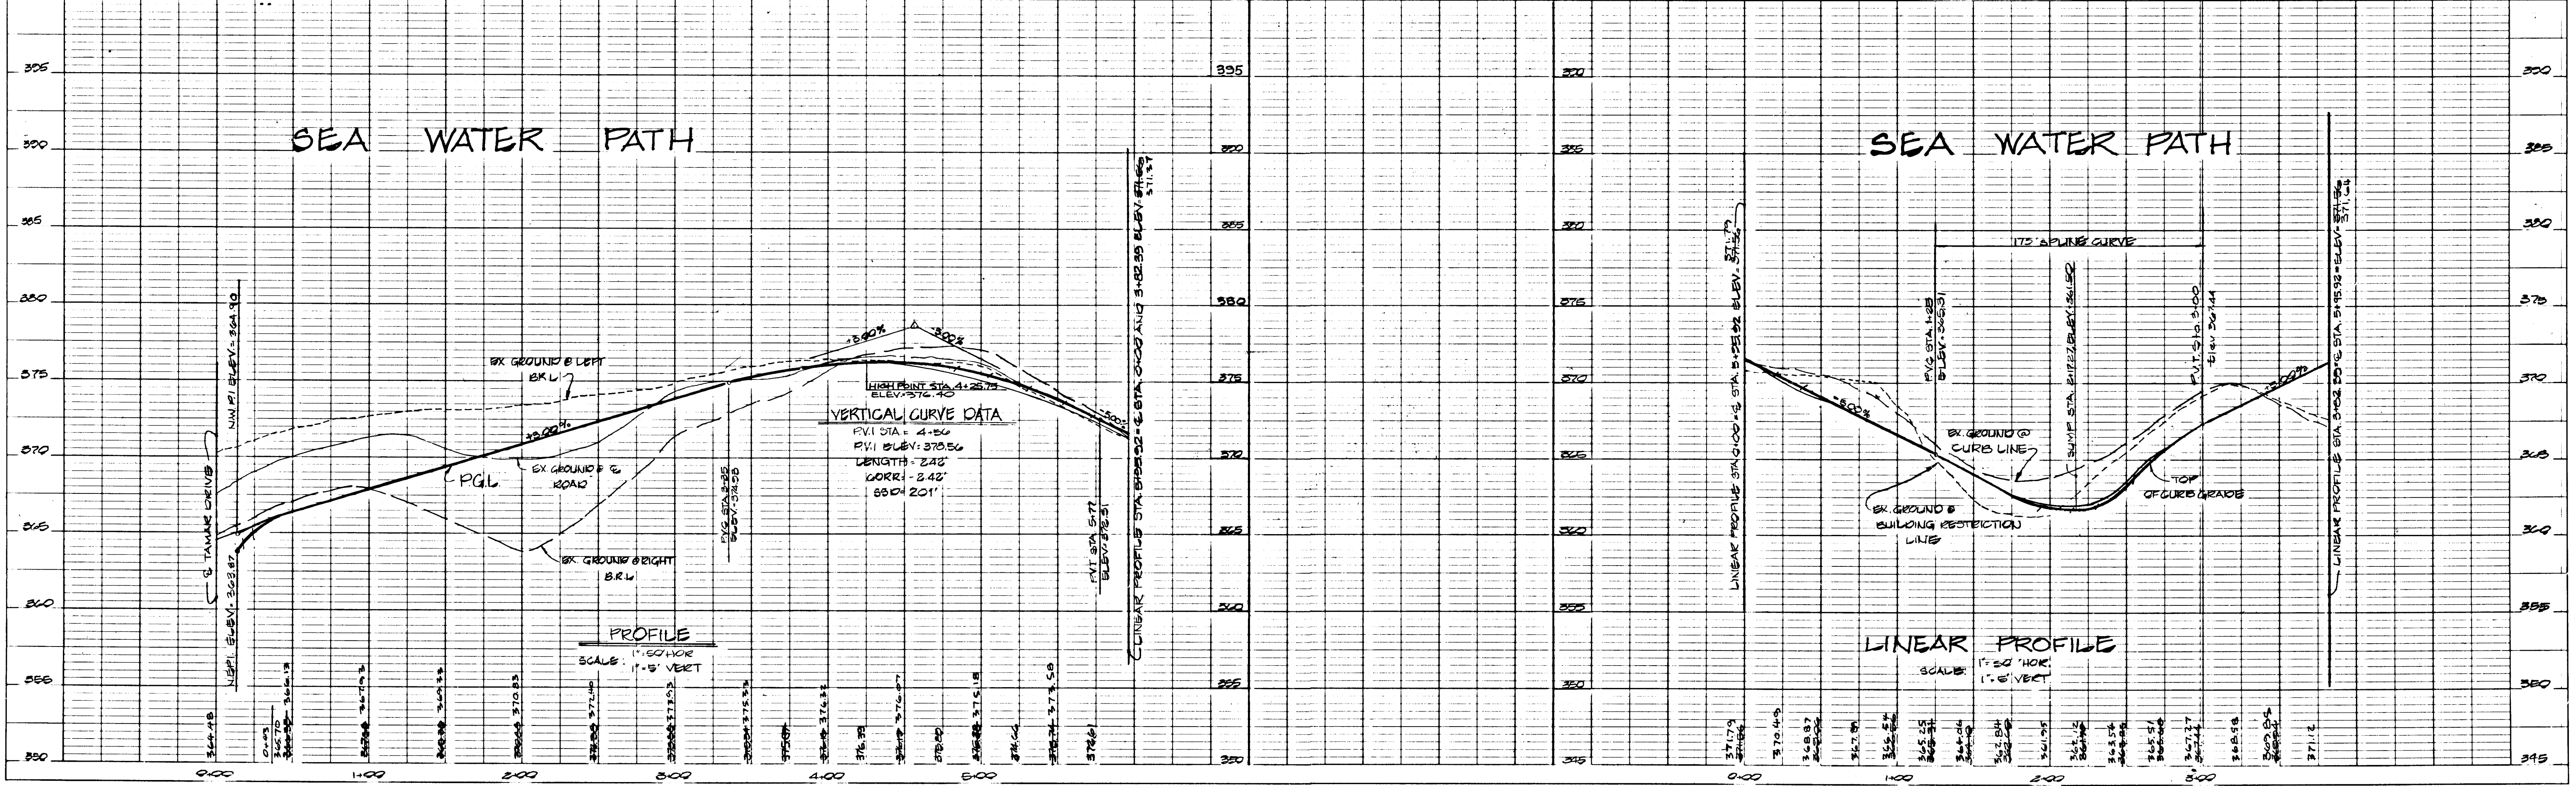

100

DATE
BY
SURVEYED
PLOTTED
CHECKED
NOTE BOOK NO.


APPROVED
DEPARTMENT OF PUBLIC WORKS
[Signature] 1/24/88
CHIEF, LAND DEVELOPMENT DIVISION DATE

APPROVED
DEPARTMENT OF PUBLIC WORKS
[Signature] 1/24/88
CHIEF, BUREAU OF HIGHWAYS DATE

APPROVED
DEPARTMENT OF PUBLIC WORKS
[Signature] 1-22-88
CHIEF, BUREAU OF ENGINEERING DATE

APPROVED
OFFICE OF PLANNING AND ZONING
[Signature] 1/26/88
AND LAND DEVELOPMENT DATE

DATE
BY
SURVEYED
PLOTTED
CHECKED
NOTE BOOK NO.
STRUCTURE NOTATIONS (PNC)

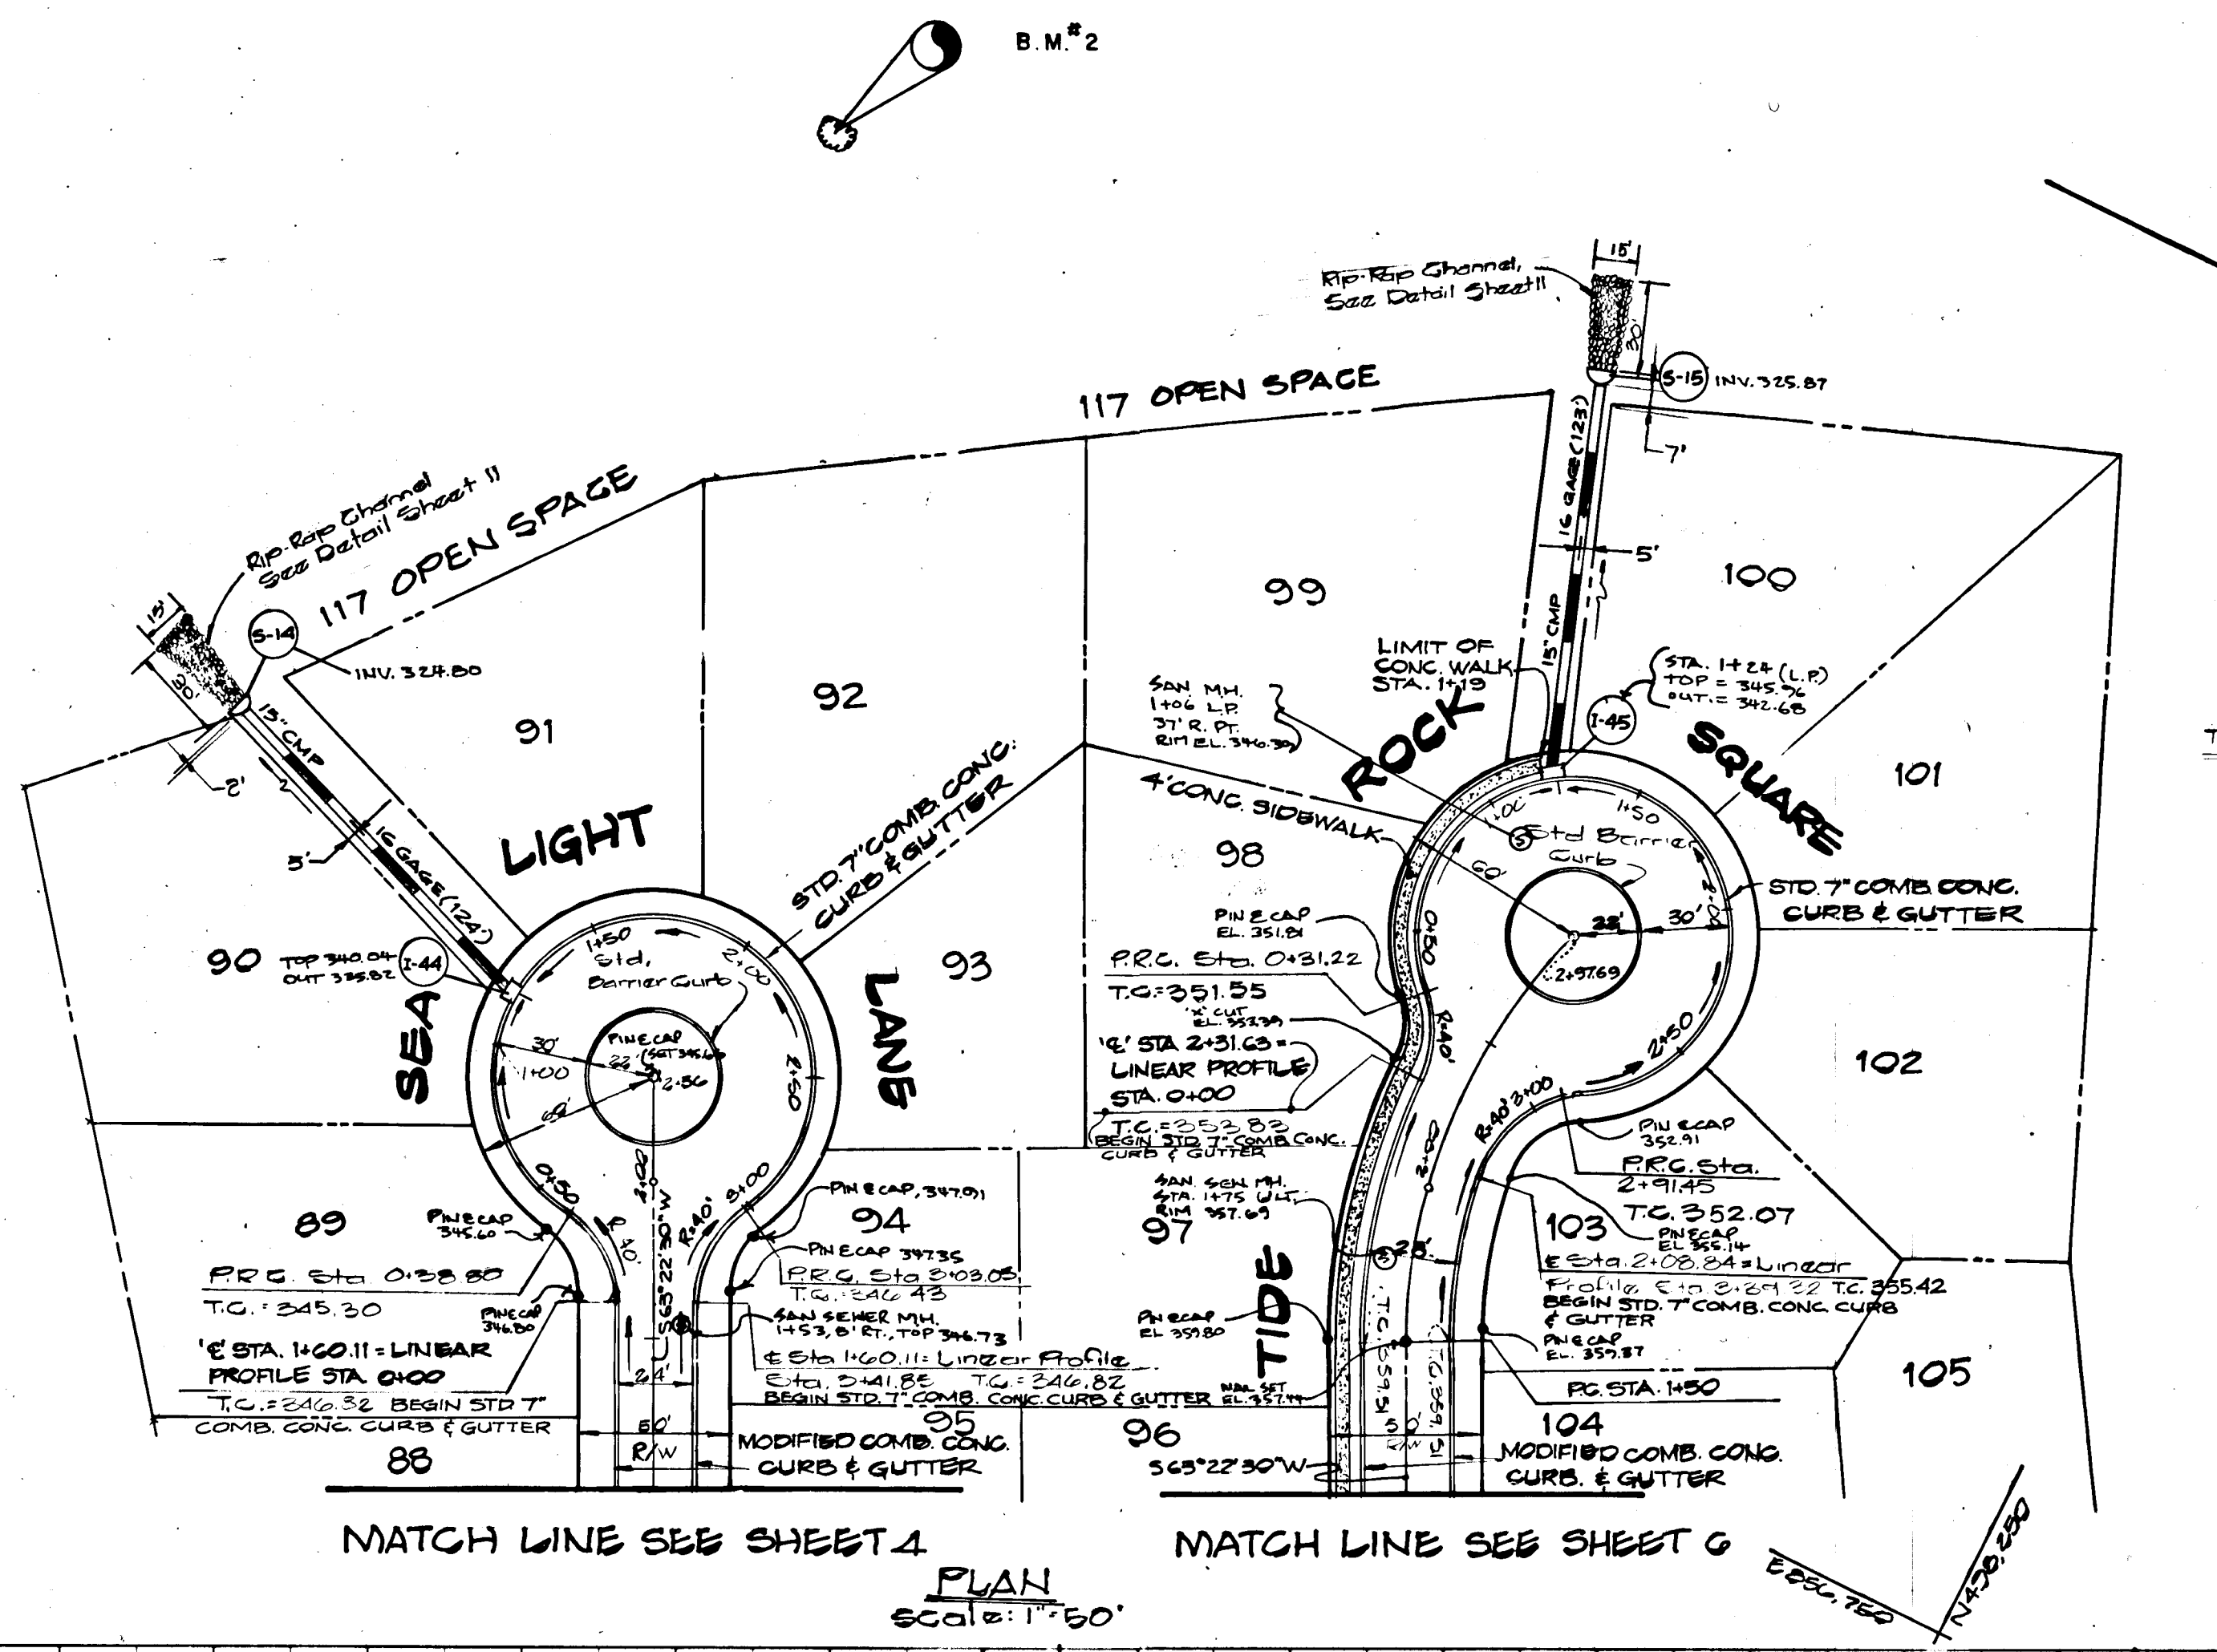

Tide Rock Square
Curve Data
E Sta. 1430 to E Sta. 2197.69
R=190.00'
L=147.69'
Δ=44°02'18"
T=77.80'
CUD= S 25°28'37" W 144.00'

STATE OF MARYLAND
REGISTERED PROFESSIONAL ENGINEER
No. 13204
Charles J. Crovo Sr.
DATE 1/11/87

VILLAGE OF LONGREACH
SECTION 2 AREA 1
LOTS 1-117
6TH ELECTION DISTRICT
HOWARD COUNTY, MARYLAND


TIDE ROCK SQUARE
SEA LIGHT LANE
PLAN & PROFILE

OWNER AND DEVELOPER
THE HOWARD RESEARCH AND
DEVELOPMENT LAND COMPANY
10275 LITTLE PATUXENT PARKWAY
COLUMBIA, MARYLAND 21044

SCALE(S) SHOWN DATE: SEPT 24, 1987 DWG. NO. 7 OF 18
DES. R. ISAACS DRN. D. PARRAN CHK. C. J. CROVO

FISHER, COLLINS AND CARTER, INC.
CIVIL ENGINEERS AND LAND SURVEYORS
8388 COURT AVE. ELLICOTT CITY, MARYLAND 21043

100

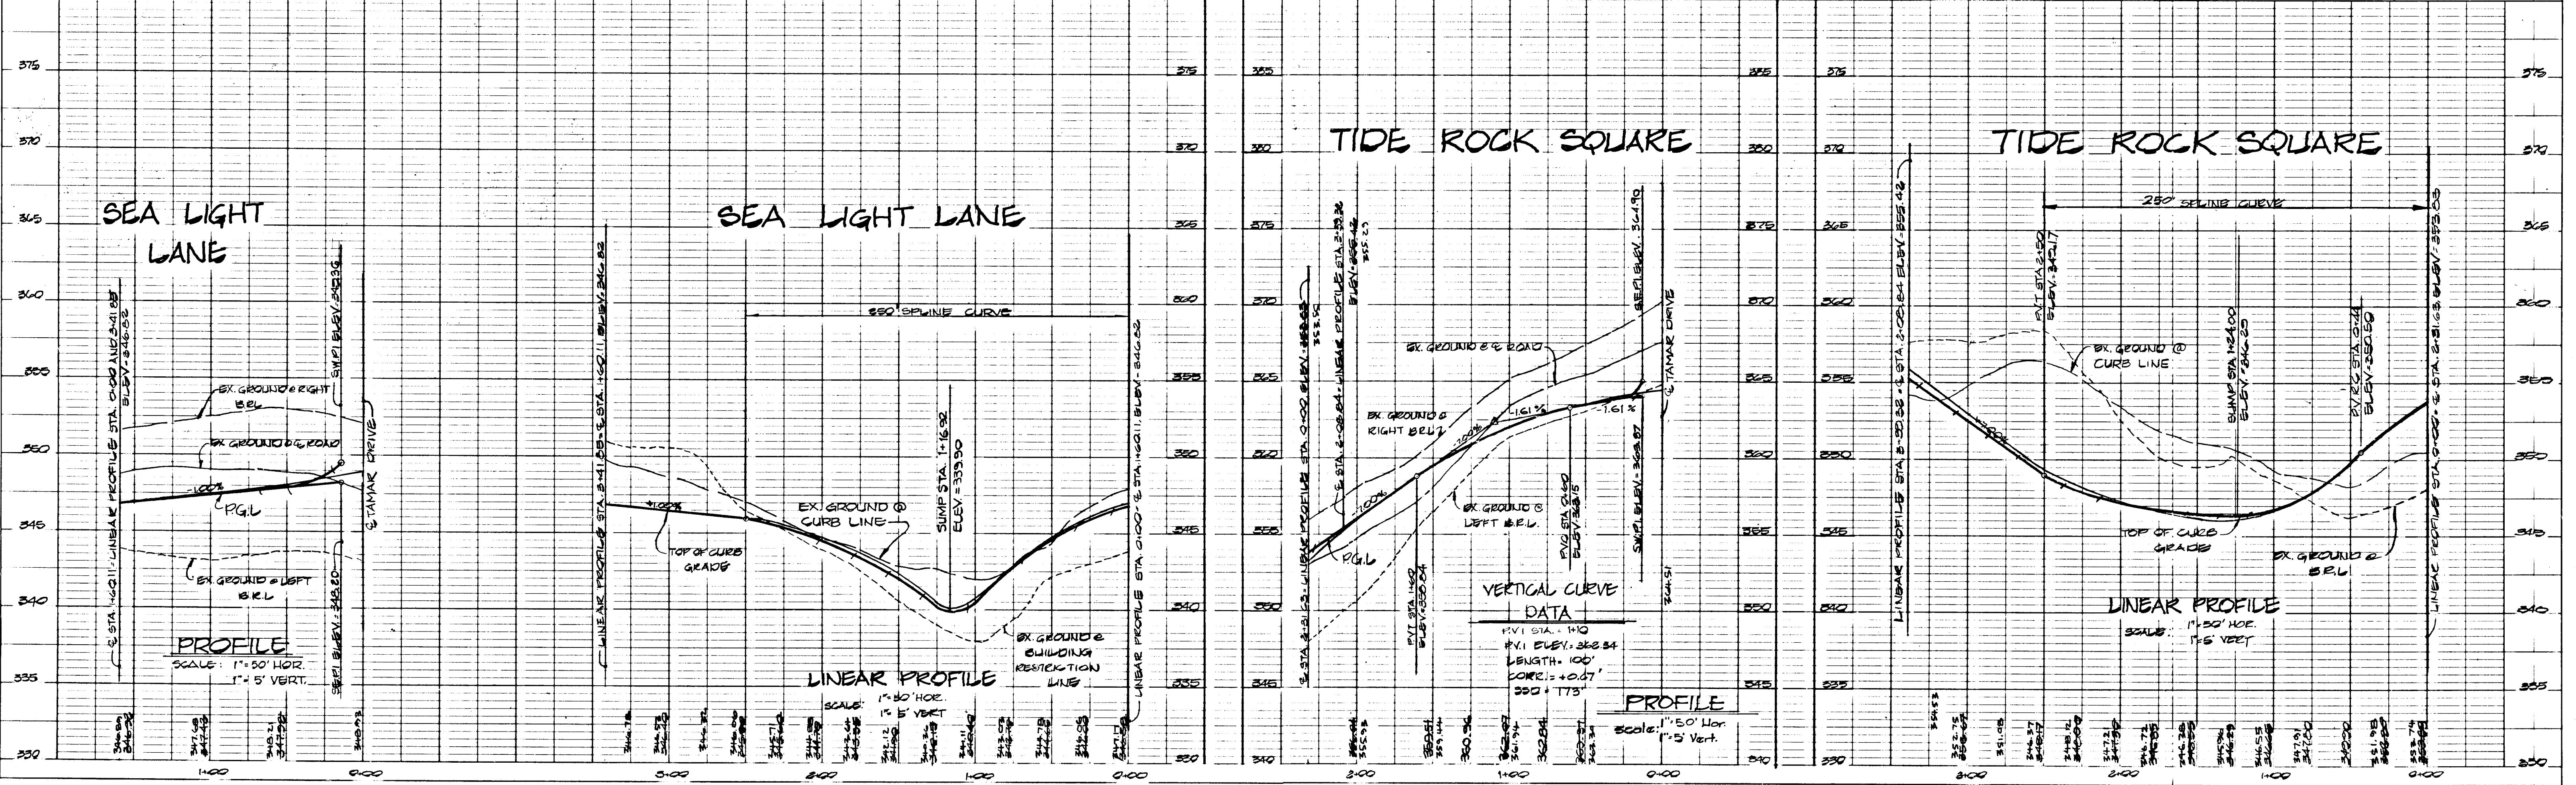

DATE: _____
 BY: _____
 SURVEYED: _____
 GROUND: _____
 ALIGNMENT: _____
 CHECKED: _____
 RT. OF WAY: _____
 NO. _____


DATE: _____
 BY: _____
 SURVEYED: _____
 GROUND: _____
 CHECKED: _____
 STRUCTURE: _____
 NOTATIONS: _____
 CHFD: _____
 NO. _____

APPROVED DEPARTMENT OF PUBLIC WORKS
Granville W. Weiland 1/21/88
 CHIEF, BUREAU OF HIGHWAYS
 DATE

APPROVED DEPARTMENT OF PUBLIC WORKS
D. S. ... 1-22-88
 CHIEF, BUREAU OF ENGINEERING
 DATE

APPROVED OFFICE OF PLANNING AND ZONING
Joseph ... 1/26/88
 COMMUNITY PLANNING AND LAND DEVELOPMENT
 DATE

APPROVED DEPARTMENT OF PUBLIC WORKS
... 1-22-88
 CHIEF, LAND DEVELOPMENT DIVISION
 DATE

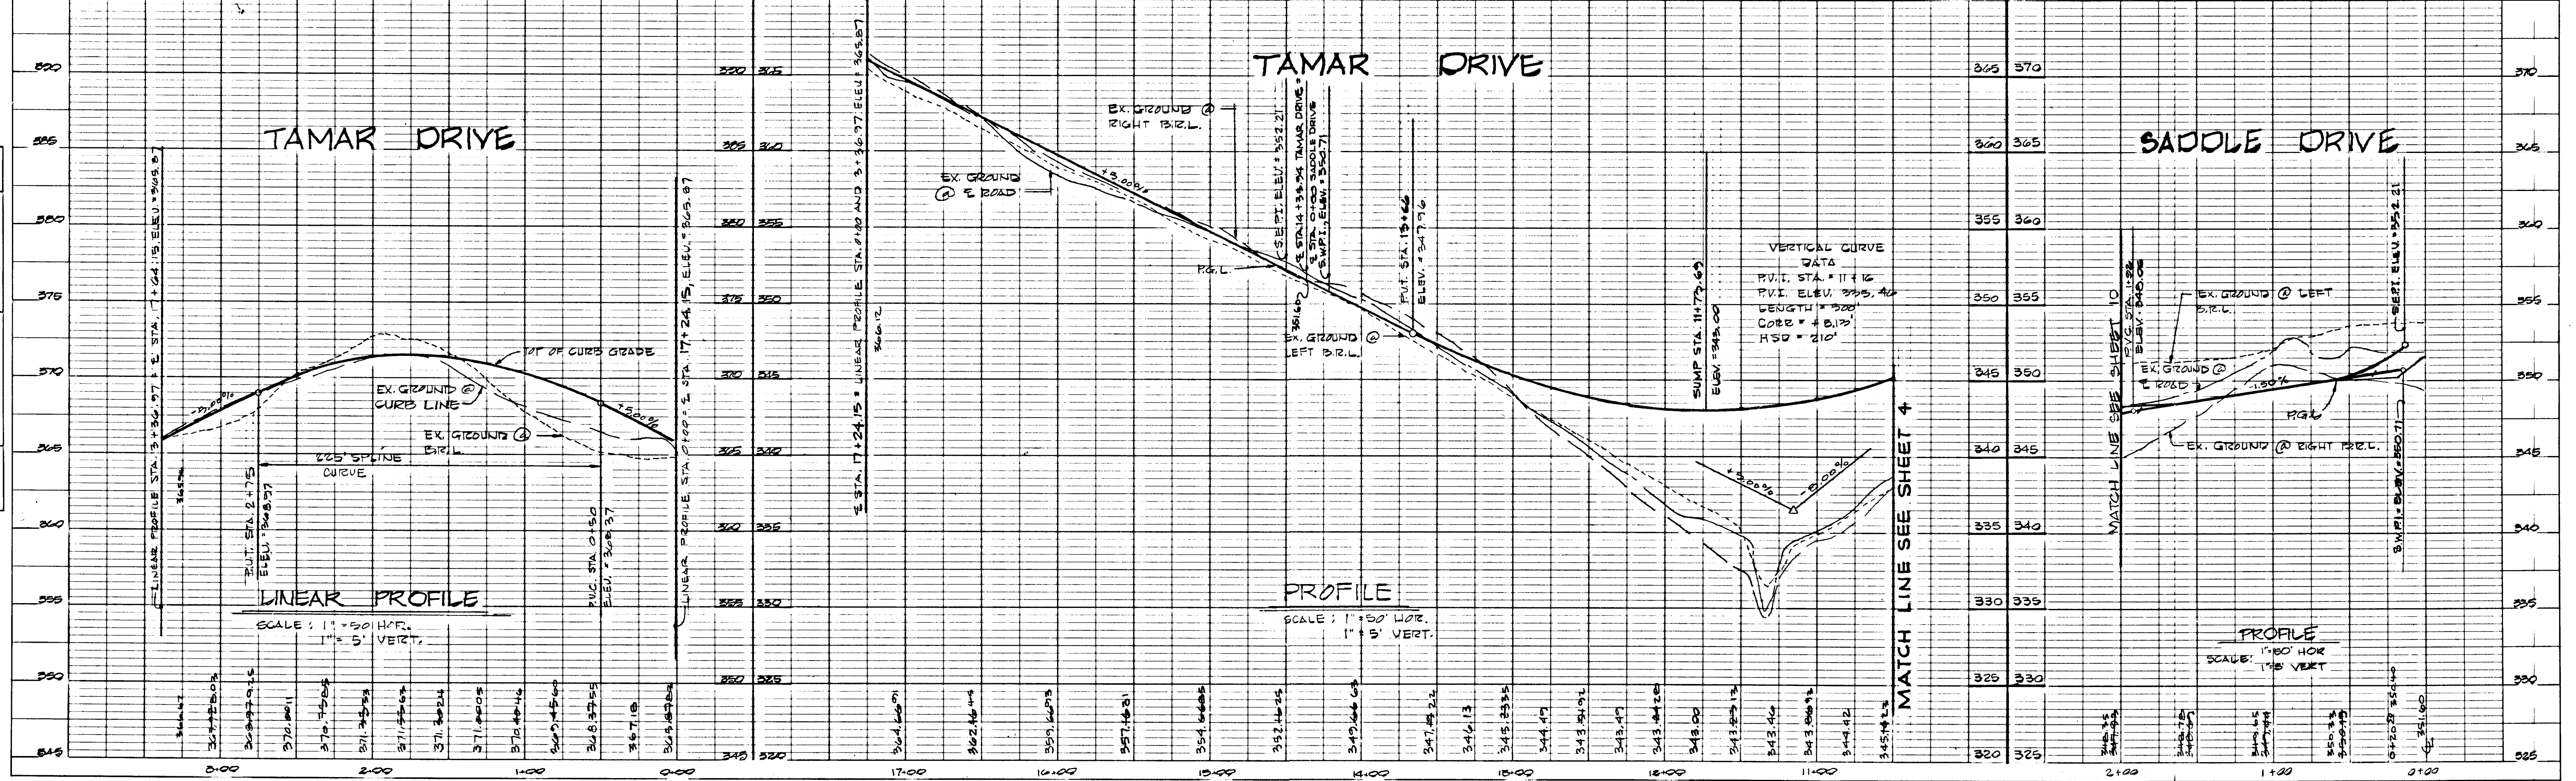


VILLAGE OF LONGREACH
 SECTION 2 AREA I
 LOTS 1-117
 6TH ELECTION DISTRICT
 HOWARD COUNTY, MARYLAND

TAMAR DRIVE SADDLE DRIVE
 PLAN & PROFILE PLAN

OWNER AND DEVELOPER
 THE HOWARD RESEARCH AND
 DEVELOPMENT LAND COMPANY
 10275 LITTLE PATUXENT PARKWAY
 COLUMBIA, MARYLAND 21044

SCALE AS SHOWN DATE: SEPT. 24, 1987 DWS. NO. 8 OF 18
 DES. R. ISAACS DRN. D. PARRAN CHK. C. J. CROVO

FISHER, COLLINS AND CARTER, INC.
 CIVIL ENGINEERS AND LAND SURVEYORS
 8388 COURT AVE. ELLICOTT CITY, MARYLAND 21043

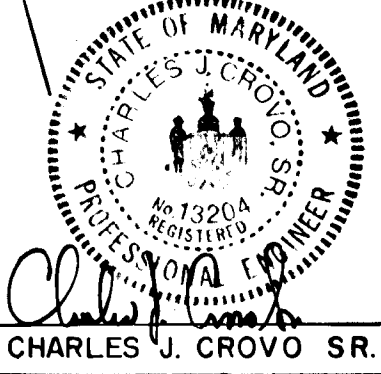

DATE
BY
SURVEYED
PLOTTED
CHECKED
NOTE BOOK
NO.


APPROVED DEPARTMENT OF PUBLIC WORKS
Middle 1-22-88
 CHIEF, LAND DEVELOPMENT DIVISION DATE

APPROVED DEPARTMENT OF PUBLIC WORKS
Shawville W. Wallace 1/21/88
 CHIEF, BUREAU OF HIGHWAYS DATE



APPROVED DEPARTMENT OF PUBLIC WORKS
William R. Riley 1-22-88
 CHIEF, BUREAU OF ENGINEERING DATE

APPROVED OFFICE OF PLANNING AND ZONING
Joseph R. Buth 1/26/88
 COMMUNITY PLANNING AND LAND DEVELOPMENT DATE

DATE
BY
SURVEYED
PLOTTED
CHECKED
NOTE BOOK
NO.

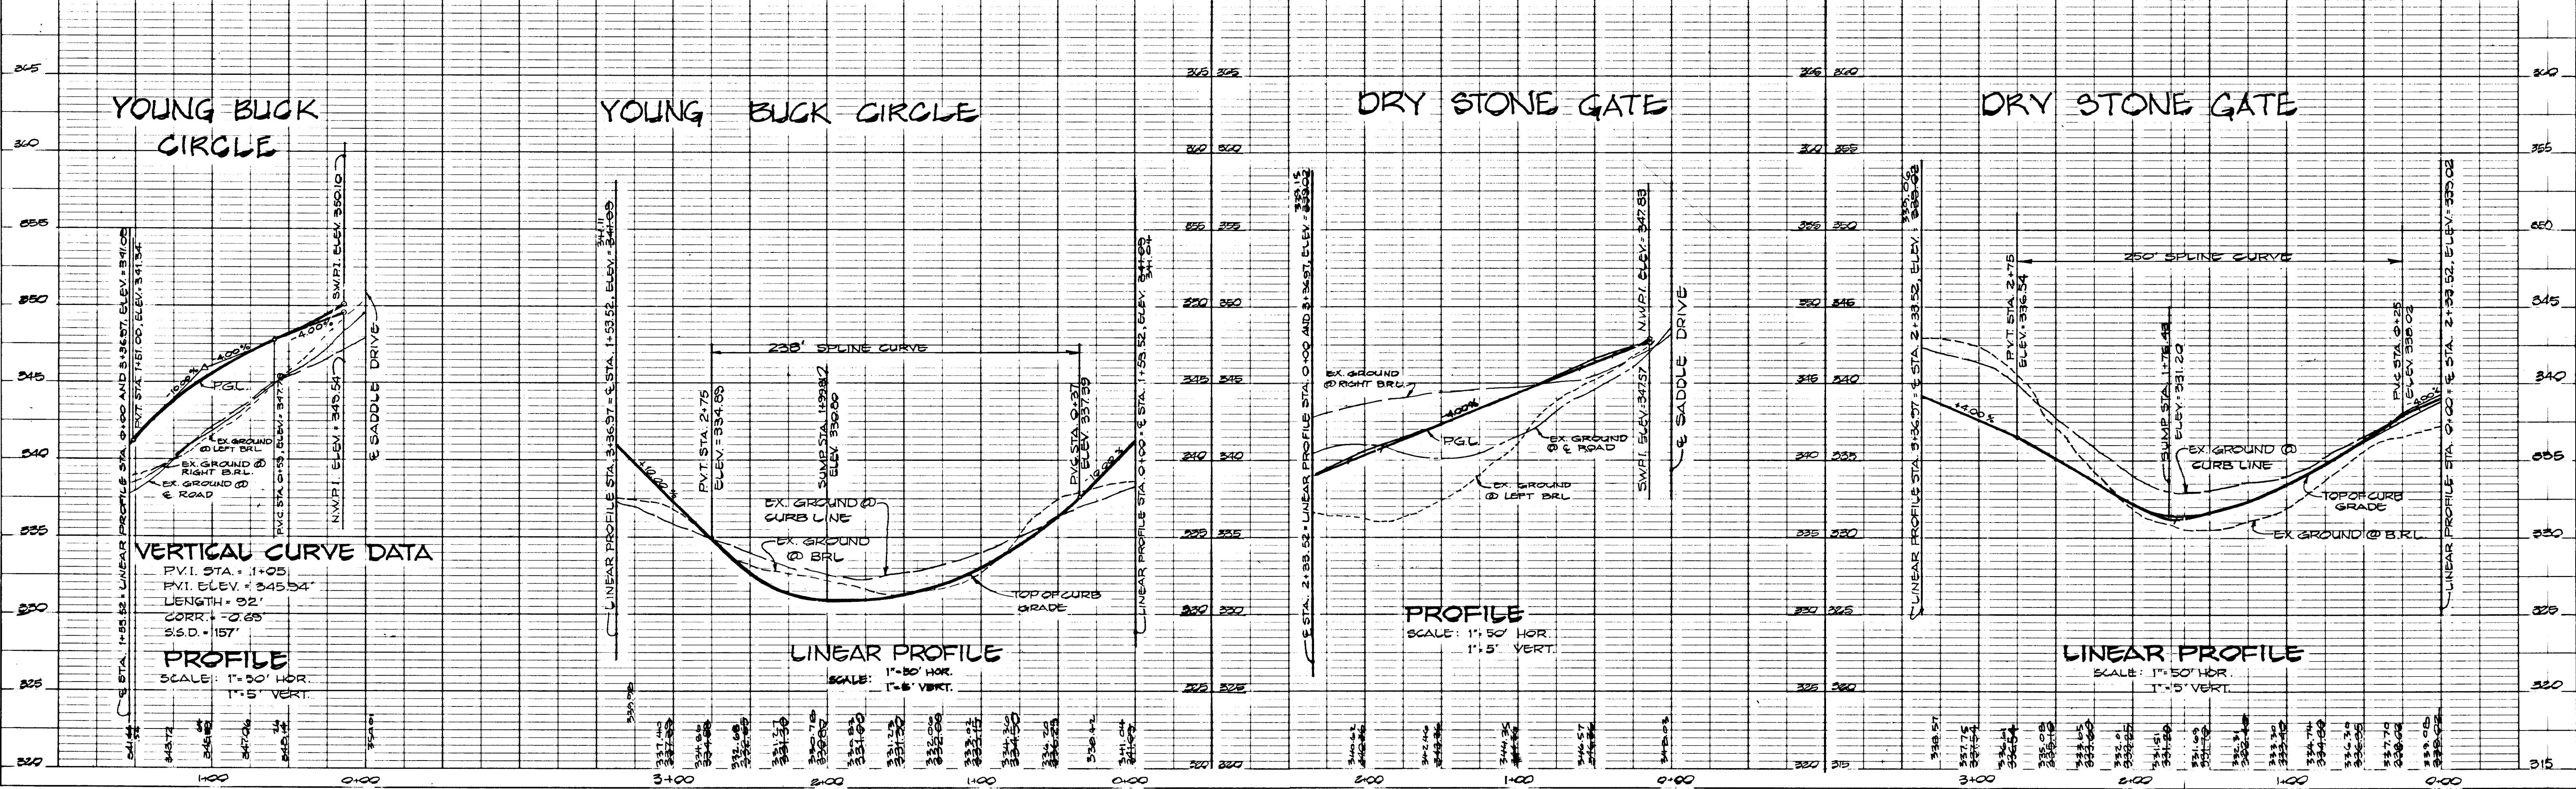

100

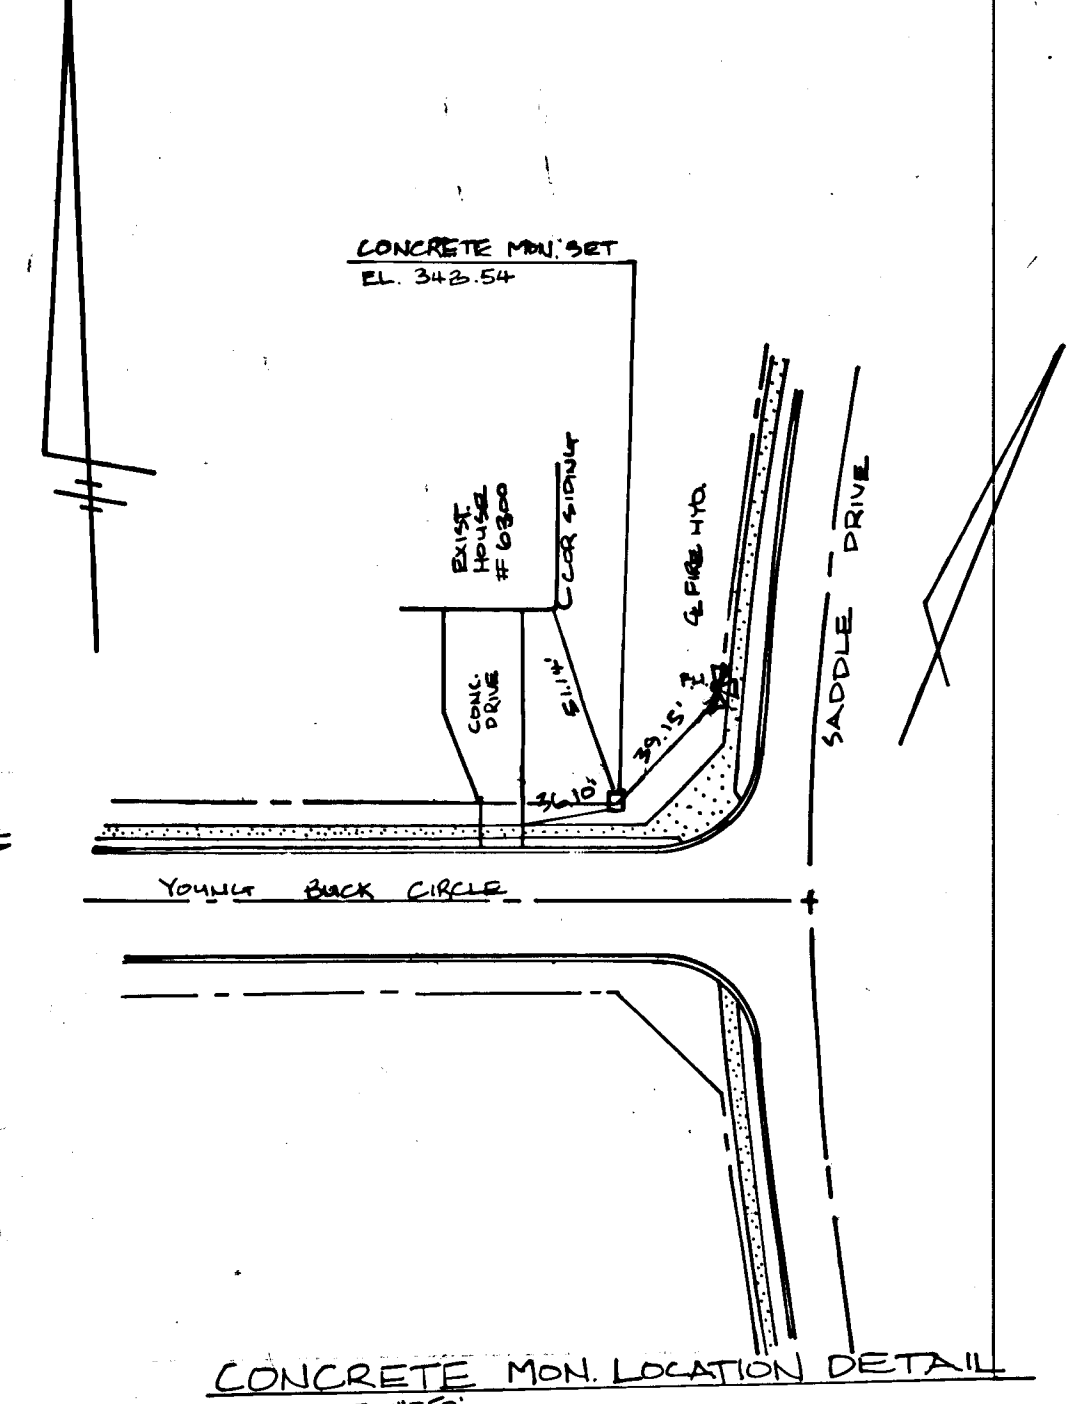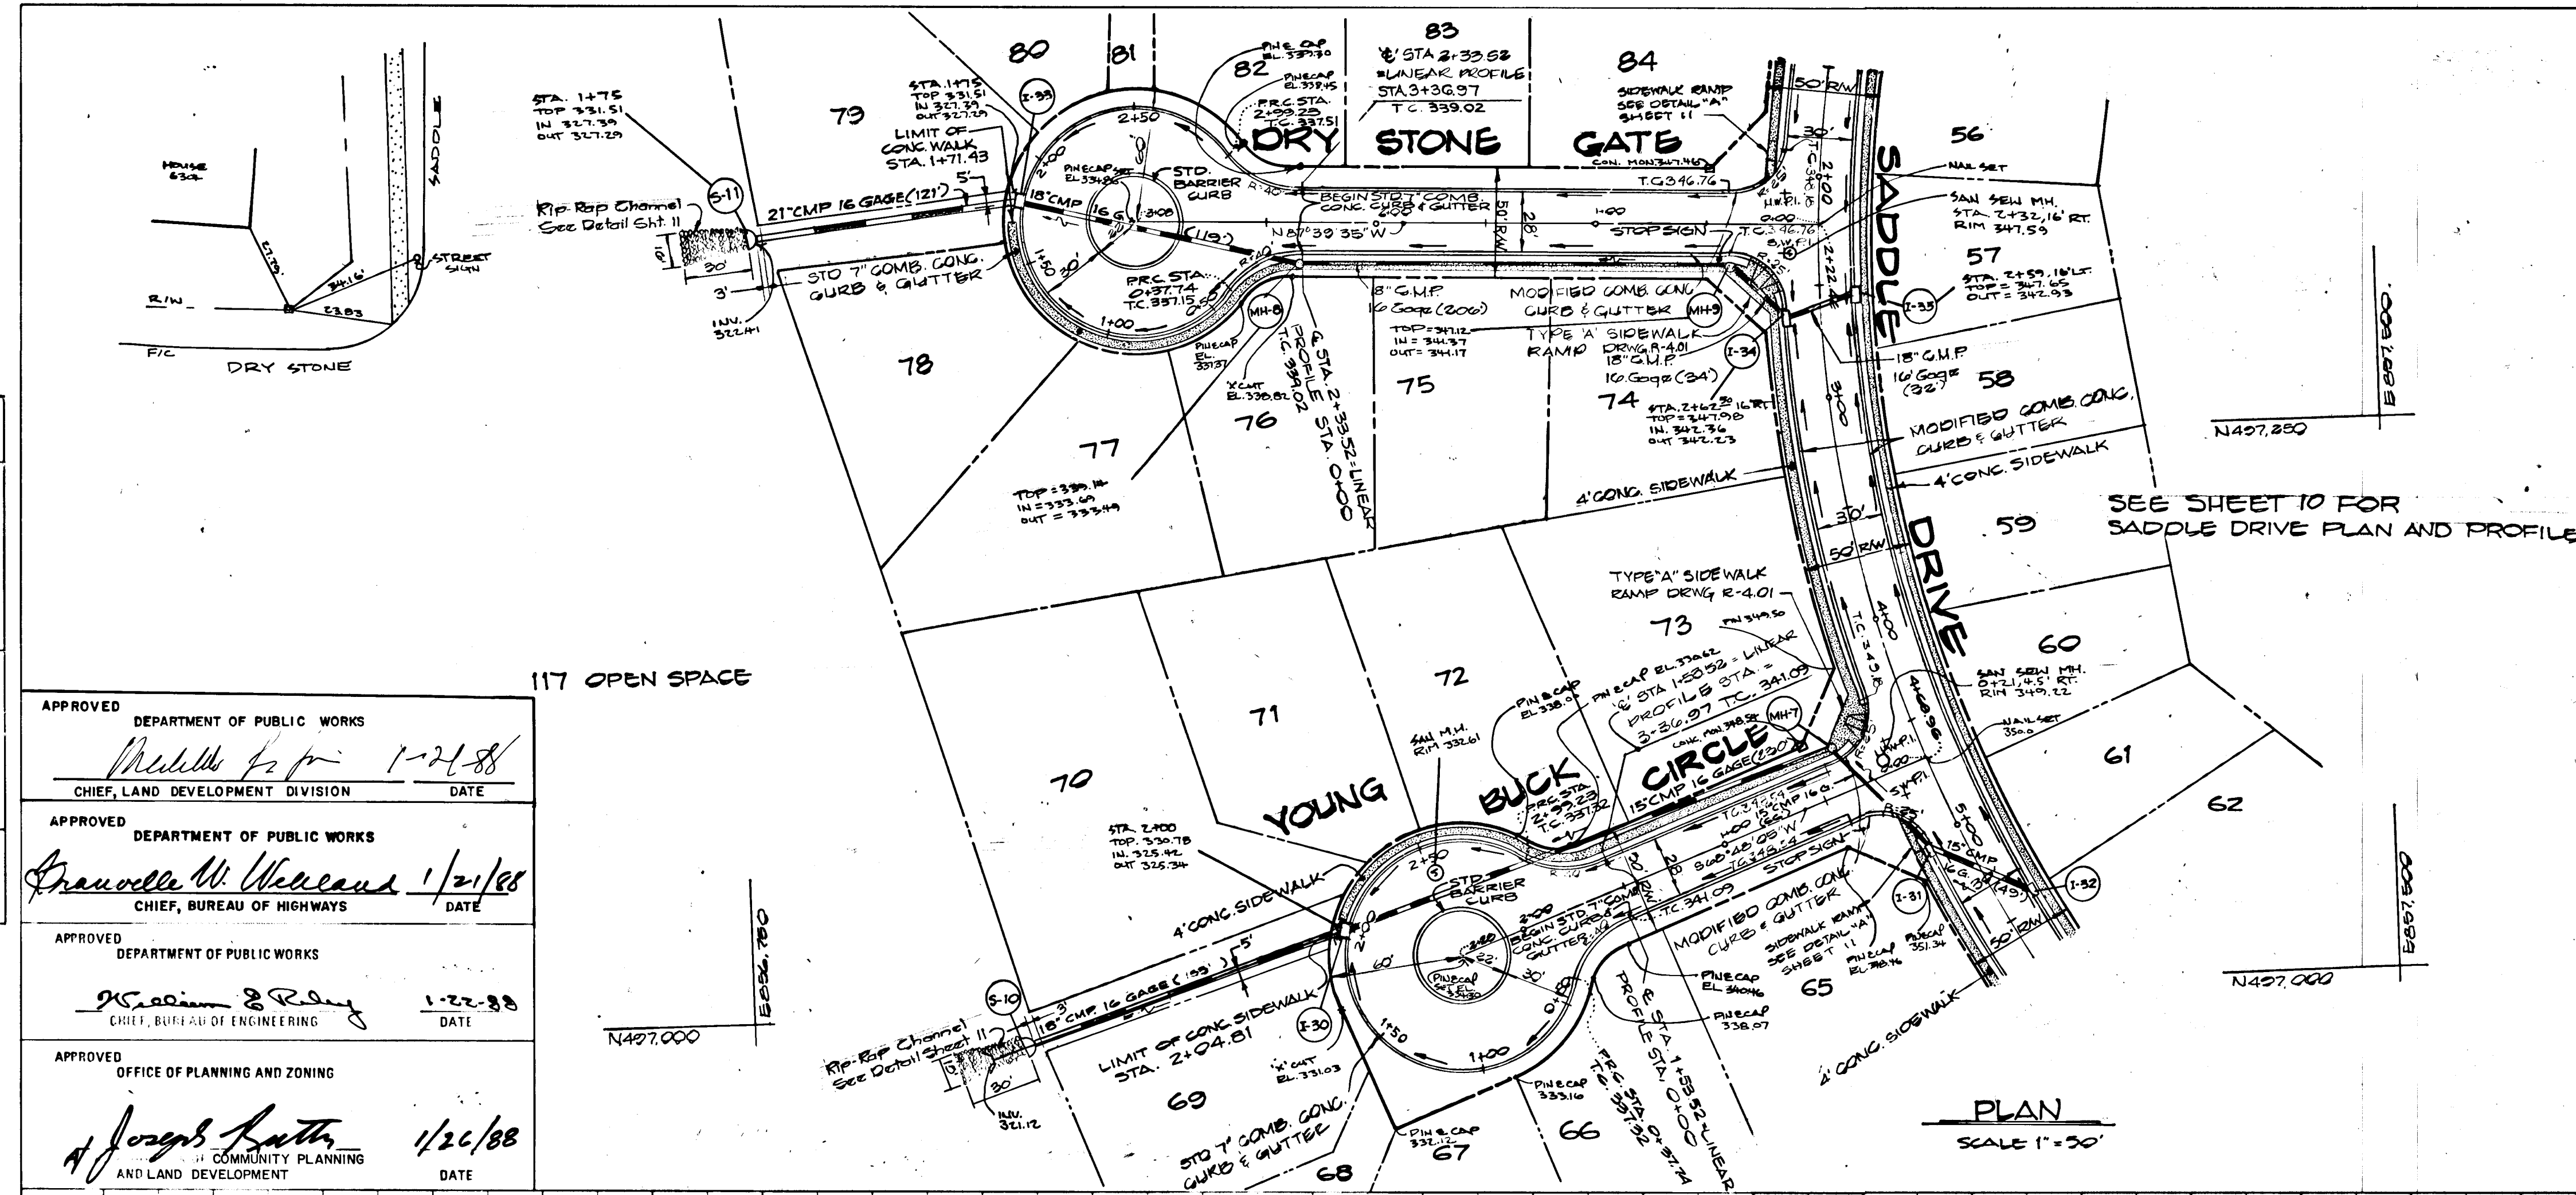

VILLAGE OF LONGREACH
 SECTION 2 AREA 1
 LOTS 1-117
 6TH ELECTION DISTRICT
 HOWARD COUNTY, MARYLAND

DRY STONE GATE YOUNG BUCK CIRCLE
 PLAN & PROFILE PLAN & PROFILE


OWNER AND DEVELOPER
 THE HOWARD RESEARCH AND
 DEVELOPMENT LAND COMPANY
 10275 LITTLE PATUXENT PARKWAY
 COLUMBIA, MARYLAND 21044

SCALEAS SHOWN DATE: SEPT. 24, 1987 DWG. NO. 9 OF 18
 DES. R. ISAACS DRN. D. PARRAN CHK. C. J. CROVO

FISHER, COLLINS AND CARTER, INC.
 CIVIL ENGINEERS AND LAND SURVEYORS
 8388 COURT AVE. ELLICOTT CITY, MARYLAND 21043

CHARLES J. CROVO SR.
 DATE 1/11/87

DATE: _____ BY: _____
 SURVEYED: _____
 NOTE BOOK NO. _____
 ALIGNMENT CHECKED: _____
 P.T. OF WAY CHECKED: _____

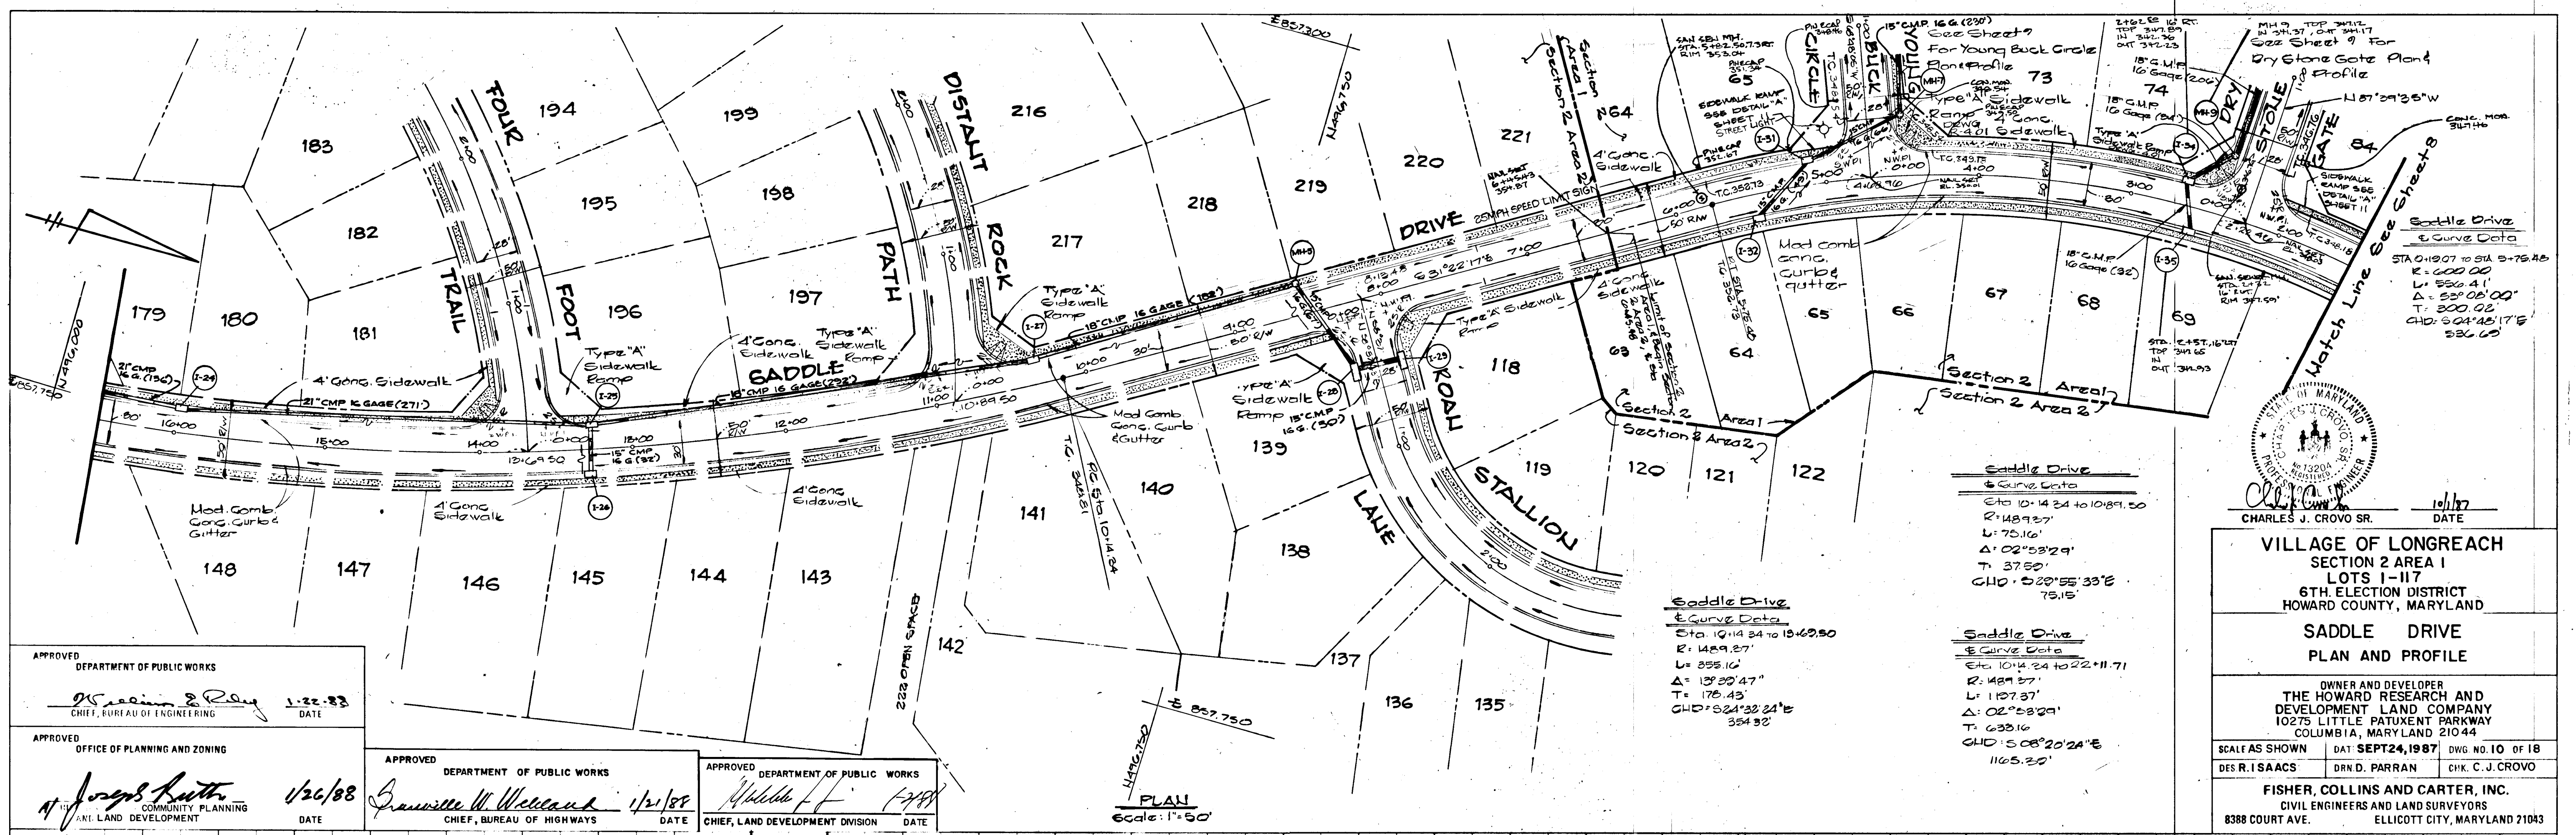

CHARLES J. CROVO SR. 12/1/77
 DATE
VILLAGE OF LONGREACH
 SECTION 2 AREA 1
 LOTS 1-117
 6TH ELECTION DISTRICT
 HOWARD COUNTY, MARYLAND
SADDLE DRIVE
 PLAN AND PROFILE

OWNER AND DEVELOPER
THE HOWARD RESEARCH AND DEVELOPMENT LAND COMPANY
 10275 LITTLE PATUXENT PARKWAY
 COLUMBIA, MARYLAND 21044

SCALE AS SHOWN DATE: SEPT 24, 1987 DWG NO. 10 OF 18
 DESIGNED BY: DR. R. ISAACS DRAWN BY: DR. D. PARRAN CHECKED BY: C. J. CROVO
FISHER, COLLINS AND CARTER, INC.
 CIVIL ENGINEERS AND LAND SURVEYORS
 8388 COURT AVE. ELLICOTT CITY, MARYLAND 21043

APPROVED DEPARTMENT OF PUBLIC WORKS
Charles J. Crovo Sr. 1/22/83
 CHIEF, BUREAU OF ENGINEERING DATE


APPROVED OFFICE OF PLANNING AND ZONING
Joseph Rutter 1/26/88
 COMMUNITY PLANNING DATE
 ANI. LAND DEVELOPMENT

APPROVED DEPARTMENT OF PUBLIC WORKS
Granville W. Wellman 1/21/88
 CHIEF, BUREAU OF HIGHWAYS DATE


APPROVED DEPARTMENT OF PUBLIC WORKS
Michelle H. [Signature] 1/21/88
 CHIEF, LAND DEVELOPMENT DIVISION DATE

PLAN
 Scale: 1"=50'

DATE: _____ BY: _____
 SURVEYED: _____
 NOTE BOOK NO. _____
 GRADES CHECKED: _____
 IS M.A. NOTED: _____
 STRUCTURE NOTATIONS CHECKED: _____

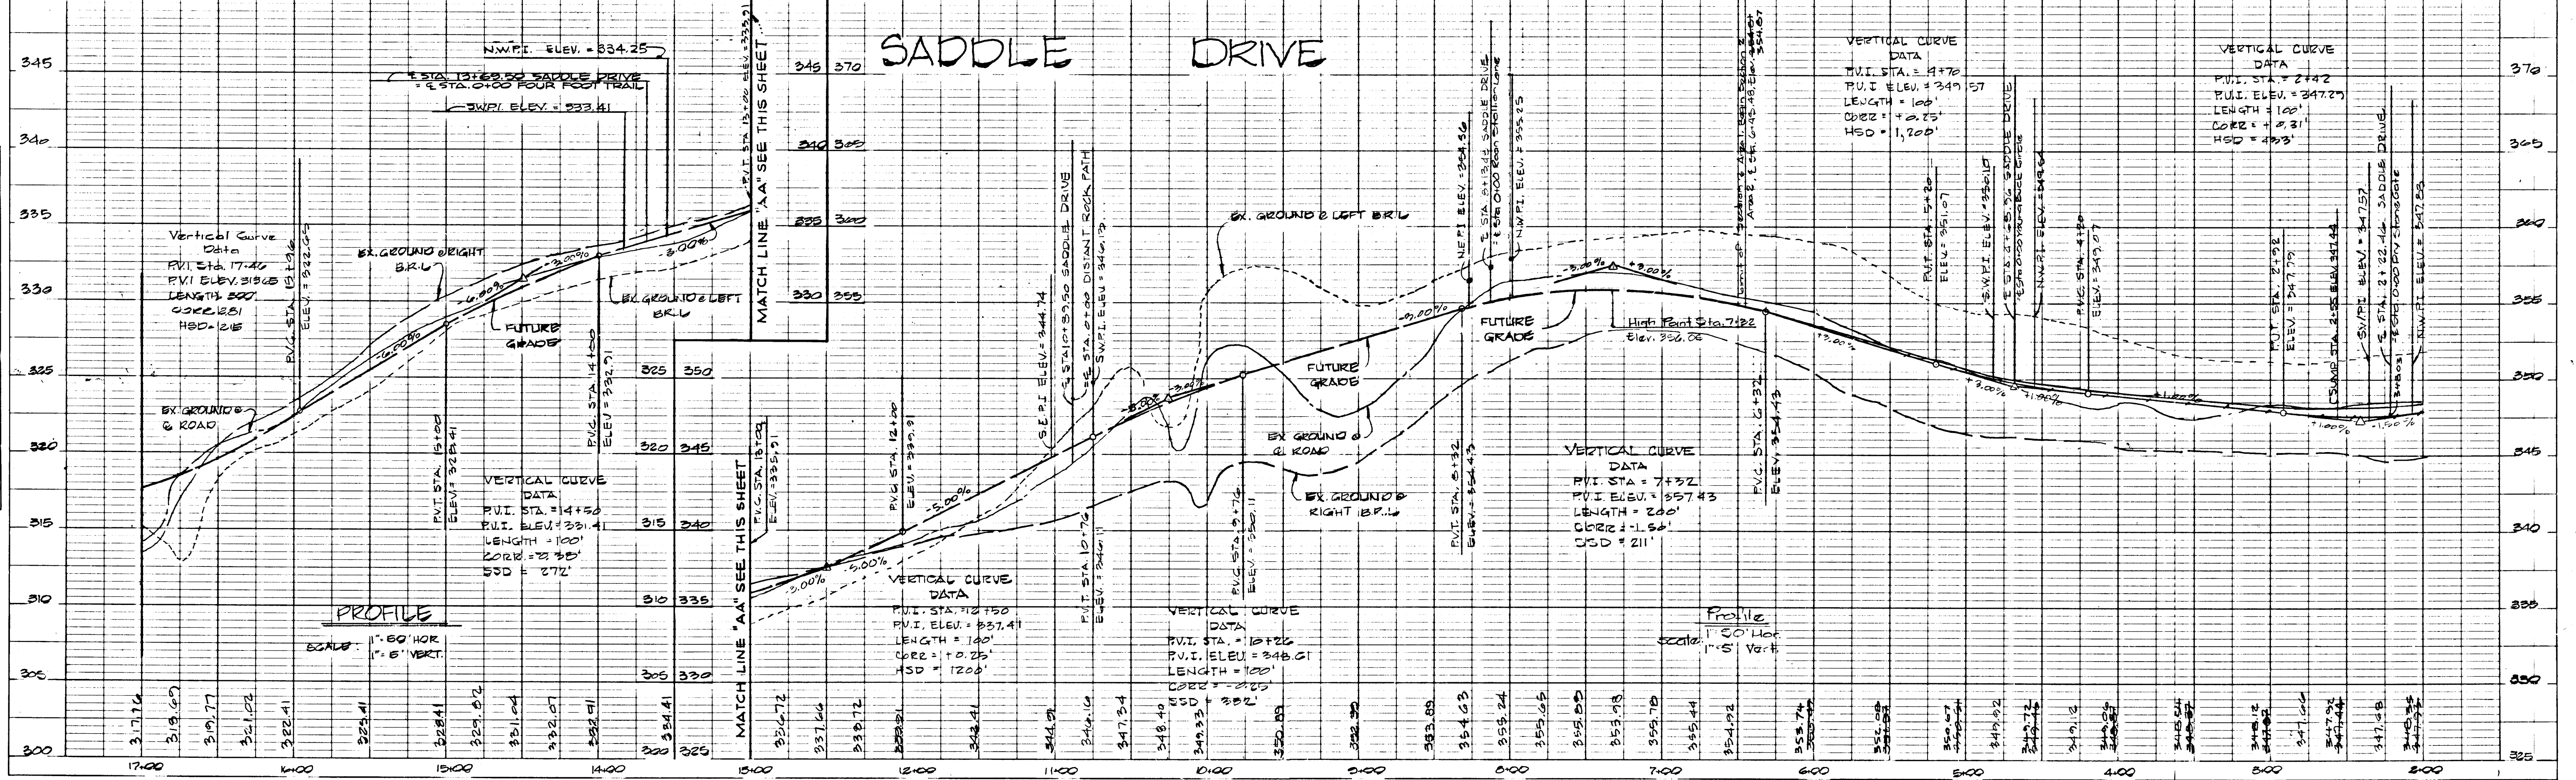


100

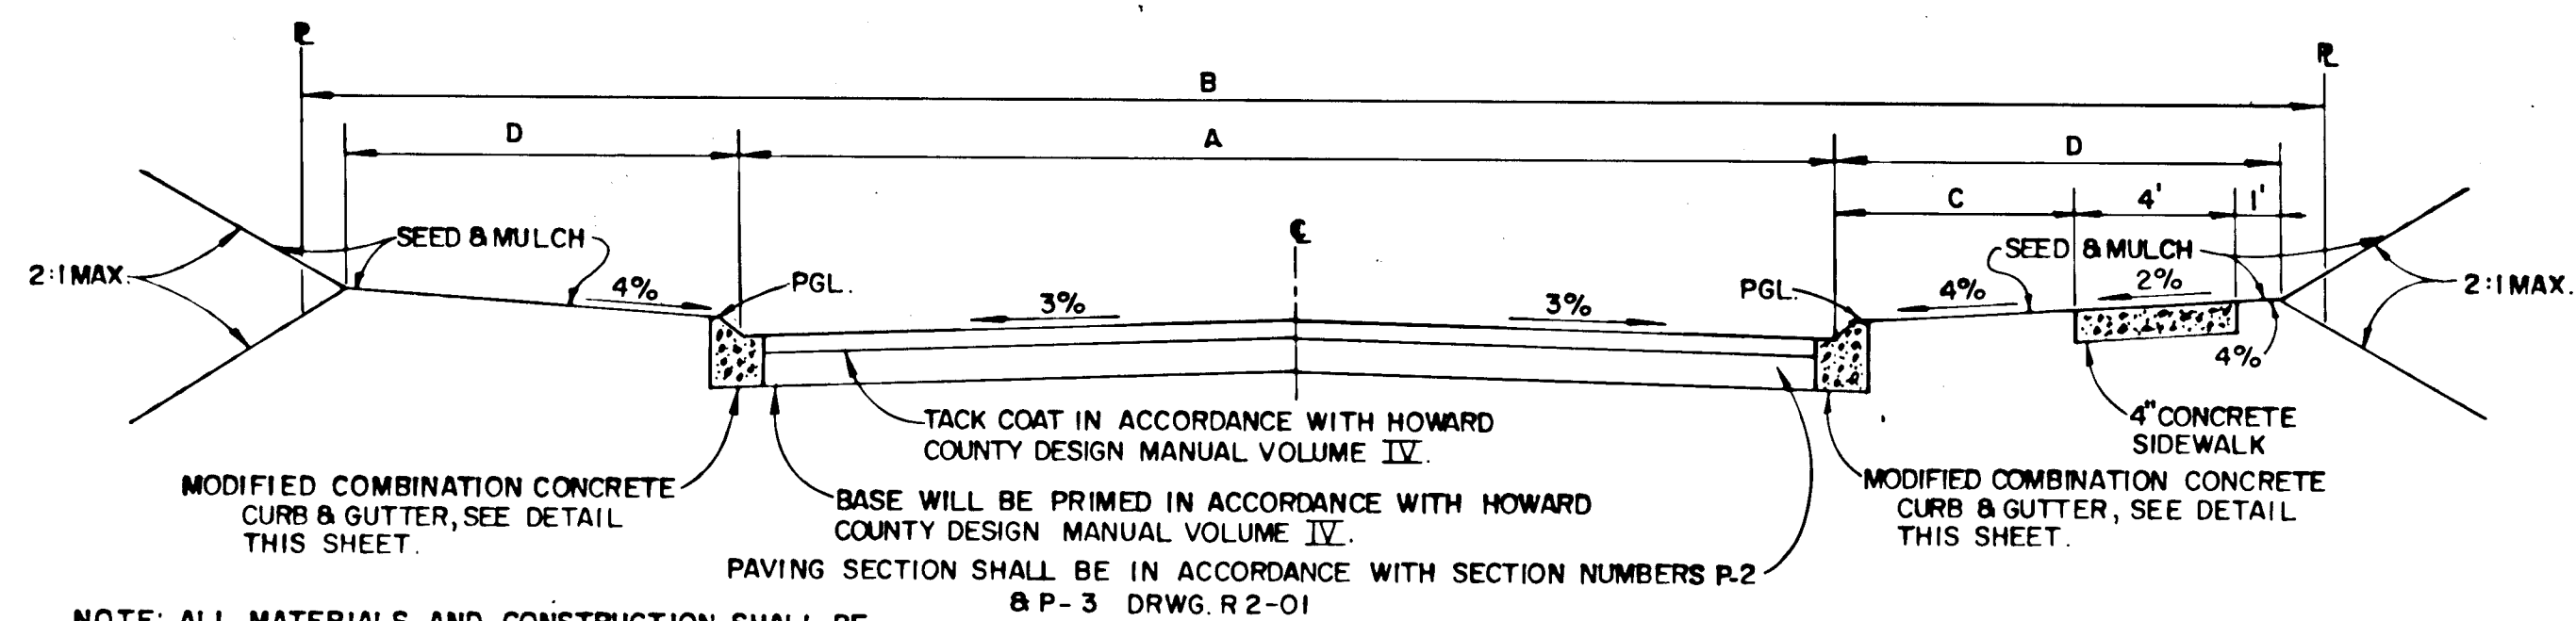

TYPICAL ROADWAY SECTION


NO SCALE

NOTE: ALL MATERIALS AND CONSTRUCTION SHALL BE IN ACCORDANCE WITH HOWARD COUNTY DESIGN MANUAL VOLUME IV, STANDARD SPECIFICATION AND DETAILS FOR CONSTRUCTION.

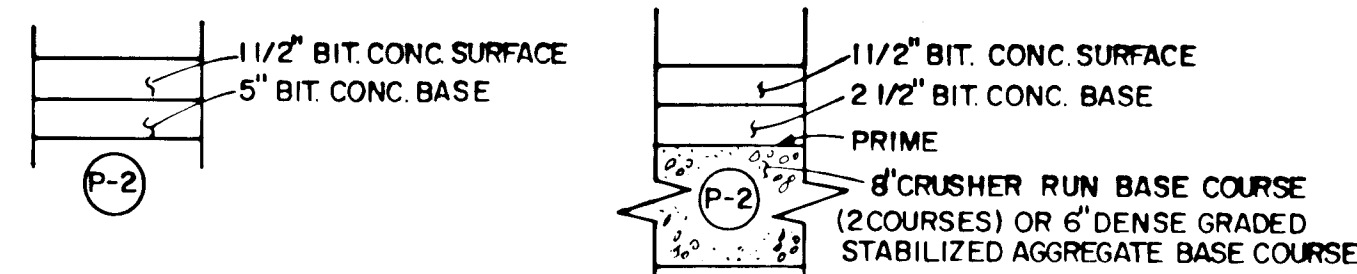


PAVING SECTION P-2

NO SCALE

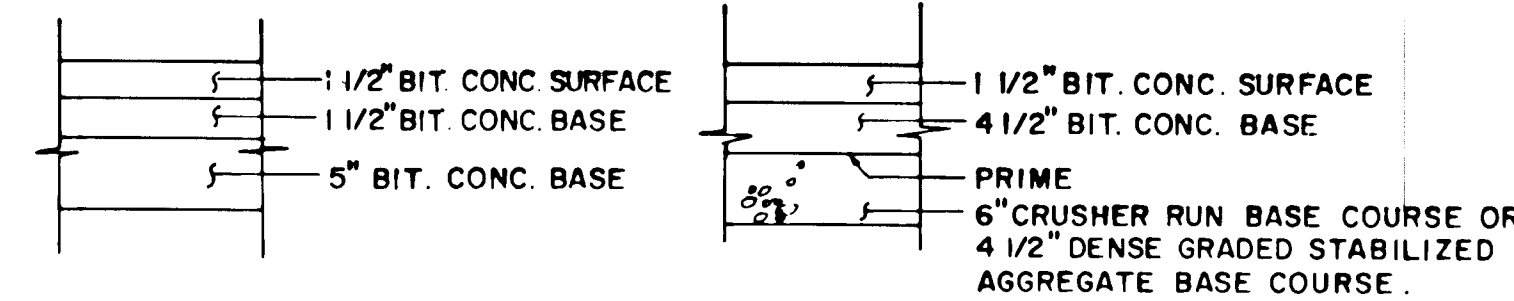

PAVING SECTION P-3


NO SCALE

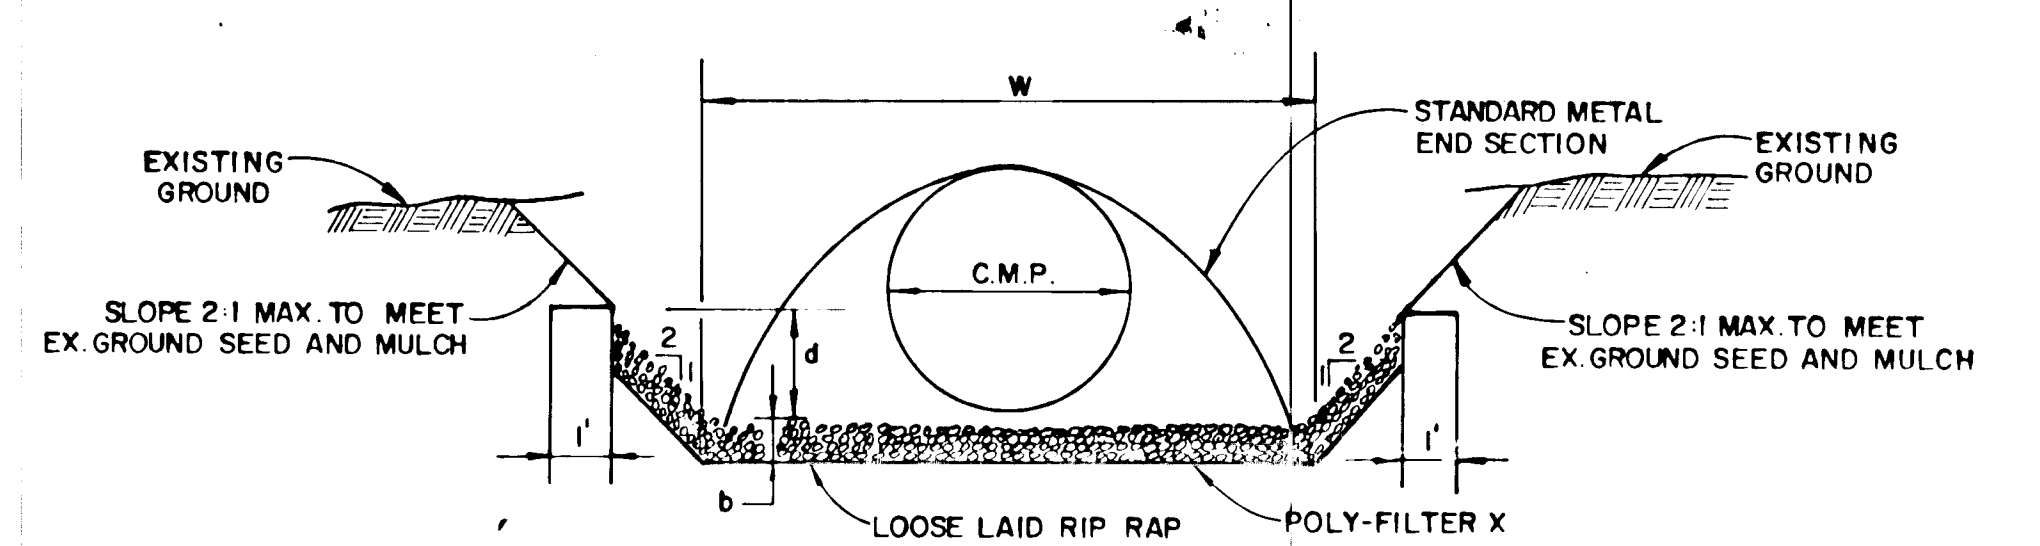

RIP RAP CHANNEL DETAIL


NO SCALE

RIP-RAP CHANNEL DESIGN DATA													
STRUCTURE	AREA	WETTED PERIMETER	R	R 2/3	S	S 1/2	8	D	N	V	Q	RIP-RAP SIZE	BLANKET THICKNESS
S-1	2.81	6.45	4.342	-5.718	1.000	0.0700	4.0'	0.55'	.04	2.127/SEC.	5.96 C.F.S.	6"	9"
S-2	4.13	7.63	5.412	-6.628	0.500	0.0707	4.5'	0.70'	.04	1.747/SEC.	7.19 C.F.S.	6"	9"
S-3	2.74	6.42	4.276	-5.660	0.500	0.0707	4.0'	0.54'	.04	1.497/SEC.	4.08 C.F.S.	6"	9"
S-4	7.41	10.20	7.259	-8.069	0.500	0.0707	6.0'	0.94'	.04	2.127/SEC.	15.70 C.F.S.	6"	9"
S-5	3.51	6.91	5.048	-6.335	0.500	0.0707	4.0'	0.65'	.04	1.697/SEC.	5.86 C.F.S.	6"	9"
S-6	2.74	6.42	4.276	-5.660	0.500	0.0707	4.0'	0.52'	.04	1.497/SEC.	4.08 C.F.S.	6"	9"
S-7	5.19	8.25	6.291	-7.331	0.500	0.0707	4.5'	0.84'	.04	1.937/SEC.	10.01 C.F.S.	6"	9"
S-10	4.43	7.81	5.672	-6.839	0.500	0.0707	4.5'	0.74'	.04	1.807/SEC.	7.97 C.F.S.	6"	9"
S-11	7.00	9.47	7.392	-8.167	0.500	0.0707	5.0'	1.00'	.04	2.157/SEC.	15.05 C.F.S.	6"	9"
S-14	2.62	6.32	4.143	-5.541	0.500	0.0707	4.0'	0.52'	.04	1.467/SEC.	3.81 C.F.S.	6"	9"
S-15	3.18	6.73	4.733	-6.058	0.500	0.0707	4.0'	0.61'	.04	1.597/SEC.	5.06 C.F.S.	6"	9"
S-16	3.45	6.91	4.988	-6.275	0.500	0.0707	4.0'	0.65'	.04	1.657/SEC.	5.69 C.F.S.	6"	9"
S-19	2.87	6.50	4.408	-5.776	0.500	0.0707	4.0'	0.56'	.04	1.527/SEC.	4.35 C.F.S.	6"	9"
S-20	8.71	10.79	8.076	-8.866	0.500	0.0707	6.0'	1.07'	.04	2.287/SEC.	19.82 C.F.S.	6"	9"

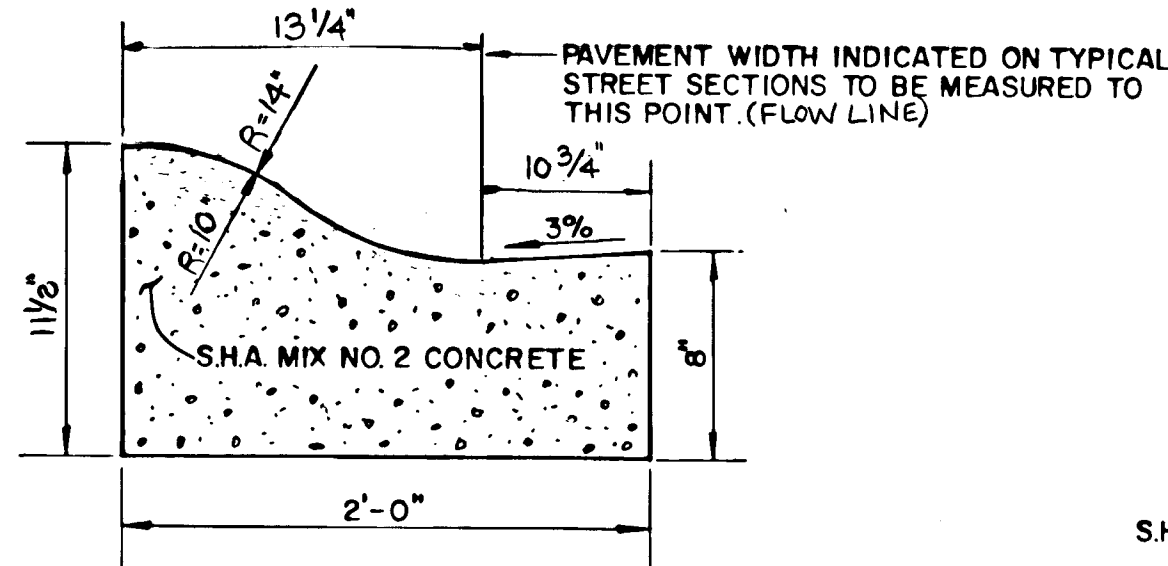

MODIFIED COMBINATION CURB AND GUTTER


NO SCALE

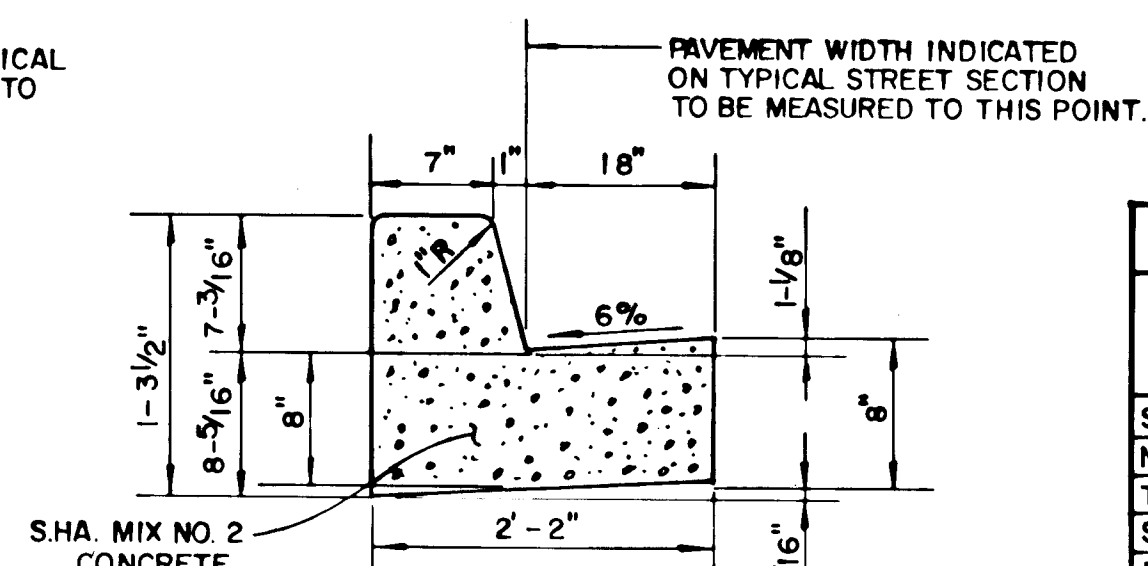

STANDARD 7" COMB. CONC. CURB & GUTTER

NO SCALE

ROAD NAME	CLASSIFICATION	DESIGN SPEED	ZONING	A	B	C	D	STATION LIMITS	PAVING SECTION
TAMAR DRIVE	MINOR COLLECTOR	35 M.P.H.	NT	36'	60'	7'	12'	0+00 TO 0+55	P-3
	LOCAL ROAD	30 M.P.H.	NT	30'	50'	4'	9'	0+00 TO 14+35.94	P-2
	CUL-DE-SAC	30 M.P.H.	NT	28'	50'	4'	11'	14+35 TO 17+24.15	P-2
SEA WATER PATH	CUL-DE-SAC	30 M.P.H.	NT	28'	50'	4'	11'	0+00 TO 5+95.92	P-2
NORTH SLOPE PATH	CUL-DE-SAC	25 M.P.H.	NT	24'	50'	-	13'	0+00 TO 3+41.85	P-2
TIDE ROCK SQUARE	CUL-DE-SAC	25 M.P.H.	NT	28'	50'	4'	11'	0+00 TO 2+31.63	P-2
SEA LIGHT LANE	CUL-DE-SAC	25 M.P.H.	NT	24'	50'	-	13'	0+00 TO 1+60.11	P-2
DRY STONE GATE	CUL-DE-SAC	25 M.P.H.	NT	28'	50'	4'	11'	0+00 TO 2+33.52	P-2
YOUNG BUCK CIRCLE	CUL-DE-SAC	25 M.P.H.	NT	28'	50'	4'	11'	0+00 TO 1+53.52	P-2
SADDLE DRIVE	LOCAL ROAD	30 M.P.H.	NT	30'	50'	4'	9'	0+00 TO 6+45.48	P-2
OLD MONTGOMERY RD	MINOR COLLECTOR	35 M.P.H.	NT	36'	60'	7'	12'	0+00 TO 7+74.10	P-3

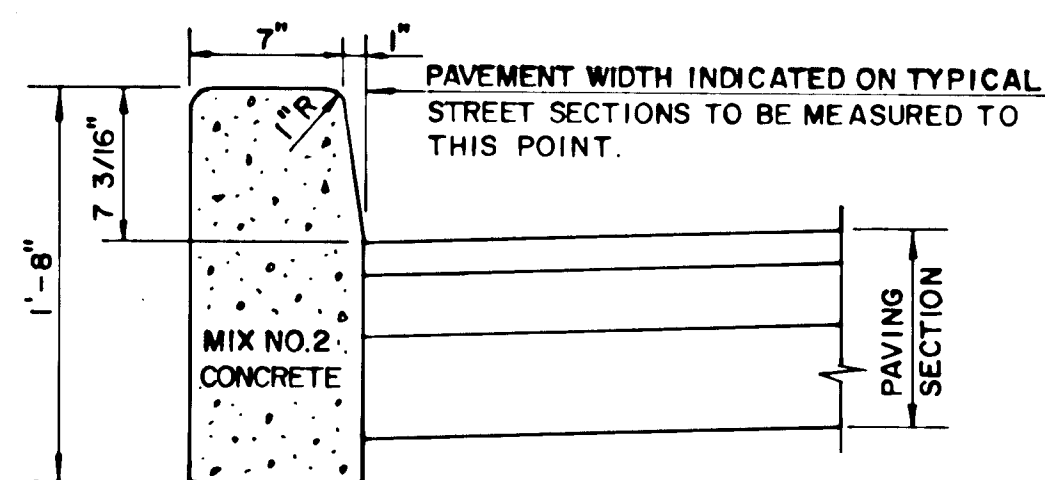


STANDARD BARRIER CURB

NO SCALE


CONSTRUCTION SPECIFICATIONS FOR RIP-RAP OUTFALLS

- The subgrade for the filter, riprap or gabion shall be prepared to the required lines and grades. Any fill required in the subgrade shall be compacted to a density of approximately that of the surrounding undisturbed material.
- The rock or gravel shall conform to the specified grading limits when installed respectively in the riprap or filter.
- Filter cloth shall be protected from punching, cutting or tearing. Any damage other than an occasional small hole shall be repaired by placing another piece of cloth over the damaged part or by completely replacing the cloth. All overlaps whether for repairs or for joining two pieces of cloth shall be a minimum of one foot.
- Stone for the riprap or gabion outlets may be placed by equipment. Both shall each be constructed to the full course thickness in one operation and in such a manner as to avoid displacement of underlying materials. The stone for riprap or gabion outlets shall be delivered and placed in a manner that will insure that it is reasonably homogenous with the smaller stones and spalls filling the voids between the larger stones. Riprap shall be placed in a manner to prevent damage to the filter blanket or filter cloth. Hand placement will be required to the extent necessary to prevent damage to the permanent works.

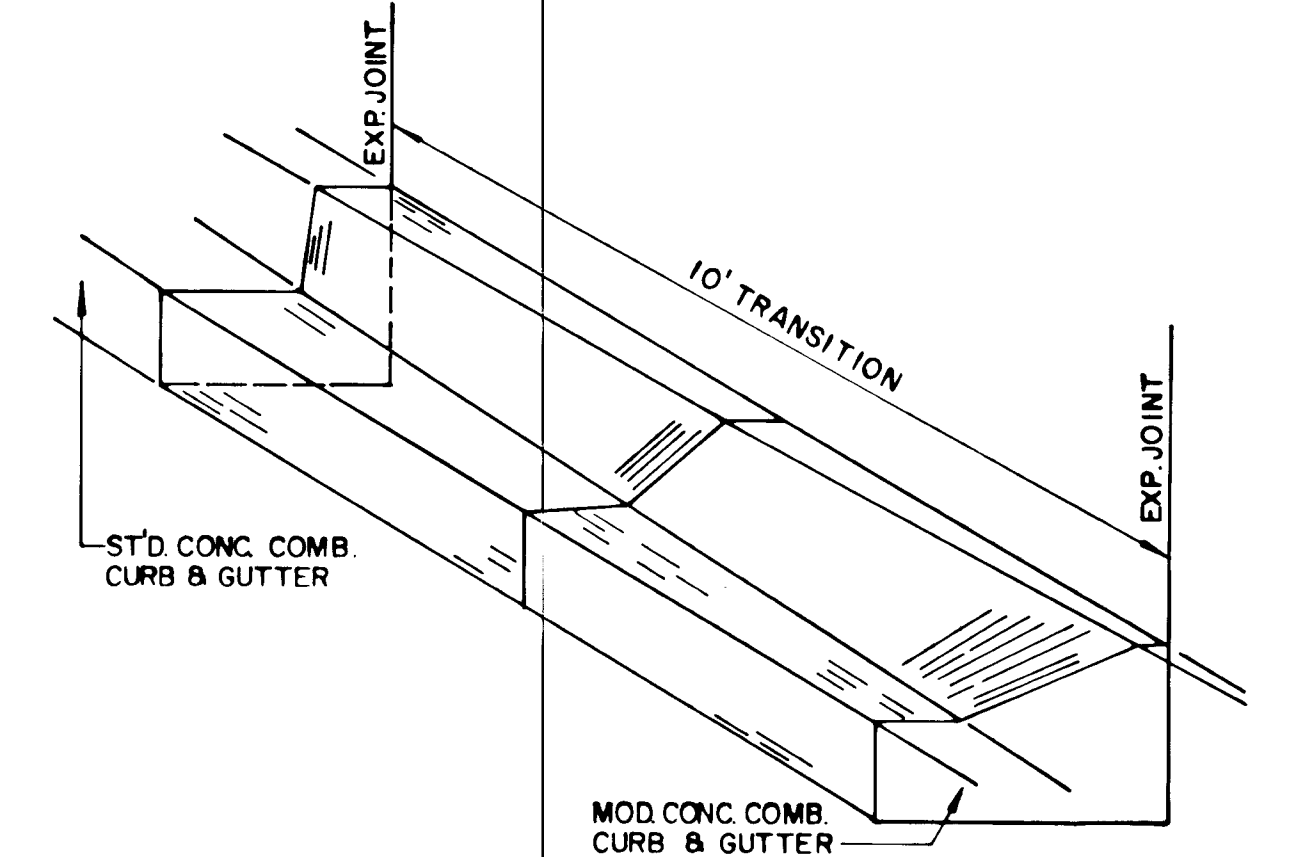


CURB TRANSITION DETAIL

NO SCALE

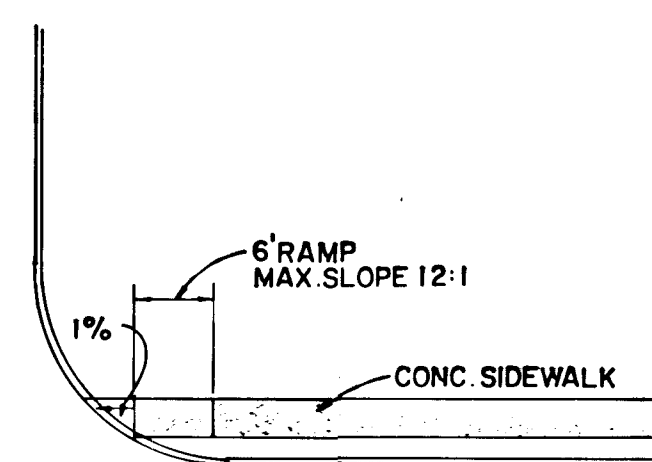

SIDEWALK RAMP DETAIL "A"

NO SCALE

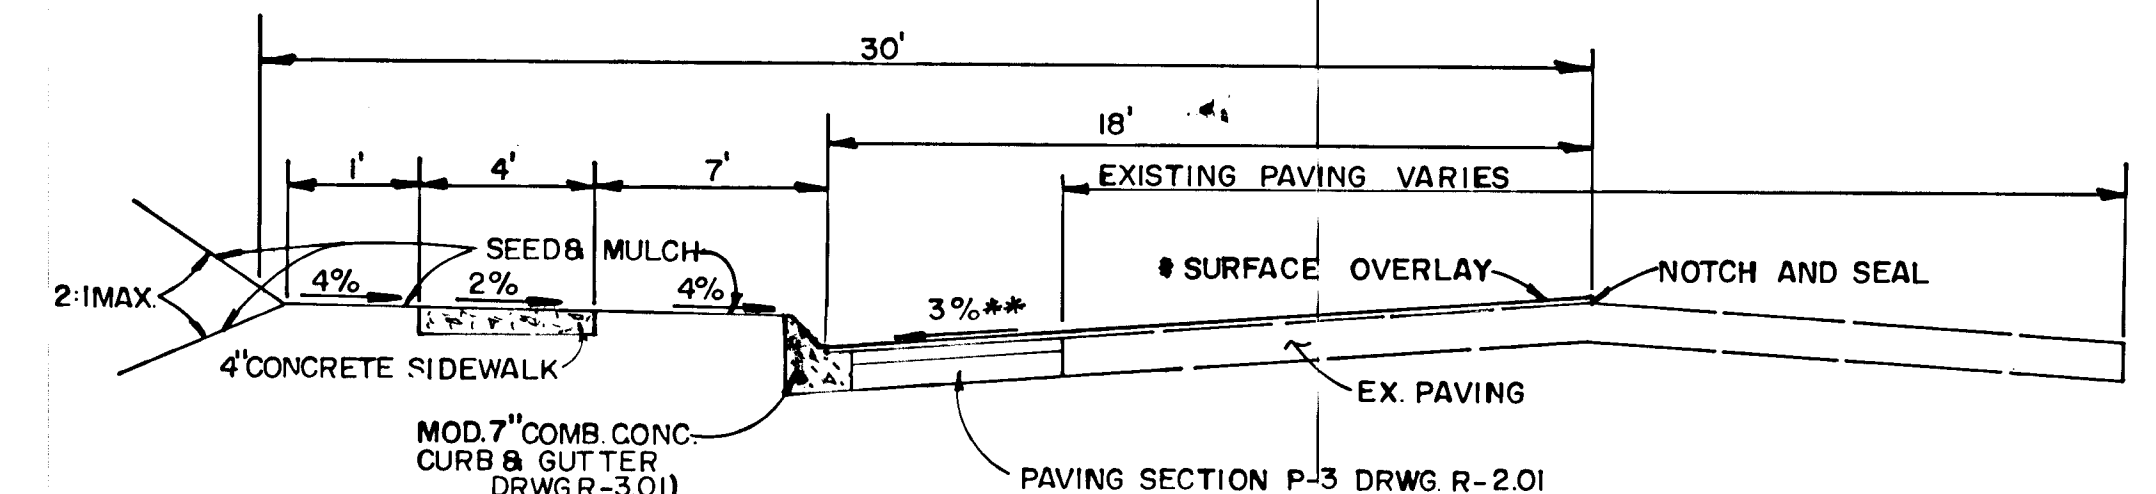

TYPE OF TRAFFICWAY: MINOR COLLECTOR DESIGN SPEED: 35 MPH. * NOTE: SURFACE OVERLAY COURSE TO BE ZONED NT EQUAL TO SURFACE COURSE OF TYPICAL PAVING SECTION OF SUBDIVISION.
 @ STA. LIMITS 2+25.00 TO 7+74.10
TYPICAL WIDENING SECTION ALONG OLD MONTGOMERY ROAD
 ** NOTE: CONTRACTOR SHALL VARY CROSS SLOPE FROM @ STA. 6+20 TO @ STA. 7+75 TO PROVIDE POSITIVE DRAINAGE ALONG CURB LINE.

APPROVED	DEPARTMENT OF PUBLIC WORKS	<i>Granville W. Weiland</i>	1/21/88
	CHIEF, BUREAU OF HIGHWAYS		DATE
APPROVED	DEPARTMENT OF PUBLIC WORKS	<i>William S. Reid</i>	1-22-88
	CHIEF, BUREAU OF ENGINEERING		DATE
APPROVED	OFFICE OF PLANNING AND ZONING	<i>Joseph R. Butler</i>	1/26/88
	CHIEF, DIVISION OF COMMUNITY PLANNING AND LAND DEVELOPMENT		DATE
APPROVED	DEPARTMENT OF PUBLIC WORKS	<i>Charles J. Crovo</i>	1-21-88
	CHIEF LAND DEVELOPMENT DIVISION		DATE
	REVISION	DATE	
	Added Cross Slope Note	1-22-88	

FISHER, COLLINS & CARTER, INC.
 CIVIL ENGINEERS & LAND SURVEYORS
 8388 COURT AVENUE
 ELLICOTT CITY, MARYLAND 21043

OWNER AND DEVELOPER
 THE HOWARD RESEARCH AND DEVELOPMENT LAND COMPANY
 10275 LITTLE PATUXENT PARKWAY
 COLUMBIA, MARYLAND 21044

STATE OF MARYLAND
 COUNTY OF HOWARD
 CHARLES J. CROVO SR.
 10/1/87
 DATE

ROADWAY SECTIONS, NOTES AND DETAILS
VILLAGE OF LONGREACH

SECTION 2 AREA 1
 LOTS 1-117
 6TH ELECTION DISTRICT
 HOWARD COUNTY, MARYLAND

SCALE AS SHOWN SHEET 11 OF 18 SEPTEMBER, 24 1987

AS BUILT JAN. 15, 1992 F 88-78

STRUCTURE SCHEDULE FOR SECTION 2 AREA 1


STRUCTURE	TYPE	INV. IN	INV. OUT	Q TOP ELEV.	E ROAD STATION	REMARKS	STRUCTURE	TYPE	INV. IN	INV. OUT	Q TOP ELEV.	E ROAD STATION	REMARKS
I-30	A-S W/ DEFLECTORS	325.68	325.28	330.00	L.P. STA. 1+99.81 YOUNG BUCK CIRCLE	S.D. 4.01	MH 6	STANDARD MANHOLE	324.00	324.00	348.00	0+00.00 YOUNG BUCK CIRCLE	G. 5.01
I-31	A-S W/ DEFLECTORS	345.05	344.25	350.00	5+10.00 SADDLE DRIVE	S.D. 4.01	MH 7	STANDARD MANHOLE	343.00	343.00	348.00	0+00.00 YOUNG BUCK CIRCLE	G. 5.01
I-32	A-S W/ DEFLECTORS	346.11	345.25	352.00	5+47.00 SADDLE DRIVE	S.D. 4.01	MH 8	STANDARD MANHOLE	342.00	342.00	339.00	0+00.00 YOUNG BUCK CIRCLE	G. 5.01
I-33	A-S W/ DEFLECTORS	327.30	327.00	331.00	L.P. STA. 1+100.00 DRY STONE GATE	S.D. 4.01	MH 9	STANDARD MANHOLE	333.00	333.00	339.00	0+40.00 DRY STONE GATE	G. 5.01
I-34	A-S W/ DEFLECTORS	342.51	342.20	347.00	2+37.00 SADDLE DRIVE	S.D. 4.01	MH 9	STANDARD MANHOLE	341.00	341.00	346.00	0+40.00 DRY STONE GATE	G. 5.01
I-35	A-S W/ DEFLECTORS	342.51	342.20	347.00	2+37.00 SADDLE DRIVE	S.D. 4.02	MH 10	STANDARD MANHOLE	341.00	341.00	346.00	13+18.00 TAMAR DRIVE	G. 5.01
I-36	A-S W/ DEFLECTORS	334.00	333.00	338.00	11+15.00 TAMAR DRIVE	S.D. 4.01	MH 11	STANDARD MANHOLE	335.00	335.00	342.00	13+18.00 TAMAR DRIVE	G. 5.01
I-37	A-S W/ DEFLECTORS	347.00	346.00	352.00	14+00.00 TAMAR DRIVE	S.D. 4.01	MH 11	STANDARD MANHOLE	350.00	350.00	357.00	14+00.00 TAMAR DRIVE	G. 5.01
I-38	A-S W/ DEFLECTORS	347.00	346.00	352.00	14+00.00 TAMAR DRIVE	S.D. 4.01	MH 11	STANDARD MANHOLE	350.00	350.00	357.00	14+00.00 TAMAR DRIVE	G. 5.01
I-39	A-S W/ DEFLECTORS	348.00	347.00	353.00	14+78.94 TAMAR DRIVE	S.D. 4.01	MH 10	STANDARD MANHOLE	347.00	347.00	353.00	0+00.00 TAMAR DRIVE	G. 5.01
I-40	A-S W/ DEFLECTORS	348.00	347.00	353.00	14+78.94 TAMAR DRIVE	S.D. 4.01	MH 11	STANDARD MANHOLE	347.00	347.00	353.00	0+00.00 TAMAR DRIVE	G. 5.01
I-41	A-S W/ DEFLECTORS	358.00	357.00	363.00	9+22.00 TAMAR DRIVE	S.D. 4.01	MH 12	STANDARD MANHOLE	356.00	356.00	363.00	0+00.00 TAMAR DRIVE	G. 5.01
I-42	A-S W/ DEFLECTORS	358.00	357.00	363.00	9+22.00 TAMAR DRIVE	S.D. 4.01	MH 13	STANDARD MANHOLE	356.00	356.00	363.00	0+00.00 TAMAR DRIVE	G. 5.01
I-43	A-S W/ DEFLECTORS	362.00	361.00	367.00	0+43.00 SEA WATER PATH	S.D. 4.01	MH 14	STANDARD MANHOLE	360.00	360.00	367.00	0+43.00 SEA WATER PATH	G. 5.01
I-44	A-S W/ DEFLECTORS	362.00	361.00	367.00	0+43.00 SEA WATER PATH	S.D. 4.01	MH 15	STANDARD MANHOLE	360.00	360.00	367.00	0+43.00 SEA WATER PATH	G. 5.01
I-45	A-S W/ DEFLECTORS	362.00	361.00	367.00	0+43.00 SEA WATER PATH	S.D. 4.01	MH 16	STANDARD MANHOLE	360.00	360.00	367.00	0+43.00 SEA WATER PATH	G. 5.01
I-46	A-S W/ DEFLECTORS	358.00	357.00	363.00	L.P. STA. 1+16.92 SEA LIGHT LANE	S.D. 4.01	MH 17	STANDARD MANHOLE	356.00	356.00	363.00	0+00.00 TAMAR DRIVE	G. 5.01
I-47	A-S W/ DEFLECTORS	338.00	337.00	343.00	L.P. STA. 1+24.00 TIDE ROCK SQUARE	S.D. 4.01	MH 18	STANDARD MANHOLE	336.00	336.00	343.00	0+00.00 TAMAR DRIVE	G. 5.01
I-48	A-S W/ DEFLECTORS	346.00	345.00	351.00	L.P. STA. 2+17.47 SEA WATER PATH	S.D. 4.01	MH 19	STANDARD MANHOLE	344.00	344.00	351.00	0+00.00 TAMAR DRIVE	G. 5.01
I-49	A-S W/ DEFLECTORS	346.00	345.00	351.00	L.P. STA. 2+17.47 SEA WATER PATH	S.D. 4.01	MH 20	STANDARD MANHOLE	344.00	344.00	351.00	0+00.00 TAMAR DRIVE	G. 5.01
I-50	A-S W/ DEFLECTORS	347.00	346.00	352.00	2+82.50 TAMAR DRIVE	S.D. 4.01	MH 21	STANDARD MANHOLE	345.00	345.00	352.00	0+00.00 TAMAR DRIVE	G. 5.01
I-51	A-S W/ DEFLECTORS	334.00	333.00	339.00	0+48.00 TAMAR DRIVE	S.D. 4.01	MH 22	STANDARD MANHOLE	332.00	332.00	339.00	0+00.00 TAMAR DRIVE	G. 5.01
I-52	A-S W/ DEFLECTORS	338.00	337.00	343.00	0+48.00 TAMAR DRIVE	S.D. 4.01	MH 23	STANDARD MANHOLE	336.00	336.00	343.00	0+00.00 TAMAR DRIVE	G. 5.01
I-53	A-S W/ DEFLECTORS	339.00	338.00	344.00	0+48.00 TAMAR DRIVE	S.D. 4.01	MH 24	STANDARD MANHOLE	337.00	337.00	344.00	0+00.00 TAMAR DRIVE	G. 5.01
I-54	A-S W/ DEFLECTORS	339.00	338.00	344.00	0+48.00 TAMAR DRIVE	S.D. 4.01	MH 25	STANDARD MANHOLE	337.00	337.00	344.00	0+00.00 TAMAR DRIVE	G. 5.01

APPROVED DEPARTMENT OF PUBLIC WORKS
 CHIEF, LAND DEVELOPMENT DIVISION
 DATE 1/21/88

APPROVED DEPARTMENT OF PUBLIC WORKS
 CHIEF, BUREAU OF HIGHWAYS
 DATE 1/21/88

APPROVED DEPARTMENT OF PUBLIC WORKS
 CHIEF, BUREAU OF ENGINEERING
 DATE 1/22/88

APPROVED OFFICE OF PLANNING AND ZONING
 CHIEF, DIVISION OF COMMUNITY PLANNING AND LAND DEVELOPMENT
 DATE 1/22/88

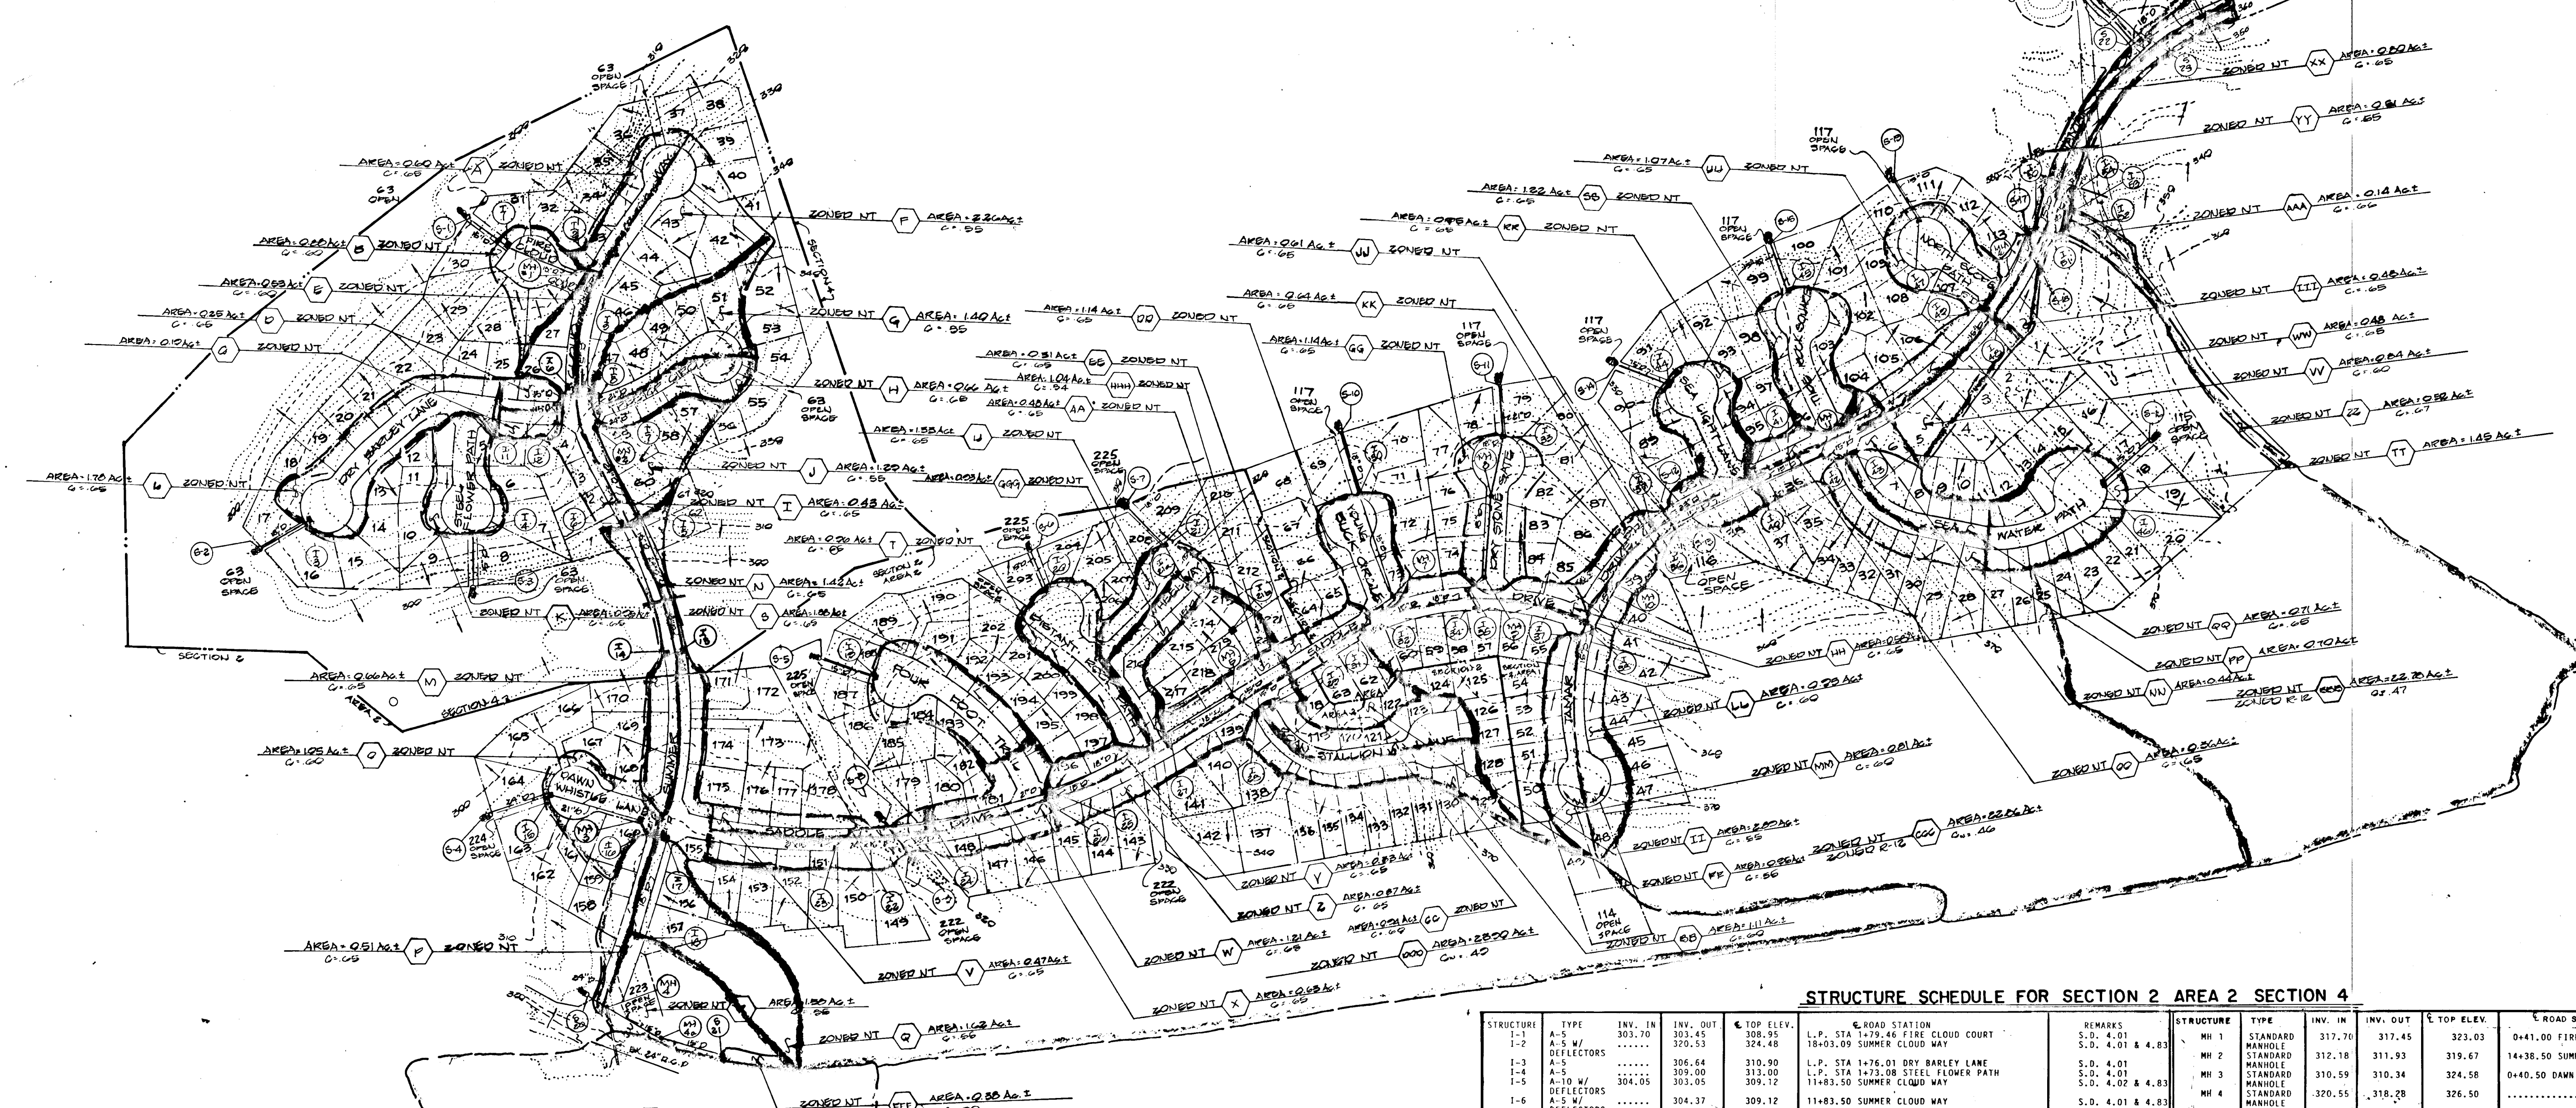

DRAINAGE AREA MAP
 SCALE 1"=200'

STRUCTURE SCHEDULE FOR SECTION 2 AREA 2 SECTION 4




STRUCTURE	TYPE	INV. IN	INV. OUT	Q TOP ELEV.	E ROAD STATION	REMARKS	STRUCTURE	TYPE	INV. IN	INV. OUT	Q TOP ELEV.	E ROAD STATION	REMARKS
I-1	A-S W/ DEFLECTORS	303.70	303.45	308.95	L.P. STA 1+79.46 FIRE CLOUD COURT	S.D. 4.01 & 4.83	MH 1	STANDARD MANHOLE	317.70	317.45	323.03	0+41.00 FIRE CLOUD COURT	G. 5.01
I-2	A-S W/ DEFLECTORS	303.70	303.45	308.95	18+03.09 SUMMER CLOUD WAY	S.D. 4.01 & 4.83	MH 2	STANDARD MANHOLE	317.70	317.45	323.03	0+41.00 FIRE CLOUD COURT	G. 5.01
I-3	A-S W/ DEFLECTORS	306.64	310.90	310.90	L.P. STA 1+76.01 DRY BARLEY LANE	S.D. 4.01	MH 3	STANDARD MANHOLE	312.18	311.93	319.67	14+38.50 SUMMER CLOUD WAY	G. 5.01
I-4	A-S W/ DEFLECTORS	309.00	313.00	313.00	L.P. STA 1+73.08 STEEL FLOWER PATH	S.D. 4.01	MH 4	STANDARD MANHOLE	310.59	310.34	324.58	0+40.50 DAWN WHISTLE LANE	G. 5.01
I-5	A-S W/ DEFLECTORS	304.05	309.05	309.05	11+83.50 SUMMER CLOUD WAY	S.D. 4.01 & 4.83	MH 5	STANDARD MANHOLE	320.55	318.28	326.50	0+40.50 DAWN WHISTLE LANE	G. 5.01
I-6	A-S W/ DEFLECTORS	304.37	309.12	309.12	11+83.50 SUMMER CLOUD WAY	S.D. 4.01 & 4.83	MH 6	STANDARD MANHOLE	327.50	327.25	334.31	0+40.50 DAWN WHISTLE LANE	G. 5.01
I-7	A-S W/ DEFLECTORS	313.25	313.00	321.84	0+43.00 TREETOP CIRCLE	S.D. 4.01 & 4.83	MH 7	STANDARD MANHOLE	347.75	347.50	353.98	8+53.50 SADDLE DRIVE	G. 5.01
I-8	A-S W/ DEFLECTORS	314.08	314.07	321.84	0+43.00 TREETOP CIRCLE	S.D. 4.02	MH 8	STANDARD MANHOLE	347.75	347.50	353.98	8+53.50 SADDLE DRIVE	G. 5.01
I-9	A-S W/ DEFLECTORS	315.85	315.60	325.62	15+33.77 SUMMER CLOUD WAY	S.D. 4.01	MH 9	STANDARD MANHOLE	329.95	329.89	301.20	0+40.50 DAWN WHISTLE LANE	G. 5.01
I-10	A-S W/ DEFLECTORS	316.47	316.22	321.62	15+33.77 SUMMER CLOUD WAY	S.D. 4.01	MH 10	STANDARD MANHOLE	299.95	299.89	301.20	0+40.50 DAWN WHISTLE LANE	G. 5.01
I-11	A-S W/ DEFLECTORS	317.15	316.90	322.41	0+43.00 DRY BARLEY LANE	S.D. 4.01 & 4.83	MH 11	STANDARD MANHOLE	304.33	304.29	305.83	0+40.50 DAWN WHISTLE LANE	G. 5.01
I-12	A-S W/ DEFLECTORS	317.45	317.45	322.41	0+43.00 DRY BARLEY LANE	S.D. 4.01 & 4.83	MH 12	STANDARD MANHOLE	296.10	296.90	297.35	0+40.50 DAWN WHISTLE LANE	G. 5.01
I-13	A-S W/ DEFLECTORS	301.12	300.87	306.30	8+73.95 SUMMER CLOUD WAY	S.D. 4.01	MH 13	STANDARD MANHOLE	329.63	329.57	300.63	0+40.50 DAWN WHISTLE LANE	G. 5.01
I-14	A-S W/ DEFLECTORS	315.85	314.90	319.58	0+73.95 SUMMER CLOUD WAY	S.D. 4.01	MH 14	STANDARD MANHOLE	303.30	303.19	304.55	0+40.50 DAWN WHISTLE LANE	G. 5.01
I-15	A-S W/ DEFLECTORS	301.25	301.00	306.50	L.P. STA. 1+43.43 DAWN WHISTLE LANE	S.D. 4.01	MH 15	STANDARD MANHOLE	303.30	303.19	304.55	0+40.50 DAWN WHISTLE LANE	G. 5.01
I-16	A-S W/ DEFLECTORS	311.48	311.23	317.57	4+84.30 SUMMER CLOUD WAY	S.D. 4.01 & 4.83	MH 16	STANDARD MANHOLE	305.00	304.88	306.25	0+40.50 DAWN WHISTLE LANE	G. 5.01
I-17	A-S W/ DEFLECTORS	312.25	312.00	317.67	4+84.30 SUMMER CLOUD WAY	S.D. 4.02	MH 17	STANDARD MANHOLE	310.20	312.12	311.70	0+40.50 DAWN WHISTLE LANE	G. 5.01
I-18	A-S W/ DEFLECTORS	314.08	314.08	319.58	L.P. STA. 1+73.38 FOUR FOOT TRAIL	S.D. 4.01	MH 18	STANDARD MANHOLE	309.30	309.21	312.05	0+40.50 DAWN WHISTLE LANE	G. 5.01
I-19	A-S W/ DEFLECTORS	314.08	314.08	319.58	L.P. STA. 1+73.38 FOUR FOOT TRAIL	S.D. 4.01	MH 19	STANDARD MANHOLE	309.30	309.21	312.05	0+40.50 DAWN WHISTLE LANE	G. 5.01
I-20	A-S W/ DEFLECTORS	314.08	314.08	319.58	L.P. STA. 1+73.38 FOUR FOOT TRAIL	S.D. 4.01	MH 20	STANDARD MANHOLE	309.30	309.21	312.05	0+40.50 DAWN WHISTLE LANE	G. 5.01
I-21	A-S W/ DEFLECTORS	314.33	314.08	318.80	L.P. STA. 1+53.94 SHORT WHEEL WAY	S.D. 4.01	MH 21	STANDARD MANHOLE	311.10	311.01	313.76	0+40.50 DAWN WHISTLE LANE	G. 5.01
I-22	A-S W/ DEFLECTORS	312.15	311.90	324.04	L.P. STA. 2+98.40 SHORT WHEEL WAY	S.D. 4.02	MH 22	STANDARD MANHOLE	315.99	315.90	317.99	0+40.50 DAWN WHISTLE LANE	G. 5.01
I-23	A-S W/ DEFLECTORS	311.50	311.40	315.45	18+36.00 SADDLE DRIVE	S.D. 4.01	MH 23	STANDARD MANHOLE	315.99	315.90	317.99	0+40.50 DAWN WHISTLE LANE	G. 5.01
I-24	A-S W/ DEFLECTORS	317.75	317.50	322.59	15+97.00 SADDLE DRIVE	S.D. 4.01 & 4.83	MH 24	STANDARD MANHOLE	334.25	334.25	335.50	0+40.50 DAWN WHISTLE LANE	G. 5.01
I-25	A-S W/ DEFLECTORS	329.50	329.00	335.03	13+29.25 SADDLE DRIVE	S.D. 4.01 & 4.83	MH 25	STANDARD MANHOLE	334.25	334.25	335.50	0+40.50 DAWN WHISTLE LANE	G. 5.01
I-26	A-S W/ DEFLECTORS	329.50	329.00	335.03	13+29.25 SADDLE DRIVE	S.D. 4.02 & 4.83	MH 26	STANDARD MANHOLE	334.25	334.25	335.50	0+40.50 DAWN WHISTLE LANE	G. 5.01
I-27	A-S W/ DEFLECTORS	347.75	347.50	348.15	10+31.09 SADDLE DRIVE	S.D. 4.01 & 4.83	MH 27	STANDARD MANHOLE	334.25	334.25	335.50	0+40.50 DAWN WHISTLE LANE	G. 5.01
I-28	A-S W/ DEFLECTORS	350.46	350.21	355.55	0+45.50 ROAN STALLION LANE	S.D. 4.02	MH 28	STANDARD MANHOLE	334.25	334.25	335.50	0+40.50 DAWN WHISTLE LANE	G. 5.01
I-29	A-S W/ DEFLECTORS	350.46	350.21	355.55	0+45.50 ROAN STALLION LANE	S.D. 4.02	MH 29	STANDARD MANHOLE	334.25	334.25	335.50	0+40.50 DAWN WHISTLE LANE	G. 5.01

DRAINAGE AREA MAP
 VILLAGE OF LONGREACH
 SECTION 2 AREA 1, SECTION 2 AREA 2 & SECTION 4
 LOTS 1-117, LOTS 118-225 & LOTS 1-63
 6TH ELECTION DISTRICT
 HOWARD COUNTY, MARYLAND
 SCALE: AS SHOWN SHEET 12 OF 18 SEPTEMBER 24, 1987

APPROVED
 CHARLES J. CROVO SR.
 DATE 1/27/88

100

FISHER, COLLINS AND CARTER, INC.
 CONSULTING ENGINEERS AND LAND SURVEYORS
 8388 COURT AVENUE
 ELLICOTT CITY, MARYLAND 21043
 TELEPHONE (301) 461-2855

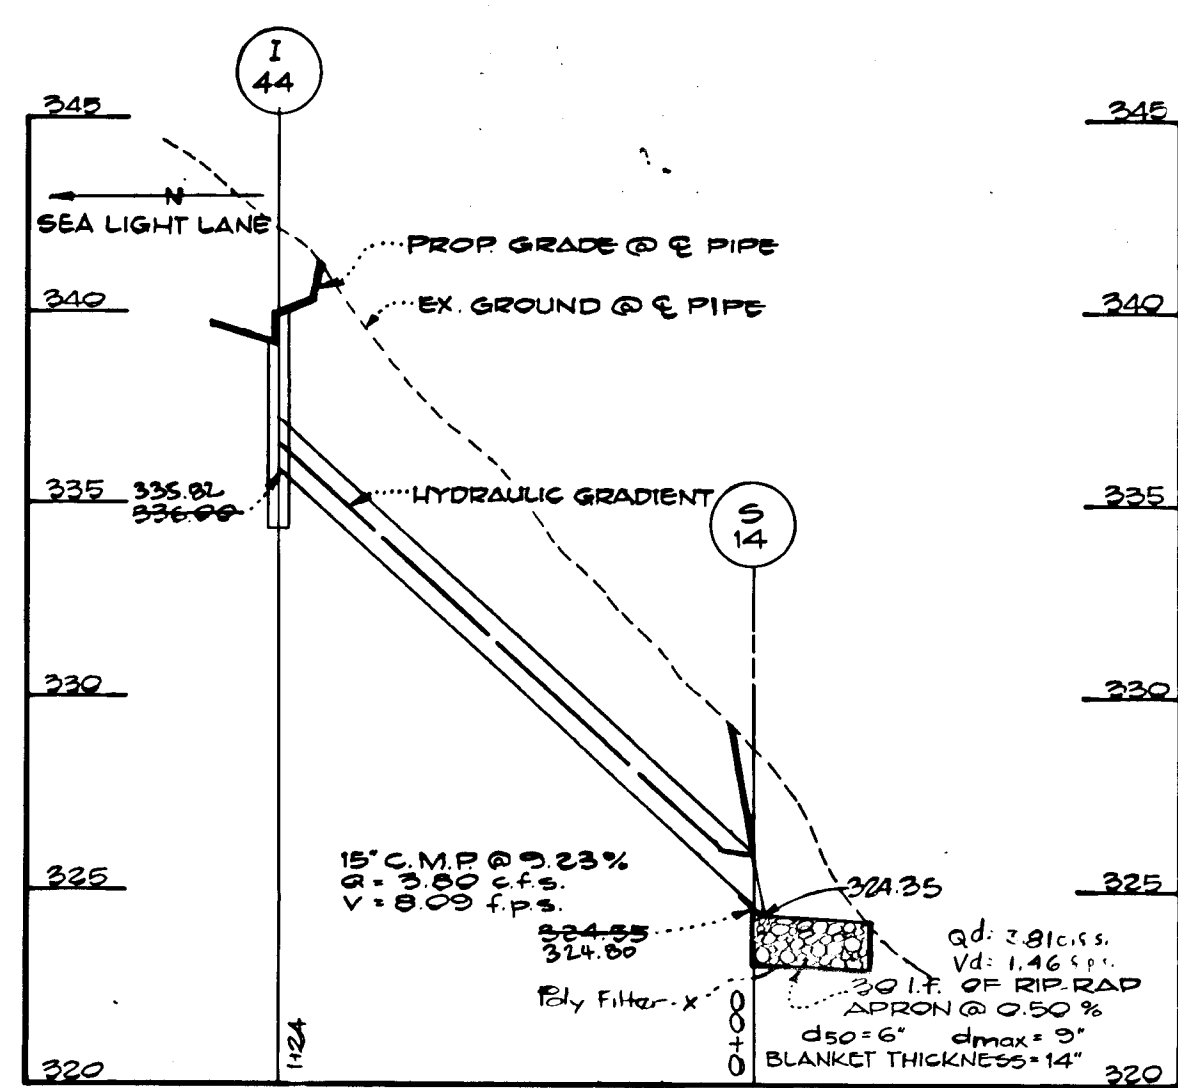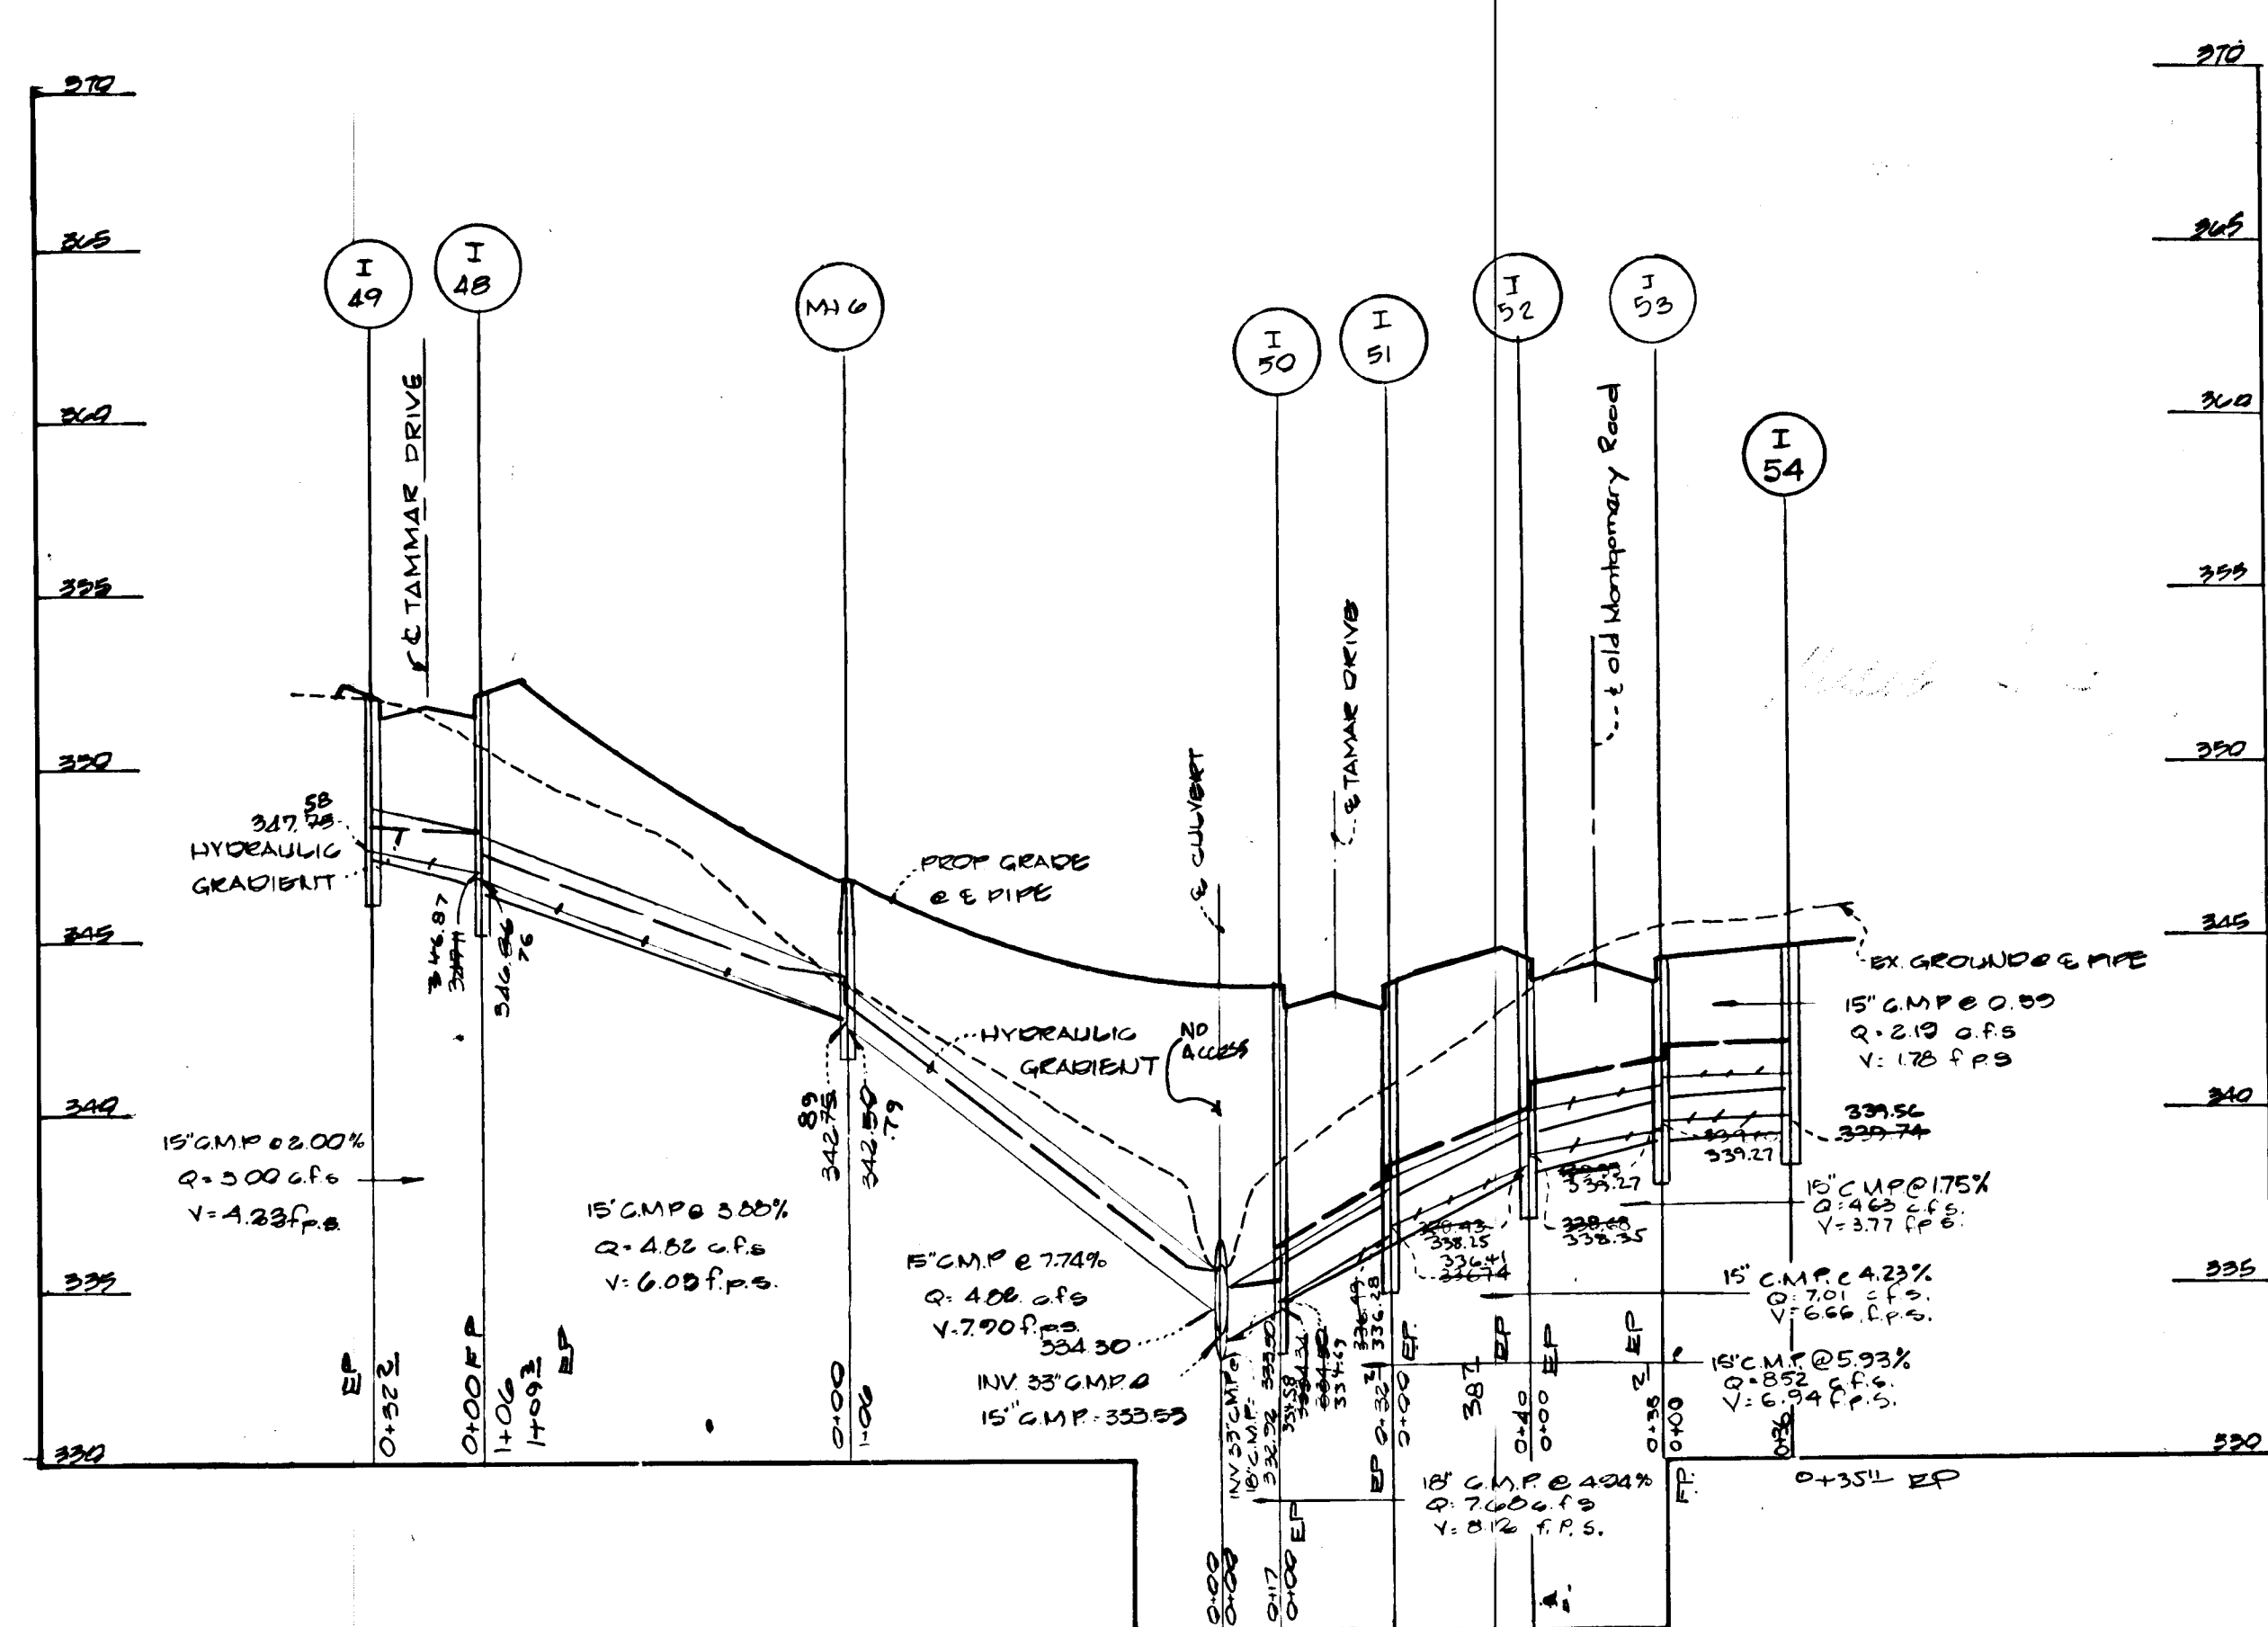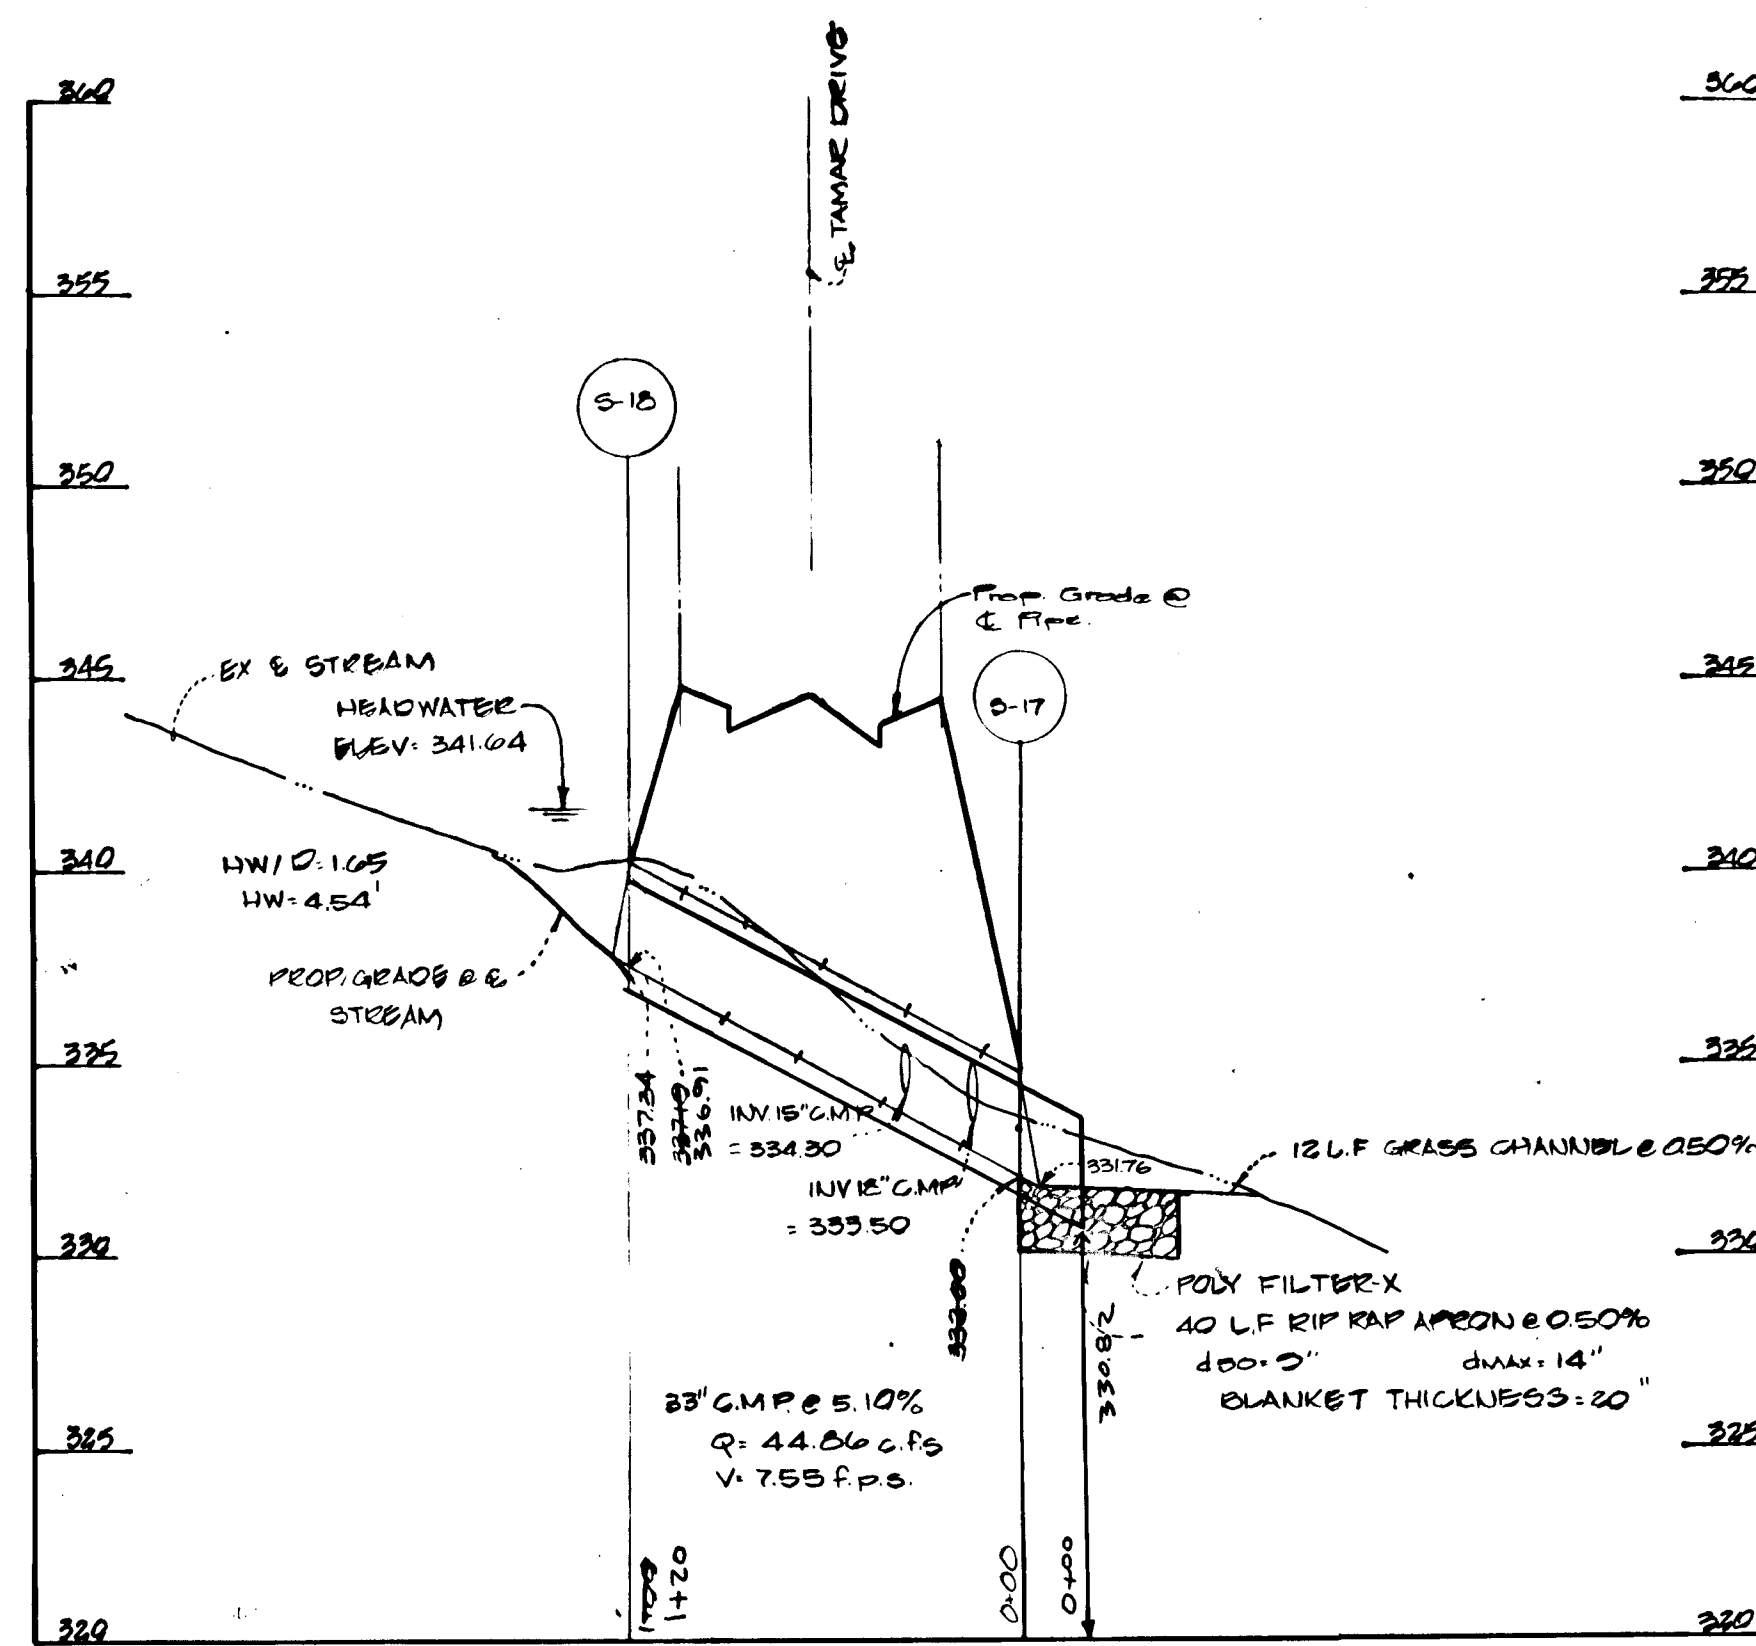

FISHER, COLLINS AND CARTER, INC.
 CIVIL ENGINEERS & LAND SURVEYORS
 8388 COURT AVENUE
 ELLICOTT CITY, MARYLAND 21043

OWNER AND DEVELOPER
 THE HOWARD RESEARCH AND
 DEVELOPMENT LAND COMPANY
 10275 LITTLE PATUXENT PARKWAY
 COLUMBIA, MARYLAND 21044

APPROVED	DEPARTMENT OF PUBLIC WORKS		
	<i>Mills H.</i>	1-2-88	DATE
	CHIEF, LAND DEVELOPMENT DIVISION		
APPROVED	DEPARTMENT OF PUBLIC WORKS		
	<i>Frederick W. McNease</i>	1/2/88	DATE
	CHIEF, BUREAU OF HIGHWAYS		
APPROVED	DEPARTMENT OF PUBLIC WORKS		
	<i>William J. Ray</i>	1-22-88	DATE
	CHIEF, BUREAU OF ENGINEERING		
APPROVED	OFFICE OF PLANNING AND ZONING		
	<i>James Booth</i>	1/26/88	DATE
	CHIEF, DIVISION OF COMMUNITY PLANNING AND LAND DEVELOPMENT		

PROFILES
 SCALE: 1" = 50' HOR.
 1" = 5' VERT.






STORM DRAIN PROFILES
 VILLAGE OF LONGREACH

SECTION 2 AREA 1
 LOTS 1-117

6TH ELECTION DISTRICT
 HOWARD COUNTY, MARYLAND

SCALE AS SHOWN SHEET 15 OF 18 SEPTEMBER 24, 1987

AS-BUILT JAN. 15, 1992

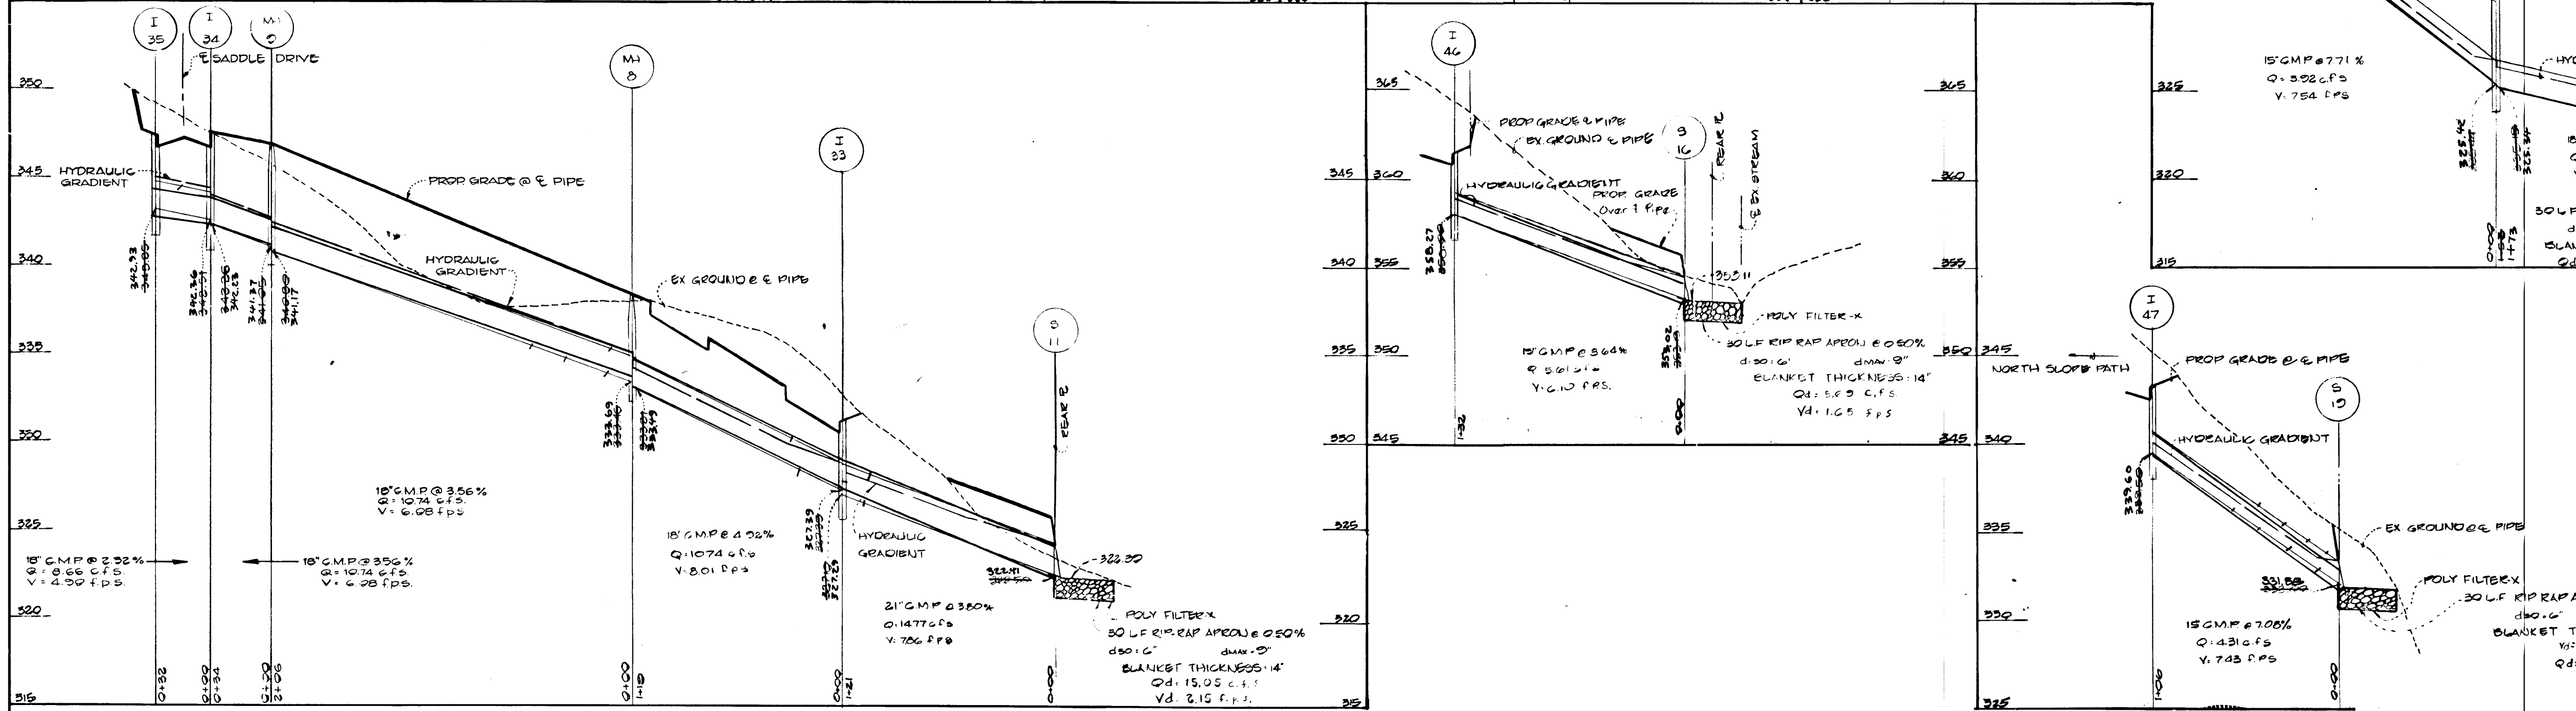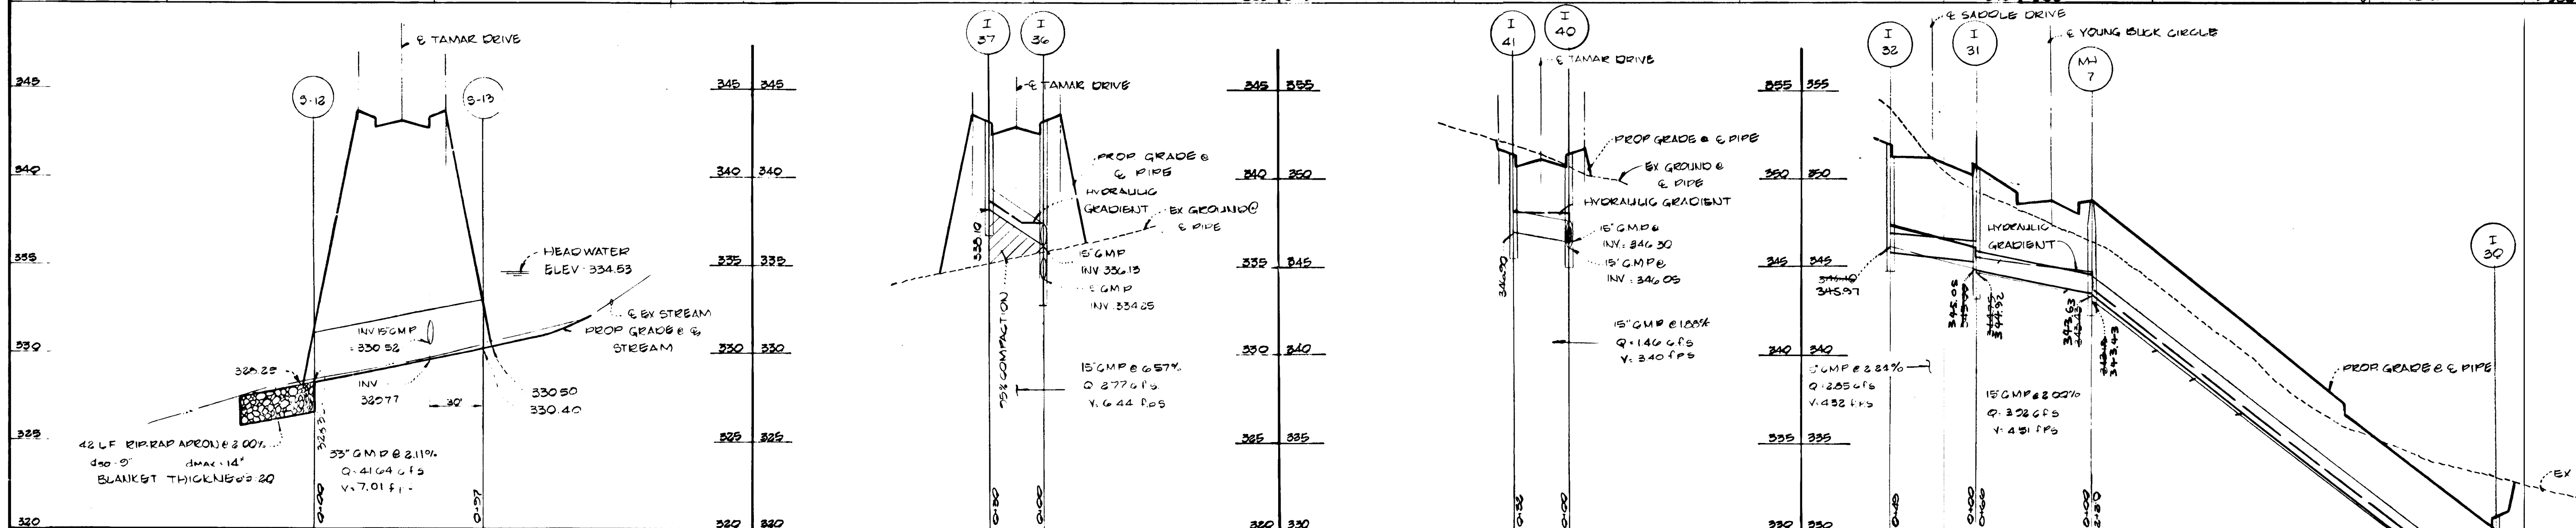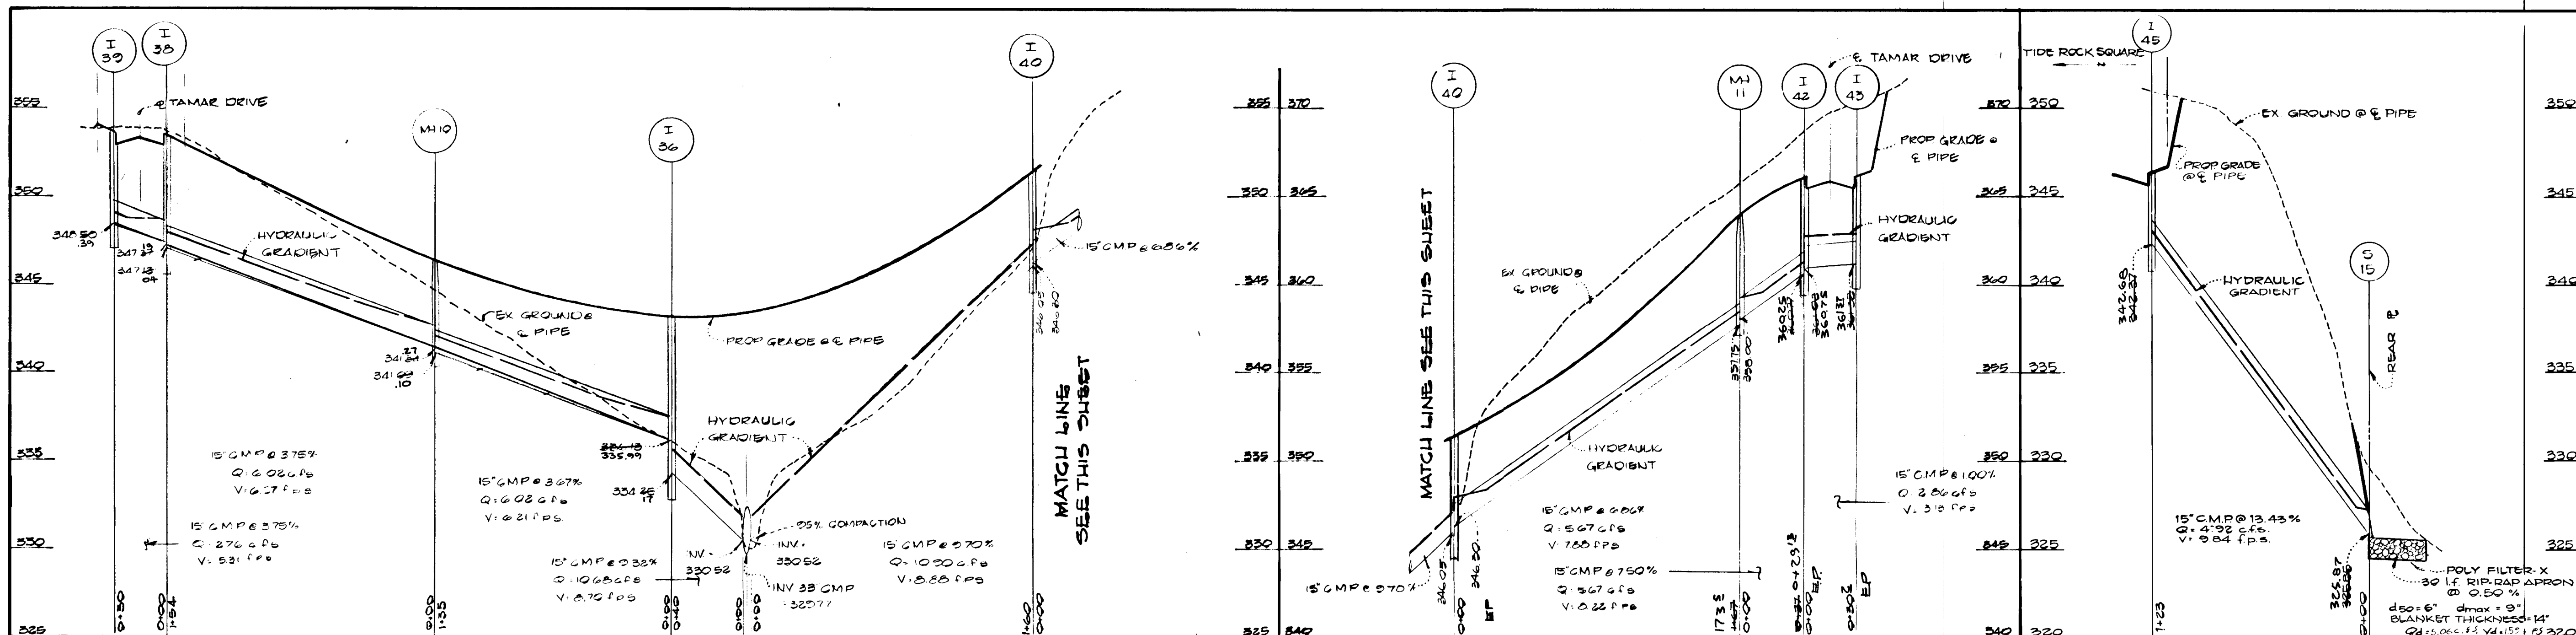

APPROVED	DEPARTMENT OF PUBLIC WORKS	<i>Granville W. Weiland</i>	1/21/88
		CHIEF, BUREAU OF HIGHWAYS	DATE
APPROVED	DEPARTMENT OF PUBLIC WORKS	<i>William E. Riley</i>	1-22-88
		CHIEF, BUREAU OF ENGINEERING	DATE
APPROVED	OFFICE OF PLANNING AND ZONING	<i>James Smith</i>	1/26/88
		ASST. DIVISION OF COMMUNITY PLANNING AND LAND DEVELOPMENT	DATE
APPROVED	DEPARTMENT OF PUBLIC WORKS	<i>William F. 10881</i>	
		CHIEF, LAND DEVELOPMENT DIVISION	DATE

106

FISHER, COLLINS AND CARTER, INC.
 CIVIL ENGINEERS & LAND SURVEYORS
 8388 COURT AVENUE
 ELLICOTT CITY, MARYLAND 21043

OWNER AND DEVELOPER
 THE HOWARD RESEARCH AND DEVELOPMENT LAND COMPANY
 10275 LITTLE PATUXENT PARKWAY
 COLUMBIA, MARYLAND 21044

PROFILES
 1" = 50' Hor.
 Scale: 1" = 5' Vert.

Charles J. Crovo Sr.
 CHARLES J. CROVO SR.
 DATE 1/11/87

STORM DRAIN PROFILES
 VILLAGE OF LONGREACH


SECTION 2 AREA I
 LOTS I-117
 6TH ELECTION DISTRICT
 HOWARD COUNTY, MARYLAND

SCALE AS SHOWN SHEET 14 OF 18 SEPTEMBER 24 1987

TRAP #	DRAINAGE AREA	VOLUME REQUIRED	VOLUME PROVIDED	TOP DIMENSIONS	BOTTOM DIMENSIONS	SIDE SLOPES	DEPTH	BOTTOM ELEVATION	WEIR CREST ELEVATION	CLEANOUT ELEVATION	WEIR CREST "L" DIMENSION
1	1.6AC ±	107 CU. YDS.	109 CU. YDS.	60'x20'	54'x14'	1:1	3'	322.0	326.0	323.5	6.4'
2	1.8AC ±	120 CU. YDS.	120 CU. YDS.	70'x19'	64'x13'	1:1	3'	327.0	331.0	328.5	7.2'
3	1.3AC ±	87 CU. YDS.	90 CU. YDS.	50'x20'	44'x14'	1:1	3'	351.0	355.0	352.5	5.2'
4	3.0AC ±	200 CU. YDS.	208 CU. YDS.	100'x20'	93'x13'	1:1	3.5'	323.50	328.0	325.25	12.0'
5	1.4AC ±	93 CU. YDS.	94 CU. YDS.	52'x20'	46'x14'	1:1	3'	339.0	343.0	340.5	5.6'
6	0.8AC ±	53 CU. YDS.	54 CU. YDS.	31'x20'	25'x14'	1:1	3'	339.0	343.0	340.5	3.2'
2A	0.5AC ±	34 CU. YDS.	34 CU. YDS.	30'x14'	24'x8'	1:1	3'	333.0	337.0	334.5	2.0'
2B	0.5AC ±	34 CU. YDS.	34 CU. YDS.	30'x14'	24'x8'	1:1	3'	333.0	337.00	334.5	2.0'

NOTE: THE 8" SEWER IS SHOWN FOR THE PURPOSE OF SEDIMENT TRAP LOCATIONS.

NOTE: THE SEWER CONSTRUCTION SHOWN HEREIN IS INCLUDED IN THE LIMITS OF DISTURBANCE.

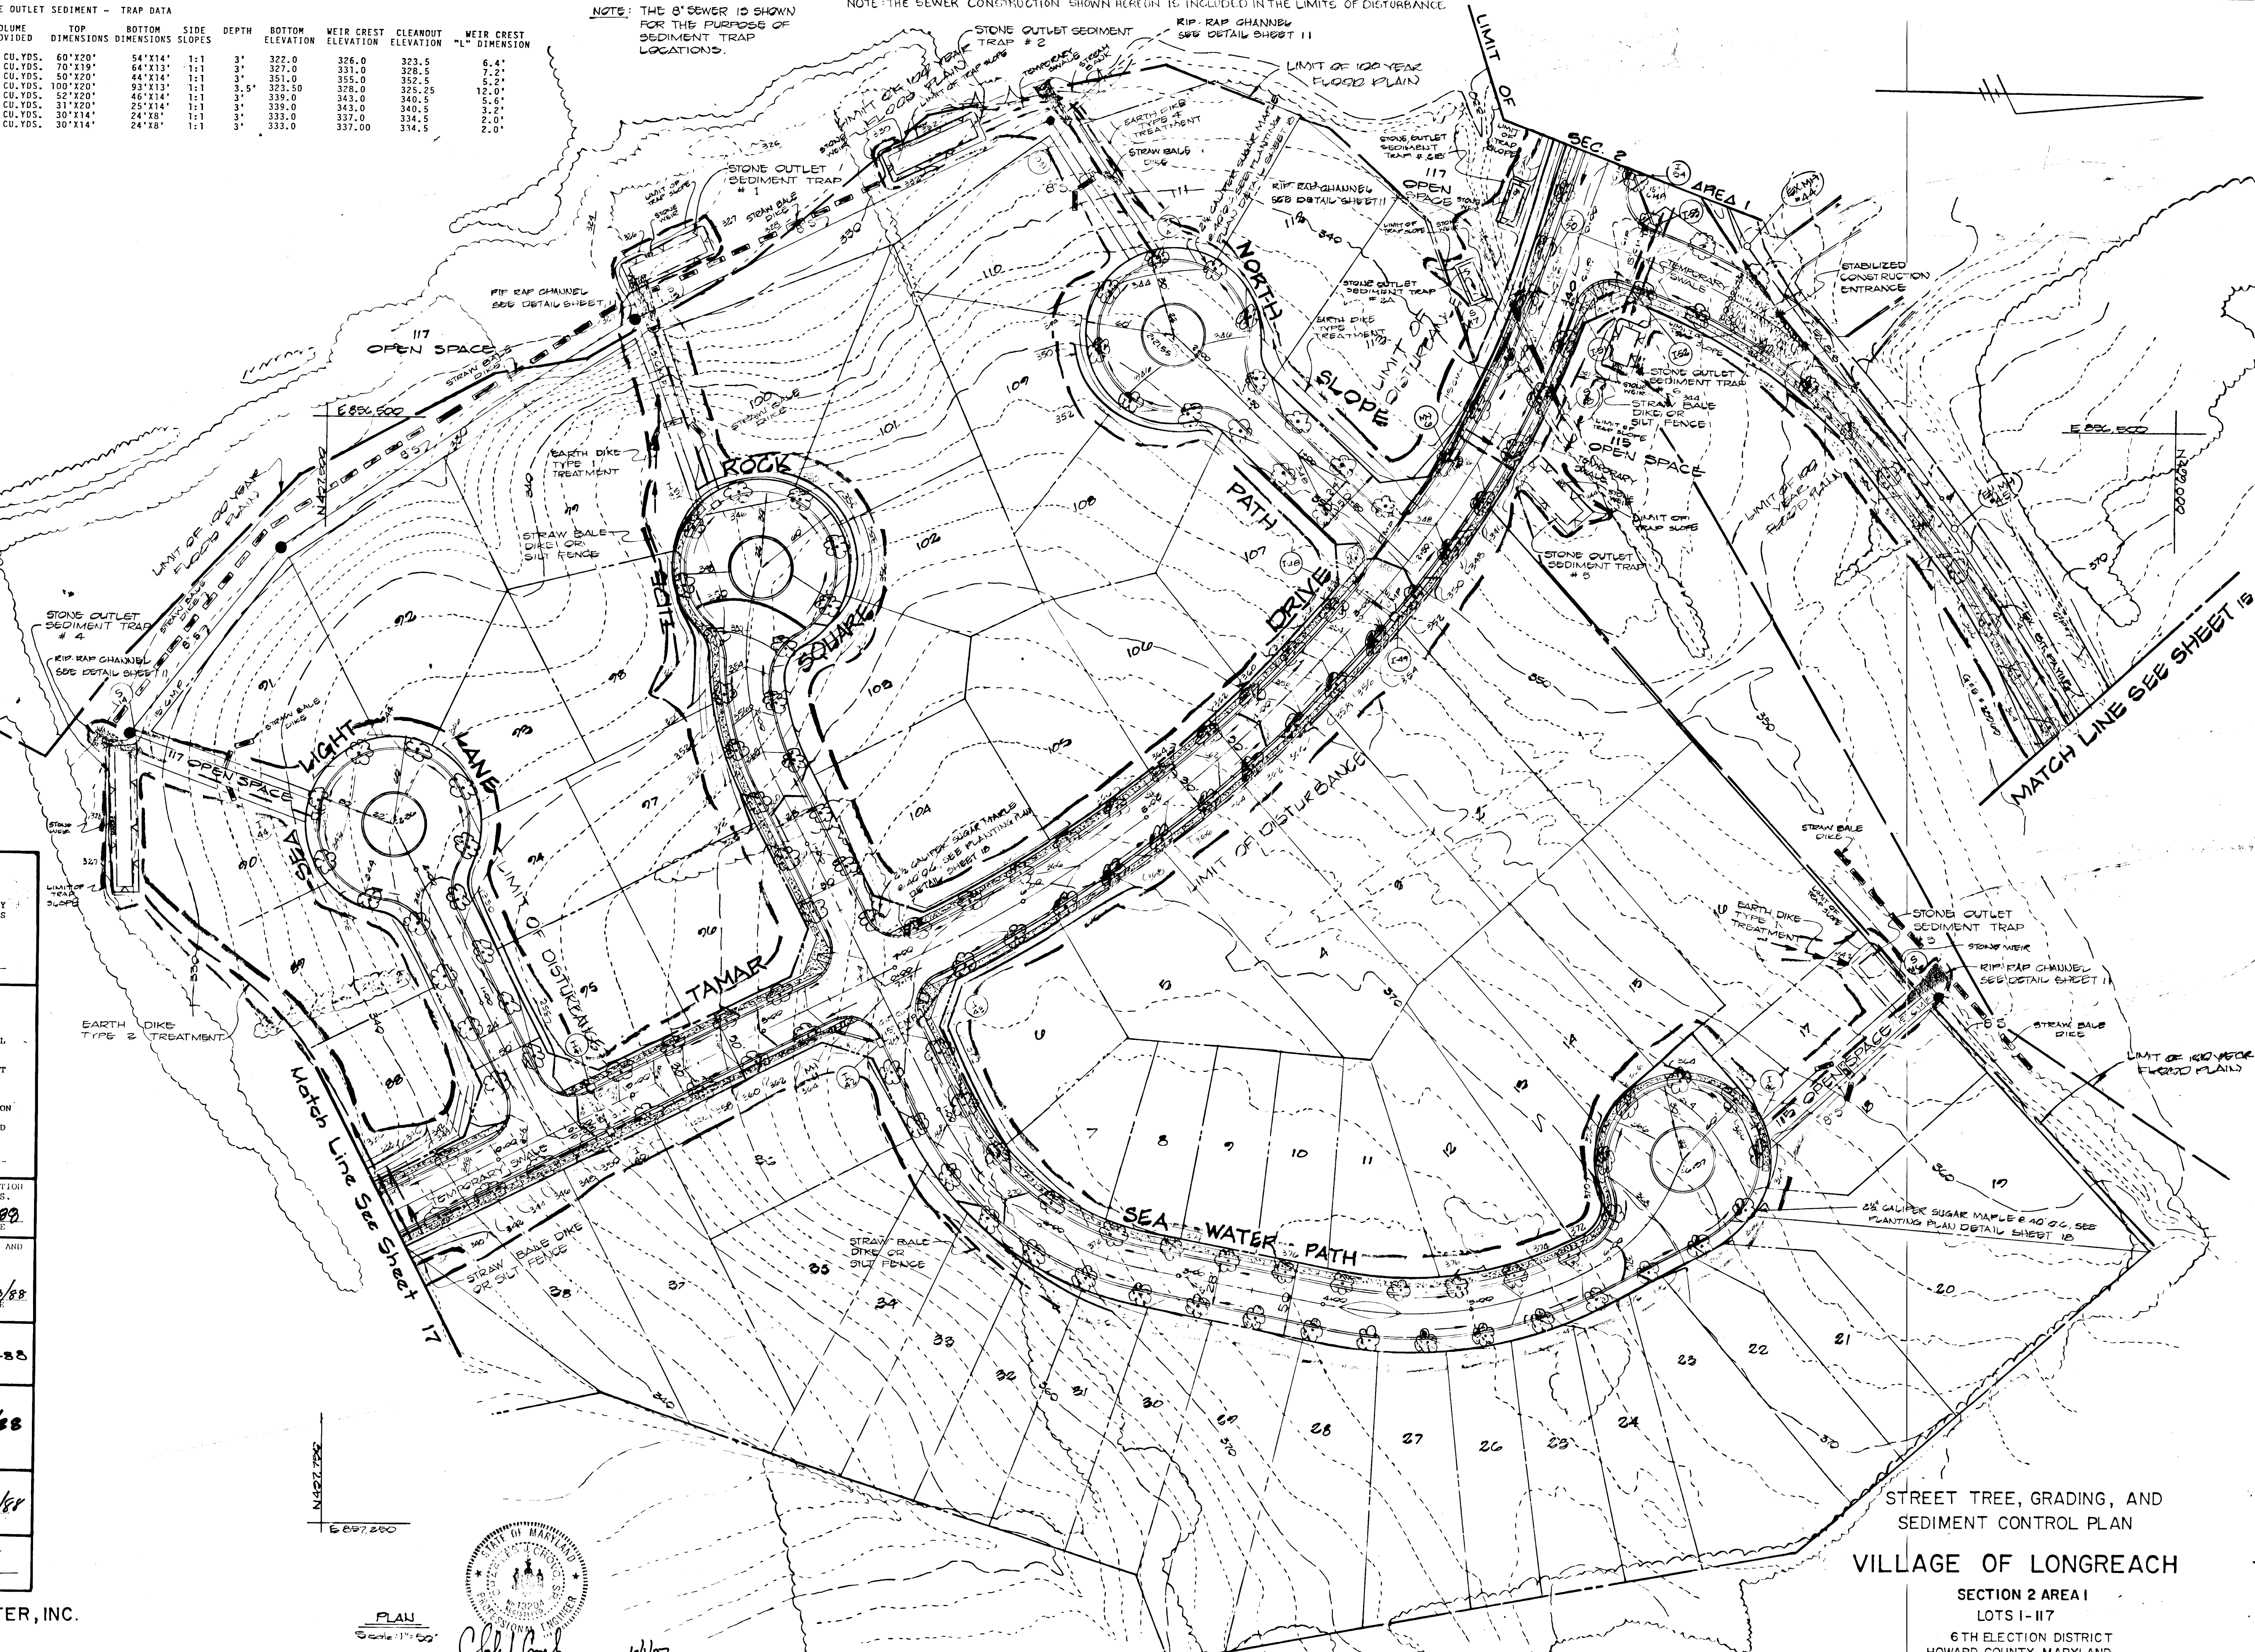

ENGINEER'S CERTIFICATE
I HEREBY CERTIFY THAT THIS PLAN FOR EROSION AND SEDIMENT CONTROL REPRESENTS A PRACTICAL AND WORKABLE PLAN BASED ON MY PERSONAL KNOWLEDGE OF THE SITE CONDITIONS AND THAT IT WAS PREPARED IN ACCORDANCE WITH THE REQUIREMENTS OF THE HOWARD SOIL CONSERVATION DISTRICT.

Charles J. Crovo, Sr. 10/1/87
SIGNATURE OF ENGINEER DATE

DEVELOPER'S CERTIFICATE
I HEREBY CERTIFY THAT ALL DEVELOPMENT AND CONSTRUCTION WILL BE DONE ACCORDING TO THIS PLAN OF DEVELOPMENT AND PLAN FOR EROSION AND SEDIMENT CONTROL AND THAT ALL RESPONSIBLE PERSONNEL INVOLVED IN THE CONSTRUCTION PROJECT WILL HAVE A CERTIFICATE OF ATTENDANCE AT A DEPARTMENT OF NATURAL RESOURCES APPROVED TRAINING PROGRAM FOR THE CONTROL OF SEDIMENT AND EROSION BEFORE BEGINNING THE PROJECT. I ALSO AUTHORIZE PERIODIC ON-SITE INSPECTION BY THE HOWARD SOIL CONSERVATION DISTRICT OR THEIR AUTHORIZED AGENTS, AS ARE DEEMED NECESSARY.

Stephen R. Huber 10-1-87
SIGNATURE OF DEVELOPER DATE

REVIEWED FOR HOWARD COUNTY SOIL CONSERVATION DISTRICT AND MEETS TECHNICAL REQUIREMENTS.
J. Helmutz 1-20-89
U.S. SOIL CONSERVATION DISTRICT DATE

THIS DEVELOPMENT IS APPROVED FOR EROSION AND SEDIMENT CONTROL BY THE HOWARD SOIL CONSERVATION DISTRICT.
Stephen R. Huber 1/20/88
DISTRICT HOWARD SOIL CONSERVATION DISTRICT DATE

APPROVED: DEPARTMENT OF PUBLIC WORKS
William E. Ryan 1-22-88
CHIEF, BUREAU OF ENGINEERING DATE

APPROVED: OFFICE OF PLANNING AND ZONING
James R. Batten 1/26/88
CHIEF, PLANNING AND LAND DEVELOPMENT DATE

APPROVED: DEPARTMENT OF PUBLIC WORKS
Dannille W. Halstead 1/16/88
CHIEF, BUREAU OF HIGHWAYS DATE

APPROVED: DEPARTMENT OF PUBLIC WORKS
Charles J. Crovo, Sr. 1-21-88
CHIEF, LAND DEVELOPMENT DIVISION DATE

FISHER, COLLINS & CARTER, INC.
CIVIL ENGINEERS & LAND SURVEYORS
8388 COURT AVENUE
ELLICOTT CITY, MARYLAND 21043

PLAN
Scale: 1" = 50'
Charles J. Crovo, Sr. 10/1/87
DATE

STREET TREE, GRADING, AND
SEDIMENT CONTROL PLAN
VILLAGE OF LONGREACH

SECTION 2 AREA I
LOTS 1-117
6TH ELECTION DISTRICT
HOWARD COUNTY, MARYLAND



SCALE AS SHOWN SHEET 16 OF 18 SEPTEMBER 24, 1987

STONE OUTLET SEDIMENT - TRAP DATA

TRAP #	DRAINAGE AREA	VOLUME REQUIRED	VOLUME PROVIDED	TOP DIMENSIONS	BOTTOM DIMENSIONS	SLOPE	DEPTH	BOTTOM ELEVATION	WEIR CREST ELEVATION	CLEAROUT ELEVATION	WEIR CREST ELEVATION	"L" DIMENSION
7	4.0 AC.	357 CU. YDS.	359 CU. YDS.	120'x22'	112'x15'	1:1	4'	316.50	321.50	318.50	19.6'	
8	2.0 AC.	133 CU. YDS.	134 CU. YDS.	51'x22'	45'x22'	1:1	3'	332.0	336.0	333.5	8'	
9	3.5 AC.	324 CU. YDS.	326 CU. YDS.	100'x22'	100'x17'	1:1	4'	314.0	319.00	316.00	14'	
10	0.5 AC.	34 CU. YDS.	34 CU. YDS.	30'x14'	24'x8'	1:1	3'	331.00	335.00	332.5	14'	

Note: The 8" Sewer is Shown For the Purpose of Sediment Trap Locations.

NOTE: THE SEWER CONSTRUCTION SHOWN HEREON IS INCLUDED IN THE LIMITS OF DISTURBANCE.

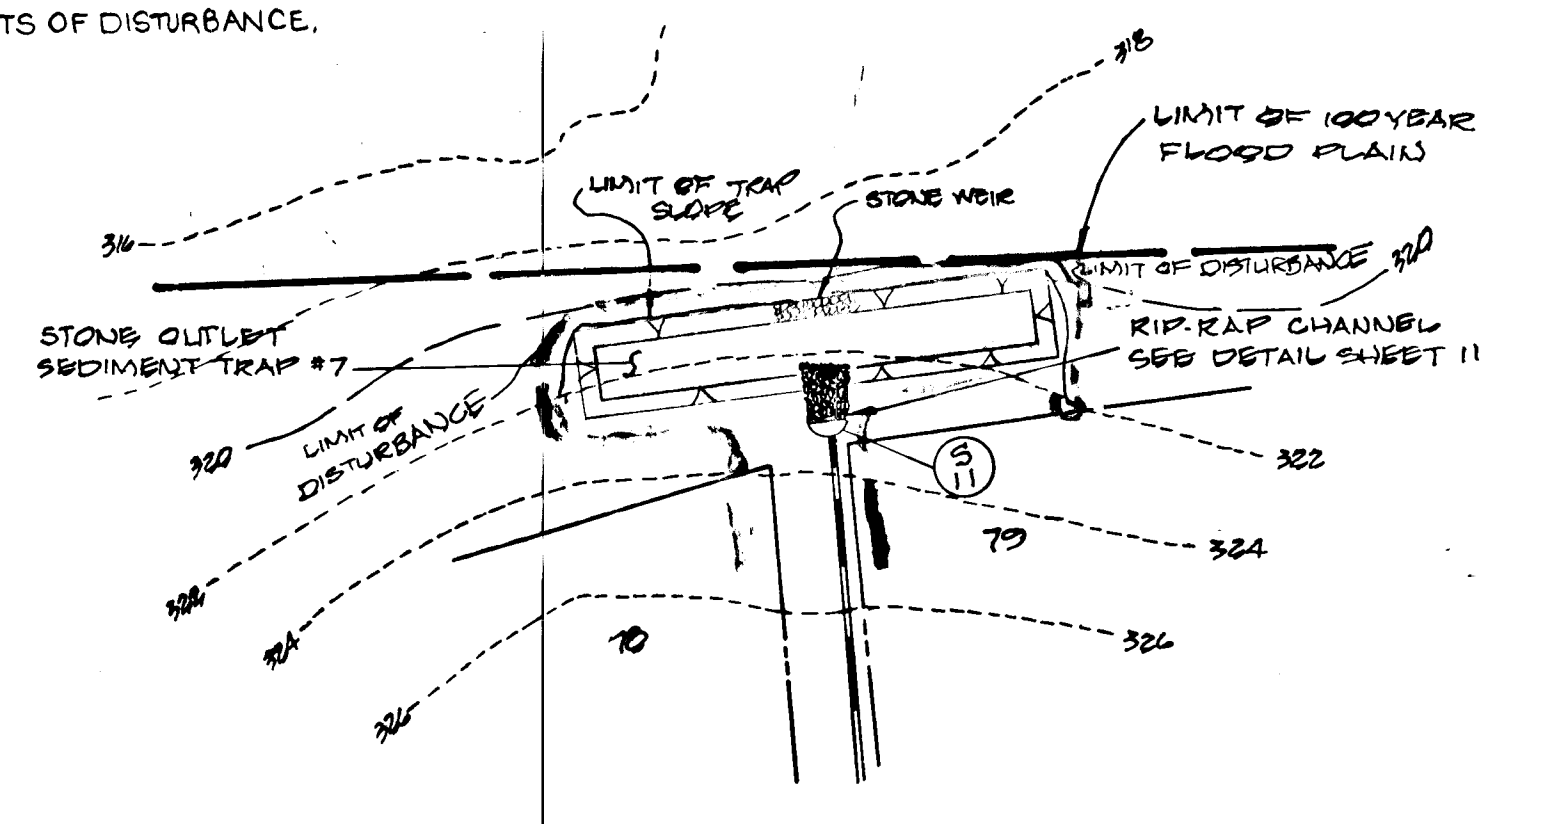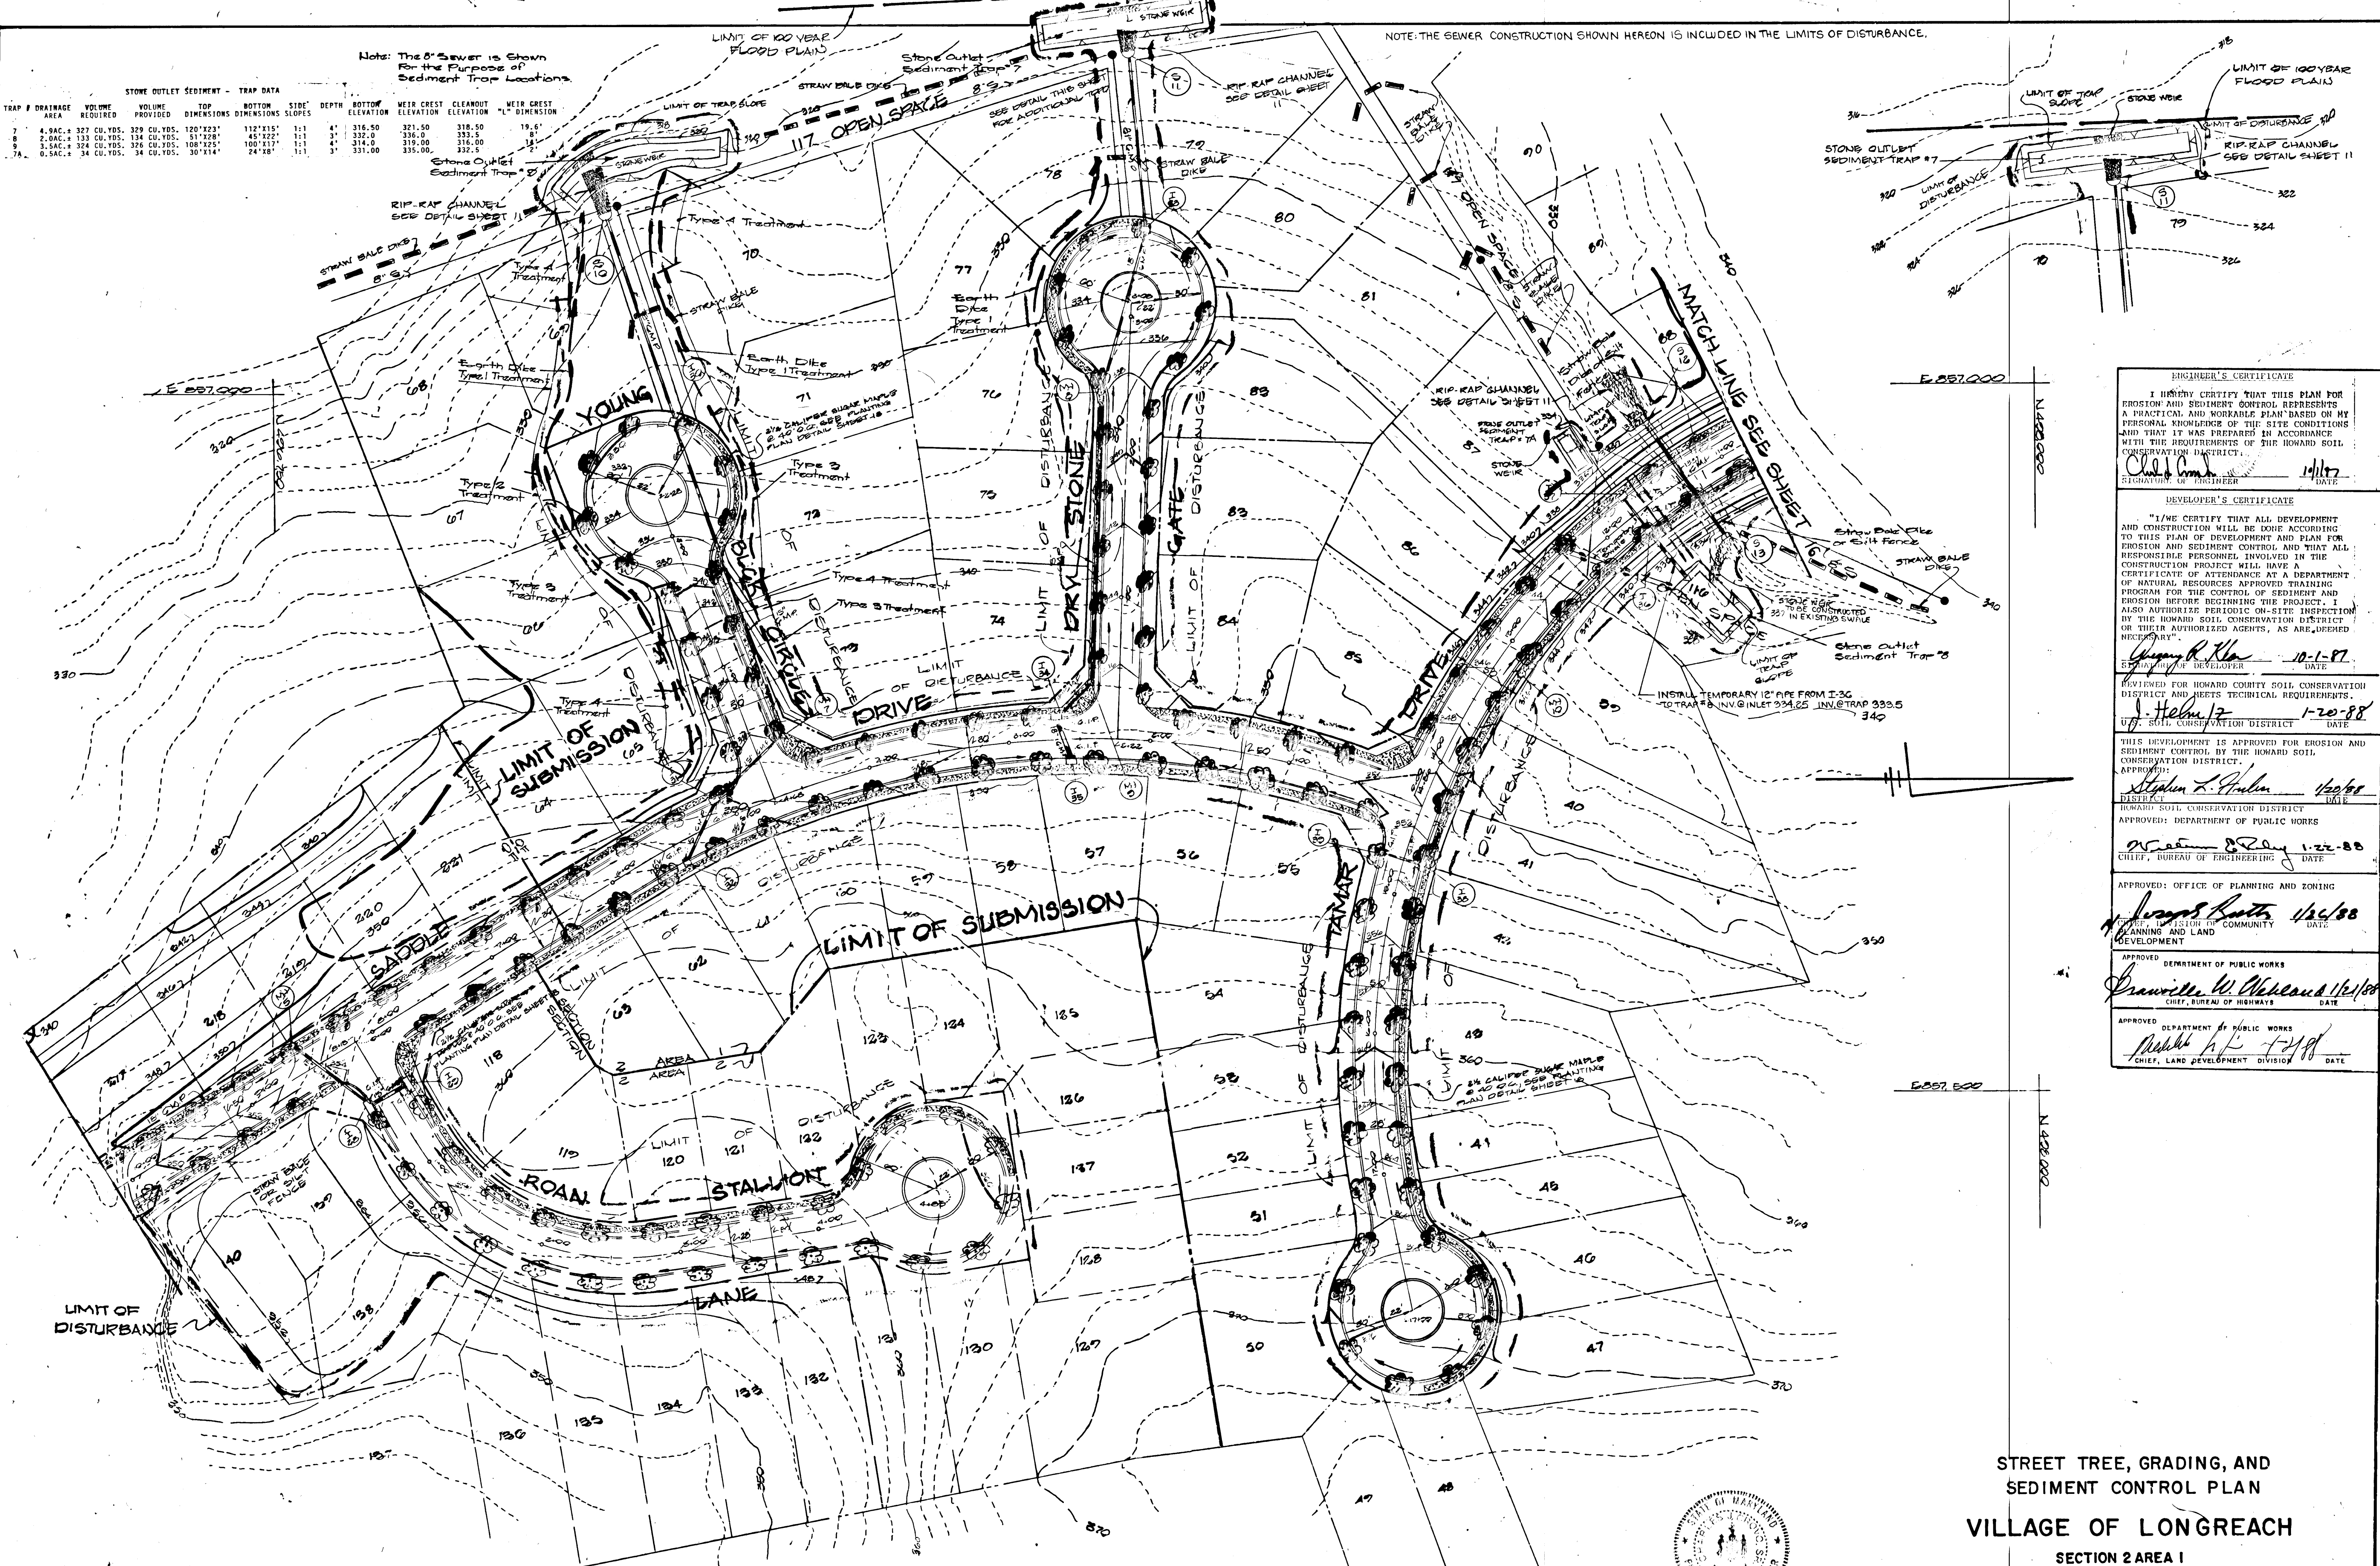

ENGINEER'S CERTIFICATE
 I HEREBY CERTIFY THAT THIS PLAN FOR EROSION AND SEDIMENT CONTROL REPRESENTS A PRACTICAL AND WORKABLE PLAN BASED ON MY PERSONAL KNOWLEDGE OF THE SITE CONDITIONS AND THAT IT WAS PREPARED IN ACCORDANCE WITH THE REQUIREMENTS OF THE HOWARD SOIL CONSERVATION DISTRICT.
 Signature: Charles J. Crovo Sr. DATE: 10/1/87
 SIGNATURE OF ENGINEER DATE

DEVELOPER'S CERTIFICATE
 I/WE CERTIFY THAT ALL DEVELOPMENT AND CONSTRUCTION WILL BE DONE ACCORDING TO THIS PLAN OF DEVELOPMENT AND PLAN FOR EROSION AND SEDIMENT CONTROL AND THAT ALL RESPONSIBLE PERSONNEL INVOLVED IN THE CONSTRUCTION PROJECT WILL HAVE A CERTIFICATE OF ATTENDANCE AT A DEPARTMENT OF NATURAL RESOURCES APPROVED TRAINING PROGRAM FOR THE CONTROL OF SEDIMENT AND EROSION BEFORE BEGINNING THE PROJECT. I ALSO AUTHORIZE PERIODIC ON-SITE INSPECTION BY THE HOWARD SOIL CONSERVATION DISTRICT OR THEIR AUTHORIZED AGENTS, AS DEEMED NECESSARY.
 Signature: Gregory R. Kline DATE: 10-1-87
 SIGNATURE OF DEVELOPER DATE

APPROVED FOR HOWARD COUNTY SOIL CONSERVATION DISTRICT AND MEETS TECHNICAL REQUIREMENTS
 Signature: J. Helm DATE: 1-20-88
 U.S. SOIL CONSERVATION DISTRICT DATE

THIS DEVELOPMENT IS APPROVED FOR EROSION AND SEDIMENT CONTROL BY THE HOWARD SOIL CONSERVATION DISTRICT.
 APPROVED:
 Signature: Stephen L. Galbraith DATE: 12/01/87
 DISTRICT
 HOWARD SOIL CONSERVATION DISTRICT
 APPROVED: DEPARTMENT OF PUBLIC WORKS
 Signature: W. R. Kelly DATE: 1-22-88
 CHIEF, BUREAU OF ENGINEERING DATE

APPROVED: OFFICE OF PLANNING AND ZONING
 Signature: August Smith DATE: 1/21/88
 PLANNING AND LAND DEVELOPMENT

APPROVED DEPARTMENT OF PUBLIC WORKS
 Signature: Draville W. Chelmsford DATE: 1/21/88
 CHIEF, BUREAU OF HIGHWAYS DATE

APPROVED DEPARTMENT OF PUBLIC WORKS
 Signature: [Signature] DATE: 1/21/88
 CHIEF, LAND DEVELOPMENT DIVISION DATE

FISHER, COLLINS & CARTER, INC.
 CIVIL ENGINEERS & LAND SURVEYORS
 8388 COURT AVENUE
 ELLICOTT CITY, MARYLAND 21043

OWNER AND DEVELOPER
 THE HOWARD RESEARCH AND
 DEVELOPMENT LAND COMPANY
 10275 LITTLE PATUXENT PARKWAY
 COLUMBIA, MARYLAND 21044

PLAN
 Scale: 1"=50'

Signature: Charles J. Crovo Sr. DATE: 10/1/87
 CHARLES J. CROVO SR. DATE

STREET TREE, GRADING, AND
 SEDIMENT CONTROL PLAN
 VILLAGE OF LONGREACH

SECTION 2 AREA I
 LOTS 1-117
 6TH ELECTION DISTRICT
 HOWARD COUNTY, MARYLAND

SCALE AS SHOWN SHEET 17 OF 18 SEPTEMBER 24, 1987

AS-BUILT JAN. 15, 1992 F 88-78

PERMANENT SEEDING NOTES:
 APPLY TO GRADED OR CLEARED AREA NOT SUBJECT TO IMMEDIATE FURTHER DISTURBANCE WHERE A PERMANENT LONG-LIVED VEGETATIVE COVER IS NEEDED.
SEEDBED PREPARATION: LOOSEN UPPER THREE-INCHES OF SOIL BY RAKING, DISCING OR OTHER ACCEPTABLE MEANS BEFORE SEEDING, IF NOT PREVIOUSLY LOGGED.
SOIL AMENDMENTS: IN LIEU OF SOIL TEST RECOMMENDATIONS, USE ONE OF THE FOLLOWING SCHEDULE:

- 1) PREFERRED -** APPLY 2 TONS PER ACRE DOLOMITIC LIMESTONE (92 LBS/1000 SQ. FT.) AND 600 LBS PER ACRE 10-10-10 FERTILIZER (14 LBS/1000 SQ. FT.) BEFORE SEEDING. HARROW OR DISC INTO UPPER THREE-INCHES OF SOIL. AT TIME OF SEEDING, APPLY 400 LBS. PER ACRE 30-0-0 UREAFORM FERTILIZER (9 LBS/1000 SQ. FT.).
- 2) ACCEPTABLE -** APPLY 2 TONS PER ACRE DOLOMITIC LIMESTONE (92 LBS/1000 SQ. FT.) AND 1000 LBS PER ACRE 10-10-10 FERTILIZER (23 LBS/1000 SQ. FT.) BEFORE SEEDING. HARROW OR DISC INTO UPPER THREE-INCHES OF SOIL.

SEEDING: FOR PERIODS MARCH 1 THRU APRIL 30, AND AUGUST 1 THRU OCTOBER 15, SEED WITH 50 LBS PER ACRE OF ANNUAL RYE (3.2 LBS/1000 SQ. FT.). FOR THE PERIOD MAY 1 THRU JULY 31, SEED WITH 60 LBS KENTUCKY 31 TALL FESCUE PER ACRE AND 2 LBS PER ACRE (.05 LBS/1000 SQ. FT.) OF WEEPING LOVEGRASS. DURING THE PERIOD OF OCTOBER 16 THRU FEBRUARY 28, PROTECT SITE BY OPTION (1) 2 TONS PER ACRE OF WELL ANCHORED STRAW MULCH AND SEED AS SOON AS POSSIBLE IN THE SPRING. OPTION (2) USE SOD. OPTION (3) SEED WITH 60 LBS/ACRE KENTUCKY 31 TALL FESCUE AND MULCH WITH 2 TONS/ACRE WELL ANCHORED STRAW.

MULCHING: APPLY 1 1/2 TO 2 TONS PER ACRE (70 TO 90 LBS/1000 SQ. FT.) OF UNWROTTEN SMALL GRAIN STRAW IMMEDIATELY AFTER SEEDING. ANCHOR MULCH IMMEDIATELY AFTER APPLICATION USING MULCH ANCHORING TOOL OR 218 GALLONS PER ACRE (5 GAL/1000 SQ. FT.) OF EMULSIFIED ASPHALT ON FLAT AREAS, ON SLOPES 8 FEET OR HIGHER, USE 348 GALLONS PER ACRE (8 GAL/1000 SQ. FT.) FOR ANCHORING.

MAINTENANCE: INSPECT ALL SEEDED AREAS AND MAKE NEEDED REPAIRS, REPLACEMENTS AND RESEEDINGS.

TEMPORARY SEEDING NOTES:
 APPLY TO GRADED OR CLEARED AREAS LIKELY TO BE REDISTURBED WHERE A SHORT-TERM VEGETATIVE COVER IS NEEDED.


SEEDBED PREPARATION: LOOSEN UPPER THREE-INCHES OF SOIL BY RAKING, DISCING OR OTHER ACCEPTABLE MEANS BEFORE SEEDING, IF NOT PREVIOUSLY LOGGED.

SOIL AMENDMENTS: APPLY 600 LBS PER ACRE 10-10-10 FERTILIZER (14 LBS/1000 SQ. FT.).

SEEDING: FOR PERIODS MARCH 1 THRU APRIL 30 AND FROM AUGUST 15 THRU NOVEMBER 15, SEED WITH 40 BUSHEL PER ACRE OF ANNUAL RYE (3.2 LBS/1000 SQ. FT.). FOR THE PERIOD MAY 1 THRU AUGUST 14, SEED WITH 3 LBS PER ACRE OF WEEPING LOVEGRASS (.07 LBS/1000 SQ. FT.). FOR THE PERIOD NOVEMBER 16 THRU FEBRUARY 28, PROTECT SITE BY APPLYING 2 TONS PER ACRE OF WELL ANCHORED STRAW MULCH AND SEED AS SOON AS POSSIBLE IN THE SPRING, OR USE SOD.

MULCHING: APPLY 1 1/2 TO 2 TONS PER ACRE (70 TO 90 LBS/1000 SQ. FT.) OF UNWROTTEN SMALL GRAIN STRAW IMMEDIATELY AFTER SEEDING. ANCHOR MULCH IMMEDIATELY AFTER APPLICATION USING MULCH ANCHORING TOOL OR 218 GAL PER ACRE (5 GAL/1000 SQ. FT.) OF EMULSIFIED ASPHALT ON FLAT AREAS, ON SLOPES, 8 FT. OR HIGHER, USE 348 GAL PER ACRE (8 GAL/1000 SQ. FT.) FOR ANCHORING.

REFER TO THE 1983 MARYLAND STANDARDS AND SPECIFICATIONS FOR SOIL EROSION AND SEDIMENT CONTROL FOR RATE AND METHODS NOT COVERED.

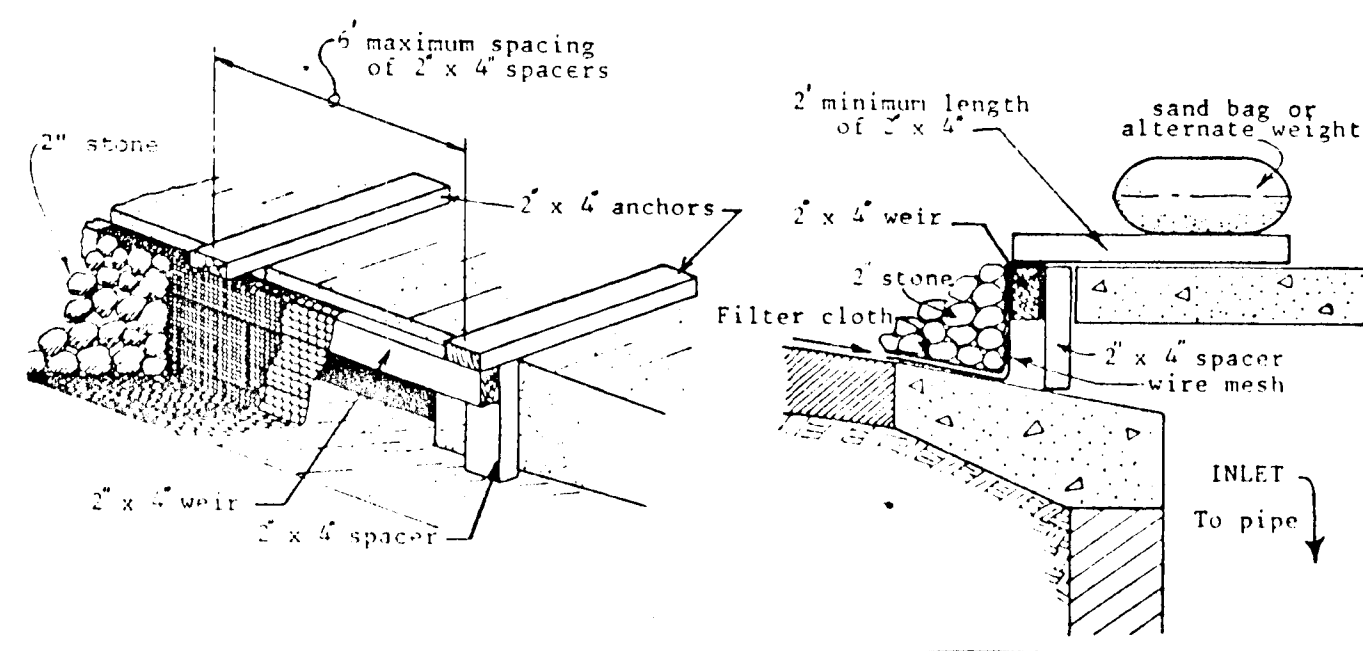


B. Curb Inlet Protection.

1. Attach a continuous piece of wire mesh (30" min. width by throat length plus 4") to the 2" x 4" weir (measuring throat length plus 2") as shown on the standard drawing.
2. Place a piece of approved filter cloth (40-85 sieve) of the same dimensions as the wire mesh over the wire mesh and securely attach to the 2" x 4" weir.
3. Securely nail the 2" x 4" weir to 9" long vertical spacers to be located between the weir and inlet face (max. 6' apart).
4. Place the assembly against the inlet throat and nail (minimum 2' lengths of 2" x 4" to the top of the weir at spacer locations. These 2" x 4" anchors shall extend across the inlet top and be held in place by sandbags or alternate weight.
5. The assembly shall be placed so that the end spacers are a minimum 1' beyond both ends of the throat opening.
6. Form the wire mesh and filter cloth to the concrete gutter and against the face of curb on both sides of the inlet. Place clean 2" stone over the wire mesh and filter fabric in such a manner as to prevent water from entering the inlet under or around the filter cloth.
7. This type of protection must be inspected frequently and the filter cloth and stone replaced when clogged with sediment.
8. Assume that storm flow does not bypass inlet by installing temporary earth or asphalt dikes directing flow into inlet.


Maximum Drainage Area: 5 Acres

STONE OUTLET SEDIMENT TRAP

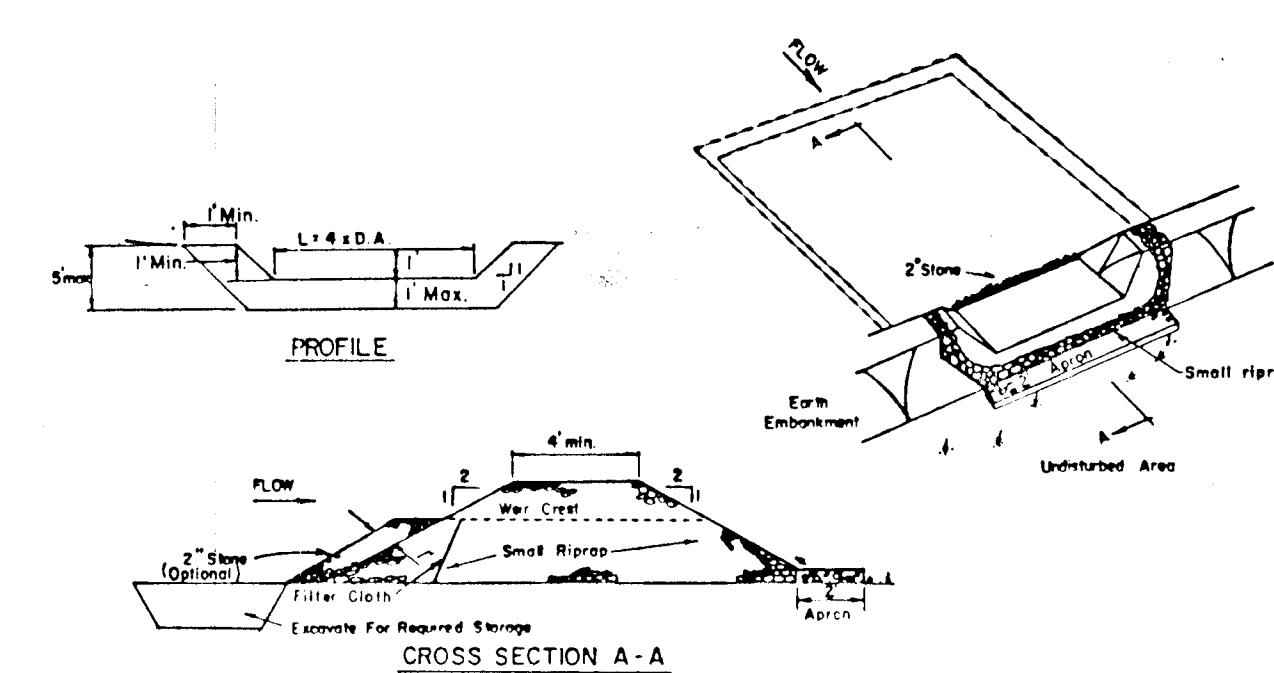

OPTION: A one foot layer of 2" stone may be placed on the upstream side of the riprap in place of the embedded filter cloth.


- CONSTRUCTION SPECIFICATIONS FOR ST-1**
1. Area under embankment shall be cleared, grubbed and skinned of any vegetation and root mat. The pool area shall be cleared.
 2. The fill material for the embankment shall be free of roots and other woody vegetation as well as oversized stones, rocks, organic material or other objectionable material. The embankment shall be compacted by traversing with equipment while it is being constructed.
 3. All cut and fill slopes shall be 2:1 or flatter.
 4. The stone used in the outlet shall be small riprap 4"-8" along with a 1' thickness of 2" aggregate placed on the upgrade side on the small riprap \pm embedded filter cloth in the trap.
 5. Sediment shall be removed and trap restored to its original dimensions when the sediment has accumulated to 1/2 the design depth of the trap.
 6. The structure shall be inspected after each rain and repairs made as needed.
 7. Construction operations shall be carried out in such a manner that erosion and water pollution is minimized.
 8. The structure shall be removed and the area stabilized when the drainage area has been properly stabilized.

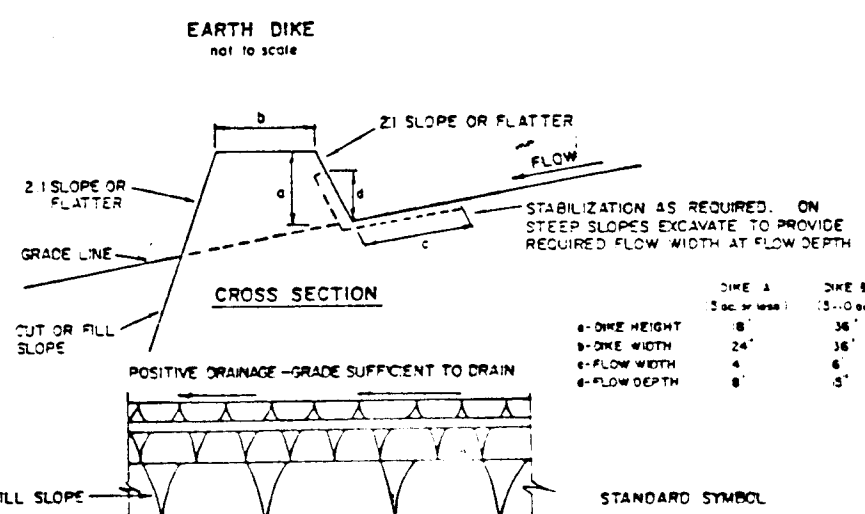


- CONSTRUCTION SPECIFICATIONS**
1. All dikes shall be compacted by earth-moving equipment.
 2. Top width shall be 4 feet and 4:1 slopes may be flatter if desired to facilitate crossing by construction traffic.
 3. Each dike shall be designed as needed to utilize a stabilized safe outlet. EARTH DIKES SHALL HAVE AN OUTLET THAT FUNCTIONS WITH A MINIMUM OF EROSION. PLACES SHALL BE DESIGNED TO PROVIDE TRAPPING DEVICES SUCH AS SEDIMENT TRAP OR SEDIMENT BASIN WHERE EITHER THE DIKE CHANNEL, OR THE DRAINAGE AREA ABOVE THE DIKE ARE NOT ADEQUATELY STABILIZED.
 4. Stabilization shall be (A) in accordance with STANDARD SPECIFICATIONS FOR SEED AND STRAW MULCH OR STRAW MULCH IF NOT IN SEEDING SEASON, (B) FLOW CHANNEL AS PER THE CHART BELOW.

TYPE OF TREATMENT	CHANNEL SIZE	DIKE A	DIKE B
1	5-5.00	SEED AND STRAW MULCH	SEED AND STRAW MULCH
2	3.1-5.00	SEED USING JUTE OR EXCELLENT SOD; 2" STONE	SEED USING JUTE OR EXCELLENT SOD; 2" STONE
3	5.1-8.00	SEED WITH JUTE OR SOD	LINED RIP-RAP 4-8"
4	8.1-20.00	LINED RIP-RAP 4-8"	ENGINEERING DESIGN

A. Stone to be 2 inch stone, or recycled concrete equivalent, in a layer at least 3 inches in thickness and be pressed into the soil with construction equipment.
 B. Rip-rap to be 2 inches thick in a layer at least 5 inches thickness and pressed into the soil.
 C. Approved Equivalents can be substituted for any of the above materials.
 D. Periodic inspection and required maintenance must be provided after each rain event.

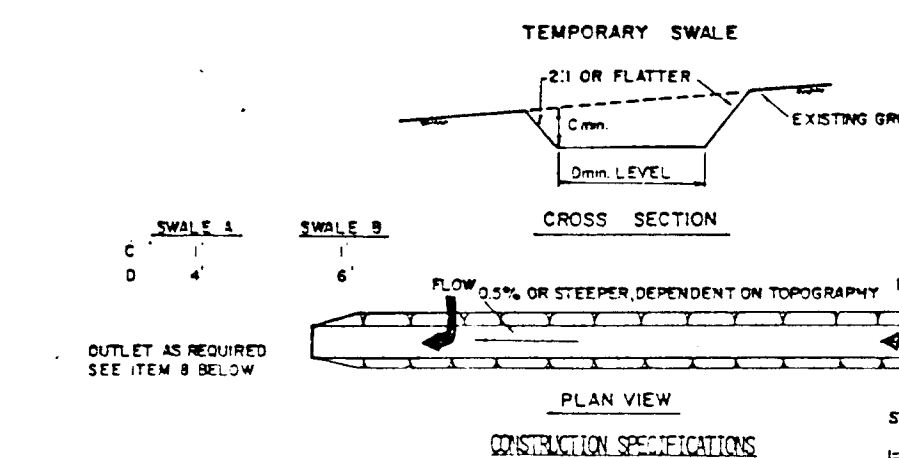

1. All temporary swales shall have uninterupted positive grade to an outlet.
 2. Diverted runoff from a disturbed area shall be conveyed to a sediment trapping device.
 3. Diverted runoff from an undisturbed area shall outlet directly into an undisturbed stabilized area at non-erosive velocity.
 4. All trees, brush, stumps, obstructions, and other objectionable material shall be removed and disposed of so as not to interfere with the proper functioning of the swale.
 5. The swale shall be elevated or shaped to line, grade, and cross section as required to meet the criteria specified herein and be free of bank projections or other irregularities which will impede runoff.
 6. Fills shall be compacted by earth moving equipment.
 7. All earth removed and not needed on construction shall be placed so that it will not interfere with the functioning of the swale.
 8. Stabilization shall be as per the chart below:
- | TYPE OF TREATMENT | CHANNEL SIZE | A (5 AC OR LESS) | B (5 AC - 10 AC) |
|-------------------|--------------|----------------------------------|----------------------------------|
| 1 | 0.5-3.00 | SEED AND STRAW MULCH | SEED AND STRAW MULCH |
| 2 | 3.1-5.00 | SEED USING JUTE OR EXCELLENT SOD | SEED USING JUTE OR EXCELLENT SOD |
| 3 | 5.1-8.00 | SEED WITH JUTE OR EXCELLENT SOD | LINED RIP-RAP 4-8" |
| 4 | 8.1-20.00 | LINED 4-8" RIP-RAP | ENGINEERING DESIGN |
9. Periodic inspection and required maintenance must be provided after each rain event.

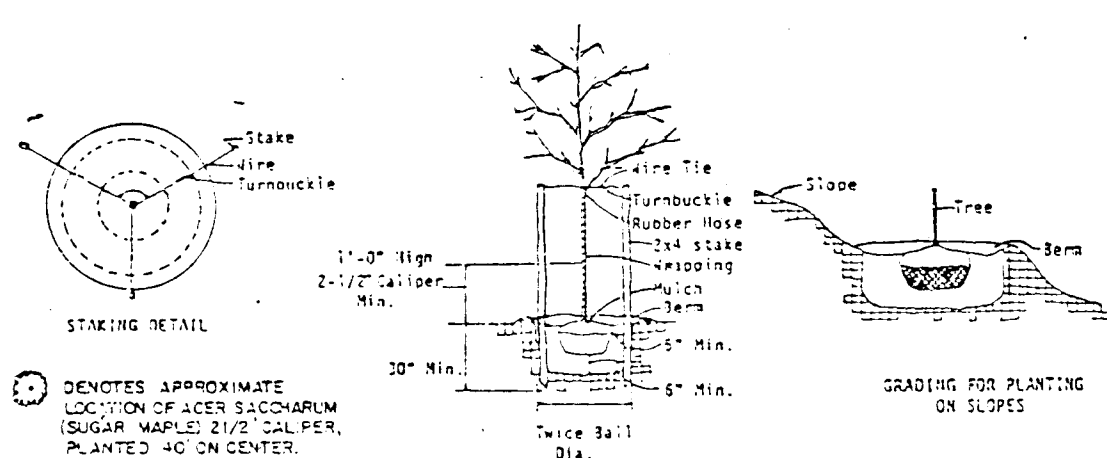

STREET TREES:
 THE LOCATIONS, TYPE AND NUMBER OF TREES SHOWN ON THESE PLANS ARE TENTATIVE AND ARE USED FOR BOND PURPOSES ONLY. THE FINAL LOCATION AND VARIETY OF TREES MAY VARY TO ACCOMMODATE FIELD CONDITIONS AND BUILDERS LANDSCAPE PROGRAM. BOND RELEASE IS CONTINGENT UPON SECTION 16.131 OF THE HOWARD COUNTY SUBDIVISION REGULATIONS, AS APPROVED BY THE OFFICE OF PLANNING AND ZONING.

FISHER, COLLINS AND CARTER INC.
 CIVIL ENGINEERS & LAND SURVEYORS
 8388 COURT AVENUE
 ELLICOTT CITY, MARYLAND 21043

CURB INLET PROTECTION DETAIL

STONE OUTLET SEDIMENT TRAP

ENGINEER'S CERTIFICATE
 I HEREBY CERTIFY THAT THIS PLAN FOR EROSION AND SEDIMENT CONTROL REPRESENTS A PRACTICAL AND WORKABLE PLAN BASED ON MY PERSONAL KNOWLEDGE OF THE SITE CONDITIONS AND THAT IT WAS PREPARED IN ACCORDANCE WITH THE REQUIREMENTS OF THE HOWARD SOIL CONSERVATION DISTRICT.
 Signature: *Charles J. Crovo* DATE: 10/1/87
 SIGNATURE OF ENGINEER DATE

DEVELOPER'S CERTIFICATE
 "I/WE CERTIFY THAT ALL DEVELOPMENT AND CONSTRUCTION WILL BE DONE ACCORDING TO THIS PLAN OF DEVELOPMENT AND PLAN FOR EROSION AND SEDIMENT CONTROL AND THAT ALL RESPONSIBLE PERSONNEL INVOLVED IN THE CONSTRUCTION PROJECT WILL HAVE A CERTIFICATE OF ATTENDANCE AT A DEPARTMENT OF NATURAL RESOURCES APPROVED TRAINING PROGRAM FOR THE CONTROL OF SEDIMENT AND EROSION BEFORE BEGINNING THE PROJECT. I ALSO AUTHORIZE PERIODIC ON-SITE INSPECTION BY THE HOWARD SOIL CONSERVATION DISTRICT OR THEIR AUTHORIZED AGENTS, AS ARE DEEMED NECESSARY."
 Signature: *James R. Klan* DATE: 10-1-87
 SIGNATURE OF DEVELOPER DATE

REVIEWED FOR HOWARD COUNTY SOIL CONSERVATION DISTRICT AND MEETS TECHNICAL REQUIREMENTS.
 Signature: *J. Helms* DATE: 1-20-88
 U.S. SOIL CONSERVATION DISTRICT DATE


THIS DEVELOPMENT IS APPROVED FOR EROSION AND SEDIMENT CONTROL BY THE HOWARD SOIL CONSERVATION DISTRICT.
 Signature: *Stephen R. Fisher* DATE: 1/20/88
 DISTRICT HOWARD SOIL CONSERVATION DISTRICT DATE

APPROVED: DEPARTMENT OF PUBLIC WORKS
 Signature: *D. J. ...* DATE: 1-22-88
 CHIEF, BUREAU OF ENGINEERING DATE

APPROVED: OFFICE OF PLANNING AND ZONING
 Signature: *Joseph ...* DATE: 1/26/88
 CHIEF, DIVISION OF COMMUNITY PLANNING AND LAND DEVELOPMENT DATE

APPROVED DEPARTMENT OF PUBLIC WORKS
 Signature: *Traville W. Wehner* DATE: 1/14/88
 CHIEF, BUREAU OF HIGHWAYS DATE

APPROVED DEPARTMENT OF PUBLIC WORKS
 Signature: *Robert L. P.* DATE: 1-21-88
 CHIEF, LAND DEVELOPMENT DIVISION DATE

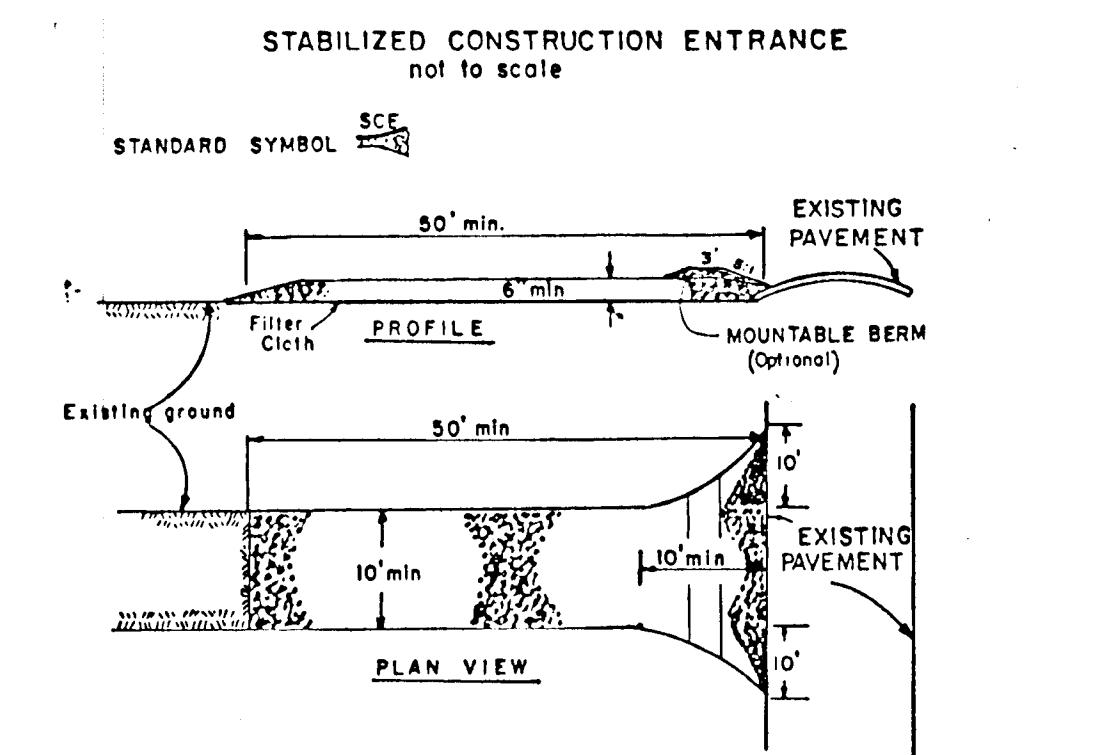

- CONSTRUCTION SPECIFICATIONS**
1. Stone Size - Use 2" stone, or recycled or recycled concrete equivalent.
 2. Length - As required, but not less than 50 feet (except on a single residence lot where a 30 foot minimum length would apply).
 3. Thickness - Not less than six (6) inches.
 4. Width - Ten (10) foot minimum, but not less than the full width at points where ingress or egress occurs.
 5. Filter Cloth - Must be placed over the entire area prior to placing of stone. Filter will not be required on a single family residence lot.
 6. Surface Water - All surface water flowing or diverted toward construction entrance shall be piped across the entrance. If piping is impractical, a mountable beam with 5:1 slopes will be permitted.
 7. Maintenance - The entrance shall be maintained in a condition which will prevent tracking or flowing of sediment onto public rights-of-way. This may require periodic top dressing with additional stone as conditions demand and repair and/or cleanout of any measures used to trap sediment. All sediment applied, dropped, washed or tracked onto public rights-of-way must be removed immediately.
 8. Washing - Wheels shall be cleaned to remove sediment prior to entrance onto public rights-of-way. When washing is required, it shall be done on an area stabilized with stone and which drains into an approved sediment trapping device.
 9. Periodic inspection and needed maintenance shall be provided after each rain.

- CONSTRUCTION SEQUENCE:**
1. OBTAIN GRADING PERMIT.
 2. PLACE STONE CONSTRUCTION ENTRANCE AS SHOWN ON PLAN.
 3. INSTALL SILT FENCE OR STRAW BALE DIKES AS SHOWN ON PLAN.
 4. CONSTRUCT SEDIMENT TRAPS, EARTH DIKES AND TEMPORARY SWALES. STABILIZE WITH TEMPORARY SEEDING.
 5. CONSTRUCT STORM DRAIN SYSTEM FROM S-12 TO S-13.
 6. INSTALL SILT FENCE OR STRAW BALE DIKE ALONG UPGRADE SIDES OF THE EXCAVATION AT THE LIMITS OF DISTURBANCE - BOTH SIDES OF STREAM.
 7. GRADE ROADS TO SUBGRADE AND CONSTRUCT STORM DRAIN SYSTEM. CONSTRUCT CURB AND GUTTER AND INSTALL BASE COURSE.
 8. SEDIMENT SHALL BE REMOVED FROM THE SEDIMENT TRAPS WHEN THE ELEVATION LEAVEL HAS BEEN REACHED.
 9. THE CONTRACTOR SHALL INSPECT AND PROVIDE NECESSARY MAINTENANCE ON THE SEDIMENT AND EROSION CONTROL STRUCTURES SHOWN HEREON, AFTER EACH RAINFALL AND ON A DAILY BASIS.
 10. THE SEDIMENT TRAPS SHALL BE DETERMINED BY PUMPING. THE SEDIMENT FROM THE TRAPS SHALL BE PLACED UP-GRADE FROM THE SEDIMENT TRAPS IN SUCH A MANNER AS NOT TO INTERFERE WITH CONSTRUCTION OPERATIONS OR CAUSE EROSION DOWNGRADE FROM THE SEDIMENT TRAP.
 11. REMOVE SEDIMENT FROM ROADWAYS AND DRESS STONE CONSTRUCTION ENTRANCE AS REQUIRED.
 12. REMOVE INLET PROTECTION DEVICES AND FLUSH STORM DRAIN SYSTEM TO REMOVE ANY TRAPPED SEDIMENT. INSTALL RIP-RAP APRONS.
 13. REMOVE STONE CONSTRUCTION ENTRANCE AND STRAW BALE DIKE/SILT FENCE. CLEAN BASE COURSE. APPLY TACK COAT TO BASE COURSE AND LAY SURFACE COURSE.
 14. ALL DISTURBED AREAS DUE TO REMOVAL OF SEDIMENT CONTROL MEASURES SHALL BE GRADED AND STABILIZED WITH PERMANENT SEEDING MIXTURE.
 15. COMPLETE DRAINAGE AREA STABILIZATION MUST BE ACHIEVED PRIOR TO SEDIMENT CONTROL REMOVAL.
 - * 7) INSTALL TEMPORARY 12" PIPE FROM S-3 TO TRAP #6. LIMIT OF WORK FOR TAMAR DRIVE & STA. 44+53.25



STREET TREE, GRADING, AND SEDIMENT CONTROL PLAN
VILLAGE OF LONGREACH
 SECTION 2 AREA I
 LOTS I-117
 6TH ELECTION DISTRICT
 HOWARD COUNTY, MARYLAND
 SCALE AS SHOWN SHEET 18 OF 18 SEPTEMBER 24, 1987
 AS-BUILT JAN. 15, 1992 F 88-78