

ANTICIPATED POLES RELOCATION TO BE CONFIRMED BY BG&E AND AT&T PRIOR TO CONSTRUCTION.


NOTE: IMPROVEMENTS ON MD RTE 216 HAVE BEEN REVISED BASED ON MSHA'S COMMENTS DATED FEB 4, 1988.

VAN MALCOLM & DENNIS MALCOLM
1325/593

MARYLAND ROUTE 216
SCAGGSVILLE ROAD

- GENERAL NOTES
1. ALL STORM DRAIN & PAVING SHALL BE CONSTRUCTED IN ACCORDANCE WITH THE LATEST DETAILS AND SPECIFICATIONS OF HOWARD COUNTY & MD. STATE HIGHWAY ADMINISTRATION.
 2. TYPES OF STORM DRAIN STRUCTURES REFER TO THE STANDARD DETAILS OF HOWARD COUNTY & MD STATE HIGHWAY ADMINISTRATION.
 3. TRENCH COMPACTOR FOR STORM DRAINS WITHIN ROADS OR STREET RIGHS OF WAY LIMIT SHALL BE IN ACCORDANCE WITH THE LATEST HOWARD COUNTY ROAD CODE.
 4. INFORMATION CONCERNING UNDERGROUND UTILITIES WAS OBTAINED FROM AVAILABLE RECORDS, BUT THE CONTRACTOR MUST DETERMINE THE EXACT LOCATION AND ELEVATION OF THE MAINS BY DIGGING TEST PITS, BY HAND, AT ALL UTILITY CROSSINGS, WELL IN ADVANCE OF CONSTRUCTION.
 5. ALL UTILITY COMPANIES SHALL BE NOTIFIED 24 HRS. IN ADVANCE OF CONSTRUCTION, AT 1-800-257-7777.
 6. ALL TRAFFIC CONTROL SERVICES, PARKING AND SIGNING TO BE DONE IN ACCORDANCE WITH THE "MANUAL OF UNIFORM TRAFFIC CONTROL DEVICES" (MUTCD) 4TH EDITION.
 7. SAC & CREST VERTICAL CURVES WERE DESIGNED IN ACCORDANCE WITH HOWARD COUNTY DESIGN MANUAL VOLUME III, ROADS & BRIDGES.
 8. MIN. COVER OF 12" SHALL BE PROVIDED OVER STORM DRAIN PIPES ON ALL AREAS NOT BEING FINAL GRADED BY THESE PLANS.
 9. DESIGN SPEED: 35 M.P.H.
 10. ALL HORIZONTAL AND VERTICAL CONTROLS BASED ON MARYLAND STATE DATUM.
 11. TOPOGRAPHY ALONG PROPOSED AND EXISTING ROADS WAS SURVEYED BY KIDDE CONSULTANTS, INC. (100' ON BOTH SIDES OF THE CENTERLINE OF PROPOSED ROAD)
 12. SEE ALSO: S-85-55 AND: P-87-14
 13. EOWING: R 41.03 ACRES
 14. A 4.0 FOOT LONG SECTION OF HO. CO. STD CONCRETE CURB AND GUTTER SHALL BE PROVIDED ON BOTH SIDES OF ALL INLETS.

NOTE: ALL MARYLAND ROUTE 216 ROAD IMPROVEMENTS ARE BASED ON STATE HIGHWAY ADMINISTRATION REQUIREMENTS FOR MSHA CONCRETE CURB AND ROAD IMPROVEMENTS SECTIONS. REFER TO SHEET 6099.
RELOCATION OF GUARD RAIL PER MSHA PERMIT.

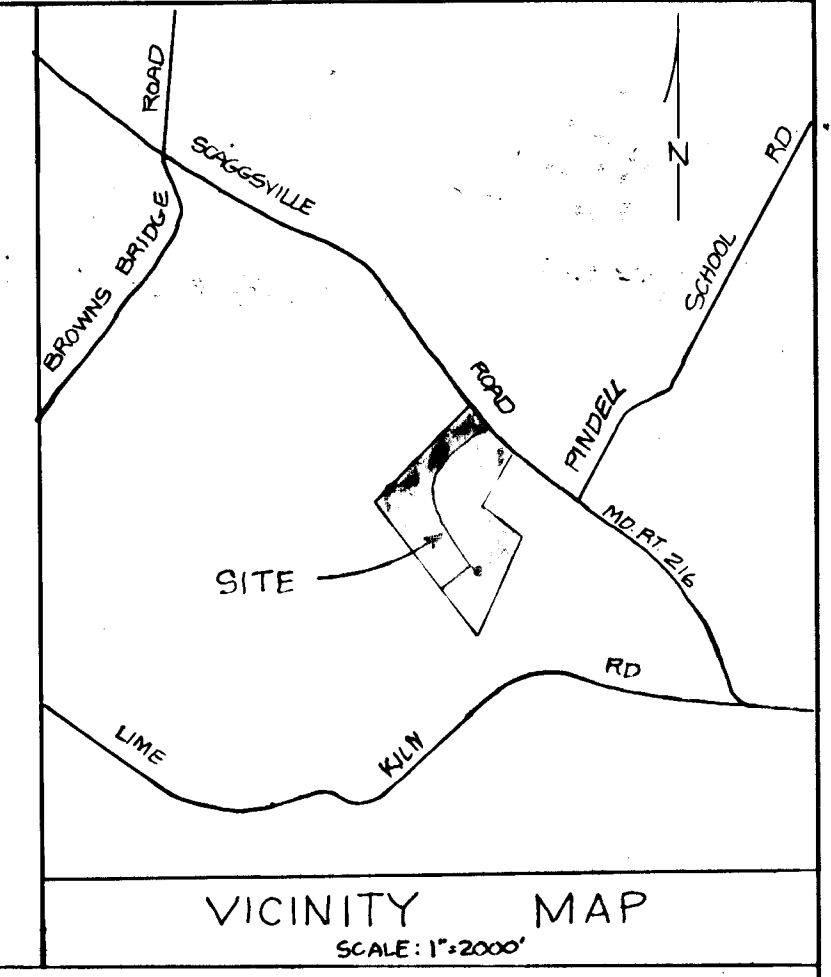

OWNER / DEVELOPER
WARREN MATZEN
10440 BALTIMORE AVENUE
BELTSVILLE, MARYLAND 20705

APPROVED: HOWARD COUNTY OFFICE OF PLANNING AND ZONING
James Smith 5/11/88
Chief, Division of COMMUNITY PLANNING AND LAND DEVELOPMENT

APPROVED: HOWARD COUNTY DEPARTMENT OF PUBLIC WORKS
William F. L. 5/10/88
Chief, Land Development Division
James W. Cleveland 5/9/88
Chief, Bureau of Highways
James E. Ryan 5-10-88
Chief, Bureau of Engineering

MD. RT. 216 IMPROVEMENT PLAN AND PROFILE

KCI JOB 1687105 SHEET 1 OF 9


FULTON ESTATES
TAX MAP 41 PARCELS 69, 203
5th ELECTION DISTRICT HOWARD COUNTY, MARYLAND

KIDDE CONSULTANTS, INC.
ENGINEERS • PLANNERS • SURVEYORS
1100 WEST STREET • SUITE 100 • LAUREL, MD 20707
(Wash.) (301) 953-1821 792-8086 (Balt.)


DATE JANUARY 1988 SCALE AS SHOWN

SHEET INDEX

SHEET	TITLE
1	MD. Route 216 improvement
2	Fulton Estates Court, Road Plan & Profile
3	Fulton Estates Court, Road A Road Plan & Profile
4	Grading & Sediment Control
5	Grading & Sediment Control
6	Construction Details & Storm Drain Profiles
7	Sediment Control Detail Sheet
8	Drainage Area Map
9	Soil Map

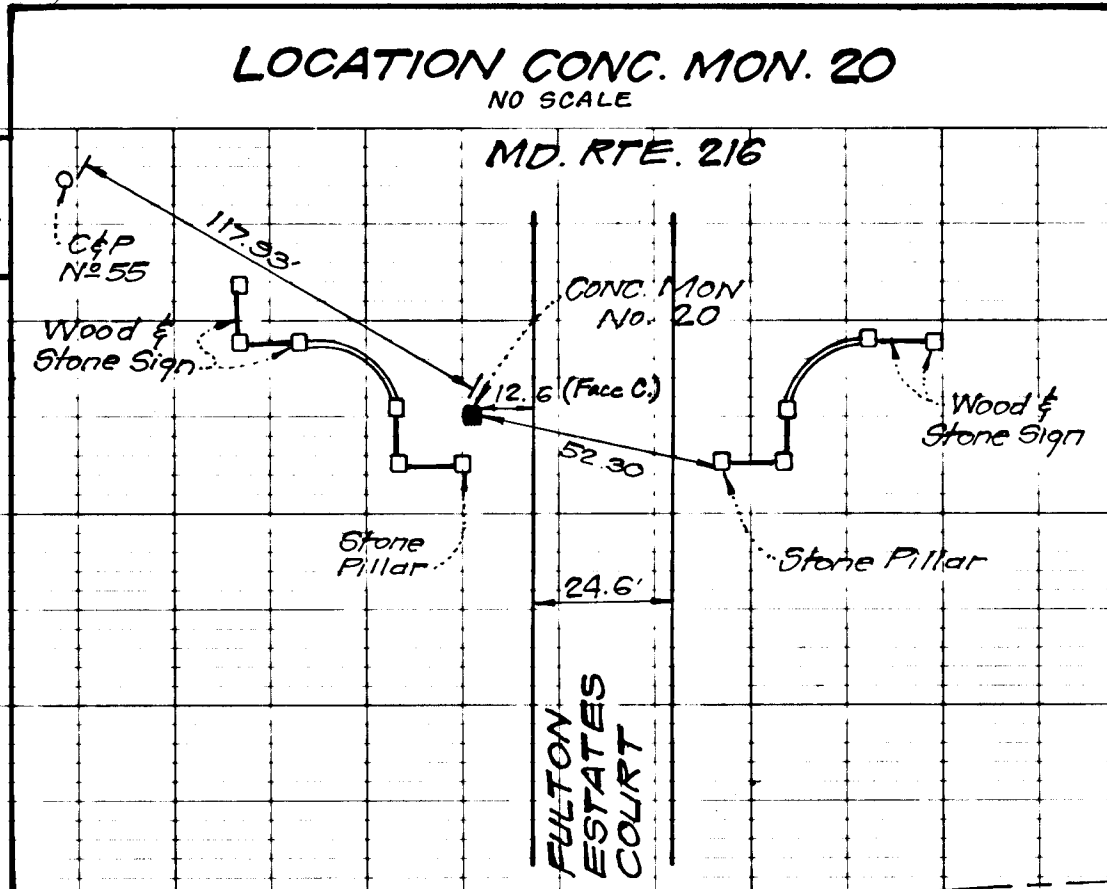

PLAN VIEW
1" = 50'

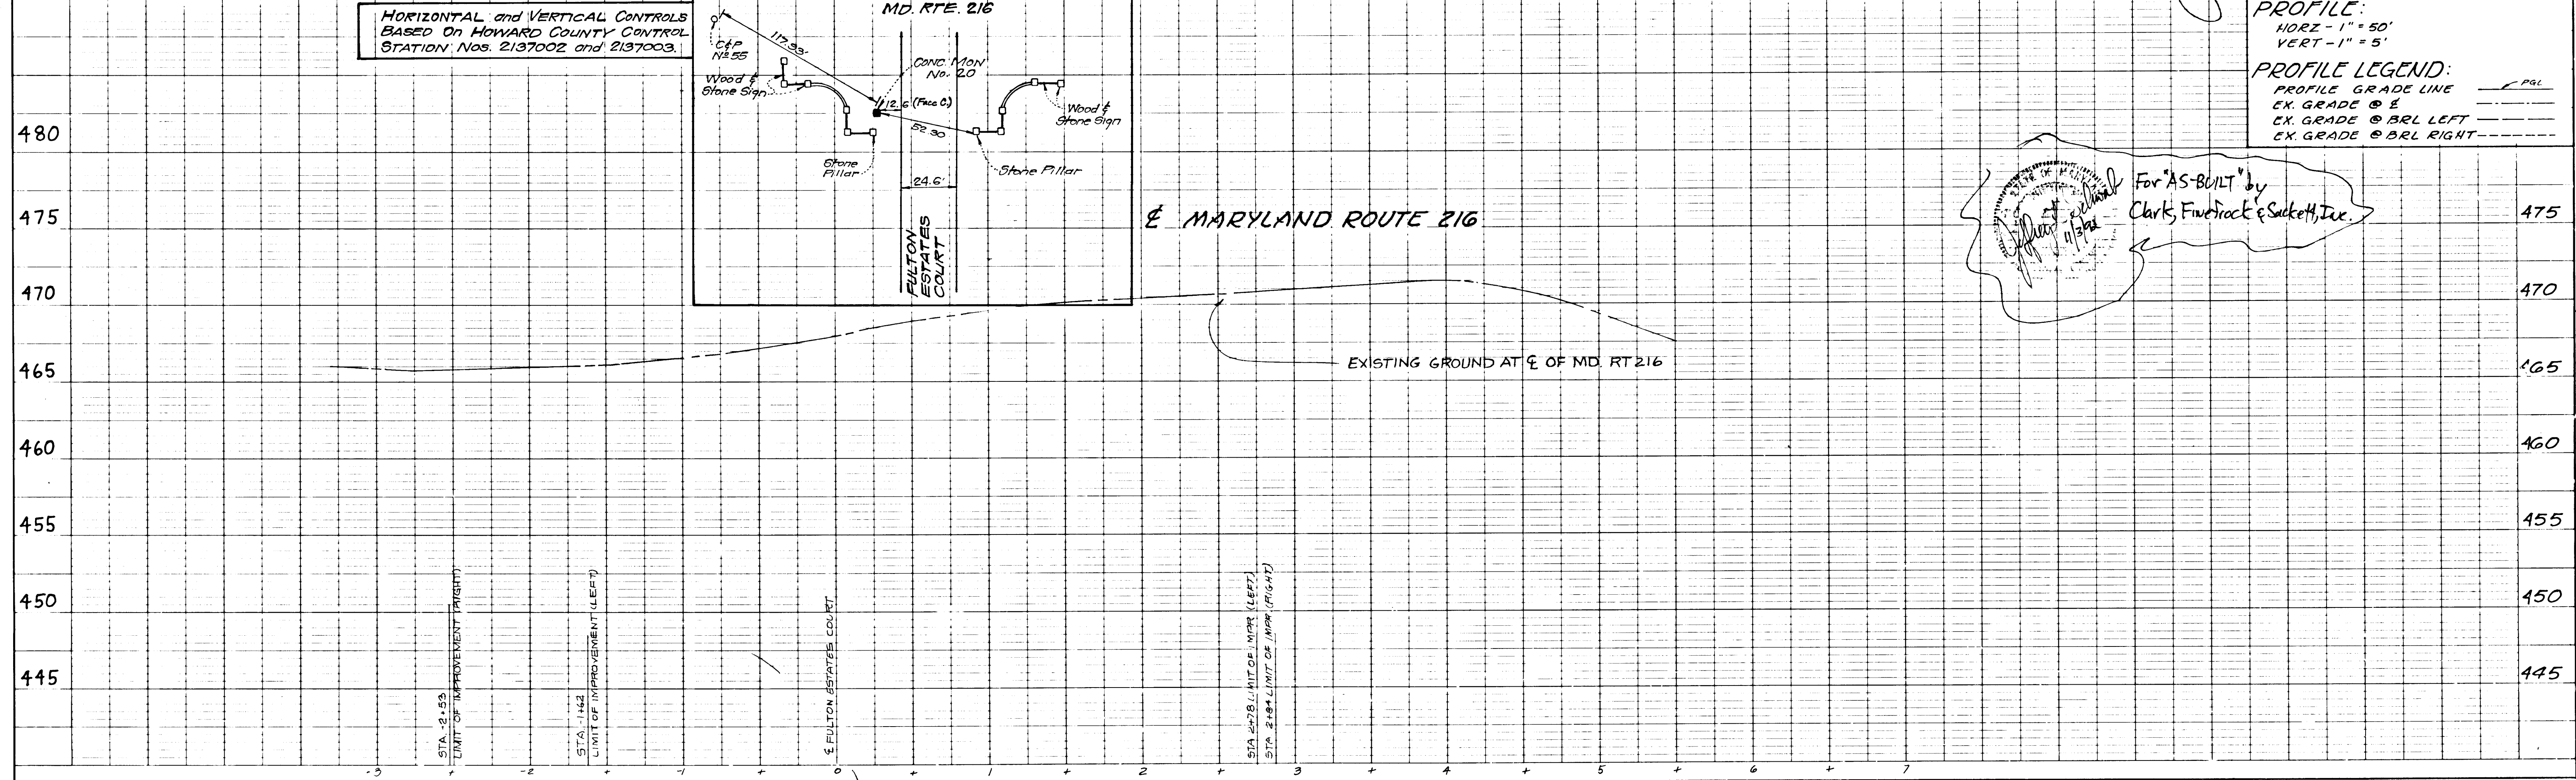



PROFILE:
HORZ - 1" = 50'
VERT - 1" = 5'

PROFILE LEGEND:
PROFILE GRADE LINE ——— PGL
EX. GRADE @ E ———
EX. GRADE @ BRL LEFT - - - -
EX. GRADE @ BRL RIGHT - - - -

For "AS-BUILT" by
Clark, Finetrock & Sackett, Inc.

1360

LOCATION OF CONCRETE MON. No. 8

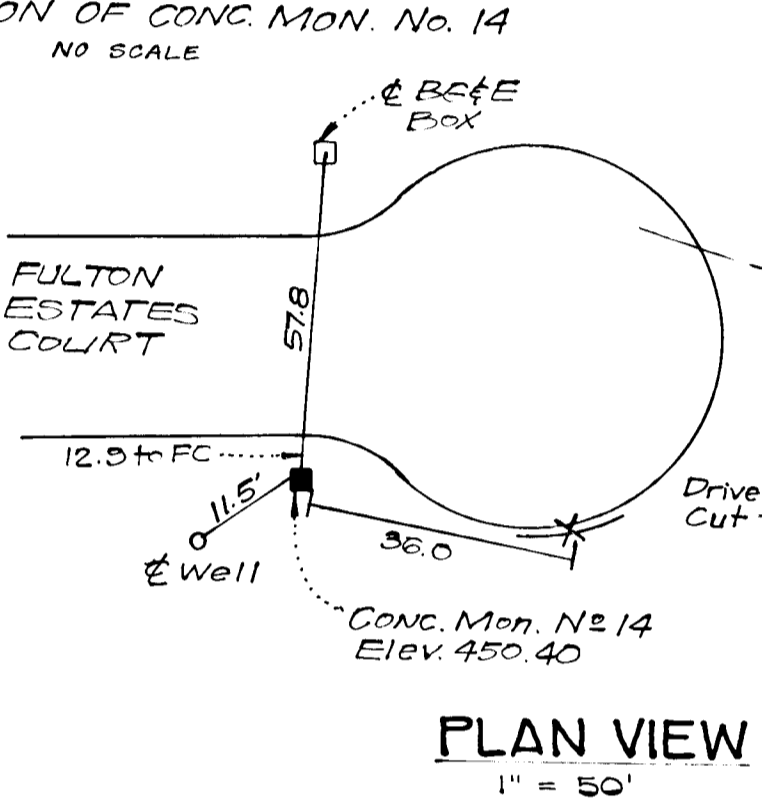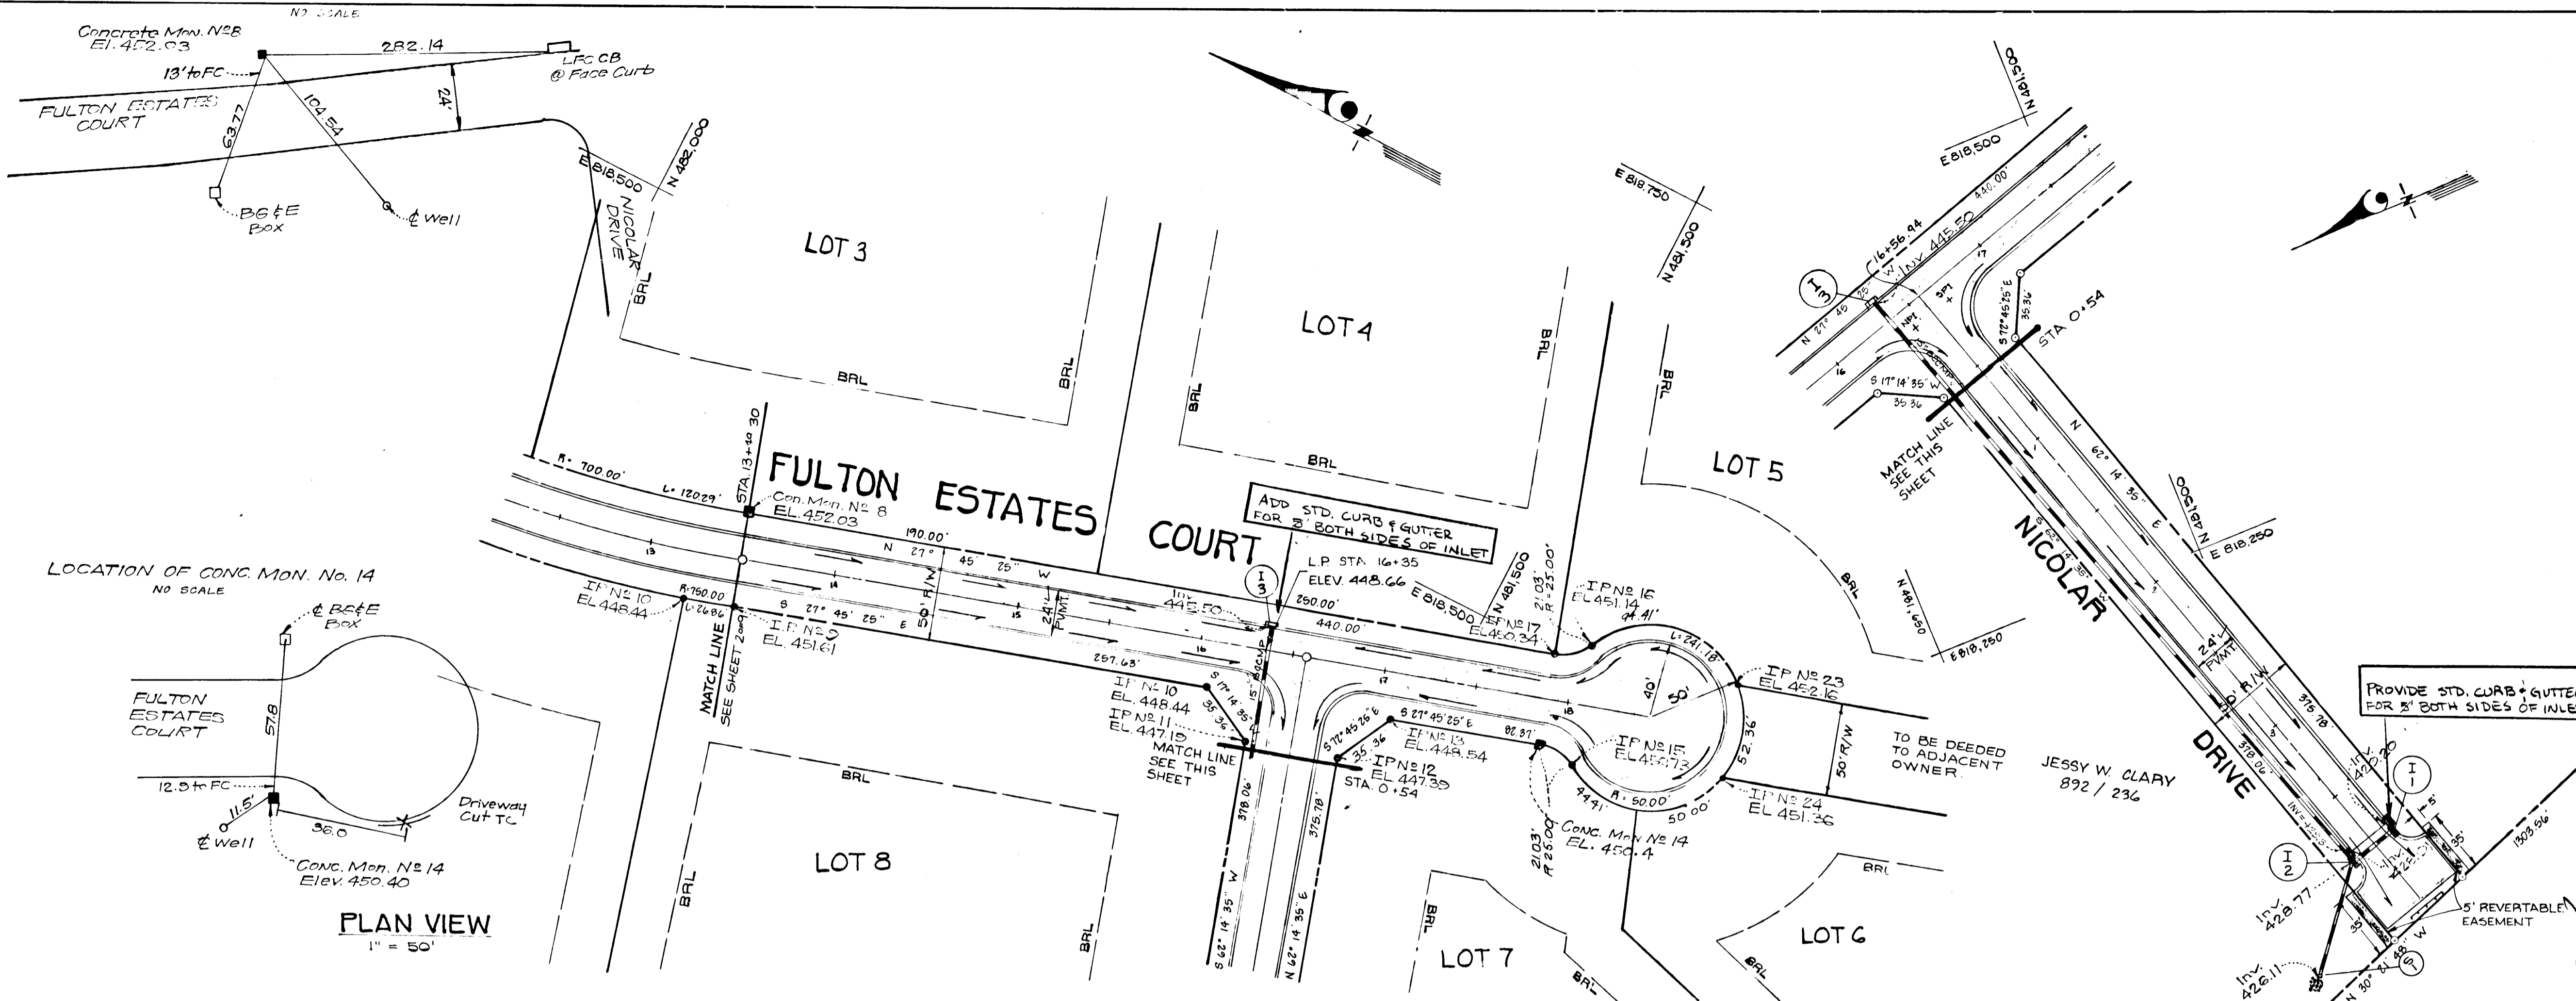

APPROVED: HOWARD COUNTY DEPARTMENT OF PUBLIC WORKS
 Chief, Land Development Division
Gravelle W. Weirland 5/19/88
 Chief, Bureau of Highways
William E. Ray 5-10-88
 Chief, Bureau of Engineering

APPROVED: HOWARD COUNTY OFFICE OF PLANNING AND ZONING
 Chief, Division of Community Planning and Land Development
Robert L. ... 5/11/88


OWNER/DEVELOPER
 WARREN MATZEN
 10440 BALTIMORE AVENUE
 BELTSVILLE, MARYLAND 20705

FULTON ESTATES COURT & NICOLAR DRIVE
 ROAD PLAN AND PROFILE




KCI JOB #1687105 SHEET 3 OF 9
 FULTON ESTATES
 TAX MAP 41 PARCELS 69, 203
 5th ELECTION DISTRICT HOWARD COUNTY, MARYLAND

KIDDE CONSULTANTS, INC.
 ENGINEERS • PLANNERS • SURVEYORS
 1100 WEST STREET, SUITE 100 LAUREL, MD 20707
 (WASH. 1-301-953-1821 - 702-8086-1541)
 DATE: JANUARY 1988 SCALE: AS SHOWN

For AS-BUILT by
 Clark Firetrak & Sackett, Inc.

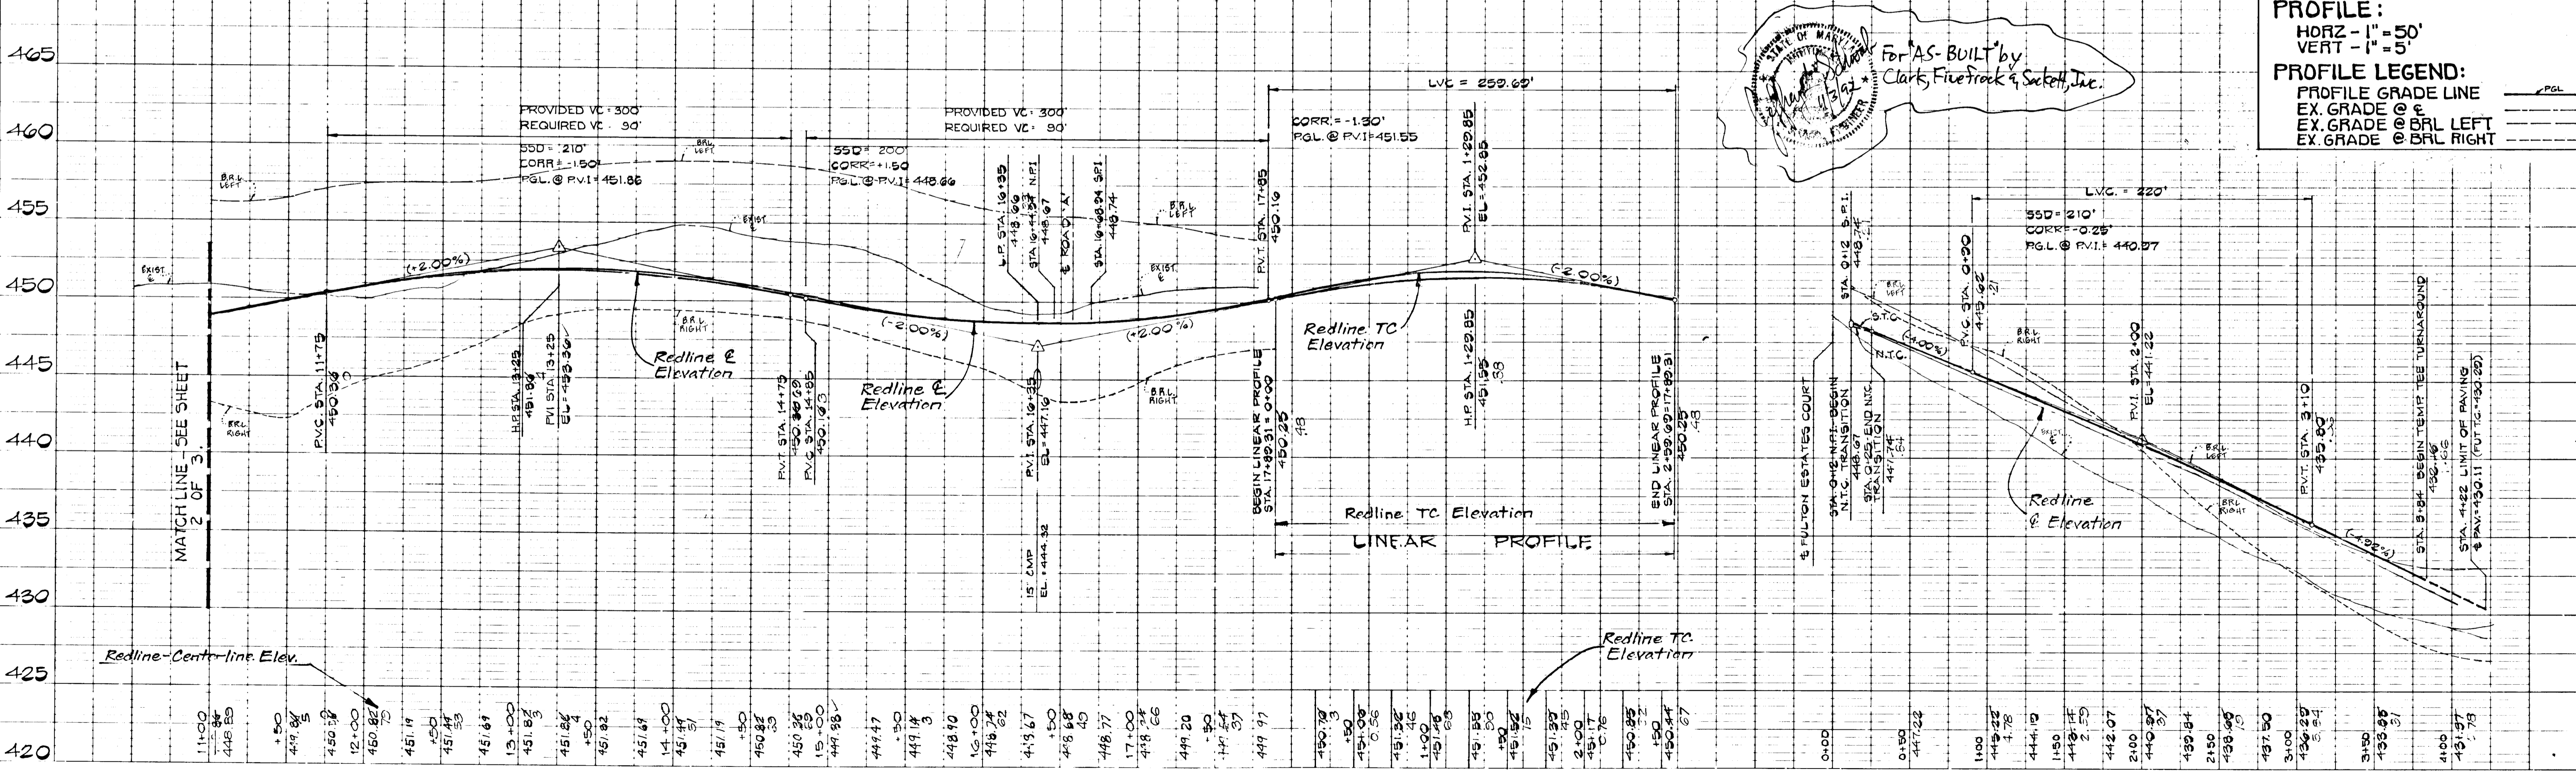


1360

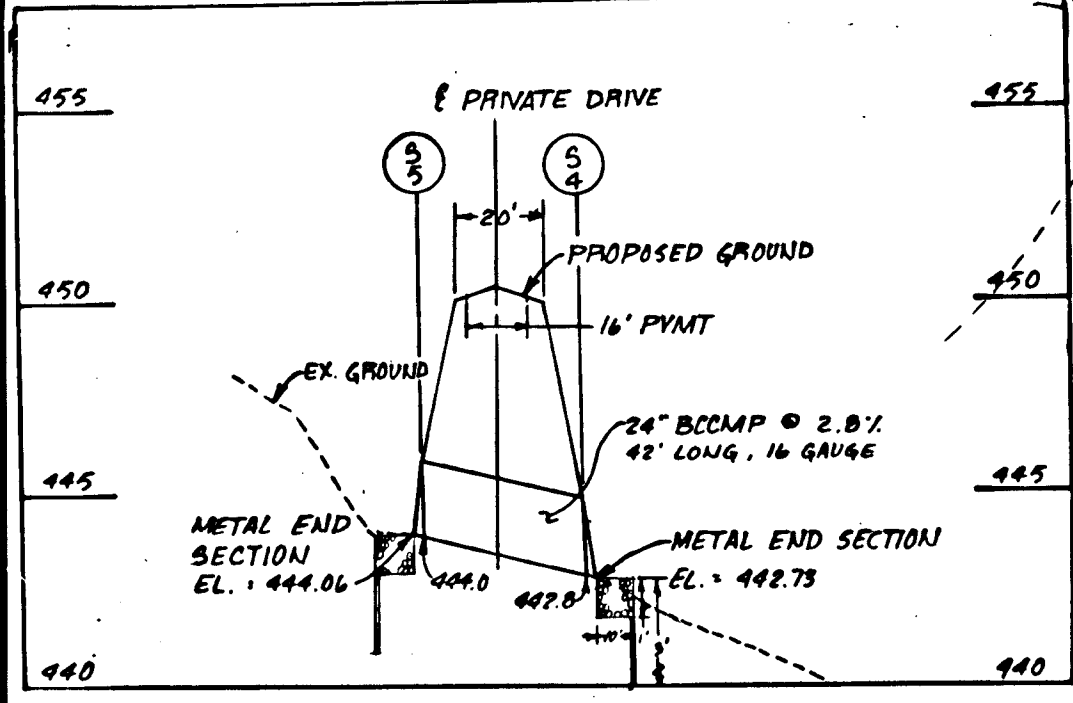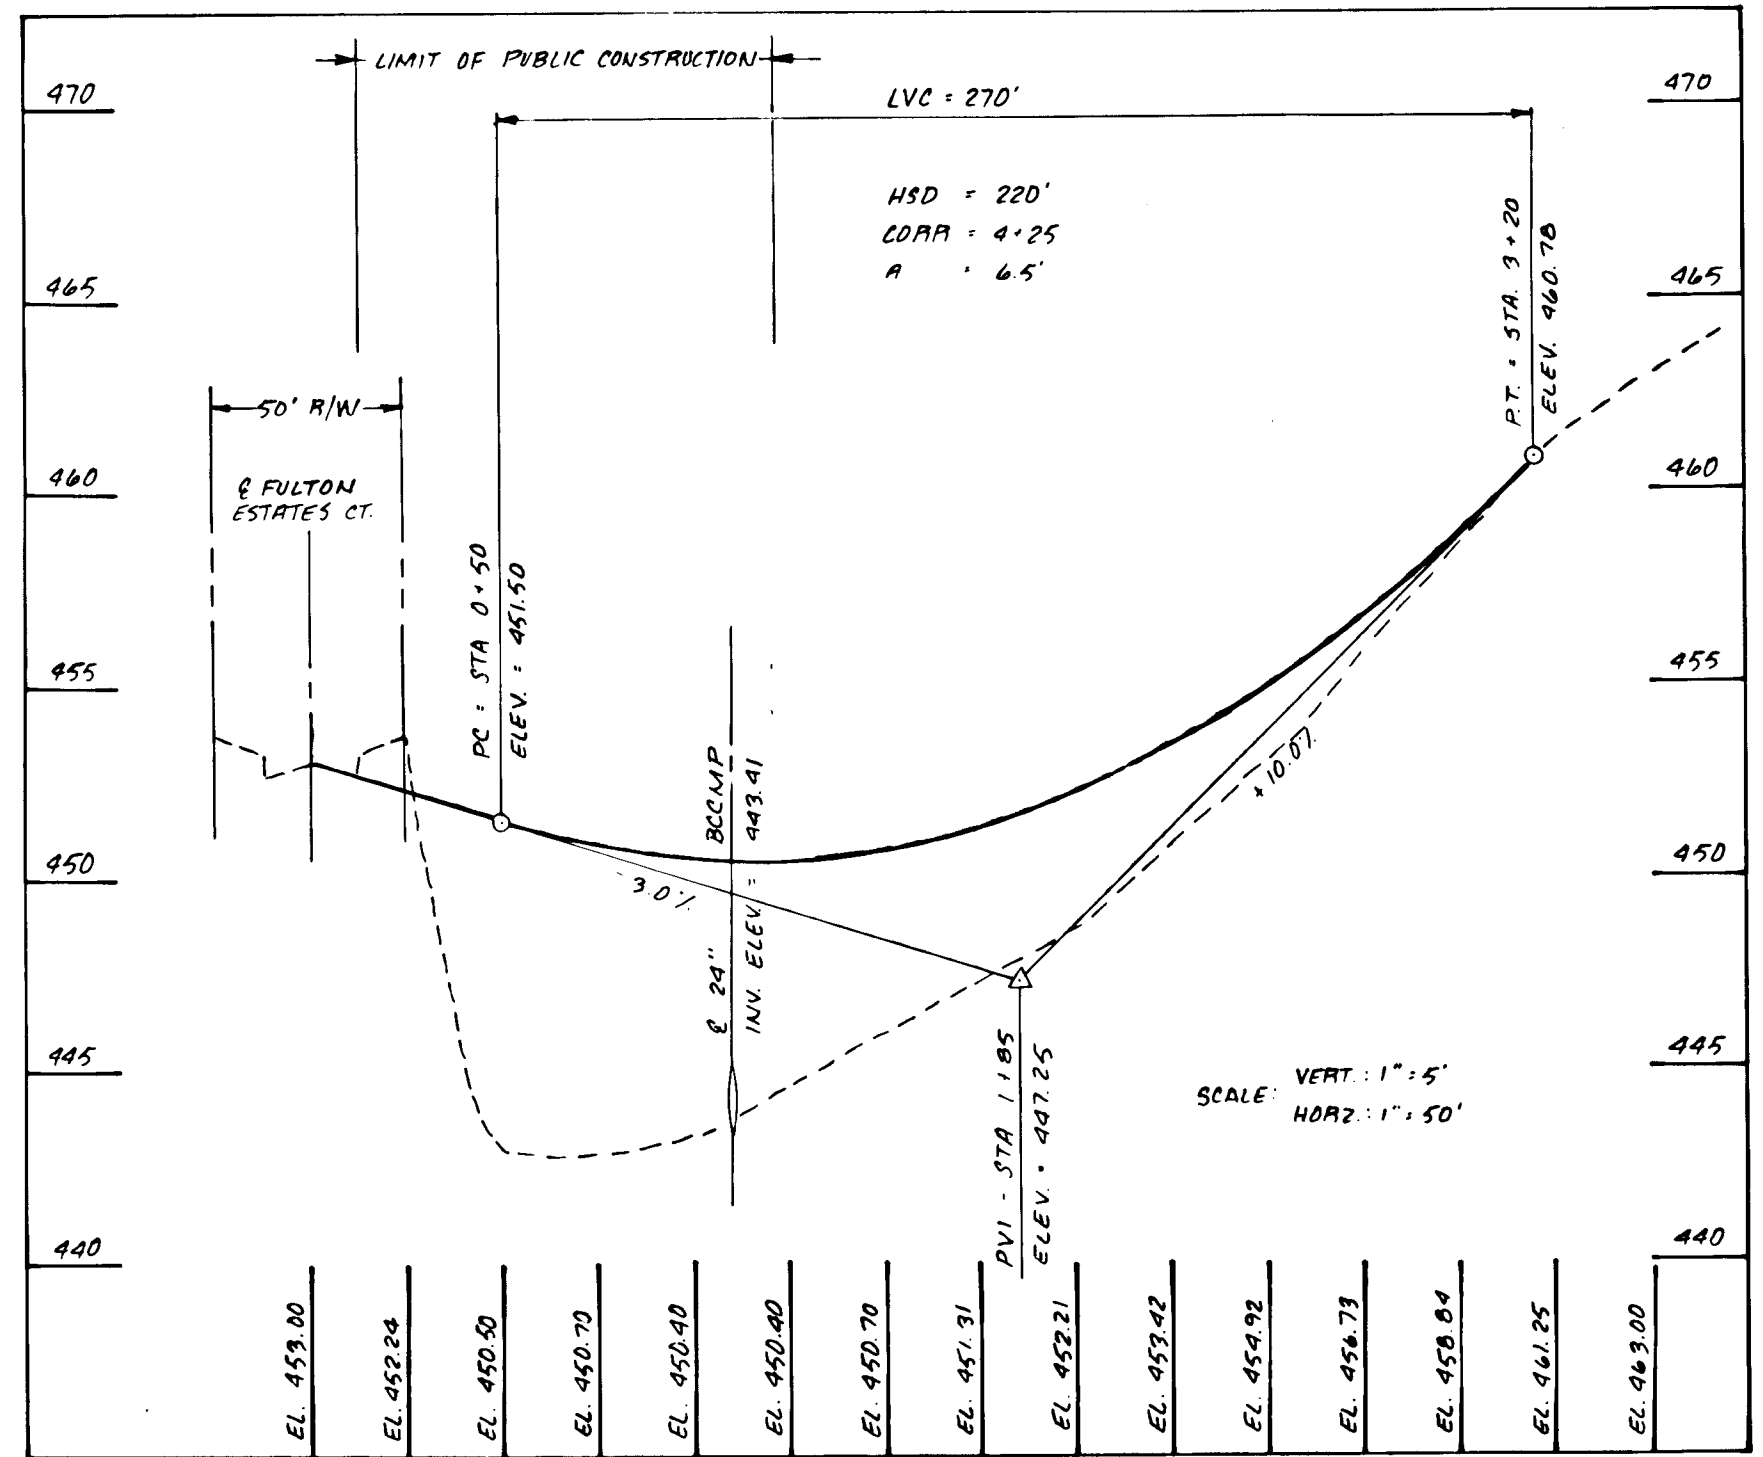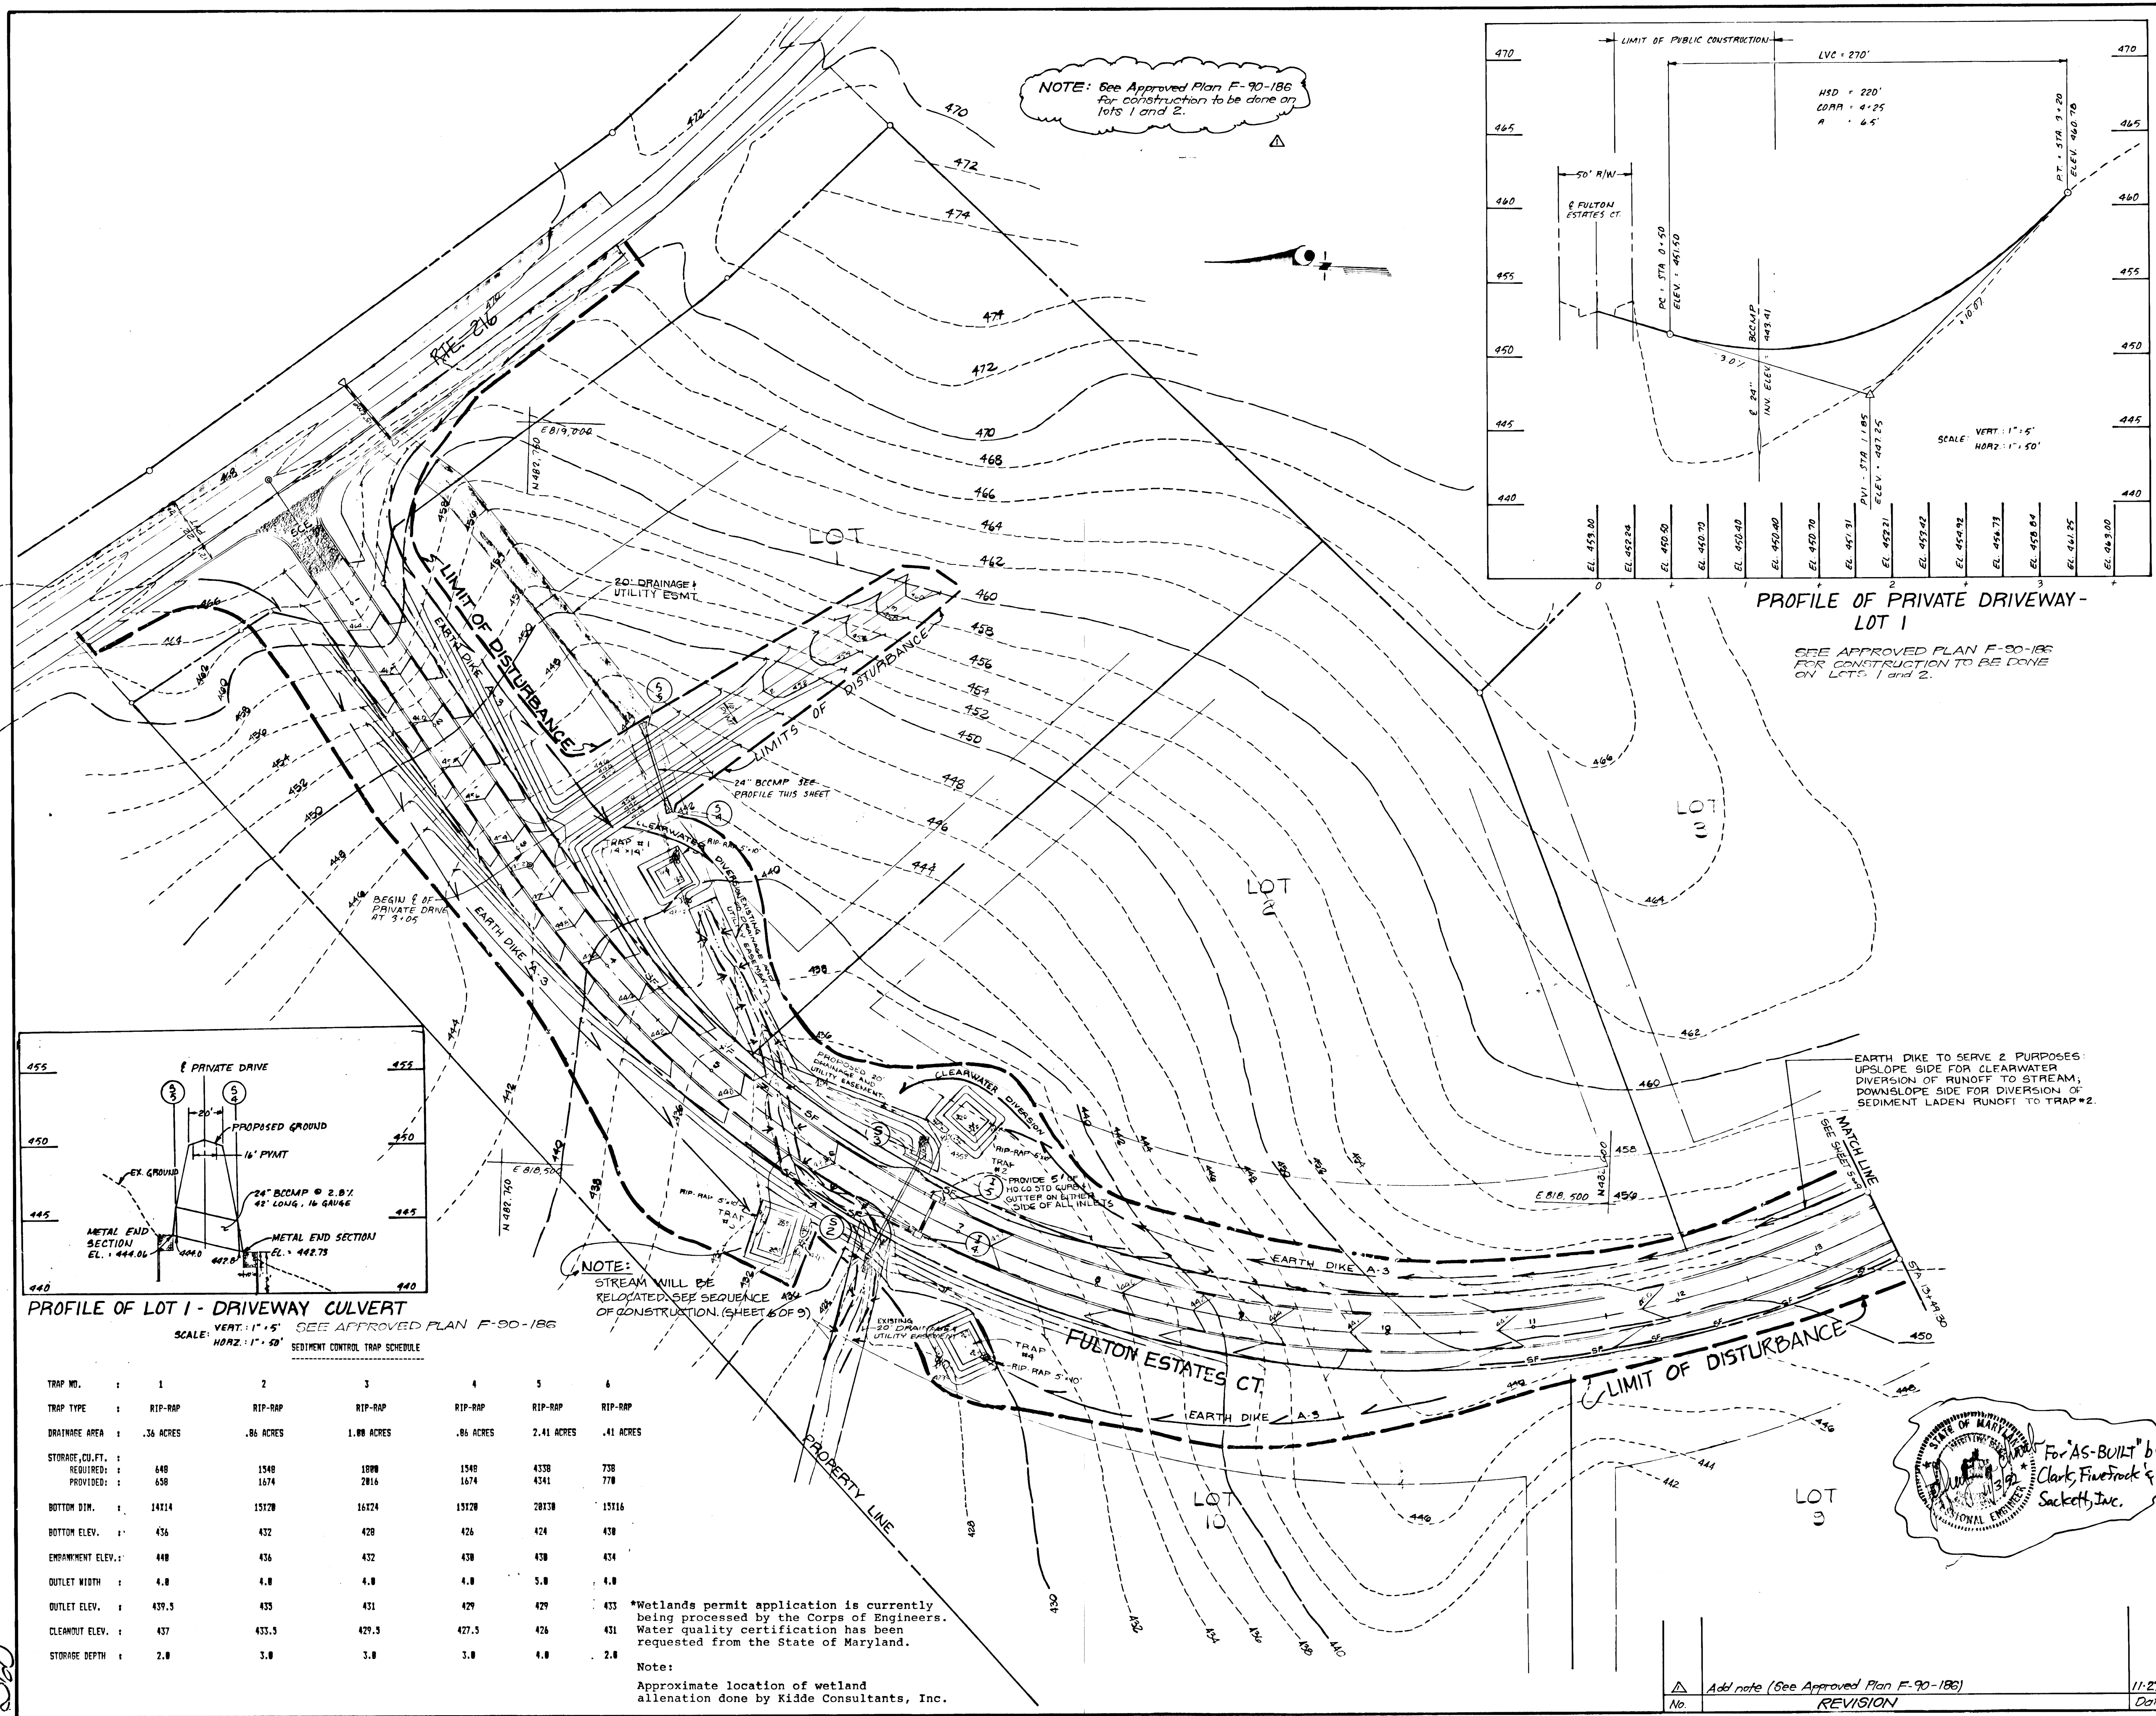

SEEDMENT CONTROL TRAP SCHEDULE

TRAP NO.	1	2	3	4	5	6
TRAP TYPE	RIP-RAP	RIP-RAP	RIP-RAP	RIP-RAP	RIP-RAP	RIP-RAP
DRAINAGE AREA	.36 ACRES	.86 ACRES	1.88 ACRES	.86 ACRES	2.41 ACRES	.41 ACRES
STORAGE, CU. FT.						
REQUIRE:	648	1548	1888	1548	4338	738
PROVIDED:	658	1674	2816	1674	4341	778
BOTTOM DIM.	14214	15128	16124	15128	28138	15116
BOTTOM ELEV.	436	432	428	426	424	438
ENDANGERMENT ELEV.	448	436	432	438	438	434
OUTLET WIDTH	4.8	4.8	4.8	4.8	5.8	4.8
OUTLET ELEV.	439.3	433	431	429	429	433
CLEAROUT ELEV.	437	433.3	429.3	427.5	426	431
STORAGE DEPTH	2.8	3.8	3.8	3.8	4.8	2.8

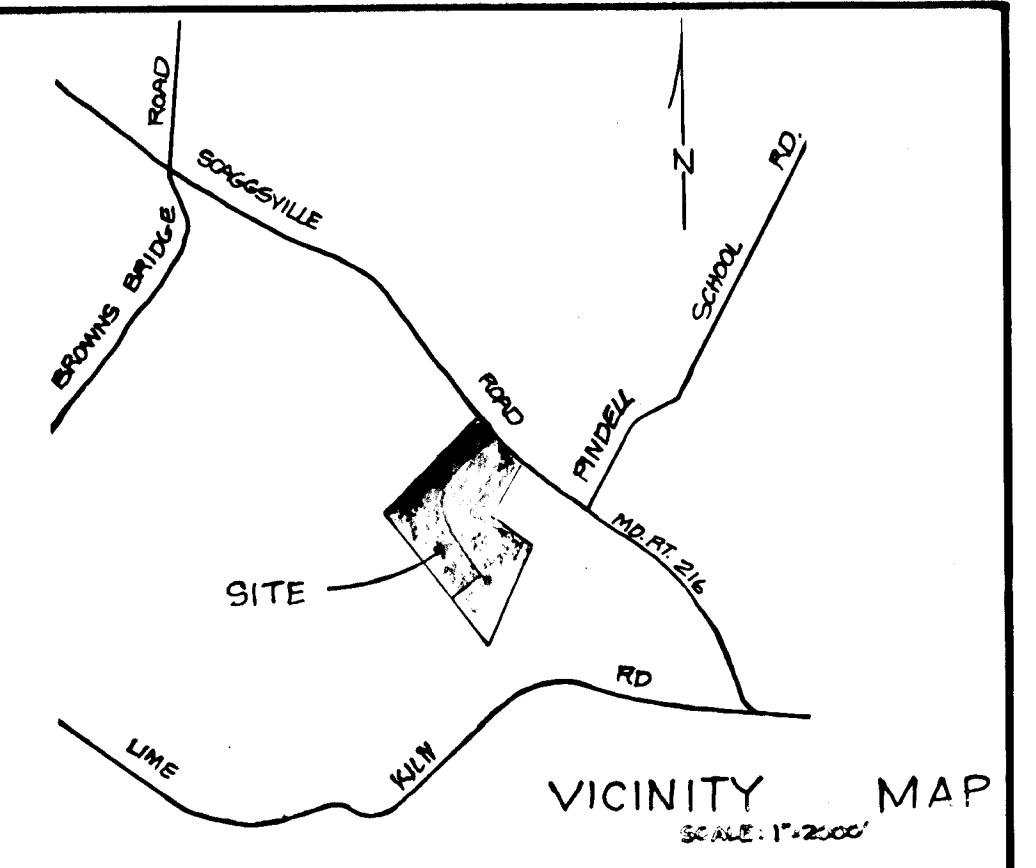

OWNER'S/DEVELOPER'S CERTIFICATION

"I/We certify that all development and/or construction will be done according to these plans, and that any responsible personnel involved in the construction project will have a Certificate of Attendance at a Department of Natural Resources Approved Training Program for the Control of Sediment and Erosion before beginning the project. I will provide the Howard Soil Conservation District with an "as-built" plan of the pond within 30 days of completion. I also authorize periodic on-site inspections by the Howard Soil Conservation District."

Signature: Warren Matzen Date: 1/20/88
Title: Owner Phone No.:
Firm: Complete Address

ENGINEERS CERTIFICATE

"I certify that this plan for erosion and sediment control represents a practical and workable plan based on my personal knowledge of the site conditions and that it was prepared in accordance with the requirements of the Howard Soil Conservation District."

Signature: John E.C. Patmore Date: 4/26/88
Title: Registered Professional Engineer # 8978

REVIEWED FOR HOWARD SOIL CONSERVATION DISTRICT AND MEETS TECHNICAL REQUIREMENTS.

Signature: John E.C. Patmore Date: 4-28-88

U.S. SOIL CONSERVATION SERVICE

THIS DEVELOPMENT PLAN IS APPROVED FOR SOIL EROSION AND SEDIMENT CONTROL BY THE HOWARD SOIL CONSERVATION DISTRICT.

Signature: John E.C. Patmore Date: 4/28/88
Approved: Howard S.C.D.

APPROVED: HOWARD COUNTY DEPARTMENT OF PUBLIC WORKS

Signature: Dravella W. McLeod Date: 5/9/88
Title: Chief, Bureau of Highways

Signature: James B. Ryan Date: 5-10-88
Title: Chief, Bureau of Engineering

APPROVED: HOWARD COUNTY OFFICE OF PLANNING AND ZONING

Signature: James B. Ryan Date: 5/11/88
Title: Chief, Bureau of Engineering

OWNER/DEVELOPER **WARREN MATZEN**
10440 BALTIMORE AVENUE
BELTSVILLE, MARYLAND 20705

GRADING & SEDIMENT CONTROL


KCI JOB #1687105 SHEET 4 OF 9

FULTON ESTATES

TAX MAP 41 PARCELS 69, 203
5th ELECTION DISTRICT HOWARD COUNTY, MARYLAND



KILDE CONSULTANTS, INC.
ENGINEERS • PLANNERS • SURVEYORS
1100 WEST STREET SUITE 100 LAUREL, MD 20784
(301) 943-1811 (702) 8086 (Home)

DATE: JANUARY 1988 SCALE: 1" = 50'

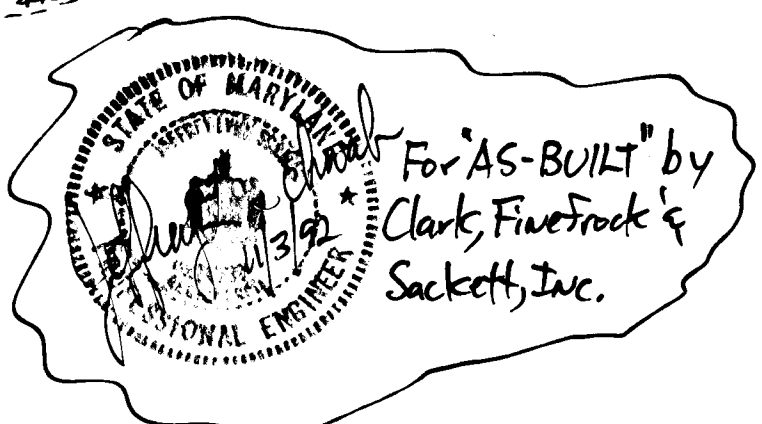

Add note (See Approved Plan F-90-186)
11-27-90
REVISION
Date

6360

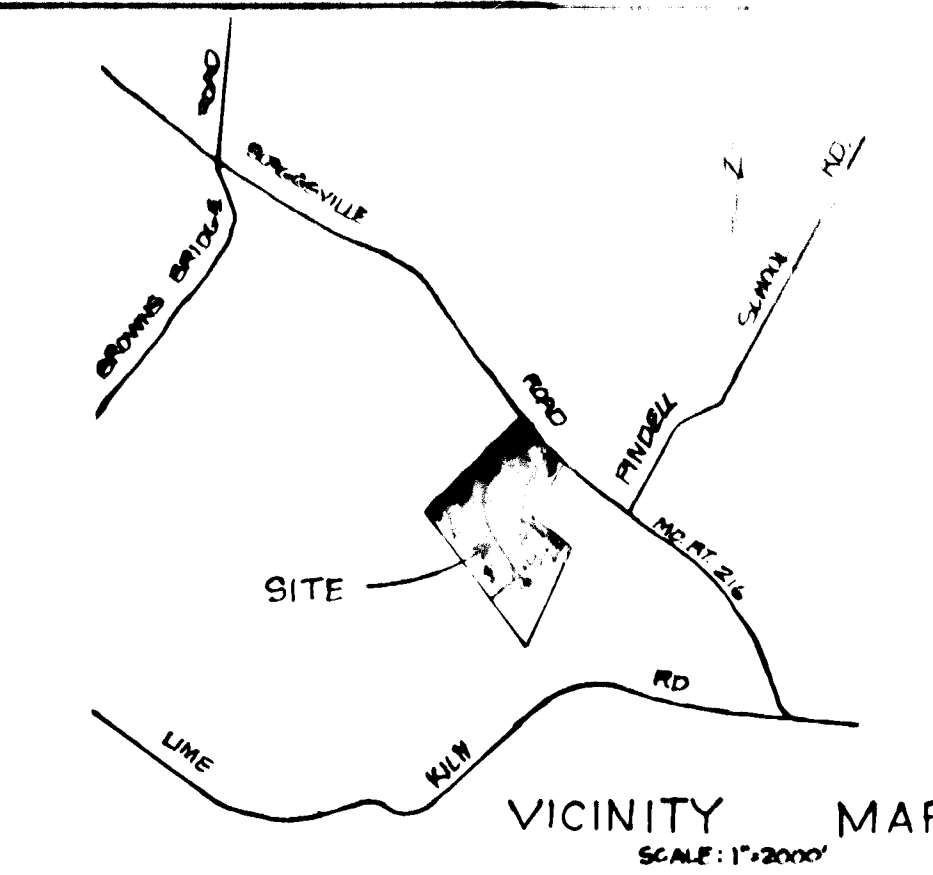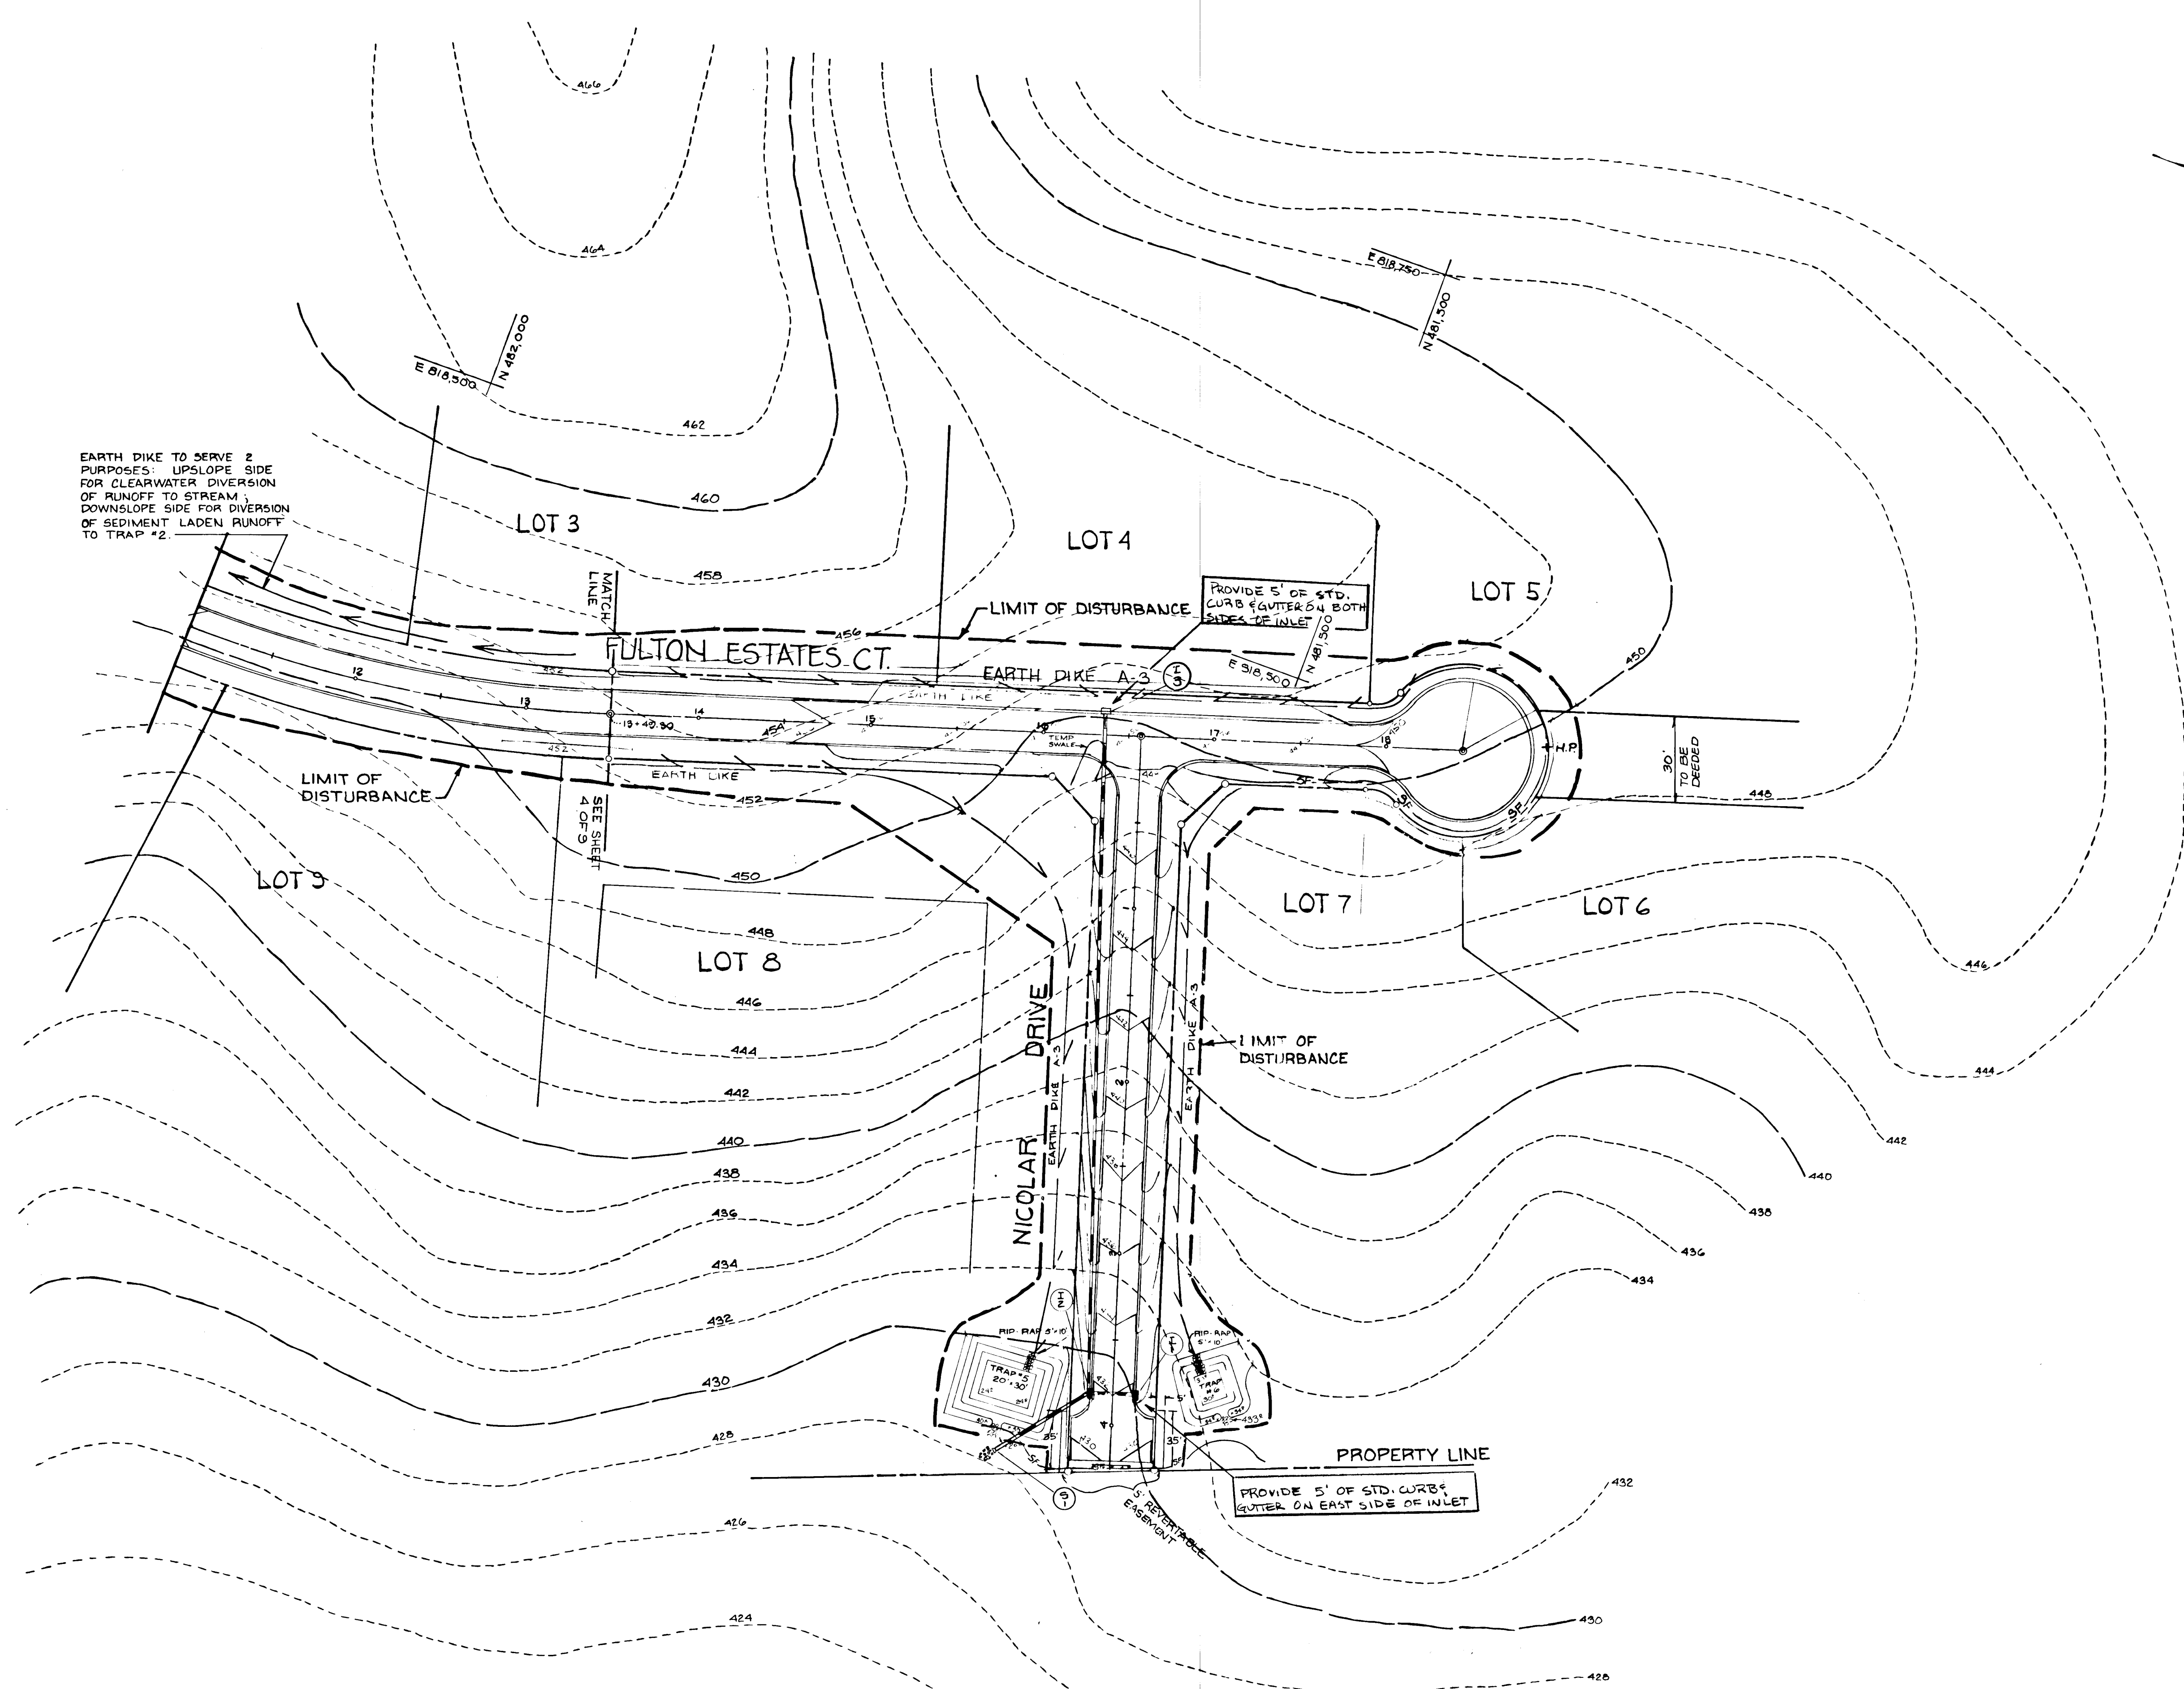

OWNER'S/DEVELOPER'S CERTIFICATION
 "I/We certify that all development and/or construction will be done according to these plans, and that any responsible personnel involved in the construction project will have a Certificate of Attendance at a Department of Natural Resources Approved Training Program for the Control of Sediment and Erosion before beginning the project. I will provide the Howard Soil Conservation District with an "as-built" plan of the pond within 30 days of completion. I also authorize periodic on-site inspections by the Howard Soil Conservation District."

Signature: J. A. Matzen Date: 1/20/88
 Name: _____ Title: _____ Phone No.: _____
 Firm: _____ Complete Address: _____

ENGINEERS CERTIFICATE
 "I certify that this plan for erosion and sediment control represents a practical and workable plan based on my personal knowledge of the site conditions and that it was prepared in accordance with the requirements of the Howard Soil Conservation District."

Signature: John E. C. Patmore Date: 4/20/88
 Name: JOHN E. C. PATMORE
 Registered Professional Engineer # 8978

REVIEWED FOR HOWARD SOIL CONSERVATION DISTRICT (AND MEETS TECHNICAL REQUIREMENTS.)

Signature: James M. Hahn Date: 4-28-88
 Name: _____ Title: _____
 Firm: _____ Complete Address: _____

U.S. SOIL CONSERVATION SERVICE
 THIS DEVELOPMENT PLAN IS APPROVED FOR SOIL EROSION AND SEDIMENT CONTROL BY THE HOWARD SOIL CONSERVATION DISTRICT.

Signature: Stephen L. Hahn Date: 4/28/88
 Name: Stephen L. Hahn
 Approved Howard S.C.D. DATE

APPROVED: HOWARD COUNTY DEPARTMENT OF PUBLIC WORKS

Signature: William W. Weiland Date: 5-18-88
 Name: William W. Weiland
 Chief, Bureau of Highways
 Signature: Richard E. Roney Date: 5-10-88
 Name: Richard E. Roney
 Chief, Bureau of Engineering

APPROVED: HOWARD COUNTY OFFICE OF PLANNING AND ZONING

Signature: Joseph R. Rutter Date: 5/11/88
 Name: Joseph R. Rutter
 Chief, Division of Community Planning and Land Development

OWNER/DEVELOPER
 WARREN MATZEN
 10440 BALTIMORE AVENUE
 BELTSVILLE, MARYLAND 20705

GRADING & SEDIMENT CONTROL













KCI JOB #1687105 SHEET 5 OF 9
FULTON ESTATES
 TAX MAP 41 PARCELS 69, 203
 5th ELECTION DISTRICT HOWARD COUNTY, MARYLAND

KIDDE CONSULTANTS, INC.
 ENGINEERS • PLANNERS • SURVEYORS
 1100 WEST STREET, SUITE 100, LAUREL, MD 20707
 (301) 953-1822 • (301) 953-1821

DATE: JANUARY 1988 SCALE: 1" = 50'



AS-BUILT F-88-161

1300

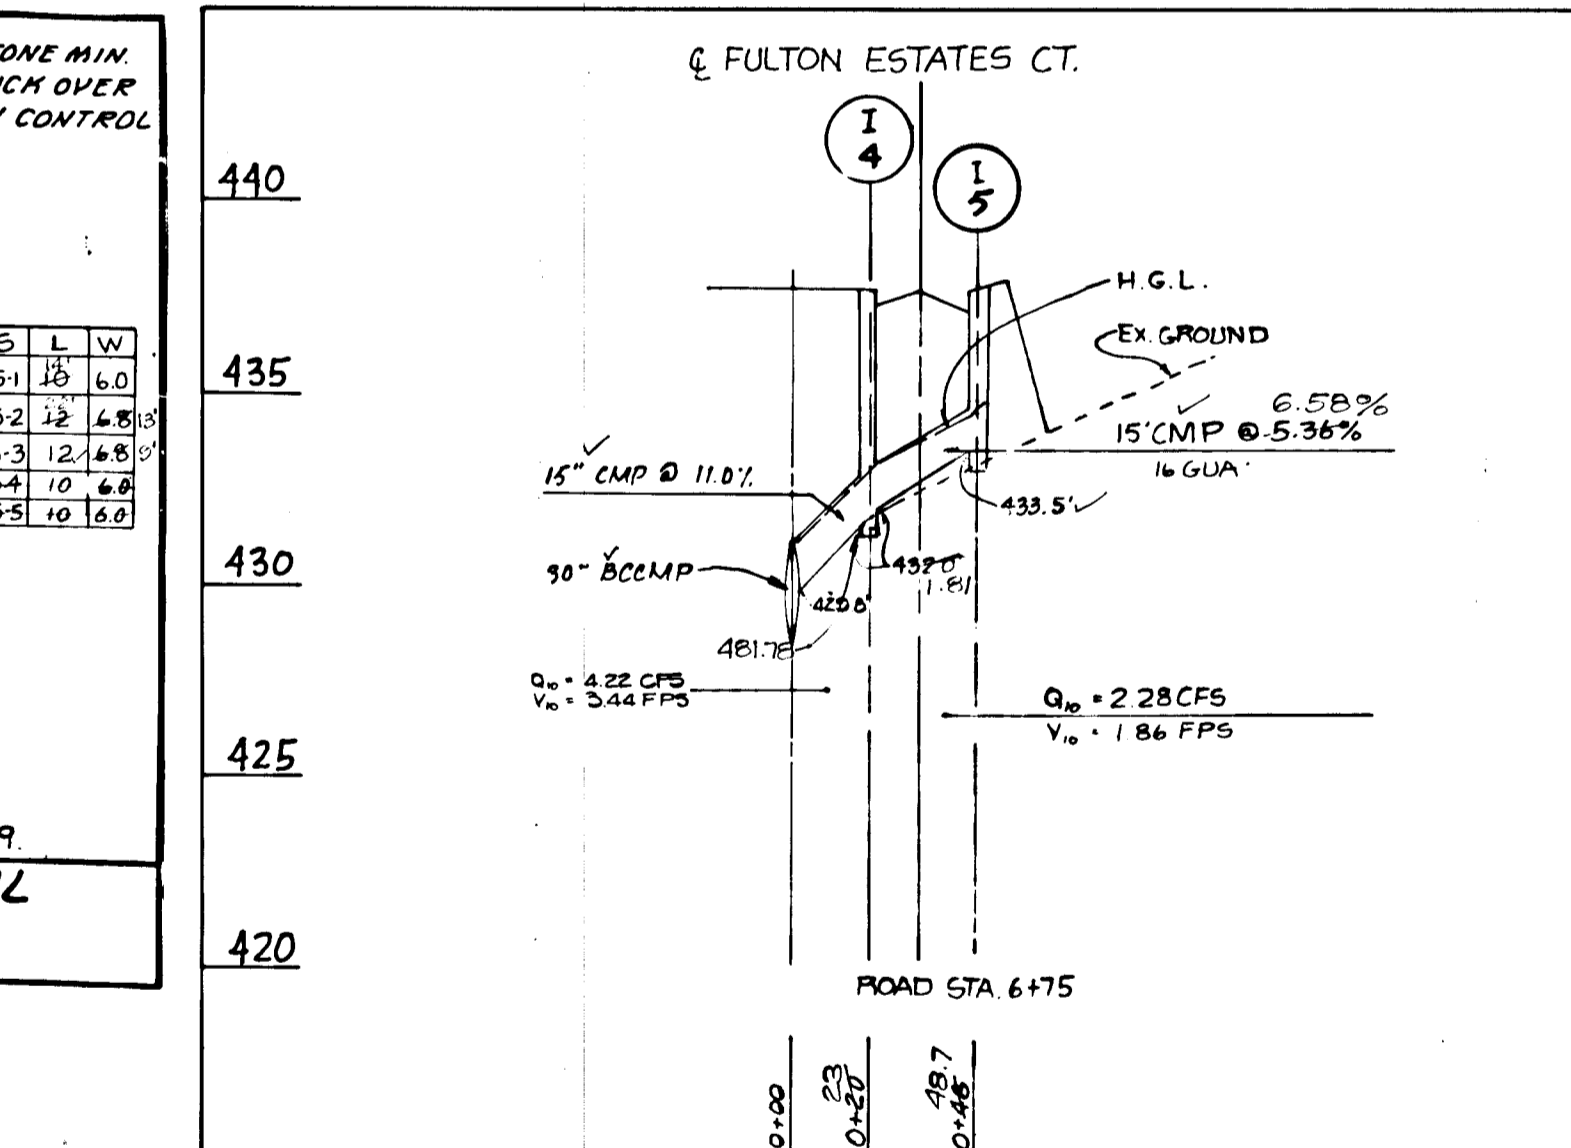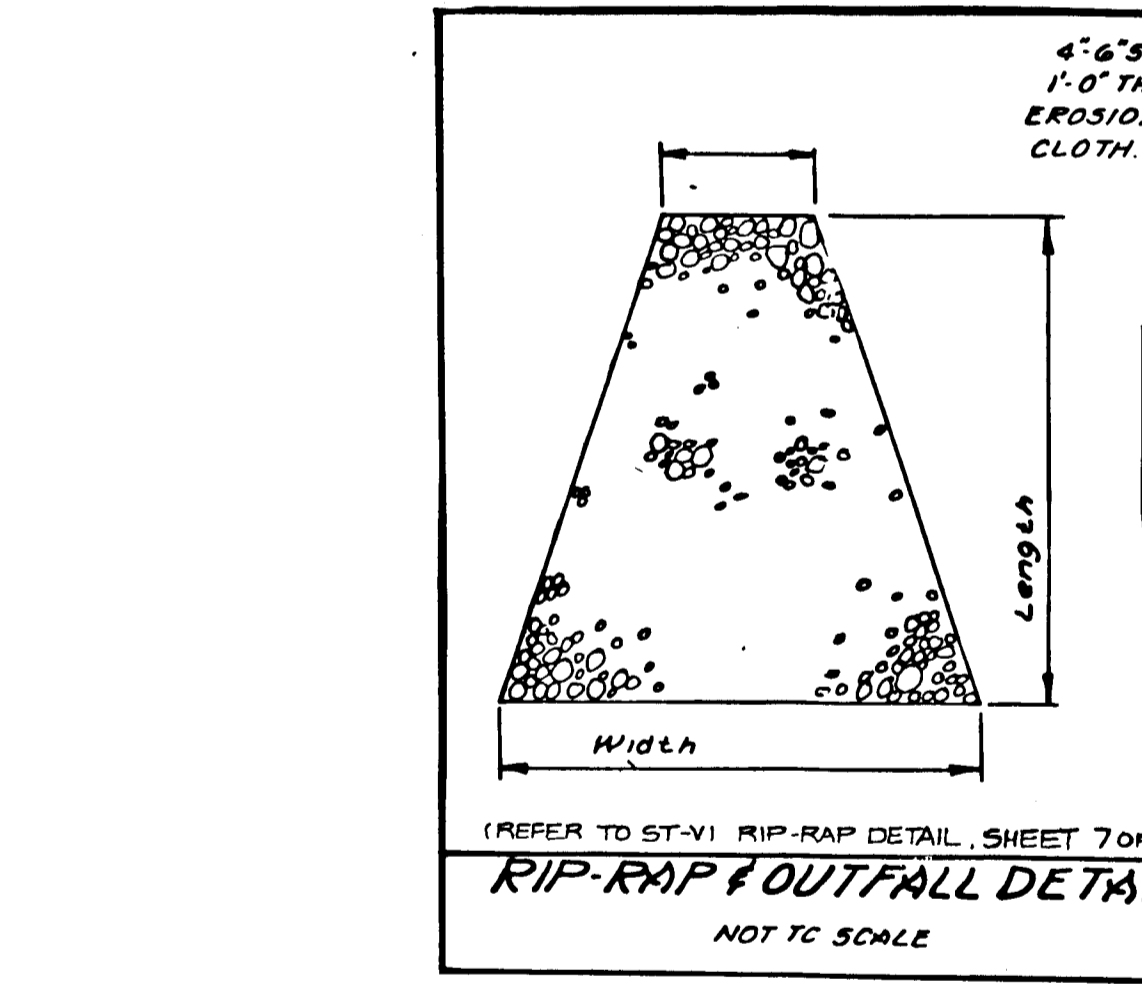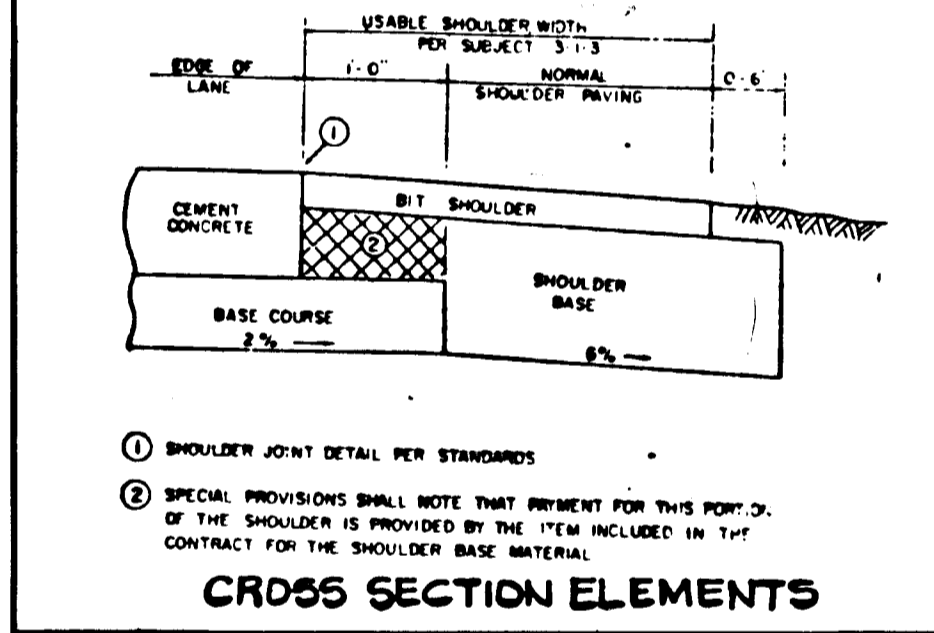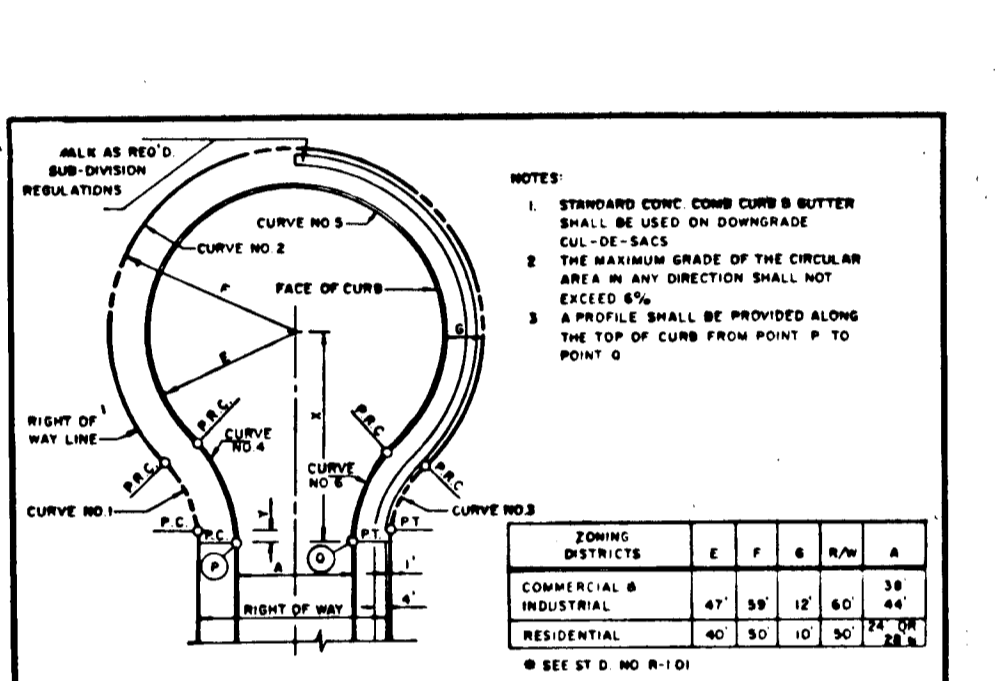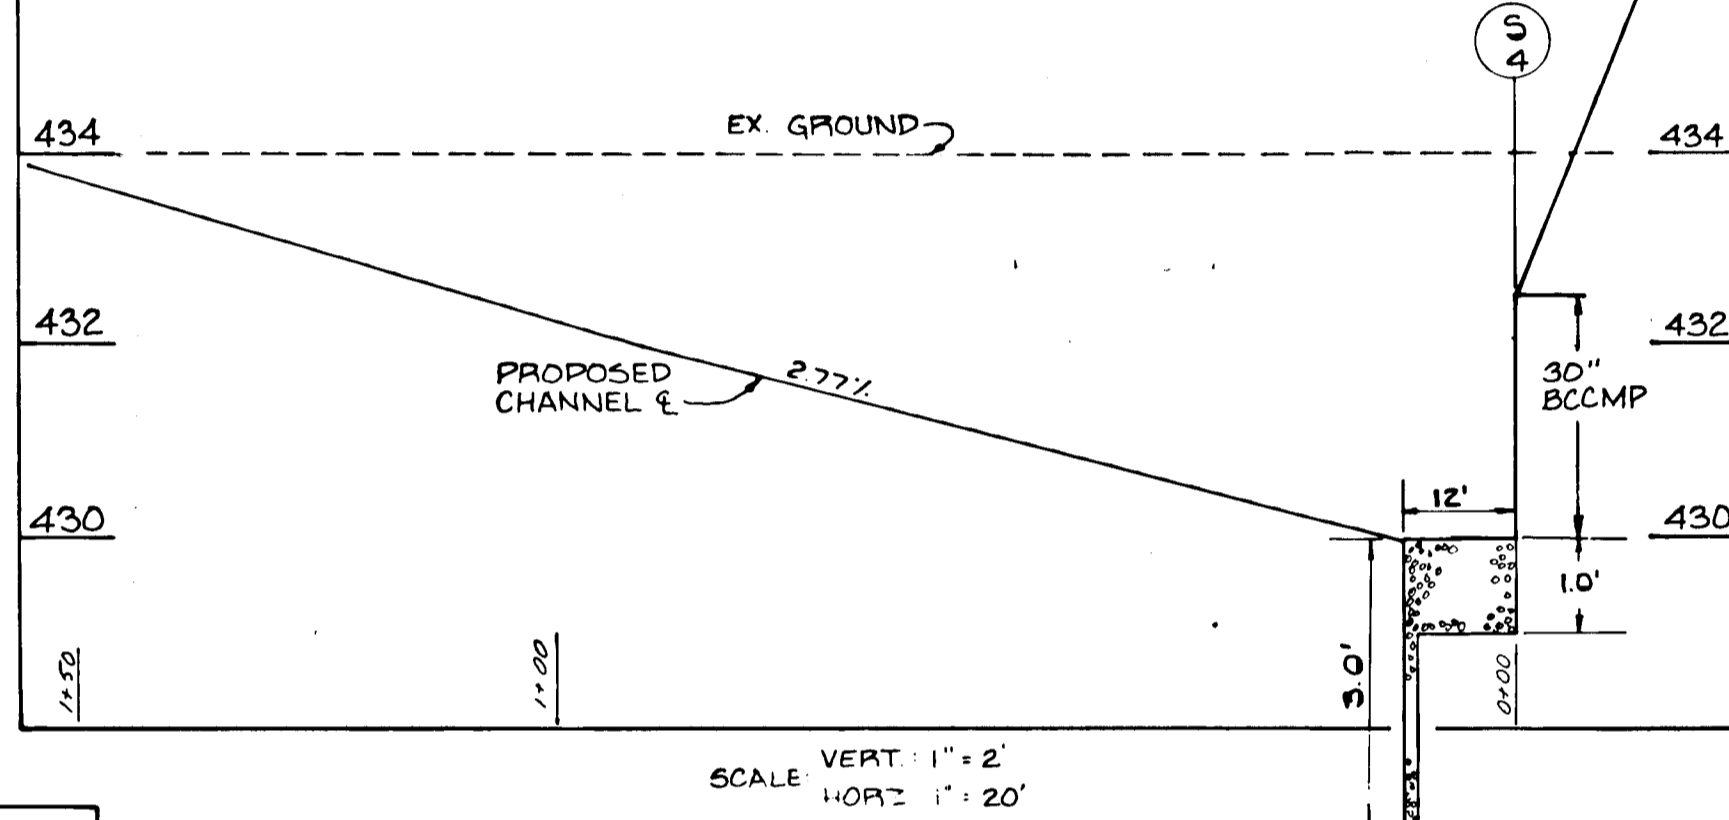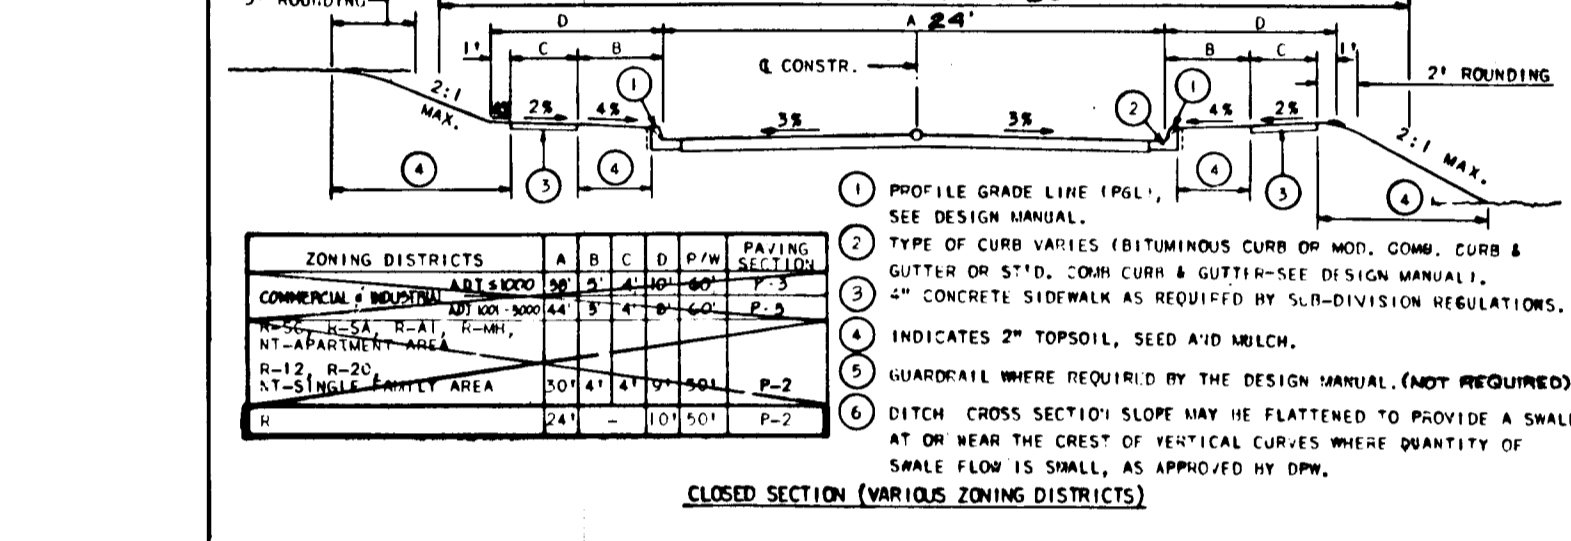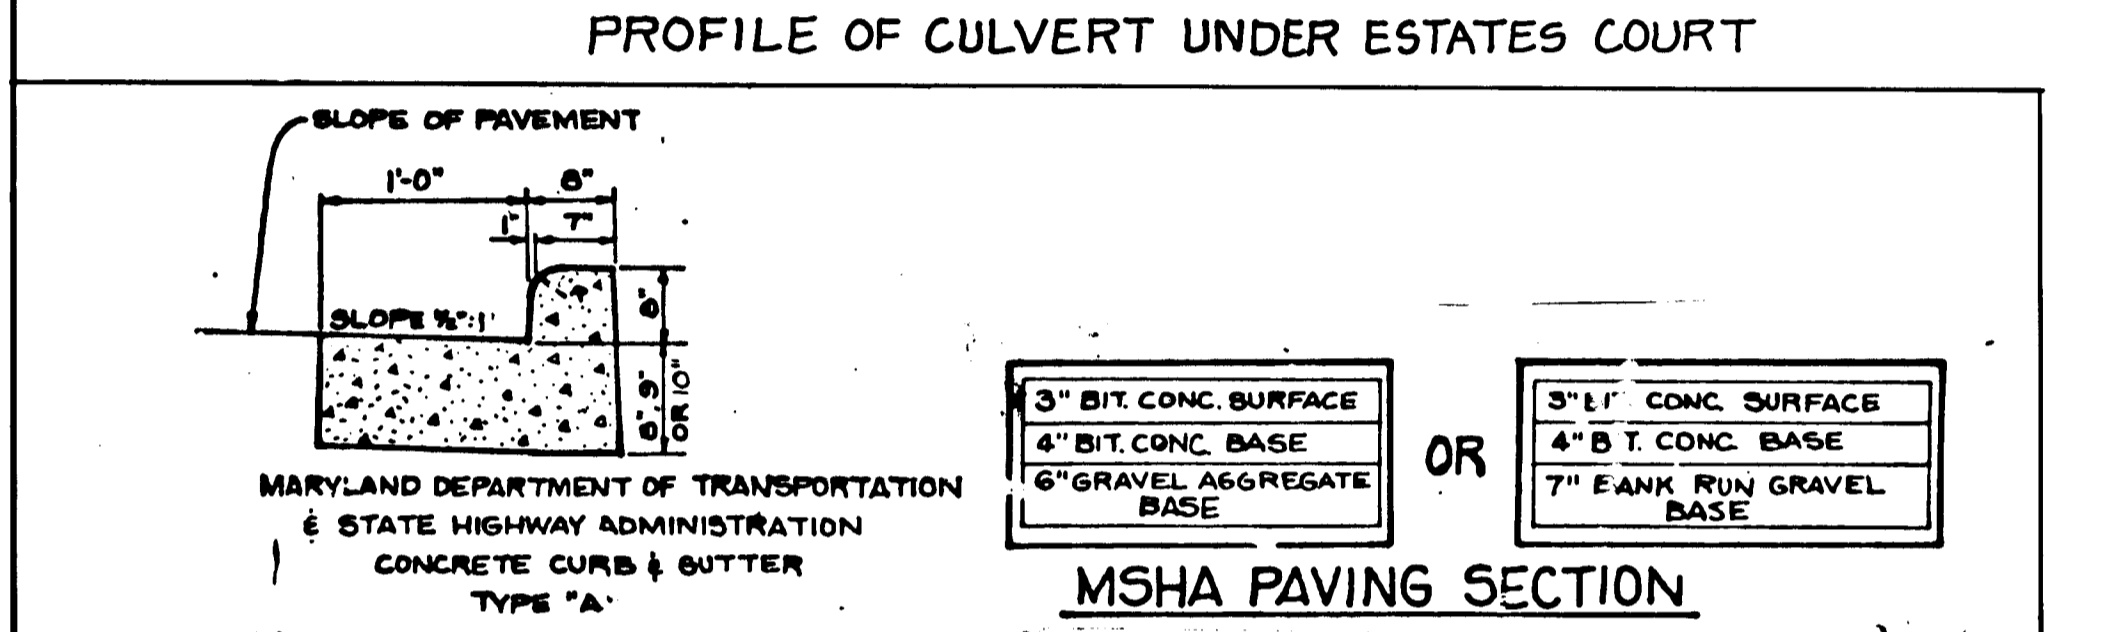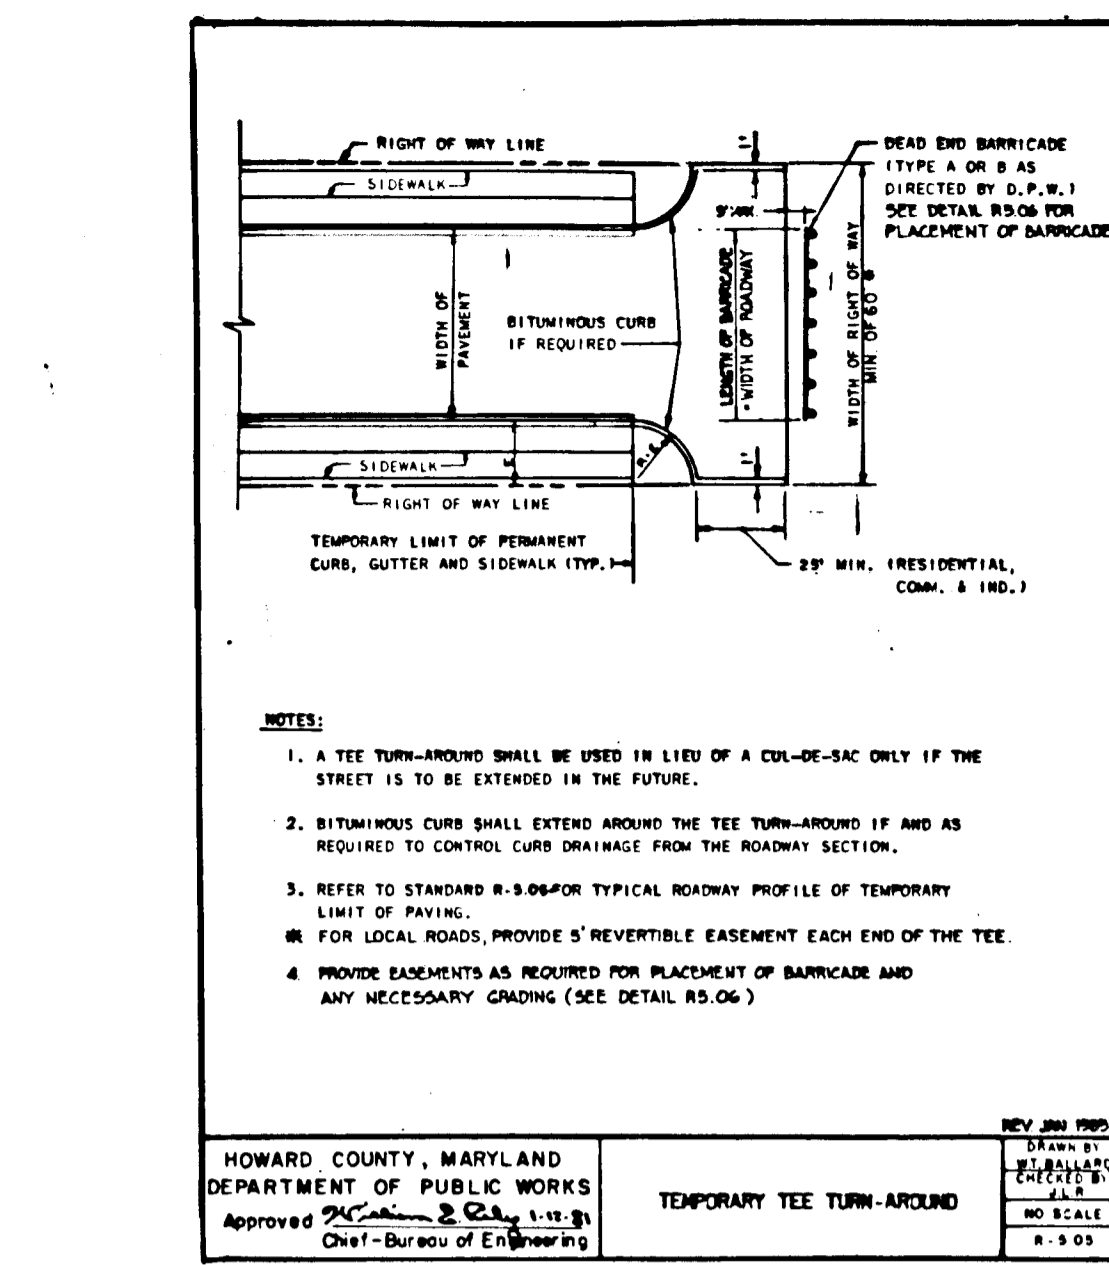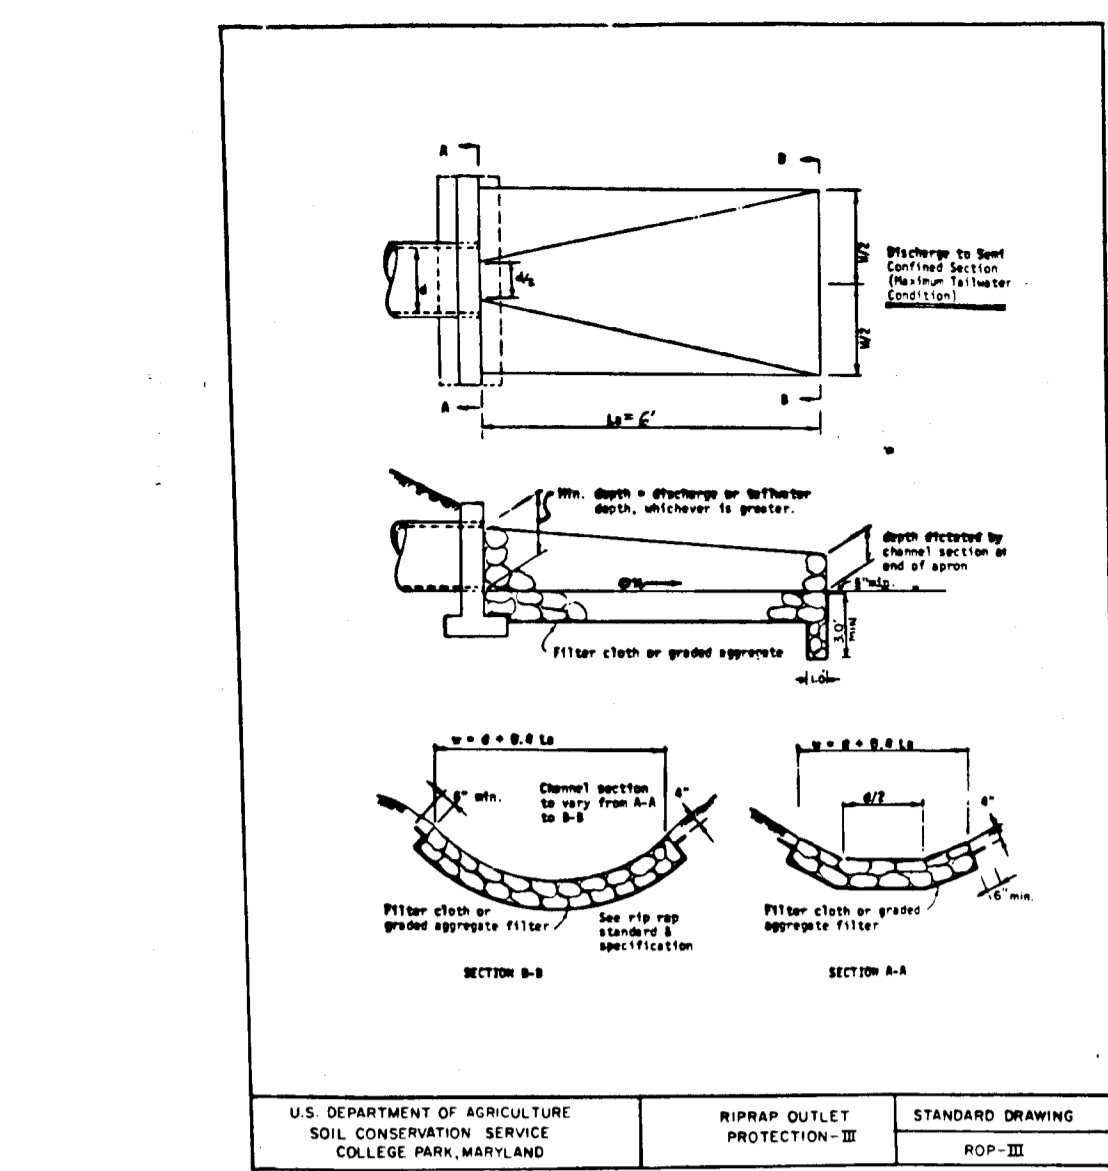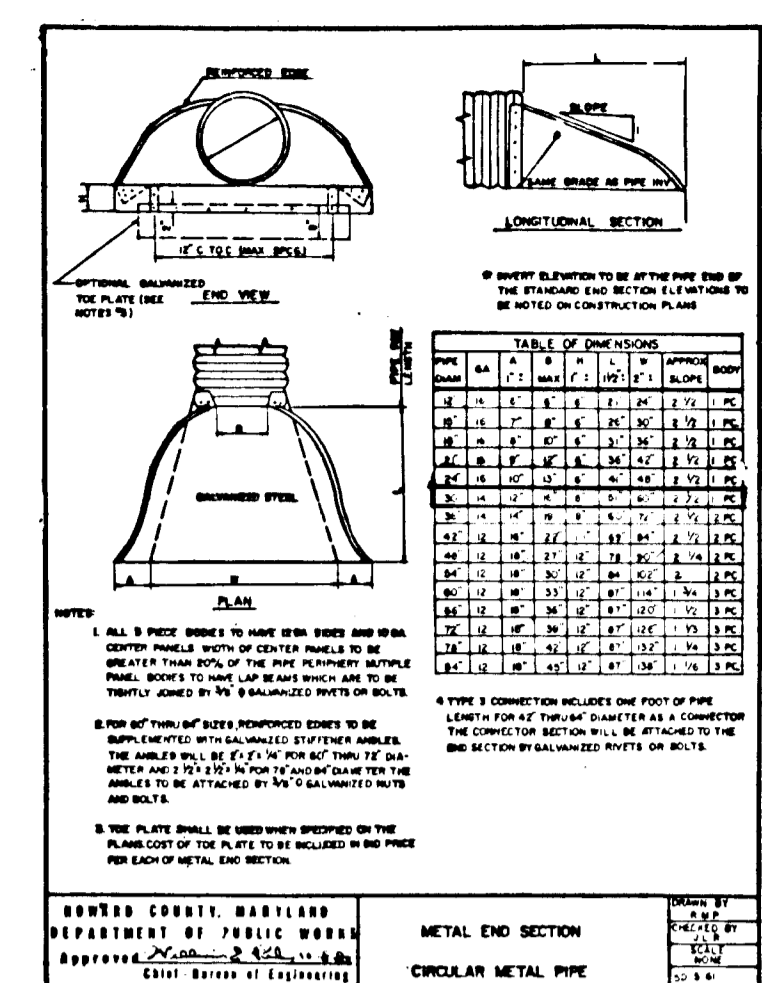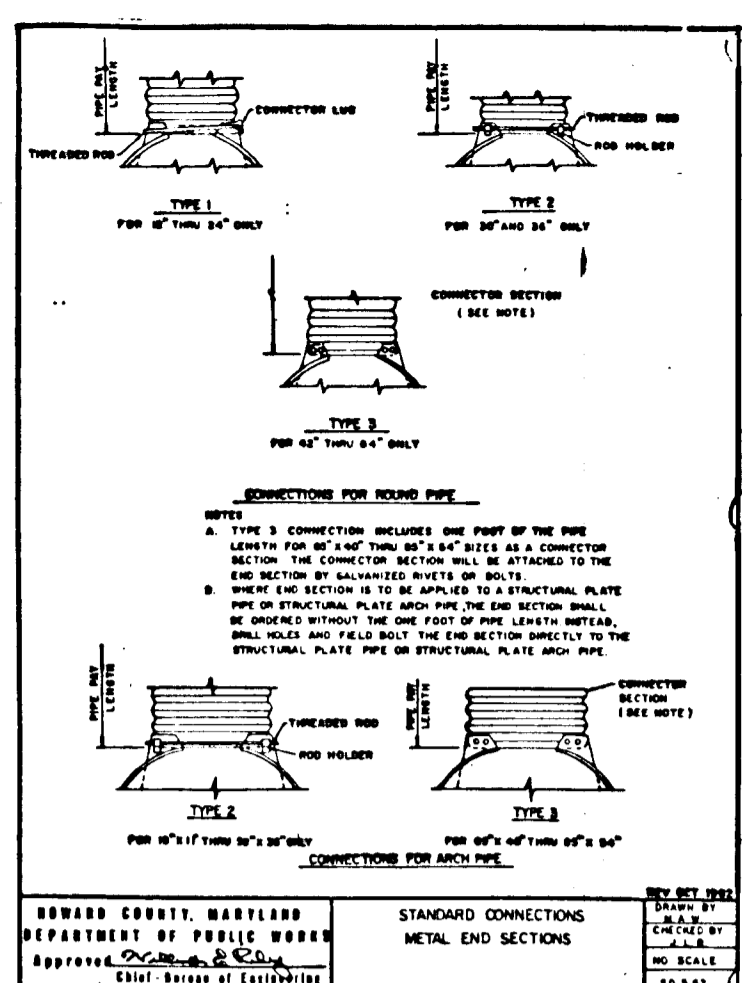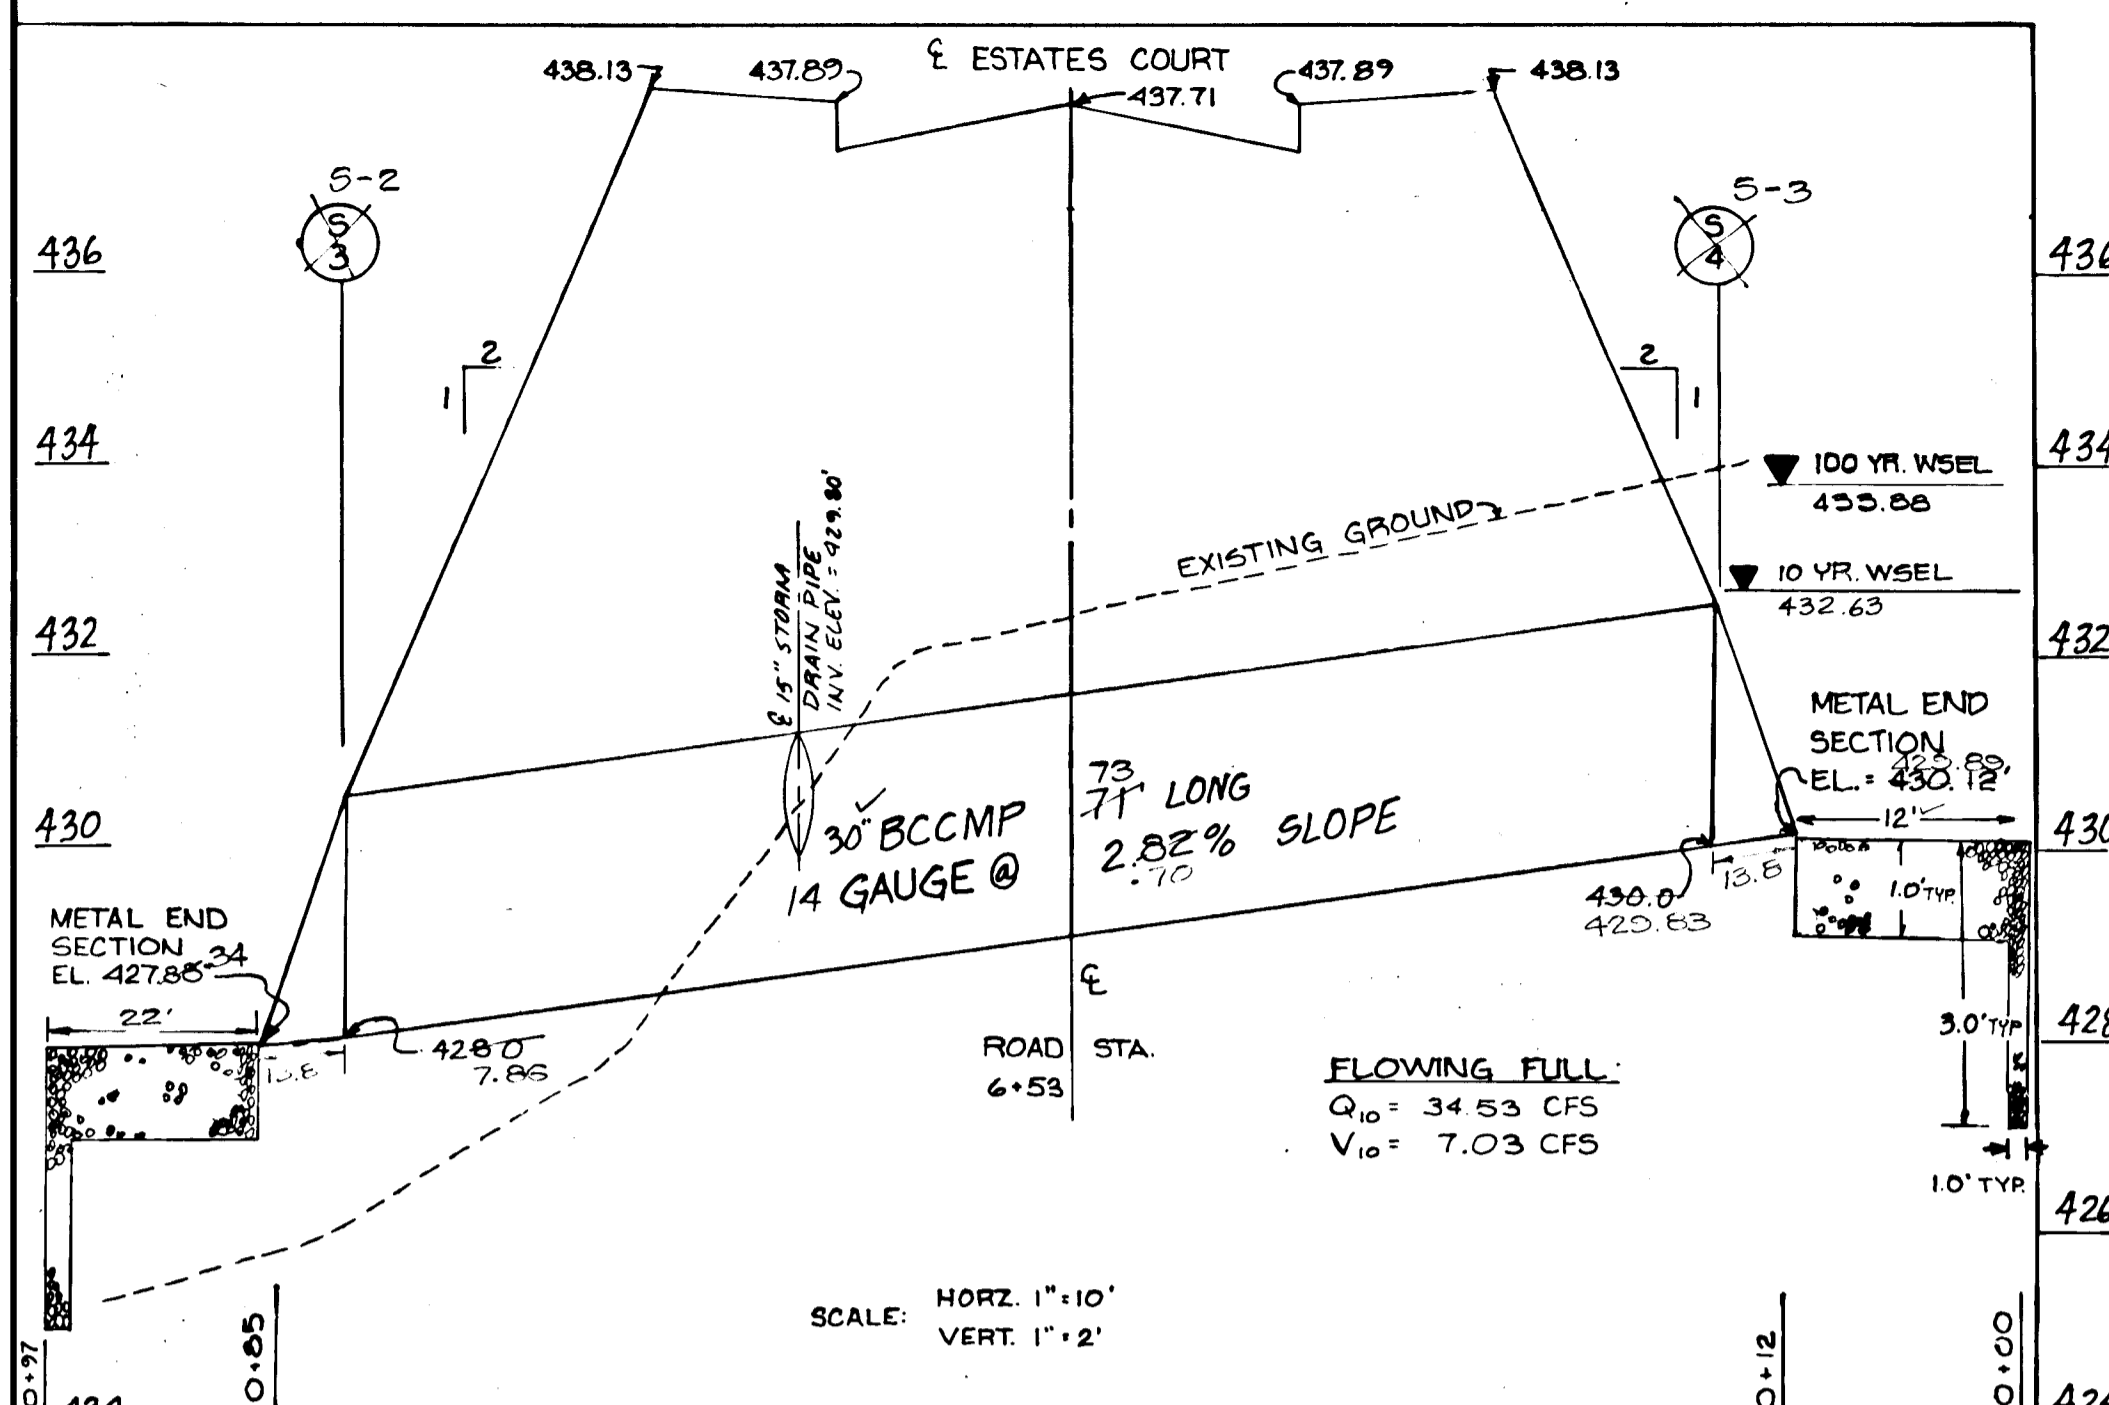

SMITHSONIAN STRUCTURE SCHEDULE

NO.	TYPE	IMP. IN.	IMP. MET.	TOP ELEV.	REMARKS
1-1	A-S	427.2	427.0	427.0	NO. CO. STD. METAL 3.41
1-2	A-S	428.7	427.8	427.8	NO. CO. STD. METAL 3.41
1-3	A-S	431.1	429.4	429.4	NO. CO. STD. METAL 3.41
1-4	A-S	431.7	429.8	429.8	NO. CO. STD. METAL 3.41
1-5	A-S	431.8	429.8	429.8	NO. CO. STD. METAL 3.41
1-6	A-S	431.8	429.8	429.8	NO. CO. STD. METAL 3.41
1-7	A-S	431.8	429.8	429.8	NO. CO. STD. METAL 3.41
1-8	A-S	431.8	429.8	429.8	NO. CO. STD. METAL 3.41
1-9	A-S	431.8	429.8	429.8	NO. CO. STD. METAL 3.41
1-10	A-S	431.8	429.8	429.8	NO. CO. STD. METAL 3.41

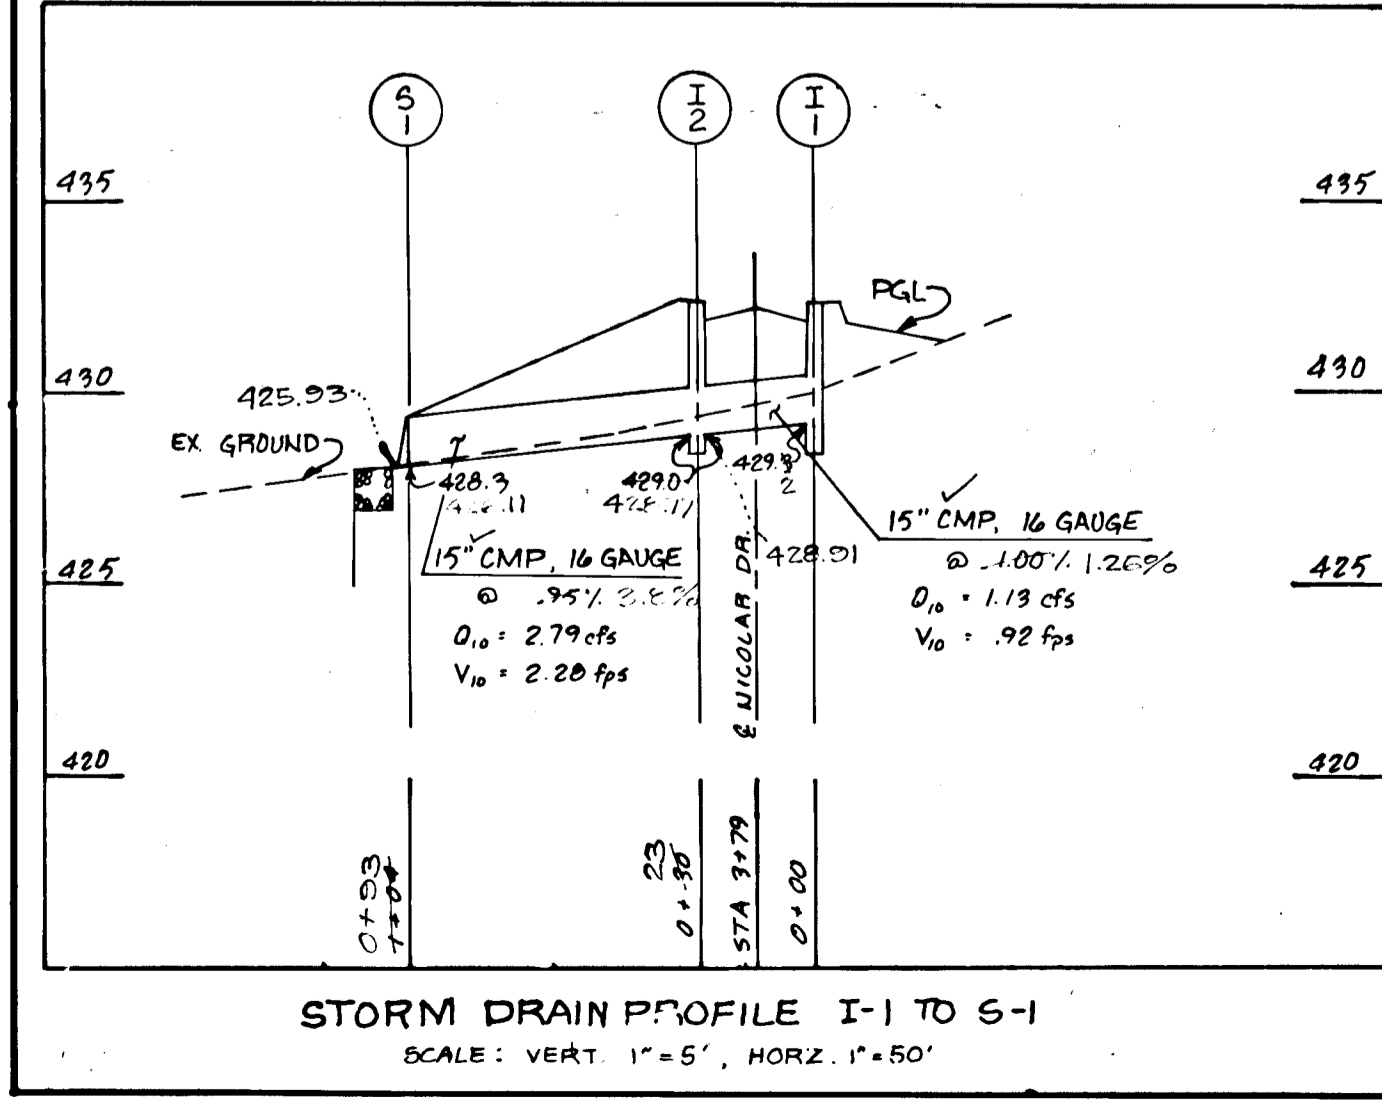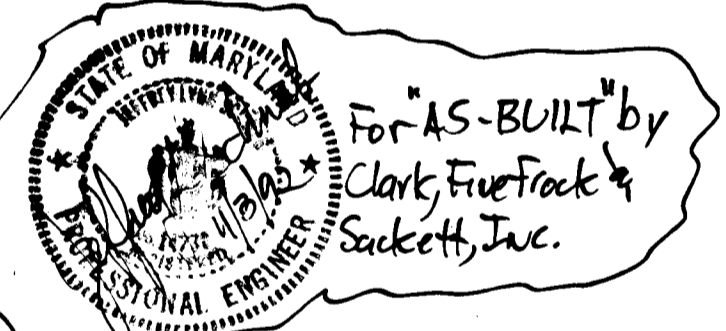

- SEQUENCE OF CONSTRUCTION
- OBTAIN GRADING PERMIT.
 - INSTALL CULVERT UNDER ESTATES COURT, STA 6+53. GRADE THE UPSTREAM CHANNEL IN ORDER TO DIVERT THE FLOW THROUGH THE CULVERT.
 - INSTALL ALL SEDIMENT CONTROL DEVICES, INCLUDING SILT FENCE, EARTH DICES AND SEDIMENT TRAPS 1-6. (SEE MODIFIED DIKE DETAIL SHT 7 OF 9)
 - ROUGH GRADE THE SITE.
 - INSTALL STORM DRAIN SYSTEM, 1-2 TO S-1, AND 1-4 TO S-4. IMMEDIATELY BLOCK ALL INLETS. (REFER TO SHT 7 OF 9 FOR BLOCKING DETAIL)
 - FINE GRADE THE SITE AS PER GRADING PLAN.
 - INSTALL MSHA CURB ALONG RD RT 216 AT SITE ENTRANCE.
 - INSTALL BITUMINOUS CURB ALONG ESTATES COURT AND NICOLAR DRIVE.
 - INSTALL ALL PAVING.
 - WITH PERMISSION OF THE SEDIMENT CONTROL INSPECTOR, REMOVE ALL SEDIMENT CONTROL DEVICES AND UNBLOCK INLETS. IMMEDIATELY STABILIZE ALL AFFECTED AREAS.



REVIEWED FOR HOWARD SOIL CONSERVATION AND MEETS TECHNICAL REQUIREMENTS.
 U.S. SOIL CONSERVATION SERVICE
 DATE: 4/28/88
 THIS DEVELOPMENT PLAN IS APPROVED FOR SOIL EROSION & SEDIMENT CONTROL BY THE HOWARD SOIL CONSERVATION DISTRICT.
 DATE: 4/28/88

ENGINEERS CERTIFICATE
 I certify that this plan for erosion and sediment control represents a practical and workable plan based on my personal knowledge of the site conditions and that it was prepared in accordance with the requirements of the Howard Soil Conservation District.
 JOHN E. PATMORE
 Registered Professional Engineer # 8978
 DATE: 4/26/88

APPROVED: HOWARD COUNTY DEPARTMENT OF PUBLIC WORKS
 Chief, Land Development Division
 Chief, Bureau of Highways
 Chief, Bureau of Engineering
 DATE: 5-10-88

KIDDE CONSULTANTS, INC.
 ENGINEERS • PLANNERS • SURVEYORS
 1100 WEST STREET / SUITE 100 / LAUREL, MD 20707
 (Wash.) (301) 553-1821 / 782-8086 (Balt.)


DESIGNED: RA
 DRAWN: SK
 CHECKED: DW
 DATE: JAN., 1988
 FULTON ESTATES
 TAX MAP 41 PARCELS 69, 203
 5th ELECTION DISTRICT
 HOWARD COUNTY, MARYLAND
 CONSTRUCTION DETAILS
 & STORM DRAIN PROFILES
 (SEE SHT. 7 OF 9 FOR ADDITIONAL STORM DRAIN PROFILES)
 SCALE AS SHOWN
 DWG NO. 6 OF 9
 JOB NO. 1687105
 FILE NO.

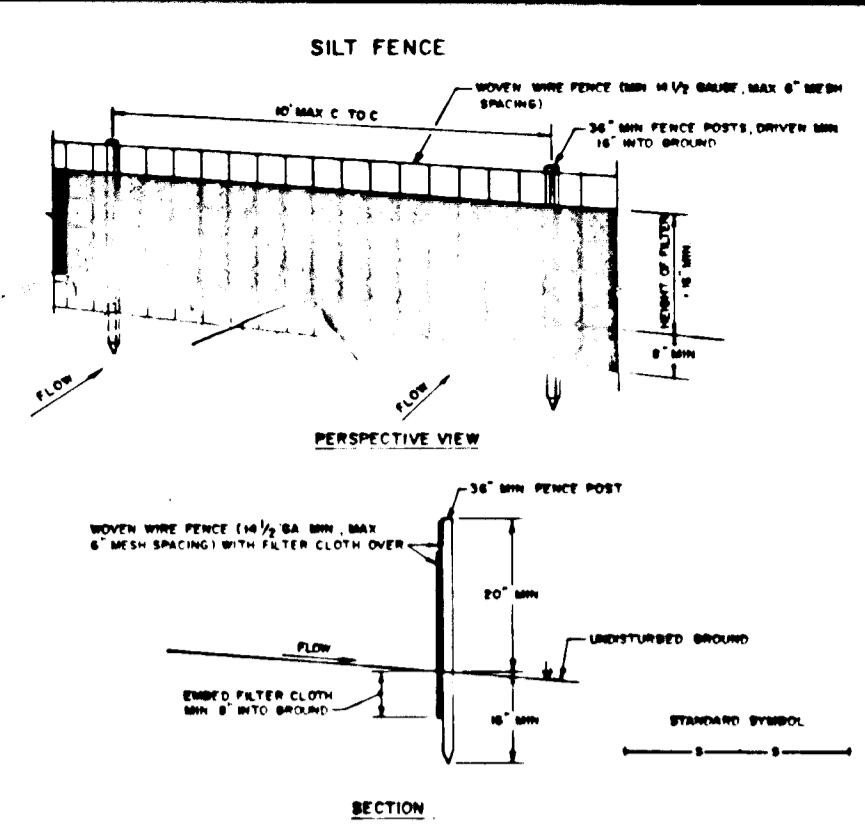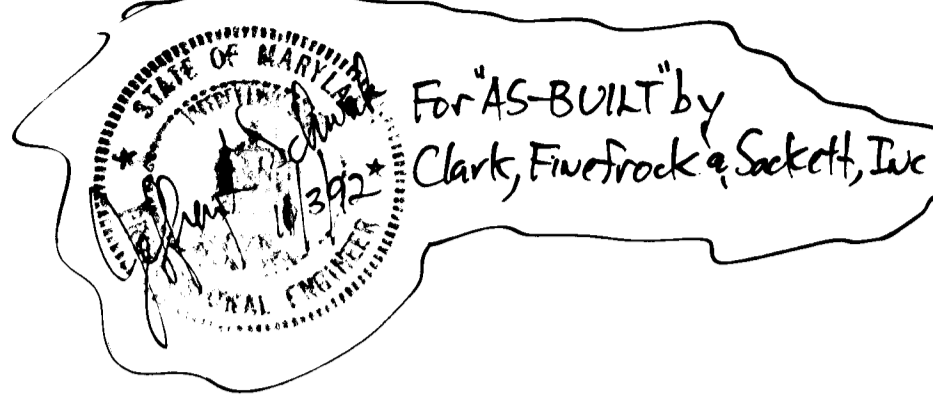

CONSTRUCTION NOTES FOR FABRICATED SILT FENCE

1. MONY WIRE FENCE TO BE FASTENED SECURELY TO POKE POSTS WITH WIRE TIES OR STAPLES.
2. FILTER CLOTH TO BE FASTENED SECURELY TO MONY WIRE FENCE WITH TIES SPACED EVERY 2' AT TOP AND MID SECTION.
3. WHEN THE SECTIONS OF FILTER CLOTH ADJOIN EACH OTHER THEY SHALL BE OVERLAPPED BY SIX INCHES AND POLLED.
4. MAINTENANCE SHALL BE PERFORMED AS SOON AS WEAR AND MATERIAL REMOVED. WEAR MARKS DEVELOPED IN THE SILT FENCE.


POSTS: STEEL STAPLES 1 OR U TYPE OR 2" WIDENESS
FENCE: MONY WIRE 1/4 GA. OR 1/4" ALUM. OPENING
FILTER CLOTH: FILTER X, HRAFF 1000, STAIN-1000, 1500, OR APPROVED EQUAL.
PRE-FABRICATED UNIT: GEORAB, H-100, H-150, OR APPROVED EQUAL.

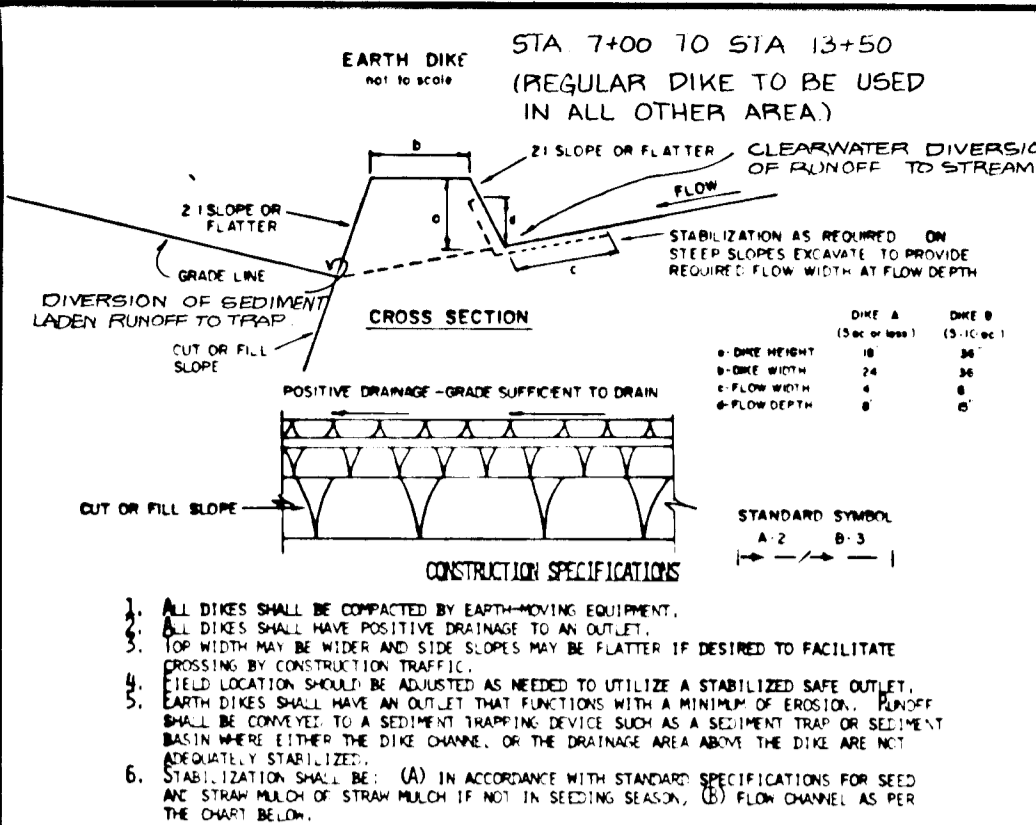

ELONG CHANNEL STABILIZATION


TYPE OF TREATMENT	CHANNEL SIZE	DIKE A	DIKE B
1	5-3-0.00	SEED AND STRAW MULCH	SEED AND STRAW MULCH
2	3-1-5-0.00	SEED AND STRAW MULCH	SEED USING JUTE, OR EXCELLEN, SEE 10-10-10
3	5-1-8-0.00	SEED WITH JUTE, OR SOE, STONE	LINED RIP-RAP 4-8"
4	8-1-2-0.00	LINED RIP-RAP 4-8"	ENGINEERING DESIGN

A. STONE TO BE 2 INCH STONE, OR RECYCLED CONCRETE EQUIVALENT, IN A LAYER AT LEAST 3 INCHES IN THICKNESS AND BE PRESSED INTO THE SOIL WITH CONSTRUCTION EQUIPMENT.
 B. RIP-RAP TO BE 4-8 INCHES IN A LAYER AT LEAST 8 INCHES THICKNESS AND PRESSED INTO THE SOIL.
 C. APPROVED EQUIVALENTS CAN BE SUBSTITUTED FOR ANY OF THE ABOVE MATERIALS.
 7. PERIODIC INSPECTION AND REQUIRED MAINTENANCE MUST BE PROVIDED AFTER EACH RAIN EVENT.

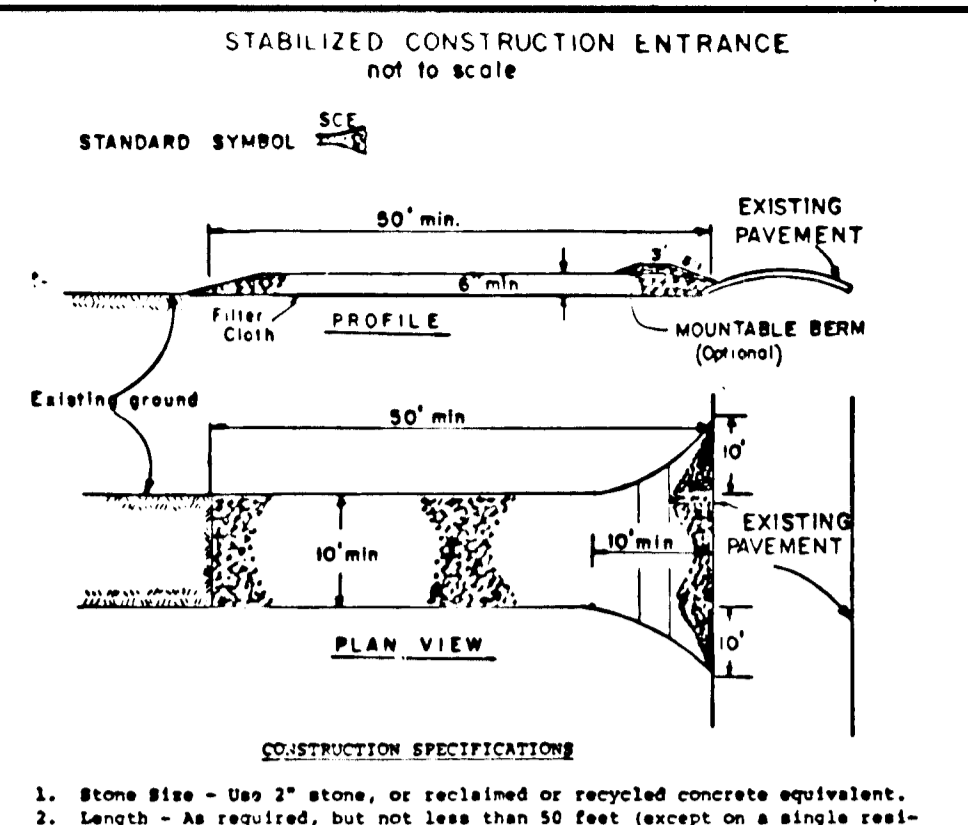

CONSTRUCTION SPECIFICATIONS

1. Stone Size - One 3" stone, or reclaimed or recycled concrete equivalent.
2. Length - As specified, but not less than 50 feet (except on a single residence lot where a 30 foot minimum length would apply).
3. Thickness - Not less than six (6) inches.
4. Width - Two (2) foot minimum, but not less than the full width at points where ingress or egress occurs.
5. Filter Cloth - Will be placed over the entire area prior to placing of stone. Filter will not be required on a single family residence lot.
6. Surface Water - All surface water flowing or diverted toward construction entrances shall be piped across the entrance. If piping is impractical, a mounable berm with 1:1 slope will be permitted.
7. Maintenance - The entrance shall be maintained in a condition which will prevent tracking or flowing of sediment onto public rights-of-way. This may require periodic top dressing with additional stone as conditions demand and repair and/or cleanout of any measures used to trap sediment. All sediment applied, dropped, washed or tracked onto public rights-of-way must be removed immediately.
8. Washing - Vehicles shall be cleaned to remove sediment prior to entrance onto public rights-of-way. When washing is required, it shall be done on an area stabilized with stone and which drains into an approved sediment trapping device.
9. Periodic inspection and needed maintenance shall be provided after each rain.

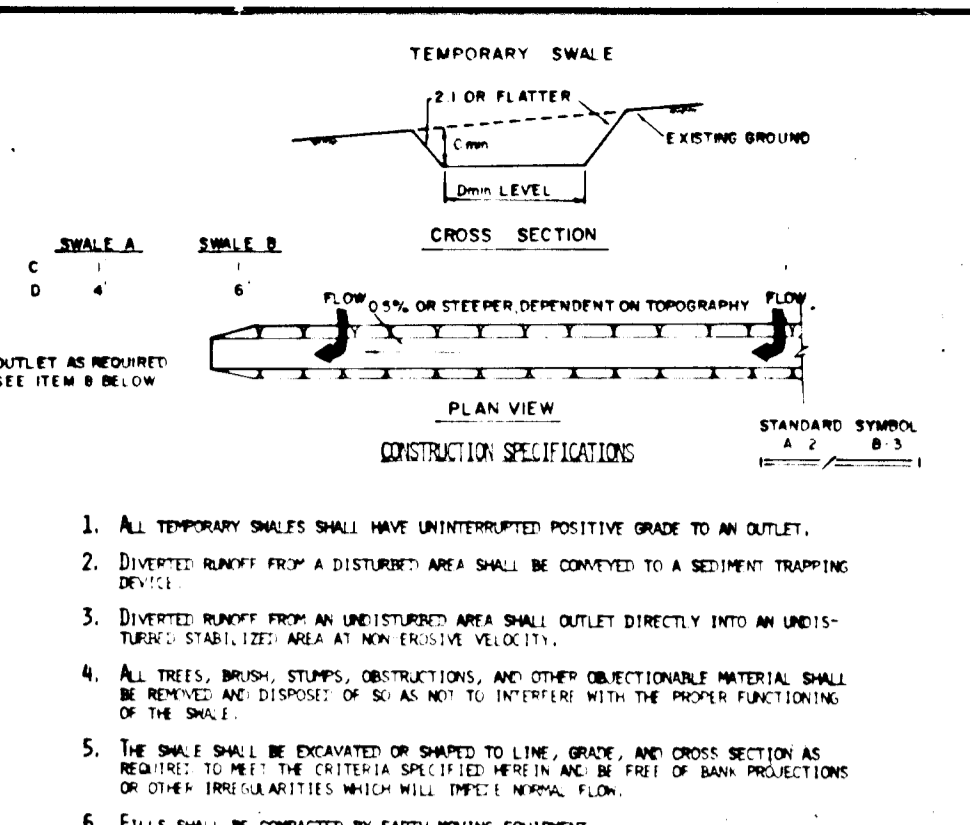

CONSTRUCTION SPECIFICATIONS

1. ALL TEMPORARY SWALES SHALL HAVE UNINTERFERED POSITIVE GRADE TO AN OUTLET.
2. DIVERTED RUNOFF FROM A DISTURBED AREA SHALL BE CONVEYED TO A SEDIMENT TRAPPING DEVICE.
3. DIVERTED RUNOFF FROM AN UNDISTURBED AREA SHALL OUTLET DIRECTLY INTO AN UNDISTURBED AREA.
4. ALL TREES, BUSHES, STUBS, OBSTRUCTIONS, AND OTHER OBSTRUCTIVE MATERIAL SHALL BE REMOVED AND DISPOSED OF SO AS NOT TO INTERFERE WITH THE PROPER FUNCTIONING OF THE SWALE.
5. THE SWALE SHALL BE ENHANCED TO MATCH THE LINE, GRADE, AND CROSS SECTION AS NEARLY AS POSSIBLE TO THE EXISTING SWALE WITHIN AN AREA OF 10' FROM THE PROJECTIONS OF OTHER INSTALMENTS WHICH WILL IMPAIR WORKING OF THE SWALE.
6. FILLS SHALL BE COMPACTED BY EARTH MOVING EQUIPMENT.
7. ALL EARTH WORK SHALL BE CONSTRUCTED TO THE LINE, GRADE, AND CROSS SECTION AS NEARLY AS POSSIBLE TO THE EXISTING SWALE WITHIN AN AREA OF 10' FROM THE PROJECTIONS OF OTHER INSTALMENTS WHICH WILL IMPAIR WORKING OF THE SWALE.
8. STABILIZATION SHALL BE PER THE CHART BELOW:

TYPE OF TREATMENT	CHANNEL SIZE	A (5' OR LESS)	B (5' - 10')
1	0.5-3-0.00	SEED AND STRAW MULCH	SEED AND STRAW MULCH
2	3-1-5-0.00	SEED AND STRAW MULCH	SEED USING JUTE OR EXCELLEN, SEE 10-10-10
3	5-1-8-0.00	SEED WITH JUTE, OR EXCELLEN, SEE 10-10-10	LINED RIP-RAP 4-8"
4	8-1-2-0.00	LINED RIP-RAP 4-8"	ENGINEERING DESIGN

PERMANENT SEEDING NOTES

Apply to graded or cleared areas not subject to immediate further disturbance where a permanent long-lived vegetative cover is needed.

Seeded Preparation: Loosen upper three inches of soil by raking, discing or other acceptable means before seeding, IF NOT PREVIOUSLY LOOSENED.

Soil Amendments: In lieu of soil test recommendations, use one of the following schedules:

- 1) Preferred - Apply 2 tons per acre dolomitic limestone (92 lbs/1000 square ft) and 600 lbs per acre 10-10-10 fertilizer (14 lbs/1000 square ft) before seeding. Narrow or disc into upper three inches of soil. At time of seeding, apply 400 lbs per acre 30-0-0 ureaform fertilizer (9 lbs/1000 square ft).
- 2) Acceptable - Apply 2 tons per acre dolomitic limestone (92 lbs/1000 square ft) and 1000 lbs per acre 10-10-10 fertilizer (23 lbs/1000 square ft) before seeding. Narrow or disc into upper three inches of soil.

Seeding - For the periods March 1 thru April 30, and August 1 thru October 15, seed with 60 lbs per acre of annual ryegrass (3.2 lbs/1000 square ft). For the period May 1 thru July 31, seed with 60 lbs Kentucky 31 Tall Fescue per acre and 2 lbs per acre (.05 lbs/1000 square ft) of weeping lovegrass. During the period of October 16 thru February 28, seed with 60 lbs Kentucky 31 Tall Fescue per acre and 2 lbs per acre (.05 lbs/1000 square ft) of weeping lovegrass. For the period of October 16 thru February 28, protect area by: Option (1) 2 tons per acre of well anchored straw mulch and seed as soon as possible in the spring. Option (2) Use sod. Option (3) Seed with 60 lbs/acre Kentucky 31 Tall Fescue and mulch with 2 tons/acre well anchored straw.

Mulching - Apply 14 to 2 tons per acre (70 to 90 lbs/1000 square ft) of unrotted small grain straw immediately after seeding. Anchor mulch immediately after application using mulch anchoring tool or 218 gallons per acre (5 gal/1000 square ft) of emulsified asphalt on flat areas. On slopes 8 feet or higher, use 348 gallons per acre (8 gal/1000 square ft) for anchoring.

Maintenance - Inspect all seeded areas and make needed repairs, replacements and reseedings.

TEMPORARY SEEDING NOTES

Apply to graded or cleared areas likely to be redisturbed where a short-term vegetative cover is needed.



Seeded Preparation: Loosen upper three inches of soil by raking, discing or other acceptable means before seeding, IF NOT PREVIOUSLY LOOSENED.

Soil Amendments: Apply 600 lbs per acre 10-10-10 fertilizer (14 lbs/1000 square ft).

Seeding - For periods March 1 thru April 30 and from August 15 thru November 15, seed with 25 bushel per acre of annual ryegrass (3.2 lbs/1000 square ft). For the period May 1 thru August 14, seed with 3 lbs per acre of weeping lovegrass (.07 lbs/1000 square ft). For the period November 16 thru February 28, protect area by applying 2 tons per acre of well anchored straw mulch and seed as soon as possible in the spring, or use sod.

Mulching: Apply 14 to 2 tons per acre (70 to 90 lbs/1000 square ft) of unrotted small grain straw immediately after seeding. Anchor mulch immediately after application using mulch anchoring tool or 218 gal per acre (5 gal/1000 square ft) of emulsified asphalt on flat areas. On slopes 8 ft or higher, use 348 gal per acre (8 gal/1000 square ft) for anchoring.

Refer to the 1983 MARYLAND STANDARDS AND SPECIFICATIONS FOR SOIL EROSION AND SEDIMENT CONTROL for rate and methods not covered.

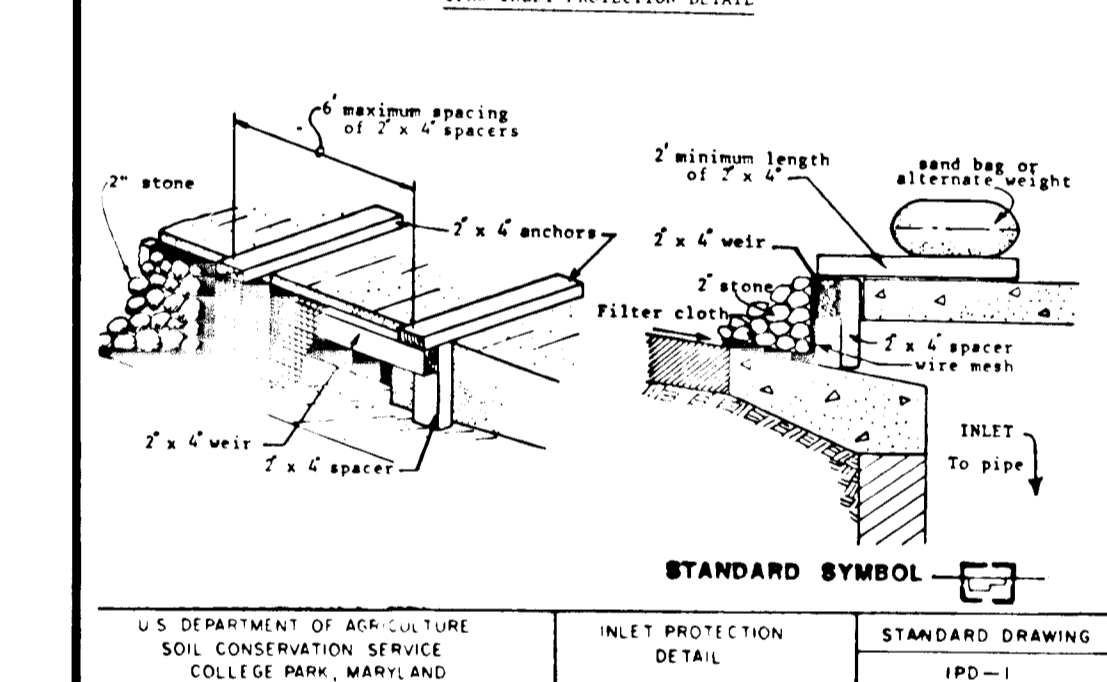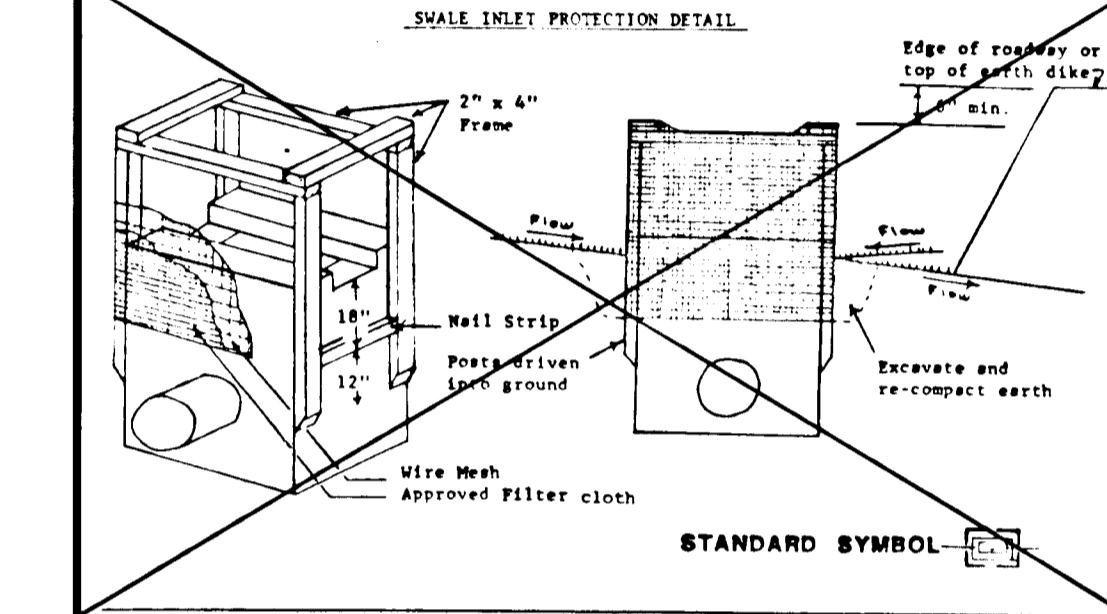

Construction Specifications

Materials

- A. Wooden frame is to be constructed of 2"x4" construction grade lumber.
- B. Plywood is to be a minimum thickness of 1/4" construction grade lumber.

Installation

1. Cut plywood to extend a minimum of 6" past throat along curb.
2. Attach to anchors in a secure manner which will insure a water tight fit against throat.
3. Brace accurately using sandbag or alternate weight. If not watertight, use approved filter cloth under plywood and attach securely.

REVIEWED FOR HOWARD SOIL CONSERVATION DISTRICT AND MEETS TECHNICAL REQUIREMENTS.





Signature: *[Signature]* DATE: 4/28/88

U.S. SOIL CONSERVATION SERVICE

THIS DEVELOPMENT PLAN IS APPROVED FOR SOIL EROSION AND SEDIMENT CONTROL BY THE HOWARD SOIL CONSERVATION DISTRICT.

Signature: *[Signature]* DATE: 4/28/88

Approved Howard S.C.D.

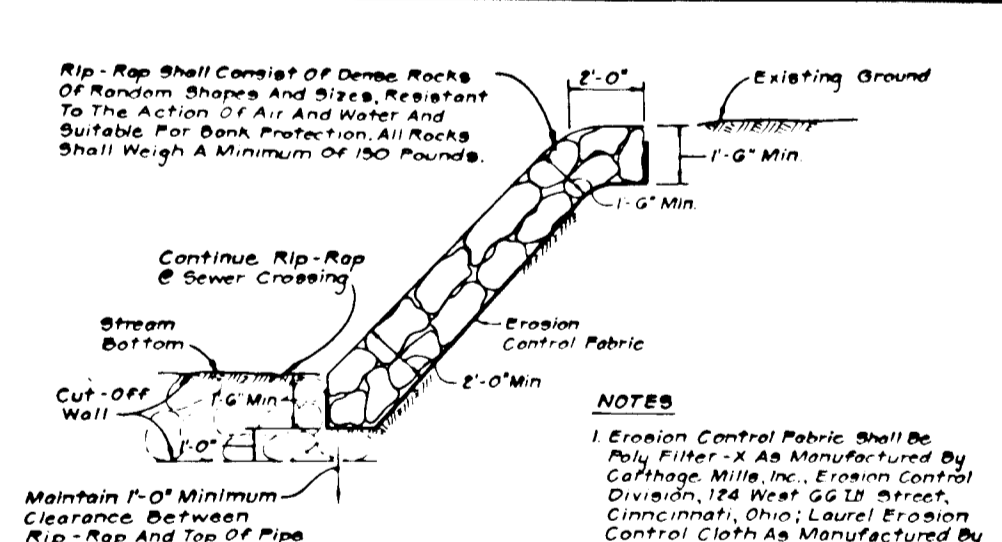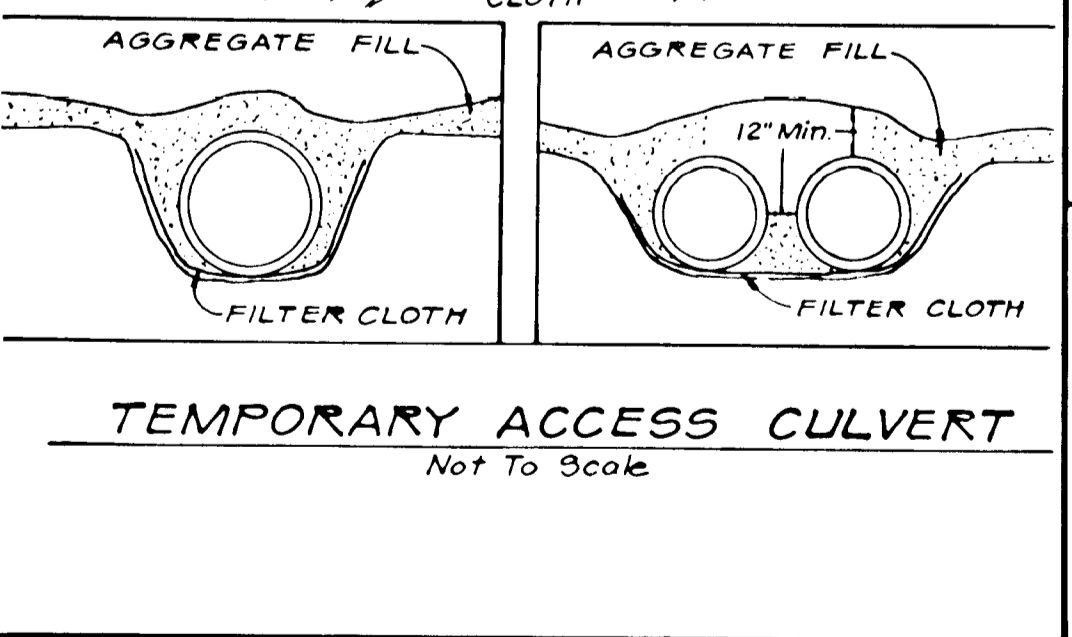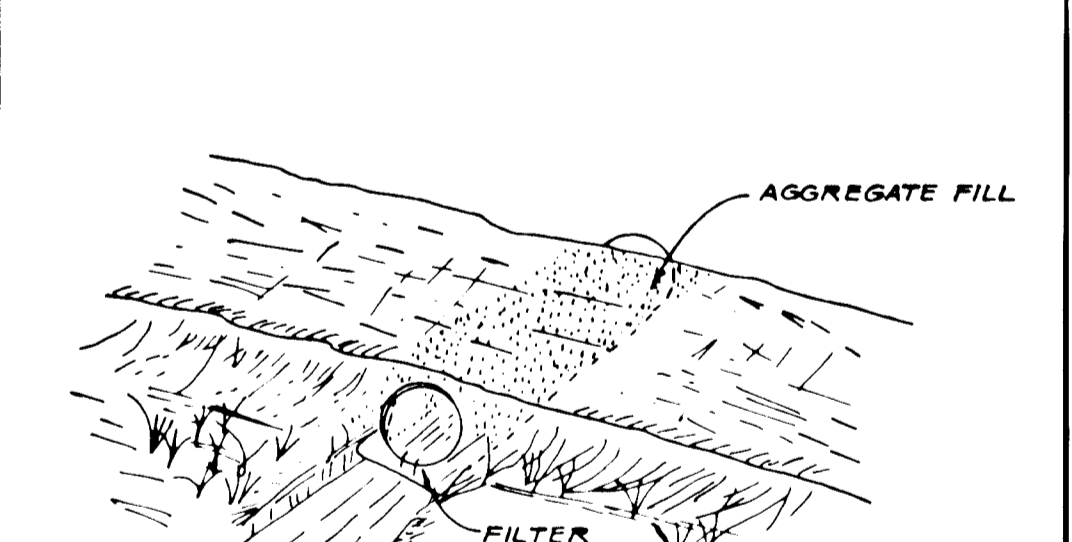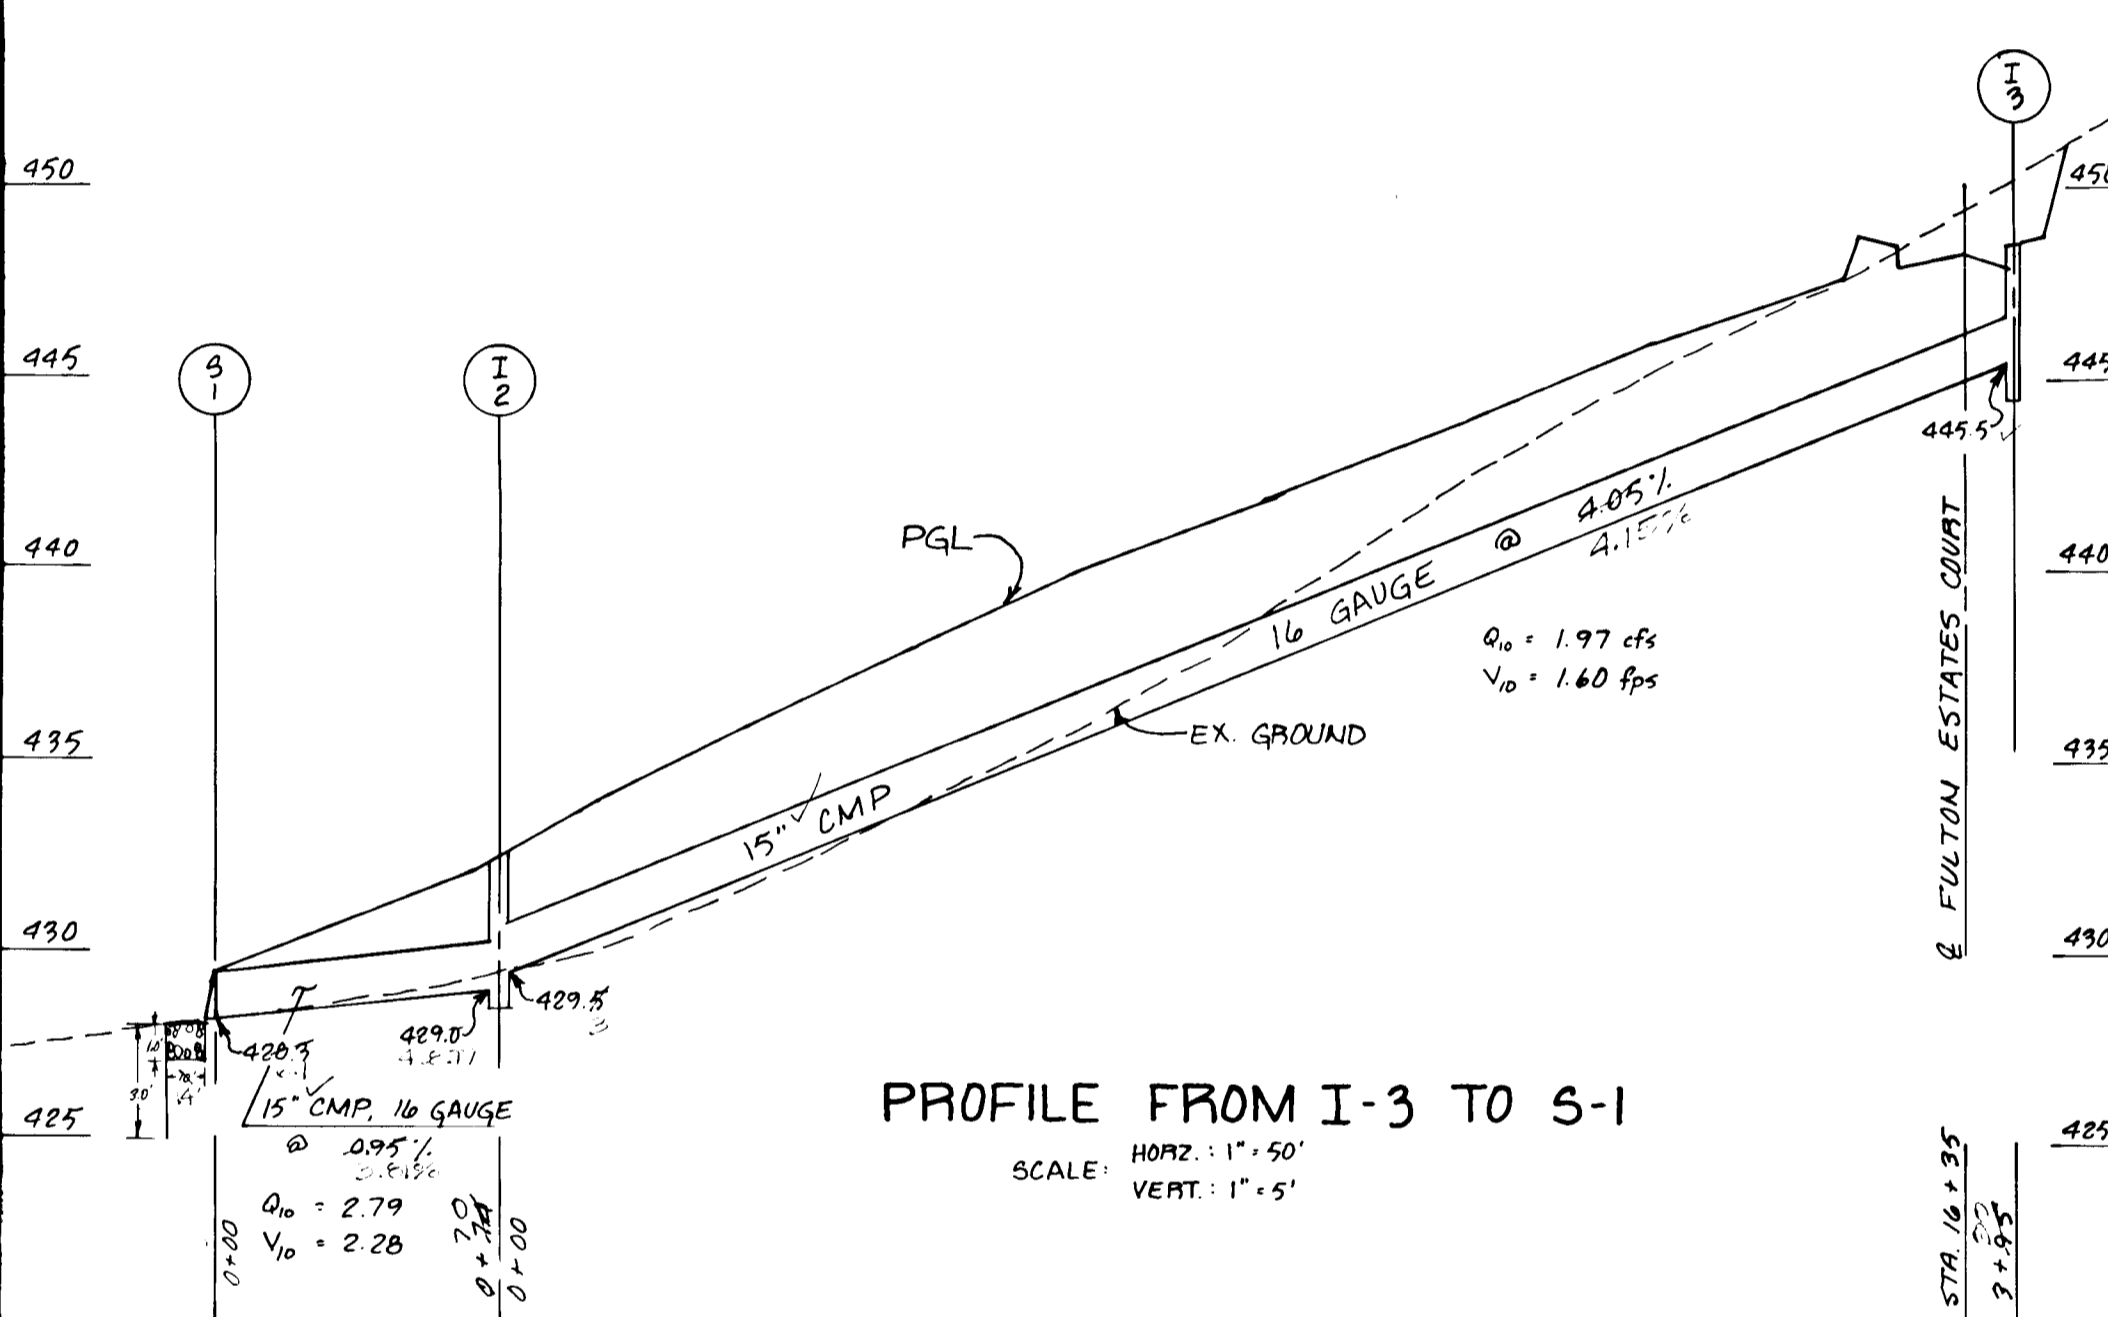



SOIL CONSERVATION MEASURES AT SMALL STREAM CROSSING

NOT TO SCALE

APPROVED: HOWARD COUNTY DEPARTMENT OF PUBLIC WORKS

Signature: *[Signature]* DATE: 5/9/88

Signature: *[Signature]* DATE: 5-10-88

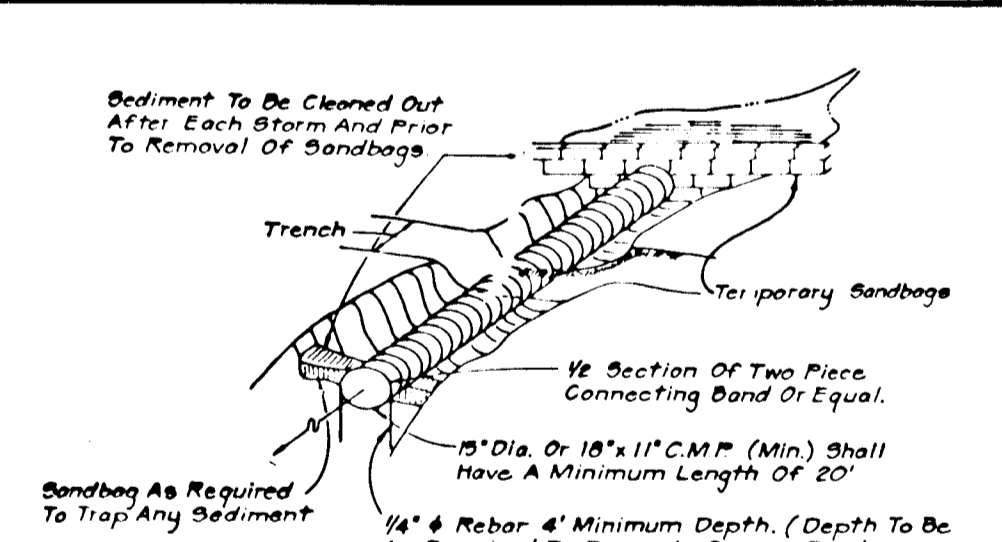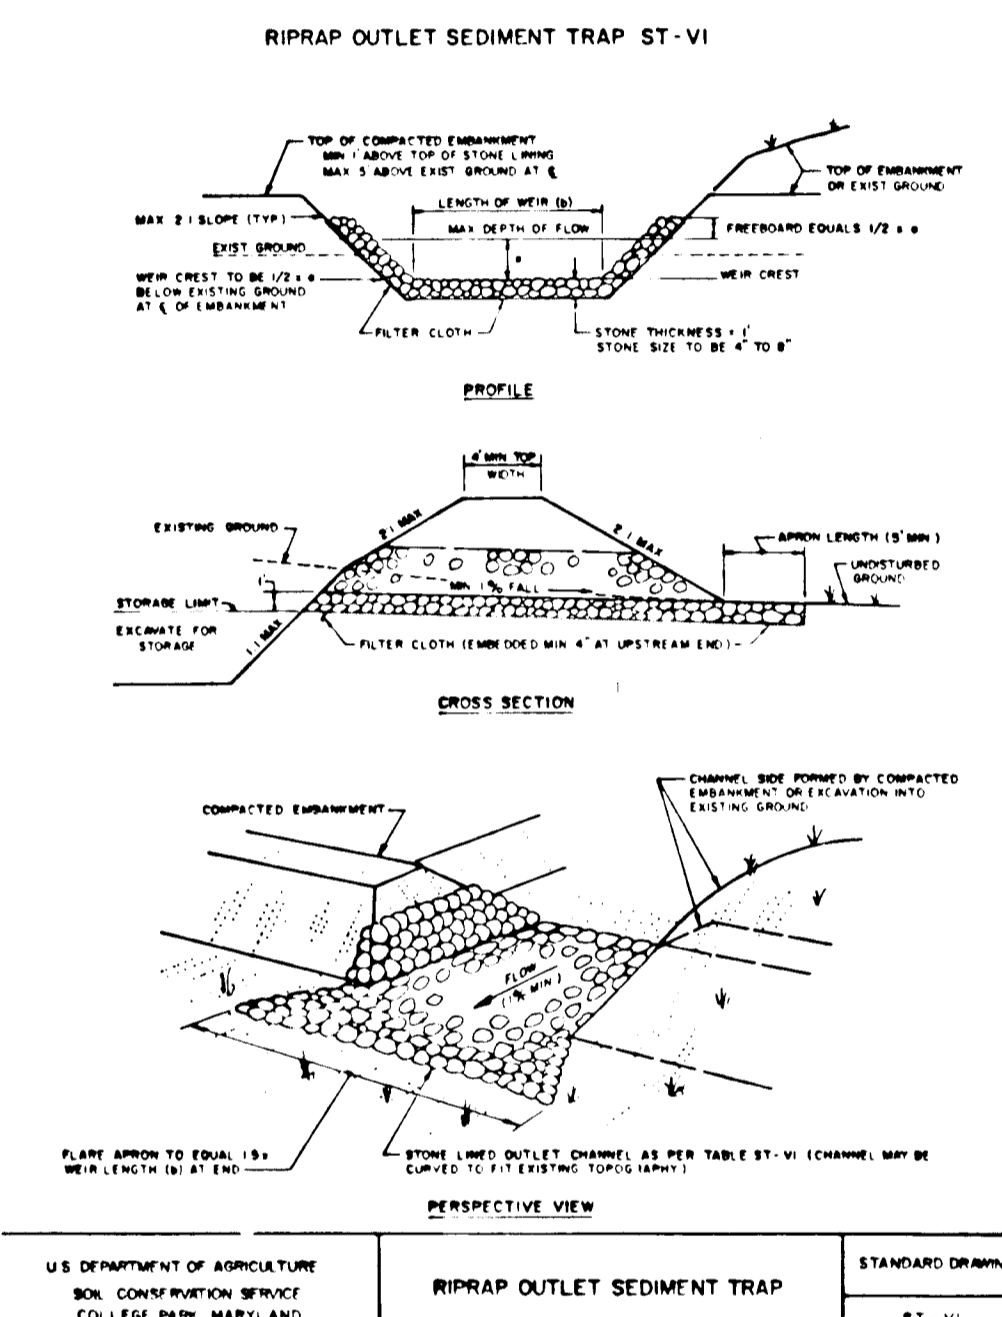

SOIL CONSERVATION MEASURES AT SMALL STREAM CROSSING

NOT TO SCALE

Contributing Drainage Area (Acres)	Depth of Channel (Feet)	Length of Weir (b) (Feet)
1	1.5	4.0
2	1.5	5.0
3	1.5	6.0
4	1.5	10.0
5	1.5	12.0
6	1.5	14.0
7	1.5	16.0
8	2.0	10.0
9	2.0	10.0
10	2.0	12.0
11	2.0	14.0
12	2.0	14.0
13	2.0	16.0
14	2.0	16.0
15	2.0	18.0

CONSTRUCTION SPECIFICATIONS FOR ST-VI

1. The area under embankment shall be cleared, grubbed and stripped of any vegetation and root mat. The pool area shall be cleared.
2. The fill material for the embankment shall be free of roots or other woody vegetation as well as over-sized stones, rocks, organic material or other objectionable material. The embankment shall be constructed by traversing with equipment while it is being constructed. Maximum height of embankment shall be five (5) feet, measured at centerline of embankment.
3. All fill slopes shall be 2:1 or flatter; cut slopes 1:1 or flatter.
4. Elevation of the top of any dike directing water into trap must equal or exceed the height of embankment.
5. Storage area provided shall be figured by computing the volume available behind the outlet channel up to an elevation of one (1) foot below the level weir crest.
6. Filter cloth shall be placed over the bottom and sides of the outlet channel prior to placement of stone. Sections of fabric must overlap at least one (1) foot with section nearest the entrance placed on top. Fabric shall be embedded at least six (6) inches into existing ground at entrance of outlet channel.
7. Stone used in the outlet channel shall be four (4) to eight (8) inches (riprap). To provide a filtering effect, a layer of filter cloth shall be embedded one (1) foot back into the upstream face of the outlet stone or a one (1) foot thick layer of two (2) inch or finer aggregate shall be placed on the upstream face of the outlet.
8. Sediment shall be removed and trap restored to its original dimensions when the sediment has accumulated to 1/2 the design depth of the trap. Removed sediment shall be deposited in a suitable area and in such a manner that it will not erode.
9. The structure shall be inspected after each rain and repaired as needed.
10. Construction operations shall be carried out in such a manner that erosion and water pollution are minimized.
11. The structure shall be removed and the area stabilized when the drainage area has been properly stabilized.
12. Drainage area for this practice is limited to 15 acres or less.

APPROVED: HOWARD COUNTY OFFICE OF PLANNING AND ZONING

Signature: *[Signature]* DATE: 5/11/88

Signature: *[Signature]* DATE: 5-10-88

OWNER/DEVELOPER

WARREN MATZEN
 10440 BALTIMORE AVENUE
 BELTSVILLE, MARYLAND 20705

Signature: *[Signature]* DATE: 11/21/88

OWNER'S/DEVELOPER'S CERTIFICATION

"I/We certify that all development and construction will be done according to this plan, and that any responsible personnel involved in the construction project will have a Certificate of Attendance at a Department of Natural Resources Approved Training Program for the Control of Sediment and Erosion before beginning the project. I also authorize periodic on-site inspection by the Howard Soil Conservation District."

Signature: *[Signature]* DATE: 11/21/88

ENGINEER'S CERTIFICATE

"I certify that this plan for erosion and sediment control represents a practical and workable plan based on my personal knowledge of the site conditions and that it was prepared in accordance with the requirements of the Howard Soil Conservation District."

Signature: *[Signature]* DATE: 4/26/88

JOHN L. C. PAJ MORE
 Registered Professional Engineer # 8978

KIDDE CONSULTANTS, INC.
 ENGINEERS • PLANNERS • SURVEYORS

1100 WEST STREET / SUITE 100 / LAUREL, MD 20707
 (Wash.) (301) 953-1821 / 792-8086 (Balt.)

FULTON ESTATES

TAX MAP 41 PARCELS 69, 203

5th ELECTION DISTRICT HOWARD COUNTY, MARYLAND

DATE	REVISIONS	SHEET	DATE	JULY NUMBER
		7		
		OF		
		9		

SCALE: 1686002


SEDIMENT CONTROL DETAIL SHEET

On all sites with disturbed areas in excess of 2 acres, approval of the inspection agency shall be requested upon completion of installation of perimeter erosion and sediment controls, but before proceeding with any other earth disturbance or grading. Other building or grading inspection approvals may not be authorized until this initial approval by the inspection agency is made.

NOTE: FOR SEQUENCE OF CONSTRUCTIONS, SEE SHEET 6 OF 9

1360

SYMBOL	DESCRIPTION	TYPE
ChA	CHESTER SILT LOAM 0-3% SLOPE	B
ChB2	CHESTER SILT LOAM 3-8% SLOPE	B
ChC2	CHESTER SILT LOAM 8-15% SLOPE	B
ChC3	CHESTER SILT LOAM 9-15% SLOPE	B
Co	CODORUS SILT LOAM	C
CuB	COMUS SILT LOAM 3-8% SLOPE	B
EKA	ELIOAK SILT LOAM 0-3% SLOPE	B
EKB2	ELIOAK SILT LOAM 3-8% SLOPE	B
EIC3	ELIOAK SILT CLAY LOAM 8-15% SLOPE	B
G1B2	GLENELG LOAM 3-8% SLOPE	B
G1C2	GLENELG LOAM 8-15% SLOPE	B
GnB2	GLENVILLE SILT LOAM 3-8% SLOPE	C
GnC2	GLENVILLE SILT LOAM 8-15% SLOPE	C
M1C2	MANOR LOAM 8-15% SLOPE	B
M1C3	MANOR LOAM 8-15% SLOPE	B
M1D2	MANOR LOAM 15-25% SLOPE	B
M1D3	MANOR LOAM 15-25% SLOPE	B

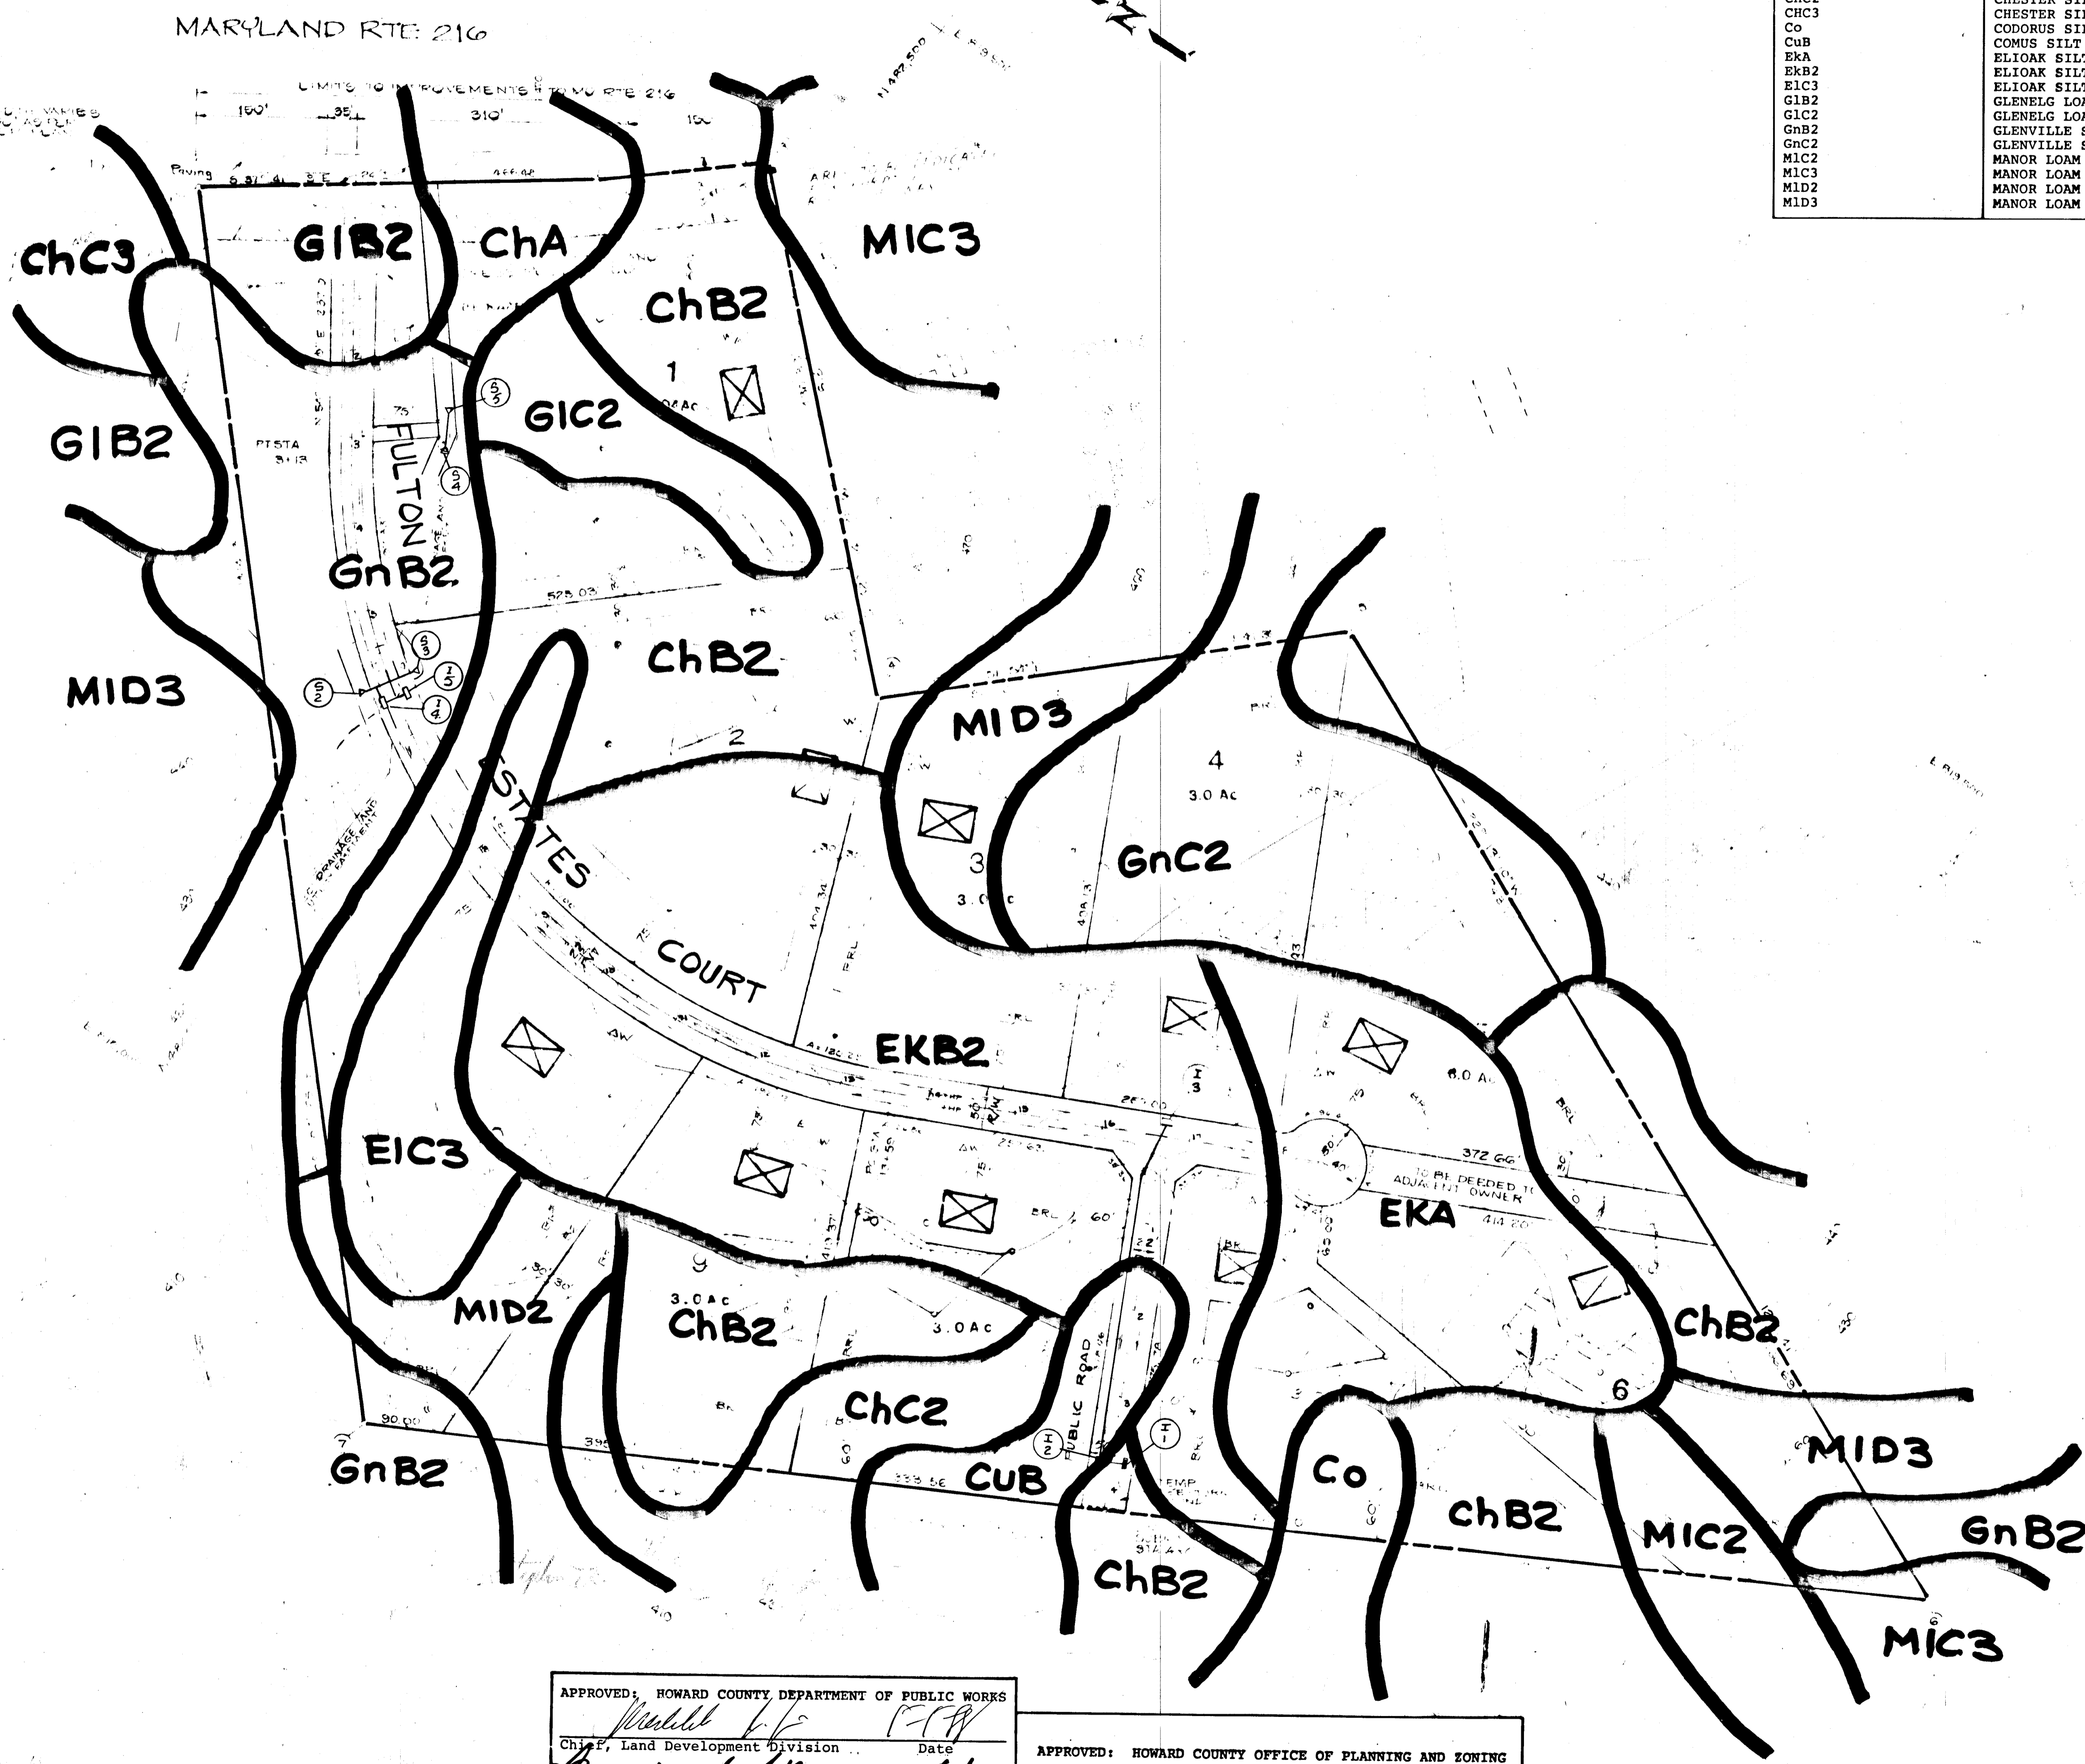

● WELL
 ▨ PERC TEST LOCATIONS


SOILS MAP
FULTON ESTATES
 TAX MAP # 41 PARCELS 69, 203
 5TH ELECTION DISTRICT HOWARD CO MD
 SOILS BOOK SHEET # 28
 SHEET 9 OF 9

KIDDE CONSULTANTS, INC.

APPROVED: HOWARD COUNTY DEPARTMENT OF PUBLIC WORKS
 Chief, Land Development Division *[Signature]* Date *5/9/88*
 Chief, Bureau of Highways *[Signature]* Date *5-10-88*
 Chief, Bureau of Engineering *[Signature]* Date

APPROVED: HOWARD COUNTY OFFICE OF PLANNING AND ZONING
 Chief, Division of Community Planning and Land Development *[Signature]* Date *5/10/88*

OWNER/
 DEVELOPER
 WARREN MATZEN
 10440 BALTIMORE AVENUE
 BELTSVILLE, MARYLAND 20705

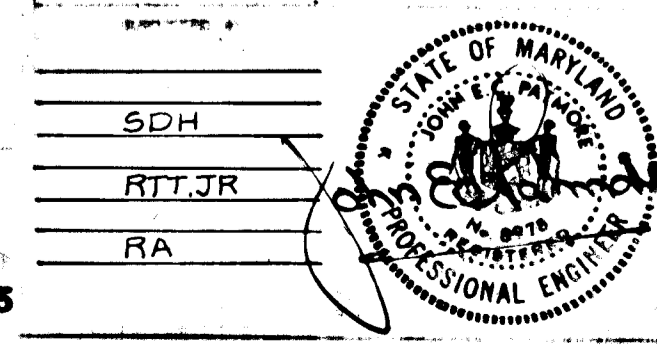

OCT, 1987 1"=100'

1360