

| STRUCTURE SCHEDULE | | | | | | |
|--------------------|-----------------|---------|----------|-----------|-----------|---------------------------|
| NO. | TYPE | INV. IN | INV. OUT | UPPER END | LOWER END | HO. CO. STD. & LOCATION |
| I-1 | A-B/W/DEFLECTOR | 255.62 | 255.72 | 255.45 | 255.55 | SD-401 7+53.15R (HOR) |
| I-2 | A-B/W/DEFLECTOR | 255.69 | 255.79 | 255.52 | 255.62 | SD-401 0+47.5, 14R (CH) |
| I-3 | A-B/W/DEFLECTOR | 244.25 | 244.35 | 244.08 | 244.18 | SD-401 2+50.5, 14L (CH) |
| I-4 | A-B/W/DEFLECTOR | 244.25 | 244.35 | 244.08 | 244.18 | SD-401 2+50.5, 14R (CH) |
| I-5 | A-10W/DEFLECTOR | 242.84 | 242.94 | 242.67 | 242.77 | SD-402 6+17, 14L (DON) |
| I-6 | A-10W/DEFLECTOR | 242.84 | 242.94 | 242.67 | 242.77 | SD-402 6+17, 14R (DON) |
| I-7 | A-B/W/DEFLECTOR | 244.25 | 244.35 | 244.08 | 244.18 | SD-401 6+45, 14R (DON) |
| I-8 | A-B/W/DEFLECTOR | 244.25 | 244.35 | 244.08 | 244.18 | SD-401 0+00.00, 14L (DON) |
| I-9 | A-B/W/DEFLECTOR | 244.25 | 244.35 | 244.08 | 244.18 | SD-401 5+51, 14R (DON) |
| I-10 | A-B | 244.25 | 244.35 | 244.08 | 244.18 | SD-401 12+00.5, 14R (DON) |
| I-11 | A-B | 244.25 | 244.35 | 244.08 | 244.18 | SD-401 SEE PLAN |
| M-1 | MANHOLE | 244.25 | 244.35 | 244.08 | 244.18 | G-511 7+67.5, 25R (DON) |
| E-1 | END SECTION | 100.00 | 100.00 | 100.50 | 100.50 | SD-552 SEE PLAN (DON) |
| M-2 | MANHOLE | 200.00 | 200.00 | 200.50 | 200.50 | G-511 SEE PLAN |
| M-3 | MANHOLE | 200.00 | 200.00 | 200.50 | 200.50 | G-511 13+32, 30R (HOR) |

(HOR) - HORSHAM DRIVE
(CH) - CHIPPENHAM DRIVE
(DON) - DONNAN CASTLE COURT

| PIPE SCHEDULE | | | |
|---------------|----------|-------|-------------|
| DIAMETER | MATERIAL | CLASS | LENGTH (FT) |
| 15" | CMP | | 67' |
| 21" | CMP | | 35' |
| 24" | CMP | | 44' |
| 27" | CMP | | 710' |
| 36" | CMP | | 6' |
| 24" | RCP | IV | 101' |

| LEGEND | |
|----------------------|--------------|
| PROPOSED STORM DRAIN | 15" RCP C.V. |
| PROPOSED CONTOURS | 230 |
| PROPOSED R/W | 214 |
| EXISTING CONTOURS | 214 |
| LIMITS OF SUBMISSION | --- |
| MANHOLE NUMBER | M3 |
| EASEMENT | --- |
| HANDICAP RAMP | --- |

APPROVED: HOWARD COUNTY OFFICE OF PLANNING AND ZONING
Jaesha S. Taylor 8-5-88
Chief, Division of Community Planning & Land Development

REVIEWED FOR HOWARD SOIL CONSERVATION DISTRICT AND MEETS TECHNICAL REQUIREMENT
James M. Helm 7/26/88
SIGNATURE DATE

THIS DEVELOPMENT PLAN IS APPROVED FOR SOIL EROSION AND SEDIMENT CONTROL BY THE HOWARD COUNTY CONSERVATION DISTRICT.
APPROVED *Stephen L. Fisher* 7/26/88
HOWARD SCD DATE


APPROVED: HOWARD COUNTY DEPARTMENT OF PUBLIC WORKS
Paul W. Jernigan 8/2/88
Chief, Land Development Division Date

Charles H. ... 7/29/88
Chief, Bureau of Highways Date


... 8-1-88
Chief, Bureau of Engineering Date

OWNER/DEVELOPER
GORMAN ROAD LIMITED PARTNERSHIP
C/O JAMES F. KNOTT DEVELOPMENT CORPORATION
110 WEST ROAD, SUITE 203
TOWSON MARYLAND 21204
(801) 321-6436

| NO. | DESCRIPTION | DATE | APPROVED | DATE |
|-----|--------------------|---------|----------|------|
| 5 | AS-BUILT REVISIONS | 8-9-88 | | |
| 4 | REVISIONS | 10-7-88 | | |
| 3 | REVISIONS | 8-20-88 | | |
| 2 | REVISIONS | 7-2-88 | | |
| 1 | ISSUED TO HOCD | 8-2-88 | | |

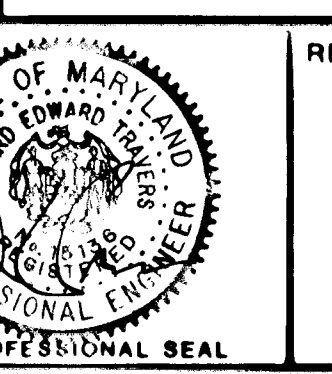

BOWLING BROOK FARMS PARCEL G (LOTS 1 THRU 100)

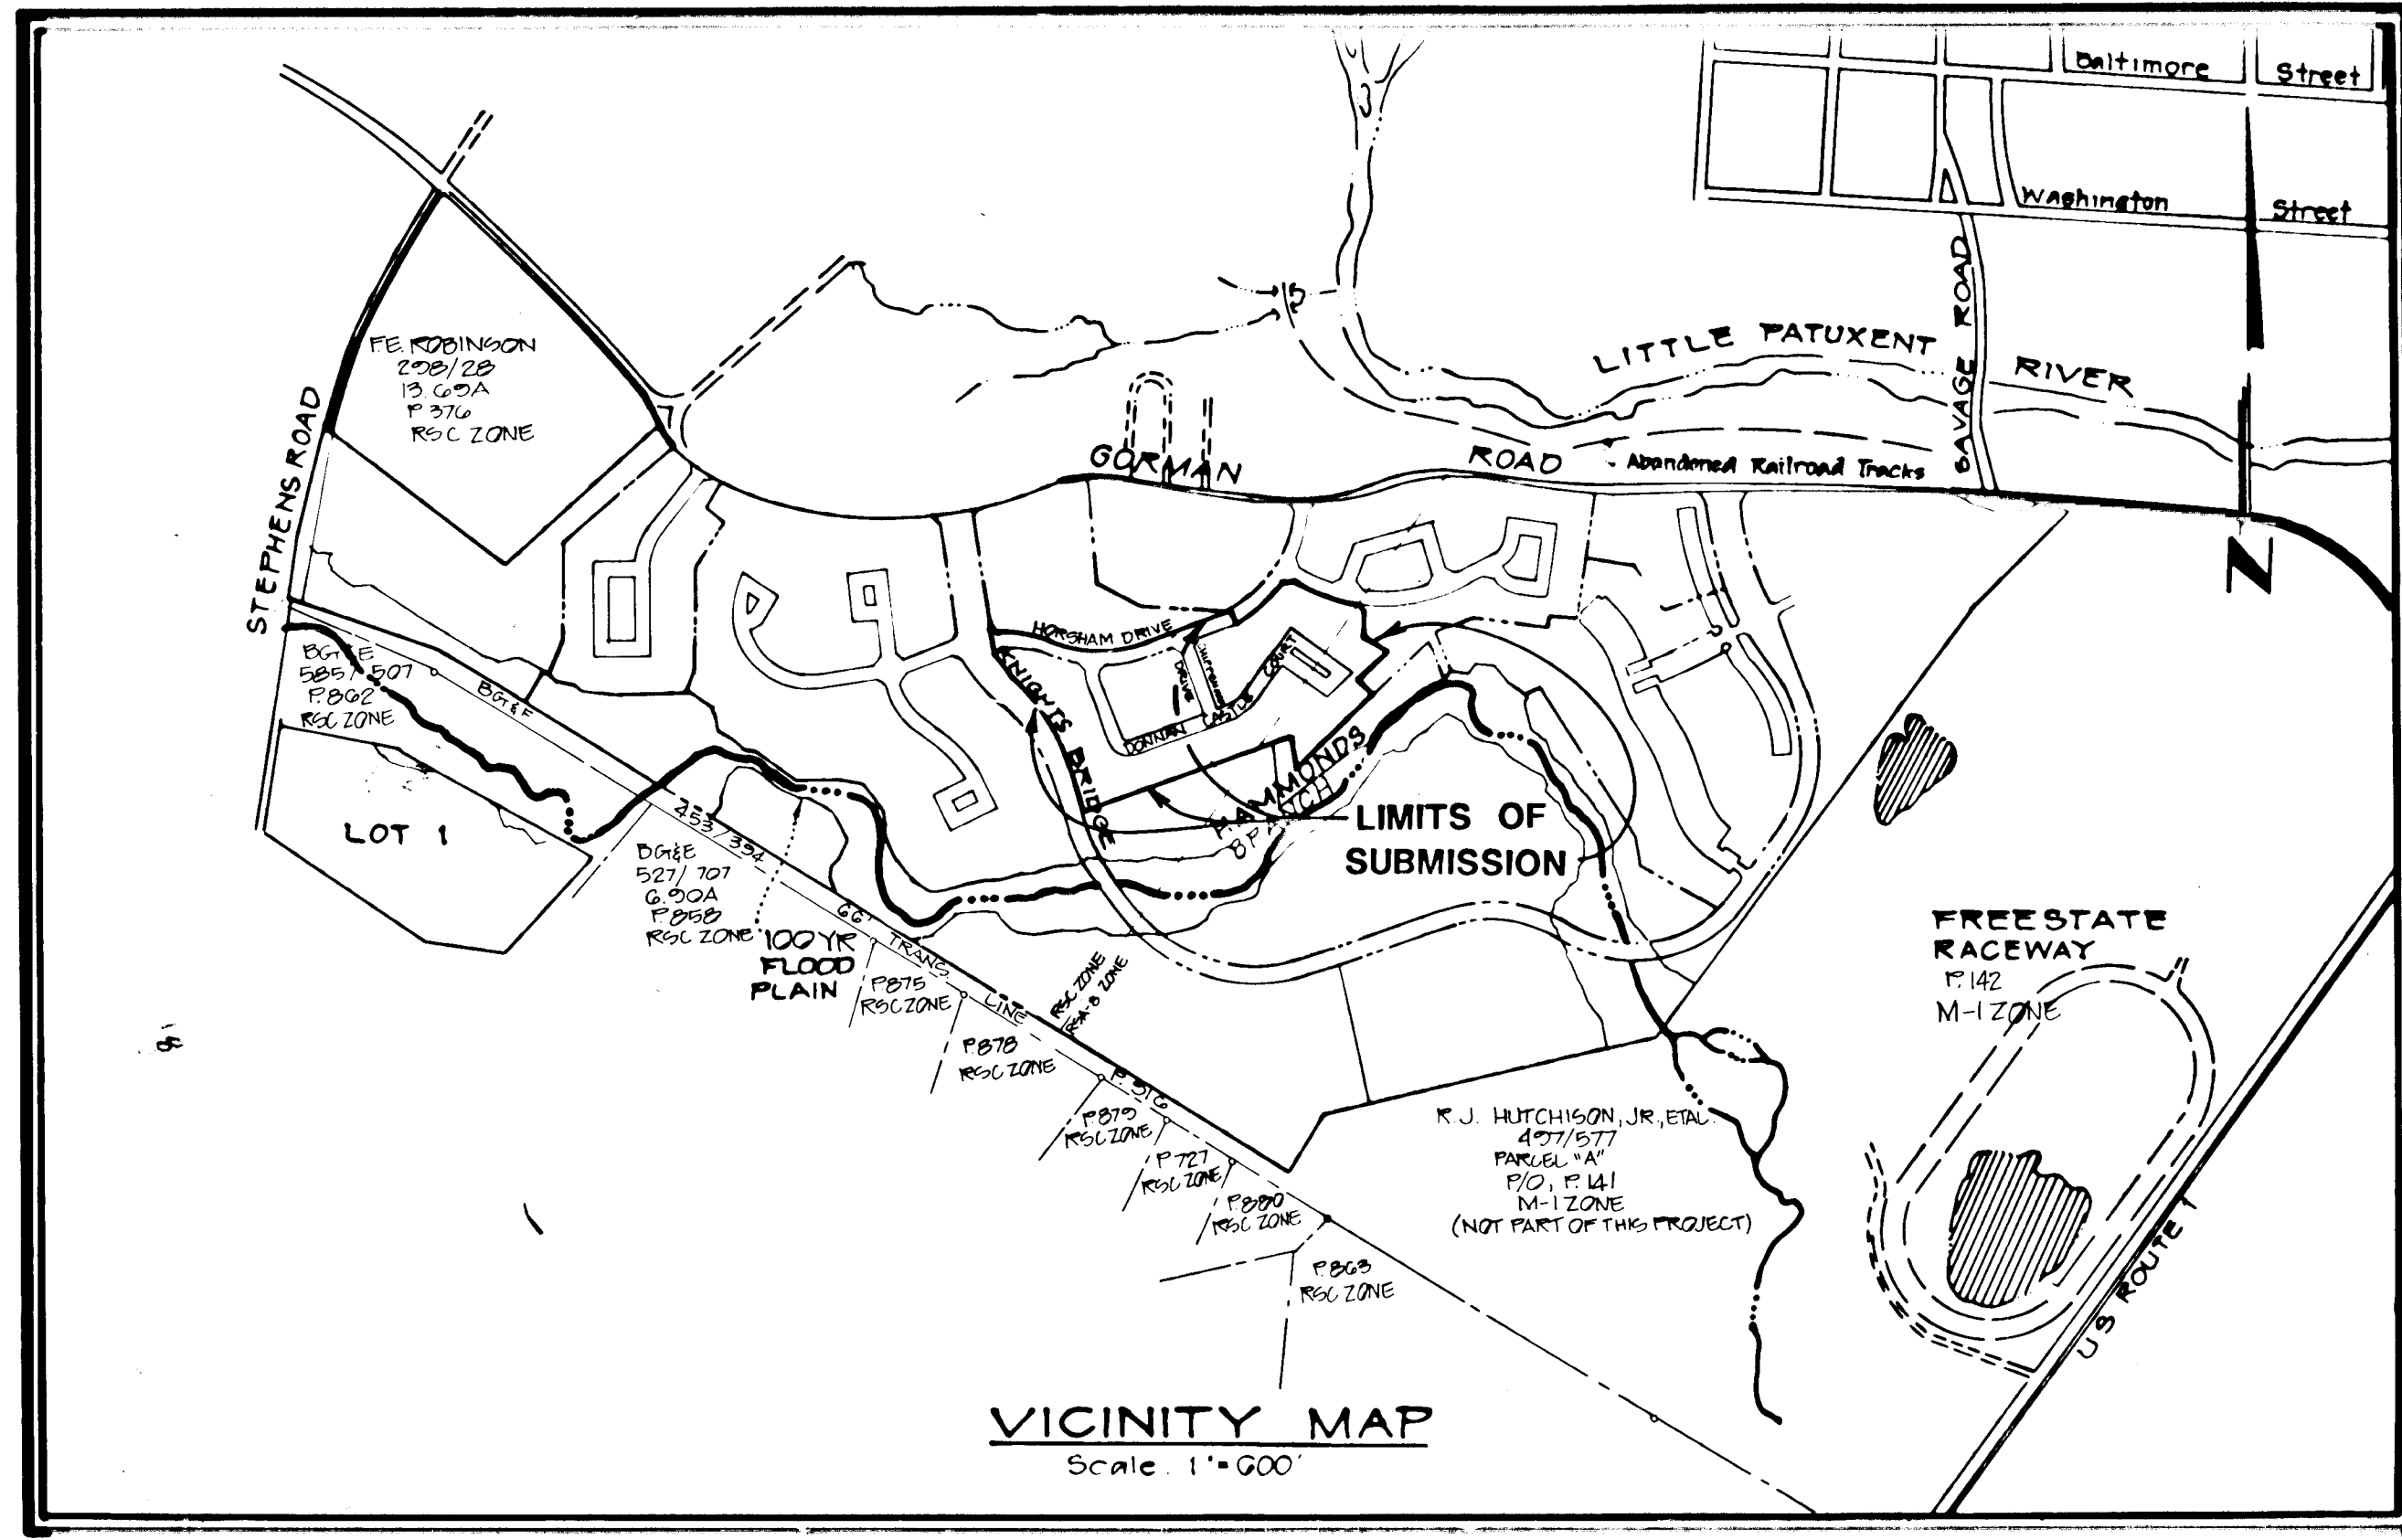

PAVING AND STORM DRAIN CONSTRUCTION PLANS HOWARD COUNTY, MARYLAND

- ### GENERAL NOTES
- THE APPROXIMATE LOCATION OF ALL UTILITIES IS SHOWN BASED ON INFORMATION OBTAINED FROM AVAILABLE RECORDS. THE CONTRACTOR SHALL LOCATE, PROTECT AND SUPPORT THE EXISTING UTILITIES AND MAINTAIN UNINTERRUPTED SERVICE. ANY DAMAGE INCURRED SHALL BE REPAIRED IMMEDIATELY TO THE SATISFACTION OF THE ENGINEER/INSPECTOR, AT THE CONTRACTOR'S EXPENSE.
 - CONTRACTOR SHALL LOCATE EXISTING UTILITIES A MINIMUM OF TWO (2) WEEKS IN ADVANCE OF CONSTRUCTION OPERATIONS IN THE VICINITY OF PROPOSED UTILITIES AT HIS OWN EXPENSE.
 - CONTRACTOR SHALL NOTIFY THE FOLLOWING UTILITIES OR AGENCIES AT LEAST FIVE (5) WORKING DAYS BEFORE STARTING WORK SHOWN ON THESE PLANS.
STATE HIGHWAY ADMINISTRATION - 531-5533
BALTIMORE GAS & ELECTRIC COMPANY - 561-2585
(CONTRACTOR SERVICES)
BALTIMORE GAS & ELECTRIC COMPANY - 234-6313
(UNDERGROUND DAMAGE CONTROL)
BALTIMORE GAS & ELECTRIC COMPANY - 298-9013
(TROUBLE SHOOTING)
"MISS UTILITY" - 800-257-7777
CHESAPEAKE & POTOMAC (C&P) TELEPHONE COMPANY - 725-9976
BUREAU OF UTILITIES/HOWARD COUNTY - 992-2366
 - ALL DETAILS NOT SHOWN ON THE DRAWINGS SHALL BE CONSTRUCTED IN ACCORDANCE WITH HOWARD COUNTY STANDARD DETAILS.
 - ALL MATERIALS AND CONSTRUCTION METHODS SHALL BE IN ACCORDANCE WITH HOWARD COUNTY SPECIFICATIONS AND HOWARD COUNTY DESIGN MANUAL, VOLUME IV.
 - ALL TRAFFIC CONTROL DEVICES SHALL BE IN ACCORDANCE WITH STANDARD SPECIFICATIONS FOR CONSTRUCTION AND MATERIALS, LATEST EDITION AND THE MANUAL ON UNIFORM TRAFFIC CONTROL DEVICES, LATEST EDITION.
 - TREES SHALL BE PROTECTED FROM DAMAGE TO THE MAXIMUM EXTENT POSSIBLE. TREES SIX INCH (6") DIAMETER OR GREATER (MEASURED FOUR FEET (4') ABOVE EXISTING GRADE) ADJACENT TO THE LIMITS OF CONSTRUCTION SHALL NOT BE REMOVED OR DAMAGED BY THE CONTRACTOR.
 - ALL HORIZONTAL AND VERTICAL CONTROLS ARE BASED ON MARYLAND STATE PLANE COORDINATES SYSTEM PROVIDED BY HOWARD COUNTY.
 - TOPOGRAPHY TAKEN FROM MAPS PREPARED BY PHOTOGRAMMETRY BY "AERIAL SURVEYS" IN 1984. TOPOGRAPHY FIELD CHECKED 1986.
 - ALL PIPE ELEVATIONS ARE INVERT ELEVATIONS.
 - CLEAR ALL UTILITIES BY A MINIMUM OF 12" CLEAR, CLEAR ALL POLES BY 2'-0" MINIMUM OR TUNNEL AS REQUIRED. ANY COST INCURRED TO THE CONTRACTOR FOR TUNNELING OR BRACING AT POLES SHALL BE INCLUDED IN UNIT PRICES BID FOR EXCAVATION AND SHALL BE INCLUDED IN UNIT PRICES BID FOR EXCAVATION BACKFILL.
 - ALL PIPE BEDDING SHALL BE CLASS C.
 - ROAD RIGHT-OF-WAY INFORMATION IS SHOWN ON THE RECORD PLATS.
 - SPOT ELEVATIONS SHOWN ARE TOP OF CURB UNLESS OTHERWISE NOTED.
 - SHADED AREAS INDICATE WATER, SEWER, UTILITY, DRAINAGE AND/OR ACCESS EASEMENT(S).

- ### LANDSCAPING NOTES
- CONTRACTOR SHALL VERIFY LOCATION OF ALL UNDERGROUND UTILITIES PRIOR TO PLANTING (SEE NOTE #3 ABOVE)
 - ALL PLANT MATERIAL AND PLANTING SHALL BE IN ACCORDANCE WITH "AMERICAN STANDARD FOR NURSERY STOCK" BY THE A.A.N.
 - SUBSTITUTIONS MAY BE PERMITTED WITH THE APPROVAL OF THE LANDSCAPE ARCHITECT, (762-2220).
 - PLACE "GREEN VASE ZELKOVA" AND "SUMMER SHADE MAPLE" AT RADIUS POINTS ON THE PARKING ISLANDS AND 2' BEHIND THE SIDEWALK.
 - PLACE "REGENT SCHOLAR TREE", "GREENSPIRE LINDEN", AND "HEDGE MAPLE" 3' BEHIND SIDEWALK.

| KEY | PLANT NAME | SIZE | QUANTITY | REMARKS |
|-----|--------------------------------|---------------|----------|---------|
| (Z) | ZELKOVA SERRATA "GREEN VASE" | 2 1/2"-3" CAL | 35 | B & B |
| (P) | ACER PLATANOIDES "SUMMERSHADE" | 12-14' HT. | 33 | |
| (S) | SOPHORA JAPONICA "REGENT" | | 17 | |
| (T) | TILIA CORDATA "GREENSPIRE" | | 10 | |
| (G) | ACER CAMPESTRE | | 12 | |

| INDEX TO DRAWINGS | |
|--|--|
| 1. TITLE SHEET | 6. DETAIL SHEET (PAVING AND STORM DRAIN) |
| 2. PAVING AND STORM DRAIN PLAN AND PROFILE HORSHAM DRIVE | 7. DETAIL SHEET (EROSION AND SEDIMENT CONTROL) |
| 3. PAVING AND STORM DRAIN PLAN AND PROFILE CHIPPENHAM DRIVE | 8. DETAIL SHEET (EROSION AND SEDIMENT CONTROL) |
| 4. PAVING AND STORM DRAIN PLAN AND PROFILE DONNAN CASTLE COURT | 9. EROSION AND SEDIMENT CONTROL PLAN |
| 5. STORM DRAIN PROFILES | 10. DRAINAGE AREA MAP |


| REVISION APPROVED BY | | DATE | APPROVED | DATE |
|----------------------|--------------------|---------|----------|------|
| 5 | AS-BUILT REVISIONS | 8-9-88 | | |
| 4 | REVISIONS | 10-7-88 | | |
| 3 | REVISIONS | 8-20-88 | | |
| 2 | REVISIONS | 7-2-88 | | |
| 1 | ISSUED TO HOCD | 8-2-88 | | |

Patton Harris Rust and Associates
A Professional Corporation
Engineers, Surveyors, Planners and Landscape Architects
7609 Standish Place Rockville, Maryland 20855 (301)762-2220

BOWLING BROOK FARMS
PARCEL G, PARCEL H
SECTION 4, AREA 1
LOTS G-1 THRU G-102
A RESUBDIVISION OF LOT 216 BOWLING BROOK FARMS
SIXTH ELECTION DISTRICT
TAX MAP 47 PARCEL 141
L.1394 F.632

SURVEY DATE: 8-3-88
DESIGN: M.J.K.
DRAWN: P.A.
CHECKED: 1 OF 10
SCALE: AS SHOWN
FILE NO.: 264-1-7

1271

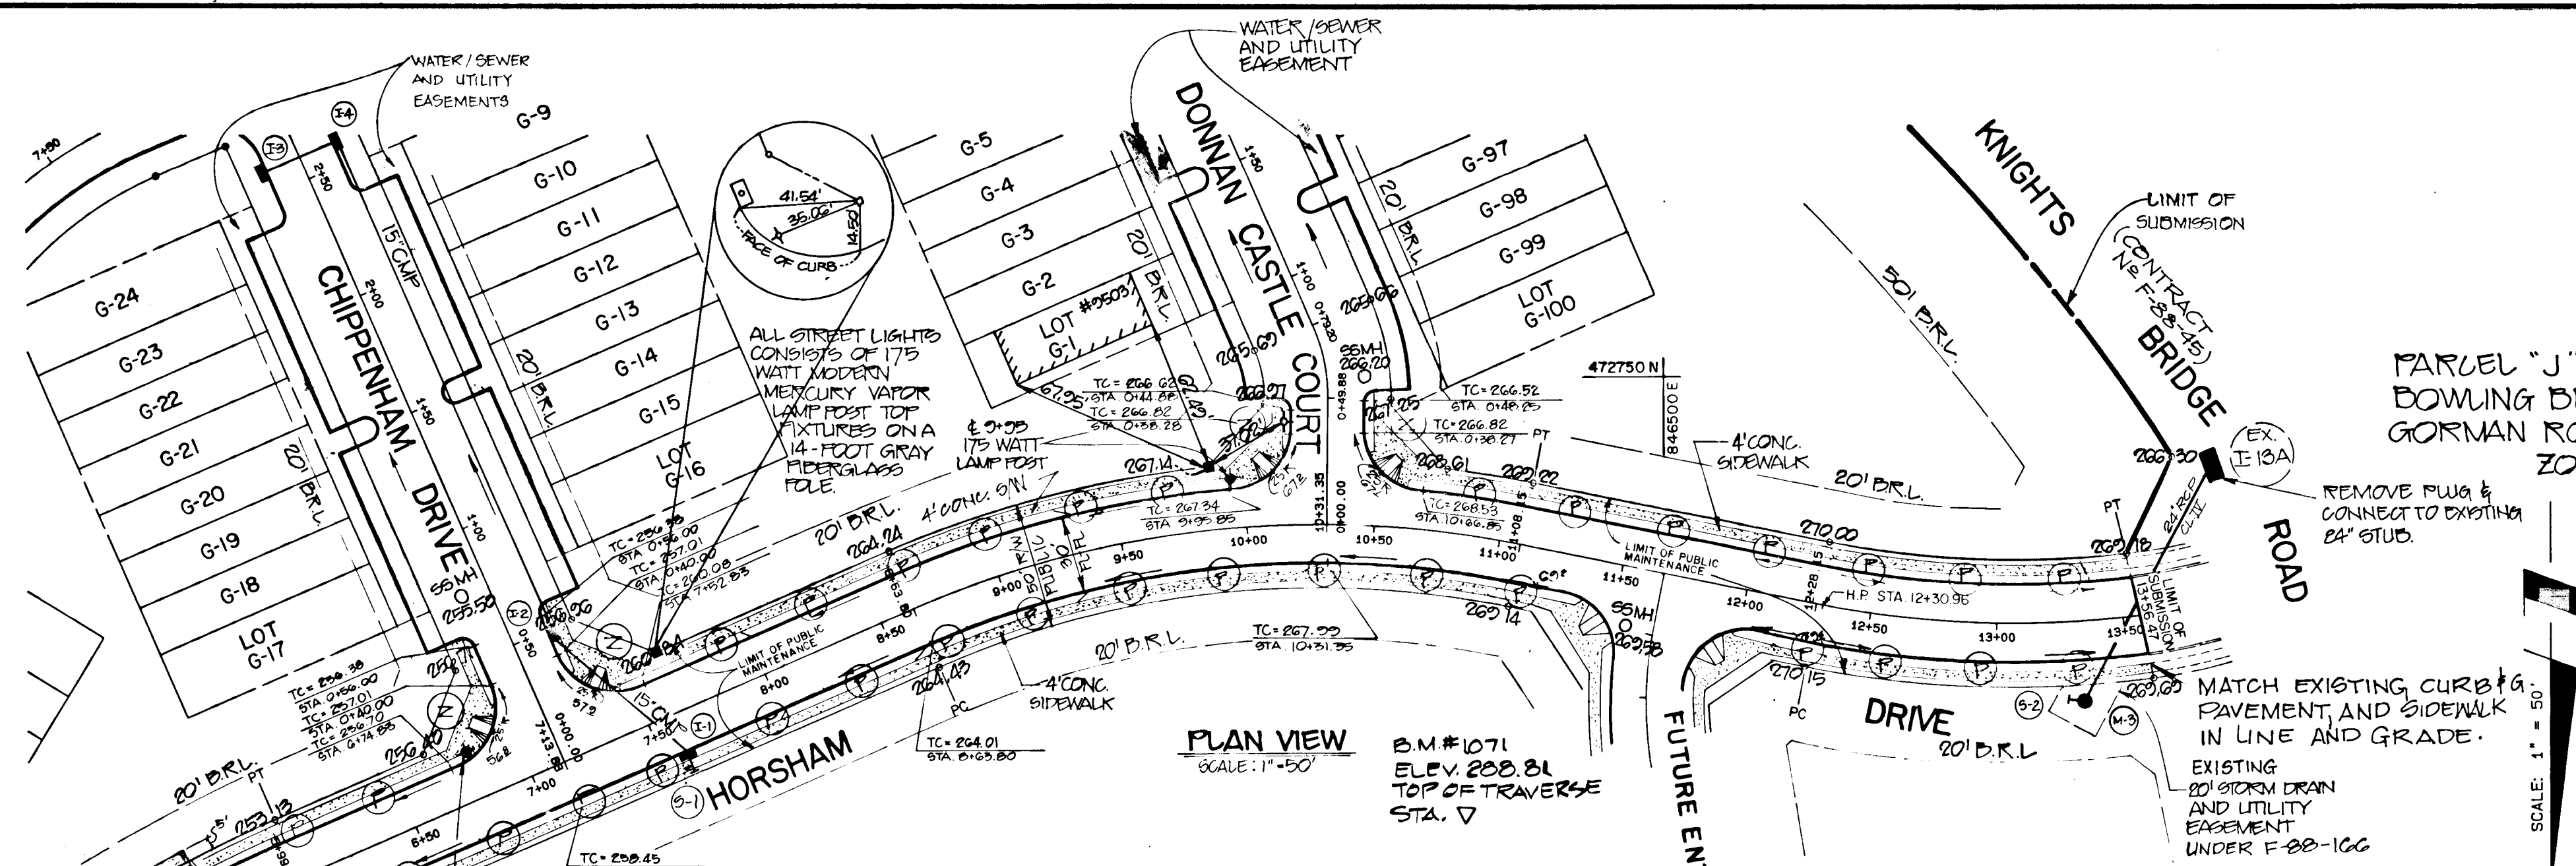

PLAN VIEW SCALE: 1" = 50'

B.M.#1071 ELEV 200.81 TOP OF TRAVERSE STA. 7

SCALE: 1" = 50'

REMOVE PUGH & CONNECT TO EXISTING 24" STUB.

MATCH EXISTING CURB & PAVEMENT, AND SIDEWALK IN LINE AND GRADE.

EXISTING 20" STORM DRAIN AND UTILITY EASEMENT UNDER F-20-100

OWNER/DEVELOPER
GORMAN ROAD LIMITED PARTNERSHIP
C/O JAMES F. KNOTT DEVELOPMENT CORPORATION
110 WEST ROAD, SUITE 203
TOWSON, MARYLAND 21204

| PC Sta. | to | PT Sta. | RADIUS | Δ | ARC | TAN | CHORD | CHORD BEARING |
|----------|----|----------|--------|-------------|--------|--------|--------|----------------|
| 5+37.45 | | 5+99.92 | 450.00 | 7° 57' 15" | 62.47 | 31.29 | 62.42 | S62° 26' 41" W |
| 8+63.80 | | 11+08.15 | 400.00 | 35° 00' 00" | 244.35 | 162.12 | 240.56 | S83° 55' 19" W |
| 12+28.15 | | 13+56.47 | 400.00 | 10° 22' 48" | 128.32 | 64.72 | 127.77 | N87° 46' 05" W |

TEMP TEE TURN-AROUND PER HOCO STD DETAIL R-5.05 IF CONSTRUCTION OF ADJACENT HORSHAM DRIVE HAS BEEN COMPLETED PRIOR TO THE START OF THIS CONTRACT, THE INTD EXISTING CURB & GUTTER (INCLUDING WITH GRADE)


5' REVERSEABLE EASEMENT AROUND TEMP TEE TURN-AROUND.

B.M.# 1070 ELEV 204.03 TOP OF TRAVERSE STATION

PROFILE LEGEND

- LEFT BRL -----
- RIGHT BRL -----
- PROPOSED GRADE -----
- EXISTING GRADE -----

| STA. | TO STA. | BEARING | DISTANCE (ft) |
|----------|----------|----------------|---------------|
| 5+99.92 | 7+13.83 | S66° 25' 19" W | 113.91 |
| 7+13.83 | 8+63.80 | S66° 25' 19" W | 149.97 |
| 11+08.15 | 12+28.15 | N78° 34' 41" W | 120.00 |

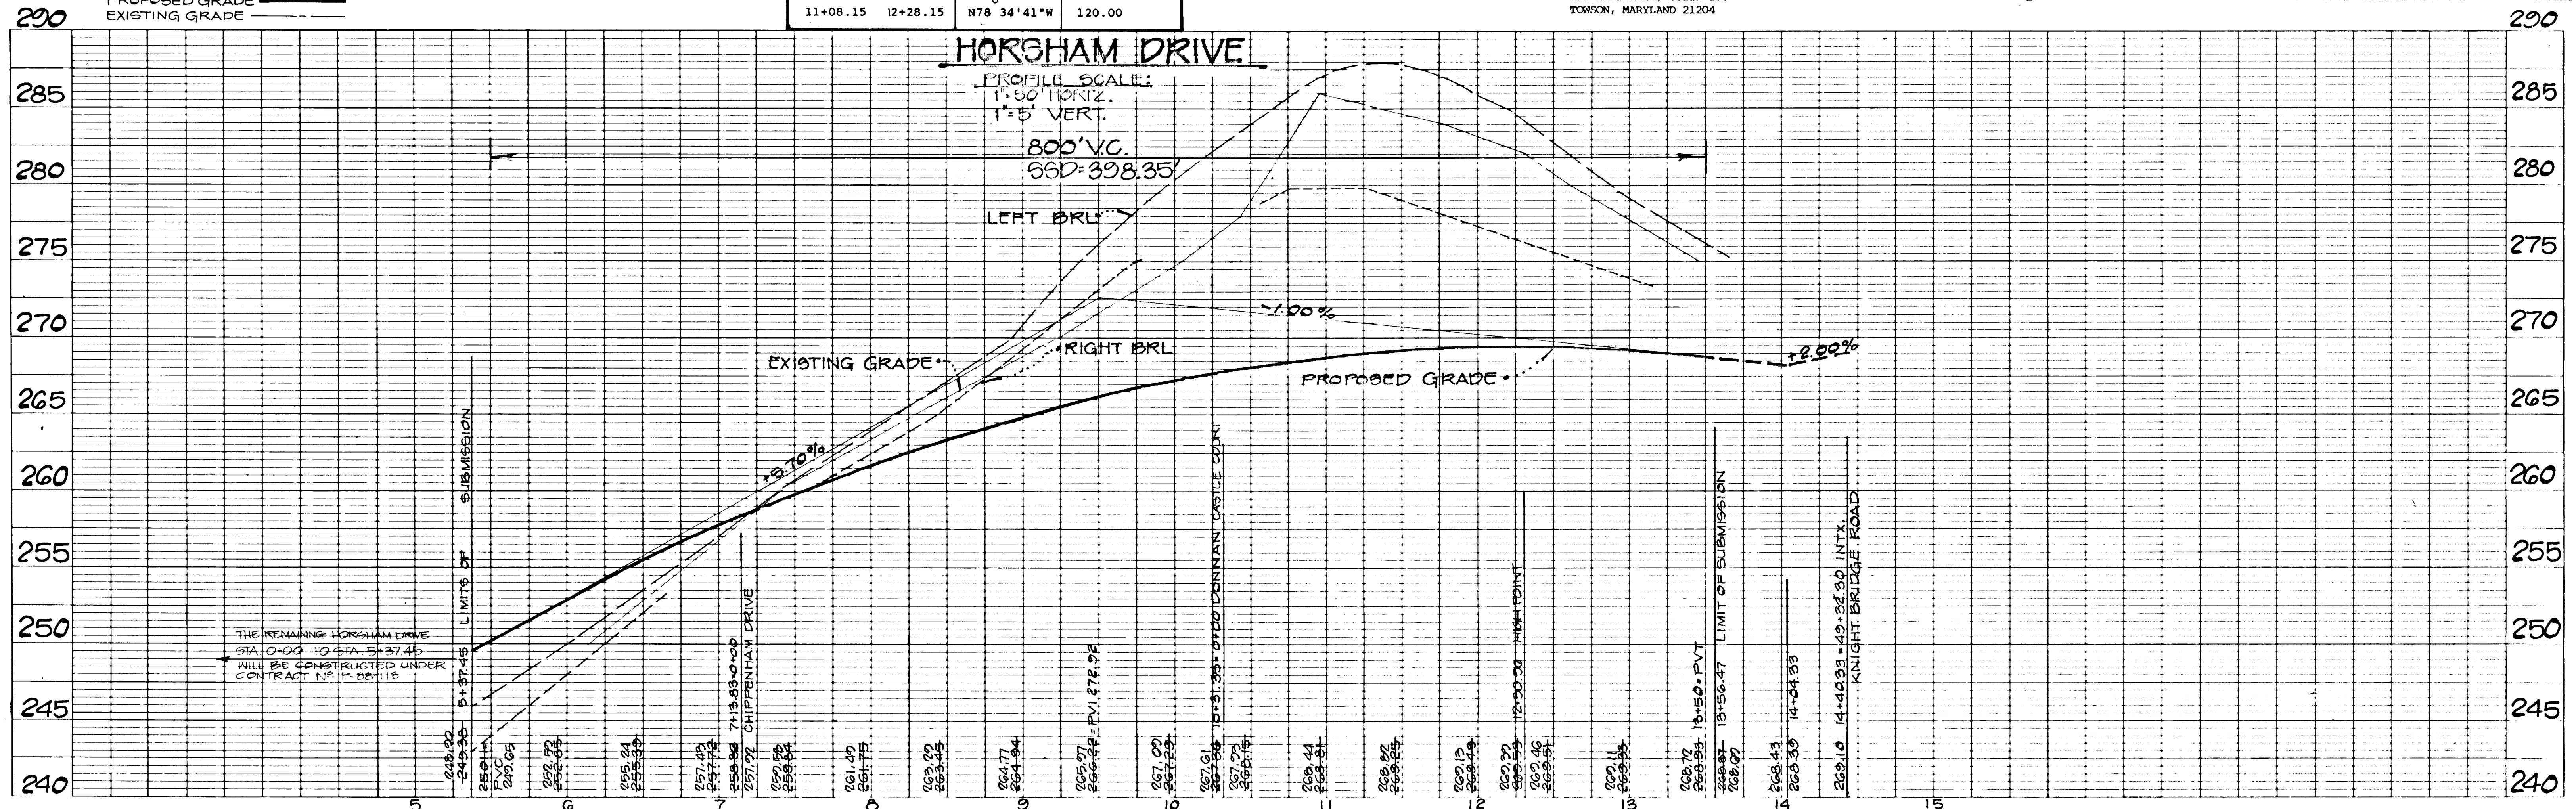

APPROVED: HOWARD COUNTY DEPARTMENT OF PUBLIC WORKS
Donald Epsom 8/2/88
 Chief, Land Development Division Date

Charles A. Acton 7/29/88
 Chief, Bureau of Highways Date

William E. Roy 8-2-88
 Chief, Bureau of Engineering Date


APPROVED: HOWARD COUNTY OFFICE OF PLANNING AND ZONING
Trisha S. McLaughlin 8-5-88
 Chief, Division of Community Planning & Land Development Date

| NO. | DESCRIPTION | DATE | APPROVED | DATE |
|-----|---|----------|----------|------|
| 5 | AS-BUILT REVISIONS | 08/21/88 | | |
| 4 | REDLINE REVISIONS | 10/27/88 | | |
| 3 | REVISIONS FROM CIVIL COMMENTS FROM G-10 | 07/20/88 | | |
| 2 | FINAL SUBMISSION TO HOCO | 07/20/88 | | |
| 1 | ISSUED TO HOCO | 08/20/88 | | |



REVISED

PAVING AND STORM DRAIN PLAN AND PROFILE HORSHAM DRIVE

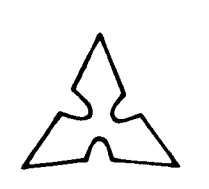

Patton Harris Rust and Associates
 A Professional Corporation
 Engineers, Surveyors, Planners and Landscape Architects
 7609 Standish Place Rockville, Maryland 20855 (301) 762-2220


BOWLING BROOK FARMS
 PARCEL G, PARCEL H
 SECTION 4, AREA 1
 LOTS G-1 THRU G-102
 A RESUBDIVISION OF LOT 216 BOWLING BROOK FARMS
 SIXTH ELECTION DISTRICT
 TAX MAP 47 PARCEL 141
 L. 1394 F. 632

| SURVEY PHRQA | DATE |
|----------------|----------|
| DESIGN MJK | 3-3-88 |
| DRAWN BLP/CSR | SHEET |
| CHECKED | 2 of 10 |
| SCALE AS SHOWN | FILE NO. |
| | 2184-1-7 |

AS-BUILT

F-88-717

1271

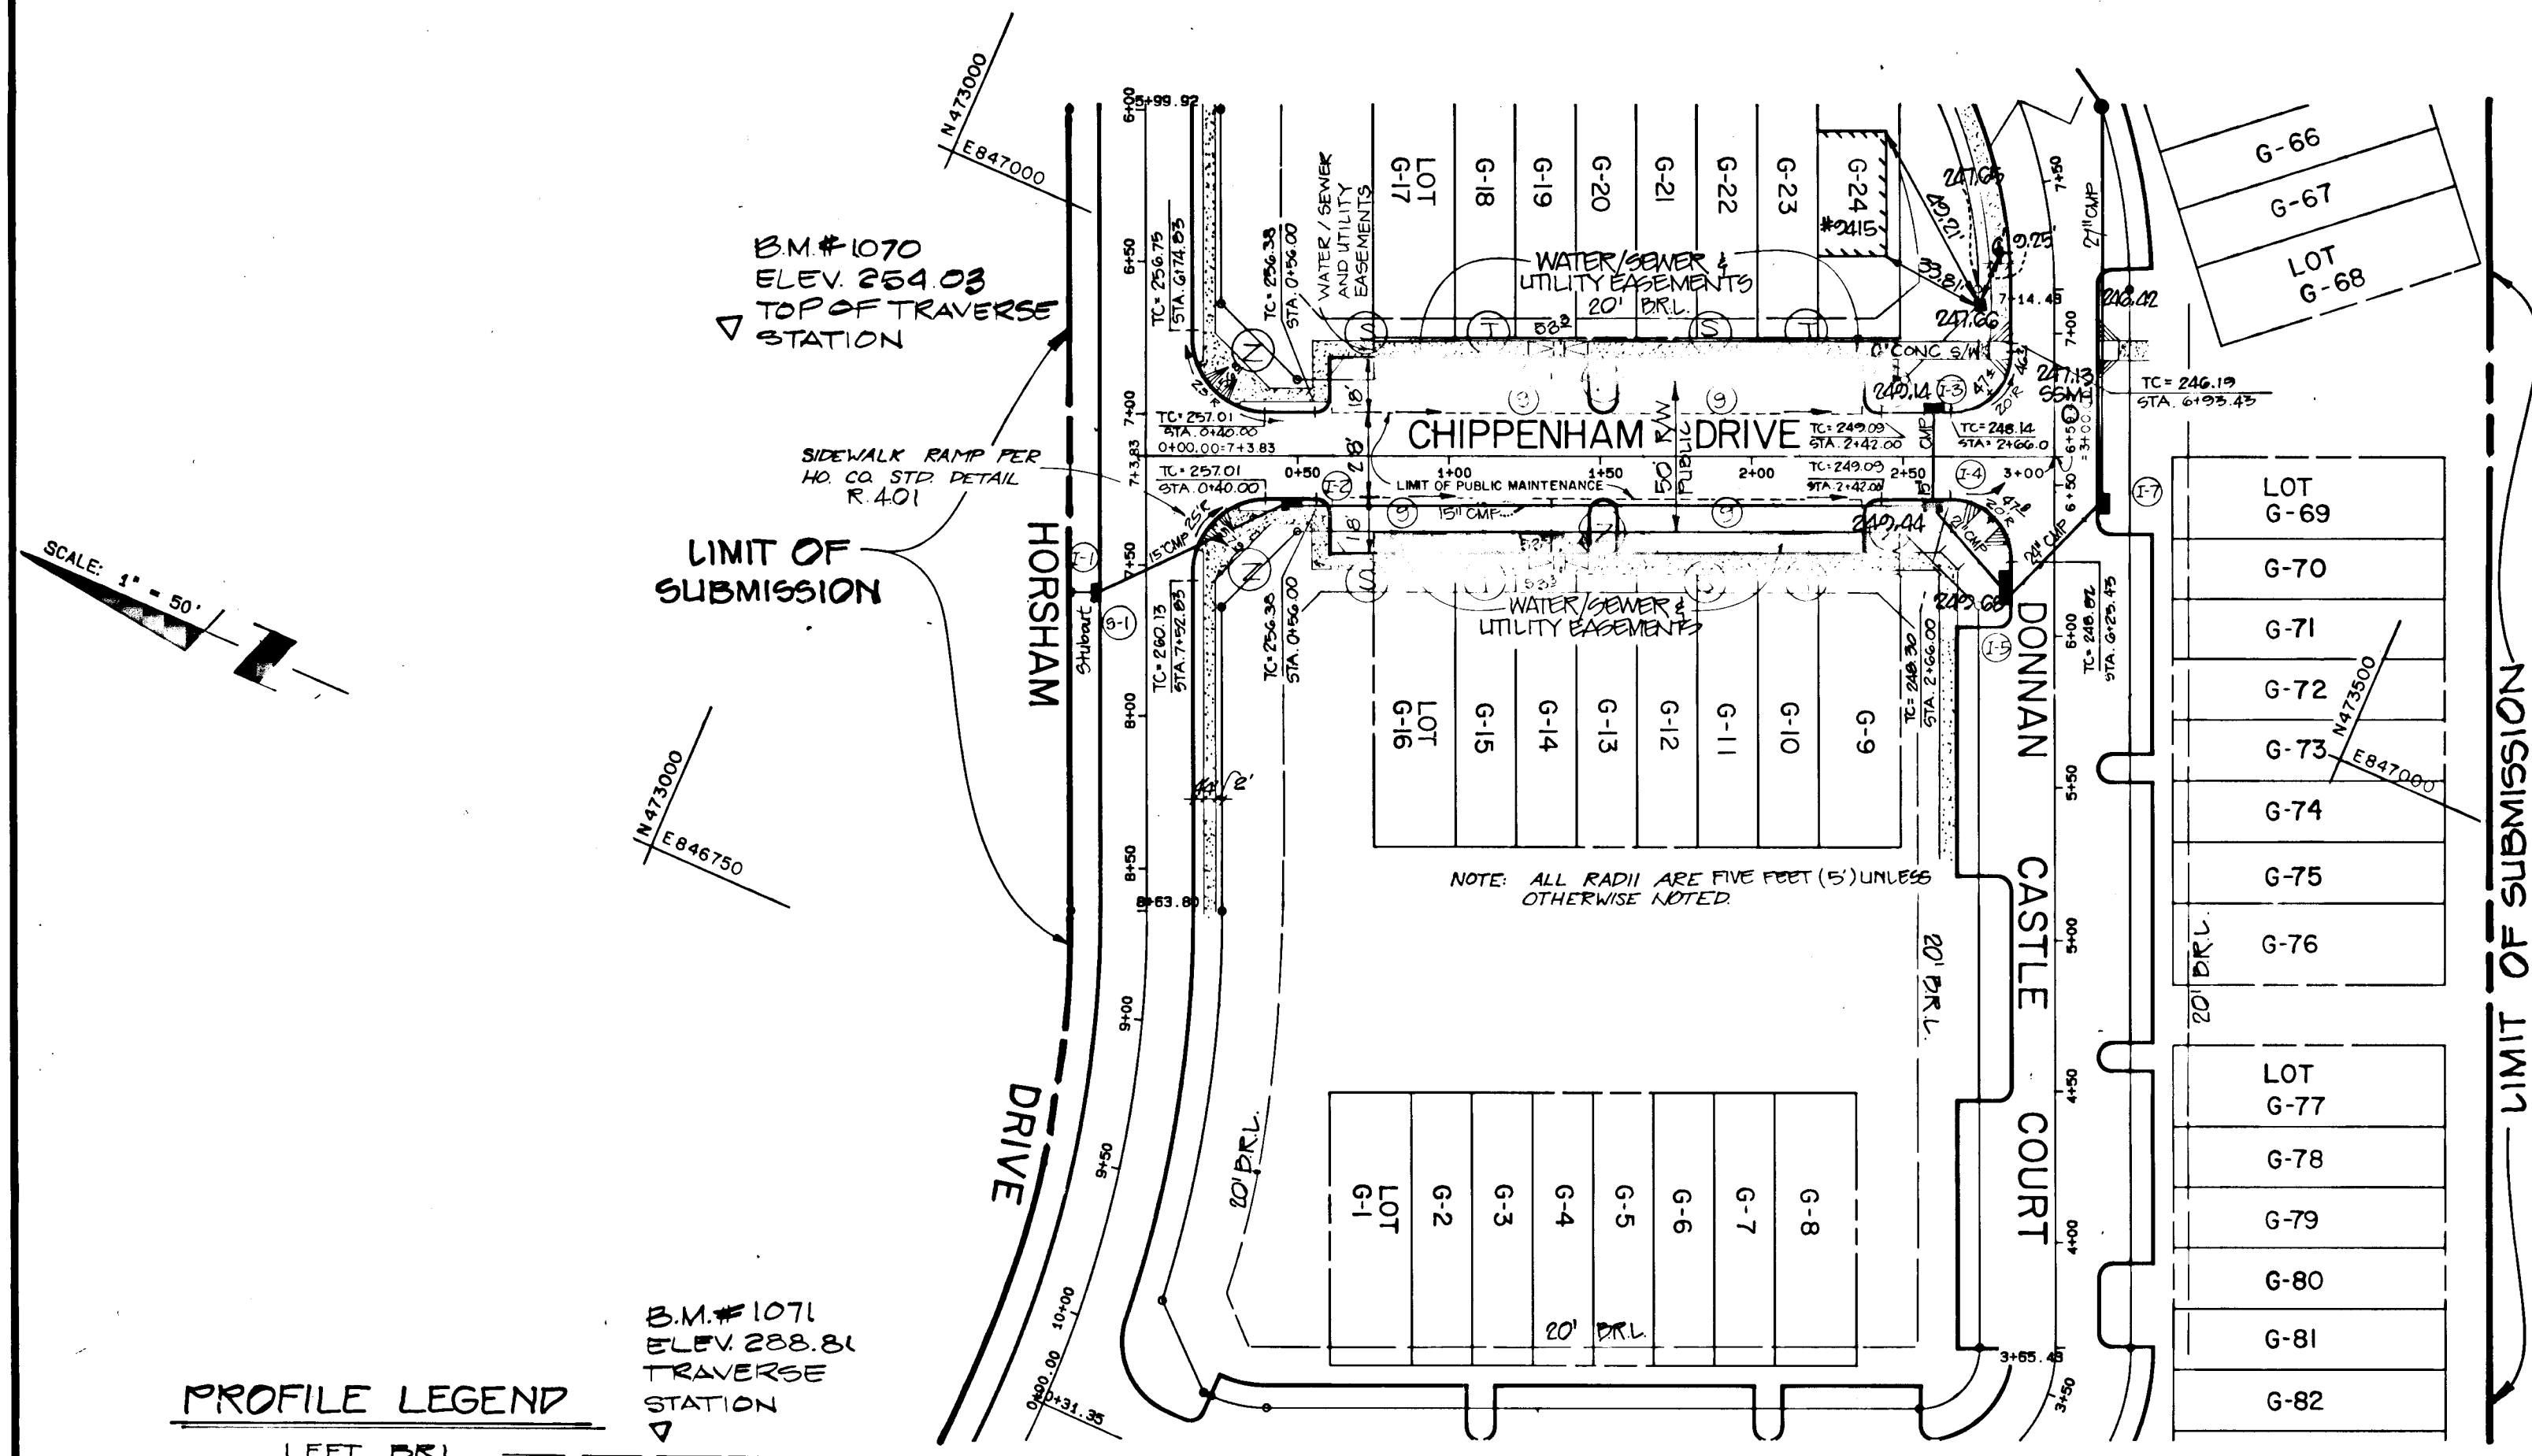

CENTERLINE LINE DATA

| STA. TO STA. | BEARING | DISTANCE (ft) |
|--------------|---------|-------------------|
| 0+00 | 3+00 | S23 34'41" 300.00 |

OWNER/DEVELOPER
GORMAN ROAD LIMITED PARTNERSHIP
C/O JAMES F. KNOTT DEVELOPMENT CORPORATION
110 WEST ROAD, SUITE 203
TOWSON, MARYLAND 21204

APPROVED: HOWARD COUNTY DEPARTMENT OF PUBLIC WORKS


Donald J. Sepp 5/2/88
Chief, Land Development Division Date

Robert W. Smith 7/27/88
Chief, Bureau of Highways Date

William E. Ray 8-2-88
Chief, Bureau of Engineering Date

APPROVED: HOWARD COUNTY OFFICE OF PLANNING AND ZONING

Wesley S. Langley 8-5-88
Chief, Division of Community Planning & Land Development Date

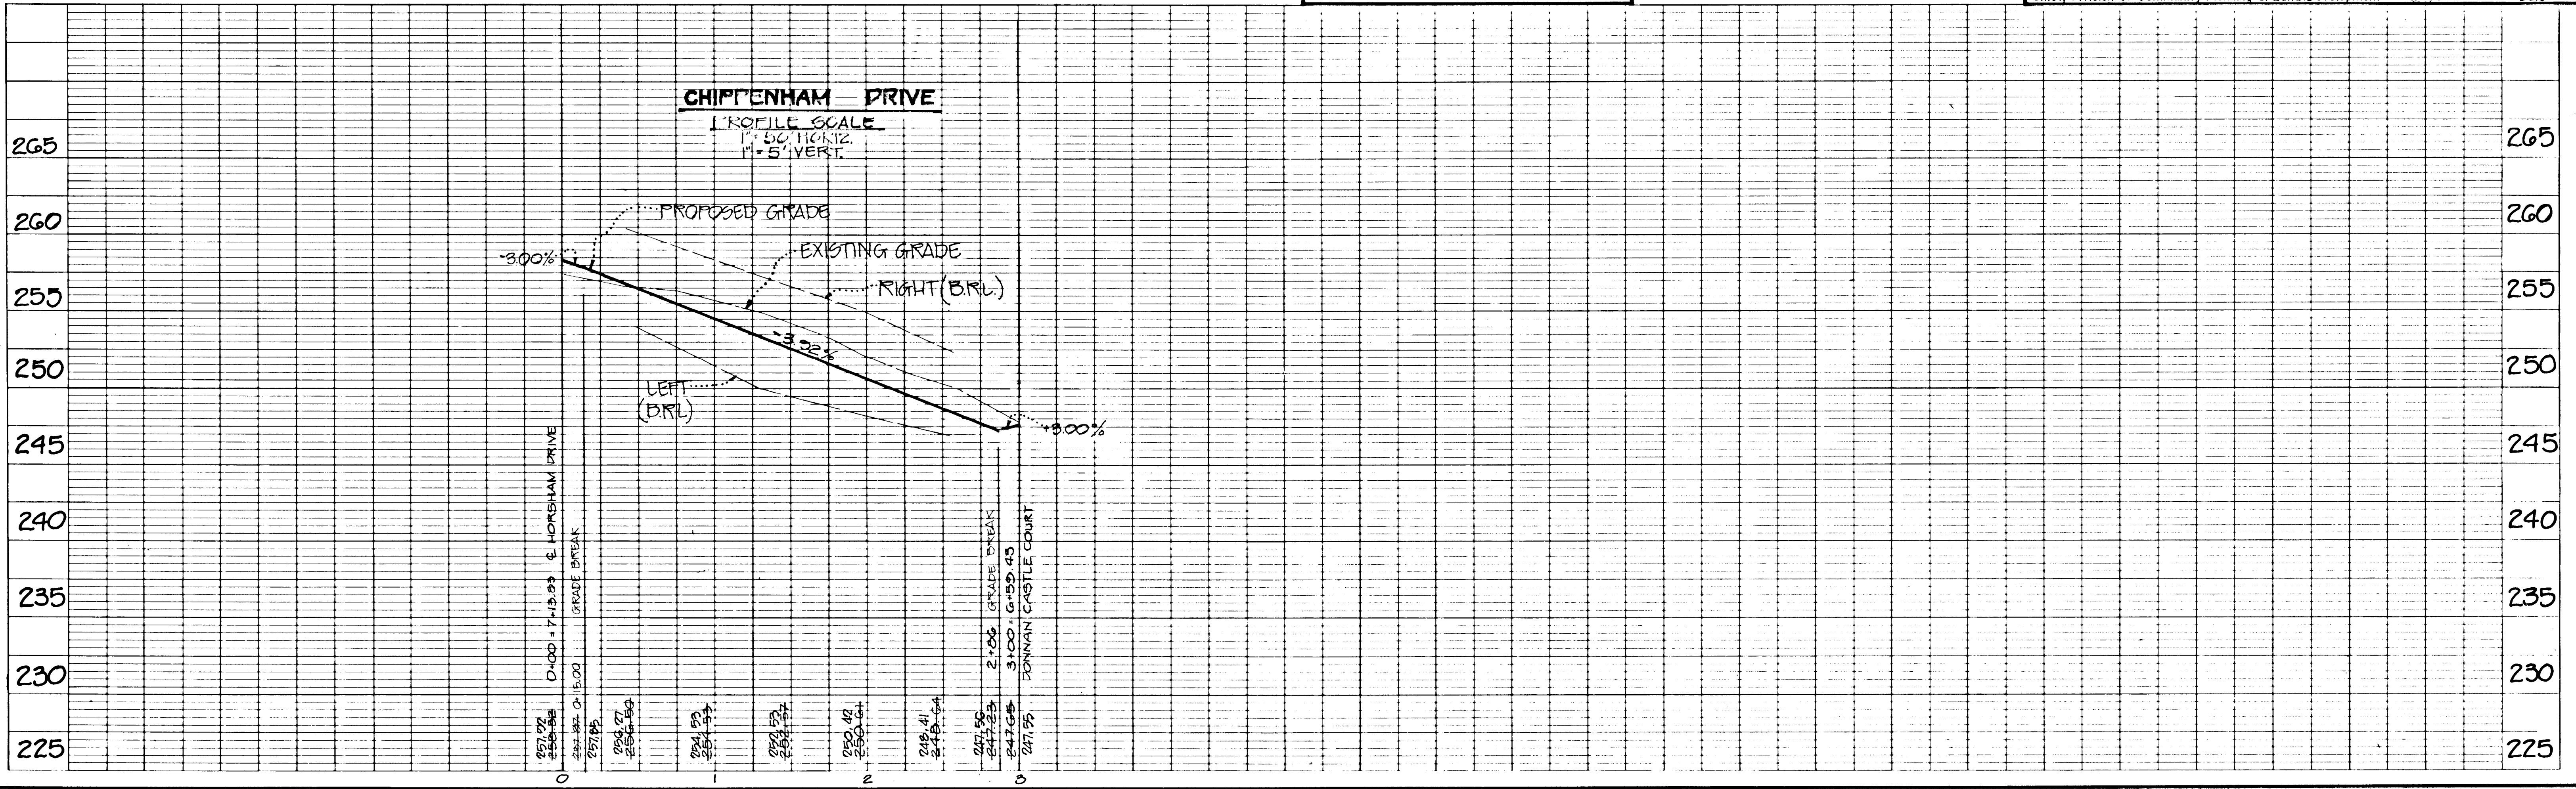

| NO. | DESCRIPTION | DATE | APPROVED | DATE |
|-----|--------------------|----------|----------|------|
| 5 | AS-BUILT REVISIONS | 10-6-21 | | |
| 4 | REQUIRE REVISIONS | 10-7-88 | | |
| 3 | REQUIRE REVISIONS | 10-20-88 | | |
| 2 | REQUIRE REVISIONS | 10-12-88 | | |
| 1 | ISSUED TO HQCD | 3-3-88 | | |



REVISED


**PAVING AND STORM DRAIN
PLAN AND PROFILE
CHIPPENHAM DRIVE**

Patton Harris Rust and Associates
A Professional Corporation
Engineers, Surveyors, Planners and Landscape Architects
7609 Standish Place Rockville, Maryland 20855 (301) 762-2220

BOWLING BROOK FARMS
PARCEL G, PARCEL H
SECTION 4, AREA 1
LOTS G-1 THRU G-102
A RESUBDIVISION OF LOT 216 BOWLING BROOK FARMS
SIXTH ELECTION DISTRICT
TAX MAP 47 L.1394 PARCEL 141 F.632

| SURVEY | PHR&A | DATE |
|---------|----------|----------|
| DESIGN | MJK | 3-3-88 |
| DRAWN | CN2 | SHEET |
| CHECKED | | 3 OF 10 |
| SCALE | AS SHOWN | FILE NO. |
| | | 2184-1-7 |

AS-BUILT

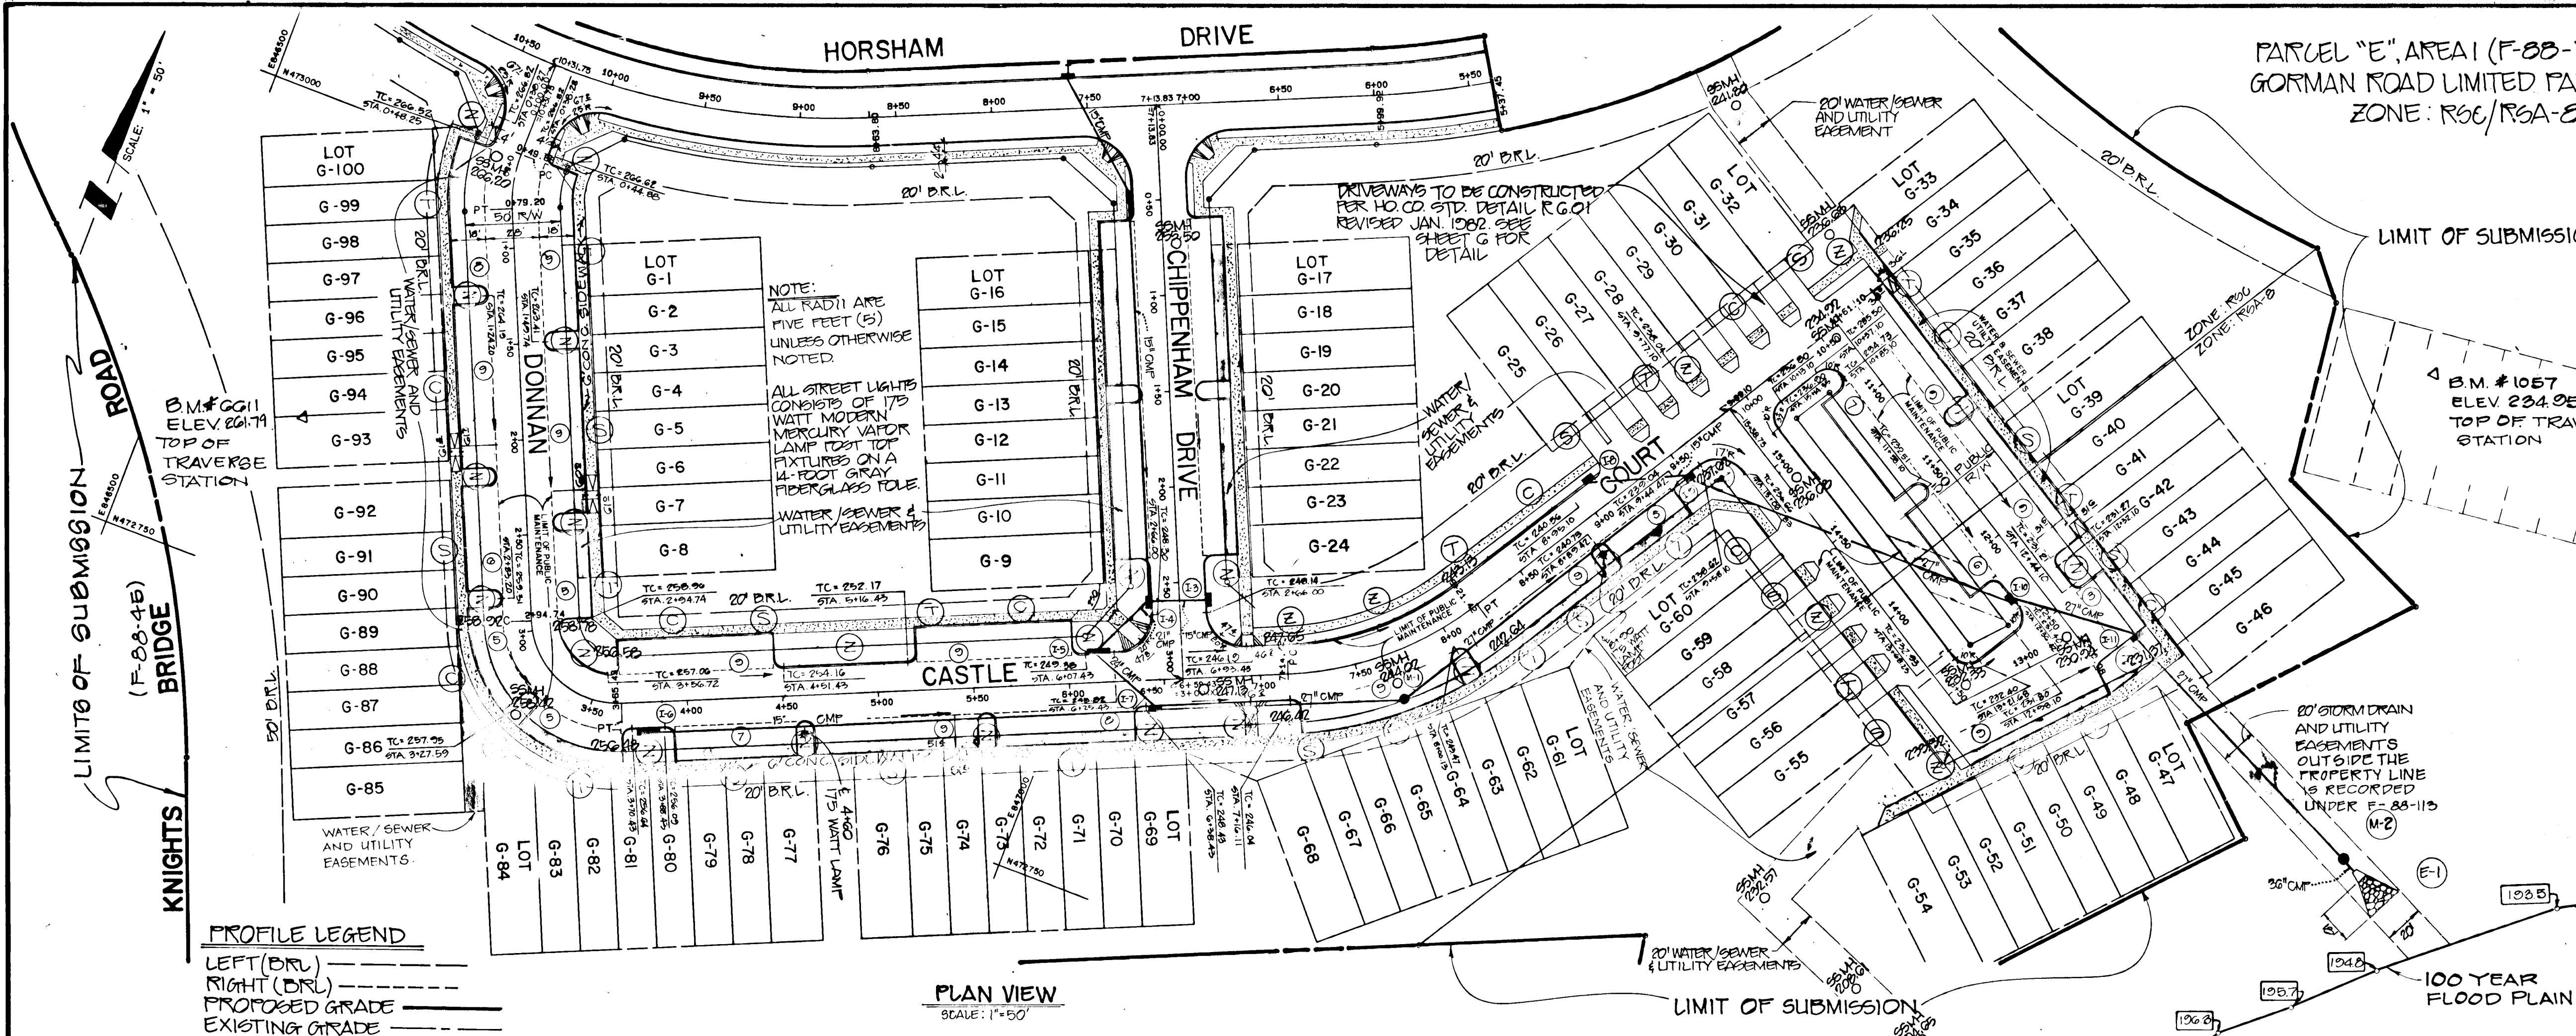

PARCEL "E", AREA I (F-88-113)
 GORMAN ROAD LIMITED PARTNERSHIP
 ZONE: R56/R5A-B

OWNER/DEVELOPER
 GORMAN ROAD LIMITED PARTNERSHIP
 C/O JAMES P. KNOTT DEVELOPMENT CORPORATION
 110 WEST ROAD, SUITE 203
 TOWSON, MARYLAND 21284

CENTERLINE LINE DATA

| STA. | TO STA. | BEARING | DISTANCE (ft) |
|----------|----------|-------------|---------------|
| 0+00 | 0+49.88 | S0 25'19"W | 49.88 |
| 0+79.20 | 2+94.74 | S23 34'41"E | 215.54 |
| 3+65.43 | 6+59.43 | N66 25'19"E | 294.00 |
| 6+59.43 | 7+14.43 | N66 25'19"E | 55.00 |
| 8+21.42 | 9+89.10 | N31 23'30"E | 167.68 |
| 9+89.10 | 10+61.10 | N31 23'30"E | 72.00 |
| 10+61.10 | 12+70.09 | S58 36'30"E | 208.98 |
| 12+70.09 | 13+43.40 | S42 16'04"W | 73.32 |
| 13+43.40 | 15+38.55 | N58 36'30"W | 195.15 |

CENTERLINE CURVE DATA


| PC STA. | TO PT STA. | RADIUS | ARC | TAN | CHORD | CHORD BEARING |
|---------|------------|--------|-----------|--------|-------|-------------------|
| 0+49.88 | 0+79.20 | 70.00 | 24 00'00" | 29.32 | 14.88 | 29.11 S11 34'41"E |
| 2+94.74 | 3+65.43 | 45.00 | 90 00'00" | 70.69 | 45.00 | S68 34'41"E |
| 7+14.43 | 8+21.42 | 175.00 | 35 01'48" | 106.99 | 55.23 | N48 54'24"E |

APPROVED: HOWARD COUNTY DEPARTMENT OF PUBLIC WORKS
Charles J. Smith 8/2/88
 Chief, Land Development Division Date

Charles J. Smith 7/29/88
 Chief, Bureau of Highways Date

William E. Ryan 8-2-88
 Chief, Bureau of Engineering Date

APPROVED: HOWARD COUNTY OFFICE OF PLANNING AND ZONING
Janice S. J. [Signature] 8-5-88
 Chief, Division of Community Planning & Land Development Date

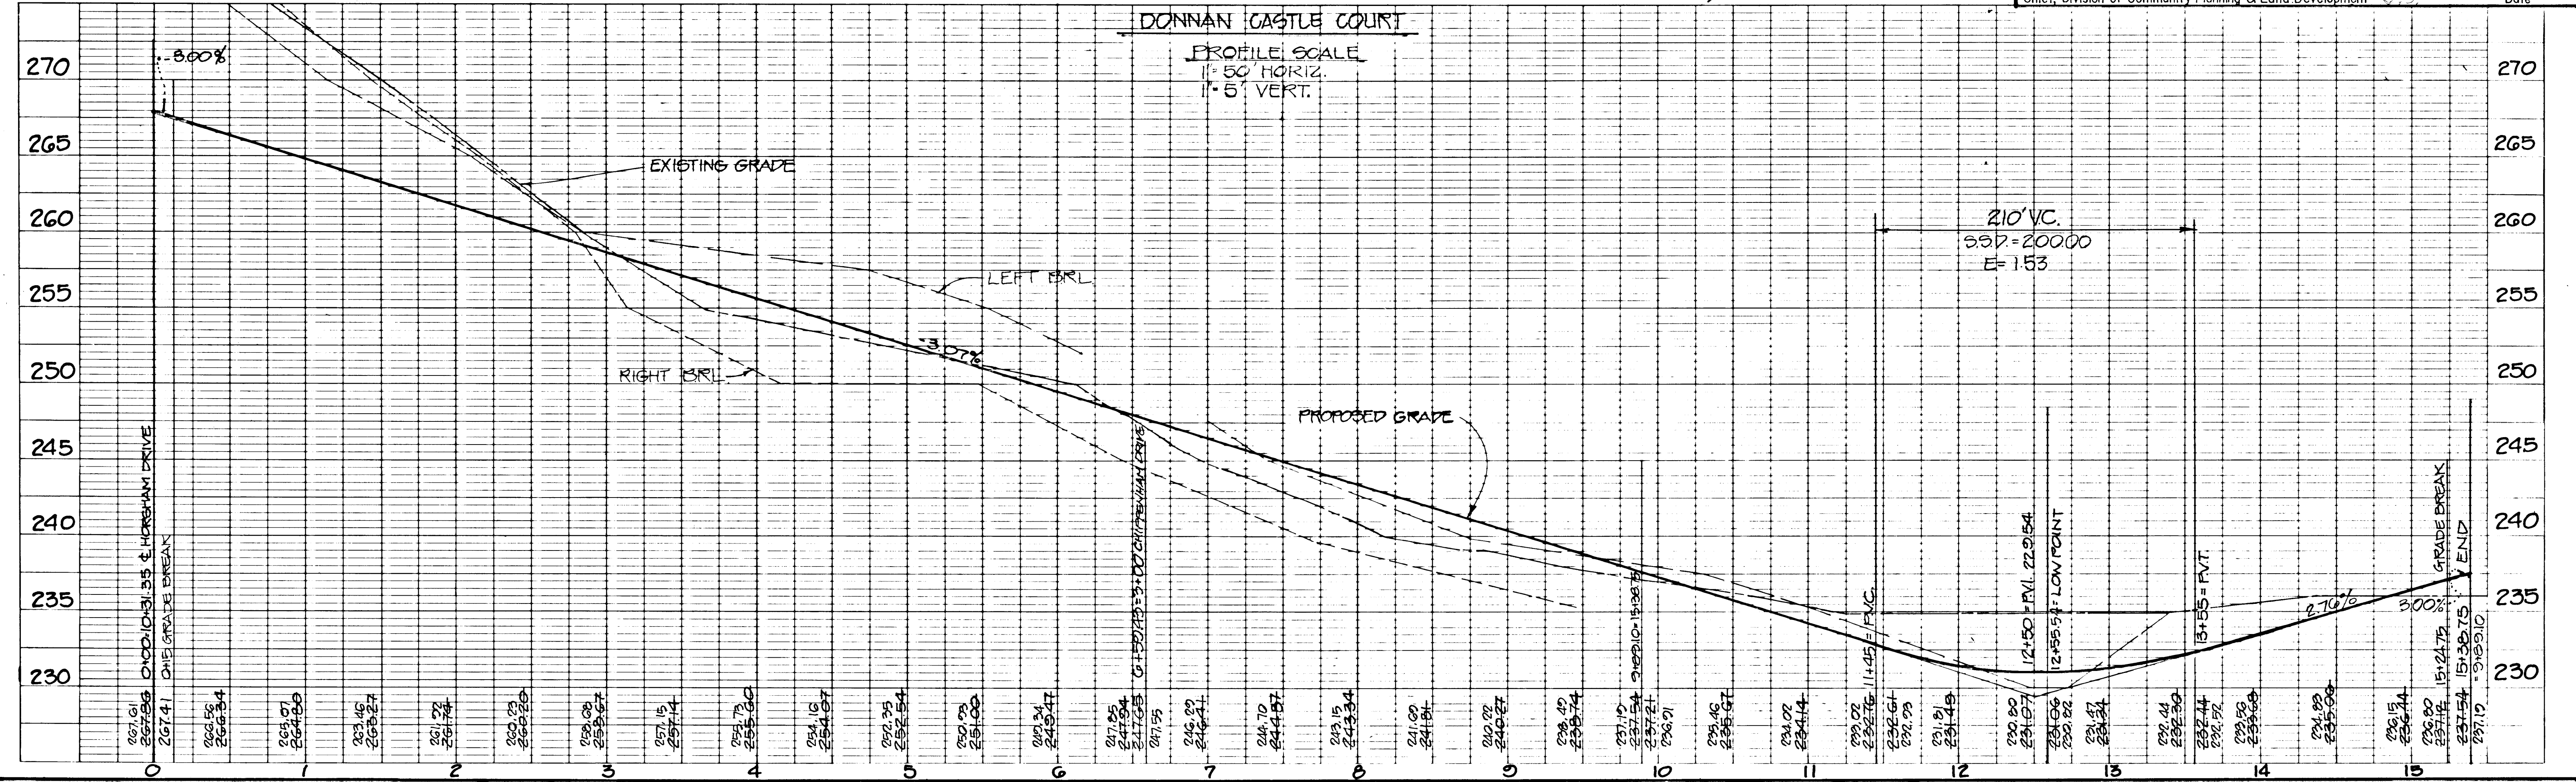

| NO. | DESCRIPTION | DATE | APPROVED | DATE |
|-----|---------------------|------|----------|---------|
| 5 | AS-BUILT REVISIONS | | BP | 15-6-21 |
| 4 | REVISIONS | | MK | 10/7/88 |
| 3 | REVISIONS FROM TAX | | | 2/2/88 |
| 2 | REVISIONS FROM SITE | | | 5/2/88 |
| 1 | ISSUED TO HCCO | | | 3-2-88 |



REVISED

**PAVING AND STORM DRAIN
 PLAN AND PROFILE
 DONNAN CASTLE COURT**

Patton Harris Rust and Associates
 A Professional Corporation
 Engineers, Surveyors, Planners and Landscape Architects
 7609 Standish Place Rockville, Maryland 20855 (301) 762-2220

BOWLING BROOK FARMS
 PARCEL G, PARCEL H
 SECTION 4 AREA I
 LOTS G-1 THRU G-102
 A RESUBDIVISION OF LOT 216 BOWLING BROOK FARMS
 SIXTH ELECTION DISTRICT
 TAX MAP 47 PARCEL 141
 L.1394 F.632

| SURVEY P.H.R.# | DATE |
|----------------|--------|
| 15-30-85 | 8-3-88 |

| DESIGN | SHEET |
|--------|---------|
| M.J.R. | 4 OF 10 |

| CHECKED | FILE NO. |
|---------|----------|
| C.N.Z. | 2124-1-7 |

1271






AS-BUILT

APPROVED: HOWARD COUNTY DEPARTMENT OF PUBLIC WORKS
Small *Sepp* 5/2/88
 Chief, Land Development Division Date

Charles *Wolcott* Acting 7/23/88
 Chief, Bureau of Highways Date

William *DePa* 8-2-88
 Chief, Bureau of Engineering Date

APPROVED: HOWARD COUNTY OFFICE OF PLANNING AND ZONING
Janice *S. D. Lang* 1-5-88
 Chief, Division of Community Planning & Land Development Date

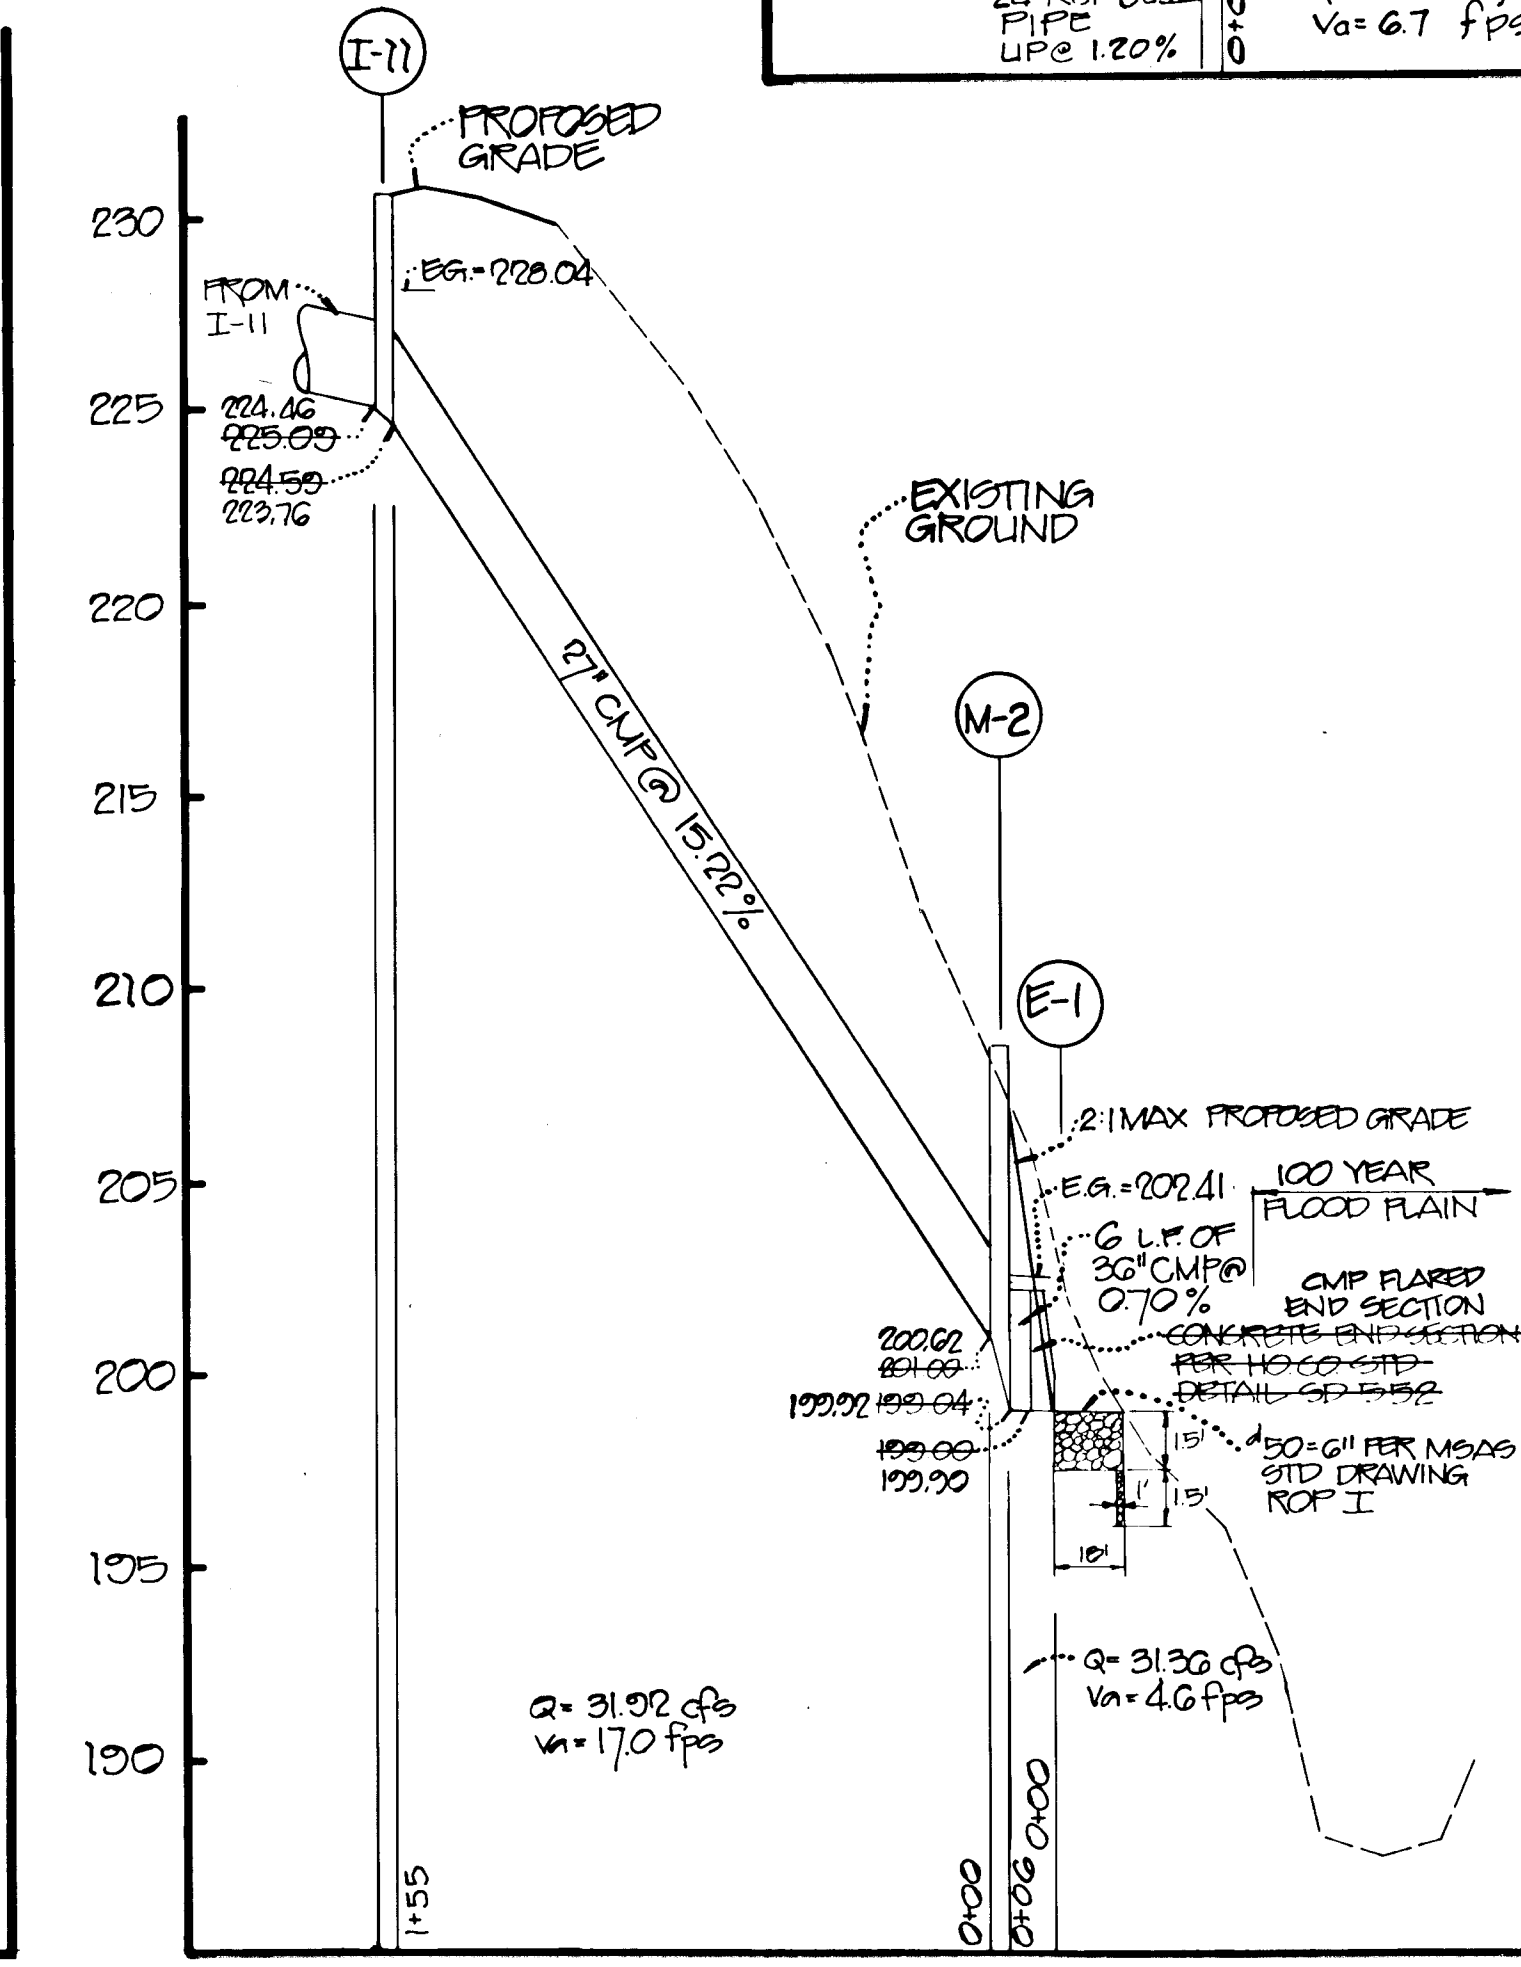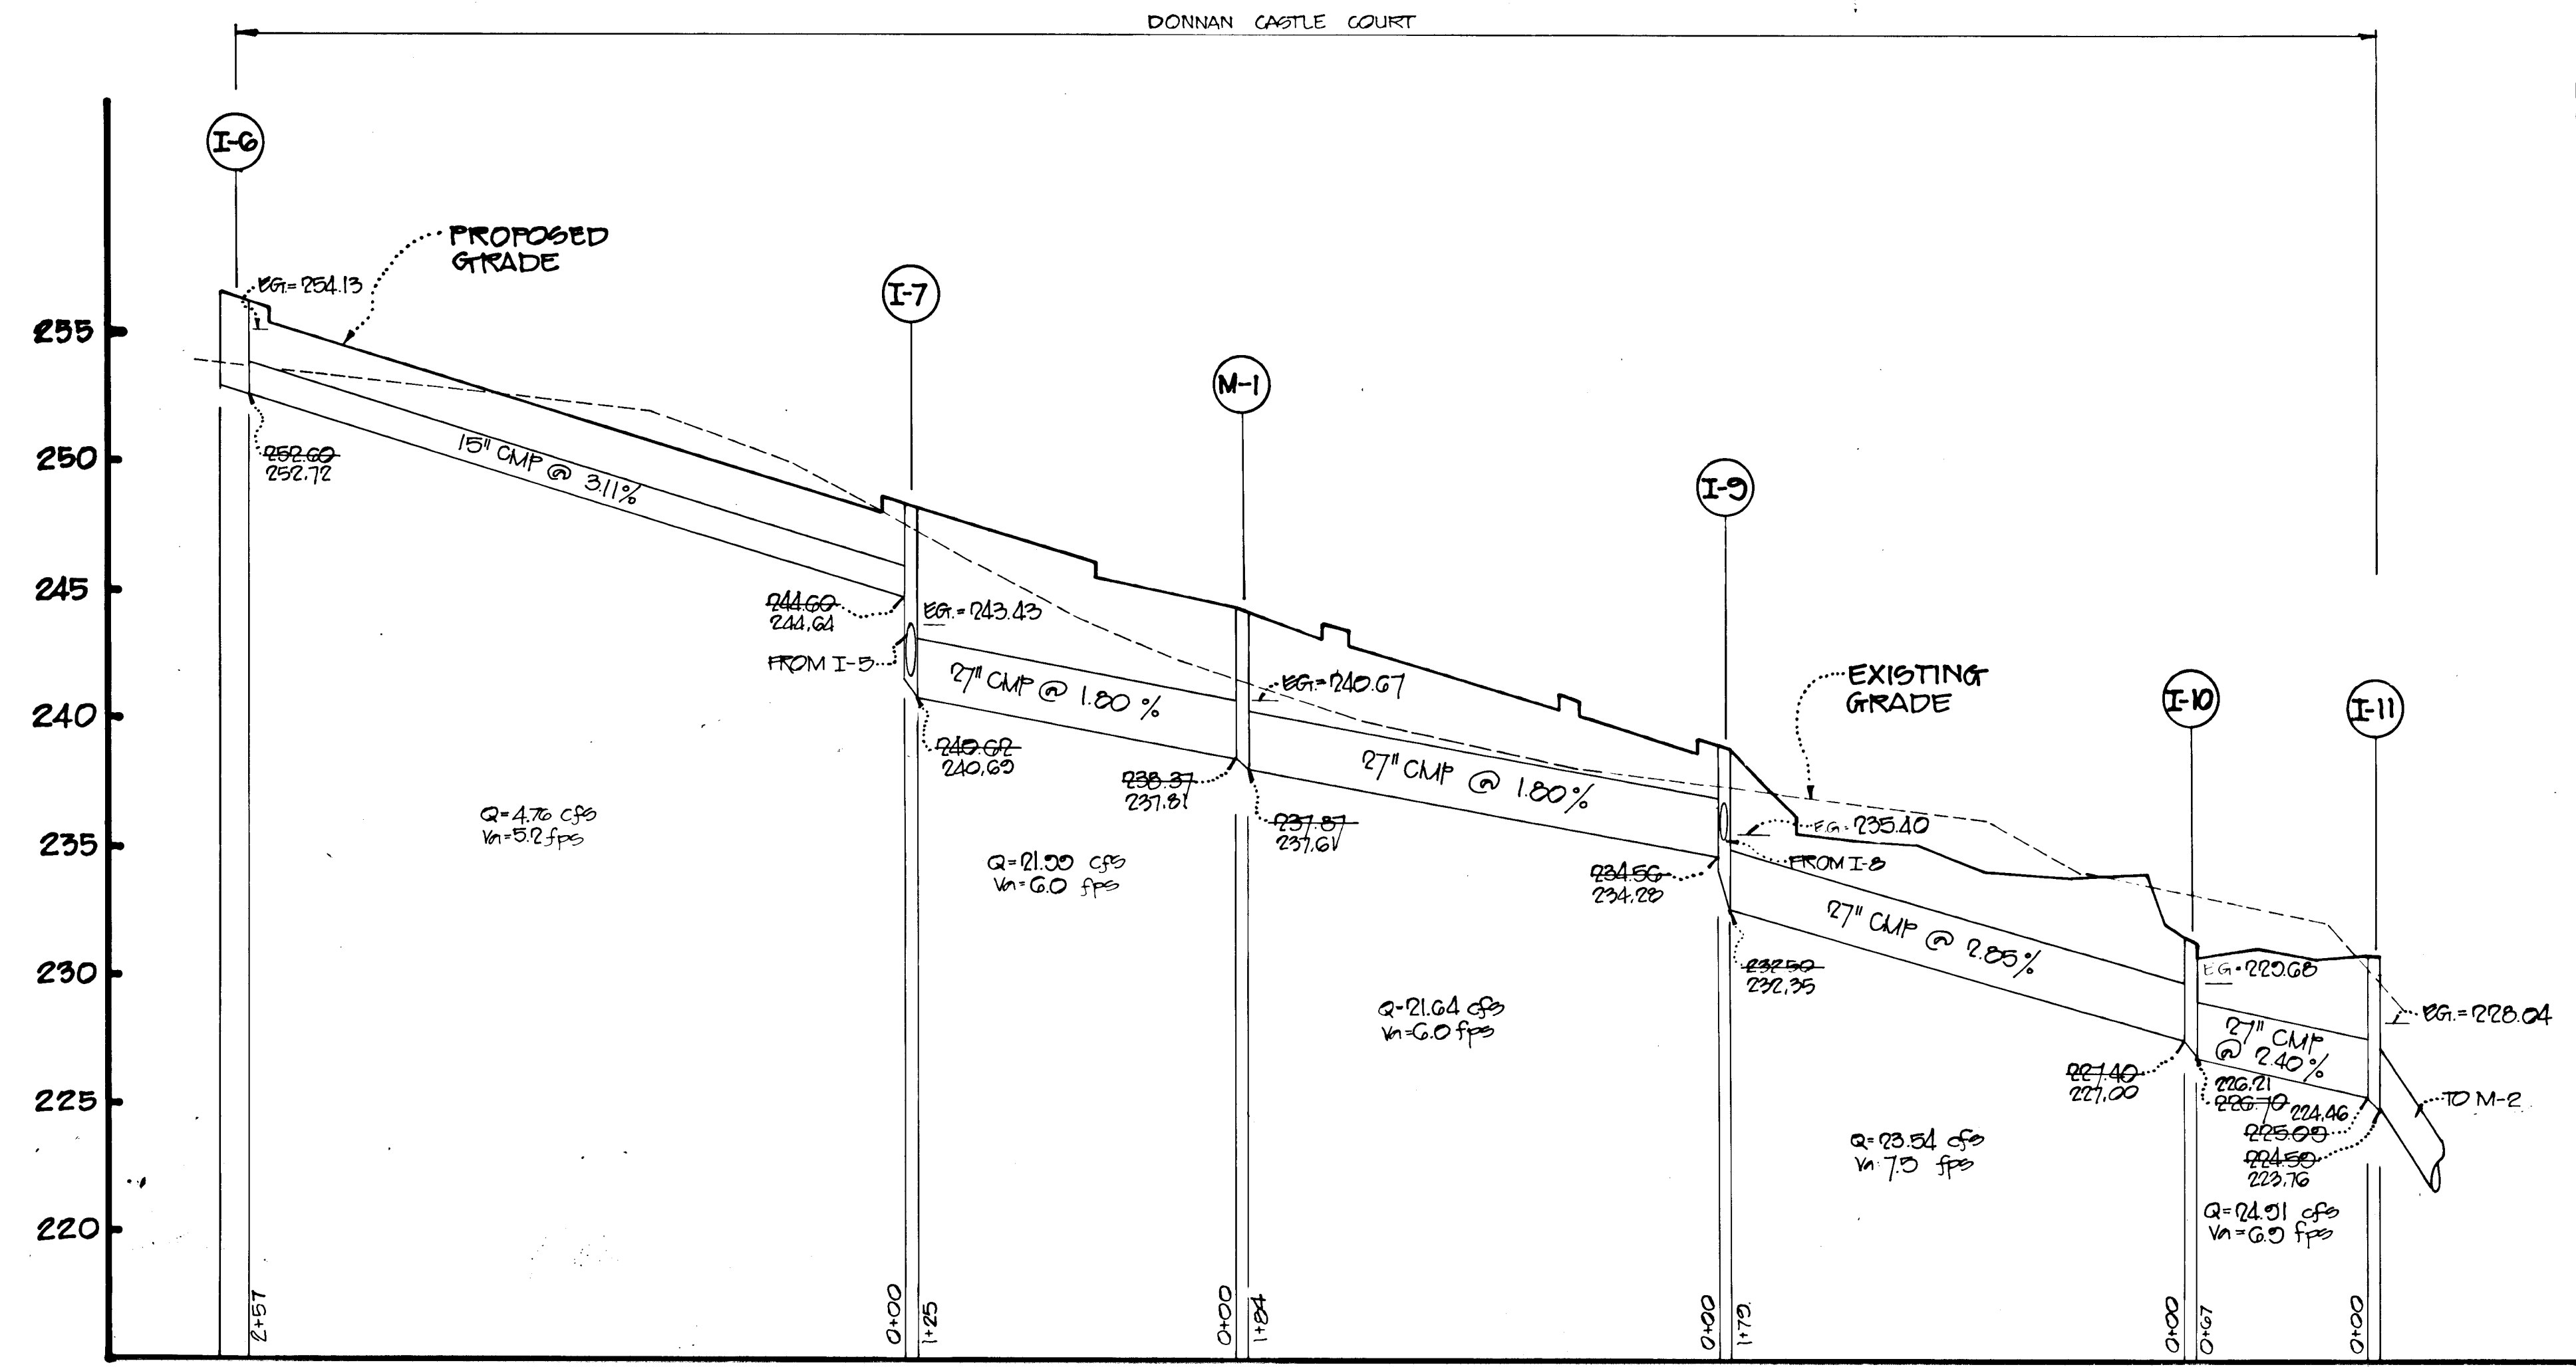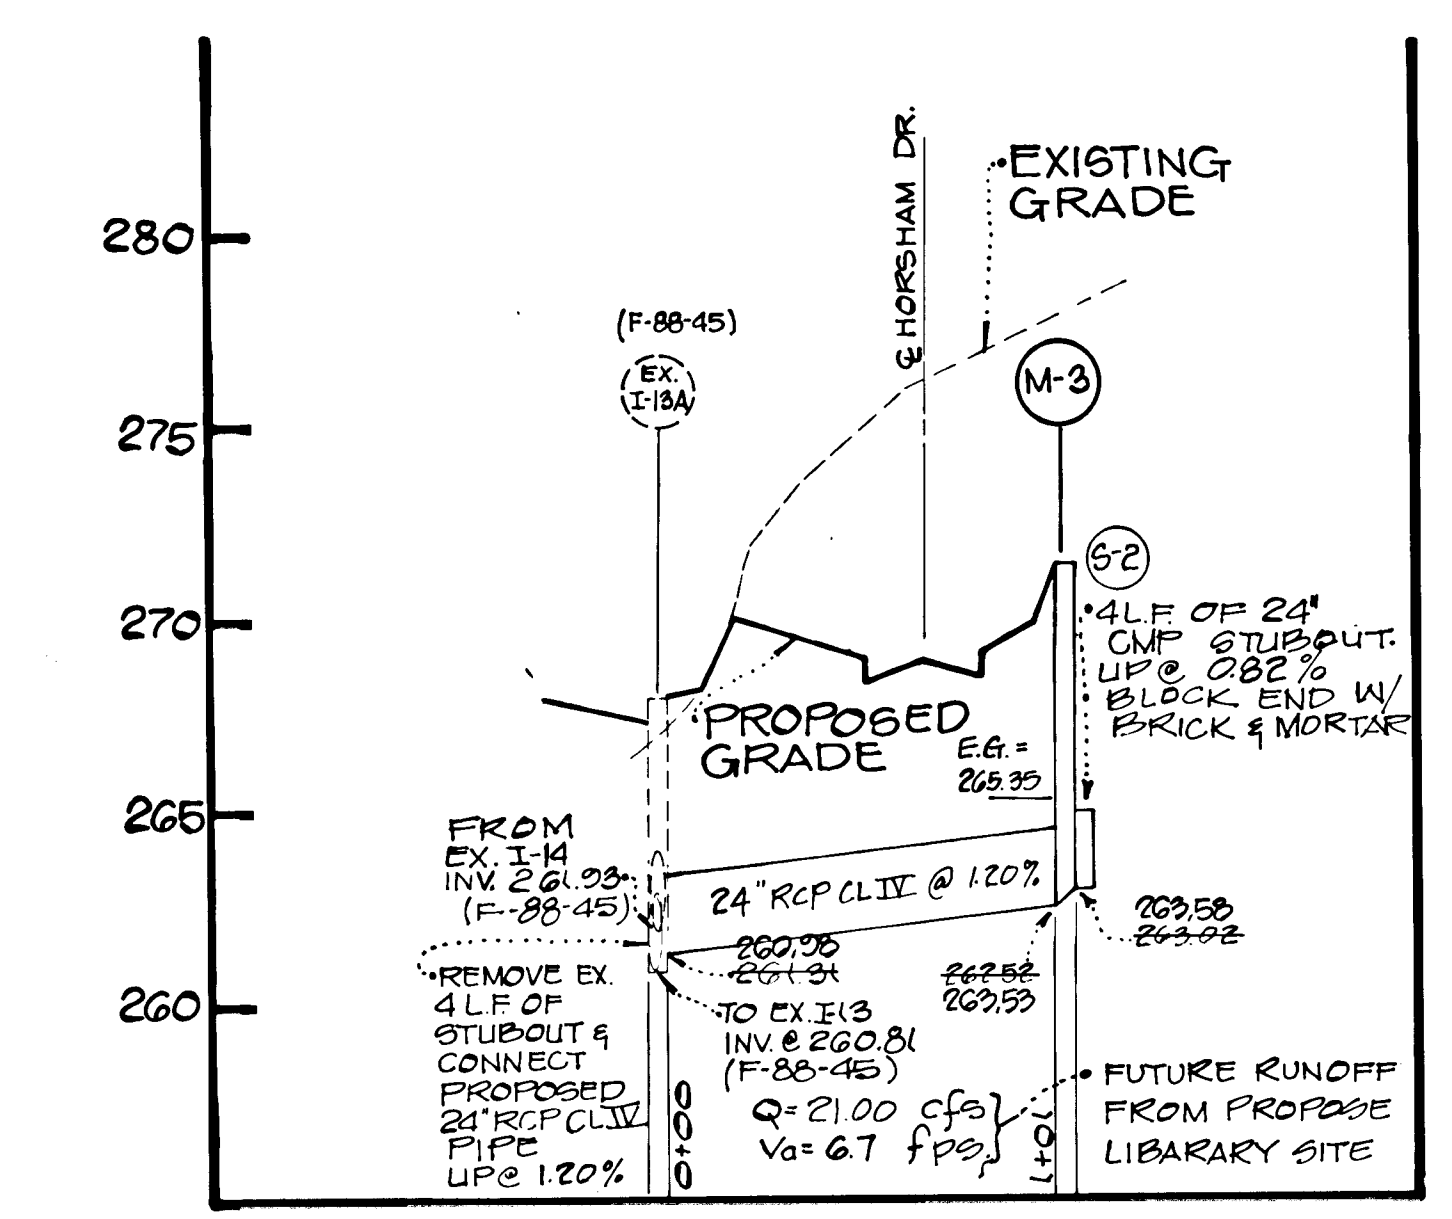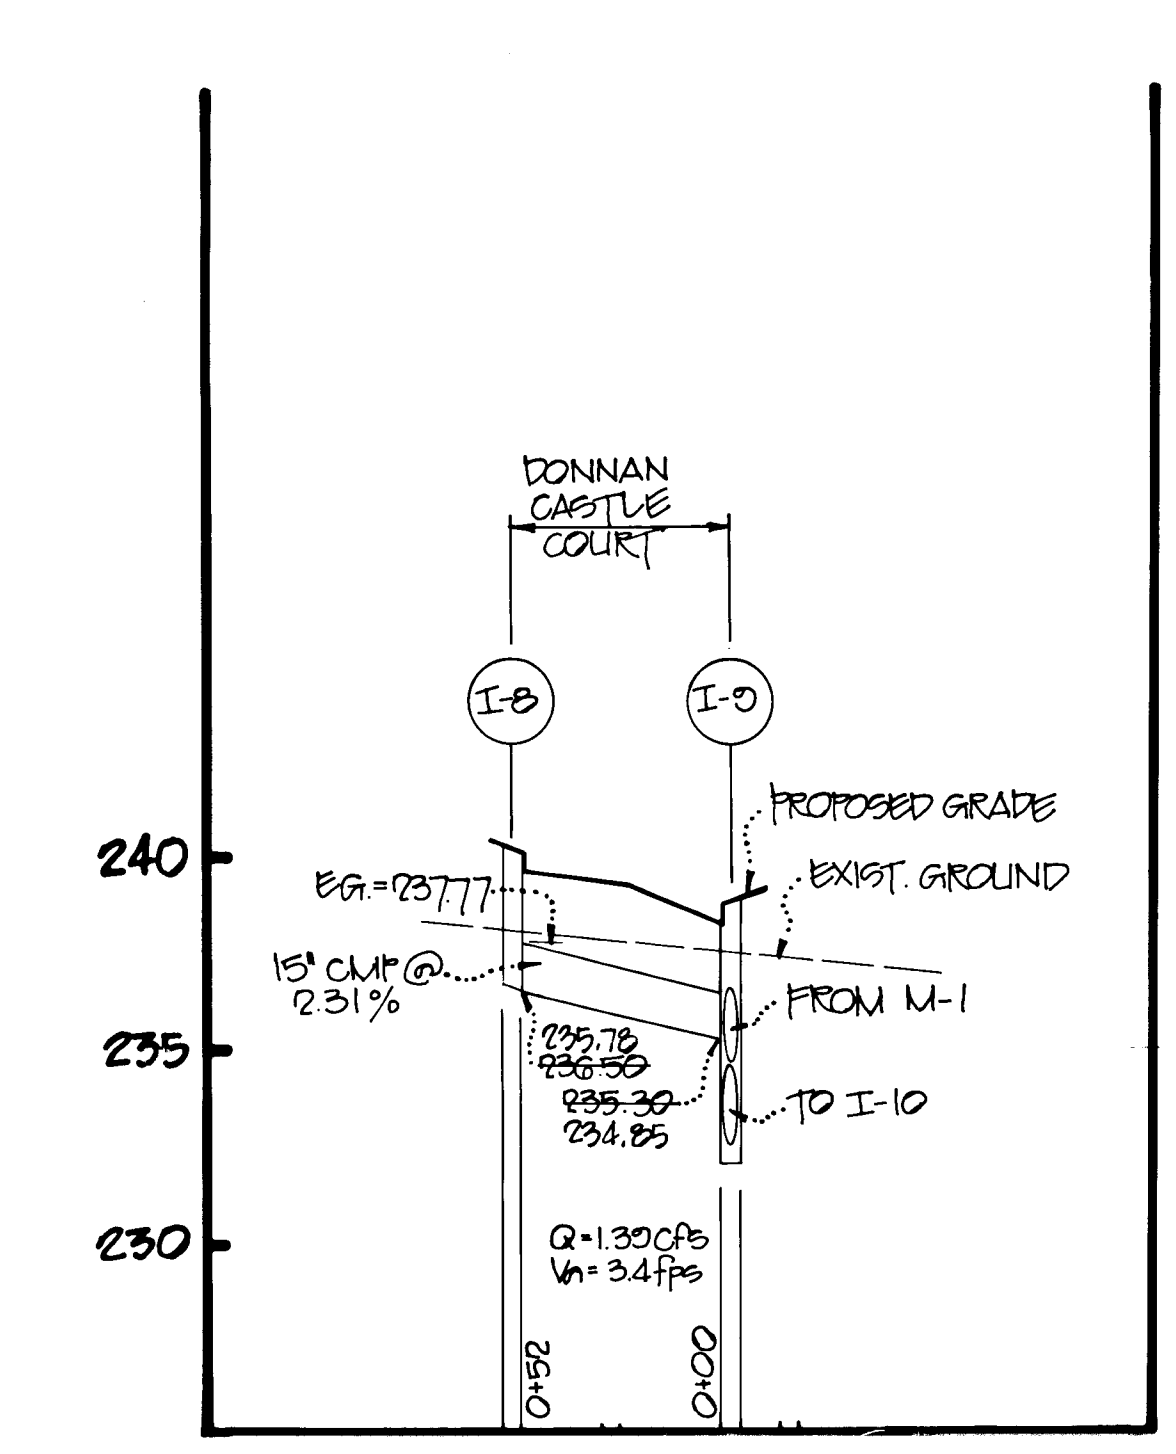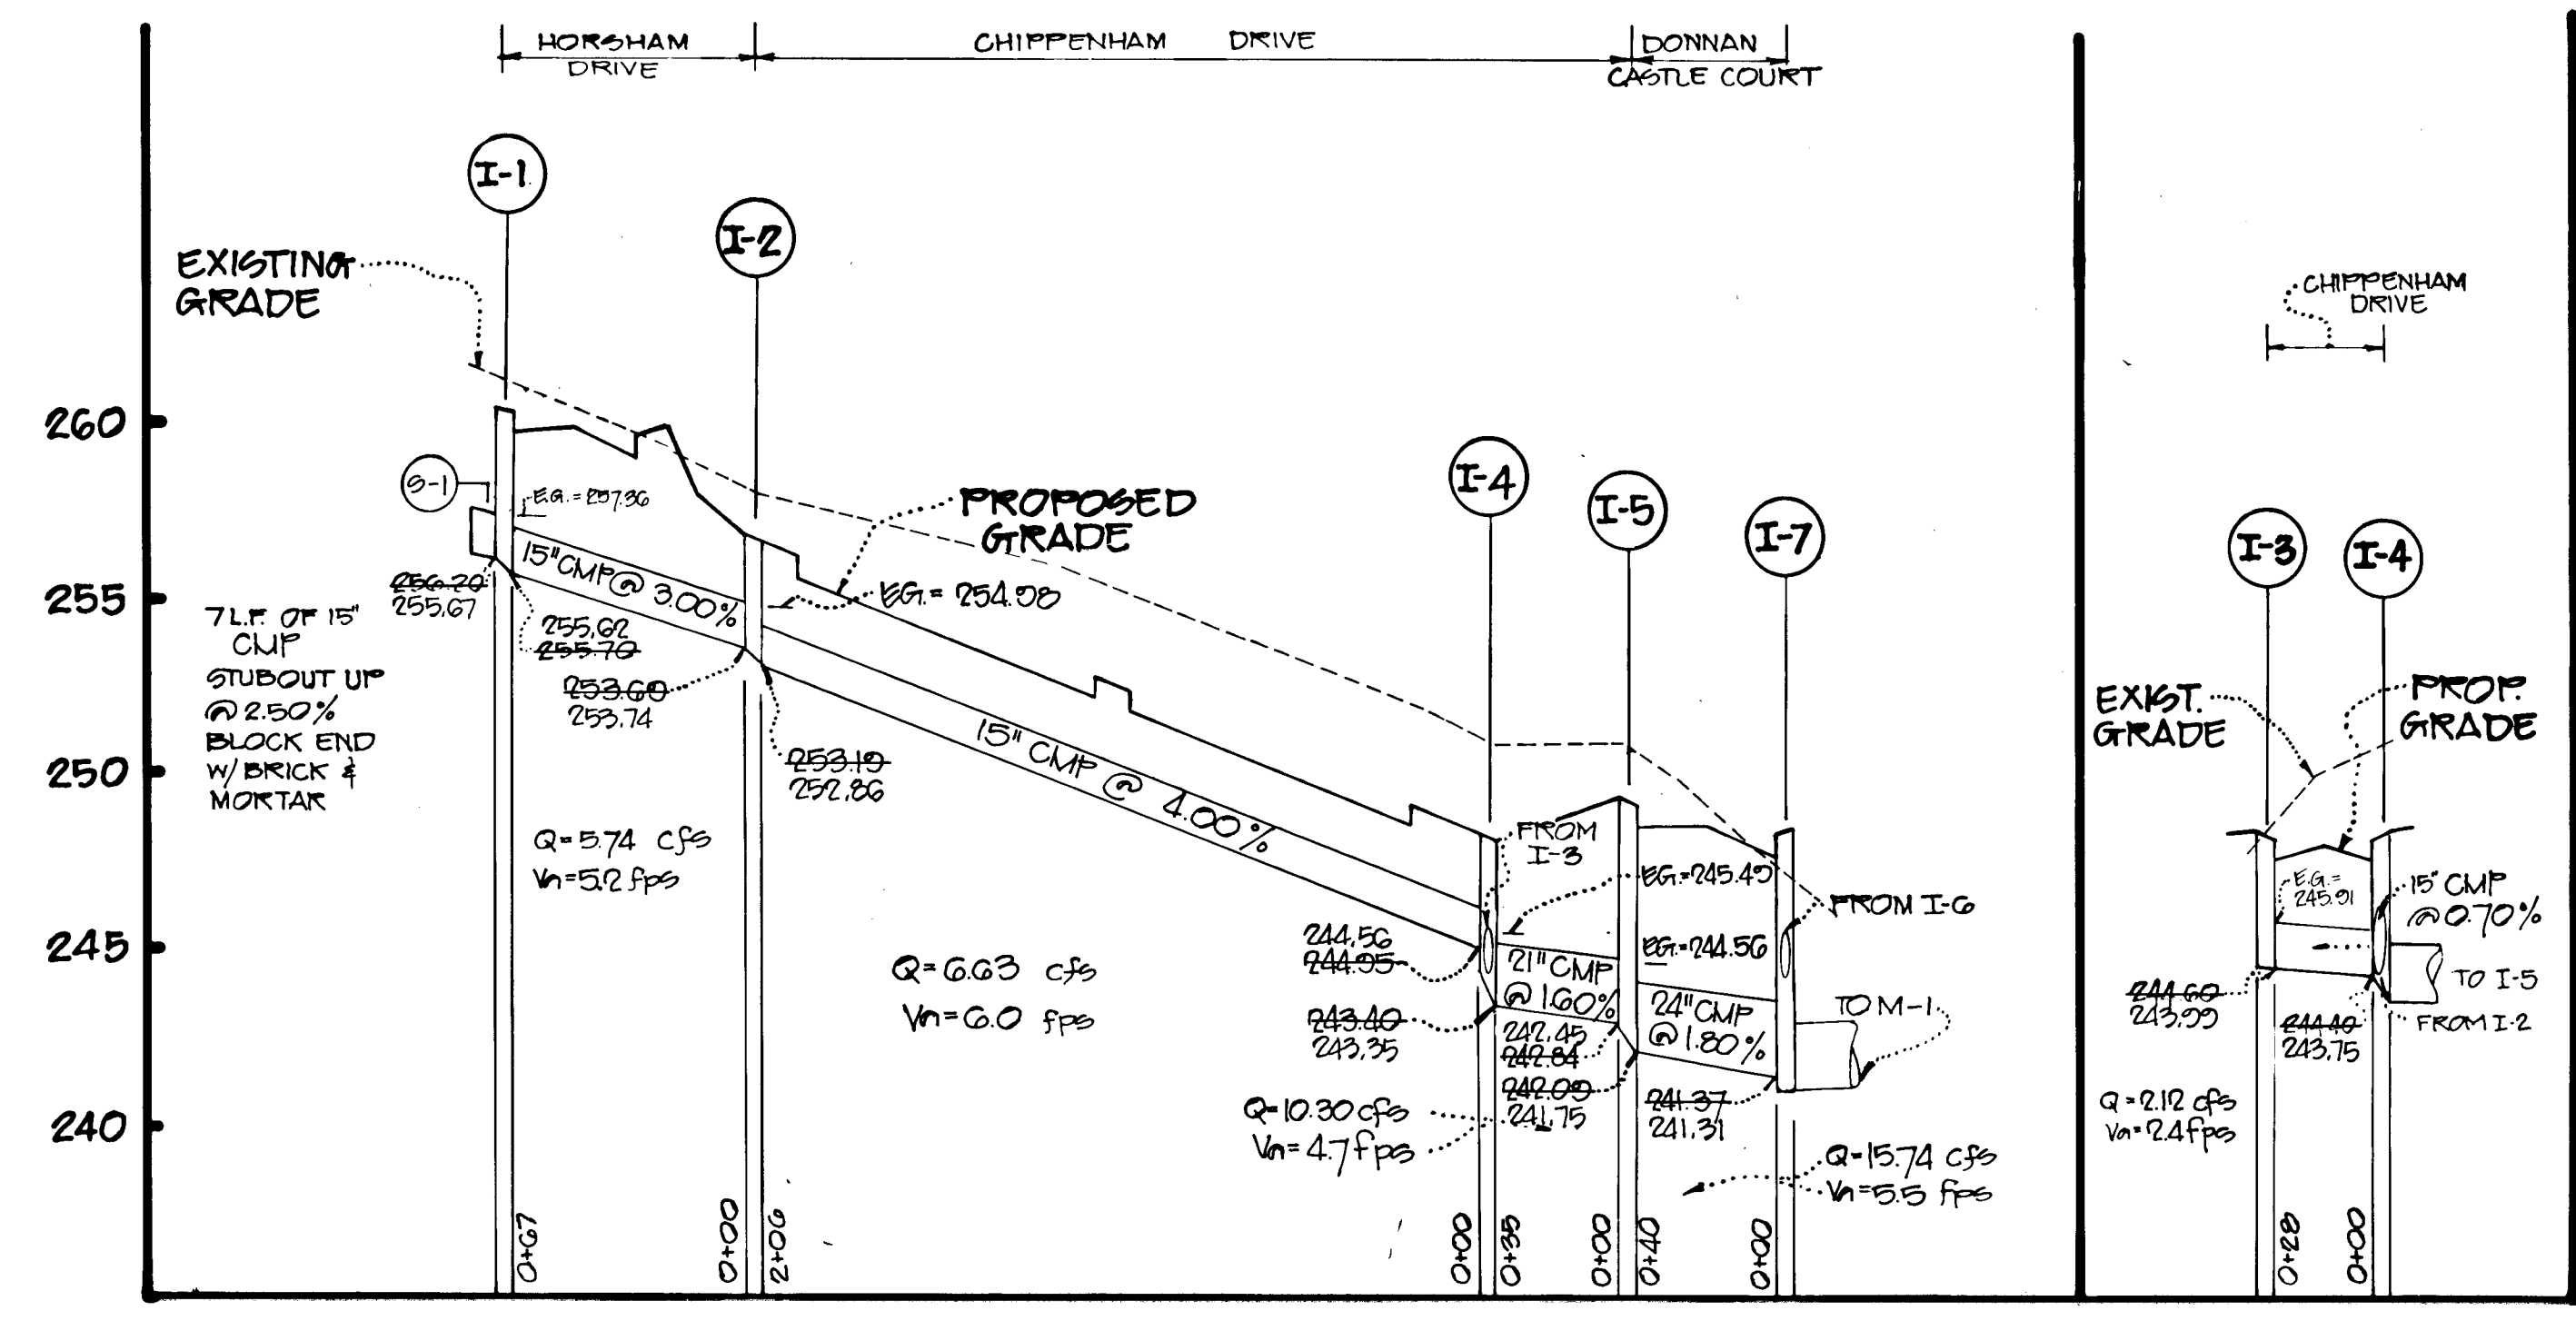

NOTE:
 FOR ALL STORM DRAIN PIPES
 USE CLASS C PIPE BEDDING
 PER HOWARD COUNTY STORM
 DRAIN DESIGN MANUAL
 VOLUME I, FIGURE 11.4
 (FOR DETAIL SEE SHEET G)

OWNER/DEVELOPER
 GORMAN ROAD LIMITED PARTNERSHIP
 C/O JAMES F. KNOTT DEVELOPMENT CORPORATION
 110 WEST ROAD, SUITE 203
 TOWSON, MARYLAND 21284

| | | | |
|-----|------------------------------|------|----------|
| 5 | AS-BUILT REVISIONS | PP | 15-6-21 |
| 4 | REDLINE REVISIONS | NK | 10/7/88 |
| 3 | REVISION FROM CIVIL ENGINEER | | 8/2/88 |
| 2 | 2ND SUBMISSION TO HOCO | MK | 5/2/88 |
| 1 | ISSUED TO HOCO | | 3/3/88 |
| NO. | DESCRIPTION | DATE | APPROVED |
| | | | DATE |



REVISION APPROVED BY

STORM DRAIN PROFILES

Patton Harris Rust and Associates
 A Professional Corporation
 Engineers, Surveyors, Planners and Landscape Architects
 7609 Standish Place Rockville, Maryland 20855 (301)762-2220


BOWLING BROOK FARMS
 PARCEL G, PARCEL H
 SECTION 4, AREA 1
 LOTS G-1 THRU G-102
 A RESUBDIVISION OF LOT 216 BOWLING BROOK FARMS
 SIXTH ELECTION DISTRICT
 TAX MAP 47 L.1394 PARCEL 141 F.632

| | |
|----------------|----------|
| SURVEY | DATE |
| DESIGN M.J.K. | 8-3-88 |
| DRAWN J.D.W. | SHEET |
| CHECKED | 5 OF 10 |
| SCALE AS SHOWN | FILE NO |
| C.I. | 2104-1-7 |



AS-BUILT

*NOTE: USE SECTION P-2 FOR ALL PARKING AND ROADWAY PAVING.


| SECTION NUMBER | ROAD AND STREET CLASSIFICATION | PAVEMENT MATERIALS | |
|----------------|---|---|---|
| | | FULL DEPTH BIT. CONC. ALTERNATE | GRANULAR BASE ALTERNATE |
| P-1 | PARKING AREAS AND TRAVELWAYS APARTMENTS AND COMMERCIAL-INDUSTRIAL ZONES WITH NO HEAVY TRUCKS | 1" BIT. CONC. SURFACE 4" BIT. CONC. BASE | 2" BIT. CONC. SURFACE 4" BIT. CONC. BASE |
| P-2 | RESIDENTIAL ZONES LOCAL CUL-DE-SACS ALLEYS AND PRIVATE ROADS SERVING INDIVIDUAL PARKING AREAS APARTMENTS AND COMMERCIAL-INDUSTRIAL ZONES WITH NO MORE THAN 10 HEAVY TRUCKS PER DAY* | 1" BIT. CONC. SURFACE 5" BIT. CONC. BASE | 2" BIT. CONC. SURFACE 5" BIT. CONC. BASE |

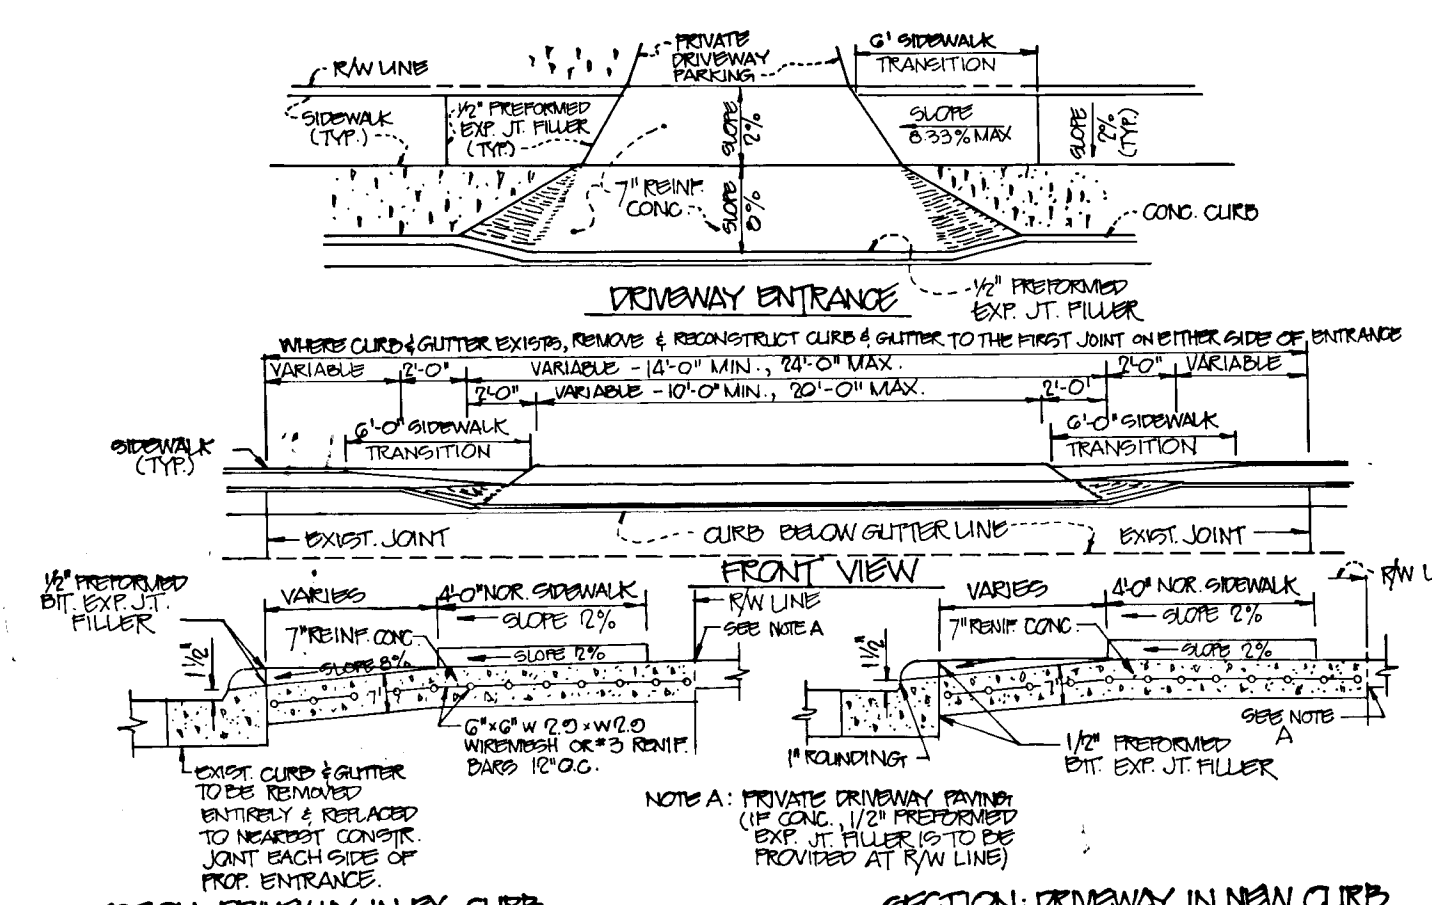

RESIDENTIAL DRIVEWAY ENTRANCE CLOSED SECTION WITH STANDARD 7" COMBINATION CURB & GUTTER & SIDEWALK SET BACK FROM CURB

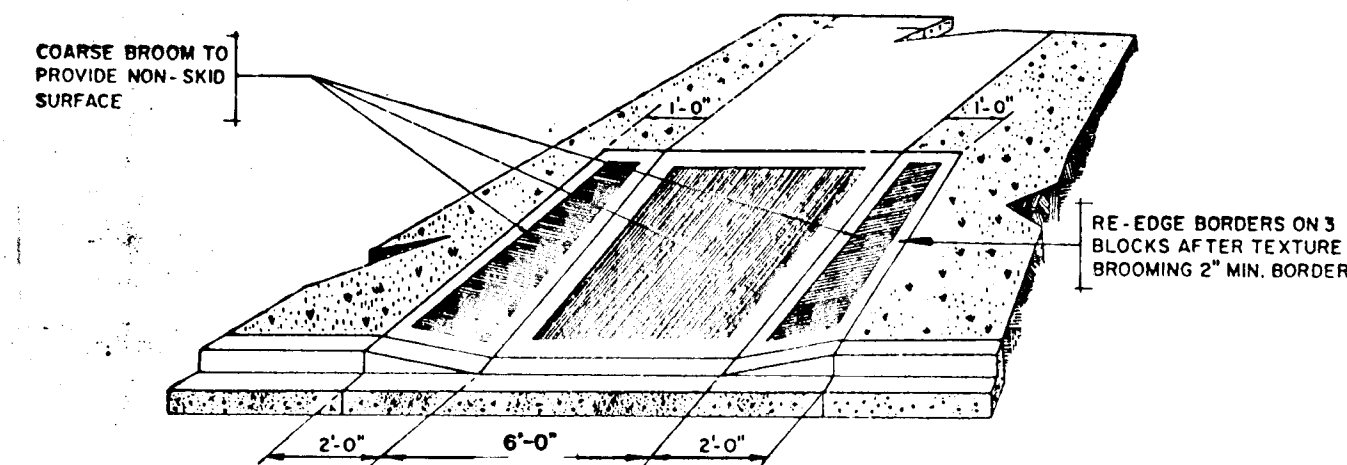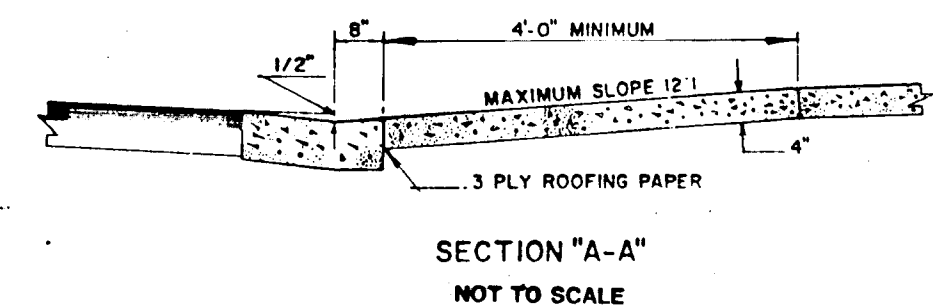

SIDEWALK RAMP

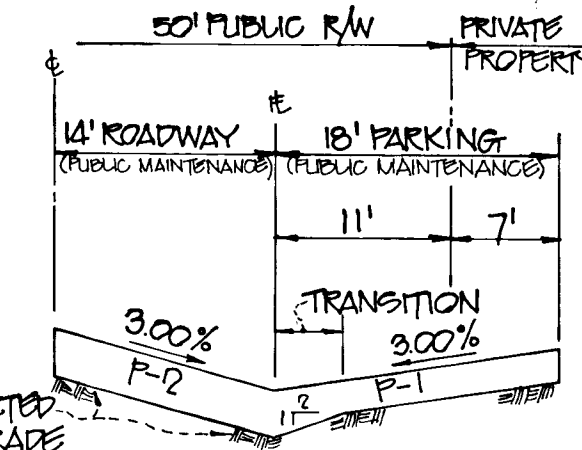

ALTERNATE PAVING SECTION

APPROVED: HOWARD COUNTY DEPARTMENT OF PUBLIC WORKS

Small Thompson 3/2/88
Chief, Land Development Division Date


Charles M. Smith 7/29/88
Chief, Bureau of Highways Date

W. Edwin P. Smith 8-2-88
Chief, Bureau of Engineering Date


APPROVED: HOWARD COUNTY OFFICE OF PLANNING AND ZONING

Mariska J. DeLaugh 9-5-88
Chief, Division of Community Planning & Land Development Date


| NO. | DESCRIPTION | DATE | APPROVED | DATE |
|-----|--|---------|----------|------|
| 4 | RELINE REVISIONS | 10/7/88 | | |
| 3 | REVISIONS FROM P.A.W. COMMENTS FROM C.O.P. | 6/20/88 | | |
| 2 | REVISED FROM C.O.P. COMMENTS | 5/2/88 | | |
| 1 | ISSUED TO HOCO | 3-2-88 | | |

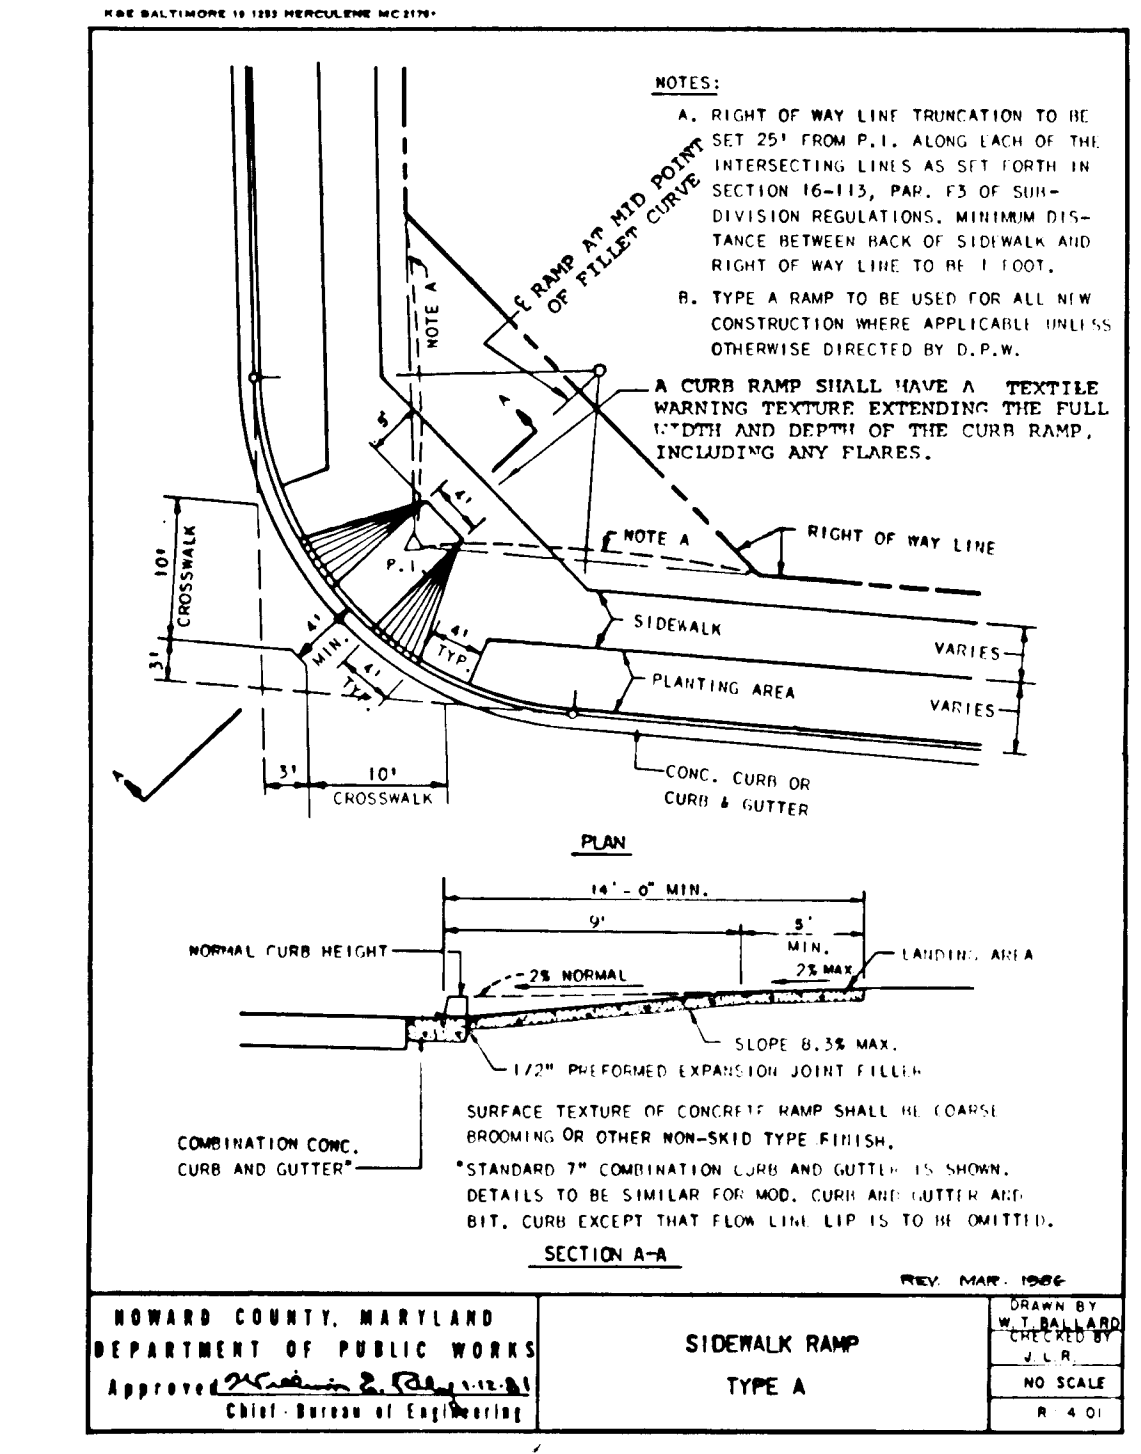


HOWARD COUNTY, MARYLAND DEPARTMENT OF PUBLIC WORKS SIDEWALK RAMP TYPE A

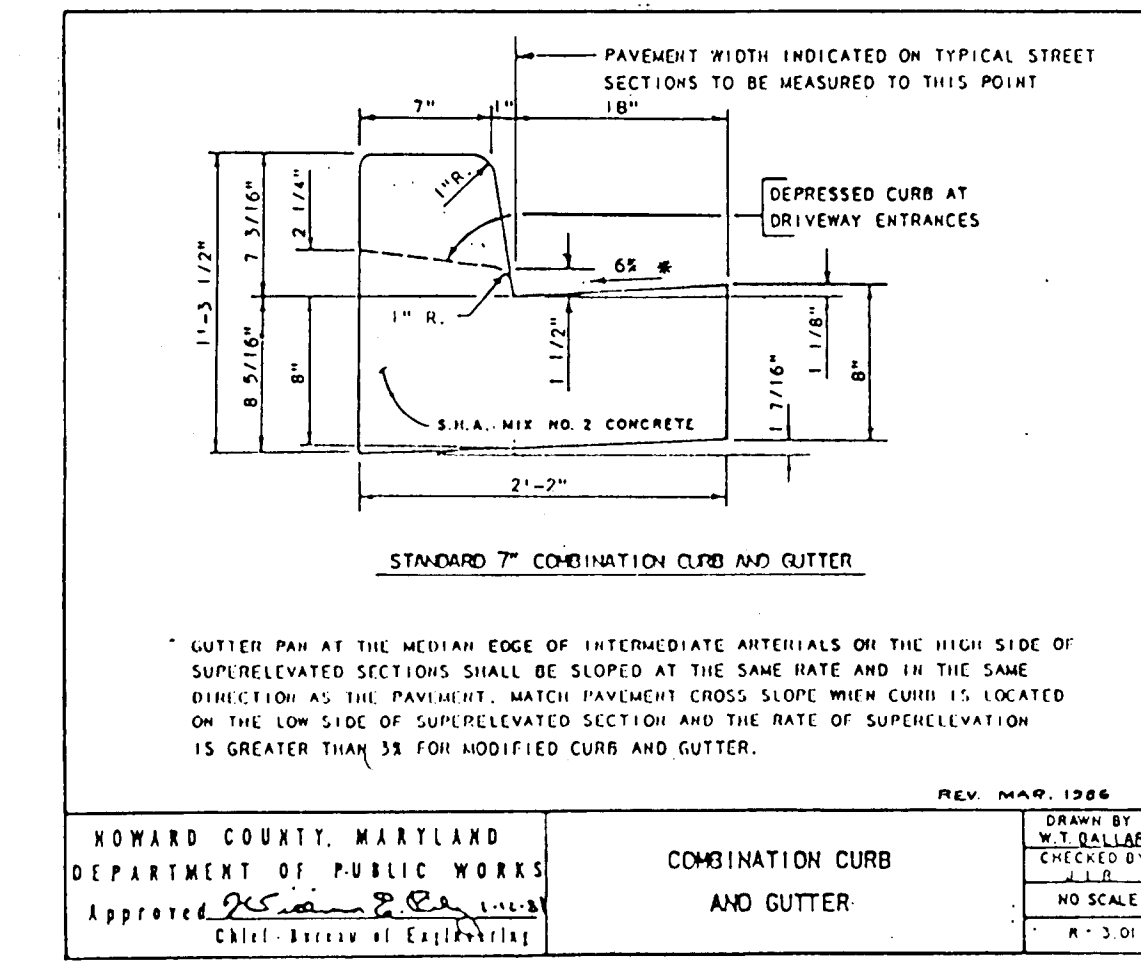


HOWARD COUNTY, MARYLAND DEPARTMENT OF PUBLIC WORKS STANDARD 7" COMBINATION CURB AND GUTTER

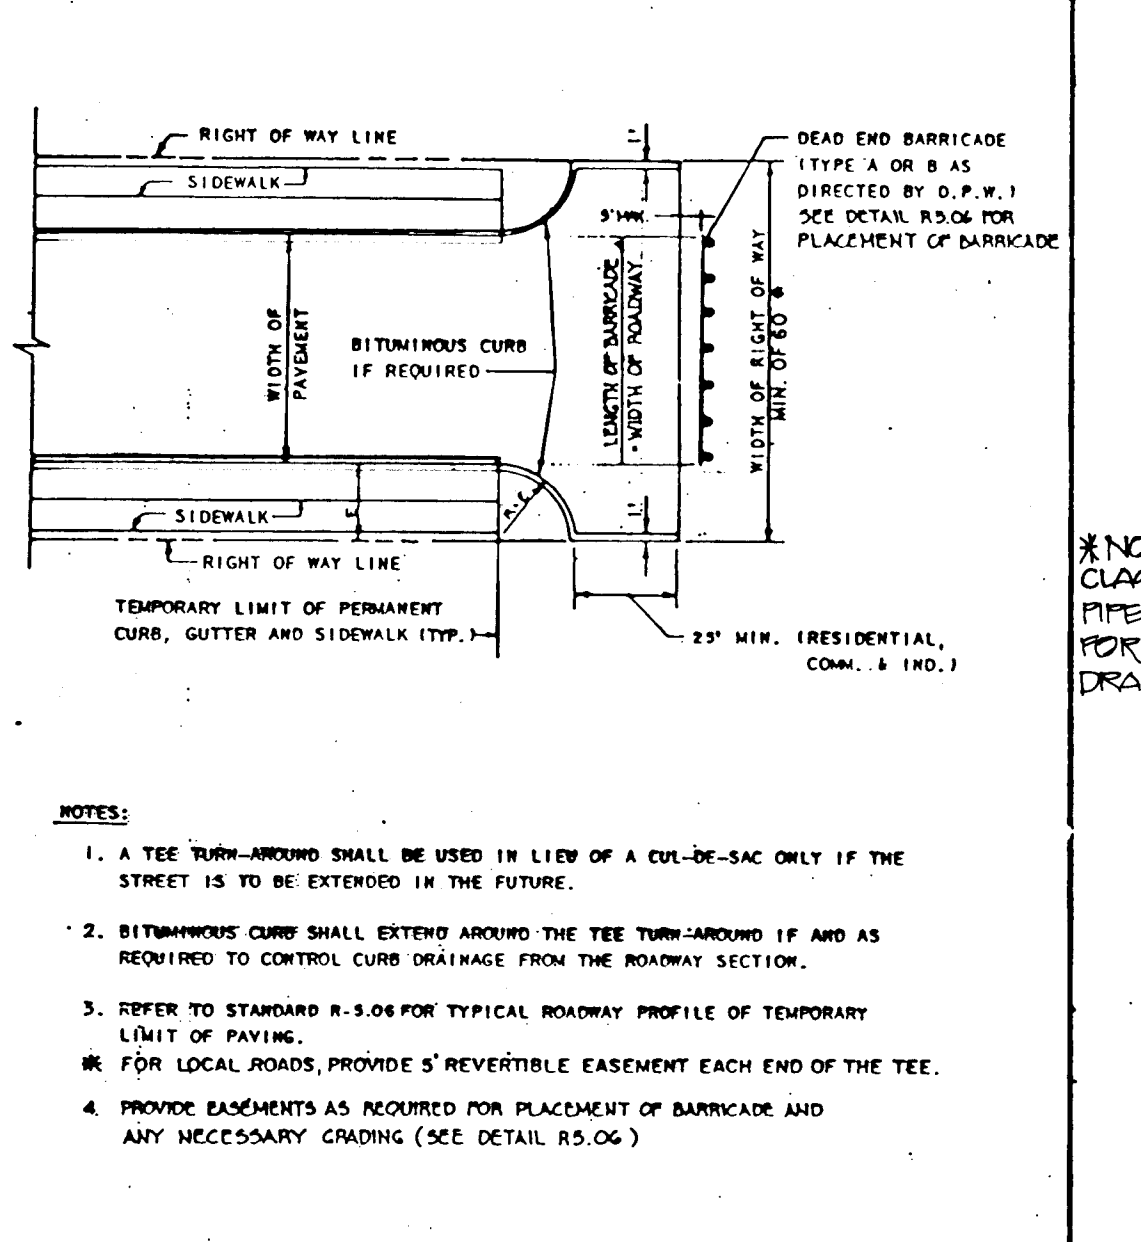

HOWARD COUNTY, MARYLAND DEPARTMENT OF PUBLIC WORKS TEMPORARY TEE TURN-AROUND

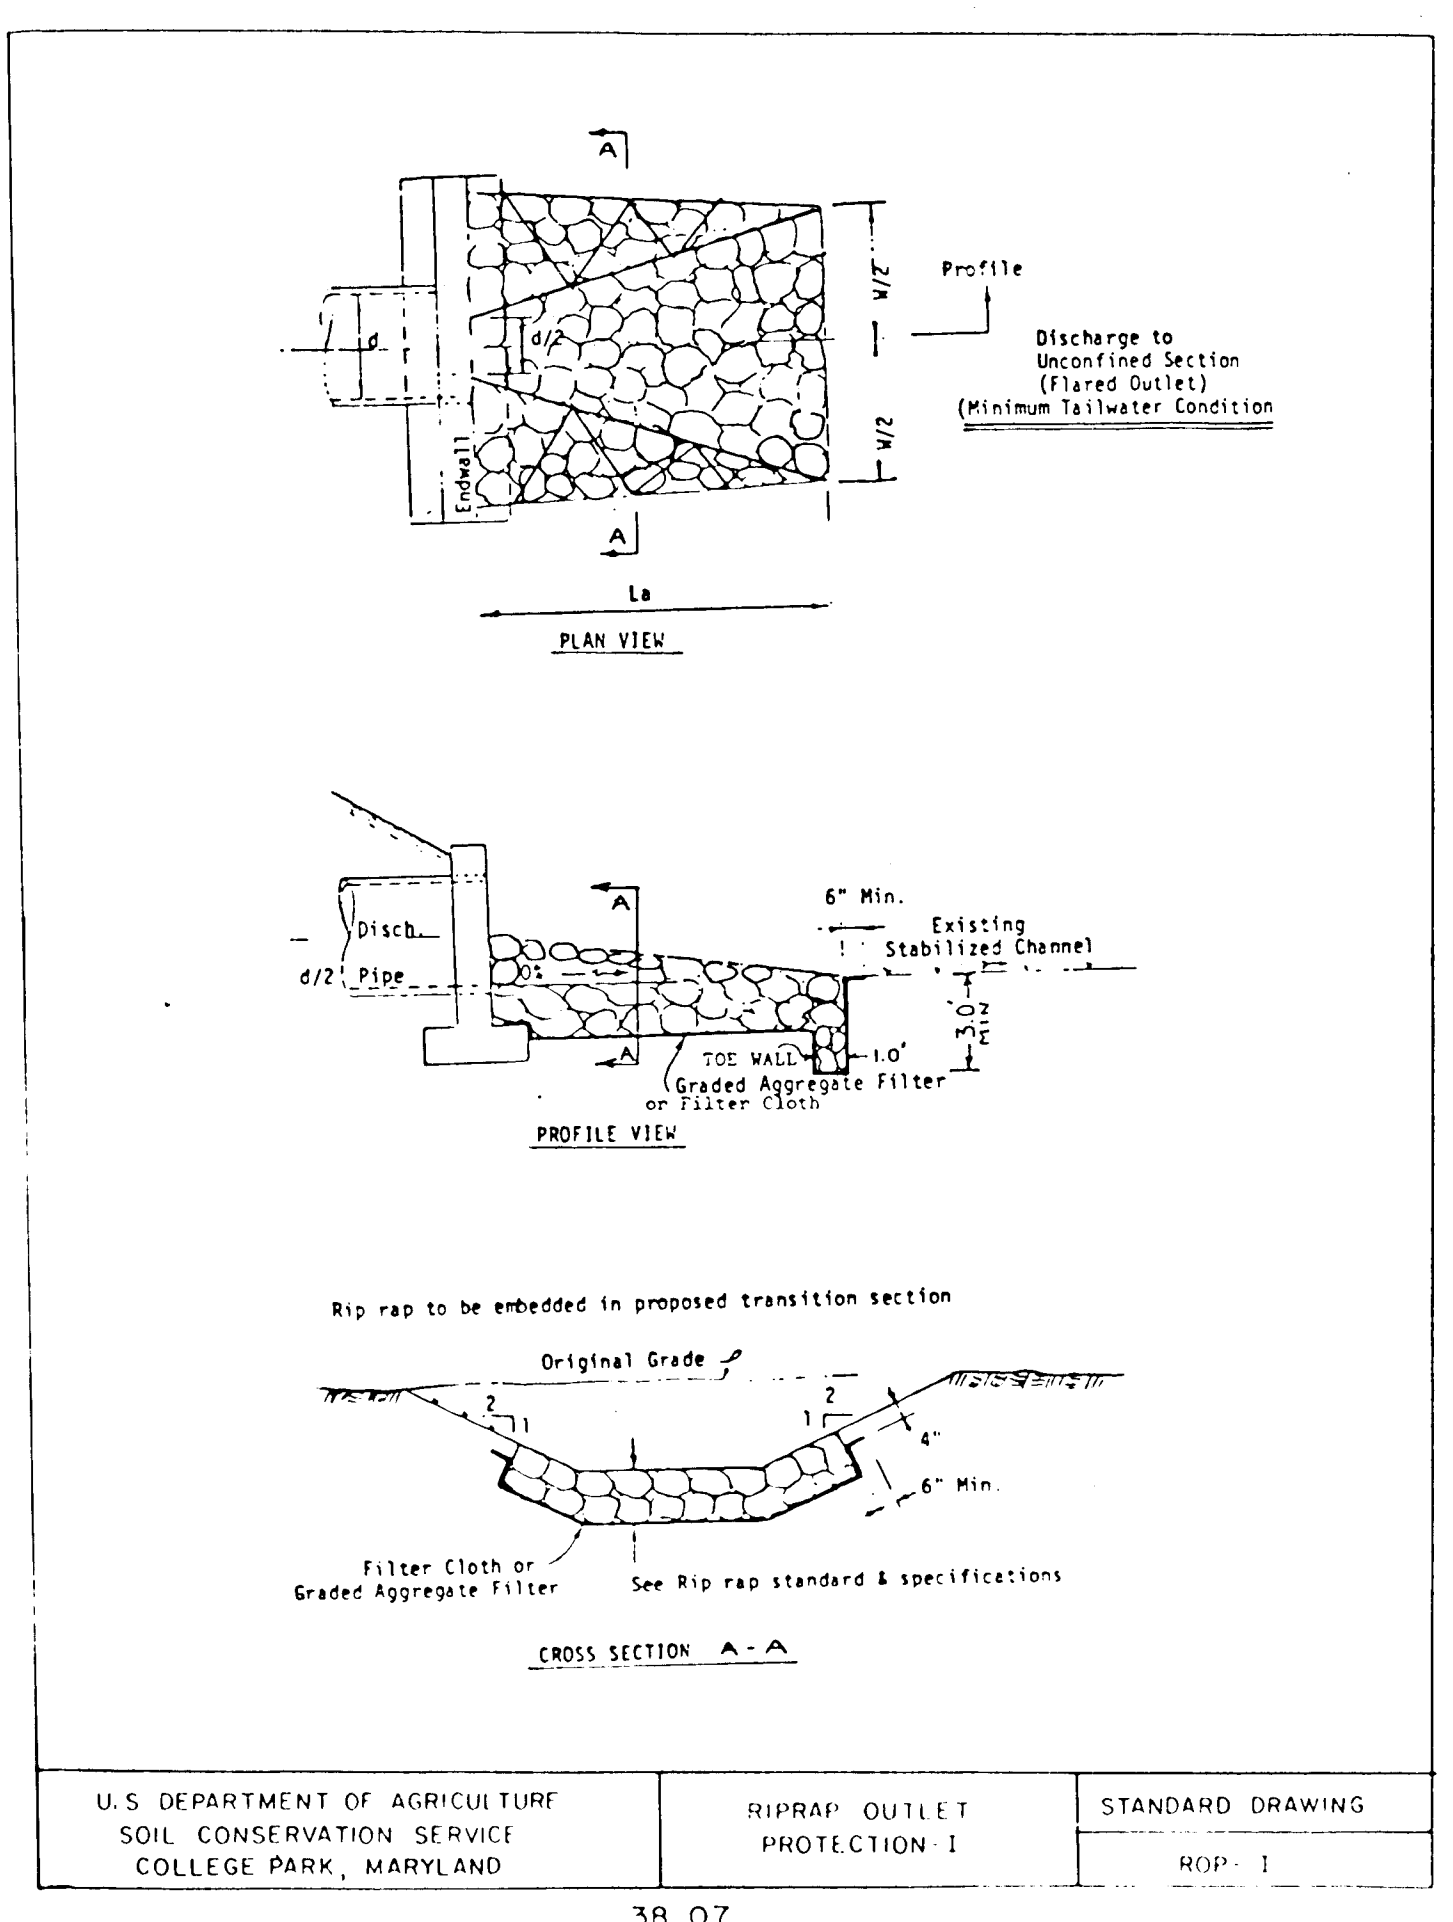

U.S. DEPARTMENT OF AGRICULTURE SOIL CONSERVATION SERVICE COLLEGE PARK, MARYLAND RIPRAP OUTLET PROTECTION I

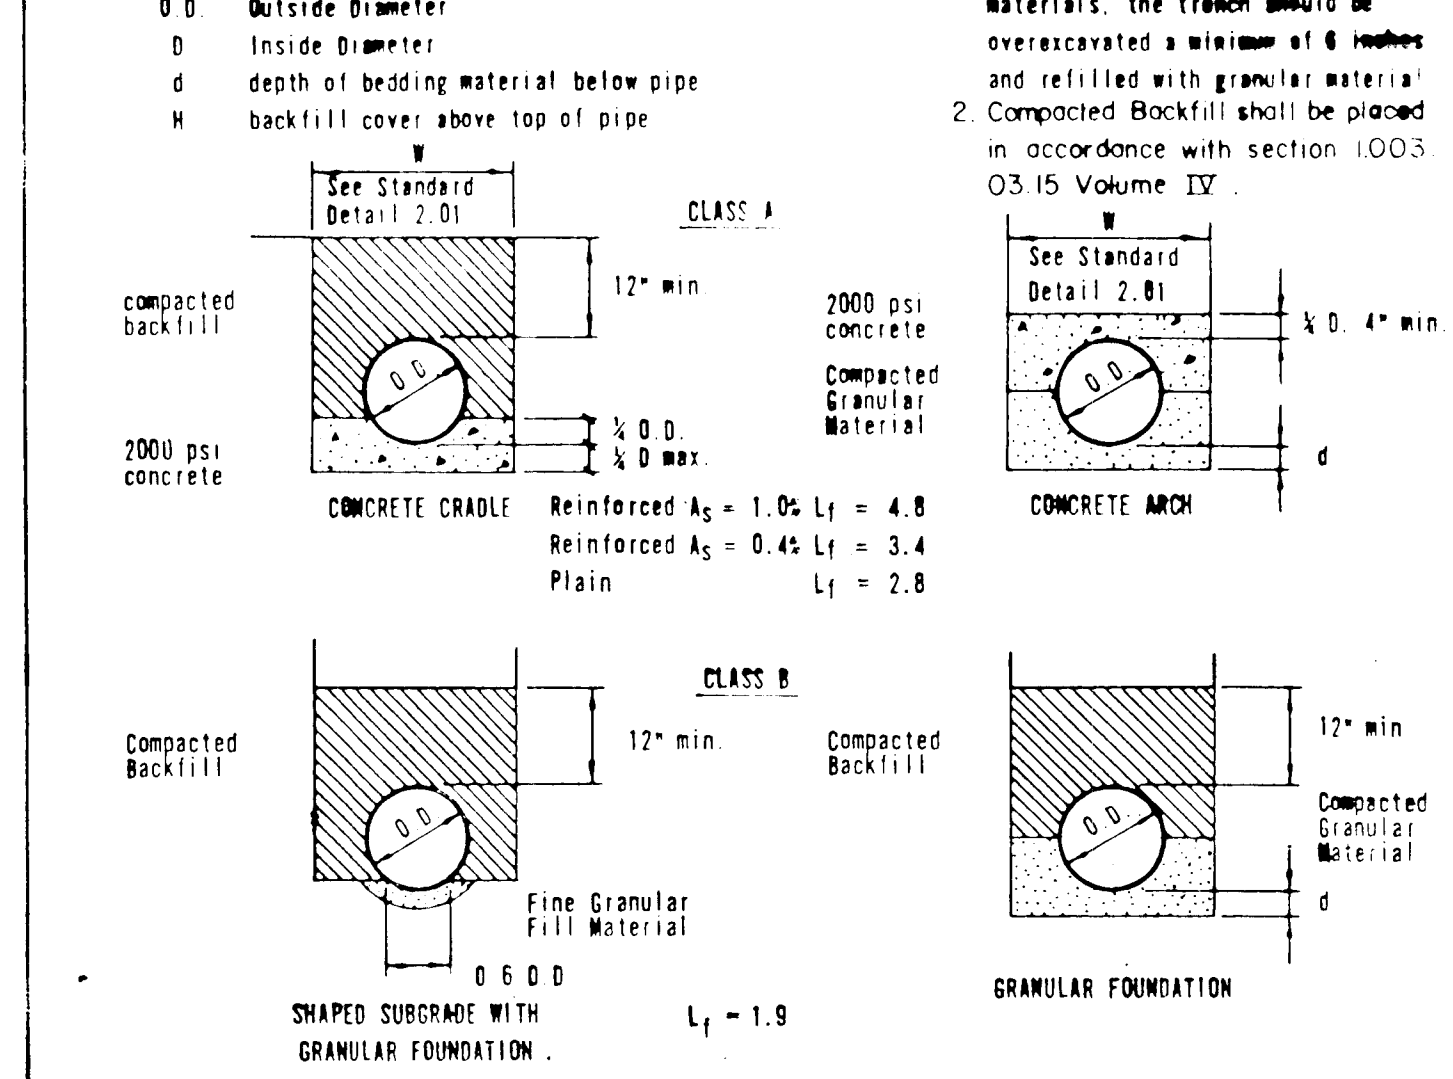

CONCRETE CRADLE CLASS A

CONCRETE ARCH CLASS B

SHAPED SUBGRADE WITH GRANULAR FOUNDATION CLASS C


SHAPED SUBGRADE CLASS D (Not Acceptable)

FLAT SUBGRADE CLASS E (Not Acceptable)


| DEPTH OF BEDDING MATERIAL BELOW PIPE | D | d (min.) |
|--------------------------------------|----|----------|
| 27" & smaller | 3" | |
| 30" thru 60" | 4" | |
| 66" & larger | 6" | |

APPROVED: HOWARD COUNTY, MARYLAND DEPARTMENT OF PUBLIC WORKS PIPE BEDDING CLASSES


W. Edwin P. Smith 11-4
Chief, Bureau of Eng. Date

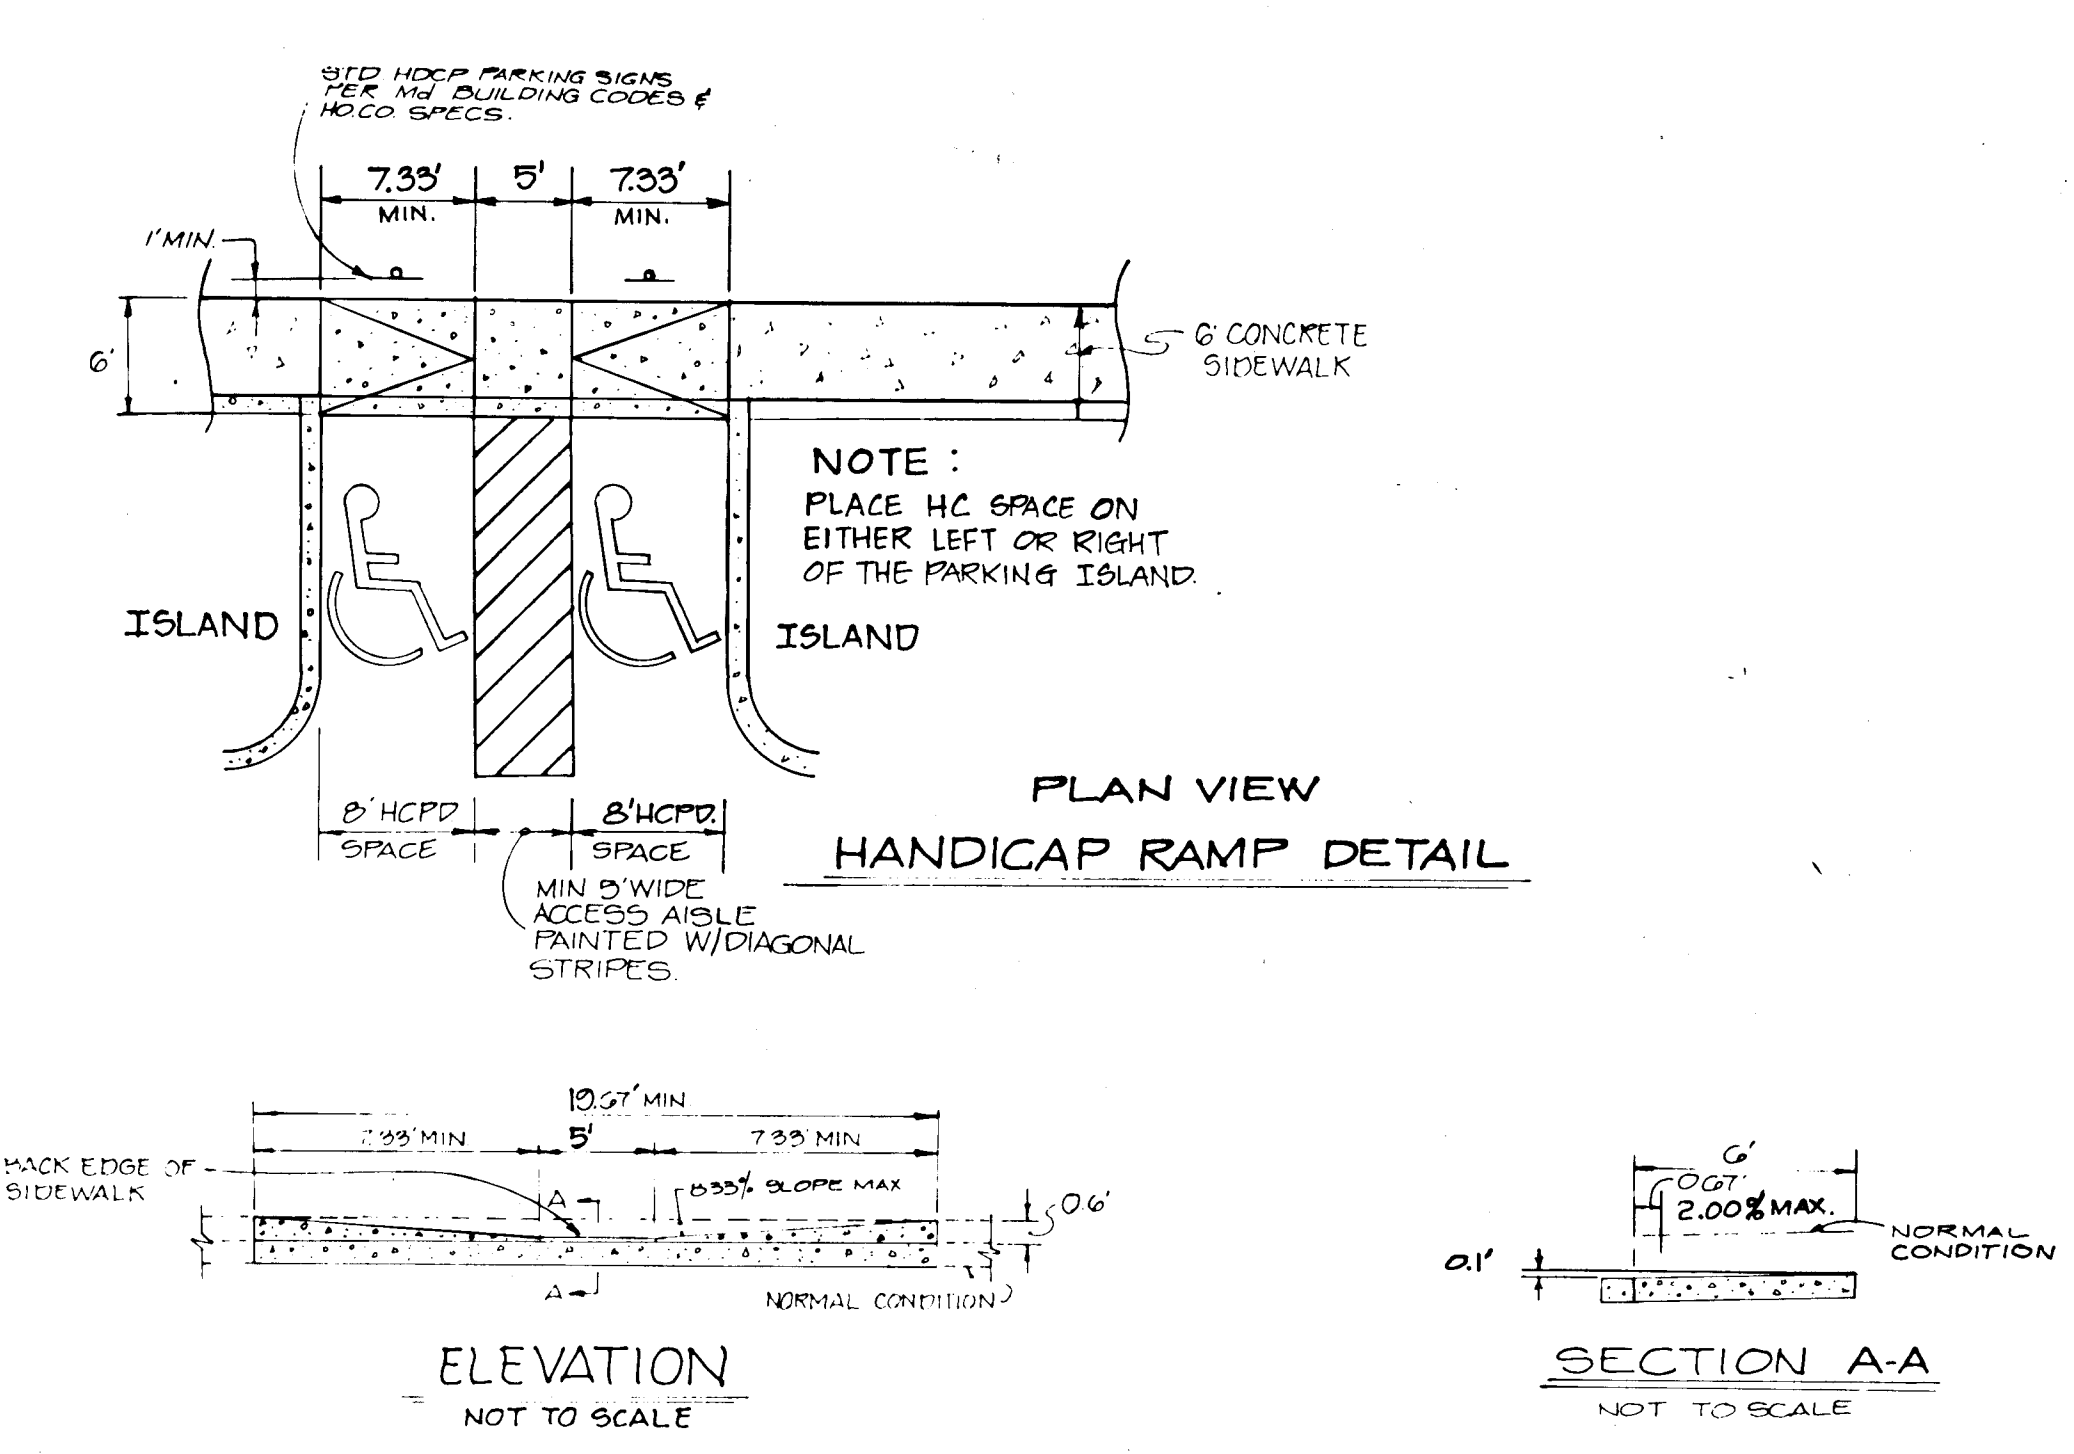


U.S. DEPARTMENT OF AGRICULTURE SOIL CONSERVATION SERVICE COLLEGE PARK, MARYLAND HANDICAP RAMP DETAIL

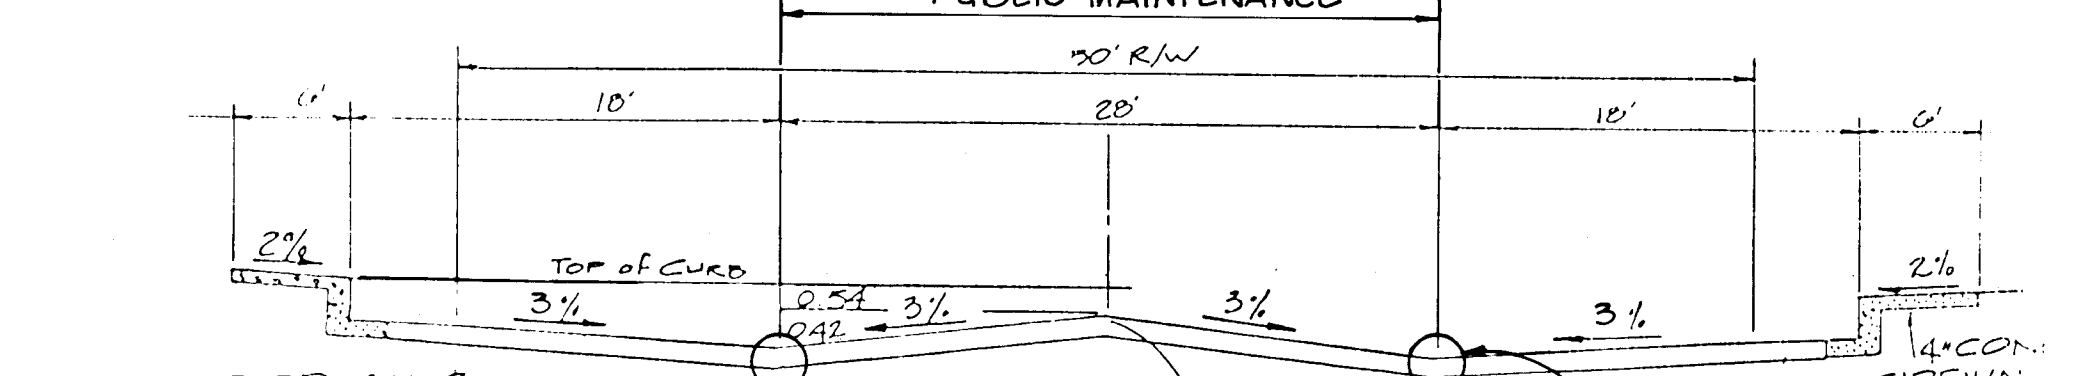

STANDARD COMB. CURB & GUTTER PER HOCO STD. R-3-01

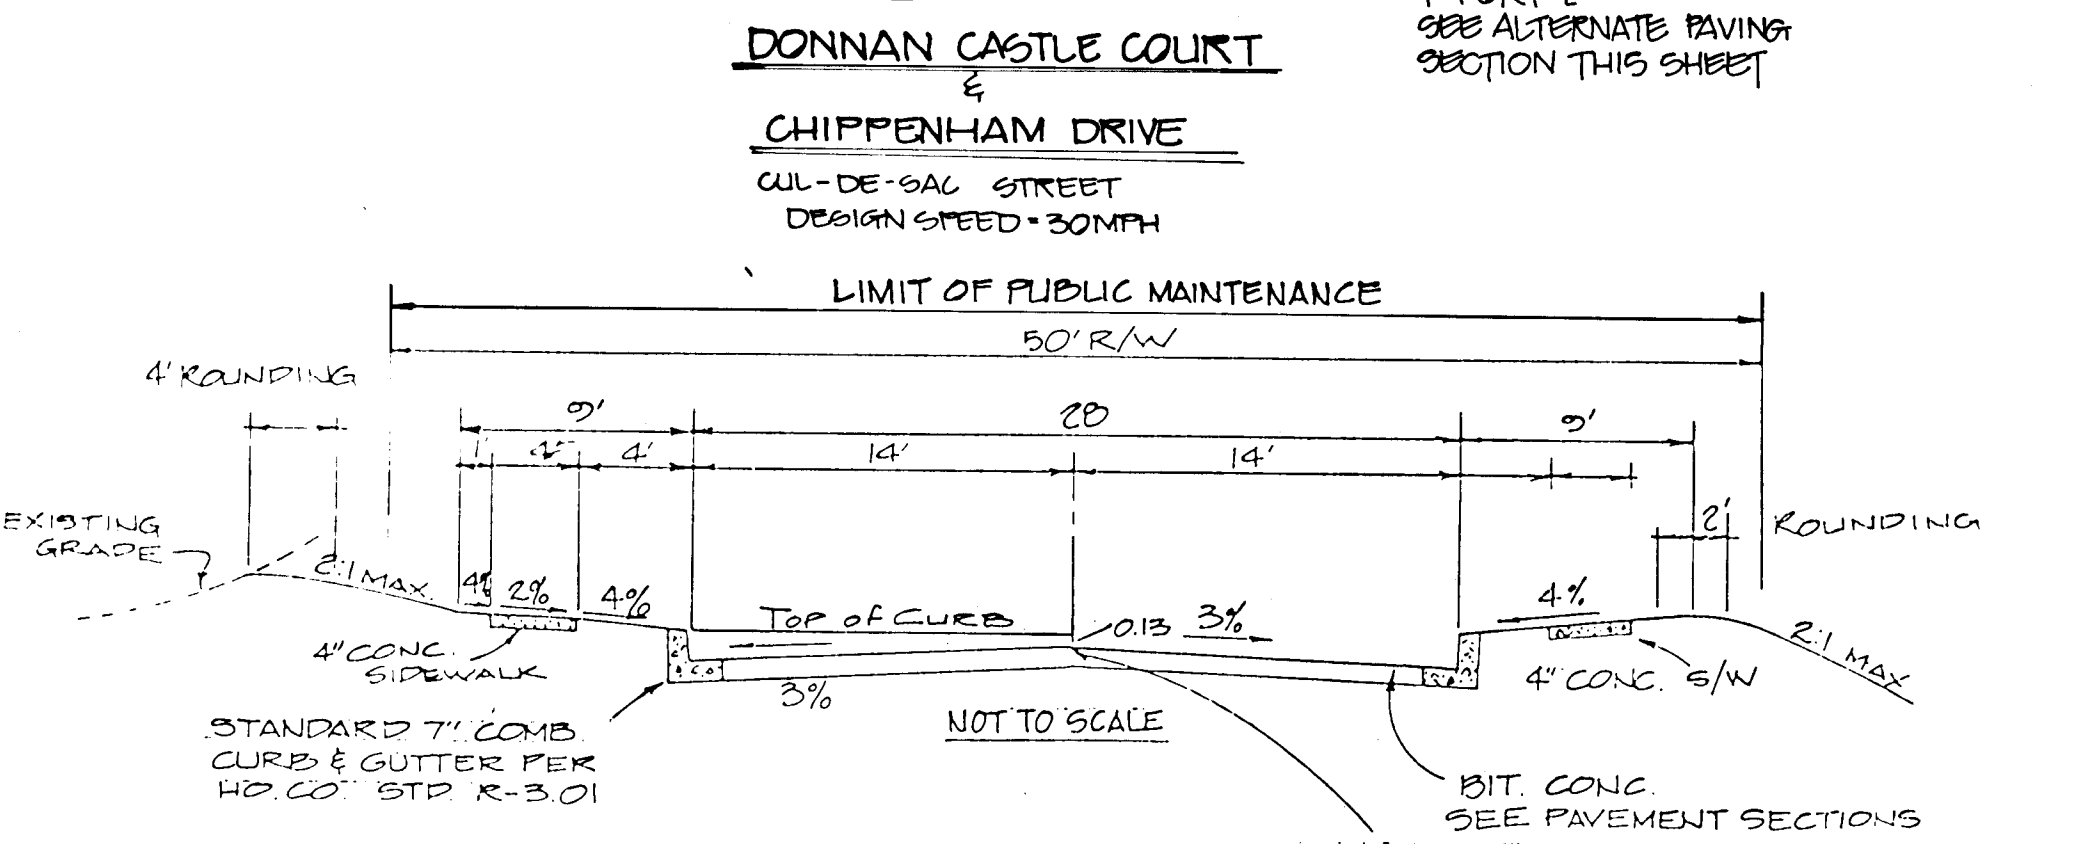

DONNAN CASTLE COURT & CHIPPENHAM DRIVE CUL-DE-SAC STREET DESIGN SPEED = 30MPH

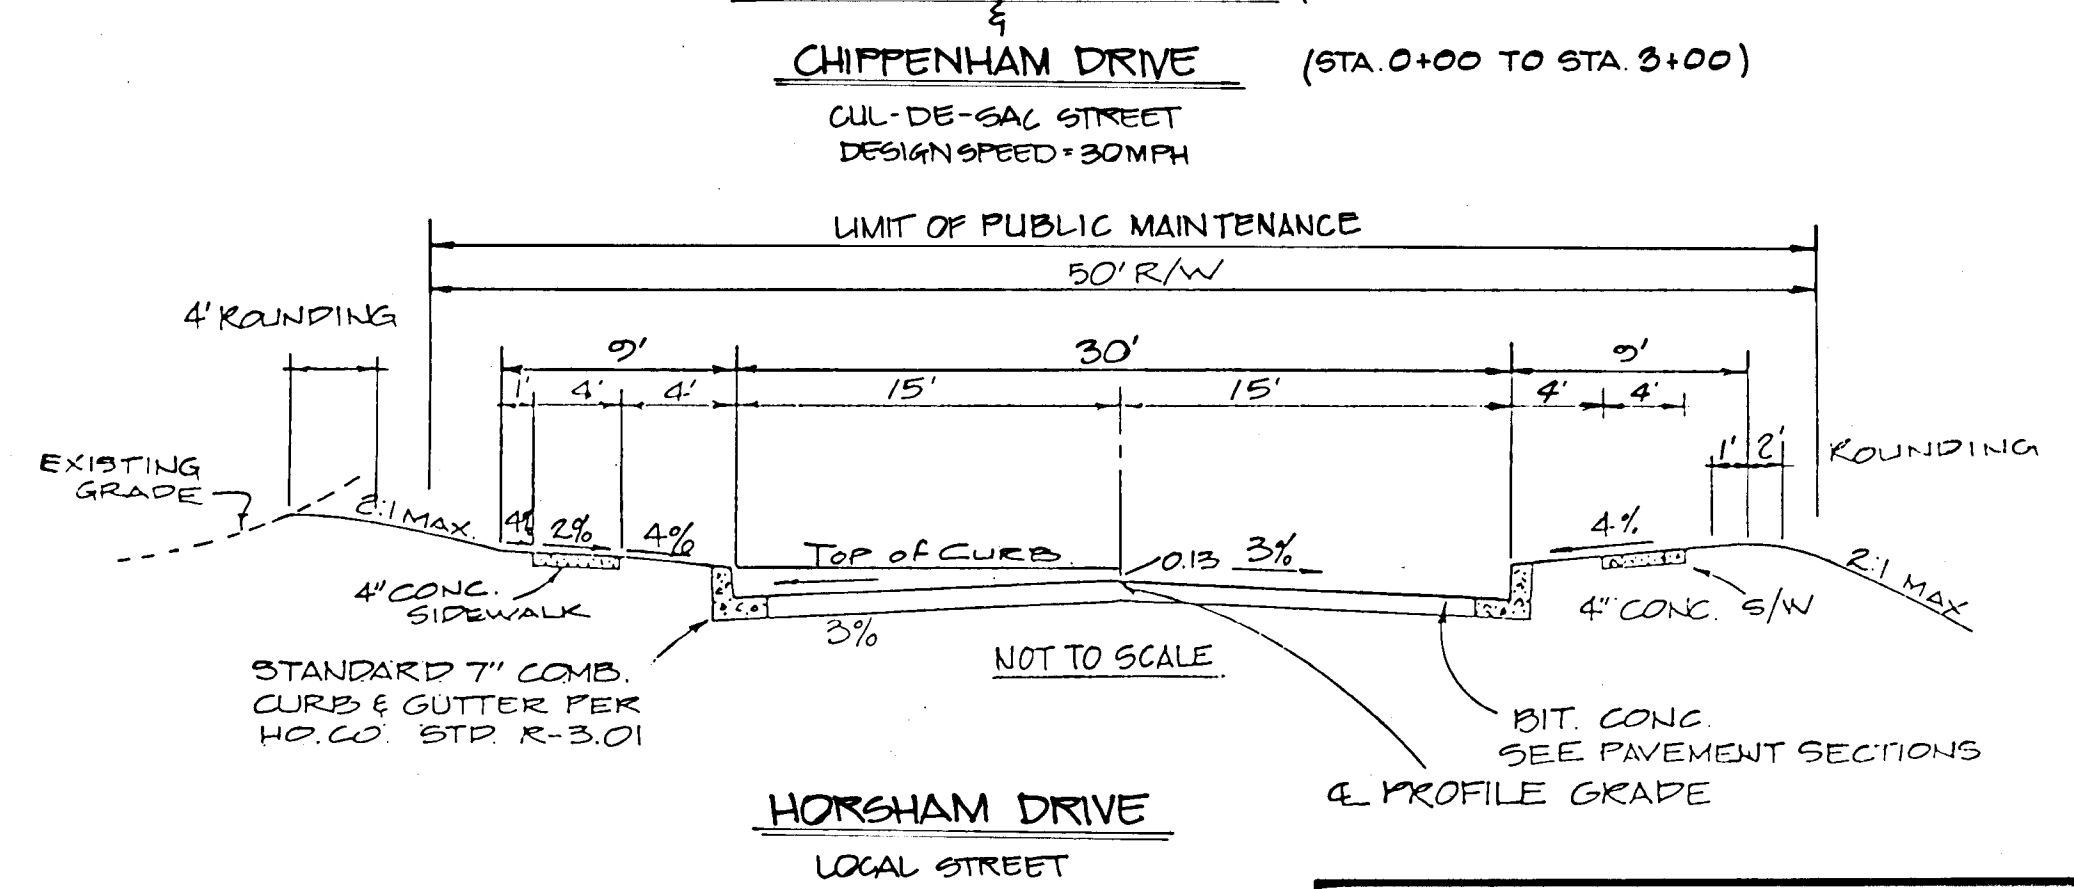

DONNAN CASTLE COURT (STA. 0+00 TO STA. 13+30.75) & CHIPPENHAM DRIVE (STA. 0+00 TO STA. 3+00) CUL-DE-SAC STREET DESIGN SPEED = 30MPH

APPROVED: HOWARD COUNTY, MARYLAND DEPARTMENT OF PUBLIC WORKS HORSHAM DRIVE LOCAL STREET DESIGN SPEED = 30MPH (STA. 5+37.45 TO STA. 13+56.47)

W. Edwin P. Smith 11-4
Chief, Bureau of Eng. Date

DETAIL SHEET (PAVING AND STORM DRAIN)

Patton Harris Rust and Associates
A Professional Corporation
Engineers, Surveyors, Planners and Landscape Architects
7609 Standish Place Rockville, Maryland 20855 (301)762-2220

BOWLING BROOK FARMS
PARCEL G, PARCEL H
SECTION 4 AREA 1
LOTS G-1 THRU G-102
A RESUBDIVISION OF LOT 216 BOWLING BROOK FARMS
SIXTH ELECTION DISTRICT
TAX MAP 47 PARCEL 141
L. 1594 P. 632

| SURVEY | DATE |
|---------------|----------|
| DESIGN | 3-3-88 |
| DRAWN | SHEET |
| CHECKED | G OF 10 |
| C.I. AS SHOWN | FILE NO. |
| | 2184-1-7 |

SEDIMENT CONTROL NOTES

- 1) A minimum of 24 hours notice must be given to the Howard County Office of Inspection and Permits prior to the start of any construction. (992-2437)
- 2) All vegetative and structural practices are to be installed according to the provisions of this plan and are to be in conformance with the 1983 MARYLAND STANDARDS AND SPECIFICATIONS FOR SOIL EROSION AND SEDIMENT CONTROL.
- 3) Following initial soil disturbance or redisturbance, permanent or temporary stabilization shall be completed within: a) 7 calendar days for all perimeter sediment control structures, dikes, perimeter slopes and all slopes greater than 3:1, b) 14 days as to all other disturbed or graded areas on the project site.
- 4) All sediment traps/basins shown must be fenced and warning signs posted around their perimeter in accordance with Vol. 1, Chapter 12, of the HOWARD COUNTY DESIGN MANUAL, Storm Drainage.
- 5) All disturbed areas must be stabilized within the time period specified above in accordance with the 1983 MARYLAND STANDARDS AND SPECIFICATIONS FOR SOIL EROSION AND SEDIMENT CONTROL for permanent seedings (Sec. 51) sod (Sec. 54), temporary seeding (Sec. 50) and mulching (Sec. 52.) Temporary stabilization with mulch alone can only be done when recommended seeding dates do not allow for proper germination and establishment of grasses.
- 6) All sediment control structures are to remain in place and are to be maintained in operative condition until permission for their removal has been obtained from the Howard County Sediment Control Inspector
- 7) Site Analysis:
 Total Area of Site 10.1 Acres
 Area Disturbed 11.4 Acres
 Area to be roofed or paved 60 Acres
 Area to be vegetatively stabilized 5.4 Acres
 Total Cut 30,005 Cu. yds
 Total Fill 38,406 Cu. yds
 Offsite waste/borrow area location _____
- 8) Any sediment control practice which is disturbed by grading activity for placement of utilities must be repaired on the same day of disturbance.
- 9) Additional sediment controls must be provided, if deemed necessary by the Howard County DPW sediment control inspector.
- 10) On all sites with disturbed areas in excess of 2 acres, approval of the inspection agency shall be requested upon completion of installation of perimeter erosion and sediment controls, but before proceeding with any other earth disturbance or grading. Other building or grading inspection approvals may not be authorized until this initial approval by the inspection agency is made.

PERMANENT SEEDING NOTES

Apply to graded or cleared areas not subject to immediate further disturbance where a permanent long-lived vegetative cover is needed.

- Seedbed Preparation:** Loosen upper three inches of soil by raking, discing or other acceptable means before seeding.
- Soil Amendments:** In lieu of soil test recommendations, use one of the following schedules:
- 1) Preferred -- Apply 2 tons per acre dolomitic limestone (92 lbs/1000 sq ft) and 600 lbs per acre 10-10-10 fertilizer (14 lbs/1000 sq ft) before seeding. Harrow or disc into upper three inches of soil. At time of seeding, apply 400 lbs per acre 30-0-0 ureaform fertilizer (9 lbs/1000 sq ft).
 - 2) Acceptable -- Apply 2 tons per acre dolomitic limestone (92 lbs/1000 sq ft) and 1000 lbs per acre 10-10-10 fertilizer (23 lbs/1000 sq ft) before seeding. Harrow or disc into upper three inches of soil.

Seeding - For the periods March 1 thru April 30, and August 1 thru October 15, seed with 60 lbs per acre (1.4 lbs/1000 sq ft) of Kentucky 31 Tall Fescue. For the period May 1 thru July 31, seed with 60 lbs Kentucky 31 Tall Fescue per acre and 2 lbs per acre (.05 lbs/1000 sq ft) of weeping lovegrass. During the period of October 16 thru February 28, protect site by: Option (1) 2 tons per acre of well anchored straw mulch and seed as soon as possible in the spring. Option (2) Use sod. Option (3) Seed with 60 lbs/acre Kentucky 31 Tall Fescue and mulch with 2 tons/acre well anchored straw.

Mulching - Apply 1 1/2 to 2 tons per acre (70 to 90 lbs/1000 sq ft) of unrotted small grain straw immediately after seeding. Anchor mulch immediately after application using mulch anchoring tool or 218 gallons per acre (5 gal/1000 sq ft) of emulsified asphalt on flat areas. On slopes 8 feet or higher, use 348 gallons per acre (8 gal/1000 sq ft) for anchoring.

Maintenance - Inspect all seeded areas and make needed repairs, replacements and reseedings.

TEMPORARY SEEDING NOTES

Apply to graded or cleared areas likely to be redisturbed where a short-term vegetative cover is needed.


Seedbed Preparation: Loosen upper three inches of soil by raking, discing or other acceptable means before seeding.

Soil Amendments: Apply 60 lbs per acre 10-10-10 fertilizer (14 lbs/1000 sq ft).

Seeding: For periods March 1 thru April 30 and from August 15 thru November 15, seed with 2 1/2 bushel per acre of annual rye (3.2 lbs/1000 sq ft). For the period May 1 thru August 14, seed with 3 lbs per acre of weeping lovegrass (.07 lbs/1000 sq ft). For the period November 16 thru February 28, protect site by applying 2 tons per acre of well anchored straw mulch and seed as soon as possible in the spring. Use sod.

Mulching: Apply 1 1/2 to 2 tons per acre (70 to 90 lbs/1000 sq ft) of unrotted small grain straw immediately after seeding. Anchor mulch immediately after application using mulch anchoring tool or 218 gal per acre (5 gal/1000 sq ft) of emulsified asphalt on flat areas. On slopes 8 ft or higher, use 348 gal per acre (8 gal/1000 sq ft) for anchoring.

Refer to the 1983 MARYLAND STANDARDS AND SPECIFICATIONS FOR SOIL EROSION AND SEDIMENT CONTROL for rate and methods not covered.

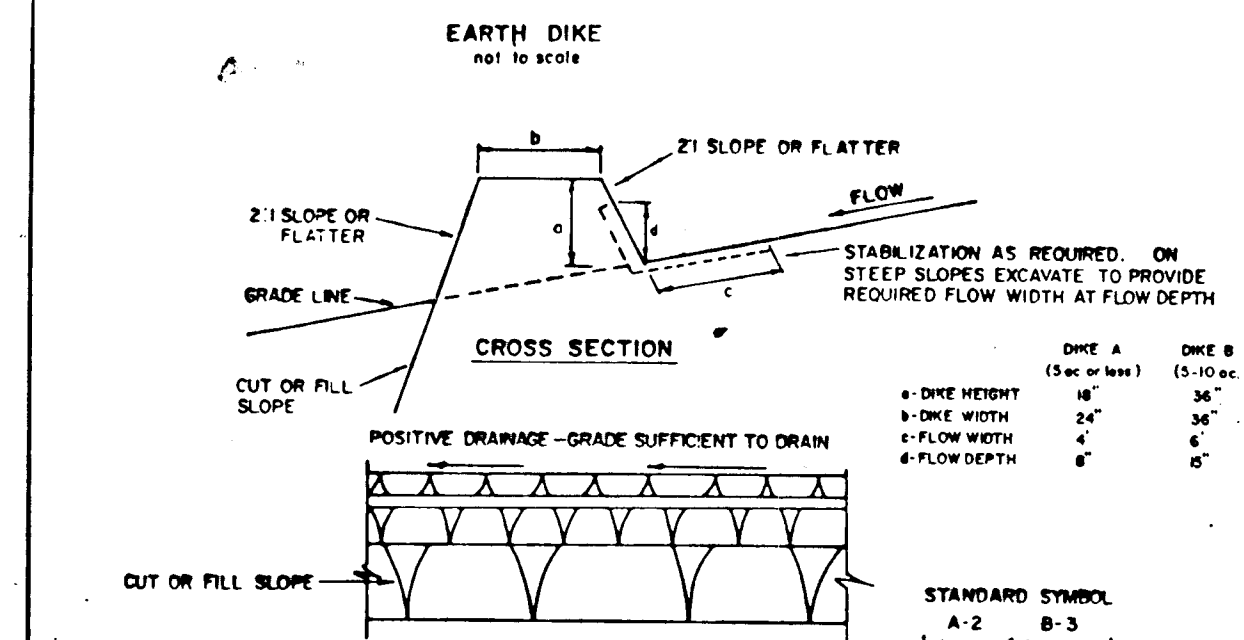

CONSTRUCTION SPECIFICATIONS


1. ALL DIKES SHALL BE COMPACTED BY EARTH-MOVING EQUIPMENT.
2. ALL DIKES SHALL HAVE POSITIVE DRAINAGE TO AN OUTLET.
3. TOP WIDTH MAY BE WIDER AND SIDE SLOPES MAY BE FLATTER IF DESIRED TO FACILITATE CROSSING BY CONSTRUCTION TRAFFIC.
4. FIELD LOCATION SHOULD BE ADJUSTED AS NEEDED TO UTILIZE A STABILIZED SAFE OUTLET.
5. EARTH DIKES SHALL HAVE AN OUTLET THAT FUNCTIONS WITH A MINIMUM OF EROSION. RIFFLE SHALL BE CONVEYED TO A SEDIMENT TRAPPING DEVICE SUCH AS A SEDIMENT TRAP OR SEDIMENT BASIN WHERE EITHER THE DIKE CHANNEL OR THE DRAINAGE AREA ABOVE THE DIKE ARE NOT IMMEDIATELY STABILIZED.
6. STABILIZATION SHALL BE: (A) IN ACCORDANCE WITH STANDARD SPECIFICATIONS FOR SEED AND STRAW MULCH OR STRAW MULCH IF NOT IN SEEDING SEASON, (B) FLOW CHANNEL AS PER THE CHART BELOW.

| TYPE OF TREATMENT | CHANNEL GRADE | FLOW CHANNEL STABILIZATION | |
|-------------------|---------------|----------------------------|--|
| | | DIKE A | DIKE B |
| 1 | 5-3.0% | SEED AND STRAW MULCH | SEED AND STRAW MULCH |
| 2 | 3.1-5.0% | SEED AND STRAW MULCH | SEED USING JUTE, OR EXCELSTON, OR SOD, 2\"/> |

U.S. DEPARTMENT OF AGRICULTURE
SOIL CONSERVATION SERVICE
COLLEGE PARK, MARYLAND

EARTH DIKE

STANDARD DRAWING
ED-1

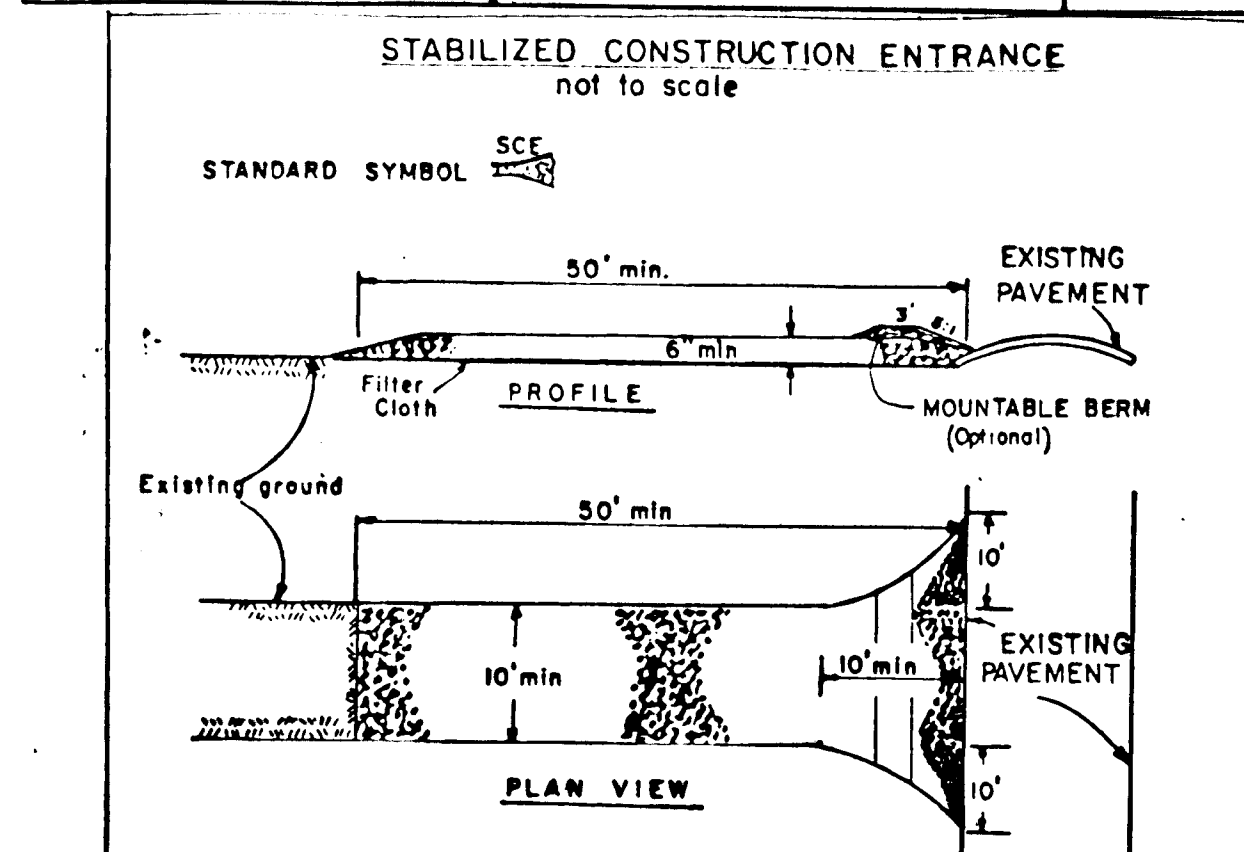

CONSTRUCTION SPECIFICATIONS

1. Stone Size - Use 2" stone, or reclaimed or recycled concrete equivalent.
2. Length - As required, but not less than 50 feet (except on a single residence lot where a 30 foot minimum length would apply).
3. Thickness - not less than six (6) inches.
4. Width - Ten (10) foot minimum, but not less than the full width at points where ingress or egress occurs.
5. Filter Cloth - Will be placed over the entire area prior to placing of stone. Filter will not be required on a single family residence lot.
6. Surface Water - All surface water flowing or diverted toward construction entrances shall be piped across the entrance. If piping is impractical, a mountable berm with 5:1 slopes will be permitted.
7. Maintenance - The entrance shall be maintained in a condition which will prevent tracking or flowing of sediment onto public rights-of-way. This may require periodic top dressing with additional stone as conditions demand and repair and/or cleanout of any measures used to trap sediment. All sediment applied, dropped, washed or tracked onto public rights-of-way must be removed immediately.
8. Washing - Wheels shall be cleaned to remove sediment prior to entrance onto public rights-of-way. When washing is required, it shall be done on an area stabilized with stone and which drains into an approved sediment trapping device.
9. Periodic inspection and needed maintenance shall be provided after each rain.

| U. S. DEPARTMENT OF AGRICULTURE SOIL CONSERVATION SERVICE College Park, Md. | STABILIZED CONSTRUCTION ENTRANCE | Standard Drawing SCE-1 |
|---|----------------------------------|---------------------------|
|---|----------------------------------|---------------------------|

DEVELOPER'S/BUILDER'S CERTIFICATE

I/We certify that all development and construction will be done according to this plan of development and plan for erosion and sediment control and that all responsible personnel involved in the construction project will have a Certificate of Attendance at a Department of Natural Resources Approved Training Program for the Control of Sediment and Erosion before beginning the project. I also authorize periodic onsite inspection by the Howard Soil Conservation District or their authorized agents, as are deemed necessary.

Kim T. van Poin
Signature of Developer/Builder

7/21/88
Date

ENGINEER'S CERTIFICATE

I hereby certify that this plan for Erosion and Sediment Control represents a practical and workable plan based on my personal knowledge of the site conditions and that it was prepared in accordance with the requirements of the Howard Soil Conservation District.


John J. ...
Signature of Engineer

7/21/88
Date

STATE OF MARYLAND
PROFESSIONAL ENGINEER

SEQUENCE OF CONSTRUCTION

1. OBTAIN REVISED GRADING PERMIT
2. MAINTAIN EXISTING SEDIMENT CONTROL MEASURES IN PLACE FROM ROUGH GRADING OPERATIONS, GP-88-65. (NOTE: REMOVAL OF INTERIOR EARTH DIKE SHALL BE DONE UNDER THE DIRECTION OF THE SEDIMENT CONTROL INSPECTOR)
3. CONSTRUCT SANITARY SEWER, WATER MAINS AND STORM DRAINS AS INDICATED ON PLANS. CONSTRUCT TEMPORARY DIVERSIONS AS SHOWN ON PLAN.
4. CONSTRUCT REMAINING UNDERGROUND UTILITIES, PAVE STREETS AND PARKING AREAS
5. APPLY TEMPORARY AND/OR PERMANENT VEGETATIVE STABILIZATION TO DISTURBED AREAS NOT SUBJECT TO IMMEDIATE CONSTRUCTION AS REQUIRED BY THE SEEDING NOTES ON THIS SHEET
6. AS THEIR CONTRIBUTING DRAINAGE AREAS ARE BROUGHT TO FINAL GRADE AND STABILIZED, REMOVE SEDIMENT CONTROL MEASURES AT THE DIRECTION OF THE SEDIMENT CONTROL INSPECTOR

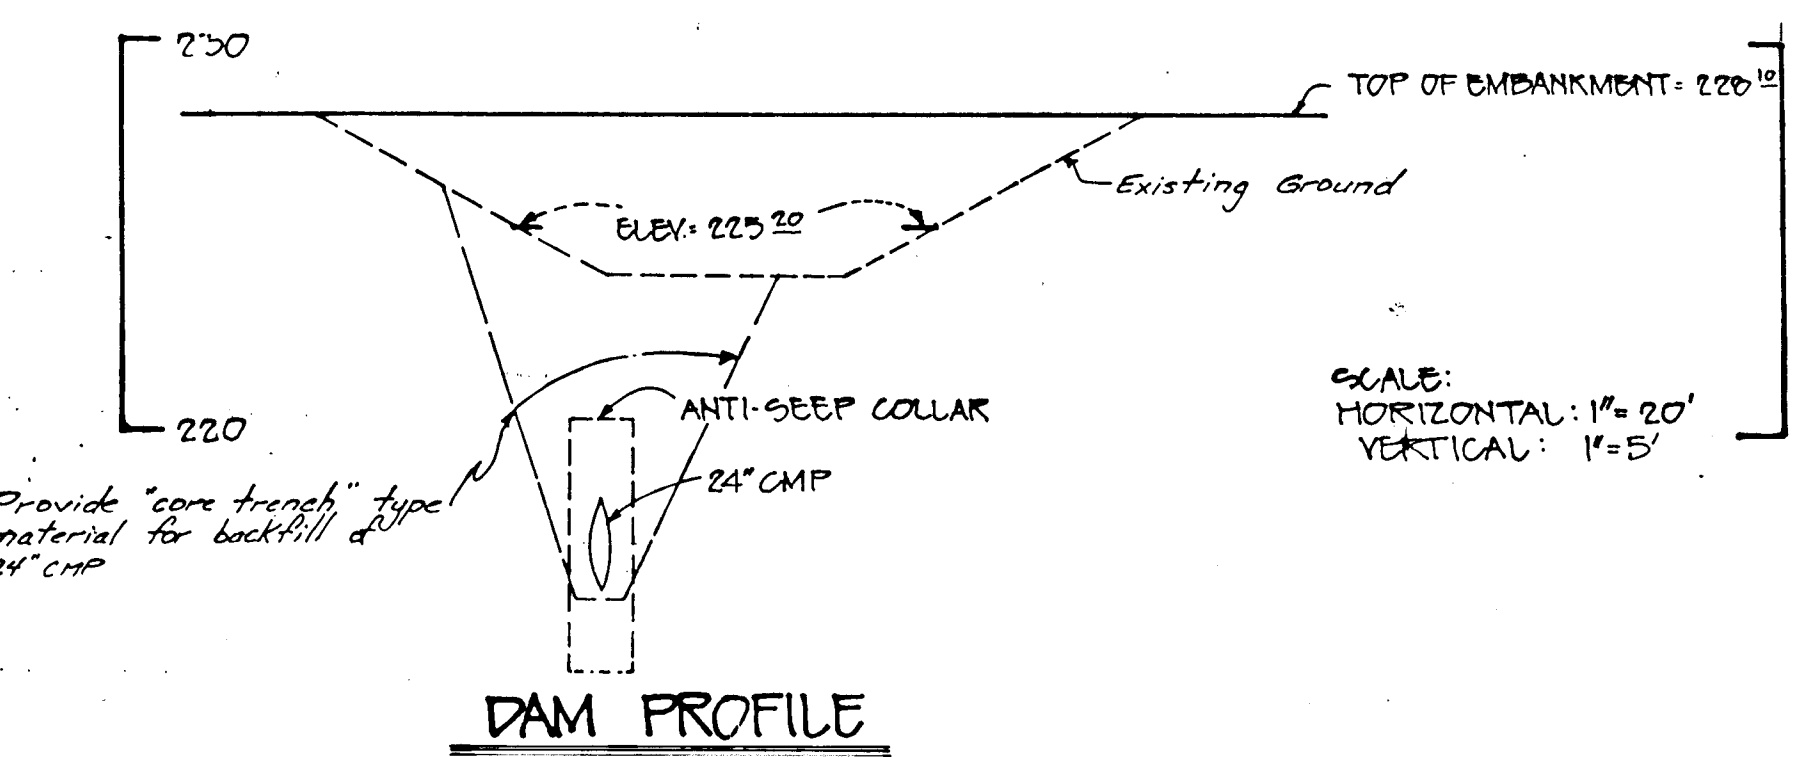

SCALE:
HORIZONTAL: 1"=20'
VERTICAL: 1"=5'

Provide "core trench" type material for backfill at 24" CMP

THESE PLANS HAVE BEEN REVIEWED FOR THE HOWARD SOIL CONSERVATION DISTRICT AND MEET TECHNICAL REQUIREMENTS.

John J. ...
U.S. Soil Conservation Service

7/21/88
Date

THIS PLAN IS APPROVED FOR SOIL EROSION AND SEDIMENT CONTROL BY THE HOWARD SOIL CONSERVATION DISTRICT.


Stephen J. ...
Howard S.C.D.

7/21/88
Date


PLAN NUMBER _____

OWNER/DEVELOPER
GORMAN ROAD LIMITED PARTNERSHIP
C/O JAMES F. KNOTT DEVELOPMENT CORPORATION
110 WEST ROAD, SUITE 203
TOWSON, MARYLAND 21284

THIS PLAN FOR STREET AND UTILITY CONSTRUCTION ONLY.

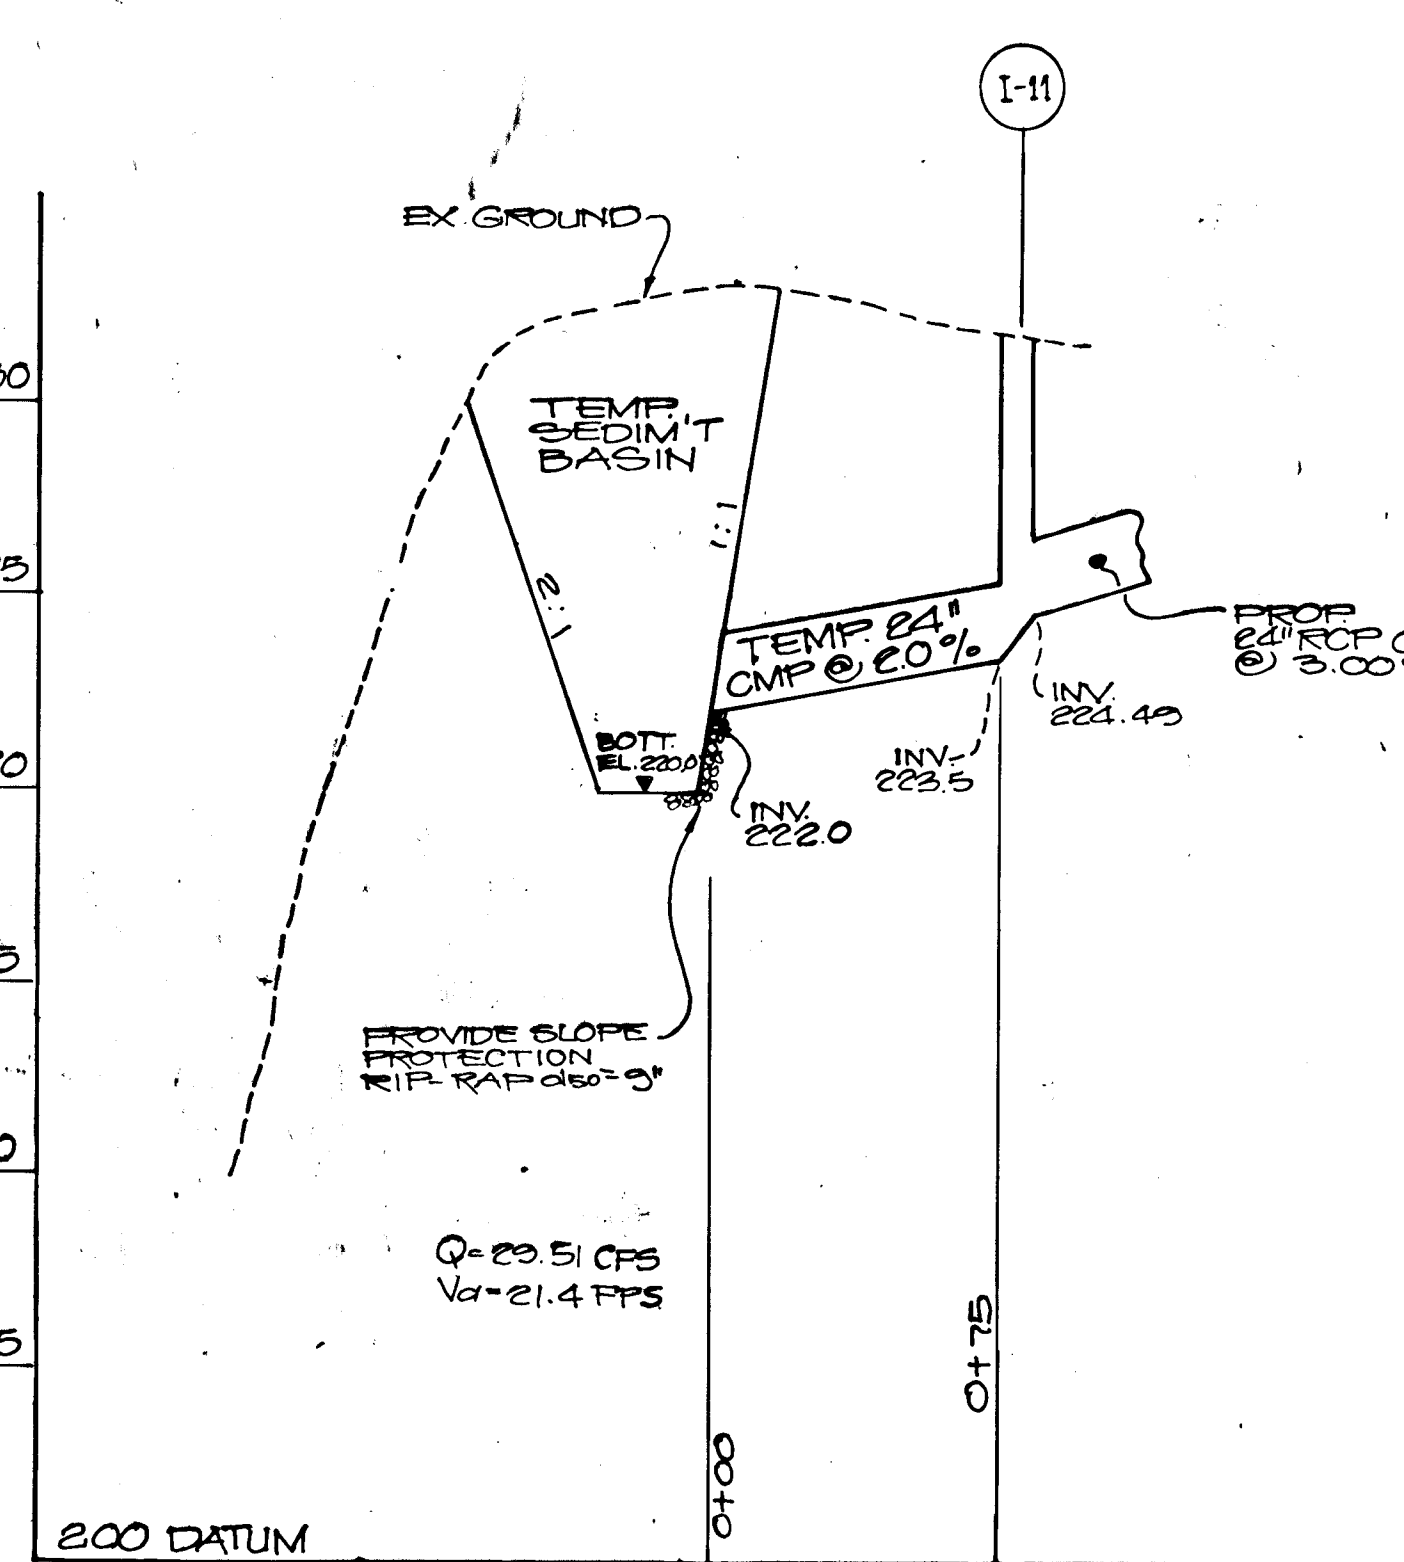

TEMP 24" CMP PROFILE FOR EROSION and SEDIMENT CONTROL
HORIZ. 1"=50'
SCALE: VERT. 1"=5'

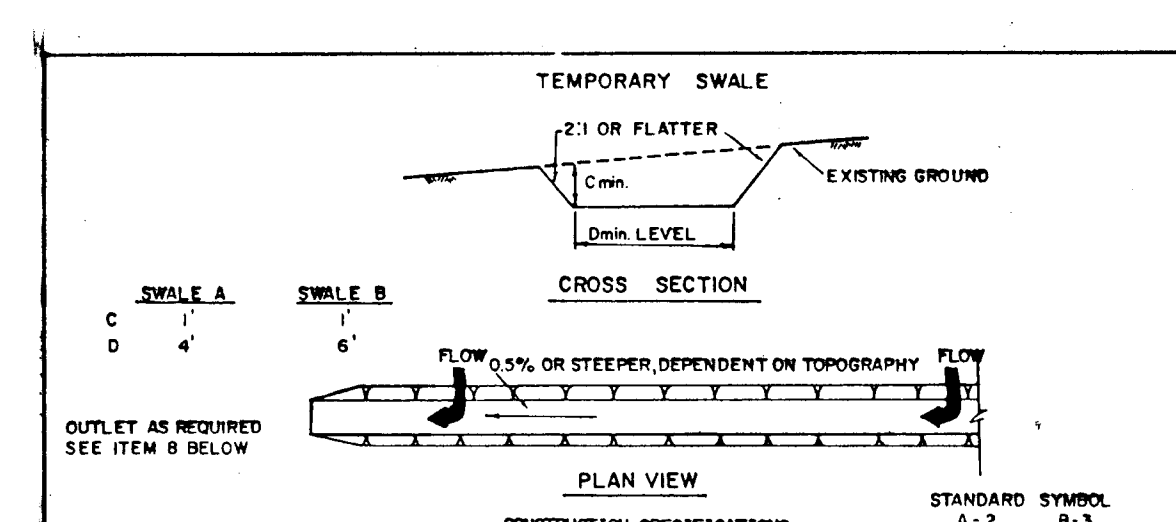

1. ALL TEMPORARY SWALES SHALL HAVE UNINTERRUPTED POSITIVE GRADE TO AN OUTLET.
2. DIVERTED RUNOFF FROM A DISTURBED AREA SHALL BE CONVEYED TO A SEDIMENT TRAPPING DEVICE.
3. DIVERTED RUNOFF FROM AN UNDISTURBED AREA SHALL OUTLET DIRECTLY INTO AN UNDISTURBED STABILIZED AREA AT NON-EROSIVE VELOCITY.
4. ALL TREES, BRUSH, STUMPS, OBSTRUCTIONS, AND OTHER OBJECTIONABLE MATERIAL SHALL BE REMOVED AND DISPOSED OF SO AS NOT TO INTERFERE WITH THE PROPER FUNCTIONING OF THE SWALE.
5. THE SWALE SHALL BE EXCAVATED OR SHAPED TO LINE, GRADE, AND CROSS SECTION AS REQUIRED TO MEET THE CRITERIA SPECIFIED HEREIN AND BE FREE OF BANK PROJECTIONS OR OTHER IRREGULARITIES WHICH WILL IMPED NORMAL FLOW.
6. FILLS SHALL BE COMPACTED BY EARTH MOVING EQUIPMENT.
7. ALL EARTH REMOVED AND NOT NEEDED ON CONSTRUCTION SHALL BE PLACED SO THAT IT WILL NOT INTERFERE WITH THE FUNCTIONING OF THE SWALE.
8. STABILIZATION SHALL BE AS PER THE CHART BELOW:

| TYPE OF TREATMENT | CHANNEL GRADE | FLOW CHANNEL STABILIZATION | |
|-------------------|---------------|----------------------------------|------------------------------|
| | | A (5 AC OR LESS) | B (5 AC - 10 AC) |
| 1 | 0.5-3.0% | SEED AND STRAW MULCH | SEED AND STRAW MULCH |
| 2 | 3.1-5.0% | SEED AND STRAW MULCH | SEED USING JUTE OR EXCELSTON |
| 3 | 5.1-8.0% | SEED WITH JUTE OR EXCELSTON, SOD | LINED RIP-RAP 4-8\"/> |

U.S. DEPARTMENT OF AGRICULTURE
SOIL CONSERVATION SERVICE
COLLEGE PARK, MARYLAND

TEMPORARY SWALE

STANDARD DRAWING
TS-1

APPROVED: HOWARD COUNTY OFFICE OF PLANNING AND ZONING

Janice S. ...
Chief, Division of Community Planning & Land Development

7/21/88
Date

APPROVED: HOWARD COUNTY DEPARTMENT OF PUBLIC WORKS

Charles ...
Chief, Land Development Division

8/1/88
Date

Charles ...
Chief, Bureau of Highways

7/29/88
Date

William ...
Chief, Bureau of Engineering

7-2-88
Date

| NO. | DESCRIPTION | DATE | APPROVED | DATE |
|-----|------------------------------|------|----------|---------|
| 4 | REVISIONS PER HCCO COMMENTS | | | 7/21/88 |
| 3 | REVISIONS FROM CITY COMMENTS | | | 8/2/88 |
| 2 | REVISIONS FROM HCCO COMMENTS | | | 7/21/88 |
| 1 | ISSUED TO HCCO | | | 8/2/88 |

REVISION APPROVED BY _____

PROFESSIONAL SEAL

DETAIL SHEET (EROSION AND SEDIMENT CONTROL)

Patton Harris Rust and Associates
A Professional Corporation
Engineers, Surveyors, Planners and Landscape Architects
7609 Standish Place Rockville, Maryland 20855 (301)762-2220

| BOWLING BROOK FARMS | | SURVEY FHR&A | DATE |
|---|--|----------------|-----------------|
| PARCEL G, PARCEL H SECTION 4 AREA 1 LOTS G-I THRU G-102 | | DESIGN EIC | 8-3-88 |
| A RESUBDIVISION OF LOT 216 BOWLING BROOK FARMS SIXTH ELECTION DISTRICT TAX MAP 47 L.1394 PARCEL 141 F.632 | | DRAWN EIC | SHEET |
| | | CHECKED | 7 OF 10 |
| | | SCALE AS SHOWN | FILE NO. 2184-7 |
| | | C.I. - | |

PARCELS G & H

CONSTRUCTION SPECIFICATIONS

Site Preparation

Areas under the embankment shall be cleared, grubbed, and stripped of topsoil to remove trees, vegetation, roots or other objectionable material. In order to facilitate clean-out and restoration, the pool area (measured at the top of the pipe spillway) will be cleared of all brush, trees, and other objectionable materials.

Cut-off Trench

A cut-off trench shall be excavated along the centerline of earth fill embankments. The minimum depth shall be two feet. The cut-off trench shall extend up both abutments to the rise crest elevation. The minimum excavation width shall be four feet, but wide enough to permit operation of excavation and compaction equipment. The side slopes shall be no steeper than 1:1. Compaction requirements shall be the same as those for embankment. The trench shall be dewatered during the backfilling-compaction operations.

Embankment

The fill material shall be taken from approved areas shown on the plans. It shall be clean mineral soil free of roots, woody vegetation, oversized stones, rocks, or other objectionable material. Relatively pervious materials such as sand or gravel (Unified Soil Classes GW, GP, SW & SP) shall not be placed in the embankment. Areas on which fill is to be placed shall be scarified prior to placement of fill. The fill material shall contain sufficient moisture so that it can be formed by hand into a ball without crumbling. If water can be squeezed out of the ball, it is too wet for proper compaction. Fill material shall be placed six-inch to eight-inch thick continuous layers over the entire length of the fill. Compaction shall be obtained by routing and hauling the construction equipment over the fill so that the entire surface of each layer of the fill is traversed by at least one wheel or tread track of the equipment or by the use of a compactor. The embankment shall be constructed to an elevation 10 percent higher than the design height to allow for settlement.

Pipe Spillways

The riser shall be securely attached to the barrel or barrel stub by welding the full circumference making a watertight structural connection. The barrel stub must be attached to the riser at the same percent (angle) of grade as the outlet conduit. The connection between the riser and the riser base shall be watertight. All connections between barrel sections must be achieved by routing and hauling the construction equipment over the fill so that the entire surface of each layer of the fill is traversed by at least one wheel or tread track of the equipment or by the use of a compactor. The fill material around the pipe spillway shall be placed in four inch layers and compacted under and around the pipe to at least the same density as the adjacent embankment.

A minimum depth of two feet of hand compacted backfill shall be placed over the pipe spillway before crossing it with construction equipment. Steel base plates on risers shall have at least 2-1/2 feet of compacted earth, stone or gravel placed over it to prevent flotation.

Emergency Spillway

The emergency spillway shall be installed in undisturbed ground. The achievement of planned elevations, grades, design width, entrance and exit channel slopes are critical to the successful operation of the emergency spillway and must be constructed within a tolerance of ± 0.2 feet.

Vegetative Treatment

Stabilize the embankment and emergency spillway in accordance with the appropriate vegetative Standard Specifications immediately following construction. In no case shall the embankment remain unstabilized for more than seven(7) days.

Erosion and Pollution Control

Construction operations shall be carried out in such a manner that erosion and water pollution will be minimized. State and local laws shall be complied with concerning pollution abatement.

Safety



State and local requirements shall be met concerning fencing and signs, warning the public of hazards of soft sediment and floodwater.

Maintenance

1. Repair all damages caused by soil erosion and construction equipment at or before the end of each working day.
2. Sediment shall be removed from the basin when it reaches the specified distance below the top of the riser. This sediment shall be placed in such a manner that it will not erode from the site. The sediment shall not be deposited downstream from the embankment, adjacent to a stream or flood plain.

Final Disposal

When temporary structures have served their intended purpose and the contributing drainage area has been properly stabilized, the embankment and resulting sediment deposits are to be leveled or otherwise disposed of in accordance with the approved sediment control plan. The proposed use of a sediment basin site will often dictate final disposition of the basin and any sediment contained therein. If the site is scheduled for future construction, then the basin material and trapped sediments must be removed, safely disposed of, and backfilled with a structural fill. When the basin area is to remain open space the pond may be pumped dry, graded and back filled.

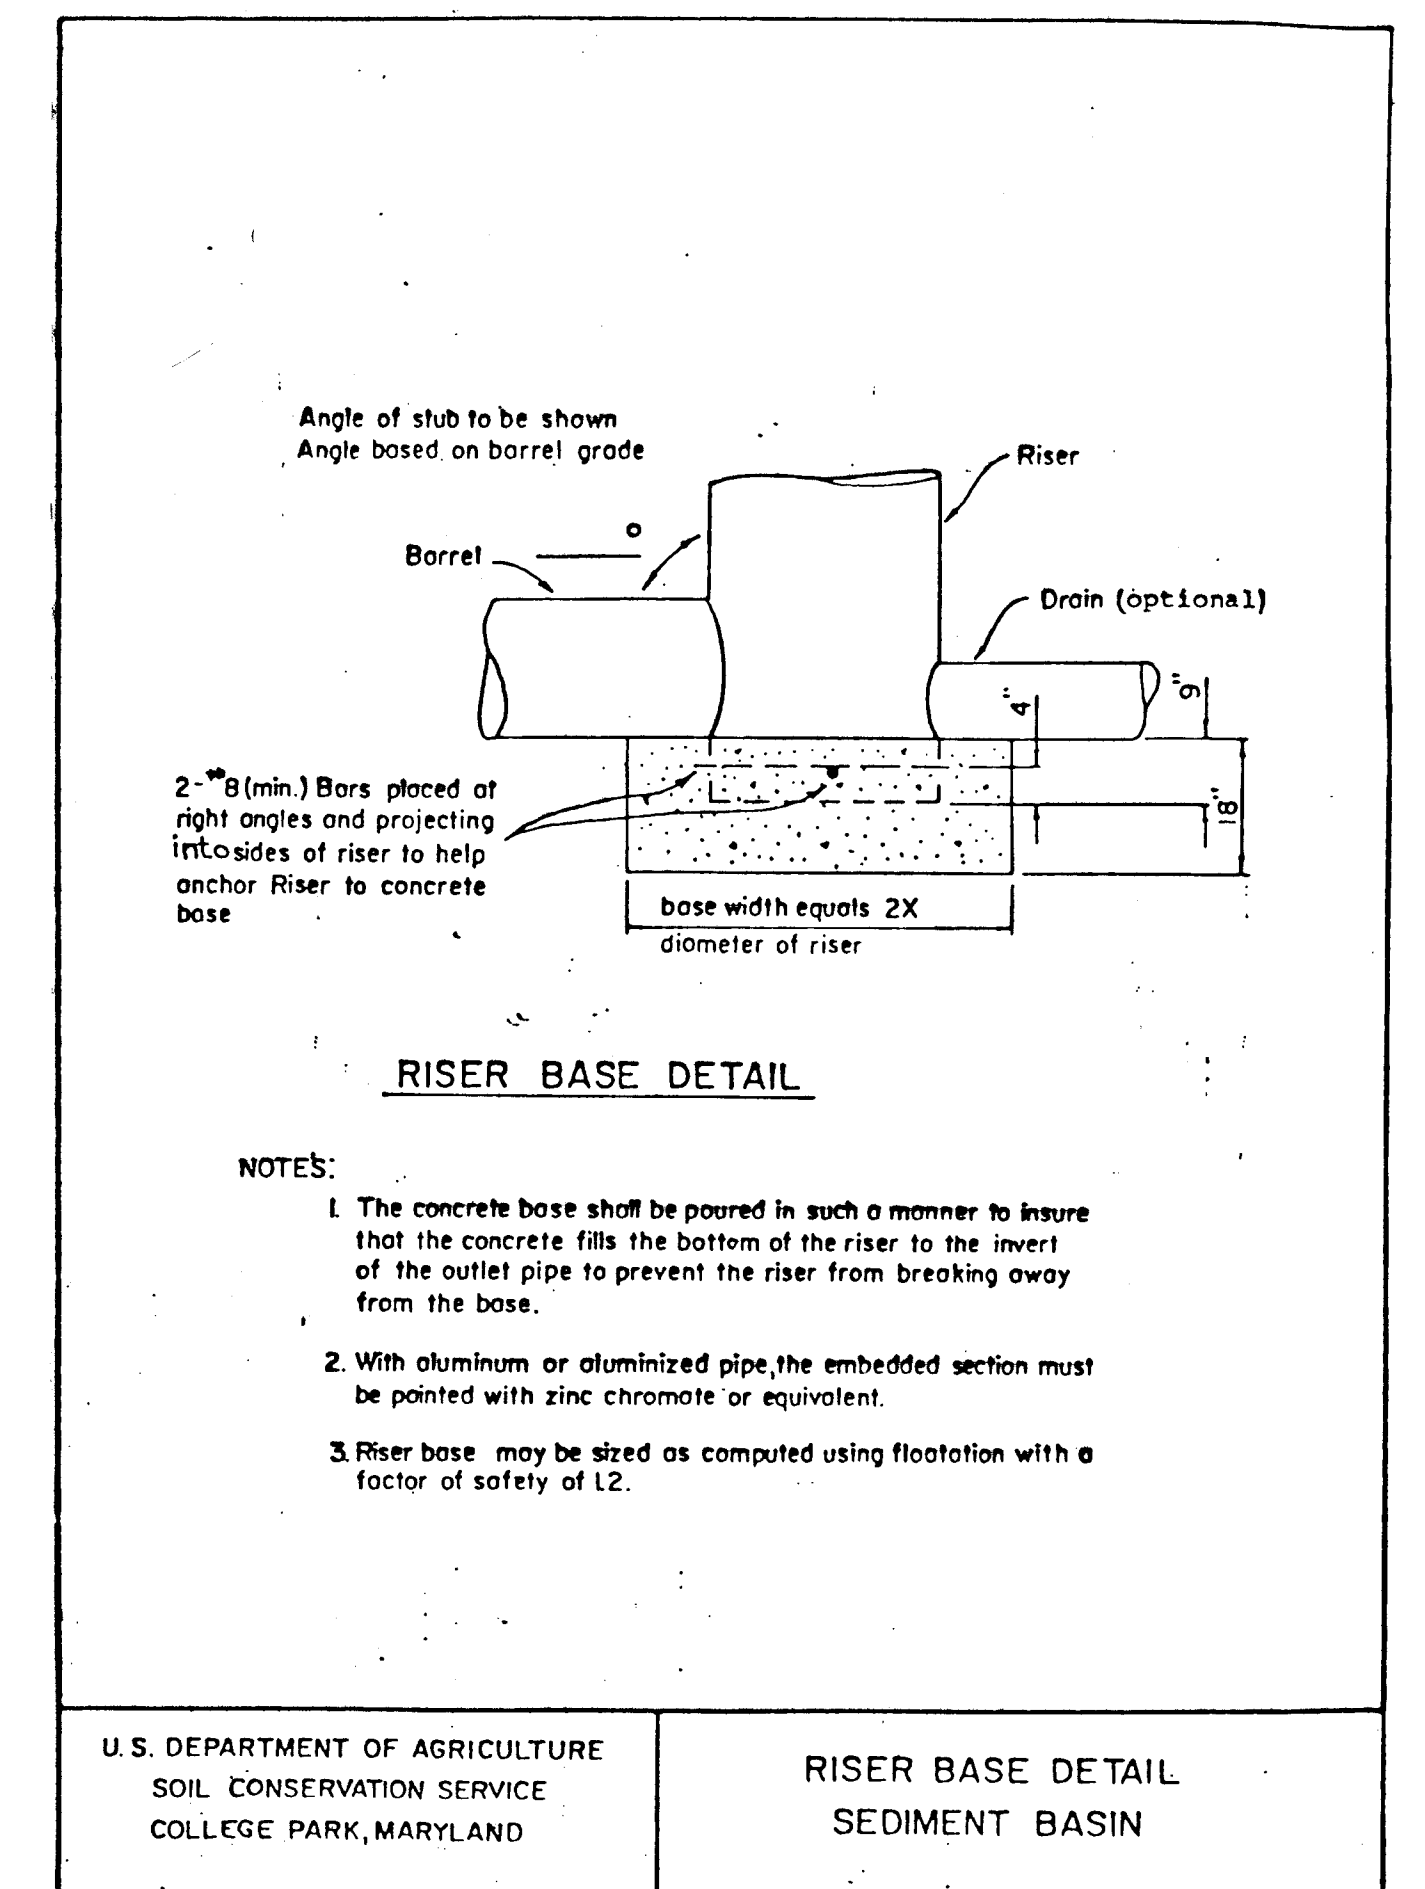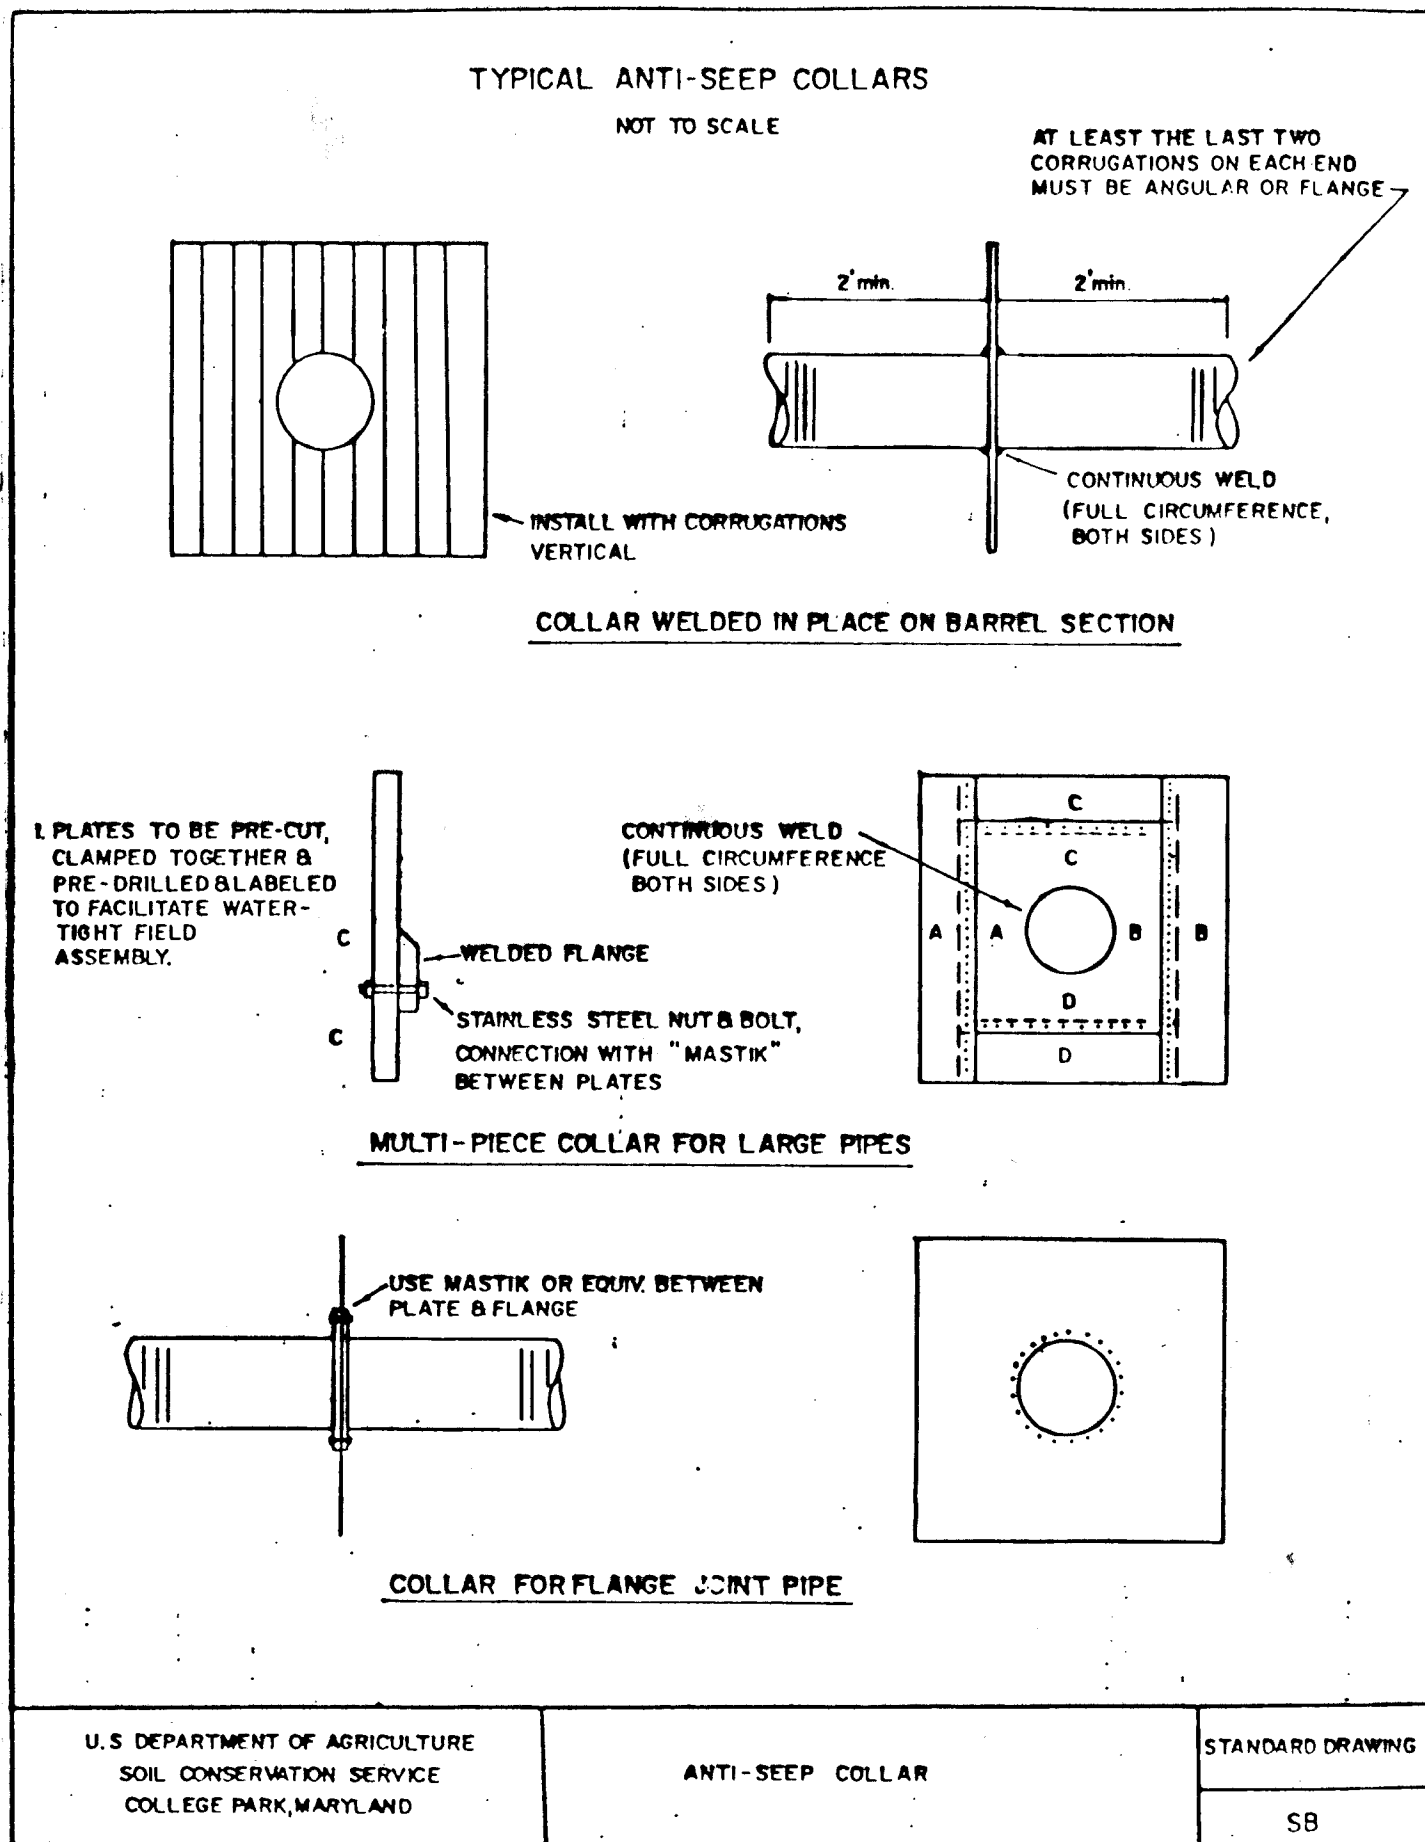

TEMPORARY SEDIMENT BASIN DESIGN DATA SHEET

Computed by KEE Date 6/6/88
Checked by KEE Date 6/6/88

Project Bowling Brook Farms
Basin Location Parcel G, south of Hemlock Branch
Total Area draining to basin, 2.0 acres.

BASIN VOLUME DESIGN

1. Min. required vol. = 67 cu. yds. x 0.0 ac. drainage = 536 cu. yds.
2. Vol. of basin = 536 cu. yds.
3. Excavate 602 cu. yds. to obtain required capacity.
- Min. vol. before cleanout = 27 cu. yds. x 0.0 ac. drainage = 216 cu. yds.
- Elevation corresponding to scheduled time to clean out 222.00
- Distance below top of riser: 2.0

DESIGN OF SPILLWAYS

4. $Q_p = 435$ cfs (EFM, Ch. 2 or other appropriate method, attach runoff computation sheet).

Pipe Spillway (Q_{ps})

5. Min. pipe spillway capacity, $Q_{ps} = 0.2 \times \text{ac. drainage} = \text{---}$ cfs.
- Note: If there is no emergency spillway, then req'd. $Q_{ps} = Q_p = 435$ cfs.
- $H = 25$ ft. Barrel length = 100 ft.
- Barrel: Diam. 24 inches; $Q_{ps} = (0.552 \times \text{cor. fac.}) \times 435$ cfs.
- Riser: Diam. 22 inches; Length 2 ft.; $h = 12$ ft.
- Trash Rack: Diam. 20 inches; $H = 20$ inches.

Emergency Spillway Design

10. Emergency Spillway Flow: $Q_{es} = Q_p = 435$ cfs.
11. Width: 100 ft. $H_e = 2$ ft. $Q_{es} = \text{---}$ cfs.
- Entrance channel slope: ---
- Exit channel slope: ---

ANTI-SEEP COLLAR DESIGN (if Required)


12. $y = 2$ ft.; $z = 2$ ft.; pipe slope = 20%; $L_p = 60$ ft.
- Use 2 collars, 6 square; projection = 2.25 ft.

DESIGN ELEVATIONS

13. Riser Crest = 224.0 Design High Water = 225.2
Dam Spvy. Crest = N/A Top of Dam = 226.0

RUNOFF COMPUTATION

$Q = CIA$
 $C = 0.85$
 $I = 64$ in/hr. (BASE ON $t_c = 11$ MIN. FROM SHA G11-402.1 FOR OVERLAND FLOW: $L = 800$ & $N = 0.10$)
 $A = 8.0$ AC.
 $Q = 0.85 \times 64 \times 80 = 435$ cfs.

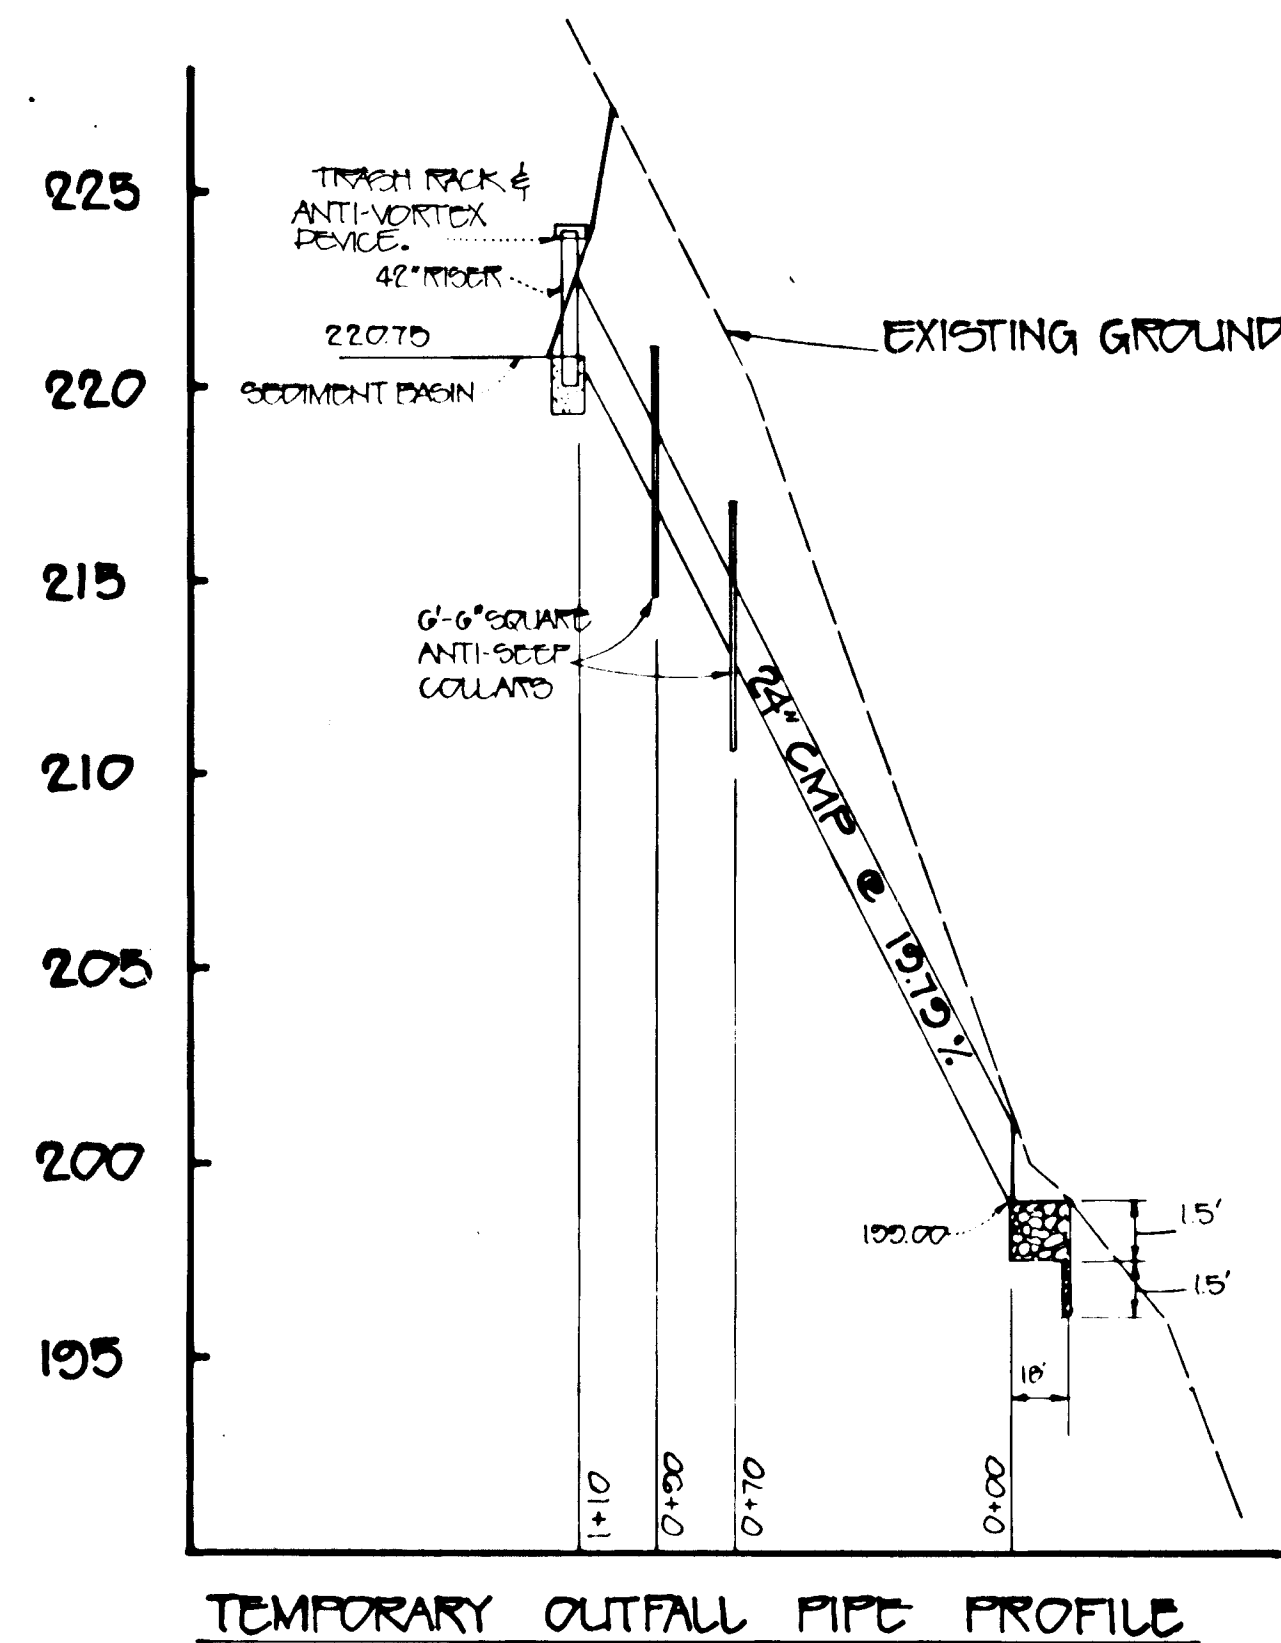

DEVELOPER'S/BUILDER'S CERTIFICATE


I/We certify that all development and construction will be done according to this plan of development and plan for erosion and sediment control and that all responsible personnel involved in the construction project will have a Certificate of Attendance at a Department of Natural Resources Approved Training Program for the Control of Sediment and Erosion before beginning the project. I also authorize periodic onsite inspection by the Howard Soil Conservation District or their authorized agents, as are deemed necessary.

Lin J. von Paris 7/2/88
Signature of Developer/Builder Date

ENGINEER'S CERTIFICATE

I hereby certify that this plan for Erosion and Sediment Control represents a practical and workable plan based on my personal knowledge of the site conditions and that it was prepared in accordance with the requirements of the Howard Soil Conservation District.

Phyllis J. ... 7/2/88
Signature of Engineer Date

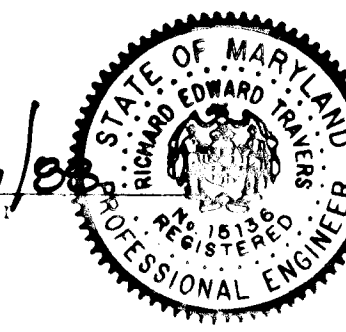

APPROVED: HOWARD COUNTY DEPARTMENT OF PUBLIC WORKS

Charles J. ... 8/2/88
Chief, Land Development Division Date

Charles W. ... 7/29/88
Chief, Bureau of Highways Date

Debra ... 8-2-88
Chief, Bureau of Engineering Date

APPROVED: HOWARD COUNTY OFFICE OF PLANNING AND ZONING

Janice S. ... 8-5-88
Chief, Division of Community Planning & Land Development Date


THESE PLANS HAVE BEEN REVIEWED FOR THE HOWARD SOIL CONSERVATION DISTRICT AND MEET TECHNICAL REQUIREMENTS.

Thomas ... 7/26/88
U.S. Soil Conservation Service Date

THIS PLAN IS APPROVED FOR SOIL EROSION AND SEDIMENT CONTROL BY THE HOWARD SOIL CONSERVATION DISTRICT.

APPROVED Stephen ... 7/2/88
Howard S.C.D. Date

PLAN NUMBER


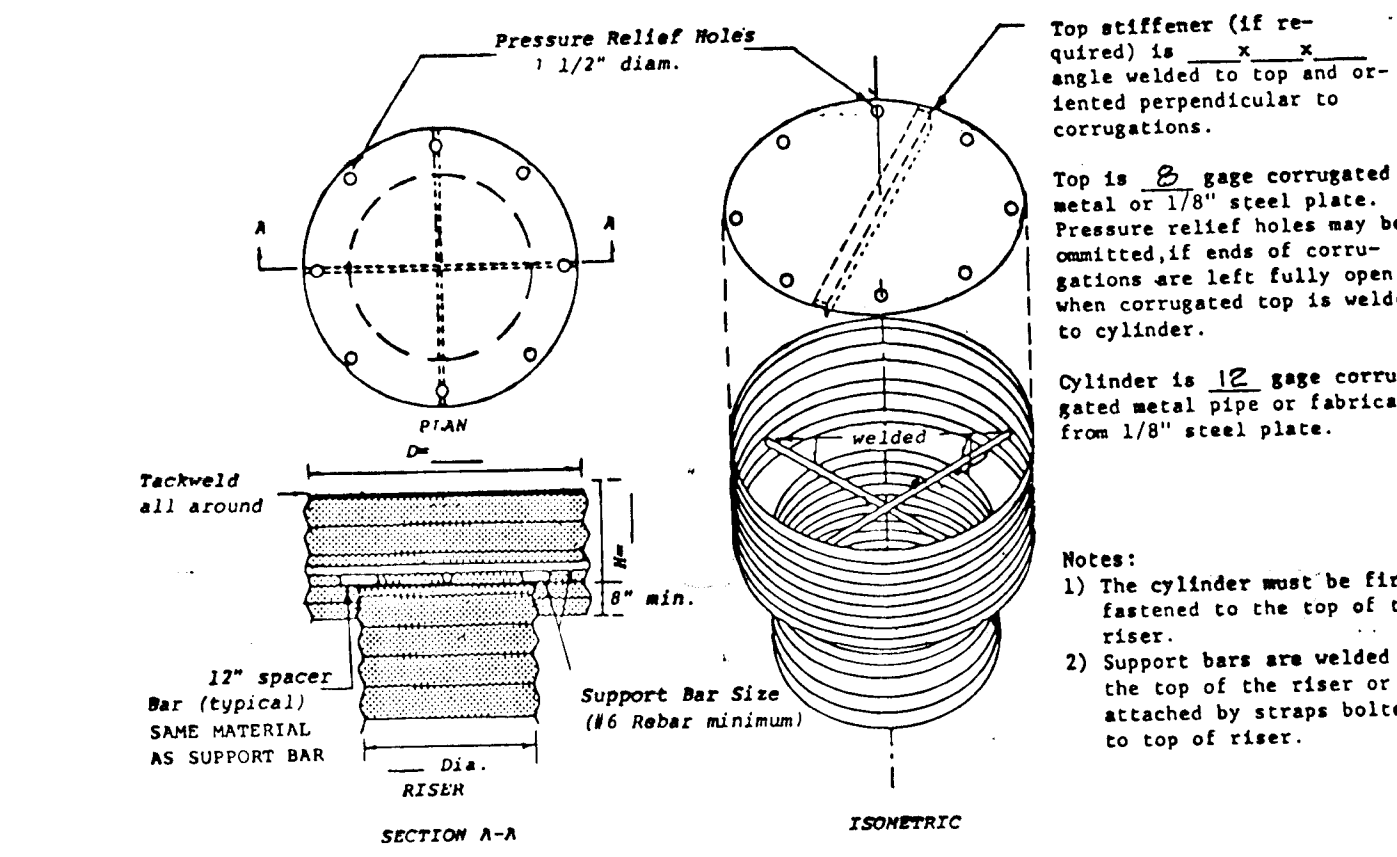


EROSION AND SEDIMENT CONTROL DETAILS

Patton Harris Rust and Associates
A Professional Corporation
Engineers, Surveyors, Planners and Landscape Architects
7609 Standish Place Rockville, Maryland 20855 (301)762-2220

| | | | |
|--|--|----------------|----------|
| BOWLING BROOK FARMS | | SURVEY | DATE |
| PARCEL G, PARCEL H | | DESIGN K.O.R. | 3-3-88 |
| SECTION 4 AREA 1 | | DRAWN F.C. | SHEET |
| LOTS 6-1 THRU 6-102 | | CHECKED | B or 10 |
| A RESUBDIVISION OF LOT 216 BOWLING BROOK FARMS | | SCALE AS SHOWN | FILE NO. |
| SIXTH ELECTION DISTRICT | | C.I. | 2184-1-7 |
| TAX MAP 47 | | | |
| L.1394 | | | |
| PARCEL 141 | | | |
| F.632 | | | |

1271

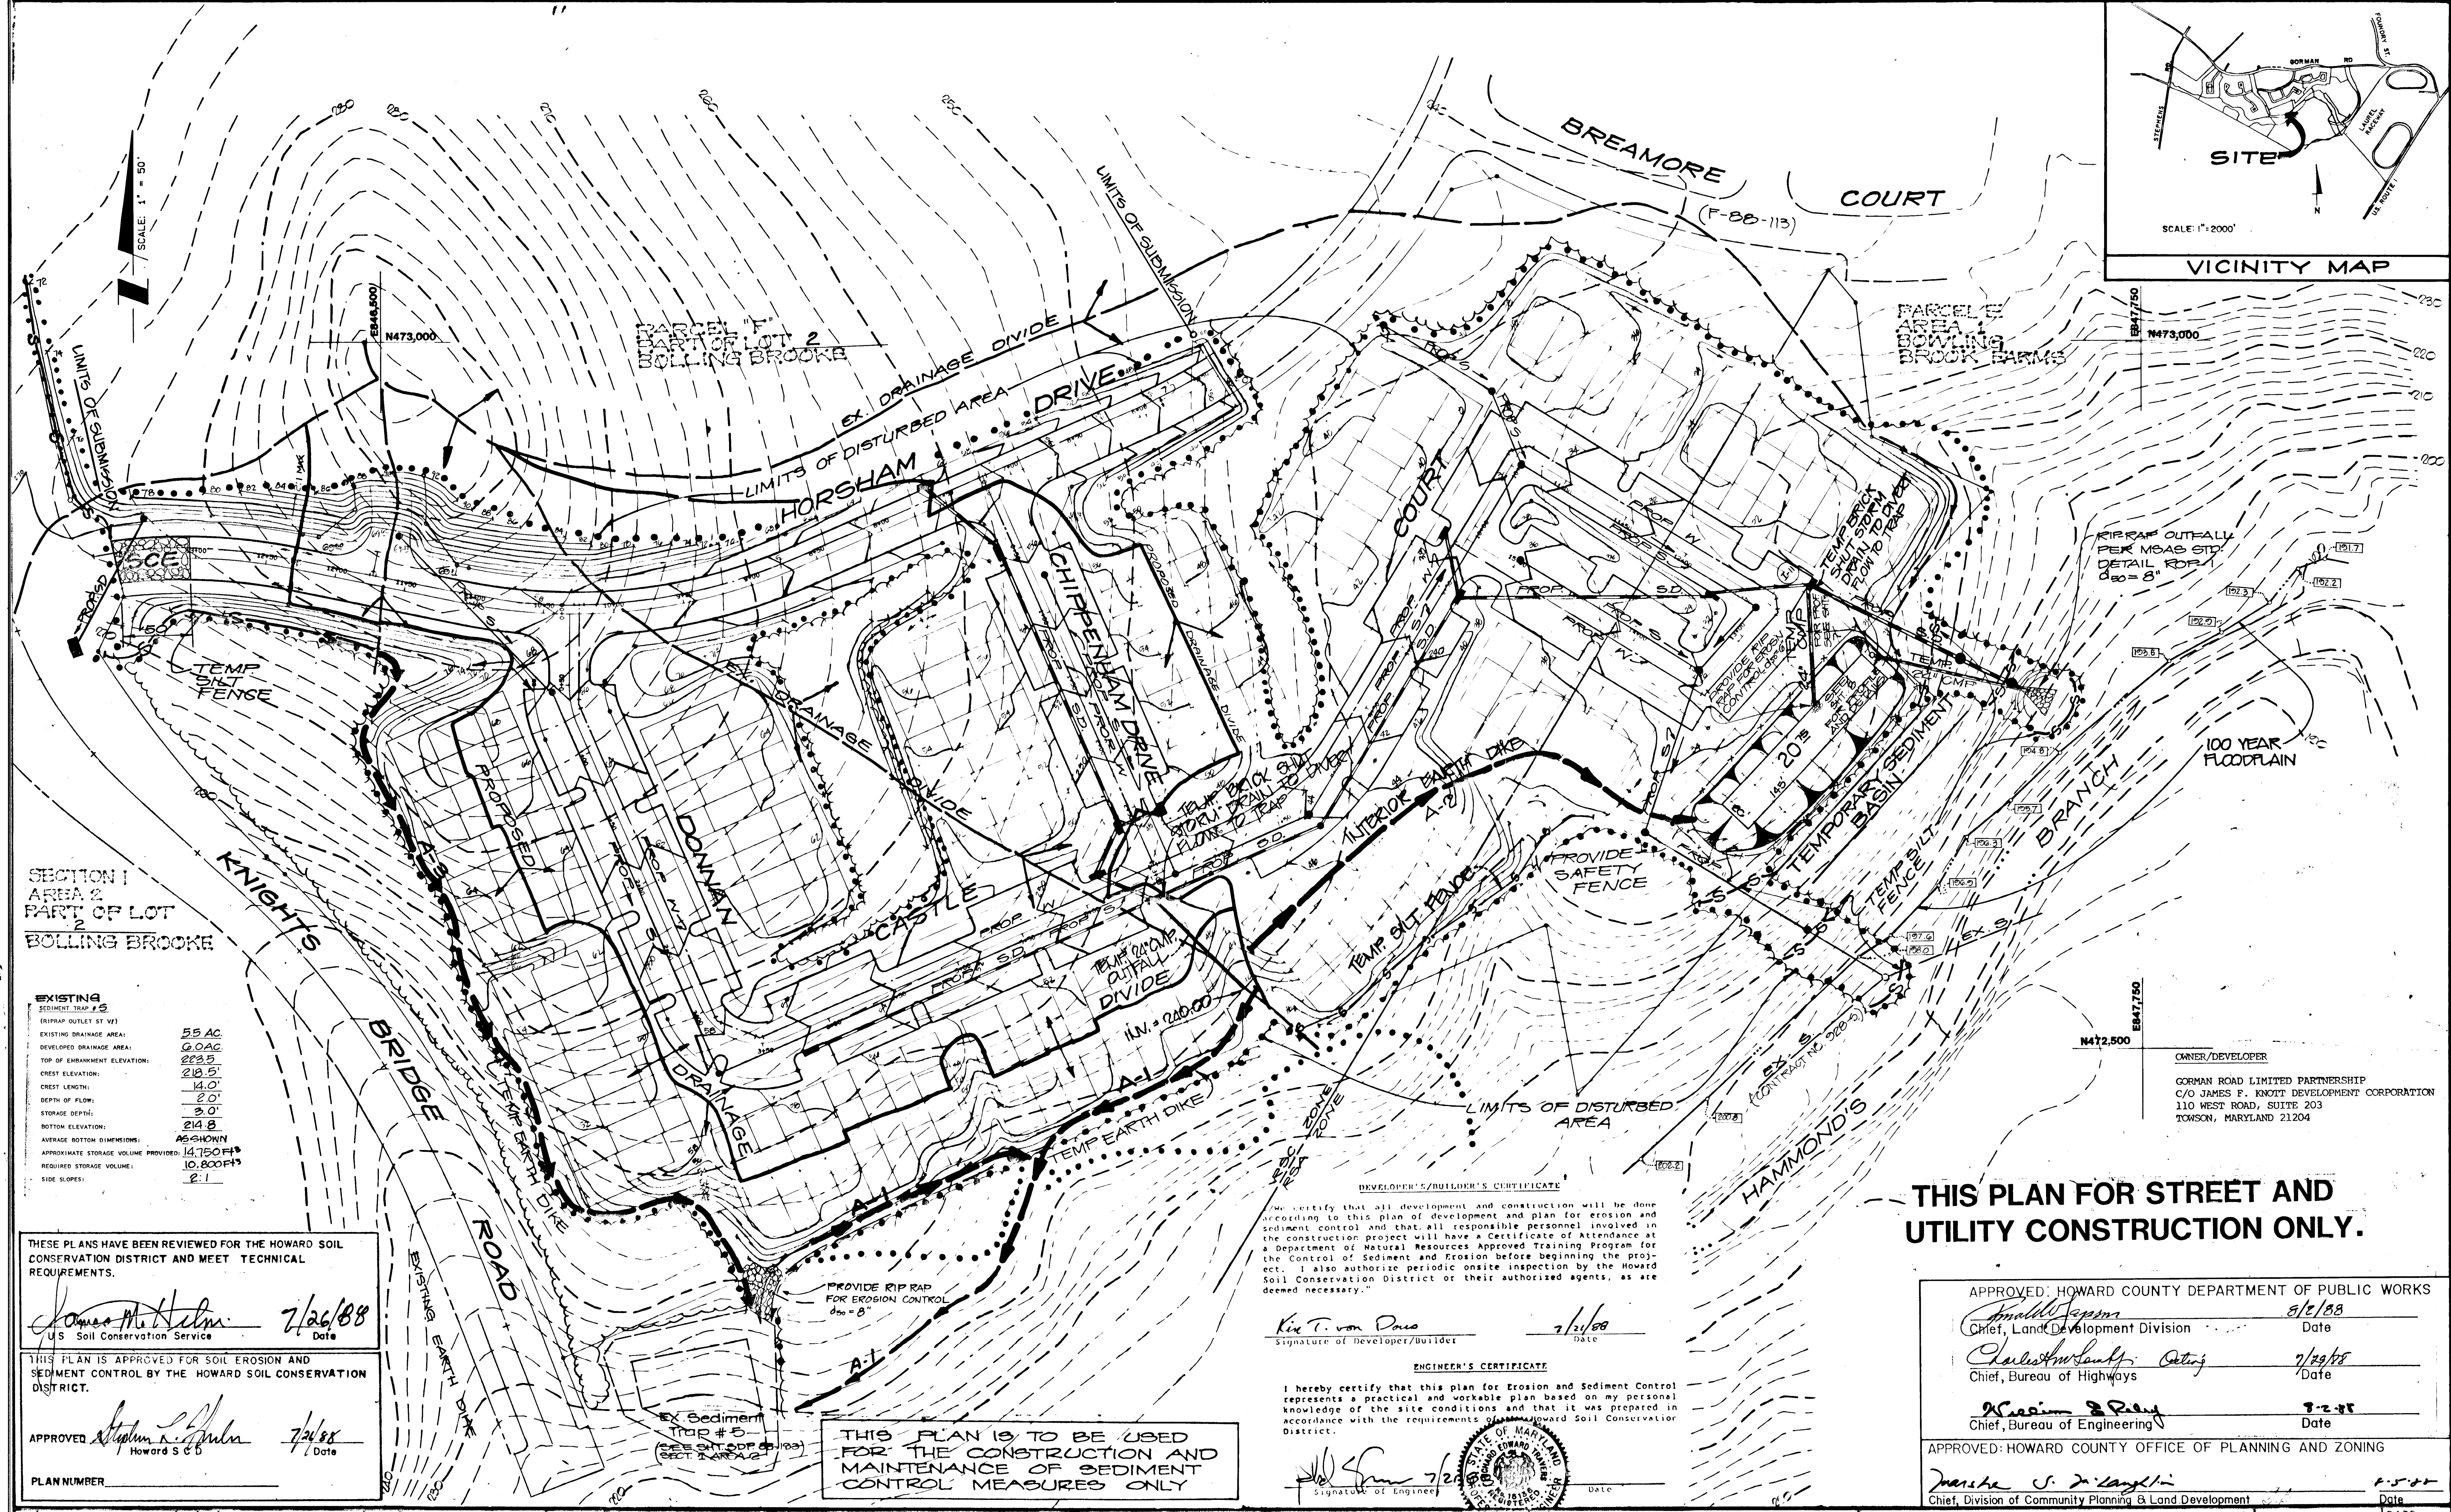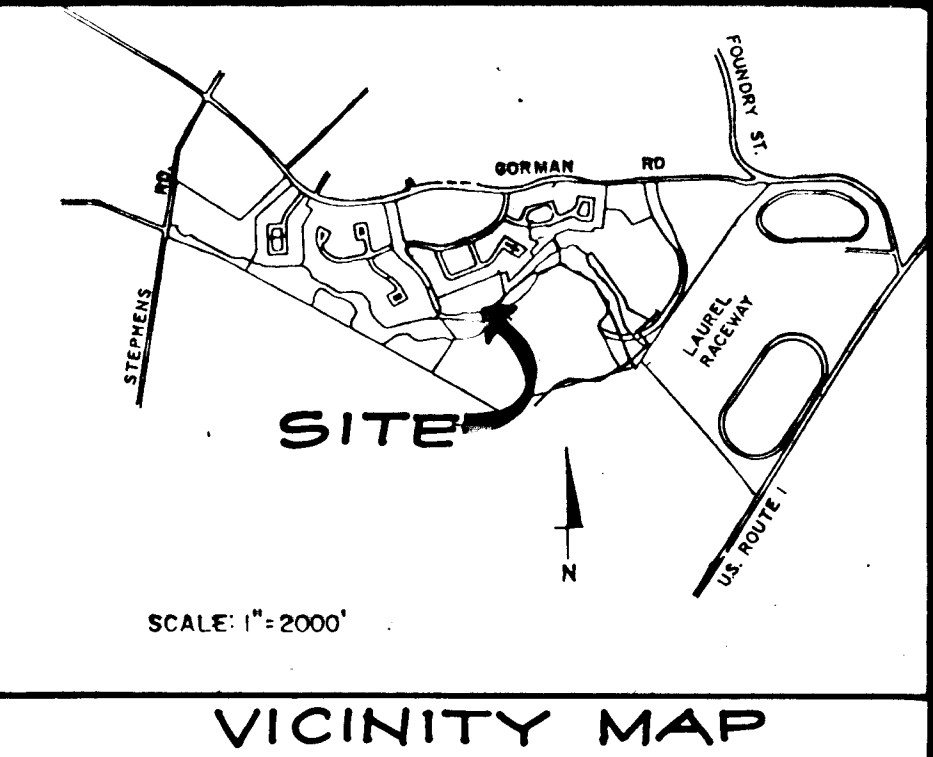

SECTION 1
AREA 2
PART OF LOT
BOLLING BROOKE

EXISTING
SEDIMENT TRAP # 2
(RIPRAP OUTLET ST VY)

EXISTING DRAINAGE AREA: 55 AC
DEVELOPED DRAINAGE AREA: 6.0 AC
TOP OF EMBANKMENT ELEVATION: 223.5
CREST ELEVATION: 218.5
CREST LENGTH: 14.0'
DEPTH OF FLOW: 2.0'
STORAGE DEPTH: 2.0'
BOTTOM ELEVATION: 214.8
AVERAGE BOTTOM DIMENSIONS: AS SHOWN
APPROXIMATE STORAGE VOLUME PROVIDED: 14,750 CU FT
REQUIRED STORAGE VOLUME: 10,800 CU FT
SIDE SLOPES: 2:1

THESE PLANS HAVE BEEN REVIEWED FOR THE HOWARD SOIL CONSERVATION DISTRICT AND MEET TECHNICAL REQUIREMENTS.

James M. Helms 7/26/88
U.S. Soil Conservation Service Date

THIS PLAN IS APPROVED FOR SOIL EROSION AND SEDIMENT CONTROL BY THE HOWARD SOIL CONSERVATION DISTRICT.

APPROVED *Stephen L. Miller* 7/26/88
Howard S.C.D. Date

PLAN NUMBER

| NO. | DESCRIPTION | DATE | APPROVED | DATE |
|-----|---------------------------|---------|----------|------|
| 1 | PRELIMINARY HOCO COMMENTS | 7/21/88 | | |
| 2 | REVISIONS TO PLAN | 8/10/88 | | |
| 3 | FINAL SUBMITTAL TO M.D. | 8/22/88 | | |
| 4 | ISSUED TO HOCO | 8/28/88 | | |


THIS PLAN IS TO BE USED FOR THE CONSTRUCTION AND MAINTENANCE OF SEDIMENT CONTROL MEASURES ONLY

DEVELOPER'S/BUILDER'S CERTIFICATE
I certify that all development and construction will be done according to this plan of development and plan for erosion and sediment control and that all responsible personnel involved in the construction project will have a Certificate of Attendance at a Department of Natural Resources Approved Training Program for the Control of Sediment and Erosion before beginning the project. I also authorize periodic onsite inspection by the Howard Soil Conservation District or their authorized agents, as are deemed necessary.

Kin T. von Daus 7/21/88
Signature of Developer/Builder Date

ENGINEER'S CERTIFICATE
I hereby certify that this plan for Erosion and Sediment Control represents a practical and workable plan based on my personal knowledge of the site conditions and that it was prepared in accordance with the requirements of the Howard Soil Conservation District.

John S. Rust 7/28/88
Signature of Engineer Date

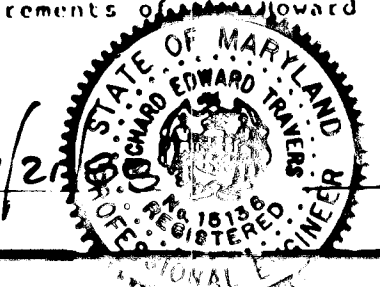

THIS PLAN FOR STREET AND UTILITY CONSTRUCTION ONLY.

APPROVED: HOWARD COUNTY DEPARTMENT OF PUBLIC WORKS
Franklin Johnson 8/12/88
Chief, Land Development Division Date
Charles H. Saults 7/29/88
Chief, Bureau of Highways Date
William S. Reed 7-2-88
Chief, Bureau of Engineering Date

APPROVED: HOWARD COUNTY OFFICE OF PLANNING AND ZONING
Janet S. Langlin 8-5-88
Chief, Division of Community Planning & Land Development Date

EROSION AND SEDIMENT CONTROL PLAN



Patton Harris Rust and Associates
A Professional Corporation
Engineers, Surveyors, Planners and Landscape Architects
7609 Standish Place Rockville, Maryland 20855 (301)762-2220

BOLLING BROOK FARMS
PARCEL G, PARCEL H
SECTION 4 AREA 1
LOTS G-1 THRU G-102
A RESUBDIVISION OF LOT 216 BOLLING BROOK FARMS
SIXTH ELECTION DISTRICT
TAX MAP 47 PARCEL 141
L.1594 F.632

SURVEY P.H.R. & A. DATE 8-3-88
DESIGN DRAWN E.I.C. SHEET 9 OF 10
CHECKED FILE NO. 2184-1-7
SCALE: 1"=50' C.I. 2'

* NOTE: DRAINAGE AREA 9-1 AND 9-2 ARE PROPOSED FUTURE DRAINAGE AREAS.

NOTE:
 * C FACTORS HAVE BEEN GENERATED FROM FIGURE G.09
 * C FACTORS FOR CLAY SOILS OF HOWARD COUNTY STORM
 DRAIN DESIGN MANUAL USING AVERAGE SLOPES OF 2% TO 7%.

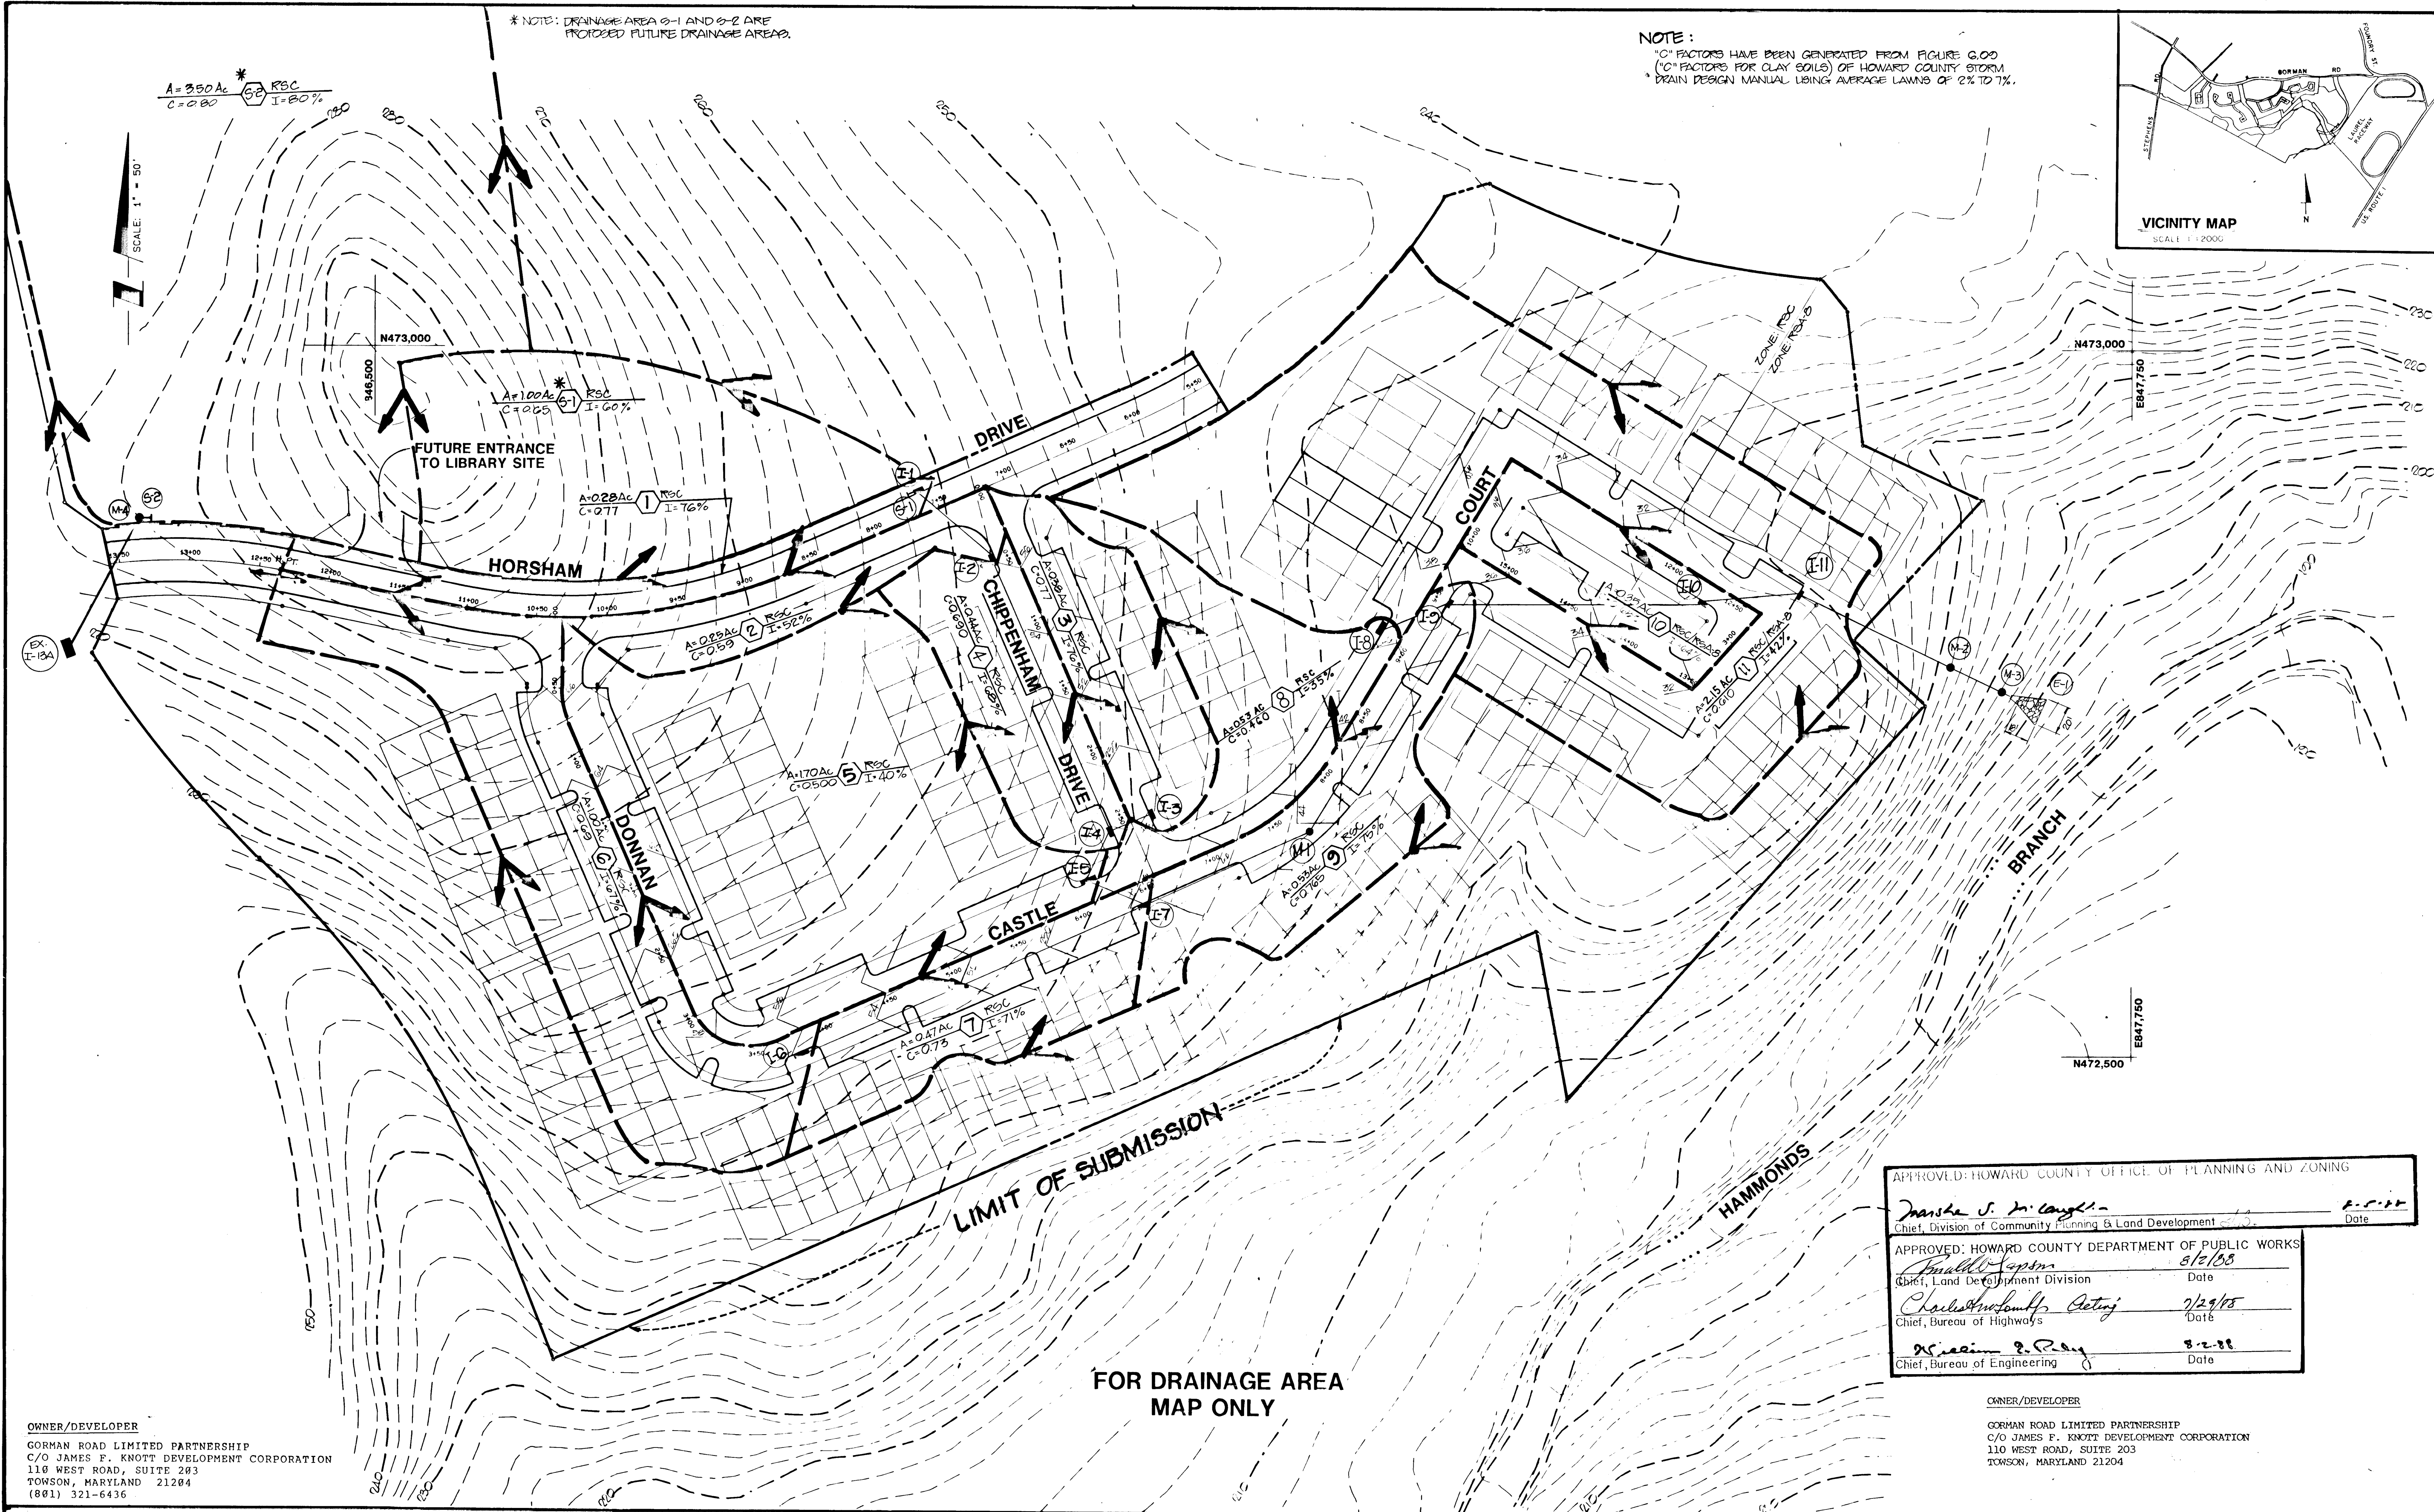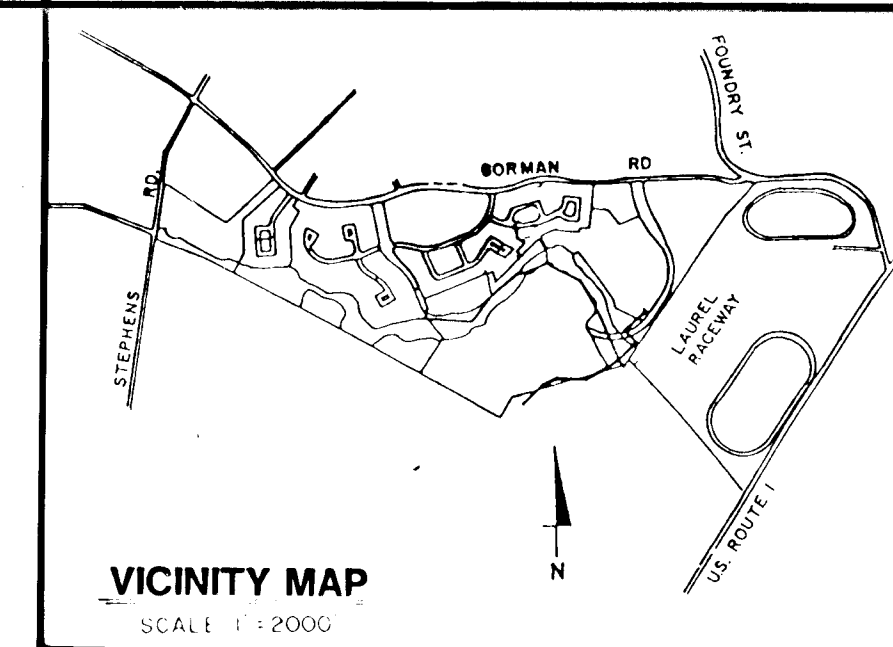

OWNER/DEVELOPER
 GORMAN ROAD LIMITED PARTNERSHIP
 C/O JAMES F. KNOTT DEVELOPMENT CORPORATION
 110 WEST ROAD, SUITE 203
 TOWSON, MARYLAND 21284
 (801) 321-6436

APPROVED: HOWARD COUNTY OFFICE OF PLANNING AND ZONING
Travis J. McCarty Chief, Division of Community Planning & Land Development 8-2-88 Date

APPROVED: HOWARD COUNTY DEPARTMENT OF PUBLIC WORKS
Charles W. Smith Chief, Land Development Division 8/2/88 Date

Charles W. Smith Chief, Bureau of Highways 7/29/88 Date

William R. Rely Chief, Bureau of Engineering 8-2-88 Date

FOR DRAINAGE AREA
 MAP ONLY

OWNER/DEVELOPER
 GORMAN ROAD LIMITED PARTNERSHIP
 C/O JAMES F. KNOTT DEVELOPMENT CORPORATION
 110 WEST ROAD, SUITE 203
 TOWSON, MARYLAND 21204

| NO. | DESCRIPTION | DATE | APPROVED | DATE |
|-----|-------------------|----------|----------|------|
| 3 | REDLINE REVISIONS | 10/27/88 | MK | |
| 2 | | 8/2/88 | MK | |
| 1 | | 8-2-88 | | |



REVISION

DRAINAGE AREA MAP

Patton Harris Rust and Associates
 A Professional Corporation
 Engineers, Surveyors, Planners and Landscape Architects
 7609 Standish Place Rockville, Maryland 20855 (301)762-2220

BOWLING BROOK FARMS
 PARCEL G, PARCEL H
 SECTION 4 AREA 1
 LOTS G-1 THRU G-102
 A RESUBDIVISION OF LOT 216 BOWLING BROOK FARMS
 SIXTH ELECTION DISTRICT
 TAX MAP 47 L. 1394 PARCEL 141 F. 632

| | |
|--------------------|-----------------|
| SURVEY P.H.R. & A. | DATE 3-2-88 |
| DESIGN M.J.K. | |
| DRAWN J.D.W. | SHEET 10 of 10 |
| CHECKED | |
| SCALE 1"=50' | FILE NO. 034-17 |
| C.I. 2' | |

1271