


SHEET INDEX	
NO.	DESCRIPTION
1	TITLE SHEET
2	PLAN AND PROFILE OF LINDEN CHAPEL ROAD
3	PLAN AND PROFILE OF SHEPARD'S CROSSING AND CHAPEL BELLS WAY
4	PLAN AND PROFILE OF CHAPEL ESTATES DRIVE
5	PLAN AND PROFILE OF CHAPEL ESTATES DRIVE
6	PLAN AND PROFILE OF CHAPEL ESTATES DRIVE
7	STORM DRAIN PROFILES AND DETAILS
8	DRAINAGE AREA MAP
9	DRAINAGE AREA MAP
10	GRADING AND SEDIMENT CONTROL PLAN
11	GRADING AND SEDIMENT CONTROL PLAN
12	DETAIL SHEET
13	PLAN AND PROFILES FOR POND IMPROVEMENTS
14	SUPER SPAN STREAM ENCLOSURE
15	CROSS SECTIONS AND DETAILS
GENERAL NOTES	

ROADWAYS AND STORM DRAINS

CHAPEL WOODS II

5TH ELECTION DISTRICT

HOWARD COUNTY, MARYLAND

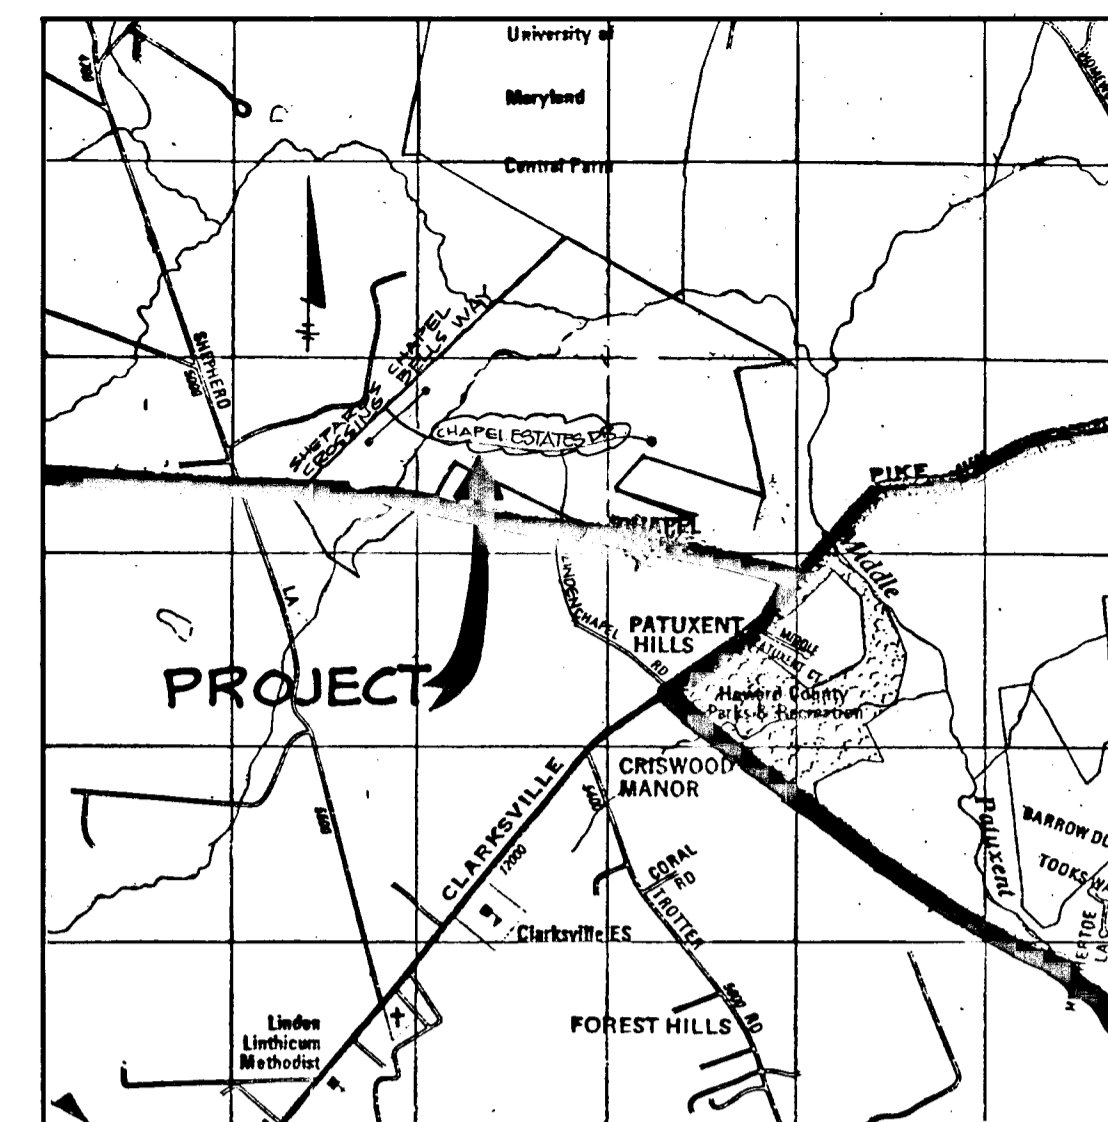

VICINITY MAP
SCALE: 1"=2000'


- ALL WORK SHALL BE PERFORMED IN ACCORDANCE WITH THE HOWARD COUNTY DESIGN MANUAL, VOL. IV, I.E., STANDARD SPECIFICATIONS AND DETAILS FOR CONSTRUCTION.
- APPROXIMATE LOCATION OF EXISTING UTILITIES ARE SHOWN. THE CONTRACTOR SHALL TAKE ALL NECESSARY PRECAUTIONS TO PROTECT THE EXISTING UTILITIES AND MAINTAIN UNINTERRUPTED SERVICE. ANY DAMAGE INCURRED DUE TO CONTRACTOR'S OPERATION SHALL BE REPAIRED IMMEDIATELY AT THE CONTRACTOR'S EXPENSE.
- THE CONTRACTOR SHALL TEST PIT EXISTING UTILITIES AT LEAST FIVE (5) DAYS BEFORE STARTING WORK SHOWN ON THESE DRAWINGS TO VERIFY THEIR LOCATION AND ELEVATION. THE CONTRACTOR SHALL NOTIFY THE ENGINEER IMMEDIATELY IF LOCATION OF UTILITIES IS OTHER THAN SHOWN.
- CONTRACTOR SHALL NOTIFY THE FOLLOWING UTILITIES AT LEAST FIVE (5) DAYS BEFORE STARTING WORK ON THESE DRAWINGS:

MISS UTILITY	1-800-257-7777
G&P TELEPHONE COMPANY	725-9976
AT&T CABLE LOCATION DIVISION	393-3553
BALTIMORE GAS AND ELECTRIC COMPANY	685-0123
STATE HIGHWAY ADMINISTRATION	531-5533
HOWARD COUNTY CONSTRUCTION/INSPECTION SURVEY DIVISION (24 HOURS NOTICE PRIOR TO COMMENCEMENT OF WORK)	792-7272

- ALL INLETS SHALL BE CONSTRUCTED IN ACCORDANCE WITH HOWARD COUNTY DESIGN MANUAL, VOL. IV, I.E., STANDARD SPECIFICATIONS AND DETAILS.
- STORM DRAIN BACKFILL WITHIN ROADWAYS, UNDER STRUCTURES AND FOR STORM DRAIN TRENCHES SHALL BE COMPACTED TO A MINIMUM OF 95% COMPACTION OF MAXIMUM DRY DENSITY AS DETERMINED BY ASTM 1557.
- NO PIPE SHALL BE LAID UNTIL LINES OF EXCAVATION HAVE BEEN BROUGHT WITHIN 6" OF FINISHED GRADE.
- ALL STORM DRAIN PIPE BEDDING SHALL BE AS SHOWN IN DETAIL G2.01 (TRENCH IN ROCK OR TRENCH IN EARTH AS DETERMINED BY FIELD CONDITIONS) IN VOL. IV OF HOWARD COUNTY DESIGN MANUAL UNLESS OTHERWISE DIRECTED BY THE ENGINEER OR AS SHOWN ON THE DRAWINGS.
- ALL STREET CURB RETURNS SHALL HAVE 35.0' RADII UNLESS OTHERWISE NOTED.
- ALL ELEVATIONS SHOWN ARE BASED ON U.S.C.S. MEAN SEA LEVEL DATUM, 1929.
- ALL PIPE ELEVATIONS SHOWN ARE INVERT ELEVATIONS.
- TOPO TAKEN FROM FIELD RUN SURVEY DATED MARCH, 1988, BY THE RIEMER GROUP INC.
- SUBJECT PROPERTY ZONED 'R' PER 8.2.85 COMPREHENSIVE ZONING PLAN.
- INSTALLATION OF TRAFFIC CONTROL DEVICES, MARKING, AND SIGNING SHALL BE IN ACCORDANCE WITH THE MANUAL OF UNIFORM TRAFFIC CONTROL DEVICES 1984 EDITION.
- DESIGNED TRAFFIC SPEED IN ACCORDANCE WITH THE AMERICAN ASSOCIATION OF STATE HIGHWAY OFFICIAL STANDARDS:

ALL 50' RIGHT-OF-WAYS 30 M.P.H.

- LOT 2 AT PLOT PLAN STAGE WILL REQUIRE AN 18" CMP 16' DIA. CULVERT UNDER DRIVEWAY.
- LOT 23 AND 24 AT PLOT PLAN STAGE WILL REQUIRE A 36" CMP 16' DIA. CULVERT UNDER DRIVEWAY.
- BEFORE EXCAVATING AND GRADING IS PERFORMED FOR THE PROPOSED LINDEN CHAPEL ROAD AT ANY LOCATION IN THE BASE RIGHT OF WAY, TEST HOLES SHOULD BE HAND DUG OVER THE PIPE LINE TO DETERMINE ITS DEPTH AND LOCATION.
- 100YR FLOODPLAIN CROSS SECTIONS LOCATION AND ELEVATION OBTAINED FROM CLYDE'S BRANCH DRAINAGE STUDY (CAPITAL PROJECT D-1028) PREPARED BY KIDDE CONSULTANTS, INC. FOR HOWARD COUNTY, MARYLAND.
- LOTS 5, 11, 23 & 24 HAVE LIMITED HOUSE SITES - ADDITIONAL PERCOLATION ADJUSTMENT NOT AVAILABLE.
- WELLS TO BE DRILLED ON LOTS 23 & 24 PRIOR TO FINAL PLAT SIGNATURE APPROVAL.
- HOUSE ON LOT 5 WILL HAVE A MINIMUM SERVICEABLE ELEVATION OF 388.0 BASED ON TOPOGRAPHY SHOWN ON PLAN.

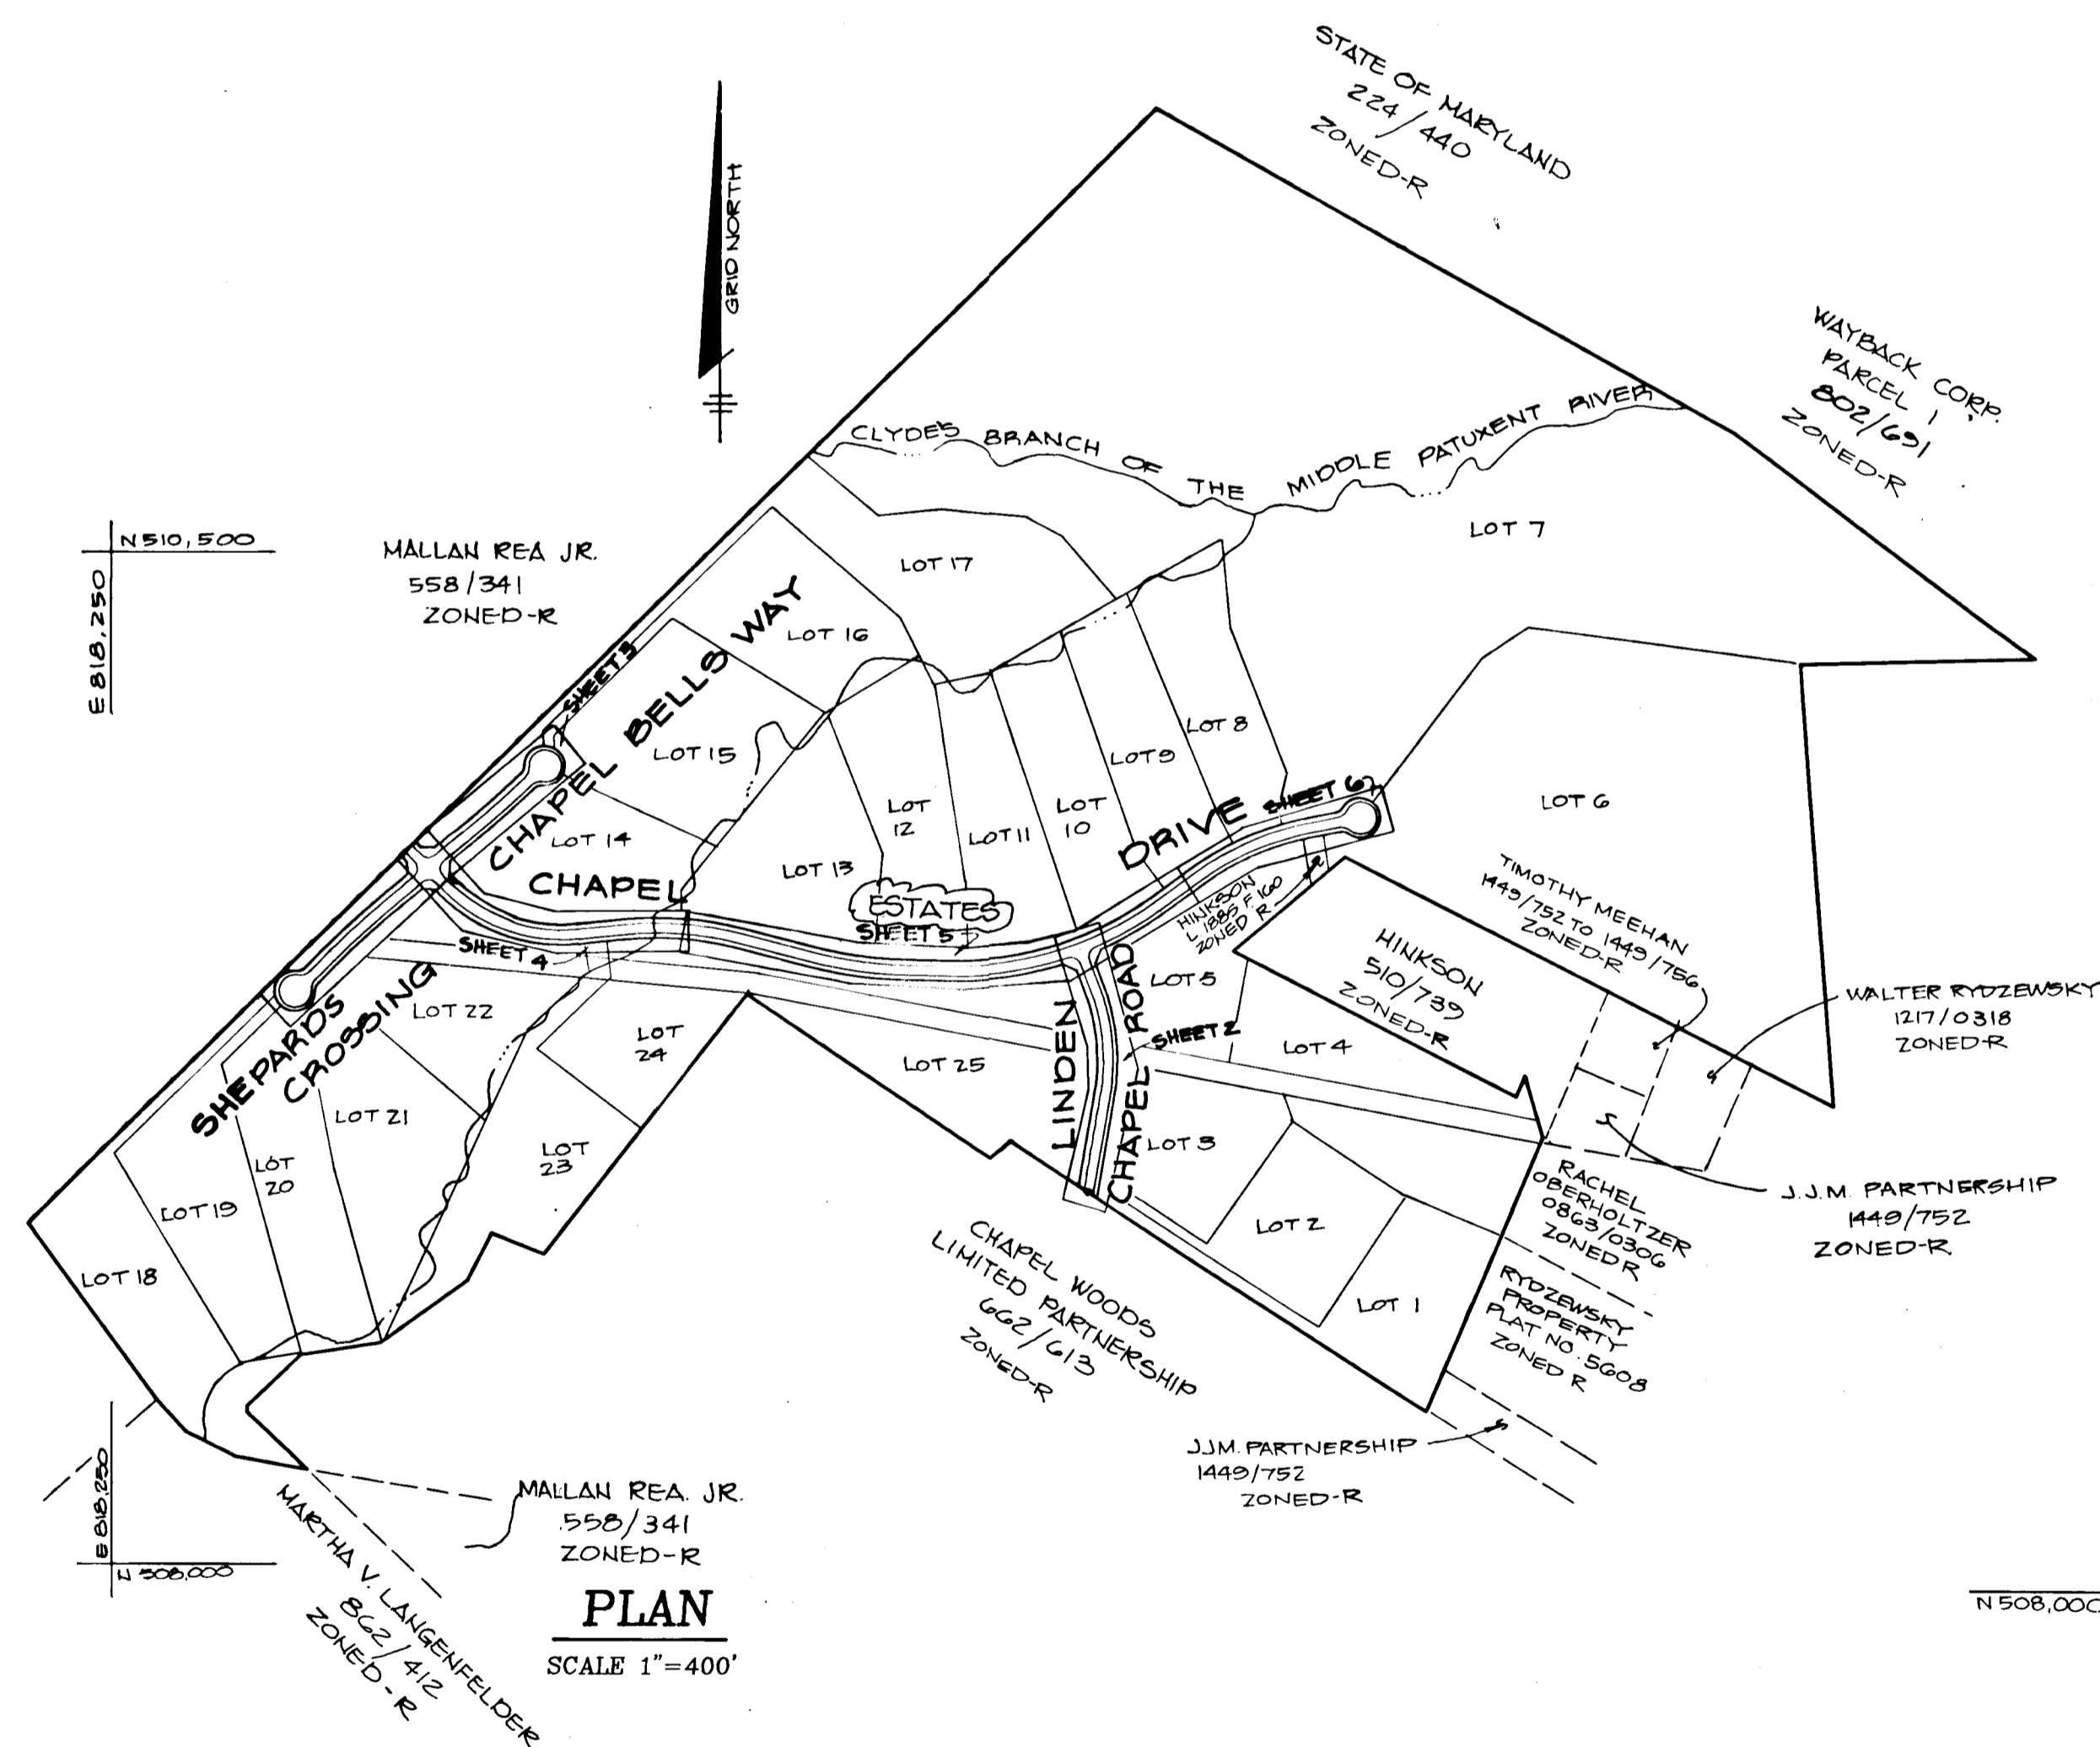

APPROVED: HOWARD COUNTY OFFICE OF PLANNING AND ZONING
Mark J. DeLong 4/1/88
CHIEF, DIVISION OF COMMUNITY PLANNING AND LAND DEVELOPMENT

APPROVED: HOWARD COUNTY DEPARTMENT OF PUBLIC WORKS
Paul J. Seaman 3/2/88
Chief, Land Development Division
Stanley W. Wilcox 3/2/88
Chief, Bureau of Highways
Andrew M. Greich 3/2/88
Chief, Bureau of Engineering

11-30-88 C REVISE ROAD NAME FOR CHAPEL ESTATES DRIVE

DATE	NO.	REVISION

OWNER: J.J.M. PARTNERSHIP
5570-201 STERRETT PLACE
COLUMBIA, MARYLAND 21044 PH (301) 740-4466

DEVELOPER: J.J.M., INC.
5570-201 STERRETT PLACE
COLUMBIA, MARYLAND 21044 PH (301) 740-4466


PROJECT
CHAPEL WOODS II

AREA: TAX MAP NO 29 PARCELS 26, 26a, 282
5th ELECTION DISTRICT
HOWARD COUNTY, MARYLAND

TITLE
TITLE SHEET


THE RIEMER GROUP, INC.
The Riemer Group, Inc. A Land Planning, Design & Civil Engineering Firm
3105 North Ridge Road, Ellicott City, Maryland 21043 (301) 461-2690

DATE 11-11-88	5-86-87, 6-87-25, 11-88-87 P-88-07, WP-88-121
DESIGNED BY: J.D.P.	
DRAWN BY: D.V.P.	
PROJECT NO: 28800	
DATE: NOVEMBER 7, 1988	
SCALE: AS SHOWN	
DRAWING NO. 1 OF 15	

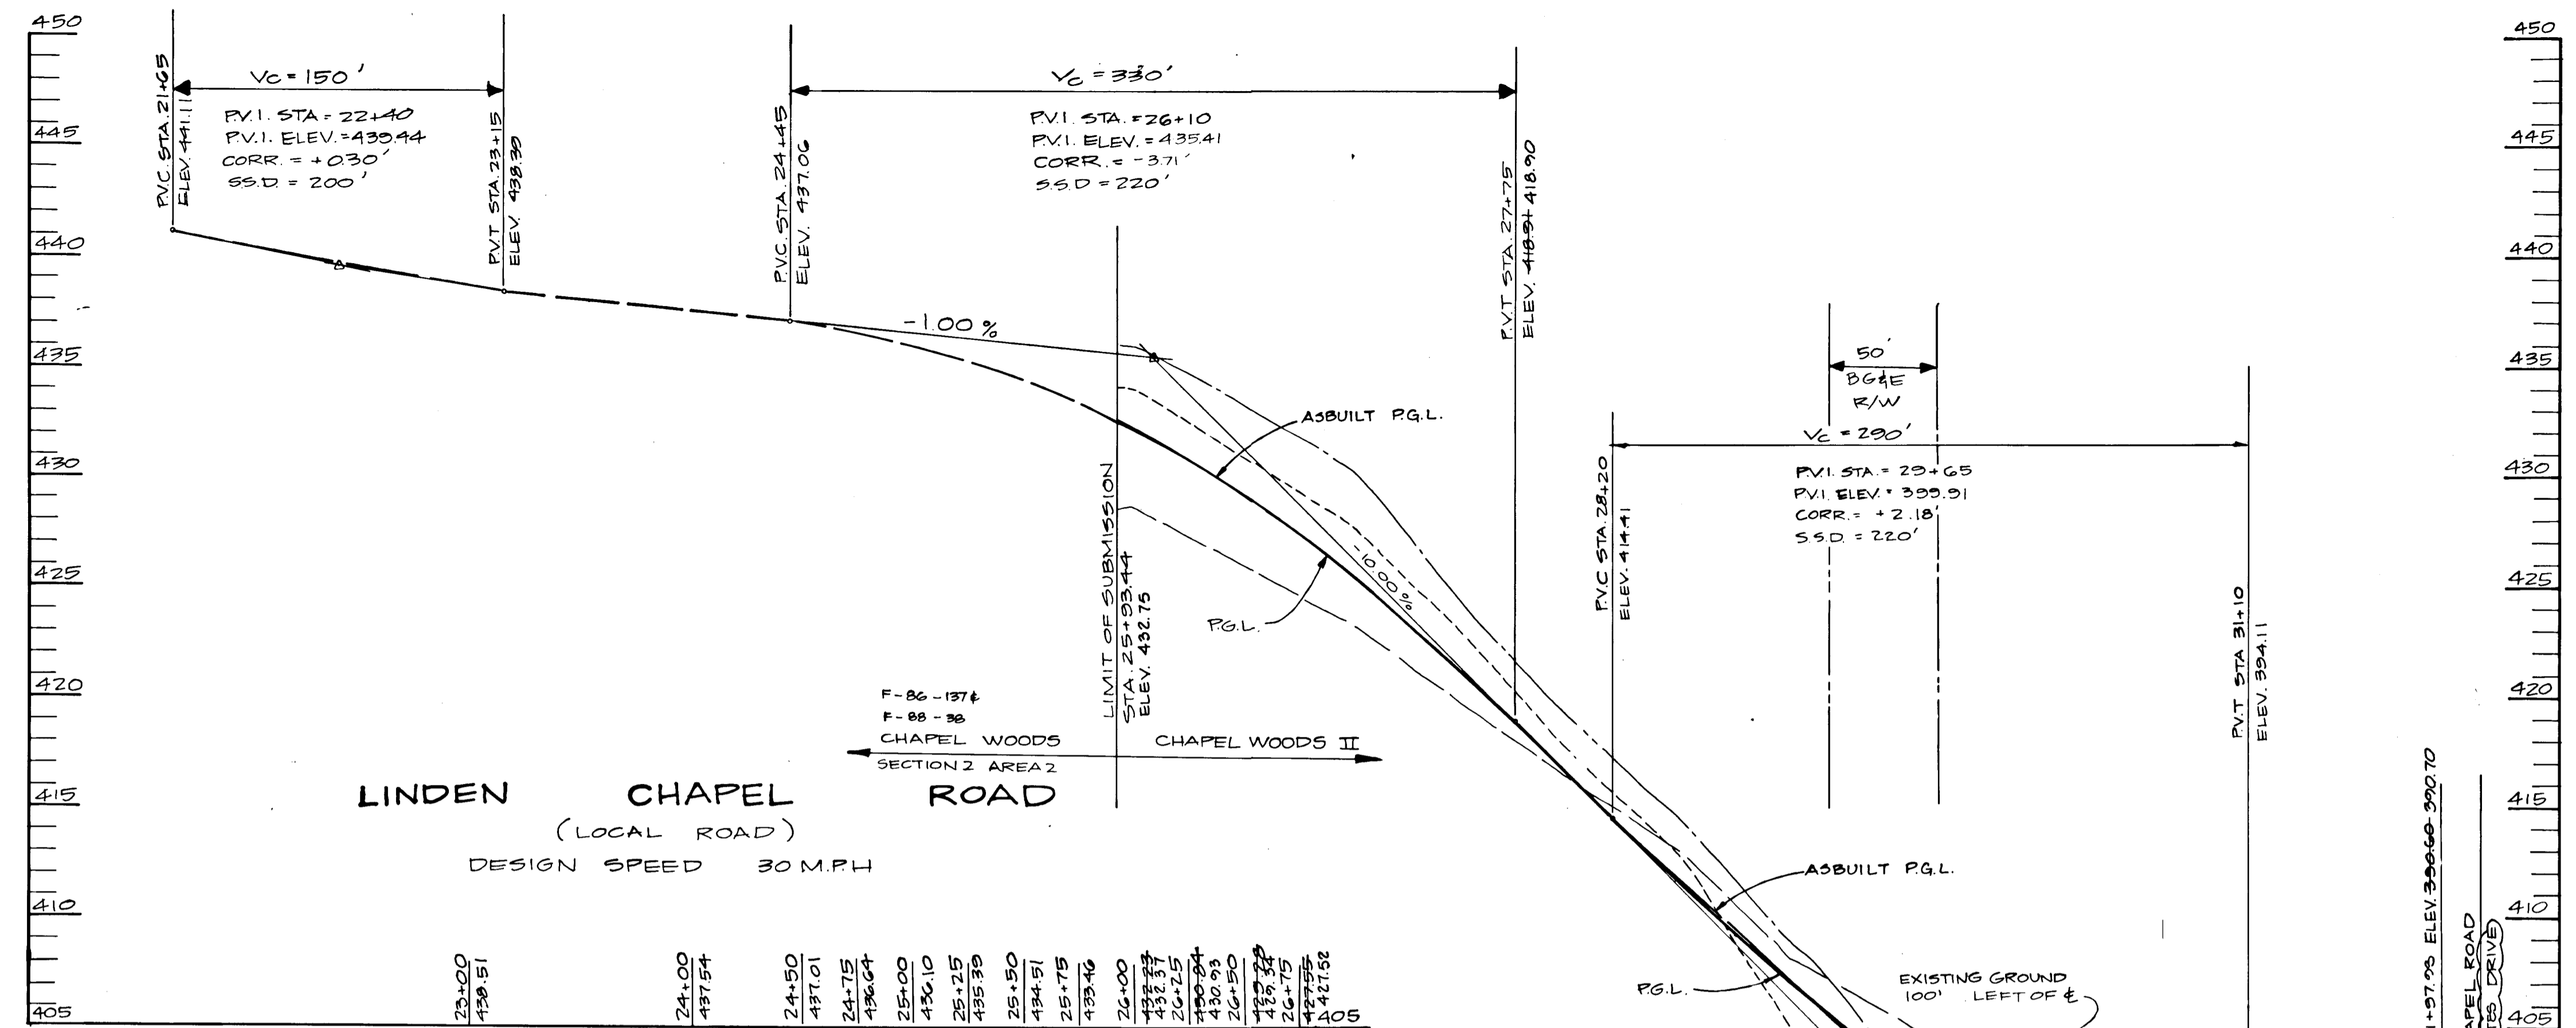


PROFILE
SCALE: HOR. 1"=50'
VERT. 1"=5'

21+00	429.51
21+10	427.54
21+20	424.50
21+30	421.01
21+40	417.75
21+50	413.64
21+60	408.00
21+70	401.10
21+80	393.33
21+90	384.51
22+00	374.75
22+10	363.40
22+20	350.00
22+30	335.37
22+40	319.84
22+50	302.84
22+60	284.95
22+70	266.75
22+80	247.75
22+90	228.50
23+00	208.50
23+10	187.75
23+20	166.75
23+30	145.00
23+40	122.75
23+50	100.50
23+60	78.75
23+70	57.00
23+80	35.75
23+90	14.50
24+00	3.25
24+10	1.50
24+20	0.25
24+30	1.00
24+40	2.25
24+50	4.00
24+60	6.25
24+70	9.00
24+80	12.25
24+90	16.00
25+00	20.25
25+10	25.00
25+20	30.25
25+30	36.00
25+40	42.25
25+50	49.00
25+60	56.25
25+70	64.00
25+80	72.25
25+90	81.00
26+00	90.25
26+10	100.00
26+20	110.25
26+30	121.00
26+40	132.25
26+50	144.00
26+60	156.25
26+70	169.00
26+80	182.25
26+90	196.00
27+00	210.25
27+10	225.00
27+20	240.25
27+30	256.00
27+40	272.25
27+50	289.00
27+60	306.25
27+70	324.00
27+80	342.25
27+90	361.00
28+00	380.25
28+10	400.00
28+20	420.25
28+30	441.00
28+40	462.25
28+50	484.00
28+60	506.25
28+70	529.00
28+80	552.25
28+90	576.00
29+00	600.25
29+10	625.00
29+20	650.25
29+30	676.00
29+40	702.25
29+50	729.00
29+60	756.25
29+70	784.00
29+80	812.25
29+90	841.00
30+00	870.25
30+10	900.00
30+20	930.25
30+30	961.00
30+40	992.25
30+50	1024.00
30+60	1056.25
30+70	1089.00
30+80	1122.25
30+90	1156.00
31+00	1190.25
31+10	1225.00
31+20	1260.25
31+30	1296.00
31+40	1332.25
31+50	1369.00
31+60	1406.25
31+70	1444.00
31+80	1482.25
31+90	1521.00
32+00	1560.25

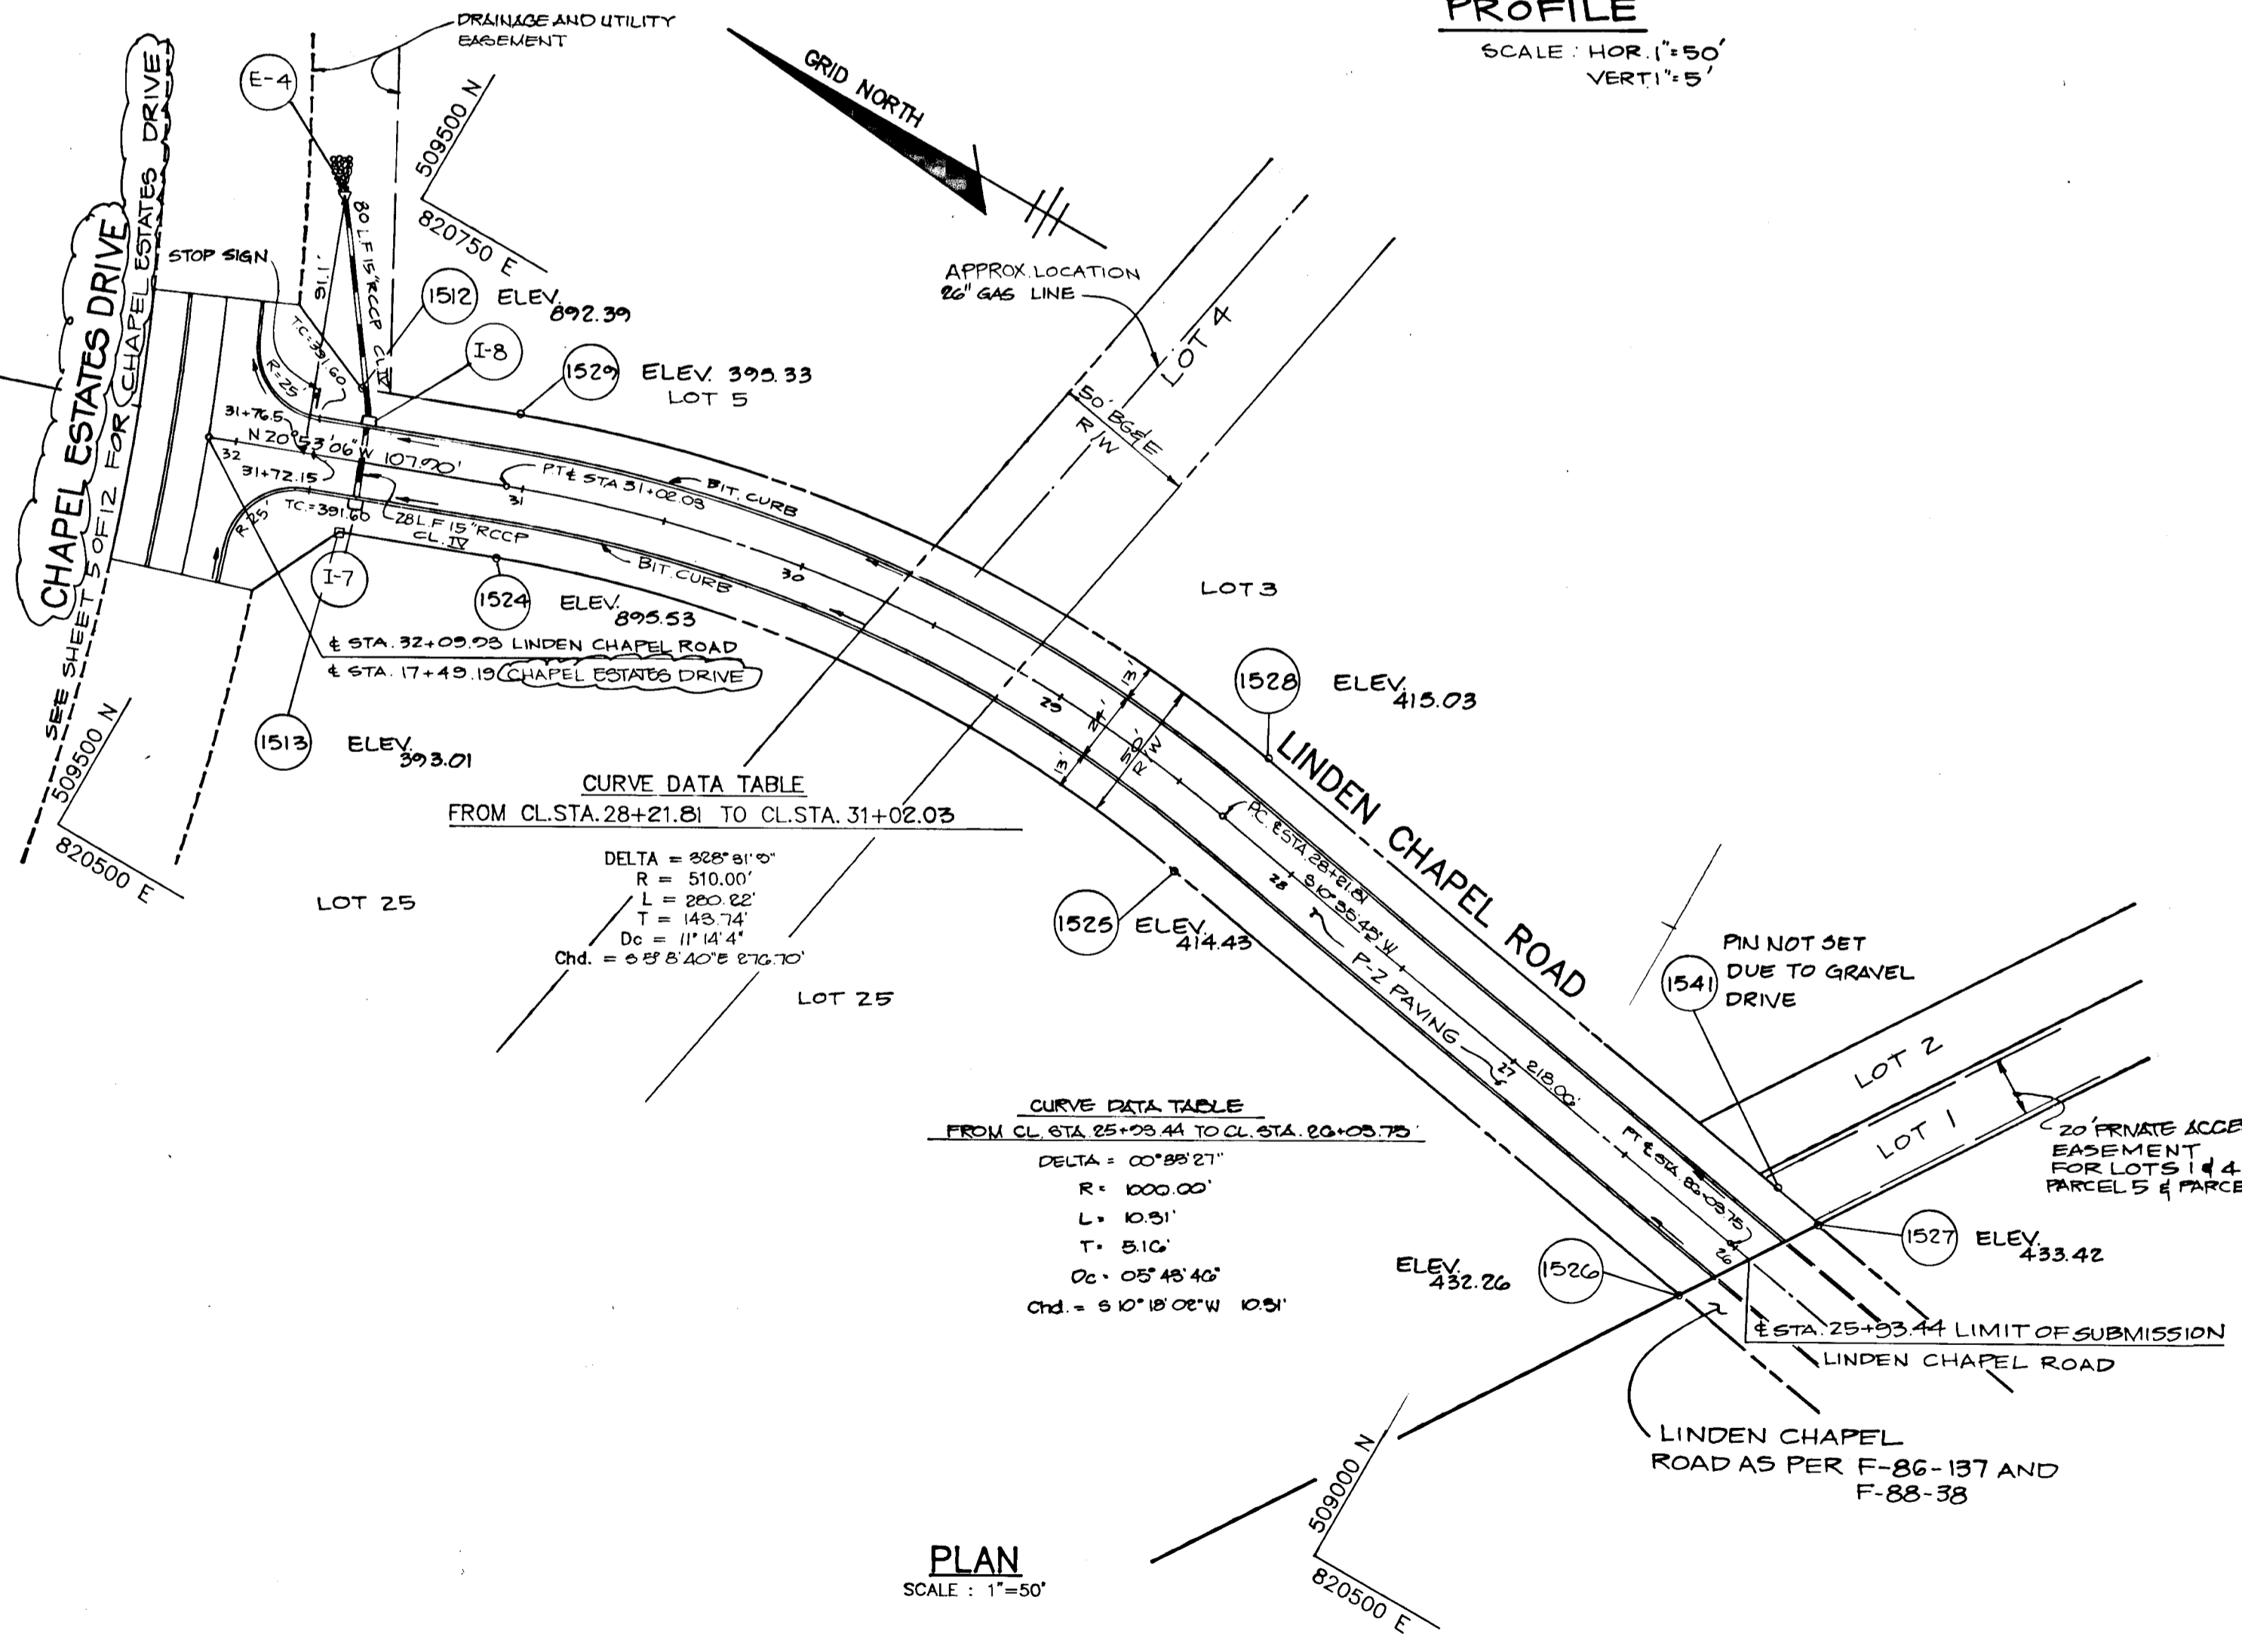

PLAN
SCALE: 1"=50'

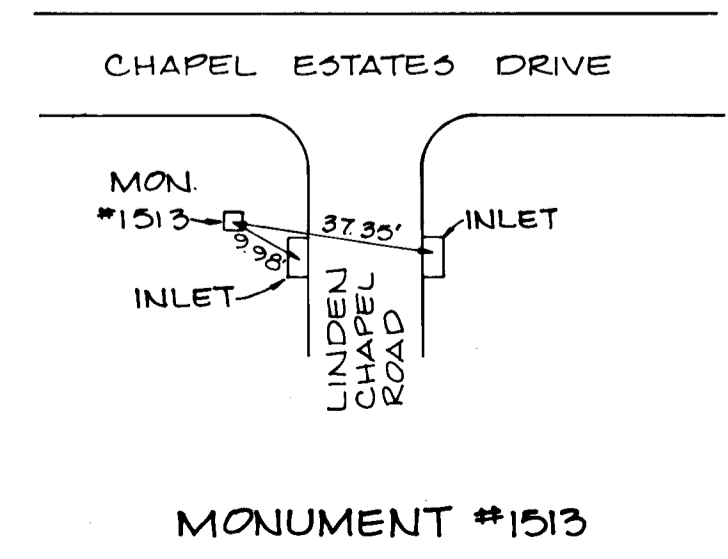

ASBUILT CERTIFICATION

Arthur E. Muegge #8707
DATE: 10-8-91

APPROVED: HOWARD COUNTY OFFICE OF PLANNING AND ZONING
Marshe J. Taylor
CHIEF, DIVISION OF COMMUNITY PLANNING AND LAND DEVELOPMENT
DATE: 9-2-89

APPROVED: HOWARD COUNTY DEPARTMENT OF PUBLIC WORKS
James W. Woodland
Chief, Bureau of Highways
DATE: 3/21/89

APPROVED: *[Signature]*
Chief, Bureau of Engineering
DATE: 3/22/89

11-20-80'S REVERSE ROAD NAME FOR CHAPEL ESTATES DRIVE

DATE	NO	REVISION
		J.J.M. PARTNERSHIP
		5570 STERRETT PLACE SUITE 201
		COLUMBIA MD. 21044 (301) 740-4466
		DEVELOPER: J.J.M., INC.
		5570 STERRETT PLACE SUITE 201
		COLUMBIA MD. 21044 (301) 740-4466



PROJECT: CHAPEL WOODS II

AREA TAX MAP NO 29 PARCELS 26, 80, 282
5TH ELECTION DISTRICT
HOWARD COUNTY, MARYLAND

TITLE: PLAN AND PROFILE FOR LINDEN CHAPEL ROAD

THE RIEMER GROUP, INC.
The Riemer Group, Inc. A Land Planning, Design & Civil Engineering Firm
3105 North Ridge Road, Ellicott City, Maryland 21043 (301) 461-2690

DATE: 11-11-88
DESIGNED BY: C.J.R.
DRAWN BY: J.L.B.
PROJECT NO: 28800
DATE: NOVEMBER 7, 1988
SCALE: AS SHOWN
DRAWING NO. 2 OF 15

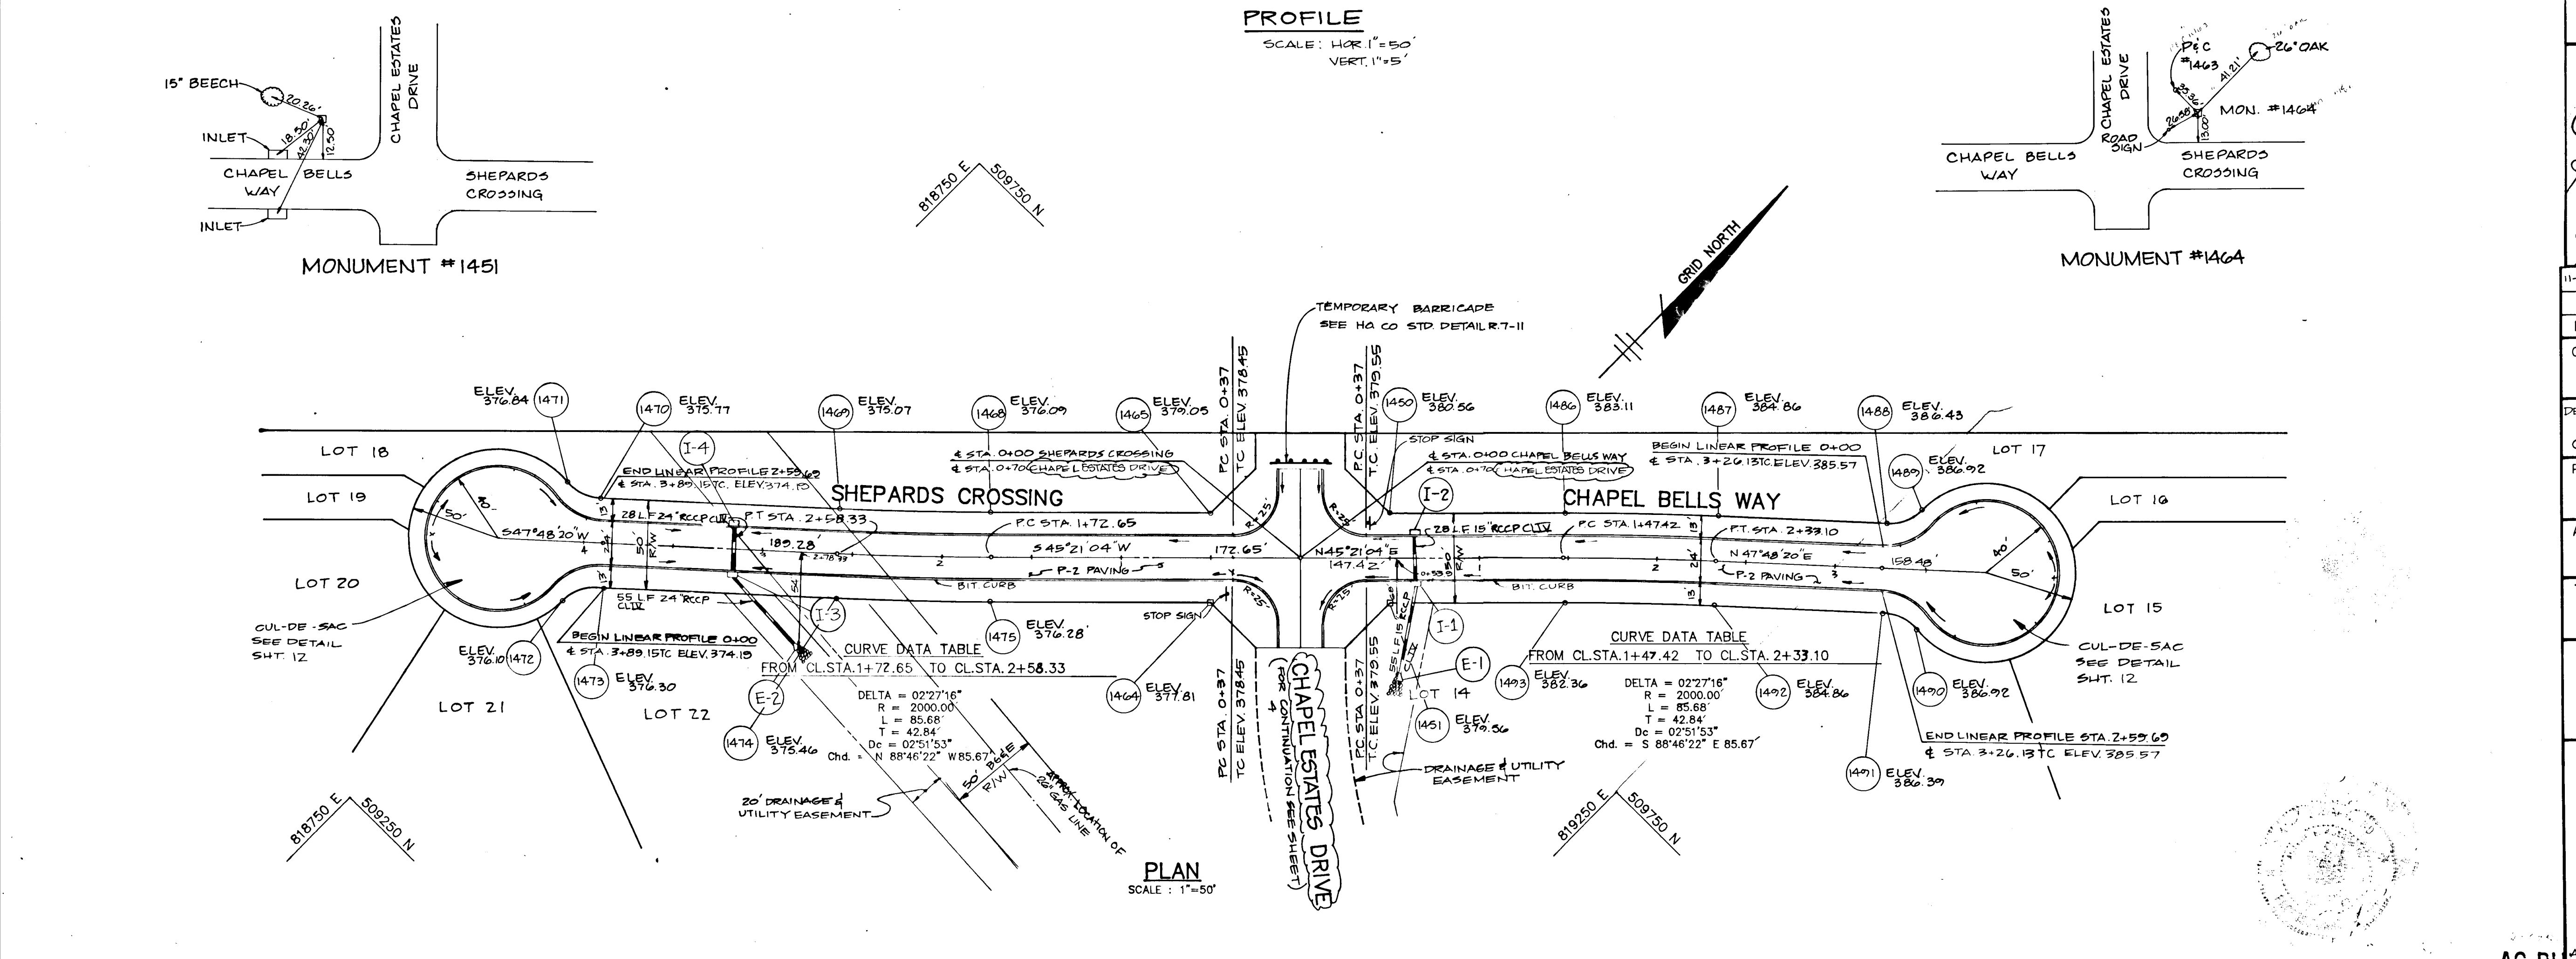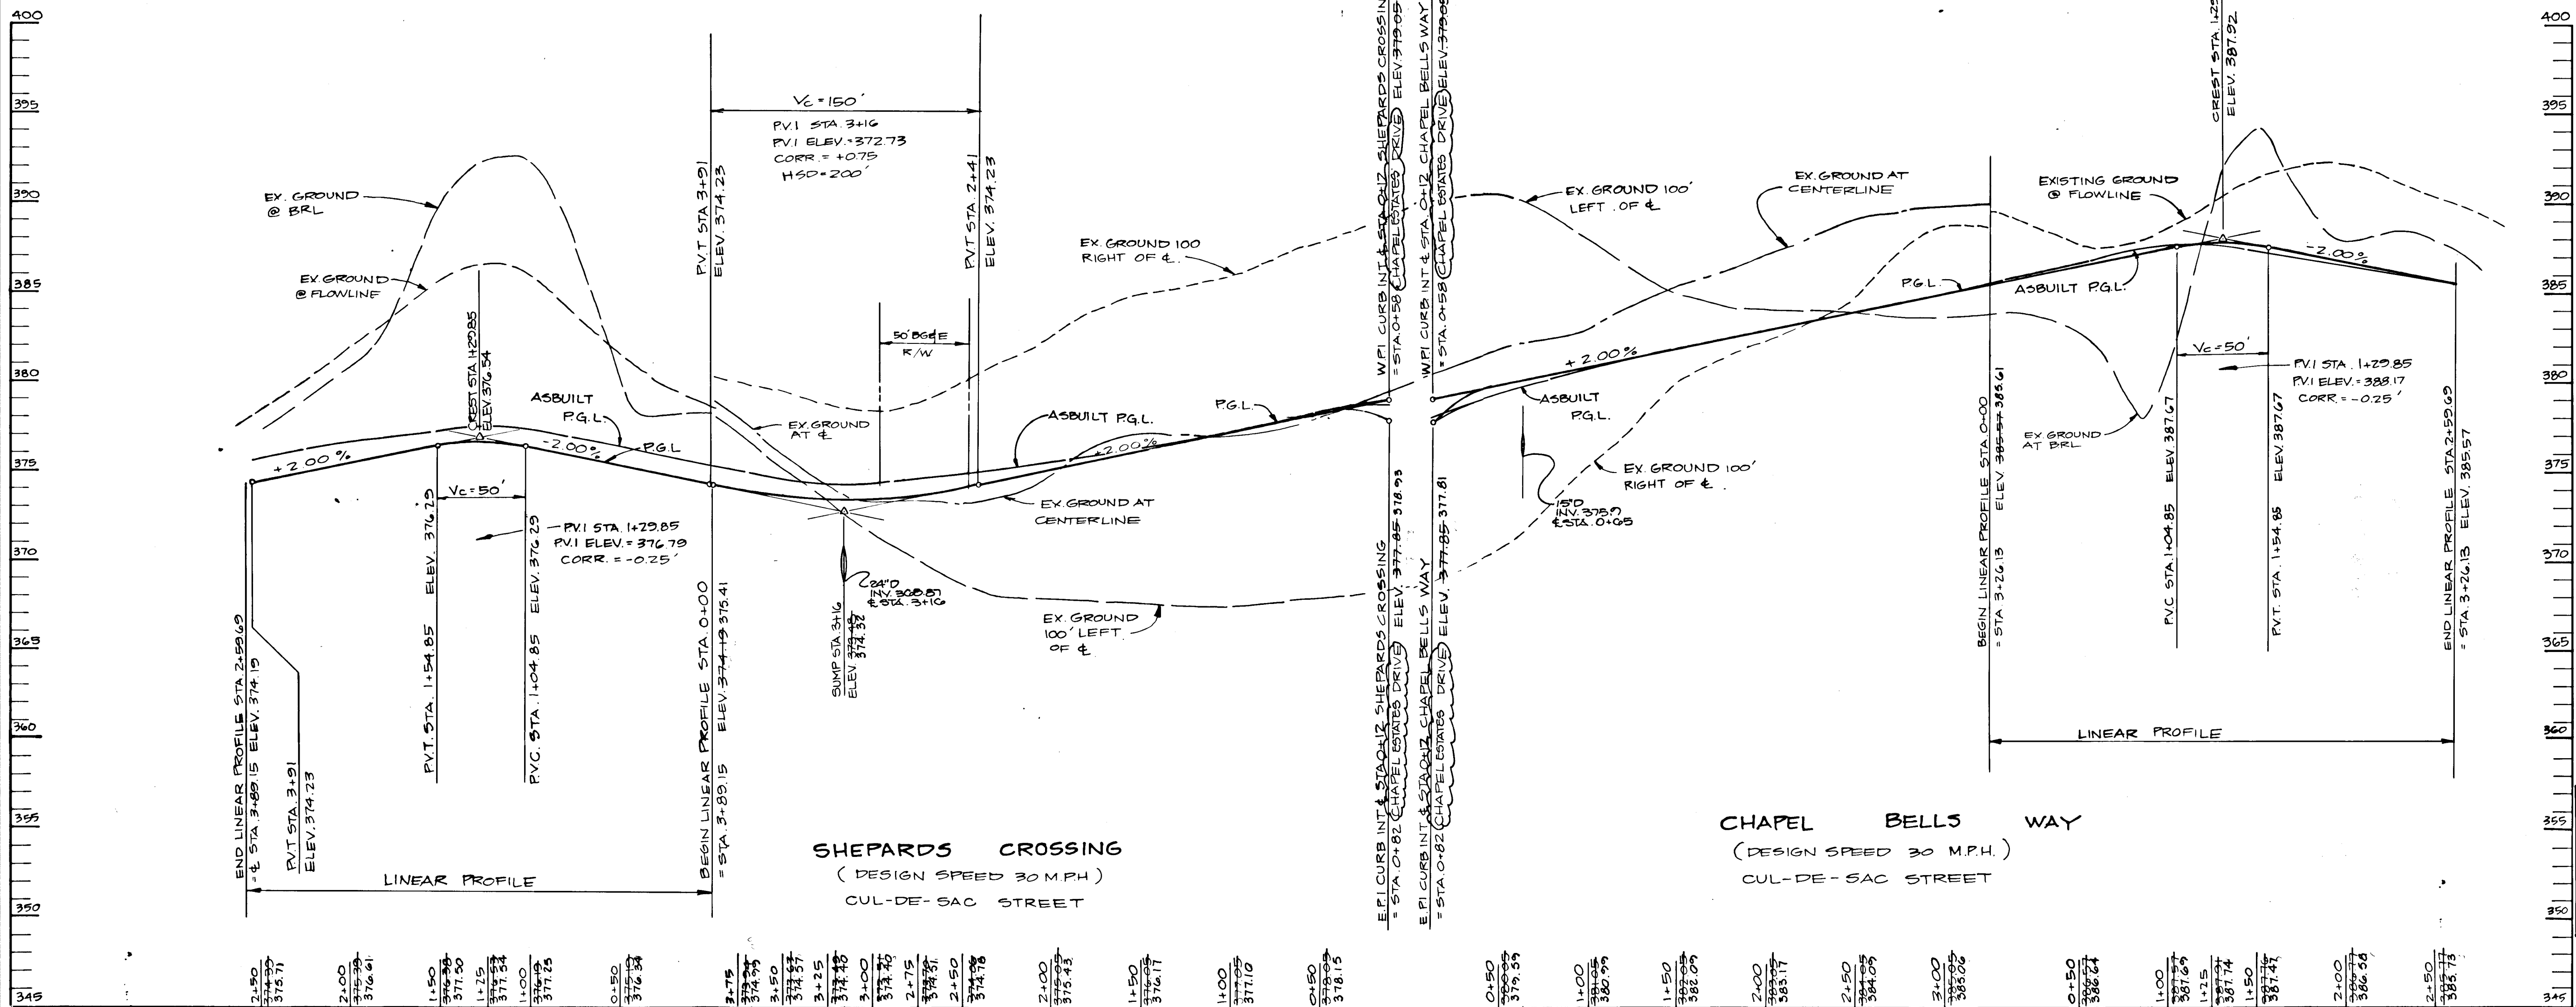

APPROVED: HOWARD COUNTY OFFICE OF PLANNING AND ZONING

Arthur E. Muegge, P.E. 10.8.91
ARTHUR E. MUEGGE #8107 DATE

APPROVED: HOWARD COUNTY DEPARTMENT OF PUBLIC WORKS

Frank S. DeCangelis, Chief, Division of Community Planning and Land Development 4.2.89 DATE

Paul J. Seaman, Chief, Land Development Division 3/21/89 DATE

Francis W. McManus, Chief, Bureau of Highways 8/2/89 DATE

Robert M. Danks, Chief, Bureau of Engineering 7/22/89 DATE

DATE	NO	REVISION
11-20-80	2	REVISE ROAD NAME FOR CHAPEL ESTATES DRIVE

OWNER: J.J.M. PARTNERSHIP
5570 STERRETT PLACE SUITE 201
COLUMBIA, MARYLAND 21044 (301) 740-4466

DEVELOPER: J.J.M. INC.
5570 STERRETT PLACE SUITE 201
COLUMBIA MARYLAND 21044 (301) 740-4466

PROJECT: CHAPEL WOODS II

AREA: TAX MAP # 25 PARCELS 26, 86, 282
5TH ELECTION DISTRICT
HOWARD COUNTY MARYLAND

TITLE: PLAN AND PROFILE OF SHEPARDS CROSSING AND CHAPEL BELLS WAY

THE RIEMER GROUP, INC.
The Riemer Group, Inc. A Land Planning, Design & Civil Engineering Firm
3105 North Ridge Road, Ellicott City, Maryland 21043 (301) 461-2690

DATE: 11-11-88

DESIGNED BY: C.J.R.


DRAWN BY: J.L.B.

PROJECT NO: 28800


DATE: NOVEMBER 7, 1988

SCALE: AS SHOWN


DRAWING NO. 3 OF 15

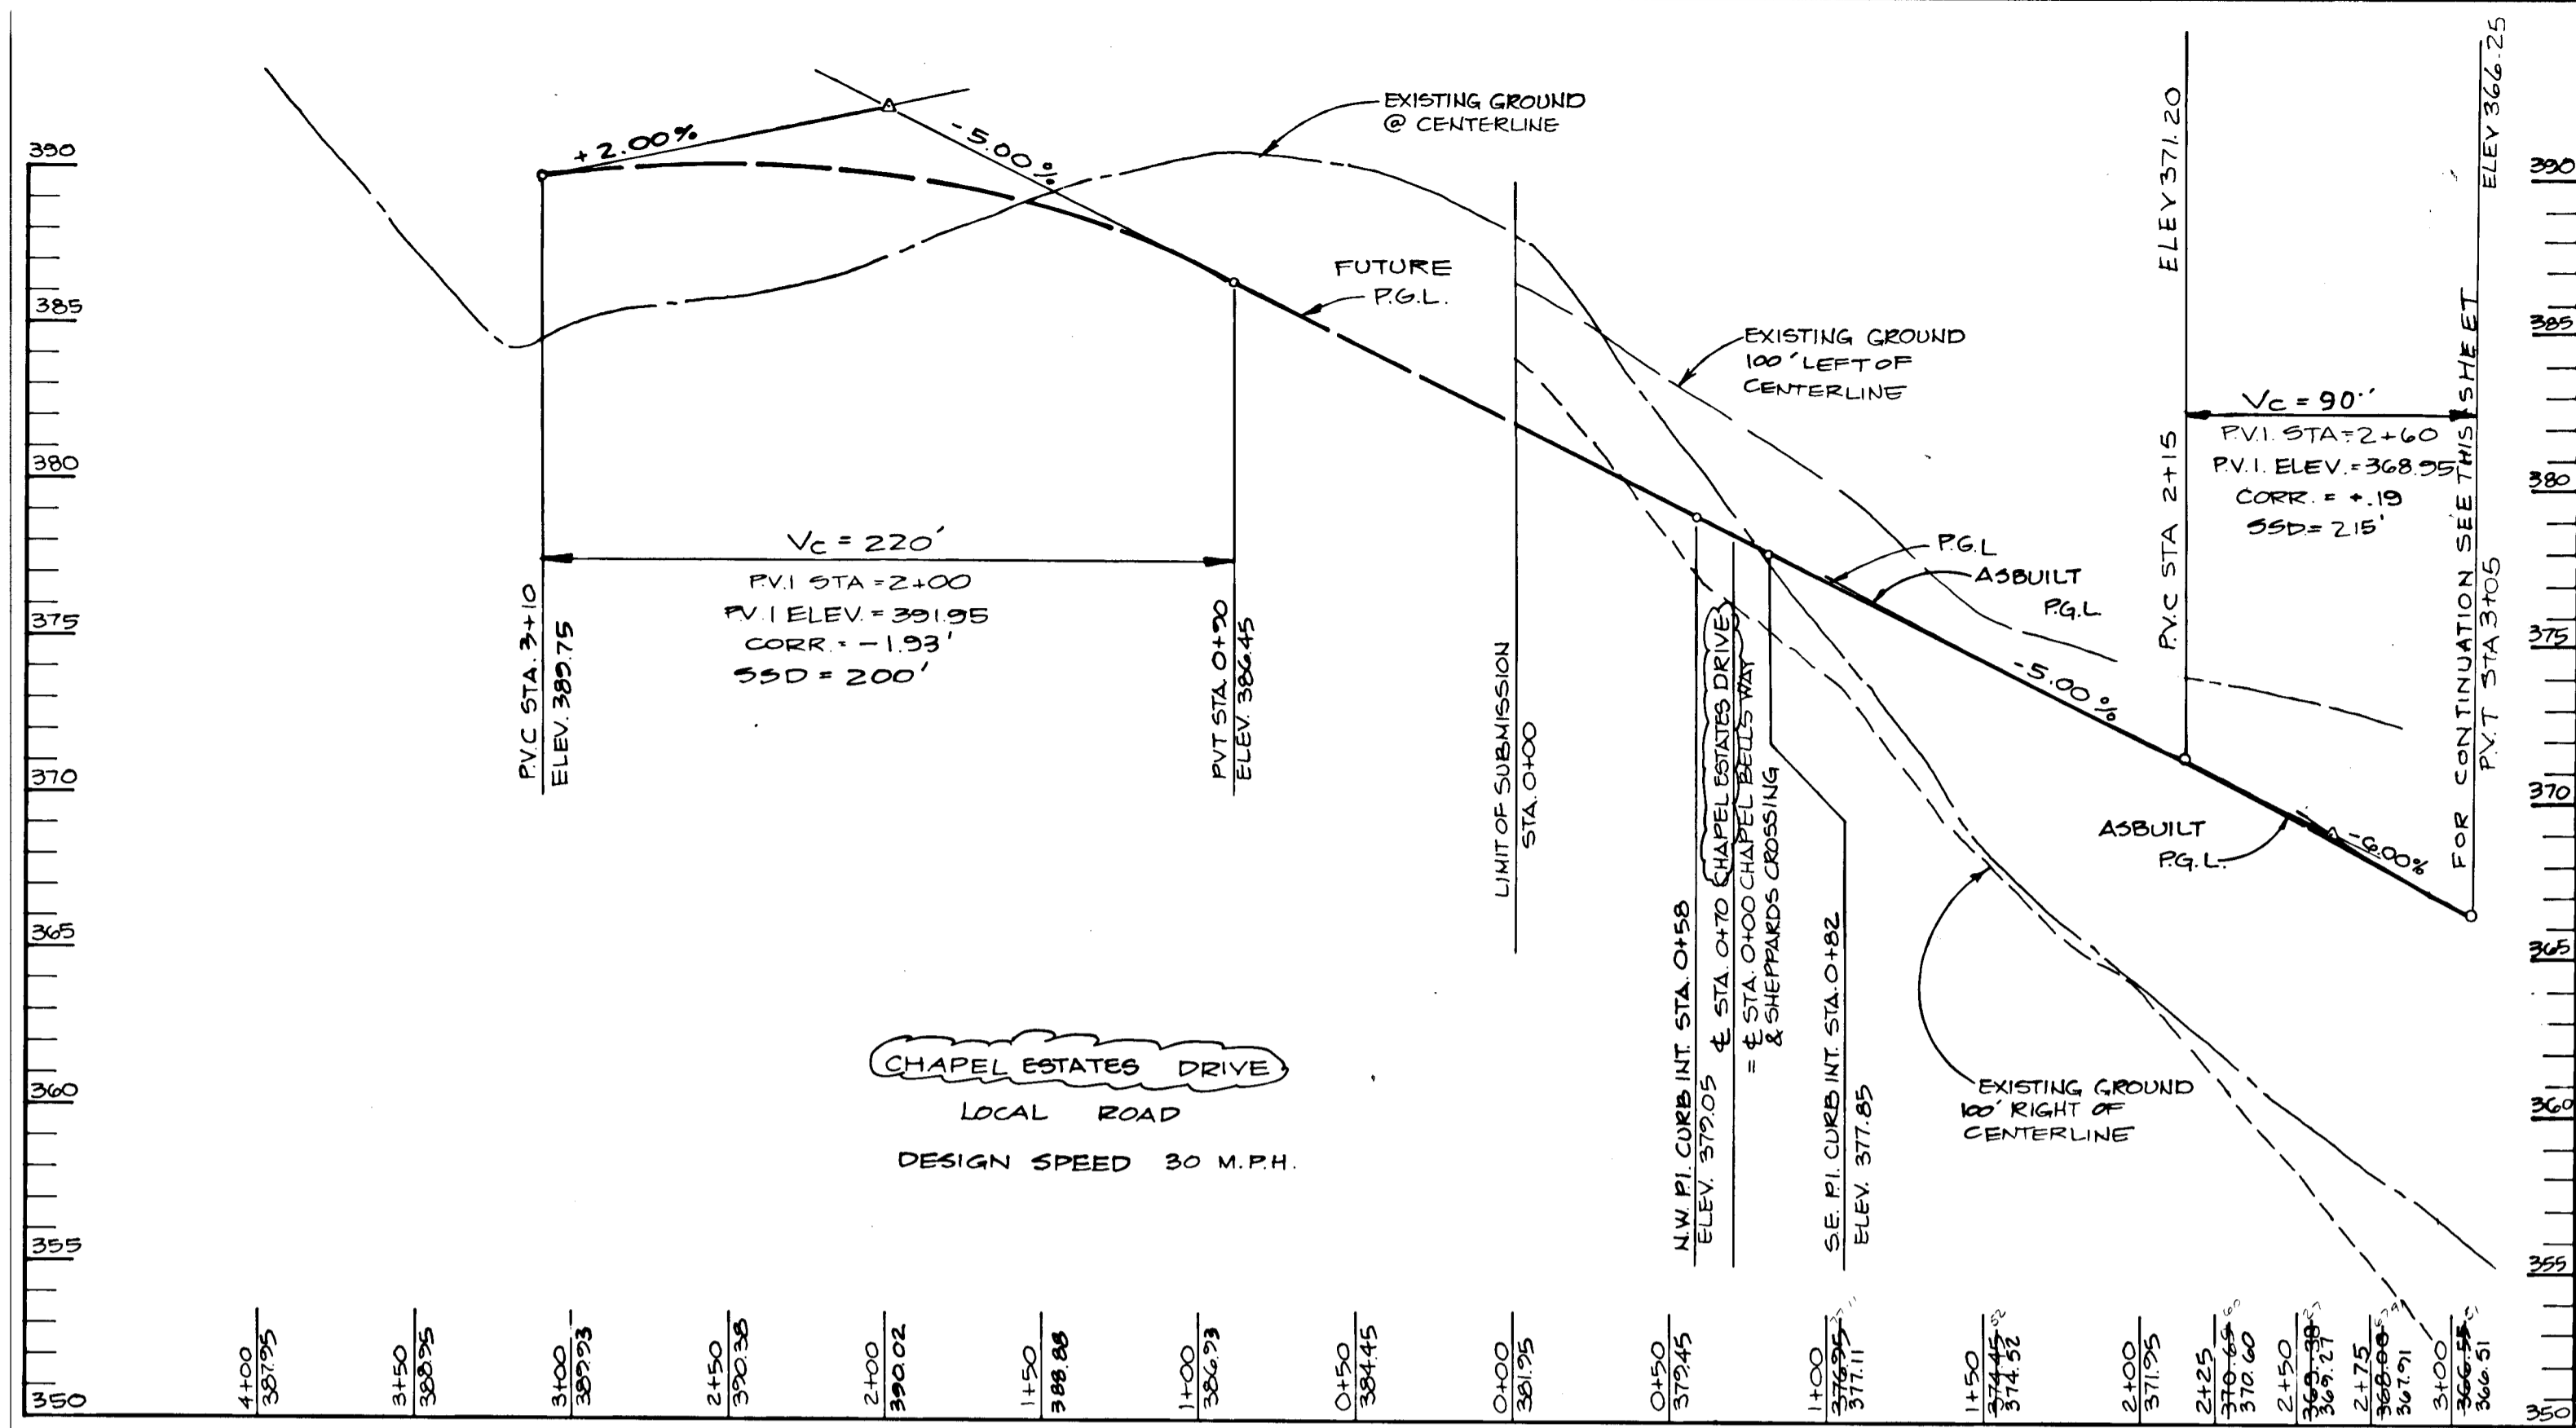



PROFILE
SCALE HOR 1"=50'
VERT 1"=5'

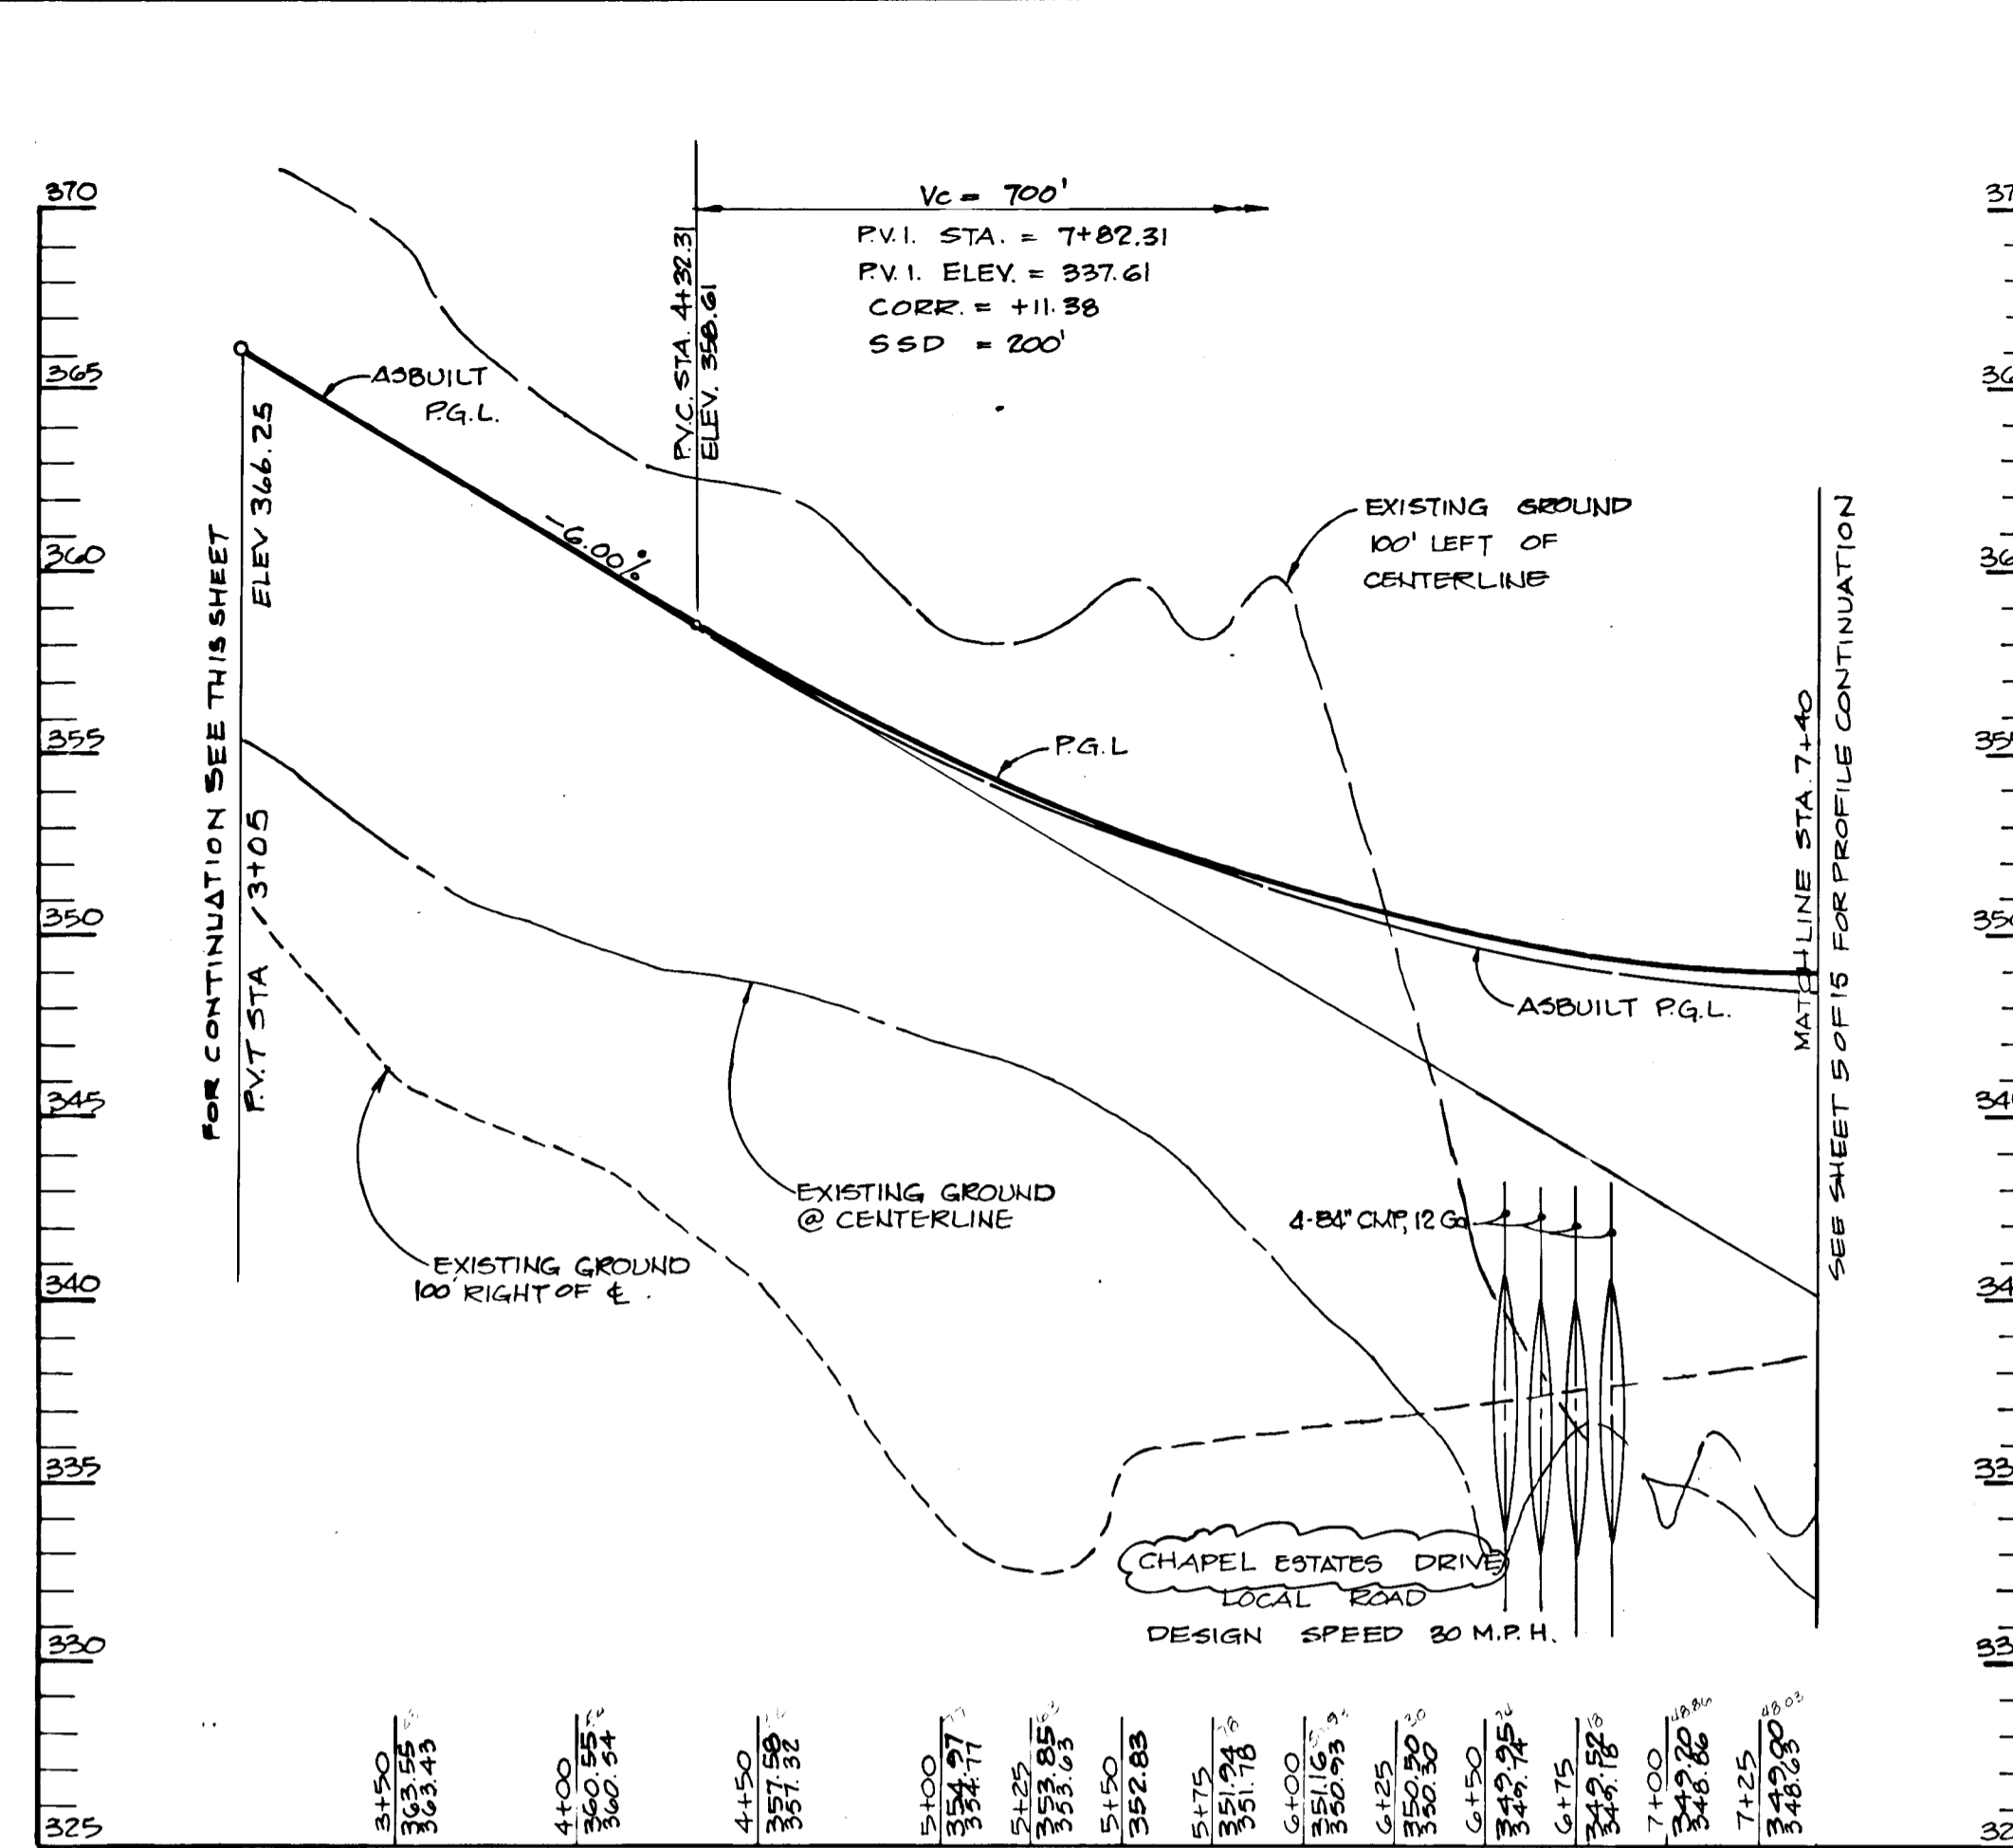


PROFILE
SCALE HOR 1"=50'
VERT 1"=5'

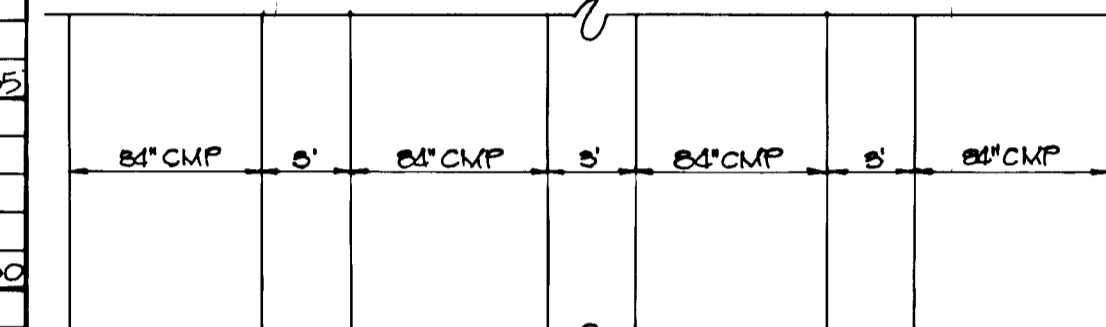


TYPICAL CULVERT SECTION
NO SCALE

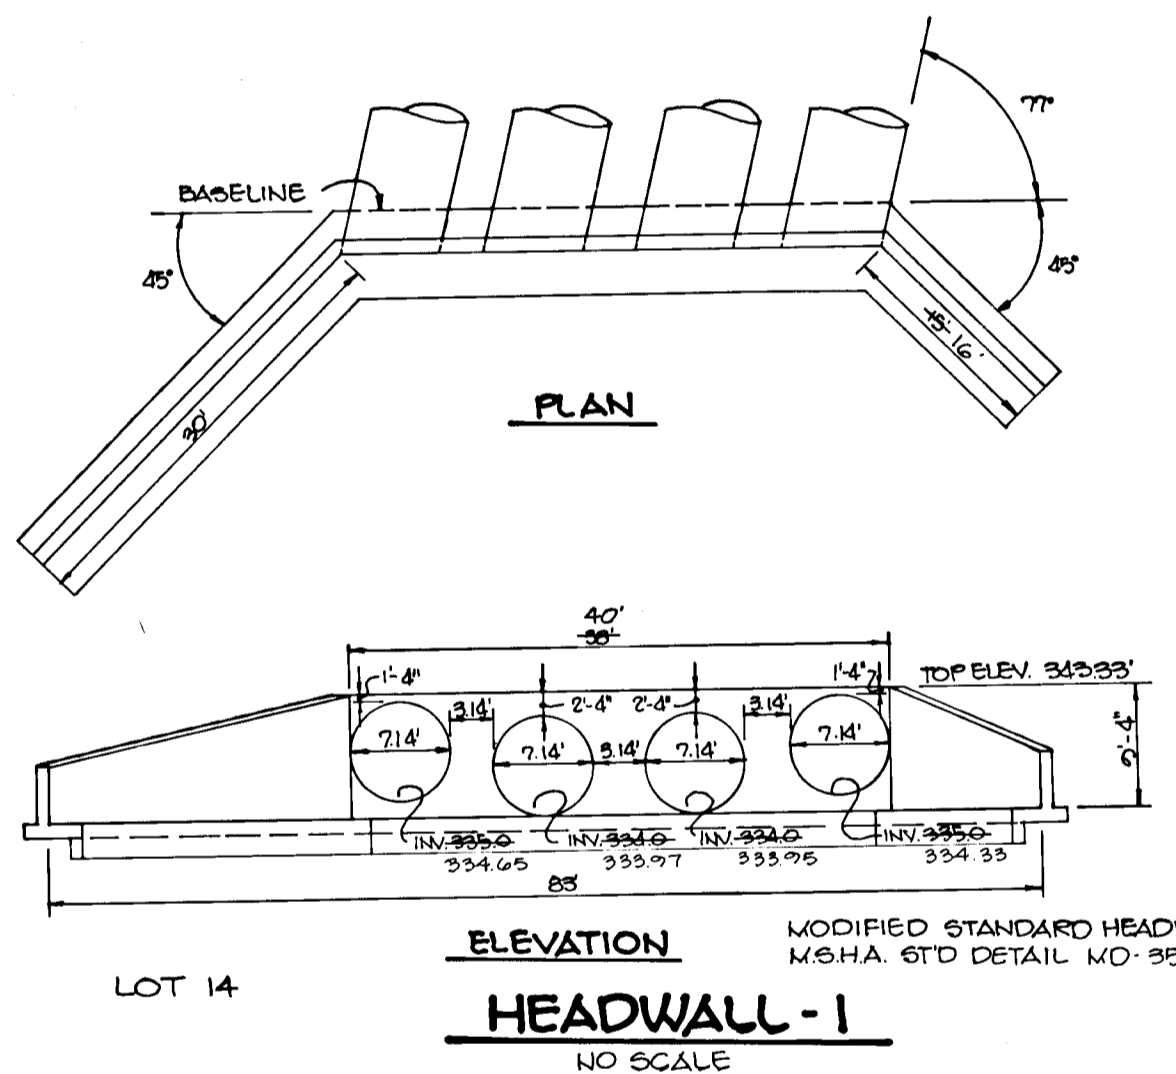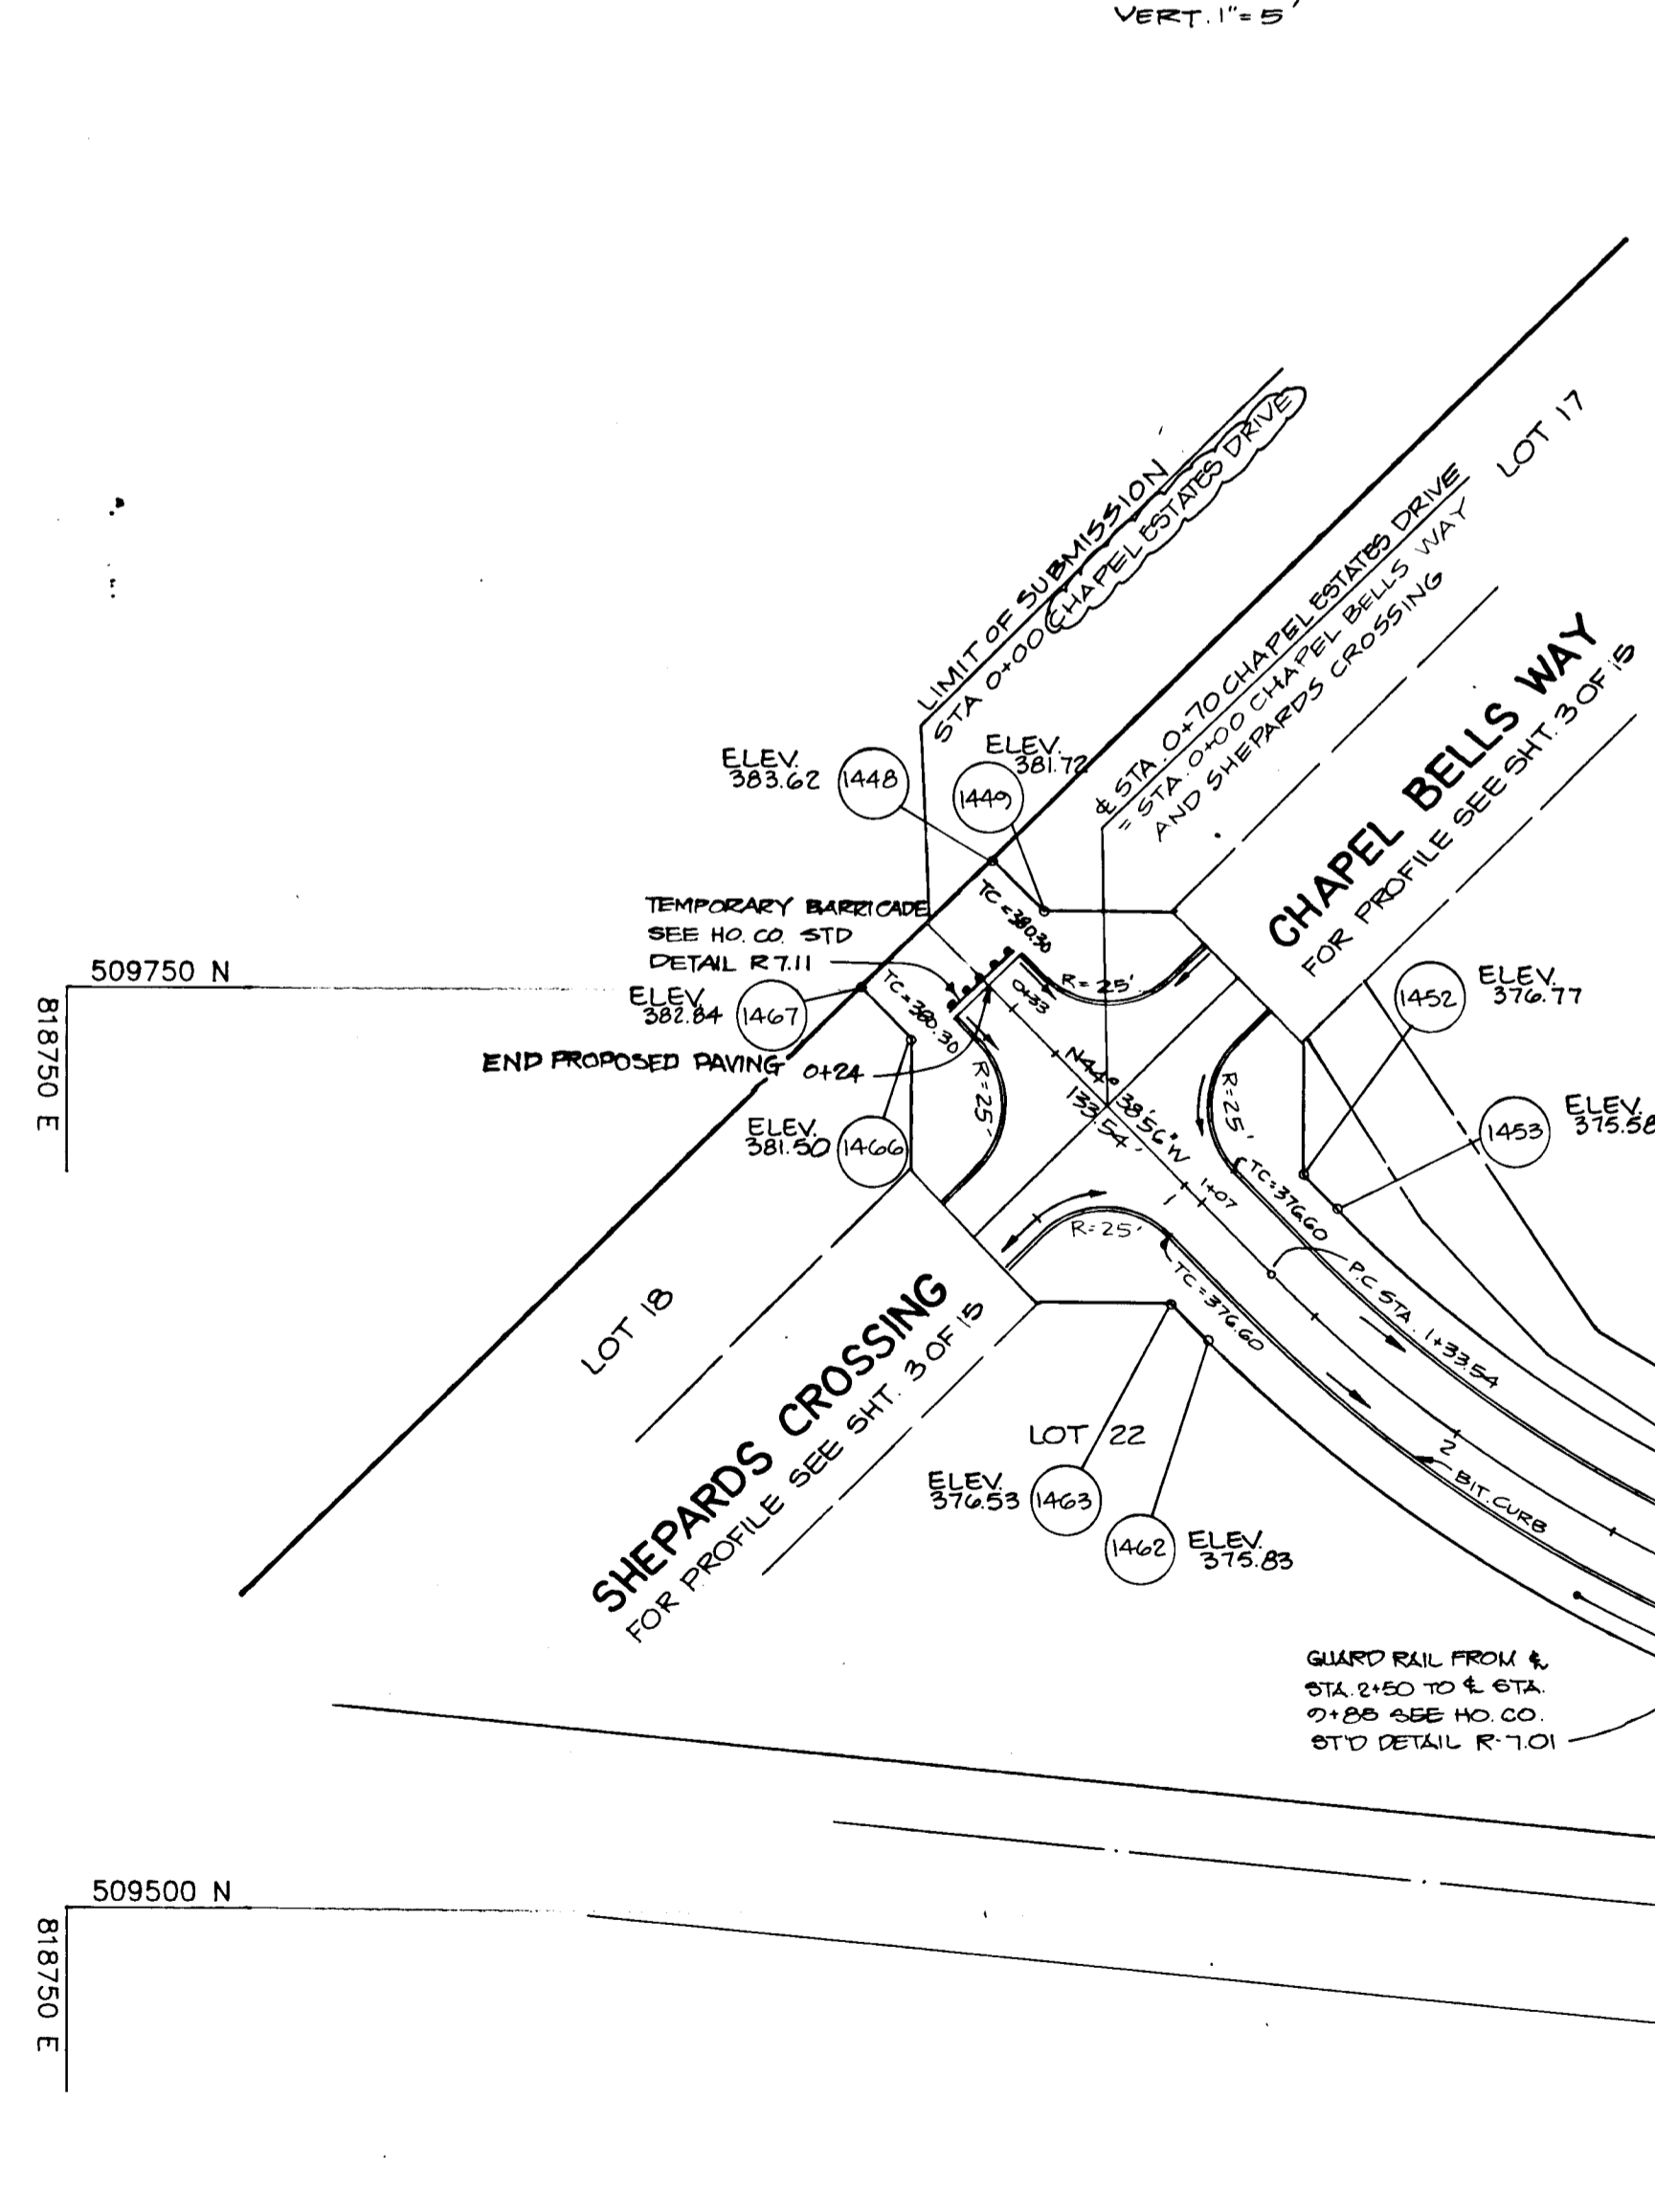

HEADWALL-1
NO SCALE

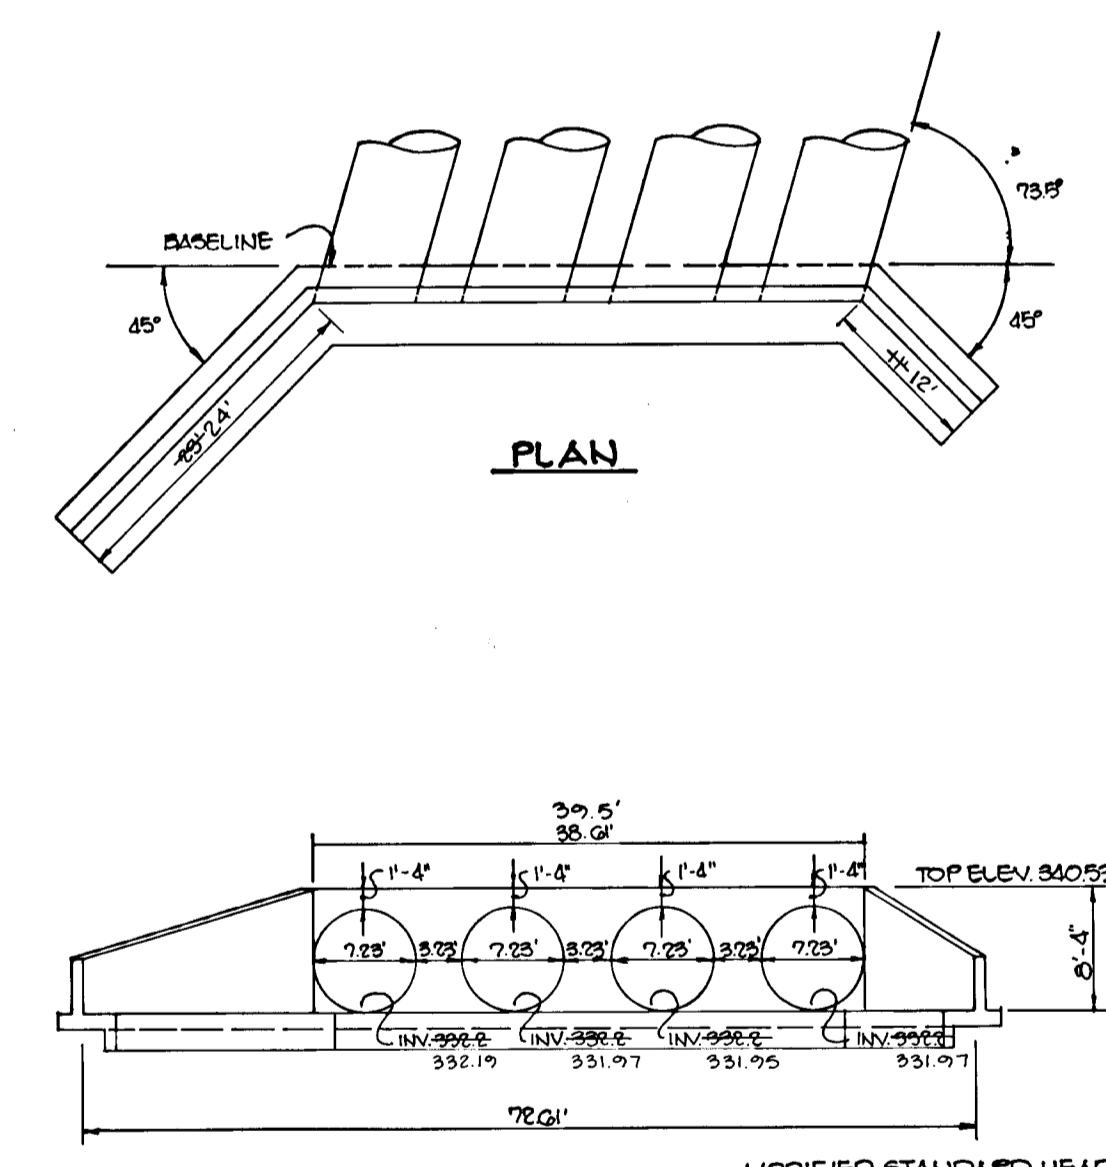

HEADWALL-2
NO SCALE

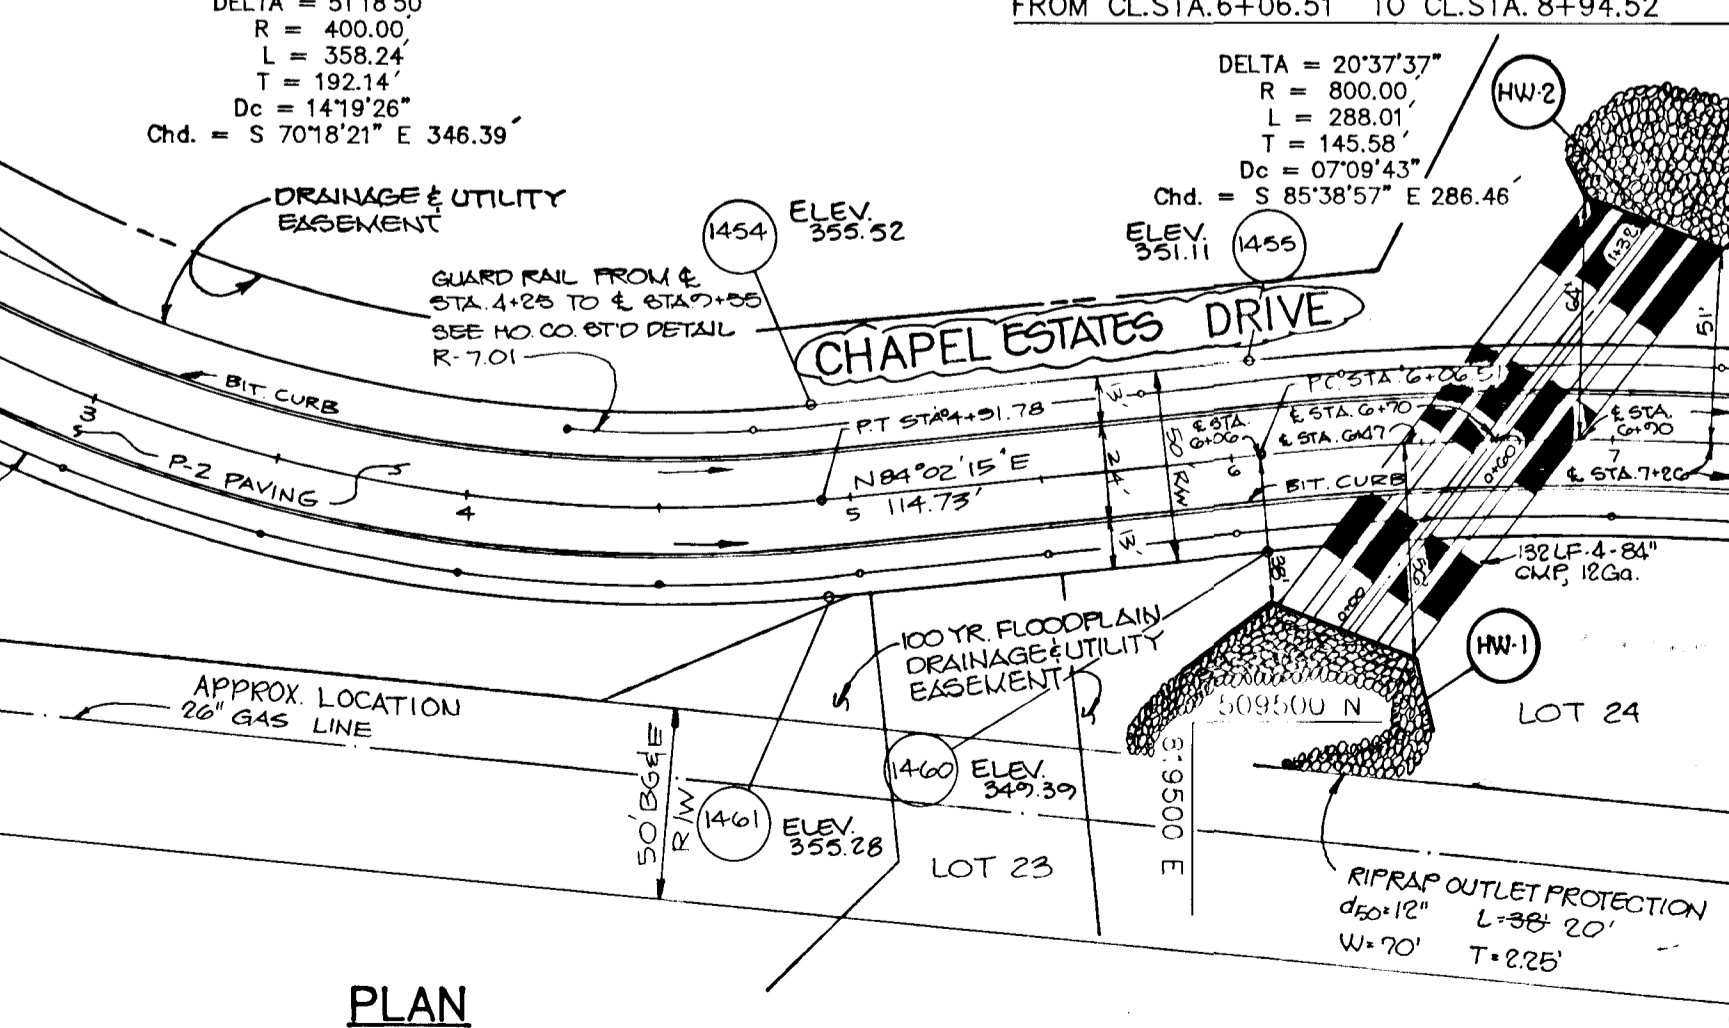

PLAN
SCALE 1"=50'

APPROVED: HOWARD COUNTY OFFICE OF PLANNING AND ZONING
Donna J. Langley 7/2/89
CHIEF, DIVISION OF COMMUNITY PLANNING AND LAND DEVELOPMENT

APPROVED: HOWARD COUNTY DEPARTMENT OF PUBLIC WORKS
Paul Deacon 5/21/89
Chief, Land Development Division
Stanley W. Woodard 7/2/89
Chief, Bureau of Highways
Andrew M. Danek 7/22/89
Chief, Bureau of Engineering

DATE	NO	REVISION
11-20-80	1/2	REVISE ROAD NAME FOR CHAPEL ESTATES DRIVE
12-20-80	1	REPLACED ARCH BRIDGE WITH CULVERTS

OWNER: J.J.M. PARTNERSHIP
5570 STERRETT PLACE SUITE 201
COLUMBIA, MARYLAND 21044 (301) 740-4466


DEVELOPER: J.J.M. INC.
5570 STERRETT PLACE SUITE 201
COLUMBIA MARYLAND 21044 (301) 740-4466





PROJECT: **CHAPEL WOODS II**
AREA: TAX MAP N# 20 PARCELS 26, 28, 28.2
5TH ELECTION DISTRICT
HOWARD COUNTY MARYLAND

TITLE: **PLAN AND PROFILE OF CHAPEL ESTATES DRIVE**


THE RIEMER GROUP, INC.
The Riemer Group, Inc. A Land Planning, Design & Civil Engineering Firm
3105 North Ridge Road, Ellicott City, Maryland 21043 (301) 461-2690

DATE: 11-11-88
DESIGNED BY: C.J.R.
DRAWN BY: J.L.B.
PROJECT NO: 28800
DATE: NOVEMBER 7, 1988
SCALE: AS SHOWN
DRAWING NO: 4 OF 15

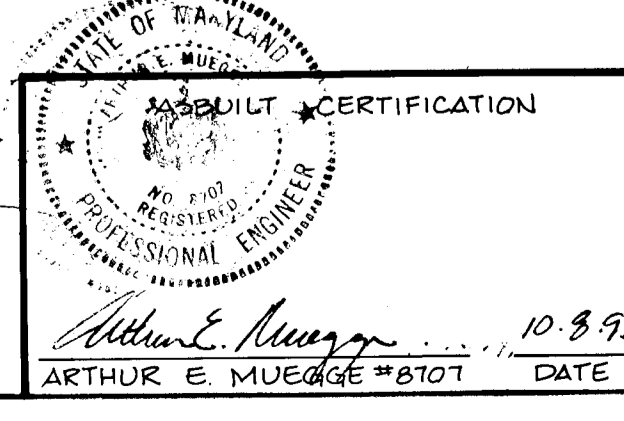

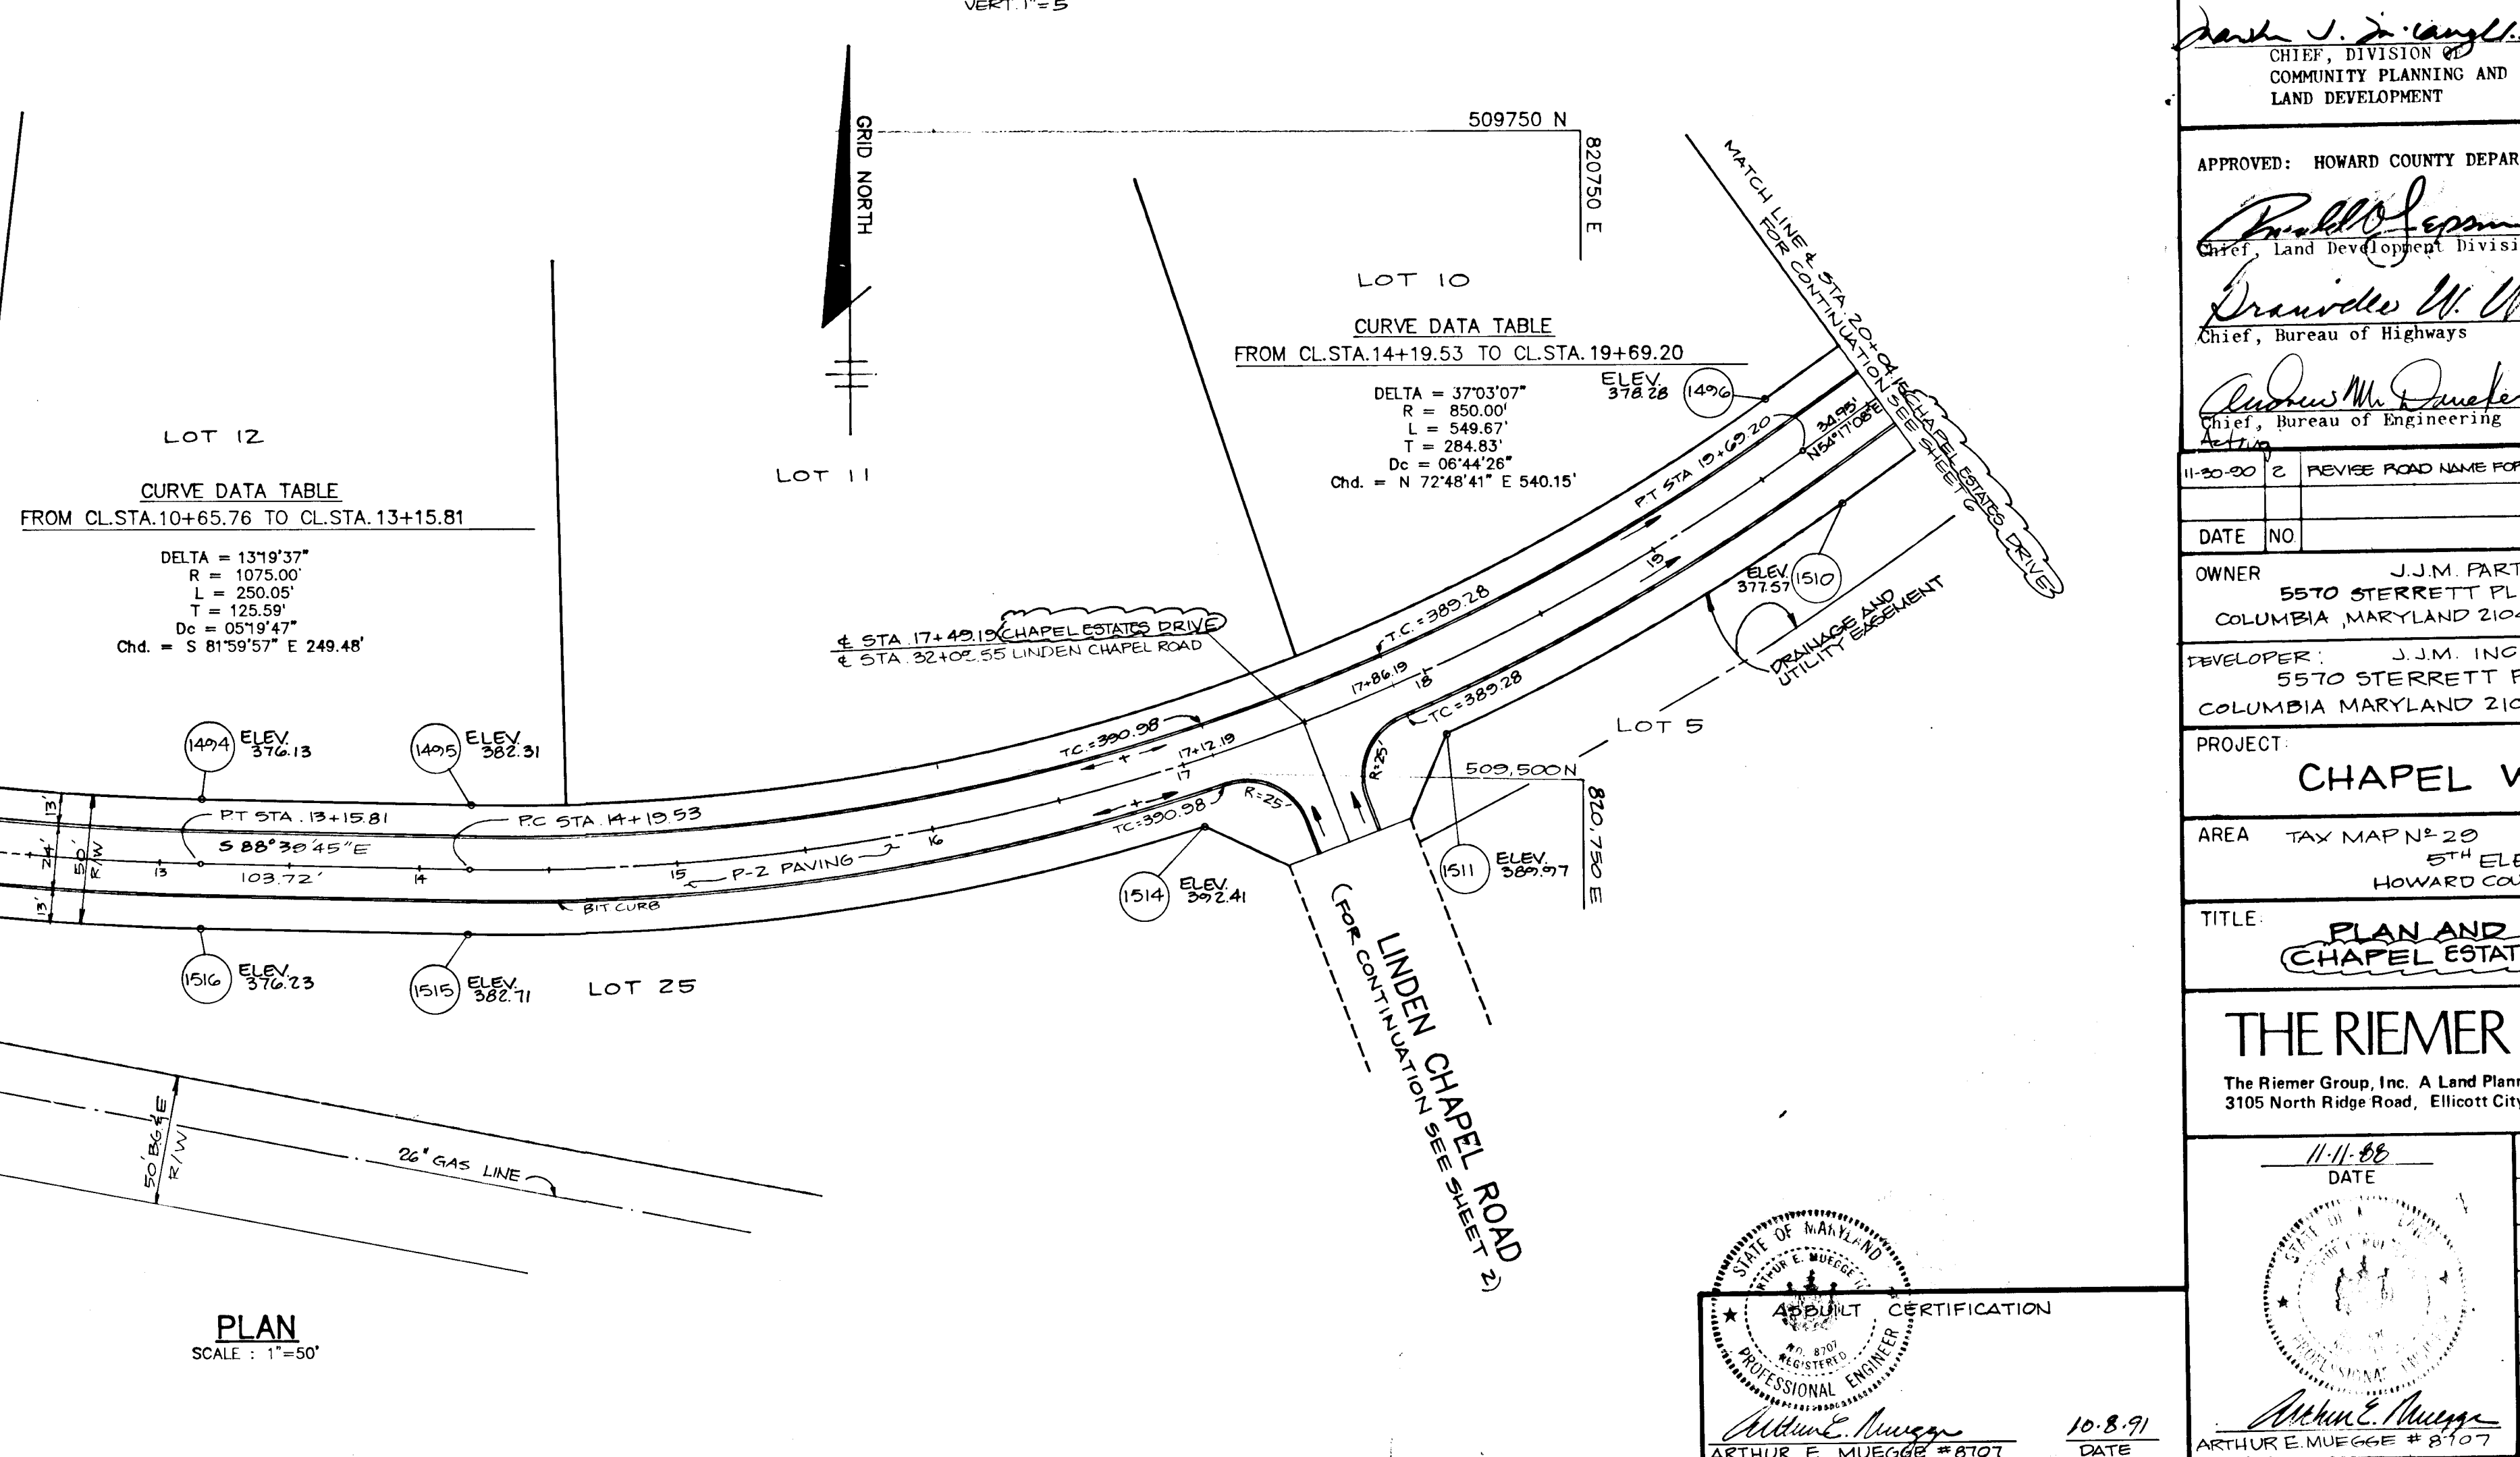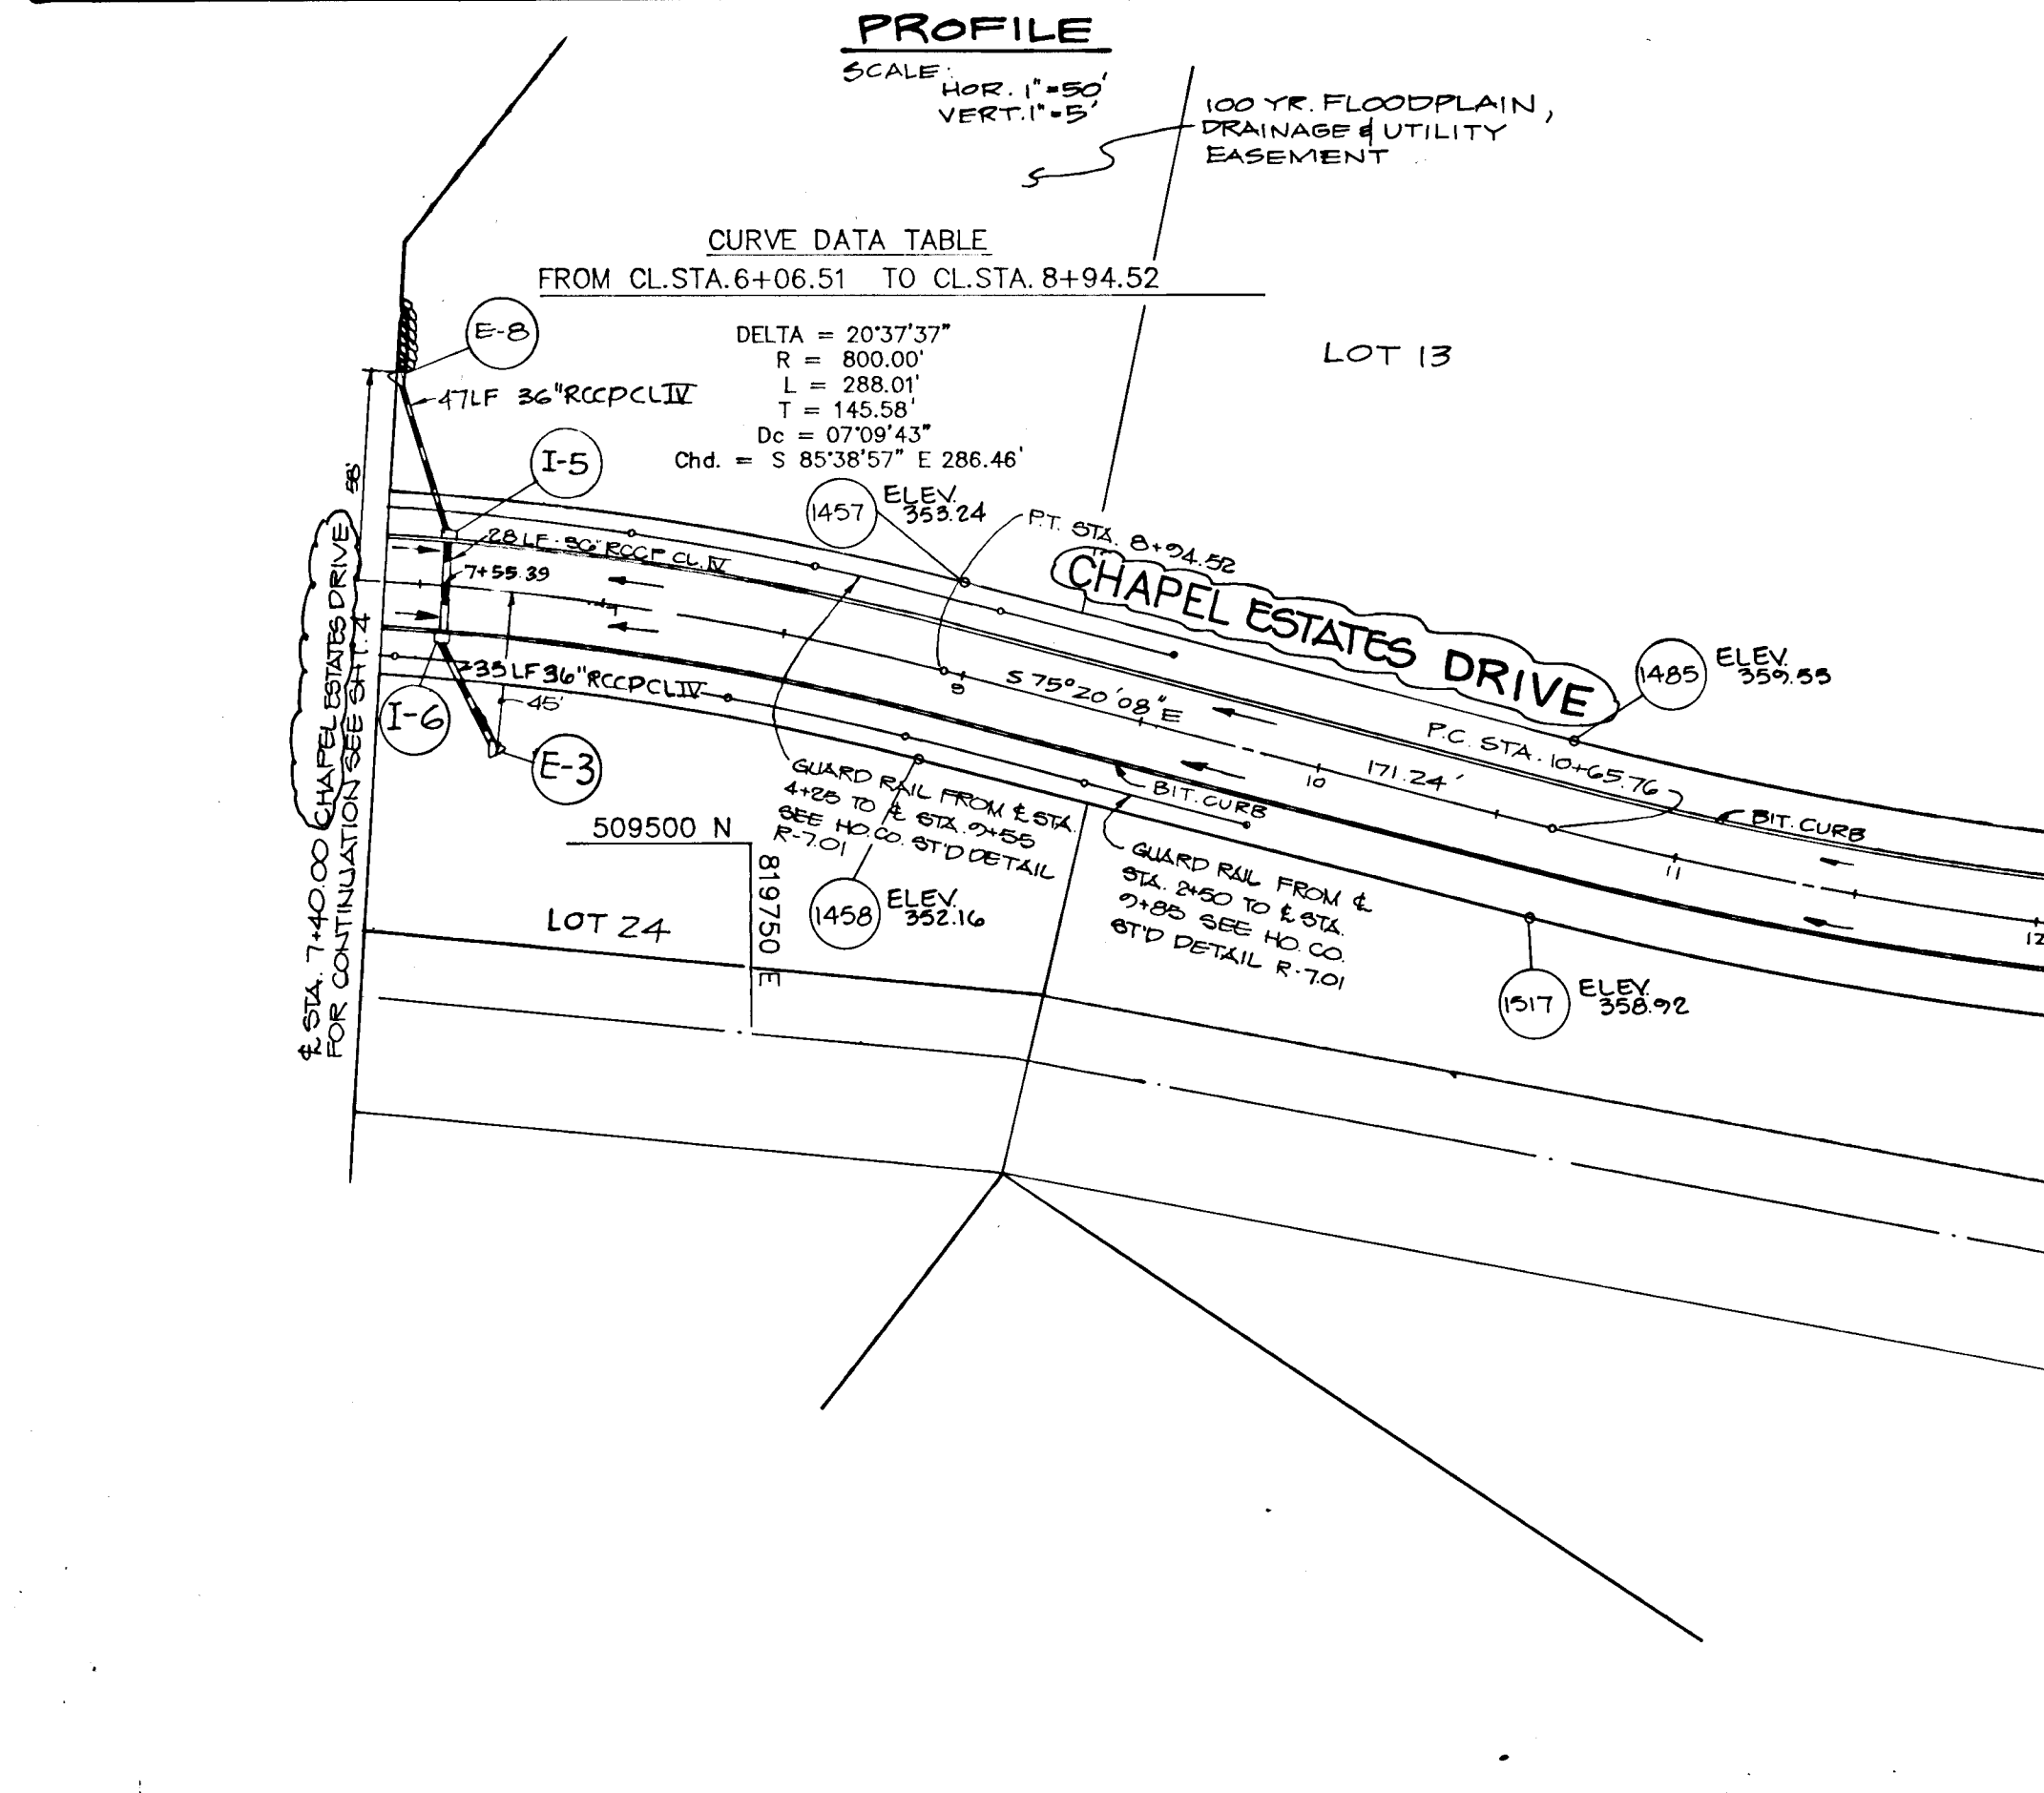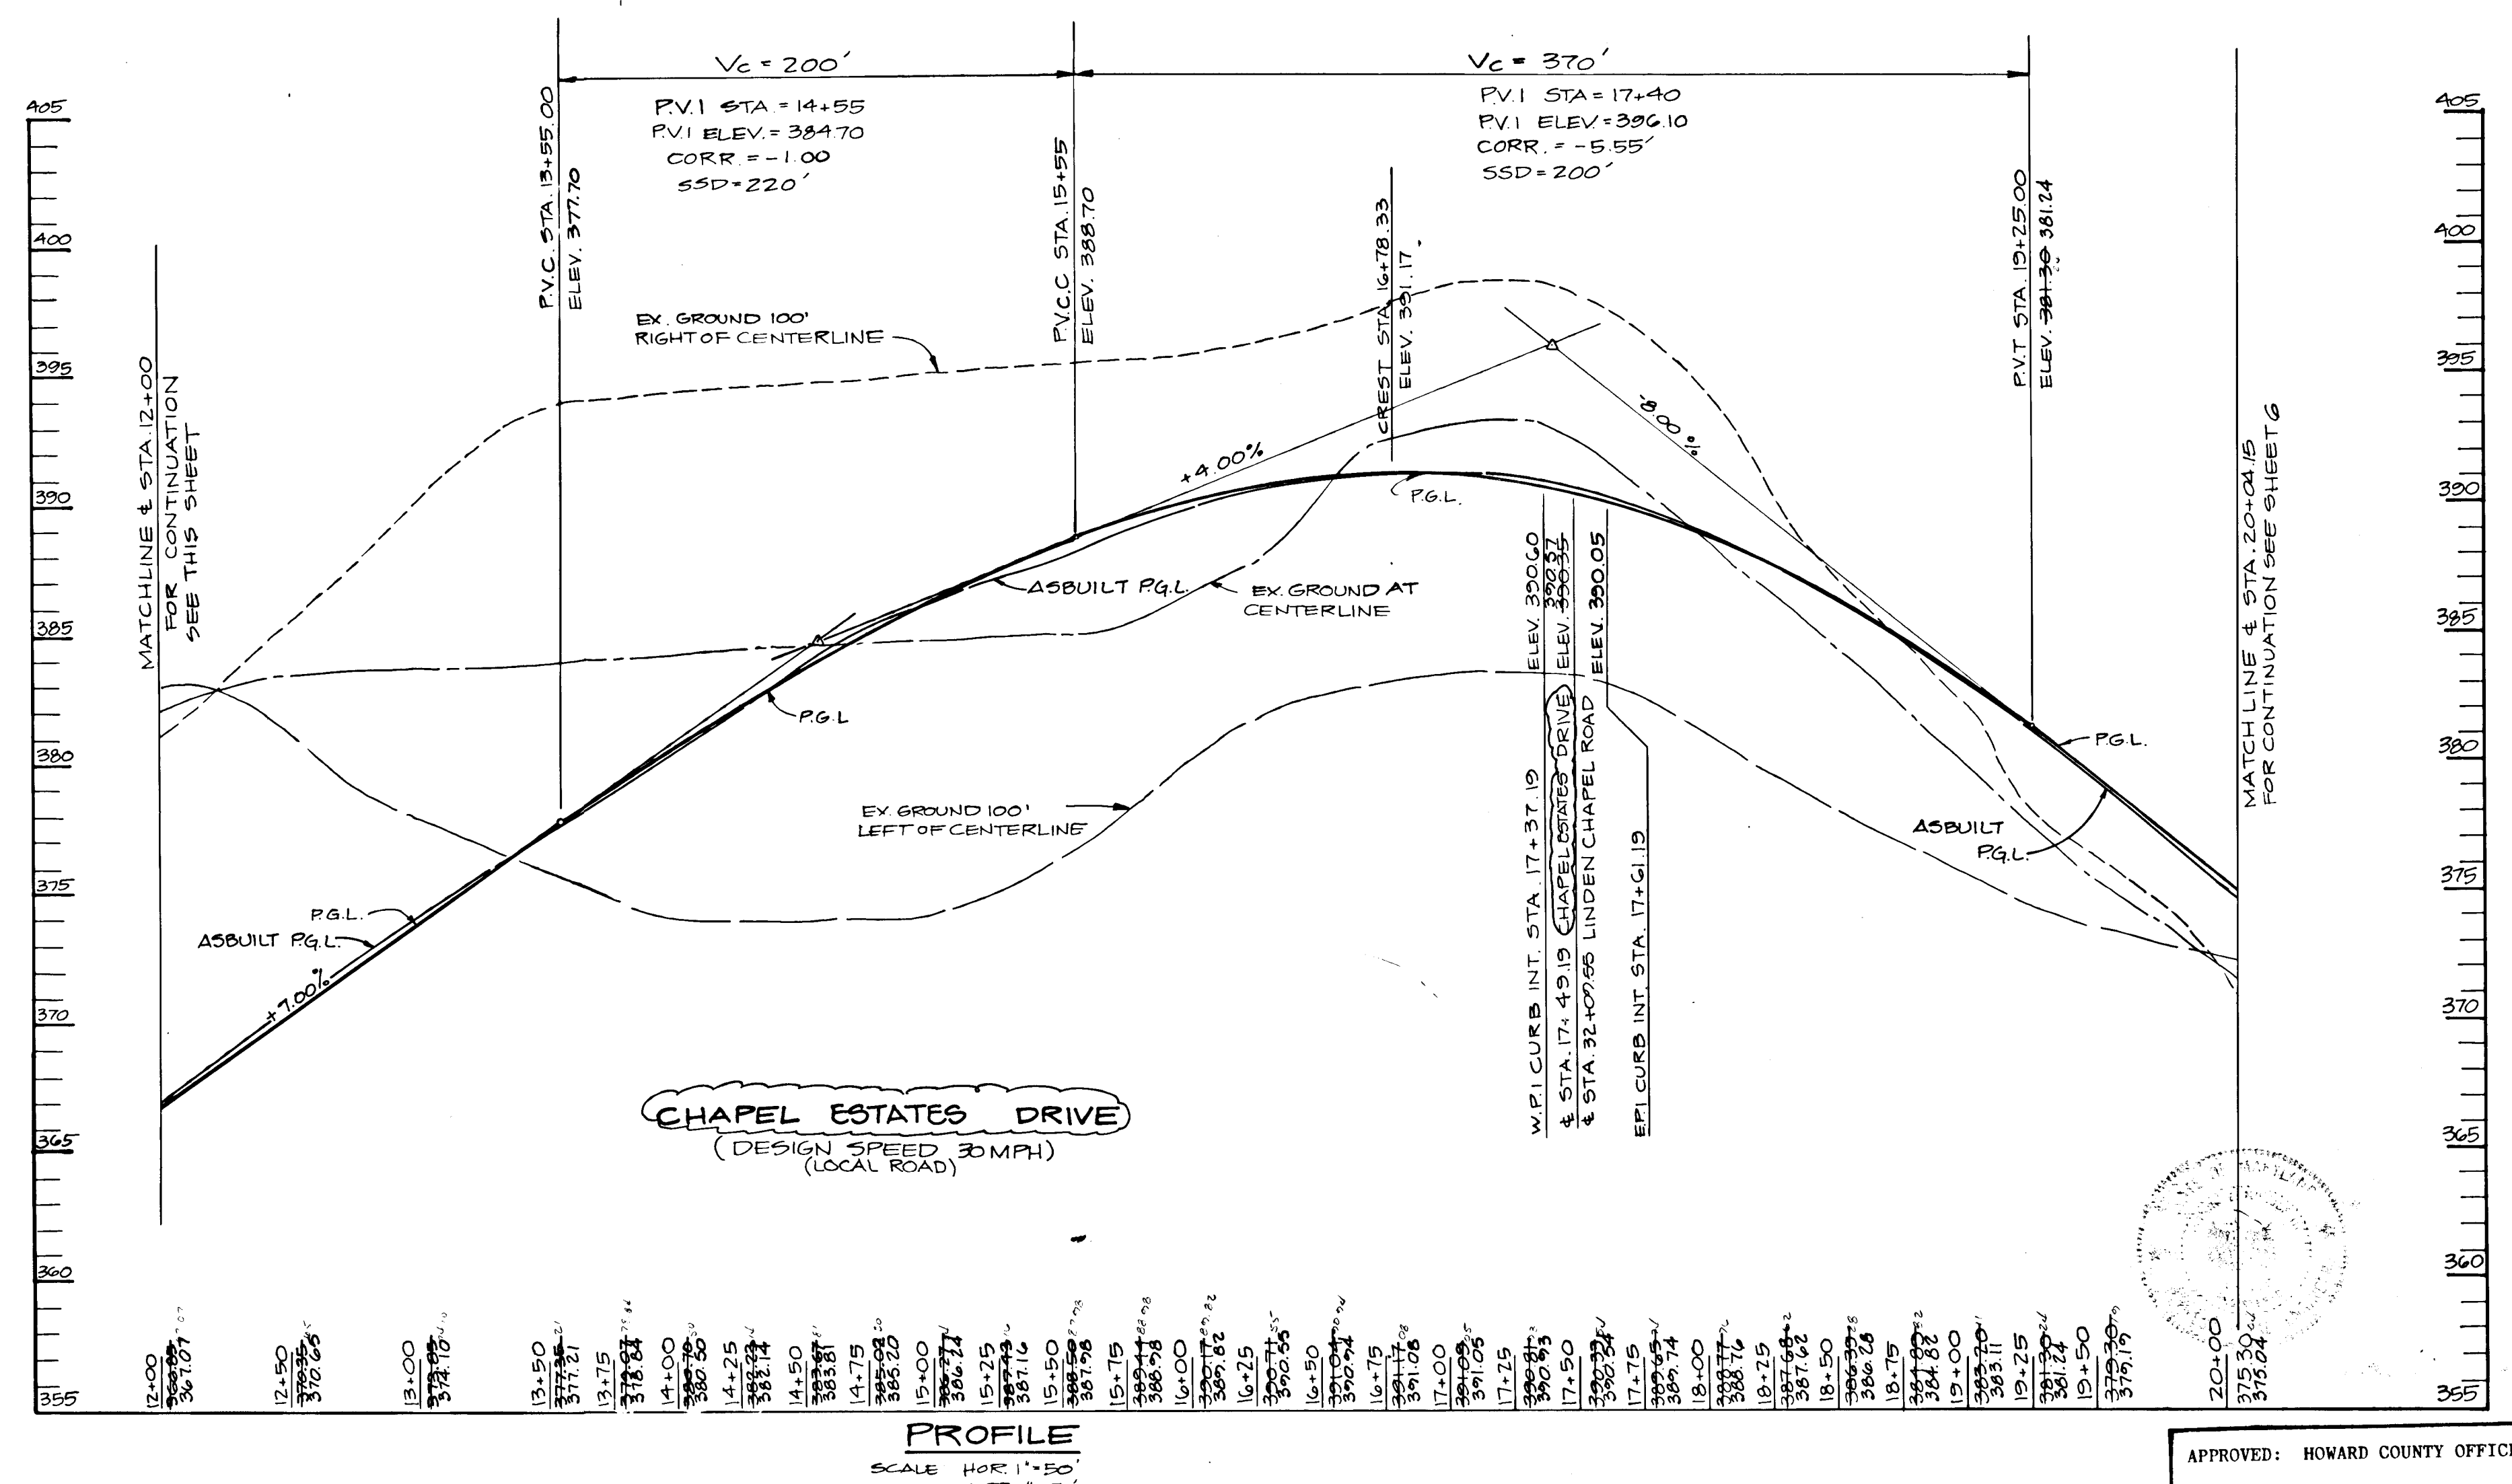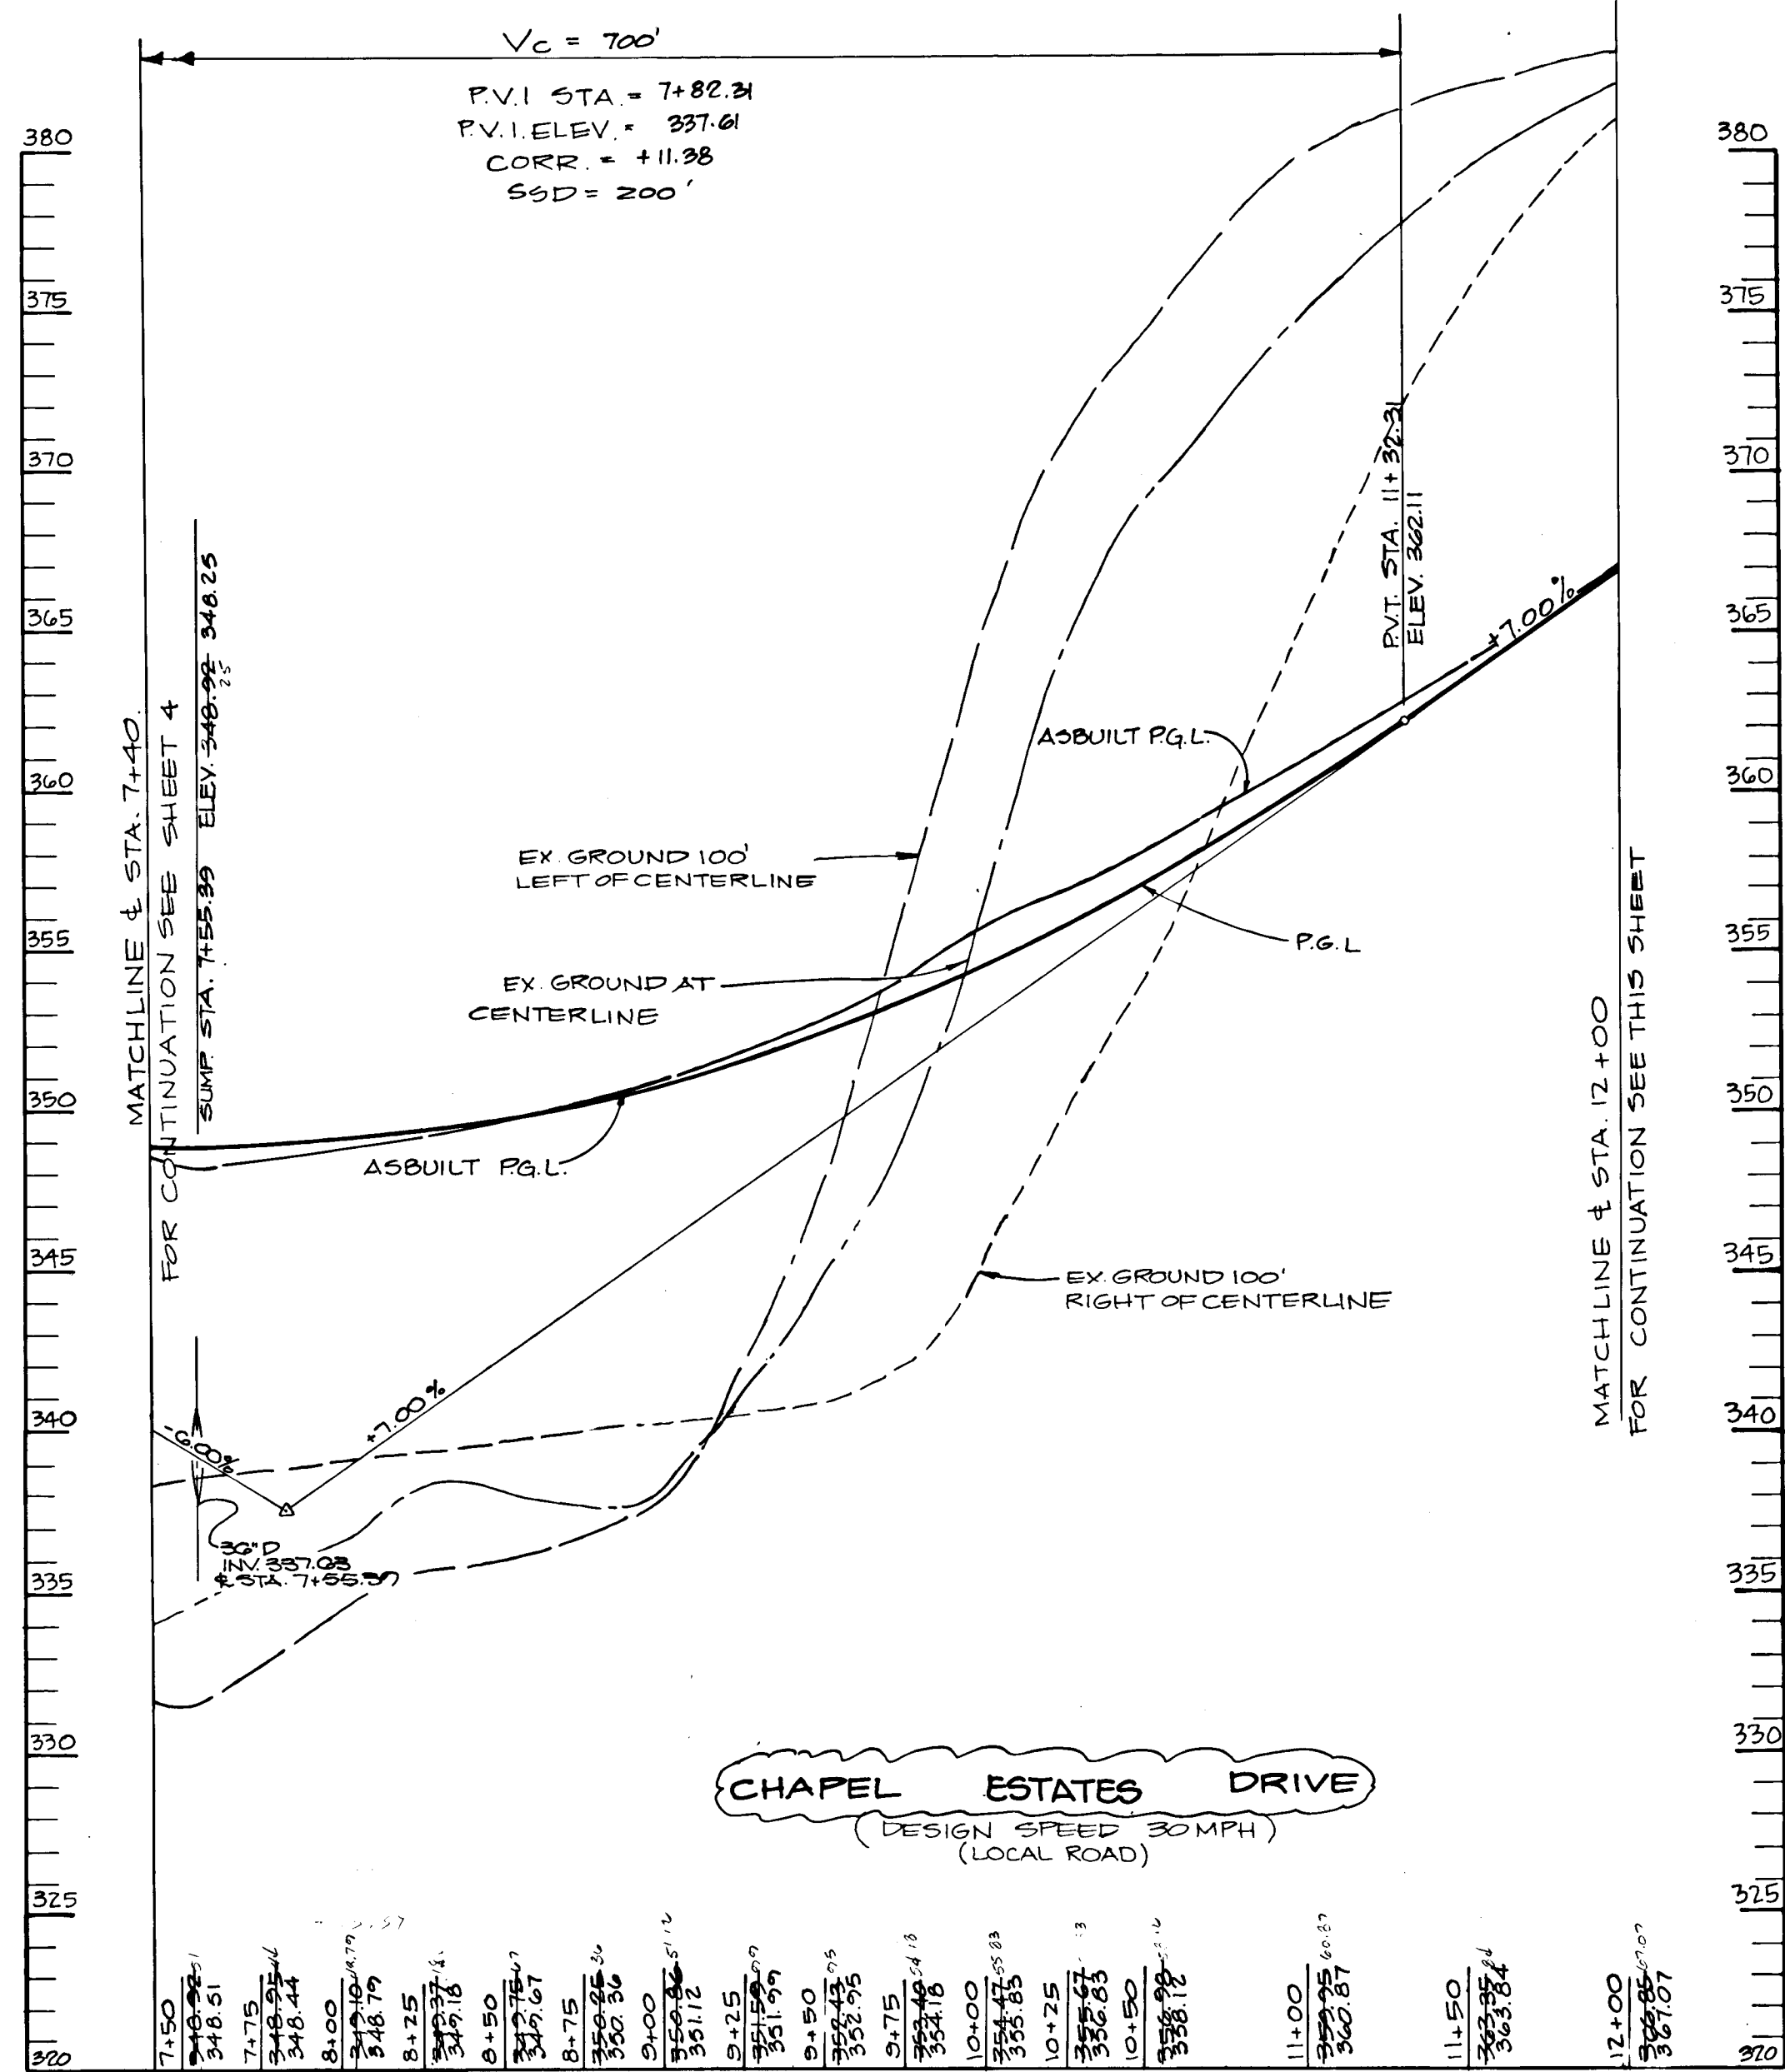

717

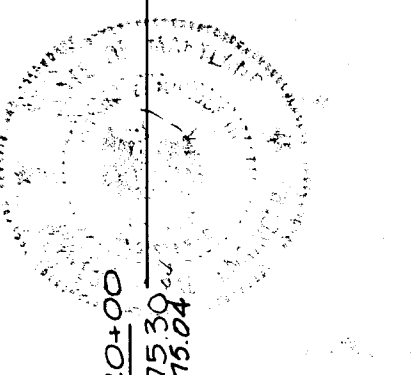

APPROVED: HOWARD COUNTY OFFICE OF PLANNING AND ZONING
 Chief, Division of Community Planning and Land Development
 Date: 9-7-89

APPROVED: HOWARD COUNTY DEPARTMENT OF PUBLIC WORKS
 Chief, Land Development Division
 Date: 3/2/89
 Chief, Bureau of Highways
 Date: 3/2/89
 Chief, Bureau of Engineering
 Date: 7/2/89

DATE	NO.	REVISION
11-30-80	2	REVISE ROAD NAME FOR CHAPEL ESTATES DRIVE

OWNER: J.J.M. PARTNERSHIP
 5570 STERRETT PLACE SUITE 201
 COLUMBIA, MARYLAND 21044 (301) 740-4466

DEVELOPER: J.J.M. INC.
 5570 STERRETT PLACE SUITE 201
 COLUMBIA, MARYLAND 21044 (301) 740-4466


PROJECT: CHAPEL WOODS II

AREA: TAX MAP N# 20 PARCELS 26, 26, 28, 22
 5TH ELECTION DISTRICT
 HOWARD COUNTY MARYLAND



TITLE: PLAN AND PROFILE OF CHAPEL ESTATES DRIVE

THE RIEMER GROUP, INC.
 The Riemer Group, Inc. A Land Planning, Design & Civil Engineering Firm
 3105 North Ridge Road, Ellicott City, Maryland 21043 (301) 461-2690

DATE: 11-11-88
 DESIGNED BY: C.J.R.
 DRAWN BY: J.L.B.
 PROJECT NO: 28800
 DATE: NOVEMBER 7, 1988
 SCALE: AS SHOWN
 DRAWING NO. 5 OF 15

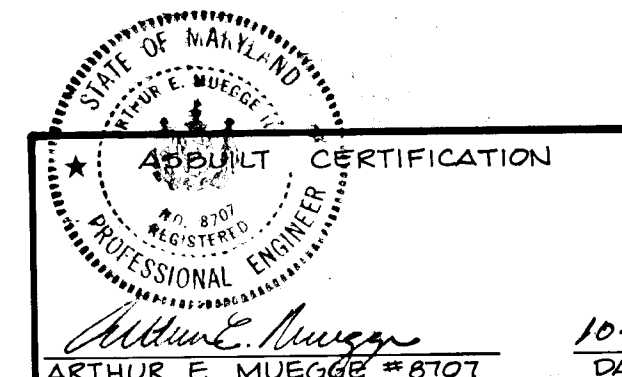

F-88-231 ASBUILT OCT. 8, 1991

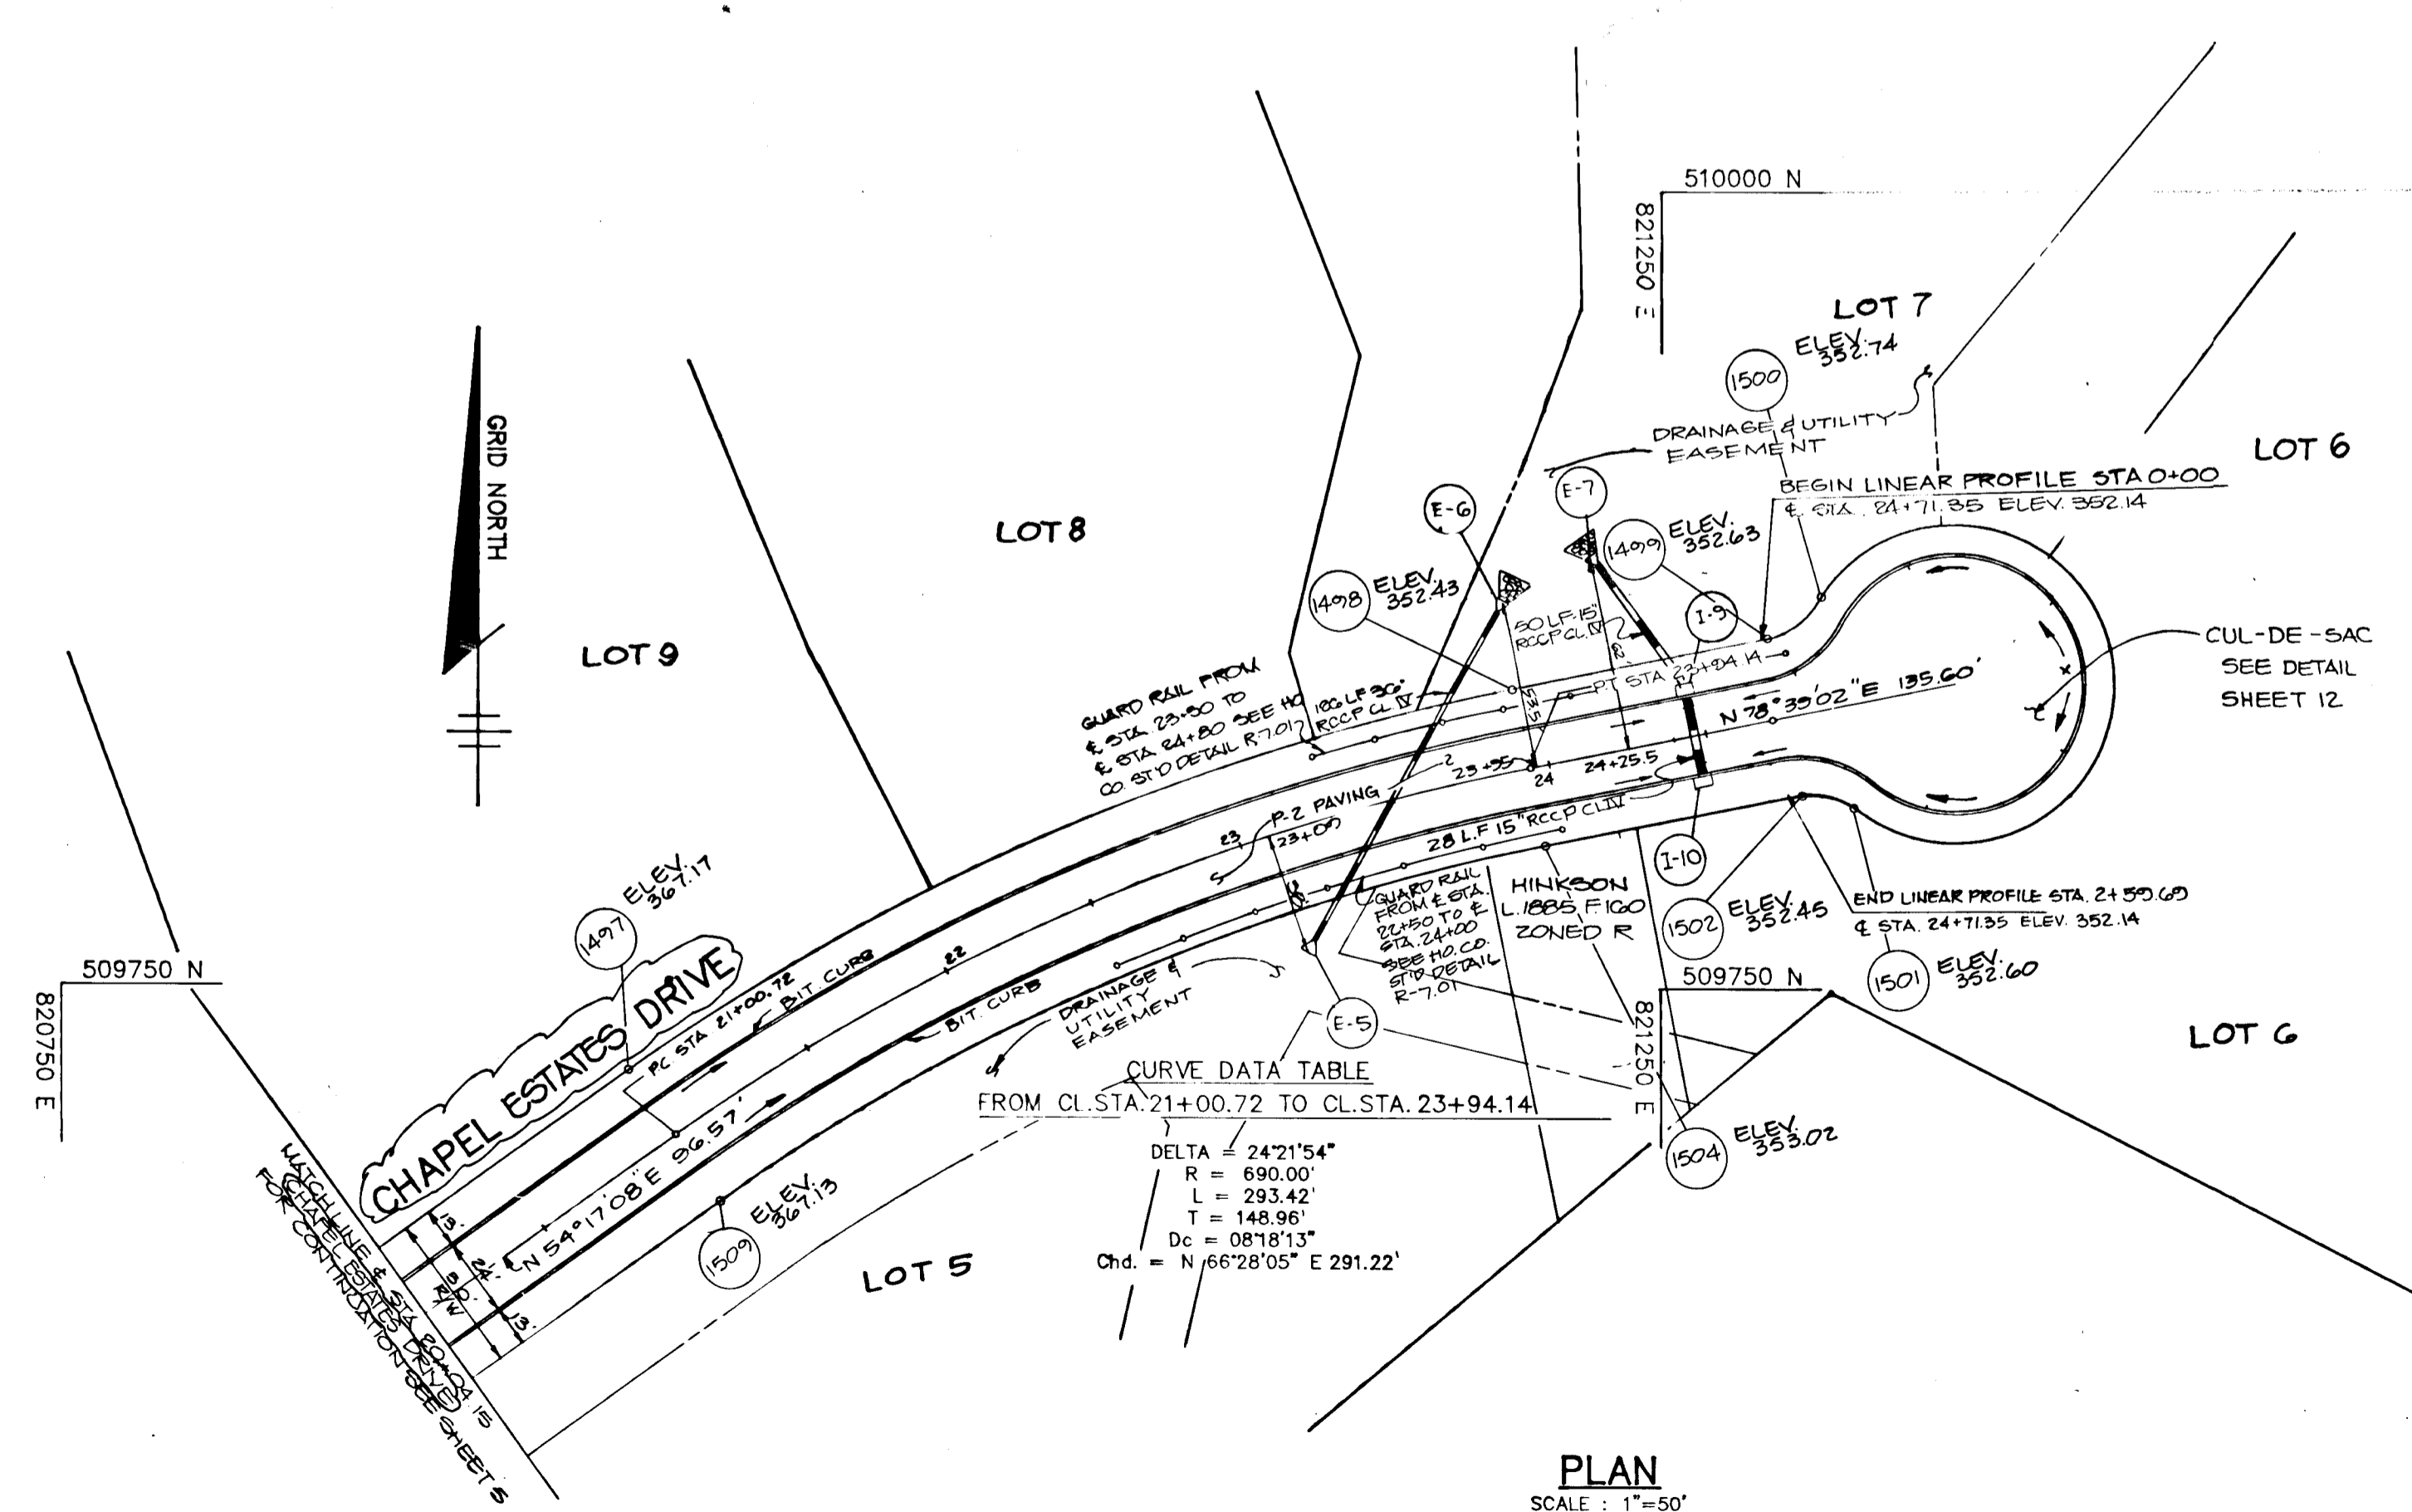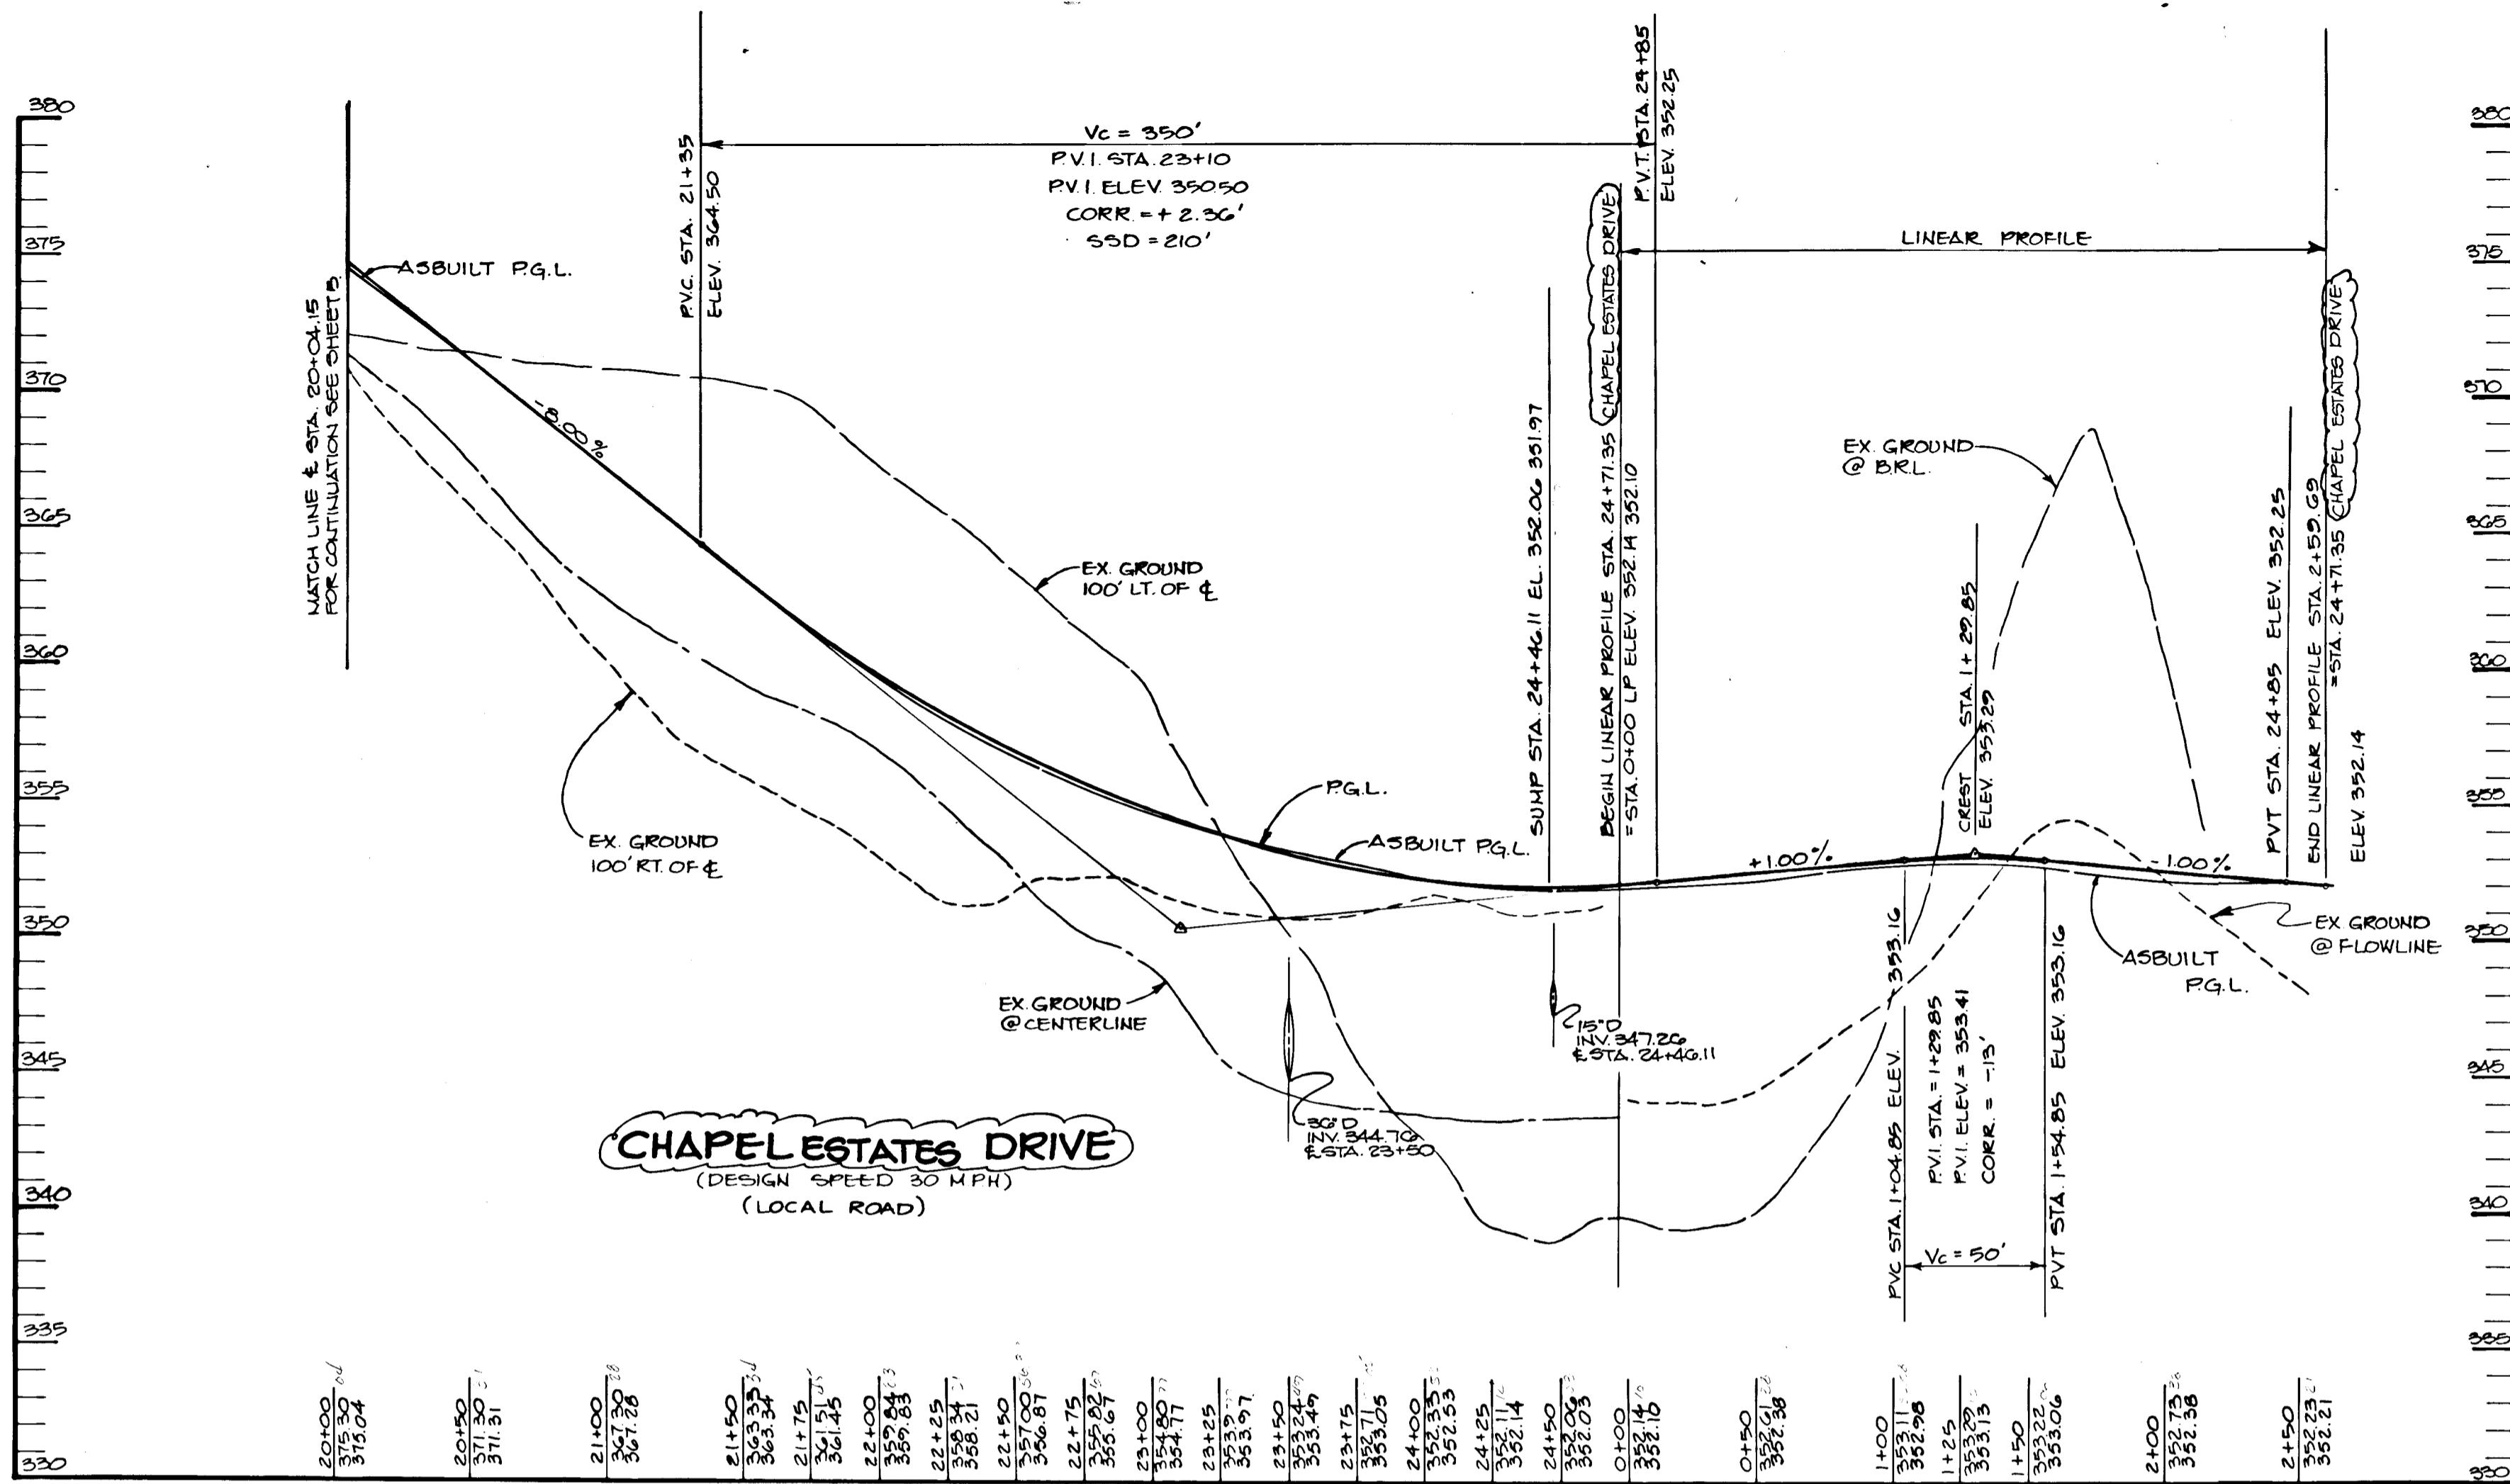

ASBUILT CERTIFICATION

APPROVED: HOWARD COUNTY OFFICE OF PLANNING AND ZONING
 Arthur E. Muegge # 8707 DATE 10.8.91

APPROVED: HOWARD COUNTY DEPARTMENT OF PUBLIC WORKS
 Dan S. DeAngelis # 4215 DATE 4.2.89




APPROVED: HOWARD COUNTY DEPARTMENT OF PUBLIC WORKS
 Donald B. Spear # 312189 DATE 3/2/89
 Travis W. Woodard # 312189 DATE 3/2/89
 Arthur M. Daneker # 312189 DATE 3/2/89

11-20-80 2 REVERSE ROAD NAME FOR CHAPEL ESTATES DRIVE










DATE NO REVISION
 OWNER: J.J.M. PARTNERSHIP
 5570 STERRETT PLACE SUITE 201
 COLUMBIA MD 21044 (301) 740-4466
 DEVELOPER: J.J.M. INC.
 5570 STERRETT PLACE SUITE 201
 COLUMBIA MD 21044 (301) 740-4466
 PROJECT: CHAPEL WOODS II
 AREA: TAX MAP NO 29 PARCELS 20, 86, 282
 5TH ELECTION DISTRICT
 HOWARD COUNTY, MARYLAND
 TITLE: PLAN AND PROFILE
 CHAPEL ESTATES DRIVE
 THE RIEMER GROUP, INC.
 The Riemer Group, Inc. A Land Planning, Design & Civil Engineering Firm
 3105 North Ridge Road, Ellicott City, Maryland 21043 (301) 461-2690

DATE 11-11-88
 DESIGNED BY: C.J.R.
 DRAWN BY: K.J.E.
 PROJECT NO: 28800
 DATE: NOVEMBER 7, 1988
 SCALE: AS SHOWN
 DRAWING NO. 6 OF 15

717

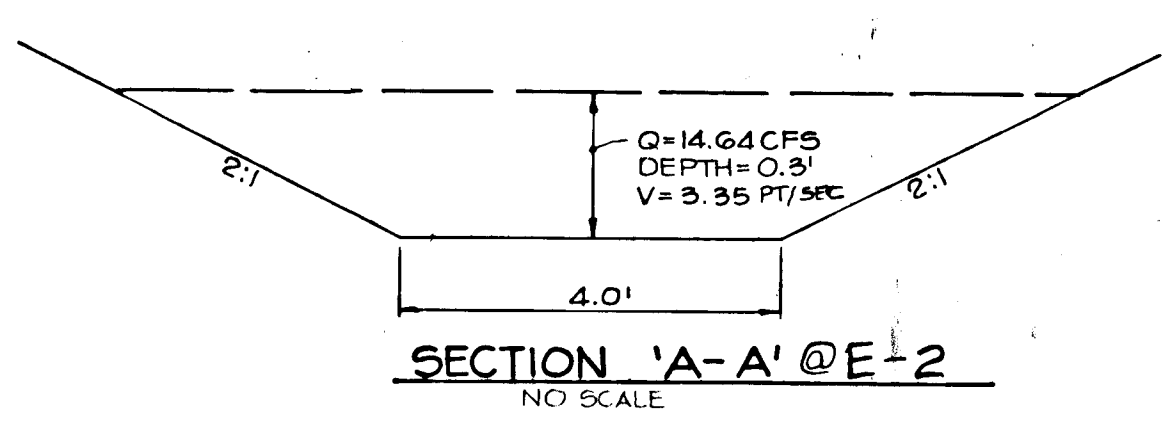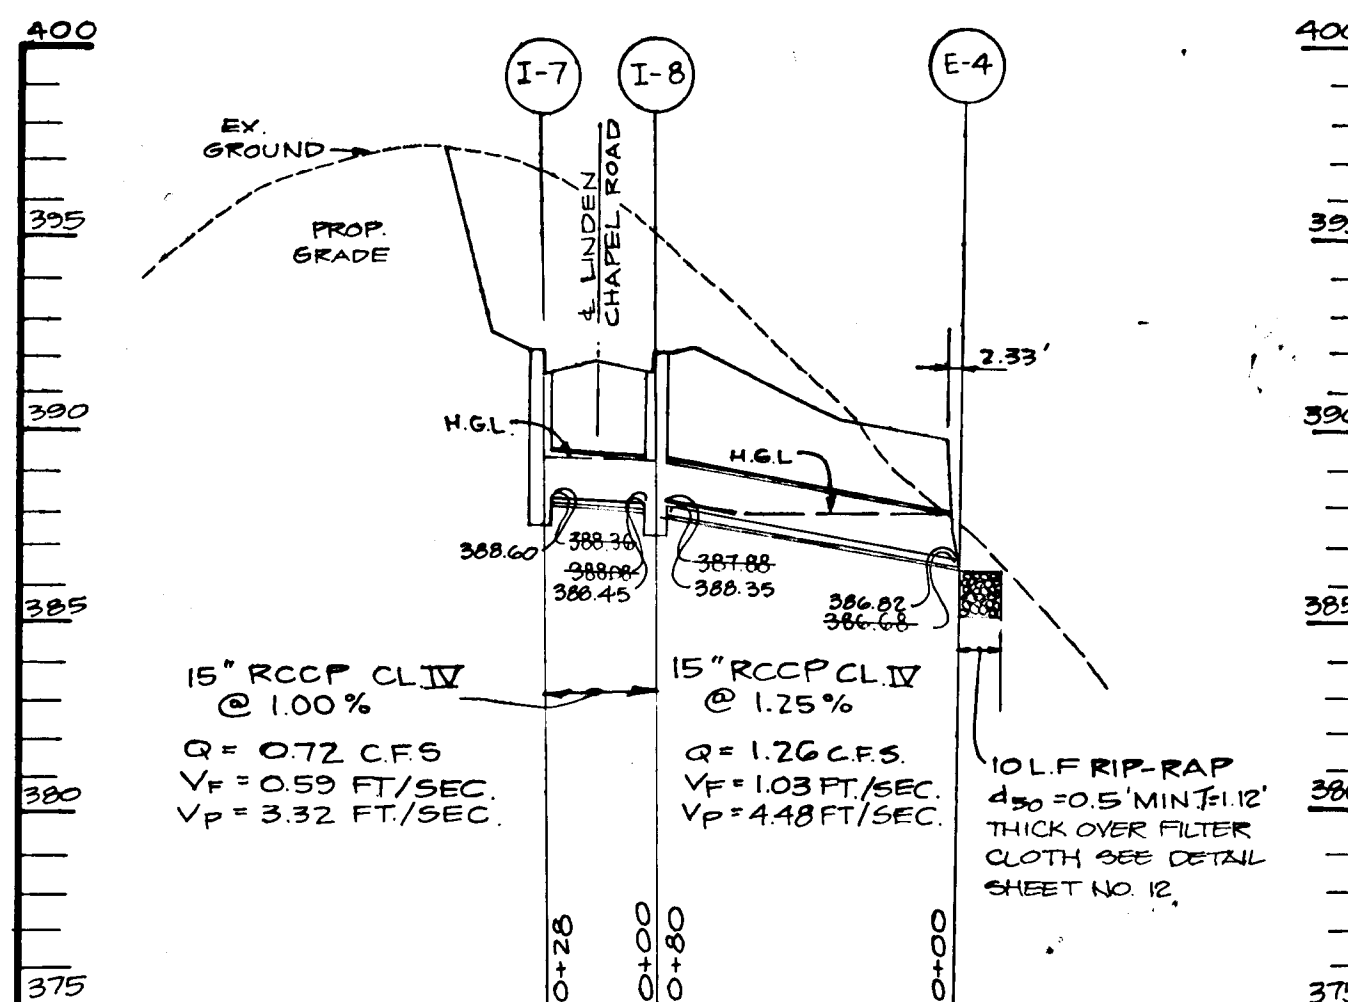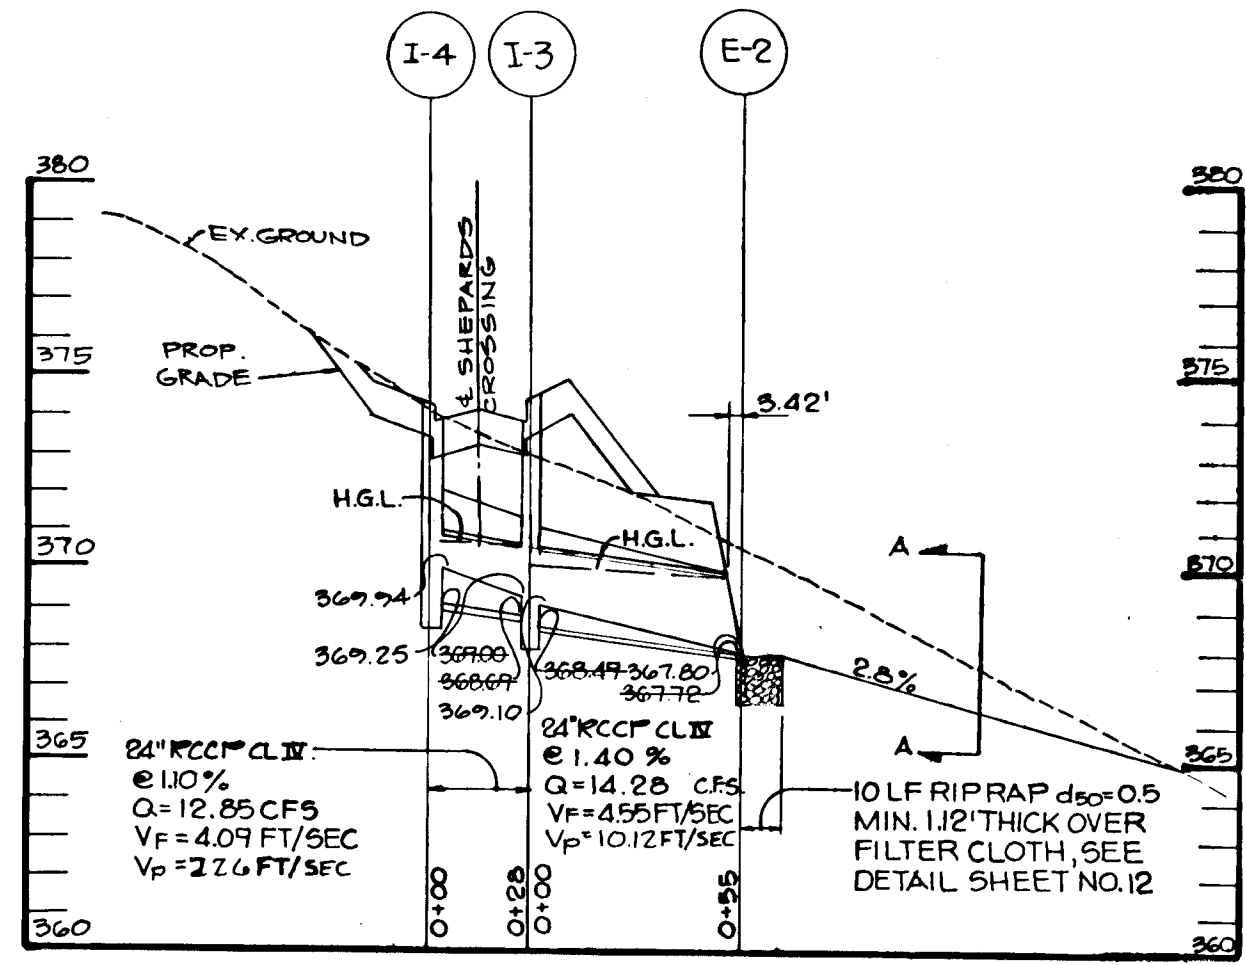

No.	Type	Location	Top Elev.	Inv. In.	Inv. Out	Remarks
I-1	A-5 INLET	12' RIGHT C/L STA 0+65 CHAPEL BELLS WAY	380.35	380.00	375.38	HO. CO. STD. DTL. SD 4.01
I-2	A-5 INLET	12' LEFT C/L STA 0+65 CHAPEL BELLS WAY	380.35	379.91	376.49	HO. CO. STD. DTL. SD 4.01
I-3	A-5 INLET	12' LEFT C/L STA 3+16 SHEPARD'S CROSSING	373.48	374.25	368.69	HO. CO. STD. DTL. SD 4.01
I-4	A-10 DEPRESSED	12' RIGHT C/L STA 3+16 SHEPARD'S CROSSING	373.48	374.29	369.00	HO. CO. STD. DTL. SD 4.81 & SD 4.02
I-5	A-5 INLET	12' LEFT C/L STA 7+55.99 CHAPEL ESTATES DRIVE	348.92	348.16	337.01	HO. CO. STD. DTL. SD 4.01
I-6	A-5 INLET	12' RIGHT C/L STA 7+55.99 CHAPEL ESTATES DRIVE	348.92	348.42	337.05	HO. CO. STD. DTL. SD 4.01
I-7	A-5 W/ DEFLECTORS	12' LEFT C/L STA 31+50 LINCOLN CHAPEL ROAD	380.27	382.25	388.08	HO. CO. STD. DTL. SD 4.83 & SD 4.01
I-8	A-5 W/ DEFLECTORS	12' RIGHT C/L STA 31+50 LINCOLN CHAPEL ROAD	380.27	382.25	388.08	HO. CO. STD. DTL. SD 4.83 & SD 4.01
I-9	A-5 INLET	12' LEFT C/L STA 24+46.11 CHAPEL ESTATES DRIVE	352.06	352.01	346.04	HO. CO. STD. DTL. SD 4.01
I-10	A-5 INLET	12' RIGHT C/L STA 24+46.11 CHAPEL ESTATES DRIVE	352.06	352.00	347.93	HO. CO. STD. DTL. SD 4.01
E-1	15" CONC. END SECTION	SEE PLAN	---	---	372.50	HO. CO. STD. DTL. 5.5
E-2	24" CONC. END SECTION	SEE PLAN	---	---	367.77	HO. CO. STD. DTL. 5.5
E-4	15" CONCRETE END SECTION	SEE PLAN	---	---	366.64	HO. CO. STD. DTL. 5.51
E-5	50" CONC. END SECTION	SEE PLAN	---	---	348.00	HO. CO. STD. DTL. 5.51
E-6	50" CONC. END SECTION	SEE PLAN	---	---	340.00	HO. CO. STD. DTL. 5.51
E-7	15" CONC. END SECTION	SEE PLAN	---	---	340.00	HO. CO. STD. DTL. 5.51
E-8	50" CONC. END SECTION	SEE PLAN	---	---	339.00	HO. CO. STD. DTL. 5.51
HW-1	HEADWALL	SEE PLAN	---	---	---	HO. CO. STD. DTL. 5.51
HW-2	HEADWALL	SEE PLAN	---	---	---	HO. CO. STD. DTL. 5.51
E-8	50" CONC. END SECTION	SEE PLAN	---	---	334.07	HO. CO. STD. DTL. 5.51

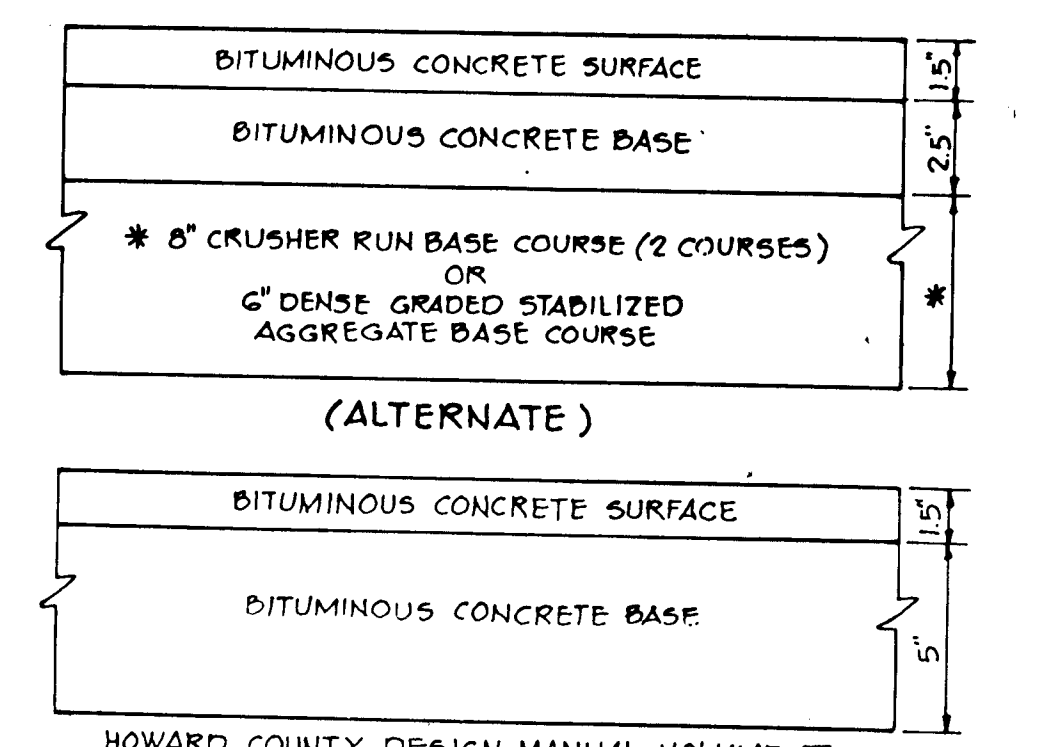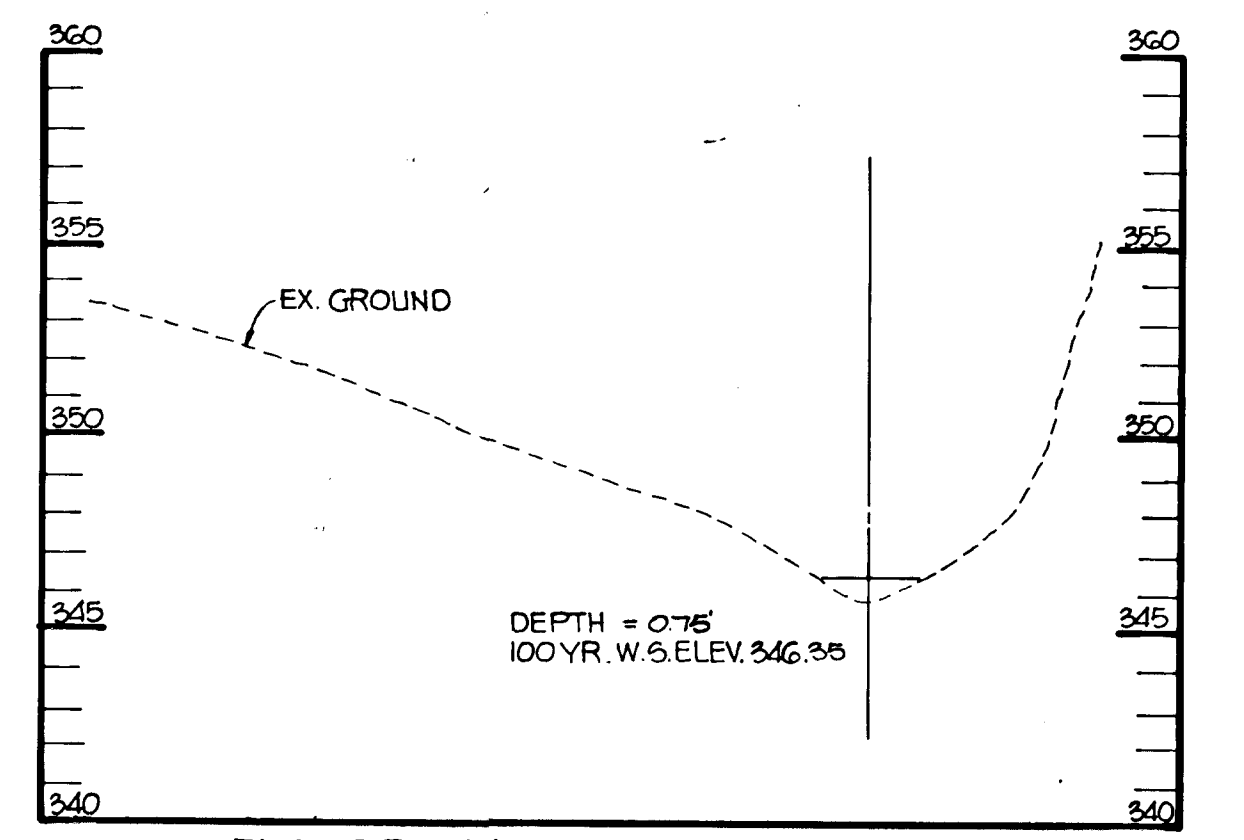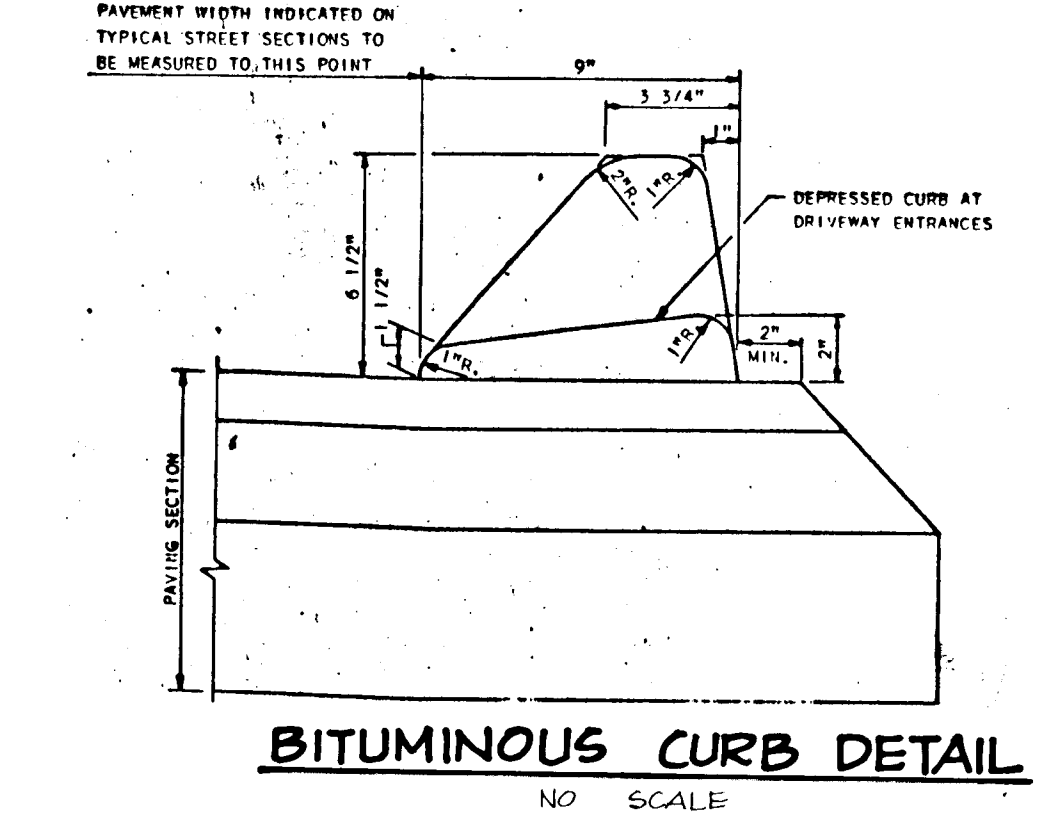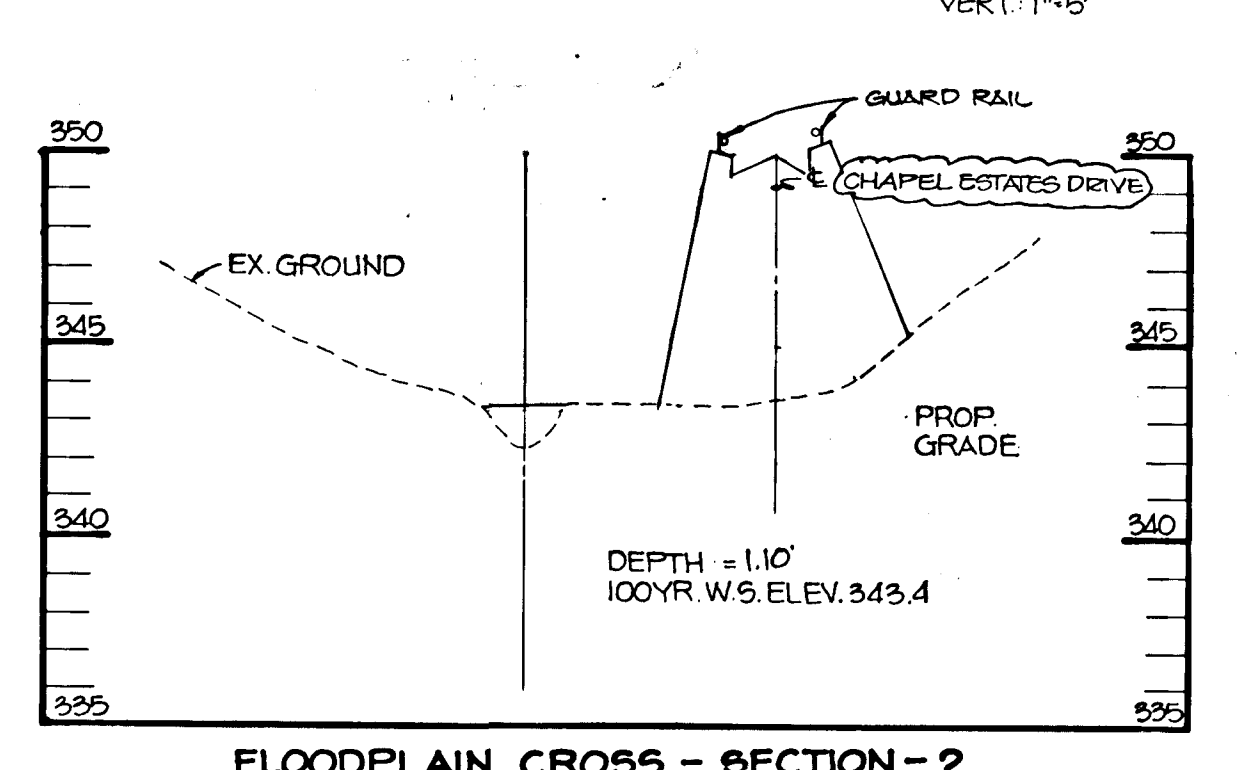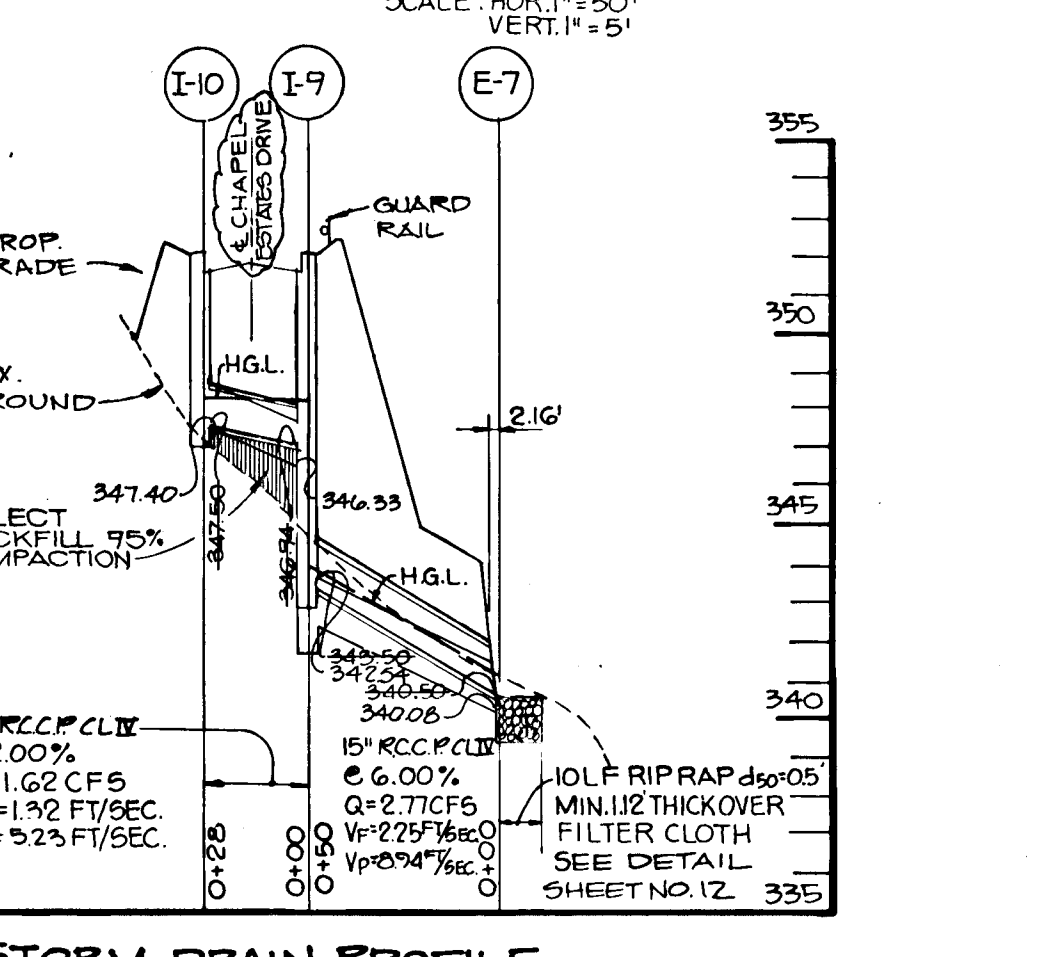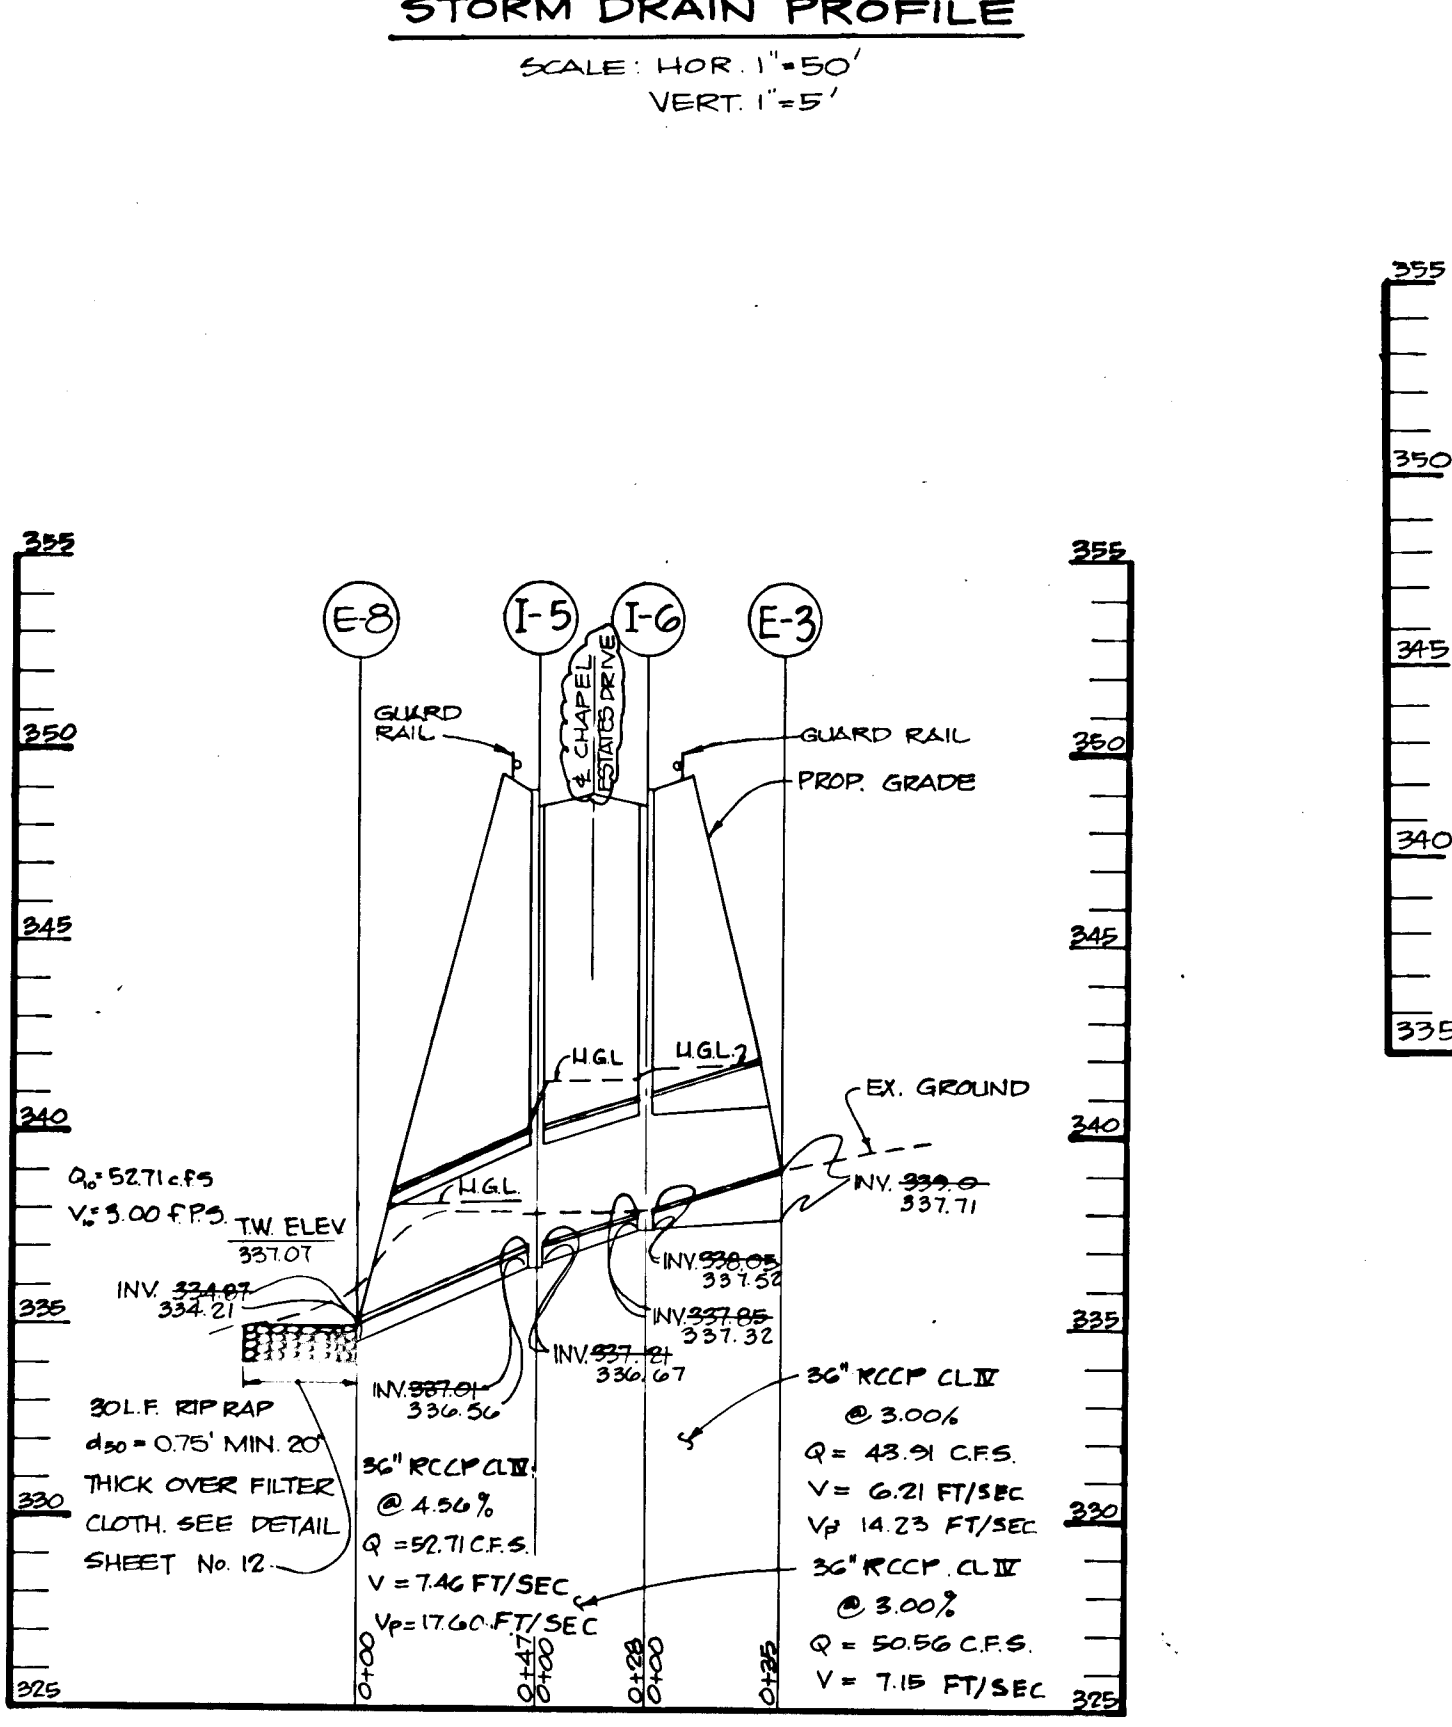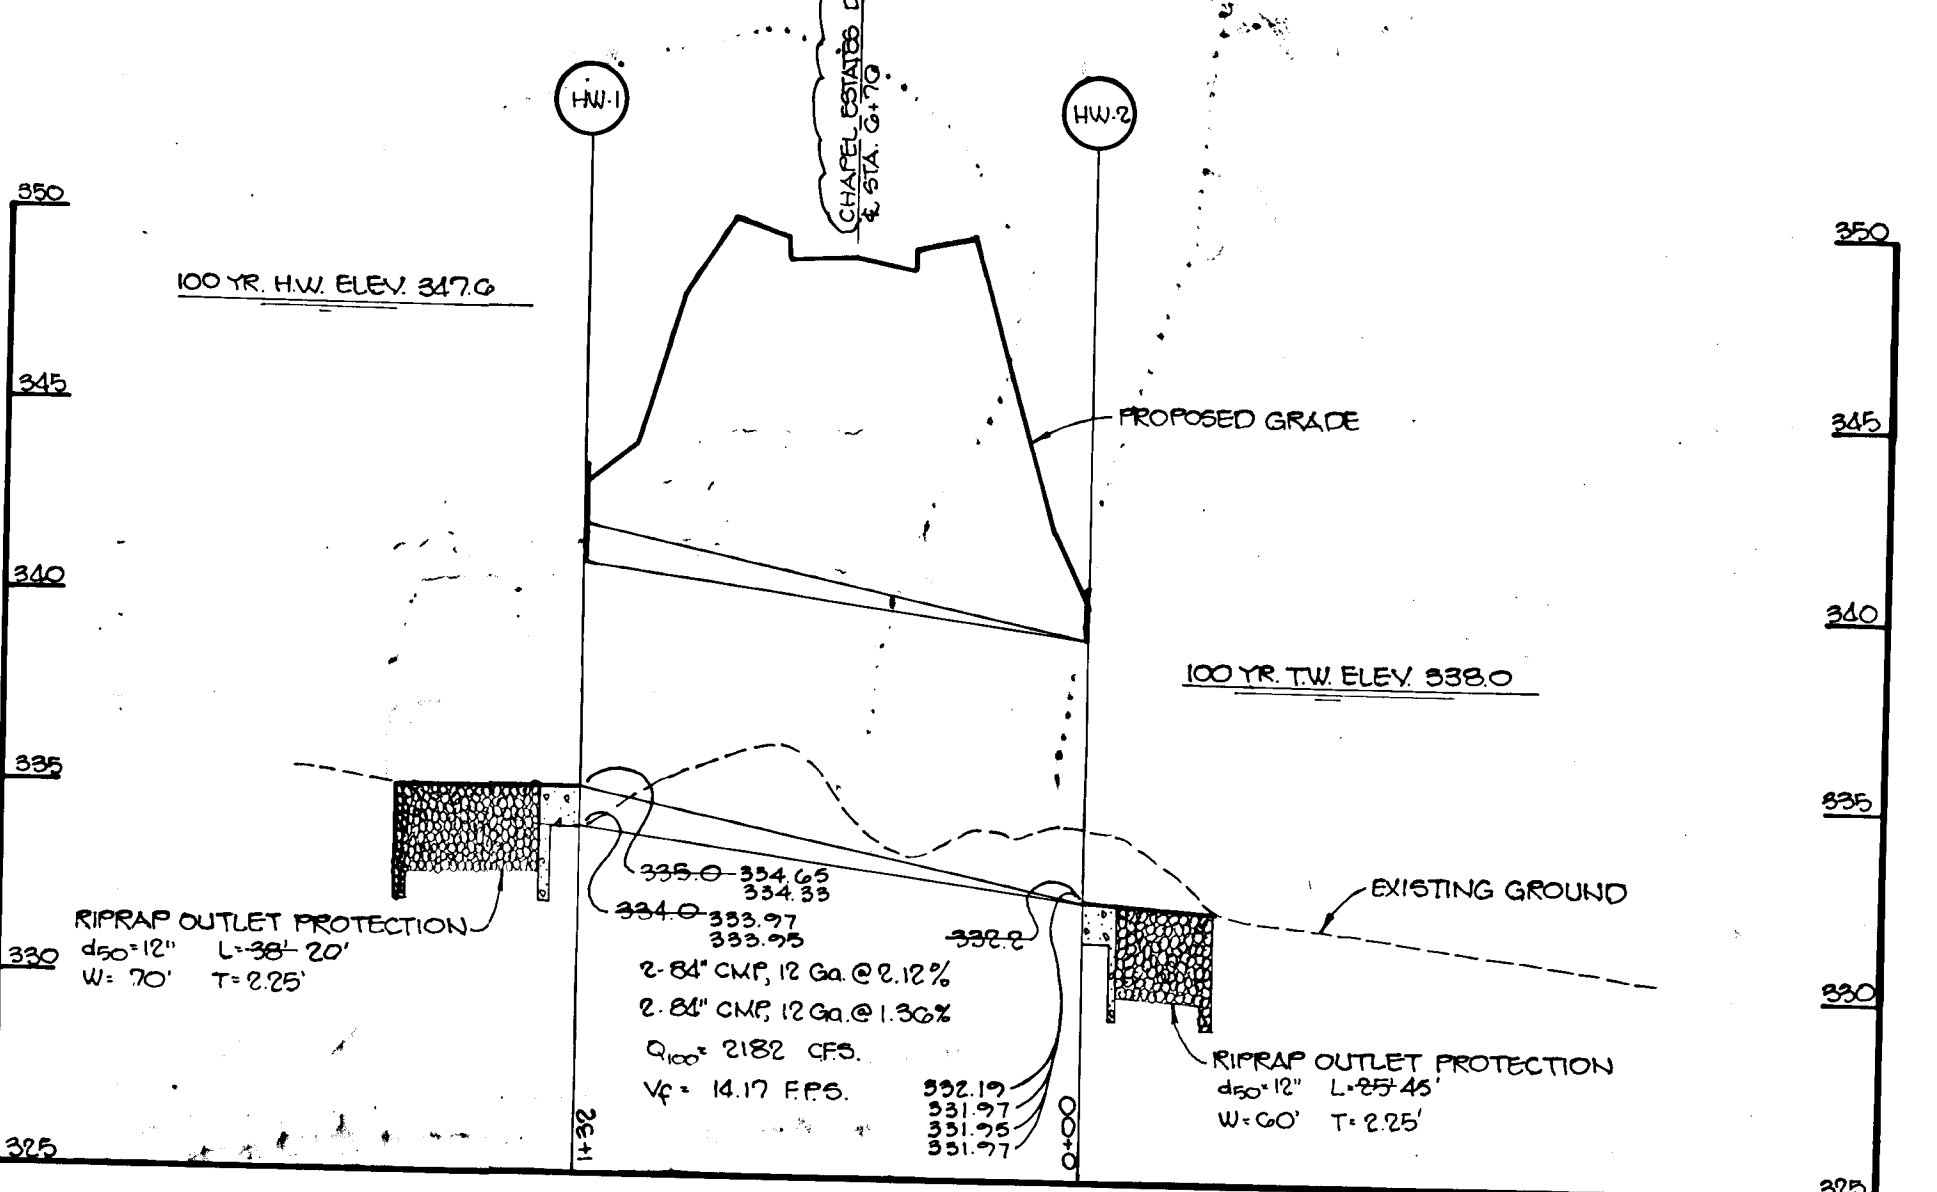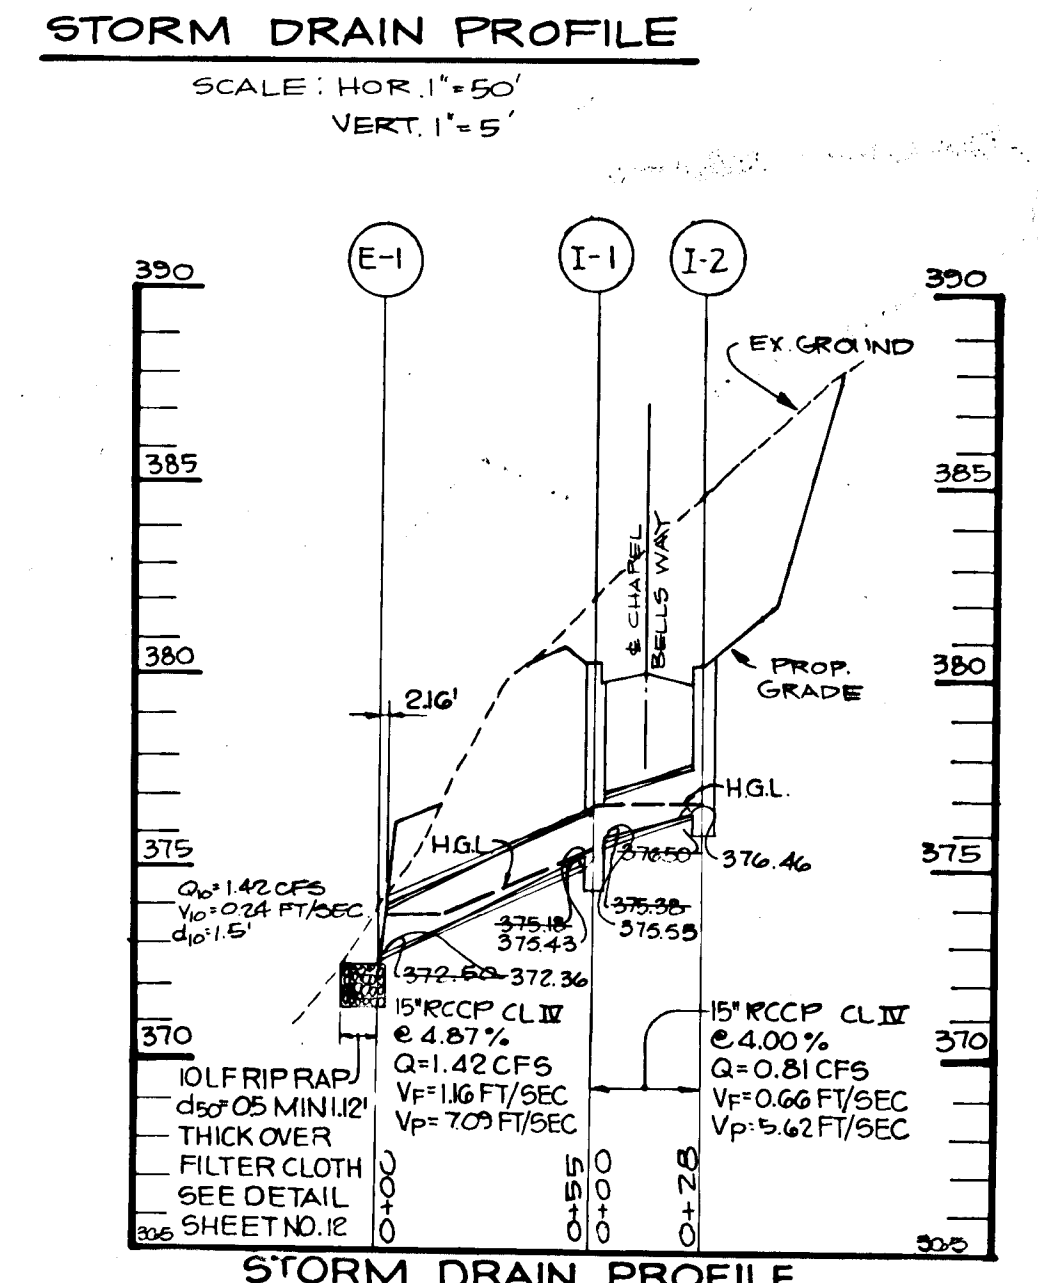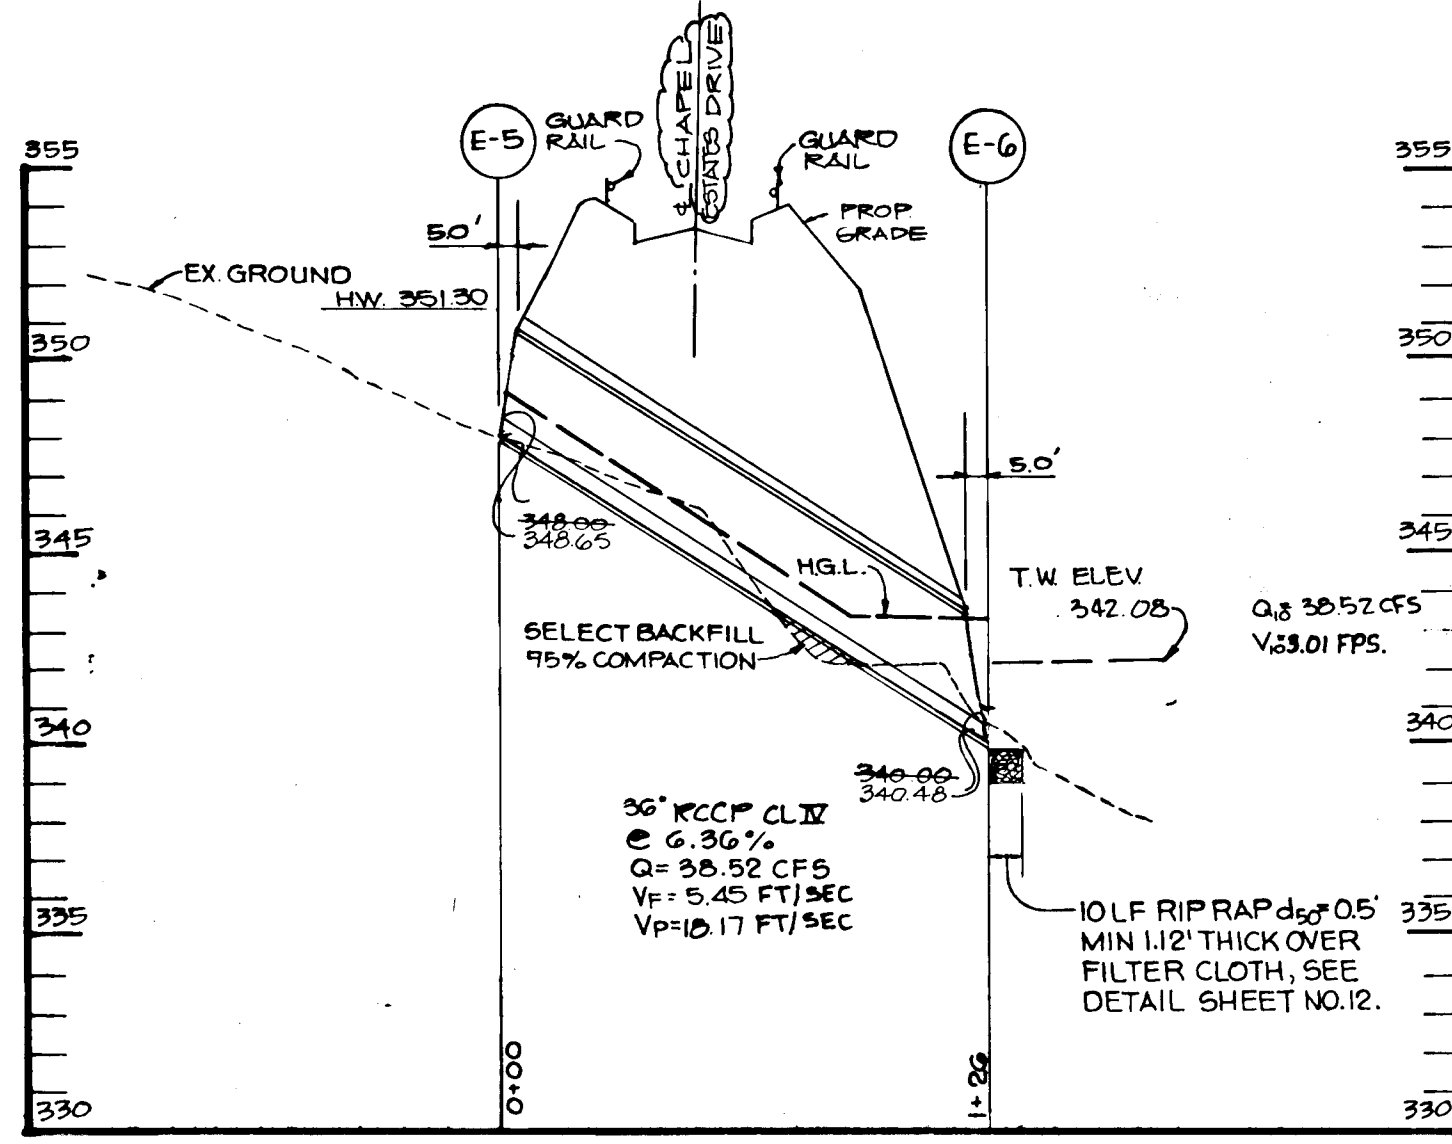

PROFESSIONAL ENGINEER
ARTHUR E. MUEGGE #8107
 10.8.91
 DATE

APPROVED: HOWARD COUNTY OFFICE OF PLANNING AND ZONING
Mark J. Zangl
 4.1.91
 DATE

APPROVED: HOWARD COUNTY DEPARTMENT OF PUBLIC WORKS
Donald J. Leppan
 3/21/89
 DATE

APPROVED: **Dr. William W. McLeod**
 3/11/89
 DATE

APPROVED: **Andrew M. Danks**
 3/22/89
 DATE

11-50-00 2 REVISE FROM LHM#8 FOR CHAPEL ESTATES DRIVE
 R-20-00 1 REMOVED BROKE PROFILE & SUBMIT DETAIL
 ADDED STORM DRAIN PROFILE

DATE NO REVISION

OWNER: J.J.M. PARTNERSHIP
 5570 STERRETT PLACE SUITE 201
 COLUMBIA, MARYLAND 21044 (301)740-4466

DEVELOPER: J.J.M. INC.
 5570 STERRETT PLACE SUITE 201
 COLUMBIA, MARYLAND 21044 (301)740-4466

PROJECT: **CHAPEL WOODS II**

AREA: TAX MAP # 28 PARCELS 26, 86, 282
 5TH ELECTION DISTRICT
 HOWARD COUNTY MARYLAND

TITLE: **STORM DRAIN PROFILES AND DETAILS**

THE RIEMER GROUP, INC.
 The Riemer Group, Inc. A Land Planning, Design & Civil Engineering Firm
 3105 North Ridge Road, Ellicott City, Maryland 21043 (301)461-2690

DATE: 11-10-88
 5-86-87, 5-87-88, WP 88-57
 P-88-07, WP 88-121


DESIGNED BY: C.J.R.
 DRAWN BY: J.C.R.

PROJECT NO: 28800
 DATE: NOVEMBER 7, 1988
 SCALE: AS SHOWN
 DRAWING NO. 7 OF 15

APPROVED: **Arthur E. Muegge #8107**
 10.8.91
 DATE

717

MARYLAND BLUEPRINT CO., INC.

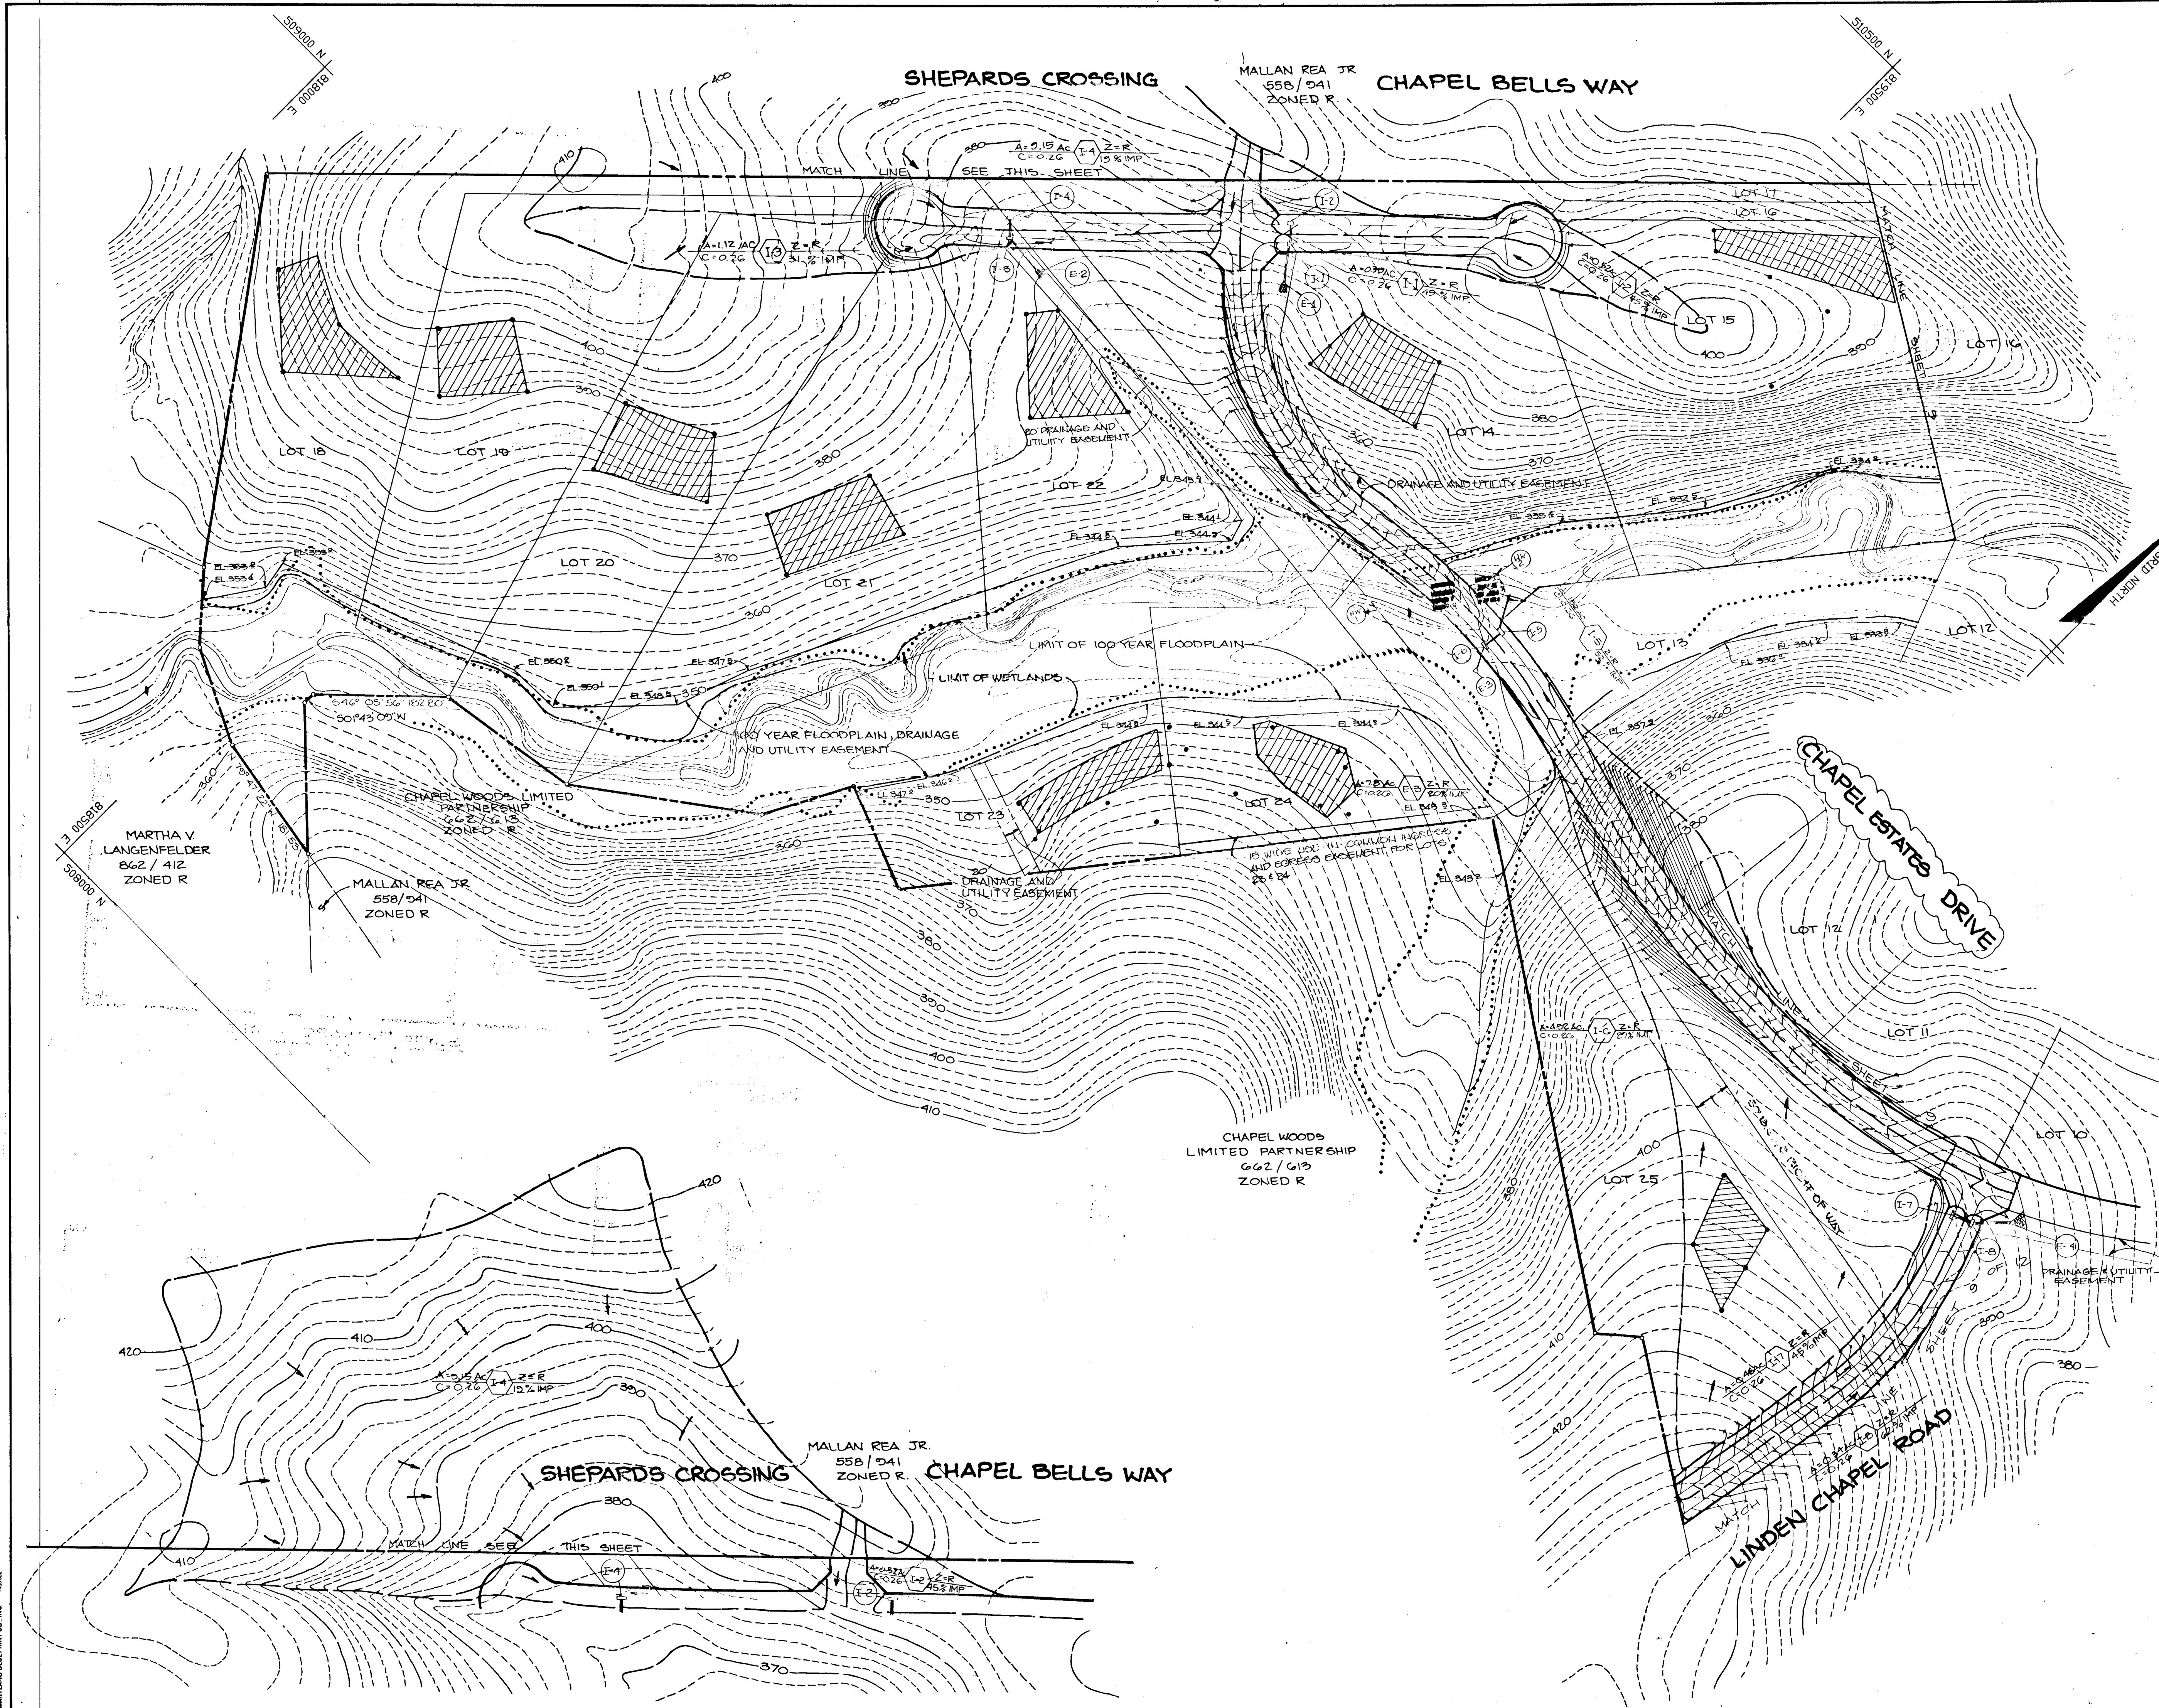



APPROVED: HOWARD COUNTY OFFICE OF PLANNING AND ZONING	
CHIEF, DIVISION OF COMMUNITY PLANNING AND LAND DEVELOPMENT	DATE
APPROVED: HOWARD COUNTY DEPARTMENT OF PUBLIC WORKS	
Chief, Land Development Division	Date
Chief, Bureau of Highways	
Chief, Bureau of Engineering	Date
11-00-00	2 REVISE POND NAME FOR CHAPEL ESTATES DRIVE.
12-00-00	1 REPLACED ARCH BRIDGE WITH CULVERTS
DATE	NO. REVISION
OWNER/DEVELOPER	
(OWN) JJM PARTNERSHIP 5570-201 STERRETT PLACE COLUMBIA, MARYLAND 21044 PH (301) 740-4466	
(DEV) JJM INC. 5570-201 STERRETT PLACE COLUMBIA, MARYLAND 21044 PH (301) 740-4466	
PROJECT	
CHAPEL WOODS II	
AREA TAX MAP NO 29 PARCELS 26, 86, 282 5TH ELECTION DISTRICT HOWARD COUNTY, MARYLAND	
TITLE	
DRAINAGE AREA MAP	
THE RIEMER GROUP, INC.	
The Riemer Group, Inc. A Land Planning, Design & Civil Engineering Firm 3105 North Ridge Road, Ellicott City, Maryland 21043 (301) 461-2690	
DATE	5-86-27, 5-87-23, WF-08-57 F-88-07 WFA-121
DESIGNED BY: C.J.R.	
DRAWN BY: DDB	
PROJECT NO: 28800	
DATE: NOVEMBER 7, 1988	
SCALE: 1" = 100'	
DRAWING NO. 8 OF 15	

Mark S. Taylor 2-2-89
 CHIEF, DIVISION OF
 COMMUNITY PLANNING AND
 LAND DEVELOPMENT
 DATE

James M. Egan 3/21/89
 Chief, Land Development Division
 DATE

Brian W. Wrenn 3/2/89
 Chief, Bureau of Highways
 DATE

Andrew M. Janicki 3/22/89
 Chief, Bureau of Engineering
 DATE

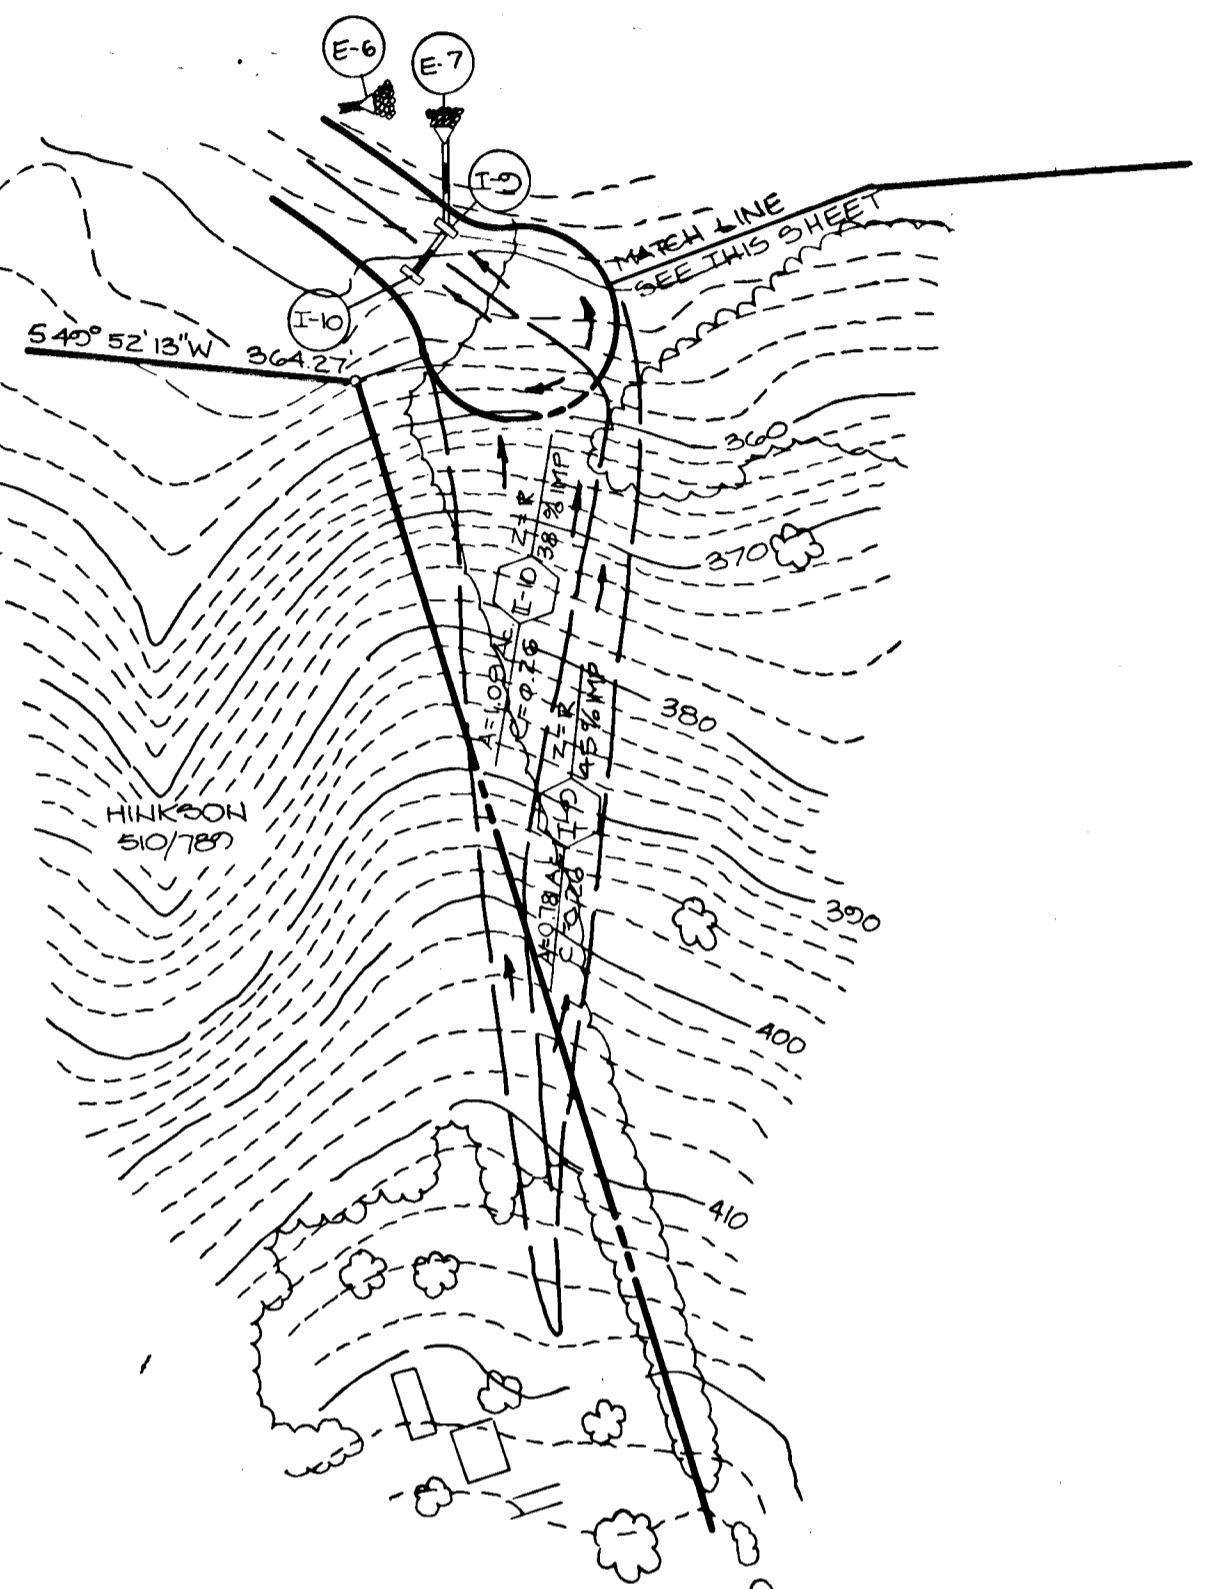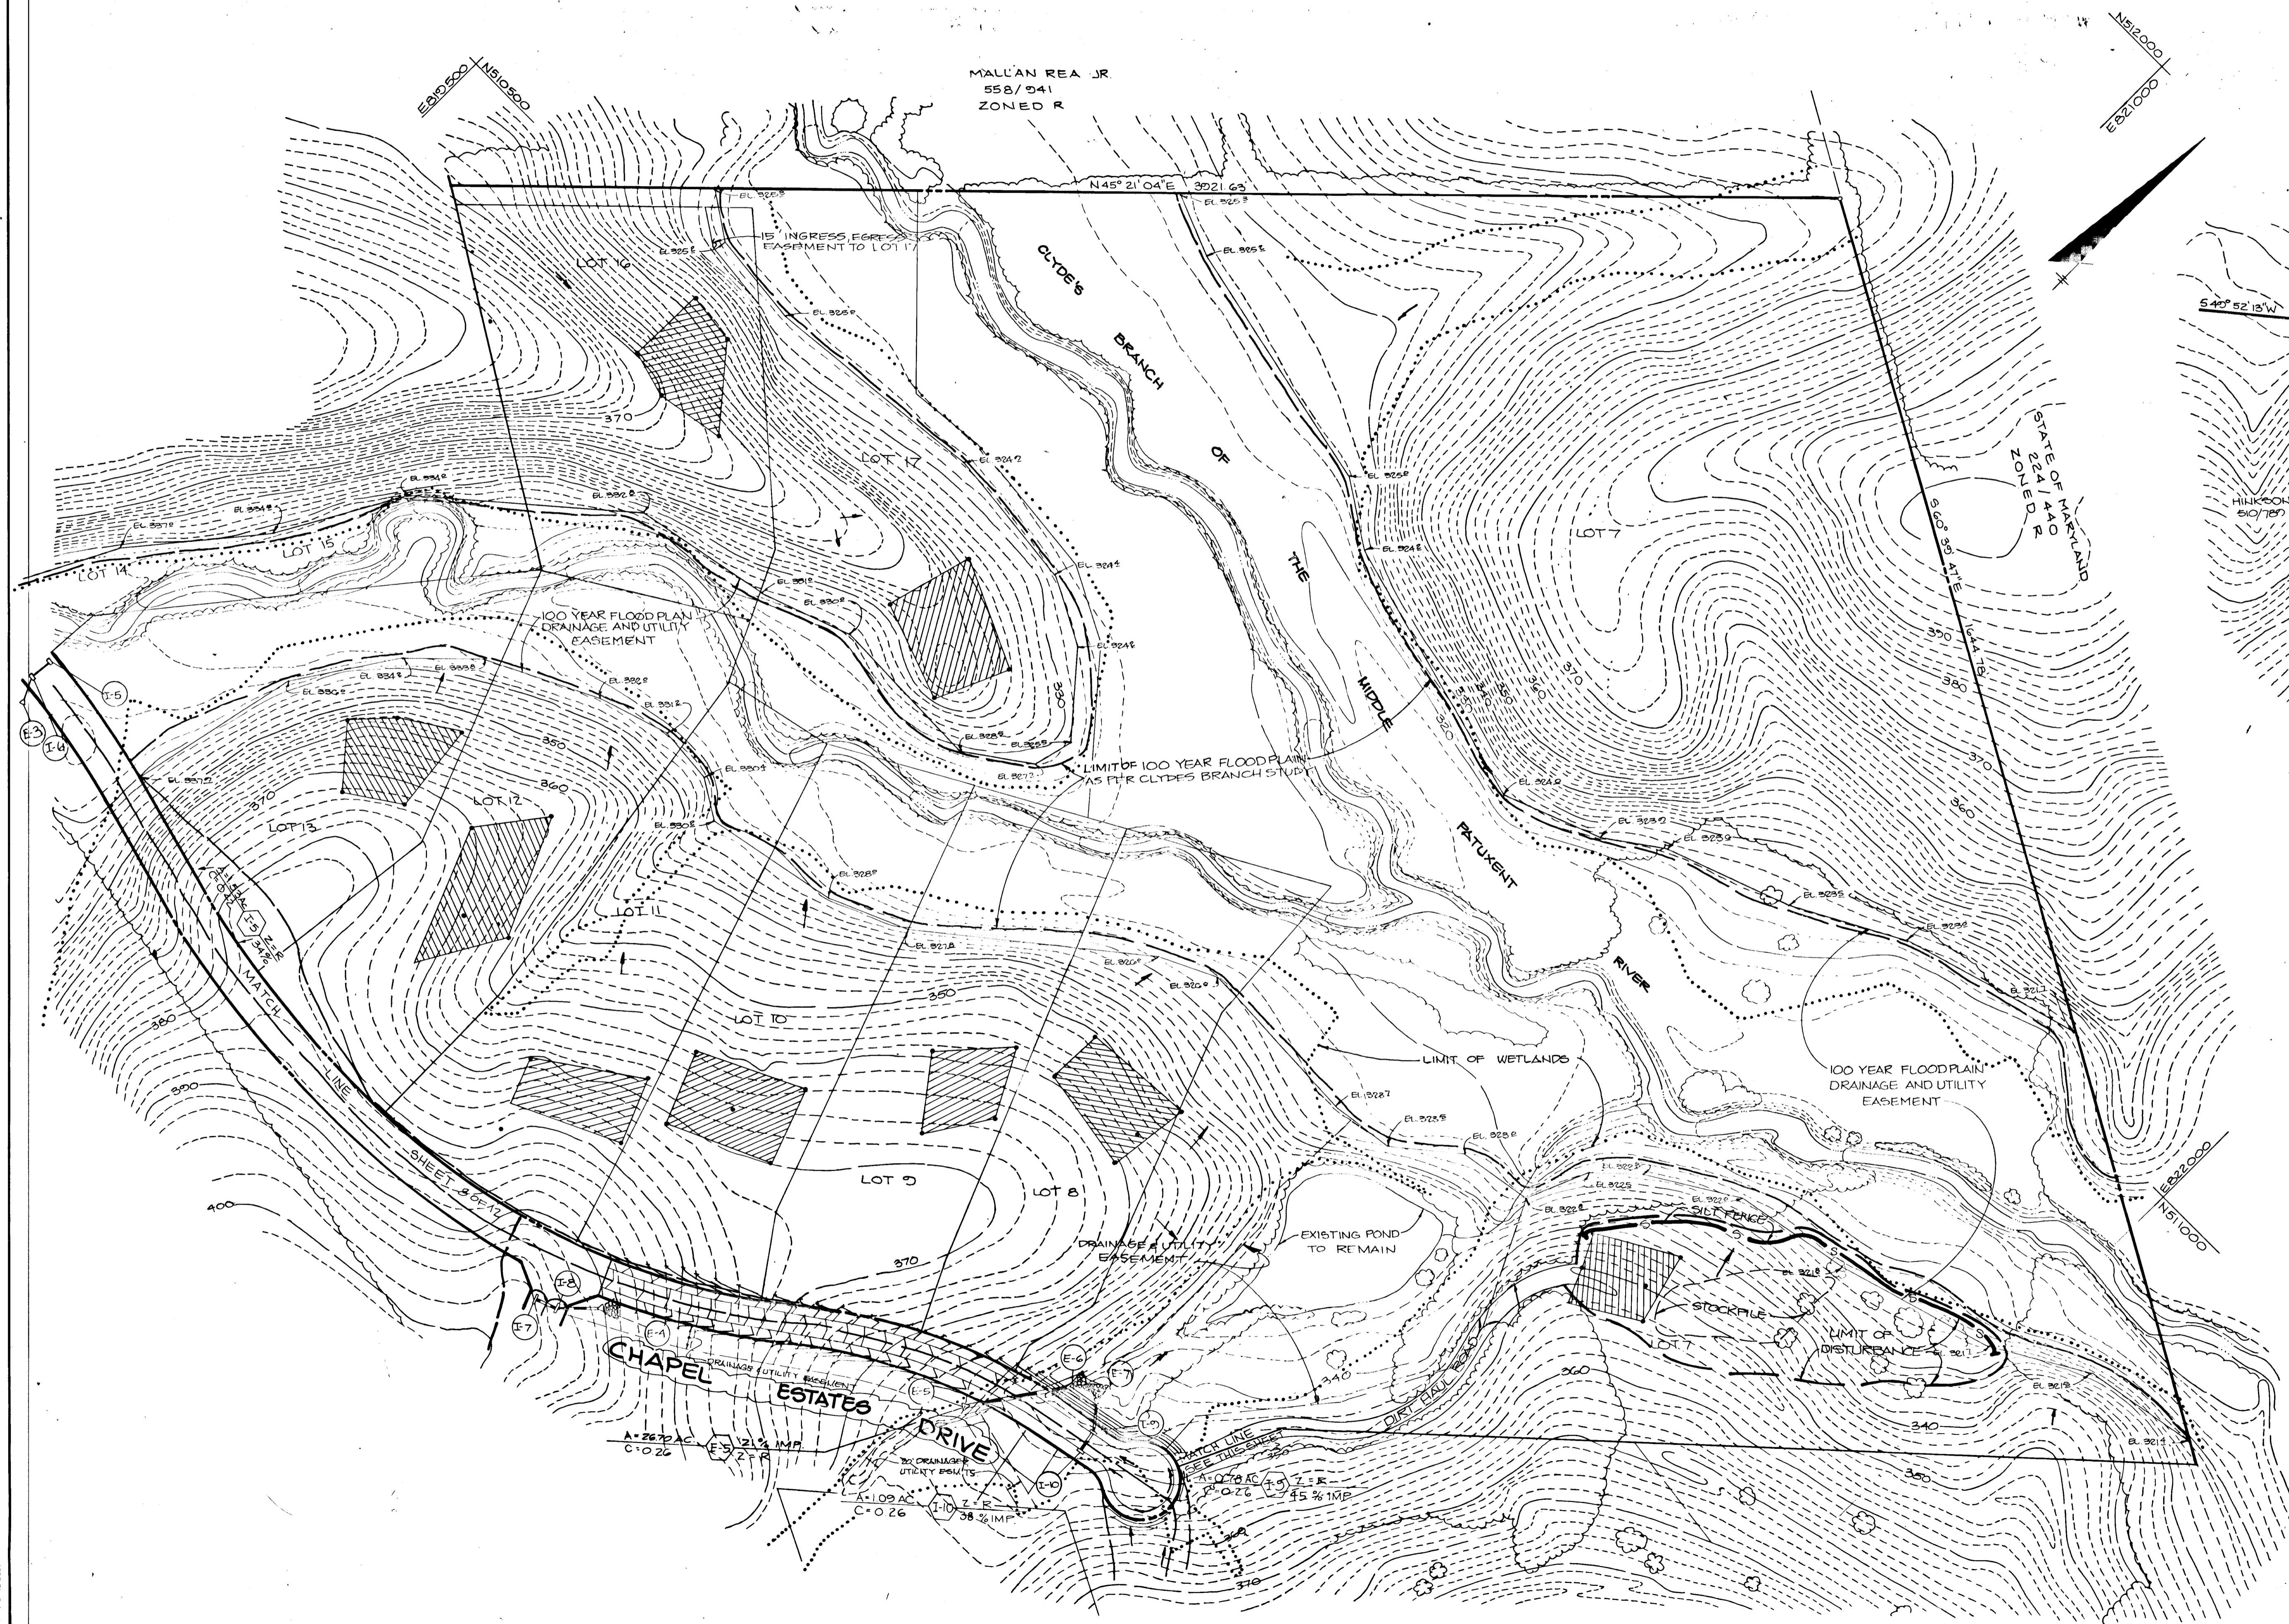

11-30-80	2	REVISE ROAD NAME FOR CHAPEL ESTATES DRIVE
1-9-80	1	ADDED LIMIT OF DISTURBANCE FOR STOCKPILE AREA
DATE	NO.	REVISION
OWNER / DEVELOPER		
OWN: JJM PARTNERSHIP 5570-201 STERRETT PLACE COLUMBIA, MARYLAND 21044 PH(301)740-4466		
DEV: JJM, INC. 5570-201 STERRETT PLACE COLUMBIA, MARYLAND 21044 PH(301)740-4466		

PROJECT: **CHAPEL WOODS II**


AREA: TAX MAP NO 25 PARCELS 26, 26, 28, 27
 5TH ELECTION DISTRICT
 HOWARD COUNTY, MARYLAND

TITLE: **DRAINAGE AREA MAP**

THE RIEMER GROUP, INC.
 The Riemer Group, Inc. A Land Planning, Design & Civil Engineering Firm
 3105 North Ridge Road, Ellicott City, Maryland 21043 (301) 461-2690

11-11-88	DATE
	DESIGNED BY: C.J.R.
	DRAWN BY: DDB
	PROJECT NO: 28800
	DATE: NOVEMBER 7, 1988
	SCALE: 1" = 100'
	DRAWING NO. 2 OF 15

717

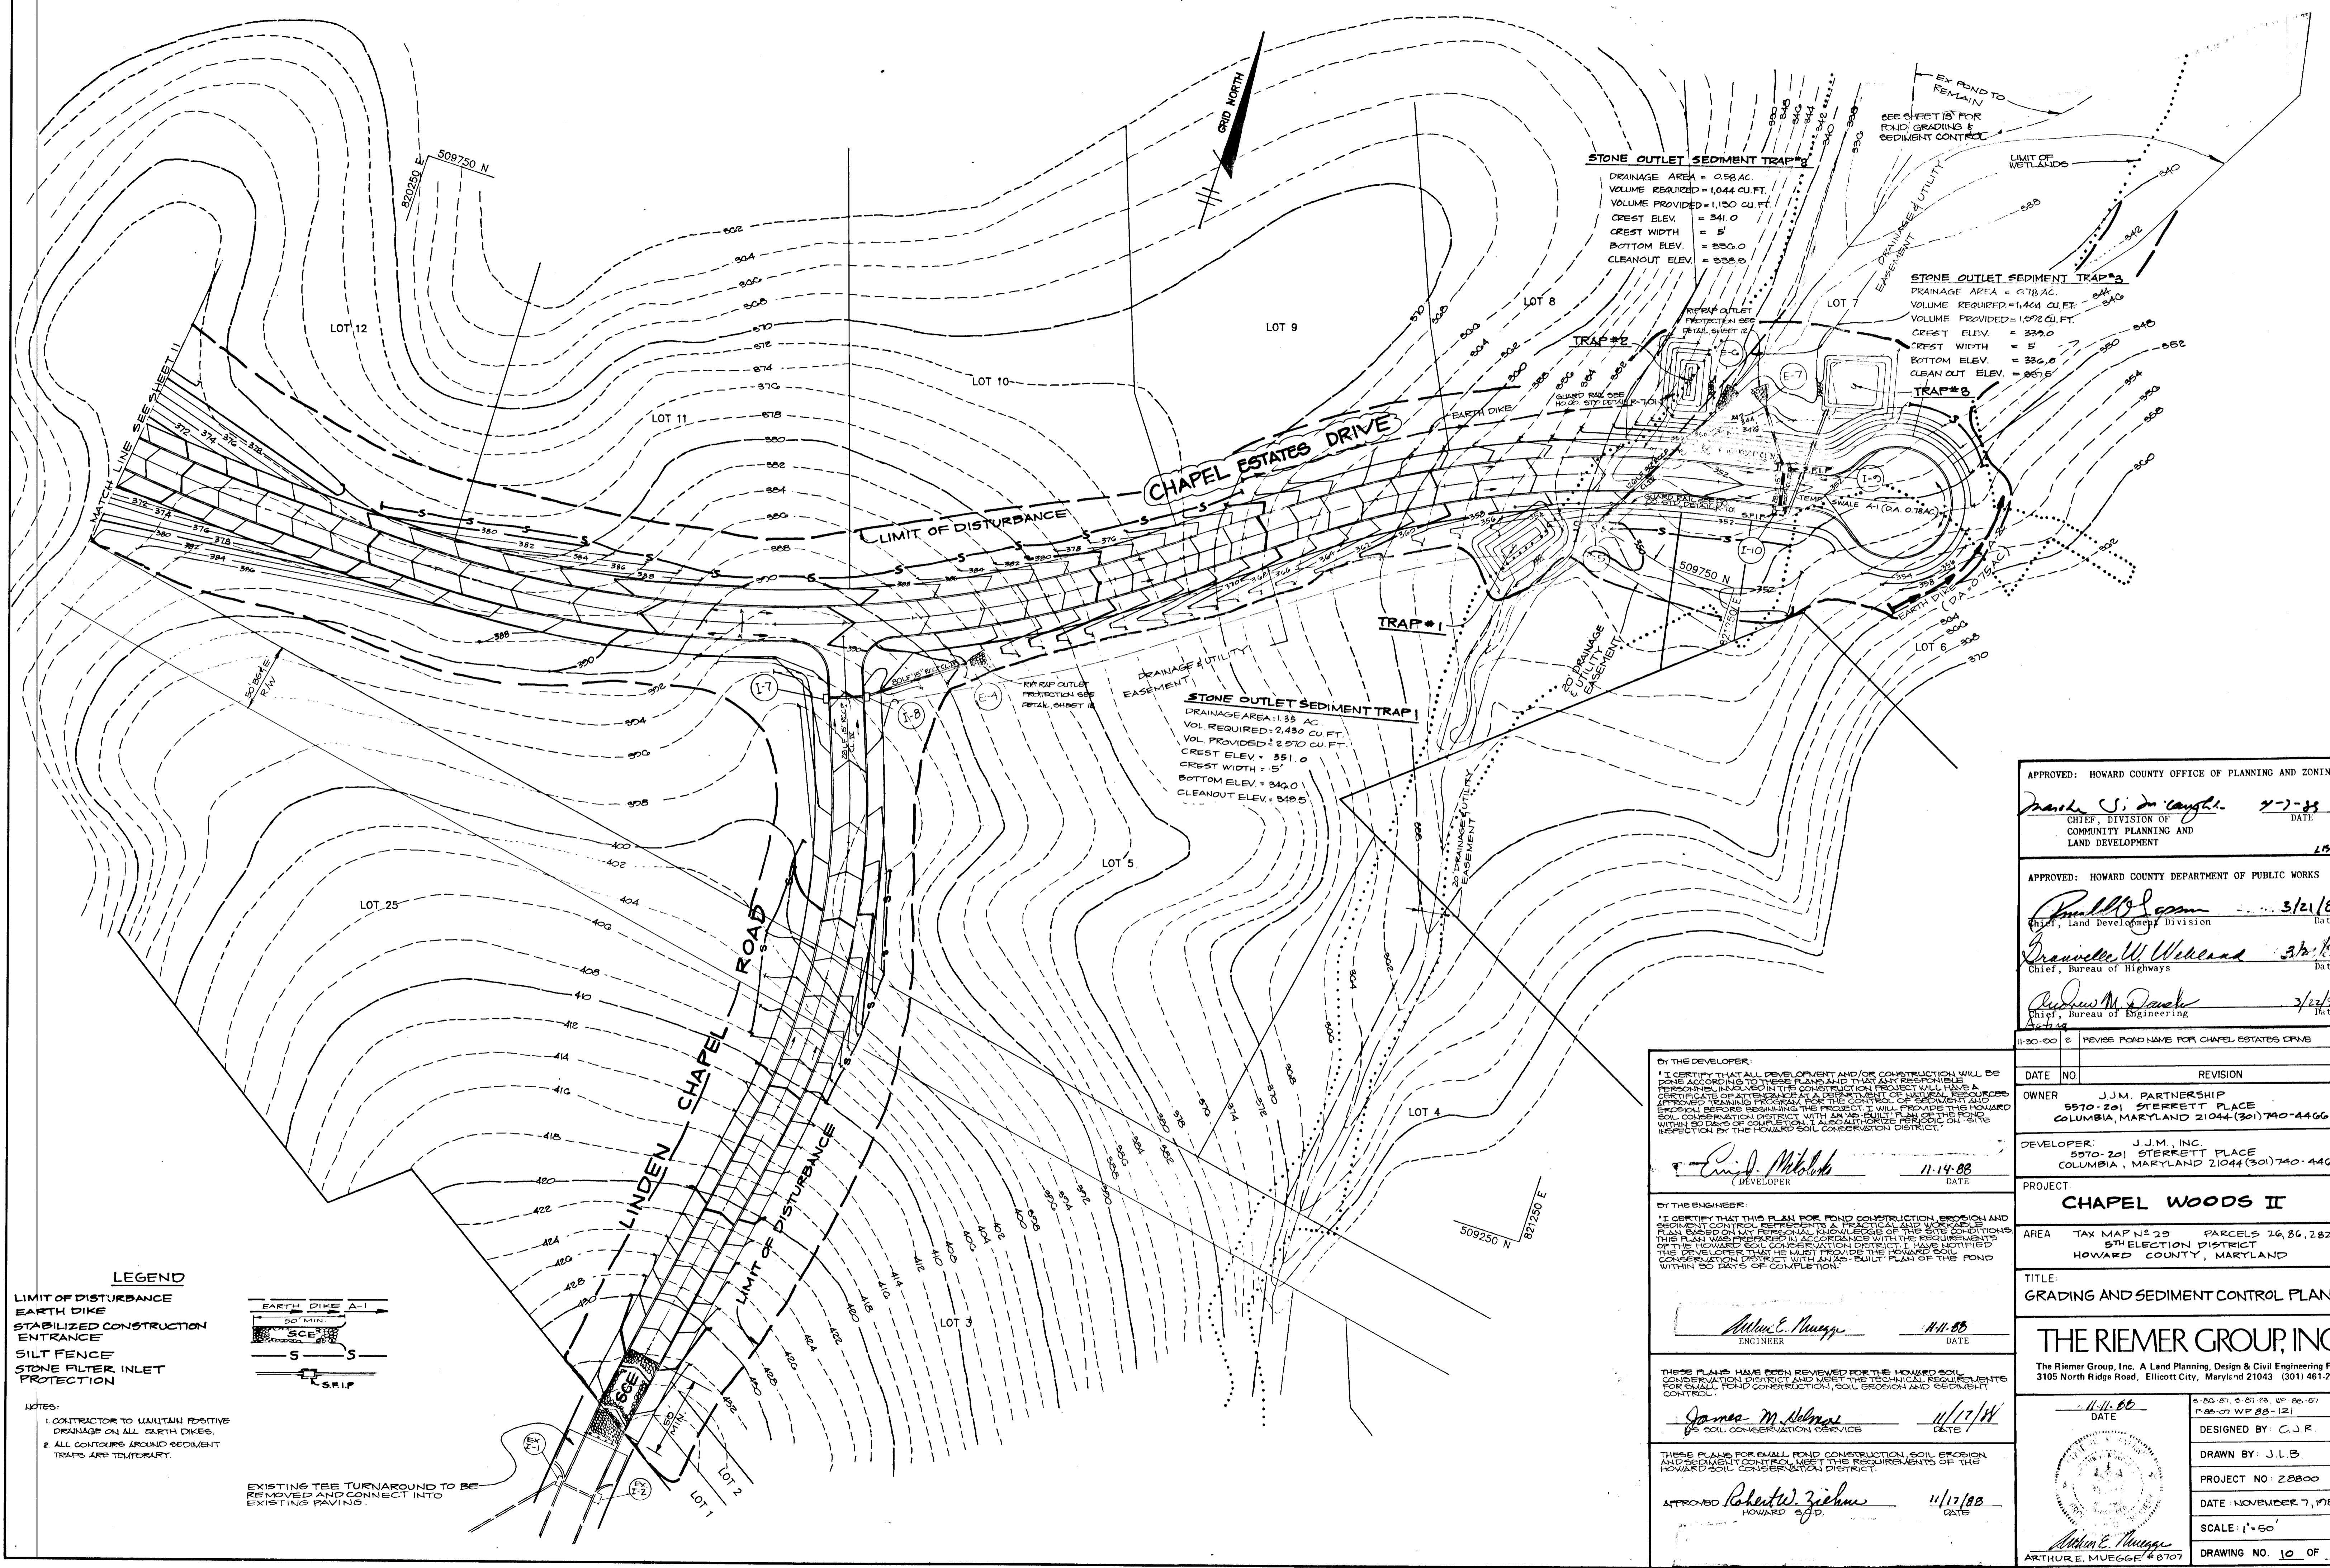


LEGEND

LIMIT OF DISTURBANCE
 EARTH DIKE
 STABILIZED CONSTRUCTION ENTRANCE
 SILT FENCE
 STONE FILTER INLET PROTECTION

NOTES:

1. CONTRACTOR TO MAINTAIN POSITIVE DRAINAGE ON ALL EARTH DIKES.
 2. ALL CONTOURS AROUND SEDIMENT TRAPS ARE TEMPORARY.

EXISTING TEE TURNAROUND TO BE REMOVED AND CONNECT INTO EXISTING PAVING.

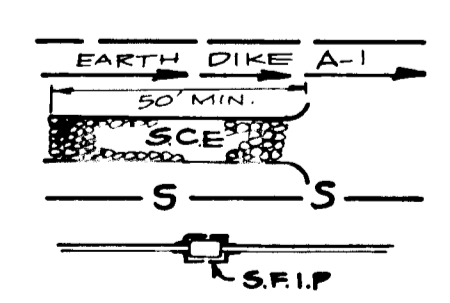

APPROVED: HOWARD COUNTY OFFICE OF PLANNING AND ZONING
Mark S. DeCough 4-7-88 DATE
 CHIEF, DIVISION OF COMMUNITY PLANNING AND LAND DEVELOPMENT

APPROVED: HOWARD COUNTY DEPARTMENT OF PUBLIC WORKS
Donald S. Green 3/21/89 DATE
 Chief, Land Development Division

Travis W. Williams 3/2/88 DATE
 Chief, Bureau of Highways

Richard M. Danks 7/22/89 DATE
 Chief, Bureau of Engineering

BY THE DEVELOPER:
 I CERTIFY THAT ALL DEVELOPMENT AND/OR CONSTRUCTION WILL BE DONE ACCORDING TO THESE PLANS AND THAT ANY RESPONSIBLE PERSONNEL INVOLVED IN THE CONSTRUCTION PROJECT WILL HAVE A CERTIFICATE OF ATTENDANCE AT AN APPROVED TRAINING PROGRAM APPROVED BEFORE BEGINNING THE PROJECT. I WILL PROVIDE THE HOWARD SOIL CONSERVATION DISTRICT WITH AN AS-BUILT PLAN OF THE POND WITHIN 30 DAYS OF COMPLETION. ALSO AUTHORIZES PERSONNEL ON SITE INSPECTION BY THE HOWARD SOIL CONSERVATION DISTRICT.

Erin M. Malachuk 11-19-88 DATE
 (DEVELOPER)

BY THE ENGINEER:
 I CERTIFY THAT THIS PLAN FOR POND CONSTRUCTION, EROSION AND SEDIMENT CONTROL, RESTRICTED TO THE PROPOSED WORK AREA, IS A PLAN BASED ON MY PERSONAL KNOWLEDGE OF THE SITE CONDITIONS. THIS PLAN WAS PREPARED IN ACCORDANCE WITH THE REQUIREMENTS OF THE HOWARD SOIL CONSERVATION DISTRICT. I HAVE NOTIFIED THE HOWARD SOIL CONSERVATION DISTRICT WITH AN AS-BUILT PLAN OF THE POND WITHIN 30 DAYS OF COMPLETION. ALSO AUTHORIZES PERSONNEL ON SITE INSPECTION BY THE HOWARD SOIL CONSERVATION DISTRICT.

Arthur E. Muegge 11-11-88 DATE
 ENGINEER

THESE PLANS HAVE BEEN REVIEWED FOR THE HOWARD SOIL CONSERVATION DISTRICT AND MEET THE TECHNICAL REQUIREMENTS FOR SMALL POND CONSTRUCTION, SOIL EROSION AND SEDIMENT CONTROL.

James M. Holmes 11/17/88 DATE
 SOIL CONSERVATION SERVICE

APPROVED *Robert Zichus* 11/12/88 DATE
 HOWARD S.O.D.

11-30-00	2	REVISE POND NAME FOR CHAPEL ESTATES DRIVE
DATE	NO	REVISION
OWNER	J.J.M. PARTNERSHIP 5570-201 STERRETT PLACE COLUMBIA, MARYLAND 21044 (301) 740-4466	
DEVELOPER	J.J.M., INC. 5570-201 STERRETT PLACE COLUMBIA, MARYLAND 21044 (301) 740-4466	
PROJECT	CHAPEL WOODS II	
AREA	TAX MAP NO 29 PARCELS 26, 86, 282 5TH ELECTION DISTRICT HOWARD COUNTY, MARYLAND	
TITLE	GRADING AND SEDIMENT CONTROL PLAN	
THE RIEMER GROUP, INC.		
The Riemer Group, Inc. A Land Planning, Design & Civil Engineering Firm 3105 North Ridge Road, Ellicott City, Maryland 21043 (301) 461-2690		
DATE	11-11-88	DESIGNED BY: C.J.R.
DATE	11-17-88	DRAWN BY: J.L.B.
DATE	11-12-88	PROJECT NO: 28800
DATE	11-12-88	DATE: NOVEMBER 7, 1988
DATE	11-12-88	SCALE: 1"=50'
DATE	11-12-88	DRAWING NO. 10 OF 15

717

MARYLAND BLUEPRINT CO. INC.


LEGEND

LIMIT OF DISTURBANCE
 EARTH DIKE
 SILT FENCE
 STONE FILTER INLET PROTECTION

NOTE: ALL CONTOURS AROUND SEDIMENT TRAPS ARE TEMPORARY CONTRACTORS MUST MAINTAIN POSITIVE DRAINAGE ON ALL EARTH DIKE

NOTE: SEE SHEET 14 FOR BRIDGE BORING LOGS.

NOTE: FOR FLOODPLAIN CROSS SECTIONS A & D SEE FLOODPLAIN COMPUTATIONS.

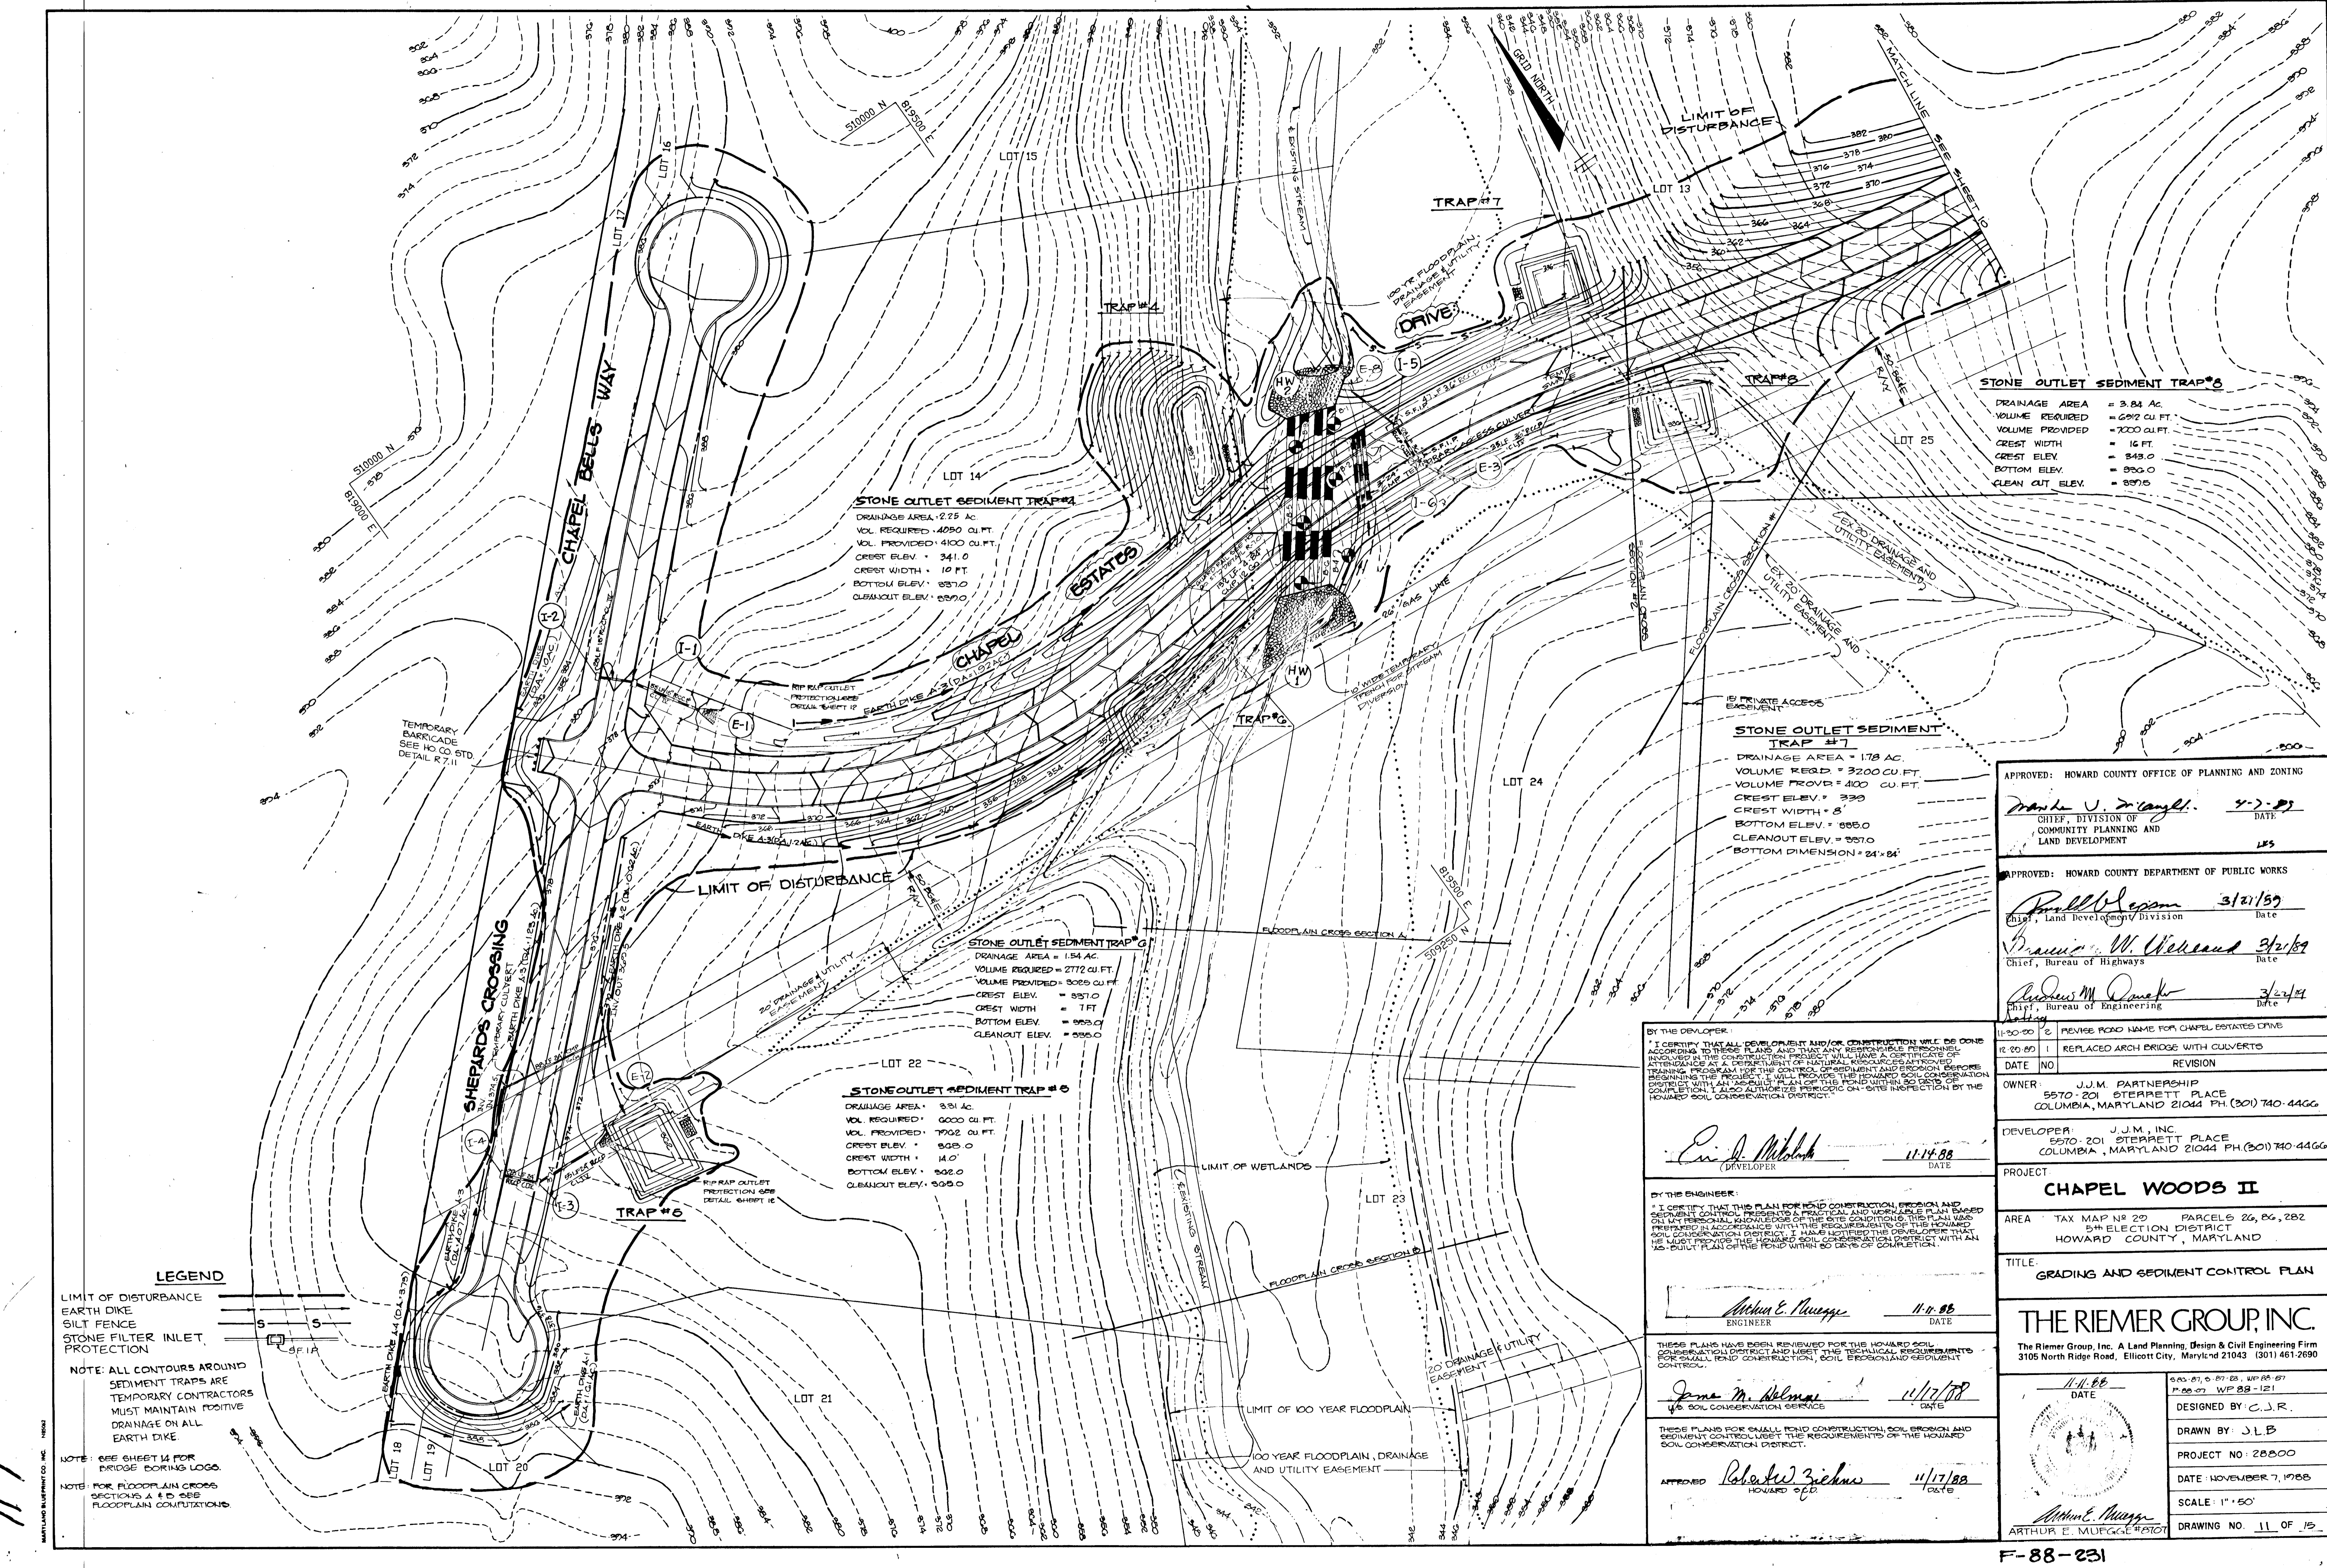

STONE OUTLET SEDIMENT TRAP #8

DRAINAGE AREA = 3.84 AC
 VOLUME REQUIRED = 6912 CU. FT.
 VOLUME PROVIDED = 7000 CU. FT.
 CREST WIDTH = 16 FT.
 CREST ELEV. = 843.0
 BOTTOM ELEV. = 826.0
 CLEANOUT ELEV. = 827.5

STONE OUTLET SEDIMENT TRAP #4

DRAINAGE AREA = 2.25 AC
 VOL. REQUIRED = 4050 CU. FT.
 VOL. PROVIDED = 4100 CU. FT.
 CREST ELEV. = 341.0
 CREST WIDTH = 10 FT.
 BOTTOM ELEV. = 337.0
 CLEANOUT ELEV. = 339.0

STONE OUTLET SEDIMENT TRAP #7

DRAINAGE AREA = 1.78 AC
 VOLUME REQ'D = 3200 CU. FT.
 VOLUME PROVIDED = 4100 CU. FT.
 CREST ELEV. = 330
 CREST WIDTH = 8'
 BOTTOM ELEV. = 325.0
 CLEANOUT ELEV. = 327.0
 BOTTOM DIMENSION = 24' x 24'

STONE OUTLET SEDIMENT TRAP #5

DRAINAGE AREA = 1.54 AC
 VOLUME REQUIRED = 2712 CU. FT.
 VOLUME PROVIDED = 3025 CU. FT.
 CREST ELEV. = 337.0
 CREST WIDTH = 7 FT
 BOTTOM ELEV. = 333.0
 CLEANOUT ELEV. = 335.0

STONE OUTLET SEDIMENT TRAP #6

DRAINAGE AREA = 3.31 AC
 VOL. REQUIRED = 6030 CU. FT.
 VOL. PROVIDED = 7902 CU. FT.
 CREST ELEV. = 328.0
 CREST WIDTH = 14.0'
 BOTTOM ELEV. = 322.0
 CLEANOUT ELEV. = 323.0

APPROVED: HOWARD COUNTY OFFICE OF PLANNING AND ZONING

Frank J. D'Angelis 4-2-89 DATE
 CHIEF, DIVISION OF COMMUNITY PLANNING AND LAND DEVELOPMENT

APPROVED: HOWARD COUNTY DEPARTMENT OF PUBLIC WORKS

Paul Blagden 3/21/89 DATE
 Chief, Land Development Division

Brian W. Welsand 3/21/89 DATE
 Chief, Bureau of Highways

Andrew M. Quaker 3/21/89 DATE
 Chief, Bureau of Engineering

BY THE DEVELOPER:

I CERTIFY THAT ALL DEVELOPMENT AND/OR CONSTRUCTION WILL BE DONE ACCORDING TO THESE PLANS AND THAT ANY RESPONSIBLE PERSONNEL INVOLVED IN THE CONSTRUCTION PROJECT WILL HAVE A CERTIFICATE OF ATTENDANCE AT A DEPARTMENT OF NATURAL RESOURCES APPROVED TRAINING PROGRAM FOR THE CONTROL OF EROSION AND SEDIMENT BEFORE BEGINNING THE PROJECT. I WILL PROVIDE THE HOWARD SOIL CONSERVATION DISTRICT WITH A COPY OF THIS PLAN AND A LETTER FROM THE DEVELOPER THAT HE MUST PROVIDE THE HOWARD SOIL CONSERVATION DISTRICT WITH AN AS-BUILT PLAN OF THE POND WITHIN 60 DAYS OF COMPLETION.

Eric J. Melchior 11-14-88 DATE
 DEVELOPER

BY THE ENGINEER:

I CERTIFY THAT THIS PLAN FOR POND CONSTRUCTION, EROSION AND SEDIMENT CONTROL PRESENTS A PRACTICAL AND WORKABLE PLAN BASED ON MY PERSONAL OBSERVATION OF THE SITE CONDITIONS. THIS PLAN WAS PREPARED IN ACCORDANCE WITH THE REQUIREMENTS OF THE HOWARD SOIL CONSERVATION DISTRICT. I HAVE ADVISED THE DEVELOPER THAT HE MUST PROVIDE THE HOWARD SOIL CONSERVATION DISTRICT WITH AN AS-BUILT PLAN OF THE POND WITHIN 60 DAYS OF COMPLETION.

Arthur E. Muegge 11-14-88 DATE
 ENGINEER

THESE PLANS HAVE BEEN REVIEWED FOR THE HOWARD SOIL CONSERVATION DISTRICT AND MEET THE TECHNICAL REQUIREMENTS FOR SMALL POND CONSTRUCTION, SOIL EROSION AND SEDIMENT CONTROL.

Jane M. Helms 11/17/88 DATE
 U.S. SOIL CONSERVATION SERVICE

THESE PLANS HAVE BEEN REVIEWED FOR THE HOWARD SOIL CONSERVATION DISTRICT AND MEET THE TECHNICAL REQUIREMENTS OF THE HOWARD SOIL CONSERVATION DISTRICT.

APPROVED *Robert Zickus* 11/17/88 DATE
 HOWARD S.O.D.

11-30-88	2	REVISE POND NAME FOR CHAPEL ESTATES DRIVE
12-20-88	1	REPLACED ARCH BRIDGE WITH CULVERTS
DATE	NO	REVISION
OWNER: J.J.M. PARTNERSHIP 5570-201 STEPPETT PLACE COLUMBIA, MARYLAND 21044 PH.(301) 740-4466		
DEVELOPER: J.J.M., INC. 5570-201 STEPPETT PLACE COLUMBIA, MARYLAND 21044 PH.(301) 740-4466		
PROJECT: CHAPEL WOODS II		
AREA: TAX MAP NO 20 PARCELS 26, 26A, 282 5th ELECTION DISTRICT HOWARD COUNTY, MARYLAND		
TITLE: GRADING AND SEDIMENT CONTROL PLAN		

THE RIEMER GROUP, INC.

The Riemer Group, Inc. A Land Planning, Design & Civil Engineering Firm
 3105 North Ridge Road, Ellicott City, Maryland 21043 (301) 461-2690

DATE: 11-14-88
 DESIGNED BY: C.J.R.
 DRAWN BY: J.L.B.
 PROJECT NO: 28800
 DATE: NOVEMBER 7, 1988
 SCALE: 1" = 50'
 DRAWING NO. 11 OF 12

PROPOSED SEEDING NOTES

Apply to graded or cleared areas not subject to immediate further disturbance where a permanent vegetative cover is needed.

Soil Preparation: Loosen upper three inches of soil by raking, discing or other acceptable means before seeding, if not previously loosened.

Soil Amendments: In lieu of soil test recommendations, use one of the following schedules:

- Preferred - Apply 2 tons per acre dolomitic limestone (92 lbs/1000 square ft) and 400 lbs per acre 10-10-10 fertilizer (14 lbs/1000 sq ft) before seeding. Before or after seed apply three inches of soil. At time of seeding, apply 400 lbs per acre 10-10-10 urea fertilizer (9 lbs/1000 sq ft).
- Acceptable - Apply 2 tons per acre dolomitic limestone (92 lbs/1000 sq ft) and 1000 lbs per acre 10-10-10 fertilizer (13 lbs/1000 sq ft) before seeding. Before or after seed apply three inches of soil.

Seeding - For the periods March 1 thru April 30, and August 1 thru October 15, seed with 60 lbs per acre (1-1/2 lbs/1000 sq ft) of Kentucky 31 Tall Fescue. For the period May 1 thru July 31, seed with 60 lbs Kentucky 31 Tall Fescue per acre and 2 lbs per acre (50 lbs/1000 sq ft) of weeping lovegrass. During the period of October 16 thru February 28, seed with 60 lbs per acre of Kentucky 31 Tall Fescue and 2 lbs per acre of weeping lovegrass. For the period of March 1 thru May 31, seed with 60 lbs per acre of Kentucky 31 Tall Fescue and 2 lbs per acre of weeping lovegrass. For the period of June 1 thru August 31, seed with 60 lbs per acre of Kentucky 31 Tall Fescue and 2 lbs per acre of weeping lovegrass.

Mulching - Apply 1/4 to 2 tons per acre (20 to 160 lbs/1000 sq ft) of unrotted small grain straw immediately after seeding. Anchor mulch immediately after application using a mulching tool or 218 gal per acre (5 gal/1000 sq ft) of unrotted asphalt on flat areas. On slopes 4 feet or higher, use 348 gal per acre (8 gal/1000 sq ft) for anchoring.

Maintenance - Inspect all seeded areas and make needed repairs, replacements and reseedings.

TEMPORARY SEEDING NOTES

Apply to graded or cleared areas likely to be regraded where a short-term vegetative cover is needed.

Soil Preparation: Loosen upper three inches of soil by raking, discing or other acceptable means before seeding, if not previously loosened.

Soil Amendments: Apply 400 lbs per acre 10-10-10 fertilizer (14 lbs/1000 sq ft).

Seeding - For the periods March 1 thru April 30, and August 1 thru October 15, seed with 15 lbs per acre of annual ryegrass (3.7 lbs/1000 sq ft). For the period May 1 thru November 15, seed with 15 lbs per acre of weeping lovegrass (0.7 lbs/1000 sq ft). For the period of November 16 thru February 28, seed with 15 lbs per acre of weeping lovegrass and 2 tons per acre of well-rotted straw mulch and seed as soon as possible in the spring. Option (2) Seed with 60 lbs/acre Kentucky 31 Tall Fescue and mulch with 2 tons/acre well-rotted straw.

Mulching - Apply 1/4 to 2 tons per acre (20 to 160 lbs/1000 sq ft) of unrotted small grain straw immediately after seeding. Anchor mulch immediately after application using a mulching tool or 218 gal per acre (5 gal/1000 sq ft) of unrotted asphalt on flat areas. On slopes 4 feet or higher, use 348 gal per acre (8 gal/1000 sq ft) for anchoring.

Maintenance - Inspect all seeded areas and make needed repairs, replacements and reseedings.

TEMPORARY SEEDING NOTES

Apply to graded or cleared areas likely to be regraded where a short-term vegetative cover is needed.

Soil Preparation: Loosen upper three inches of soil by raking, discing or other acceptable means before seeding, if not previously loosened.

Soil Amendments: Apply 400 lbs per acre 10-10-10 fertilizer (14 lbs/1000 sq ft).

Seeding - For the periods March 1 thru April 30, and August 1 thru October 15, seed with 15 lbs per acre of annual ryegrass (3.7 lbs/1000 sq ft). For the period May 1 thru November 15, seed with 15 lbs per acre of weeping lovegrass (0.7 lbs/1000 sq ft). For the period of November 16 thru February 28, seed with 15 lbs per acre of weeping lovegrass and 2 tons per acre of well-rotted straw mulch and seed as soon as possible in the spring, or use seed.

Mulching - Apply 1/4 to 2 tons per acre (20 to 160 lbs/1000 sq ft) of unrotted small grain straw immediately after seeding. Anchor mulch immediately after application using a mulching tool or 218 gal per acre (5 gal/1000 sq ft) of unrotted asphalt on flat areas. On slopes 4 feet or higher, use 348 gal per acre (8 gal/1000 sq ft) for anchoring.


Maintenance - Inspect all seeded areas and make needed repairs, replacements and reseedings.

SEEDING CONTROL NOTES

- A minimum of 24 hours notice must be given to the Howard County Office of Inspections and Permits prior to the start of any construction (1992-2433).
- All vegetative and structural practices are to be installed according to the provisions of this plan and are to be in accordance with the 1983 MARYLAND STANDARDS AND SPECIFICATIONS FOR SOIL EROSION AND SEDIMENT CONTROL.
- Following initial soil disturbance or re disturbance, permanent or temporary stabilization shall be completed within: a) 7 calendar days for all perimeter sediment control structures, dikes, perimeter slopes and all slopes greater than 3:1, 30 to 60 days as to all other disturbed or graded areas on the project site.
- All sediment traps/basins shown must be fenced and warning signs posted around their perimeter in accordance with Vol. 1, Chapter 12, of the HOWARD COUNTY DESIGN MANUAL, Storm Drainage.
- All disturbed areas must be stabilized within the time period specified above in accordance with the 1983 MARYLAND STANDARDS AND SPECIFICATIONS FOR SOIL EROSION AND SEDIMENT CONTROL and approved seedings (Sec. 51) and (Sec. 54), temporary seeding (Sec. 50) and mulching (Sec. 52). Temporary stabilization with mulch alone can only be done when recommended seedings do not allow for proper germination and establishment of grasses.
- All sediment control structures are to remain in place and are to be maintained in operative condition until permission for their removal has been obtained from the Howard County Sediment Control Inspector.
- Site Analysis:

IGB 532 acres
Total Area of Site
Area Disturbed
Area to be roofed or paved
Area to be vegetatively stabilized
Total Cut
total fill
TOPSOIL
CU yds.
CU yds.
- Any sediment control practice which is disturbed by grading activity for placement of utilities must be repaired on the same day of disturbance.
- Additional sediment controls must be provided, if deemed necessary by the Howard County DPW sediment control inspector.
- Site grading will begin only after all perimeter sediment control measures have been installed and are in a functioning condition.
- Sediment will be removed from traps when its depth reaches the clean out elevation shown on the plans.


STANDARD SYMBOL

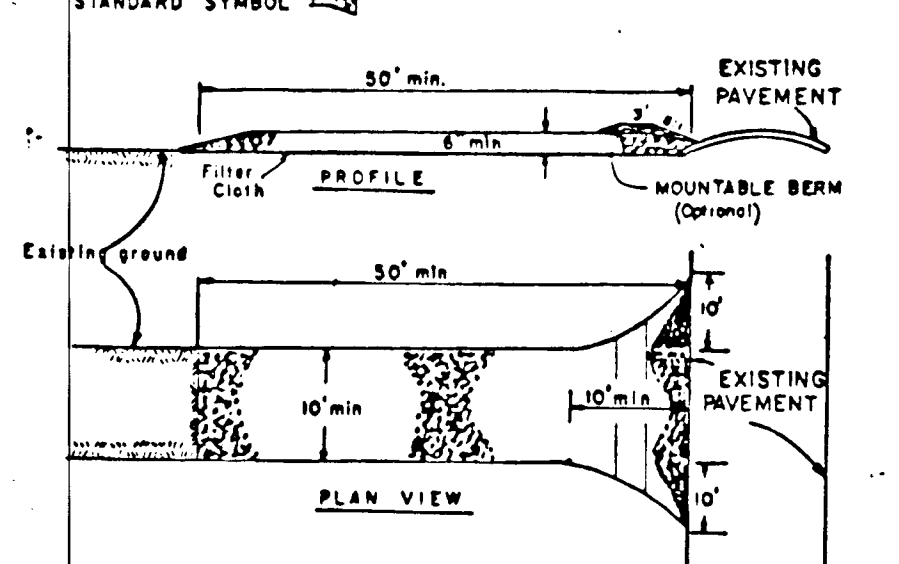

CONSTRUCTION SPECIFICATIONS

- Stone Size - Use 2" stone, or recycled or recycled concrete equivalent.
- Length - As required, but not less than 30 feet (except on a single residence lot where a 30 foot minimum length would apply).
- Thickness - Not less than 6" inches.
- Width - The 180 foot minimum, but not less than the full width at points where ingress or egress occurs.
- Filter Cloth - Will be placed over the entire area prior to placing of stone. Filter cloth will not be required on a steeply sloping embankment, a mounded beam with 1:1 slopes will be permitted.
- Maintenance - The entrance shall be maintained in a condition which will prevent backing up or flowing of sediment onto public right-of-way. This may require periodic top dressing with additional stone as conditions demand and traps and/or cleanouts may be required to trap sediment. An sediment applied, draped, washed or tracked onto public right-of-way must be removed immediately.
- Warning - Where shall be cleaned to remove sediment prior to entrance onto public right-of-way. When washing is required, it shall be done on an area stabilized with stone and which drains into an approved sediment trapping device.
- Periodic inspection and needed maintenance shall be provided after each rain.


STABILIZED CONSTRUCTION ENTRANCE

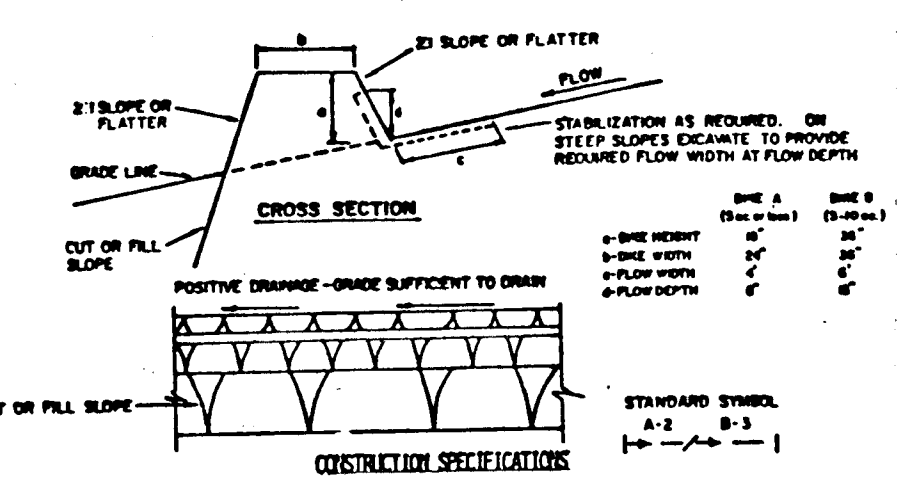

CONSTRUCTION SPECIFICATIONS

- ALL DIKES SHALL BE CONSTRUCTED BY EARTH-MOVING EQUIPMENT.
- ALL DIKES SHALL HAVE POSITIVE DRAINAGE TO AN OUTLET.
- TOP WIDTH MAY BE WIDER AND SIDE SLOPES MAY BE FLATTER, IF DESIRED TO FACILITATE CROSSING BY CONSTRUCTION TRAFFIC.
- FILL LOCATION SHALL BE ADJUSTED AS NEEDED TO UTILIZE A STABILIZED SLOPE OUTLET. EARTH DIKES SHALL HAVE AN OUTLET THAT FUNCTIONS WITH A MINIMUM OF OBSTRUCTION. DIKES SHALL BE CONSTRUCTED TO A SEDIMENT TRAPPING DEVICE SUCH AS A SEDIMENT BASIN WHERE EITHER THE DIKE CHANNEL OR THE DRAINAGE AREA ABOVE THE DIKE ARE NOT POSITIVELY STABILIZED.
- STABILIZATION SHALL BE: (A) IN ACCORDANCE WITH STANDARD SPECIFICATIONS FOR SEED AND SHOW HELD ON STORM WELLS IF NOT IN SEEDING SEASON, (B) FLOW CHANNEL AS PER THE CURVE BELOW.

SEEDING CONTROL NOTES

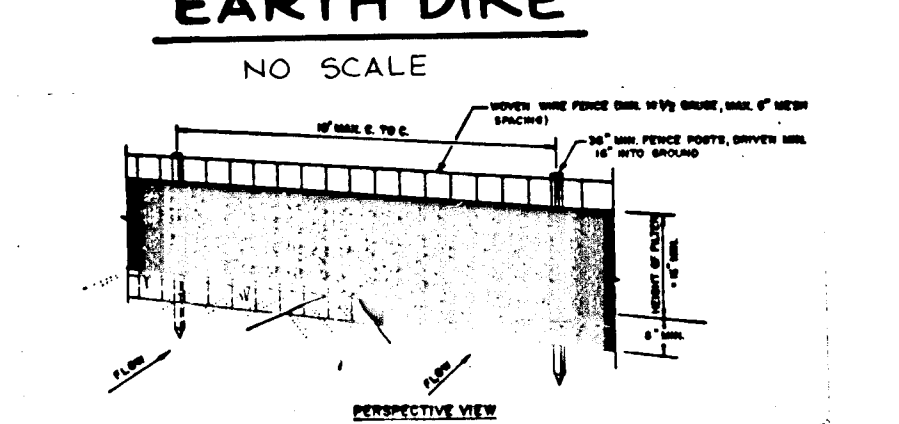

CONSTRUCTION NOTES FOR PROPOSED SILT FENCE


- WOODEN FRAME SHALL BE MAINTAINED REGULARLY TO PREVENT ROT AND TO MAINTAIN PROPER TENSION.
- FILTER CLOTH TO BE MAINTAINED REGULARLY TO PREVENT ROT AND TO MAINTAIN PROPER TENSION.
- WOODEN FRAME SHALL BE MAINTAINED REGULARLY TO PREVENT ROT AND TO MAINTAIN PROPER TENSION.
- POSTS SHALL BE MAINTAINED REGULARLY TO PREVENT ROT AND TO MAINTAIN PROPER TENSION.

CONSTRUCTION NOTES FOR PROPOSED SILT FENCE


- WOODEN FRAME SHALL BE MAINTAINED REGULARLY TO PREVENT ROT AND TO MAINTAIN PROPER TENSION.
- FILTER CLOTH TO BE MAINTAINED REGULARLY TO PREVENT ROT AND TO MAINTAIN PROPER TENSION.
- WOODEN FRAME SHALL BE MAINTAINED REGULARLY TO PREVENT ROT AND TO MAINTAIN PROPER TENSION.
- POSTS SHALL BE MAINTAINED REGULARLY TO PREVENT ROT AND TO MAINTAIN PROPER TENSION.

SILT FENCE

NO SCALE

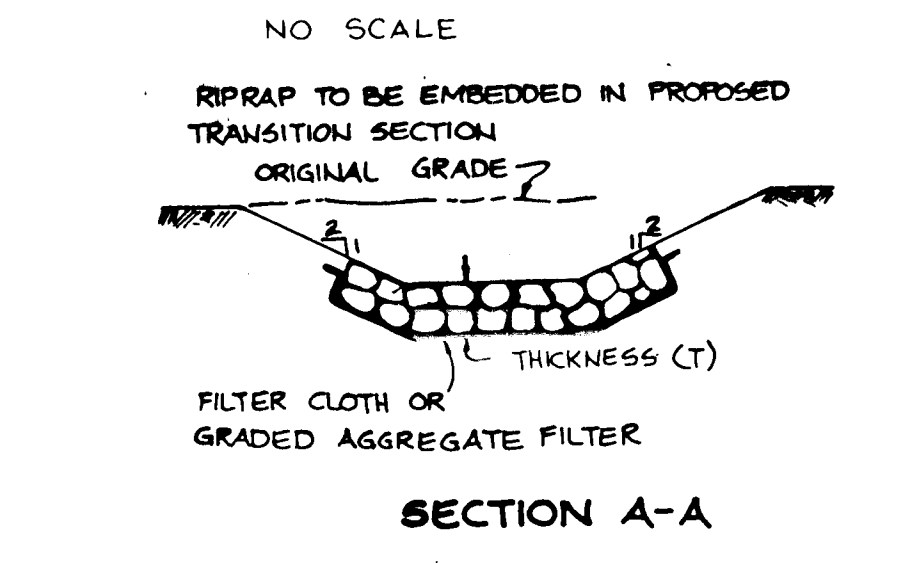

SECTION A-A


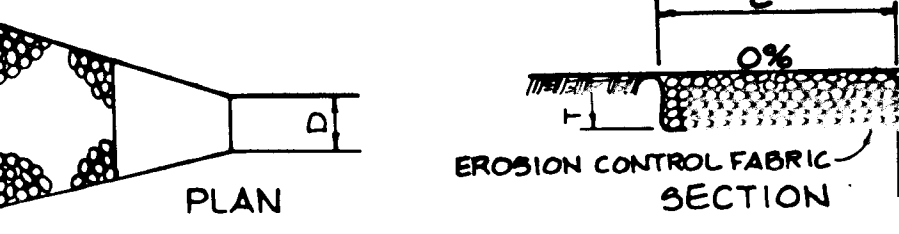


OUTLET PROTECTION DETAIL

NO SCALE

STRUCTURE	MEDIUM STONE DIA.	LENGTH (L)	WIDTH (W)	THICKNESS (T)
E1	0.5'	10'	11.25'	1.12'
E2	0.5'	10'	12'	1.12'
E-B	0.75'	30'	20'	2.0'
E4	0.5'	10'	11.25'	1.12'
E6	0.5'	10'	13'	1.12'
E7	0.5'	18'	11.25'	1.12'

NO SCALE

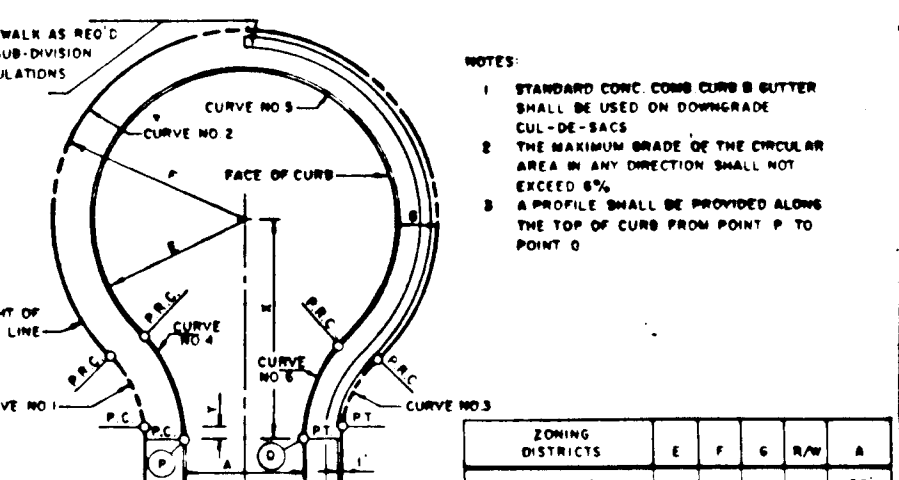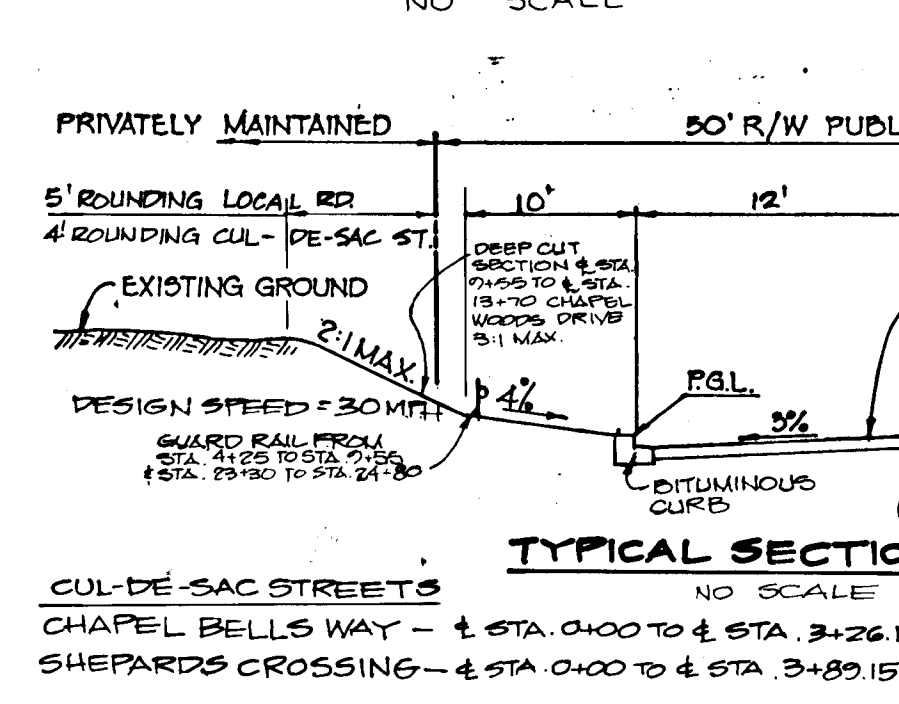

CUL-DE-SAC DETAIL

NO SCALE


CURVE DATA TABLE

X = 58.45 Y = 2.55 LP = 259.69'

CURVE 143	CURVE 2	CURVE 446	CURVE 5
Δ 48°11'23"	276°22'46"	51°11'43"	182°23'26"
R 25.00	50.00	35.00	40.00
L 21.03'	241.19'	31.27'	197.15'
T 11.18'	—	16.77'	—
LC 204.1'	—	30.24'	—

CUL-DE-SAC DETAIL

NO SCALE

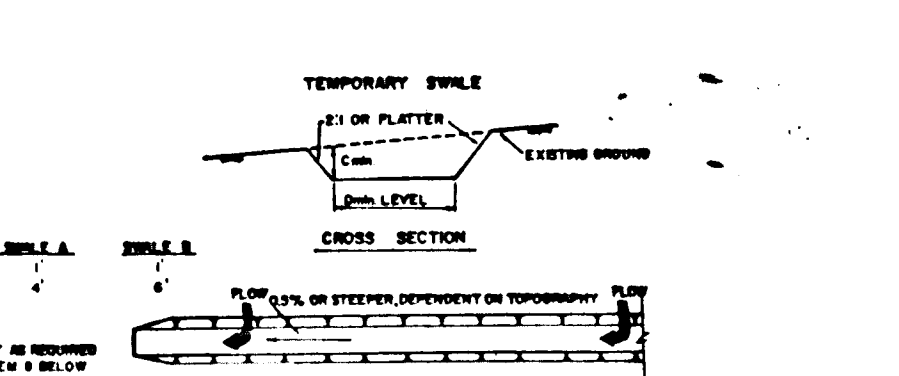

CONSTRUCTION SPECIFICATIONS



- ALL TEMPORARY DIKES SHALL HAVE UNINTERRUPTED POSITIVE DRAINAGE TO AN OUTLET.
- DISBURSED RAINFALL FROM A DISTURBED AREA SHALL BE CONVEYED TO A SEDIMENT TRAPPING DEVICE.
- DISBURSED RAINFALL FROM A DISTURBED AREA SHALL BE CONVEYED TO A SEDIMENT TRAPPING DEVICE.
- ALL TRAP, SWALE, STORM, CONDUIT, AND OTHER COLLECTIONS STRUCTURES SHALL BE MAINTAINED AND CLEANED TO PREVENT OBSTRUCTION TO THE FLOW OF WATER.
- THE SWALE SHALL BE MAINTAINED TO PREVENT OBSTRUCTION TO THE FLOW OF WATER.
- FILLS SHALL BE CONSTRUCTED BY EARTH-MOVING EQUIPMENT.
- ALL EARTH REMOVED AND NOT REUSED IN CONSTRUCTION SHALL BE PLACED SO THAT IT WILL NOT INTERFERE WITH THE FUNCTIONING OF THE SWALE.
- STABILIZATION SHALL BE AS PER THE CURVE BELOW.

SEEDING CONTROL NOTES

TYPE OF TREATMENT	CURVE DATA	SEEDING CONTROL NOTES
1	0.5'-5.0'	SEED AND STORM FENCE
2	5.1'-8.0'	SEED WITH MULCH OR DECISION
3	8.1'-20'	SEED WITH MULCH OR DECISION

TEMPORARY SWALE

 NO SCALE

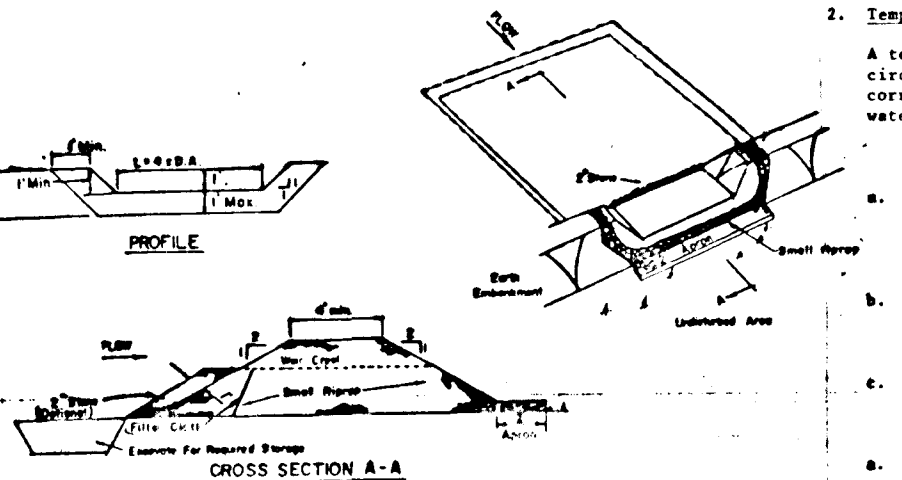

STONE OUTLET SEDIMENT TRAP

NO SCALE

- Area under sedimentation shall be cleared, graded and stripped of any vegetation and root mat. The soil area shall be cleared.
- The fill material for the sedimentation shall be free of rocks and other woody vegetation. It will be overlaid with straw, rock, organic material or other objectionable material. The sedimentation shall be completed by treating with equipment while it is being constructed.
- All cut and fill slopes shall be 3:1 or flatter.
- The stone used in the outlet shall be small riprap 4" to 6" in size with a 1" diameter of the aggregate placed on the upgrade side of the trap. A 1/2" diameter filter cloth is to be placed in the outlet.
- Insufficient shall be removed and trap extended to its original elevation when the sediment has accumulated to the design depth of the trap.
- The structure shall be inspected after each rain and repairs made as needed.
- Construction operations shall be carried out in such a manner that erosion and water pollution is minimized.
- The structure shall be removed and the area stabilized when the drainage area has been properly stabilized.


SEQUENCE OF CONSTRUCTION

NO SCALE

- Obtain a grading permit.
- Remove existing temporary tee turnaround, barricade and any existing paving as necessary at existing Linden Chapel Road (1 day)
- Install stabilized construction entrance (1 day)
- Install temporary culverts under Shepards Crossing and Chapel (1 week)
- Drive including temporary trench for stream diversion, silt fence, earth dikes, stone outlet sediment traps #1 through #8 and temporary swales (1 week)
- Perform grading maintaining positive drainage on all earth dikes. (1 week)
- Install storm drains and stone filter inlet protection as per plan. UPON INSTALLATION OF CULVERT FROM HWY-1 TO HWY-2, REMOVE TEMPORARY ACCESS CULVERT. (1 WEEK)
- COMPLETE GRADING BRINGING ROAD TO SUBGRADE ELEVATION.
- Complete all construction, including curb and paving.
- Stabilize all disturbed areas in accordance with permanent seeding notes.
- Upon approval of the Howard County Department of Public Works Sediment Control Inspector, remove all remaining sediment control devices and stabilize all areas disturbed in their removal according to the permanent seeding notes.

STONE FILTER INLET PROTECTION

NO SCALE

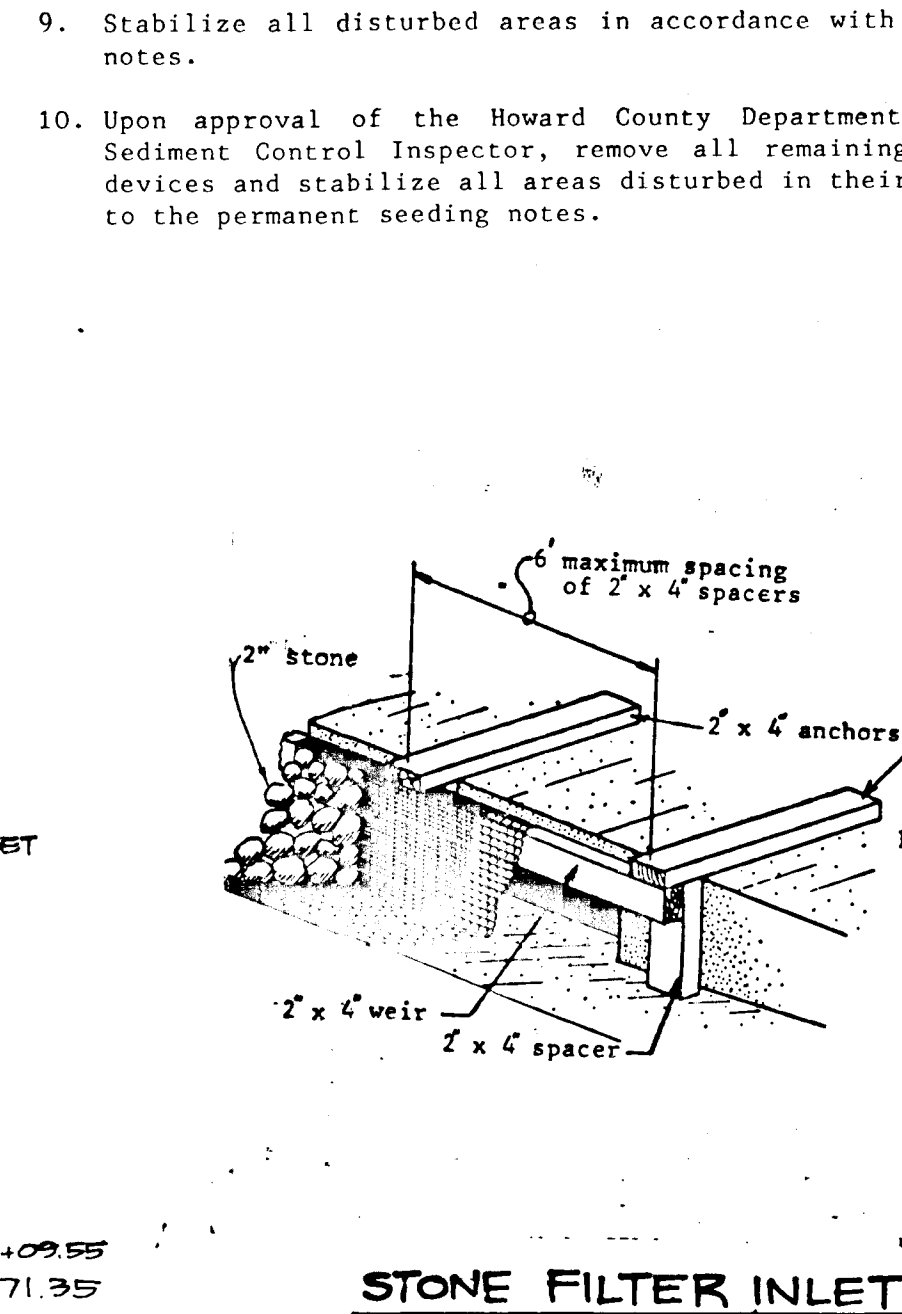

TEMPORARY ACCESS CULVERT - (STANDARD DRAWING TAC-1)

A temporary access culvert is a structure consisting of a section(s) of circular pipe, pipe arch(es), or steel pipes of reinforced concrete, corrugated metal, or structural plate, which is used to convey flowing water through the crossing.

Considerations

- Temporary culverts are used where (1) the channel is too wide for normal bridge construction, (2) and/or where the channel may prove unsafe for single span bridges, or (3) access is not needed from bank to bank.
- The temporary culvert crossing method is normally preferred over a fixed type of crossing, since disturbance to the waterway is only during construction and removal of the culvert.
- Temporary culverts can be salvaged and reused.

CONSTRUCTION SPECIFICATIONS FOR TEMPORARY ACCESS CULVERT

- Area under sedimentation shall be cleared, graded and stripped of any vegetation and root mat. The soil area shall be cleared.
- The fill material for the sedimentation shall be free of rocks and other woody vegetation. It will be overlaid with straw, rock, organic material or other objectionable material. The sedimentation shall be completed by treating with equipment while it is being constructed.
- All cut and fill slopes shall be 3:1 or flatter.
- The stone used in the outlet shall be small riprap 4" to 6" in size with a 1" diameter of the aggregate placed on the upgrade side of the trap. A 1/2" diameter filter cloth is to be placed in the outlet.
- Insufficient shall be removed and trap extended to its original elevation when the sediment has accumulated to the design depth of the trap.
- The structure shall be inspected after each rain and repairs made as needed.
- Construction operations shall be carried out in such a manner that erosion and water pollution is minimized.
- The structure shall be removed and the area stabilized when the drainage area has been properly stabilized.

CONSTRUCTION SPECIFICATIONS

- Temporary culverts are used where (1) the channel is too wide for normal bridge construction, (2) and/or where the channel may prove unsafe for single span bridges, or (3) access is not needed from bank to bank.
- The temporary culvert crossing method is normally preferred over a fixed type of crossing, since disturbance to the waterway is only during construction and removal of the culvert.
- Temporary culverts can be salvaged and reused.

CONSTRUCTION SPECIFICATIONS


- Temporary culverts are used where (1) the channel is too wide for normal bridge construction, (2) and/or where the channel may prove unsafe for single span bridges, or (3) access is not needed from bank to bank.
- The temporary culvert crossing method is normally preferred over a fixed type of crossing, since disturbance to the waterway is only during construction and removal of the culvert.
- Temporary culverts can be salvaged and reused.

CONSTRUCTION SPECIFICATIONS

- Temporary culverts are used where (1) the channel is too wide for normal bridge construction, (2) and/or where the channel may prove unsafe for single span bridges, or (3) access is not needed from bank to bank.
- The temporary culvert crossing method is normally preferred over a fixed type of crossing, since disturbance to the waterway is only during construction and removal of the culvert.
- Temporary culverts can be salvaged and reused.


CONSTRUCTION SPECIFICATIONS

- Temporary culverts are used where (1) the channel is too wide for normal bridge construction, (2) and/or where the channel may prove unsafe for single span bridges, or (3) access is not needed from bank to bank.
- The temporary culvert crossing method is normally preferred over a fixed type of crossing, since disturbance to the waterway is only during construction and removal of the culvert.
- Temporary culverts can be salvaged and reused.

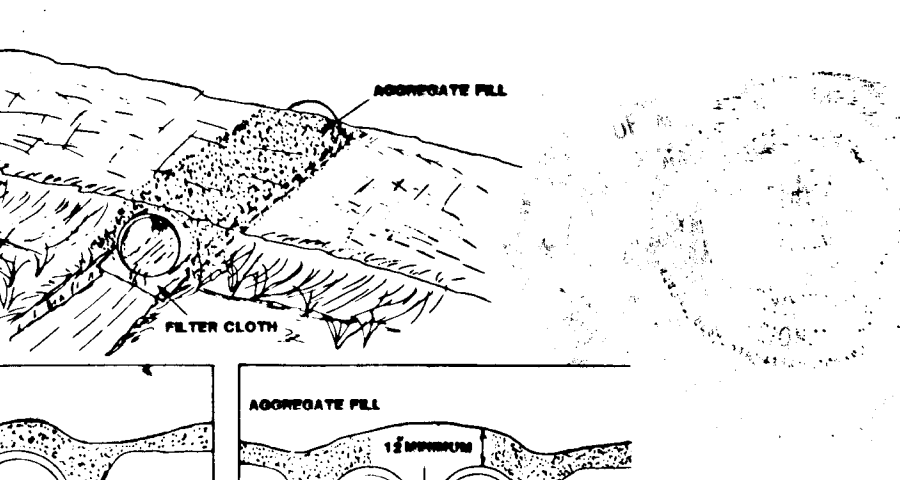


TEMPORARY ACCESS CULVERT

NO SCALE

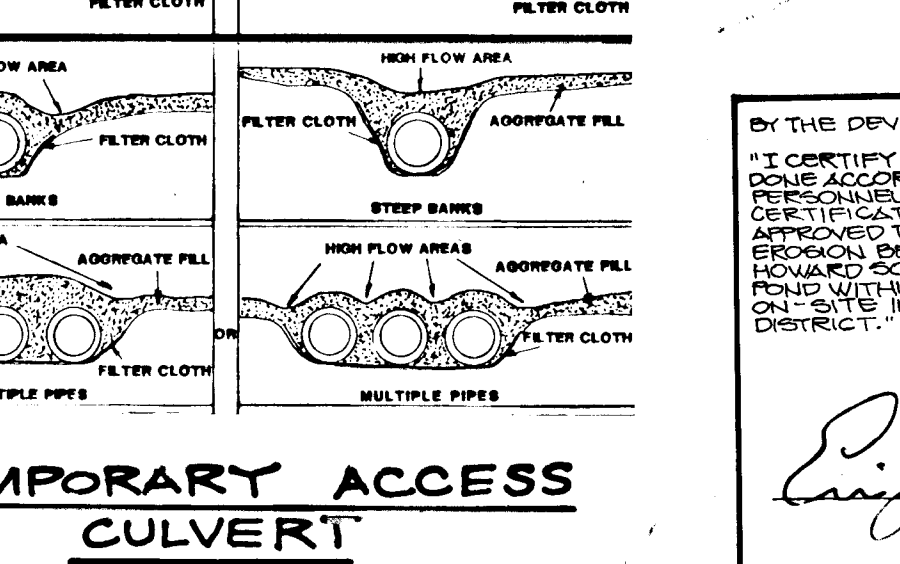

TEMPORARY ACCESS CULVERT

NO SCALE

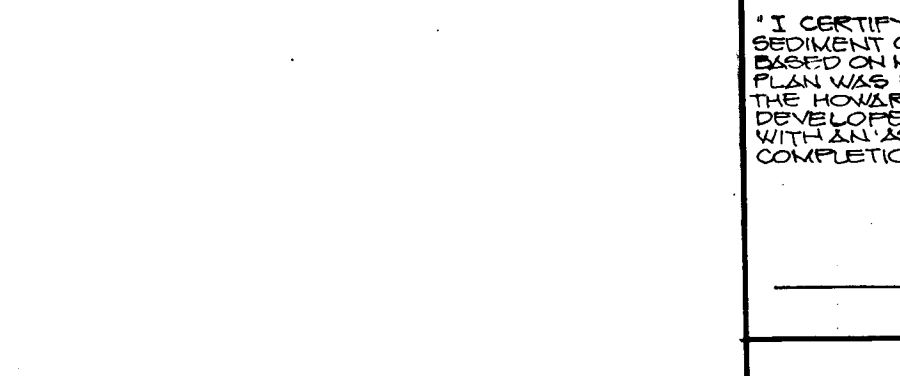

TEMPORARY ACCESS CULVERT

NO SCALE



TEMPORARY ACCESS CULVERT

NO SCALE




TEMPORARY ACCESS CULVERT

NO SCALE




TEMPORARY ACCESS CULVERT

NO SCALE

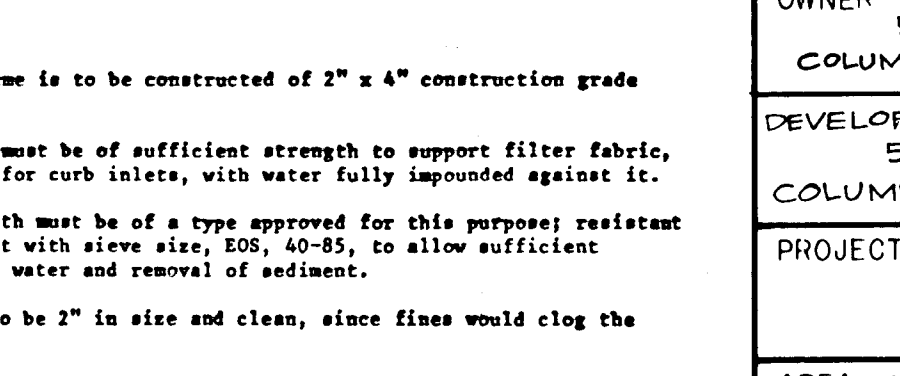


TEMPORARY ACCESS CULVERT

NO SCALE

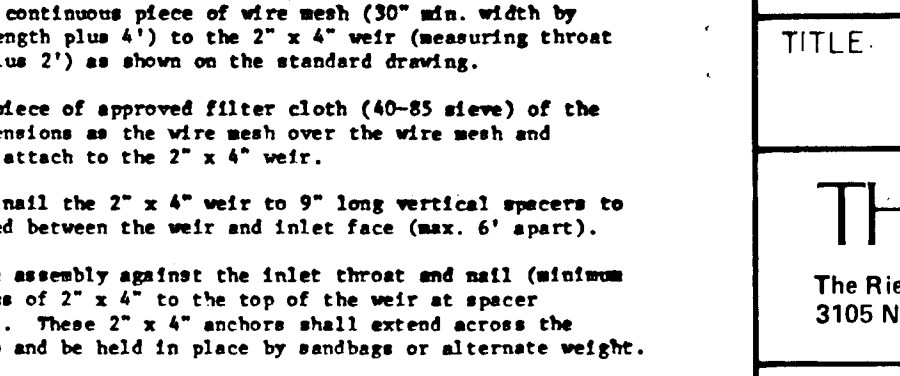

TEMPORARY ACCESS CULVERT

NO SCALE

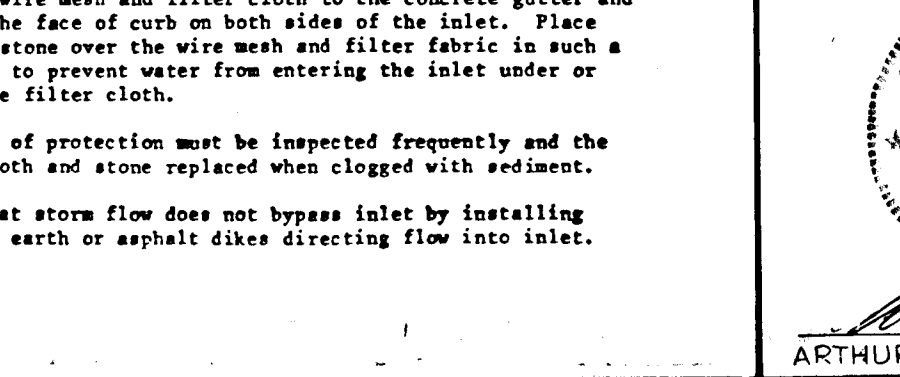

BY THE DEVELOPER:

I CERTIFY THAT ALL DEVELOPMENT AND FOR CONSTRUCTION WILL BE DONE ACCORDING TO THESE PLANS AND THAT ALL RESPONSIBLE PERSONNEL INVOLVED IN THE DESIGN AND CONSTRUCTION OF THIS PROJECT HAVE BEEN PROPERLY TRAINED AND QUALIFIED TO PERFORM THE WORK AND APPROVED TRAINING PROGRAM FOR THE CONTROL OF EROSION AND SEDIMENTATION DURING CONSTRUCTION. I WILL PROVIDE THE HOWARD COUNTY CONSERVATION DISTRICT WITH A COPY OF THE HOWARD COUNTY CONSERVATION DISTRICT'S EROSION AND SEDIMENTATION CONTROL PLAN AND A COPY OF THE HOWARD COUNTY CONSERVATION DISTRICT'S EROSION AND SEDIMENTATION CONTROL PLAN AT THE TIME OF THE HOWARD COUNTY CONSERVATION DISTRICT'S PERIODIC ON-SITE INSPECTION OF THE HOWARD COUNTY CONSERVATION DISTRICT.

Erin J. Muegge
DEVELOPER

11-14-88
DATE

BY THE ENGINEER:

I CERTIFY THAT THIS PLAN FOR FLOOD PROTECTION EROSION AND SEDIMENT CONTROL REPRESENTS A PRACTICAL AND WORKABLE PLAN AND THAT I AM A LICENSED PROFESSIONAL ENGINEER AND THAT I HAVE BEEN PROPERLY TRAINED AND QUALIFIED TO PERFORM THE WORK AND APPROVED TRAINING PROGRAM FOR THE CONTROL OF EROSION AND SEDIMENTATION DURING CONSTRUCTION. I WILL PROVIDE THE HOWARD COUNTY CONSERVATION DISTRICT WITH A COPY OF THE HOWARD COUNTY CONSERVATION DISTRICT'S EROSION AND SEDIMENTATION CONTROL PLAN AND A COPY OF THE HOWARD COUNTY CONSERVATION DISTRICT'S EROSION AND SEDIMENTATION CONTROL PLAN AT THE TIME OF THE HOWARD COUNTY CONSERVATION DISTRICT'S PERIODIC ON-SITE INSPECTION OF THE HOWARD COUNTY CONSERVATION DISTRICT.

Arthur E. Muegge
ENGINEER

11-14-88
DATE

THESE PLANS HAVE BEEN REVIEWED FOR THE HOWARD COUNTY CONSERVATION DISTRICT AND MEET THE TECHNICAL REQUIREMENTS FOR SOIL EROSION AND SEDIMENTATION CONTROL DURING CONSTRUCTION, SOIL EROSION AND SEDIMENTATION CONTROL.

James M. Kellert
UPPER SOIL CONSERVATION SERVICE

11/17/88
DATE

THESE PLANS FOR SMALL POND CONSTRUCTION SOIL EROSION AND SEDIMENTATION CONTROL MEET THE REQUIREMENTS OF THE HOWARD COUNTY CONSERVATION DISTRICT.

Robert J. Zickler
HOWARD COUNTY

11/17/88
DATE

APPROVED: HOWARD COUNTY OFFICE OF PLANNING AND ZONING

Donald J. Muegge
CHIEF, DIVISION OF COMMUNITY PLANNING AND LAND DEVELOPMENT

11-17-88
DATE

APPROVED: HOWARD COUNTY DEPARTMENT OF PUBLIC WORKS

Donald J. Muegge
Chief, Land Development Division

11/30/89
DATE

Dr. William W. Wickham
Chief, Bureau of Highways

11/30/89
DATE

Arthur E. Muegge
Chief, Bureau of Engineering

11/30/89
DATE

11-30-00 2 REVISE ROAD NAME FOR CHAPEL ESTATES DRIVE

R-27-89 1 REVISED SEQUENCE OF CONSTRUCTION

DATE	NO	REVISION

OWNER: J.J.M. PARTNERSHIP
5570 STERRETT PLACE SUITE 201
COLUMBIA, MARYLAND 21044 (301) 740-4466

DEVELOPER: J.J.M. INC.
5570 STERRETT PLACE SUITE 201
COLUMBIA MARYLAND 21044

PROJECT: CHAPEL WOODS II

AREA TAX MAP NO 29 PARCELS 26,86,282
5TH ELECTION DISTRICT
HOWARD COUNTY, MARYLAND

TITLE: **DETAIL SHEET**

THE RIEMER GROUP, INC.

The Riemer Group, Inc. A Land Planning, Design & Civil Engineering Firm
3105 North Ridge Road, Ellicott City, Maryland 21043 (301) 461-2690

11-11-88
DATE

5-86-87, 8-87-88, WP 88-57
P-88-07 WP 88-121

DESIGNED BY: C.J.R.

DRAWN BY: J.E.P.

PROJECT NO 28800


DATE NOVEMBER 7, 1988

SCALE: AS SHOWN


DRAWING NO. 12 OF 15

Arthur E. Muegge
ARTHUR E. MUEGGE 6707


F-88-231

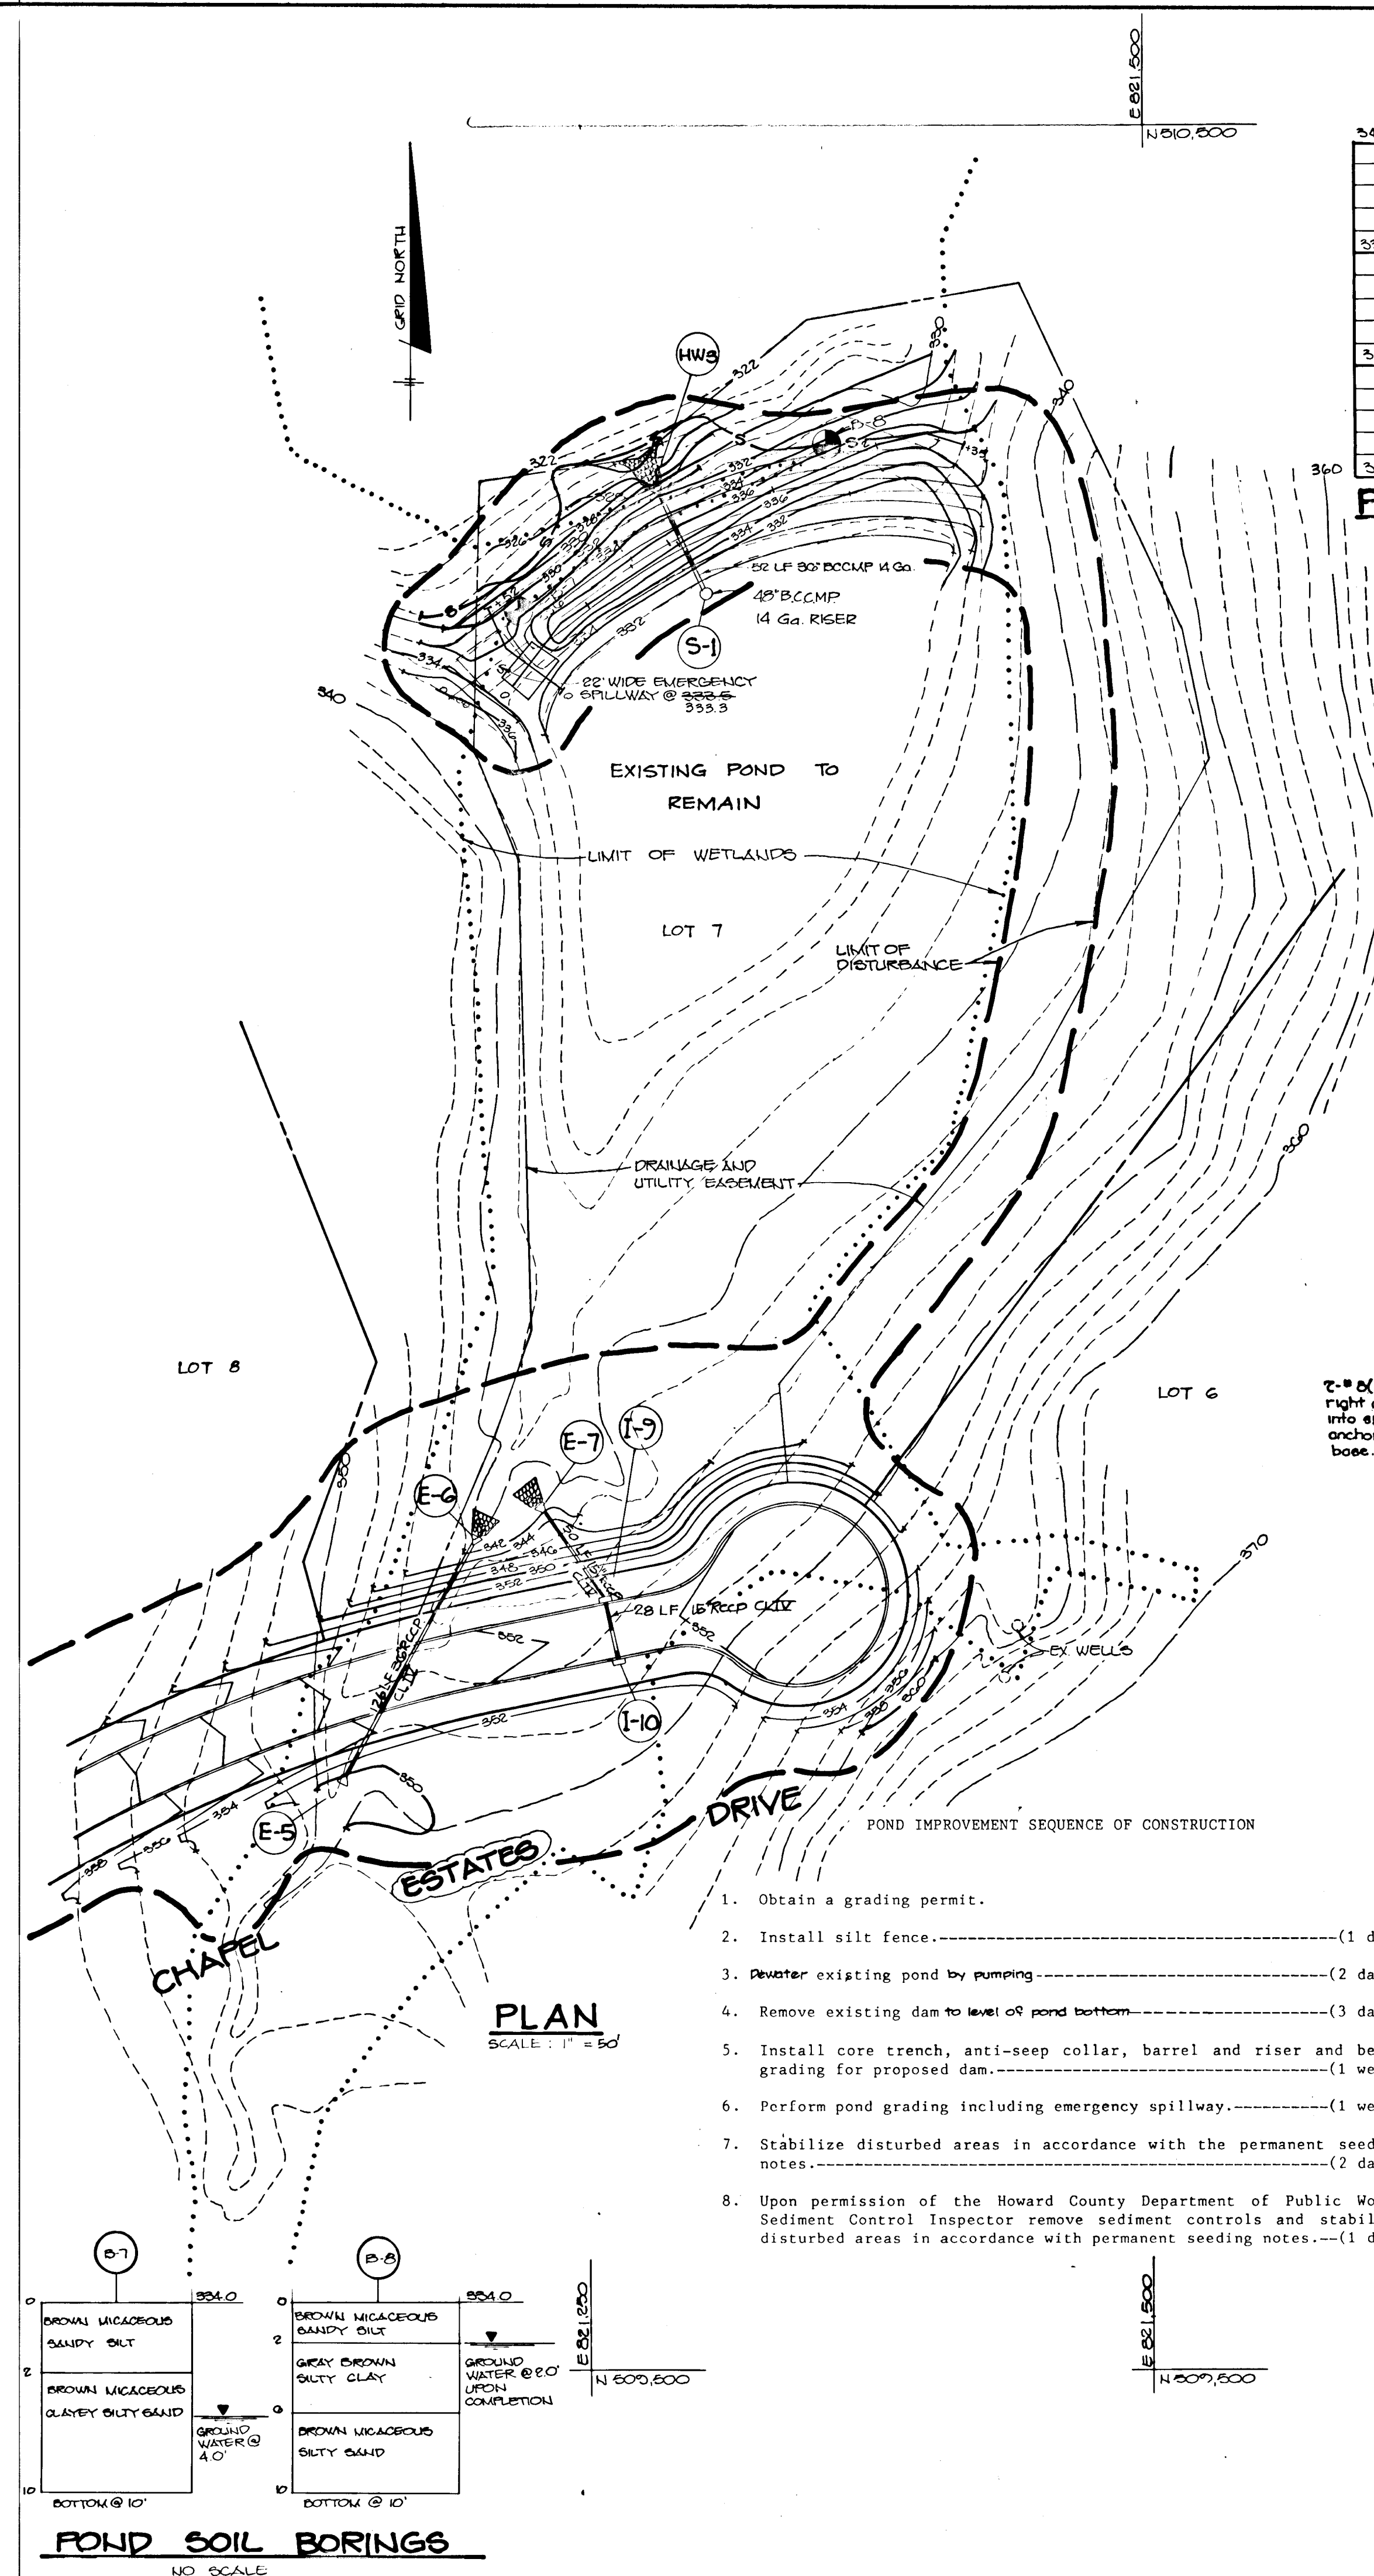


PROFILE THROUGH EMERGENCY SPILLWAY

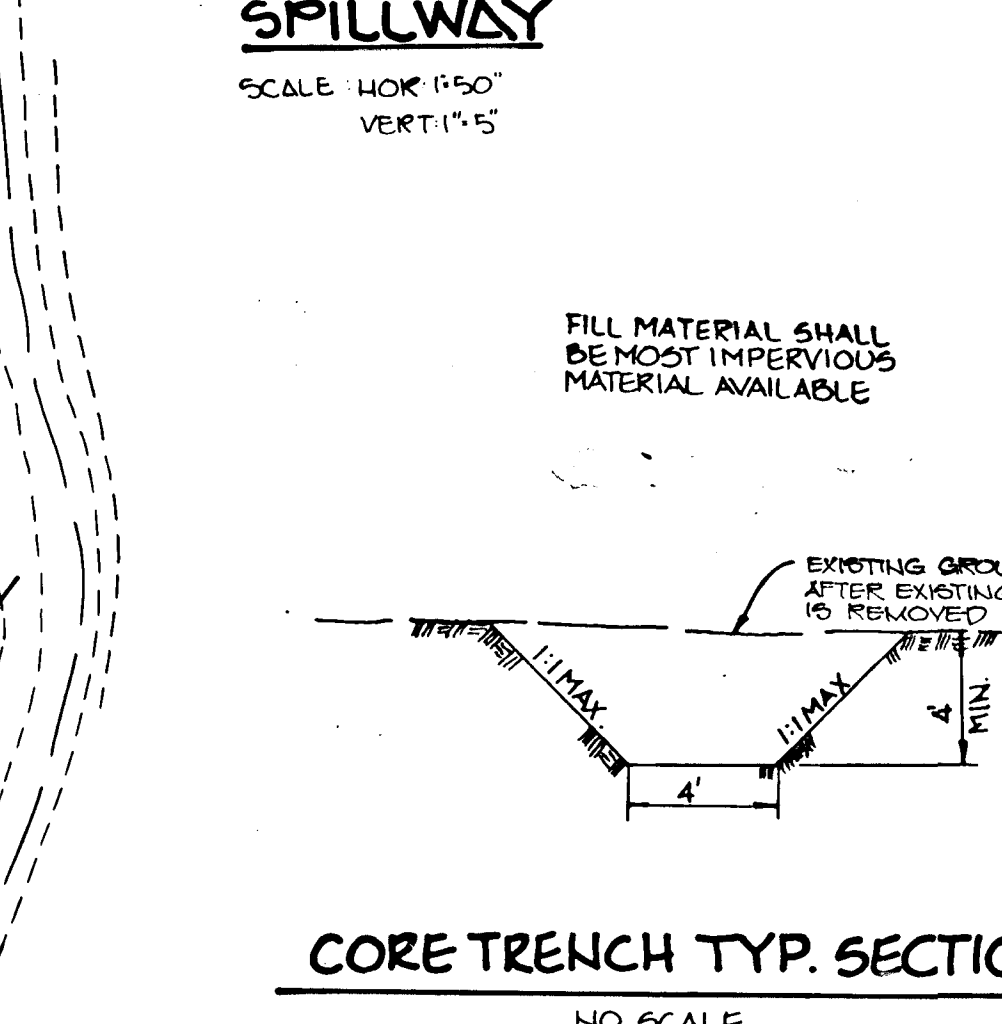

CORE TRENCH TYP. SECTION

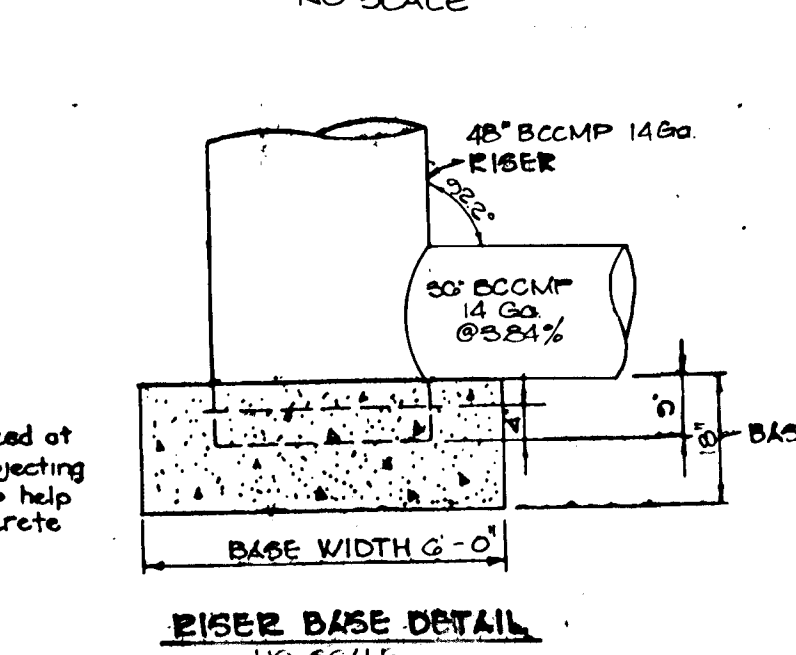


RISER BASE DETAIL

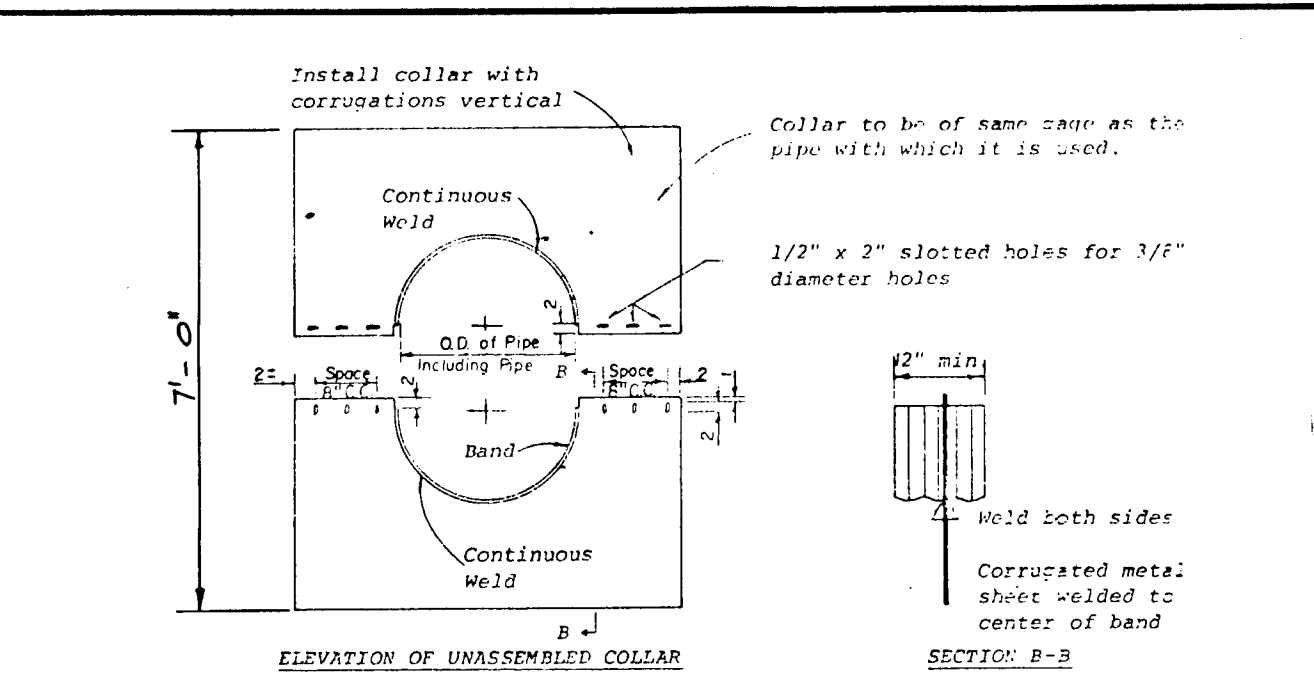

NOTES FOR COLLARS:

- All materials to be in accordance with construction and construction material specifications.
- When specified on the plans, coating of collars shall be in accordance with construction and construction material specifications.
- Unassembled collars shall be marked by painting or tagging to identify matching pairs.
- The lap between the two half sections and between the pipe and connecting band shall be caulked with asphalt mastic at time of installation.
- Each collar shall be furnished with two 1/2" diameter rods with standard tank lugs for connecting collars to pipe.

ANTI-SEEP COLLAR

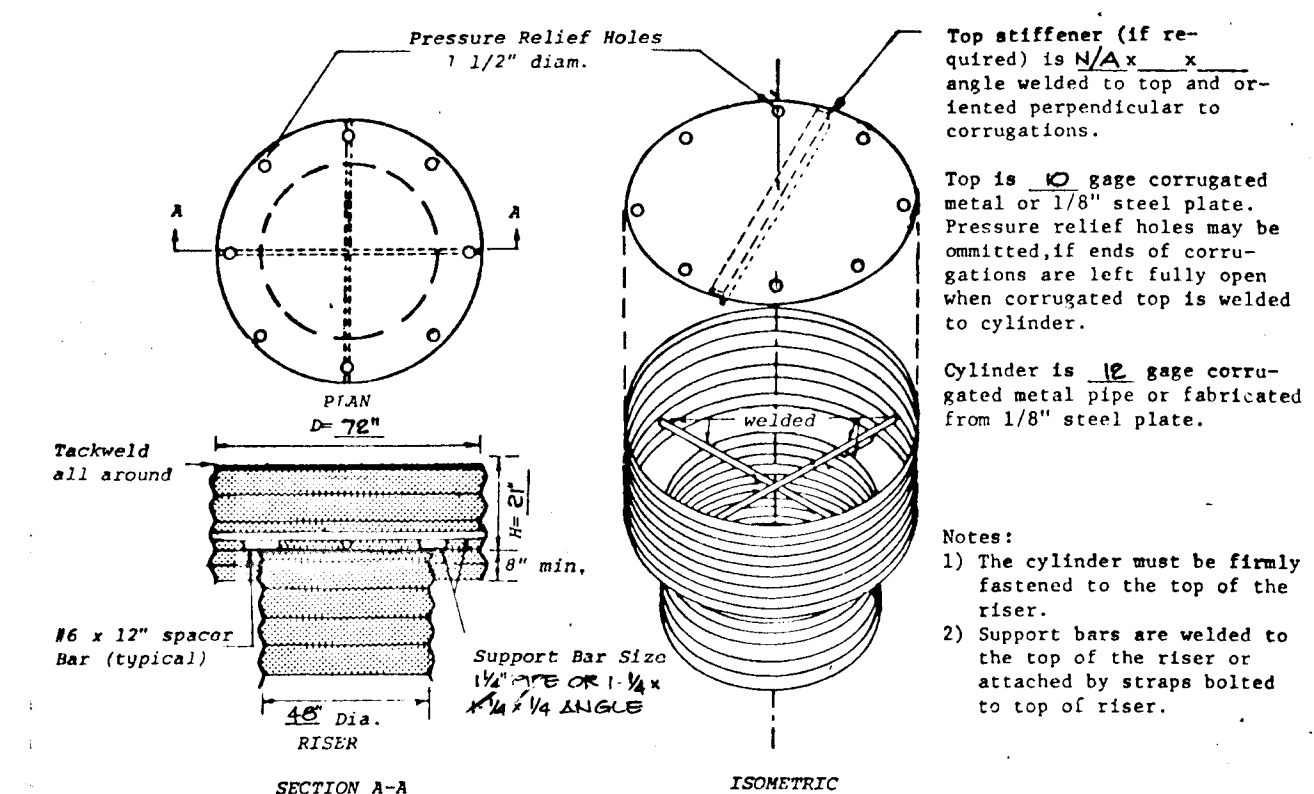

CONCENTRIC TRASH RACK AND ANTI-VORTEX DEVICE

POND CONSTRUCTION SPECIFICATIONS

- SITE PREPARATION**
Areas under the borrow areas, embankment, and structural works shall be cleared, grubbed and the copoll strips to remove all trees, vegetation, roots or other objectionable material. Channel banks and sharp breaks shall be sloped to no steeper than 1:1.
Areas covered by the pond or reservoir will be cleared of all trees, brush, logs, fences, rubbish and other objectionable material otherwise designated on the plans. Trees, brush and stumps shall be cut approximately level with the ground surface.
All cleared and grubbed material shall be disposed of outside the limits of the dam and reservoir as directed by the owner or his representative. When specified, a sufficient quantity of copoll will be stockpiled in a suitable location for use on the embankment and other designated areas.
- BANK FILL**
Materials:
The fill material shall be taken from approved designated borrow areas or areas. It shall be free of roots, stumps, rocks, rubbish, coarse stones, frozen or other objectionable materials. The embankment shall be constructed to a minimum of four compact passes for anticipated settlement to the design elevation. The fill height all along the length of the embankment shall be maintained above the design elevation (including freeboard) as shown on the plans.
Placement:
Areas on which fill is to be placed shall be scarified prior to placement of fill. Fill materials shall be placed in 8-inch maximum thickness (before compaction) layers which are to be continuous over the entire length of the fill. The most porous borrow material shall be placed in the downstream portions of the embankment.
Compaction:
The movement of the hauling and spreading equipment over the fill shall be controlled so that the entire surface of each lift shall be traversed by not less than one tread track of the equipment or compaction shall be achieved by a minimum of four compact passes of a sheepsfoot, rubber tired or vibratory roller. Fill material shall contain sufficient moisture such that the required degree of compaction can be obtained with the equipment used.

CERTIFICATION

ARTHUR E. MUEGGE #8707
DATE 10-5-91

"I CERTIFY THAT ALL DEVELOPMENT AND/OR CONSTRUCTION WILL BE DONE ACCORDING TO THESE PLANS, AND THAT ANY RESPONSIBLE PERSONNEL INVOLVED IN THE CONSTRUCTION PROJECT WILL HAVE A CERTIFICATE OF ATTENDANCE AT A DEPARTMENT OF NATURAL RESOURCES APPROVED TRAINING PROGRAM FOR THE CONTROL OF SEDIMENT AND EROSION BEFORE BEGINNING THE PROJECT. I WILL PROVIDE THE HOWARD SOIL CONSERVATION DISTRICT WITH AN 'AS-BUILT' PLAN OF THE POND WITHIN 30 DAYS OF COMPLETION. I ALSO AUTHORIZE THE HOWARD SOIL CONSERVATION DISTRICT WITH AN 'AS-BUILT' PLAN OF THE POND WITHIN 30 DAYS OF COMPLETION."
DATE 11-14-88

BY THE DEVELOPER:

ARTHUR E. MUEGGE #8707
DATE 11-14-88

BY THE ENGINEER:

"I CERTIFY THAT THIS PLAN FOR POND CONSTRUCTION, EROSION AND SEDIMENT CONTROL REPRESENTS A PRACTICAL AND WORKABLE PLAN BASED ON MY PERSONAL KNOWLEDGE OF THE SITE CONDITIONS. THIS PLAN WAS PREPARED IN ACCORDANCE WITH THE REQUIREMENTS OF THE HOWARD SOIL CONSERVATION DISTRICT. I HAVE NOTIFIED THE DEVELOPER THAT HE MUST PROVIDE THE HOWARD SOIL CONSERVATION DISTRICT WITH AN 'AS-BUILT' PLAN OF THE POND WITHIN 30 DAYS OF COMPLETION."
DATE 11-14-88

THESE PLANS HAVE BEEN REVIEWED FOR THE HOWARD SOIL CONSERVATION DISTRICT AND MEET THE TECHNICAL REQUIREMENTS FOR SMALL POND CONSTRUCTION, SOIL EROSION AND SEDIMENT CONTROL.

DATE 11/7/88

APPROVED: HOWARD COUNTY OFFICE OF PLANNING AND ZONING

DATE 11/12/88

APPROVED: HOWARD COUNTY DEPARTMENT OF PUBLIC WORKS

DATE 3-2-89

APPROVED: HOWARD COUNTY DEPARTMENT OF PUBLIC WORKS

DATE 3/21/89

APPROVED: HOWARD COUNTY DEPARTMENT OF PUBLIC WORKS

DATE 3/2/89

APPROVED: HOWARD COUNTY DEPARTMENT OF PUBLIC WORKS

DATE 3/2/89

APPROVED: HOWARD COUNTY DEPARTMENT OF PUBLIC WORKS

DATE 3/2/89

APPROVED: HOWARD COUNTY DEPARTMENT OF PUBLIC WORKS



DATE 3/2/89

APPROVED: HOWARD COUNTY DEPARTMENT OF PUBLIC WORKS


DATE 3/2/89

APPROVED: HOWARD COUNTY DEPARTMENT OF PUBLIC WORKS


DATE 3/2/89

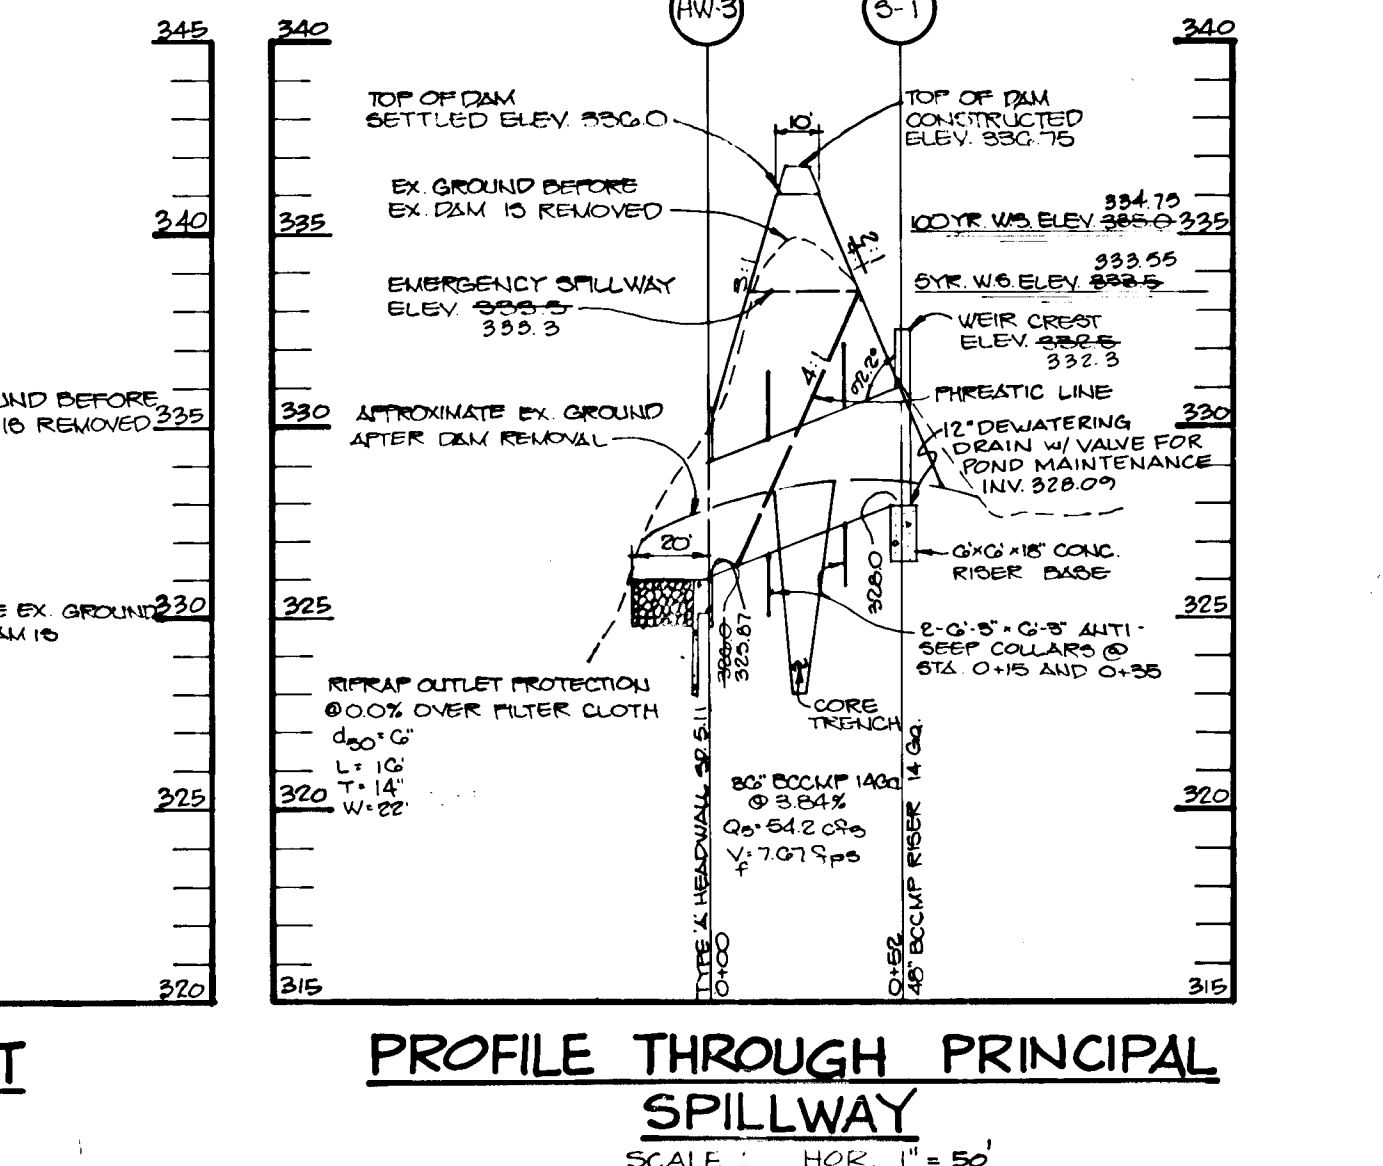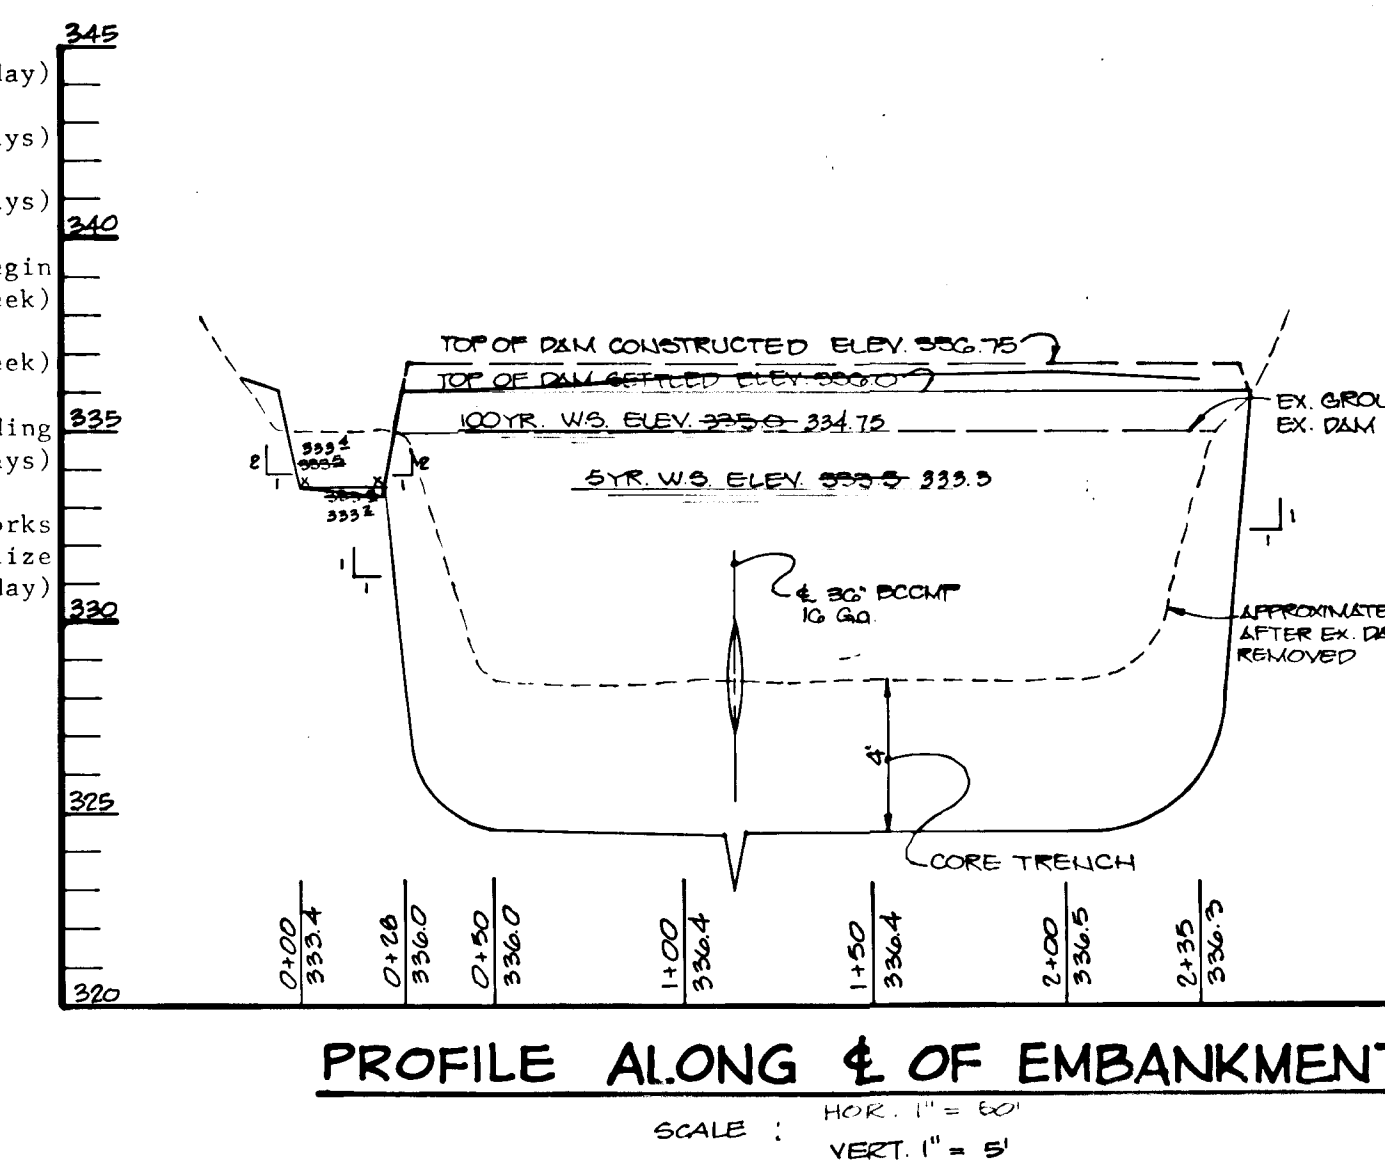

POND SOIL BORINGS

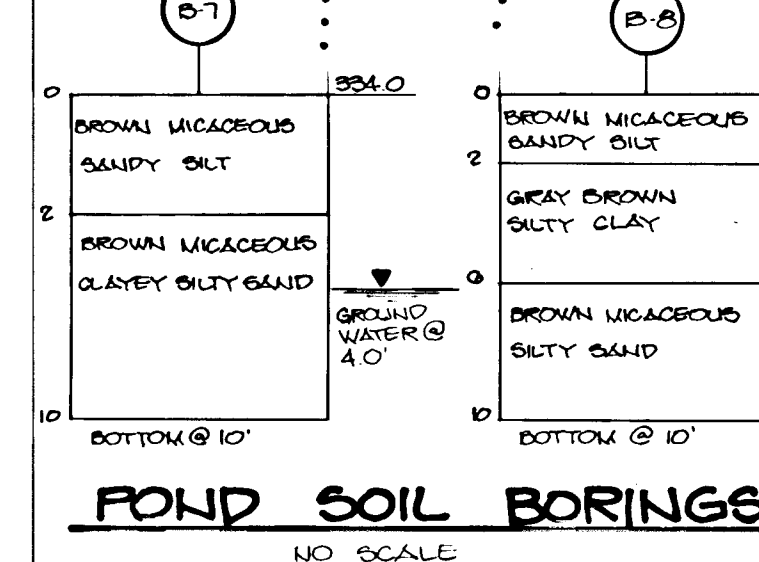


AS-BUILT
F-88-231
DATE 11-14-88
DESIGNED BY: C.J.R.
DRAWN BY: O.S.
PROJECT NO: 28800
DATE: NOVEMBER 7, 1988
SCALE: AS SHOWN
DRAWING NO. 13 OF 15

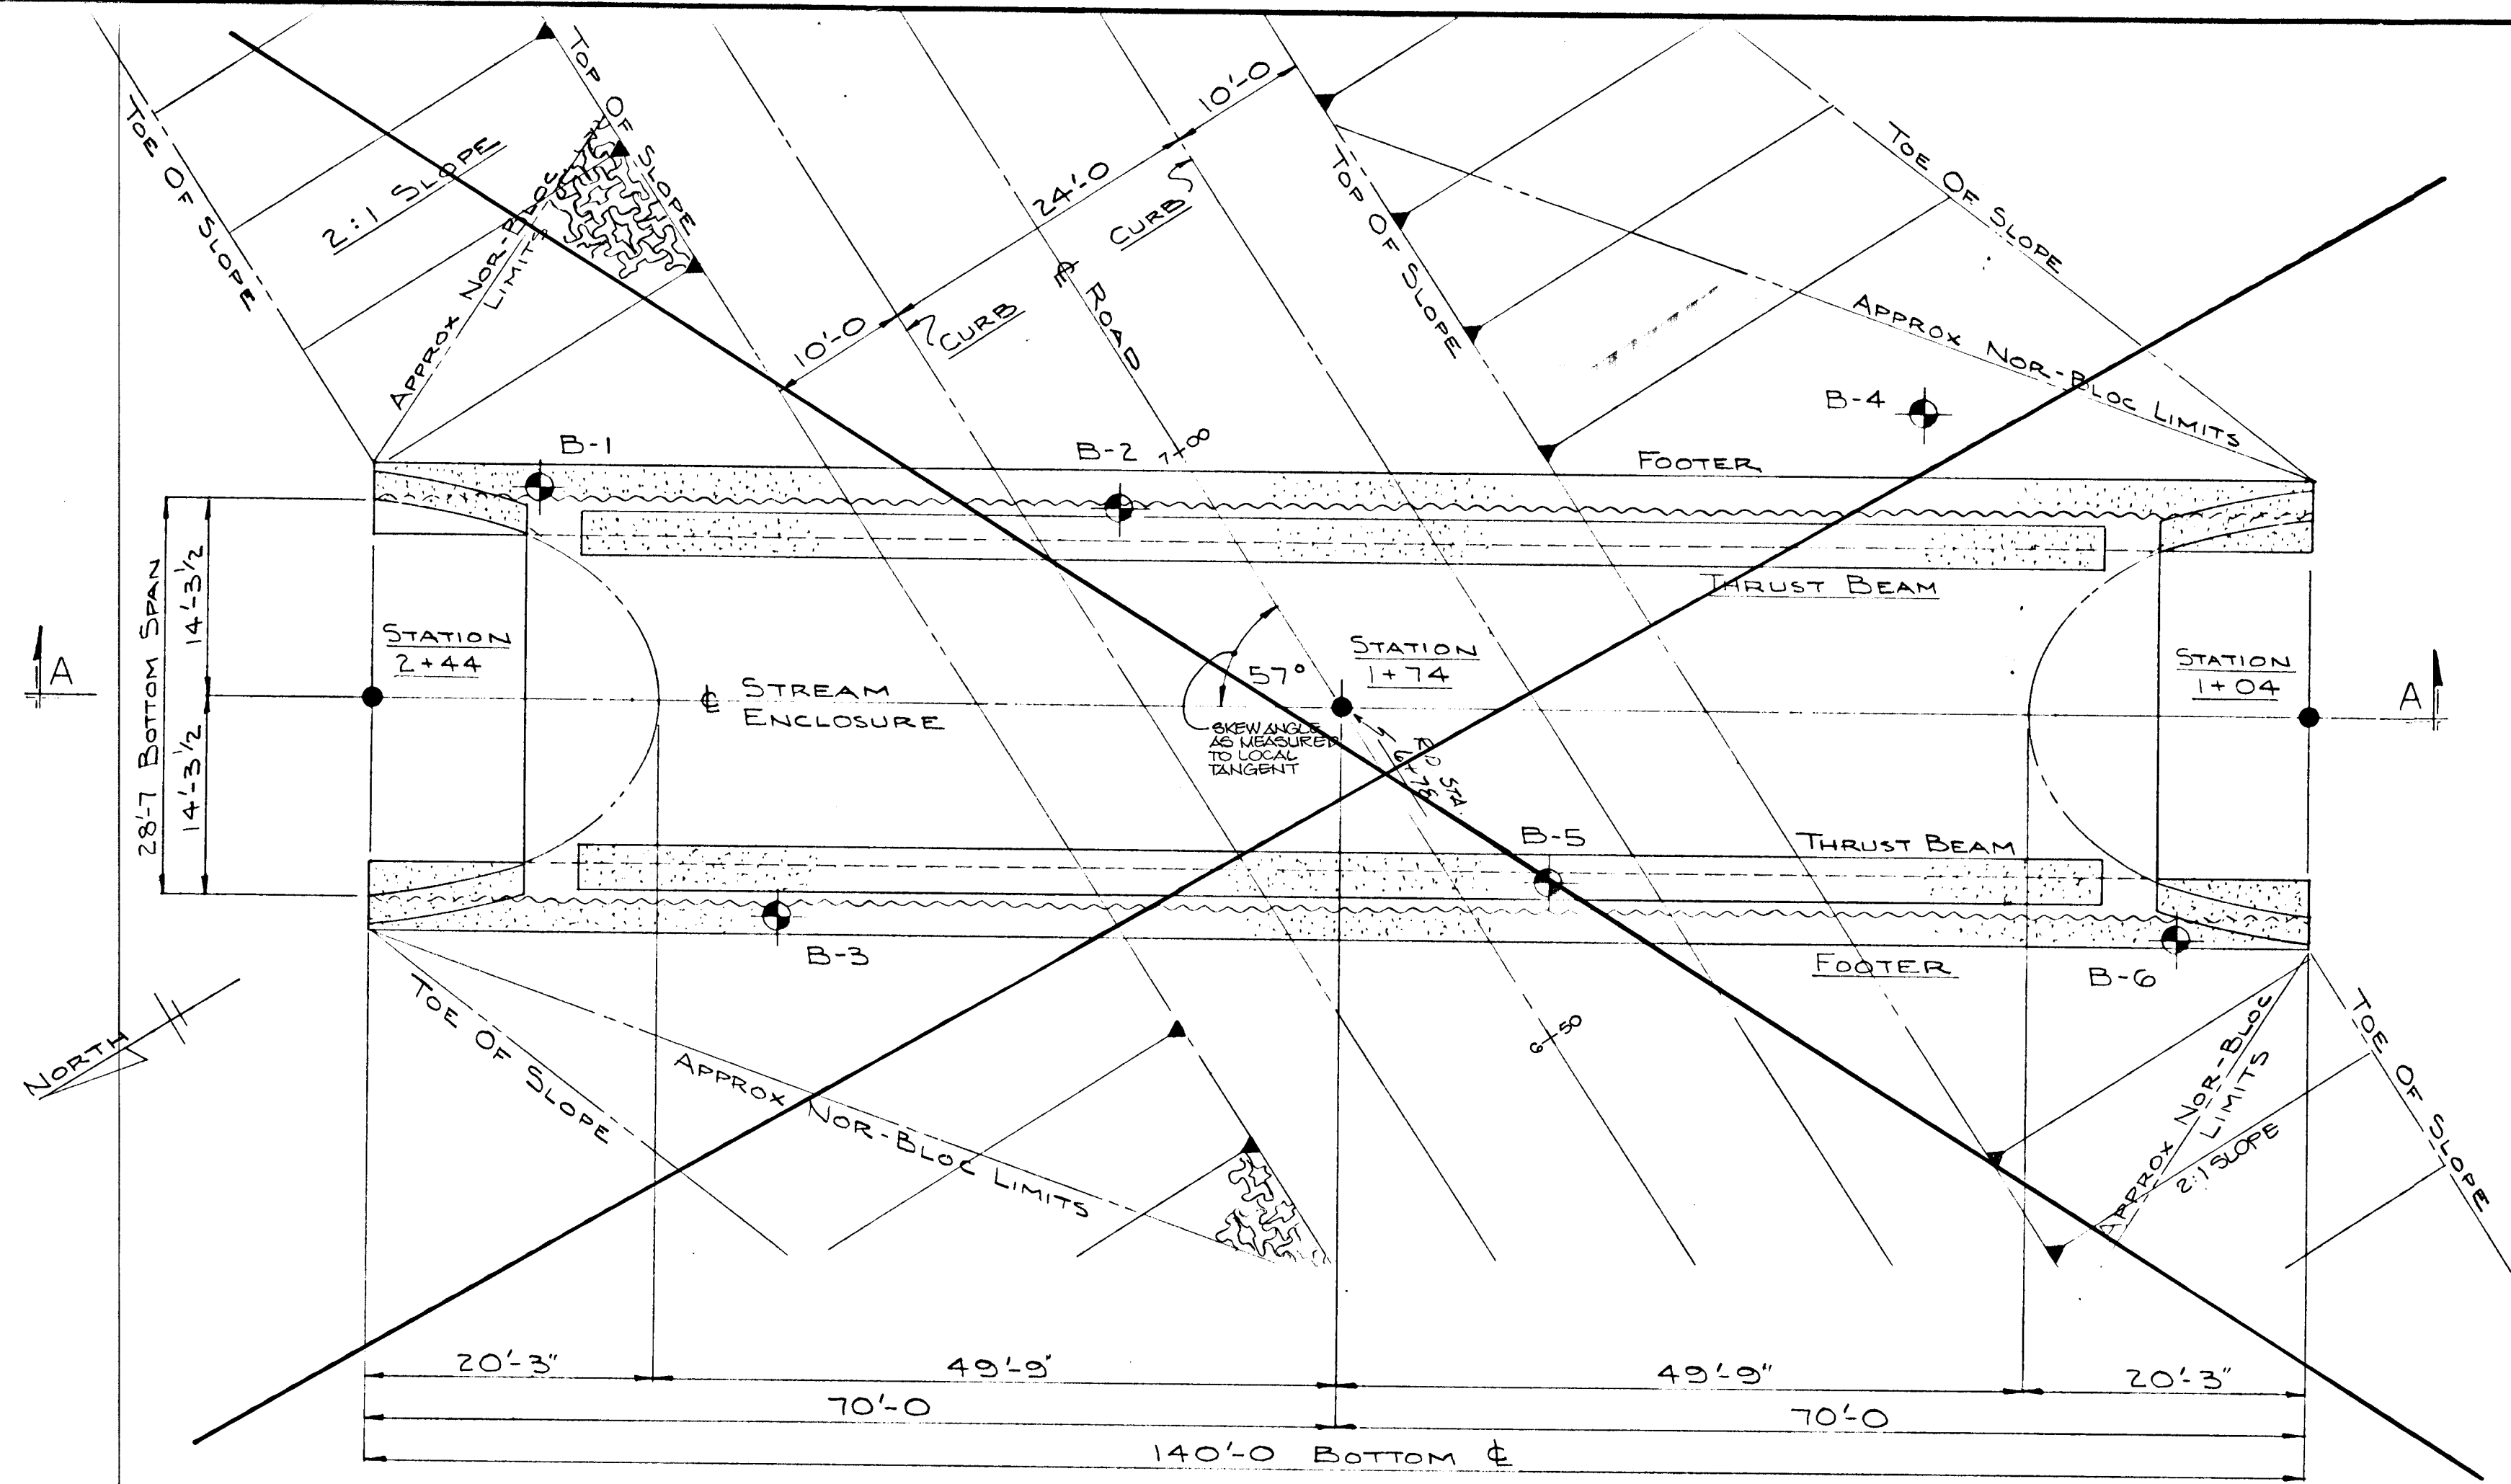

PLAN VIEW
SCALE 1"=10'

NOTE:
SEE DETAILS FOR SLOPE
COLLAR, THRUST BEAM
AND FOOTER DETAILS

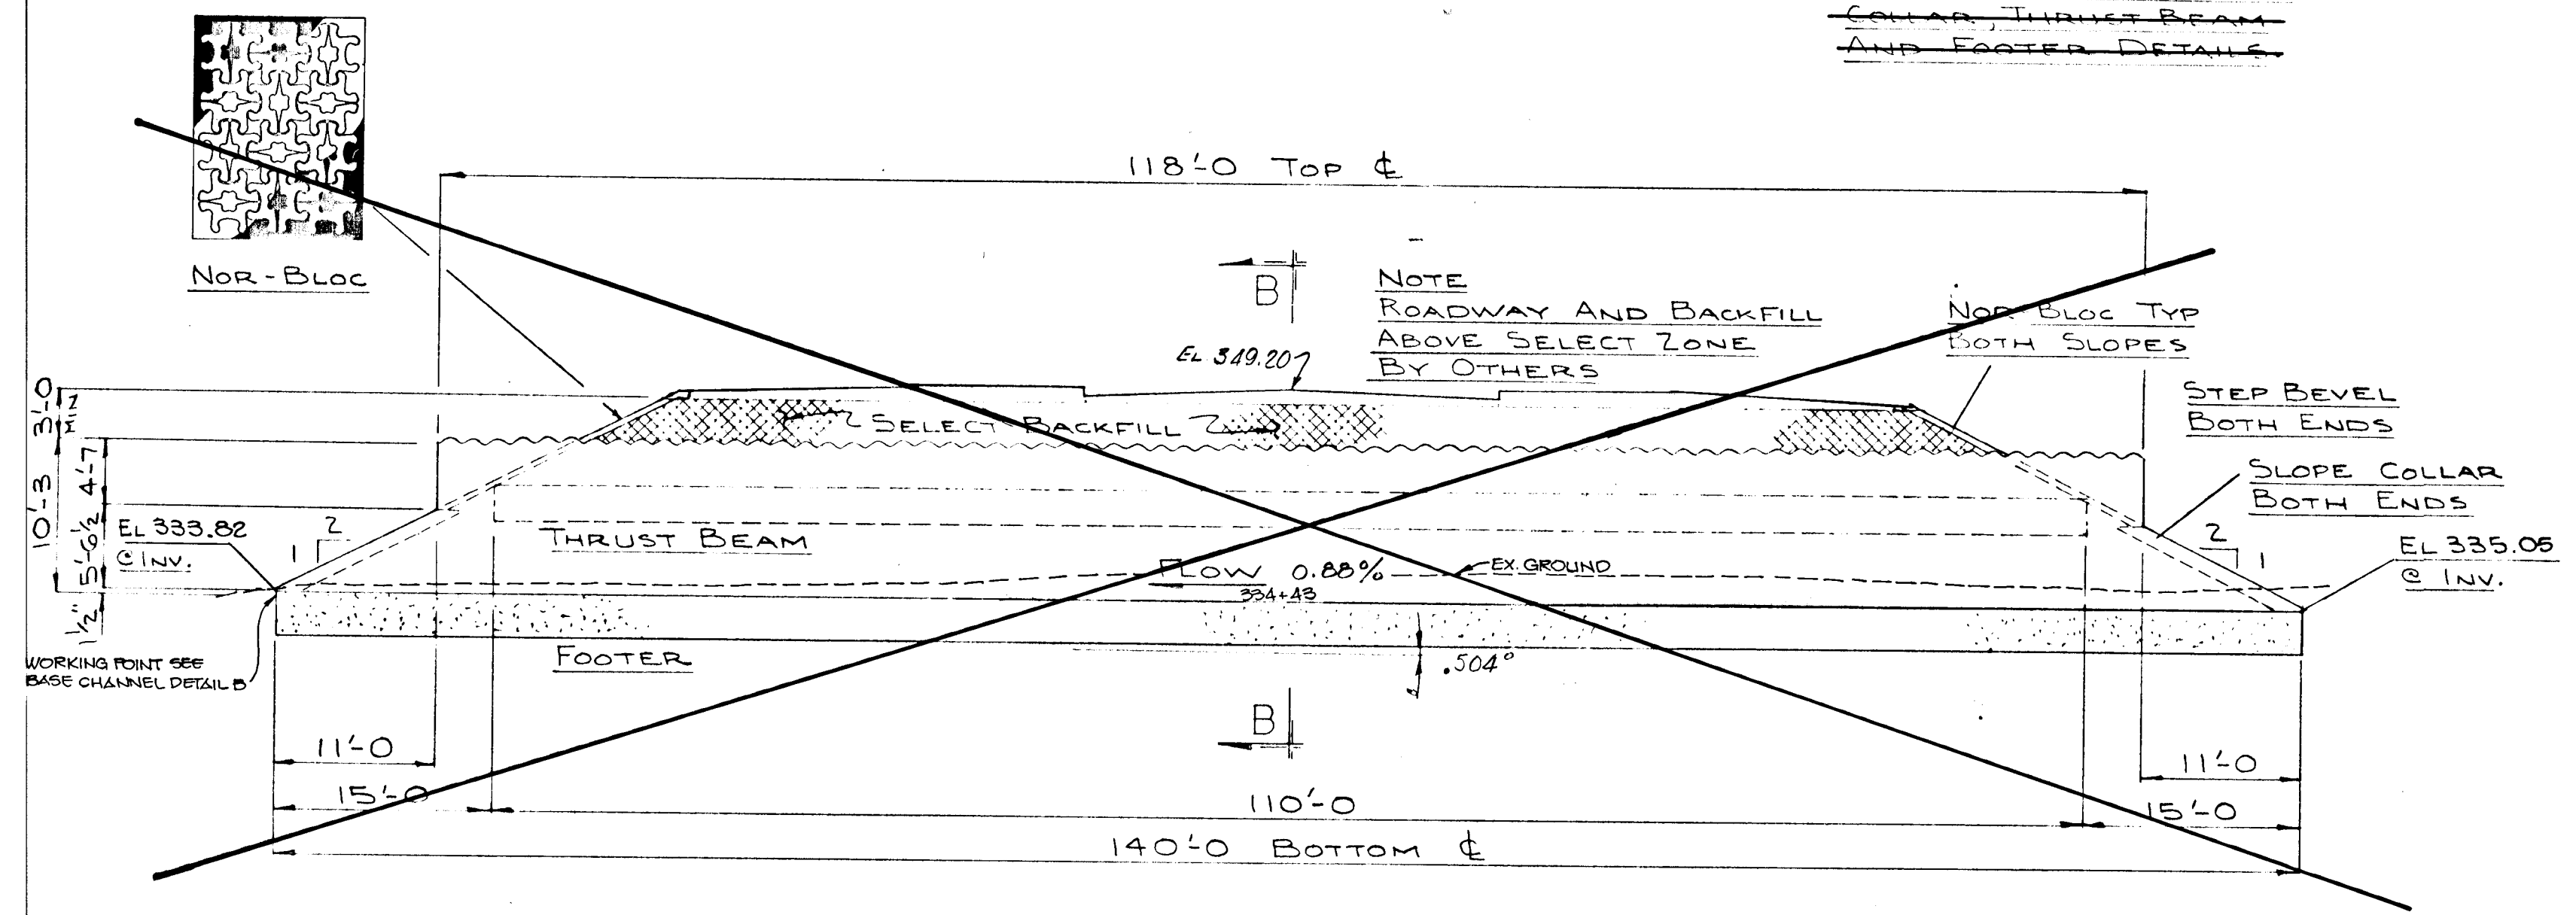

SECTION A-A
SCALE 1"=10'

B-1		B-2		B-3		B-4		B-5		B-6	
NO.	DESCRIPTION	NO.	DESCRIPTION	NO.	DESCRIPTION	NO.	DESCRIPTION	NO.	DESCRIPTION	NO.	DESCRIPTION
1	Top of backfill	1	Top of backfill	1	Top of backfill	1	Top of backfill	1	Top of backfill	1	Top of backfill
2	Top of thrust beam	2	Top of thrust beam	2	Top of thrust beam	2	Top of thrust beam	2	Top of thrust beam	2	Top of thrust beam
3	Top of footer	3	Top of footer	3	Top of footer	3	Top of footer	3	Top of footer	3	Top of footer
4	Bottom of footing	4	Bottom of footing	4	Bottom of footing	4	Bottom of footing	4	Bottom of footing	4	Bottom of footing

STRUCTURAL PLATE SUPER-SPAN ARCH

The structural plate steel arch shall be manufactured in accordance with the current AASHTO Specification M-107. The plate, base channel and connectors will be galvanized only. The design shall be in accordance with the current AASHTO Standard Specifications for Highway Bridges, Sections 12 and 23. The size and gage shall be as shown on the contract drawings.

The unbalanced base channel will be the manufacturer's standard shown on the drawings and will be cast with the footing when the footing is poured. The concrete thrust beam will be as shown on the drawings and included in the price for the arch. The bent and threaded rods shall be black steel per ASTM A36.

The supplier shall submit design calculations and assembly/plate layout drawings. Fabrication of the structure will not proceed until the design and layout have been approved by the Engineer.

The structure shall be installed in accordance with the manufacturer's requirements and instructions including specific requirements as to the backfill material and compaction. The sieve analysis, Proctor curve and moisture content of proposed backfill will be submitted for approval before backfilling.

Backfill material shall be A-1 material conforming to the soil classification of AASHTO M-145. Placed in horizontal, uniform layers not exceeding 8" in thickness, before compaction, and shall be brought up uniformly on both sides of the structure. Optimum moisture and maximum density shall be determined by AASHTO Test Method No. T-99. Each layer of backfill shall be compacted and tested to not less than 98% maximum density per AASHTO T-180. Complete and regular monitoring of the arch shape shall be performed during the backfilling. Compaction equipment or methods that produce horizontal or vertical earth pressures which cause excessive distortion in the shape in excess of 1", or which cause damage to the structure shall not be used.

The manufacturer of the structural plate arch shall provide inspection of all the structural backfilling to 2' above the structure. This inspector shall approve all backfill materials and the placement and compaction thereof. The inspector shall have full authority to stop such work. The Engineer shall have field quality tests made of the compacted backfill at the request and direction of the manufacturer's inspector. A pre-construction meeting between the manufacturer's representative and the Engineer and the Contractor to review the assembly and backfilling sequence and requirements is recommended.

NOR-BLOC SPECIFICATIONS

GENERAL: NOR-BLOC is an engineered erosion control system that uses one "block" block. It articulates and interlocks four ways without the use of cables or stakes. It can go around curves in any direction without using special biops or concrete wedges. When the system is complete, the blocks interlock to form a complete revetment by using concrete only.

NOR-BLOC SPECIFICATIONS: The block shall be machine produced using high vibrating compaction equipment. The cement used in making the block shall be Air-Entrained (ASTM C260), producing a block with a Compressive Strength of 4000 psi. (ASTM C140). The mix design is (ASTM-C33), Over-Dry Weight 6.125 lbs./cf. The height of the block is 4.25 in., Weight 35.2 lbs./sf. and has approximately 20% open area. Compressive testing shall be performed on random samples of NOR-BLOC components.

FILTER FABRIC: The underlay and mat support geotextile for the NOR-BLOC shall be Nicolon 70/06 as manufactured by the Nicolon Corp. The material is a woven polypropylene fabric and shall meet the following specifications:

Grab Tensile Str. (ASTM 1682)	(lbs)	410/235	Elongation & Break (ASTM D-1682)	%	28
Burst Strength (ASTM D-751)	(psi)	520	Transected Tear Str. (ASTM D-2263)	(lbs)	90/55
Puncture Str. (ASTM D-751)	(lbs)	150	E.O.S. (US Standard Sieve)		70/100

INSTALLATION: The ground surface that is to receive the NOR-BLOC shall be graded and raked to the subgrade of the NOR-BLOC. All wet spots are to be removed and all depressions filled and compacted. The NOR-BLOC can be installed on the filter fabric by hand (starting in one area and proceeding from there). On special projects such as underwater installations NOR-BLOC may be supplied on pre-assembled mats, utilizing special installation techniques. The NOR-BLOC at the ends of the revetment shall be turned into the ground or saw cut to provide a smooth slope.

The open areas of the NOR-BLOC shall be filled with an inch of small crushed stone to insure that the filter fabric is protected from UV. This shall be accomplished by sprinkling a small amount of stone on the NOR-BLOC and brushing.

RE-VEGETATION: The open areas may be filled with top soil and seeded to restore a natural state if so desired. In this option stone should be omitted.

PERFORMANCE: NOR-BLOC has been used successfully with water velocities in excess of 23 f.p.s.

SUPER-SPAN DESIGN USING A.I.S.I. CRITERIA

Project Reference: CHAPEL WOODS, Howard County
Structure Reference No. 99A001
Span = 28'9" Rise = 10'3"
Top Radius = R = 18'10" (226")
Side Radius = R = 6'4" (76")
Minimum Cover = 3'0"
Maximum Cover = 4'0"
Live Load = LL-20
Gage of Structure = 8 (.168")

1. COMPLETE RING COMPRESSION
Pressure on Crown = FT. PD+PL
PD for max. cover = PD=4.64+180 psf =180 psf
PL for min. cover = PL=8.07 min earth fill for distribution of wheel load.
Ref. AASHTO Section 1.9.5
A-C(94)(C)7/2
A-E(94)(C)7/2
A-E(94)(C)7/2
A-E(94)(C)7/2
PL=10000/77.6=128.86 USG psf
FT for design FT=150+1000=1150 psf
Ring Compression C-PT = 9/8=1100/2876/4=10,075 #/LF

2. COMPLETE WALL STRESS
Stress = Cc - CA where: C = 10,075 #/LF
Cc = 10000/77.6 = 128.86 psf
A = 2.449 sq.in./LF
C = 2.449/128.86 = .019

3. CHECK WALL STRESS
USING A.I.S.I. criteria for full round pipe where K=10 (see extended density, compressive)
Check for D/r for r = .666
D/r = 452 / .666 = 678 > 500
fc = 4.93 x 10^6 = 5,004 psi
(.678)^2

SUPER-SPAN design isolated top arc to a partial arc of 80 degrees. For a partial arc less than 180 degrees (created by thrust beams) , buckling strength is proportional to the inverse of the central angle squared. Ratio for adjustment using 180 degrees as a base. Reference Timoshenko and Gere, (Theory of Elastic Stability) pg. 301, Table 7-2.

fc* = (180/80)^2 x fc = 5 x 5004 = 25,020 psi
fc* > fc 25,020 > 5,004 psi
However, maximum allowable wall stress normally considered fy/2 where fy = 33,000 psi
fy/2 = 16,500 psi > 5,004 psi OK 1

CHAPEL WOODS, 99A24 page 2

4. CHECK SEAM STRENGTH
Seam Strength/Ring Compression >
Seam Strength for 8 gage = 81,000 #/LF
81,000/10,075 = 8.04 > 2 OK

5. CHECK FLEXIBILITY FACTOR OF 8 GAGE
For full round pipe of diameter = 2 ft
FF = D^3/EI, D=452", I = 1.154 in^4/ft, E = 30x10^6
FF = (452)^3 / 1.154 = 0.0099
30x10^6 x 1.154

Adjustment for partial top arc = 1/5 for SUPER-SPAN with thrust beams.
Effective FF = 0.0099/5 = 0.00198 < 0.020 OK 1

6. LOADING REACTIONS
DEAD LOAD = (28.75x14.80-234) x 120 = 25,221 #/ft
LIVE LOAD = 64,000/(8 + 2x14.80) = 1,004 #/ft
Plate weight and thrust beam = 1,484 #/ft
24,737 #/ft
Entry angle 8.92 degrees
R = 20,460 #/ft / 2 = 10,230 #/ft
Rh = R x sin 8.92 = 1,592 #/ft
Rv = R x cos 8.92 = 19,075 #/ft

The calculations are based upon values provided by contractor and variables such as heights of cover, live loads, structural backfill grade and density, foundation placement and in situ soil quality.


12-29-89 | REMOVED ARCH BRIDGE DETAILS
DRAWING 14 OF 15

APPROVED: HOWARD COUNTY OFFICE OF PLANNING AND ZONING
Donald S. Z. Langley 9-2-89
DATE
CHIEF, DIVISION OF COMMUNITY PLANNING AND LAND DEVELOPMENT
LPS

APPROVED: HOWARD COUNTY DEPARTMENT OF PUBLIC WORKS
Paul D. Brown 8/21/89
Date
Chief, Land Development Division
Brannan W. Cleland 3/21/89
Date
Chief, Bureau of Highways
Andrew M. Dando 3/22/89
Date
Chief, Bureau of Engineering
Antig


CHAPEL WOODS II
HOWARD COUNTY, MD.
SCALE: 1"=10' APPROVED BY
DATE: 10-26-88 DRAWN BY BURGIN
SUPER SPAN STREAM ENCLOSURE
NORWOOD OF MARYLAND DRAWING NUMBER: 1788-157-1

CONTECH 28'-9" SPAN X 10'-3" RISE, LOW PROFILE, 8-GAGE CORRUGATED
MULTI-PLATE STEEL SUPER SPAN STREAM ENCLOSURE

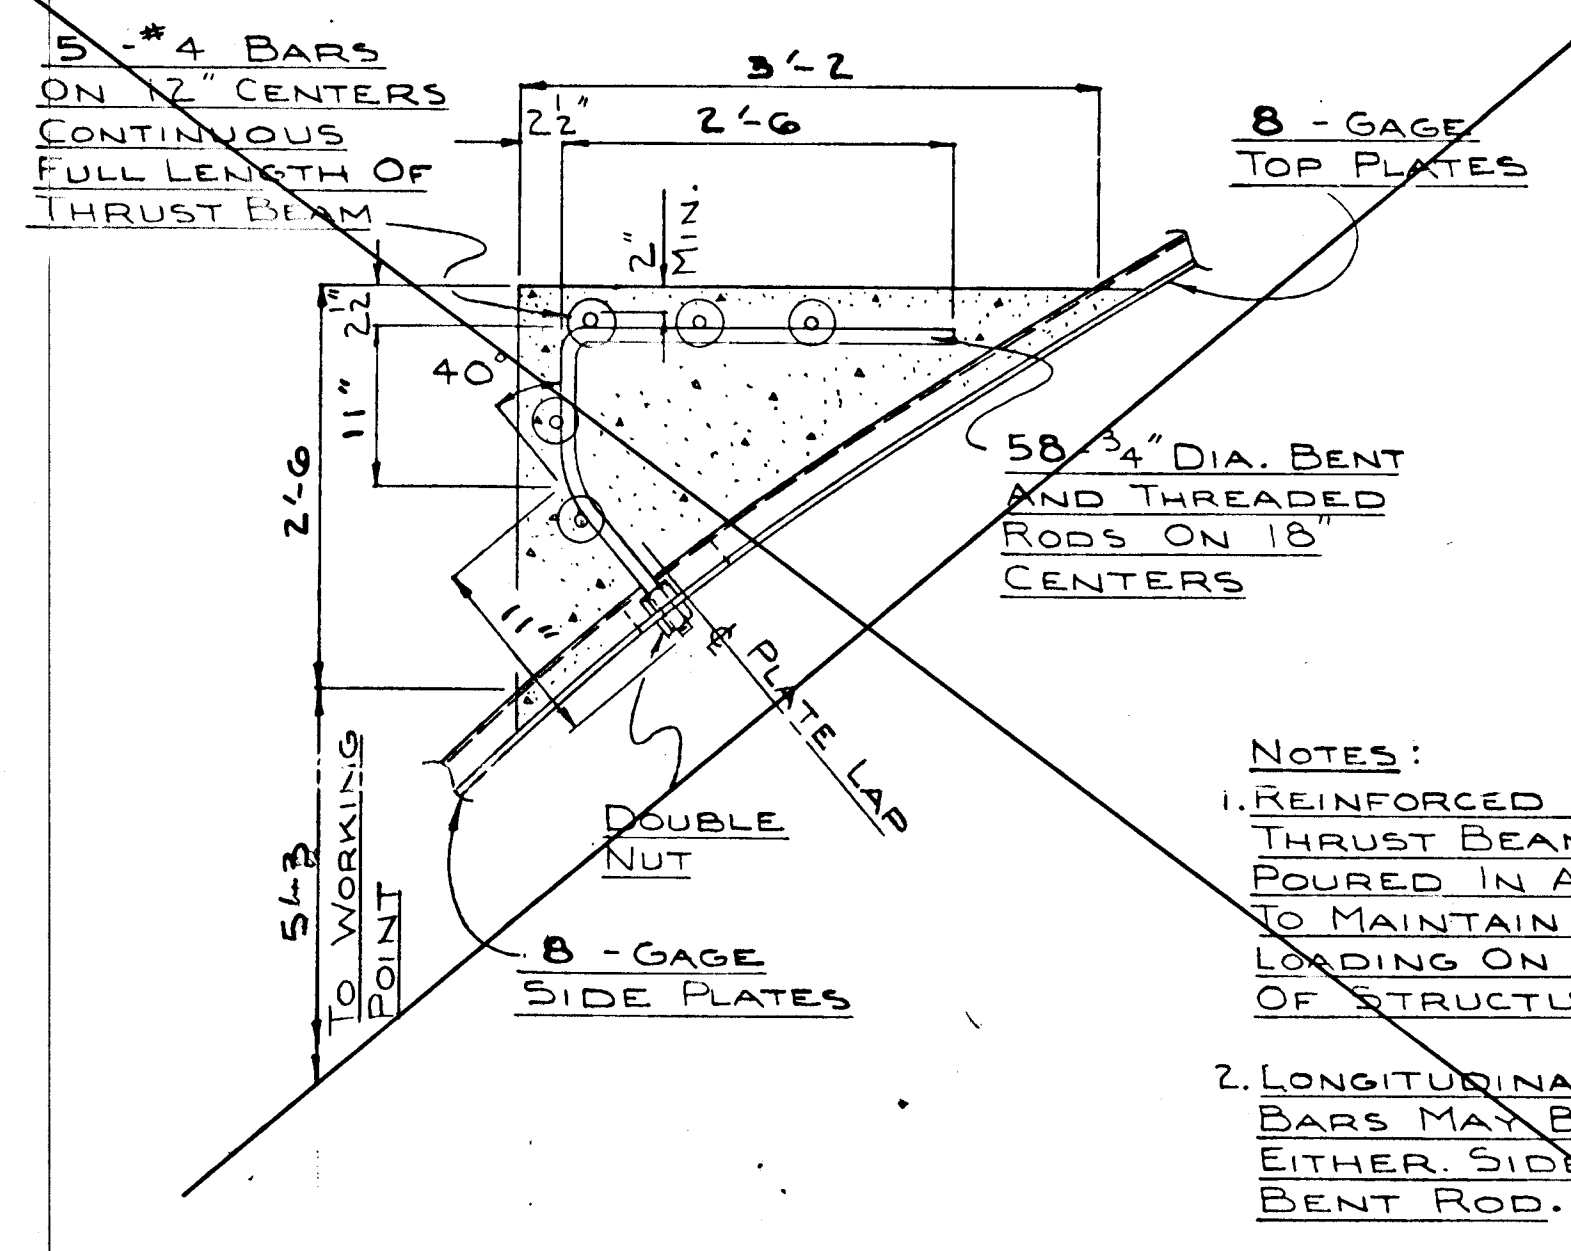


CONCRETE THRUST BEAM
DETAIL-A
NOT TO SCALE

NOTES:
1. REINFORCED CONCRETE THRUST BEAMS TO BE POURED IN A MANNER TO MAINTAIN BALANCE LOADING ON EACH SIDE OF STRUCTURE.
2. LONGITUDINAL REINFORCING BARS MAY BE PLACED ON EITHER SIDE OF THE BENT ROD.

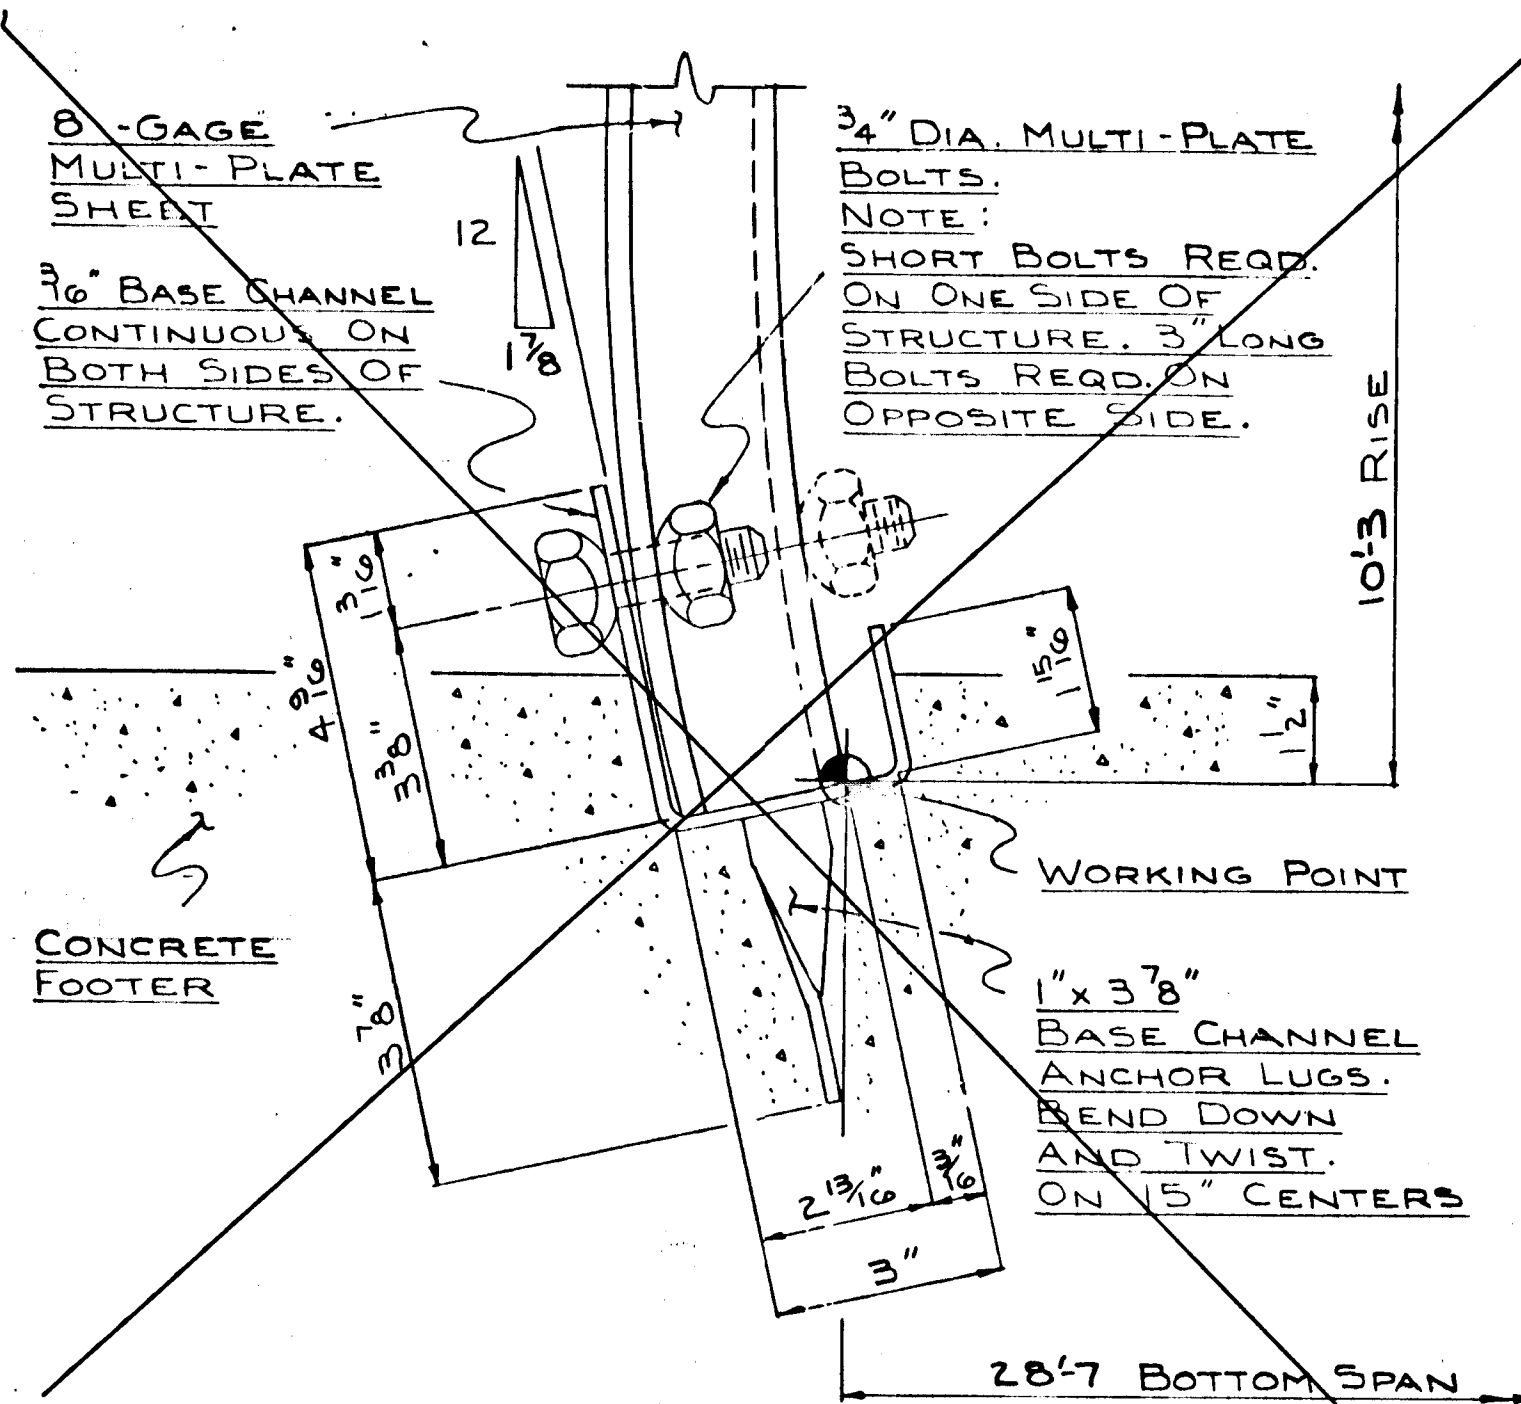

BASE CHANNEL
DETAIL-B
SCALE 3/8"=1"

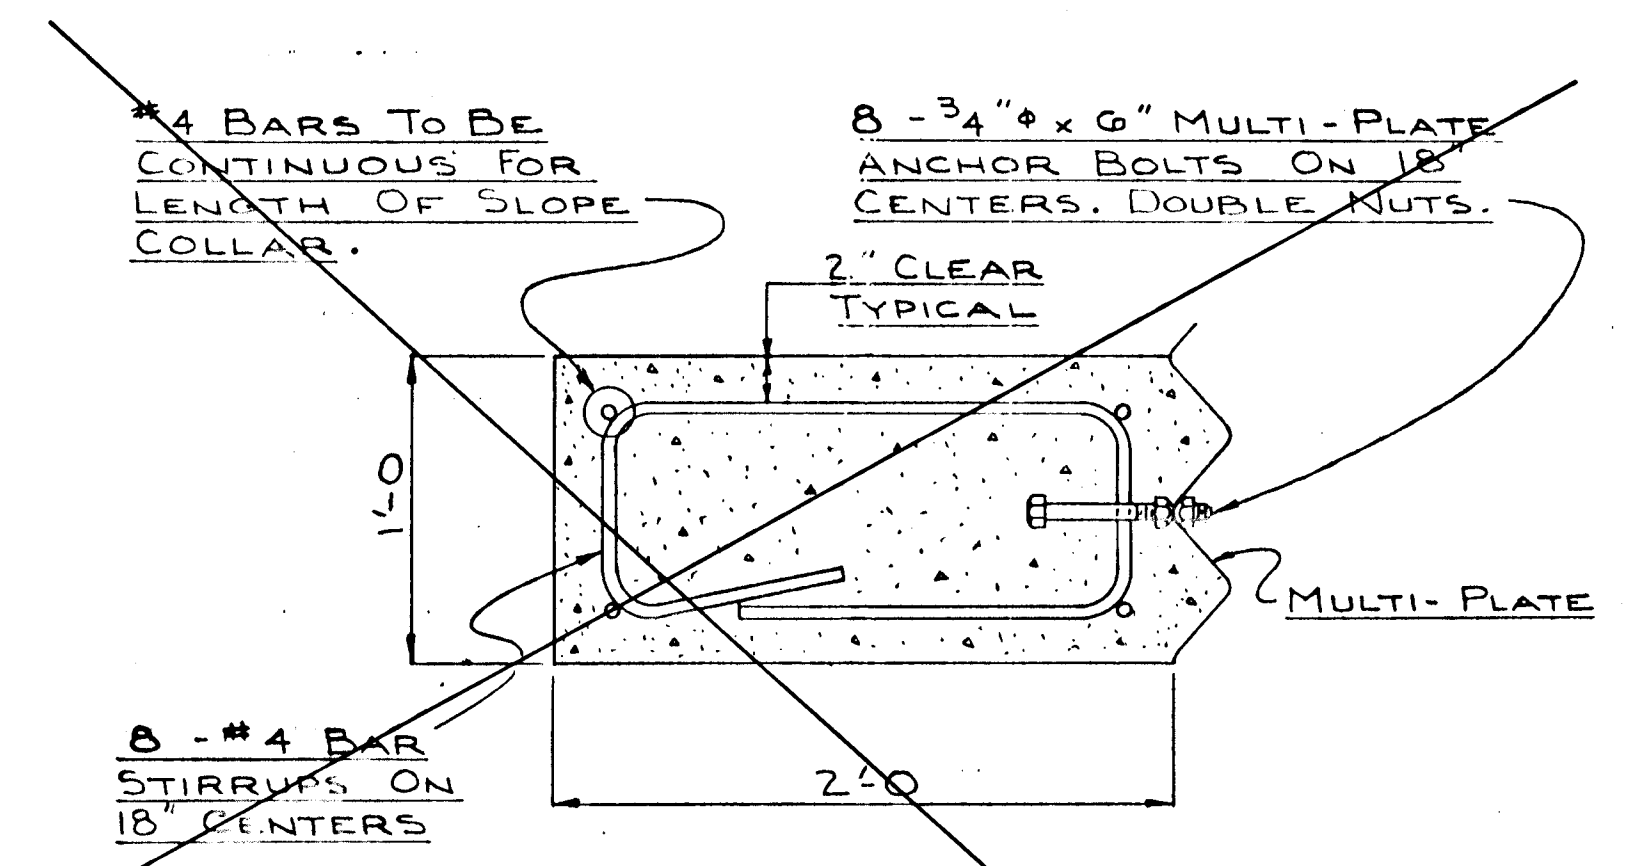

SECTION THROUGH CONCRETE SLOPE COLLAR
SCALE 1/2"=1'-0"

FOOTING CALCULATIONS

DESIGN CRITERIA
CONCRETE $f'_c = 3000 \text{ psi}$
REINFORCING $f_y = 60,000 \text{ psi}$
 $f_s = 24,000 \text{ psi}$
DEPTH OF FOOTING = 4'-0"
ALLOWABLE SOIL BEARING PRESSURE $q_a = 5000 \text{ psf}$
ALLOWABLE PASSIVE EARTH RESISTANCE $P_a = 5000 \text{ psf}$
(PROVIDED BY GEOTECHNICAL ENGINEER PER CONVERSION BETWEEN CHARLES BRADLEY OF MOTT & MICKELSON OF HOKWOOD CONSTRUCTION). USE CONCRETE WORKING STRESS DESIGN METHOD.

2. REACTIONS
 $R_v = 15075 \text{ lb/ft}$
 $R_h = 2092 \text{ lb/ft}$


3. MINIMUM SOIL BEARING REQUIREMENT
D = DEPTH = 5.0 ft
S = WT. OF CONCRETE = $150 \text{ pcf} \times 150 \text{ pcf} \times 5.0 \text{ ft} = 1125 \text{ lb/ft}$
D + CRV = $1125 + (15075 \times 5.0) / 1500 = 2107 \text{ lb/ft}$
USE 12" WIDE FOOTING.

4. SHEAR
 $V_u = (15075 \times 5.0) - (150 \times 5.0 \times 5.0) = 72875 \text{ lb}$
 $V_c = (15075 \times 5.0) - (150 \times 5.0 \times 5.0) = 72875 \text{ lb}$
 $V_c > V_u$ OK

5. BENDING MOMENT
 $M_u = (15075 \times 5.0^2) / 2 = 188437.5 \text{ lb-ft}$
 $M_c = (150 \times 5.0^3) / 6 = 62500 \text{ lb-ft}$
 $M_u > M_c$

6. AREA OF STEEL
 $A_s = \frac{M_u}{\phi F_y} = \frac{188437.5}{(0.9)(60000)} = 3.57 \text{ in}^2$
USE 4 #10 (3.99 in²)

7. HORIZONTAL RESISTANCE
DRIVING FORCE = $F_{11} = 802 \text{ lb/ft} \times 5.0 \text{ ft} = 4010 \text{ lb}$
 $A = 5.0 \text{ ft} \times (15075 \times 5.0) = 376875 \text{ lb}$
 $A_s = \frac{4010}{376875} = 0.0106 \text{ in}^2/\text{ft}$
USE #4 @ 12" O.C. VERTICAL BARS

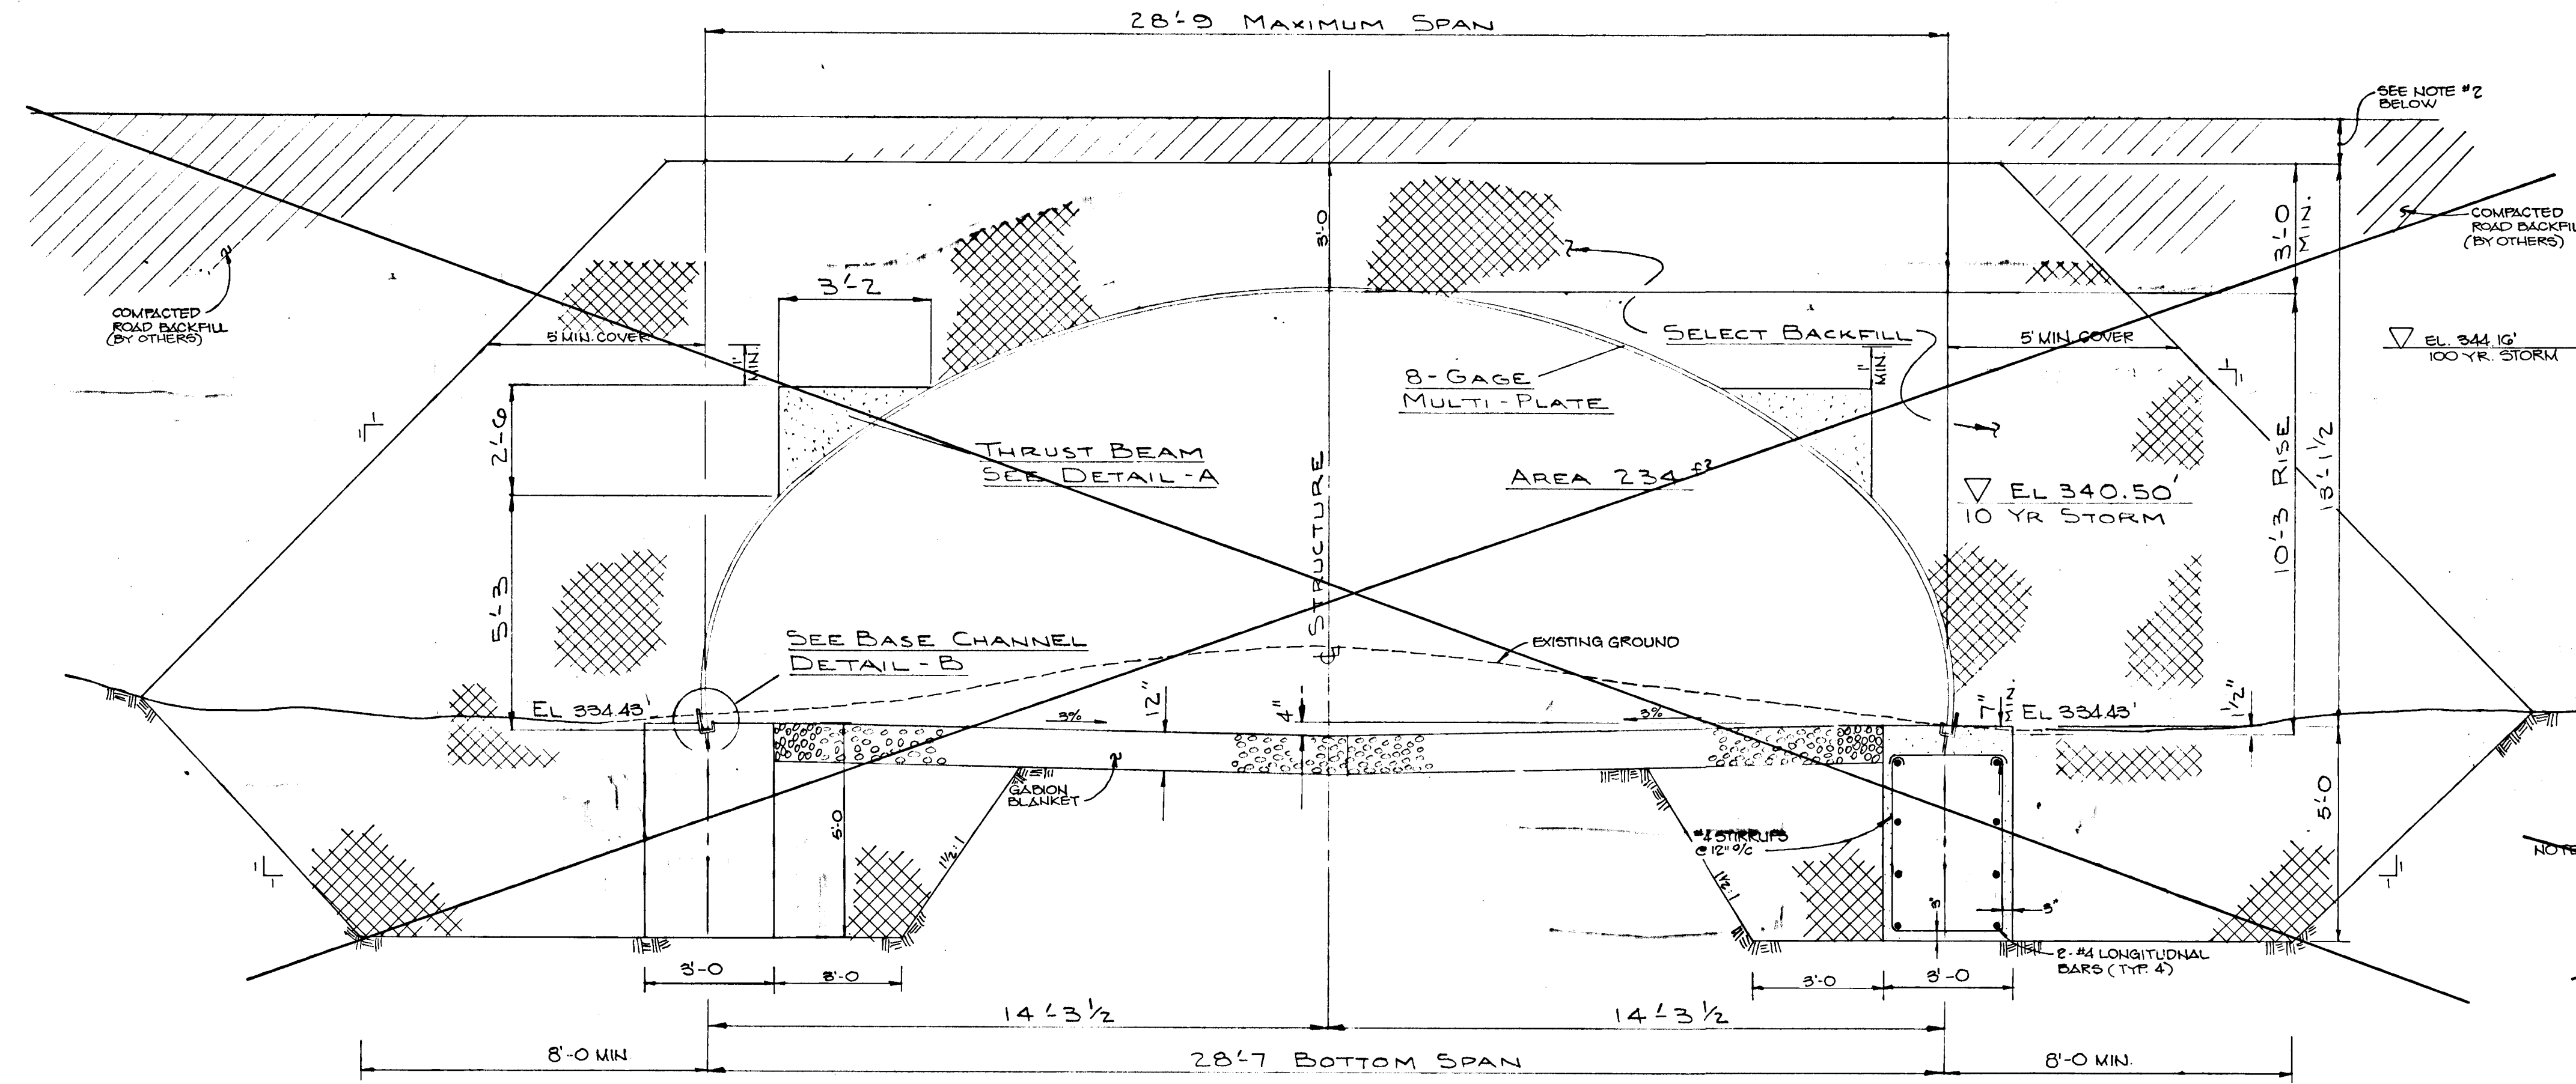

SECTION B-B
SCALE 3/8"=1'-0"

CONTINUOUS FOOTING
1. FOOTING DESIGN IS BASED ON AN ALLOWABLE SOIL BEARING PRESSURE OF 5000 PSF AND ALLOWABLE PASSIVE EARTH RESISTANCE OF 5000 PSF. GEOTECHNICAL ENGINEER WILL VERIFY ON-SITE SOILS AND NOTIFY ENGINEER IF DIFFERENT SOIL CAPACITIES ARE ENCOUNTERED.

NOTES:
1. SELECT BACKFILL WILL BE REQUIRED ON THE SIDE OF THE ARCH CONCRETE FOOTING. A GEOTECHNICAL ENGINEER SHALL MONITOR THE PLACEMENT OF BACKFILL.
2. THE PAVING SECTION FROM STA 0+25 TO STA 1+25 WILL BE FULL DEPTH ASPHALT (1 1/2" THICK).
3. FILTER CLOTH TO BE PLACED BETWEEN STRUCTURAL SELECT BACKFILL AND COMPACTED ROAD BACKFILL.



12-25-89 | REMOVED ARCH BRIDGE DETAILS

DRAWING 15 & 15

APPROVED: HOWARD COUNTY OFFICE OF PLANNING AND ZONING
Frank S. Dangel 4-2-89
CHIEF, DIVISION OF COMMUNITY PLANNING AND LAND DEVELOPMENT

APPROVED: HOWARD COUNTY DEPARTMENT OF PUBLIC WORKS
Paul J. Spon 3/21/89
CHIEF, Land Development Division

Frank W. Williams 3/21/89
CHIEF, Bureau of Highways

Andrew M. Davelos 3/21/89
CHIEF, Bureau of Engineering

CHAPEL WOODS II
HOWARD COUNTY, MD.

SCALE: NOTES | APPROVED BY: | DRAWN BY: |
DATE: 07-0-88

SECTION B-B & DETAILS
DRAWING NUMBER: NORWOOD OF MARYLAND P-88-157-2


REVISED FOOTING CALCULATIONS 3-2-89

PROJECT DATA

1. All information contained on this map is current as of September 1, 1990.
2. Wetland areas were identified and delineated using a multi-parameter approach. This approach requires positive identification of WETLAND PLANTS, HYDRIC SOILS, and WETLAND HYDROLOGY for a determination that the area is a wetland.
 - A) WETLAND PLANTS: Dominant hydrophytic vegetation was identified within the wetland limits and adjacent land areas.
 - B) HYDRIC SOILS: Color and mottle characteristics of the undisturbed "B" horizon were used to determine the limits of the hydric soils.
 - C) WETLAND HYDROLOGY: The topography of the area is characteristic of a floodplain valley with a distinct stream channel.
3. WETLAND CLASSIFICATIONS
 - A) EXISTING CONDITIONS:

System.....	Palustrine
Class.....	Forested
Subclass.....	Broadleaf/deciduous
Modifiers.....	Temporarily flooded
Water regime.....	Fresh
Salinity.....	
 - B) PROPOSED CONDITIONS

System.....	Palustrine
Class.....	Forested
Subclass.....	Broadleaf/deciduous
Modifiers.....	Temporarily flooded
Water regime.....	Fresh
Salinity.....	
4. WATERBODY: Middle Patuxent drainage basin/Class I stream
5. ANTICIPATED CONSTRUCTION DATE: Spring 1991
6. ANTICIPATED RESTORATION CONSTRUCTION DATE: Spring 1991
7. OWNER: J.J.M Partnership
5770-201 Sterrett Place
Columbia, Maryland 21044

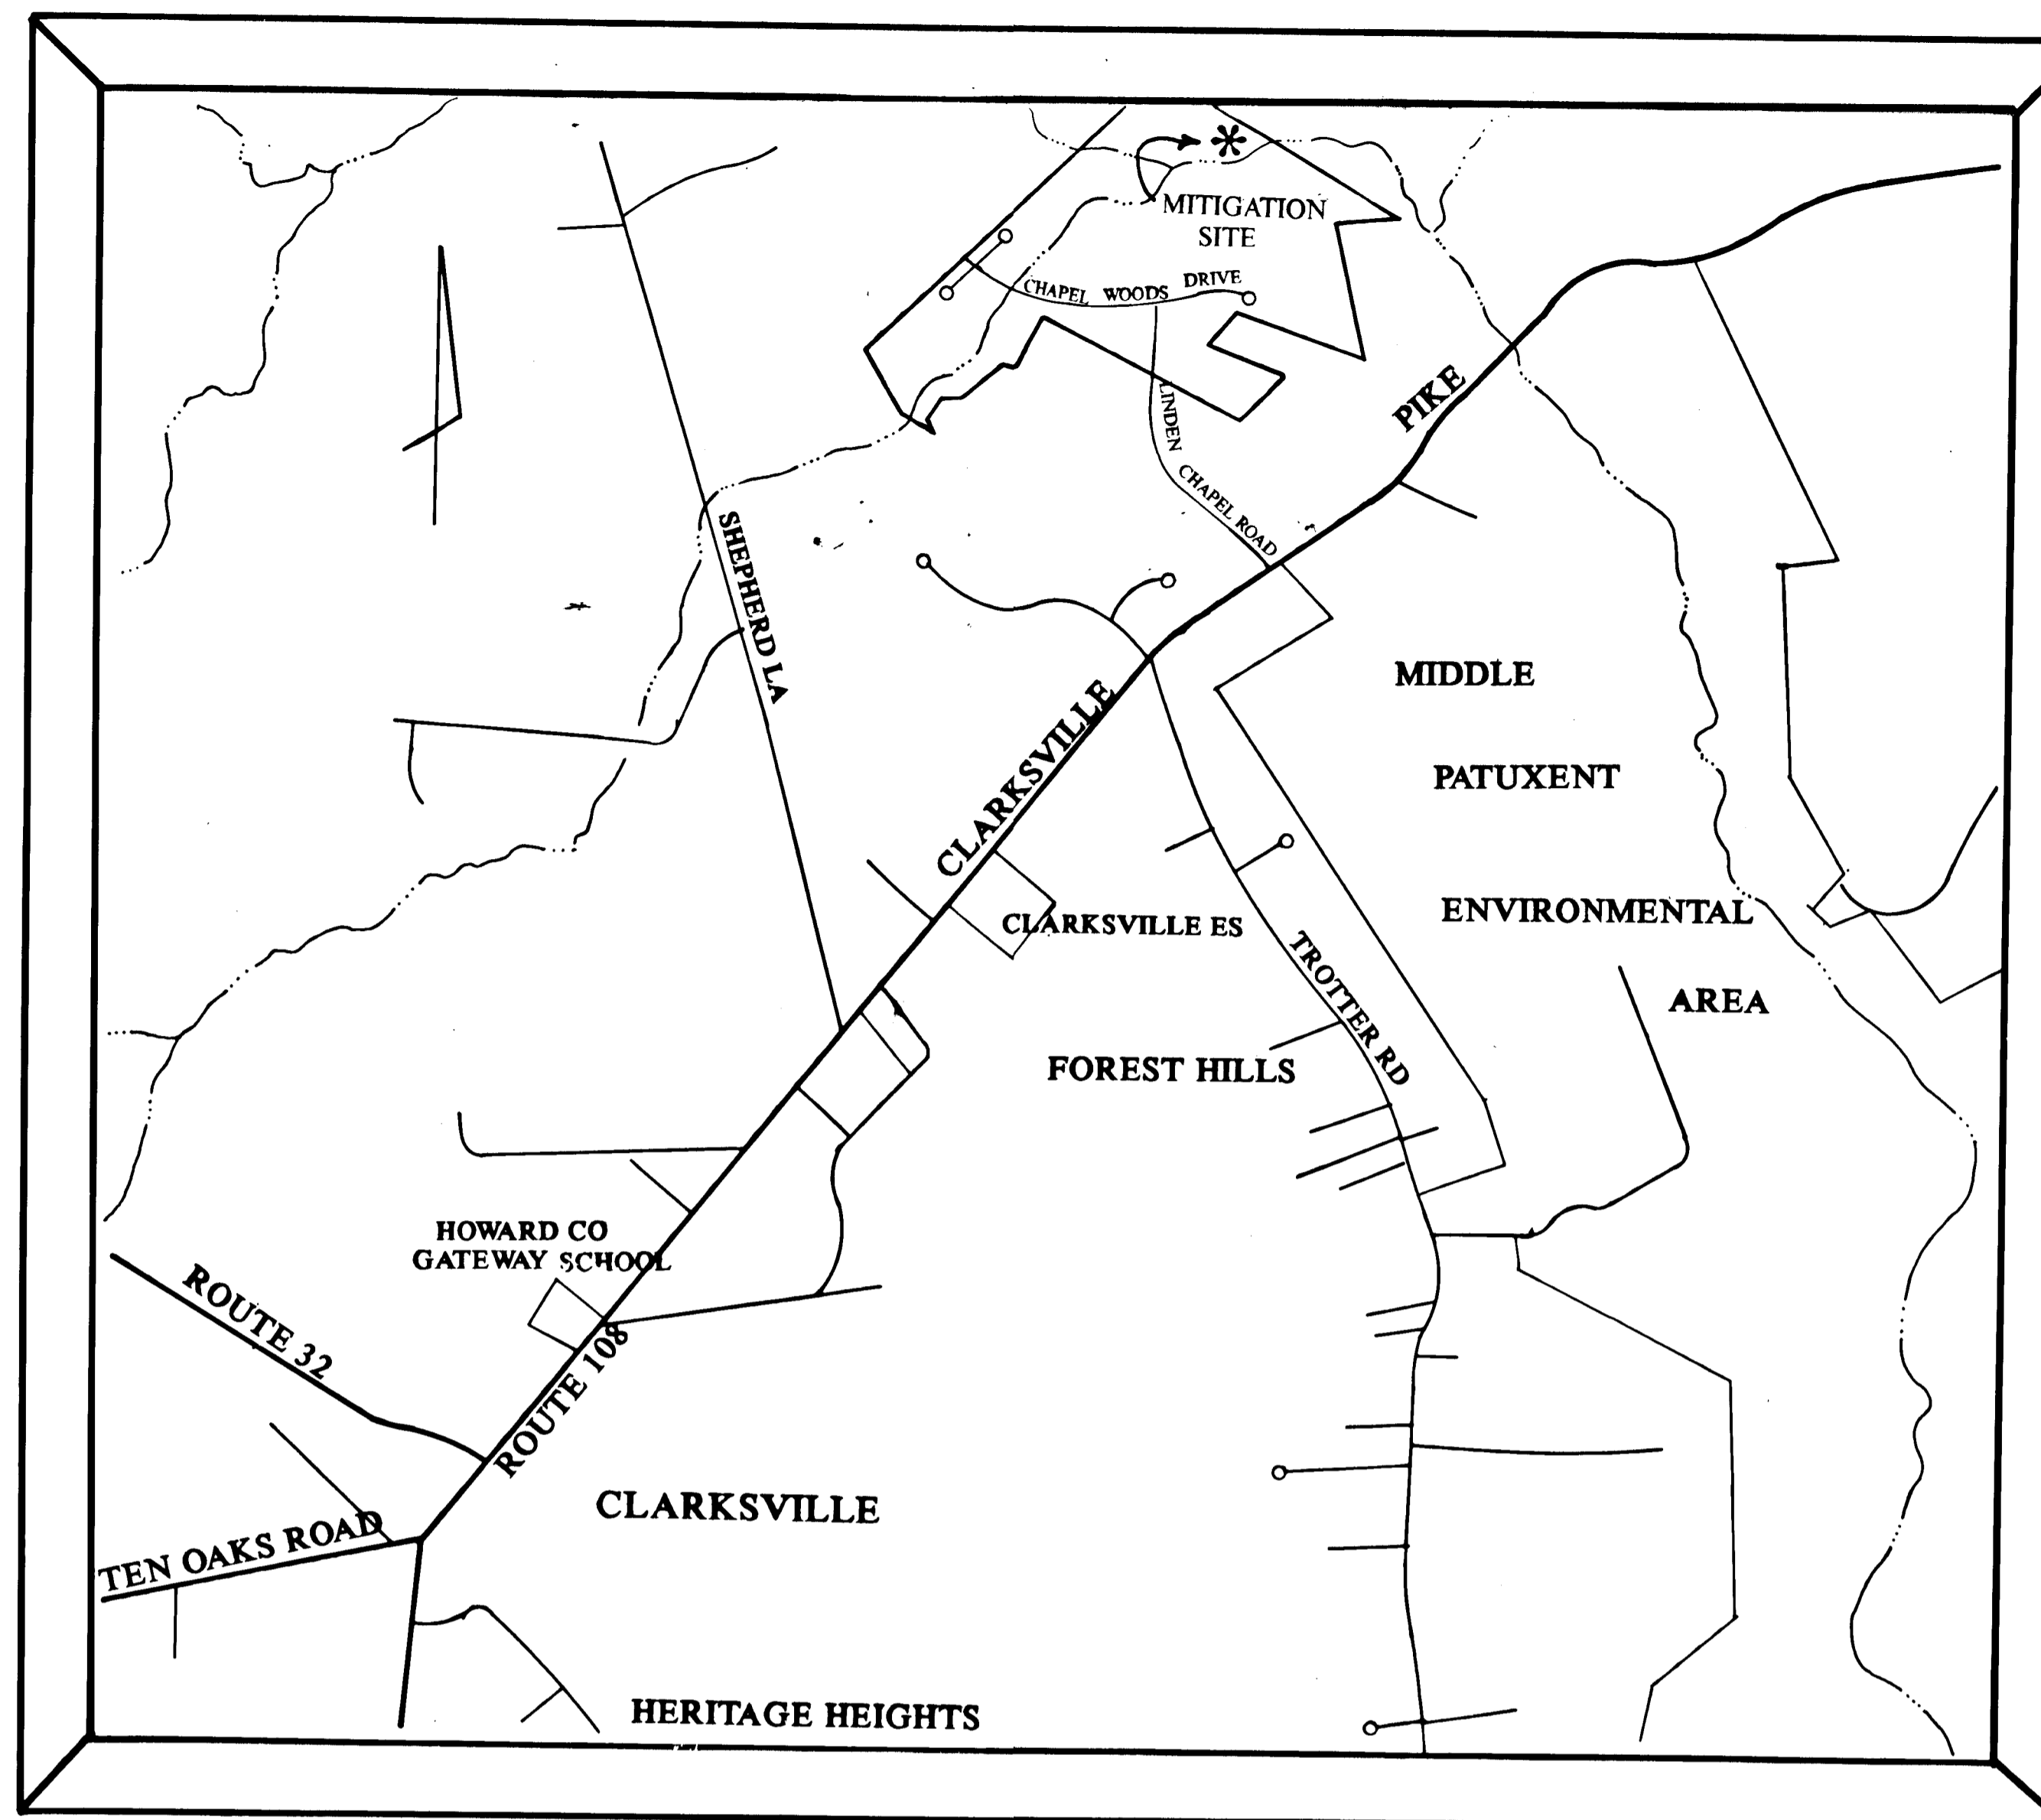

VICINITY MAP
NOT TO SCALE

**BALTIMORE DISTRICT CORPS OF ENGINEERS
MITIGATION REQUIREMENTS**

The mitigation plan is acceptable provided the following condition(s) are met:

1. The permittee shall successfully create a minimum of 0.76 acre of palustrine forested wetlands in accordance with the mitigation conditions required by the Maryland Department of the Environment (MDE), Water Quality Certification (WQC) 89-WQ-0532.
2. The permit shall be automatically suspended if any one of the following is not met:
 - a) A final mitigation plan shall be submitted to MDE and the Corps of Engineers and shall be approved by both agencies prior to starting work.
 - b) The mitigation shall be implemented in accordance with the approved plan by April 30, 1991.
 - c) Woody species vegetation proposed in the mitigation area shall have an 85% survival rate three (3) years after planting. If this rate is not achieved, additional planting(s) shall be required until this rate is achieved.
3. The permittee shall obtain Corps approval for any changes of plant species or planting schedule from that specified in the mitigation plan. The permittee shall keep this office informed of the status of each stage of the project and the mitigation work.
4. The permittee shall employ an environmental consultant who is knowledgeable and experienced in establishing wetlands. The consultant will supervise and monitor the work performed in the mitigation areas including establishment of elevations.

Any required State and local authorizations must be secured prior to initiating the work.

INDEX

- SHEET 1- COVER SHEET
- SHEET 2- GRADING PLAN
- SHEET 3- PLANTING PLAN
- SHEET 4- PROFILES
- SHEET 5- SOIL PROFILES
- SHEET 6- NOTES

CHAPEL WOODS

WQC# 89-WQ-0532

CENAB-OP-RW

(CHAPEL WOODS)

88-3856-3

EXPLORATION RESEARCH, INC.

ENVIRONMENTAL CONSULTANTS
8318 FORREST AVENUE
SUITE 101
HISTORIC ELLICOTT CITY,
MARYLAND, 21043
(301) 750-1150
FAX#: (301) 750-7350




MARYLAND DEPARTMENT OF THE ENVIRONMENT STANDARDS & CERTIFICATION DIVISION APPROVAL OF PLANS AND SPECIFICATIONS FOR COMPLIANCE WITH PERMIT
WQC# 89-WQ-0532
[Signature]
SIGNATURE OF STANDARDS & CERTIFICATION DIVISION
DATE 12/10/90

APPROVED: HOWARD CO. DEPARTMENT OF PLANNING & ZONING
[Signature] 8/13/92
CHIEF, DIVISION OF COMMUNITY PLANNING & LAND DEVELOPMENT DATE

U.S. ARMY CORPS OF ENGINEERS APPROVAL OF PLANS AND SPECIFICATIONS FOR COMPLIANCE WITH PERMIT NUMBER CENAB-OP-RW 88-3856-3
[Signature] March 27, 1991
SIGNATURE OF U.S. ARMY CORPS OF ENGINEERS DATE
BALTIMORE, MD.

717

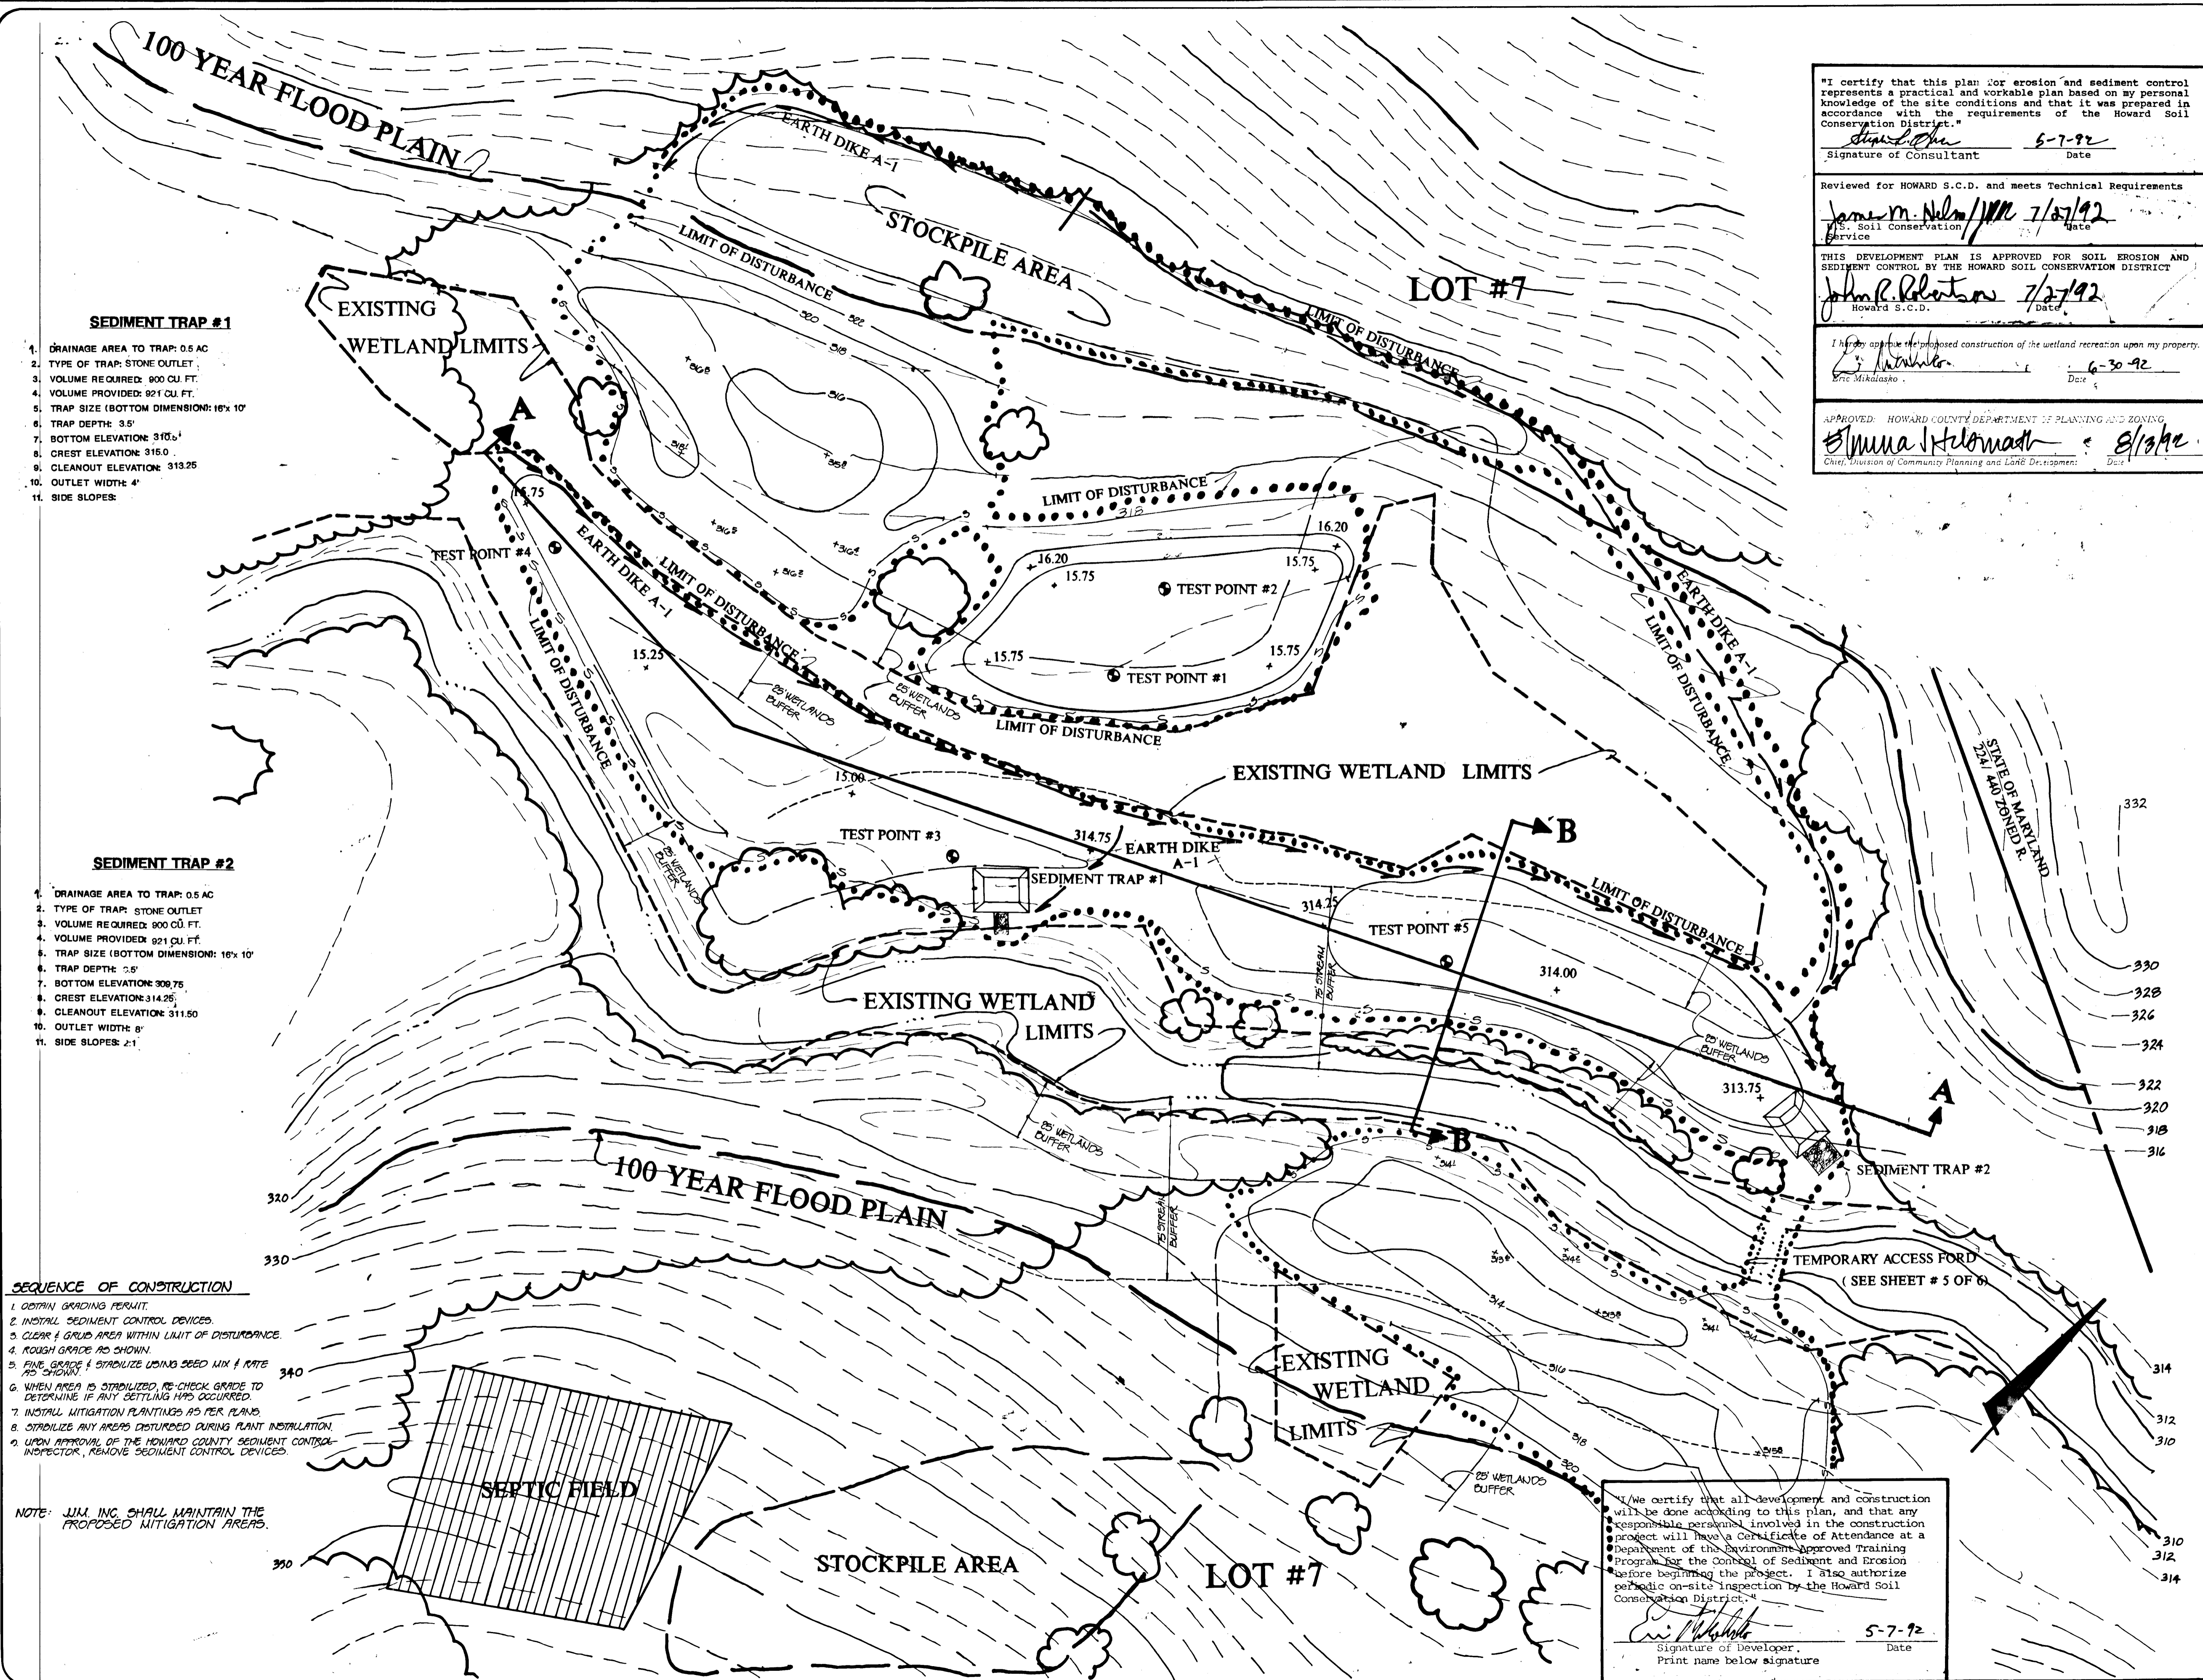

- SEDIMENT TRAP #1**
1. DRAINAGE AREA TO TRAP: 0.5 AC
 2. TYPE OF TRAP: STONE OUTLET
 3. VOLUME REQUIRED: 900 CU. FT.
 4. VOLUME PROVIDED: 921 CU. FT.
 5. TRAP SIZE (BOTTOM DIMENSION): 16' x 10'
 6. TRAP DEPTH: 3.5'
 7. BOTTOM ELEVATION: 310.5'
 8. CREST ELEVATION: 315.0'
 9. CLEANOUT ELEVATION: 313.25'
 10. OUTLET WIDTH: 4'
 11. SIDE SLOPES:

- SEDIMENT TRAP #2**
1. DRAINAGE AREA TO TRAP: 0.5 AC
 2. TYPE OF TRAP: STONE OUTLET
 3. VOLUME REQUIRED: 900 CU. FT.
 4. VOLUME PROVIDED: 921 CU. FT.
 5. TRAP SIZE (BOTTOM DIMENSION): 16' x 10'
 6. TRAP DEPTH: 2.5'
 7. BOTTOM ELEVATION: 308.75'
 8. CREST ELEVATION: 314.25'
 9. CLEANOUT ELEVATION: 311.50'
 10. OUTLET WIDTH: 8'
 11. SIDE SLOPES: 2:1

- SEQUENCE OF CONSTRUCTION**
1. OBTAIN GRADING PERMIT
 2. INSTALL SEDIMENT CONTROL DEVICES
 3. CLEAR & GRADE AREA WITHIN LIMIT OF DISTURBANCE
 4. ROUGH GRADE AS SHOWN
 5. FINE GRADE & STABILIZE USING SEED MIX & RATE AS SHOWN
 6. WHEN AREA IS STABILIZED, RE-CHECK GRADE TO DETERMINE IF ANY SETTLING HAS OCCURRED
 7. INSTALL MITIGATION PLANTINGS AS PER PLANS
 8. STABILIZE ANY AREAS DISTURBED DURING PLANT INSTALLATION
 9. UPON APPROVAL OF THE HOWARD COUNTY SEDIMENT CONTROL INSPECTOR, REMOVE SEDIMENT CONTROL DEVICES

NOTE: JLM, INC. SHALL MAINTAIN THE PROPOSED MITIGATION AREAS.

"I certify that this plan for erosion and sediment control represents a practical and workable plan based on my personal knowledge of the site conditions and that it was prepared in accordance with the requirements of the Howard Soil Conservation District."

Signature of Consultant: *James M. Nelson* Date: 6-7-92

Reviewed for HOWARD S.C.D. and meets Technical Requirements

Signature of Consultant: *James M. Nelson* Date: 7/27/92

Signature of Consultant: *John P. Robertson* Date: 7/27/92

I hereby approve the proposed construction of the wetland recreation upon my property.

Signature: *Eric Mikulas* Date: 6-30-92

APPROVED: HOWARD COUNTY DEPARTMENT OF PLANNING AND ZONING

Signature: *Stymma Holomach* Date: 8/13/92

Chief, Division of Community Planning and Land Development

EXPLORATION RESEARCH, INC.
 Environmental Consultants
 8318 Forrest Avenue, Suite 101
 Historic Ellicott City, Maryland 21043
 Tel: (301) 750-1150, FAX # (301) 750-7350

OWNER/DEVELOPER

JLM PARTNERSHIP 5570-201 STERRETT PLACE COLUMBIA, MARYLAND 21044 PH (301) 740-4466	JLM PARTNERSHIP 5570-201 STERRETT PLACE COLUMBIA, MARYLAND 21044 PH (301) 740-4466
---	---

CHAPEL WOODS
 HOWARD COUNTY, MARYLAND

WOC# 89-WQ-0532
 & WQ# 89-WQ-0101 (THE FOREST, F-89-20)
 CENAP-OP-RW
 (CHAPEL WOODS)
 88-3856-3

GRADING PLAN

U.S. Army Corps Of Engineers
 Approval Of Plans And Specifications
 For Compliance With Permit Number
 CENAP-OP-RW (CHAPEL WOODS) 88-3856-3

Signature Of U.S. Army Corps Of Engineers, Baltimore, MD: *Linda O. Mulhling* Date: March 27, 1991

Maryland Department Of The Environment
 Standards & Certification Division
 Approval Of Plans And Specifications
 For Compliance With Permit Number WOC# 89-WQ-0532

Signature Of Standards/Certification Division: *John P. Robertson* Date: 12/10/92

REQUIRED MITIGATION 0.76 AC
 WETLANDS MITIGATION FOR THE FOREST (F-89-20)

Drawn By: JLB Scale: 1"=30'
 Designed By: MAM Date: 7-21-90
 Checked By: DER Sheet: 2066

"I/we certify that all development and construction will be done according to this plan, and that any responsible personnel involved in the construction project will have a Certificate of Attendance at a Department of the Environment Approved Training Program for the Control of Sediment and Erosion before beginning the project. I also authorize periodic on-site inspection by the Howard Soil Conservation District."

Signature of Developer: *Eric Mikulas* Date: 5-7-92

717



EXPLORATION RESEARCH, INC.
 Environmental Consultants
 8318 Forrest Avenue, Suite 101
 Historic Ellicott City, Maryland 21043
 Tel: (301) 750-1150, FAX # (301) 750-7350

OWNER/DEVELOPER

JIM PARTNERSHIP
 5570-201 STERRETT PLACE
 COLUMBIA, MARYLAND 21044
 PH (301) 740-4466

JIM PARTNERSHIP
 5570-201 STERRETT PLACE
 COLUMBIA, MARYLAND 21044
 PH (301) 740-4466

CHAPEL WOODS
 HOWARD COUNTY, MARYLAND

WOC# 89-WQ-0532
 # WQ# 89-WQ-0101 (THE FOREST, F-89-20)
 CENAB-OP-RW

(CHAPEL WOODS)

88-3856-3
 PLANTING PLAN


U.S. Army Corps of Engineers
 Approval Of Plans And Specifications
 For Compliance With Permit Number
 CENAB-OP-RW (CHAPEL WOODS) 88-3856-3
Simon A. Malabina March 22, 1991
 Signature Of U.S. Army Corps Of Engineers, Baltimore, MD Date

Maryland Department of The Environment
 Standards & Certification Division
 Approval Of Plans And Specifications
 For Compliance With Permit Number WOC# 89-WQ-0532
John A. [Signature] 2/21/90
 Signature Of Standards/Certification Division Date

REQUIRED MITIGATION 0.76 AC
 WETLANDS MITIGATION FOR THE FOREST
 (F-89-20)

Drawn By: JLB Scale: 1/8" = 1'-0"
 Designed By: MAM Date: 9-21-90
 Checked By: PER Sheet: 306A

F-88-231 SUPPLEMENTAL INFORMATION

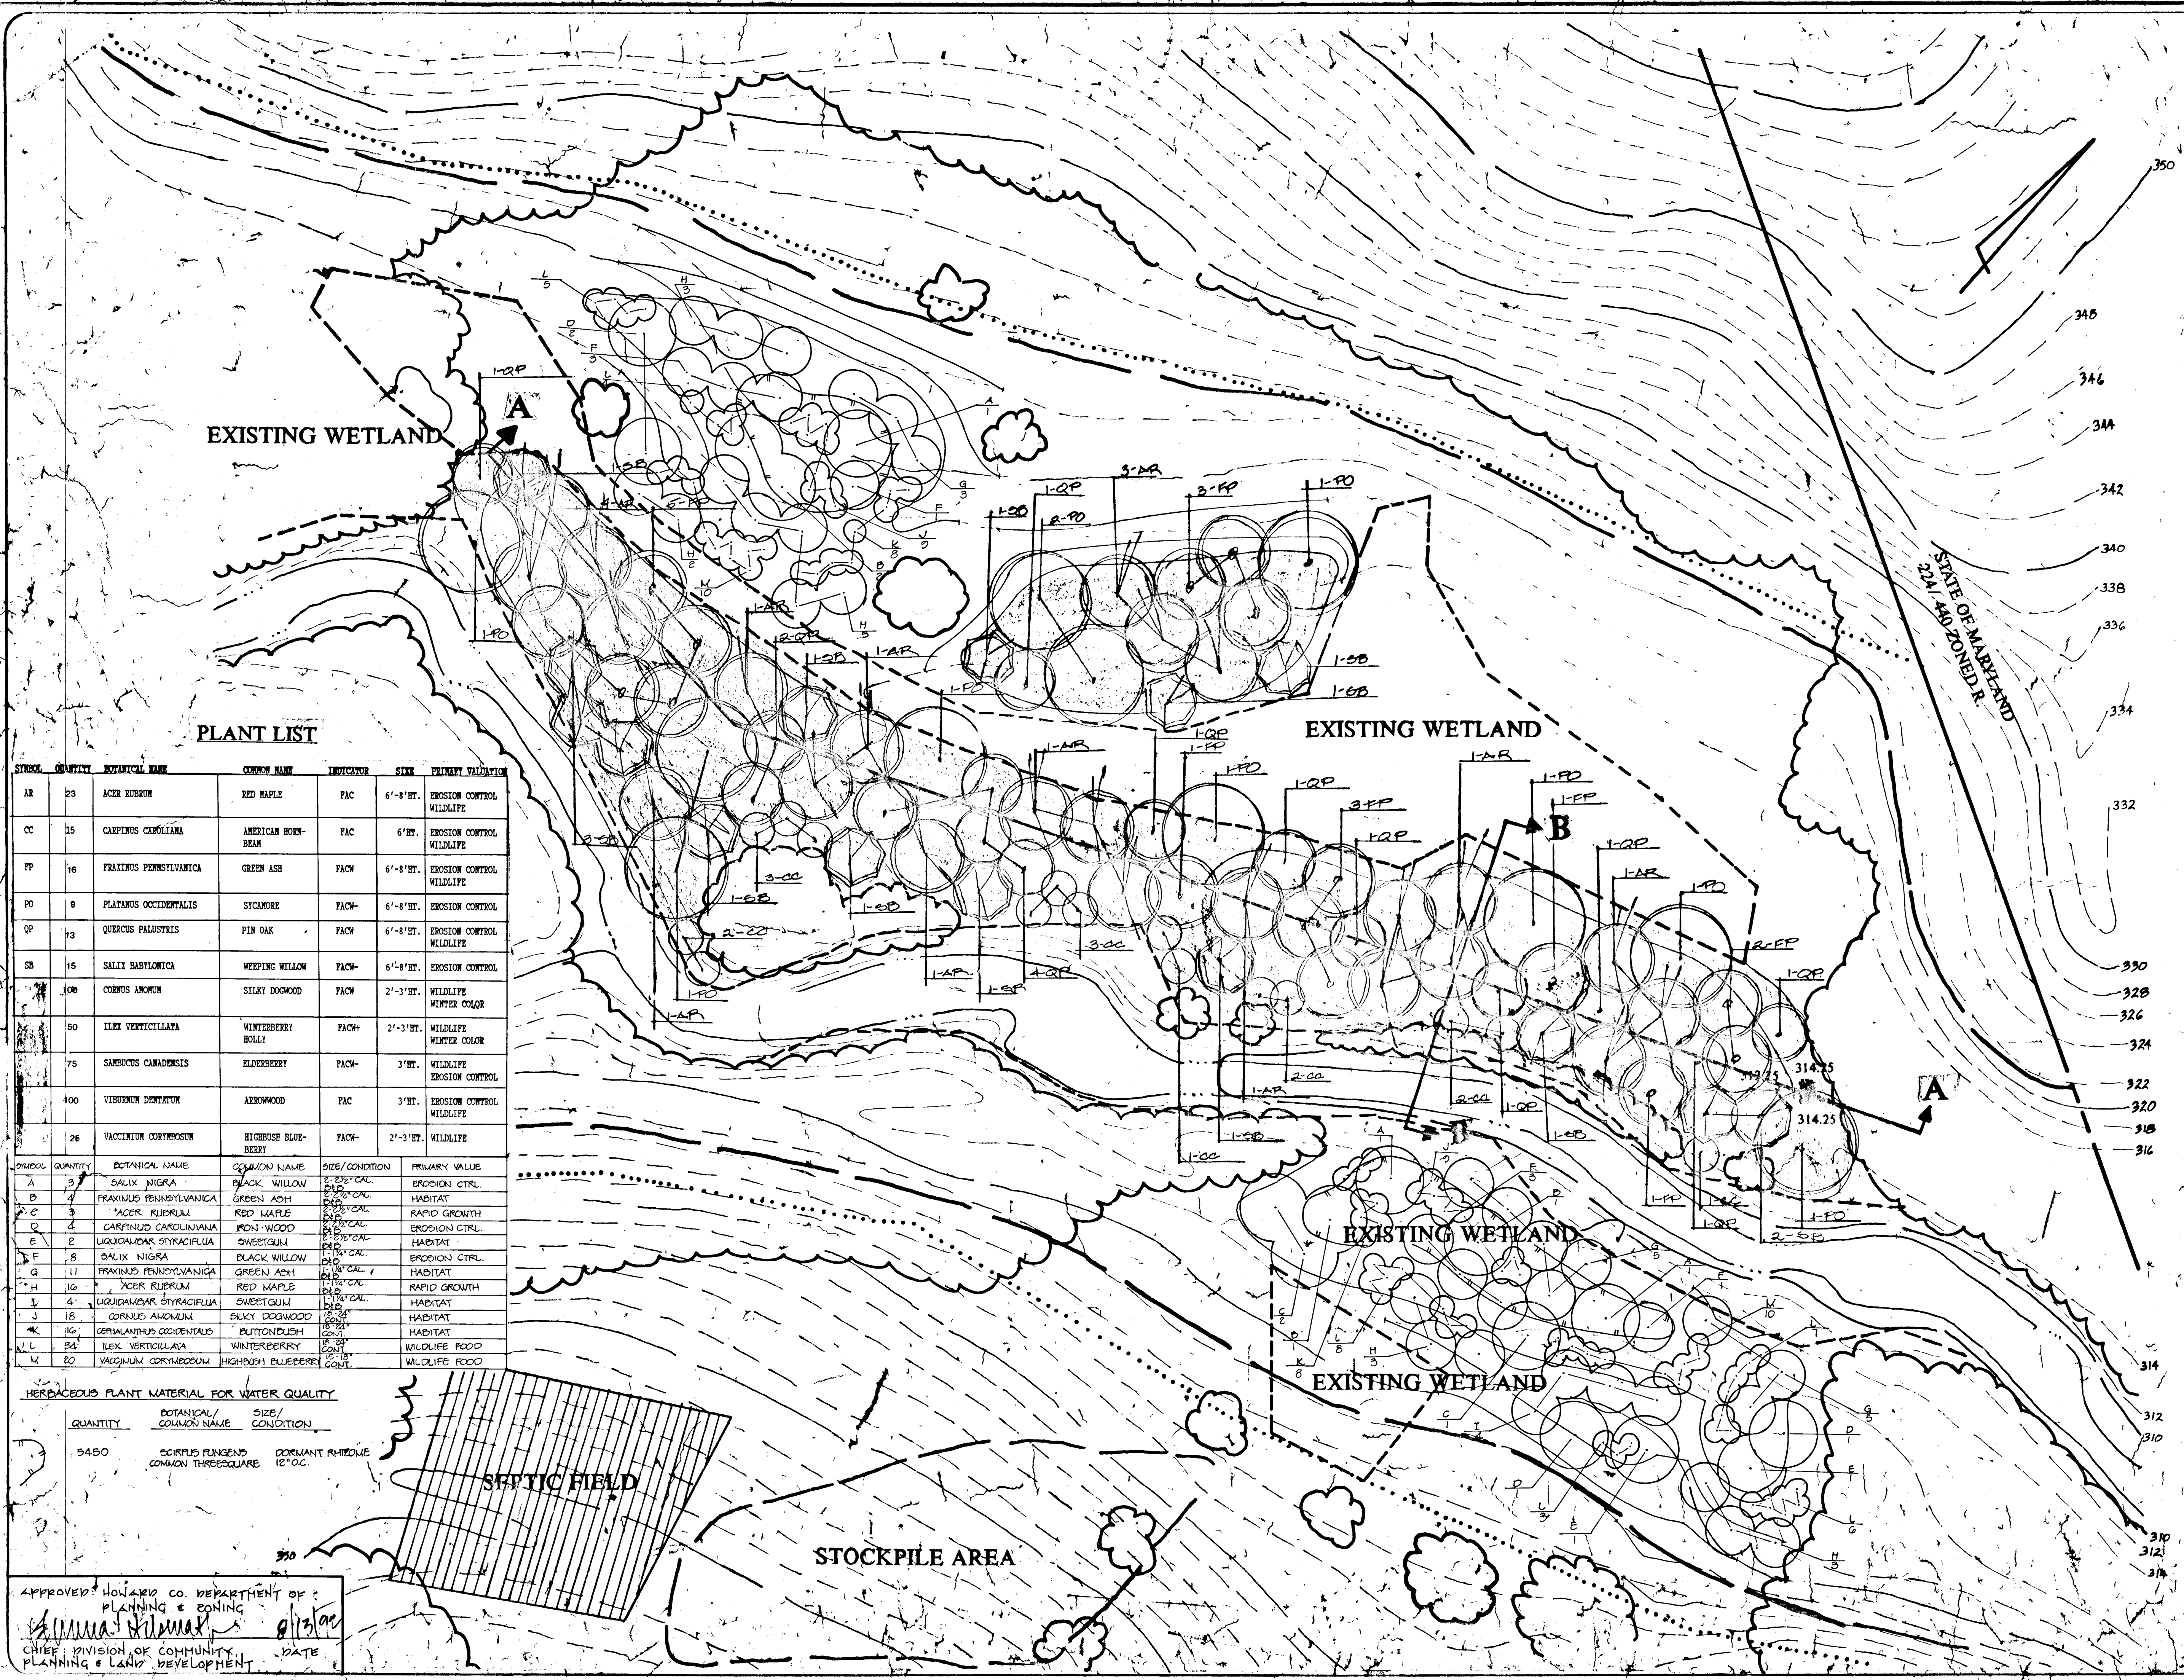

PLANT LIST

SYMBOL	QUANTITY	BOTANICAL NAME	COMMON NAME	INDICATOR	SIZE	PRIMARY VALUATION
AR	23	ACER RUBRUM	RED MAPLE	FAC	6'-8' BT.	EROSION CONTROL WILDLIFE
CC	15	CARPINUS CAROLINIANA	AMERICAN HORN-BEAN	FAC	6' BT.	EROSION CONTROL WILDLIFE
FP	16	FRAXINUS PENNSYLVANICA	GREEN ASH	FACM	6'-8' BT.	EROSION CONTROL WILDLIFE
PO	9	PLATANUS OCCIDENTALIS	SYCAMORE	FACM	6'-8' BT.	EROSION CONTROL
QP	13	QUERCUS PALUSTRIS	PIN OAK	FACM	6'-8' BT.	EROSION CONTROL WILDLIFE
SB	15	SALIX BABYLONICA	WEeping WILLOW	FACM	6'-8' BT.	EROSION CONTROL
100		CORNUS ANONUM	SILKY DOGWOOD	FACM	2'-3' BT.	WILDLIFE WINTER COLOR
50		ILEX VERTICILLATA	WINTERBERRY BOLLY	FACM	2'-3' BT.	WILDLIFE WINTER COLOR
75		SAMBUCUS CANADENSIS	ELDERBERRY	FACM	3' BT.	WILDLIFE EROSION CONTROL
100		VIBURNUM DENTATUM	ARBORWOOD	FAC	3' BT.	EROSION CONTROL WILDLIFE
26		VACCINIUM CORYMBOSUM	HIGHBUSH BLUE-BERRY	FACM	2'-3' BT.	WILDLIFE


SYMBOL	QUANTITY	BOTANICAL NAME	COMMON NAME	SIZE/CONDITION	PRIMARY VALUE
A	3	SALIX NIGRA	BLACK WILLOW	2'-2 1/2' CAL	EROSION CTRL.
B	4	FRAXINUS PENNSYLVANICA	GREEN ASH	2'-2 1/2' CAL	HABITAT
C	3	ACER RUBRUM	RED MAPLE	2'-2 1/2' CAL	RAPID GROWTH
D	4	CARPINUS CAROLINIANA	IRON WOOD	2'-2 1/2' CAL	EROSION CTRL.
E	2	LIQUIDAMBAR STYRACIFLUA	SWEETGUM	2'-2 1/2' CAL	HABITAT
F	8	SALIX NIGRA	BLACK WILLOW	2'-2 1/2' CAL	EROSION CTRL.
G	11	FRAXINUS PENNSYLVANICA	GREEN ASH	2'-2 1/2' CAL	HABITAT
H	16	ACER RUBRUM	RED MAPLE	2'-2 1/2' CAL	RAPID GROWTH
I	4	LIQUIDAMBAR STYRACIFLUA	SWEETGUM	2'-2 1/2' CAL	HABITAT
J	15	CORNUS ANONUM	SILKY DOGWOOD	2'-2 1/2' CAL	HABITAT
K	16	GERANIUM OCCIDENTALE	BUTTONBUSH	2'-2 1/2' CAL	HABITAT
L	34	ILEX VERTICILLATA	WINTERBERRY	2'-2 1/2' CAL	WILDLIFE FOOD
M	20	VACCINIUM CORYMBOSUM	HIGHBUSH BLUEBERRY	2'-2 1/2' CAL	WILDLIFE FOOD

HERBACEOUS PLANT MATERIAL FOR WATER QUALITY

QUANTITY	BOTANICAL/COMMON NAME	SIZE/CONDITION
5450	CORPUS FUNGUS COMMON THREE SQUARE	DORMANT RHIZOME 12" OC.

APPROVED: HOWARD CO. DEPARTMENT OF PLANNING & ZONING
Simon A. Malabina 8/13/90
 CHIEF, DIVISION OF COMMUNITY PLANNING & LAND DEVELOPMENT DATE

RECEIVED
DEC 4 1990
PLANNING & ZONING

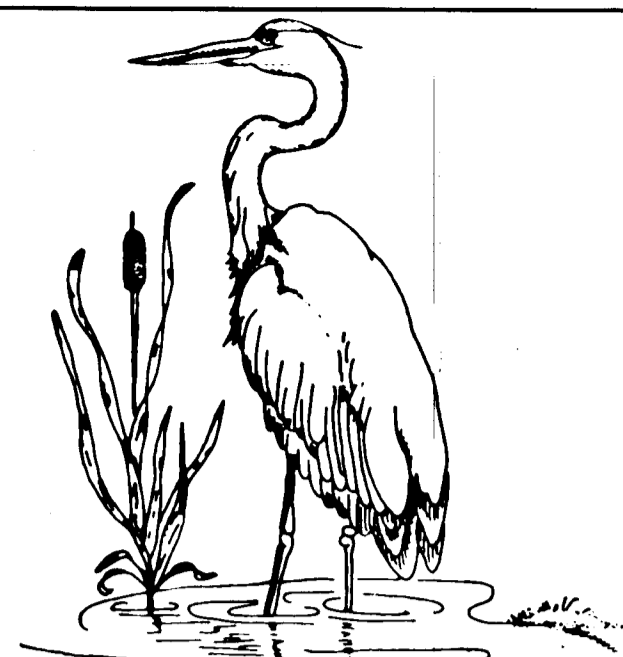

EXPLORATION RESEARCH, INC.
Environmental Consultants
8318 Forrest Avenue, Suite 101
Historic Ellicott City, Maryland 21043
Tel: (301) 750-1150, FAX # (301) 750-7350



OWNER / DEVELOPER
JIM PARTNERSHIP JIM PARTNERSHIP
5570-201 STERRETT PLACE 5570-201 STERRETT PLACE
COLUMBIA, MARYLAND 21044 COLUMBIA, MARYLAND 21044
PH: (301) 740-4466 PH: (301) 740-4466

CHAPEL WOODS
HOWARD COUNTY, MARYLAND
WQC # 89-WQ-0532
CENAB-OP-RW
(CHAPEL WOODS)
88-3856-3
PROFILES



U.S. Army Corps Of Engineers
Approval Of Plans And Specifications
For Compliance With Permit Number
CENAB-OP-RW (CHAPEL WOODS) 88-3856-3
James A. Bluhling *March 27, 1991*
Signature Of U.S. Army Corps Of Engineers, Baltimore, MD Date

Maryland Department Of The Environment
Standards & Certification Division
Approval Of Plans And Specifications
For Compliance With Permit Number WQC# 89-WQ-0532
John J. Bluhling *12/10/90*
Signature Of Standards/Certification Division Date

Drawn By: JLB Scale: As Noted
Designed By: MAM Date: 9-21-90
Checked By: DEB Sheet: 4066

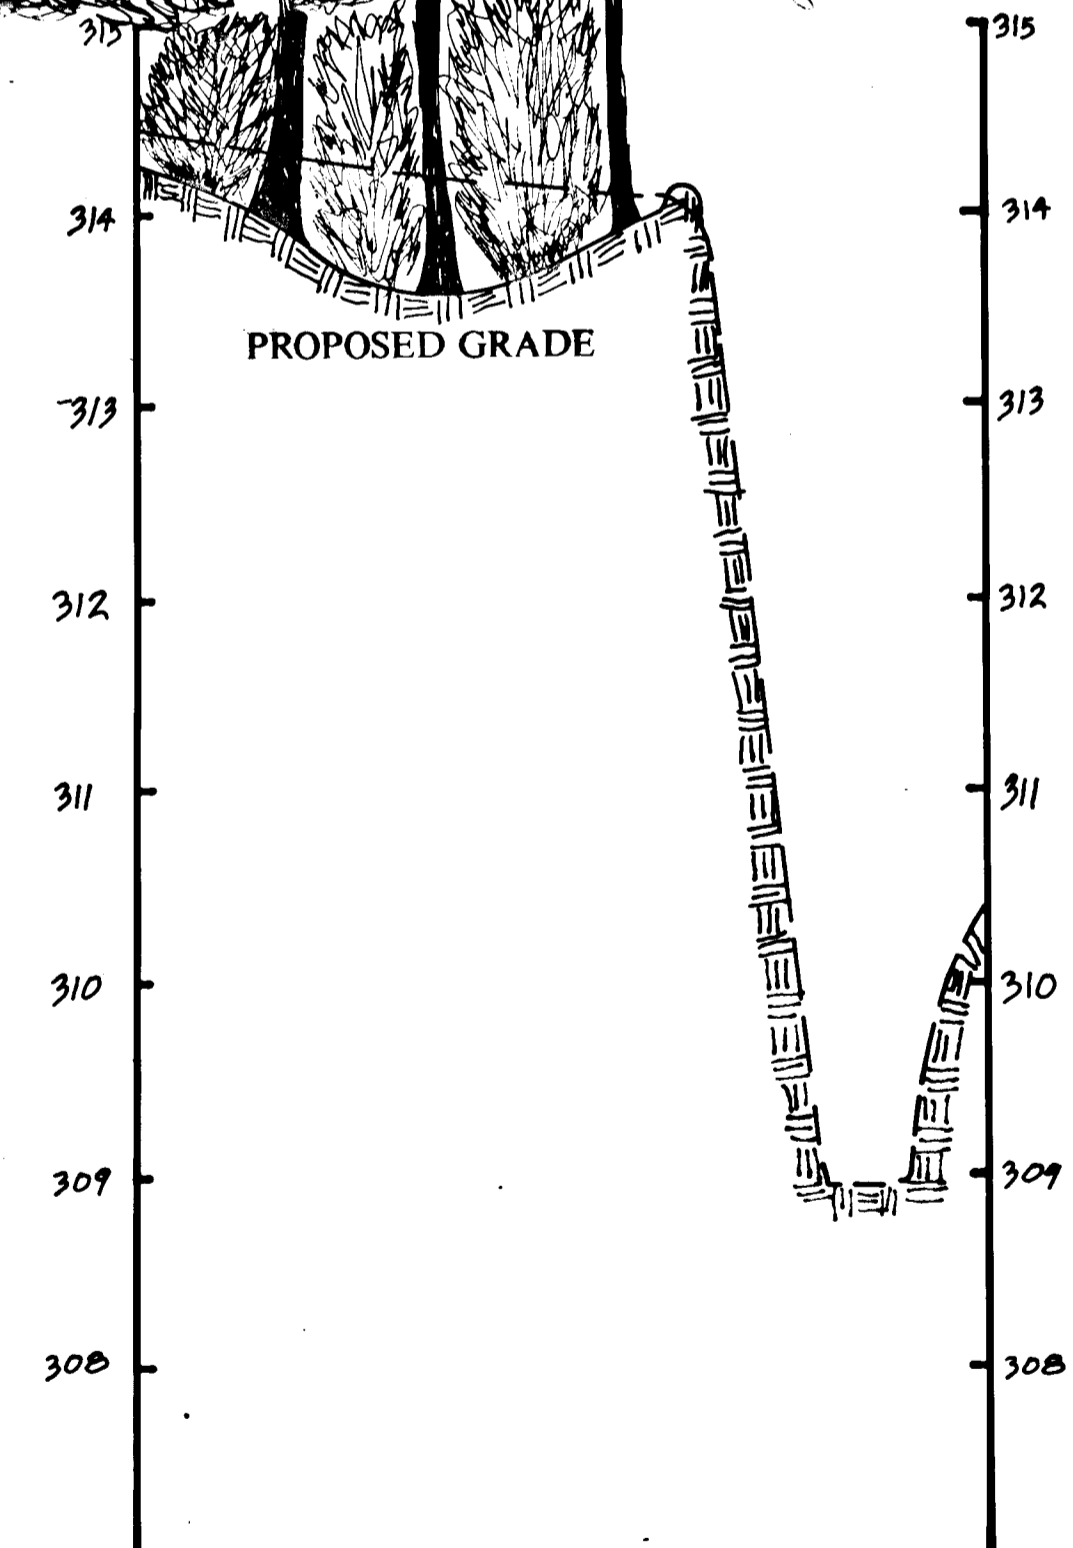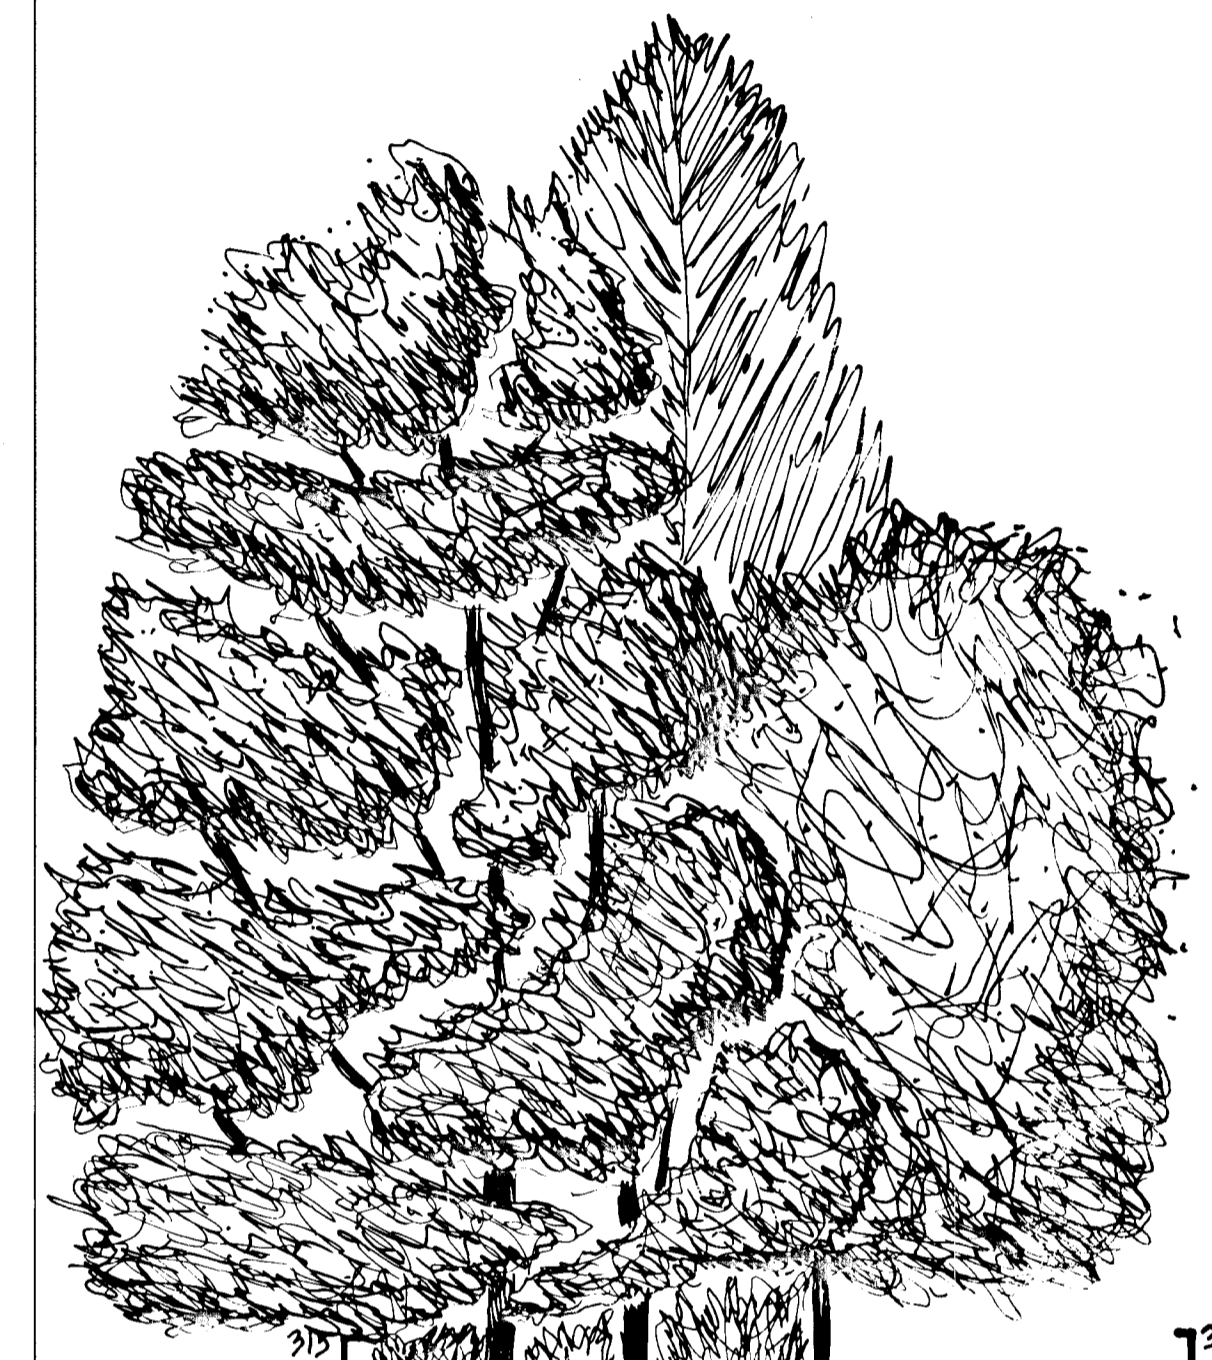

SECTION B-B
SCALE: HORIZ: 1" = 30'
VERT: 1" = 1'

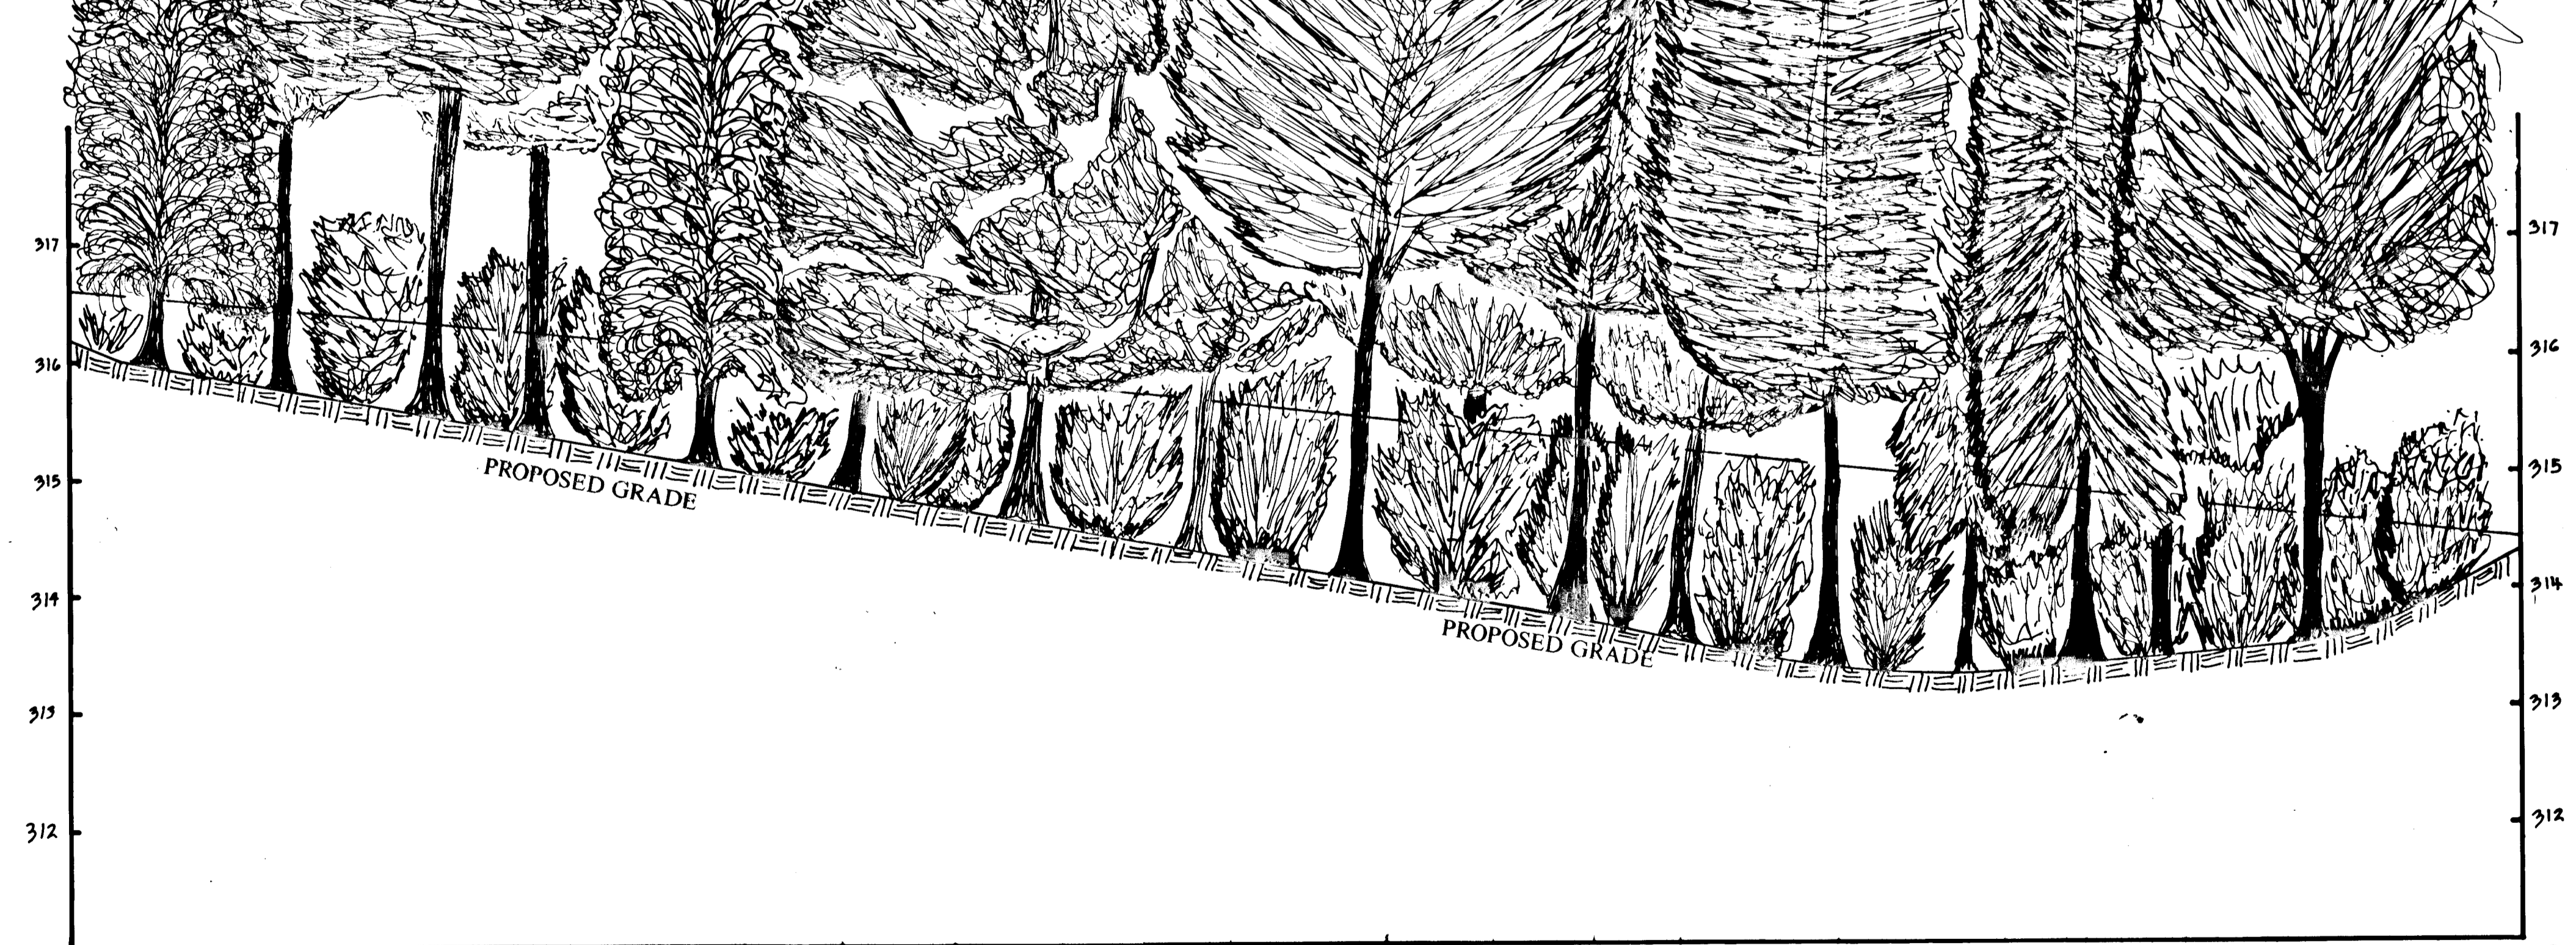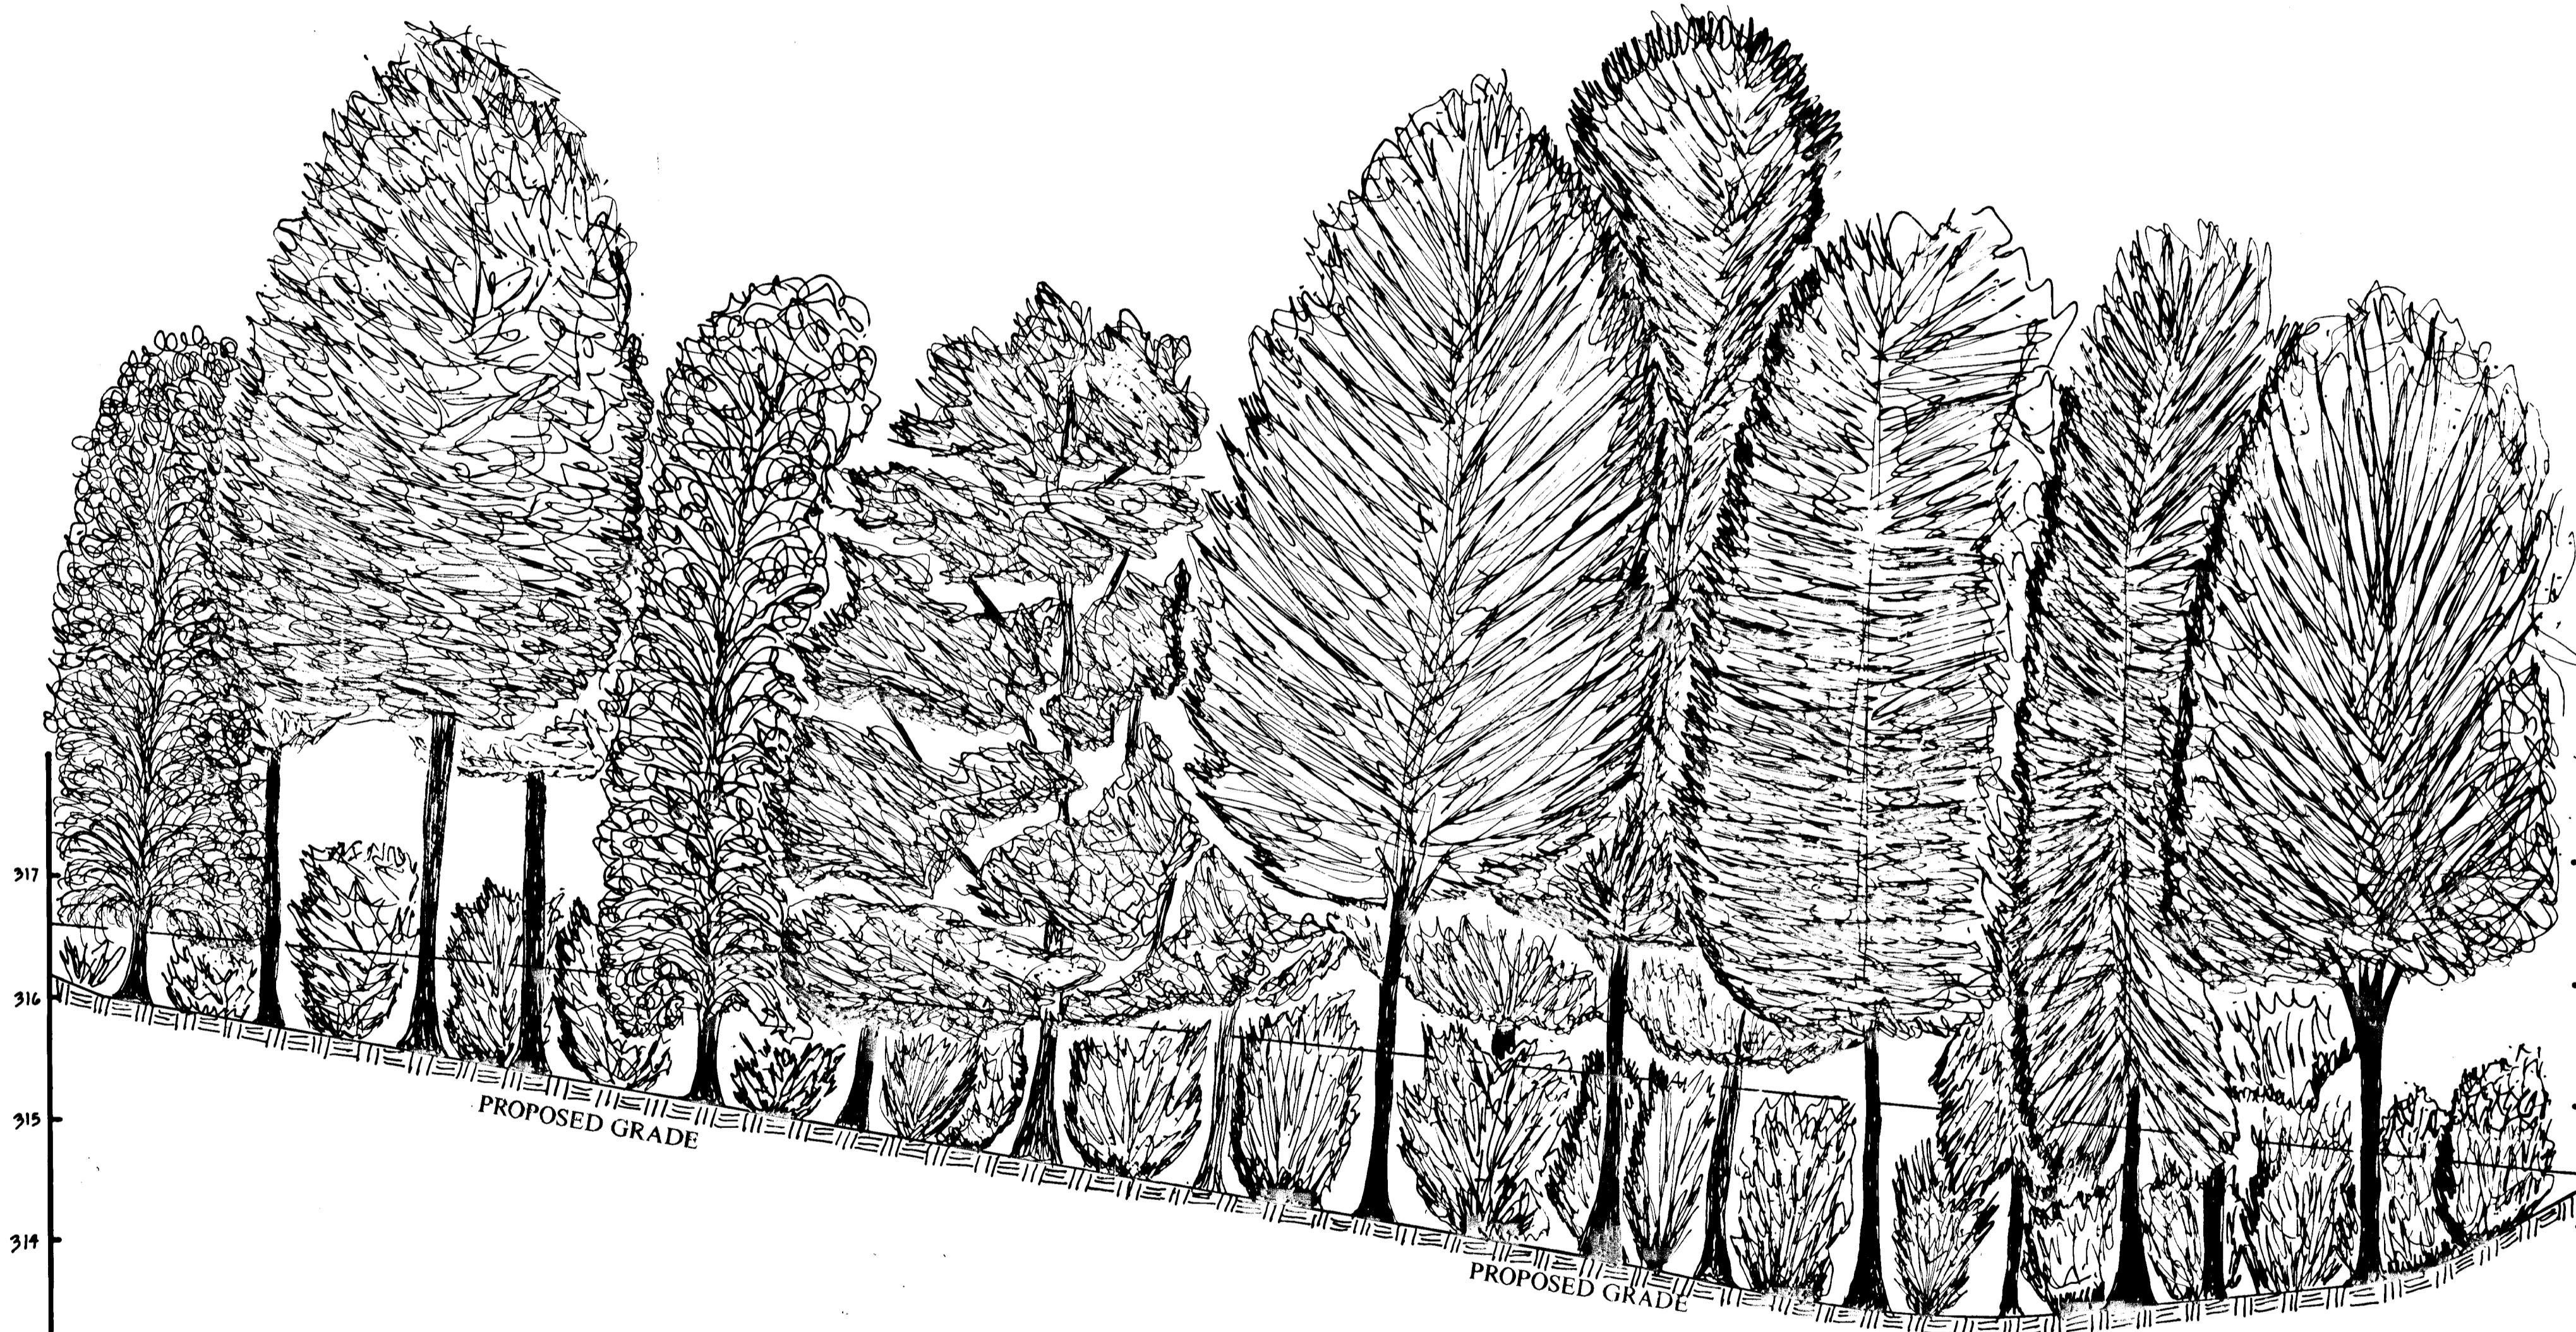


SECTION A-A
SCALE: HORIZ: 1" = 30'
VERT: 1" = 1'


APPROVED: HOWARD CO. DEPARTMENT OF PLANNING & ZONING
Emma J. Holmash *12/10/90*
CHIEF, DIVISION OF COMMUNITY PLANNING & LAND DEVELOPMENT DATE

RECEIVED
DEC 4 1990
PLANNING & ZONING

717



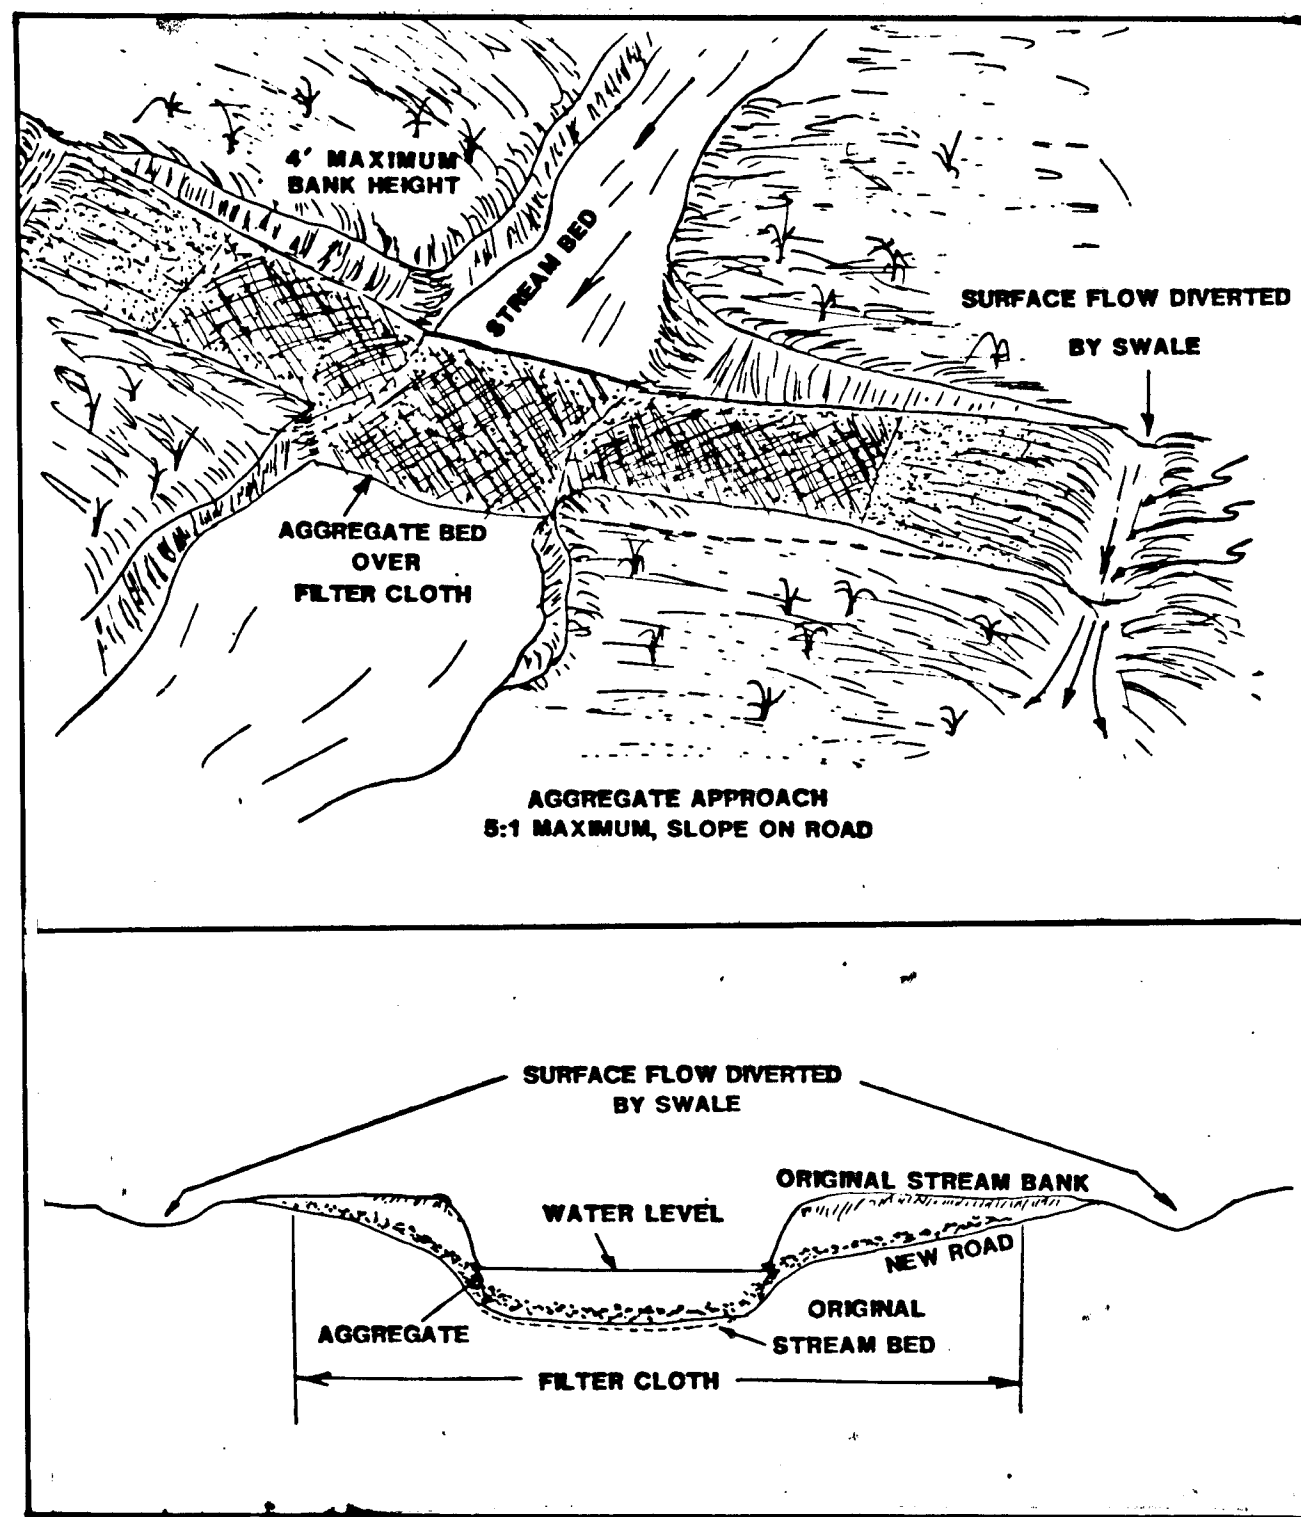


TEMPORARY ACCESS FORD
NOT TO SCALE

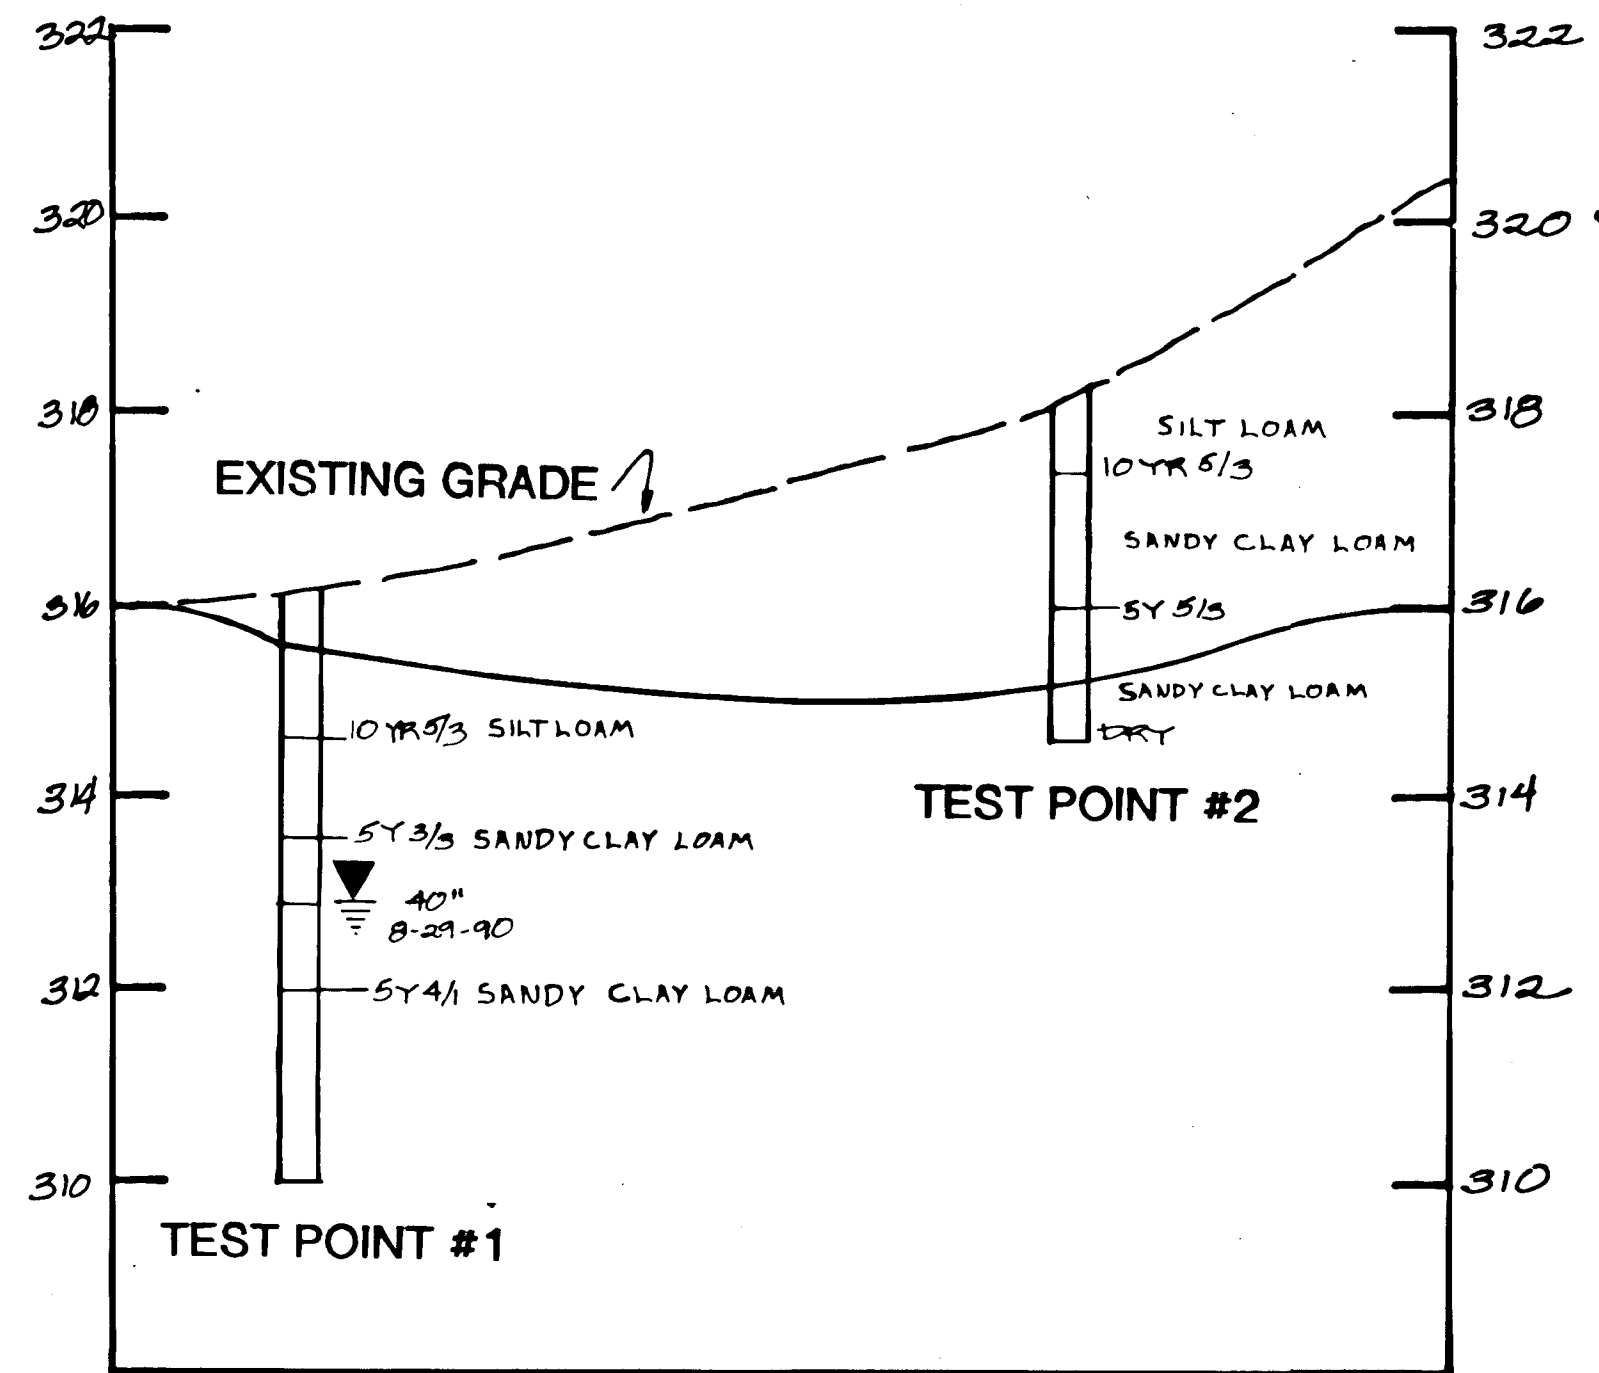


SOIL PROFILES

SCALE: HORIZ: 1"=10'
VERT: 1"=1'
NOT TO SCALE

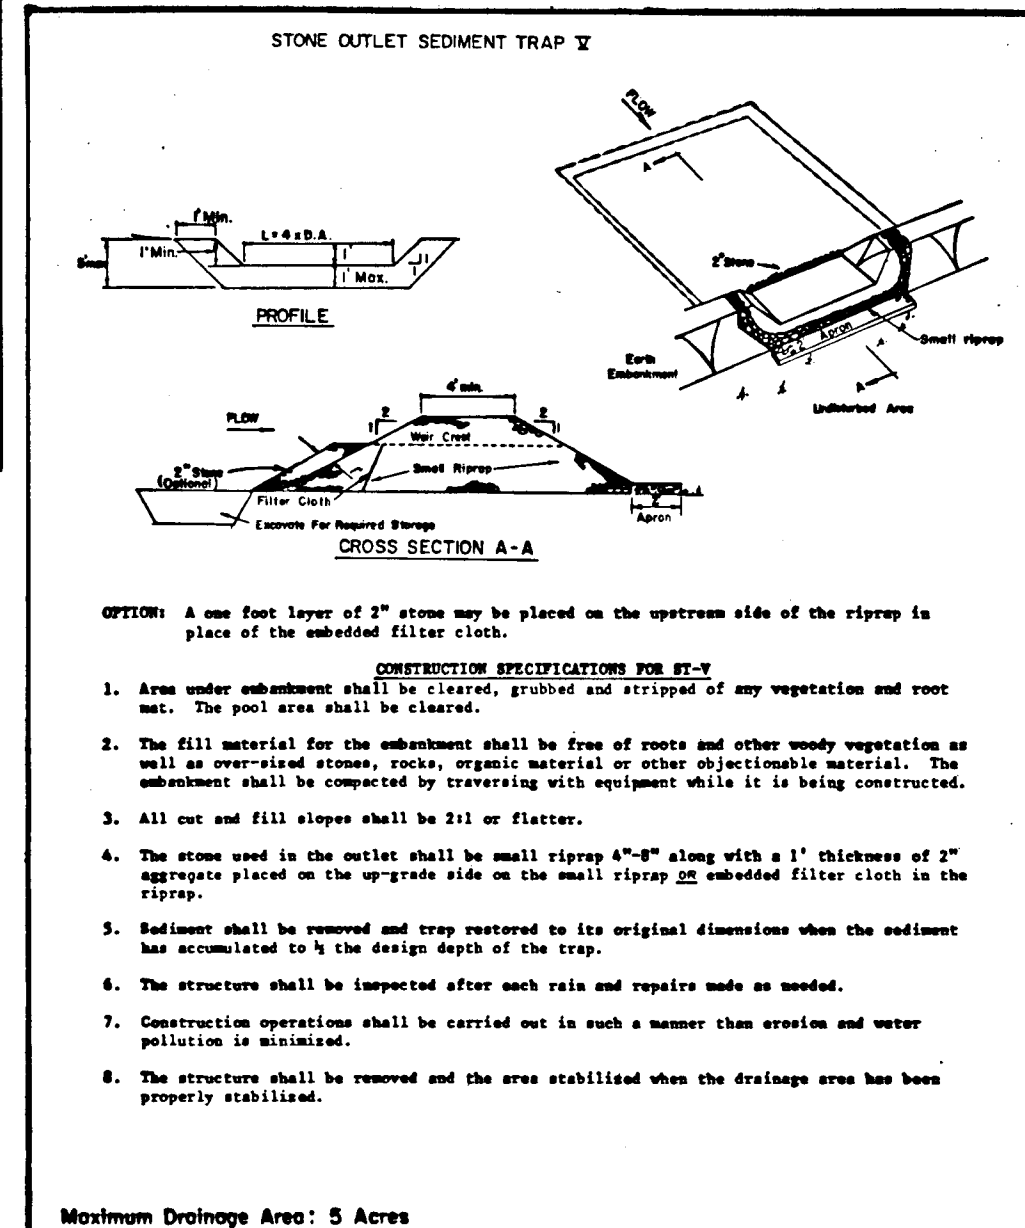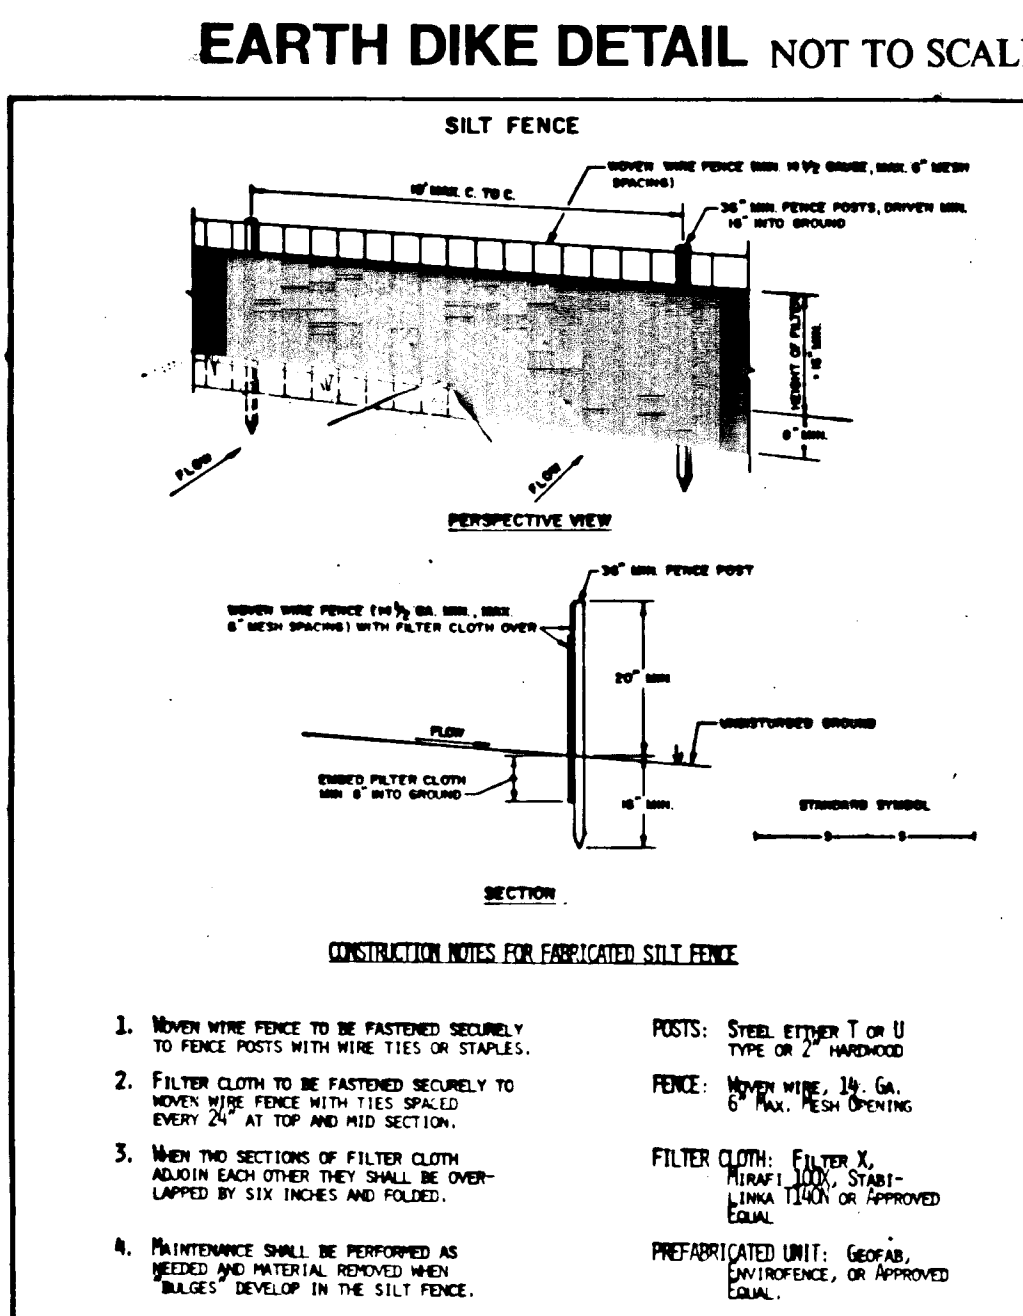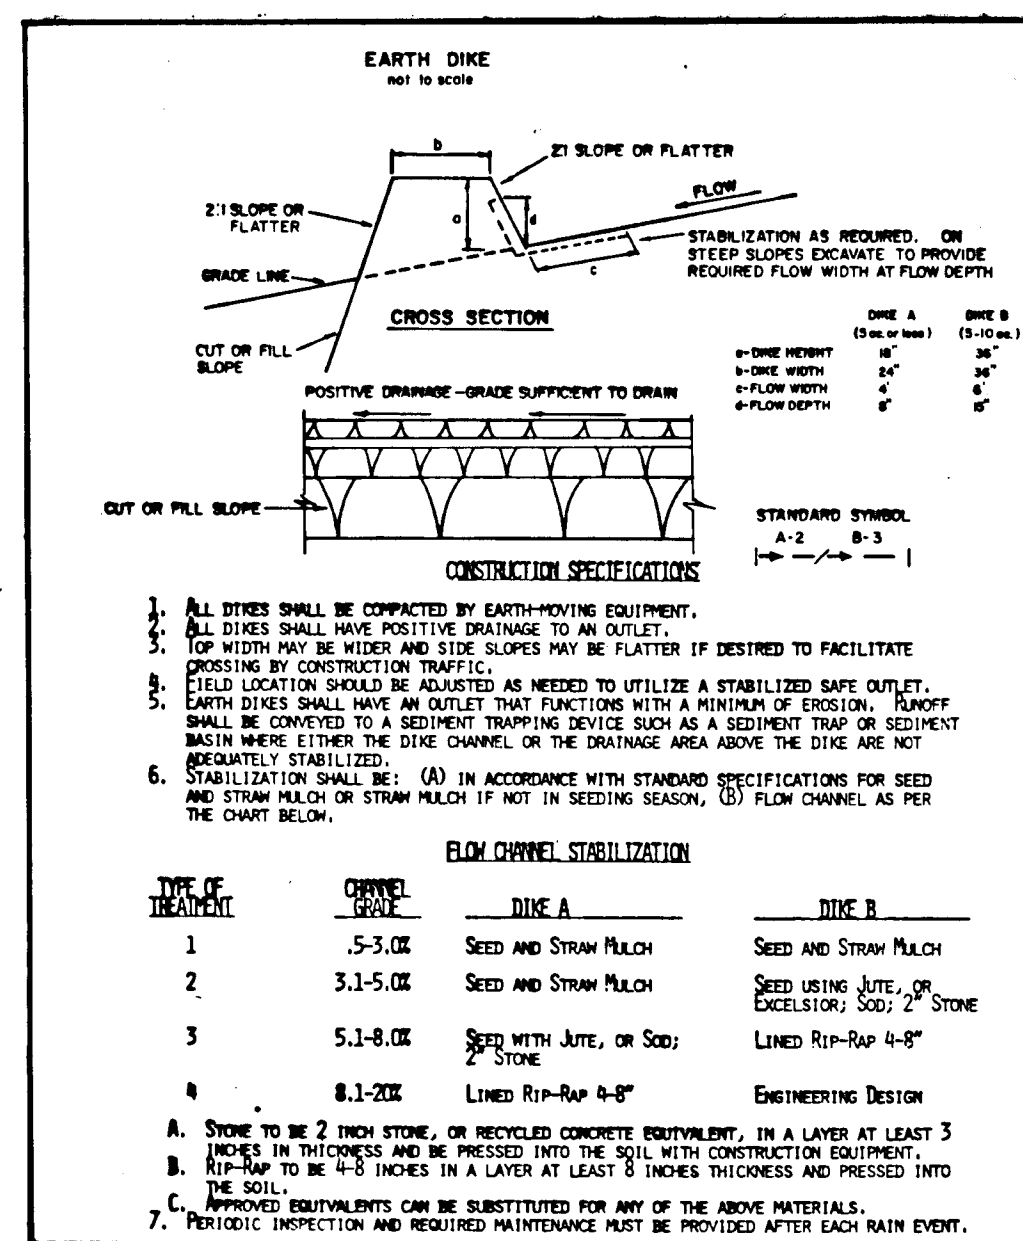

SEDIMENT CONTROL

- A minimum of 24 hours notice must be given to the Howard County Office of Inspection and Permits prior to the start of any construction. (1992-1437)
- All vegetative and structural practices are to be installed according to the provisions of this plan and are to be in conformance with the 1983 MARYLAND STANDARDS AND SPECIFICATIONS FOR SOIL EROSION AND SEDIMENT CONTROL.
- Following initial soil disturbance or redisturbance, permanent or temporary stabilization shall be completed within: a) 7 calendar days for all perimeter sediment control structures, dikes, perimeter slopes and all slopes greater than 3:1; b) 14 days as to all other disturbed or graded areas on the project site.
- All sediment traps/basins shown must be fenced and warning signs posted around their perimeter in accordance with Vol. 1, Chapter 12, of the HOWARD COUNTY DESIGN MANUAL, Storm Drainage.
- All disturbed areas must be stabilized within the time period specified above in accordance with the 1983 MARYLAND STANDARDS AND SPECIFICATIONS FOR SOIL EROSION AND SEDIMENT CONTROL for permanent seeding (Sec. 31) and (Sec. 34), temporary seeding (Sec. 30) and mulching (Sec. 32). Temporary stabilization with mulch alone can only be done when recommended seeding dates do not allow for proper germination and establishment of grasses.
- All sediment control structures are to remain in place and are to be maintained in operative condition until permission for their removal has been obtained from the Howard County Sediment Control Inspector.
- Site Analysis:
Total Area of Site: 0.80 Acres
Area Disturbed: 0.80 Acres
Area to be roofed or paved: 0.00 Acres
Area to be vegetatively stabilized: 0.80 Acres
Total Cut: 672 Cu. Yds.
Total Fill: 0.00 Cu. Yds.
Offsite waste/borrow area location: AD NORTH
- Any sediment control practice which is disturbed by grading activity for placement of utilities must be repaired on the same day of disturbance.
- Additional sediment controls must be provided, if deemed necessary by the Howard County Sediment Control Inspector.
- On all sites with disturbed areas in excess of 2 acres, approval of the inspection agency shall be requested upon completion of installation of perimeter erosion and sediment controls, but before proceeding with any other earth disturbance or grading. Other building or grading inspection approvals may not be authorized until this initial approval by the inspection agency is made.

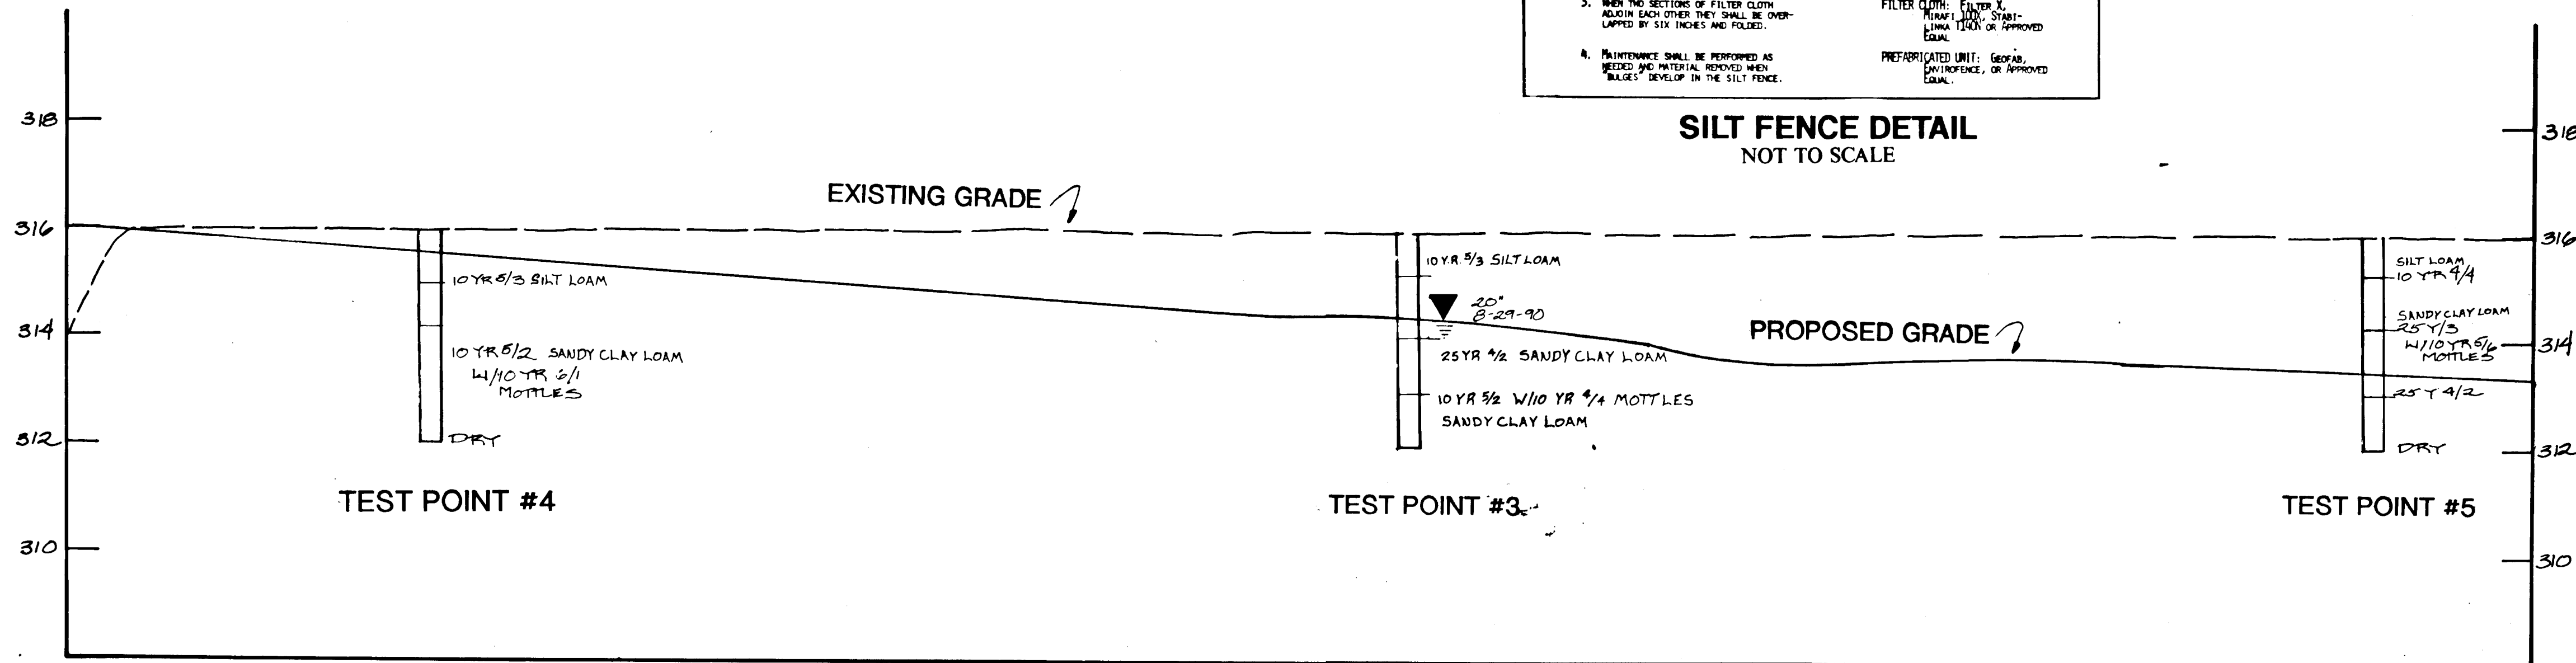

SOIL PROFILES

SCALE: HORIZ: 1"=10'
VERT: 1"=1'

I hereby approve the proposed construction of the wetland recreation upon my property.
Eric Mikalasko
Date: 6-30-92

APPROVED: HOWARD COUNTY DEPARTMENT OF PLANNING AND ZONING
Anna J. Kilmann
Date: 8/13/92
Chief, Division of Community Planning and Land Development

I certify that this plan for erosion and sediment control represents a practical and workable plan based on my personal knowledge of the site conditions and that it was prepared in accordance with the requirements of the Howard Soil Conservation District.
Signature of Consultant: [Signature]
Date: 6-2-92

Reviewed for HOWARD S.C.D. and meets Technical Requirements
Signature of Consultant: [Signature]
Date: 7/27/92
U.S. Soil Conservation Service
THIS DEVELOPMENT PLAN IS APPROVED FOR SOIL EROSION AND SEDIMENT CONTROL BY THE HOWARD SOIL CONSERVATION DISTRICT.
Signature of Consultant: [Signature]
Date: 7/27/92
Howard S.C.D.

EXPLORATION RESEARCH, INC.
Environmental Consultants
8318 Forrest Avenue, Suite 101
Historic Ellicott City, Maryland 21043
Tel: (301) 750-1150, FAX # (301) 750-7350

OWNER/DEVELOPER

JJM PARTNERSHIP
5570-201 STERRETT PLACE
COLUMBIA, MARYLAND 21044
PH (301) 740-4466

JJM PARTNERSHIP
5570-201 STERRETT PLACE
COLUMBIA, MARYLAND 21044
PH (301) 740-4466

CHAPEL WOODS
HOWARD COUNTY, MARYLAND
WQC# 89-WQ-0532
CENAP-OP-RW
(CHAPEL WOODS)
88-3856-3
SOIL PROFILES

U.S. Army Corps Of Engineers
Approval Of Plans And Specifications
For Compliance With Permit Number
CENAB-OP-RW (CHAPEL WOODS) 88-3856-3
Signature Of U.S. Army Corps Of Engineers, Baltimore, MD
Date: 7/7/92

Maryland Department Of The Environment
Standards and Certification Division
Approval Of Plans And Specifications
For Compliance With Permit Number WQC# 89-WQ-0532
Signature Of Standards/Certification Division
Date: 8/13/92

Drawn By: JLB
Designed By: MAM
Checked By: DBA

Scale: AS NOTED
Date: 9-2-90
Sheet: 5 OF 6

CONSTRUCTION RESTRICTIONS

All work in flood plain must be done in strict accordance with applicable State permit requirements.

Work in streams is prohibited during certain times of the year as follows:

Class I Streams	March 1 thru June 15
Class II Streams	June 1 thru September 30 or December 16 thru March 14
Class III Streams	October 1 thru April 30
Class IV Streams	March 1 thru May 31

CLEARING AND GRUBBING


- All vegetation, trash, and debris not marked in the field or on the plans, within the limits of disturbance, are to be disposed of off site in an approved landfill site.

GRADING

- All topsoil and excess cut is to be removed and disposed of off site.
- Grade tolerance shall be within 0.15 feet.
- Specific field elevations may be adjusted slightly during construction to allow for unanticipated field conditions.
- All final elevations shall be field checked by Exploration Research, Inc. prior to the contractor removing equipment from the site.

CONSTRUCTION SEQUENCE

- All grading to be done under approved grading permit for Chapel Woods.
- Install temporary access ford, silt fence, earth dikes, and sediment traps.
- Remove topsoil and stockpile on designated area.
- Excavate mitigation area to grades shown.
- Haul excess material to approved on site location.
- After grading is completed, all disturbed shall be stabilized with ryegrass.
- Remove modified earth dike/swale.
- Plant mitigation area in accordance with planting plan.
- Remove silt fence, earthdikes, and stabilize.

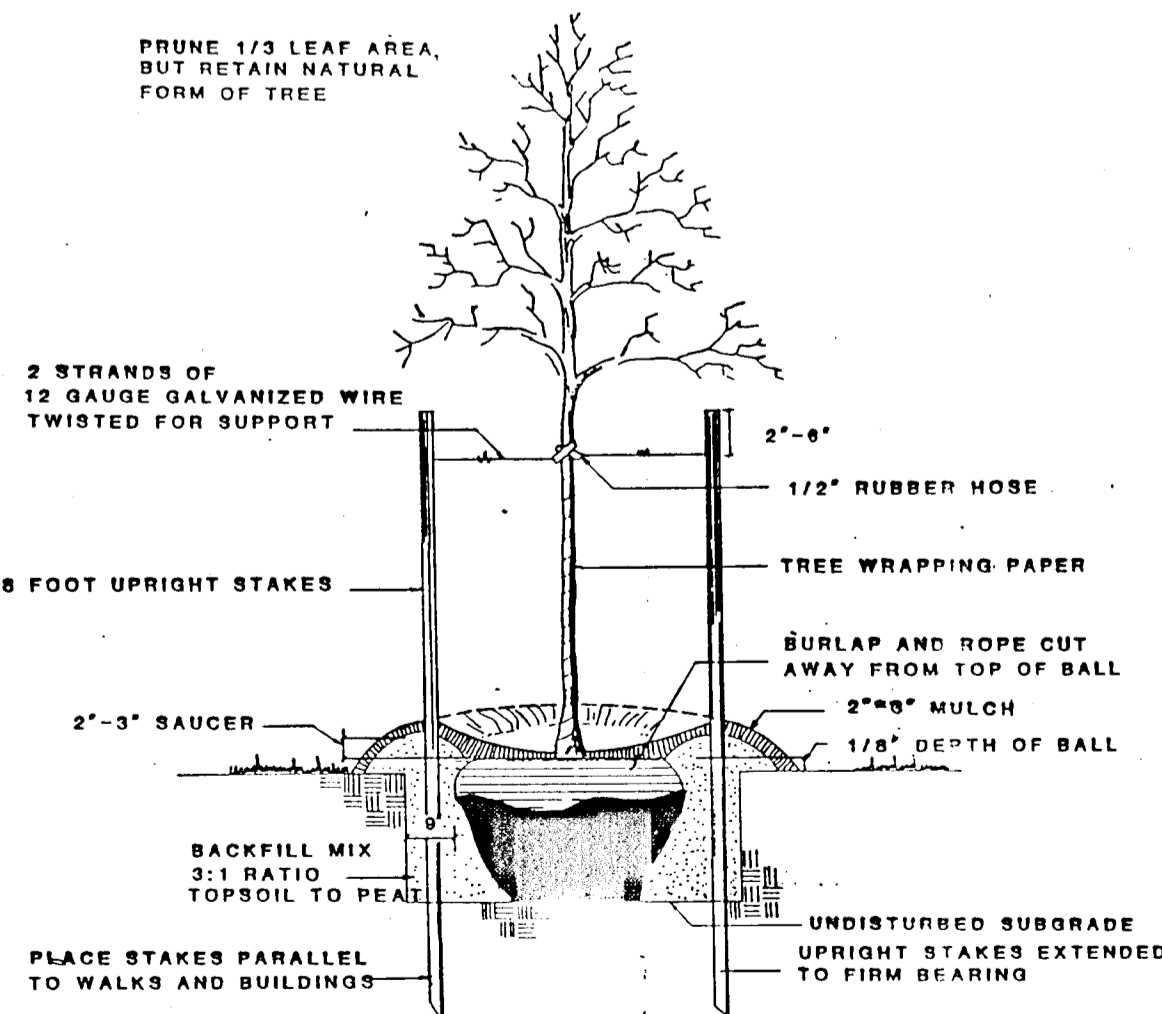

TREE PLANTING DETAIL

NOT TO SCALE

CONSTRUCTION REQUIREMENTS

The site to be restored as emergent Wetland shall be graded, planted, and fertilized as shown on the plans and in accordance with these special provisions:

- Planting schedule shall conform to the following conditions:

Planting shall commence after final grading, adjacent construction has been completed, and all sediment control measures have been removed. In order to coordinate the planting work with the entire construction schedule, plant material will not be shipped from the supplier until directed to do so by Exploration Research, Inc. All emergent Wetland plantings (peat plants and bare root-stock) shall be installed between March 1 and May 15 or as directed by Exploration Research, Inc.
- Plant Materials:
 - Root-stock of the plant material shall be kept moist during transport from the source to the job site and until planted.
 - Plant material shall be planted in existing soil with each planting pit excavated to size sufficient to contain the entire root-stock or the entire root-mass without cramping.
- Planting bed preparation:

The contractor shall prepare the area to be planted in Wetland plant materials by spreading a uniform layer of 6 inches of topsoil over the existing soil without disturbing the grade. Planting areas shall be approved by Exploration Research, Inc. prior to the installation of the plant material.
- Clean-up:

Final clean up shall be the responsibility of the contractor and consist of removing all trash and materials incidental to the project, and disposing of them off-site. In addition, the construction procedure shall not damage any areas of existing plants which are to remain.
- The planting grids are approximate and may be varied upon the approval of Exploration Research, Inc., provided the relative ratios and areas are maintained.
- Plant material selections are based upon availability at time of design. If specific plants are unavailable at time of planting, substitute plants conforming to above specifications will be made. All substitute plant materials are subject to the approval of Exploration Research, Inc. and the Army Corps of Engineers.

WETLAND PLANT MATERIAL


DESCRIPTION:

This work shall consist of furnishing and planting emergent wetland plants and shrubs as shown on the plans and/or as directed by Exploration Research, Inc. and all planting operations and care and replacement as necessary to complete the work specified.

Prior to the start of the work on this project, Exploration Research, Inc. shall submit to the Army Corps of Engineers for review, the proposed planting schedule for the wetland vegetation.

MATERIALS:

- Plant material - As shown on the plans, shall conform to the following specifications: The plant species required shall be obtained from landscape nursery sources. The Contractor will make arrangements to insure a supply of the required plant material. This shall be done five (5) months prior to planting time to allow for plant collection, storage, and preparation.
- Fertilizer - As required.
- Substitute plants - Shall conform to the above specifications and approval of Exploration Research, Inc. and the Army Corps of Engineers.

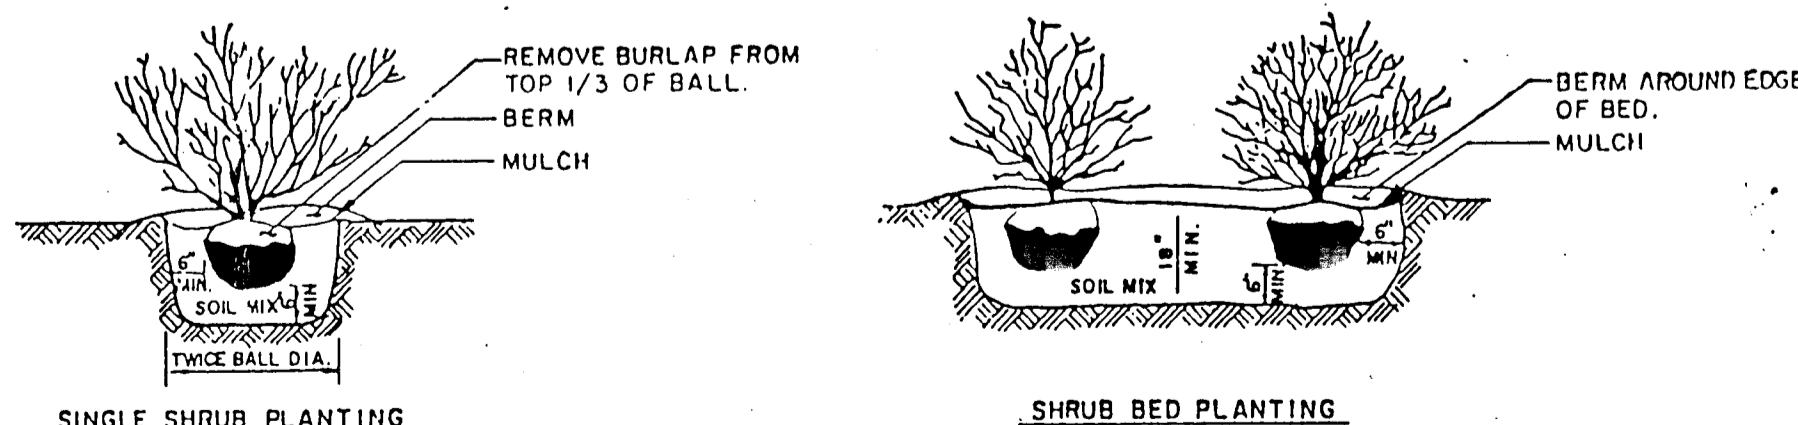

PLANTING DETAIL

NO SCALE

APPROVED: HOWARD CO. DEPARTMENT OF PLANNING & ZONING
 [Signature] 6/13/92
 CHIEF, DIVISION OF COMMUNITY PLANNING & LAND DEVELOPMENT

THIS DEVELOPMENT PLAN IS APPROVED FOR SOIL EROSION AND SEDIMENT CONTROL BY THE HOWARD SOIL CONSERVATION DISTRICT.
 [Signature] 7/27/92
 Howard S.C.D.

"I certify that this plan for erosion and sediment control represents a practical and workable plan based on my personal knowledge of the site conditions and that it was prepared in accordance with the requirements of the Howard Soil Conservation District."
 [Signature] 6-7-92
 U.S. Soil Conservation Service

Reviewed for HOWARD S.C.D. and meets Technical Requirements
 [Signature] 7/27/92
 U.S. Soil Conservation Service

TEMPORARY SEEDING NOTES:
 APPLY TO GRADED OR CLEARED AREAS LIKELY TO BE RESTORED WHERE A SHORT-TERM VEGETATIVE COVER IS REQUIRED.
SEEDING PREPARATION: LOOSEN UPPER THREE-INCHES OF SOIL BY BAKING, DISCING OR OTHER ACCEPTABLE MEANS BEFORE SEEDING. IF NOT PREVIOUSLY LOOSENED.
SOIL AMENDMENTS: APPLY 600 LBS PER ACRE 10-10-10 FERTILIZER (14 LBS/1000 SQ. FT.).
SEEDING: FOR PERIODS MARCH 1 THRU APRIL 30 AND FROM AUGUST 15 THRU NOVEMBER 15, SEED WITH 1 1/2 BUSHES PER ACRE OF ANNUAL RYE (3.2 LBS/1000 SQ. FT.). FOR THE PERIOD MAY 1 THRU AUGUST 14, SEED WITH 3 LBS PER ACRE OF WHEAT LOVEGRASS (1.07 LBS/1000 SQ. FT.). FOR THE PERIOD NOVEMBER 16 THRU FEBRUARY 28, PROTECT SITE BY APPLYING 2 TONS PER ACRE OF WELL ANCHORED STRAW MULCH AND SEED AS SOON AS POSSIBLE IN THE SPRING, OR USE SOU.
MULCHING: APPLY 1 1/2 TO 2 TONS PER ACRE (70 TO 90 LBS/1000 SQ. FT.) OF UNROTTED SMALL GRASS STRAW IMMEDIATELY AFTER SEEDING. ANCHOR MULCH IMMEDIATELY AFTER APPLICATION USING MULCH ANCHORING TOOL OR 218 GAL PER ACRE (5 GAL/1000 SQ. FT.) OF ENRICHED ASPHALT ON FLAT AREAS. ON SLOPES, 8 FT. OR HIGHER, USE 348 GAL PER ACRE (8 GAL/1000 SQ. FT.) FOR ANCHORING.
REFER TO THE USES WETLAND STANDARDS AND SPECIFICATIONS FOR SOIL EROSION AND SEDIMENT CONTROL FOR RATE AND METHODS NOT COVERED.

PERMANENT SEEDING NOTES:
 APPLY TO GRADED OR CLEARED AREAS NOT SUBJECT TO IMMEDIATE FURTHER RESTORATION WHERE A PERMANENT LOW-LIVED VEGETATIVE COVER IS NEEDED.
SEEDING PREPARATION: LOOSEN UPPER THREE-INCHES OF SOIL BY BAKING, DISCING OR OTHER ACCEPTABLE MEANS BEFORE SEEDING. IF NOT PREVIOUSLY LOOSENED.
SOIL AMENDMENTS: IN LIEU OF SOIL TEST RECOMMENDATIONS, USE ONE OF THE FOLLOWING SCHEDULES:
 1) PREFERRED - APPLY 2 TONS PER ACRE DOLOMITIC LIMESTONE (92 LBS/1000 SQ. FT.) AND 500 LBS PER ACRE 10-10-10 FERTILIZER (14 LBS/1000 SQ. FT.) BEFORE SEEDING. BARROW OR DISC INTO UPPER THREE-INCHES OF SOIL. AT TIME OF SEEDING, APPLY 400 LBS PER ACRE 10-0-0 UREAFORM FERTILIZER (948/1000 SQ. FT.).
 2) ACCEPTABLE - APPLY 2 TONS PER ACRE DOLOMITIC LIMESTONE (92 LBS/1000 SQ. FT.) AND 1000 LBS PER ACRE 10-10-10 FERTILIZER (21 LBS/1000 SQ. FT.) BEFORE SEEDING. BARROW OR DISC INTO UPPER THREE-INCHES OF SOIL.
SEEDING: FOR THE PERIODS MARCH 1 THRU APRIL 30, AND AUGUST 1 THRU OCTOBER 15, SEED WITH 40 LBS PER ACRE (1.4 LBS/1000 SQ. FT.) OF KENTUCKY 31 TALL FESCUE. FOR THE PERIOD MAY 1 THRU JULY 31, SEED WITH 40 LBS KENTUCKY 31 TALL FESCUE PER ACRE AND 2 LBS PER ACRE (.08 LBS/1000 SQ. FT.) OF WHEAT LOVEGRASS. DURING THE PERIOD OF OCTOBER 16 THRU FEBRUARY 28, PROTECT SITE BY OPTION (1) 2 TONS PER ACRE OF WELL ANCHORED STRAW MULCH AND SEED AS SOON AS POSSIBLE IN THE SPRING. OPTION (2) USE SOU. OPTION (3) SEED WITH 40 LBS/ACRE KENTUCKY 31 TALL FESCUE AND MULCH WITH 2 TONS/ACRE WELL ANCHORED STRAW.
MULCHING: APPLY 1 1/2 TO 2 TONS PER ACRE (70 TO 90 LBS/1000 SQ. FT.) OF UNROTTED SMALL GRASS STRAW IMMEDIATELY AFTER SEEDING. ANCHOR MULCH IMMEDIATELY AFTER APPLICATION USING MULCH ANCHORING TOOL OR 218 GALLONS PER ACRE (5 GAL/1000 SQ. FT.) OF ENRICHED ASPHALT ON FLAT AREAS. ON SLOPES 8 FEET OR HIGHER, USE 348 GALLONS PER ACRE (8 GAL/1000 SQ. FT.) FOR ANCHORING.
INTERFERENCE: INSPECT ALL SEEDING AREAS AND MAKE NEEDED REPAIRS, REPLACEMENTS AND RESEEDINGS.

VI. STABILIZATION

ALL EXPOSED AREAS SHALL BE GRADED TO PROVIDE PROPER DRAINAGE AND LEFT IN A STABLE CONDITION. ALL EXPOSED SURFACES OF THE ENVIRONMENT, RAILROAD, ROAD AND EROSION AREAS, AND DRENCHES SHALL BE STABILIZED BY SEEDING, LIMING, FERTILIZING AND MULCHING (IF REQUIRED) IN ACCORDANCE WITH THE VEGETATIVE TREATMENT SPECIFICATIONS AS SHOWN ON THE ACCOMPANYING DRAWINGS.

VII. EROSION AND SEDIMENT CONTROL

CONSTRUCTION OPERATIONS WILL BE CARRIED OUT IN SUCH A MANNER THAT EROSION WILL BE CONTROLLED AND WATER AND AIR POLLUTION MINIMIZED. STATE AND LOCAL LAWS CONCERNING POLLUTION ABATEMENT WILL BE FOLLOWED. CONSTRUCTION PLANS SHALL DETAIL EROSION AND SEDIMENT CONTROL MEASURES TO BE EMPLOYED DURING THE CONSTRUCTION PROCESS.

WETLAND MANAGEMENT NOTES

In order to establish a productive, functioning wetland ecosystem, an effective wetland management plan has been developed. The objectives of the management plan include:

- Re-establish a healthy, self-sustaining vegetative cover.
- Re-establish self-sustaining hydrological conditions.
- Enhance and promote maximum wildlife habitat.

In order to establish an effective, workable, and practical wetland management plan, the following strategy is recommended:

- During and immediately proceeding construction of the wetland areas, potential or existing problems will be identified and corrective management techniques will be implemented.

NATURAL CYCLE

Natural cycles must be maintained to prevent "succession" from wetland to solid ground. Although this is a long term goal exceeding the limits of this management program, several techniques can be implemented over the two year period enhance stability.

IMMEDIATE MANAGEMENT TECHNIQUES

No management strategies planned.

LONG TERM MANAGEMENT TECHNIQUES

Overall ecology and stability of the restored wetland areas will be assessed in comparison to similar adjacent areas. Recommendations and strategies will be planned to enhance and protect the overall ecology of the site.

SHORT TERM MANAGEMENT TECHNIQUES

Wetland area will be periodically monitored for altered hydrologic conditions, invasive plant species, transition of wetland species to upland plants, and cultural impacts such as human disturbance, filling, non-point, and point source pollution. Management techniques will be recommended to stabilize unnatural ecological successions including:

- Altering the hydrological regime.
- Removing undesirable plant species.
- Restricting or discouraging destructive human interaction.

HYDROLOGIC REGIME

The duration, timing, and source of surface inundation determines and regulates wetland functions and their characteristics.

IMMEDIATE MANAGEMENT TECHNIQUES

Vegetation demonstrating immediate stress or dieback will be replaced. In addition, soil and climatic factors will be analyzed in relation to plant growth. The following management techniques will be utilized:

- Replace plant species with similar vegetation.
- Add soil amendments to enhance survivability.
- Replace plant species with specified alternative.
- Prune plant species to establish desired growth characteristics and enhance survivability.

LONG TERM MANAGEMENT TECHNIQUES

Re-assess vegetation for its functional value in relation to wetland cycles and habitat enhancement. Recommend and implement corrective and preventive action.

SHORT TERM MANAGEMENT TECHNIQUES

Survey vegetation after major storm events or droughts to determine appropriate management techniques as specified in Immediate Management Techniques.

VEGETATION

Vegetation sustains wildlife species, filters and reduces flood velocity. A goal of 85% vegetative cover will be established in two (2) years.

IMMEDIATE MANAGEMENT TECHNIQUES

Vegetation demonstrating immediate stress or dieback will be replaced. In addition, soil and climatic factors will be analyzed in relation to plant growth. The following management techniques will be utilized:


- Replace plant species with similar vegetation.
- Add soil amendments to enhance survivability.
- Replace plant species with specified alternative.
- Prune plant species to establish desired growth characteristics and enhance survivability.

LONG TERM MANAGEMENT TECHNIQUES

Re-assess vegetation for its functional value in relation to wetland cycles and habitat enhancement. Recommend and implement corrective and preventive action.

SHORT TERM MANAGEMENT TECHNIQUES

Survey vegetation after major storm events or droughts to determine appropriate management techniques as specified in Immediate Management Techniques.

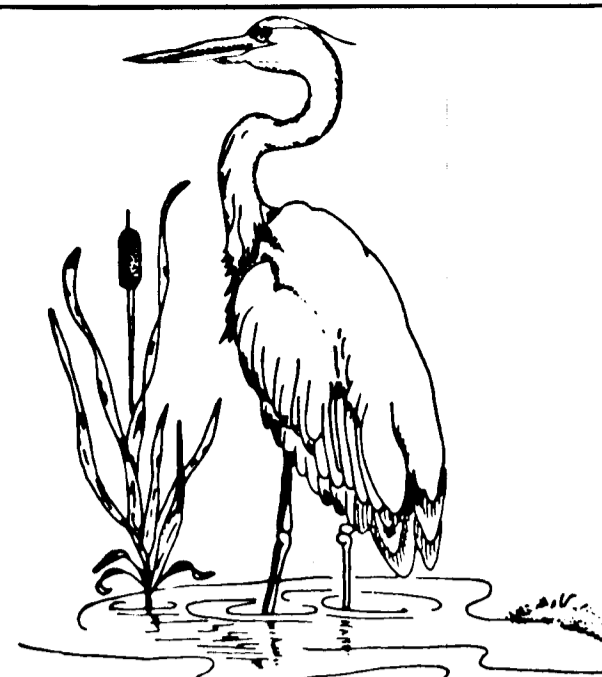

EXPLORATION RESEARCH, INC.

Environmental Consultants

8318 Forrest Avenue, Suite 101
 Historic Ellicott City, Maryland 21043
 Tel: (301) 750-1150, FAX # (301) 750-7350

OWNER/DEVELOPER

JIM PARTNERSHIP	JIM PARTNERSHIP
5570-201 STERRETT PLACE	5570-201 STERRETT PLACE
COLUMBIA, MARYLAND 21044	COLUMBIA, MARYLAND 21044
PH (301) 740-4466	PH (301) 740-4466

CHAPEL WOODS
 HOWARD COUNTY, MARYLAND

WQC# 89-WQ-0532

CENAB-OP-RW

(CHAPEL WOODS)

88-3856-3

NOTES

U.S. Army Corps of Engineers
 Approval Of Plans And Specifications
 For Compliance With Permit Number
 CENAB-OP-RW (CHAPEL WOODS) 88-3856-3
 [Signature] March 27, 1991
 Signature Of U.S. Army Corps Of Engineers, Baltimore, MD Date

Maryland Department Of The Environment
 Standards & Certification Division
 Approval Of Plans And Specifications
 For Compliance With Permit Number wqc# 89-WQ-0532
 [Signature] 6/10/92
 Signature Of Standards/Certification Division Date

Drawn By: JLB
 Designed By: MAM
 Checked By: DER
 Scale: N/A
 Date: 9-21-90
 Sheet: 6 OF 6