


ENGINEER'S CERTIFICATE
 I CERTIFY THAT THIS PLAN FOR EROSION AND SEDIMENT CONTROL REPRESENTS A PRACTICAL AND WORKABLE PLAN BASED ON MY PERSONAL KNOWLEDGE OF THE SITE CONDITIONS AND THAT IT WAS PREPARED IN ACCORDANCE WITH THE REQUIREMENTS OF THE HOWARD SOIL CONSERVATION DISTRICT.

Joseph Lambert 7/12/89
 DATE

DEVELOPER'S CERTIFICATE
 I CERTIFY THAT ALL DEVELOPMENT AND CONSTRUCTION WILL BE ACCORDING TO THIS PLAN OF DEVELOPMENT AND PLAN FOR EROSION AND SEDIMENT CONTROL AND THAT ALL RESPONSIBLE PERSONNEL INVOLVED IN THE CONSTRUCTION PROJECT WILL HAVE A CERTIFICATE OF ATTENDANCE AT A DEPARTMENT OF NATURAL RESOURCES APPROVED TRAINING PROGRAM FOR THE CONTROL OF EROSION AND SEDIMENT BEFORE BEGINNING THE PROJECT. I ALSO AUTHORIZE PERIODIC INSPECTIONS BY THE HOWARD COUNTY SOIL CONSERVATION DISTRICT OR THEIR AUTHORIZED AGENTS, AS ARE DEEMED NECESSARY.

Kenneth J. Mah 7/13/89
 DATE

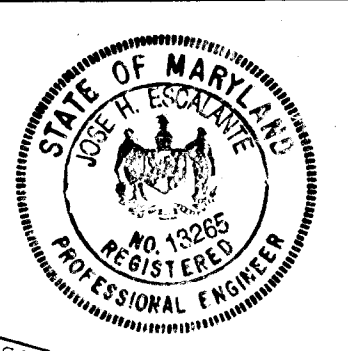

STATE OF MARYLAND
 DEPARTMENT OF TRANSPORTATION
 PROFESSIONAL ENGINEER



PLAN
 SURVEYED
 PLOTTED
 ALIGNMENT CHECKED
 NOTE BOOK
 NO. OF WAY CHECKED

APPROVED HOWARD COUNTY DEPT. OF PLANNING AND ZONING
Paul J. Dwyer 7/6/89
 CHIEF, DIVISION OF LAND DEVELOPMENT AND COMMUNITY PLANNING

APPROVED HOWARD COUNTY DEPARTMENT OF PUBLIC WORKS
Donald Brown 4/16/90
 CHIEF, LAND DEVELOPMENT DIVISION

Drummond W. Usherwood 5/1/90
 CHIEF, BUREAU OF HIGHWAYS

William E. Ray 4-16-90
 CHIEF, BUREAU OF ENGINEERING

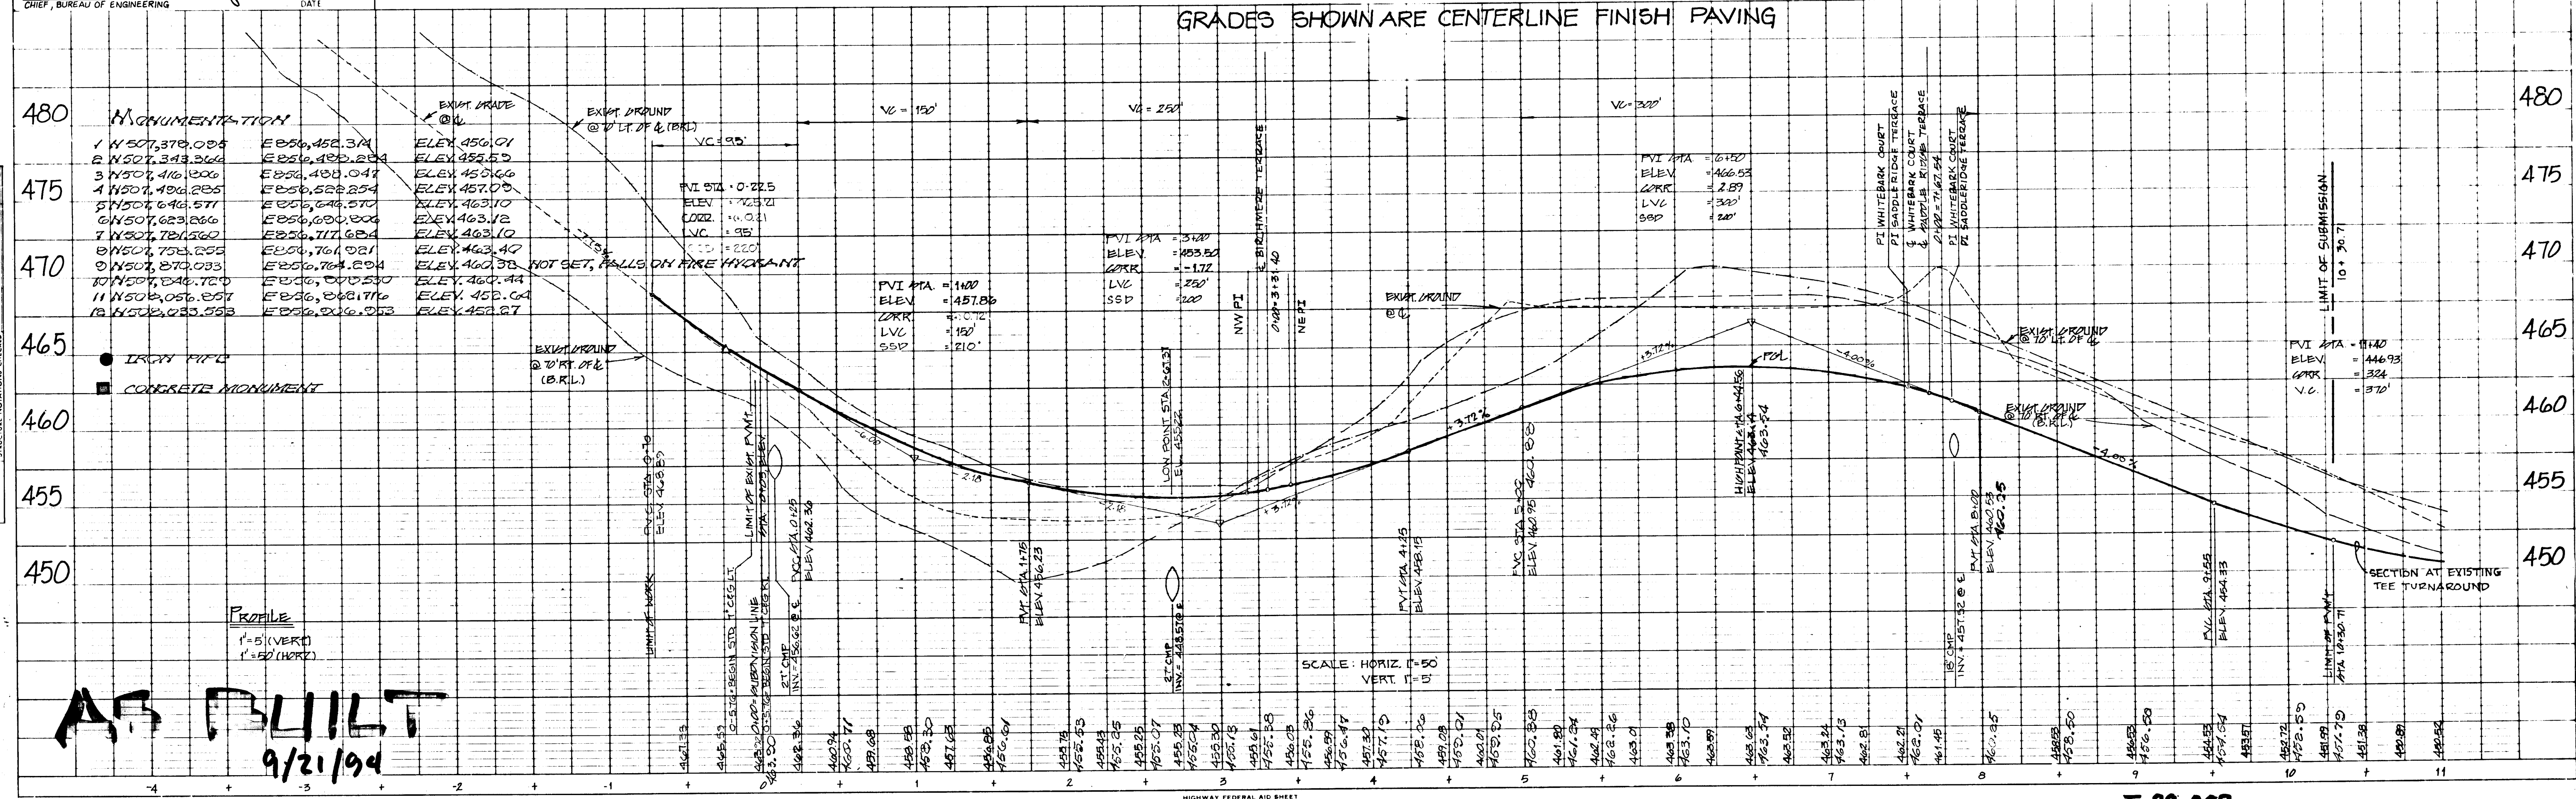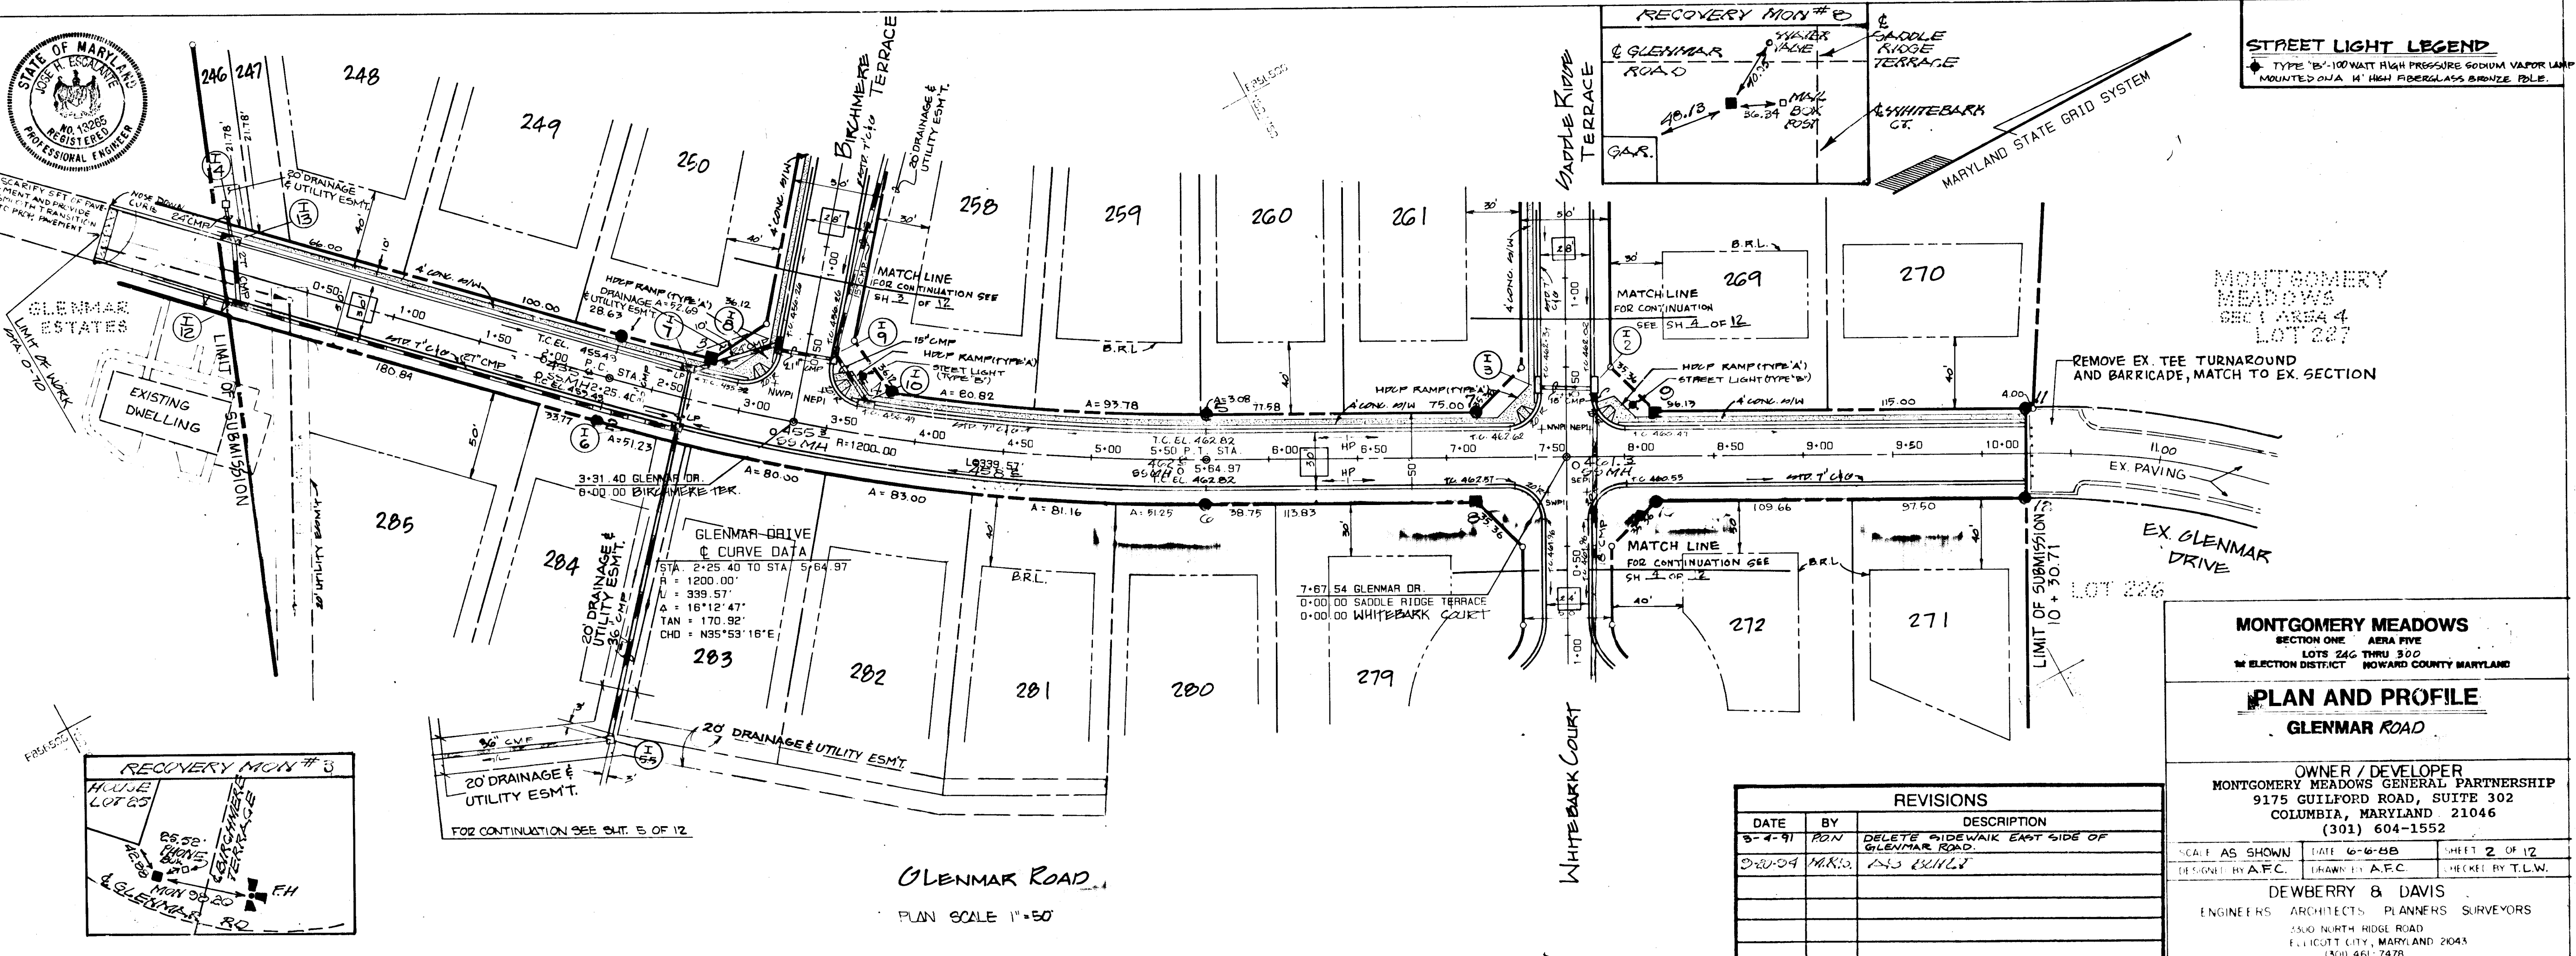

1443

AS-BUILTS

ENGINEER'S CERTIFICATE
 I CERTIFY THAT THIS PLAN FOR EROSION AND SEDIMENT CONTROL REPRESENTS A PRACTICAL AND WORKABLE PLAN BASED ON MY PERSONAL KNOWLEDGE OF THE SITE CONDITIONS AND THAT IT WAS PREPARED IN ACCORDANCE WITH THE REQUIREMENTS OF THE HOWARD SOIL CONSERVATION DISTRICT.

Joseph J. Mahan 7/12/89
 DATE

DEVELOPER'S CERTIFICATE
 I HEREBY CERTIFY THAT ALL DEVELOPMENT AND CONSTRUCTION WILL BE DONE ACCORDING TO THIS PLAN OF DEVELOPMENT AND PLAN FOR EROSION AND SEDIMENT CONTROL AND THAT ALL RESPONSIBLE PERSONNEL INVOLVED IN THE CONSTRUCTION PROJECT WILL HAVE A CERTIFICATE OF ATTENDANCE AT A DEPARTMENT OF NATURAL RESOURCES APPROVED TRAINING PROGRAM FOR THE CONTROL OF EROSION AND SEDIMENT BEFORE BEGINNING THE PROJECT. I ALSO AUTHORIZE FRICTIONLESS INSPECTION BY THE HOWARD COUNTY SOIL CONSERVATION DISTRICT OR THEIR AUTHORIZED AGENTS AS ARE DEEMED NECESSARY.

Robert S. Mahan 7/13/89
 DATE



PLAN
 SURVEYED
 NOTED
 CHECKED
 BY
 DATE

APPROVED HOWARD COUNTY DEPT. OF PLANNING AND ZONING


Mark V. Ziegler 7/12/89
 CHIEF, DIVISION OF LAND DEVELOPMENT AND COMMUNITY PLANNING

APPROVED HOWARD COUNTY DEPARTMENT OF PUBLIC WORKS

Paul J. Egan 4/16/90
 CHIEF, LAND DEVELOPMENT DIVISION

Francis W. Weiland 3/1/90
 DATE

William E. Ray 4-16-89
 DATE

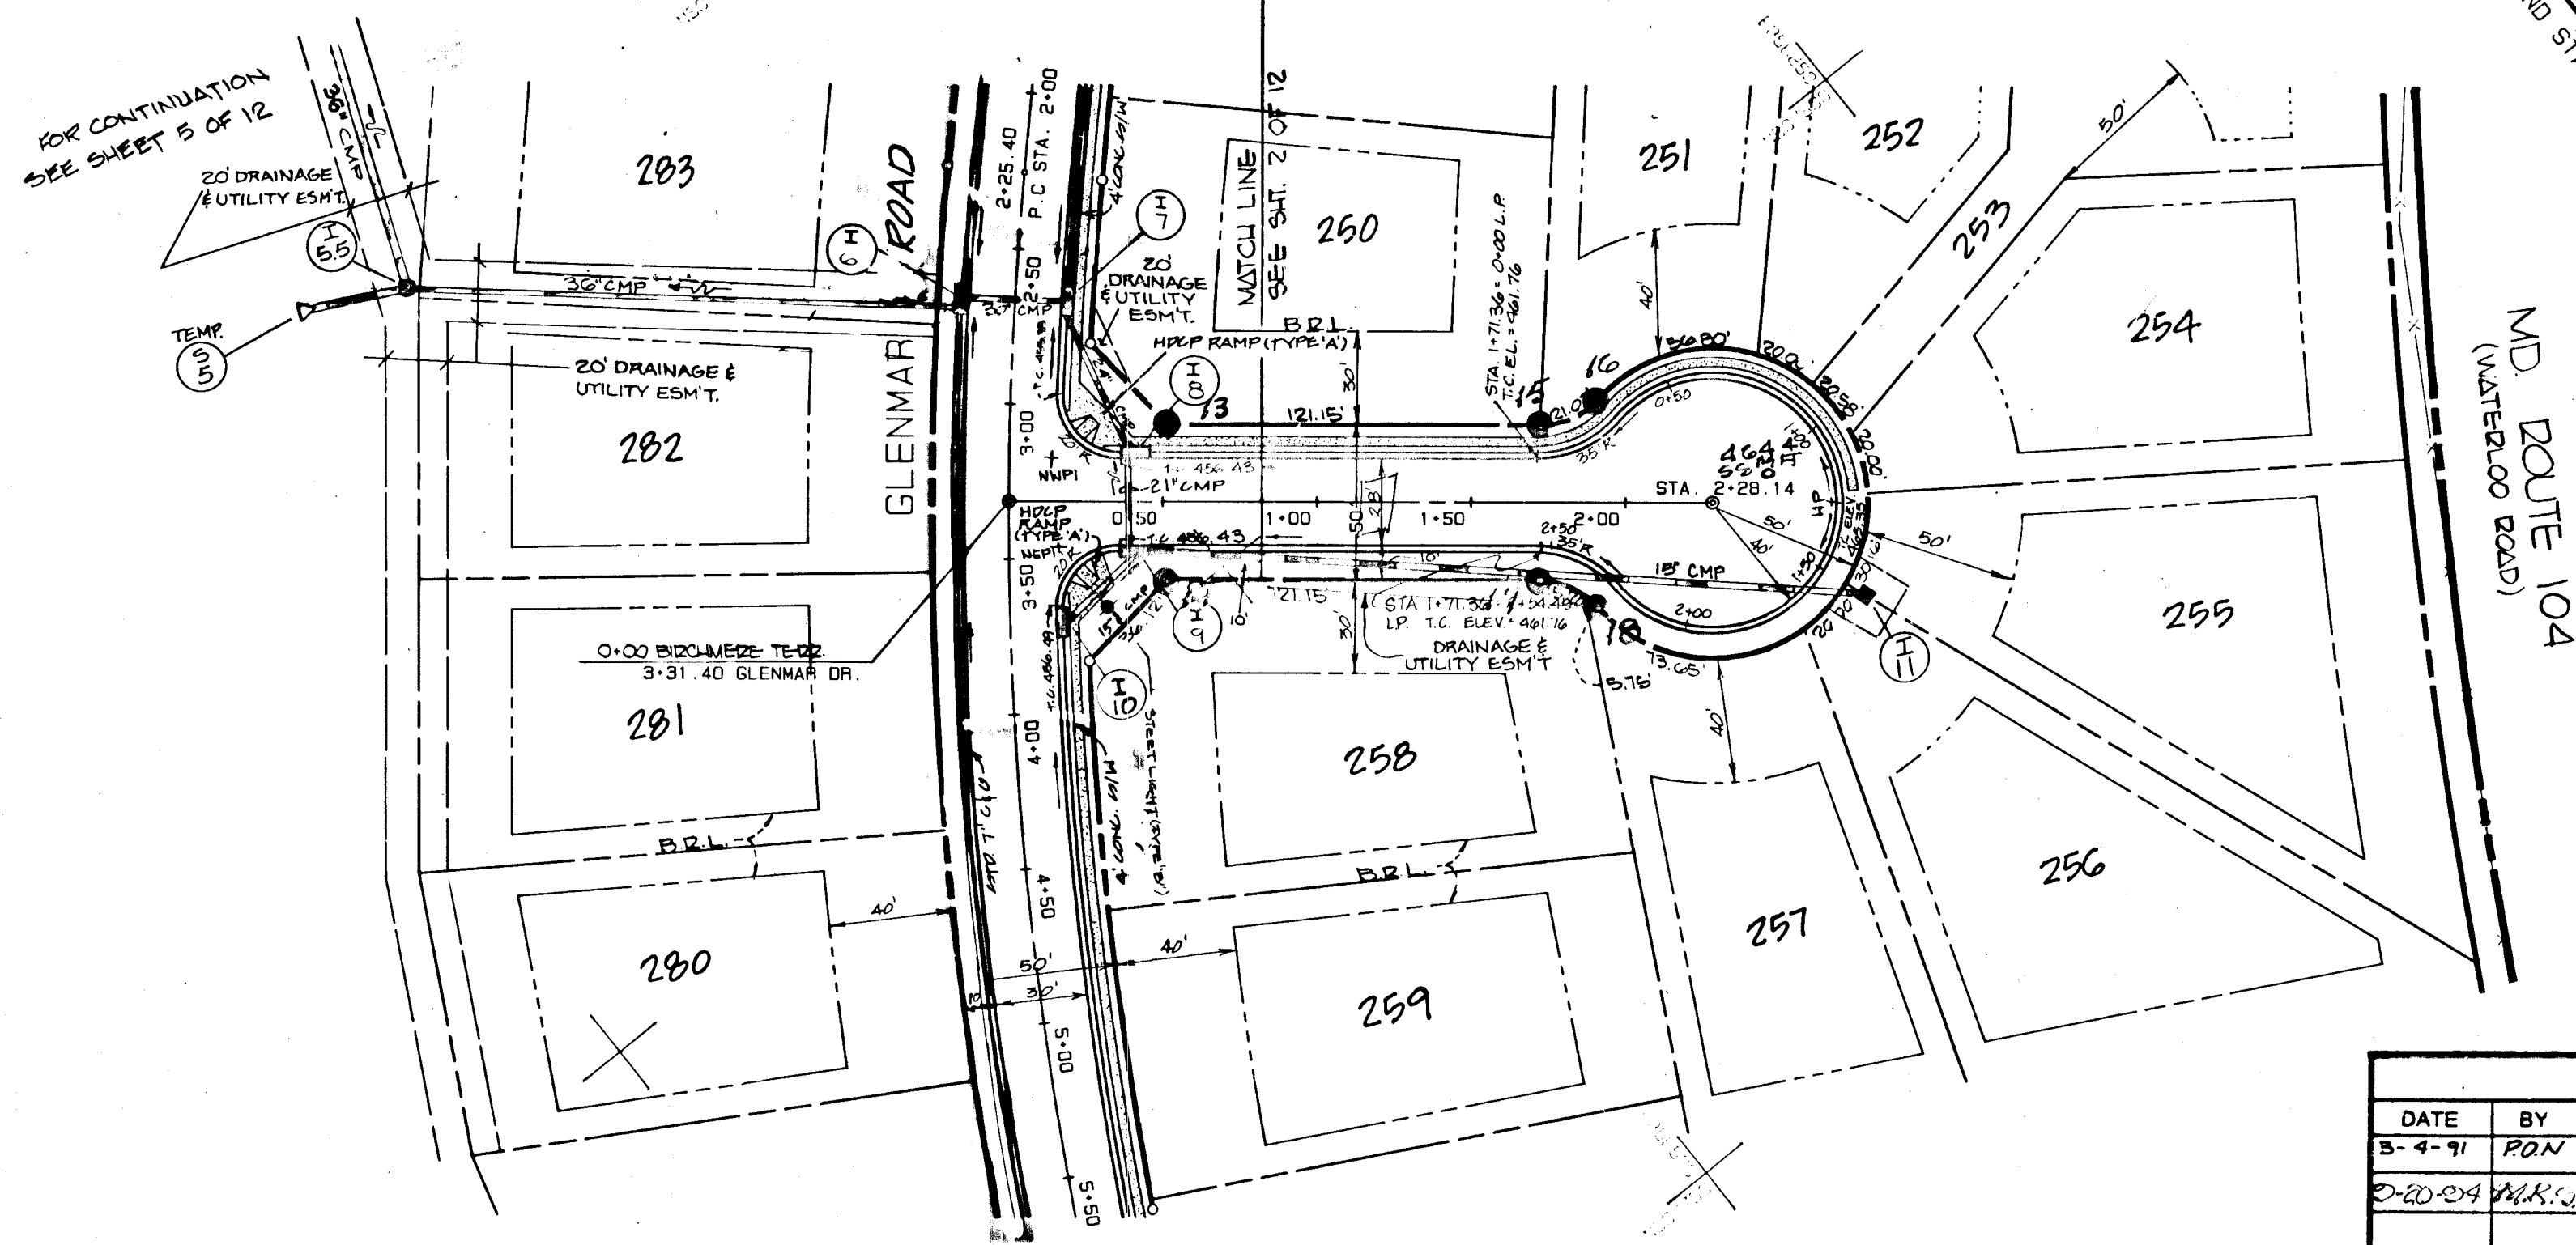

REVISIONS		
DATE	BY	DESCRIPTION
5-4-91	RON	DELETED SIDEWALK EAST SIDE OF GLENMAR ROAD
2-20-91	MARK	AS BUILT

MONTGOMERY MEADOWS
 SECTION ONE AERA FIVE
 LOTS 246 THRU 300
 14 ELECTION DISTRICT HOWARD COUNTY MARYLAND

PLAN AND PROFILE
BIRCHMERE TERRACE

OWNER / DEVELOPER
 MONTGOMERY MEADOWS GENERAL PARTNERSHIP
 9175 GUILFORD ROAD, SUITE 302
 COLUMBIA, MARYLAND 21046
 (301) 604-1552


SCALE AS SHOWN DATE SHEET 3 OF 12
 DESIGNED BY A.F.C. DRAWN BY A.F.C. CHECKED BY T.L.W.

DEWBERRY & DAVIS
 ENGINEERS ARCHITECTS PLANNERS SURVEYORS
 3300 NORTH RIDGE ROAD
 ELLICOTT CITY, MARYLAND 2083
 (301) 481-7478

MONUMENTATION

STATION	N50°45'27.04"	E 089°48'5.012"	ELEV. 457.80
13	N50°45'27.04"	E 089°48'5.012"	ELEV. 457.80
14	N50°45'27.04"	E 089°48'5.012"	ELEV. 457.80
15	N50°45'27.04"	E 089°48'5.012"	ELEV. 457.80
16	N50°45'27.04"	E 089°48'5.012"	ELEV. 457.80
17	N50°45'27.04"	E 089°48'5.012"	ELEV. 457.80
18	N50°45'27.04"	E 089°48'5.012"	ELEV. 457.80

GRADES SHOWN ARE CENTERLINE FINISH PAVING

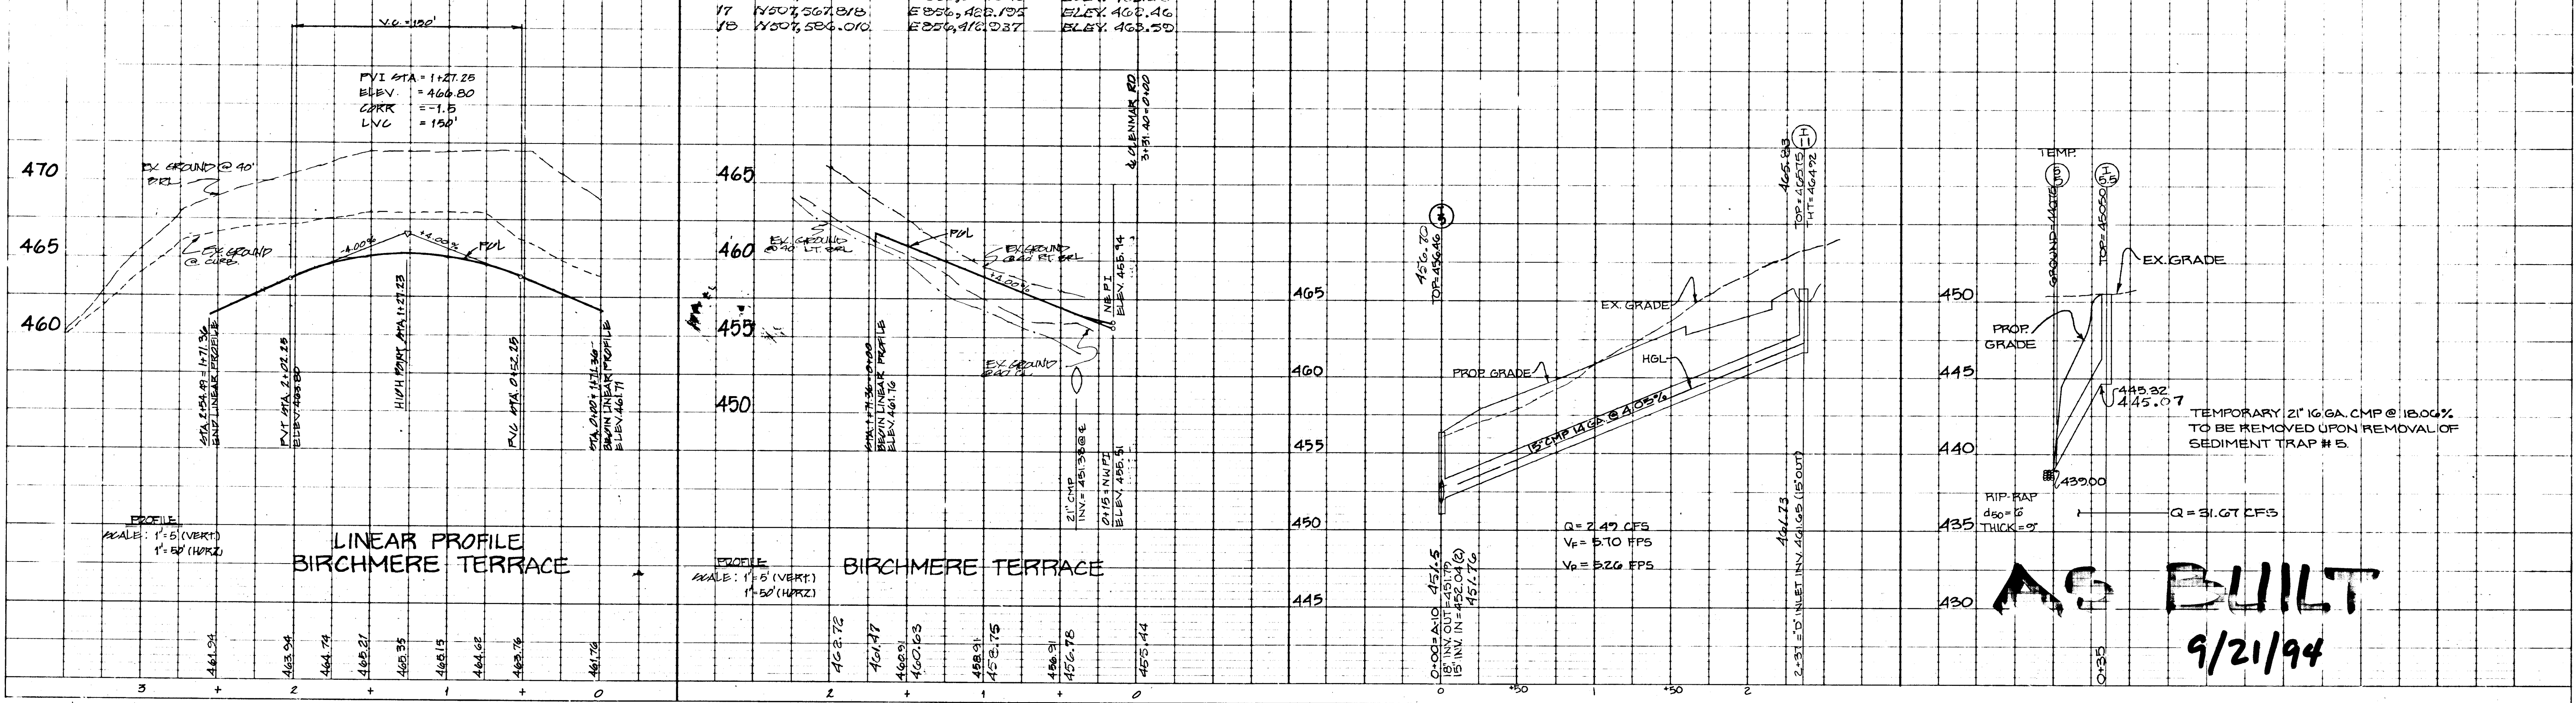

1443

ENGINEER'S CERTIFICATE
 I CERTIFY THAT THIS PLAN FOR EROSION AND SEDIMENT CONTROL REPRESENTS A PRACTICAL AND WORKABLE PLAN BASED ON MY PERSONAL KNOWLEDGE OF THE SITE CONDITIONS AND THAT IT WAS PREPARED IN ACCORDANCE WITH THE REQUIREMENTS OF THE HOWARD SOIL CONSERVATION DISTRICT.


Joseph Lab 7/12/89
 DATE

DEVELOPER'S CERTIFICATE
 I HEREBY CERTIFY THAT ALL DEVELOPMENT AND CONSTRUCTION WILL BE DONE ACCORDING TO THIS PLAN OF DEVELOPMENT AND PLAN FOR EROSION AND SEDIMENT CONTROL AND THAT ALL RESPONSIBLE PERSONNEL INVOLVED IN THE CONSTRUCTION PROJECT WILL HAVE A CERTIFICATE OF ATTENDANCE AT A DEPARTMENT OF NATURAL RESOURCES APPROVED TRAINING PROGRAM FOR THE CONTROL OF EROSION AND SEDIMENT BEFORE BEGINNING THE PROJECT. I ALSO AUTHORIZE THE HOWARD COUNTY DEPARTMENT OF NATURAL RESOURCES TO CONDUCT INSPECTION OF THEIR AUTHORIZED AGENTS AS ARE DEEMED NECESSARY.

Kent G. Mahr 7/12/89
 DATE



PLAN SURVEYED BY DATE
 PLOTTED BY DATE
 NOTE BOOK NO. BY OF WAY CHECKED

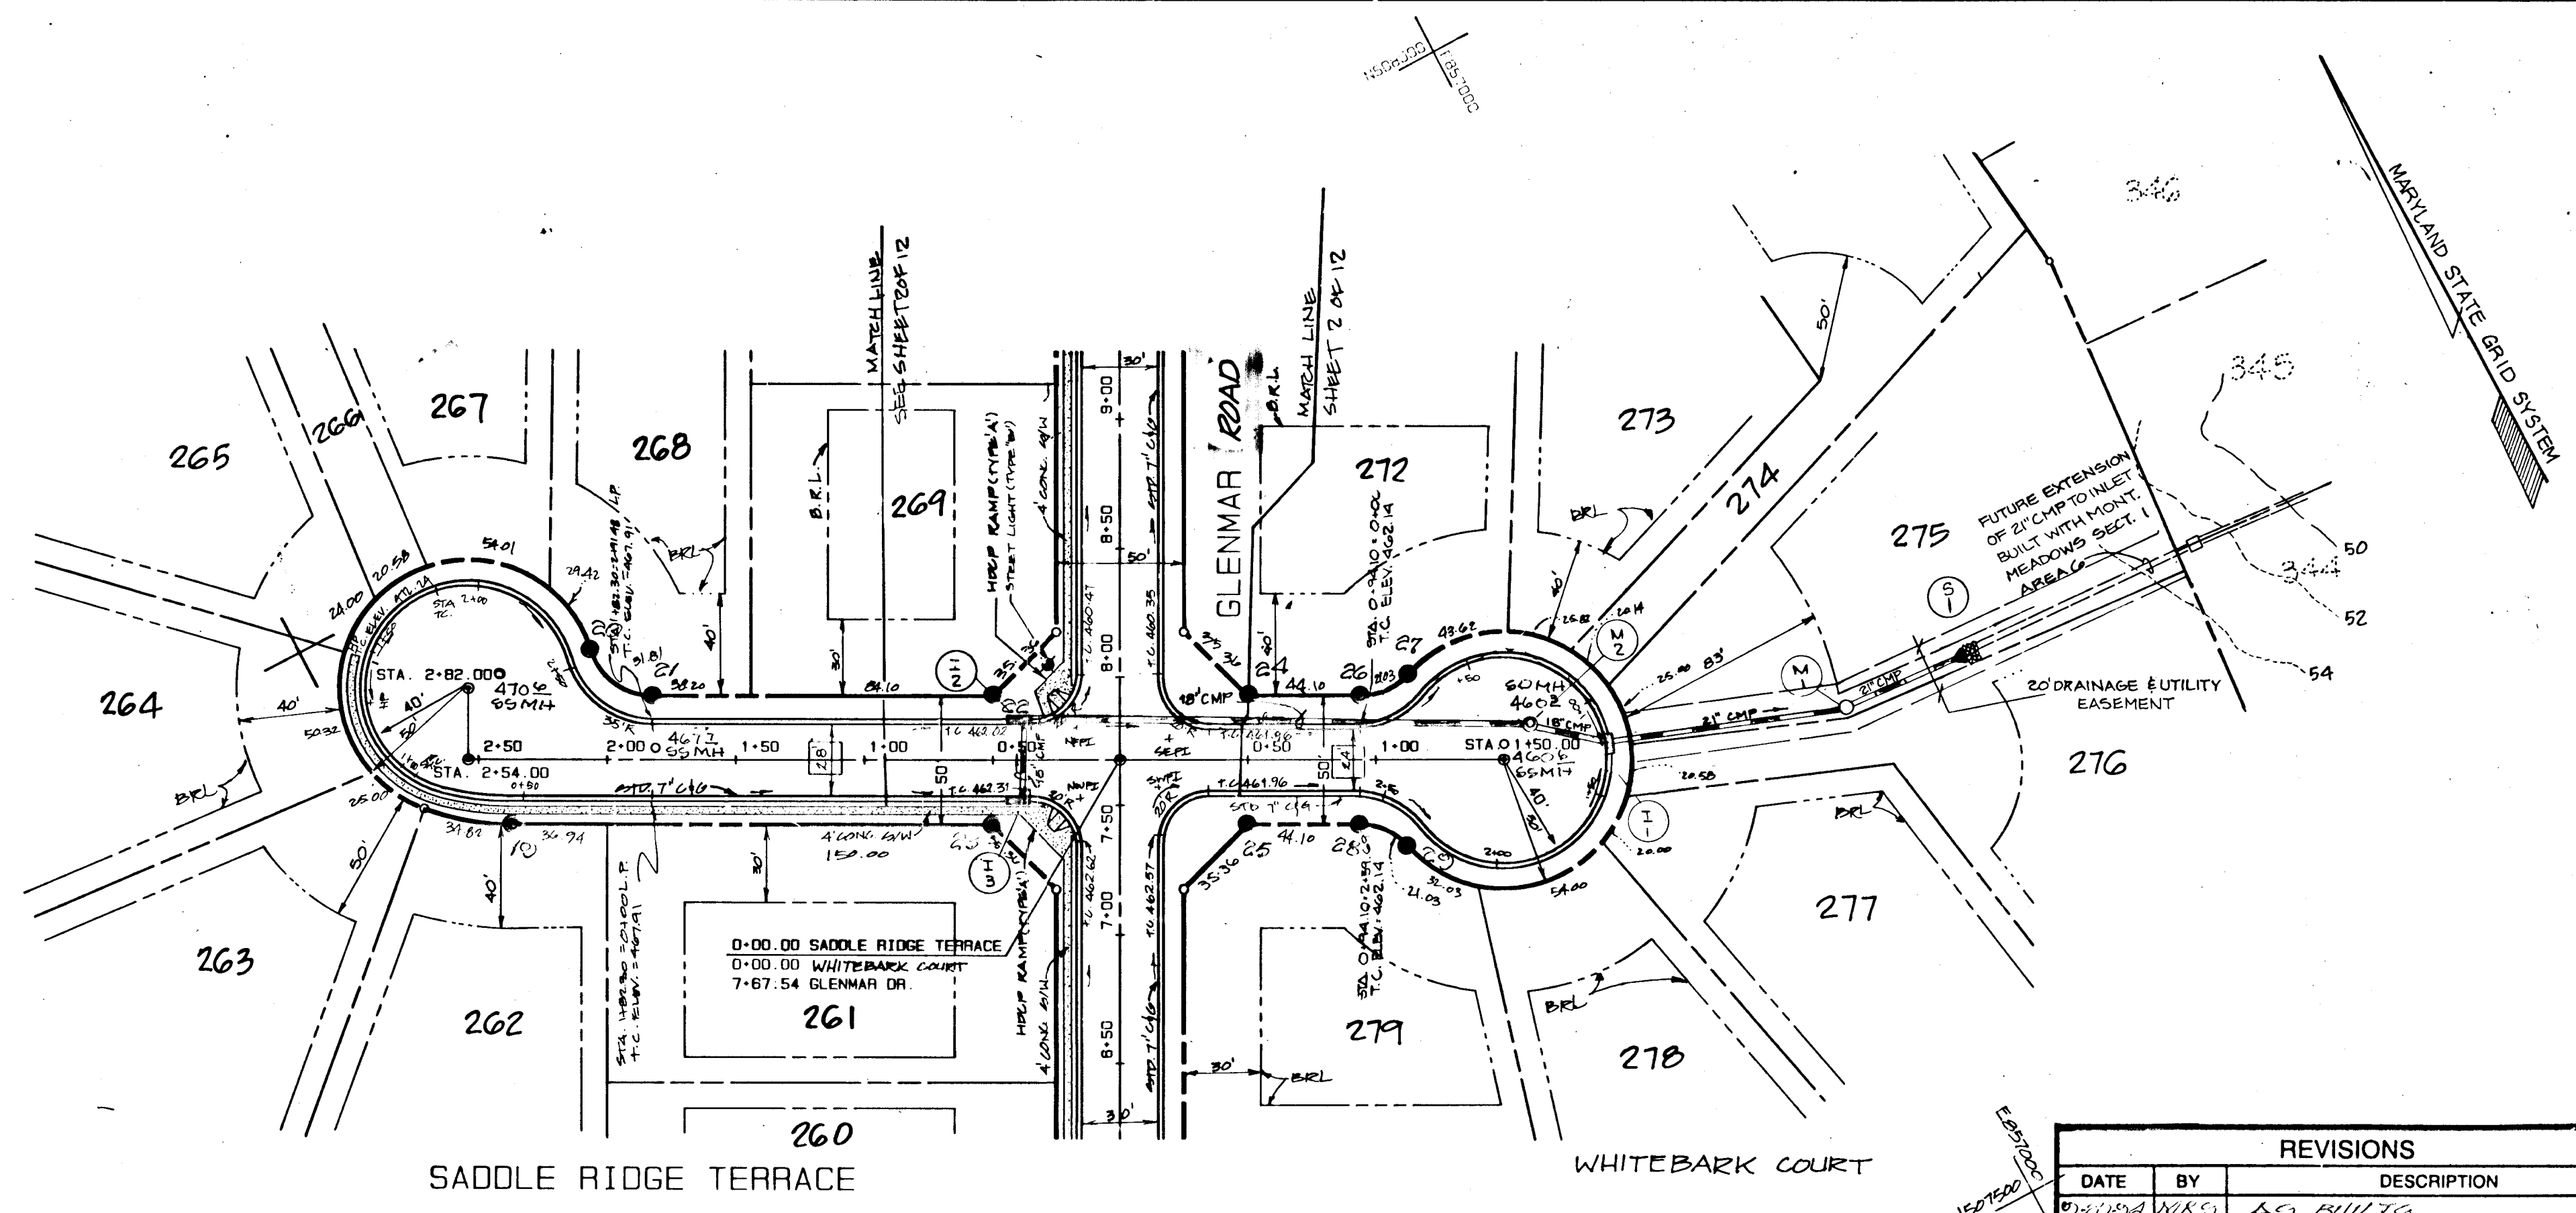

APPROVED: HOWARD COUNTY DEPT. OF PLANNING AND ZONING
Frank J. Dwyer 7/12/89
 COMMUNITY PLANNING

APPROVED: HOWARD COUNTY DEPARTMENT OF PUBLIC WORKS
Paul R. Pagan 4/16/90
 LAND DEVELOPMENT DIVISION

Francis W. Walsand 3/1/90
 DATE

Aracelis E. Pelay 4-16-90
 DATE

MONTGOMERY MEADOWS
 SECTION ONE AREA FIVE
 LOTS 246 THRU 302
 W. ELECTION DISTRICT HOWARD COUNTY MARYLAND

PLAN AND PROFILE
SADDLE RIDGE TERRACE
WHITEBARK COURT

OWNER / DEVELOPER
 MONTGOMERY MEADOWS GENERAL PARTNERSHIP
 9175 GUILFORD ROAD, SUITE 302
 COLUMBIA, MARYLAND 21046
 (301) 604-1552

SCALE AS SHOWN DATE 6-6-88 SHEET 4 OF 12
 DESIGNED BY A.F.C. DRAWN BY A.F.C. CHECKED BY T.L.W.

DEWBERRY & DAVIS
 ENGINEERS ARCHITECTS PLANNERS SURVEYORS
 3300 NORTH RIDGE ROAD
 ELLICOTT CITY, MARYLAND 20834
 (301) 461-7478

REVISIONS		
DATE	BY	DESCRIPTION
6/20/88	M.R.C.	AS BUILT

PLAN SCALE 1"=50'

LINEAR PROFILE SADDLE RIDGE TERRACE

MONUMENTATIONS

GRADES SHOWN ARE CENTERLINE PROFILE

WHITEBARK COURT PAVING

LINEAR PROFILE WHITEBARK COURT

STATION	ELEVATION	STATION	ELEVATION	STATION	ELEVATION
19	4502.908.463	20	4502.948.001	21	4507.702.401
22	4507.702.401	23	4507.742.107	24	4507.782.109
25	4507.822.000	26	4507.862.000	27	4507.902.000
28	4507.942.000	29	4507.982.000	30	4508.022.000
31	4508.062.000	32	4508.102.000	33	4508.142.000
424	4523.782.000	425	4523.822.000	426	4523.862.000
427	4523.902.0				

ENGINEER'S CERTIFICATE
 I CERTIFY THAT THIS PLAN FOR EROSION AND SEDIMENT CONTROL REPRESENTS A PRACTICAL AND WORKABLE PLAN BASED ON MY PERSONAL KNOWLEDGE OF THE SITE CONDITIONS AND THAT IT WAS PREPARED IN ACCORDANCE WITH THE REQUIREMENTS OF THE HOWARD SOIL CONSERVATION DISTRICT.

Joseph L. ... 7/12/79
 DATE



DEVELOPER'S CERTIFICATE
 I HEREBY CERTIFY THAT ALL DEVELOPMENT AND CONSTRUCTION WILL BE ACCORDING TO THIS PLAN OF DEVELOPMENT AND PLAN FOR EROSION AND SEDIMENT CONTROL, AND THAT ALL RESPONSIBLE PERSONNEL INVOLVED IN THE CONSTRUCTION PROJECT WILL HAVE A CERTIFICATE OF ATTENDANCE AT A DEPARTMENT OF NATURAL RESOURCES APPROVED TRAINING PROGRAM FOR THE CONTROL OF EROSION AND SEDIMENTATION FOR CONSTRUCTION PROJECTS. I ALSO AUTHORIZE THE DEVELOPER TO OBTAIN THE NECESSARY PERMITS FROM THE HOWARD COUNTY SOIL CONSERVATION DISTRICT THROUGH THEIR AUTHORIZED AGENTS AS ARE DEEMED NECESSARY.

Kurt J. Mah 7/13/79
 DATE

PLAN SHEET
 NOTE BOOK, AUTOMATIC CHECKER
 No. _____


APPROVED: HOWARD COUNTY DEPT. OF PLANNING AND ZONING
Frank J. ... 9/20/79
 COMMUNITY PLANNING

APPROVED: HOWARD COUNTY DEPARTMENT OF PUBLIC WORKS
Donald ... 4/16/80
 LAND DEVELOPMENT DIVISION

Francis W. ... 3/1/80
 DATE

... 4-16-80
 DATE

PROFILE SHEET
 NOTE BOOK, AUTOMATIC CHECKER
 No. _____

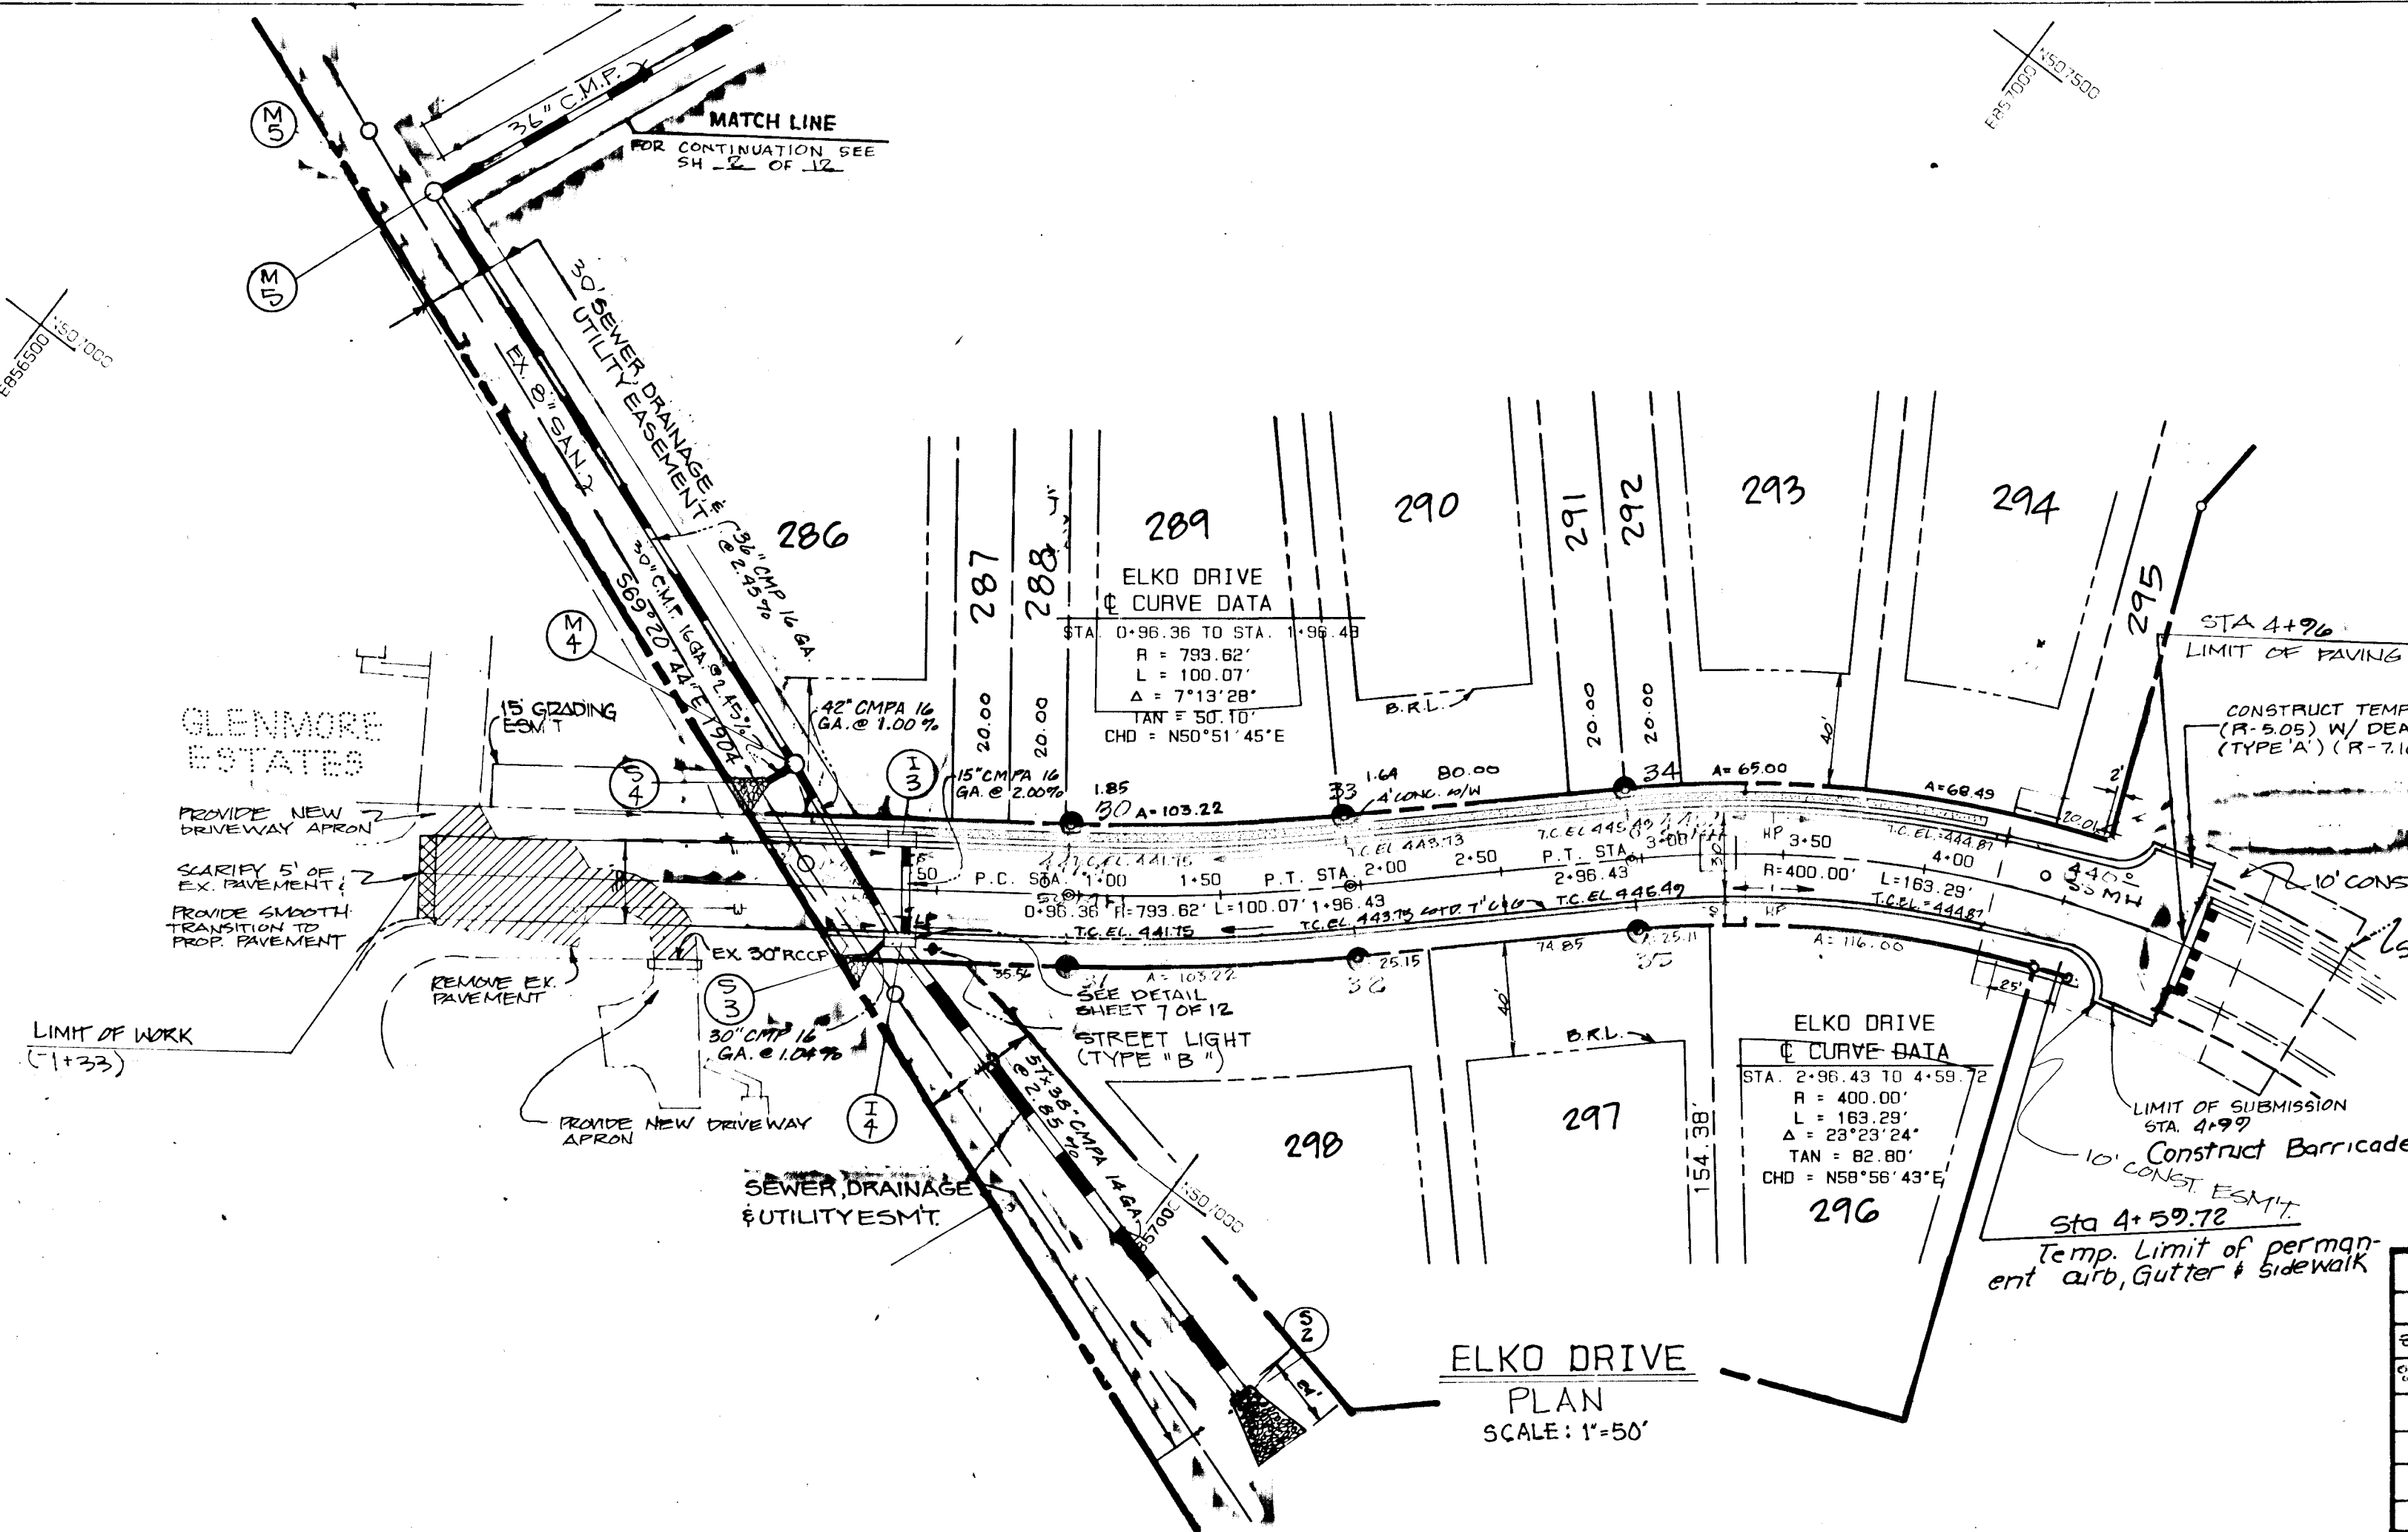

REVISIONS		
DATE	BY	DESCRIPTION
8-28-81	P.D.	RELOCATE STORM DRAINS WITHIN EASMT
8-28-81	W.H.H.	ADD BURL'S


MONTGOMERY MEADOWS
 SECTION ONE AREA FIVE
 LOTS 246 THRU 300
 W. ELECTION DISTRICT HOWARD COUNTY MARYLAND

PLAN AND PROFILE
ELKO DRIVE

OWNER / DEVELOPER
 MONTGOMERY MEADOWS GENERAL PARTNERSHIP
 9175 GUILFORD ROAD, SUITE 302
 COLUMBIA, MARYLAND 21046
 (301) 604-1552

SCALE AS SHOWN DATE 6-6-88 SHEET 5 OF 12
 DESIGNED BY A.F.C. DRAWN BY A.F.C. CHECKED BY T.L.W.







DEWBERRY & DAVIS
 ENGINEERS ARCHITECTS PLANNERS SURVEYORS
 3300 NORTH RIDGE ROAD
 ELLICOTT CITY, MARYLAND 2043
 (301) 461-7478

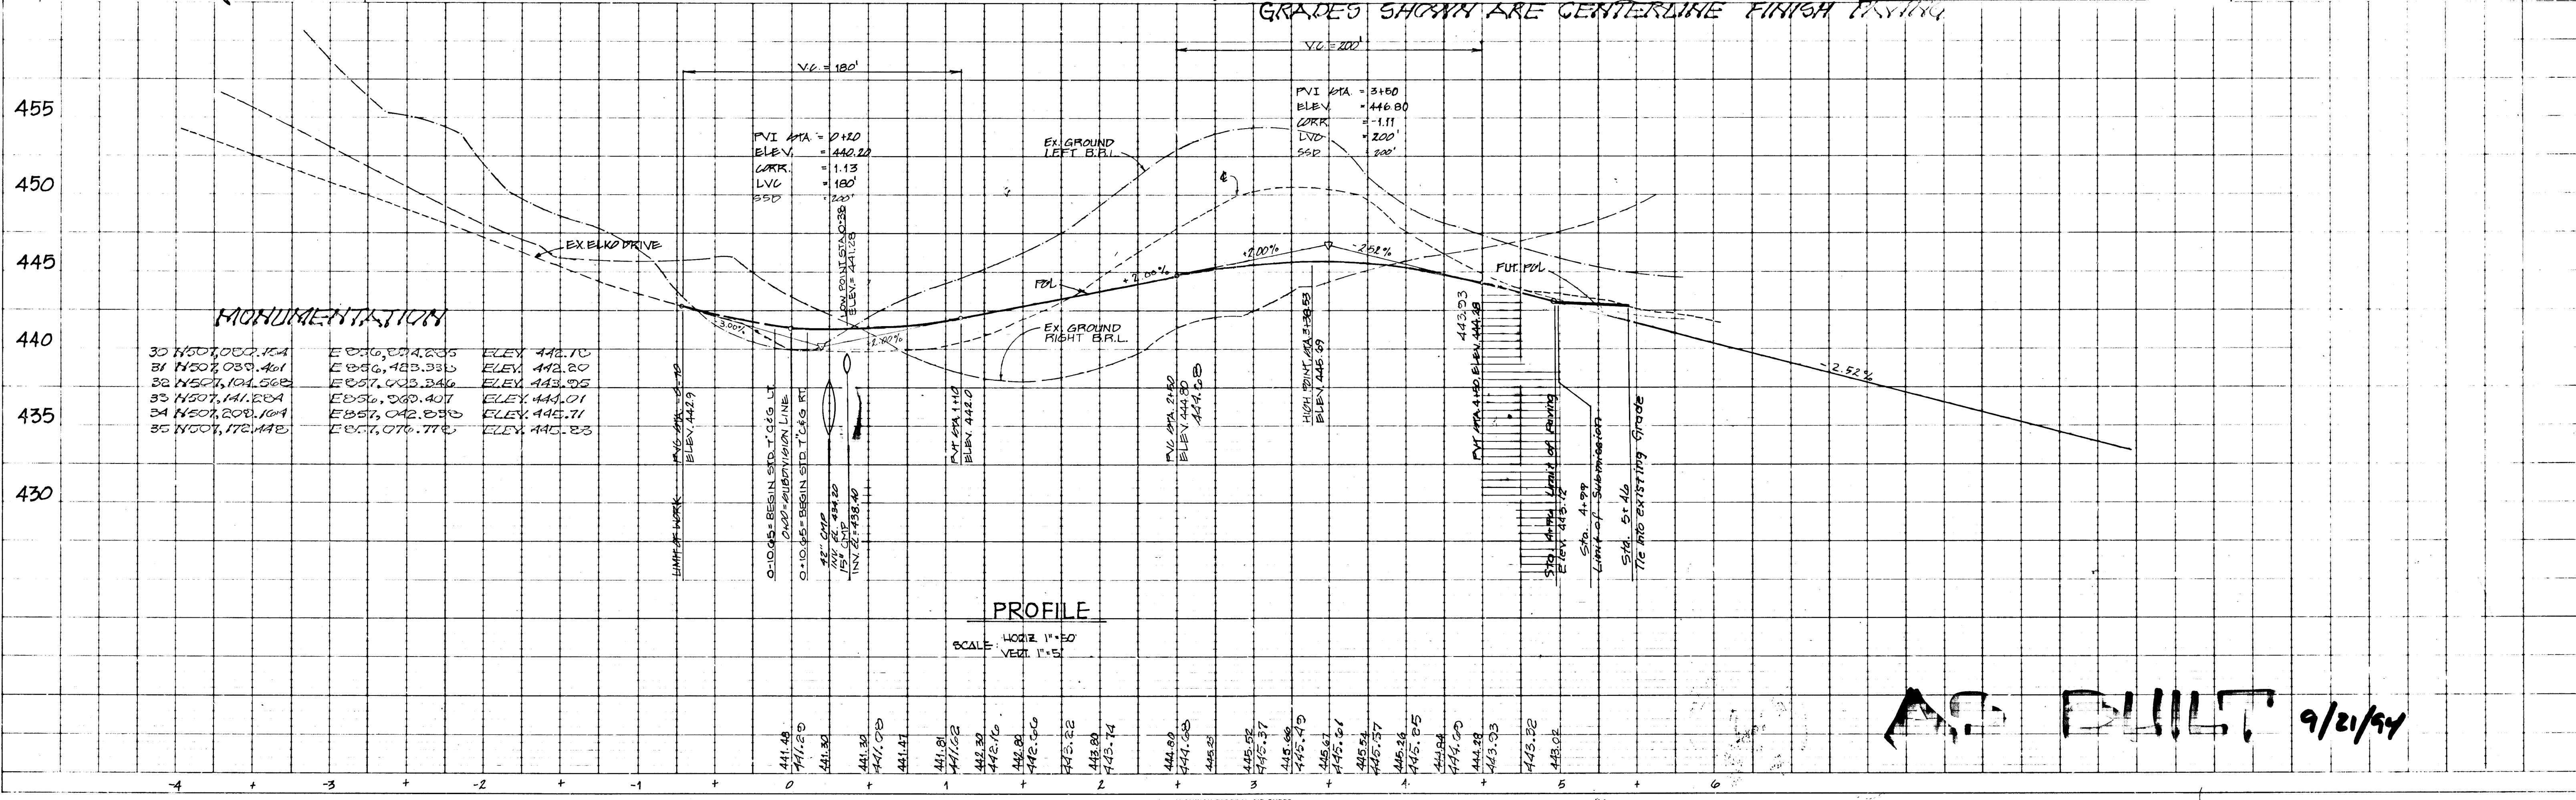

AS BUILT 9/21/84






1443

DATE	BY	DESCRIPTION
11/27/91	R.D.	REVISED STRUCTURE SCHEDULE 1400 DETAIL FOR INLET #4

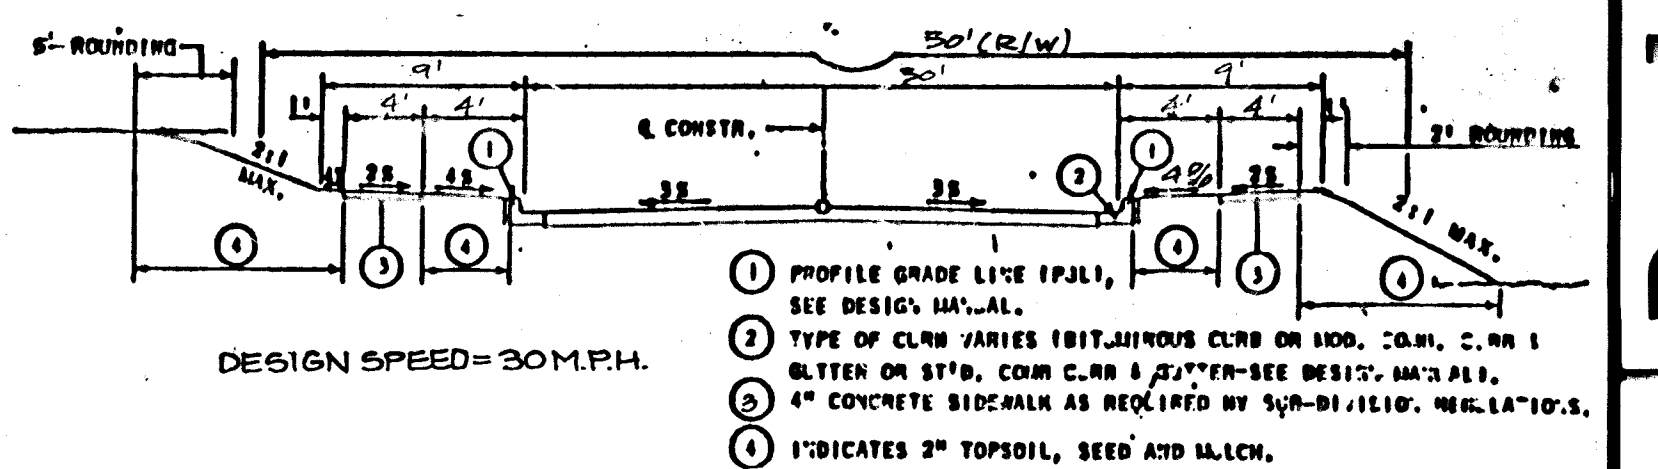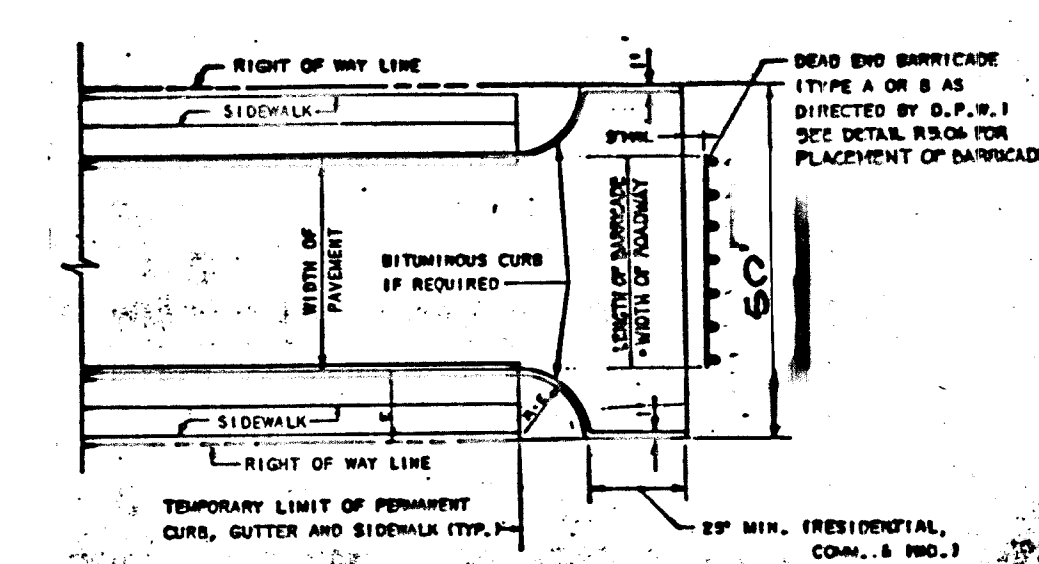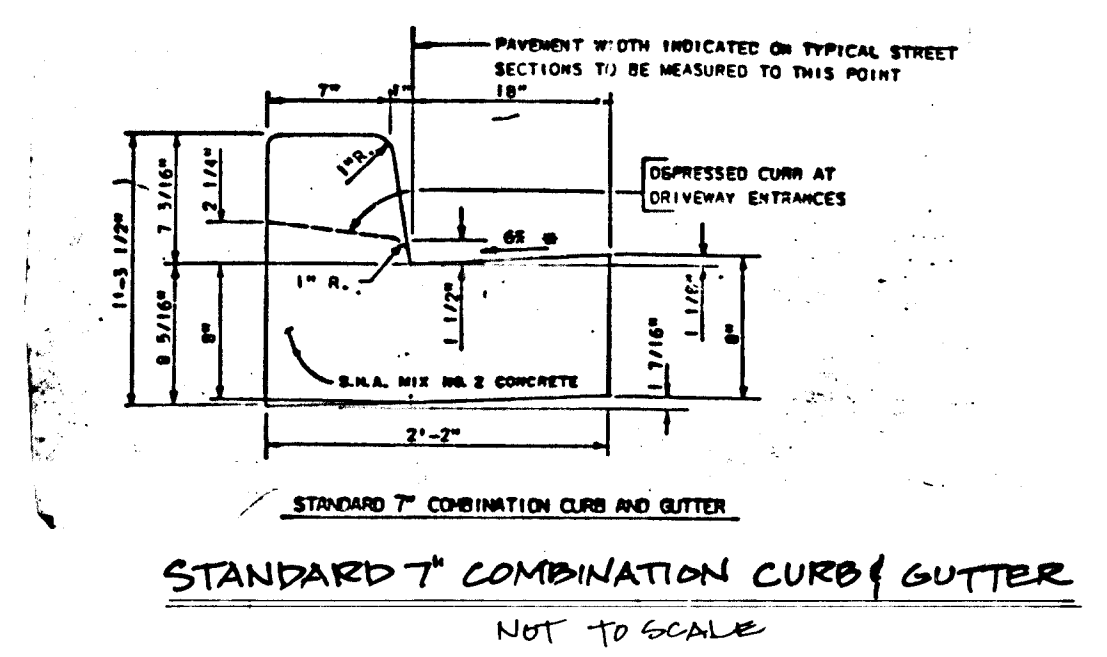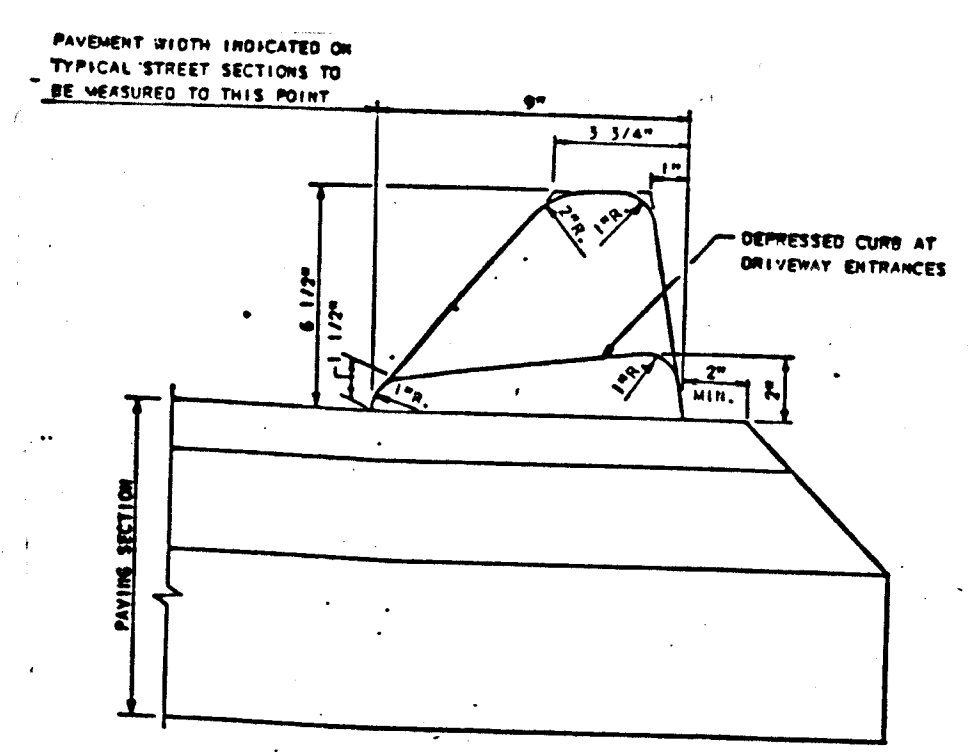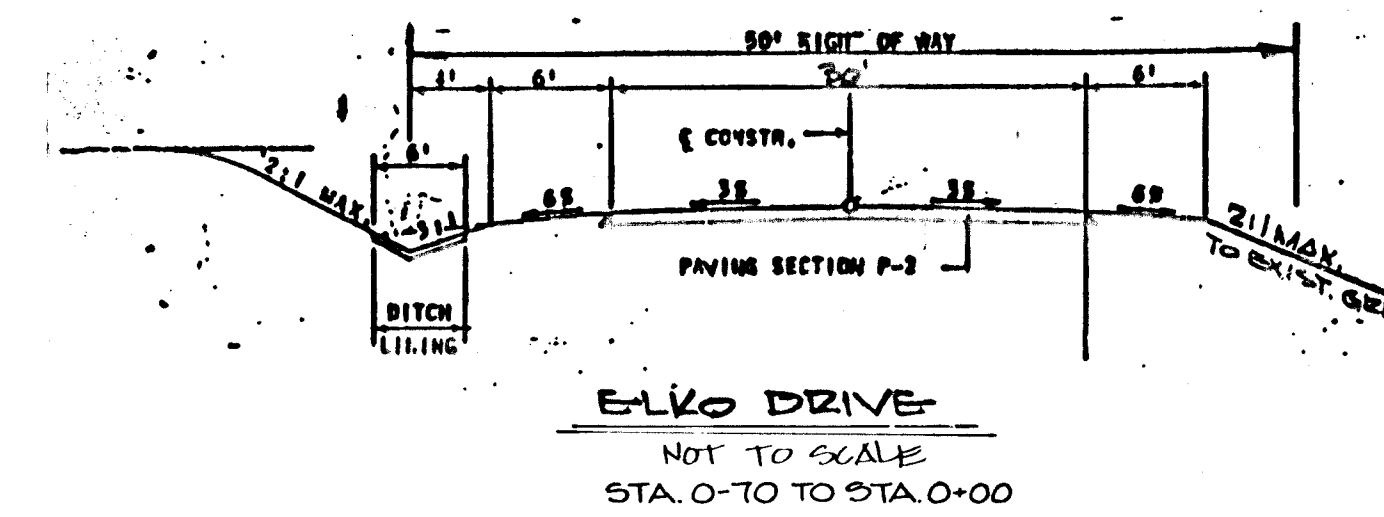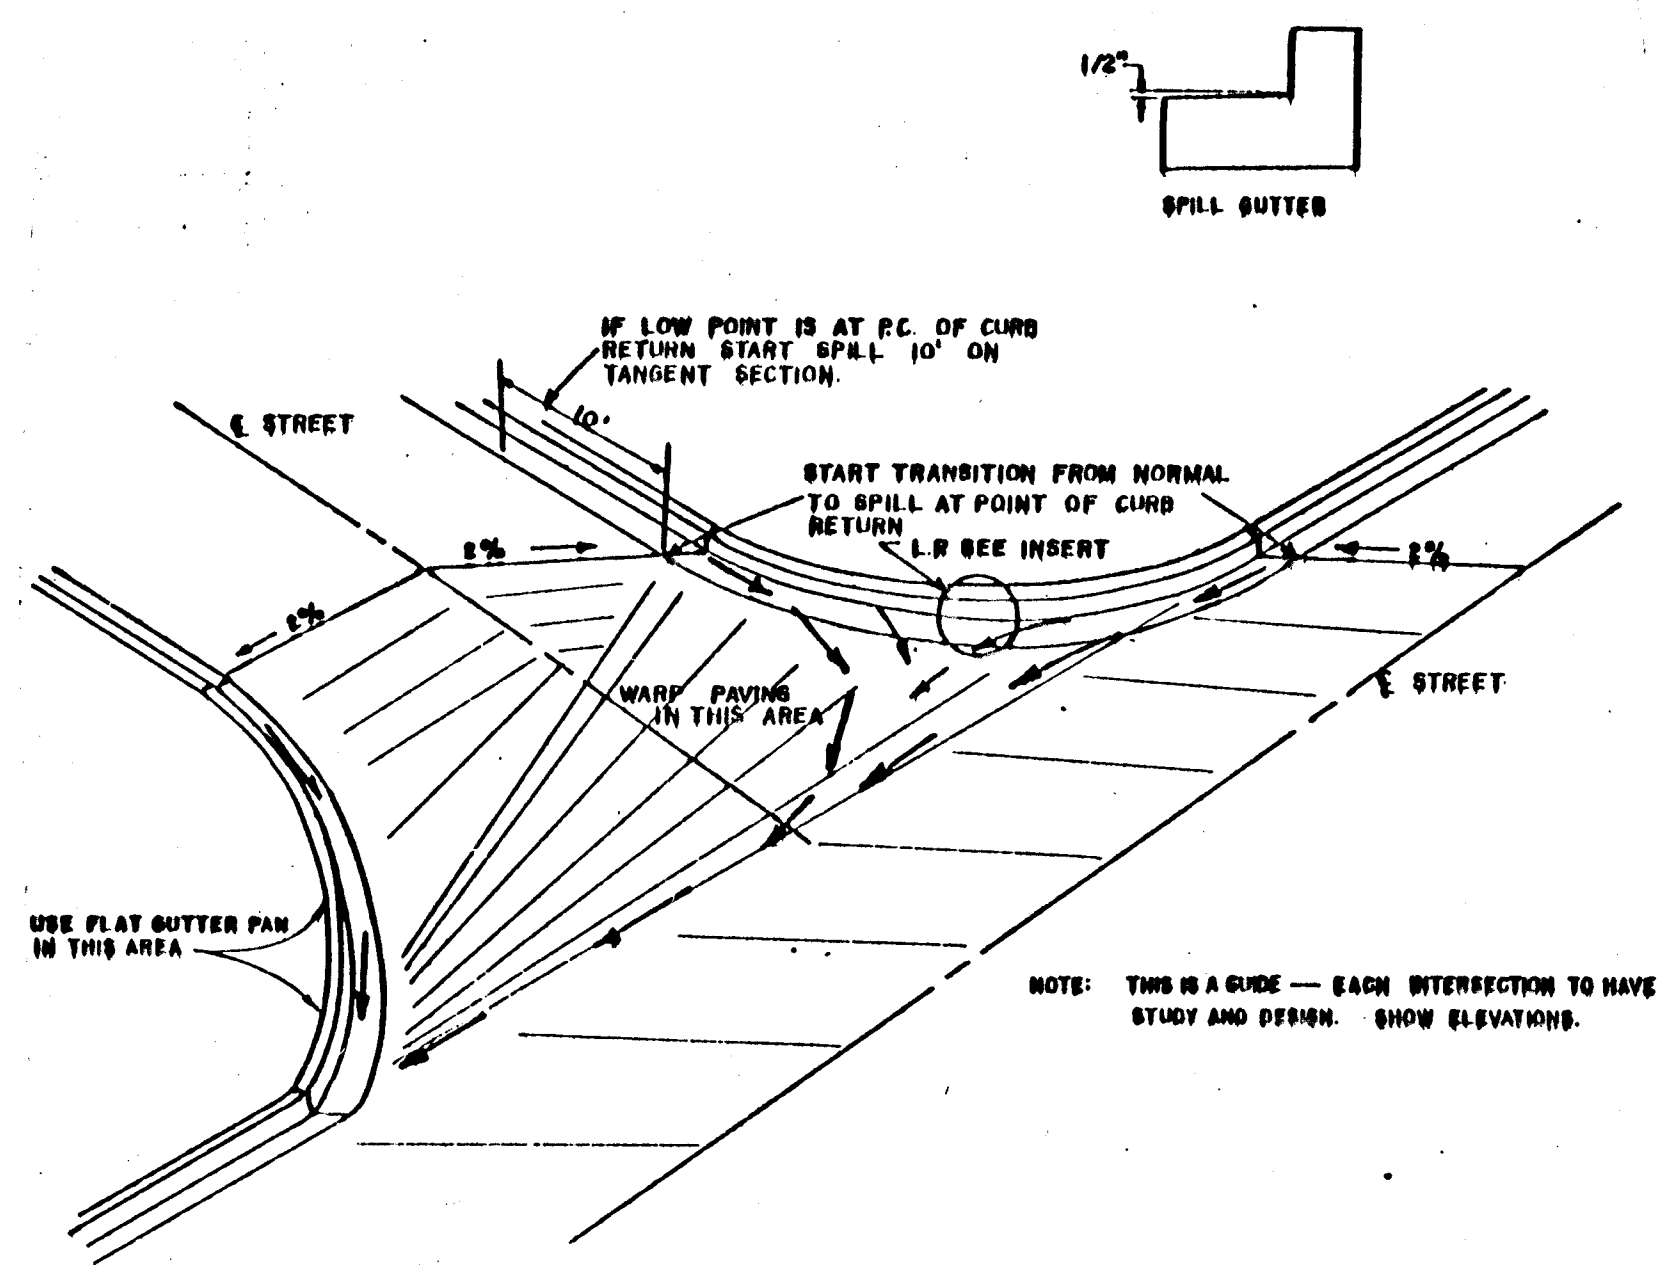

RESIDENTIAL ZONES	FULL DEPTH BIT. CONC. ALTERNATE	CONCRETE BASE ALTERNATES
LOCAL DRIVE BACK STS. ALLEYS AND PRIVATE ROADS SERVING INDIVIDUAL LOTS	1 1/2" BIT. CONC. SURFACE	1 1/2" BIT. CONC. SURFACE
PARKING AREAS	3" BIT. CONC. BASE	3" BIT. CONC. BASE
ADJUSTMENTS AND COMMERCIAL-INDUSTRIAL ZONES WITH HEAVY TRAFFIC	4" CRUMPER RUN BASE COURSE	17 COURSE 1" OR 2" CRUMPER RUN BASE COURSE
		17 COURSE 1" OR 2" CRUMPER RUN BASE COURSE

P-2 PAVING (LOCAL AND CUL-DE-SAC STREETS)
NOT TO SCALE

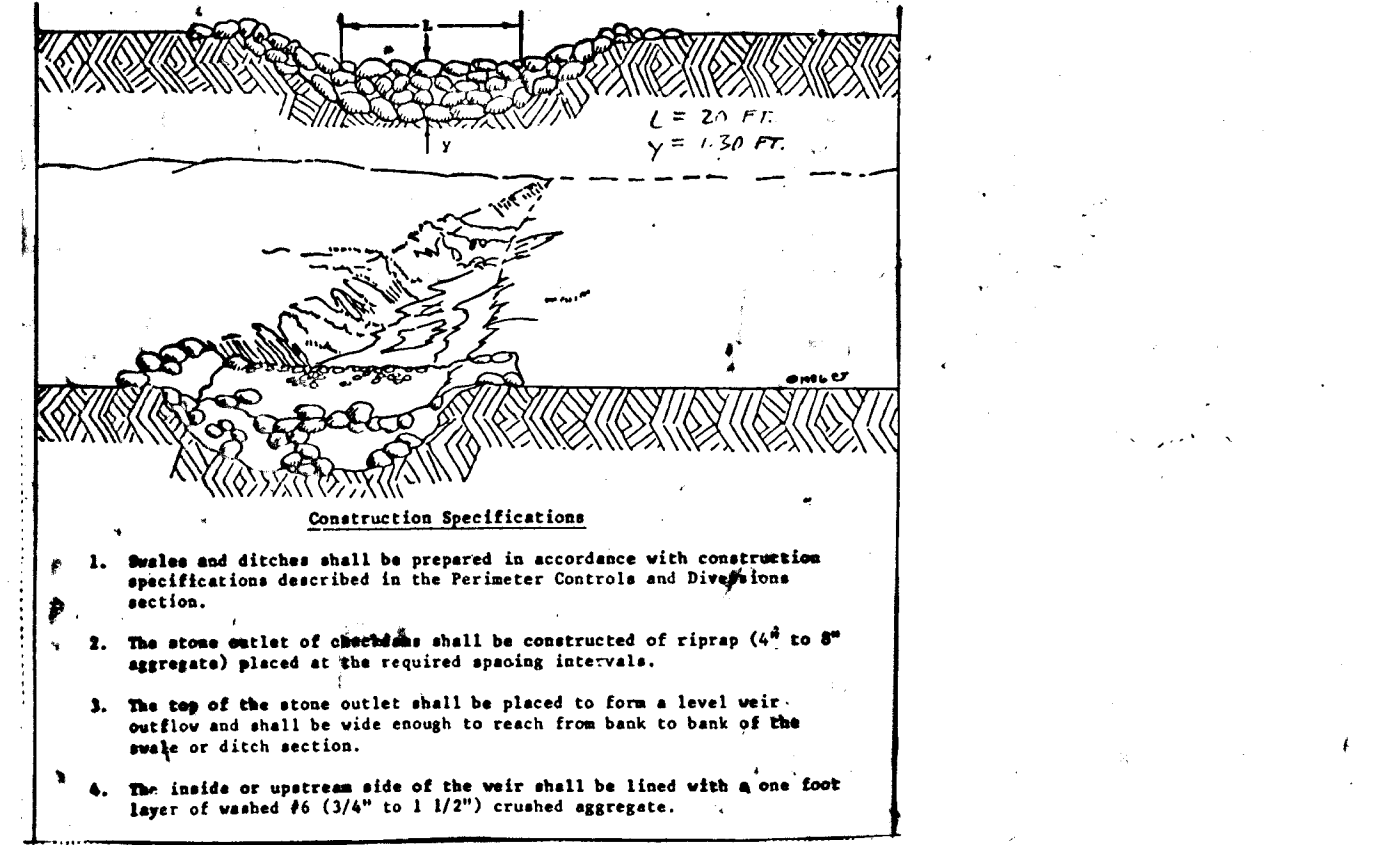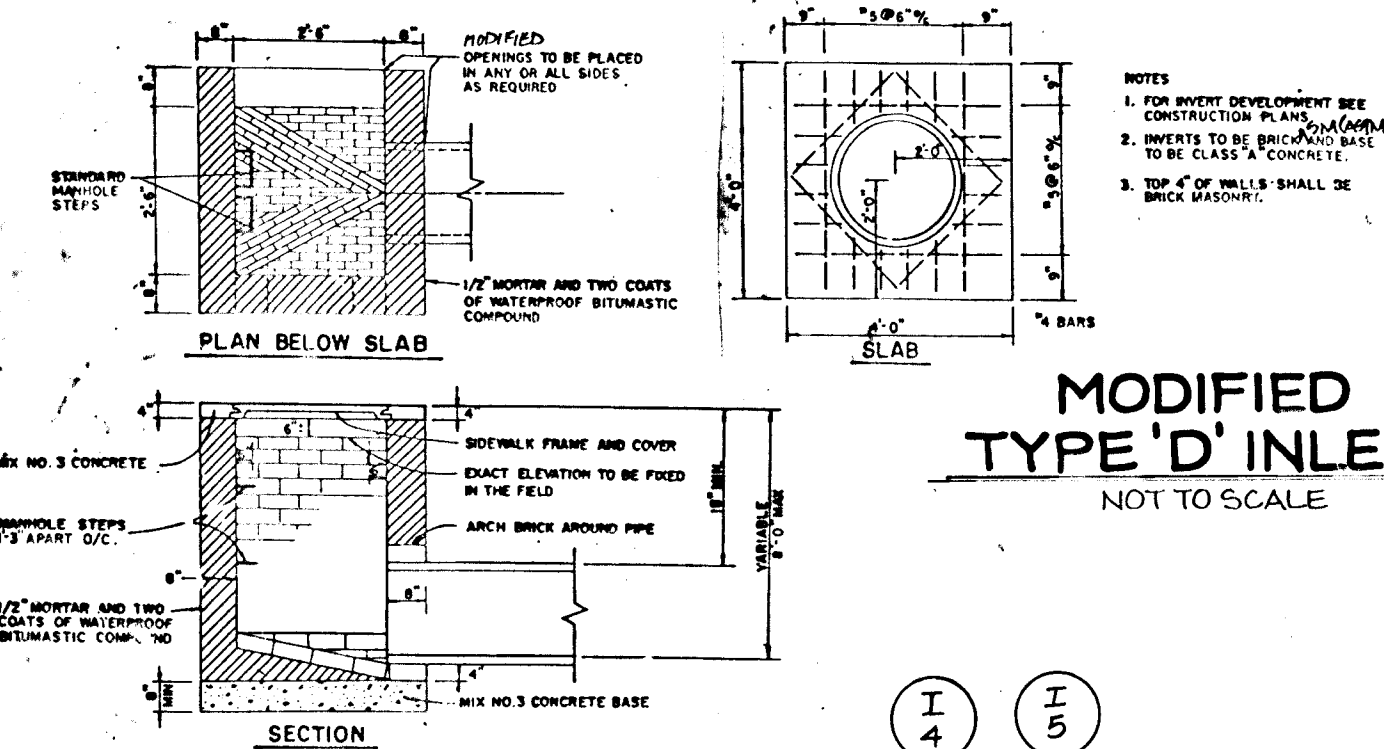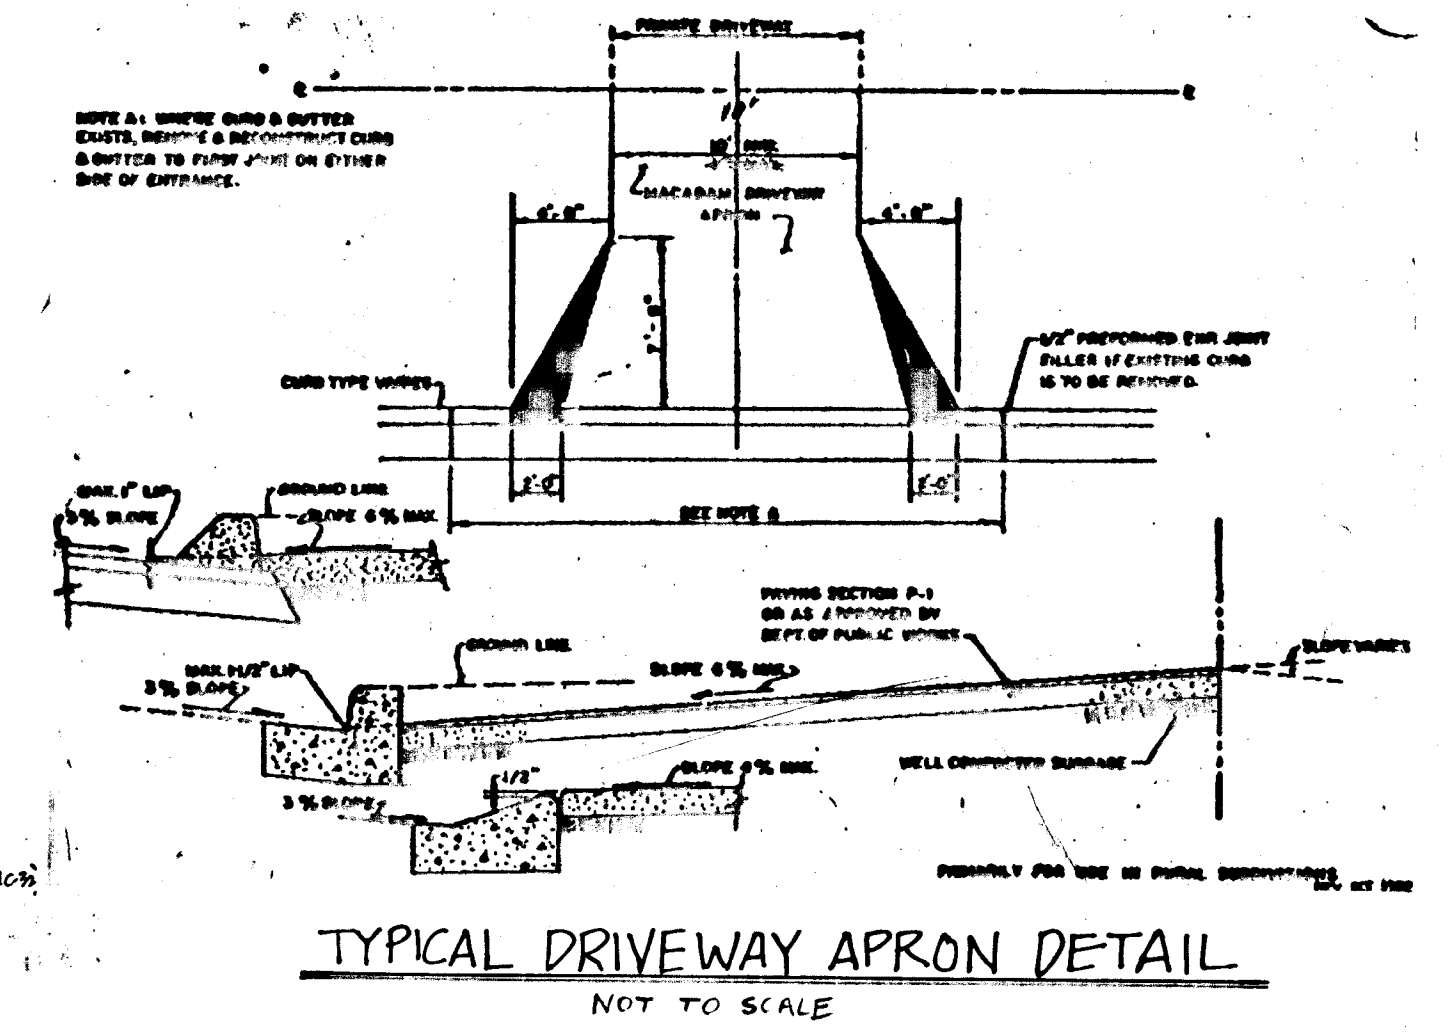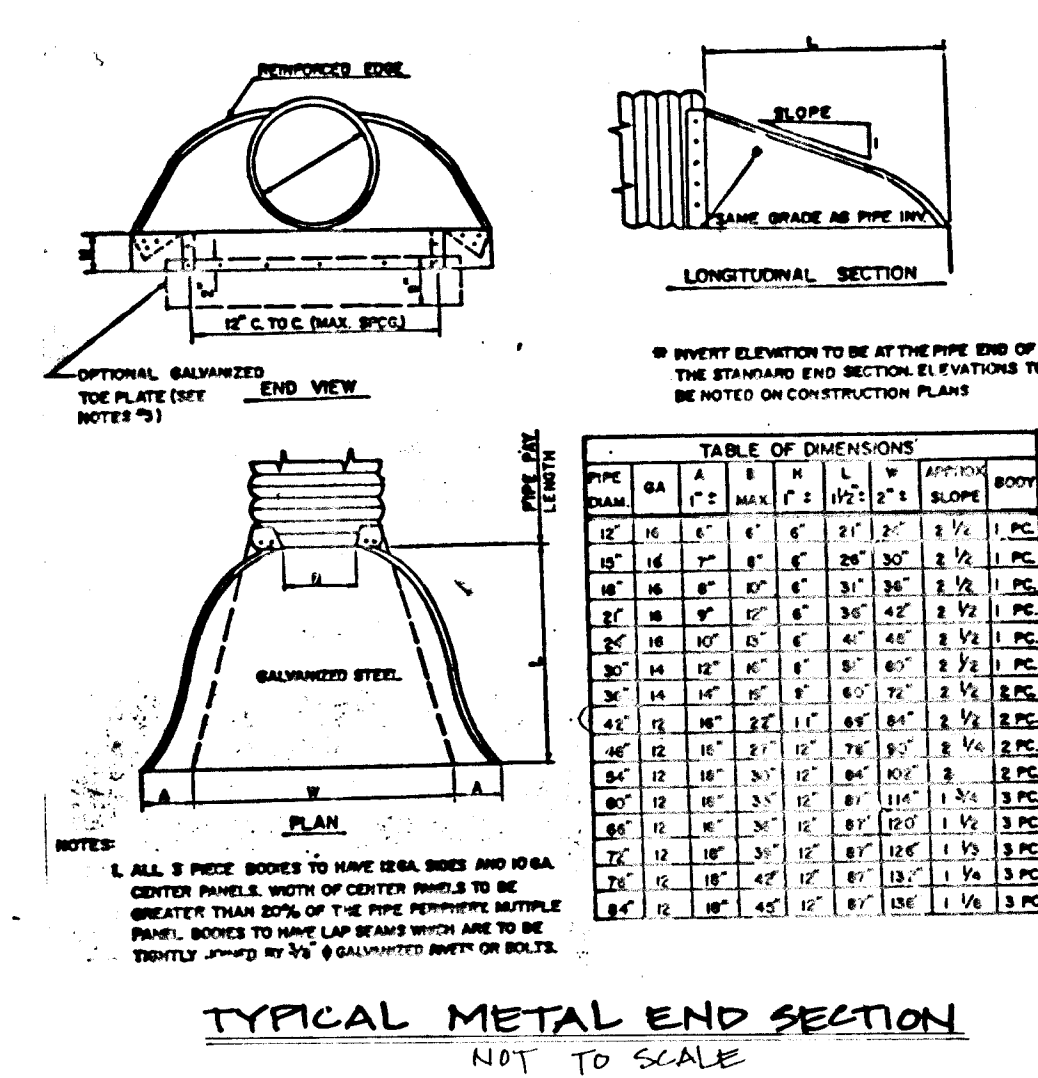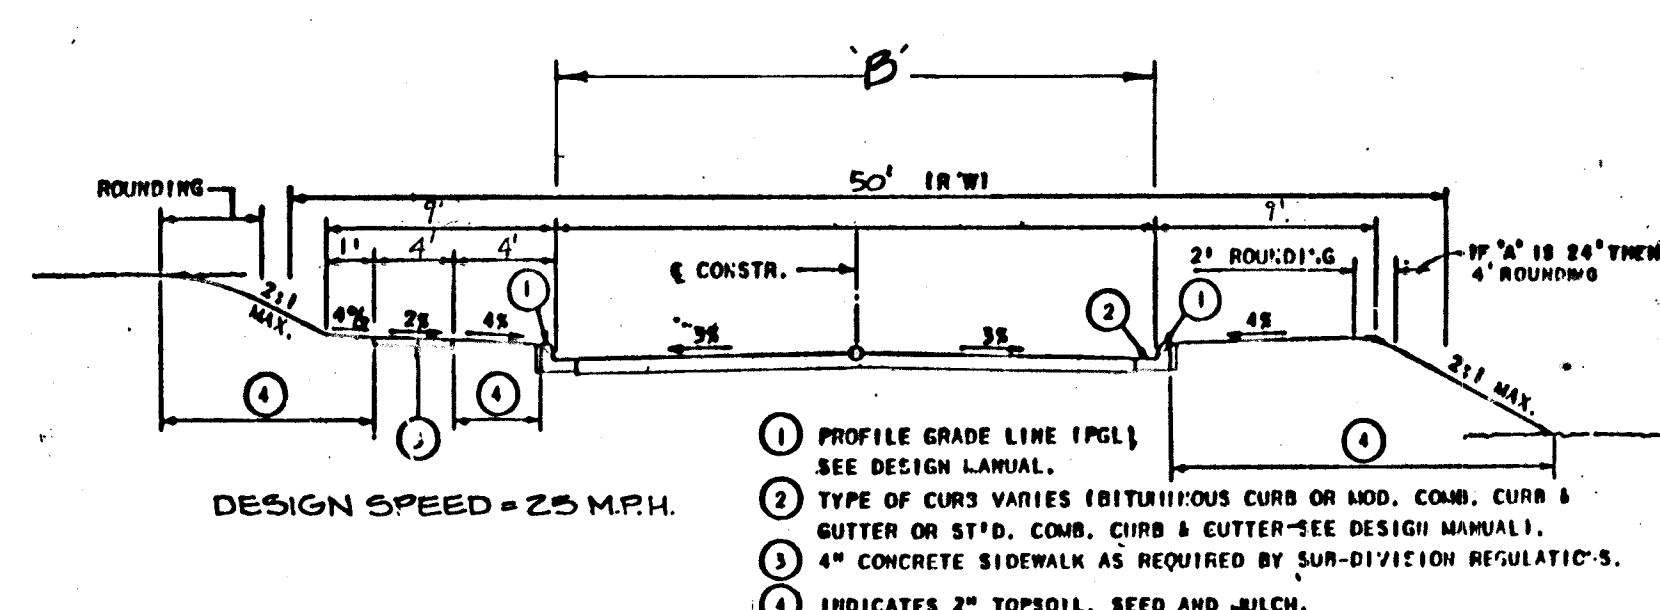

STRUCTURE NO.	LOCATION	TOP EL.	INV. IN.	INV. OUT	STRUCTURE TYPE	REMARKS *
I-1	WHITEBARK COURT 1420 E	460.07	455.36	459.11	A-5	SD-4.01 GUMP
I-2	SADDLE RIDGE TERR 0+38 RT 15'	462.24	458.12	457.88	A-10	SD-4.02 W/SD 4.83 DEFLECTORS
I-3	SADDLE RIDGE TERR 0+38 RT 15'	462.91	458.41	458.41	A-10	SD-4.02 W/SD 4.83 DEFLECTORS
I-4	ELKO DRIVE 0+38 RT 15'	441.28	434.00	433.57	A-10	SD-4.02 W/SD 4.83 DEFLECTORS
I-5	ELKO DRIVE 0+38 RT 15'	441.28	434.00	433.57	A-5	SD-4.01 GUMP
I-5S	SEE SHEET 2 OF 12	450.50	445.92	449.92	YARD INLET	SD-4.14
I-6	GLENMAR DR. 2+68 RT 15'	455.22	448.91	447.91	A-5	SD-4.01 GUMP
I-7	GLENMAR DR. 2+68 RT 15'	455.22	448.91	447.91	A-10	SD-4.02 W/SD 4.83 DEFLECTORS
I-8	BIRCHMERE TERR. 0+36 LT 15'	456.46	451.22	450.97	A-10	SD-4.02 W/SD 4.83 DEFLECTORS
I-9	BIRCHMERE TERR. 0+36 LT 15'	456.46	451.22	450.97	A-10	SD-4.02 W/SD 4.83 DEFLECTORS
I-10	GLENMAR DR. 3+17 LT 15'	456.35	452.04	452.38	A-5	SD-4.02 W/SD 4.83 DEFLECTORS
I-11	LOT LINE BETWEEN LOTS 295 & 280	465.75	461.05	461.05	TYPE 'D'	SD-4.39 W/ FOUR THROATS @ INV. EL. 464.72
I-12	GLENMAR DR. 0+14 RT 15'	463.80	456.44	455.28	A-10	SD-4.02 W/SD 4.83 DEFLECTORS
I-13	GLENMAR DR. 0+00 LT 15'	463.80	457.30	456.00	A-10	SD-4.02 W/SD 4.83 DEFLECTORS
M-1	WHITEBARK CT (EXTENDED) 2+84 LT 20'	461.00	454.19	453.92	STANDARD	G-5.01
M-2	WHITEBARK CT (EXTENDED) 2+84 LT 14'	460.00	453.95	453.68	"	G-5.01
M-3	ELKO DR. 0+38 RT 15'	441.28	434.00	433.57	STANDARD	G-5.03
M-4	ELKO DR. 0+38 RT 15'	441.28	434.00	433.57	"	G-5.03
M-5	SEE SHEET 5 OF 12	448.40	443.97	441.50	"	G-5.02
S-1	SEE SHEET 4 OF 12	453.20	445.19	445.19	METAL END SEC	SD 5.61
S-2	ELKO DR. 5 OF 12	433.11	427.83	427.83	METAL END SEC	SD 5.61
S-3	ELKO DR. 0+16 RT 15'	441.03	437.43	437.43	METAL END SEC	SD 5.61
S-4	ELKO DR. 0+16 RT 15'	440.44	438.00	438.00	METAL END SEC	SD 5.61
I-14	GLENMARDR 0+576 LT 37	461.00	457.50	457.50	TYPE 'D'	SD 4.39 W/FOUR THROATS @ INV. EL. 464.72
I-15	FRONT OF LOT 295	441.00	436.54	436.54	TYPE 'D'	SD 4.39

* ALL STANDARDS ARE OF HOWARD COUNTY EXCEPT WHERE NOTED

44' C.M.P. From V44 Inv. = 434.02

30' C.M.P. From S-3 Inv. = 437.43

15' C.P. From I-5 Inv. = 438.1

30' C.M.P. From I-5 TO S-7 Inv. = 437.43

STREET NAME	'D'
BIRCHMERE TERRACE	28'
WHITEBARK COURT	24'
SADDLE RIDGE TERRACE	28'

REVIEWED FOR HOWARD COUNTY DEPT. OF PLANNING AND ZONING

TECHNICAL APPROVALS

James H. Helm 11/18/89

John K. Roberts 8/10/89

APPROVED HOWARD COUNTY DEPT. OF PLANNING AND ZONING

Mark A. Long 10/10/89


CHIEF, DIVISION OF COMMUNITY PLANNING AND LAND DEVELOPMENT

APPROVED HOWARD COUNTY DEPARTMENT OF PUBLIC WORKS

Donald W. Williams 4/16/90

Drumville W. Williams 3/11/90

D. S. ... 4-16-90

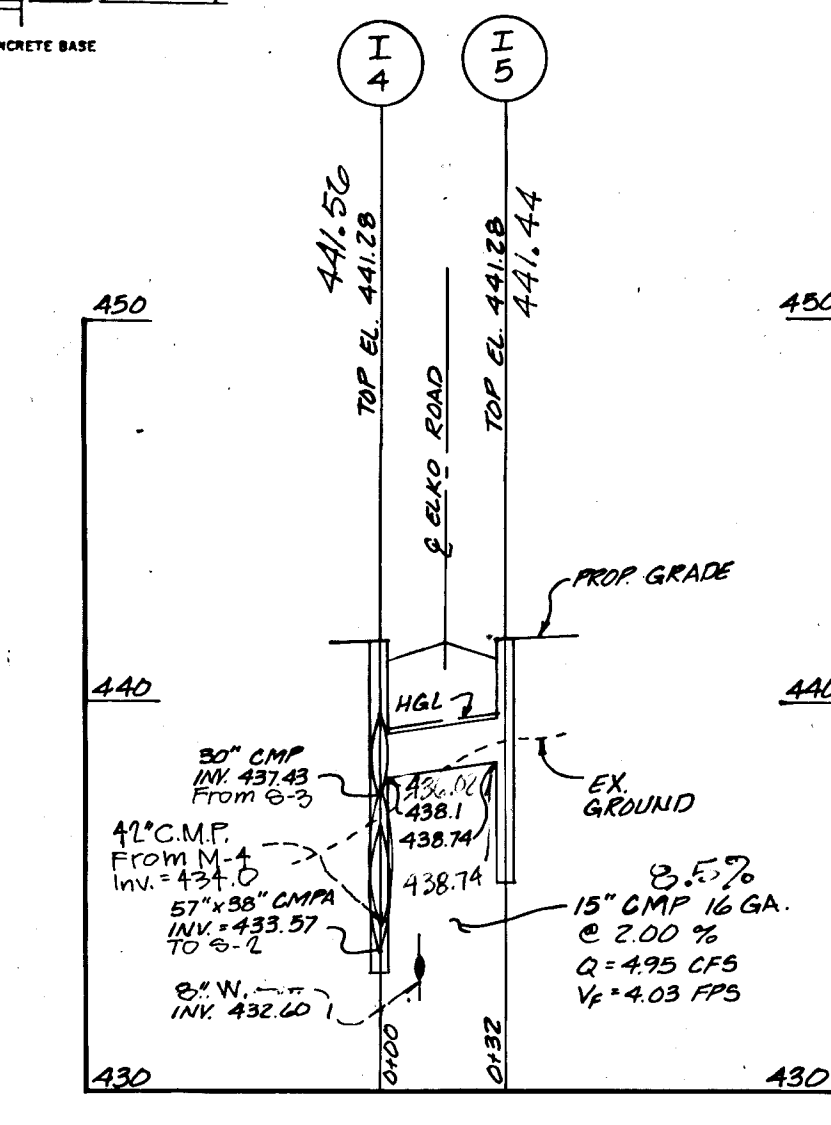


1443

Detail: Inlet #4
NOT TO SCALE

Dewberry & Davis
Architects Engineers Planners Surveyors
3500 N. RIDGE ROAD, SUITE 100
ELLCOTT CITY, MD. 21043
(301) 451-7478

MONTGOMERY MEADOWS
SECTION ONE
AREA FIVE
THRU 300
LOTS 24G
1ST ELECTION DISTRICT
HOWARD COUNTY MARYLAND

Scale: NO SCALE
Sheet: 7 of 12
Date: 9/21/94
File Number: F-88-287 AS-BUILT

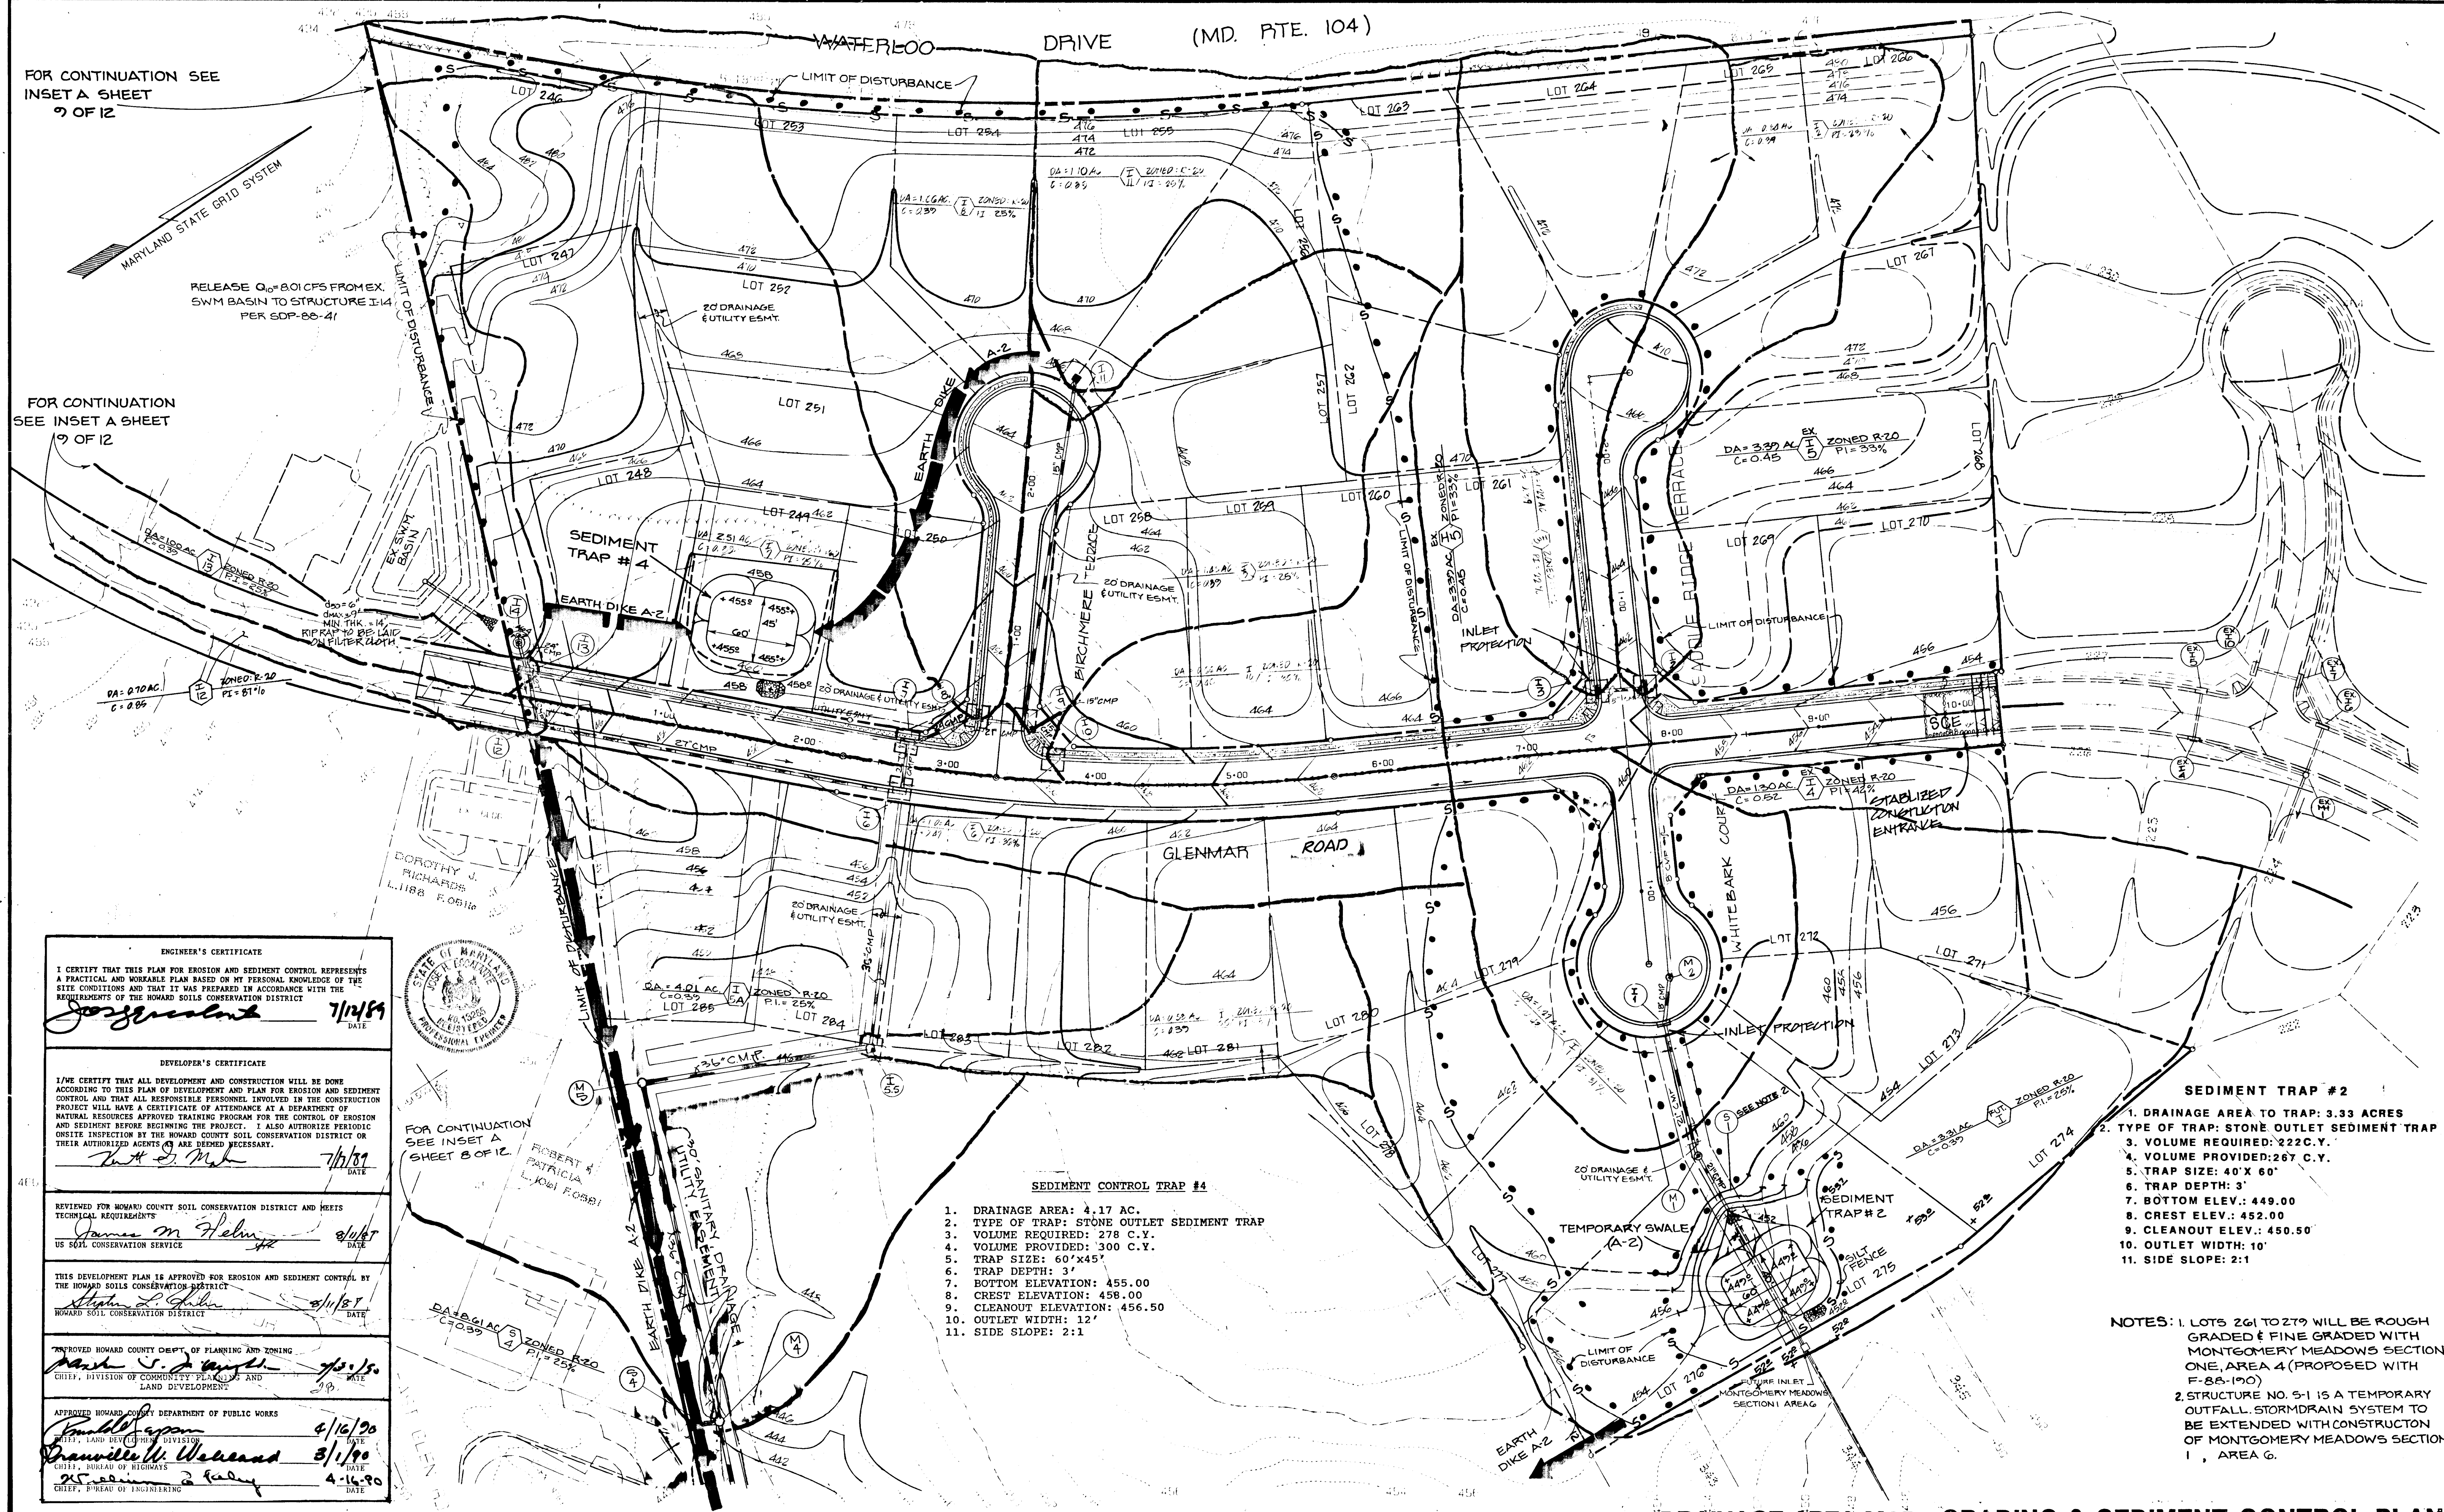

FOR CONTINUATION SEE
INSET A SHEET
9 OF 12

FOR CONTINUATION
SEE INSET A SHEET
9 OF 12

RELEASE Q₁₀ = 8.01 CFS FROM EX.
SWM BASIN TO STRUCTURE I-14
PER SDP-88-41

<p>ENGINEER'S CERTIFICATE</p> <p>I CERTIFY THAT THIS PLAN FOR EROSION AND SEDIMENT CONTROL REPRESENTS A PRACTICAL AND WORKABLE PLAN BASED ON MY PERSONAL KNOWLEDGE OF THE SITE CONDITIONS AND THAT IT WAS PREPARED IN ACCORDANCE WITH THE REQUIREMENTS OF THE HOWARD SOILS CONSERVATION DISTRICT</p> <p><i>Joseph A. Davis</i> 7/14/89 DATE</p>	
<p>DEVELOPER'S CERTIFICATE</p> <p>I/WE CERTIFY THAT ALL DEVELOPMENT AND CONSTRUCTION WILL BE DONE ACCORDING TO THIS PLAN OF DEVELOPMENT AND PLAN FOR EROSION AND SEDIMENT CONTROL, AND THAT ALL RESPONSIBLE PERSONNEL INVOLVED IN THE CONSTRUCTION PROJECT WILL HAVE A CERTIFICATE OF ATTENDANCE AT A DEPARTMENT OF NATURAL RESOURCES APPROVED TRAINING PROGRAM FOR THE CONTROL OF EROSION AND SEDIMENT BEFORE BEGINNING THE PROJECT. I ALSO AUTHORIZE PERIODIC ON-SITE INSPECTION BY THE HOWARD COUNTY SOIL CONSERVATION DISTRICT OR THEIR AUTHORIZED AGENTS AS ARE DEEMED NECESSARY.</p> <p><i>Robert A. Fossell</i> 7/14/89 DATE</p>	
<p>REVIEWED FOR HOWARD COUNTY SOIL CONSERVATION DISTRICT AND MEETS TECHNICAL REQUIREMENTS</p> <p><i>James M. Helm</i> 8/14/89 DATE US SOIL CONSERVATION SERVICE</p>	
<p>THIS DEVELOPMENT PLAN IS APPROVED FOR EROSION AND SEDIMENT CONTROL BY THE HOWARD SOILS CONSERVATION DISTRICT</p> <p><i>Stephen L. Geller</i> 8/14/89 DATE HOWARD SOILS CONSERVATION DISTRICT</p>	
<p>APPROVED HOWARD COUNTY DEPT. OF PLANNING AND ZONING</p> <p><i>Mark S. Smith</i> 7/15/89 DATE CHIEF, DIVISION OF COMMUNITY PLANNING AND LAND DEVELOPMENT</p>	
<p>APPROVED HOWARD COUNTY DEPARTMENT OF PUBLIC WORKS</p> <p><i>Donald Egan</i> 4/16/90 DATE CHIEF, LAND DEVELOPMENT DIVISION</p> <p><i>Danville H. Weiland</i> 3/1/90 DATE CHIEF, BUREAU OF HIGHWAYS</p> <p><i>Richard J. Kelly</i> 4-16-90 DATE CHIEF, BUREAU OF ENGINEERING</p>	



FOR CONTINUATION
SEE INSET A
SHEET 8 OF 12

ROBERT A. FOSSELL
L. HOWARD FOSSELL

- SEDIMENT CONTROL TRAP #4**
1. DRAINAGE AREA: 4.17 AC.
 2. TYPE OF TRAP: STONE OUTLET SEDIMENT TRAP
 3. VOLUME REQUIRED: 278 C.Y.
 4. VOLUME PROVIDED: 300 C.Y.
 5. TRAP SIZE: 60'x45'
 6. TRAP DEPTH: 3'
 7. BOTTOM ELEVATION: 455.00
 8. CREST ELEVATION: 458.00
 9. CLEANOUT ELEVATION: 456.50
 10. OUTLET WIDTH: 12'
 11. SIDE SLOPE: 2:1

- SEDIMENT TRAP #2**
1. DRAINAGE AREA TO TRAP: 3.33 ACRES
 2. TYPE OF TRAP: STONE OUTLET SEDIMENT TRAP
 3. VOLUME REQUIRED: 222 C.Y.
 4. VOLUME PROVIDED: 267 C.Y.
 5. TRAP SIZE: 40' X 60'
 6. TRAP DEPTH: 3'
 7. BOTTOM ELEV.: 449.00
 8. CREST ELEV.: 452.00
 9. CLEANOUT ELEV.: 450.50
 10. OUTLET WIDTH: 10'
 11. SIDE SLOPE: 2:1


NOTES: 1. LOTS 261 TO 279 WILL BE ROUGH GRADED & FINE GRADED WITH MONTGOMERY MEADOWS SECTION ONE, AREA 4 (PROPOSED WITH F-88-190)

2. STRUCTURE NO. 5-1 IS A TEMPORARY OUTFALL STORMDRAIN SYSTEM TO BE EXTENDED WITH CONSTRUCTION OF MONTGOMERY MEADOWS SECTION I, AREA G.

DRAINAGE AREA MAP, GRADING & SEDIMENT CONTROL PLAN

REVISIONS		
DESIGNED	DATE	DESCRIPTION
	3-4-90	DELETED SIDEWALK EAST SIDE OF GLENMAR ROAD
CHECKED		
APPROVED	3-28-91	RELOCATE STORMDRAIN WITHIN ESMT
	8-25-90	Revised Sediment Trap #2

Dewberry & Davis
ENGINEERS — ARCHITECTS — PLANNERS — SURVEYORS
3300 N. RIDGE ROAD, SUITE 100
ELLICOTT CITY, MD. 21043
(301) 461-7478

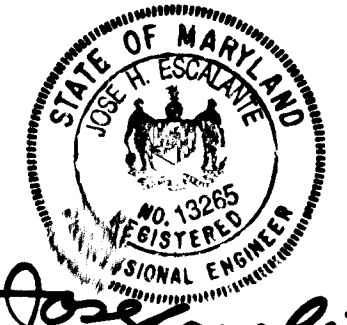

MONTGOMERY MEADOWS GENERAL PARTNERSHIP
9175 GUILFORD ROAD, SUITE 302
COLUMBIA, MARYLAND 21046
(301) 604-1552





MONTGOMERY MEADOWS
SECTION 1 AREA 5
LOTS 246 THRU LOTS 300
TAX MAP 31 PARCEL 123
1ST ELECTION DISTRICT HOWARD CO. MARYLAND

GENERAL NOTES






- 1. THE DEVELOPER IS RESPONSIBLE FOR THE ACQUISITION OF ALL REQUIRED EASEMENTS, RIGHT, AND/OR RIGHTS-OF-WAY PURSUANT TO THE DISBURSEMENT OF THE SEDIMENT AND EROSION CONTROL PRACTICES, STORM WATER MANAGEMENT PRACTICES AND THE DISBURSEMENT OF STORM WATER ONTO OR ACROSS OR GRADING OR OTHER WORK TO BE PERFORMED ON ADJACENT OR DOWNSTREAM PROPERTIES AFFECTED BY THIS PLAN.

VEGETATIVE STABILIZATION

- Permanent and Temporary Seeding, Sodding and Mulching
I. Site Preparation
II. Seeded Preparation and Seeding Application
III. Soil Amendments
IV. Sediment Control Practices Seeding
V. Temporary Seeding: For growing season
VI. Permanent Seeding
VII. Mulching
VIII. Sodding
IX. Maintenance



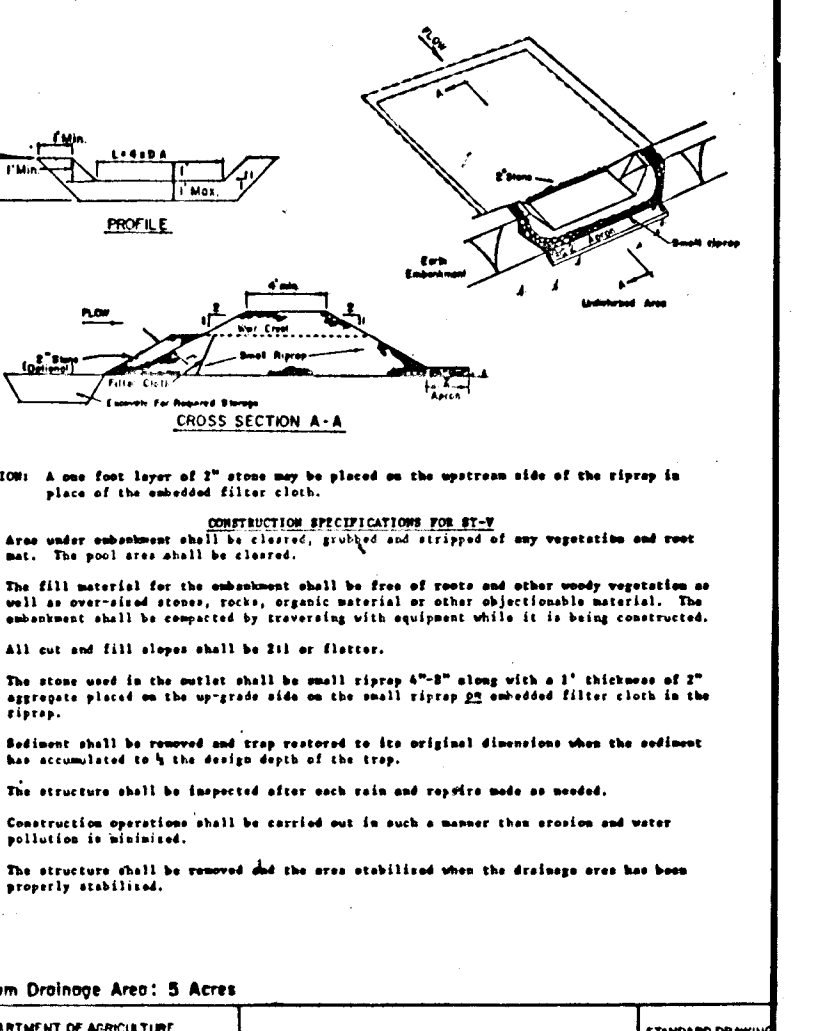
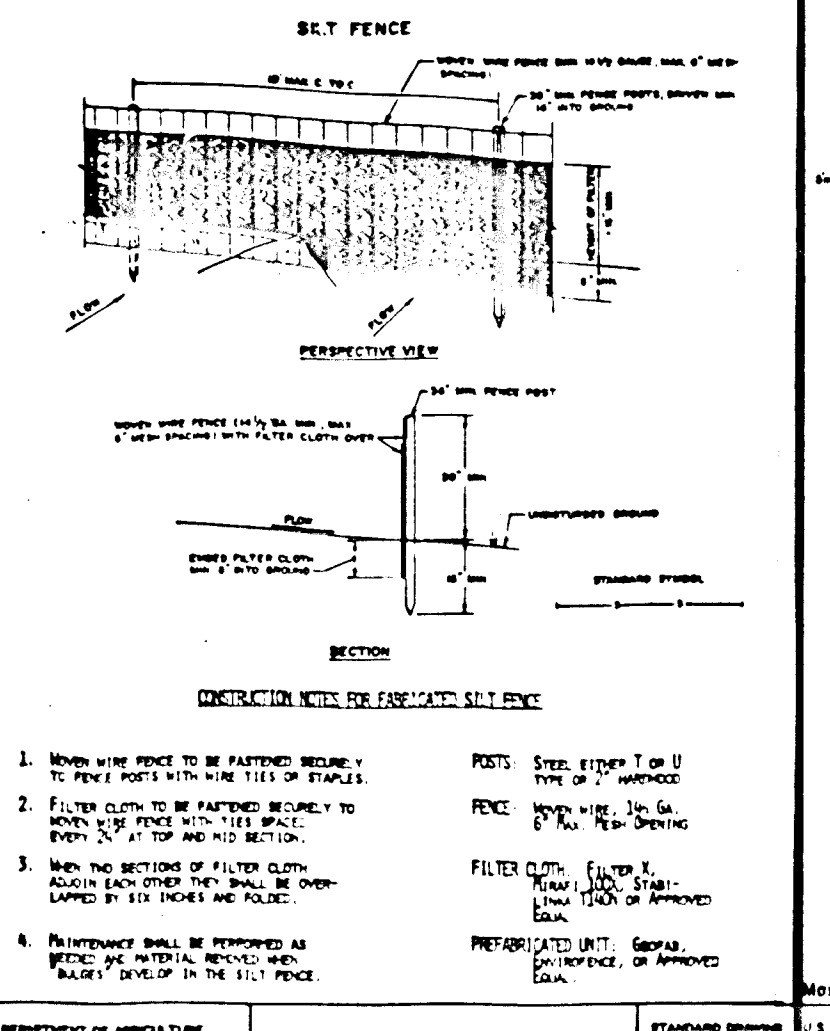
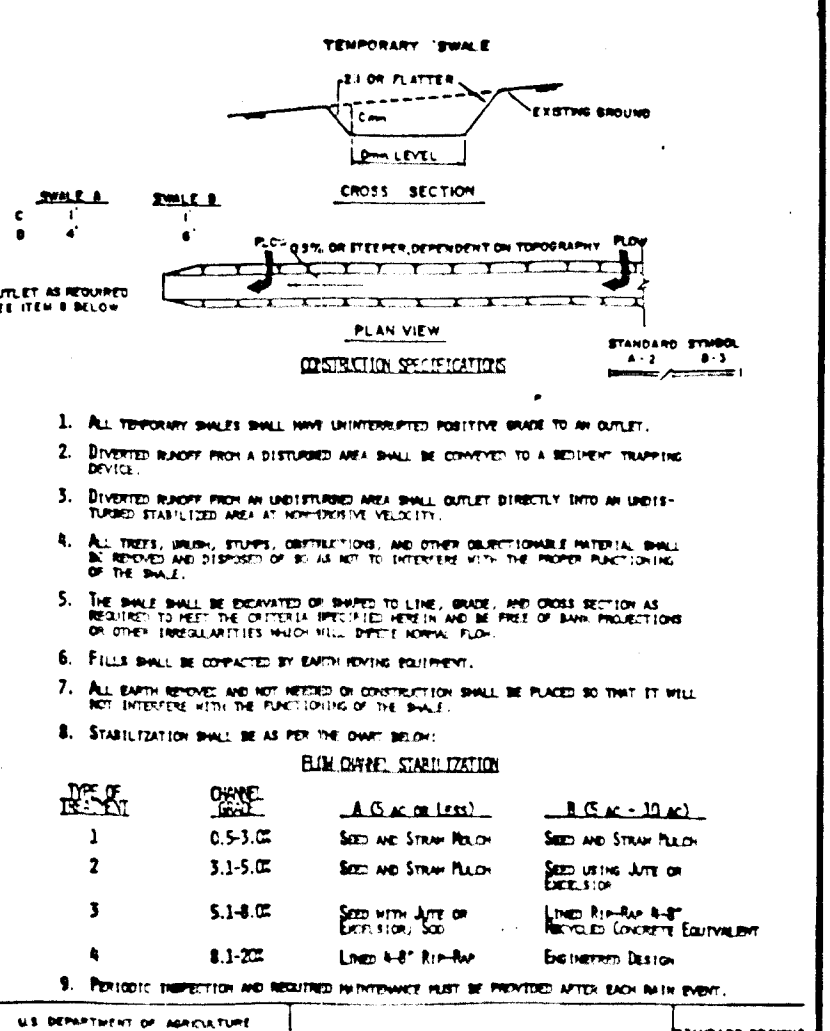
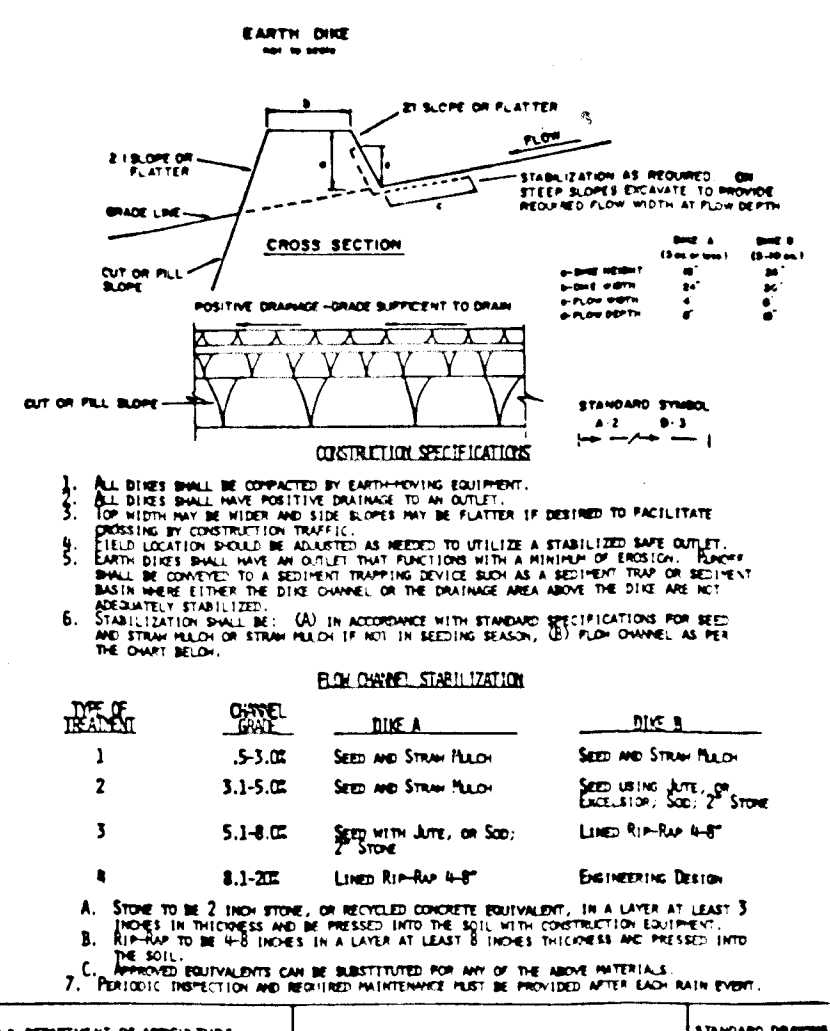


STANDARD AND SPECIFICATIONS FOR TOPSOILING
Definition
Purpose
Conditions Where Practice Applies
This practice is recommended for sites of 2:1 or flatter slopes where:
1. The texture of the exposed subsoil or parent material is not suitable to produce adequate vegetative growth.
2. The soil material is so shallow that the rooting zone is not deep enough to support plants or furnish continuing supplies of moisture and plant nutrients.
3. The original soil to be vegetated contains material toxic to plant growth.
4. The soil is so acid that treatment with limestone is not feasible.


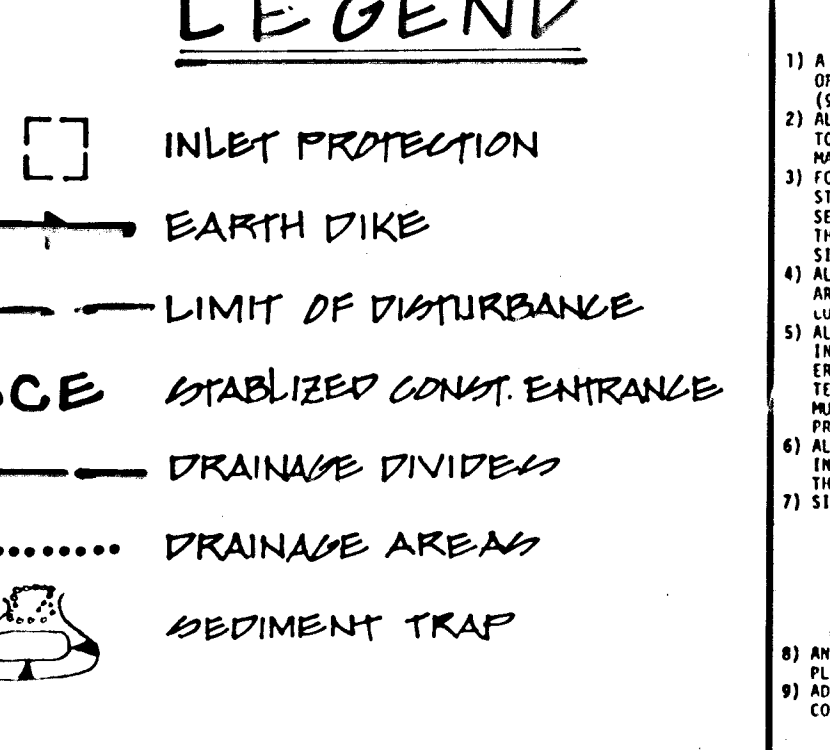
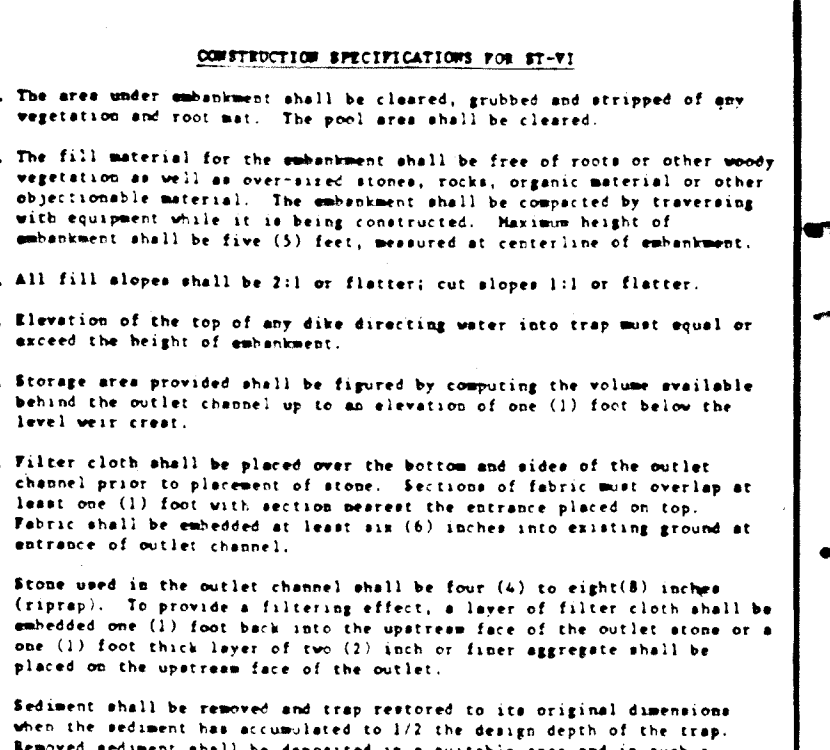
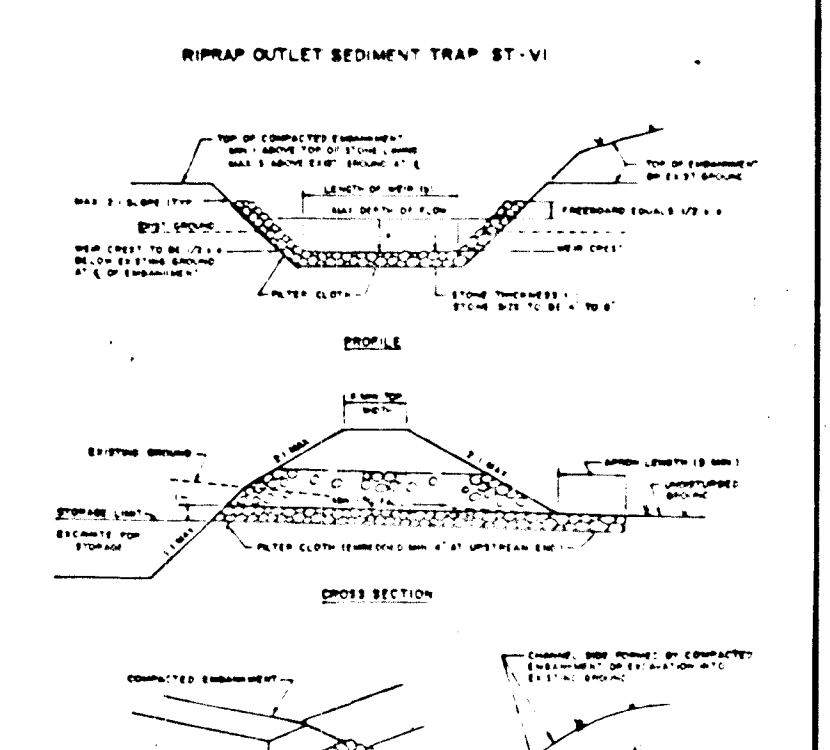
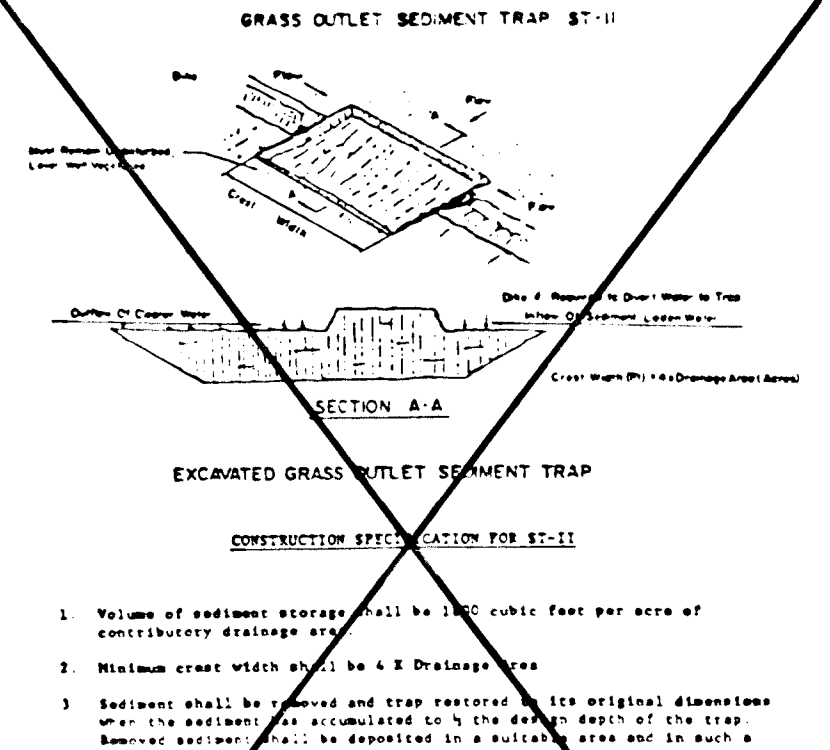
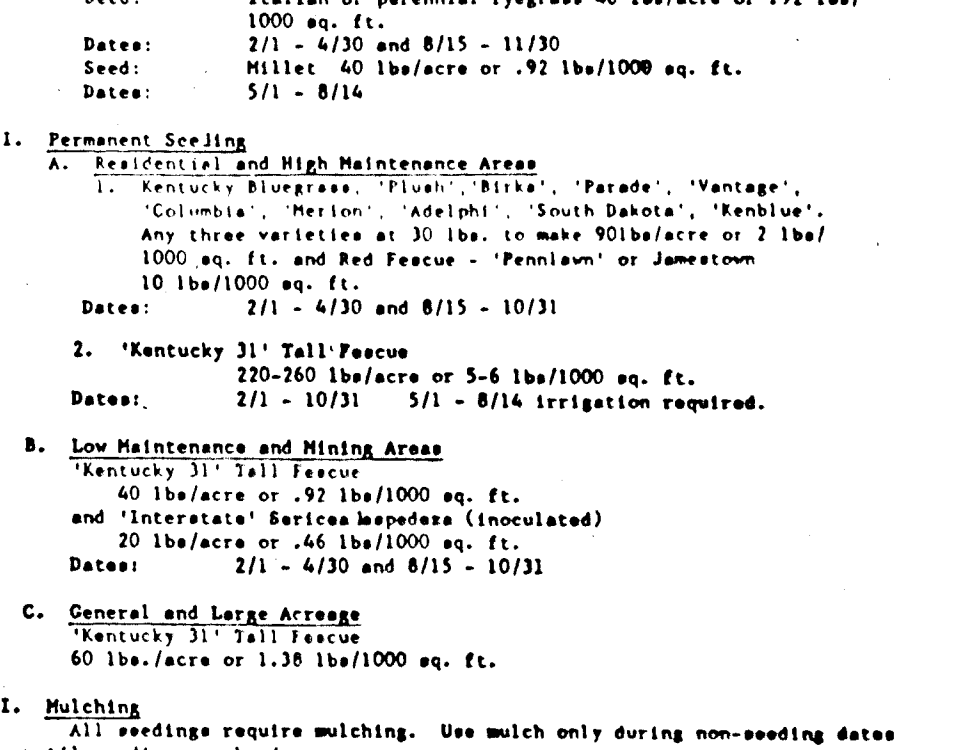


- 1) A MINIMUM OF 48 HOURS NOTICE MUST BE GIVEN TO THE HOWARD COUNTY OFFICE OF INSPECTIONS AND PERMITS PRIOR TO THE START OF ANY CONSTRUCTION...
2) ALL VEGETATIVE AND STRUCTURAL PRACTICES ARE TO BE INSTALLED ACCORDING TO THE PROVISIONS OF THIS PLAN AND ARE TO BE IN CONFORMANCE WITH THE 1983 MARYLAND STANDARDS AND SPECIFICATIONS FOR SOIL EROSION AND SEDIMENT CONTROL...
3) FOLLOWING INITIAL SOIL DISTURBANCE OR RESTORATION, PERMANENT OR TEMPORARY STABILIZATION SHALL BE COMPLETED WITHIN 30 CALENDAR DAYS FOR ALL PERMANENT SEDIMENT CONTROL STRUCTURES, DICES, PERMETER SLOPES AND ALL SLOPES GRATER THAN 3:1, 3:1 DICES AND ALL OTHER DISTURBED OR GRADED AREAS ON THE PROJECT SITE...
4) ALL SEDIMENT TRAPPING/STORAGE SHALL BE FENCED AND WARNING SIGNS POSTED AROUND THEIR PERIPHERY IN ACCORDANCE WITH VOL. 1, CHAPTER 12, OF THE HOWARD COUNTY DESIGN MANUAL, STORM DRAINAGE...
5) ALL DISTURBED AREAS MUST BE STABILIZED WITHIN THE TIME PERIOD SPECIFIED ABOVE IN ACCORDANCE WITH THE 1983 MARYLAND STANDARDS AND SPECIFICATIONS FOR SOIL EROSION AND SEDIMENT CONTROL, FOR PERMANENT SEEDINGS (SEC. 51) 500 (SEC. 52) TEMPORARY SEEDING (SEC. 50) AND MULCHING (SEC. 52). TEMPORARY STABILIZATION WITH MULCH SHALL BE COMPLETED WITHIN 30 CALENDAR DAYS FOR ALL PERMANENT SEDIMENT CONTROL STRUCTURES, DICES, PERMETER SLOPES AND ALL SLOPES GRATER THAN 3:1, 3:1 DICES AND ALL OTHER DISTURBED OR GRADED AREAS ON THE PROJECT SITE...
6) ALL SEDIMENT CONTROL STRUCTURES ARE TO REMAIN IN PLACE AND ARE TO BE MAINTAINED IN OPERATIVE CONDITION UNTIL PERMITS FOR THEIR REMOVAL HAS BEEN OBTAINED FROM THE HOWARD COUNTY SEEDING CONTROL INSPECTOR...
7) SITE ANALYSIS:
TOTAL AREA OF SITE: 287 ACRES
AREA TO BE ROOFED OR PAVED: 18.2 ACRES
AREA TO BE VEGETATIVELY STABILIZED: 15.6 ACRES
TOTAL FILL: 105,000 CU. YDS.
TOTAL EXCAVATION: 105,000 CU. YDS.
8) ANY SEDIMENT CONTROL PRACTICE WHICH IS DISTURBED BY GRADING ACTIVITY FOR A PERIOD OF 48 HOURS MUST BE REPAIRED ON THE SAME DAY OF DISTURBANCE...
9) ADDITIONAL SEDIMENT CONTROL MEASURES MUST BE PROVIDED, IF DEEMED NECESSARY BY THE HOWARD COUNTY SOIL SEDIMENT CONTROL INSPECTOR.

Section I - Site Preparation (Where Topsoil is to be added)
A. When topsoiling, maintain needed erosion and sediment control practices such as diversion, grade stabilization structures, berms, dikes, waterways and sediment basins.
B. Grading: Grades on the areas to be topsoiled which have previously established shall be maintained.
C. Light: Where the subsoil is either highly acid or composed of heavy clay, ground limestone shall be spread at the rate of 4-8 tons/acre (200-400 pounds per 1,000 square feet). Lime shall be distributed uniformly over designated areas and worked into the soil in conjunction with tillage operations as described in the following procedures.
D. Tilling: After the areas to be topsoiled have been brought to grade, and immediately prior to dumping and spreading the topsoil, the subgrade shall be loosened by disking or by scarifying to a depth of at least 3 inches to permit bonding of the topsoil to the subsoil. Pack by passing a bulldozer up and down over the entire surface area of the slope to create horizontal erosion check slots to prevent topsoil from sliding down the slope.

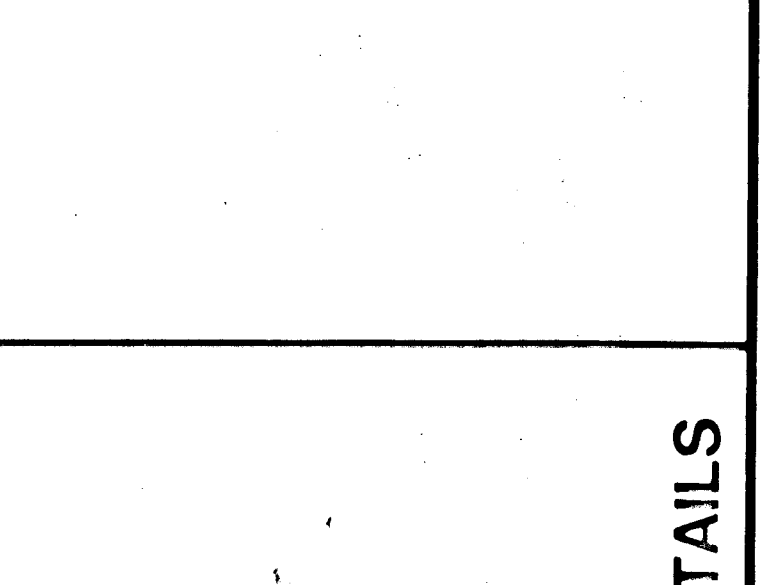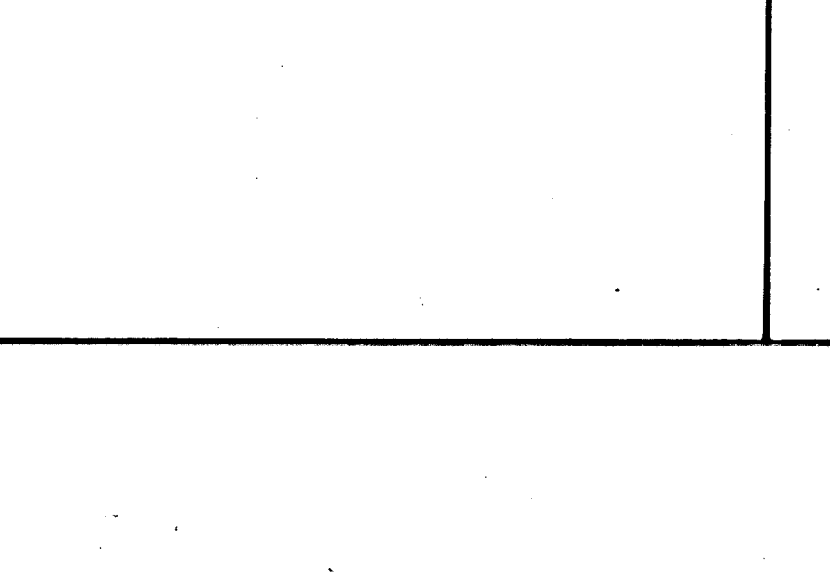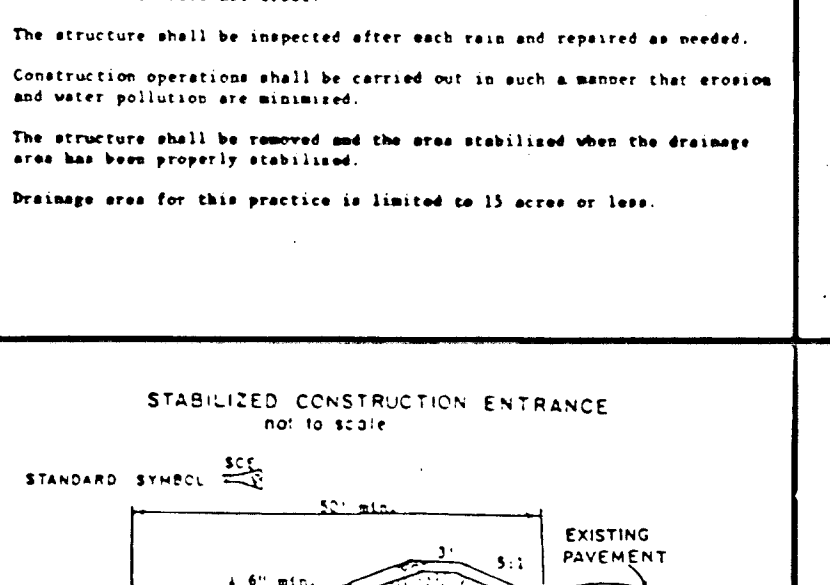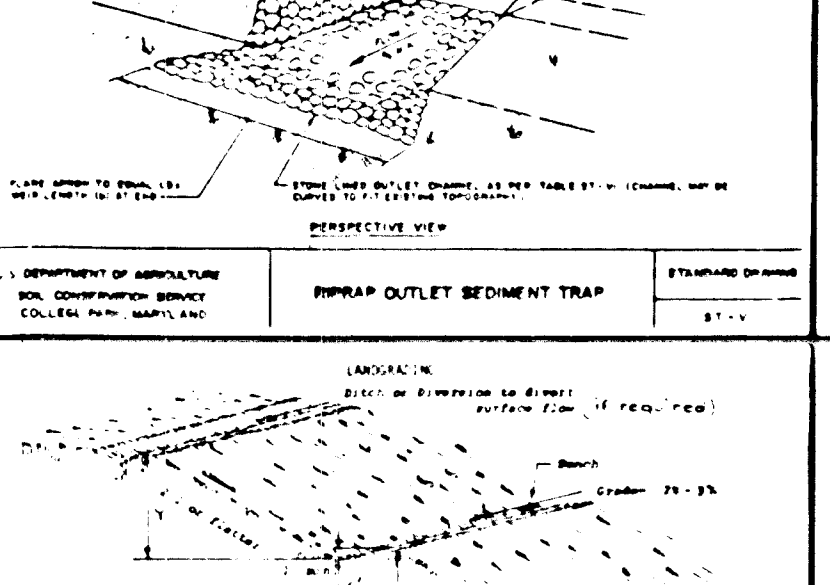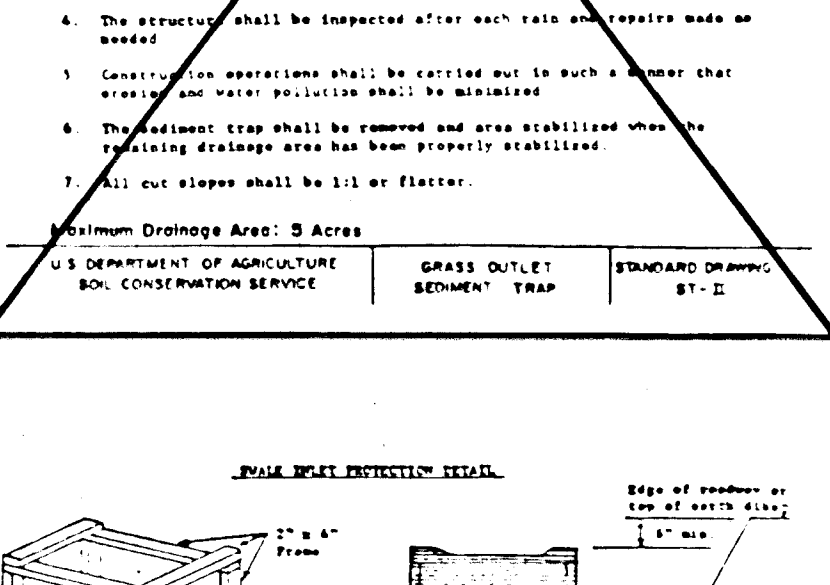
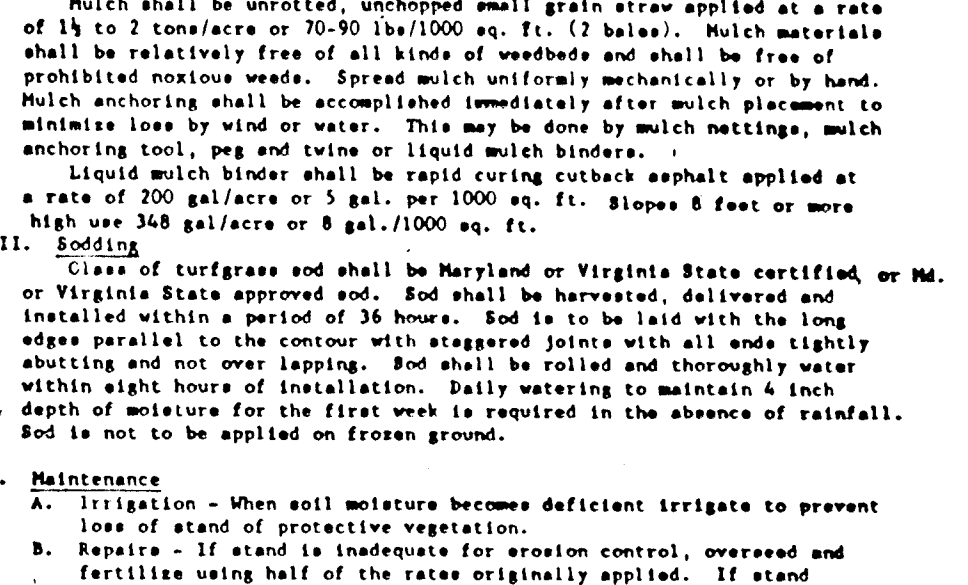


Section II - Topsoil Material and Application.
Note: Topsoil salvaged from the existing site may often be used but it should meet the same standards as set forth in the specifications. The depth of topsoil to be salvaged shall be no more than the depth described as a representative profile for that particular soil type as described in the soil survey published by USDA-SCS in cooperation with Maryland Agricultural Experiment Station.
A. Materials: Topsoil shall be a low, sandy loam, clay loam, silt loam, sandy clay loam, loam sand or other soil as approved by an agronomist or soil scientist. It shall not have a mixture of contrasting textured subsoil and contain no more than 5 percent by volume of cinders, stones, slag, coarse fragment, gravel, sticks, roots, trash or other extraneous materials larger than 1 1/2 inches in diameter. Topsoil must be free of plants or plant parts of beresegrass, quackgrass, Johnsongrass, nutgrass, poison ivy, thistle, or others as specified. All topsoil shall be tested by a recognized laboratory for organic matter content, pH and soluble salts. A pH of 6.0 to 7.5 and an organic content of not less than 1.5 percent by weight is required. If pH value is less than 6.0, lime shall be applied and incorporated with the topsoil to adjust the pH to 6.5 or higher. Topsoil containing soluble salts greater than 500 parts per million shall not be used.
No soil or seed shall be placed on soil which has been treated with soil sterilants or chemicals used for weed control until sufficient time has elapsed to permit dissipation of toxic materials.
Note: Topsoil substitutes or amendments as approved by a qualified agronomist or soil scientist, may be used in lieu of natural topsoil.
B. Grading: The topsoil shall be uniformly distributed and compacted to a minimum of four (4) inches. Spreading shall be performed in such a manner that sodding or seeding can proceed with a minimum of additional soil preparation and tillage. Any irregularities on the surface resulting from topsoiling or other operations shall be corrected in order to prevent the formation of depressions or water pockets. Top soil shall not be placed while in a frozen or muddy condition when the subgrade is excessively wet, so in a condition that may adversely affect the effectiveness to proper grading and seeded preparation.

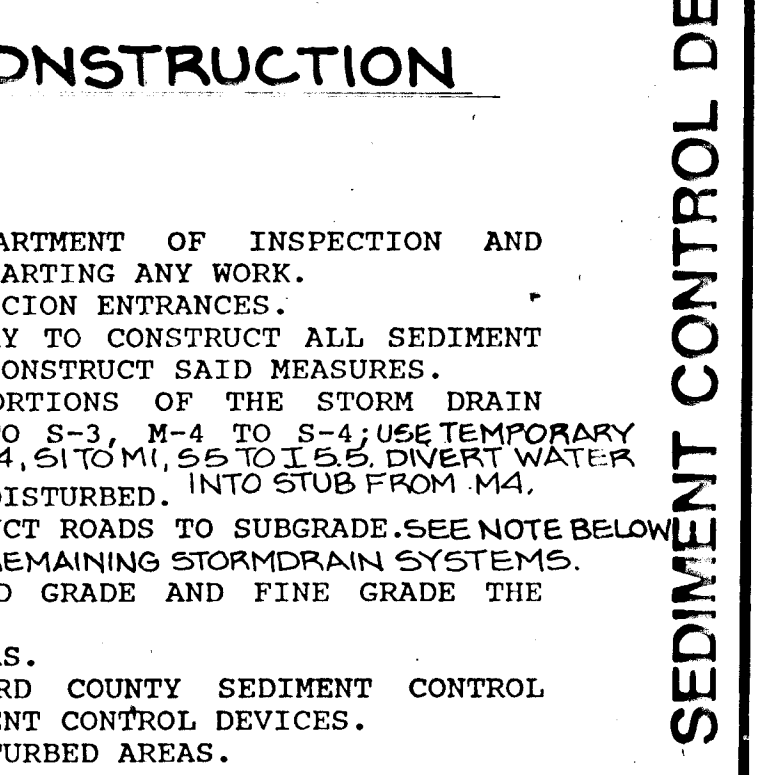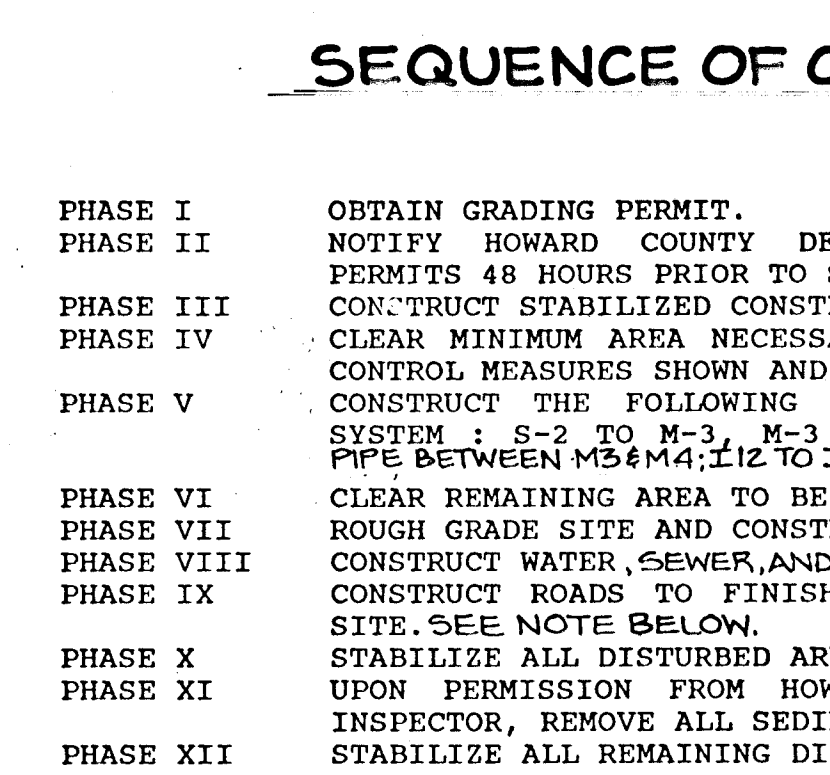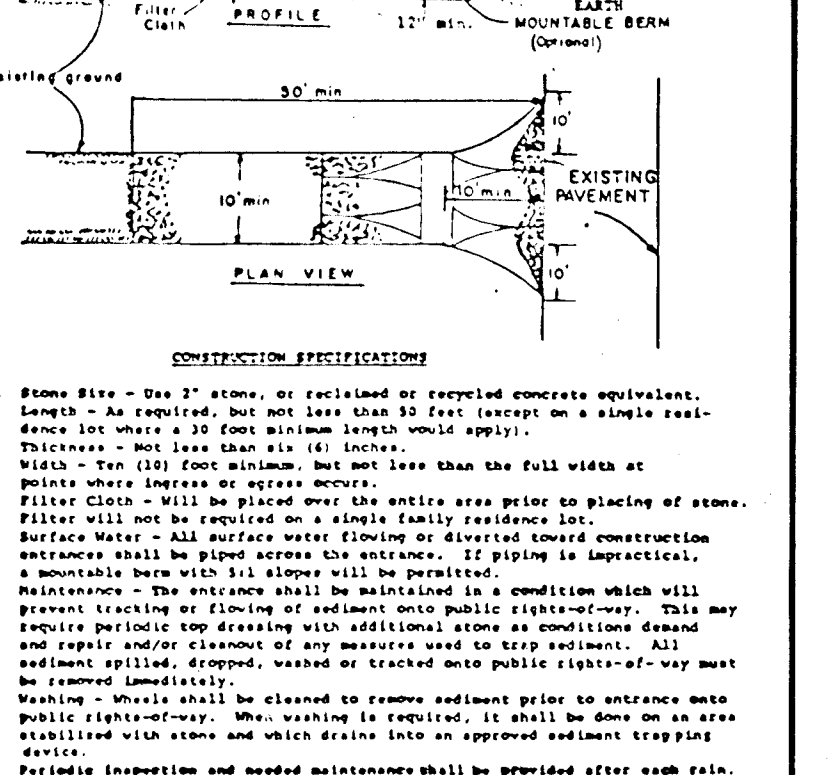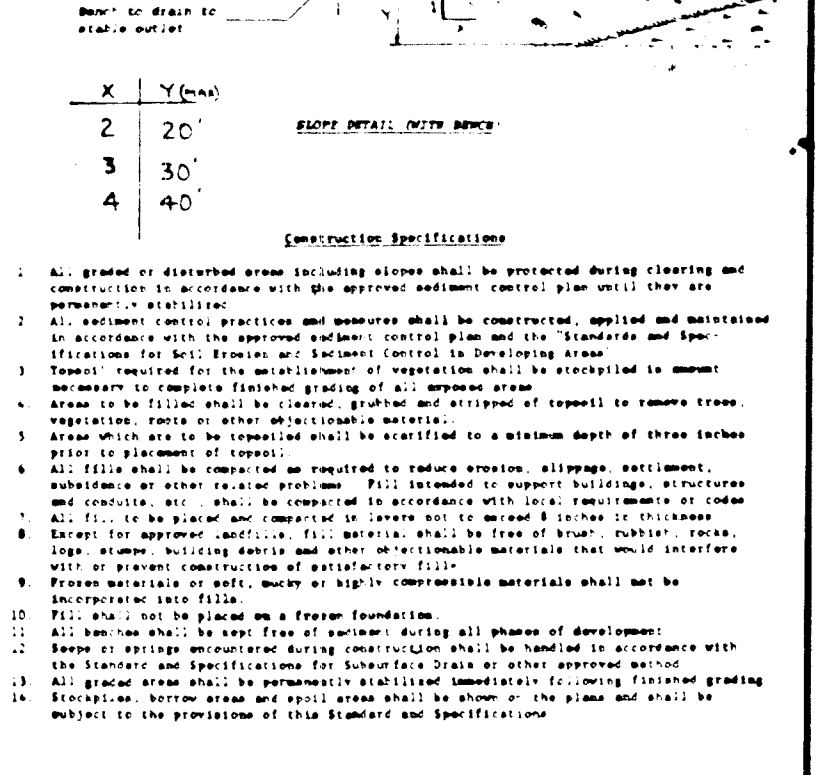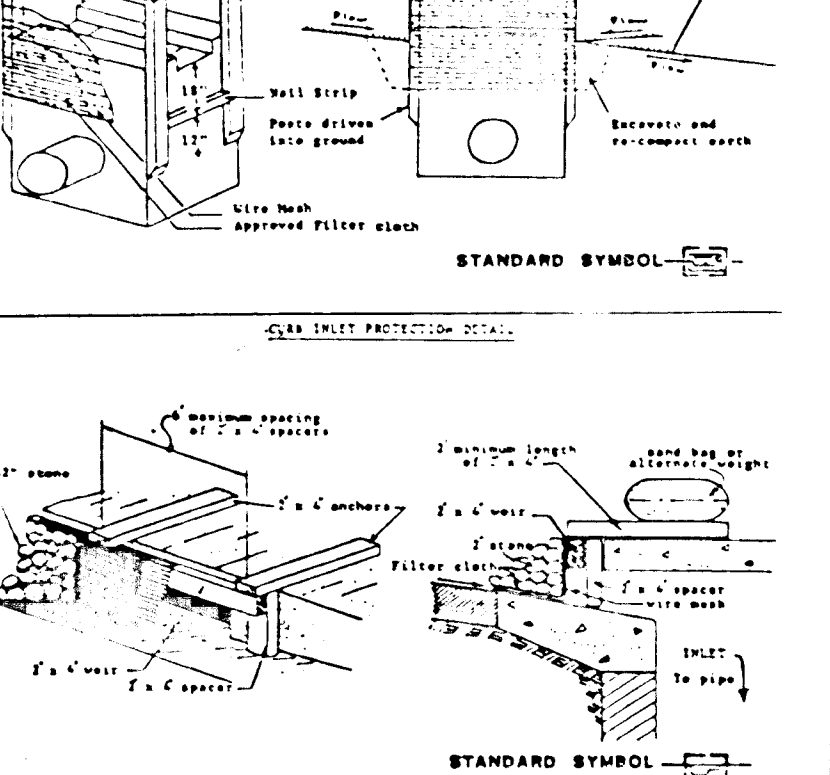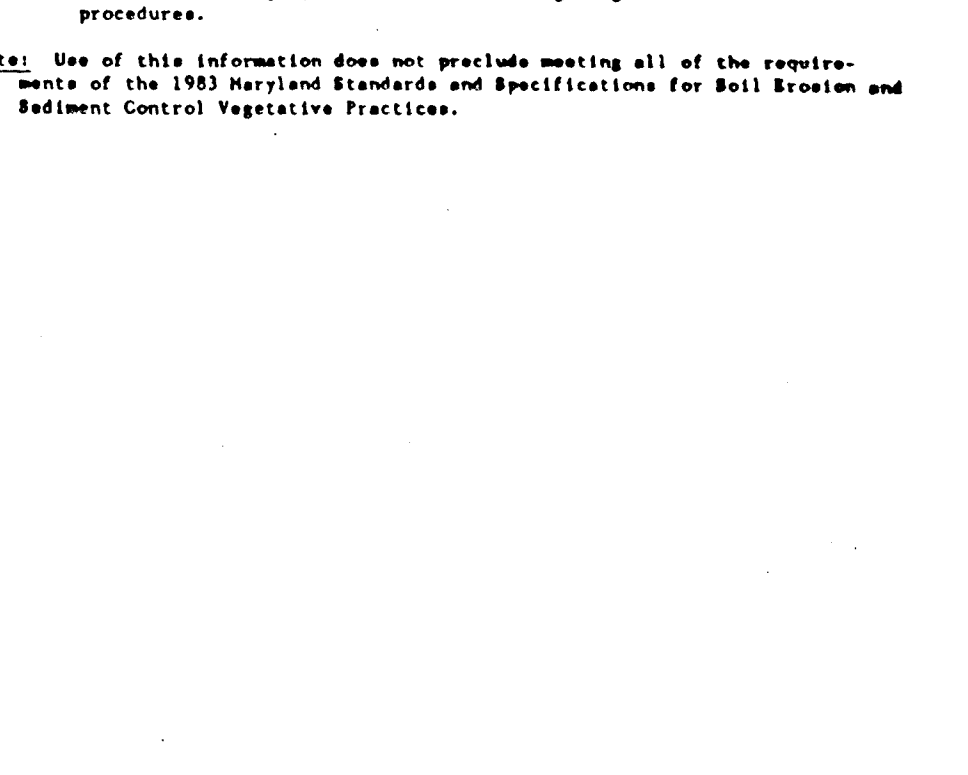

Alternative for Permanent Seeding
As an option to applying the full amounts of lime and commercial fertilizer, apply Composted Sludge as specified below, a normal fertilizer at the rate of 4 pounds per 1,000 square foot and 1/3 the normal lime application rate.
Composted Sludge Material
Composted sludge for use as a soil amendment or conditioner shall conform to the following requirements:
1. Be supplied by or originate from a person or persons that are permitted (i.e. the time of acquisition of the compost) by the Maryland Department of Health and Mental Hygiene under Regulation 10.17.10.
2. Shall contain at least 1 percent nitrogen, 1.5 percent phosphorus and 2 percent potassium and have a pH of 7.0 and 8.0.
If compost does not meet these requirements, the appropriate constituents must be added so that the requirements are met prior to use of the compost.
3. Be applied at a rate of 2,000 pounds per 1,000 square feet.
References
1. Guideline Specifications, Soil Preparation and Sodding, MD-1A, Pub. #1, Cooperative Extension Service, University of Maryland and Virginia Polytechnic Institute, Revised 1973.

APPROVED FOR HOWARD COUNTY SOIL CONSERVATION DISTRICT AND MEETS TECHNICAL REQUIREMENTS
APPROVED FOR HOWARD COUNTY DEPT. OF PLANNING AND ZONING
APPROVED HOWARD COUNTY DEPARTMENT OF PUBLIC WORKS

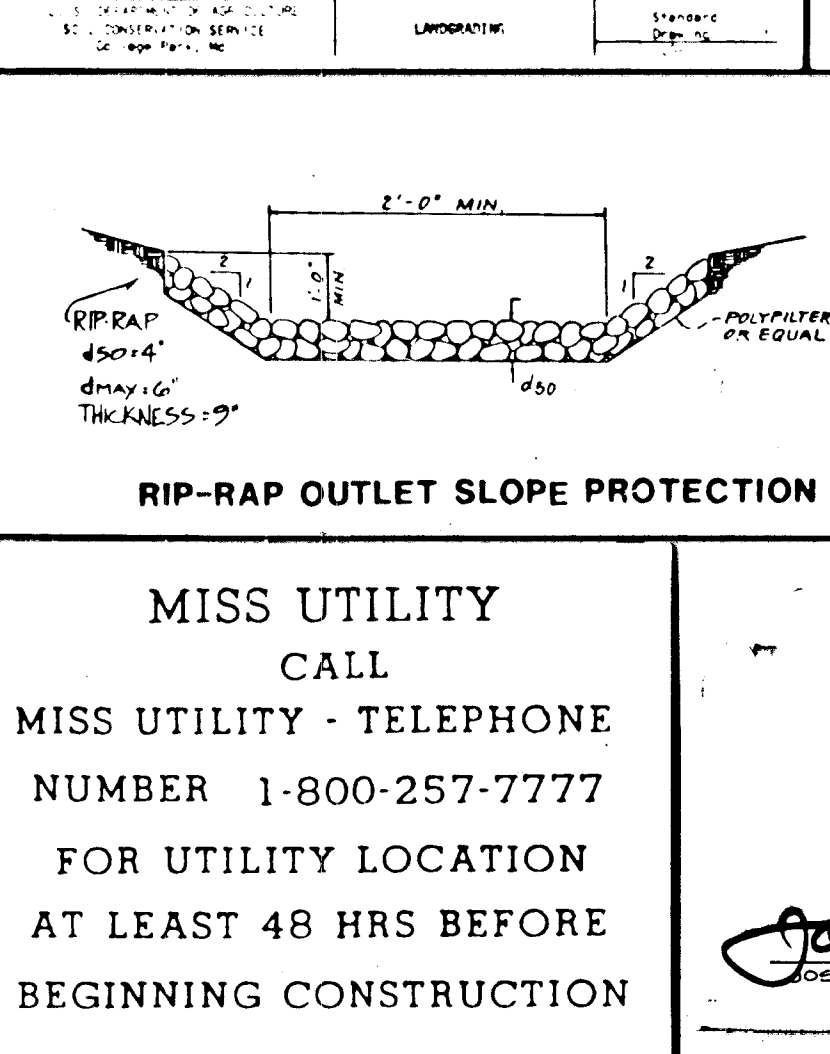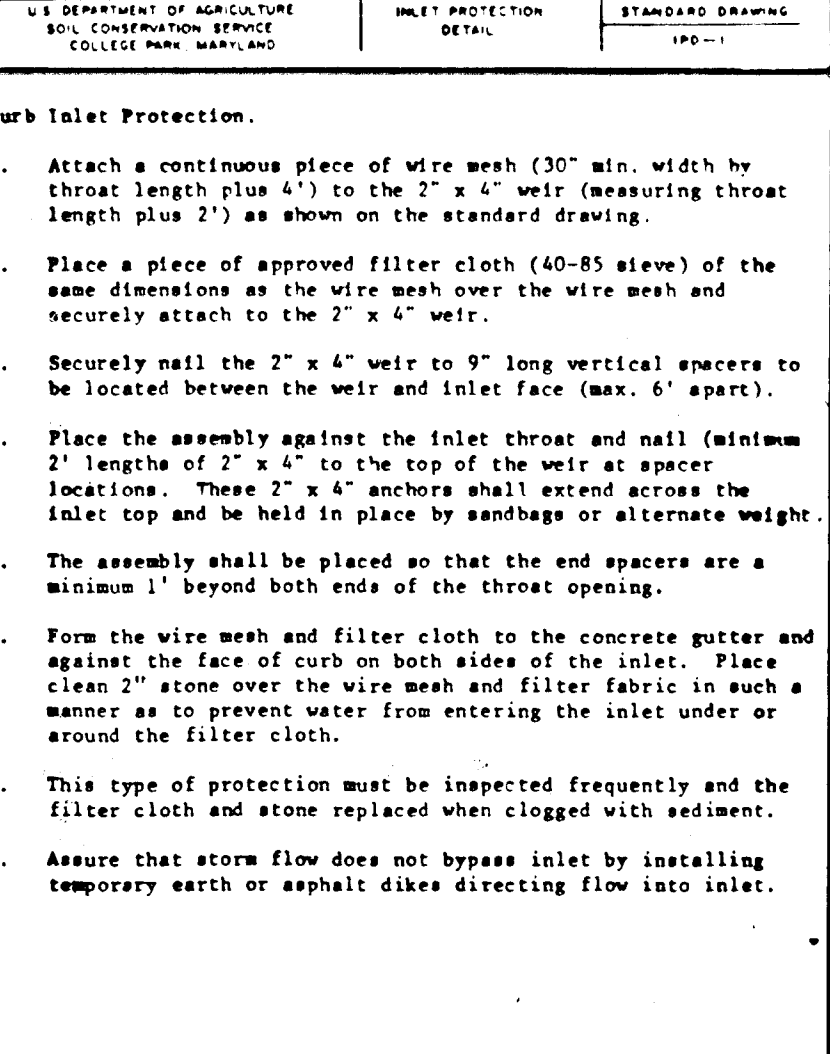


ENGINEER'S CERTIFICATE
I CERTIFY THAT THIS PLAN FOR FOND CONSTRUCTION, EROSION AND SEDIMENT CONTROL REPRESENTS A PRACTICAL AND WORKABLE PLAN BASED ON MY PERSONAL KNOWLEDGE OF THE SITE CONDITIONS...
DEVELOPER'S CERTIFICATE
I/WE CERTIFY THAT ALL DEVELOPMENT AND/OR CONSTRUCTION WILL BE DONE ACCORDING TO THESE PLANS AND THAT ANY RESPONSIBLE PERSONNEL INVOLVED IN THE CONSTRUCTION PROJECT WILL HAVE A CERTIFICATE OF ATTENDANCE AT A DEPARTMENT OF NATURAL RESOURCES APPROVED TRAINING PROGRAM FOR THE CONTROL OF SEDIMENT AND EROSION BEFORE BEGINNING THE PROJECT...
TOTAL SITE = 28.7 Ac.
TOTAL DISTURBED = 18.2 Ac.
TOTAL UNDISTURBED = 10.5 Ac.
VOLUME OF SPOIL =
VOLUME OF BORROW =


SEDIMENT CONTROL DETAILS
MONTGOMERY MEADOWS SECTION 1 - AREA 5
PHASE I OBTAIN GRADING PERMIT.
PHASE II NOTIFY HOWARD COUNTY DEPARTMENT OF INSPECTION AND PERMITS 48 HOURS PRIOR TO STARTING ANY WORK.
PHASE III CONSTRUCT STABILIZED CONSTRUCTION ENTRANCES.
PHASE IV CLEAR MINIMUM AREA NECESSARY TO CONSTRUCT ALL SEDIMENT CONTROL MEASURES SHOWN AND CONSTRUCT SAID MEASURES.
PHASE V CONSTRUCT THE FOLLOWING PORTIONS OF THE STORM DRAIN SYSTEM: 6" TO 8" DIA. 18" TO 24" DIA. 24" TO 36" DIA. 36" TO 48" DIA. USE TEMPORARY PIPE BETWEEN M3/M4, I2/I4, S10/M15, TO I5, DIVERT WATER CLEAR REMAINING AREA TO BE DISTURBED. INTO SUB FROM M4.
PHASE VI CLEAR REMAINING AREA TO BE DISTURBED.
PHASE VII ROUGH GRADE SITE AND CONSTRUCT ROADS TO SUBGRADE. SEE NOTE BELOW.
PHASE VIII CONSTRUCT WATER, SEWER, AND REMAINING STORM DRAIN SYSTEMS.
PHASE IX CONSTRUCT ROADS TO FINISHED GRADE AND FINE GRADE THE SITE. SEE NOTE BELOW.
PHASE X STABILIZE ALL DISTURBED AREAS.
PHASE XI UPON PERMISSION FROM HOWARD COUNTY SEDIMENT CONTROL INSPECTOR, REMOVE ALL SEDIMENT CONTROL DEVICES.
PHASE XII STABILIZE ALL REMAINING DISTURBED AREAS.
PHASE XIII MAINTENANCE.
NOTE: LOTS 261 TO 279 WILL BE ROUGH GRADED AND FINE GRADED WITH MONTGOMERY MEADOWS SECTION ONE AREA 4 (PROPOSED WITH F-88-190)

SOILS MAP
APPROVED FOR HOWARD COUNTY SOIL CONSERVATION DISTRICT AND MEETS TECHNICAL REQUIREMENTS
APPROVED FOR HOWARD COUNTY DEPT. OF PLANNING AND ZONING
APPROVED HOWARD COUNTY DEPARTMENT OF PUBLIC WORKS

Dewberry & Davis
Engineers Architects Planners Surveyors
3500 N. RIDGE ROAD, SUITE 100
ELLCOTT CITY, MD. 21043
(301) 461-7478
MONTGOMERY MEADOWS SECTION 1 - AREA 5
1ST ELECTION DISTRICT HOWARD COUNTY MARYLAND
Scale N/A
Sheet 10 of 12
Date 7/12/89
File Number

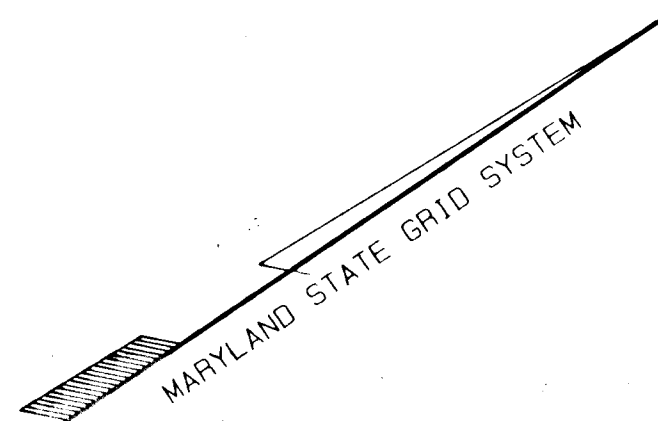

LANDSCAPE TABULATION				
SYMBOL	NO.	NAME	SIZE	REMARKS
	92	SUGAR MAPLE	2 1/2" CAL	440
	12	FLOWERING TREE (HAWTHORN)	2 1/2" CAL	440

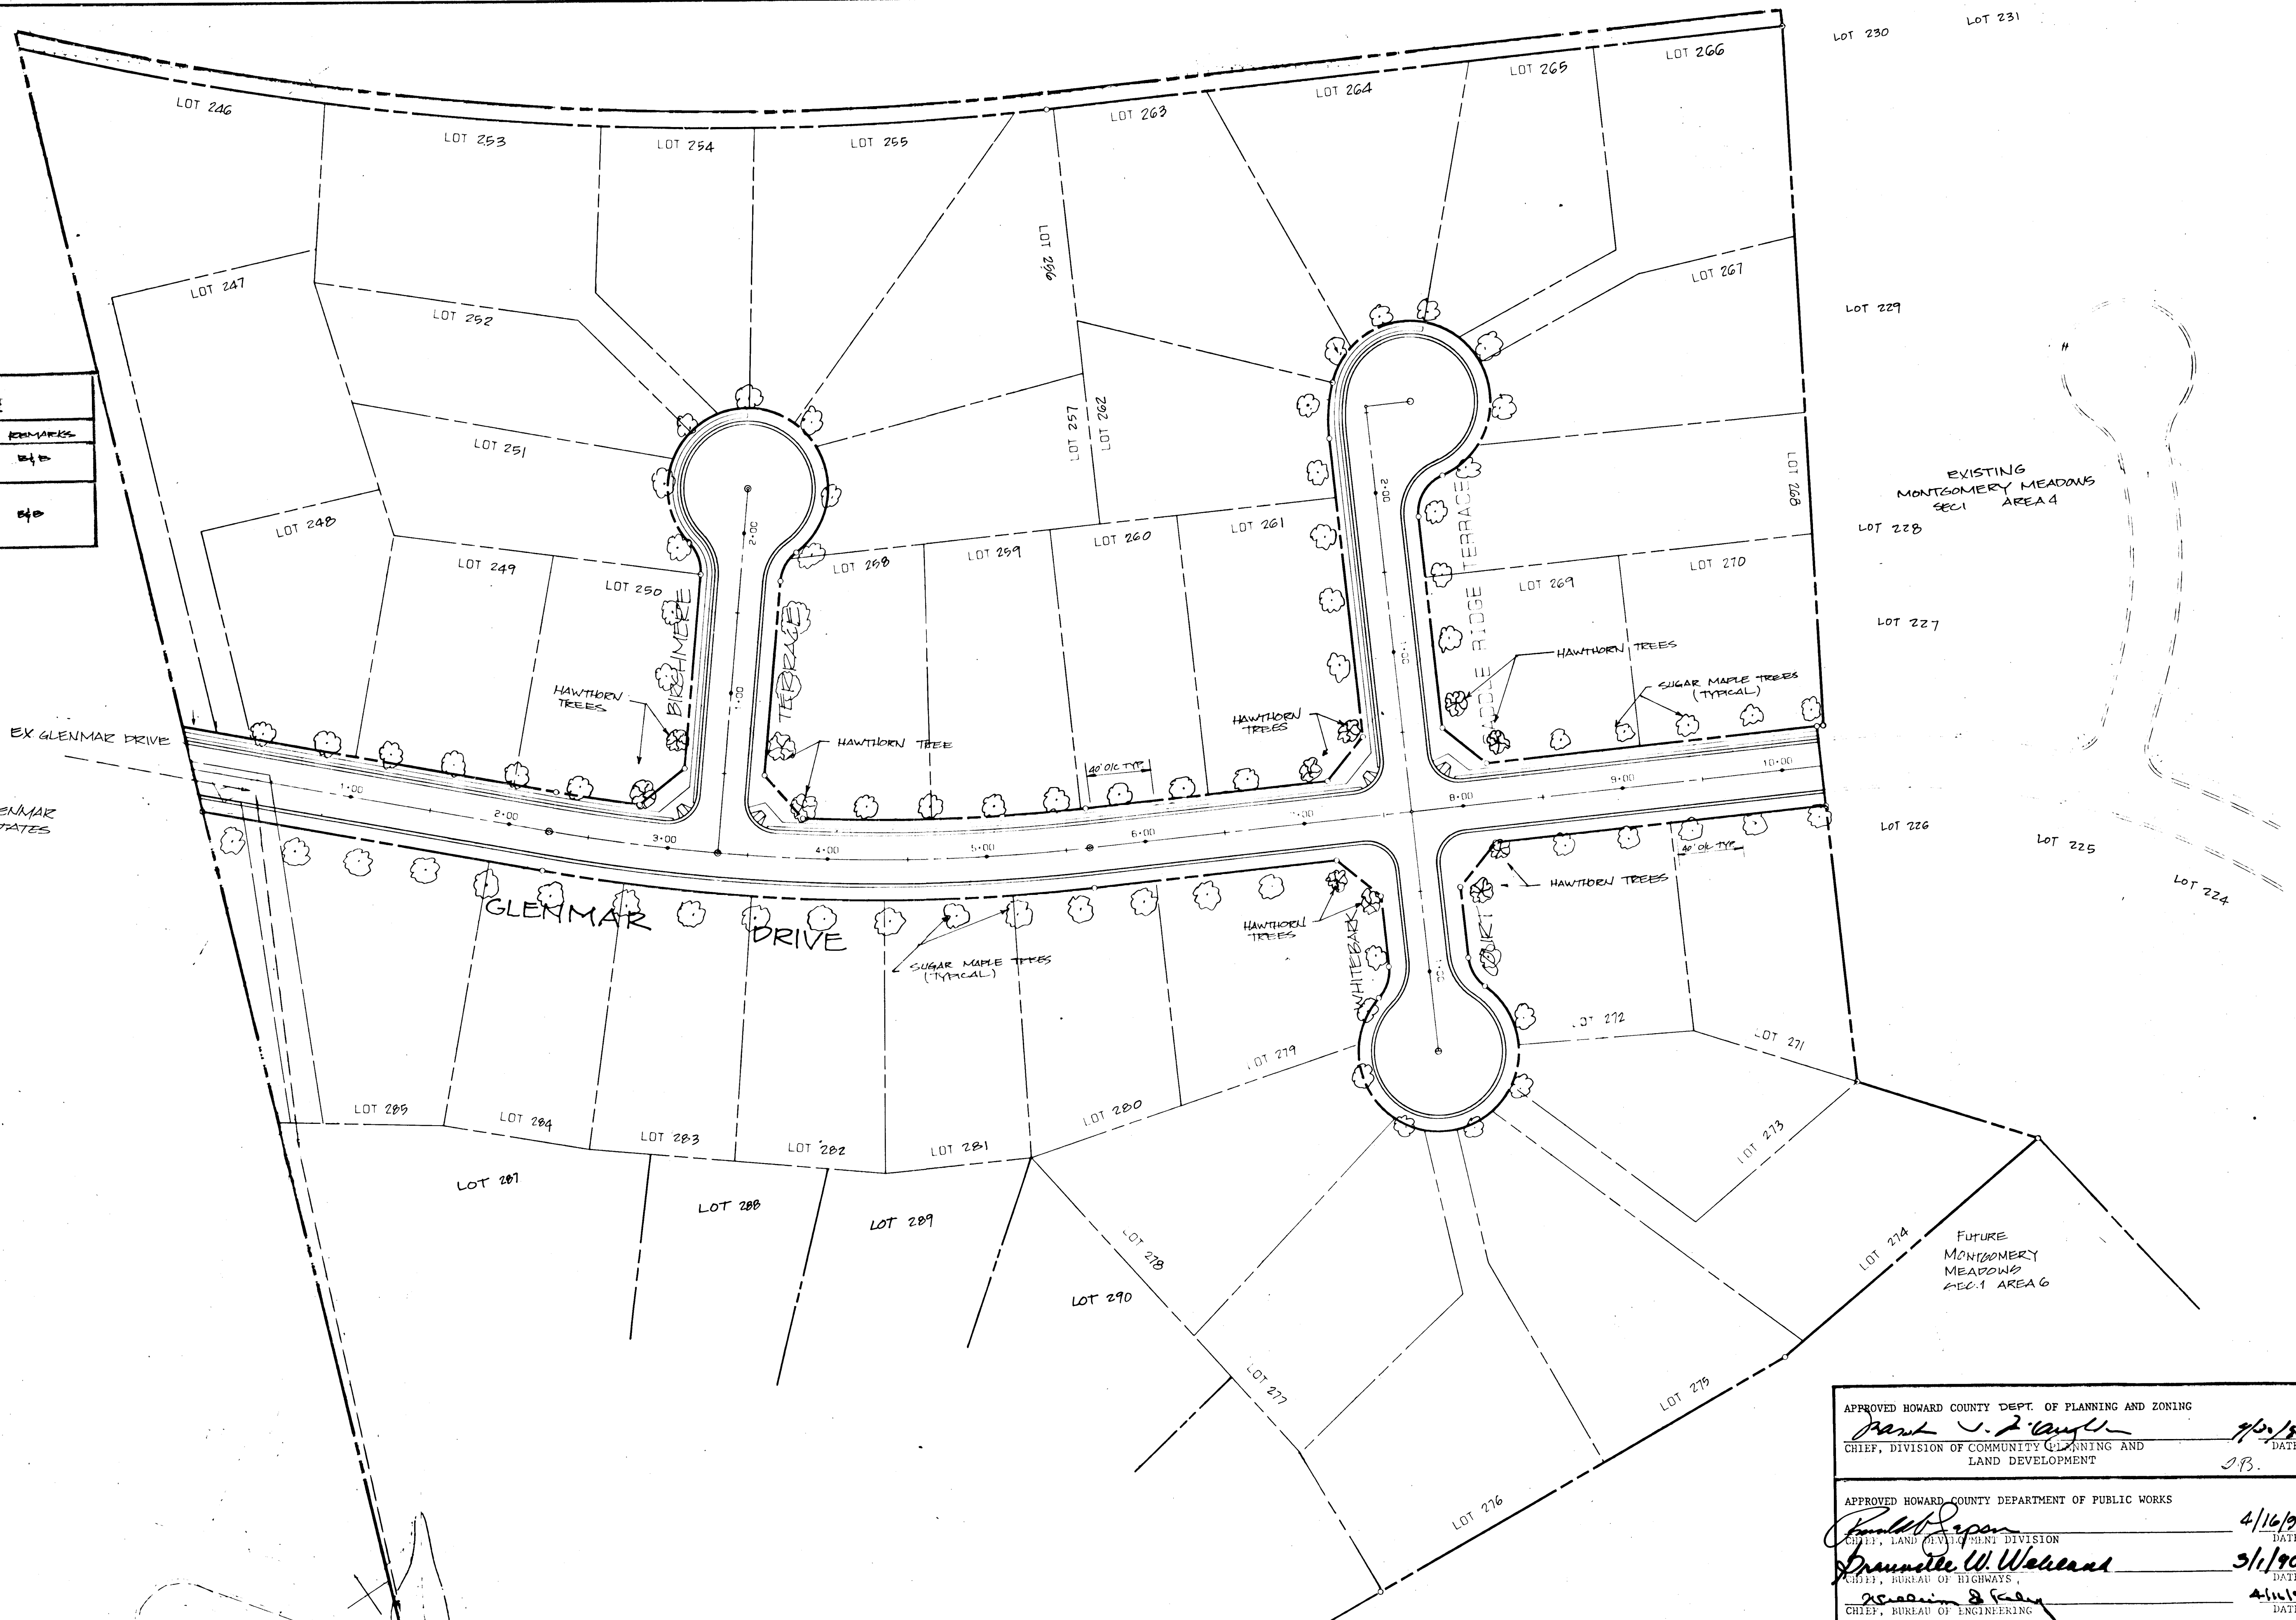

NOTE: FOR TREE PLANTING DETAILS SEE LANDSCAPE PLANS SHEET 12 OF 12

APPROVED HOWARD COUNTY DEPT. OF PLANNING AND ZONING
Paul J. Langley 4/16/90
 CHIEF, DIVISION OF COMMUNITY PLANNING AND LAND DEVELOPMENT
 J.P.

APPROVED HOWARD COUNTY DEPARTMENT OF PUBLIC WORKS
Donald E. Brown 4/16/90
 CHIEF, LAND DEVELOPMENT DIVISION
Drummond W. Wallace 5/1/90
 CHIEF, BUREAU OF HIGHWAYS
Thomas S. Kelly 4/16/90
 CHIEF, BUREAU OF ENGINEERING

THIS SHEET IS FOR LANDSCAPE PURPOSES ONLY

1443

DESIGNED	date	REVISIONS	
		DATE	DESCRIPTION
DRAWN	date		
CHECKED	date		
APPROVED	date		

Dewberry & Davis
 ENGINEERS — ARCHITECTS — PLANNERS — SURVEYORS
 3300 N. RIDGE ROAD, SUITE 100
 ELLICOTT CITY, MD. 21043
 (301) 461-7478




MONTGOMERY MEADOWS GENERAL PARTNERSHIP
 9175 GUILFORD ROAD, SUITE 302
 COLUMBIA, MARYLAND 21046
 (301) 604-1552

LANDSCAPE PLAN




MONTGOMERY MEADOWS
 SECTION 1 AREA 5
 LOTS 246 THRU LOTS 300
 TAX MAP 31 PARCEL 423
 1ST ELECTION DISTRICT HOWARD CO. MARYLAND

SCALE 1" = 50' CONTRACT NO. FILE NO. SHEET 11 OF 12

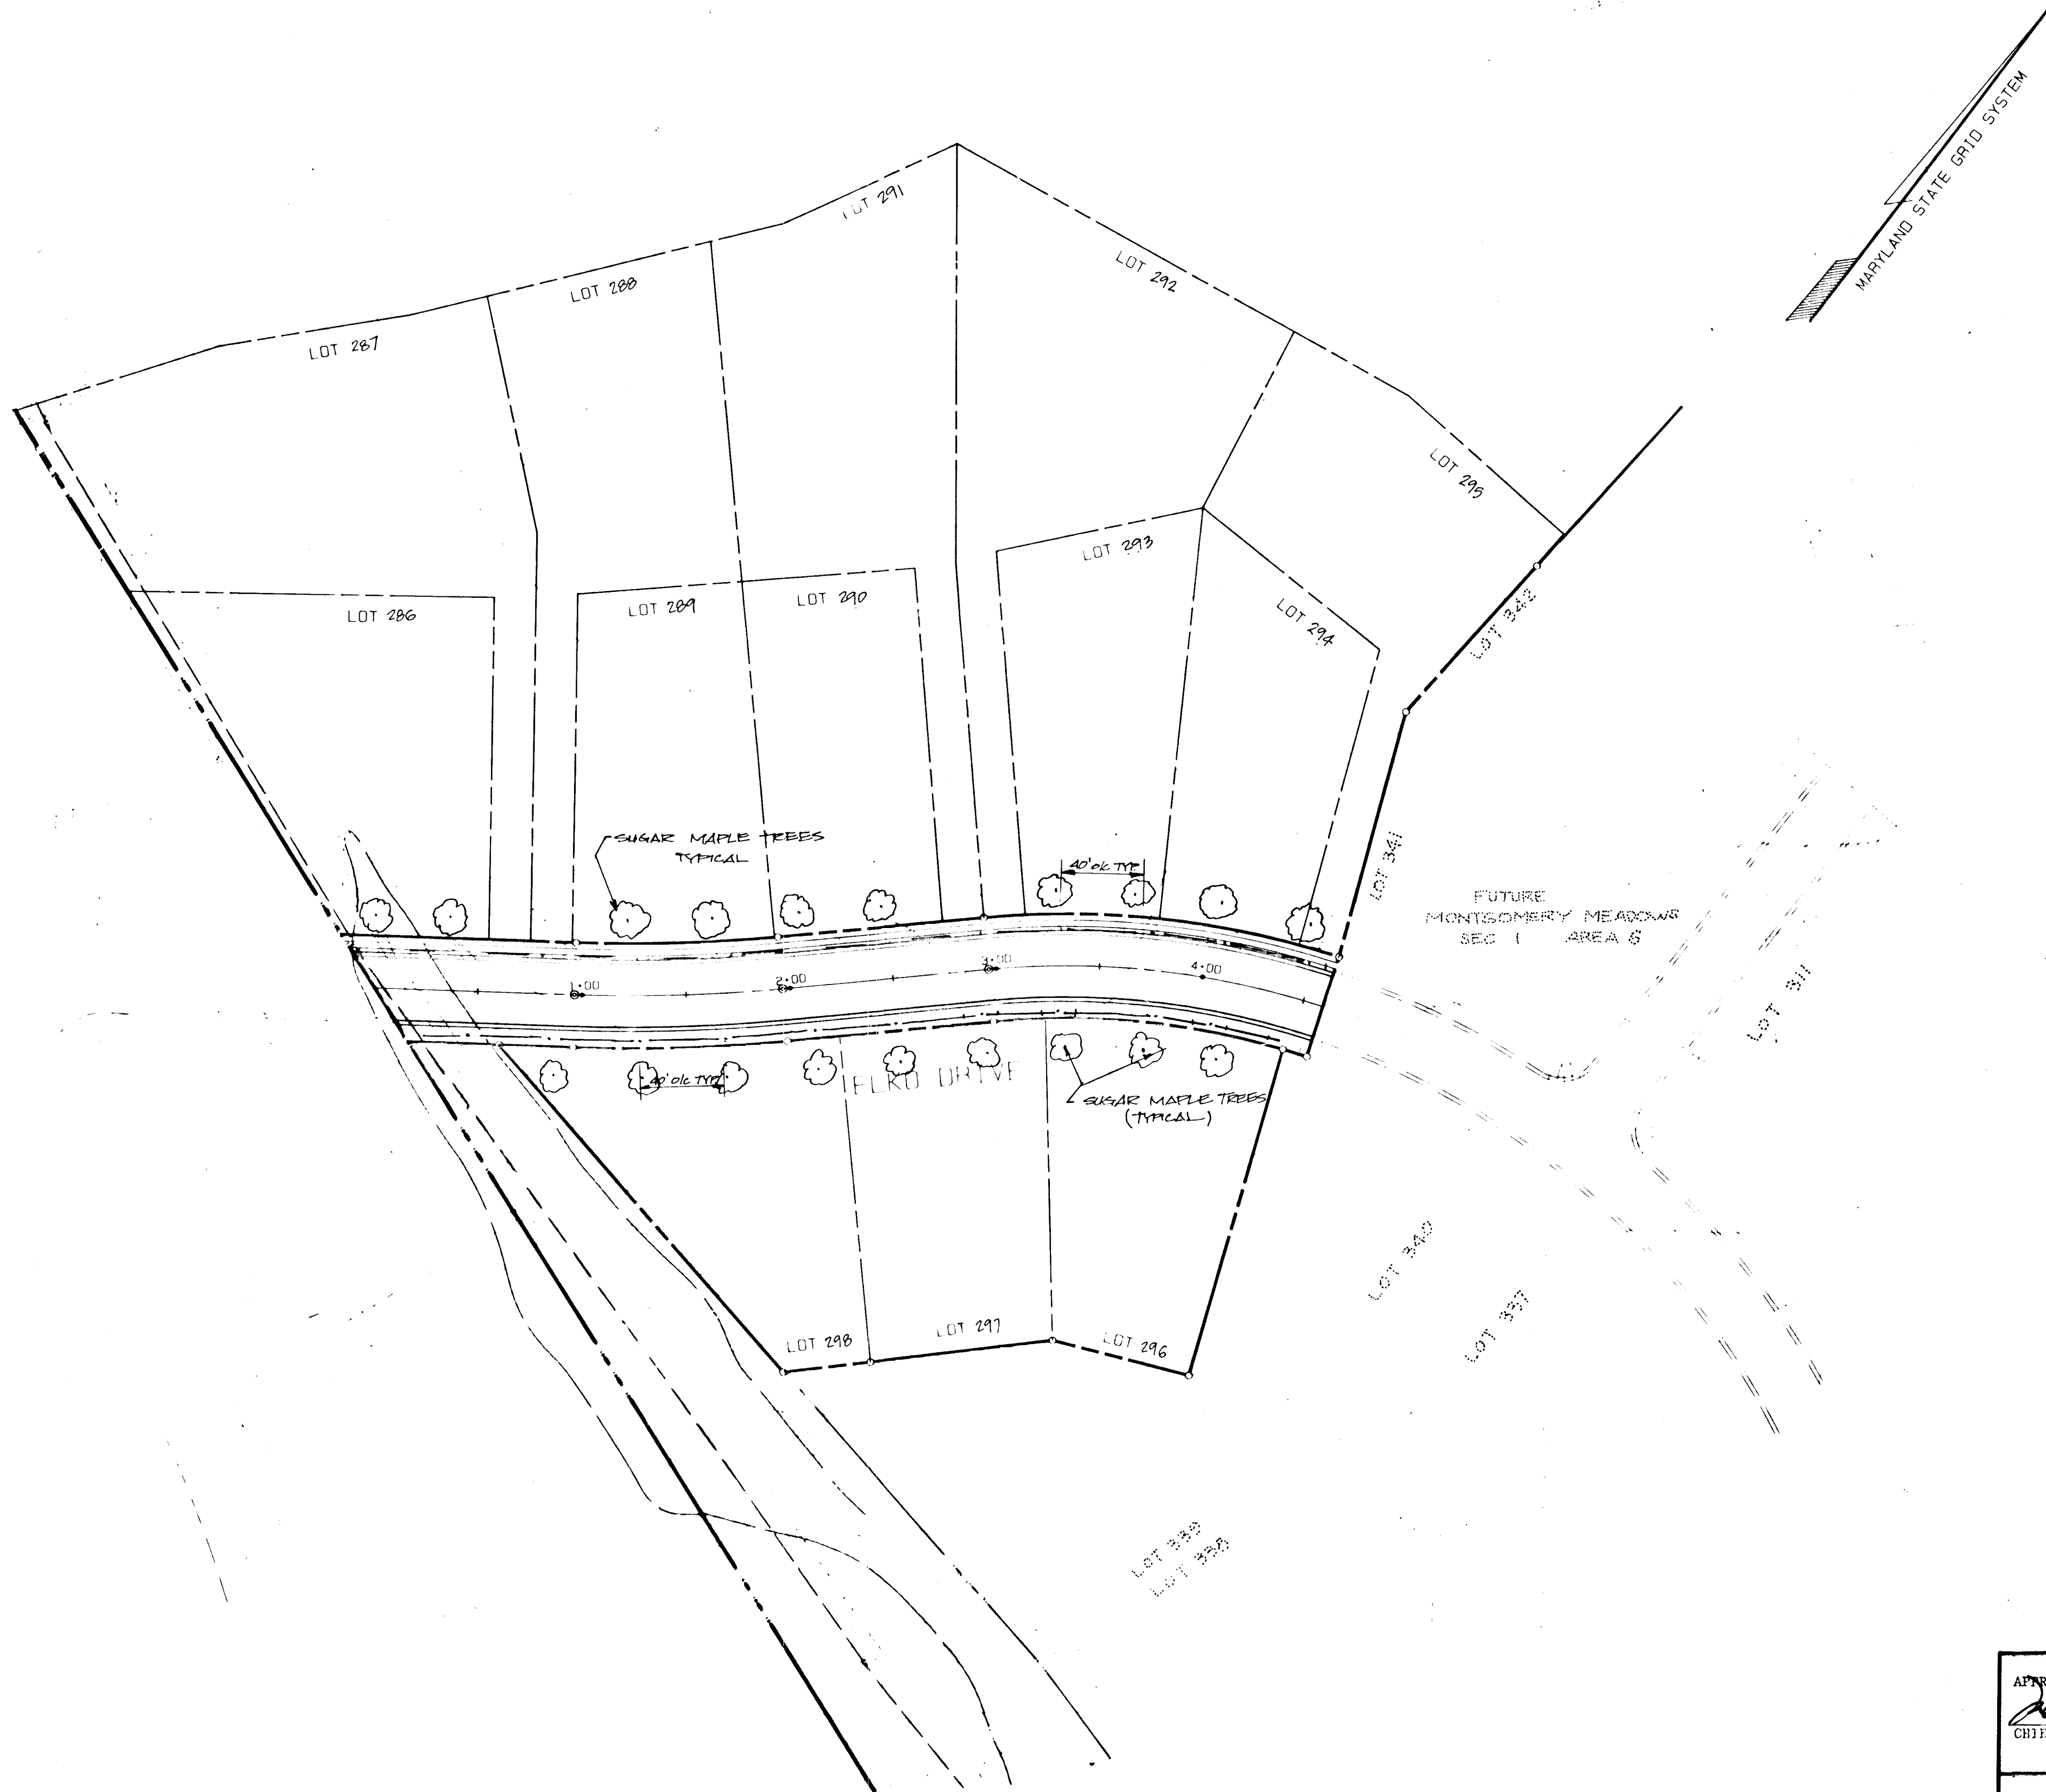

CONTRACTOR SHALL VERIFY LOCATION UNDERGROUND UTILITIES PRIOR TO DIGGING. FINAL LOCATION OF TREES MAY BE ADJUSTED SLIGHTLY TO ACCOMMODATE FIELD CONDITIONS. PLANTING PROCEDURES SHALL COMPLY WITH "LANDSCAPE SPECIFICATIONS FOR BALTIMORE-WASHINGTON METROPOLITAN AREAS" SUBSTITUTIONS TO THE ABOVE SPECIES MAY BE PERMITTED, PROVIDED THAT THE PLANTING IS IN ACCORDANCE WITH THE STREET TREE AND LANDSCAPE REQUIREMENTS AS SPECIFIED IN SECTION 16.131 OF THE HOWARD COUNTY SUBDIVISION REGULATIONS.

● DENOTES APPROXIMATE LOCATION OF STREET TREES

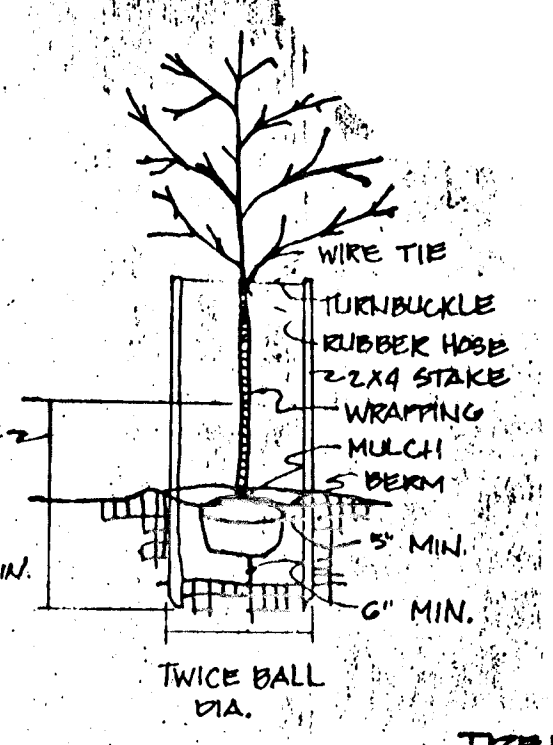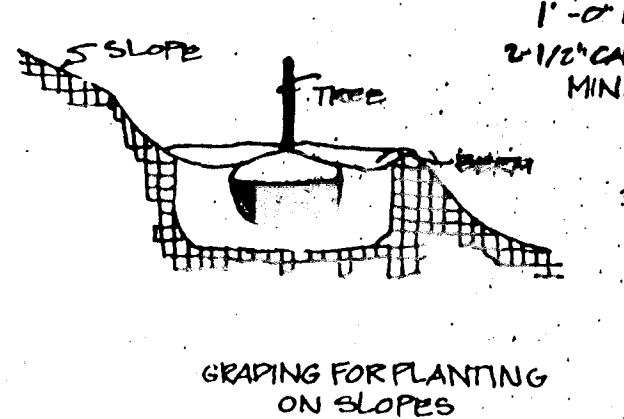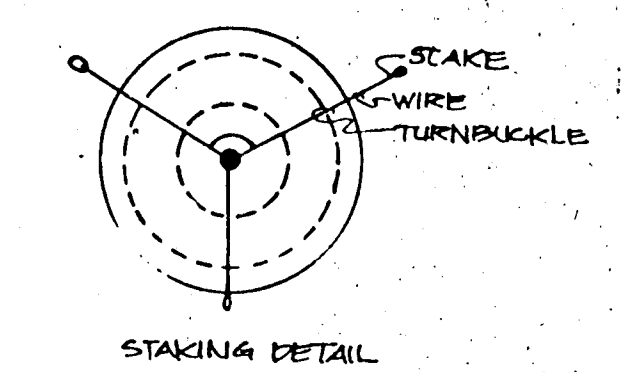

Note: REMOVE BURLAP FROM TOP 1/3 OF BALL

TREE PLANTING DETAIL
NOT TO SCALE

THIS SHEET IS FOR LANDSCAPE PURPOSES ONLY

APPROVED HOWARD COUNTY DEPT. OF PLANNING AND ZONING
Paul S. J. J. J. 4/16/90
 CHIEF, DIVISION OF COMMUNITY PLANNING AND LAND DEVELOPMENT

APPROVED HOWARD COUNTY DEPARTMENT OF PUBLIC WORKS
Franklin J. J. 4/16/90
 CHIEF, LAND DEVELOPMENT DIVISION

Dr. J. J. J. 3/1/90
 CHIEF, BUREAU OF HIGHWAYS

J. J. J. 4-16-90
 CHIEF, BUREAU OF ENGINEERING

	DATE	REVISIONS	
		DATE	DESCRIPTION
DESIGNED	_____		
DRAWN	_____		
CHECKED	_____		
APPROVED	_____		

Dewberry & Davis
 ENGINEERS — ARCHITECTS — PLANNERS — SURVEYORS
 3300 N. RIDGE ROAD, SUITE 100
 ELLICOTT CITY, MD. 21043
 (301) 461-7478



MONTGOMERY MEADOWS GENERAL PARTNERSHIP
 9175 GUILFORD ROAD, SUITE 302
 COLUMBIA, MARYLAND 21046
 (301) 604-1552

MONTGOMERY MEADOWS
 SECTION 1 AREA 5
 LOTS 246 THRU LOTS 300
 TAX MAP 31 PARCEL 423
 1ST ELECTION DISTRICT HOWARD CO. MARYLAND

SCALE 1"=50' CONTRACT NO. FILE NO. SHEET 12 OF 12