


SHEET INDEX	
NO.	DESCRIPTION
1	TITLE SHEET
2	PLAN AND PROFILE OF TEN OAKS ROAD
3	PLAN AND PROFILE OF RUTHERFORD WAY STA. 0+00 TO 12+00
4	PLAN AND PROFILE OF RUTHERFORD WAY STA. 12+00 TO END
5	DRAINAGE AREA MAP
6	GRADING AND SEDIMENT CONTROL PLAN
7	GRADING AND SEDIMENT CONTROL PLAN
8	STORM DRAIN AND POND PROFILES
9	PROFILE AND DETAIL SHEET
10	DETAIL SHEET

ROADWAYS AND STORM DRAINS

RUTHERFORD

5th ELECTION DISTRICT

HOWARD COUNTY, MARYLAND

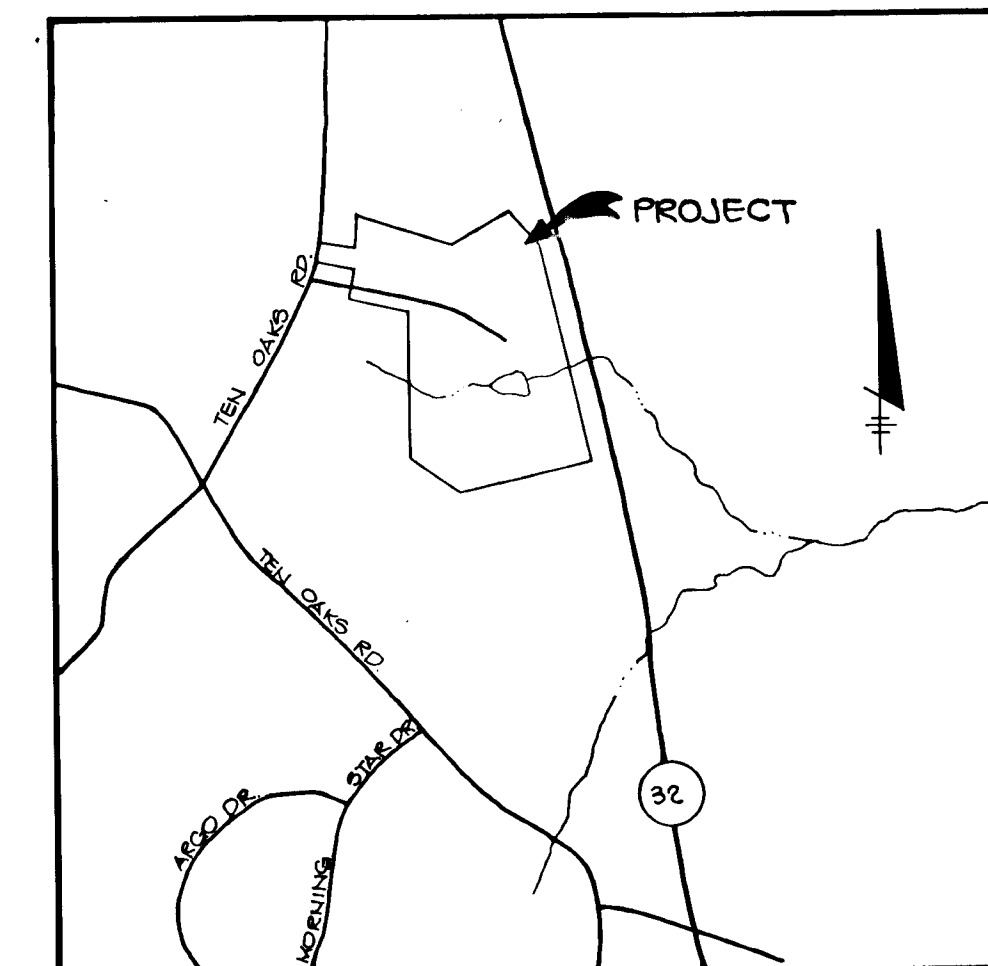

VICINITY MAP
SCALE: 1"=2000'

GENERAL NOTES

- ALL WORK SHALL BE PERFORMED IN ACCORDANCE WITH THE HOWARD COUNTY DESIGN MANUAL, VOL. IV, I.E., STANDARD SPECIFICATIONS AND DETAILS FOR CONSTRUCTION, 1989 AMENDMENTS.
- APPROXIMATE LOCATION OF EXISTING UTILITIES ARE SHOWN. THE CONTRACTOR SHALL TAKE ALL NECESSARY PRECAUTIONS TO PROTECT THE EXISTING UTILITIES AND MAINTAIN UNINTERRUPTED SERVICE. ANY DAMAGE INCURRED DUE TO CONTRACTOR'S OPERATION SHALL BE REPAIRED IMMEDIATELY AT THE CONTRACTOR'S EXPENSE.
- THE CONTRACTOR SHALL TEST PIT EXISTING UTILITIES AT LEAST FIVE (5) DAYS BEFORE STARTING WORK SHOWN ON THESE DRAWINGS.
- CONTRACTOR SHALL NOTIFY THE FOLLOWING UTILITIES AT LEAST FIVE (5) DAYS BEFORE STARTING WORK ON THESE DRAWINGS:


MISS UTILITY	1-800-257-7777
BELL TELEPHONE SYSTEM	393-3649
LONG DISTANCE CABLE DIVISION	393-3553 or 3554
BALTIMORE GAS AND ELECTRIC CO.	539-8000, ext. 691
HOWARD COUNTY BUREAU OF UTILITIES	992-2366
HOWARD COUNTY CONSTRUCTION	792-7272
INSPECTION SURVEY DIVISION (24 HOURS NOTICE PRIOR TO COMMENCEMENT OF WORK)	
COASTAL PIPELINE	795-1390
- ALL INLETS SHALL BE CONSTRUCTED IN ACCORDANCE WITH HOWARD COUNTY STANDARDS.
- ALL STREET CURB RETURNS SHALL HAVE 35.0' RADII UNLESS OTHERWISE NOTED.
- STORM DRAIN TRENCHES WITHIN ROAD RIGHT-OF-WAY SHALL BE BACKFILLED AND COMPACTED IN ACCORDANCE WITH HOWARD COUNTY DESIGN MANUAL, VOLUME IV, I.E., STANDARD SPECIFICATIONS AND DETAILS FOR CONSTRUCTION, 1989 AMENDMENTS.
- INSTALLATION OF TRAFFIC CONTROL DEVICES, MARKING, AND SIGNING SHALL BE IN ACCORDANCE WITH THE MANUAL OF UNIFORM TRAFFIC CONTROL DEVICES, 1984 REVISED EDITION.
- PIPE SHALL NOT BE INSTALLED BY THE CONTRACTOR UNTIL THE LENGTH CALLED FOR AT EACH STATION HAS BEEN APPROVED BY THE ENGINEER IN THE FIELD.
- DESIGNED TRAFFIC SPEED IN ACCORDANCE WITH THE AMERICAN ASSOCIATION OF STATE HIGHWAY OFFICIAL STANDARDS:

ALL 80' RIGHT-OF-WAYS	30	M.P.H.
ALL 50' RIGHT-OF-WAYS	30	M.P.H.
- ALL ELEVATIONS SHOWN ARE BASED ON U.S.C. AND G.S. MEAN SEA LEVEL DATUM, 1929.
- ALL FILL AREAS WITHIN ROADWAY AND UNDER STRUCTURES TO BE COMPACTED TO A MINIMUM OF 95% COMPACTION.
- ALL PIPE ELEVATIONS SHOWN ARE INVERT \ominus ELEVATIONS.
- PROFILE STATIONS SHALL BE ADJUSTED AS NECESSARY TO CONFORM TO PLAN DIMENSIONS.
- SUBJECT PROPERTY ZONED R PER B-2-85 COMPREHENSIVE ZONING PLAN.
- TOPO TAKEN FROM FIELD RUN SURVEY DATED JULY, 1988 BY RIEMER MUEGGE & ASSOC., INC.
- NO PIPE SHALL BE LAID UNTIL LINES OF EXCAVATION HAVE BEEN BROUGHT WITHIN 6" OF FINISHED GRADE.
- ALL STORM DRAIN PIPE BEHIND SHALL BE CLASS 'C' AS SHOWN IN FIG. 11.4, VOLUME 1 OF HOWARD COUNTY DESIGN MANUAL UNLESS OTHERWISE NOTED.
- SEE DEPT. OF PLANNING AND ZONING FILE Nos. S-88-82, P-88-50, WP-88-11
- WP-88-11 IS A WAIVER FOR EXCEEDING THE ALLOWABLE 1200 FEET LENGTH FOR A CUL-DE-SAC STREET.



BENCH MARKS

B.M.#1 ELEV. 571.80
 N511513.020 E 808,010.861
 REINFORCING ROD, 3/4" INCH 0.5' BELOW SURFACE
 WEST SIDE OF PAVING ON TEN OAKS ROAD
 0.15 MILE SOUTH OF GREEN BRIDGE ROAD

B.M.#2 ELEV. 573.46
 N512020.605 E 808,685.125
 CONCRETE MONUMENT 0.2' BELOW SURFACE
 AT INTERSECTION OF TEN OAKS ROAD, GREEN
 BRIDGE ROAD AND LINTHICUM ROAD

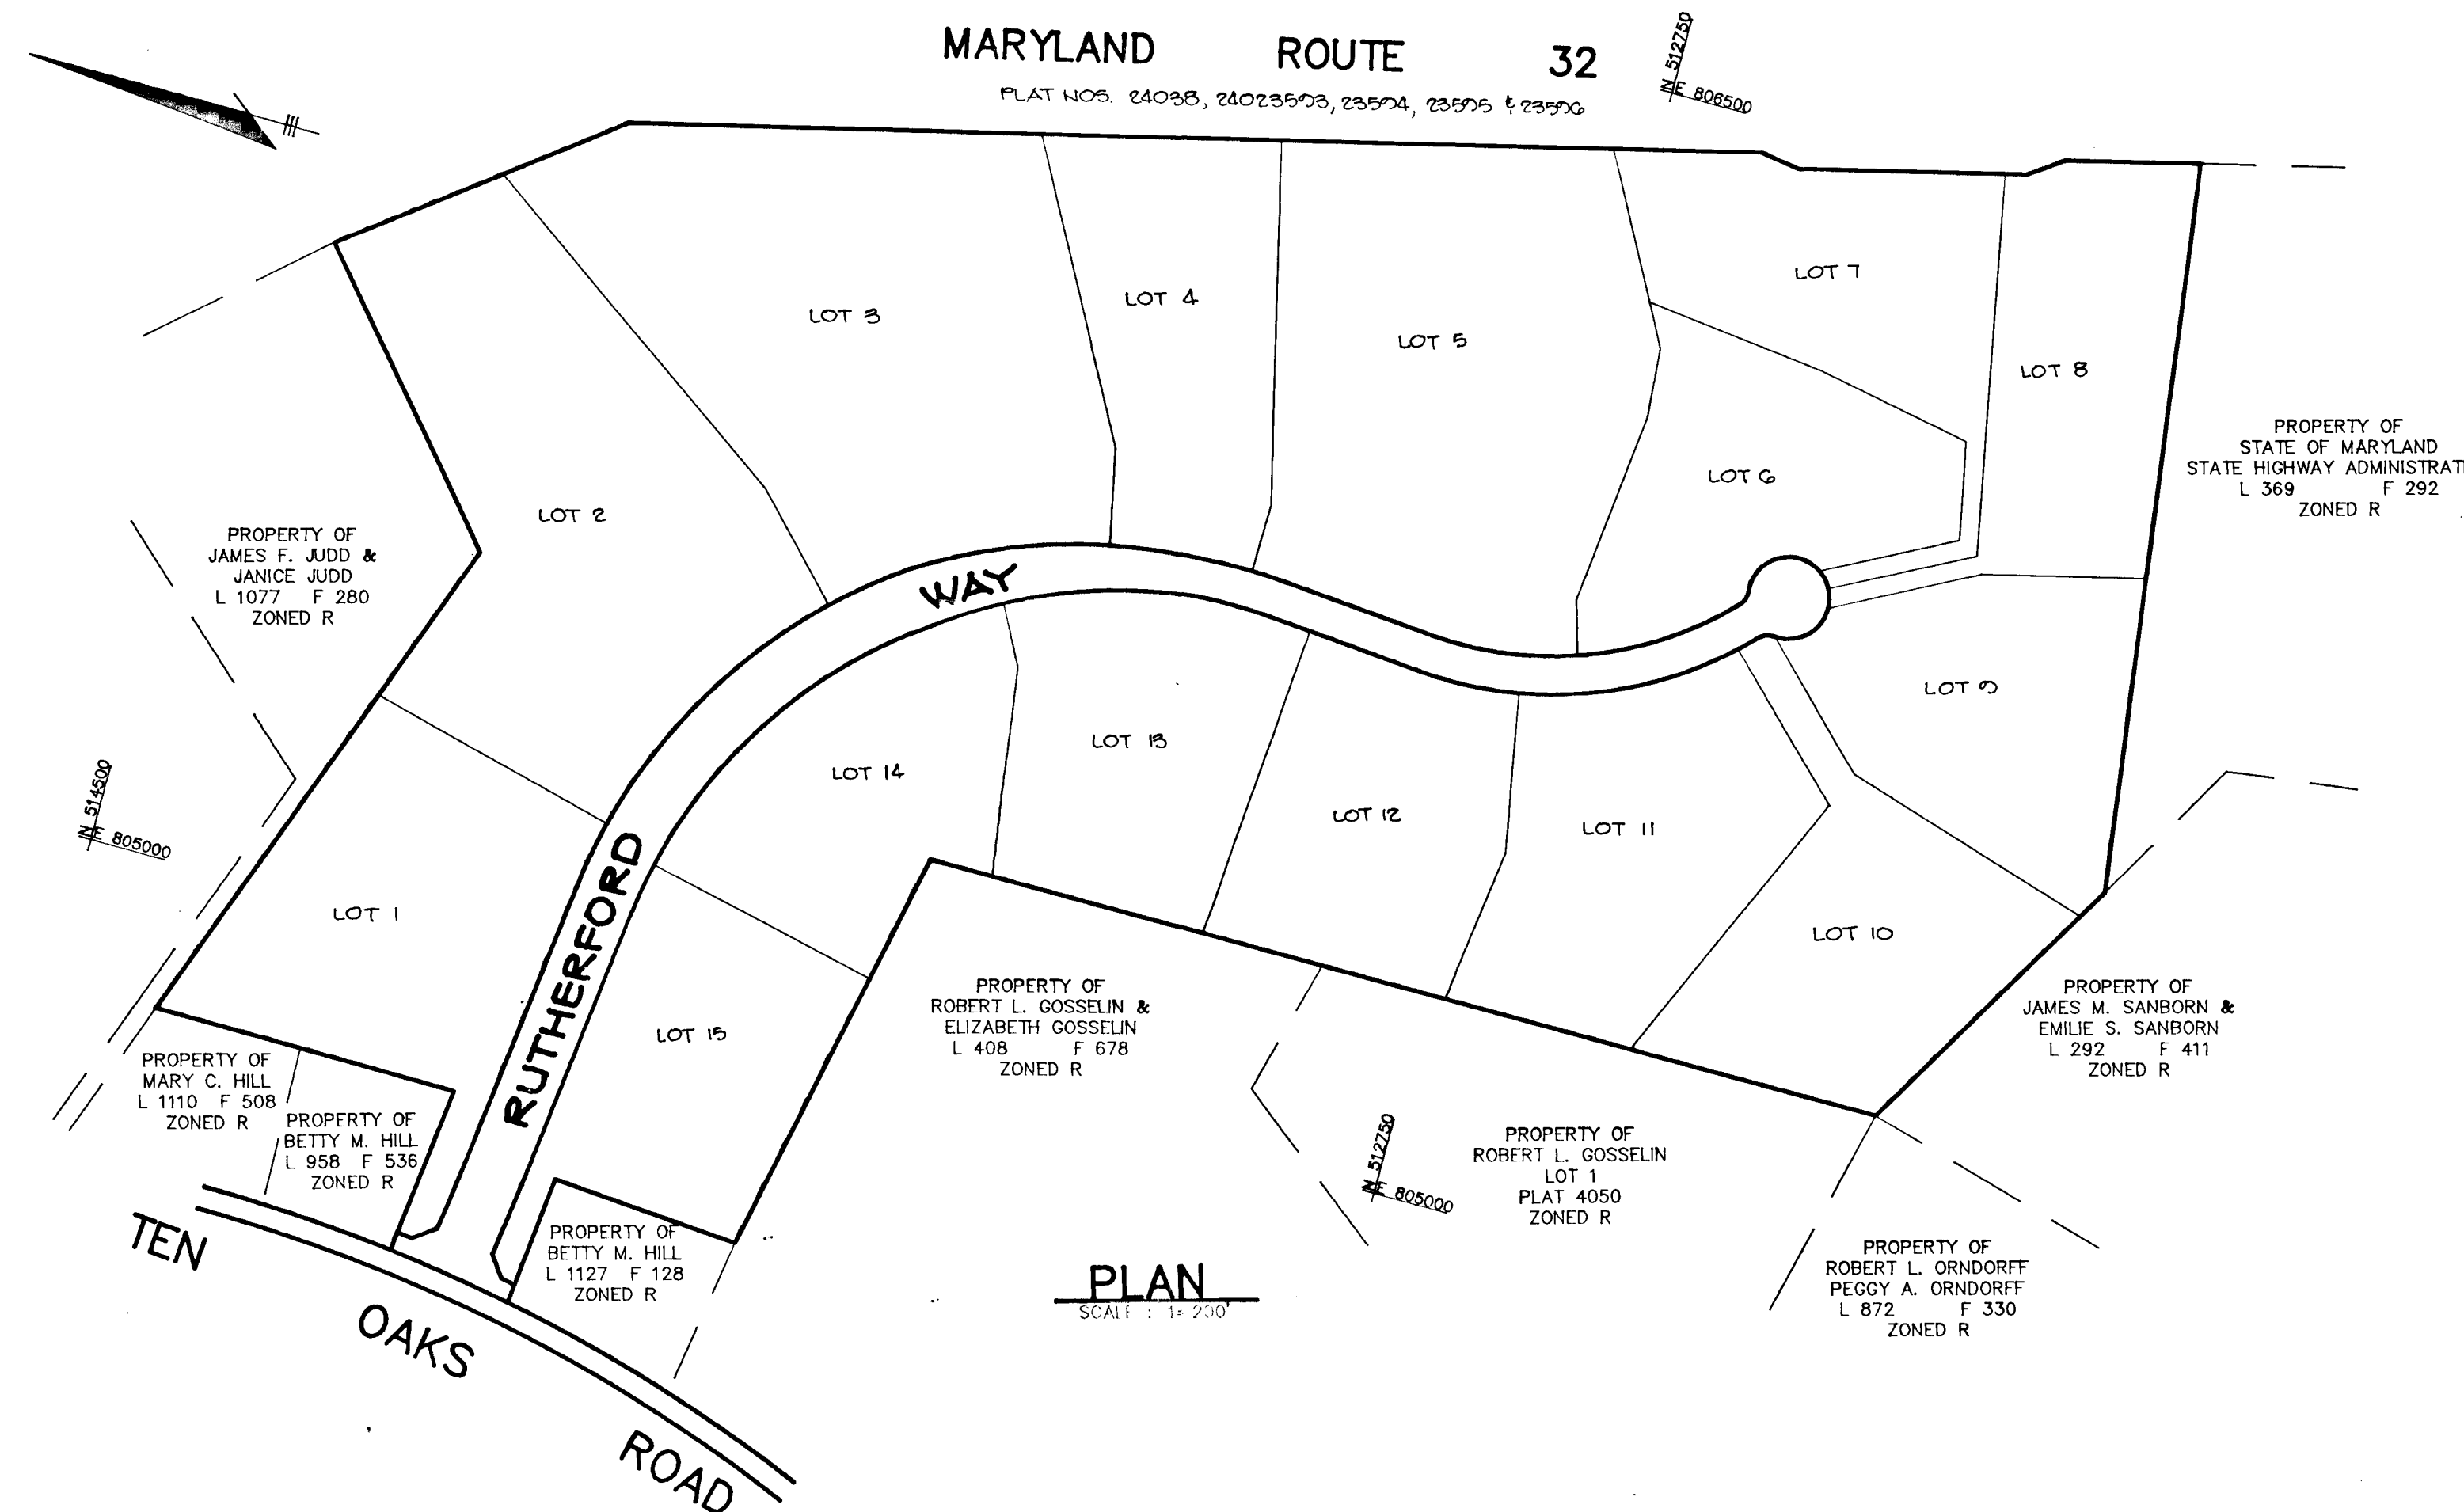


AS BUILT CERTIFICATION	
ENGINEER	DATE
APPROVED: HOWARD COUNTY DEPARTMENT OF PLANNING AND ZONING	
<i>David J. Bayle</i> 4/2/90 CHIEF, DIVISION OF COMMUNITY PLANNING AND LAND DEVELOPMENT	
APPROVED: HOWARD COUNTY DEPARTMENT OF PUBLIC WORKS	
<i>Donald J. Sisson</i> 3/7/90 CHIEF, LAND DEVELOPMENT DIVISION	
<i>Franklin W. Wansand</i> 2/16/90 CHIEF, BUREAU OF HIGHWAYS	
<i>William E. Pugh</i> 3-9-90 CHIEF, BUREAU OF ENGINEERING	
DATE	NO. REVISION
OWNER/DEVELOPER	
MARY C. HILL ET AL 6642 SENECA DRIVE COLUMBIA, MARYLAND 21044	
PROJECT	
RUTHERFORD	
AREA	TAX MAP 28 ZONED R PARCEL 75
5TH ELECTION DISTRICT HOWARD COUNTY, MARYLAND	
TITLE	
TITLE SHEET	
RIEMER MUEGGE & ASSOCIATES, INC.	
A Land Planning, Engineering and Consulting Firm 3105 North Ridge Road Ellicott City, Maryland 21043 301-461-2690 FAX: 301-750-3176	
DATE	5-88-82 WP-88-11 P-87-57
DESIGNED BY: D.A.M.	
DRAWN BY: C.A.D.	
PROJECT NO: 51206	
DATE: JANUARY 16, 1990	
SCALE: AS SHOWN	
DRAWING NO. 1 OF 10	

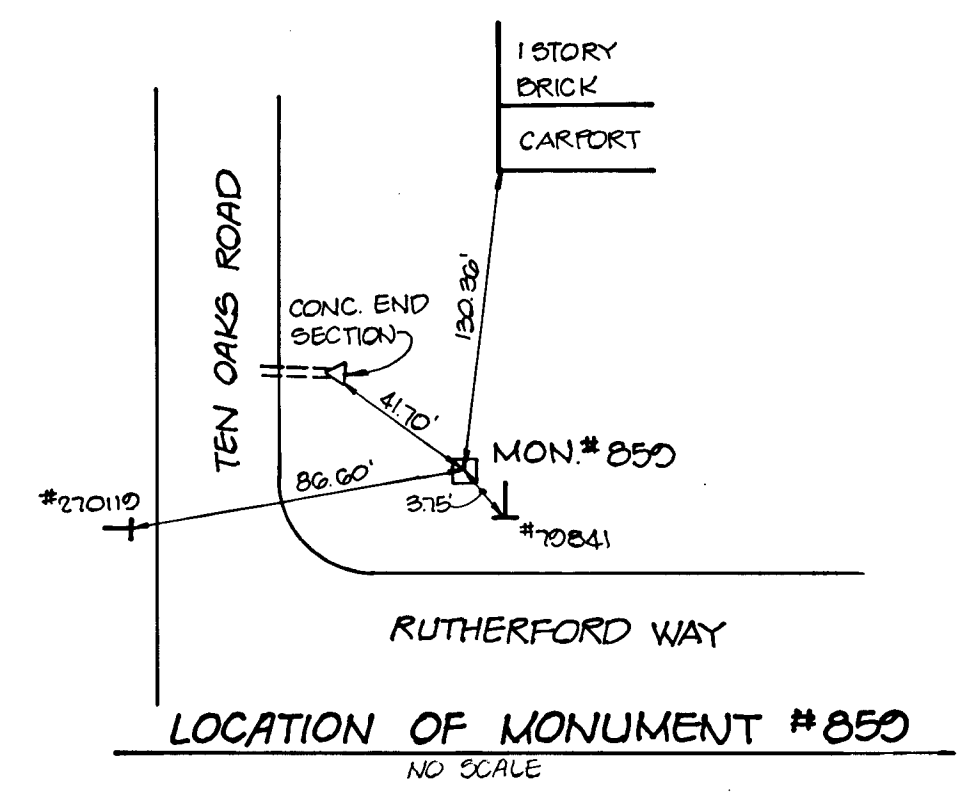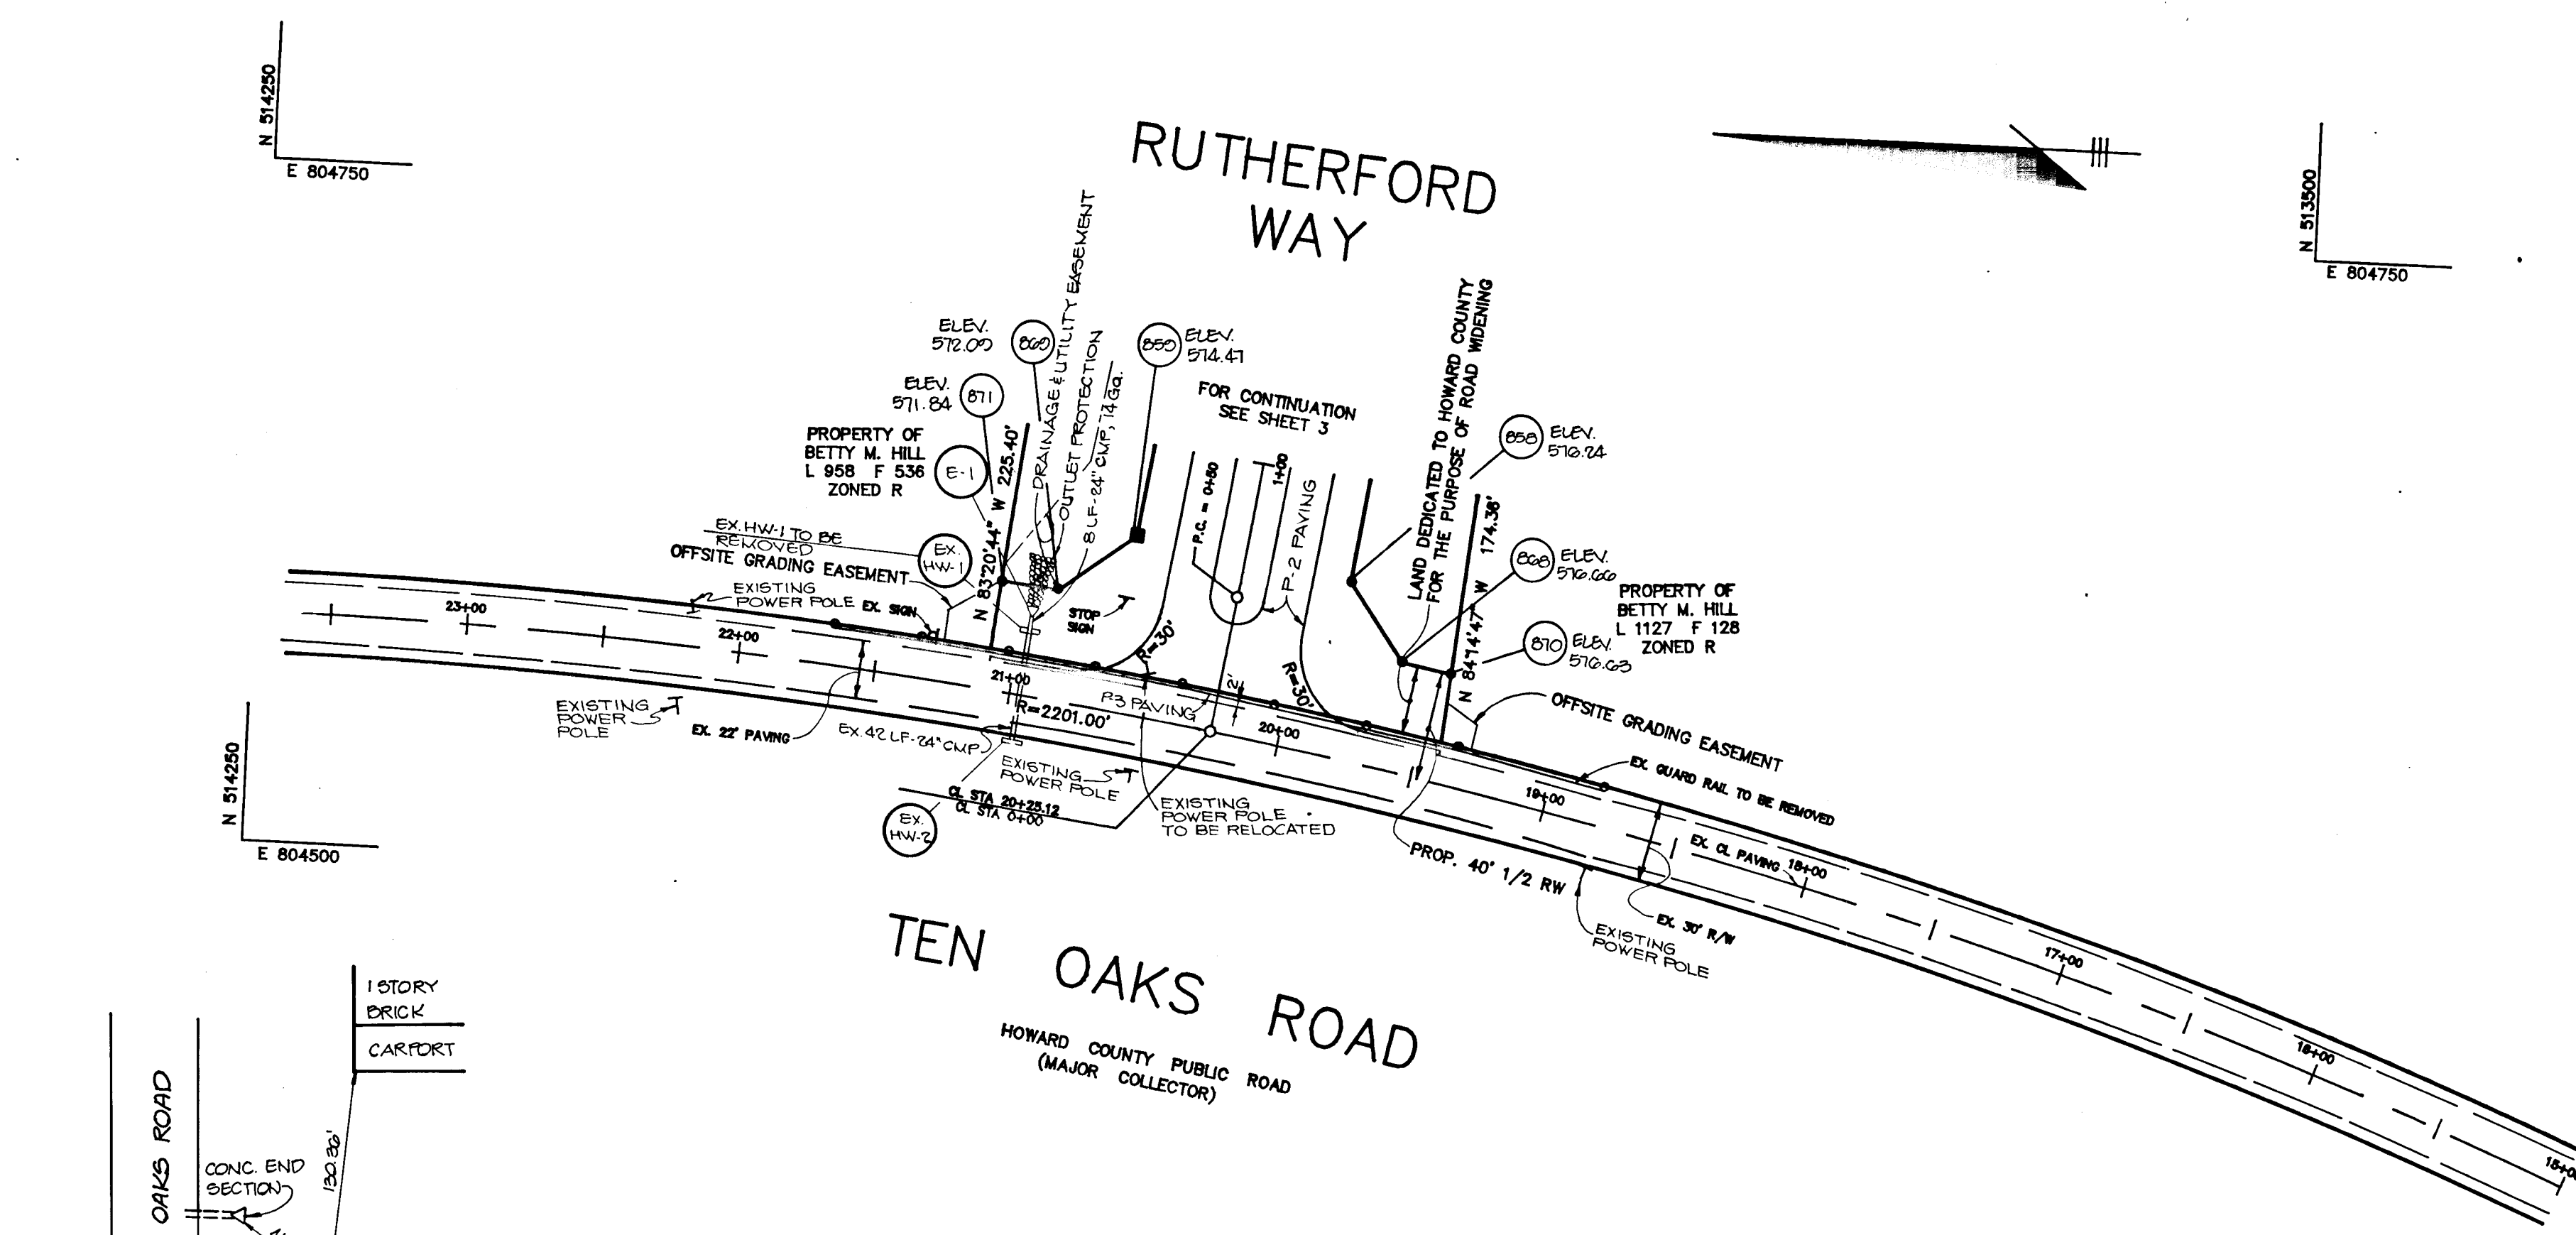

PLAN
SCALE: 1"=50'

- DENOTES 4"X4"X56" CONCRETE MONUMENT
- DENOTES 1/2" Ø PIPE OR IRON PIN SET

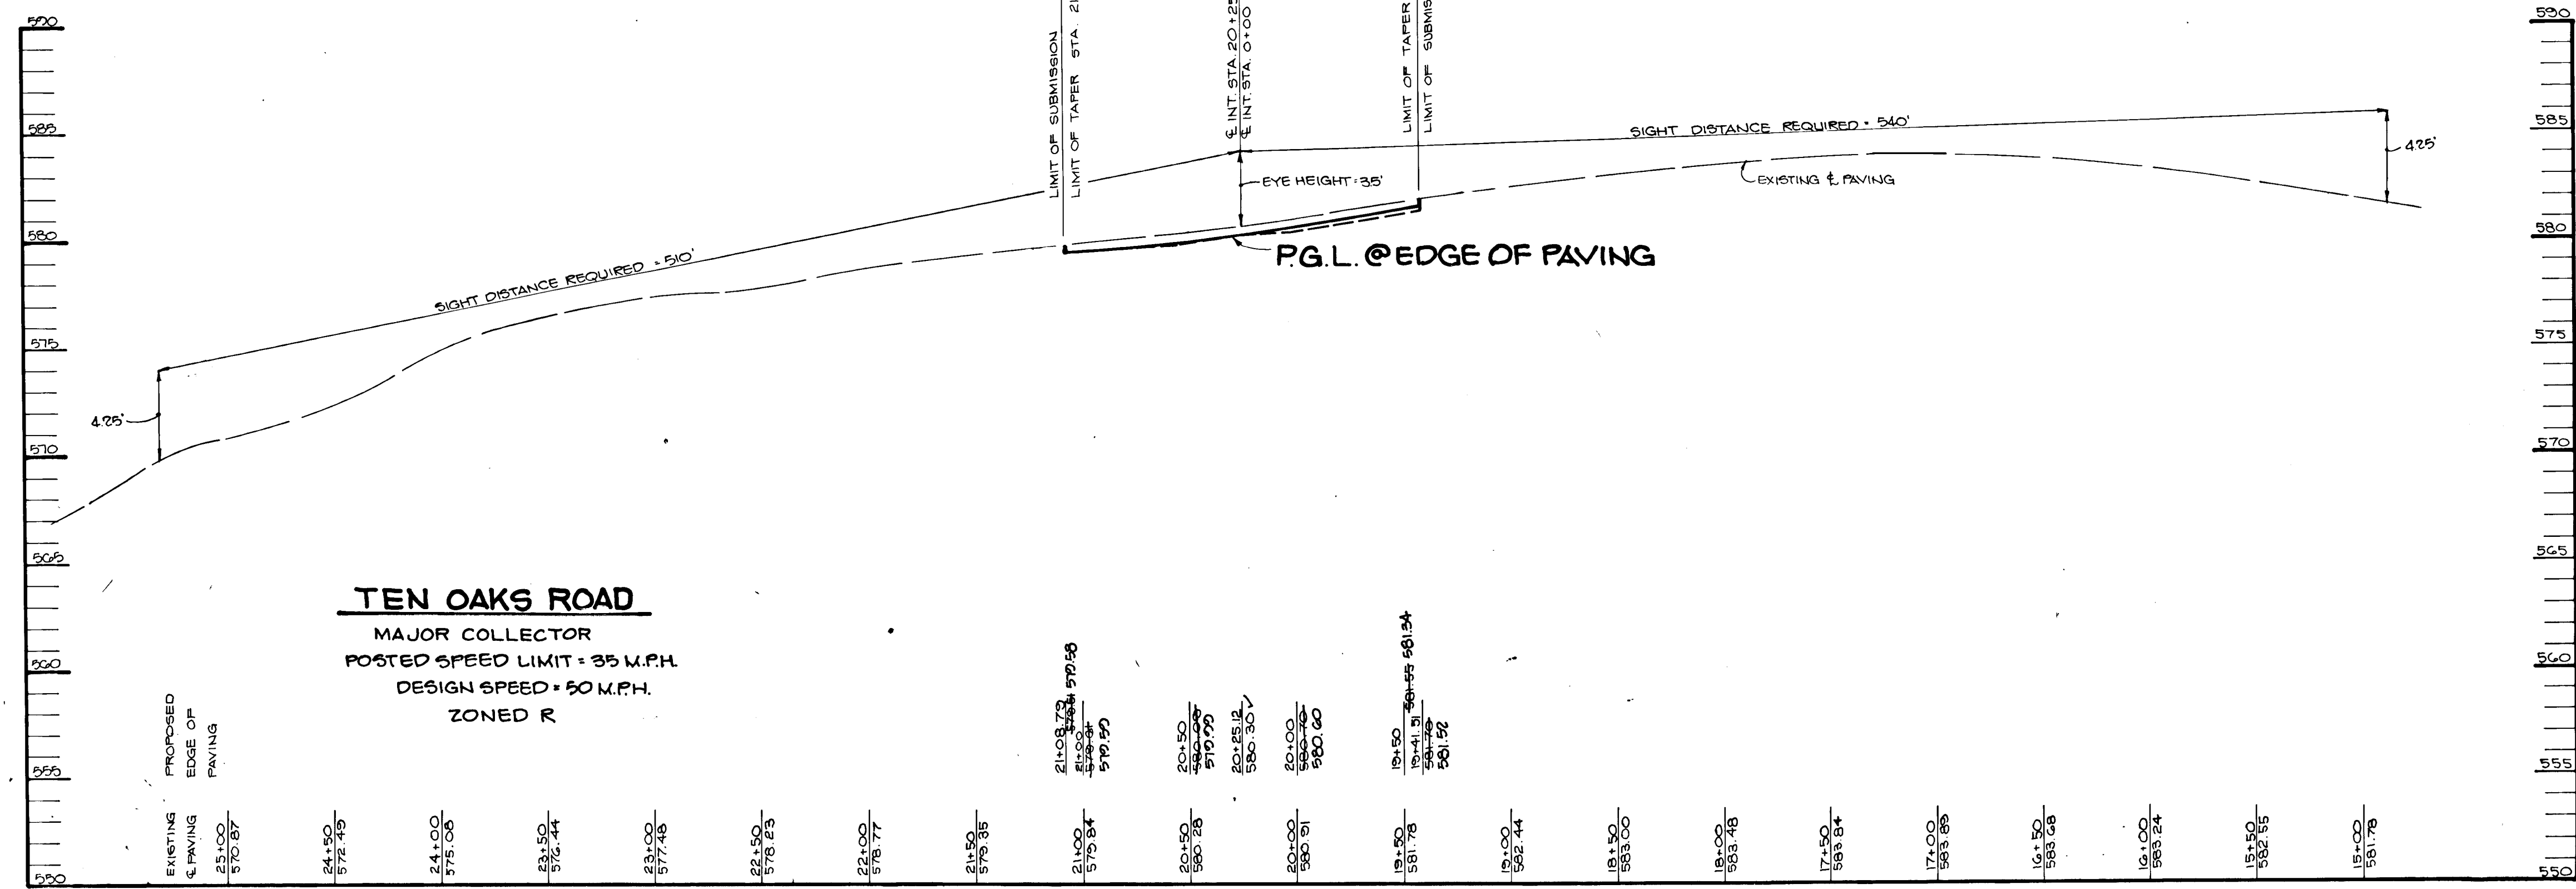

PROFILE
SCALE: HOR. 1"=50'
VERT. 1"=5'

AS BUILT CERTIFICATION	
ENGINEER: <i>J. Parekh</i>	DATE: 9.1.92
APPROVED: HOWARD COUNTY DEPARTMENT OF PLANNING AND ZONING	
<i>David S. Dwyer</i>	DATE: 9/23/92
CHIEF, DIVISION OF COMMUNITY PLANNING AND LAND DEVELOPMENT	
APPROVED: HOWARD COUNTY DEPARTMENT OF PUBLIC WORKS	
<i>Robert J. Sporn</i>	DATE: 3/7/90
CHIEF, LAND DEVELOPMENT DIVISION	
<i>Stanley W. McLeod</i>	DATE: 2/16/90
CHIEF, BUREAU OF HIGHWAYS	
<i>William E. Reilly</i>	DATE: 3-9-80
CHIEF, BUREAU OF ENGINEERING	
DATE: NO.	REVISION
OWNER/DEVELOPER	
MARY C. HILL ET AL 6642 SENECA DRIVE COLUMBIA, MARYLAND, 21044	
PROJECT: RUTHERFORD	
AREA: TAX MAP 28 ZONED R PARCEL 75 5TH ELECTION DISTRICT HOWARD COUNTY, MARYLAND	
TITLE: PLAN AND PROFILE OF TEN OAKS ROAD	
RIEMER MUEGGE & ASSOCIATES, INC. A Land Planning, Engineering and Consulting Firm 3105 North Ridge Road Ellicott City, Maryland 21043 301-461-2690 FAX: 301-750-3176	
DATE: 1-15-90	S-88-82 WP-88-11 P-87-59
DESIGNED BY: D.A.M.	
DRAWN BY: G.D.H.	
PROJECT NO: 51206	
DATE: JANUARY 16, 1990	
SCALE: AS SHOWN	
DRAWING NO. 2 OF 10	
ARTHUR E. MUEGGE #767	

TEN OAKS ROAD

CL CURVE DATA
 FROM CL STA. 0+50 TO CL STA. 1+60.76
 R = 3000.00'
 L = 110.76'
 T = 55.38'
 DELTA = 02° 06' 55"
 CHD = N82° 11'07" W 110.75'

PROPERTY OF
 BETTY M. HILL
 L 958 L 536
 ZONED R

PROPERTY OF
 BETTY M. HILL
 L 1127 L 128
 ZONED R

RUTHERFORD WAY

PLAN
 SCALE: 1"=50'

CL CURVE DATA
 FROM CL STA. 5+50.36 TO CL STA. 10+21.42
 R = 700.00'
 L = 1071.06'
 T = 672.07' ELEV. 545.99
 DELTA = 87° 40' 05"
 CHD = S 93° 24' 32" E 969.60'

- DENOTES 4" x 4" x 36" CONCRETE MONUMENT
- DENOTES 1/2" Ø PIPE OR IRON PIN SET

1/4" INT STA. 20+25.12 TEN OAKS ROAD - 1/4" INT STA. 0+00 RUTHERFORD WAY
 PROPOSED EDGE OF PAVING STA. 0+12
 ELEV. 560.30

RUTHERFORD WAY
 LOCAL ROAD / CUL-DE-SAC STREET
 DESIGN SPEED 30 MPH
 ZONED R

PROFILE
 SCALE: HOR. 1"=50'
 VERT. 1"=5'

AS BUILT CERTIFICATION

ENGINEER JAYKANT PAREKH

PE # 19148 DATE 9.1.92

APPROVED: HOWARD COUNTY DEPARTMENT OF PLANNING AND ZONING
Paul J. Taylor DATE 2.5

APPROVED: HOWARD COUNTY DEPARTMENT OF PUBLIC WORKS
Donald H. Brown DATE 3/7/90
Lawrence W. Woodard DATE 2/16/90
William E. Kelly DATE 3.9.90

DATE NO. REVISION

OWNER/DEVELOPER
 MARY C. HILL ET AL
 6642 SENECA DRIVE
 COLUMBIA, MARYLAND, 21044

PROJECT: RUTHERFORD


AREA TAX MAP 28 ZONED R PARCEL 75
 5TH ELECTION DISTRICT
 HOWARD COUNTY, MARYLAND

TITLE: PLAN AND PROFILE OF
 RUTHERFORD WAY
 FROM STA. 0+00 TO STA. 12+00


RIEMER MUEGGE & ASSOCIATES, INC.
 A Land Planning, Engineering and Consulting Firm
 3105 North Ridge Road Ellicott City, Maryland 21043
 301-461-2690 FAX: 301-750-3176

DATE 1-15-93
 DESIGNED BY: D.A.M.
 DRAWN BY: G.D.H.
 PROJECT NO: B120G
 DATE: JANUARY 16, 1993
 SCALE: AS SHOWN
 DRAWING NO. 3 OF 10


ARTHUR E. MUEGGE #6707


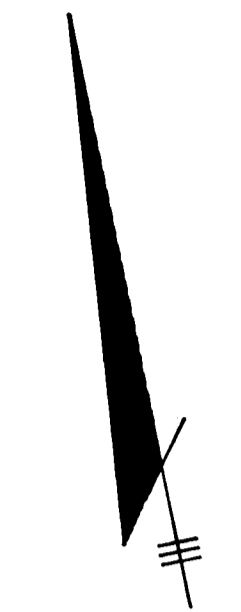


1551

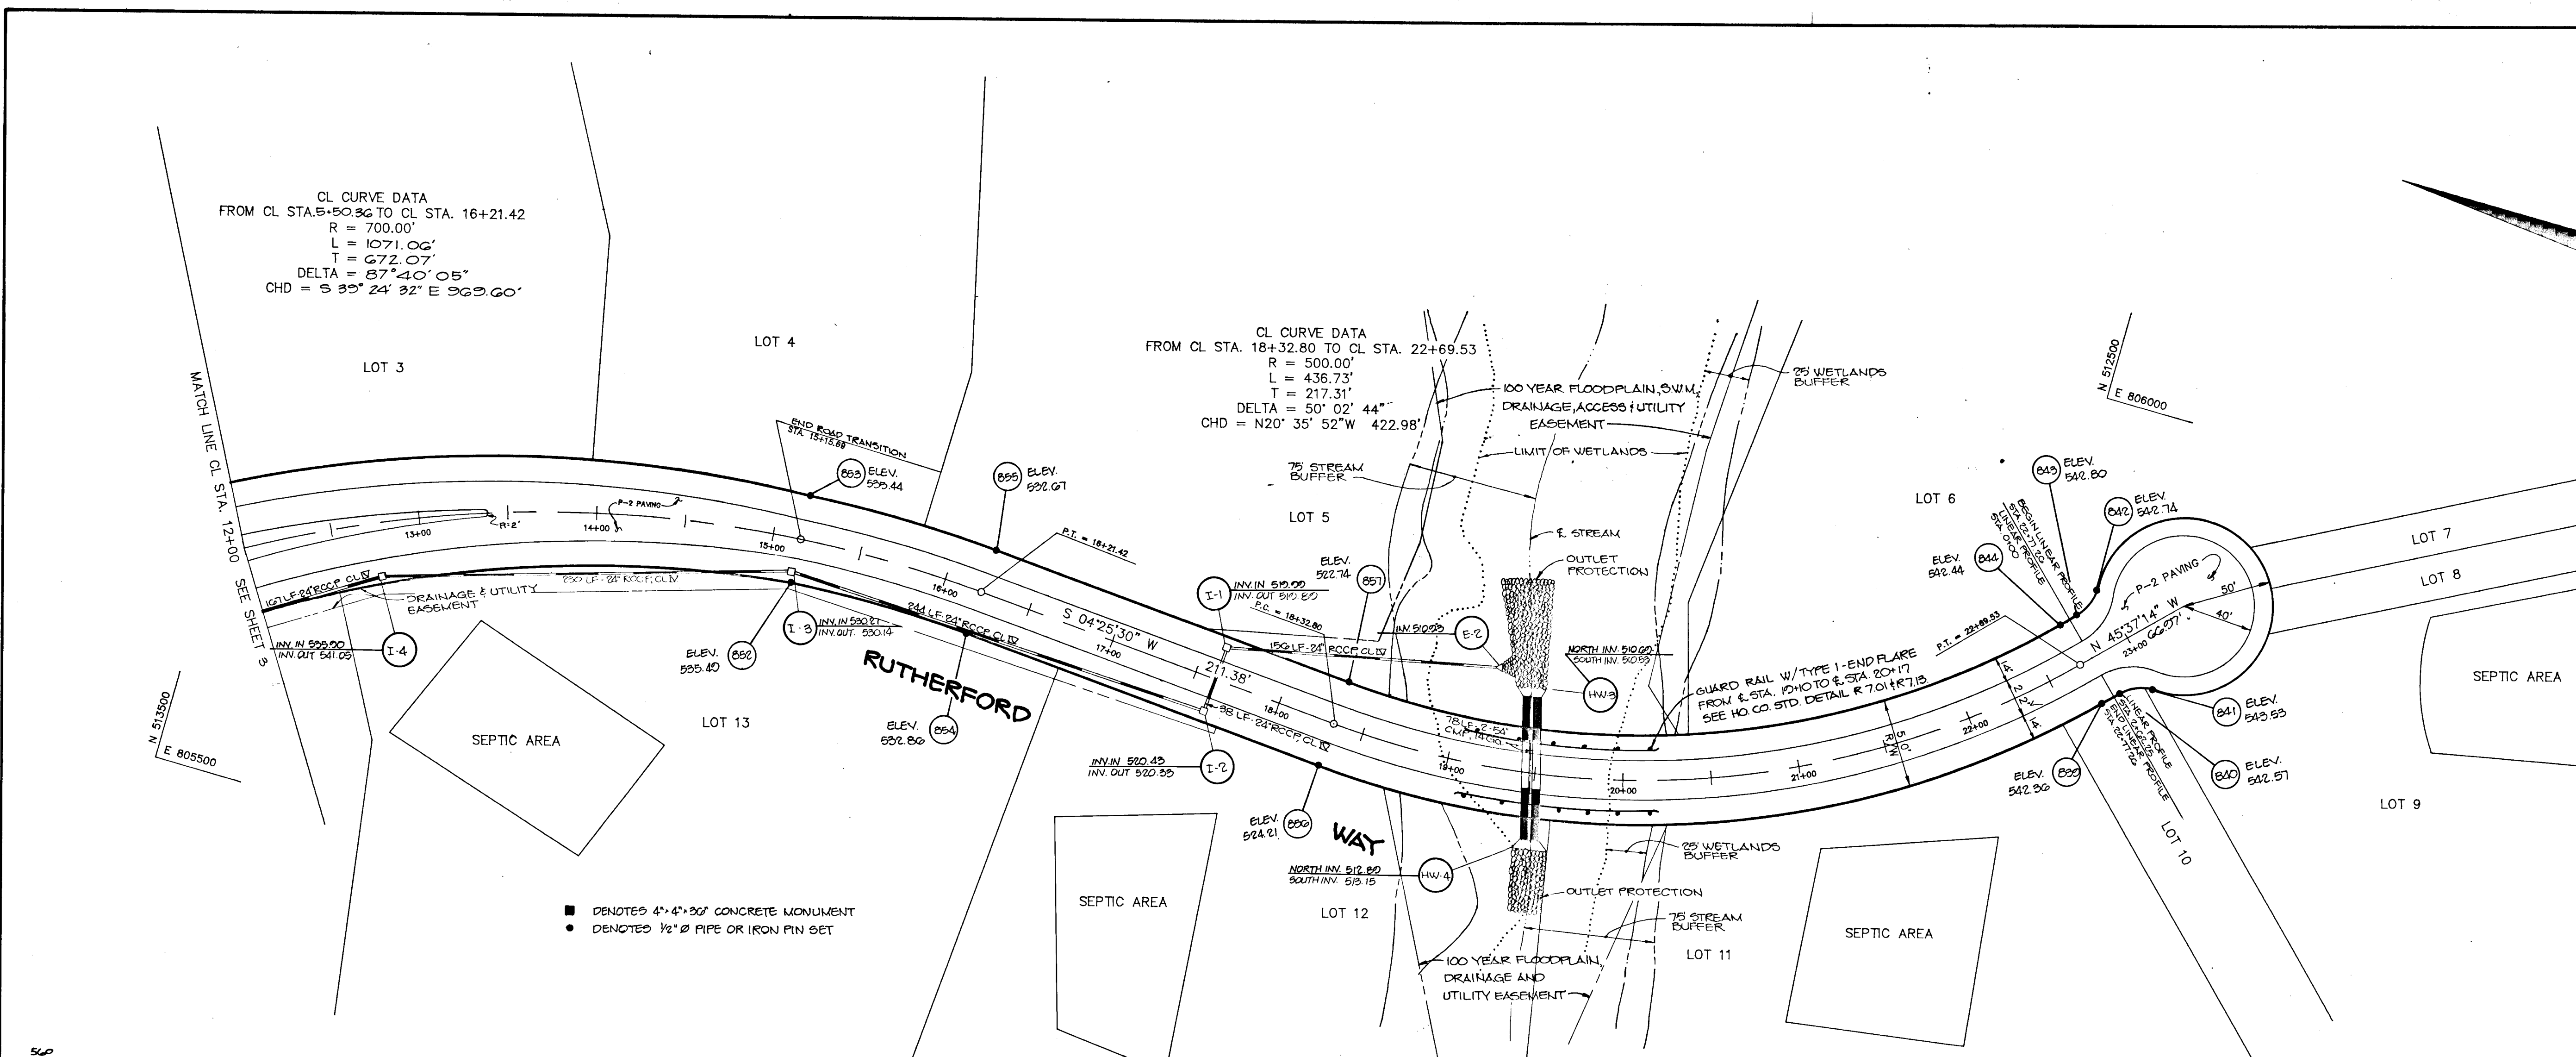

PLAN
SCALE: 1"=50'

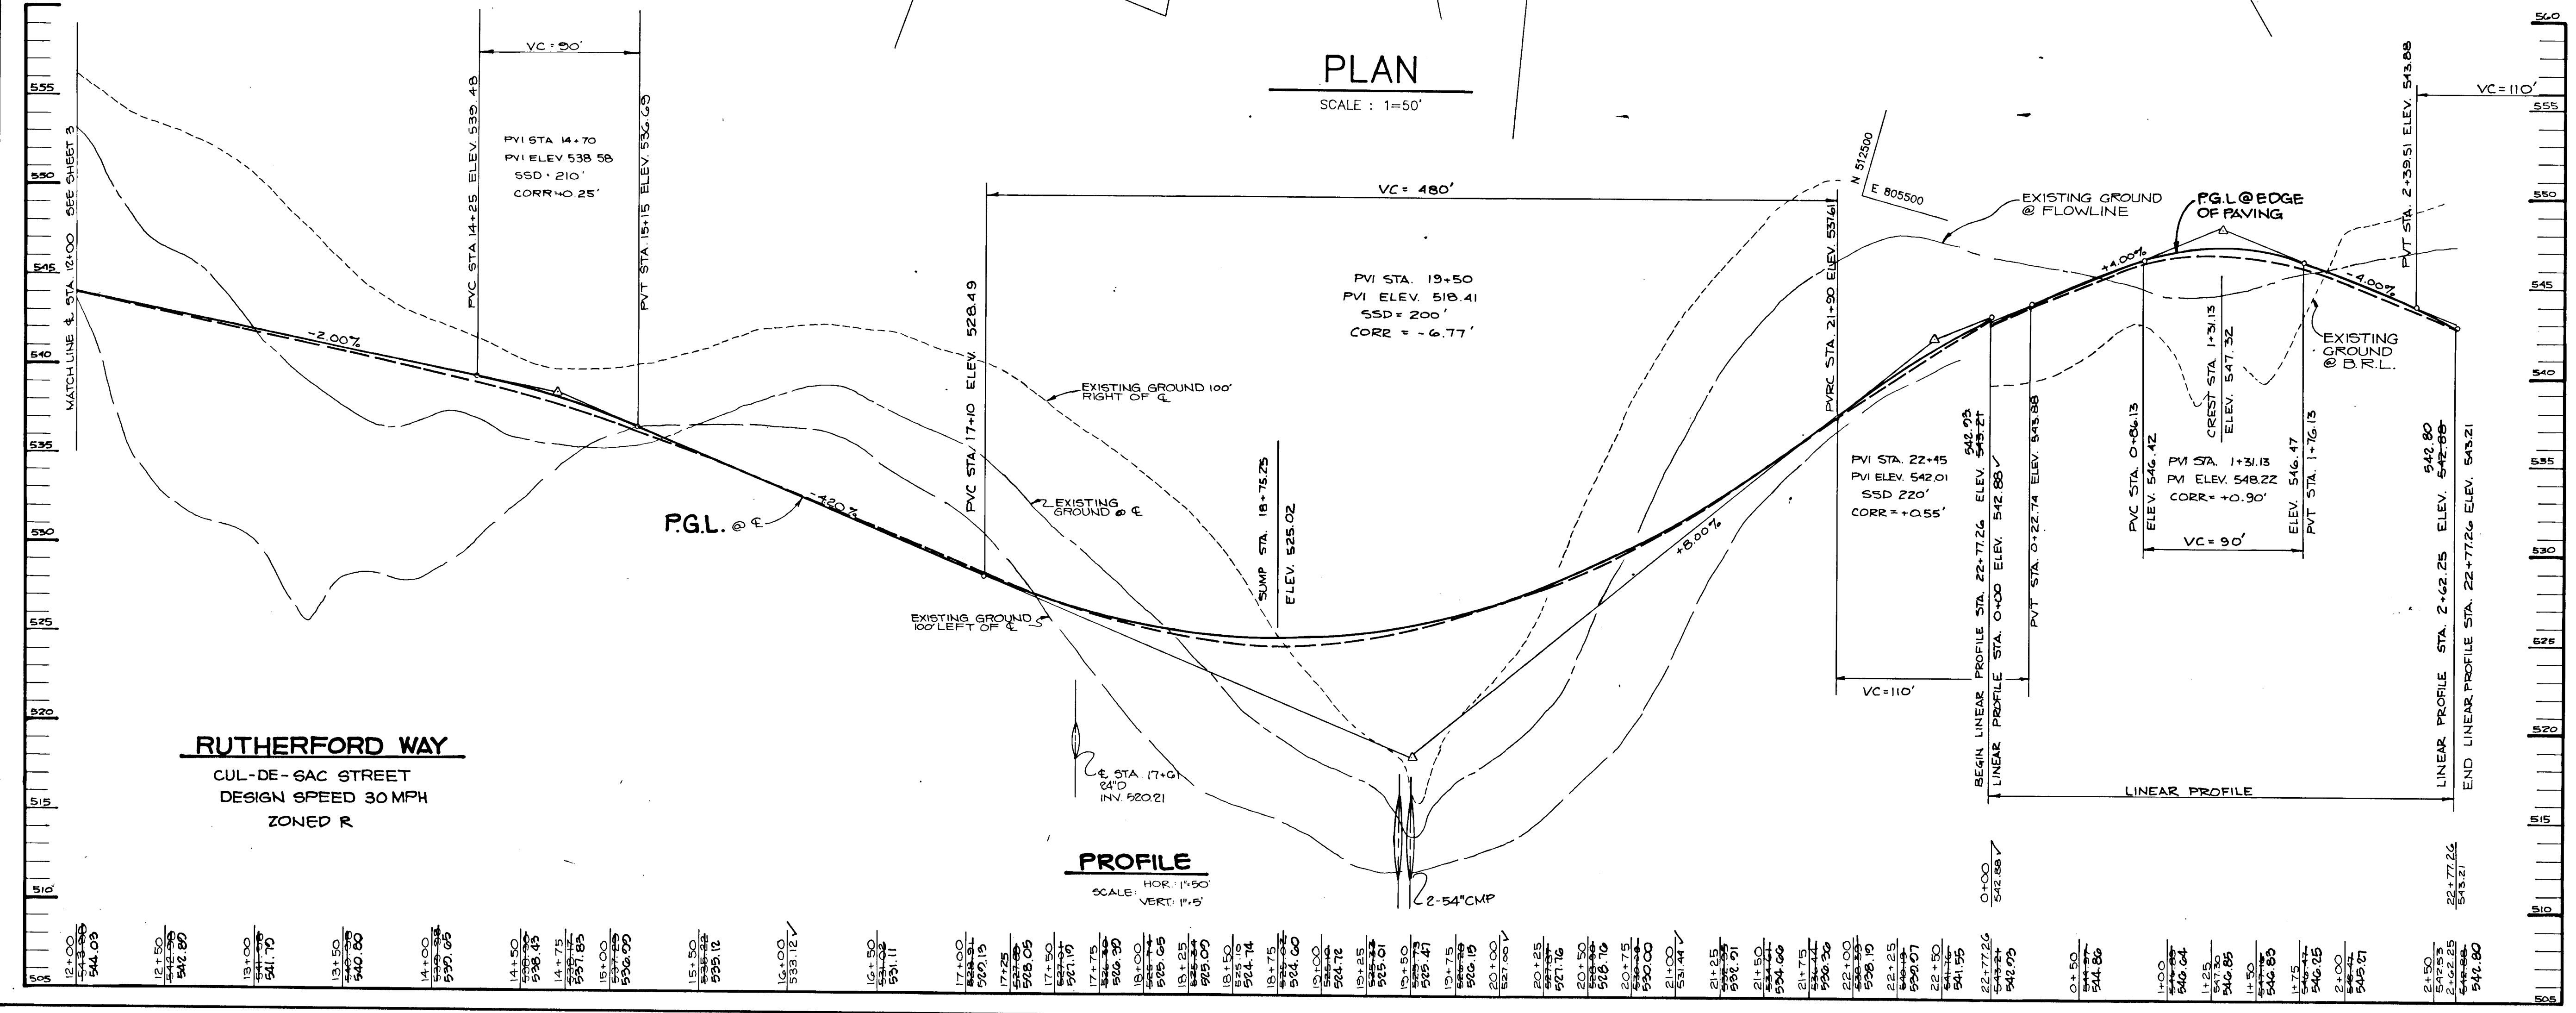

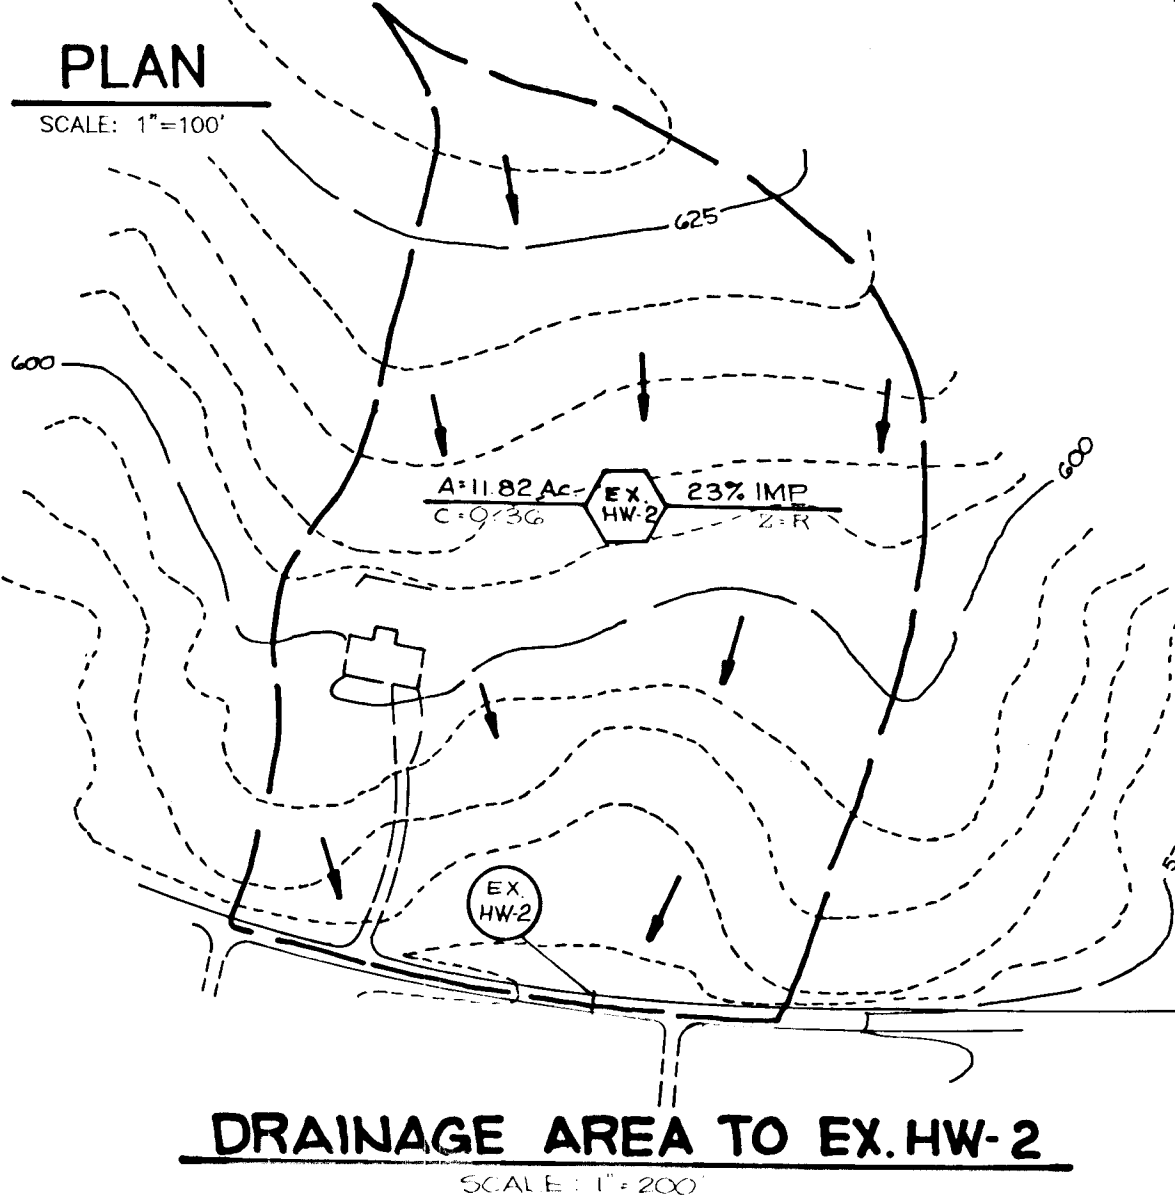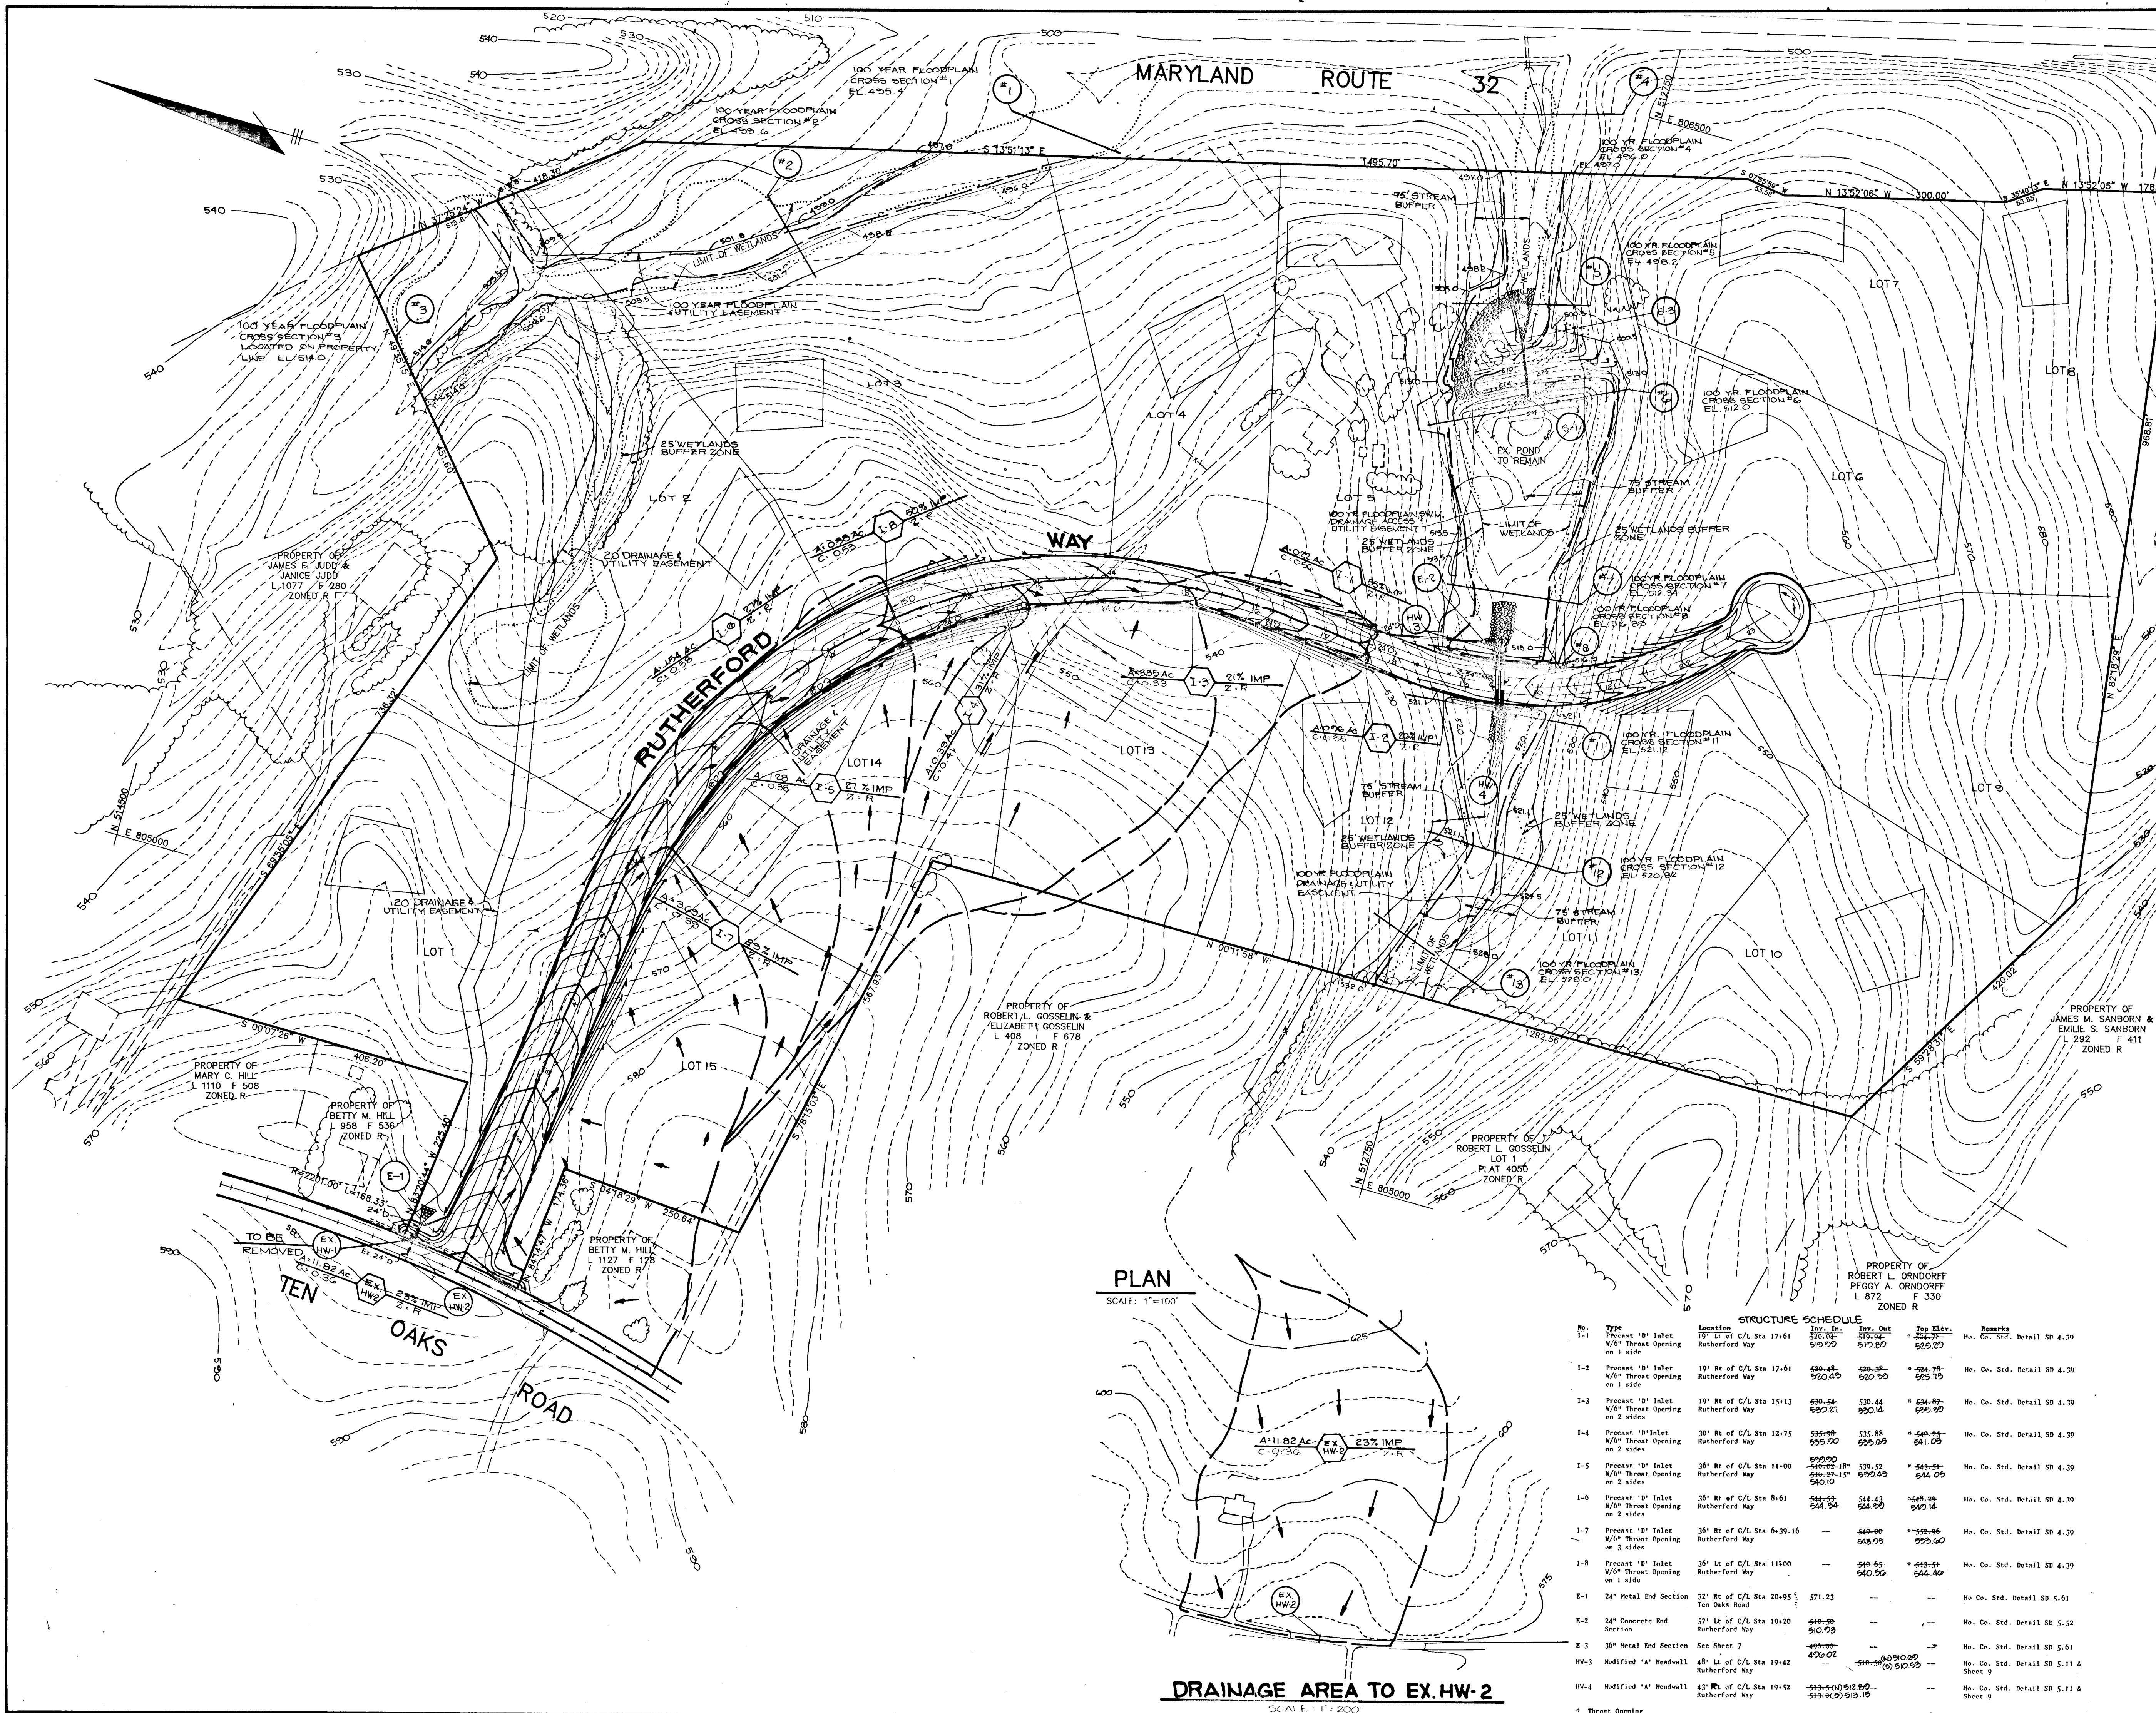

No.	Type	Location	Inv. In.	Inv. Out	Top Elev.	Remarks
1-1	Precast 'B' Inlet	19' Lt of C/L Sta 17-61 Rutherford Way	520.00	519.00	520.00	No. Co. Std. Detail SD 4-30
1-2	Precast 'B' Inlet	19' Rt of C/L Sta 17-61 Rutherford Way	520.48	520.00	520.48	No. Co. Std. Detail SD 4-30
1-3	Precast 'B' Inlet	19' Rt of C/L Sta 15-13 Rutherford Way	520.44	520.14	520.44	No. Co. Std. Detail SD 4-30
1-4	Precast 'B' Inlet	30' Rt of C/L Sta 12-75 Rutherford Way	520.00	520.00	520.00	No. Co. Std. Detail SD 4-30
1-5	Precast 'B' Inlet	36' Rt of C/L Sta 11-00 Rutherford Way	520.00	520.00	520.00	No. Co. Std. Detail SD 4-30
1-6	Precast 'B' Inlet	26' Rt of C/L Sta 8-61 Rutherford Way	520.00	520.00	520.00	No. Co. Std. Detail SD 4-30
1-7	Precast 'B' Inlet	30' Rt of C/L Sta 6-39.16 Rutherford Way	520.00	520.00	520.00	No. Co. Std. Detail SD 4-30
1-8	Precast 'B' Inlet	36' Lt of C/L Sta 11-00 Rutherford Way	520.00	520.00	520.00	No. Co. Std. Detail SD 4-30
E-1	24" Metal End Section	32' Rt of C/L Sta 20-95 Ten Oaks Road	521.23			No. Co. Std. Detail SD 5-61
E-2	24" Concrete End Section	57' Lt of C/L Sta 10-20 Rutherford Way	520.00			No. Co. Std. Detail SD 5-52
E-3	36" Metal End Section	See Sheet 7				No. Co. Std. Detail SD 5-61
HW-1	Modified 'A' Headwall	45' Lt of C/L Sta 10-42 Rutherford Way	520.00	520.00	520.00	No. Co. Std. Detail SD 5-11 & Sheet 9
HW-4	Modified 'A' Headwall	43' Rt of C/L Sta 19-52 Rutherford Way	520.00	520.00	520.00	No. Co. Std. Detail SD 5-11 & Sheet 9

AS BUILT CERTIFICATION

ENGINEER: JAVANT PARELL
DATE: 9-1-92

APPROVED: HOWARD COUNTY DEPARTMENT OF PLANNING AND ZONING
Mark J. McLaughlin 2/23/90
 CHIEF, DIVISION OF COMMUNITY PLANNING AND LAND DEVELOPMENT

APPROVED: HOWARD COUNTY DEPARTMENT OF PUBLIC WORKS
Paul D. Mason 3/7/90
 CHIEF, LAND DEVELOPMENT DIVISION

Stanley W. Winkler 2/16/90
 CHIEF, BUREAU OF HIGHWAYS

William E. Edy 2-9-90
 CHIEF, BUREAU OF ENGINEERING

DATE: NO. REVISION

OWNER/DEVELOPER
 MARY C. HILL ET AL
 6642 SENECA DRIVE
 COLUMBIA, MARYLAND 21044

PROJECT: RUTHERFORD

AREA: TAX MAP 28 ZONED R PARCEL 75
 5TH ELECTION DISTRICT
 HOWARD COUNTY, MARYLAND.

TITLE: DRAINAGE AREA MAP

RIEMER MUEGGE & ASSOCIATES, INC.
 A Land Planning, Engineering and Consulting Firm
 3105 North Ridge Road Ellicott City, Maryland 21043
 301-461-2690 FAX: 301-750-3176

DATE: 1/2/90
 DESIGNED BY: D.A.M.
 DRAWN BY: G.D.H.
 PROJECT NO: 5120G
 DATE: JANUARY 10, 1990
 SCALE: AS SHOWN
 DRAWING NO. 5 OF 10

ARTHUR E. MUEGGE #6707

ENGINEER _____
DATE _____

BY THE DEVELOPER:
"I CERTIFY THAT ALL DEVELOPMENT AND/OR CONSTRUCTION WILL BE DONE ACCORDING TO THESE PLANS, AND THAT ANY RESPONSIBLE PERSONNEL INVOLVED IN THE CONSTRUCTION PROJECT WILL HAVE A CERTIFICATE OF ATTENDANCE AT A DEPARTMENT OF NATURAL RESOURCES APPROVED TRAINING PROGRAM FOR THE CONTROL OF SEDIMENT AND EROSION BEFORE BEGINNING THE PROJECT. I WILL PROVIDE THE HOWARD SOIL CONSERVATION DISTRICT WITH AN 'AS-BUILT' PLAN OF THE POND WITHIN 30 DAYS OF COMPLETION. I ALSO AUTHORIZE PERIODIC ON-SITE INSPECTIONS BY THE HOWARD SOIL CONSERVATION DISTRICT."

DEVELOPER _____ DATE _____

BY THE ENGINEER:
"I CERTIFY THAT THIS PLAN FOR POND CONSTRUCTION, EROSION AND SEDIMENT CONTROL REPRESENTS A PRACTICAL AND WORKABLE PLAN BASED ON MY PERSONAL KNOWLEDGE OF THE SITE CONDITIONS. THIS PLAN WAS PREPARED IN ACCORDANCE WITH THE REQUIREMENTS OF THE HOWARD SOIL CONSERVATION DISTRICT. I HAVE NOTIFIED THE DEVELOPER THAT HE MUST PROVIDE THE HOWARD SOIL CONSERVATION DISTRICT WITH AN 'AS-BUILT' PLAN OF THE POND WITHIN 30 DAYS OF COMPLETION."

ENGINEER *Arthur E. Muegge* 1-13-90 DATE

THESE PLANS HAVE BEEN REVIEWED FOR THE HOWARD SOIL CONSERVATION DISTRICT AND MEET THE TECHNICAL REQUIREMENTS FOR SMALL POND CONSTRUCTION, SOIL EROSION AND SEDIMENT CONTROL.

SOIL CONSERVATION SERVICE *James R. Helm* 1-31-90 DATE

THESE PLANS FOR SMALL POND CONSTRUCTION, SOIL EROSION AND SEDIMENT CONTROL MEET THE REQUIREMENTS OF THE HOWARD SOIL CONSERVATION DISTRICT.

APPROVED *Richard Zick* 1-31-90 DATE

APPROVED: HOWARD COUNTY DEPARTMENT OF PLANNING AND ZONING

David V. Sample 4/15/90 DATE
CHIEF, DIVISION OF COMMUNITY PLANNING AND LAND DEVELOPMENT

APPROVED: HOWARD COUNTY DEPARTMENT OF PUBLIC WORKS

Tom Allgeier 3/7/90 DATE
CHIEF, LAND DEVELOPMENT DIVISION

Stanley W. Wobens 2/16/90 DATE
CHIEF, BUREAU OF HIGHWAYS

William R. Kelly 3-9-90 DATE
CHIEF, BUREAU OF ENGINEERING

DATE NO REVISION

OWNER/DEVELOPER
MARY C. HILL ET AL
6642 SENECA DRIVE
COLUMBIA, MARYLAND, 21044

PROJECT: RUTHERFORD

AREA TAX MAP 28 ZONED R PARCEL 75
5TH ELECTION DISTRICT
HOWARD COUNTY, MARYLAND

TITLE: GRADING AND SEDIMENT CONTROL PLAN

RIEMER MUEGGE & ASSOCIATES, INC.
A Land Planning, Engineering and Consulting Firm
3105 North Ridge Road Ellcott City, Maryland 21043
301-461-2690 FAX: 301-750-3176


DATE 1-13-90
DESIGNED BY: C.J.R. & DAK
DRAWN BY: M.A.D.
PROJECT NO: 5120G
DATE: JANUARY 10, 1990
SCALE: AS SHOWN
DRAWING NO. 6 OF 10

STONE OUTLET SEDIMENT TRAP #6

DRAINAGE AREA	321 AC
STORAGE REQUIRED	5718 CF
STORAGE PROVIDED	7050 CF
BOTTOM ELEV.	542.0
CREST ELEV.	547.0
CLEANOUT ELEV.	545.5
BOTTOM DIMENSIONS	20'x60'
CREST WIDTH	17'
DEPTH	6'

STONE OUTLET SEDIMENT TRAP #7

DRAINAGE AREA	2.1 AC
STORAGE REQUIRED	3780 CF
STORAGE PROVIDED	3820 CF
BOTTOM ELEV.	532.0
CREST ELEV.	541.0
CLEANOUT ELEV.	538.5
BOTTOM DIMENSION	27'x17'
CREST WIDTH	11'
DEPTH	5'

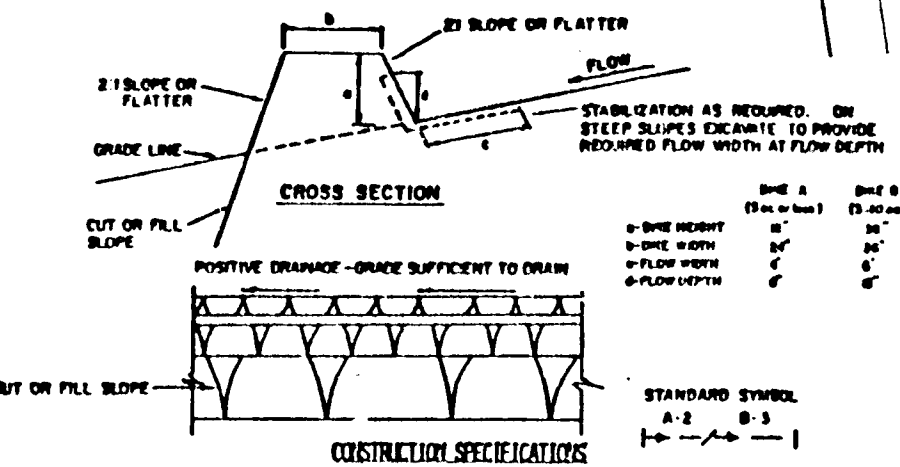


- CONSTRUCTION SPECIFICATIONS
- ALL DIKES SHALL BE CONSTRUCTED BY EARTH-MOVING EQUIPMENT.
 - DIKES SHALL HAVE POSITIVE DRAINAGE TO THE SOIL.
 - TOP WIDTH MAY BE WIDER AND SIDE SLOPES MAY BE FLATTER IF DESIRED TO FACILITATE CROSSING BY CONSTRUCTION TRAFFIC.
 - FIELD LOCATION SHOULD BE ADJUSTED AS NEEDED TO UTILIZE A STABILIZED SAFE OUTLET.
 - EARTH DIKES SHALL HAVE AN OUTLET WITH FUNCTIONS WITH A MINIMUM OF FRICTION. GRASS SHALL BE PLANTED TO A SEDIMENT TRAPPING DEVICE SUCH AS A SEDIMENT TRAP OR SEDIMENT BARRIER NEAR EITHER THE DIKE CHANNEL OR THE DISTANCE AREA NEAR THE DIKE AND NOT IMMEDIATELY STABILIZED.
 - STABILIZATION SHALL BE: (A) IN ACCORDANCE WITH STANDARD SPECIFICATIONS FOR SEED AND STRAW PALM OR STRAW PALM IF NOT IN SEEDING SEASON, (B) FLOW CHANNEL AS PER THE CHART BELOW.
- | TYPE OF TREATMENT | CURVELENGTH | DIKE A | DIKE B |
|-------------------|-------------|------------------------|--|
| 1 | 5-3.0K | SEED AND STRAW PALM | SEED AND STRAW PALM |
| 2 | 3.1-5.0K | SEED AND STRAW PALM | SEED USING JUTE, OR EXCELSTON, SOO, 2" STONE |
| 3 | 5.1-8.0K | SEED WITH JUTE, OR SOO | LINED RIP-RAP 4-8" |
| 4 | 8.1-20K | LINED RIP-RAP 4-8" | ENGINEERING DESIGN |
- A. Stone to be 2 inch stone, or recycled concrete equivalent, on a layer at least 3 inches in thickness and be pressed into the soil with construction equipment.
B. Rip-rap to be 1/2 inch in a layer at least 8 inches thickness and pressed into the soil.
C. Approved equivalents can be substituted for any of the above materials.
7. Periodic inspection and required maintenance must be provided after each rain event.


EARTH DIKE
NO SCALE

PLAN
SCALE: 1"=50'

STONE FILTER INLET PROTECTION
NO SCALE

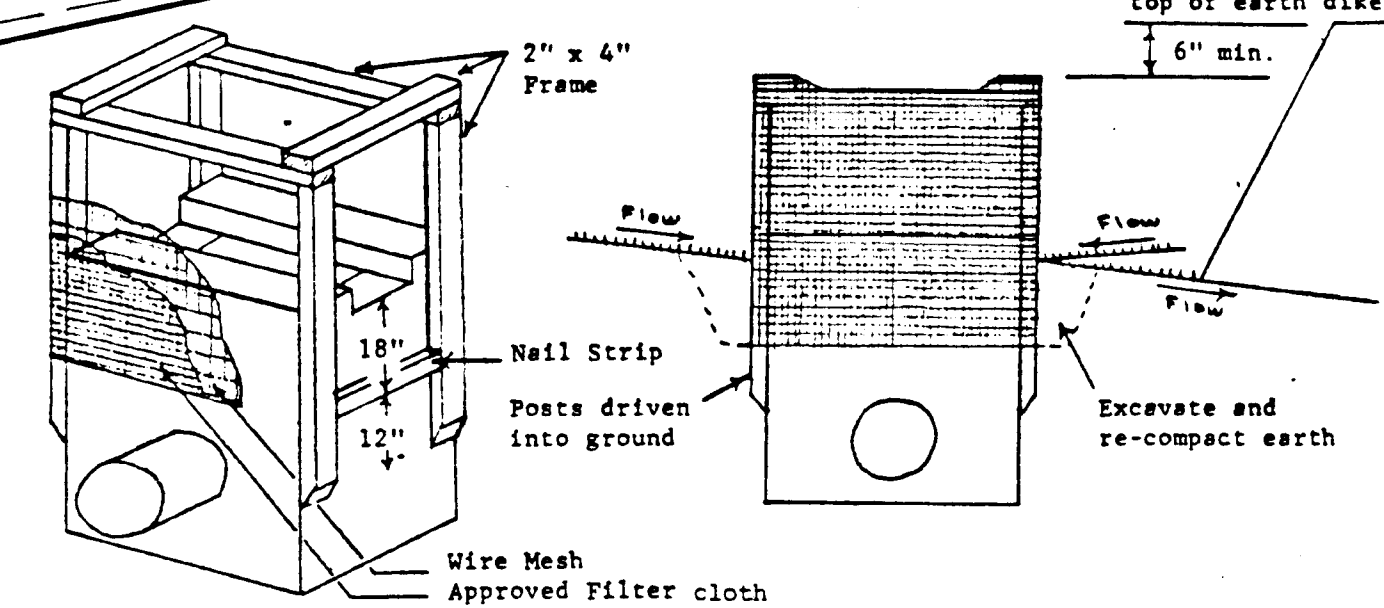

- II. Procedure
- Excavate completely around inlet to a depth of 18" below notch elevation.
 - Drive 2 x 4 post 1' into ground at four corners of inlet. Place nail strips between posts on ends of inlet. Assemble top portion of 2 x 4 frame using overlap joint shown. Top of frame (weir) must be 6" below edge of roadway adjacent to inlet.
 - Stretch wire mesh tightly around frame and fasten securely. Ends must meet at post.
 - Stretch filter cloth tightly over wire mesh, the cloth must extend from top of frame to 18" below inlet notch elev. Fasten securely to frame. Ends must meet at post, be overlapped and folded, then fastened down.
 - Backfill around inlet in compacted 6" layers until layer of earth is even with notch elevation on ends and top elevation on sides.
 - If the inlet is not in a low point, construct a compacted earth dike in the ditchline below it. The top of this dike is to be at least 6" higher than the top of frame (weir).
 - This structure must be inspected frequently and the filter fabric replaced when clogged.

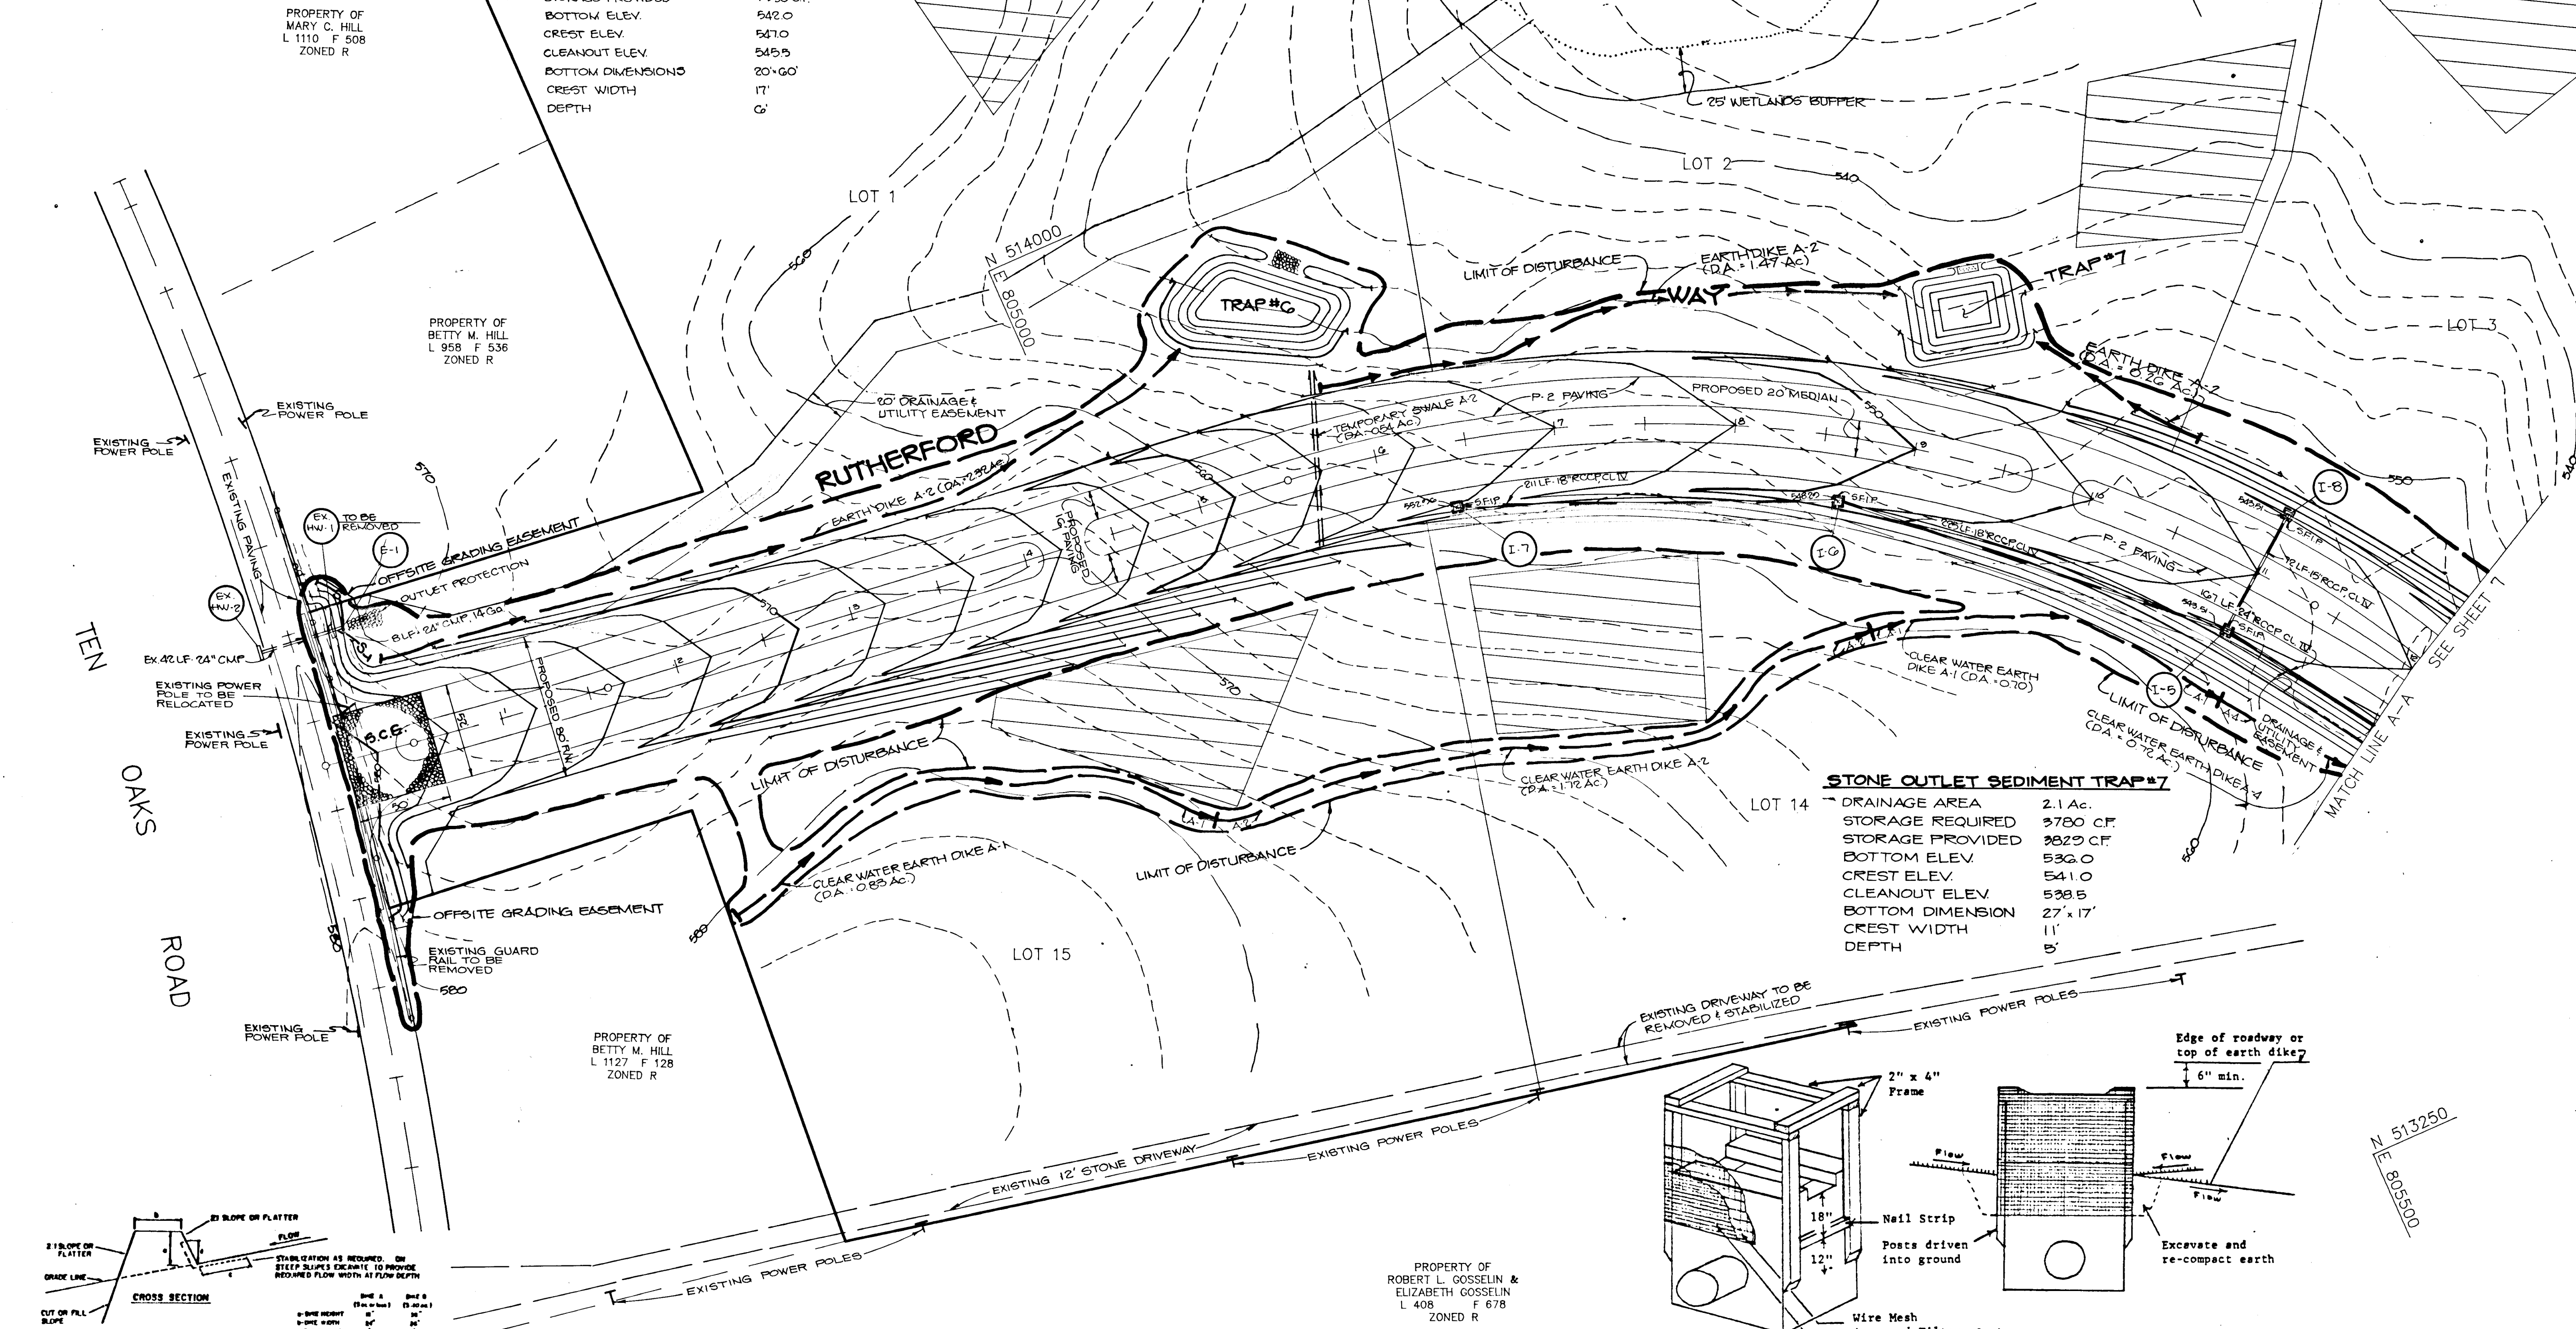

PROPERTY OF MARY C. HILL
L 1110 F 508
ZONED R

PROPERTY OF BETTY M. HILL
L 958 F 536
ZONED R

PROPERTY OF BETTY M. HILL
L 1127 F 128
ZONED R

PROPERTY OF ROBERT L. GOSSELIN & ELIZABETH GOSSELIN
L 408 F 678
ZONED R

1557

ROUTE 32

AS BUILT CERTIFICATION

ENGINEER JAYRANT PAREKH
FE # 19148 DATE 9-1-90

BY THE DEVELOPER:
"I CERTIFY THAT ALL DEVELOPMENT AND/OR CONSTRUCTION WILL BE DONE ACCORDING TO THESE PLANS, AND THAT ANY RESPONSIBLE PERSONNEL INVOLVED IN THE CONSTRUCTION PROJECT WILL HAVE A CERTIFICATE OF ATTENDANCE AT A DEPARTMENT OF NATURAL RESOURCES APPROVED TRAINING PROGRAM FOR THE CONTROL OF SEDIMENT AND EROSION BEFORE BEGINNING THE PROJECT. I WILL PROVIDE THE HOWARD SOIL CONSERVATION DISTRICT WITH AN 'AS-BUILT' PLAN OF THE POND WITHIN 30 DAYS OF COMPLETION. I ALSO AUTHORIZE PERIODIC ON-SITE INSPECTIONS BY THE HOWARD SOIL CONSERVATION DISTRICT."

BY THE ENGINEER:
"I CERTIFY THAT THIS PLAN FOR POND CONSTRUCTION, EROSION AND SEDIMENT CONTROL REPRESENTS A PRACTICAL AND WORKABLE PLAN BASED ON MY PERSONAL KNOWLEDGE OF THE SITE CONDITIONS. THIS PLAN WAS PREPARED IN ACCORDANCE WITH THE REQUIREMENTS OF THE HOWARD SOIL CONSERVATION DISTRICT. I HAVE NOTIFIED THE DEVELOPER THAT HE MUST PROVIDE THE HOWARD SOIL CONSERVATION DISTRICT WITH AN 'AS-BUILT' PLAN OF THE POND WITHIN 30 DAYS OF COMPLETION."

THESE PLANS HAVE BEEN REVIEWED FOR THE HOWARD SOIL CONSERVATION DISTRICT AND MEET THE TECHNICAL REQUIREMENTS FOR SMALL POND CONSTRUCTION, SOIL EROSION AND SEDIMENT CONTROL.

THESE PLANS FOR SMALL POND CONSTRUCTION, SOIL EROSION AND SEDIMENT CONTROL MEET THE REQUIREMENTS OF THE HOWARD SOIL CONSERVATION DISTRICT.

APPROVED: HOWARD COUNTY DEPARTMENT OF PLANNING AND ZONING

APPROVED: HOWARD COUNTY DEPARTMENT OF PUBLIC WORKS

DATE NO REVISION

OWNER/DEVELOPER
MARY C. HILL ET AL
6642 SENECA DRIVE
COLUMBIA, MARYLAND 21044

PROJECT: RUTHERFORD

AREA TAX MAP 28 ZONED R PARCEL 75
5TH ELECTION DISTRICT
HOWARD COUNTY, MARYLAND

TITLE: GRADING AND
SEDIMENT CONTROL PLAN

RIEMER MUEGGEL & ASSOCIATES, INC.
A Land Planning, Engineering and Consulting Firm
3105 North Ridge Road Ellicott City, Maryland 21043
301-461-2690 FAX: 301-750-3176

DATE 1/5/90
S-88-82 WP-88-11
P-89-59
DESIGNED BY: CJR
DRAWN BY: DJE
PROJECT NO: 5120G
DATE: JANUARY 16, 1990
SCALE: AS SHOWN
DRAWING NO. 7 OF 10

F-00-25

STONE OUTLET SEDIMENT TRAP #5

DRAINAGE AREA	2.74 AC
VOLUME REQUIRED	5292 CF
VOLUME PROVIDED	5700 CF
BOTTOM ELEVATION	522.0
CREST ELEVATION	527.0
CLEANOUT ELEVATION	524.5
CREST WIDTH	15'
BOTTOM DIMENSIONS	30' x 30'
DEPTH	6'

STONE OUTLET SEDIMENT TRAP #3

DRAINAGE AREA	0.91 AC
STORAGE REQUIRED	559 CF
STORAGE PROVIDED	639 CF
BOTTOM ELEVATION	519.0
CREST ELEVATION	514.5
CLEANOUT ELEVATION	514.5
CREST WIDTH	15'
BOTTOM DIMENSIONS	15' x 22'

STONE OUTLET SEDIMENT TRAP #2

DRAINAGE AREA	0.48 AC
STORAGE REQUIRED	774 CF
STORAGE PROVIDED	816 CF
BOTTOM ELEVATION	519.0
CREST ELEVATION	515.0
CLEANOUT ELEVATION	515.0
CREST WIDTH	15'
BOTTOM DIMENSIONS	15' x 24'

STONE OUTLET SEDIMENT TRAP #4


DRAINAGE AREA	0.78 AC
STORAGE REQUIRED	1404 CF
STORAGE PROVIDED	1512 CF
BOTTOM ELEVATION	518.0
CREST ELEVATION	514.0
CLEANOUT ELEVATION	514.5
CREST WIDTH	15'
BOTTOM DIMENSIONS	15' x 32'

STONE OUTLET SEDIMENT TRAP #1

DRAINAGE AREA	0.02 AC
STORAGE REQUIRED	1696 CF
STORAGE PROVIDED	1750 CF
BOTTOM ELEVATION	518.0
CREST ELEVATION	521.0
CLEANOUT ELEVATION	519.5
CREST WIDTH	5'
BOTTOM DIMENSIONS	11' x 5'


PLAN
SCALE: 1"=50'

- SEQUENCE OF CONSTRUCTION**
1. Obtain a grading permit, Army Corps 404 Wetland Permit and Maryland Department of Environment 401 Water Quality Permit prior to start of construction.
 2. Obtain grading easement for offsite grading.
 3. Install Stabilized Construction Entrance. (1 day)
 4. Install earth dikes, silt fence, temporary swales, stone outlet sediment traps #1-7, and temporary culvert at Station 19 + 83 with stream diversion. (2 weeks)
 5. Perform widening of Ten Oaks Road. Contractor must maintain one lane of traffic at all times during roadway construction. (1 week)
 6. Begin site grading, maintaining positive drainage on all earth dikes and temporary swales.
 7. Install storm drain and stone filter inlet protection including culverts. Upon installation of road culverts remove temporary stream diversion and temporary culvert. (2 weeks)
 8. Stabilize all disturbed areas in accordance with the temporary seeding notes. (2 days)
 9. Dewater existing pond by pumping out standing water. (1 day)
 10. Remove existing embankment. Install core trench and riser-barrel structure, including installation of permanent dewatering pipe and valve. (2 weeks)
 11. Begin grading for new embankment.
 12. Complete pond grading and stabilize area in accordance with the permanent seeding notes.
 13. Within 30 days of pond completion, an 'as-built' survey of the pond will have to be completed.
 14. Complete construction including paving and stabilize all areas in accordance with the permanent seeding notes.
 15. Upon approval of the Howard County Department of Public Works Sediment Control Inspector, remove all sediment controls and stabilize areas in accordance with the permanent seeding notes.

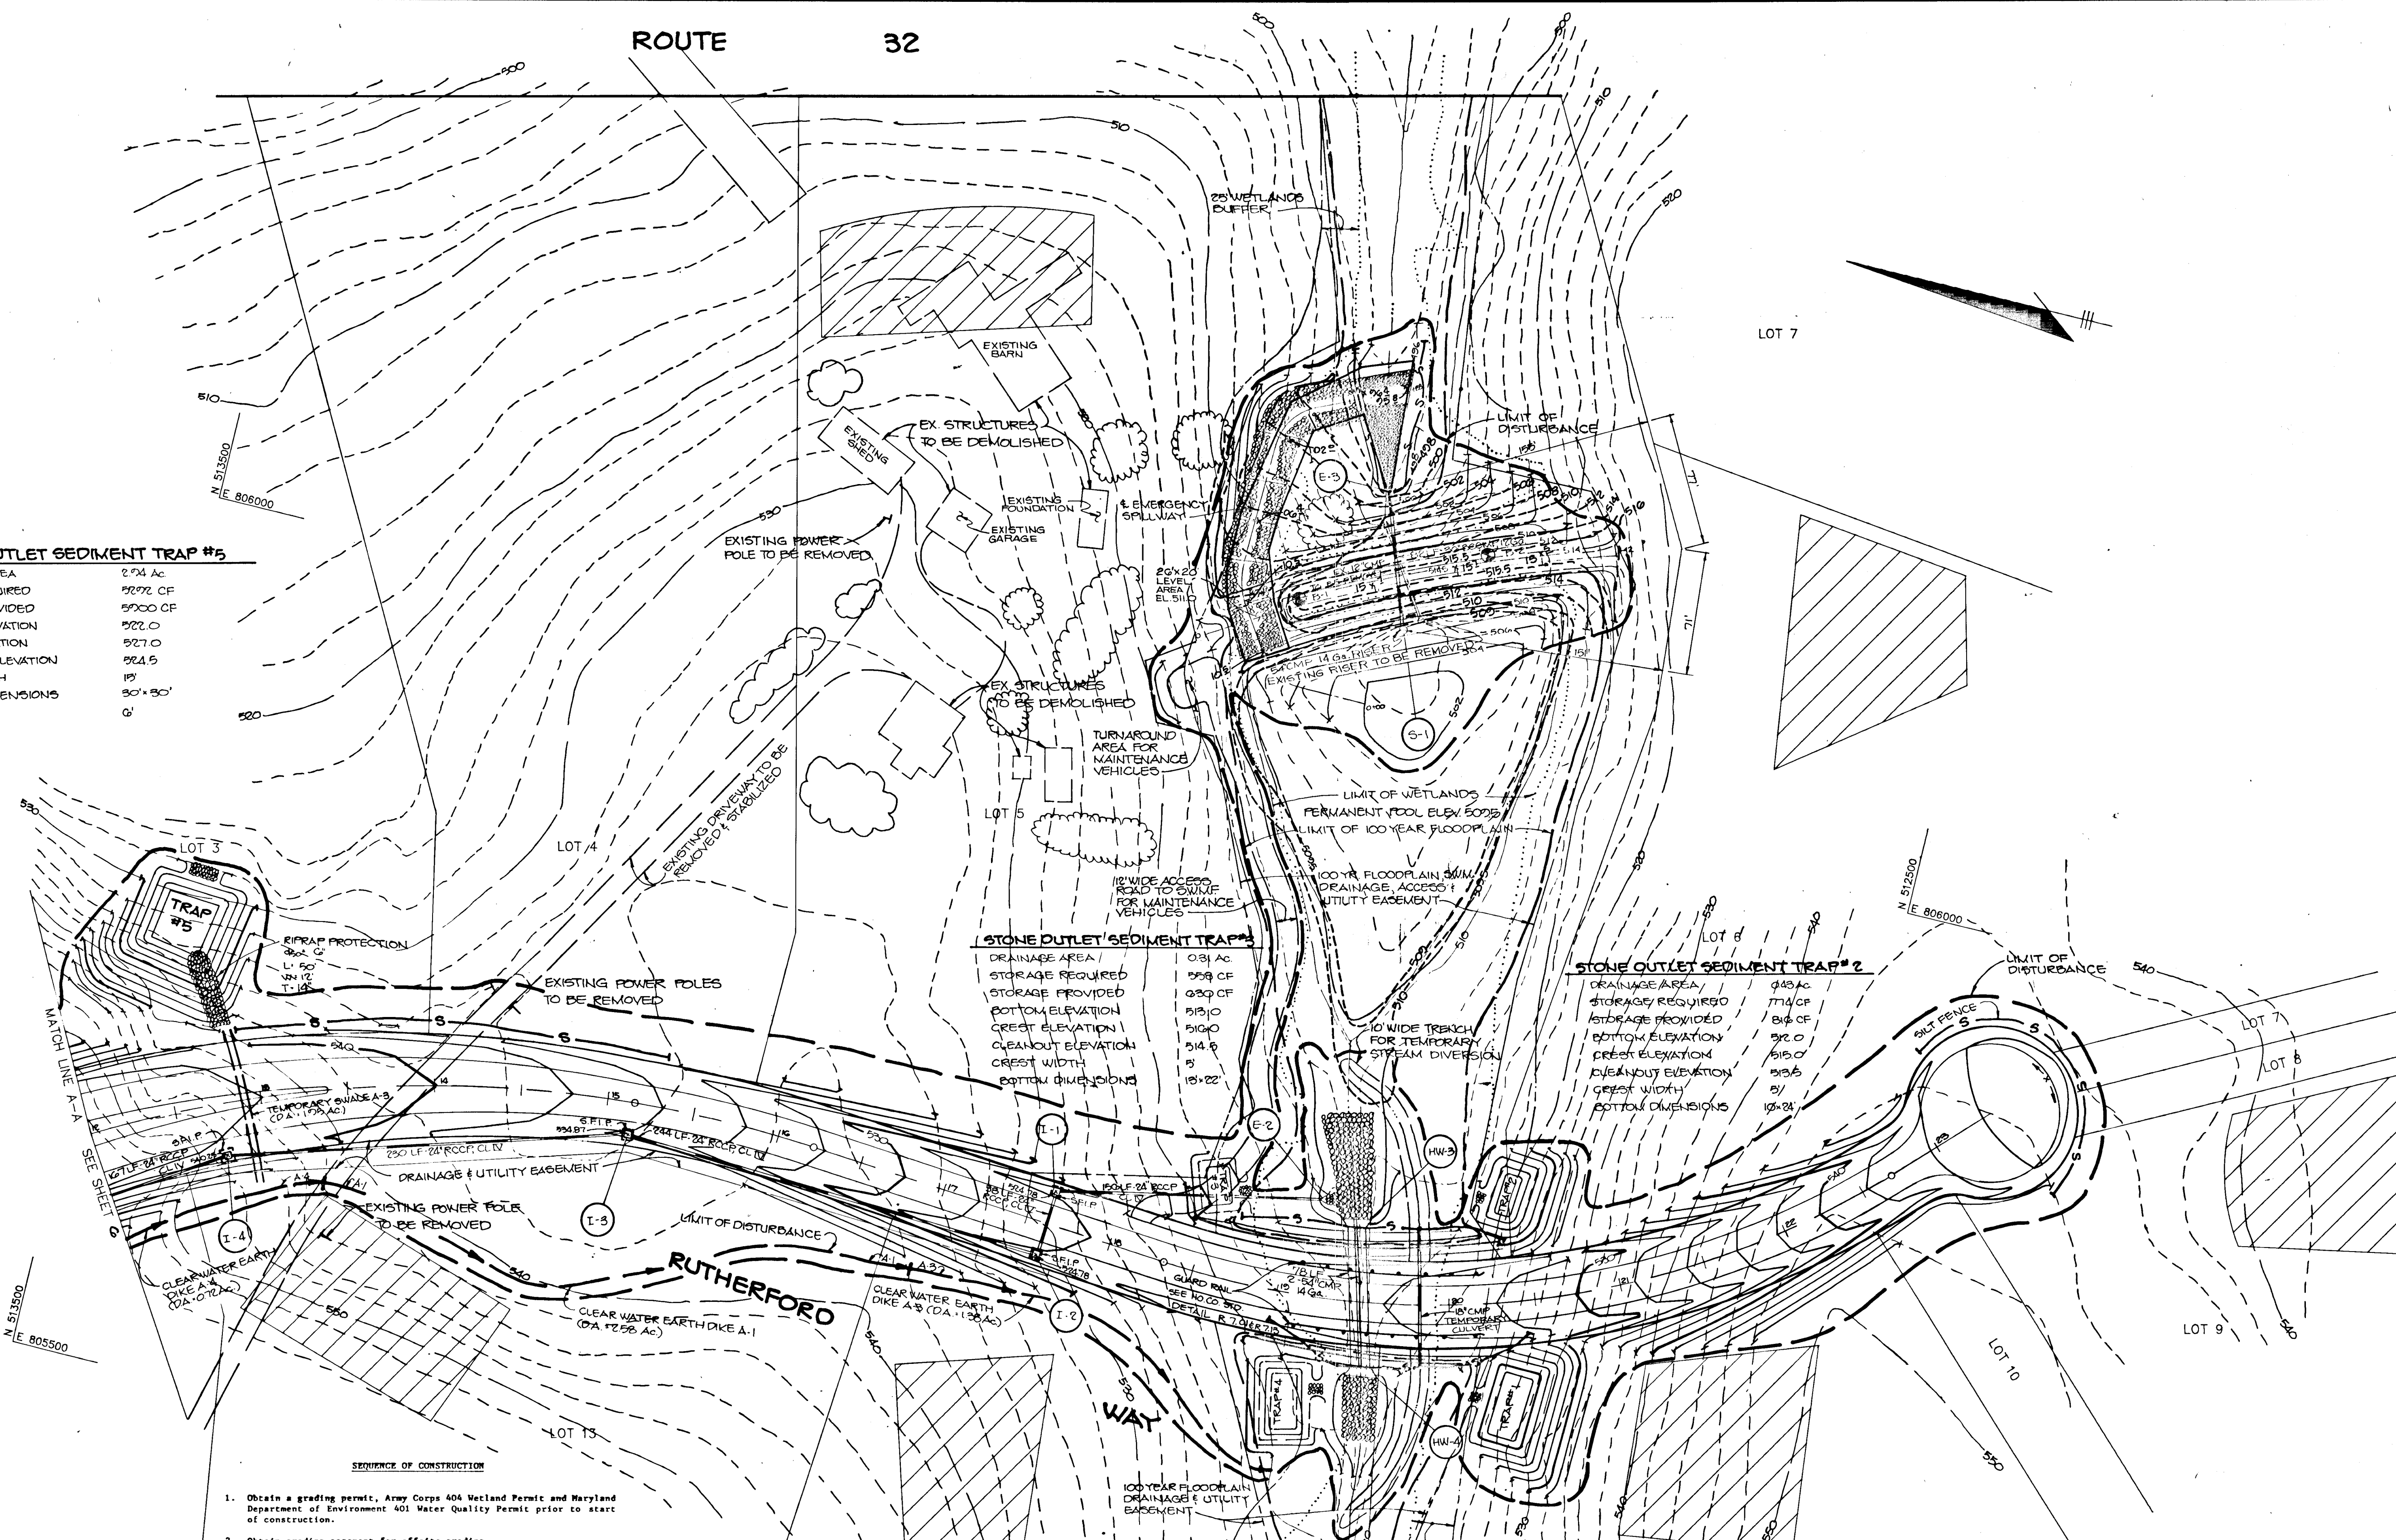


1557

MARYLAND BLUEPRINT CO. INC. 192000

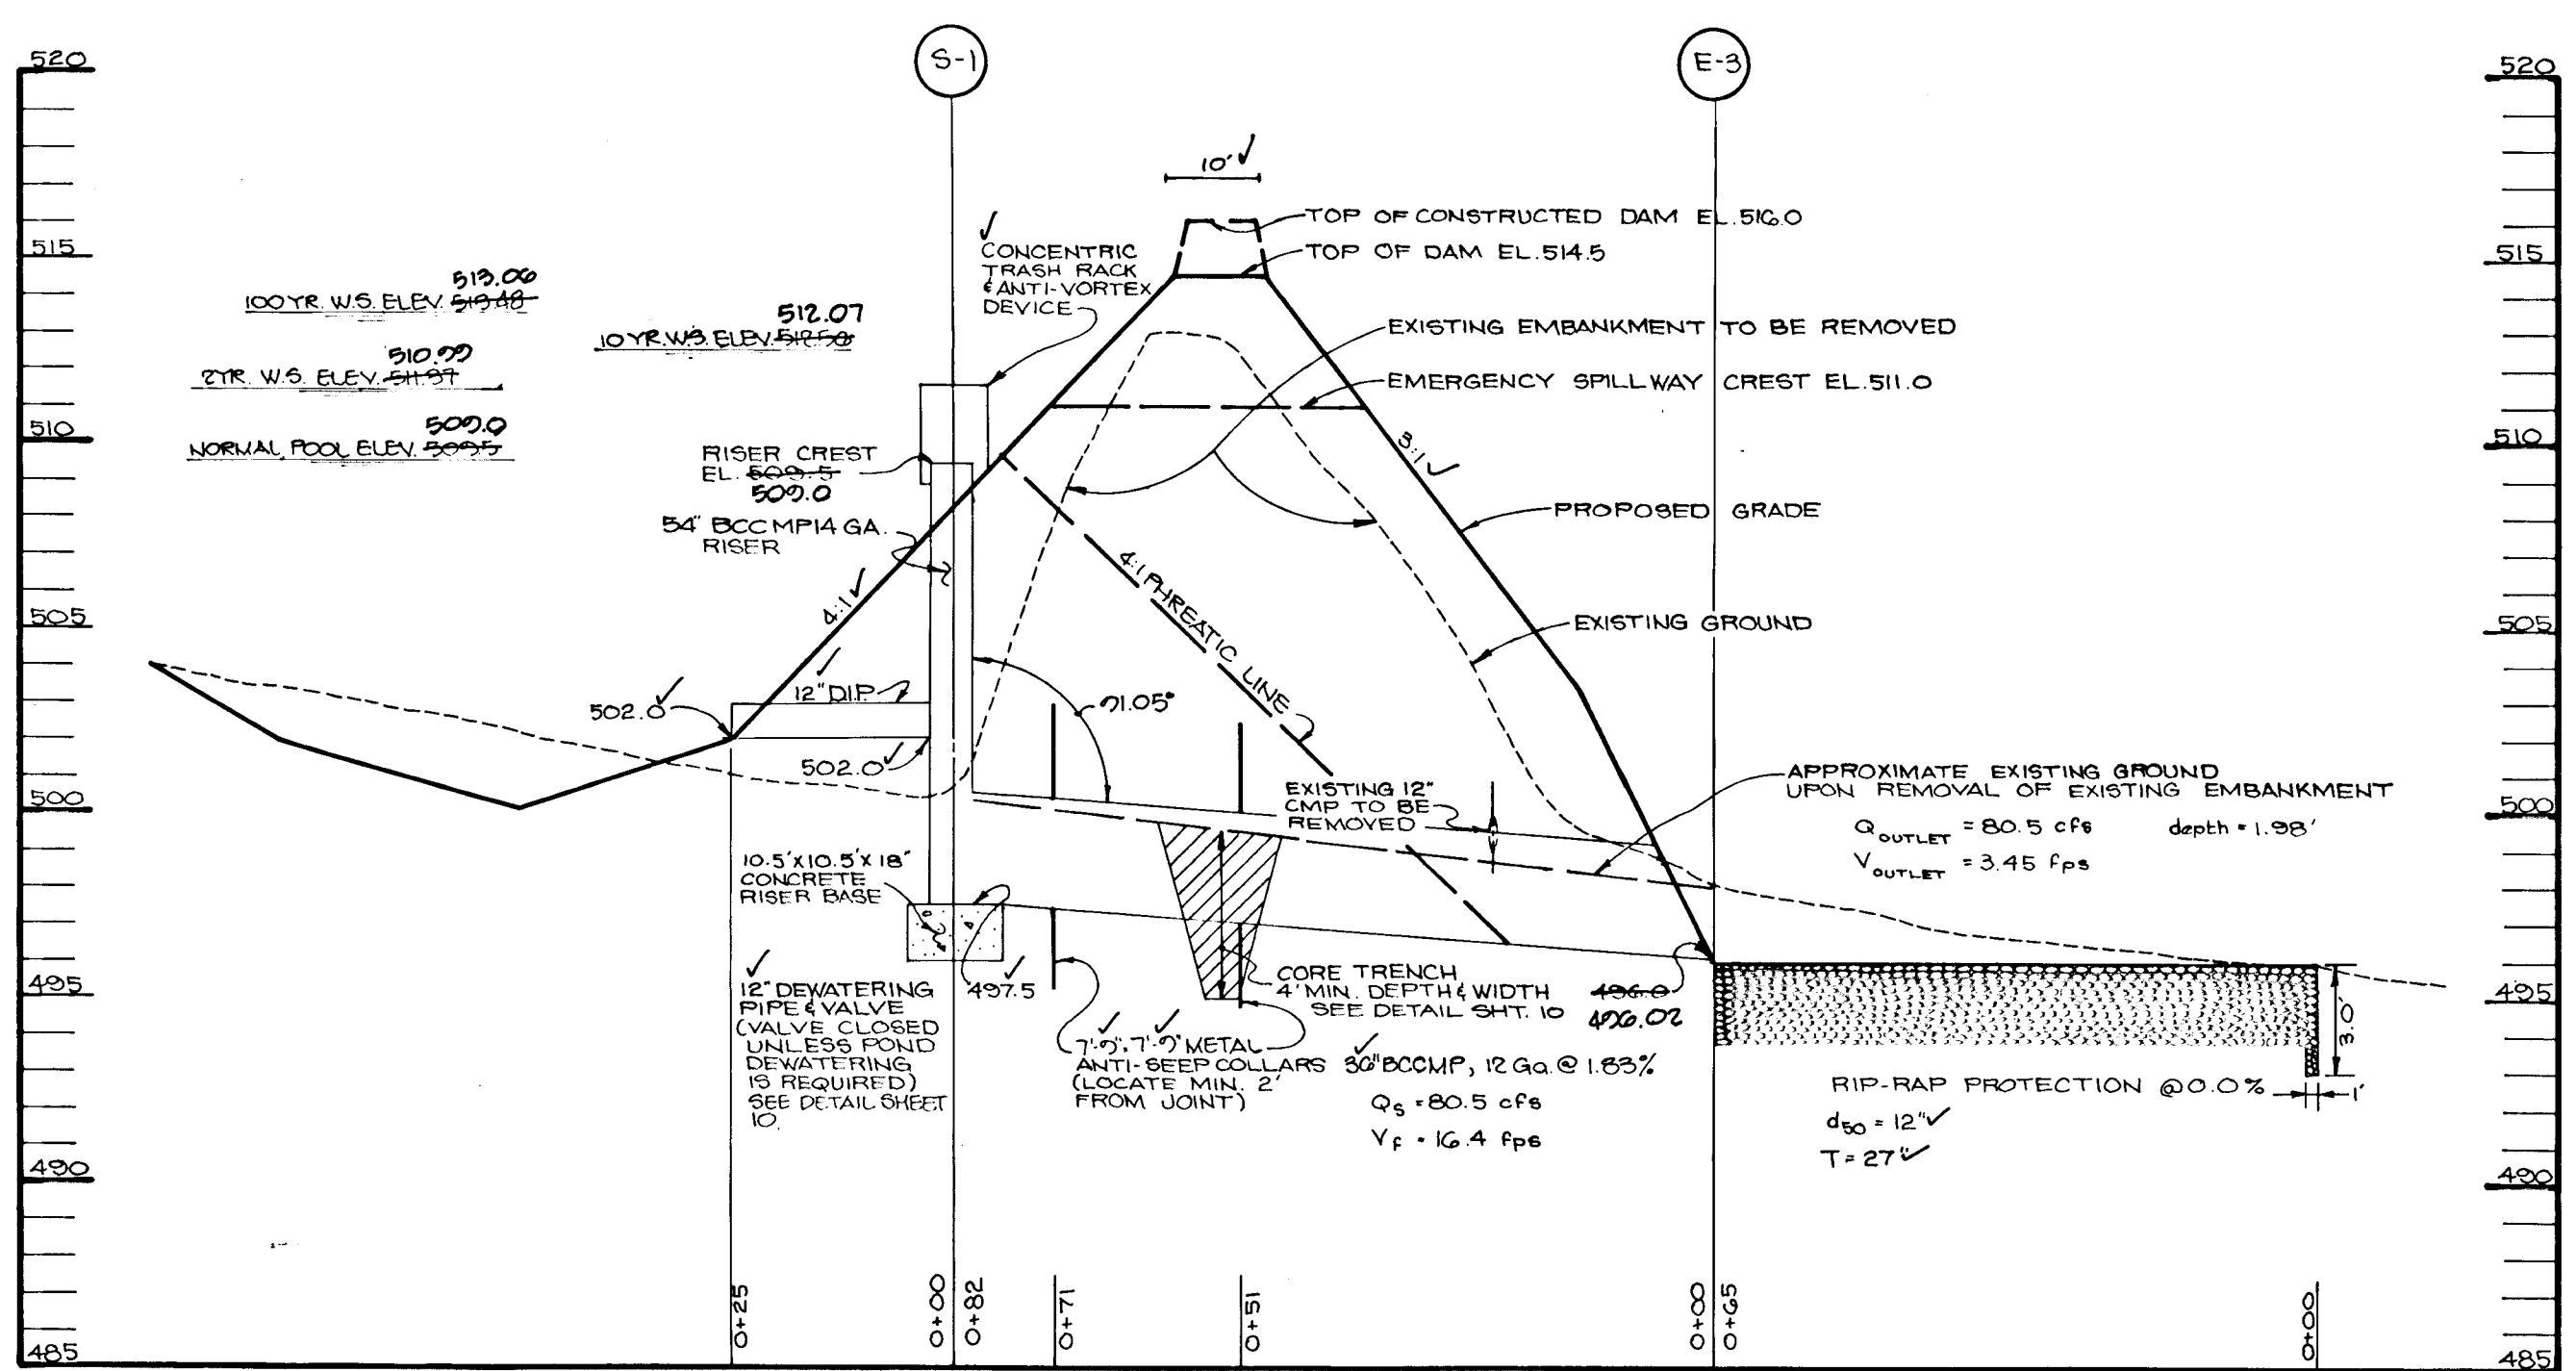


PROFILE THROUGH PRINCIPAL SPILLWAY

SCALE: HOR. 1"=20'
VERT. 1"=5'

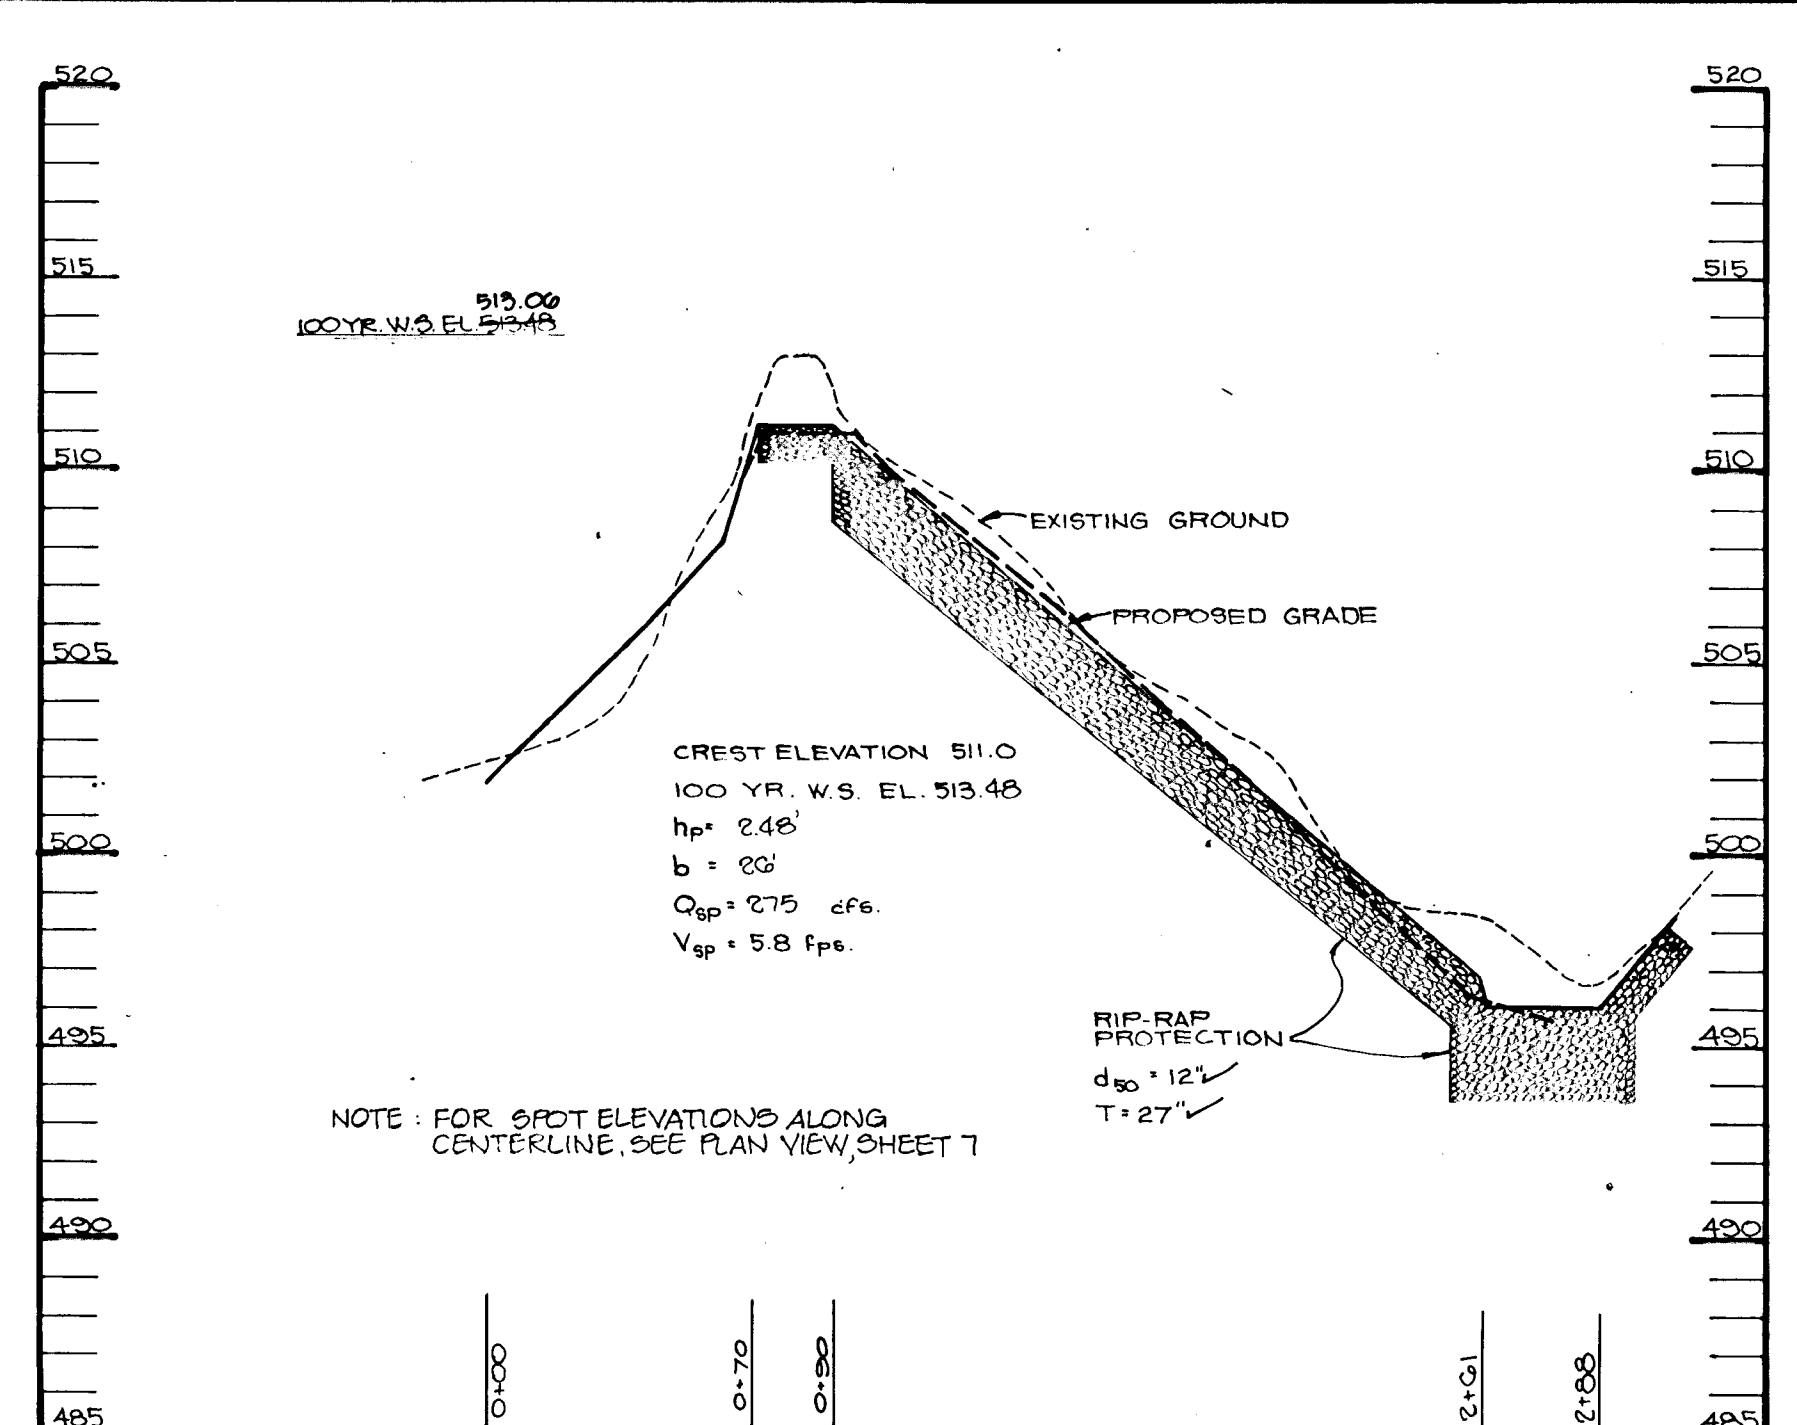


PROFILE THROUGH EMERGENCY SPILLWAY

SCALE: HOR. 1"=50'
VERT. 1"=5'

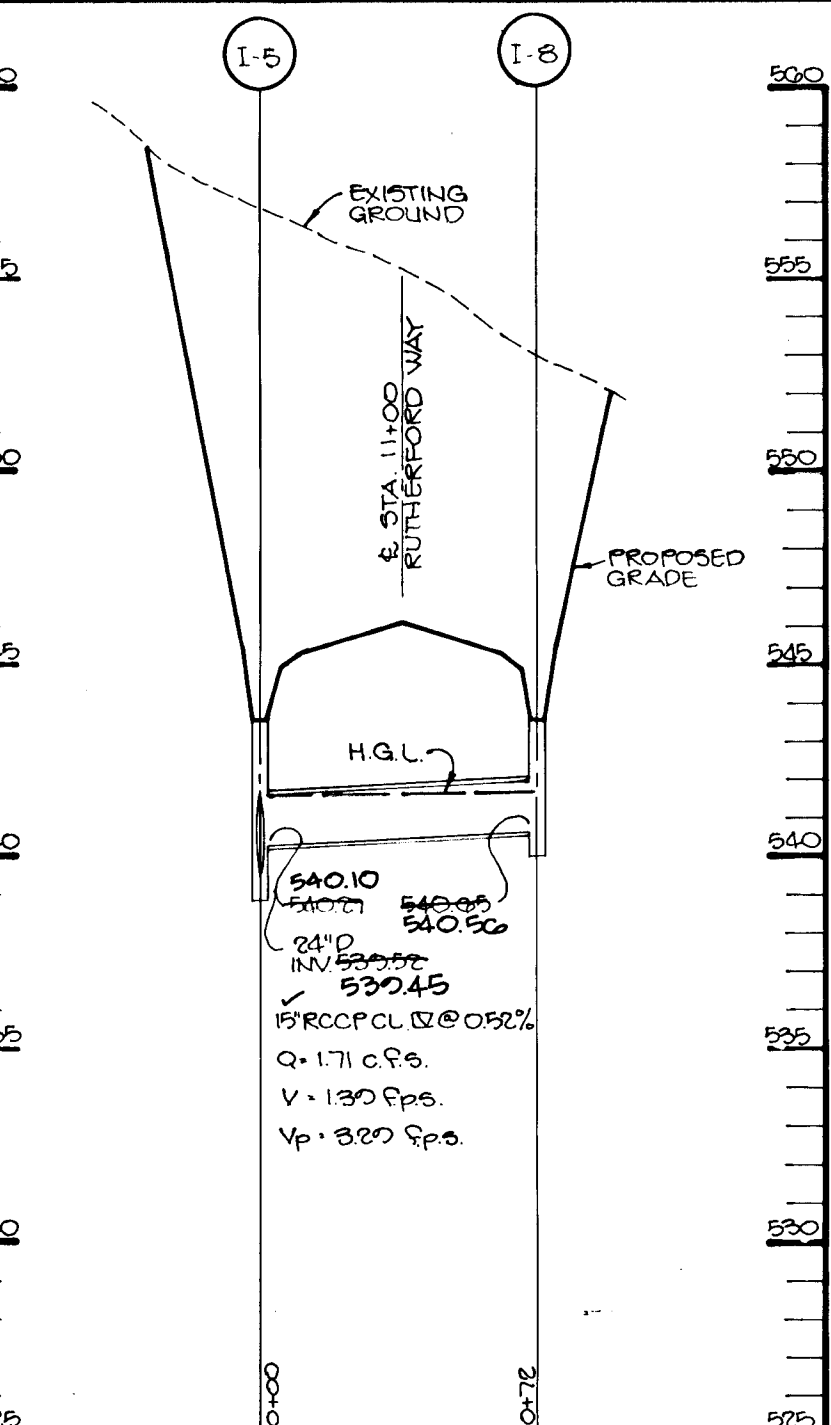

STORM DRAIN PROFILE

SCALE: HOR. 1"=50'
VERT. 1"=5'

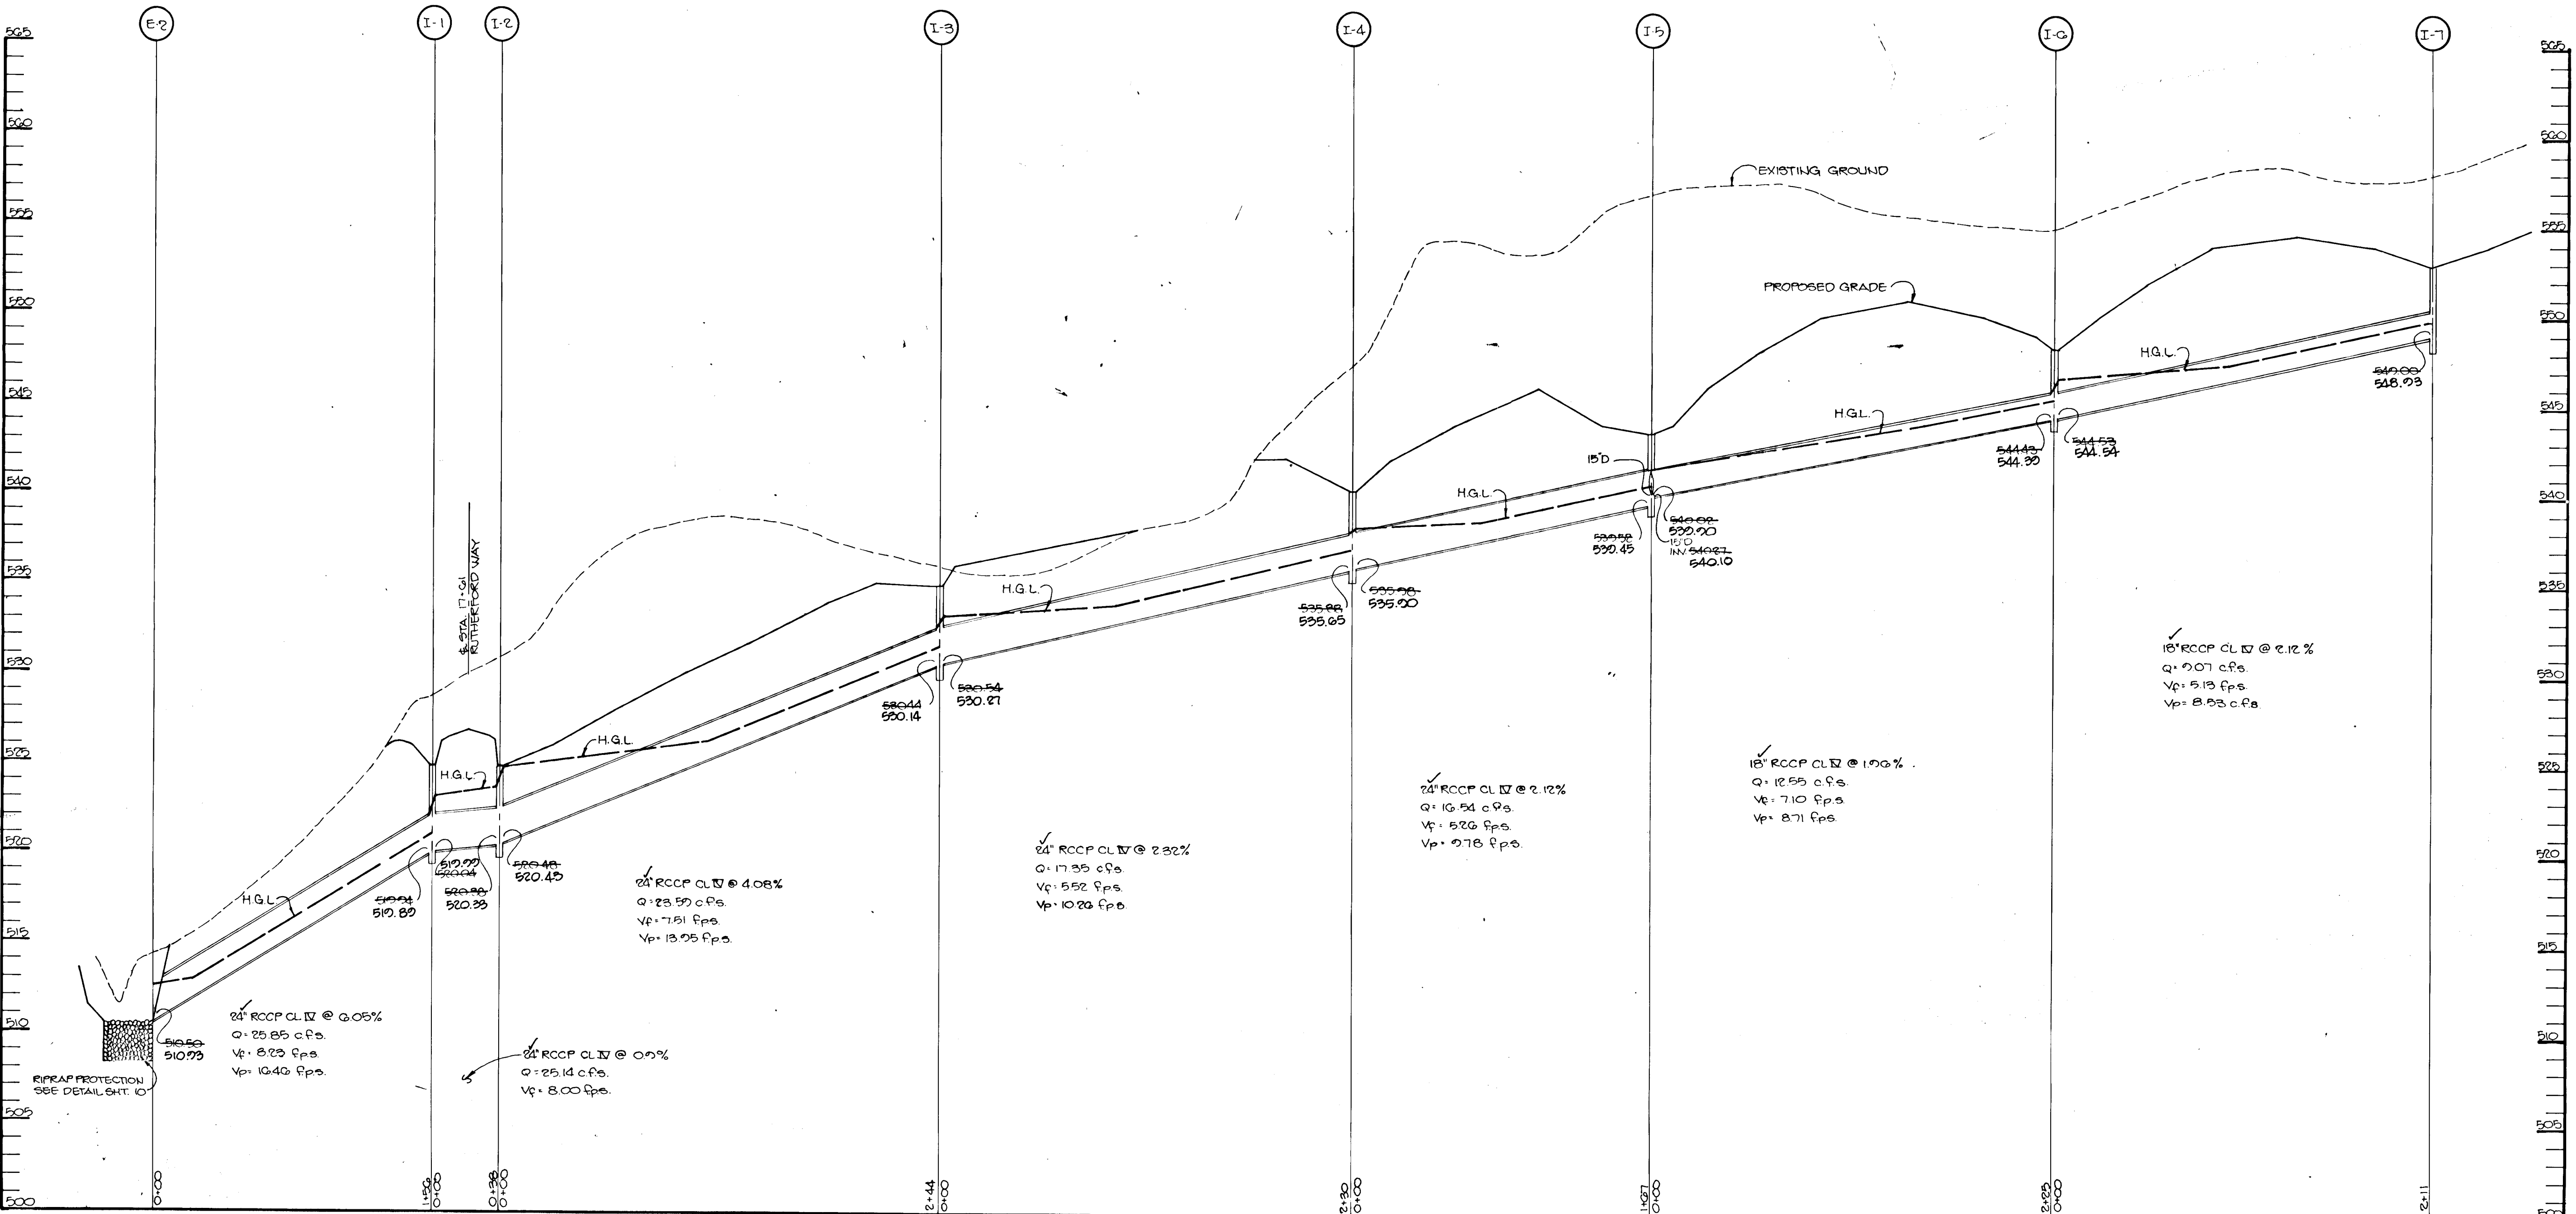

STORM DRAIN PROFILE

SCALE: HOR. 1"=50'
VERT. 1"=5'

AS-BUILT CERTIFICATION

ENGINEER: *Mary C Hill* DATE: 1-15-90

BY THE DEVELOPER:

"I CERTIFY THAT ALL DEVELOPMENT AND/OR CONSTRUCTION WILL BE DONE ACCORDING TO THESE PLANS, AND THAT ANY RESPONSIBLE PERSONNEL INVOLVED IN THE CONSTRUCTION PROJECT WILL HAVE A CERTIFICATE OF ATTENDANCE AT A DEPARTMENT OF NATURAL RESOURCES APPROVED TRAINING PROGRAM FOR THE CONTROL OF SEDIMENT AND EROSION BEFORE BEGINNING THE PROJECT. I WILL PROVIDE THE HOWARD SOIL CONSERVATION DISTRICT WITH AN 'AS-BUILT' PLAN OF THE POND WITHIN 30 DAYS OF COMPLETION. I ALSO AUTHORIZE PERIODIC ON-SITE INSPECTIONS BY THE HOWARD SOIL CONSERVATION DISTRICT."

DEVELOPER: _____ DATE: _____

BY THE ENGINEER:

"I CERTIFY THAT THIS PLAN FOR POND CONSTRUCTION, EROSION AND SEDIMENT CONTROL REPRESENTS A PRACTICAL AND WORKABLE PLAN BASED ON MY PERSONAL KNOWLEDGE OF THE SITE CONDITIONS. THIS PLAN WAS PREPARED IN ACCORDANCE WITH THE REQUIREMENTS OF THE HOWARD SOIL CONSERVATION DISTRICT. I HAVE NOTIFIED THE DEVELOPER THAT HE MUST PROVIDE THE HOWARD SOIL CONSERVATION DISTRICT WITH AN 'AS-BUILT' PLAN OF THE POND WITHIN 30 DAYS OF COMPLETION."

Arthur E. Muegge 1-15-90
ENGINEER DATE

THESE PLANS HAVE BEEN REVIEWED FOR THE HOWARD SOIL CONSERVATION DISTRICT AND MEET THE TECHNICAL REQUIREMENTS FOR SMALL POND CONSTRUCTION, SOIL EROSION AND SEDIMENT CONTROL.

James H. ... 1-31-90
U.S. SOIL CONSERVATION SERVICE DATE

THESE PLANS FOR SMALL POND CONSTRUCTION, SOIL EROSION AND SEDIMENT CONTROL MEET THE REQUIREMENTS OF THE HOWARD SOIL CONSERVATION DISTRICT.

APPROVED: *Blake Ziehl* 1-31-90
HOWARD COUNTY DATE

APPROVED: HOWARD COUNTY DEPARTMENT OF PLANNING AND ZONING

David S. ... 2/1/90
CHIEF, DIVISION OF COMMUNITY PLANNING AND LAND DEVELOPMENT DATE

APPROVED: HOWARD COUNTY DEPARTMENT OF PUBLIC WORKS

Paul W. ... 3/7/90
CHIEF, LAND DEVELOPMENT DIVISION DATE

Stanley W. ... 2/16/90
CHIEF, BUREAU OF HIGHWAYS DATE

William ... 3-9-90
CHIEF, BUREAU OF ENGINEERING DATE

DATE	NO.	REVISION

OWNER/DEVELOPER: MARY C HILL ET AL, 6642 SENECA DRIVE, COLUMBIA, MARYLAND 21044

PROJECT: RUTHERFORD

AREA TAX MAP 28 ZONE R PARCEL 75, 5TH ELECTION DISTRICT, HOWARD COUNTY, MARYLAND

TITLE: STORMDRAIN AND POND PROFILES

RIEMER MUEGGE & ASSOCIATES, INC.
A Land Planning, Engineering and Consulting Firm
3105 North Ridge Road Ellicott City, Maryland 21043
301-461-2690 FAX: 301-750-3176

DATE: 1-15-90

DESIGNED BY: DAM & C.U.R.

DRAWN BY: G.D.H.


PROJECT NO: 51206

DATE: JANUARY 16, 1990

SCALE: AS SHOWN


DRAWING NO. B OF 10

ARTHUR E. MUEGGE #8707

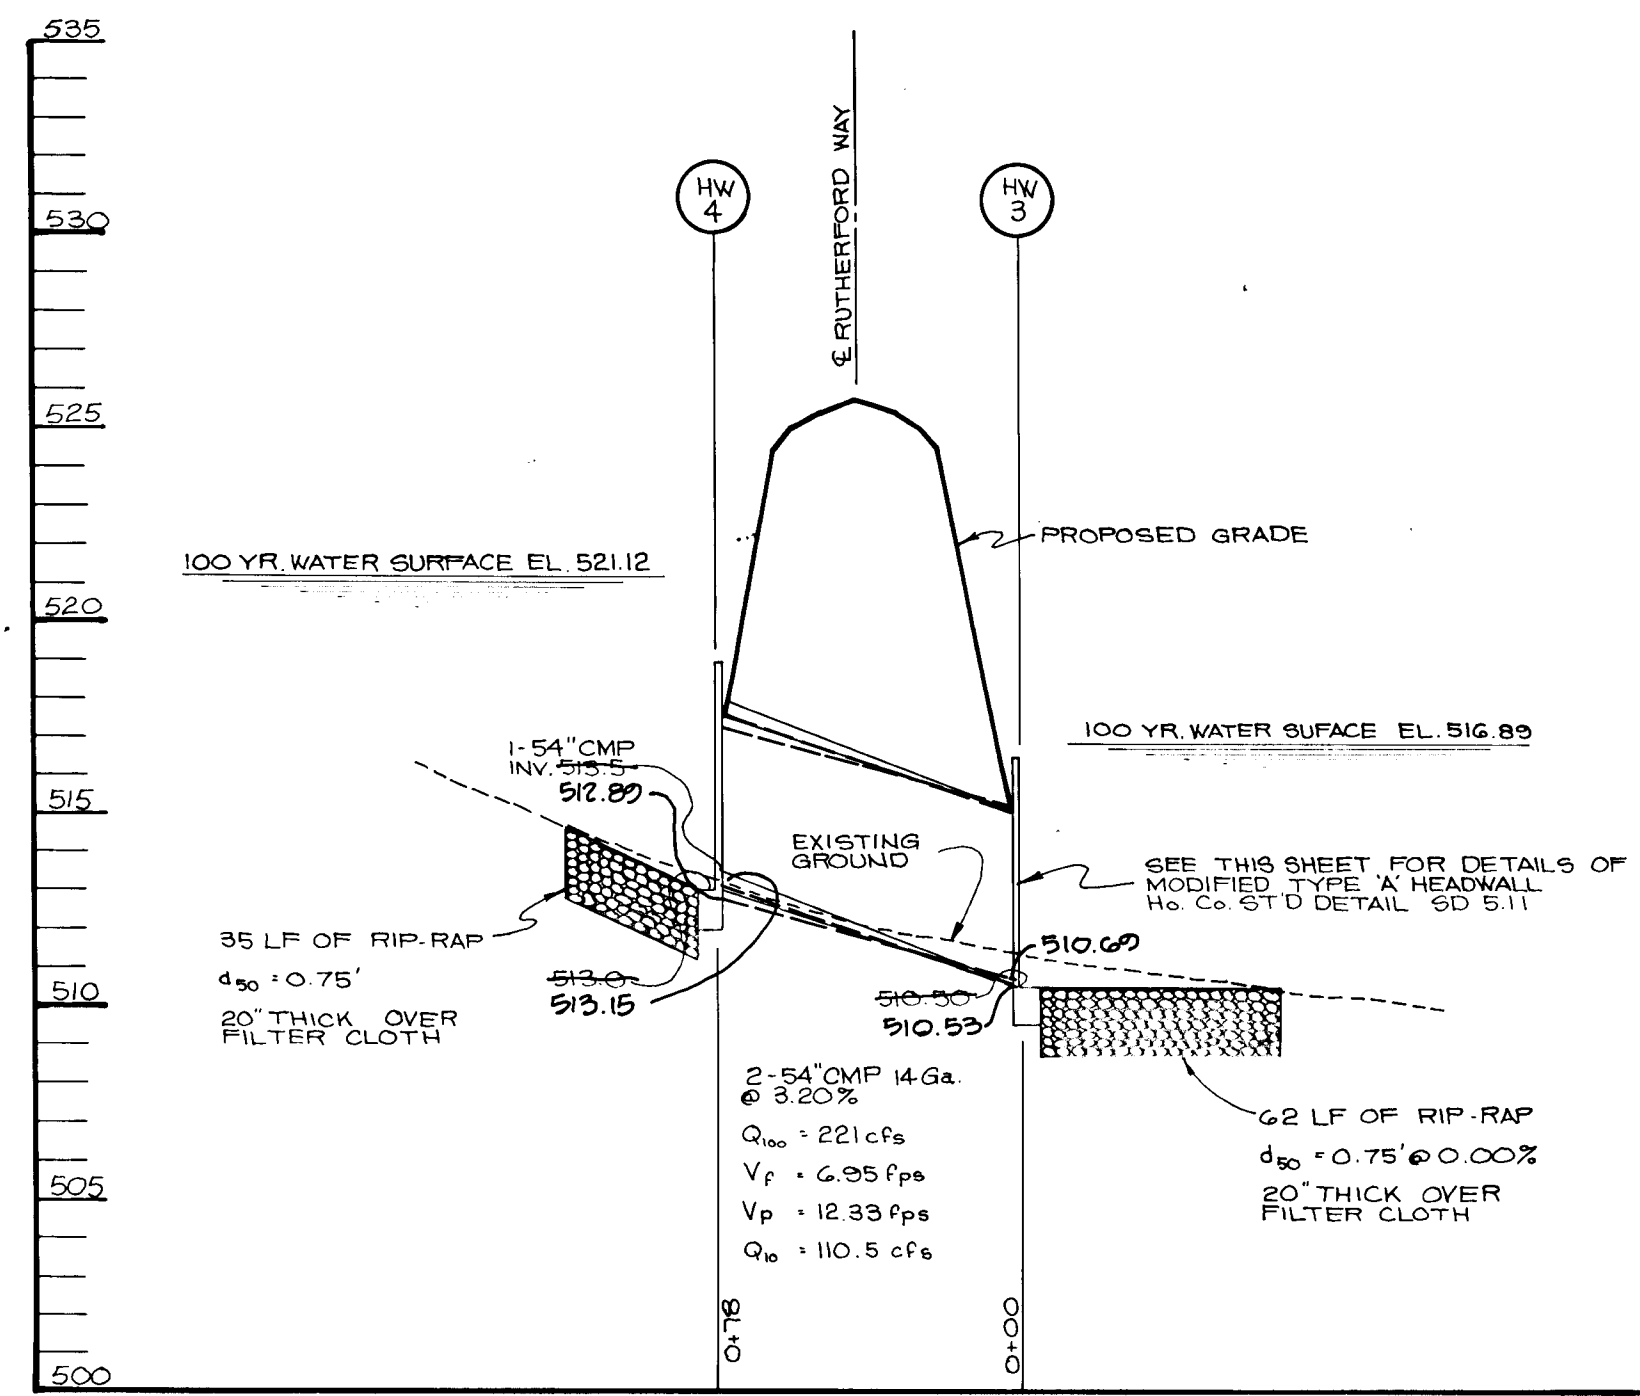

STORMDRAIN PROFILE

SCALE: HORIZ. 1"=50' VERT. 1"=5'

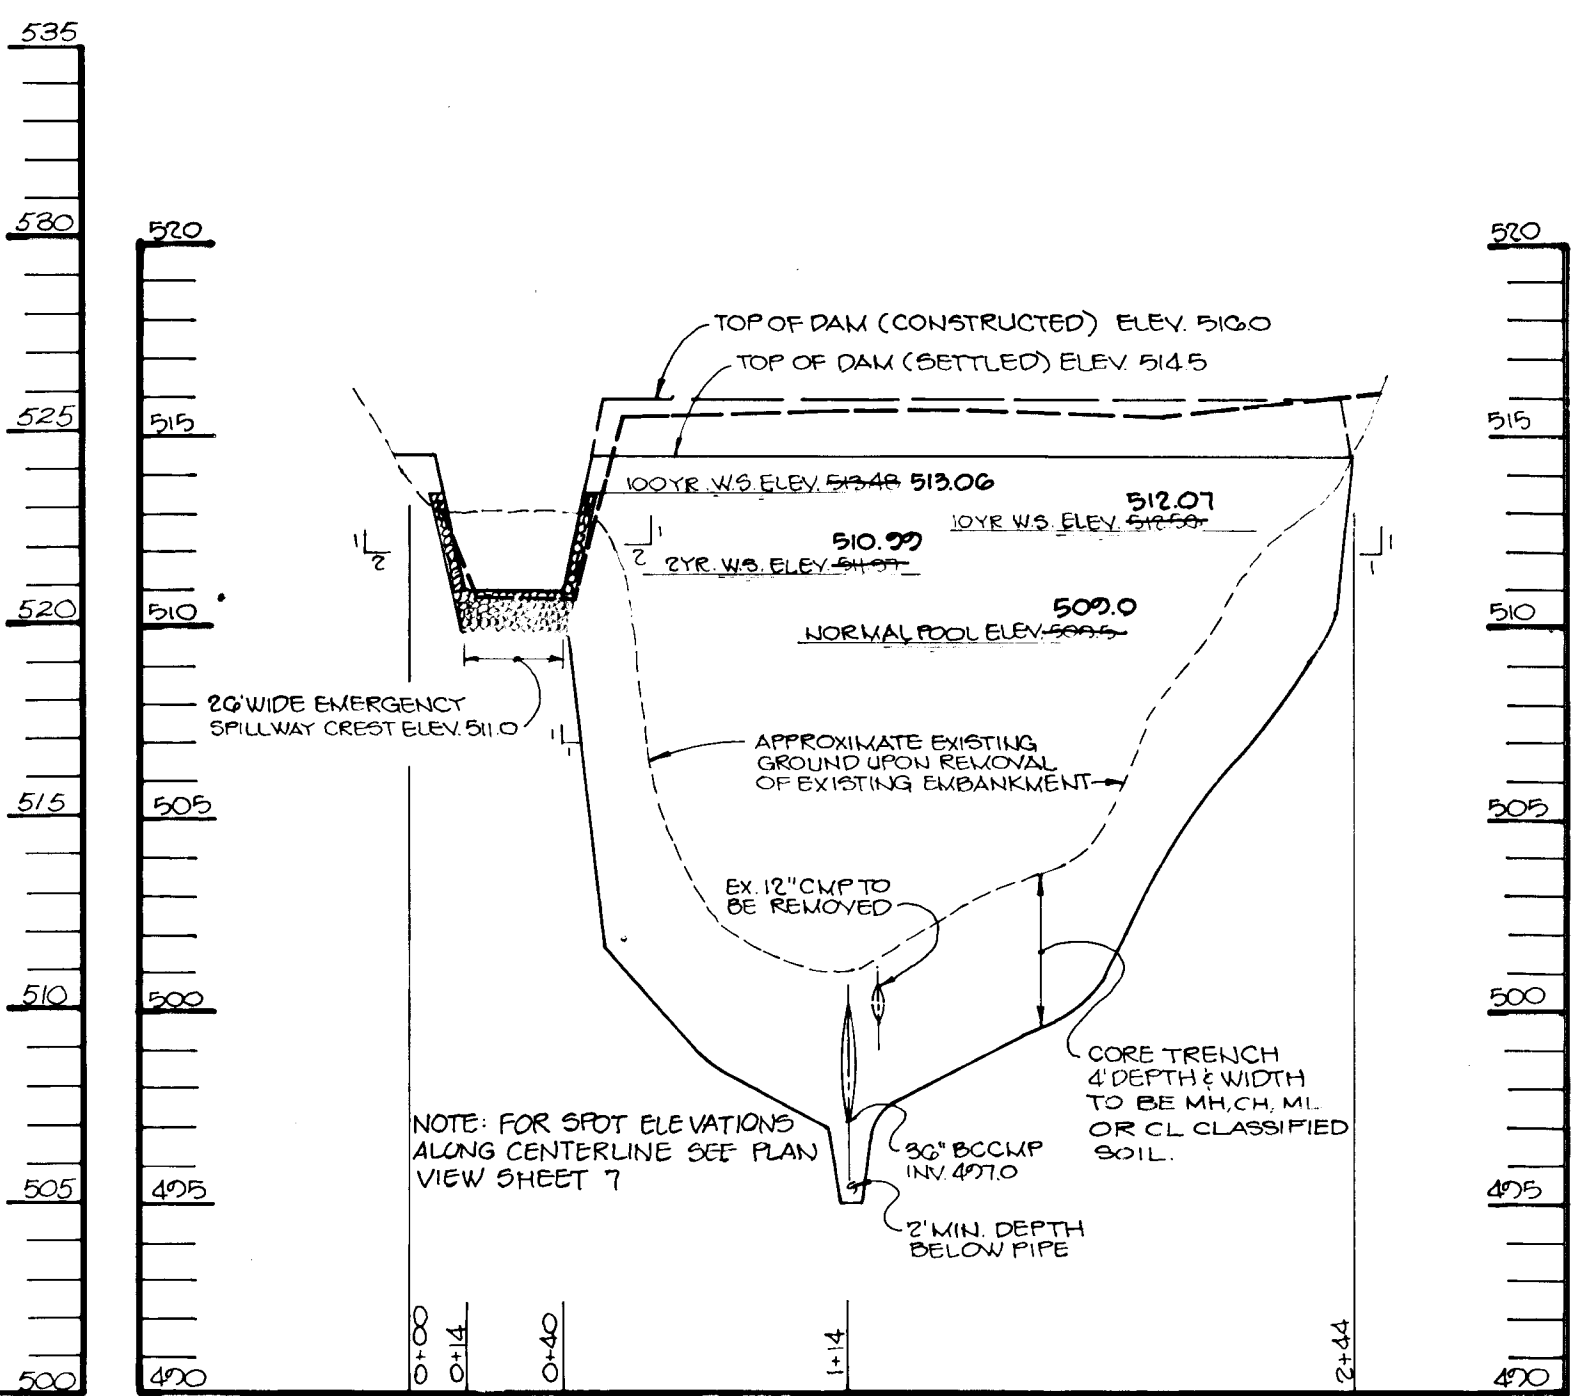


PROFILE ALONG C. OF EMBANKMENT

SCALE: HORIZ. 1"=50' VERT. 1"=5'

- SEDIMENT CONTROL NOTES**
- A minimum of 24 hours notice must be given to the Howard County Office of Inspections and Permits prior to the start of any construction (192-2437).
 - All vegetative and structural practices are to be installed according to the provisions of this plan and are to be in conformance with the 1983 MARYLAND STANDARDS AND SPECIFICATIONS FOR SOIL EROSION AND SEDIMENT CONTROL.
 - Following initial soil disturbance or redistribution, permanent or temporary stabilization shall be completed within: a) 7 calendar days for all permanent sediment control structures, dikes, perimeter slopes and all slopes greater than 3:1; b) 14 days as to all other disturbed or graded areas on the project site.
 - All sediment traps/basins shown must be fenced and warning signs posted around their perimeter in accordance with Vol. 1, Chapter 12, of the HOWARD COUNTY DISTRICT MANUAL, Storm Drainage.
 - All disturbed areas must be stabilized within the time period specified above in accordance with the 1983 MARYLAND STANDARDS AND SPECIFICATIONS FOR SOIL EROSION AND SEDIMENT CONTROL for permanent seedings (Sec. 51) and (Sec. 54), temporary seedings (Sec. 50) and mulching (Sec. 52). Temporary stabilization with mulch alone can only be done when recommended seedings do not allow for proper germination and establishment of grasses.
 - All sediment control structures are to remain in place and are to be maintained in operative condition until permission for their removal has been obtained from the Howard County Sediment Control Inspector.
 - Site Analysis:


Total Area of Site	65.93 acres
Area Disturbed	56.25 acres
Area to be roofed or paved	1.42 acres
Area to be vegetatively stabilized	8.18 acres
Total Cut	22,650 Cu. yds.
Total Fill	25,671 Cu. yds.
TOPSOIL	4082 Cu. yds.
 - Any sediment control practice which is disturbed by grading activity for placement of utilities must be repaired on the same day of disturbance.
 - Additional sediment controls must be provided, if deemed necessary by the Howard County Department of Public Works Sediment Control Inspector.
 - Site grading will begin only after all perimeter sediment control measures have been installed and are in functioning condition.
 - Sediment will be removed from traps when its depth reaches the clean out elevation shown on the plans.
 - Cut and fill quantities provided under site analysis do not represent bid quantities. These quantities do not distinguish between topsoil, structural fill or embankment material, nor do they reflect consideration of removal of any unsuitable material. The contractor shall familiarize himself with site conditions which may affect the work.

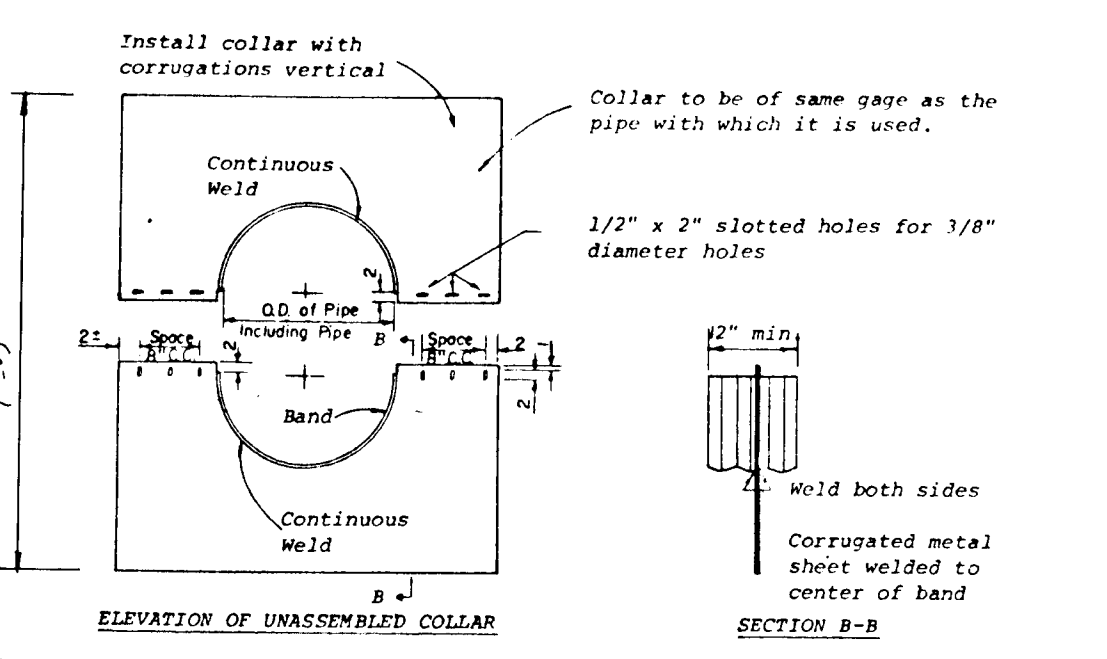

- NOTES FOR COLLARS:**
- All materials to be in accordance with construction and construction material specifications.
 - When specified on the plans, coating of collars shall be in accordance with construction and construction material specifications.
 - Unassembled collars shall be marked by painting or tagging to identify matching parts.
 - The lap between the two half sections and between the pipe and connecting band shall be caulked with asphalt mastic at time of installation.
 - Each collar shall be furnished with two 1/2" diameter rods with standard tank lugs for connecting collars to pipe.

ANTI-SEEP COLLAR DETAIL

NO SCALE

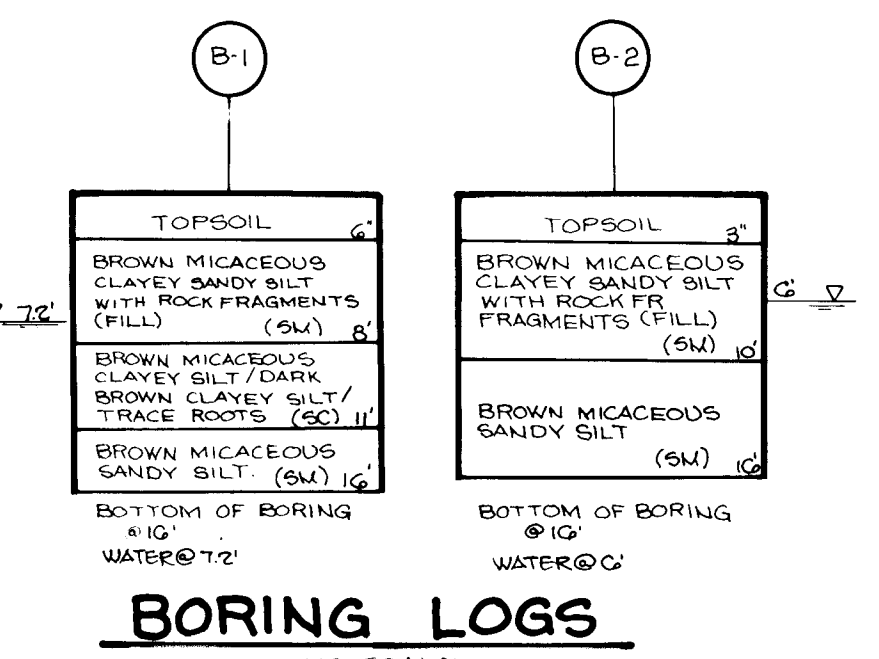

BORING LOGS

PERMANENT SEEDING NOTES

Apply to graded or cleared areas not subject to immediate further disturbance where a permanent long-lived vegetative cover is needed.

Seedbed Preparation: Loosen upper three inches of soil by raking, discing or other acceptable means before seeding, if not previously loosened.

Soil Amendments: In lieu of soil test recommendations, use one of the following schedules:

- Preferred - Apply 2 tons per acre dolomitic limestone (92 lbs./1000 sq ft) and 600 lbs per acre 10-10-10 fertilizer (14 lbs./1000 sq ft) before seeding. Harrow or disc into upper three inches of soil. At time of seeding, apply 400 lbs per acre 30-0-0 ureaform fertilizer (9 lbs./1000 sq ft).
- Acceptable - Apply 2 tons per acre dolomitic limestone (92 lbs./1000 sq ft) and 1000 lbs per acre 10-10-10 fertilizer (23 lbs./1000 sq ft) before seeding. Harrow or disc into upper three inches of soil.

Seeding: For the periods March 1 thru April 30, and August 1 thru October 15, seed with 60 lbs. per acre (1.4 lbs./1000 sq ft.) of Kentucky 31 Tall Fescue. For the period May 1 thru July 31, seed with 60 lbs. Kentucky 31 Tall Fescue per acre and 2 lbs per acre (4.05 lbs./1000 sq ft) of weeping lovegrass. During the period of October 16 thru February 28, protect site by: Option (1) 2 tons per acre of well-anchored straw mulch and seed as soon as possible in the spring. Option (2) Use seed, Option (3) Seed with 60 lbs. Kentucky 31 Tall Fescue and mulch with 2 tons/acre well-anchored straw.

Mulching: Apply 1 1/2 to 2 tons per acre (70 to 90 lbs./1000 sq. ft.) of unrotted small grain straw immediately after seeding. Anchor mulch immediately after application using mulch anchoring tool or 218 gal. per acre (5 gal./1000 sq. ft.) of emulsified asphalt on flat areas. On slopes 8 feet or higher, use 348 gallons per acre (8 gal./1000 sq. ft.) for anchoring.

Maintenance: Inspect all seeded areas and make needed repairs, replacements and reseeding.


Seedbed Preparation: Loosen upper three inches of soil by raking, discing or other acceptable means before seeding, if not previously loosened.

Soil Amendments: Apply 600 lbs. per acre 10-10-10 fertilizer (14 lbs./1000 sq. ft.).

Seeding: For periods March 1 thru April 30 and from August 15 thru November 15, seed with 2 1/2 bushel per acre of annual rye (3.2 lbs./1000 sq. ft.). For the period May 1 thru August 14, seed with 3 lbs. per acre of weeping lovegrass (.07 lbs./1000 sq. ft.). For the period November 16 thru February 28, protect site by applying 2 tons per acre of well anchored straw mulch and seed as soon as possible in the spring, or use sod.

Mulching: Apply 1 1/2 to 2 tons per acre (70 to 90 lbs./1000 sq. ft.) of unrotted small grain straw immediately after seeding. Anchor mulch immediately after application using mulch anchoring tool or 218 gal. per acre (5 gal./1000 sq. ft.) of emulsified asphalt on flat areas. On slopes, 8 ft. or higher, use 348 gal. per acre (8 gal./1000 sq. ft.) for anchoring.

Refer to the 1983 MARYLAND STANDARDS AND SPECIFICATIONS FOR SOIL EROSION AND SEDIMENT CONTROL for rate and methods not covered.

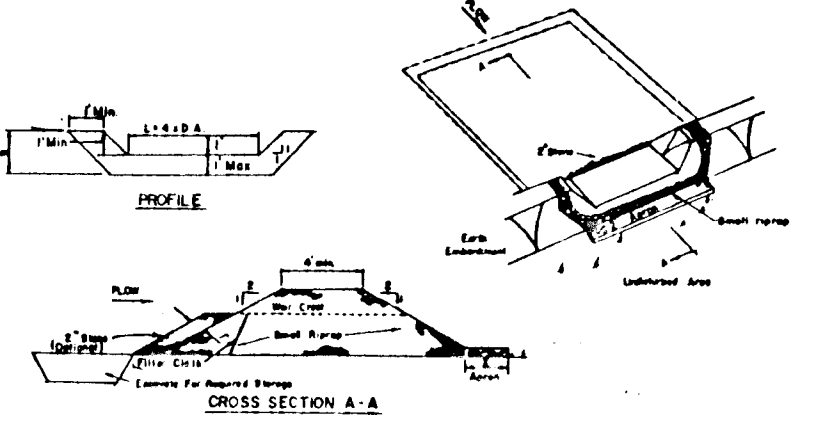

STONE OUTLET SEDIMENT TRAP

NO SCALE

These specifications are appropriate to ponds within the scope of the Standard for practice 378.


- I. SITE PREPARATION**
- Areas designated for borrow areas, embankment, and structural works shall be cleared, grubbed and stripped of topsoil. All trees, vegetation, roots and other objectionable material shall be removed. Channel banks and sharp breaks shall be sloped to no steeper than 1:1.
- Areas to be covered by the pond or reservoir will be cleared of all trees, brush, logs, fences, rubbish and other objectionable material unless otherwise designated on the plans. Trees, brush and stumps shall be cut approximately level with the ground surface.
- All cleared and grubbed material shall be disposed of outside and below the 1:1 slope of the dam and reservoir as directed by the owner or his representative. When specified, a sufficient quantity of topsoil will be stockpiled in a suitable location for use on the embankment and other designated areas.
- II. EARTH FILL**
- Material**
- The fill material shall be taken from approved designated borrow area or areas. It shall be free of roots, stumps, wood, rubbish, oversize stones, frozen or other objectionable materials. The embankment shall be constructed to an elevation which provides for anticipated settlement to the design elevation. The fill height all along the length of the embankment shall be increased above the design elevation (including freeboard) as shown on the plans.
- Placement**
- Areas on which fill is to be placed shall be scarified prior to placement of fill. Fill materials shall be placed in 8-inch maximum thickness (before compaction) layers which are to be continuous over the entire length of the fill. The most porous borrow material shall be placed in the downstream portions of the embankment.
- Compaction**
- The movement of the hauling and spreading equipment over the fill shall be controlled so that the entire surface of each lift shall be traversed by not less than one tread track of the equipment or compaction shall be achieved by a minimum of four complete passes of a sheepsfoot, rubber tired or vibratory roller. Fill material shall contain sufficient moisture such that the required degree of compaction can be obtained with the equipment used.
- Where a minimum required density is specified, each layer of fill shall be V. compacted as necessary to obtain that density and is to be certified by the Engineer.
- Outcrop Trench**
- Where specified, a cutoff trench shall be excavated along or parallel to the centerline of the embankment as shown on the plans. The bottom width of the trench shall be as shown on the drawings, with the minimum width being four feet. The depth shall be at least four feet or as shown on the plans. The side slopes of the trench shall be 1 to 1 or flatter. The backfill material for the cutoff trench shall be the same impervious material available and shall be compacted with equipment or rollers to assure maximum density and minimum permeability.
- III. STRUCTURAL BACKFILL**
- Backfill material shall be of the type and quality conforming to that specified for the adjoining fill material. The fill shall be placed in horizontal layers not to exceed four inches in thickness and compacted by hand tampers or other compaction equipment. The material needs to fill completely all spaces under and adjacent to the pipe. At no time during the backfilling operation shall driven equipment be allowed to operate closer than four feet, measured horizontally, to any part of a structure. Under no circumstances shall equipment be driven over any part of a concrete structure or pipe unless there is a compacted fill of twenty-four inches or greater over the structure or pipe.
- IV. PIPE CONDUITS**
- All pipes shall be circular in cross section.
- A. Corrugated Metal Pipe**
- Materials - (Steel Pipe) - This pipe and its appurtenances shall be galvanized and fully bituminous coated and shall conform to the requirements of AASHTO Specification M-190 Type A with watertight coupling bands. Any bituminous coating damaged or otherwise removed shall be replaced with cold applied bituminous coating compound.

TEMPORARY SWALE

NO SCALE


TYPE OF PROTECTIVE	ORIGIN SOURCE	APPLICABLE TO (S. AC OR LESS)	APPLICABLE TO (S. AC - 30 AC)
1	0.5-1.0	SEED AND STRAW MULCH	SEED AND STRAW MULCH
2	3.1-5.0	SEED AND STRAW MULCH	SEED USING AURE OR EXCELUSION
3	5.1-8.0	SEED WITH AURE OR EXCELUSION, SO2	SEED USING AURE OR EXCELUSION
4	8.1-20	LINED 4" RIP-RAP	ENGINEERED DESIGN

PERIODIC INSPECTION AND REQUIRED MAINTENANCE MUST BE PROVIDED AFTER EACH RAIN EVENT.

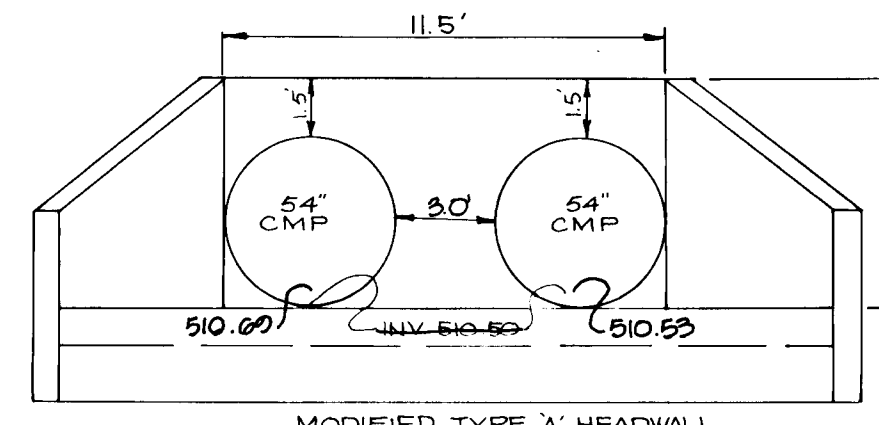

HEADWALL 3 (HW-3)

NO SCALE

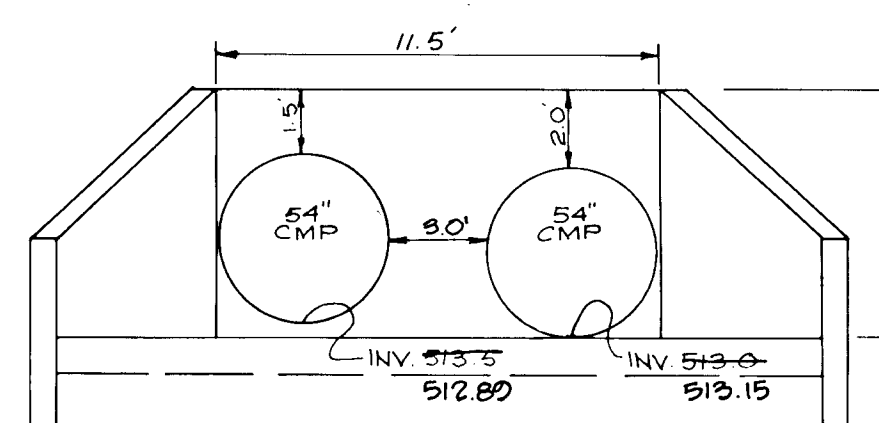

HEADWALL 4 (HW-4)

NO SCALE

AS BUILT CERTIFICATION

ENGINEER: *Arthur E. Muegge* DATE: 1-1-90

BY THE DEVELOPER:

BY THE ENGINEER:

APPROVED: *Robert J. Zick* 1-15-90
HOWARD COUNTY DEPARTMENT OF PLANNING AND ZONING

APPROVED: *Charles J. Dwyer* 1-31-90
CHIEF, DIVISION OF COMMUNITY PLANNING AND LAND DEVELOPMENT

APPROVED: *James W. Wexland* 3-7-90
CHIEF, BUREAU OF HIGHWAYS

APPROVED: *William B. Ray* 2-16-90
CHIEF, BUREAU OF ENGINEERING

OWNER/DEVELOPER: MARY C. HILL ET AL
6642 SENECA DRIVE
COLUMBIA, MD. 21044

PROJECT: **RUTHERFORD**

AREA: TAX MAP 28 ZONED-R PARCEL 75
6TH ELECTION DISTRICT
HOWARD COUNTY, MARYLAND

TITLE: **PROFILE AND DETAIL SHEET**

RIEMER MUEGGE & ASSOCIATES, INC.
A Land Planning, Engineering and Consulting Firm
3105 North Ridge Road Ellcott City, Maryland 21043
301-461-2690 FAX: 301-750-3176

DATE: 1-15-90

DESIGNED BY: D.A.M.
DRAWN BY: G.D.H.
PROJECT NO: 5120G
DATE: JANUARY 16, 1990
SCALE: AS SHOWN
DRAWING NO. 9 OF 10

F-90-25

ENGINEER *J. P. Hill*
 PE # *1111*
 DATE *9-1-92*

BY THE DEVELOPER:
 "I CERTIFY THAT ALL DEVELOPMENT AND/OR CONSTRUCTION WILL BE DONE ACCORDING TO THESE PLANS, AND THAT ANY RESPONSIBLE PERSONNEL INVOLVED IN THE CONSTRUCTION PROJECT WILL HAVE A CERTIFICATE OF ATTENDANCE AT A DEPARTMENT OF NATURAL RESOURCES APPROVED TRAINING PROGRAM FOR THE CONTROL OF SEDIMENT AND EROSION BEFORE BEGINNING THE PROJECT. I WILL PROVIDE THE HOWARD SOIL CONSERVATION DISTRICT WITH AN 'AS-BUILT' PLAN OF THE POND WITHIN 30 DAYS OF COMPLETION. I ALSO AUTHORIZE PERIODIC ON-SITE INSPECTIONS BY THE HOWARD SOIL CONSERVATION DISTRICT."

DEVELOPER _____ DATE _____

BY THE ENGINEER:
 "I CERTIFY THAT THIS PLAN FOR POND CONSTRUCTION, EROSION AND SEDIMENT CONTROL REPRESENTS A PRACTICAL AND WORKABLE PLAN BASED ON MY PERSONAL KNOWLEDGE OF THE SITE CONDITIONS. THIS PLAN WAS PREPARED IN ACCORDANCE WITH THE REQUIREMENTS OF THE HOWARD SOIL CONSERVATION DISTRICT. I HAVE NOTIFIED THE DEVELOPER THAT HE MUST PROVIDE THE HOWARD SOIL CONSERVATION DISTRICT WITH AN 'AS-BUILT' PLAN OF THE POND WITHIN 30 DAYS OF COMPLETION."

Arthur E. Muegge
 ENGINEER *1-15-90*
 DATE

THESE PLANS HAVE BEEN REVIEWED FOR THE HOWARD SOIL CONSERVATION DISTRICT AND MEET THE TECHNICAL REQUIREMENTS FOR SMALL POND CONSTRUCTION, SOIL EROSION AND SEDIMENT CONTROL.

J. P. Hill
 SOIL CONSERVATION SERVICE *1-31-90*
 DATE

THESE PLANS FOR SMALL POND CONSTRUCTION, SOIL EROSION AND SEDIMENT CONTROL MEET THE REQUIREMENTS OF THE HOWARD SOIL CONSERVATION DISTRICT.

APPROVED *Robert J. Zich* *1-31-90*
 HOWARD COUNTY *1-31-90*
 DATE

APPROVED: HOWARD COUNTY DEPT. OF PLANNING AND ZONING

Mark J. Conner *2/25/90*
 CHIEF, DIVISION OF COMMUNITY PLANNING AND LAND DEVELOPMENT *2/25/90*
 DATE

APPROVED: HOWARD COUNTY DEPARTMENT OF PUBLIC WORKS

Paul J. Conner *3/7/90*
 CHIEF, LAND DEVELOPMENT DIVISION *3/7/90*
 DATE

Granville W. Waterland *2/16/90*
 CHIEF, BUREAU OF HIGHWAYS *2/16/90*
 DATE

William J. Conner *3-9-90*
 CHIEF, BUREAU OF ENGINEERING *3-9-90*
 DATE

DATE NO REVISION

OWNER/DEVELOPER
 MARY C. HILL ETAL
 6642 SEJENEA DRIVE
 COLUMBIA, MARYLAND



PROJECT: **RUTHERFORD**

AREA: TAX MAP 28 ZONED R PARCEL 75
 5th ELECTRIC DISTRICT
 HOWARD COUNTY, MARYLAND

TITLE: **DETAIL SHEET**

RIEMER MUEGGE & ASSOCIATES, INC.
 A Land Planning, Engineering and Consulting Firm
 3105 North Ridge Road Ellicott City, Maryland 21043
 301-461-2690 FAX: 301-750-3176

DATE *1-15-90* 5-28-82 WP-88-11
 DESIGNED BY DAM
 DRAWN BY G.D.H.
 PROJECT NO: 5120G
 DATE: JANUARY 10, 1990
 SCALE: AS SHOWN
 DRAWING NO. 10 OF 10

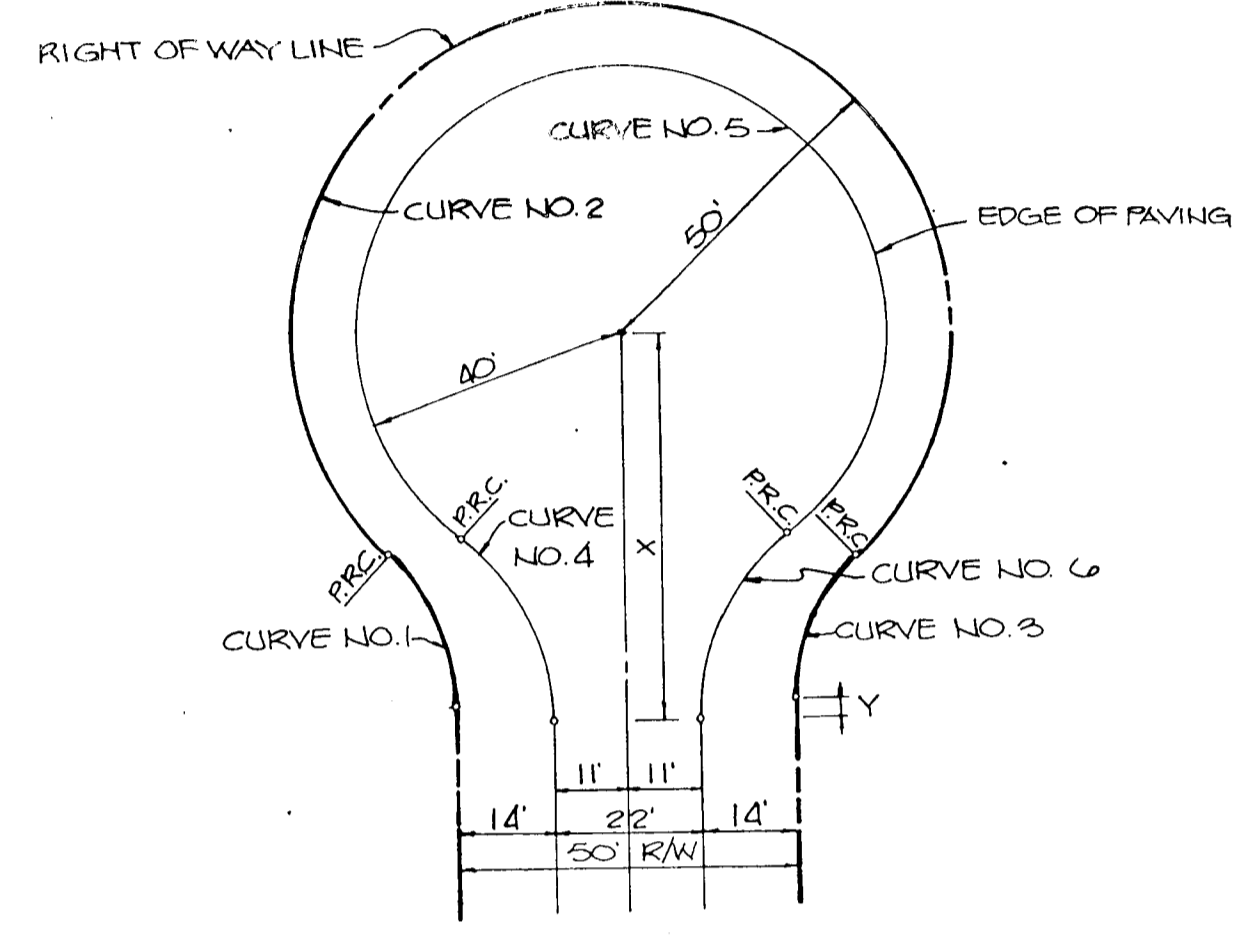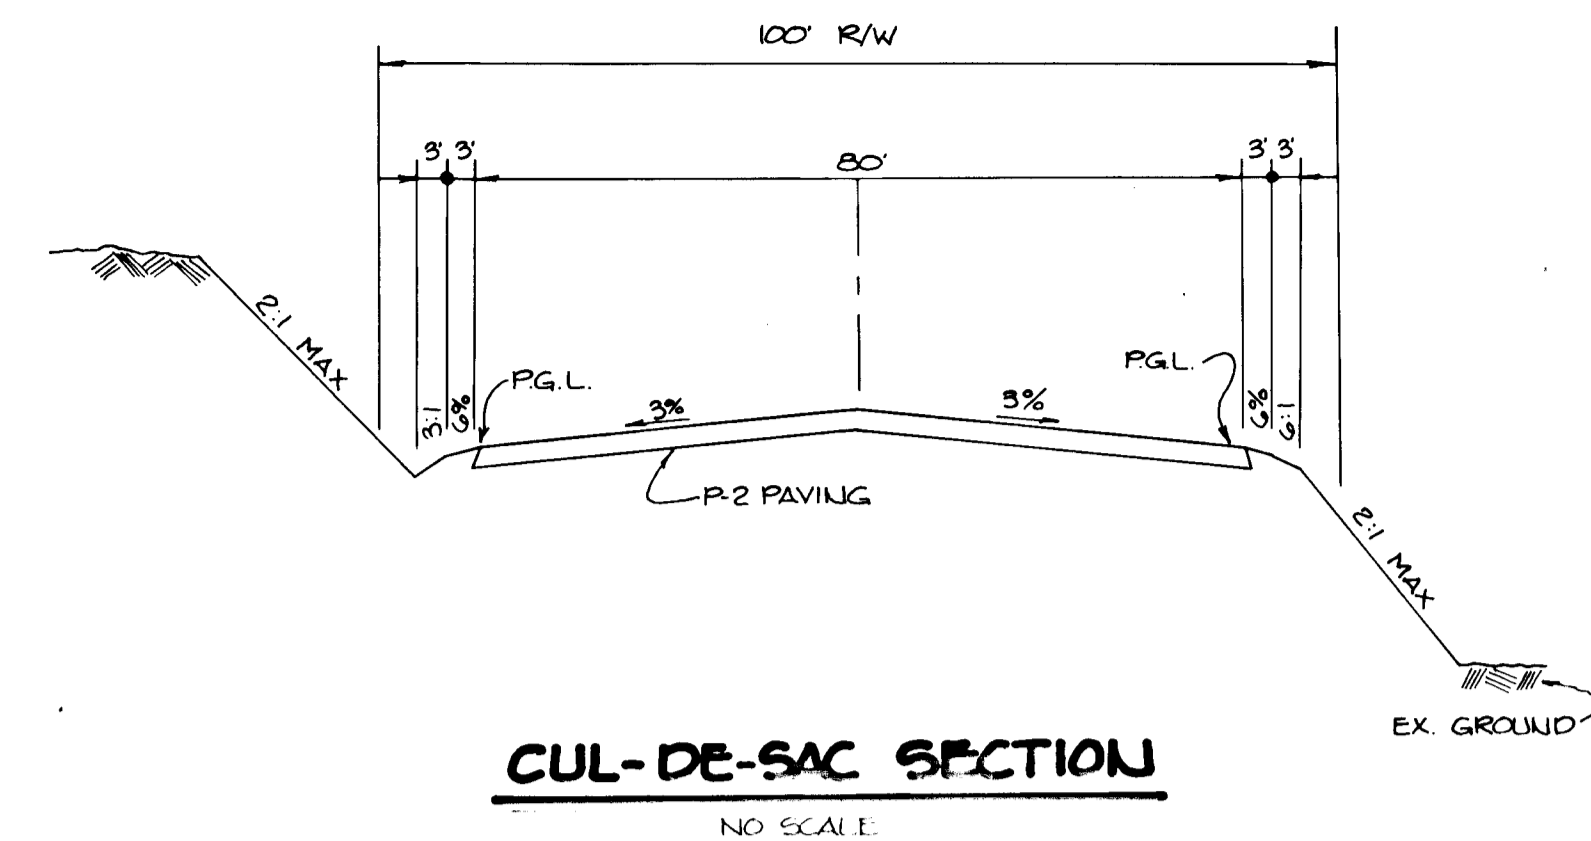

CUL-DE-SAC DETAIL
 NO SCALE

