

NOTE: WETLANDS MITIGATION AREA STABILIZATION

THIS AREA IS TO BE STABILIZED IN ACCORDANCE WITH MD SHA STAMPED SPECIFICATIONS FOR CONSTRUCTION AND MATERIALS, JANUARY 1982, SECTIONS 701-TURF ESTABLISHMENT AND 714-WOODY SHRUB SEEDING & MULCHING TO BE APPLIED AS FOLLOWS:

MD SHA WOODY SHRUB MIX: 50 LBS/AC.
REGION 2 COVER COMPANION SEED MIX: 35 LBS/AC.

MAINTENANCE: THERE SHALL BE NO MOWING OF THE WETLANDS MITIGATION AREA.

PEAK MANAGEMENT FACILITY

STORM	ALLOWABLE RELEASE	Q IN	Q OUT	W.S. EL.	STORAGE (AC.-FT.)
2	41.93	120.28	23.50	279.50	2.40
10	108.08	224.26	99.14	281.69	4.75
100	216.05	362.54	177.88	283.15	7.25

STRUCTURE NOTES

STRUCTURE TYPE: POND/ROADWAY EMBANKMENT
STRUCTURE CLASSIFICATION: A
HYDROLOGIC CRITERIA: 2410 YR. PEAK MANAGEMENT REQUIRED. 2, 10 & 100 YR. PEAK MANAGEMENT PROVIDED.
DRAINAGE AREA: ULTIMATE CONDITIONS 64.18 AC.
EFFECTIVE HEIGHT TO ELEV. 284.5: 13.60'
STORAGE HEIGHT PRODUCT: 136

PARCEL S-4
PLAT 8802

PARCEL S-5
PLAT 8802


PARCEL S-3
PLAT 8802

MANHOLE SCHEDULE

NO.	TYPE	TOP ELEV.	INV. IN	INV. OUT	REMARKS
16	BRICK MH	323.5	311.67	311.47	SEE HO. CO. STD. G-5,02

OUTLET SCHEDULE

NO.	TYPE	TOP ELEV.	INV. IN	INV. OUT	REMARKS
E-2	METAL END SECTION	310.76	306.76	306.00	SEE HO. CO. STD. SD-5,61

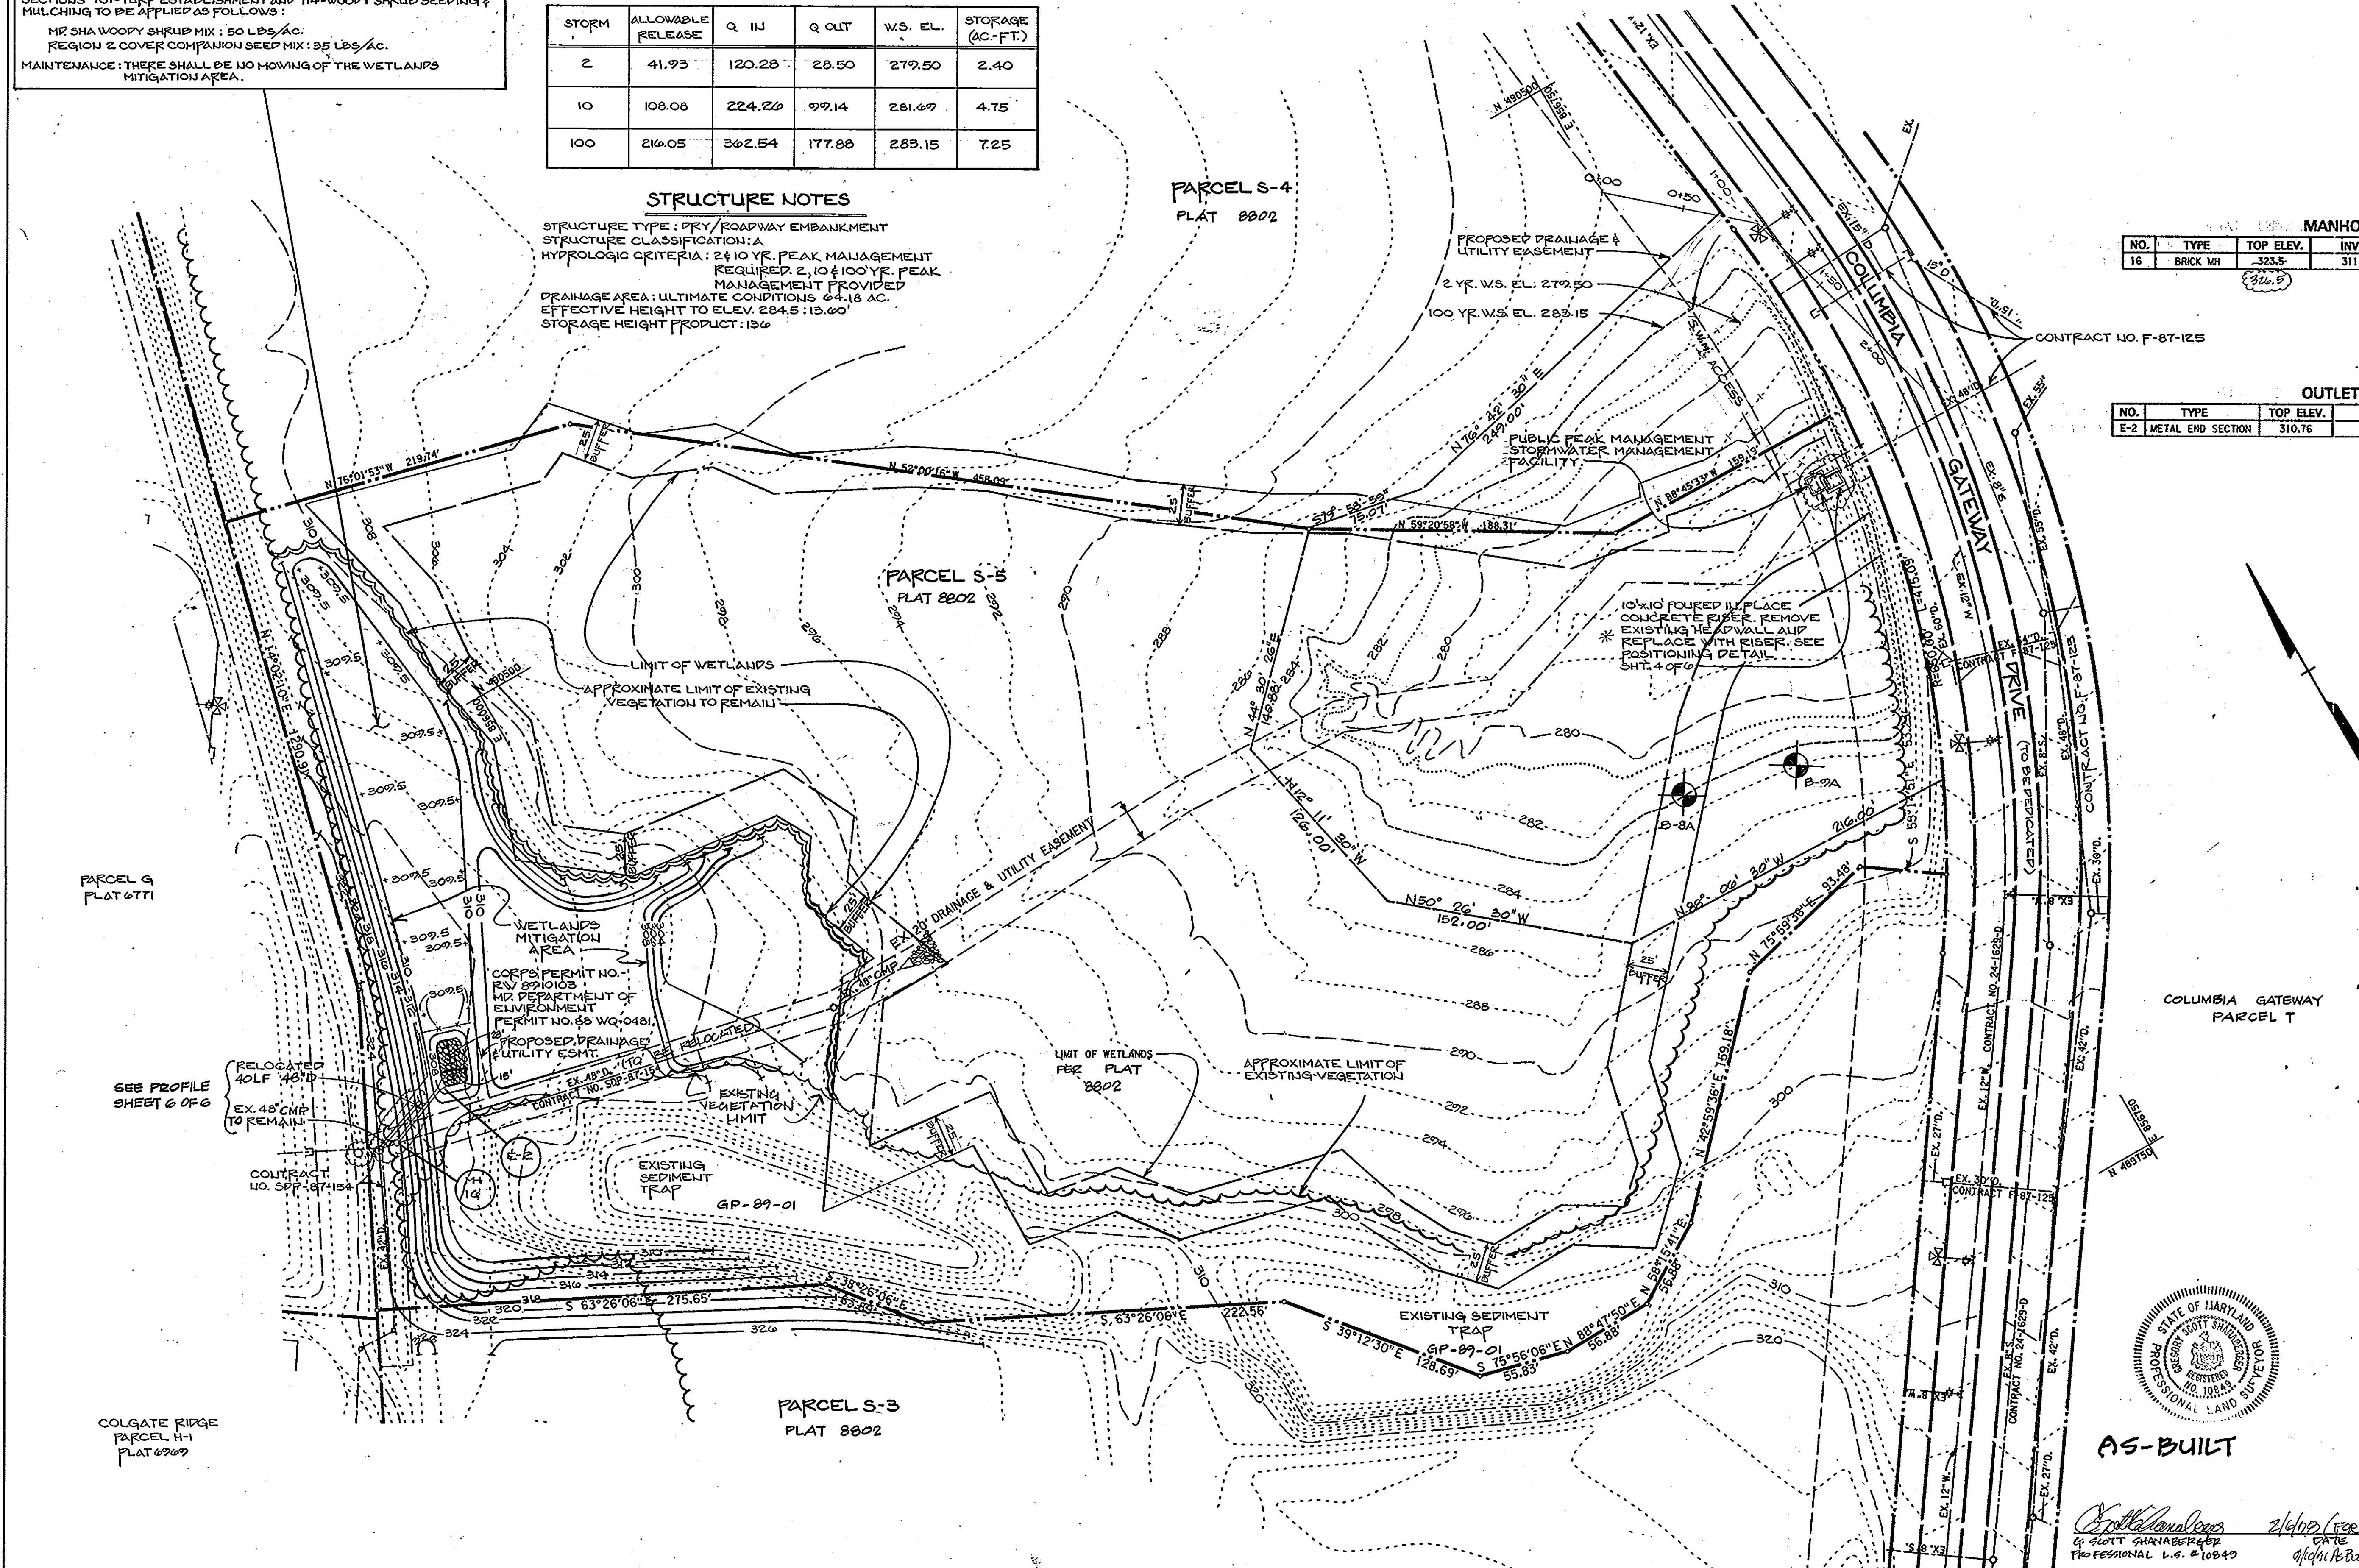

APPROVED: HOWARD COUNTY, DEPT. OF PUBLIC WORKS
William W. Weiland 9/5/90
CHIEF, BUREAU OF HIGHWAYS DATE

William E. Redman 9-13-90
CHIEF, BUREAU OF ENGINEERING DATE

Chad M. Sorenson 9/14/90
CHIEF, LAND DEVELOPMENT DIVISION DATE

APPROVED: HOWARD COUNTY DEPT. OF PLANNING AND ZONING
Paul J. D. Wright 9/14/90
CHIEF, DIVISION OF COMMUNITY PLANNING & LAND DEVELOPMENT DATE

Date No. Revision Description

COLUMBIA GATEWAY
PARCEL S-3/S-4 #55
8TH ELECTION DISTRICT
HOWARD COUNTY, MARYLAND

OWNER / DEVELOPER
THE HOWARD RESEARCH
AND DEVELOPMENT LAND COMPANY
10276 LITTLE PATUXENT PARKWAY, COLUMBIA, MD 21043

DAFT McCUNE WALKER, INC.
LAND PLANNING CONSULTANTS
LANDSCAPE ARCHITECTS
ENGINEERS SURVEYORS
200 EAST PENNSYLVANIA AVENUE
TOWSON, MD 21284
TELEPHONE: 501-236-3333

TITLE FINAL CONSTRUCTION PLAN
STORMWATER MANAGEMENT PLAN

SUBDIVISION NAME: COLUMBIA GATEWAY SECT./AREA: A/JA LOT/PARCEL #: S-3/S-5
PLAT OR L/F: 8802-8805 BLOCK: 43 TAX/ZONE MAP: M-1 ELEC. DIST.: 6 CENSUS TR.: 6005.02
WATER CODE: SEWER CODE:

ADDRESS CHART

LOT NUMBER	STREET ADDRESS

Des By JWP Scale 1" = 50' Proj. No. 88030
Drn By REZ/JMS Date 8-29-89
Chk By JWP/AD Approved 2 OF 6

THESE PLANS HAVE BEEN REVIEWED FOR THE HOWARD SOIL CONSERVATION DISTRICT AND MEET THE TECHNICAL REQUIREMENTS FOR SMALL POND CONSTRUCTION, SOIL EROSION AND SEDIMENT CONTROL.

James M. Hahn 8/24/90
SOIL CONSERVATION SERVICE DATE

THESE PLANS FOR SMALL POND CONSTRUCTION, SOIL EROSION AND SEDIMENT CONTROL MEET THE REQUIREMENTS OF HOWARD SOIL CONSERVATION DISTRICT.

APPROVED: *Robert Zielman* 8/24/90
HOWARD SOIL CONSERVATION DISTRICT DATE

PLAN NUMBER

DEVELOPER'S CERTIFICATE:
I/WE CERTIFY THAT ALL DEVELOPMENT AND/OR CONSTRUCTION WILL BE DONE ACCORDING TO THESE PLANS AND THAT ANY RESPONSIBLE PERSONNEL INVOLVED IN THE CONSTRUCTION PROJECT WILL HAVE CERTIFICATE OF ATTENDANCE AT A DEPT. OF NATURAL RESOURCES APPROVED TRAINING PROGRAM FOR THE CONTROL OF SEDIMENT AND EROSION BEFORE BEGINNING THE PROJECT. I ALSO AUTHORIZE PERIODIC ON-SITE INSPECTION BY THE HOWARD SOIL CONSERVATION DISTRICT OR THEIR AUTHORIZED AGENTS AS ARE DEEMED NECESSARY. DEVIATION FROM THIS PLAN WILL NOT BE MADE UNLESS AUTHORIZED BY THE HOWARD SOIL CONSERVATION DISTRICT. I WILL PROVIDE THE HOWARD SOIL CONSERVATION DISTRICT WITH A RED-LINED "AS-BUILT" OF THE POND WITHIN 30 DAYS OF COMPLETION.

DEVELOPER: *Shanaberger & Lane* DATE: 8/7/90


ENGINEER'S CERTIFICATE:
I/WE CERTIFY THAT THIS PLAN FOR POND CONSTRUCTION, EROSION AND SEDIMENT CONTROL REPRESENTS A PRACTICAL AND WORKABLE PLAN BASED ON MY PERSONAL KNOWLEDGE OF THE SITE CONDITIONS. THIS PLAN WAS PREPARED IN ACCORDANCE WITH THE REQUIREMENTS OF THE SITE CONDITIONS. THIS PLAN WAS PREPARED IN ACCORDANCE WITH THE REQUIREMENTS OF THE HOWARD SOIL CONSERVATION DISTRICT. I HAVE NOTIFIED THE DEVELOPER THAT HE MUST PROVIDE THE HOWARD SOIL CONSERVATION DISTRICT WITH A RED-LINED "AS-BUILT" OF THE POND WITHIN 30 DAYS OF COMPLETION.

ENGINEER: *Shanaberger & Lane* 16551 REG. NO. 9/29/90 DATE




AS-BUILT


Shanaberger & Lane
9122 TRIM & COUNTRY BLDG
SUITE 101 RT
EUMMOTT CTRY, MD 21043

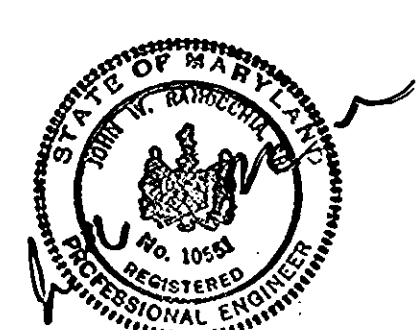


1158

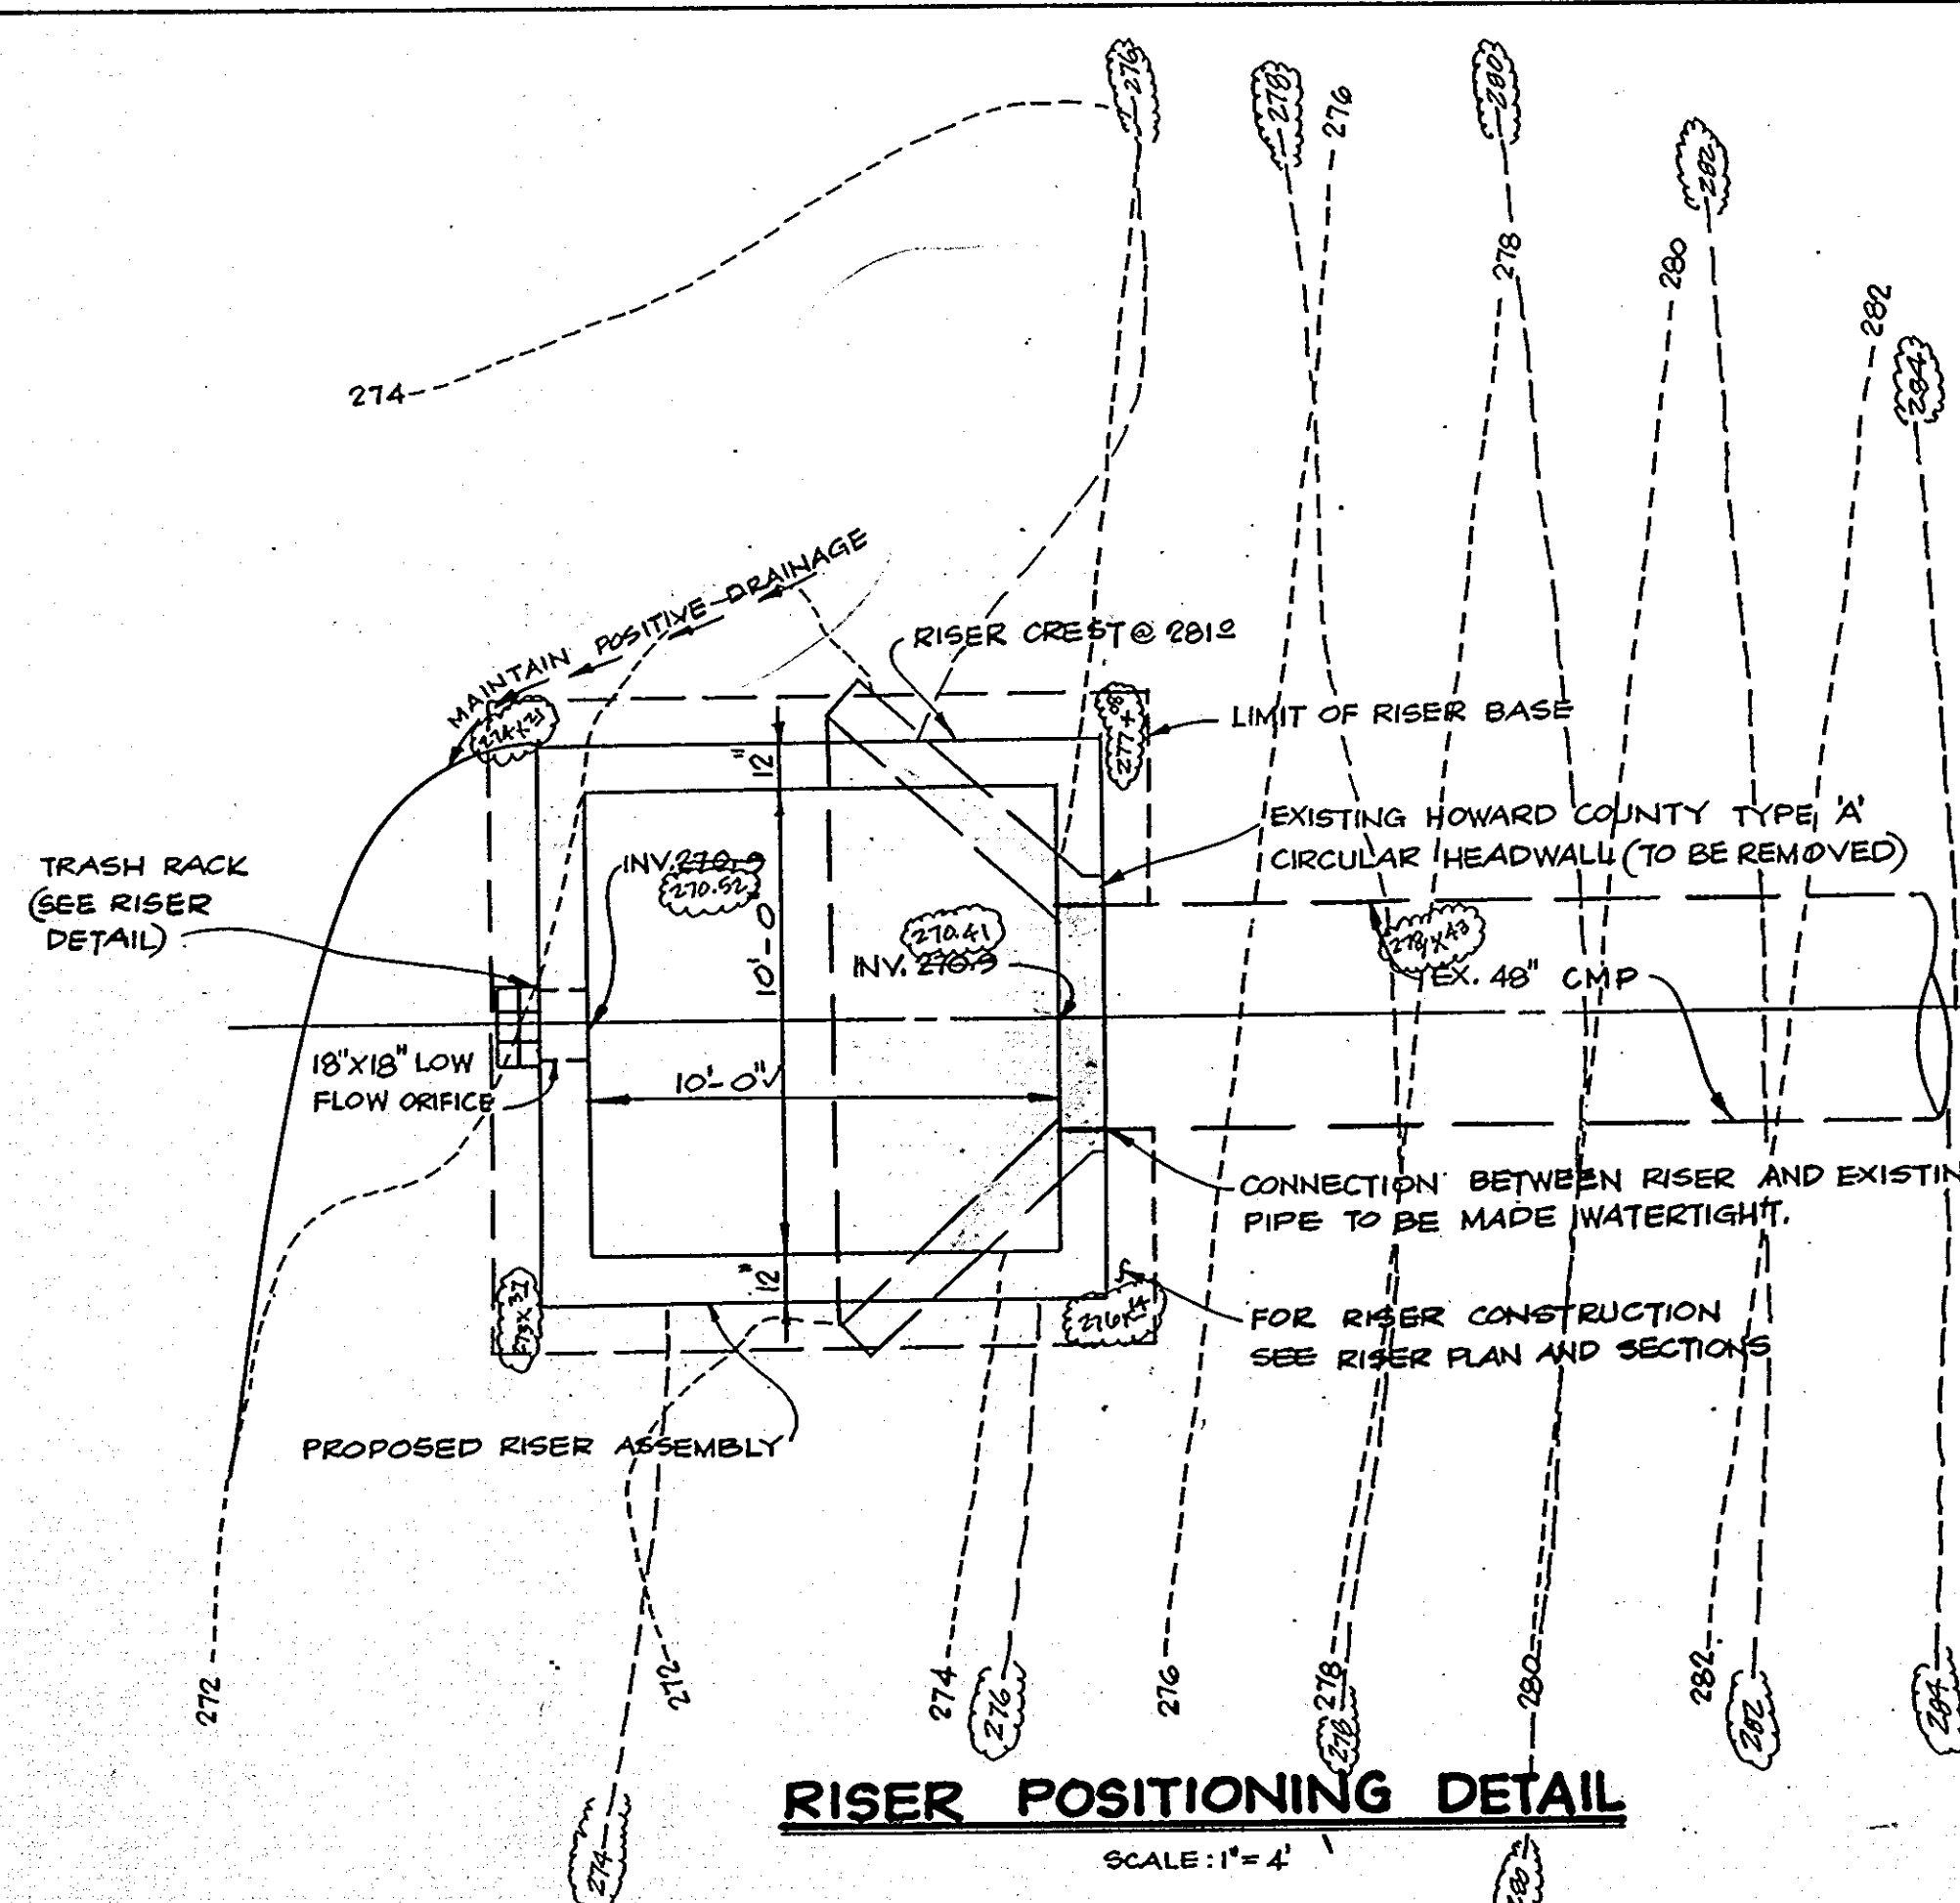


RISER POSITIONING DETAIL
SCALE: 1" = 4'

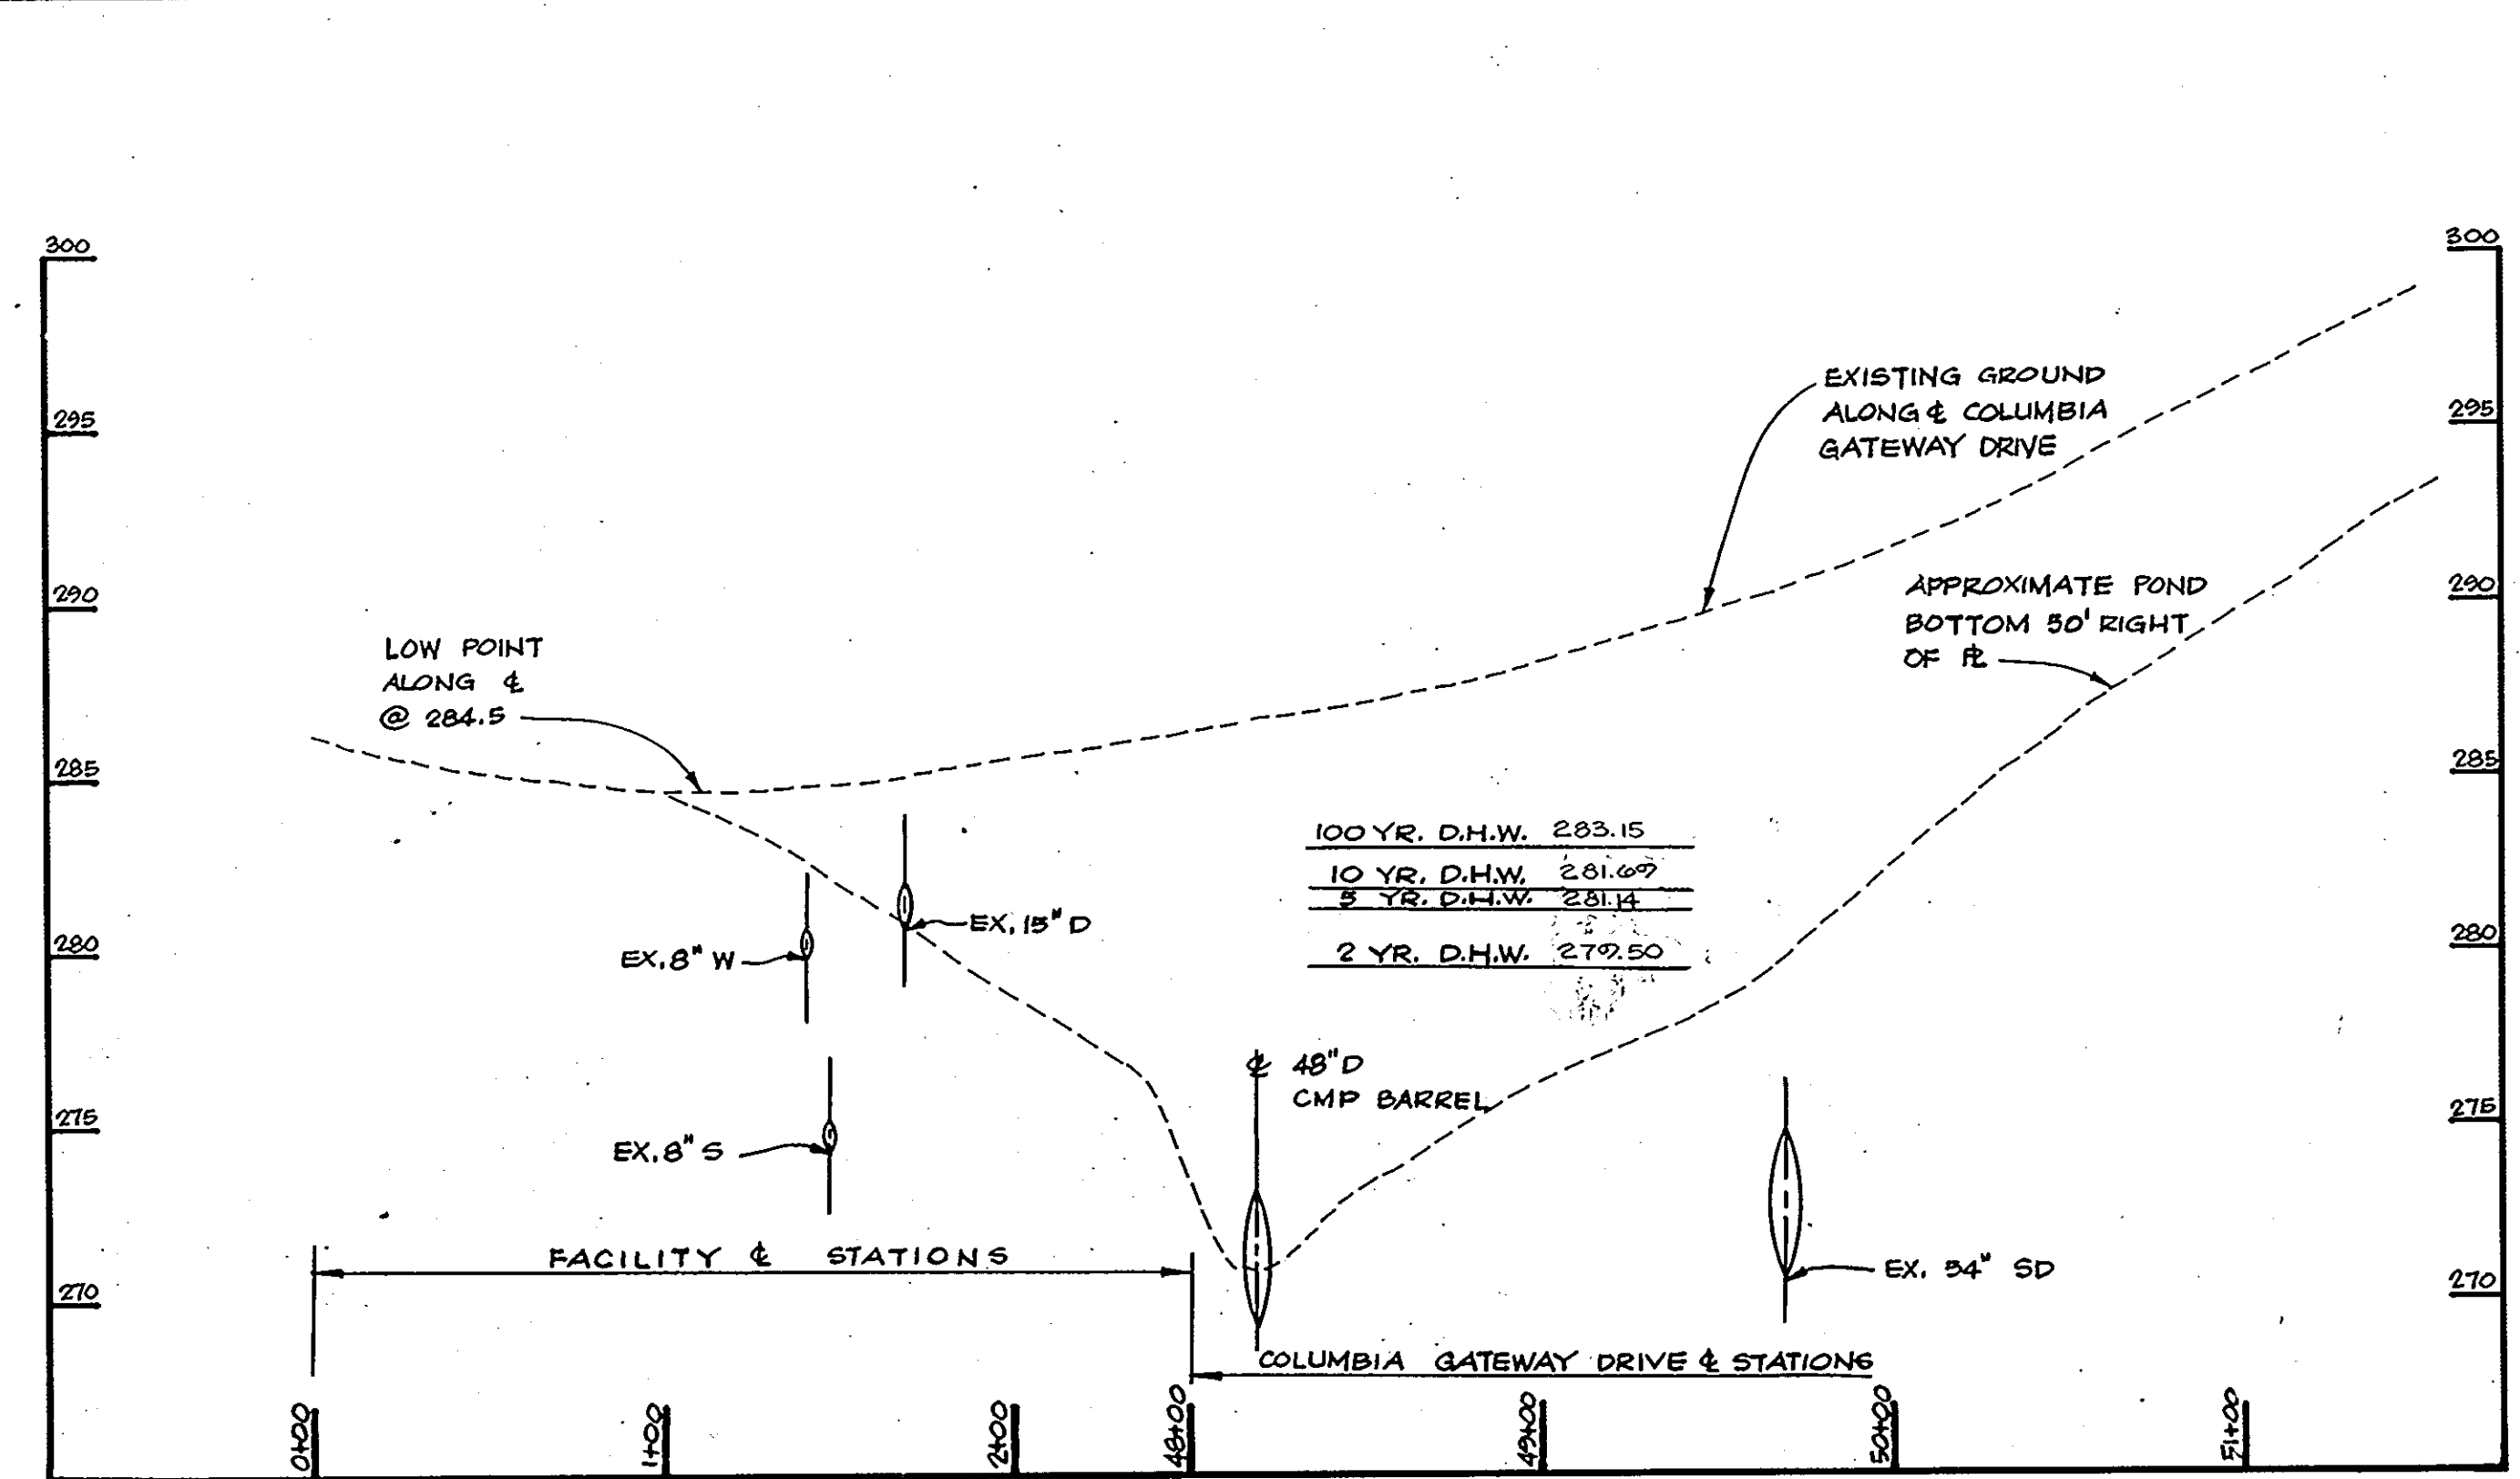

SECTION ALONG & OF EMBANKMENT
SCALE: HOR. 1" = 50' VERT. 1" = 5'

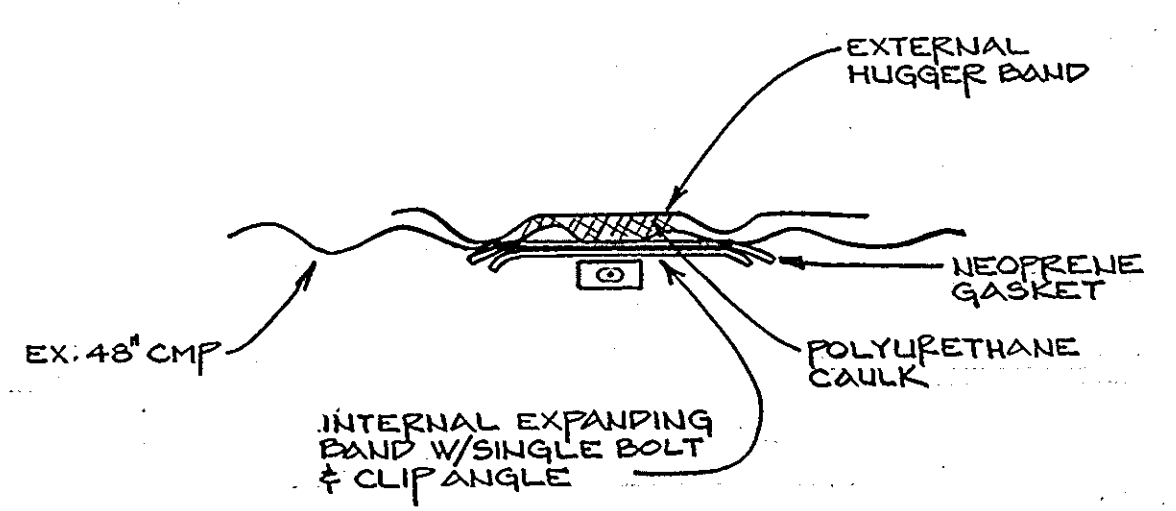

WATERPROOFING DETAIL FOR EXISTING 48\"/>

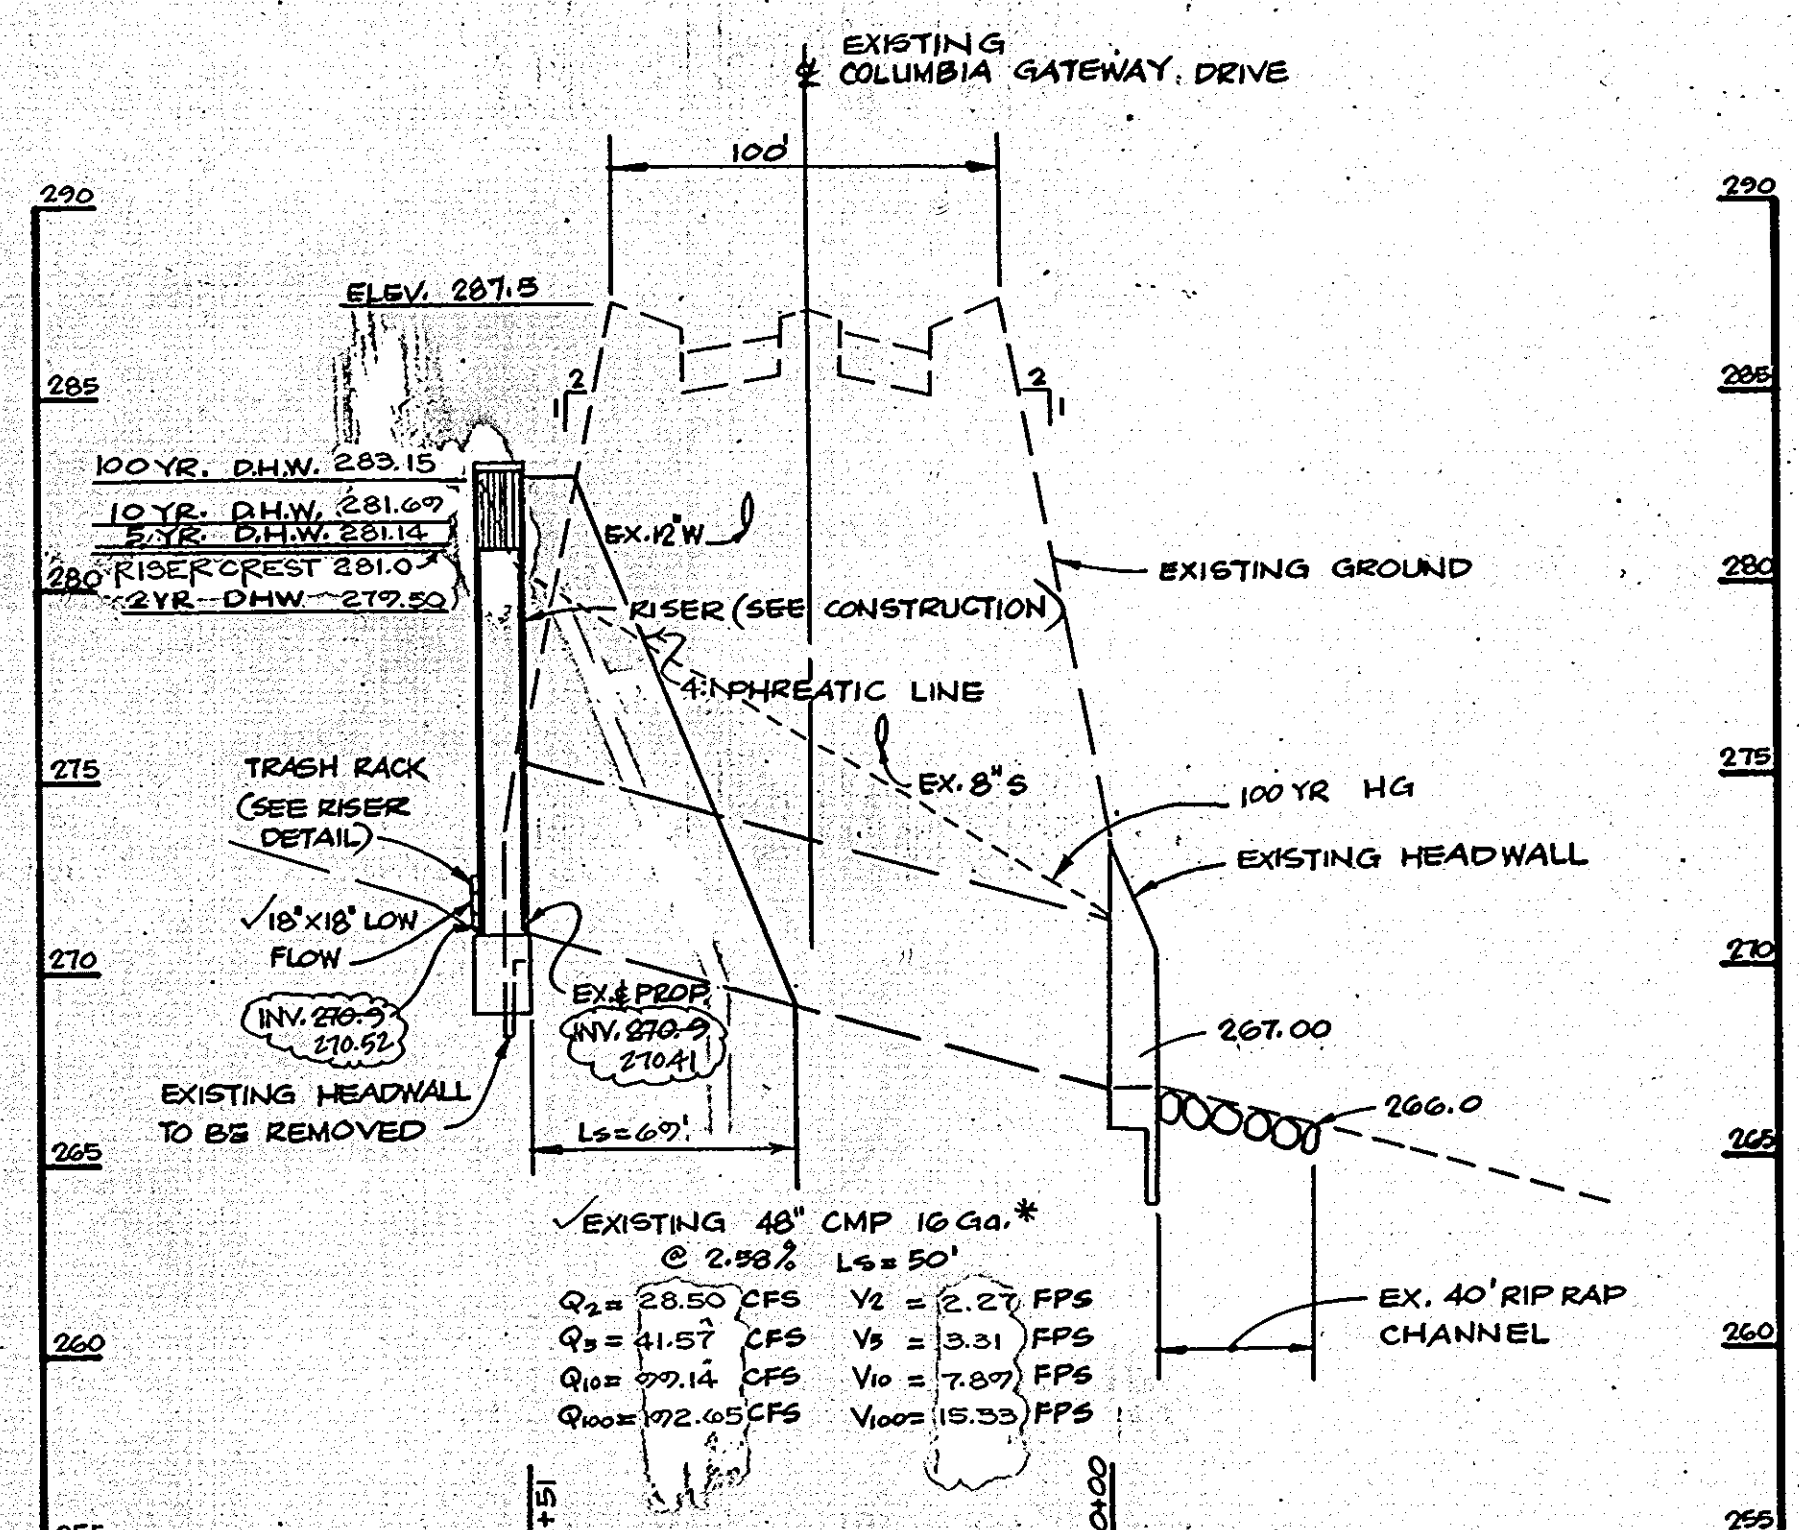

PROFILE PRINCIPLE SPILLWAY
SCALE: HOR. 1" = 50' VERT. 1" = 5'

GENERAL
All stormwater management facilities shall be constructed in accordance with the Howard County Design Manual (Vol. 1 revised 12/1988) and the Howard County "Standard Specifications for Construction (1989)" and the S.C.S. Maryland "Standard and Specifications for Ponds".

SITE PREPARATION
Areas under the embankment, structural works and inlet and outlet channels and spillways shall be cleared, grubbed and topsoil stripped. All trees, debris, vegetation, roots, or other objectionable or organic material shall be removed. Areas to be covered by the pond will be cleared of all trees, brush, logs, fences, rubbish, and other objectionable material. Trees, brush, and stumps shall be cut level with the ground surface. All cleared and grubbed material shall be disposed of outside and below the limits of the dam and outside of the 100 year flood plain limit as directed by the owner.

BORROW FILL MATERIAL
The fill material shall be taken from an approved borrow area. All material shall be free from roots, stumps, wood, rubbish, oversized stones, frozen or other objectionable materials. For cutoff trenches and dam cores the material used shall conform to the Unified Soil Classification SC or CL.

PLACEMENT
All areas on which fill is to be placed shall be scarified prior to placement of fill. Soils so scarified, or which have been disturbed by grubbing and stripping operations, shall be compacted to undisturbed soil below by discing, leveling, rolling and compacting at the moisture content and to the density specified below for compacted embankments. Where fills are made on hillsides or slopes, the slope of the original ground upon which the fill is to be placed shall be plowed or scarified deeply, or where the slope ratio of the original ground is steeper than 5 horizontal on 1 vertical, the bank shall be stepped or benched, when considered necessary by the Engineer, to permit placement of the fill in horizontal layers. The final decision as to the suitability of the exposed soil shall be made by the Soils Engineer at the time of construction. Fill materials shall be placed in 8 inch maximum thickness (before compaction) layers which are to be continuous over the entire length of the fill.

Each layer shall be spread uniformly and evenly and shall be thoroughly blade mixed during the spreading to insure uniformity of materials in each layer. The top portion of borrow material shall be placed in the downstream portions of the embankment.

COMPACTION
The movement of the hauling and spreading equipment over the fill shall be controlled so that the entire surface of each lift shall be traversed by not less than one tread track of equipment and compaction shall be achieved by a minimum of four complete passes of a sheepsfoot, rubber tired or vibratory roller. All compaction is to be 95 percent of the maximum density as determined by A.S.T.M. Specification T-99 (Standard Proctor) and is to be certified by the Soils Engineer at the time of construction. The moisture content of the fill shall be as required in order to attain the degree of compaction specified. The filling operation shall be continued as specified above until the fill has been brought to the constructed top elevation shown on the plans. The fill shall be constructed in such a manner that the surface will be sloped to drain at all times and all fill shall be deposited to prevent excessive moisture accumulation from rainwater. When the work is interrupted by rain, fillings shall not be resumed until tests indicate that the moisture content and density of the top 6 inches of fill conform to the above specification requirements. All fill placed around CMP barrels shall be compacted using hand compaction equipment within a foot of the pipes. DAM CORE A dam core shall be constructed parallel to the centerline of the embankment where shown on the plans. The top of the core shall be a minimum of 4 feet in width. The side slopes shall be 1 to 1 or flatter.

CUTOFF TRENCH
A cutoff trench shall be excavated parallel to the center line of the embankment as shown on the plans. The bottom width of the trench shall be governed by the equipment used for excavation with the minimum width being four feet. The depth shall be 4 feet (minimum) below the barrel pipe and or existing ground. The side slopes of the trench shall be 1 to 1 or flatter.

STRUCTURAL BACKFILL
Backfill material shall be of the type and quality conforming to that specified for the adjoining fill material. The fill shall be placed in horizontal layers not to exceed four inches in thickness and compacted by hand tamper or other compaction equipment. The material needs to fill completely all spaces under and adjacent to the pipes. At no time during the backfilling operation shall driven equipment be allowed to operate closer than four feet, measured horizontally, to any part of a structure or pipe unless there is a compacted fill of twenty-four inches or greater over the structure or pipe.

PIPE CONDUITS MATERIALS (CORROATED STEEL PIPE)
This pipe and its appearance shall be galvanized and fully bituminous coated and shall conform to the requirements of A.S.T.M. specifications M-190 Type A with watertight coupling bands. Any bituminous coating damaged or otherwise removed shall be replaced with cold applied bituminous coating compound. Coated CP shall have a minimum coating thickness of 10 mil on both sides of pipe and shall meet requirements of A.S.T.M. M-245 and M-246.

CONNECTIONS
All connections with pipes must be completely watertight. The drain pipe or barrel connections to the riser shall be welded all around. Watertight coupling bands or flanges shall be used at all joints. Anti-seep collars shall be connected to the pipe in such a manner as to be completely watertight. Dipble bands are not considered to be watertight. For a prefabricated barrel and riser structure, the angle of the barrel at the barrel and riser connection must reflect the slope of the barrel.

BEDDING
The pipe shall be firmly and uniformly bedded throughout its entire length. Where rock or soft, spongy or other unstable soil is encountered, all such materials shall be removed and replaced with suitable earth material, compacted to provide adequate support.

LAYING PIPE
The pipe shall be placed with inside circumferential face pointing downstream and with the longitudinal laps at the sides.

BACKFILLING
Backfill shall conform to structural backfill as shown above.

OTHER DETAILS
(Anti-seep collars, valves, etc.) shall be as shown on the drawings.

MATERIALS (REINFORCED CONCRETE PIPE)
Reinforced concrete pipe shall have a rubber gasket joint and shall equal or exceed A.S.T.M. Specification O-361. An approved equivalent is A.W.W.A. Specification C-301.

BEDDING
All reinforced concrete pipe conduits shall be laid in a concrete bedding for their entire length. This bedding shall consist of high slump concrete placed under the pipe and up the sides of the pipe at least 10% of its diameter with a minimum thickness of 3 inches or as shown on the plans.

LAYING PIPE
Bell and spigot pipe shall be placed with the bell end upstream. Joints shall be made in accordance with recommendations of the manufacturer of the material. After the joints are sealed on the entire line, the bedding shall be placed so that all spaces under the pipe are filled. Care shall be exercised to prevent any deviation from the original line and grade of the pipe.

BACKFILLING
Shall conform to structural backfill as shown above.

CONNECTIONS
All connections (to anti-seep collars, riser, etc.) shall be watertight.

OTHER DETAILS
(Anti-seep collars, valves, etc.) shall be as shown on the drawings.

CONCRETE
Concrete shall meet minimum requirements set forth in Maryland State Highway Administration Standard Specifications for Construction and Materials Section 918 (Portland Cement Concrete Mixtures), Mix No. 3. Reinforcing steel shall be A.S.T.M. A-615, Grade 60. Rebars shall have 3" cover (minimum) and a minimum overlap of 30 bar diameters, except as noted on the plans. Steel angles and anchor bars shall be A.S.T.M. A-36.

STABILIZATION
All borrow and spoil areas shall be graded to provide proper drainage and left in a slightly condition. All exposed surfaces of the embankment, spillway, berm, borrow and spoil areas shall be stabilized by seeding and applying straw mulch in accordance with "Standards and Specifications for Soil Erosion and Sediment Control in Urbanizing Areas", or as shown elsewhere in these specifications, immediately after finished grading.

EROSION CONTROL FACILITIES
All disturbed areas shall be controlled by an Erosion and Sediment Control Plan which has been approved by the Howard County Soil Conservation District (H.C.S.C.D.).

SEEDING
Seeding, fertilizing and mulching shall be as follows:
Seed Mix: 90% Kentucky 31 Tall Fescue, 10% Kentucky CR.
Applied at a rate of 300 lbs. per acre.
70% Kentucky 31 Tall Fescue, 30% Charming Crowwetch, Inoculated Applied at a rate of 55 lbs. per acre.
Optimum seeding dates: March 1 to April 30.
Lime: 2 tons/acre Dolomitic Limestone.
Fertilizer: 600 lbs./acre 10-10-10 fertilizer before seeding, 400 lbs./acre 30-0-0 ureaform fertilizer at time of seeding.
Mulch: Straw at 4,000 lbs. per acre.
Anchoring: Mulching tool or emulsified asphalt binder at a rate of 8 gal. per 1,000 square feet.

FILTER CLOTH
All filter cloth shall conform to Miraf 140N, Dupont TYPAR 3341 or 3401, GYMAC SP or approved equal.

RIPRAP
All riprap shall conform to Howard County Specifications.

GABIONS
All gabions shall be P.V.C. coated Class IV, wire baskets.

FENCING
Fencing shall be constructed in accordance with State Highway Administration Details 690.01 and 690.02. The specifications for a 6" x 6" fence shall be used, substituting 4" x 4" fabric and 6" x 6" line posts. The gate shall be constructed in accordance with S.H.A. Standard Detail 692.01 with 4" x 4" fabric. The fabric used for the fence and gate shall conform to A.S.T.M. Designation H81-74.

CONSTRUCTION INSPECTION BY DESIGNATED ENGINEERS
The construction of the pond and embankment, and certification that the pond and embankment have been built in accordance with the plans shall be under the supervision of a Registered Professional Engineer. The Engineer shall be notified sufficiently in advance of construction in order that arrangements can be made for (1) inspection of pipe trench and bedding, (2) inspection of riser and anti-seep collars and (3) supervision of embankment construction and compaction testing. The Engineer shall direct the handling of water during construction, minor changes not affecting the integrity of the dam in order to compensate for unusual soil conditions, and the removal and replacement of defective fill.

CARE OF WATER DURING CONSTRUCTION
All work on permanent structures shall be carried out in areas free from water. The Contractor shall construct and maintain all temporary dikes, levees, cofferdams and drainage channels necessary to protect the areas to be occupied by the permanent necessary pumping and other equipment required for removal of water from the areas as required or directed by the Engineer for construction each part of the work. After having served their purpose, all temporary protective works shall be removed or leveled and graded to the extent required to prevent obstruction in any degree whatsoever of the flow of water to the spillway or outlet works and so as not to interfere in any way with the operation or maintenance of the structure.

The removal of water from the required excavation and the foundations shall be accomplished in a manner and to the extent that will maintain stability of the excavated slopes and bottom of the required excavations and will allow satisfactory performance of all construction operations.

POLYURETHANE SEALANT & INTERNAL EXPANSION BANDS
Polyurethane sealant to be applied PRC Rapidseal-365 Sediment or RMS Siluxite 221. Pipe joints are to be thoroughly cleaned of all dirt. Pipe joints are to be milled. Pipe to be cleaned with stiff brush, soap and water. Soap residue to be removed. Polyurethane sealant pumped with a caulking gun into void space between pipe and external huggie band. After caulking open wide flat neoprene gasket and 10 gauge, 2 1/2" wide internal expanding band, with single bolt and clip angle.

APPROVED: HOWARD COUNTY DEPT. OF PUBLIC WORKS
Draville W. Wallace 9/5/90
 CHIEF, BUREAU OF HIGHWAYS DATE

William S. Ryan 9/13/90
 CHIEF, BUREAU OF ENGINEERING DATE

John M. Simpson 9/14/90
 CHIEF, LAND DEVELOPMENT DIVISION DATE

APPROVED: HOWARD COUNTY, DEPT. OF PLANNING AND ZONING
David S. Langley 9/14/90
 CHIEF, DIVISION OF COMMUNITY PLANNING & LAND DEVELOPMENT DATE

COLUMBIA GATEWAY
 PARCEL 9-3, 8-4, & 8-5
 6TH ELECTION DISTRICT
 HOWARD COUNTY, MARYLAND

OWNER/DEVELOPER
 THE HOWARD RESEARCH
 AND DEVELOPMENT LAND COMPANY
 10275 LITTLE PATRICK PARKWAY, COLUMBIA, MD. 21043

DAFT McCUNE WALKER, INC.
 LAND PLANNING CONSULTANTS
 LANDSCAPE ARCHITECTS
 ENGINEERS SURVEYORS
 200 EAST PENNSYLVANIA AVENUE
 TOWSON, MD. 21284
 TELEPHONE: 301-256-3333

TITLE FINAL CONSTRUCTION PLAN
PEAK STORMWATER MANAGEMENT FACILITY DETAILS

SUBDIVISION NAME: COLUMBIA GATEWAY
 LOT/AREA: 9-3, 8-4, & 8-5
 PLAT OR L/F: 8802-8809
 BLOCK: M-1
 ZONE: 43
 TAX ZONE MAP: 6
 ELEC. DIST.: 6
 CENSUS TR.: 2009.02

ADDRESS CHART
 LOT NUMBER: _____ STREET ADDRESS: _____

Des By: AJD Scale: AS SHOWN Proj. No.: 88096
 Drn By: DBS/JMS Date: 8/29/89
 Chk By: JWF/AJD Approved: 3 OF 6

DEVELOPER'S CERTIFICATE:
 I/WE CERTIFY THAT ALL DEVELOPMENT AND/OR CONSTRUCTION WILL BE DONE ACCORDING TO THESE PLANS AND THAT ANY RESPONSIBLE PERSONNEL INVOLVED IN THE CONSTRUCTION PROJECT WILL HAVE CERTIFICATE OF ATTENDANCE AT A DEPT. OF NATURAL RESOURCES APPROVED TRAINING PROGRAM FOR THE CONTROL OF SEDIMENT AND EROSION BEFORE BEGINNING THE PROJECT. I/ALSO AUTHORIZE PERIODIC ON-SITE INSPECTION BY THE HOWARD SOIL CONSERVATION DISTRICT OR THEIR AUTHORIZED AGENTS AS ARE DEEMED NECESSARY. DEVIATION FROM THIS PLAN WILL NOT BE MADE UNLESS AUTHORIZED BY THE HOWARD SOIL CONSERVATION DISTRICT. I/WE PROVIDE THE HOWARD SOIL CONSERVATION WITH A RED-LINED "AS-BUILT" OF THE POND WITHIN 30 DAYS OF COMPLETION.

DEVELOPER: *Gregory K. Man* DATE: 8/7/90

ENGINEER'S CERTIFICATE:
 I/WE CERTIFY THAT THIS PLAN FOR POND CONSTRUCTION, EROSION AND SEDIMENT CONTROL REPRESENTS A PRACTICAL AND WORKABLE PLAN BASED ON MY PERSONAL KNOWLEDGE OF THE SITE CONDITIONS. THIS PLAN WAS PREPARED IN ACCORDANCE WITH THE REQUIREMENTS OF THE SITE CONDITIONS. THIS PLAN WAS PREPARED IN ACCORDANCE WITH THE REQUIREMENTS OF THE HOWARD SOIL CONSERVATION DISTRICT. I/HAVE NOTIFIED THE DEVELOPER THAT HE MUST PROVIDE THE HOWARD SOIL CONSERVATION DISTRICT WITH A RED-LINED "AS-BUILT" OF THE POND WITHIN 30 DAYS OF COMPLETION.

ENGINEER: *J. W. F.* 10551- REG. NO. DATE: 7/29/89

THESE PLANS HAVE BEEN REVIEWED FOR THE HOWARD SOIL CONSERVATION DISTRICT AND MEET THE TECHNICAL REQUIREMENTS FOR ALL POND CONSTRUCTION, SOIL EROSION AND SEDIMENT CONTROL.

James M. Helm 8/21/90
 U.S. SOIL CONSERVATION SERVICE DATE

THESE PLANS FOR SMALL POND CONSTRUCTION, SOIL EROSION AND SEDIMENT CONTROL MEET THE REQUIREMENTS OF HOWARD SOIL CONSERVATION DISTRICT.

Robert J. Helm 8/21/90
 HOWARD SOIL CONSERVATION DISTRICT DATE

PLAN NUMBER: _____

1158

NOTE: WETLANDS MITIGATION AREA STABILIZATION

THIS AREA IS TO BE STABILIZED IN ACCORDANCE WITH MR. SHA STANDARD SPECIFICATIONS FOR CONSTRUCTION AND MATERIALS, JANUARY 1982, SECTIONS 701-TURF ESTABLISHMENT AND T14-WOODY SHRUB SEEDING & MULCHING TO BE APPLIED AS FOLLOWS:
 MR. SHA WOODY SHRUB MIX: 50 LBS./AC.
 REGION 2 COVER COMPANION SEED MIX: 35 LBS./AC.
 MAINTENANCE: THERE SHALL BE NO MOWING OF THE WETLANDS MITIGATION AREA.

SEDIMENT TRAP SCHEDULE

TRAP NO.	1	S.O.S.T.
TYPE	1.8 AC.	3840 CU. FT.
DRAINAGE AREA	16728 CU. FT.	
STORAGE PROVIDED	300.0	
WEIR LENGTH	302.5	
BOTTOM ELEV.	1.0'	
C.O. ELEV.	305.0	
EMBANKMENT HEIGHT	305.0	
E.X. GROUND ELEV.	305.0	
CREST ELEV.	306.0	
TOP OF EMBANKMENT ELEV.	306.0	
APPROXIMATE BOTTOM DIMENSIONS	60 X 10	

MANHOLE SCHEDULE


NO.	TYPE	TOP ELEV.	INV. IN	INV. OUT	REMARKS
16	BRICK MH	323.5	311.67	311.47	SEE HO. CO. STD. 6-5.02

OUTLET SCHEDULE

NO.	TYPE	TOP ELEV.	INV. IN	INV. OUT	REMARKS
E-2	METAL END SECTION	310.76	306.76	306.69	SEE HO. CO. STD. SD-5.61

SEDIMENT CONTROL LEGEND

- EXISTING CONTOURS
- PROPOSED CONTOURS
- EXISTING DRAINAGE AREA
- PROPOSED DRAINAGE AREA
- LIMIT OF DISTURBANCE
- LIMIT OF TEMPORARY STOCKPILE
- SILT FENCE
- EARTH DIKE
- STABILIZED CONSTRUCTION ENTRANCE
- MOUNTABLE BERM
- EXISTING SILT FENCE
- EXISTING EARTH DIKE
- INTERIM GRADING

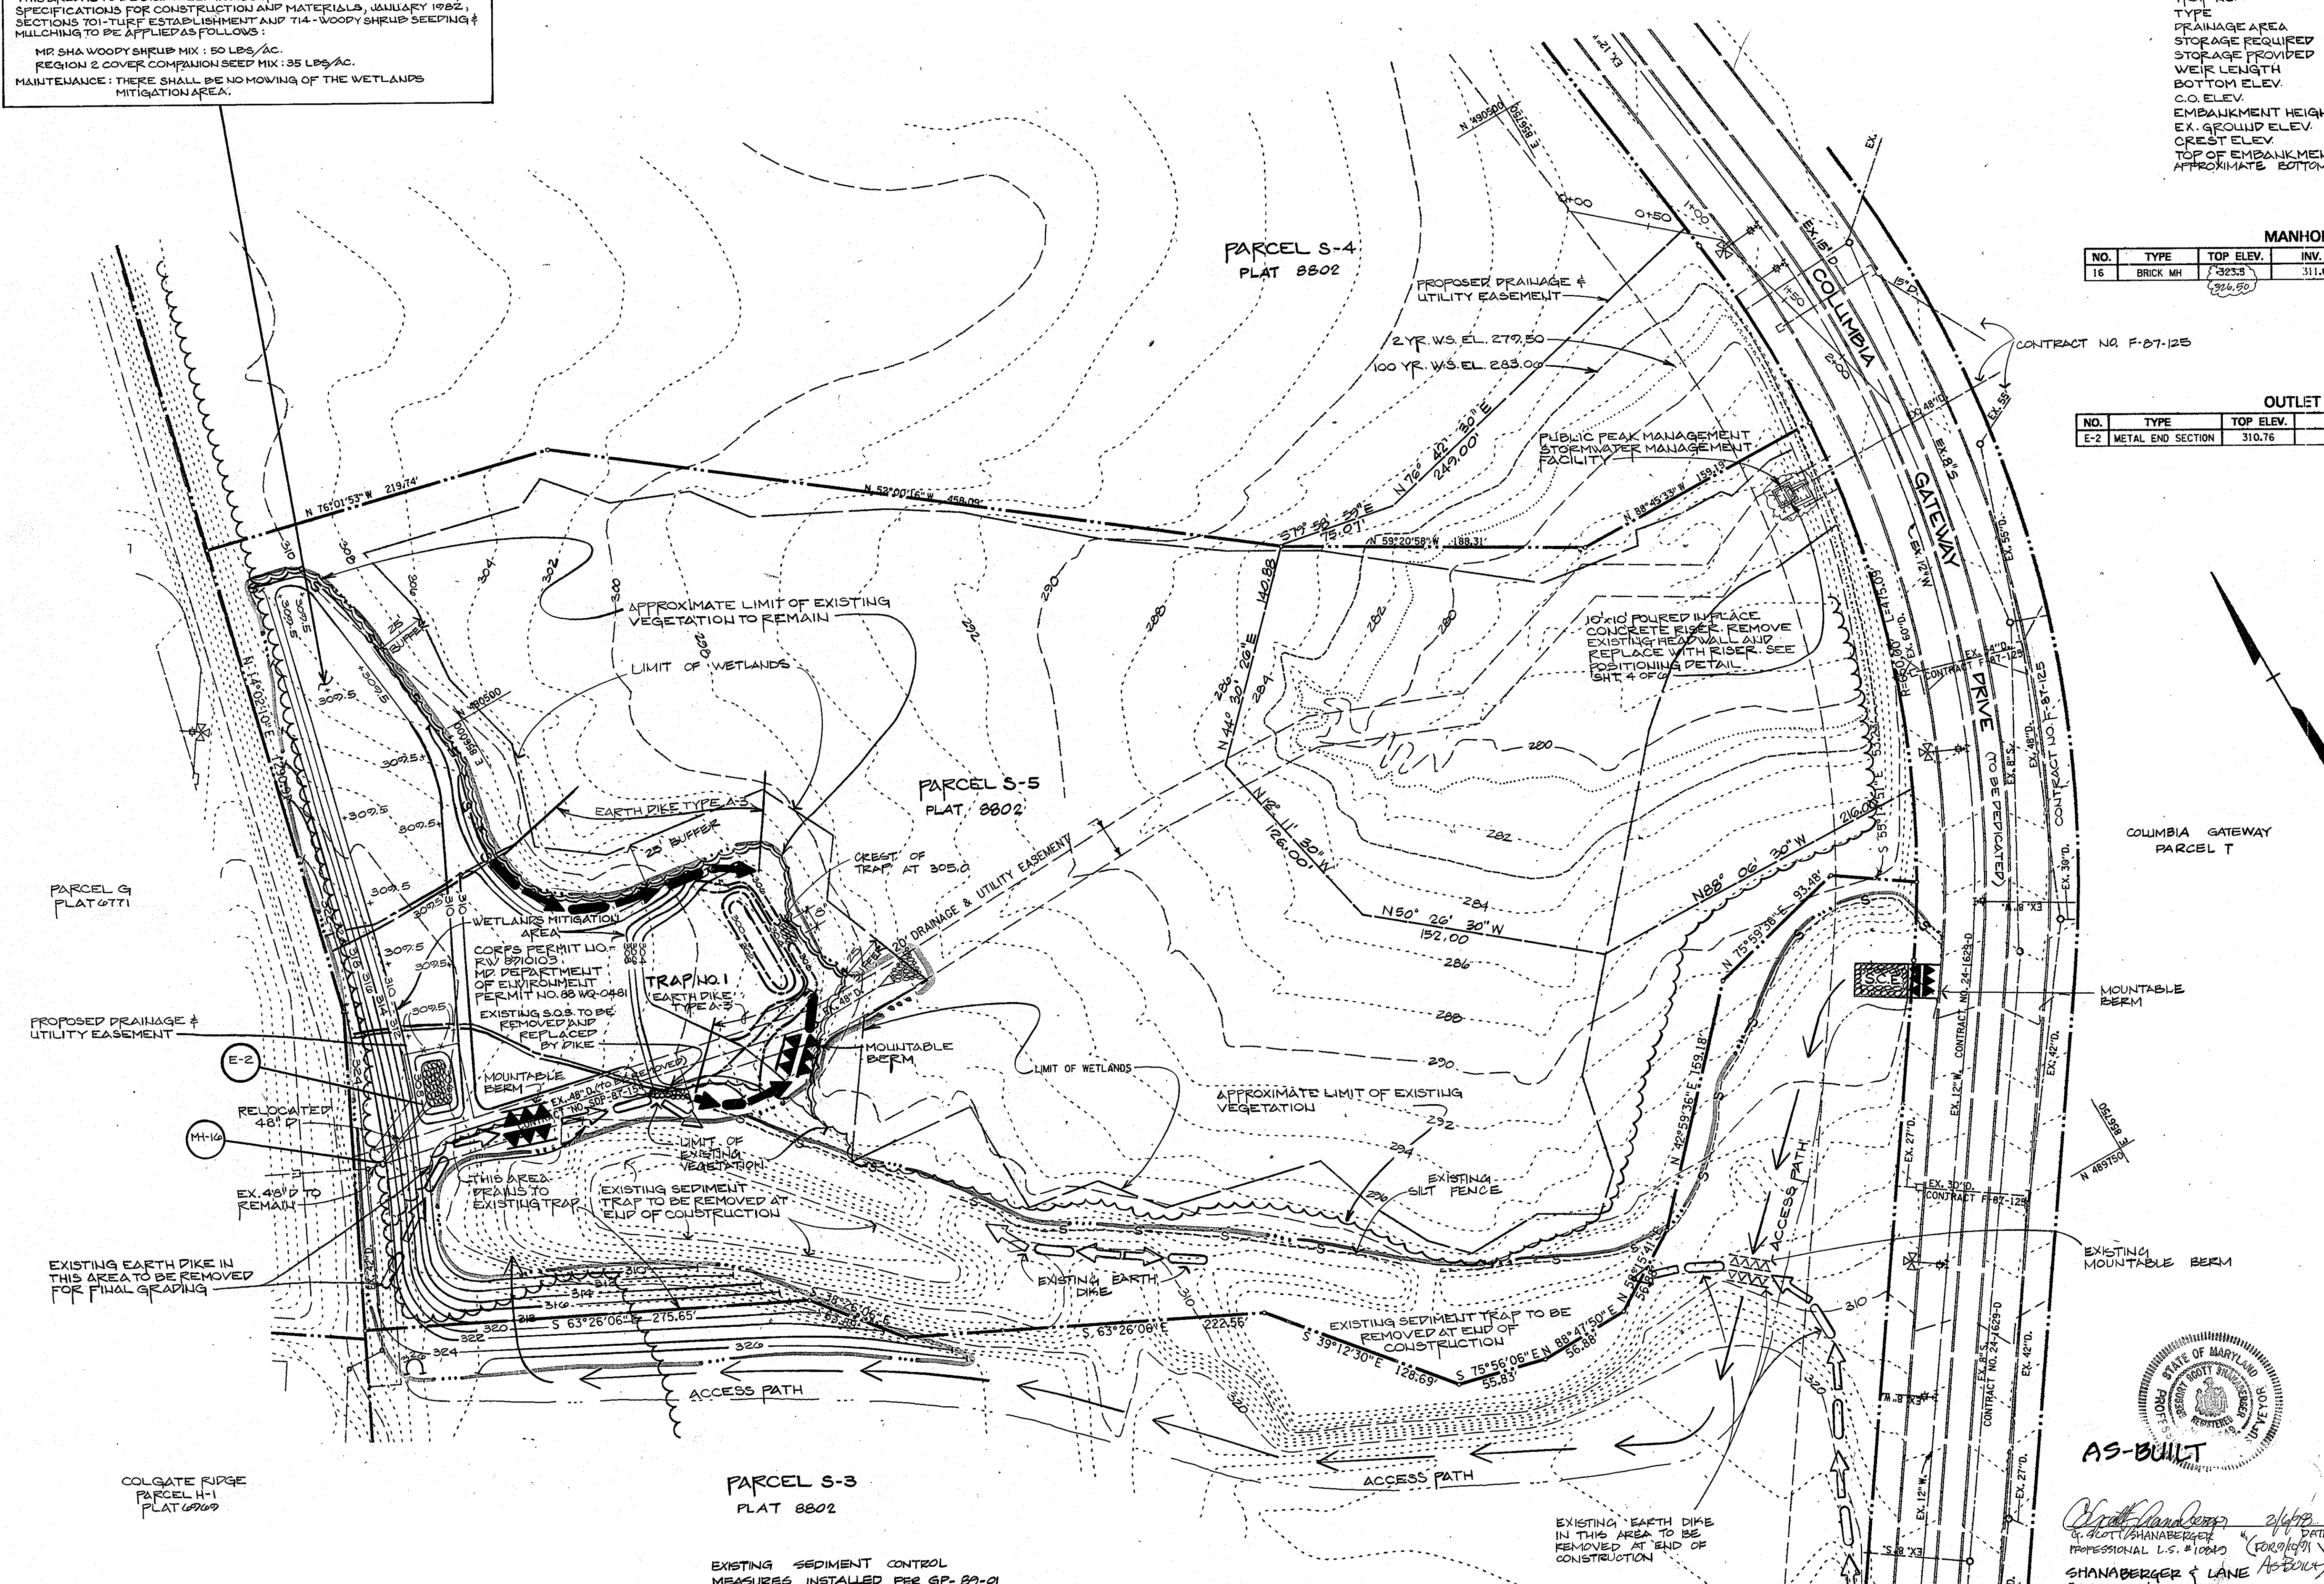

APPROVED: HOWARD COUNTY DEPT. OF PUBLIC WORKS
Howell W. Weiland 9/5/90
 CHIEF, BUREAU OF HIGHWAYS DATE

William B. Ryan 9-13-90
 CHIEF, BUREAU OF ENGINEERING DATE

Chas. M. Ferguson 9/2/90
 CHIEF, LAND DEVELOPMENT DIVISION DATE


APPROVED: HOWARD COUNTY DEPT. OF PLANNING AND ZONING
Marsha S. Campbell 10/15/90
 CHIEF, DIVISION OF COMMUNITY PLANNING & LAND DEVELOPMENT DATE

Date No. Revision Description

COLUMBIA GATEWAY
 PARCEL S-3/S-4 & S-5
 6TH ELECTION DISTRICT
 HOWARD COUNTY, MARYLAND

OWNER / DEVELOPER
 THE HOWARD RESEARCH
 AND DEVELOPMENT LAND COMPANY
 10275 LITTLE PATUXENT PARKWAY, COLUMBIA, MD 21043

DAFT McCUNE WALKER, INC.
 LAND PLANNING CONSULTANTS
 LANDSCAPE ARCHITECTS
 ENGINEERS SURVEYORS
 200 EAST PENNSYLVANIA AVENUE
 TOWSON, MD 21284
 TELEPHONE: 301-296-3333

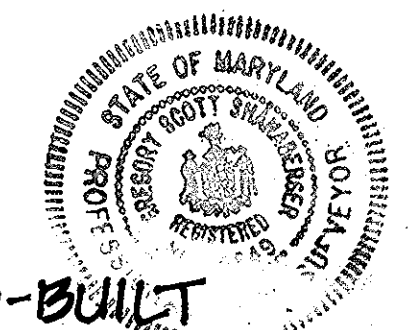

Scott Shanaberger 9/14/90
 PROFESSIONAL U.S. #10089 (FOR SIGNATURE)
 SHANABERGER & LANE ARCHITECTS
 SUITES 1061/107
 BULLCOTT CITY, MD 21043

REVISED FOR HOWARD S.C.D. AND MEETS TECHNICAL REQUIREMENTS
John A. Zichner 9/13/90
 U.S. SOIL CONSERVATION SERVICE DATE

THIS DEVELOPMENT PLAN IS APPROVED FOR SOIL EROSION AND SEDIMENT CONTROL BY HOWARD SOIL CONSERVATION DISTRICT.
John A. Zichner 9/13/90
 HOWARD S.C.D. DATE

CERTIFICATION BY THE ENGINEER:
 I CERTIFY THAT THIS PLAN FOR EROSION AND SEDIMENT CONTROL REPRESENTS A PRACTICAL AND WORKABLE PLAN BASED ON MY PERSONAL KNOWLEDGE OF THE SITE CONDITIONS AND THAT IT WAS PREPARED IN ACCORDANCE WITH THE REQUIREMENTS OF THE HOWARD SOIL CONSERVATION DISTRICT."

John A. Zichner 9/23/90
 DATE

CERTIFICATION BY THE DEVELOPER:
 I/WE CERTIFY THAT ALL DEVELOPMENT AND CONSTRUCTION WILL BE DONE ACCORDING TO THIS PLAN, AND THAT ANY RESPONSIBLE PERSONNEL INVOLVED IN THE CONSTRUCTION PROJECT WILL HAVE A CERTIFICATE OF ATTENDANCE AT A DEPARTMENT OF NATURAL RESOURCES APPROVED TRAINING PROGRAM FOR THE CONTROL OF SEDIMENT AND EROSION BEFORE BEGINNING THE PROJECT. I ALSO AUTHORIZE PERIODIC ON-SITE INSPECTION BY THE HOWARD SOIL CONSERVATION DISTRICT."

Gregory R. Khan 9/17/90
 DATE

NOTE: ACCESS TO BE GAINED THROUGH PARCEL S-3

1158

TITLE: FINAL CONSTRUCTION PLAN
SEDIMENT CONTROL PLAN

SUBDIVISION NAME: COLUMBIA GATEWAY	SECT./AREA: N/A	LOT/PARCEL: S-3/S-5
PLAT* OR L/P: 8802-8805	BLOCK: M-1	TAX/ZONE MAP: 43
WATER CODE	ELEC. DIST.: 6	CENSUS TR.: 2005.02

ADDRESS CHART

LOT NUMBER	STREET ADDRESS

Des By AJP Scale 1"=50' Proj. No. 88036
 Drn By FEZ/JMS Date 8-23-89
 Chk By JWP/AJD Approved 5 OF 6

