
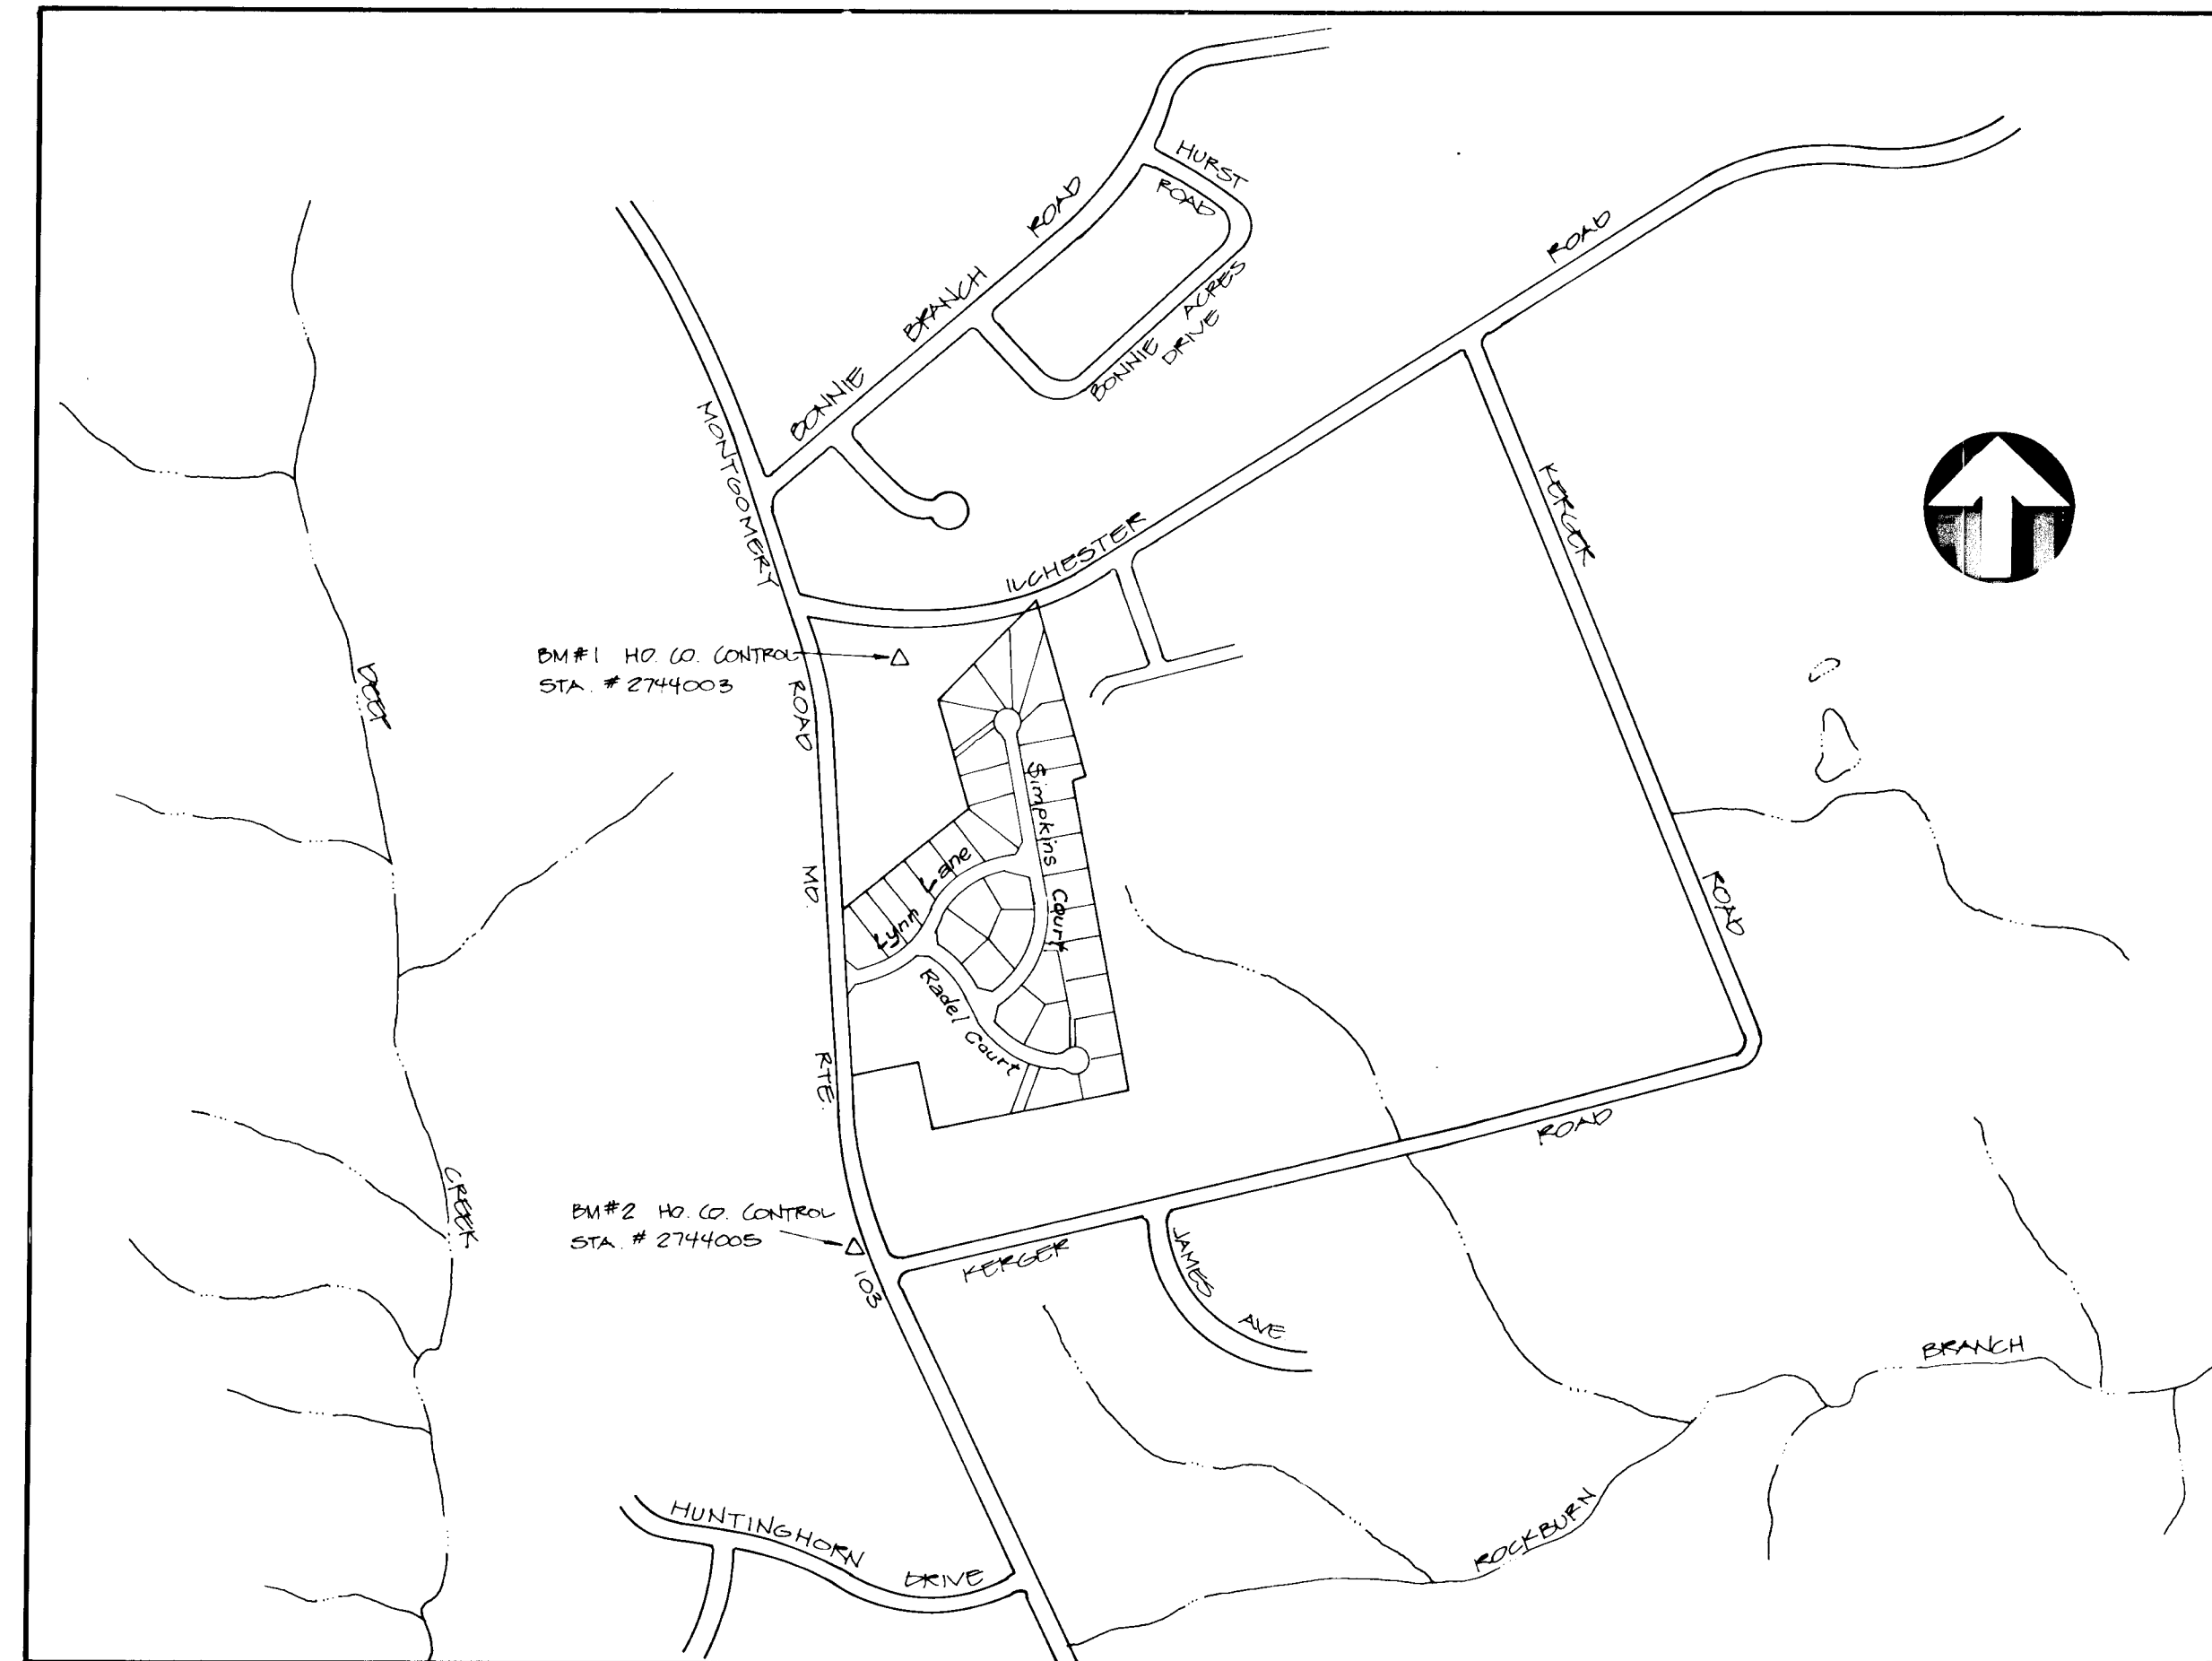


SHEET INDEX

SHEET NO.	TITLE
1	TITLE SHEET
2	PLAN AND PROFILE (Lynn Lane)
3	PLAN AND PROFILE (Simpkins Court)
4	PLAN AND PROFILE (Radel Court)
5	GRADING, SEDIMENT CONTROL & LANDSCAPING
6	DETAIL SHEET
7	DRAINAGE AREA MAP
8	STORMWATER MANAGEMENT PLAN
9	STORMWATER MANAGEMENT DETAILS
10	STORMWATER MANAGEMENT STRUCTURE DETAILS
11	STORM DRAIN AND STORMWATER MANAGEMENT DETAILS
12	STORM DRAIN PROFILE

BENCHMARKS

BM#1 HOWARD COUNTY CONTROL STATION 2744003 ELEV. 489.218, CONC. MON. AT SURFACE ON HILL IN POWER LINES BETWEEN ILCHESTER RD & MONTGOMERY RD.
 BM#2 HOWARD COUNTY CONTROL STATION 2744005 ELEV. 419.625, 3/4" REBAR 0.6 BELOW SURFACE 10' ± W. EDGE OF ROUTE 103 & 80' ± N. OF E OF KERGER RD.

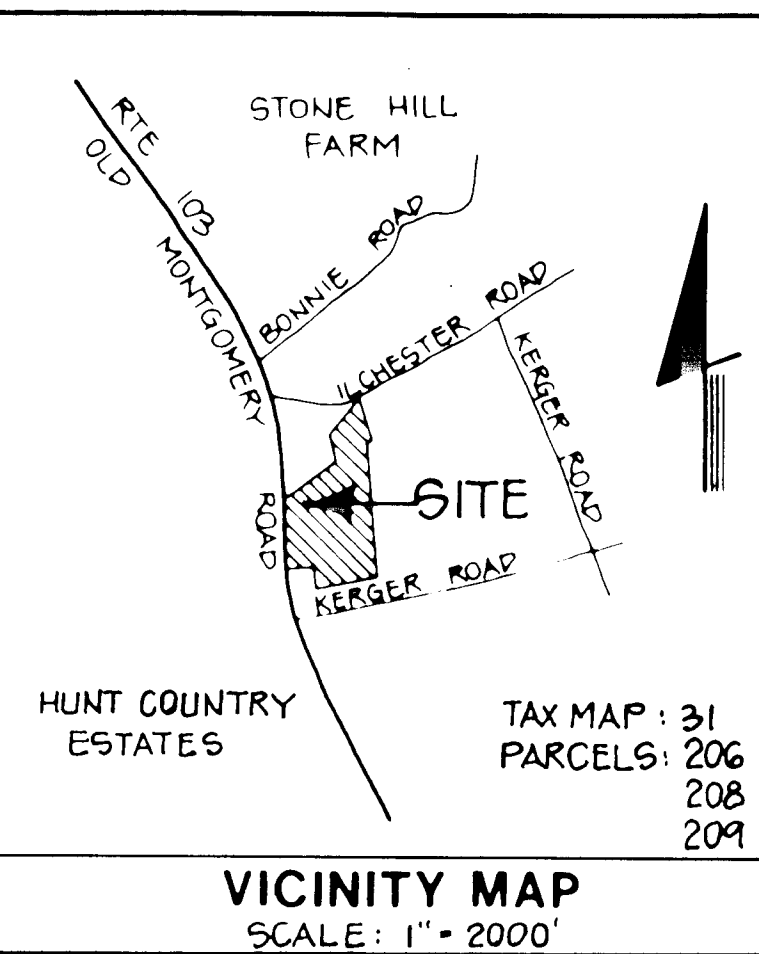

LOCATION MAP
1" = 600'

General Notes:

- All construction shall be in accordance with the current Howard County Design Manual, Volume II, plus MSHA standards and specifications.
- The contractor shall notify the Department of Public Works/Construction Inspection Division at (410) 313-1880 at least five (5) working days prior to the start of work.
- The contractor shall notify "Miss Utility" at (800) 257-7777 at least 48 hours prior to any excavation work.
- Project Background:
 Location: Howard County Tax Map 31, Parcel 206-208-209
 Zoning: R-20
 Election District: 1st
 Section/Area: One
 Total Tract Area: 25.0 Ac.
 Section Area: 25.0 Ac.
 Number of Proposed Lots: 35 Buildable
 Date Preliminary Plan Approved and DPZ Reference#: P-93-01 12/02/93
 S-90-09 08/17/89
- Traffic control devices, markings, and signing shall be in accordance with the latest edition of the Manual on Uniform Traffic Control Devices (MUTCD). All street and regulatory signs shall be in place prior to the placement of any asphalt.
- Boundary survey prepared by Lavelle & Associates, Inc. dated November, 1992. Vertical contour interval is 2'.
- Horizontal and vertical datum based on:
 BM #1
 Howard County Control Station 2744003 Elevation 489.218, conc. mon. at surface on hill in power lines between Ilchester Road and Montgomery Road.
 BM #2
 Howard County Control Station 2744005 Elevation 419.625, 3/4" Rebar 0.6' below surface 10' +/- W. edge of Route 103 & 80' +/- N. of center line of Kerger Road.
- Street light placement and the type of fixture and pole selected shall be in accordance with Howard County Design Manual, Volume III (1993) and as modified by Guidelines for Street Lights in Residential Developments (June 1993).
- Public water and sewer is proposed. Water line connections to Howard County Contract 132-W. Sewer line connections to Howard County #10-1215 Project #S-6089, draining into Kerger Road collection system and pumping station.
- Extended detention is proposed for Stormwater Management water quality control 2 and 10 year attenuation and 100 year safe pass is proposed for water quantity control.
- In all roadway fill areas 95% compaction shall be used and shall be done in accordance with A.A.S.H.T.O. T-180.
- All sidewalk ramps shall be in conformity with the current ADA requirements.
- A minimum of 20 feet shall be maintained between any street tree and street light.
- Street trees to be provided as required by Section 16.124 of the Howard County Subdivision and Land Development Regulations.
- Flood Plain Study by Lavelle and Associates, compiled January 1993, Approved October 21, 1993. P-93-01.
- Wetlands Delineation Study by McCarthy and Associates, compiled September 1992, Approved October 21, 1993. P-93-01.
- Noise Study by Scott Harvey, Acoustical Engineer, compiled October 1992, Approved October 21, 1993. P-93-01.
- Geotechnical Report by Hydro-Terra, Inc. compiled June 30, 1994, Approval pending, submitted with F-94-09 July 8, 1994.
- Existing Utilities field located.

ABBNEYFIELD ESTATES

ROAD CONSTRUCTION DRAWINGS

1ST ELECTION DISTRICT

HOWARD COUNTY, MARYLAND

DEPARTMENT OF PLANNING AND ZONING DRAWING NO# : P-93-01, S-90-09

"I/WE CERTIFY THAT ALL DEVELOPMENT AND/OR CONSTRUCTION WILL BE DONE ACCORDING TO THESE PLANS, AND THAT ANY RESPONSIBLE PERSONNEL INVOLVED IN THE CONSTRUCTION PROJECT WILL HAVE A CERTIFICATE OF ATTENDANCE AT DEPARTMENT OF NATURAL RESOURCES APPROVED TRAINING PROGRAM FOR THE CONTROL OF SEDIMENT AND EROSION PROGRAM FOR THE CONTROL OF SEDIMENT AND EROSION BEFORE BEGINNING THE PROJECT. I WILL PROVIDE THE HOWARD SOIL CONSERVATION DISTRICT WITH AN "AS-BUILT" PLAN OF THE POND WITHIN 30 DAYS OF COMPLETION. I ALSO AUTHORIZE PERIODIC ON-SITE INSPECTIONS BY THE HOWARD SOIL CONSERVATION DISTRICT."

Jang H. Lee
 JANG H. LEE PROFESSIONAL ENGINEER 3/5/94 DATE

"I CERTIFY THAT THIS PLAN FOR POND CONSTRUCTION, EROSION AND SEDIMENT CONTROL REPRESENTS A PRACTICAL AND WORKABLE PLAN BASED ON MY PERSONAL KNOWLEDGE OF THE SITE CONDITIONS. THIS PLAN WAS PREPARED IN ACCORDANCE WITH THE REQUIREMENTS OF THE HOWARD SOIL CONSERVATION DISTRICT. I HAVE NOTIFIED THE DEVELOPER THAT HE MUST PROVIDE THE HOWARD SOIL CONSERVATION DISTRICT WITH AN "AS-BUILT" PLAN OF THE POND WITHIN 30 DAYS OF COMPLETION."

Jang H. Lee
 JANG H. LEE PROFESSIONAL ENGINEER 3/5/94 DATE

APPROVED: HOWARD COUNTY DEPARTMENT OF PUBLIC WORKS
[Signature]
 CHIEF, LAND DEVELOPMENT DIVISION 11/14/94 DATE

Andrew M. Donale
 CHIEF, BUREAU OF HIGHWAY HS 11-10-94 DATE

[Signature]
 CHIEF, BUREAU OF ENGINEERING 11/14/94 DATE

APPROVED HOWARD COUNTY DEPARTMENT OF PLANNING AND ZONING
Aina Srivastava
 CHIEF, DIVISION OF LAND DEVELOPMENT AND RESEARCH 11/18/94 DATE

DESIGNED	date	REVISIONS	
		DATE	DESCRIPTION
DRAWN	date	9/95	RCH Per Howard County (Sheets 2, 3, 4 of 12) (Transition Curve & Gutter)
CHECKED	date		
APPROVED	date		

LAVELLE & ASSOCIATES INCORPORATED
 CIVIL ENGINEERS • LAND PLANNERS • LAND SURVEYORS

10 NORTH JEFFERSON STREET SUITE 203 FREDERICK, MARYLAND 21701
 OFFICE: (301) 831-4510 FAX: (301) 695-9766
 (301) 695-9722

OWNER/DEVELOPER
 THE PICH CORPORATION
 13200 SKY WAY
 ELLICOTT CITY, MD. 21043


TITLE SHEET
ABBNEYFIELD ESTATES
 TAX MAP 31 PARCELS 206, 208 & 209
 1st. ELECTION DISTRICT
 HOWARD COUNTY, MARYLAND

1 OF 12

[Signature]
 "AS-BUILT" F-94-09

Lighting Legend

- Type "A" - 250 Watt High Pressure Sodium Vapor Cobra Fixture with cut-off optics mounted on 30 foot Galvanized Steel Pole with a breakaway transformer base, use a 15 foot arm extending over MD 103 at street light at intersection of Lynn Lane and MD 103.
- Type "B" - 100 Watt High Pressure Sodium Vapor Traditional Fast-Top Fixture mounted on a 14 foot Black Fiberglass Pole.

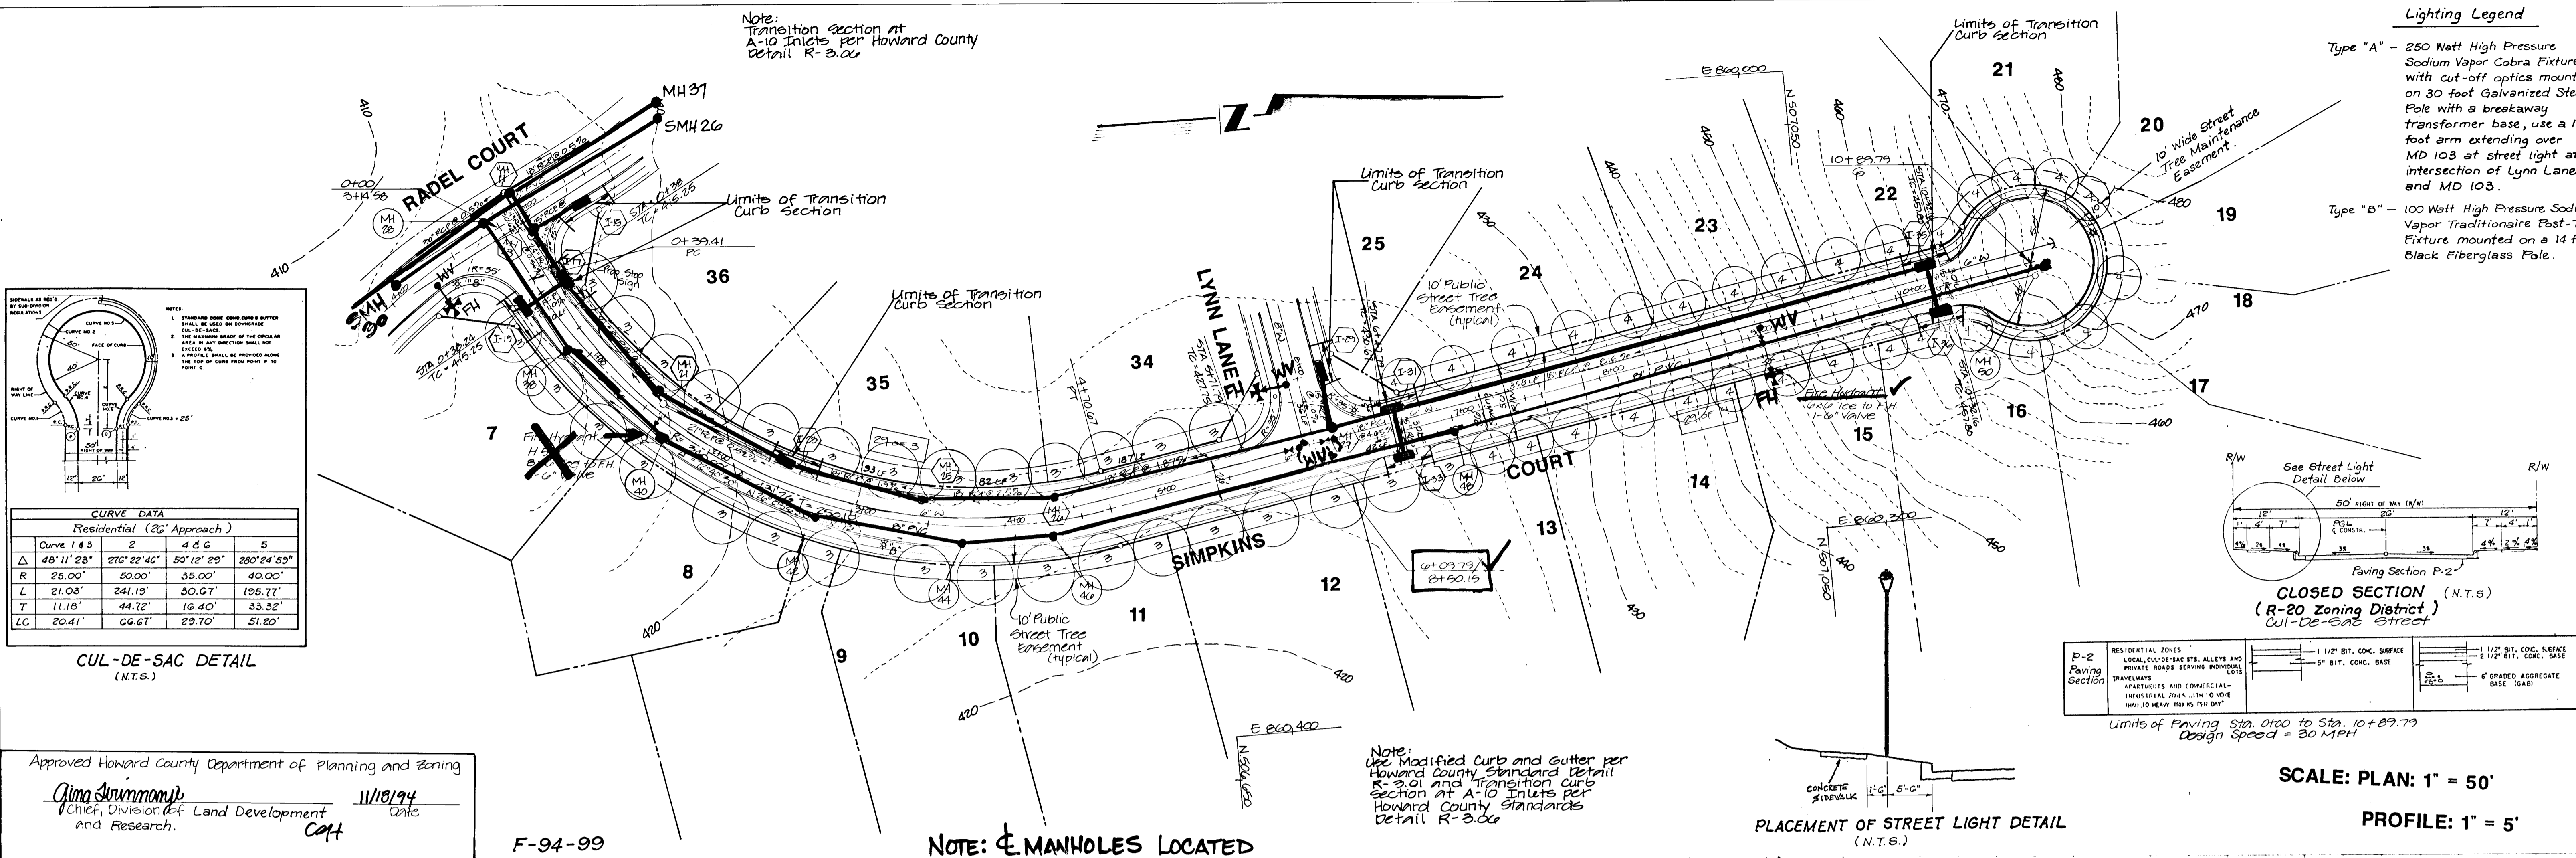

Approved Howard County Department of Planning and Zoning
 Gina Summons, Chief, Division of Land Development and Research, 11/18/94


Note: Use Modified Curb and Gutter per Howard County Standard Detail R-3.01 and Transition Curb Section at A-10 Inlets per Howard County Standards Detail R-3.06

NOTE: MANHOLES LOCATED

F-94-99

SIMPKINS COURT

ENGINEER'S "AS-BUILT" CERTIFICATE
 I hereby certify that the "As-Built" information shown hereon is accurate and complete.
 Jang H. Lee, P.E., Date: 7/10/99, MD Lic. #18632

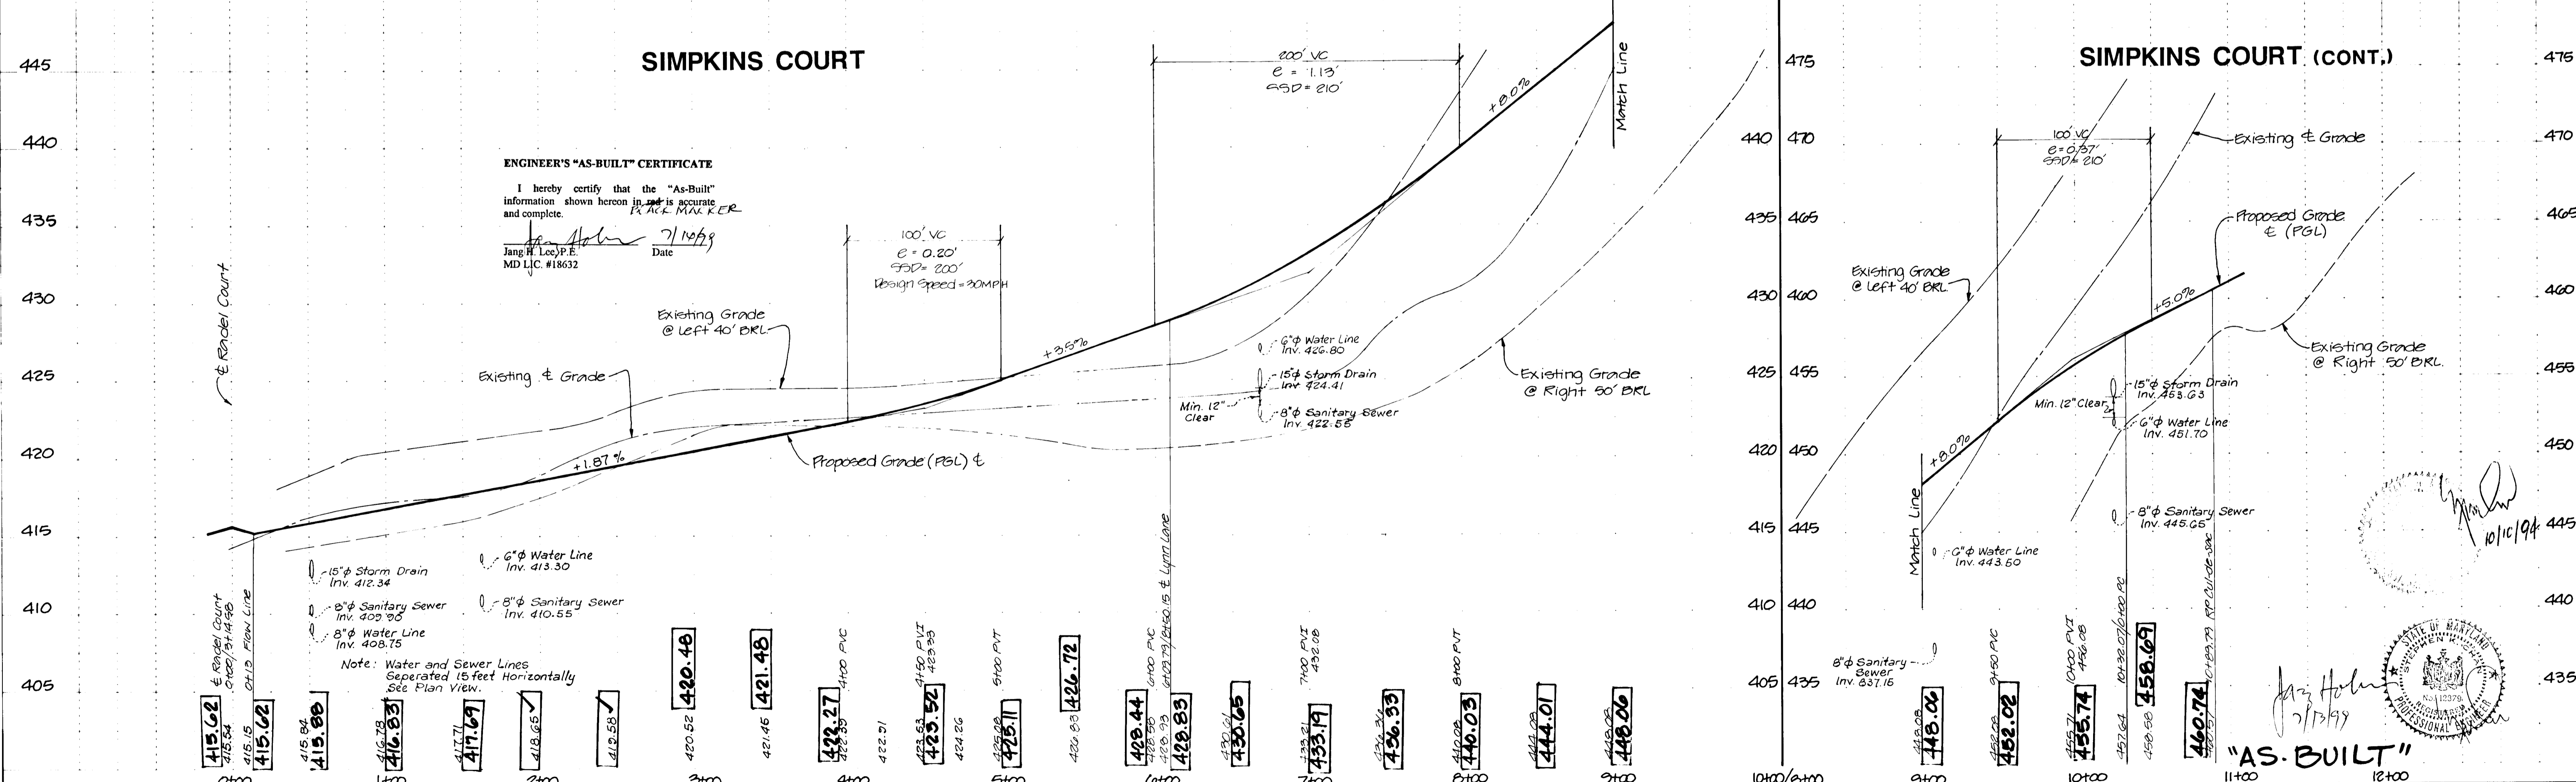

"AS-BUILT"

PLAN AND PROFILE
ABBEYFIELD ESTATES
 TAX MAP 31 PARCELS 206, 208 & 209
 1st. ELECTION DISTRICT
 HOWARD COUNTY, MARYLAND

DES:	RCH	1	Revise Per Howard County (Transition Curb & Gutter)	9/95
DN:				
CHK:				
DATE:	BY	NO.	REVISION	DATE


1714

f-94-99

CUL-DE-SAC DETAIL (N.T.S.)

STANDARD CONC. CURB CURB & GUTTER SHALL BE USED ON DOWNGRADE CUL-DE-SACS
 THE MAXIMUM GRADE OF THE CIRCULAR AREA IN ANY DIRECTION SHALL NOT EXCEED 5%
 A PROFILE SHALL BE PROVIDED ALONG THE TOP OF CURB FROM POINT P TO POINT Q


CURVE DATA				
Residential (20' Approach)				
Curve 1 & 3	2	4 & 6	5	
Δ 48° 11' 23"	276° 22' 46"	50° 12' 29"	280° 24' 59"	
R 25.00'	50.00'	35.00'	40.00'	
L 21.03'	241.19'	30.67'	105.77'	
T 11.18'	44.72'	16.40'	33.32'	
LC 20.41'	66.67'	29.70'	51.20'	

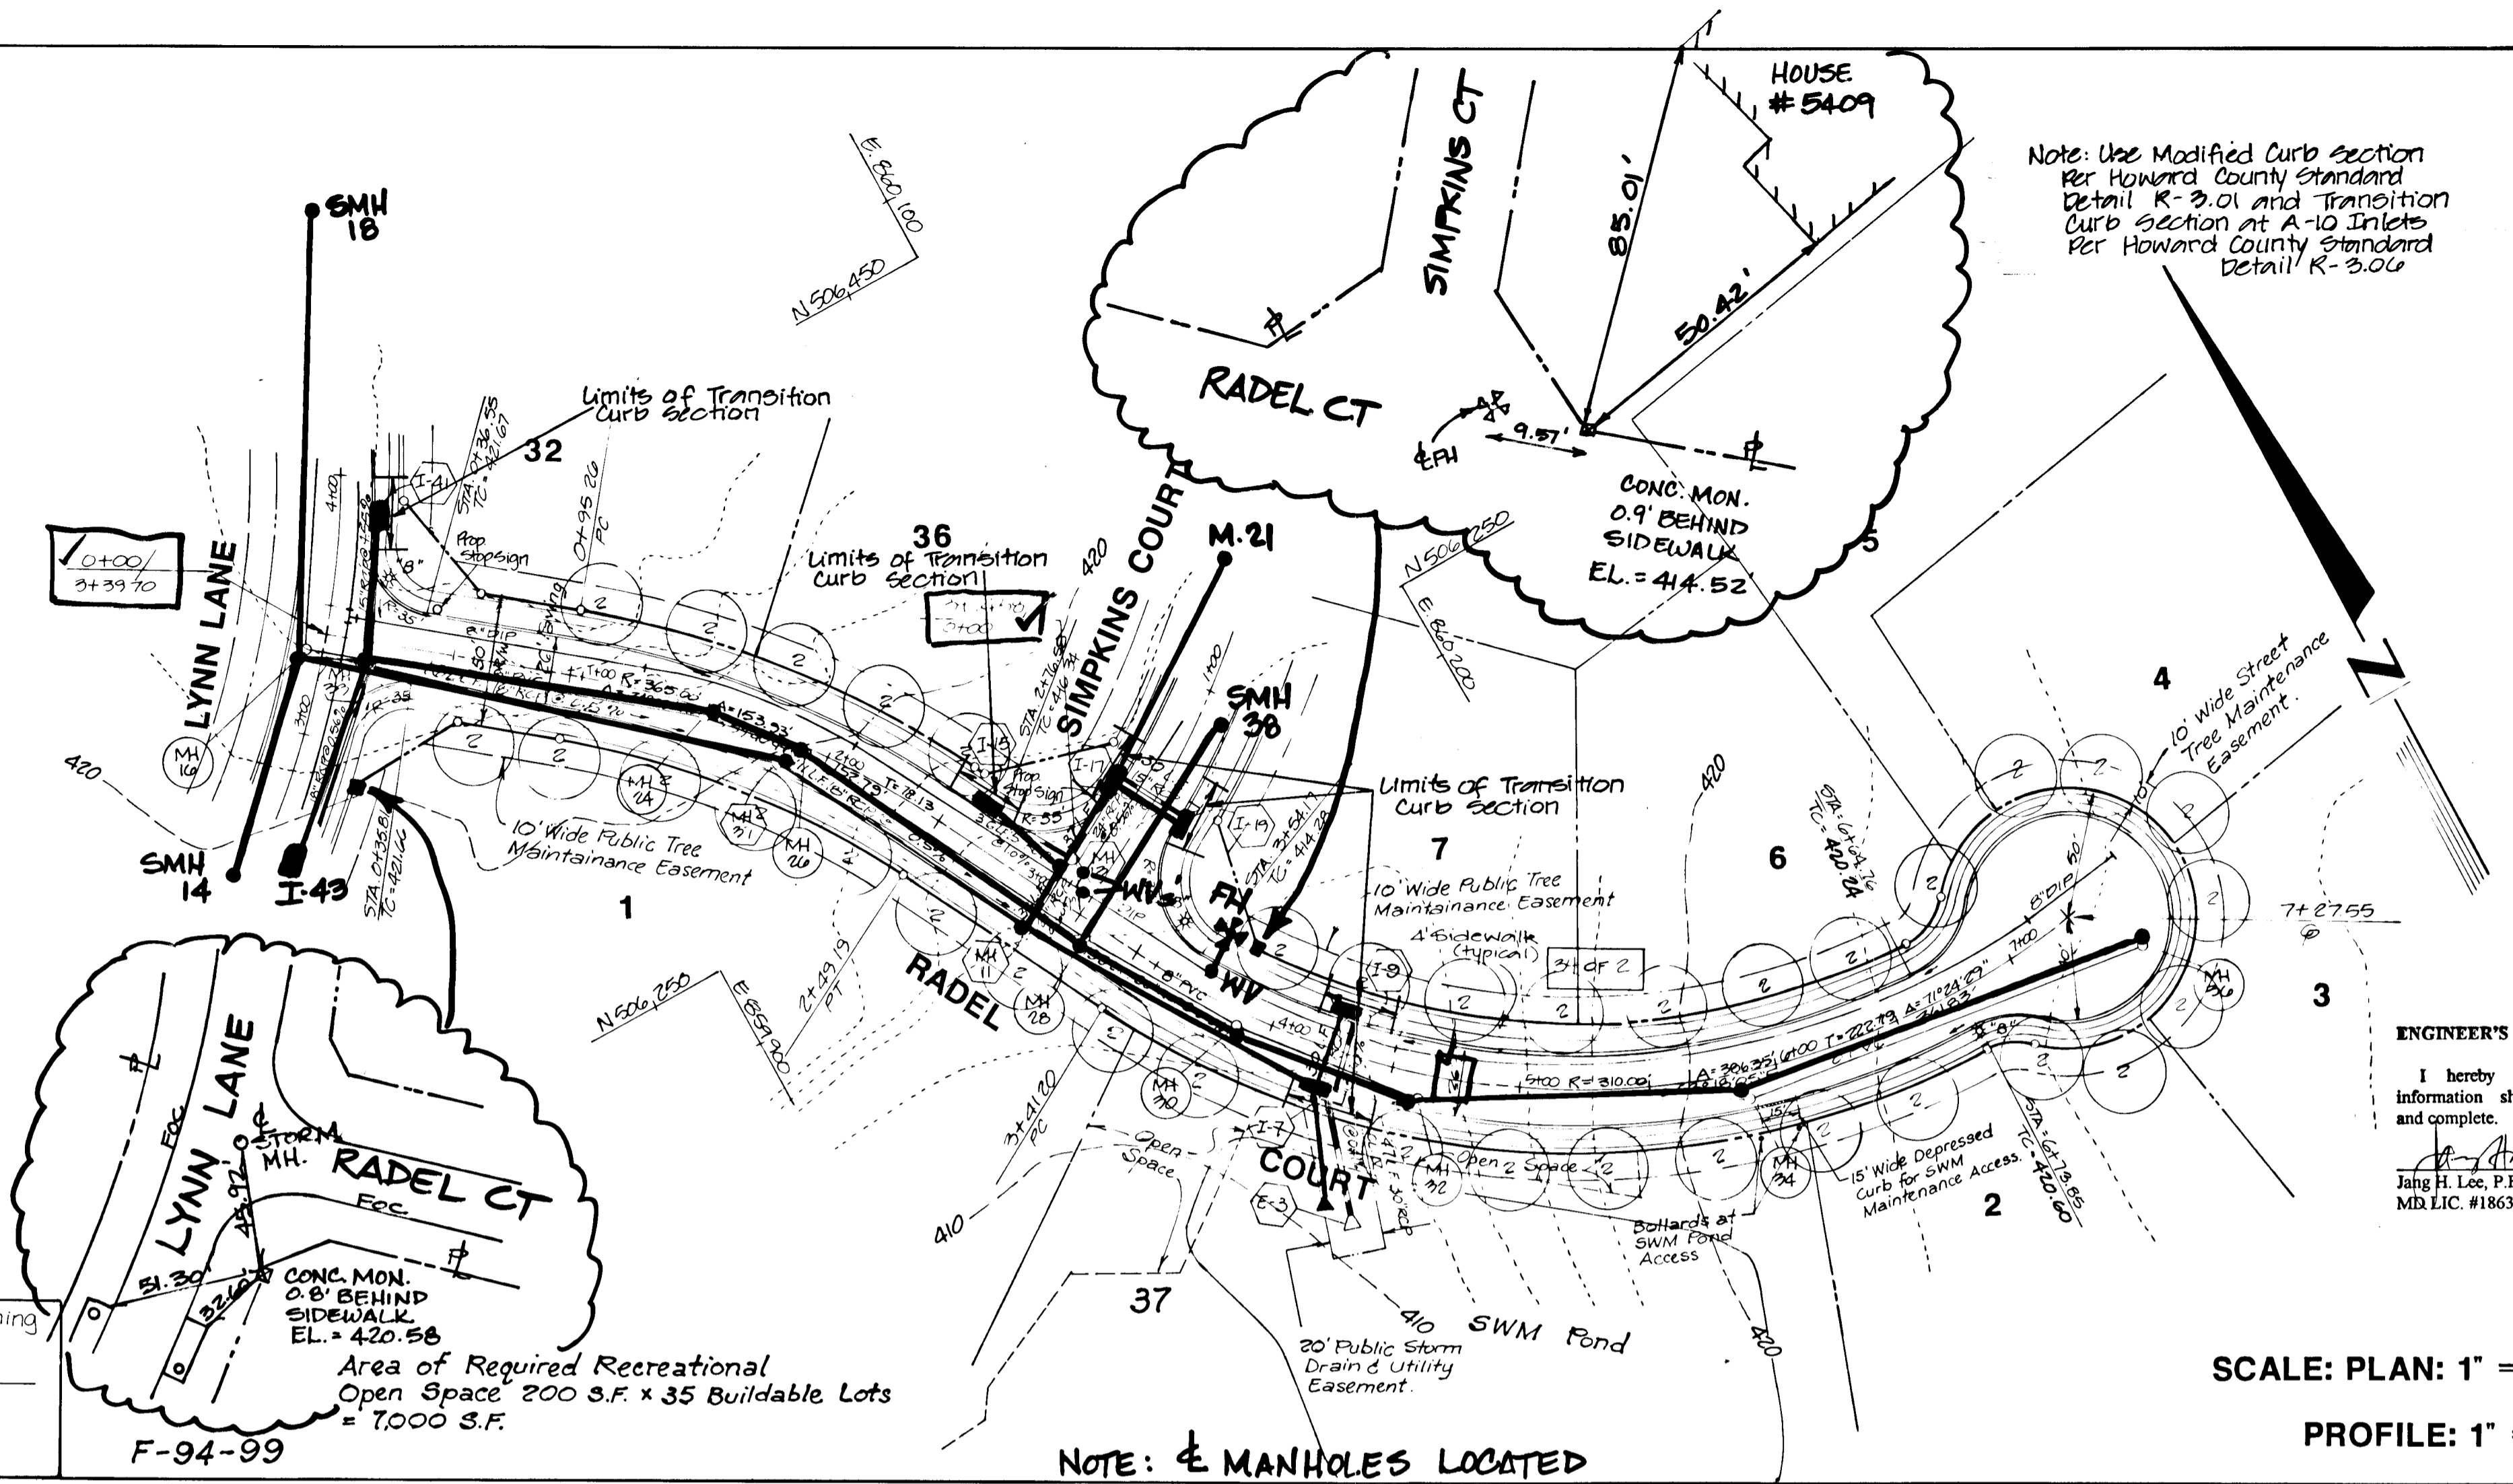


Approved Howard County Department of Planning and Zoning
 Olga Jaramany, Chief, Division of Land Development and Research, 11/10/94 Date

Area of Required Recreational Open Space: 200 S.F. x 35 Buildable Lots = 7,000 S.F.
 F-94-99

NOTE: MANHOLES LOCATED

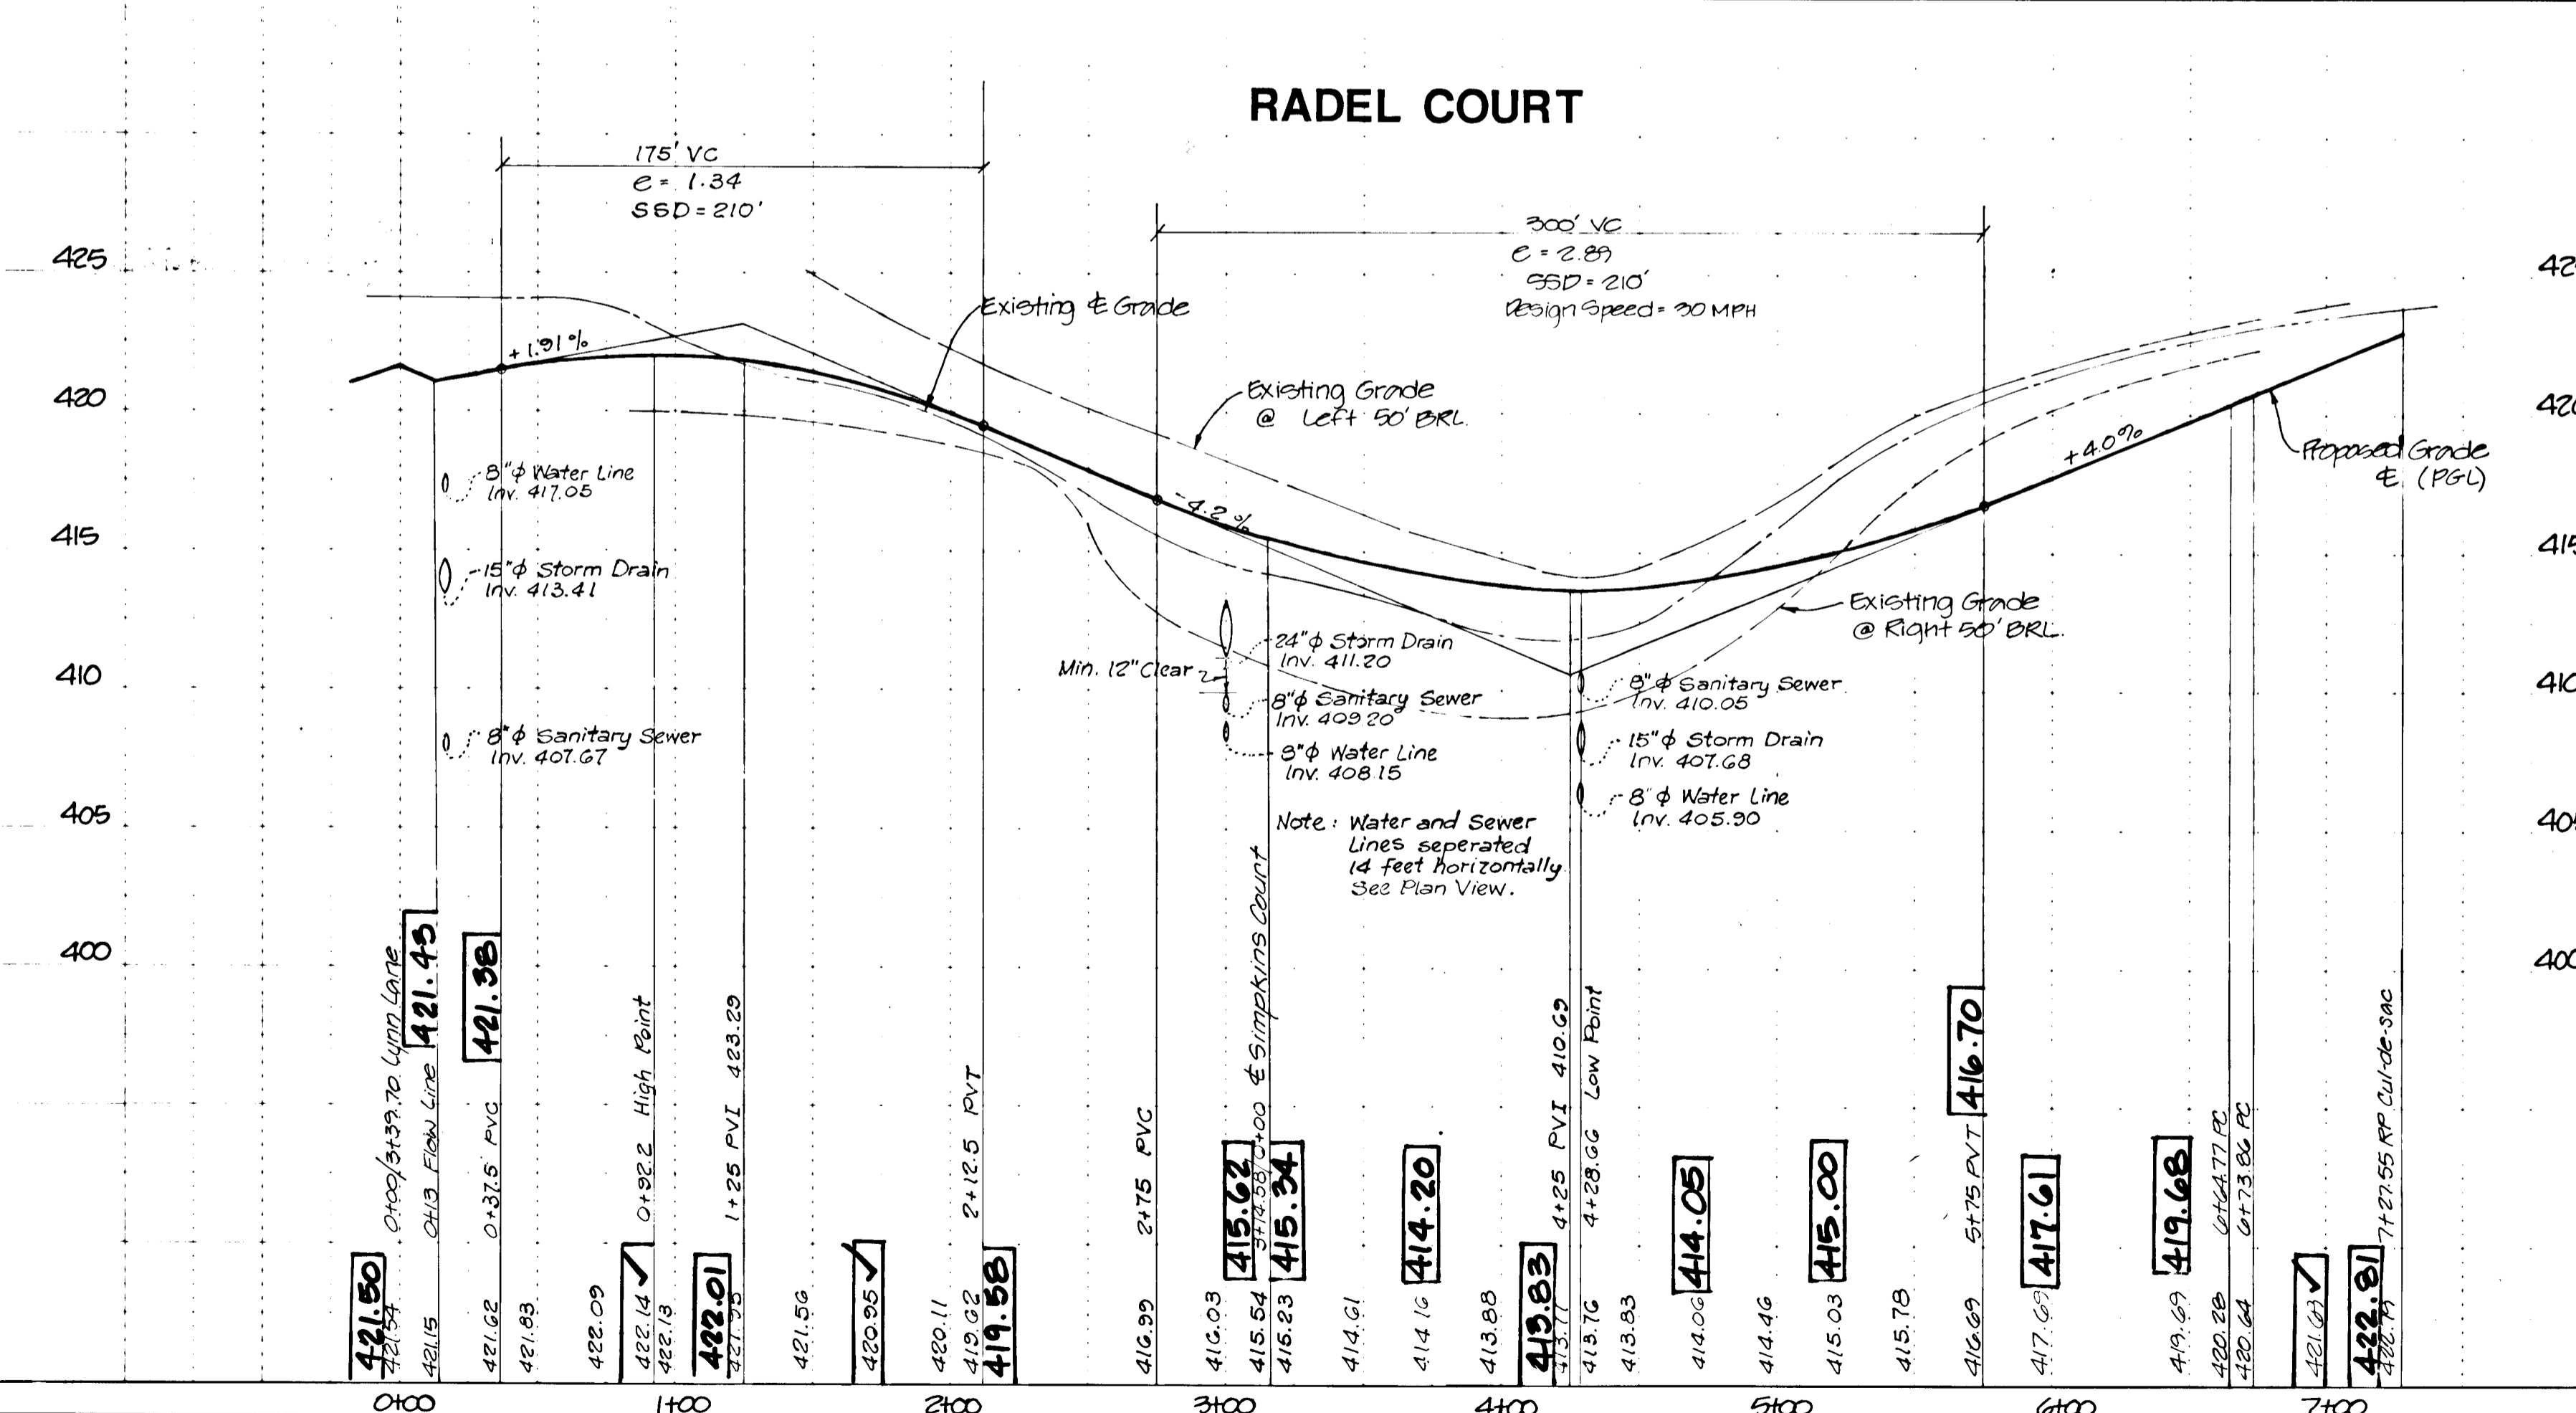

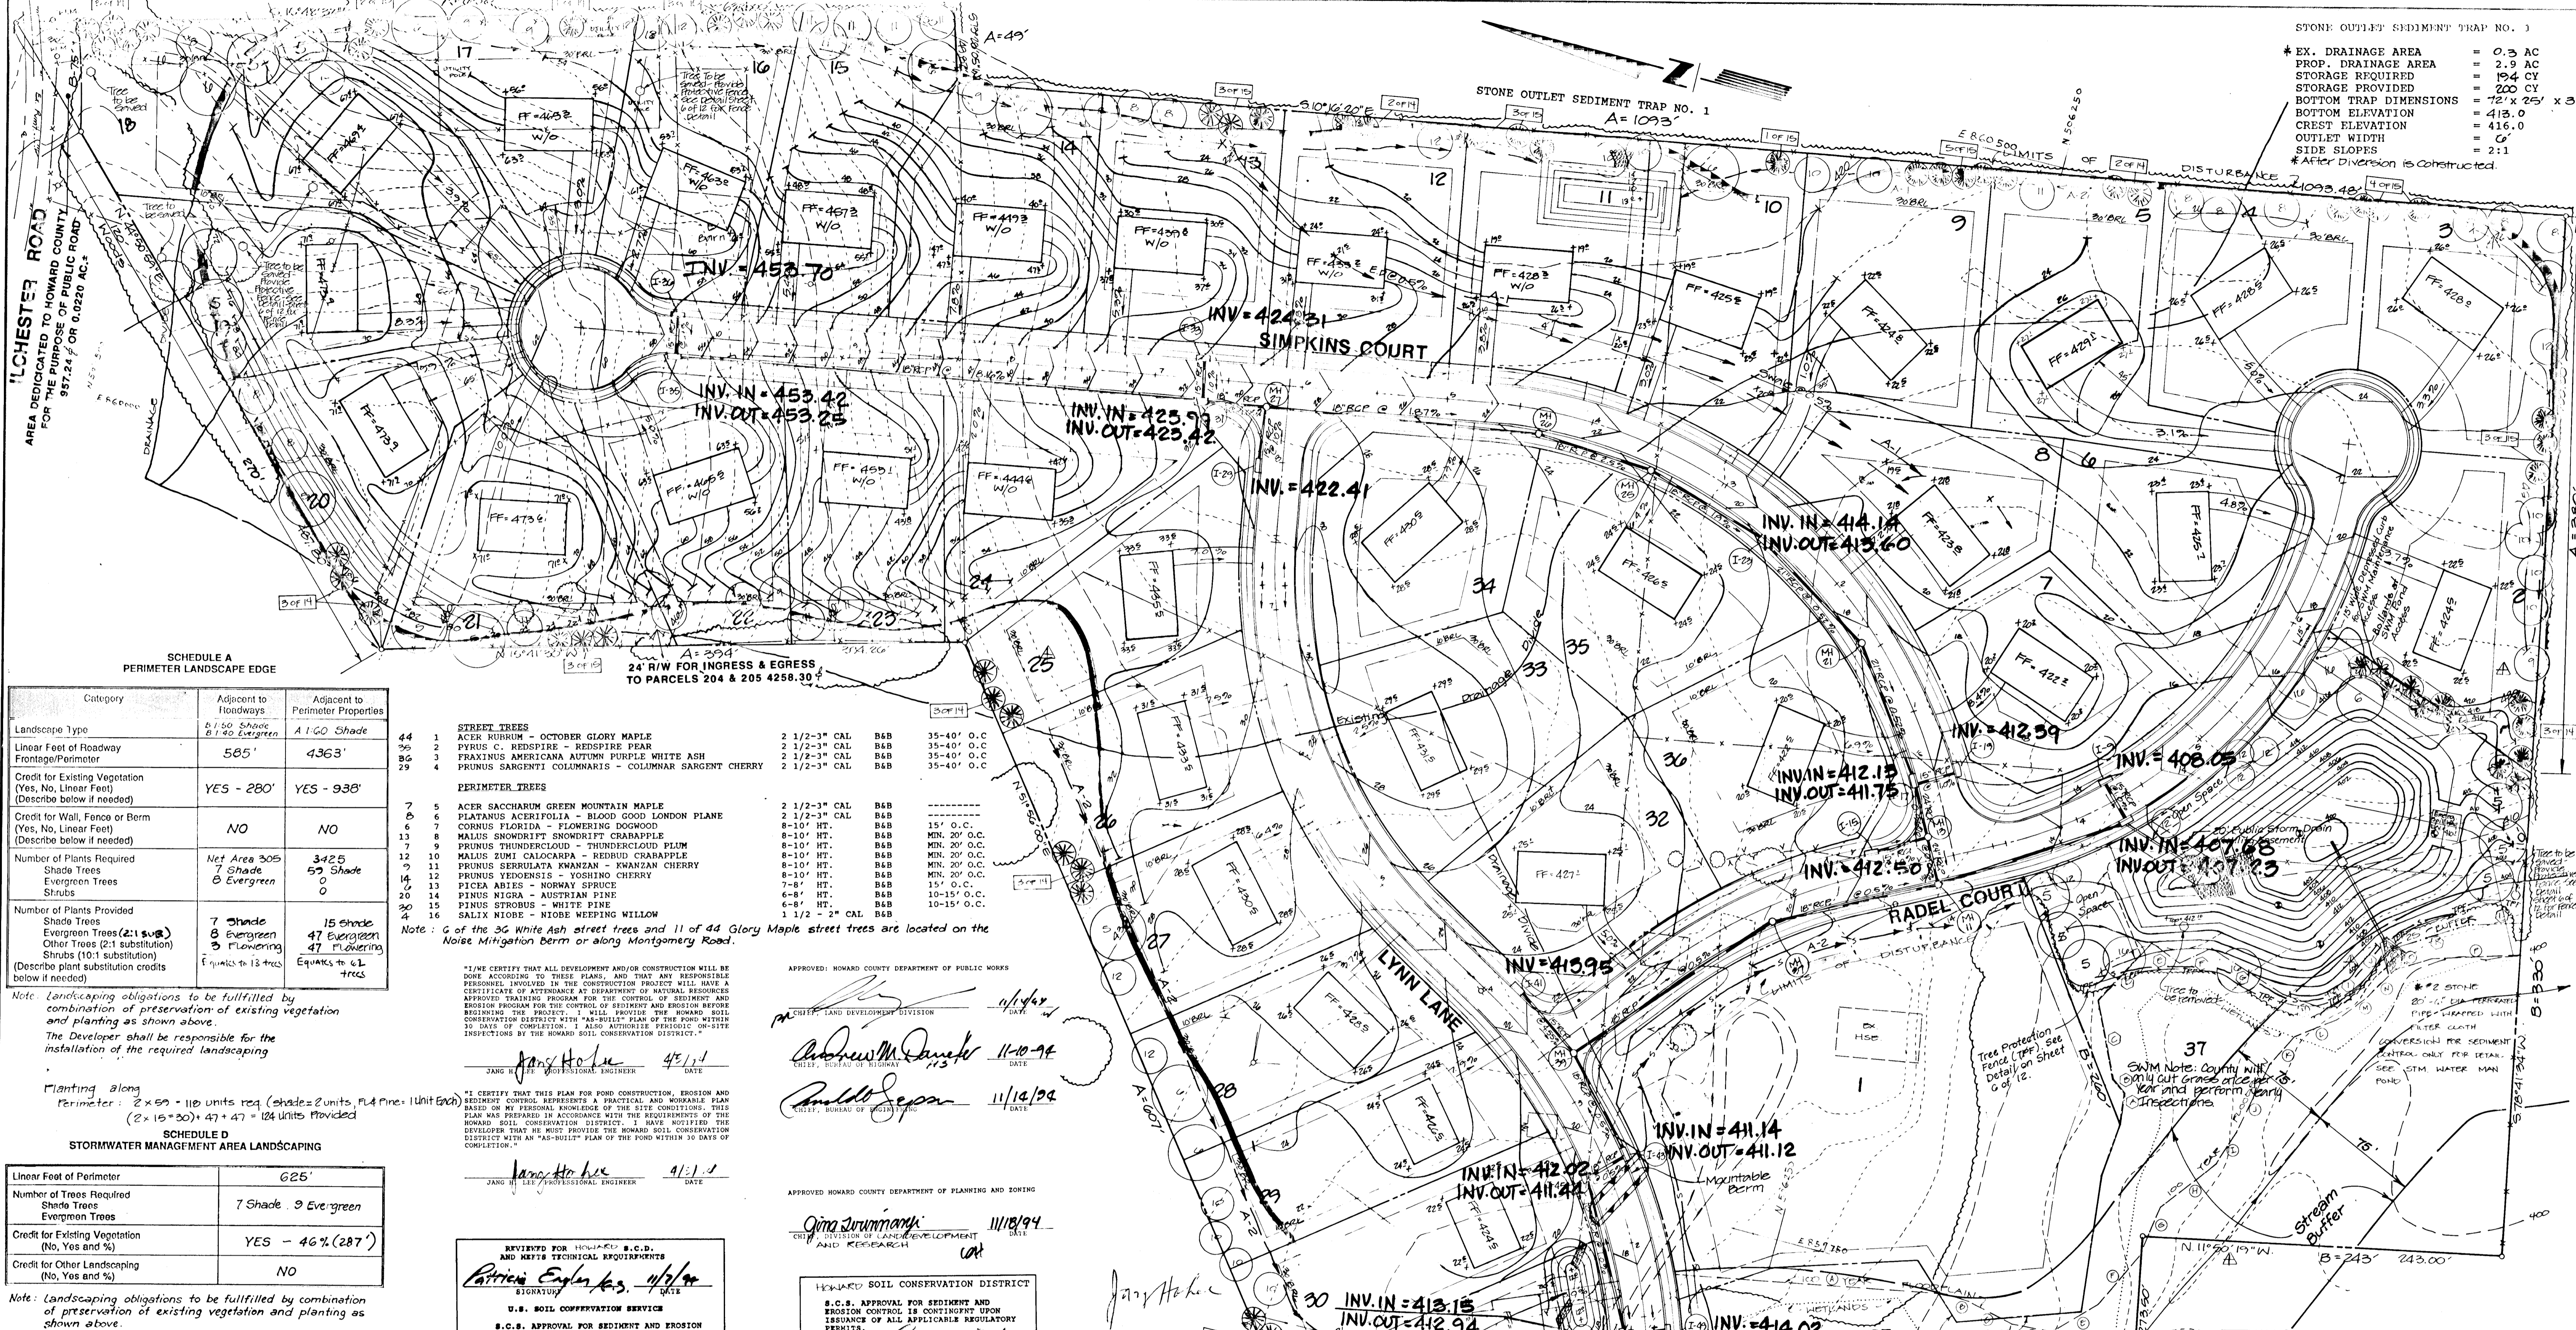

STONE OUTLET SEDIMENT TRAP NO. 1

* EX. DRAINAGE AREA	= 0.3 AC
PROP. DRAINAGE AREA	= 2.9 AC
STORAGE REQUIRED	= 194 CY
STORAGE PROVIDED	= 200 CY
BOTTOM TRAP DIMENSIONS	= 72' x 25' x 3'
BOTTOM ELEVATION	= 415.0
CREST ELEVATION	= 416.0
OUTLET WIDTH	= 6'
SIDE SLOPES	= 2:1

* After diversion is constructed.

SCHEDULE A
PERIMETER LANDSCAPE EDGE

Category	Adjacent to Roadways 81.60 Shade 61.40 Evergreen	Adjacent to Perimeter Properties A1.60 Shade
Landscape Type	585'	4363'
Linear Foot of Roadway Frontage/Perimeter		
Credit for Existing Vegetation (Yes, No, Linear Foot) (Describe below if needed)	YES - 280'	YES - 938'
Credit for Wall, Fence or Berm (Yes, No, Linear Foot) (Describe below if needed)	NO	NO
Number of Plants Required	Net Area 305 7 Shade 8 Evergreen	3425 53 Shade 0 Evergreen
Number of Plants Provided	7 Shade 8 Evergreen Other Trees (2:1 sub) 47 Other Shrubs (10:1 sub) 47	15 Shade 47 Evergreen 47 Shrubs

Category	Plant	Quantity	Notes
STREET TREES	1 ACER RUPESTRIS - OCTOBER GLORY MAPLE	2 1/2-3" CAL	B&B 35-40' O.C.
	2 PYRUS C. REDSPIRE - REDSPIRE PEAR	2 1/2-3" CAL	B&B 35-40' O.C.
	3 PRAXINUS AMERICANA AUTUMN PURPLE WHITE ASH	2 1/2-3" CAL	B&B 35-40' O.C.
	4 PRUNUS SARGENTI COLUMNARIS - COLUMNAR SARGENT CHERRY	2 1/2-3" CAL	B&B 35-40' O.C.
PERIMETER TREES	5 ACER SACCHARINUM GREEN MOUNTAIN MAPLE	2 1/2-3" CAL	B&B
	6 PLATANUS ACERIFOLIA - BLOOD GOOD LONDON PLANE	2 1/2-3" CAL	B&B
	7 CORNUS FLORIDA - FLOWERING DOGWOOD	8-10" HT.	B&B 15' O.C.
	8 MALUS SODORICA - CRABAPPLE	8-10" HT.	B&B MN. 20' O.C.
	9 PRUNUS THUNDERCLOUD - THUNDERCLOUD PLUM	8-10" HT.	B&B MN. 20' O.C.
	10 MALUS ZUMI CALOCARPA - REDBUD CRABAPPLE	8-10" HT.	B&B MN. 20' O.C.
	11 PRUNUS SERRULATA KWANZAN - KWANZAN CHERRY	8-10" HT.	B&B MN. 20' O.C.
	12 PRUNUS VEDENSIS - YOSHINO CHERRY	8-10" HT.	B&B MN. 20' O.C.
	13 PICEA ABIES - NORWAY SPRUCE	7-8' HT.	B&B 15' O.C.
	14 PINUS NIGRA - AUSTRIAN PINE	6-8' HT.	B&B 10-15' O.C.
	15 PINUS STROBILIS - WHITE PINE	6-8' HT.	B&B 10-15' O.C.
	16 SALIX NIobe - NIobe WEeping WILLOW	1 1/2 - 2" CAL	B&B

Note: 1 of the 36 White Ash street trees and 11 of 44 Glory Maple street trees are located on the Noise Mitigation Berm along Montgomery Road.

Note: Landscaping obligations to be fulfilled by combination of preservation of existing vegetation and planting as shown above. The Developer shall be responsible for the installation of the required landscaping.

Planting along Perimeter: 2 x 59' = 118 units req (shade = 2 units, PL & Pine = 1 Unit Each) (2 x 15' x 30' = 47) + 47 = 124 units provided

SCHEDULE D
STORMWATER MANAGEMENT AREA LANDSCAPING

Category	Quantity
Linear Foot of Perimeter	625'
Number of Trees Required	7 Shade 9 Evergreen
Credit for Existing Vegetation (No, Yes and %)	YES - 46% (287')
Credit for Other Landscaping (No, Yes and %)	NO

Note: Landscaping obligations to be fulfilled by combination of preservation of existing vegetation and planting as shown above.

THIS IS TO CERTIFY THAT THE LANDSCAPE PLANTING SHOWN ON THE PERIMETER AND THE STREETS MEETS THE REQUIREMENTS SET FORTH IN THE HOWARD COUNTY LANDSCAPE MANUAL AS ADOPTED JANUARY 4, 1993.

Signature: Lawrence J. Reader R.L.A. #193 4/4/94



LANDSCAPE READER ASSOCIATES, INC.
landscape architecture / site planning / recreation planning
15304 spenningville court / suite 102 / bunnville md 20866-1600
phone: 301-384-3076 / fax: 301-384-6096

GRADING, SEDIMENT CONTROL & LANDSCAPING
ABBEYFIELD ESTATES
TAX MAP 31 PARCELS 206, 208 & 209
1st. ELECTION DISTRICT
HOWARD COUNTY, MARYLAND
Scale: 1" = 60' April, 1994

U.S. SOIL CONSERVATION SERVICE
S.C.S. APPROVAL FOR SEDIMENT AND EROSION CONTROL IS CONTINGENT UPON REGULATORY PERMITS.
Signature: Patricia Taylor 4/1/94
Signature: Jang H. Lee 4/1/94

APPROVED HOWARD COUNTY DEPARTMENT OF PUBLIC WORKS
Signature: Andrew M. Daniels 11-10-94
Signature: Danilo Segan 11/16/94

APPROVED HOWARD COUNTY DEPARTMENT OF PLANNING AND ZONING
Signature: Gina Jaramana 11/18/94
Signature: Jang H. Lee 4/1/94

HOWARD SOIL CONSERVATION DISTRICT
S.C.S. APPROVAL FOR SEDIMENT AND EROSION CONTROL IS CONTINGENT UPON REGULATION OF ALL APPLICABLE REGULATORY PERMITS.
Signature: Jang H. Lee 4/1/94





ENGINEER'S "AS-BUILT" CERTIFICATE
I hereby certify that the "As-Built" information shown hereon in this certificate is accurate and complete.
Signature: Jang H. Lee 7/10/99
Date: 7/10/99

Stone Outlet Sediment Trap No. 2
Drainage Area = 2.2 AC
Storage Required = 149 CY
Storage Provided = 160 CY
Bottom Elevation = 412.0
Crest Elevation = 416.0
Outlet Width = 6'
Side Slopes = 2:1

100 Year Flood Plain Chart		25' Wetlands Buffer Chart	
A	51°25'00"E 105.92'	A	N 22°21'52"E 20.95'
B	51°23'34" E 100.05'	B	N 33°50'00"E 11.65'
C	51°20'08" W 20.01'	C	N 69°24'18"E 53.72'
D	51°04'05" E 20.01'	D	S 01°41'41"E 53.95'
E	51°45'00" E 20.71'	E	S 21°21'57"W 22.19'
F	51°04'03" E 21.80'	F	S 33°51'41"E 24.66'
G	51°15'00" E 21.80'	G	S 10°09'26"W 24.39'
H	51°52'29" E 21.80'	H	S 04°54'26"W 24.24'
I	51°23'44" E 21.80'	I	S 53°05'34"E 26.40'
J	51°23'44" E 21.80'	J	S 65°35'34"E 31.61'
K	51°23'44" E 21.80'	K	S 22°35'34"E 54.76'
L	51°23'44" E 21.80'	L	S 17°17'35"E 76.75'
M	51°23'44" E 21.80'	M	S 11°21'34"E 76.05'
N	51°23'44" E 21.80'	N	S 07°06'25"W 116.15'
O	51°23'44" E 21.80'	O	N 66°29'55"W 45.95'
P	51°23'44" E 21.80'		
Q	51°23'44" E 21.80'		
R	51°23'44" E 21.80'		
S	51°23'44" E 21.80'		
T	51°23'44" E 21.80'		
U	51°23'44" E 21.80'		
V	51°23'44" E 21.80'		
W	51°23'44" E 21.80'		
X	51°23'44" E 21.80'		
Y	51°23'44" E 21.80'		
Z	51°23'44" E 21.80'		

"AS-BUILT" F-94-99

F-94-99

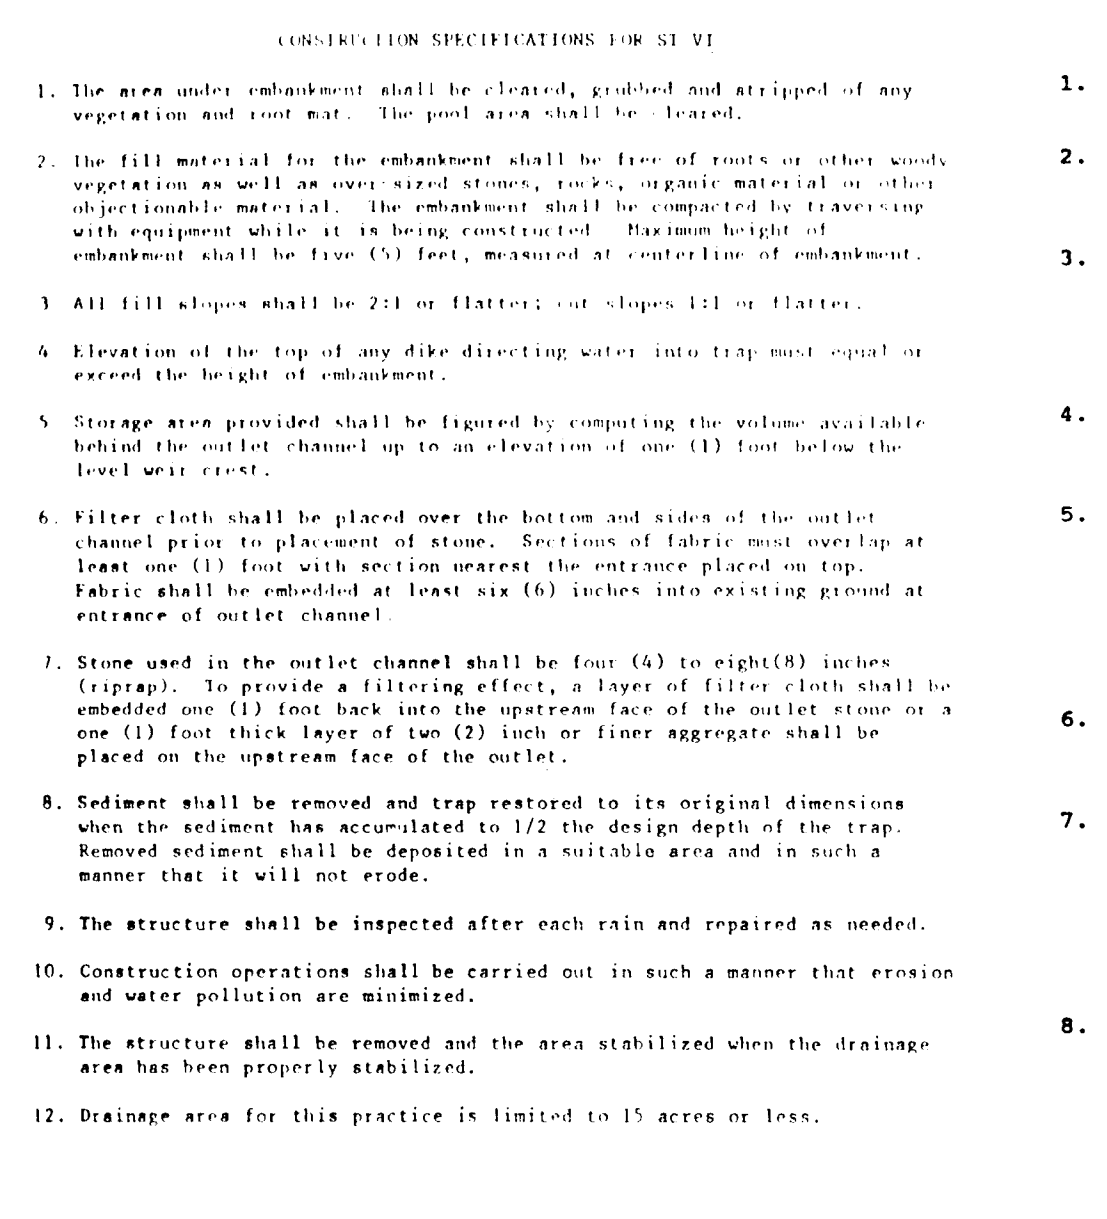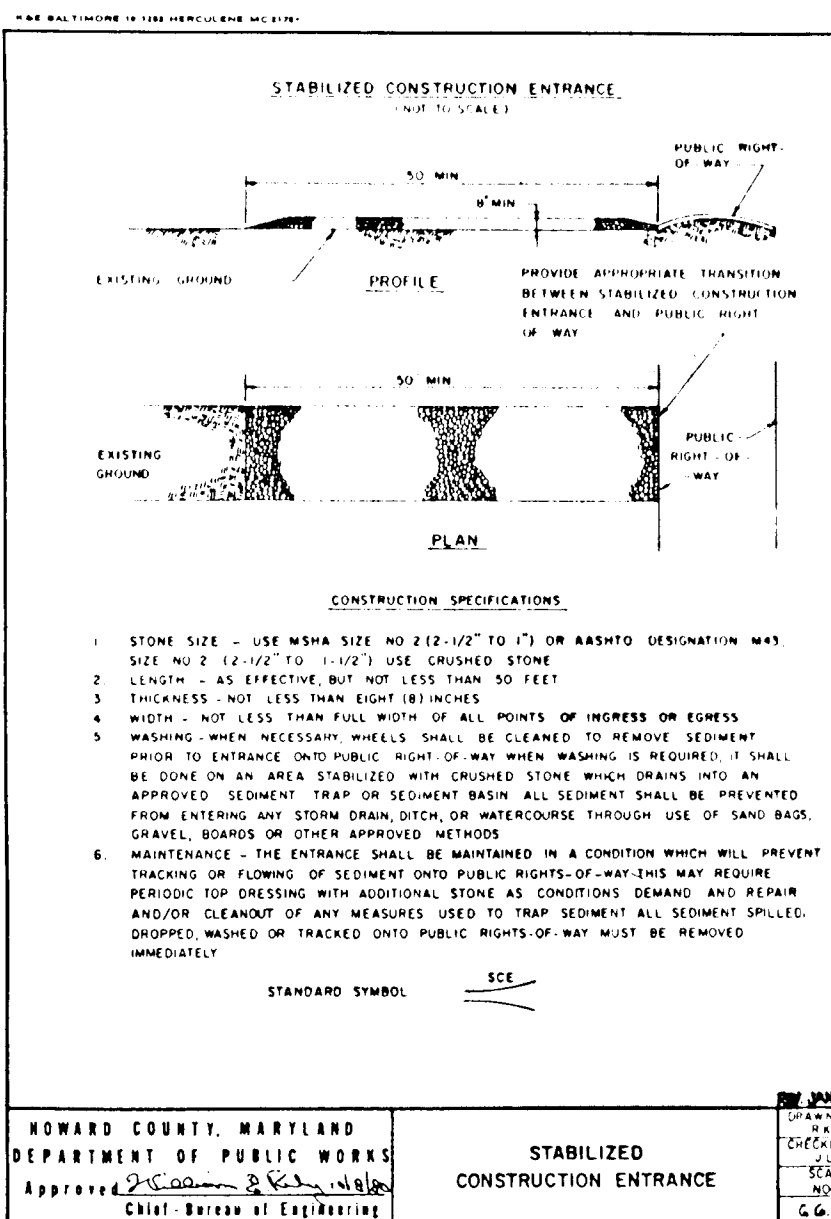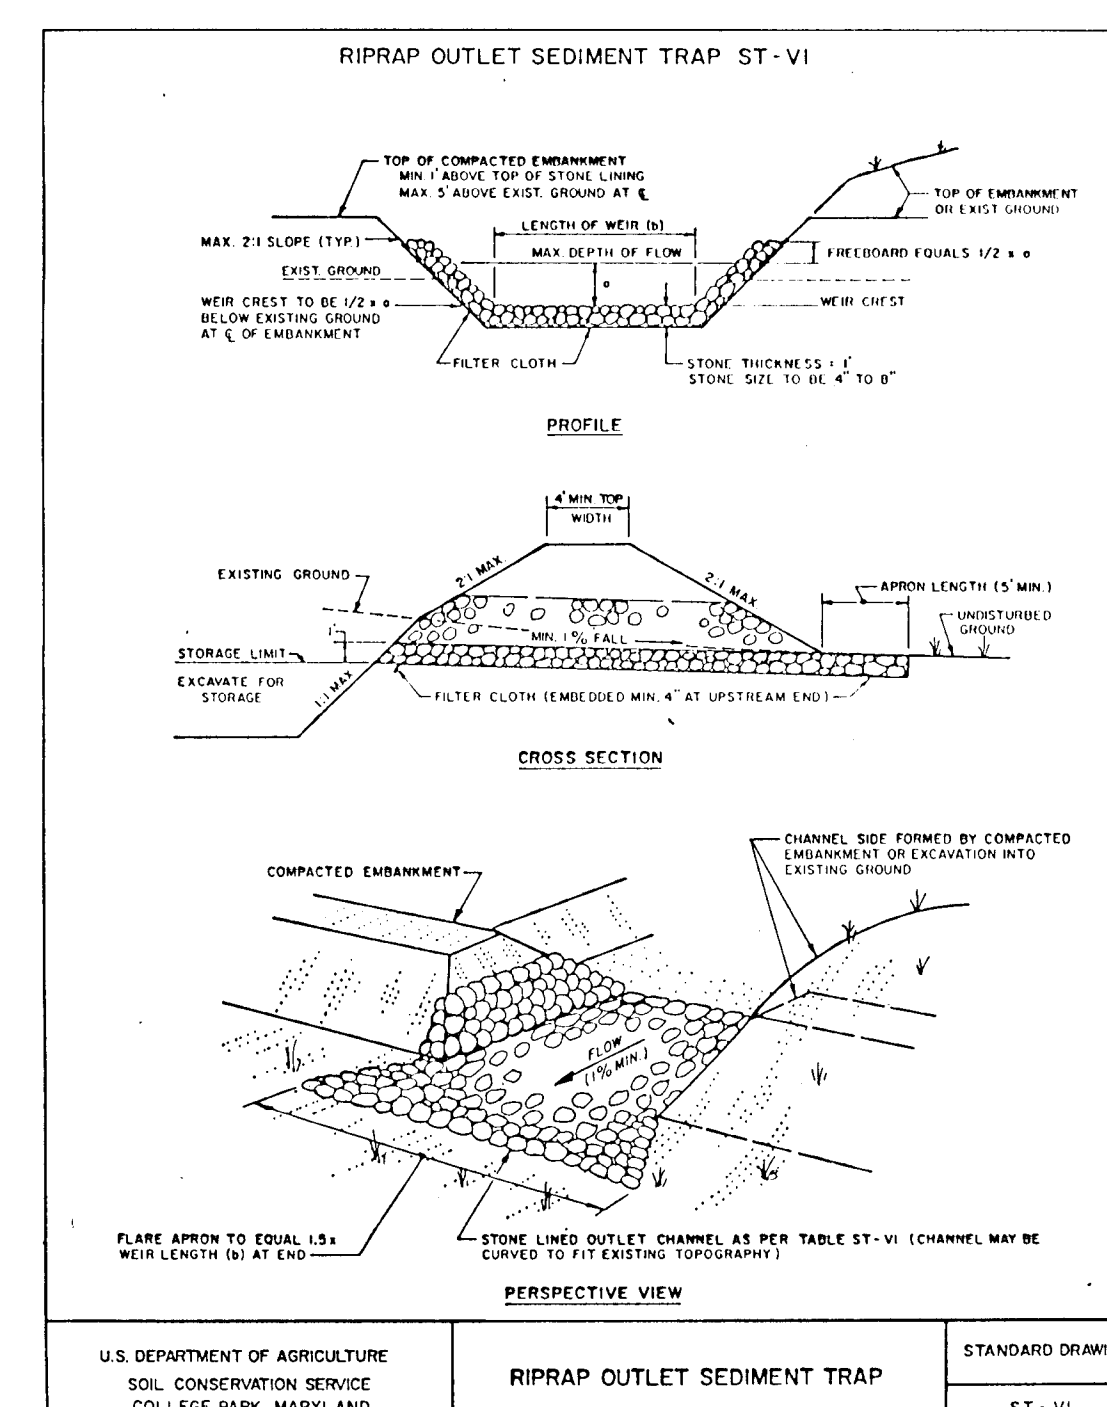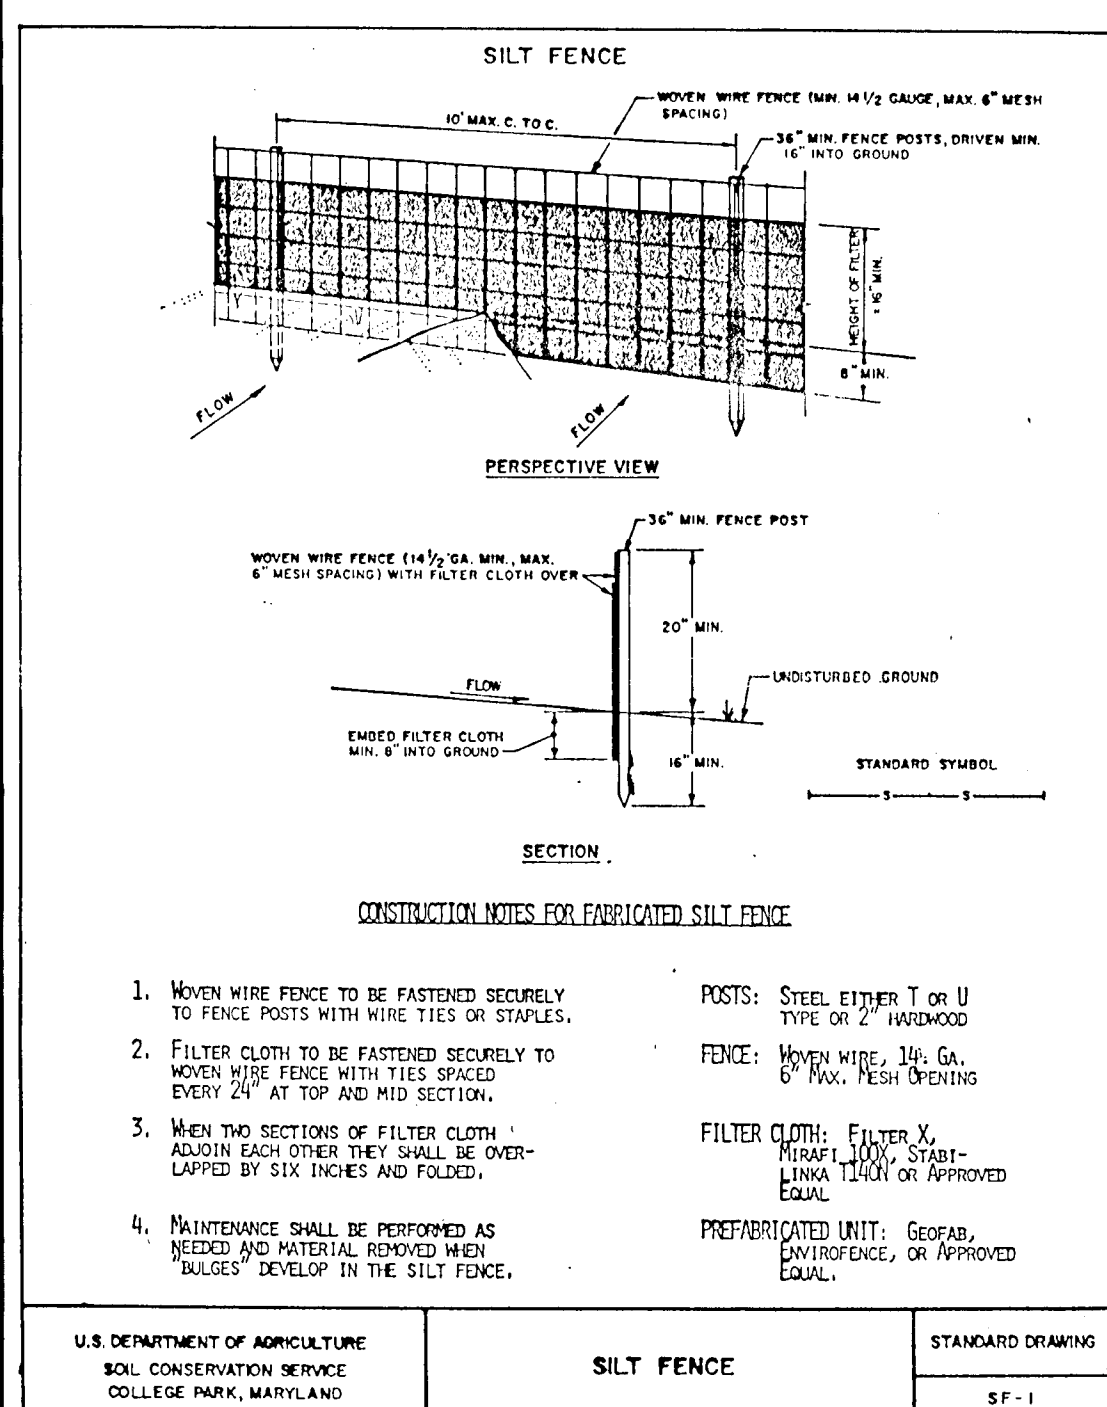

SEQUENCE OF CONSTRUCTION

- OBTAIN GRADING PERMIT. - 1 Day
- INSTALL AND STABILIZE CONSTRUCTION ENTRANCE. - 1 Day
- INSTALL EARTH-DIKES, CUT SWALE, SILT FENCES AND STONE OUTLET SEDIMENT TRAP NO. 142 AND INSTALL STORMWATER POND AND CONVERT TO TEMPORARY SEDIMENT TRAP. - 6 Weeks
- INSTALL CULVERT UNDER LYNN LANE. - 1 Week
- INSTALL DITCH ALONG LOT 31. PROVIDE EROSION CONTROL MATTING ALONG DITCH TO BY-PASS OFF SITE DRAINAGE. - 1 Week
- GRADE AS NECESSARY TO INSTALL STORM DRAIN ALONG LYNN LANE/RADEL COURT TO SWM/SED. POND. - 2 Weeks
- GRADE REMAINING SITE, NOT TO INCLUDE LOT GRADING ON 7-13 UNTIL SIMPKINS COURT GRADING IS COMPLETE. - 1 Month
- INSTALL REMAINING UTILITIES. - 2 Months
- PAVE STREETS. - 1 Week
- CONSTRUCT HOUSES (EXCEPT FOR LOTS 10 & 11). - 2 Weeks
- STABILIZE ENTIRE SITE (CONSTRUCT LOTS 10 & 11). - 1 Week
- REMOVE SEDIMENT CONTROL DEVICES. - 1 Day
- STABILIZE REMAINING AREAS. - 1 Day
- FLUSH OUT STORM DRAIN SYSTEM. - 1 Day
- CONVERT STORMWATER MANAGEMENT POND. - 1 Week











TEMPORARY SEEDING NOTES

GENERAL:

- SCOPE: PLANTING SHORT-TERM VEGETATION TO STABILIZED, CLEARED OR GRADED AREAS SUBJECT TO EROSION FOR A PERIOD OF 14 DAYS OR MORE.
- STANDARDS: TEMPORARY SEEDING SHALL CONFORM TO ALL REQUIREMENTS OF "1983 MARYLAND STANDARDS AND SPECIFICATIONS FOR SOIL EROSION AND SEDIMENT CONTROL" PUBLISHED JOINTLY BY WATER RESOURCES ADMINISTRATION, SOIL CONSERVATION SERVICE, AND STATE SOIL CONSERVATION COMMITTEE.
- SEDIMENT AND EROSION CONTROL: ALL PERIMETER CONTROLS MUST BE STABILIZED IN 7 DAYS. ALL INTERIOR CONTROLS MUST BE STABILIZED IN 14 DAYS.

SPECIFICATIONS

- SITE PREPARATION
 - PRIOR TO SEEDING INSTALL ALL REQUIRED SEDIMENT AND EROSION CONTROL MEASURES.
 - FINE GRADING NOT REQUIRED FOR TEMPORARY SEEDING.
- SOIL AMENDMENTS
 - FERTILIZER SHALL BE APPLIED AT THE RATE OF 600 LBS/ACRE USING 10-10-10 OR EQUIVALENT.
 - ACID SOILS SHALL BE LIMED.
- SEEDING PREPARATION
 - SOIL SHALL BE LOOSENED TO A DEPTH OF 3 INCHES BY RAKING, DISCING, OR OTHER ACCEPTABLE MEANS PRIOR TO SEEDING.
- SEEDING
 - SELECT A MIXTURE FROM TABLE 50-1 IN STANDARD SPECIFICATIONS.
 - APPLY SEED UNIFORMLY WITH A CYCLONE SEEDER DRILL, CULTIPACKER, OR HYDRO SEEDER.
- MULCHING
 - MULCH SHALL BE APPLIED IMMEDIATELY AFTER SEEDING. MULCH MATERIALS AND APPLICATIONS SHALL CONFORM TO THE STANDARD SPECIFICATIONS.

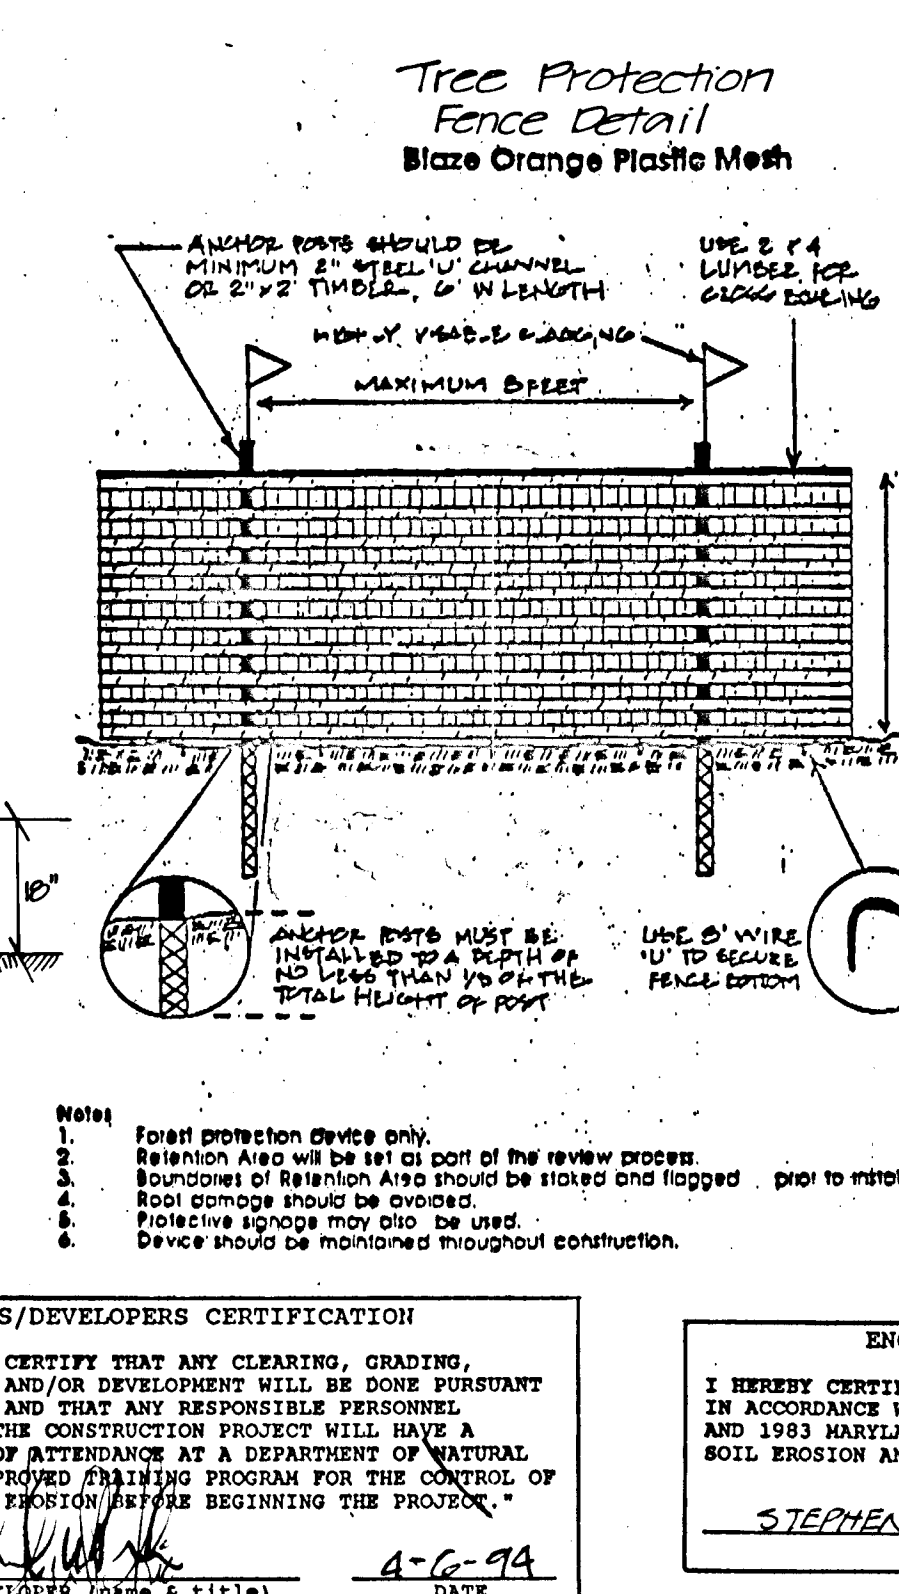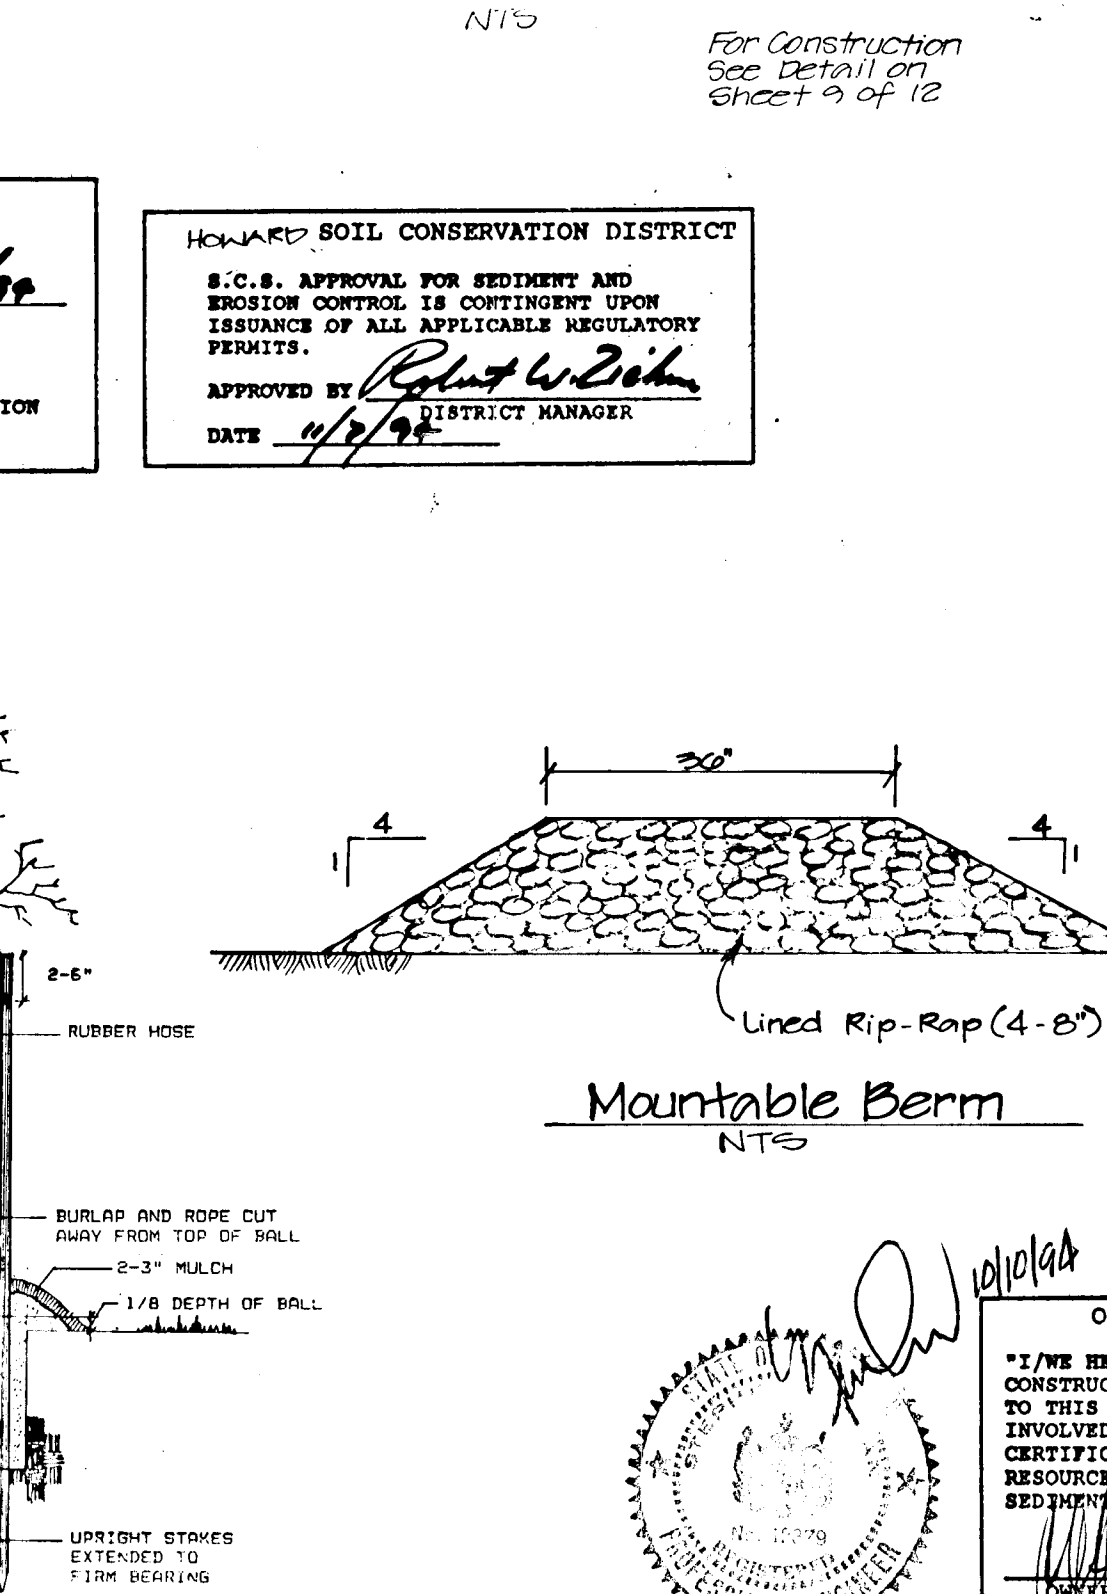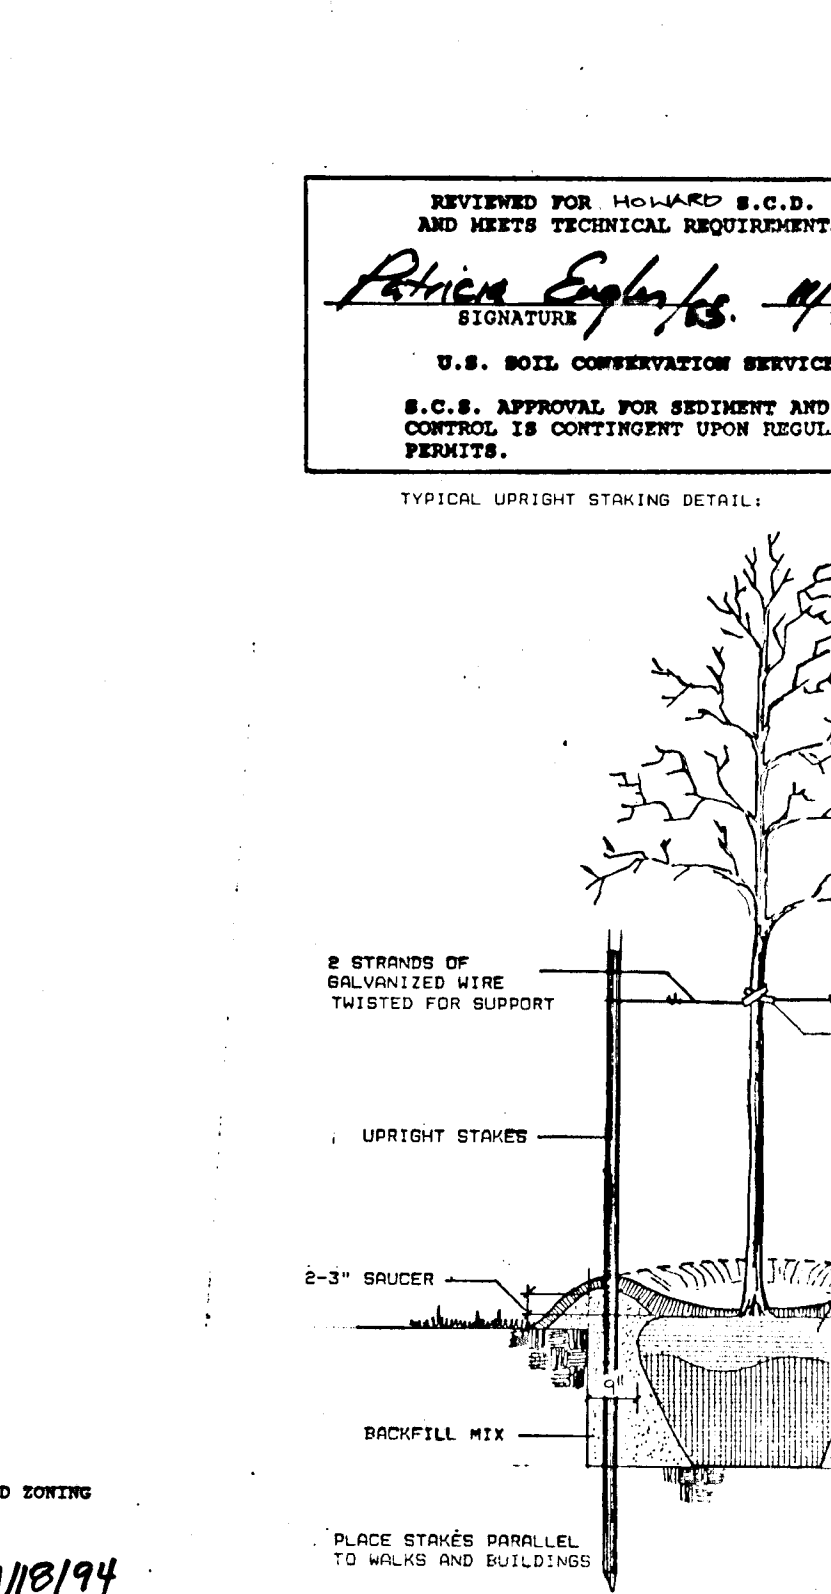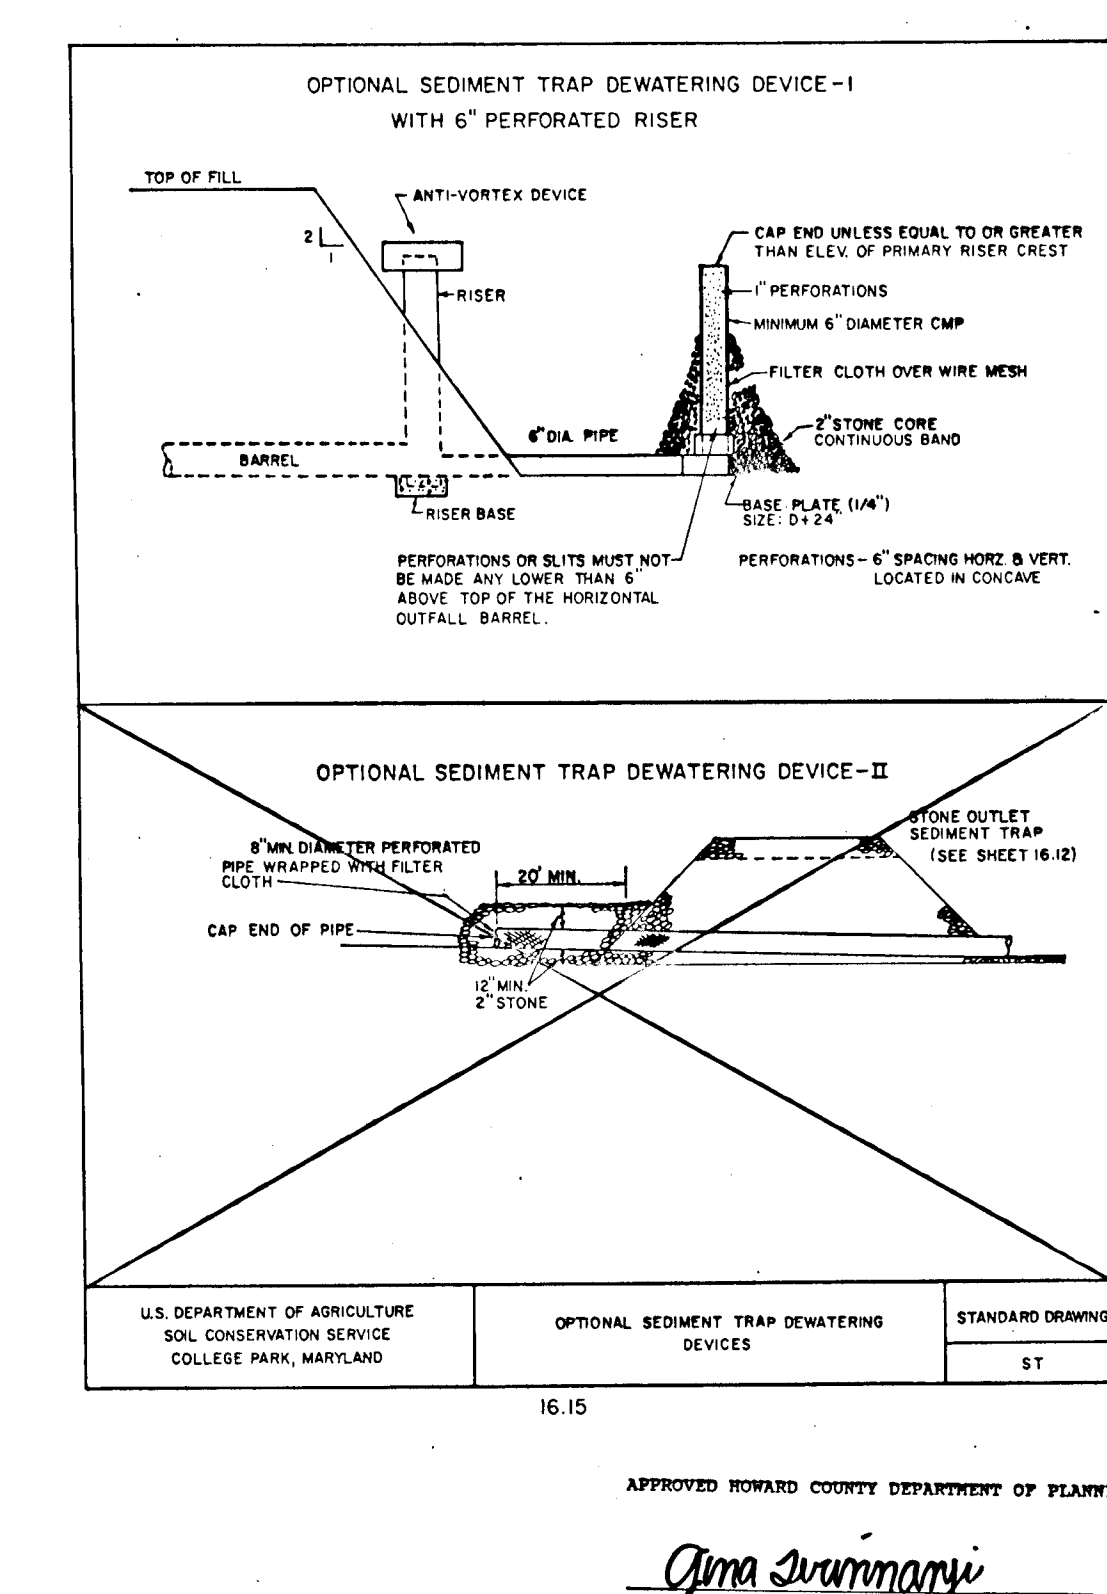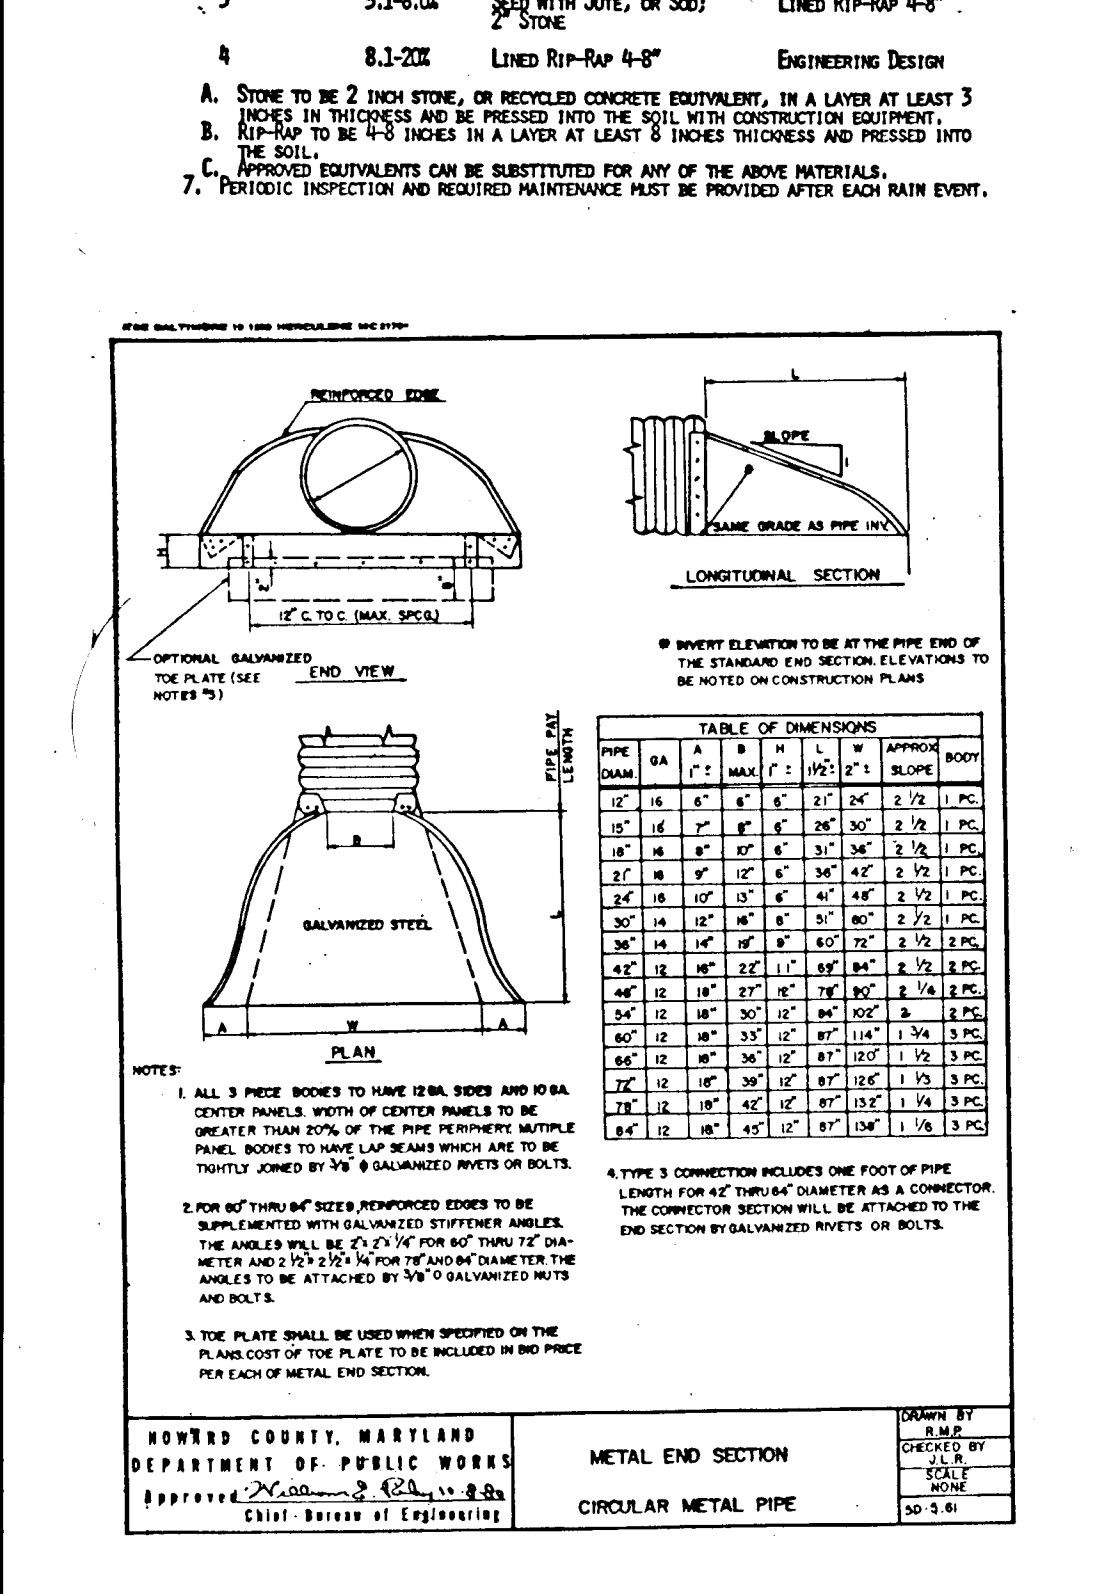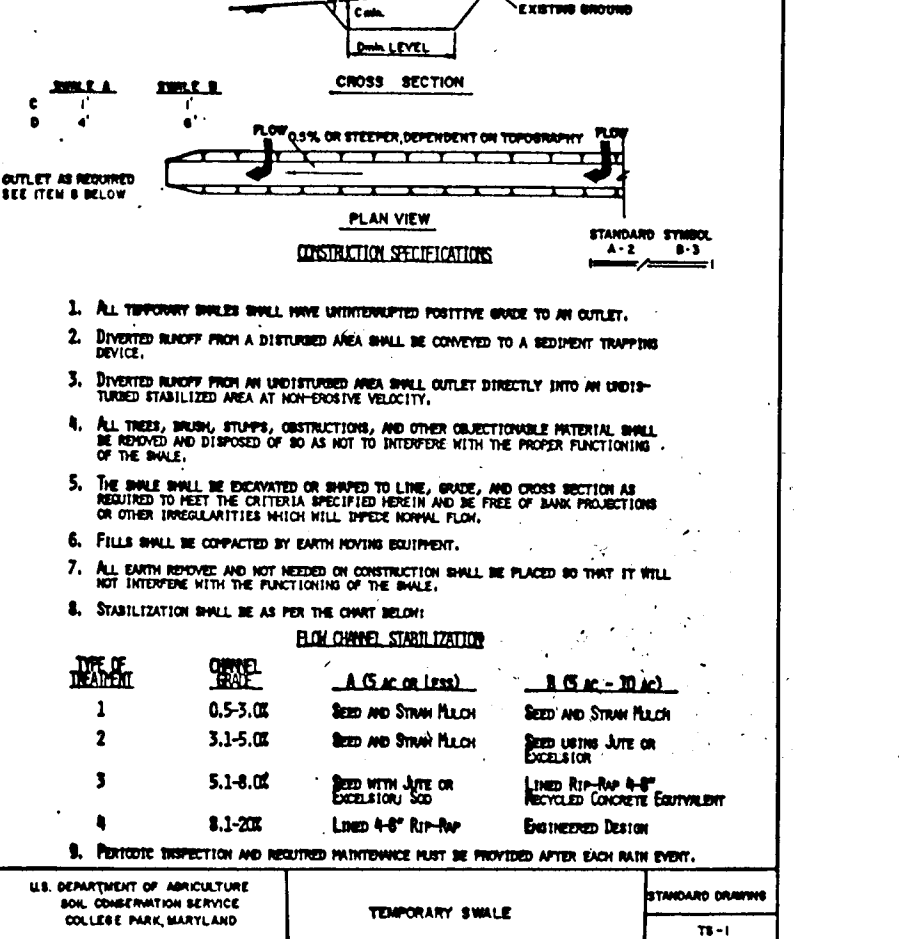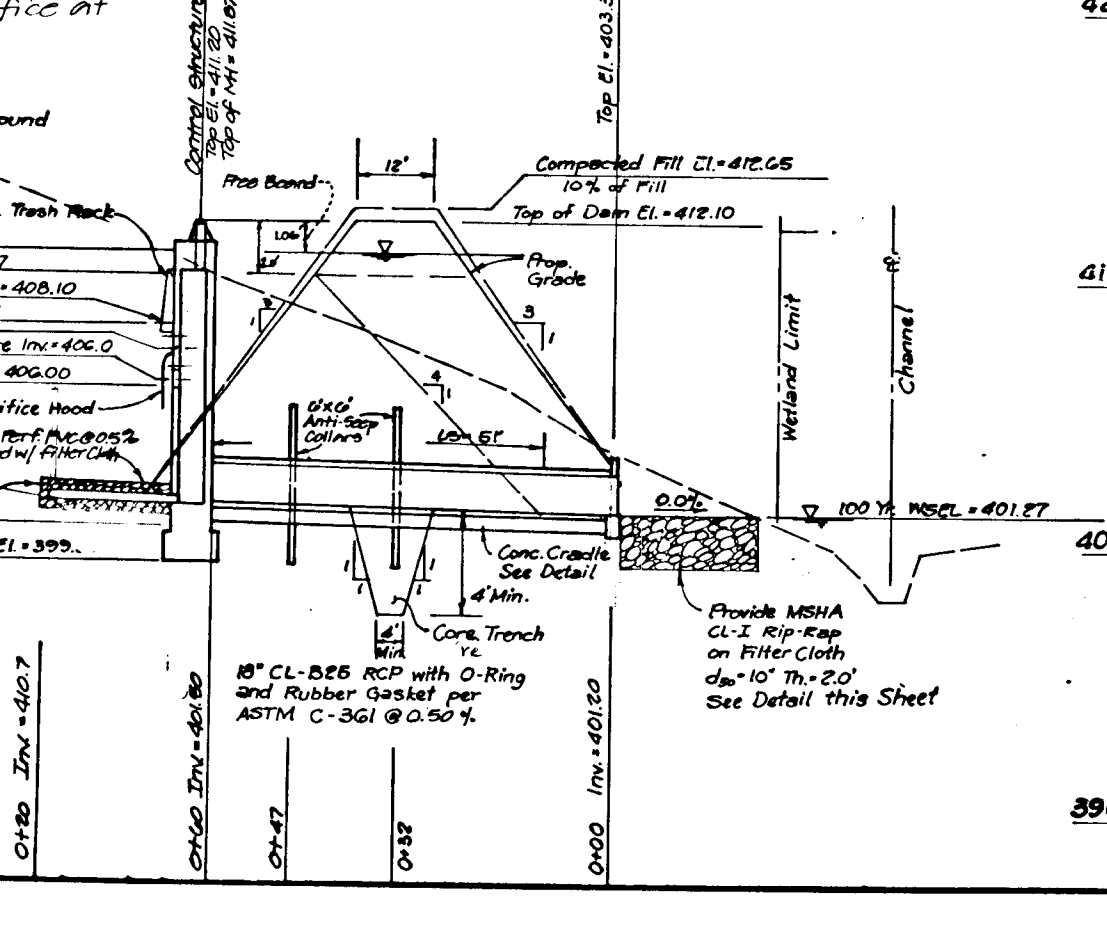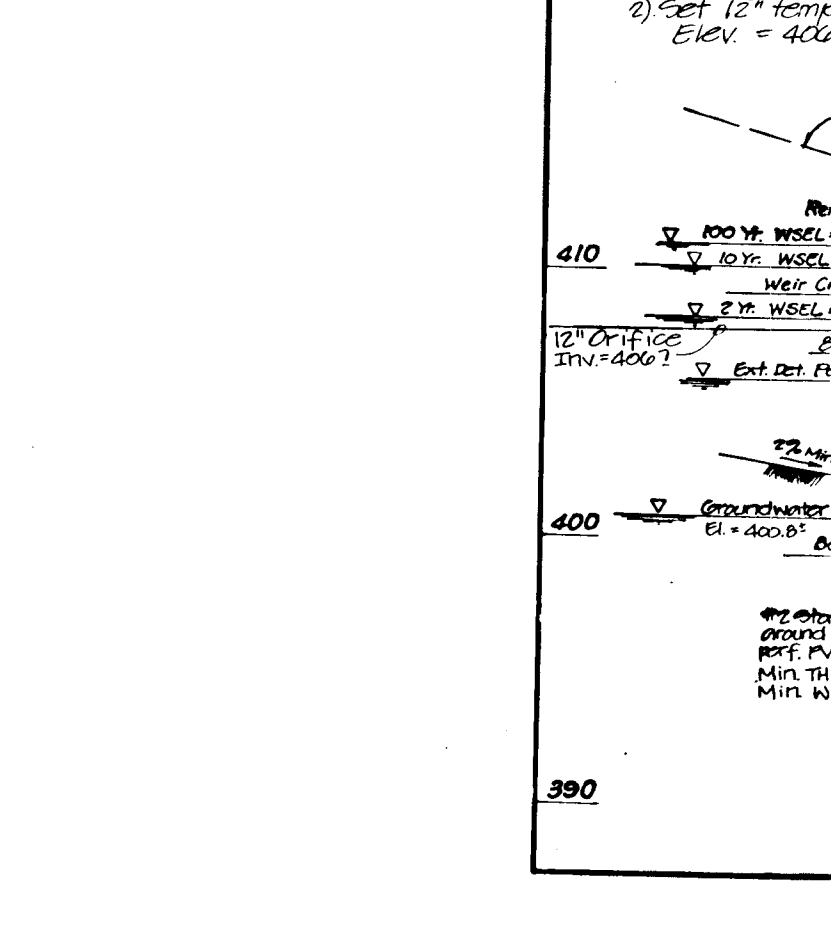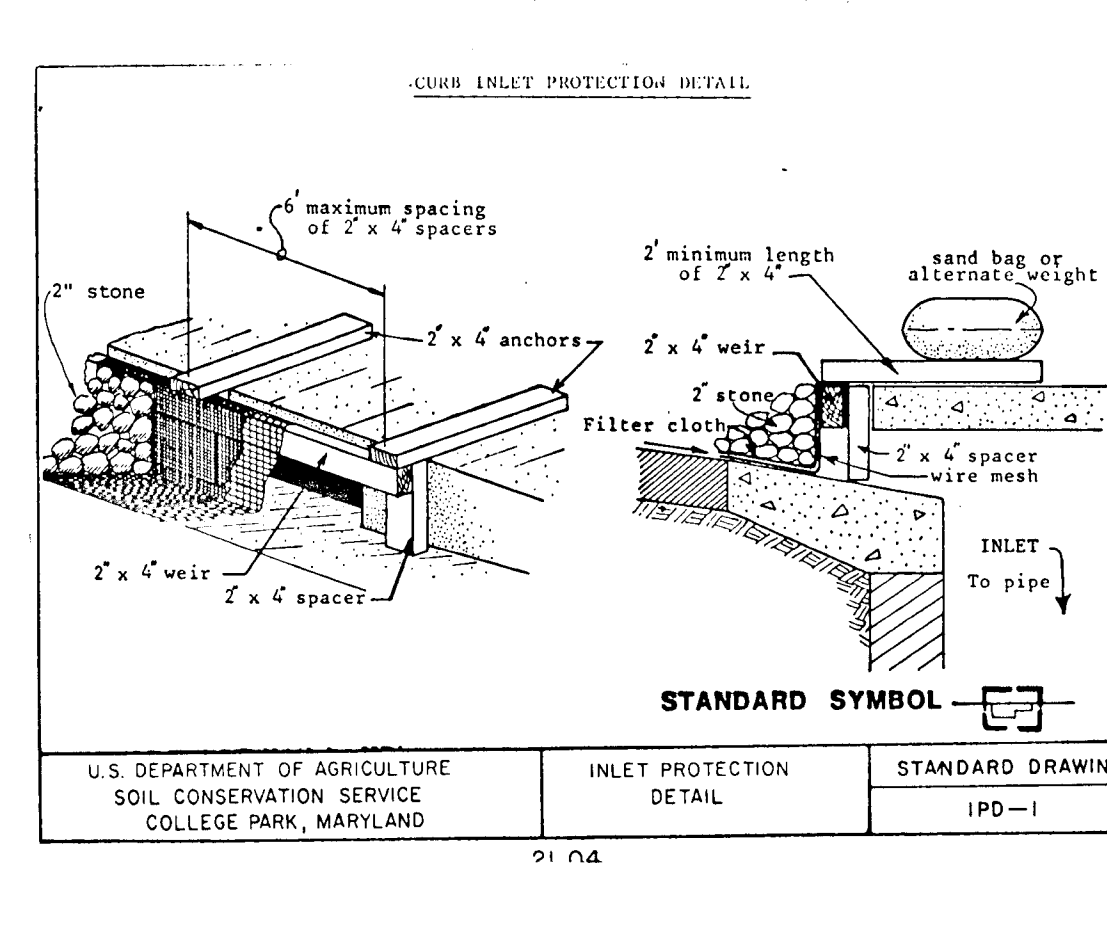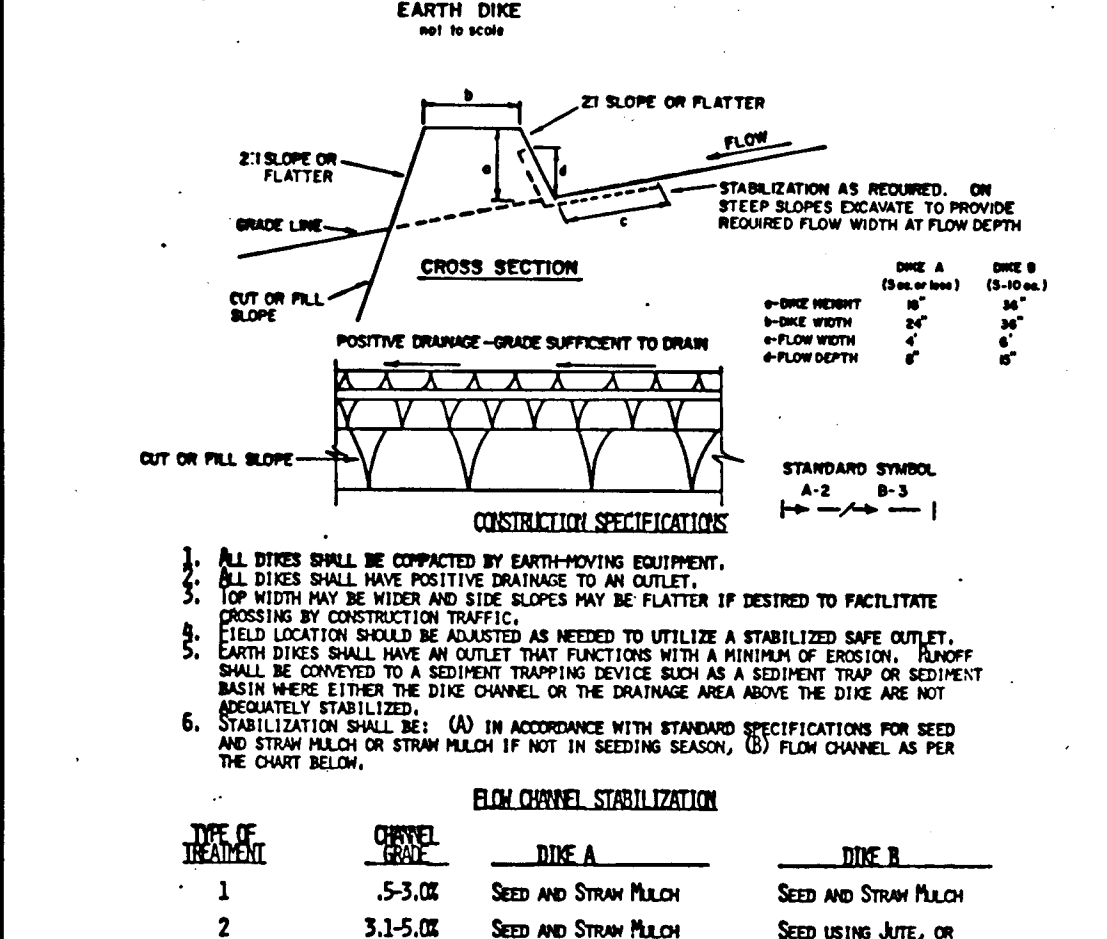

DEPARTMENT OF PUBLIC WORKS
HOWARD COUNTY, MARYLAND

DATE: 11/10/98
BY: Andrew M. Daniels
CH. BR. OF HWYS.

DATE: 11/18/94
BY: Anna Summary
CHIEF, DIVISION OF LAND DEVELOPMENT AND RESEARCH

DEPARTMENT OF PUBLIC WORKS
HOWARD COUNTY, MARYLAND

DATE: 11/18/94
BY: Anna Summary
CHIEF, DIVISION OF LAND DEVELOPMENT AND RESEARCH

DEPARTMENT OF PUBLIC WORKS
HOWARD COUNTY, MARYLAND

DATE: 11/18/94
BY: Anna Summary
CHIEF, DIVISION OF LAND DEVELOPMENT AND RESEARCH

TEST BORING LOG		HYDRO-TERRA, INCORPORATED		PAGE 1
BORING NO.: SB-3	PROJECT: ABBEYFIELD ESTATES	DATE: 4/24/94		
PROJECT NO: 8420	DRAWN: H.H. Carter	DRAWN: H.H. Carter	DRILLING BIT: Auger	
LOCATION: Howard County MD	TRD TYPE: Make B-81	GROUND ELEVATION: 412.4		
INSPECTION: Tom Mals	METHOD: H.B. Auger	SAMPLING METHOD: Split-Spoon		
WELL TYPE: None	SCREEN LENGTH: 0	PROFOT WIDTH/TYP: 4		
WELL DEPTH: 15	SCREEN LENGTH/TYP: 0	PROFOT ELEVATION: 412.4		
SCHEMATIC: 1/4" = 1'-0"	REAL LENGTH/TYP: 0	TOO ELEVATION: 412.4		
BLT SIZE: 4	FILTER LENGTH/TYP: 0	STICK UP/GROUND: 0		
SAMPLE COLLECTION DATA		DESCRIPTION		
DEPTH	SAMPLE NUMBER	HT. TEST (BLWS / FT)	HT. (IN)	DESCRIPTION
0-1	2-2-3	12		Brown Silt, Trace Sand, Trace Clay, Trace Organic Matl, Moist (Sandy Loam/ML)
0-2	3-6-21	15		Tan & Brown Silt, Trace Clay, Trace Sand, Moist (Silt Loam)
0-3	10-64-32	18		Brown & Rust Brown Sand and Gravel, Trace Sil (Some Sil Near Bottom), Wet (Sand/GW)
0-4	10-10-13	18		Bottom of boring

Note: Water standing in auger hole at depth of 2.5 ft. immediately after withdrawing auger.

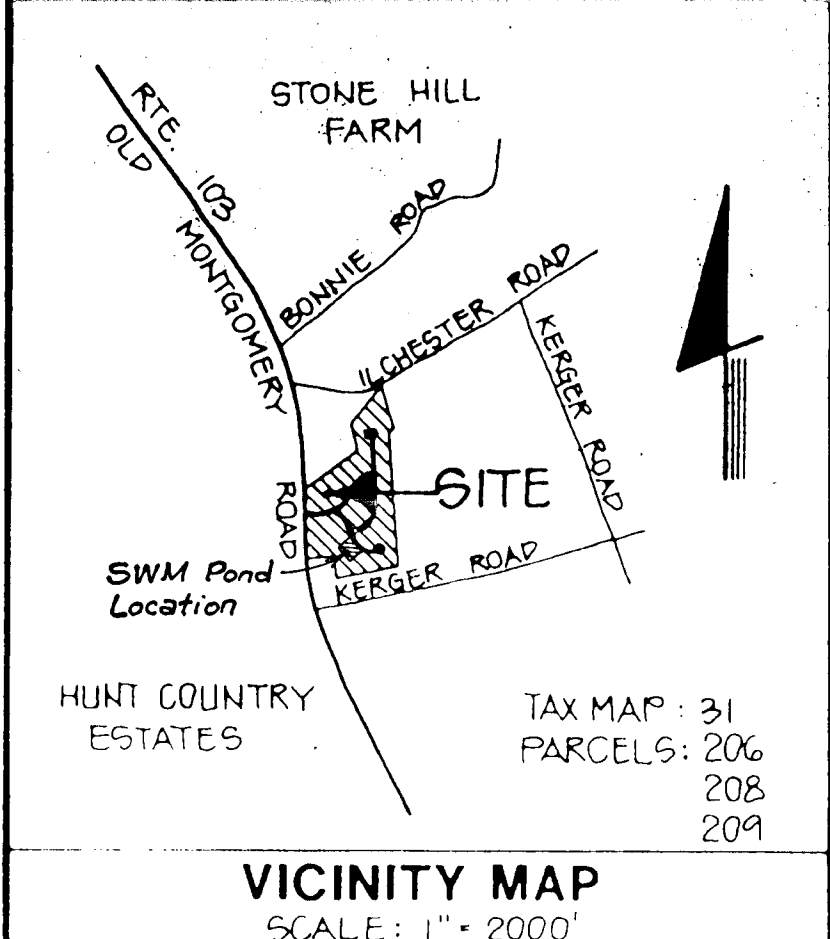


DESIGN	JL
DRAFT	T.C. Tang
CHECKED	JL
DATE	April 5, 1994
SCALE	1" = 30'

SWM Plan Notes:

- Hazard class of Dam is "A".
- Type of water quality device: *Extended Retention*
- Existing Topography shown thusly: *-----*
- Proposed Topography shown thusly: *-----*
- Existing spot elevation shown thusly: *+400.2*
- Proposed spot elevation shown thusly: *+400.5*
- Wetland delineation by McCarthy and Assoc., Inc.
- Maintenance will be provided by: *County (No Home Owner's Association)*
- Summary Table:

Drainage area to the facility: 15.27 Acr.	2 year	10 year	100 year
Allowable release rate to West:	9.05 cfs	29.31 cfs	77.04 cfs
Computed inflow to the facility:	17.21 cfs	44.33 cfs	77.04 cfs
Discharge from the facility:	2.62 cfs	17.79 cfs	63.52 cfs
Discharge elevation at facility:	408.11	410.00	411.04
Storage provided at the elevation:	0.48 Ac-ft	1.04 Ac-ft	1.40 Ac-ft
Total discharge to West:	9.05 cfs	28.47 cfs	87.34 cfs
Top of Dam Elevation = 412.10			
Emergency Spill Way Elevation = 410.10			
Invert of Principal Spill Way = 401.50			

10. All Construction shall be in accordance with the current Howard County Design Manual Volume IX.

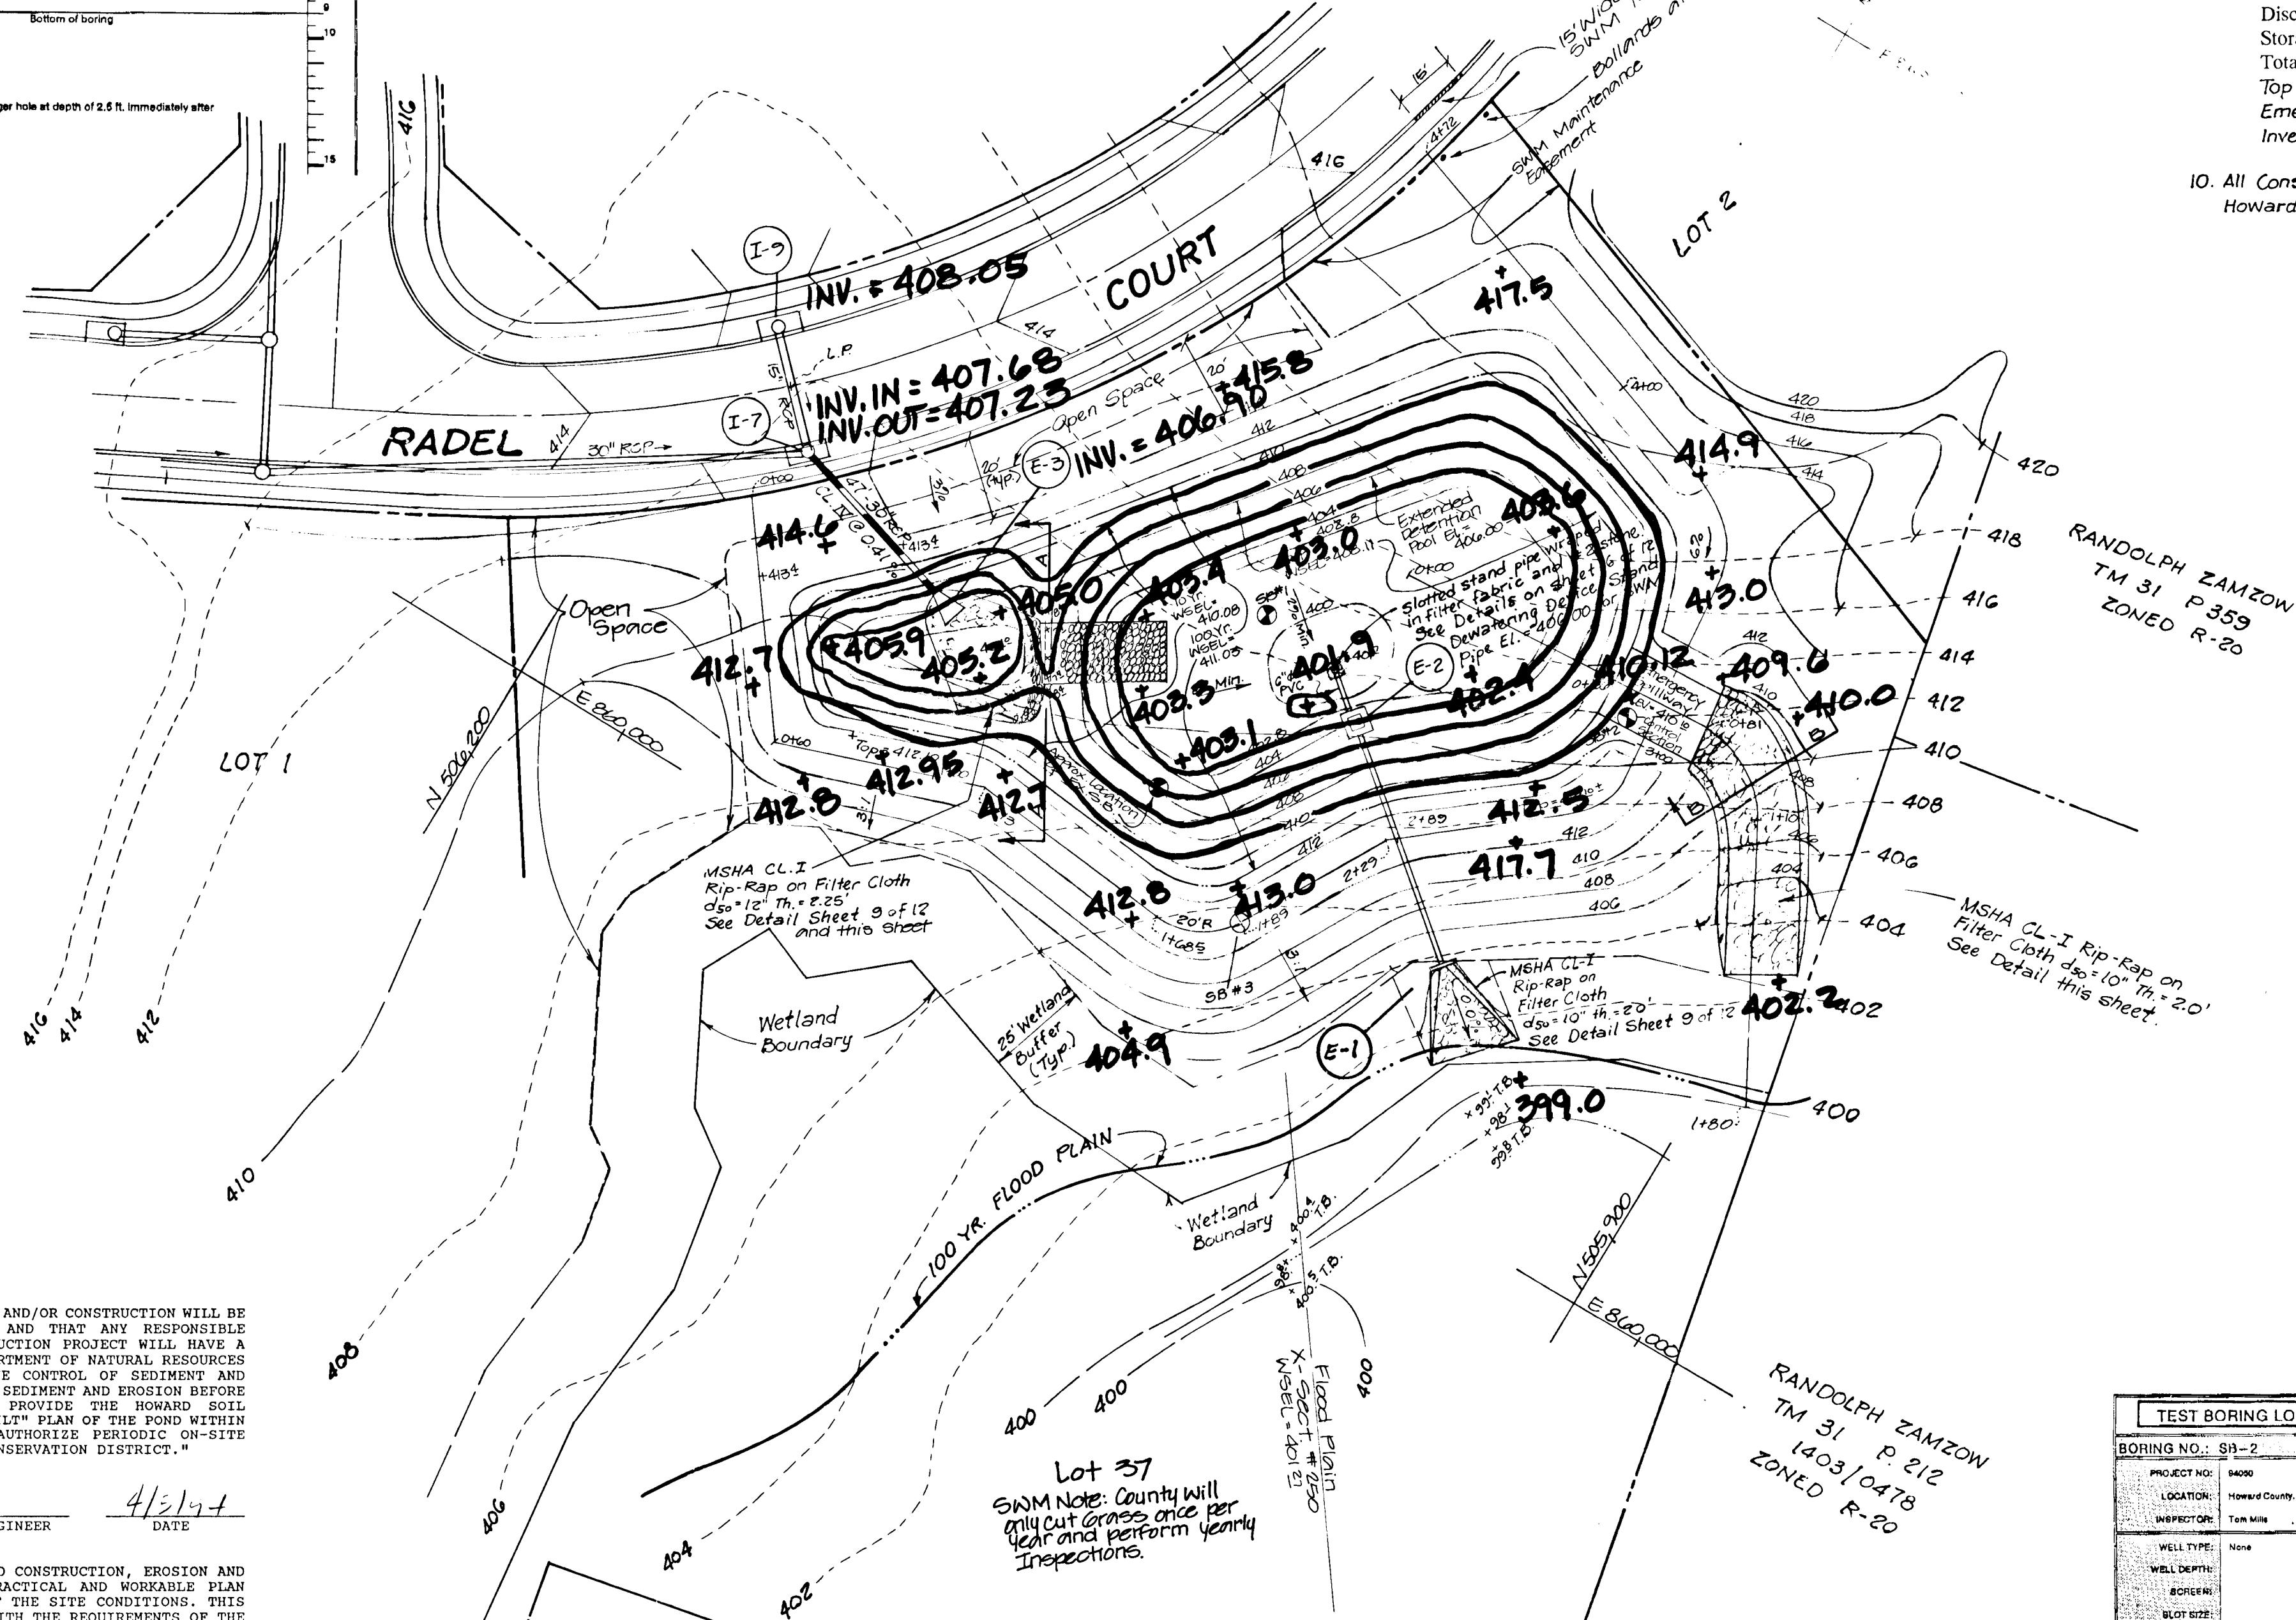

TEST BORING LOG		HYDRO-TERRA, INCORPORATED		PAGE 1
BORING NO.: SB-1	PROJECT: ABBEYFIELD ESTATES	DATE: 4/24/94		
PROJECT NO: 8420	DRAWN: H.H. Carter	DRAWN: H.H. Carter	DRILLING BIT: Auger	
LOCATION: Howard County MD	TRD TYPE: Make B-81	GROUND ELEVATION: 412.4		
INSPECTION: Tom Mals	METHOD: H.B. Auger	SAMPLING METHOD: Split-Spoon		
WELL TYPE: None	SCREEN LENGTH: 0	PROFOT WIDTH/TYP: 4		
WELL DEPTH: 15	SCREEN LENGTH/TYP: 0	PROFOT ELEVATION: 412.4		
SCHEMATIC: 1/4" = 1'-0"	REAL LENGTH/TYP: 0	TOO ELEVATION: 412.4		
BLT SIZE: 4	FILTER LENGTH/TYP: 0	STICK UP/GROUND: 0		
SAMPLE COLLECTION DATA		DESCRIPTION		
DEPTH	SAMPLE NUMBER	HT. TEST (BLWS / FT)	HT. (IN)	DESCRIPTION
0-1	2-3-3	9		Brown Silt, Trace Sand, Trace Clay, Trace Gravel Near Bottom, Moist (Sandy Loam/ML)
0-2	2-7-16	12		
0-3	5-12-14	12		
0-4	8-18-21	18		Brown Sand, Trace Sil, Moist to Wet (Silt Loam/ML)
0-5	8-10-18	18		Tan and Rust Brown Sil, Some Sand, Trace Clay, Moist - Occasional Thin Sand Banks, More Clay Near Bottom. (Silt Loam/ML)
0-6	5-16-17	18		
0-7	4-23-78	18		
0-8	11-48-119	18		White to Tan Sand and Gravel, Trace Sil, Wet (Sand/GW)
0-9	40-100-			Bottom of boring at 21 feet

Note: Hole collapsed to 10 ft. when auger withdrawn. New hole drilled 10 ft. away at slightly higher elevation to depth of 18 ft. and drilled one-inch PVC pipe installed to 18 ft. in order to measure water table. Water at 402.8 ft. elevation 98 hrs. after installation. Abandoned by filling pipe with red cement.

By the Developer:
 "I do certify that all development and/or construction will be done according to these plans, and that any responsible personnel involved in the construction project will have a Certificate of Attendance as a Department of the Environment Approved Training Program for the Control of Sediment and Erosion before beginning the project. I shall engage a registered professional engineer to supervise pond construction and provide the Howard Soil Conservation District with an "as-built" plan of the pond within 30 days of completion. I also authorize periodic on-site inspections by the Howard Soil Conservation District."
 Signature of Developer: *[Signature]* Date: 7/7/94
 Print name below signature: *MICHAEL T. TAYLOR*


By the Engineer:
 "I certify that this plan for pond construction, erosion and sediment control represents a practical and workable plan based on my personal knowledge of the site conditions. This plan was prepared in accordance with the requirements of the Howard Soil Conservation District. I have notified the developer that he/she must engage a registered professional engineer to supervise pond construction and provide the Howard Soil Conservation District with an "as-built" plan of the pond within 30 days of completion."
 Signature of Engineer: *[Signature]* Date: 7-7-94
 Print name below signature: *JANG H. LEE*

These plans have been reviewed for the Howard Soil Conservation District and meet the technical requirements for small pond construction, soil erosion and sediment control.
[Signature] 4/1/94
 District Manager

HOWARD SOIL CONSERVATION DISTRICT
 S.C.S. APPROVAL FOR SEDIMENT AND EROSION CONTROL IS CONTINGENT UPON ISSUANCE OF ALL APPLICABLE REGULATORY PERMITS.
 APPROVED BY: *[Signature]*
 DATE: 4/1/94
 DISTRICT MANAGER

REVIEWED FOR HOWARD S.C.D. AND METS TECHNICAL REQUIREMENTS
 Signature: *[Signature]* Date: 4/1/94
 U.S. SOIL CONSERVATION SERVICE
 S.C.S. APPROVAL FOR SEDIMENT AND EROSION CONTROL IS CONTINGENT UPON REGULATORY PERMITS.

TEST BORING LOG		HYDRO-TERRA, INCORPORATED		PAGE 1
BORING NO.: SB-2	PROJECT: ABBEYFIELD ESTATES	DATE: 4/24/94		
PROJECT NO: 8420	DRAWN: H.H. Carter	DRAWN: H.H. Carter	DRILLING BIT: Auger	
LOCATION: Howard County MD	TRD TYPE: Make B-81	GROUND ELEVATION: 412.4		
INSPECTION: Tom Mals	METHOD: H.B. Auger	SAMPLING METHOD: Split-Spoon		
WELL TYPE: None	SCREEN LENGTH: 0	PROFOT WIDTH/TYP: 4		
WELL DEPTH: 15	SCREEN LENGTH/TYP: 0	PROFOT ELEVATION: 412.4		
SCHEMATIC: 1/4" = 1'-0"	REAL LENGTH/TYP: 0	TOO ELEVATION: 412.4		
BLT SIZE: 4	FILTER LENGTH/TYP: 0	STICK UP/GROUND: 0		
SAMPLE COLLECTION DATA		DESCRIPTION		
DEPTH	SAMPLE NUMBER	HT. TEST (BLWS / FT)	HT. (IN)	DESCRIPTION
0-1	1-8-18	9		Brown Silt, Trace Sand, Trace Clay, Moist (Sandy Loam/ML)
0-2	8-10-10	12		Brown Sand and Gravel, Trace Sil, Moist (Sand/GW)
0-3	10-17-18	18		Tan & Brown Sil, Some Sand, Trace Clay, Moist Bottom of Boring

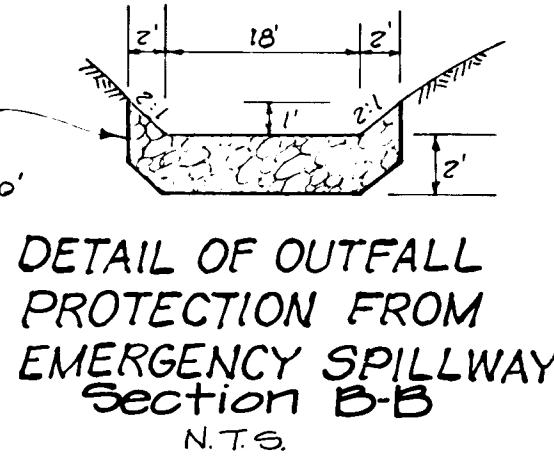


OPERATION, MAINTENANCE AND INSPECTION
 Inspection of the pond(s) shown hereon shall be performed at least annually, in accordance with the checklist and requirements contained within USDA, SCS "Standards and Specifications For Ponds" (MD-378). The pond owner(s) and any heirs, successors, or assigns shall be responsible for the safety of the pond and the continued operation, surveillance, inspection, and maintenance thereof. The pond owner(s) shall promptly notify the Soil Conservation District of any unusual observations that may be indications of distress such as excessive seepage, turbid seepage, sliding or slumping.

"I/WE CERTIFY THAT ALL DEVELOPMENT AND/OR CONSTRUCTION WILL BE DONE ACCORDING TO THESE PLANS, AND THAT ANY RESPONSIBLE PERSONNEL INVOLVED IN THE CONSTRUCTION PROJECT WILL HAVE A CERTIFICATE OF ATTENDANCE AT DEPARTMENT OF NATURAL RESOURCES APPROVED TRAINING PROGRAM FOR THE CONTROL OF SEDIMENT AND EROSION PROGRAM FOR THE CONTROL OF SEDIMENT AND EROSION BEFORE BEGINNING THE PROJECT. I WILL PROVIDE THE HOWARD SOIL CONSERVATION DISTRICT WITH AN "AS-BUILT" PLAN OF THE POND WITHIN 30 DAYS OF COMPLETION. I ALSO AUTHORIZE PERIODIC ON-SITE INSPECTIONS BY THE HOWARD SOIL CONSERVATION DISTRICT."
 Signature: *[Signature]* Date: 4/1/94
 PROFESSIONAL ENGINEER

"I CERTIFY THAT THIS PLAN FOR POND CONSTRUCTION, EROSION AND SEDIMENT CONTROL REPRESENTS A PRACTICAL AND WORKABLE PLAN BASED ON MY PERSONAL KNOWLEDGE OF THE SITE CONDITIONS. THIS PLAN WAS PREPARED IN ACCORDANCE WITH THE REQUIREMENTS OF THE HOWARD SOIL CONSERVATION DISTRICT. I HAVE NOTIFIED THE DEVELOPER THAT HE MUST PROVIDE THE HOWARD SOIL CONSERVATION DISTRICT WITH AN "AS-BUILT" PLAN OF THE POND WITHIN 30 DAYS OF COMPLETION."
 Signature: *[Signature]* Date: 4/1/94
 PROFESSIONAL ENGINEER

ENGINEER'S "AS-BUILT" CERTIFICATE
 I hereby certify that the "As-Built" information shown hereon in black is accurate and complete.
 Signature: *[Signature]* Date: 7/10/99
 Jang H. Lee, P.E.
 MD LIC. #18632

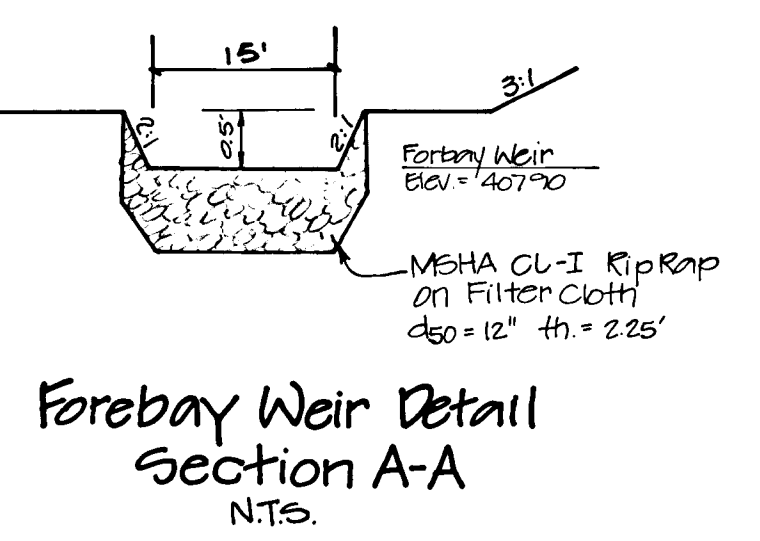

4/1/94

LAVELLE & ASSOCIATES INCORPORATED
 CIVIL ENGINEERS • LAND PLANNERS • LAND SURVEYORS
 OFFICE: (301) 831-4510 SUITE 203
 FREDERICK, MARYLAND 21701
 FAX: (301) 695-9745

STORMWATER MANAGEMENT PLAN
 ABBEYFIELD ESTATES
 TAX MAP 31 PARCELS 206, 208 & 209
 1st. ELECTION DISTRICT
 HOWARD COUNTY, MARYLAND

APPROVED: HOWARD COUNTY DEPARTMENT OF PUBLIC WORKS
 CHIEF, LAND DEVELOPMENT DIVISION: *[Signature]* Date: 4/1/94
 CHIEF, BUREAU OF HIGHWAY: *[Signature]* Date: 11-10-94
 CHIEF, BUREAU OF ENGINEERING: *[Signature]* Date: 11/14/94
 APPROVED HOWARD COUNTY DEPARTMENT OF PLANNING AND ZONING
 CHIEF, DIVISION OF LAND DEVELOPMENT AND RESEARCH: *[Signature]* Date: 11/18/94

F-94-99 "AS-BUILT"
 F 94.99

APPROVED: HOWARD COUNTY DEPARTMENT OF PUBLIC WORKS
 LAND DEVELOPMENT DIVISION
 Andrew M. Daniels, Chief, Bureau of Highway, 11-10-99
 Ronald D. Segan, Chief, Bureau of Engineering, 11/14/99

APPROVED HOWARD COUNTY DEPARTMENT OF PLANNING AND ZONING
 Gina J. Jaramila, Chief, Division of Land Development and Research, 11/10/99

HOWARD SOIL CONSERVATION DISTRICT
 S.C.S. APPROVAL FOR SEDIMENT AND EROSION CONTROL IS CONTINGENT UPON ISSUANCE OF ALL APPLICABLE REGULATORY PERMITS.
 Approved by: [Signature], District Manager, 11/7/99

REVIEWED FOR: HOWARD S.C.D. AND MEETS TECHNICAL REQUIREMENTS
 Signature: [Signature], Date: 11/17/99
 U.S. SOIL CONSERVATION SERVICE
 S.C.S. APPROVAL FOR SEDIMENT AND EROSION CONTROL IS CONTINGENT UPON REGULATORY PERMITS.
 SEDIMENT CONTROL & POND CONSTRUCTION

() By the Developer:
 "I/We certify that all development and/or construction will be done according to these plans, and that any responsible personnel involved in the construction project will have a Certificate of Attendance at a Department of the Environment Approved Training Program for the Control of Sediment and Erosion before beginning the project. I shall engage a registered professional engineer to supervise pond construction and provide the Howard Soil Conservation District with an "as-built" plan of the pond within 30 days of completion. I also authorize periodic on-site inspections by the Howard Soil Conservation District."
 Signature: [Signature], Date: 7/7/99

() By the Engineer:
 "I certify that this plan for pond construction, erosion and sediment control represents a practical and workable plan based on my personal knowledge of the site conditions. This plan was prepared in accordance with the requirements of the Howard Soil Conservation District. I have notified the developer that he/she must engage a registered professional engineer to supervise pond construction and provide the Howard Soil Conservation District with an "as-built" plan of the pond within 30 days of completion."
 Signature: [Signature], Date: 7-7-99

() These plans have been reviewed for the Howard Soil Conservation District and meet the technical requirements for small pond construction, soil erosion and sediment control.
 Signature: [Signature], Date: 11/17/99


() These plans for small pond construction, soil erosion and sediment control meet the requirements of the Howard Soil Conservation District.
 Signature: [Signature], Date: 11/17/99

DESIGN	JL
DRAFT	T.C. Tang
CHECKED	JL
DATE	April 5, 1994
SCALE	As Shown


REVISION	DATE	BY
NO.		

LAVELLE & ASSOCIATES INCORPORATED
 CIVIL ENGINEERS • LAND PLANNERS • LAND SURVEYORS
 10 NORTH JEFFERSON STREET, SUITE 203, FREDERICK, MARYLAND 21701
 OFFICE: (301) 831-4510, (301) 695-9722, FAX: (301) 695-9756


SWM DETAILS
 ABBEYFIELD ESTATES
 TAX MAP 31 PARCELS 206, 208 & 209
 1st. ELECTION DISTRICT
 HOWARD COUNTY, MARYLAND

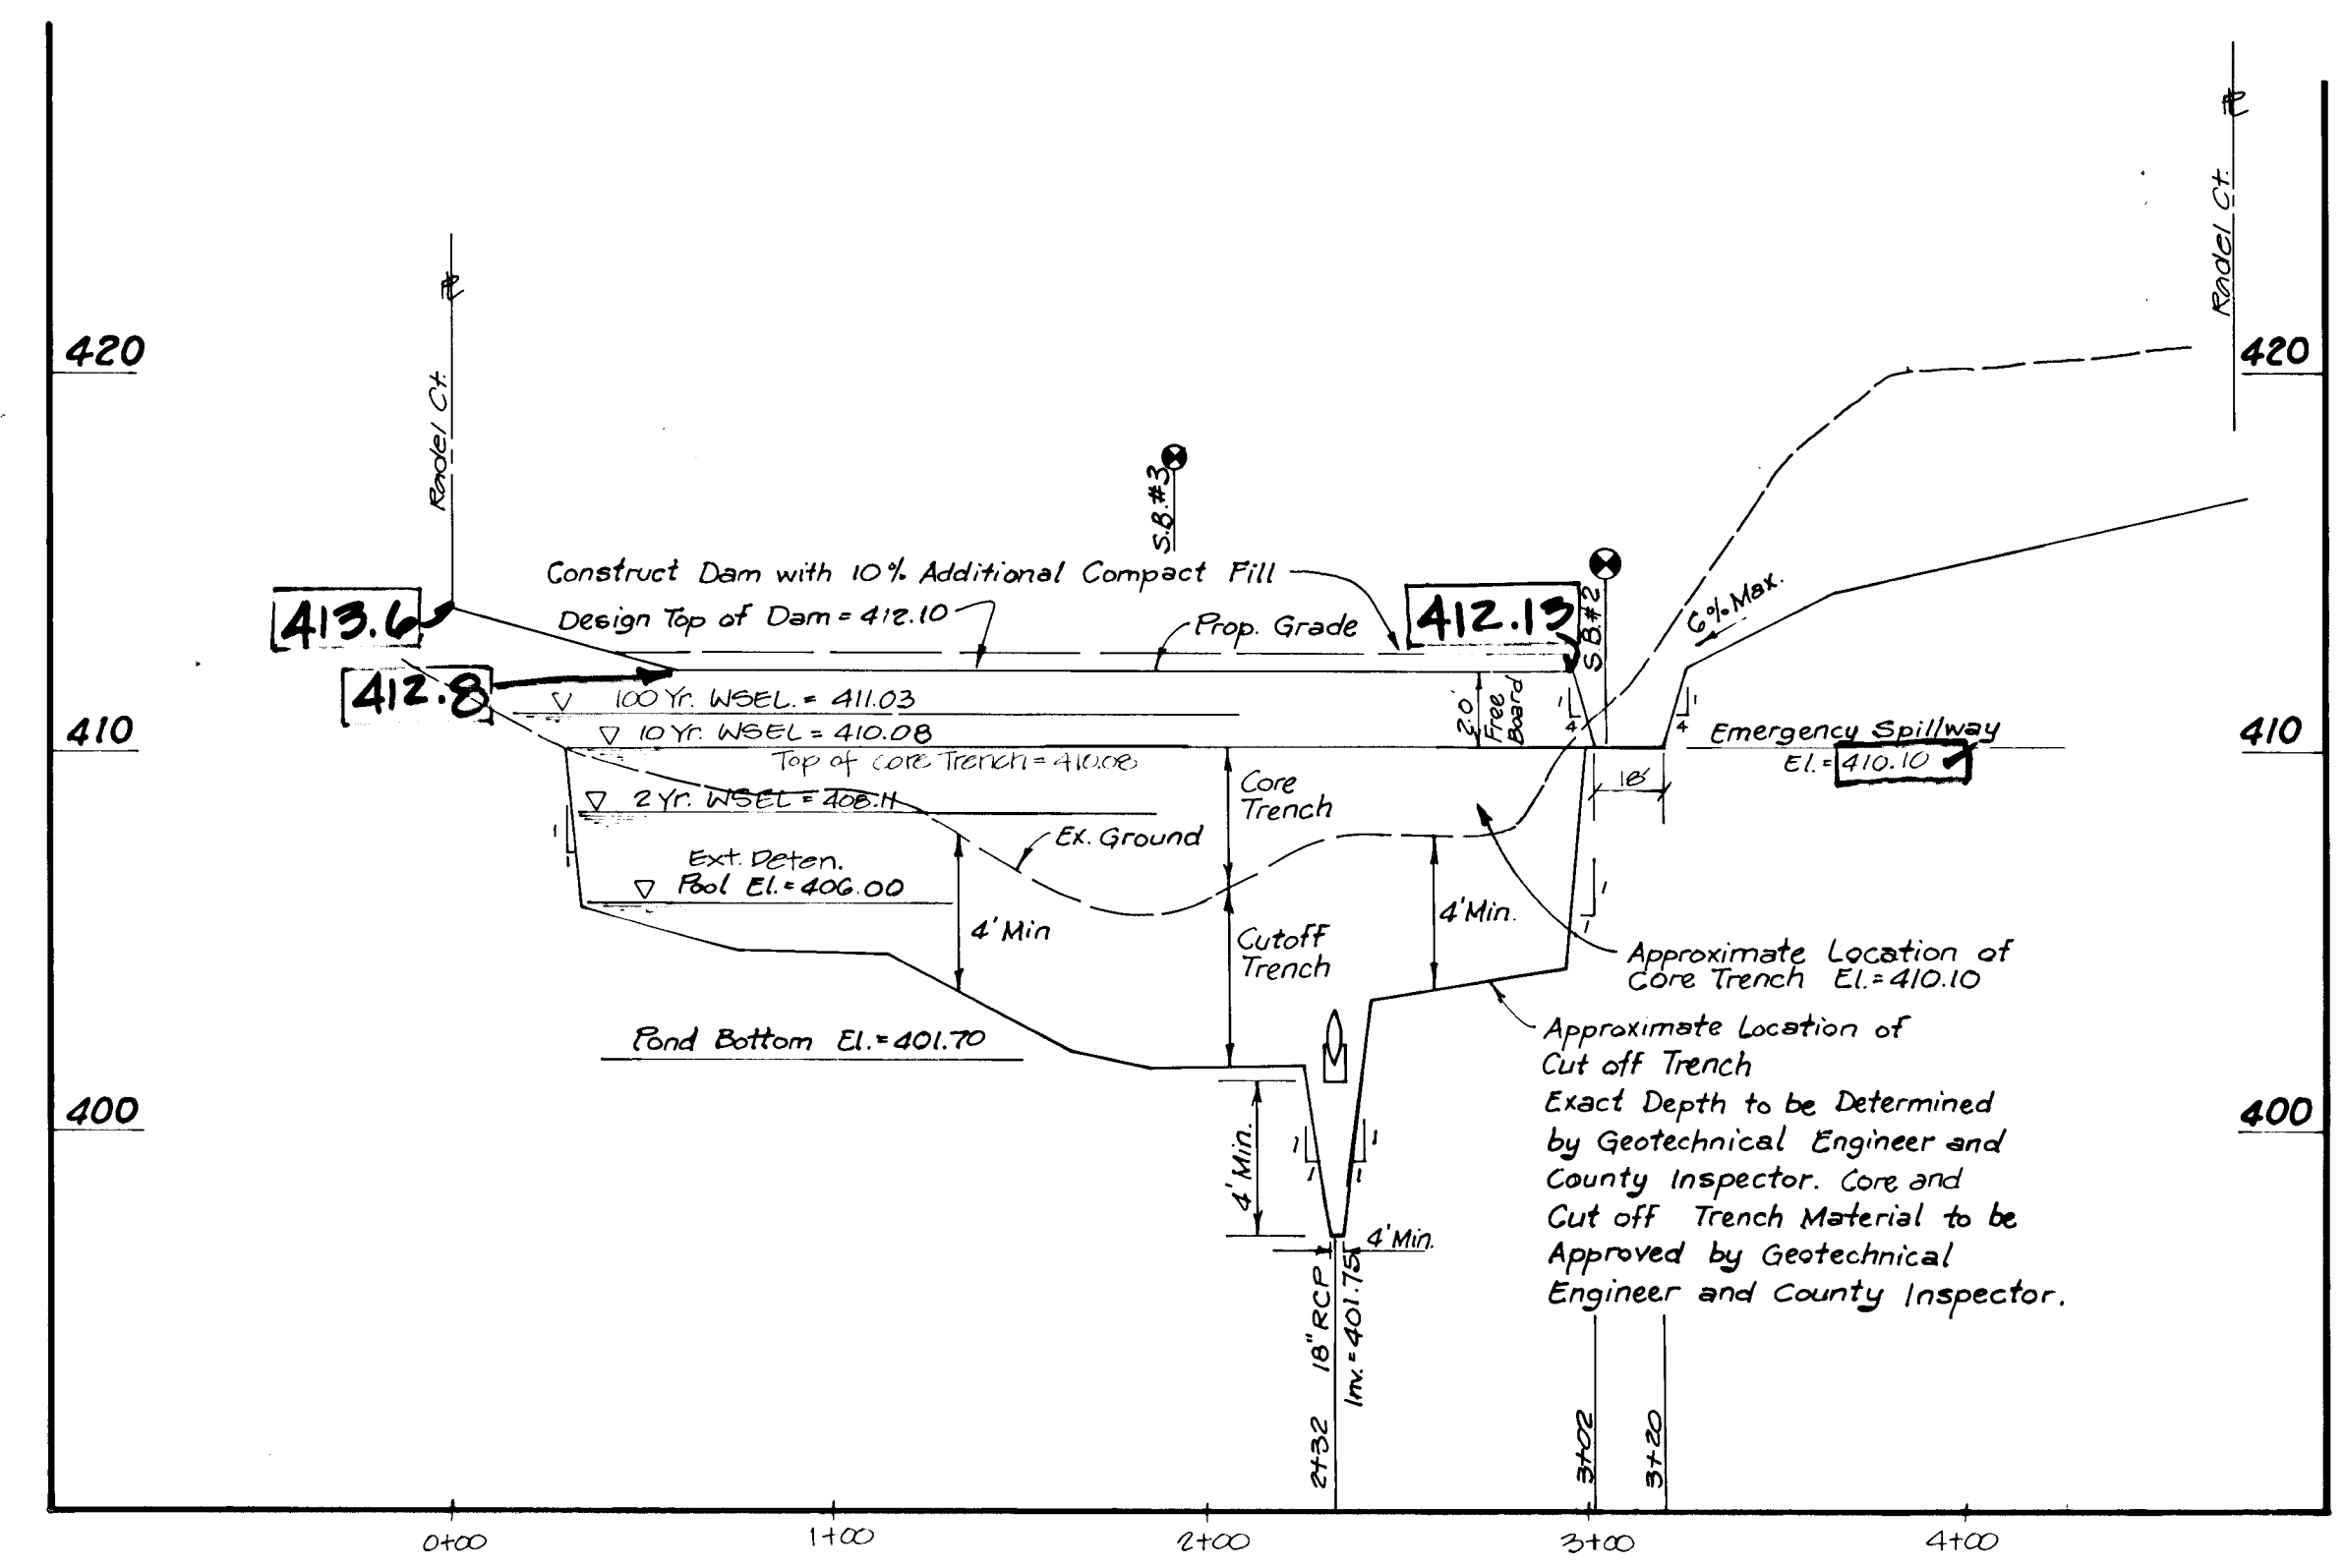


PROFILE ALONG E OF DAM
 SCALE: H: 1" = 50'
 V: 1" = 5'

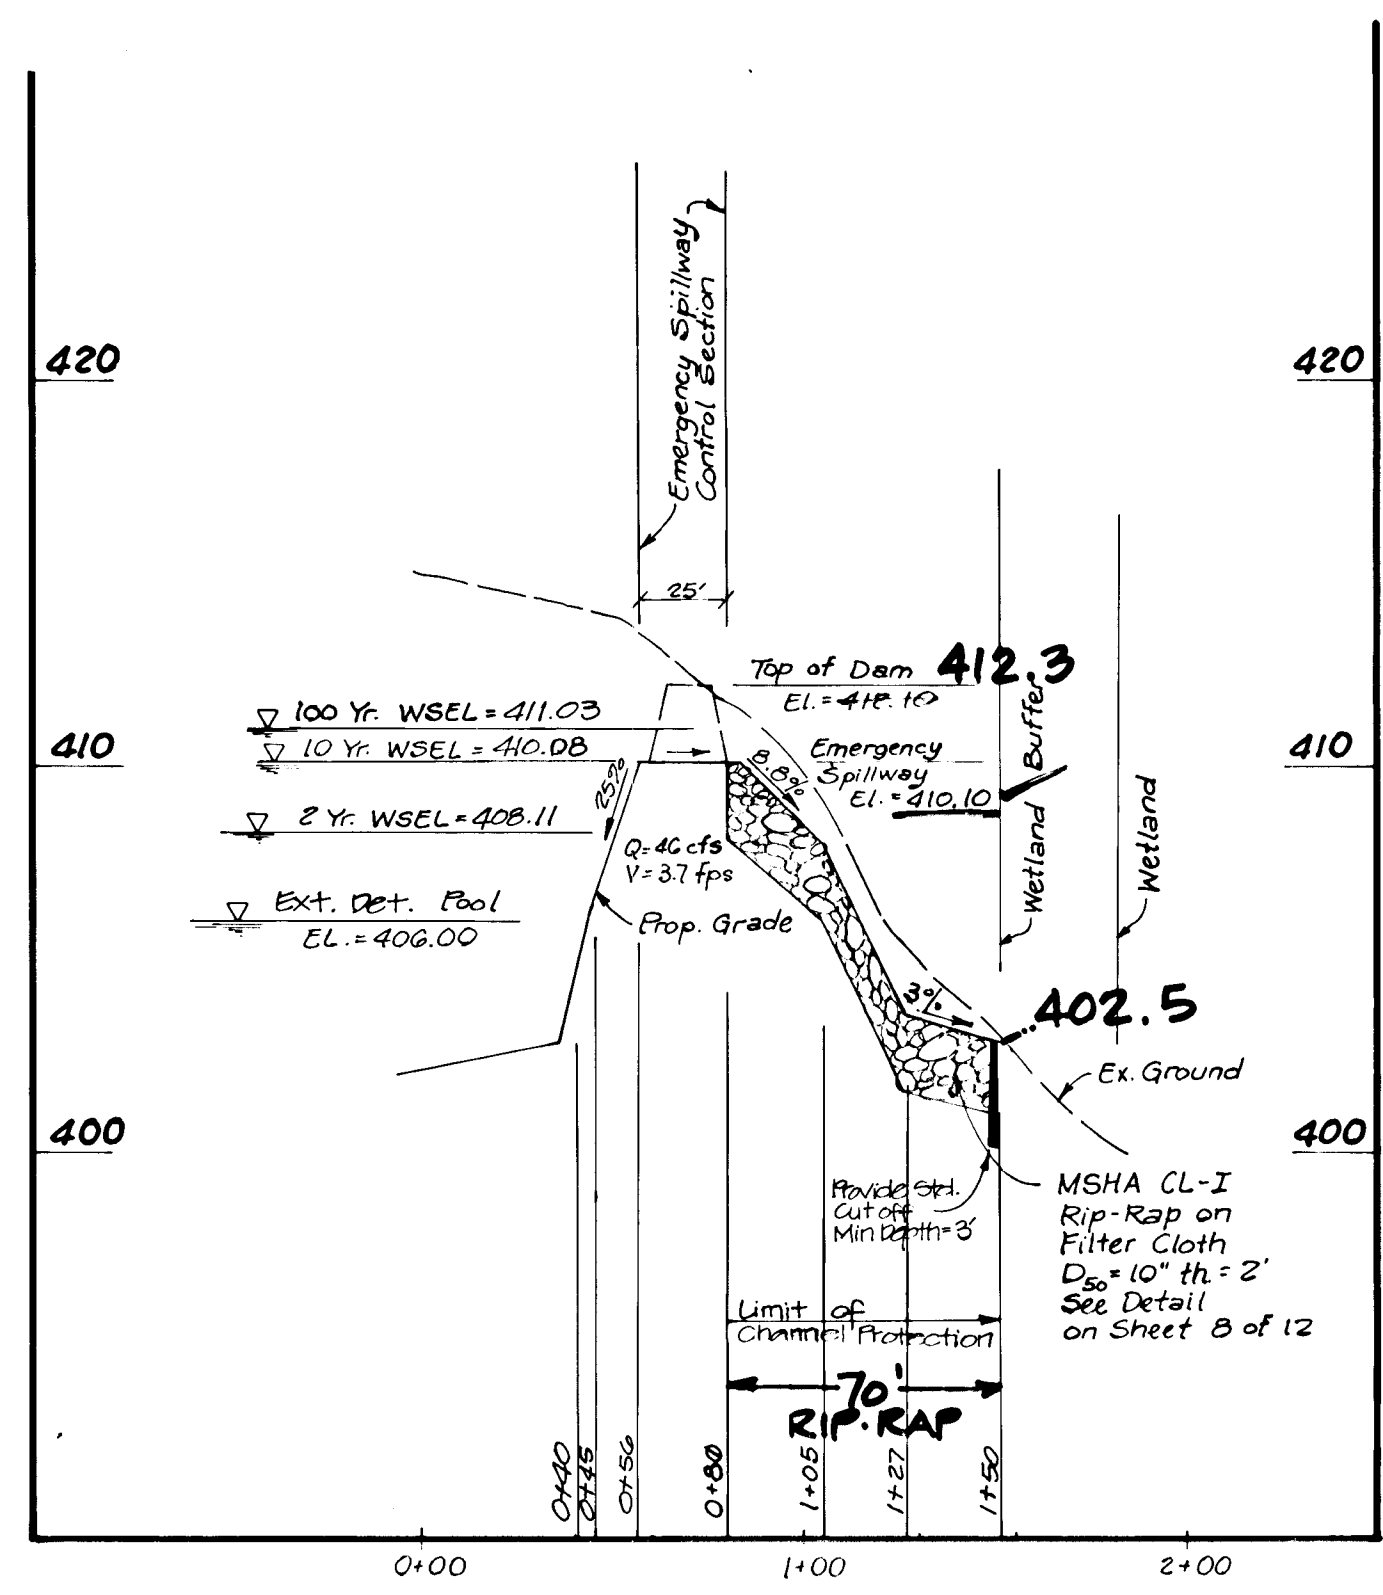


PROFILE ALONG E OF EMERGENCY SPILLWAY
 SCALE: H: 1" = 50'
 V: 1" = 5'

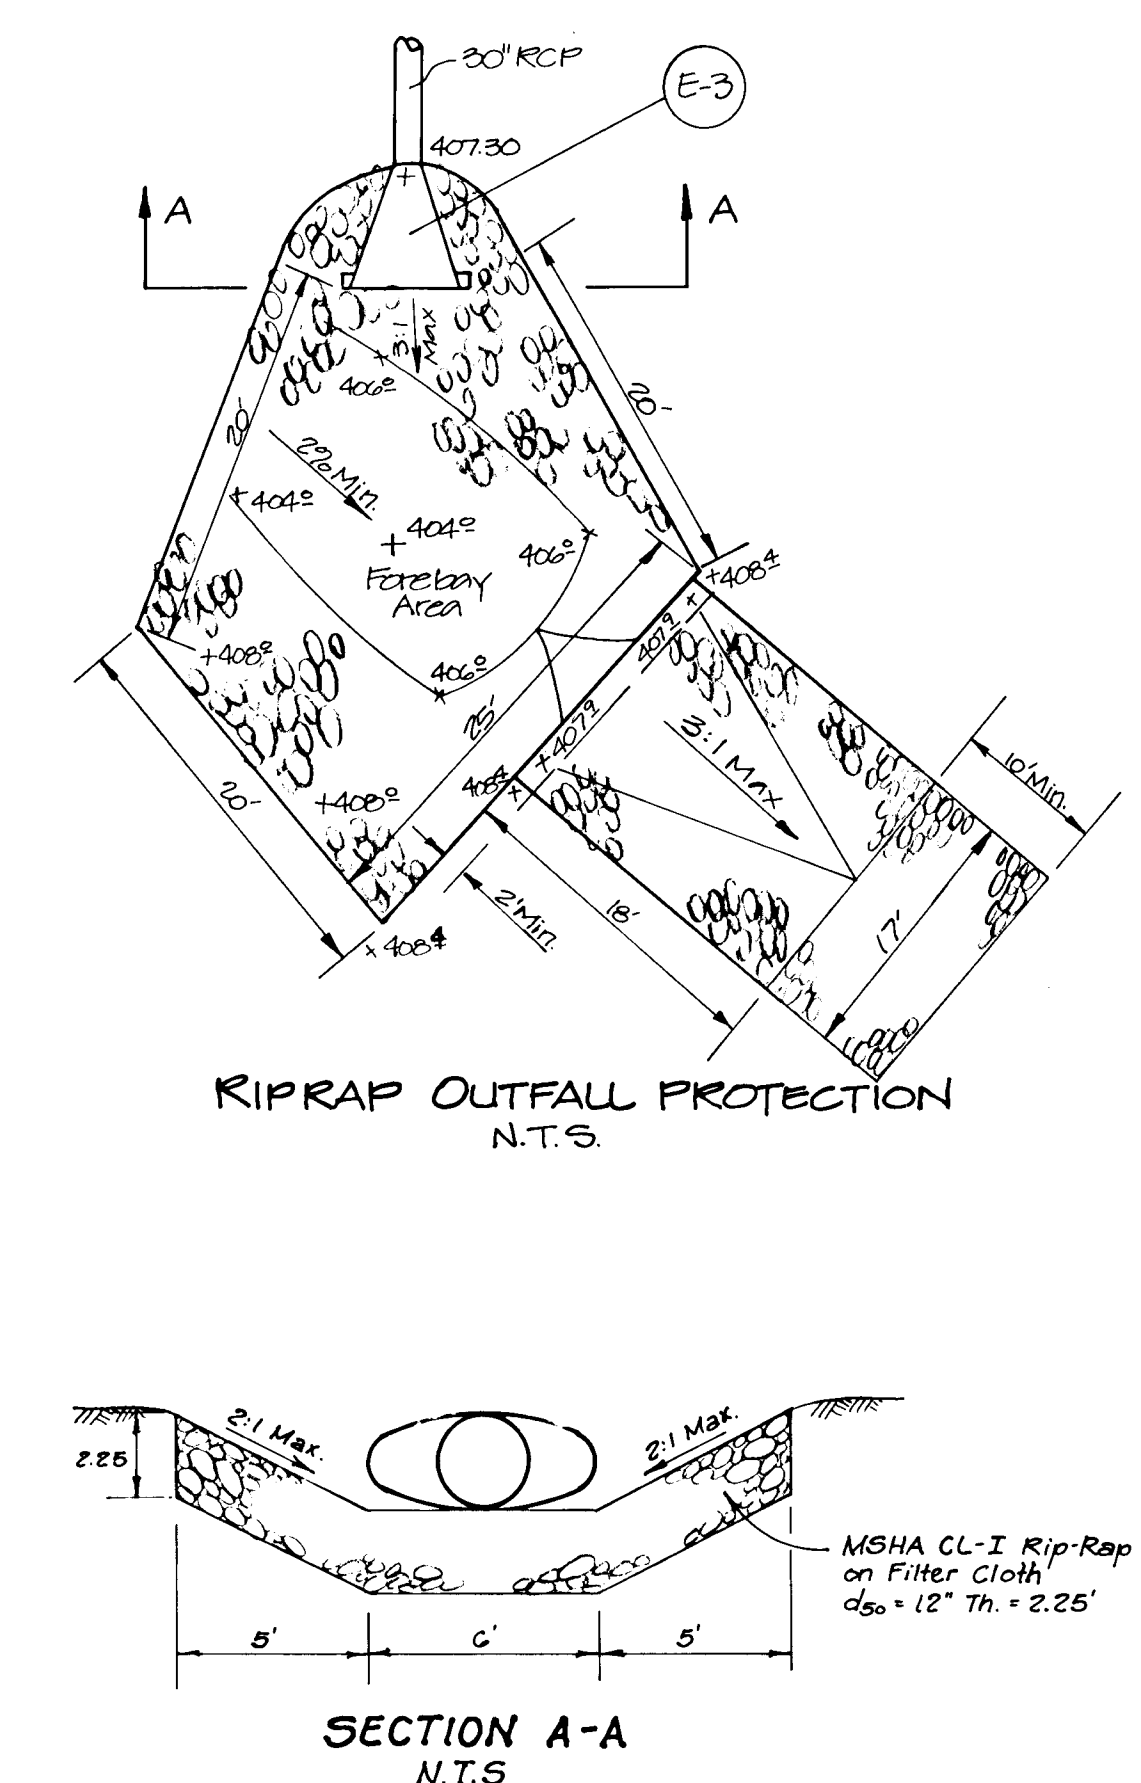


SECTION A-A
 N.T.S.

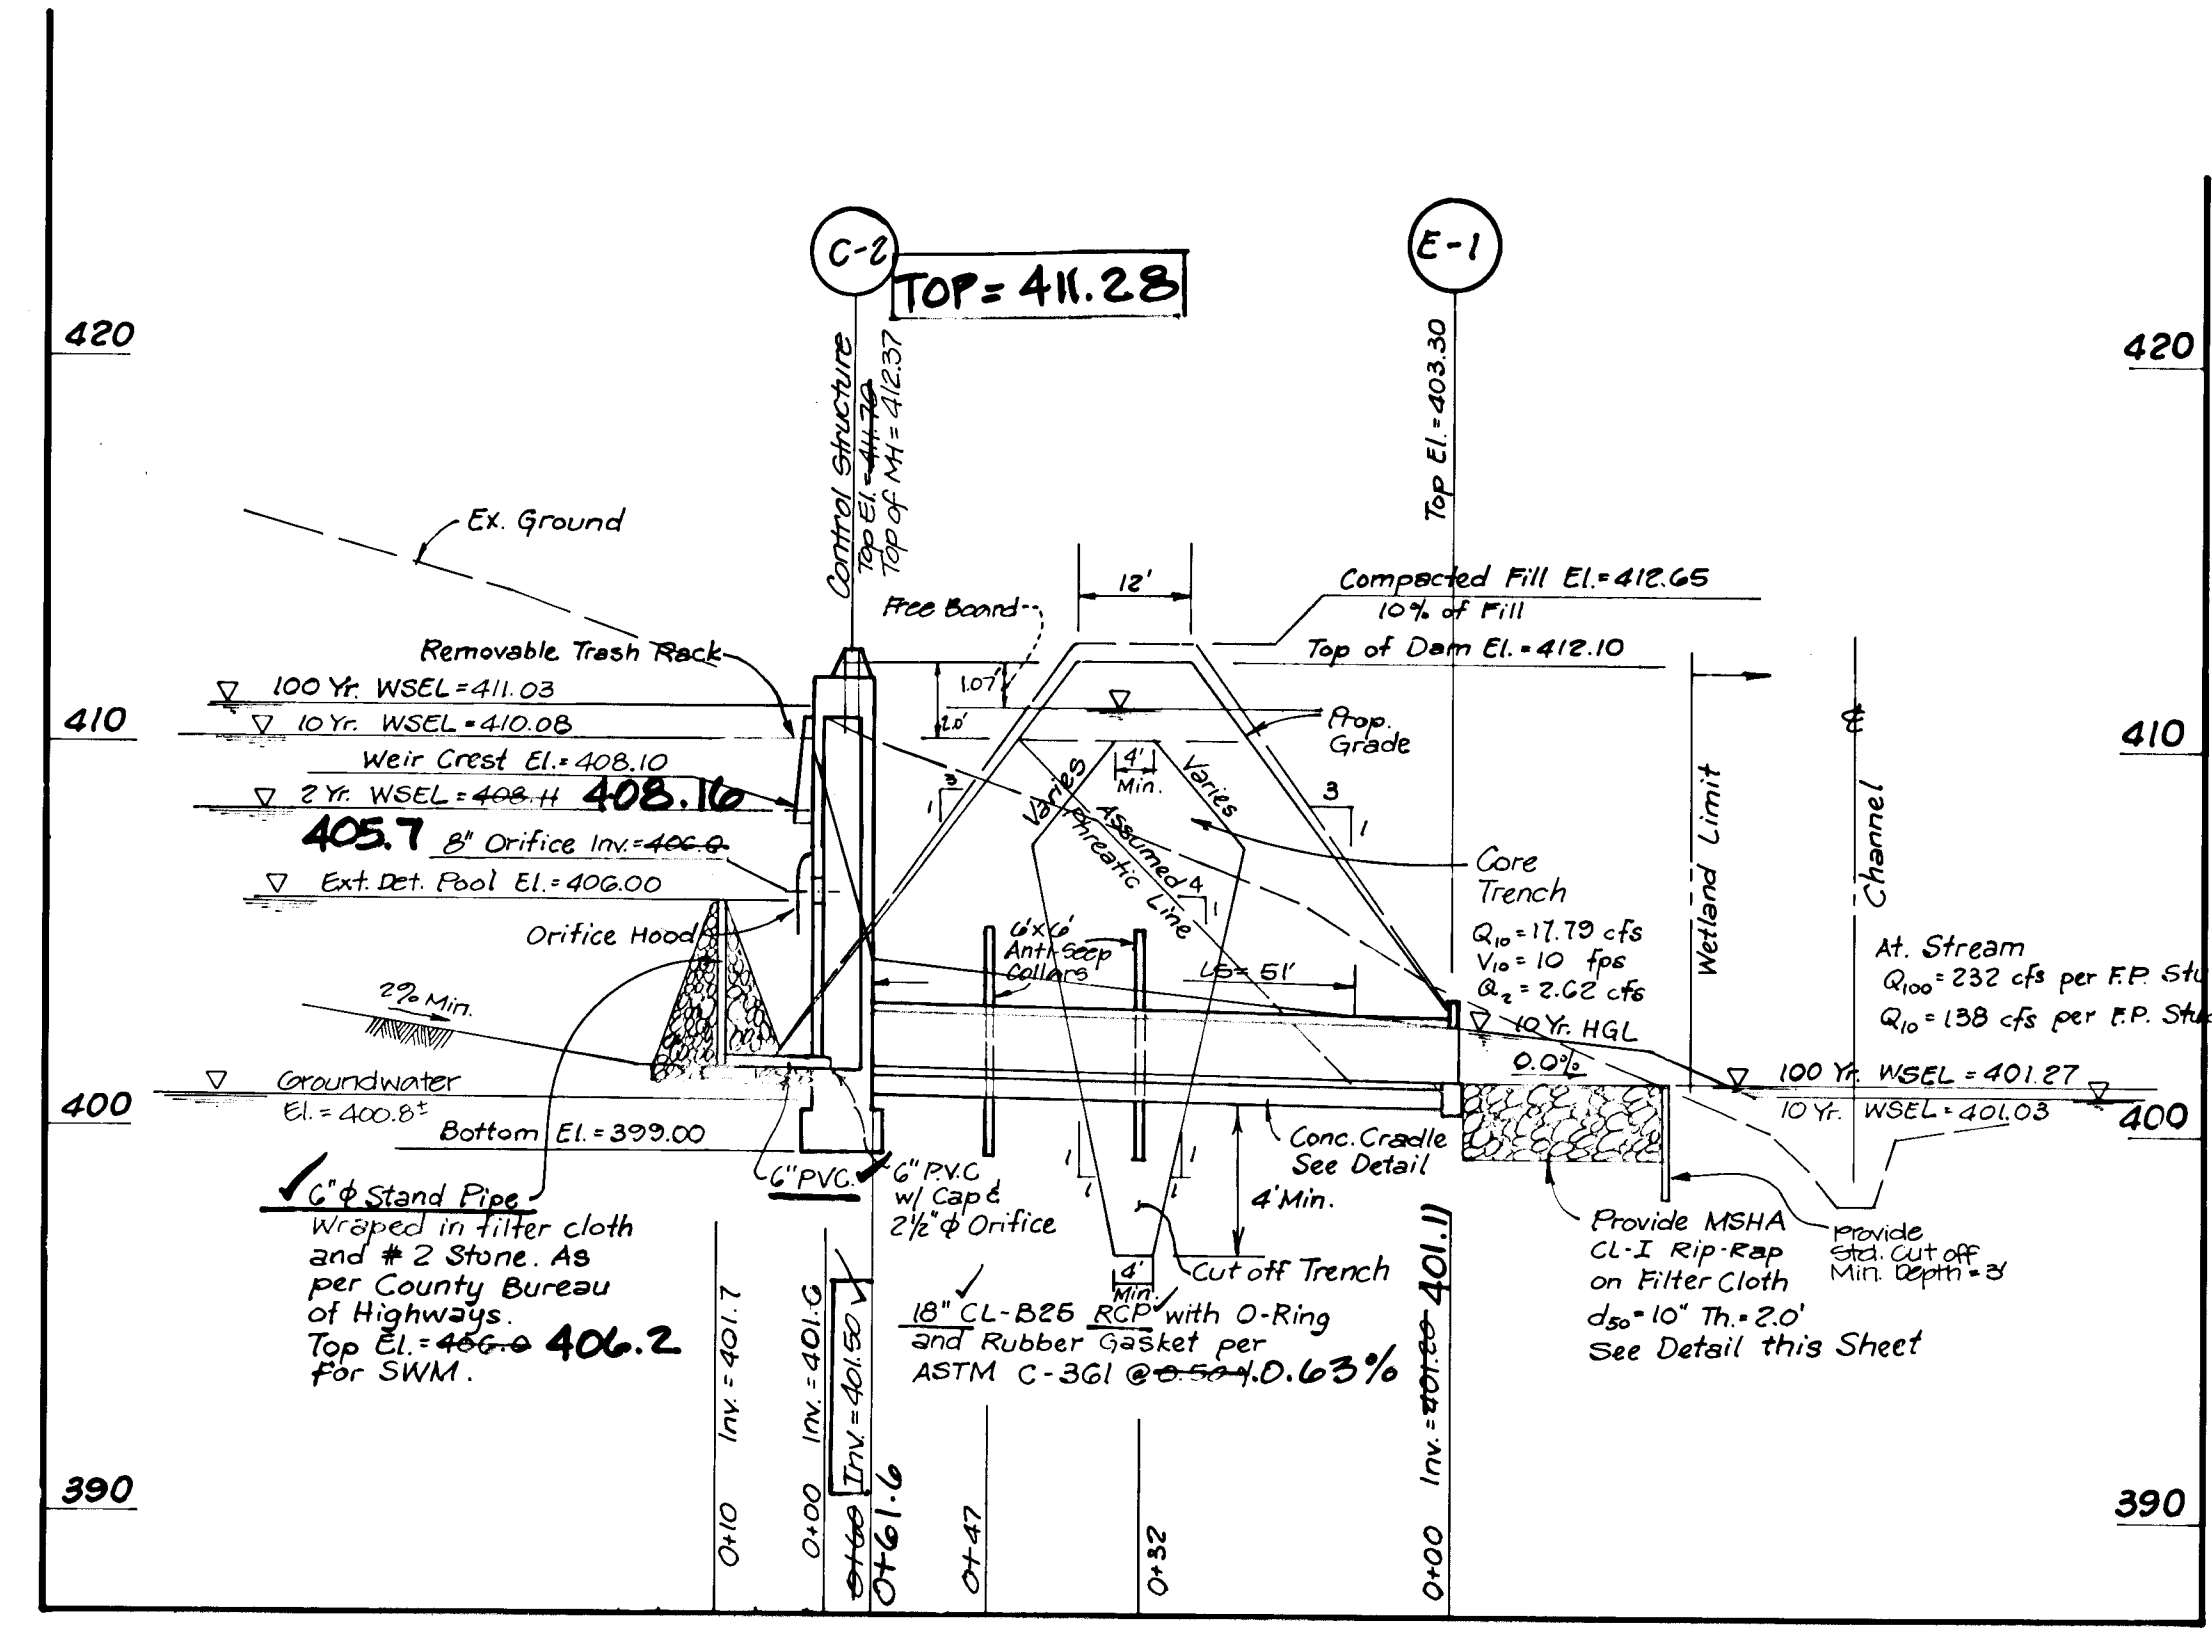

PROFILE ALONG PRINCIPAL SPILLWAY
 SCALE: H: 1" = 20'
 V: 1" = 5'

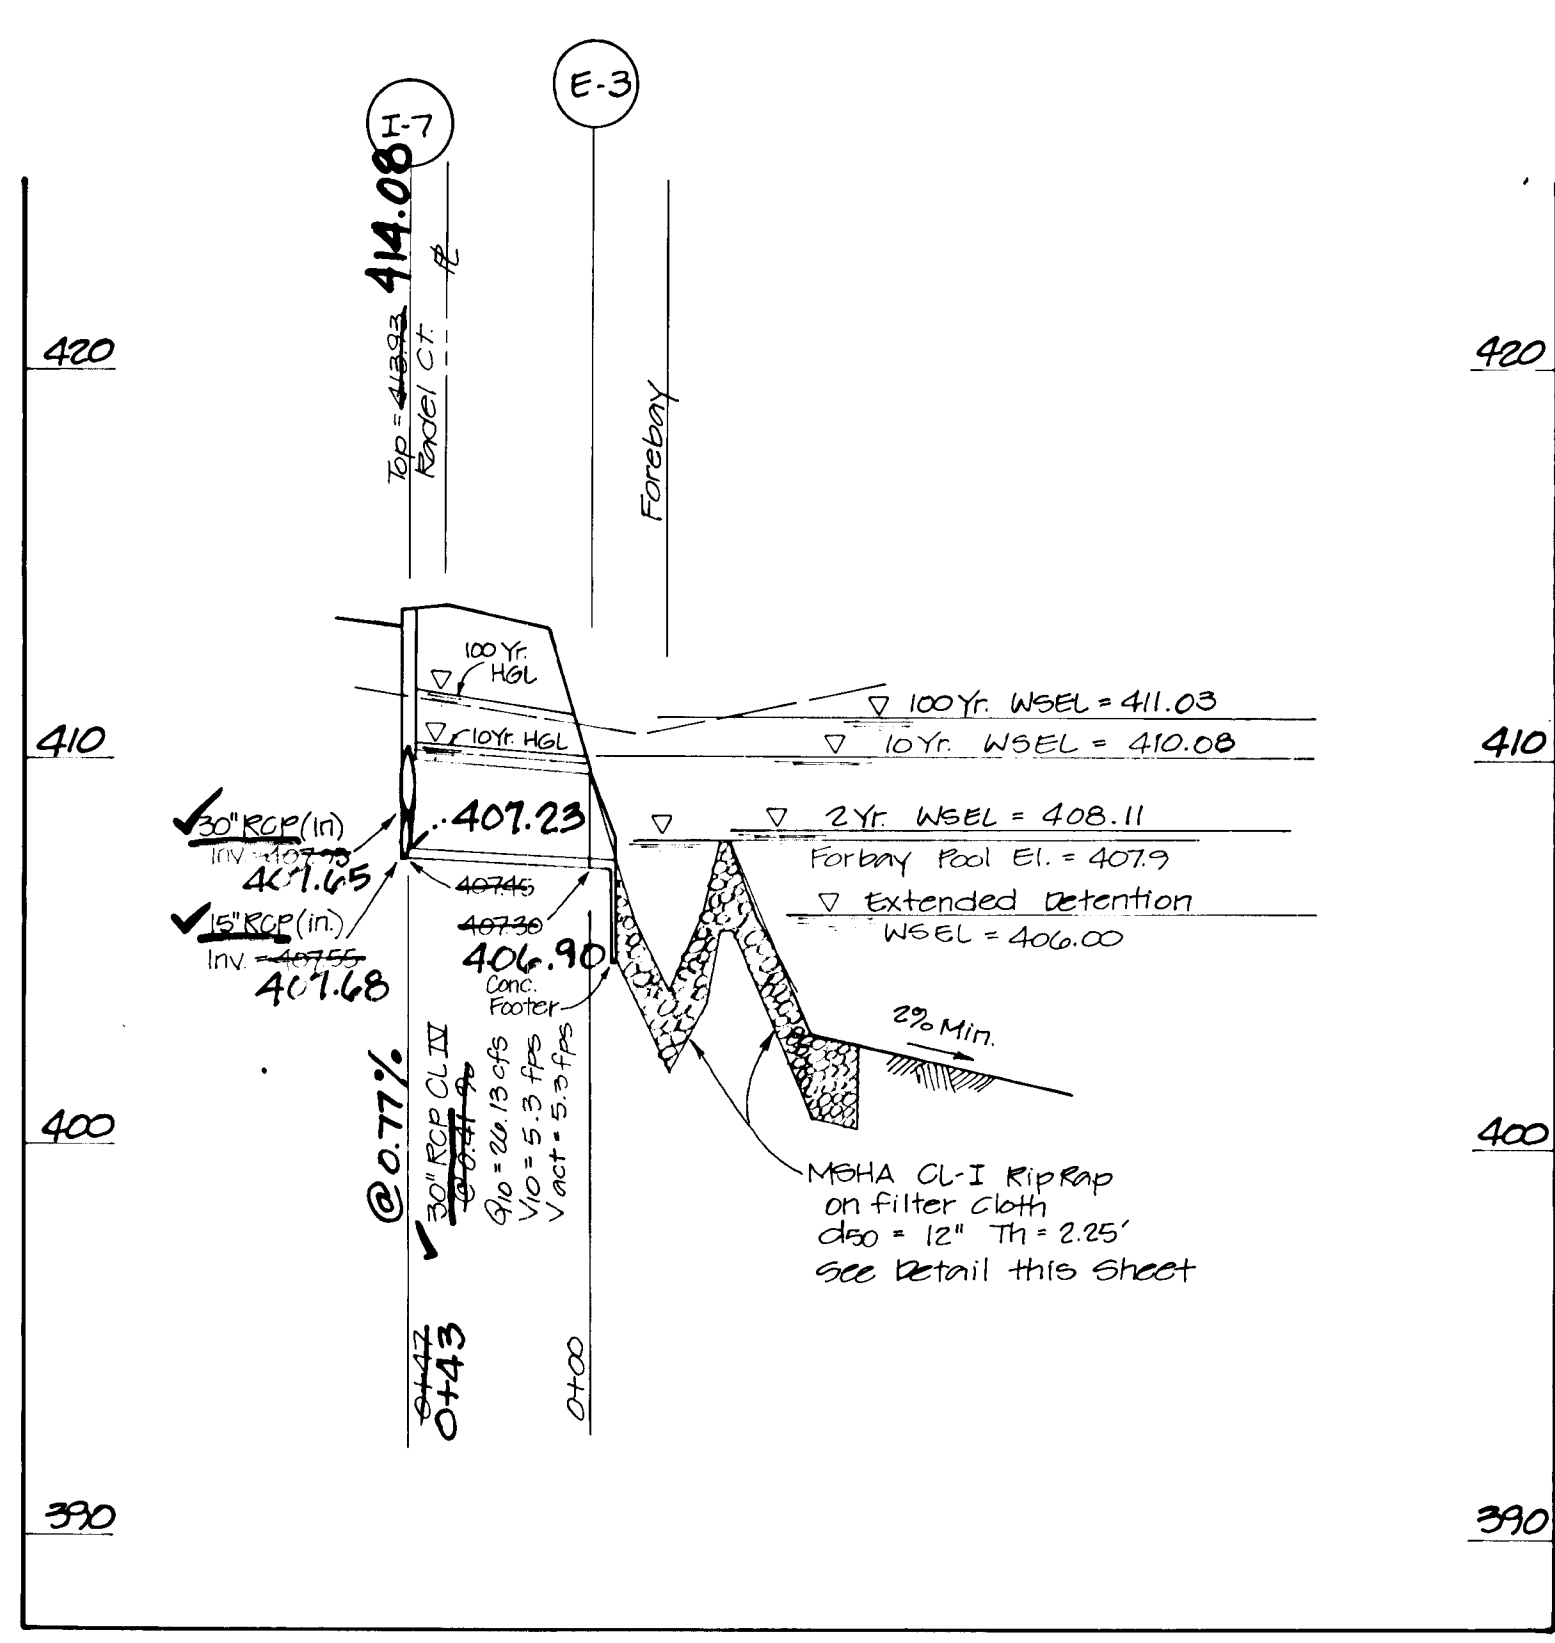

FOREBAY SECTION A-A
 SCALE: H: 1" = 30'
 V: 1" = 5'

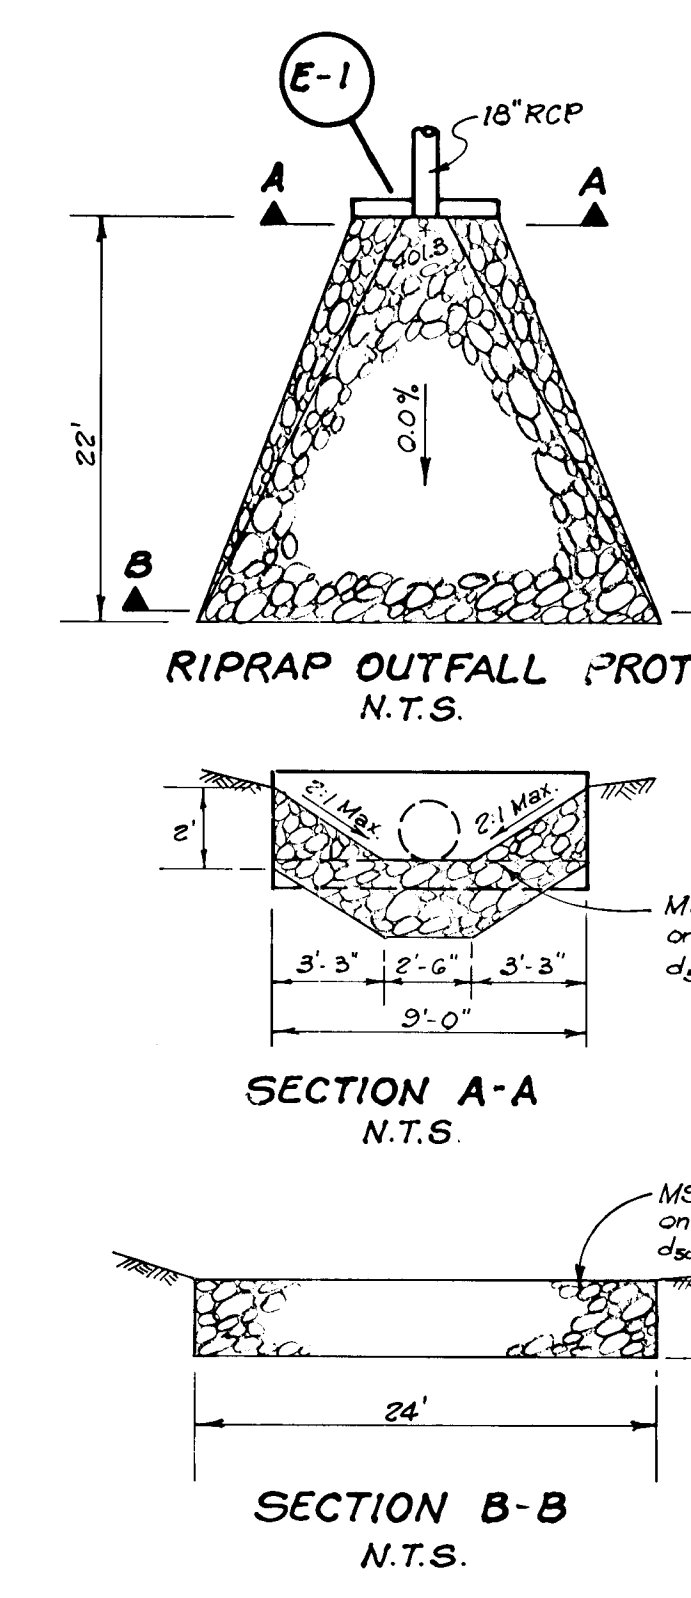


SECTION A-A
 N.T.S.

SECTION B-B
 N.T.S.


ENGINEER'S "AS-BUILT" CERTIFICATE
 I hereby certify that the "As-Built" information shown herein is accurate and complete.
 Signature: [Signature], Date: 7/13/99
 Jang H. Lee, P.E., MD LIC. #18632




"AS-BUILT"
 f-94-99

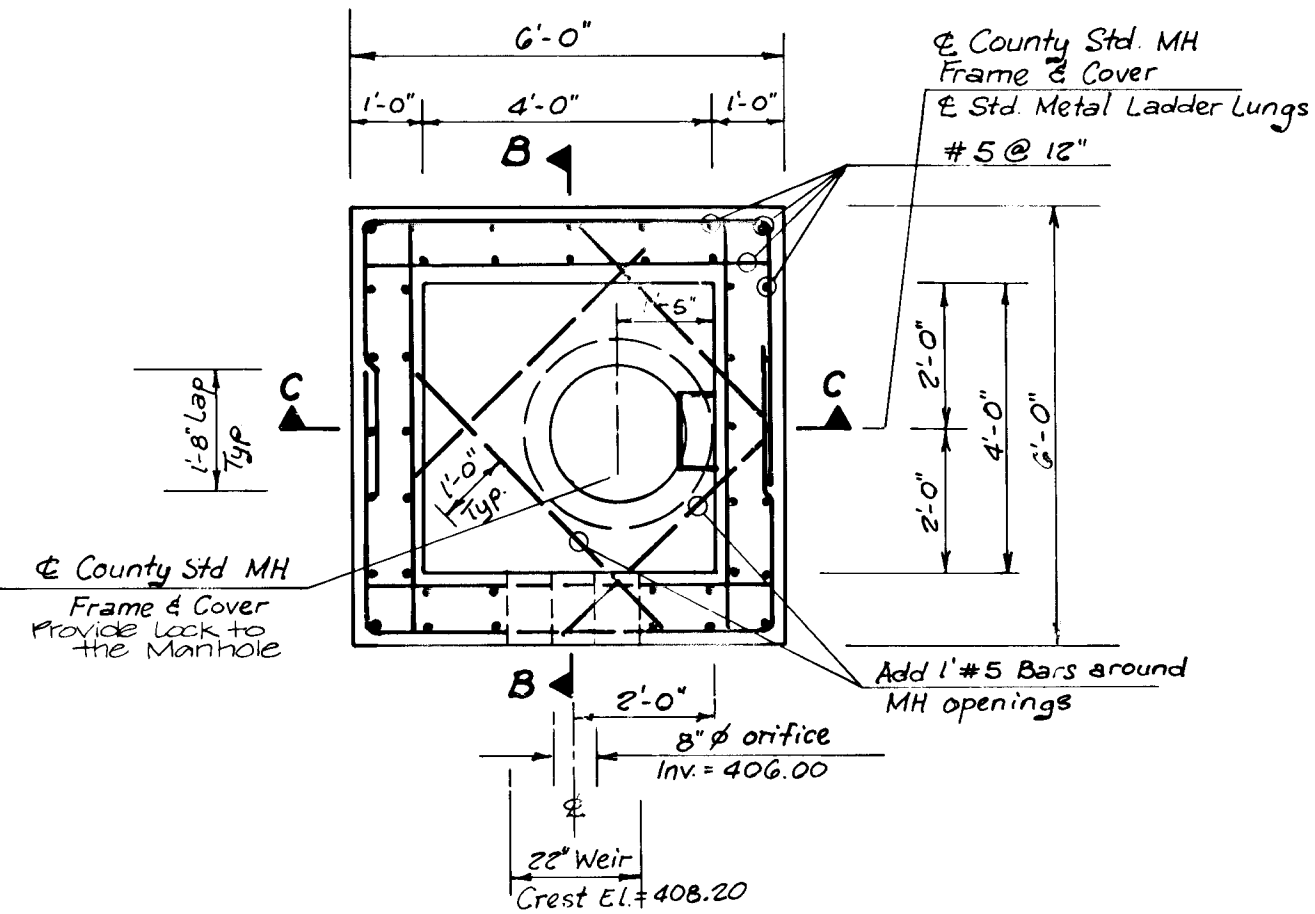

TOP PLAN VIEW (SECTION A-A)
N.T.S.

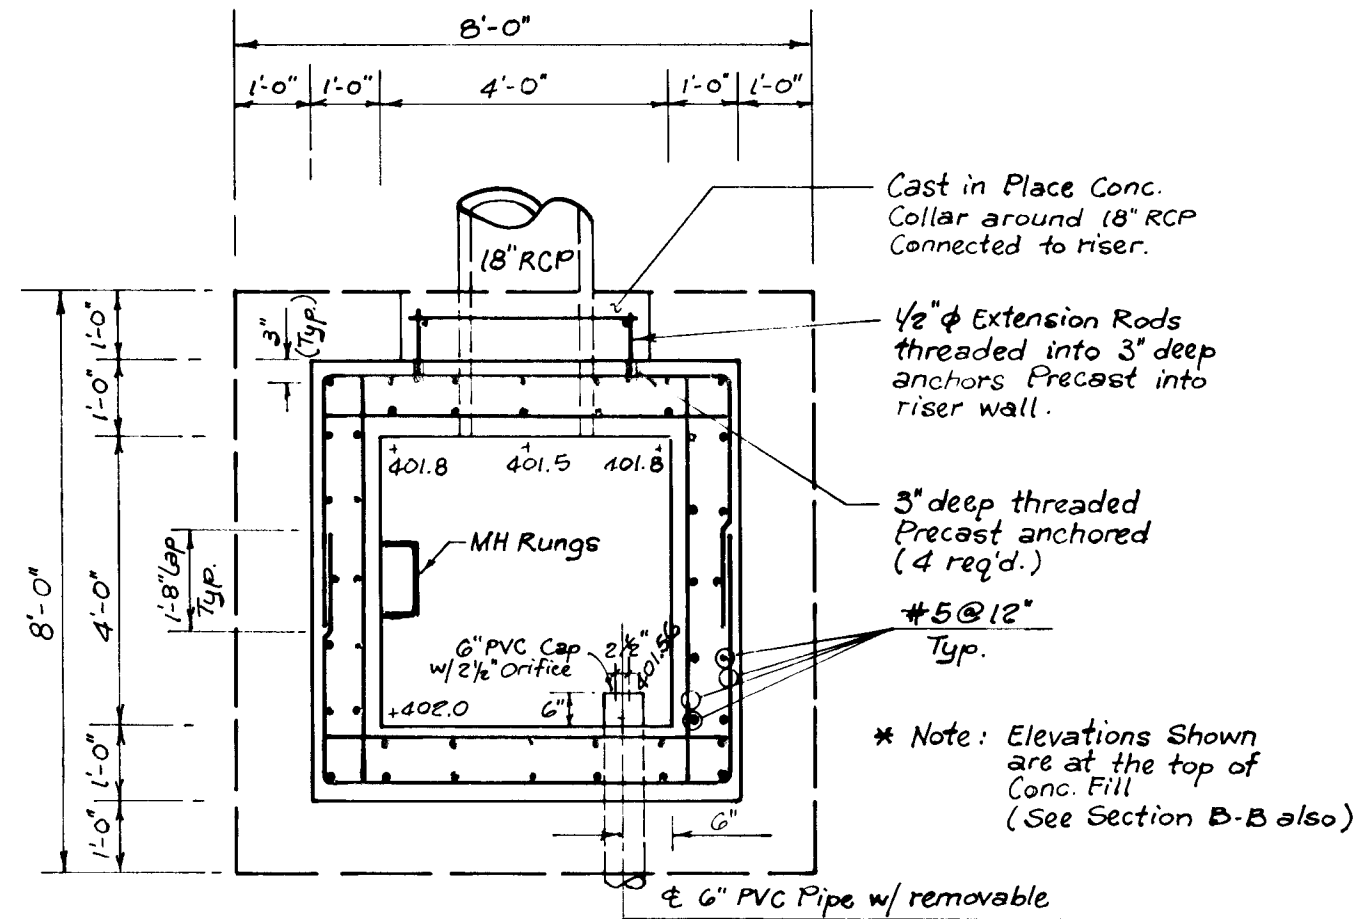


BOTTOM PLAN VIEW (SECTION D-D)
N.T.S.

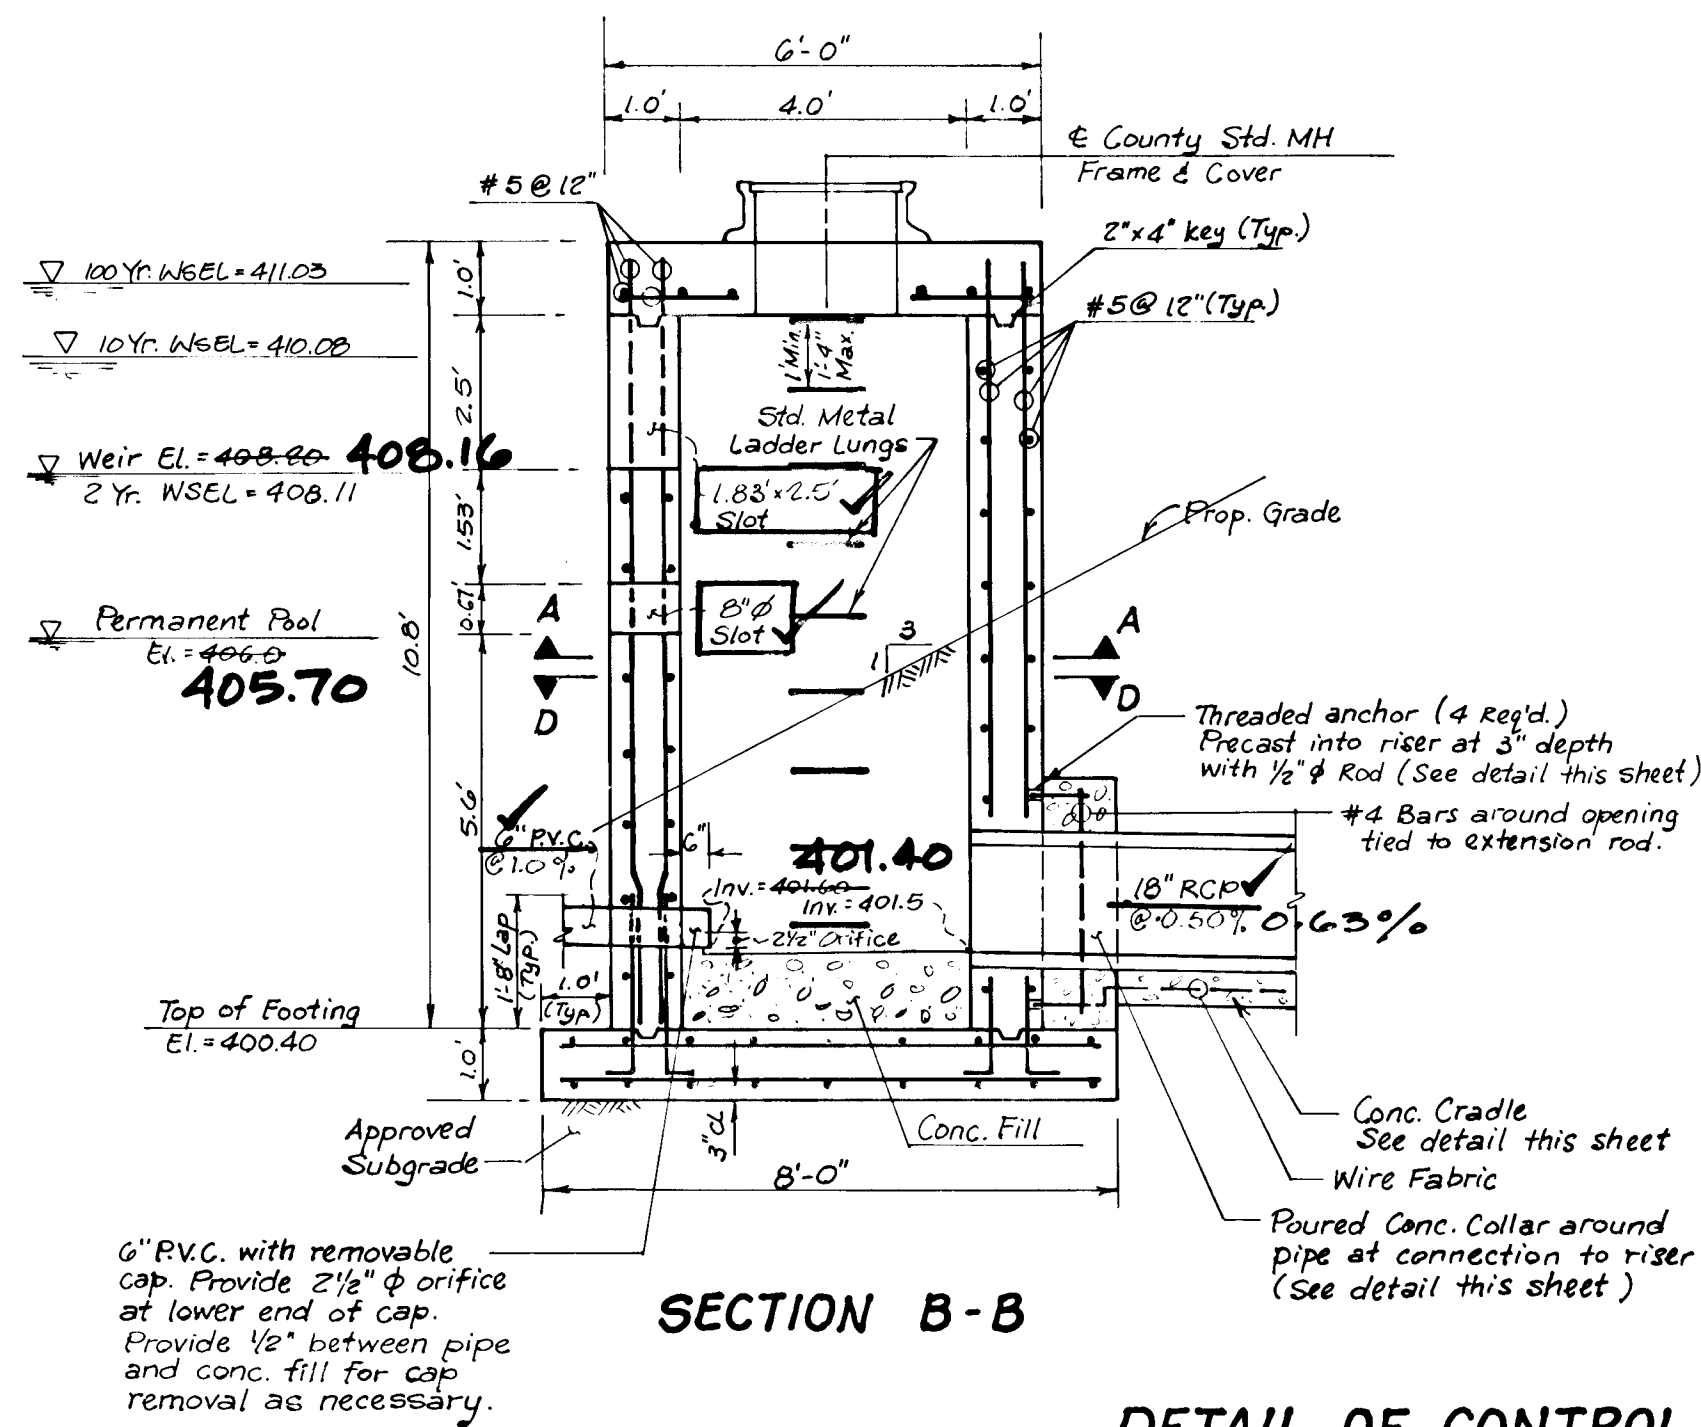


SECTION B-B


DETAIL OF CONTROL STRUCTURE ②
N.T.S.

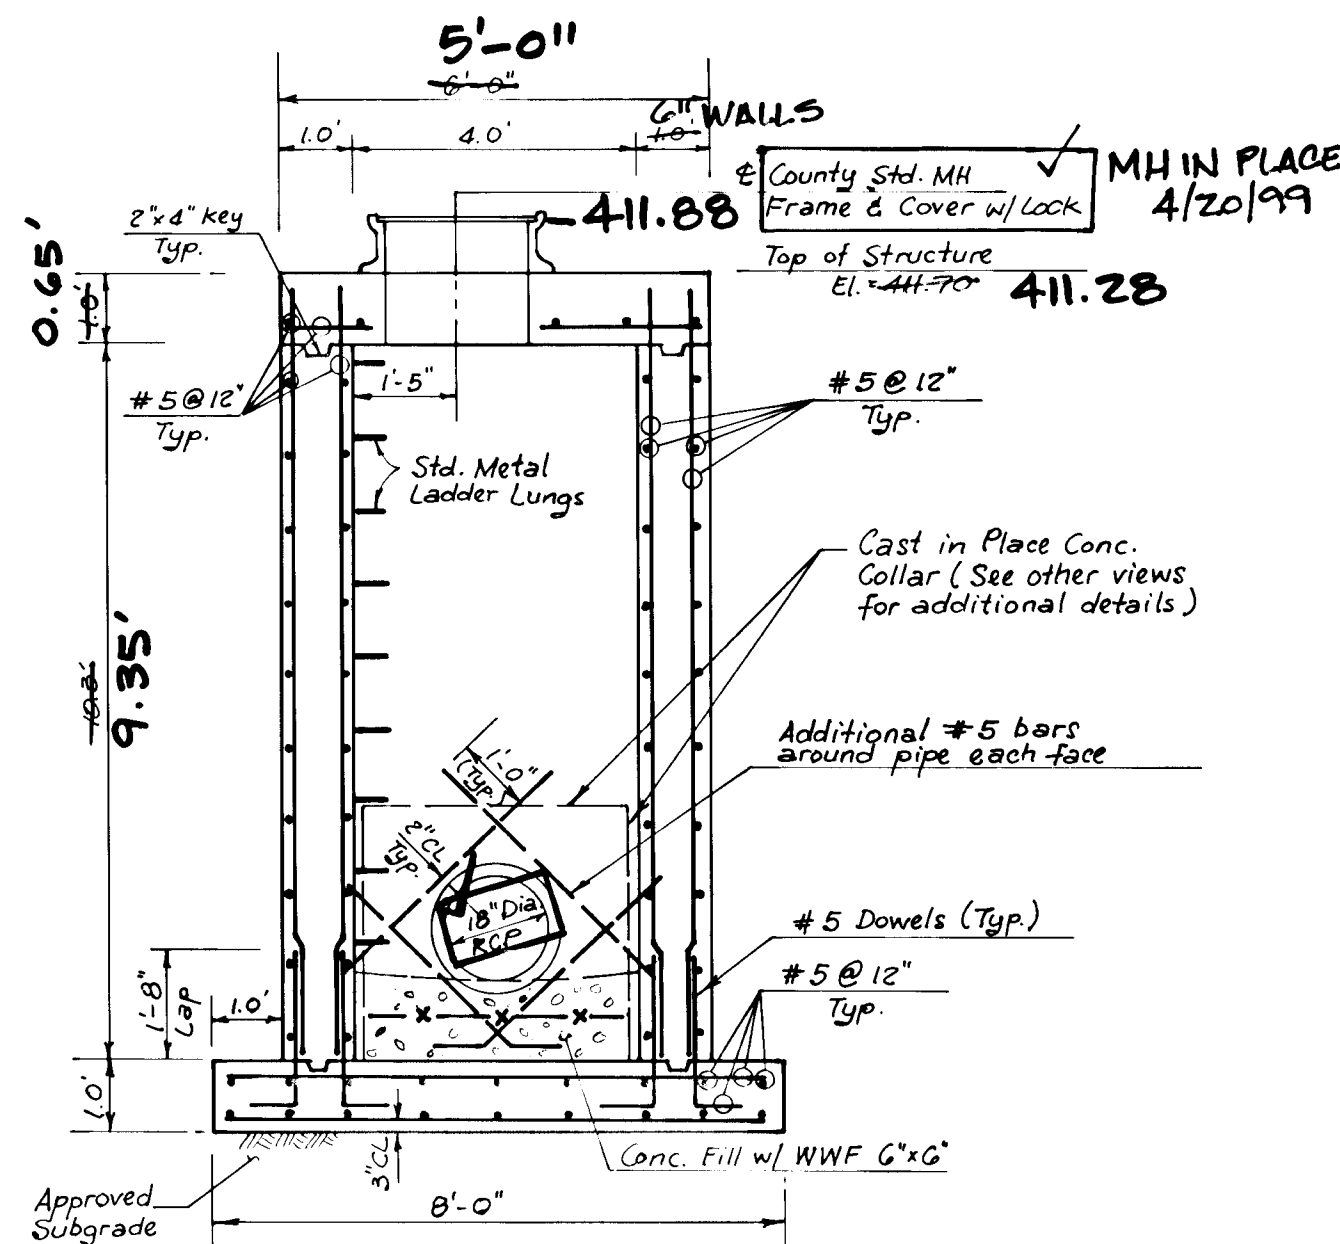

SECTION C-C

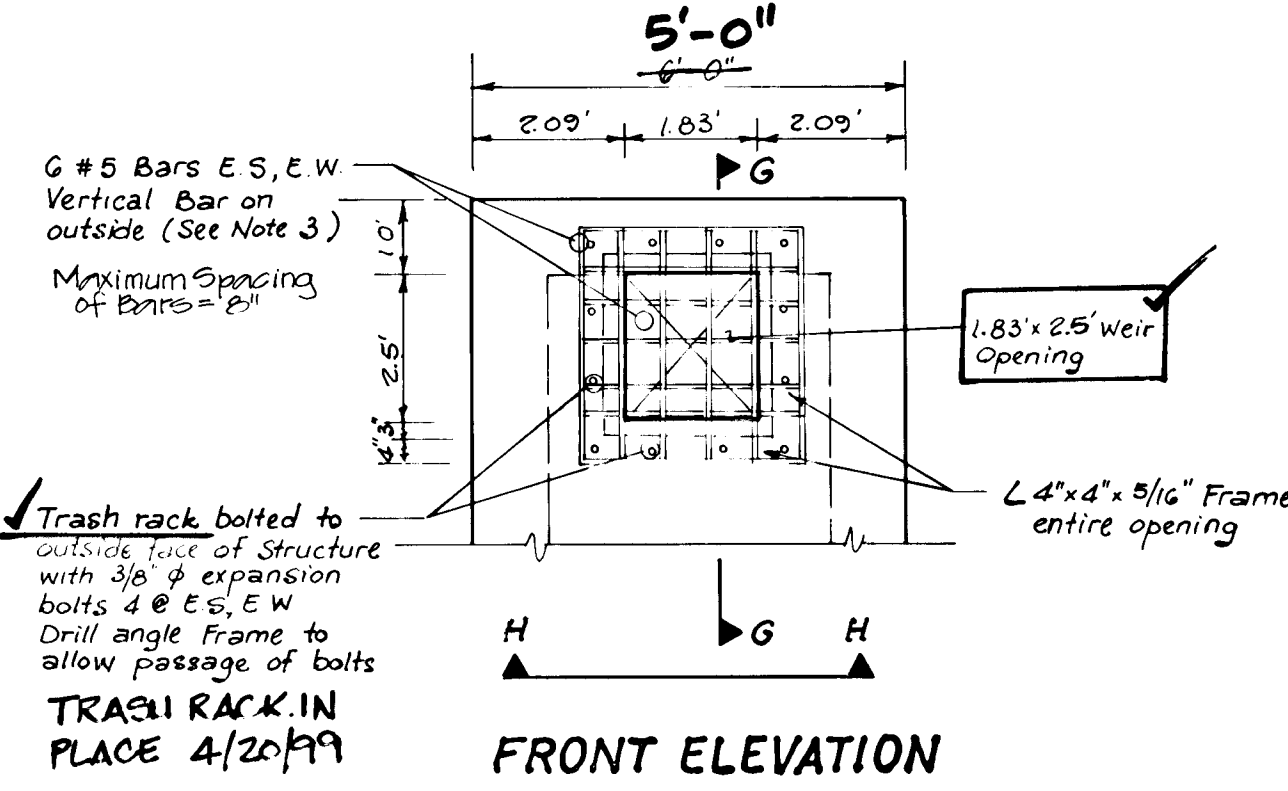

FRONT ELEVATION

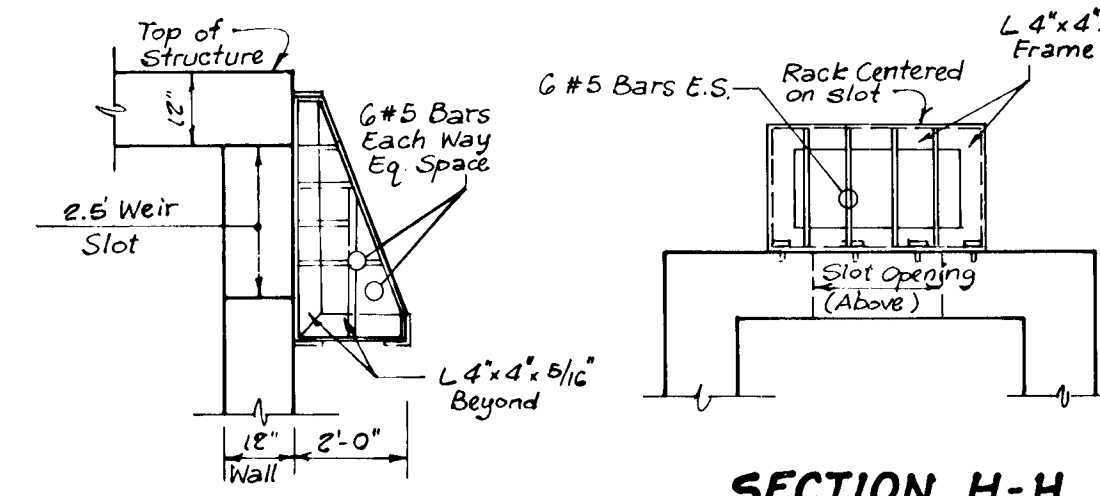

SECTION G-G (SIDE VIEW)
N.T.S.

SECTION H-H (BOTTOM VIEW)
N.T.S.

REMOVABLE TRASH RACK DETAILS
N.T.S.

- REMOVABLE TRASH RACK NOTES:
1. For exposed steel, re-bar shall be hot dipped galvanized, and angles shall be painted with 2 coats of ZRC cold galvanizing compound.
 2. Butt weld frame angle, fillet weld bars to angle frame.
 3. Provide 5/16" fillet weld at bar crossings.
 4. Angle frames and bars shall be fabricated using ASTM A-36 steel.
 5. Trash rack shall be mounted to riser with 3/8" dia. hex. head bolts stainless steel.
 6. Horizontal bars to be behind vertical bars.
 7. All metal surface in contact with concrete shall be coated with bitumastic.
 8. All trash racks and their components to be galvanized after fabrication and to be painted. Paintship Gray.

STRUCTURAL NOTES

SPECIFICATIONS: All construction and materials shall conform to the latest edition of the Maryland State Highway Administration Specifications dated January 1982, including all revisions and additions thereto.

DESIGN METHOD: Cast-In-Place Concrete Design: Service Load Design Method
Concrete Design: $f_c = 2,975 \text{ p.s.i.}$
Reinforcing Steel Design: $f_s = 24,000 \text{ p.s.i.}$

DESIGN CONDITIONS:
1. 100 year flood elevation
2. 100 psf Live Load

GEOTECHNICAL INFORMATION: A geotechnical engineering report has been prepared for this project and is available for information and design purposes only and may not be sufficient for the preparation of an accurate bid.

The following geotechnical parameters were used for design:
1. Unit weight of wet soil = 120 pcf
2. Coefficient of soil pressure = 0.58
3. Minimum safe bearing capacity = 3000 psf

The design foundation bearing capacity and soil properties shall be verified in the field by a qualified geotechnical engineer prior to construction. If the actual bearing capacity or design properties do not meet the design parameters assumed, the Structural Engineer shall be contacted before construction continues. When directed by the Geotechnical Engineer, the subgrade beneath the base slab shall be removed and backfilled with 2000 psi concrete.


CONCRETE: All cast-in-place concrete shall obtain a minimum compressive strength of 3500 psi at 28 days, and shall conform to MSHA Specification Section 908. All exposed corners of concrete shall be chamfered 3/4" X 3/4". All keys are nominal size.

REINFORCING STEEL: All reinforcing steel bars shall conform to ASTM A-615, Grade 60. Concrete cover over all reinforcing shall be 2", unless noted otherwise. All rebar laps, bends and embedment depth shall meet the requirements of ACI 318-89.

CONSTRUCTION Dewatering: All work performed for permanent structures shall be carried out in areas free from water. Dewatering of the excavations shall be accomplished by methods approved by the Engineer. After having served their purpose, all temporary protective works required by dewatering shall be removed as required to prevent any obstruction to flow of water.


STRUCTURAL Backfilling: When directed by the Geotechnical Engineer, undercutting of the soil below the footing and backfilling with materials acceptable to the Geotechnical Engineer shall be performed. Backfilling of the undercut areas shall conform to MD 378. No backfill shall be placed against the cast-in-place walls until the concrete has attained the specified 28-day compressive strength. The static weight of compaction equipment used adjacent to walls shall not exceed 3000 pound.

SHOP DRAWINGS: All shop drawings, working drawings and calculations submitted to the Structural Engineer for review or approval shall be sealed, signed and dated by a Professional Engineer registered in the State of Maryland.

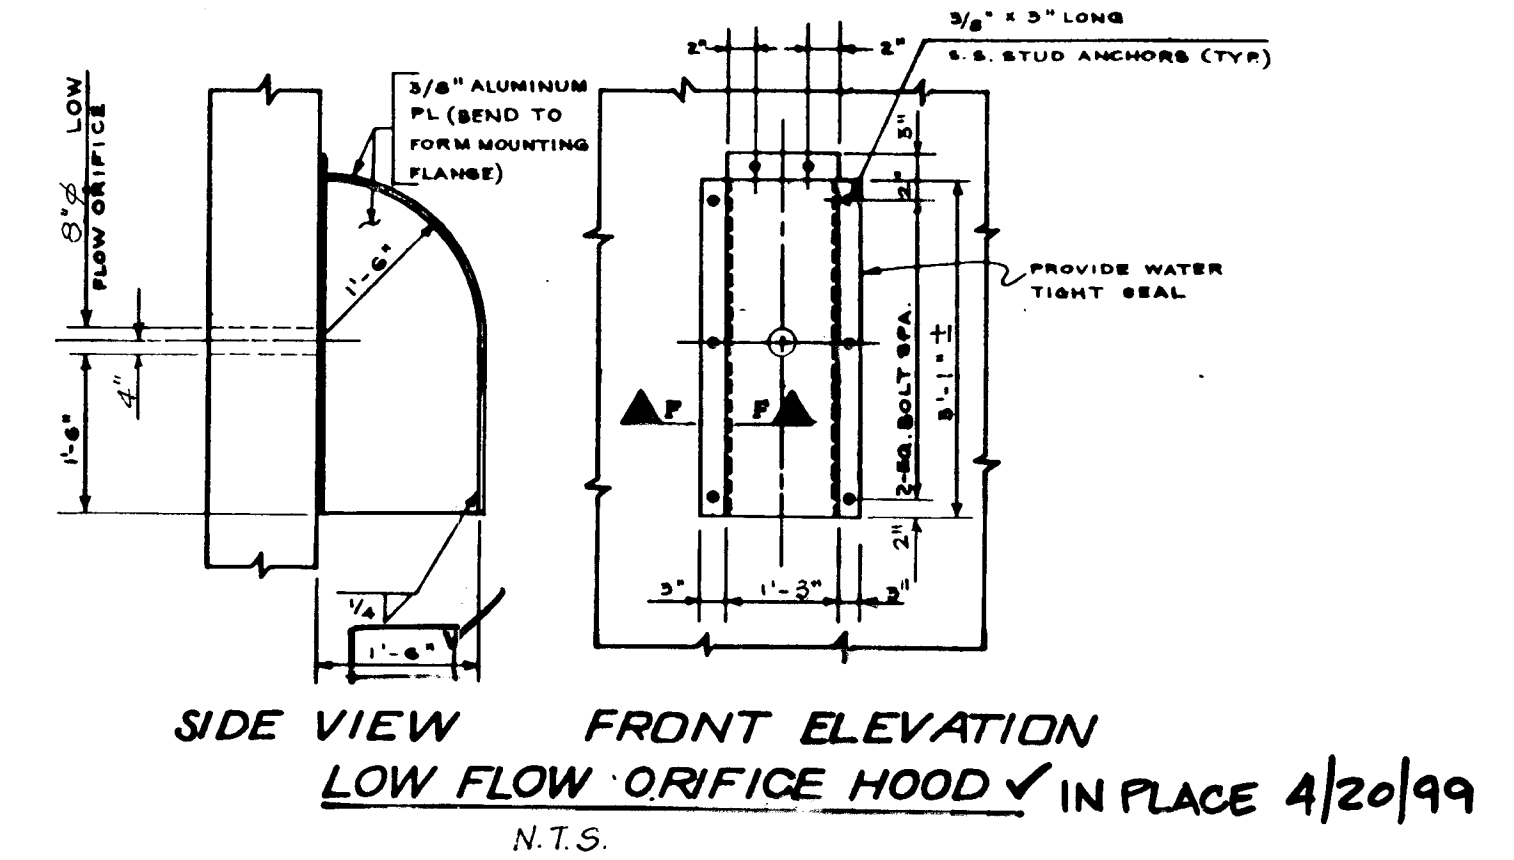


SIDE VIEW FRONT ELEVATION

LOW FLOW ORIFICE HOOD IN PLACE 4/20/99
N.T.S.

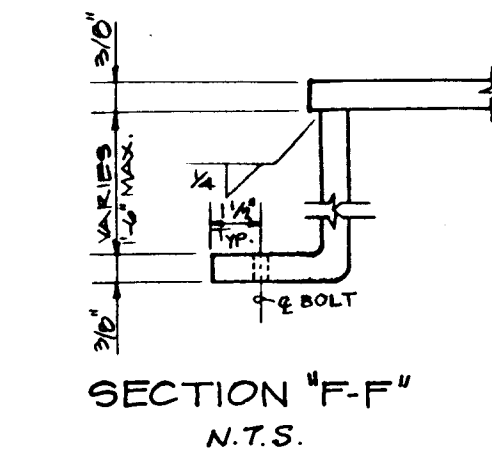


SECTION F-F
N.T.S.

- ORIFICE HOOD NOTES:
1. ALL METAL SURFACES IN CONTACT WITH CONCRETE SHALL BE COATED WITH BITUMASTIC.
 2. ALL EXPOSED METAL FOR HOOD SHALL BE PAINTED WITH 2 COATS OF ZRC COLD GALVANIZING COMPOUND.

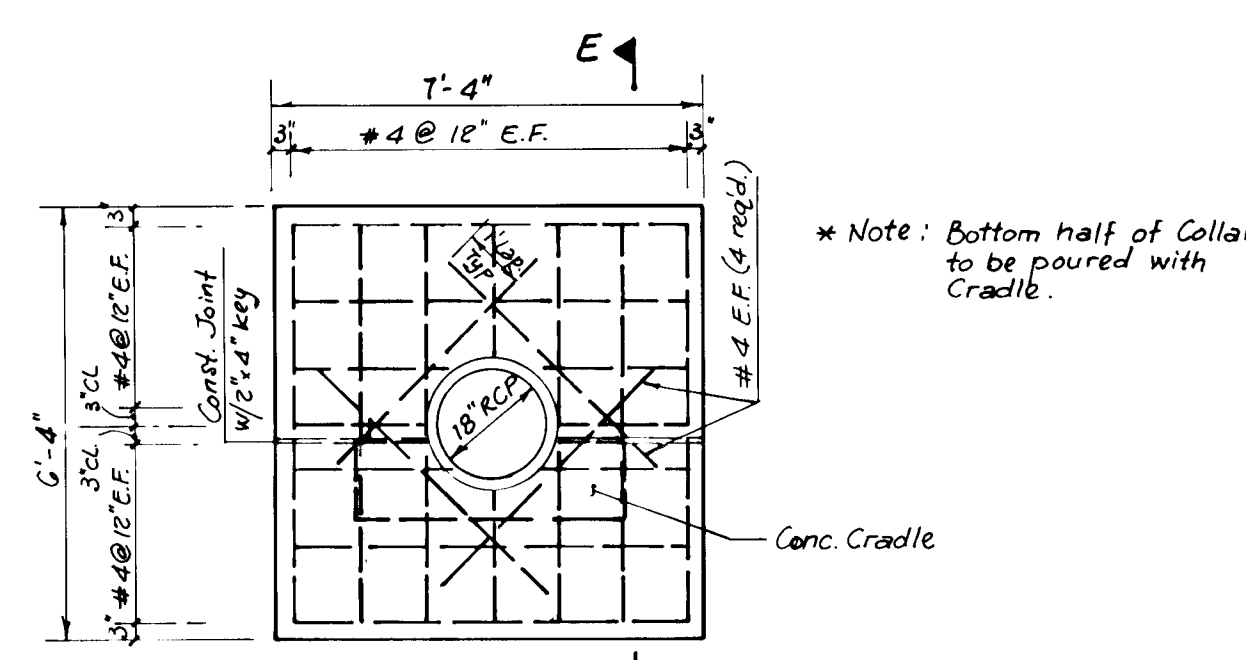


SECTION E-E
ANTI-SEEP COLLAR DETAIL
N.T.S.

NOTE: Asphalt joint filler material shall be placed between all concrete surface except between the pipe and cradle.

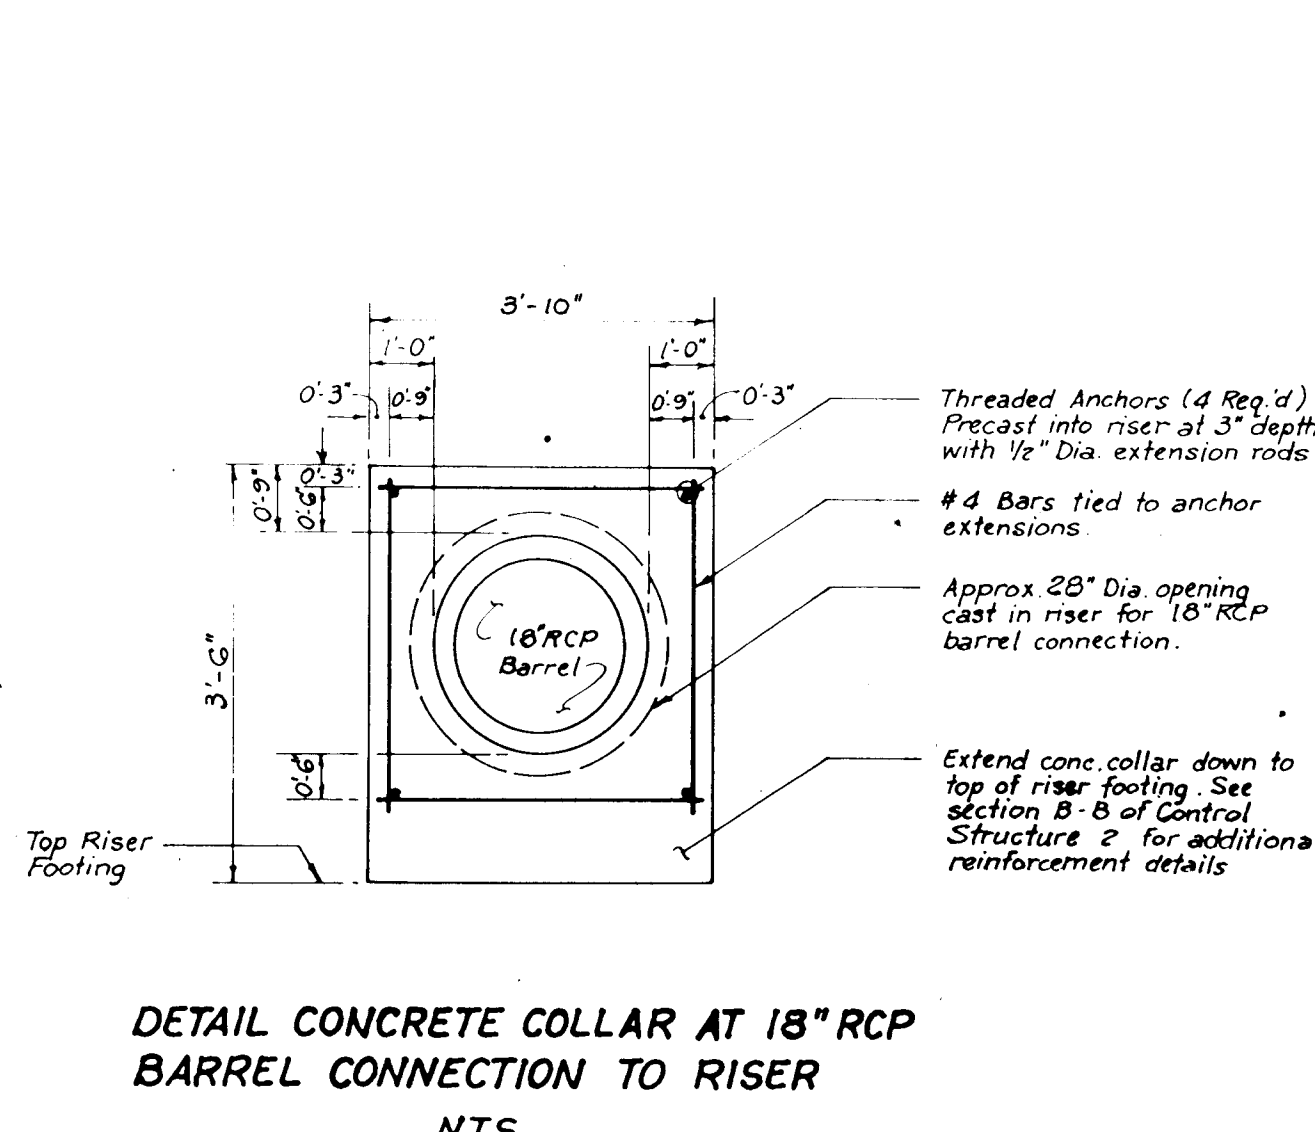

DETAIL CONCRETE COLLAR AT 18" RCP BARREL CONNECTION TO RISER
N.T.S.

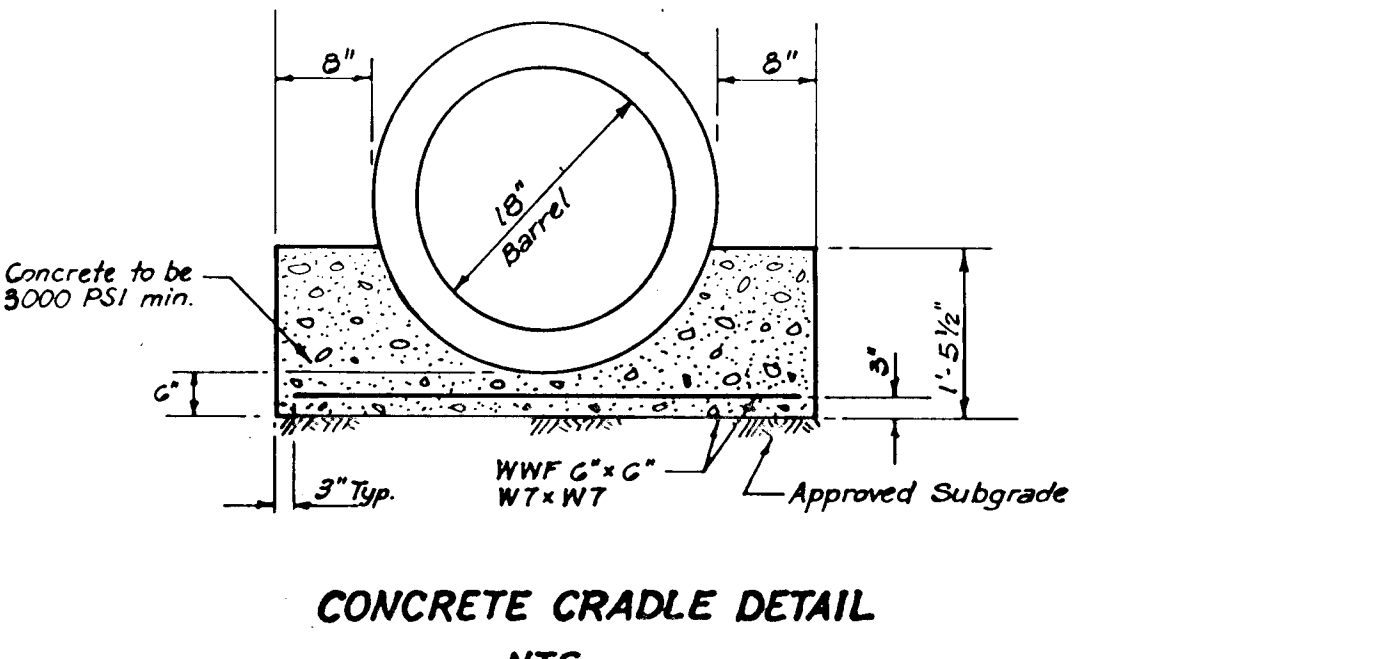

CONCRETE CRADLE DETAIL
N.T.S.

APPROVED: HOWARD COUNTY DEPARTMENT OF PUBLIC WORKS

[Signature] 11/14/94
CHIEF, LAND DEVELOPMENT DIVISION

[Signature] 11-10-94
CHIEF, BUREAU OF HIGHWAY

[Signature] 11/14/94
CHIEF, BUREAU OF ENGINEERING

APPROVED HOWARD COUNTY DEPARTMENT OF PLANNING AND ZONING

[Signature] 11/18/94
CHIEF, DIVISION OF LAND DEVELOPMENT AND RESEARCH

REVIEWED FOR HOWARD COUNTY AND MEETS TECHNICAL REQUIREMENTS

[Signature] 11/18/94
SIGNATURE DATE

U.S. SOIL CONSERVATION SERVICE

S.C.S. APPROVAL FOR SEDIMENT AND EROSION CONTROL IS CONTINGENT UPON REGULATORY PERMITS.

HOWARD SOIL CONSERVATION DISTRICT

S.C.S. APPROVAL FOR SEDIMENT AND EROSION CONTROL IS CONTINGENT UPON ISSUANCE OF ALL APPLICABLE REGULATORY PERMITS.

APPROVED BY *[Signature]* DATE 11/18/94
DISTRICT MANAGER

ENGINEER'S "AS-BUILT" CERTIFICATE

I hereby certify that the "As-Built" information shown herein is accurate and complete.

[Signature] 7/13/99
Date

Jang H. Lee, P.E.
MD LIC #18632

[Signature]

JANG H. LEE
No. 18632
PROFESSIONAL ENGINEER

J/L	T.C. Tang
DESIGN	CHECKED
DRAFT	DATE
DATE	SCALE
APRIL 5, 1994	AS SHOWN

REVISION	DATE	BY
NO.		

LAVELLE & ASSOCIATES INCORPORATED
CIVIL ENGINEERS • LAND PLANNERS • LAND SURVEYORS

10 NORTH JEFFERSON STREET
SUITE 203
FREDERICK, MARYLAND 21701

OFFICE: (301) 831-4510
(301) 695-9722

FAX: (301) 695-9766


SWM STRUCTURE DETAILS
ABBEYFIELD ESTATES
TAX MAP 31 PARCELS 206, 208 & 209
1st. ELECTION DISTRICT
HOWARD COUNTY, MARYLAND

F-94-99

10 OF 12

"AS-BUILT"

F-94-99

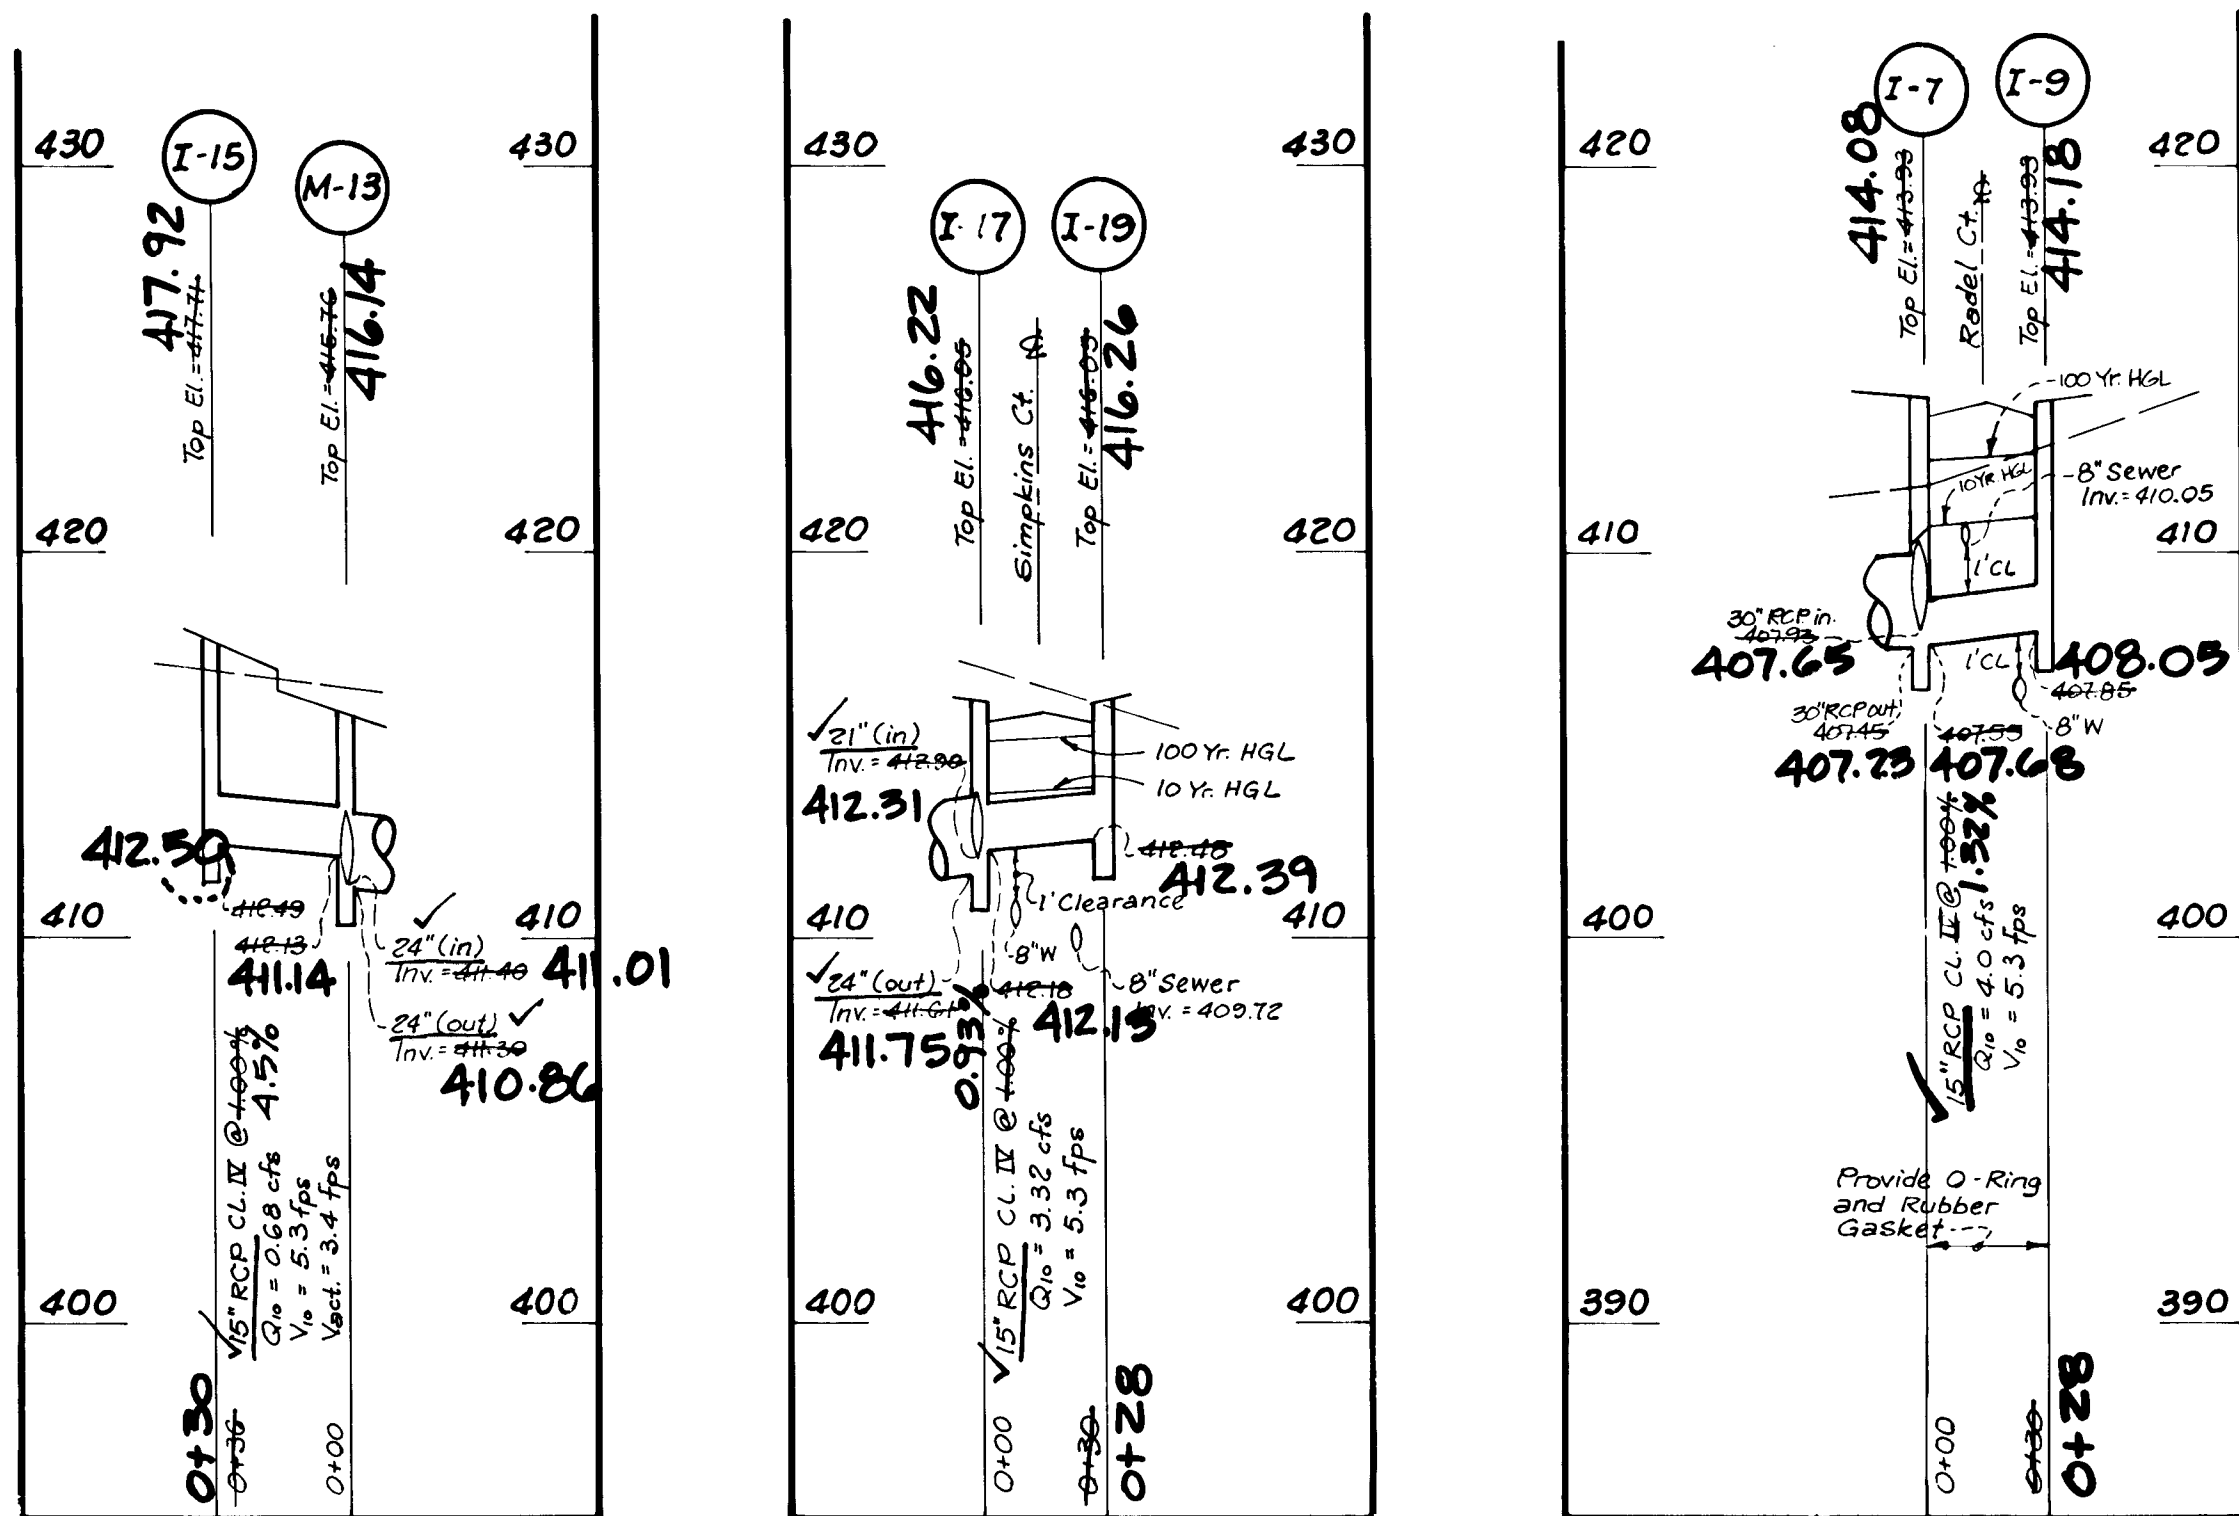

Site Preparation

Areas designated for borrow areas, embankment, and structural works shall be cleared, grubbed and stripped of topsoil. All trees, vegetation, roots and other objectionable material shall be removed. Channel banks and sharp breaks shall be sloped to no steeper than 1:1.

Areas to be covered by the reservoir will be cleared of all trees, brush, logs, fences, rubbish and other objectionable material unless otherwise designated on the plans. Trees, brush and stumps shall be cut approximately level with the ground surface. For dry stormwater management practice, a minimum of a 50 foot radius around the inlet structure shall be cleared.

All cleared and grubbed material shall be disposed of outside and below the limits of the dam and reservoir as directed by the owner or his representative. When specified, a sufficient quantity of topsoil will be stockpiled in a suitable location for use on the embankment and other designated areas.

Earth Fill

Material: The fill material shall be taken from approved designated borrow areas. It shall be free of roots, stumps, wood, rubbish, stones greater than 6", frozen or other objectionable materials. Fill material for the center of the embankment and cut off trench shall conform to Unified Soil Classification GC, SC, CH, or CL. Consideration may be given to the use of other materials in the embankment if design and construction are supervised by a geotechnical engineer.

Placement: Areas on which fill is to be placed shall be scarified prior to placement of fill. Fill materials shall be placed in maximum 6 inch thick (before compaction) layers which are to be continuous over the entire length of the fill. The most permeable borrow material shall be placed in the downstream portions of the embankment. The principal spillway must be installed concurrently with fill placement and not excavated into the embankment.

Compaction: The movement of the hauling and spreading equipment over the fill shall be controlled so that the entire surface of each lift shall be traversed by not less than one tread track of the equipment or compaction shall be achieved by a minimum of four complete passes of a sheepsfoot, rubber tired or vibratory roller. Fill material shall contain sufficient moisture such that the required degree of compaction will be obtained with the equipment used. The fill material shall contain sufficient moisture so that when formed into a ball it will not crumble yet not be so wet that water can be squeezed out.

Where a minimum required density is specified, it shall not be less than 95% of maximum dry density with a moisture content within $\pm 2\%$ of the optimum. Each layer of fill shall be compacted as necessary to obtain that density, and is to be certified by the Engineer at the time of construction. All compaction is to be determined by AASHTO Method T-99.

Cut Off Trench: The cutoff trench shall be excavated into impervious material along or parallel to the centerline of the embankment as shown on the plans. The bottom width of the trench shall be governed by the equipment used for excavation, with the minimum width being four feet. The depth shall be at least four feet below existing grade or as shown on the plans. The side slopes of the trench shall be 1 to 1 or flatter. The backfill shall be compacted with construction equipment, rollers, or hand tampers to assure maximum density and minimum permeability.

Structure Backfill

Backfill adjacent to pipes or structures shall be of the type and quality conforming to that specified for the adjoining material. The fill shall be placed in horizontal layers not to exceed four inches in thickness and compacted by hand tampers or other manually directed compaction equipment. The material needs to fill completely all spaces under and adjacent to the pipe. At no time during the backfilling operation shall driven equipment be allowed to operate closer than four feet, measured horizontally, to any part of a structure. Under no circumstances shall equipment be driven over any part of a concrete structure or pipe, unless there is a compacted fill of 24" or greater over the structure or pipe.

Reinforced Concrete Pipe: All of the following criteria shall apply for reinforced concrete pipe:

- Materials - Reinforced concrete pipe shall have bell and spigot joints with rubber gaskets and shall equal or exceed ASTM Designation C-381. An approved equivalent is AWWA Specification C-302.
- Bedding - All reinforced concrete pipe conduits shall be laid in a concrete bedding for their entire length. This bedding shall consist of high slump concrete placed under the pipe and up the sides of the pipe at least 10% of its outside diameter with a minimum thickness of 3 inches, or as shown on the drawings.
- Laying pipe - Bell and spigot pipe shall be placed with the bell end upstream. Joints shall be made in accordance with recommendations of the manufacturer of the material. After the joints are sealed for the entire line, the bedding shall be placed so that all spaces under the pipe are filled. Care shall be exercised to prevent any deviation from the original line and grade of the pipe. The first joint must be located within 2 feet from the riser.
- Backfilling shall conform to "Structure Backfill."
- Other details (anti-sweep collars, valves, etc.) shall be as shown on the drawings.

Concrete


Concrete shall meet the requirements of Maryland Department of Transportation, State Highway Administration Standard Specifications for Construction and Materials, Section 608, Mix No. 3

Care of Water during Construction

All work on permanent structures shall be carried out in areas free from water. The Contractor shall construct and maintain all temporary dikes, levees, cofferdams, drainage channels, and stream diversions necessary to protect the areas to be occupied by the permanent works. The contractor shall also furnish, install, operate, and maintain all necessary pumping and other equipment required for removal of water from the various parts of the work and for maintaining the excavations, foundation, and other parts of the work free from water as required or directed by the engineer for constructing each part of the work. After having served their purpose, all temporary protective works shall be removed or leveled and graded to the extent required to prevent obstruction in any degree whatsoever of the flow of water to the spillway or outlet works and so as not to interfere in any way with the operation or maintenance of the structure. Stream diversions shall be maintained until the full flow can be passed through the permanent works. The removal of water from the required excavation and the foundation shall be accomplished in a manner and to the extent that will maintain stability of the excavated slopes and bottom of required excavations and will allow satisfactory performance of all construction operations. During the placing and compacting of material in required excavations, the water level at the locations being refilled shall be maintained below the bottom of the excavation at such locations which may require draining the water to sumps from which the water shall be pumped.

Stabilization

All borrow areas shall be graded to provide proper drainage and left in a slightly condition. All exposed surfaces of the embankment, spillway, spoil and borrow areas, and berms shall be stabilized by seeding, liming, fertilizing and mulching in accordance with the Maryland Soil Conservation Service Standards and Specifications for Critical Area Planting (MD-342) or as shown on the accompanying drawings.

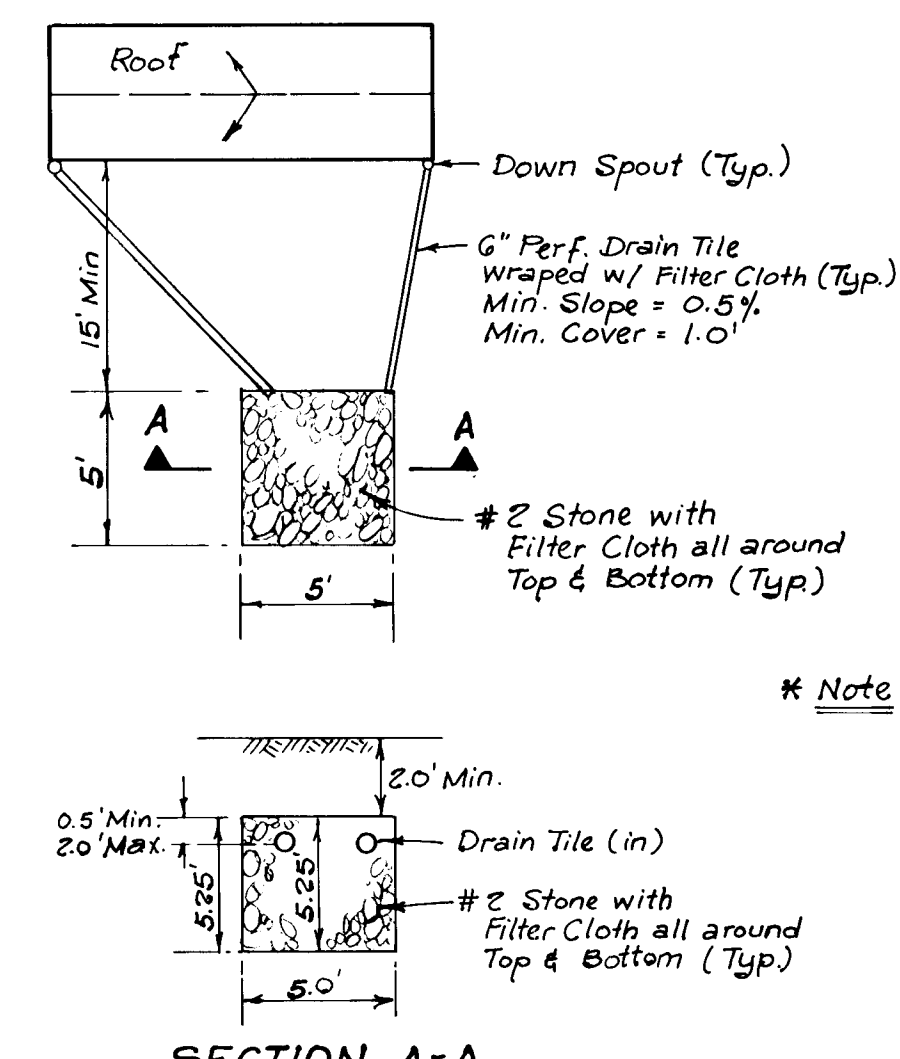

SECTION A-A
DETAIL OF DRYWELL FOR ROOF DRAIN
N.T.S.

APPROVED: HOWARD COUNTY DEPARTMENT OF PUBLIC WORKS

[Signature] 11/14/99
CHIEF, LAND DEVELOPMENT DIVISION
[Signature] 11-10-99
CHIEF, BUREAU OF HIGHWAY
[Signature] 11/14/99
CHIEF, BUREAU OF ENGINEERING

REVIEWED FOR HOWARD S.C.D. AND METS TECHNICAL REQUIREMENTS
[Signature] 11/14/99
U.S. SOIL CONSERVATION SERVICE
S.C.S. APPROVAL FOR SEDIMENT AND EROSION CONTROL IS CONTINGENT UPON REGULATORY PERMITS.
HOWARD SOIL CONSERVATION DISTRICT
S.C.S. APPROVAL FOR SEDIMENT AND EROSION CONTROL IS CONTINGENT UPON ISSUANCE OF ALL APPLICABLE REGULATORY PERMITS.
APPROVED BY *[Signature]*
DISTRICT MANAGER
DATE 11/14/99


APPROVED HOWARD COUNTY DEPARTMENT OF PLANNING AND ZONING

[Signature] 11/18/99
CHIEF, DIVISION OF LAND DEVELOPMENT AND RESEARCH


STRUCTURE SCHEDULE					
STR. NO.	TYPE	TOP ELEV.	INV. IN	INV. OUT	REMARKS LOCATION
E-1	Conc. EW	405.45	-	401.20	SD 5.21 See SWM Plan
E-2	SM Str.	411.20	-	407.30	See Control Structure Details
E-3	Conc. ES	407.30	-	407.30	SD 5.51 Radel Ct. 4+40, 59' R
I-7	A-10	413.93	-	407.55	407.45 SD 4.02 Radel Ct. 4+28.66, 15' R
I-9	A-10	413.93	-	407.85	SD 4.02 Radel Ct. 4+28.66, 15' L
M-11	Shallow	416.27	-	411.10	408.60 SD 5.05 Radel Ct. 2+98, 15' R
M-13	Shallow	415.76	-	411.40	411.30 SD 5.12 Radel Ct. 2+98, 15' L
I-15	PC MH	417.71	-	412.13	SD 4.02 Radel Ct. 2+62, 15' L
I-17	A-10	416.05	-	412.09	411.61 SD 4.02 Slapkins Ct. 0+52, 15' L
I-19	A-10	416.05	-	412.18	SD 4.02 Slapkins Ct. 0+52, 15' R
M-21	Shall. MH	417.57	-	412.78	412.63 SD 5.12 Slapkins Ct. 1+57, 9' L
I-23	A-10	419.80	-	413.73	413.26 SD 4.02 Slapkins Ct. 2+52, 15' L
M-25	Shall. MH	421.61	-	415.70	415.50 SD 5.12 Slapkins Ct. 3+49, 15' L
M-26	Shall. MH	423.29	-	418.00	417.75 SD 5.12 Slapkins Ct. 4+34, 15' L
M-27	Std. MH	429.10	-	422.25	421.50 SD 5.12 Slapkins Ct. 6+23, 15' L
I-29	A-10	429.31	-	422.61	SD 4.02 Lynn La. 8+00, 15' L
I-31	A-10	431.50	-	424.10	423.70 SD 4.02 Slapkins Ct. 6+65, 15' L
I-33	A-10	431.50	-	424.55	SD 4.02 Slapkins Ct. 6+65, 15' R
I-35	A-10	427.29	-	423.22	SD 4.02 Slapkins Ct. 10+25, 15' L
I-36	A-10	427.29	-	423.77	SD 4.02 Slapkins Ct. 10+25, 15' R
M-37	Std. PC MH	420.42	-	410.44	410.34 SD 5.11 Radel Ct. 1+82, 9' R
M-39	Std. PC MH	420.95	-	411.60	411.25 SD 5.11 Lynn La. 3+28, 17' R
I-41	A-10	422.75	-	415.50	SD 4.02 Lynn La. 3+81, 15' R
I-43	A-10	419.54	-	412.00	411.80 SD 4.02 Lynn La. 4+55, 15' R
I-45	A-10	419.47	-	412.77	412.16 SD 4.02 Lynn La. 4+50, 15' L
I-47	A-10	417.94	-	414.10	413.85 SD 4.02 Lynn La. 1+40, 28, 15' L
I-49	A-10	417.94	-	414.40	SD 4.02 Lynn La. 1+40, 28, 15' R
I-51	Conc. EW	417.75	-	411.75	SD 5.21 Lynn La. 1+12, 35' R
I-53	Conc. EW	415.75	-	412.75	SD 5.21 Lynn La. 1+12, 35' L

PIPE SCHEDULE				
ITEM NO.	TYPE	CLASS	LENGTH	REMARKS
1	2.5"	PVC	10'	With 30 - 1/2" perf.
2	18"	RCP	60'	With O-ring and Rubber Gasket
3	18"	RCP	30'	With O-ring and Rubber Gasket
4	15"	RCP	1V	277'
5	18"	RCP	1V	1253'
6	21"	RCP	1V	192'
7	24"	RCP	1V	70'
8	27"	RCP	1V	67'
9	30"	RCP	1V	182'

* Length taken from storm drain profile measuring center to center. Contractor shall verify all quantity considering slope and structural connections.

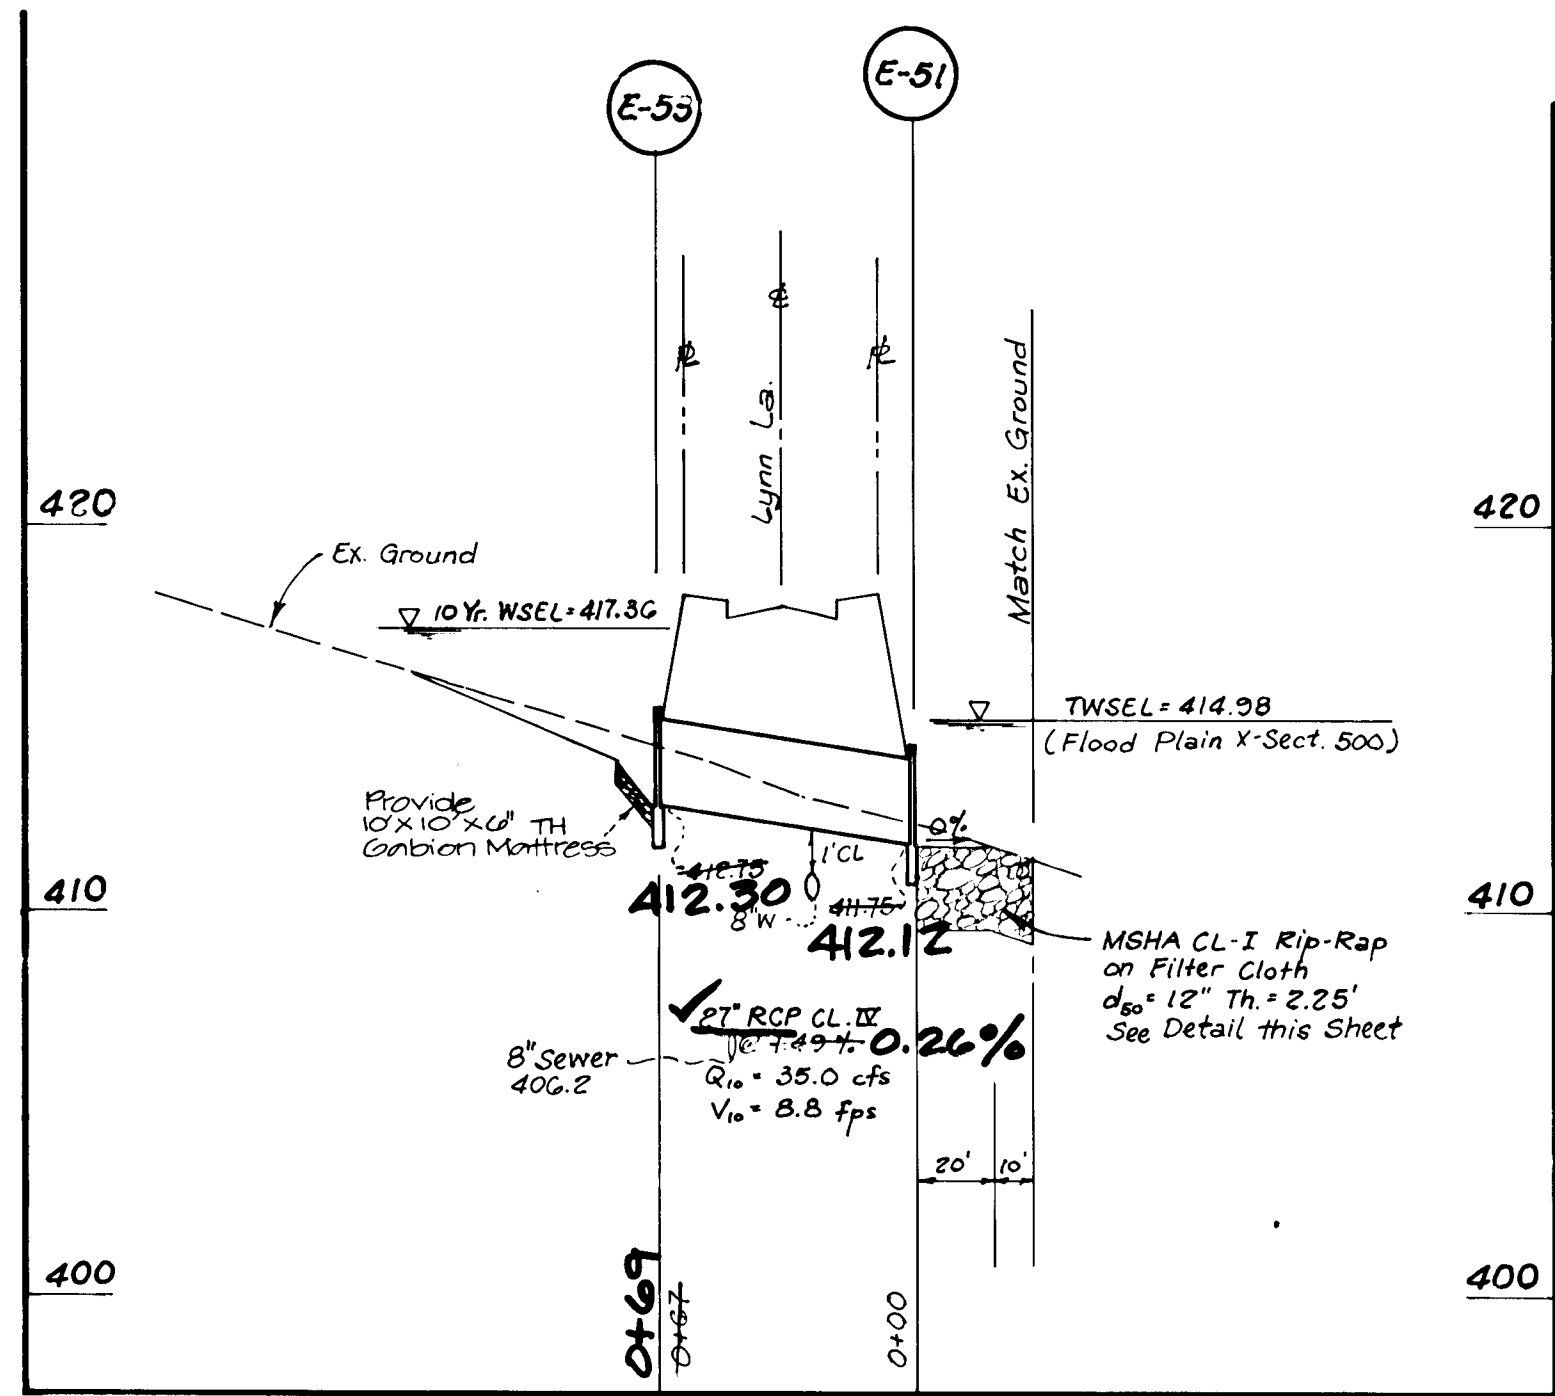

24" CULVERT PROFILE @ LYNN LANE
STA. 1+12
SCALE: H: 1" = 50'
V: 1" = 5'

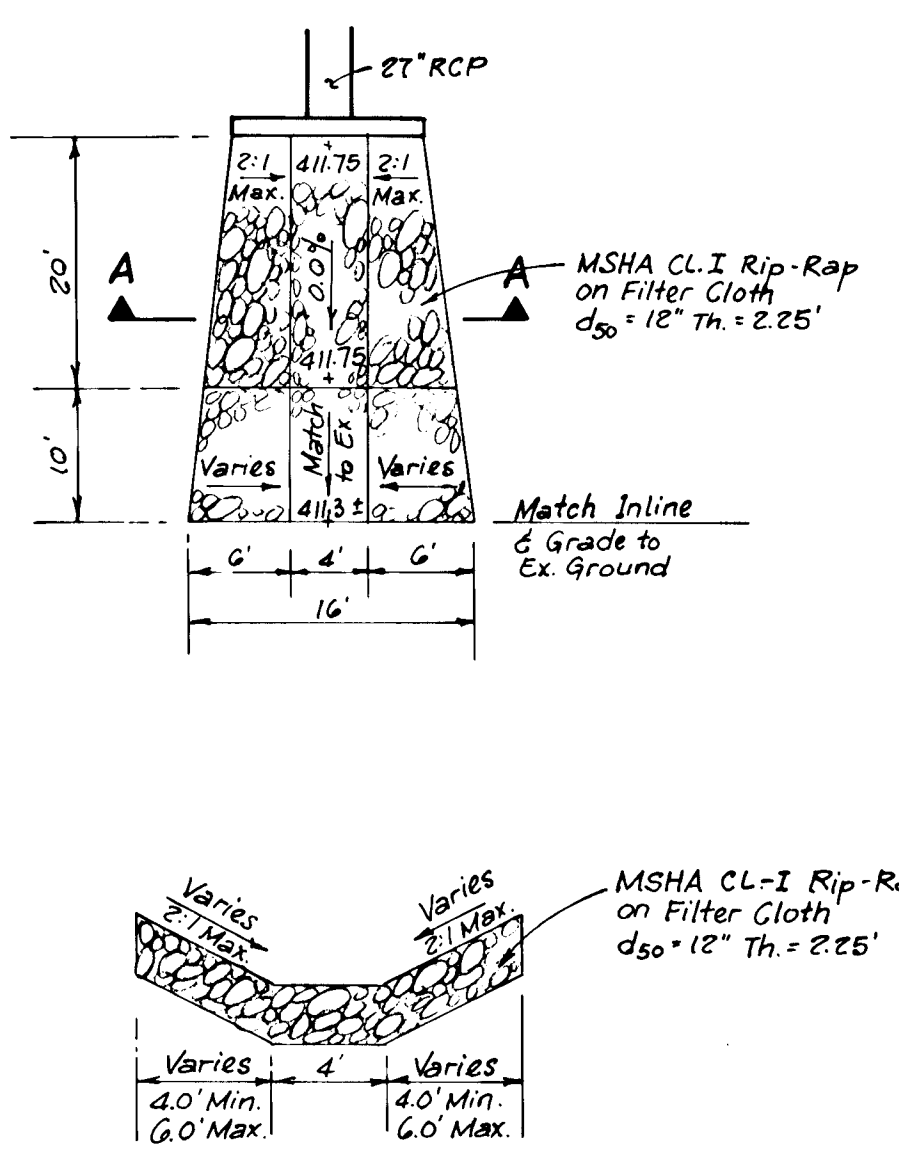

DETAILS FOR OUTFALL PROTECTION
@ STR. #51

ENGINEER'S "AS-BUILT" CERTIFICATE

I hereby certify that the "As-Built" information shown hereon in red is accurate and complete.
[Signature] 1/10/99
Jang H. Lee, P.E.
MD LIC. #18632

[Signature]
STATE OF MARYLAND
JANG H. LEE
No. 18632
1999

"AS-BUILT"

F-94-99

STORM DRAIN AND SWM DETAILS
ABBEYFIELD ESTATES
TAX MAP 31 PARCELS 206, 208 & 209
1st. ELECTION DISTRICT
HOWARD COUNTY, MARYLAND

LAVELLE & ASSOCIATES INCORPORATED
CIVIL ENGINEERS • LAND PLANNERS • LAND SURVEYORS
10 NORTH JEFFERSON STREET
SUITE 203
FREDERICK, MARYLAND 21701
OFFICE: (301) 831-4510
FAX: (301) 695-9722

DESIGN	DRAFT	CHECKED	DATE	SCALE
JL	T.C. Tang	JL	April 5, 1994	As Shown
REVISION	NO.	DATE	BY	

