
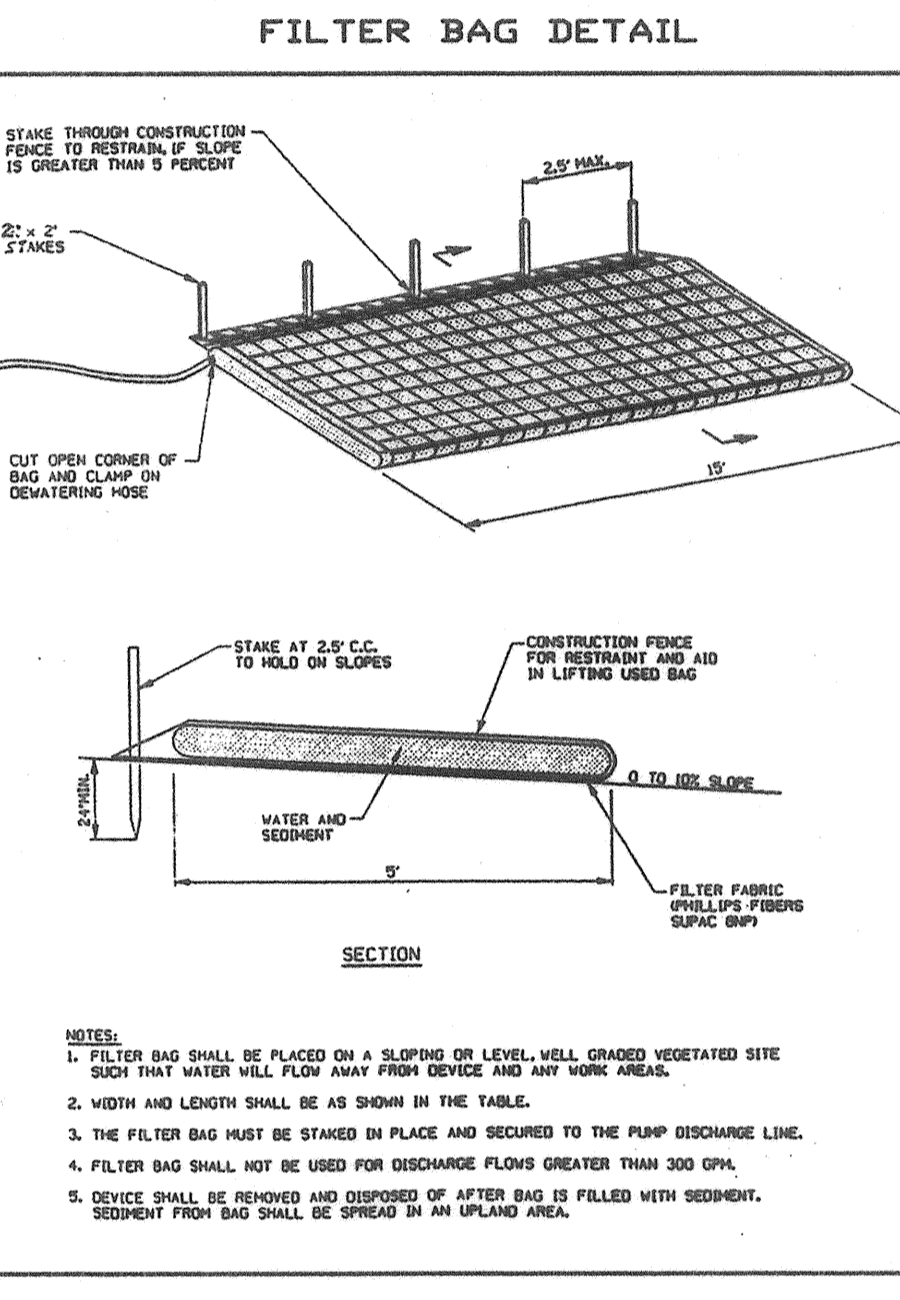
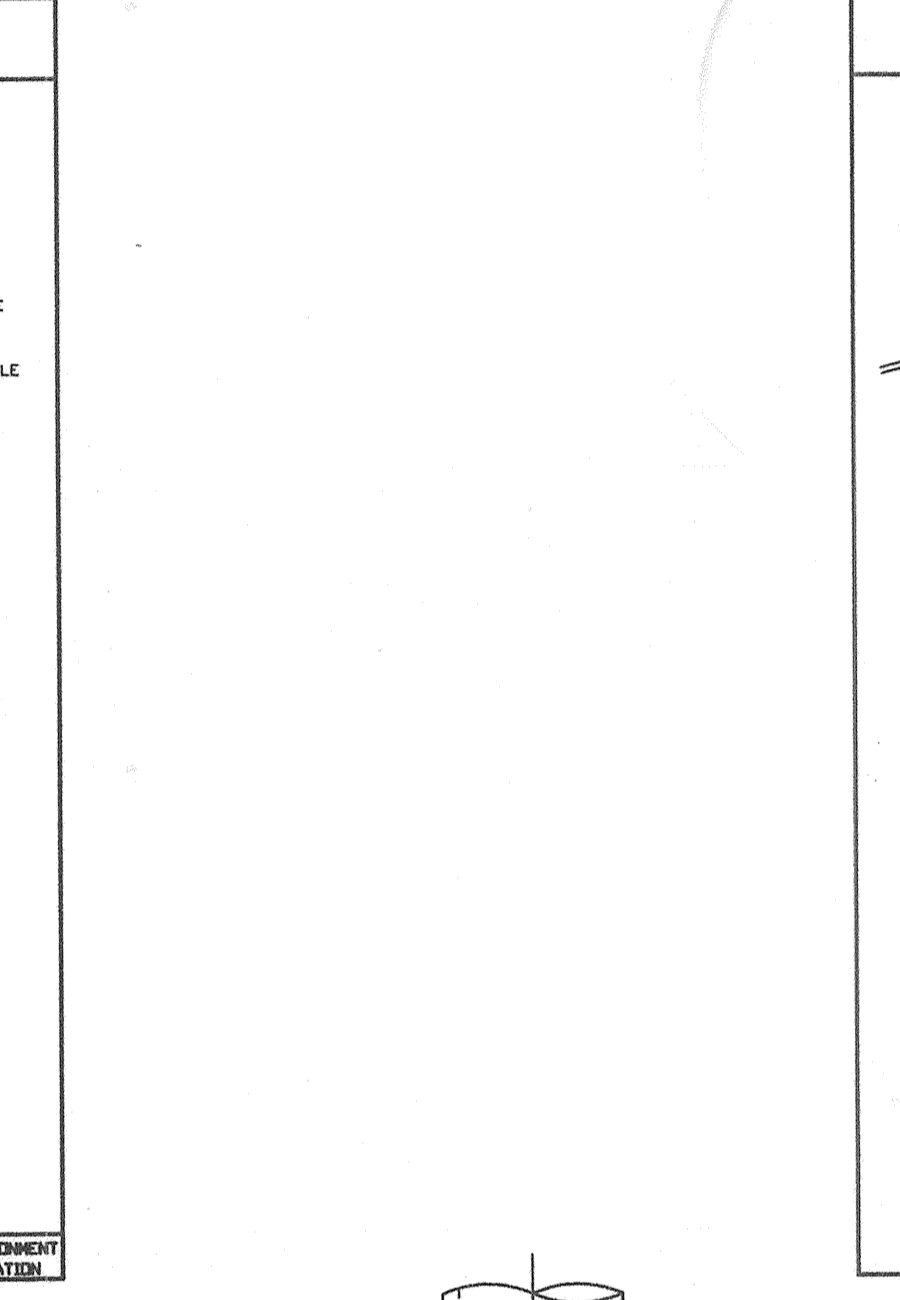
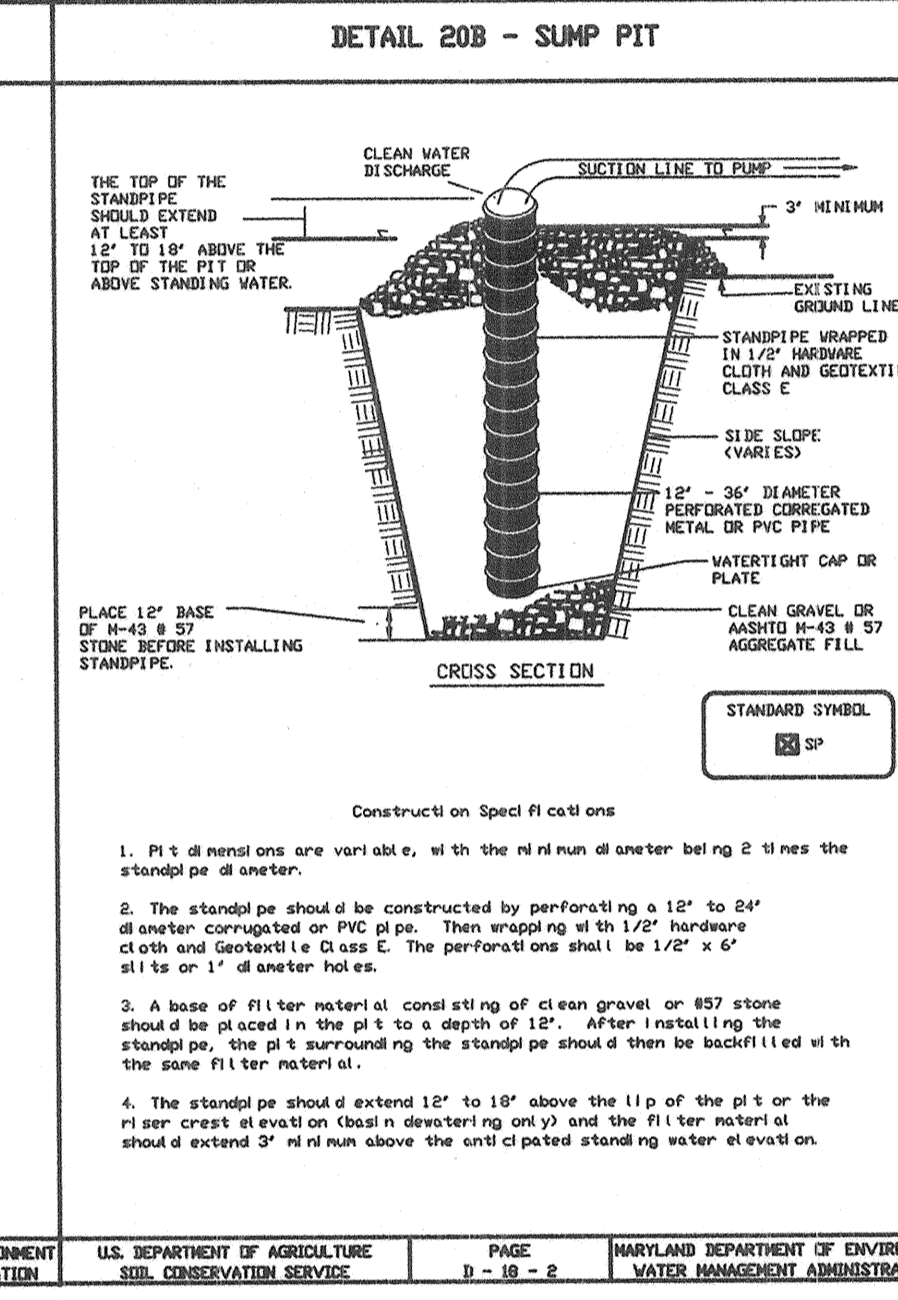
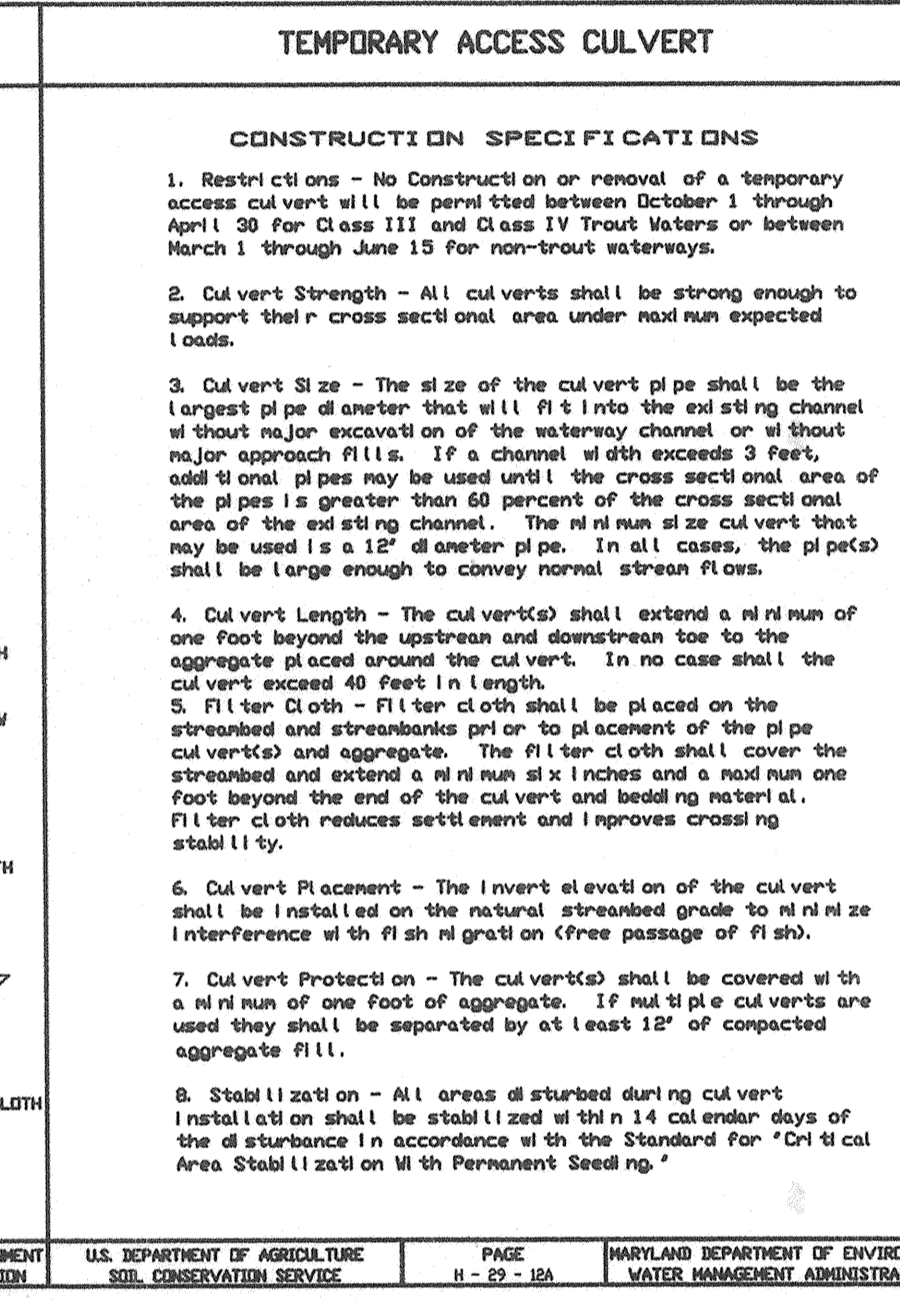
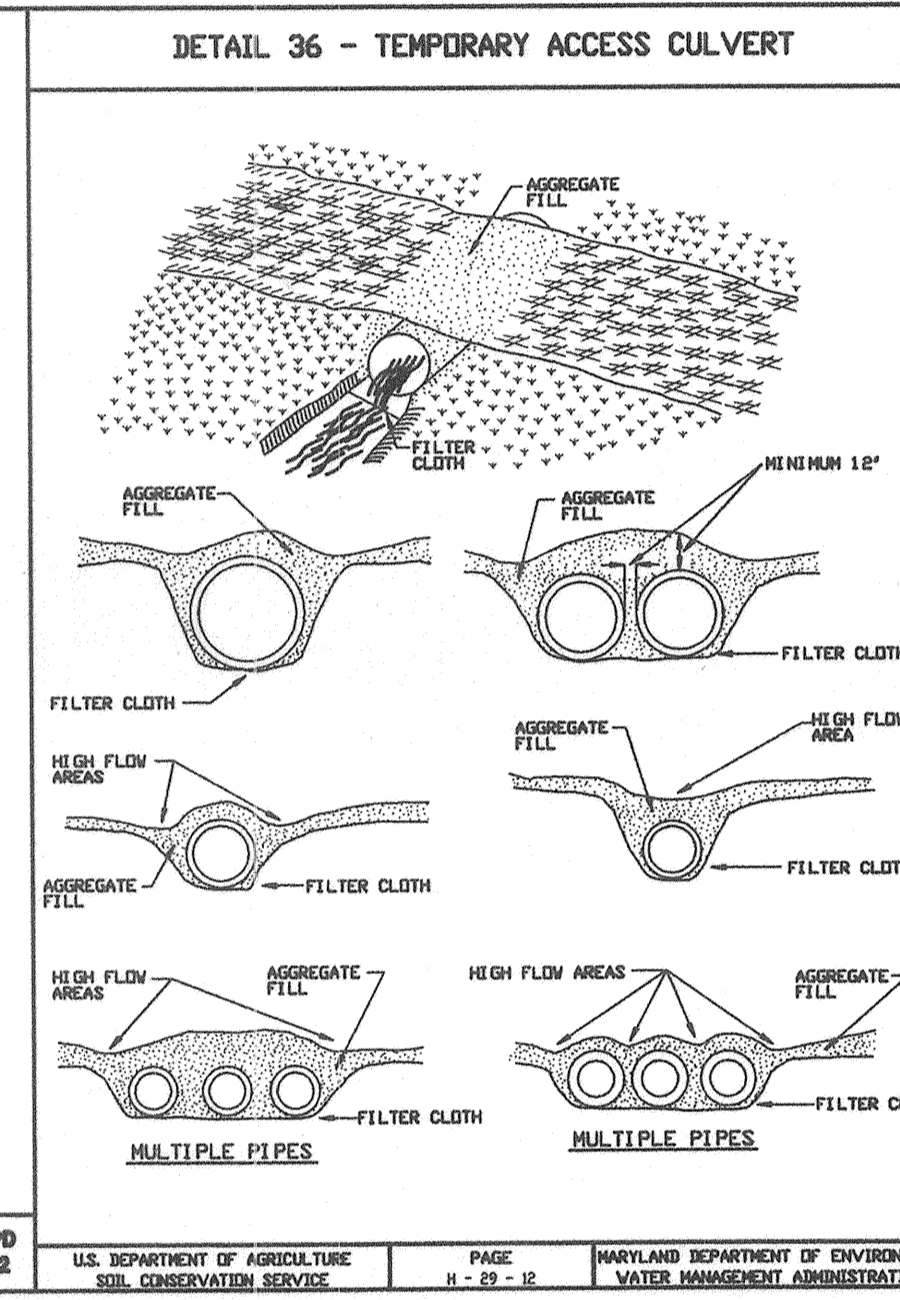
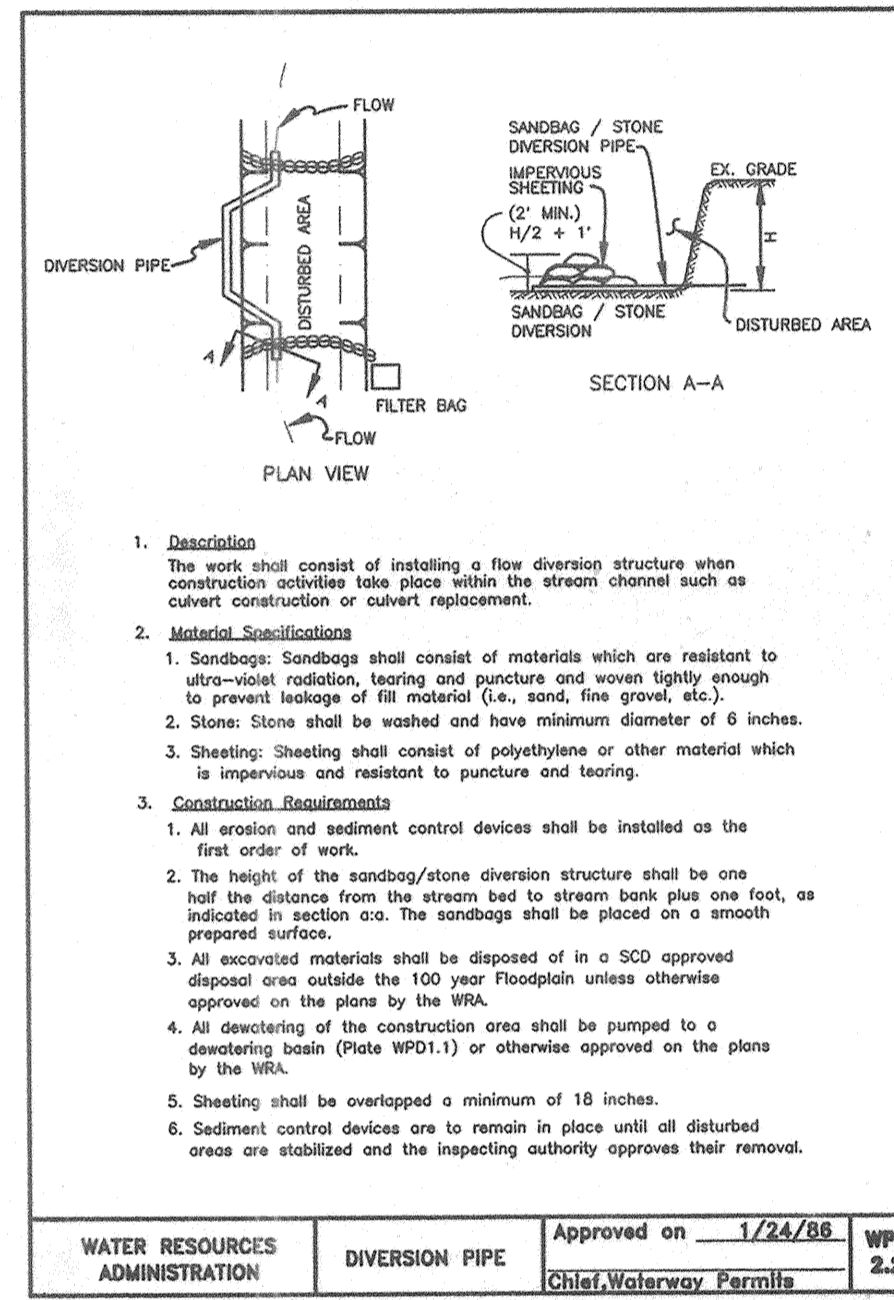


Trap #	Trap Size	Trap Material	Trap Weight	Trap Dimensions
1	18" x 18"	304 SS	16 lbs	18" x 18" x 12"
2	24" x 24"	304 SS	24 lbs	24" x 24" x 12"
3	36" x 36"	304 SS	36 lbs	36" x 36" x 12"
4	48" x 48"	304 SS	48 lbs	48" x 48" x 12"
5	60" x 60"	304 SS	60 lbs	60" x 60" x 12"
6	72" x 72"	304 SS	72 lbs	72" x 72" x 12"
7	84" x 84"	304 SS	84 lbs	84" x 84" x 12"
8	96" x 96"	304 SS	96 lbs	96" x 96" x 12"
9	108" x 108"	304 SS	108 lbs	108" x 108" x 12"
10	120" x 120"	304 SS	120 lbs	120" x 120" x 12"

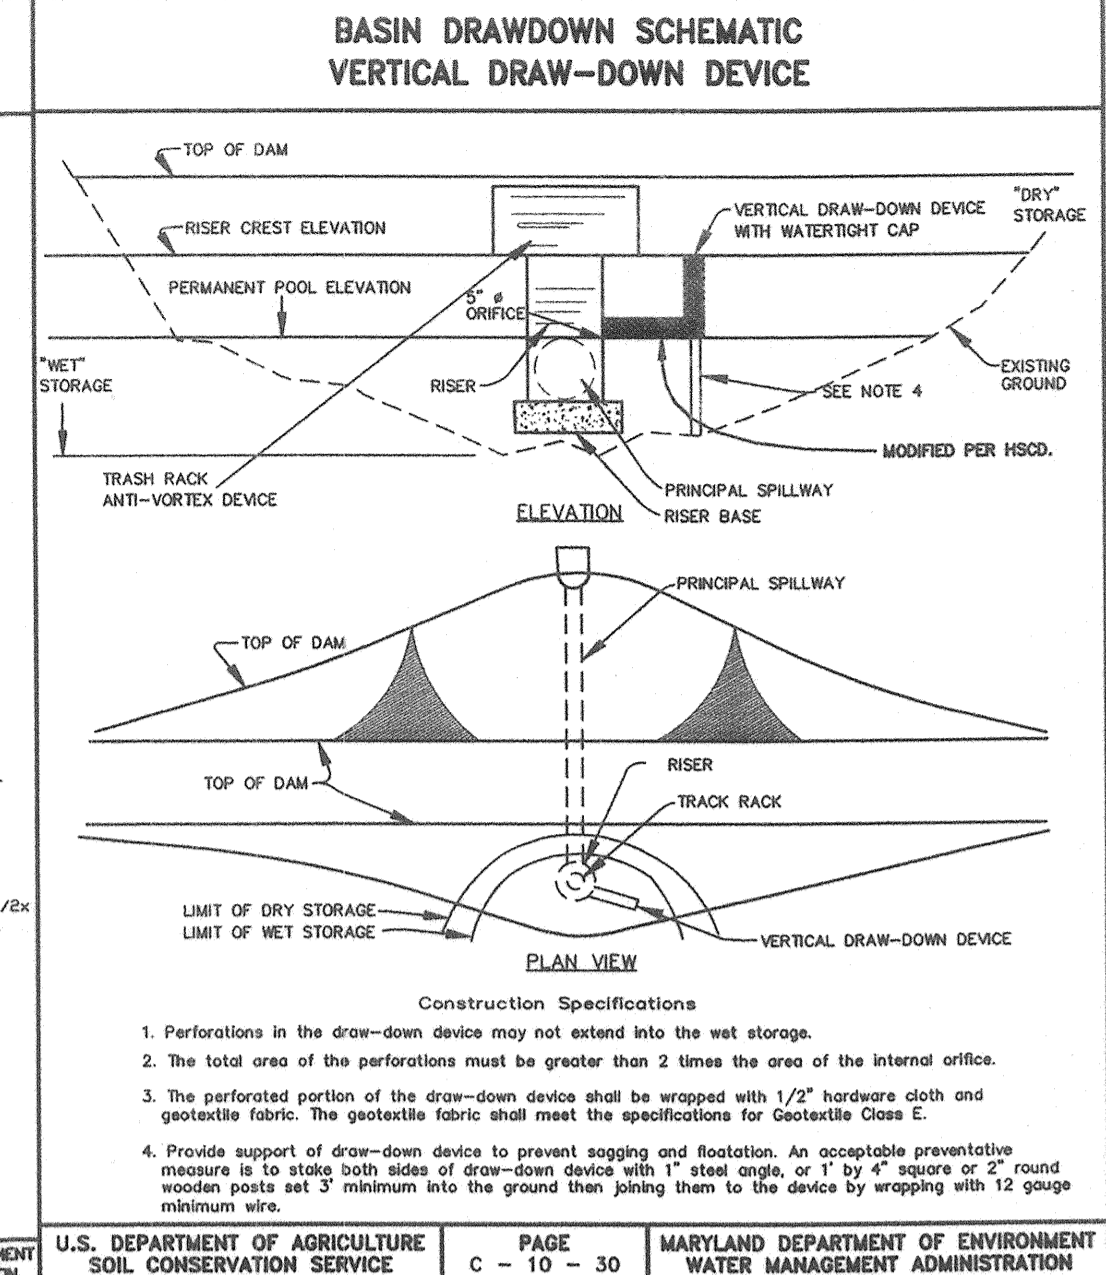

BY THE DEVELOPER:  
 I/WE CERTIFY THAT ALL DEVELOPMENT AND/OR CONSTRUCTION WILL BE DONE ACCORDING TO THESE PLANS, AND THAT ANY RESPONSIBLE PERSONNEL INVOLVED IN THE CONSTRUCTION PROJECT WILL HAVE A CERTIFICATE OF ATTENDANCE AT A DEPARTMENT OF THE ENVIRONMENT APPROVED TRAINING PROGRAM FOR THE CONTROL OF SEDIMENT AND EROSION BEFORE BEGINNING THE PROJECT. I SHALL ENGAGE A REGISTERED PROFESSIONAL ENGINEER TO SUPERVISE POND CONSTRUCTION AND PROVIDE THE HOWARD SOIL CONSERVATION DISTRICT WITH AN "AS-BUILT" PLAN OF THE POND WITHIN 30 DAYS OF COMPLETION. I ALSO AUTHORIZE PERIODIC ON-SITE INSPECTIONS BY THE HOWARD SOIL CONSERVATION DISTRICT.

DEVELOPER - TOLL AND LIMITED PARTNERSHIP  
 DATE: 6-1-99

BY THE ENGINEER:  
 I/WE CERTIFY THAT THIS PLAN FOR POND CONSTRUCTION, EROSION AND SEDIMENT CONTROL, REPRESENTS A PRACTICAL AND WORKABLE PLAN BASED ON MY PERSONAL KNOWLEDGE OF THE SITE CONDITIONS. THIS PLAN WAS PREPARED IN ACCORDANCE WITH THE REQUIREMENTS OF THE HOWARD SOIL CONSERVATION DISTRICT. I HAVE NOTIFIED THE DEVELOPER THAT HE/SHE MUST ENGAGE A REGISTERED PROFESSIONAL ENGINEER TO SUPERVISE POND CONSTRUCTION AND PROVIDE THE HOWARD SOIL CONSERVATION DISTRICT WITH AN "AS-BUILT" PLAN OF THE POND WITHIN 30 DAYS OF COMPLETION.

ENGINEER - DONALD A. MASON, P.E. # 21443  
 DATE: 5/10/99

THESE PLANS HAVE BEEN REVIEWED FOR THE HOWARD SOIL CONSERVATION DISTRICT AND MEET THE TECHNICAL REQUIREMENTS FOR SMALL POND CONSTRUCTION, SOIL EROSION, AND SEDIMENT CONTROL.

NATURAL RESOURCES CONSERVATION SERVICE  
 DATE: 6/3/99






THESE PLANS FOR SMALL POND CONSTRUCTION, SOIL EROSION, AND SEDIMENT CONTROL MEET THE REQUIREMENTS OF THE HOWARD SOIL CONSERVATION DISTRICT.

HOWARD SOIL CONSERVATION DISTRICT  
 DATE: 6/9/98

APPROVED: HOWARD COUNTY DEPARTMENT OF PUBLIC WORKS  
 DATE: 6-15-99

APPROVED: HOWARD COUNTY DEPARTMENT OF PLANNING AND ZONING  
 DATE: 6/23/99

DATE: 6/22/98

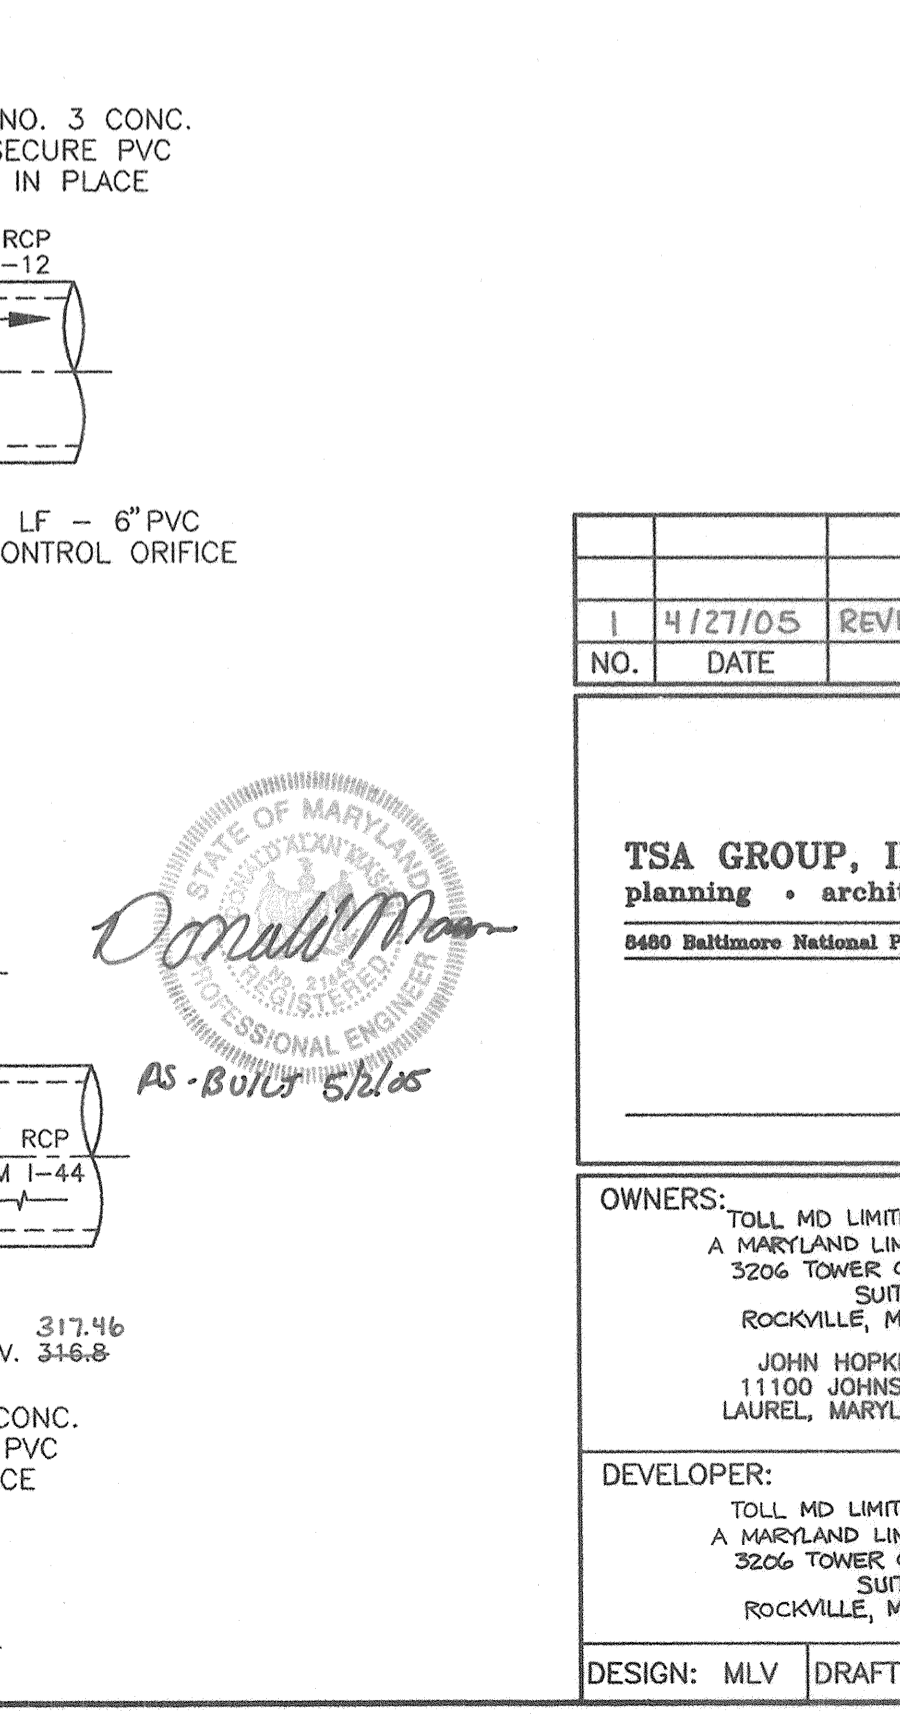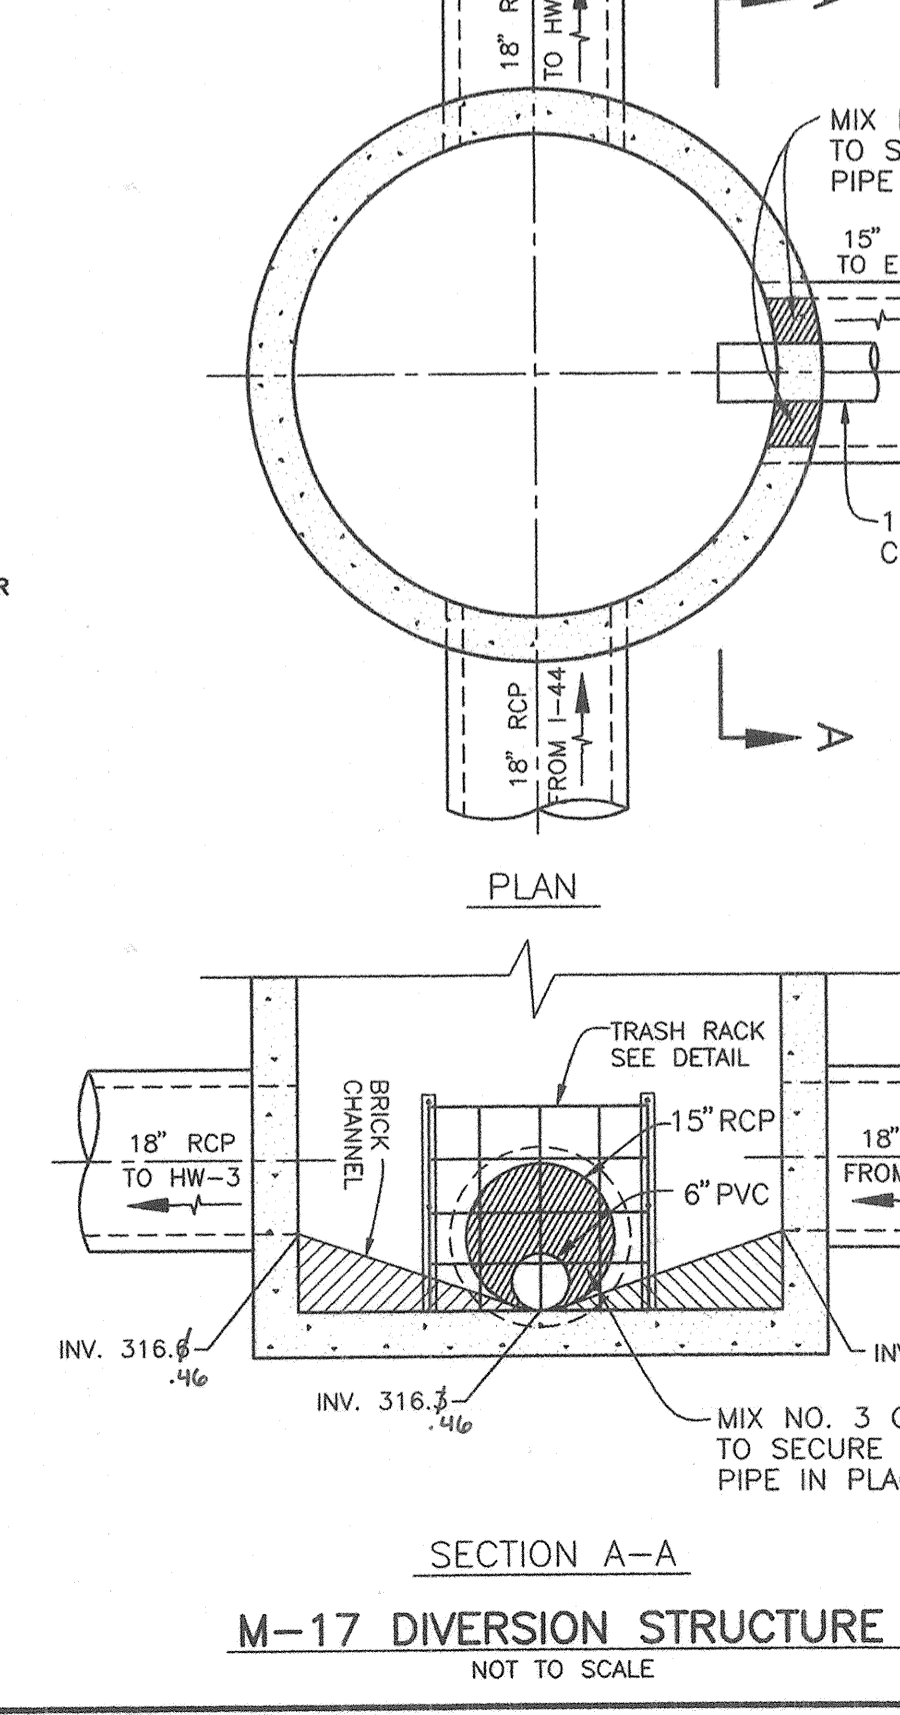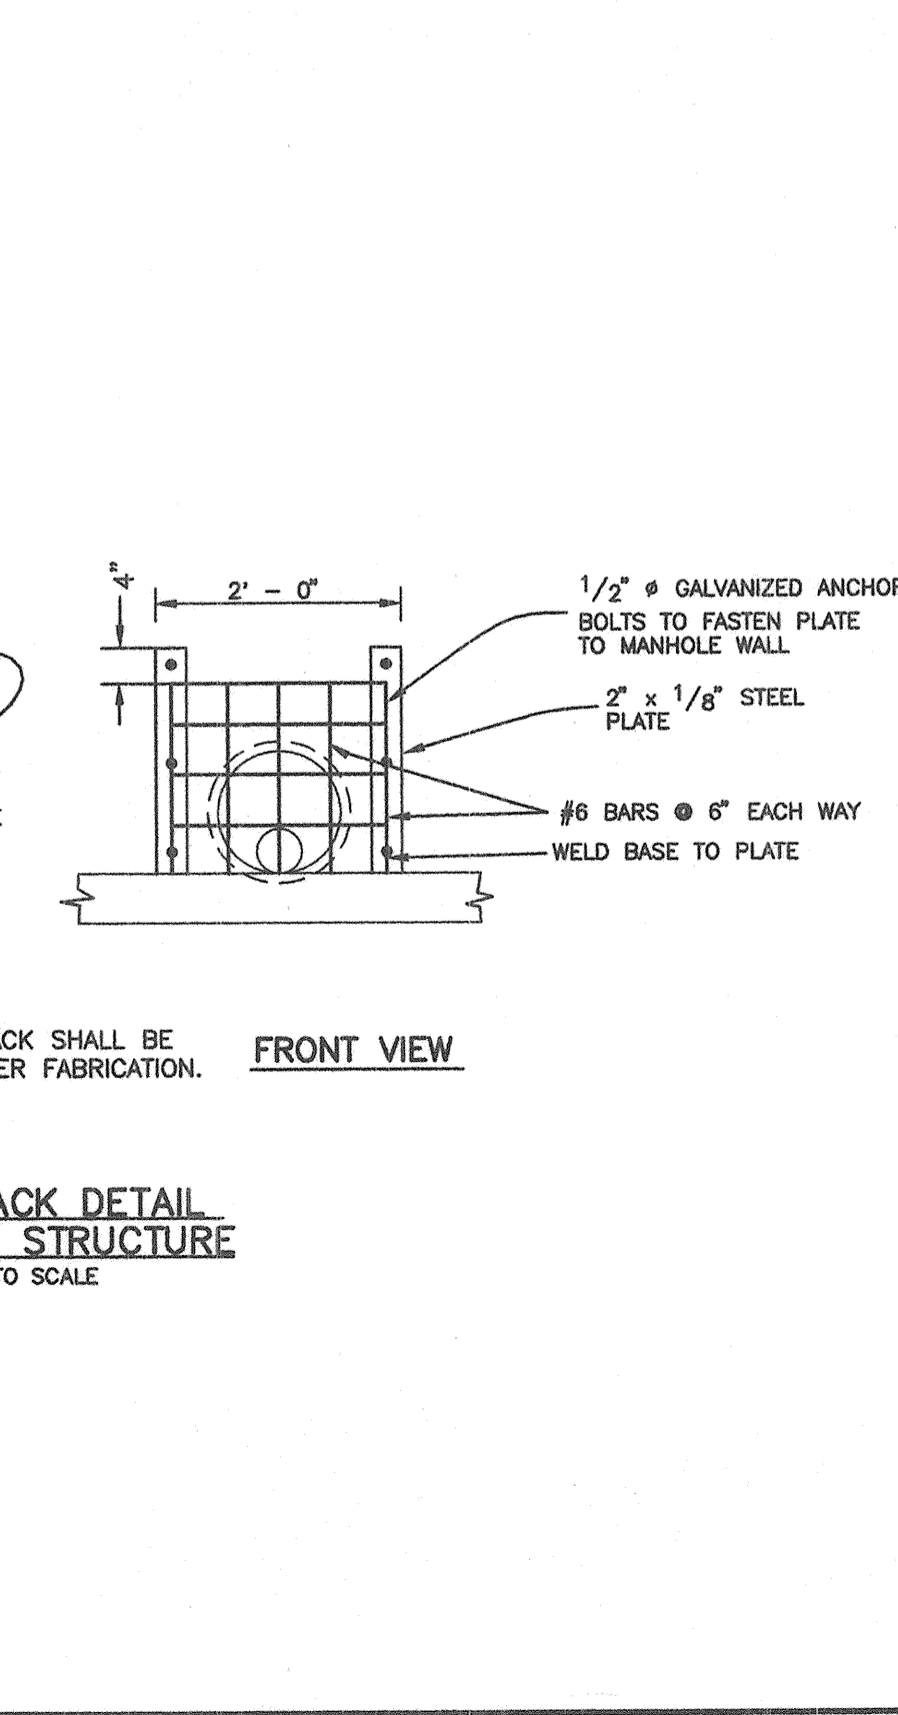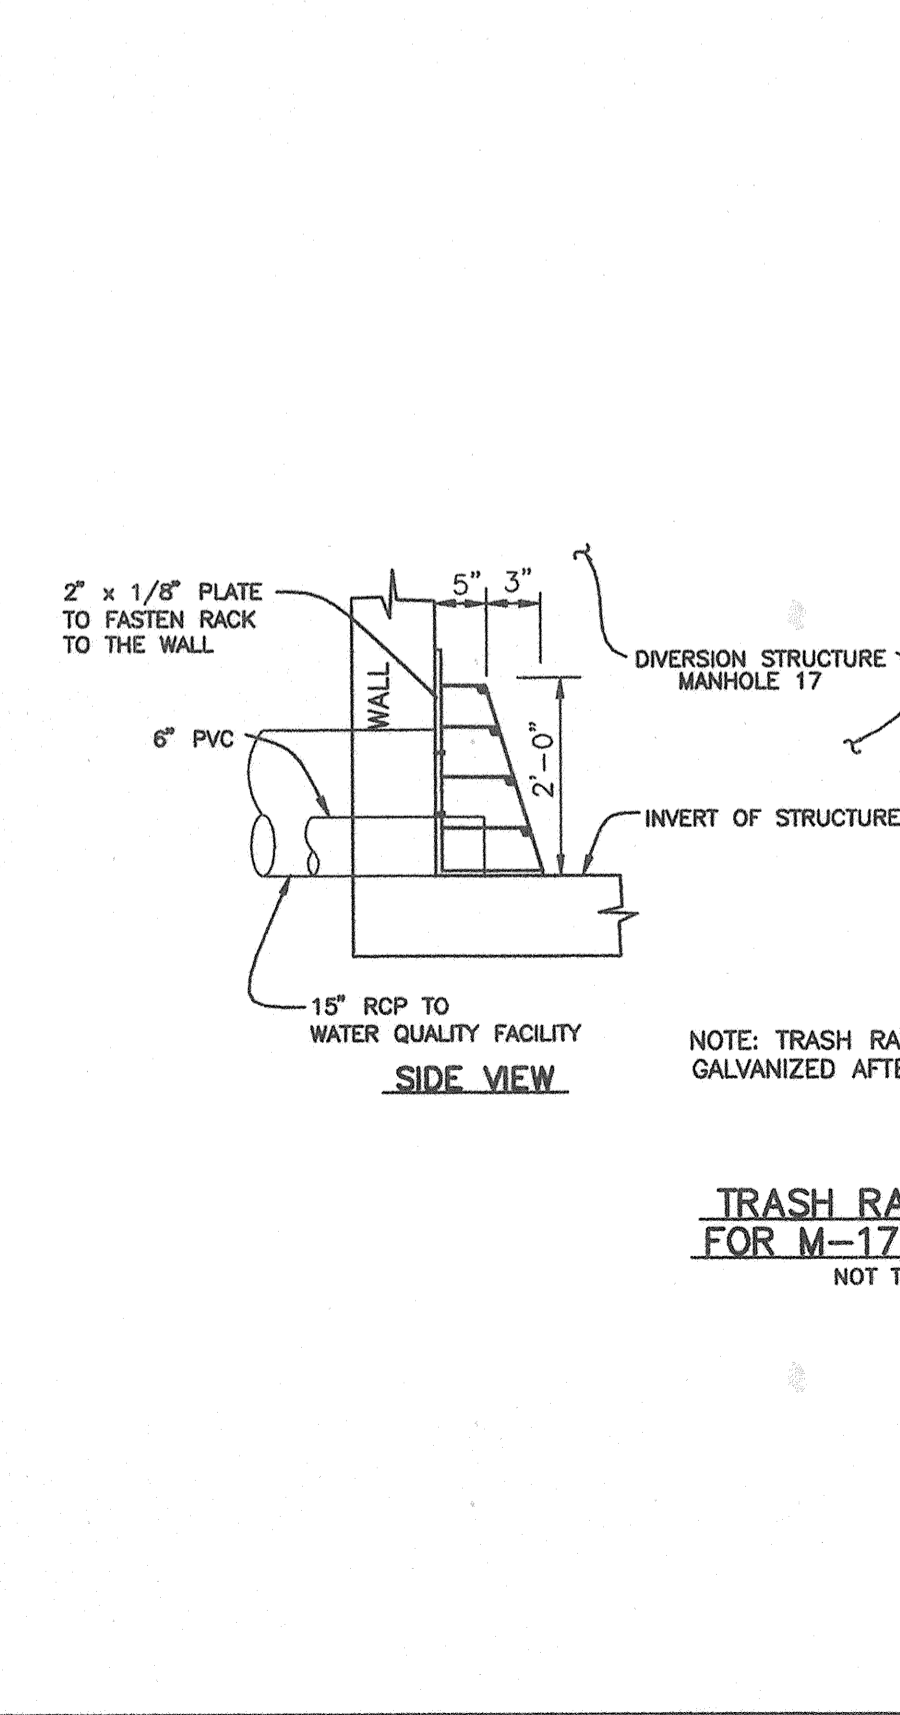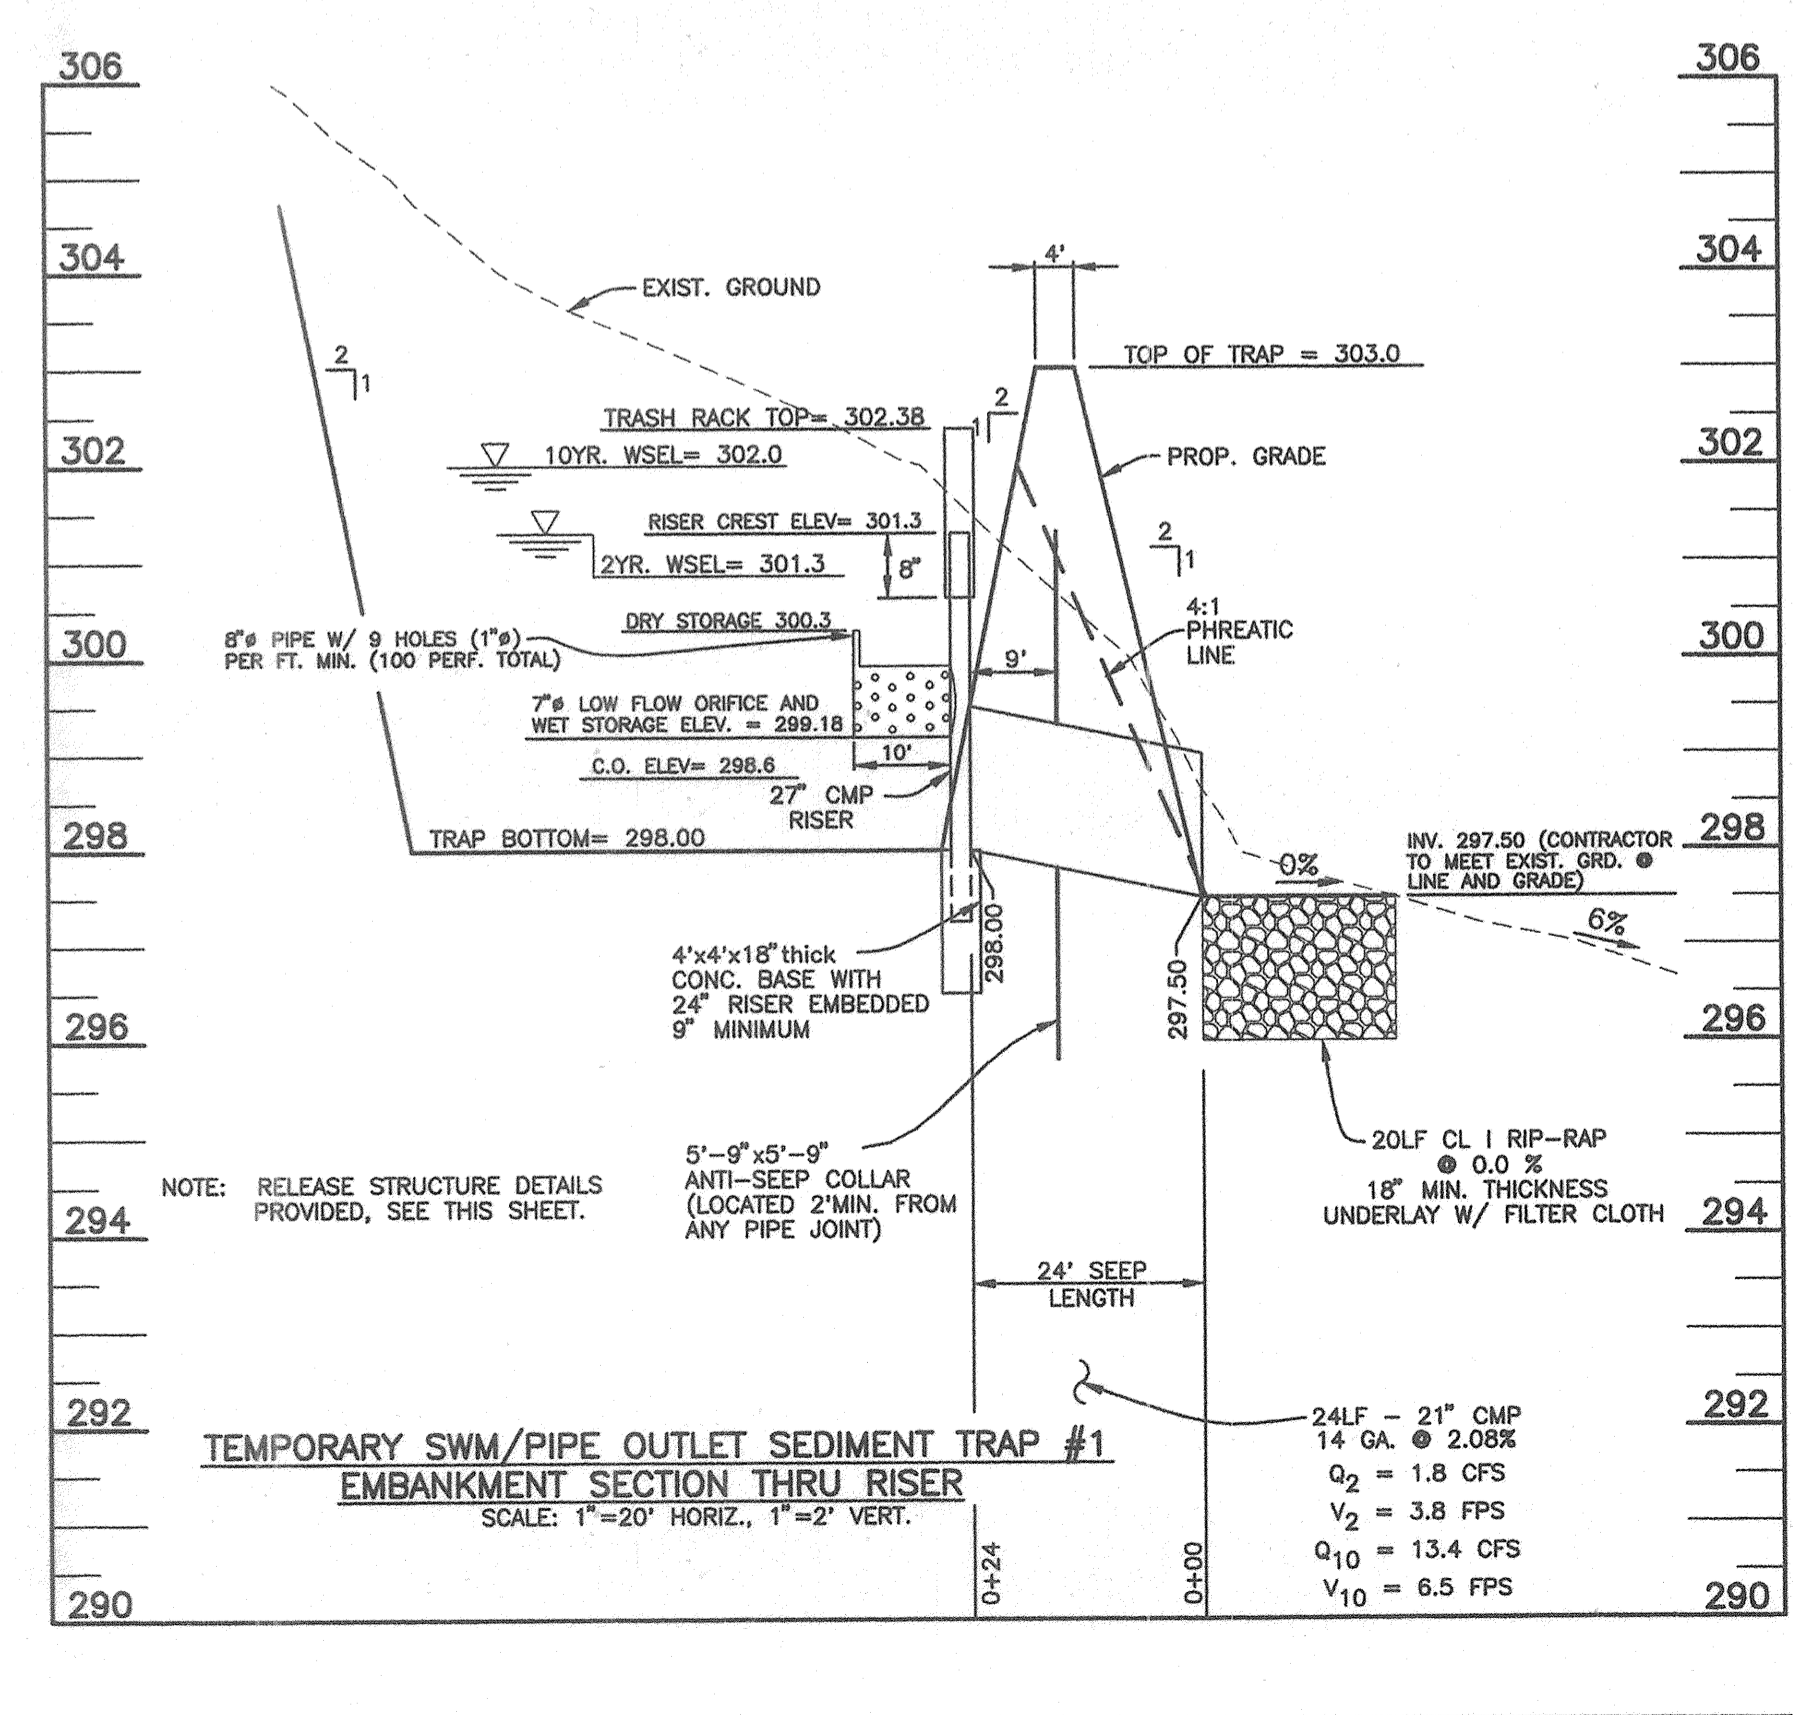

NO. DATE REVISION

1 4/27/05 REVISED PER AS-BUILT CONDITIONS

NO. DATE REVISION

TSA GROUP, INC.  
 planning • architecture • engineering • surveying  
 8400 Baltimore National Pike • Millcreek City, Maryland 21048 • 410-666-8108

OWNERS:  
 TOLL AND LIMITED PARTNERSHIP,  
 A MARYLAND LIMITED PARTNERSHIP  
 3206 TOWER OAKS BOULEVARD  
 SUITE 310  
 ROCKVILLE, MARYLAND 20852

DEVELOPER:  
 TOLL AND LIMITED PARTNERSHIP,  
 A MARYLAND LIMITED PARTNERSHIP  
 3206 TOWER OAKS BOULEVARD  
 SUITE 310  
 ROCKVILLE, MARYLAND 20852

















DESIGN: MLV DRAFT: DBT CHECK: DAM SCALE: AS SHOWN SHEET 26 OF 31

PROJECT: VILLAGE OF CEDAR RIDGE  
 A SUBDIVISION OF PARCEL 44 (TAX MAP 41) AND A RESUBDIVISION OF LOTS 1 AND 2 OF THE EDITH S. PARLETTE SUBDIVISION (PLAT 10735 PARCEL 43) AND A SUBDIVISION OF PARCEL 123 FOR A ROAD RIGHT-OF-WAY

LOCATION: TAX MAP 41 - PARCELS 43 & 44, P/O 123  
 5th ELECTION DISTRICT  
 HOWARD COUNTY, MARYLAND

TITLE: WATER QUALITY FACILITY AND TEMPORARY SWM NOTES AND DETAILS  
 SP-97-02 WP-97-78 PB 312 F-93-70 WP-98-82  
 DATE: OCTOBER, 1997 PROJECT NO. 0518  
 MAY, 1998



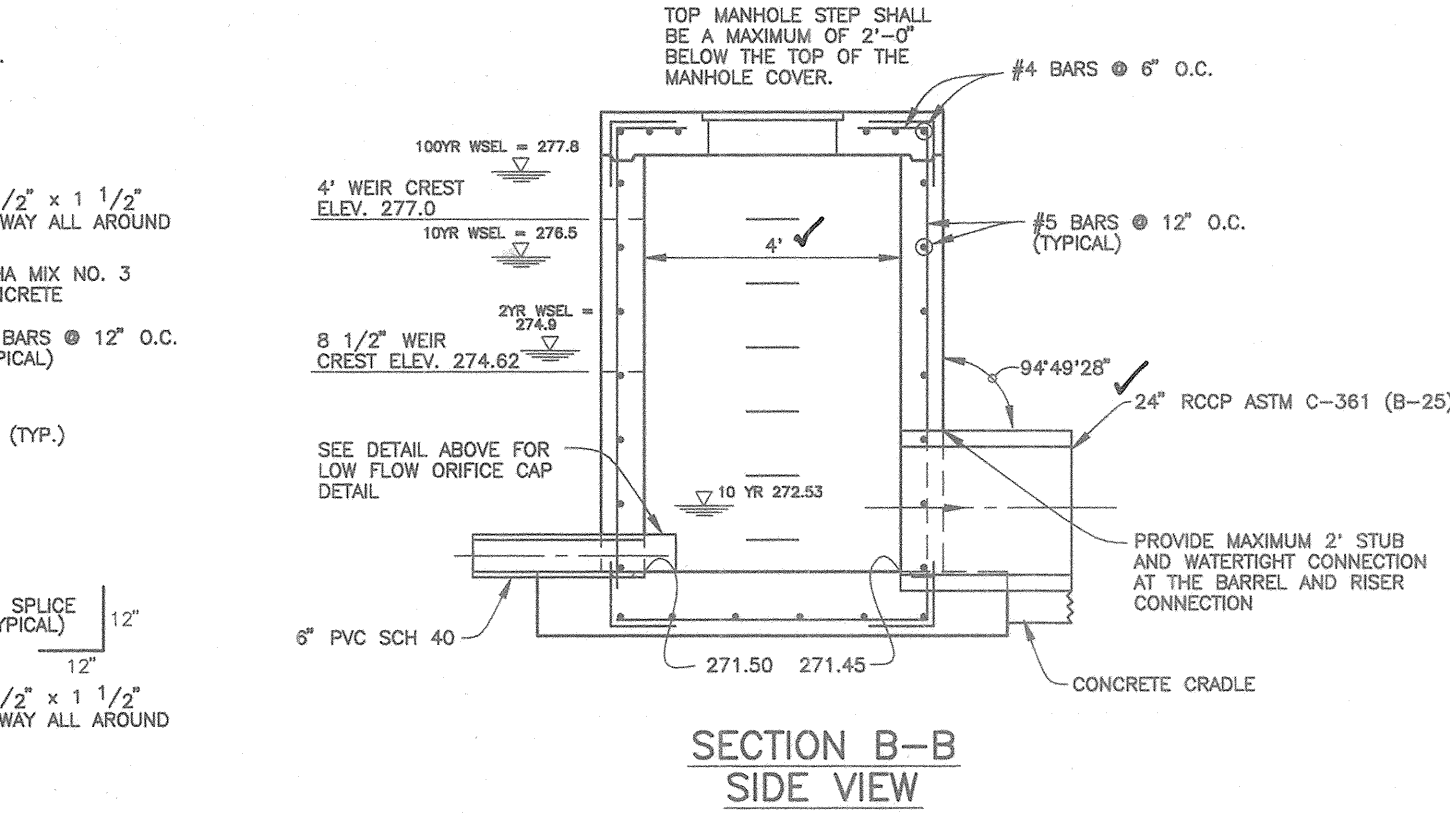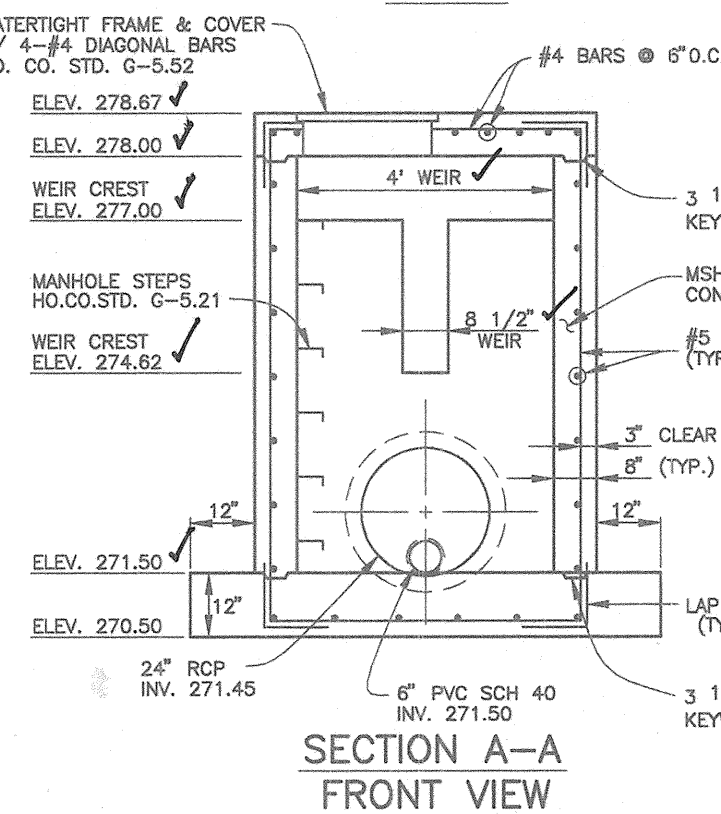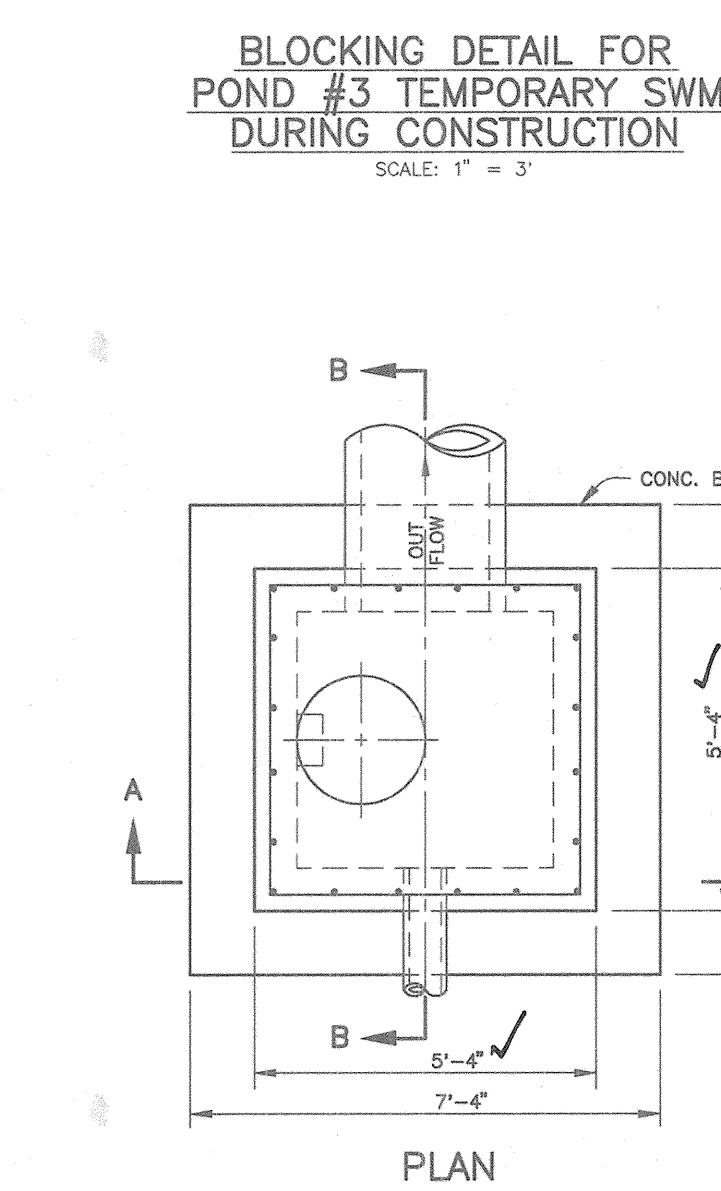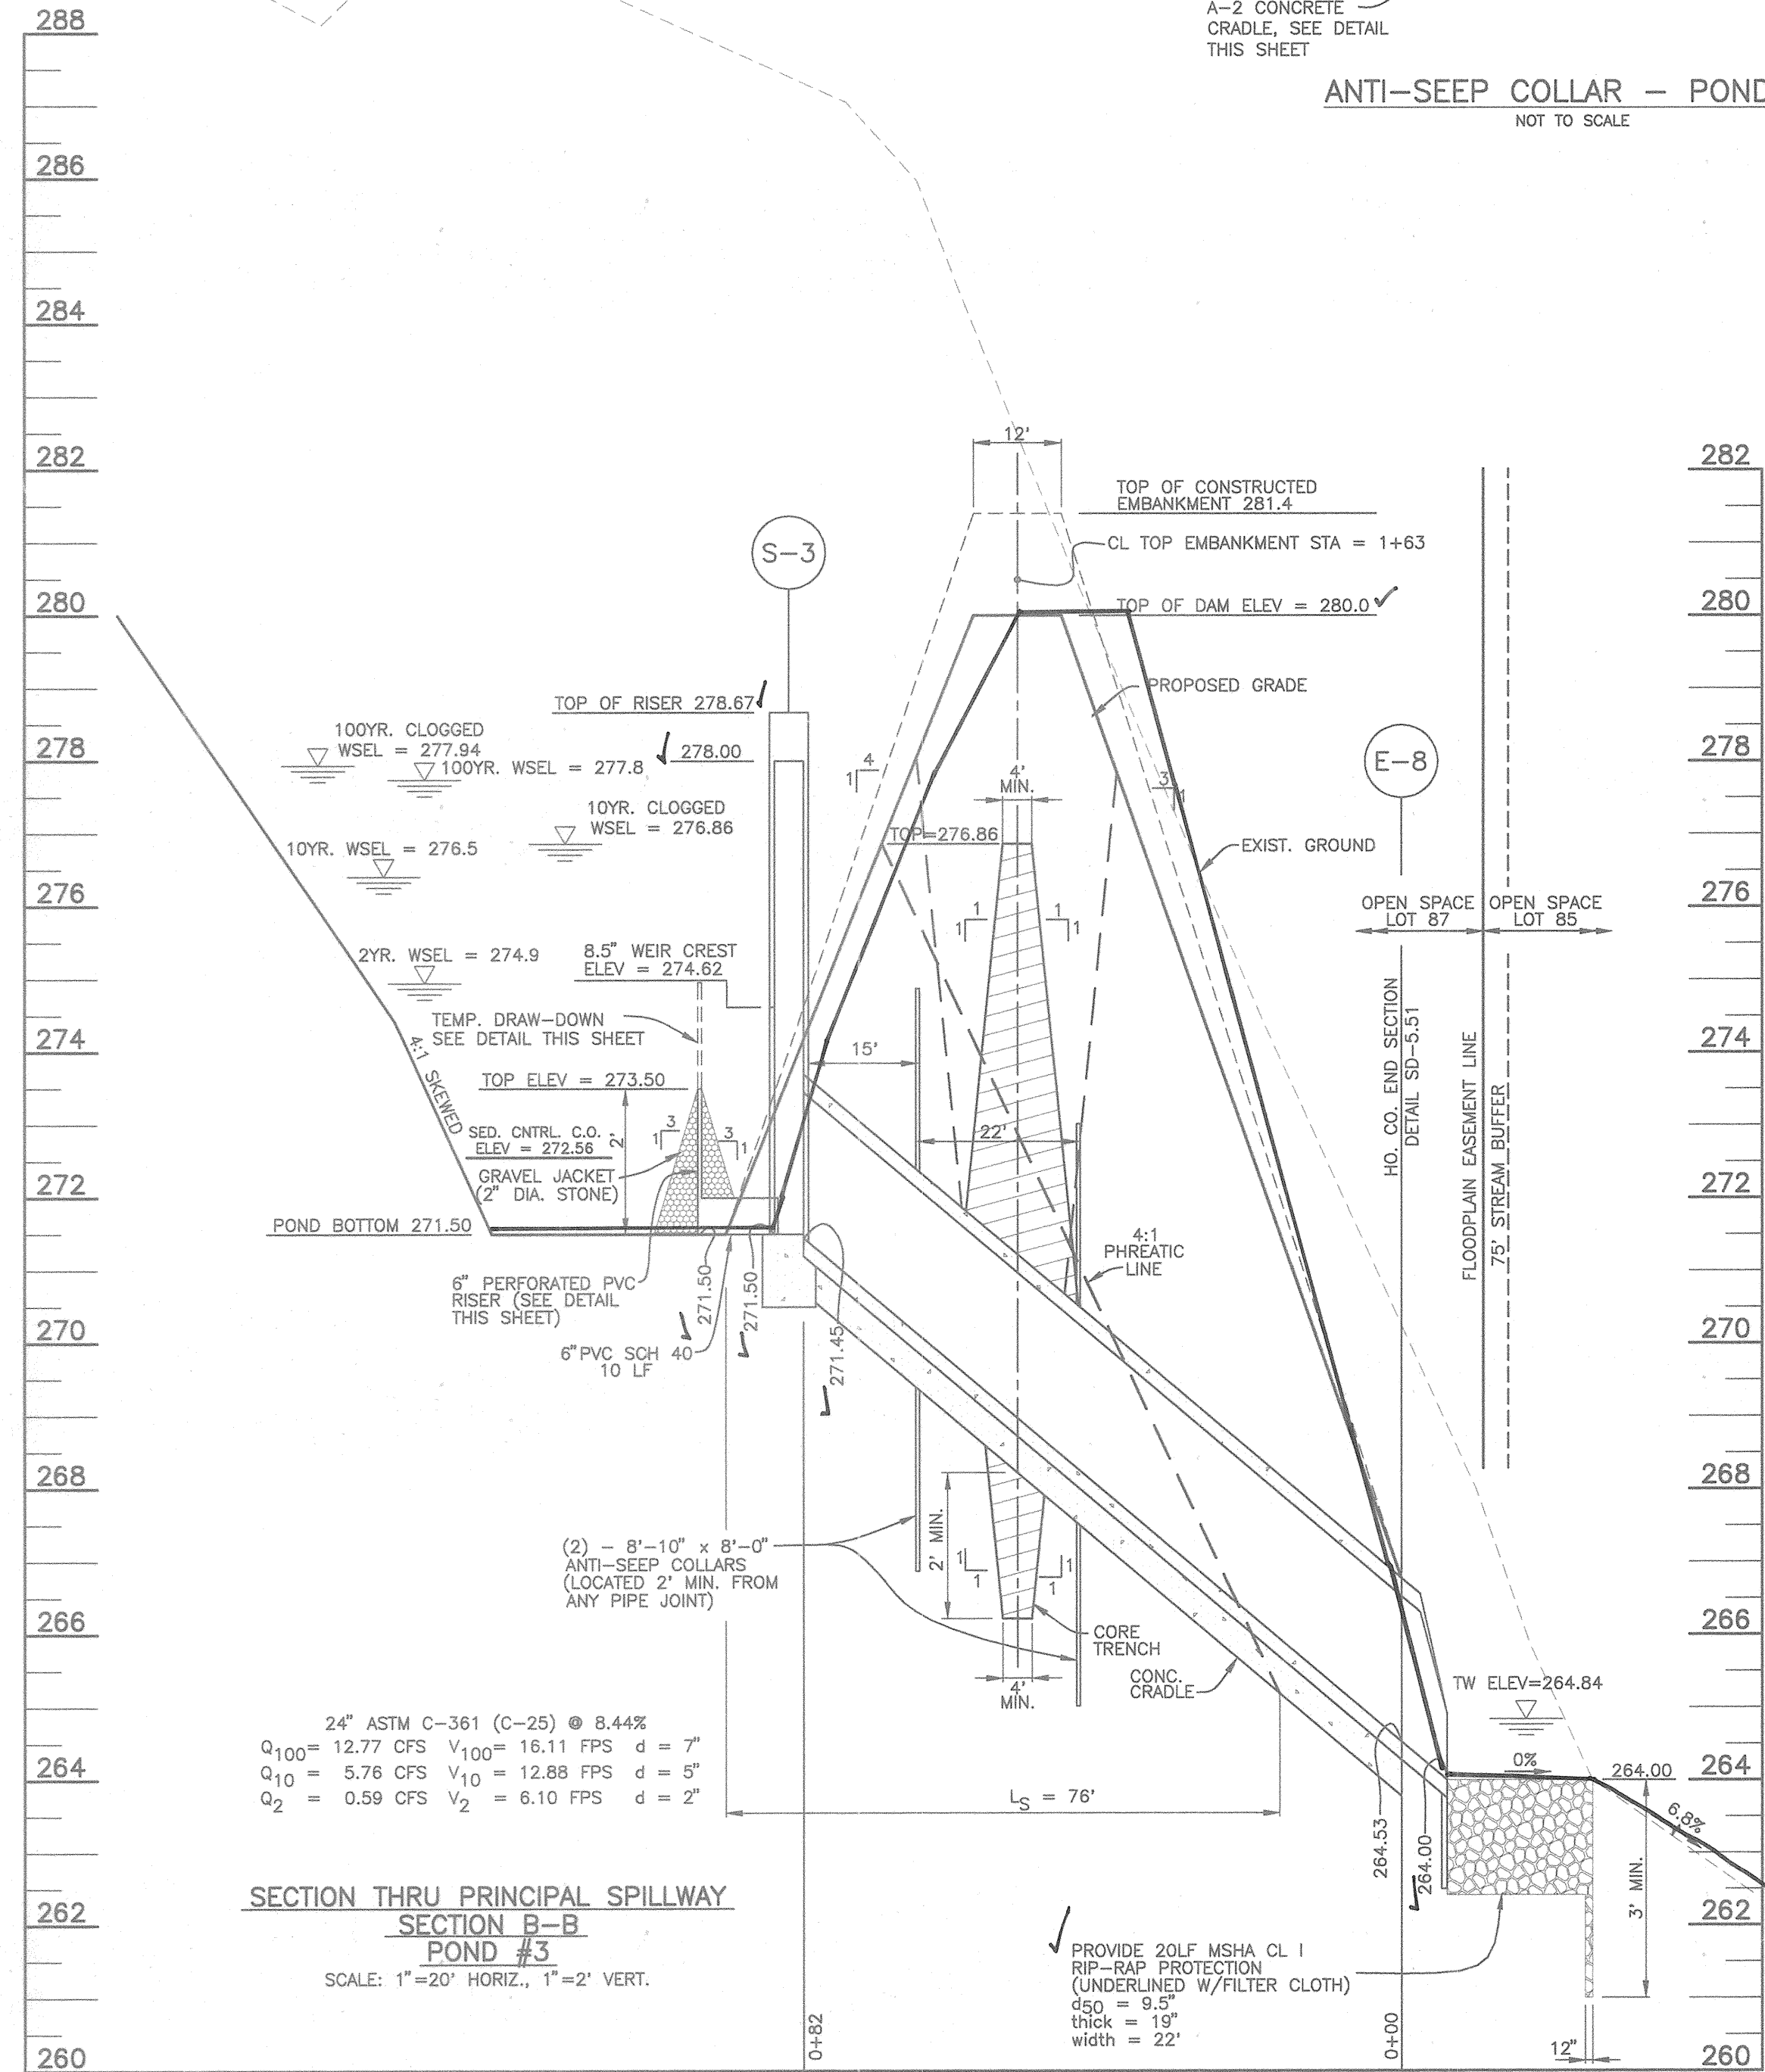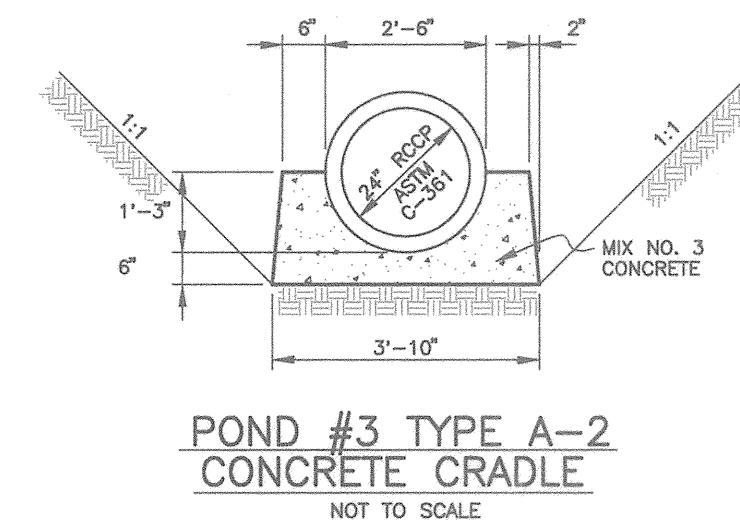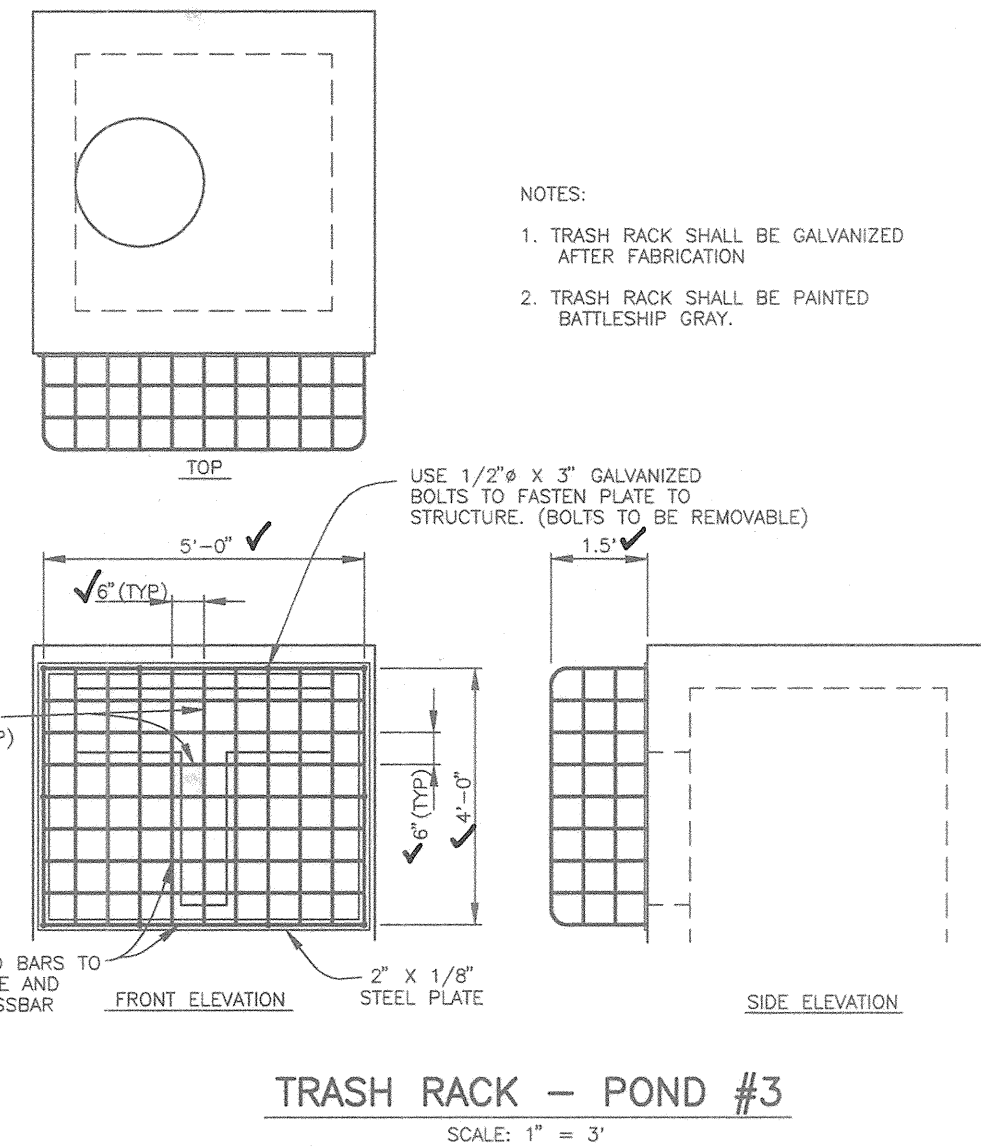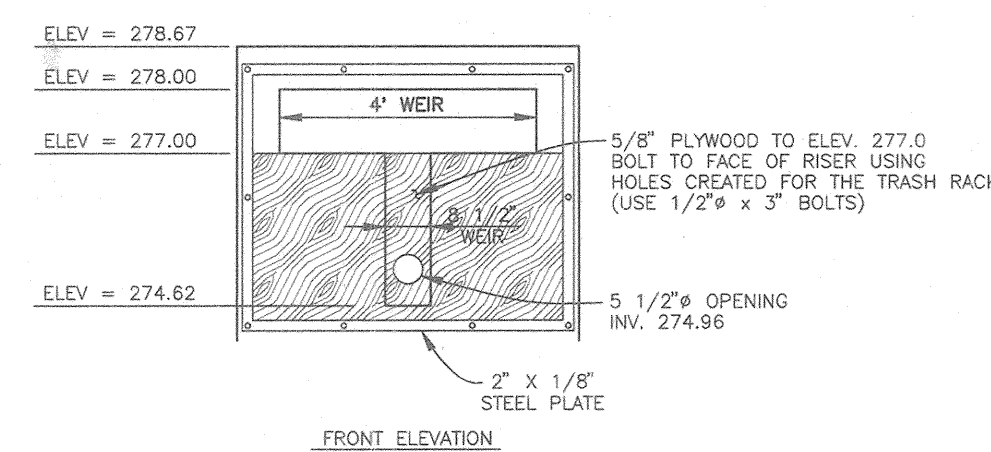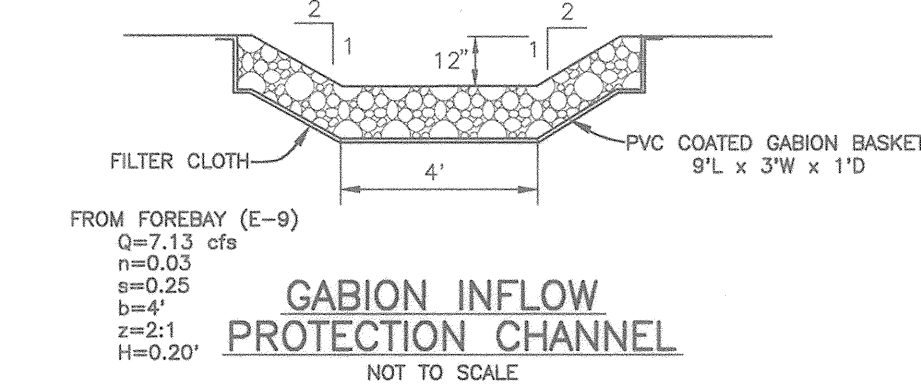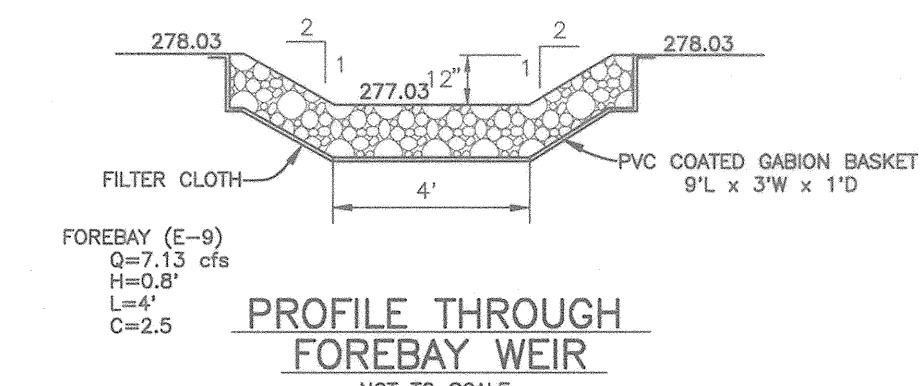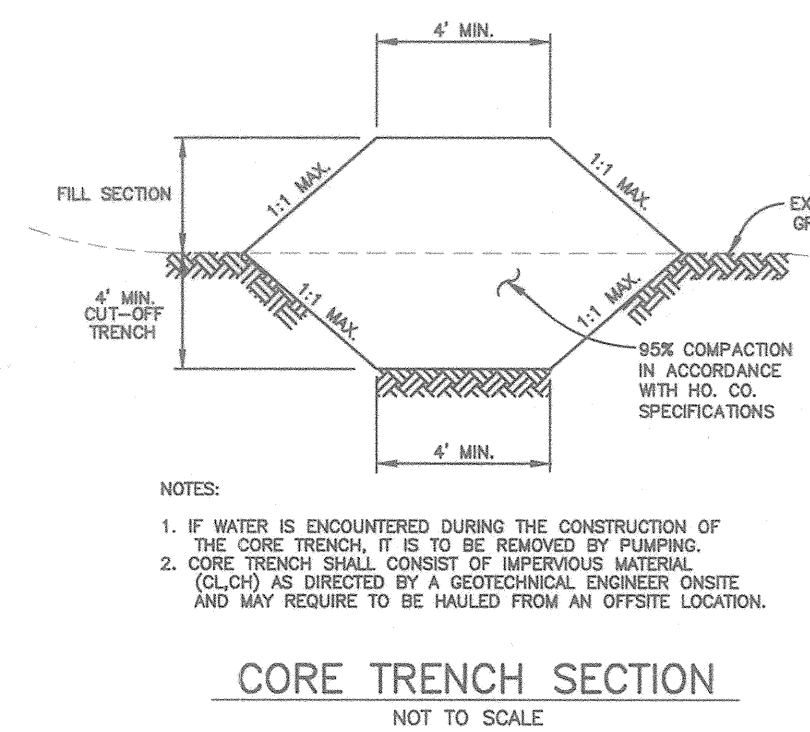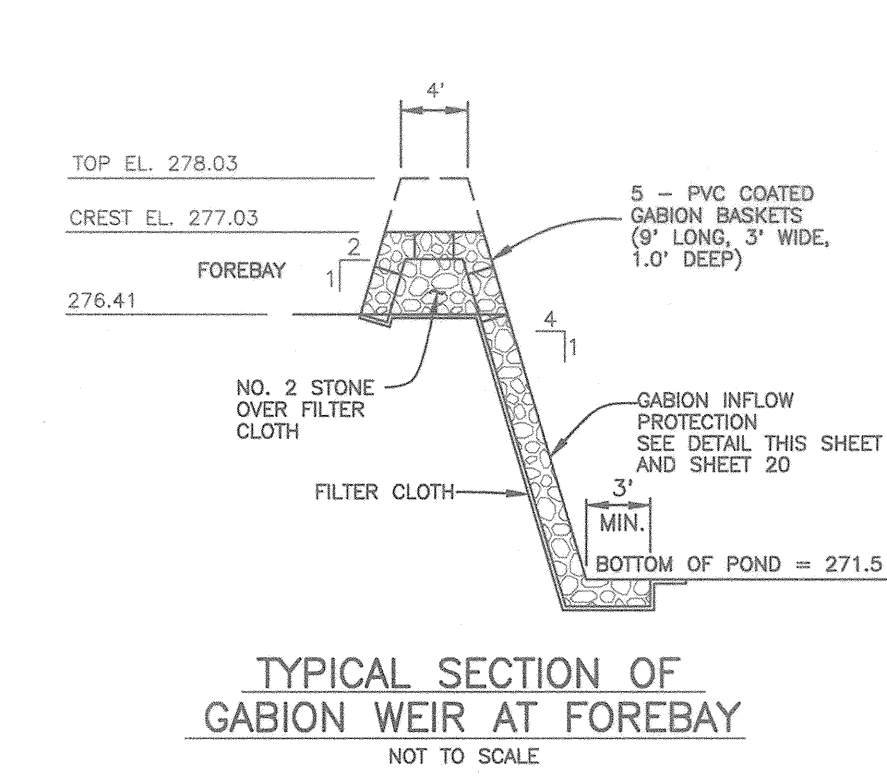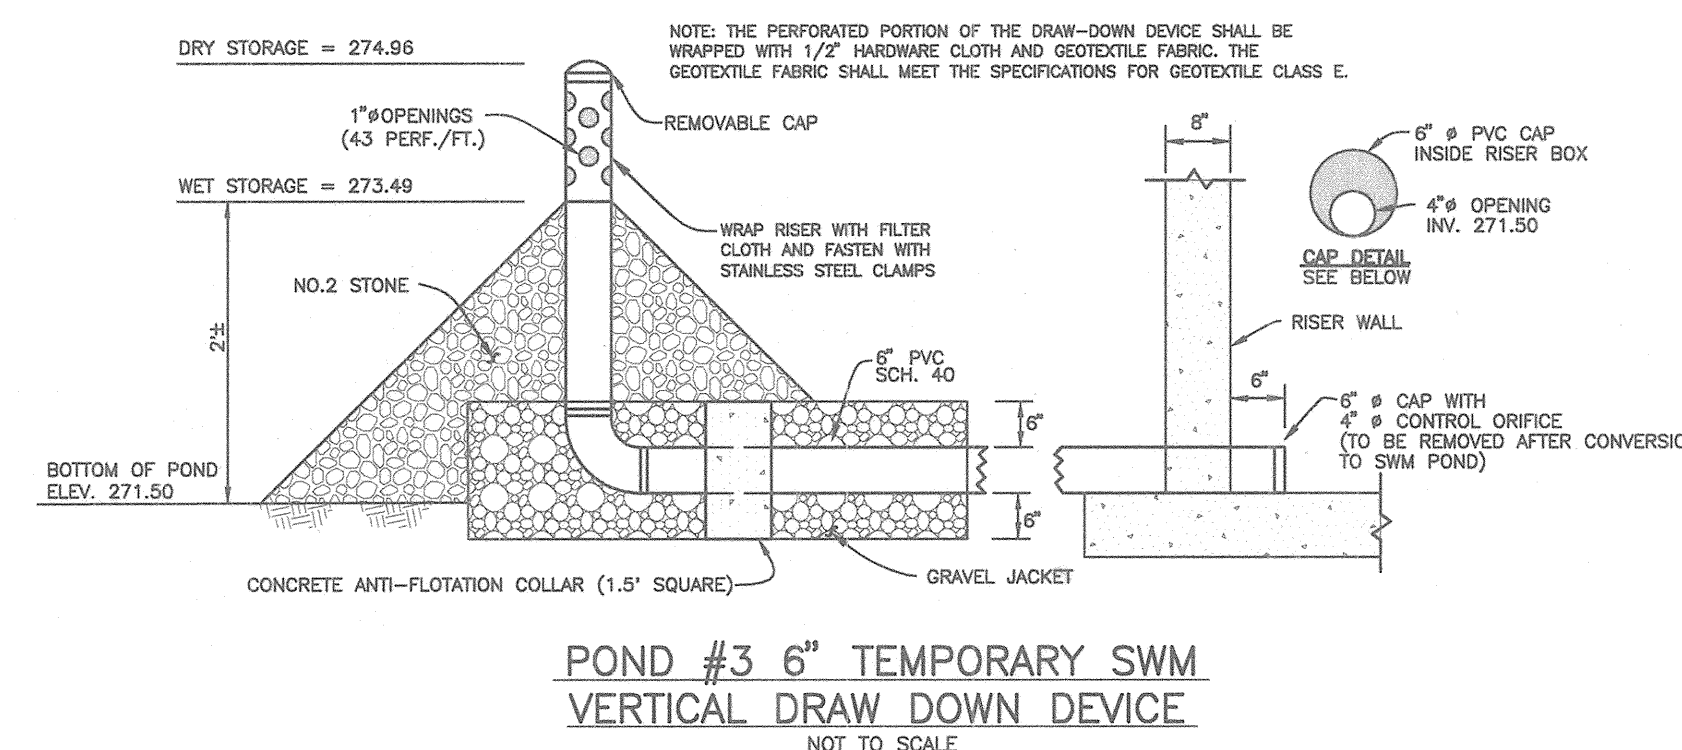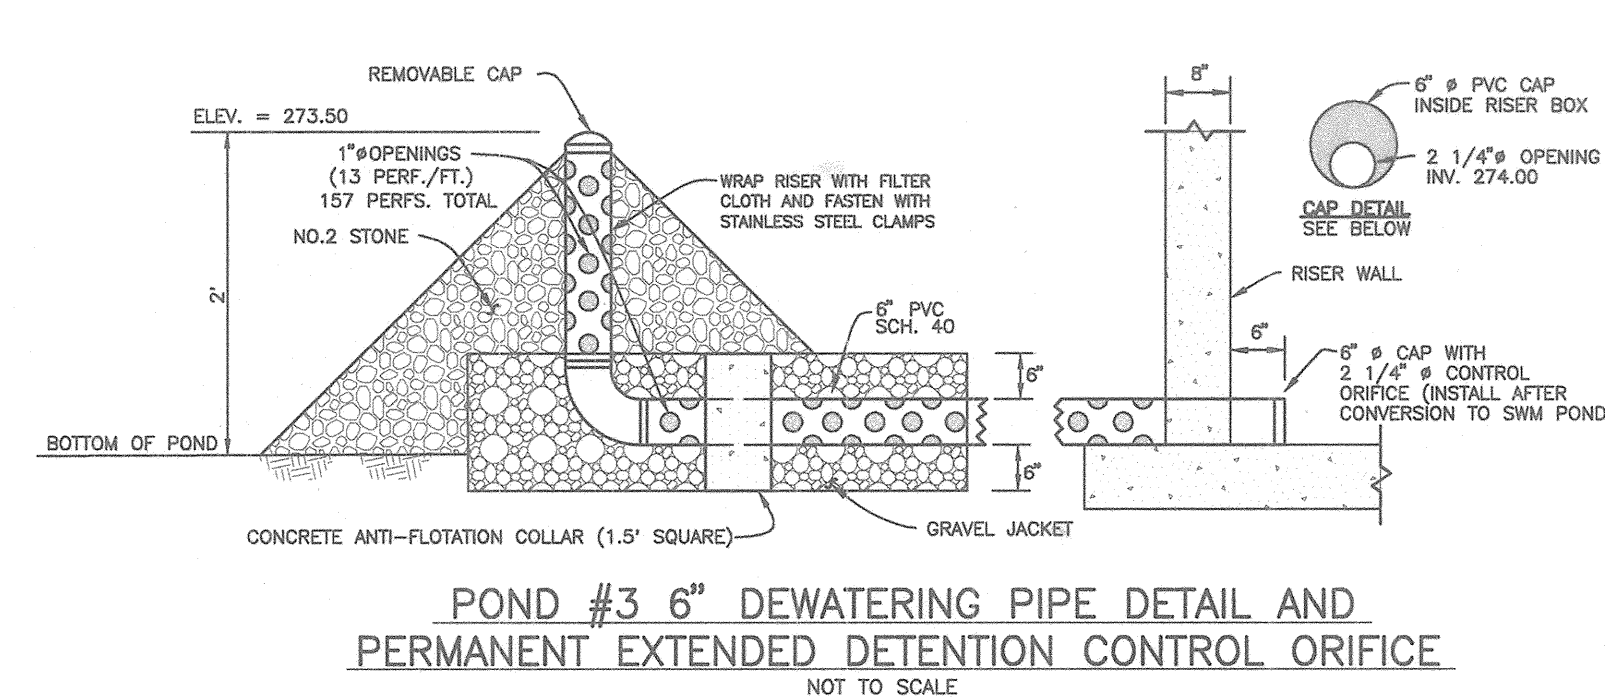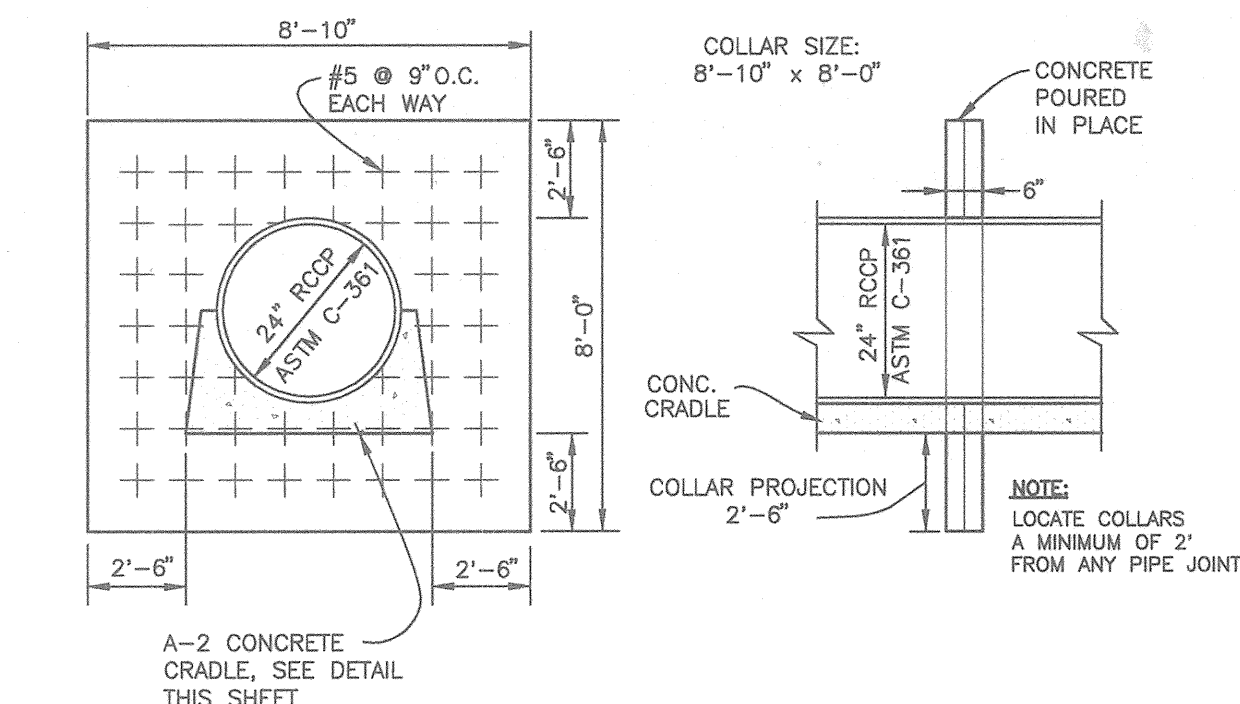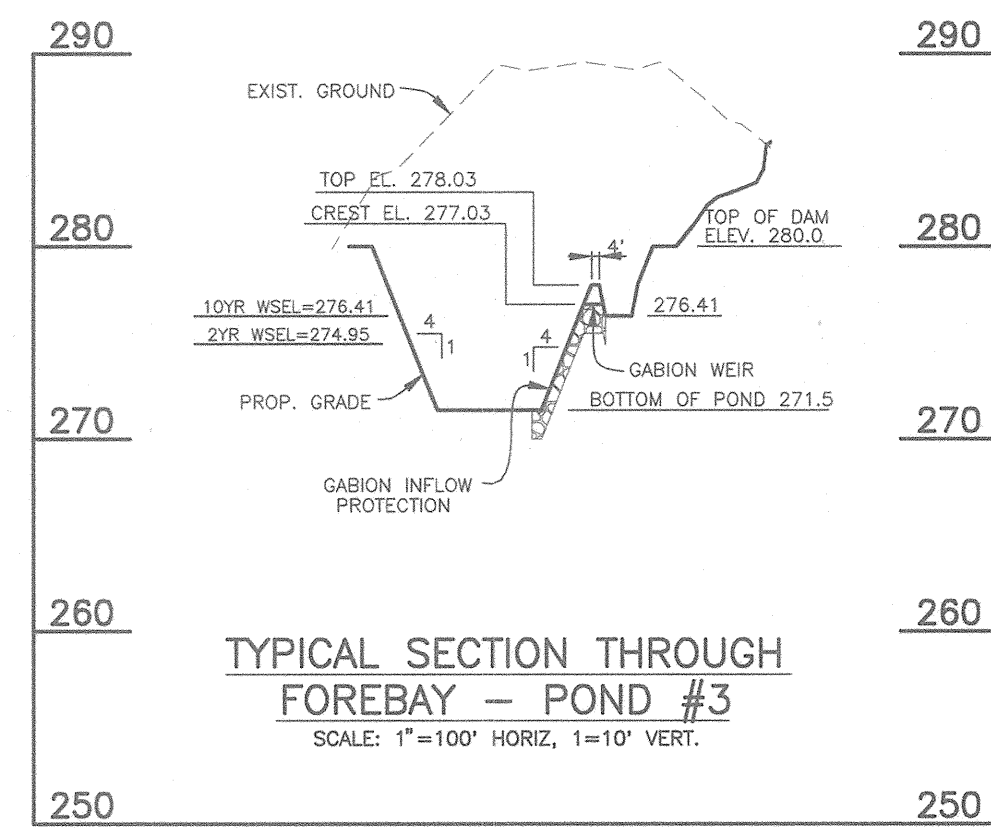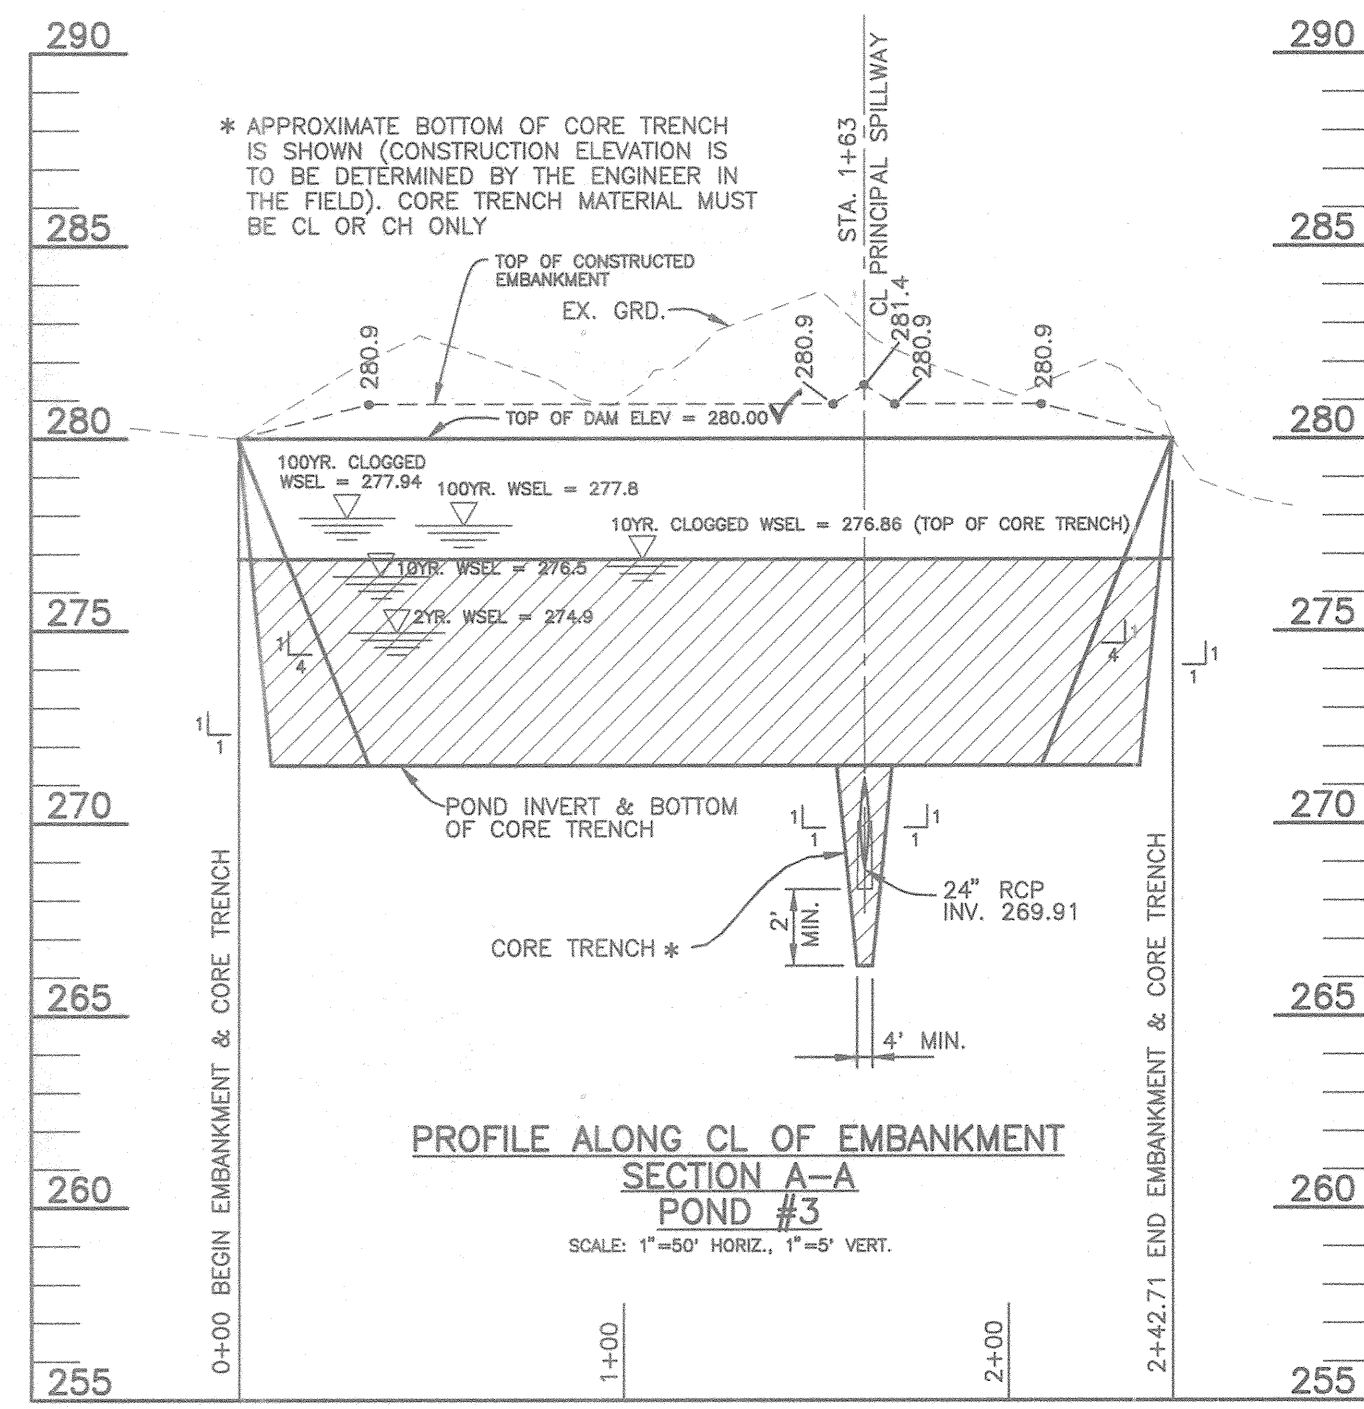

OPERATION, MAINTENANCE AND INSPECTION NOTE	
INSPECTION OF THE POND(S) SHOWN HEREON SHALL BE PERFORMED AT LEAST ANNUALLY, IN ACCORDANCE WITH THE CHECKLIST AND REQUIREMENTS CONTAINED WITHIN USDA SCS' STANDARDS AND SPECIFICATIONS FOR PONDS (40-270), THE POND OWNERS' AND ANY SUCCESSORS OR ASSIGNS SHALL BE RESPONSIBLE FOR THE SAFETY OF THE POND AND THE CONTINUED OPERATION, SURVEILLANCE, INSPECTION AND MAINTENANCE THEREOF. THE POND OWNERS SHALL PROMPTLY NOTIFY THE SOIL CONSERVATION DISTRICT OF ANY UNUSUAL OBSERVATIONS THAT MAY BE INDICATORS OF DISTRESS SUCH AS EXCESSIVE SEEPAGE, TURBID SEEPAGE, SLIDING OR SLUMPING.	
AS-BUILT CERTIFICATION	
I HEREBY CERTIFY THAT THE FACILITY SHOWN ON THIS PLAN WAS CONSTRUCTED AS SHOWN ON THE AS-BUILT PLANS AND MEETS THE APPROVED PLANS AND SPECIFICATIONS.	
<i>Donald Mason</i> DONALD A. MASON	PE NO. 21443 DATE 5/2/05
CERTIFY MEANS TO STATE OR DECLARE A PROFESSIONAL OPINION BASED UPON ONSITE INSPECTIONS AND MATERIAL TESTS WHICH ARE CONDUCTED DURING CONSTRUCTION. THE ONSITE INSPECTIONS AND MATERIAL TESTS ARE THOSE INSPECTIONS AND TESTS DEEMED SUFFICIENT AND APPROPRIATE BY COMMONLY ACCEPTED ENGINEERING STANDARDS. CERTIFY DOES NOT MEAN OR IMPLY A GUARANTEE BY THE ENGINEER NOR DOES AN ENGINEER'S CERTIFICATION RELIEVE ANY OTHER PARTY FROM MEETING REQUIREMENTS IMPOSED BY CONTRACT, EMPLOYMENT, OR OTHER MEANS, INCLUDING MEETING COMMONLY ACCEPTED INDUSTRY PRACTICES.	
BY THE DEVELOPER:	
I/WE CERTIFY THAT ALL DEVELOPMENT AND/OR CONSTRUCTION WILL BE DONE ACCORDING TO THESE PLANS, AND THAT ANY RESPONSIBLE PERSONNEL INVOLVED IN THE CONSTRUCTION PROJECT WILL HAVE A CERTIFICATE OF ATTENDANCE AT A DEPARTMENT OF THE ENVIRONMENT APPROVED TRAINING PROGRAM FOR THE CONTROL OF SEDIMENT AND EROSION BEFORE BEGINNING THE PROJECT. I SHALL ENGAGE A REGISTERED PROFESSIONAL ENGINEER TO SUPERVISE POND CONSTRUCTION AND PROVIDE THE HOWARD SOIL CONSERVATION DISTRICT WITH AN "AS-BUILT" PLAN OF THE POND WITHIN 30 DAYS OF COMPLETION. I ALSO AUTHORIZE PERIODIC ON-SITE INSPECTIONS BY THE HOWARD SOIL CONSERVATION DISTRICT.	
<i>Chap. U.P.</i>	6-1-98 DATE
DEVELOPER - TOLL MD LIMITED PARTNERSHIP	
BY THE ENGINEER:	
I/WE CERTIFY THAT THIS PLAN FOR POND CONSTRUCTION, EROSION AND SEDIMENT CONTROL REPRESENTS A PRACTICAL AND WORKABLE PLAN BASED ON MY PERSONAL KNOWLEDGE OF THE SITE CONDITIONS. THIS PLAN WAS PREPARED IN ACCORDANCE WITH THE REQUIREMENTS OF THE HOWARD SOIL CONSERVATION DISTRICT. I HAVE NOTIFIED THE DEVELOPER THAT HE/SHE MUST ENGAGE A REGISTERED PROFESSIONAL ENGINEER TO SUPERVISE POND CONSTRUCTION AND PROVIDE THE HOWARD SOIL CONSERVATION DISTRICT WITH AN "AS-BUILT" PLAN OF THE POND WITHIN 30 DAYS OF COMPLETION.	
<i>Donald Mason</i> ENGINEER - DONALD A. MASON, P.E. # 21443	5/10/98 DATE
THESE PLANS HAVE BEEN REVIEWED FOR THE HOWARD SOIL CONSERVATION DISTRICT AND MEET THE TECHNICAL REQUIREMENTS FOR SMALL POND CONSTRUCTION, SOIL EROSION, AND SEDIMENT CONTROL.	
<i>Chad Simons/as</i>	6/9/98 DATE
NATURAL RESOURCES CONSERVATION SERVICE	
THESE PLANS FOR SMALL POND CONSTRUCTION, SOIL EROSION, AND SEDIMENT CONTROL MEET THE REQUIREMENTS OF THE HOWARD SOIL CONSERVATION DISTRICT.	
<i>Robert W. Zich, JES</i>	6/9/98 DATE
HOWARD SOIL CONSERVATION DISTRICT	
APPROVED: HOWARD COUNTY DEPARTMENT OF PUBLIC WORKS	
<i>Andrew M. Dancker</i>	6-15-98 DATE
CHIEF, BUREAU OF HIGHWAYS	
APPROVED: HOWARD COUNTY DEPARTMENT OF PLANNING AND ZONING	
<i>Catherine</i>	6/23/98 DATE
<i>Mr. Daum</i>	6/23/98 DATE
CHIEF, DEVELOPMENT ENGINEERING DIVISION	

NO.	DATE	REVISION
1	4/27/05	REVISED PER AS-BUILT CONDITIONS













  

<b>TSA GROUP, INC.</b> planning • architecture • engineering • surveying 8480 Baltimore National Pike • Ellicott City, Maryland 21045 • 410-465-6105		
<b>OWNERS:</b> TOLL MD LIMITED PARTNERSHIP, A MARYLAND LIMITED PARTNERSHIP 3205 TOWER OAKS BOULEVARD SUITE 310 ROCKVILLE, MARYLAND 20852	<b>PROJECT: VILLAGE OF CEDAR RIDGE</b> A SUBDIVISION OF PARCEL 44 (TAX MAP 41) AND A RESUBDIVISION OF LOTS 1 AND 2 OF THE EDITH S. PARLETTE SUBDIVISION (PLAT 10735 PARCEL 43) AND A SUBDIVISION OF PARCEL 123 FOR A ROAD RIGHT-OF-WAY	
<b>DEVELOPER:</b> TOLL MD LIMITED PARTNERSHIP, A MARYLAND LIMITED PARTNERSHIP 3205 TOWER OAKS BOULEVARD SUITE 310 ROCKVILLE, MARYLAND 20852	<b>LOCATION:</b> TAX MAP 41 - PARCELS 43 & 44, P/O 123 580 ELECTION DISTRICT HOWARD COUNTY, MARYLAND	<b>TITLE:</b> STORMWATER MANAGEMENT DETAILS POND #3 SP-97-02 WP-97-78 PB 312 F-93-70 WP-98-82 DATE: OCTOBER, 1997 PROJECT NO. 0518 MAY, 1998
<b>DESIGN:</b> MLV <b>DRAFT:</b> DBT <b>CHECK:</b> DAM	<b>SCALE:</b> AS SHOWN	<b>SHEET 25 OF 31</b>












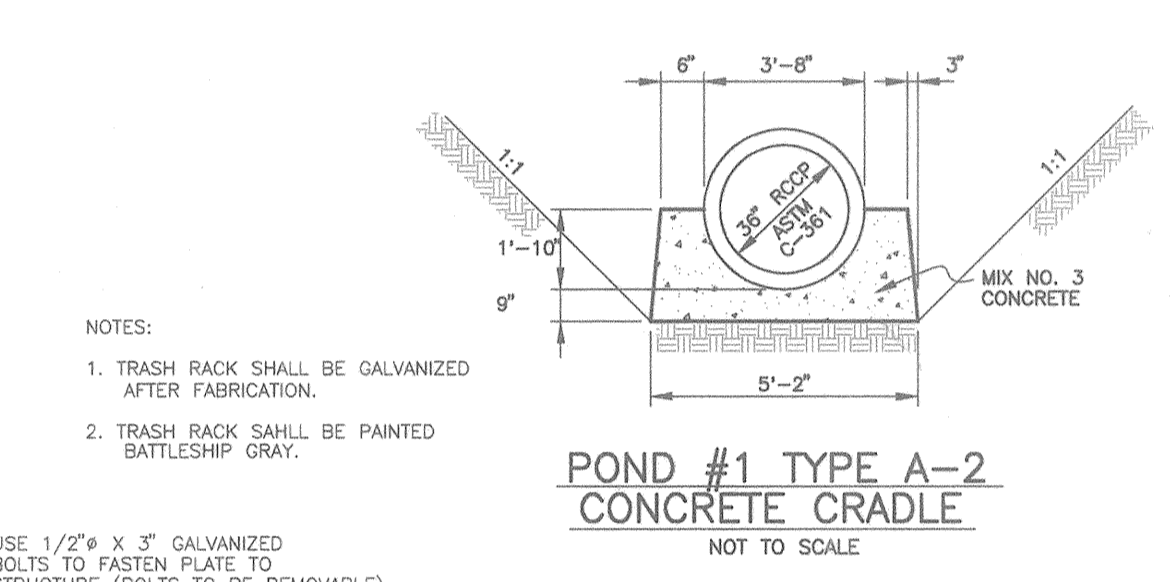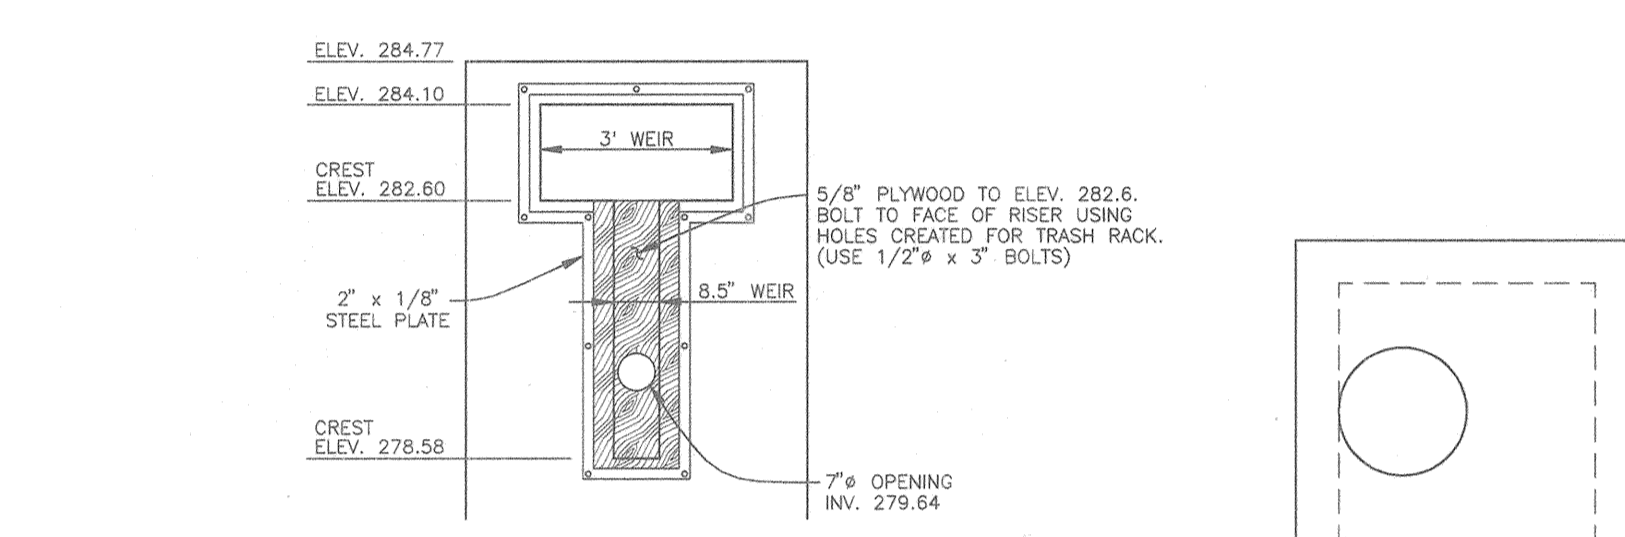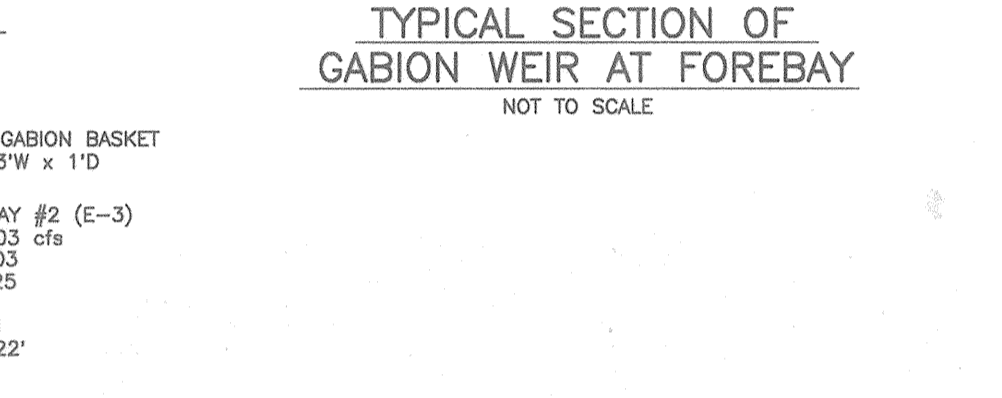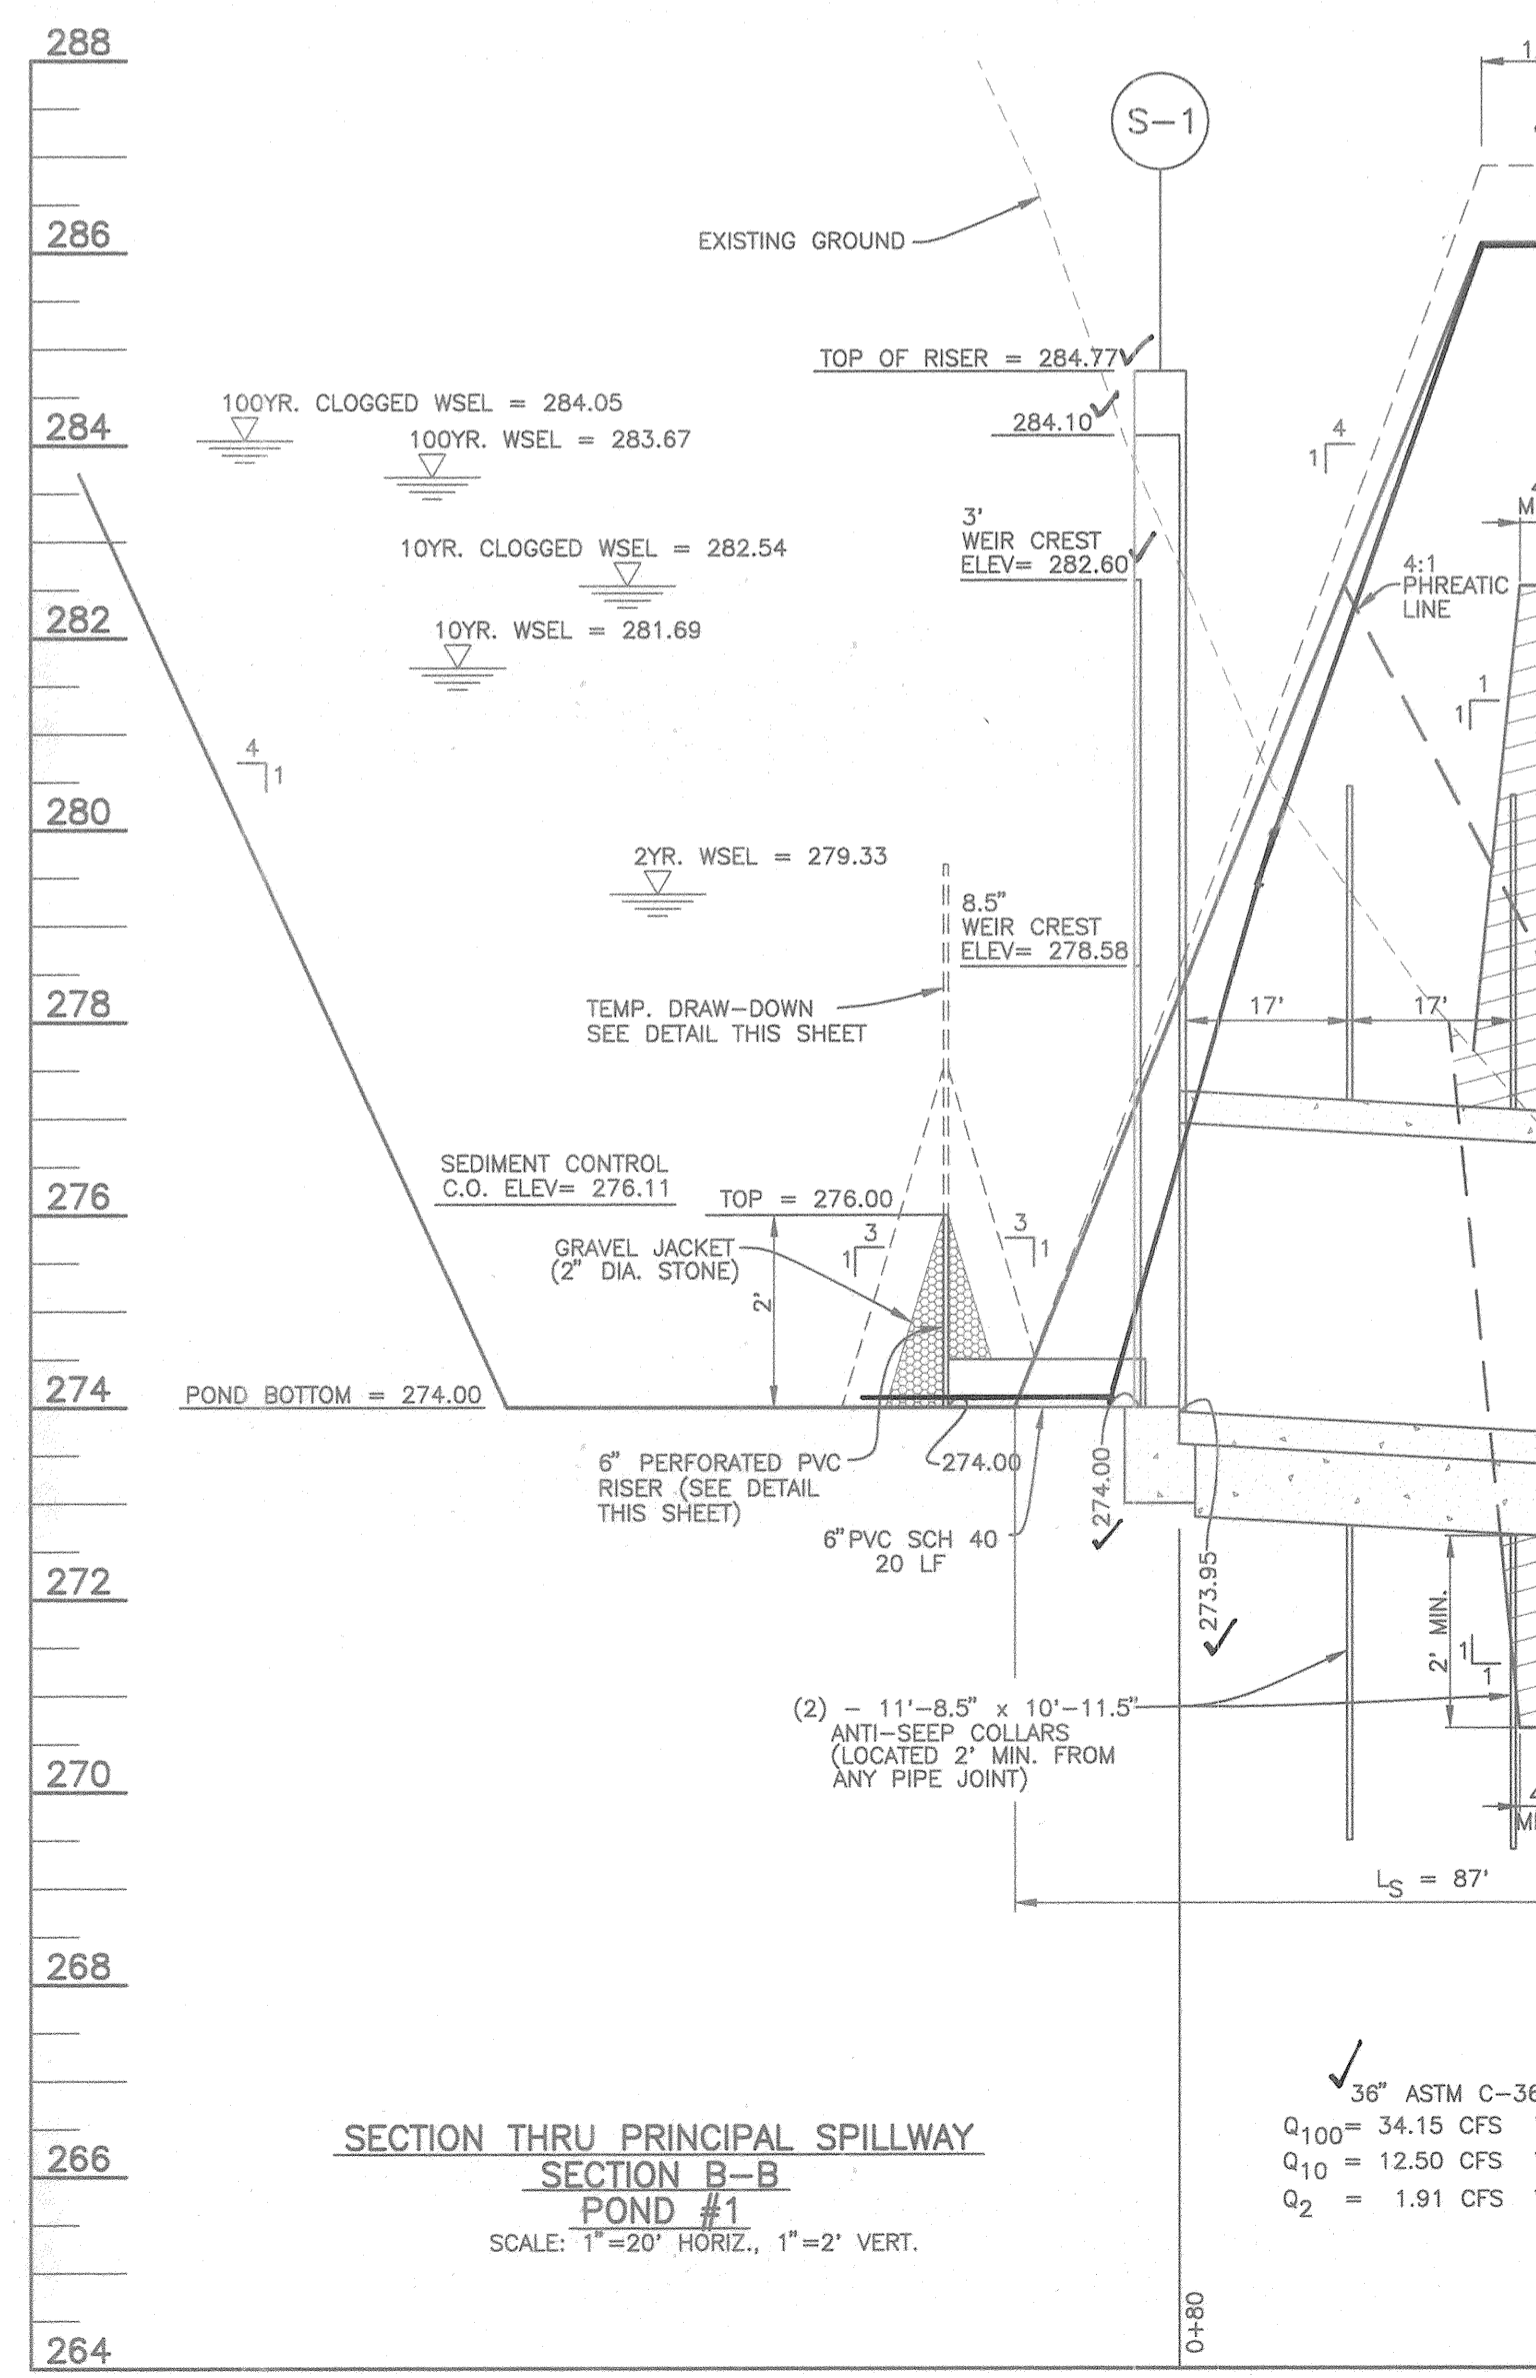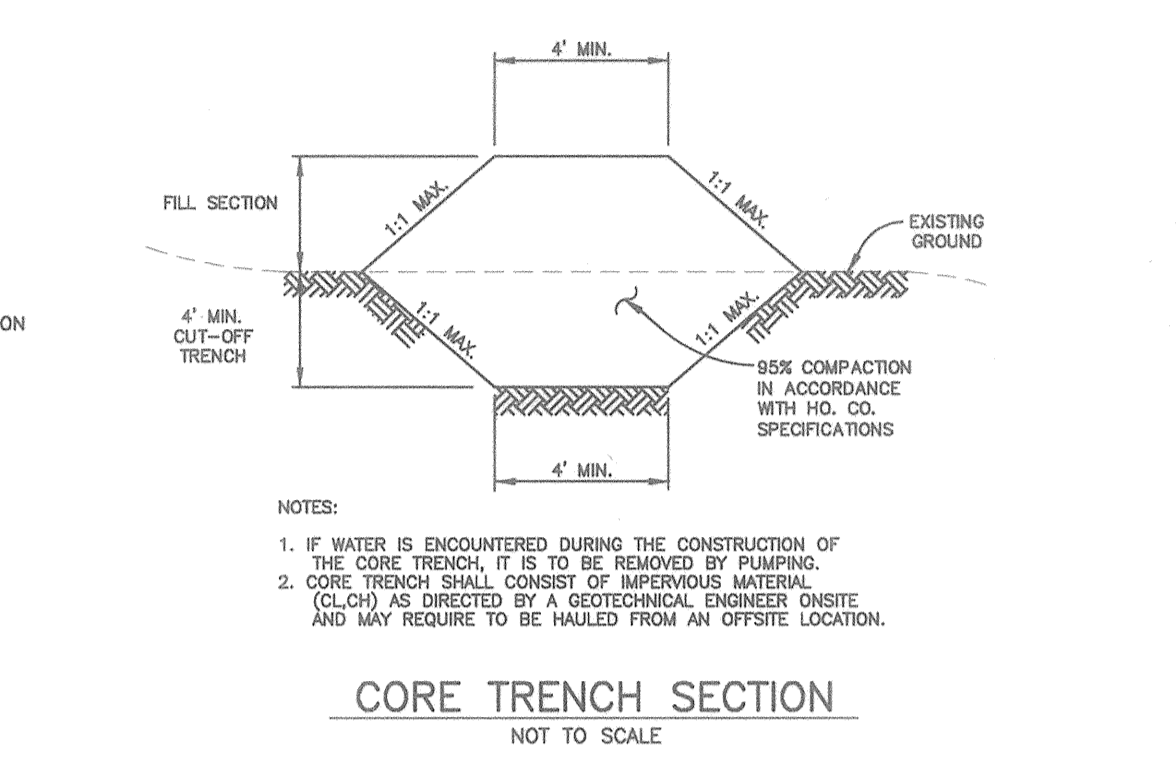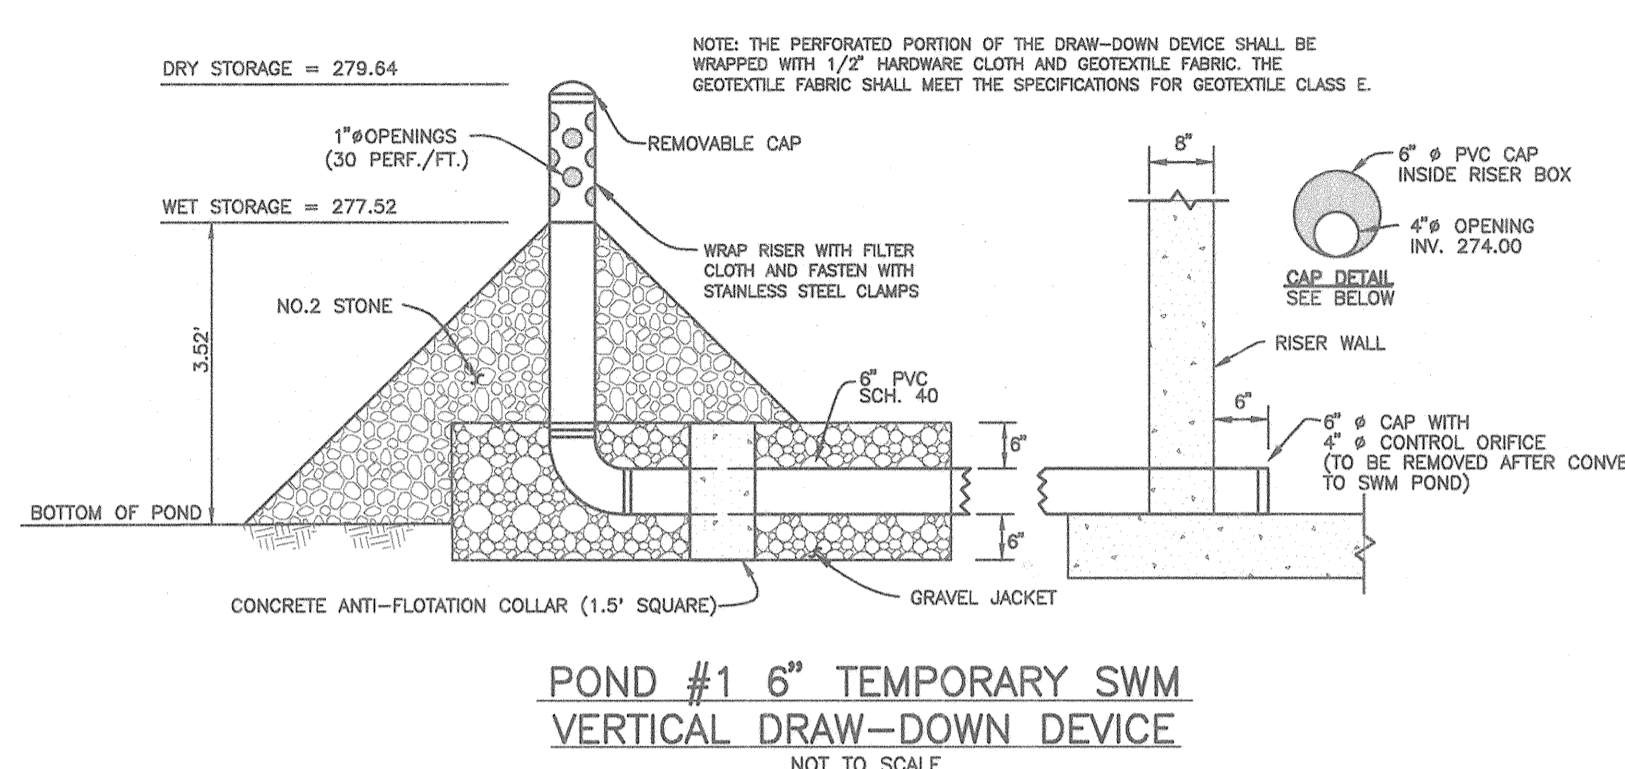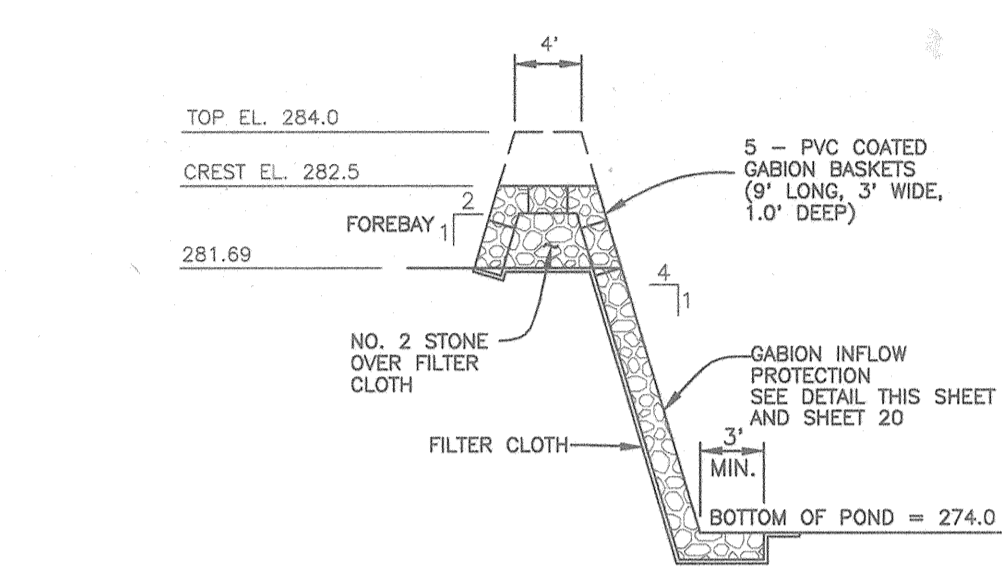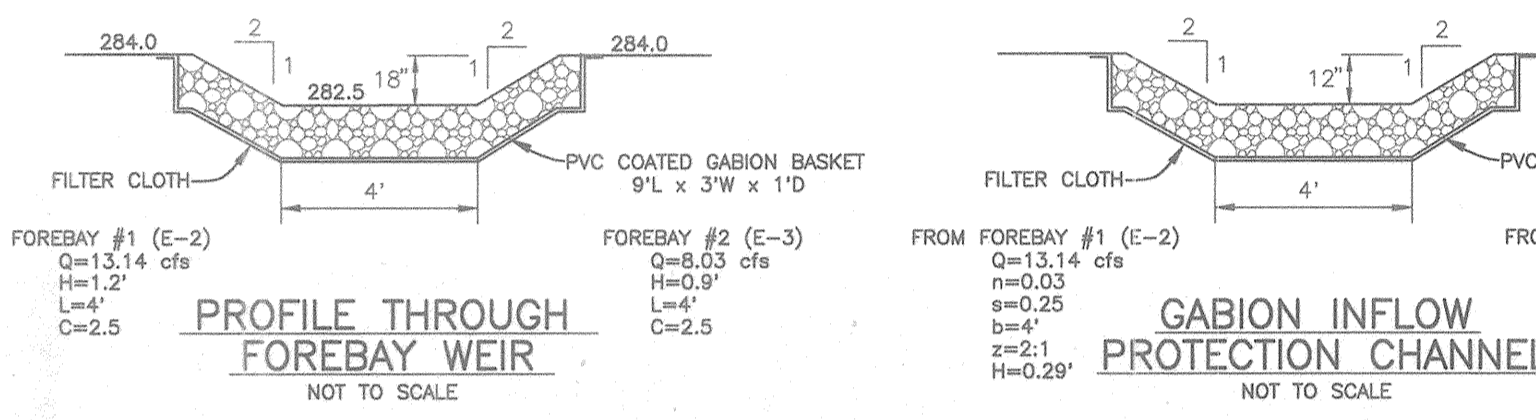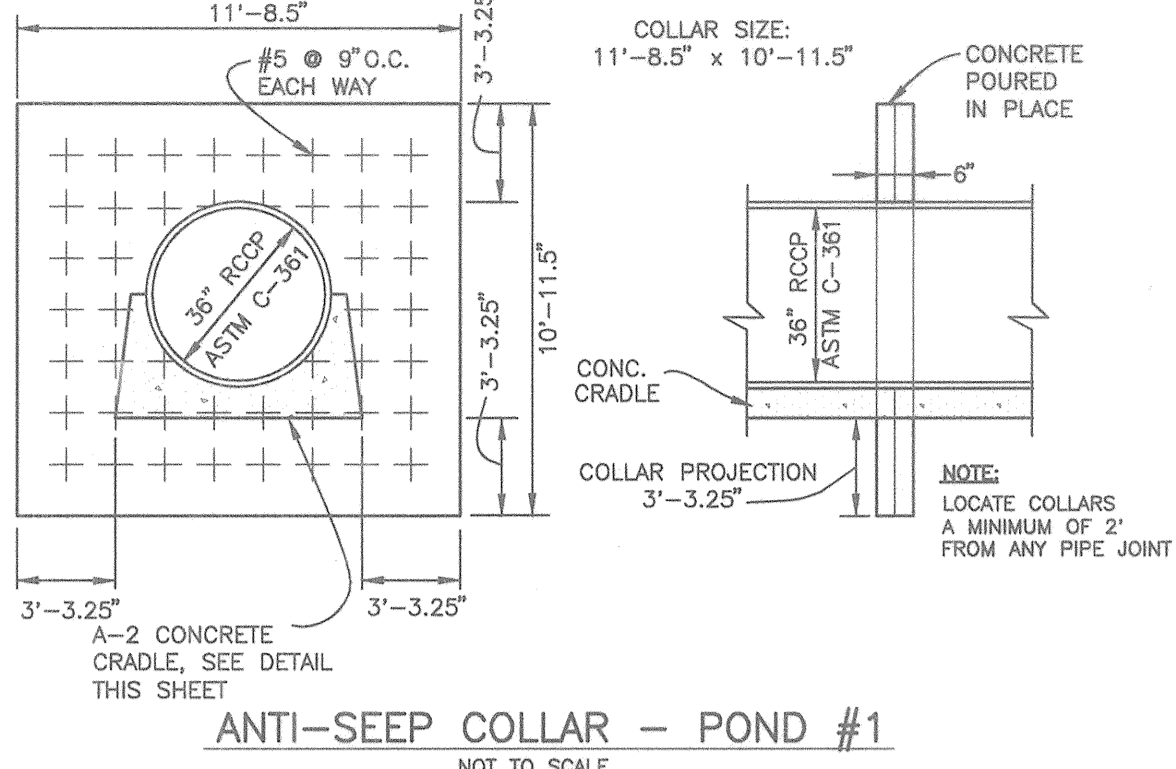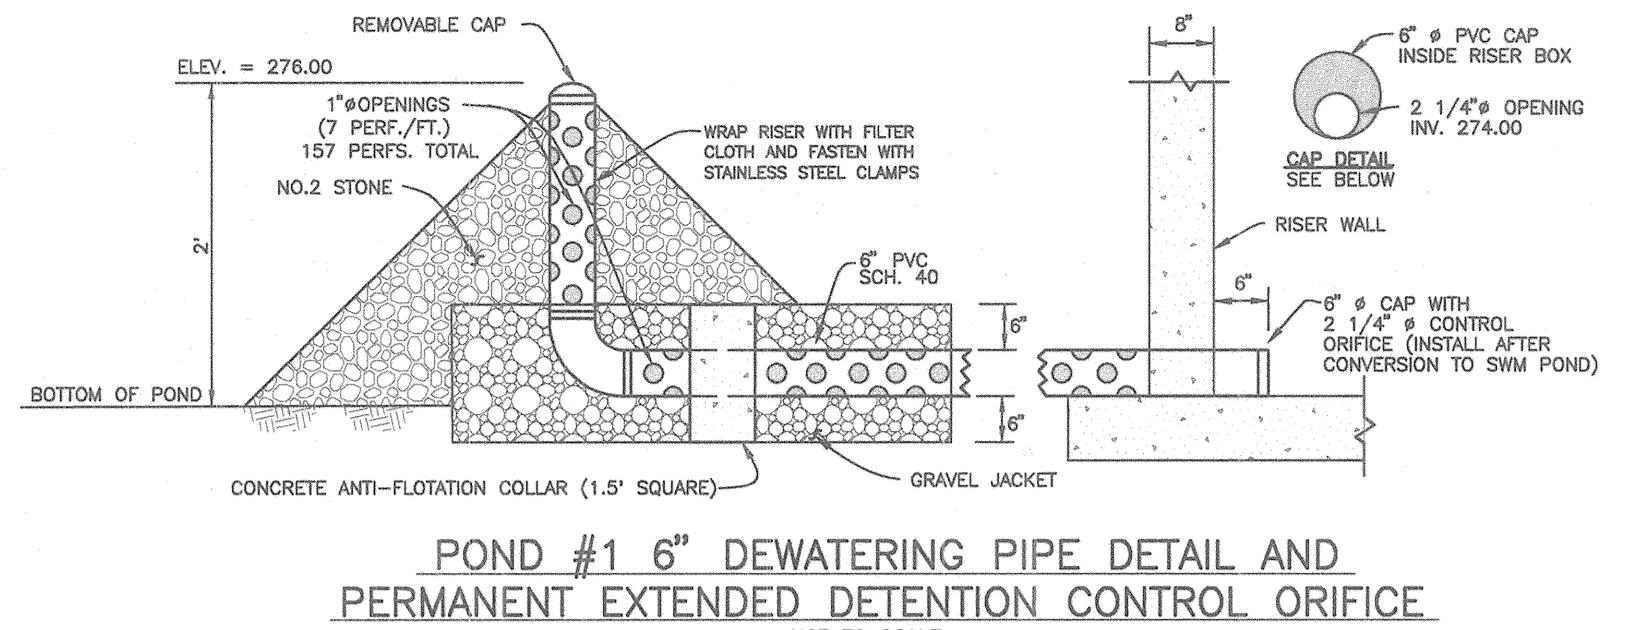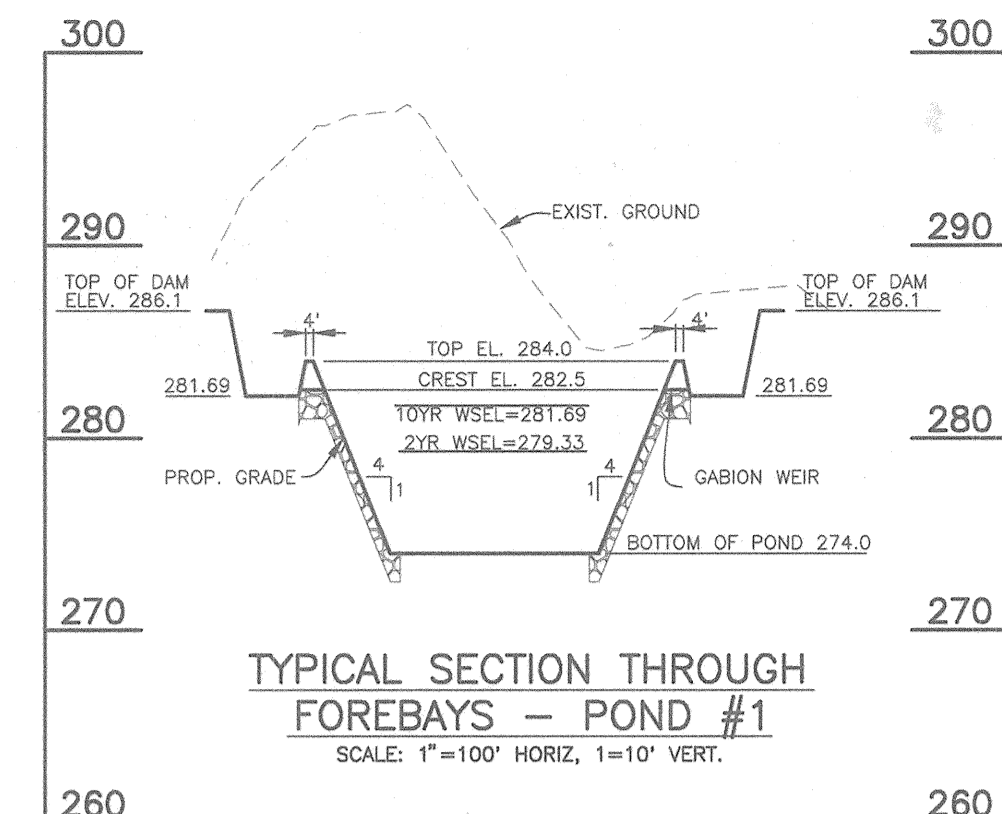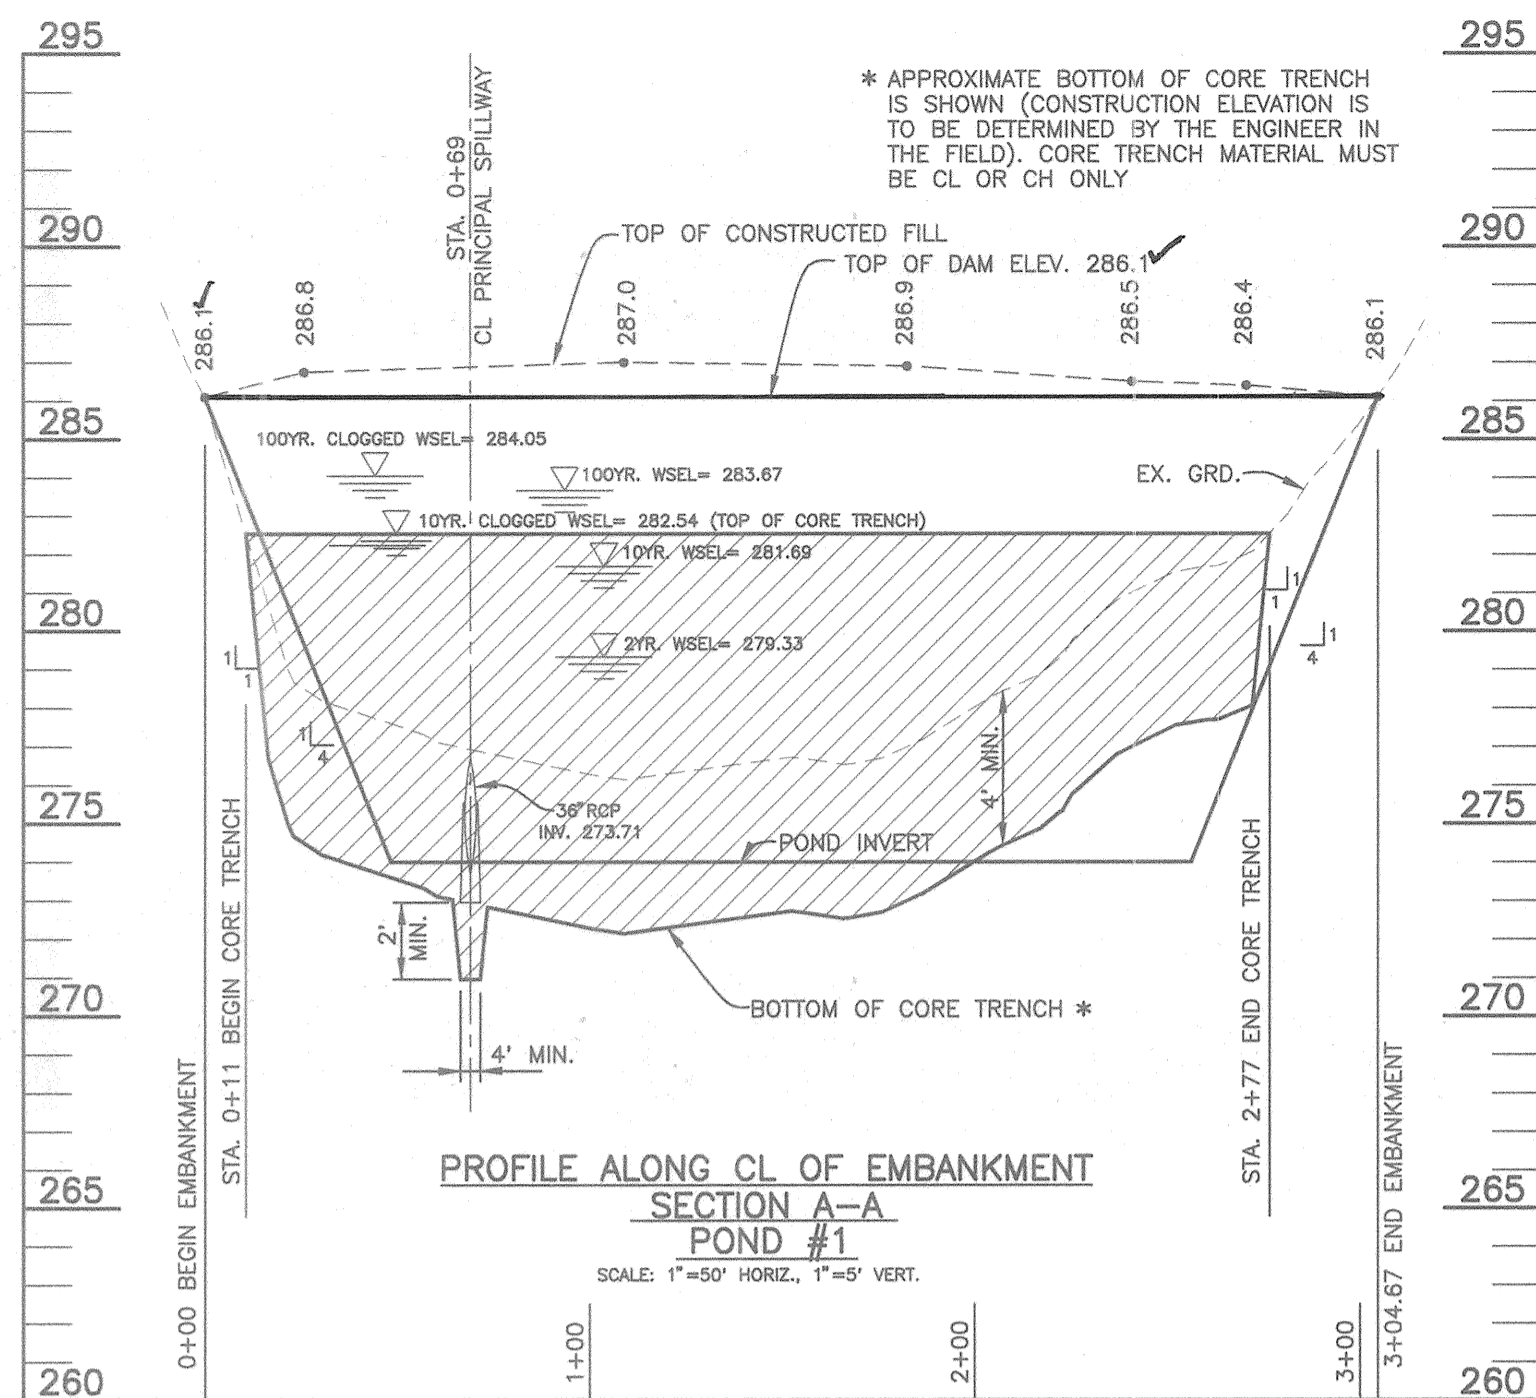

SECTION THRU PRINCIPAL SPILLWAY SECTION B-B POND #1  
SCALE: 1"=20' HORIZ., 1"=2' VERT.

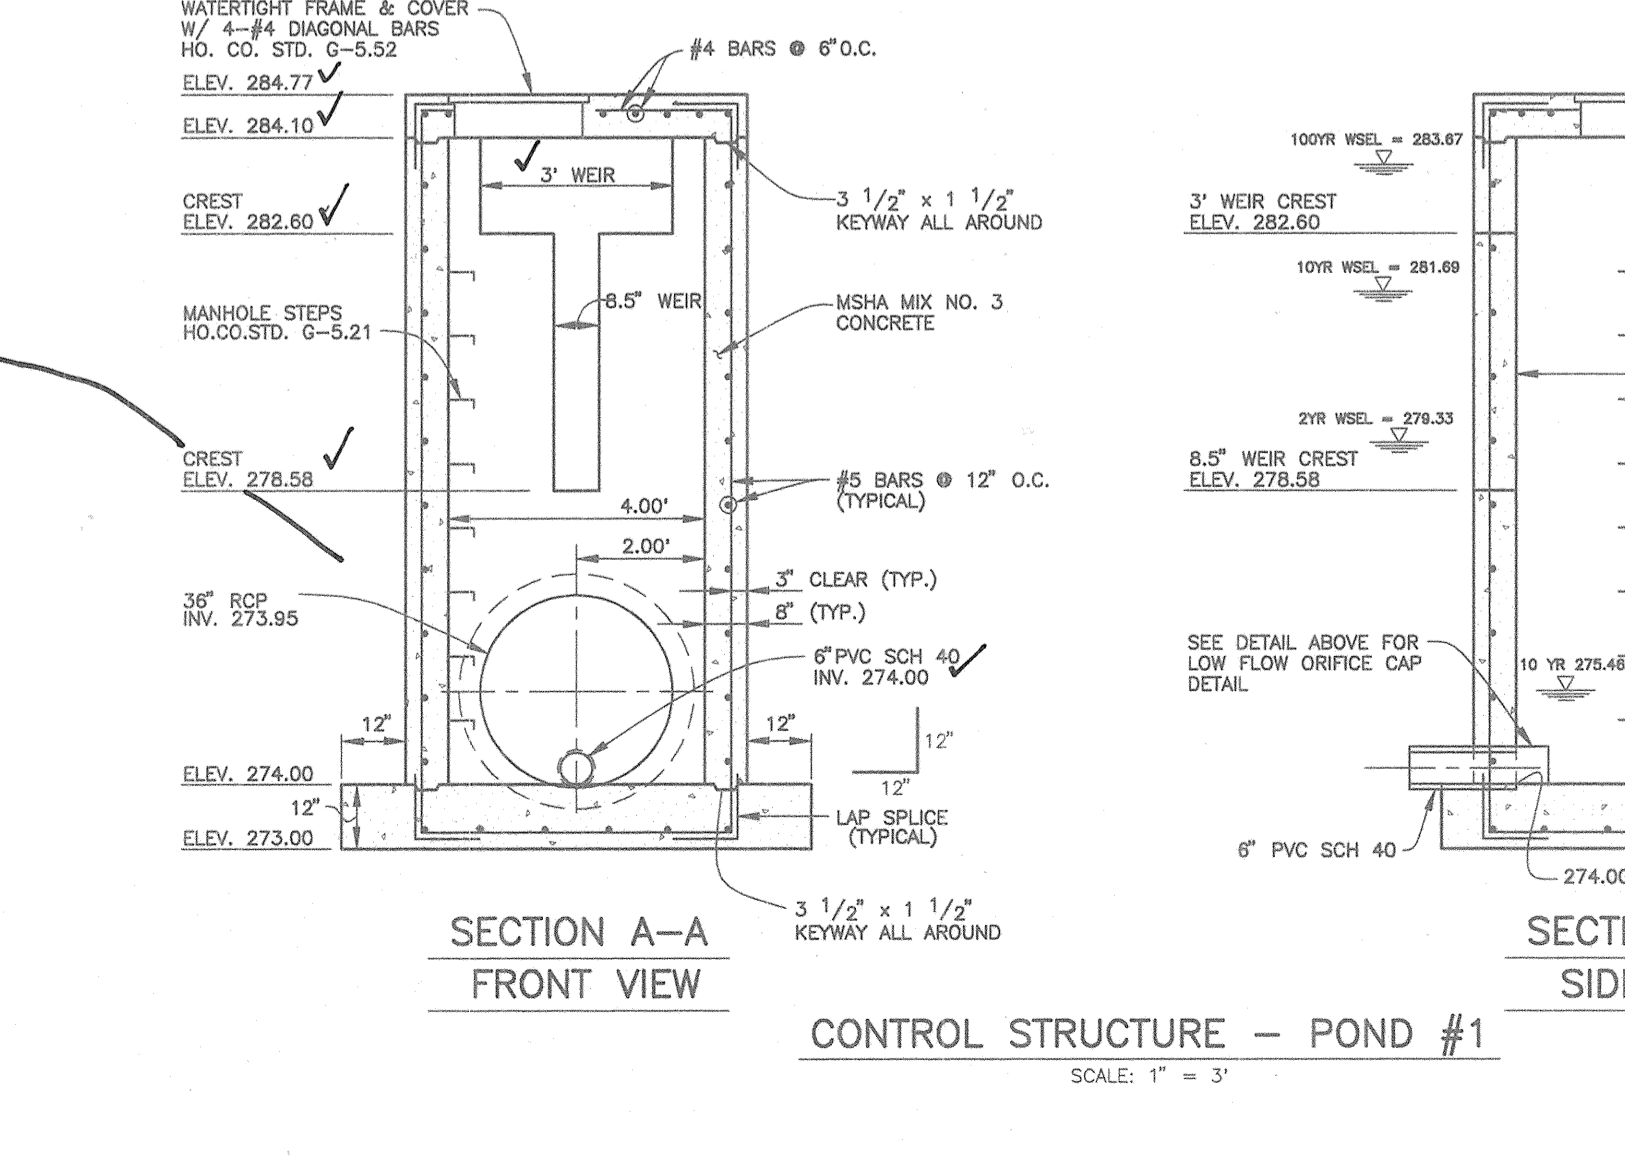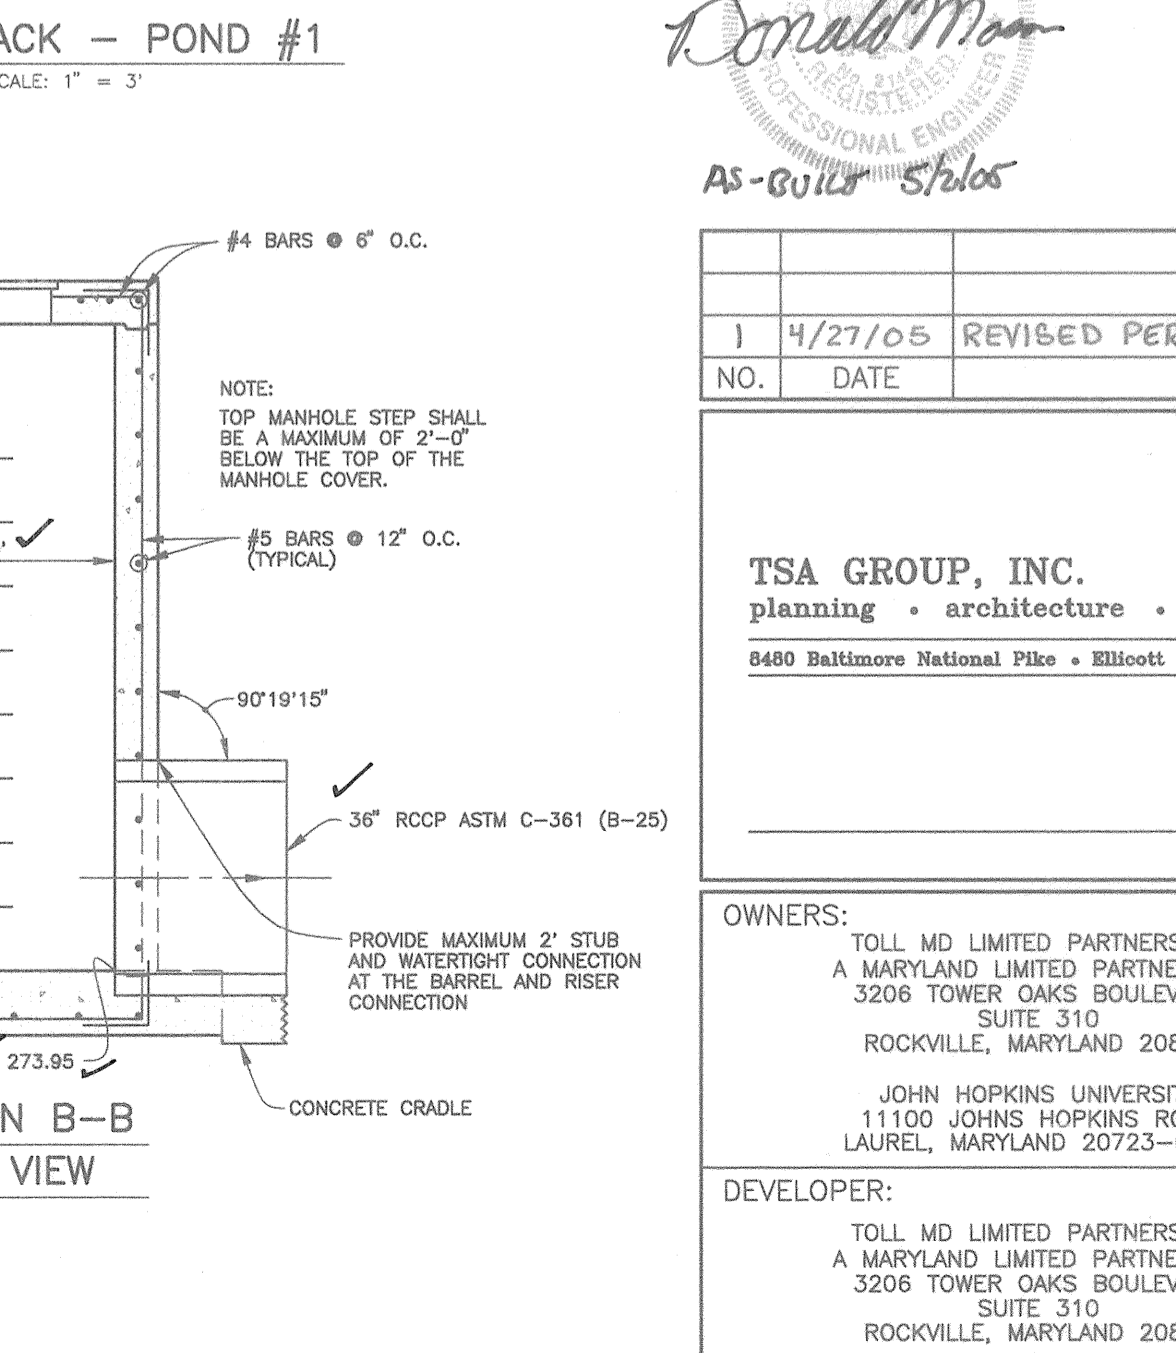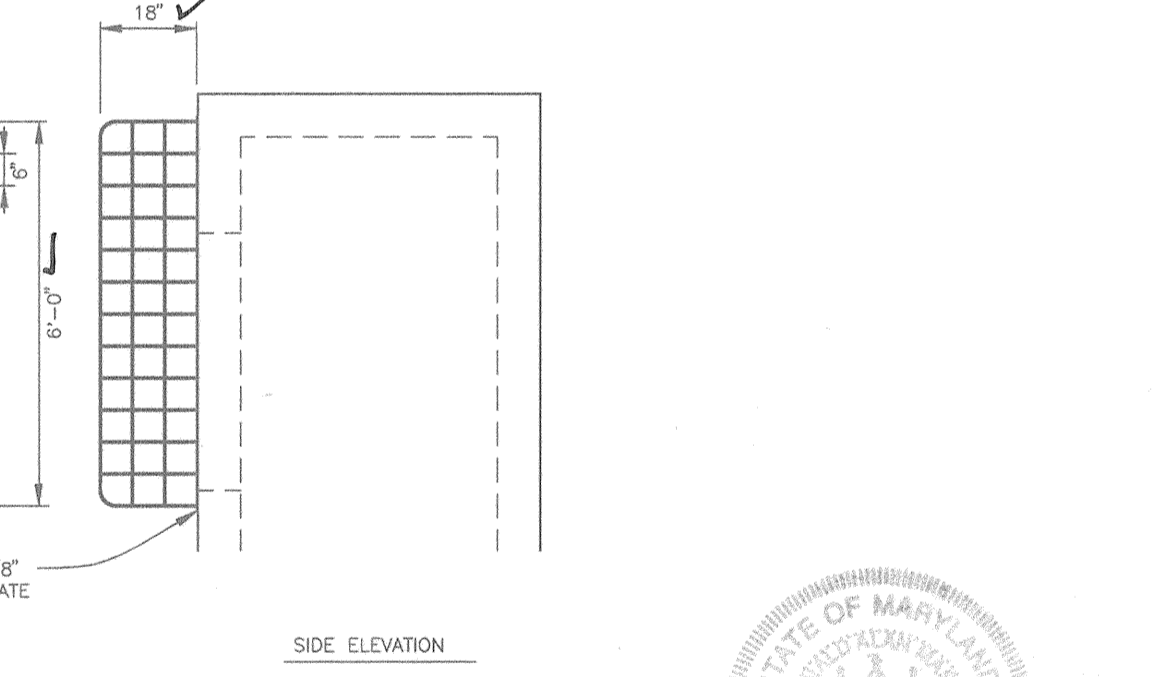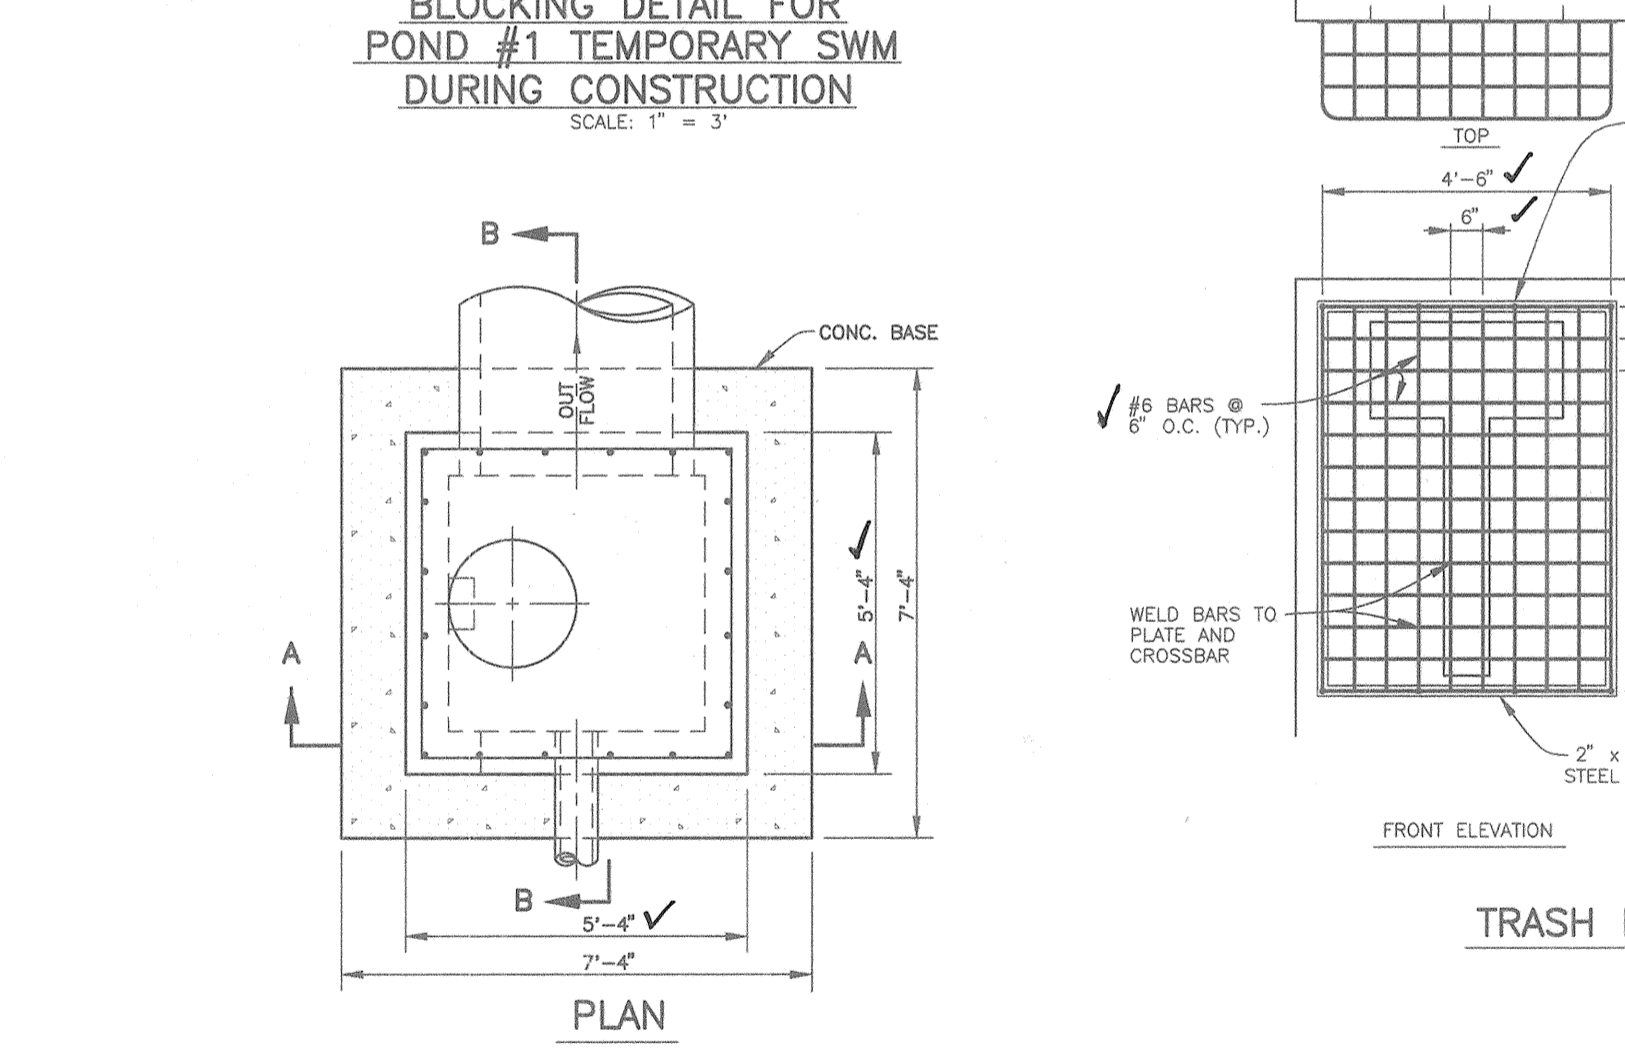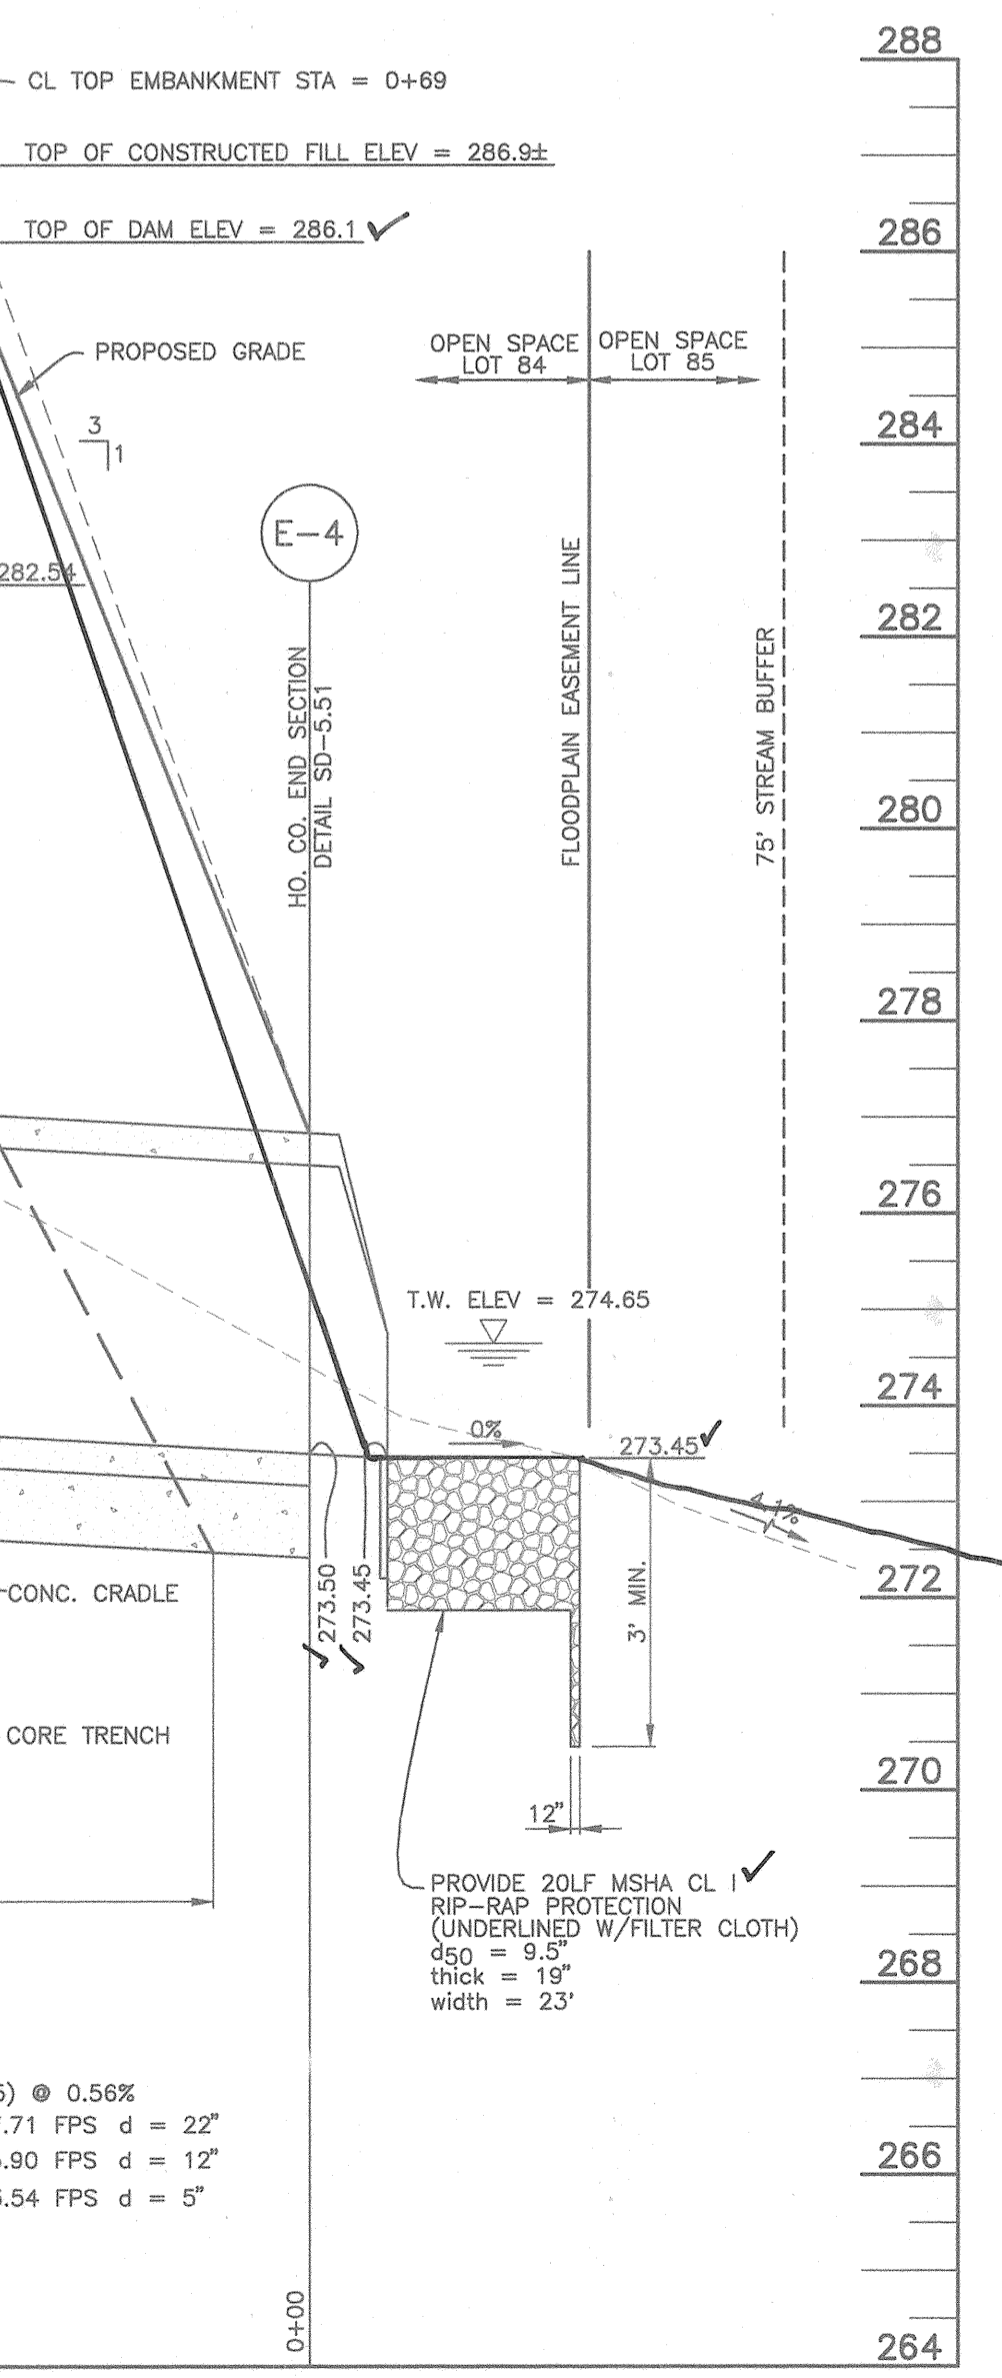

OPERATION AND MAINTENANCE SCHEDULE OF PRIVATELY OWNED AND MAINTAINED STORMWATER MANAGEMENT FACILITY

**ROUTINE MAINTENANCE**

- FACILITY SHALL BE INSPECTED ANNUALLY AND AFTER MAJOR STORMS. INSPECTIONS SHOULD BE PERFORMED DURING WET WEATHER TO DETERMINE IF THE POND IS FUNCTIONING PROPERLY.
- TOP AND SIDE SLOPES OF THE EMBANKMENT SHALL BE MOWED A MINIMUM OF TWO (2) TIMES A YEAR, ONCE IN JUNE AND ONCE IN SEPTEMBER. OTHER SIDE SLOPES AND MAINTENANCE ACCESS SHOULD BE MOWED AS NEEDED.
- DEBRIS AND LITTER SHALL BE REMOVED DURING ROUTINE MOWING OPERATIONS AND AS NEEDED.
- VISIBLE SIGNS OF EROSION IN THE POND AS WELL AS RIPRAP OUTLET AREA SHALL BE REPAIRED AS SOON AS IT IS NOTICED.

**NON-ROUTINE MAINTENANCE**

- STRUCTURAL COMPONENTS OF THE POND SUCH AS THE DAM, THE RISER, AND THE PIPES SHALL BE REPAIRED UPON THE DETECTION OF ANY DAMAGE. THE COMPONENTS SHOULD BE INSPECTED DURING ROUTINE MAINTENANCE OPERATIONS.
- SEDIMENT SHOULD BE REMOVED FROM THE POND NO LATER THAN WHEN THE CAPACITY OF THE POND IS HALF FULL OF SEDIMENT, WHEN DEEMED NECESSARY FOR AESTHETIC REASONS, OR WHEN DEEMED NECESSARY BY HOWARD COUNTY'S DEPARTMENT OF PUBLIC WORKS.

**OPERATION, MAINTENANCE AND INSPECTION NOTE**

INSPECTION OF THE POND(S) SHOWN HEREON SHALL BE PERFORMED AT LEAST ANNUALLY, IN ACCORDANCE WITH THE CHECKLIST AND REQUIREMENTS CONTAINED WITHIN USGA SCS' STANDARDS AND SPECIFICATIONS FOR PONDS (M-376). THE POND OWNER(S) AND ANY HEIRS, SUCCESSORS, OR ASSIGNS SHALL BE RESPONSIBLE FOR THE SAFETY OF THE POND AND THE CONTINUED OPERATION, MAINTENANCE, INSPECTION AND REPAIRS THEREOF. THE POND OWNER(S) SHALL PROMPTLY NOTIFY THE SOIL CONSERVATION DISTRICT OF ANY UNUSUAL OBSERVATIONS THAT MAY BE INDICATIONS OF DISTRESS SUCH AS EXCESSIVE SEEPAGE, TURBID SEEPAGE, SLIDING OR SLUMPING.

**AS-BUILT CERTIFICATION**

I HEREBY CERTIFY THAT THE FACILITY SHOWN ON THIS PLAN WAS CONSTRUCTED AS SHOWN ON THE AS-BUILT PLANS AND MEETS THE APPROVED PLANS AND SPECIFICATIONS.

*Donald Mason* PE NO. 21443  
DONALD A. MASON DATE 5/2/05

CERTIFY MEANS TO STATE OR DECLARE A PROFESSIONAL OPINION BASED UPON ON-SITE INSPECTIONS AND MATERIAL TESTS WHICH ARE CONDUCTED DURING CONSTRUCTION. THE ON-SITE INSPECTIONS AND MATERIAL TESTS ARE CONDUCTED AT A DEPARTMENT OF THE ENVIRONMENT APPROVED TRAINING PROGRAM FOR THE CONTROL OF SEDIMENT AND EROSION BEFORE BEGINNING THE PROJECT. I SHALL ENGAGE A REGISTERED PROFESSIONAL ENGINEER TO SUPERVISE POND CONSTRUCTION AND PROVIDE THE HOWARD SOIL CONSERVATION DISTRICT WITH AN "AS-BUILT" PLAN OF THE POND WITHIN 30 DAYS OF COMPLETION. I ALSO AUTHORIZE PERIODIC ON-SITE INSPECTIONS BY THE HOWARD SOIL CONSERVATION DISTRICT.

BY THE DEVELOPER:

I/WE CERTIFY THAT ALL DEVELOPMENT AND/OR CONSTRUCTION WILL BE DONE ACCORDING TO THESE PLANS, AND THAT ANY RESPONSIBLE PERSONNEL INVOLVED IN THE CONSTRUCTION PROJECT WILL HAVE A CERTIFICATE OF ATTENDANCE AT A DEPARTMENT OF THE ENVIRONMENT APPROVED TRAINING PROGRAM FOR THE CONTROL OF SEDIMENT AND EROSION BEFORE BEGINNING THE PROJECT. I SHALL ENGAGE A REGISTERED PROFESSIONAL ENGINEER TO SUPERVISE POND CONSTRUCTION AND PROVIDE THE HOWARD SOIL CONSERVATION DISTRICT WITH AN "AS-BUILT" PLAN OF THE POND WITHIN 30 DAYS OF COMPLETION. I ALSO AUTHORIZE PERIODIC ON-SITE INSPECTIONS BY THE HOWARD SOIL CONSERVATION DISTRICT.

*Donald Mason* V.P. 6-1-98  
DEVELOPER - TOLL MD LIMITED PARTNERSHIP DATE

BY THE ENGINEER:

I/WE CERTIFY THAT THIS PLAN FOR POND CONSTRUCTION, EROSION AND SEDIMENT CONTROL REPRESENTS A PRACTICAL AND WORKABLE PLAN BASED ON MY PERSONAL KNOWLEDGE OF THE SITE CONDITIONS. THIS PLAN WAS PREPARED IN ACCORDANCE WITH THE REQUIREMENTS OF THE HOWARD SOIL CONSERVATION DISTRICT. I HAVE NOTICED THE DEVELOPER THAT HE/MUST ENGAGE A REGISTERED PROFESSIONAL ENGINEER TO SUPERVISE POND CONSTRUCTION AND PROVIDE THE HOWARD SOIL CONSERVATION DISTRICT WITH AN "AS-BUILT" PLAN OF THE POND WITHIN 30 DAYS OF COMPLETION.

*Donald Mason* 5/10/98  
ENGINEER - DONALD A. MASON, P.E. # 21443 DATE

THESE PLANS HAVE BEEN REVIEWED FOR THE HOWARD SOIL CONSERVATION DISTRICT AND MEET THE TECHNICAL REQUIREMENTS FOR SMALL POND CONSTRUCTION, SOIL EROSION, AND SEDIMENT CONTROL.

*Cheryl Simon / cs* 6/9/98  
NATURAL RESOURCES CONSERVATION SERVICE DATE

THESE PLANS FOR SMALL POND CONSTRUCTION, SOIL EROSION, AND SEDIMENT CONTROL MEET THE REQUIREMENTS OF THE HOWARD SOIL CONSERVATION DISTRICT.

*Robert W. Zick / rz* 6/9/98  
HOWARD SOIL CONSERVATION DISTRICT DATE

APPROVED: HOWARD COUNTY DEPARTMENT OF PUBLIC WORKS

*Andrew M. Donker* 6-15-98  
CHIEF, BUREAU OF HIGHWAYS DATE

APPROVED: HOWARD COUNTY DEPARTMENT OF PLANNING AND ZONING

*C. Hanlon* 6/23/98  
CHIEF, DIVISION OF LAND DEVELOPMENT DATE

*Donald Mason* 6/2/00  
CHIEF, DEVELOPMENT ENGINEERING DIVISION DATE

STATE OF MARYLAND  
DONALD A. MASON  
REGISTERED PROFESSIONAL ENGINEER  
AS-BUILT 5/2/05

NO.	DATE	REVISION
1	4/27/05	REVISED PER AS-BUILT CONDITIONS

**TSA GROUP, INC.**  
planning • architecture • engineering • surveying  
6450 Baltimore National Pike • Ellicott City, Maryland 21043 • 410-465-8105

**OWNERS:**  
TOLL MD LIMITED PARTNERSHIP,  
A MARYLAND LIMITED PARTNERSHIP  
3206 TOWER OAKS BOULEVARD  
SUITE 310  
ROCKVILLE, MARYLAND 20852

**DEVELOPER:**  
TOLL MD LIMITED PARTNERSHIP,  
A MARYLAND LIMITED PARTNERSHIP  
3206 TOWER OAKS BOULEVARD  
SUITE 310  
ROCKVILLE, MARYLAND 20852

**PROJECT:**  
VILLAGE OF CEDAR RIDGE  
A SUBDIVISION OF PARCEL 44 (TAX MAP 41) AND A RESUBDIVISION OF LOTS 1 AND 2 OF THE EDITH S. PARLETTE SUBDIVISION PLAT 10735 PARCEL 43) AND A SUBDIVISION OF PARCEL 123 FOR A ROAD RIGHT-OF-WAY.

**LOCATION:**  
TAX MAP 41 - PARCELS 43 & 44, P/O 123  
580 ELECTION DISTRICT  
HOWARD COUNTY, MARYLAND

**TITLE:**  
STORMWATER MANAGEMENT DETAILS POND #1

SP-97-02 WP-97-78 PB 312 F-93-70 WP-98-82

DATE: OCTOBER 1997 PROJECT NO. 0518  
MAY 1998

DESIGN: MLV DRAFT: DBT CHECK: DAM SCALE: AS SHOWN SHEET 23 OF 31

STATE OF MARYLAND  
DONALD A. MASON  
REGISTERED PROFESSIONAL ENGINEER



**STORMWATER MANAGEMENT SUMMARY TABLE**

STORM FREQUENCY	COMBINED AT THE DESIGN POINT PRE-DEVELOPMENT RUNOFF (cfs)	COMBINED AT THE DESIGN POINT POST-DEVELOPMENT RUNOFF (cfs) W/ SWM
2	24.27	22.57
10	131.19	130.01
100	293.55	N/A

YEARS	POND #1			POND #2			POND #3		
	2	10	100	2	10	100	2	10	100
INFLOW Q (cfs)	22.52	48.61	79.07	39.58	87.69	144.44	8.35	18.27	29.89
DISCHARGE Q (cfs)	1.91	12.50	34.15	4.15	33.51	117.90	0.59	5.76	12.77
ELEVATION	279.33	281.69	283.67	278.72	280.85	282.01	274.94	276.46	277.82
STORAGE VOLUME PROVIDED (AC FT)	0.90	1.62	2.43	1.39	2.45	3.15	0.26	0.47	0.72

**OPERATION, MAINTENANCE AND INSPECTION NOTE**

INSPECTION OF THE POND(S) SHOWN HEREON SHALL BE PERFORMED AT LEAST ANNUALLY, IN ACCORDANCE WITH THE CRITERIA AND REQUIREMENTS CONTAINED WITHIN USPA, SSC STANDARDS AND SPECIFICATIONS FOR PONDS (MD-378), THE POND OWNER(S) AND ANY HERB. SUCCESSORS, OR ASSIGNS SHALL BE RESPONSIBLE FOR THE SAFETY OF THE POND AND THE CONTINUED OPERATION, SURVEILLANCE, INSPECTION AND MAINTENANCE THEREOF. THE POND OWNER(S) SHALL PROMPTLY NOTIFY THE SOIL CONSERVATION DISTRICT OF ANY UNUSUAL OBSERVATIONS THAT MAY BE INDICATORS OF DISTRESS SUCH AS EXCESSIVE SEEPAGE, TURBID SEEPAGE, SLIDING OR SLUMPING.

**AS-BUILT CERTIFICATION**

I HEREBY CERTIFY THAT THE FACILITY SHOWN ON THIS PLAN WAS CONSTRUCTED AS SHOWN ON THE "AS-BUILT" PLANS AND MEETS THE APPROVED PLANS AND SPECIFICATIONS.

*Donald Mason* PE NO. 21443  
DONALD A. MASON DATE 5/16/98

CERTIFY MEANS TO STATE OR DECLARE A PROFESSIONAL OPINION BASED UPON ON-SITE INSPECTIONS AND MATERIAL TESTS WHICH ARE CONDUCTED DURING CONSTRUCTION. THE ON-SITE INSPECTIONS AND MATERIAL TESTS ARE THOSE INSPECTIONS AND TESTS DEEMED SUFFICIENT AND APPROPRIATE BY COMMONLY ACCEPTED ENGINEERING STANDARDS. CERTIFY DOES NOT MEAN OR IMPLY A GUARANTEE BY THE ENGINEER NOR DOES AN ENGINEER'S CERTIFICATION RELIEVE ANY OTHER PARTY FROM MEETING REQUIREMENTS IMPOSED BY CONTRACT, EMPLOYMENT, OR OTHER MEANS, INCLUDING MEETING COMMONLY ACCEPTED INDUSTRY PRACTICES.

BY THE DEVELOPER:  
I/WE CERTIFY THAT ALL DEVELOPMENT AND/OR CONSTRUCTION WILL BE DONE ACCORDING TO THESE PLANS, AND THAT ANY RESPONSIBLE PERSONNEL INVOLVED IN THE CONSTRUCTION PROJECT WILL HAVE A CERTIFICATE OF ATTENDANCE AT A DEPARTMENT OF THE ENVIRONMENT APPROVED TRAINING PROGRAM FOR THE CONTROL OF SEDIMENT AND EROSION BEGANNING THE PROJECT. I SHALL ENGAGE A REGISTERED PROFESSIONAL ENGINEER TO SUPERVISE POND CONSTRUCTION AND PROVIDE THE HOWARD SOIL CONSERVATION DISTRICT WITH AN "AS-BUILT" PLAN OF THE POND WITHIN 30 DAYS OF COMPLETION. I ALSO AUTHORIZE PERIODIC ON-SITE INSPECTIONS BY THE HOWARD SOIL CONSERVATION DISTRICT.

*Chp J. V.P.* 6-1-98  
DEVELOPER - TOLL MD LIMITED PARTNERSHIP DATE

BY THE ENGINEER:  
I/WE CERTIFY THAT THIS PLAN FOR POND CONSTRUCTION, EROSION AND SEDIMENT CONTROL REPRESENTS A PRACTICAL AND WORKABLE PLAN BASED ON MY PERSONAL KNOWLEDGE OF THE SITE CONDITIONS. THIS PLAN WAS PREPARED IN ACCORDANCE WITH THE REQUIREMENTS OF THE HOWARD SOIL CONSERVATION DISTRICT. I HAVE NOTIFIED THE DEVELOPER THAT HE/SHE MUST ENGAGE A REGISTERED PROFESSIONAL ENGINEER TO SUPERVISE POND CONSTRUCTION AND PROVIDE THE HOWARD SOIL CONSERVATION DISTRICT WITH AN "AS-BUILT" PLAN OF THE POND WITHIN 30 DAYS OF COMPLETION.

*Donald Mason* 5/27/98  
ENGINEER - DONALD A. MASON, P.E. # 21443 DATE

THESE PLANS HAVE BEEN REVIEWED FOR THE HOWARD SOIL CONSERVATION DISTRICT AND MEET THE TECHNICAL REQUIREMENTS FOR SMALL POND CONSTRUCTION, SOIL EROSION, AND SEDIMENT CONTROL.

*Chp J. V.P.* 6/3/98  
NATURAL RESOURCES CONSERVATION SERVICE DATE

THESE PLANS FOR SMALL POND CONSTRUCTION, SOIL EROSION, AND SEDIMENT CONTROL MEET THE REQUIREMENTS OF THE HOWARD SOIL CONSERVATION DISTRICT.

*Robert W. Zidner/Es.* 6/9/98  
HOWARD SOIL CONSERVATION DISTRICT DATE

APPROVED: HOWARD COUNTY DEPARTMENT OF PUBLIC WORKS

*Andrew M. Daneker* 6-15-98  
CHIEF, BUREAU OF HIGHWAYS DATE

APPROVED: HOWARD COUNTY DEPARTMENT OF PLANNING AND ZONING

*William M. ...* 6/23/98  
CHIEF, DIVISION OF LAND DEVELOPMENT DATE

*Mr. ...* 6/23/98  
CHIEF, DEVELOPMENT ENGINEERING DIVISION DATE



NO.	DATE	REVISION
1	4/27/05	REVISED PER AS-BUILT CONDITIONS

**TSA GROUP, INC.**  
planning • architecture • engineering • surveying  
8460 Baltimore National Pike • Ellicott City, Maryland 21048 • 410-465-6105




**OWNERS:**  
TOLL MD LIMITED PARTNERSHIP,  
A MARYLAND LIMITED PARTNERSHIP  
3206 TOWER OAKS BOULEVARD  
SUITE 310  
ROCKVILLE, MARYLAND 20852

**PROJECT:**  
**VILLAGE OF CEDAR RIDGE**  
A SUBDIVISION OF PARCEL 44 (TAX MAP 41) AND A RESUBDIVISION OF LOTS 1 AND 2 OF THE EDITH S. PARLETTE SUBDIVISION (PLAT 10735 PARCEL 43) AND A SUBDIVISION OF PARCEL 123 FOR A ROAD RIGHT-OF-WAY

**LOCATION:**  
TAX MAP 41 - PARCELS 43 & 44, P/O 123  
5th ELECTION DISTRICT  
HOWARD COUNTY, MARYLAND

**DEVELOPER:**  
TOLL MD LIMITED PARTNERSHIP,  
A MARYLAND LIMITED PARTNERSHIP  
3206 TOWER OAKS BOULEVARD  
SUITE 310  
ROCKVILLE, MARYLAND 20852

**TITLE:**  
**GRADING, SEDIMENT AND EROSION CONTROL PLAN**  
SP-97-02 WP-97-78 PB 312 F-93-70 WP-98-82  
DATE: OCTOBER, 1997 PROJECT NO. 0518  
MAY, 1998  
SCALE: 1" = 50' SHEET 21 OF 31

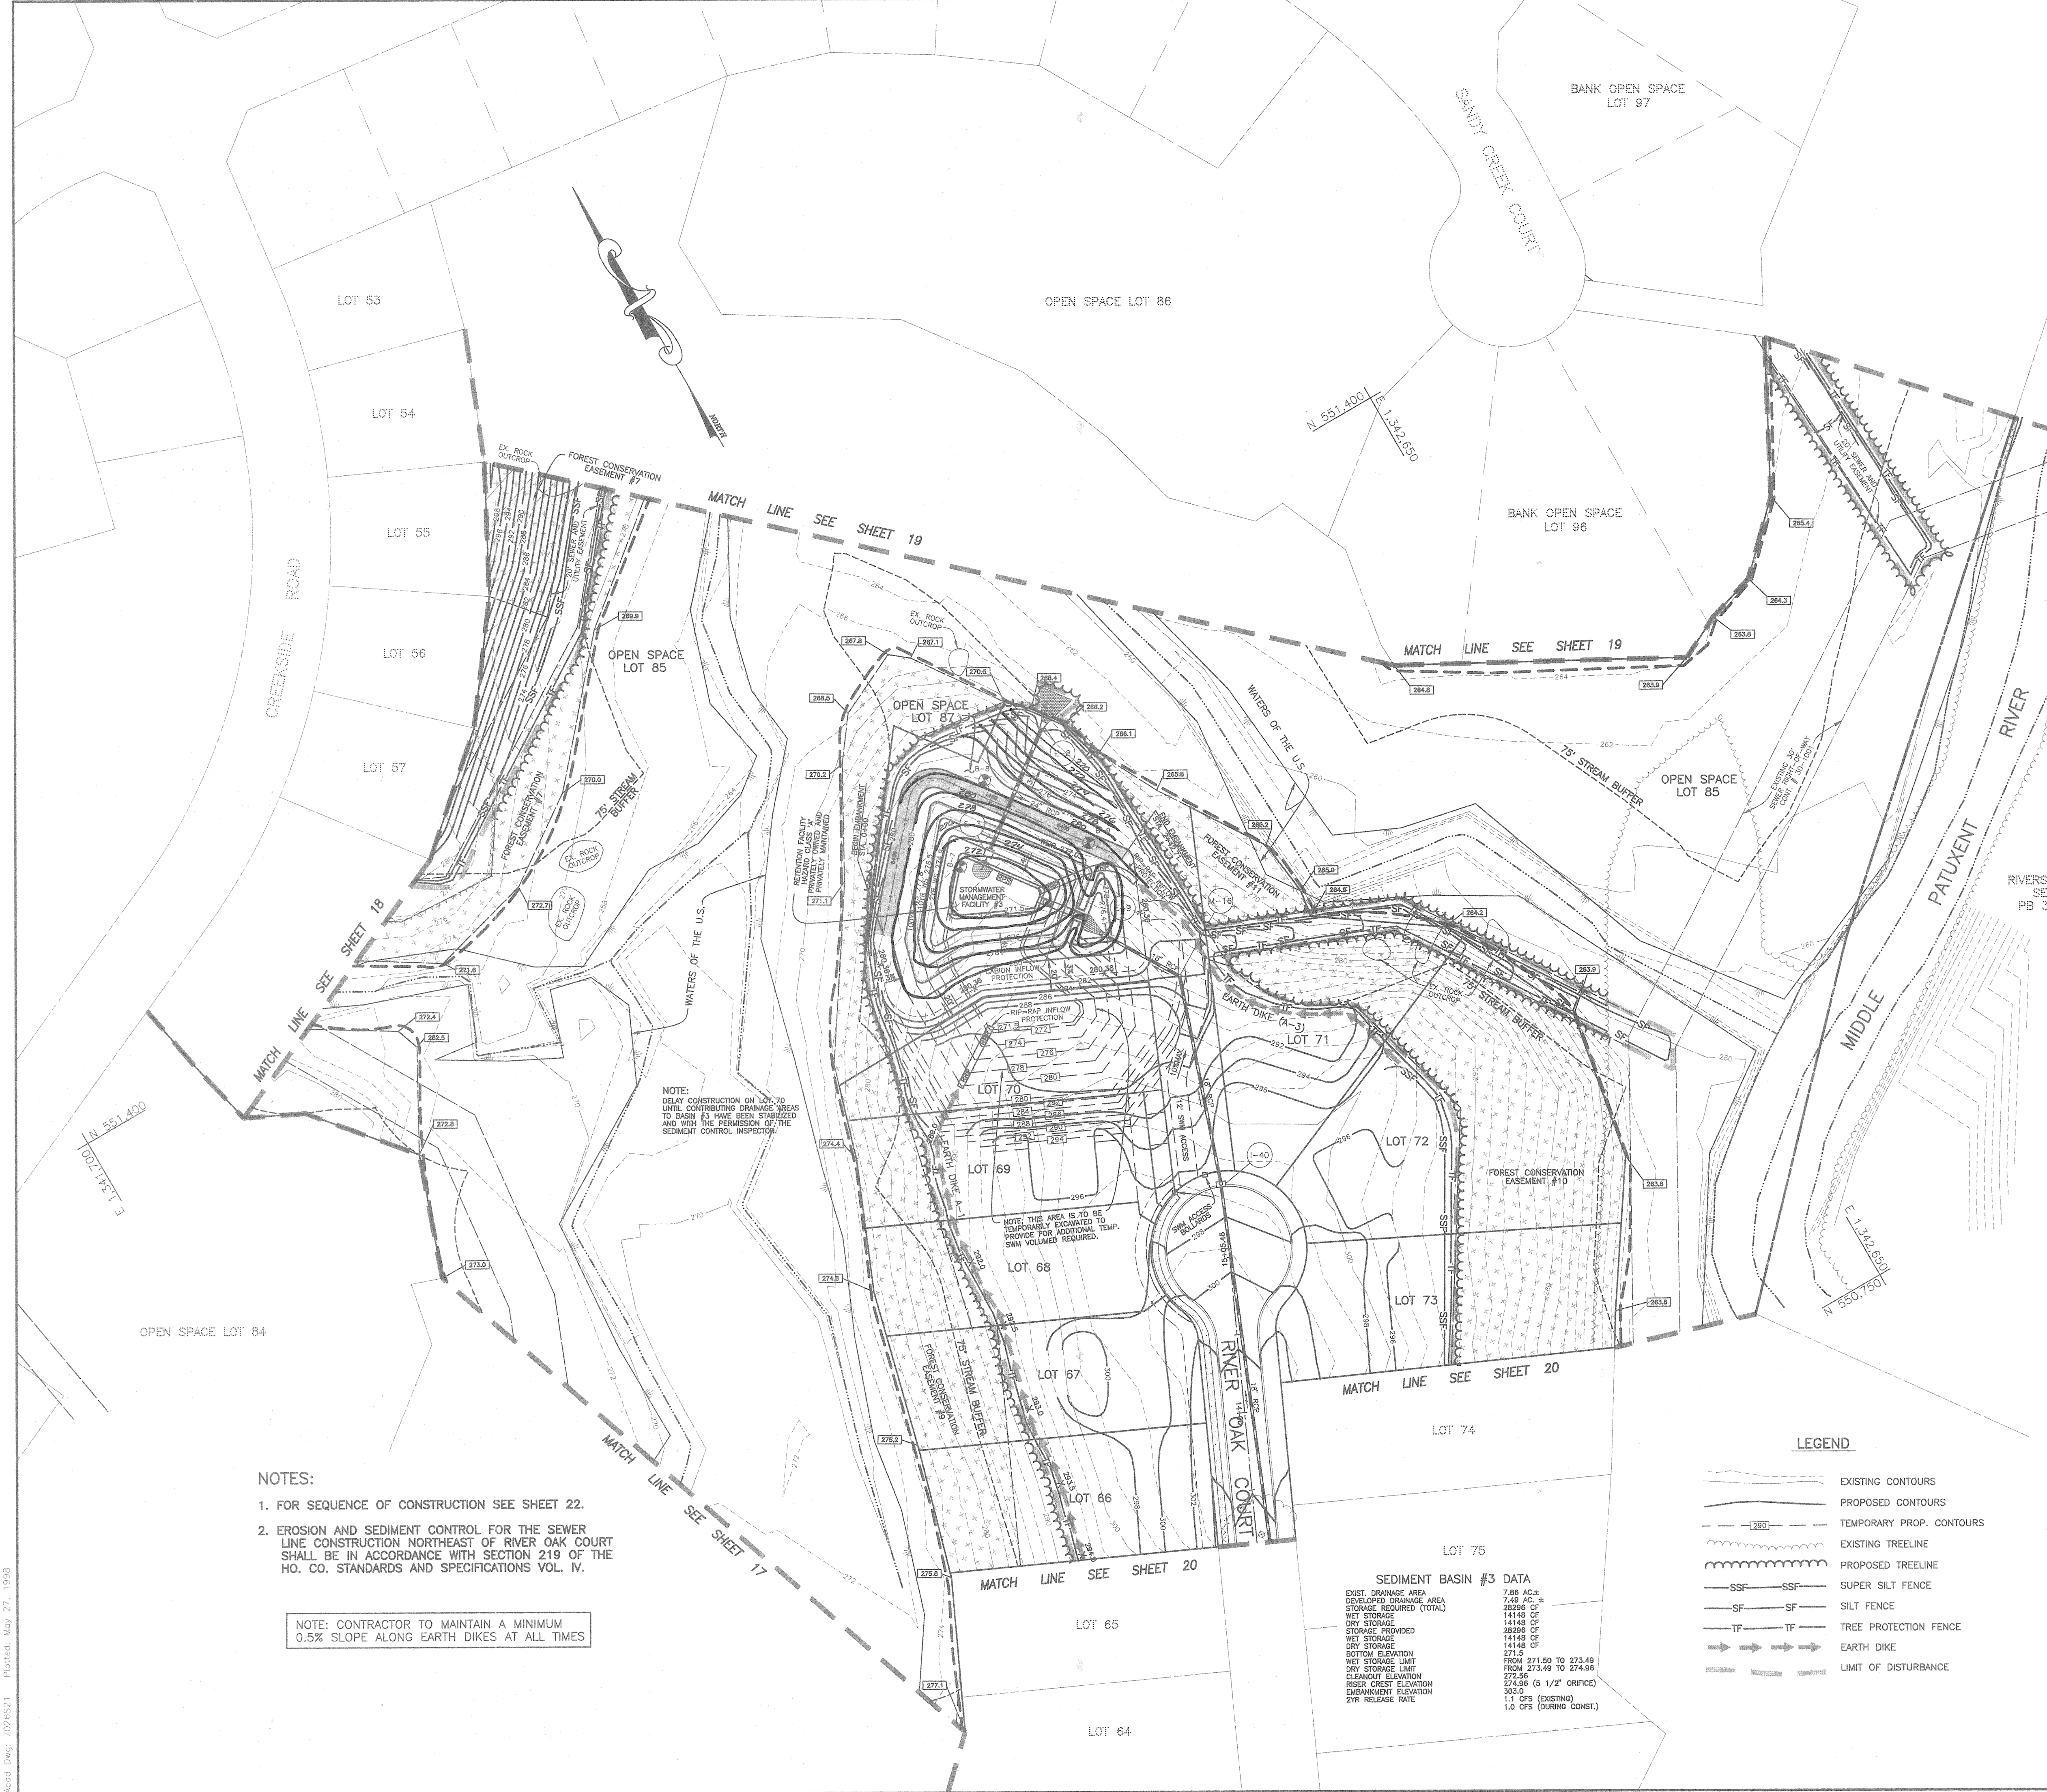

- LEGEND**
- - - - - EXISTING CONTOURS
  - — — — — PROPOSED CONTOURS
  - - - - - TEMPORARY PROP. CONTOURS
  - ~~~~~ EXISTING TREELINE
  - ~~~~~ PROPOSED TREELINE
  - SSF--- SUPER SILT FENCE
  - SF--- SILT FENCE
  - TF--- TREE PROTECTION FENCE
  - → → → → EARTH DIKE
  - --- LIMIT OF DISTURBANCE


**SEDIMENT BASIN #3 DATA**

EXIST. DRAINAGE AREA	7.86 AC ±
DEVELOPED DRAINAGE AREA	7.49 AC ±
STORAGE REQUIRED (TOTAL)	26296 CF ±
WET STORAGE	14148 CF
DRY STORAGE	26296 CF
WET STORAGE	14148 CF
DRY STORAGE	14148 CF
BOTTOM ELEVATION	271.5
NET STORAGE LIMIT	FROM 271.50 TO 273.49
DRY STORAGE LIMIT	FROM 273.49 TO 274.06
NET STORAGE	272.50
PLEASANT ELEVATION	274.06 (5 1/2" ORIFICE)
RISER ORIFICE ELEVATION	353.0
EMBANKMENT ELEVATION	1.1 CFS (EXISTING)
2YR RELEASE RATE	1.0 CFS (DURING CONST.)

- NOTES:**
- FOR SEQUENCE OF CONSTRUCTION SEE SHEET 22.
  - EROSION AND SEDIMENT CONTROL FOR THE SEWER LINE CONSTRUCTION NORTHEAST OF RIVER OAK COURT SHALL BE IN ACCORDANCE WITH SECTION 219 OF THE HO. CO. STANDARDS AND SPECIFICATIONS VOL. IV.

NOTE: CONTRACTOR TO MAINTAIN A MINIMUM 0.5% SLOPE ALONG EARTH DIKES AT ALL TIMES



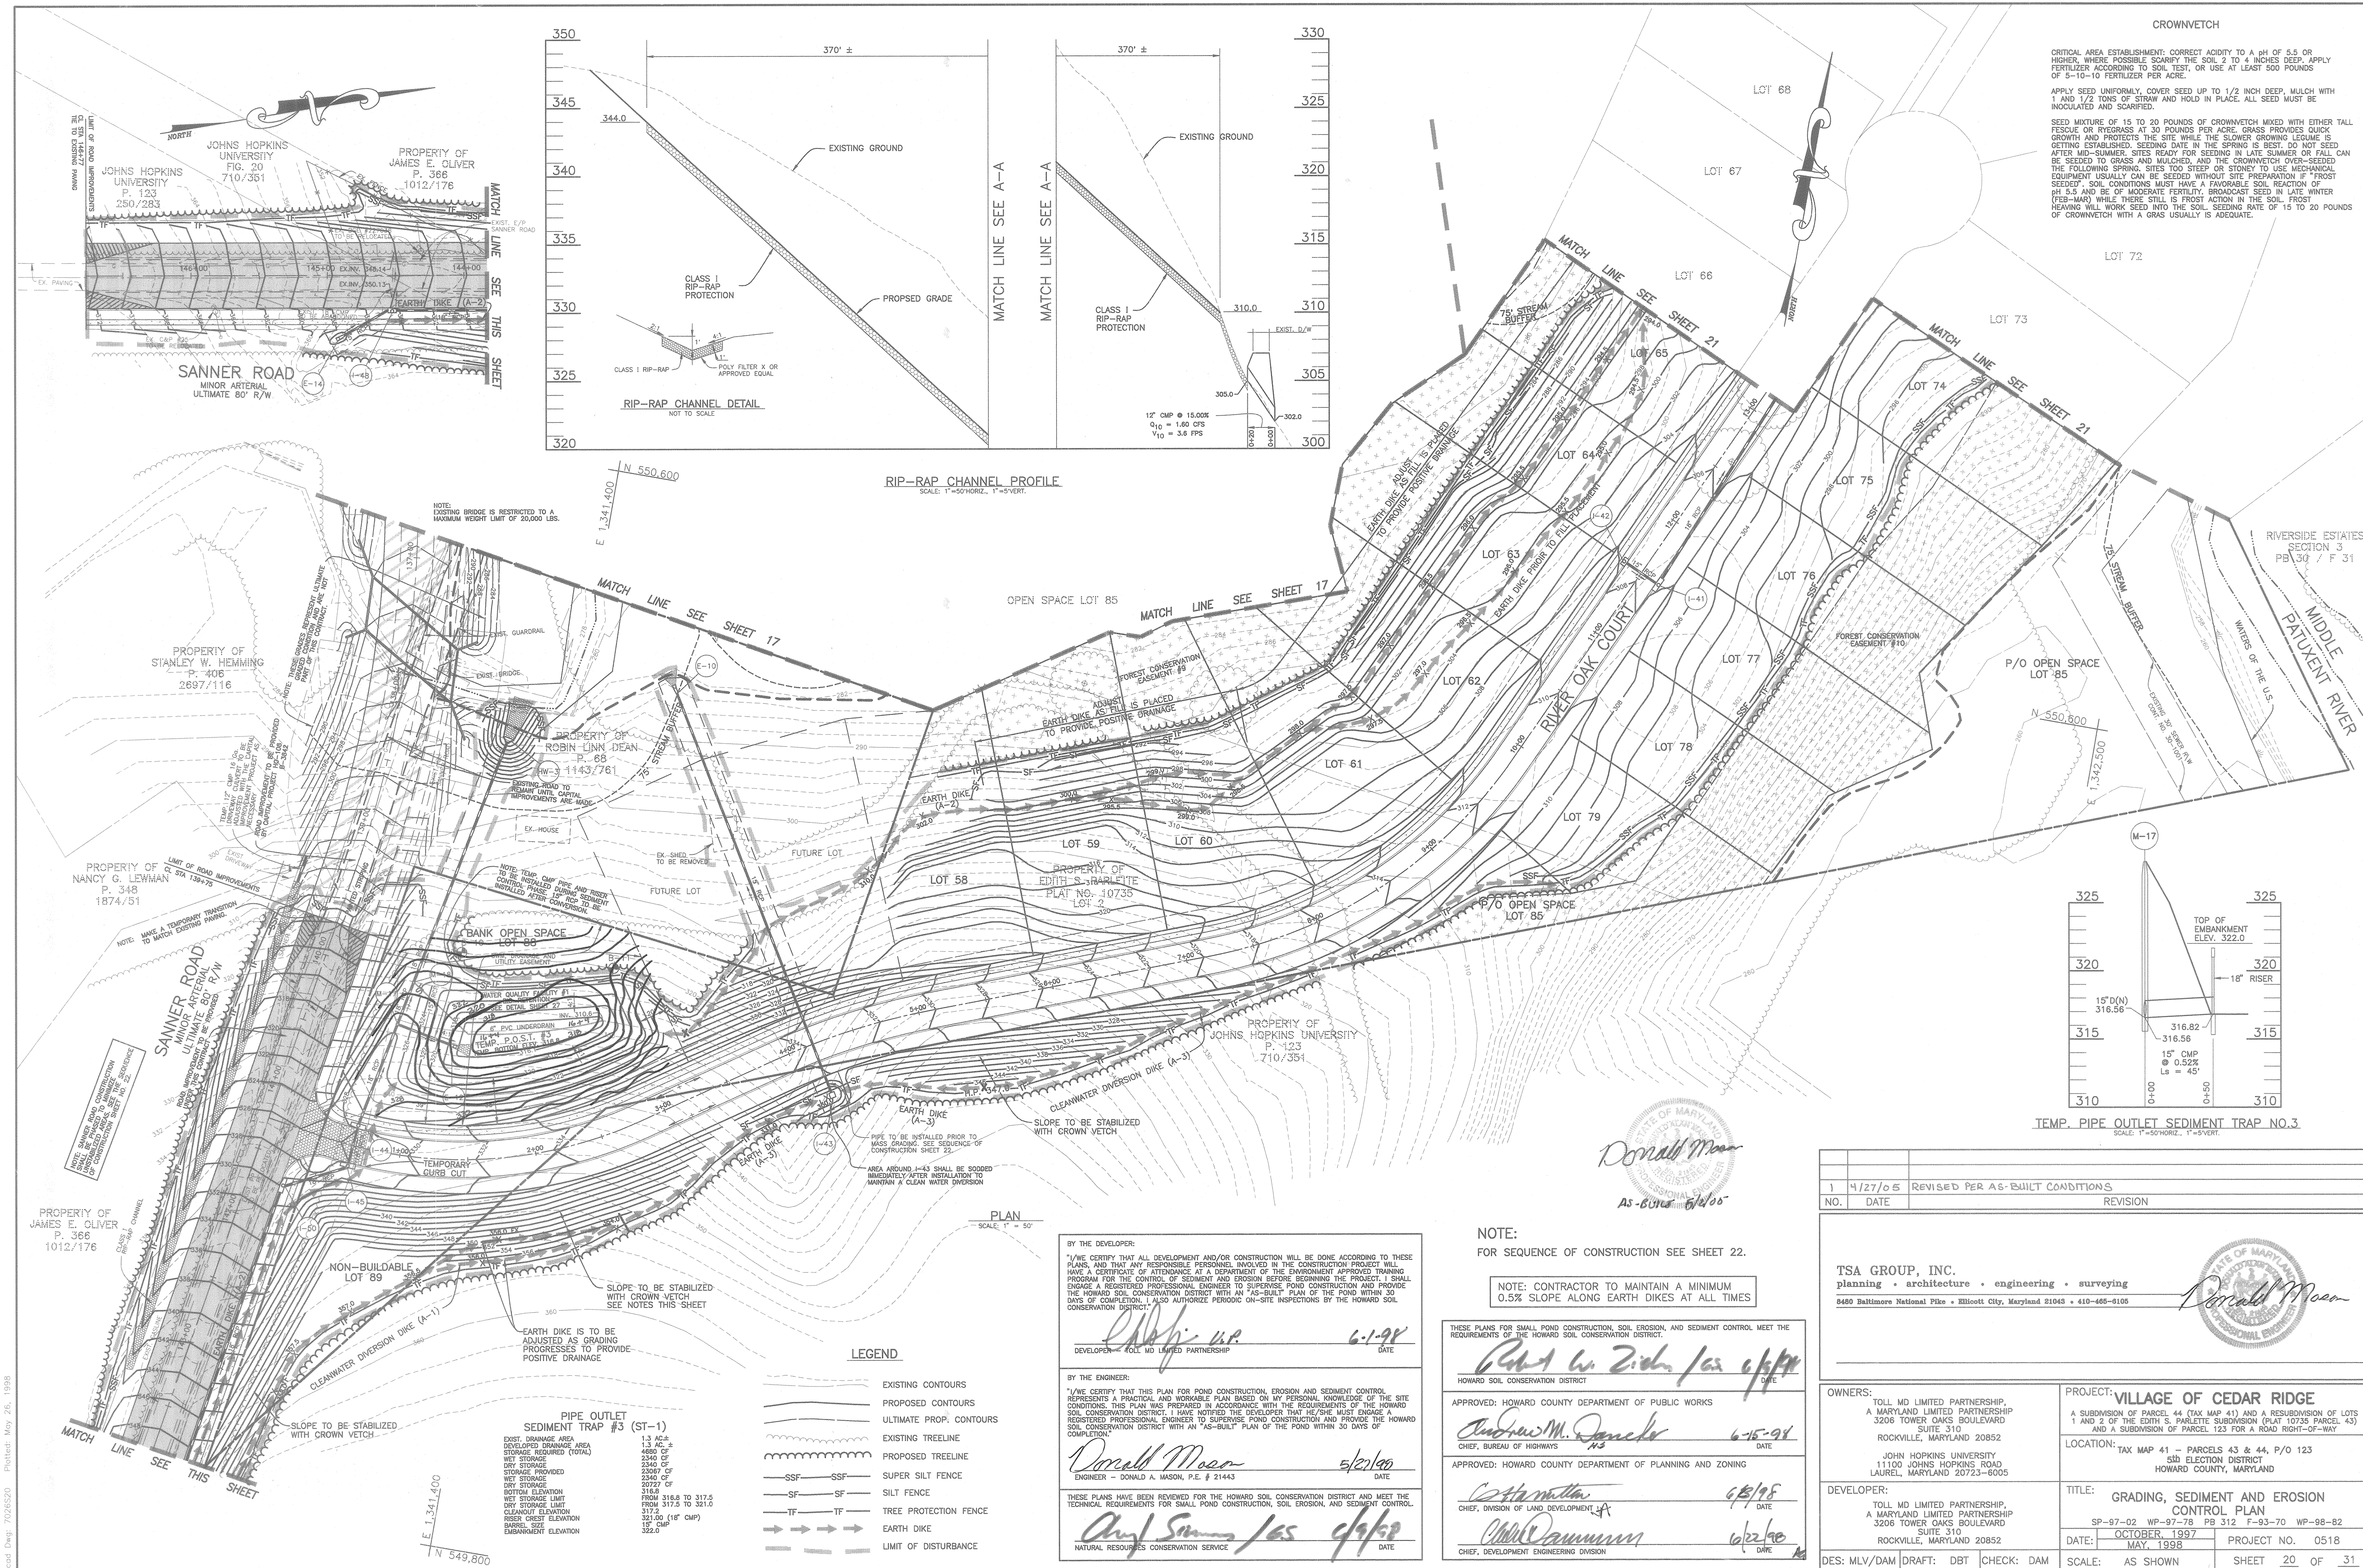

Acad. Dwg. 7/26/92/20 Printed: May 26, 1998





**LEGEND**

- EXISTING CONTOURS
- PROPOSED CONTOURS
- TEMPORARY PROP. CONTOURS
- EXISTING TREELINE
- PROPOSED TREELINE
- SF --- SILT FENCE
- SSF --- SUPER SILT FENCE
- TF --- TREE PROTECTION FENCE
- EARTH DIKE
- LIMIT OF DISTURBANCE
- EROSION CONTROL MATTING

**OPERATION, MAINTENANCE AND INSPECTION NOTE**  
 INSPECTION OF THE POND(S) SHOWN HEREON SHALL BE PERFORMED AT LEAST ANNUALLY IN ACCORDANCE WITH THE CHECKLIST AND REQUIREMENTS CONTAINED WITHIN USDA, SCS STANDARDS AND SPECIFICATIONS FOR PONDS (16-378). THE POND OWNER(S) AND ANY HEIRS, SUCCESSORS OR ASSIGNS SHALL BE RESPONSIBLE FOR THE SAFETY OF THE POND AND THE CONTINUED OPERATION, SURVEILLANCE, INSPECTION, AND MAINTENANCE THEREOF. THE POND OWNER(S) SHALL PROMPTLY NOTIFY THE SOIL CONSERVATION DISTRICT OF ANY UNUSUAL OBSERVATIONS THAT MAY BE INDICATORS OF DISTRESS SUCH AS EXCESSIVE SEEPAGE, TURBID SEEPAGE, SLIDING OR SLUMPING.

**AS-BUILT CERTIFICATION**  
 I HEREBY CERTIFY THAT THE FACILITY SHOWN ON THIS PLAN WAS CONSTRUCTED AS SHOWN ON THE "AS-BUILT" PLANS AND MEETS THE APPROVED PLANS AND SPECIFICATIONS.

*Donald A. Mason* PE NO. 21443  
 DONALD A. MASON DATE 5/2/98

CERTIFY MEANS TO STATE OR DECLARE A PROFESSIONAL OPINION BASED UPON ONSITE INSPECTIONS AND MATERIAL TESTS WHICH ARE CONDUCTED DURING CONSTRUCTION. THE ONSITE INSPECTIONS AND MATERIAL TESTS ARE THOSE INSPECTIONS AND TESTS DEEMED SUFFICIENT AND APPROPRIATE BY COMMONLY ACCEPTED ENGINEERING STANDARDS. CERTIFY DOES NOT MEAN OR IMPLY A GUARANTEE BY THE ENGINEER NOR DOES AN ENGINEER'S CERTIFICATION RELIEVE ANY OTHER PARTY FROM MEETING REQUIREMENTS IMPOSED BY CONTRACT, EMPLOYMENT, OR OTHER MEANS, INCLUDING MEETING COMMONLY ACCEPTED INDUSTRY PRACTICES.

BY THE DEVELOPER:  
 "I/WE CERTIFY THAT ALL DEVELOPMENT AND/OR CONSTRUCTION WILL BE DONE ACCORDING TO THESE PLANS, AND THAT ANY RESPONSIBLE PERSONNEL INVOLVED IN THE CONSTRUCTION PROJECT WILL HAVE ATTENDANCE AT A DEPARTMENT OF THE ENVIRONMENT APPROVED TRAINING PROGRAM FOR THE CONTROL OF SEDIMENT AND EROSION BEFORE BEGINNING THE PROJECT. I SHALL ENGAGE A REGISTERED PROFESSIONAL ENGINEER TO SUPERVISE POND CONSTRUCTION AND PROVIDE THE HOWARD SOIL CONSERVATION DISTRICT WITH AN "AS-BUILT" PLAN OF THE POND WITHIN 30 DAYS OF COMPLETION. I ALSO AUTHORIZE PERIODIC ON-SITE INSPECTIONS BY THE HOWARD SOIL CONSERVATION DISTRICT."

*John P. V.P.* 6-1-98  
 DEVELOPER - TOLL MD LIMITED PARTNERSHIP DATE

BY THE ENGINEER:  
 "I/WE CERTIFY THAT THIS PLAN FOR POND CONSTRUCTION, EROSION AND SEDIMENT CONTROL REPRESENTS A PRACTICAL AND WORKABLE PLAN BASED ON MY PERSONAL KNOWLEDGE OF THE SITE CONDITIONS. THIS PLAN WAS PREPARED IN ACCORDANCE WITH THE REQUIREMENTS OF THE HOWARD SOIL CONSERVATION DISTRICT. I HAVE NOTIFIED THE DEVELOPER THAT HE/SHE MUST ENGAGE A REGISTERED PROFESSIONAL ENGINEER TO SUPERVISE POND CONSTRUCTION AND PROVIDE THE HOWARD SOIL CONSERVATION DISTRICT WITH AN "AS-BUILT" PLAN OF THE POND WITHIN 30 DAYS OF COMPLETION."


*Donald A. Mason* 5/27/98  
 ENGINEER - DONALD A. MASON, P.E. # 21443 DATE

THESE PLANS HAVE BEEN REVIEWED FOR THE HOWARD SOIL CONSERVATION DISTRICT AND MEET THE TECHNICAL REQUIREMENTS FOR SMALL POND CONSTRUCTION, SOIL EROSION, AND SEDIMENT CONTROL.  
*Paul Simon* /es 6/9/98  
 NATURAL RESOURCES CONSERVATION SERVICE DATE

THESE PLANS FOR SMALL POND CONSTRUCTION, SOIL EROSION, AND SEDIMENT CONTROL MEET THE REQUIREMENTS OF THE HOWARD SOIL CONSERVATION DISTRICT.  
*Richard W. Zick* /es 6/9/98  
 HOWARD SOIL CONSERVATION DISTRICT DATE

APPROVED: HOWARD COUNTY DEPARTMENT OF PUBLIC WORKS  
*Andrew M. Doucker* 6-15-98  
 CHIEF, BUREAU OF HIGHWAYS DATE

APPROVED: HOWARD COUNTY DEPARTMENT OF PLANNING AND ZONING  
*William* 6/25/98  
 CHIEF, DIVISION OF LAND DEVELOPMENT DATE  
*William* 6/25/98  
 CHIEF, DEVELOPMENT ENGINEERING DIVISION DATE

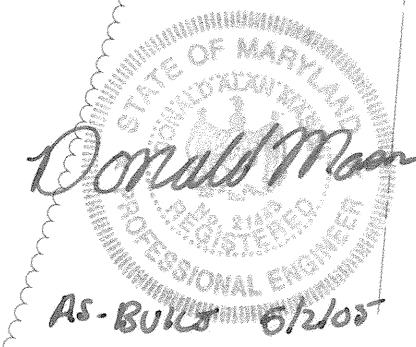

NO.	DATE	REVISION
1	4/27/05	REVISED PER AS-BUILT CONDITIONS

**TSA GROUP, INC.**  
 planning • architecture • engineering • surveying  
 6460 Baltimore National Pike • Ellicott City, Maryland 21043 • 410-466-8105

*Donald A. Mason*  
 PROFESSIONAL ENGINEER

<b>OWNERS:</b> TOLL MD LIMITED PARTNERSHIP, A MARYLAND LIMITED PARTNERSHIP 3206 TOWER OAKS BOULEVARD SUITE 310 ROCKVILLE, MARYLAND 20852	<b>PROJECT:</b> <b>VILLAGE OF CEDAR RIDGE</b> A SUBDIVISION OF PARCEL 44 (TAX MAP 41) AND A RESUBDIVISION OF LOTS 1 AND 2 OF THE EDITH S. PARLETTE SUBDIVISION (PLAT 10735 PARCEL 43) AND A SUBDIVISION OF PARCEL 123 FOR A ROAD RIGHT-OF-WAY.
<b>DEVELOPER:</b> TOLL MD LIMITED PARTNERSHIP, A MARYLAND LIMITED PARTNERSHIP 3206 TOWER OAKS BOULEVARD SUITE 310 ROCKVILLE, MARYLAND 20852	<b>LOCATION:</b> TAX MAP 41 - PARCELS 43 & 44, P/O 123 5th ELECTION DISTRICT HOWARD COUNTY, MARYLAND
<b>TITLE:</b> GRADING, SEDIMENT AND EROSION CONTROL PLAN SP-97-02 WP-97-78 PB 312 F-93-70 WP-98-82	<b>DATE:</b> OCTOBER 1997 MAY 1998
<b>DES: MLV/DAM DRAFT: DBT CHECK: DAM</b>	<b>PROJECT NO. 0518</b> <b>SHEET 19 OF 31</b>

**SEDIMENT BASIN #2 DATA**

EXIST. DRAINAGE AREA	28.4 AC.
DEVELOPED DRAINAGE AREA	27.3 AC.
STORAGE REQUIRED (TOTAL)	60200 CU FT
WET STORAGE	49140 CU FT
DRY STORAGE	11060 CU FT
STORAGE PROVIDED	60200 CU FT
WET STORAGE	49140 CU FT
DRY STORAGE	11060 CU FT
BOTTOM ELEVATION	271.00
WET STORAGE LIMIT	FROM 271.00 TO 275.9
DRY STORAGE LIMIT	FROM 275.9 TO 278.24
CLEANOUT ELEVATION	274.1
RISER CREST ELEVATION	278.9 (15" ORIFICE)
EMBANKMENT ELEVATION	284.2
2YR RELEASE RATE	8.5 CFS (EXISTING)
	8.5 CFS (DURRIG CONST.)

- NOTES:**
- FOR SEQUENCE OF CONSTRUCTION SEE SHEET 22.
  - EROSION AND SEDIMENT CONTROL FOR SEWER LINE CONSTRUCTION SOUTHEAST OF SANDY CREEK COURT SHALL BE IN ACCORDANCE WITH SECTION 219 OF THE HO. CO. STANDARDS AND SPECIFICATIONS VOL. IV.

NOTE: CONTRACTOR TO MAINTAIN A MINIMUM 0.5% SLOPE ALONG EARTH DIKES AT ALL TIMES



**OPERATION, MAINTENANCE AND INSPECTION NOTE**

INSPECTION OF THE POND(S) SHOWN HEREON SHALL BE PERFORMED AT LEAST ANNUALLY, IN ACCORDANCE WITH THE CHECKLIST AND REQUIREMENTS CONTAINED WITHIN USGS STANDARDS AND SPECIFICATIONS FOR PONDS (40-270). THE POND OWNER(S) AND ANY HEIRS, SUCCESSORS, OR ASSIGNS SHALL BE RESPONSIBLE FOR THE SAFETY OF THE POND AND THE CONTINUED OPERATION, SURVEILLANCE, INSPECTION, AND MAINTENANCE THEREOF. THE POND OWNER(S) SHALL PROMPTLY NOTIFY THE SOIL CONSERVATION DISTRICT OF ANY UNUSUAL OBSERVATIONS THAT MAY BE INDICATORS OF DISTRESS SUCH AS EXCESSIVE SEEDING, TURBID SEEPAGE, SLIDING OR SLUMPING.

**AS-BUILT CERTIFICATION**

I HEREBY CERTIFY THAT THE FACILITY SHOWN ON THIS PLAN WAS CONSTRUCTED AS SHOWN ON THE AS-BUILT PLANS AND MEETS THE APPROVED PLANS AND SPECIFICATIONS.

*Donald A. Mason*  
DONALD A. MASON  
PE NO. 21463  
DATE 6/2/05

CERTIFY MEANS TO STATE OR DECLARE A PROFESSIONAL OPINION BASED UPON ON-SITE INSPECTIONS AND MATERIAL TESTS WHICH ARE CONDUCTED DURING CONSTRUCTION. THE ON-SITE INSPECTIONS AND MATERIAL TESTS ARE THOSE INSPECTIONS AND TESTS DEEMED SUFFICIENT AND APPROVED BY COMMONLY ACCEPTED ENGINEERING STANDARDS. CERTIFY DOES NOT MEAN OR IMPLY A GUARANTEE BY THE ENGINEER NOR TAKES AN ENGINEER'S CERTIFICATION RELIEVE ANY OTHER PARTY FROM MEETING REQUIREMENTS IMPOSED BY CONTRACT, EMPLOYMENT, OR OTHER MEANS, INCLUDING MEETING COMMONLY ACCEPTED INDUSTRY PRACTICES.

BY THE DEVELOPER:

"I/WE CERTIFY THAT ALL DEVELOPMENT AND/OR CONSTRUCTION WILL BE DONE ACCORDING TO THESE PLANS, AND THAT ANY RESPONSIBLE PERSONNEL INVOLVED IN THE CONSTRUCTION PROJECT WILL HAVE A CERTIFICATE OF ATTENDANCE AT A DEPARTMENT OF THE ENVIRONMENT APPROVED TRAINING PROGRAM FOR THE CONTROL OF SEDIMENT AND EROSION BEFORE BEGINNING THE PROJECT. I SHALL ENGAGE A REGISTERED PROFESSIONAL ENGINEER TO SUPERVISE POND CONSTRUCTION AND PROVIDE THE HOWARD SOIL CONSERVATION DISTRICT WITH AN AS-BUILT PLAN OF THE POND WITHIN 30 DAYS OF COMPLETION. I ALSO AUTHORIZE PERIODIC ON-SITE INSPECTIONS BY THE HOWARD SOIL CONSERVATION DISTRICT."

*Donald A. Mason*  
DEVELOPER - TOLL MO LIMITED PARTNERSHIP  
DATE 6-1-98

BY THE ENGINEER:

"I/WE CERTIFY THAT THIS PLAN FOR POND CONSTRUCTION, EROSION AND SEDIMENT CONTROL REPRESENTS A PRACTICAL AND WORKABLE PLAN BASED ON MY PERSONAL KNOWLEDGE OF THE SITE CONDITIONS. THIS PLAN WAS PREPARED IN ACCORDANCE WITH THE REQUIREMENTS OF THE HOWARD SOIL CONSERVATION DISTRICT. I HAVE NOTIFIED THE DEVELOPER THAT HE/SHE MUST ENGAGE A REGISTERED PROFESSIONAL ENGINEER TO SUPERVISE POND CONSTRUCTION AND PROVIDE THE HOWARD SOIL CONSERVATION DISTRICT WITH AN AS-BUILT PLAN OF THE POND WITHIN 30 DAYS OF COMPLETION. I ALSO AUTHORIZE PERIODIC ON-SITE INSPECTIONS BY THE HOWARD SOIL CONSERVATION DISTRICT."

*Donald A. Mason*  
ENGINEER - DONALD A. MASON, P.E. # 21443  
DATE 5/21/99

THESE PLANS HAVE BEEN REVIEWED FOR THE HOWARD SOIL CONSERVATION DISTRICT AND MEET THE TECHNICAL REQUIREMENTS FOR SMALL POND CONSTRUCTION, SOIL EROSION, AND SEDIMENT CONTROL.

*Chaf Sims / cs* 6/9/98  
NATURAL RESOURCES CONSERVATION SERVICE  
DATE

THESE PLANS FOR SMALL POND CONSTRUCTION, SOIL EROSION, AND SEDIMENT CONTROL MEET THE REQUIREMENTS OF THE HOWARD SOIL CONSERVATION DISTRICT.

*Robert V. Zick / rcs* 6/9/98  
HOWARD SOIL CONSERVATION DISTRICT  
DATE

APPROVED: HOWARD COUNTY DEPARTMENT OF PUBLIC WORKS

*Robert M. Daneker* 6-15-98  
CHIEF, BUREAU OF HIGHWAYS  
DATE

APPROVED: HOWARD COUNTY DEPARTMENT OF PLANNING AND ZONING

*Chaf Sims* 6/23/98  
CHIEF, DIVISION OF LAND DEVELOPMENT  
DATE

*McDannun* 6/24/98  
CHIEF, DEVELOPMENT ENGINEERING DIVISION  
DATE

**STONE OUTLET SEDIMENT TRAP #2 (ST-II)**

EXIST. DRAINAGE AREA 1.89 AC ±  
DEVELOPED DRAINAGE AREA 0.07 AC ±  
STORAGE REQUIRED 8654 CF  
STORAGE PROVIDED 8348 CF

WEIR LENGTH 10'  
STORAGE DEPTH BELOW OUTLET 292.55  
EMBANKMENT ELEVATION 298.00  
BOTTOM ELEVATION 292.00  
WEIR CREST ELEVATION 293.00  
WET STORAGE ELEVATION 293.00  
EXIST. GROUND ELEV. @ OUTLET 293.00  
BOTTOM DIMENSION 70' X 35'

**SEDIMENT BASIN #1 DATA**

EXIST. DRAINAGE AREA 7.73 AC ±  
DEVELOPED DRAINAGE AREA 11.82 AC ±  
STORAGE REQUIRED (TOTAL) 42552 CF  
WET STORAGE 21276 CF  
DRY STORAGE 21276 CF  
STORAGE PROVIDED 42552 CF  
WET STORAGE 21276 CF  
DRY STORAGE 21276 CF  
BOTTOM ELEVATION 274.00  
WET STORAGE LIMIT FROM 274.00 TO 277.52  
DRY STORAGE LIMIT FROM 277.52 TO 279.84  
CLEANOUT ELEVATION 276.11  
RESER CREST ELEVATION 278.84 (7' OVERFLOW)  
288.1  
2.1 CFS (EXISTING)  
2.1 CFS (DURING CONST.)

**TMP. SWM/PIPE OUTLET SEDIMENT TRAP #1 (ST-I)**

EXIST. DRAINAGE AREA 3.64 AC ±  
DEVELOPED DRAINAGE AREA 1.50 AC ±  
STORAGE REQUIRED (TOTAL) 13104 CF  
WET STORAGE 6552 CF  
DRY STORAGE 6552 CF  
STORAGE PROVIDED 13104 CF  
WET STORAGE 6552 CF  
DRY STORAGE 6552 CF  
BOTTOM DIMENSION 80' X 55'  
EMBANKMENT ELEVATION 298.00  
WET STORAGE LIMIT FROM 288.00 TO 298.18  
DRY STORAGE LIMIT FROM 298.18 TO 300.30  
CLEANOUT ELEVATION 298.50  
RESER CREST ELEVATION 301.3 (27' CMP)  
21' CMP (24' I)  
300.00  
EMBANKMENT ELEVATION 300.46  
EXISTING GROUND @ EMBANKMENT 300.46  
2.8 CFS (EXISTING)  
1.8 CFS (DURING CONST.)  
2.8 CFS (DURING CONST.)

**NOTE:**

DELAY CONSTRUCTION ON LOT 24 UNTIL CONTRIBUTING DRAINAGE AREAS TO SEDIMENT TRAP #2 HAVE BEEN STABILIZED AND WITH THE PERMISSION OF THE SEDIMENT CONTROL INSPECTOR.



- LEGEND**
- EXISTING CONTOURS
  - PROPOSED CONTOURS
  - ULTIMATE PROP. CONTOURS
  - EXISTING TREELINE
  - PROPOSED TREELINE
  - SF - SF - SILT FENCE
  - SSF - SSF - SUPER SILT FENCE
  - TF - TF - TREE PROTECTION FENCE
  - EARTH DIKE
  - LIMIT OF DISTURBANCE
  - EROSION CONTROL MATTING

**TSA GROUP, INC.**  
planning • architecture • engineering • surveying  
8450 Baltimore National Pike • Ellicott City, Maryland 21043 • 410-465-6105

*Donald A. Mason*  
REGISTERED PROFESSIONAL ENGINEER

<b>OWNERS:</b> TOLL MD LIMITED PARTNERSHIP, A MARYLAND LIMITED PARTNERSHIP 3206 TOWER OAKS BOULEVARD SUITE 310 ROCKVILLE, MARYLAND 20852	<b>PROJECT:</b> <b>VILLAGE OF CEDAR RIDGE</b> A SUBDIVISION OF PARCEL 44 (TAX MAP 41) AND A RESUBDIVISION OF LOTS 1 AND 2 OF THE EDITH S. PARLETTE SUBDIVISION (PLAT 10735 PARCEL 43) AND A SUBDIVISION OF PARCEL 123 FOR A ROAD RIGHT-OF-WAY.
<b>DEVELOPER:</b> TOLL MD LIMITED PARTNERSHIP, A MARYLAND LIMITED PARTNERSHIP 3206 TOWER OAKS BOULEVARD SUITE 310 ROCKVILLE, MARYLAND 20852	<b>LOCATION:</b> TAX MAP 41 - PARCELS 43 & 44, P/O 123 S80 ELECTION DISTRICT HOWARD COUNTY, MARYLAND
<b>DES: DAM/MLV DRAFT: DBT CHECK: DAM</b>	<b>TITLE:</b> <b>GRADING, SEDIMENT AND EROSION CONTROL PLAN</b> SP-97-02 WP-97-78 PB 312 F-93-70 WP-98-82 <b>DATE:</b> OCTOBER, 1997 MAY, 1998 <b>PROJECT NO. 0518</b>
	<b>SCALE:</b> 1" = 50' <b>SHEET 17 OF 31</b>

STABILIZED CONSTRUCTION ENTRANCE W/MOUNTABLE BERM

ROAD IMPROVEMENT TO BE PROVIDED UNDER THIS CONTRACT

PROPERTY OF ROBERT A. GASKILL  
P. 372  
637/155

NOTE: CONTRACTOR TO MAINTAIN A MINIMUM 0.5% SLOPE ALONG EARTH DIKES AT ALL TIMES

FOR SEQUENCE OF CONSTRUCTION SEE SHEET 22.

NO.	DATE	REVISION
1	4/27/05	REVISED PER AS-BUILT CONDITIONS







SEQUENCE OF CONSTRUCTION FOR CULVERT INSTALLATION

- (DAY 1) 1. INSTALL SEDIMENT CONTROL DEVICES AS SHOWN ON PLAN.
- (DAY 2-4) 2. CONSTRUCT A DIVERSION PIPE IN CONJUNCTION WITH WPD2.2.
- (DAY 4) 3. INSTALL FILTER BAG.
- (DAY 5) 4. CONSTRUCT A TEMPORARY SANDBAG DIVERSION UPSTREAM TO DIVERT WATER INTO THE PIPE. (EPD2.3).
- (DAY 5) 5. PLACE A SANDBAG DIKE DOWNSTREAM TO PREVENT THE STREAM FROM BACKWASHING INTO CONSTRUCTION AREA.
- (DAY 6-13) 6. UPON APPROVAL OF THE HOWARD COUNTY SEDIMENT CONTROL INSPECTOR, INSTALL NEW CULVERTS, DEPRESSING ONE OF THEM 1 FOOT BENEATH THE NATURAL STREAM INVERT TO ALLOW SILTATION FOR IMPROVED FISH PASSAGE. (WPD5.3)
- (DAY 14-16) 7. BACKFILL TO SUBGRADE AND CONSTRUCT THE NEW ROADWAY.
- (DAY 17) 8. STABILIZE THE STREAM BED WITH RIP-RAP PROTECTION. (WPD3.1)
- (DAY 18) 9. DEWATER THE AREA BY INSTALLING SUMP PIT AND PUMP THROUGH FILTER BAG, THEN, REMOVE THE TEMPORARY STREAM DIVERSION FROM DOWNSTREAM TO UPSTREAM.
- (DAY 19) 10. SEED AND MULCH ANY REMAINING DISTURBANCES.
- (DAY 19) 11. CLEAN UP THE CONSTRUCTION SITE.
- (DAY 19) 12. UPON APPROVAL OF THE HOWARD COUNTY SEDIMENT CONTROL INSPECTOR, REMOVE ANY SILT FENCES INSTALLED BEFORE CONSTRUCTION.


- NOTES:
1. A 5 DAY CLEAR WEATHER FORECAST SHALL BE PREDICTED PRIOR TO THE TEMPORARY DIVERSION PIPE INSTALLATION AND BEFORE THE REMOVAL OF THE TEMPORARY DIVERSION PIPE.
  2. THIS CULVERT IS BEING PLACED WITHIN A CLASS I TROUT STREAM. NO WORK SHALL BE PERFORMED WITHIN THIS STREAM FROM MARCH 1st THRU JUNE 15th.
  3. ANY CULVERT WORK-AREA DEWATERING MUST BE PUMPED THROUGH THE FILTER BAG.

STRUCTURE SCHEDULE									
NO.	TYPE	LOCATION	INV. IN	INV. OUT	TOP ELEV.	HO. CO. STD.			
E-1	18" CONC. END SECTION	CL STA 0+55.00 OFFS. 79.75' RT CREKESIDE ROAD	245.50	244.02	244.50	SD - 5.52			
E-2	24" CONC. END SECTION	N 551185.59 E 1341844.80	281.70	281.69	281.70	SD - 5.52			
E-3	18" CONC. END SECTION	N 551398.55 E 1341747.02	282.18	281.69	281.77	SD - 5.52			
E-4	36" CONC. END SECTION	N 551266.61 E 1341841.80	273.50	273.45	273.50	SD - 5.52			
E-5	24" CONC. END SECTION	N 551666.90 E 1342510.95	281.30	281.20	281.20	SD - 5.52			
E-6	24" CONC. END SECTION	N 551435.25 E 1342682.29	281.23	281.20	281.20	SD - 5.52			
E-7	24" CONC. END SECTION	N 551416.51 E 1342536.66	286.08	286.00	286.00	SD - 5.52			
E-8	24" CONC. END SECTION	N 551311.56 E 1342346.74	284.53	284.00	284.00	SD - 5.52			
E-9	18" CONC. END SECTION	N 551185.51 E 1342331.29	276.49	276.44	276.40	SD - 5.52			
E-10	15" CONC. END SECTION	N 550446.92 E 1341470.33	282.02	281.25	281.25	SD - 5.52			
E-12	15" CONC. END SECTION	N 550164.92 E 1341349.55	316.13	316.10	316.10	SD - 5.52			
E-14	15" CONC. END SECTION	CL STA 144+87.79 OFFS. 43.99' LT SANNER ROAD	355.96	356.27	355.83	SD - 5.52			
HW-1	TYPE "A" HEADWALL	CL STA 9+44.35 OFFS. 61.36' RT CREKESIDE ROAD	274.35	274.35	274.35	SD - 5.11			
HW-2	TYPE "A" HEADWALL	CL STA 9+30.13 OFFS. 57.75' RT CREKESIDE ROAD	274.35	274.35	274.35	SD - 5.11			
HW-3	TYPE "A" HEADWALL	N 550390.46 E 1341353.92	277.80	277.80	277.80	SD - 5.11			
I-1	A-10	CL STA. 0+55.00 OFFS. 20.43' RT CREKESIDE ROAD	286.70	286.50	286.70	SD - 4.02 OR 4.41			
I-2	A-10	CL STA. 0+55.00 OFFS. 20.43' RT CREKESIDE ROAD	287.81	287.67	287.81	SD - 4.02 OR 4.41			
I-3	TYPE "D" INLET	N 551173.50 E 1341022.89	286.70	286.50	286.70	SD - 4.11 OR 4.39			
I-4	TYPE "D" INLET	LP STA. 3+51.23 OFFS. 115.55' TURTLE CREEK COURT	282.74	282.64	282.74	SD - 4.11 OR 4.39			
I-5	A-10	LP STA. 3+91.63 OFFS. 0' TURTLE CREEK COURT	286.70	286.53	286.70	SD - 4.02 OR 4.41			
I-6	A-5	LP STA. 1+73.57 OFFS. 0' TRAIL CREEK COURT	288.49	288.49	288.49	SD - 4.01 OR 4.40			
I-7	TYPE "D" INLET	N 550907.30 E 1341172.55	288.49	288.49	288.49	SD - 4.11 OR 4.39			
I-8	A-5	CL STA. 0+46.00 OFFS. 13.43' RT WALNUT CREEK COURT	309.26	309.26	309.26	SD - 4.01 OR 4.40			
I-9	A-10	CL STA. 0+46.00 OFFS. 13.43' LT WALNUT CREEK COURT	309.26	309.26	309.26	SD - 4.01 OR 4.41			
I-10	A-5	CL STA. 2+57.30 OFFS. 13.43' RT WALNUT CREEK COURT	315.35	315.10	315.10	SD - 4.01 OR 4.40			
I-11	A-10	CL STA. 2+57.30 OFFS. 13.43' LT WALNUT CREEK COURT	315.35	315.24	315.24	SD - 4.02 OR 4.41			
I-14	A-5	CL STA. 8+58.79 OFFS. 13.43' RT CREKESIDE ROAD	287.04	286.58	286.58	SD - 4.01 OR 4.40			
I-15	A-10	CL STA. 8+58.79 OFFS. 13.43' LT CREKESIDE ROAD	287.04	286.58	286.58	SD - 4.02 OR 4.41			
I-16	A-5	CL STA. 4+39.06 OFFS. 13.43' RT SANDY CREEK COURT	287.04	286.58	286.58	SD - 4.01 OR 4.40			
I-17	A-5	CL STA. 4+17.49 OFFS. 13.43' LT SANDY CREEK COURT	287.04	286.58	286.58	SD - 4.11 OR 4.39			
I-18	TYPE "D" INLET	N 552029.55 E 1342240.28	286.70	286.50	286.70	SD - 4.01 OR 4.40			
I-19	A-5	CL STA. 4+41.86 OFFS. 13.43' RT CROSSFIELD COURT	340.24	340.50	340.50	SD - 4.01 OR 4.40			
I-20	A-5	CL STA. 4+41.86 OFFS. 13.43' LT CROSSFIELD COURT	340.24	340.50	340.50	SD - 4.01 OR 4.40			
I-21	A-10	CL STA. 15+35.00 OFFS. 13.43' LT CREKESIDE ROAD	337.04	336.96	336.96	SD - 4.02 OR 4.41			
I-22	A-5	CL STA. 15+35.00 OFFS. 13.43' RT CREKESIDE ROAD	337.04	336.96	336.96	SD - 4.01 OR 4.40			
I-23	A-5	LP STA. 2+57.50 OFFS. 0' WOLF CREEK COURT	329.34	329.34	329.34	SD - 4.01 OR 4.40			
I-24	TYPE "D" INLET	LP STA. 3+19.53 OFFS. 122.01' WOLF CREEK COURT	331.08	330.55	330.55	SD - 4.11 OR 4.39			
I-25	A-5	LP STA. 6+70.00 OFFS. 0' CREEKWOOD COURT	332.23	332.23	332.23	SD - 4.01 OR 4.40			
I-26	TYPE "D" INLET	LP STA. 7+09.74 OFFS. 141.06' CREEKWOOD COURT	335.10	334.41	334.41	SD - 4.11 OR 4.39			
I-27	A-5	LP STA. 11+07.37 OFFS. 0.00' SANDY CREEK COURT	281.68	281.60	281.60	SD - 4.01 OR 4.40			
I-28	A-10	CL STA. 0+45.98 OFFS. 13.43' RT TIMBER CREEK COURT	287.44	287.44	287.44	SD - 4.02 OR 4.41			
I-29	A-10	CL STA. 0+45.98 OFFS. 13.43' LT TIMBER CREEK COURT	287.44	287.44	287.44	SD - 4.02 OR 4.41			
I-30	A-5	CL STA. 8+35.25 OFFS. 13.43' LT SANDY CREEK COURT	289.04	289.04	289.04	SD - 4.01 OR 4.40			
I-31	A-5	CL STA. 8+35.25 OFFS. 13.43' RT SANDY CREEK COURT	289.04	289.04	289.04	SD - 4.01 OR 4.40			
I-32	A-5	CL STA. 2+36.84 OFFS. 13.43' LT TIMBER CREEK COURT	289.11	289.11	289.11	SD - 4.01 OR 4.40			
I-33	A-5	CL STA. 2+72.85 OFFS. 13.43' RT TIMBER CREEK COURT	289.11	289.11	289.11	SD - 4.01 OR 4.40			
I-34	TYPE "D" INLET	N 551761.40 E 1342871.28	300.40	300.40	300.40	SD - 4.11 OR 4.39			
I-35	TYPE "D" INLET	N 551880.71 E 1342748.59	306.23	306.23	306.23	SD - 4.11 OR 4.39			
I-36	TYPE "D" INLET	N 552027.46 E 1343080.44	316.66	316.66	316.66	SD - 4.11 OR 4.39			
I-37	A-10	LP STA. 8+53.58 OFFS. 0.00' CROSSFIELD COURT	316.66	316.66	316.66	SD - 4.02 OR 4.41			
I-38	A-5	CL STA. 7+11.71 OFFS. 13.43' LT CROSSFIELD COURT	326.66	326.66	326.66	SD - 4.02 OR 4.41			
I-39	TYPE "D" INLET	N 55173.47 E 1342888.68	336.66	336.66	336.66	SD - 4.11 OR 4.39			
I-40	A-5	LP STA. 15+75.33 OFFS. 0.00' RIVER OAK COURT	322.50	322.50	322.50	SD - 4.01 OR 4.40			
I-41	A-10	CL STA. 11+54.66 OFFS. 13.43' RT RIVER OAK COURT	303.43	303.43	303.43	SD - 4.02 OR 4.41			
I-42	A-5	CL STA. 11+54.66 OFFS. 13.43' LT RIVER OAK COURT	303.43	303.43	303.43	SD - 4.01 OR 4.40			
I-43	TYPE "D" INLET	CL STA. 4+18.79 OFFS. 40.00' RT RIVER OAK COURT	322.60	322.60	322.60	SD - 4.11 OR 4.39			
I-44	A-10	CL STA. 0+65.00 OFFS. 13.43' LT RIVER OAK COURT	323.76	323.76	323.76	SD - 4.02 OR 4.41			
I-45	A-10	CL STA. 0+65.00 OFFS. 13.43' RT RIVER OAK COURT	323.90	323.90	323.90	SD - 4.02 OR 4.41			
I-46	A-5	CL STA. 5+58.85 OFFS. 13.43' LT TIMBER CREEK COURT	288.85	288.85	288.85	SD - 4.01 OR 4.40			
I-48	A-5	CL STA. 14+4+52.60 OFFS. 24.00' LT SANNER ROAD	350.65	350.65	350.65	SD - 4.01 OR 4.40			
I-50	A-10	CL STA. 14+1+09.65 OFFS. 24.00' LT SANNER ROAD	326.66	326.66	326.66	SD - 4.02 OR 4.41			
M-1	4" MANHOLE	LP STA. 3+51.23 OFFS. 5.55' LT TURTLE CREEK COURT	286.70	286.70	286.70	G - 5.12			
M-2	4" MANHOLE	CL STA. 2+52.82 OFFS. 6.50' LT TURTLE CREEK COURT	284.34	284.34	284.34	G - 5.12			
M-3	4" MANHOLE	LP STA. 2+25.93 OFFS. 20.81' RT TRAIL CREEK COURT	285.40	285.40	285.40	G - 5.12			
M-4	4" MANHOLE	N 550964.23 E 1341253.91	286.30	286.30	286.30	G - 5.12			
M-5	4" MANHOLE	CL STA. 4+39.06 OFFS. 178.76' RT SANDY CREEK COURT	286.00	286.00	286.00	G - 5.12			
M-6	4" MANHOLE	N 552010.58 E 1342514.29	326.66	326.66	326.66	G - 5.12			
M-7	4" MANHOLE	CL STA. 1+50.00 OFFS. 15.50' RT SANDY CREEK COURT	326.66	326.66	326.66	G - 5.12			
M-8	4" MANHOLE	CL STA. 14+88.74 OFFS. 14.75' LT CREKESIDE ROAD	327.50	327.50	327.50	G - 5.12			
M-9	4" MANHOLE	LP STA. 3+19.53 OFFS. 4.00' RT WOLF CREEK COURT	328.82	328.82	328.82	G - 5.12			
M-10	4" MANHOLE	CL STA. 4+29.97 OFFS. 15.50' LT CREEKWOOD COURT	332.16	332.16	332.16	G - 5.12			
M-11	4" MANHOLE	LP STA. 7+09.74 OFFS. 4.00' CREEKWOOD COURT	333.93	333.93	333.93	G - 5.12			
M-12	4" MANHOLE	CL STA. 1+39.95 OFFS. 19.00' LT TIMBER CREEK COURT	334.92	334.92	334.92	G - 5.12			
M-13	4" MANHOLE	CL STA. 1+39.95 OFFS. 123.22' LT TIMBER CREEK COURT	334.92	334.92	334.92	G - 5.12			
M-14	4" MANHOLE	N 551935.91 E 1343008.47	341.96	341.96	341.96	G - 5.12			
M-16	4" MANHOLE	N 551140.87 E 1342358.16	277.47	277.47	277.47	G - 5.12			
M-17	4" MANHOLE	N 550172.78 E 1341310.33	316.80	316.80	316.80	G - 5.12			
M-18	4" MANHOLE	N 550205.13 E 1341316.81	320.05	320.05	320.05	G - 5.12			
S-1	SEE DETAIL	N 551281.47 E 1341763.67	274.00	273.95	273.95	-			
S-2	SEE DETAIL	N 551473.32 E 1342593.69	273.00	266.86	266.86	-			
S-3	SEE DETAIL	N 551270.75 E 1342292.35	271.50	271.45	271.45	-			

NOTE: 1) PRECAST STRUCTURES MEETING HS-20 LOADING MAY BE USED.  
2) ALL STORM DRAINS SHALL BE CLASS II REINFORCED CONCRETE PIPE UNLESS OTHERWISE NOTED.  
3) TOP OF SLAB ELEVATION SHOWN FOR 'D' TYPE INLETS.  
\* INDICATES MODIFIED DESIGN, SEE SHEET 26

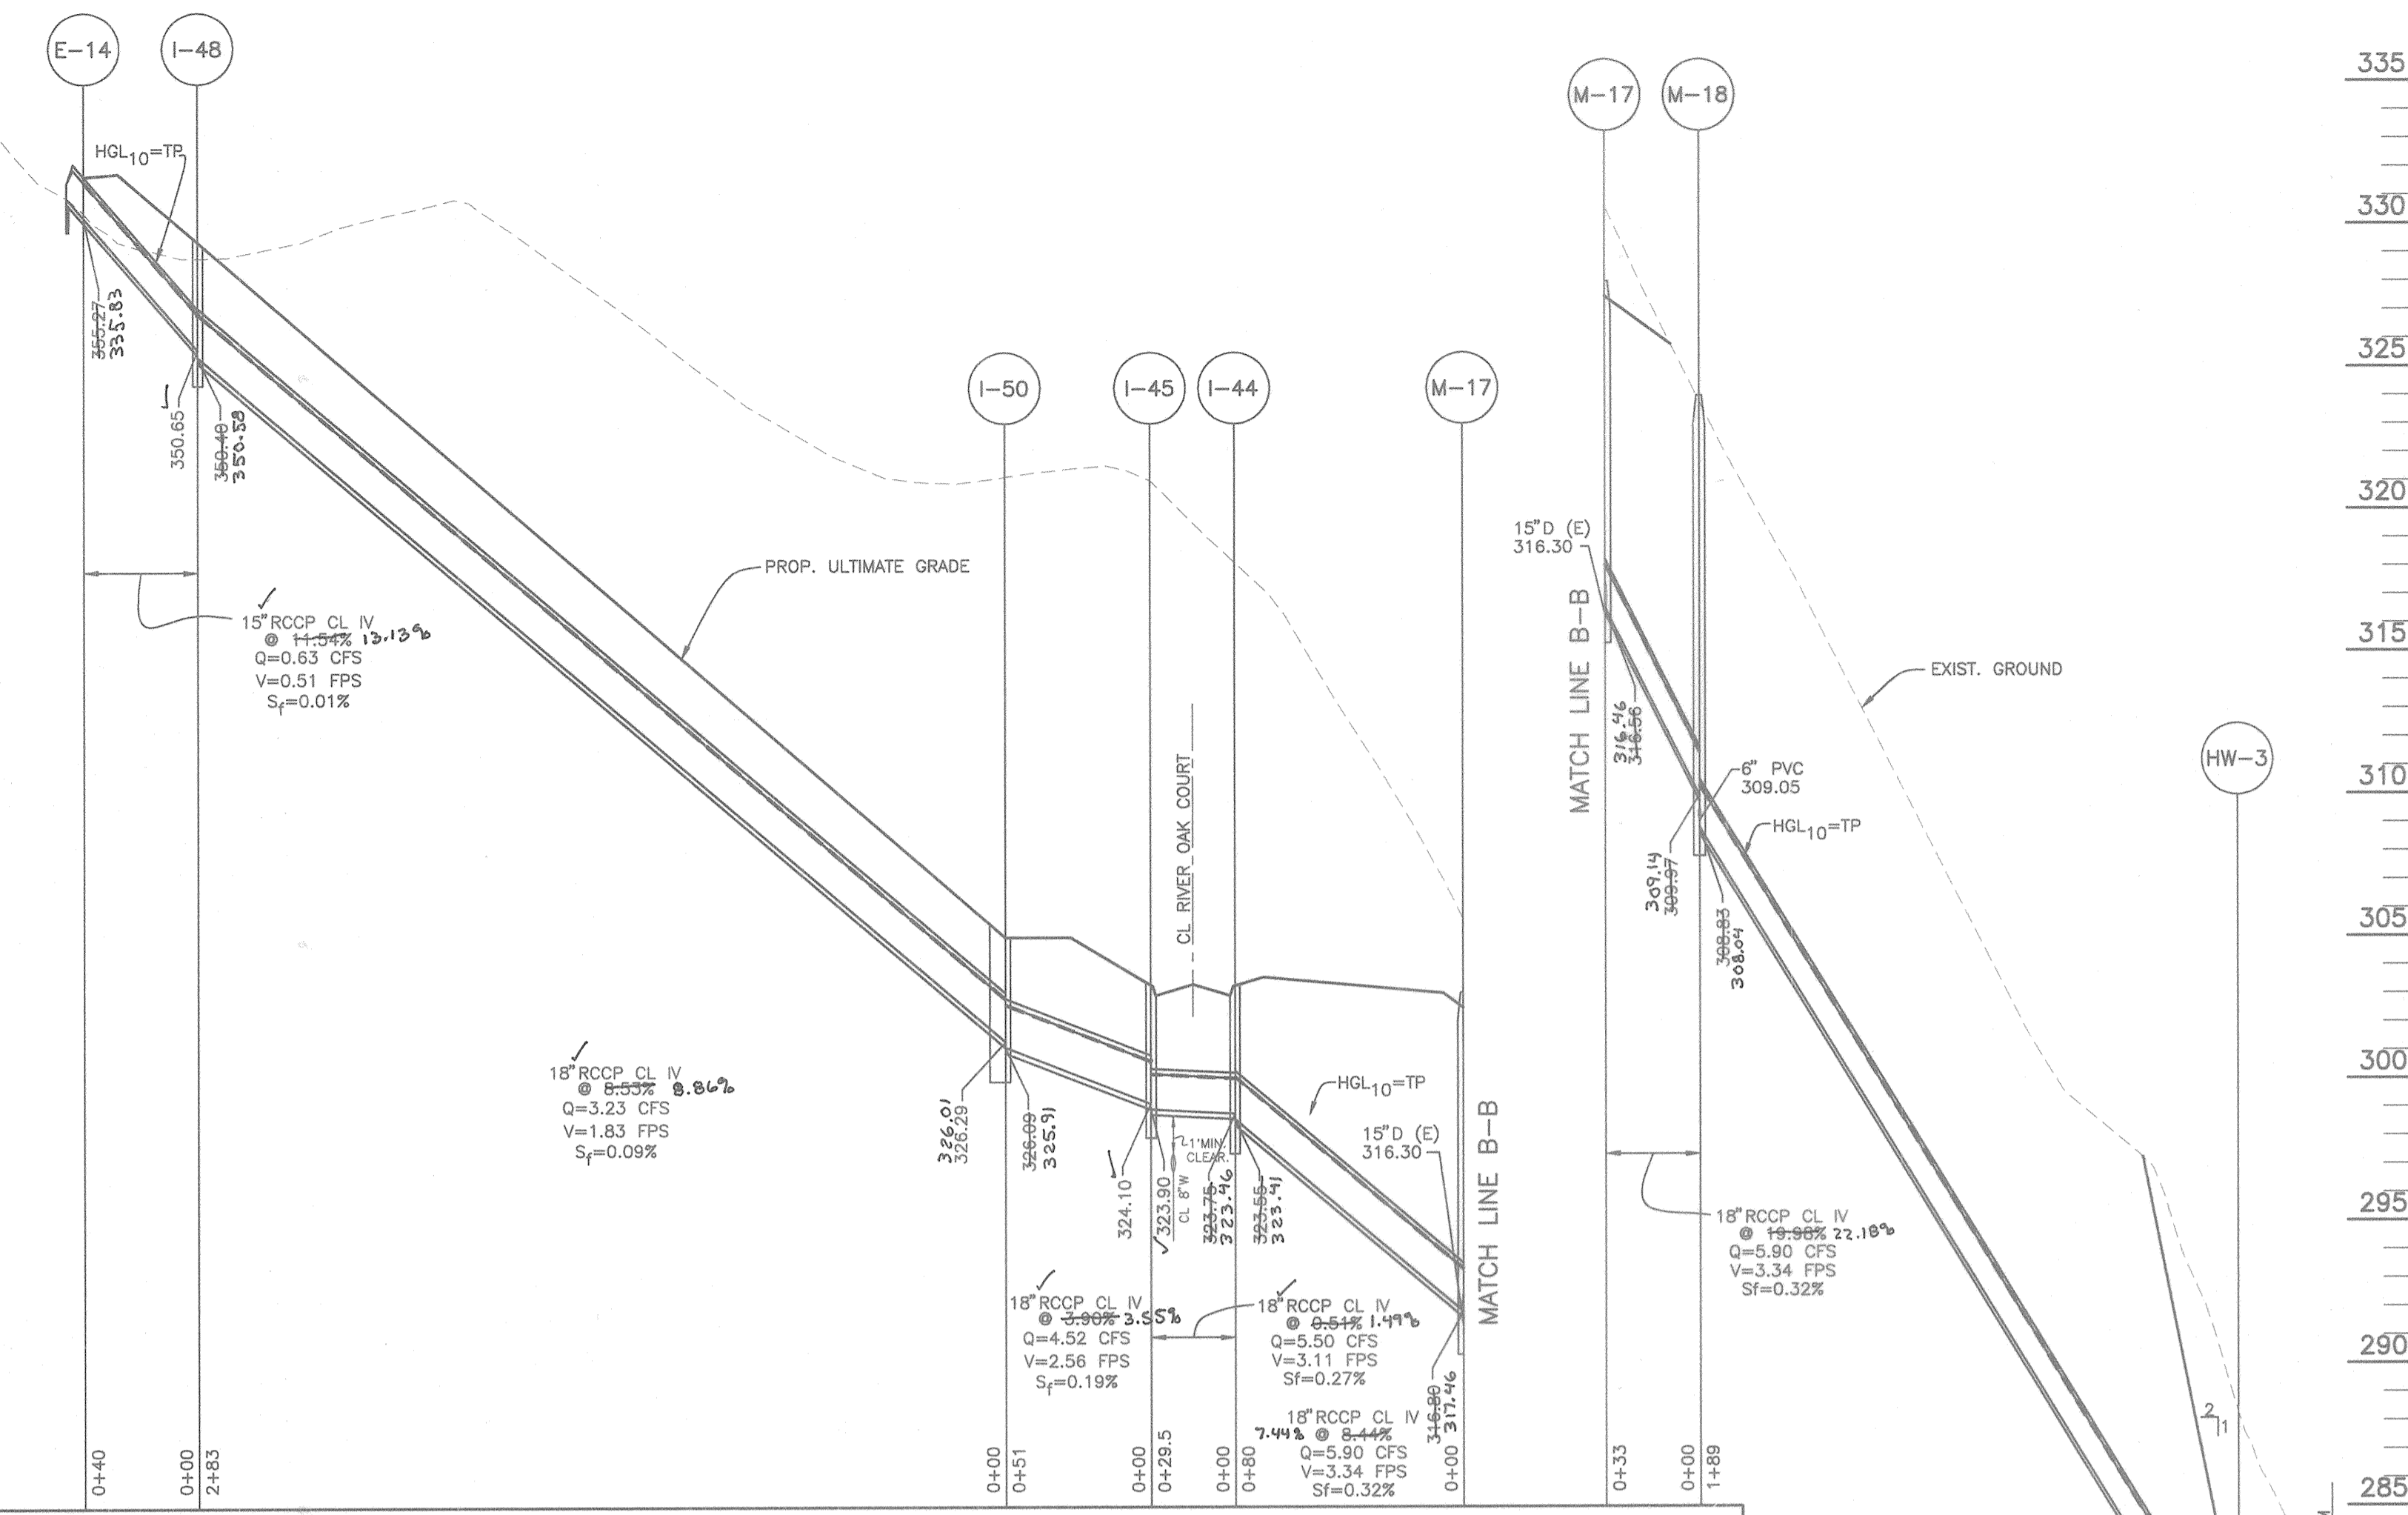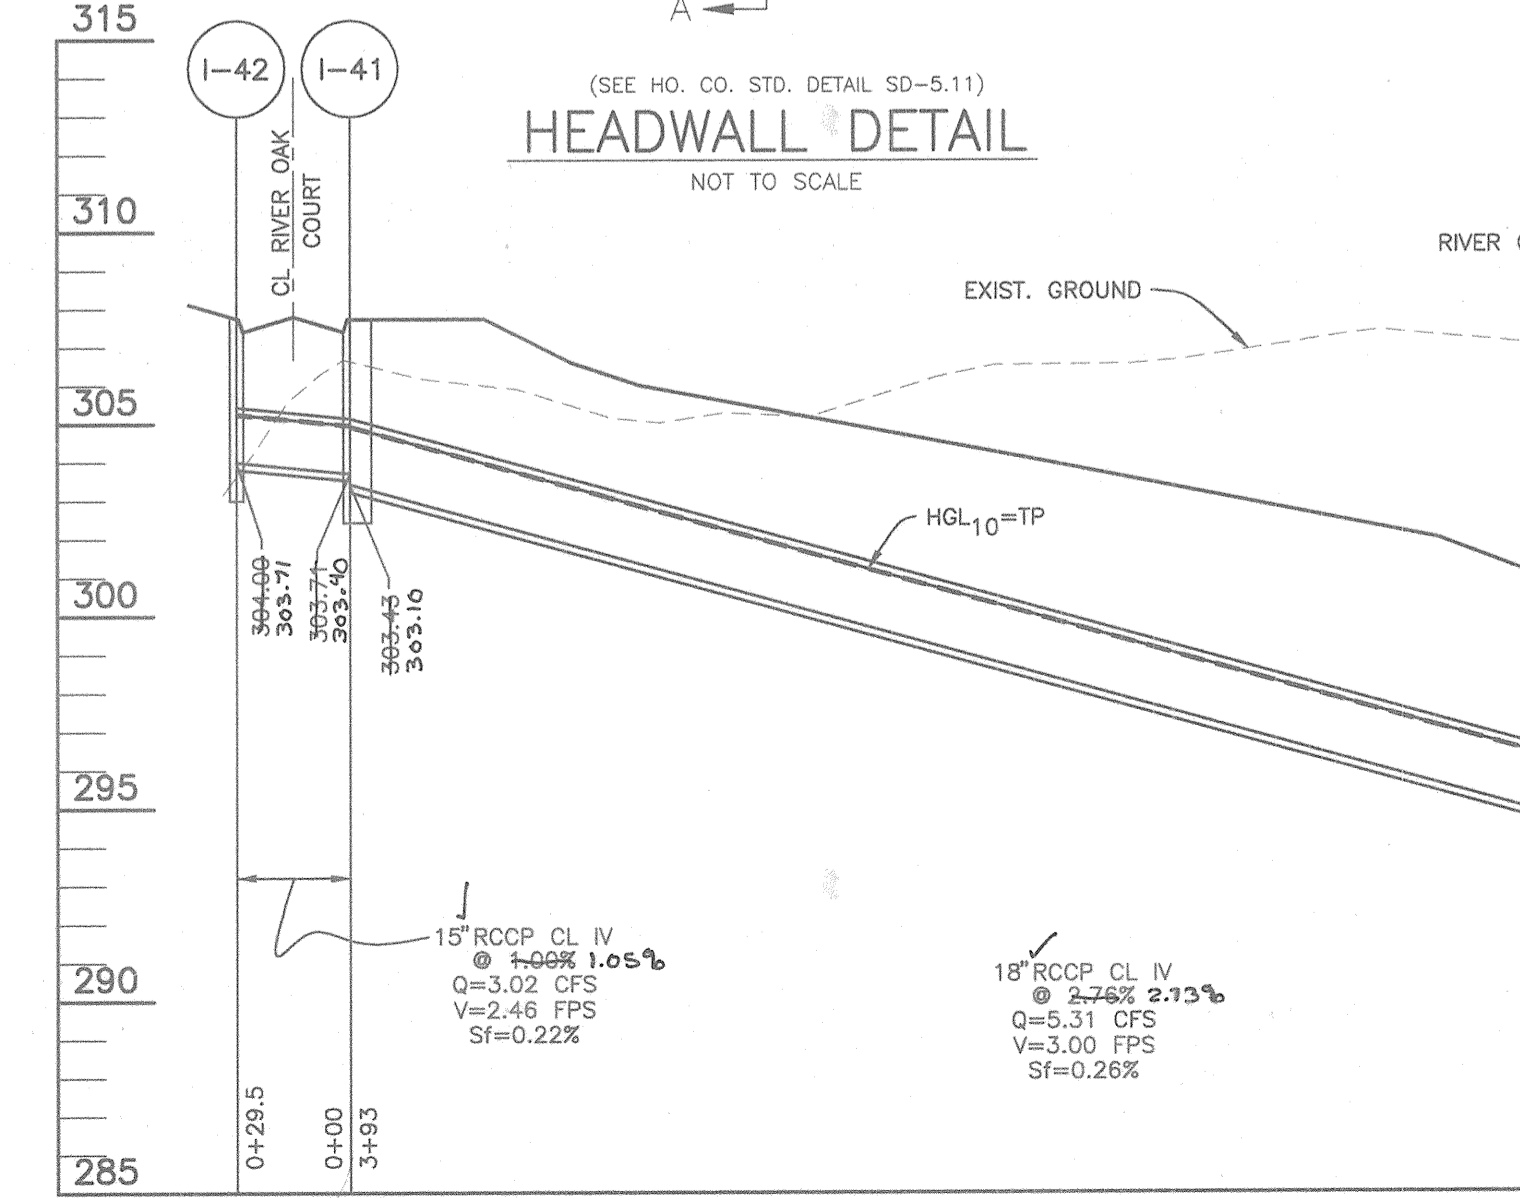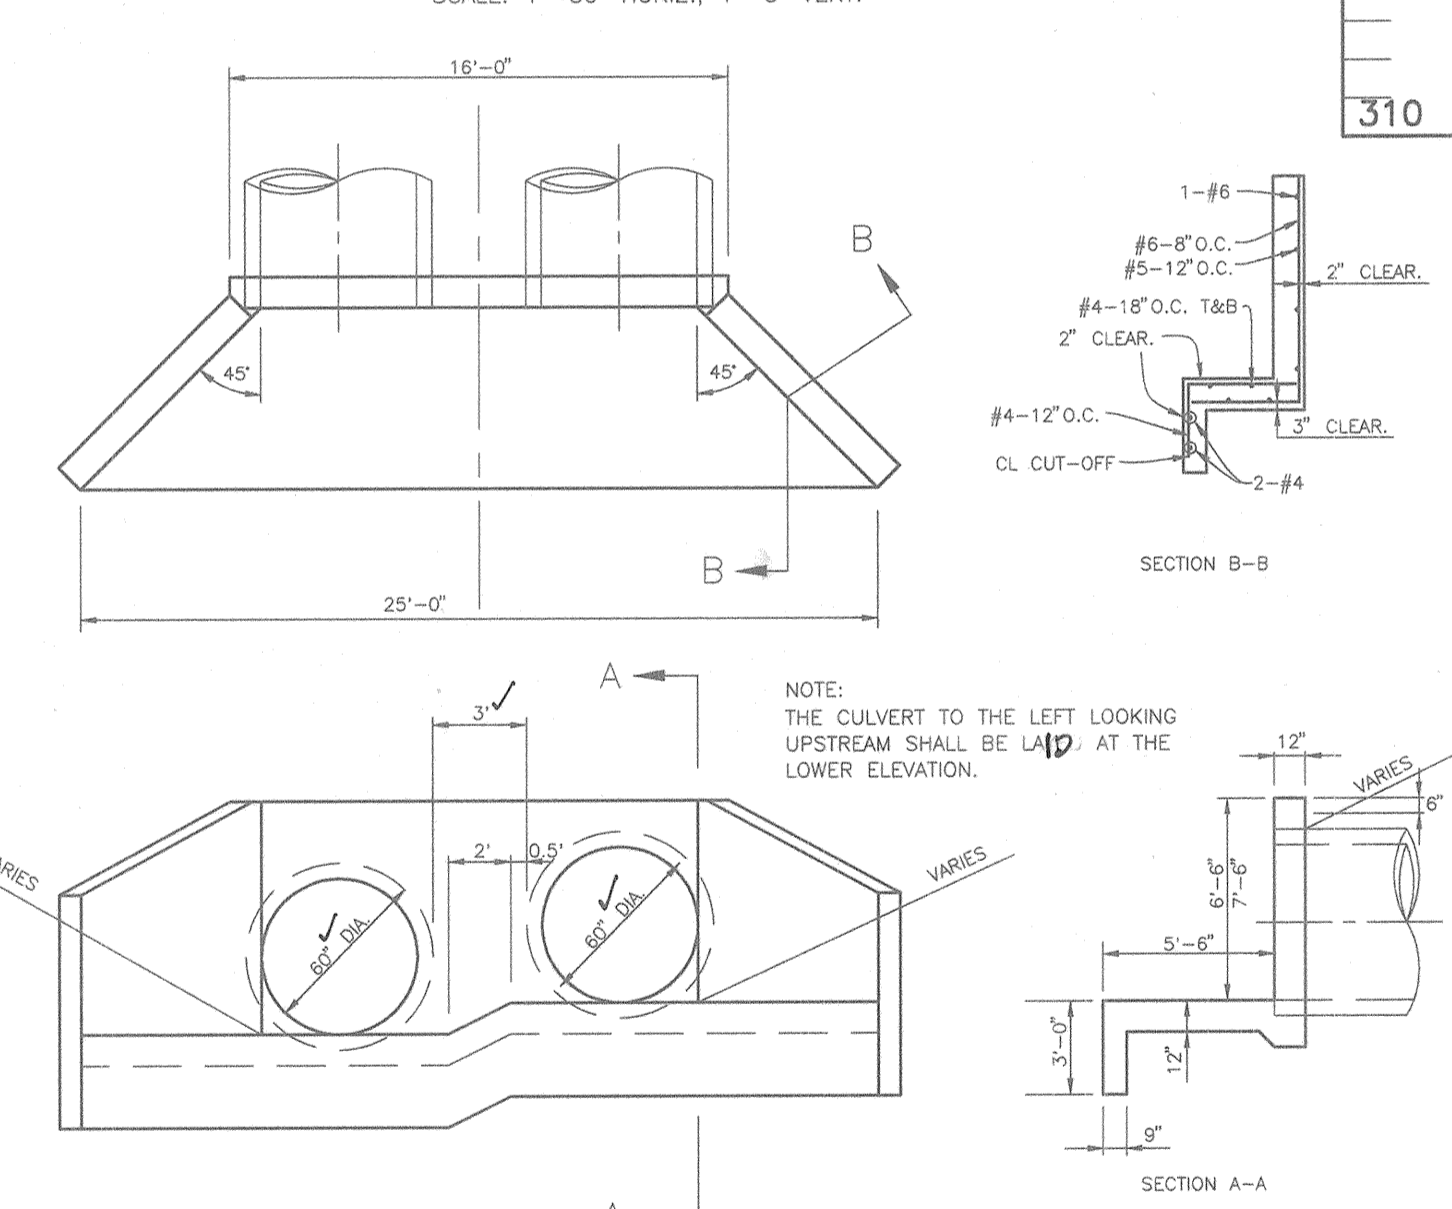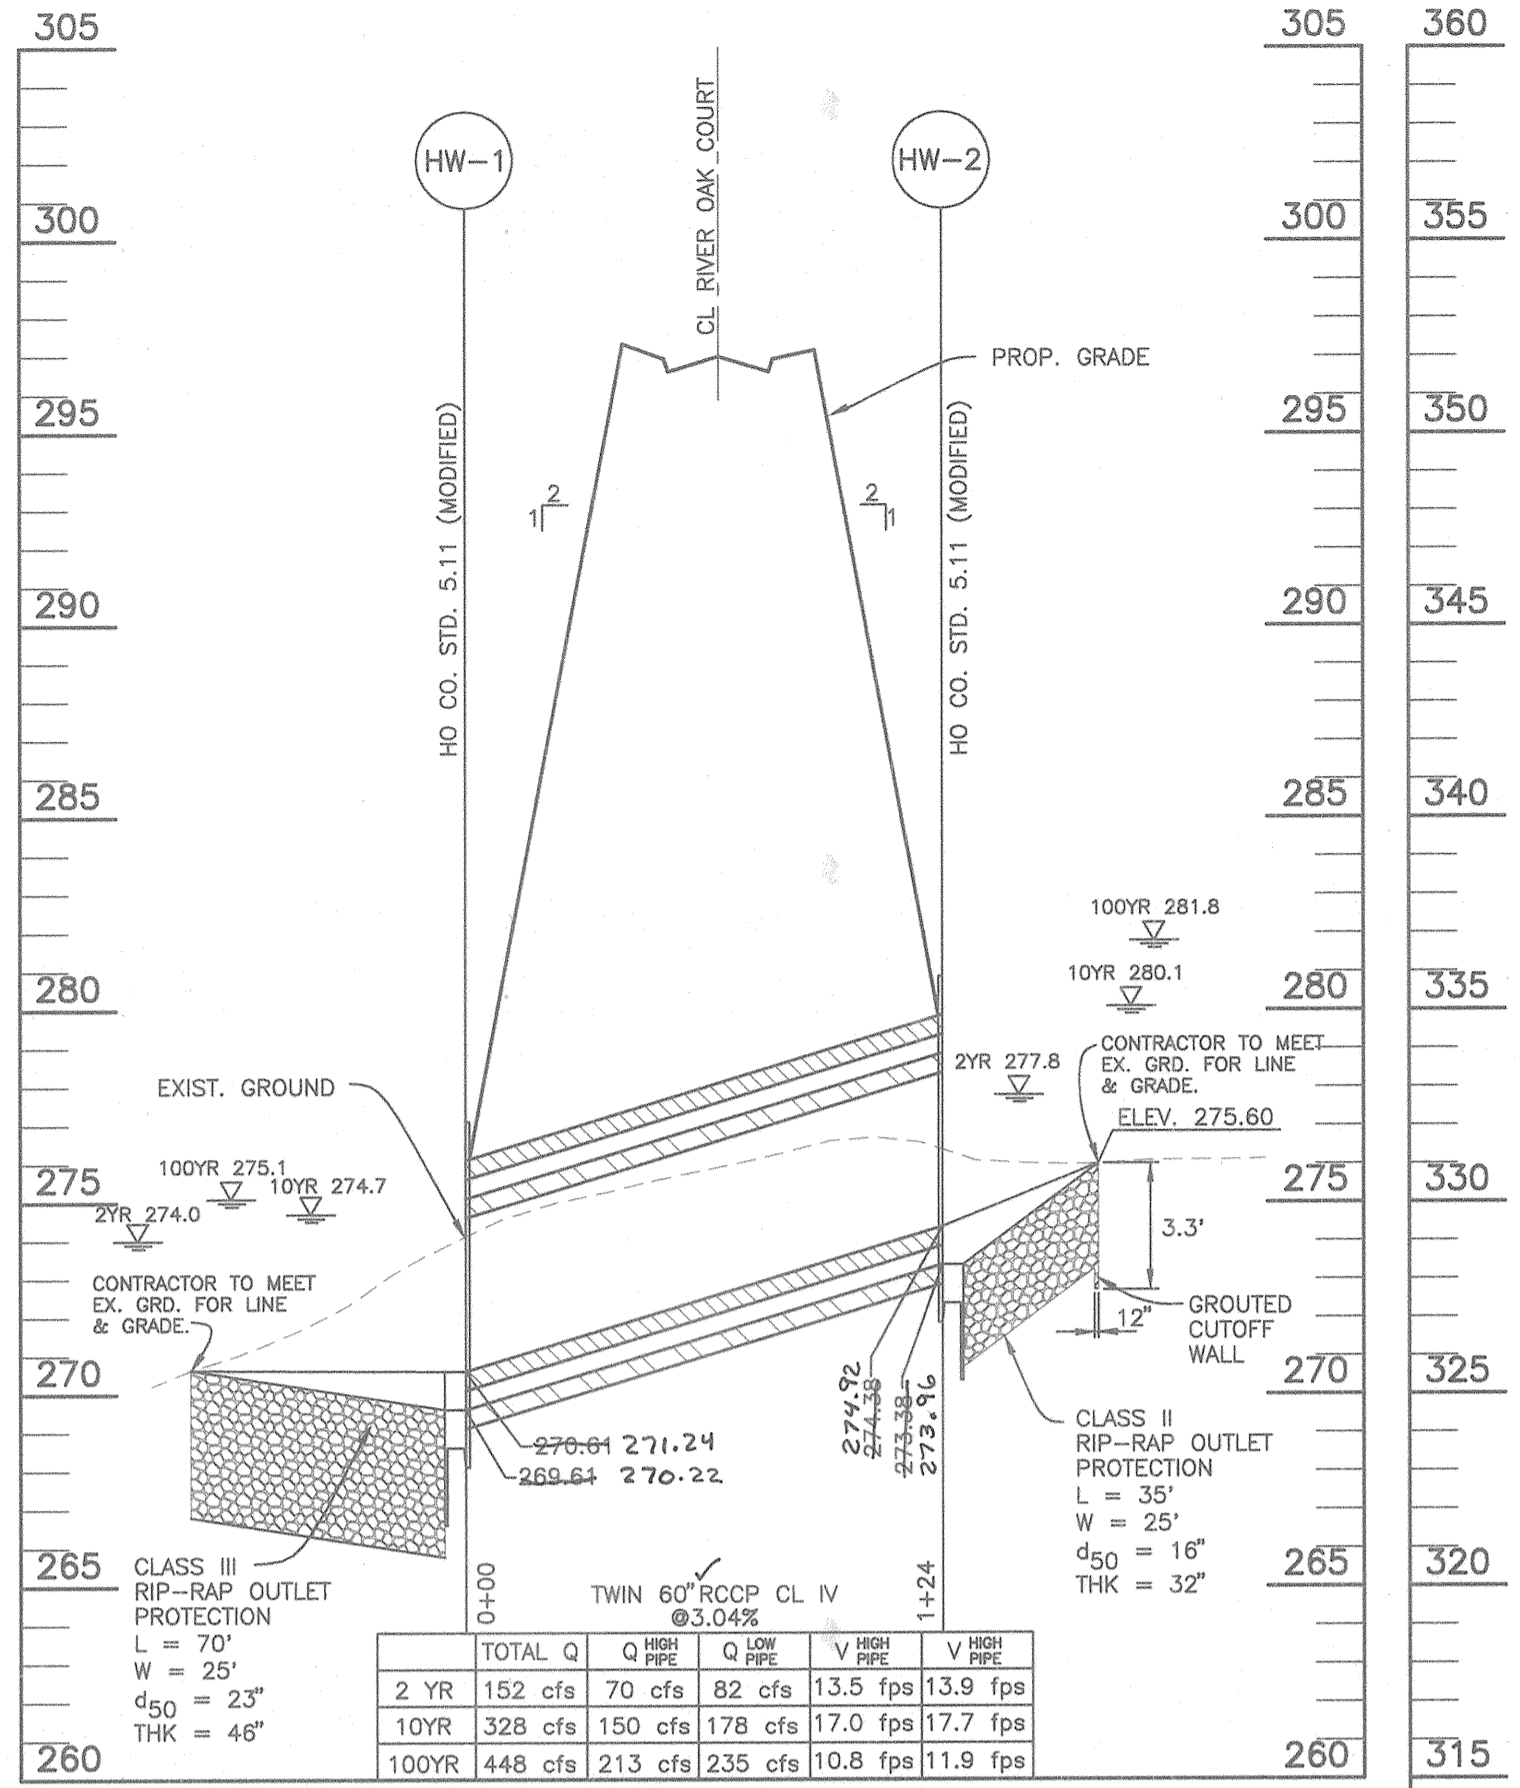

NOTE: SEE SHEET 22 FOR OUTLET PROTECTION DETAIL.

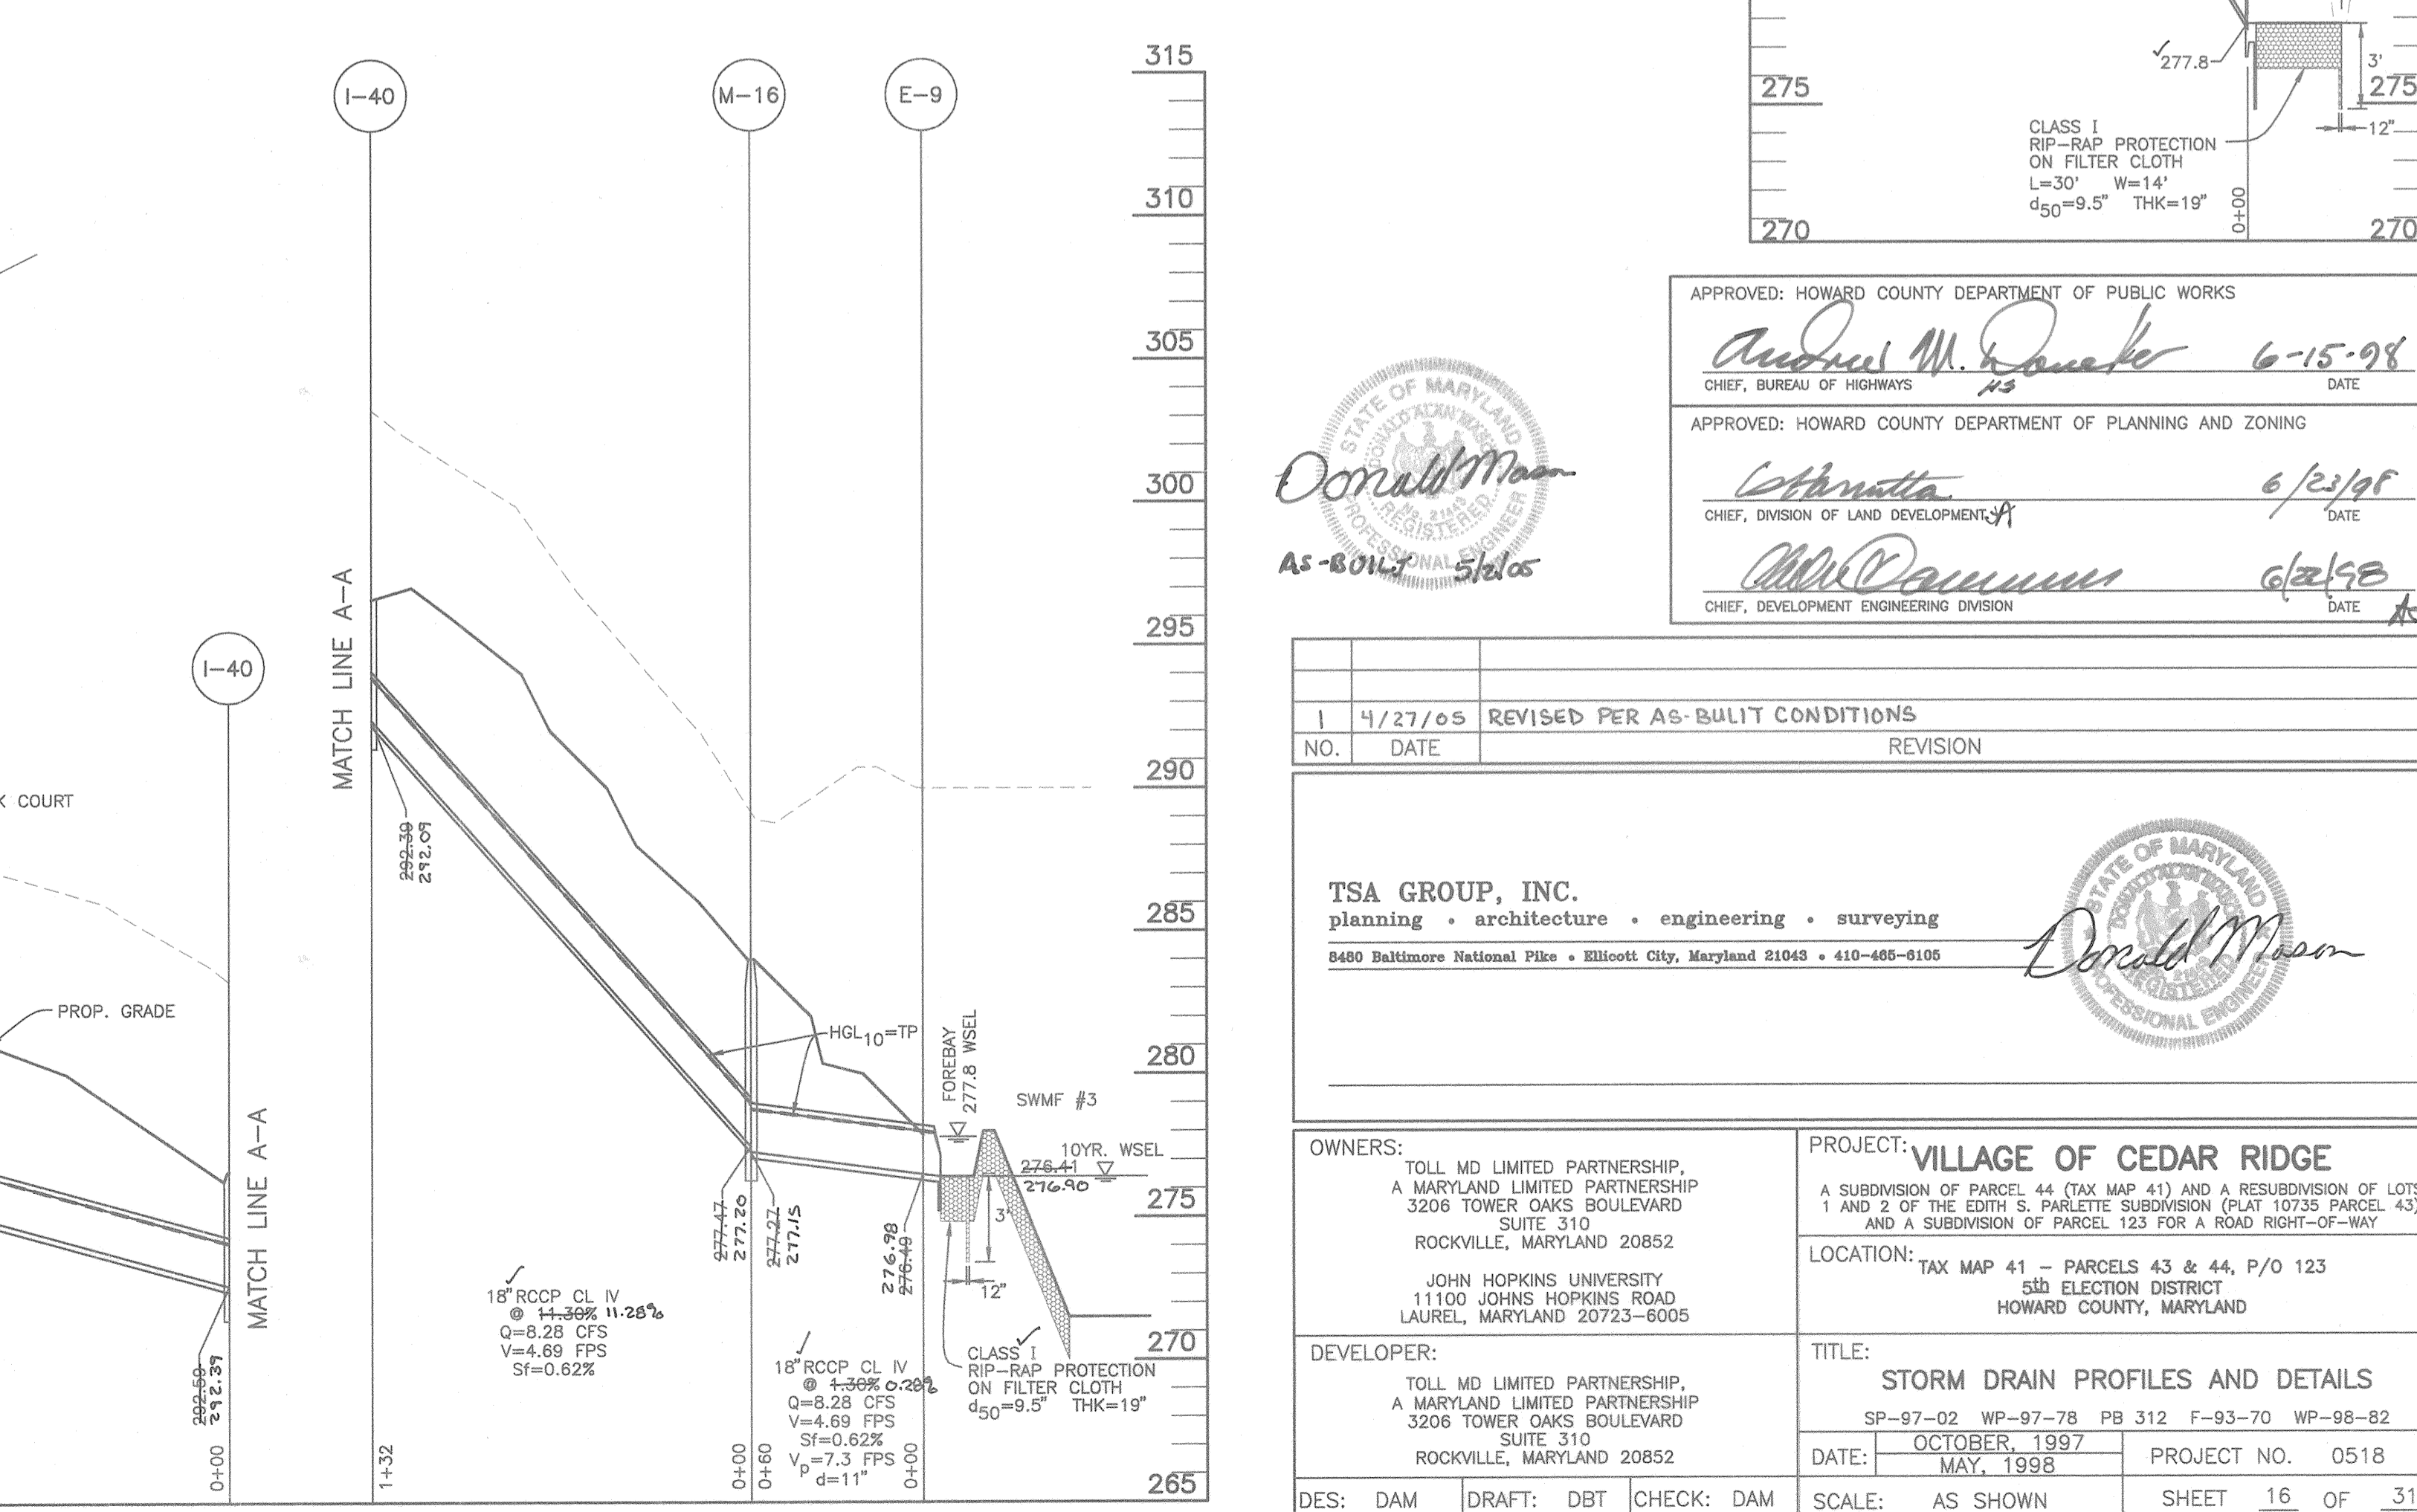

APPROVED: HOWARD COUNTY DEPARTMENT OF PUBLIC WORKS  
*Andrew M. Donaker* 6-15-98  
 CHIEF, BUREAU OF HIGHWAYS  
 APPROVED: HOWARD COUNTY DEPARTMENT OF PLANNING AND ZONING  
*Donald Moon* 6/23/98  
 CHIEF, DIVISION OF LAND DEVELOPMENT  
*Mr. [Signature]* 6/23/98  
 CHIEF, DEVELOPMENT ENGINEERING DIVISION

TSA GROUP, INC.  
 planning • architecture • engineering • surveying  
 8480 Baltimore National Pike • Ellicott City, Maryland 21043 • 410-485-8105

OWNERS: TOLL MD LIMITED PARTNERSHIP, A MARYLAND LIMITED PARTNERSHIP  
 3206 TOWER OAKS BOULEVARD SUITE 310 ROCKVILLE, MARYLAND 20852

PROJECT: VILLAGE OF CEDAR RIDGE  
 A SUBDIVISION OF PARCEL 44 (TAX MAP 41) AND A RESUBDIVISION OF LOTS 1 AND 2 OF THE EDITH S. PARLETTE SUBDIVISION (PLAT 10735 PARCEL 43) AND A SUBDIVISION OF PARCEL 123 FOR A ROAD RIGHT-OF-WAY




LOCATION: TAX MAP 41 - PARCELS 43 & 44, P/O 123 5th ELECTION DISTRICT HOWARD COUNTY, MARYLAND

DEVELOPER: TOLL MD LIMITED PARTNERSHIP, A MARYLAND LIMITED PARTNERSHIP  
 3206 TOWER OAKS BOULEVARD SUITE 310 ROCKVILLE, MARYLAND 20852



TITLE: STORM DRAIN PROFILES AND DETAILS  
 SP-97-02 WP-97-78 PB 312 F-93-70 WP-98-82  
 DATE: OCTOBER, 1997 PROJECT NO. 0518  
 MAY, 1998

DES: DAM DRAFT: DBT CHECK: DAM SCALE: AS SHOWN SHEET 16 OF 31



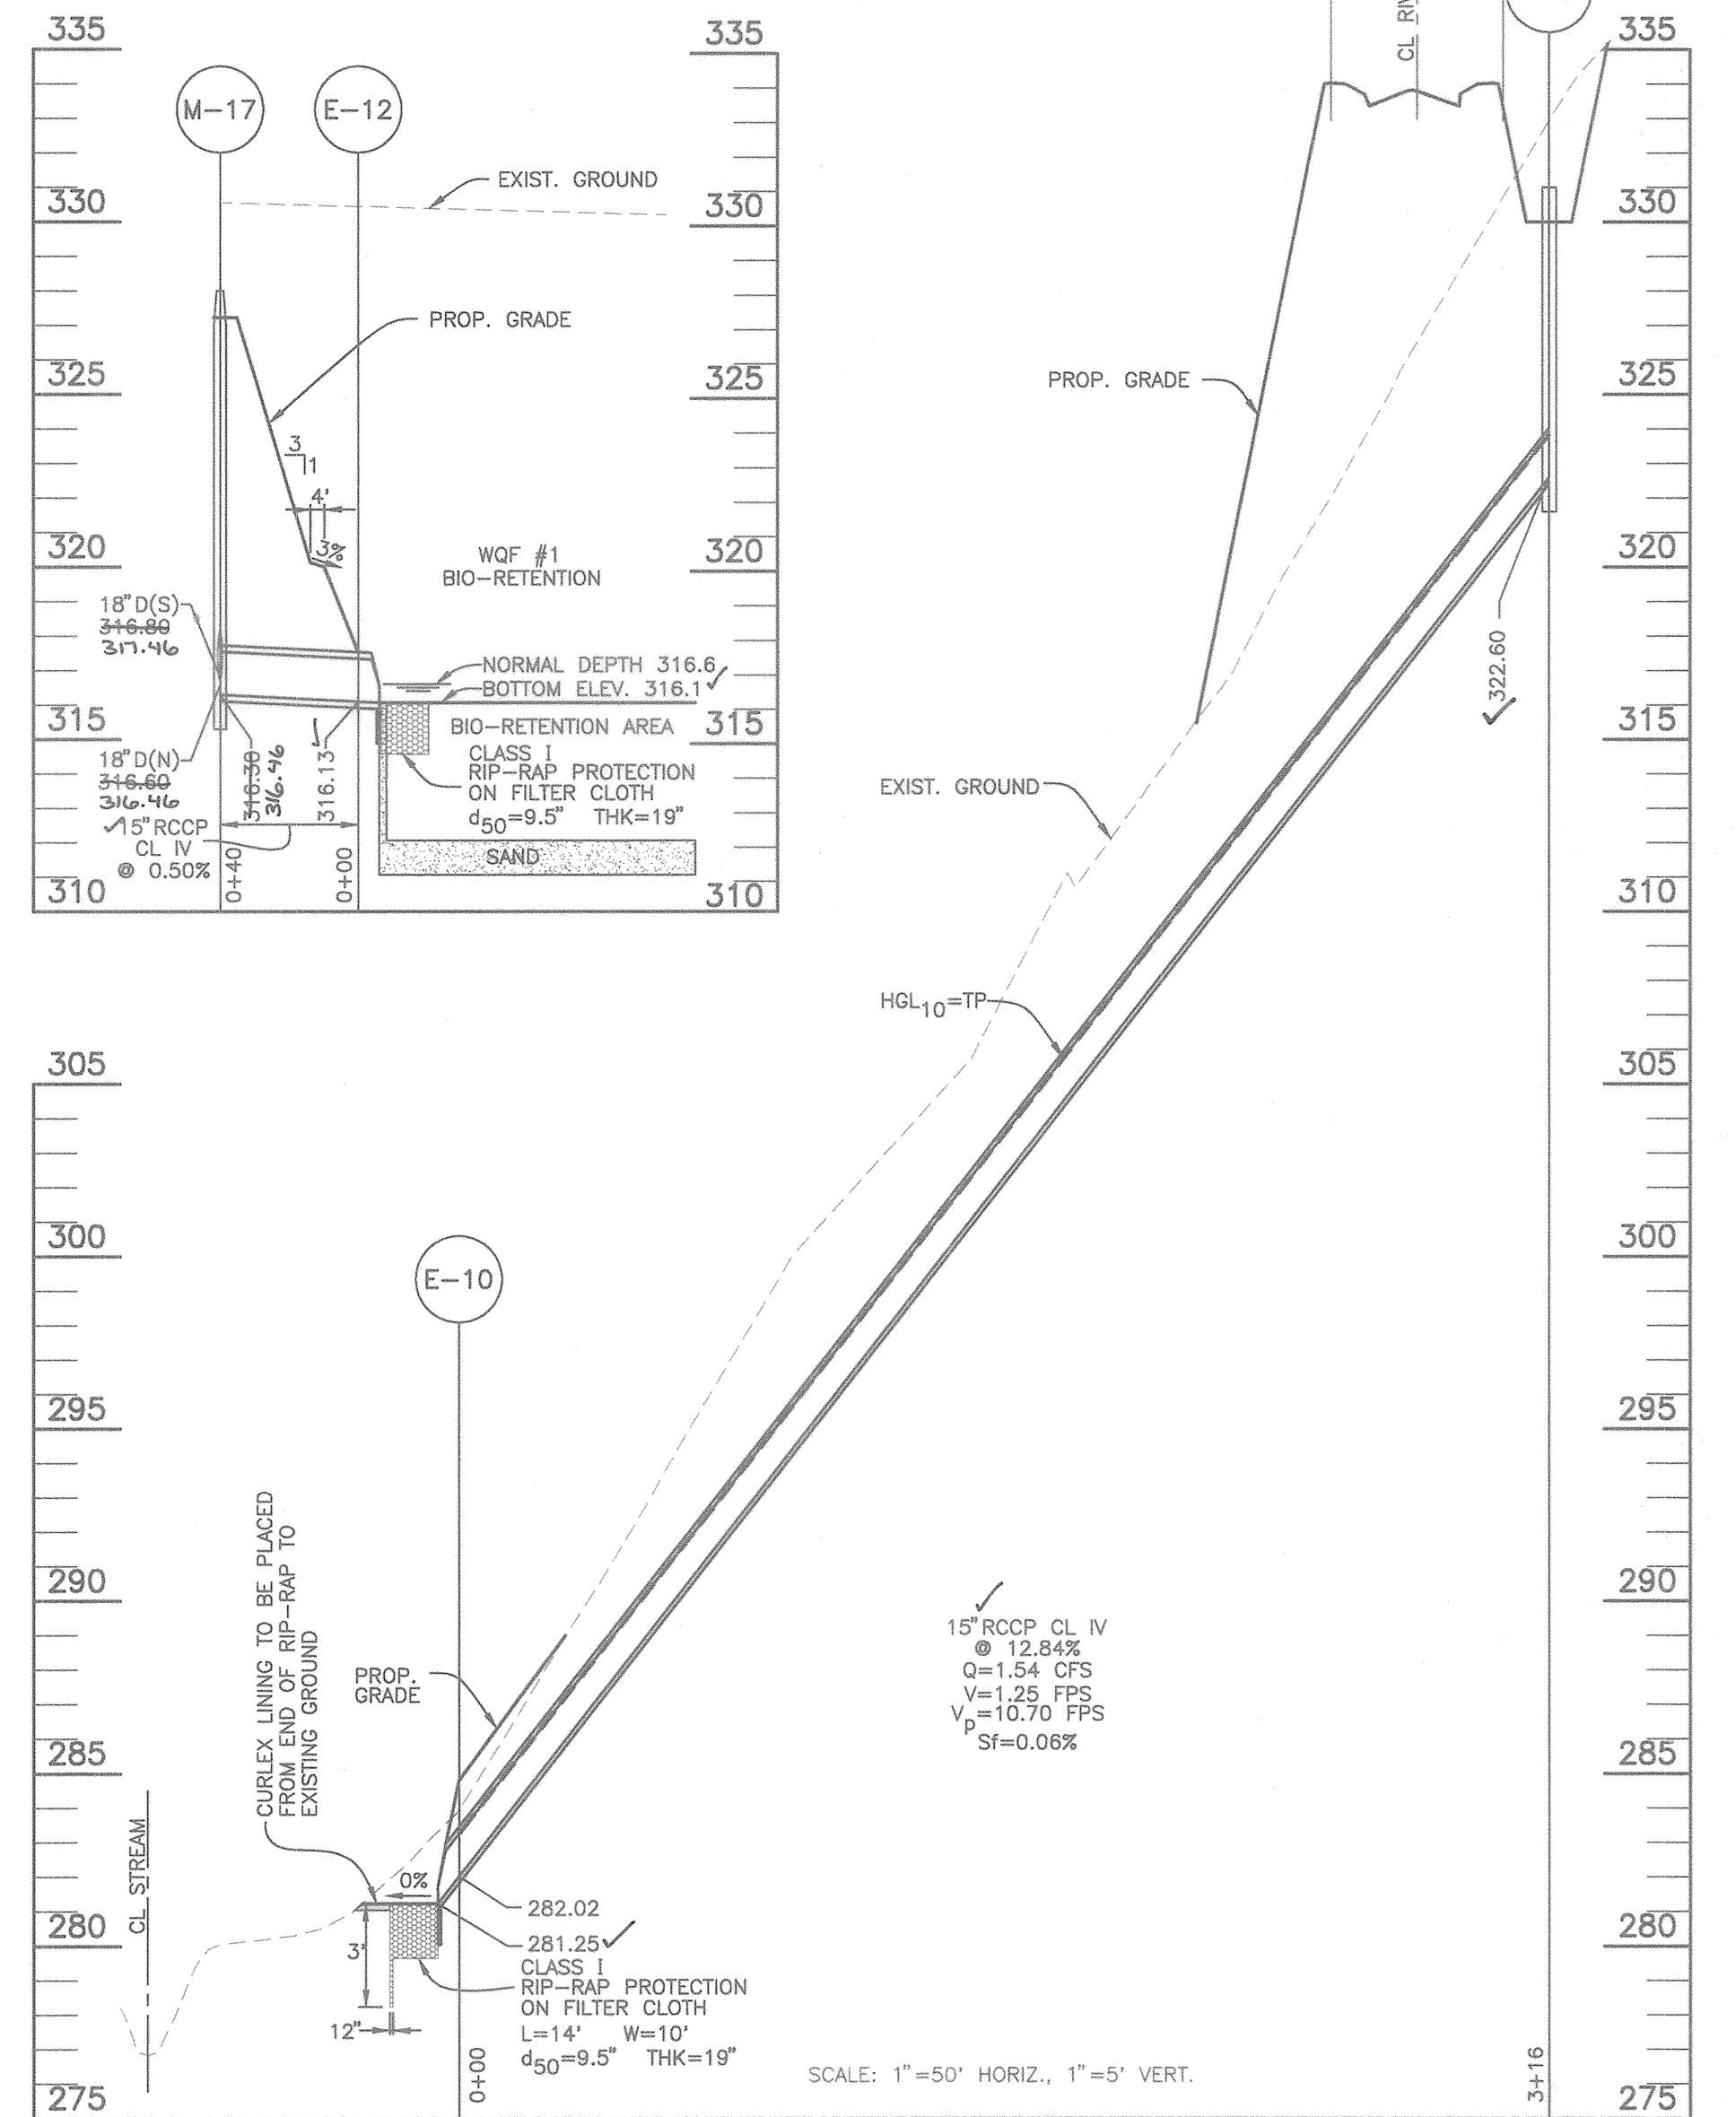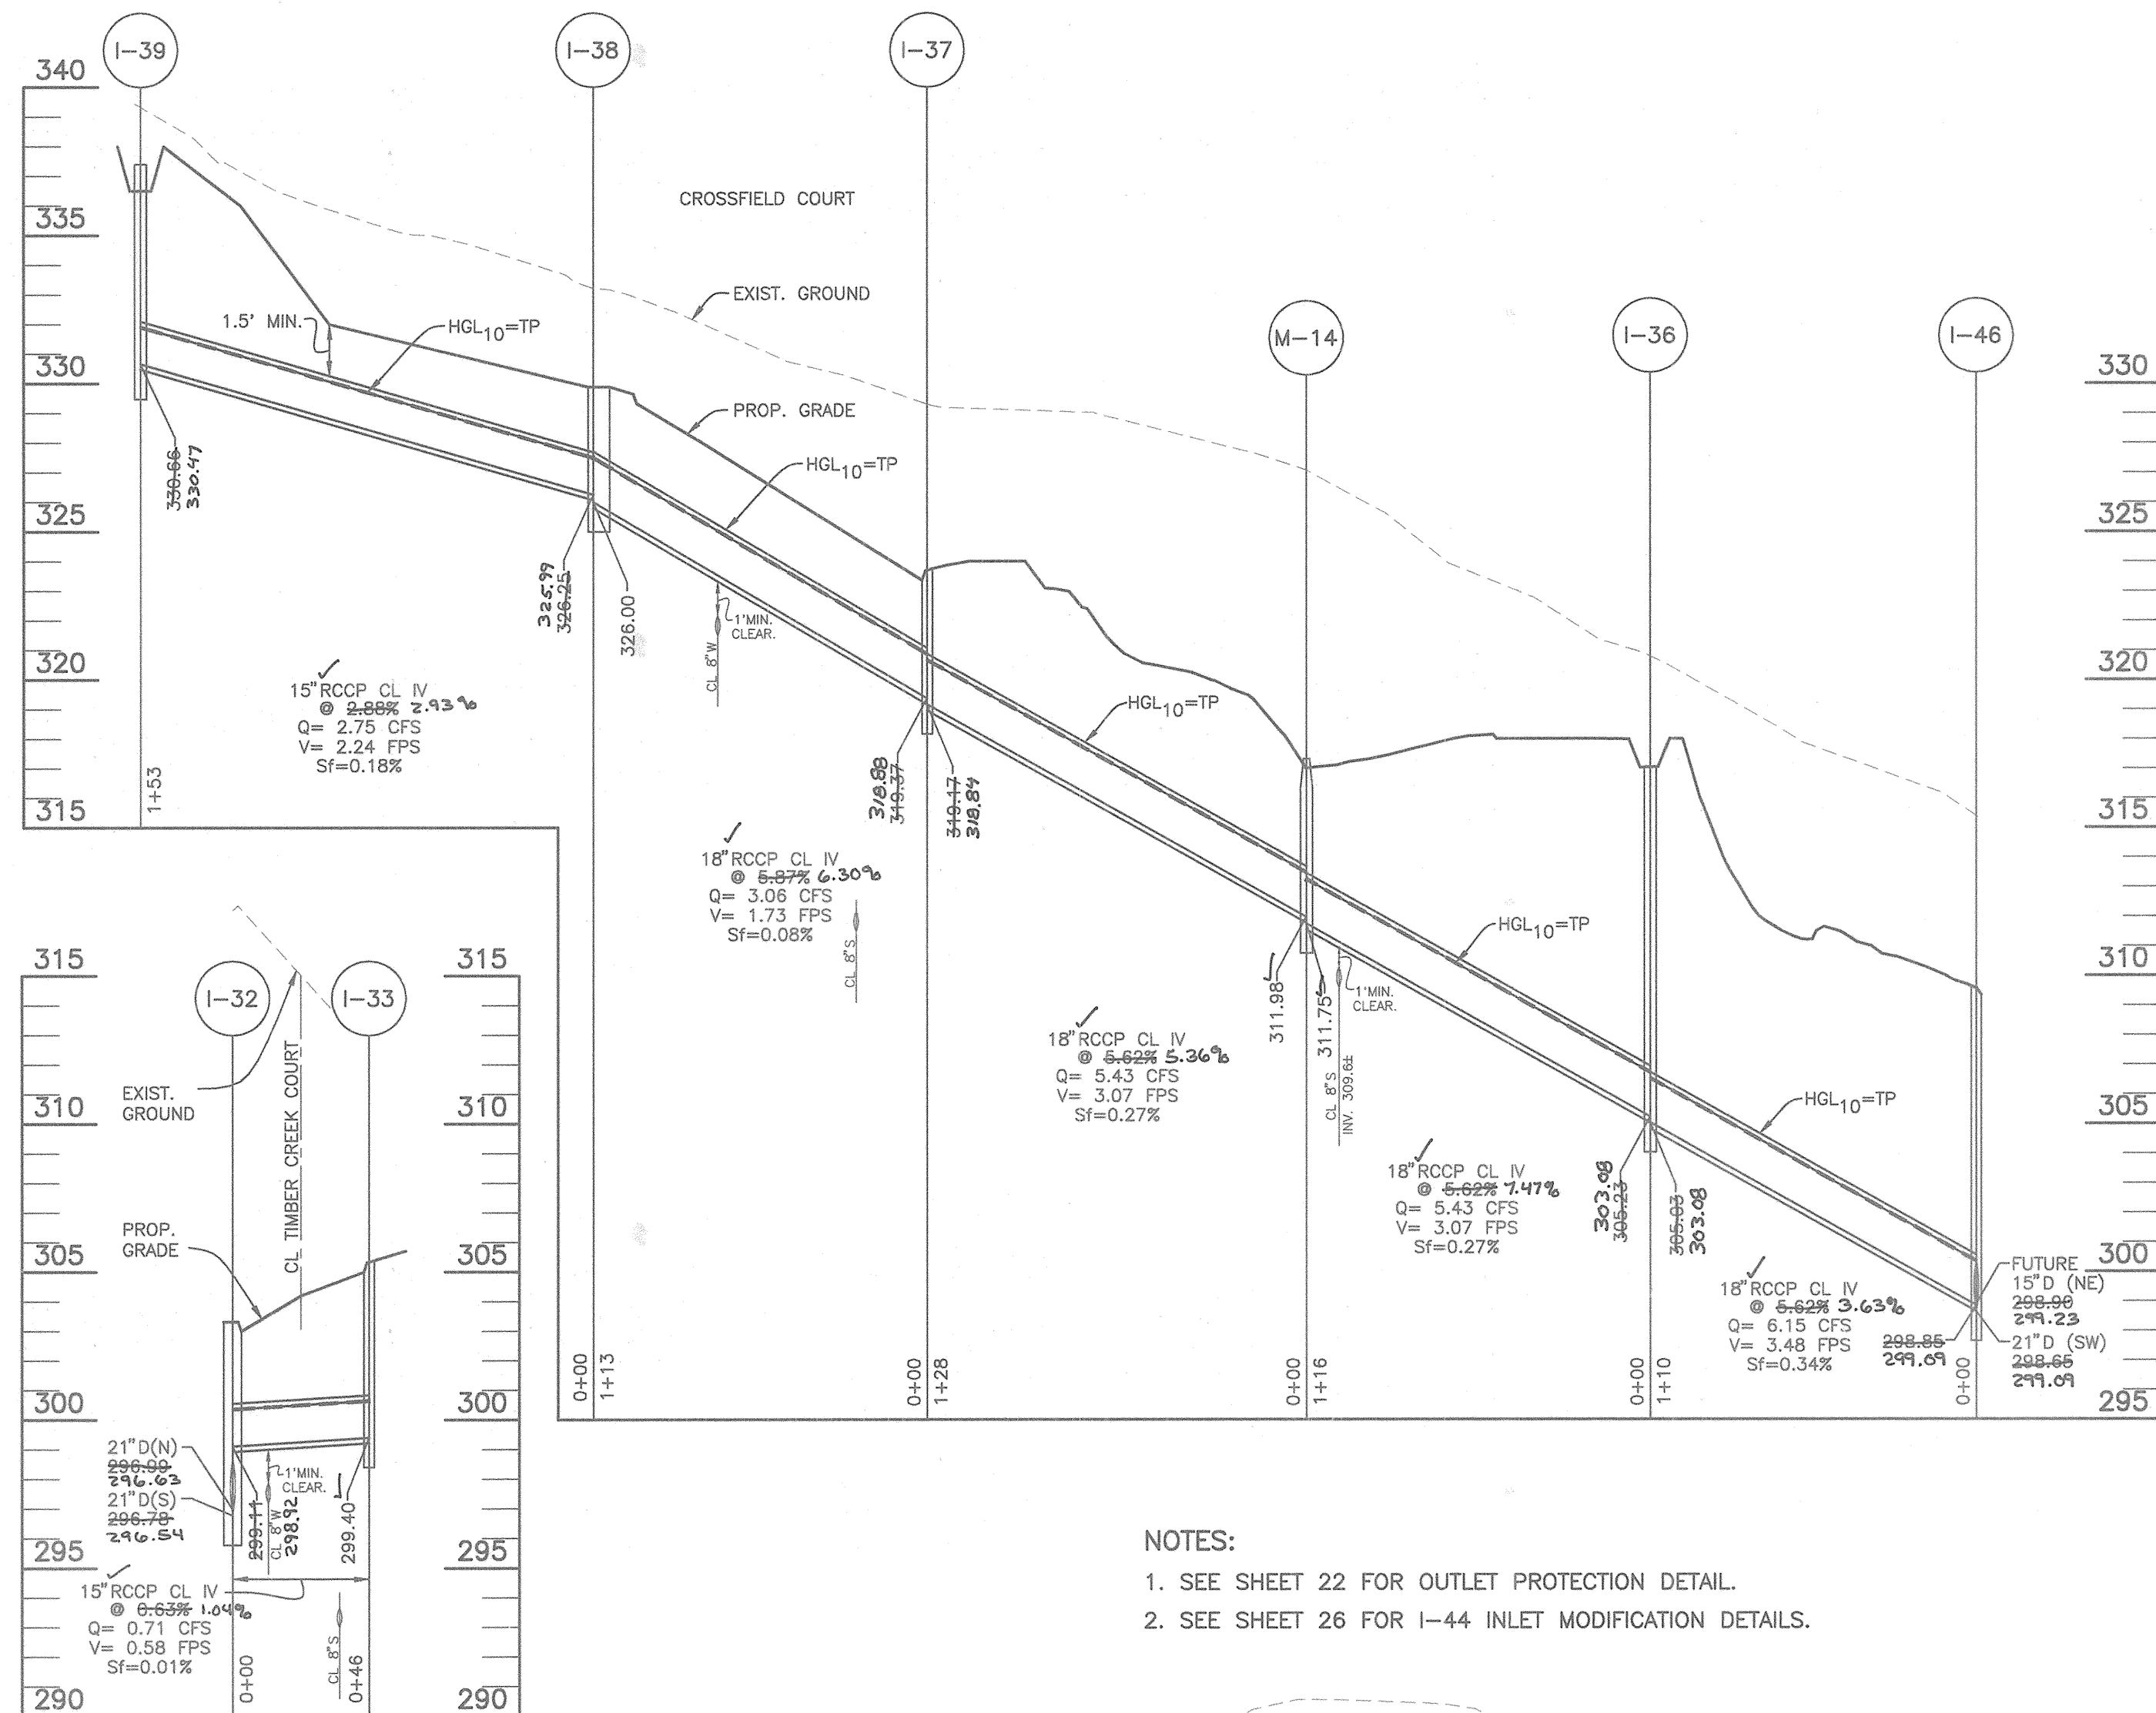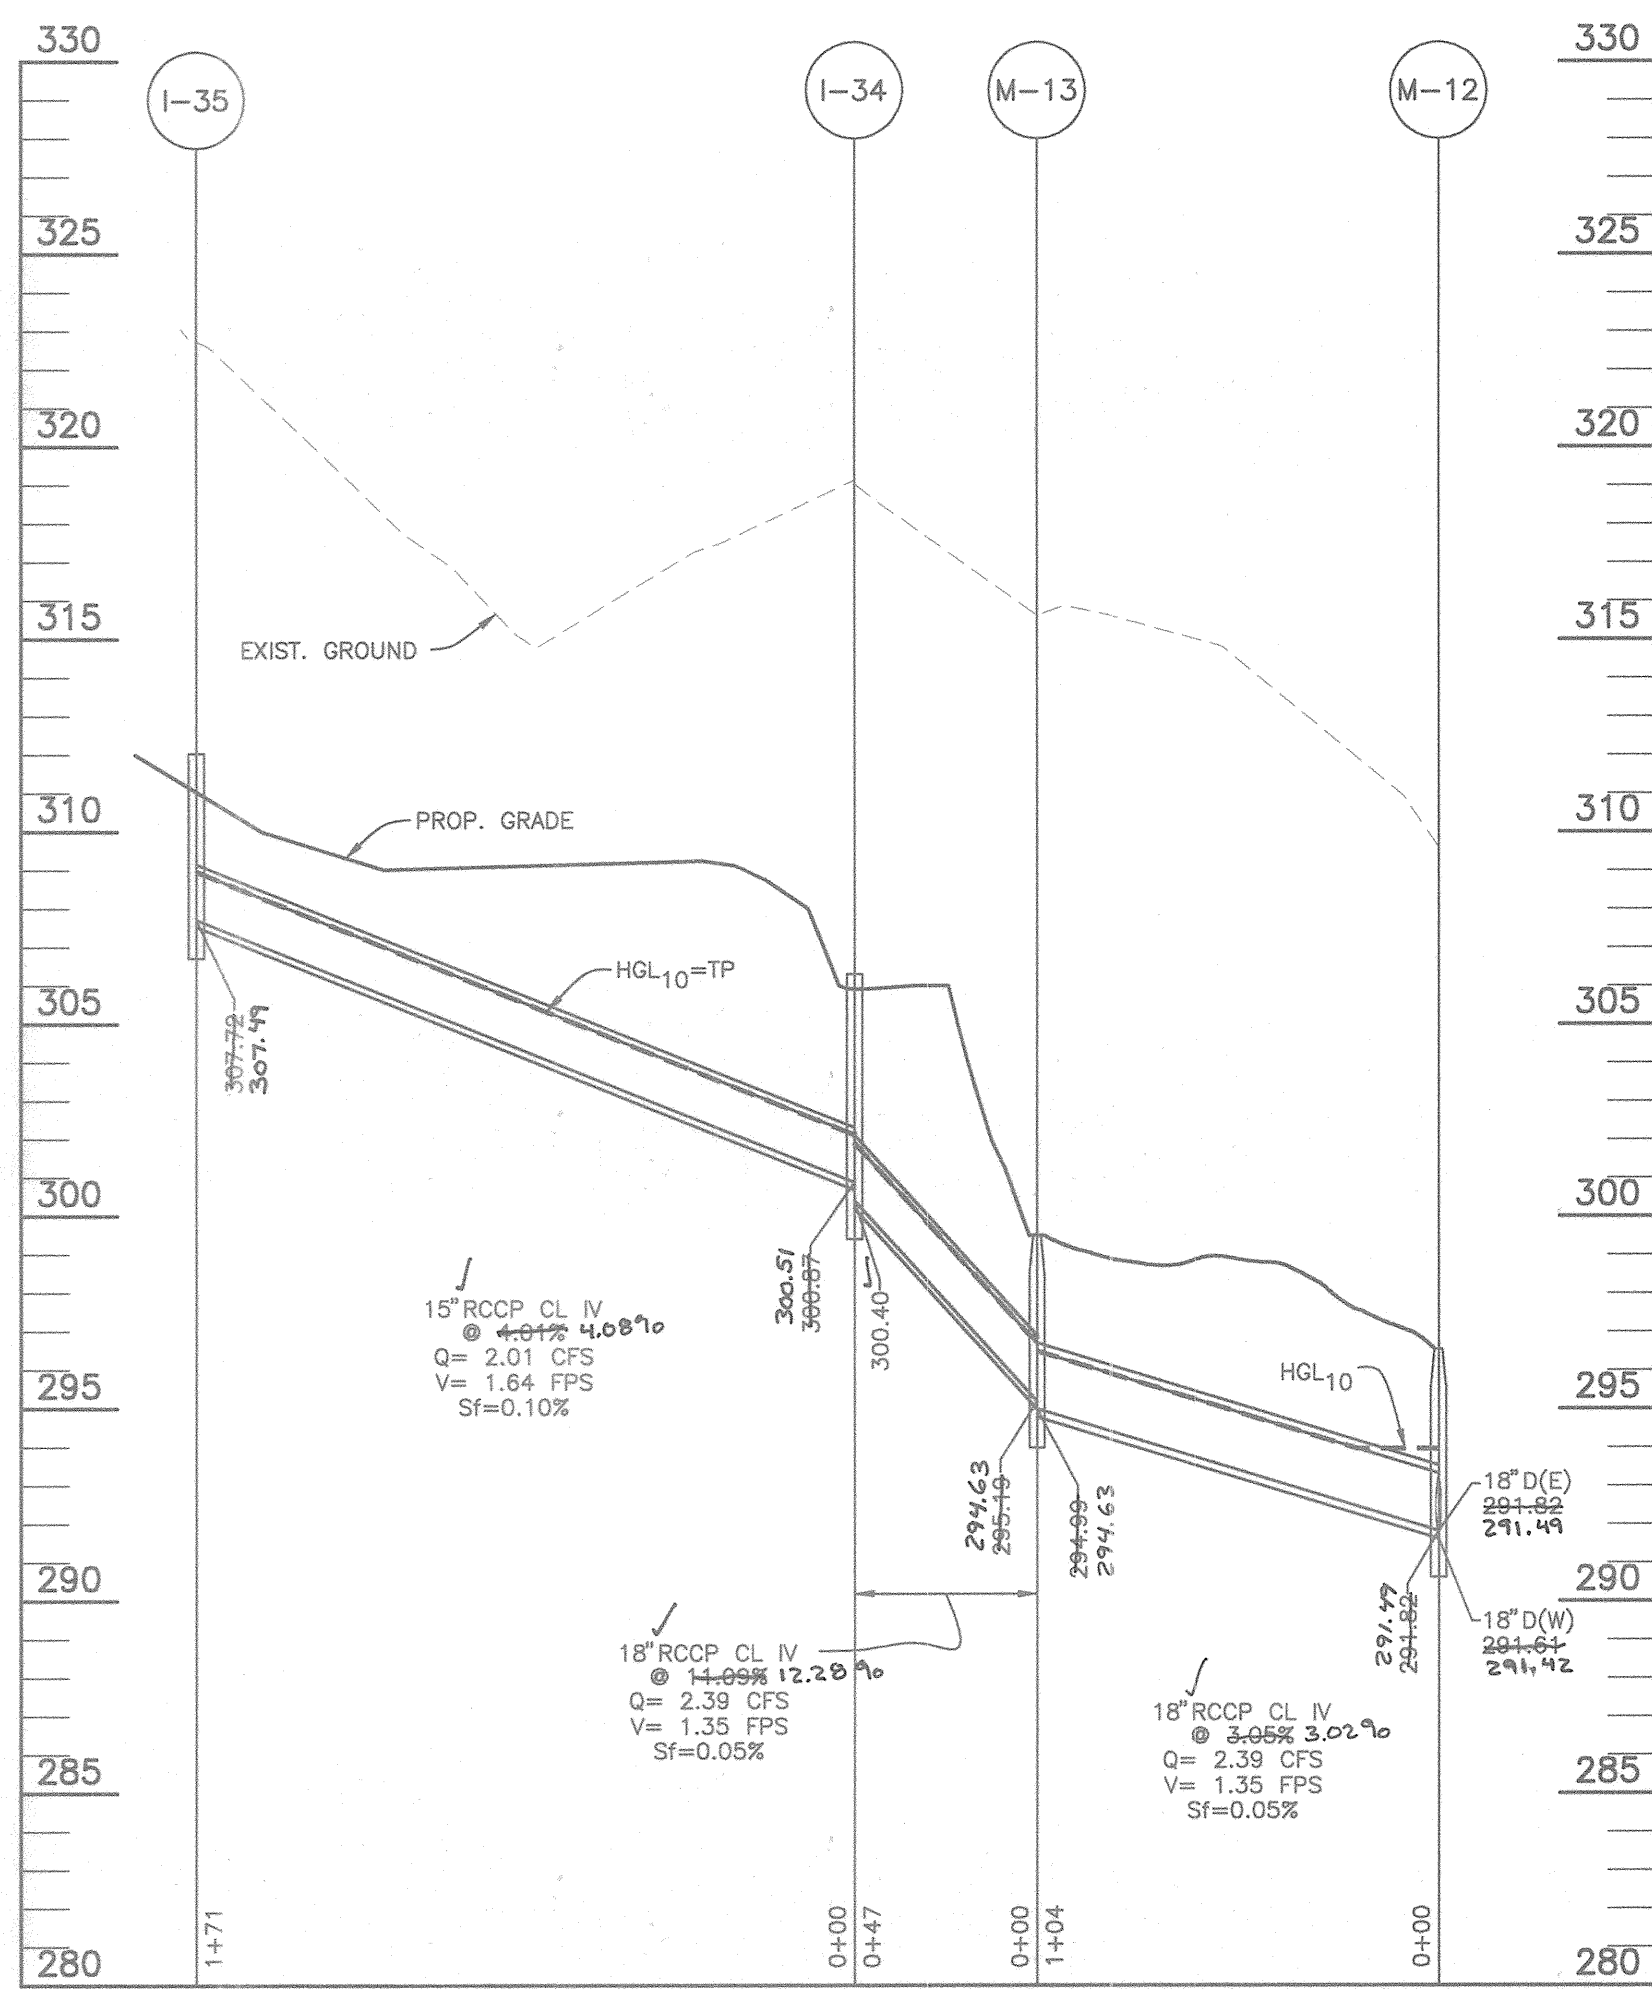

NOTES:  
 1. SEE SHEET 22 FOR OUTLET PROTECTION DETAIL.  
 2. SEE SHEET 26 FOR I-44 INLET MODIFICATION DETAILS.

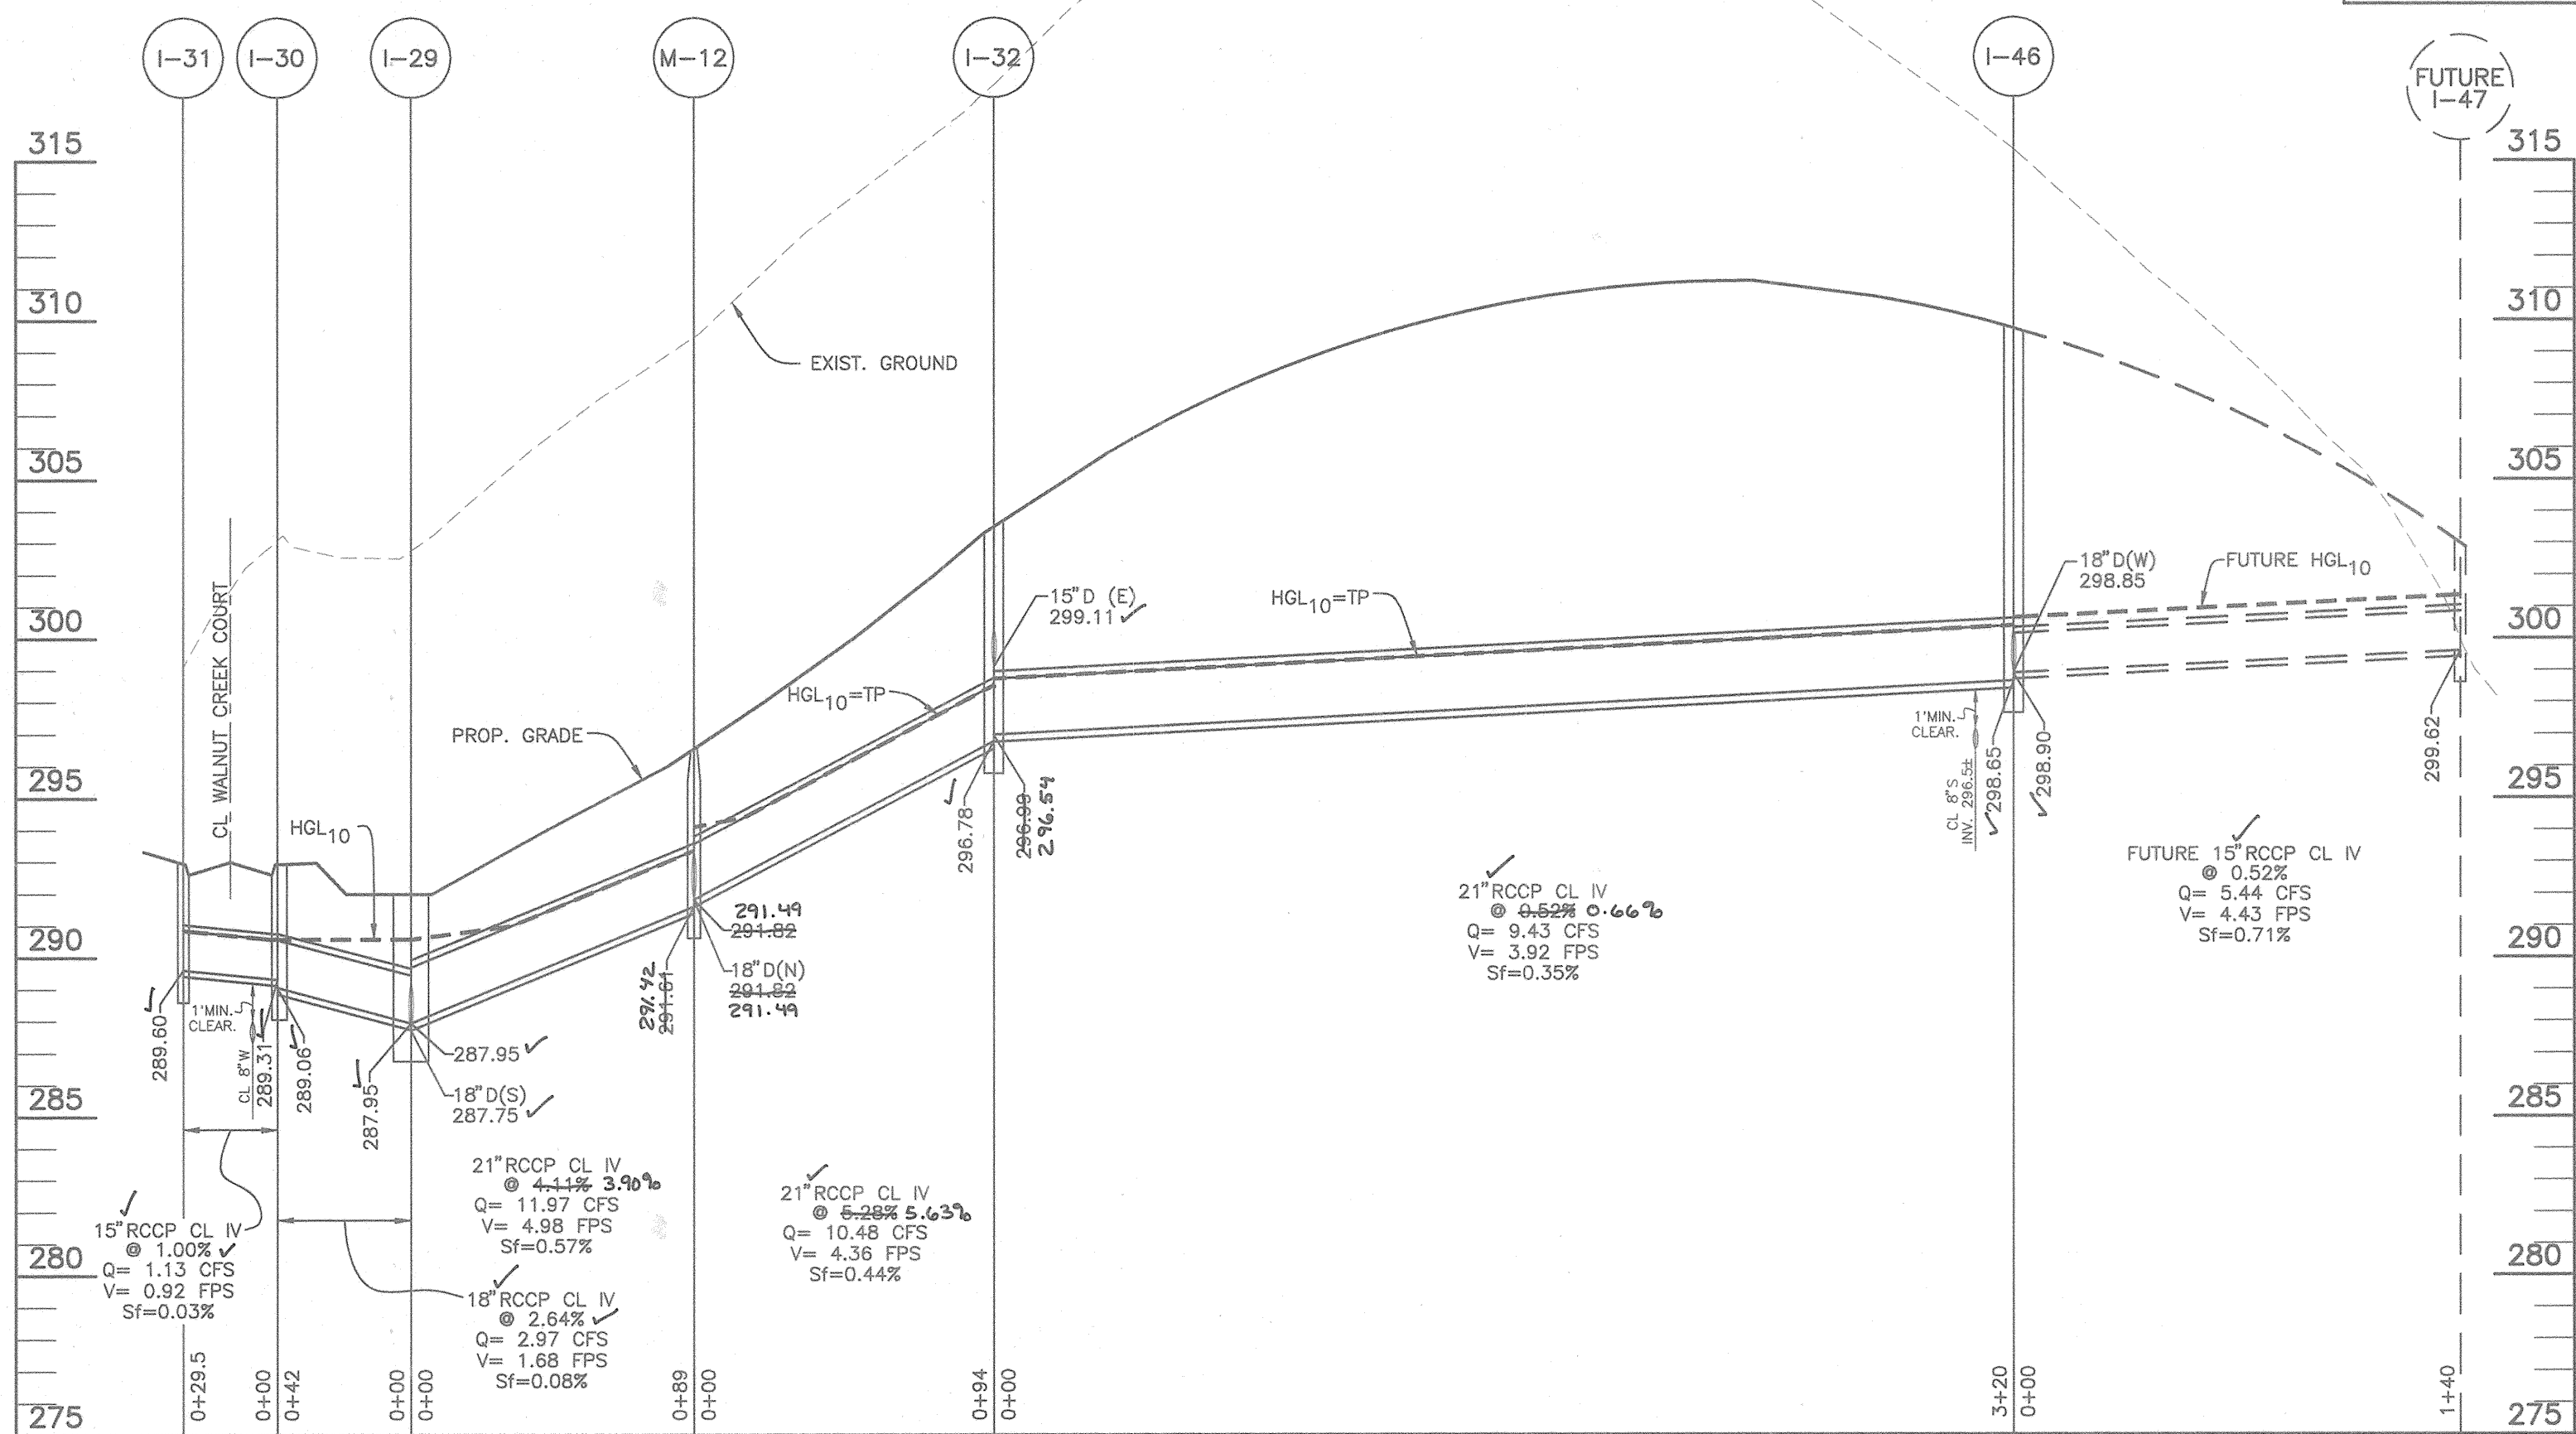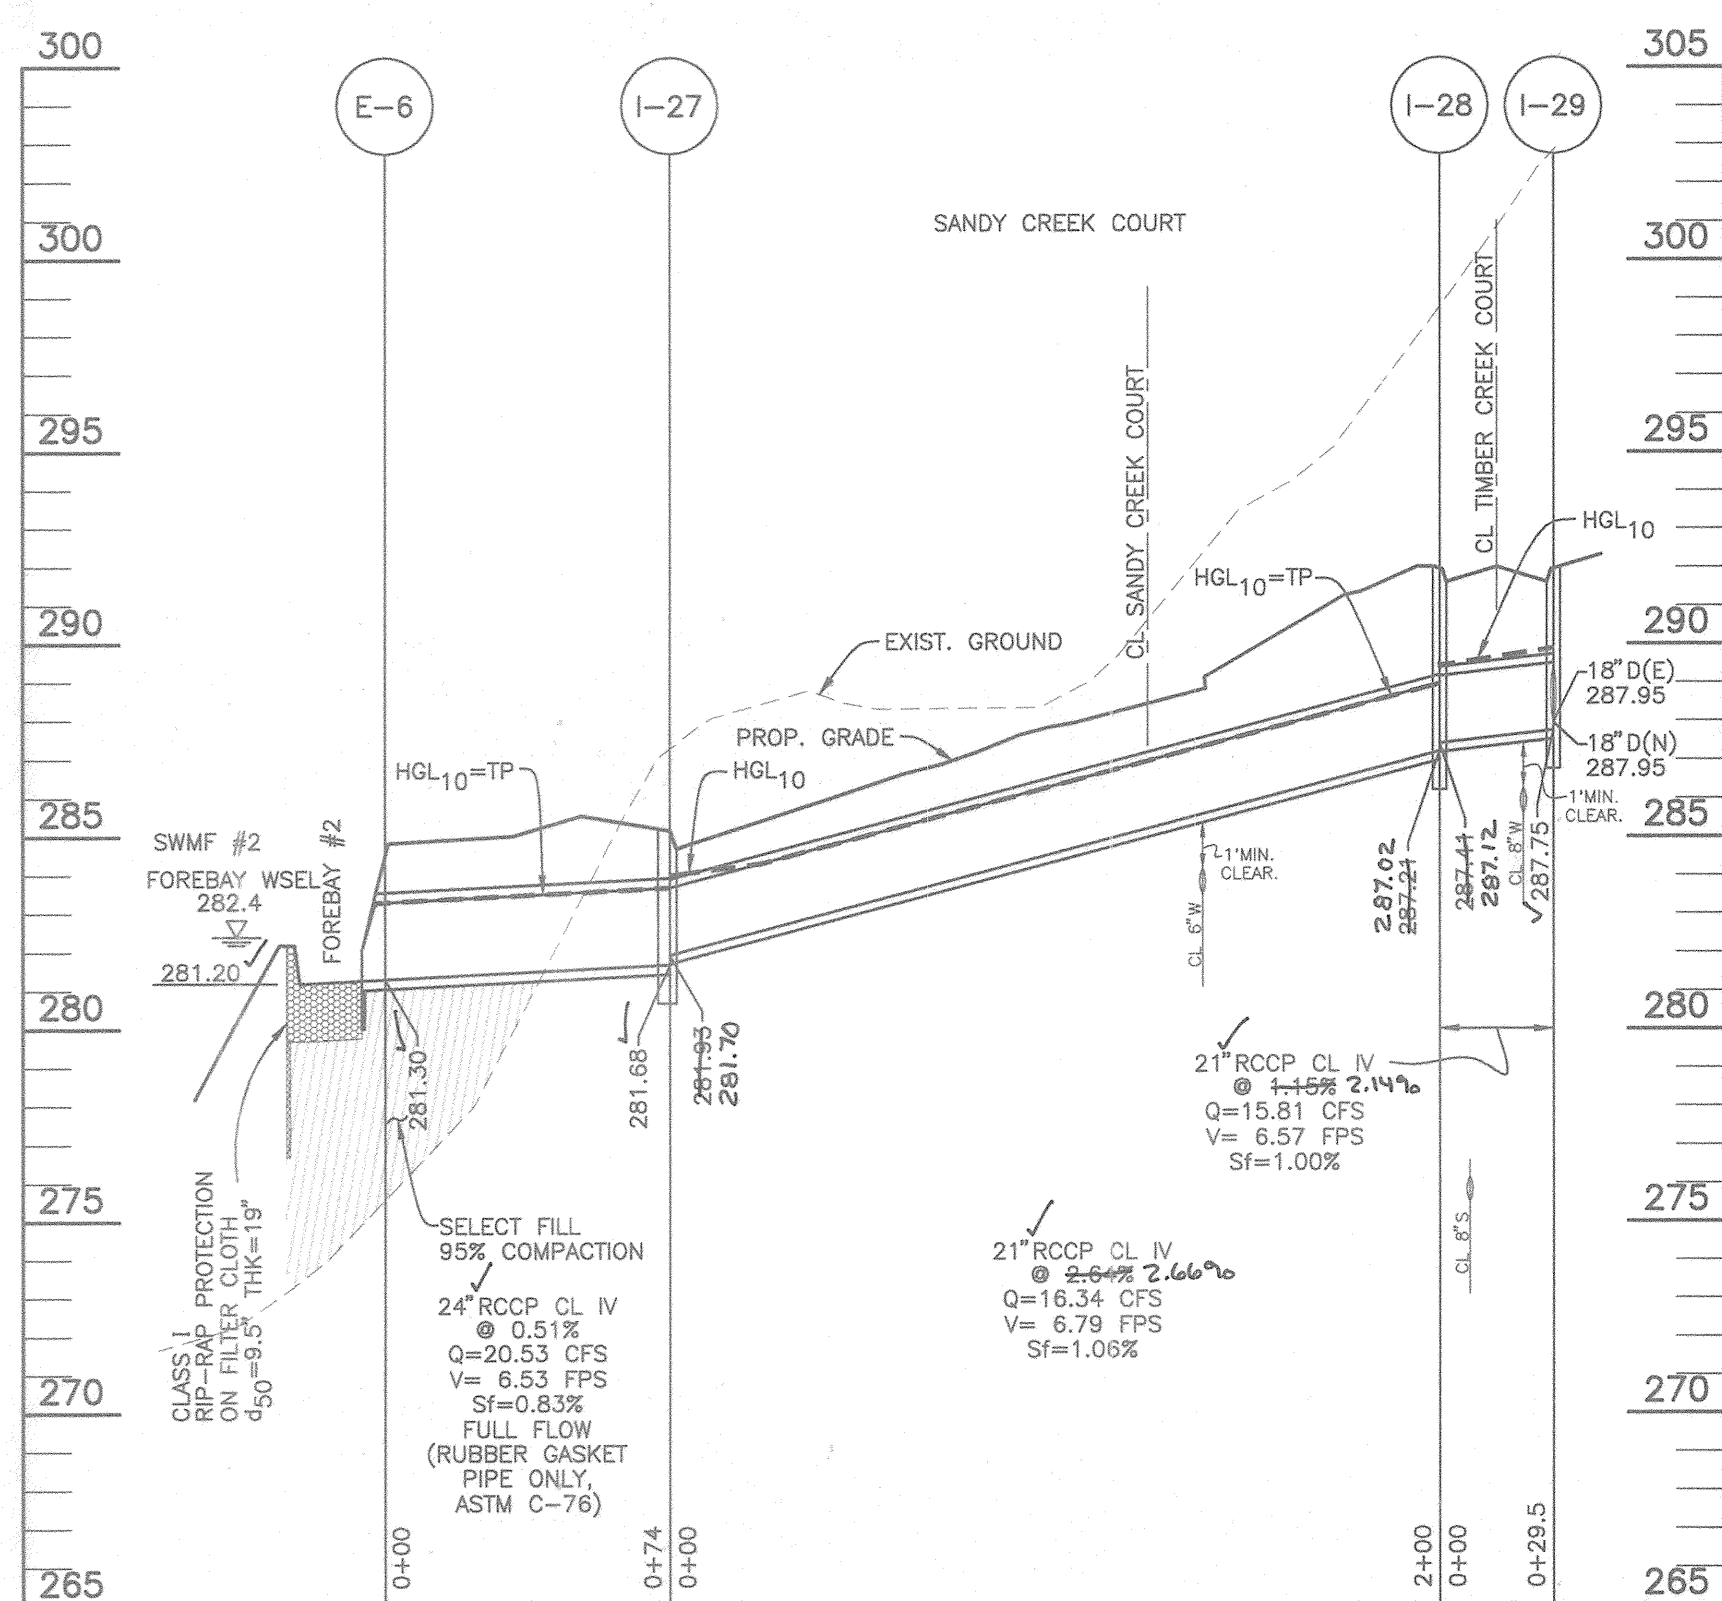

APPROVED: HOWARD COUNTY DEPARTMENT OF PUBLIC WORKS  
*Andrew M. Ducker* 6-15-98  
 CHIEF, BUREAU OF HIGHWAYS

APPROVED: HOWARD COUNTY DEPARTMENT OF PLANNING AND ZONING  
*Christina* 6/23/98  
 CHIEF, DIVISION OF LAND DEVELOPMENT

*Donald Mason*  
 AS-BUILT STALOS  
 PROFESSIONAL ENGINEER







NO.	DATE	REVISION
1	4/27/05	REVISED PER AS-BUILT CONDITIONS

**TSA GROUP, INC.**  
 planning • architecture • engineering • surveying  
 8460 Baltimore National Pike • Ellicott City, Maryland 21043 • 410-465-9105

*Donald Mason*  
 PROFESSIONAL ENGINEER

OWNERS: TOLL MD LIMITED PARTNERSHIP, A MARYLAND LIMITED PARTNERSHIP 3206 TOWER OAKS BOULEVARD SUITE 310 ROCKVILLE, MARYLAND 20852	PROJECT: <b>VILLAGE OF CEDAR RIDGE</b> A SUBDIVISION OF PARCEL 44 (TAX MAP 41) AND A RESUBDIVISION OF LOTS 1 AND 2 OF THE EDITH S. PARLETTE SUBDIVISION (TAX MAP 10735 PARCEL 43) AND A SUBDIVISION OF PARCEL 123 FOR A ROAD RIGHT-OF-WAY
DEVELOPER: TOLL MD LIMITED PARTNERSHIP, A MARYLAND LIMITED PARTNERSHIP 3206 TOWER OAKS BOULEVARD SUITE 310 ROCKVILLE, MARYLAND 20852	LOCATION: TAX MAP 41 - PARCELS 43 & 44, P/O 123 5th ELECTION DISTRICT HOWARD COUNTY, MARYLAND
TITLE: <b>STORM DRAIN PROFILES</b>	DATE: SP-97-02 WP-97-78 PB 312 F-93-70 WP-98-82 OCTOBER, 1997 MAY, 1998
DES: MLV/DAM DRAFT: DBT CHECK: DAM	PROJECT NO. 0518 SHEET 15 OF 31 SCALE: 1"=50' HORIZ. 1"=5' VERT.



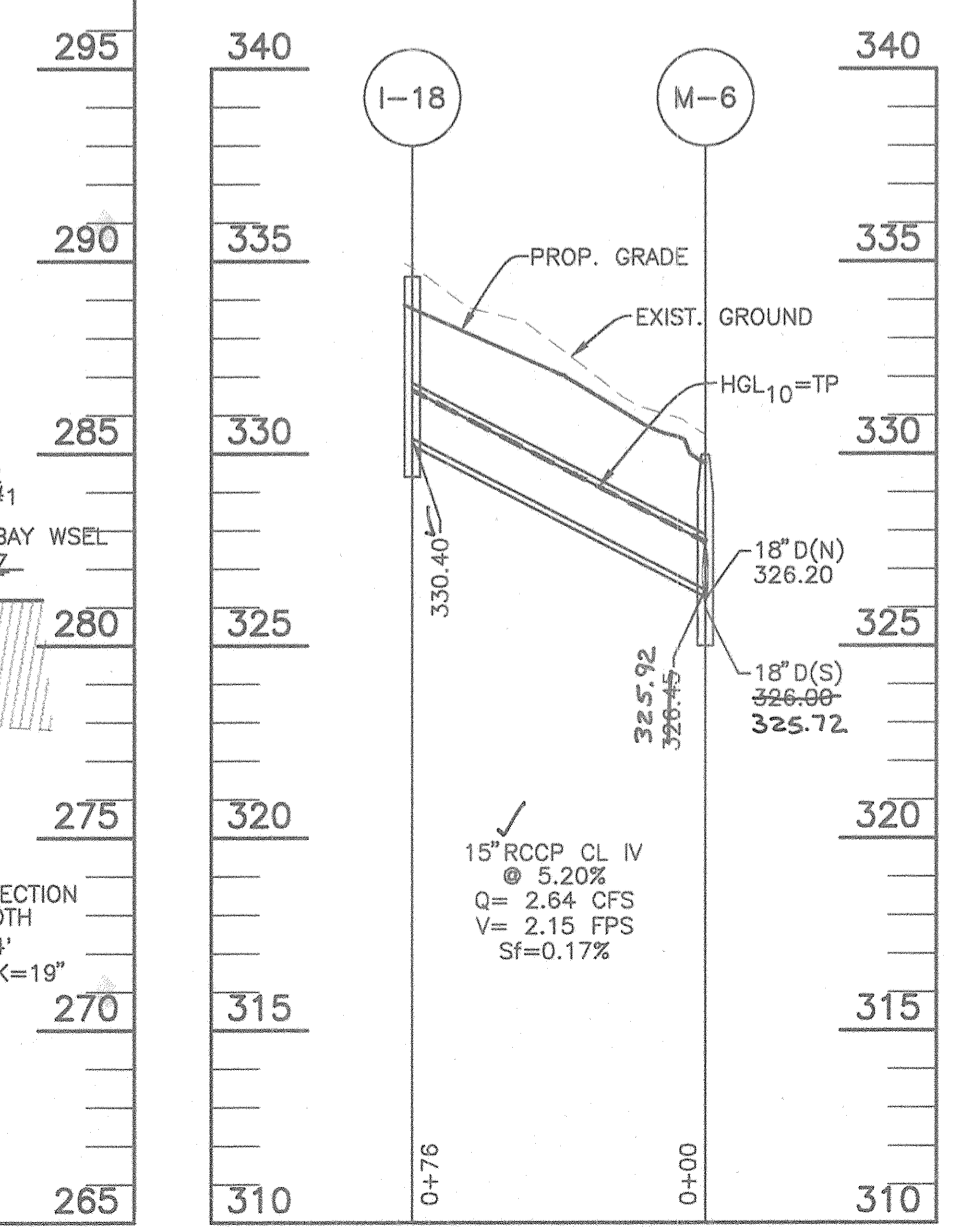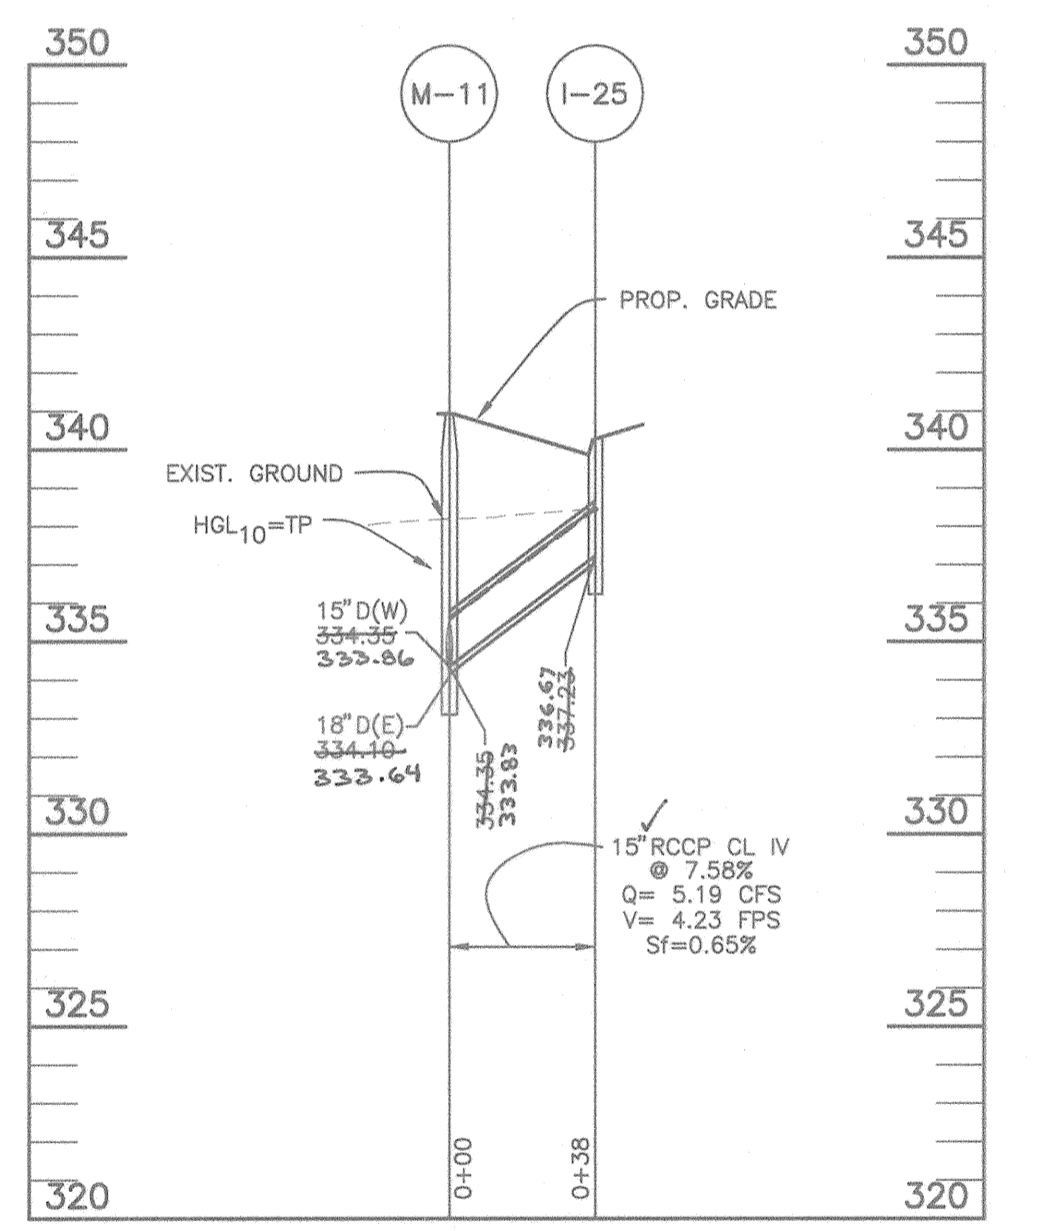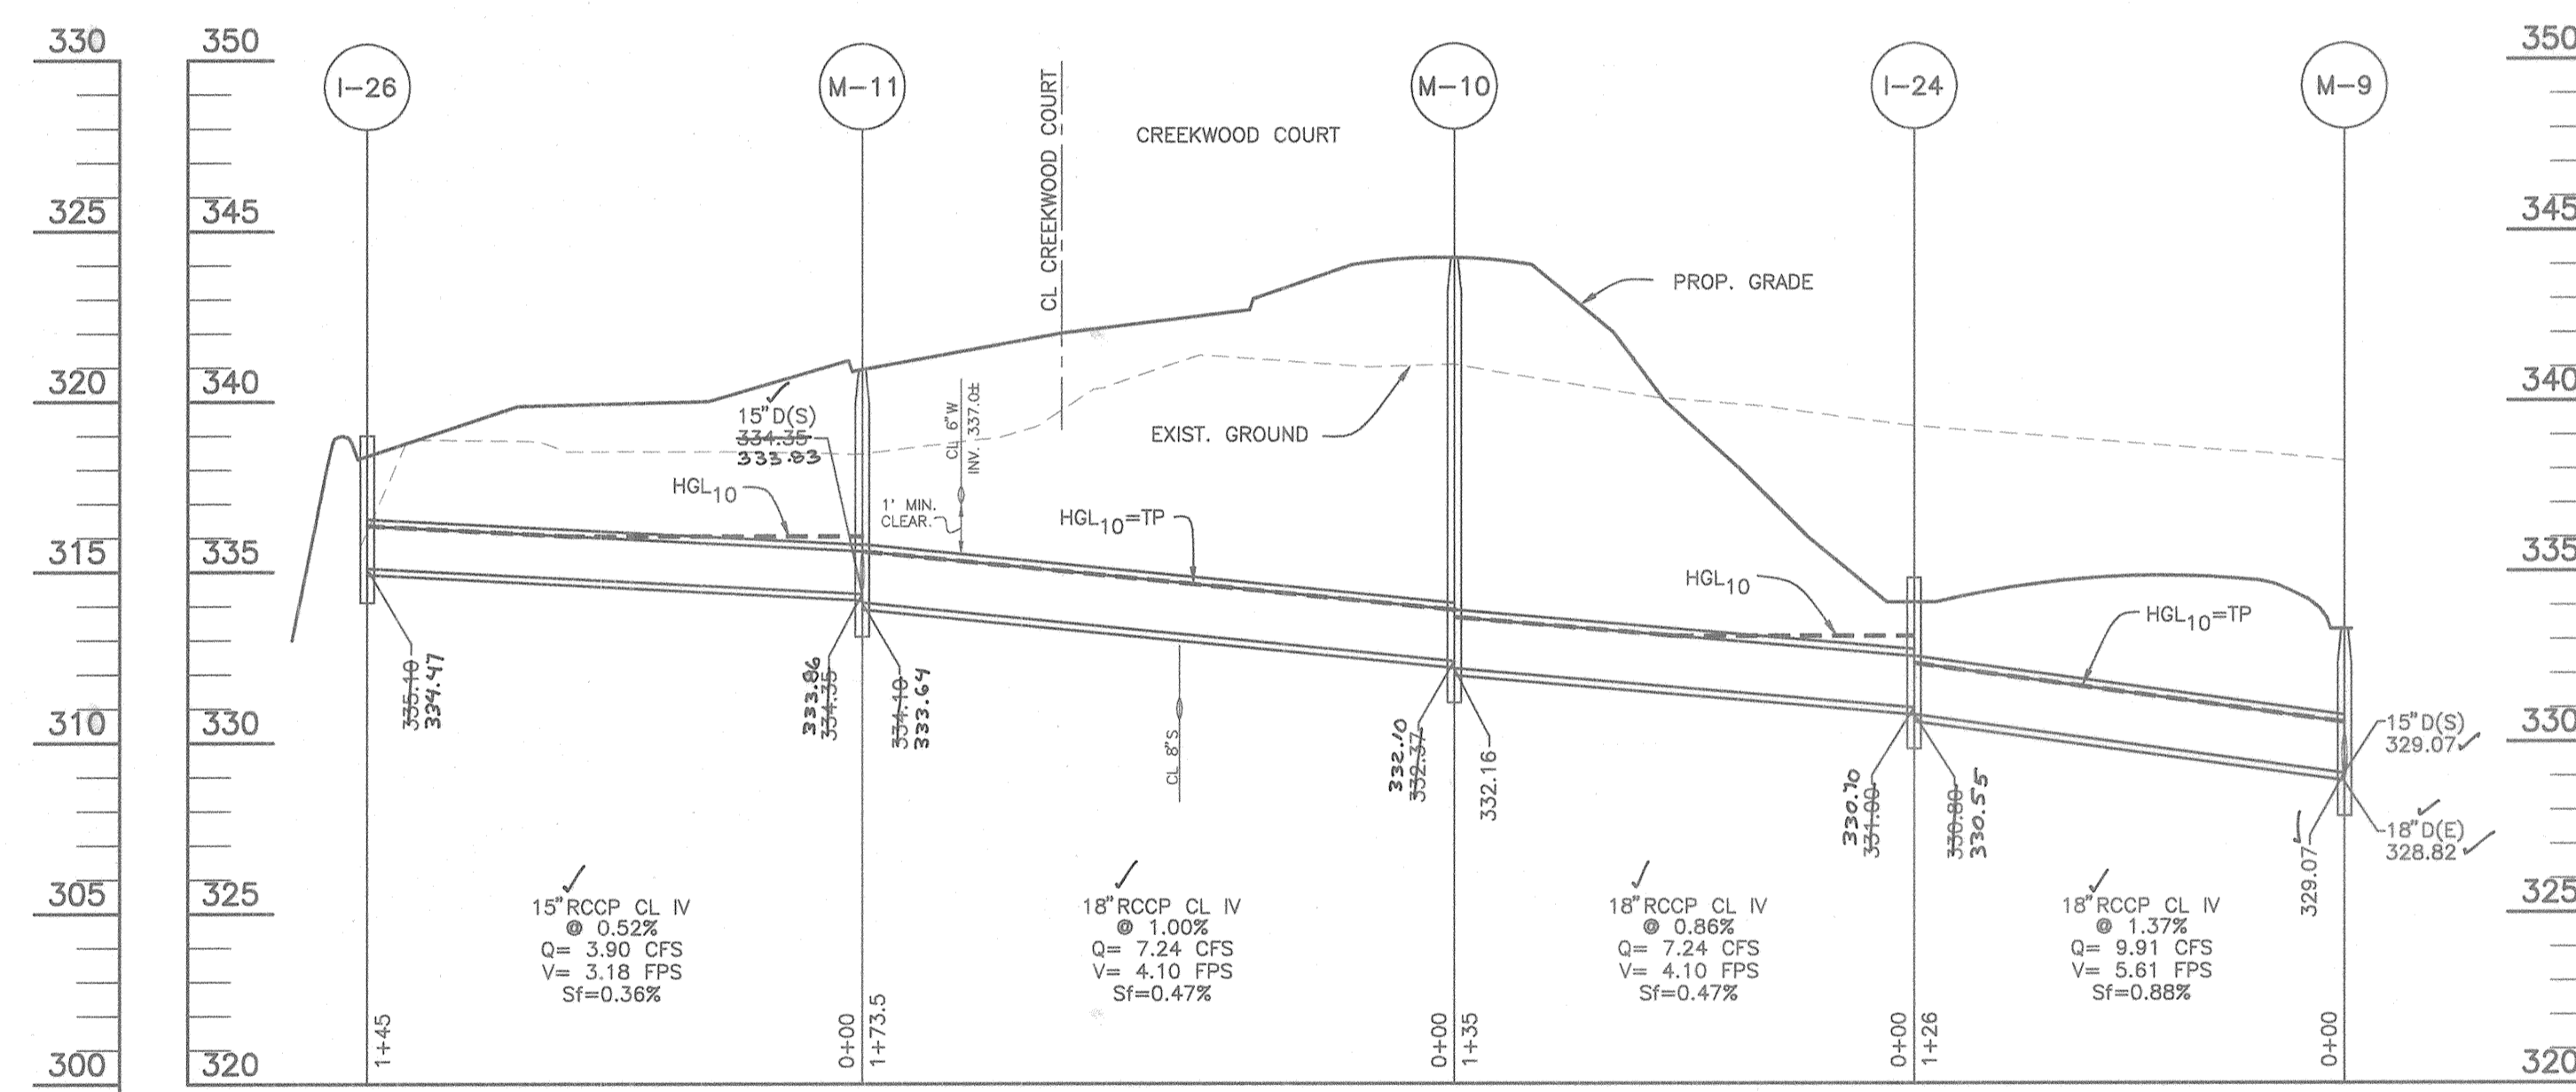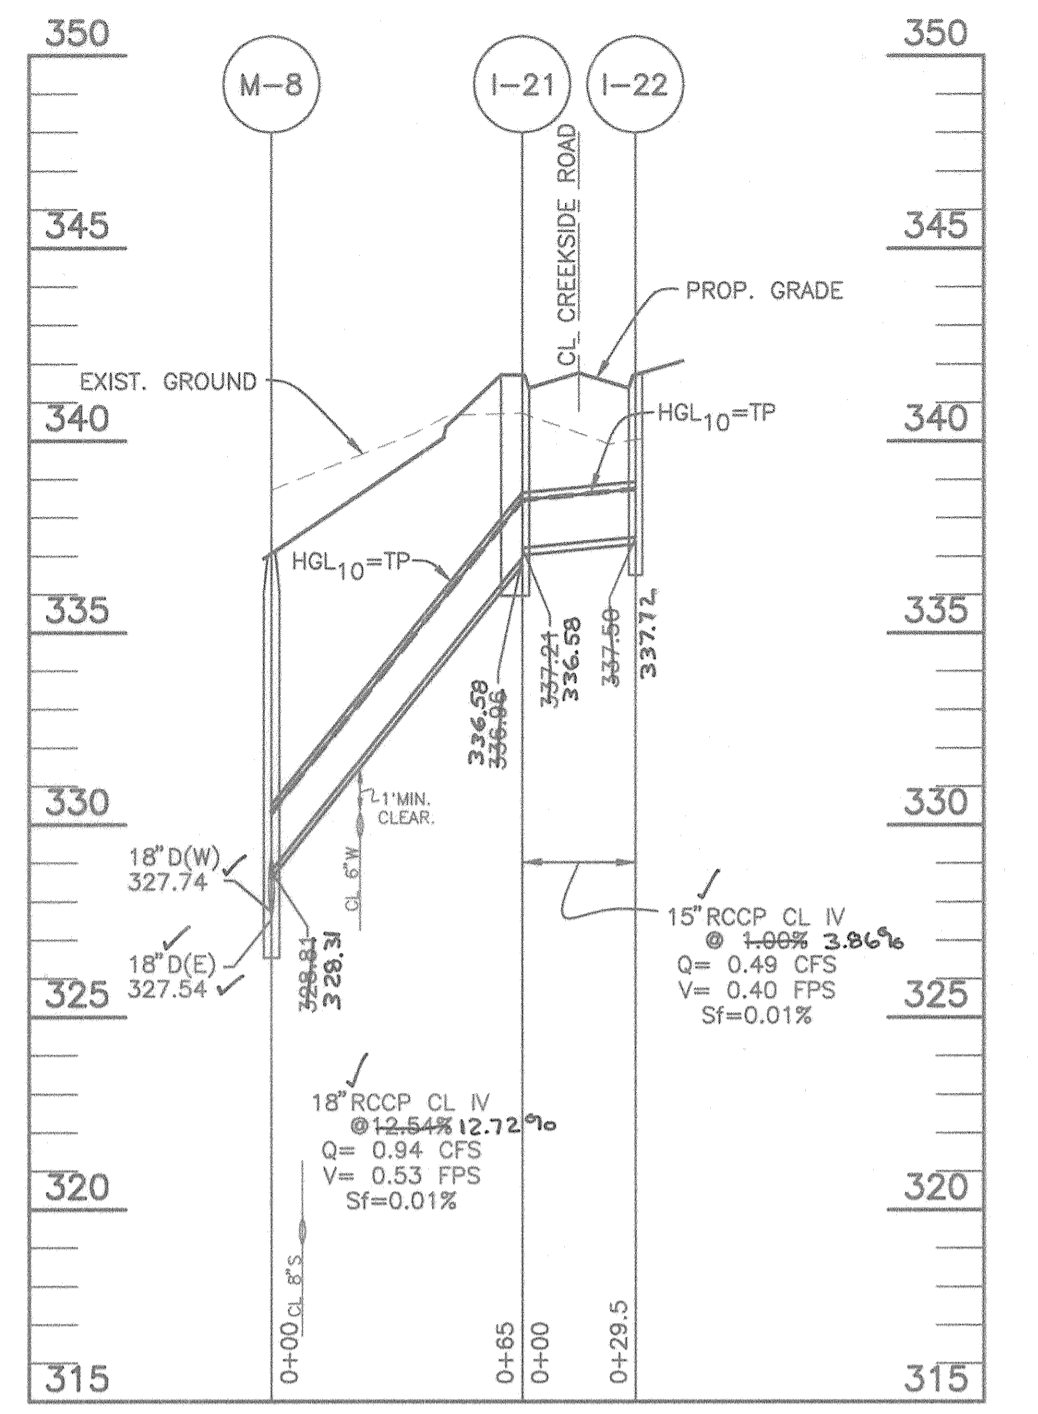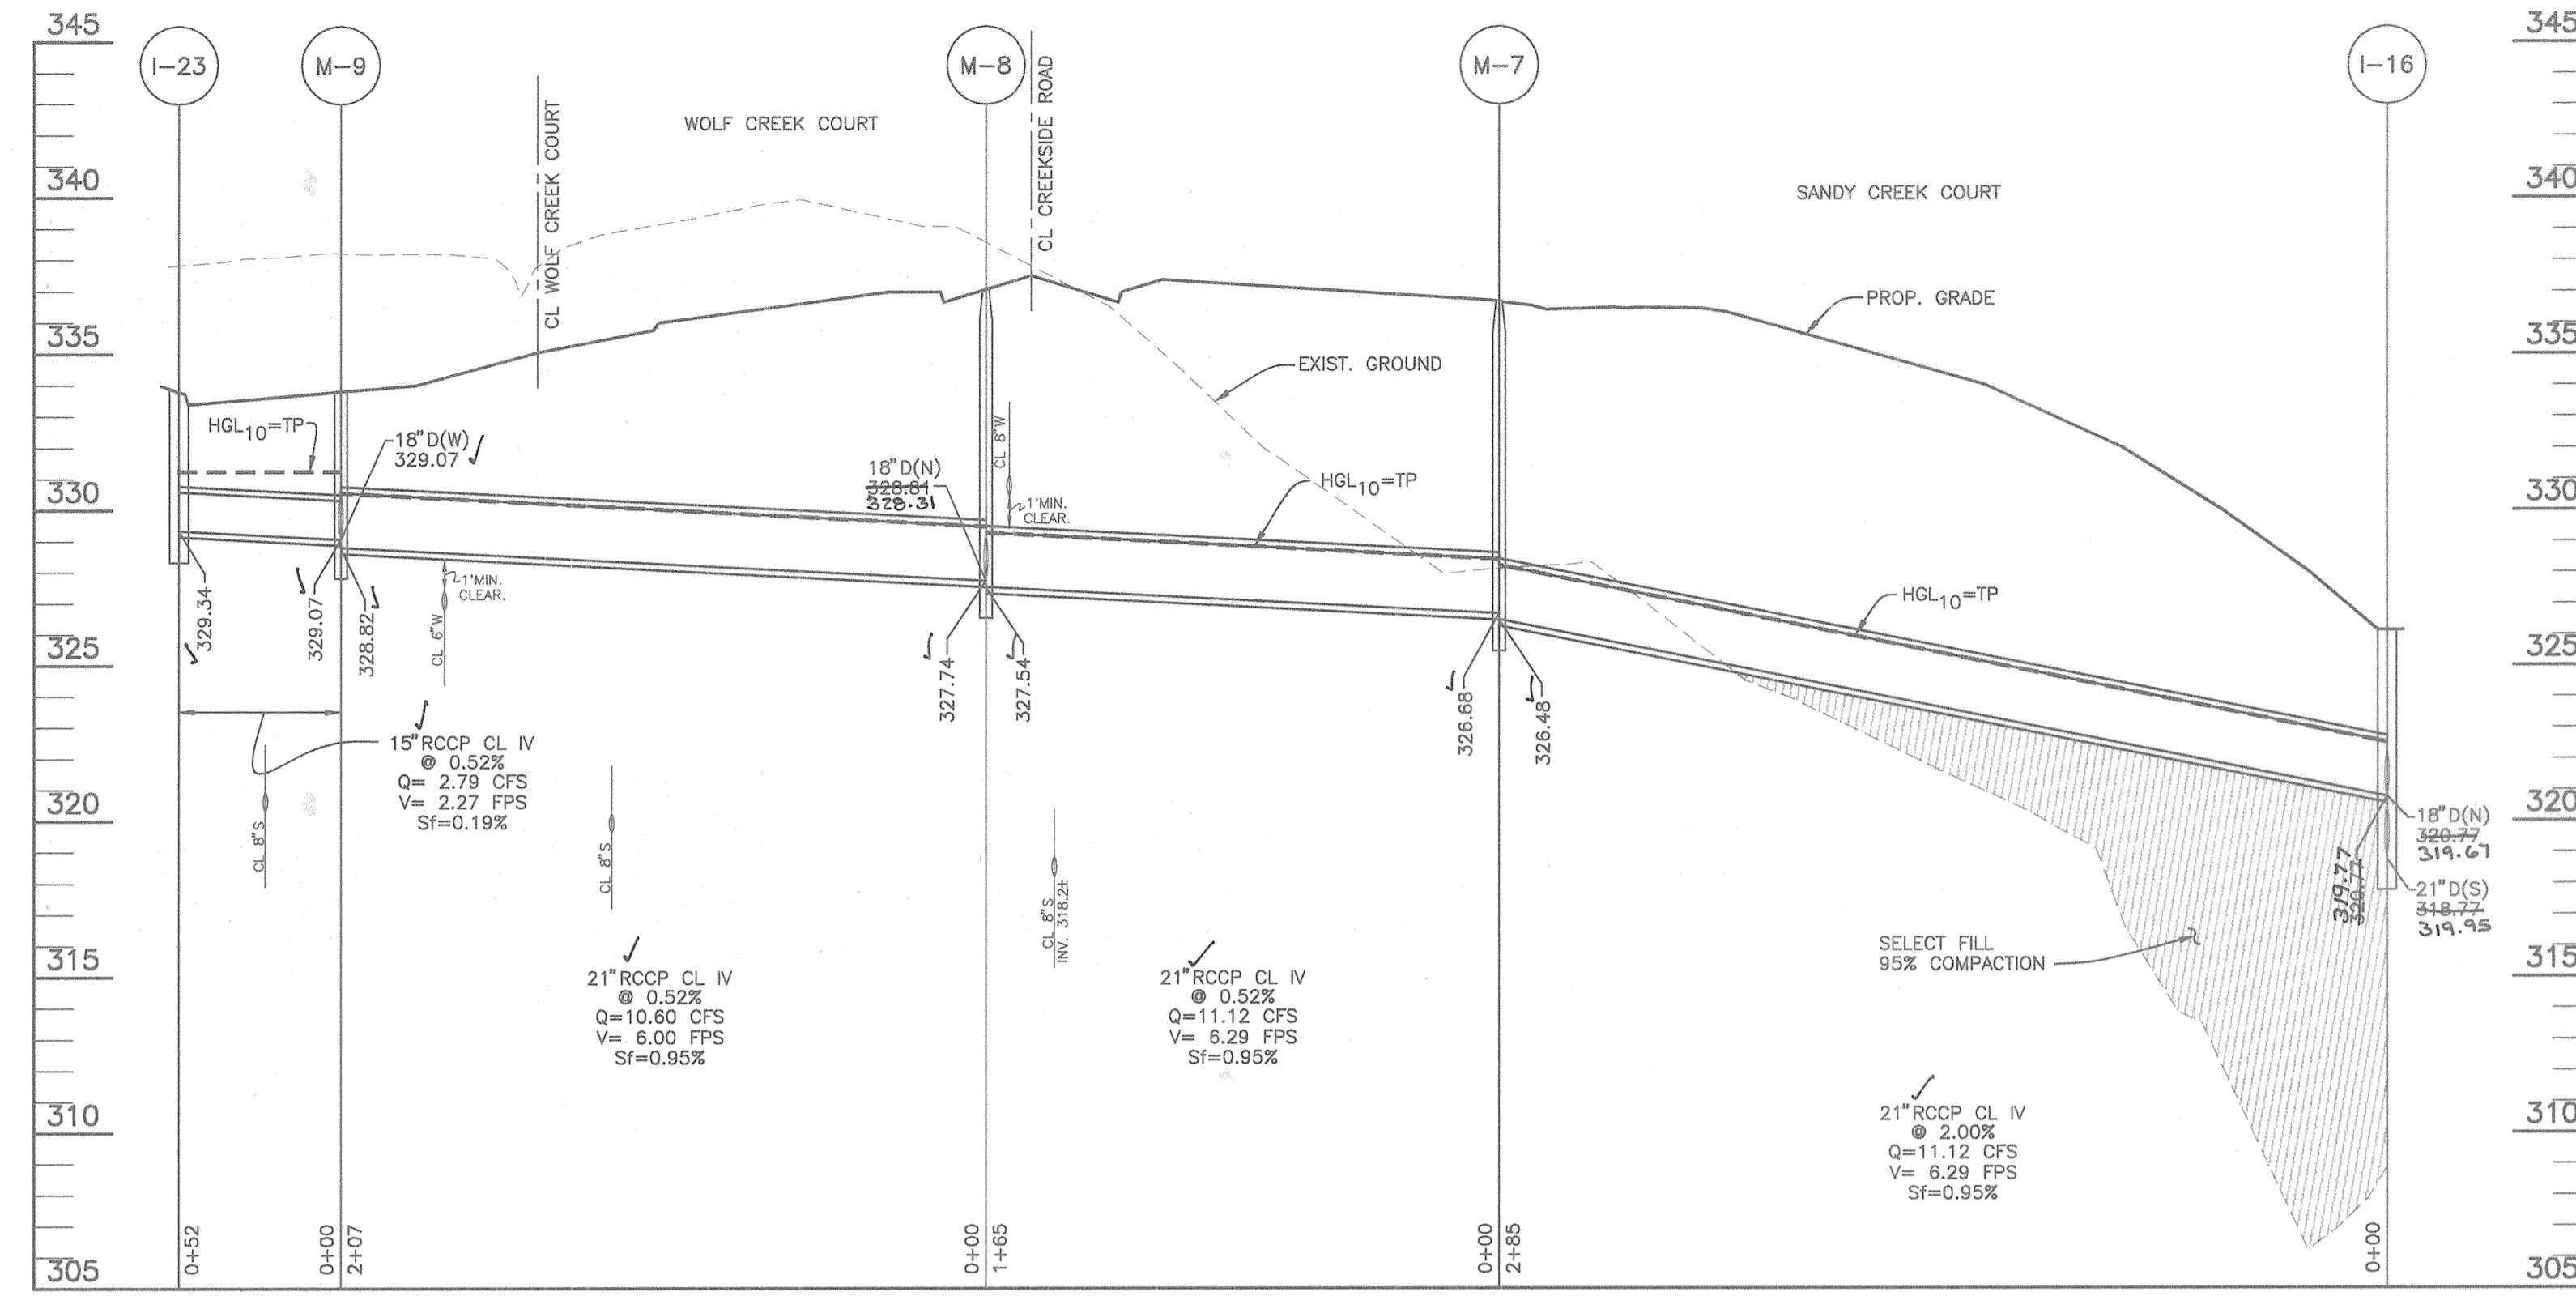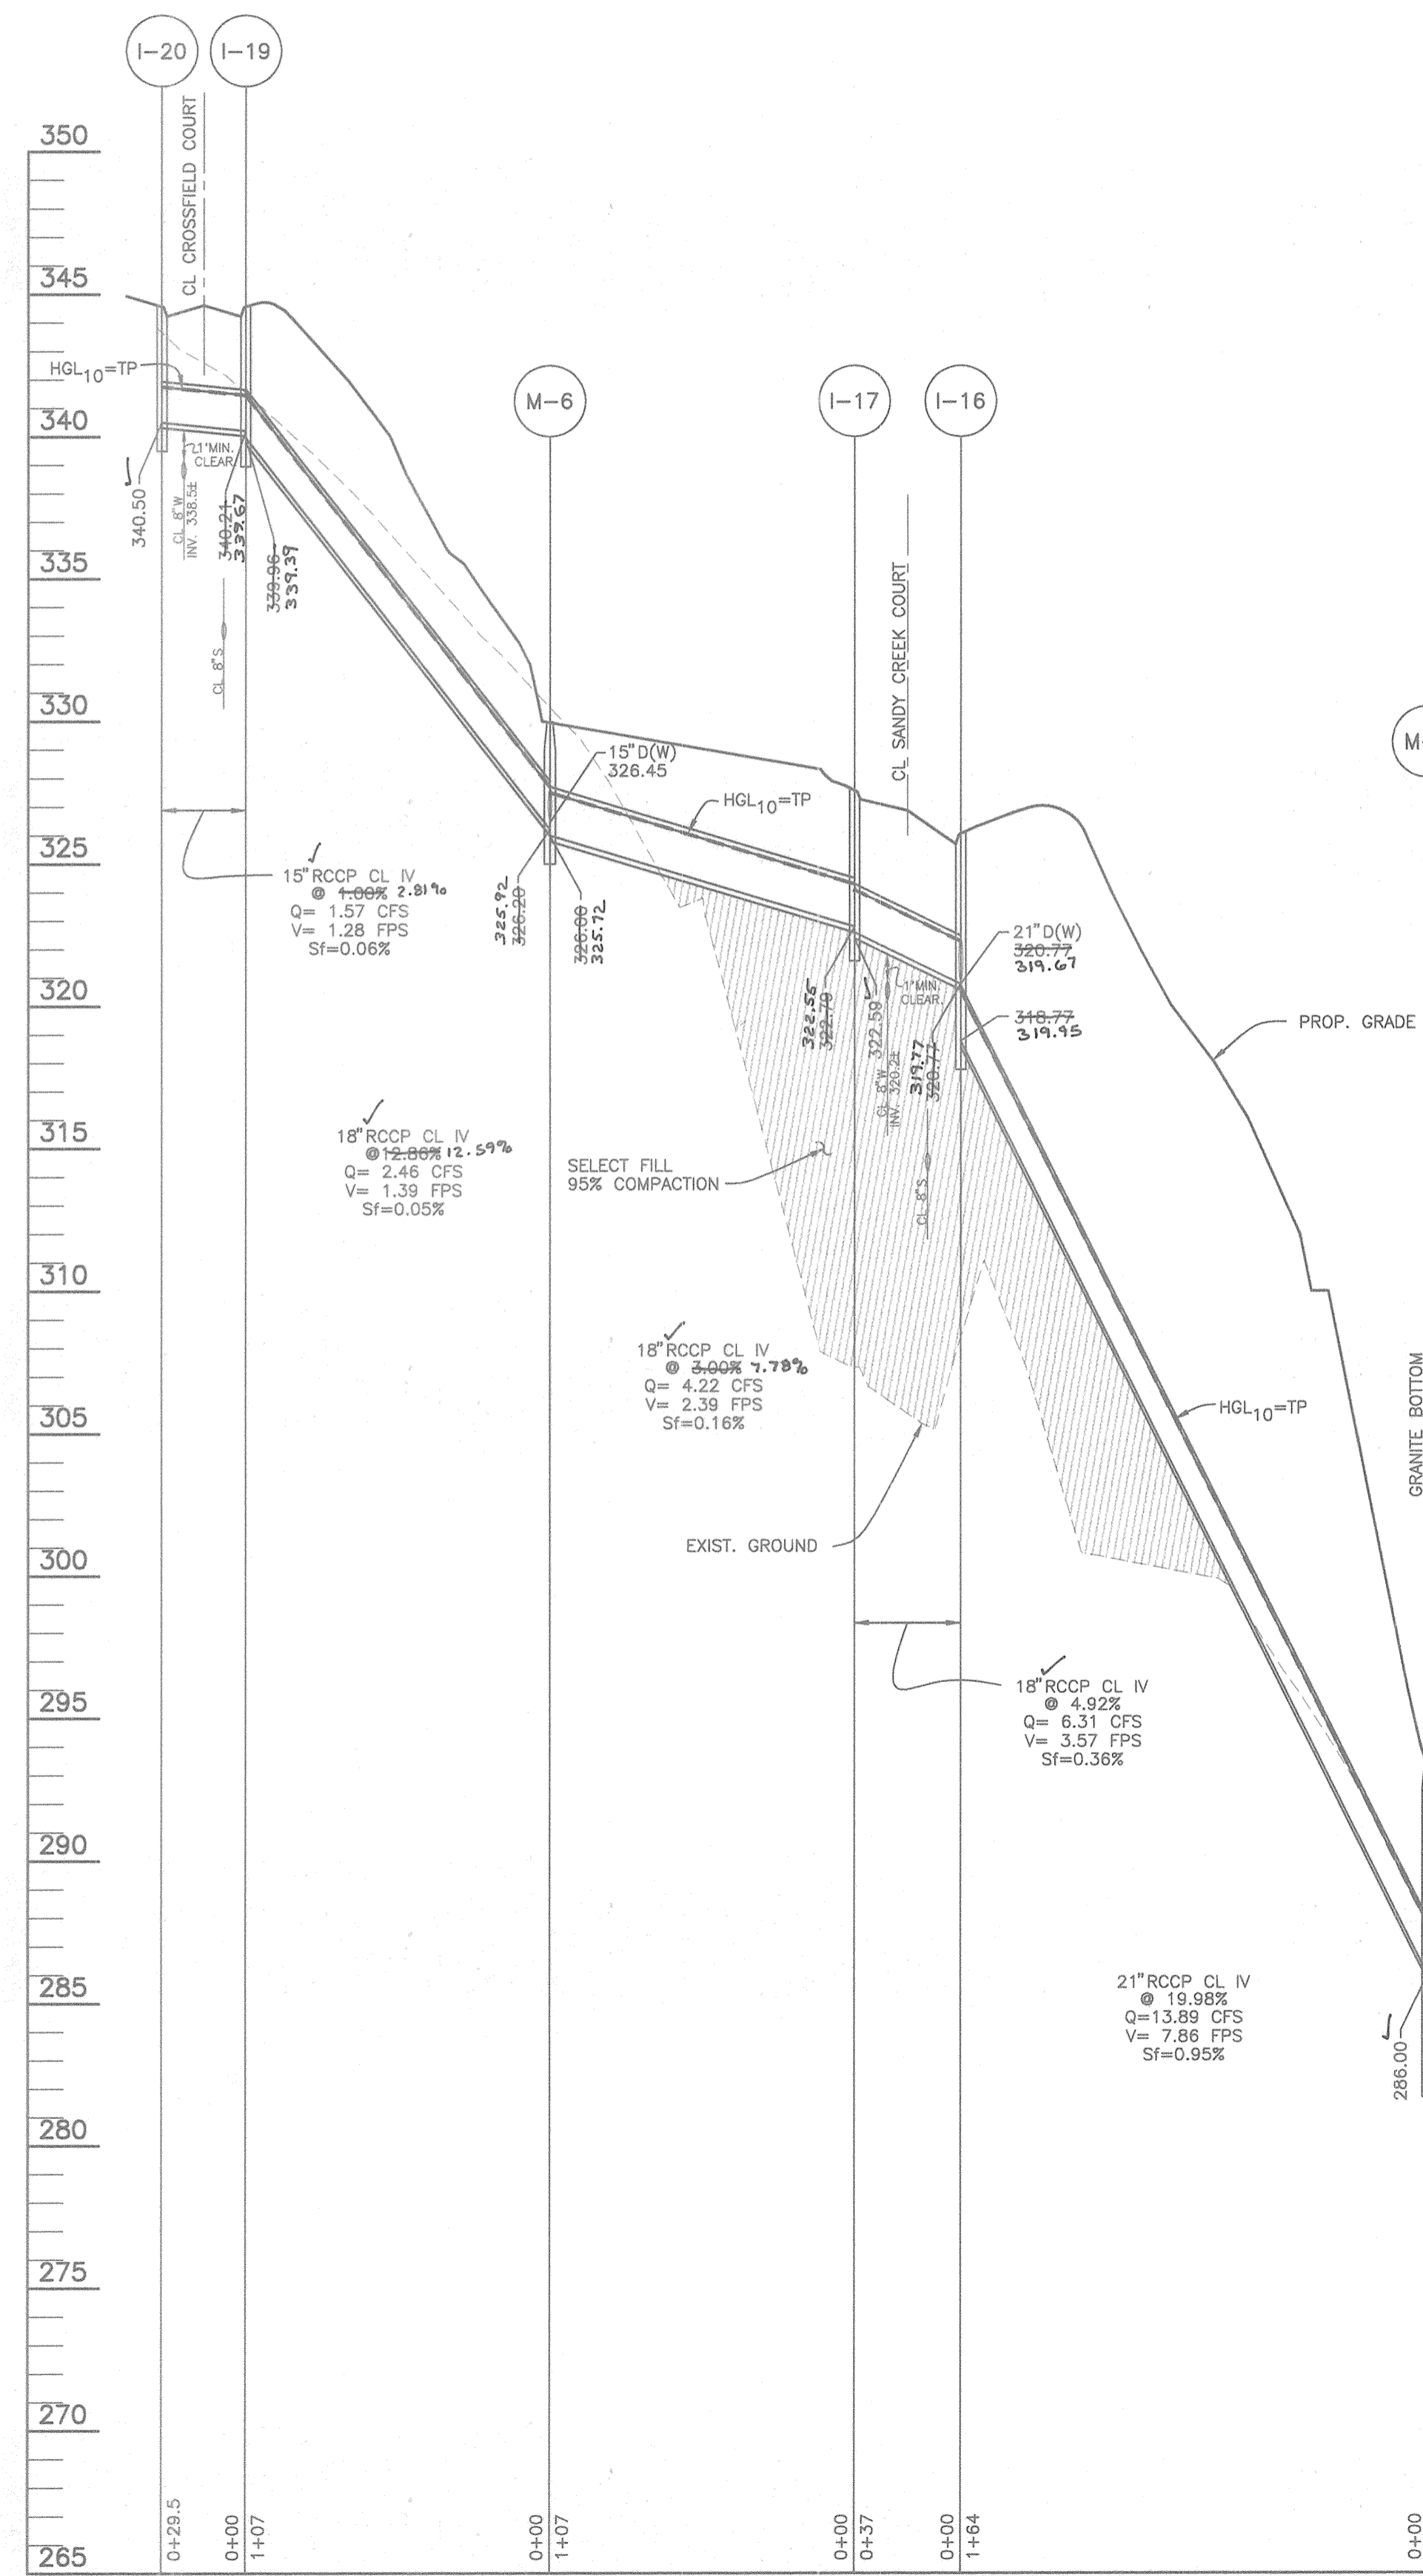

*Donald M. Moore*  
 PROFESSIONAL ENGINEER  
 AS-BUILT 5/12/05

NOTE:  
 SEE SHEET 22 FOR OUTLET PROTECTION DETAIL

APPROVED: HOWARD COUNTY DEPARTMENT OF PUBLIC WORKS  
*Randall M. Daniels* 6-15-98  
 CHIEF, BUREAU OF HIGHWAYS  
 APPROVED: HOWARD COUNTY DEPARTMENT OF PLANNING AND ZONING  
*C. Hamilton* 6/23/98  
 CHIEF, DIVISION OF LAND DEVELOPMENT  
*Donald M. Moore* 6/23/98  
 CHIEF, DEVELOPMENT ENGINEERING DIVISION






NO.	DATE	REVISION
1	4/21/05	REVISED PER AS-BUILT CONDITIONS

**TSA GROUP, INC.**  
 planning • architecture • engineering • surveying  
 8480 Baltimore National Pike • Ellicott City, Maryland 21043 • 410-685-0105






OWNERS: TOLL MD LIMITED PARTNERSHIP, A MARYLAND LIMITED PARTNERSHIP 3206 TOWER OAKS BOULEVARD SUITE 310 ROCKVILLE, MARYLAND 20852	PROJECT: <b>VILLAGE OF CEDAR RIDGE</b> A SUBDIVISION OF PARCEL 44 (TAX MAP 41) AND A RESUBDIVISION OF LOTS 1 AND 2 OF THE EDITH S. PARLETTE SUBDIVISION (PLAT 10738 PARCEL 43) AND A SUBDIVISION OF PARCEL 123 FOR A ROAD RIGHT-OF-WAY
DEVELOPER: TOLL MD LIMITED PARTNERSHIP, A MARYLAND LIMITED PARTNERSHIP 3206 TOWER OAKS BOULEVARD SUITE 310 ROCKVILLE, MARYLAND 20852	LOCATION: TAX MAP 41 - PARCELS 43 & 44, P/O 123 5th ELECTION DISTRICT HOWARD COUNTY, MARYLAND
TITLE: <b>STORM DRAIN PROFILES</b>	DATE: OCTOBER, 1997 MAY, 1998
DES: MLV/DAM DRAFT: DBT CHECK: DAM	PROJECT NO. 0518 SHEET 14 OF 31



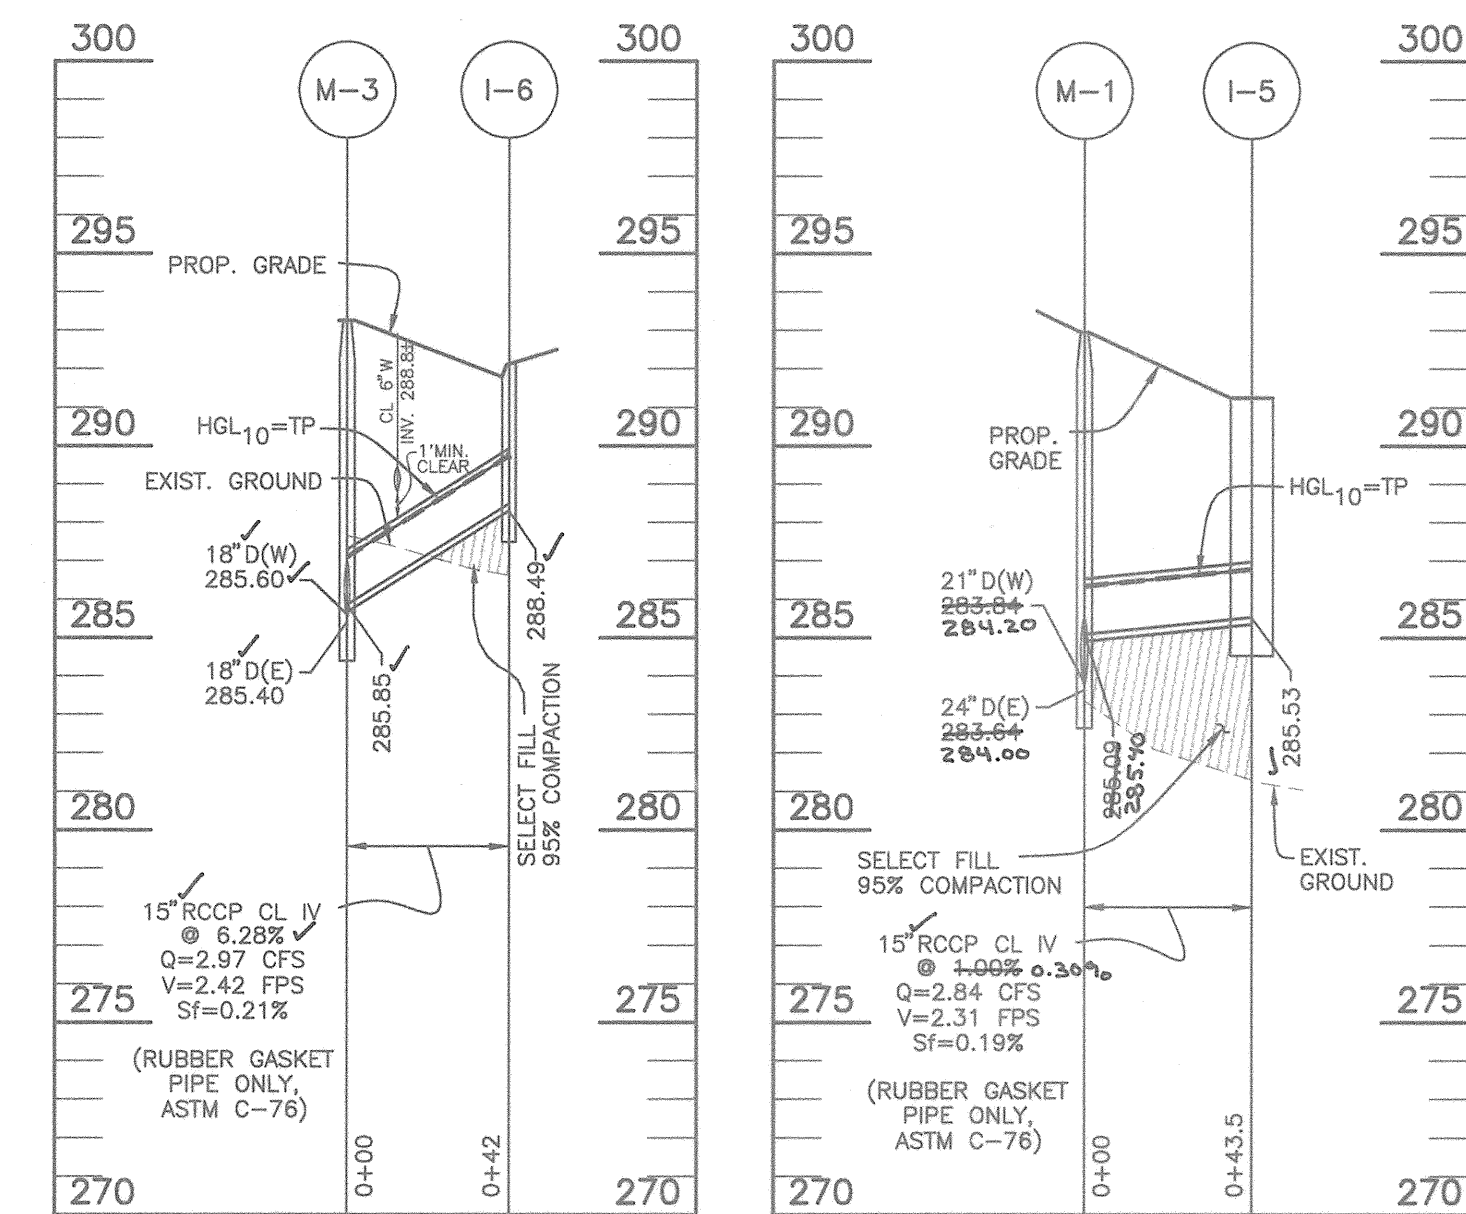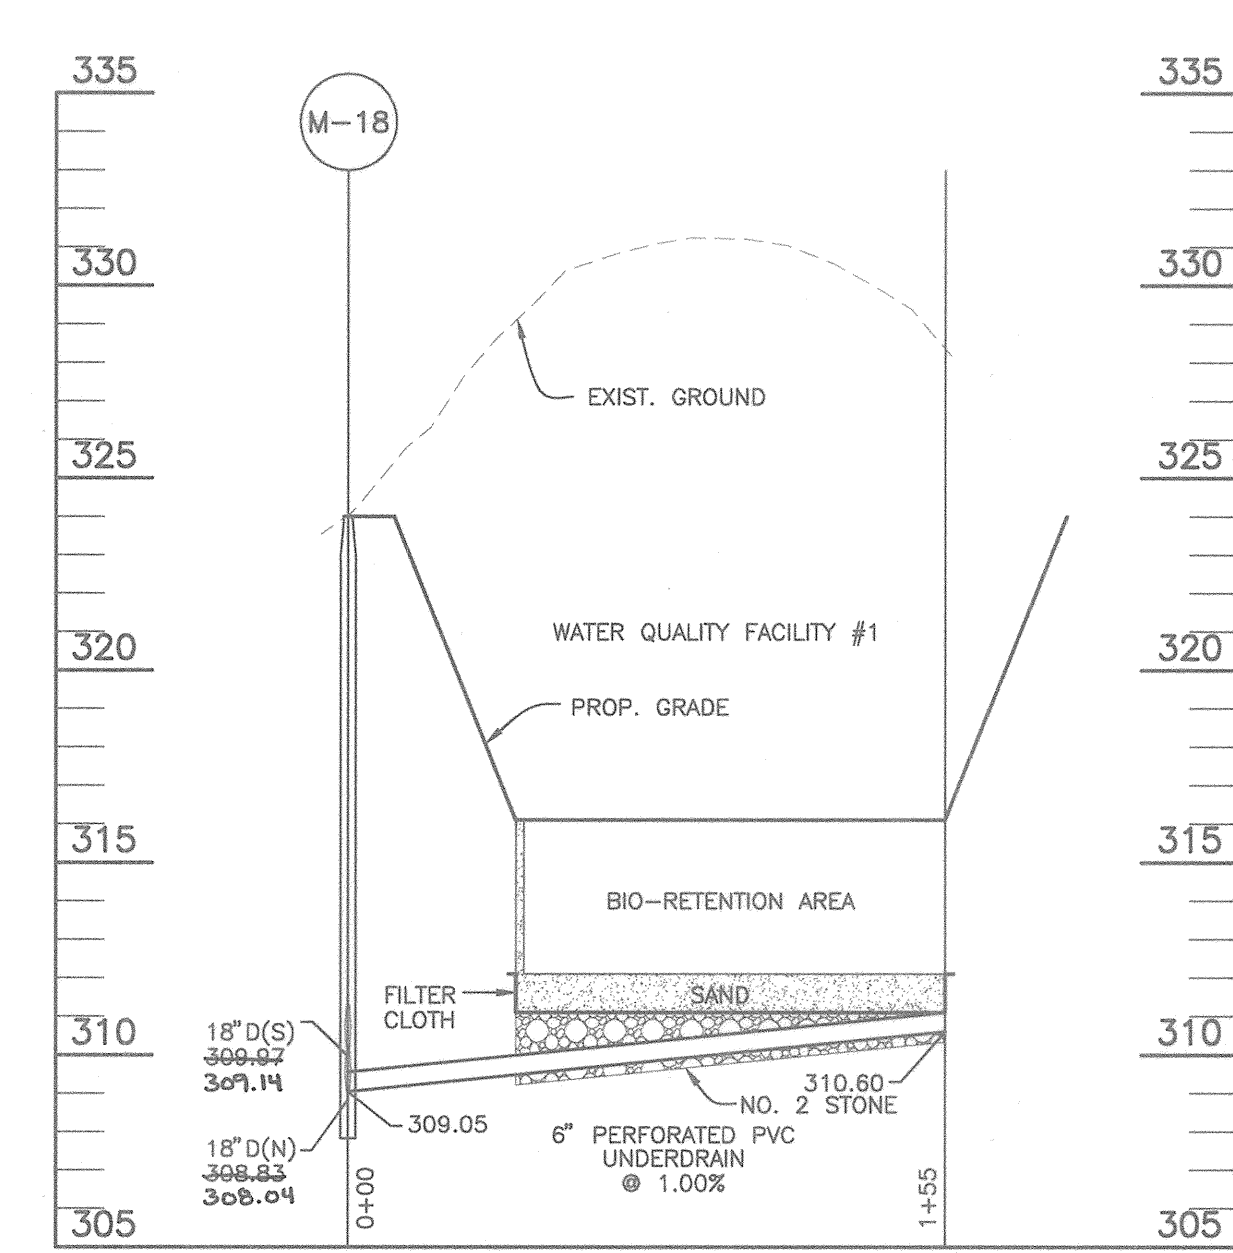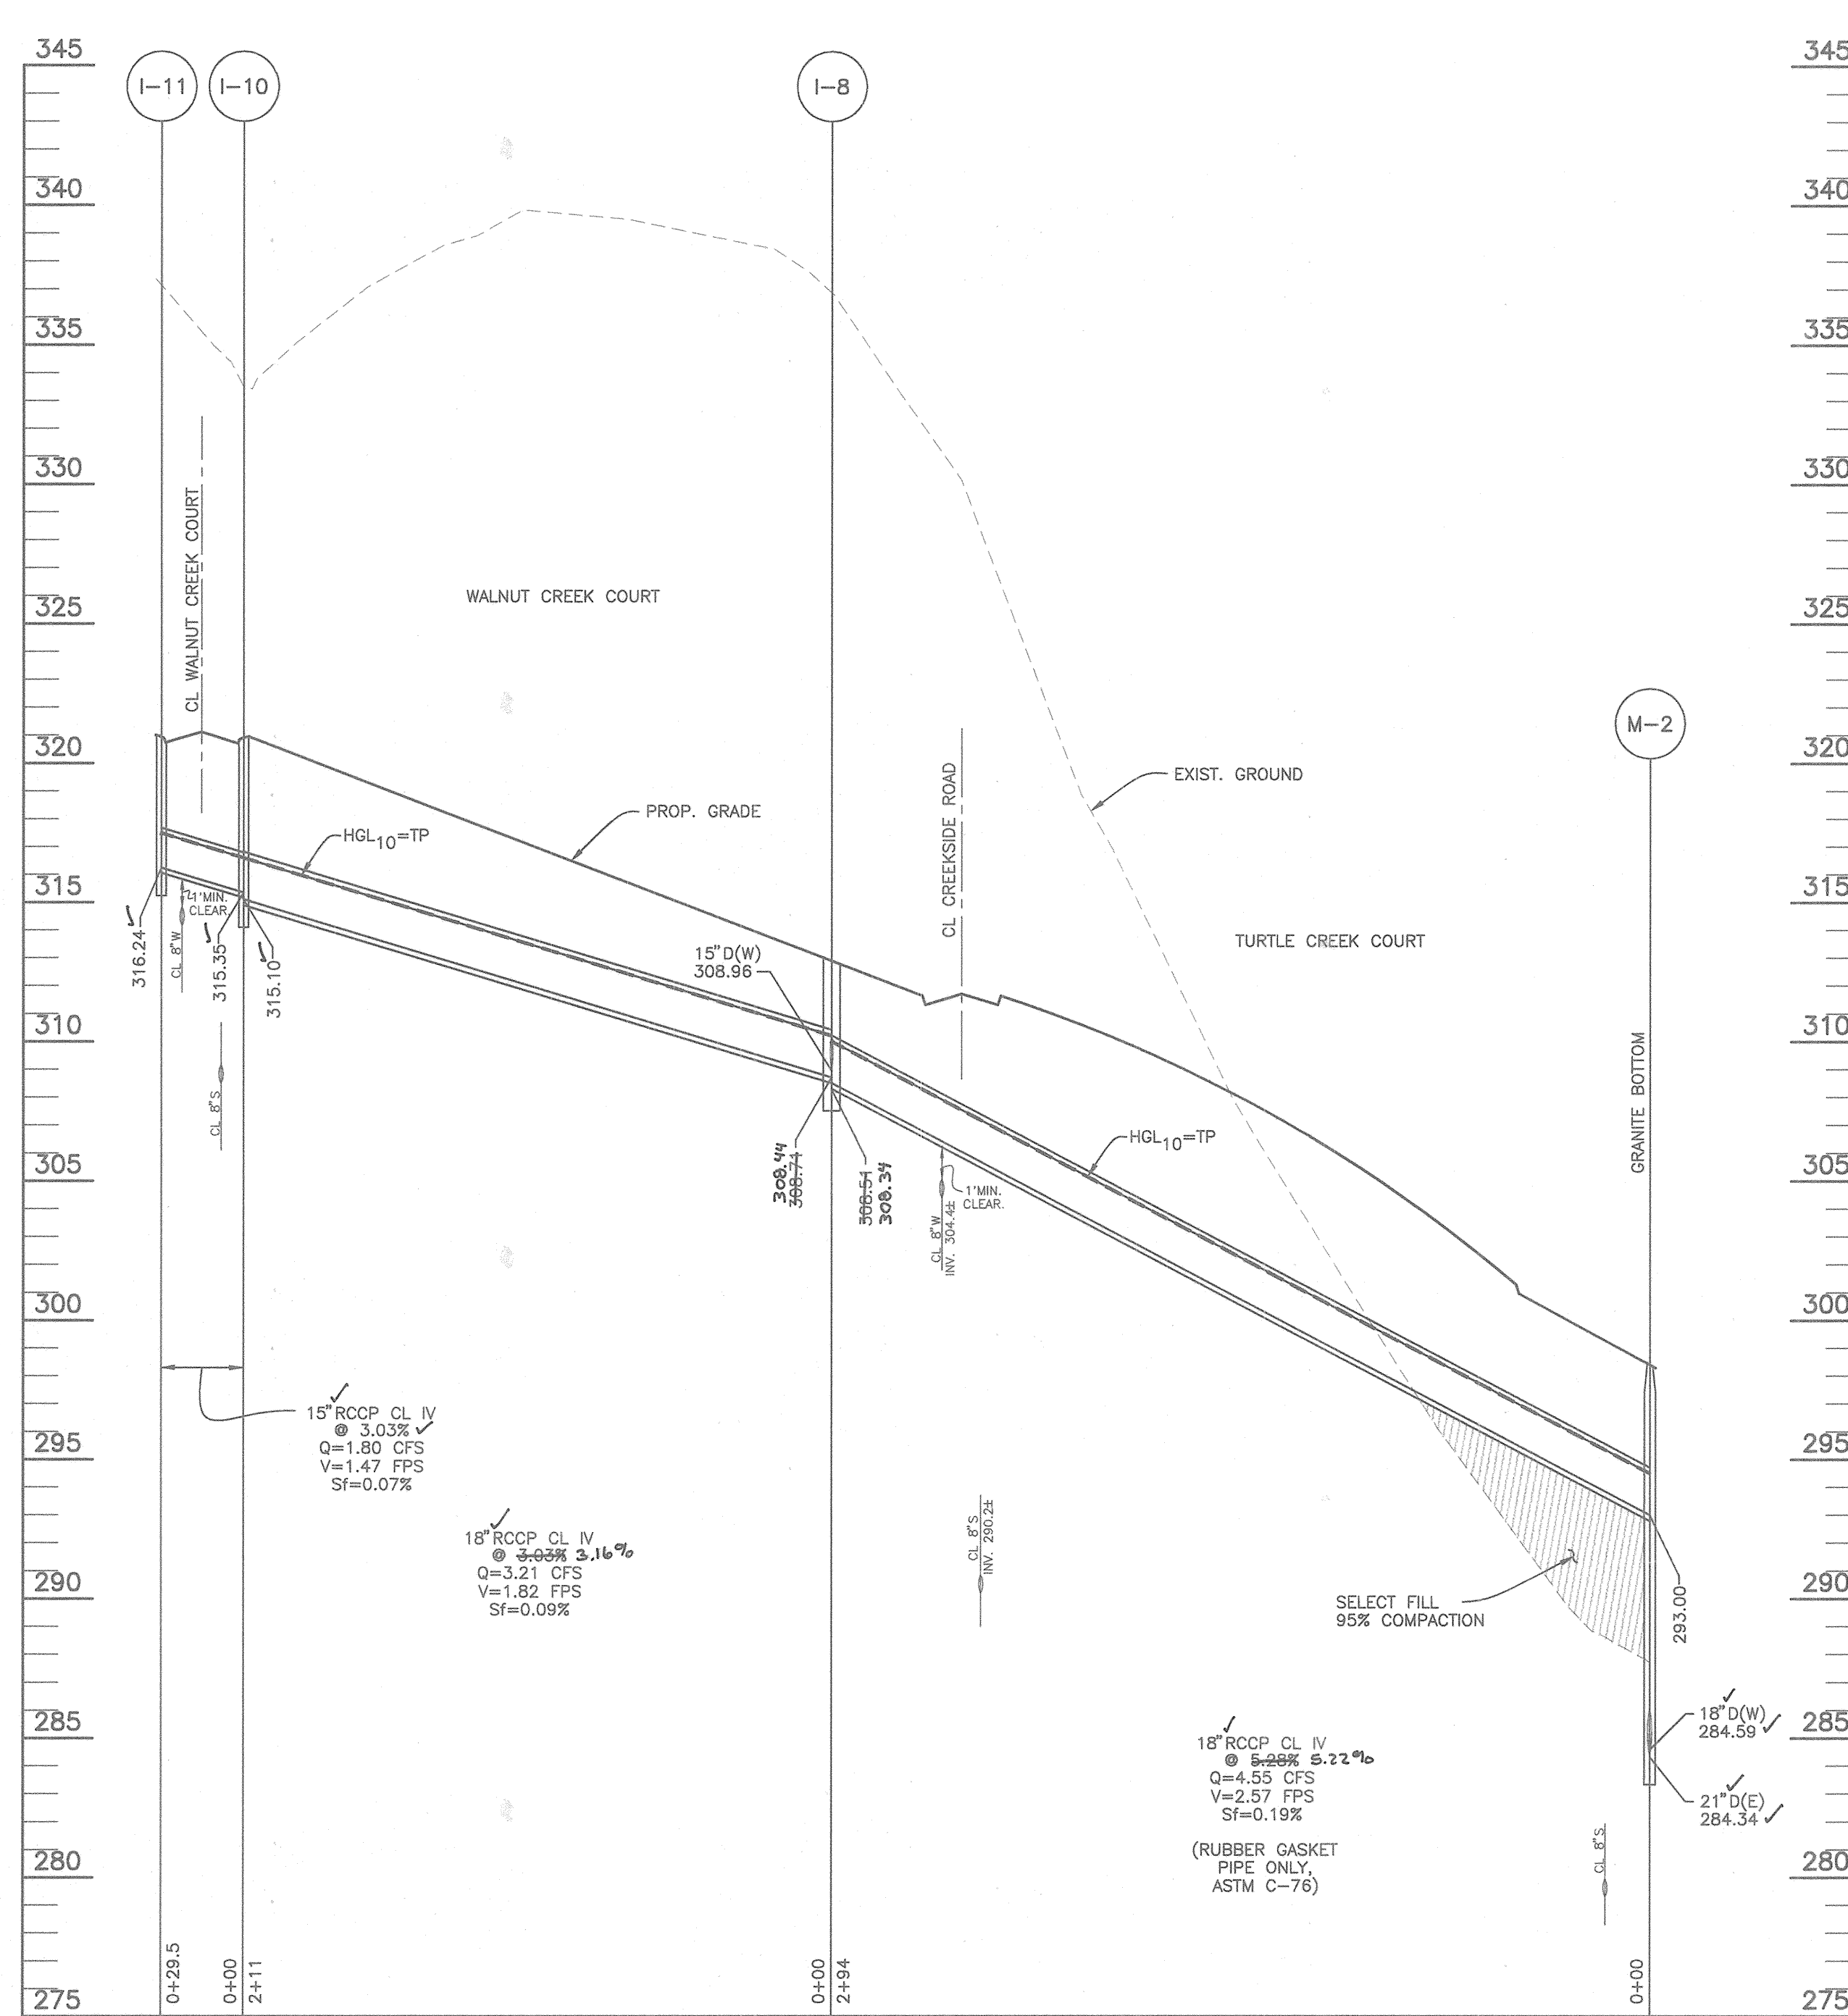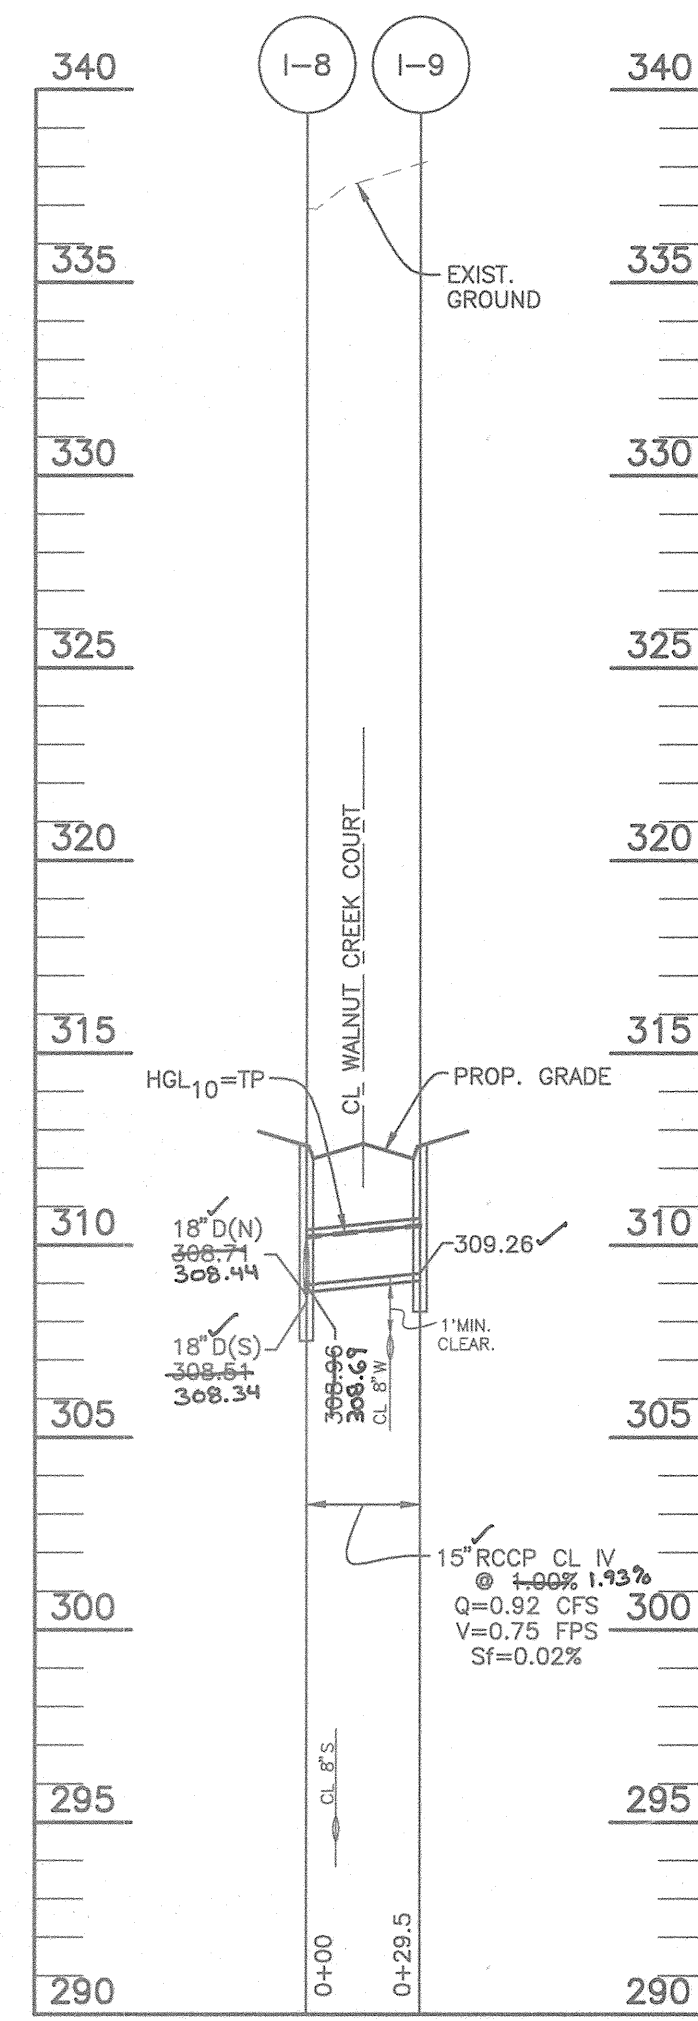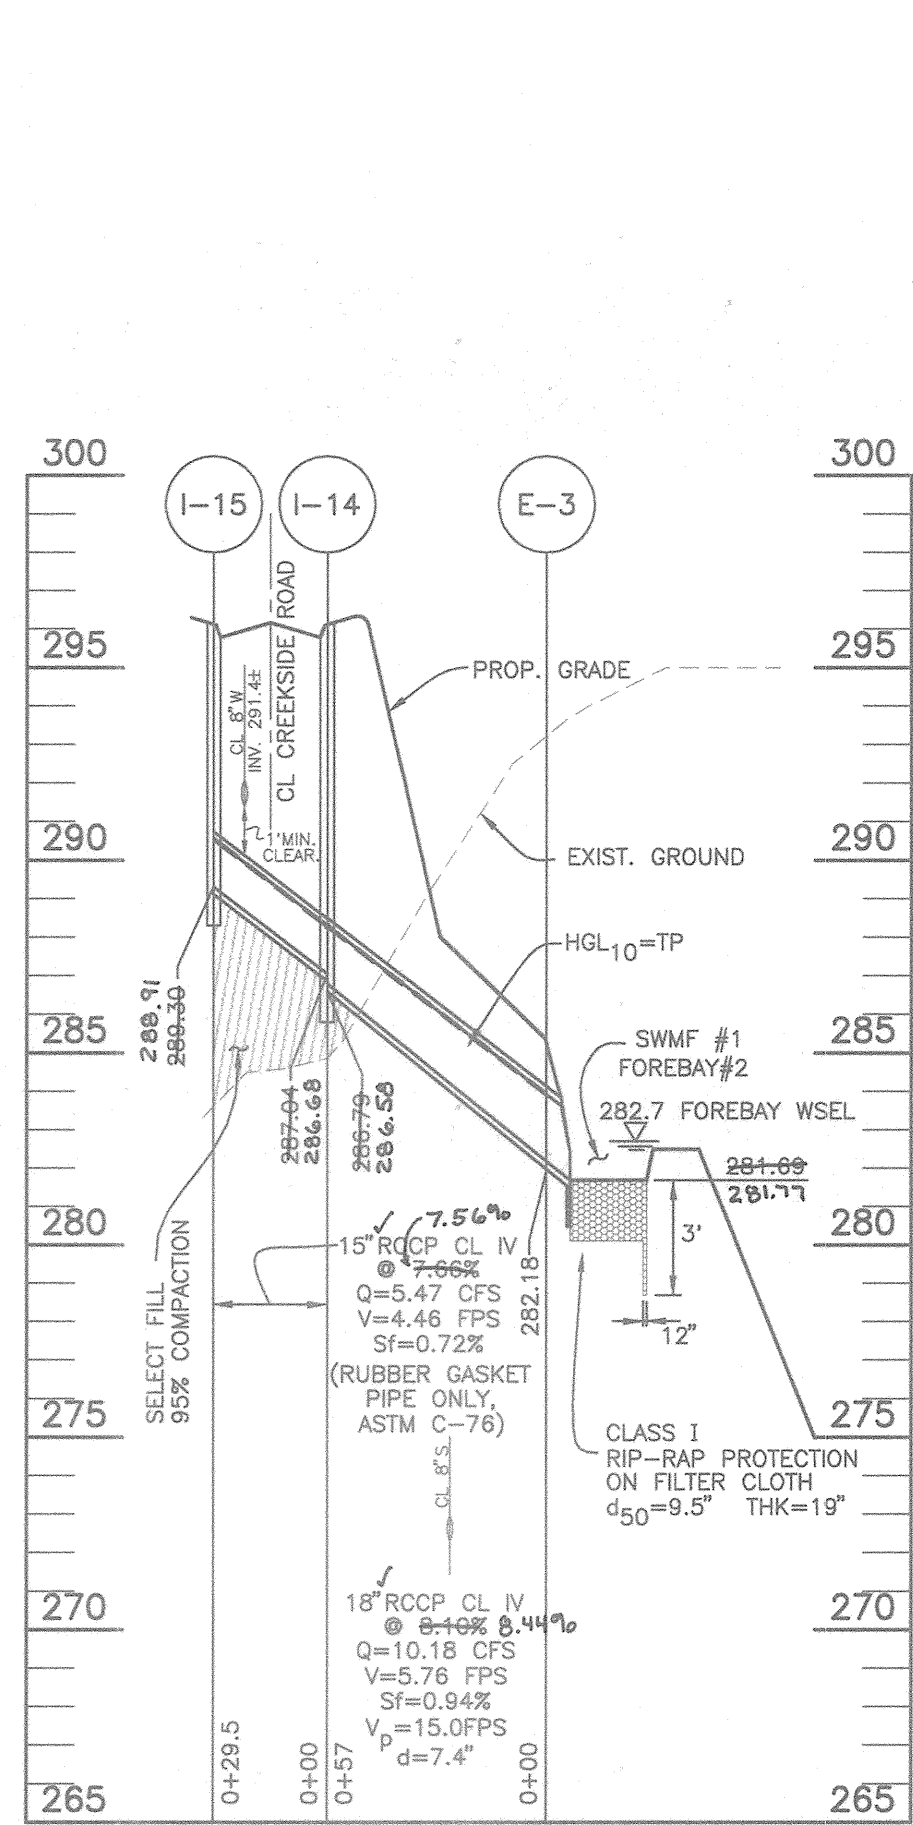

NOTE:  
SEE SHEET 22 FOR OUTLET PROTECTION DETAIL

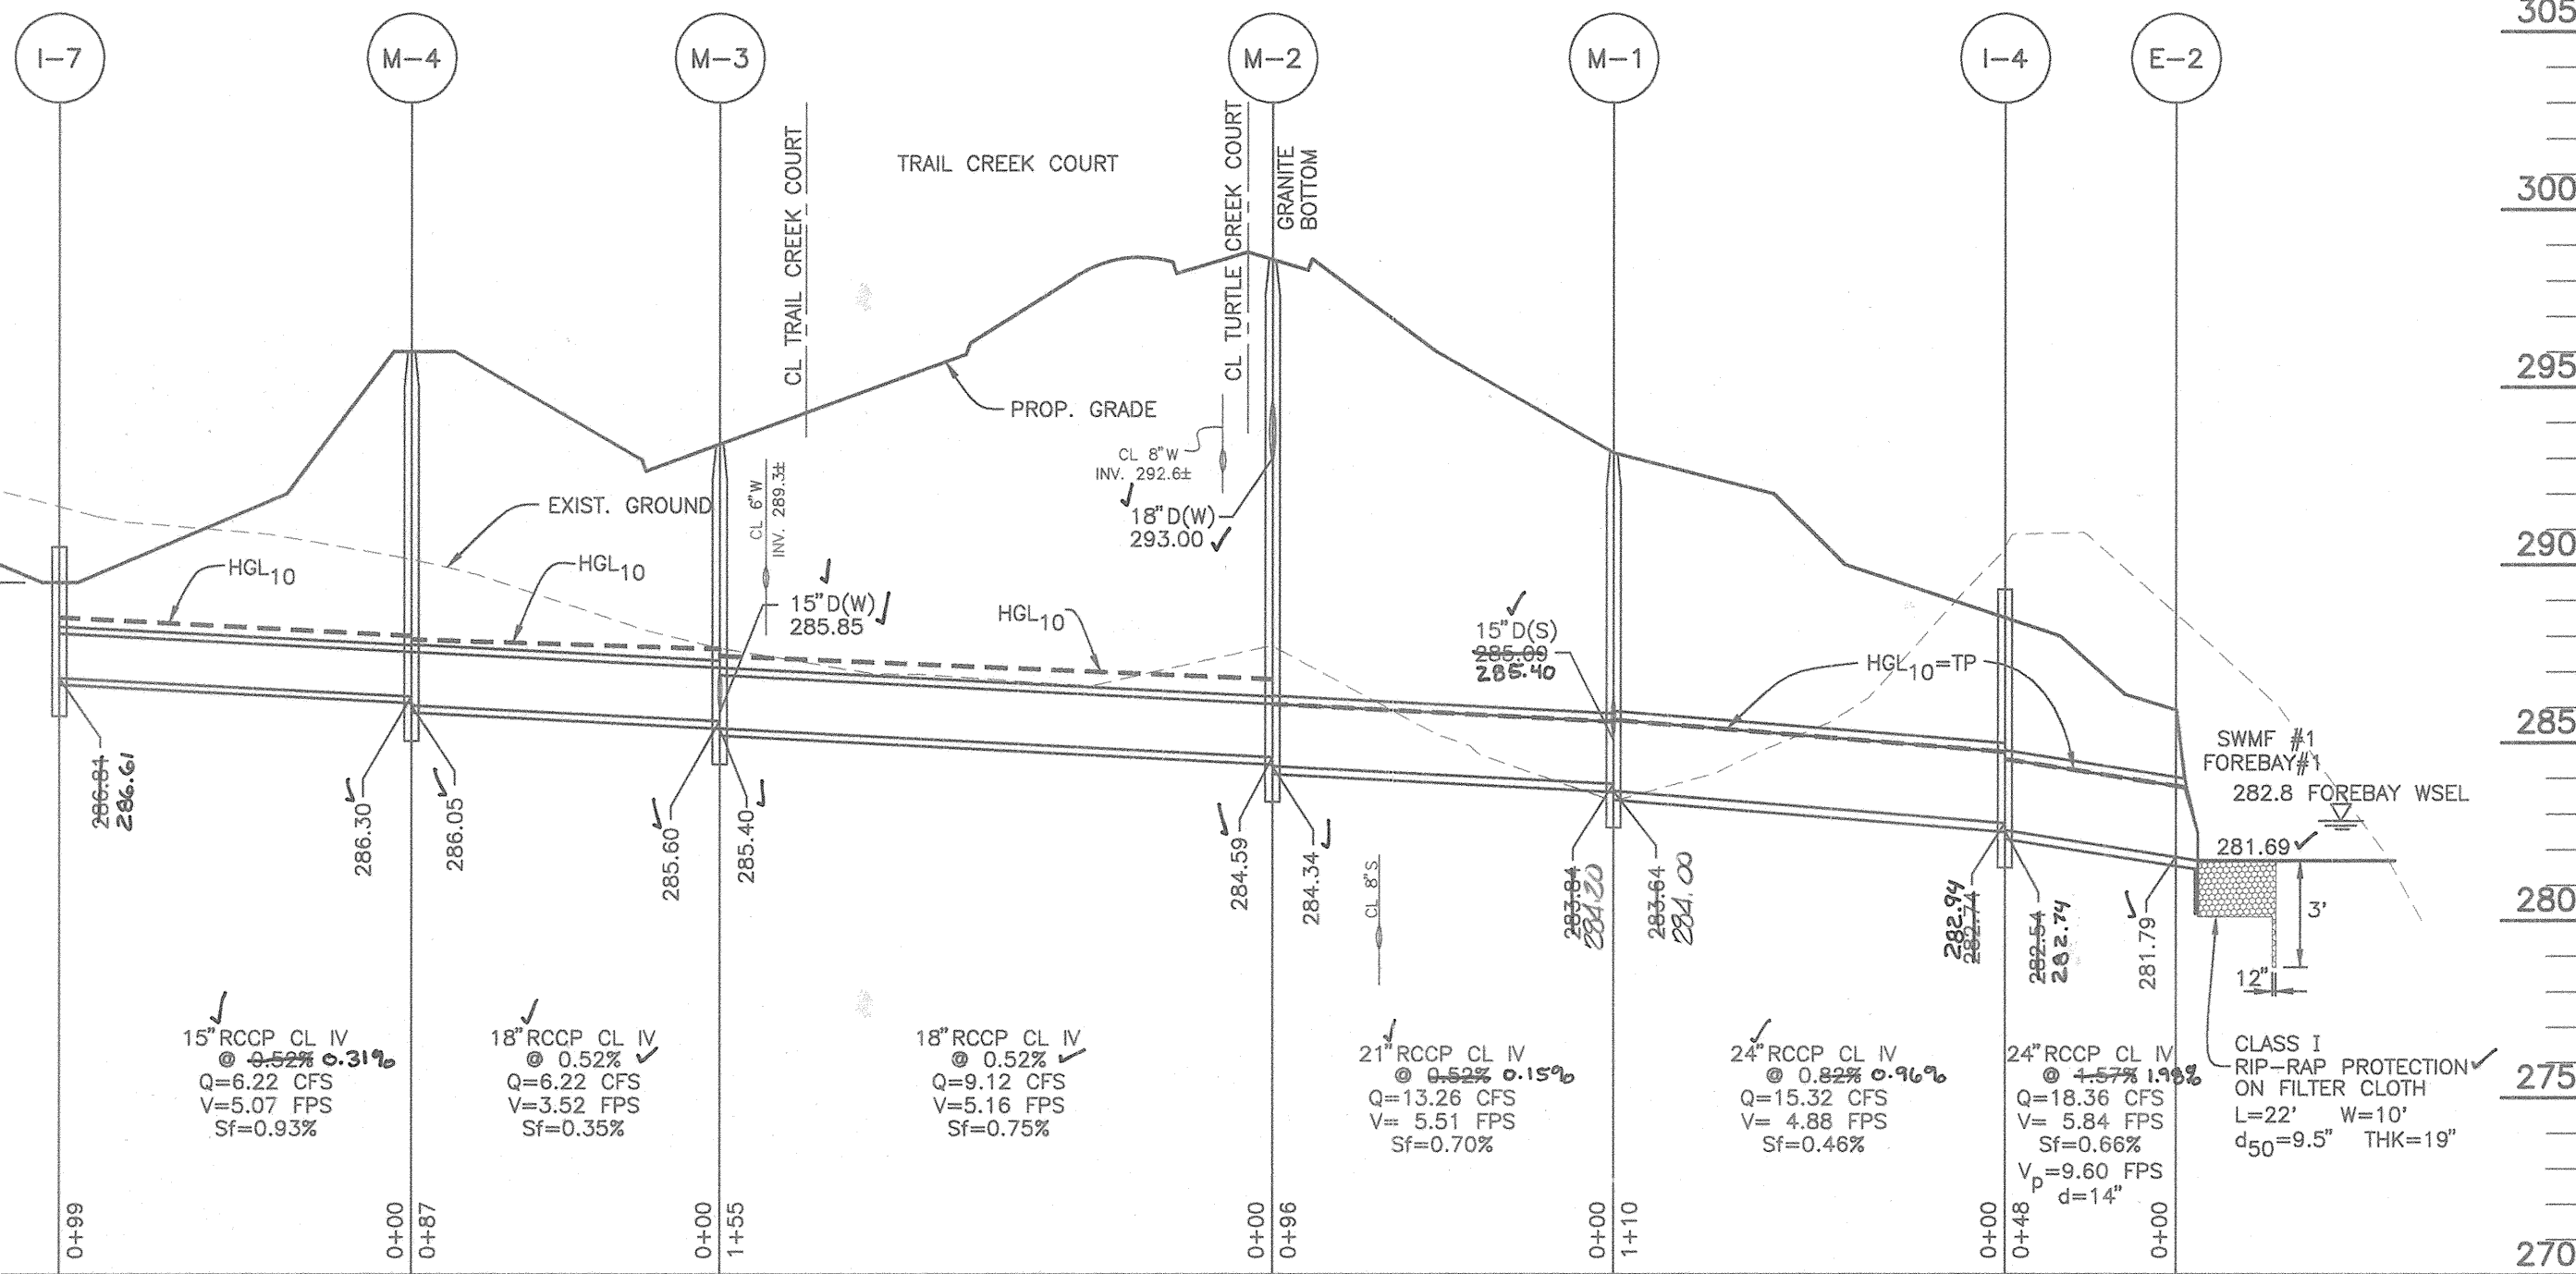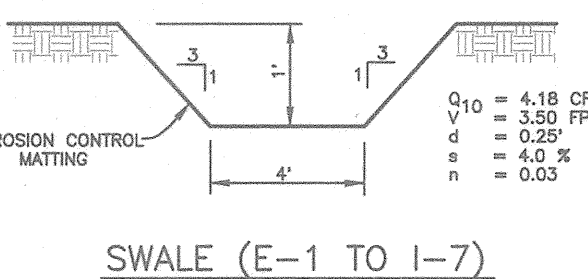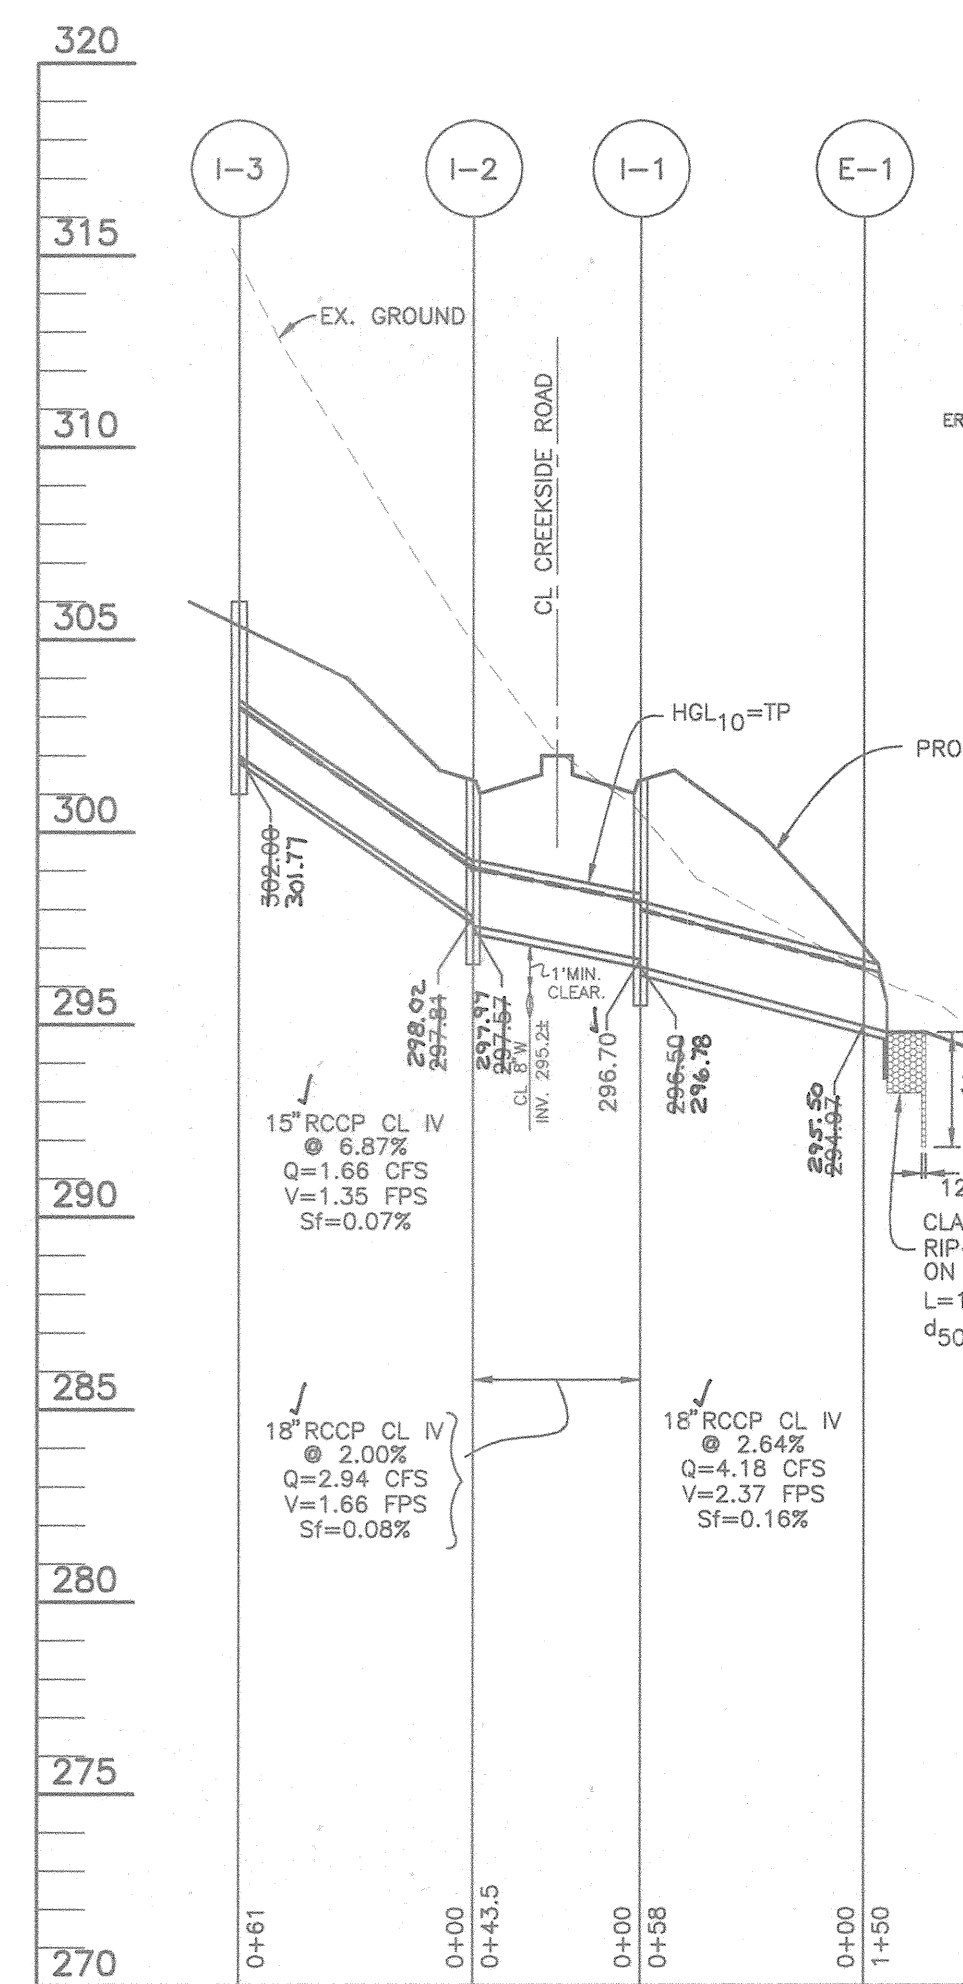

APPROVED: HOWARD COUNTY DEPARTMENT OF PUBLIC WORKS  
*Stephen M. Dancker* 6-15-94  
 CHIEF, BUREAU OF HIGHWAYS DATE

APPROVED: HOWARD COUNTY DEPARTMENT OF PLANNING AND ZONING  
*Donald Maas* 6/23/98  
 CHIEF, DIVISION OF LAND DEVELOPMENT DATE


*AS-BUILT 5/2/05*  
 CHIEF, DEVELOPMENT ENGINEERING DIVISION DATE

NO.	DATE	REVISION
1	4/27/05	REVISED PER AS-BUILT CONDITIONS


**TSA GROUP, INC.**  
 planning • architecture • engineering • surveying  
 5450 Baltimore National Pike • Ellicott City, Maryland 21043 • 410-466-6105

<b>OWNERS:</b> TOLL MD LIMITED PARTNERSHIP, A MARYLAND LIMITED PARTNERSHIP 3206 TOWER OAKS BOULEVARD SUITE 310 ROCKVILLE, MARYLAND 20852	<b>PROJECT:</b> <b>VILLAGE OF CEDAR RIDGE</b> A SUBDIVISION OF PARCEL 44 (TAX MAP 41) AND A RESUBDIVISION OF LOTS 1 AND 2 OF THE EDITH S. PARLETTE SUBDIVISION (PLAT 10735 PARCEL 43) AND A SUBDIVISION OF PARCEL 123 FOR A ROAD RIGHT-OF-WAY.
<b>DEVELOPER:</b> TOLL MD LIMITED PARTNERSHIP, A MARYLAND LIMITED PARTNERSHIP 3206 TOWER OAKS BOULEVARD SUITE 310 ROCKVILLE, MARYLAND 20852	<b>LOCATION:</b> TAX MAP 41 - PARCELS 43 & 44, P/O 123 5th ELECTION DISTRICT HOWARD COUNTY, MARYLAND
<b>TITLE:</b> <b>STORM DRAIN PROFILES</b>	<b>DATE:</b> OCTOBER 1997 MAY 1998
<b>DES: MLV/DAM</b> <b>DRAFT: DBT</b> <b>CHECK: DAM</b>	<b>PROJECT NO.:</b> 0518 <b>SHEET 13 OF 31</b>



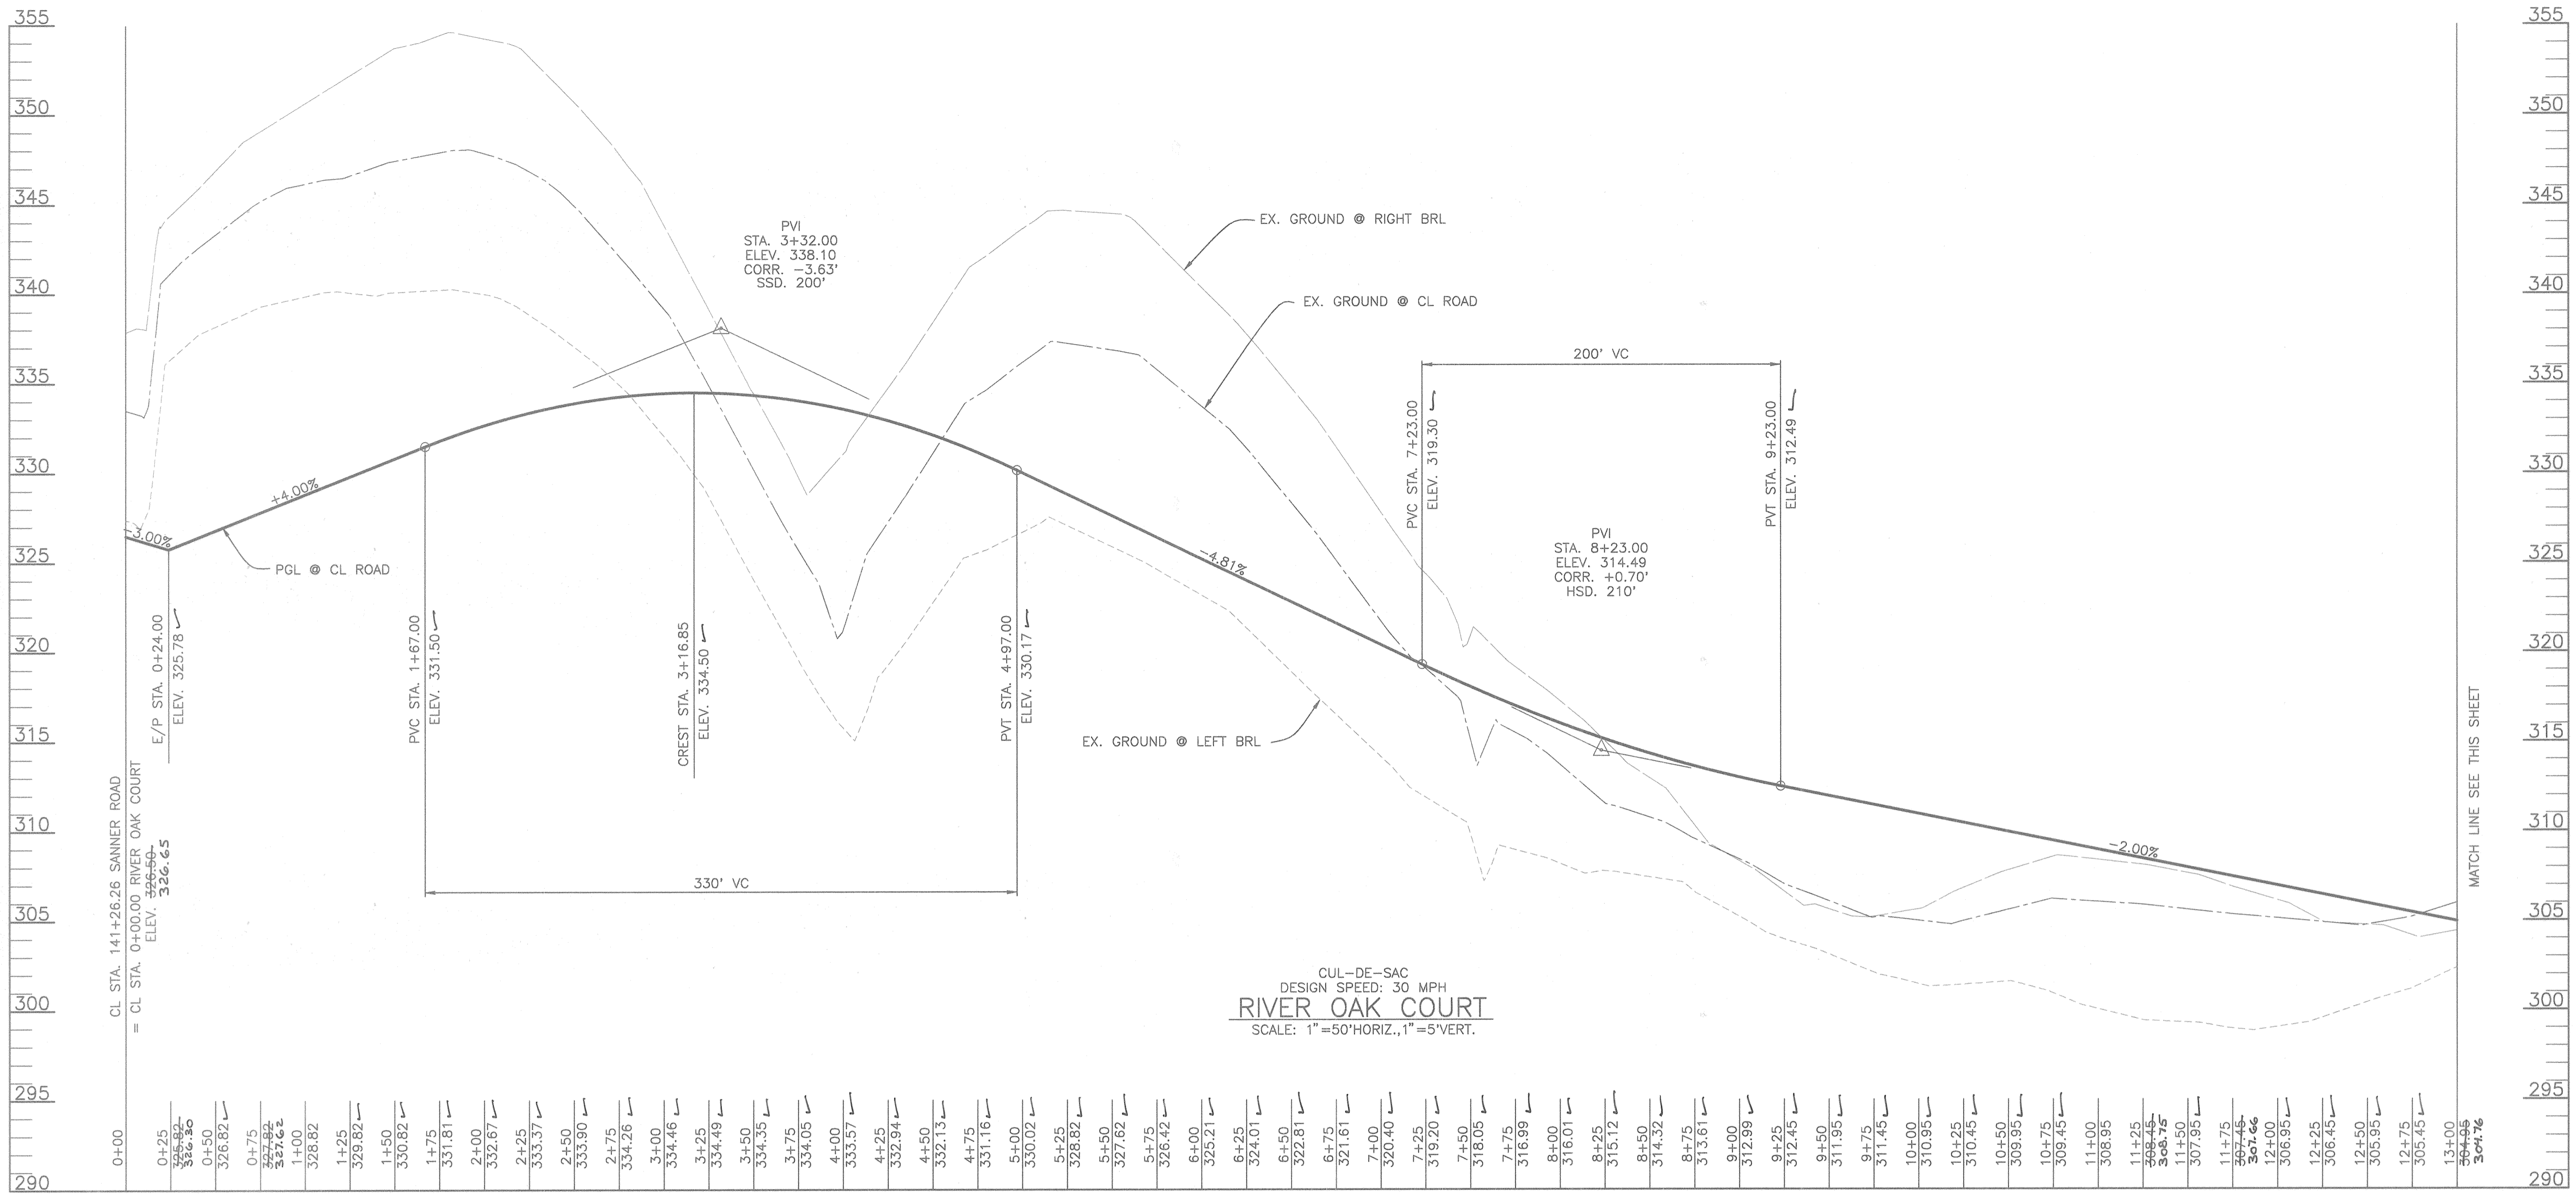

CUL-DE-SAC  
DESIGN SPEED: 30 MPH  
**RIVER OAK COURT**  
SCALE: 1"=50'HORIZ., 1"=5'VERT.

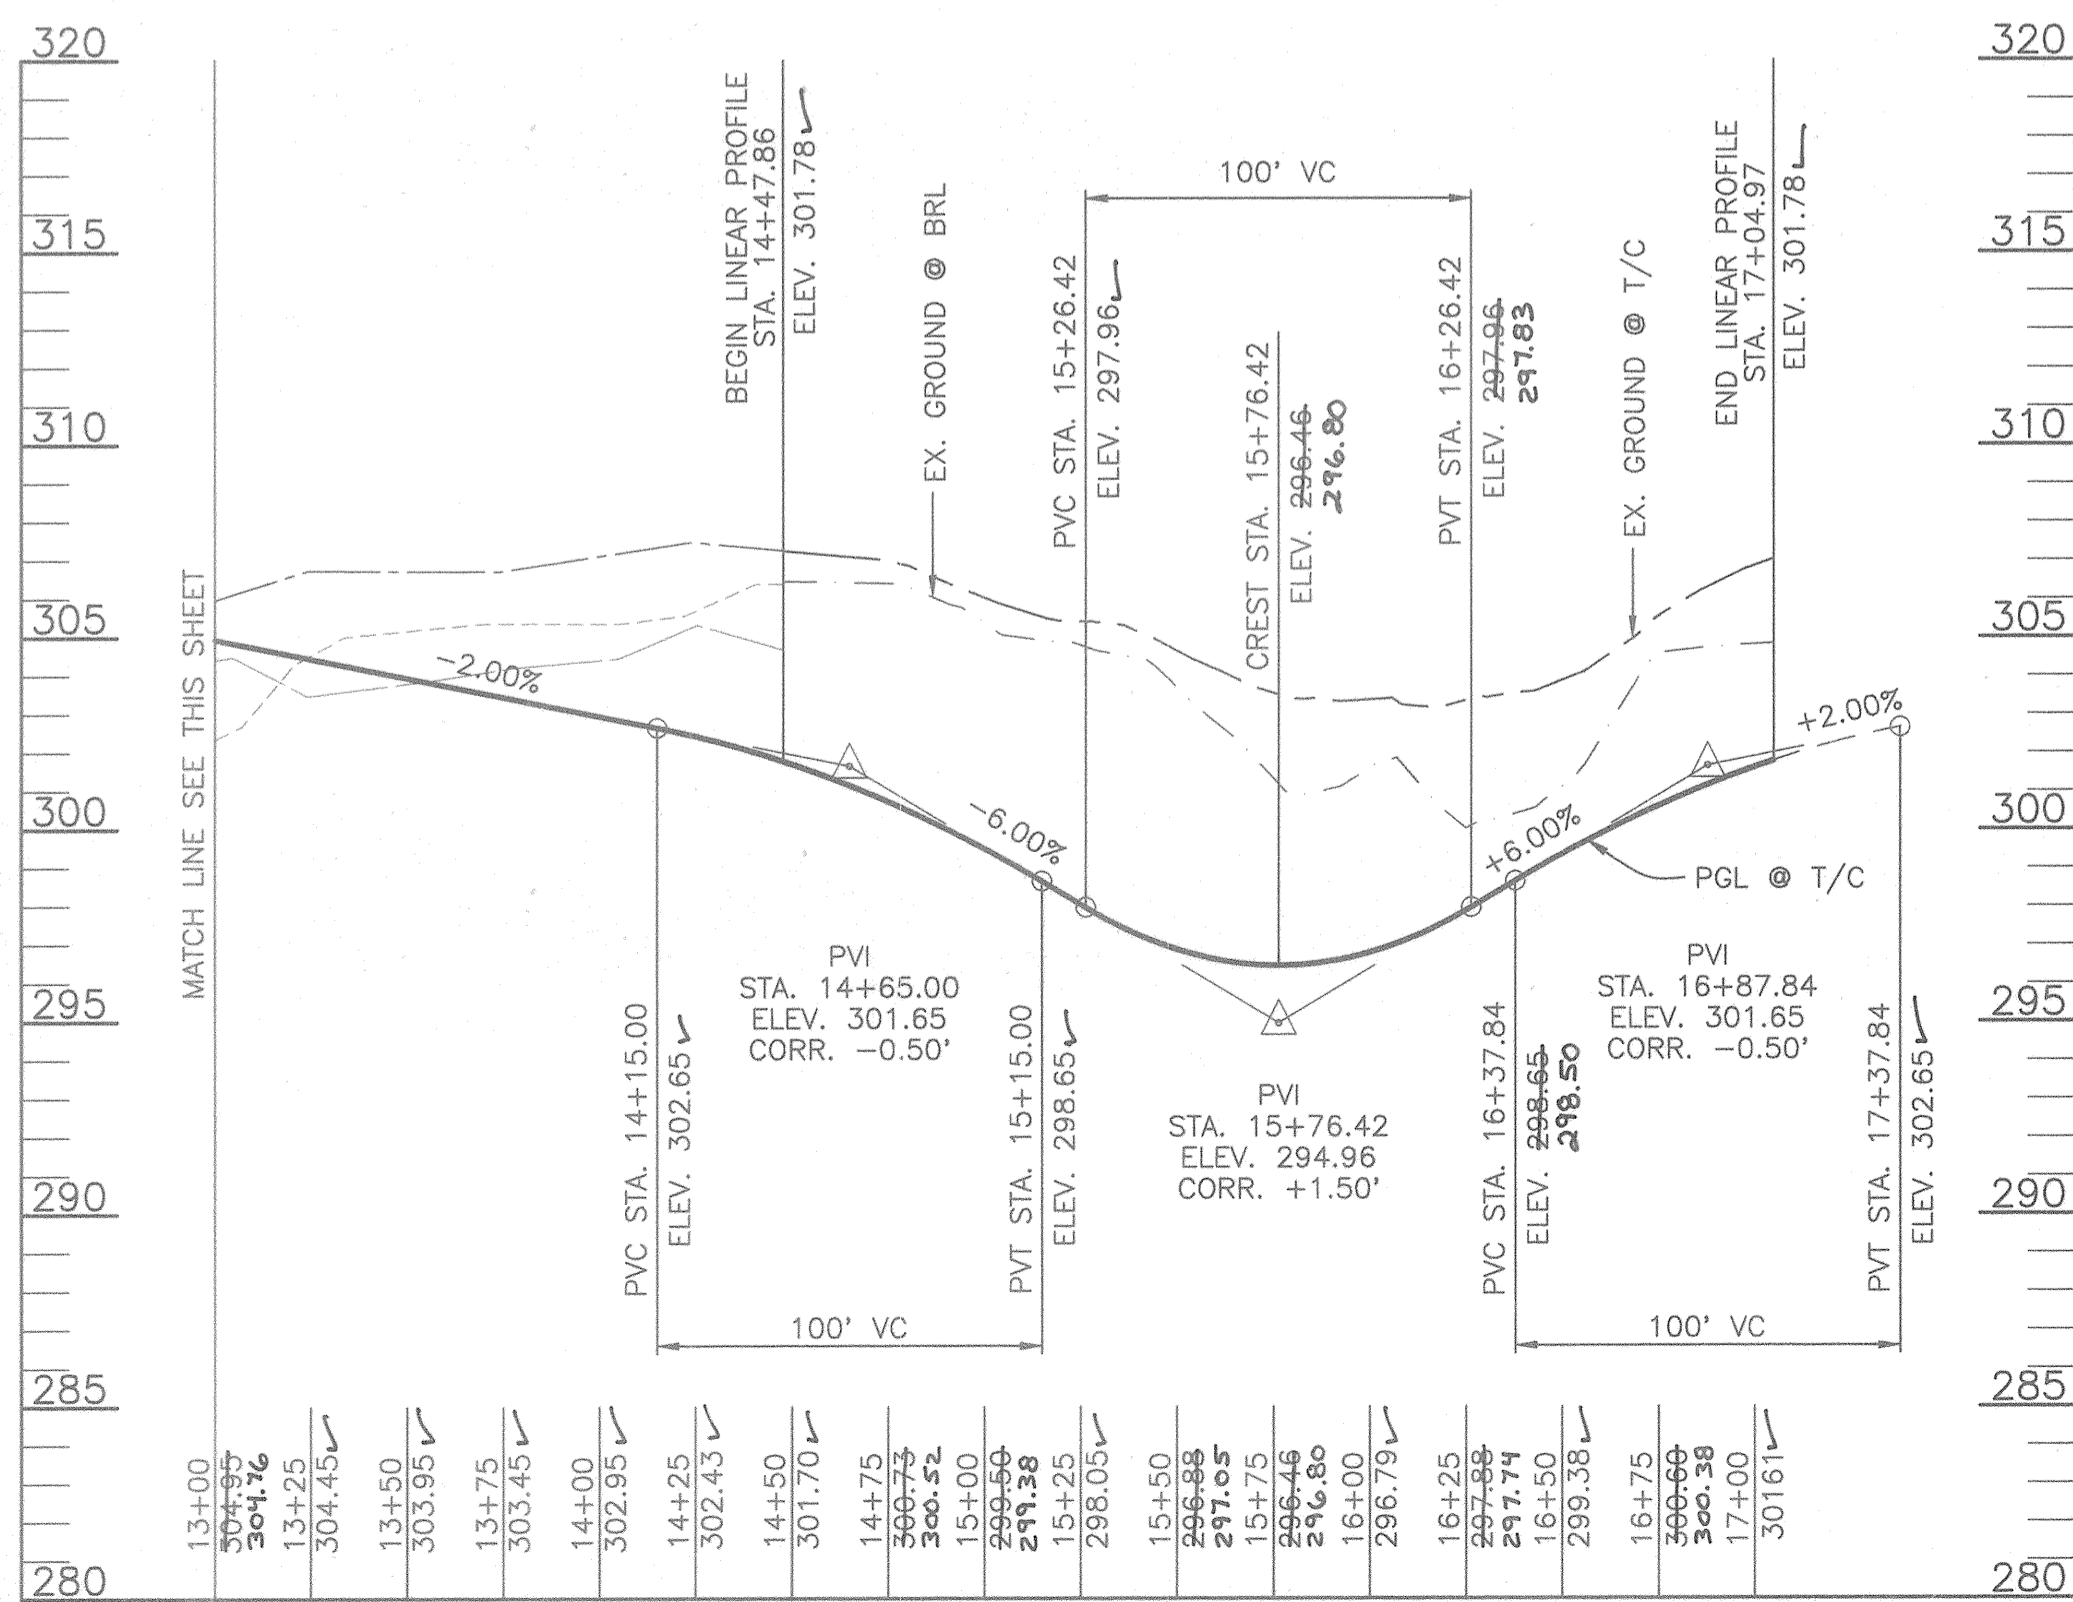

APPROVED: HOWARD COUNTY DEPARTMENT OF PUBLIC WORKS  
*Andrew M. Danek* 6-15-98  
 CHIEF, BUREAU OF HIGHWAYS  
 APPROVED: HOWARD COUNTY DEPARTMENT OF PLANNING AND ZONING  
*Donald Mason* 6/23/98  
 CHIEF, DIVISION OF LAND DEVELOPMENT  
*Ms. Dammun* 6/22/98  
 CHIEF, DEVELOPMENT ENGINEERING DIVISION

STATE OF MARYLAND  
 PROFESSIONAL ENGINEER  
 DONALD MASON  
 AS-BUILT 5/2/05


NO.	DATE	REVISION
1	4/27/05	REVISED PER AS BUILT CONDITIONS

**TSA GROUP, INC.**  
 planning • architecture • engineering • surveying  
 6460 Baltimore National Pike • Ellicott City, Maryland 21043 • 410-465-0105

STATE OF MARYLAND  
 PROFESSIONAL ENGINEER  
 DONALD MASON


<b>OWNERS:</b> TOLL MD LIMITED PARTNERSHIP, A MARYLAND LIMITED PARTNERSHIP 3206 TOWER OAKS BOULEVARD SUITE 310 ROCKVILLE, MARYLAND 20852	<b>PROJECT:</b> <b>VILLAGE OF CEDAR RIDGE</b> A SUBDIVISION OF PARCEL 44 (TAX MAP 41) AND A RESUBDIVISION OF LOTS 1 AND 2 OF THE EDITH S. PARLETTE SUBDIVISION (PLAT 10738 PARCEL 43) AND A SUBDIVISION OF PARCEL 123 FOR A ROAD RIGHT-OF-WAY
<b>DEVELOPER:</b> TOLL MD LIMITED PARTNERSHIP, A MARYLAND LIMITED PARTNERSHIP 3206 TOWER OAKS BOULEVARD SUITE 310 ROCKVILLE, MARYLAND 20852	<b>LOCATION:</b> TAX MAP 41 - PARCELS 43 & 44, P/O 123 5th ELECTION DISTRICT HOWARD COUNTY, MARYLAND
<b>TITLE:</b> <b>ROAD PROFILES</b>	<b>DATE:</b> OCTOBER, 1997 MAY, 1998
<b>DESIGN:</b> DAM	<b>DRAFT:</b> DBT
<b>CHECK:</b> DAM	<b>SCALE:</b> AS SHOWN
<b>PROJECT NO. 0518</b>	
<b>SHEET 11 OF 31</b>	



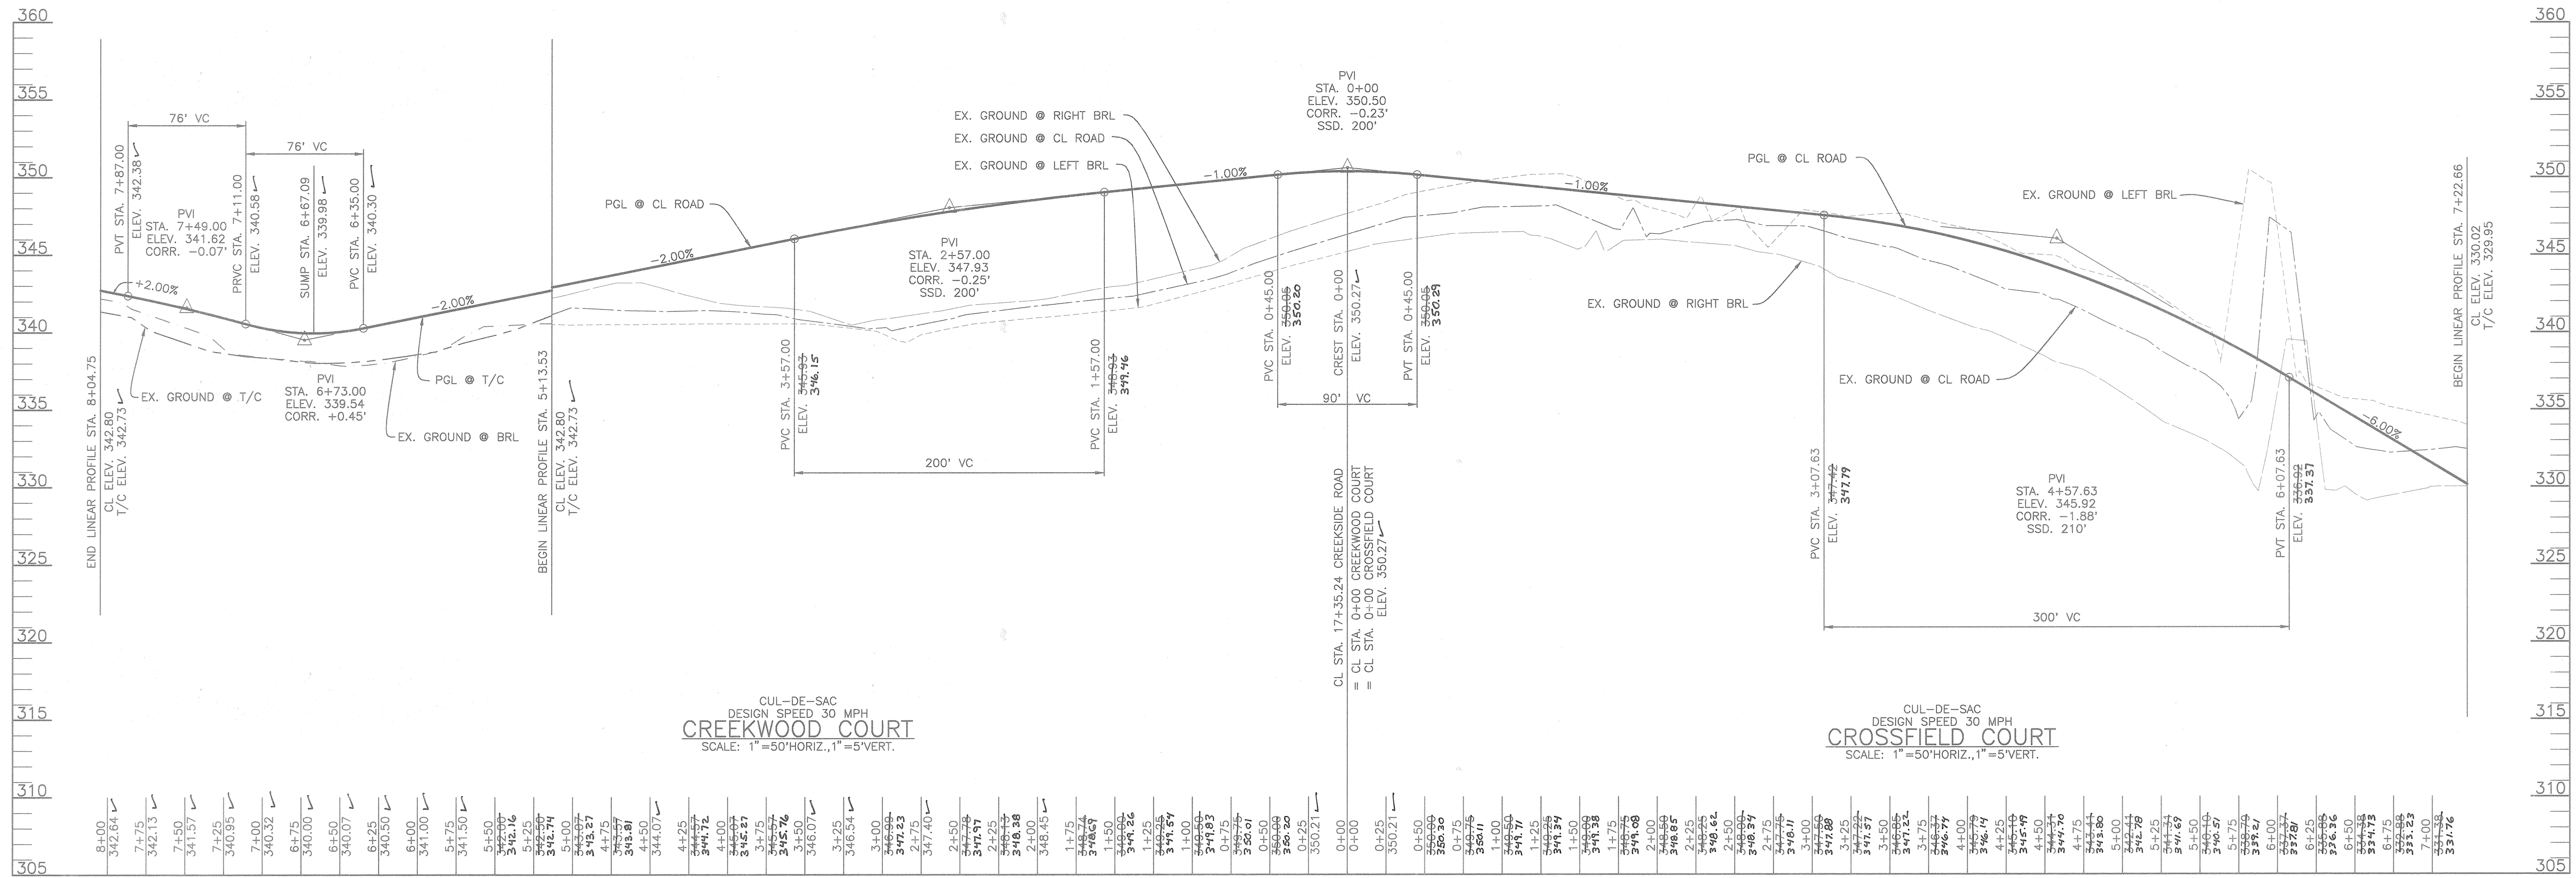

CUL-DE-SAC  
DESIGN SPEED 30 MPH  
**CREEKWOOD COURT**  
SCALE: 1"=50'HORIZ., 1"=5'VERT.


CUL-DE-SAC  
DESIGN SPEED 30 MPH  
**CROSSFIELD COURT**  
SCALE: 1"=50'HORIZ., 1"=5'VERT.

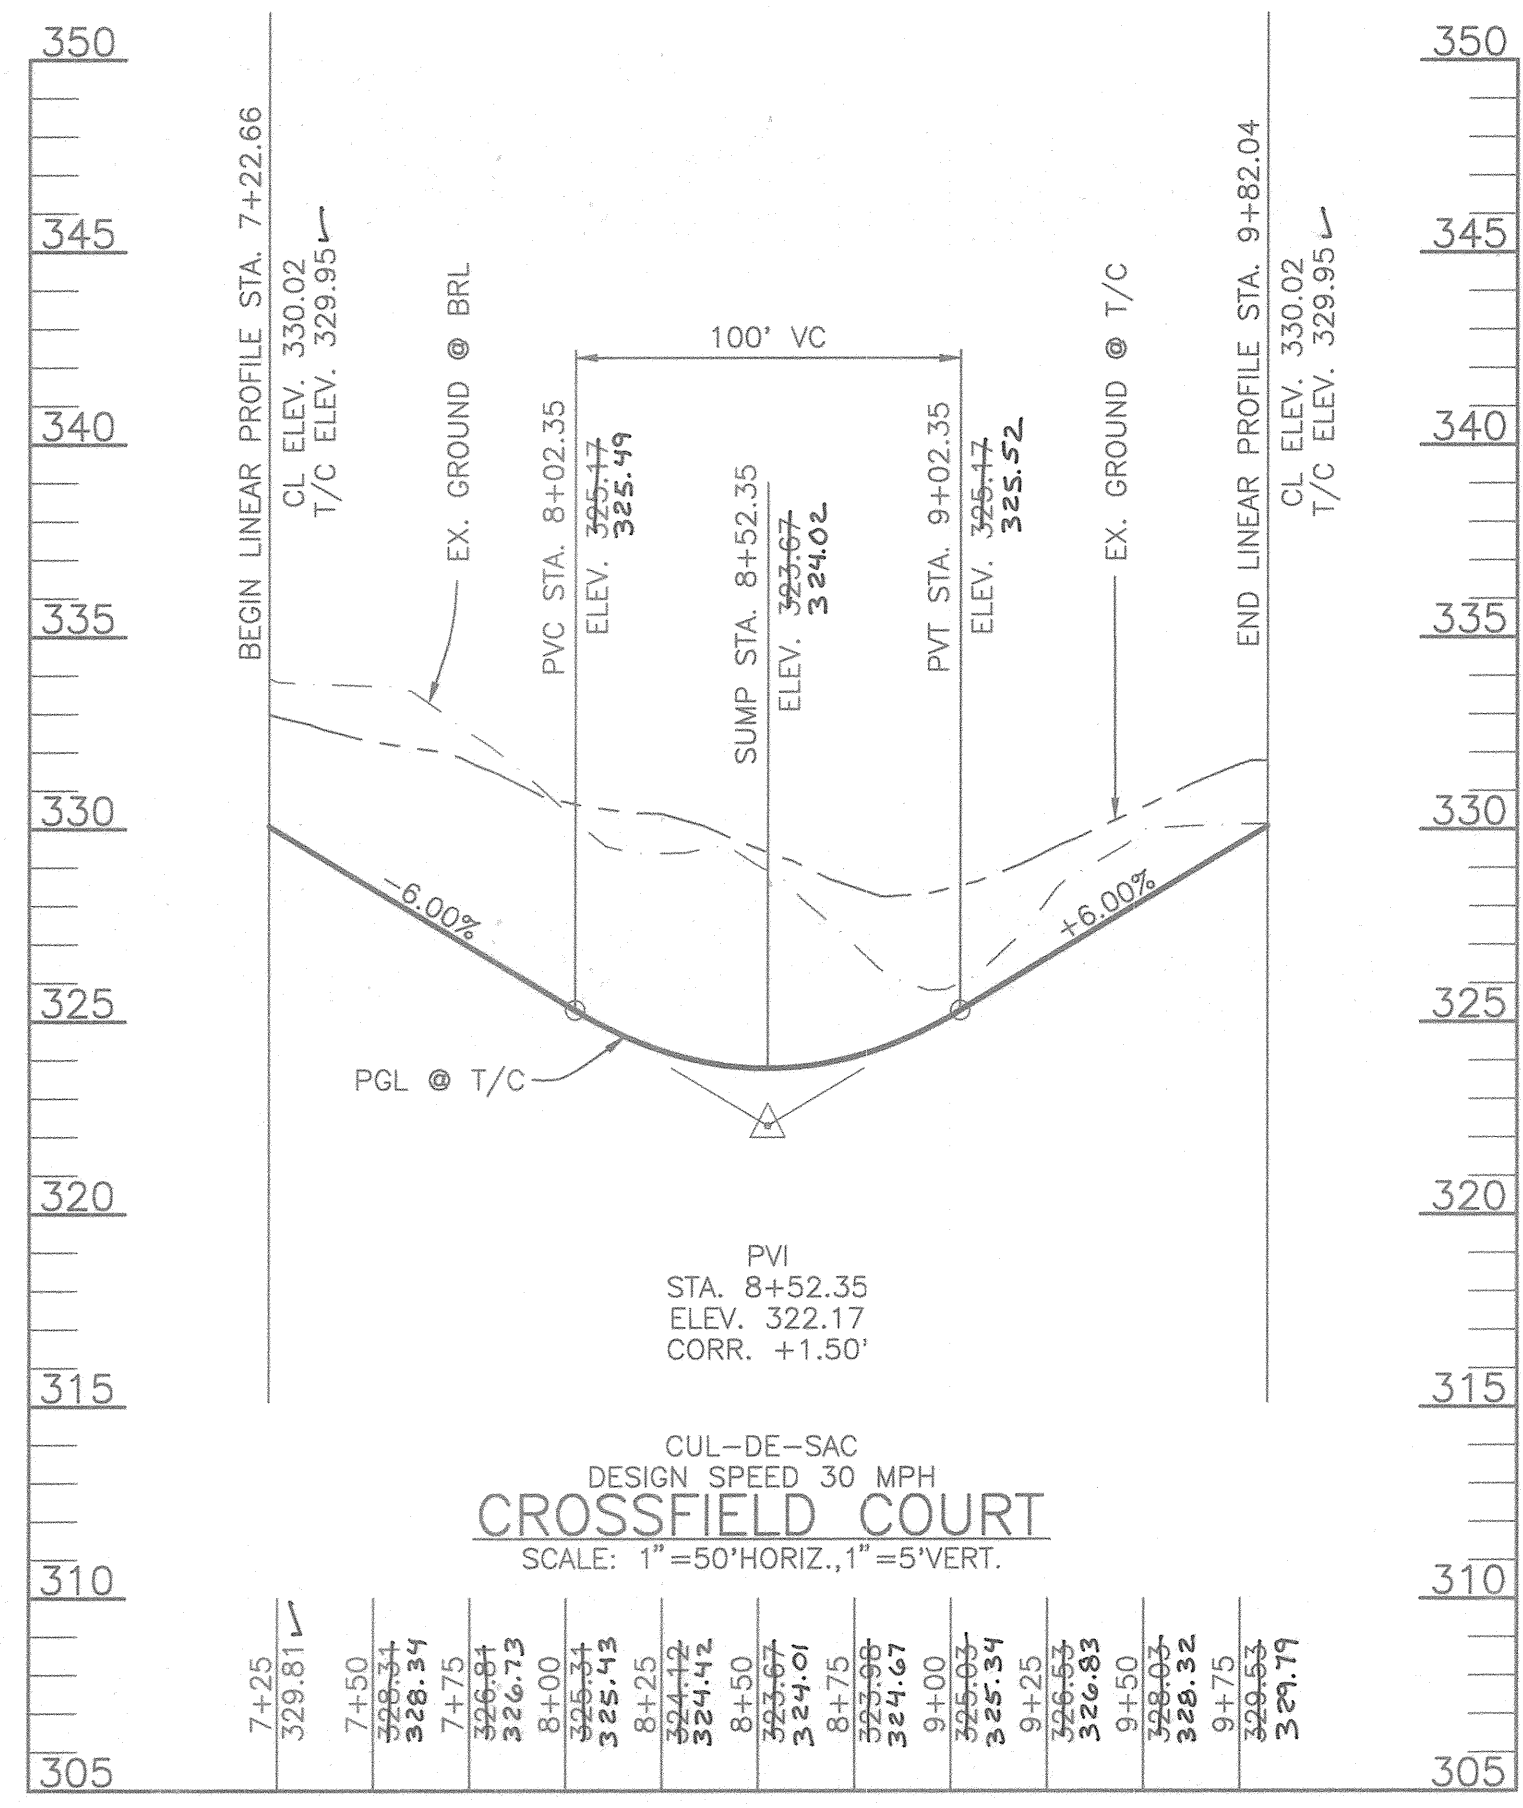

CUL-DE-SAC  
DESIGN SPEED 30 MPH  
**CROSSFIELD COURT**  
SCALE: 1"=50'HORIZ., 1"=5'VERT.

R/W PNT.	DESCRIPTION	ELEVATION
109	REBAR / CAP	302.26'
110	REBAR / CAP	308.61'
111	REBAR / CAP	308.28'
112	P.K. NAIL SET	302.36'
113	CONC. MONUMENT SET	292.28'
114	REBAR / CAP	290.04'
115	REBAR / CAP	289.03'
116	REBAR / CAP	289.25'
117	X-CUT IN DRIVEWAY	287.17'
118	REBAR / CAP	287.58'
119	REBAR / CAP	288.44'
120	REBAR / CAP	289.01'
121	P.K. NAIL SET IN DRIVEWAY	333.14'
122	CONC. MONUMENT SET	337.79'
123	REBAR / CAP	335.21'
124	P.K. NAIL IN DRIVEWAY	327.00'
125	REBAR / CAP	296.60'
126	REBAR / CAP	311.31'
127	CONC. MONUMENT SET	311.50'
128	REBAR / CAP	310.68'
129	REBAR / CAP	306.58'
130	REBAR / CAP	297.63'
131	REBAR / CAP	295.25'
132	REBAR / CAP	293.92'
133	REBAR / CAP	296.99'
134	REBAR / CAP	297.62'
135	REBAR / CAP	297.40'
136	REBAR / CAP	295.75'
137	REBAR / CAP	295.14'
138	REBAR / CAP	298.68'
139	REBAR / CAP	303.95'
140	REBAR / CAP	305.48'
141	REBAR / CAP	310.15'
142	REBAR / CAP	310.88'
143	REBAR / CAP	310.66'
144	PUNCH IN CONCRETE	309.73'
145	PUNCH IN CONCRETE	308.60'
146	REBAR / CAP	301.65'
147	REBAR / CAP	299.51'
148	REBAR / CAP	300.00'
149	REBAR / CAP	323.23'
151	REBAR / CAP	327.82'
152	REBAR / CAP	334.62'
153	REBAR / CAP	333.81'
154	REBAR / CAP	329.76'
155	REBAR / CAP	319.77'
156	NAIL IN ROCK	311.17'
157	REBAR / CAP	301.93'
158	REBAR / CAP	300.73'
159	REBAR / CAP	301.82'
160	REBAR / CAP	302.09'

R/W PNT.	DESCRIPTION	ELEVATION
101	REBAR / CAP	311.36'
102	REBAR / CAP	320.83'
103	REBAR / CAP	330.16'
104	REBAR / CAP	334.59'
105	REBAR / CAP	338.22'
106	REBAR / CAP	324.33'
107	CONC. MONUMENT SET	331.95'

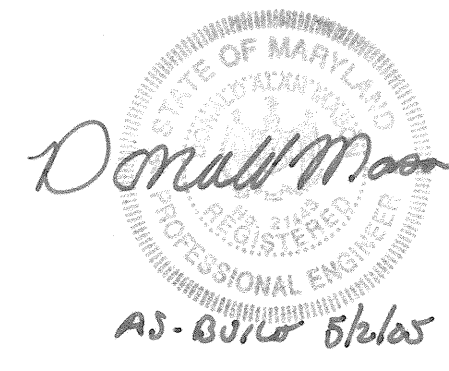

APPROVED: HOWARD COUNTY DEPARTMENT OF PUBLIC WORKS  
*Andrew M. Danaher* 6-15-98  
 CHIEF, BUREAU OF HIGHWAYS DATE

APPROVED: HOWARD COUNTY DEPARTMENT OF PLANNING AND ZONING  
*C. Hamilton* 6/21/98  
 CHIEF, DIVISION OF LAND DEVELOPMENT DATE

*M. D. Cummings* 6/21/98  
 CHIEF, DEVELOPMENT ENGINEERING DIVISION DATE

NO.	DATE	REVISION
1	4/27/05	REVISED PER AS-BUILT CONDITIONS

**TSA GROUP, INC.**  
 planning • architecture • engineering • surveying  
 5450 Baltimore National Pike • Ellicott City, Maryland 21043 • 410-485-0105

OWNERS:  
 TOLL MD LIMITED PARTNERSHIP,  
 A MARYLAND LIMITED PARTNERSHIP  
 3206 TOWER OAKS BOULEVARD  
 SUITE 310  
 ROCKVILLE, MARYLAND 20852

PROJECT: **VILLAGE OF CEDAR RIDGE**  
 A SUBDIVISION OF PARCEL 44 (TAX MAP 41) AND A RESUBDIVISION OF LOTS 1 AND 2 OF THE EDITH S. PALLETT SUBDIVISION (PLAT 10738 PARCEL 43) AND A SUBDIVISION OF PARCEL 123 FOR A ROAD RIGHT-OF-WAY



LOCATION: TAX MAP 41 - PARCELS 43 & 44, P/O 123  
 5th ELECTION DISTRICT  
 HOWARD COUNTY, MARYLAND

DEVELOPER:  
 TOLL MD LIMITED PARTNERSHIP,  
 A MARYLAND LIMITED PARTNERSHIP  
 3206 TOWER OAKS BOULEVARD  
 SUITE 310  
 ROCKVILLE, MARYLAND 20852

TITLE: **ROAD PROFILES**  
 SP-97-02 WP-97-78 PB 312 F-93-70 WP-98-82  
 DATE: OCTOBER, 1997  
 MAY, 1998 PROJECT NO. 0518

DESIGN: DAM DRAFT: DBT CHECK: DAM SCALE: AS SHOWN SHEET 10 OF 31



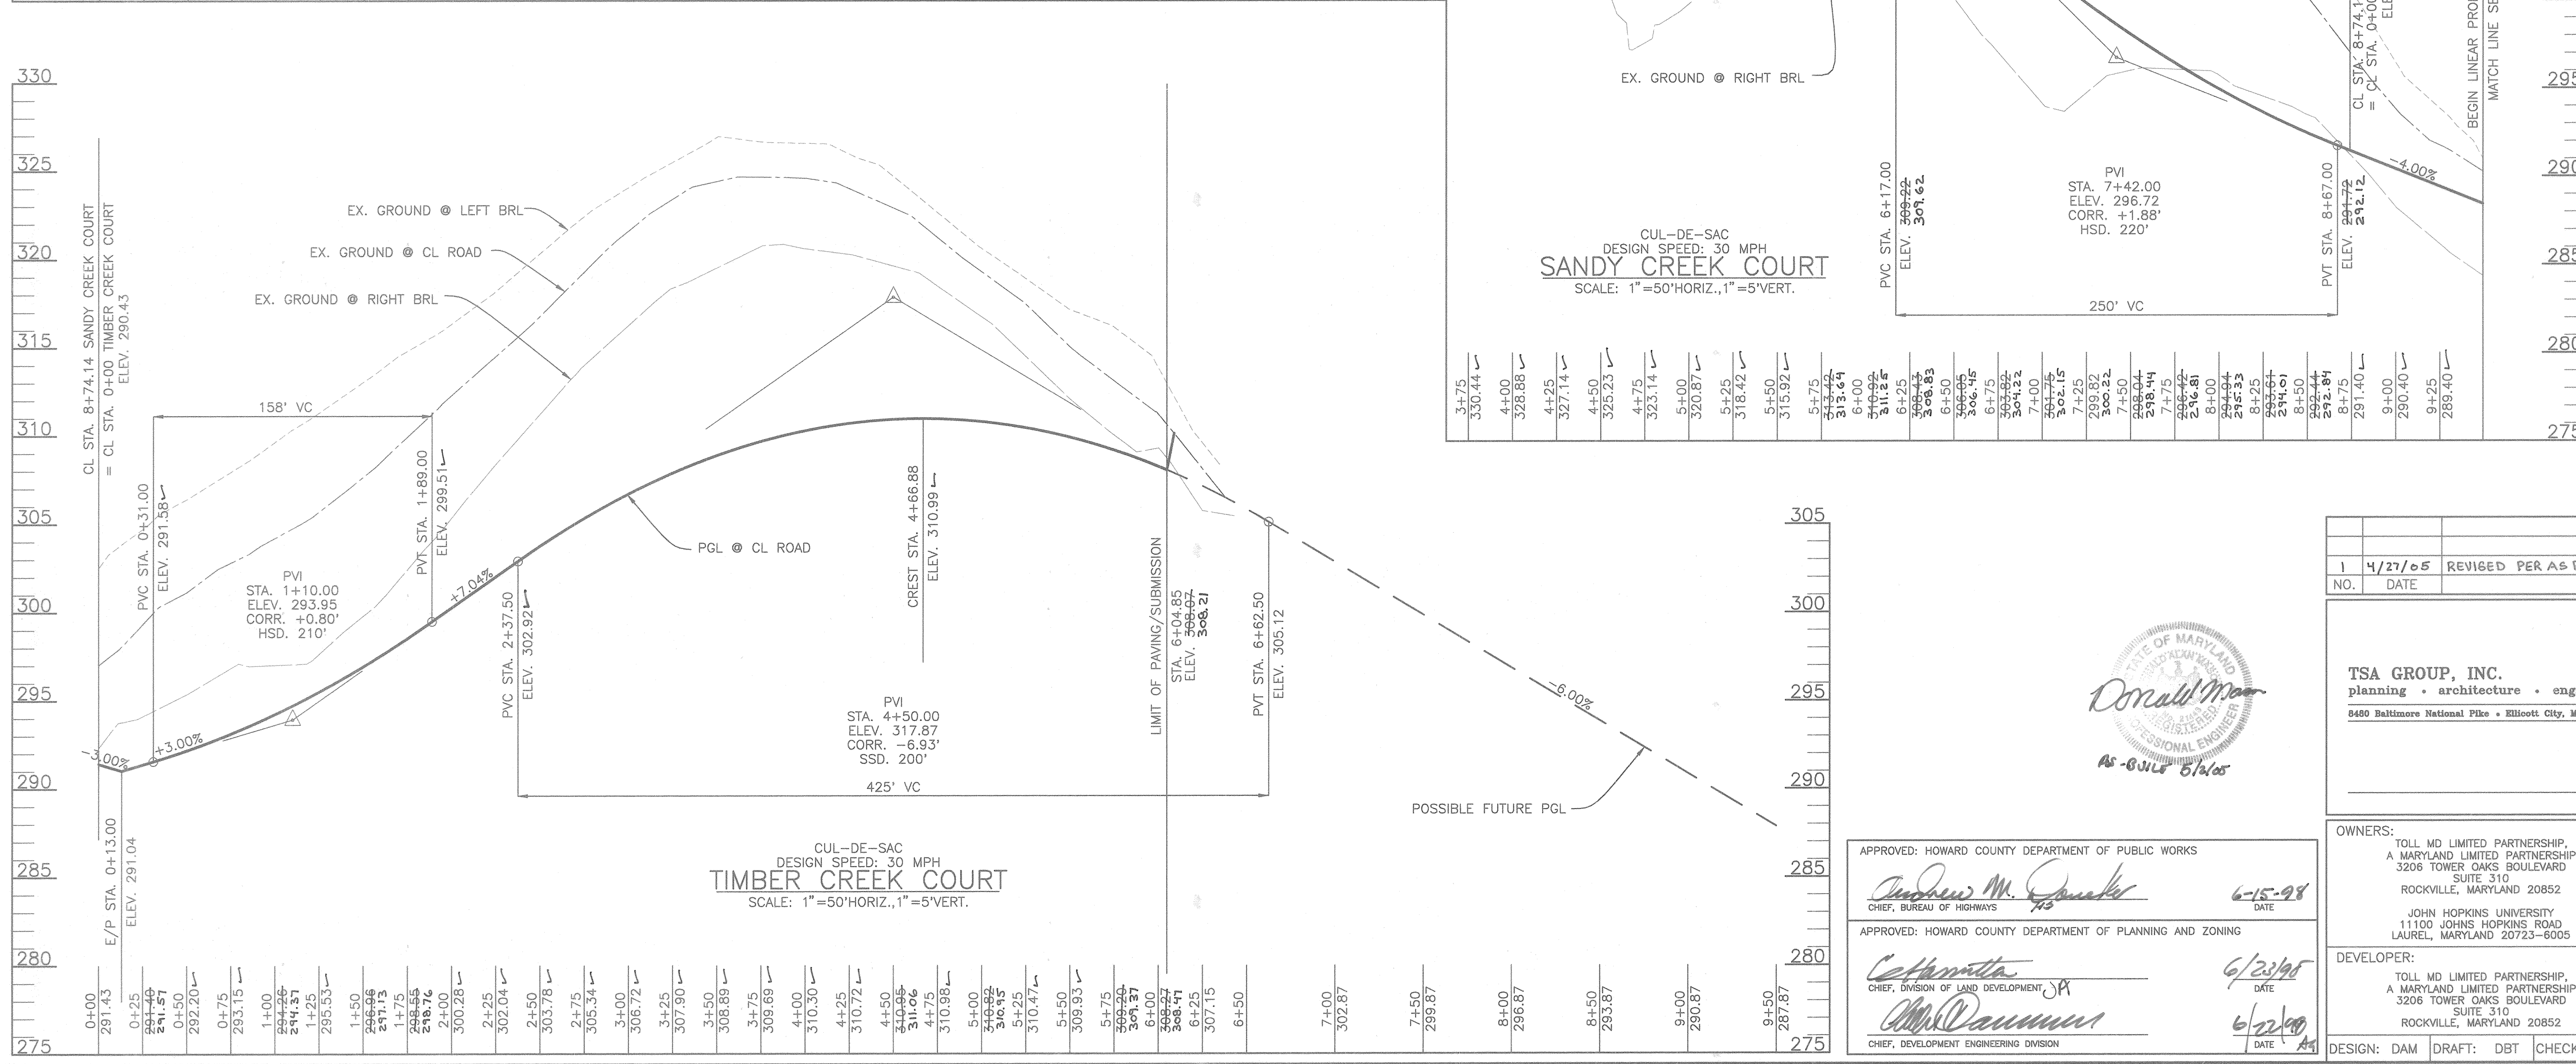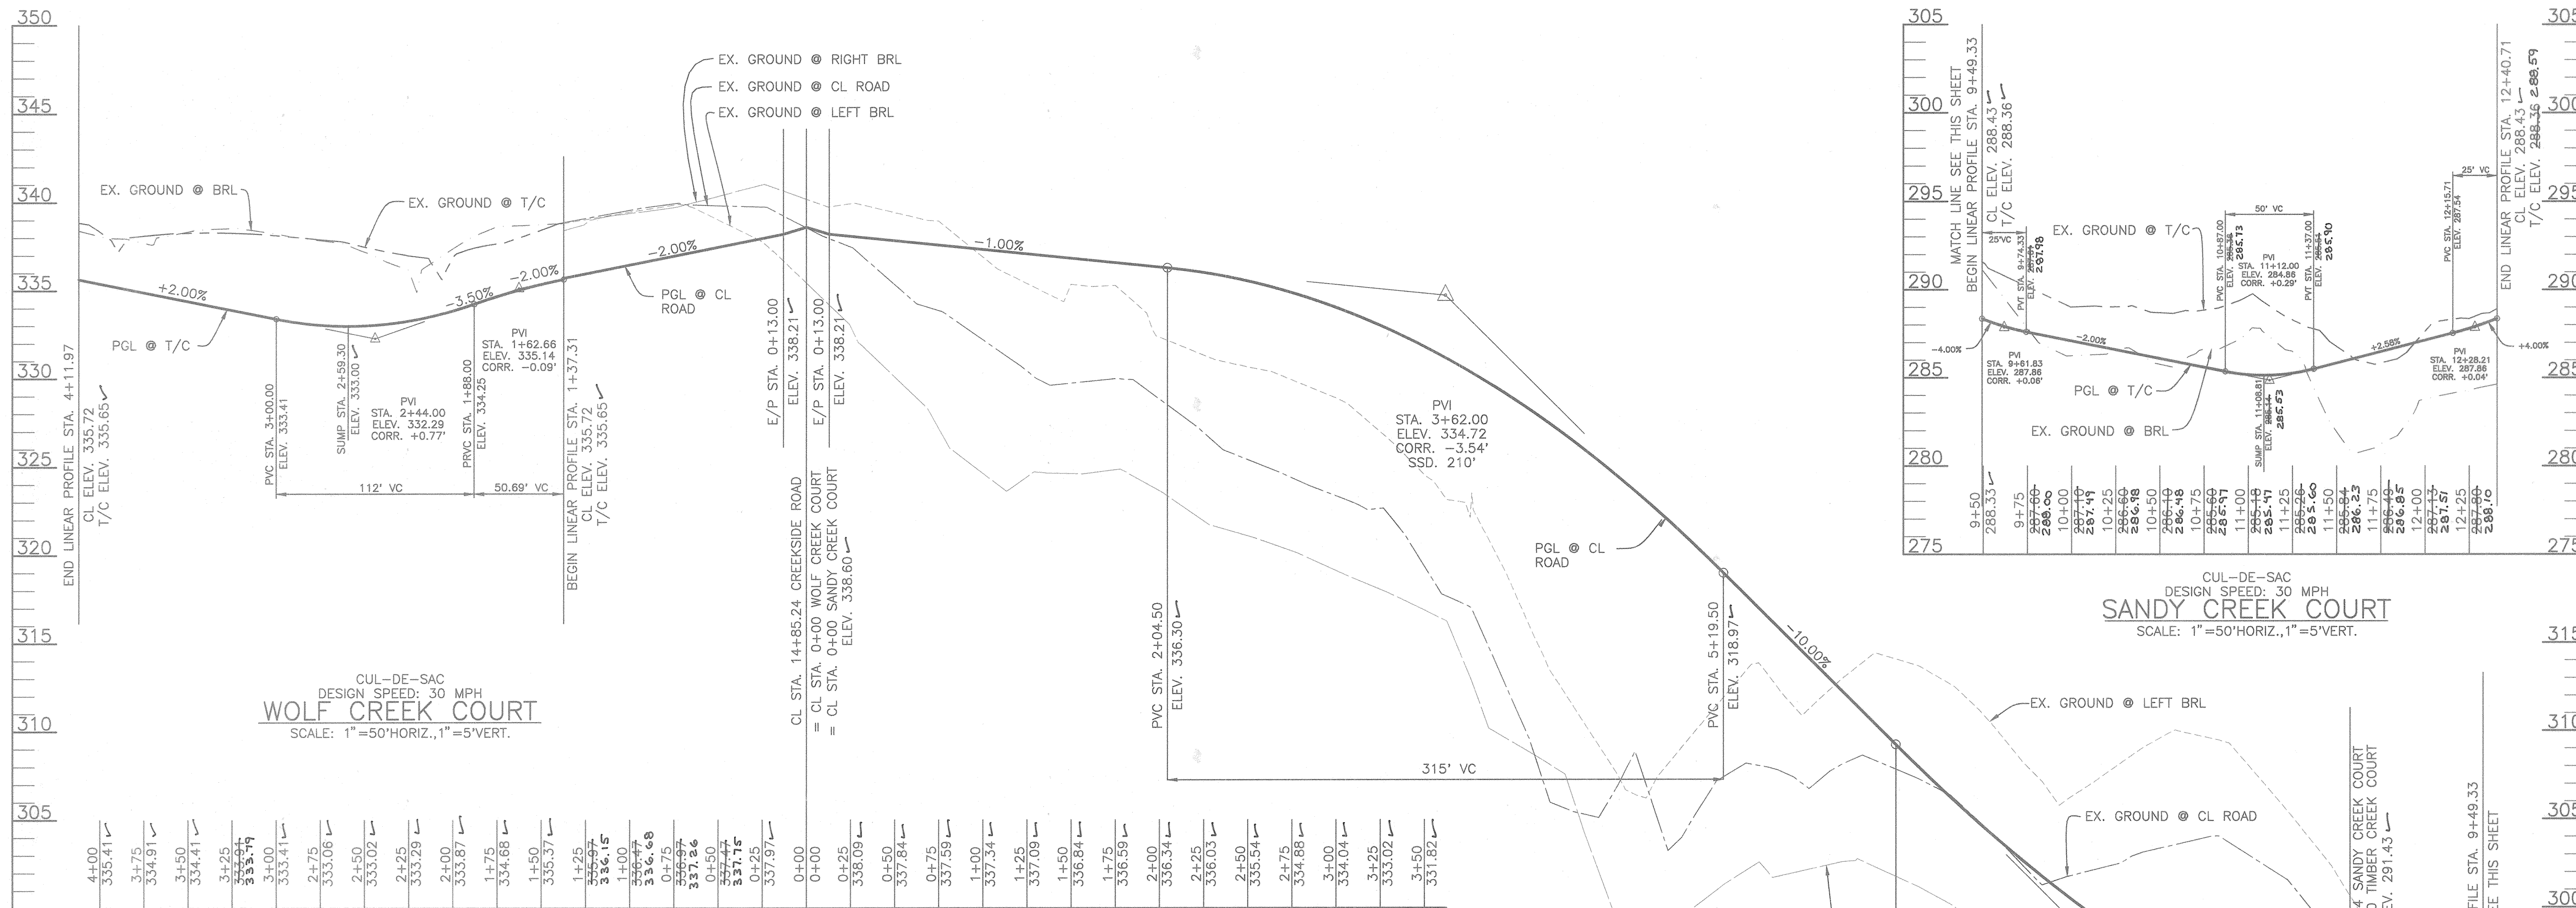

APPROVED: HOWARD COUNTY DEPARTMENT OF PUBLIC WORKS  
*Andrew M. Spangler* 6-15-98  
 CHIEF, BUREAU OF HIGHWAYS DATE

APPROVED: HOWARD COUNTY DEPARTMENT OF PLANNING AND ZONING  
*C. Hamilton* 6/23/98  
 CHIEF, DIVISION OF LAND DEVELOPMENT DATE



*Chris Dammann* 6/22/98  
 CHIEF, DEVELOPMENT ENGINEERING DIVISION DATE

NO.	DATE	REVISION
1	4/27/05	REVISED PER AS BUILT CONDITIONS

<b>TSA GROUP, INC.</b> planning • architecture • engineering • surveying 8450 Baltimore National Pike • Ellicott City, Maryland 21043 • 410-485-0105		
OWNERS:	TOLL MD LIMITED PARTNERSHIP, A MARYLAND LIMITED PARTNERSHIP 3205 TOWER OAKS BOULEVARD SUITE 310 ROCKVILLE, MARYLAND 20852	
PROJECT:	<b>VILLAGE OF CEDAR RIDGE</b> A SUBDIVISION OF PARCEL 44 (TAX MAP 41) AND A RESUBDIVISION OF LOTS 1 AND 2 OF THE EDITH S. PALETTE SUBDIVISION (PLAT 10738 PARCEL 43) AND A SUBDIVISION OF PARCEL 123 FOR A ROAD RIGHT-OF-WAY	
LOCATION:	TAX MAP 41 - PARCELS 43 & 44, P/O 123 8th ELECTION DISTRICT HOWARD COUNTY, MARYLAND	
DEVELOPER:	TOLL MD LIMITED PARTNERSHIP, A MARYLAND LIMITED PARTNERSHIP 3205 TOWER OAKS BOULEVARD SUITE 310 ROCKVILLE, MARYLAND 20852	
TITLE:	<b>ROAD PROFILES</b>	
DATE:	SP-97-02 WP-97-78 PB 312 F-93-70 WP-98-82 OCTOBER, 1997 MAY, 1998	PROJECT NO. 0518 SHEET 9 OF 31
DESIGN:	DAM	DRAFT: DBT
CHECK:	DAM	



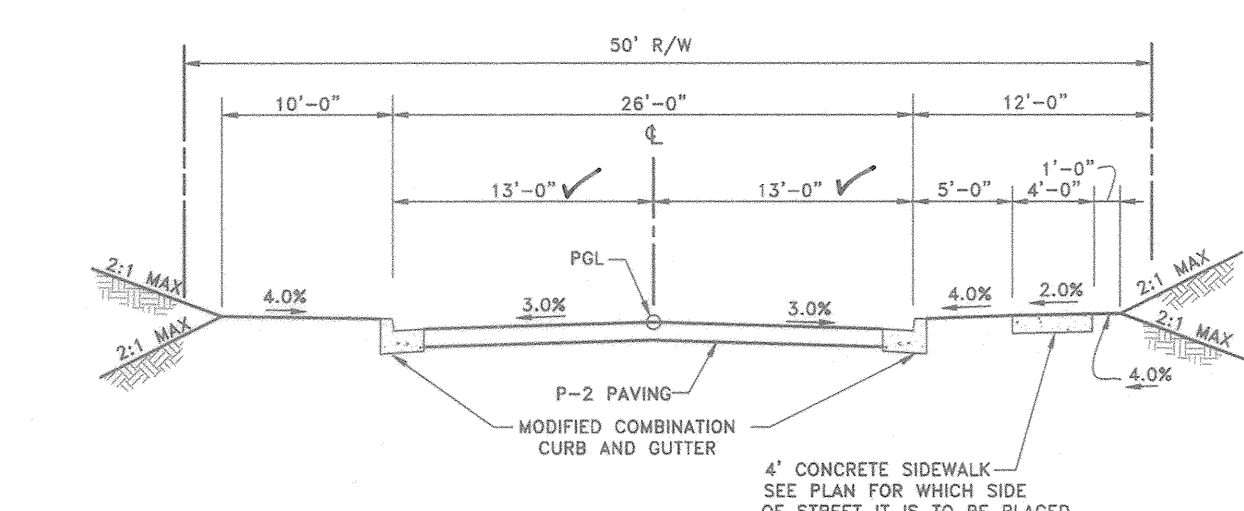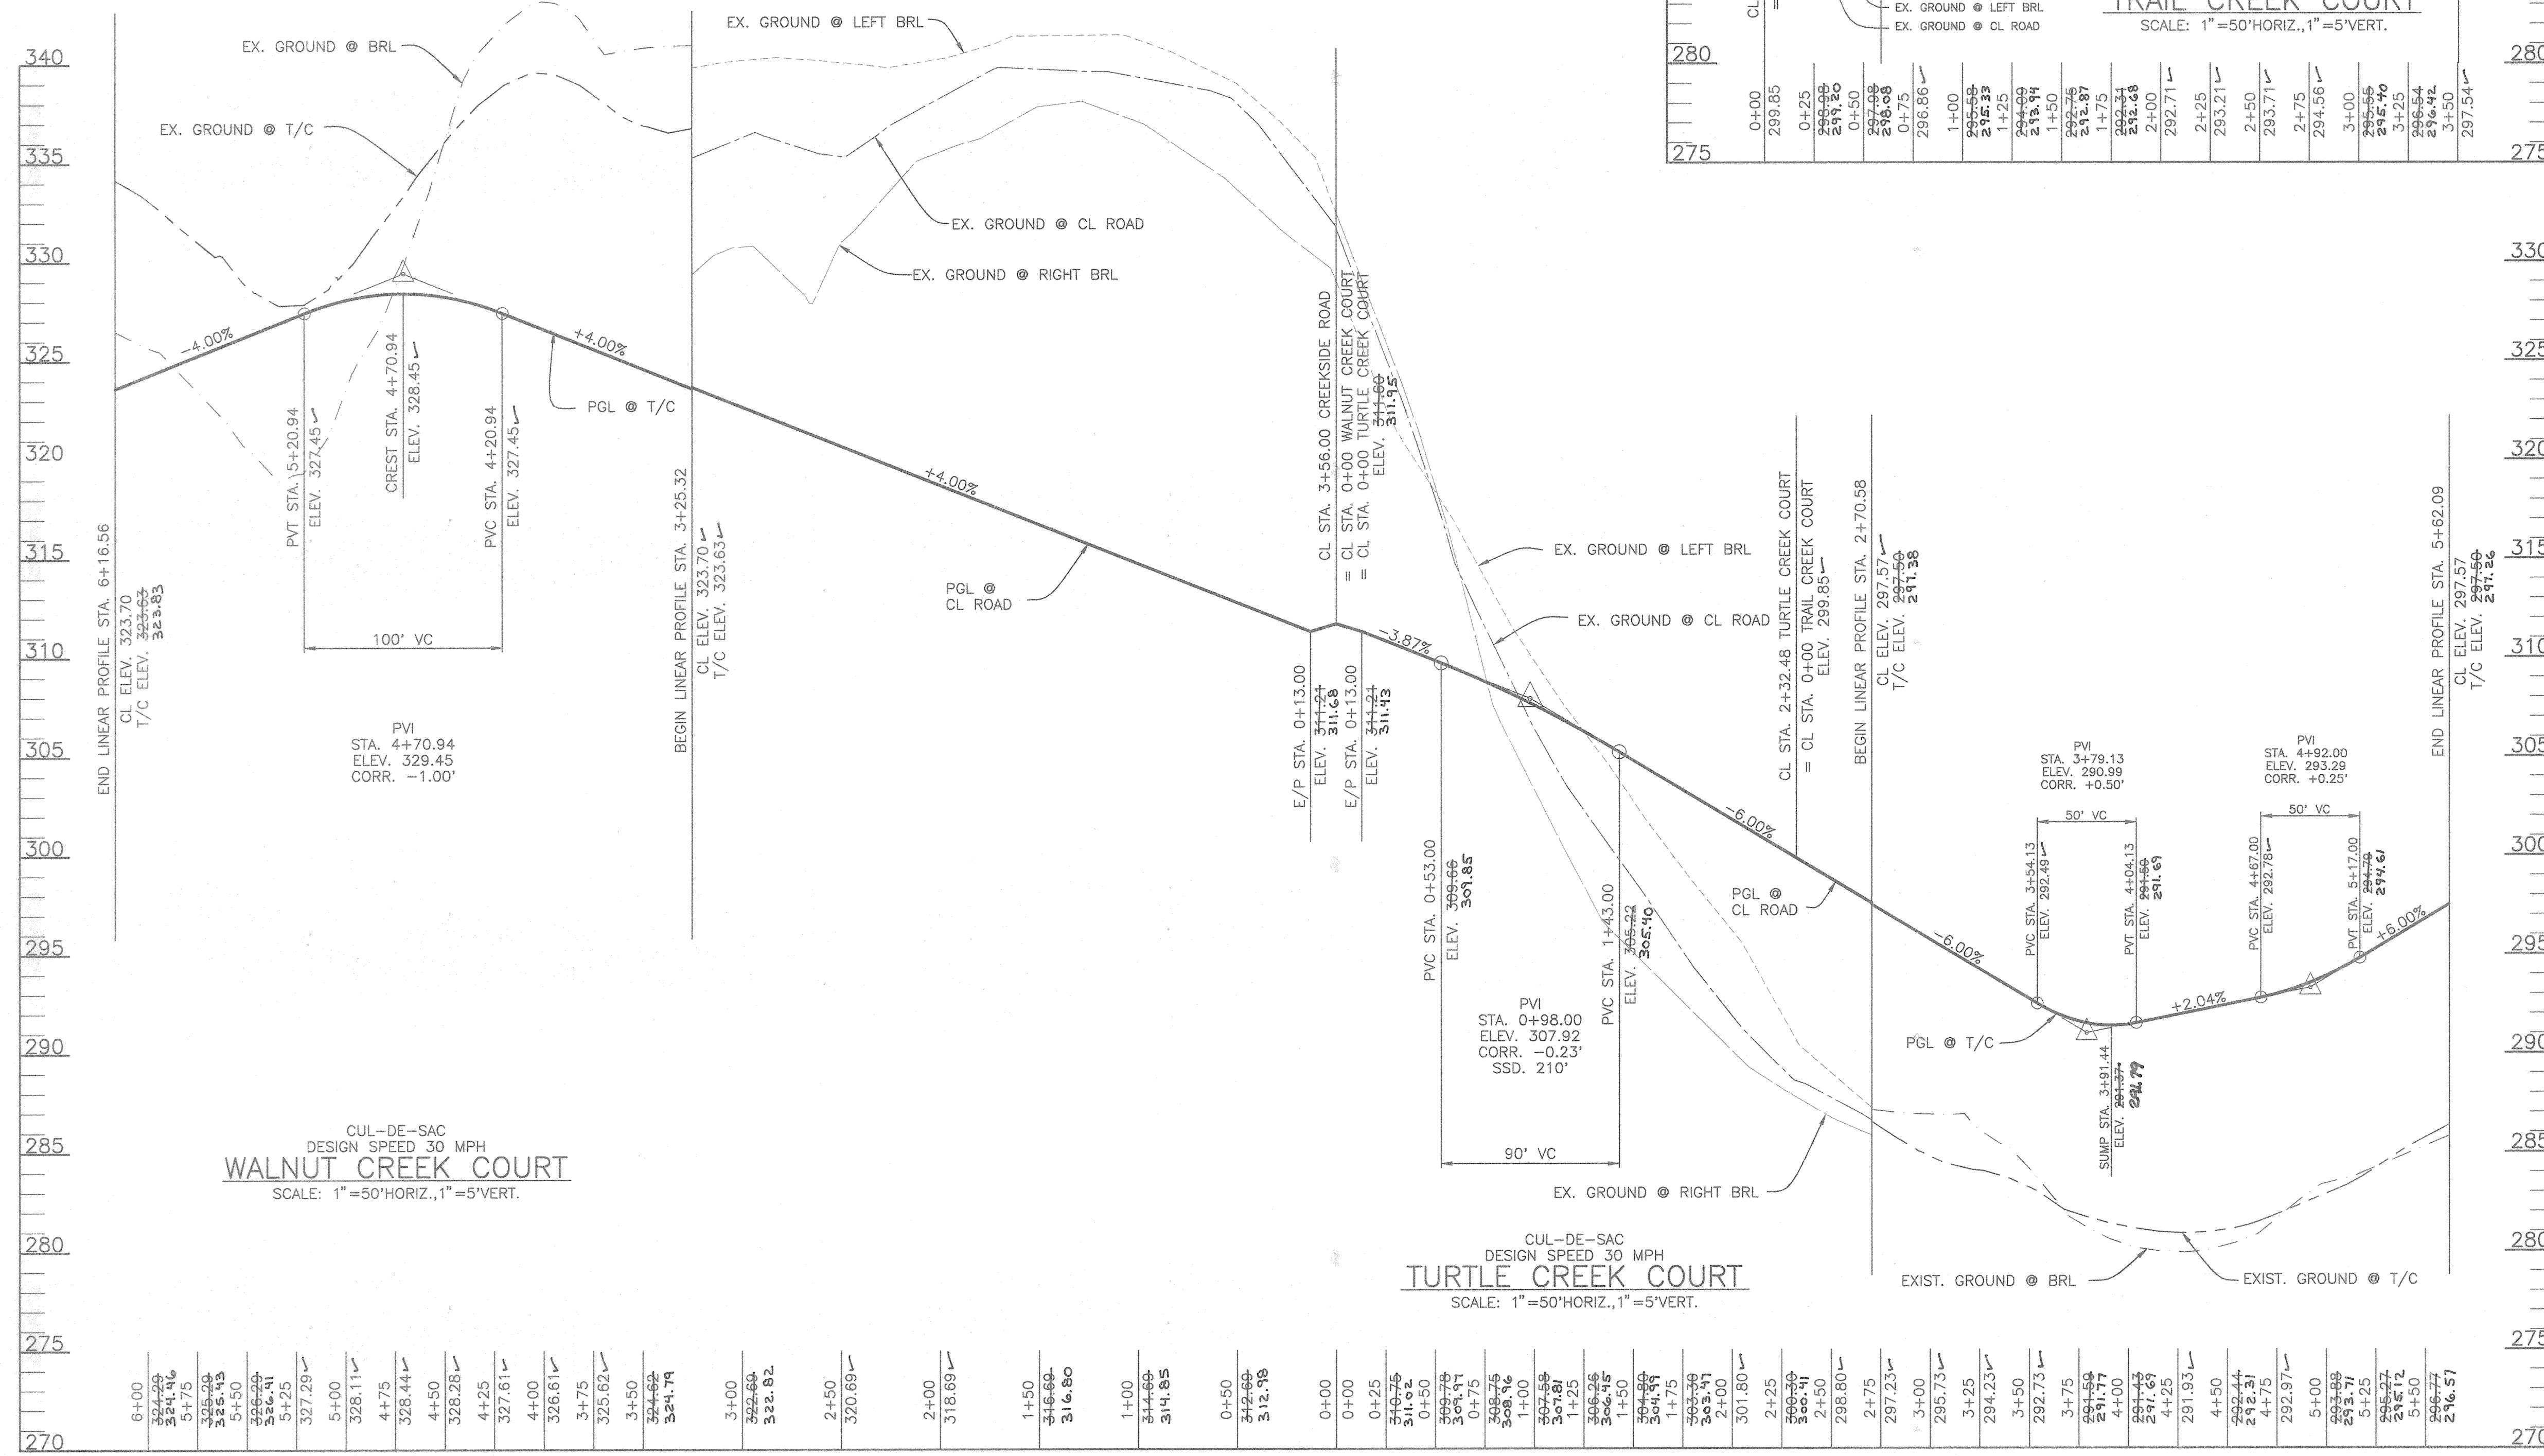

WALNUT CREEK COURT CL STATION 0+37.30 TO CL STATION 3+85.80  
 TURTLE CREEK COURT CL STATION 0+39.34 TO CL STATION 2+70.58  
 TRAIL CREEK COURT CL STATION 0+38.00 TO CL STATION 0+58.86  
 WOLF CREEK COURT CL STATION 0+38.00 TO CL STATION 1+37.31  
 CREEKWOOD COURT CL STATION 0+38.00 TO CL STATION 5+13.53  
 CROSSFIELD COURT CL STATION 0+38.00 TO CL STATION 7+22.66  
 SANDY CREEK COURT CL STATION 0+38.00 TO CL STATION 9+49.33  
 TIMBER CREEK COURT CL STATION 0+39.48 TO CL STATION 5+79.86  
 RIVER OAK COURT CL STATION 0+50.25 TO CL STATION 14+47.86

APPROVED: HOWARD COUNTY DEPARTMENT OF PUBLIC WORKS  
*Andrew M. Daneker*  
 CHIEF, BUREAU OF HIGHWAYS  
 DATE: 6-15-98

APPROVED: HOWARD COUNTY DEPARTMENT OF PLANNING AND ZONING  
*Costantina*  
 CHIEF, DIVISION OF LAND DEVELOPMENT  
 DATE: 6/23/98

*David Primm*  
 CHIEF, DEVELOPMENT ENGINEERING DIVISION  
 DATE: 6/22/98

NO.	DATE	REVISION
1	4/27/05	REVISED PER AS BUILT CONDITIONS

**TSA GROUP, INC.**  
 planning • architecture • engineering • surveying  
 8480 Baltimore National Pike • Ellicott City, Maryland 21043 • 410-465-0105

*Donald Mason*  
 PROFESSIONAL ENGINEER

**OWNERS:**  
 TOLL MD LIMITED PARTNERSHIP,  
 A MARYLAND LIMITED PARTNERSHIP  
 3206 TOWER OAKS BOULEVARD  
 SUITE 310  
 ROCKVILLE, MARYLAND 20852

**PROJECT:**  
**VILLAGE OF CEDAR RIDGE**  
 A SUBDIVISION OF PARCEL 44 (TAX MAP 41) AND A RESUBDIVISION OF LOTS 1 AND 2 OF THE EDITH S. PALETTE SUBDIVISION (PLAT 10735 PARCEL 43) AND A SUBDIVISION OF PARCEL 123 FOR A ROAD RIGHT-OF-WAY




**DEVELOPER:**  
 TOLL MD LIMITED PARTNERSHIP,  
 A MARYLAND LIMITED PARTNERSHIP  
 3206 TOWER OAKS BOULEVARD  
 SUITE 310  
 ROCKVILLE, MARYLAND 20852

**LOCATION:**  
 TAX MAP 41 - PARCELS 43 & 44, P/O 123  
 5th ELECTION DISTRICT  
 HOWARD COUNTY, MARYLAND

**TITLE:**  
**ROAD PROFILES**


SP-97-02 WP-97-78 PB 312 F-93-70 WP-98-82  
 DATE: OCTOBER, 1997  
 MAY, 1998  
 PROJECT NO. 0518  
 SCALE: AS SHOWN SHEET 8 OF 31



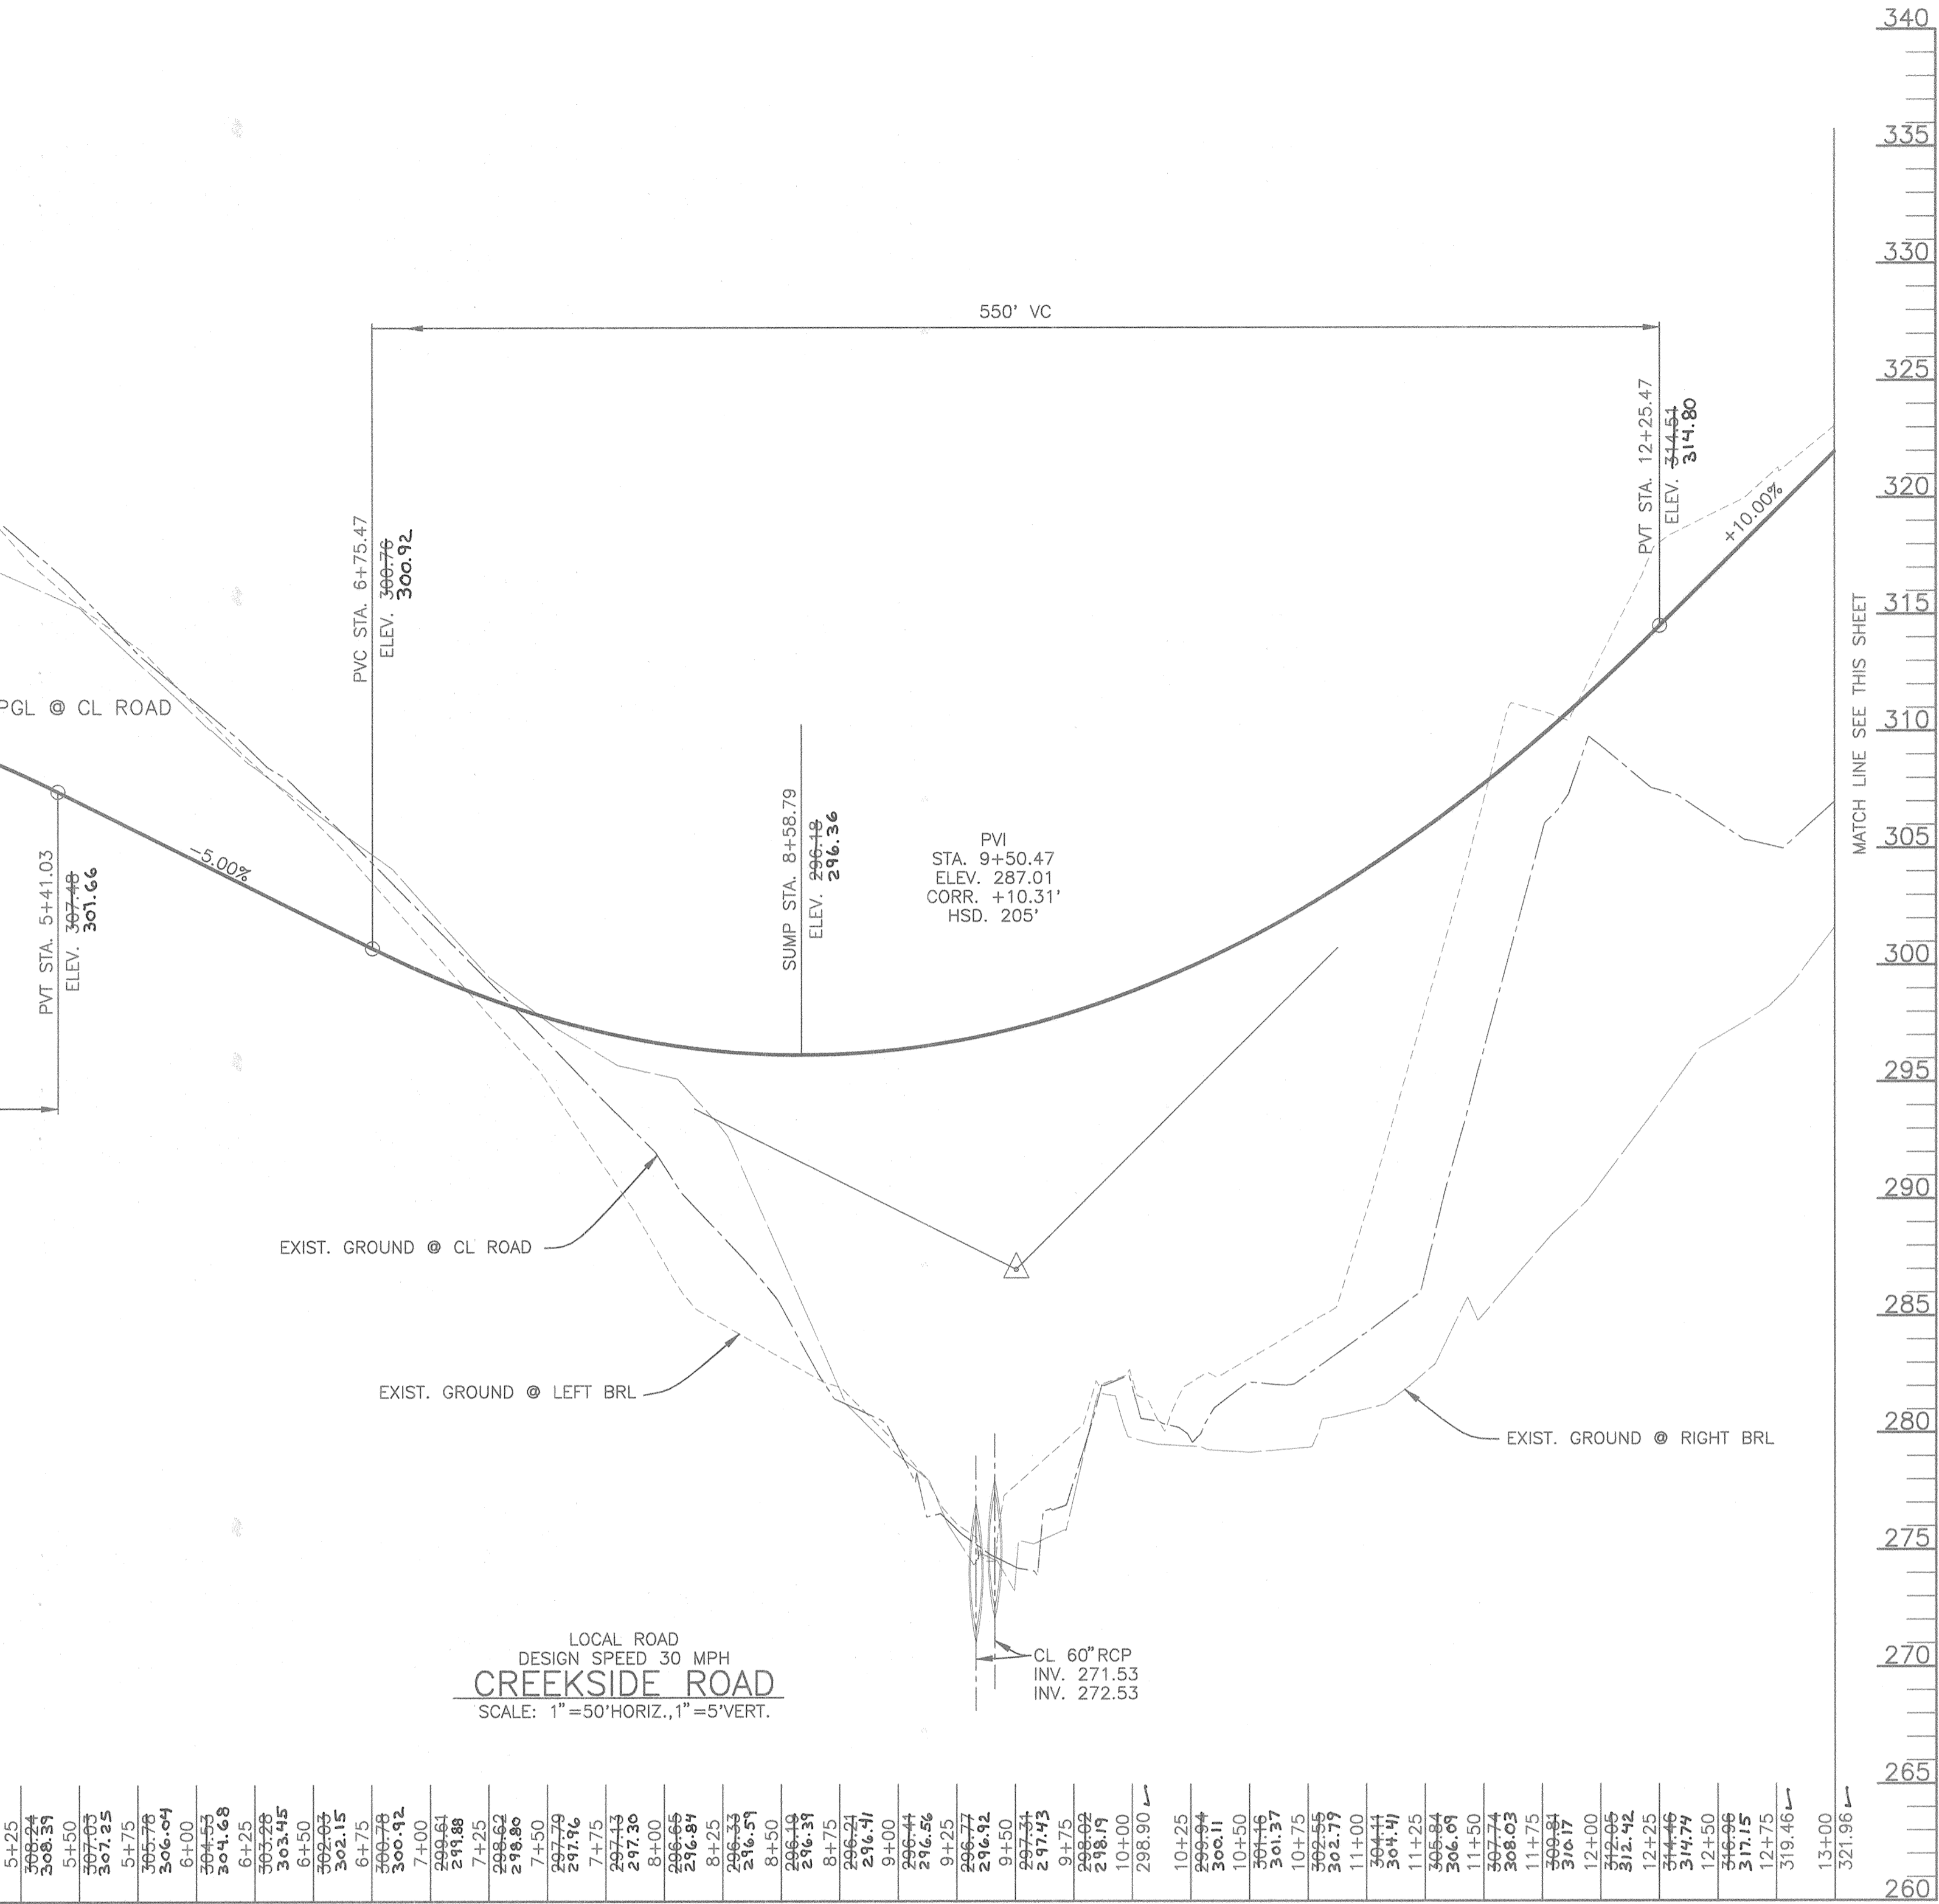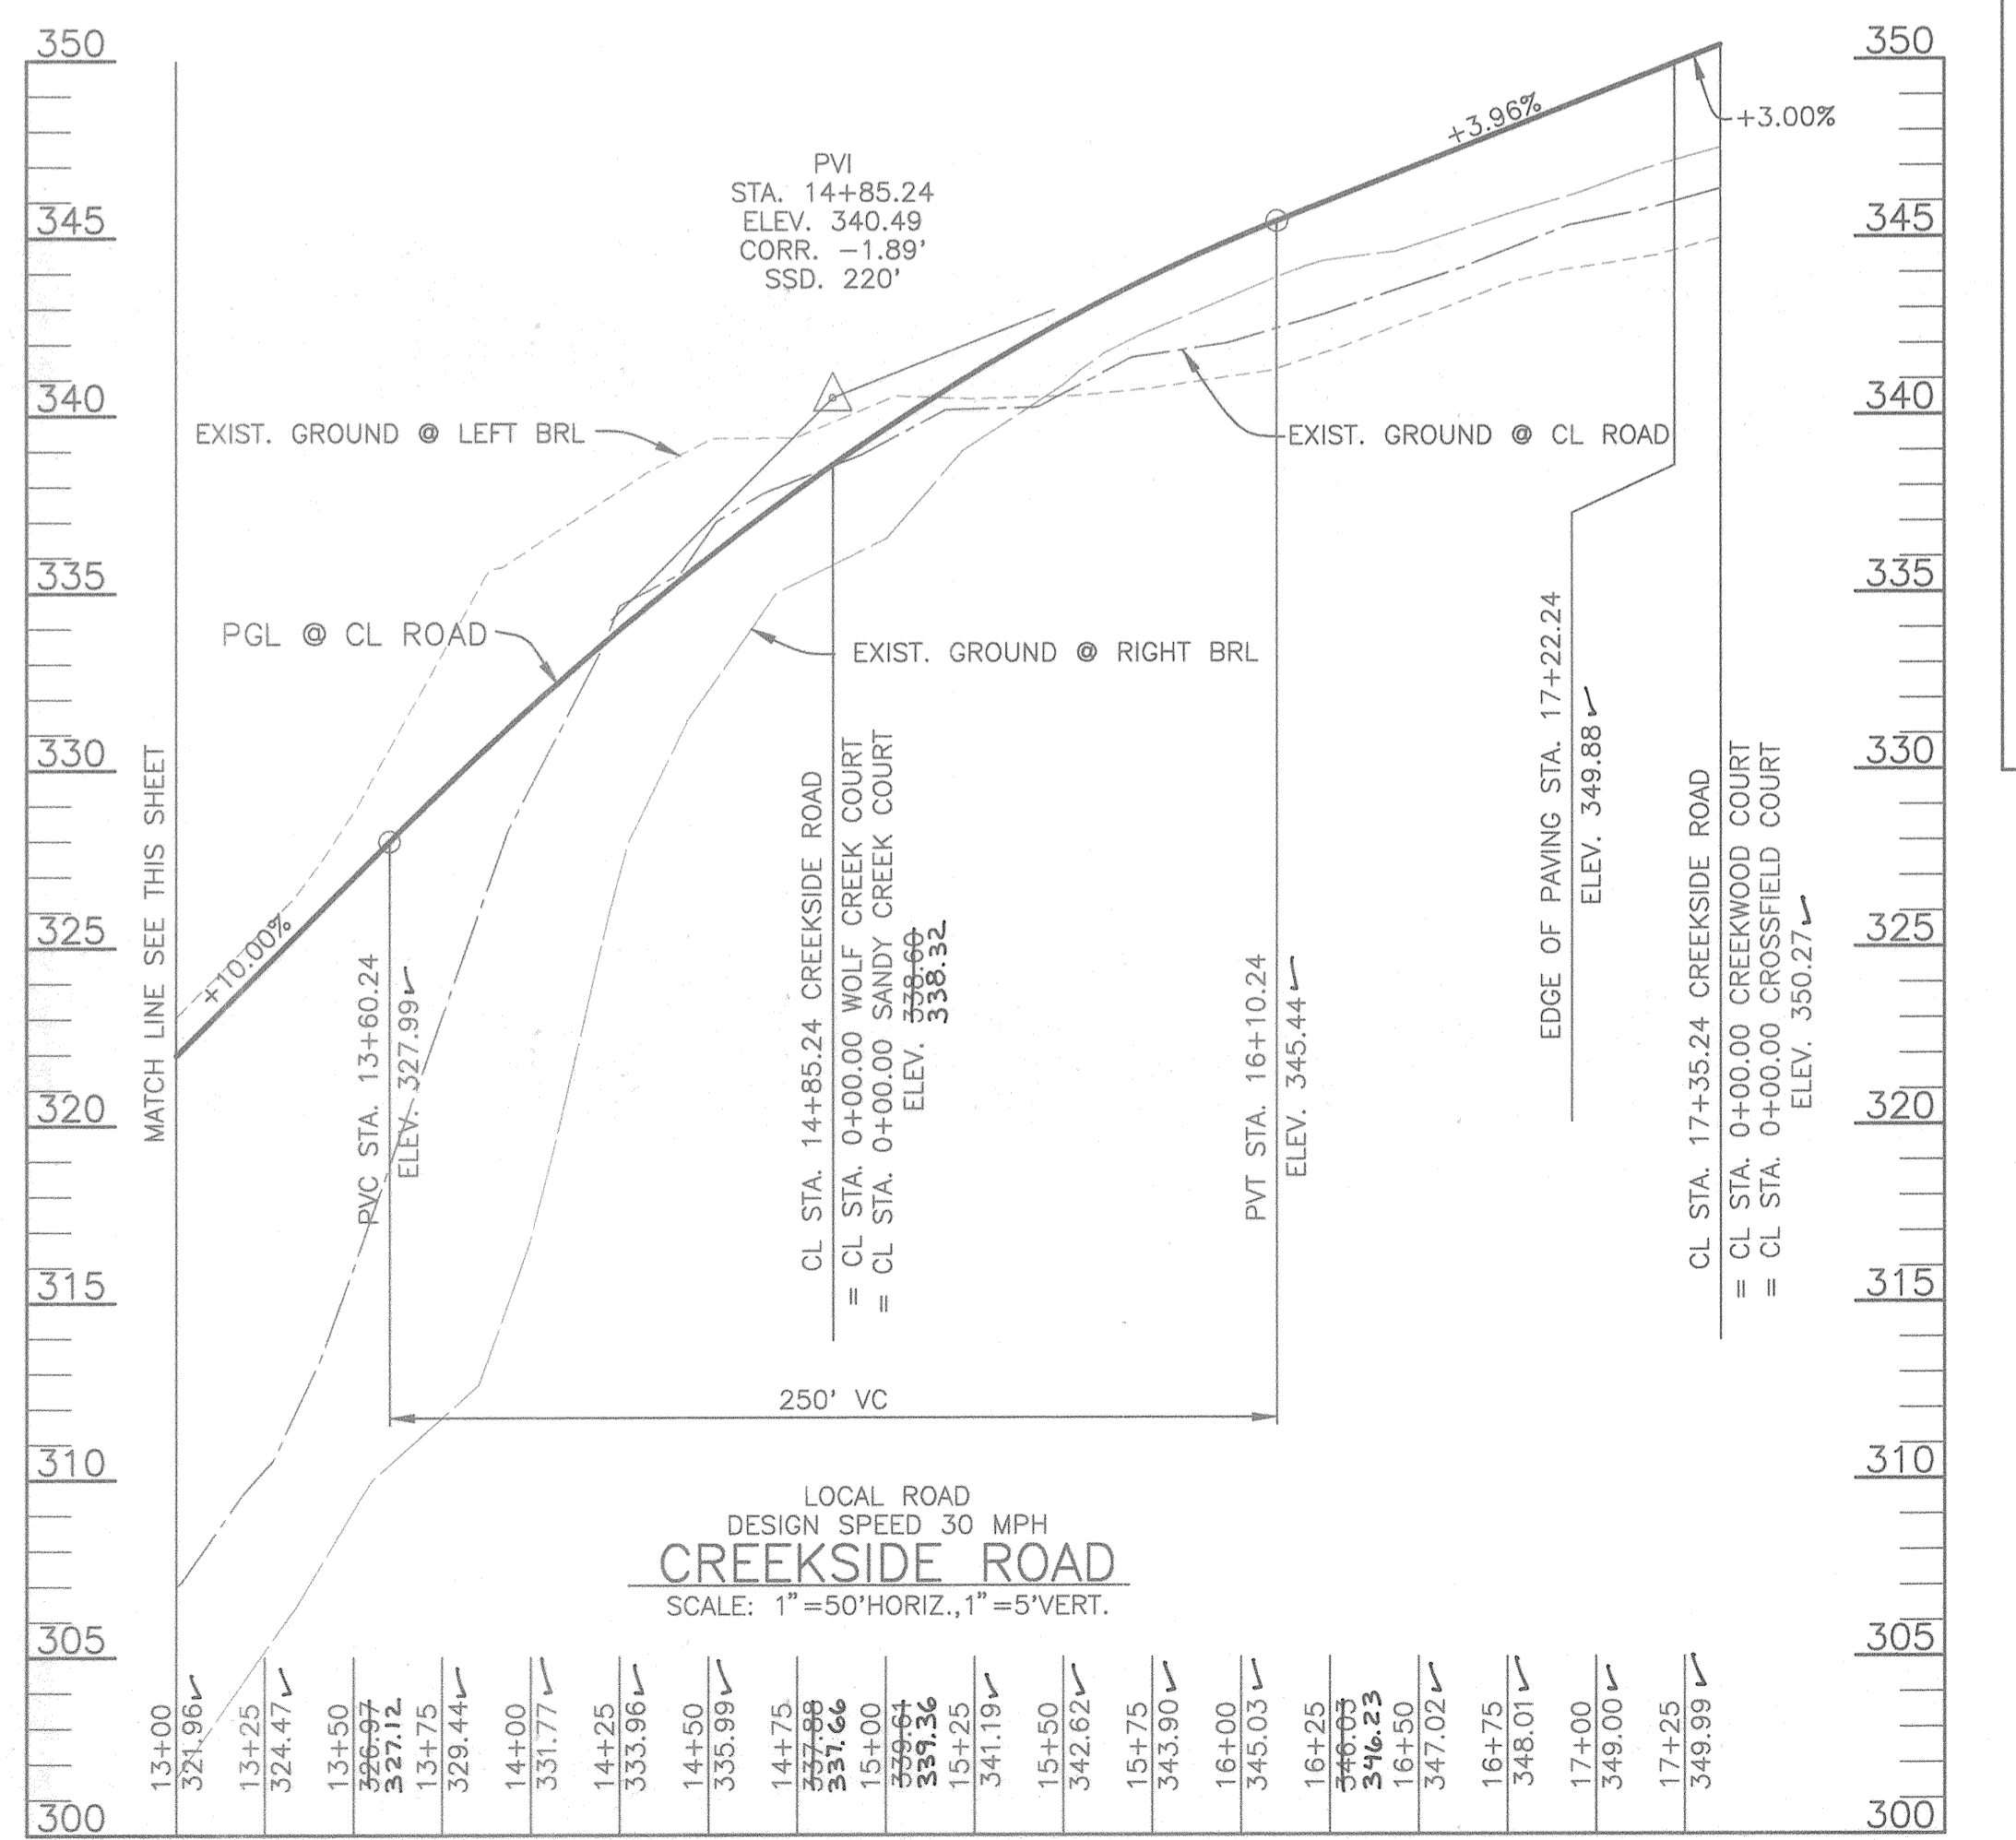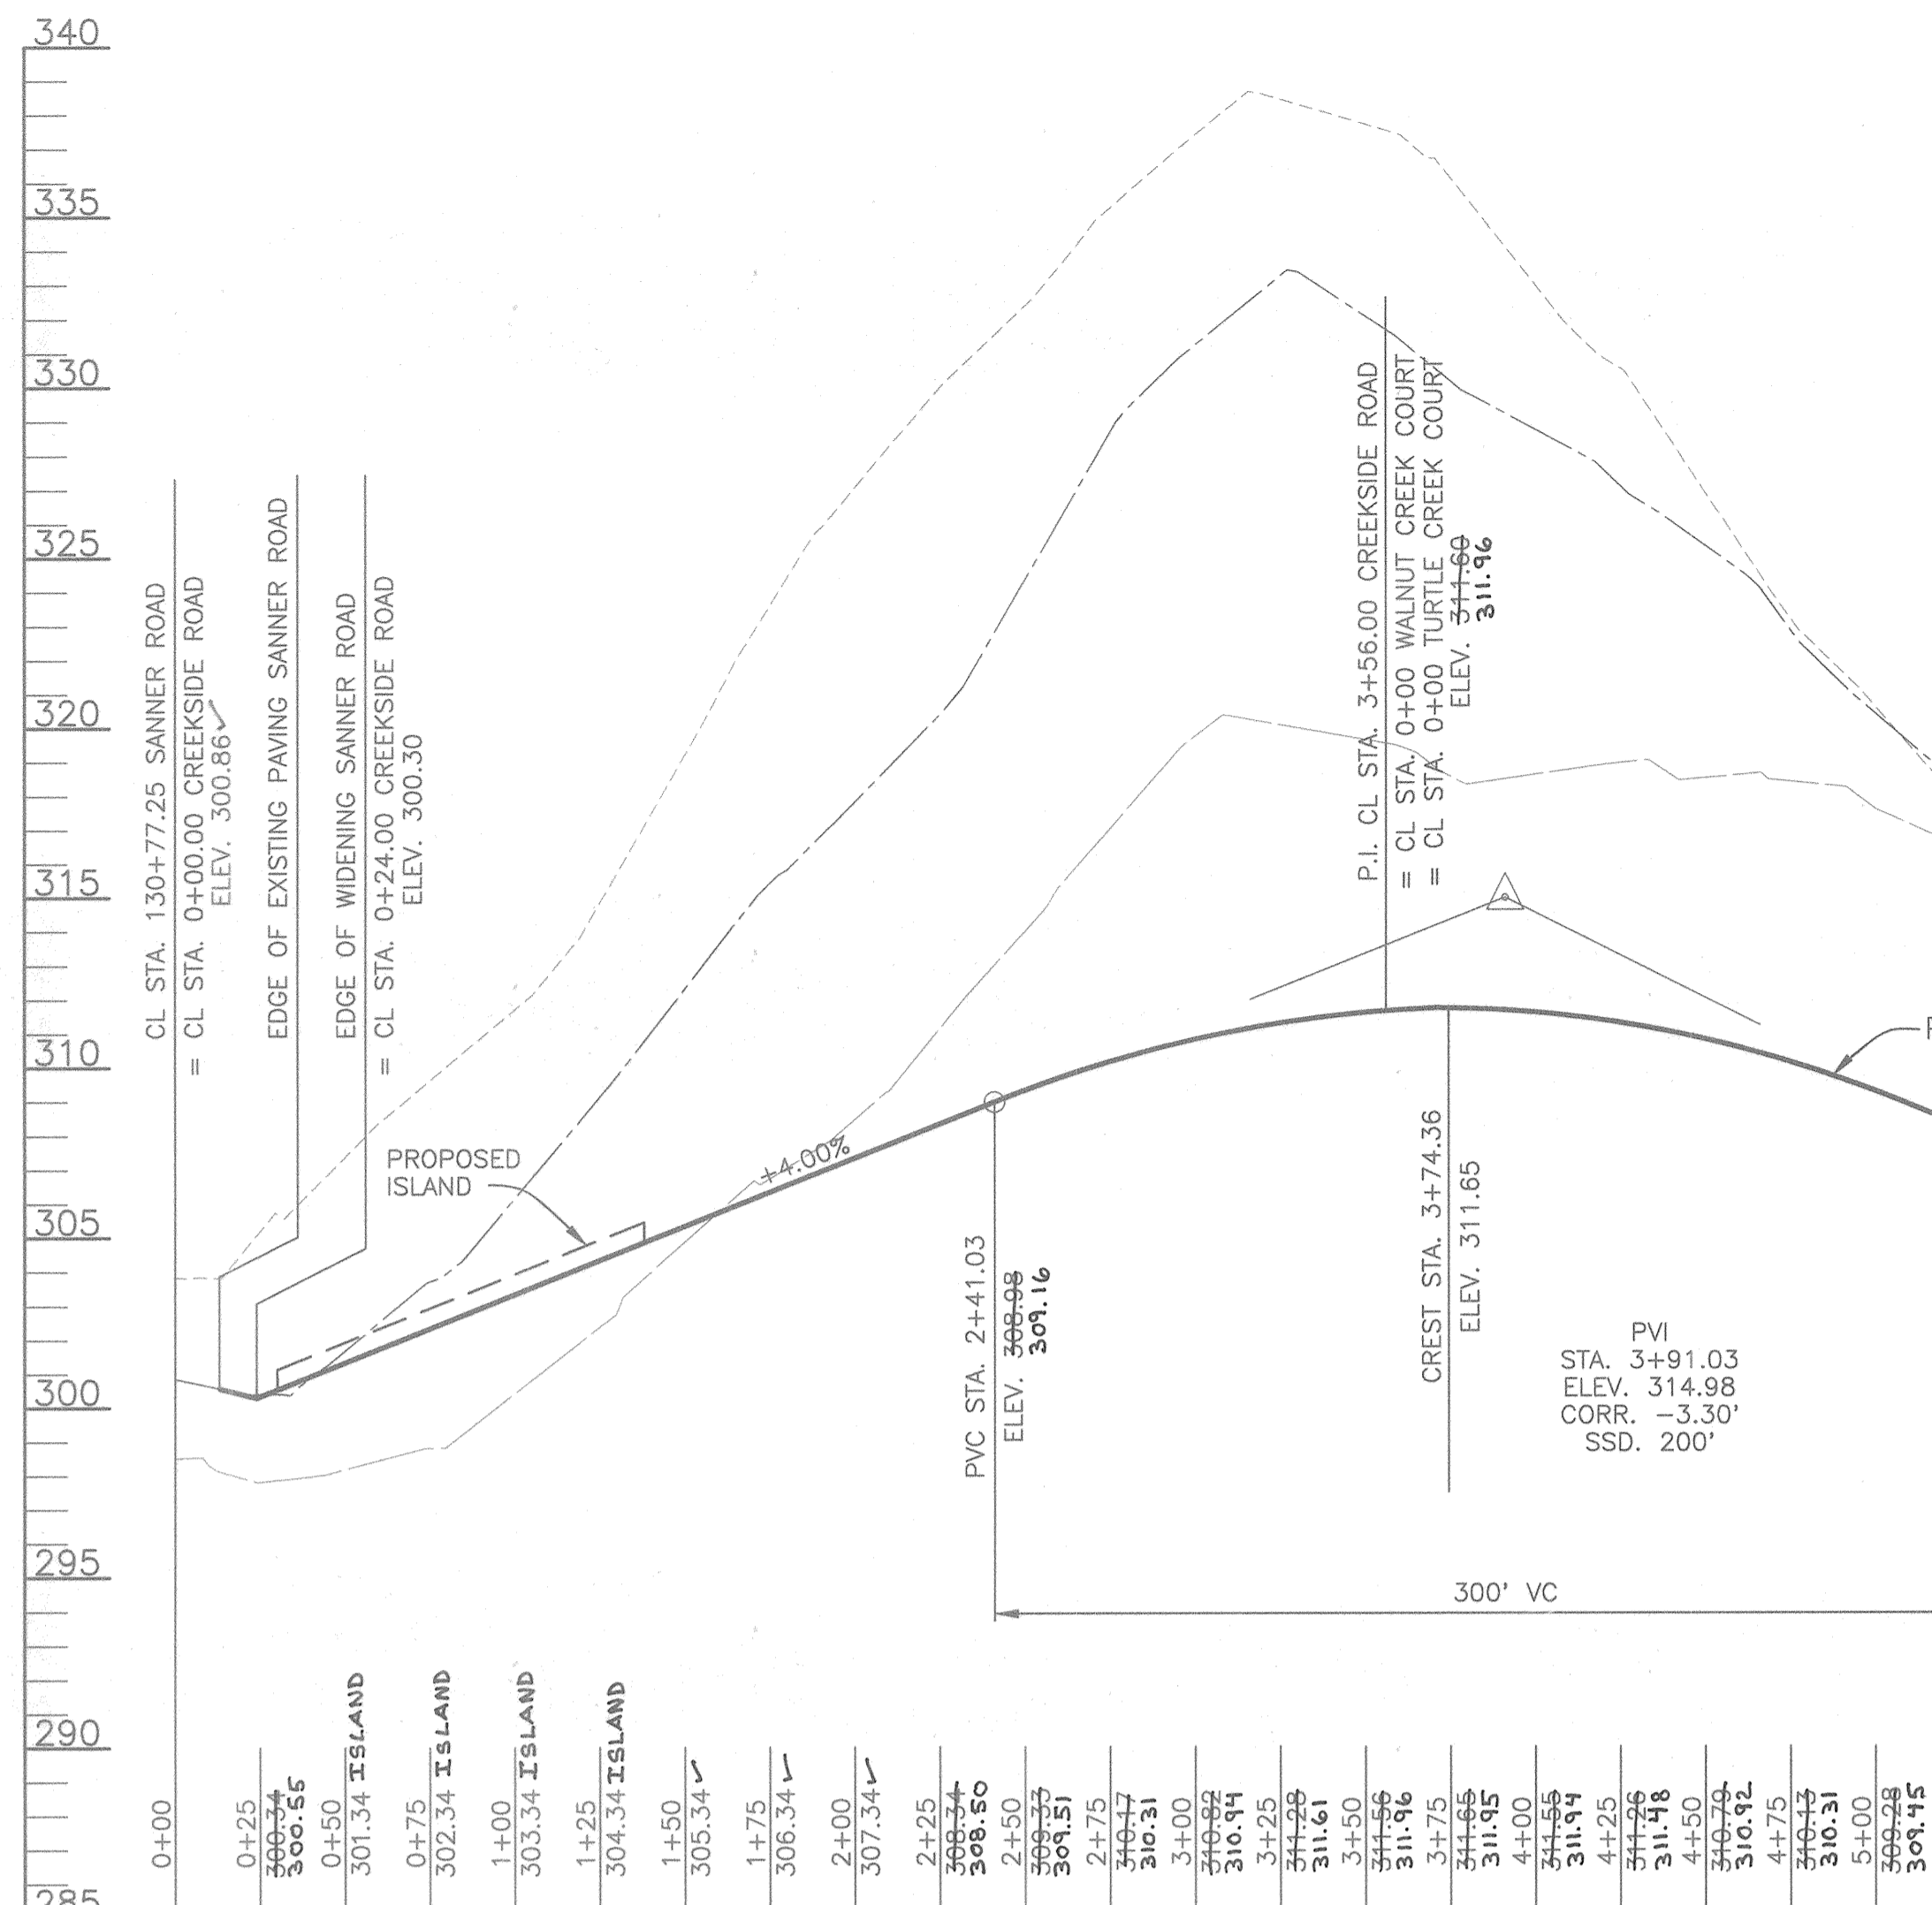


LOCAL ROAD  
DESIGN SPEED 30 MPH  
**CREEKSIDE ROAD**  
SCALE: 1"=50'HORIZ., 1"=5'VERT.


5+25	308.24
5+50	307.93
5+75	307.75
6+00	307.74
6+25	307.74
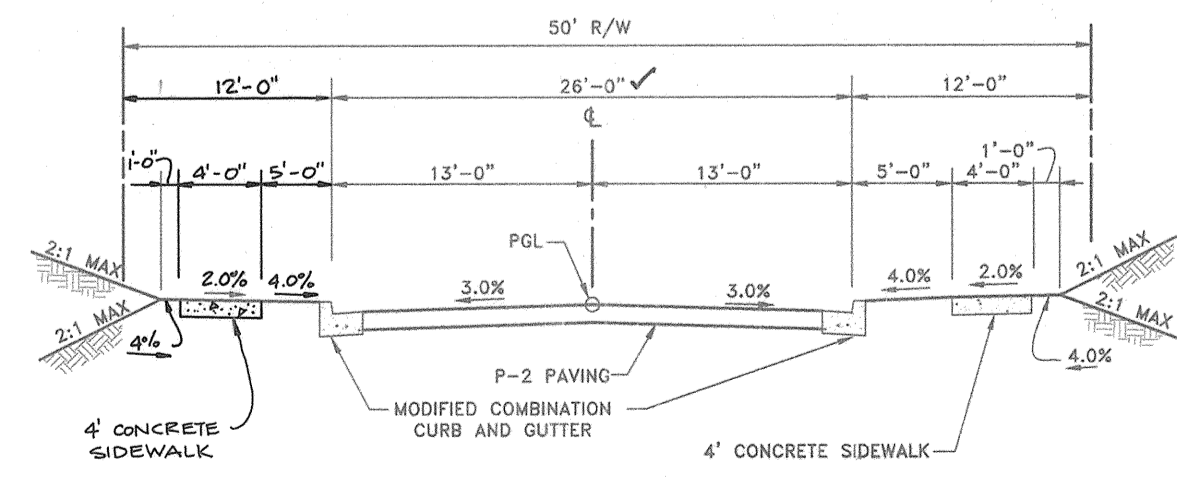

**TYPICAL ROAD SECTION**  
CLASSIFICATION: LOCAL ROAD  
DESIGN SPEED 30 MPH  
SCALE: NOT TO SCALE

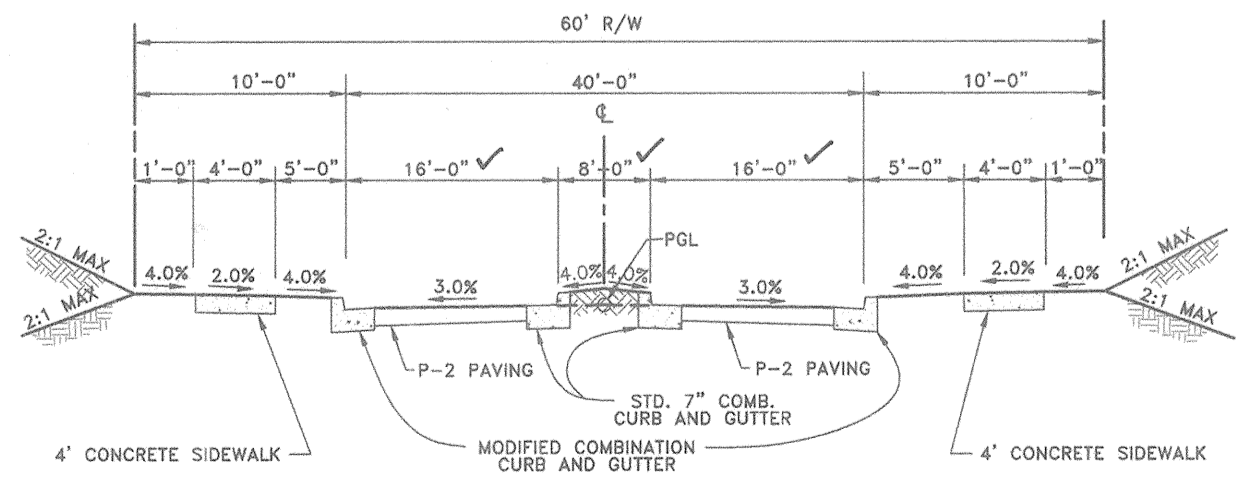

**TYPICAL ROAD SECTION**  
CLASSIFICATION: LOCAL ROAD  
DESIGN SPEED 30 MPH  
SCALE: NOT TO SCALE

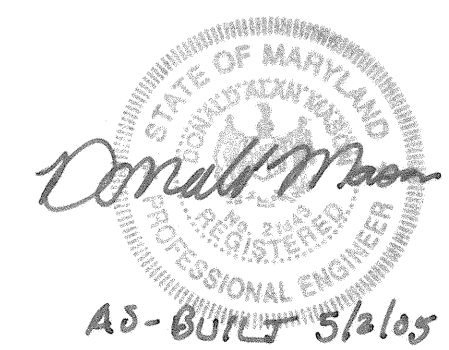

APPROVED: HOWARD COUNTY DEPARTMENT OF PUBLIC WORKS  
*Andrew M. Druker* 6-15-98  
CHIEF, BUREAU OF HIGHWAYS  
DATE

APPROVED: HOWARD COUNTY DEPARTMENT OF PLANNING AND ZONING  
*Colanita* 6/23/98  
CHIEF, DIVISION OF LAND DEVELOPMENT  
DATE



*Donald M. Mason* 6/22/98  
CHIEF, DEVELOPMENT ENGINEERING DIVISION  
DATE

NO.	DATE	REVISION
1	4/21/05	REVISED PER AS-BUILT CONDITIONS


**TSA GROUP, INC.**  
planning • architecture • engineering • surveying  
8480 Baltimore National Pike • Ellicott City, Maryland 21043 • 410-466-6106

<b>OWNERS:</b>	TOLL MD LIMITED PARTNERSHIP, A MARYLAND LIMITED PARTNERSHIP 3206 TOWER OAKS BOULEVARD SUITE 310 ROCKVILLE, MARYLAND 20852
<b>DEVELOPER:</b>	TOLL MD LIMITED PARTNERSHIP, A MARYLAND LIMITED PARTNERSHIP 3206 TOWER OAKS BOULEVARD SUITE 310 ROCKVILLE, MARYLAND 20852
<b>PROJECT:</b>	<b>VILLAGE OF CEDAR RIDGE</b> A SUBDIVISION OF PARCEL 44 (TAX MAP 41) AND A RESUBDIVISION OF LOTS 1 AND 2 OF THE EDITH S. PARLETTE SUBDIVISION (PLAY 10724 PARCEL 43) AND A SUBDIVISION OF PARCEL 123 FOR A ROAD RIGHT-OF-WAY
<b>LOCATION:</b>	TAX MAP 41 - PARCELS 43 & 44, P/O 123 5th ELECTION DISTRICT HOWARD COUNTY, MARYLAND
<b>TITLE:</b>	<b>ROAD PROFILES</b>
<b>DATE:</b>	SP-97-02 WP-97-78 PB 312 F-93-70 WP-98-82 OCTOBER, 1997 MAY, 1998
<b>DESIGN:</b>	DAM DRAFT: DBT CHECK: DAM
<b>SCALE:</b>	AS SHOWN
<b>SHEET</b>	7 OF 31




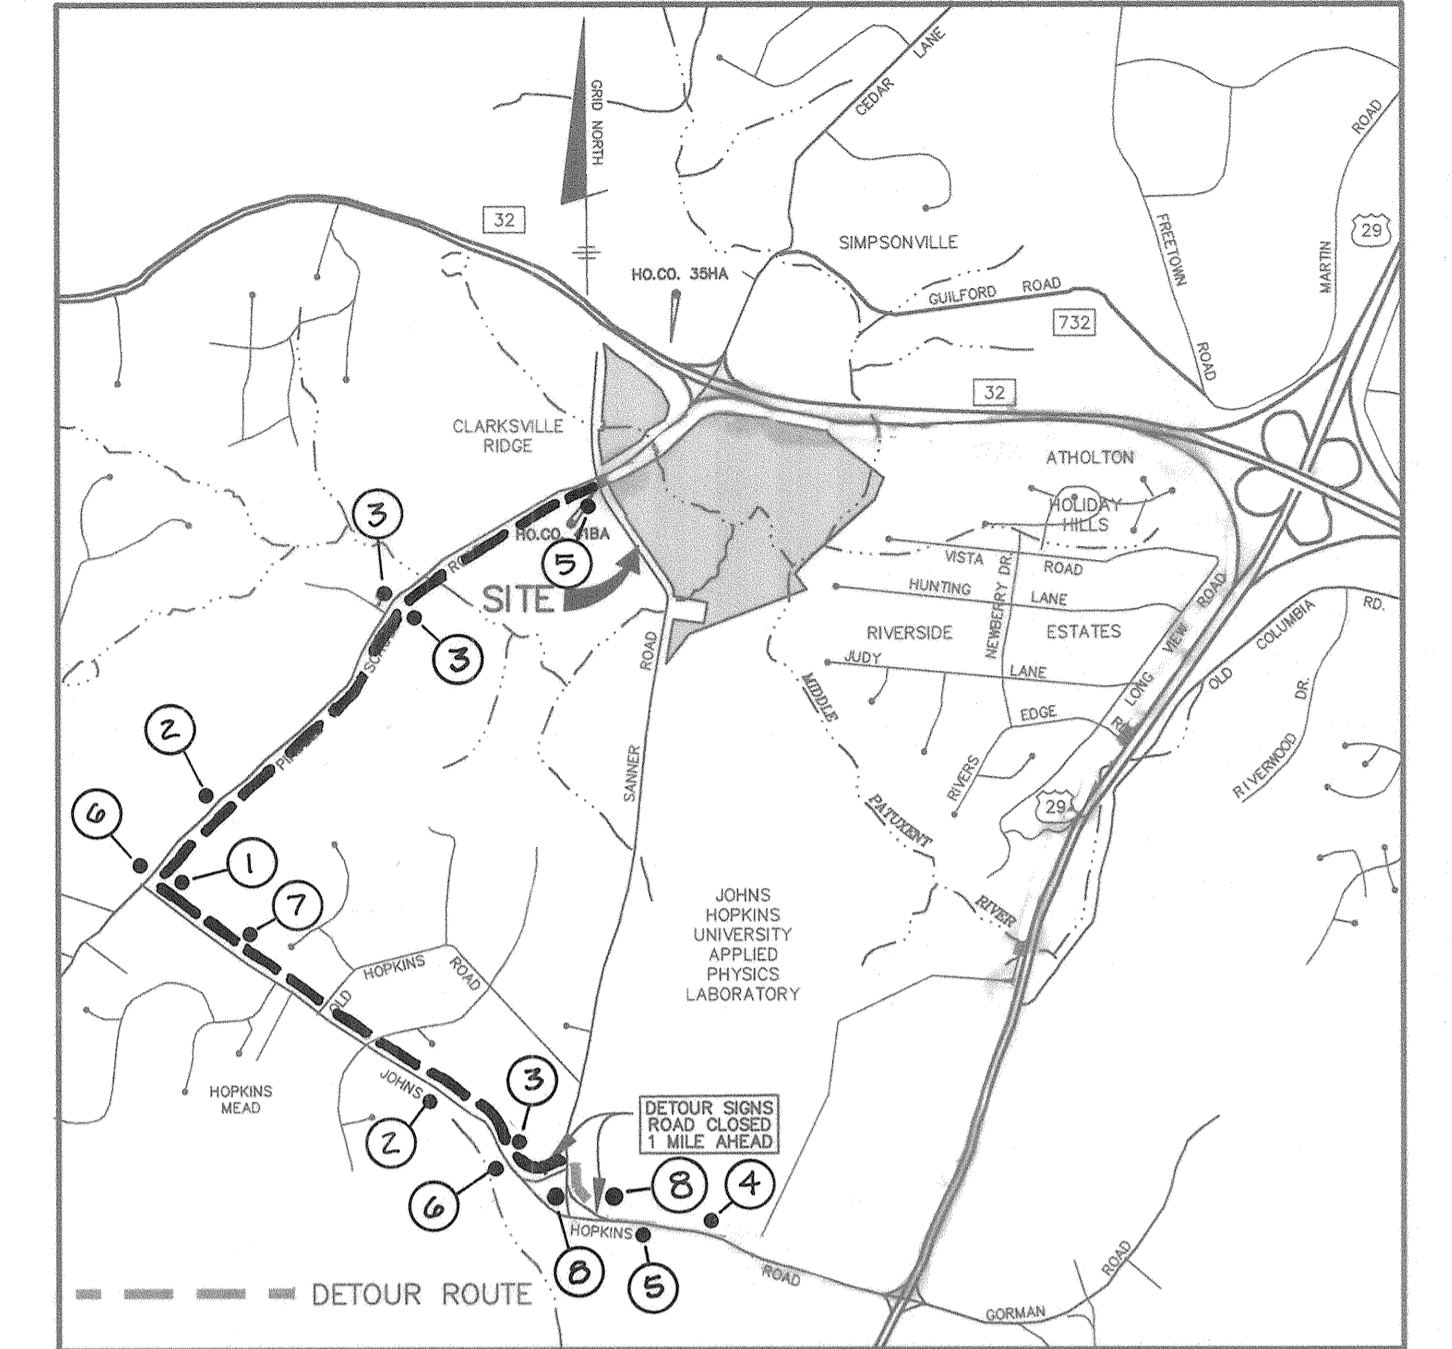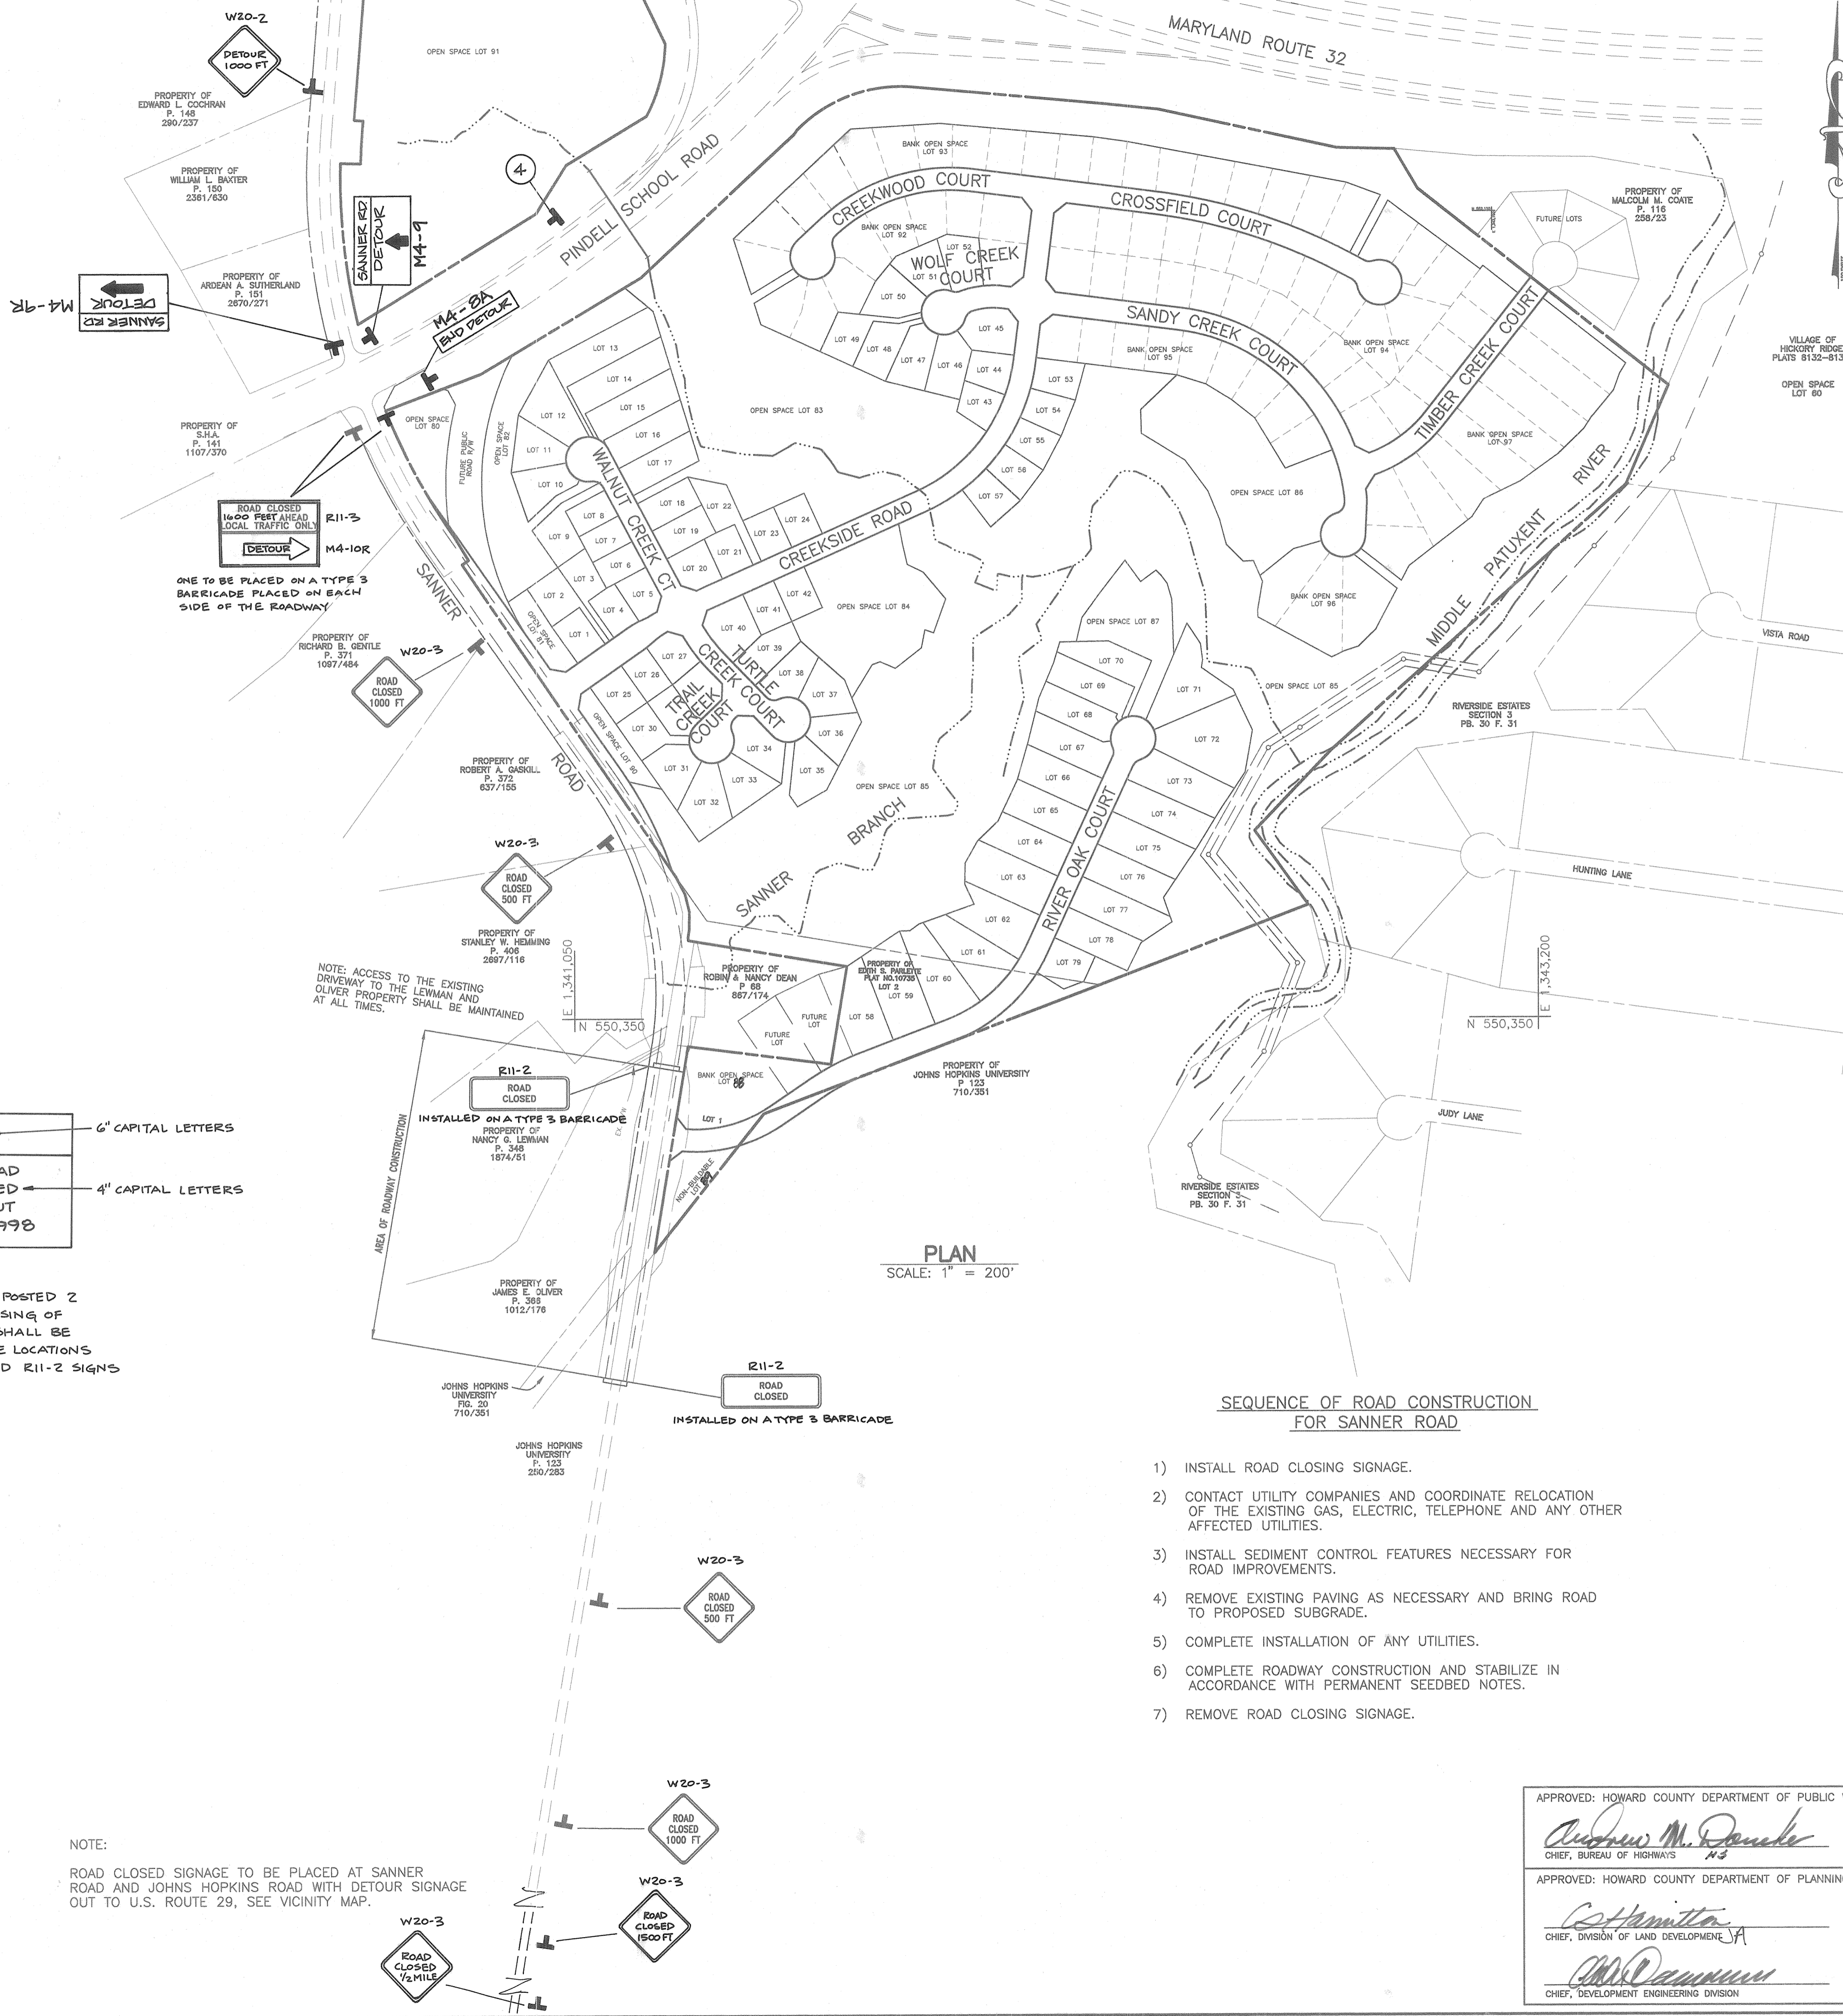

VICINITY MAP FOR DETOUR ROUTE  
SCALE: 1" = 2000'

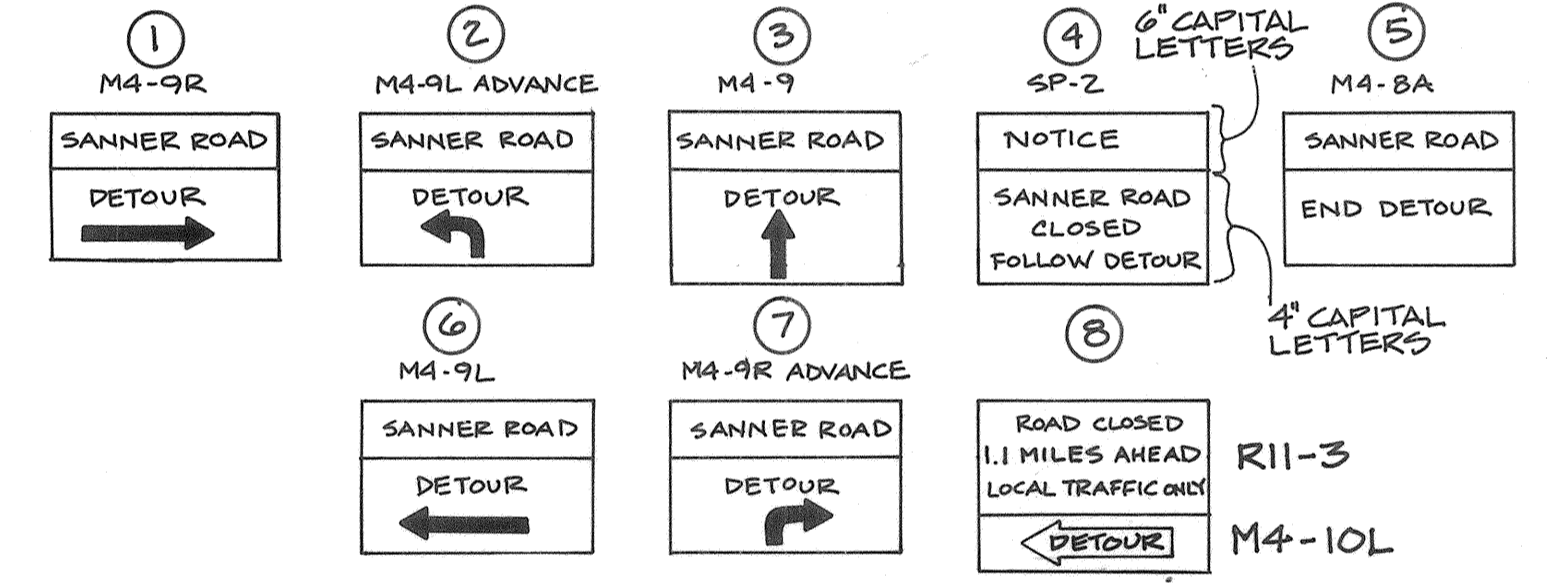

NOTES:  
1. ALL DETOUR SIGNAGE SHALL HAVE SANNER ROAD NAME SIGN PLACED ABOVE. 30" X 6" SIGN, CAPITAL LETTERS.

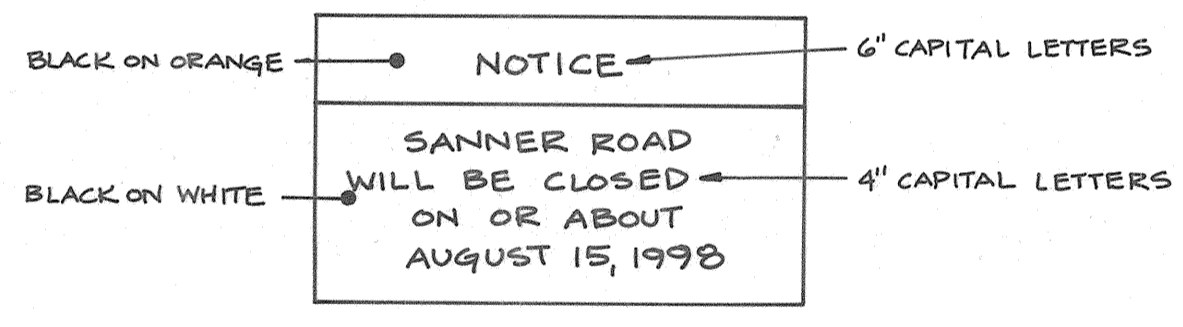

\* THIS SIGN SHALL BE POSTED 2 WEEKS PRIOR TO CLOSING OF SANNER ROAD AND SHALL BE PLACED AT THE SAME LOCATIONS AS THE ROAD CLOSED R11-2 SIGNS ARE TO BE PLACED.

PLAN  
SCALE: 1" = 200'

SEQUENCE OF ROAD CONSTRUCTION FOR SANNER ROAD

- 1) INSTALL ROAD CLOSING SIGNAGE.
- 2) CONTACT UTILITY COMPANIES AND COORDINATE RELOCATION OF THE EXISTING GAS, ELECTRIC, TELEPHONE AND ANY OTHER AFFECTED UTILITIES.
- 3) INSTALL SEDIMENT CONTROL FEATURES NECESSARY FOR ROAD IMPROVEMENTS.
- 4) REMOVE EXISTING PAVING AS NECESSARY AND BRING ROAD TO PROPOSED SUBGRADE.
- 5) COMPLETE INSTALLATION OF ANY UTILITIES.
- 6) COMPLETE ROADWAY CONSTRUCTION AND STABILIZE IN ACCORDANCE WITH PERMANENT SEEDBED NOTES.
- 7) REMOVE ROAD CLOSING SIGNAGE.

NO.	DATE	REVISION
1	8-4-98	REVISE DETOUR ROUTE AND SIGNAGE

TSA GROUP, INC.  
planning • architecture • engineering • surveying  
8460 Baltimore National Pike • Ellicott City, Maryland 21048 • 410-465-6105  
*Donald Mason*



OWNERS: TOLL MD LIMITED PARTNERSHIP, A MARYLAND LIMITED PARTNERSHIP 3206 TOWER OAKS BOULEVARD SUITE 310 ROCKVILLE, MARYLAND 20852	PROJECT: VILLAGE OF CEDAR RIDGE A SUBDIVISION OF PARCEL 44 (TAX MAP 41) AND A RESUBDIVISION OF LOTS 1 AND 2 OF THE 60TH S. PARLETTE SUBDIVISION (PLAT 10735 PARCEL 43) AND A SUBDIVISION OF PARCEL 123 FOR A ROAD RIGHT-OF-WAY
DEVELOPER: JOHN HOPKINS UNIVERSITY 11100 JOHN HOPKINS ROAD LAUREL, MARYLAND 20723-6005	LOCATION: TAX MAP 41 - PARCELS 43 & 44, P/O 123 5th ELECTION DISTRICT HOWARD COUNTY, MARYLAND
TITLE: SANNER ROAD TRAFFIC CONTROL PLAN	DATE: OCTOBER, 1997 MAY, 1998
DESIGN: DAM	DRAFT: DBT CHECK: DAM
SCALE: AS SHOWN	SHEET 5 OF 31


APPROVED: HOWARD COUNTY DEPARTMENT OF PUBLIC WORKS  
*Andrew M. D... 6-15-98*  
CHIEF, BUREAU OF HIGHWAYS

APPROVED: HOWARD COUNTY DEPARTMENT OF PLANNING AND ZONING  
*... 6/23/98*  
CHIEF, DIVISION OF LAND DEVELOPMENT

*... 6/23/98*  
CHIEF, DEVELOPMENT ENGINEERING DIVISION

NOTE:  
ROAD CLOSED SIGNAGE TO BE PLACED AT SANNER ROAD AND JOHN HOPKINS ROAD WITH DETOUR SIGNAGE OUT TO U.S. ROUTE 29, SEE VICINITY MAP.



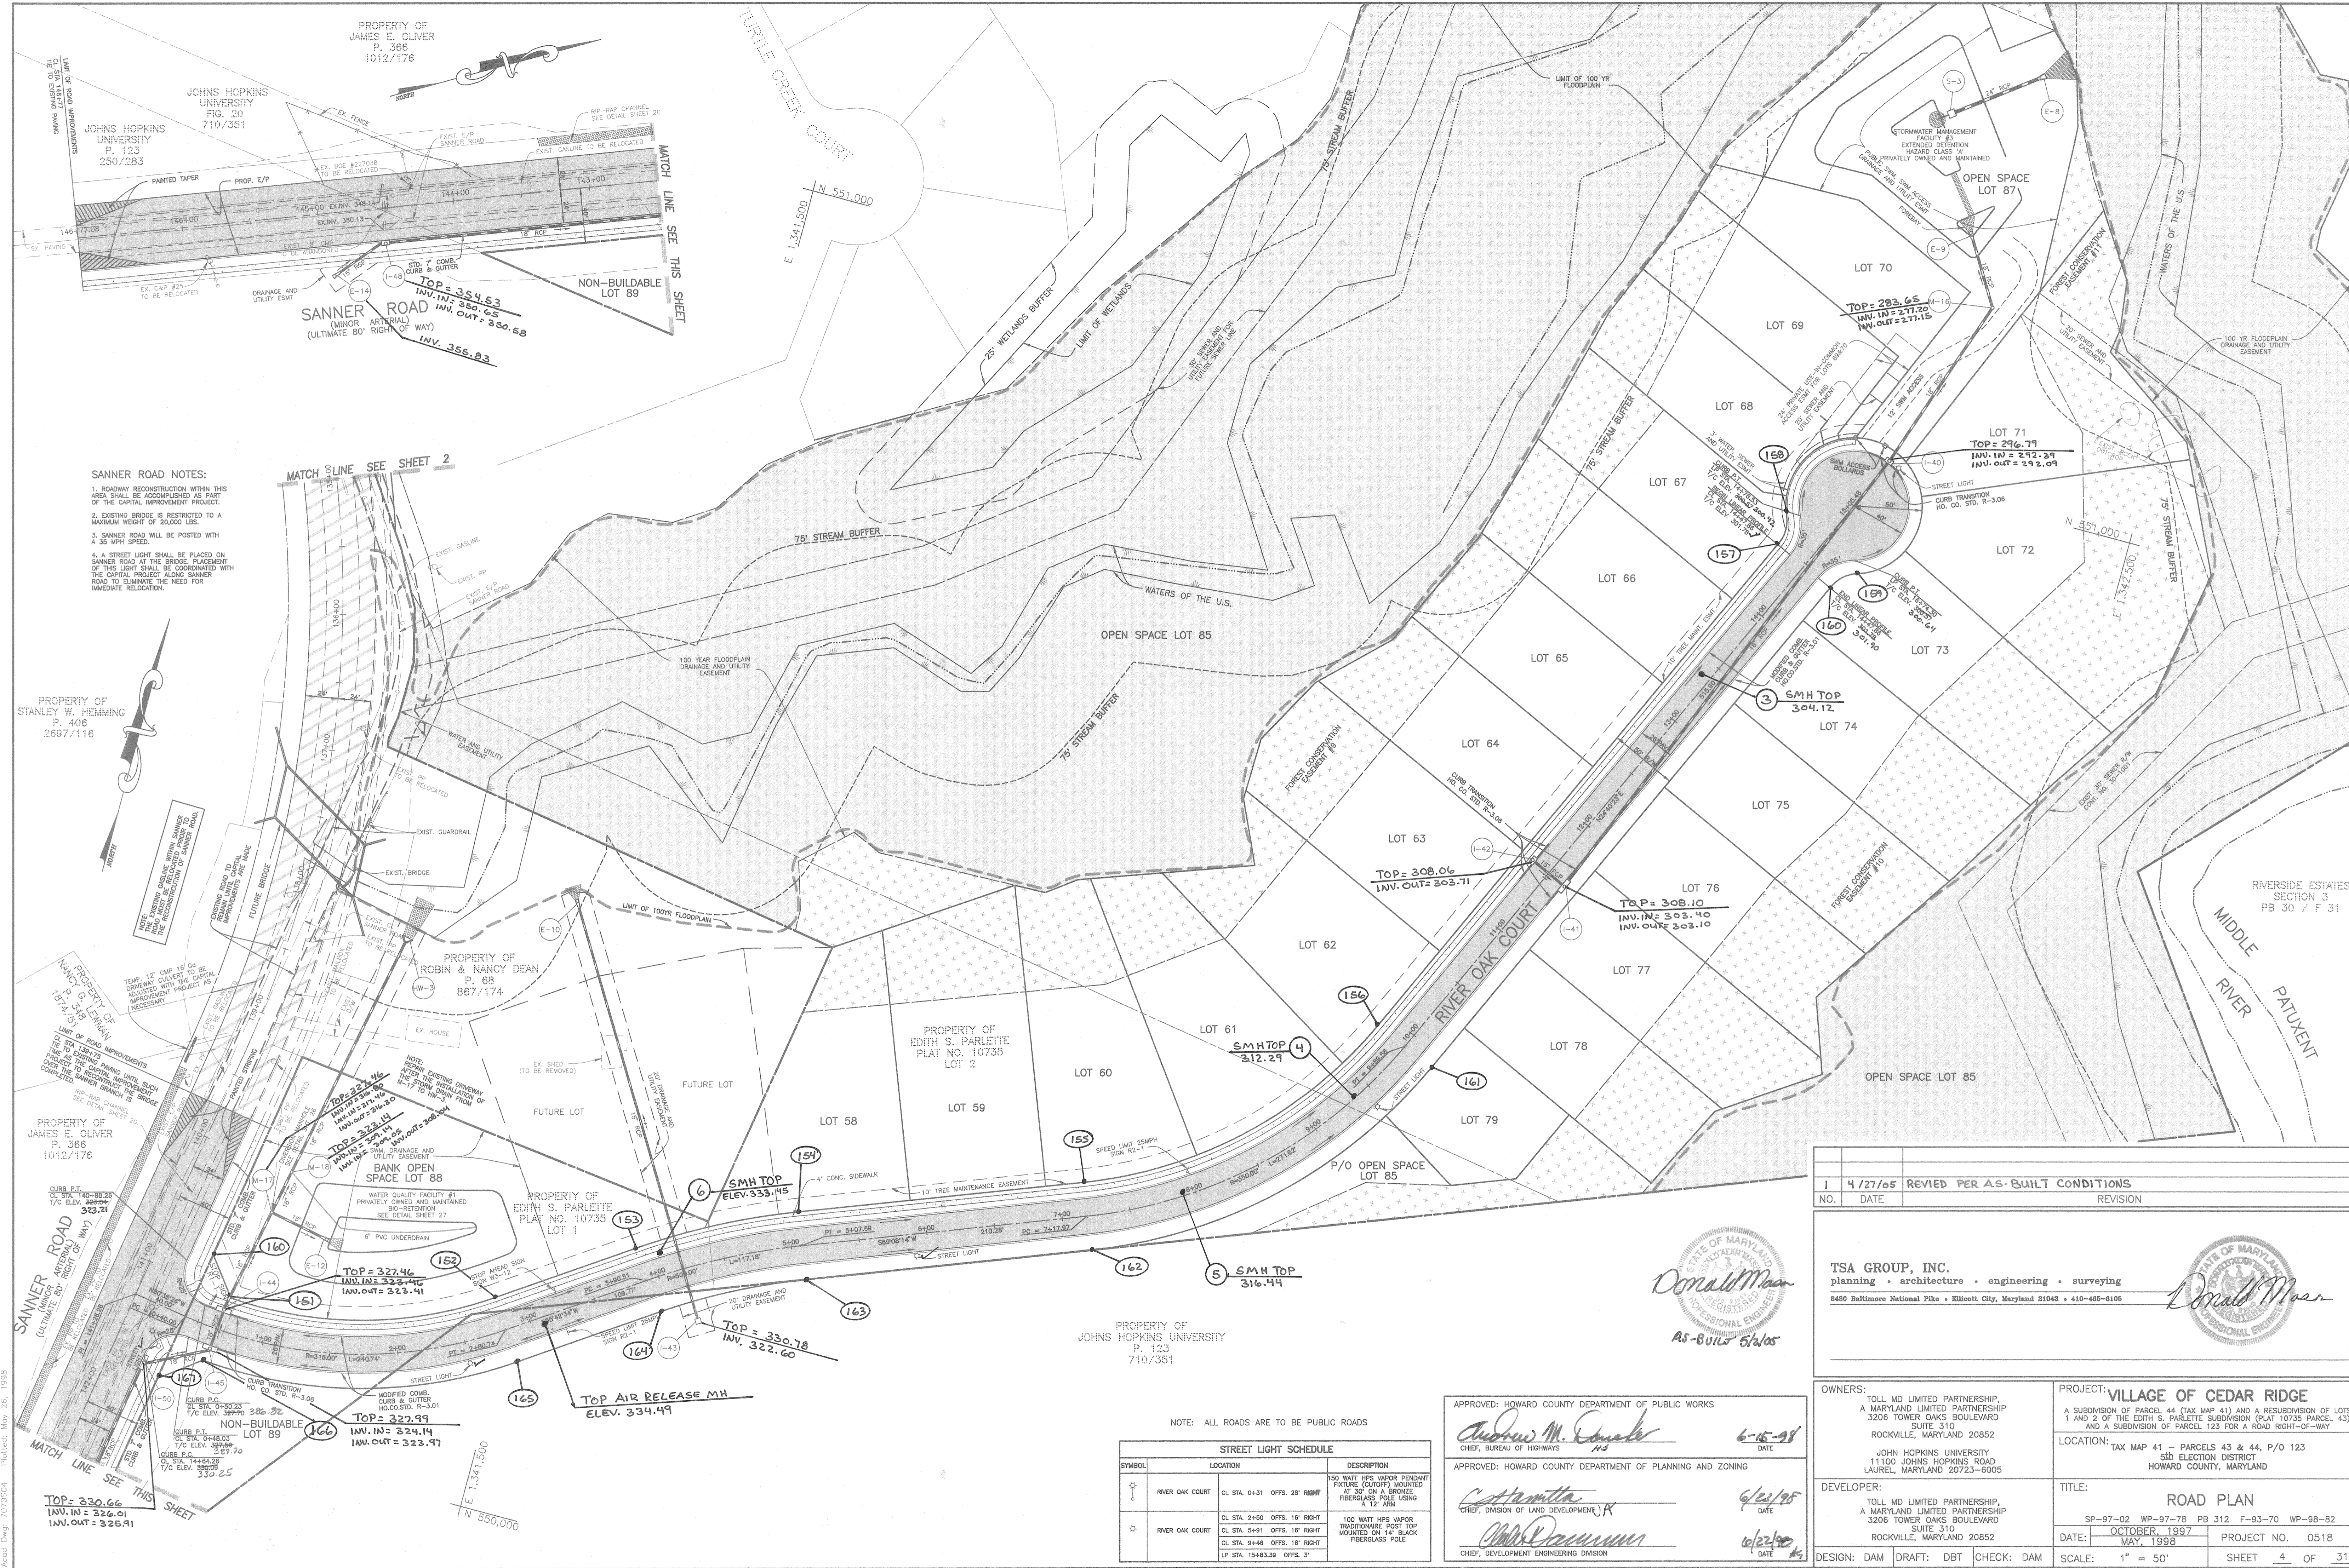

MATCH LINE SEE SHEET 2

**SANNER ROAD NOTES:**

- ROADWAY RECONSTRUCTION WITHIN THIS AREA SHALL BE ACCOMPLISHED AS PART OF THE CAPITAL IMPROVEMENT PROJECT.
- EXISTING BRIDGE IS RESTRICTED TO A MAXIMUM WEIGHT OF 20,000 LBS.
- SANNER ROAD SHALL BE POSTED WITH A 35 MPH SPEED.
- A STREET LIGHT SHALL BE PLACED ON SANNER ROAD AT THE BRIDGE. PLACEMENT OF THIS LIGHT SHALL BE COORDINATED WITH THE CAPITAL PROJECT ALONG SANNER ROAD TO ELIMINATE THE NEED FOR IMMEDIATE RELOCATION.

**SANNER ROAD**  
(MINOR ARTERIAL)  
(ULTIMATE 80' RIGHT OF WAY)

TOP = 354.53  
INV. IN = 350.65  
INV. OUT = 350.58

**BANK OPEN SPACE LOT 88**

TOP = 322.14  
INV. IN = 319.14  
INV. OUT = 320.45

**TOP AIR RELEASE MH**  
ELEV. 334.49

**TOP = 327.99**  
INV. IN = 324.14  
INV. OUT = 323.47

**TOP = 327.46**  
INV. IN = 323.41  
INV. OUT = 323.41

**TOP = 322.14**  
INV. IN = 319.14  
INV. OUT = 320.45

**TOP = 324.46**  
INV. IN = 321.46  
INV. OUT = 320.45

**TOP = 324.46**  
INV. IN = 321.46  
INV. OUT = 320.45

NOTE: ALL ROADS ARE TO BE PUBLIC ROADS

STREET LIGHT SCHEDULE		
SYMBOL	LOCATION	DESCRIPTION
(Symbol)	RIVER OAK COURT	CL. STA. 0+31 OFFS. 28' RIGHT 150 WATT HPS VAPOR PENDANT FITTURE (OUTOFF) MOUNTED AT 20' ON A BRONZE FIBERGLASS POLE USING A 12" ARM
(Symbol)	RIVER OAK COURT	CL. STA. 2+50 OFFS. 10' RIGHT CL. STA. 5+91 OFFS. 10' RIGHT CL. STA. 9+48 OFFS. 10' RIGHT LP STA. 15+83.38 OFFS. 3'

APPROVED: HOWARD COUNTY DEPARTMENT OF PUBLIC WORKS  
*Andrew M. Daniels* 6-15-98  
CHIEF, BUREAU OF HIGHWAYS

APPROVED: HOWARD COUNTY DEPARTMENT OF PLANNING AND ZONING  
*C. Hammit* 6/22/98  
CHIEF, DIVISION OF LAND DEVELOPMENT

APPROVED: HOWARD COUNTY DEPARTMENT OF PUBLIC WORKS  
*Donald M. Man* 6/22/98  
PROFESSIONAL ENGINEER

NO.	DATE	REVISION
1	4/27/05	REVISED PER A.S.-BUILT CONDITIONS

**TSA GROUP, INC.**  
planning • architecture • engineering • surveying  
8480 Baltimore National Pike • Ellicott City, Maryland 21045 • 410-465-8105

**OWNERS:**  
TOLL MD LIMITED PARTNERSHIP,  
A MARYLAND LIMITED PARTNERSHIP  
3206 TOWER OAKS BOULEVARD  
SUITE 310  
ROCKVILLE, MARYLAND 20852

**DEVELOPER:**  
TOLL MD LIMITED PARTNERSHIP,  
A MARYLAND LIMITED PARTNERSHIP  
3206 TOWER OAKS BOULEVARD  
SUITE 310  
ROCKVILLE, MARYLAND 20852

**PROJECT:**  
**VILLAGE OF CEDAR RIDGE**  
A SUBDIVISION OF PARCEL 44 (TAX MAP 41) AND A RESUBDIVISION OF LOTS  
1 AND 2 OF THE EDITH S. PARLETTE SUBDIVISION (PLAT 10735 PARCEL 43)  
AND A SUBDIVISION OF PARCEL 123 FOR A ROAD RIGHT-OF-WAY

**LOCATION:**  
TAX MAP 41 - PARCELS 43 & 44, P/O 123  
530 ELECTION DISTRICT  
HOWARD COUNTY, MARYLAND

**TITLE:**  
**ROAD PLAN**

SP-97-02 WP-97-78 PB 312 F-93-70 WP-98-82  
DATE: OCTOBER 1997 PROJECT NO. 0518  
MAY 1998  
SCALE: 1" = 50' SHEET 4 OF 31

Asad Dwg: 20702004 Printed: May 26, 1998



STREET LIGHT SCHEDULE		
SYMBOL	LOCATION	DESCRIPTION
○	CROSSFIELD COURT	CL STA. 3+88 OPTS. 16' LEFT
		LP STA. 8+30.94 OPTS. 3'
	SANDY CREEK COURT	CL STA. 5+54 OPTS. 16' LEFT
		CL STA. 9+00 OPTS. 16' LEFT
	TIMBER CREEK COURT	CL STA. 3+50 OPTS. 16' RIGHT



VILLAGE OF HICKORY RIDGE  
PLATS 8132-8134

OPEN SPACE  
LOT 60

*Donald Mason*  
Professional Engineer  
AS - 60115 5/2/05

RIVERSIDE ESTATES  
SECTION 3  
PB. 30 F. 31

NOTE: ALL ROADS ARE TO BE PUBLIC ROADS

APPROVED: HOWARD COUNTY DEPARTMENT OF PUBLIC WORKS  
*Andrew M. Daniels* 6/15/98  
CHIEF, BUREAU OF HIGHWAYS

APPROVED: HOWARD COUNTY DEPARTMENT OF PLANNING AND ZONING  
*C. Hamilton* 6/23/98  
CHIEF, DIVISION OF LAND DEVELOPMENT

*W. D. ...* 6/22/98  
CHIEF, DEVELOPMENT ENGINEERING DIVISION

NO.	DATE	REVISION
1	4/27/05	REVISED PER AS-BUILT CONDITIONS

**TSA GROUP, INC.**  
planning • architecture • engineering • surveying  
6460 Baltimore National Pike • Ellicott City, Maryland 21043 • 410-466-8105

*Donald Mason*  
Professional Engineer

OWNERS: TOLL MD LIMITED PARTNERSHIP, A MARYLAND LIMITED PARTNERSHIP, 3206 TOWER OAKS BOULEVARD, SUITE 310, ROCKVILLE, MARYLAND 20852

DEVELOPER: JOHN HOPKINS UNIVERSITY, 11100 JOHNS HOPKINS ROAD, LAUREL, MARYLAND 20723-6005

PROJECT: **VILLAGE OF CEDAR RIDGE**  
A SUBDIVISION OF PARCEL 44 (TAX MAP 41) AND A RESUBDIVISION OF LOTS 1 AND 2 OF THE EDITH S. PARLETTE SUBDIVISION (PLAT 10735 PARCEL 43) AND A SUBDIVISION OF PARCEL 123 FOR A ROAD RIGHT-OF-WAY.

LOCATION: TAX MAP 41 - PARCELS 43 & 44, P/O 123  
5th ELECTION DISTRICT  
HOWARD COUNTY, MARYLAND

TITLE: **ROAD PLAN**  
SP-97-02 WP-97-78 PB 312 F-93-70 WP-98-82

DATE: OCTOBER 1997  
MAY, 1998


PROJECT NO. 0518

DESIGN: DAM DRAFT: DBT CHECK: DAM SCALE: 1" = 50'

SHEET 3 OF 31

Asad Draw: 7/27/05/03 Printed: May 26, 1998



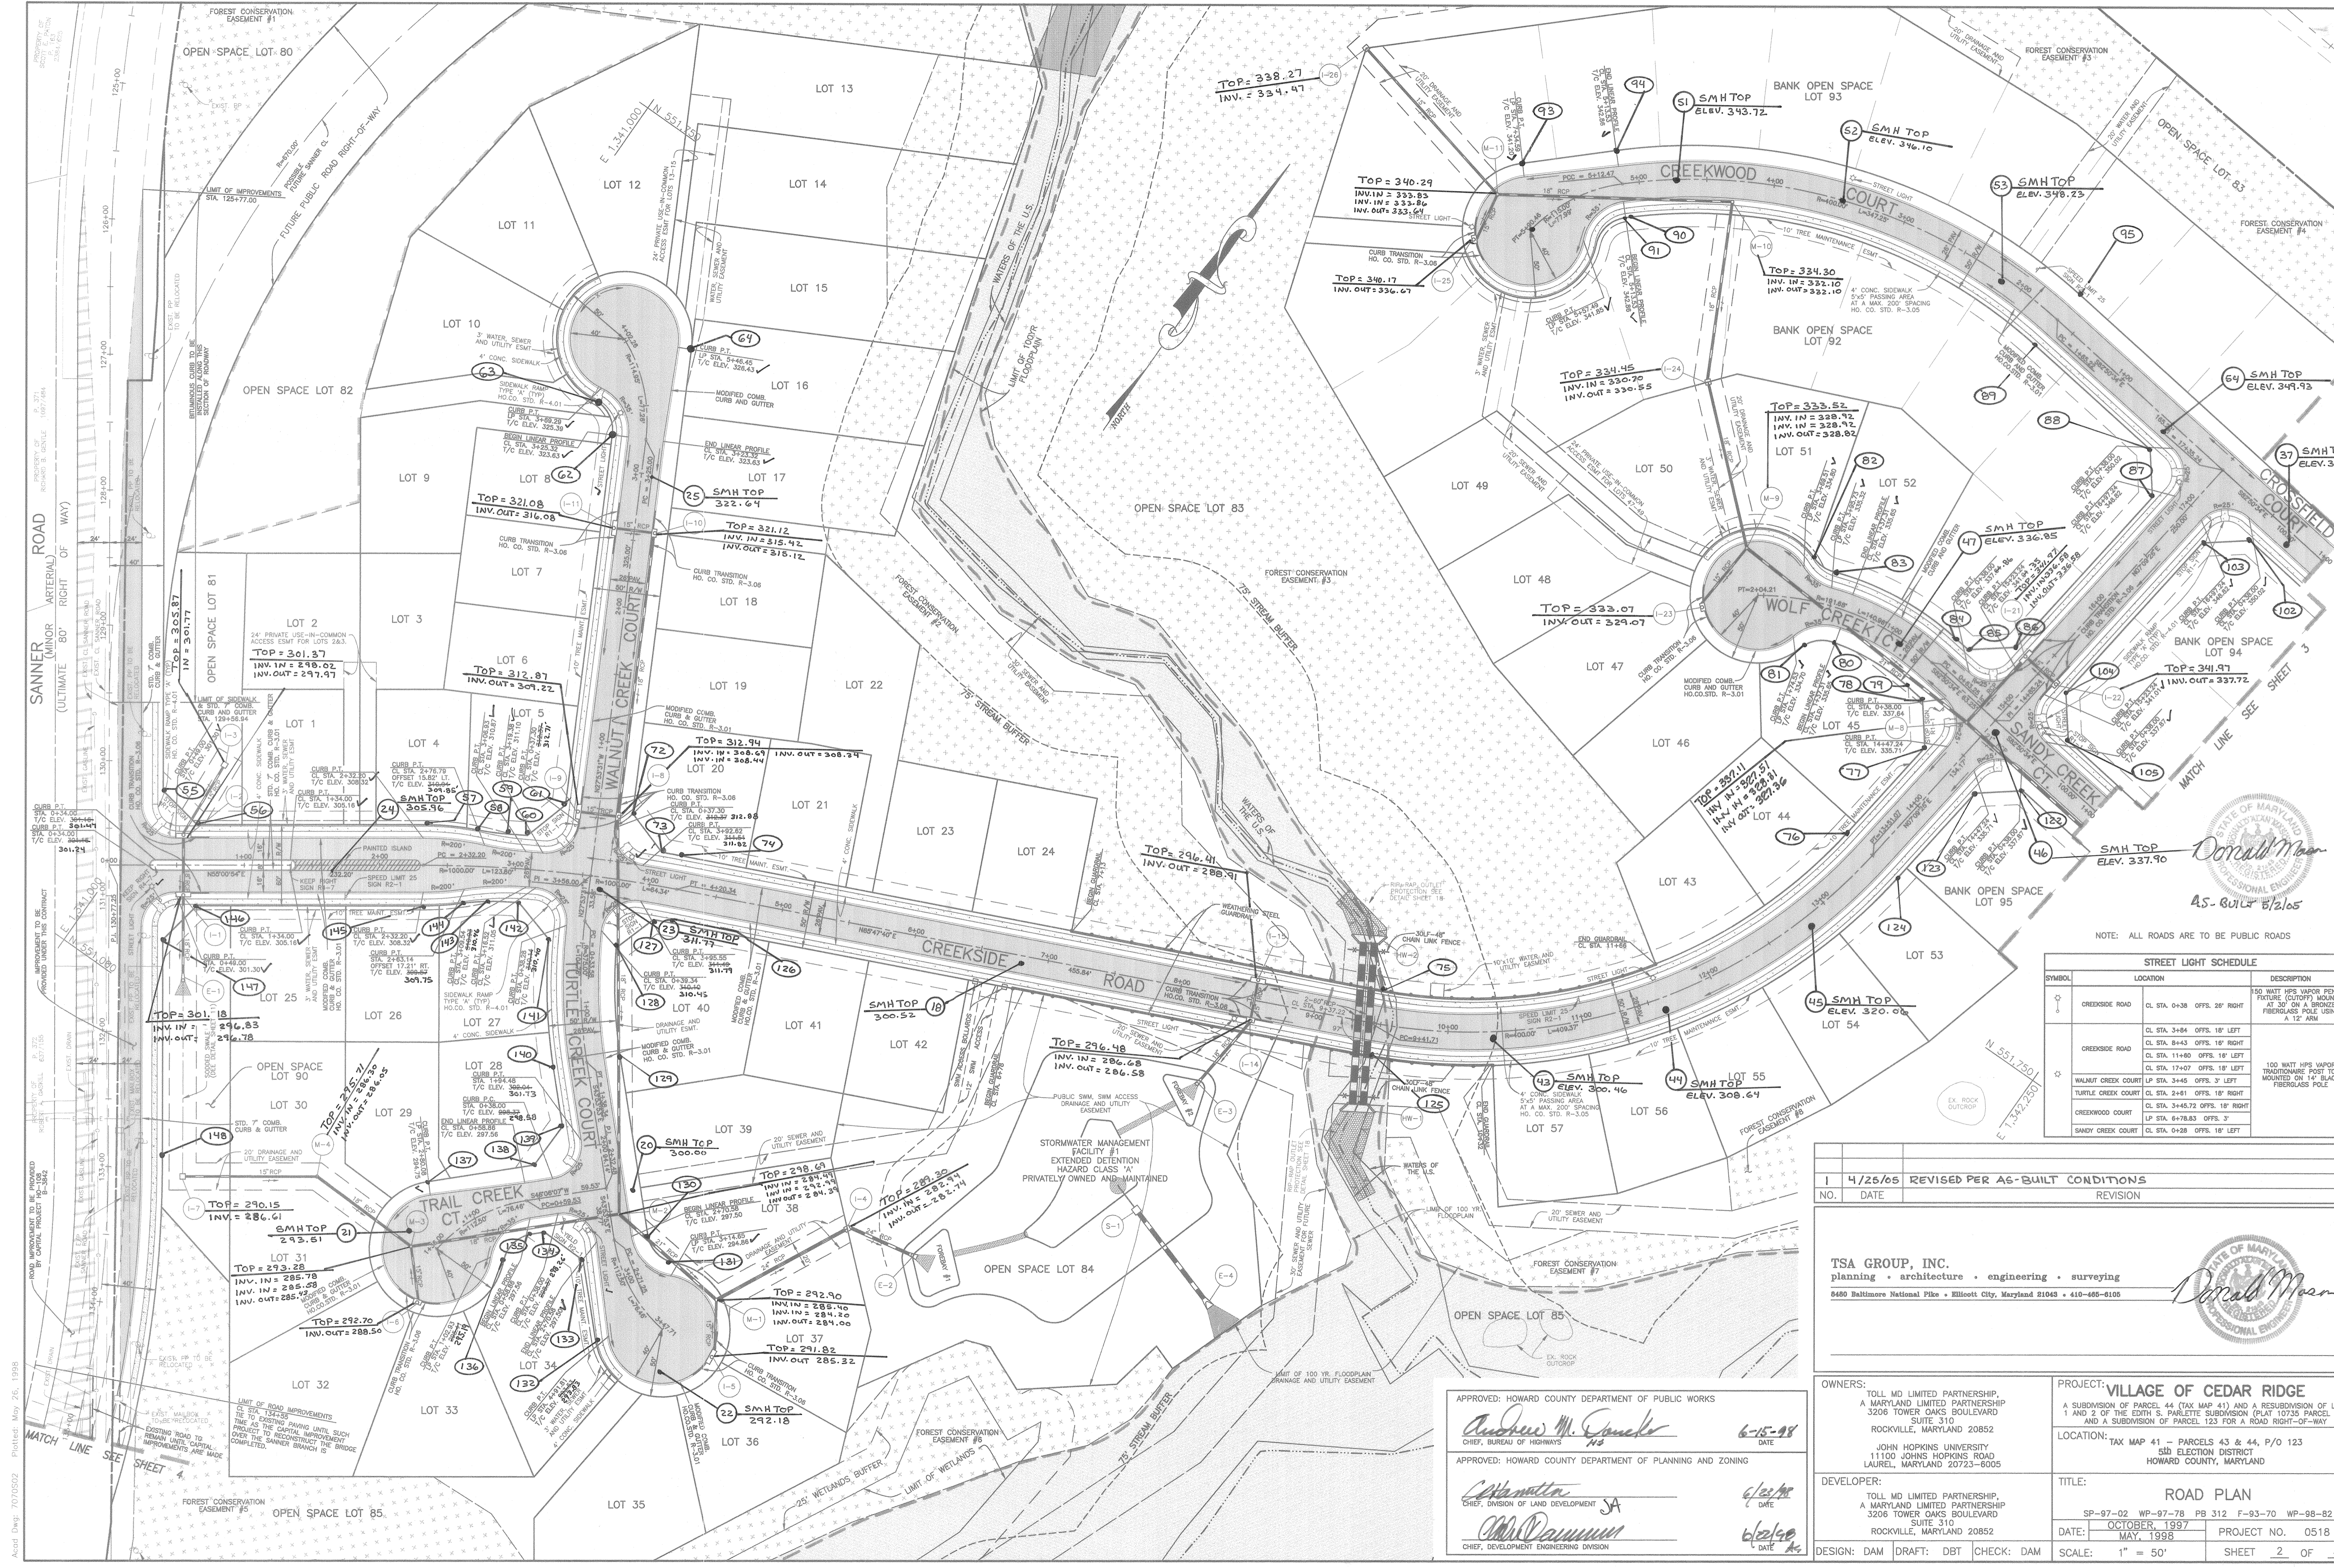

Donald Mason
   
 PROFESSIONAL ENGINEER
   
 45-0117 5/2/15

NOTE: ALL ROADS ARE TO BE PUBLIC ROADS

STREET LIGHT SCHEDULE			
SYMBOL	LOCATION	DESCRIPTION	
○	CREEKSIDE ROAD	CL STA. 0+38 OFFS. 26' RIGHT	150 WATT HPS VAPOR PENDANT FIXTURE (COTOPY) MOUNTED AT 30' ON A BRONZE, FIBERGLASS POLE USING A 12" ARM
○	CREEKSIDE ROAD	CL STA. 3+84 OFFS. 16' LEFT	
○	CREEKSIDE ROAD	CL STA. 8+43 OFFS. 16' RIGHT	
○	CREEKSIDE ROAD	CL STA. 11+80 OFFS. 16' LEFT	
○	WALNUT CREEK COURT	LP STA. 17+07 OFFS. 3' LEFT	100 WATT HPS VAPOR PENDANT FIXTURE MOUNTED ON 14" BLACK FIBERGLASS POLE
○	TURTLE CREEK COURT	CL STA. 2+61 OFFS. 16' RIGHT	
○	CREEKSIDE COURT	CL STA. 3+46.72 OFFS. 16' RIGHT	
○	SANDY CREEK COURT	LP STA. 6+78.83 OFFS. 3'	
○	SANDY CREEK COURT	CL STA. 0+28 OFFS. 16' LEFT	

NO.	DATE	REVISION
1	4/25/05	REVISED PER AS-BUILT CONDITIONS

**TSA GROUP, INC.**  
 planning • architecture • engineering • surveying  
 5680 Baltimore National Pike • Ellicott City, Maryland 21045 • 410-465-6105

Donald Mason
   
 PROFESSIONAL ENGINEER

**OWNERS:**  
 TOLL MD LIMITED PARTNERSHIP,  
 A MARYLAND LIMITED PARTNERSHIP  
 3206 TOWER OAKS BOULEVARD  
 SUITE 310  
 ROCKVILLE, MARYLAND 20852

**DEVELOPER:**  
 TOLL MD LIMITED PARTNERSHIP,  
 A MARYLAND LIMITED PARTNERSHIP  
 3206 TOWER OAKS BOULEVARD  
 SUITE 310  
 ROCKVILLE, MARYLAND 20852

**PROJECT:** VILLAGE OF CEDAR RIDGE  
 A SUBDIVISION OF PARCEL 44 (TAX MAP 41) AND A RESUBDIVISION OF LOTS 1 AND 2 OF THE EDITH S. PARLETT SUBDIVISION (PLAT 10735 PARCEL 43) AND A SUBDIVISION OF PARCEL 123 FOR A ROAD RIGHT-OF-WAY

**LOCATION:** TAX MAP 41 - PARCELS 43 & 44, P/O 123  
 5th ELECTION DISTRICT  
 HOWARD COUNTY, MARYLAND

**TITLE:** ROAD PLAN  
 SP-97-02 WP-97-78 PB 312 F-93-70 WP-98-82  
**DATE:** OCTOBER 1997  
 MAY 1998  
**PROJECT NO.:** 0518  
**SCALE:** 1" = 50'  
**SHEET 2 OF 31**

APPROVED: HOWARD COUNTY DEPARTMENT OF PUBLIC WORKS  
  
 Andrew M. Conner  
 CHIEF, BUREAU OF HIGHWAYS  
 6-15-98 DATE

APPROVED: HOWARD COUNTY DEPARTMENT OF PLANNING AND ZONING  
  
 William J. Hamilton  
 CHIEF, DIVISION OF LAND DEVELOPMENT  
 6/25/98 DATE

Chris Pannunzi  
 CHIEF, DEVELOPMENT ENGINEERING DIVISION  
 6/25/98 DATE

Acad. Draw: 70702022  
 Printed: May 26, 1998




# ROADWAYS, STORM DRAINAGE AND STORMWATER MANAGEMENT VILLAGE OF CEDAR RIDGE 5th ELECTION DISTRICT HOWARD COUNTY, MARYLAND

SHEET INDEX	
NO.	DESCRIPTION
1	TITLE SHEET
2	ROAD PLAN
3	ROAD PLAN
4	ROAD PLAN
5	SANNER ROAD TRAFFIC CONTROL PLAN
6	SANNER ROAD PROFILE AND DETAIL
7	ROAD PROFILES
8	ROAD PROFILES
9	ROAD PROFILES
10	ROAD PROFILES
11	ROAD PROFILES
12	DRAINAGE AREA MAP
13	STORM DRAIN PROFILES
14	STORM DRAIN PROFILES
15	STORM DRAIN PROFILES
16	STORM DRAIN PROFILES AND HEADWALL DETAILS
17	GRADING AND SEDIMENT AND EROSION CONTROL PLAN
18	GRADING AND SEDIMENT AND EROSION CONTROL PLAN
19	GRADING AND SEDIMENT AND EROSION CONTROL PLAN
20	GRADING AND SEDIMENT AND EROSION CONTROL PLAN
21	GRADING AND SEDIMENT AND EROSION CONTROL PLAN
22	SEDIMENT CONTROL NOTES AND DETAILS
23	STORMWATER MANAGEMENT DETAILS - POND #1
24	STORMWATER MANAGEMENT DETAILS - POND #2
25	STORMWATER MANAGEMENT DETAILS - POND #3
26	WQF/TEMPORARY STORMWATER MANAGEMENT DETAILS
27	SWM NOTES AND BORING DETAILS
28	LANDSCAPE PLAN
29	FOREST CONSERVATION PLAN
30	FOREST CONSERVATION PLAN AND DETAILS
31	FOREST CONSERVATION NOTES AND DETAILS




RIGHT OF WAY ELEVATION CHART NAD 83		
R/W P.I. NO.	DESCRIPTION	ELEVATION
82	REBAR # CAP	335.23'
83	REBAR # CAP	335.70'
84	REBAR # CAP	337.79'
85	REBAR # CAP	338.05'
86	REBAR # CAP	341.81'
87	P.K. NAIL IN DRIVEWAY	348.85'
88	REBAR # CAP	350.11'
89	REBAR # CAP	349.28'
90	REBAR # CAP	349.35'
91	REBAR # CAP	349.31'
92	P.K. NAIL IN DRIVEWAY	342.14'
93	REBAR # CAP	341.51'
94	REBAR # CAP	342.37'
95	REBAR # CAP	349.91'
96	REBAR # CAP	348.55'
97	REBAR # CAP	340.12'
98	REBAR # CAP	348.96'
99	REBAR # CAP	328.70'
100	REBAR # CAP	330.27'
101	REBAR # CAP	340.91'
102	CONC. MONUMENT SET	350.38'
103	REBAR # CAP	348.86'
104	REBAR # CAP	342.12'
105	REBAR # CAP	338.86'
106	REBAR # CAP	333.70'
107	REBAR # CAP	294.14'
108	REBAR # CAP	293.89'

RIGHT OF WAY ELEVATION CHART NAD 83		
R/W P.I. NO.	DESCRIPTION	ELEVATION
55	REBAR # CAP	305.98'
56	REBAR # CAP	302.29'
57	REBAR # CAP	308.82'
58	P.K. NAIL SET	310.29'
59	REBAR # CAP	310.76'
60	REBAR # CAP	311.104'
61	REBAR # CAP	313.29'
62	P.K. NAIL IN DRIVEWAY	324.23'
63	REBAR # CAP	325.58'
64	REBAR # CAP	326.51'
72	REBAR # CAP	313.50'
73	REBAR # CAP	312.32'
74	REBAR # CAP	312.02'
75	REBAR # CAP	297.17'
76	REBAR # CAP	327.28'
77	REBAR # CAP	325.40'
78	REBAR # CAP	327.60'
79	REBAR # CAP	327.49'
80	REBAR # CAP	326.17'
81	REBAR # CAP	325.34'

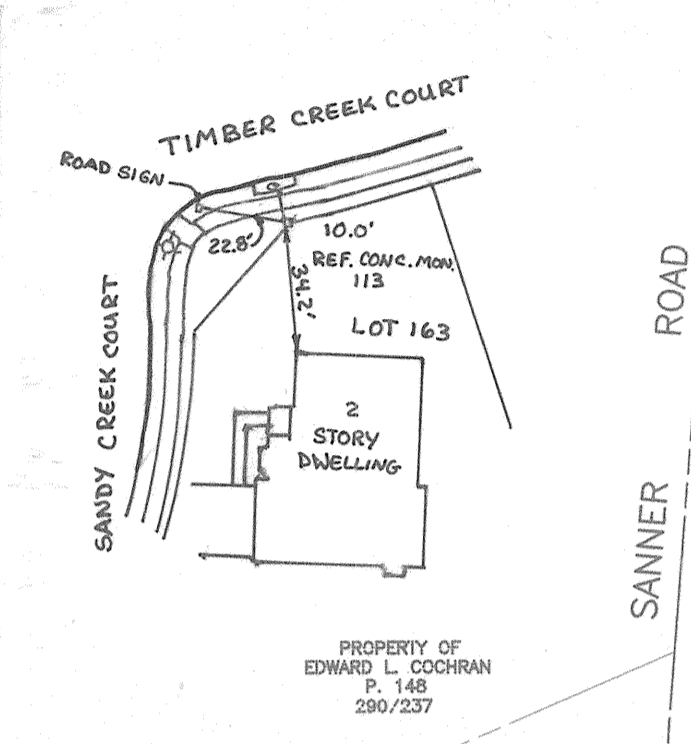

CENTERLINE CONTROL DATA			
STREET NAME	STATION	NORTH	EAST
CREEKSIDE ROAD	0+00	51064.2012	1340995.6189
	PC=2+32.20	51197.3378	1341185.8639
	PT=4+20.34	51290.1165	1341348.2158
	PC=9+41.71	51503.8814	1341824.7433
	PT=13+51.07	51818.8778	1342057.6228
CREEKWOOD COURT	0+00	52200.0538	1342105.4865
	PC=1+65.22	52220.6391	1341941.5496
	PCC=5+12.47	52218.2767	1341621.0523
	PT=5+90.46	52200.7243	1341585.1492
	0+00	52200.0538	1342105.4865
CROSSFIELD COURT	0+00	52170.0216	1342344.6561
	PT=7+81.44	51990.6676	1342849.9611
	0+00	52008.1501	1341229.3031
	PC=0+40.00	55008.6450	1341268.7706
	PT=2+80.74	55013.3618	1341498.1918
RIVER OAK COURT	PC=3+90.51	55019.2064	1341588.8848
	PT=5+07.69	55029.3286	1341692.5136
	PC=7+17.97	55032.2150	1341889.0042
	PT=9+89.58	55050.1637	1342082.4048
	15+05.48	55073.9641	1342297.7616
SANDY CREEK COURT	0+00	55192.0017	1342074.3390
	PC=3+32.33	551910.5968	1342404.0780
	PCC=9+30.78	551516.1790	1342794.9880
	PT=10+26.34	551427.5247	1342767.4980
	0+00	551571.8844	1342784.9142
TIMBER CREEK COURT	PC=0+14.44	551575.3439	1342798.9378
	PT=2+23.86	551686.8482	1342971.6759
	6+04.85	551986.3698	1343207.1435
	0+00	551079.7658	1341433.6226
	PC=0+59.53	551036.4864	1341390.7239
TRAIL CREEK COURT	PT=1+36.00	550971.4429	1341357.1059
	0+00	551261.8666	1341291.4197
	PC=0+33.58	551232.1896	1341307.1275
	PT=1+38.34	551147.6008	1341368.3482
	PC=2+71.25	551051.8261	1341460.5076
TURTLE CREEK COURT	PT=3+47.71	551018.2081	1341527.5511
	0+00	551261.8666	1341291.4197
	PC=3+25.00	551549.1118	1341139.3828
	PT=4+02.26	551600.6743	1341083.8051
	0+00	551952.0017	1342074.3390
WOLF CREEK COURT	PC=0+63.25	551959.8817	1342011.5851
	PT=2+04.21	551926.7531	1341877.8215

CENTER LINE CURVE DATA						
STREET NAME	STATION	RADIUS	ARC	DELTA	TANGENT	CHORD
CREEKSIDE ROAD	PC=2+32.20	188.14'	107'48"46"	94.35'	S60°24'17"W	187.88'
	PT=4+20.34	400.00'	409.37'	58°38'15"	N36°28'33"E	391.73'
CREEKWOOD COURT	PC=1+65.22	400.00'	347.25'	49°44'23"	N72°17'14"E	336.45'
	PT=5+90.46	115.00'	77.99'	38°51'17"	S27°59'24"W	76.50'
CROSSFIELD COURT	PC=2+41.05	1250.00'	540.39'	24°46'11"	N70°27'29"W	536.19'
	PT=7+81.44	316.00'	240.74'	43°39'00"	N73°32'04"E	234.98'
RIVER OAK COURT	PC=3+90.51	117.18'	13'25'40"	58.86'	S62°25'24"W	116.91'
	PT=5+07.69	350.00'	271.62'	44°27'51"	S45°54'18"W	264.85'
SANDY CREEK COURT	PC=3+32.33	450.00'	598.45'	76°11'51"	N44°44'39"W	555.32'
	PT=9+30.78	114.67'	95.56'	47°44'50"	N17°13'42"E	92.82'
TIMBER CREEK COURT	PC=0+14.44	316.00'	209.41'	37°58'11"	N108°71'	205.60'
	PT=2+23.86	112.50'	76.46'	38°56'33"	N26°37'51"E	75.00'
TRAIL CREEK COURT	PC=0+33.58	375.00'	104.76'	16°00'22"	N35°53'42"W	104.42'
	PT=1+38.34	112.50'	76.46'	38°56'33"	N63°22'09"W	75.00'
TURTLE CREEK COURT	PC=2+71.25	112.50'	76.46'	38°56'33"	N63°22'09"W	75.00'
	PT=3+47.71	114.95'	77.28'	38°30'30"	N47°08'46"E	75.61'
WALNUT CREEK COURT	PC=3+85.48	114.95'	77.28'	38°30'30"	N47°08'46"E	75.61'
	PT=4+62.74	181.68'	140.96'	42°08'05"	N76°05'23"E	137.81'

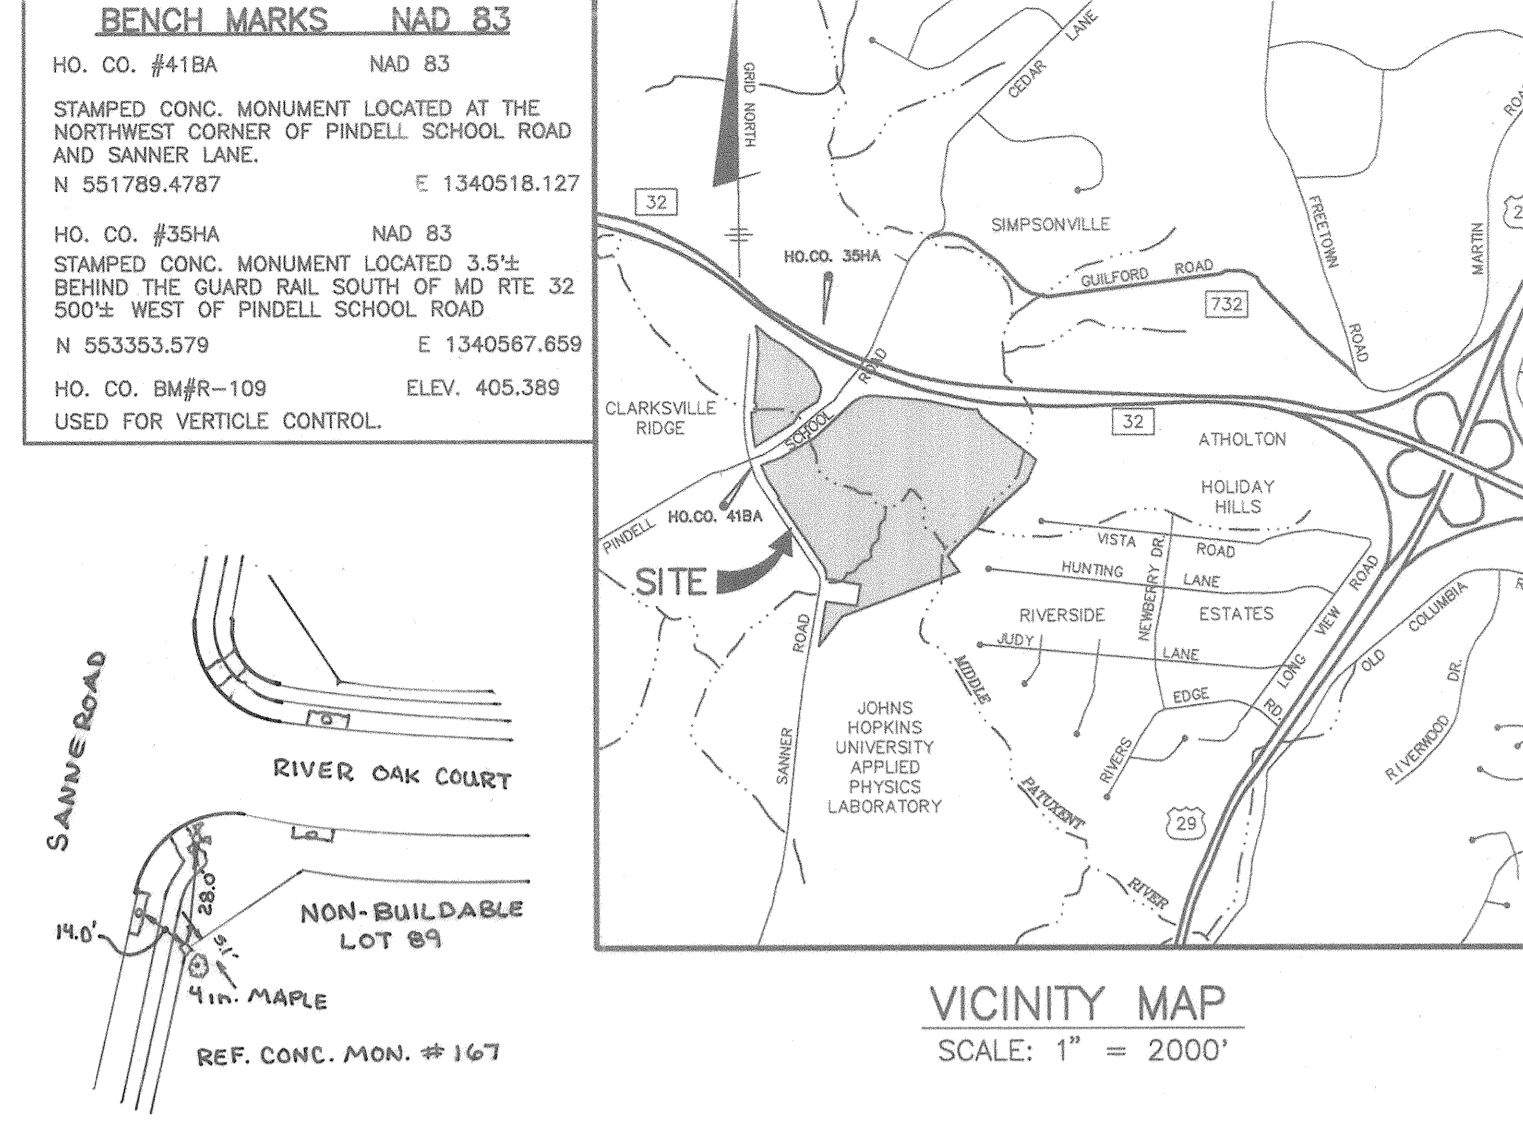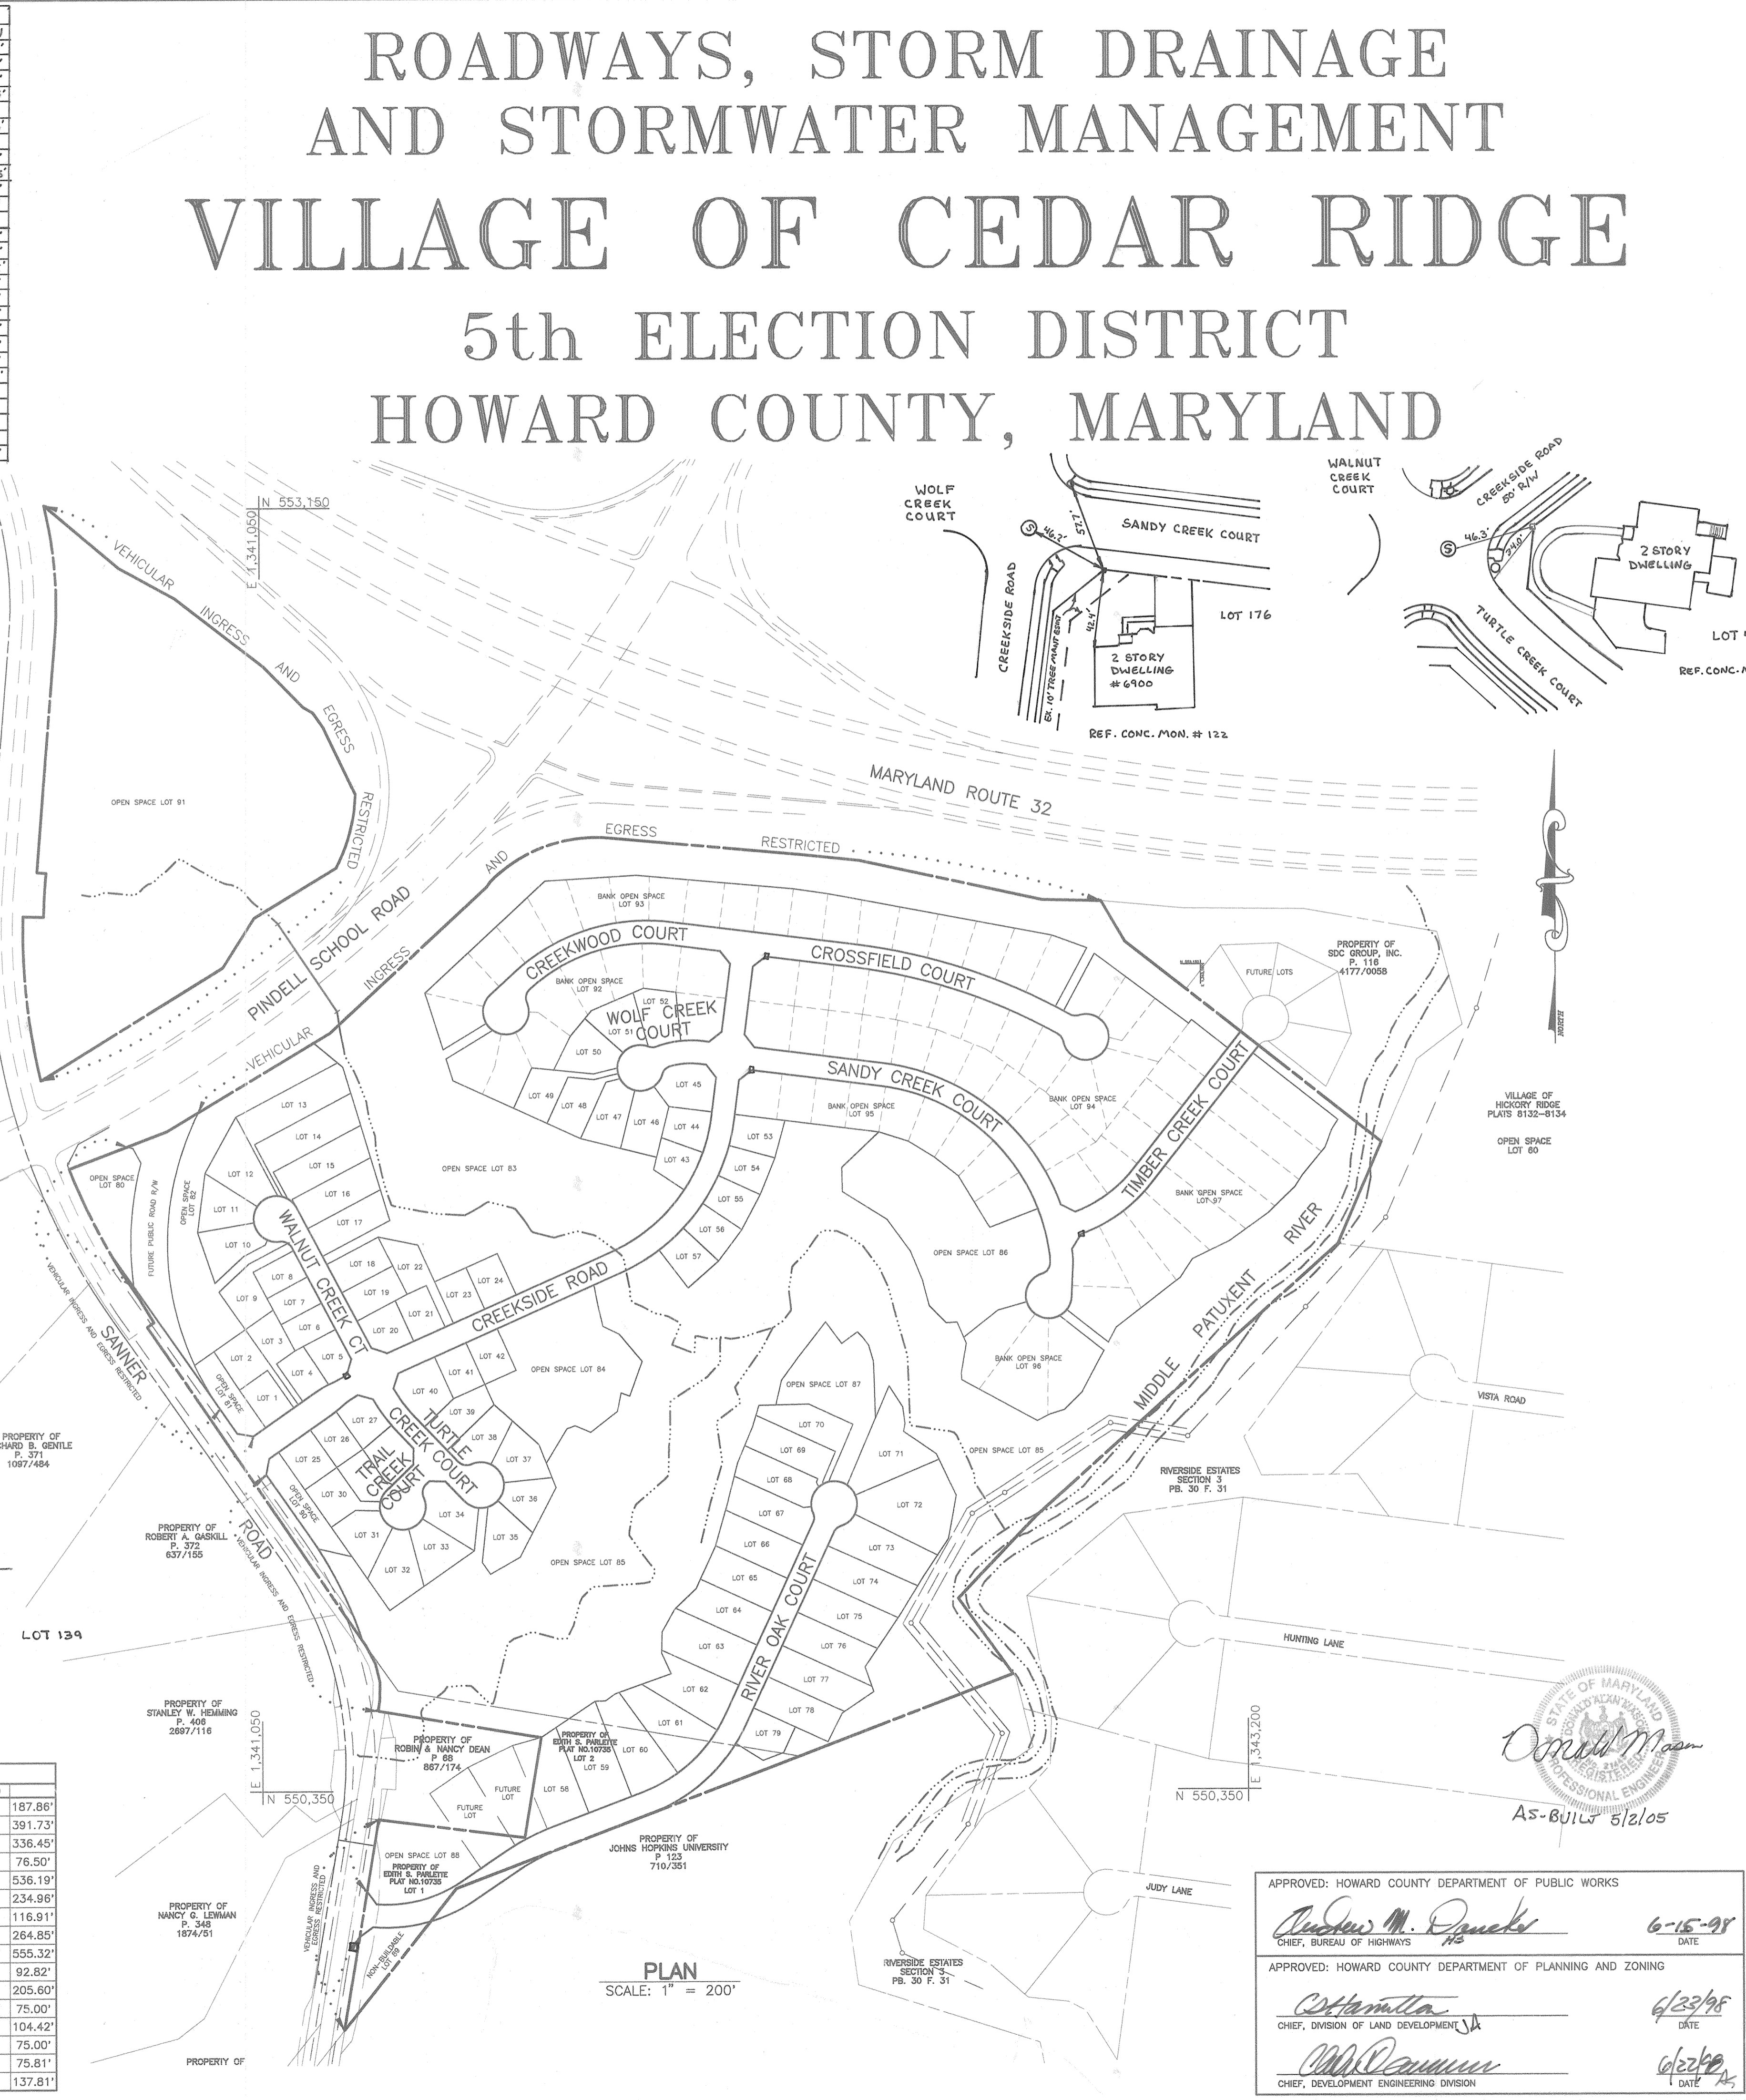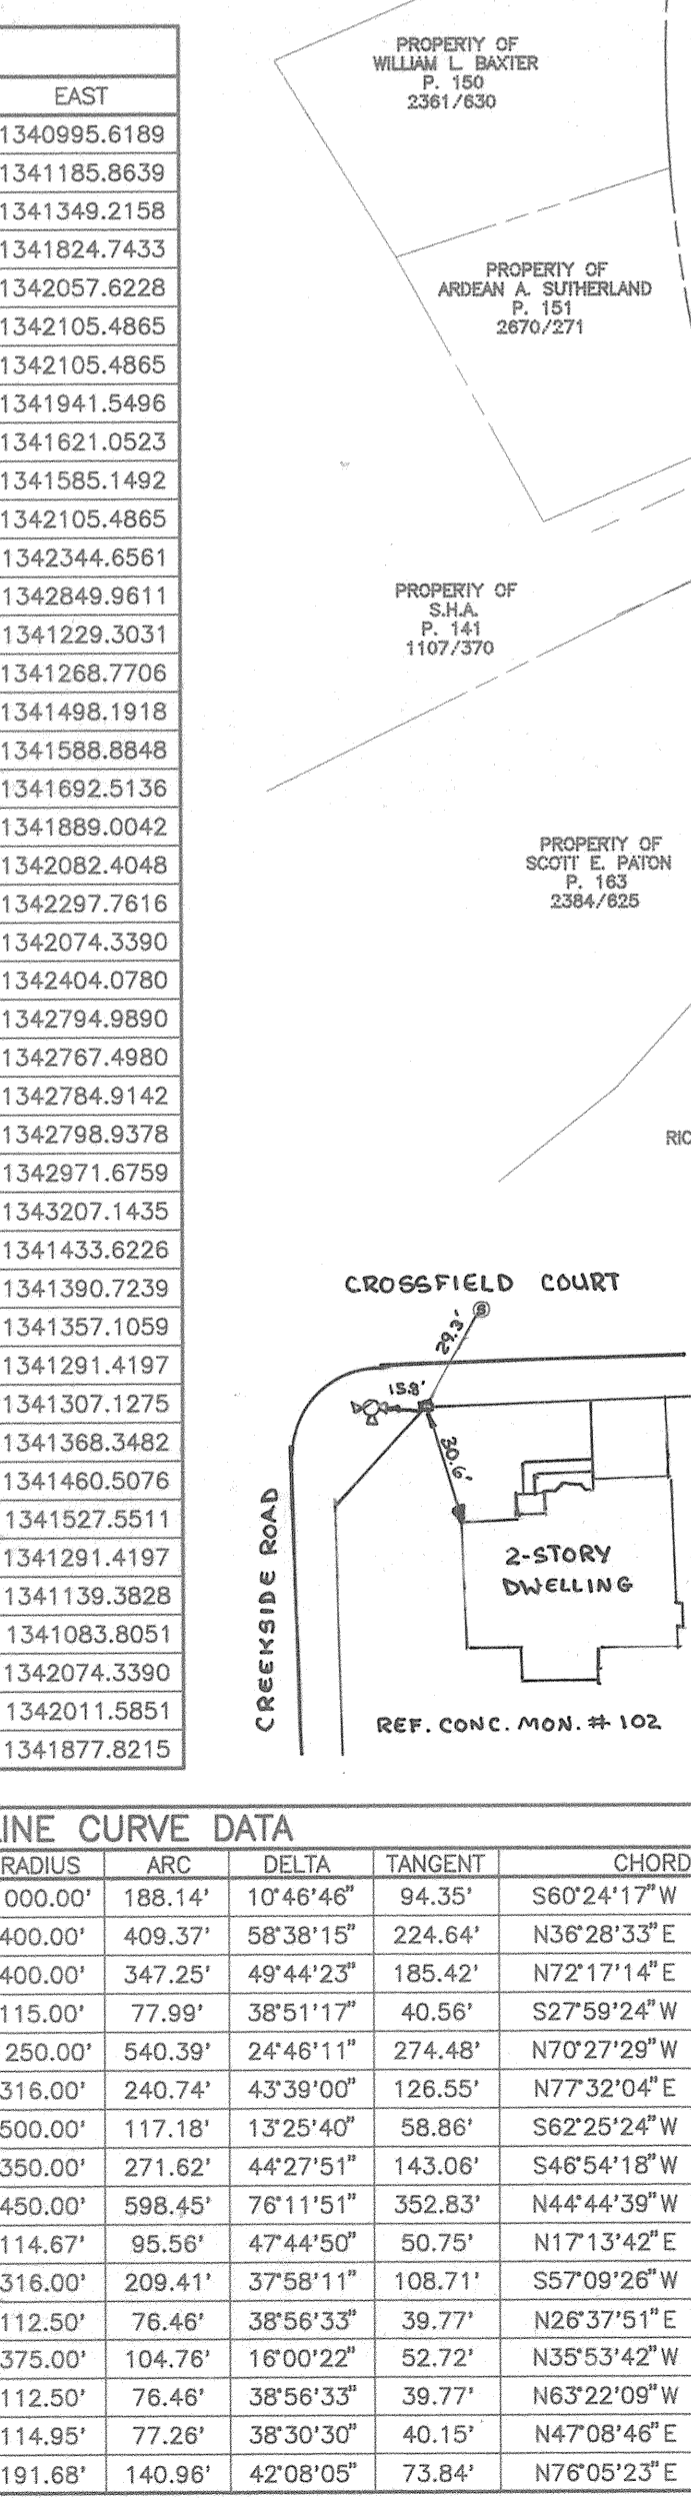

- GENERAL NOTES**
- ALL CONSTRUCTION SHALL BE IN ACCORDANCE WITH THE CURRENT HOWARD COUNTY DESIGN MANUAL VOL. IV, PLUS USHA STANDARDS AND SPECIFICATIONS, IF APPLICABLE.
  - THE CONTRACTOR SHALL NOTIFY THE DEPARTMENT OF PUBLIC WORKS CONSTRUCTION INSPECTION DIVISION AT (410) 313-1880 AT LEAST 24 HOURS PRIOR TO THE START OF WORK.
  - THE CONTRACTOR SHALL NOTIFY "MISS UTILITY" AT 1-800-257-7777 AT LEAST 48 HOURS PRIOR TO ANY EXCAVATION WORK.
  - PROJECT BACKGROUND : LOCATION : TAX MAP 41 - PARCELS 43 & 44, AND P/O PARCEL 123 ZONING : R-10 TOTAL TRACT AREA : 100.58 AC. NUMBER OF PROPOSED LOTS : 79 BUILDABLE, 9 OPEN SPACE, PLUS 6 BANK OPEN SPACE LOT TO BE RESUBDIVIDED DATE PRELIMINARY PLAN APPROVED : 07/27/02, WP-97-02, WP-97-78, PB 312, F-93-70, WP-98-82 DRZ REFERENCE # : SP-97-02, WP-97-78, PB 312, F-93-70, WP-98-82
  - TRAFFIC CONTROL DEVICES, MARKINGS, AND SIGNING SHALL BE IN ACCORDANCE WITH THE MOST CURRENT EDITION OF THE MANUAL ON UNIFORM TRAFFIC CONTROL DEVICES (MUTCD). ALL STREET AND REGULATORY SIGNS SHALL BE IN PLACE PRIOR TO THE PLACEMENT OF ANY ASPHALT.
  - TOPOGRAPHY TAKEN FROM FIELD RUN SURVEY BY TSA GROUP, INC., 5/95. CONTROL INTERVAL IS 2 FEET.
  - HOWARD COUNTY MONUMENTS 418A AND 35HA USED FOR HORIZONTAL DATUM. HO. CO. BENCH MARK R-109 WAS USED FOR VERTICAL DATUM.
  - STREET LIGHT PLACEMENT, TYPE OF FIXTURE AND POLE SELECTION SHALL BE IN ACCORDANCE WITH THE LATEST HOWARD COUNTY DESIGN MANUAL, VOLUME III.
  - ALL ROAD FILLS SHALL BE COMPACTED TO 95% AS DETERMINED BY AASHTO T-190.
  - ALL SIDEWALKS AND SIDEWALK RAMPS SHALL BE IN CONFORMANCE WITH CURRENT ADA CRITERIA.
  - WATER AND SEWER FOR THIS SUBDIVISION IS PUBLIC. DRAINAGE AREA IS PATENTED, CONTRACT NUMBERS 34-3652-0 AND 34-3662-0.
  - WETLANDS DELINEATION COMPILED BY M.A. DIRKS AND ASSOC. DATED JANUARY 1995.
  - TRAFFIC STUDY COMPILED BY LEE CUNNINGHAM & ASSOC. DATED JANUARY 1995. REVISED AUGUST 20, 1997 TO ACCOMMODATE PHASING OF THE PROJECT. APPROVED FEBRUARY 14, 1997.
  - NOISE STUDY PREPARED BY POLYSONICS CORPORATION. APPROVED JUNE 16, 1997.
  - GEOTECHNICAL REPORT COMPILED BY HILLIS-CARNES ASSOC., INC.
  - EXISTING UTILITIES WERE LOCATED BY RECORD DRAWINGS AND/OR FIELD RUN SURVEY BY TSA GROUP, INC., 5/95. CONTRACTOR IS RESPONSIBLE FOR VERIFYING THE LOCATION OF ALL EXISTING UTILITIES PRIOR TO START OF CONSTRUCTION.
  - UNLESS NOTED AS "PRIVATE" ALL EASEMENTS ARE PUBLIC.
  - STORMWATER MANAGEMENT AND WATER QUALITY SHALL BE PROVIDED BY EXTENDED DETENTION STORMWATER MANAGEMENT FACILITIES. VEGETATED BUFFERS SHALL PROVIDE WATER QUALITY TREATMENT FOR ANY UNMANAGED AREAS. THESE FACILITIES ARE PRIVATELY OWNED AND MAINTAINED.
  - NO CLEARING, GRADING OR CONSTRUCTION IS PERMITTED WITHIN WETLANDS, WETLANDS BUFFERS, STREAM BUFFERS OR FOREST CONSERVATION AREAS EXCEPT FOR THE WORK ASSOCIATED WITH THE ROAD CROSSING OF CREEKSIDE ROAD AS REPRESENTED ON THESE PLANS.
  - THE FLOODPLAIN STUDY WAS PERFORMED BY THE TSA GROUP, INC. DATED 4/97.
  - A MINIMUM OF 20' SHALL BE MAINTAINED BETWEEN TREES AND STREET LIGHTS.

**PLAN**  
SCALE: 1" = 200'

APPROVED: HOWARD COUNTY DEPARTMENT OF PUBLIC WORKS

*Andrew M. Dunks*  
CHIEF, BUREAU OF HIGHWAYS

6-15-97  
DATE

APPROVED: HOWARD COUNTY DEPARTMENT OF PLANNING AND ZONING

*William J. ...*  
CHIEF, DIVISION OF LAND DEVELOPMENT

6/23/97  
DATE

OWNERS:

TOLL MD LIMITED PARTNERSHIP  
A MARYLAND LIMITED PARTNERSHIP  
3206 TOWER OAKS BOULEVARD  
SUITE 310  
ROCKVILLE, MARYLAND 20852

DEVELOPER:

TOLL MD LIMITED PARTNERSHIP  
A MARYLAND LIMITED PARTNERSHIP  
3206 TOWER OAKS BOULEVARD  
SUITE 310  
ROCKVILLE, MARYLAND 20852

PROJECT: **VILLAGE OF CEDAR RIDGE**

A SUBDIVISION OF PARCEL 44 (TAX MAP 41) AND A RESUBDIVISION OF LOTS 1 AND 2 OF THE EDITH S. PARLETTE SUBDIVISION (PLAT 10735 PARCEL 43) AND A SUBDIVISION OF PARCEL 123 FOR A ROAD RIGHT-OF-WAY

LOCATION: TAX MAP 41 - PARCELS 43 & 44, P/O 123  
5th ELECTION DISTRICT  
HOWARD COUNTY, MARYLAND

TITLE: **TITLE SHEET**

SP-97-02 WP-97-78 PB 312 F-93-70 WP-98-82  
DATE: OCTOBER, 1997  
MAY, 1998 PROJECT NO. 0518

DESIGN: DAM DRAFT: DBT CHECK: DAM SCALE: AS SHOWN SHEET 1 OF 31



**FOREST PROTECTION PROCEDURES - Preconstruction Phase**

- The edge of the woods to be protected will be marked (staked or flagged) in the field per the limits of forest conservation easement shown in the approved site development plan prior to the start of construction activity. All areas within protective easement are to be considered "off limits" to any construction activities. The optional protective fencing shall be installed at the outside edge of forested areas and should be combined with sediment control devices when possible. The limit of the critical root zone and therefore the location of the protective devices is to be determined as follows:  
Edge of Forested Area - 1 foot of protective radius/inch of DBH or an eight foot protective radius, whichever is greater.  
Critical Root Zone for the forest on this site is an average of 12 feet from the trunk of the tree. Critical root zones for Specimen Tree #1 and #2 are 34' and 30'.
- Construction activities expressly prohibited within the preservation areas are:  
Placing or stockpiling backfill or top soil in protected areas  
Felling trees into protected areas  
Driving construction equipment into or through protected areas  
Burning in or in close proximity to protected areas  
Stacking or storing supplies of any kind  
Concrete wash-off areas  
Conducting trenching operations  
Grading beyond the limits of disturbance  
Parking vehicles or construction equipment  
Removal of root mat or topsoil  
Siting and construction of: Utility lines  
Access roads  
Impervious surfaces  
Stormwater management devices  
Staging areas
- Protective fencing (see Figure "Protective Fencing") shall be the responsibility of the general contractor. The general contractor shall affix signs to the fencing at 25' minimum intervals indicating that these areas are "Forest Retention Area" (see Figure "Signage"). The general contractor shall take great care to assure the restricted areas are not violated and that root systems are protected from smothering, flooding, excessive wetting from dewatering operations, off-site runoff, spillage, and drainage or solutions containing materials hazardous to tree roots.
- The general contractor shall be responsible for any tree damaged or destroyed within the preservation areas whether caused by the contractor, his agents, employees, subcontractors, or licensees.
- Foot traffic shall be kept to a minimum in the protective areas.
- All trees which are not to be preserved within fifty feet of any tree preservation areas are to be removed in a manner that will not damage those trees that are designated for preservation. It is highly recommended that tree stumps within this fifty foot area be ground out with a stump grinding machine to minimize damage.
- The general contractor shall designate a "wash out" area onsite for concrete trucks which will not drain toward a protected area.
- A pre-construction meeting shall be held with local authorities before any disturbance has taken place on site.

**FOREST PROTECTION PROCEDURES - Construction Phase**

- Forest and tree conditions should be monitored during construction and corrective measures taken when appropriate. The following shall be monitored:
- Soil compaction
  - Root injury - prune and monitor; consider crown reduction
  - Limb injury - prune and monitor
  - Flooded conditions - drain and monitor; correct problem
  - Drought conditions - water and monitor; correct problem
  - Other stress signs - determine reason, correct, and monitor

**FOREST PROTECTION PROCEDURES - Post Construction Phase**

- The following measures shall be taken:
- Corrective measures if damages were incurred due to negligence:
    - Stress reduction
    - Removal of dead or dying trees. This may be done only if trees pose an immediate safety hazard.
  - Removal of temporary structures:
    - No burial of discarded materials will occur onsite within the conservation area.
    - No open burning within 100 feet of a wooded area.
    - All temporary forest protection structures will be removed after construction.
    - Remove temporary roads by removing stone or broadcasting mulch; pre-construction elevation should be maintained.
    - Aerate compacted soil.
    - Replant disturbed sites with trees, shrubs and/or herbaceous plants.
    - Retain signs for retention areas or specimen trees.
    - A County official shall inspect the entire site.

**Future protection measures:**

- Howard County and the developer shall arrange for the dedication of an appropriate forest conservation easement at a later date.

**FOREST PROTECTION PROCEDURES - Preconstruction Phase**

**Stress Reduction and Protection of Specimen Trees Isolated from Forest Retention Areas and General Forest Retention Areas (as they may apply)**

Isolated specimen trees that are to be preserved will be examined to determine if stress reduction techniques are needed. Protective measures and their evaluation criteria are provided on this plan only if they are employed herein.

**Root Pruning**

**Evaluation Criteria**

Will the critical root zone be affected by construction activities such as grade changes, digging for foundations and roads or utility installation?

**Design Considerations**

- Prune prior to construction as shown on the plan (see Figure "Root Pruning Detail").
- Prune root with a clean cut using proper pruning equipment such as a vibratory knife.
- Exact location of pruning trench should be identified, and immediately backfilled to cover exposed roots after pruning with soil removed other topsoil, peat moss, or other suitable material or with other high organic soil.
- For trees over 15" in diameter, root pruning may be done up to one year in advance of construction.
- Tree(s) will be monitored for signs of stress.

**Crown Reduction or Pruning**

**Evaluation Criteria**

Has the root system been significantly reduced (>30%) or are there dead, damaged, or diseased limbs?

**Design Considerations**

- Reduce only at specified times of the year:  
Flowering trees - only after flowering and before bud set  
Non-flowering trees - in late winter, early spring or mid summer
- No more than 1/3 of the crown should be removed at one time using acceptable pruning methods (see Figure "Crown Reduction Detail")
- Monitor for signs of stress

**Watering**

**Evaluation Criteria**

Will construction activities alter the hydrology of the site? Has or will root pruning occur?

**Design Considerations**

- Water only as necessary
- Monitor for signs of stress (see Figure "Tree Planting and Maintenance Calendar")

**Fertilizing**

**Evaluation Criteria**

Is or will be tree(s) be under stressful conditions? Has or will root pruning occur?

**Design Considerations**

- Use low nitrogen and slow release fertilizers.
- Apply in late fall or early spring (see Figure "Tree Planting and Maintenance Calendar")
- For small trees (<3" in diameter), use punch hole method or pressurized injection method (see Figure "Application of Fertilizers by Injection.")
- For larger trees (>3" diameter), use punch hole method or pressurized injection method (see Figure "Application of Fertilizers by Injection.")
- Do not apply fertilizer any closer than 3' from tree trunk for pressurized injection method.
- Monitor for signs of stress.

**PLANT SPECIFICATIONS AND NOTES**

**I. Site Preparation and Soils**

- Disturbance of soils should be limited to the Planting Field for each plant. Planting hole will be a minimum 18" auger hole, dug to the depth of the root ball. As shown on the detail view, a Planting Field of 18" diameter for whips or 2.5 times the width of the root ball is recommended.
- In areas of steep slopes or erodible soils, soil disturbance will be limited to the Planting Field which is equal to the 18" diameter auger hole.
- Soil mix for all plants shall be native soil with no soil amendment, unless a soils analysis determines that soil amendments are required (disturbed sites). Natural amendments, such as organic mulch or leaf mold compost, are preferred.

**II. Plant Storage and Inspection**

- For container grown nursery stock, planting should occur within two weeks after delivery to site.
- Planting stock should be inspected prior to planting. Plants not conforming to standard nurseryman specifications for size, form, and vigor, roots, trunk wounds, insects and disease should be replaced.

**III. Soil Amendments**

- Amendments are not recommended in the planting field as studies have shown that roots will be encouraged to stay within the amended soils.

**IV. Plant Installation**

- Container grown stock should be removed from the container and roots gently loosened from the soil. If the roots encircle the root ball, substitution is required. J-shaped or kinked root systems should also be rejected. **ROOTS MAY NOT BE TRIMMED ON SITE.**
- The Planting Field should be prepared as specified (see detail). Stock must be planted in random pattern (see detail). Native dug soils should be used to backfill Planting Field. Set plant material no more than 1" above existing ground and no lower than existing ground. Gently pack native soil around plant to eliminate all air pockets. After whip and container installation, rake soils evenly over the Planting Field and cover hole with three inches of composted hardwood mulch. Water to settle soil and provide moisture, as needed.
- Prune whips to encourage branching. Container stock will be pruned to eliminate broken and dead branches.
- Newly planted trees may need watering depending on weather conditions. During the next two years watering may be required during summer and dry months. Any watering should consider for recent rainfall patterns.
- Staking of stock is not required, if preferred stock type used.
- Side dressing fertilization 1 year after planting may be warranted. Fertilizer may be added to each tree or shrub at the end of the first growing season and will contain the following by weight:  
5% nitrogen, 10% phosphoric acid, and 5% potash. Nitrogen shall be derived from natural organic sources or ureaform; 40-50% of nitrogen shall be water soluble. Organic fertilizers are preferred to synthetic fertilizers. See Tree Planting and Maintenance Calendar for planting and maintenance dates.
- Integrated Pest Management (IPM) is one of the most effective and safest approaches for maintaining a healthy forest. A full IPM program can include:
  - Elimination of low vegetation before planting to help control rodents.
  - Use of tree shelters to protect the trunks of seedlings or whips from animal damage. (These trees need more water than those without tree shelters.)
  - Mulching around the trees to minimize trunk damage from mowers.
  - Pruning dead or diseased branches with a clean cut.
  - To prevent sunscald, allow small non-competitive branches, commonly pruned during or before planting, to grow on the sunny side of the trunk.

**V. Maintenance Schedule**

- Landscape should conduct an inspection at the following intervals: 6 months after planting, 1 year after planting and 2 years after planting. The purpose of inspection is to evaluate survival rate with reference to the survival required at the end of the two year period (75% minimum).  
Regular visits during the first growing season (year 1) are to assess the success of the plantings and determine if supplemental watering or other actions are necessary. Early spring visits will determine winter kill and autumn visits will determine summer kill.
- Assess tree mortality of planting stock, remove and replace any dead or diseased plantings for the first 2 growing seasons.
- Volunteer seeding of native, local and endemic vegetation is to be expected. Do not discourage this effort unless it is negatively affecting the planted stock.
- Landscape shall remove or control aggressive, noxious, invasive species (i.e. Multiflora Rose, Japanese Honeysuckle, and all herbaceous vegetation) within a 3-foot radius surrounding the planted woody nursery stock for 2 years after planting.
- The landscape shall be responsible to remove down and dead material that is smothering planting stock. Naturally occurring material that is not affecting planted stock shall not be removed.
- Mowing is one of the most effective means to control exotic and/or invasive species. No mowing shall occur during the wildlife nesting period of early April through mid-July. The landscaper is responsible for mowing and/or weed wacking and/or applying herbicide around planting stock, if needed for 2 growing seasons after planting.

**PLANTING AREA # 1 = 0.5 AC.**

QUANTITY	SPECIES	SIZE
20	Acer Rubrum Red Maple	5'-6" 1" caliper
20	Liriodendron Tulipifera Poplar	5'-6"
20	Quercus Alba White Oak or Pin Oak	5'-6"
35	Cornus florida Flowering Dogwood	3'-4' whip
35	Lindera benzoin Spicebush	3'-4' whip

**PLANTING AREA # 2 = 0.3 AC.**

QUANTITY	SPECIES	SIZE
12	Acer Rubrum Red Maple	5'-6" 1" caliper
12	Liriodendron Tulipifera Poplar	5'-6"
12	Quercus Alba White Oak or Pin Oak	5'-6"
21	Cornus florida Flowering Dogwood	3'-4' whip
21	Lindera benzoin Spicebush	3'-4' whip

**PLANTING AREA # 3 = 0.1 AC.**

QUANTITY	SPECIES	SIZE
4	Acer Rubrum Red Maple	5'-6" 1" caliper
4	Liriodendron Tulipifera Poplar	5'-6"
4	Quercus Alba White Oak or Pin Oak	5'-6"
7	Cornus florida Flowering Dogwood	3'-4' whip
7	Lindera benzoin Spicebush	3'-4' whip

**PLANTING AREA # 4 = 4.0 AC.**

QUANTITY	SPECIES	SIZE
160	Acer Rubrum Red Maple	5'-6" 1" caliper
160	Liriodendron Tulipifera Poplar	5'-6"
160	Quercus Alba White Oak or Pin Oak	5'-6"
280	Cornus florida Flowering Dogwood	3'-4' whip
280	Lindera benzoin Spicebush	3'-4' whip

**PLANTING AREA # 5 = 1.1 AC.**

QUANTITY	SPECIES	SIZE
44	Acer Rubrum Red Maple	5'-6" 1" caliper
44	Liriodendron Tulipifera Poplar	5'-6"
44	Quercus Alba White Oak or Pin Oak	5'-6"
77	Cornus florida Flowering Dogwood	3'-4' whip
77	Lindera benzoin Spicebush	3'-4' whip

**PLANTING AREA # 6 = 0.7 AC.**

QUANTITY	SPECIES	SIZE
28	Acer Rubrum Red Maple	5'-6" 1" caliper
28	Liriodendron Tulipifera Poplar	5'-6"
28	Quercus Alba White Oak or Pin Oak	5'-6"
49	Cornus florida Flowering Dogwood	3'-4' whip
49	Lindera benzoin Spicebush	3'-4' whip

**PLANTING AREA # 7 = 0.2 AC.**

QUANTITY	SPECIES	SIZE
8	Acer Rubrum Red Maple	5'-6" 1" caliper
8	Liriodendron Tulipifera Poplar	5'-6"
8	Quercus Alba White Oak or Pin Oak	5'-6"
14	Cornus florida Flowering Dogwood	3'-4' whip
14	Lindera benzoin Spicebush	3'-4' whip

**PLANTING AREA # 8 = 6.5 AC.**

QUANTITY	SPECIES	SIZE
260	Acer Rubrum Red Maple	5'-6" 1" caliper
260	Liriodendron Tulipifera Poplar	5'-6"
260	Quercus Alba White Oak or Pin Oak	5'-6"
455	Cornus florida Flowering Dogwood	3'-4' whip
455	Lindera benzoin Spicebush	3'-4' whip

*Mary A. Dircks*  
**M.A. DIRCKS & CO., INC.**

Environmental Consulting Services  
15228 Old Hanover Road  
Upperco, Maryland 21155  
Phone/Fax: 410-526-7388

APPROVED: HOWARD COUNTY DEPARTMENT OF PUBLIC WORKS  
*[Signature]* 6-15-98  
CHIEF, BUREAU OF HIGHWAYS

APPROVED: HOWARD COUNTY DEPARTMENT OF PLANNING AND ZONING  
*[Signature]* 6/23/98  
CHIEF, DIVISION OF LAND DEVELOPMENT

*[Signature]* 6/22/98  
CHIEF, DEVELOPMENT ENGINEERING DIVISION

NO.	DATE	REVISION

**TSA GROUP, INC.**  
planning • architecture • engineering • surveying  
8460 Baltimore National Pike • Ellicott City, Maryland 21040 • 410-465-8105

STATE OF MARYLAND  
PROFESSIONAL ENGINEER

**OWNERS:**  
TOLL MD LIMITED PARTNERSHIP,  
A MARYLAND LIMITED PARTNERSHIP  
3206 TOWER GATE BOULEVARD  
SUITE 210  
ROCKVILLE, MARYLAND 20852

**DEVELOPER:**  
TOLL MD LIMITED PARTNERSHIP,  
A MARYLAND LIMITED PARTNERSHIP  
3206 TOWER GATE BOULEVARD  
SUITE 210  
ROCKVILLE, MARYLAND 20852

**PROJECT:** VILLAGE OF CEDAR RIDGE  
A SUBDIVISION OF PARCEL 44 (TAX MAP 41) AND A RESUBDIVISION OF LOTS 1 AND 2 OF THE EDITH S. PARLETTE SUBDIVISION (PLAT 10735 PARCEL 43) AND A SUBDIVISION OF PARCEL 123 FOR A ROAD RIGHT-OF-WAY

**LOCATION:** TAX MAP 41 - PARCELS 43 & 44, P/O 123  
5th ELECTION DISTRICT  
HOWARD COUNTY, MARYLAND

**TITLE:** FOREST CONSERVATION NOTES AND DETAILS  
SP-97-02 WP-97-78 PB 312 F-93-70 WP-98-82

**DATE:** OCTOBER, 1997  
MAY, 1998

**PROJECT NO. 0518**



**DESIGN: DAM DRAFT: DBT CHECK: DAM SCALE: NONE DRAWING 31 OF 31**

NOTE: PRIORITY FOREST HAS BEEN PLACED IN FOREST CONSERVATION EASEMENT. SPECIMEN TREES WILL BE PRESERVED AS FEASIBLE. ADDITIONAL PLANTINGS WILL BE DONE OFF-SITE AS SHOWN.







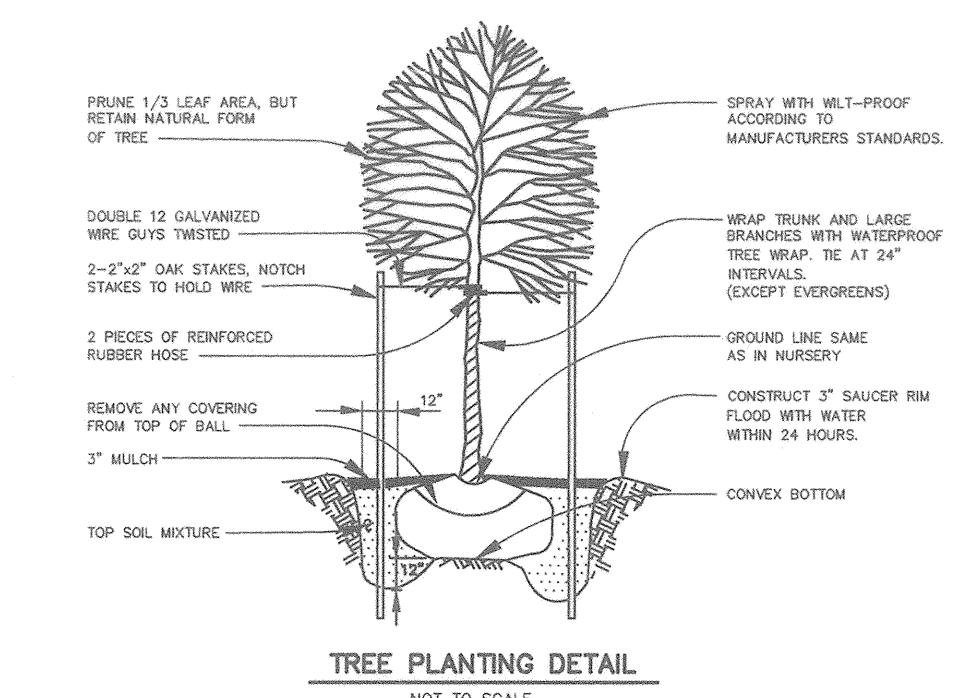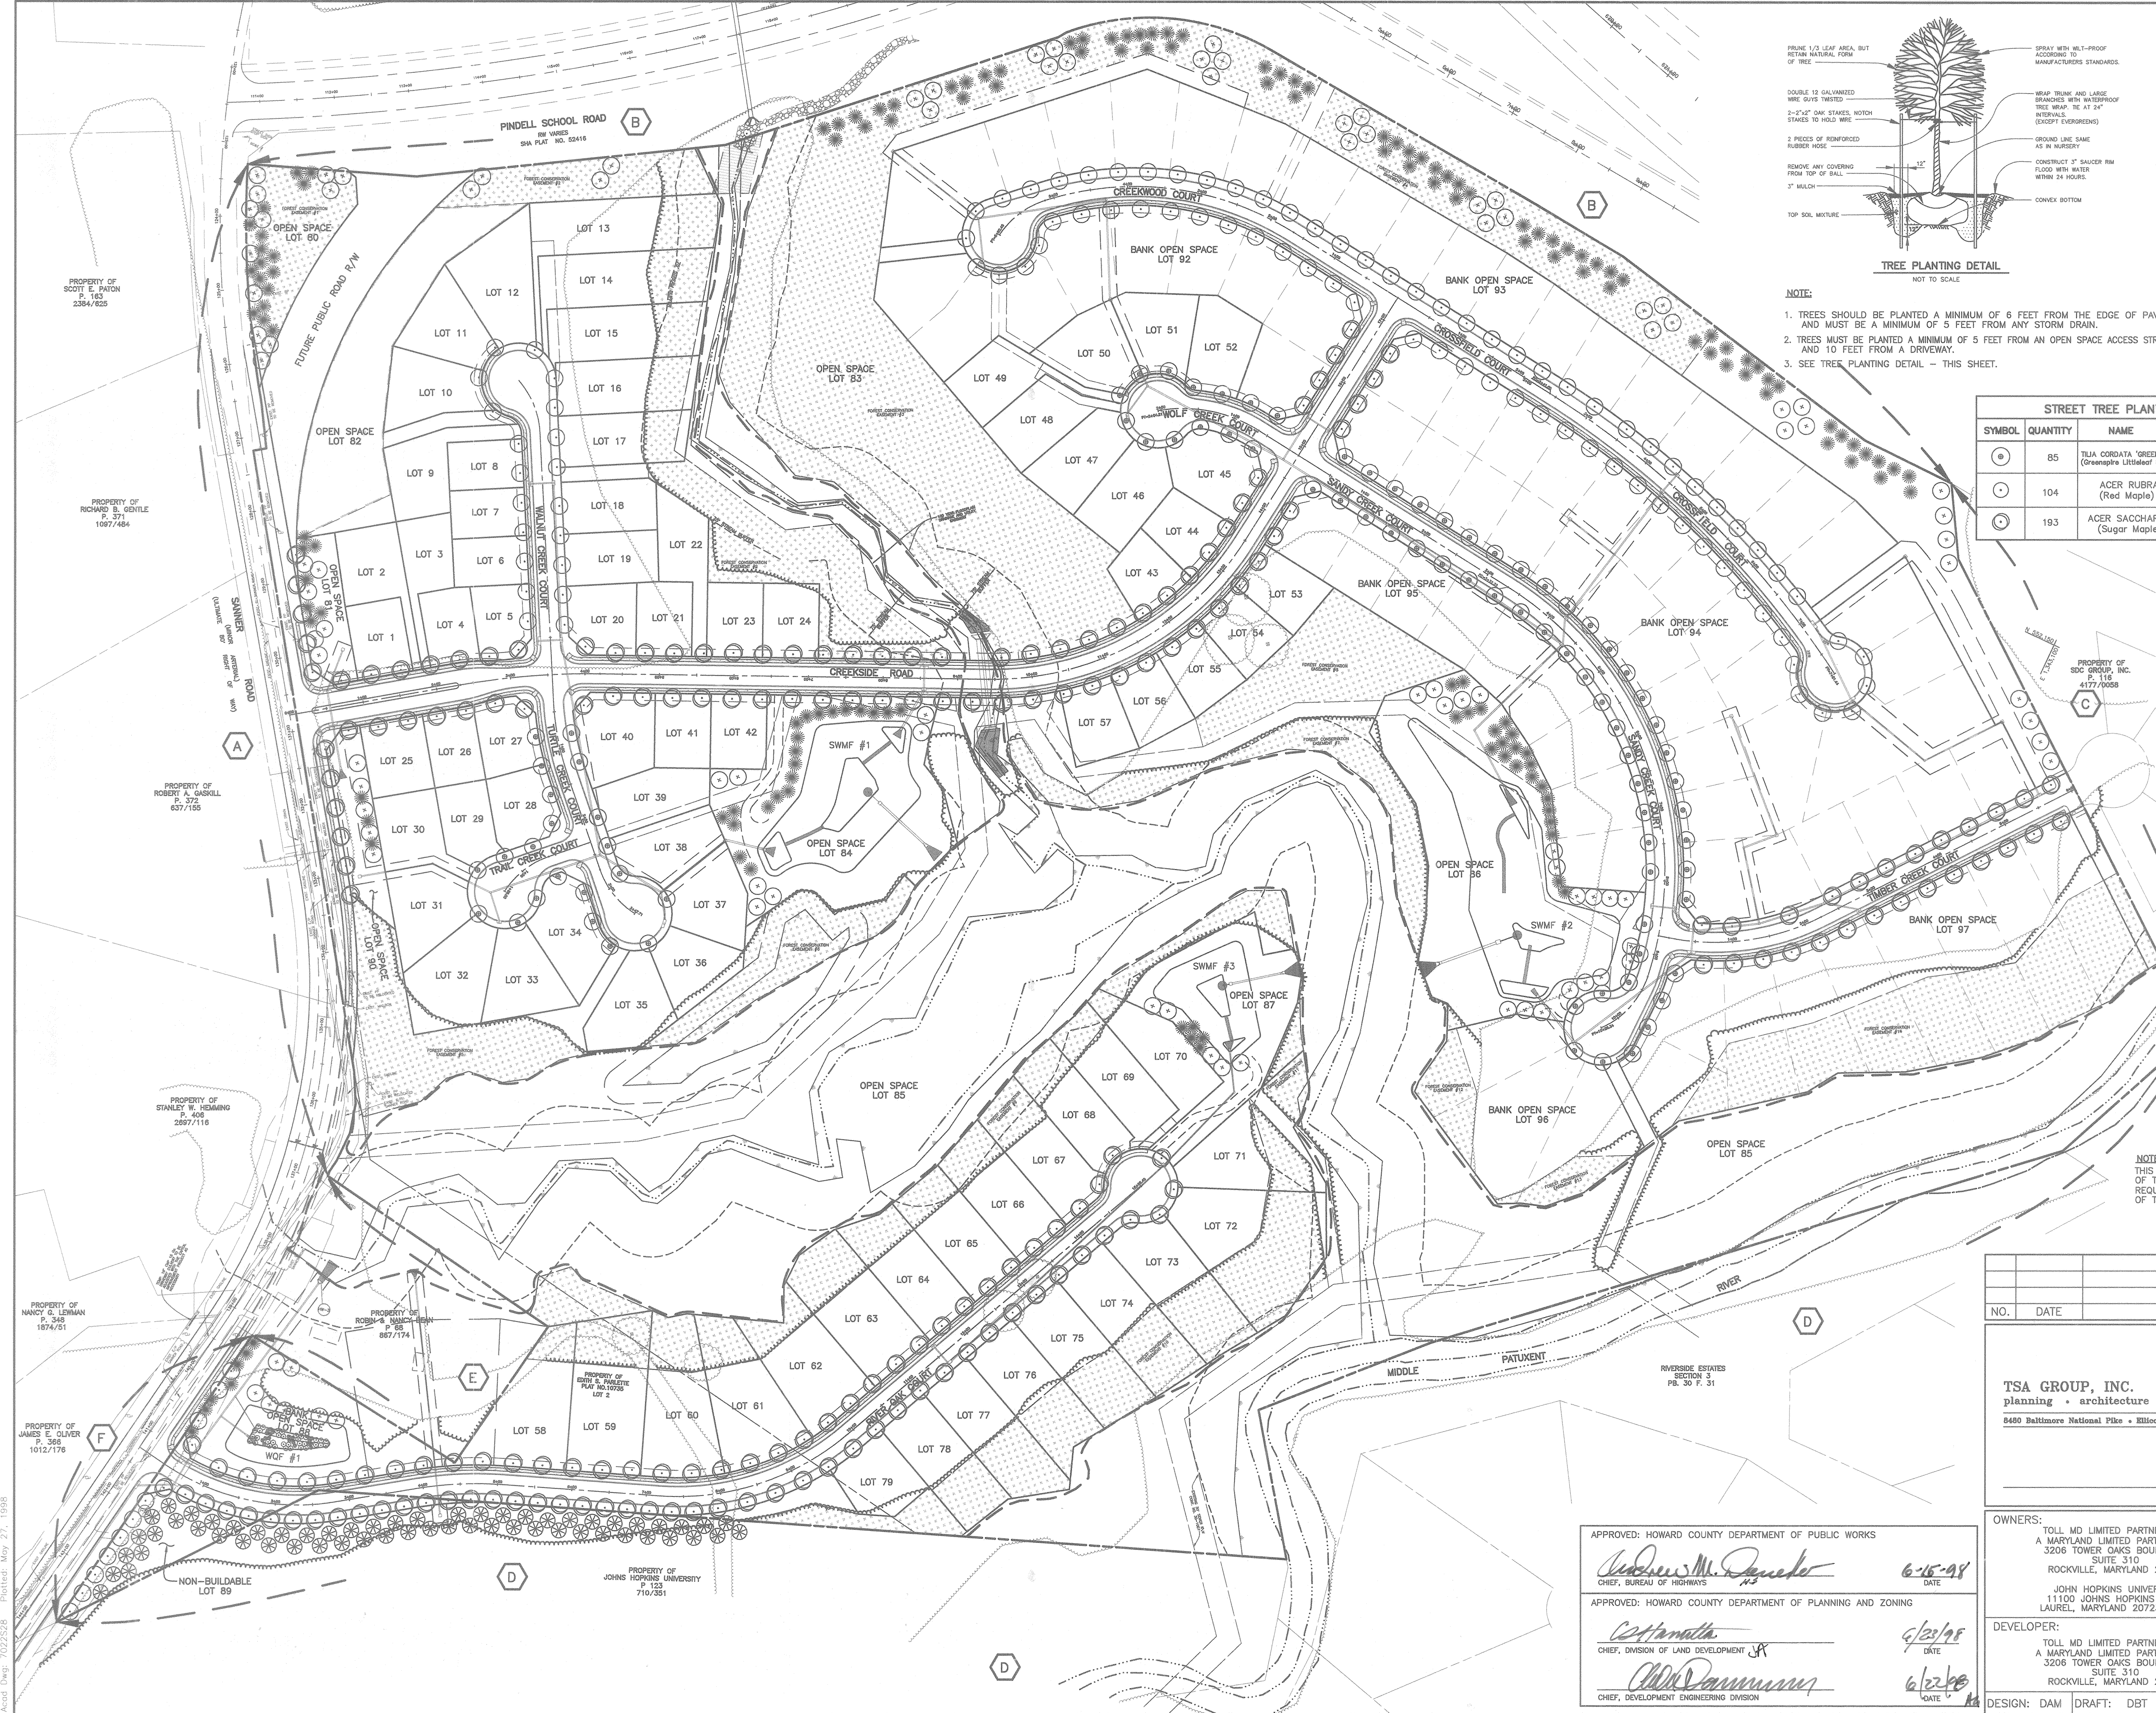

- NOTE:**
- TREES SHOULD BE PLANTED A MINIMUM OF 6 FEET FROM THE EDGE OF PAVING AND MUST BE A MINIMUM OF 5 FEET FROM ANY STORM DRAIN.
  - TREES MUST BE PLANTED A MINIMUM OF 5 FEET FROM AN OPEN SPACE ACCESS STRIP AND 10 FEET FROM A DRIVEWAY.
  - SEE TREE PLANTING DETAIL - THIS SHEET.

CATEGORY	PERIMETER LANDSCAPE EDGE					
	A	B	B	F	G	A
LANDSCAPE TYPE						
LINEAR FEET OF ROADWAY FRONTAGE/PERIMETER	1,371'	2,480'	468'	810'	3481'	802'
CREDIT FOR EXISTING VEGETATION (YES, NO, LINEAR FEET) (DESCRIBE BELOW IF NEEDED)	0'	0'	0'	0'	0'	0'
CREDIT FOR WALL, FENCE OR BERM (YES, NO, LINEAR FEET) (DESCRIBE BELOW IF NEEDED)	NO	NO	NO	NO	NO	NO
NUMBER OF PLANTS REQUIRED	971 LF.	2300 LF.	218 LF.	450 LF.	870 LF.	402 LF.
SHADE TREES	20	46	4	8	15	7
EVERGREEN TREES	24	57	6	—	—	—
OTHER TREES (2:1 SUBSTITUTE)	—	—	—	—	—	—
NUMBER OF PLANTS PROVIDED	20	34	0	8	0	7
SHADE TREES	24	81	16	—	48	—
EVERGREEN TREES	—	—	—	—	—	—
OTHER TREES (2:1 SUBSTITUTE)	—	—	—	—	—	—

Ⓢ EXISTING WOODS WITH WIDTH 20' OR GREATER.

SYMBOL	QUANTITY	NAME	REMARKS
Ⓢ	85	TILIA CORDATA 'GREENSPICE' (Greenspire Littleleaf Linden)	2 1/2" MIN. CAL. B&B FULL HEAD
Ⓢ	104	ACER RUBRA (Red Maple)	2 1/2" MIN. CAL. B&B FULL HEAD
Ⓢ	193	ACER SACCHARUM (Sugar Maple)	2 1/2" MIN. CAL. B&B FULL HEAD

SYMBOL	QUANTITY	NAME	REMARKS
Ⓢ	106	PLATANUS ACERIFOLIA 'BLOODGOOD' (Bloodgood London Plane)	2 1/2" MIN. CAL. B&B FULL HEAD
Ⓢ	168	PINUS STROBUS (Eastern White Pine)	5'-8" ht. UNSHEARED
Ⓢ	59	CUPRESSOCYPRUS LEYLANDII (Leyland Cypress)	5'-6" HEIGHT

LINEAR FEET OF PERIMETER	STORMWATER MANAGEMENT AREA LANDSCAPING			
	FACILITY 1	FACILITY 2	FACILITY 3	WOF
980	1400	710		
440	470	500		
540	930	210		
—	"B"	"B"	"B"	
NUMBER OF TREES REQUIRED	11	19	4	
SHADE TREES	13	23	5	
EVERGREEN TREES	NO	NO	NO	
CREDIT FOR EXISTING VEGETATION (NO, YES AND %)	NO	NO	NO	
CREDIT FOR OTHER LANDSCAPING (NO, YES AND %)	NO	NO	NO	
NUMBER OF TREES PROVIDED	7	19	5	
SHADE TREES	21	23	5	
EVERGREEN TREES				
OTHER TREES (2:1 SUBSTITUTE)				

Ⓢ BIO-RETENTION SEE PLANTING DETAIL SHEET NO. 27 NO ADDITIONAL LANDSCAPING REQUIRED.


SYMBOL	DESCRIPTION
Ⓢ	STREET TREES TO BE PROVIDED BY THE DEVELOPER TO BE INCORPORATED ON FINAL PLANS.
Ⓢ	SHADE TREES ALONG PERIMETER AND STORMWATER MANAGEMENT TO BE PROVIDED BY THE DEVELOPER AND INCORPORATED ON FINAL PLANS.
Ⓢ	EVERGREEN TREES ALONG PERIMETER AND STORMWATER MANAGEMENT AREA TO BE PROVIDED BY THE DEVELOPER AND INCORPORATED ON FINAL PLANS.

- LANDSCAPING NOTES**
- PERIMETER LANDSCAPING SHALL BE PROVIDED BY THE EXISTING VEGETATION TO REMAIN AND BY THE PLANTINGS AS SHOWN ON THESE PLANS.
  - THE DEVELOPER SHALL BE RESPONSIBLE FOR THE STREET TREES, STORMWATER MANAGEMENT POND PLANTING, THE PRESERVATION OF THE PERIMETER VEGETATION AS SHOWN ON THESE PLANS, AND FOR PERIMETER PLANTING ON PERIMETERS A,B,C,D & E. BONDING FOR PERIMETER PLANTING IS THE OBLIGATION OF THE DEVELOPER AS PART OF THE DEVELOPERS AGREEMENT.
  - A MINIMUM OF 20' SHALL BE MAINTAINED BETWEEN TREES AND STREET LIGHTS.

**NOTE:**  
THIS PLAN HAS BEEN PREPARED IN ACCORDANCE WITH THE PROVISIONS OF SECTION 16.124 OF THE HOWARD COUNTY CODE AND LANDSCAPING MANUAL. FINANCIAL SURETY FOR THE REQUIRED LANDSCAPE TREES IN THE AMOUNT OF \$26,600.00 MUST BE POSTED AS PART OF THE DEVELOPERS AGREEMENT.

NO.	DATE	REVISION

**TSA GROUP, INC.**  
planning • architecture • engineering • surveying  
5480 Baltimore National Pike • Ellicott City, Maryland 21043 • 410-485-6105

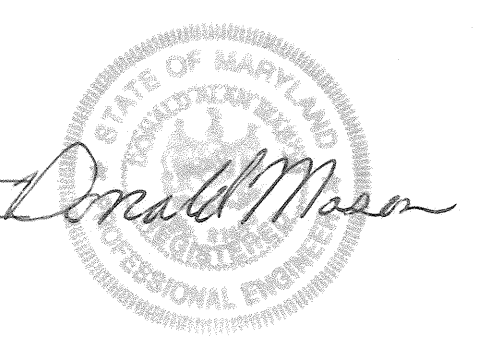

APPROVED: HOWARD COUNTY DEPARTMENT OF PUBLIC WORKS  
*Andrew M. Dwyer* 6/15/98  
CHEF, BUREAU OF HIGHWAYS

APPROVED: HOWARD COUNTY DEPARTMENT OF PLANNING AND ZONING  
*William H. ...* 6/23/98  
CHEF, DIVISION OF LAND DEVELOPMENT

APPROVED: HOWARD COUNTY DEPARTMENT OF PLANNING AND ZONING  
*William H. ...* 6/23/98  
CHEF, DEVELOPMENT ENGINEERING DIVISION

**OWNERS:**  
TOLL MD LIMITED PARTNERSHIP, A MARYLAND LIMITED PARTNERSHIP  
3206 TOWER OAKS BOULEVARD SUITE 310 ROCKVILLE, MARYLAND 20852

**DEVELOPER:**  
TOLL MD LIMITED PARTNERSHIP, A MARYLAND LIMITED PARTNERSHIP  
3206 TOWER OAKS BOULEVARD SUITE 310 ROCKVILLE, MARYLAND 20852

**PROJECT:** VILLAGE OF CEDAR RIDGE  
A SUBDIVISION OF PARCEL 44 (TAX MAP 41) AND A RESUBDIVISION OF LOTS 1 AND 2 OF THE EDITH S. PARLETTE SUBDIVISION (PLAT 10735 PARCEL 43) AND A SUBDIVISION OF PARCEL 123 FOR A ROAD RIGHT-OF-WAY

**LOCATION:** TAX MAP 41 - PARCELS 43 & 44, P/O 123  
5th ELECTION DISTRICT  
HOWARD COUNTY, MARYLAND

**TITLE:** LANDSCAPE PLAN, NOTES AND DETAILS  
SP-97-02 WP-97-78 PB 312 F-93-70 WP-98-82

**DATE:** OCTOBER 1997  
MAY 1998

**PROJECT NO.:** 0518

**SCALE:** 1" = 100'

**SHEET 28 OF 31**

DESIGN: DAM DRAFT: DBT CHECK: DAM

Acad. Draw: 7/22/98 2:28 PM Plotted: May 27, 1998



POND CONSTRUCTION SPECIFICATIONS

Site Preparation

Areas designated for borrow areas, embankment, and structural works shall be cleared, grubbed and stripped of topsoil. All trees, vegetation, roots and other objectionable material shall be removed. Channel banks and sharp breaks shall be sloped to no steeper than 1:1.

Areas to be covered by the reservoir will be cleared of all trees, brush, logs, fences, rubbish and other objectionable material unless otherwise designated on the plans. Trees, brush and stumps shall be cut approximately level with the ground surface. For dry stormwater management ponds, a minimum of a 50 foot radius around the inlet structure shall be cleared.

All cleared and grubbed material shall be disposed of outside and below the limits of the dam and reservoir as directed by the owner or his representative. When specified, a sufficient quantity of topsoil will be stockpiled in a suitable location for use on the embankment and other designated areas.

Earth Fill

Material - The fill material shall be taken from approved designated borrow areas. It shall be free of roots, stumps, wood, rubbish, stones greater than 6", frozen or other objectionable materials. Fill material for the center of the embankment and cut-off trench shall conform to Unified Soil Classification GC, SC, CH, or CL. Consideration may be given to the use of other materials in the embankment if design and construction are supervised by a geotechnical engineer.

Placement - Areas on which fill is to be placed shall be scarified prior to placement of fill. Fill materials shall be placed in maximum 8 inch thick (before compaction) layers which are to be compacted over the entire length of the fill. The most permeable borrow material shall be placed in the center of the embankment and cut-off embankment. The principal spillway must be installed concurrently with fill placement and not excavated into the embankment.

Compaction - The movement of the hauling and spreading equipment over the fill shall be controlled so that the entire surface of each lift shall be traversed by not less than one tread track of the equipment or compaction shall be achieved by a minimum of four complete passes of a sheepsfoot, rubber tired or vibratory roller. Fill material shall contain sufficient moisture such that the required degree of compaction will be obtained with the equipment used. The fill material shall contain sufficient moisture so that if formed into a ball it will not crumble yet not be so wet that water can be squeezed out.

Where a minimum required density is specified, it shall not be less than 95% of maximum dry density with a moisture content within +2% of the optimum. Each layer of fill shall be compacted as necessary to obtain that density, and is to be certified by the Engineer at the time of construction. All compaction is to be determined by AASHTO Method T-99.

Cut Off Trench - The cutoff trench shall be excavated into impervious material along or parallel to the centerline of the embankment as shown on the plans. The bottom width of the trench shall be governed by the equipment used for excavation, with the minimum width being four feet. The depth shall be at least four feet below existing grade or as shown on the plans. The side slopes of the trench shall be 1 to 1 or flatter. The backfill shall be compacted with construction equipment, rollers, or hand tampers to assure maximum density and minimum permeability.

Structure Backfill

Backfill adjacent to pipes or structures shall be of the type and quality conforming to that specified for the adjoining fill material. The fill shall be placed in horizontal layers 6" to 8" thick and compacted by hand tampers or other manually directed compaction equipment. The material needs to fill completely all spaces under and adjacent to the pipe. At no time during the backfilling operation shall driven equipment be allowed to operate closer than four feet, measured horizontally, to any part of a structure. Under no circumstances shall equipment be driven over any part of a concrete structure or pipe, unless there is a compacted fill of 24" or greater over the structure or pipe.

Pipe Conduits

All pipes shall be circular in cross section.

Corrugated Metal Pipe - All of the following criteria shall apply for corrugated metal pipe:

- Materials - (Steel Pipe) - This pipe and its appurtenances shall be galvanized and fully bituminous coated and shall conform to the requirements of AASHTO Specification M-190 Type A with watertight coupling bands. Any bituminous coating damaged or otherwise removed shall be replaced with cold applied bituminous coating compound. Steel pipes with polymeric coatings shall have a minimum coating thickness of 0.01 inch (10 mil) on both sides of the pipe. The following coatings or an approved equal may be used: Nexon, Plast-Cote, Blac-Klad, and Beth-Cu-Loy. Coated corrugated steel pipe shall meet the requirements of AASHTO M-245 and M-246.

Materials - (Aluminum Coated Pipe) - This pipe and its appurtenances shall conform to the requirements of AASHTO Specification M-274 with watertight coupling bands or flanges. Any aluminum coating damaged or otherwise removed shall be replaced with cold applied bituminous coating compound.

Materials - (Aluminum Pipe) - This pipe and its appurtenances shall conform to the requirements of AASHTO Specification M-196 or M-211 with watertight coupling bands or flanges. Aluminum surfaces that are to be in contact with concrete shall be painted with one coat of zinc chromate primer. Hot dip galvanized bolts may be used for connections. The pH of the surrounding soils shall be between 4 and 9.

- Coupling bands, anti-seep collars, and sections, etc., must be composed of the same material as the pipe. Metals must be insulated from dissimilar materials with use of rubber or plastic insulating materials at least 24 mils in thickness.

- Connections - All connections with pipes must be completely watertight. The drain pipe or barrel connection to the riser shall be welded all around when the pipe and riser are metal. Anti-seep collars shall be connected to the pipe in such a manner as to be completely watertight. Dimple bands are not considered to be watertight.

All connections shall use a rubber or neoprene gasket when joining pipe sections. The end of each pipe shall be re-rolled an adequate number of corrugations to accommodate the band width. The following type connections are acceptable for pipes, less than 48" in diameter: flanges on both ends of the pipe, a 12" wide standard lap type band with 12" wide by 3/8" thick closed cell circular neoprene gasket; and a 12" wide hugger type band with O-ring gaskets having a minimum diameter of 1/2" greater than the corrugation depth. Pipes 48" in diameter and larger shall be connected by a 24" long annular corrugated band using rods and nuts. A 12" wide by 3/8" thick closed cell circular neoprene gasket will be installed on the end of each pipe for a total of 24". Helically corrugated pipe shall have either continuously welded seams or have lock seams.

- Bedding - The pipe shall be firmly and uniformly bedded throughout its entire length. Where rock or soft, spongy or other unstable soil is encountered, all such material shall be removed and replaced with suitable earth compacted to provide adequate support.

- Backfilling shall conform to "Structure Backfill."

- Other details (anti-seep collars, valves, etc.) shall be as shown on the drawings.

Reinforced Concrete Pipe - All of the following criteria shall apply for reinforced concrete pipe:

- Materials - Reinforced concrete pipe shall have bell and spigot joints with rubber gaskets and shall equal or exceed ASTM Designation C-361. An approved equivalent is AWWA Specification C-302.

- Bedding - All reinforced concrete pipe conduits shall be laid in a concrete bedding for their entire length. This bedding shall consist of high slump concrete placed under the pipe and up the sides of the pipe at least 10% of its outside diameter with a minimum thickness of 3 inches, or as shown on the drawings.

- Laying pipe - Bell and spigot pipe shall be placed with the bell end upstream. Joints shall be made in accordance with recommendations of the manufacturer of the material. After the joints are sealed for the entire line, the bedding shall be placed so that all spaces under the pipe are filled. Care shall be exercised to prevent any deviation from the original line and grade of the pipe. The first joint must be located within 2 feet from the riser.

- Backfilling shall conform to "Structure Backfill."

- Other details (anti-seep collars, valves, etc.) shall be as shown on the drawings.

Polyvinyl Chloride (PVC) Pipe - All of the following criteria shall apply for polyvinyl chloride (PVC) pipe:

- Materials - PVC pipe shall be PVC-1120 or PVC-1220 conforming to ASTM D-1785 or ASTM D-2241.

- Joints and connections to anti-seep collars shall be completely watertight.

- Bedding - The pipe shall be firmly and uniformly bedded throughout its entire length. Where rock or soft, spongy or other unstable soil is encountered, all such material shall be removed and replaced with suitable earth compacted to provide adequate support.

- Backfilling shall conform to "Structure Backfill."

- Other details (anti-seep collars, valves, etc.) shall be as shown on the drawings.

Concrete

Concrete shall meet the requirements of Maryland Department of Transportation, State Highway Administration Standard Specifications for Construction and Materials, Section 60B, Mix No. 3.

Rock Riprap

All rock shall be dense, sound, and free from cracks, seams, and other defects conducive to accelerated weathering. The rock fragments shall be angular to subrounded in shape. The least dimension of an individual rock fragment shall be not less than three times the greatest dimension of the fragment.

The rock shall have the following properties:

- Bulk specific gravity (saturated surface-dry basis) not less than 2.5.
- Absorption not more than three percent.
- Soundness: Weight loss in five cycles not more than 20 percent when sodium sulfate is used.

Bulk specific gravity and absorption shall be determined according to ASTM C 88. The test for soundness shall be performed according to ASTM C 88.

The riprap shall be placed to the required thickness in one operation. The rock shall be delivered and placed in a manner that will insure the riprap in place shall be reasonably homogeneous with the larger rocks uniformly distributed and firmly in contact one to another with the smaller rocks filling the voids between the larger rocks. Filter cloth shall be placed under all riprap and shall meet the requirements of Maryland Department of Transportation, State Highway Administration Standard Specifications for Construction and Materials, Section 919.12.

Care of Water during Construction

All work on permanent structures shall be carried out in areas free from water. The Contractor shall construct and maintain all temporary dikes, levees, cofferdams, drainage channels, and stream diversions necessary to protect the area to be occupied by the permanent works. The contractor shall also furnish, install, operate, and maintain all necessary pumping and other equipment required for removal of water from the various parts of the work and for maintaining the excavations, foundation, and other parts of the work free from water as required or directed by the engineer for constructing each part of the work. After having served their purpose, all temporary protective works shall be removed or leveled and graded to the extent required to prevent obstruction in any degree whatsoever of the flow of water to the spillway or outlet works and so as not to interfere in any way with the operation or maintenance of the structure. Stream diversions shall be maintained until the full flow can be passed through the permanent works. The removal of water from the required excavation and the foundation shall be accomplished in a manner and to the extent that will maintain stability of the excavated slopes and bottom of required excavations and will allow satisfactory performance of all construction operations. During the placing and compacting of material in required excavations, the water level at the locations being refilled shall be maintained below the bottom of the excavation at such locations which may require draining the water to sumps from which the water shall be pumped.

Stabilization

All borrow areas shall be graded to provide proper drainage and left in a slightly condition. All exposed surfaces of the embankment, spillway, spoil and borrow areas, and berms shall be stabilized by seeding, liming, fertilizing and mulching in accordance with the Maryland Soil Conservation Service Standards and Specifications for Critical Area Planting (MD-342) or as shown on the accompanying drawings.

Erosion and Sediment Control

Construction operations will be carried out in such a manner that erosion will be controlled and water and air pollution minimized. State and local laws concerning pollution abatement will be followed. The following type connections are acceptable for construction operations which may require draining the sediment control measures to be employed during the construction process.

Embankment and Cut-off Trench Construction

The site should be stripped of topsoil and any other unsuitable materials from the embankment or structure area in accordance with Soil Conservation Guidelines. After stripping operations have been completed, the exposed subgrade materials should be profiled with a load dumptruck or similar equipment in the presence of a geotechnical engineer or his representative. For areas that are not accessible to a dump truck, the exposed materials should be observed and tested by a geotechnical engineer or his representative utilizing a Dynamic Cone Penetrometer. Any excessively soft or loose materials identified by profiling or penetrometer testing should be excavated to suitable firm soil, and then grades re-established by backfilling with suitable soil.

A representative of the geotechnical Engineer should be present to monitor placement and compaction of fill for each embankment and cut-off trench. In accordance with Maryland Soil Conservation Specification 378, soils considered suitable for the center of embankment and cut-off trench shall conform to Unified Soil Classification GC, SC, CH, or CL. A review of the site borings did not indicate the presence of suitable core or cut-off trench materials at the tested locations. All fill materials must be placed and compacted in accordance with MD SCS 378 specifications.

Record of Soil Exploration Boring No. 1

SOIL DESCRIPTION	DEPTH (FT.)	Sample	BORING & SAMPLING NOTES
Color, Moisture, Density, Size, Proportion			
SURFACE	0.0		6" Topsoil
10' to 15' micaceous silty sand (SM)	1.0		No groundwater encountered while excavating
15' to 20' micaceous silty sand and gravel (SM-GM)	15.0		No infiltration test performed
Refused at 7.5'	7.5		Backfilled at completion.

Record of Soil Exploration Boring No. 2

SOIL DESCRIPTION	DEPTH (FT.)	Sample	BORING & SAMPLING NOTES
Color, Moisture, Density, Size, Proportion			
SURFACE	0.0		6" Topsoil
10' to 15' micaceous silty sand, some mica (SM)	1.0		No groundwater encountered while excavating
15' to 20' micaceous silty sand and gravel (SM-GM)	15.0		No infiltration test performed
Refused at 10.0'	10.0		Backfilled at completion.

Record of Soil Exploration Boring No. 3

SOIL DESCRIPTION	DEPTH (FT.)	Sample	BORING & SAMPLING NOTES
Color, Moisture, Density, Size, Proportion			
SURFACE	0.0		6"-8" Topsoil
10' to 15' micaceous silty sand, some mica (SM)	1.0		Groundwater encountered at 5.0' while excavating
15' to 20' micaceous silty sand and gravel (SM-GM)	15.0		No infiltration test performed
Bottom of hole at 10.0'	10.0		Backfilled at completion.

Record of Soil Exploration Boring No. 4

SOIL DESCRIPTION	DEPTH (FT.)	Sample	BORING & SAMPLING NOTES
Color, Moisture, Density, Size, Proportion			
SURFACE	0.0		6"-8" Topsoil
10' to 15' micaceous silty sand, some mica (SM)	1.0		Groundwater encountered at 5.0' while excavating
15' to 20' micaceous silty sand and gravel (SM-GM)	15.0		No infiltration test performed
Bottom of hole at 10.0'	10.0		Backfilled at completion.

Record of Soil Exploration Boring No. 5

SOIL DESCRIPTION	DEPTH (FT.)	Sample	BORING & SAMPLING NOTES
Color, Moisture, Density, Size, Proportion			
SURFACE	0.0		6" Topsoil
10' to 15' micaceous silty sand, some mica (SM)	1.0		Groundwater encountered at 5.0' while excavating
15' to 20' micaceous silty sand and gravel (SM-GM)	15.0		No infiltration test performed
Bottom of hole at 8.0'	8.0		Backfilled at completion.

Record of Soil Exploration Boring No. 6

SOIL DESCRIPTION	DEPTH (FT.)	Sample	BORING & SAMPLING NOTES
Color, Moisture, Density, Size, Proportion			
SURFACE	0.0		4" Topsoil
10' to 15' micaceous silty sand, some mica (SM)	1.0		Groundwater encountered at 5.0' while excavating
15' to 20' micaceous silty sand and gravel (SM-GM)	15.0		No infiltration test performed
Bottom of hole at 6.5'	6.5		Backfilled at completion.

Record of Soil Exploration Boring No. 7

SOIL DESCRIPTION	DEPTH (FT.)	Sample	BORING & SAMPLING NOTES
Color, Moisture, Density, Size, Proportion			
SURFACE	0.0		6" Topsoil
10' to 15' micaceous silty sand, some mica (SM)	1.0		Groundwater encountered at 5.0' while excavating
15' to 20' micaceous silty sand and gravel (SM-GM)	15.0		No infiltration test performed
Bottom of hole at 9.0'	9.0		Backfilled at completion.

Record of Soil Exploration Boring No. 8

SOIL DESCRIPTION	DEPTH (FT.)	Sample	BORING & SAMPLING NOTES
Color, Moisture, Density, Size, Proportion			
SURFACE	0.0		6" Topsoil
10' to 15' micaceous silty sand, some mica (SM)	1.0		Groundwater encountered at 5.0' while excavating
15' to 20' micaceous silty sand and gravel (SM-GM)	15.0		No infiltration test performed
Bottom of hole at 14.0'	14.0		Backfilled at completion.

Record of Soil Exploration Boring No. 9

SOIL DESCRIPTION	DEPTH (FT.)	Sample	BORING & SAMPLING NOTES
Color, Moisture, Density, Size, Proportion			
SURFACE	0.0		4"-6" Topsoil
10' to 15' micaceous silty sand, some mica (SM)	1.0		No groundwater encountered while excavating
15' to 20' micaceous silty sand and gravel (SM-GM)	15.0		No infiltration test performed
Bottom of hole at 15.0'	15.0		Backfilled at completion.

Record of Soil Exploration Boring No. 10

SOIL DESCRIPTION	DEPTH (FT.)	Sample	BORING & SAMPLING NOTES
Color, Moisture, Density, Size, Proportion			
SURFACE	0.0		4"-6" Topsoil
10' to 15' micaceous silty sand, some mica (SM)	1.0		No groundwater encountered while excavating
15' to 20' micaceous silty sand and gravel (SM-GM)	15.0		No infiltration test performed
Bottom of hole at 10.0'	10.0		Backfilled at completion.

Record of Soil Exploration Boring No. 11

SOIL DESCRIPTION	DEPTH (FT.)	Sample	BORING & SAMPLING NOTES
Color, Moisture, Density, Size, Proportion			
SURFACE	0.0		4" Topsoil
10' to 15' micaceous silty sand, some mica (SM)	1.0		No groundwater encountered while excavating
15' to 20' micaceous silty sand and gravel (SM-GM)	15.0		No infiltration test performed
Bottom of hole at 7.0'	7.0		Backfilled at completion.

Record of Soil Exploration Boring No. 12

SOIL DESCRIPTION	DEPTH (FT.)	Sample	BORING & SAMPLING NOTES
Color, Moisture, Density, Size, Proportion			
SURFACE	0.0		6"-8" Topsoil
10' to 15' micaceous silty sand, some mica (SM)	1.0		Groundwater encountered at 5.0' while excavating
15' to 20' micaceous silty sand and gravel (SM-GM)	15.0		No infiltration test performed
Bottom of hole at 10.0'	10.0		Backfilled at completion.

Record of Soil Exploration Boring No. 13

SOIL DESCRIPTION	DEPTH (FT.)	Sample	BORING & SAMPLING NOTES
Color, Moisture, Density, Size, Proportion			
SURFACE	0.0		4"-6" Topsoil
10' to 15' micaceous silty sand, some mica (SM)	1.0		No groundwater encountered while excavating
15' to 20' micaceous silty sand and gravel (SM-GM)	15.0		No infiltration test performed
Bottom of hole at 8.0'	8.0		Backfilled at completion.

OPERATION AND MAINTENANCE SCHEDULE OF PRIVATELY OWNED AND MAINTAINED BIORETENTION AREA

Description	Method	Frequency	Time of the Year
<b>SOIL</b>			
Inspect and Repair	Visual	Monthly	Monthly
<b>ORGANIC LAYER</b>			
Remove previous mulch layer before applying new layer (optional)	By hand	Once a year	Spring
Any additional mulch added (optional)	By hand	Once a year	Spring
<b>PLANTS</b>			
Removal and replacement of all dead and diseased vegetation considered beyond treatment	See planting	Twice a year	3/15 to 4/30 and 10/1 to 11/30
Treat all diseased trees and shrubs	Mechanical or by hand	N/A	Varies, depends on insect or disease infestation
Watering of plant material shall take place at the end of each day for fourteen consecutive days after planting has been completed	By hand	Immediately after completion of project	N/A
Replace stakes after one year	By hand	Once a year	Only remove stakes in the spring
Replace any deficient stakes or wires	By hand	N/A	Whenever needed

MATERIAL SPECIFICATIONS FOR BIORETENTION AREA PLANTING SOIL

The bioretention areas shall consist of a planting soil having a composition of at least 10 to 25 percent clay and shall be of a sandy loam or loamy sand texture. Loamy soils may be utilized for the planting soil but must consist of 25% sand. In addition, the furnished planting soil shall be of uniform composition, free of stones, stumps, roots or similar objects larger than one inch, brush, or any other material or substance which may be harmful to plants, growth, or a hindrance to planting or maintenance operations.

The planting soil shall be free of plants or plant parts of Bermuda grass, Quack grass, Johnson grass, Mugwort, Nutsedge, Poison ivy, Canadian Thistle or others as specified.

It shall not contain toxic substances harmful to plant growth.

The planting soil shall be tested and meet the following criteria:

- pH range 5.5 - 6.5
- Organic matter 1.5 - 3.0%
- Magnesium - Mg 35 lbs./acre
- Phosphorus - P<sub>2</sub>O<sub>5</sub> 100lbs./acre
- Potassium - K<sub>2</sub>O 85 lbs./acre
- Soluble salts not to exceed 500ppm

The following testing frequencies shall apply to the above soil constituents:

PH, Organic Matter: 1 test per 90 cubic yards, but no more than 1 test per Bioretention area.

Magnesium, Phosphorus, Potassium, Soluble Salts: 1 test per 500 cubic yards, but not less than 1 test per borrow source

One grain size analysis shall be performed per 90 cubic yards of planting soil, but no less than 1 test per Bioretention Area.

MULCH LAYER SPECIFICATIONS

A mulch layer approximately 2"-3" in depth shall be provided on top of the planting soil. An acceptable mulch layer shall include shredded hardwood or shredded wood chips.


Of the approved mulch products all must be well aged, uniform in color, and free of foreign material including plant material. Well aged mulch is defined as mulch that has been stockpiled or stored for at least twelve (12) months.

SAND SPECIFICATIONS

The sand shall be free of deleterious material and rocks greater than 1 inch in diameter.

COMPACTION

Soil shall be placed in lifts less than 18 inches and lightly compacted (minimal compactive effort) by tamping with a bucket from a dozer or a backhoe.

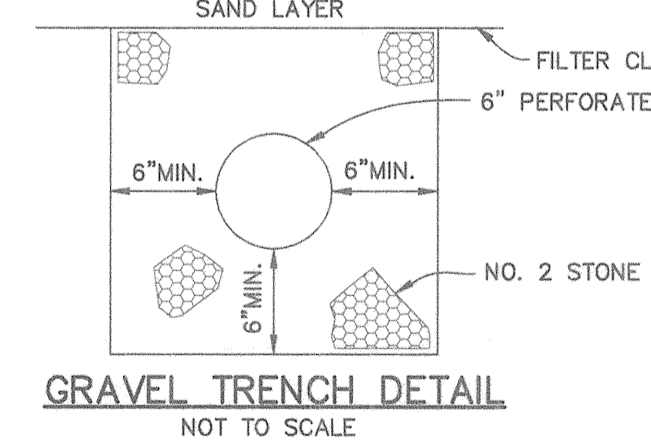


PLANTING LIST FOR THE BIORETENTION AREA

SYMBOL	QUANTITY	NAME	REMARKS
+	34	ACER RUBRUM (RED MAPLE)	2 1/2" MIN. CAL B&B FULL HEAD
⊗	20	JUNIPERUS HORIZONTALIS (CREEPING JUNIPER)	18" TO 24" SPREAD

- \* PLANTING TABULATION: TREES: 1 (450-650/AC.) USE 550/AC (AVER.)x0.061 AC.=34 TREES TREES PROVIDED: 34 SHRUBS: 1 (200-450/AC.) USE 325/AC (AVER.)x0.061 AC.=20 SHRUBS SHRUBS PROVIDED: 20
- \* - TABULATIONS BASED ON INFORMATION PROVIDED BY BIOHABITATS, INC.

NOTE: CONTRACTOR SHALL BE RESPONSIBLE FOR IMPORTING APPROPRIATE CORE TRENCH MATERIAL FROM OFF-SITE IF ON-SITE MATERIAL CANNOT BE FOUND.

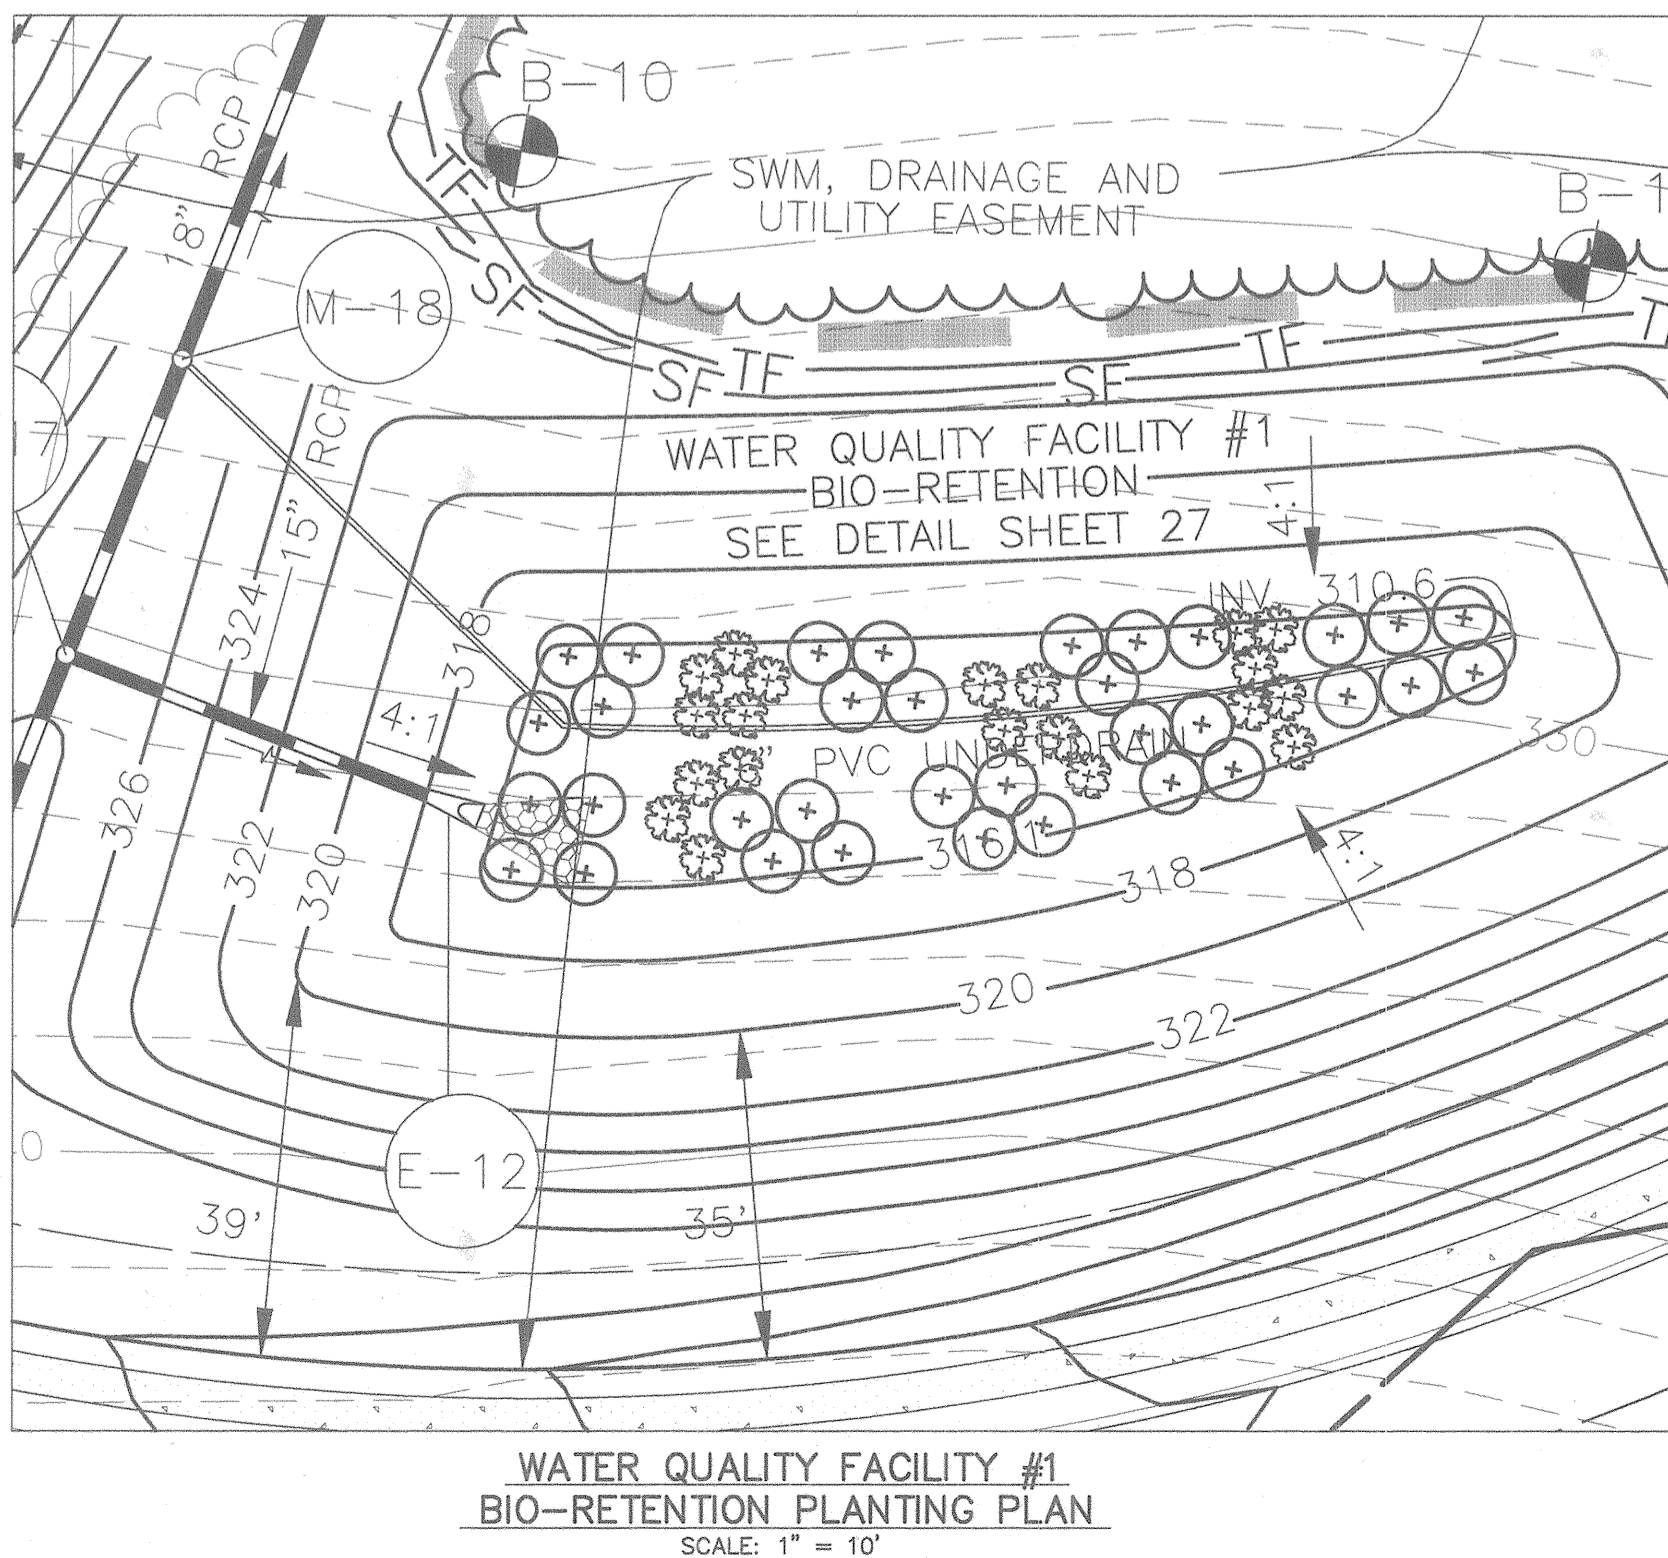



**SEDIMENT CONTROL NOTES**

- A MINIMUM OF 24 HOURS NOTICE MUST BE GIVEN TO THE HOWARD COUNTY DEPARTMENT OF INSPECTION, LICENSES AND PERMITS, SEDIMENT CONTROL DIVISION PRIOR TO THE START OF ANY CONSTRUCTION, (313-1850).
- ALL VEGETATIVE AND STRUCTURAL PRACTICES ARE TO BE INSTALLED ACCORDING TO THE PROVISIONS OF THIS PLAN AND ARE TO BE IN CONFORMANCE WITH THE MOST CURRENT "MARYLAND STANDARDS AND SPECIFICATION FOR SOIL EROSION AND SEDIMENT CONTROL", REVISIONS THERETO.
- FOLLOWING INITIAL SOIL DISTURBANCE OR REDISTURBANCE, PERMANENT OR TEMPORARY STABILIZATION SHALL BE COMPLETED WITHIN: A) 7 CALENDAR DAYS FOR ALL PERIMETER SEDIMENT CONTROL STRUCTURES, DIKES, PERIMETER SLOPES AND ALL SLOPES GREATER THAN 3:1, B) 14 DAYS AS TO ALL OTHER DISTURBED OR GRADED AREAS ON THE PROJECT SITE.
- ALL SEDIMENT TRAPS/BASINS SHOWN MUST BE FENCED AND WARNING SIGNS POSTED AROUND THEIR PERIMETER IN ACCORDANCE WITH VOL. 1, CHAPTER 12, OF THE HOWARD COUNTY DESIGN MANUAL, STORM DRAINAGE.
- ALL DISTURBED AREAS MUST BE STABILIZED WITHIN THE TIME PERIOD SPECIFIED ABOVE IN ACCORDANCE WITH THE 1994 MARYLAND STANDARDS AND SPECIFICATIONS FOR SOIL EROSION AND SEDIMENT CONTROL FOR PERMANENT SEEDINGS (SEC. 51) 500 (SEC. 54), TEMPORARY SEEDING (SEC. 52) AND MULCHING (SEC. 52). TEMPORARY STABILIZATION WITH MULCH ALONE CAN ONLY BE DONE WHEN RECOMMENDED SEEDING DATES DO NOT ALLOW FOR PROPER GERMINATION AND ESTABLISHMENT OF GRASSES.
- ALL SEDIMENT CONTROL STRUCTURES ARE TO REMAIN IN PLACE AND ARE TO BE MAINTAINED IN OPERATIVE CONDITION UNTIL PERMITS FOR THEIR REMOVAL HAVE BEEN OBTAINED FROM THE HOWARD COUNTY SEDIMENT CONTROL INSPECTOR.
- SITE ANALYSIS:
 

TOTAL AREA OF SITE	100.58	ACRES
AREA DISTURBED	55.55	ACRES
AREA TO BE GRADED OR PAVED	6.28	ACRES
AREA TO BE VEGETATIVELY STABILIZED	49.27	ACRES
TOTAL CUT	308,000	CY
TOTAL FILL	308,000	CY
OFFSITE WASTE/BORROW AREA LOCATION	N/A	
- ANY SEDIMENT CONTROL PRACTICE WHICH IS DISTURBED BY GRADING ACTIVITY FOR PLACEMENT OF UTILITIES MUST BE REPAIRED ON THE SAME DAY OF DISTURBANCE.
- ADDITIONAL SEDIMENT CONTROL MUST BE PROVIDED, IF DEEMED NECESSARY BY THE HOWARD COUNTY SEDIMENT CONTROL INSPECTOR.
- ON ALL SITES WITH DISTURBED AREAS IN EXCESS OF 2 ACRES, APPROVAL OF THE INSPECTION AGENCY SHALL BE REQUESTED UPON COMPLETION OF INSTALLATION OF PERIMETER EROSION AND SEDIMENT CONTROL STRUCTURES, BUT BEFORE ANY OTHER EARTH DISTURBANCE OR GRADING, OTHER BUILDING OR GRADING INSPECTION APPROVALS MAY NOT BE AUTHORIZED UNTIL THIS INITIAL APPROVAL BY THE INSPECTION AGENCY IS MADE.
- TRENCHES FOR THE CONSTRUCTION OF UTILITIES IS LIMITED TO THREE PIPE LENGTHS OR THAT WHICH CAN BE BACK FILLED AND STABILIZED WITHIN ONE WORKING DAY, WHICHEVER IS SHORTER.

**TEMPORARY SEEDBED PREPARATIONS**

APPLY TO GRADED OR CLEARED AREAS LIKELY TO BE REDISTURBED WHERE A SHORT-TERM VEGETATIVE COVER IS NEEDED.

SEEDBED PREPARATION: LOOSEN UPPER THREE INCHES OF SOIL BY RAKING, DISCING OR OTHER ACCEPTABLE MEANS BEFORE SEEDING, IF NOT PREVIOUSLY LOOSENED.

SOIL AMENDMENTS: APPLY 600 LBS PER ACRE 10-10-10 FERTILIZER (14 LBS/1000 SQ FT).

SEEDING: FOR PERIOD MARCH 1 THROUGH APRIL 30 AND FROM AUGUST 15 THROUGH NOVEMBER 15, SEED WITH 2-1/2 BUSHELS PER ACRE OF ANNUAL RYE (3.2 LBS/1000 SQ FT).

MULCHING: APPLY 1-1/2 TO 2 TONS PER ACRE (70 TO 90 LBS/1000 SQ FT) OF UNROTATED SMALL GRAIN STRAW IMMEDIATELY AFTER SEEDING. ANCHOR MULCH IMMEDIATELY AFTER APPLICATION USING MULCH ANCHORING TOOL OR 216 GALLONS PER ACRE (5 GAL/1000 SQ FT) OF EMULSIFIED ASPHALT ON FLAT AREAS, ON SLOPES, 8 FT. OR HIGHER, USE 348 GALLONS PER ACRE (8 GAL/1000 SQ FT) FOR ANCHORING.

**PERMANENT SEEDBED PREPARATIONS**

SEEDBED PREPARATION: LOOSEN UPPER THREE INCHES OF SOIL BY RAKING, DISCING OR OTHER ACCEPTABLE MEANS BEFORE SEEDING, IF NOT PREVIOUSLY LOOSENED.














SOIL AMENDMENTS: IN LIEU OF SOIL TEST RECOMMENDATIONS, USE ON OF THE FOLLOWING SCHEDULES:

- PREFERRED - APPLY 2 TONS PER ACRE DOLOMITIC LIMESTONE (92 LBS/1000 SQ FT) AND 600 LBS PER ACRE 10-10-10 FERTILIZER (14 LBS/1000 SQ FT) BEFORE SEEDING. HARROW OR DISC INTO UPPER THREE INCHES OF SOIL. AT TIME OF SEEDING, APPLY 400 LBS PER ACRE 30-0-0 UREAFORM FERTILIZER (9 LBS/1000 SQ FT).
- ACCEPTABLE - APPLY 2 TONS PER ACRE DOLOMITIC LIMESTONE (92 LBS/1000 SQ FT) AND 1000 LBS PER ACRE 10-10-10 FERTILIZER (23 LBS/1000 SQ FT) BEFORE SEEDING. HARROW OR DISC INTO UPPER THREE INCHES OF SOIL.

**TOPSOIL SPECIFICATIONS**

- Topsoil salvaged from the existing site may be used provided that it meets that standards as set forth in the attached Topsoil Salvage and Use Manual. Topsoil to be salvaged for a given soil type can be found in the representative soil profile section in the Soil Survey published by USDA-SCS in cooperation with Maryland Agricultural Experiment Station.
- Topsoil Specifications - Soil to be used as topsoil must meet the following:
  - Topsoil shall be a loam, sandy loam, clay loam, silt loam, sandy clay loam, loamy sand. Other soils may be used if recommended by an agronomist or soil scientist and approved by the appropriate approval authority. Regardless, topsoil shall not be a mixture of contrasting texture subsoils and shall contain less than 5% by volume of cinders, stones, silt, coarse fragments, gravel, sticks, roots, trash, or other materials larger than 1-1/2" in diameter.
  - Topsoil must be free of plants or plant parts such as Bermuda grass, quack grass, Johnson grass, nutsedge, poison ivy, thistle, or others as specified.
  - Where the subsoil is either highly acidic or composed of heavy clays, ground limestone shall be spread at the rate of 4-8 tons/acre (200-400 pounds per 1,000 square feet) prior to the placement of topsoil. Lime shall be distributed uniformly over designated areas and worked into the soil in conjunction with tillage operations as described in the following procedures.
- For sites having disturbed areas under 5 acres:
  - Place topsoil (if required) and apply soil amendments as specified in 2.0 Vegetative Stabilization - Section 1 - Vegetative Stabilization Methods and Materials.
- For sites having disturbed areas over 5 acres:
  - On soil meeting Topsoil specifications, obtain test results dictating fertilizer and lime amendments required to bring the soil into compliance with the following:
    - pH for topsoil shall be between 6.0 and 7.5. If the tested soil demonstrates a pH of less than 6.0, sufficient lime shall be prescribed to raise the pH to 6.0 or higher.
    - Organic content of topsoil shall be not less than 1.5 percent by weight.
  - Topsoil having soluble salt content greater than 500 parts per million shall not be used.
  - No sod or seed shall be placed on soil which has been treated with soil sterilants or chemicals used for weed control until sufficient time has elapsed (14 days) to permit dissipation of phytotoxic materials.

- Note: Topsoil substitutes or amendments, as recommended by a qualified agronomist or soil scientist and approved by the appropriate approval authority, may be used in lieu of natural topsoil.
- Place topsoil (if required) and apply soil amendments as specified in 2.0 Vegetative Stabilization - Section 1 - Vegetative Stabilization Methods and Materials.

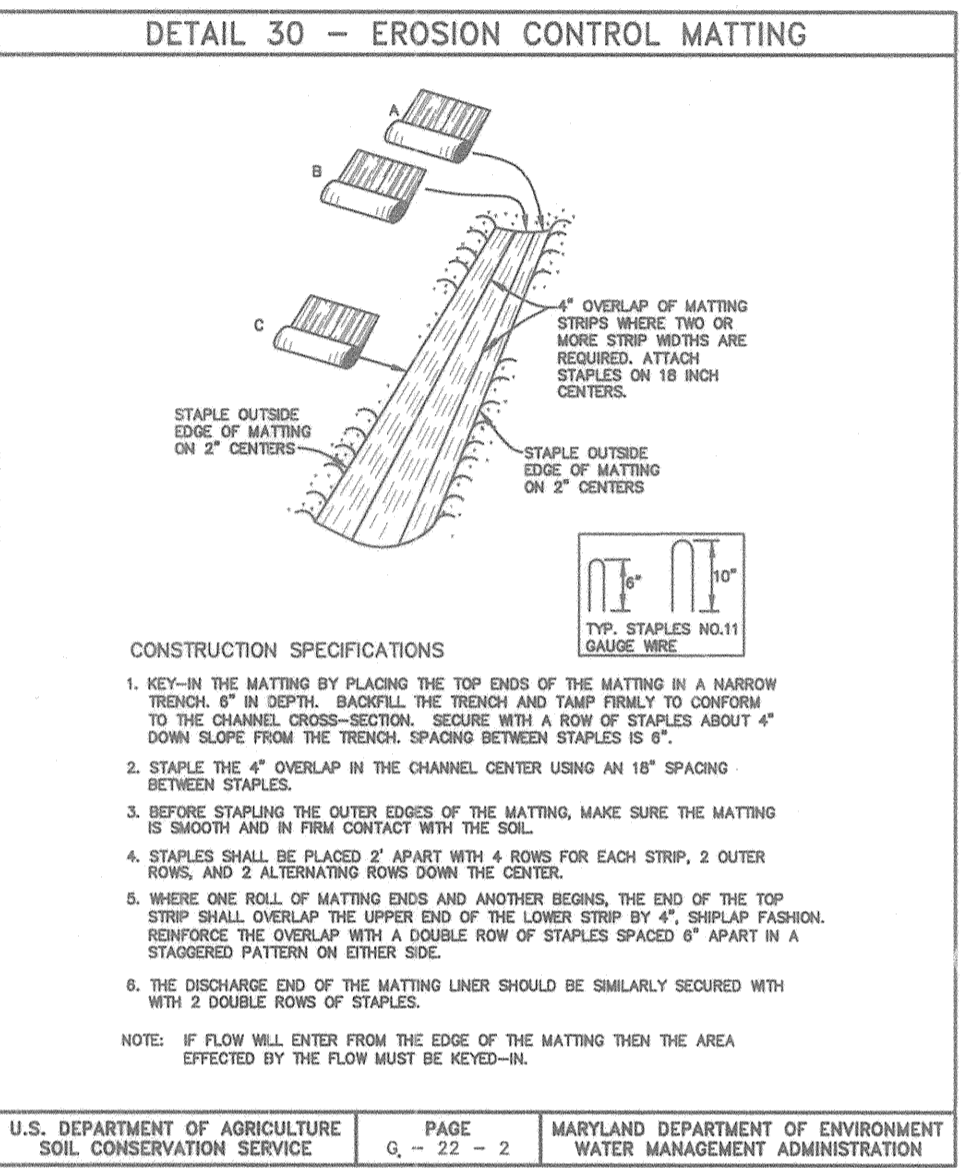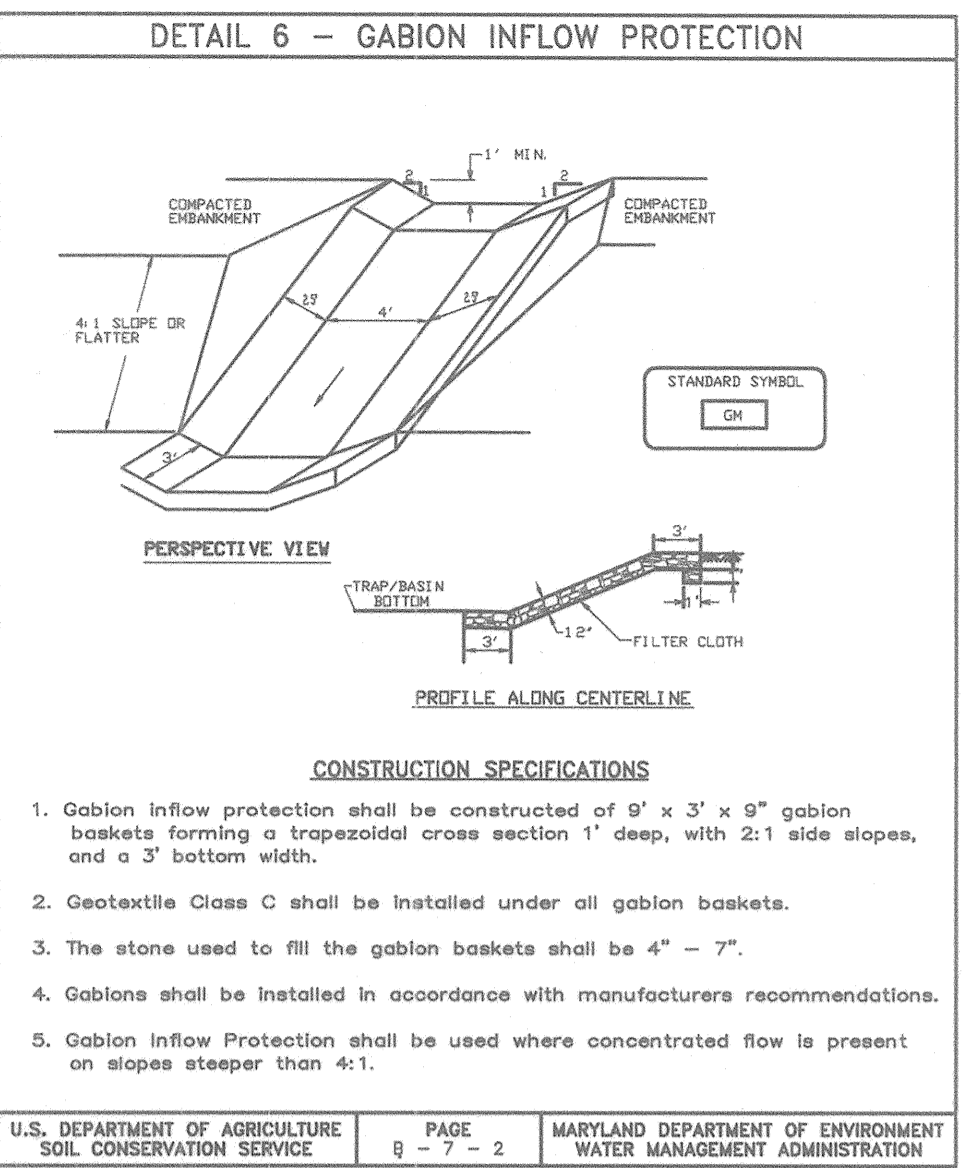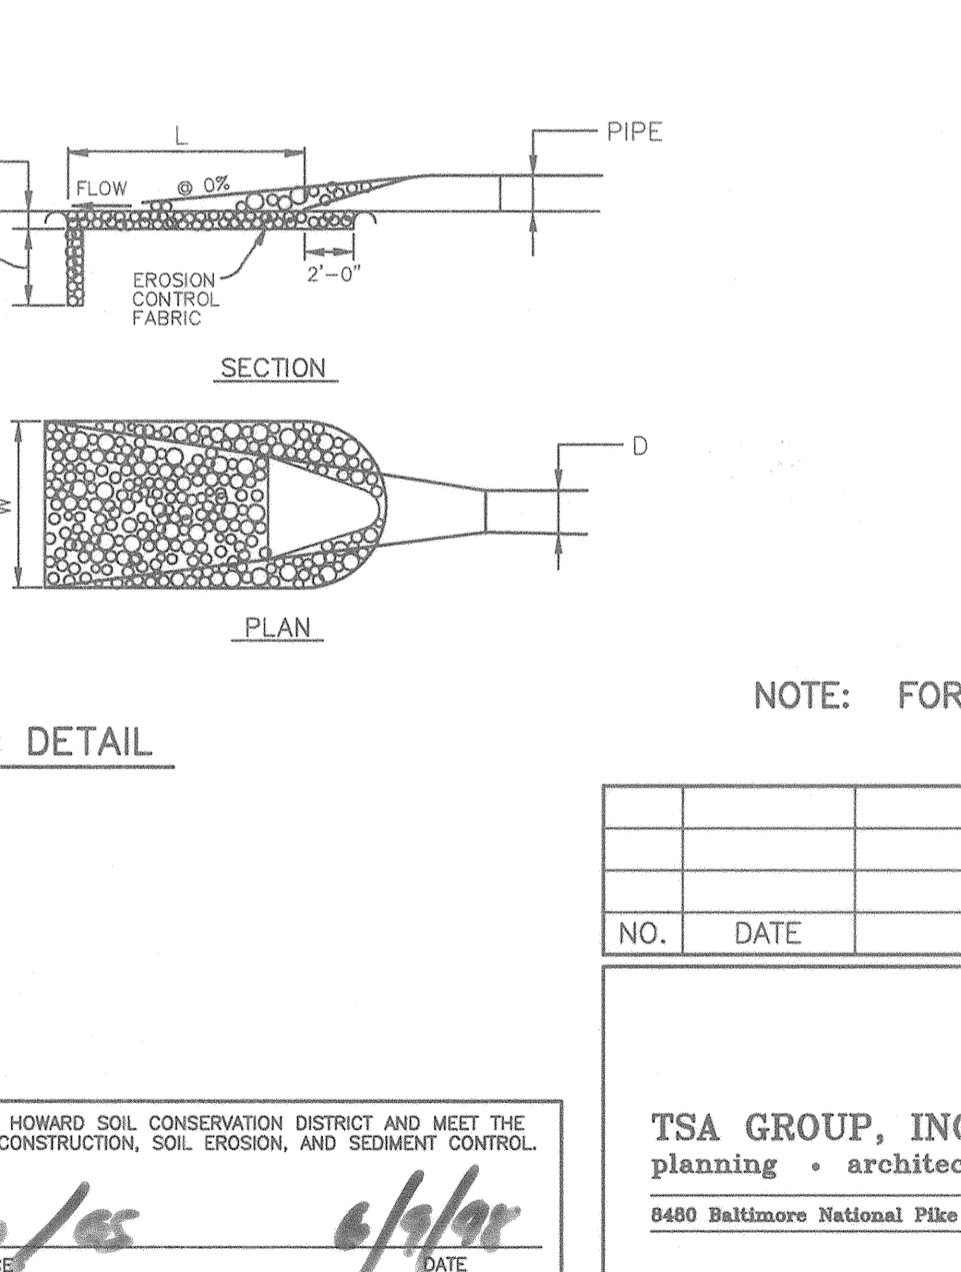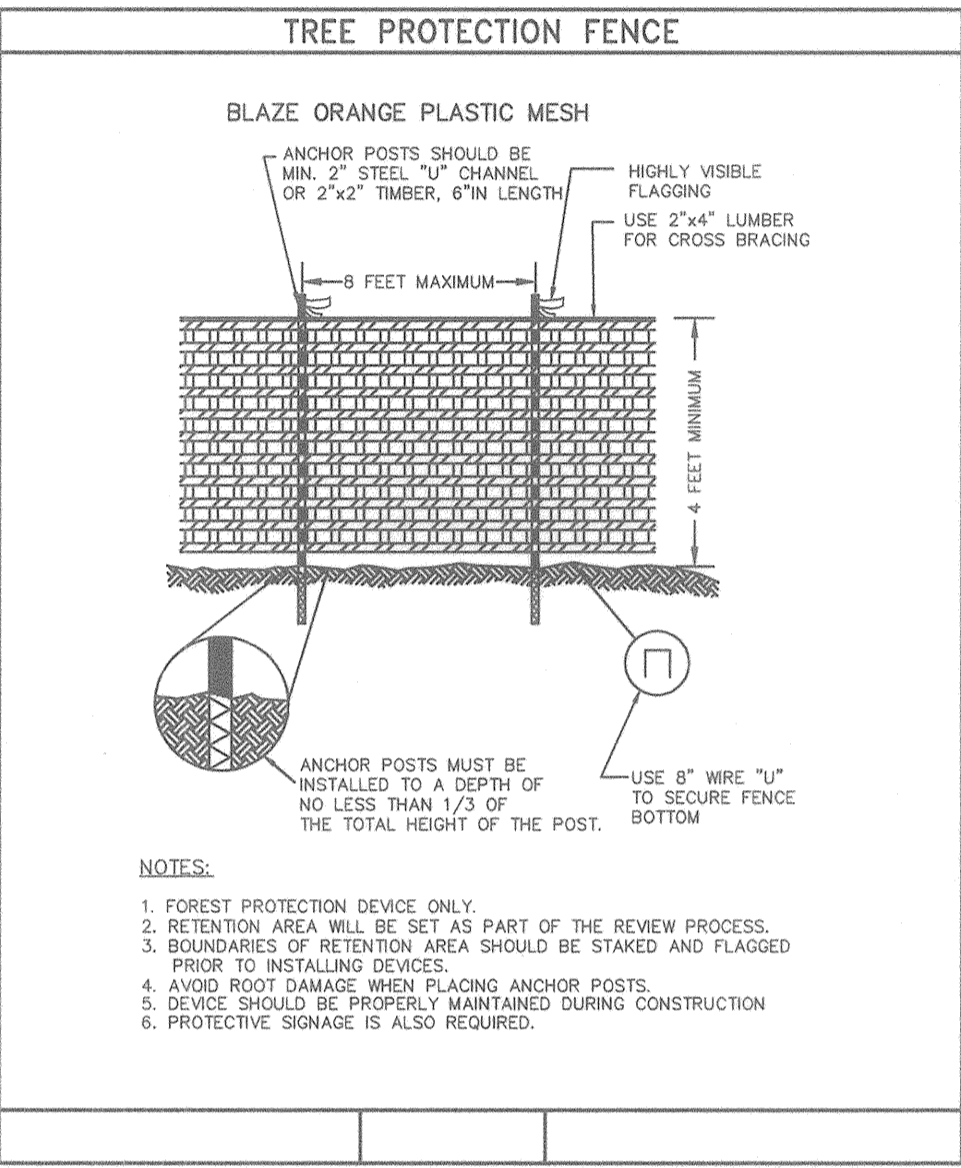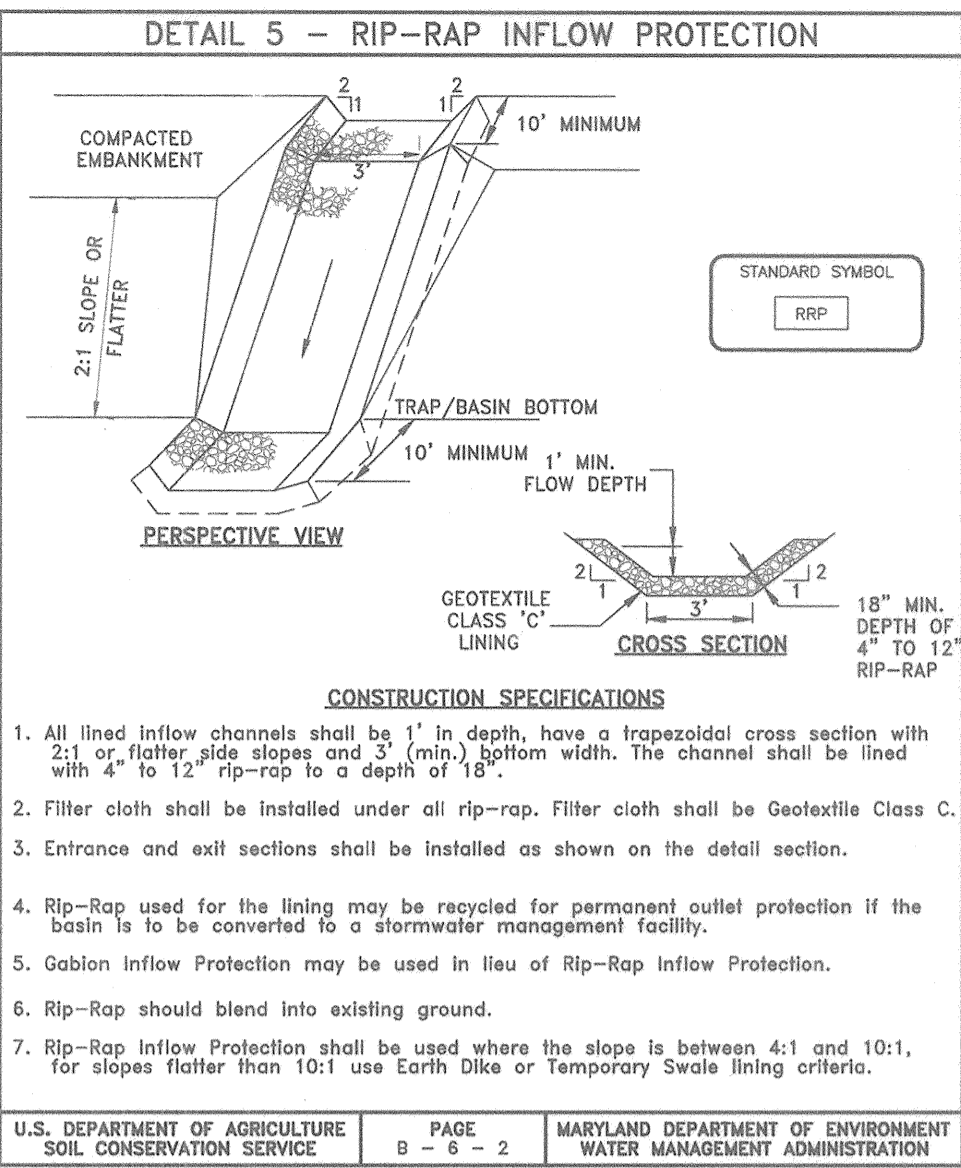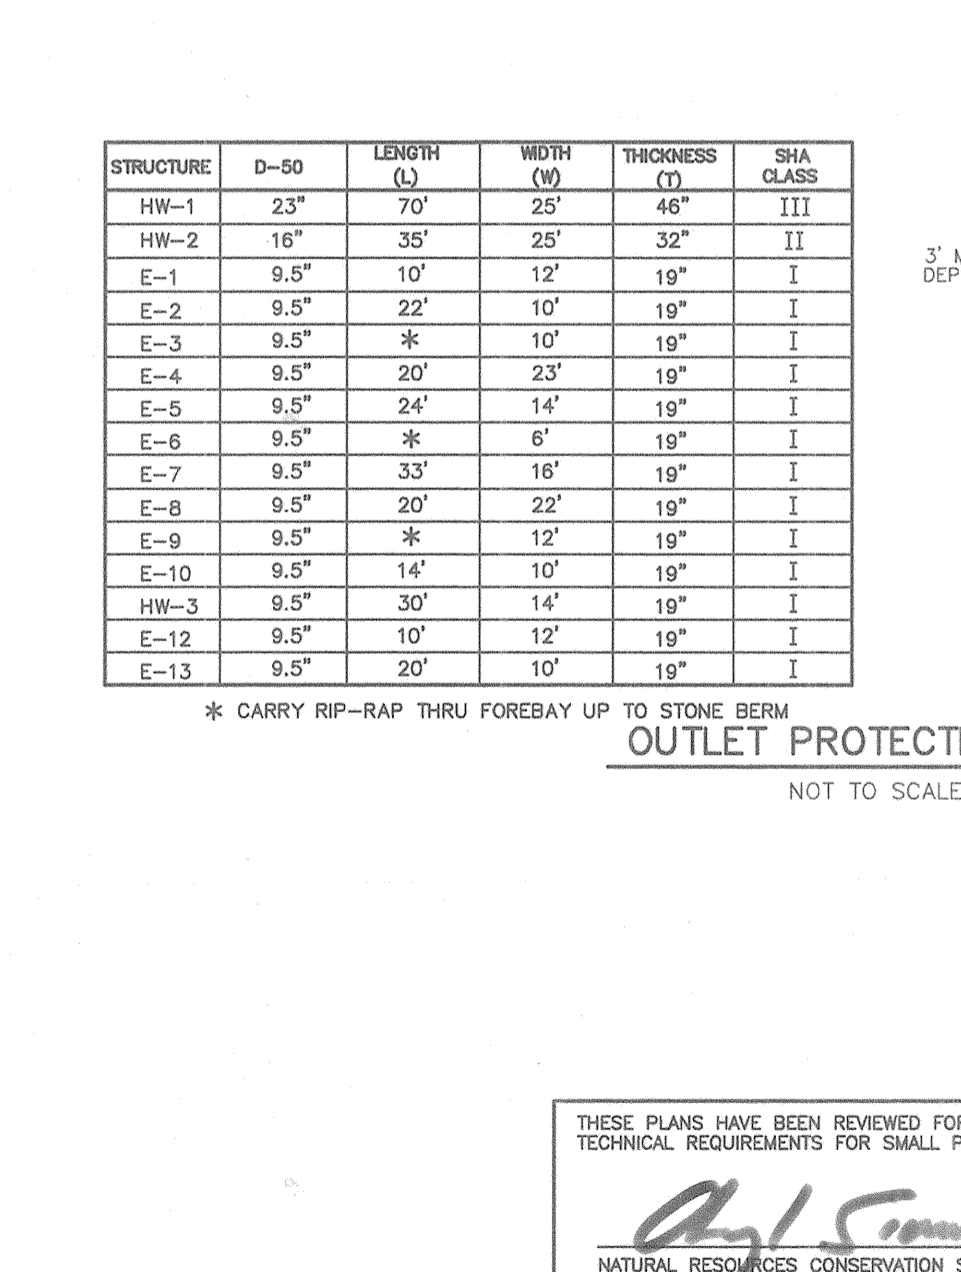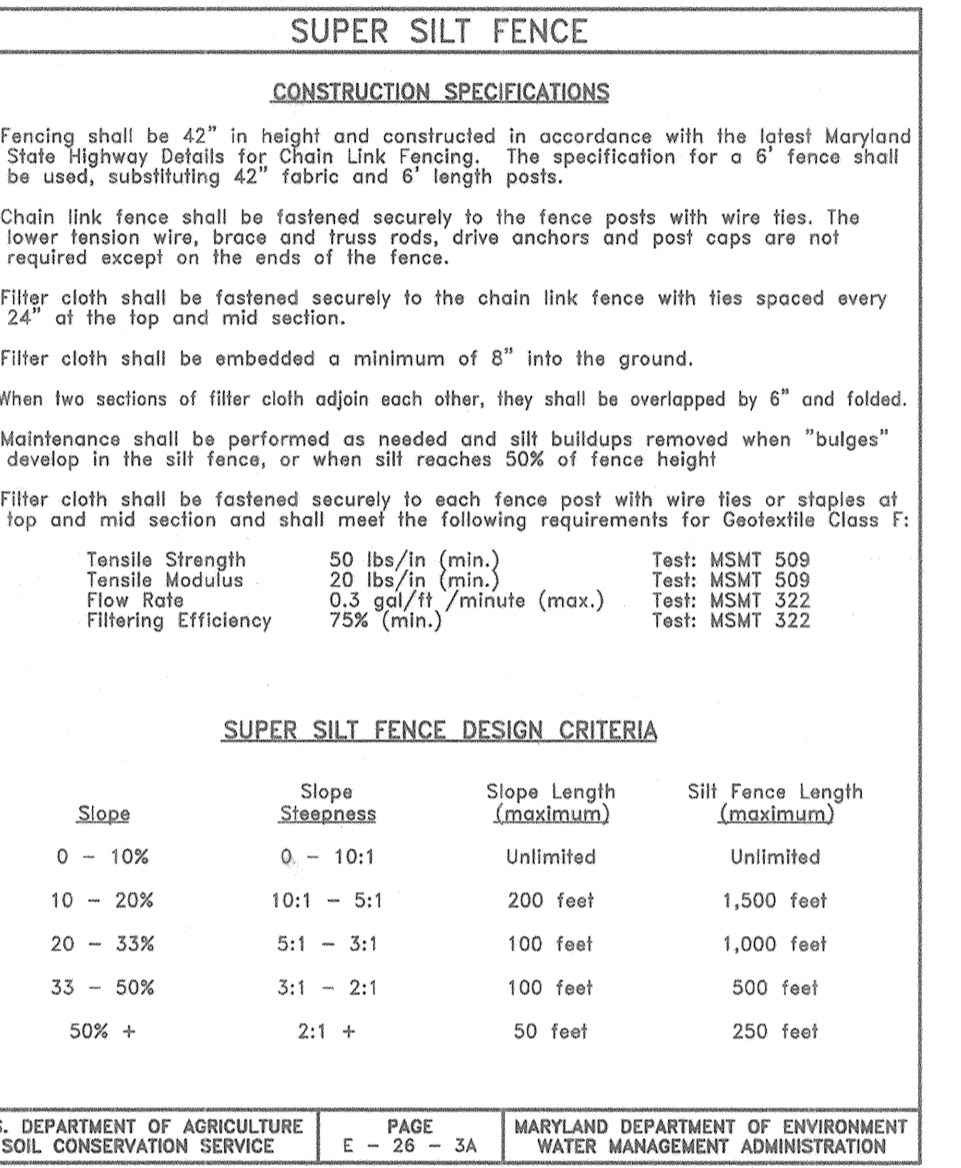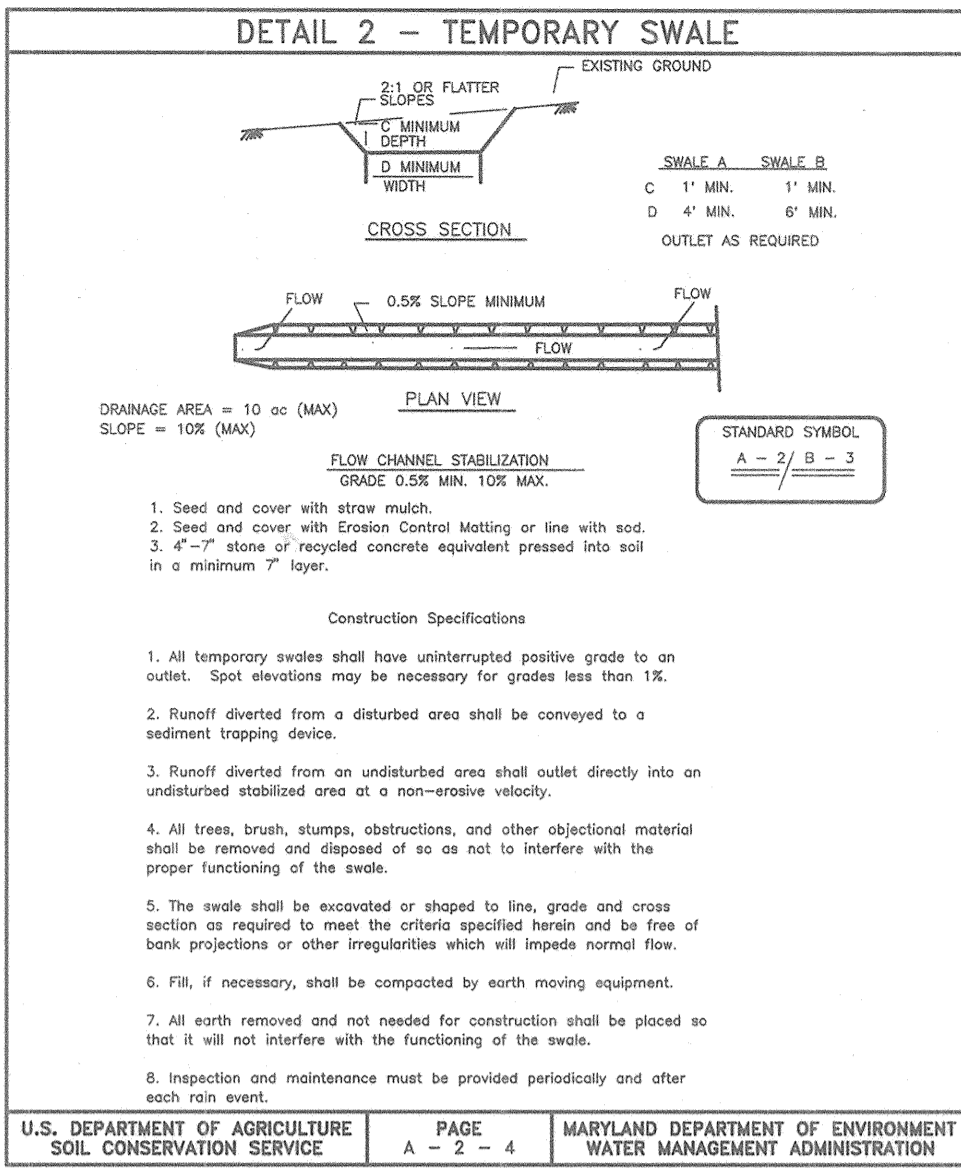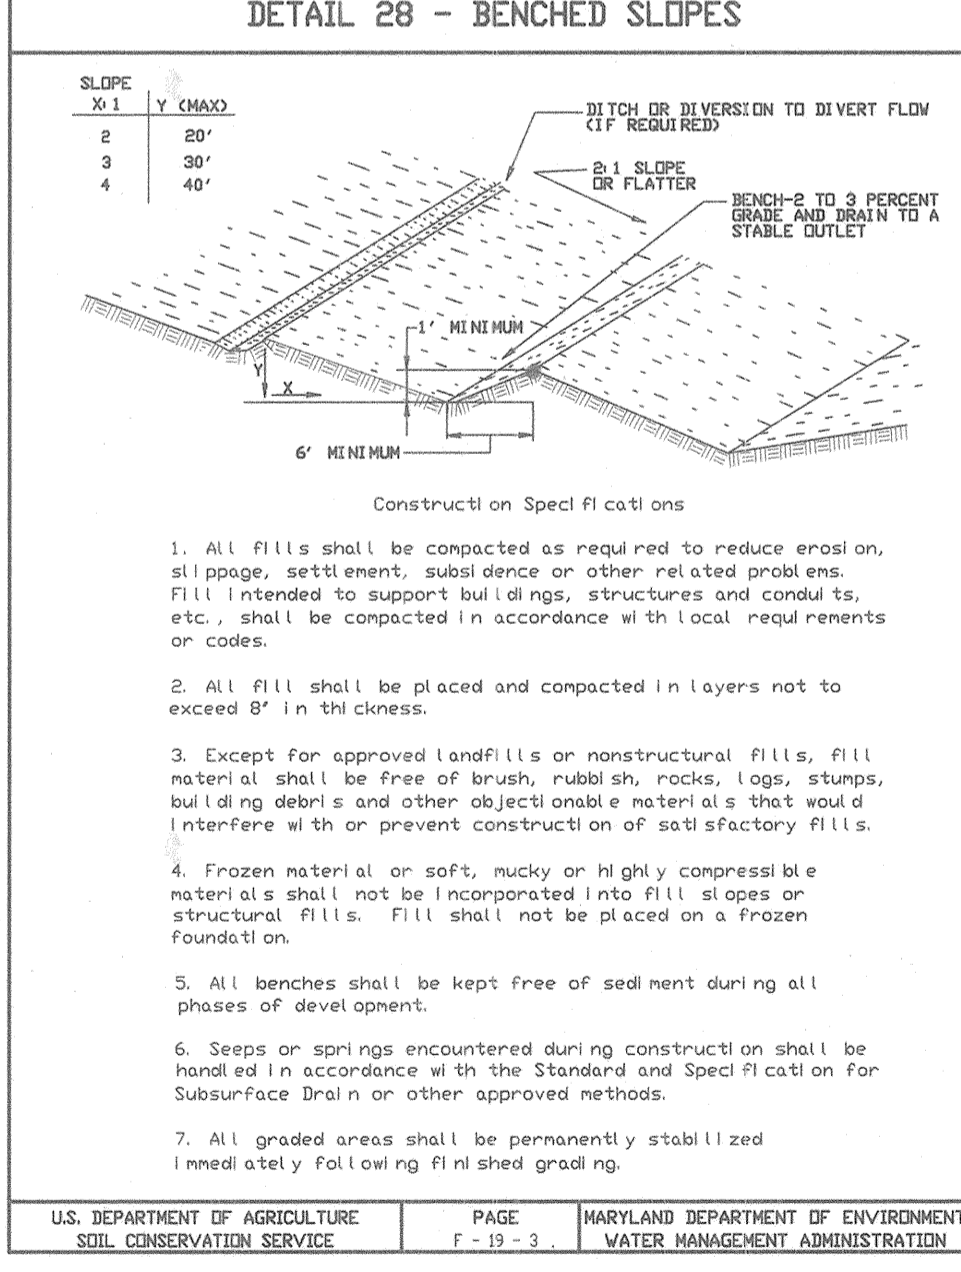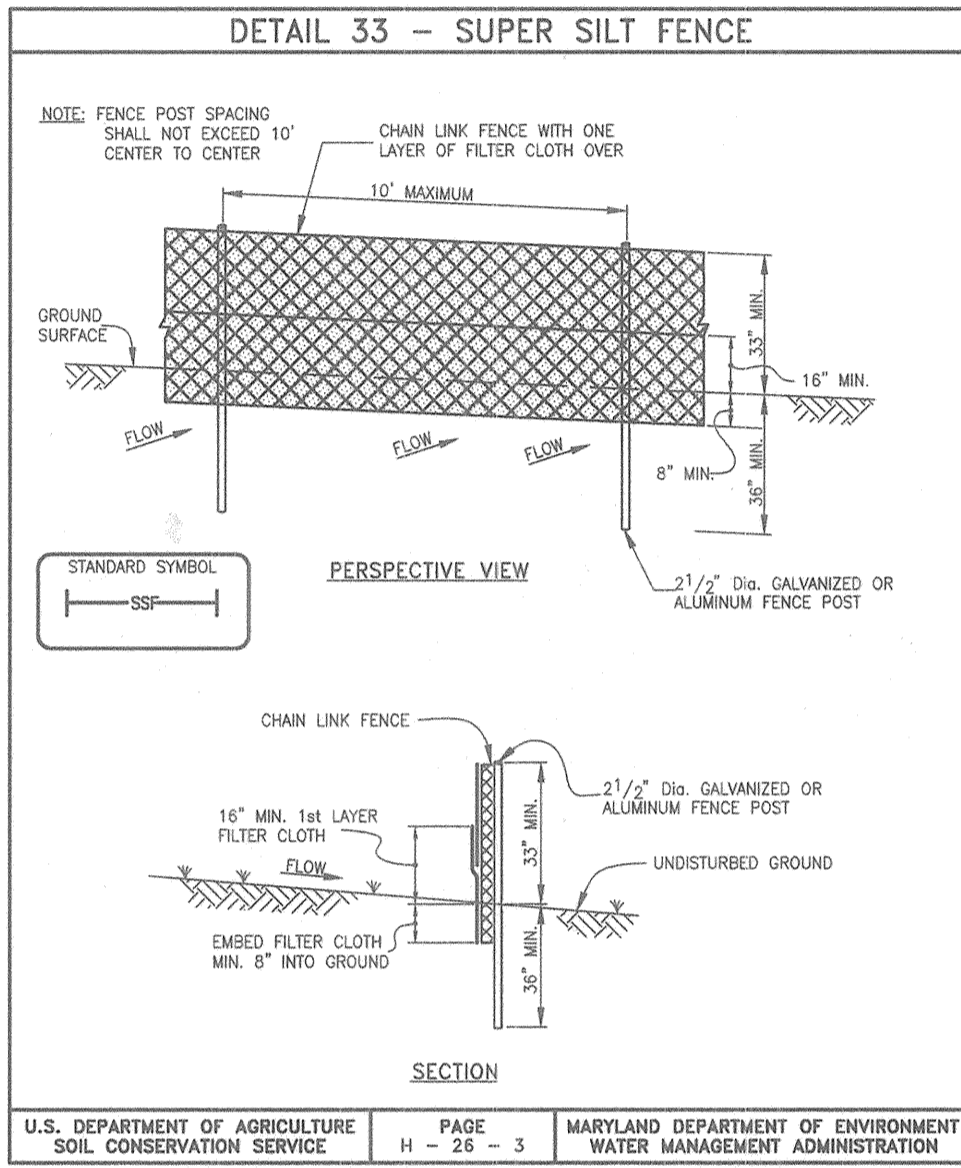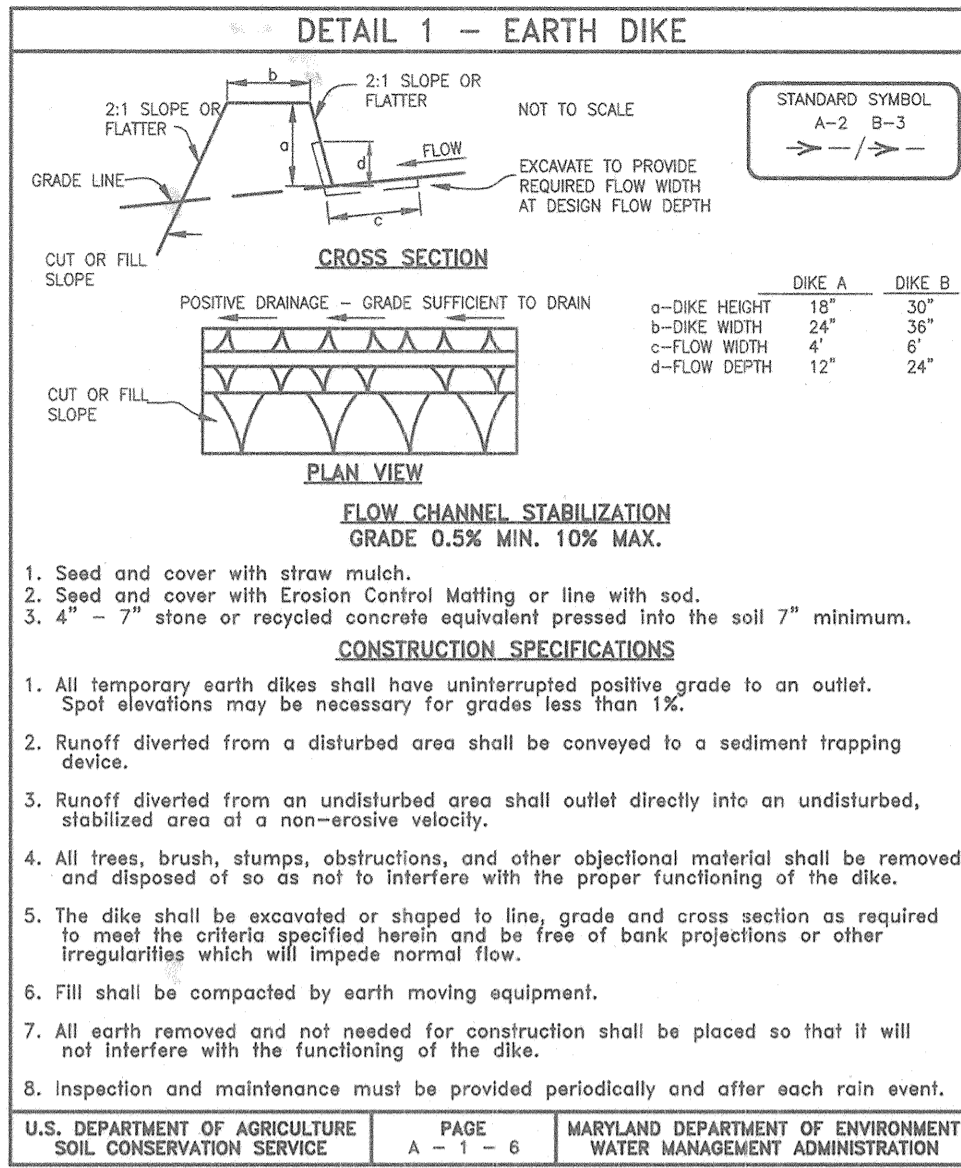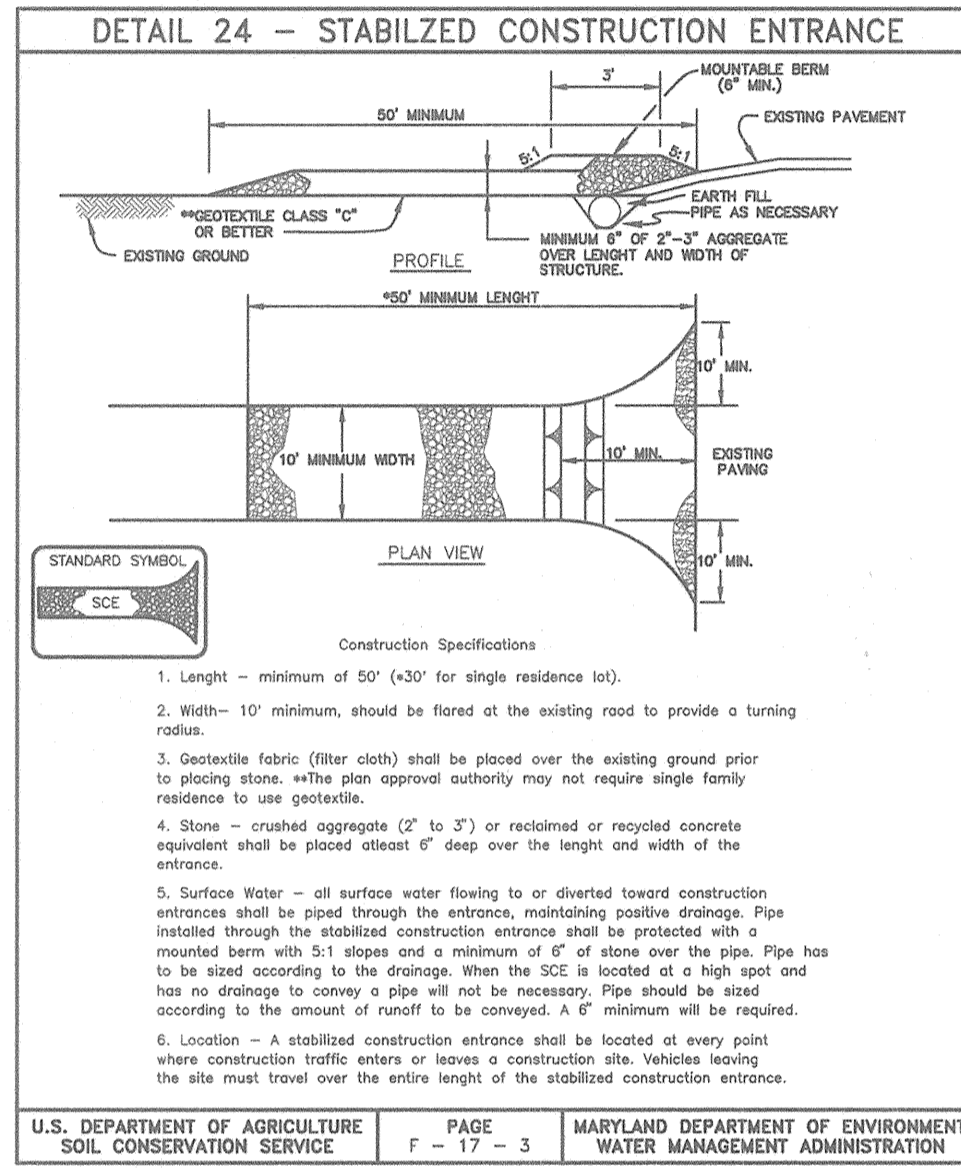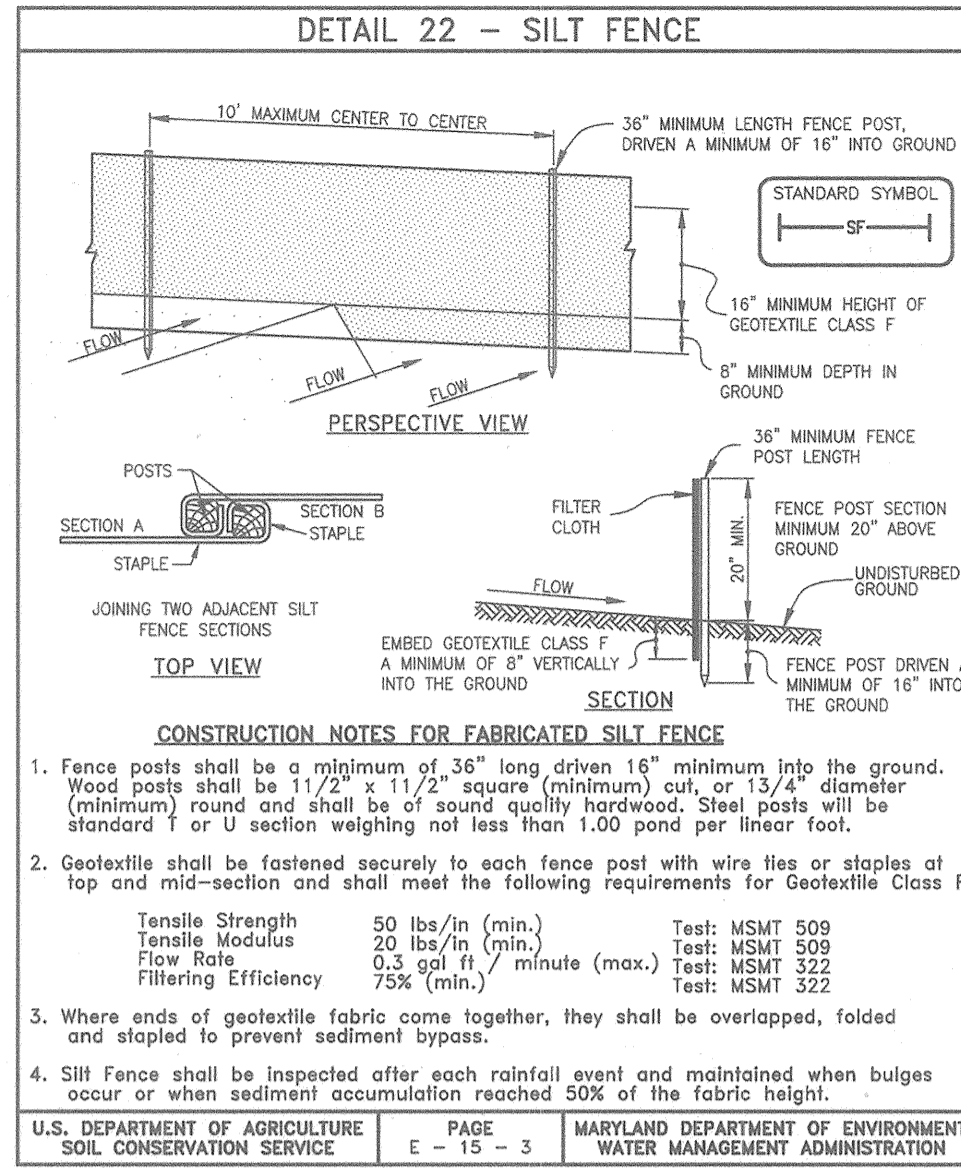

NOTE: FOR A STOCKPILE OR SPOIL AREA CONDITION SEE SHEET 30.

THESE PLANS HAVE BEEN REVIEWED FOR THE HOWARD SOIL CONSERVATION DISTRICT AND MEET THE TECHNICAL REQUIREMENTS FOR SMALL POND CONSTRUCTION, SOIL EROSION, AND SEDIMENT CONTROL.

*Angela Simon / ss* 6/19/98  
NATURAL RESOURCES CONSERVATION SERVICE DATE

*Robert W. Zick / ss* 6/19/98  
DATE

HOWARD SOIL CONSERVATION DISTRICT DATE

APPROVED: HOWARD COUNTY DEPARTMENT OF PUBLIC WORKS  
*Richard M. Daniels* 6-15-98  
CHIEF, BUREAU OF HIGHWAYS DATE

APPROVED: HOWARD COUNTY DEPARTMENT OF PLANNING AND ZONING  
*William D. ...* 6/23/98  
CHIEF, DIVISION OF LAND DEVELOPMENT DATE

*William D. ...* 6/23/98  
CHIEF, DEVELOPMENT ENGINEERING DIVISION DATE

BY THE DEVELOPER:

I/WE CERTIFY THAT ALL DEVELOPMENT AND/OR CONSTRUCTION WILL BE DONE ACCORDING TO THESE PLANS, AND THAT ANY RESPONSIBLE PERSONNEL INVOLVED IN THE CONSTRUCTION PROJECT WILL HAVE A CERTIFICATE OF ATTENDANCE AT A DEPARTMENT OF THE ENVIRONMENT APPROVED TRAINING PROGRAM FOR THE CONTROL OF SEDIMENT AND EROSION BEFORE BEGINNING THE PROJECT. I SHALL ENGAGE A REGISTERED PROFESSIONAL ENGINEER TO SUPERVISE POND CONSTRUCTION AND PROVIDE THE HOWARD SOIL CONSERVATION DISTRICT WITH AN AS-BUILT PLAN OF THE POND WITHIN 30 DAYS OF COMPLETION. I ALSO AUTHORIZE PERIODIC ON-SITE INSPECTIONS BY THE HOWARD SOIL CONSERVATION DISTRICT.

*Donall M. Mason* 6-15-98  
DEVELOPER - TOLL MD LIMITED PARTNERSHIP DATE

I/WE CERTIFY THAT THIS PLAN FOR POND CONSTRUCTION, EROSION AND SEDIMENT CONTROL REPRESENTS A PRACTICAL AND WORKABLE PLAN BASED ON MY PERSONAL KNOWLEDGE OF THE SITE CONDITIONS. THIS PLAN WAS PREPARED IN ACCORDANCE WITH THE REQUIREMENTS OF THE HOWARD SOIL CONSERVATION DISTRICT. I HAVE NOTIFIED THE DEVELOPER THAT HE/SHE MUST ENGAGE A REGISTERED PROFESSIONAL ENGINEER TO SUPERVISE POND CONSTRUCTION AND PROVIDE THE HOWARD SOIL CONSERVATION DISTRICT WITH AN AS-BUILT PLAN OF THE POND WITHIN 30 DAYS OF COMPLETION.

*Donall M. Mason* 5/27/98  
ENGINEER - DONALD A. MASON, P.E. # 21443 DATE

**TSA GROUP, INC.**  
planning • architecture • engineering • surveying  
5680 Baltimore National Pike • Ellicott City, Maryland 21045 • 410-465-8105

*Donall M. Mason*  
DONALD MASON  
CONSULTING ENGINEER

OWNERS:  
TOLL MD LIMITED PARTNERSHIP,  
A MARYLAND LIMITED PARTNERSHIP  
3206 TOWER OAKS BOULEVARD  
SUITE 310  
ROCKVILLE, MARYLAND 20852

ROCKVILLE, MARYLAND 20852  
JOHN HOPKINS UNIVERSITY  
11100 JOHNS HOPKINS ROAD  
LAUREL, MARYLAND 20723-6005

DEVELOPER:  
TOLL MD LIMITED PARTNERSHIP,  
A MARYLAND LIMITED PARTNERSHIP  
3206 TOWER OAKS BOULEVARD  
SUITE 310  
ROCKVILLE, MARYLAND 20852

PROJECT: **VILLAGE OF CEDAR RIDGE**  
A SUBDIVISION OF PARCEL 44 (TAX MAP 41) AND A RESUBDIVISION OF LOTS 1 AND 2 OF THE EDITH S. PARLETTE SUBDIVISION (PLAT 10735 PARCEL 43) AND A SUBDIVISION OF PARCEL 123 FOR A ROAD RIGHT-OF-WAY.

LOCATION: TAX MAP 41 - PARCELS 43 & 44, P/O 123  
530 ELECTION DISTRICT  
HOWARD COUNTY, MARYLAND





TITLE:  
**SEDIMENT CONTROL NOTES AND DETAILS**

SP-97-02 WP-97-78 PB 312 F-93-70 WP-98-82

DATE: OCTOBER 1997  
MAY, 1998 PROJECT NO. 0518

DESIGN: MLV DRAFT: DBT CHECK: DAM SCALE: NOT TO SCALE SHEET 22 OF 31



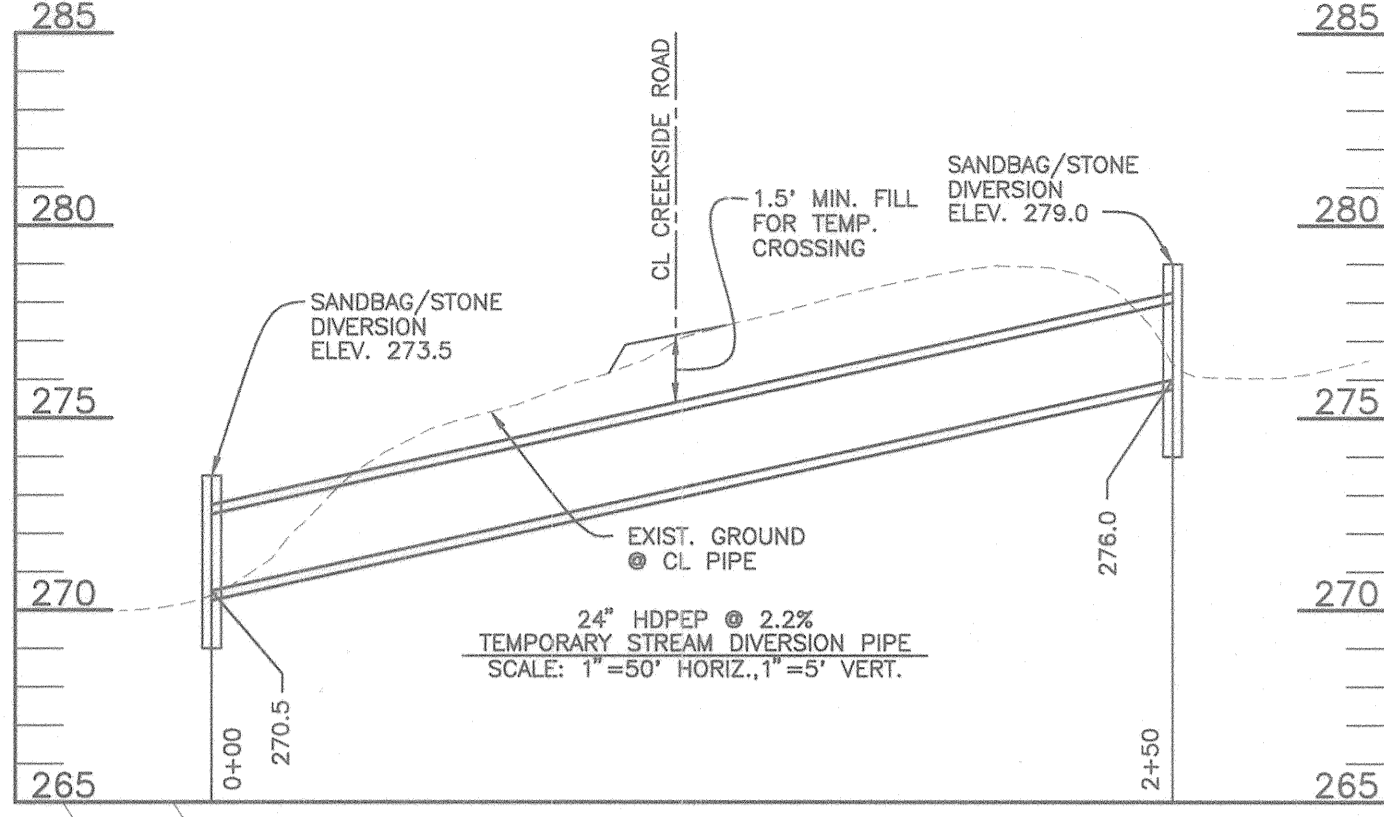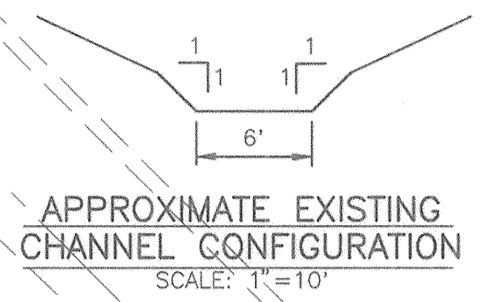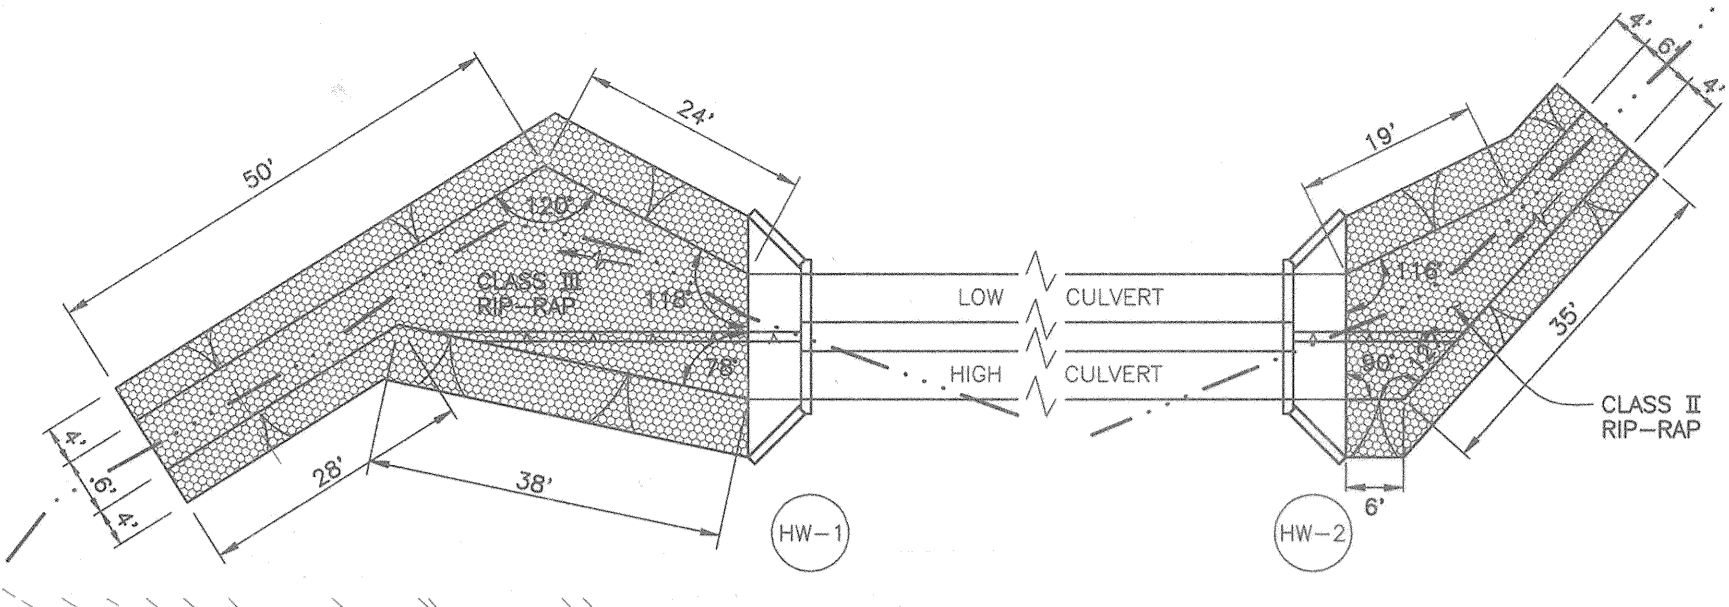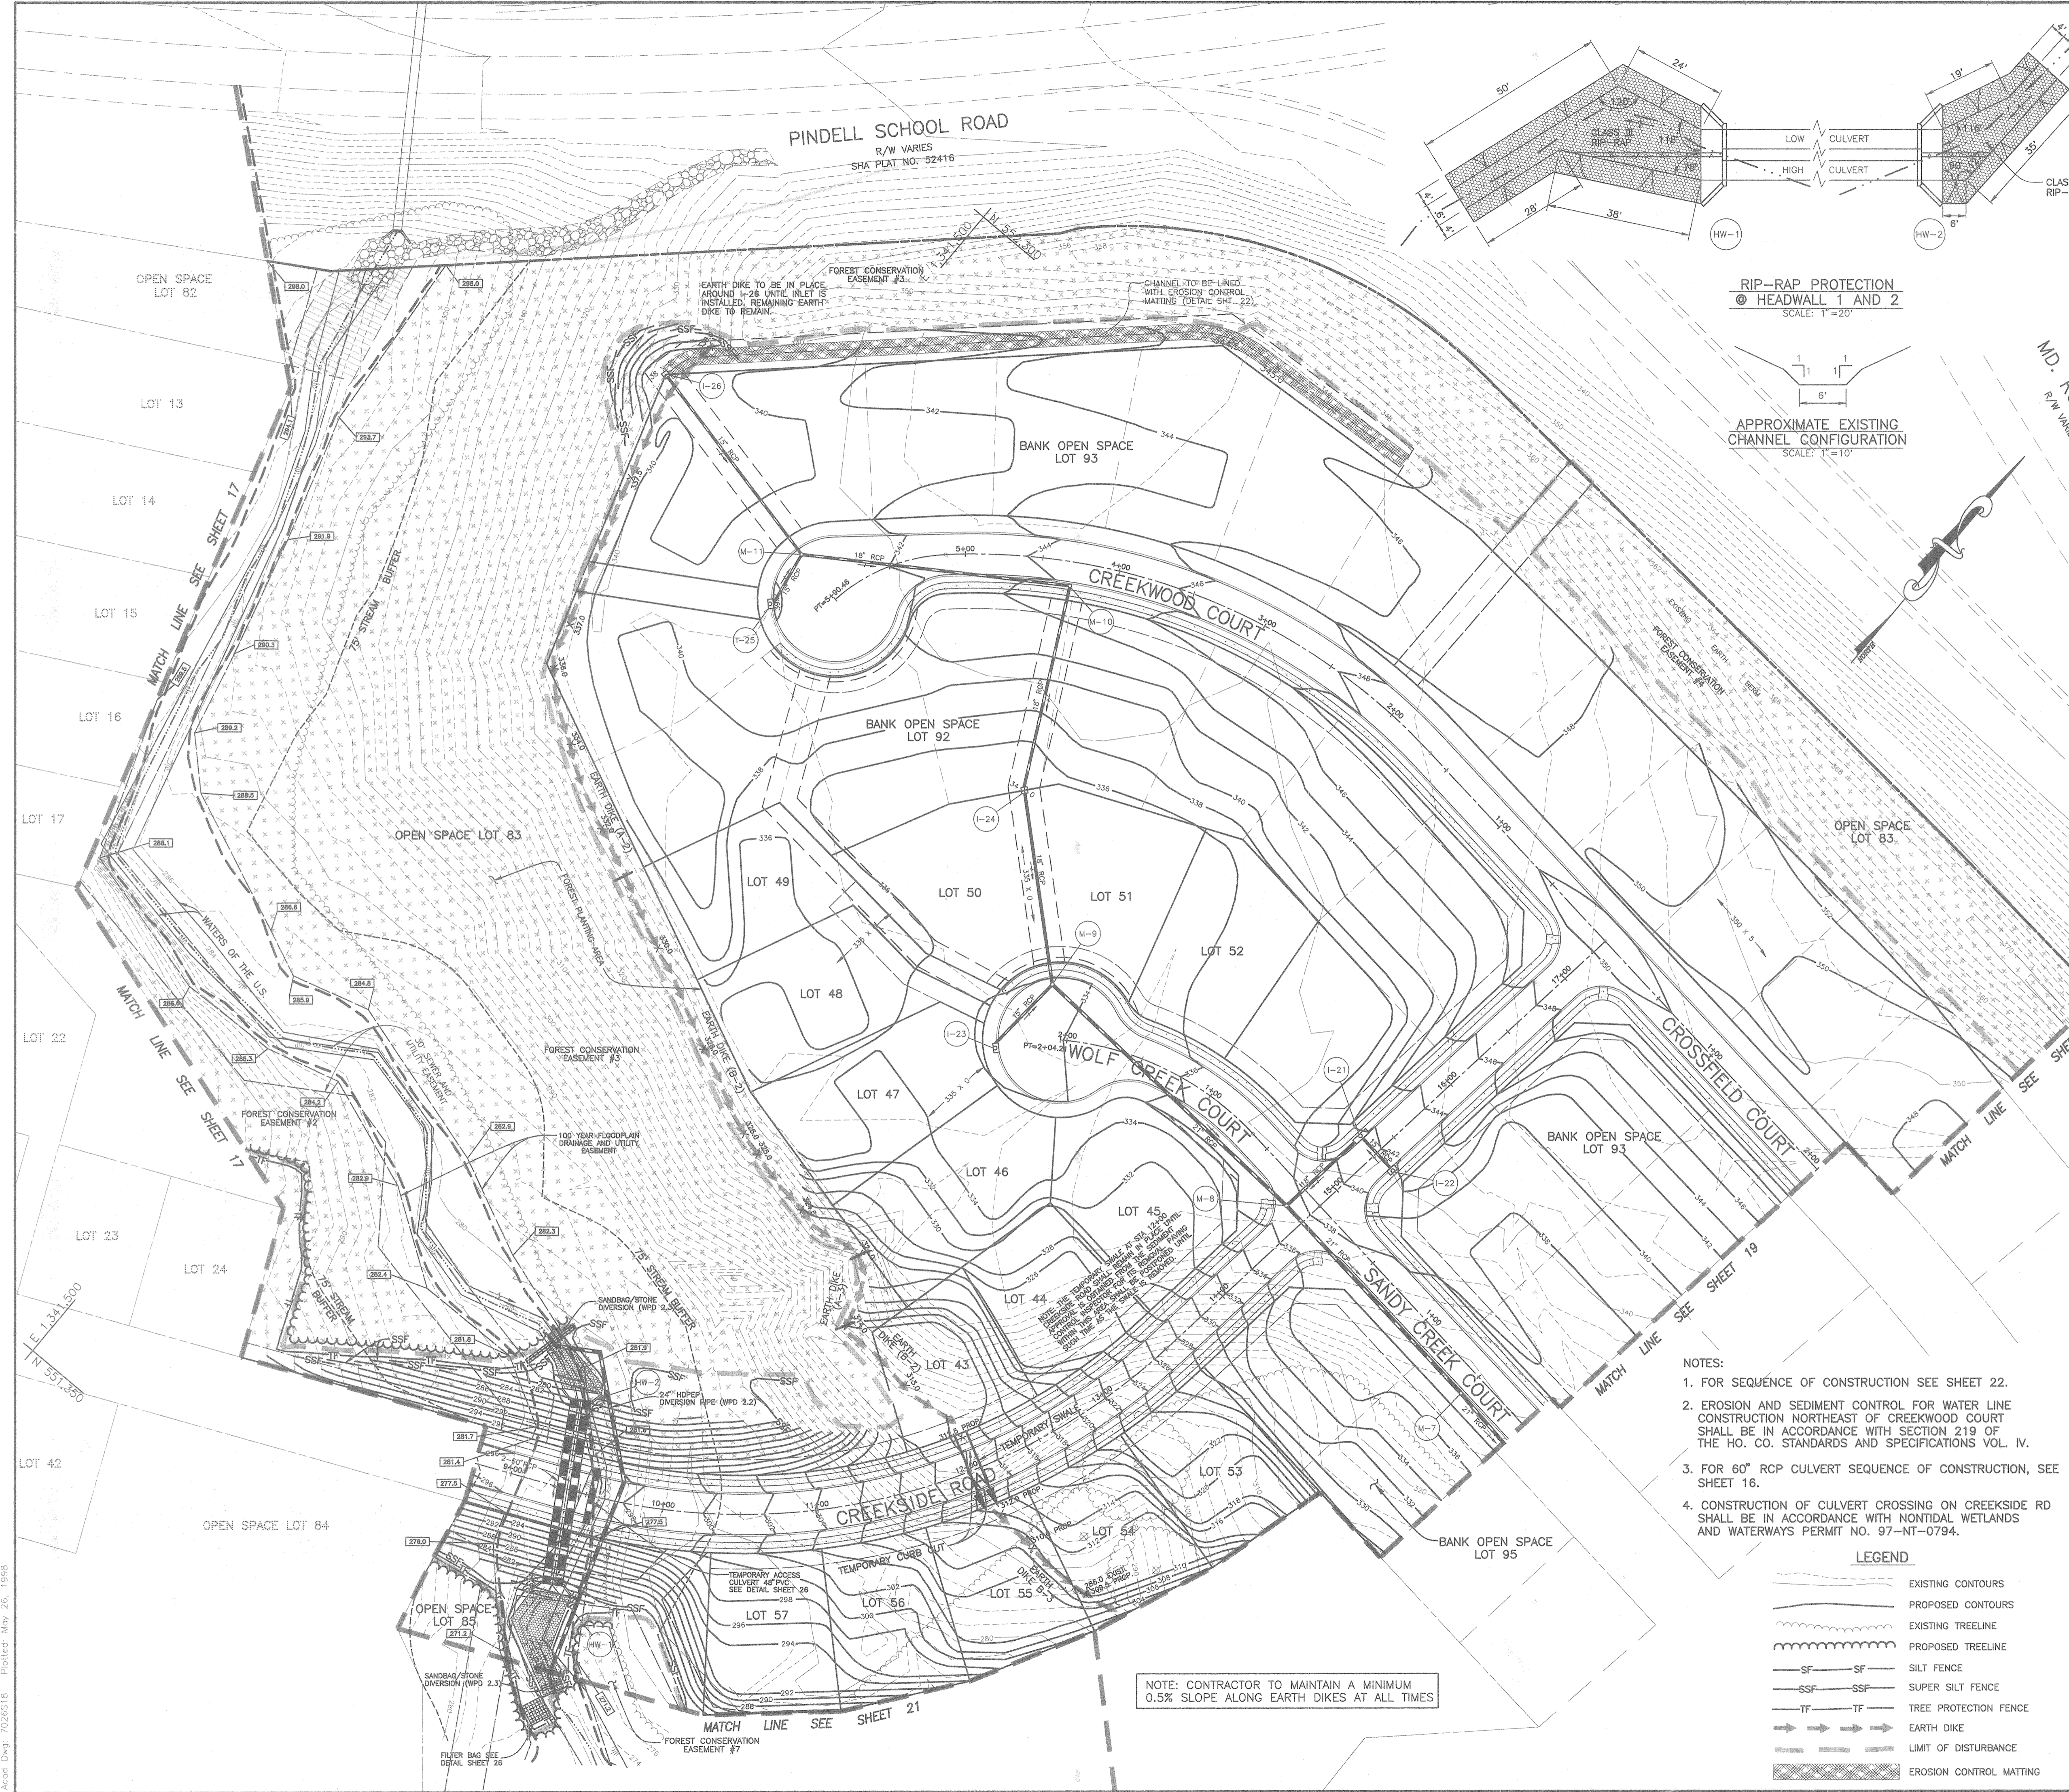

BY THE DEVELOPER:  
 I/WE CERTIFY THAT ALL DEVELOPMENT AND/OR CONSTRUCTION WILL BE DONE ACCORDING TO THESE PLANS, AND THAT ANY RESPONSIBLE PERSONNEL INVOLVED IN THE CONSTRUCTION PROJECT WILL HAVE A CERTIFICATE OF ATTENDANCE AT A DEPARTMENT OF THE ENVIRONMENT APPROVED TRAINING PROGRAM FOR THE CONTROL OF SEDIMENT AND EROSION BEFORE BEGINNING THE PROJECT. I SHALL ENGAGE A REGISTERED PROFESSIONAL ENGINEER TO SUPERVISE POND CONSTRUCTION AND PROVIDE THE HOWARD SOIL CONSERVATION DISTRICT WITH AN "AS-BUILT" PLAN OF THE POND WITHIN 30 DAYS OF COMPLETION. I ALSO AUTHORIZE PERIODIC ON-SITE INSPECTIONS BY THE HOWARD SOIL CONSERVATION DISTRICT.

*[Signature]* VP. 6-1-98  
 DEVELOPER - TOLL LIMITED PARTNERSHIP DATE

BY THE ENGINEER:  
 I/WE CERTIFY THAT THIS PLAN FOR POND CONSTRUCTION, EROSION AND SEDIMENT CONTROL REPRESENTS A PRACTICAL AND WORKABLE PLAN BASED ON MY PERSONAL KNOWLEDGE OF THE SITE CONDITIONS. THIS PLAN WAS PREPARED IN ACCORDANCE WITH THE REQUIREMENTS OF THE HOWARD SOIL CONSERVATION DISTRICT. I HAVE NOTICED THE DEVELOPER THAT HE/SHE MUST ENGAGE A REGISTERED PROFESSIONAL ENGINEER TO SUPERVISE POND CONSTRUCTION AND PROVIDE THE HOWARD SOIL CONSERVATION DISTRICT WITH AN "AS-BUILT" PLAN OF THE POND WITHIN 30 DAYS OF COMPLETION.

*[Signature]* 5/27/98  
 ENGINEER - DONALD A. MASON, P.E. # 21443 DATE

THESE PLANS HAVE BEEN REVIEWED FOR THE HOWARD SOIL CONSERVATION DISTRICT AND MEET THE TECHNICAL REQUIREMENTS FOR SMALL POND CONSTRUCTION, SOIL EROSION, AND SEDIMENT CONTROL.  
*[Signature]* 6/9/98  
 NATURAL RESOURCES CONSERVATION SERVICE DATE

THESE PLANS FOR SMALL POND CONSTRUCTION, SOIL EROSION, AND SEDIMENT CONTROL MEET THE REQUIREMENTS OF THE HOWARD SOIL CONSERVATION DISTRICT.  
*[Signature]* 6/9/98  
 HOWARD SOIL CONSERVATION DISTRICT DATE

APPROVED: HOWARD COUNTY DEPARTMENT OF PUBLIC WORKS  
*[Signature]* 6-15-98  
 CHIEF, BUREAU OF HIGHWAYS DATE

APPROVED: HOWARD COUNTY DEPARTMENT OF PLANNING AND ZONING  
*[Signature]* 6/23/98  
 CHIEF, DIVISION OF LAND DEVELOPMENT DATE

*[Signature]* 6/22/98  
 CHIEF, DEVELOPMENT ENGINEERING DIVISION DATE

- NOTES:
- FOR SEQUENCE OF CONSTRUCTION SEE SHEET 22.
  - EROSION AND SEDIMENT CONTROL FOR WATER LINE CONSTRUCTION NORTHEAST OF CREEKWOOD COURT SHALL BE IN ACCORDANCE WITH SECTION 219 OF THE HO. CO. STANDARDS AND SPECIFICATIONS VOL. IV.
  - FOR 60" RCP CULVERT SEQUENCE OF CONSTRUCTION, SEE SHEET 16.
  - CONSTRUCTION OF CULVERT CROSSING ON CREEKSIDE RD SHALL BE IN ACCORDANCE WITH NONTIDAL WETLANDS AND WATERWAYS PERMIT NO. 97-NI-0794.

LEGEND

	EXISTING CONTOURS
	PROPOSED CONTOURS
	EXISTING TREELINE
	PROPOSED TREELINE
	SILT FENCE
	SUPER SILT FENCE
	TREE PROTECTION FENCE
	EARTH DIKE
	LIMIT OF DISTURBANCE
	EROSION CONTROL MATTING

NOTE: CONTRACTOR TO MAINTAIN A MINIMUM 0.5% SLOPE ALONG EARTH DIKES AT ALL TIMES

NO.	DATE	REVISION

**TSA GROUP, INC.**  
 planning • architecture • engineering • surveying  
 8480 Baltimore National Pike • Ellicott City, Maryland 21045 • 410-465-8105

OWNERS: TOLL MD LIMITED PARTNERSHIP, A MARYLAND LIMITED PARTNERSHIP 3206 TOWER OAKS BOULEVARD SUITE 310 ROCKVILLE, MARYLAND 20852	PROJECT: <b>VILLAGE OF CEDAR RIDGE</b> A SUBDIVISION OF PARCEL 44 (TAX MAP 41) AND A RESUBDIVISION OF LOTS 1 AND 2 OF THE EDITH S. PALLETT SUBDIVISION (PLAT 10735 PARCEL 43) AND A SUBDIVISION OF PARCEL 123 FOR A ROAD RIGHT-OF-WAY.
	LOCATION: TAX MAP 41 - PARCELS 43 & 44, P.O. 123 530 ELECTION DISTRICT HOWARD COUNTY, MARYLAND
DEVELOPER: TOLL MD LIMITED PARTNERSHIP, A MARYLAND LIMITED PARTNERSHIP 3206 TOWER OAKS BOULEVARD SUITE 310 ROCKVILLE, MARYLAND 20852	TITLE: <b>GRADING, SEDIMENT &amp; EROSION CONTROL PLAN</b> SP-97-02 WP-97-78 PB 312 F-93-70 WP-98-82 DATE: OCTOBER, 1997 PROJECT NO. 0518 MAY, 1998
DES: MLV/DAM DRAFT: DBT CHECK: DAM	SCALE: 1" = 50' SHEET 18 OF 31




SOILS LEGEND		
MAP SYMBOL	SOIL TYPE	MAPPING UNIT
Ba	D	BALE SILT LOAM
CgC2	B	CHESTER GRAVELLY SILT LOAM, 8 TO 15 PERCENT SLOPES, MODERATELY ERODED
CmB2	B	CHESTER SILT LOAM, 3 TO 8 PERCENT SLOPES, MODERATELY ERODED
ChB2	B	CHESTER SILT LOAM, 15 TO 25 PERCENT SLOPES, MODERATELY ERODED
Cs	B	COMUS SILT LOAM
EA	B	ELIOAK SILT LOAM, 0 TO 3 PERCENT SLOPES
EB2	B	ELIOAK SILT LOAM, 3 TO 8 PERCENT SLOPES, MODERATELY ERODED
ED2	B	ELIOAK SILT LOAM, 15 TO 25 PERCENT SLOPES, MODERATELY ERODED
GA	B	GLENELO LOAM, 0 TO 3 PERCENT SLOPES
GB2	B	GLENELO LOAM, 3 TO 8 PERCENT SLOPES, MODERATELY ERODED
GC2	B	GLENELO LOAM, 8 TO 15 PERCENT SLOPES, MODERATELY ERODED
GD2	B	GLENELO LOAM, 15 TO 25 PERCENT SLOPES, MODERATELY ERODED
GnB2	C	GLENELO SILT LOAM, 3 TO 8 PERCENT SLOPES, MODERATELY ERODED
GnC2	C	GLENELO SILT LOAM, 8 TO 15 PERCENT SLOPES, MODERATELY ERODED
Ha	D	HATBORO SILT LOAM
MgB2	B	MANOR GRAVELLY LOAM, 3 TO 8 PERCENT SLOPES, MODERATELY ERODED
MgC2	B	MANOR GRAVELLY LOAM, 8 TO 15 PERCENT SLOPES, MODERATELY ERODED
MgD3	B	MANOR GRAVELLY LOAM, 8 TO 15 PERCENT SLOPES, SEVERELY ERODED
MnA	B	MANOR LOAM, 0 TO 3 PERCENT SLOPES
MnB2	B	MANOR LOAM, 3 TO 8 PERCENT SLOPES, MODERATELY ERODED
MnC2	B	MANOR LOAM, 8 TO 15 PERCENT SLOPES, MODERATELY ERODED
MnD3	B	MANOR LOAM, 8 TO 15 PERCENT SLOPES, SEVERELY ERODED
MnE2	B	MANOR LOAM, 15 TO 25 PERCENT SLOPES, MODERATELY ERODED
MnF	B	MANOR LOAM, 25 TO 45 PERCENT SLOPES, SEVERELY ERODED
MnG	B	MANOR VERY STONY LOAM, 3 TO 8 PERCENT SLOPES
MnH	B	MANOR VERY STONY LOAM, 8 TO 15 PERCENT SLOPES
MnI	B	MANOR VERY STONY LOAM, 25 TO 45 PERCENT SLOPES
MnJ	B	MIXED ALLUVIAL LAND

STORM DRAINAGE DATA					
INLET NO.	DRAINAGE AREA (AC)	% IMPERVIOUS	SOIL CLASS	ZONING	C FACTOR
1	0.55	54	B,C	R-ED	0.44
2	0.64	49	B	R-ED	0.38
3	1.46	28	B	R-ED	0.28
4	0.53	35	B	R-ED	0.28
5	0.82	56	B,C	R-ED	0.46
6	0.87	56	B,C	R-ED	0.46
7	0.68	40	B,C	R-ED	0.31
8	0.36	50	B	R-ED	0.38
9	0.55	49	B	R-ED	0.38
10	0.69	50	B,C	R-ED	0.40
11	0.68	51	B	R-ED	0.40
14	1.19	57	B	R-ED	0.45
15	1.93	51	B	R-ED	0.40
16	0.54	54	B	R-ED	0.43
17	0.61	54	B	R-ED	0.42
18	1.18	40	B	R-ED	0.30
19	0.32	65	B	R-ED	0.53
20	0.71	51	B	R-ED	0.40
21	0.13	69	B	R-ED	0.57
22	0.13	69	B	R-ED	0.57
23	1.11	51	B,C	R-ED	0.40
24	2.48	40	B,C	R-ED	0.30
25	2.15	53	B,C	R-ED	0.42
26	2.31	20	B,C	R-ED	0.24
27	0.44	85	B	R-ED	0.80
28	0.32	52	B	R-ED	0.41
29	1.33	43	B	R-ED	0.32
30	0.72	51	B	R-ED	0.40
31	0.33	63	B	R-ED	0.52
32	0.54	47	B	R-ED	0.36
33	0.26	54	B	R-ED	0.43
34	0.26	40	B	R-ED	0.30
35	0.84	40	B	R-ED	0.30
36	0.63	35	B	R-ED	0.28
37	0.78	59	B	R-ED	0.47
38	0.38	52	B	R-ED	0.41
39	1.98	19	B	R-ED	0.23
40	1.13	37	B	R-ED	0.45
41	1.00	40	B	R-ED	0.37
42	1.23	54	B	R-ED	0.43
43	2.11	0	B	R-ED	0.11
44	0.22	33	B	R-ED	0.39
45	1.23	6	B	R-ED	0.17
46	0.28	35	B	R-ED	0.44
47	2.25	33	B	R-ED	0.34
48	2.29	9	B	R-ED	0.22
49	0.99	0	B	R-ED	0.11
50	1.64	9	B	R-ED	0.19
51	0.44	52	B	R-ED	0.55

PROPERTY OF		
PROPERTY OF SCOTT E. PATON	P. 163	2384/625
PROPERTY OF RICHARD B. GENTLE	P. 371	1097/484
PROPERTY OF ROBERT A. GASKILL	P. 372	637/155
PROPERTY OF STANLEY W. BEMMING	P. 408	2697/116
PROPERTY OF NANCY G. LEWMAN	P. 348	1874/51
PROPERTY OF JAMES E. OLIVER	P. 368	1012/176
PROPERTY OF JOHN HOPKINS UNIVERSITY	P. 123	710/351



**TSA GROUP, INC.**  
 planning • architecture • engineering • surveying  
 5460 Baltimore National Pike • Ellicott City, Maryland 21045 • 410-465-6105

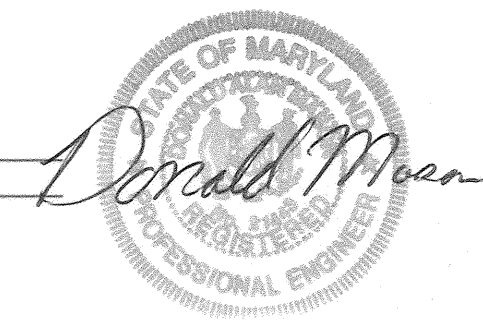

APPROVED: HOWARD COUNTY DEPARTMENT OF PUBLIC WORKS  
*Andrew M. Daniels* 6-15-98  
 CHIEF, BUREAU OF HIGHWAYS DATE

APPROVED: HOWARD COUNTY DEPARTMENT OF PLANNING AND ZONING  
*Col Hammit* 6/25/98  
 CHIEF, DIVISION OF LAND DEVELOPMENT DATE

*Mike Wynn* 6/26/98  
 CHIEF, DEVELOPMENT ENGINEERING DIVISION DATE

OWNERS: TOLL MD LIMITED PARTNERSHIP, A MARYLAND LIMITED PARTNERSHIP 3206 TOWER OAKS BOULEVARD SUITE 310 ROCKVILLE, MARYLAND 20852	PROJECT: <b>VILLAGE OF CEDAR RIDGE</b> A SUBDIVISION OF PARCEL 44 (TAX MAP 41) AND A RESUBDIVISION OF LOTS 1 AND 2 OF THE EDITH S. PARLETTE SUBDIVISION (PLAT 10735 PARCEL 43) AND A SUBDIVISION OF PARCEL 123 FOR A ROAD RIGHT-OF-WAY
DEVELOPER: TOLL MD LIMITED PARTNERSHIP, A MARYLAND LIMITED PARTNERSHIP 3206 TOWER OAKS BOULEVARD SUITE 310 ROCKVILLE, MARYLAND 20852	LOCATION: TAX MAP 41 - PARCELS 43 & 44, P/O 123 5th ELECTION DISTRICT HOWARD COUNTY, MARYLAND
TITLE: <b>STORM DRAIN DRAINAGE AREA MAP</b> SP-97-02 WP-97-78 PB 312 F-93-70 WP-98-82	DATE: <b>OCTOBER 1997</b> MAY, 1998
DESIGN: MLV DRAFT: DBT CHECK: DAM	PROJECT NO. 0518 SHEET 12 OF 31

NO.	DATE	REVISION