

§ CURVE DATA
SYCAMORE VALLEY DRIVE
 STA. 29+90.79 TO 29+91.14
 R = 240.00'
 L = 0.35'
 Δ = 00°05'05"
 T = 0.18'
 CHD. = N 75°12'26" E, 0.35'

§ CURVE DATA
SYCAMORE VALLEY DRIVE
 STA. 29+91.14 TO 30+92.45
 R = 316.00'
 L = 101.31'
 Δ = 18°22'10"
 T = 51.09'
 CHD. = N 84°19'18" E, 100.88'

§ CURVE DATA
SYCAMORE VALLEY DRIVE
 STA. 30+92.45 TO 32+08.55
 R = 406.30'
 L = 196.10'
 Δ = 27°39'15"
 T = 100.00'
 CHD. = N 79°40'46" E, 194.20'


SYCAMORE VALLEY II
 LOTS 1-17 AND
 PRESERVATION PARCELS "A" - "C"
 ZONED: RC-DEO
 FOURTH ELECTION DISTRICT HOWARD COUNTY, MARYLAND

SYCAMORE VALLEY RUN PLAN AND PROFILE
CHAMPIONSHIP DRIVE PLAN AND PROFILE

OWNER AND DEVELOPER
 MID-ATLANTIC DEVELOPMENT II, L.L.C.
 c/o THE THOMAS SCOVENES
 5058 ROUSEY HALL DRIVE, SUITE 204
 ELLICOTT CITY, MARYLAND 21042

SCALE: AS SHOWN DATE: FEB. 6, 1998 DWG. NO. 2 OF 12
 DES. J.V.P. DRN. J.C.L. CHK. C.J.C.


FISHER, COLLINS & CARTER, INC.
 CIVIL ENGINEERING CONSULTANTS & LAND SURVEYORS
 CENTENAL SQUARE OFFICE PARK - 10272 BALDORNE NATIONAL PIKE
 ELLICOTT CITY, MARYLAND 21042
 4100 401 - 8995

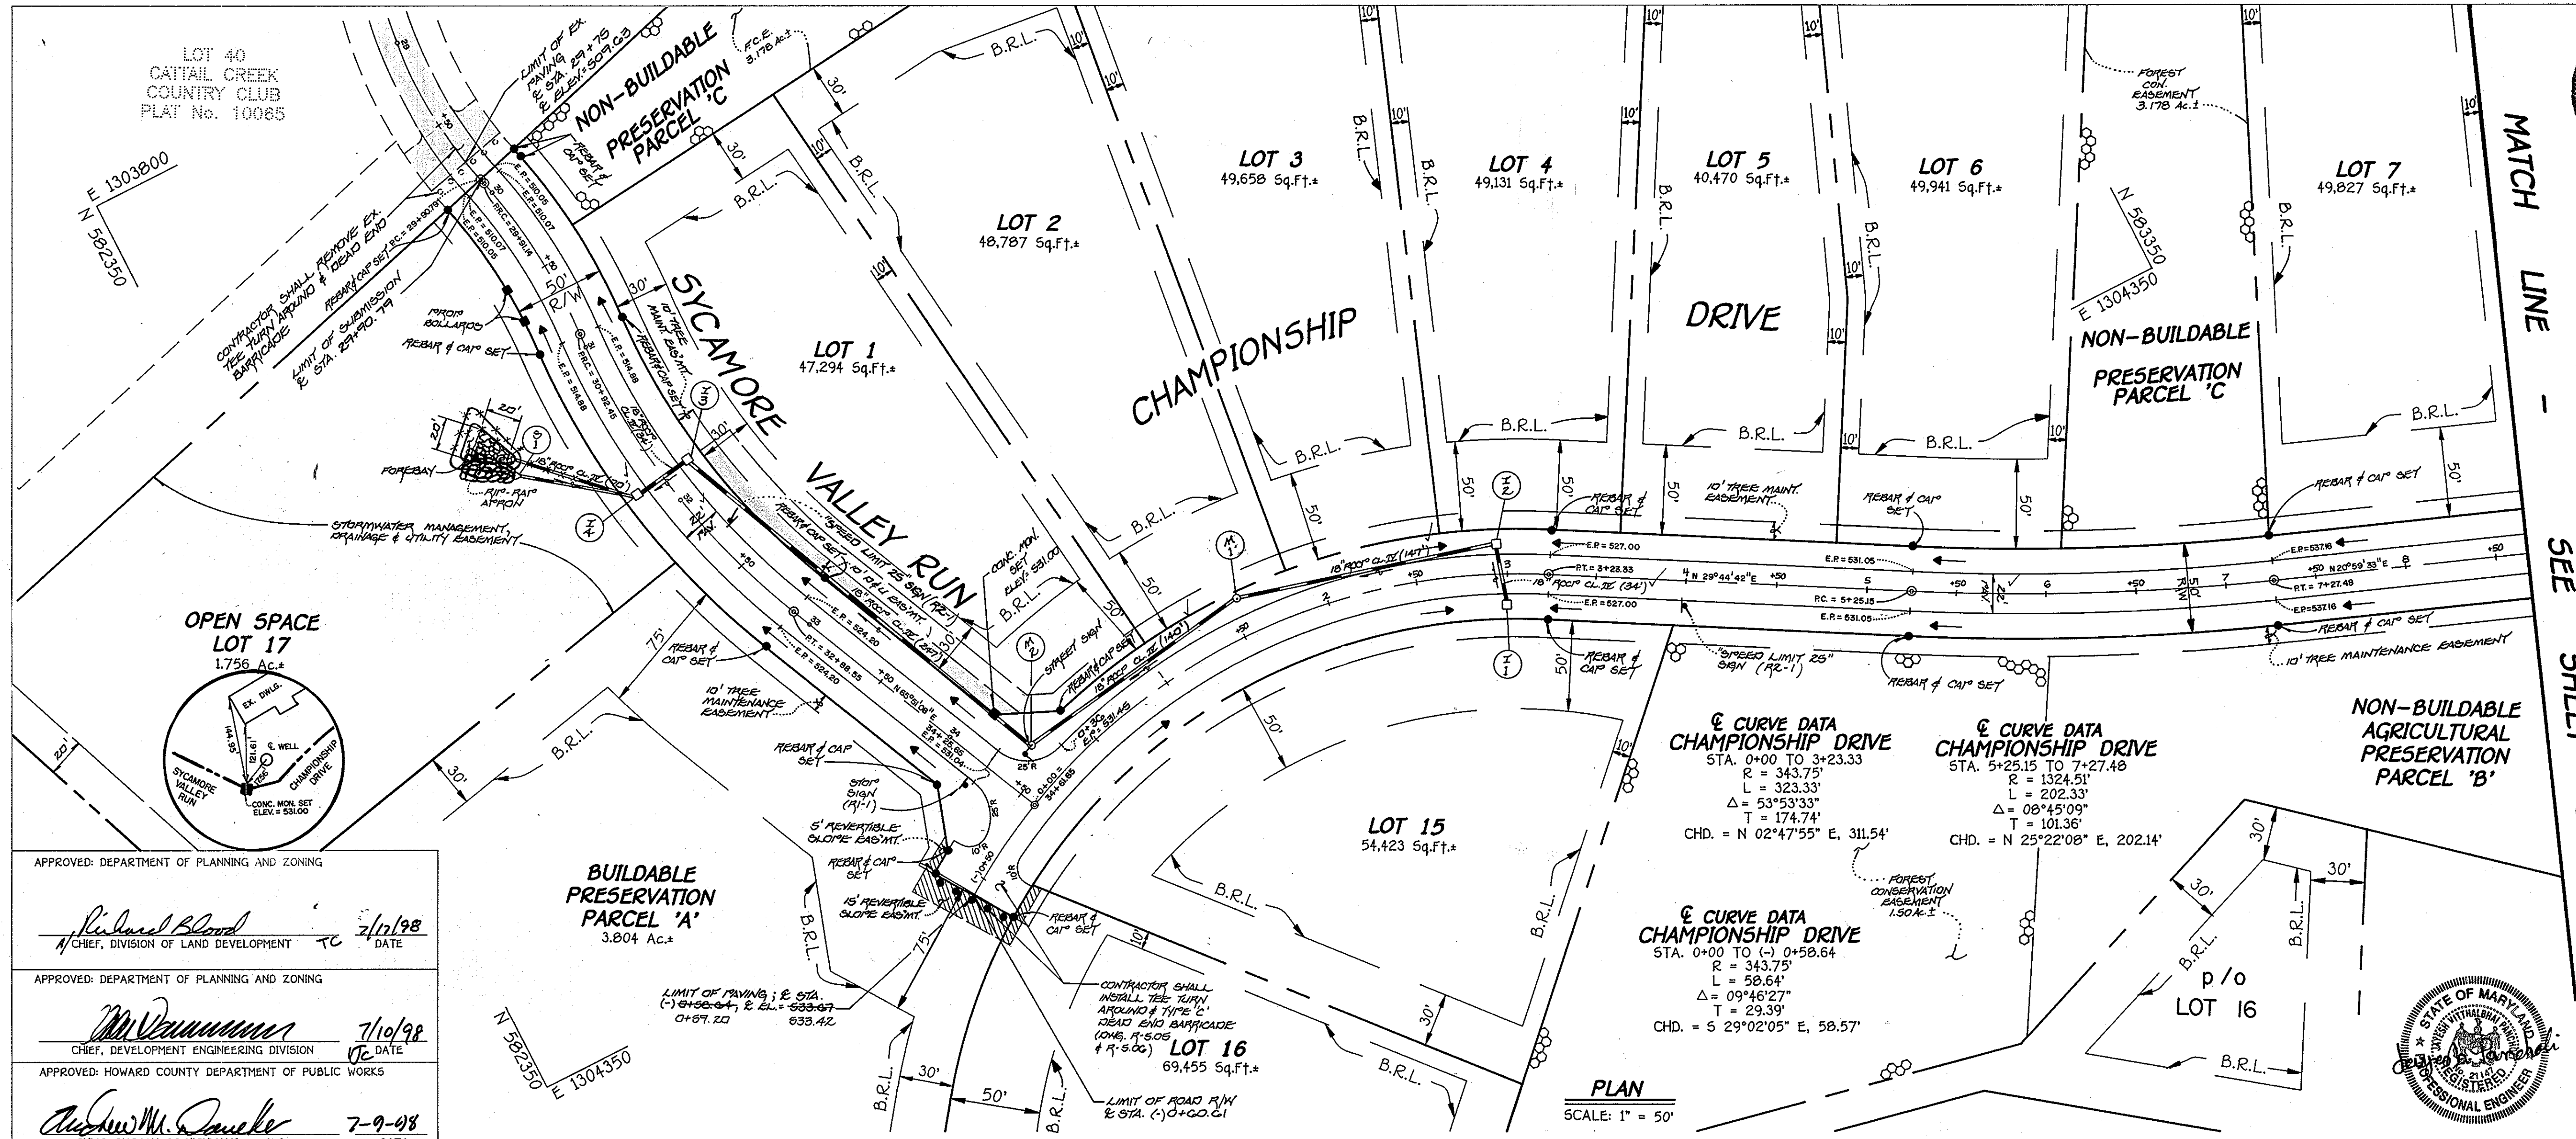


APPROVED: DEPARTMENT OF PLANNING AND ZONING
Richard Blood 2/10/98
 CHIEF, DIVISION OF LAND DEVELOPMENT DATE

APPROVED: DEPARTMENT OF PLANNING AND ZONING
Mr. [Signature] 7/10/98
 CHIEF, DEVELOPMENT ENGINEERING DIVISION DATE


APPROVED: HOWARD COUNTY DEPARTMENT OF PUBLIC WORKS
Arthur M. [Signature] 7-9-98
 CHIEF, BUREAU OF HIGHWAYS DATE

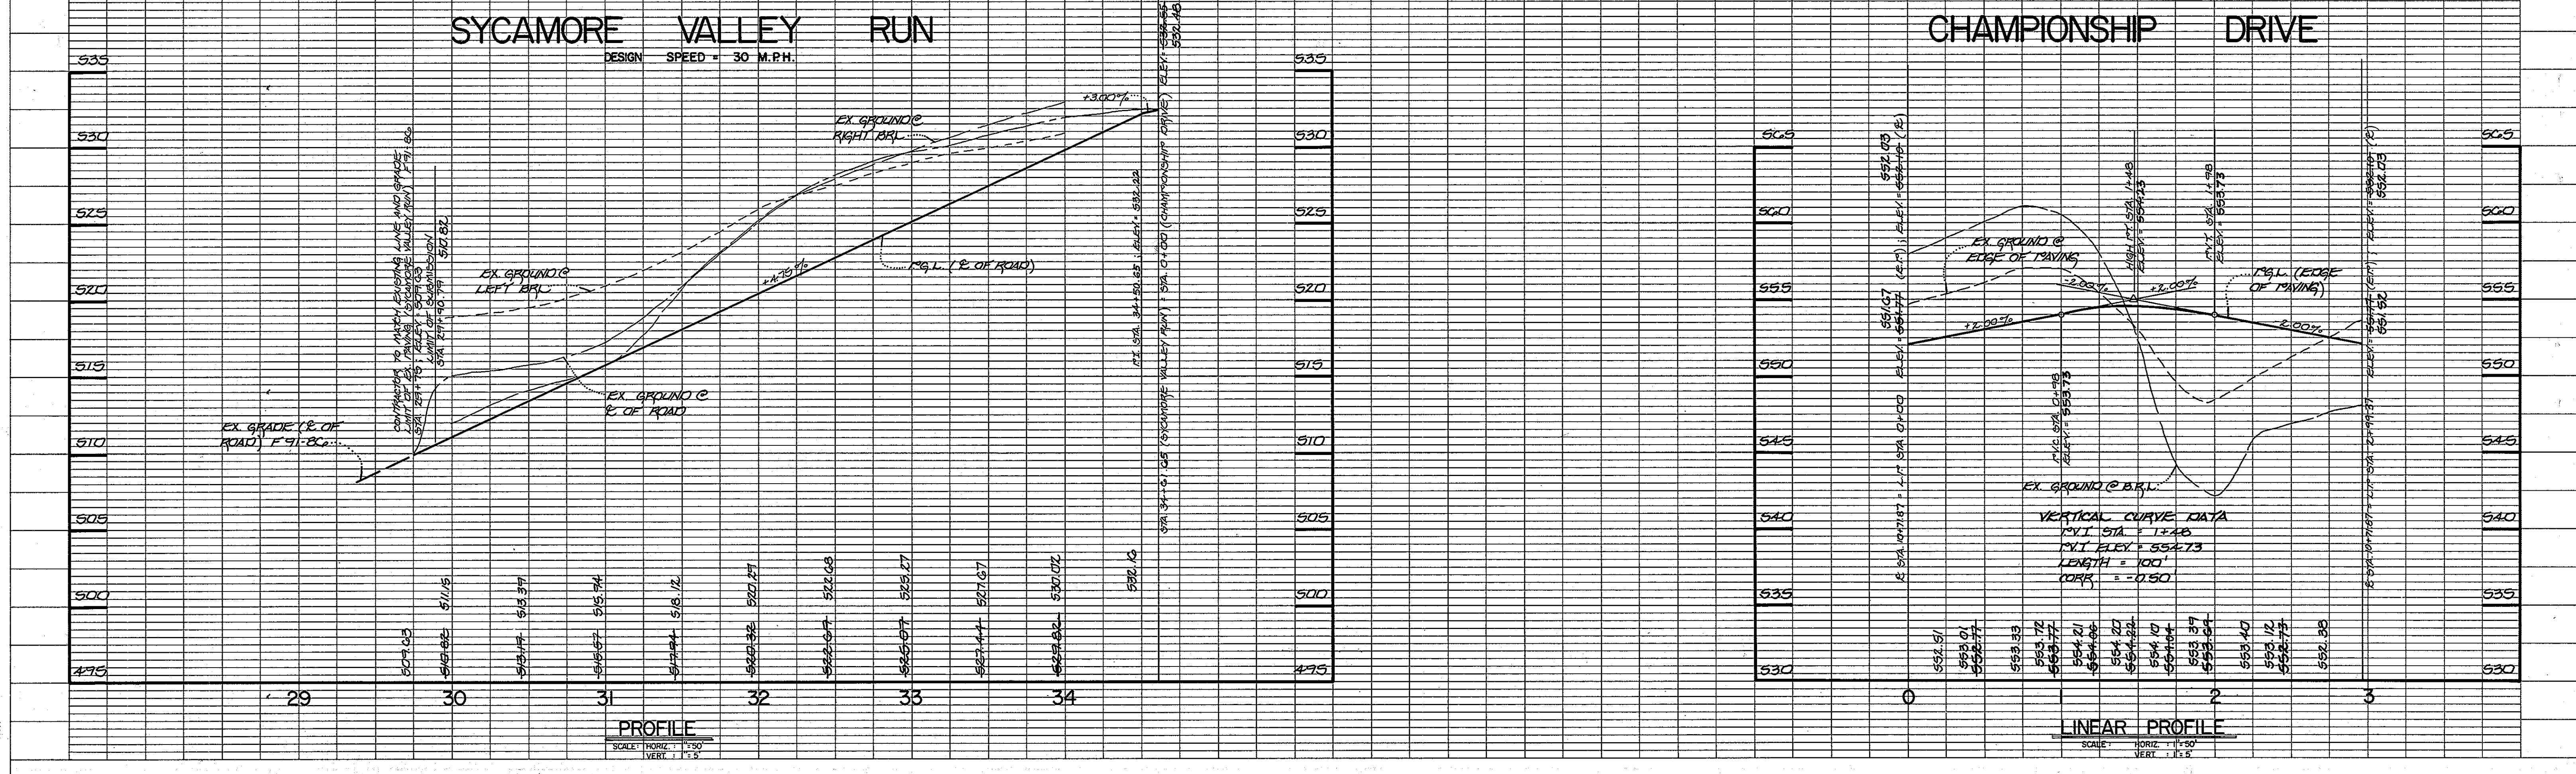

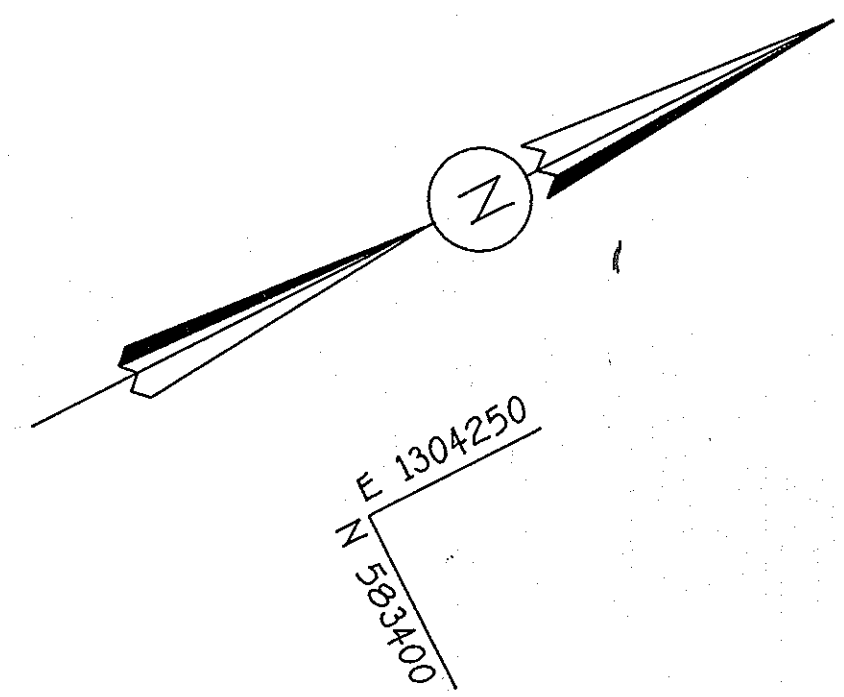

**Q CURVE DATA
CHAMPIONSHIP DRIVE**
 STA. 10+71.87 TO STA. 11+42.16
 R = 104.74'
 L = 70.23'
 Δ = 39°26'59"
 T = 35.52'
 CHD. = N 40°13'02" E, 68.97'

MATCH LINE - SEE SHEET 2

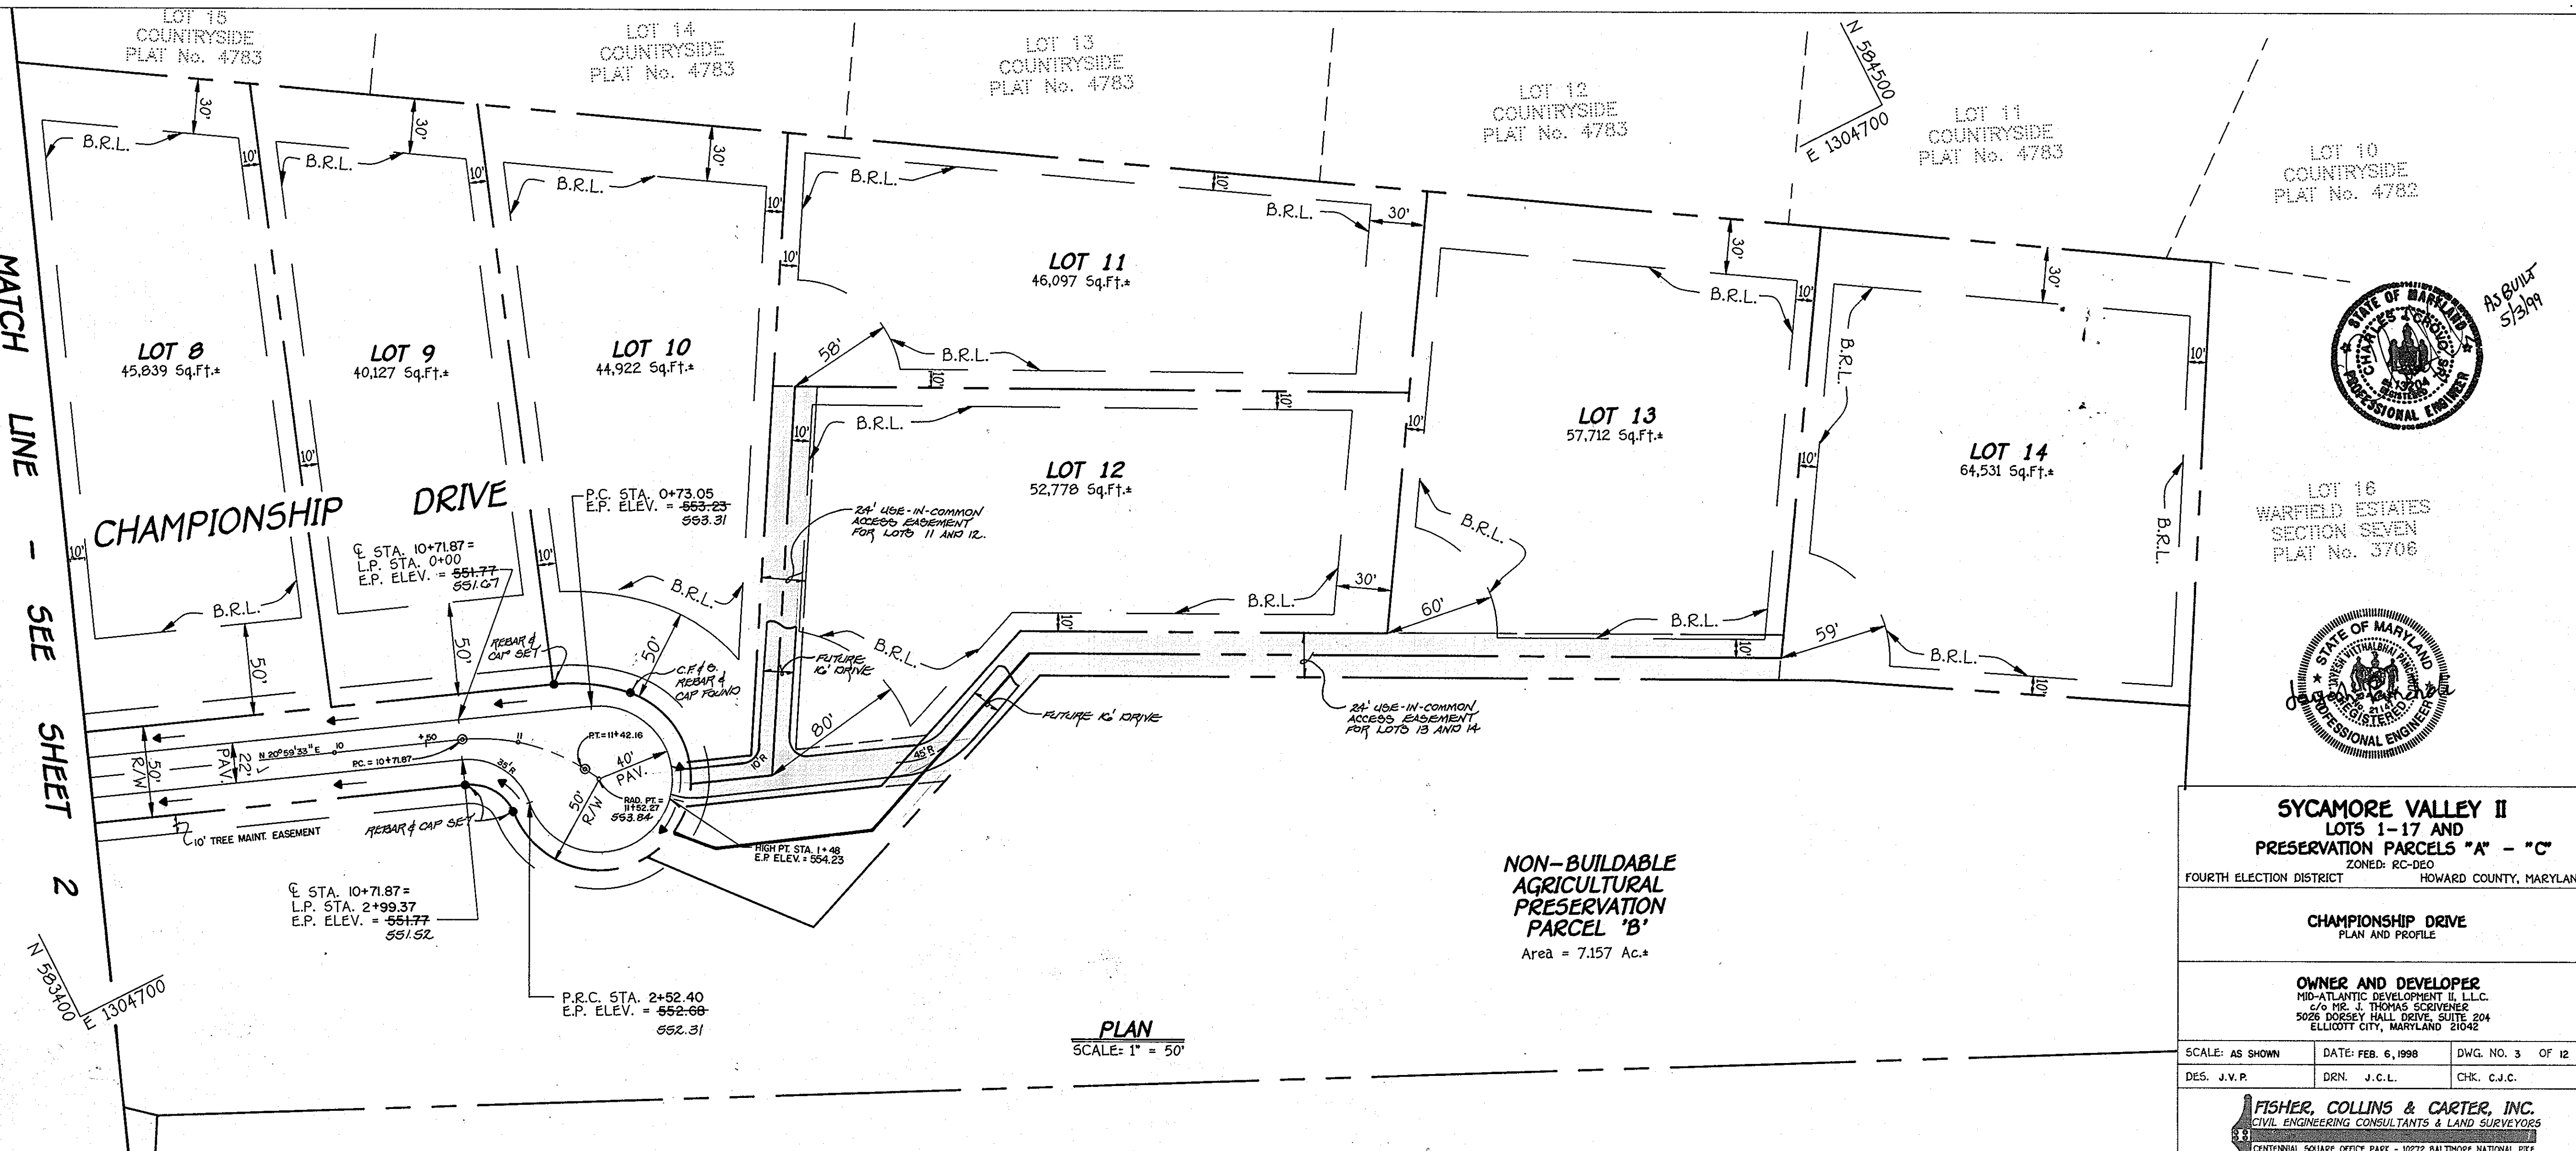

APPROVED: DEPARTMENT OF PLANNING AND ZONING
Richard Blood 7/12/98
 CHIEF, DIVISION OF LAND DEVELOPMENT DATE

APPROVED: DEPARTMENT OF PLANNING AND ZONING
Mr. [Signature] 7/16/98
 CHIEF, DEVELOPMENT ENGINEERING DIVISION DATE

APPROVED: HOWARD COUNTY DEPARTMENT OF PUBLIC WORKS
Charles M. [Signature] 7-9-98
 CHIEF, BUREAU OF HIGHWAYS DATE

STATE OF MARYLAND
 PROFESSIONAL ENGINEER
 AS BUILT 5/3/99


SYCAMORE VALLEY II
 LOTS 1-17 AND
 PRESERVATION PARCELS "A" - "C"
 ZONED: RC-DEO
 FOURTH ELECTION DISTRICT HOWARD COUNTY, MARYLAND

CHAMPIONSHIP DRIVE
 PLAN AND PROFILE

OWNER AND DEVELOPER
 MID-ATLANTIC DEVELOPMENT II, L.L.C.
 670 NIS. J. THOMAS SCOVENER
 5025 DORSEY HALL DRIVE, SUITE 204
 ELLICOTT CITY, MARYLAND 21042

SCALE: AS SHOWN DATE: FEB. 6, 1998 DWG. NO. 3 OF 12
 DES. J.V.P. DRN. J.C.L. CHK. C.J.C.

FISHER, COLLINS & CARTER, INC.
 CIVIL ENGINEERING CONSULTANTS & LAND SURVEYORS
 CENTENNIAL SQUARE OFFICE PARK - 10272 BALTIMORE NATIONAL PIKE
 ELLICOTT CITY, MARYLAND 21042
 (410) 461-2855

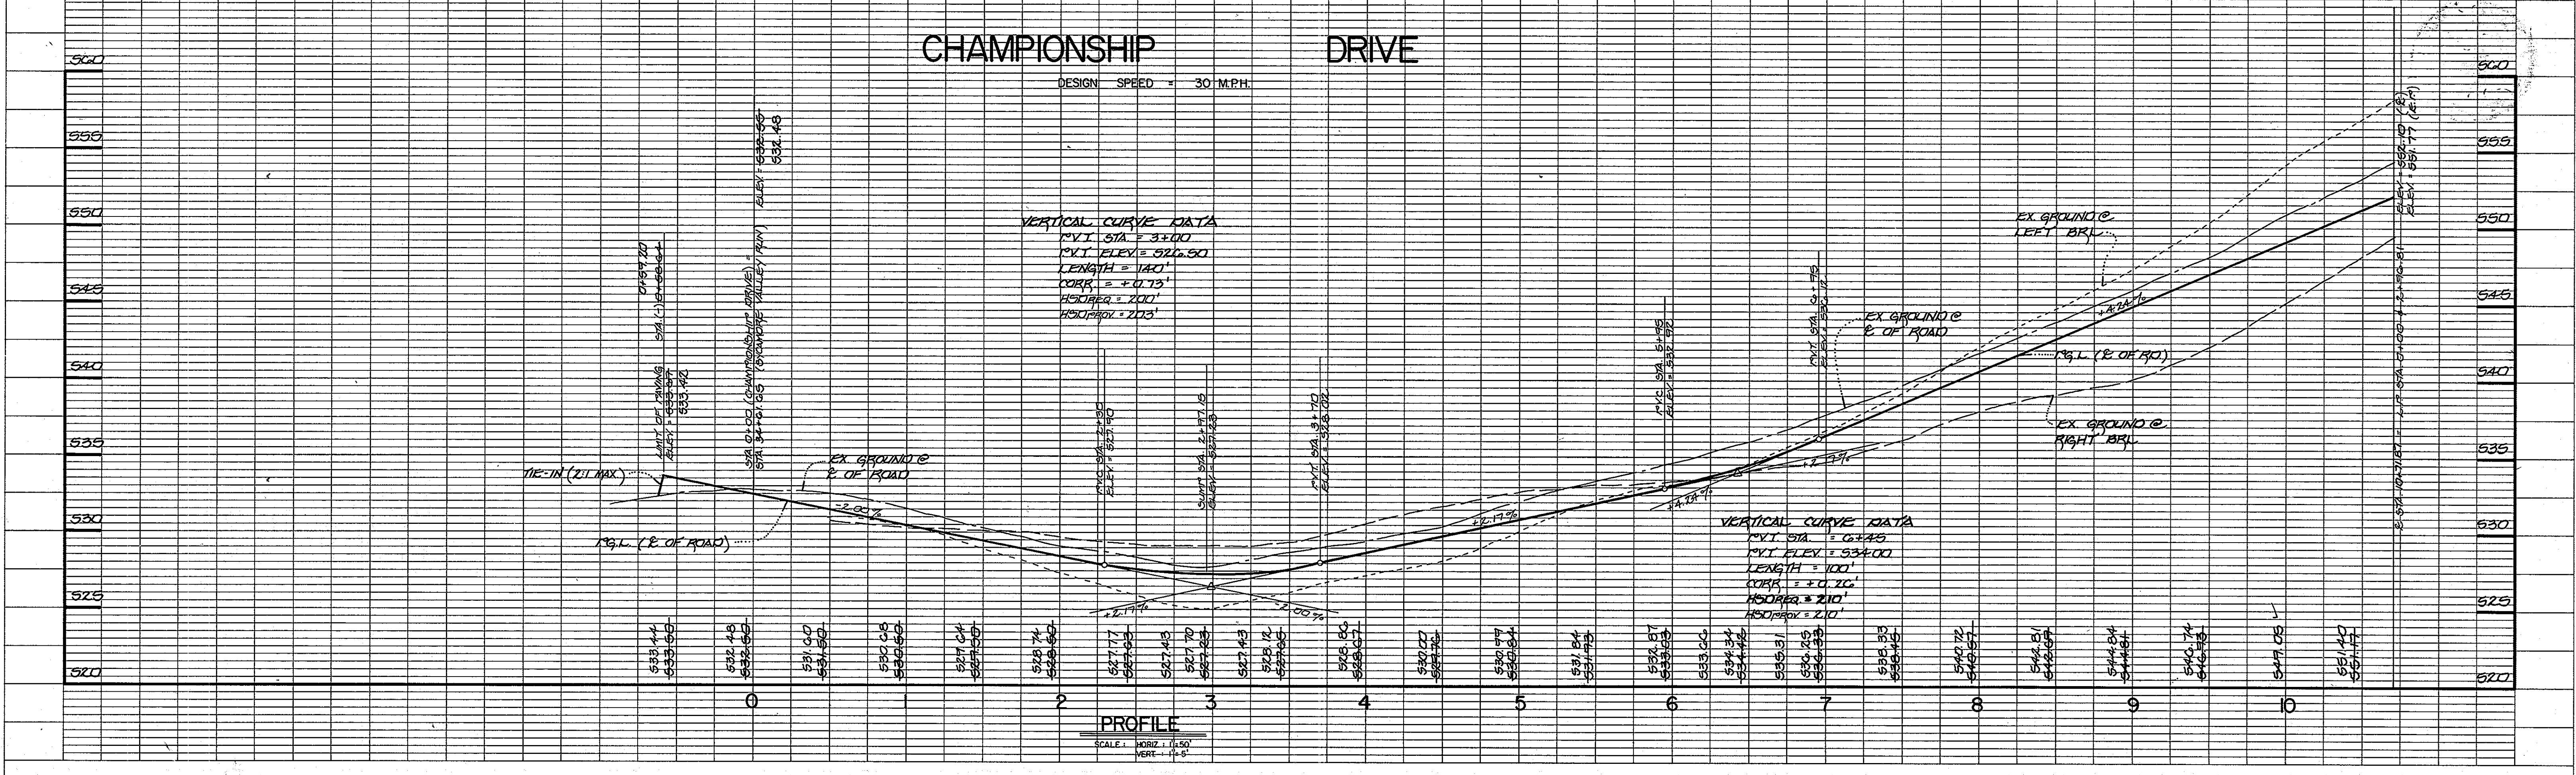

Approved: Department of Public Works

Andrew M. Dancake 7-9-98
Chief, Bureau of Highways Date

Approved: Department of Planning And Zoning

Richard Blood 2/17/98
Chief, Division of Land Development TC Date
Michael Munn 7/10/98
Chief, Development Engineering Division TC Date

By The Developer:

"I/We Certify That All Development And/Or Construction Will Be Done According To These Plans, And That Any Responsible Personnel Involved In The Construction Project Will Have A Certificate Of Attendance At A Department Of The Environment Approved Training Program For The Control Of Sediment And Erosion Before Beginning The Project. I Shall Engage A Registered Professional Engineer To Supervise Pond Construction And Provide The Howard Soil Conservation District With An "As-Built" Plan Of The Pond Within 30 Days Of Completion. I Also Authorize Periodic On-Site Inspections By The Howard Soil Conservation District."

Thomas Scrivener 2/11/98
Signature Of Developer Date
THOMAS SCRIVENER
Printed Name Of Developer

By The Engineer:


"I Certify That This Plan For Pond Construction, Erosion And Sediment Control Represents A Practical And Workable Plan Based On My Personal Knowledge Of The Site Conditions. This Plan Was Prepared In Accordance With The Requirements Of The Howard Soil Conservation District. I Have Notified The Developer That He/She Must Engage A Registered Professional Engineer To Supervise Pond Construction And Provide The Howard Soil Conservation District With An "As-Built" Plan Of The Pond Within 30 Days Of Completion."

Jayesh V. Panchol 2-11-98
Signature Of Engineer Date
JAYESH V. PANCHOL
Printed Name Of Engineer

These Plans Have Been Reviewed For The Howard Soil Conservation District And Meet The Technical Requirements For Small Pond Construction, Soil Erosion And Sediment Control.

Cheryl Semmons 7/1/98
USDA-Natural Resources Conservation Service Date

These Plans For Small Pond Construction, Soil Erosion And Sediment Control Meet The Requirements Of The Howard Soil Conservation District.
Robert W. Ziehn 7/1/98
Howard Soil Conservation District Date

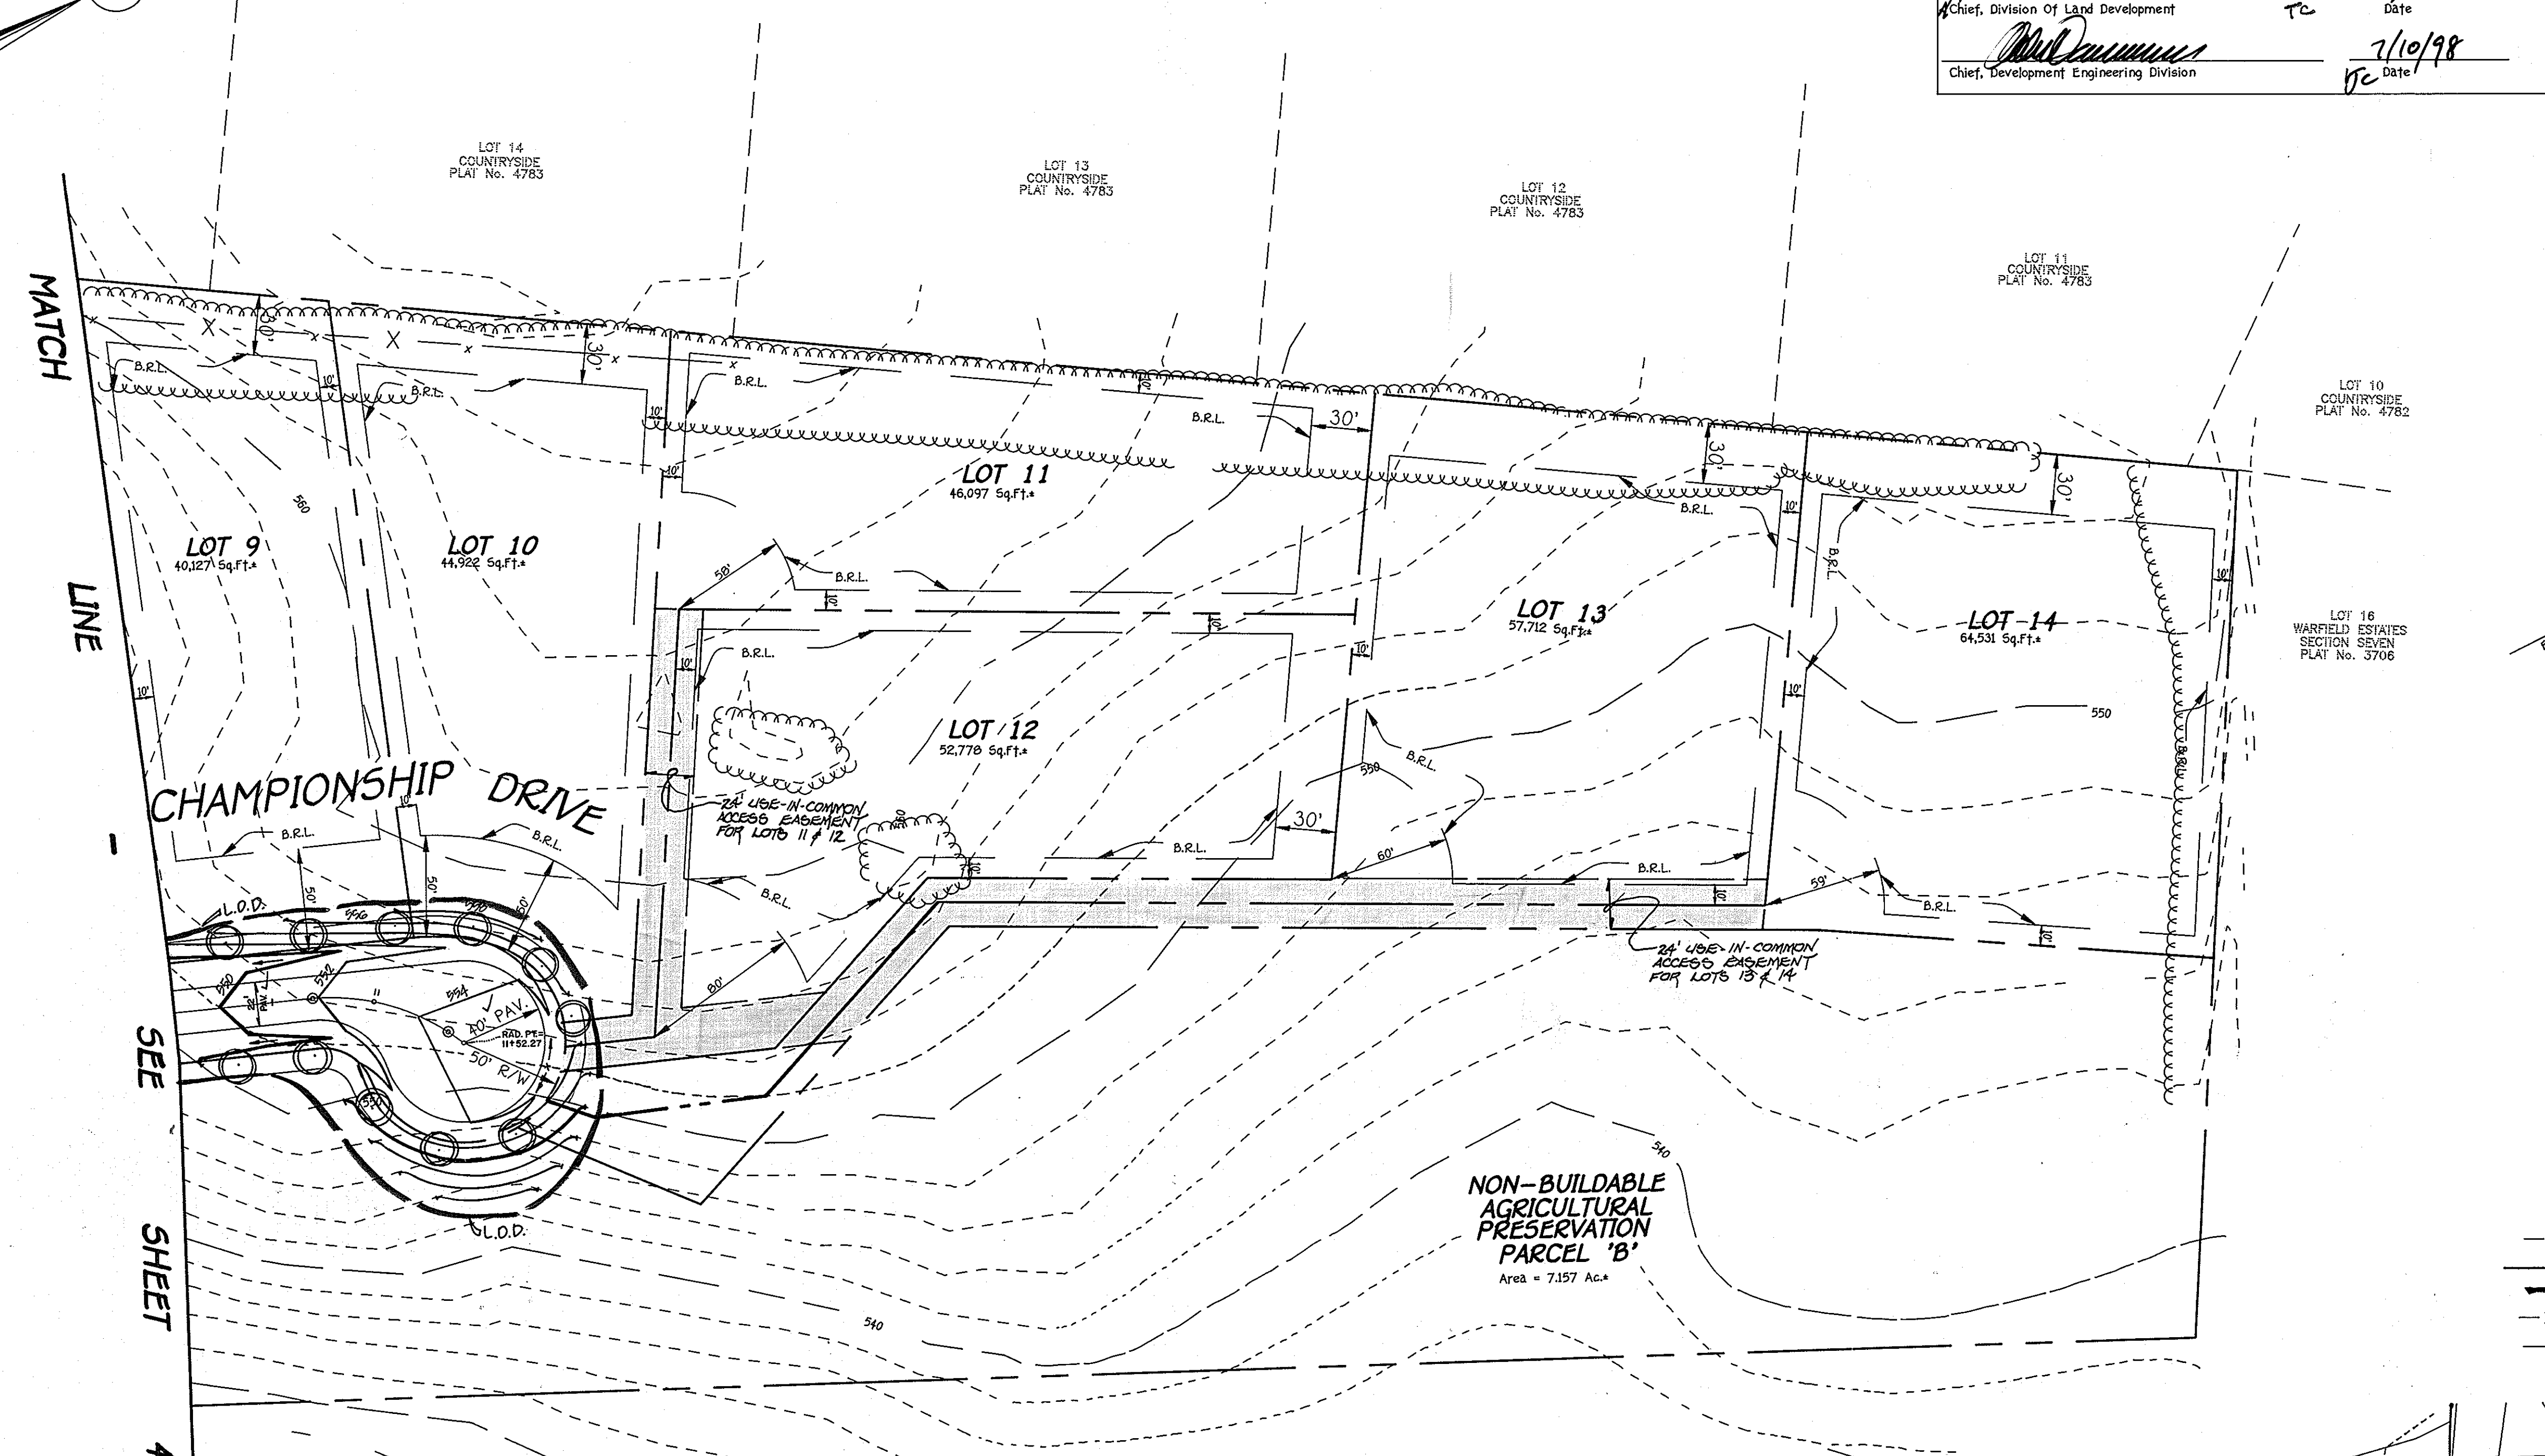


MATCH LINE SEE SHEET 4

NON-BUILDABLE AGRICULTURAL PRESERVATION PARCEL 'B'
Area = 7.157 Ac.

PLAN
SCALE: 1" = 50'

SEDIMENT TRAP #1
TYPE: STONE OUTLET SEDIMENT TRAP
DRAINAGE AREA: 10 Ac.
STORAGE REQUIRED: 10 Ac. x 3600 CF = 36,000 CF
STORAGE PROVIDED: 18,250 CF
WEIR CREST EL.: 511.00
WEIR DEPTH: 10"
CLEAN OUT EL.: 519.00
BOTTOM EL.: 512.75
NET STORAGE = 10 Ac. x 1800 REQUIRED = 18,000 CU. FT.
NET STORAGE EL. = 510.00
OUTLET EL. = 510.00
DRY STORAGE REQUIRED: 2880 CU. FT.
DRY STORAGE EL. = 517.00

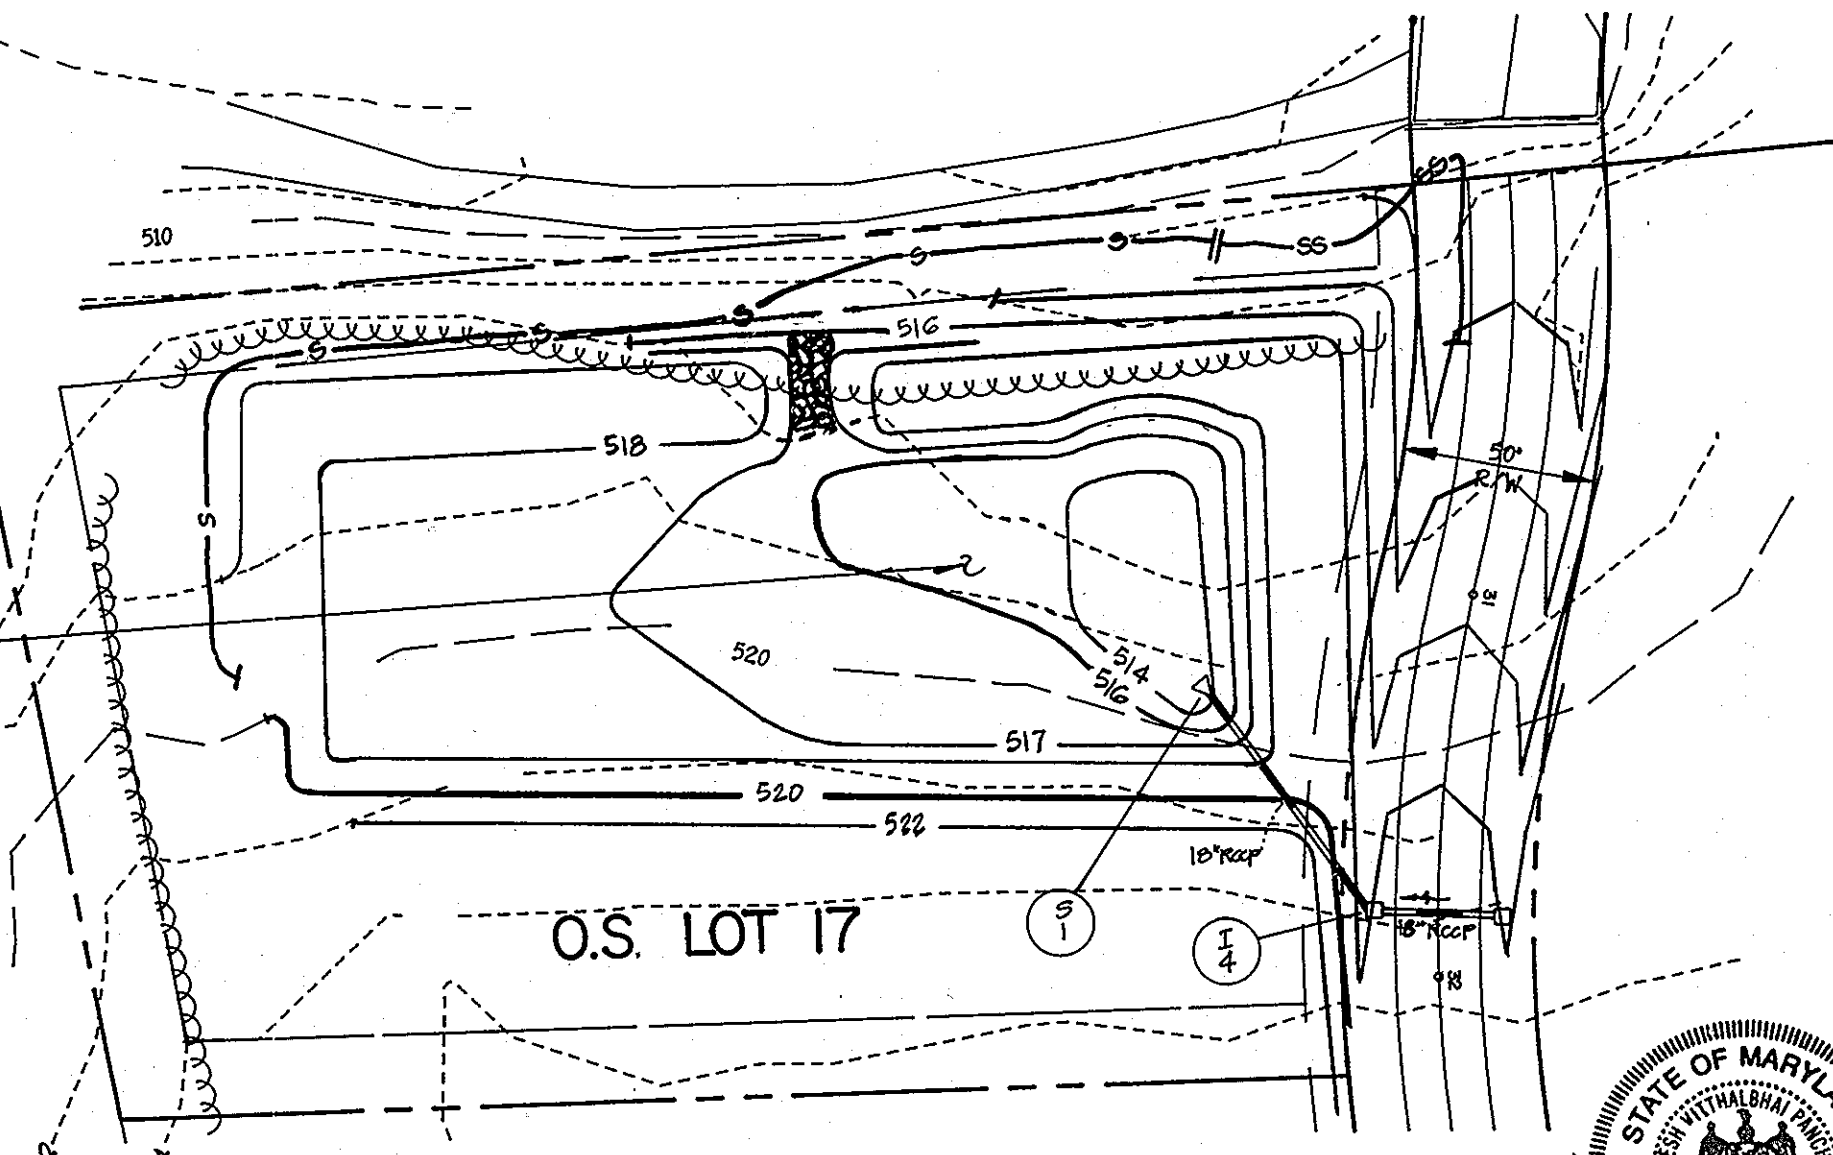

SEDIMENT TRAP GRADING
SCALE: 1" = 50'

LEGEND

- S—S—S— STABILIZED CONSTRUCTION ENTRANCE
- A-2— EARTH DIKE
- X—X—X— LIMIT OF DISTURBANCE
- X—X—X— TREE PROTECTION FENCE
- SS—SS— SUPER-SILT FENCE



SEE SHEET 4 OF 12 FOR STREET TREE SCHEDULE.

STREET TREE, GRADING AND SEDIMENT CONTROL PLAN
SYCAMORE VALLEY II
LOTS 1 - 17 AND PRESERVATION PARCELS "A" - "C"
ZONING: RC-DEO
TAX MAP NO.: 21 PARCEL NO.: 7
FOURTH ELECTION DISTRICT HOWARD COUNTY, MARYLAND
SCALE: AS SHOWN - DATE: FEBRUARY 6, 1998
SHEET 5 OF 12

FISHER, COLLINS & CARTER, INC.
CIVIL ENGINEERING CONSULTANTS & LAND SURVEYORS
CONTONIAL SQUARE OFFICE PARK - 10272 BALTIMORE NATIONAL PIKE
ELLCOTT CITY, MARYLAND 21042
410-461-2959

OWNER AND DEVELOPER
MID-ATLANTIC DEVELOPMENT II, L.L.C.
c/o MR. THOMAS SCRIVENER
5628 DORSEY HALL DRIVE
SUITE 204
ELLCOTT CITY, MARYLAND 21042

STREET TREE SCHEDULE			
SYMBOL	BOTANICAL AND COMMON NAME	SIZE	COMMENTS
	ACER RUBUM 'OCTOBER GLORY' RED MAPLE	2 1/2" - 3" CALIPER	40' APART ON PUBLIC R/W
	PLATANUS OCCIDENTALIS 'BLOODGOOD' LONDON PLANETREE	2 1/2" - 3" CALIPER	40' APART ON PUBLIC R/W

NOTE: STREET TREES ARE ONLY A RECOMMENDATION. THIS MAY BE REVISED TO A COUNTY ACCEPTABLE EQUIVALENT.
TOTAL NUMBER OF STREET TREES: 95


- 22 STREET TREES
- 63 STREET TREES

DRAINAGE AREA DATA					
STRUCTURE NO.	DRAINAGE AREA	AREA	'C'	ZONED	% IMP.
I-1	A	0.92	0.59	RC-DEO	49%
I-2	B	1.33	0.52	RC-DEO	39%
I-3	C	0.30	0.54	RC-DEO	42%
I-4	D	0.37	0.53	RC-DEO	40%

APPROVED: DEPARTMENT OF PUBLIC WORKS
Richard M. Dancy
 CHIEF, BUREAU OF HIGHWAYS
 DATE: 7-9-99

APPROVED: DEPARTMENT OF PLANNING AND ZONING
Richard Blood
 CHIEF, DIVISION OF LAND DEVELOPMENT
 DATE: 7/17/98

Michael J. ...
 CHIEF, DEVELOPMENT ENGINEERING DIVISION
 DATE: 7/10/98

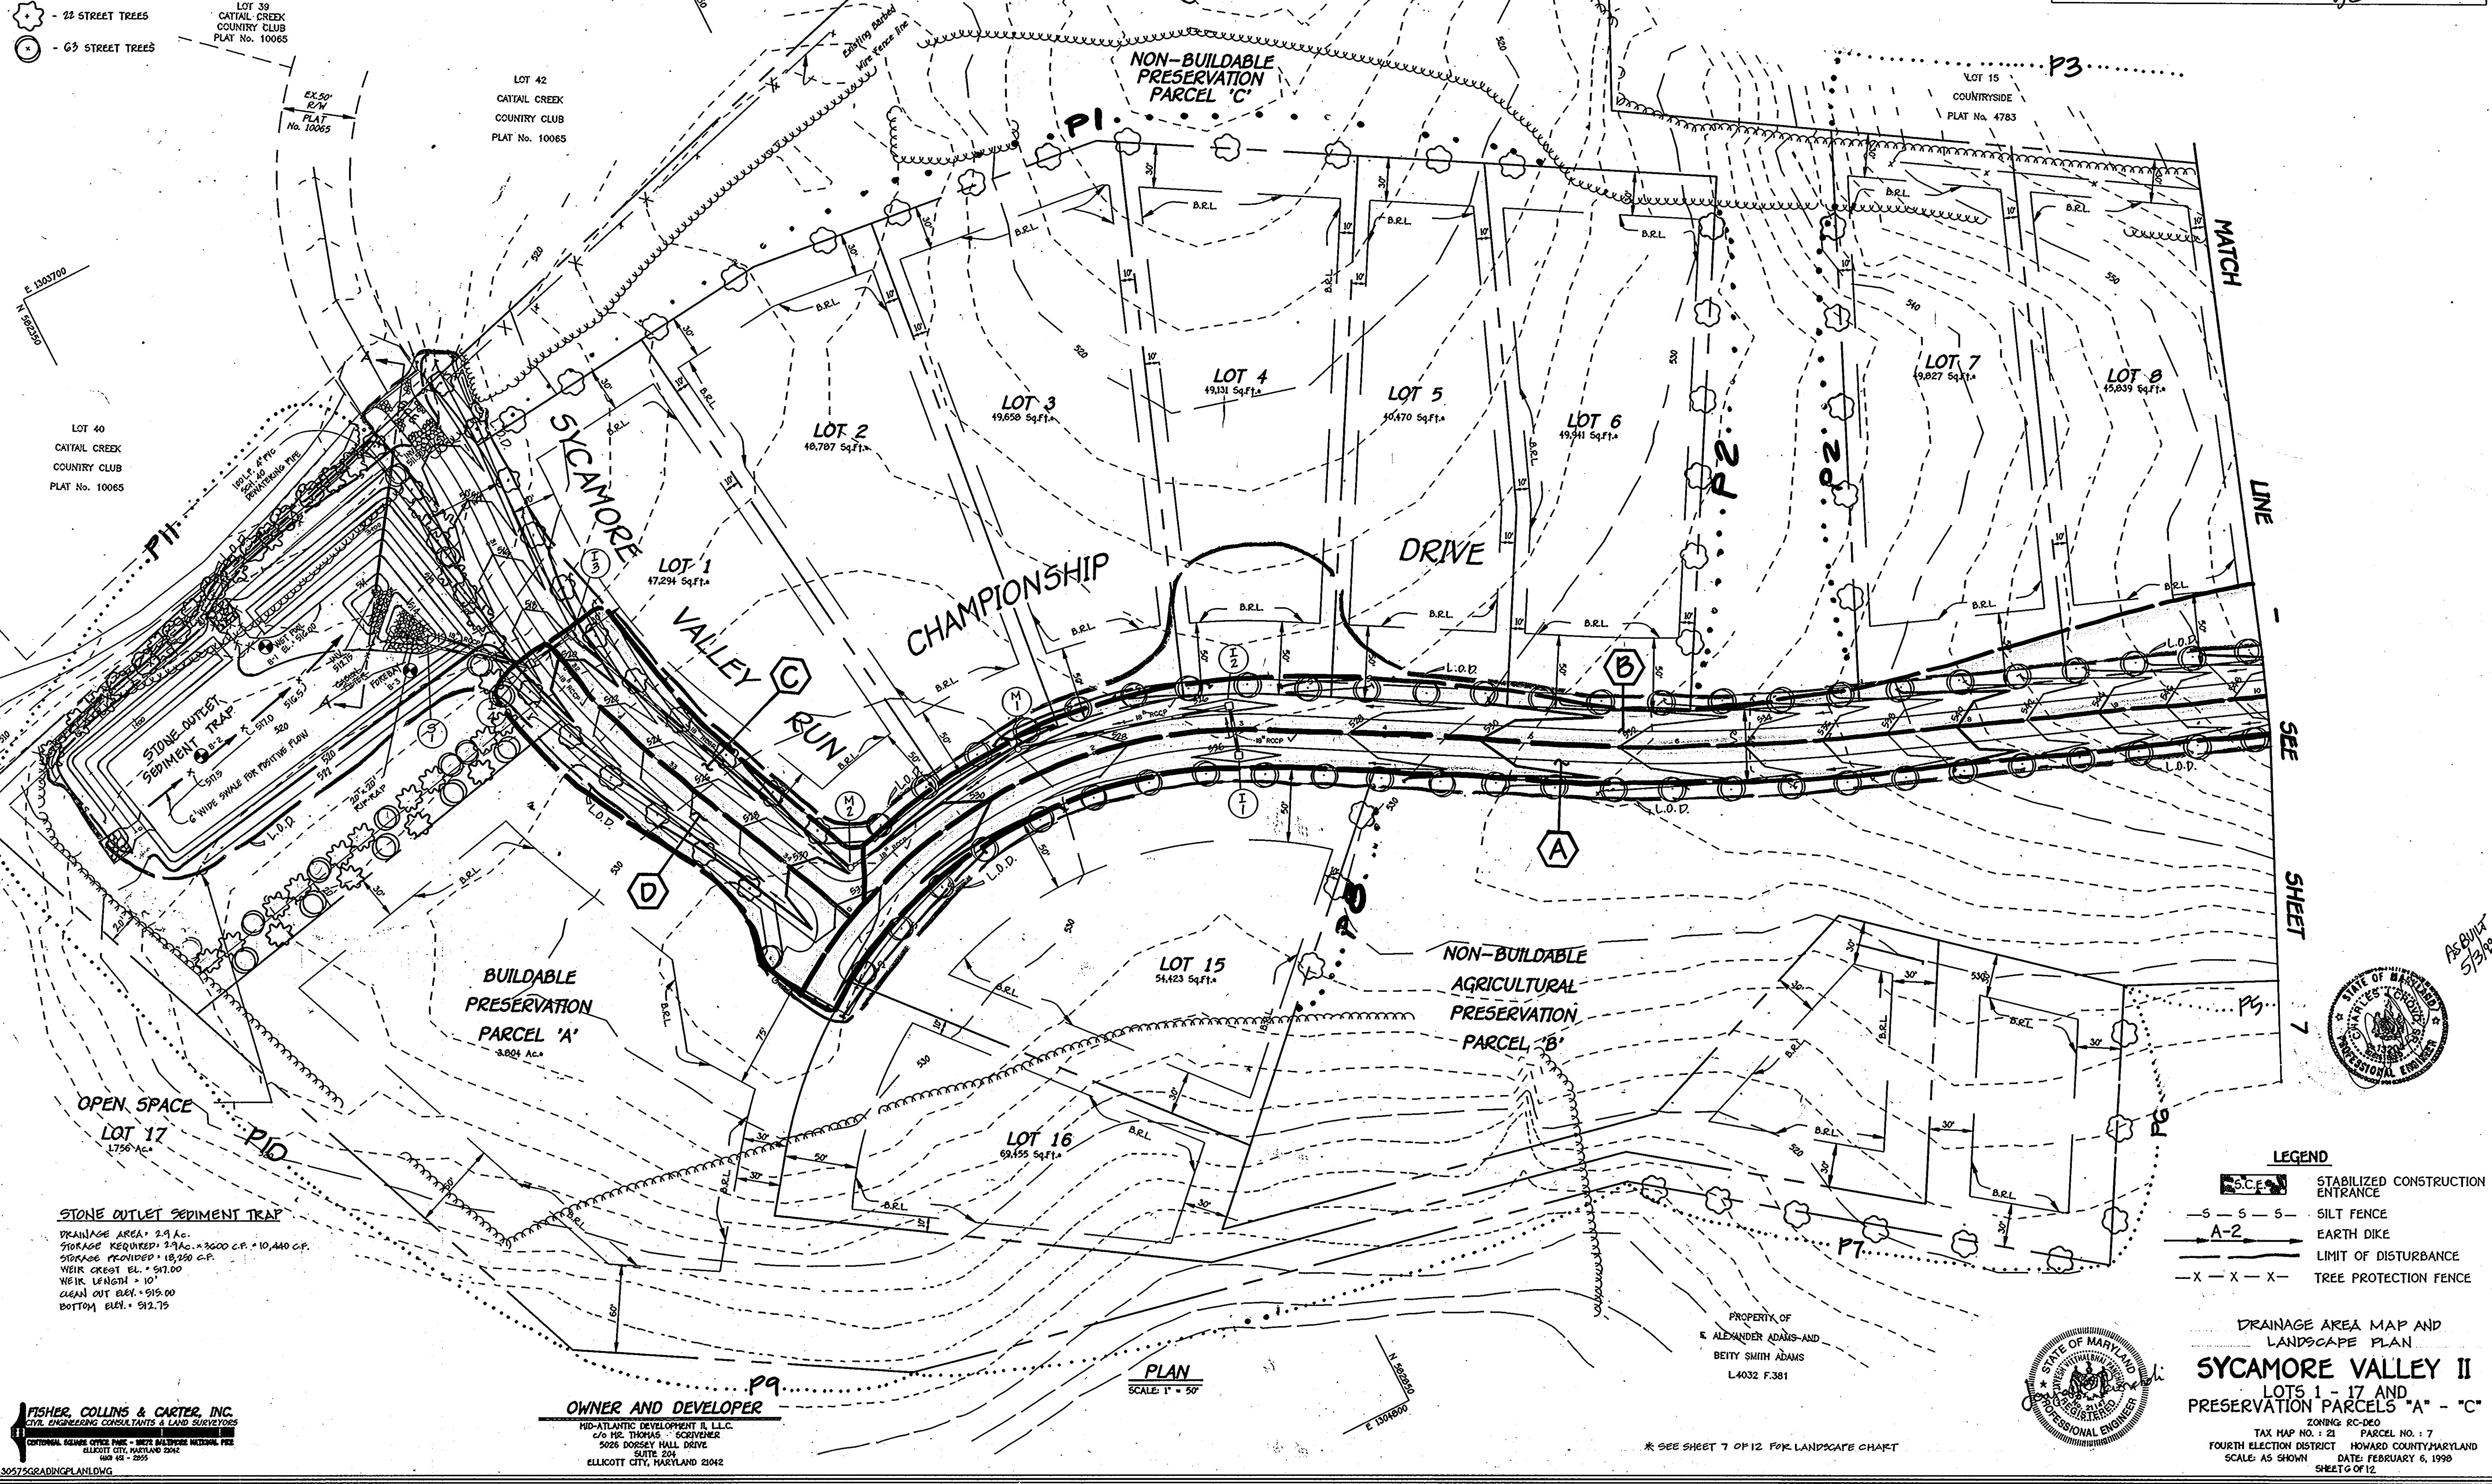

STONE OUTLET SEDIMENT TRAP
 DRAINAGE AREA: 2.9 ac.
 STORAGE REQUIRED: 2.9 ac. x 3600 c.f. = 10,440 c.f.
 STORAGE PROVIDED: 18,250 c.f.
 WEIR CREST EL. = 917.00
 WEIR LENGTH = 10'
 CLEAN OUT B.G. = 915.00
 BOTTOM EL. = 912.75

LEGEND	
	STABILIZED CONSTRUCTION ENTRANCE
- S - S - S -	SILT FENCE
- A-2 -	EARTH DIKE
- - - - -	LIMIT OF DISTURBANCE
- X - X - X -	TREE PROTECTION FENCE

DRAINAGE AREA MAP AND LANDSCAPE PLAN
SYCAMORE VALLEY II
 LOTS 1 - 17 AND PRESERVATION PARCELS "A" - "C"
 ZONING: RC-DEO
 PARCEL NO.: 7
 TAX MAP NO.: 21
 FOURTH ELECTION DISTRICT
 HOWARD COUNTY, MARYLAND
 SCALE: AS SHOWN
 DATE: FEBRUARY 6, 1998
 SHEET OF 12

FISHER, COLLINS & CARTER, INC.
 CIVIL ENGINEERING CONSULTANTS & LAND SURVEYORS
 3057 GRADING PLAN/DWG

OWNER AND DEVELOPER
 MID-ATLANTIC DEVELOPMENT II, L.L.C.
 c/o H.E. THOMAS, SCRIVENER
 5025 DORSEY HALL DRIVE
 SUITE 204
 ELLICOTT CITY, MARYLAND 21042


PLAN
 SCALE: 1" = 50'

* SEE SHEET 7 OF 12 FOR LANDSCAPE CHART

APPROVED: DEPARTMENT OF PUBLIC WORKS
Andrew M. Dancy 7-9-98
 CHIEF, BUREAU OF HIGHWAYS DATE


APPROVED: DEPARTMENT OF PLANNING AND ZONING
Richard Blood 7/17/98
 CHIEF, DIVISION OF LAND DEVELOPMENT DATE

W.D. Dammert 7/10/98
 CHIEF, DEVELOPMENT ENGINEERING DIVISION DATE

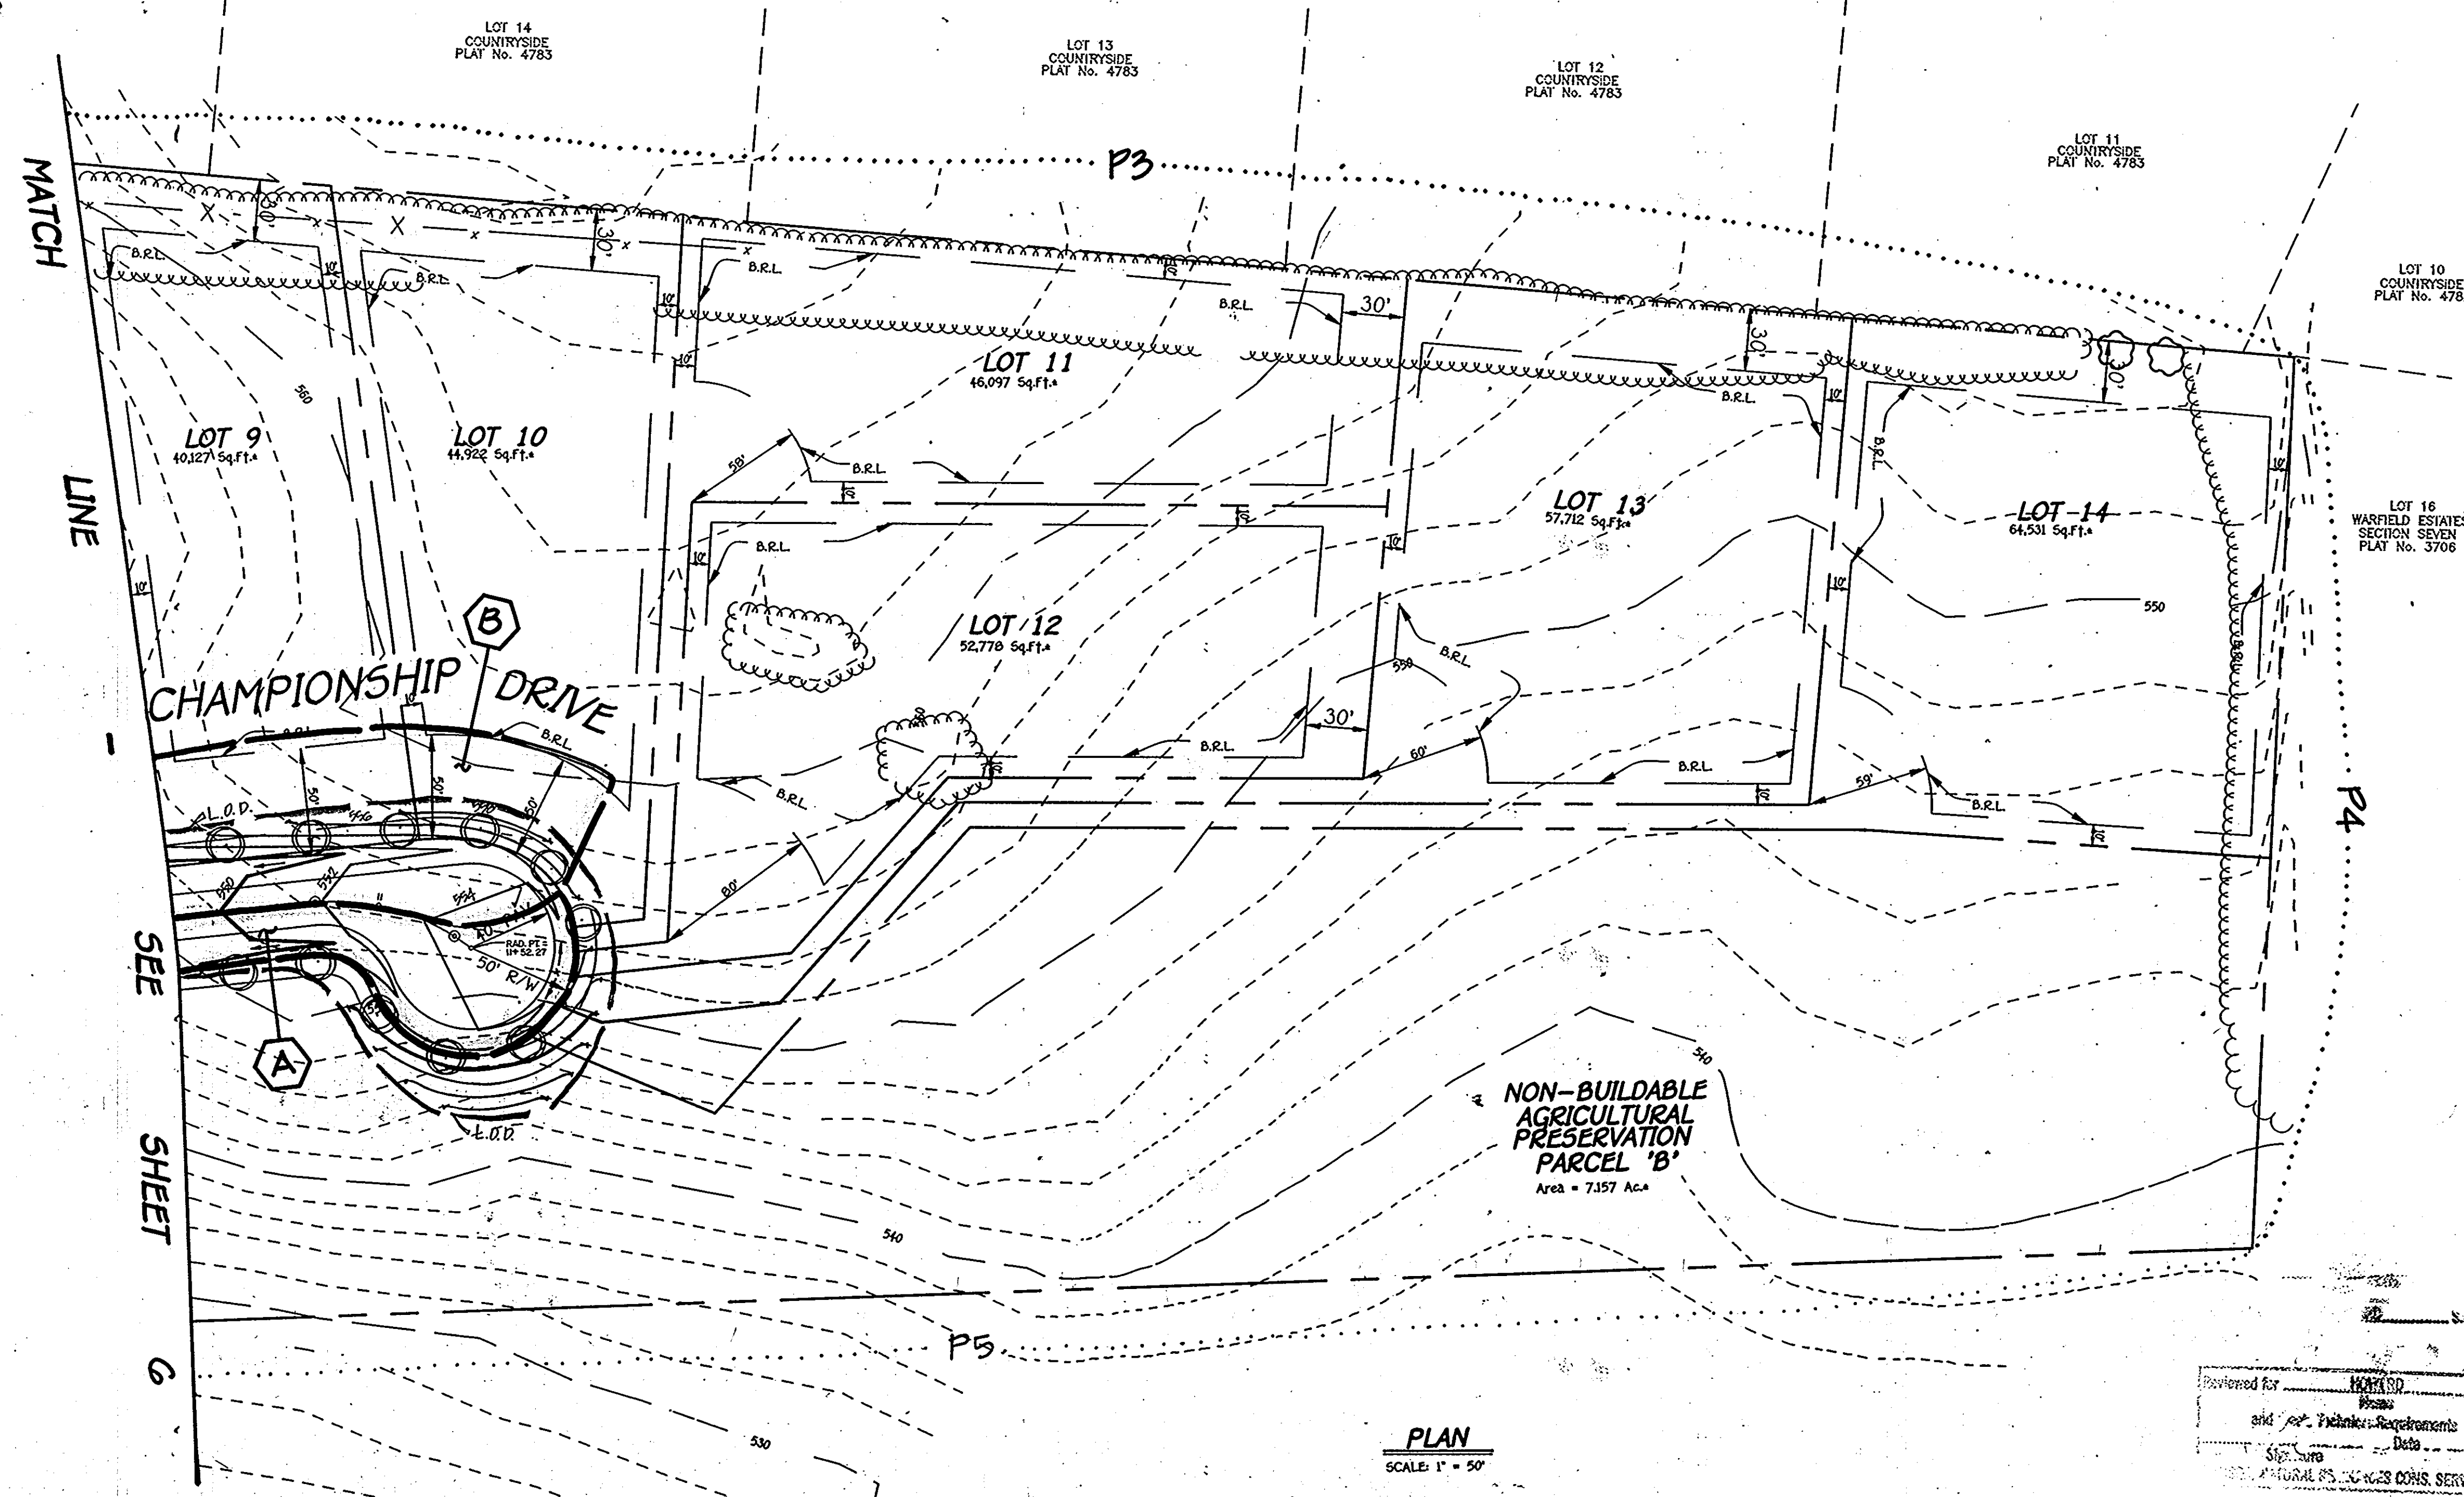

SCHEDULE D STORMWATER MANAGEMENT AREA LANDSCAPING

LINEAR FEET OF PERIMETER	1070'
NUMBER OF TREES REQUIRED:	BASED ON 1070' - 370' x 700'
SHADE TREES	14
EVERGREEN TREES	17
CREDIT FOR EXISTING VEGETATION (NO, YES AND 2)	YES 370'
CREDIT FOR OTHER LANDSCAPING (NO, YES AND 2)	NO
NUMBER OF TREES PROVIDED:	
SHADE TREES	14
EVERGREEN TREES	17
OTHER TREES (2:1 SUBSTITUTION)	

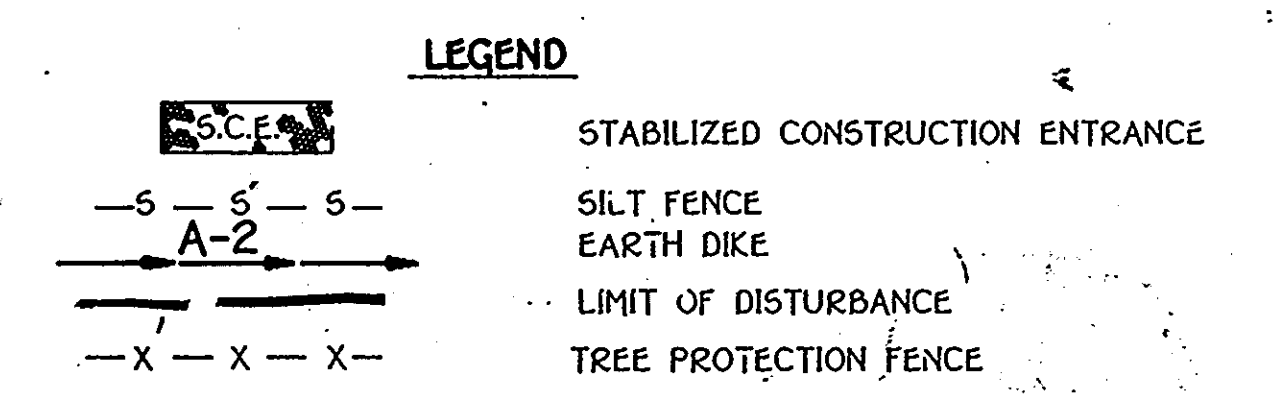

SCHEDULE A PERIMETER LANDSCAPE EDGE

PERIMETER	CATEGORY (PROPERTIES/ROADWAYS)	LANDSCAPE TYPE	LINEAR FEET OF PERIMETER	CREDIT FOR EXISTING VEGETATION (YES, NO, LINEAR FEET) (DESCRIBE BELOW IF NEEDED)	CREDIT FOR WALL FENCE OR BERM (YES, NO, LINEAR FEET) (DESCRIBE BELOW IF NEEDED)	NUMBER OF PLANTS REQUIRED			NUMBER OF PLANTS PROVIDED				
						SHADE TREES	EVERGREEN TREES	SHRUBS	SHADE TREES	EVERGREEN TREES	OTHER TREES (2:1 SUBSTITUTION)	SHRUBS	
P-1	ADJACENT TO PERIMETER	A	180'	NO	NO	13	-	-	13	-	-	-	-
P-2	ADJACENT TO PERIMETER	A	650'	NO	NO	11	-	-	11	-	-	-	-
P-3	ADJACENT TO PERIMETER	A	1555'	YES 1555'	NO	2	-	-	2	-	-	-	-
P-4	ADJACENT TO PERIMETER	A	430'	YES 320'	NO	0	-	-	0	-	-	-	-
P-5	ADJACENT TO PERIMETER	A	1100'	NO	NO	0	-	-	0	-	-	-	-
P-6	ADJACENT TO PERIMETER	A	190'	NO	NO	3	-	-	3	-	-	-	-
P-7	ADJACENT TO PERIMETER	A	335'	NO	NO	6	-	-	6	-	-	-	-
P-8	ADJACENT TO PERIMETER	A	245'	YES 155'	NO	3	-	-	3	-	-	-	-
P-9	ADJACENT TO PERIMETER	A	230'	YES 230'	NO	0	-	-	0	-	-	-	-
P-10	ADJACENT TO PERIMETER	A	555'	YES 555'	NO	0	-	-	0	-	-	-	-
P-11	ADJACENT TO ROADWAY	B	380'	NO	NO	7	9	-	7	9	-	-	-

LANDSCAPING PLANT LIST

QTY.	KEY	NAME	SIZE
59	☉	ACER RUBRUM OCTOBER GLORY (OCTOBER RED MAPLE)	2 - 2 1/2" CALIPER FULL CROWN, B&B
14	○	PLATANUS OCCIDENTALIS "BLOODSOCK" "LONDON PLANETREE"	2 - 2 1/2" CALIPER FULL CROWN, B&B
26	☼	PINUS STROBUS (EASTERN WHITE PINE)	6'-8.5' HEIGHT

"THIS PLAN HAS BEEN PREPARED IN ACCORDANCE WITH THE PROVISIONS OF SECTION 16.124 OF THE HOWARD COUNTY CODE AND THE LANDSCAPE MANUAL". FINANCIAL SURETY FOR THE REQUIRED LANDSCAPE TREES HAS BEEN POSTED AS PART OF THE DEVELOPER'S AGREEMENT IN THE AMOUNT OF \$9,900.00

FISHER, COLLINS & CARTER, INC.
 CIVIL ENGINEERING CONSULTANTS & LAND SURVEYORS
 CENTRAL SQUARE OFFICE PARK - 10772 BALTIMORE NATIONAL FREE
 BELLETT CITY, MARYLAND 21042
 410-412-2255

Approved for: **HOWARD COUNTY S.C.D.**
 and all other Requirements
 Signature: _____ Date: _____
 PROFESSIONAL ENGINEER SERVICE

STATE OF MARYLAND
 PROFESSIONAL ENGINEER
 AS-BUILT 5/3/99

OWNER AND DEVELOPER:
 MID-ATLANTIC DEVELOPMENT II, L.L.C.
 4700 MC THOMAS SCHWENKER
 5026 BURNEY HALL DRIVE
 SUITE 204
 ELICOTT CITY, MARYLAND 21042

DRAINAGE AREA MAP AND LANDSCAPE PLAN
SYCAMORE VALLEY II
 LOTS 1 - 17 AND PRESERVATION PARCELS "A" - "C"
 ZONING: RC-DEO
 TAX MAP NO.: 21 PARCEL NO.: 7
 FOURTH ELECTION DISTRICT HOWARD COUNTY, MARYLAND
 SCALE: AS SHOWN DATE: FEBRUARY 6, 1999
 SHEET 7 OF 12




APPROVED: DEPARTMENT OF PUBLIC WORKS
Andrew M. Danelski 7-9-98
 CHIEF, BUREAU OF HIGHWAYS DATE

APPROVED: DEPARTMENT OF PLANNING AND ZONING
Richard Blood 7/17/98
 CHIEF, DIVISION OF LAND DEVELOPMENT DATE

W.D. Danvers 7/10/98
 CHIEF, DEVELOPMENT ENGINEERING DIVISION DATE

DETAIL 25 - ROCK OUTLET PROTECTION I

ROCK OUTLET PROTECTION

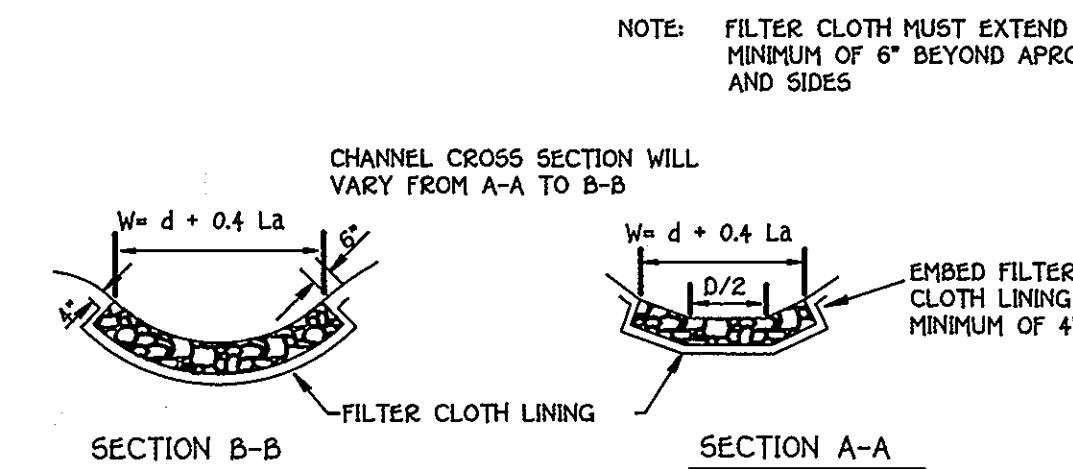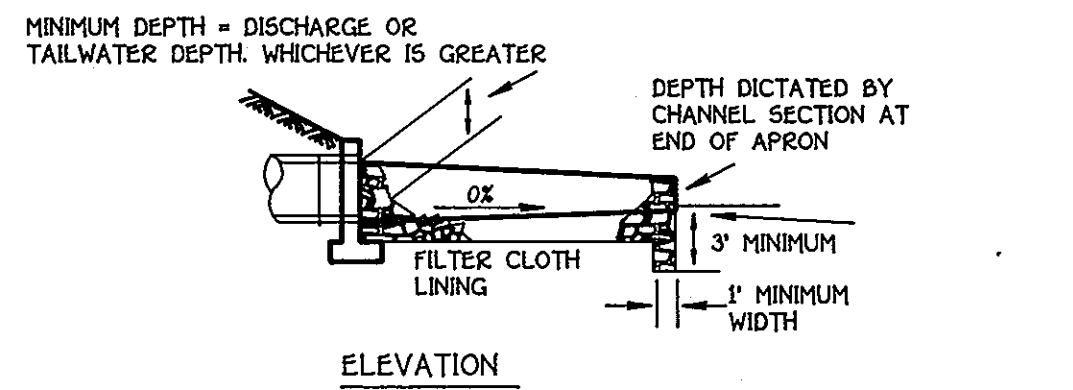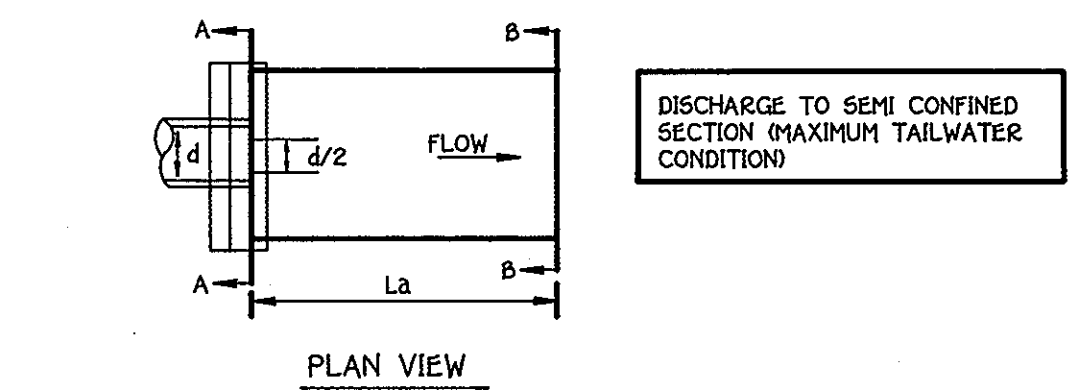


NOTE: FILTER CLOTH MUST EXTEND A MINIMUM OF 6" BEYOND APRON AND SIDES

NOTE: FILTER CLOTH SHALL BE GEOTEXTILE CLASS C

- Construction Specifications
- The subgrade for the filter, rip-rap, or gabion shall be prepared to the required lines and grades. Any fill required in the subgrade shall be compacted to a density of approximately that of the surrounding undisturbed material.
 - The rock or gravel shall conform to the specified grading limits when installed respectively in the rip-rap or filter.
 - Geotextile shall be protected from punching, cutting, or tearing. Any damage other than an occasional small hole shall be repaired by placing another piece of geotextile over the damaged part or by completely replacing the geotextile. All overlaps whether for repairs or for joining two pieces of geotextile shall be a minimum of one foot.
 - Stone for the rip-rap or gabion outlets may be placed by equipment. They shall be constructed to the full course thickness in one operation and in such a manner as to avoid displacement of underlying materials. The stone for rip-rap or gabion outlets shall be delivered and placed in a manner that will ensure that it is reasonably homogeneous with the smaller stones and spalls filling the voids between the larger stones. Rip-rap shall be placed in a manner to prevent damage to the filter blanket or geotextile. Hand placement will be required to the extent necessary to prevent damage to the permanent works.
 - The stone shall be placed so that it blends in with the existing ground. If the stone is placed too high then the flow will be forced out of the channel and scour adjacent to the stone will occur.

STRUCTURE SCHEDULE										
STRUCTURE NO.	TOP ELEVATION	THROAT ELEVATION	INV. IN	INV. OUT	ROAD NAME	ROAD STA.	OFFSET	TYPE	REMARKS	
I-1	526.76 04	525.51 525.21	---	523.90 524.08	CHAMPIONSHIP DRIVE	2+97.45 3+05	20' 47R	K' INLET	S.D. 4.13 w/ S.D. 4.36	
I-2	526.76 94	525.51 525.30	523.62 77	523.37 72	CHAMPIONSHIP DRIVE	2+92 2+94	17L	K' INLET	S.D. 4.13 w/ S.D. 4.36	
I-3	518.87 44	517.62 77	514.89 04	514.64 6/3 28	SYCAMORE VALLEY RUN	3+03 3+80	20' 47L	K' INLET	S.D. 4.13 w/ S.D. 4.36	
I-4	518.87 03	517.62 99	513.78 47	513.45 25	SYCAMORE VALLEY RUN	3+03 3+80	20' 47R	K' INLET	S.D. 4.13 w/ S.D. 4.36	
M-1	529.99	---	521.90 77	521.65 74	CHAMPIONSHIP DRIVE	1+53 1+51	20' 22L	STD. MANHOLE	G - 5.12	
M-2	530.80 17	---	520.25 12	520.00 01	SYCAMORE VALLEY RUN	3+10 3+37	22' 25L	STD. MANHOLE	G - 5.12	
S-1	514.25 13	---	512.75 03	512.75 03	---	---	---	CONC. END SECTION	S.D. 5.52	

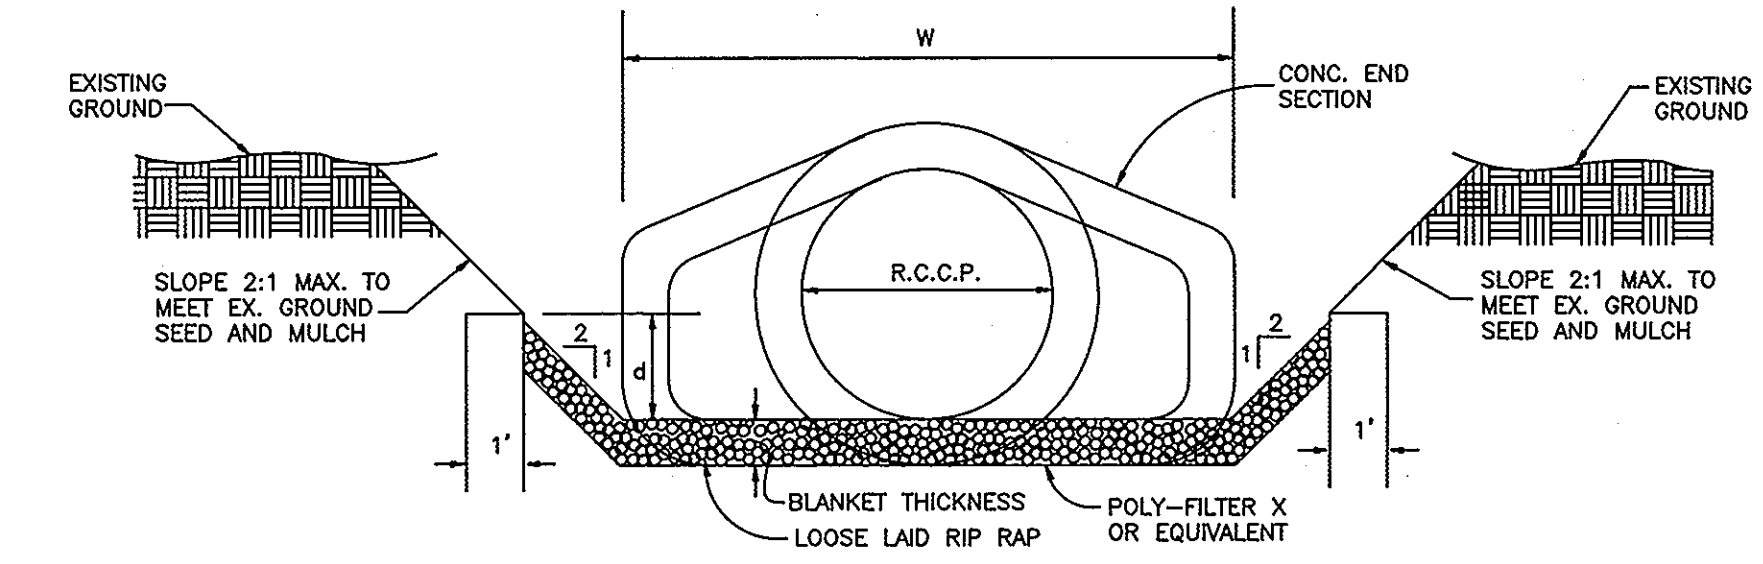

RIP-RAP CHANNEL DESIGN DATA														
STRUCTURE	CROSS SECTIONAL AREA	WETTED PERIMETER	R	R 2/3	S	S 1/2	W	d	N	V (F.P.S.)	Q (C.F.S.)	BLANKET THICKNESS	Q10 (C.F.S.)	PIPE DIA.
S-1	4.85 S.F.	7.80'	0.62	0.73	0.005 FT./FT.	0.0707	4.0'	0.85'	0.035	2.20	10.67	9.5" 15"	19"	10.61 18"

CONSTRUCTION SPECIFICATIONS FOR RIP-RAP OUTFALLS

- The subgrade for the filter, riprap or gabion shall be prepared to the required lines and grades. Any fill required in the subgrade shall be compacted to a density of approximately that of the surrounding undisturbed material.
- The rock or gravel shall conform to the specified grading limits when installed respectively in the riprap or filter.
- Filter cloth shall be protected from punching, cutting or tearing. Any damage other than an occasional hole shall be repaired by placing another piece of cloth over the damaged part or by completely replacing the cloth. All overlaps whether for repairs or for joining two pieces of cloth shall be a minimum of one foot.
- Stone for the riprap or gabion outlets may be placed by equipment. Both shall each be constructed to the full course thickness in one operation and in such a manner as to avoid displacement of underlying materials. The stone for riprap or gabion outlets shall be delivered and placed in a manner that will ensure that it is reasonably homogeneous with the smaller stones and spalls filling the voids between the larger stones. Riprap shall be placed in a manner to prevent damage to the filter blanket or filter cloth. Hand placement will be required to the extent necessary to prevent damage to the permanent works.
- The stone shall be placed so that it blends in with the existing ground. If the stone is placed too high then the flow will be forced out of the channel and scour adjacent to the stone will occur.




Reviewed for: **HOWARD SCD**
 and for Technical Requirements
Cheryl S. ... Date 7/1/98
 USDA, NATURAL RESOURCES CONSV. SERVICE

THE DEVELOPMENT PLAN IS APPROVED
 FOR EROSION CONTROL AND SEDIMENT
 CONTROL MEASURES.
Rel. to W. J. ... 7/1/98

SEQUENCE OF CONSTRUCTION


- OBTAIN A GRADING PERMIT
- NOTIFY "MISS UTILITY" 48 HOURS BEFORE BEGINNING ANY WORK AT 1-800-257-7777. NOTIFY THE HOWARD COUNTY OFFICE OF CONSTRUCTION INSPECTION AT (410) 313-1880 (5) WORKING DAYS PRIOR TO START OF CONSTRUCTION.
- INSTALL TREE PROTECTION FENCE. (2 DAYS)
- INSTALL SEDIMENT CONTROL MEASURES, STABILIZED CONSTRUCTION ENTRANCE, STONE OUTLET SEDIMENT TRAP, EARTH DIKES AND SILT FENCE. STABILIZE DISTURBED AREAS PER TEMPORARY SEEDING NOTES. (1 WEEK)
- GRADE ROAD TO SUBGRADE AND INSTALL STORM DRAINS, INLETS AND ROAD SIDE DITCHES. (1 WEEK)
- CONSTRUCT STORMWATER MANAGEMENT POND. (1 WEEK)
- CONSTRUCT ROAD. (1 WEEK)
- STABILIZE ALL DISTURBED AREAS WITH PERMANENT SEEDING. (2 DAYS)
- OBTAIN PERMISSION FROM THE SEDIMENT CONTROL INSPECTOR TO REMOVE SEDIMENT CONTROL. (2 DAYS)

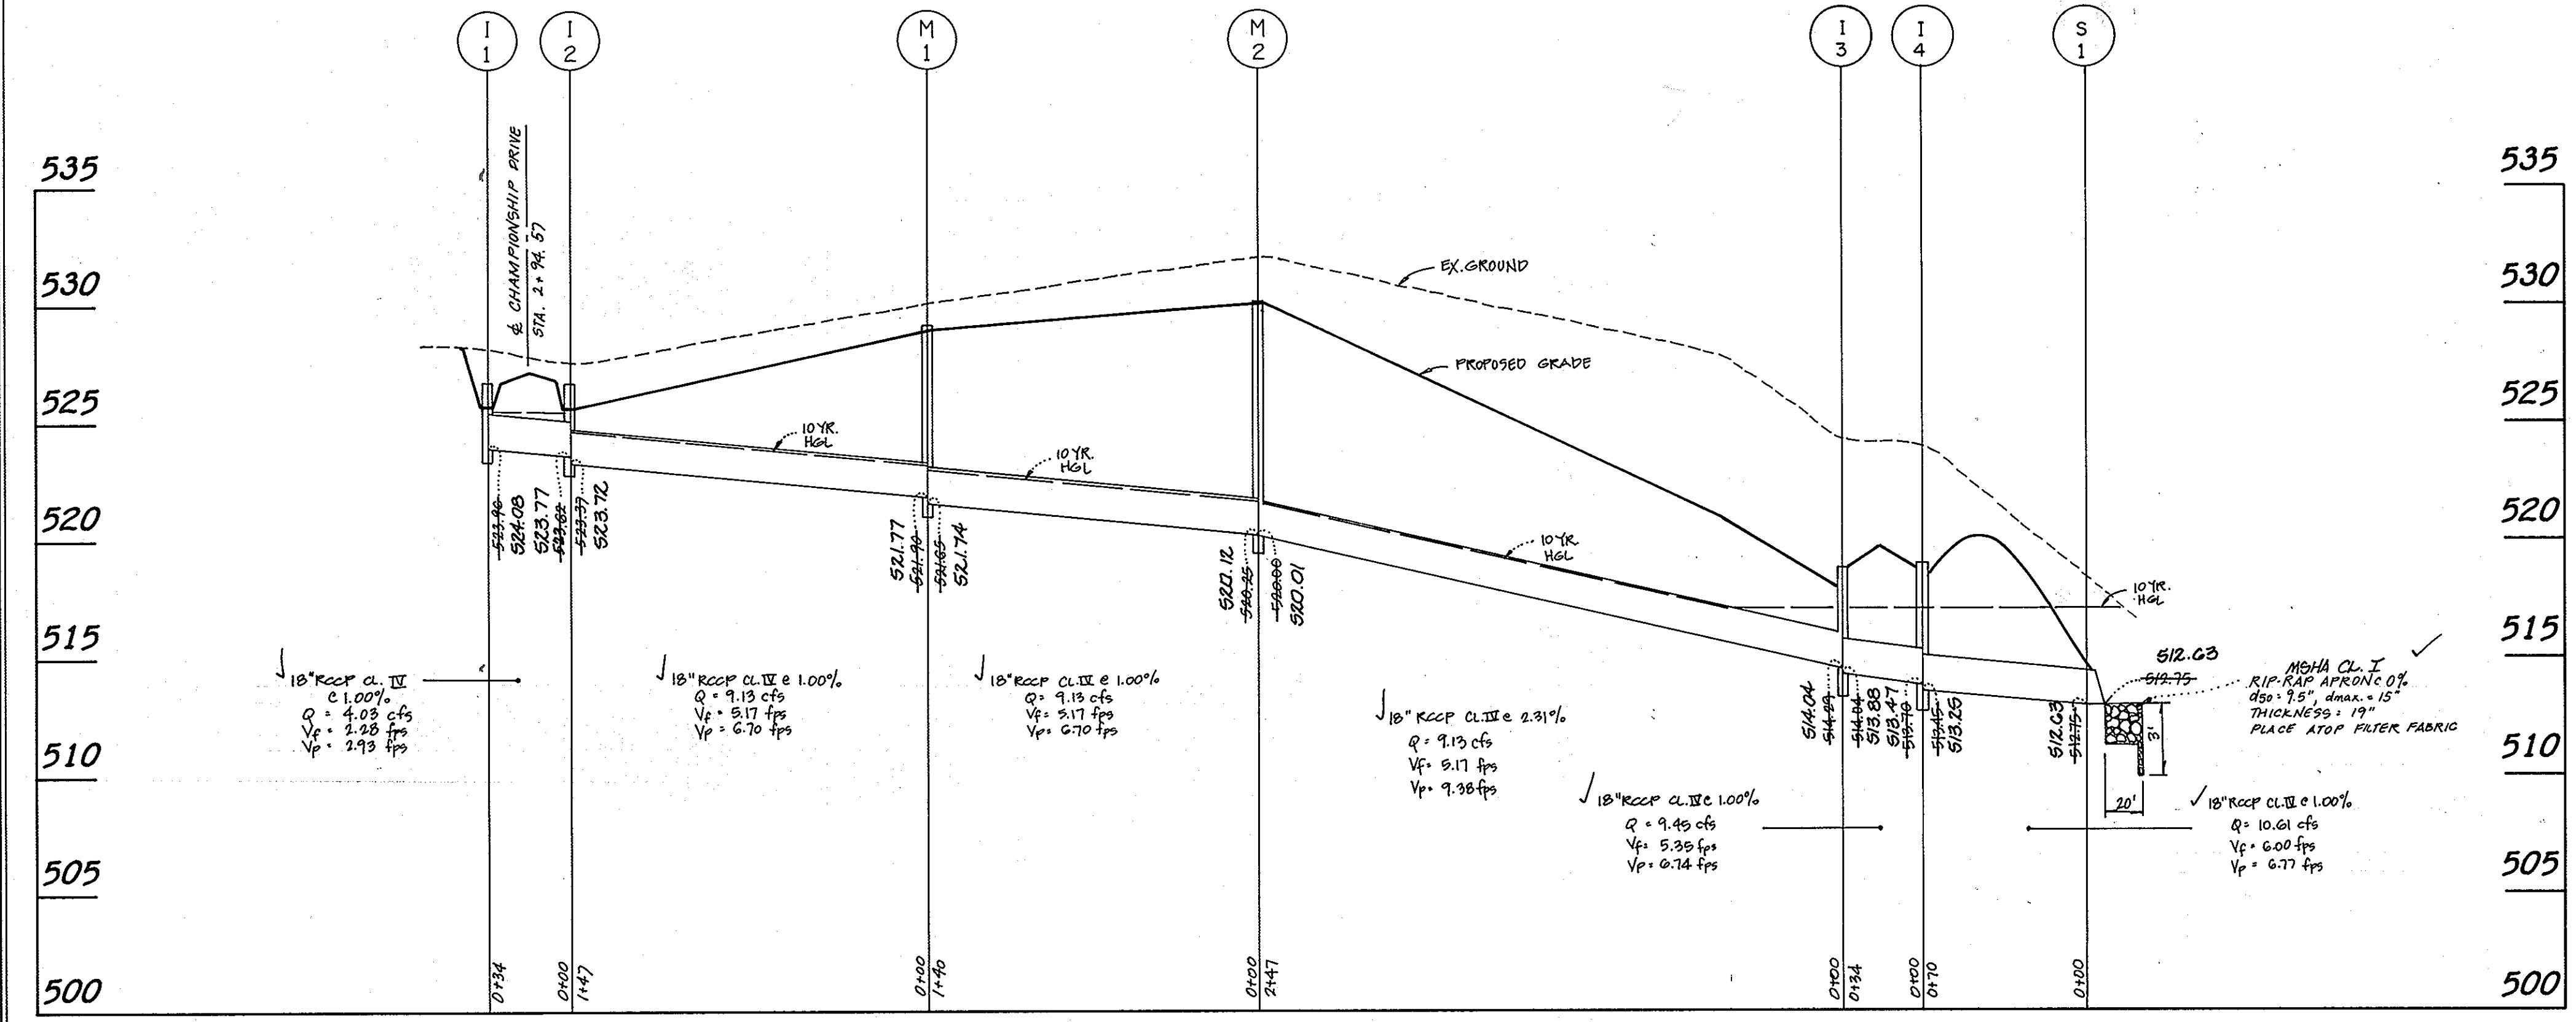


PROFILE
 SCALE: HORIZ. : 1" = 50'
 VERT. : 1" = 5'

FISHER, COLLINS & CARTER, INC.
 CIVIL ENGINEERING CONSULTANTS & LAND SURVEYORS
 CENTRAL SQUARE OFFICE PARK - 1972 BALTIMORE NATIONAL FIRE
 ELLICOTT CITY, MARYLAND 21042
 (410) 461-2222


OWNER AND DEVELOPER
 MID-ATLANTIC DEVELOPMENT & L.L.C.
 4745 W. THOMAS - KODOLINE
 2025 DORSET HALL DRIVE
 SUITE 202
 ELLICOTT CITY, MARYLAND 21042

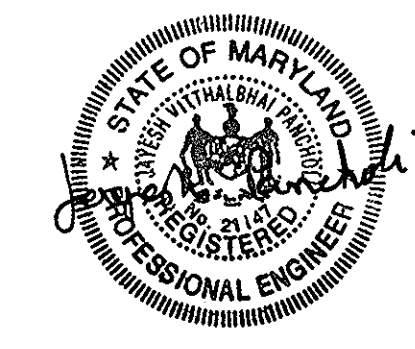


STORM DRAIN PROFILES
SYCAMORE VALLEY II
 LOTS 1 - 17 AND
 PRESERVATION PARCELS "A" - "C"
 ZONING RC-DEO
 TAX MAP NO. : 21 PARCEL NO. : 7
 FOURTH ELECTION DISTRICT HOWARD COUNTY, MARYLAND
 SCALE: AS SHOWN DATE: FEBRUARY 1998
 SHEET 8 OF 12

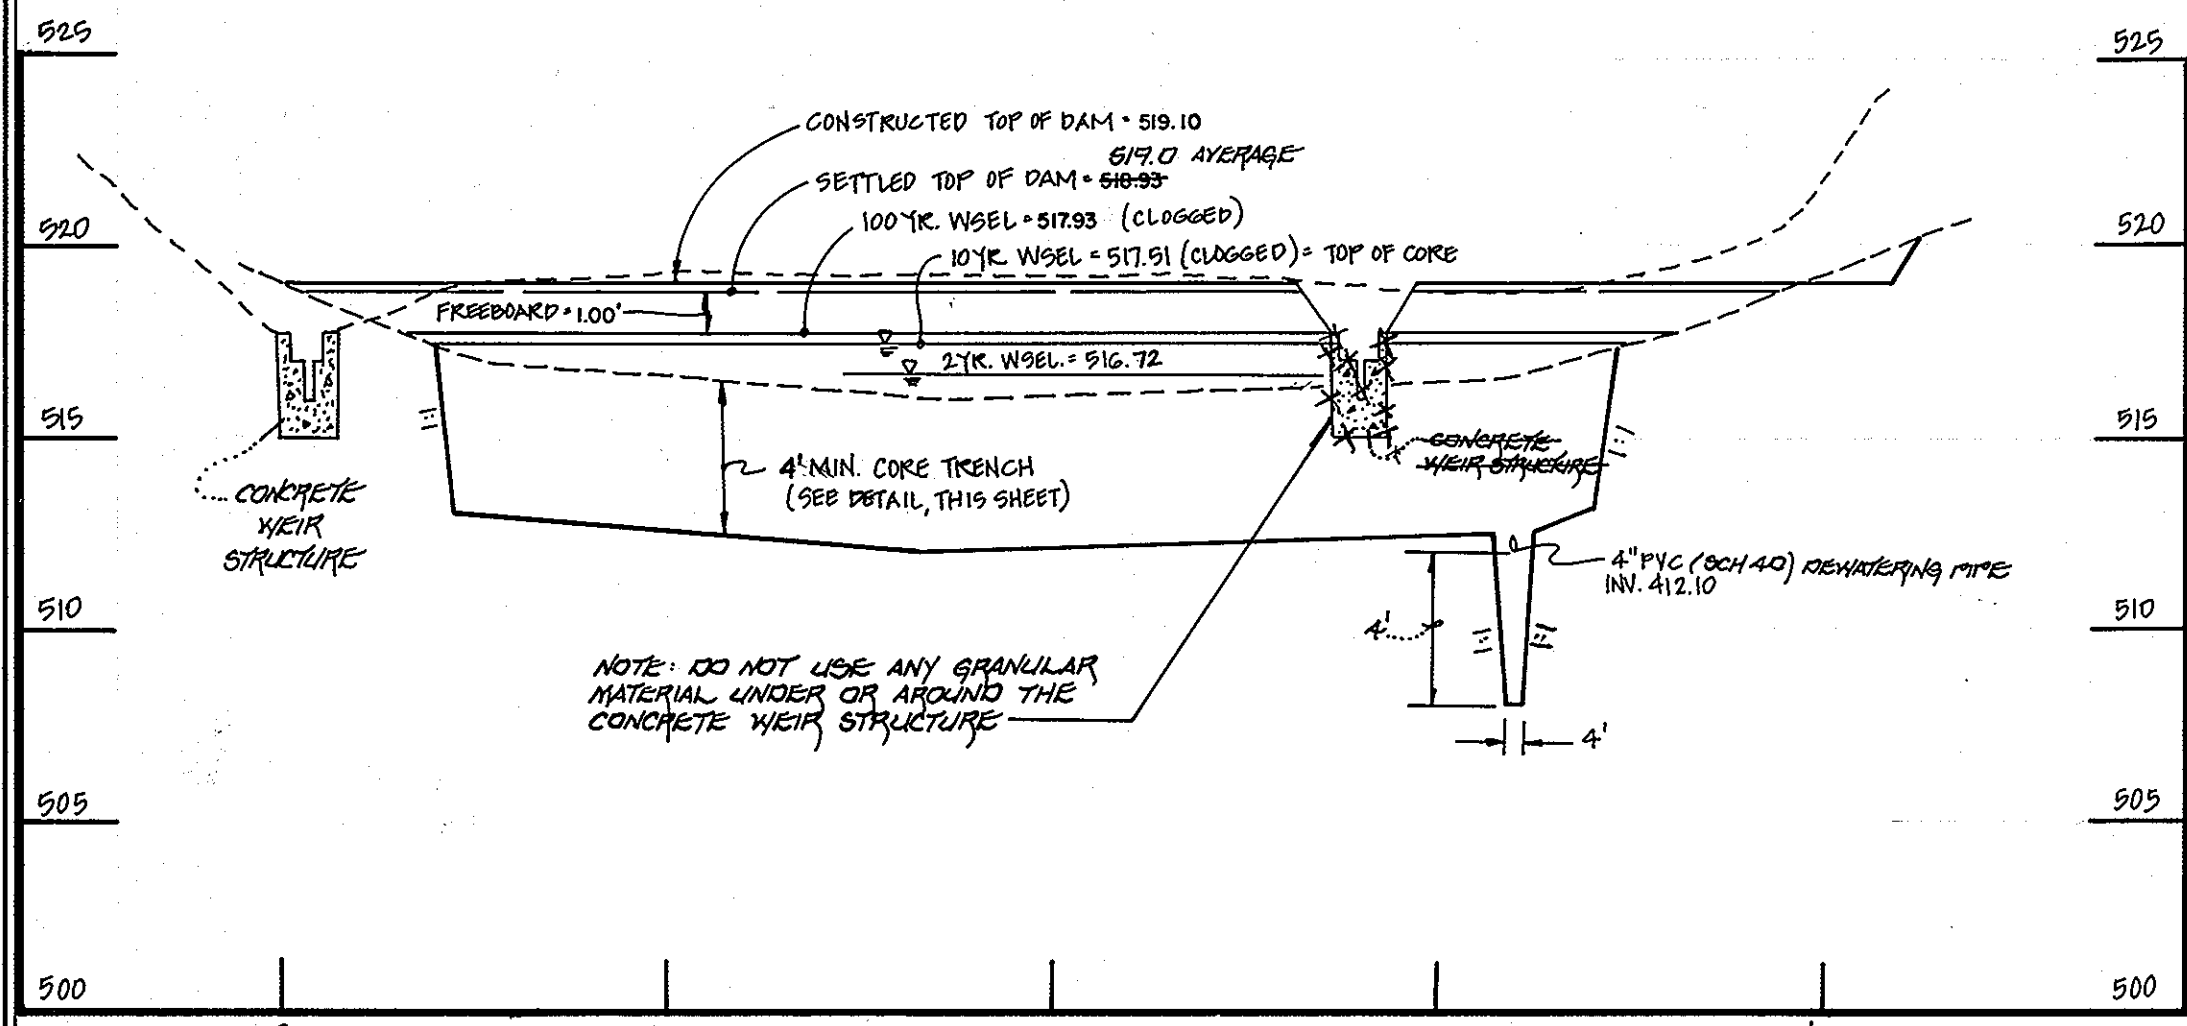


PROFILE THRU E OF DAM
SCALE: 1/4" = 5' HORIZ.
1/8" = 5' VERT.

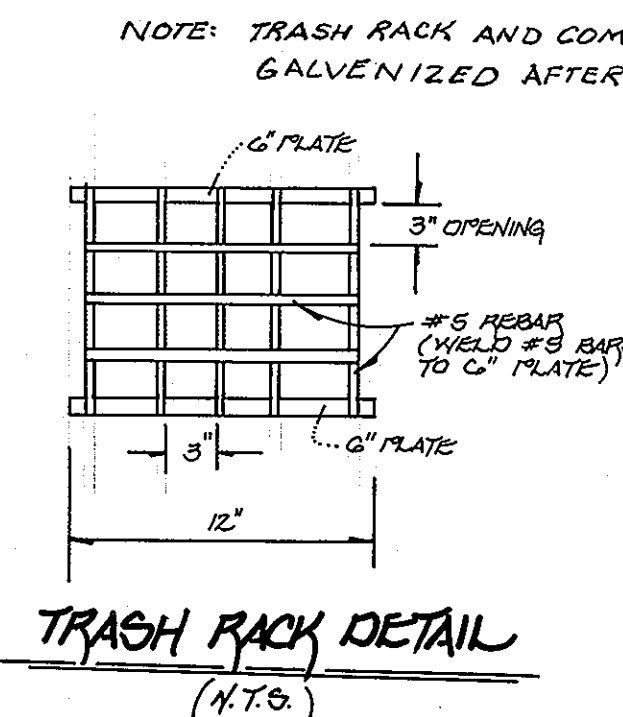


TRASH RACK DETAIL
(N.T.S.)

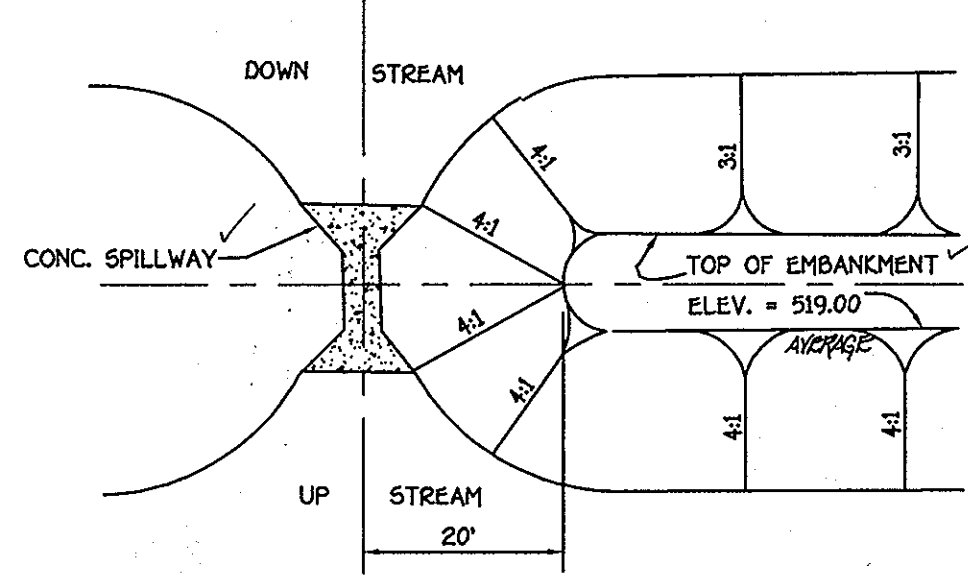


EARTH TRANSITION DETAIL
NOT TO SCALE

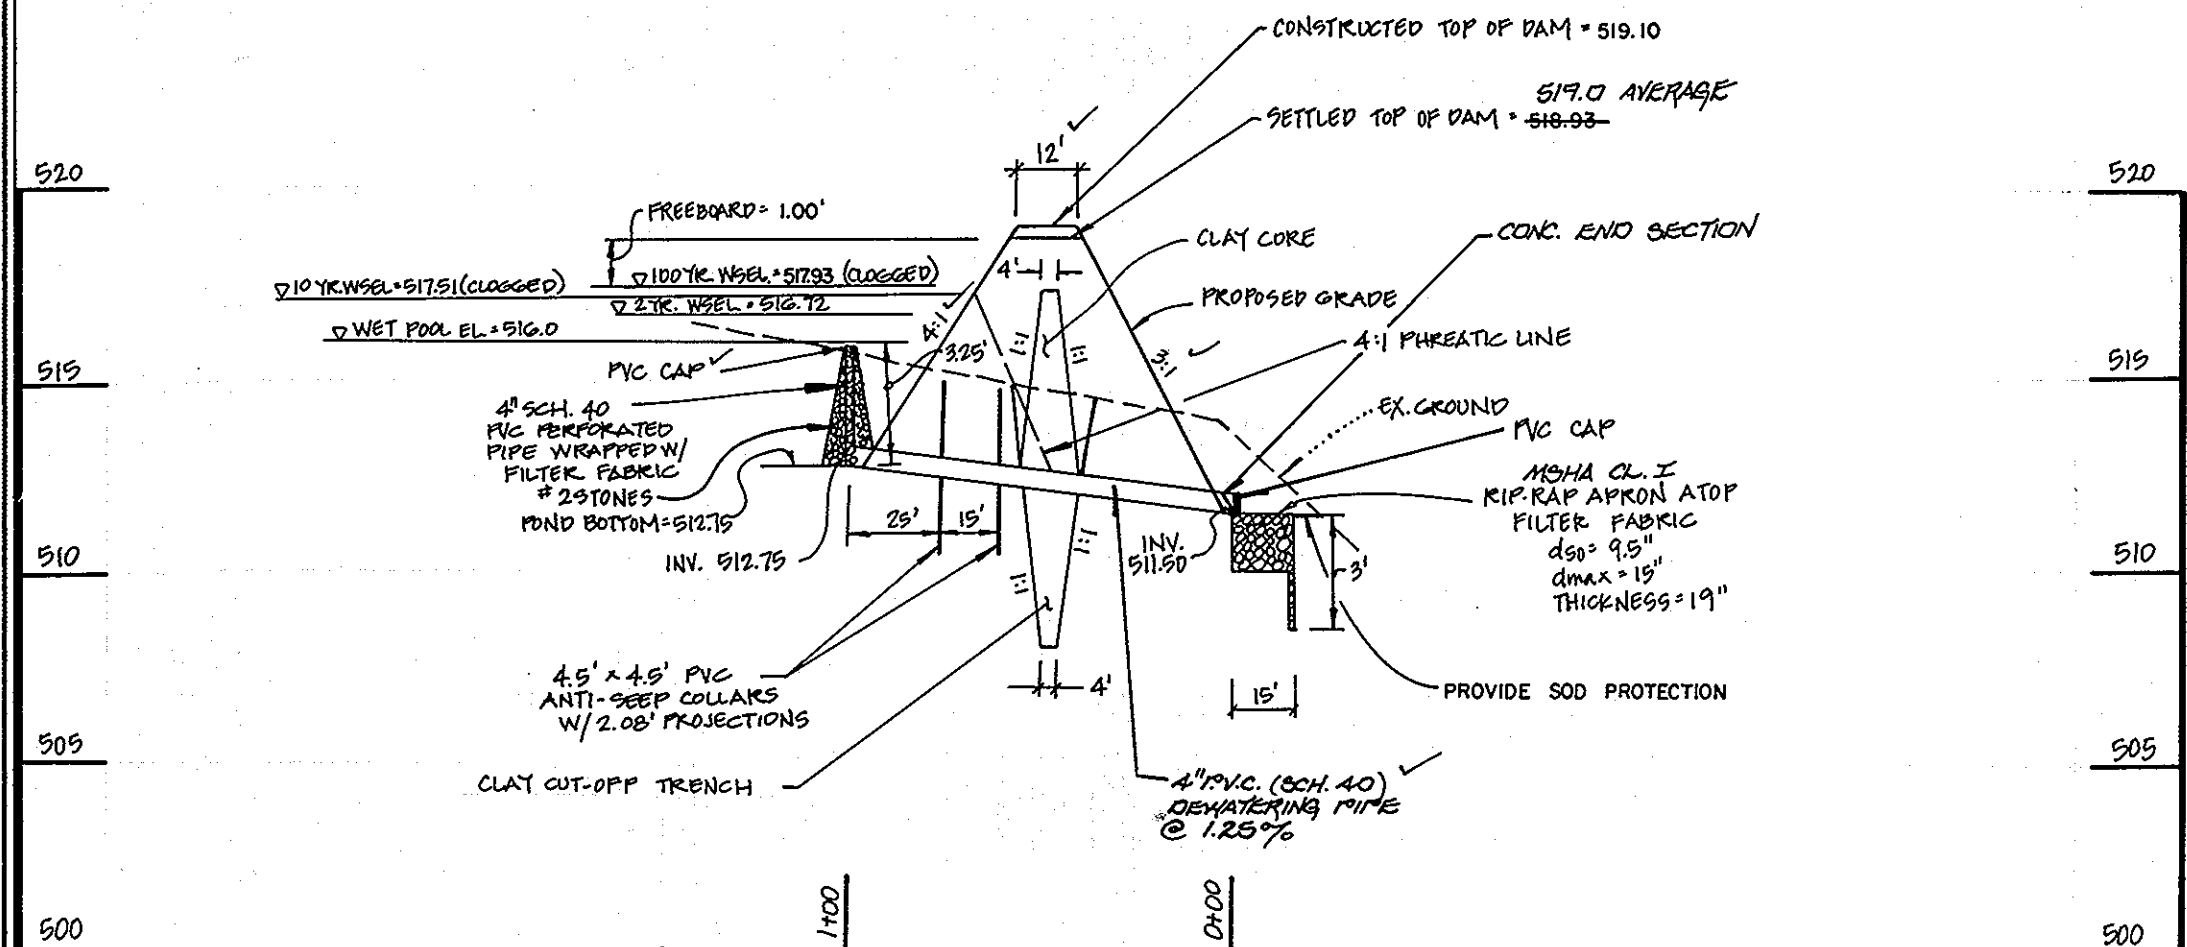


SECTION 'A-A'
SCALE: 1/4" = 5' HORIZ.
1/8" = 5' VERT.

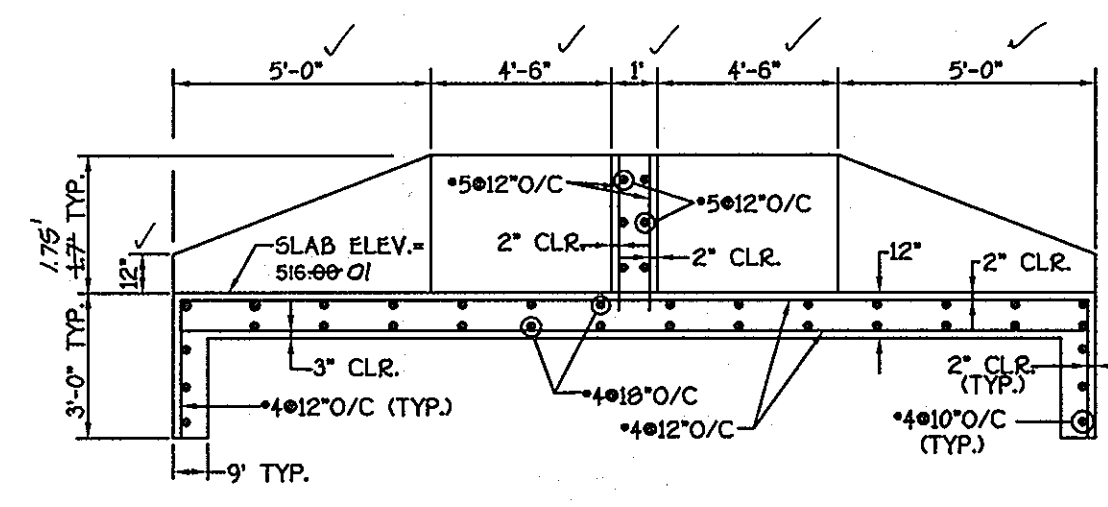


SECTION 'D-D'

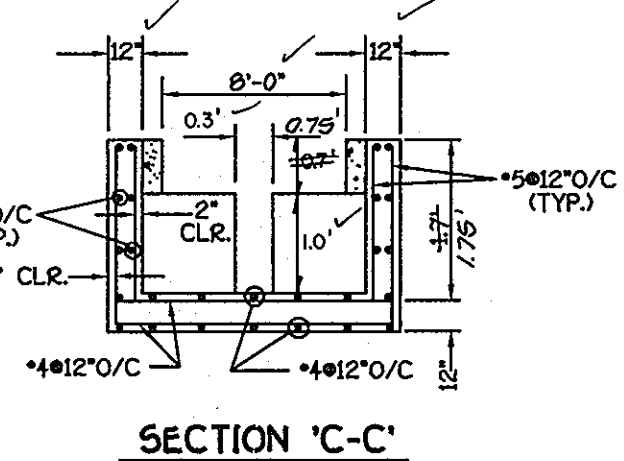


SECTION 'C-C'

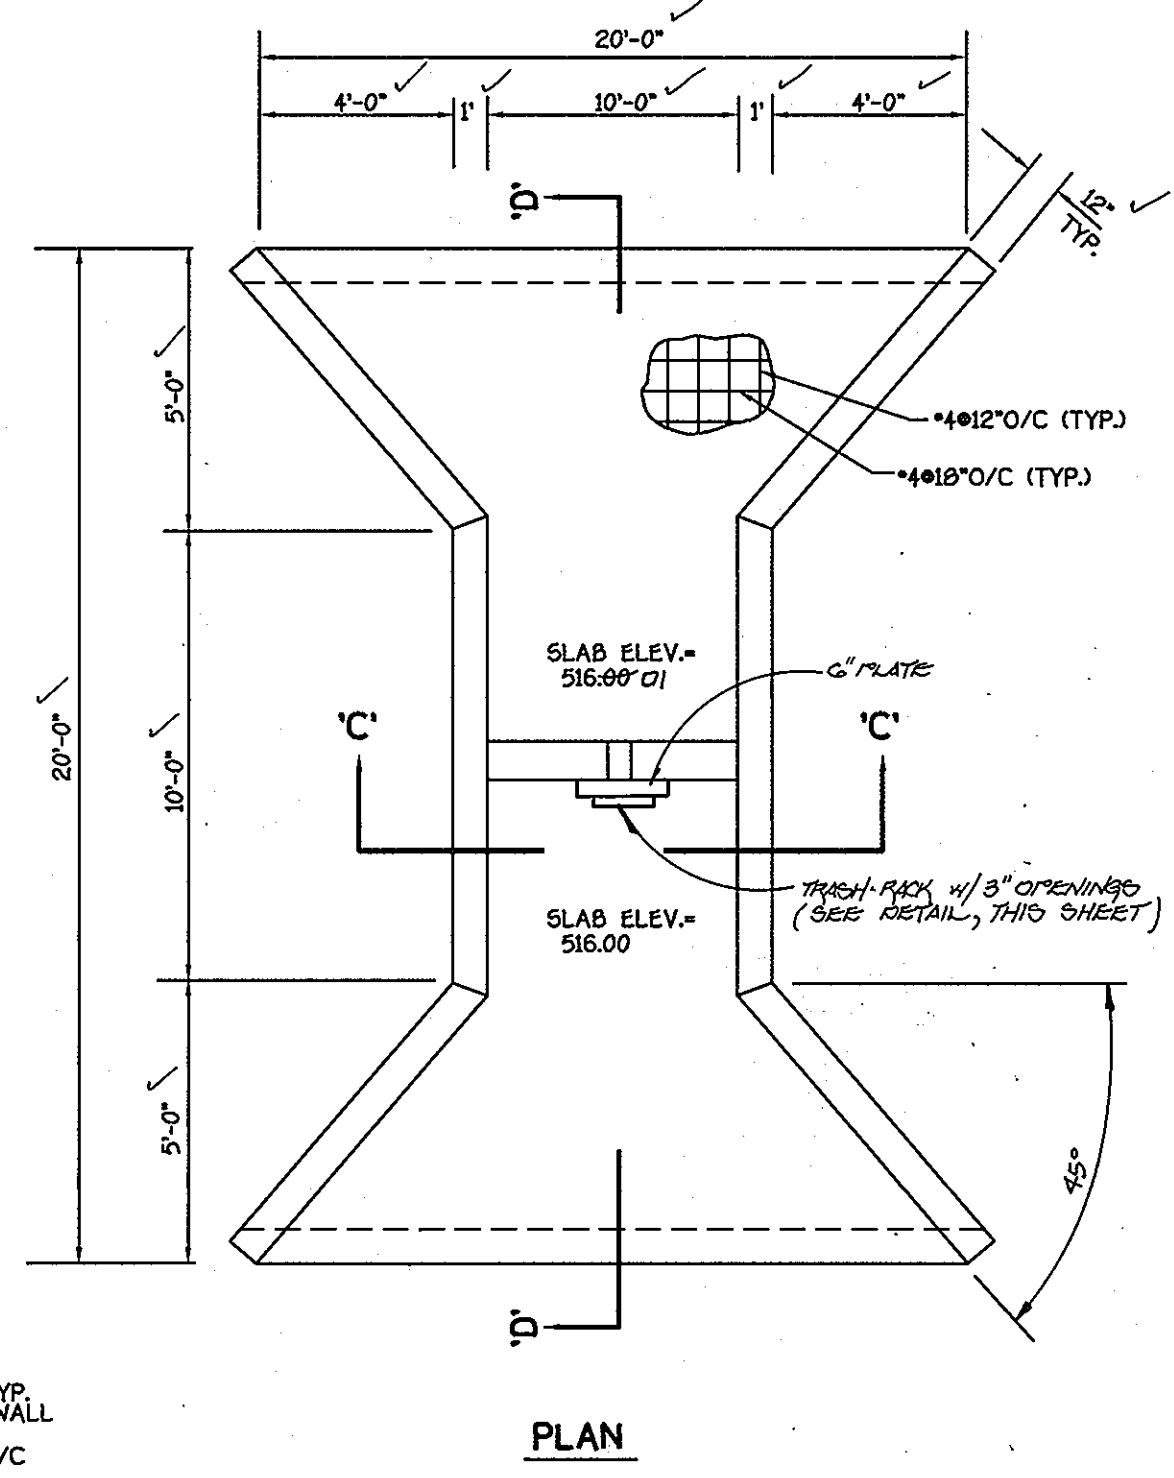


PLAN

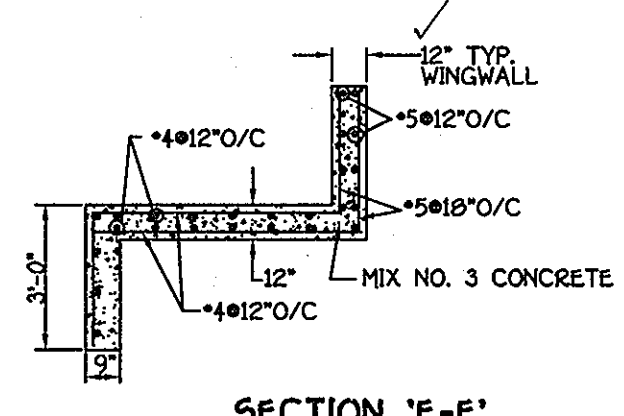

SECTION 'E-E'

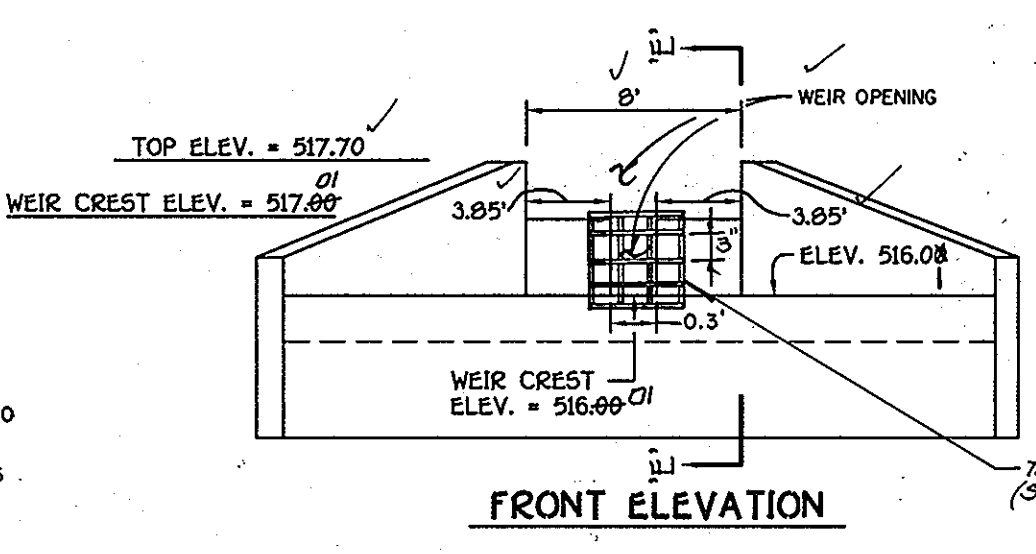


FRONT ELEVATION

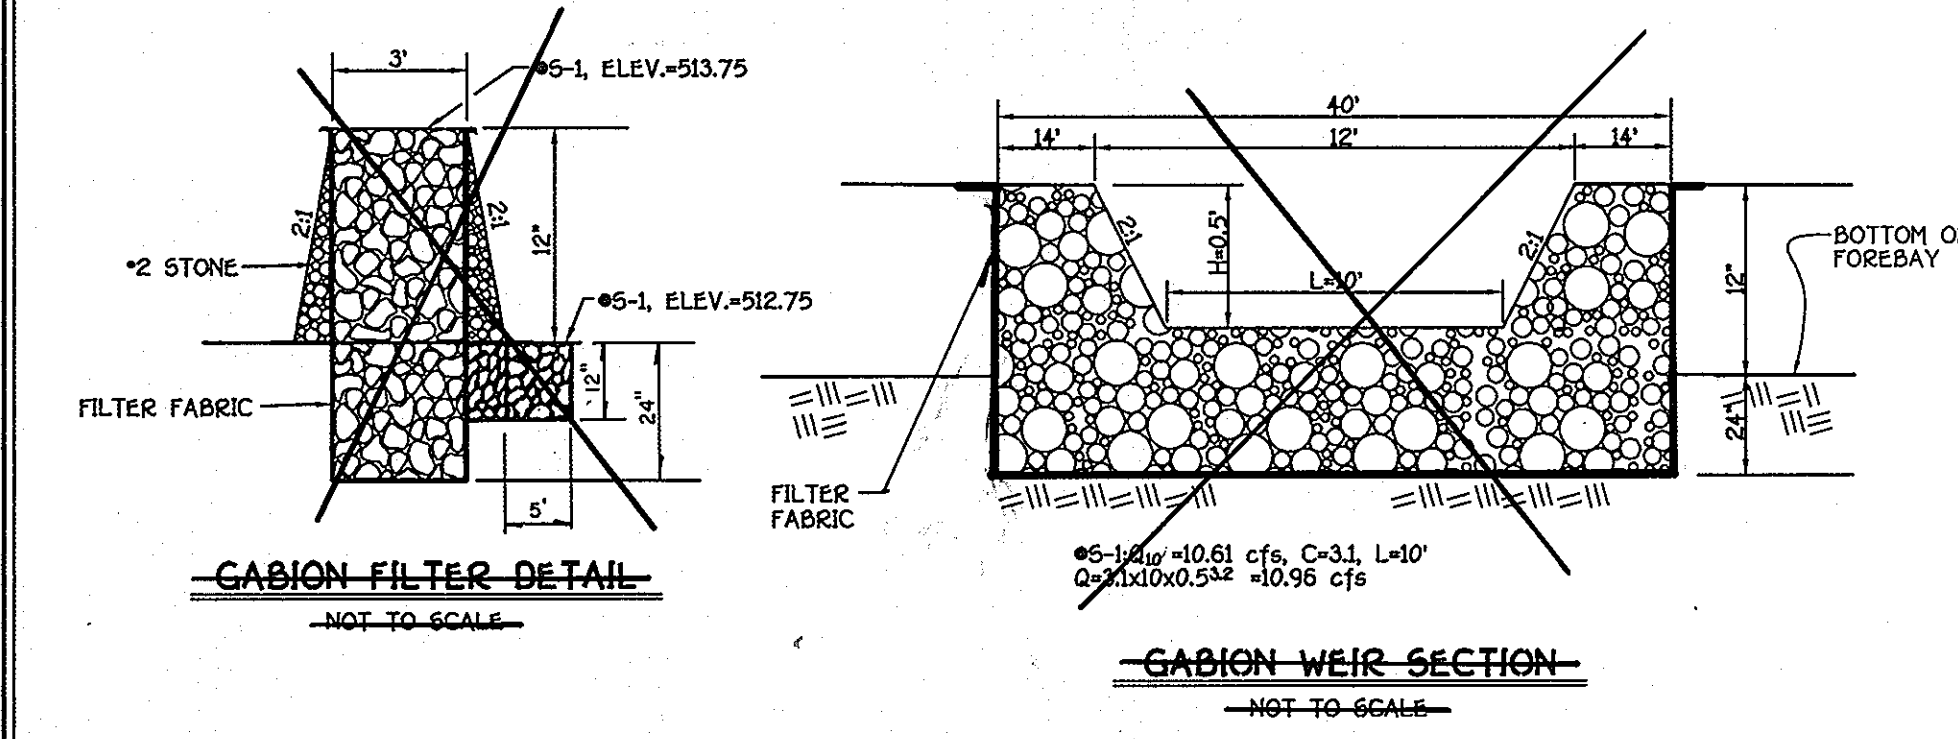

GABION FILTER DETAIL
NOT TO SCALE

GABION WEIR SECTION
NOT TO SCALE

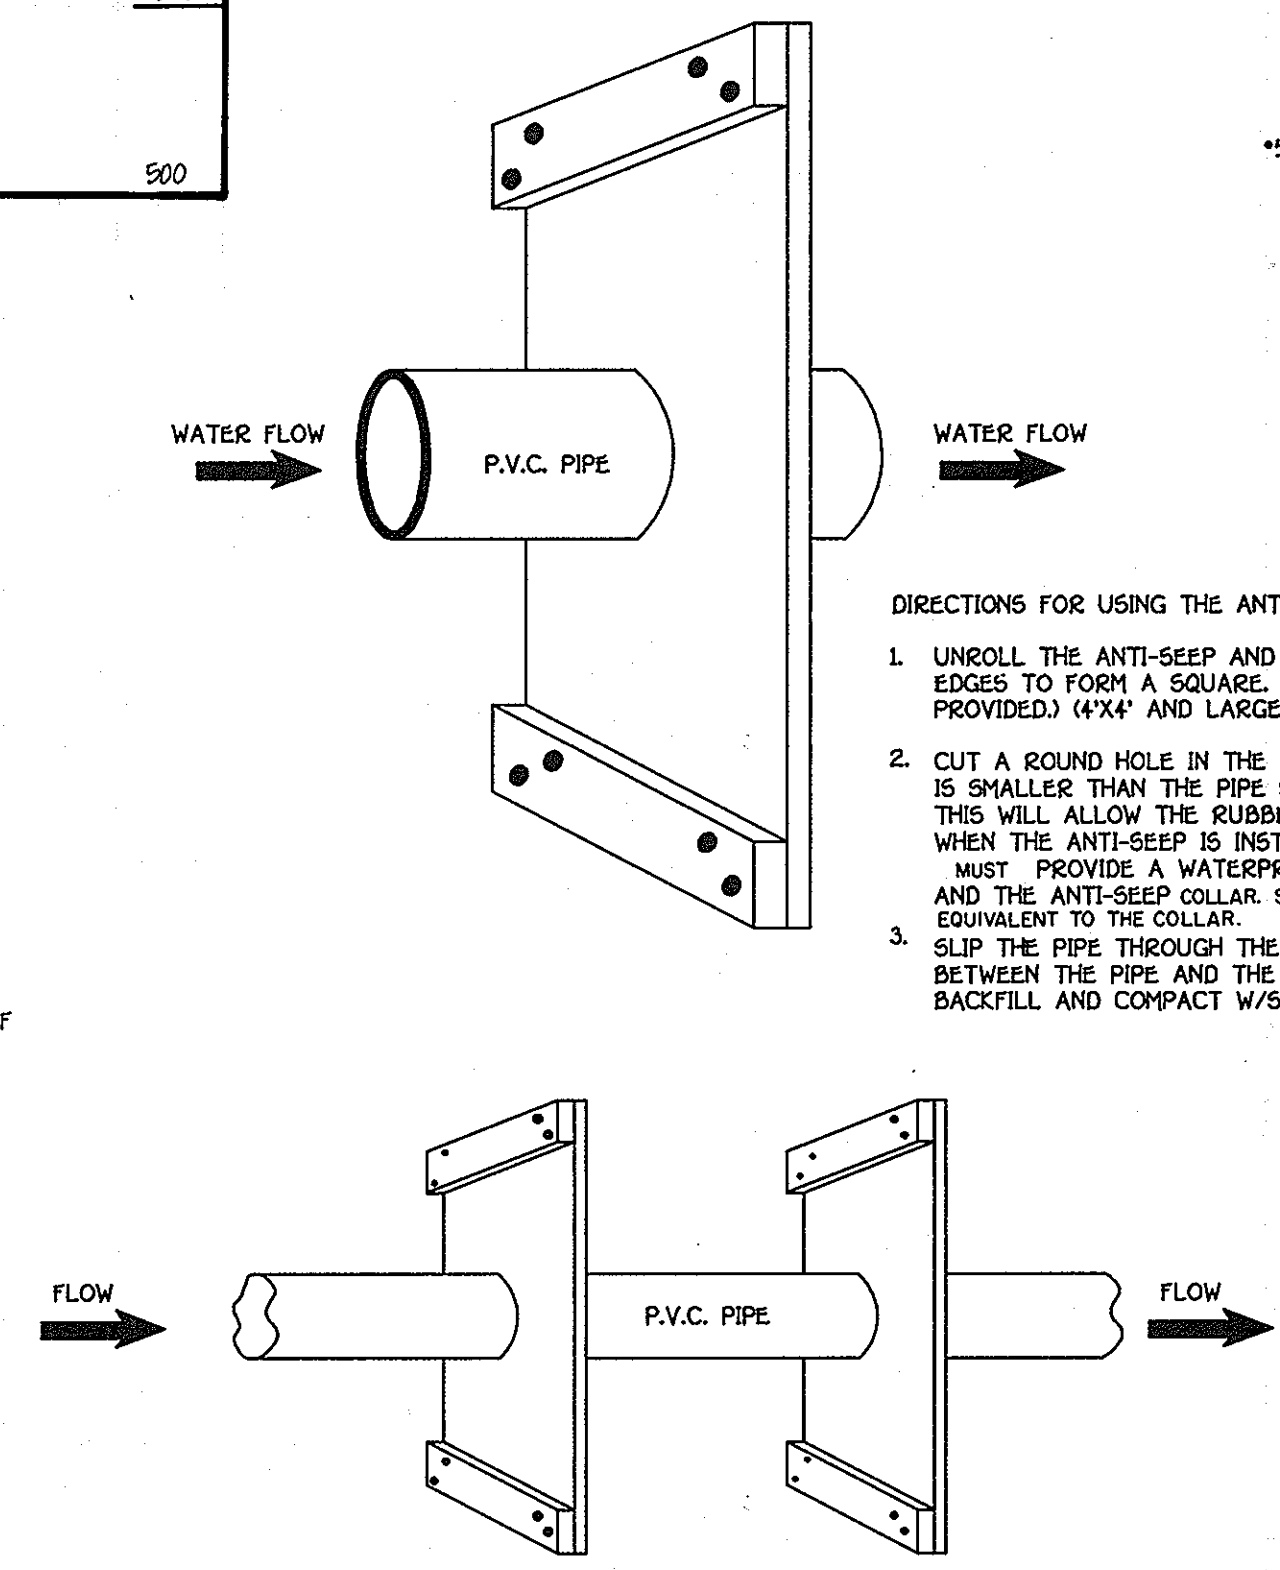

P.V.C. ANTI-SEEP COLLAR DETAIL
NOT TO SCALE

- DIRECTIONS FOR USING THE ANTI-SEEP COLLAR:
- UNROLL THE ANTI-SEEP AND ATTACH THE BOARDS TO THE EDGES TO FORM A SQUARE. (USE THE BOARDS AND NAILS PROVIDED) (4' X 4' AND LARGER).
 - CUT A ROUND HOLE IN THE CENTER OF THE RUBBER THAT IS SMALLER THAN THE PIPE SIZE (APPROX. 25% SMALLER). THIS WILL ALLOW THE RUBBER TO STRETCH OVER THE PIPE WHEN THE ANTI-SEEP IS INSTALLED ON THE PIPE. THIS MUST PROVIDE A WATERPROOF SEAL BETWEEN THE PIPE AND THE ANTI-SEEP COLLAR. SECURE THE PIPE W/ GLUE OR EQUIVALENT TO THE COLLAR.
 - SLIP THE PIPE THROUGH THE ANTI-SEEP. INSPECT THE SEAL BETWEEN THE PIPE AND THE ANTI-SEEP CAREFULLY. BACKFILL AND COMPACT W/ SUITABLE SOIL.

MODIFIED HOWARD COUNTY STD. DTL. S.D.-7.00
CONCRETE WEIR STRUCTURE DETAIL
NOT TO SCALE

- NOTES:
- ALL EXPOSED EDGES TO HAVE 3/4" x 3/4" CHAMFER OR AS DIRECTED.
 - CONC. SHALL BE S.H.A. MIX NO. 3 (1' ± 3500 P.S.I. AT 28 DAYS).
 - REINFORCING STEEL SHALL BE ASTM A-615 GRADE 60.



STORMWATER MANAGEMENT DETAILS
SYCAMORE VALLEY II
LOTS 1-17 AND PRESERVATION PARCELS 'A-C'

ZONED: "RC-DEO"
TAX MAP No. 21 PARCEL 7
FOURTH ELECTION DISTRICT HOWARD COUNTY, MARYLAND
SCALE: AS SHOWN DATE: FEBRUARY, 1998
SHEET 9 of 12

OPERATION AND MAINTENANCE SCHEDULE
OF HOME OWNERS ASSOCIATION OWNED AND MAINTAINED
STORMWATER MANAGEMENT FACILITY
WET POND

HOME OWNERS ASSOCIATION'S MAINTENANCE RESPONSIBILITIES:

- Top and side slopes of the embankment shall be mowed a minimum of two (2) times a year, once in June and once in September. Other side slopes and maintenance access should be mowed as needed.
- Debris and litter next to the outlet structure shall be removed during regular mowing operations and as needed.
- When deemed necessary for aesthetic reasons, sediment should be removed from the pond. Approval of the Department of Public Works is required.

OPERATION AND MAINTENANCE SPECIFICATIONS

I hereby certify that I will operate and maintain the completed pond in accordance with the following:

- Periodic inspections of the facility will be made to identify potential problems that may affect its safety. These inspections will be made after periods of heavy rainfall and at least twice annually. Inspection reports shall be kept until the next subsequent inspection. Inspection items to be looked at include:
 - Spillway and outlet works
 - Rip-rap
 - Vegetative cover
 - Cracks in the fill
 - Slope failures; and
 - Seepage and other signs of distress.
- Problems identified during inspections will be promptly corrected. Major problems will be brought to the attention of the soil conservation district and the dam safety division of the Maryland Water Resources Administration. As a very minimum, grassy vegetation will be maintained in a dense and healthy state, and woody vegetation will not be permitted to grow on the embankment.

NOTES

- Concrete shall conform to the Maryland D.O.T.S.H.A. Standard Specs for construction and materials, 1982 Mix No. 6, except that TY. III Cement and A.S.T.M. C 33 No. 8 coarse AGG. shall be used.

By The Developer:
Signature of Developer: *[Signature]* Date: 2/11/98

Printed Name of Developer: _____

By The Engineer:
Signature of Engineer: *[Signature]* Date: 2-11-98

Printed Name of Engineer: _____

These Plans Have Been Reviewed For The Howard Soil Conservation District And Meet The Technical Requirements For Small Pond Construction, Soil Erosion And Sediment Control.
Signature: *[Signature]* Date: 7/1/98
Title: SDA-Natural Resources Conservation Service

These Plans For Small Pond Construction, Soil Erosion And Sediment Control Meet The Requirements Of The Howard Soil Conservation District.
Signature: *[Signature]* Date: 7/1/98
Title: Howard Soil Conservation District

Approved: Department Of Public Works
Signature: *[Signature]* Date: 7-9-98
Title: Chief Bureau of Highways

Approved: Department Of Planning And Zoning
Signature: *[Signature]* Date: 7/17/98
Title: Chief, Division Of Land Development


Signature: *[Signature]* Date: 7/10/98
Title: Chief, Development Engineering Division

AS-BUILT CERTIFICATION

I hereby certify that the facility shown on this plan was constructed as shown on the "As-Built" Plans and meets the approved plans and specifications.

Signature: *[Signature]* Date: 13204
P.E. No. 512199
Date: 7/10/98

Certify Means To State Or Declare A Professional Opinion Based Upon Onsite Inspections And Material Tests Which Are Conducted During Construction. The Onsite Inspections And Material Tests Are Those Inspections And Tests Deemed Sufficient And Appropriate Commonly Accepted Engineering Standards. Certify Does Not Mean Or Imply A Guarantee By The Engineer Nor Does An Engineer's Certification Relieve Any Other Party From Meeting Requirements Imposed By Contract, Employment, Or Other Means, Including Meeting Commonly Accepted Industry Practices.

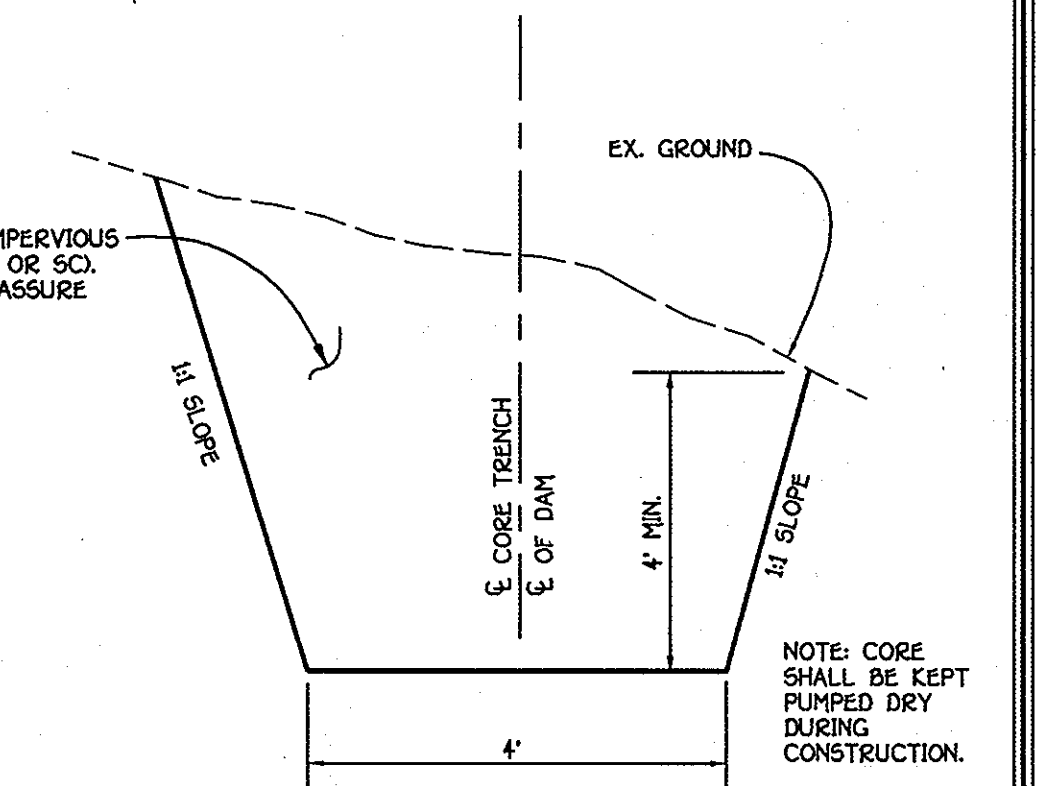

CORE TRENCH DETAIL
NOT TO SCALE

FISHER, COLLINS & CARTER, INC.
CIVIL ENGINEERING CONSULTANTS & LAND SURVEYORS
CENTRAL SQUARE OFFICE PARK - 10772 BALTIMORE NATIONAL PIKE
ELLICOTT CITY, MARYLAND 21042
4100 461 - 2299

OWNER AND DEVELOPER
MID-ATLANTIC DEVELOPMENT II, L.L.C.
C/O THOMAS SCRIVENOR
5026 DORSEY HALL DR., SUITE 204
ELLICOTT CITY, MD. 21042

ENGINEER'S CERTIFICATE
I hereby certify that this plan for Erosion and Sediment Control Represents A Practical And Workable Plan Based On My Personal Knowledge Of The Site Condition And That It Was Prepared In Accordance With The Requirements Of The Howard Soil Conservation District.

James P. Amadi 2-11-98
Signature of Engineer Date

DEVELOPER'S CERTIFICATE
I/We Certify That All Development And Construction Will Be Done According To This Plan Of Development And Plan For Erosion And Sediment Control And That All Responsible Personnel Involved In The Construction Project Will Have A Certificate Of Attendance At A Department Of Natural Resources Approved Training Program For The Control Of Sediment And Erosion Before Beginning The Project. I Also Authorize Periodic On-Site Inspection By The Howard Soil Conservation District Or Their Authorized Agents, As Are Deemed Necessary.

Robert W. Ziehm 7/10/98
Signature of Developer Date


Reviewed For Howard County Soil Conservation District And Meets Technical Requirements
Cheryl Simmons 7/1/98
USDA - Natural Resources Conservation Service Date

Approved: This Development Is Approved For Erosion And Sediment Control By The Howard Soil Conservation District.
Robert W. Ziehm 7/1/98
District Howard Soil Conservation District Date

Approved: Department Of Planning And Zoning
Richard Blood 7/13/98
Chief, Division Of Land Development Date


Mr. DeWitt 7/10/98
Chief, Development Engineering Division Date

Approved: Howard County Department Of Public Works
Andrew M. Doncker 7-9-98
Chief, Bureau Of Highway Date

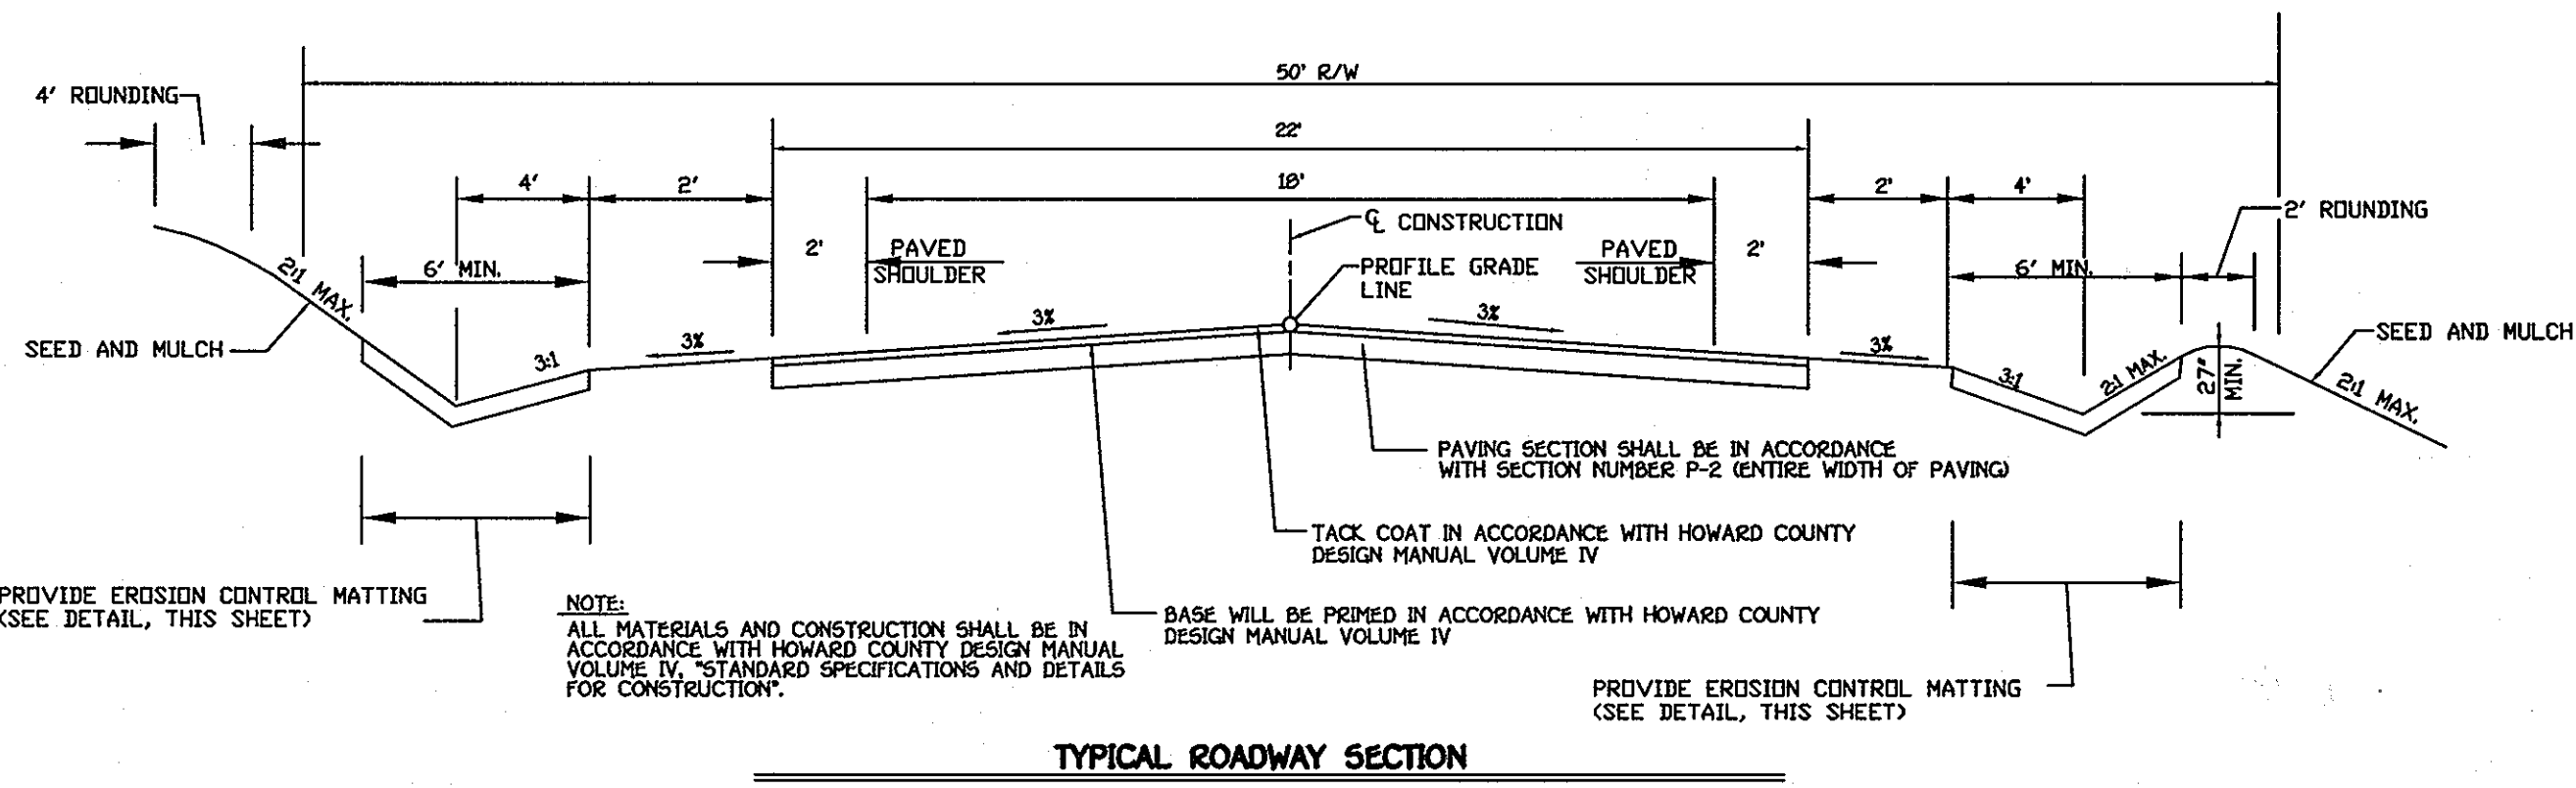

ROADWAY INFORMATION CHART

ROAD NAME	CLASSIFICATION	DESIGN SPEED	ZONING	STATION LIMITS	PAVING SECTION
SYCAMORE VALLEY DR	LOCAL ROAD	30 MPH	RC-DEO	28+00 TO 34+25	P-2
CHAMPIONSHIP DRIVE	CUL-DE-SAC	30 MPH	RC-DEO	0+00 TO 0+45	P-2
CHAMPIONSHIP DRIVE	CUL-DE-SAC	30 MPH	RC-DEO	0+00 TO 11+52.7	P-2

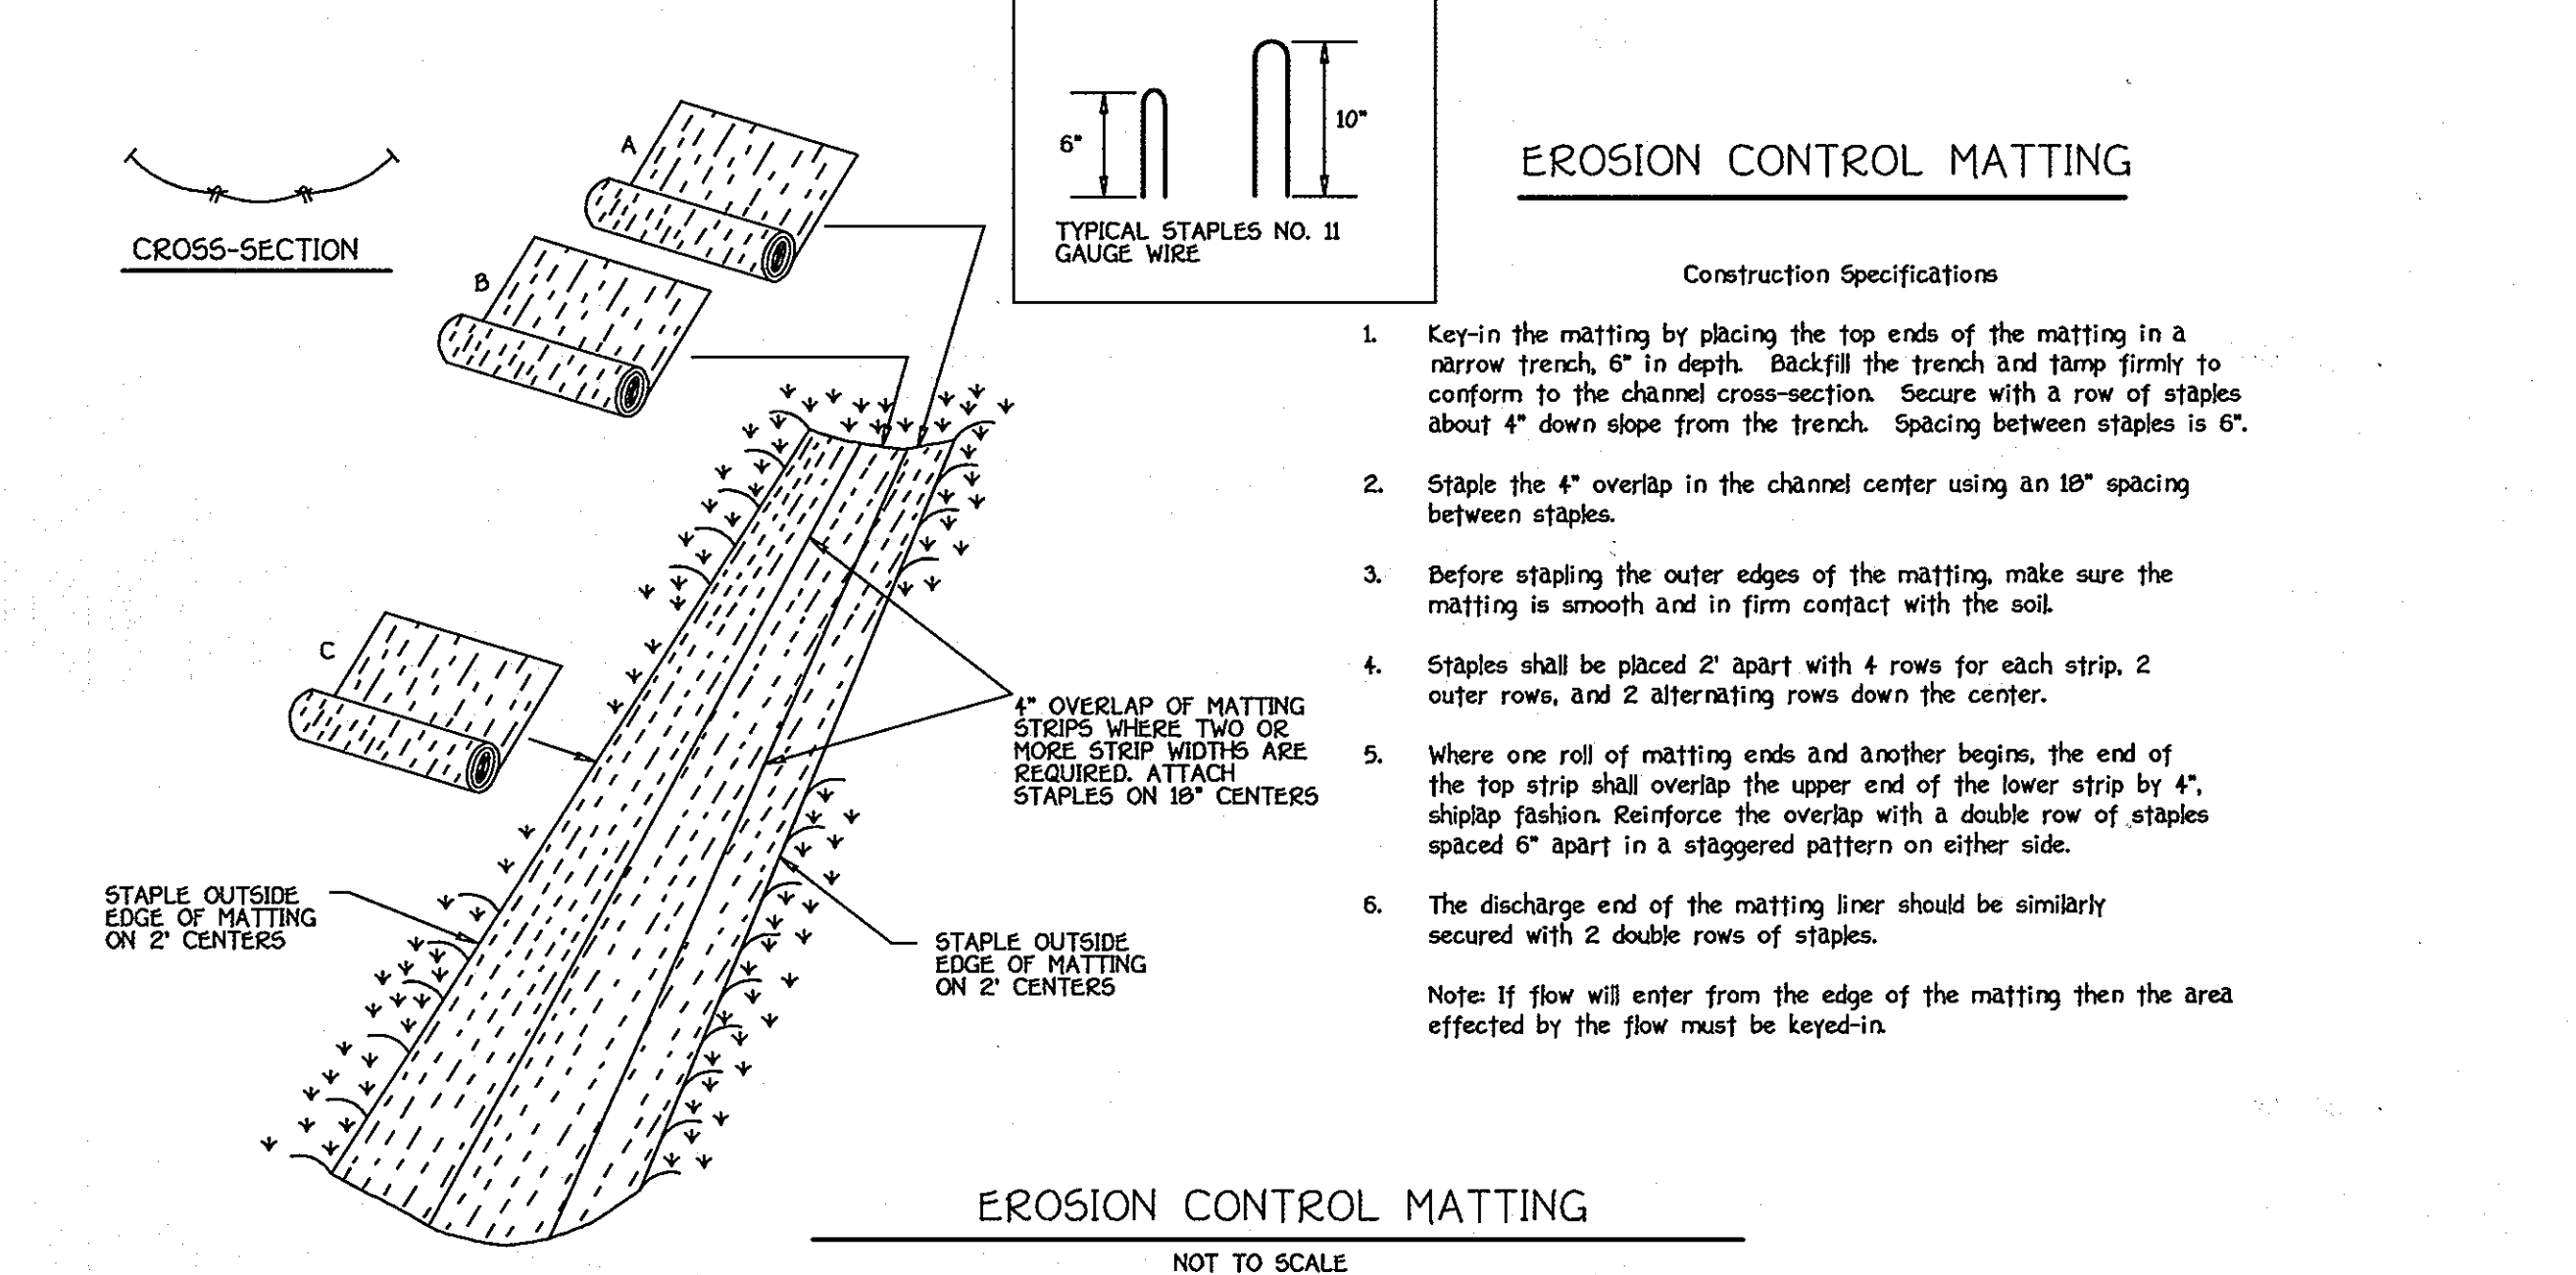

378 - 12 Pond
SPECIFICATIONS

These specifications are appropriate to all ponds within the scope of the Standard for practice MD-378. All references to ASTM and AASHTO specifications apply to the most recent version.

Site Preparation

Areas designated for borrow areas, embankment, and structural works shall be cleared, grubbed and stripped of topsoil. All trees, vegetation, roots and other objectionable material shall be removed. Channel banks and sharp breaks shall be sloped to no steeper than 1:1.

Areas to be covered by the reservoir will be cleared of all trees, brush, logs, fences, rubbish and other objectionable material unless otherwise designated on the plans. Trees, brush and stumps shall be cut approximately level with the ground surface. For dry stormwater management ponds, a minimum of a 50 foot radius around the inlet structure shall be cleared.

All cleared and grubbed material shall be disposed of outside and below the limits of the dam and reservoir as directed by the owner or his representative. When specified, a sufficient quantity of topsoil will be stockpiled in a suitable location for use on the embankment and other designated areas.

Earth Fill

Material - The fill material shall be taken from approved designated borrow areas. It shall be free of roots, stumps, wood, rubbish, stones greater than 5", frozen or other objectionable materials. Fill material for the center of the embankment and cut off trench shall conform to Unified Soil Classification GC, SC, CH, or CL. Consideration may be given to the use of other materials in the embankment if design and construction are supervised by a geotechnical engineer.

Placement - Areas on which fill is to be placed shall be scarified prior to placement of fill. Fill materials shall be placed in maximum 8 inch thick (before compaction) layers which are to be continuous over the entire length of the fill. The most permeable borrow material shall be placed in the downstream portions of the embankment. The principal spillway must be installed concurrently with fill placement and not excavated into the embankment.

Compaction - The movement of the hauling and spreading equipment over the fill shall be controlled so that the entire surface of each lift shall be traversed by not less than one tread track of the equipment or compaction shall be achieved by a minimum of four complete passes of a sheepsfoot, rubber tired or vibratory roller. Fill material shall contain sufficient moisture such that the required degree of compaction will be obtained with the equipment used. The fill material shall contain sufficient moisture so that if formed into a ball it will not crumble yet not be so wet that water can be squeezed out.



Where a minimum required density is specified, it shall not be less than 95% of maximum dry density with a moisture content within +2% of the optimum. Each layer of fill shall be compacted as necessary to obtain that density, and is to be certified by the Engineer at the time of construction. All compaction is to be determined by AASHTO Method T-99.

Cut Off Trench - The cutoff trench shall be excavated into impervious material along or parallel to the centerline of the embankment as shown on the plans. The bottom width of the trench shall be governed by the equipment used for excavation with the minimum width being four feet. The depth shall be at least four feet below existing grade or as shown on the plans. The side slopes of the trench shall be 1 to 1 or flatter. The backfill shall be compacted with construction equipment, rollers or hand tampers to assure maximum density and minimum permeability.

Structure Backfill

Backfill adjacent to pipes or structures shall be of the type and quality conforming to that specified for the adjoining fill material. The fill shall be placed in horizontal layers not to exceed four inches in thickness and compacted by hand tampers or other manually directed compaction equipment. The material needs to fill completely all spaces under and adjacent to the pipe. At no time during the backfilling operation shall driven equipment be allowed to operate closer than four feet, measured horizontally, to any part of a structure. Under no circumstances shall equipment be driven over any part of a concrete structure or pipe, unless there is a compacted fill of 24" or greater over the structure or pipe.

FISHER, COLLINS & CARTER, INC.
CIVIL ENGINEERING CONSULTANTS & LAND SURVEYORS
CENTRAL OFFICE: 1000 BALTIMORE NATIONAL PIKE
ELKOTT CITY, MARYLAND 21042
410-462-2895

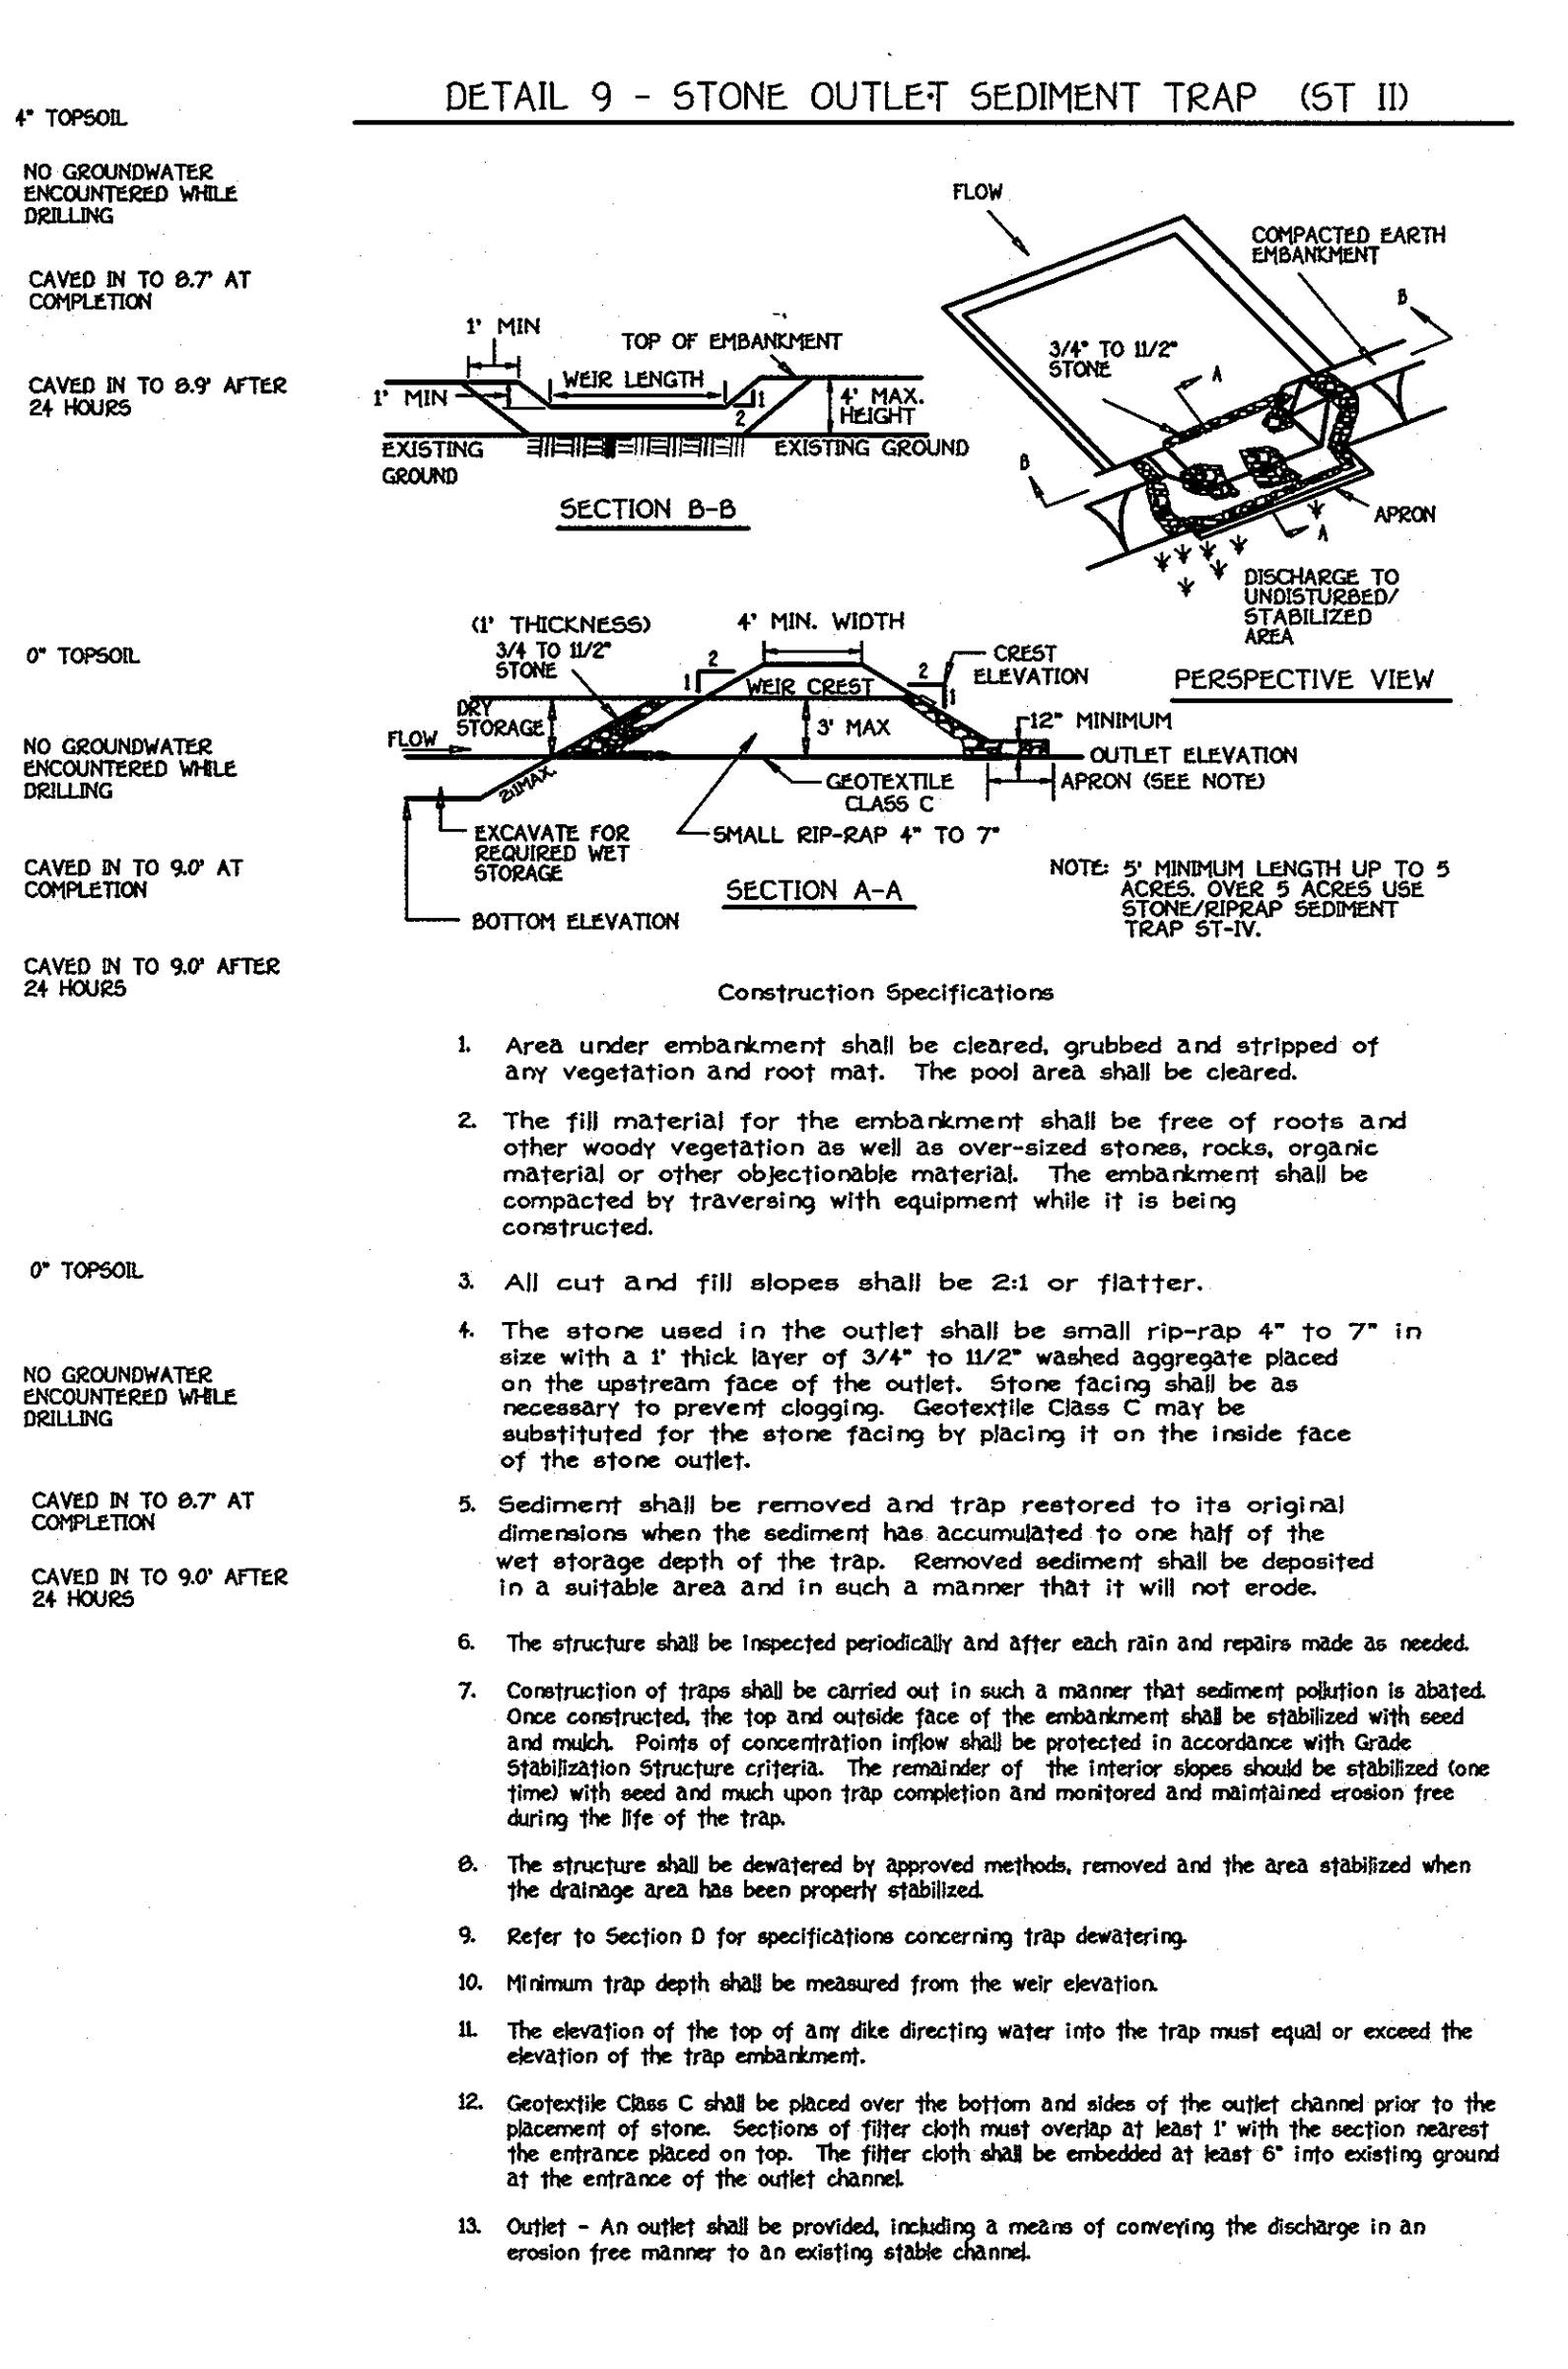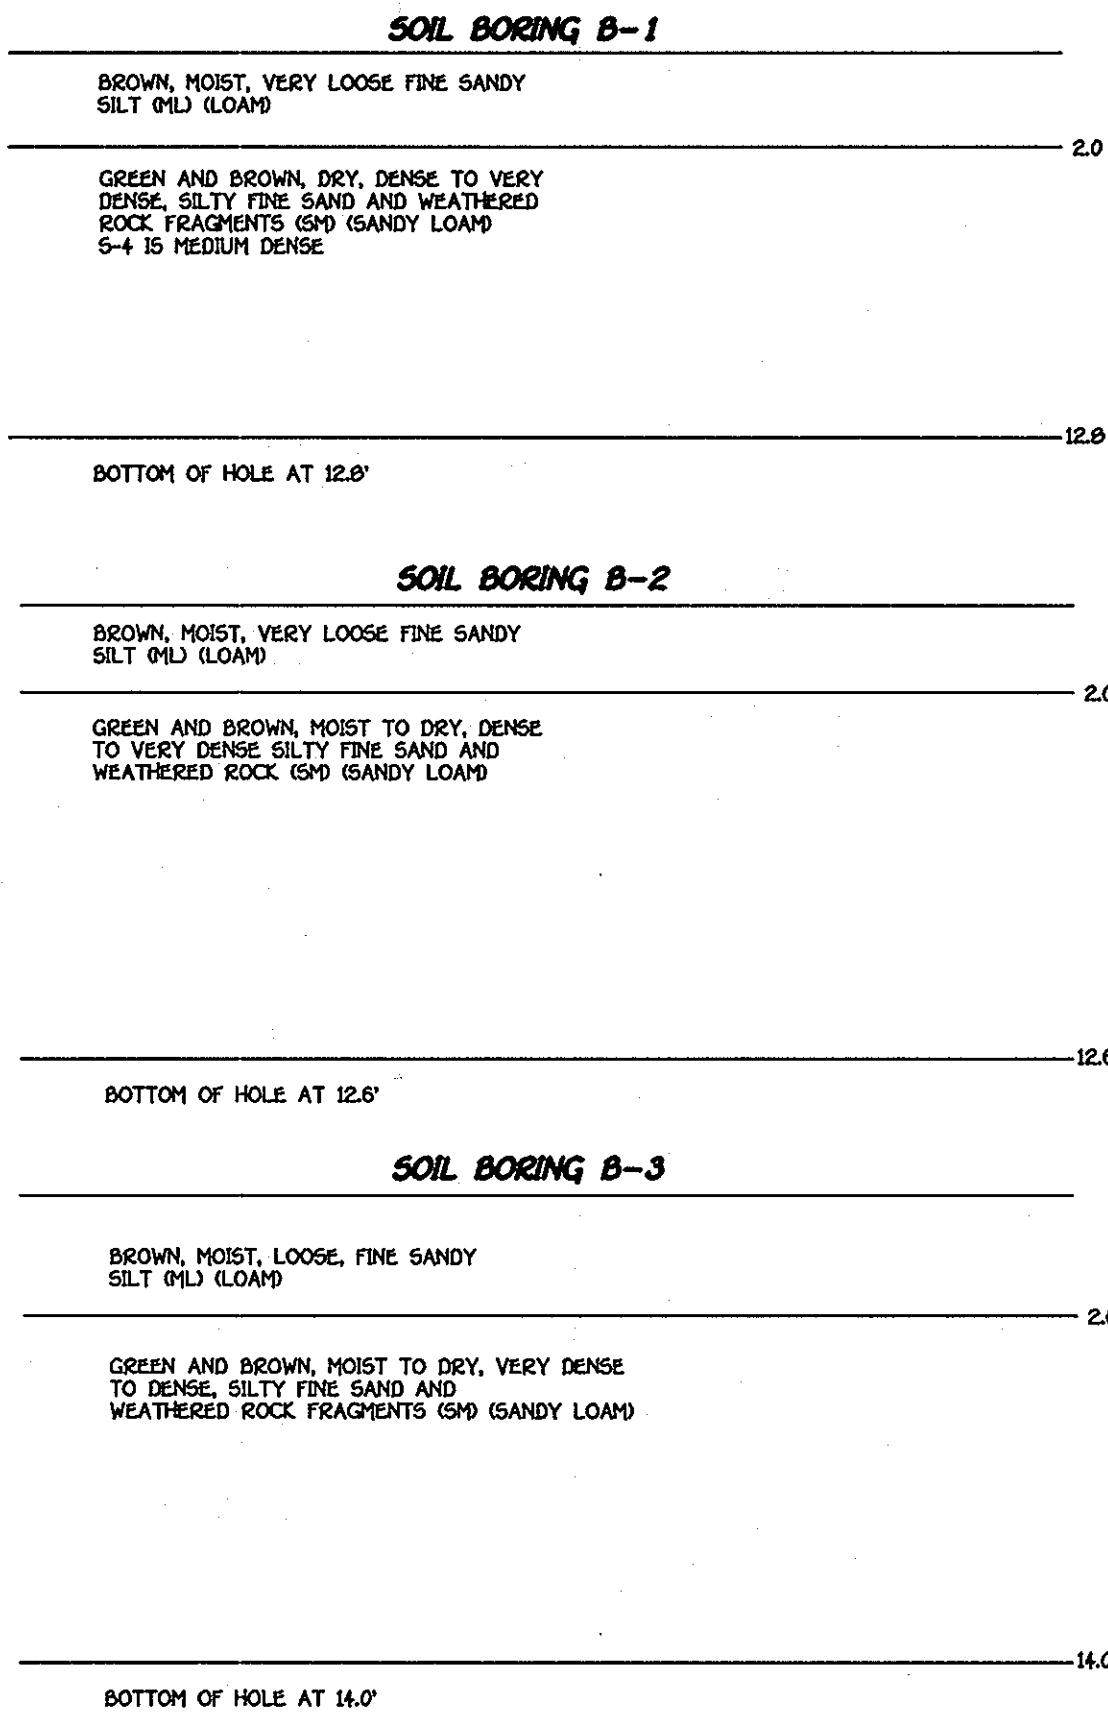

Stabilization

All borrow areas shall be graded to provide proper drainage and left in a slightly condition. All exposed surfaces of the embankment, spillway, spoil and borrow areas, and berms shall be stabilized by seeding, liming, fertilizing and mulching in accordance with the Maryland Soil Conservation Service Standards and Specifications for Critical Area Planting (MD-342) or as shown on the accompanying drawings.

Erosion and Sediment Control

Construction operations will be carried out in such a manner that erosion will be controlled and water and air pollution minimized. State and local laws concerning pollution minimized. State and local laws concerning pollution abatement will be followed. Construction plans shall detail erosion and sediment control measures to be employed during the construction process.

Concrete

Concrete shall meet the requirements of Maryland Department of Transportation, State Highway Administration Standard Specifications for Construction and Materials, Section 606; Mix No. 3.

Rock Riprap

Rock riprap shall meet the requirements of Maryland Department of Transportation, State Highway Administration Standard Specifications for Construction and Materials, Section 905.

The riprap shall be placed to the required thickness in one operation. The rock shall be delivered and placed in a manner that will insure the riprap in place shall reasonably homogeneous with the larger rocks uniformly distributed and firmly in contact one to another with the smaller rocks filling the voids between the larger rocks. Filter cloth shall be placed under all riprap and shall meet the requirements of Maryland Department of Transportation, State Highway Administration Standard Specifications for Construction and Materials, Section 912.

Care of Water during Construction

All work on permanent structures shall be carried out in areas free from water. The Contractor shall construct and maintain all temporary dikes, levees, cofferdams, drainage channels, and stream diversions necessary to protect the areas to be occupied by the permanent works. The contractor shall also furnish, install, operate, and maintain all necessary pumping and other equipment required for removal of water from the various parts of the work and for maintaining the excavations, foundation, and other parts of the work, free from water as required or directed by the engineer for constructing each part of the work. After having served their purpose, all temporary protective works shall be removed or leveled and graded to the extent required to prevent obstruction in any degree whatsoever of the flow of water to the spillway or outlet works and so as not to interfere in any way with the operation or maintenance of the structure. Stream diversions shall be maintained until the full flow can be passed through the permanent works. The removal of water from the required excavation and the foundation shall be accomplished in a manner and to the extent that will maintain stability of the excavated slopes and bottom of required excavations and will allow satisfactory performance of all construction operations. During the placing and compacting of material in required excavations, the water level at the locations being refilled shall be maintained below the bottom of the excavation at such locations which may require draining the water to pumps from which the water shall be pumped.


AS-BUILT 5/3/99

OWNER AND DEVELOPER
HEATLANTIC DEVELOPMENT & L.L.C.
100 BALTIMORE NATIONAL PIKE
SUITE 200
ELKOTT CITY, MARYLAND 21042

DETAIL SHEET
SYCAMORE VALLEY II
LOTS 1 - 17 AND
PRESERVATION PARCELS "A" - "C"

ZONING: RC-DEO
TAX MAP NO.: 21 PARCEL NO.: 7
FOURTH ELECTION DISTRICT HOWARD COUNTY, MARYLAND
SCALE: AS SHOWN DATE: FEBRUARY 6, 1998
SHEET 10 OF 12

DETAIL 22 - SILT FENCE

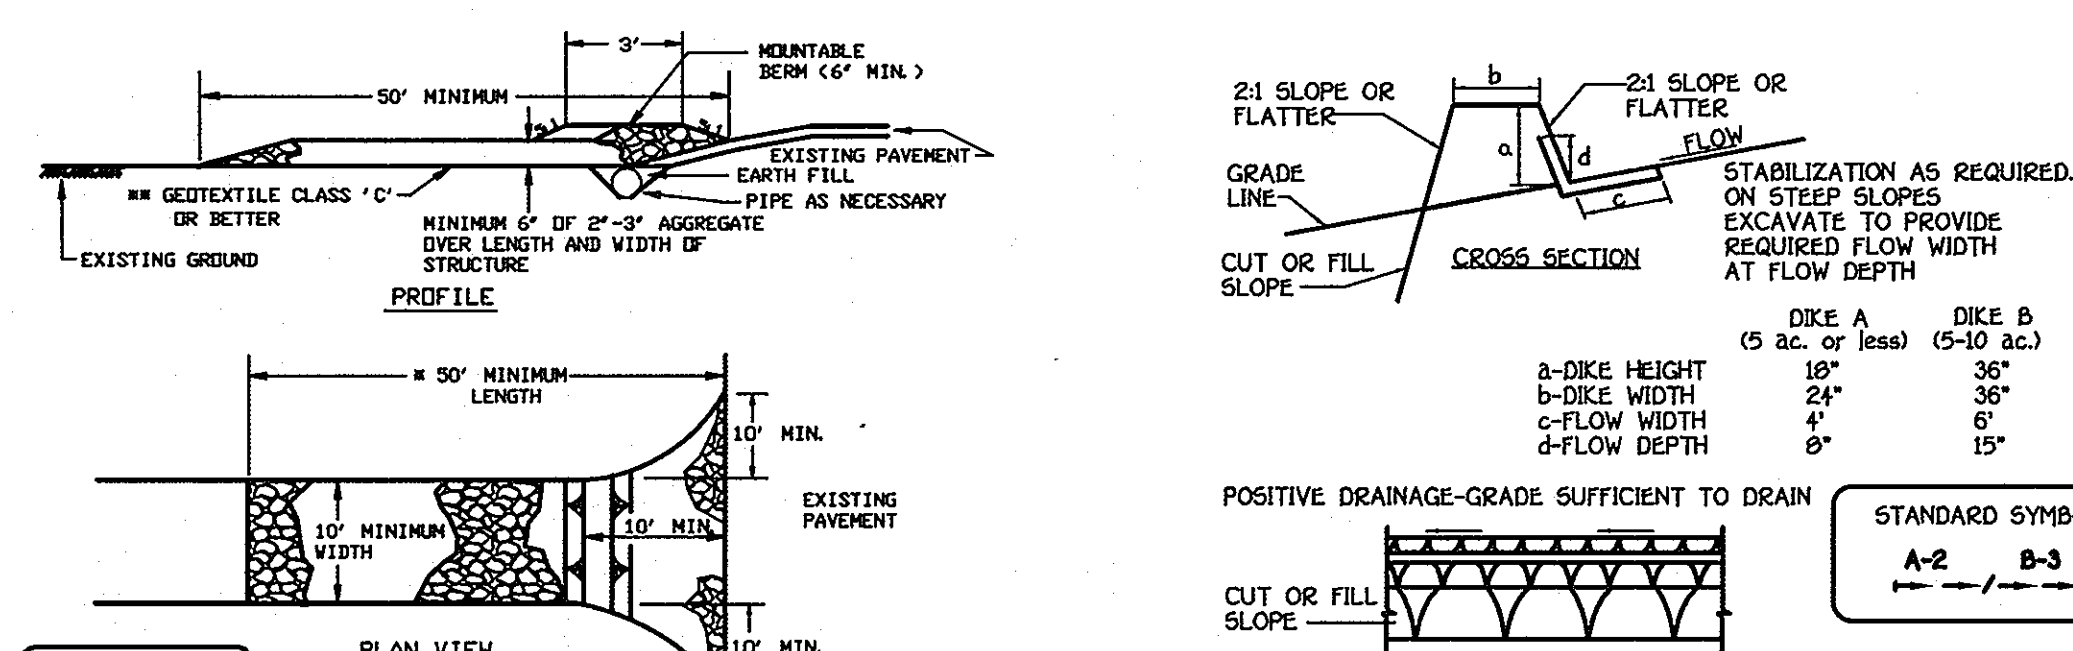


CONSTRUCTION SPECIFICATIONS

1. Length - minimum of 50' (#30' for single residence lots).
2. Width - 10' minimum, should be flared at the existing road to provide a turning radius.
3. Geotextile fabric (filter cloth) shall be placed over the existing ground prior to placing stone. The plan approval authority may not require single family residences to use geotextile.
4. Stone - crushed aggregate (2" to 3") or reclaimed or recycled concrete equivalent shall be placed at least 6" deep over the length and width of the entrance.
5. Surface Water - all surface water flowing to or diverted toward construction entrances shall be piped through the entrance, maintaining positive drainage to placing stone. The plan approval authority may not require single family residences to use geotextile.
6. Location - A stabilized construction entrance shall be located at every point where construction traffic enters or leaves a construction site. Vehicles leaving the site must travel over the entire length of the stabilized construction entrance.

FLOW CHANNEL STABILIZATION

TYPE OF TREATMENT	CHANNEL GRADE	DIKE A	DIKE B
1	5-3.0%	SEED AND STRAW MULCH	SEED AND STRAW MULCH
2	3.1-5.0%	SEED AND STRAW MULCH	SEED USING JUTE, OR EXCELXOR; SOB; 2" STONE
3	5.1-8.0%	SEED WITH JUTE, OR SOB; 2" STONE	LINED RIP-RAP 4"-8"
4	8.1-20%	LINED RIP-RAP 4"-8"	ENGINEERING DESIGN

STABILIZED CONSTRUCTION ENTRANCE - 2
NOT TO SCALE

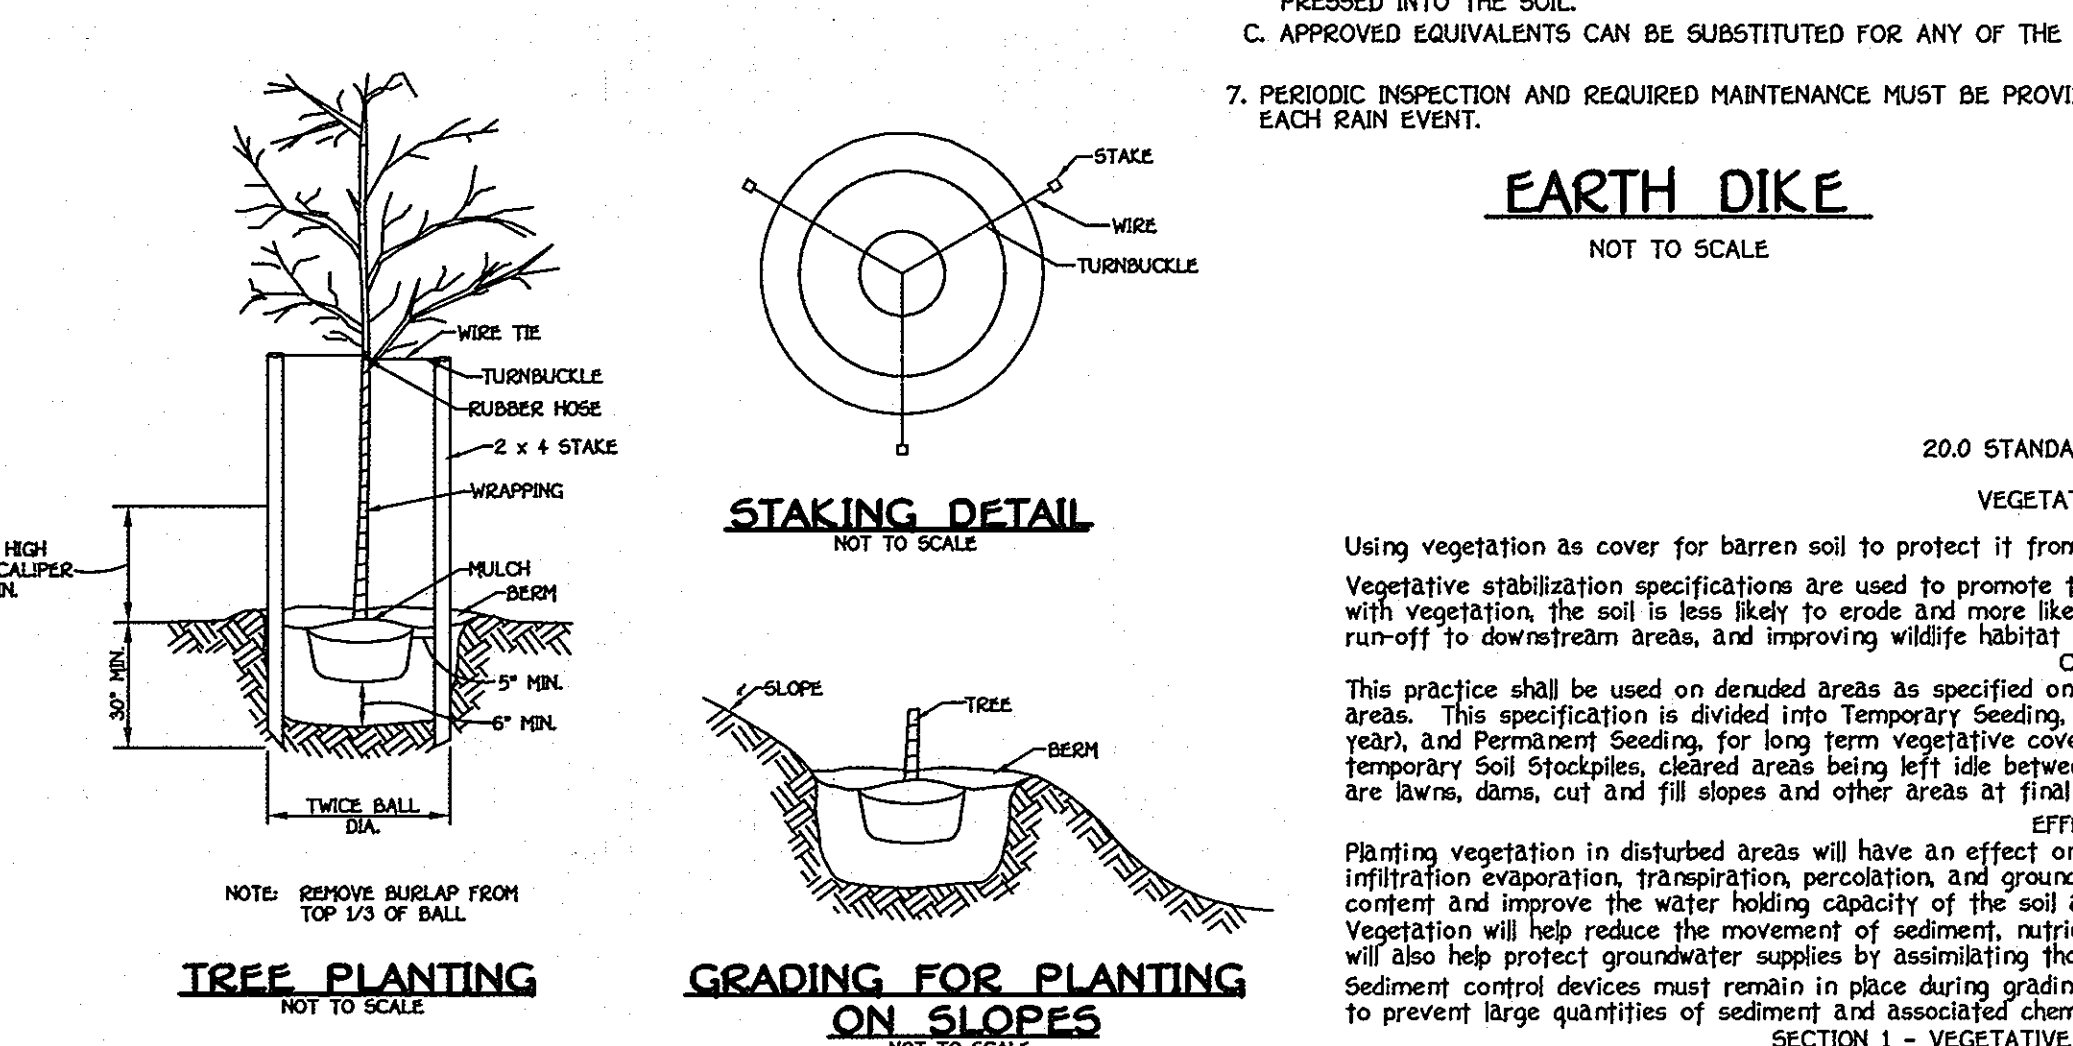

EARTH DIKE
NOT TO SCALE

20.0 STANDARDS AND SPECIFICATIONS FOR VEGETATIVE STABILIZATION DEFINITION

Using vegetation as cover for barren soil to protect it from forces that cause erosion. Vegetative stabilization is used to promote the establishment of vegetation on exposed soil. When soil is stabilized with vegetation, the soil is less likely to erode and more likely to allow infiltration of rainfall, thereby reducing sediment loads and run-off to downstream areas, and improving wildlife habitat and visual resources.

CONDITIONS WHERE PRACTICE APPLIES

This practice shall be used on denuded areas as specified on the plans and may be used on highly erodible or critically eroding areas. This specification is divided into Temporary Seeding, to quickly establish vegetative cover for short duration (up to one year), and Permanent Seeding for long term vegetative cover. Examples of applicable areas for Temporary Seeding are lawns, dams, cut and fill slopes and areas left at final grade, former stockpile and staging areas, etc.


Planting vegetation in disturbed areas will have an effect on the water budget, especially on volumes and rates of runoff, infiltration, evaporation, transpiration, percolation, and groundwater recharge. Vegetation over time, will increase organic matter content and improve the water holding capacity of the soil and subsequent plant growth. Vegetation will help reduce the movement of sediment, nutrients, and other chemicals carried by runoff to receiving waters. Plants will also help protect groundwater supplies by assimilating those substances present within the root zone. Sediment control devices must remain in place during grading, seeded preparation, seeding, mulching and vegetative establishment to prevent large quantities of sediment and associated chemicals and nutrients from washing into surface waters.

SECTION 1 - VEGETATIVE STABILIZATION METHODS AND MATERIALS

- Site Preparation**
 1. Install erosion and sediment control structures (either temporary or permanent) such as diversions, grade rollers with seeding, or sediment control basins.
 2. Perform all grading operations at right angles to the slope. Final grading and shaping is not usually necessary for temporary seeding.
 3. Schedule required soil tests to determine soil amendment composition and application rates for sites having disturbed areas over 5 acres.
- Soil Amendments (Fertilizer and Lime Specifications)**
 1. Soil tests must be performed to determine the exact ratios and application rates for both lime and fertilizer on sites having disturbed areas over 5 acres. Soil analysis may be performed by the University of Maryland or a recognized commercial laboratory. Soil samples taken for engineering purposes may also be used for chemical analysis.
 2. Fertilizers shall be uniform in composition, free flowing and suitable for accurate application by approved equipment. Manufacturers may be substituted for fertilizer with prior approval from the appropriate approval authority. Fertilizers shall be delivered to the site fully labeled according to the applicable state fertilizer laws and shall bear the name, trade name or trademark and warranties of the producer.
 3. Lime materials shall be ground limestone (hydrated or burnt lime) which contains at least 50% total oxides (calcium oxide plus magnesium oxide). Limestone shall be ground to such fineness that at least 50% will pass through a #100 mesh sieve and 99-100% will pass through a #20 mesh sieve.
 4. Incorporate lime and fertilizer into the top 3-5" of soil by disking or other suitable means.
- Seeded Preparation**
 1. Seeded preparation shall consist of loosening soil to a depth of 3" to 5" by means of suitable agricultural or construction equipment, such as disk harrows or chisel plows or rippers mounted on construction equipment. After the soil is loosened it should not be rolled or dragged smooth, but left in the roughened condition. Sloped areas (greater than 3:1) should be tracked leaving the surface in an irregular condition with ridges running parallel to the contour of the slope.
 2. Apply fertilizer and lime as prescribed on the plans.
 3. Incorporate lime and fertilizer into the top 3-5" of soil by disking or other suitable means.
- Permanent Seeding**
 1. Minimum soil conditions required for permanent vegetative establishment:
 - a. Soluble salts shall be less than 500 parts per million (ppm).
 - b. The soil shall contain less than 40% clay, but enough fine grained material (0.075 silt plus clay) to provide the capacity to hold a moderate amount of moisture. An exception is if legumes or sericea lespedezas is to be planted, then a sandy soil (<30% silt plus clay) will be acceptable.
 - c. Soil shall contain 1% minimum organic matter by weight.
 - d. Soil must contain sufficient pore space to permit adequate root penetration.
 - e. If these conditions cannot be met by soils on site, adding topsoil is required in accordance with Section 21 Standard and Specification for Topsoil.
 2. Areas previously graded in conformance with the drawings shall be maintained in a true and even grade, then scarified or otherwise loosened to a depth of 3-5" to permit bonding of the topsoil to the surface area and to create horizontal erosion check slots to prevent topsoil from sliding down a slope.
 3. Apply soil amendments as per soil test or as included on the plans.
 4. Mix soil amendments into the top 3-5" of topsoil by disking or other suitable means. Lawn areas should be raked to smooth the surface, remove large objects like stones and branches, and ready the area for seed and application. Where site conditions will not permit normal seeded preparation, loosen surface soil by dragging with a heavy chain or other equipment to roughen the surface. Steep slopes (steeper than 3:1) should be tracked by a dozer leaving the soil in an irregular condition with ridges running parallel to the contour of the slope. The top 1-2" of soil should be loose and friable. Seeded loosening may not be necessary on newly disturbed areas.

FISHER, COLLINS & CARTER, INC.
CIVIL ENGINEERING CONSULTANTS & LAND SURVEYORS
CHARTER SQUARE OFFICE PARK - 10772 BALDOR NATIONAL PIKE
ELLCOTT CITY, MARYLAND 21042
(410) 461 - 2955

DETAIL 33 - SUPER SILT FENCE

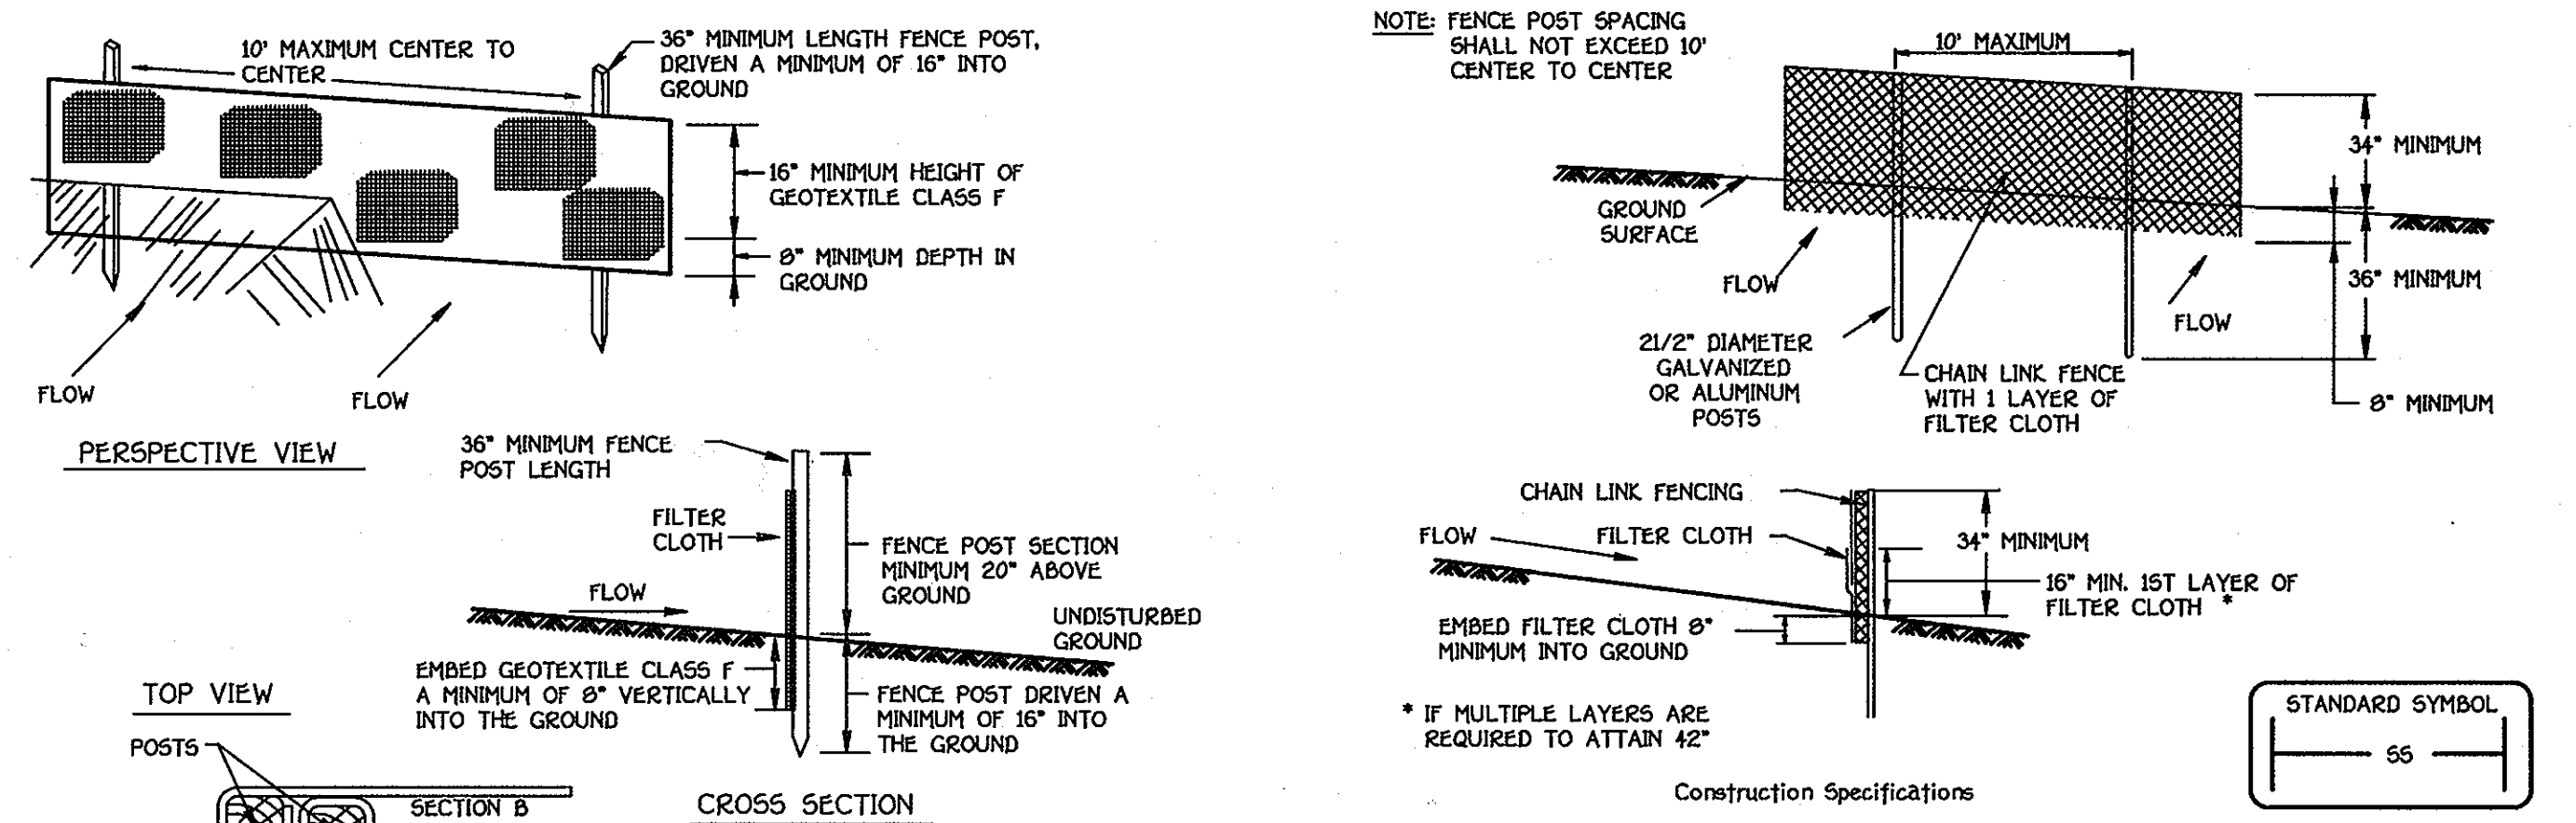


CONSTRUCTION SPECIFICATIONS

1. Fencing shall be 42" in height and constructed in accordance with the latest Maryland State Highway Details for Chain Link Fencing. The specification for a 6' fence shall be used, substituting 42" fabric and 6' length posts.
2. Chain link fence shall be fastened securely to the fence posts with wire ties. The lower tension wire, brace and truss rods, drive anchors and post caps are not required except on the ends of the fence.
3. Filter cloth shall be fastened securely to the chain link fence with ties spaced every 24" at the top and mid section.
4. Filter cloth shall be embedded a minimum of 8" into the ground.
5. When two sections of filter cloth adjoin each other, they shall be overlapped by 6" and folded.
6. Maintenance shall be performed as needed and silt buildups removed when "bulges" develop in the silt fence, or when silt reaches 50% of fence height.
7. Filter cloth shall be fastened securely to each fence post with wire ties or staples at top and mid section and shall meet the following requirements for Geotextile Class F:

Tensile Strength	50 lbs/in (min)	Test: MSMT 509
Tensile Modulus	20 lbs/in (min)	Test: MSMT 509
Flow Rate	0.3 gal/ft / minute (max)	Test: MSMT 322
Filtering Efficiency	75% (min)	Test: MSMT 322

JOINING TWO ADJACENT SILT FENCE SECTIONS

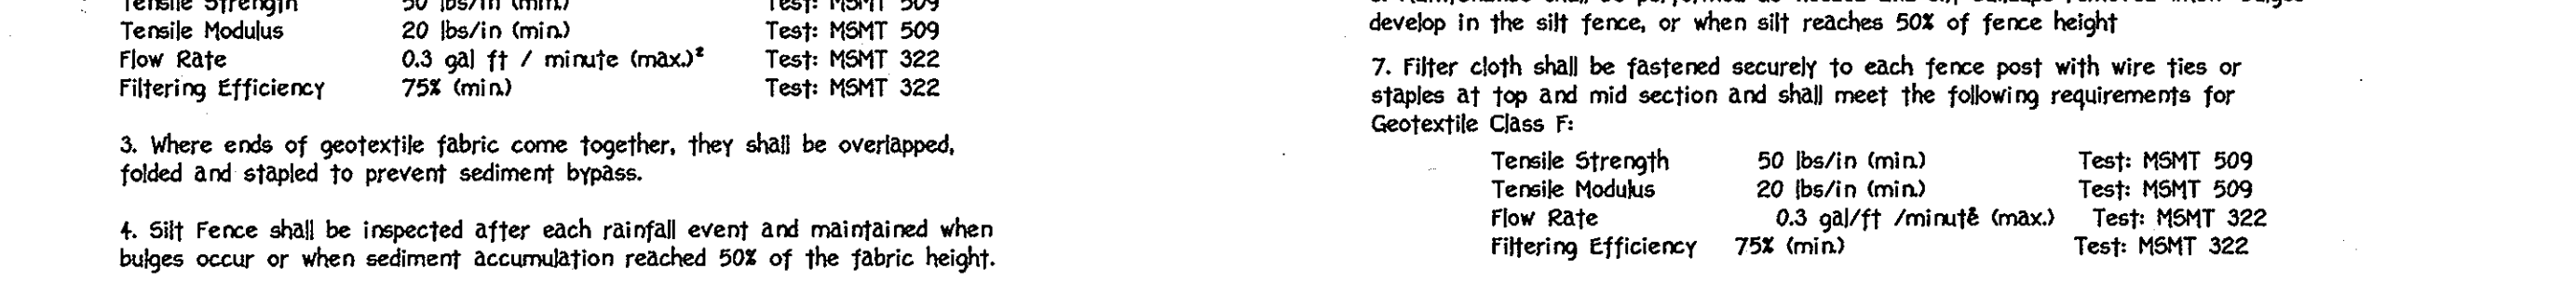

CONSTRUCTION SPECIFICATIONS

1. Fence posts shall be a minimum of 36" long driven 16" minimum into the ground. Wood posts shall be 1 1/2" x 1 1/2" square (minimum) cut, or 1 3/4" diameter (minimum) round and shall be of sound quality hardwood. Steel posts will be standard T or U section weighting not less than 100 pound per linear foot.
2. Geotextile shall be fastened securely to each fence post with wire ties or staples at top and mid-section and shall meet the following requirements for Geotextile Class F:

Tensile Strength	50 lbs/in (min)	Test: MSMT 509
Tensile Modulus	20 lbs/in (min)	Test: MSMT 509
Flow Rate	0.3 gal/ft / minute (max)	Test: MSMT 322
Filtering Efficiency	75% (min)	Test: MSMT 322
3. Where ends of geotextile fabric come together, they shall be overlapped, folded and stapled to prevent sediment bypass.
4. Silt Fence shall be inspected after each rainfall event and maintained when bulges occur or when sediment accumulation reached 50% of the fabric height.

D. Seed Specifications

1. All seed must meet the requirements of the Maryland State Seed Law. All seed shall be subject to inspection by the State Seed Laboratory. All seed used shall have been tested within the 6 months immediately preceding the date of sowing such material on this job.
2. Note: Seed tags shall be made available to the inspector to verify type and rate of seed used.
3. Incubation for testing to determine germination percentage shall be conducted in a cool and moist environment until such time as the seed is ready for sowing. Note: It is very important to keep inoculant as cool as possible until used. Temperatures above 75-80° F. can weaken bacteria and make the inoculant less effective.

E. Methods of Seeding

1. **Hydroseeding** - Apply seed uniformly with hydroseeder (slurry includes seed and fertilizer), broadcast or drop seeded, or a cultipacker seeder.
 - a. If fertilizer is being applied at the time of seeding, the application rates amounts will not exceed the following: nitrogen maximum of 100 lbs. per acre total of soluble nitrogen P205 (phosphorous) 200 lbs/acre; K2O (potassium) 200 lbs/acre.
 - b. Lime - use only ground agricultural limestone (up to 3 tons per acre may be applied by hydroseeding). Normally, not more than 2 tons are applied by hydroseeding at any one time. Do not use burnt or hydrated lime when hydroseeding.
2. **Dry Seeding** - This includes use of conventional drop or broadcast spreaders.
 - a. Seed spread dry shall be incorporated into the subsoil at the rates prescribed on the Temporary or Permanent Seeding Summaries or Tables 265 or 26. The seeded area shall be rolled with a weighted roller to provide good seed to soil contact.
 - b. Where practical, seed should be applied in two directions perpendicular to each other. Apply half the seeding rate in each direction.
3. **Drill or Cultipacker Seeding** - Mechanized seeders that apply and cover seed with soil.
 - a. Cultipacker seeders are required to bury the seed in such a fashion as to provide at least 1/4 inch of soil covering. Seeded must be firm after planting.
 - b. Where having disturbed areas over 5 acres, seed shall be applied in two directions perpendicular to each other. Apply half the seeding rate in each direction.


F. Mulch Specifications (in order of preference)

1. Straw - all covering disturbed areas over 5 acres, straw, reasonable bright in color, and shall not be musty, mold, caked, greasy, or excessively dry and shall be free of noxious weed seeds as specified in the Maryland Seed Law.
2. **Wood Cellulose Fiber Mulch (WCFM)**
 - a. WCFM shall consist of specially prepared wood cellulose processed into a uniform fibrous physical state.
 - b. WCFM shall be dried green or contain a green dye in the package that will provide an appropriate color to facilitate visual inspection of the uniform spread slurry.
 - c. WCFM, including dye, shall contain no germination or growth inhibiting factors.
 - d. WCFM materials shall be manufactured and processed in such a manner that the wood cellulose fiber mulch will remain in uniform suspension in water under agitation and will blend with seed, fertilizer and other additives to form a homogeneous slurry. The mulch material shall form a blotter-like ground cover, on application having moisture absorption and percolation properties and shall cover and hold grass seed in contact with the soil without inhibiting the growth of the grass seedlings.
 - e. WCFM material shall contain no elements or compounds at concentration levels that will be phytotoxic.
 - f. WCFM must conform to the following physical requirements: fiber length to approximately 10 mm., diameter approximately 1 mm., pH range of 4.0 to 8.5, ash content of 10% maximum and water holding capacity of 90% minimum.
3. **Mulching Seeded Areas** - Mulch shall be applied to all seeded areas immediately after seeding.
 - a. If seeding is completed under the seeding season, mulch shall be applied as prescribed in this section and maintained until the seeding season returns and seeding can be performed in accordance with these specifications.
 - b. When straw mulch is used it shall be spread over all seeded areas at the rate of 2 tons/acre. Mulch shall be applied to a uniform loose depth of between 1" and 2". Mulch applied at 2 tons/acre will provide a uniform distribution and depth so that the soil surface is not exposed. If a mulch anchoring tool is to be used, the rate of mulch shall be increased to 2.5 tons/acre.
 - c. Wood cellulose fiber used as a mulch shall be applied at a net dry weight of 1,500 lbs. per acre. The wood cellulose fiber shall be mixed with water, and the mixture shall contain a maximum of 50 lbs. of wood cellulose fiber per 100 gallons of water.

H. Securing Straw Mulch (Mulch Anchoring) - Mulch anchoring shall be performed immediately following mulch application to minimize loss by wind or water. This may be done by one of the following methods (listed by preference, depending upon size of area and erosion hazard):

1. A mulch anchoring tool (equipment designed to punch and anchor mulch into the soil surface a minimum of two (2) inches). This practice is most effective on large areas where the mulch is applied in a uniform manner. If used on sloping land, this practice should be used on the contour if possible.
2. Wood cellulose fiber may be used for anchoring straw. The fiber binder shall be applied at a net dry weight of 100 lbs. per acre. The mixture shall contain a maximum of 50 pounds of wood cellulose fiber per 100 gallons of water.
3. Application of liquid binders should be heavier at the edges where wind catches mulch, such as in valleys and crest of banks. The remainder of area should be applied after binder application. Synthetic binders - such as Acrylics (e.g. Agro-Tack), DCA-70 Petroseal, Terra-Tax II, Terra-Tack AR, or other approved equal may be used at rates recommended by the manufacturer to anchor mulch.
4. Lightweight plastic netting may be stapled over the mulch according to manufacturer's recommendations. Netting is usually available in rolls 4' to 15' feet wide and 300 to 3,000 feet long.

SWM POND GEOTECHNICAL RECOMMENDATIONS

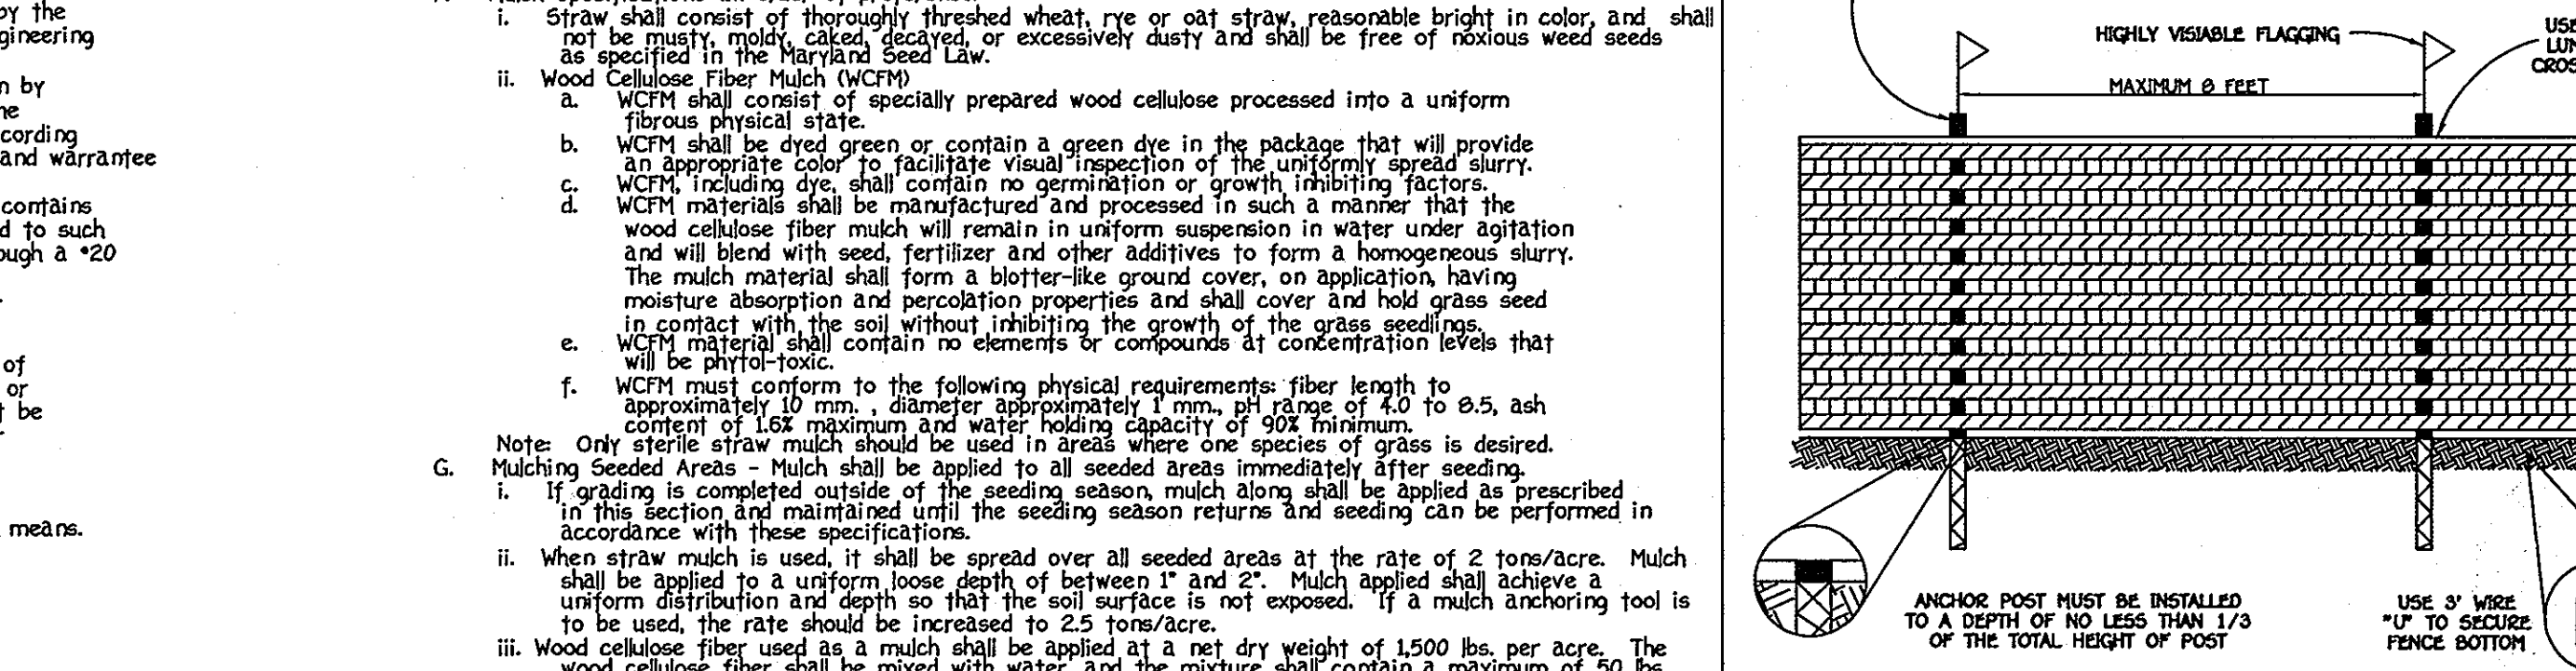

NOTES:

1. FOREST PROTECTION DEVICE ONLY.
2. RETENTION AREA WILL BE SET AS PART OF THE REVIEW PROCESS.
3. BOUNDARIES OF RETENTION AREA SHOULD BE STAKED AND FLAGGED PRIOR TO INSTALLING DEVICE.
4. ROOT DAMAGE SHOULD BE AVOIDED.
5. PROTECTIVE DEVICE MAY BE USED.
6. DEVICE SHOULD BE MAINTAINED THROUGHOUT CONSTRUCTION.

TREE PROTECTION DETAIL
NOT TO SCALE

DEVELOPER'S CERTIFICATE

I/WE CERTIFY THAT ALL DEVELOPMENT AND CONSTRUCTION WILL BE DONE ACCORDING TO THIS PLAN OF DEVELOPMENT AND THAT ANY RESPONSIBLE PERSONNEL IN THE CONSTRUCTION PROJECT WILL HAVE A CERTIFICATE OF ATTENDANCE AT A DEPARTMENT OF NATURAL RESOURCES APPROVED TRAINING PROGRAM FOR THE CONTROL OF EROSION AND SEDIMENT BEFORE BEGINNING THE PROJECT. I ALSO AUTHORIZE PERIODIC ON-SITE INSPECTION BY THE HOWARD SOIL CONSERVATION DISTRICT OR THEIR AUTHORIZED AGENTS, AS ARE DEEMED NECESSARY.

2/11/98
DATE

ENGINEER'S CERTIFICATE

I HEREBY CERTIFY THAT THIS PLAN FOR EROSION AND SEDIMENT CONTROL REPRESENTS A PRACTICAL AND WORKABLE PLAN BASED ON MY PERSONAL KNOWLEDGE OF THE SITE CONDITION AND THAT IT WAS PREPARED IN ACCORDANCE WITH THE REQUIREMENTS OF THE HOWARD SOIL CONSERVATION DISTRICT.

2-11-98
DATE

REVIEW FOR HOWARD COUNTY SOIL CONSERVATION DISTRICT AND MEETS TECHNICAL REQUIREMENTS.

7/1/98
DATE

7/1/98
DATE

7/10/98
DATE


7-9-98
DATE

SEDIMENT CONTROL NOTES AND DETAILS
SYCAMORE VALLEY II
LOTS 1 - 17 AND
PRESERVATION PARCELS "A" - "C"

ZONING: RC-DEO
TAX MAP NO.: 21 PARCEL NO.: 7
FOURTH ELECTION DISTRICT HOWARD COUNTY, MARYLAND
SCALE: AS SHOWN DATE: FEBRUARY 6, 1998
SHEET 11 OF 12

SOIL	NAME	CLASS
ChB2	Chester silt loam, 3 to 8 percent slopes, moderately eroded	B
Co	Codorus silt loam	C
CoB	Cornus silt loam, local alluvium, 3 to 8 percent slopes	B
EK2	Elk oak silt loam, 3 to 8 percent slopes, moderately eroded	B
GB2	Glenelg loam, 3 to 8 percent slopes, moderately eroded	B
GnA	Glenville silt loam, 0 to 3 percent slopes	C
GnB2	Glenville silt loam, 3 to 8 percent slopes, moderately eroded	C
Ha	Härboro silt loam	D
MIB2	Manor loam, 3 to 8 percent slopes, moderately eroded	B
MIC2	Manor loam, 8 to 15 percent slopes, moderately eroded	B
MID3	Manor loam, 15 to 25 percent slopes, severely eroded	B
ME	Manor loam, 25 to 45 percent slopes	B
MnD	Manor very stony loam, 3 to 25 percent slopes	B
MnF	Manor very stony loam, 25 to 60 percent slopes	B

NOTES:
 * Hydric soils and/or contains hydric inclusions
 ** May contain hydric inclusions
 † Generally only within 100-year floodplain areas

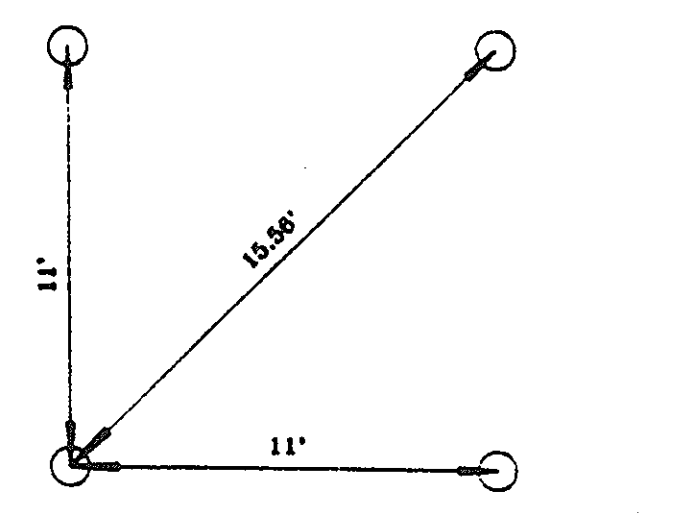

TYPICAL 11' X 11' PLAN VIEW


RANDOMIZED PLANTING DETAIL

ROW	A	B	C	D	E	F	G	H	I	J	K	L
1	1	2	3	4	5	6	7	8	9	10	11	12
2	1	2	3	4	5	6	7	8	9	10	11	12
3	1	2	3	4	5	6	7	8	9	10	11	12
4	1	2	3	4	5	6	7	8	9	10	11	12
5	1	2	3	4	5	6	7	8	9	10	11	12
6	1	2	3	4	5	6	7	8	9	10	11	12
7	1	2	3	4	5	6	7	8	9	10	11	12
8	1	2	3	4	5	6	7	8	9	10	11	12
9	1	2	3	4	5	6	7	8	9	10	11	12
10	1	2	3	4	5	6	7	8	9	10	11	12


PLANT QUANTITIES

TYPE	ROOT	SIZE	QTY
Oak (various)	1.5 GAL. CONT.	2-4'	292
TULIP POPLAR	"	"	292
RED HARE	"	"	292
FLOWER DOG	"	"	174
WHITE PINE	1.5 GAL. CONT.	2-4'	116

NOTE: INSPECT FOREST CONSERVATION PLANTINGS TWICE/YEAR TO MONITOR PLANT SURVIVAL AND TAKE APPROPRIATE MAINTENANCE STEPS TO ENSURE SURVIVAL AT SPECIFIED LEVEL. MAINTENANCE MAY INCLUDE MOWING TWICE ANNUALLY, WATERING, MULCHING, SPRAYING AND FERTILIZING.

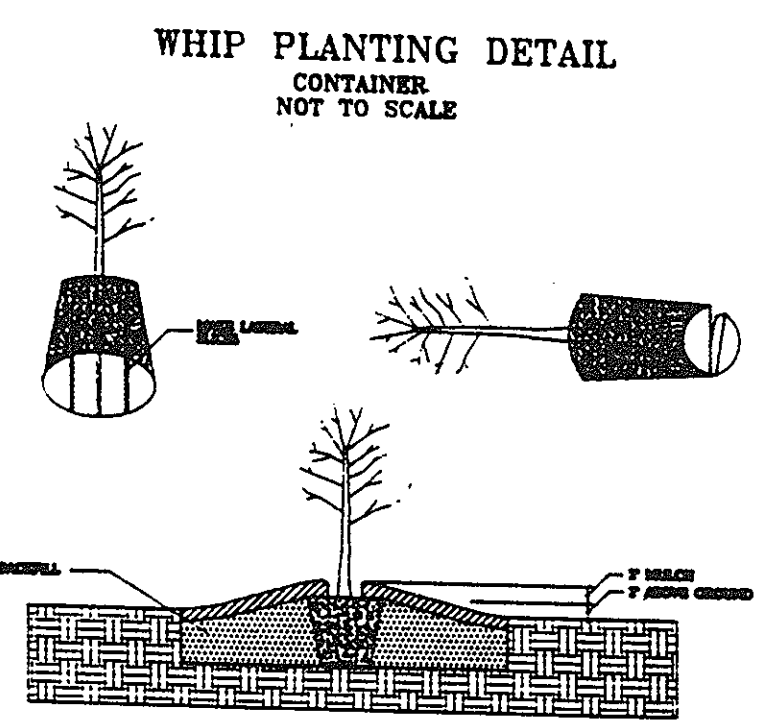


WHIP PLANTING DETAIL
CONTAINER NOT TO SCALE
PLANTING PROCEDURES FOR POT BOUND CONTAINER GROWN PLANTS
* ALL PLANT MATERIAL TO BE AUGERED WITH 18" AUGER.

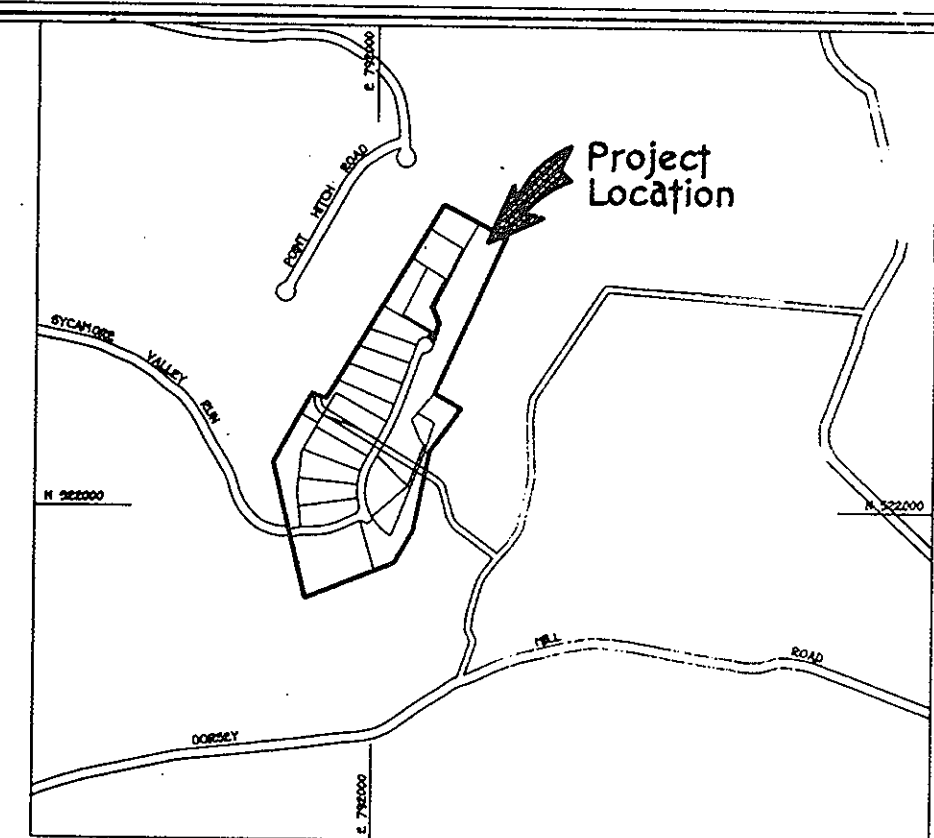

Vicinity Map
Scale: 1" = 1200'

- GENERAL NOTES:
- SUBJECT PROPERTY ZONED "RC-DEO" PER 10/18/1992 COMPREHENSIVE ZONING.
 - TOTAL AREA OF PROPERTY = 36,565 AC.
 a) AREA OF PROPOSED BUILDABLE LOTS: 10,070 AC.
 b) AREA OF ROAD RIGHT-OF-WAY: 2,135 AC.
 c) TOTAL NO. OF BUILDABLE LOTS: 17
 d) TOTAL NO. OF BUILDABLE PRESERVATION PARCELS = 1
 e) TOTAL AREA OF BUILDABLE PRESERVATION PARCELS = 3,044 AC.
 f) TOTAL NO. OF NON-BUILDABLE PRESERVATION PARCELS = 3
 g) TOTAL AREA OF NON-BUILDABLE PRESERVATION PARCELS = 11,485 AC.
 - DENSITY CALCULATIONS:
 a) BASE DENSITY: 36,565 / 4.25 AC./UNIT = 8.6 OR 8 UNITS
 b) MAX. DENSITY WITH "CEO" OPTION: 36,565 / 2 AC./UNIT = 18.28 OR 18 UNITS
 c) PROPOSED NO. OF UNITS = 17 BUILDING LOTS AND PRESERVATION PARCEL
 d) NUMBER OF CEOs REQUIRED = 17 UNITS - 8 UNITS = 9 UNITS
 - ALL ASPECTS OF THE PROJECT ARE IN CONFORMANCE WITH THE LATEST HOWARD COUNTY STANDARDS.
 - PRIVATE WATER AND SEWER WILL BE USED WITHIN THE PROJECT
 - THE WETLANDS DELINEATION STUDY AND FOREST CONSERVATION PLANS WERE PREPARED BY EXPLORATION RESEARCH, INC.
 - THE TRAFFIC-STUDY WAS PREPARED BY STREET TRAFFIC STUDIES.
 - NO CLEARING, GRADING OR CONSTRUCTION IS PERMITTED WITHIN WETLAND OR STREAM BUFFERS, UNLESS, APPROVED BY THE DEPARTMENT OF PLANNING AND ZONING OF HOWARD COUNTY, MARYLAND.
 - THIS AREA DESIGNATED A PRIVATE SEWERAGE EASEMENT OF 10,000 SQUARE FEET AS REQUIRED BY THE MARYLAND STATE DEPARTMENT OF THE ENVIRONMENT FOR INDIVIDUAL SEWER DISPOSAL. IMPROVEMENTS OF ANY NATURE IN THIS AREA ARE RESTRICTED UNTIL PUBLIC SEWERAGE IS AVAILABLE. THESE EASEMENTS SHALL BECOME NULL AND VOID UPON CONNECTION TO A PUBLIC SEWERAGE SYSTEM. THE COUNTY HEALTH OFFICER SHALL HAVE THE AUTHORITY TO GRANT VARIANCES FOR ENCROACHMENTS INTO THE PRIVATE SEWERAGE EASEMENT. RECOGNITION OF A MODIFIED EASEMENT SHALL NOT BE NECESSARY.
 - THE LOTS HEREON COMPLY WITH THE MINIMUM OWNERSHIP WIDTH AND LOT AREA AS REQUIRED BY THE MARYLAND STATE DEPARTMENT OF THE ENVIRONMENT.
 - THIS PLAN IS BASED ON FIELD RUN MONUMENTED BOUNDARY SURVEY AND TOPOGRAPHIC SURVEY PERFORMED ON OR ABOUT AUGUST, 1996 BY FISHER, COLLINS, AND CARTER, INC. DRIVEWAYS SHALL BE PROVIDED PRIOR TO RESIDENTIAL OCCUPANCY TO INSURE SAFE ACCESS FOR FIRE AND EMERGENCY VEHICLES PER THE FOLLOWING MINIMUM REQUIREMENTS:
 a) WIDTH - 12 FEET (6 FEET SERVING MORE THAN ONE RESIDENCE)
 b) SURFACE - SIX (6") INCHES OF COMPACTED CRUSHER RUN BASE WITH TAR AND CHIP COATING
 c) GEOMETRY - MAXIMUM 15% GRADE, MAXIMUM 10% GRADE CHANGE AND MINIMUM OF 15 FOOT TURNING RADIUS
 d) STRUCTURES (CULVERTS/BRIDGES) CAPABLE OF SUPPORTING 25 GROSS TONS (25) LOADING
 e) DRAINAGE ELEMENTS - CAPABLE OF SAFELY PASSING 100 YEAR FLOOD WITH NO MORE THAN 1 FOOT DEPTH OVER DRIVEWAY SURFACE
 f) STRUCTURE CLEARANCES - MINIMUM 12 FEET
 g) MAINTENANCE - SUFFICIENT TO INSURE ALL WEATHER USE
 - ALL AREAS ARE MORE OR LESS (a)
 - REUSE COLLECTION, SNOW REMOVAL AND ROAD MAINTENANCE TO BE PROVIDED AT THE JUNCTION OF THE PIPE / FLAG STEM AND THE ROAD R/W AND NOT ONTO THE PIPE / FLAG STEM DRIVEWAY.
 - NO CEMETERIES EXIST ON THE PROPERTY.
 - OPEN SPACE PROVIDED = 36,565 AC. x 5% = 1,828 AC.
 - OPEN SPACE PROVIDED = 1,831 AC.
 - ALL STREET TREE PLANTINGS AND PERMETER AND S.W.M. PLANTINGS WILL BE INSTALLED BY THE DEVELOPER IN CONJUNCTION WITH THE FINAL PLAN.

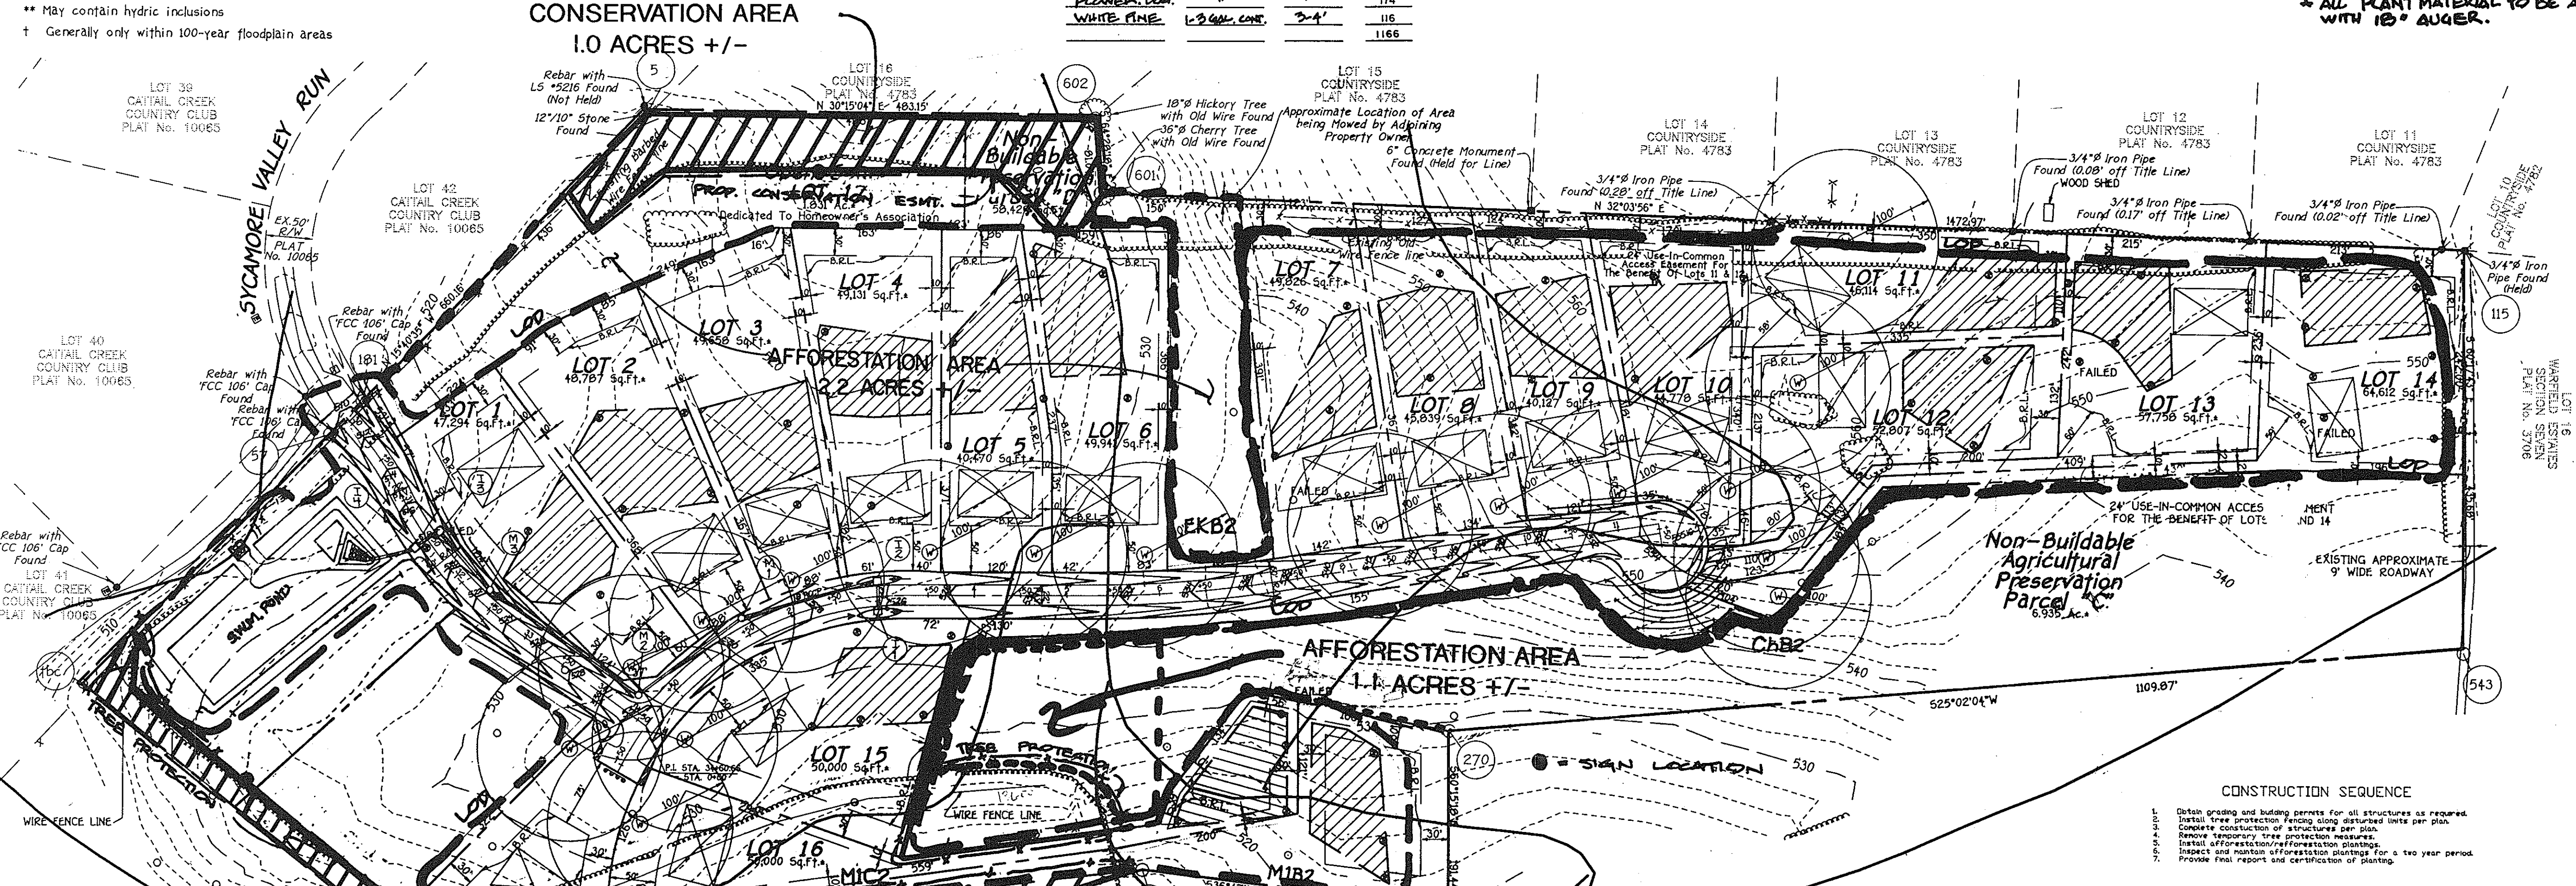


ROAD CENTERLINE CURVE TABULATION

STREET NAME	FROM STA. TO STA.	RADIUS	DELTA	ARC LENGTH
SYCAMORE VALLEY RUN	29+89.79 - 30+91.0	R=316.00'	18°22'10"	101.31'
SYCAMORE VALLEY RUN	30+91.0 - 32+87.20	R=406.30'	27°39'15"	196.10'
SYCAMORE VALLEY RUN	0+58.64 - 3+23.33	R=343.75'	82°57'28"	381.97'
SYCAMORE VALLEY RUN	5+25.15 - 7+27.48	R=432.51'	08°45'08"	202.33'

PLANTING RULES

- Areas to be planted in later and early spring. Planting may begin as soon as the ground is no longer frozen. Contact Exploration Research, Inc. for guidance prior to planting if an alternate date is proposed.
- Soil amendment and fertilization recommendations will be made based upon the results of soil analyses for nitrogen, phosphorus, potassium, organic matter content, and pH. Apply woodchips or hardwood bark mulch to the ground in detail provided.
- Planting materials will consist of containerized stock planted on 11" x 11" average density. The planting area will be 30" tree/row, hardwood species will consist of a randomized mix of three native and two non-native. A typical planting plan is shown in the RANDOM PLANTING DETAIL.
- Plant material shall be nursery grown containerized stock in compliance with all standards of the American Standard for Nursery Stock. All nursery stock to be grown in containers for a minimum of one full growing season.
- Substitutions in plant species or size shall be made only with written approval of Exploration Research, Inc.
- The contractor shall transport and handle plants to ensure protection from desiccation and breakage.
- The contractor shall guarantee 75% survival of plant stock through the second growing season.
- All trees shall be thoroughly watered immediately after planting and liberally thereafter during the first growing season.

DETAIL 1: TREE PROTECTION FENCE
BLAZE ORANGE PLASTIC MESH

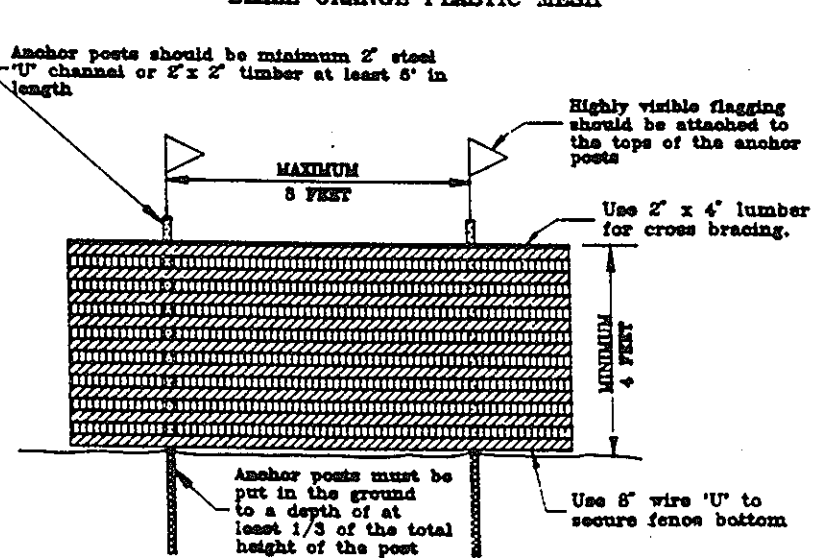


PRESERVATION AREA NOTES

- ALL PROPOSED ACTIVITIES SHALL CONFORM TO THE TERMS, CONDITIONS AND SCHEDULES OF AN APPROVED SOIL EROSION AND SEDIMENT CONTROL PLAN.
- SNOW FENCING, [TYPICAL SECTION SHOWN IN PLAN DETAIL 1] SHALL BE INSTALLED ALONG ALL TREE SAVE AREAS THAT ARE WITHIN FIFTY FEET (50') OF PROPOSED CONSTRUCTION ACTIVITIES. THE TREE PROTECTIVE DEVICES SHALL BE IN PLACE AT THE TIME CONSTRUCTION ACTIVITIES COMMENCE. NO PROTECTIVE DEVICES SHALL BE INSTALLED ALONG TREE SAVE AREAS THAT ARE GREATER THAN FIFTY (50) FEET FROM CONSTRUCTION ACTIVITY. THE LOCATION OF ALL TREE PROTECTION DEVICES ARE SHOWN ON THE SOIL EROSION AND SEDIMENT CONTROL PLAN DRAWINGS WHICH WILL BE INCORPORATED INTO THIS TREE CONSERVATION PLAN BY REFERENCE.

GENERAL NOTES

- FOREST PROTECTION DEVICES MUST BE SET AS PART OF THE EXISTING PROJECT.
- EXISTING AREAS WILL BE SET AS PART OF THE EXISTING PROJECT.
- BOUNDARIES OF PRESERVATION AREA SHOULD BE STAKED AND FLAGGED PRIOR TO INSTALLING DEVICES.
- NOV. 15/98 MARKED BY SURVEYOR.
- PROTECTIVE DEVICES SHALL BE MAINTAINED THROUGHOUT CONSTRUCTION.
- DEVICES SHOULD BE MAINTAINED THROUGHOUT CONSTRUCTION.

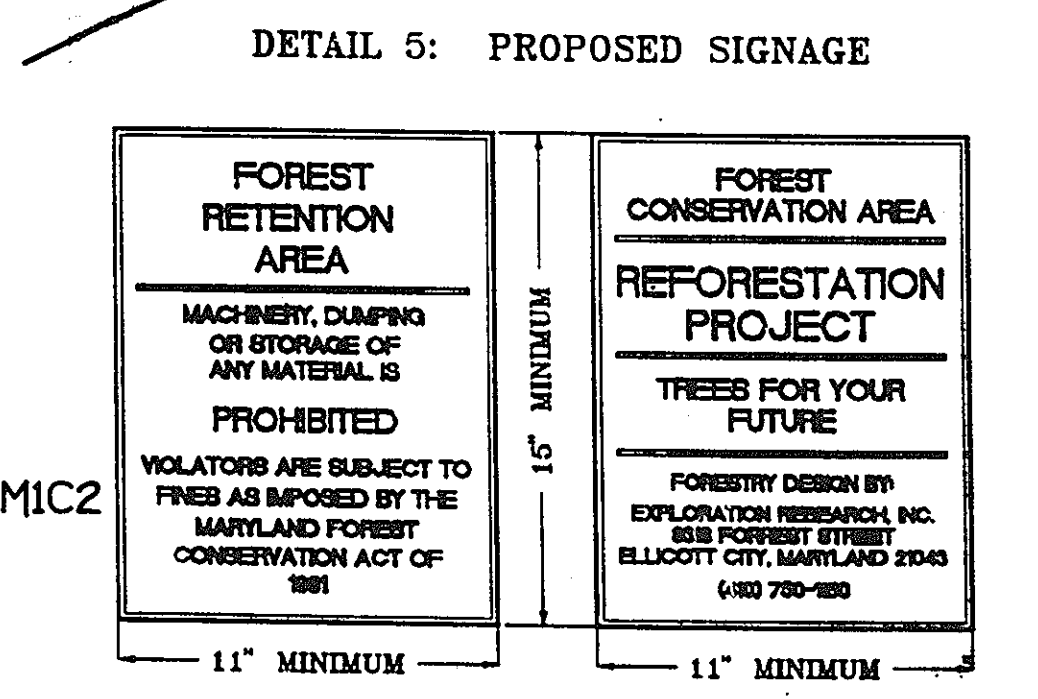

MINIMUM LOT SIZE CHART

Lot No.	Gross Area	Pipestem Area	Minimum Lot Size
11	46,114 Sq.Ft.	2,974 Sq.Ft.	43,140 Sq.Ft.
12	52,807 Sq.Ft.	581 Sq.Ft.	52,226 Sq.Ft.
13	57,758 Sq.Ft.	6,373 Sq.Ft.	51,385 Sq.Ft.
14	64,612 Sq.Ft.	10,047 Sq.Ft.	54,565 Sq.Ft.

FOREST MANAGEMENT NOTES

PRE-CONSTRUCTION
 Conduct a pre-construction meeting with the contractor(s) to review forest protection measures and practices. Conduct a site visit to assess tree locations to remove as appropriate.

DURING CONSTRUCTION
 Provide maintenance to tree protection measures.
 Water trees having critical root zone impacts on a biweekly basis or as needed.
 Monitor condition of remaining trees for signs of stress (leaf discoloration, leaf drop, insect infestation, etc.).

POST-CONSTRUCTION (END YEAR MONITORING)
 Inspect existing trees around the perimeter of disturbed limits for signs damage or stress from construction, including excessive compaction in the root zone.
 Evaluate remaining trees for signs of stress and conduct appropriate cultural management: crown reduction, pruning, watering, soil aeration, fertilizing, etc. Remove dead or dying trees and evaluate for hazard trees.
 * A licensed arborist or forester should be retained for these services.

APPENDIX G
FOREST CONSERVATION WORKSHEET

	ACRES (170 ac)
I. BASIC SITE DATA	
GROSS SITE AREA	36.6
AREA WITHIN 100 YEAR FLOODPLAIN	
AREA WITHIN AGRICULTURAL USE OR PRESERVATION PARCEL (IF APPLICABLE)	11.5
NET TRACT AREA	25.1
LAND USE CATEGORY (R-RD, R-RMO, R-S, C/IO, I) R-RMP	
II. INFORMATION FOR CALCULATIONS	
A. NET TRACT AREA	25.1
B. REFORESTATION THRESHOLD (25% x A)	6.3
C. AFFORESTATION MINIMUM (22% x A)	5.6
D. EXISTING FOREST ON NET TRACT AREA	3.1
E. FOREST AREAS TO BE CLEARED	0.2
F. FOREST AREAS TO BE RETAINED	2.4
Select the alternative that applies:	
1. No clearing below the Minimum	
If existing forests are less than the afforestation minimum (if D is less than C) and no clearing is proposed, the following calculations apply:	
TOTAL AFFORESTATION REQUIRED	0 - D
Afforestation must make total forest area equal the minimum required.	
2. Clearing below the Minimum	
If existing forests are less than the afforestation minimum (if D is less than C) and clearing is proposed, the following calculations apply:	
AFFORESTATION FOR UNFORESTED AREAS BELOW MINIMUM C - D	1.2
AFFORESTATION FOR CLEARING BELOW MINIMUM E - X	1.4
TOTAL AFFORESTATION REQUIRED (C - D) + (E - X) FOREST CON. PLAN B DETAILS	3.3

APPROVED: DEPARTMENT OF PLANNING AND ZONING
 Richard Blood, Chief, DIVISION OF LAND DEVELOPMENT, 7/17/98 DATE
 APPROVED: DEPARTMENT OF PUBLIC WORKS
 Andrew M. Davelos, Chief, BUREAU OF HIGHWAYS, 7-9-98 DATE