

**INDEX OF SHEETS**

SHEET NO.	TITLE
1	Cover Sheet
2	Grading and Soil Erosion & Sediment Control Plan
3	Soil Erosion & Sediment Control and Landscape Plan - Details
4	Landscape Planting Plan & Notes




**LOCATION MAP**  
Scale: 1" = 600'

**BENCHMARKS :**

37A2 : ELEV. = 403.707  
CONCRETE MONUMENT 0.1 FT. BELOW SURFACE AT TOP OF SLOPE NORTH SIDE OF WATERLOO ROAD NEAR # 5866

37A3 : ELEV. = 385.659  
CONCRETE MONUMENT 0.3 FT. BELOW SURFACE AT TOE OF SLOPE SOUTHWEST QUADRANT OF WATERLOO ROAD AND OLD MONTGOMERY ROAD INTERSECTION

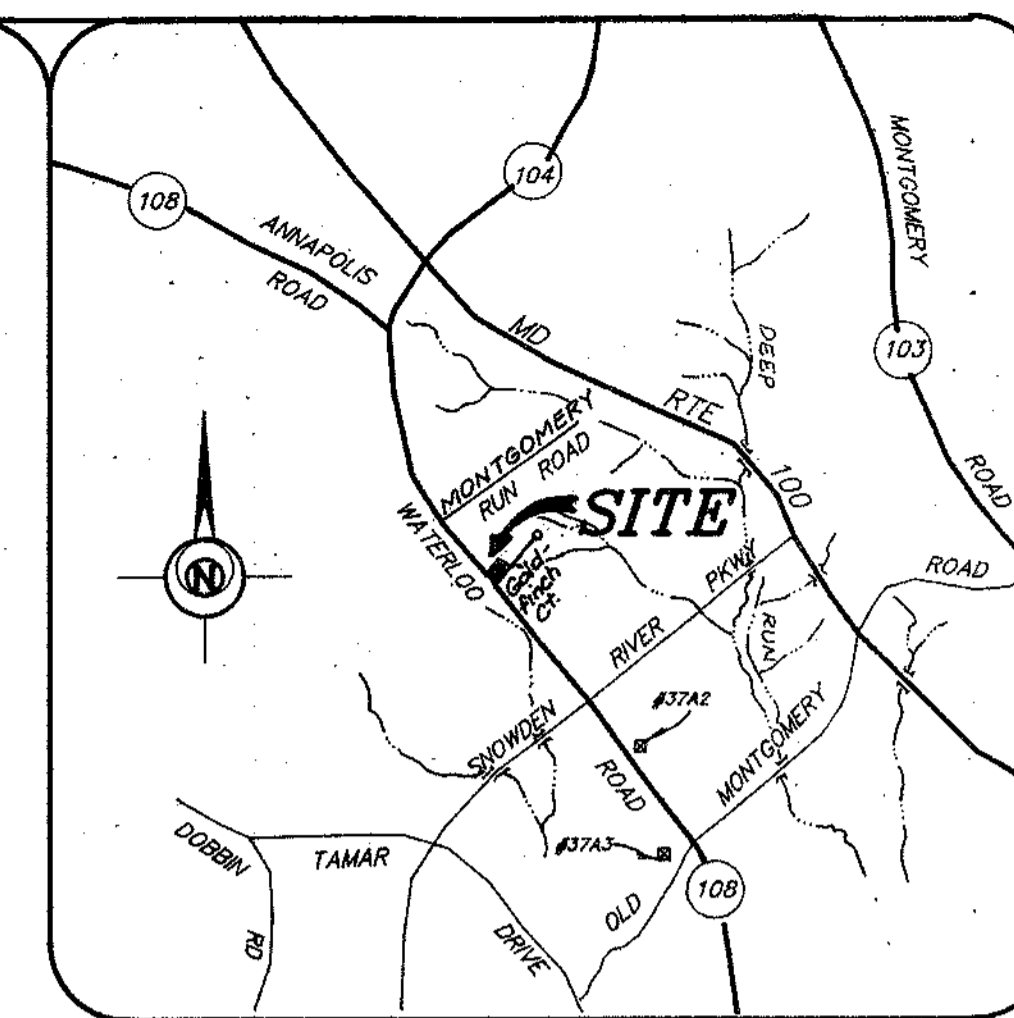

**VICINITY MAP**  
Scale 1" = 2000'

**GENERAL NOTES**

- All construction shall be in accordance with the latest standards and specifications of Howard County Design Manual Vol IV and MSHA standards & specifications.
- The contractor shall notify the Department of Public Works/Bureau of Engineering/Construction Inspection at (410) 313-1880 at least five (5) working days prior to the start of work.
- The contractor shall notify "Miss Utility" at 1-800-257-7777 at least forty-eight (48) hours prior to any excavation work.
- Project Background:  
Location: Ellicott City, Maryland  
Tax Map: 37  
Parcels: P/O 2  
Deed Reference: Liber 4150, Folio 60  
Zoning: RSA-8 (Residential - Single Attached) Per 10/18/93 Comprehensive Plan  
Election District: 1st  
Total Tract Area: 0.8885 Ac. plus/minus  
Previous Submittals: SP4-04, WP4-10, SP4-04, F95-136 SP 99-02
- Traffic control devices, markings, and signing shall be in accordance with the latest edition of the Manual on Uniform Traffic Control Devices (MUTCD). All street and regulatory signs shall be in place prior to the placement of any asphalt.
- Any damage caused by the contractor to existing public right-of-way, existing paving, existing curb and gutter, existing utilities, etc. shall be corrected at the contractor's expense.
- The existing utilities shown hereon are located from field surveys and construction drawings of record. The approximate location of existing utilities are shown for the contractor's information and convenience. The contractor shall locate existing utilities to his own satisfaction and well in advance of any construction activities. Additionally, the contractor shall take all necessary precautions to protect all existing utilities and maintain uninterrupted services.
- The topography shown hereon is compiled from field run topography prepared by LDE, Inc., March, 1995, November 1996, & January 1999; and construction drawings and as-built surveys of public record.
- Horizontal and vertical datum are related to the Maryland State Plane Coordinate System as projected from Howard County Geodetic Control station Nos. 37A2 and 37A3 (NAD 83).
- The property shown hereon is based on a field run boundary survey performed by LDE, Inc., dated March, 1995.
- The proposed Water and Sewer systems will be by House Connections from Contract # 14-3437-D. This property is located within the Metropolitan District.
- There are no existing steep slopes within the boundaries of the site; as outlined in Section 16.106(a)(3)(5) of the Subdivision and Land Development Regulations.
- All hydrologic data is for the 10-year storm unless otherwise noted.
- See sheet 2 for construction sequence.
- 95% compaction in all fill areas shall be determined by AASHTO T-190.
- The geotechnical report was compiled by Tech Earth and Environment, approved under F 95-136.
- The Noise Study was compiled by LDE, Inc., dated January, 1999 and approved under SP 99-02.
- The Wetland Delineation was compiled by M.A. Dircks & Company, July 1993. THERE ARE NO WETLANDS ON THE MONTGOMERY TOWNSHIP II SITE.
- The Traffic Study was compiled by Robert L. Morris, Inc., dated July 1998 and approved under SP 99-02.
- Stormwater management will be met in:  
Pond #1 by Quality: Retention  
Quantity: Detention
- Street Lights are existing as shown on the approved F 95-136 Construction Drawings.
- The purpose of the two monitoring wells located on open space lot 8 are part of the Maryland Department of the Environment's program to monitor the remediation activity on the adjacent property # 5651 Waterloo Road.

**ABANDONMENT NOTE:**

The existing private well and septic system located on the project shall be abandoned by the developer in accordance with approved procedures of the Howard County Health Department. The developer shall provide verification to the Health Department of the abandonment prior to signature approval of the Record Plat.

The monitoring wells located along the northern boundary line shall remain in place until such time as the Maryland Department of the Environment and/or the Environmental Protection Agency approves their removal or relocation.

PLEASE NOTE, INSPECTION BY THE HOWARD COUNTY HEALTH DEPARTMENT IS REQUESTED PRIOR TO THE INITIATION OF WORK

# FINAL CONSTRUCTION PLANS

# MONTGOMERY TOWNSHIP II

## LOTS 1 THRU 8

### 1st Election District - Howard County, Maryland

**"AS-BUILT" SURVEY**



NOTE: The "As-Built" Survey certification is limited to the expansion of the existing Stormwater Management located on Open Space Lot 8 (F 99-141) and Open Space Lot 52 (F 95-136). The "As-Built" Survey of the Stormwater Management structure, etc. (F 95-136) was certified by the Tech Group, dated 10/28/97.

APPROVED: DEPARTMENT OF PLANNING AND ZONING

*David B. Dircks*  
CHIEF, DEVELOPMENT ENGINEERING DIVISION  
7/12/99  
*Condy Hamilton*  
CHIEF, DIVISION OF LAND DEVELOPMENT  
7/13/99

APPROVED: Department of Public Works for Storm Systems and Roads  
*Samuel S. Hill*  
CHIEF, BUREAU OF HIGHWAYS  
7/19/99

THESE PLANS HAVE BEEN REVIEWED FOR THE HOWARD SOIL CONSERVATION DISTRICT AND MEET THE TECHNICAL REQUIREMENTS.

*Keith Simmons*  
NATURAL RESOURCE CONSERVATION SERVICE  
6/30/99

THIS DEVELOPMENT PLAN IS APPROVED FOR SOIL EROSION AND SEDIMENT CONTROL BY THE HOWARD SOIL CONSERVATION DISTRICT.

*John P. Robertson*  
HOWARD SOIL CONSERVATION DISTRICT  
6/30/99

**ENGINEER'S CERTIFICATE**

"I HEREBY CERTIFY THAT THESE GRADING AND SEDIMENT CONTROL REPRESENTS A PRACTICAL AND FEASIBLE PLAN BASED ON MY PERSONAL KNOWLEDGE OF THE SITE AND THAT IT WAS PREPARED IN ACCORDANCE WITH REQUIREMENTS OF THE HOWARD SOIL CONSERVATION DISTRICT."  
*David B. Dircks*  
SIGNATURE OF ENGINEER  
6/23/99

**DEVELOPER'S CERTIFICATE**

"I/WE CERTIFY THAT ALL DEVELOPMENT AND/OR CONSTRUCTION WILL BE DONE ACCORDING TO THESE PLANS AND THAT ANY RESPONSIBLE PERSONNEL INVOLVED IN THE CONSTRUCTION PROJECT WILL HAVE A CERTIFICATE OF ATTENDANCE AT A DEPARTMENT OF THE ENVIRONMENT APPROVED TRAINING PROGRAM FOR THE CONTROL OF SEDIMENT AND EROSION BEFORE BEGINNING THE PROJECT. I ALSO AUTHORIZE PERIODIC ON-SITE INSPECTION BY THE HOWARD SOIL CONSERVATION DISTRICT OR THEIR AUTHORIZED AGENTS, AS ARE DEEMED NECESSARY."  
*David B. Dircks*  
SIGNATURE OF DEVELOPER  
7/12/99



**LDE, INC.**  
9250 Rumsey Road, Suite 106, Columbia, MD 21045  
(410) 715-1070 (301) 596-3424 (410) 715-9540 (Fax)

DESIGNED	Cover Sheet	SCALE
E.D.S.	<b>MONTGOMERY TOWNSHIP II</b> LOTS 1 THRU 8	AS SHOWN
DRAWN	Tax Map # 37 BLOCK 1 P/O PARCEL NO 2 1ST ELECTION DISTRICT	SHEET 1 of 4
CHECKED	HOWARD COUNTY, MARYLAND	JOB NO. 98-015
B.D.B.	Previous Submittals: SP4-04, WP4-10, SP4-04, F95-136, SP99-02	FILE NO. F99-141
DATE	OWNER / DEVELOPER WINTHORPE DEVELOPERS P O BOX 223 HIGHLAND, MARYLAND 20777-0223	

CL STATION	CL OFFSET	ELEVATION	DESCRIPTION
100+40	80' RT	446.00	Toe Berm @ FL
100+49	78' RT	448.00	Top Berm
100+62	76' RT	450.00	Top Berm
100+75	74' RT	452.00	Top Berm
101+02	70' RT	452.90	Top Berm
101+37	70' RT	454.00	Top Berm
101+55	70' RT	454.00	Top Berm
101+60	70' RT	452.00	Toe Berm

SUMMARY TABLE

PUBLIC POND #1 (F 95-136)  
 Joint Public / Private H.O.A. Maintenance  
 Hazard Classification "A"  
 Drainage Area = 5.74 Acres  
 Water Quality Management = Retention  
 Water Quantity Management = Retention

	SWM POND		
	2 Year	10 Year	100 Year
Total Existing Flow (cfs)	24	56	89
Unmanaged Flow (cfs)	74	194	334
Acceptable Release (cfs)	17	28	38.0
Computed Inflow (cfs)	23	48	69
Facility Discharge (cfs)	17	35	54
Elevation at Discharge (ACFT)	437.16	438.02	438.72
Storage at Elevation (ACFT)	0.47	0.73	0.98
Total Developed Flow (cfs)	18	47	79

NOTE: The enlargement of the existing SWM facility constructed under F95-136 requires no modification to the existing riser structure (S-2).  
 EX SWM DRAINAGE & UTILITY EASEMENT Plat # 7274

LEGEND

- 440 --- EX. GROUND (10 FT. INTERVAL)
- 442 --- EX. GROUND (2 FT. INTERVAL)
- EX. SEWER
- EX. WATER
- EX. TREE LINE
- EX. TREES TO BE RETAINED
- PROPERTY LINE
- NON-TIDAL WETLANDS
- 442 --- PROPOSED GRADE
- EX. SPLIT RAIL FENCE
- PROP SPLIT RAIL FENCE
- 5 FT. TALL SOLID WOOD FENCE
- Ex. 4' Conc. Walk --- EX. SIDEWALK
- --- PROP SIDEWALK
- SSF --- SUPER SILT FENCE
- SF --- SILT FENCE
- --- LIMIT OF DISTURBANCE
- TPF --- TREE PROTECTION FENCE
- SCE --- STABILIZED CONSTRUCTION ENTRANCE
- --- APPROXIMATE 65 dBA LINE (POST MITIGATION)
- --- EROSION CONTROL MATTING (ECM)
- --- APPROXIMATE 65 dBA LINE (PRE MITIGATION)



VILLAGE OF MONTGOMERY RUN  
 Plat # 8042  
 Zoned RSA-8

MONTGOMERY TOWNSHIP  
 Lots 1 thru 52  
 Plat # 12048


CONSTRUCTION SEQUENCE

1. Obtain Grading Permit. - 1 day
2. Install Stabilized Construction Entrance (SCE). - 1 day
3. Stakout limits of disturbance. - 1 day
4. Install Tree Protection Fence (TPF) where shown hereon. - 1 day
5. Install Silt Fence (SF) and Super Silt Fence (SSF) at the limit of disturbance where shown. - 2 days
6. Construct SCE w/ mountable berm as shown hereon. - 1 day
7. After permission has been given by Sediment Control Inspector, dewater the existing Stormwater Management Facility (F95-136) by opening the existing gate valve. - 1 day
8. Re-install the 6" perforated riser, filter cloth and stone per the details of the F 95-136 construction drawings, also shown hereon. The gate valve shall remain open during grading operations. - 1 day
9. Clear & grub and grade site, to include completing the pond excavation and grading associated with the construction of the noise / landscape berm. The pond grading shall be in conformance with MD 378 specifications. Immediately following the completion of the pond grading, stabilize the disturbed areas with permanent seeding mixture and straw mulch. Obtain permission from the sediment control inspector to proceed. - 2 weeks
10. The contractor shall inspect and provide necessary maintenance on the sediment and erosion control structures shown hereon after each rainfall and on a daily basis - 1 day
11. Install curb & gutter and sidewalk along MD Rte. 108, and repair any curb & gutter / sidewalk from the F95-136 plans. - 1 week
12. Complete any grading, add topsoil per the specifications on sheet 3, and stabilize disturbed areas with permanent seeding mixture and straw mulch - 1 week
13. After all upgrade areas from the pond have been stabilized and permission has been given by Sediment Control Inspector, remove silt fence, super silt fence, and remove the 6" perforated riser, filter cloth and stone. At this time close the gate valve, and stabilize the disturbed areas from the aforementioned disturbances with permanent seeding mixture and straw mulch - 2 days  
 Total: 30 Days

NOTE: The "As-Built" Survey certification is limited to the expansion of the existing Stormwater Management located on Open Space Lot 8 (F99-141) and Open Space Lot 52 (F95-136). The "As-Built" Survey of the Stormwater Management structure, etc. (F95-136) was certified by the Tech Group, dated 10/28/97.

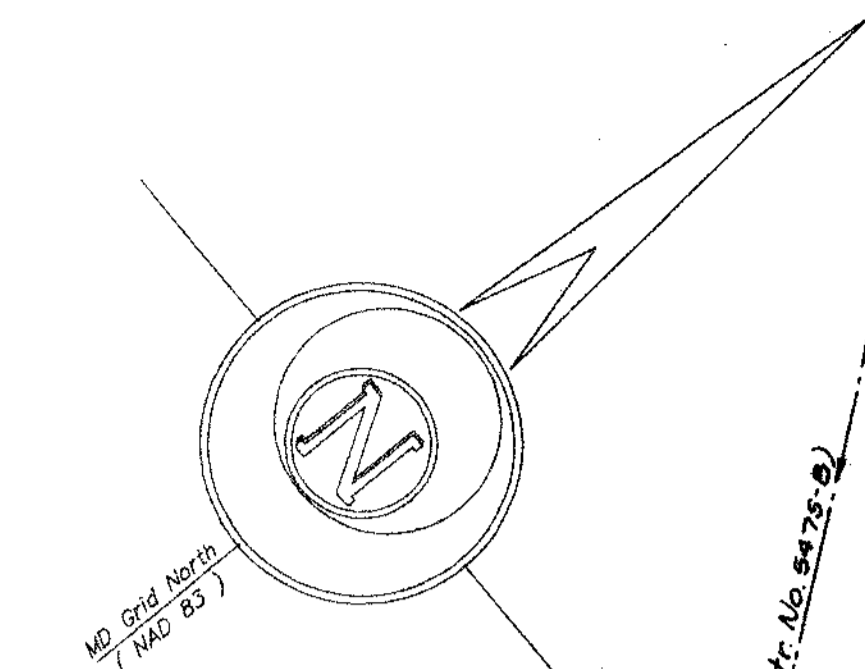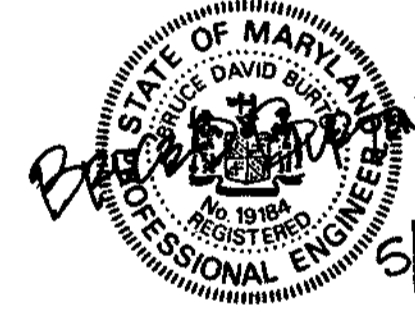


WATERLOO ROAD (MD. ROUTE 108)  
 (Existing 100' R/W - Future 120' R/W)  
 (PUBLIC)

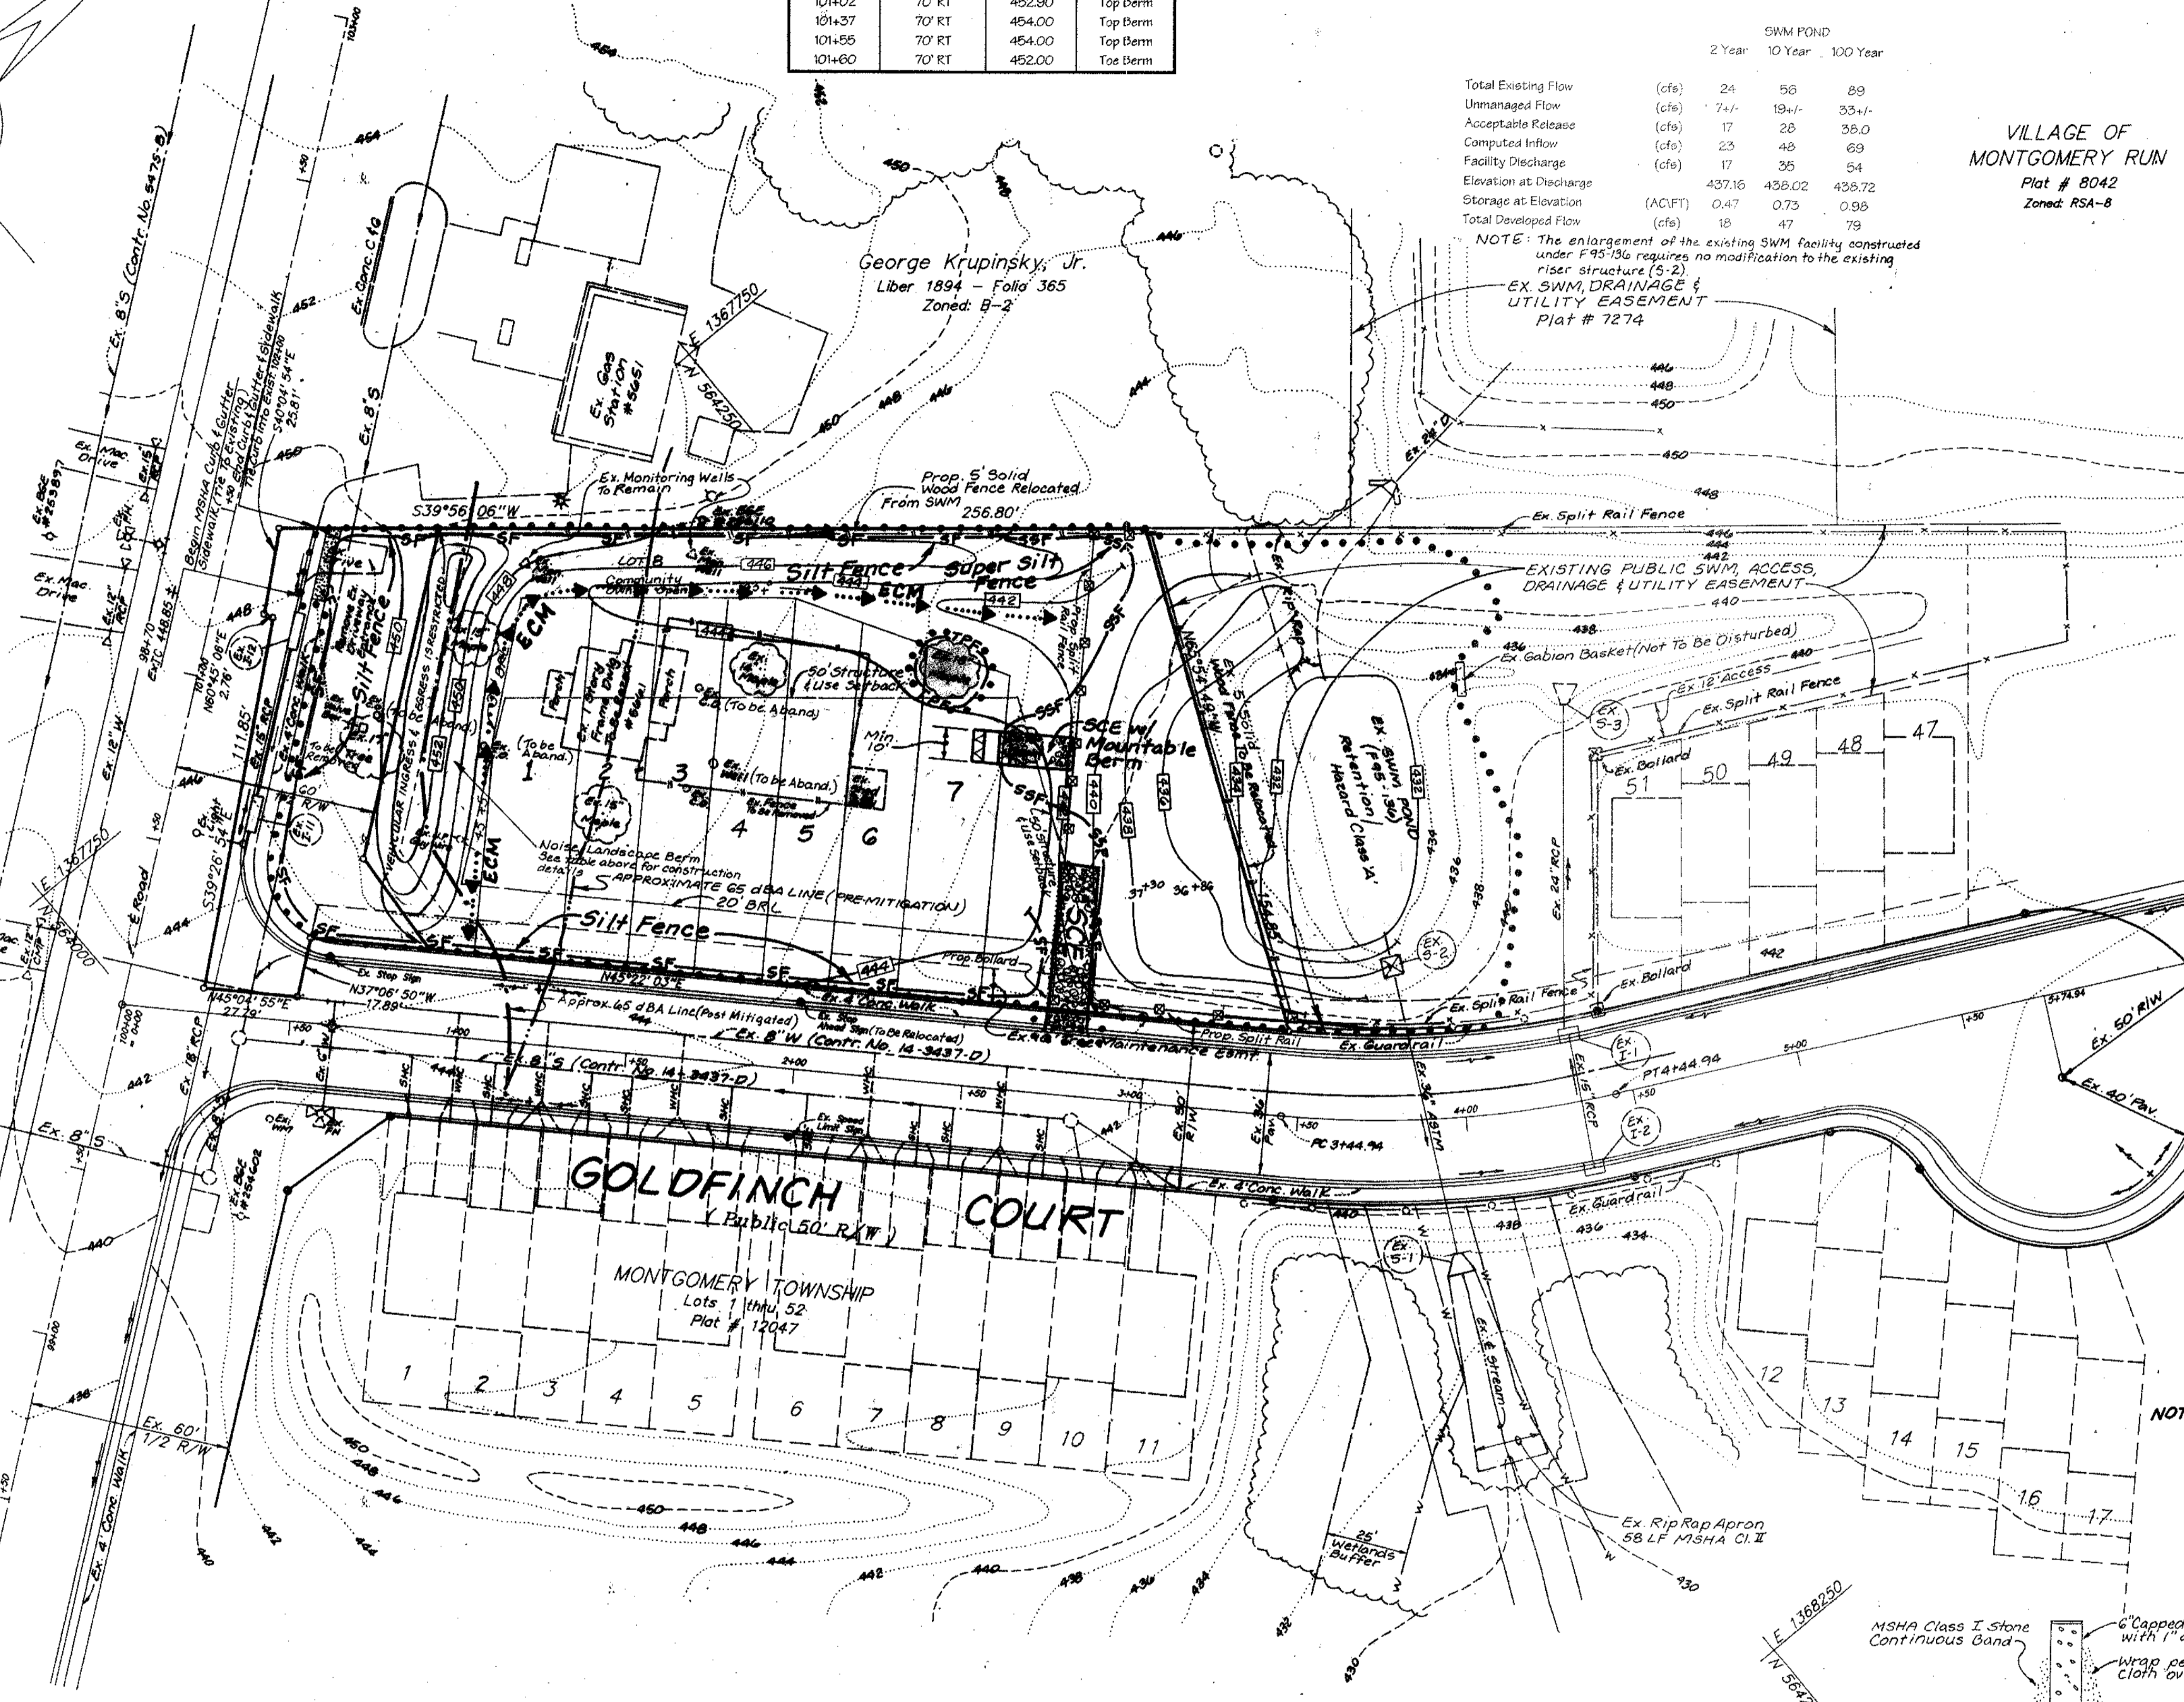

"AS-BUILT" SURVEY

DEWATERING DEVICE DETAIL

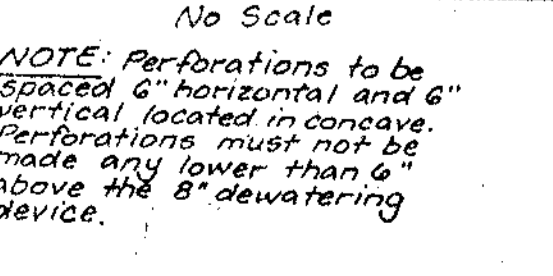

NOTE: THE EXISTING (F95-136) STORMWATER MANAGEMENT RISER SHALL BE BLOCKED DURING GRADING OPERATIONS. THE BLOCKING SHALL NOT BE REMOVED UNTIL ALL DISTURBED AREAS ARE STABILIZED AND PERMISSION HAS BEEN GIVEN BY THE SEDIMENT CONTROL INSPECTOR.

APPROVED: DEPARTMENT OF PLANNING AND ZONING

7/12/99  
 Chief, Development Engineering Division

7/13/99  
 Chief, Division of Land Development

7/13/99  
 Chief, Bureau of Highways

THESE PLANS HAVE BEEN REVIEWED FOR THE HOWARD SOIL CONSERVATION DISTRICT AND MEET THE TECHNICAL REQUIREMENTS.

6/30/99  
 Chief, Natural Resource Conservation Service

THIS DEVELOPMENT PLAN IS APPROVED FOR SOIL EROSION AND SEDIMENT CONTROL BY THE HOWARD SOIL CONSERVATION DISTRICT.

6/30/99  
 Chief, Howard Soil Conservation District

ENGINEER'S CERTIFICATE


I HEREBY CERTIFY THAT THE EROSION AND SEDIMENT CONTROL REPRESENTS A PRACTICAL AND FEASIBLE PLAN BASED ON MY PERSONAL KNOWLEDGE OF THE SITE AND THAT IT WAS PREPARED IN ACCORDANCE WITH REQUIREMENTS OF THE HOWARD SOIL CONSERVATION DISTRICT.

6/23/99  
 Bruce ...

DEVELOPER'S CERTIFICATE

I/WE CERTIFY THAT ALL DEVELOPMENT AND/OR CONSTRUCTION WILL BE DONE ACCORDING TO THESE PLANS AND THAT ANY PERSONNEL INVOLVED IN THE CONSTRUCTION PROJECT WILL HAVE A CERTIFICATE OF ATTENDANCE AT A DEPARTMENT OF THE ENVIRONMENT APPROVED TRAINING PROGRAM FOR THE CONTROL OF SEDIMENT AND EROSION BEFORE BEGINNING THE PROJECT. I ALSO AUTHORIZE PERIODIC ON-SITE INSPECTION BY THE HOWARD SOIL CONSERVATION DISTRICT OR THEIR AUTHORIZED AGENTS, AS DEEMED NECESSARY.

6/23/99  
 [Signature]

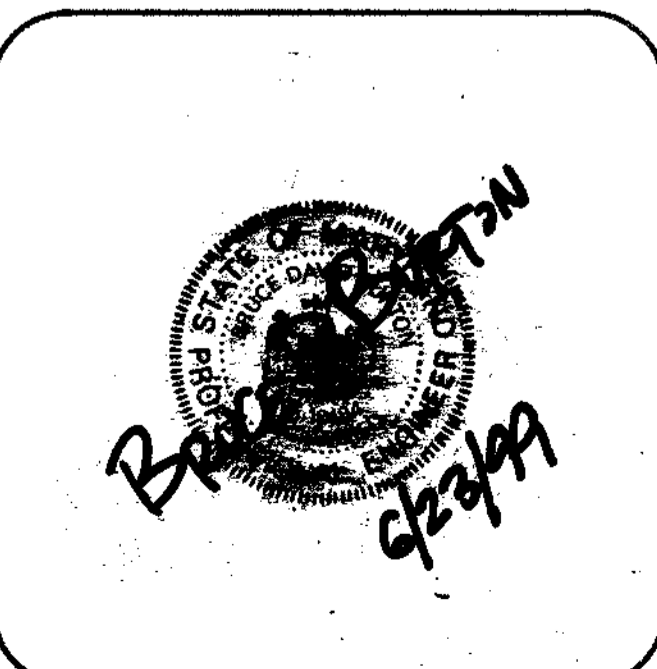

**LDE, INC.**  
 9250 Rumsey Road, Suite 106, Columbia, MD. 21045  
 (410) 715-1070 (301) 596-3424 (410) 715-9540 (Fax)

DESIGNED	GRADING and SOIL EROSION & SEDIMENT CONTROL PLAN	SCALE	1" = 30'
E.D.S.	<b>MONTGOMERY TOWNSHIP II</b>	SHEET	2 of 4
DRAWN	LOTS 1 THRU 8	JOB NO.	98-015
K.B.W.	Tax Map # 37 BLOCK 1 P/O PARCEL NO 2	FILE NO.	F 98-141
CHECKED	1ST ELECTION DISTRICT		
B.D.B.	HOWARD COUNTY, MARYLAND		
DATE	5/99		

Previous Submittals: 5/94, 7/94-10, 3/94-24, F95-136, SPP9-02  
 OWNER / DEVELOPER  
**WINTHORPE DEVELOPERS**  
 P O BOX 823  
 HIGHLAND, MARYLAND 20777-0823

### HOWARD SOIL CONSERVATION DISTRICT STANDARD SEDIMENT CONTROL NOTES

- A minimum of 48 hours notice must be given to the Howard County Department of Inspections, Licenses and Permits, Sediment Control Division prior to the start of any construction. (315-1025).
- All vegetative and structural practices are to be installed according to the provisions of this plan and are to be in conformance with the most current MARYLAND STANDARDS AND SPECIFICATIONS FOR SOIL EROSION AND SEDIMENT CONTROL, and revisions thereto.
- Following initial soil disturbance or redistribution, permanent or temporary stabilization shall be completed within 7 calendar days for all perimeter sediment control structures, dikes, perimeter slopes and all slopes greater than 3:1, b) 14 days as to all other disturbed or graded areas on the project site.
- All sediment traps/basins shown must be fenced and warning signs posted around their perimeter in accordance with Vol. 1, Chapter 7, of the HOWARD COUNTY DESIGN MANUAL, Storm Drainage.
- All disturbed areas must be stabilized within the time period specified above in accordance with the 1994 MARYLAND STANDARDS AND SPECIFICATIONS FOR SOIL EROSION AND SEDIMENT CONTROL (Section G) for permanent seeding, and, temporary seeding, and mulching. Temporary stabilization with mulch alone can only be done when recommended seeding dates do not allow for proper germination and establishment of grasses.
- All sediment control structures are to remain in place and are to be maintained in operative condition until permission for their removal has been obtained from the Howard County Sediment Control Inspector.
- Site Analysis:
 

Total Area of Site	0.89 Acres
Area to be roofed or paved	1.12 Acres
Area to be vegetatively stabilized	1.12 Acres
Total Cut	1820 Cu. Yds.
Total Fill	2320 Cu. Yds.
- Offsite waste/borrow area location
- Any sediment control practice which is disturbed by grading activity for placement of utilities must be repaired on the same day of disturbance.
- Additional sediment control must be provided, if deemed necessary by the Howard County Sediment Control Inspector.
- On all stabilization areas in excess of 2 acres, approval of the inspection agency shall be requested upon completion of installation of perimeter erosion and sediment controls, but before proceeding with any other earth disturbance or grading. Other building or grading inspection approvals may not be sufficient until this initial approval by the inspection agency is made.
- Trenches for the construction of utilities is limited to three pipe lengths or that which can be back filled and stabilized within one working day, whichever is shorter.

### HOWARD SOIL CONSERVATION DISTRICT PERMANENT SEEDING NOTES

Apply to graded or cleared areas not subject to immediate further disturbance where a permanent long-lived vegetative cover is needed.

**SEEDBED PREPARATION:** Loosen upper three inches of soil by raking, disking, or other acceptable means before seeding, if not previously loosened.

**SOIL AMENDMENTS:** In lieu of soil test recommendations, use one of the following schedules:

- PREFERRED** - Apply 2 tons per acre dolomitic limestone (92 lbs/1000sq. ft.) and 800 lbs per acre 10-10-10 fertilizer (14 lbs/1000 sq. ft.) before seeding. Harrow or disk into upper three inches of soil. At time of seeding, apply 400 lbs per acre 30-0-0 ureaform fertilizer (9 lbs/1000sq. ft.).
- ACCEPTABLE** - Apply 2 tons per acre dolomitic limestone (92 lbs/1000sq. ft.) and 1000 lbs per acre 10-10-10 fertilizer (23 lbs/1000 sq. ft.) before seeding. Harrow or disk into upper three inches of soil.

**SEEDING** - For the periods March 1 thru April 30, and August 1 thru October 15, seed with 80 lbs per acre (1.4 lbs/1000sq. ft.) of Kentucky 31 Tall Fescue 1 thru July 31, seed with 80 lbs per acre (1.4 lbs/1000sq. ft.) of Kentucky 31 Tall Fescue and 2 lbs. per acre (.05 lbs/1000sq. ft.) of weeping lovegrass. During the period of October 16 thru February 28, protect site by: Option (1) - 2 tons per acre of well anchored straw mulch and seed as soon as possible in the spring. Option (2) - Use sod. Option (3) - Seed with 80 lbs per acre Kentucky 31 Tall Fescue and mulch 2 tons / acre well anchored straw.

**MULCHING** - Apply 1-1/2 to 2 tons per acre (70 to 90 lbs/1000sq. ft.) of unrotted small grain straw immediately after seeding. Anchor mulch immediately after application using mulch anchoring tool or 218 gallons per acre (5 gal/1000sq. ft.) of emulsified asphalt on flat areas. On slopes 3 feet or higher, use 348 gallons per acre (8 gal/1000sq. ft.) for anchoring.

**MAINTENANCE** - Inspect all seeding areas and make needed repairs, replacements and reseedings.

### TEMPORARY SEEDING NOTES

Apply to graded or cleared areas likely to be redistributed where a short-term vegetative cover is needed.

**SEEDBED PREPARATION:** - Loosen upper three inches of soil by raking, disking, or other acceptable means before seeding, if not previously loosened.

**SOIL AMENDMENTS:** - Apply 800 lbs per acre 10-10-10 fertilizer (14 lbs/1000sq. ft.).

**SEEDING** - For periods March 1 thru April 30, and from August 15 thru October 15 seed with 2-12 bushels per acre of annual ryegrass (3.2 lbs/1000sq. ft.). For the period May 1 thru August 14, seed with 3 lbs. per acre (.07 lbs/1000sq. ft.). For the period November 16 thru February 28, protect site by applying 2 tons per acre of well anchored straw mulch and seed as soon as possible in the spring, or use sod.

**MULCHING** - Apply 1-1/2 to 2 tons per acre (70 to 90 lbs/1000sq. ft.) of unrotted weed free small grain straw immediately after seeding. Anchor mulch immediately after application using mulch anchoring tool or 218 gallons per acre (5 gal/1000sq. ft.) of emulsified asphalt on flat areas. On slopes 3 feet or higher, use 348 gallons per acre (8 gal/1000sq. ft.) for anchoring.


Refer to the 1994 MARYLAND STANDARDS AND SPECIFICATIONS FOR SOIL EROSION AND SEDIMENT CONTROL for additional rates and methods not covered.

APPROVED: DEPARTMENT OF PLANNING AND ZONING

APPROVED: DEPARTMENT OF PUBLIC WORKS FOR Storm Systems and Roads

APPROVED: DEPARTMENT OF HIGHWAYS

#### DETAIL 22 - SILT FENCE

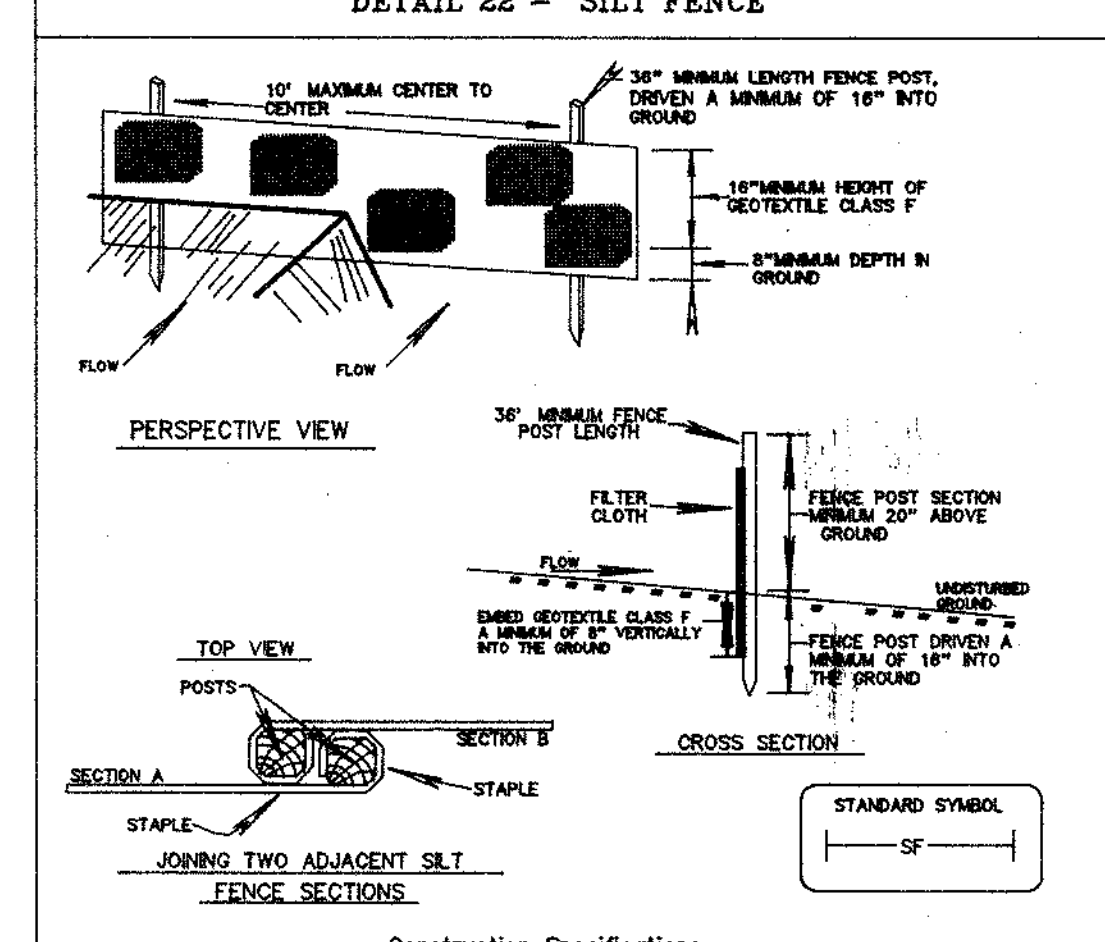

**Construction Specifications**


- Fence posts shall be a minimum of 36" long driven 18" minimum into the ground. Wood posts shall be 1 1/2" x 1 1/2" square (minimum) and, or 1 3/4" diameter (minimum) round and shall be of sound quality hardwood. Steel posts shall be standard T or U section weighing not less than 1.00 pound per linear foot.
- Geotextile shall be fastened securely to each fence post with wire ties or staples at top and mid-section and shall meet the following requirements:
 

Tensile Strength	50 lbs/in. (min.)	Test: MSMT 509
Tensile Modulus	20 lbs/in. (min.)	Test: MSMT 509
Flow Rate	0.3 gal / ft / min. (max.)	Test: MSMT 322
Flaming Efficiency	75% (min.)	Test: MSMT 322
- Where ends of geotextile fabric come together, they shall be overlapped, folded and stapled to prevent sediment bypass.
- Silt Fence shall be inspected after each rainfall event and maintained when bulges occur or when sediment accumulation reached 50% of the fabric height.

**STANDARD SYMBOL**: SF

U.S. DEPARTMENT OF AGRICULTURE SOIL CONSERVATION SERVICE      MARYLAND DEPARTMENT OF ENVIRONMENT WATER MANAGEMENT ADMINISTRATION

#### DETAIL 33 - SUPER SILT FENCE

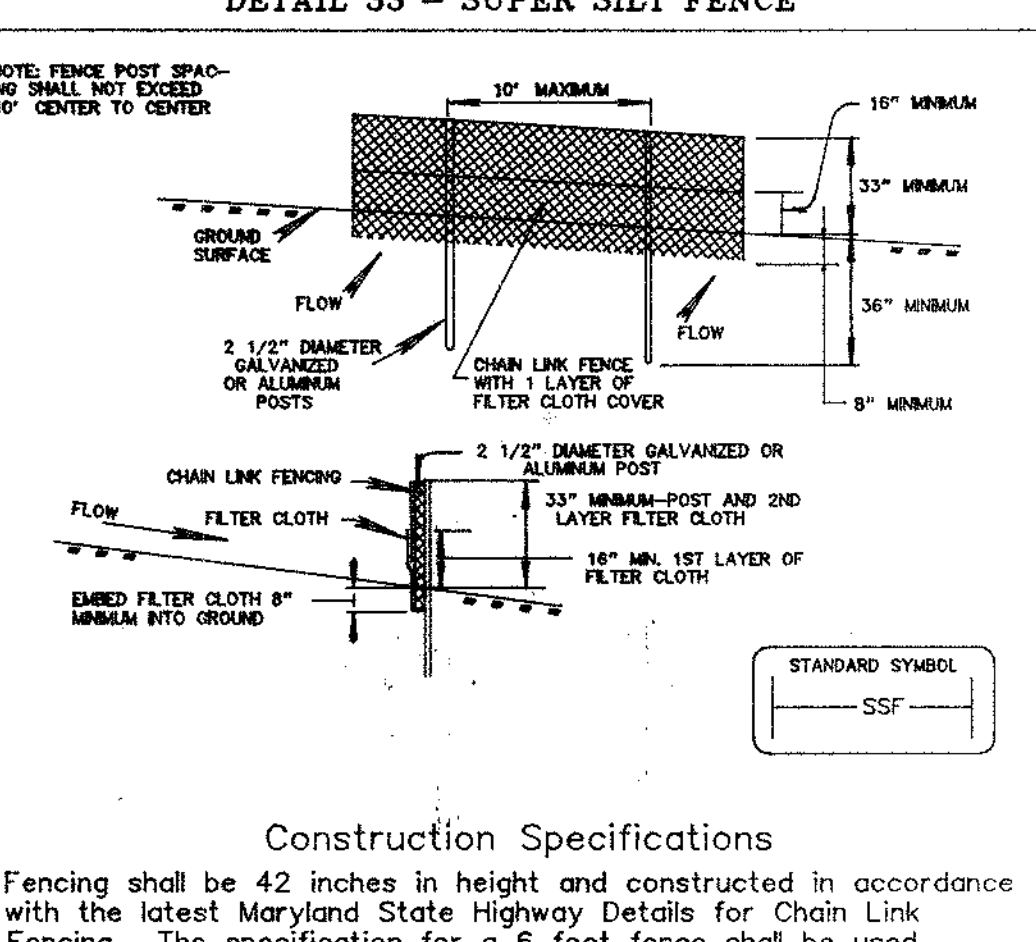

**Construction Specifications**


Fencing shall be 42 inches in height and constructed in accordance with the latest Maryland State Highway Details for Chain Link Fencing. The specification for a 6 foot fence shall be used, substituting 42 inch fabric and 6 foot length posts.

- The poles do not need to set in concrete.
- Chain link fence shall be fastened securely to the fence posts with wire ties or staples.
- Filter cloth shall be fastened securely to the chain link fence with ties spaced every 24" at the top and mid section.
- Filter cloth shall be embedded a minimum of 8" into the ground.
- When two sections of filter cloth adjoin each other, they shall be overlapped by 6" and folded.
- Maintenance shall be performed as needed and silt buildups removed when "bulges" develop in the silt fence.

**STANDARD SYMBOL**: SSF

U.S. DEPARTMENT OF AGRICULTURE SOIL CONSERVATION SERVICE      MARYLAND DEPARTMENT OF ENVIRONMENT WATER MANAGEMENT ADMINISTRATION

#### Tree Protection Fence / Blaze Orange Plastic Mesh

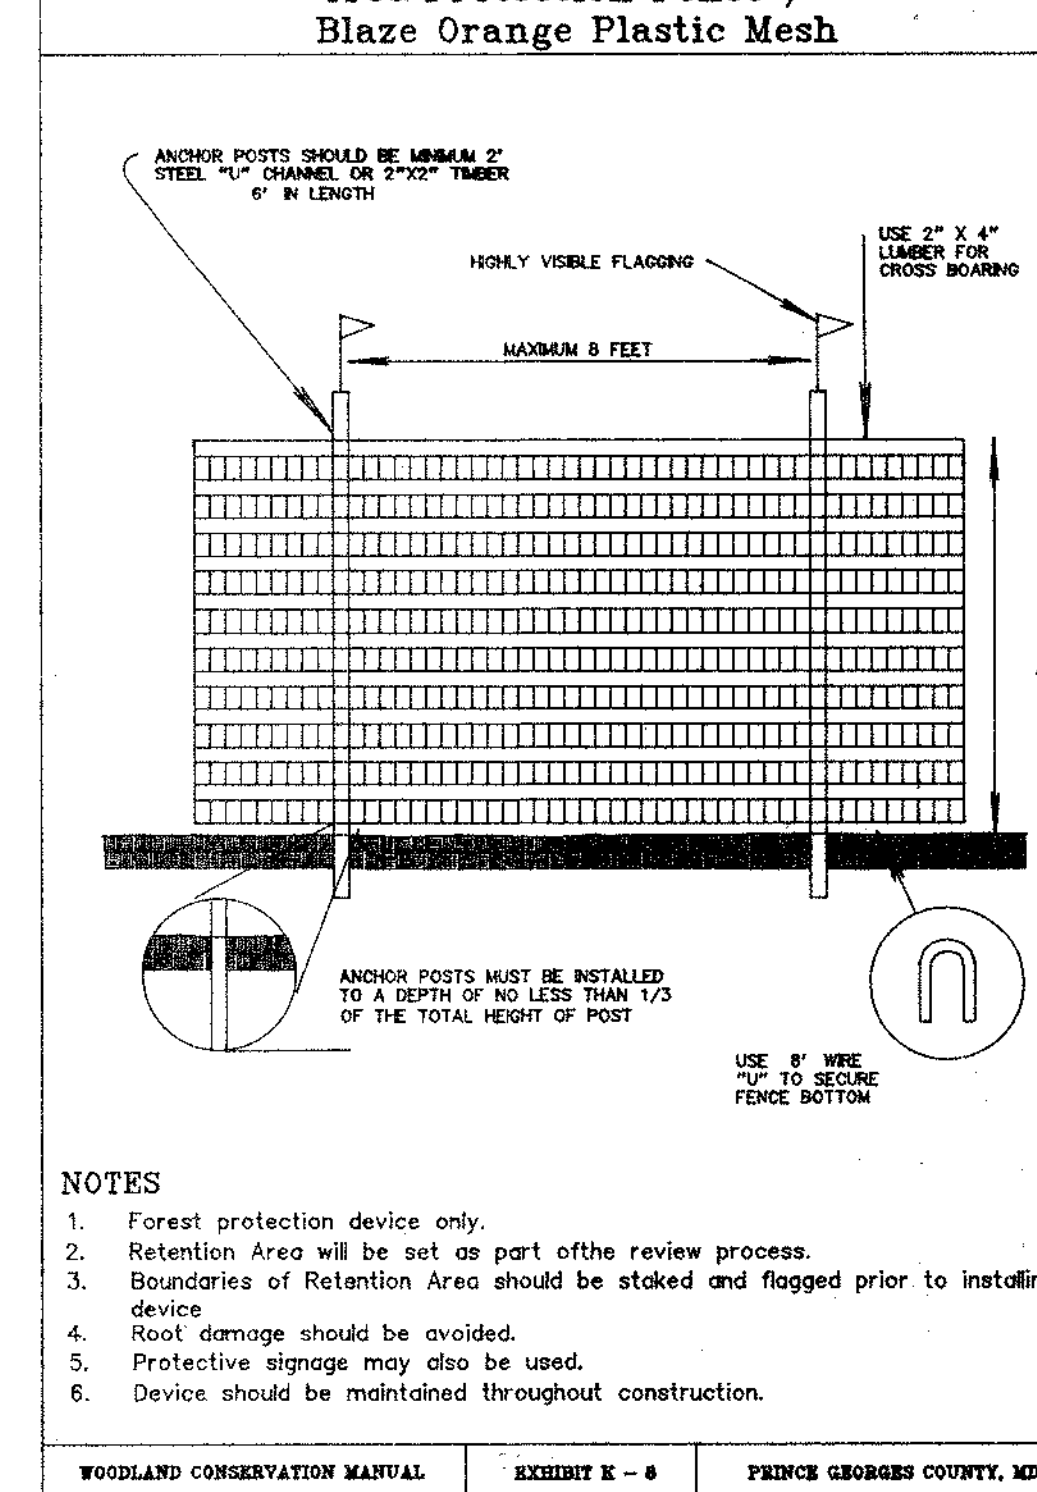

**Construction Specifications**


- Forest protection device only.
- Retention Area will be set as part of the review process.
- Boundaries of Retention Area should be staked and flagged prior to installing device.
- Root damage should be avoided.
- Protective signage may also be used.
- Device should be maintained throughout construction.

**NOTES**

- Anchor posts must be installed to a depth of no less than 1/3 of the total height of post.
- Anchor posts should be minimum 2" steel 1/2" diameter or 2"x2" timber 6" in length.
- Use 2" x 4" lumber for cross boarding.
- Use 8" wire UP to secure fence bottom.

**WOODLAND CONSERVATION MANUAL EXHIBIT K-6 PRINCE GEORGES COUNTY, MD**

#### Planting Specifications: Container Grown and Balled and Burlapped Stock

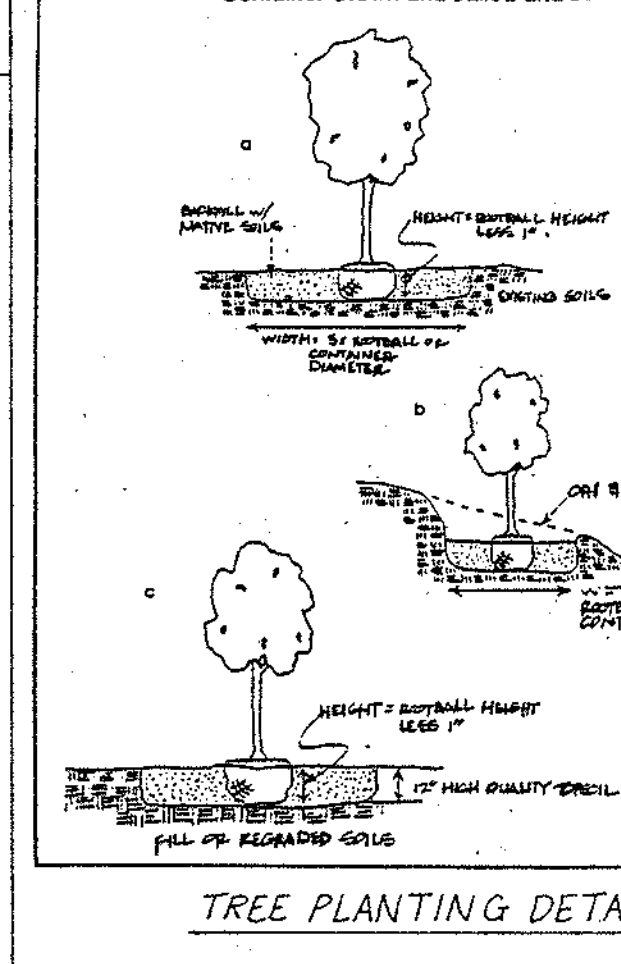

**TREE PLANTING DETAILS**

Remove covering from top of ball & place tree so that first lateral root is flush with grade


Remove top 1/3 of burlap from tree ball. Place tree in hole so that first lateral root is flush with grade. 3" Mulch

3" Soil Well

Planting Soil

**EVERGREEN TREE PLANTING DETAIL N.T.S.**

#### Staked Tree Specification

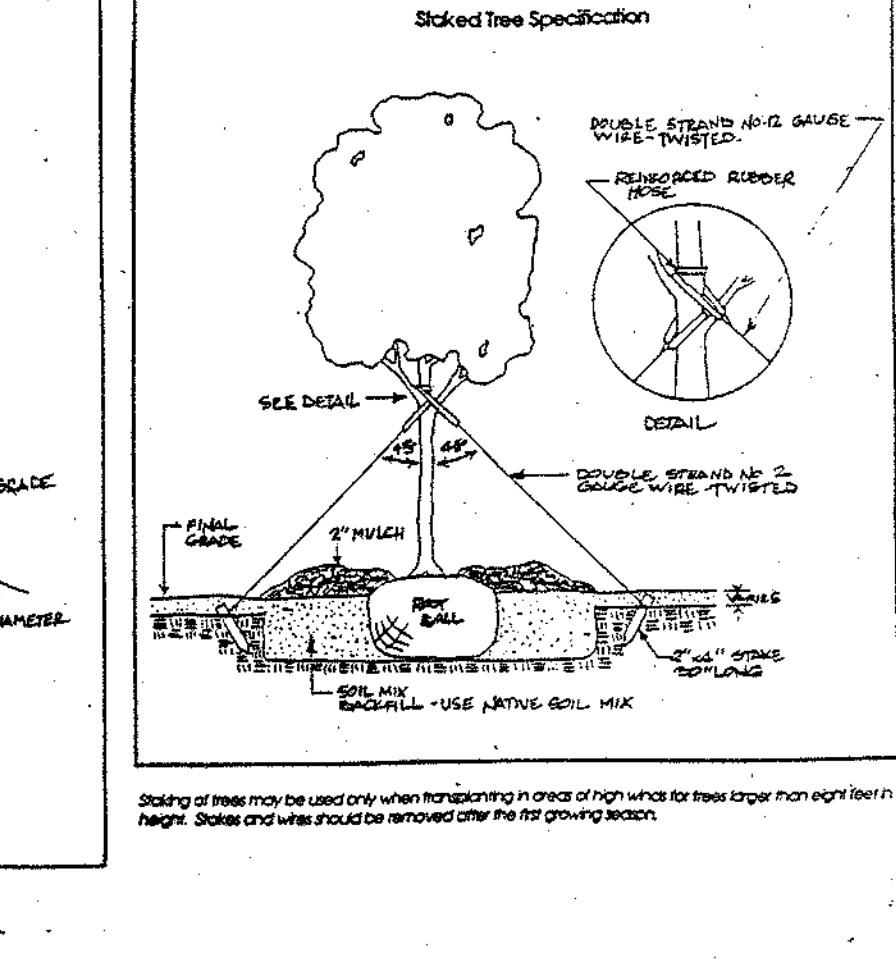

**DECIDUOUS TREE PLANTING DETAIL N.T.S.**


Provide tree stakes only if necessary.

Remove top 1/3 of burlap from tree ball. Place tree in hole so that first lateral root is flush with grade. 3" Mulch

3" Soil Well

Planting Soil

#### DETAIL 30 - EROSION CONTROL MATTING

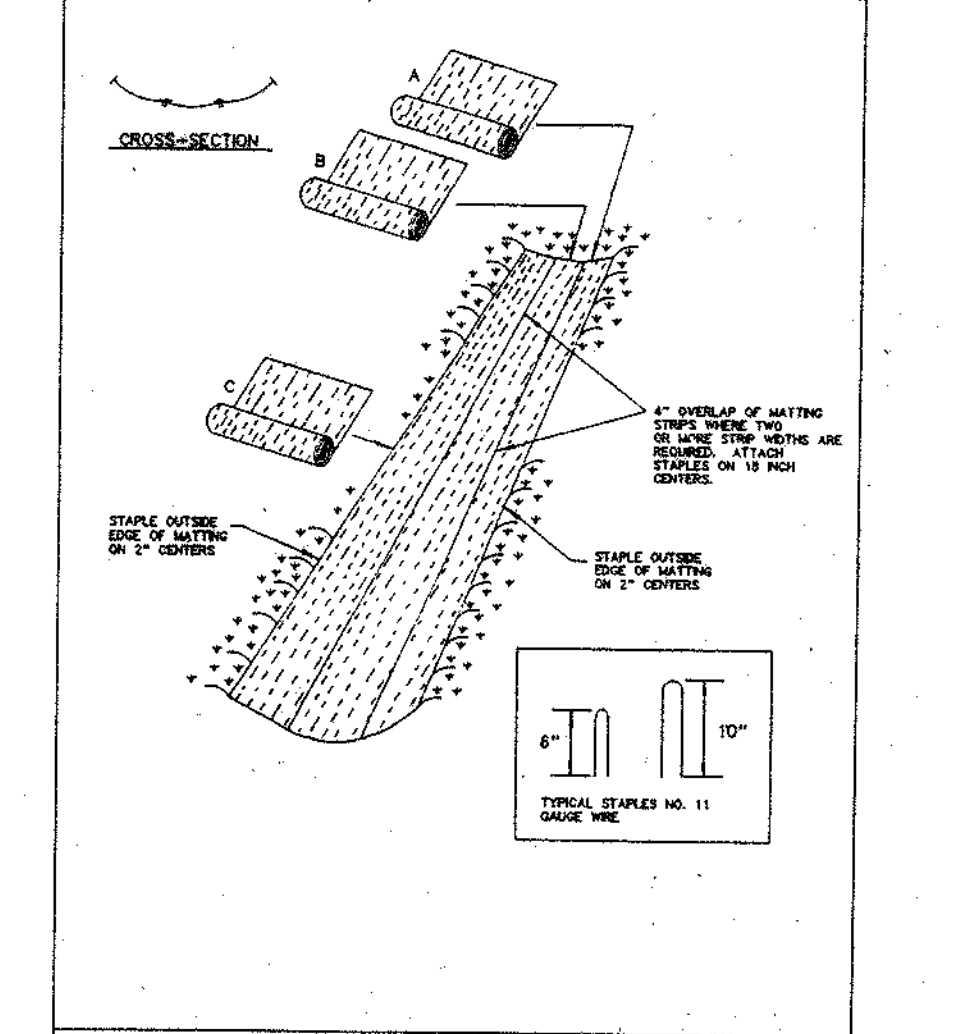

**Construction Specifications**


- Key-in the matting by placing the top ends of the matting in a narrow trench 6" in depth. Backfill the trench and tamp firmly to conform to the channel cross-section. Secure with a row of staples about 4" down slope from the trench. Spacing between staples is 2'. Staple the 4" overlap in the channel center using an 18" spacing between staples.
- Before stapling the outer edges of the matting, make sure the matting is smooth and in firm contact with the soil.
- Staples shall be placed 2' apart with 4 rows for each strip. 2 outer rows, and 2 alternating rows down the center.
- Where one roll of matting ends and another begins, the end of the top strip shall overlap the upper end of the lower strip by 4". Staple together. Reinforce the overlap with a double row of staples spaced with 2 double rows of staples.
- The discharge end of the matting liner should be similarly secured with a double row of staples.

**NOTE:** If flow will enter from the edge of the matting then the area indicated by the flow must be key-in.

**STANDARD SYMBOL**: SEC

U.S. DEPARTMENT OF AGRICULTURE SOIL CONSERVATION SERVICE      MARYLAND DEPARTMENT OF ENVIRONMENT WATER MANAGEMENT ADMINISTRATION

#### DETAIL 24 - STABILIZED CONSTRUCTION ENTRANCE

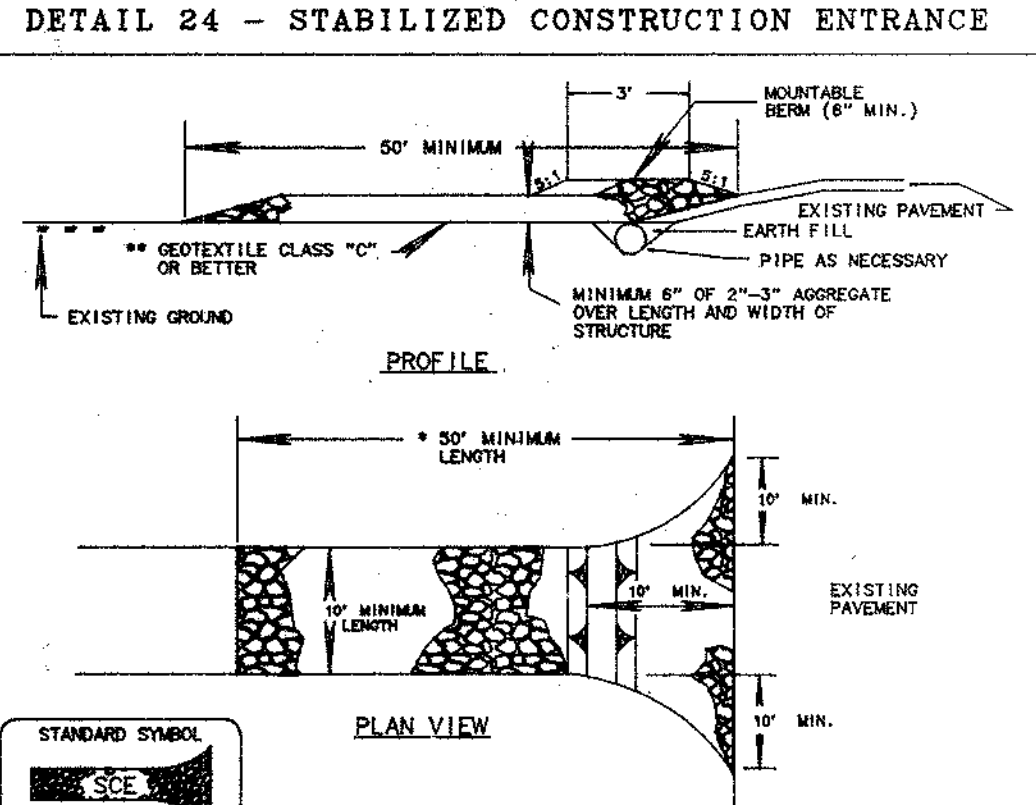

**Construction Specifications**

- Length - minimum of 50' (\*30' for single residence lot).
- Width - 10' minimum, should be flared at the existing road to provide a turning radius.
- Geotextile fabric (filter cloth) shall be placed over the existing ground prior to placing stone. \*The plan approval authority may not require single family residences.
- Stone - crushed aggregate (2" to 3") or reclaimed or recycled concrete equivalent shall be placed at least 6" deep over the length and width of the entrance.
- Surface Water - all surface water flowing to or diverted toward construction entrance shall be piped through the entrance, maintaining positive drainage. Pipe installed through the stabilized construction entrance shall be protected with a protective sleeve with 5:1 slopes and a minimum of 6" of stone over the pipe. Pipe has to be sized according to the drainage. When the SEC is located at a high spot and has no drainage to convey a pipe will not be necessary. Pipe should be sized according to the amount of runoff to be conveyed. A 6" minimum will be required.
- Location - A stabilized construction entrance shall be located at every point where construction traffic enters or leaves a construction site. Vehicles leaving the site must travel over the entire length of the stabilized construction entrance.

**STANDARD SYMBOL**: SEC

U.S. DEPARTMENT OF AGRICULTURE SOIL CONSERVATION SERVICE      MARYLAND DEPARTMENT OF ENVIRONMENT WATER MANAGEMENT ADMINISTRATION

#### 21.0 STANDARD AND SPECIFICATIONS FOR TOPSOIL

**Definition**

Placement of topsoil over a prepared subsoil prior to establishment of permanent vegetation.

**Purpose**

To provide a suitable soil medium for vegetative growth. Soils of concern have low moisture content, low nutrient levels, low pH, materials toxic to plants, and/or unacceptable soil gradation.

**Conditions Where Practice Applies**

- This practice is limited to areas having 2:1 or flatter slopes where:
  - The texture of the exposed subsoil/parent material is not adequate to grow native vegetation.
  - The soil material is so shallow that the rooting zone is not deep enough to support plants or furnish continuing supplies of moisture and plant nutrients.
  - The original soil to be vegetated contains material toxic to plant growth.
  - The soil is so acidic that treatment with limestone is not feasible.
- For the purpose of these Standards and Specifications, areas having slopes steeper than 2:1 require special consideration and design for adequate stabilization. Areas having slopes steeper than 2:1 shall have the appropriate stabilization shown on the plans.

**Construction and Material Specifications**

- Topsoil salvaged from the existing site may be used provided that it meets the standards as set forth in these specifications. Typically, the depth of topsoil to be salvaged for a given soil type can be found in the representative soil profile section in the Soil Survey published by USDA-NRCS in cooperation with Maryland Agricultural Experimental Station.
- Topsoil Specifications - Soil to be used as topsoil must meet the following:
  - Topsoil shall be a loam, sandy loam, clay loam, silt loam, sandy clay loam, loamy sand. Other soils may be used if recommended by an agronomist or soil scientist and approved by the appropriate approval authority. Regardless, topsoil shall not be a mixture of contrasting textured subsoils and shall contain less than 5% by volume of cinders, stones, slag, coarse fragments, gravel, sticks, roots, trash, or other materials larger than 1 1/2" in diameter.
  - Topsoil must be free of plants or plant parts such as bermuda grass, quackgrass, Johnsongrass, nutgrass, poison ivy, thistle, or other as specified.
  - Where the subsoil is either highly acidic or composed of heavy clays, ground limestone shall be spread at the rate of 4-8 tons/acre (200-400 pounds per 1,000 square feet) prior to the placement of topsoil. Lime shall be distributed uniformly over designated areas and worked into the soil in conjunction with tillage operations as described in the following procedures.
- For sites having disturbed areas under 5 acres:
  - Place topsoil (if required) and apply soil amendments as specified in 20.0 Vegetative Stabilization - Section 1 - Vegetative Stabilization Methods and Materials.

#### 21.1 STANDARD AND SPECIFICATIONS FOR TOPSOIL

**Definition**

Placement of topsoil over a prepared subsoil prior to establishment of permanent vegetation.

**Purpose**

To provide a suitable soil medium for vegetative growth. Soils of concern have low moisture content, low nutrient levels, low pH, materials toxic to plants, and/or unacceptable soil gradation.


**Conditions Where Practice Applies**

- This practice is limited to areas having 2:1 or flatter slopes where:
  - The texture of the exposed subsoil/parent material is not adequate to grow native vegetation.
  - The soil material is so shallow that the rooting zone is not deep enough to support plants or furnish continuing supplies of moisture and plant nutrients.
  - The original soil to be vegetated contains material toxic to plant growth.
  - The soil is so acidic that treatment with limestone is not feasible.
- For the purpose of these Standards and Specifications, areas having slopes steeper than 2:1 require special consideration and design for adequate stabilization. Areas having slopes steeper than 2:1 shall have the appropriate stabilization shown on the plans.

**Construction and Material Specifications**

- Topsoil salvaged from the existing site may be used provided that it meets the standards as set forth in these specifications. Typically, the depth of topsoil to be salvaged for a given soil type can be found in the representative soil profile section in the Soil Survey published by USDA-NRCS in cooperation with Maryland Agricultural Experimental Station.
- Topsoil Specifications - Soil to be used as topsoil must meet the following:
  - Topsoil shall be a loam, sandy loam, clay loam, silt loam, sandy clay loam, loamy sand. Other soils may be used if recommended by an agronomist or soil scientist and approved by the appropriate approval authority. Regardless, topsoil shall not be a mixture of contrasting textured subsoils and shall contain less than 5% by volume of cinders, stones, slag, coarse fragments, gravel, sticks, roots, trash, or other materials larger than 1 1/2" in diameter.
  - Topsoil must be free of plants or plant parts such as bermuda grass, quackgrass, Johnsongrass, nutgrass, poison ivy, thistle, or other as specified.
  - Where the subsoil is either highly acidic or composed of heavy clays, ground limestone shall be spread at the rate of 4-8 tons/acre (200-400 pounds per 1,000 square feet) prior to the placement of topsoil. Lime shall be distributed uniformly over designated areas and worked into the soil in conjunction with tillage operations as described in the following procedures.
- For sites having disturbed areas under 5 acres:
  - Place topsoil (if required) and apply soil amendments as specified in 20.0 Vegetative Stabilization - Section 1 - Vegetative Stabilization Methods and Materials.

### "AS-BUILT" SURVEY

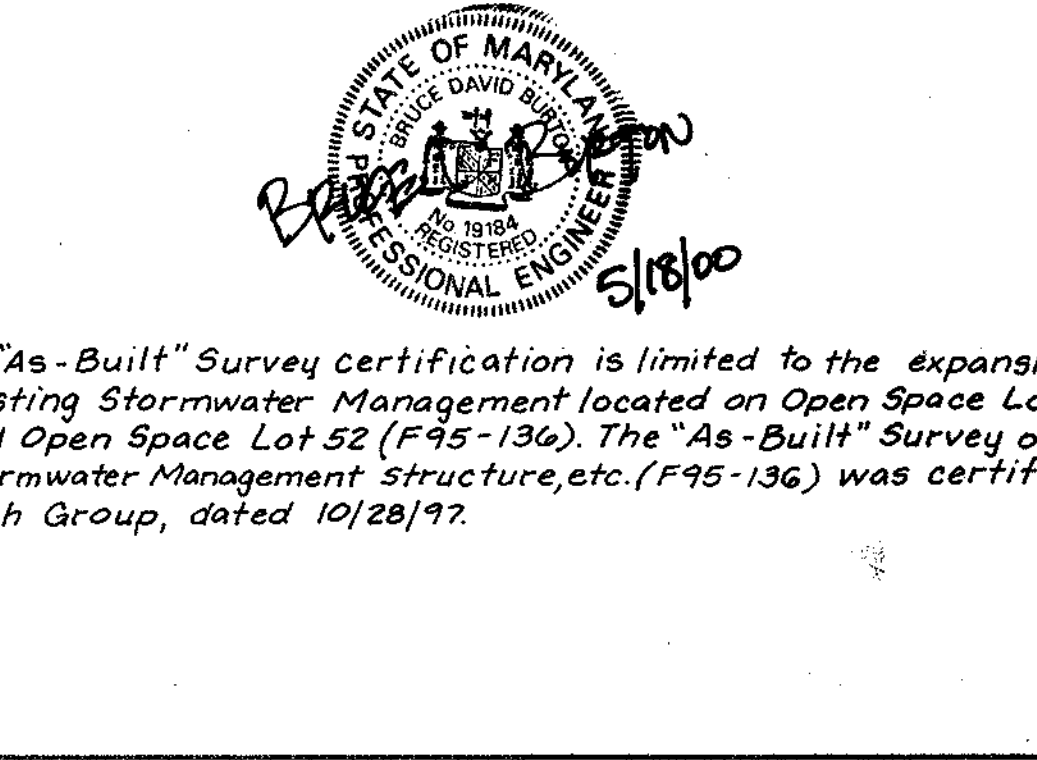

**NOTE:** The "As-Built" Survey Certification is limited to the expansion of the existing Stormwater Management located on Open Space Lot 8 (F99-141) and Open Space Lot 52 (F95-136). The "As-Built" Survey of the Stormwater Management Structure, etc. (F95-136) was certified by the Tech Group, dated 10/28/97.

**ENGINEER'S CERTIFICATE**

I HEREBY CERTIFY THAT THE DEVELOPMENT AND/OR CONSTRUCTION AND SEDIMENT CONTROL REPRESENTS A PRACTICAL SOLUTION BASED ON MY PERSONAL KNOWLEDGE OF THE SITE AND CONFORMANCE WITH REQUIREMENTS OF THE HOWARD SOIL CONSERVATION DISTRICT.

*Bruce*  
SIGNATURE OF ENGINEER  
DATE: 6/23/99

**DEVELOPER'S CERTIFICATE**

I/WE CERTIFY THAT ALL DEVELOPMENT AND/OR CONSTRUCTION WILL BE DONE ACCORDING TO THESE PLANS AND THAT ANY RESPONSIBLE PERSONNEL INVOLVED IN THE CONSTRUCTION PROJECT WILL HAVE A CERTIFICATE OF ATTENDANCE AT A DEPARTMENT OF THE ENVIRONMENT APPROVED TRAINING PROGRAM FOR THE CONTROL OF SOIL EROSION AND SEDIMENT BEFORE BEGINNING THE PROJECT. I ALSO AUTHORIZE PERIODIC ON-SITE INSPECTION BY THE HOWARD SOIL CONSERVATION DISTRICT OR THEIR AUTHORIZED AGENTS AS ARE DEEMED NECESSARY.

*Bruce*  
SIGNATURE OF DEVELOPER  
DATE: 6/23/99

**LDE, INC.**  
9250 Rumsey Road, Suite 106, Columbia, MD 21045  
(410) 715-1070 (301) 596-3424 (410) 715-9540 (Fax)

DESIGNED	E.D.S.	Soil Erosion and Sediment Control Details and Landscape Plan Details	SCALE	AS SHOWN
DRAWN	K.B.W.	<b>MONTGOMERY TOWNSHIP II</b> LOTS 1 THRU 8	SHEET	3 of 4
CHECKED	B.D.B.		JOB NO.	98-015
DATE	5/99		Tax Map # 37 BLOCK 1 P/O PARCEL NO 2 1ST ELECTION DISTRICT HOWARD COUNTY, MARYLAND Previous Submittals: 294-54, 2994-10, 3994-04, 495-136, 5994-02	FEE NO.

OWNER / DEVELOPER  
**WINTHORPE DEVELOPERS**  
HIGHLAND, MARYLAND 20777-0283

SCHEDULE C RESIDENTIAL DEVELOPMENT INTERNAL LANDSCAPING	
Number of Dwelling Units	7
Number of Trees Required (1:50 SFA; 1:3 DU APTS)	7
Number of Trees Provided	2 Shade 5 Evergreen
Shade Trees	Credit 1 Ex. Maple (Lot 7)
Other Trees (2:1 substitution)	


SCHEDULE D STORMWATER MANAGEMENT AREA LANDSCAPING	
Linear Feet of Perimeter	215 LF
Number of Trees Required	4 Shade 5 Evergreen
Shade Trees (1:50)	
Evergreen Trees (1:40)	
Credit for Existing Vegetation (Yes, No, and %)	No
Credit for Other Landscaping (Yes, No, and %)	No
Number of Trees Provided	3 Shade 15 Evergreen (#2)
Shade Trees	
Evergreen Trees	
Other Trees (2:1 substitution)	

SCHEDULE A PERIMETER LANDSCAPE EDGE		
Category	Adjacent to Roadways	Adjacent to Perimeter Properties
Landscape Type	C	C
Linear Feet of Roadway Frontage / Perimeter	130 LF	220 LF
Credit for Existing Vegetation (Yes, No, Linear Feet) (Describe below if needed)	No	No
Credit for Wall, Fence or Berm (Yes, No, Linear Feet) (Describe below if needed)	Yes, Berm	Yes, Fence* 170 LF
Number of Plants Required	3 Shade 7 Evergreen	6 Shade 11 Evergreen
Shade Trees (1:40)		
Evergreen Trees (1:20)		
Shrubs		
Number of Plants Provided	3 Shade 7 Evergreen	4 Shade* 11 Evergreen
Shade Trees		
Evergreen Trees		
Other Trees (2:1 substitution)		
Shrubs (10:1 substitution)		
(Describe plant substitution credits below if needed)		

SUBSTITUTION #1 - 70 Shrubs + 10\*7 Evergreens  
\* Relocate 150 LF of solid wood fence from 154.85' property line, installed by F95-136 at SWM Facility; add 20 LF of proposed solid wood fence to match existing.

**LEGEND**


- 440 --- EX. GROUND (10 FT. INTERVAL)
- 442 --- EX. GROUND (2 FT. INTERVAL)
- EX. SEWER
- EX. WATER
- EX. TREE LINE
- EX. TREES TO BE RETAINED
- PROPERTY LINE
- NON-TIDAL WETLANDS
- PROPOSED GRADE
- EX SPLIT RAIL FENCE
- PROP SPLIT RAIL FENCE
- 5 FT. TALL SOLID WOOD FENCE
- EX. SIDEWALK
- PROP. SIDEWALK

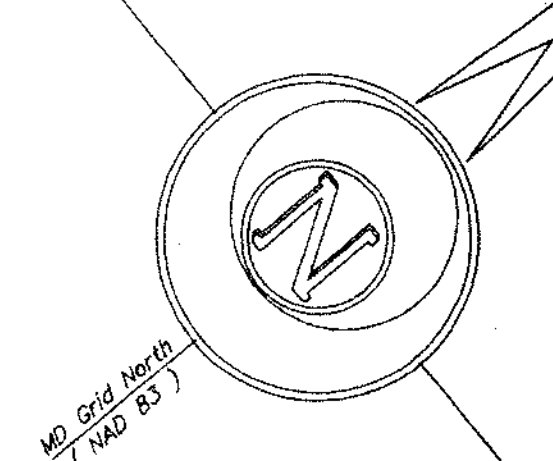


WATERLOO ROAD  
(Existing 100' R/W)  
Future 120' R/W

(MD. ROUTE 108)  
Future 120' R/W

20 EUONYMUS  
50 MISCANTHUS

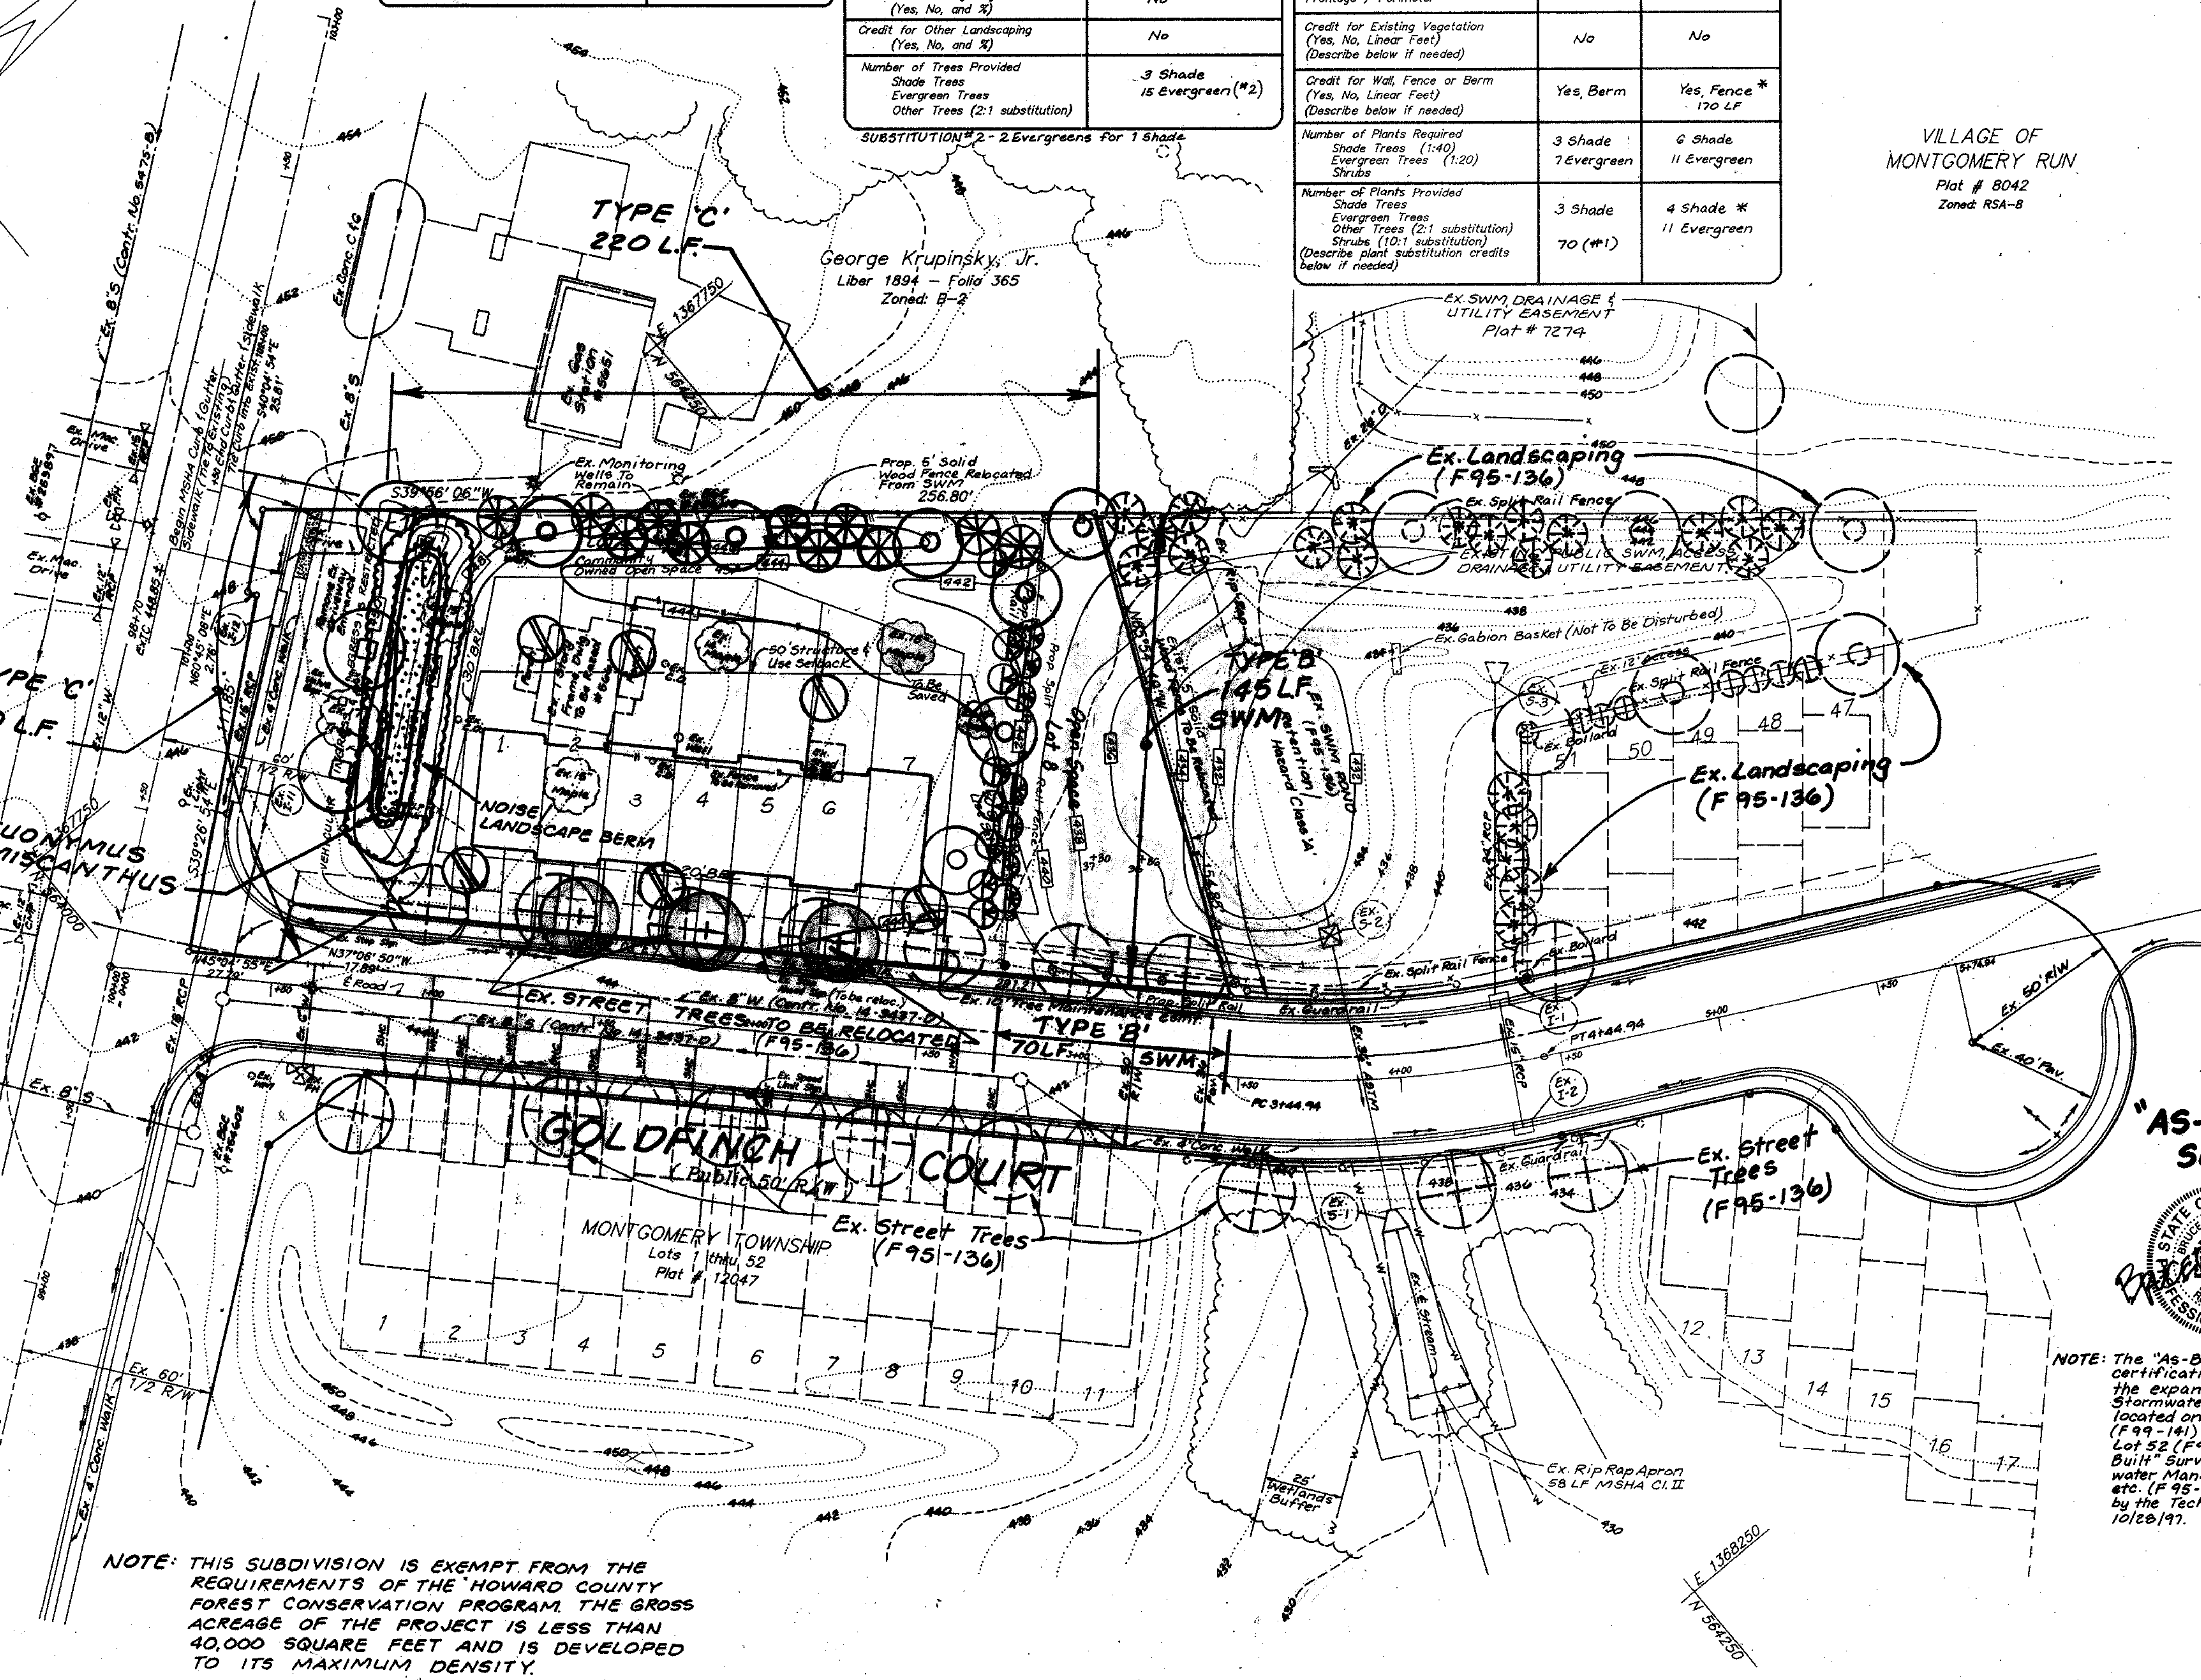

NOTE: THIS SUBDIVISION IS EXEMPT FROM THE REQUIREMENTS OF THE HOWARD COUNTY FOREST CONSERVATION PROGRAM. THE GROSS ACREAGE OF THE PROJECT IS LESS THAN 40,000 SQUARE FEET AND IS DEVELOPED TO ITS MAXIMUM DENSITY.

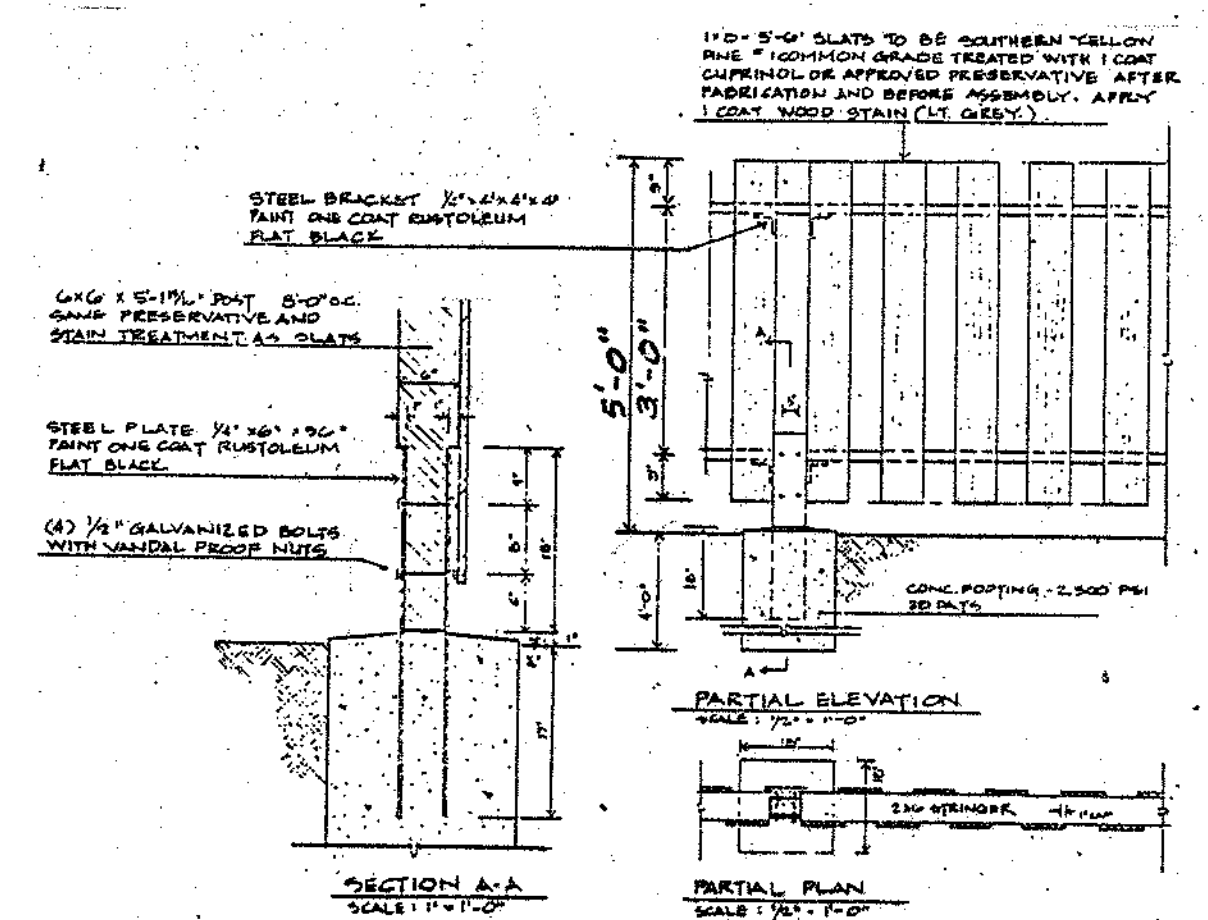

MONTGOMERY TOWNSHIP  
Lots 1 thru 52  
Plat # 12048

**GENERAL NOTES**

- This plan has been prepared in accordance with the provisions of Section 16.14 of the Howard County Code and Landscape Manual.
- The Developer is responsible for the selection of all plant material required to meet the standards established by the Howard County Landscape Manual.
- Financial Surety for the required landscaping will be posted as part of the Grading Permit, in the amount of \$10,250.00.

**PLANTING / STREET TREE NOTES**

- Notify "Miss Utility" 72 hours prior to installation of all plant material.
- Plant installation must conform to the minimum standards cited in the latest edition of Landscape Specification Guidelines, published by the Landscape Contractors Association.
- Plants to be located in the field by the owner or owner's representative. Notify owner 72 hours in advance of planting.
- A Certification of Landscape Installation is required as per the Howard County Landscape Ordinance.
- The number, size, location of plants shall not be changed without the approval of the Landscape Architect. Substitutions must be included in the recommended plant list in the Howard County Landscape Ordinance.
- Street tree locations may be adjusted for final location of driveways. The drive aprons may not allow the typical 1 per 40 foot requirement. Trees to be located a minimum of 10 feet from driveways.
- Street tree planting must conform to the Subdivision and Land Development Regulations and the Department of Public Works Design Manual of Howard County.
- Balls and burlapped plant material shall not be accepted if ball is created or broken before or during planting. Protect all plants from drying by either sun or wind.
- Tree pits shall be backfilled with 50% topsoil, 25% peat, 25% sand with one pound of 10-10-10 fertilizer per pit.
- Top soil shall be sandy loam soil free from noxious weeds or grasses, clay clumps, stones, sticks, etc. Peat moss shall be commercial with pH 4.5 to 5.5, free of woody material or harmful minerals.
- All plants shall be watered at planting with weekly watering thereafter for the first 90 days. Watering shall continue bi-monthly or as necessary to maintain plants in a healthy condition during the guarantee period.
- Maintain the site in an orderly manner. Streets and sidewalks shall be swept clean. All rejected or dead materials shall be immediately removed from the site.
- Plant material to be alive and healthy at the time of the guarantee period (one year), as specified in the Howard County Landscape Ordinance.
- Maintenance shall begin immediately after planting and continue to the end of guarantee period.
- Maintenance consist of pruning, watering, weeding, re-mulching, resetting plants, biological root inhibitor barrier or containment shall be installed for trees planted closer than 3 feet to sidewalk.
- Trees shall be placed 30 feet (min) from all signs and intersections when planting occurs between sidewalks & curb.
- Street trees may not be planted within 5 feet of drain inlets, 5 feet of an open space access strip and 10 feet of a driveway. There shall be a minimum of 20 feet between street lights and street trees.



NOTE: The "As-Built" Survey certification is limited to the expansion of the existing Stormwater Management located on Open Space Lot 8 (F99-141) and Open Space Lot 52 (F95-136). The "As-Built" Survey of the Stormwater Management structure, etc. (F95-136) was certified by the Tech Group, dated 10/28/97.

NOTE: REFER TO SHEET 3 OF 4 FOR LANDSCAPE PLAN DETAILS.

APPROVED: DEPARTMENT OF PLANNING AND ZONING

*[Signature]* 7/16/99  
DATE

*[Signature]* 7/15/99  
DATE

APPROVED: Department of Public Works for Storm Systems and Roads

*[Signature]* 7/15/99  
DATE

THESE PLANS HAVE BEEN REVIEWED FOR THE HOWARD SOIL CONSERVATION DISTRICT AND MEET THE TECHNICAL REQUIREMENTS.

*[Signature]* 6/30/99  
DATE

THE DEVELOPMENT PLAN IS APPROVED FOR SOIL EROSION AND SEDIMENT CONTROL BY THE HOWARD SOIL CONSERVATION DISTRICT.

*[Signature]* 6/30/99  
DATE

**ENGINEER'S CERTIFICATE**

"I HEREBY CERTIFY THAT THE EROSION AND SEDIMENT CONTROL REPRESENTS A PRACTICABLE AND FEASIBLE PLAN BASED ON MY PERSONAL KNOWLEDGE OF THE SITE AND THAT IT WAS PREPARED IN ACCORDANCE WITH REQUIREMENTS OF THE HOWARD SOIL CONSERVATION DISTRICT."

*[Signature]* 6/23/99  
DATE

**DEVELOPER'S CERTIFICATE**

"I/WE CERTIFY THAT ALL DEVELOPMENT AND/OR CONSTRUCTION WILL BE DONE ACCORDANCE WITH THE PLAN AND THAT ANY RESPONSIBILITY INCURRED IN THE CONSTRUCTION PROJECT WILL HAVE A CERTIFICATE OF ATTENDING AT THE DEPARTMENT OF THE ENVIRONMENT APPROVED TRAINING PROGRAM FOR THE CONTROL OF SOIL AND EROSION BEFORE BEGINNING THE PROJECT. I ALSO AUTHORIZE THE RESIDENTS TO BE INSPECTED BY THE HOWARD SOIL CONSERVATION DISTRICT OR THEIR AUTHORIZED AGENTS, AS DEEMED NECESSARY."

*[Signature]* 6/23/99  
DATE

STATE OF MARYLAND  
DAVID M. BURT  
PROFESSIONAL ENGINEER  
LICENSE NO. 10184

6/23/99

PLANT LIST					
No.	Key	Qty.	Plant Names	Size	Remarks
1	○	50	Miscanthus sinensis 'Gracillina Nano'	2'-2 1/2' ht.	40' x 6' or less shown
2	○	20	Dwarf Maiden Grass	1 gal. Container	12'-18" x 6'
TREE LIST					
1	○	7	Acer rubrum 'October Glory'	2 1/2" dbh	40' x 6' or less shown
2	○	11	October Glory Red Maple	2" dbh	12'-15' x 6'
3	○	15	Pinus strobus	1" dbh	10'-12' x 6'
4	○	3	Platanus x acerifolia 'Bloodgood'	2 1/2" dbh	40' x 6' or less shown
5	○	6	Acer saccharum 'Green Mountain'	2" dbh	As Shown

**LDE, INC.**  
9250 Rumsey Road, Suite 106, Columbia, MD. 21045  
(410) 715-1070 (301) 596-3424 (410) 715-9540 (Fax)

DESIGNED: E.D.S.  
DRAWN: K.B.W.  
CHECKED: B.D.B.  
DATE: 5/99

SCALE: 1" = 30'  
SHEET: 4 of 4  
JOB NO.: 98-015  
FILE NO.: F 99-141

LANDSCAPE PLANNING PLAN AND NOTES  
**MONTGOMERY TOWNSHIP II**  
LOTS 1 THRU 8  
Tax Map # 37 BLOCK 1 P/O PARCEL NO 2  
1ST ELECTION DISTRICT  
HOWARD COUNTY, MARYLAND  
Previous Submittals: 89A-04, 89B-04, 89C-04, 89D-04, 89E-04, 89F-04  
OWNER / DEVELOPER  
**WINTHORPE DEVELOPERS**  
P.O. BOX 883  
HIGHLAND, MARYLAND 20777-0883