
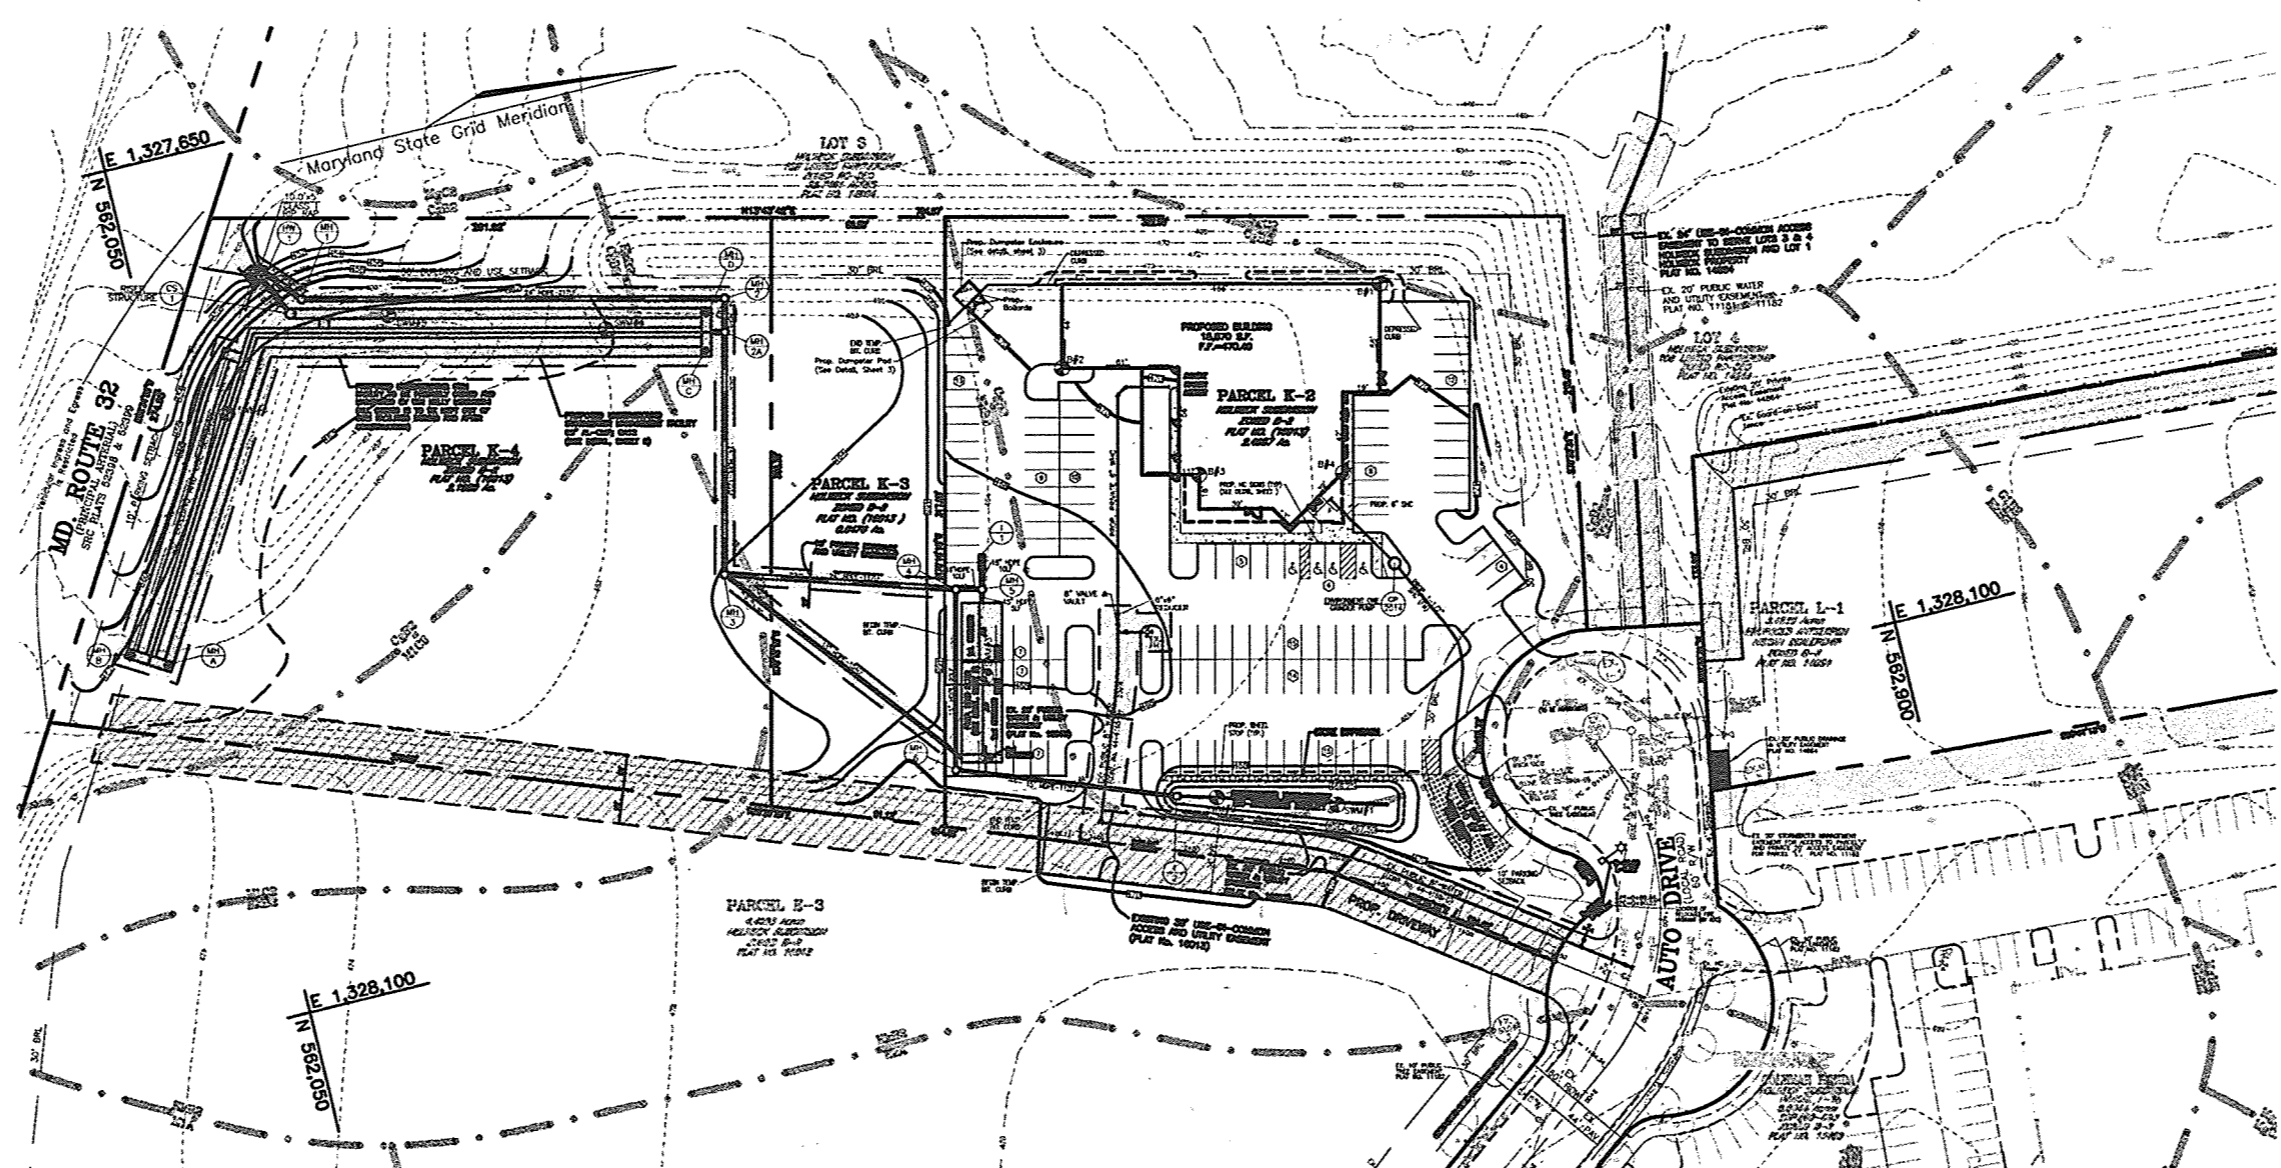


GENERAL NOTES

- 1. All construction shall be in accordance with the latest standards and specifications of Howard County plus MSHA standards and specifications, if applicable.
2. The contractor shall notify 'Miss Utility' at 1-800-257-7777 at least 48 hours prior to any excavation work.
3. The contractor is to notify the following utilities or agencies at least five days before starting work on these drawings:
Miss Utility 1-800-257-7777
Verizon Telephone Company: 1-410-954-6281
Howard County Bureau of Utilities: 313-2366
AT&T Cable Location Division: 393-3553
B.G.&E. Co. Contractor Services: 850-4620
B.G.&E. Co. Underground Damage Control: 787-4620
State Highway Administration: 531-5533
4. Site analysis:
Area of Parcel: 2.4987 Ac.
Present Zoning: B-2
Use of Structure: Auto Retail Sales & Service
Automobile Sales = 7629 sf.
Building Area: 21,887 sf.
Building Coverage On Site: 0.50 Ac. or 20% of Gross Area
Paved Parking Lot/Area On Site: 1.17 Ac. or 46.8% of Gross Area
Area of Landscape Island: .09 Ac. or 3.6% of Gross Area
Limit of Disturbed Area: 208,350 sf. or 4.78 Ac.
5. Project background:
Location: Clarksville, Md.; Tax Map 34, K-2
Zoning: B-2
Subdivision: Holweck Subdivision
Section/Area: N/A
Site Area: 2.4987 Ac.
DPZ references: F-94-38; F-98-144; F-99-205; SP-93-14; WP-93-90; ZB-947M; ZB-1008M; F-01-29; WP-03-41; F-03-202
6. The contractor shall notify the Department of Public Works/Bureau of Engineering/Construction Inspection Division at (410) 313-1880 at least five (5) working days prior to start of work.
7. Any damage to public right-of-ways, paving, or existing utilities will be corrected at the contractor's expense.
8. Existing utilities located from Road Construction Plans, Field Surveys, Public Water and Sewer Extension Plans and available record drawings. Approximate location of existing utilities are shown for the contractors information. Contractor shall locate existing utilities well in advance of construction activities and take all necessary precautions to protect the existing utilities and to maintain uninterrupted service. Any damage incurred due to contractor's operation shall be repaired immediately at the contractor's expense.
9. All reinforced concrete for storm drain structures shall have a minimum of 28 days strength of 3,500 p.s.i.
10. Traffic control devices, markings and signing shall be in accordance with the latest edition of the Manual on Uniform Traffic Control Devices (MUTCD). All street and regulatory signs shall be in place prior to the placement of any asphalt.
11. Estimates of earthwork quantities are provided solely for the purpose of calculating fees.
12. Soil compaction specifications, requirements, methods and materials are to be in accordance with the recommendations of the project Geotechnical Engineer. Geotechnical Engineer to confirm acceptability of proposed paving section, based on soil test prior to construction.
13. All storm drain pipe bedding shall be Class 'C'.
14. The existing topography is taken from field run survey with two foot contour intervals prepared by Frederick Ward and Associates, dated May 24, 2001. The coordinates shown hereon are based upon the Howard County Geocentric Control which is based upon the Maryland State Plane Coordinate System.
15. A noise study is not required for this project.
16. All paving to be minimum Howard County Standard Detail P-2 unless otherwise noted. (See details, sheet 5)
17. All curb and gutter to be Detail 3.01 unless otherwise noted. (See detail, sheet 5)
18. Contractor responsible to construct all handicap ramps and handicap access in accordance with current ADA requirements.
19. Where drainage flows away from curb, contractor to reverse the gutter pan.
20. All elevations are to flowline/bottom of curb unless otherwise noted.
21. All dimensions are to face of curb unless otherwise noted.
22. Public water is available through Contract No. 39-3942-D.
Public sewer is available through Contract No. 39-3942-D.
23. Stormwater management quantity is provided by the proposed underground detention system. Water quality is proposed by a bio-retention system, and an underground sand filter structure. The proposed SWM systems and water quality system are to be privately owned and maintained by Win Kelly Mitsubishi.
24. All exterior lighting to conform to section 134 of the Howard County Zoning Regulations. (Detail on Sheet 3)
25. Building to have inside water meter setting.
26. Traffic impact study prepared by Street Traffic Studies, LTD., dated March 20, 2003. APFO Study approval date April 29, 2003.
27. This plan has been prepared in accordance with the provisions of Section 16.124 of the Howard County Code and Landscape Manual.
28. Any existing street trees damaged or destroyed during construction will be replaced by the contractor.
29. Forest Conservation requirements for Parcel K-1 are provided in conjunction with F-01-029.
30. Financial surety for the required landscaping shall be posted as part of the developer's agreement in the amount of \$12,360.00 for 23 shade trees, 26 evergreen trees, and 42 shrubs.
31. No mezzanine level or second story is permitted in the building unless adequate parking has been approved by the Department of Planning and Zoning.
32. Reference ZB 947M and ZB 1008M for zoning cases for this site:
A) ZB 947M:
1. Date of approval for Decision and Order: March 11, 1994
a. Action Taken: Rezone part of property from B-2 to R-C and R-c to B-2
2. Conditions of approval: A 300' private easement buffer area between the zoned B-2 use on lot 4 and the existing residential house on lot 3.
B) ZB 1008M:
1. Date of approval for Decision and Order: December 4, 2000
a. Action Taken: Rezone part of Parcel 'L' from B-2 to RC.
2. Conditions of approval: No conditions of approval were specified.
33. Debris is to be kept out of all stormwater management facilities during and after construction.
34. Adjoining Parcel E-2 was the subject of WP-03-41, which allowed a temporary sales trailer to be established. A condition of approval required that within 180 days of signature approval of a site plan for Parcel K-1, the temporary use on Parcel E-2 must be vacated and all improvements removed.
35. Geotechnical report prepared by Specialized Engineering, dated January 17, 2003.
36. THE SWM REQUIREMENTS FOR REDLINE #3 HAS BEEN PROVIDED BY A MICRO-BIORETENTION (M-6) FACILITY, SWM # 3 TO BE PRIVATELY OWNED AND MAINTAINED.

BENCHMARKS
Howard County Station 34C2 (Destroyed)
N 562,321.798 E 1,329,750.722
Updated: Station 0044 N 562,176.474 E 1,329,641.868 Elev: 485.252'
Howard County Station 0013
N 564,285.946 E 1,331,309.715 Elev: 484.671'


SITE DEVELOPMENT PLAN
COLEMAN LANDROVER/JAGUAR

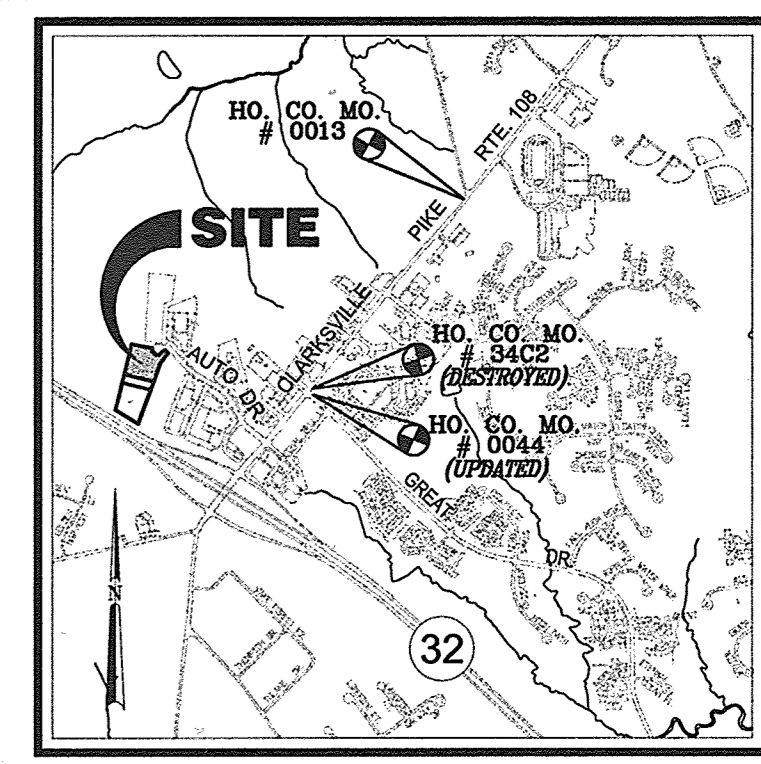


APPENDIX B-4 C SPECIFICATIONS FOR MICRO-BIORETENTION, RAIN GARDEN, LANDSCAPE INFILTRATION & INFILTRATION BERMS
1. MATERIAL SPECIFICATIONS
THE ALLOWABLE MATERIALS TO BE USED IN THESE PRACTICES ARE DETAIL IN TABLE B-4.1.
2. FILTERING MEDIA OR PLANTING SOIL
THE SOIL SHALL BE A SIFTED AND FREE OF ROOTS, STUMPS, BOOTS OR OTHER SIMILAR OBJECTS LARGER THAN TWO INCHES. THE SOIL SHALL BE A SIFTED AND FREE OF ROOTS, STUMPS, BOOTS OR OTHER SIMILAR OBJECTS LARGER THAN TWO INCHES. THE SOIL SHALL BE A SIFTED AND FREE OF ROOTS, STUMPS, BOOTS OR OTHER SIMILAR OBJECTS LARGER THAN TWO INCHES.

LEGEND:
EXISTING CONTOUR
PROPOSED CONTOUR
PROPOSED SPOT ELEVATION
EXISTING SPOT ELEVATION
EXISTING CURB AND GUTTER
PROPOSED CURB AND GUTTER
EXISTING GUTTER LINE
EXISTING UTILITY POLE
EXISTING UTILITY POLE
EXISTING LIGHT POLE
EXISTING MAILBOX
EXISTING SIGN
EXISTING BOLLARD
EXISTING SANITARY MANHOLE
EXISTING SANITARY LINE
EXISTING CLEANOUT
EXISTING FIRE HYDRANT
EXISTING WATER LINE
EXISTING SD MANHOLE
EXISTING STORM DRAIN
PROPOSED STORM DRAIN INLET
EXISTING TREES (FIELD LOCATED)
EXISTING TREELINE (FIELD LOCATED)
EXISTING VEGETATION (APPROXIMATE LOCATION)
EXISTING FENCE
PROPERTY LINE
RIGHT-OF-WAY LINE
SOILS BOUNDARY
SILT FENCE
SUPER SILT FENCE
LIMIT OF DISTURBANCE
EXISTING PAVING TO BE REMOVED AND REPLACED
PROPOSED P-2 PAVING
AT GRADE INLET PROTECTION
PROPOSED SIDEWALK
STABILIZED CONSTRUCTION ENTRANCE
PROP. ELECTRIC VEHICLE SPACE
PROP. ELECTRIC CHARGING STATION

LOCATION MAP
SCALE: 1" = 100'

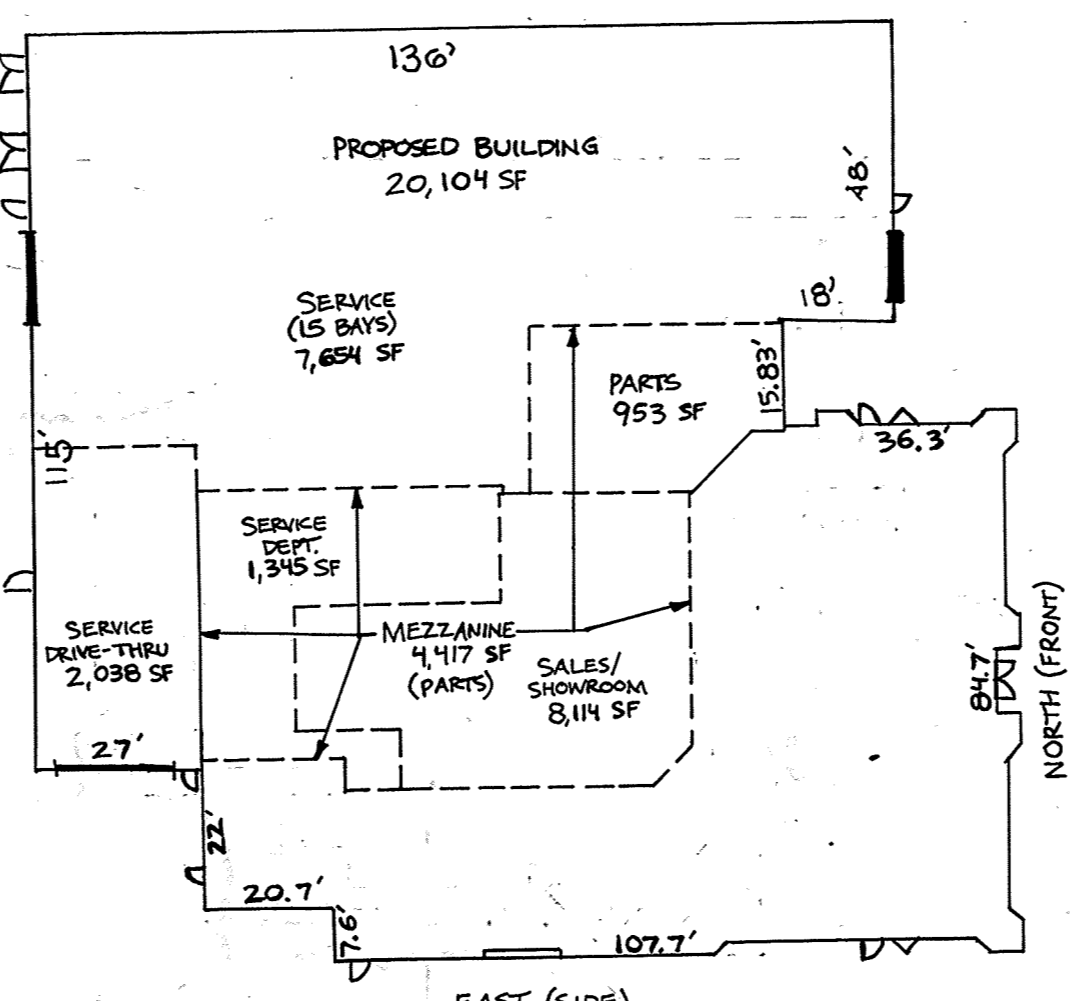

PROPOSED BUILDING PLAN VIEW
1" = 30'

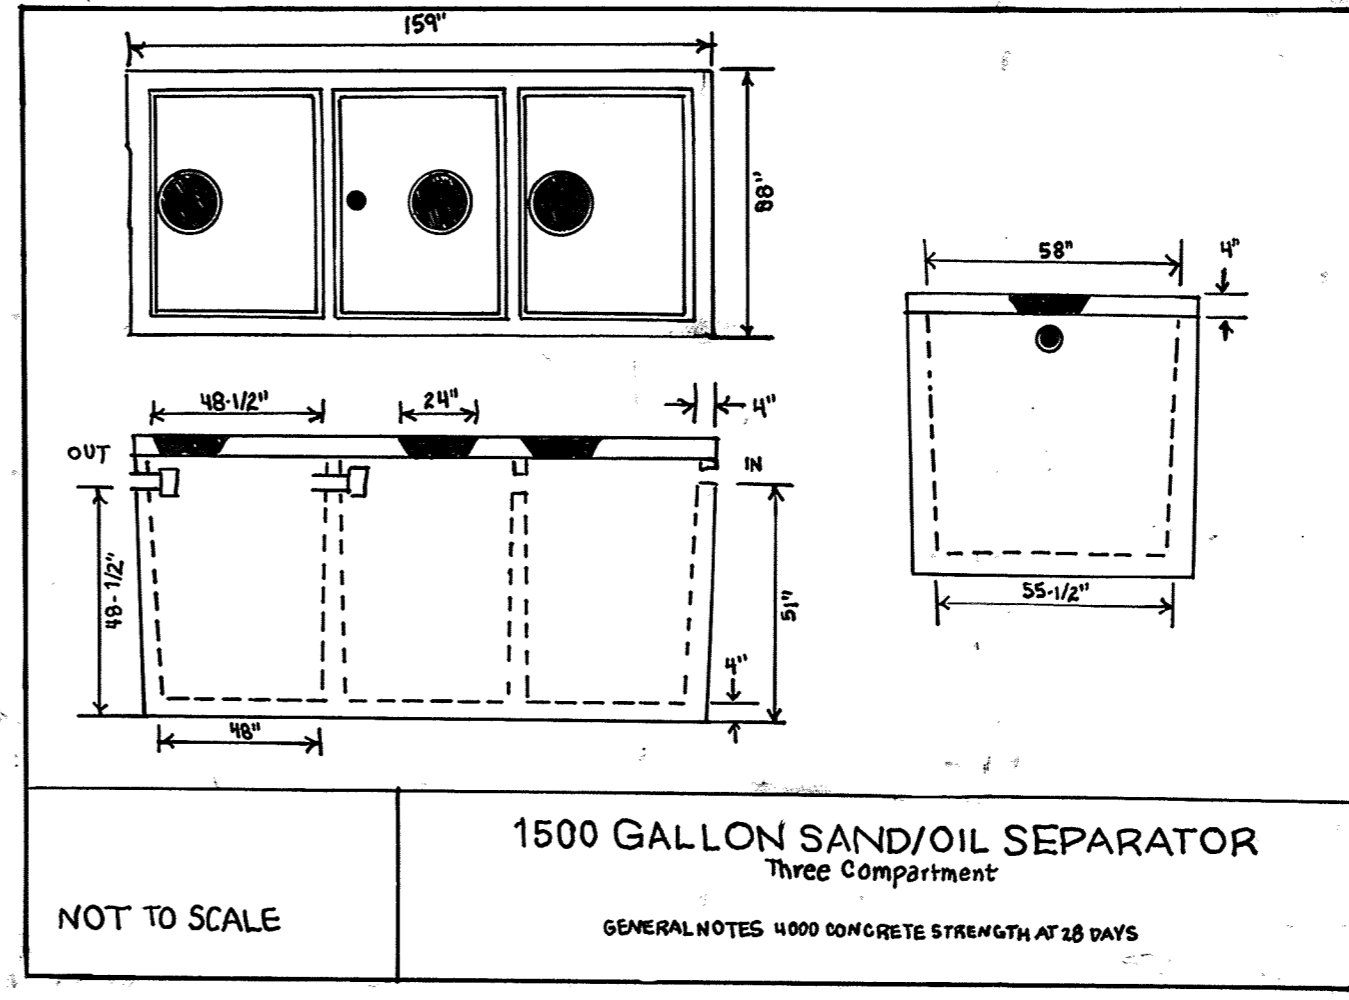

SHEET INDEX
DESCRIPTION SHEET NO.
Cover Sheet 1 of 7
Site Development, Grading, and Sediment and Erosion Control Plan 2 of 7
Sediment and Erosion Control Notes and Details 3 of 7
Storm Drain Drainage Area Map, Storm Drain Profiles and Details 4 of 7
Stormwater Management Notes and Details, Water and Sewer Profiles and Details 5 of 7
Stormwater Management Notes and Details 6 of 7
Landscape Plan 7 of 7

ADDRESS CHART
LOT/PARCEL# K-2
STREET ADDRESS 12500 NEW CAR DRIVE
PERMIT INFORMATION CHART
SUBDIVISION NAME HOLWECK SUBDIVISION
SECTION/AREA N/A
PARCEL NUMBER K-2, K-3, K-4
PLAT REF. 16013 BLOCK NO. 6 ZONE B2 TAX/ZONE 34 ELECT. DIST. 5th CENSUS TR. 6051
WATER CODE: 110 SEWER CODE: 665300

APPROVED: HOWARD COUNTY DEPARTMENT OF PLANNING AND ZONING
Chief, Development Engineering Division 12/2/03
Chief, Division of Land Development 12/17/03
Director 12/22/03

PARKING TABULATION
AUTOMOBILE DISPLAY: 6,849 SF
SALES/OFFICE: 8,114 SF (INCLUDING MEZZANINE)
SERVICE BAYS: 15 BAY AUTOMOBILE SERVICE AREA
SAND/OIL SEPARATOR: 3 SPACES/SERVICE BAY
TOTAL SPACES: 69 SPACES REQUIRED, 75 SPACES PROVIDED

REVISIONS
REV# DATE DESCRIPTION
3 5-27-00 REVISE THE PLAN TO REFLECT ADDITION OF A 2,526 SF SHOWROOM, ADDITION OF 1,620 SF OF NEW PAVEMENT AND ADDITIONAL SITE MODIFICATIONS
2 10/24/05 REVISE SAND FILTER; REVISE WHC; ADD SAND/OIL SEPARATOR; REVISE VEHICLE DISPLAY AREAS
1 05/28/05 REVISE BUILDING FOOTPRINT, RESURFACE DRIVEWAYS, CURBS AND PROTECT DRIVE CHANGES


OWNER/DEVELOPER
1318 COMPANY LLC
10400 AUTO PARK DRIVE
BETHESDA, MD 20817

VOGEL ENGINEERING
TIMMONS GROUP
3300 NORTH RIDGE ROAD, SUITE 110, ELLICOTT CITY, MD 21043

FREDERICK WARD ASSOCIATES, INC.
7125 RIVERWOOD DRIVE, COLUMBIA, MARYLAND 21046-2354
ARCHITECTS ENGINEERS PLANNERS SURVEYORS

(REVISED) SITE DEVELOPMENT PLAN
COVER SHEET
COLEMAN LANDROVER/JAGUAR
TAX MAP #34 BLOCK #6
5TH ELECTION DISTRICT
HOWARD COUNTY, MARYLAND

STATE OF MARYLAND
REGISTERED PROFESSIONAL ENGINEER
DATE SEPT 2003
SCALE JAN. 2003
DESIGN BY MMR
CHECKED BY RHV
DRAWN BY DZ
DRAWING NO. 2024096.00
SDP-03-93

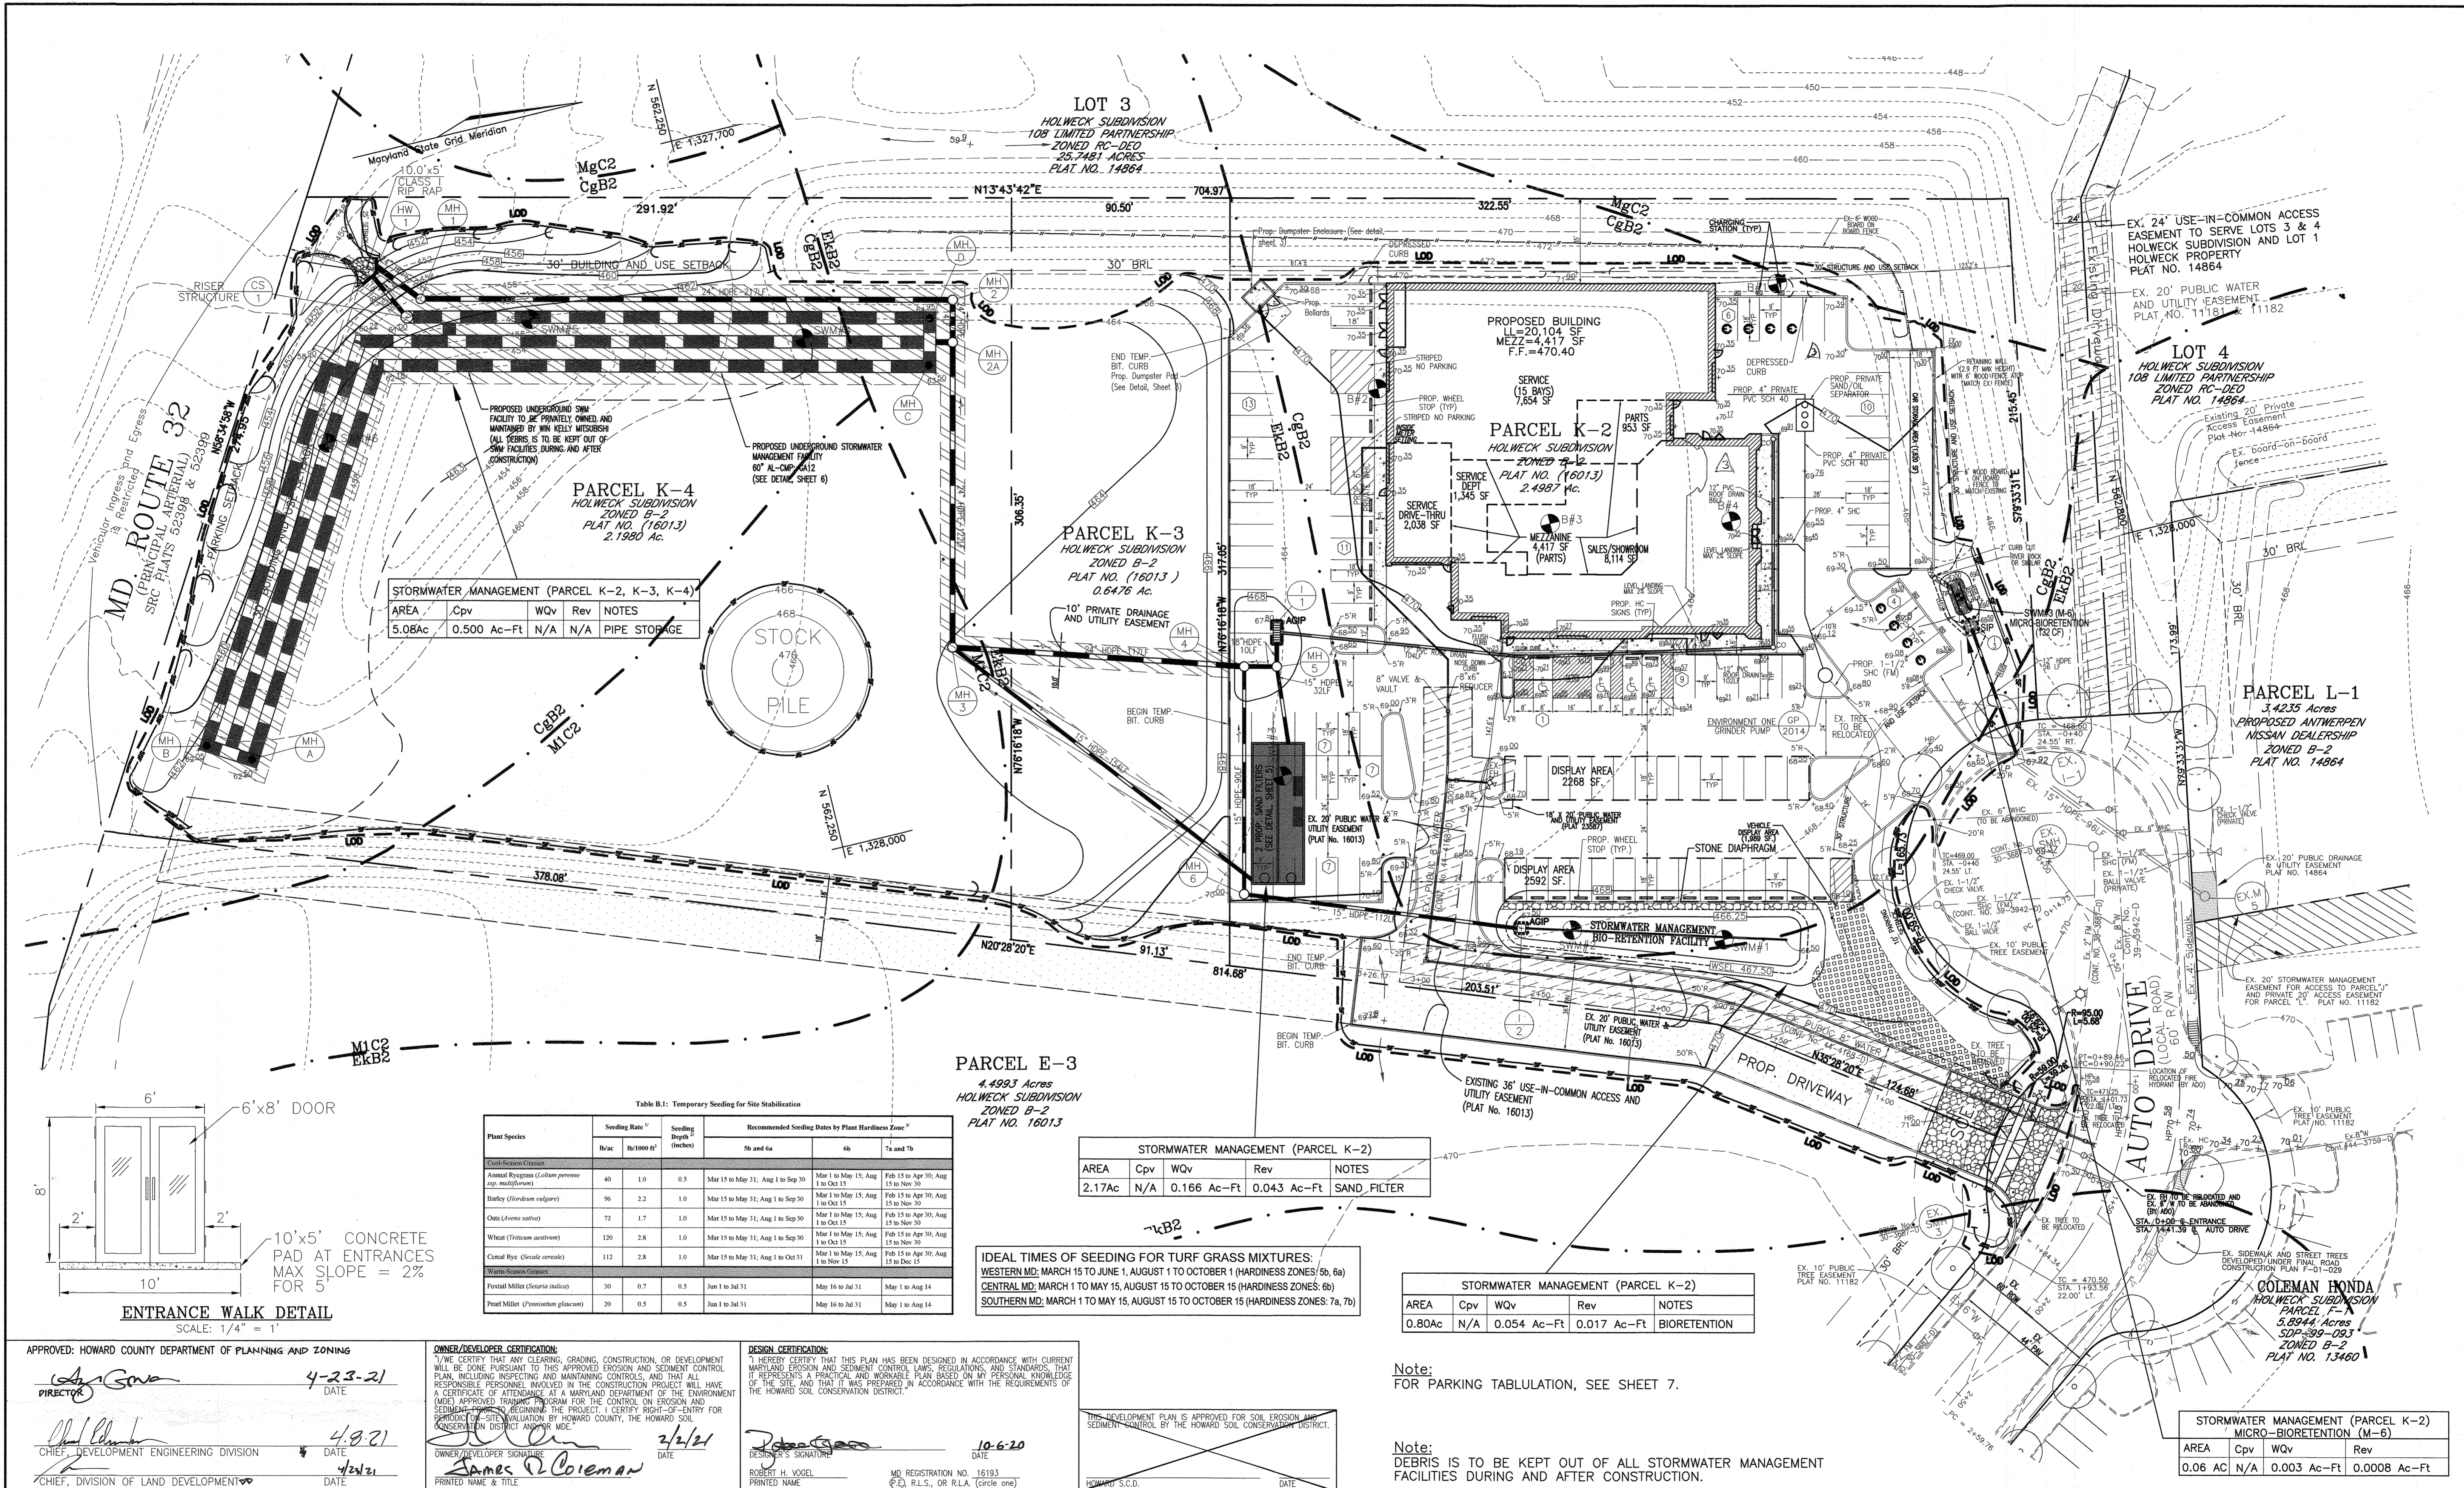

STORMWATER MANAGEMENT (PARCEL K-2, K-3, K-4)

AREA	Cpv	WQv	Rev	NOTES
5.08Ac	0.500 Ac-Ft	N/A	N/A	PIPE STORAGE

STORMWATER MANAGEMENT (PARCEL K-2)

AREA	Cpv	WQv	Rev	NOTES
2.17Ac	N/A	0.166 Ac-Ft	0.043 Ac-Ft	SAND FILTER

STORMWATER MANAGEMENT (PARCEL K-2)

AREA	Cpv	WQv	Rev	NOTES
0.80Ac	N/A	0.054 Ac-Ft	0.017 Ac-Ft	BIORETENTION

STORMWATER MANAGEMENT (PARCEL K-2) MICRO-BIORETENTION (M-6)

AREA	Cpv	WQv	Rev
0.06 AC	N/A	0.003 Ac-Ft	0.0008 Ac-Ft

PARCEL E-3
4.4993 Acres
HOLWECK SUBDIVISION
ZONED B-2
PLAT NO. 16013

IDEAL TIMES OF SEEDING FOR TURF GRASS MIXTURES:
WESTERN MD: MARCH 15 TO JUNE 1, AUGUST 1 TO OCTOBER 1 (HARDINESS ZONES: 5b, 6a)
CENTRAL MD: MARCH 1 TO MAY 15, AUGUST 15 TO OCTOBER 15 (HARDINESS ZONES: 6b)
SOUTHERN MD: MARCH 1 TO MAY 15, AUGUST 15 TO OCTOBER 15 (HARDINESS ZONES: 7a, 7b)

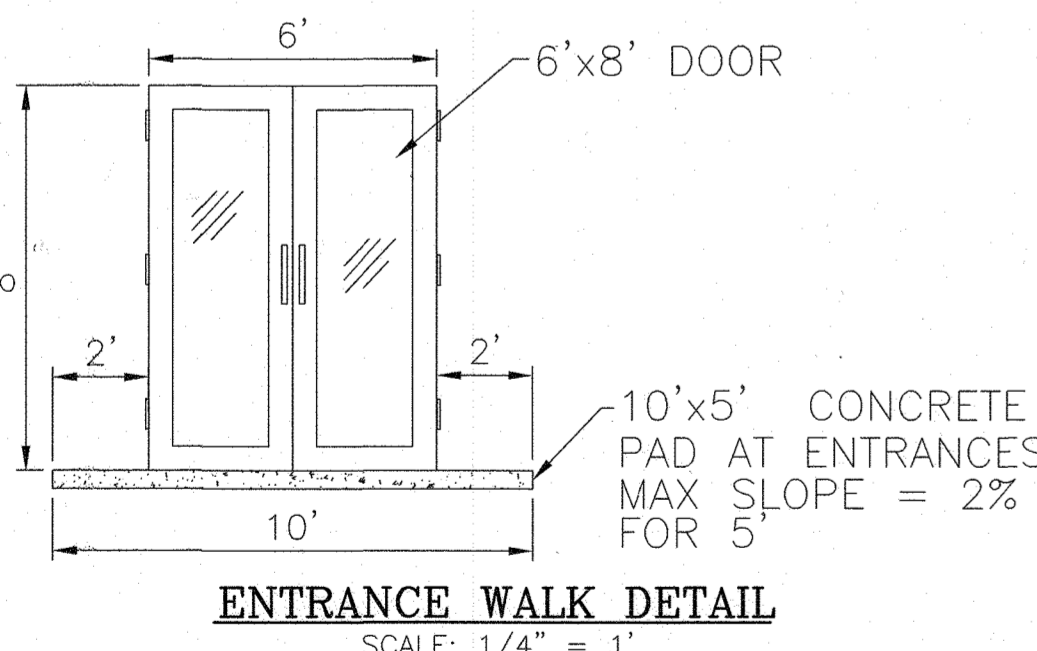


Table B.1: Temporary Seeding for Site Stabilization

Plant Species	Seeding Rate ¹		Recommended Seeding Dates by Plant Hardiness Zone ²		
	lb/ac	lb/1000 ft ²	5b and 6a	6b	7a and 7b
Coast-Season Grasses					
Annual Ryegrass (<i>Lolium perenne</i> spp. multiflorum)	40	1.0	Mar 15 to May 31; Aug 1 to Sep 30	Mar 1 to May 15; Aug 1 to Oct 15	Feb 15 to Apr 30; Aug 15 to Nov 30
Barley (<i>Lolium vulgare</i>)	96	2.2	Mar 1 to May 31; Aug 1 to Sep 30	Mar 1 to May 15; Aug 1 to Oct 15	Feb 15 to Apr 30; Aug 15 to Nov 30
Oats (<i>Avena sativa</i>)	72	1.7	Mar 15 to May 31; Aug 1 to Sep 30	Mar 1 to May 15; Aug 1 to Oct 15	Feb 15 to Apr 30; Aug 15 to Nov 30
Wheat (<i>Triticum aestivum</i>)	120	2.8	Mar 15 to May 31; Aug 1 to Sep 30	Mar 1 to May 15; Aug 1 to Oct 15	Feb 15 to Apr 30; Aug 15 to Nov 30
Creole Ryegrass (<i>Lolium perenne</i>)	112	2.8	Mar 15 to May 31; Aug 1 to Oct 31	Mar 1 to May 15; Aug 1 to Nov 15	Feb 15 to Apr 30; Aug 15 to Dec 15
Perennial Ryegrass (<i>Lolium perenne</i>)	30	0.7	Jun 1 to Jul 31	May 16 to Jul 31	May 1 to Aug 14
Perennial Ryegrass (<i>Lolium perenne</i>)	30	0.5	Jun 1 to Jul 31	May 16 to Jul 31	May 1 to Aug 14

APPROVED: HOWARD COUNTY DEPARTMENT OF PLANNING AND ZONING

[Signature] 4-23-21
DIRECTOR DATE

[Signature] 4-8-21
CHIEF, DEVELOPMENT ENGINEERING DIVISION DATE

[Signature] 4/21/21
CHIEF, DIVISION OF LAND DEVELOPMENT DATE

OWNER/DEVELOPER CERTIFICATION:
I/WE CERTIFY THAT ANY CLEARING, GRADING, CONSTRUCTION, OR DEVELOPMENT WILL BE DONE PURSUANT TO THIS APPROVED EROSION AND SEDIMENT CONTROL PLAN, INCLUDING INSPECTING AND MAINTAINING CONTROLS, AND THAT ALL RESPONSIBLE PERSONNEL INVOLVED IN THE CONSTRUCTION PROJECT WILL HAVE A CERTIFICATE OF ATTENDANCE AT A MARYLAND DEPARTMENT OF THE ENVIRONMENT (MDE) APPROVED TRAINING PROGRAM FOR THE CONTROL OF EROSION AND SEDIMENTATION BEGINS THE PROJECT. I CERTIFY RIGHT-OF-ENTRY FOR EROSION AND SEDIMENTATION CONTROL BY HOWARD COUNTY, THE HOWARD SOIL CONSERVATION DISTRICT AND FOR MDE.

[Signature] 2/2/21
OWNER/DEVELOPER SIGNATURE DATE

James P. Coleman
PRINTED NAME & TITLE

DESIGN CERTIFICATION:
I HEREBY CERTIFY THAT THIS PLAN HAS BEEN DESIGNED IN ACCORDANCE WITH CURRENT MARYLAND EROSION AND SEDIMENT CONTROL LAWS, REGULATIONS, AND STANDARDS, THAT IT REPRESENTS A PRACTICAL AND WORKABLE PLAN BASED ON MY PERSONAL KNOWLEDGE OF THE SITE AND THAT IT WAS PREPARED IN ACCORDANCE WITH THE REQUIREMENTS OF THE HOWARD SOIL CONSERVATION DISTRICT.

[Signature] 10-6-20
DESIGNER'S SIGNATURE DATE

ROBERT H. VOGEL
PRINTED NAME
MD REGISTRATION NO. 16193
(P.E.) R.L.S., OR R.L.A. (Circle one)

HOWARD S.C.D. DATE

THIS DEVELOPMENT PLAN IS APPROVED FOR SOIL EROSION AND SEDIMENT CONTROL BY THE HOWARD SOIL CONSERVATION DISTRICT.

Note:
FOR PARKING TABULATION, SEE SHEET 7.

Note:
DEBRIS IS TO BE KEPT OUT OF ALL STORMWATER MANAGEMENT FACILITIES DURING AND AFTER CONSTRUCTION.


REVISIONS

REV#	DATE	DESCRIPTION
3	05-21-20	REVISE THE PLAN TO REFLECT ADDITION OF 2,526 SFT SHOWROOM, ADDITION OF 1,620 SFT OF NEW PAVEMENT AND ADDITIONAL SITE MODIFICATIONS
2	10-24-05	REVISE SAND FILTER, REVISE WHC, ADD SANDIOL SEPARATOR, REVISE VEHICLE DISPLAY AREAS
1	03-28-05	REVISE BUILDING FOOTPRINT, ASSOCIATED GRADING CHANGES, TITLE AND PROJECT NAME CHANGES

OWNER/DEVELOPER

1318 COMPANY LLC
10400 AUTO PARK DRIVE
BETHESDA, MD 20817

VOGEL ENGINEERING
TIMMONS GROUP
3300 NORTH RIDGE ROAD, SUITE 110, ELLICOTT CITY, MD 21103
P: 410.461.7666 F: 410.461.8961 www.timmons.com

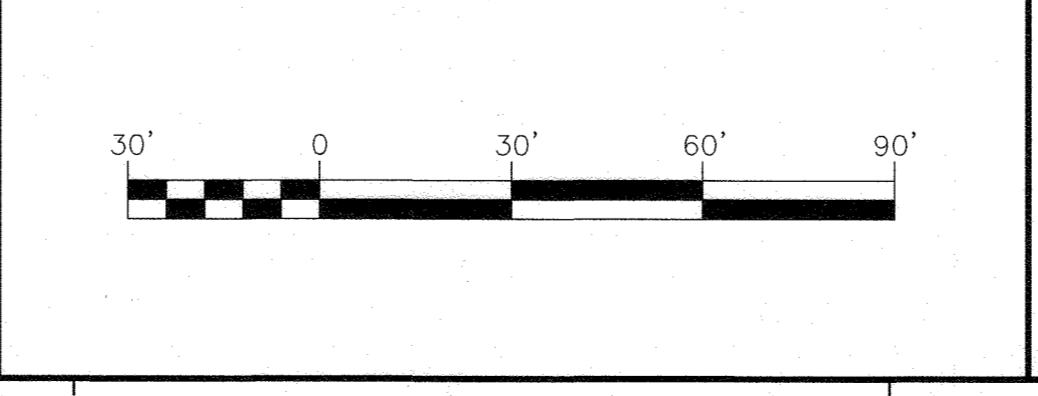

REVISED SITE DEVELOPMENT PLAN
SITE DEVELOPMENT, GRADING, AND SEDIMENT AND EROSION CONTROL PLAN
COLEMAN LANDROVER/JAGUAR

TAX MAP #34 BLOCK #6
5TH ELECTION DISTRICT

PARCEL K-2
HOWARD COUNTY, MARYLAND

STATE OF MARYLAND
ROBERT HARRIS VOGEL
NO. 16193
REGISTERED PROFESSIONAL ENGINEER




DESIGN BY: RHV/DZE
DRAWN BY: VE+T/C
CHECKED BY: RHV
DATE: JULY 2020
SCALE: 1"=30'
W.O. NO.: 03-40

PROFESSIONAL CERTIFICATE

I HEREBY CERTIFY THAT THESE DOCUMENTS WERE PREPARED OR APPROVED BY ME, AND THAT I AM A DULY LICENSED PROFESSIONAL ENGINEER UNDER THE LAWS OF THE STATE OF MARYLAND, LICENSE NO. 16193, EXPIRATION DATE: 09-27-2022


2 SHEET OF 7

SDP-03-93

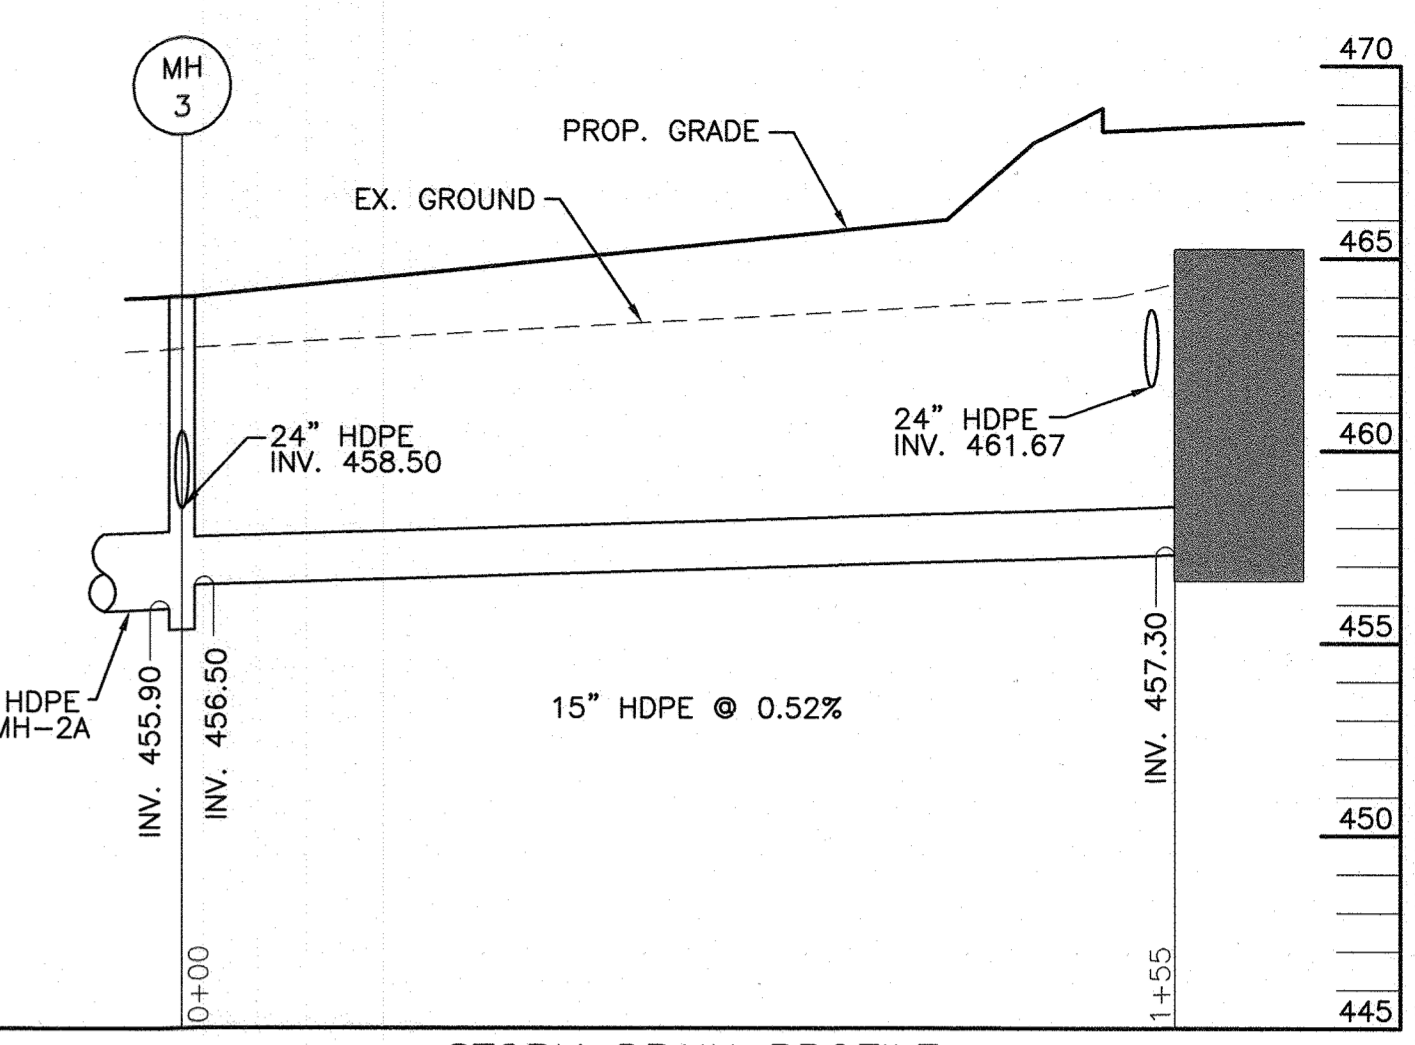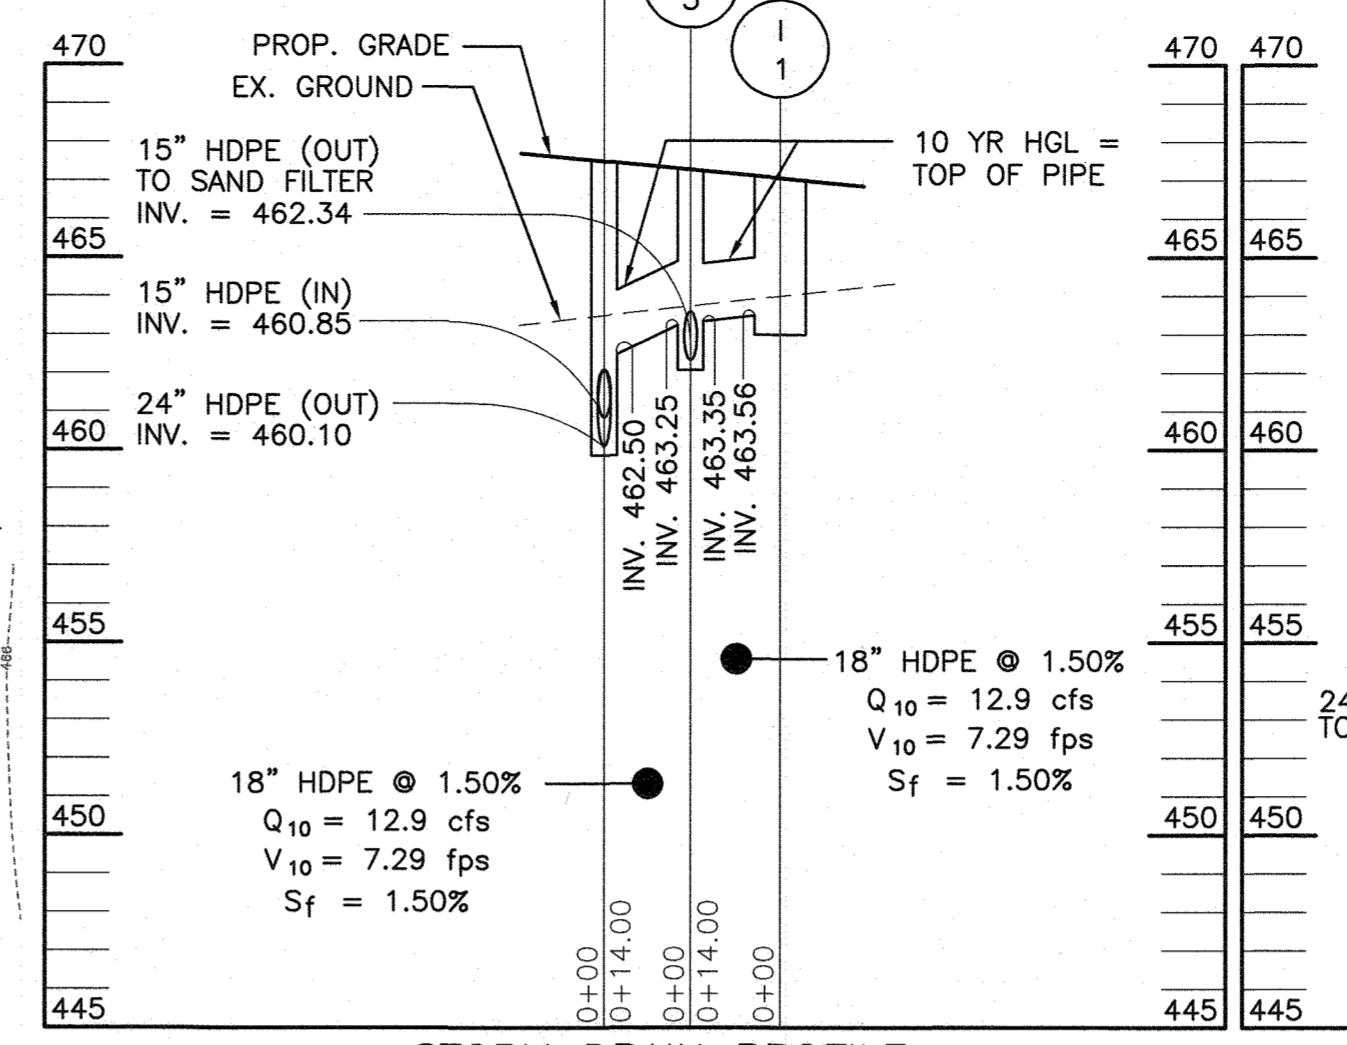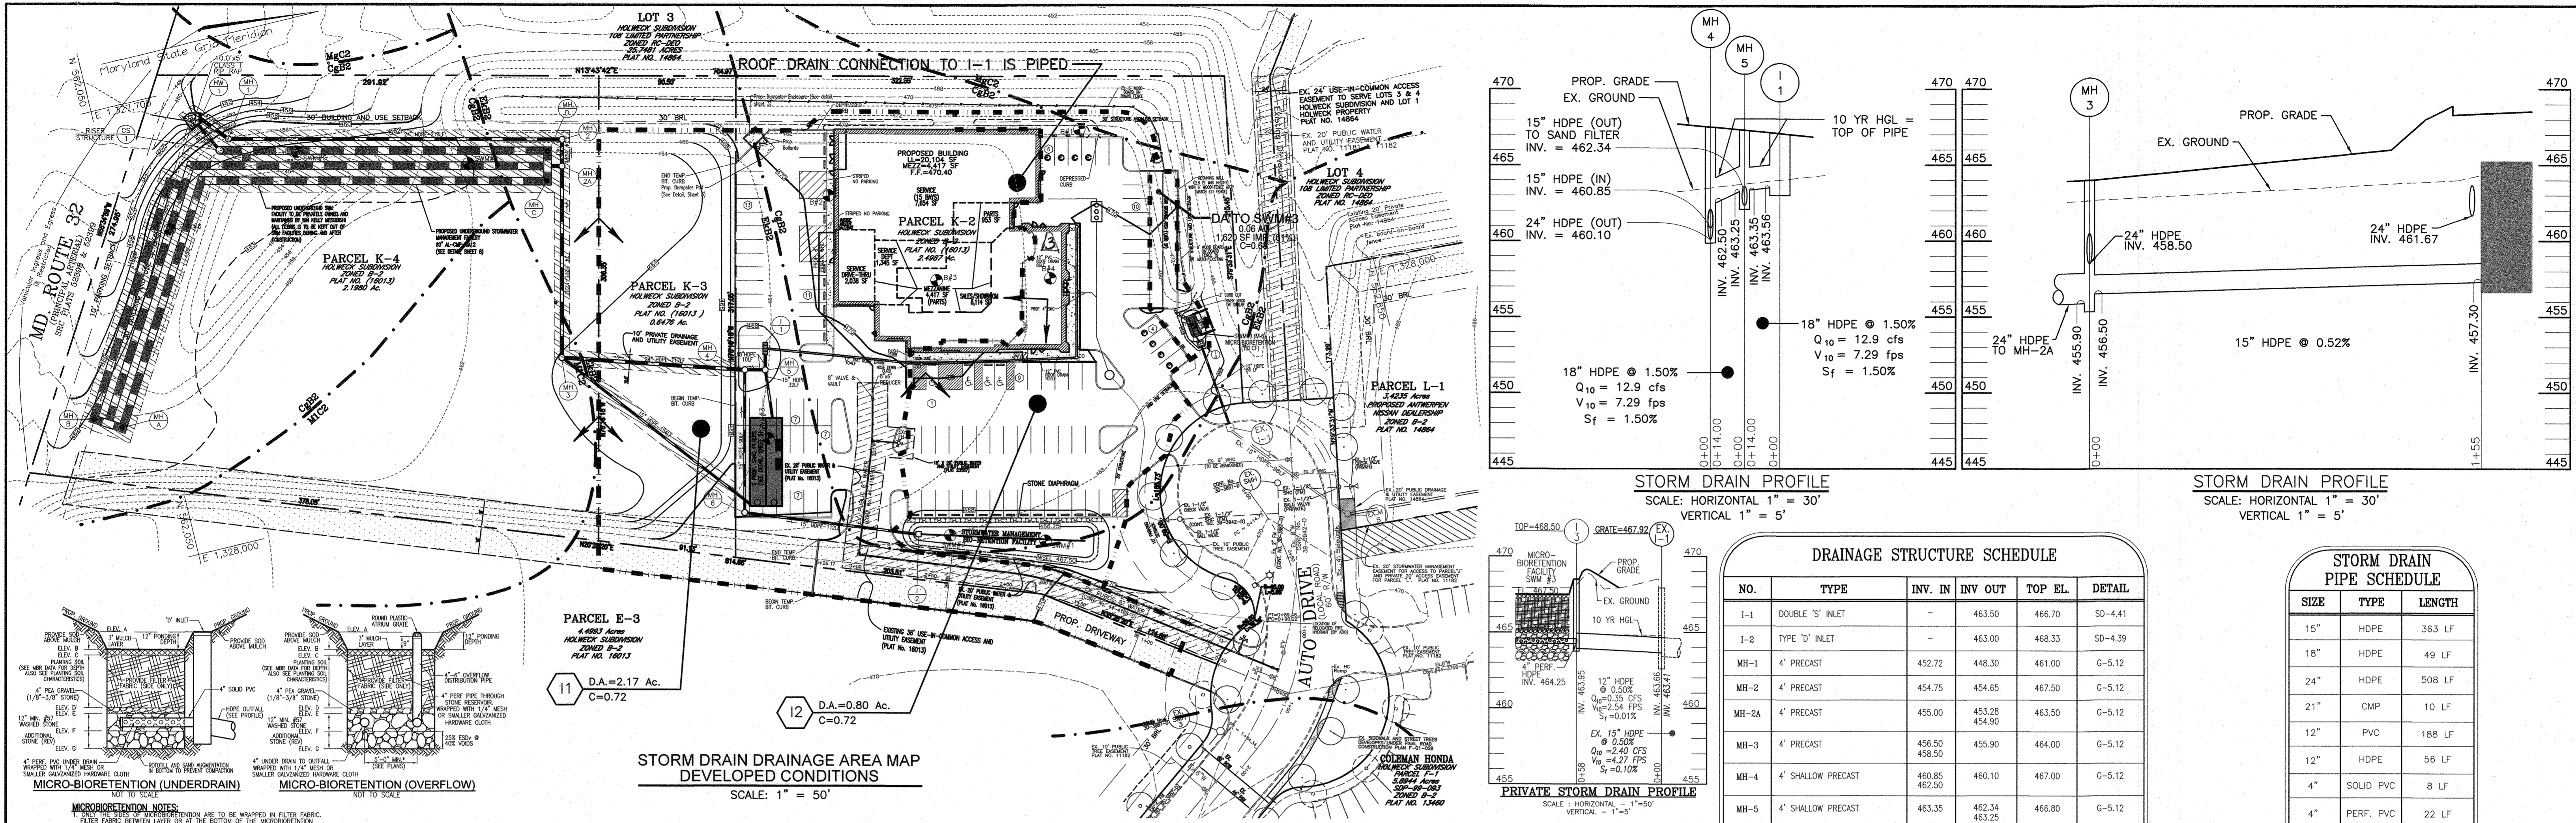

STORM DRAIN PROFILE
SCALE: HORIZONTAL 1" = 30'
VERTICAL 1" = 5'

STORM DRAIN PROFILE
SCALE: HORIZONTAL 1" = 30'
VERTICAL 1" = 5'

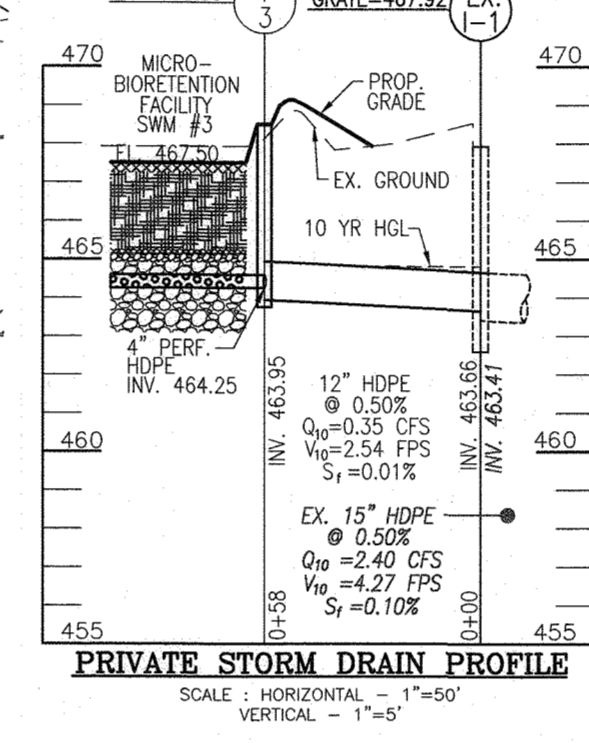


NO.	TYPE	INV. IN	INV. OUT	TOP EL.	DETAIL
I-1	DOUBLE 'S' INLET	-	463.50	466.70	SD-4.41
I-2	TYPE 'D' INLET	-	463.00	468.33	SD-4.39
MH-1	4' PRECAST	452.72	448.30	461.00	G-5.12
MH-2	4' PRECAST	454.75	454.65	467.50	G-5.12
MH-2A	4' PRECAST	455.00	453.28	463.50	G-5.12
MH-3	4' PRECAST	456.50	455.90	464.00	G-5.12
MH-4	4' SHALLOW PRECAST	460.85	460.10	467.00	G-5.12
MH-5	4' SHALLOW PRECAST	463.35	462.34	466.80	G-5.12
MH-6	4' PRECAST	461.85	461.75	468.50	G-5.12
HW-1	TYPE 'H' HEADWALL	448.00	448.00	451.50	MSHA MD 362.01
CS-1	CONTROL STRUCTURE	463.50	463.50	461.00	SEE DETAIL
I-3	'S' INLET	464.25	463.95	468.50	D-4.24

SIZE	TYPE	LENGTH
15"	HDPE	363 LF
18"	HDPE	49 LF
24"	HDPE	508 LF
21"	CMP	10 LF
12"	PVC	188 LF
12"	HDPE	56 LF
4"	SOLID PVC	8 LF
4"	PERF. PVC	22 LF


MBR Facility Number	MBR Facility Type	Surface Area (sq ft)	Ponding Elevation	Top of Mulch ELEV. A	Bottom of Mulch ELEV. B	Depth of Plant Mix ELEV. C	Bottom of Plant Mix ELEV. D	Pea Gravel ELEV. E	Stone (in) ELEV. F	Invert of Underdrain ELEV. G	Additional Stone (in) ELEV. H	Bottom of Stone (in) ELEV. I	Depth of REV Stone ELEV. J	Bottom of REV Stone ELEV. K
5	Micro-Bioretenion (M-6)	58	458.50	467.50	467.25	2.00	465.25	464.92	1.00	464.25	0.00	463.92	0.83	463.09

OPERATION AND MAINTENANCE SCHEDULE FOR LANDSCAPE INFILTRATION (M-3), MICRO-BIORETENTION (M-6), RAIN GARDENS (M-7), BIORETENTION SWALE (M-8), AND ENHANCED FILTERS (M-9)

- THE OWNER SHALL MAINTAIN THE PLANT MATERIAL, MULCH LAYER AND SOIL LAYER ANNUALLY. MAINTENANCE OF MULCH AND SOIL IS LIMITED TO CORRECTING AREAS OF GROWTH OR WASH OUT. ANY MULCH REPLACEMENT SHALL BE DONE IN THE SPRING. PLANT MATERIAL SHALL BE CHECKED FOR DISEASE AND INSECT INFESTATION AND MAINTENANCE WILL ADDRESS DEAD MATERIAL, PRUNING ACCEPTABLE REPLACEMENT PLANT MATERIAL IS LIMITED TO THE FOLLOWING: 2000 MARYLAND STORMWATER DESIGN MANUAL, VOLUME II, TABLE A.4.1 AND 2.
- THE OWNER SHALL PERFORM A PLANT IN THE SPRING AND IN THE FALL OF EACH YEAR. DURING THE INSPECTION, THE OWNER SHALL REMOVE DEAD AND DISEASED VEGETATION CONSIDERED BEYOND TREATMENT, REPLACE DEAD PLANT MATERIAL WITH ACCEPTABLE REPLACEMENT PLANT MATERIAL, TREAT DISEASED TREES AND SHRUBS, AND REPLACE ALL DEFICIENT STAKES AND WIRES.
- THE OWNER SHALL INSPECT THE MULCH EACH SPRING. THE MULCH SHALL BE REPLACED EVERY TWO TO THREE YEARS. THE PREVIOUS MULCH LAYER SHALL BE REMOVED BEFORE THE NEW LAYER IS APPLIED.
- THE OWNER SHALL CORRECT SOIL EROSION ON AN AS NEEDED BASIS, WITH A MINIMUM OF ONCE PER MONTH AND AFTER EACH HEAVY STORM.

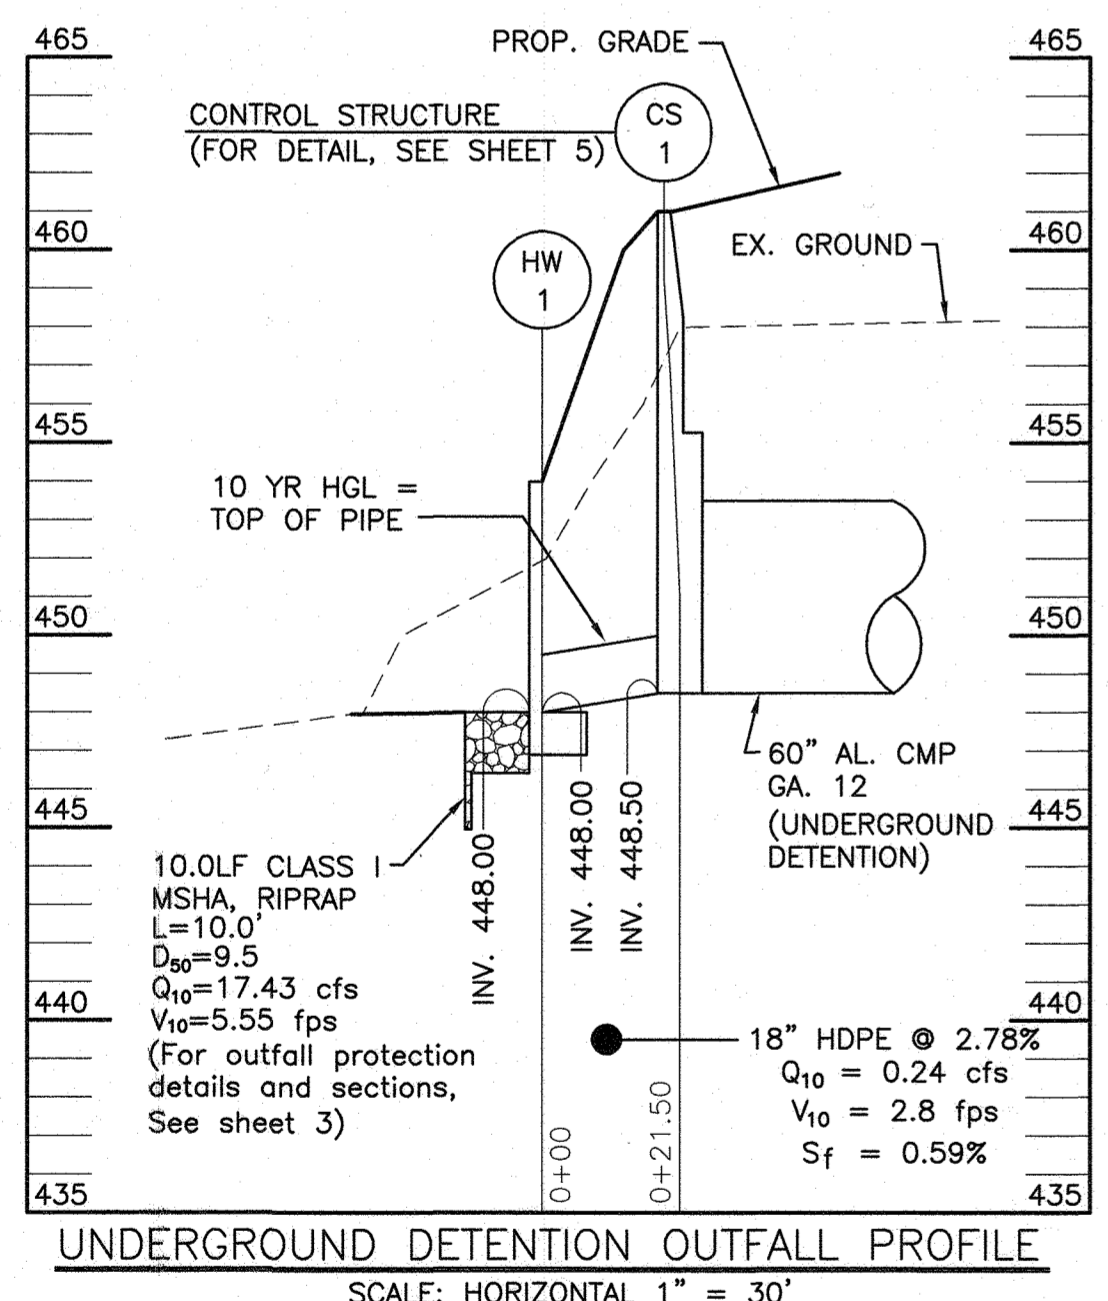

CONTROL STRUCTURE (FOR DETAIL, SEE SHEET 5)
UNDERGROUND DETENTION OUTFALL PROFILE
SCALE: HORIZONTAL 1" = 30'
VERTICAL 1" = 5'

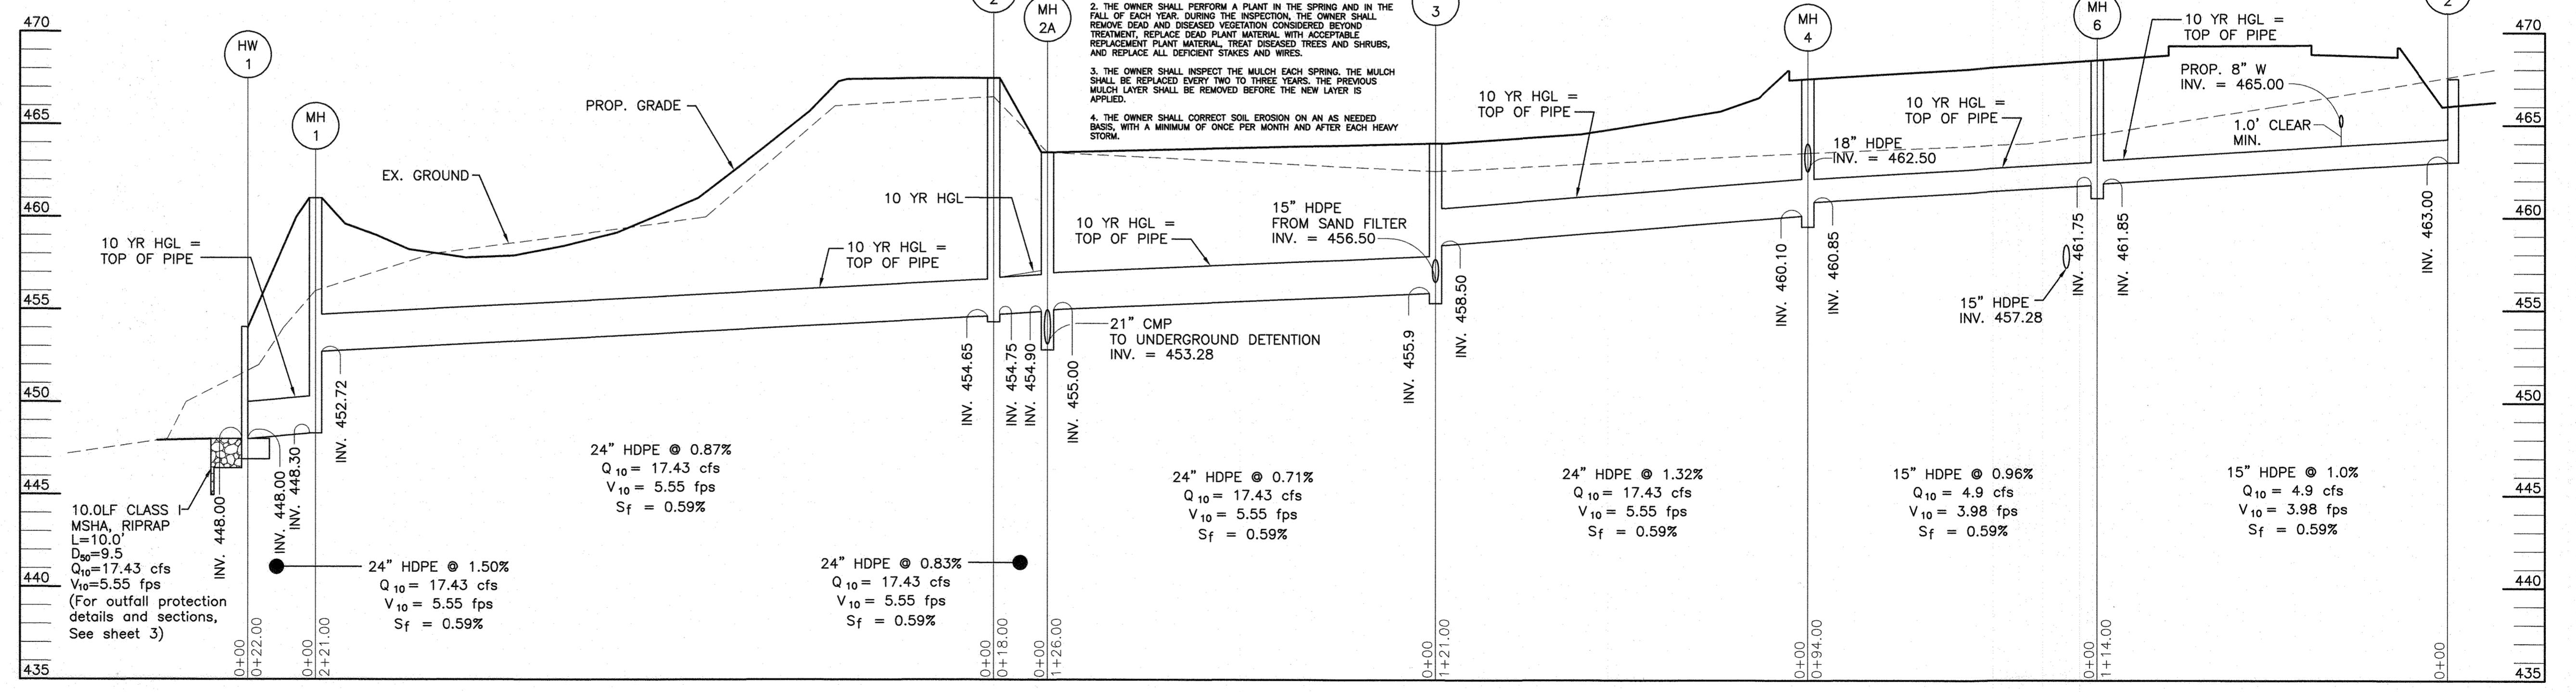


STORM DRAIN PROFILE
SCALE: HORIZONTAL 1" = 30'
VERTICAL 1" = 5'

APPROVED: HOWARD COUNTY DEPARTMENT OF PLANNING AND ZONING
DIRECTOR: [Signature] 4-23-21 DATE
CHIEF, DEVELOPMENT ENGINEERING DIVISION: [Signature] 4-23-21 DATE
CHIEF, DIVISION OF LAND DEVELOPMENT: [Signature] 4/23/21 DATE


REV#	DATE	DESCRIPTION
3	05-21-20	REVISE THE PLAN TO REFLECT ADDITION OF A 2,528 SFT SHOWROOM, ADDITION OF 1,620 SFT OF NEW PAVEMENT AND ADDITIONAL SITE MODIFICATIONS
1	03-28-05	REVISE BUILDING FOOTPRINT, ASSOCIATED GRADING CHANGES, TITLE AND PROJECT NAME CHANGES

OWNER/DEVELOPER
1318 COMPANY LLC
10400 AUTO PARK DRIVE
BETHESDA, MD 20817


VOGEL ENGINEERING
TIMMONS GROUP
3300 NORTH RIDGE ROAD, SUITE 110, ELLICOTT CITY, MD 21103
P: 410.461.7666 F: 410.461.8961 www.timmons.com

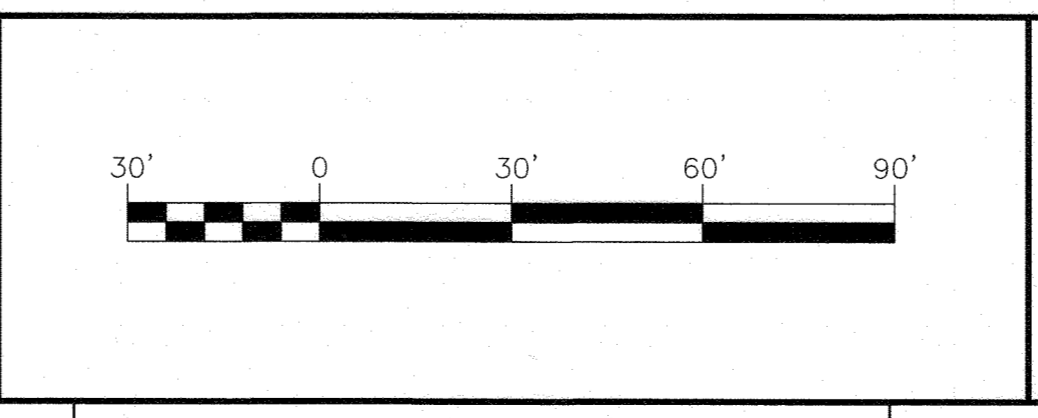


REVISED SITE DEVELOPMENT PLAN
STORM DRAIN DRAINAGE AREA MAP,
PROFILES AND DETAILS
COLEMAN LANDROVER/JAGUAR
TAX MAP #34 BLOCK #6
5TH ELECTION DISTRICT
PARCEL K-2
HOWARD COUNTY, MARYLAND

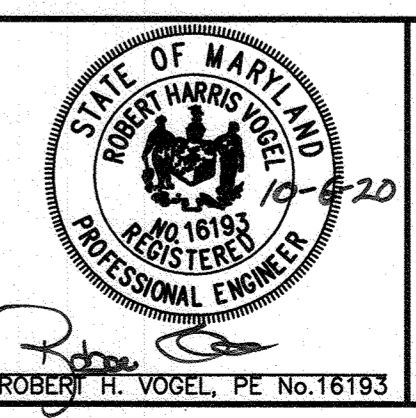

DESIGN BY: RHV/DZE
DRAWN BY: VE+TO
CHECKED BY: RHV
DATE: JULY 2020
SCALE: AS SHOWN
W.O. NO.: 03-40
PROFESSIONAL CERTIFICATE
I HEREBY CERTIFY THAT THESE DOCUMENTS WERE PREPARED OR APPROVED BY ME AND THAT I AM A DULY LICENSED PROFESSIONAL ENGINEER UNDER THE LAWS OF THE STATE OF MARYLAND, LICENSE NO. 16193, EXPIRATION DATE: 09-27-2022
4 SHEET OF 7
SDP-03-93

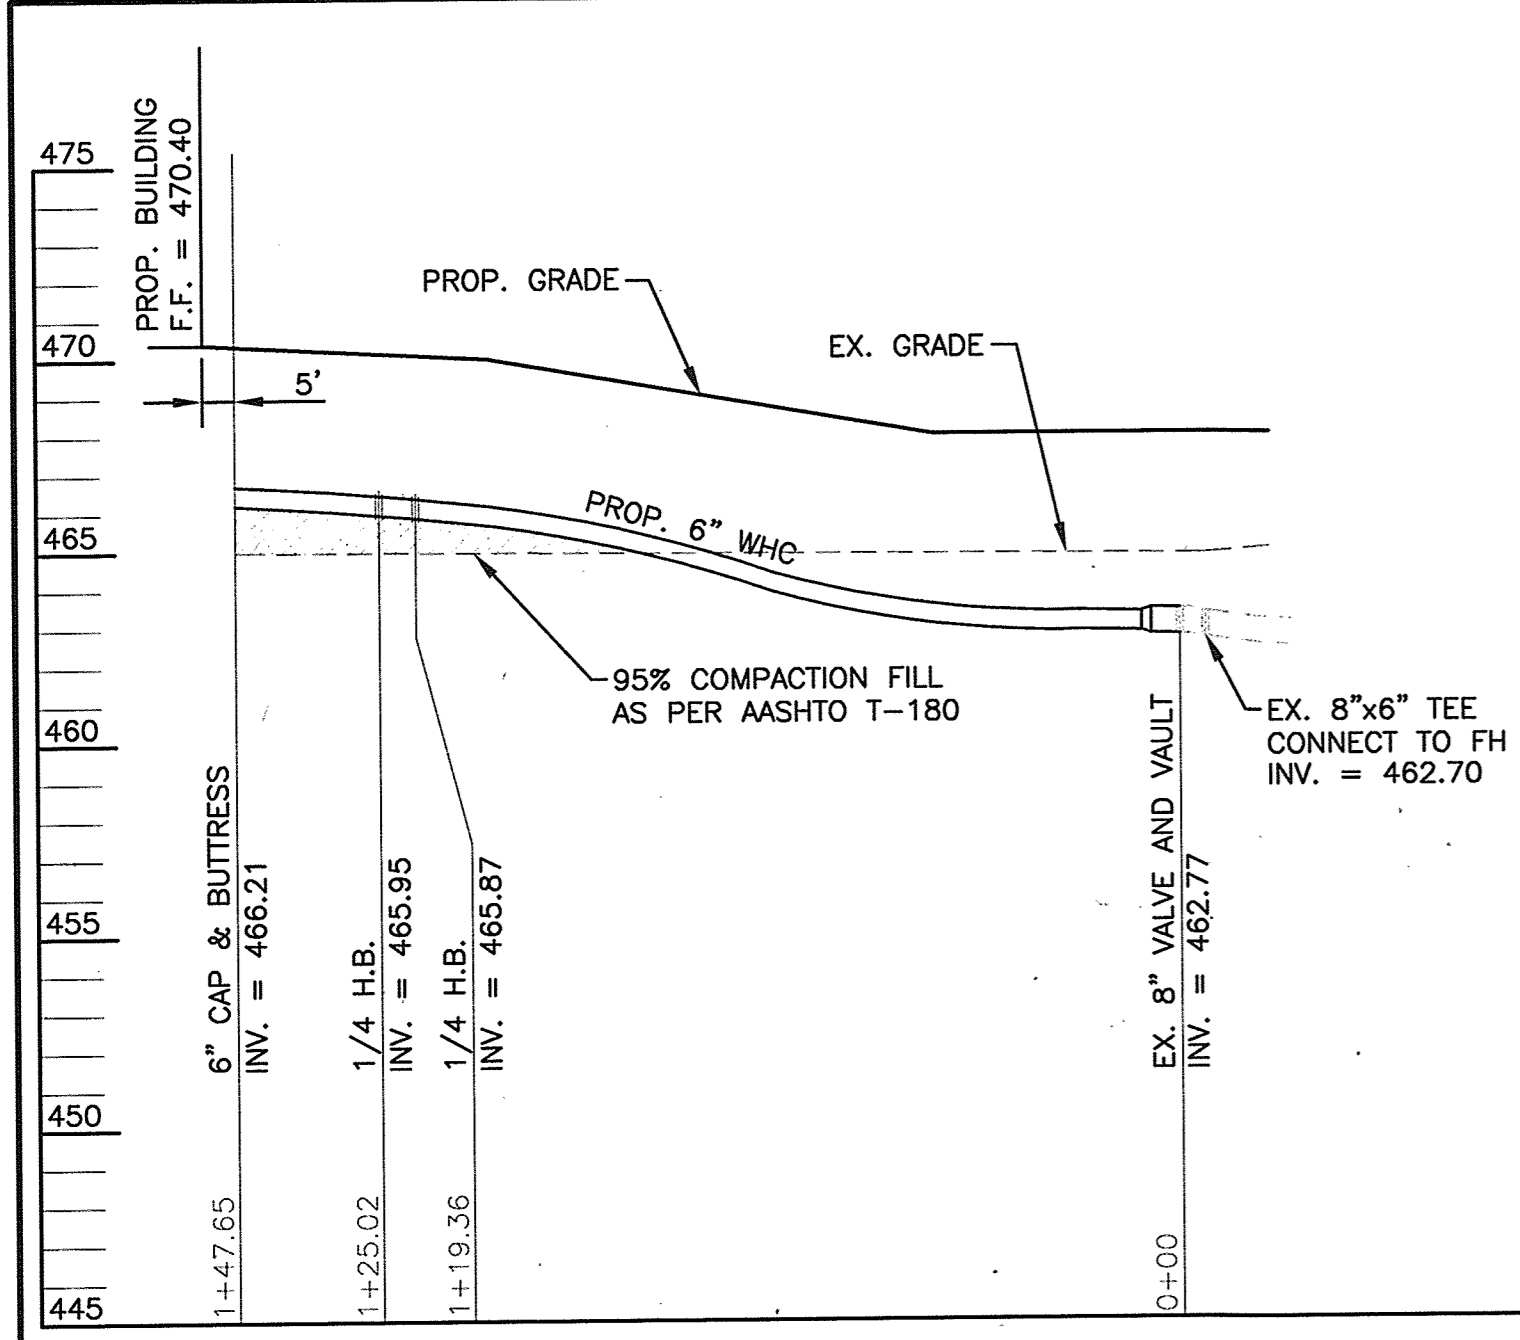


WATER HOUSE CONNECTION PROFILE
SCALE: HORIZONTAL 1" = 30'
VERTICAL 1" = 5'

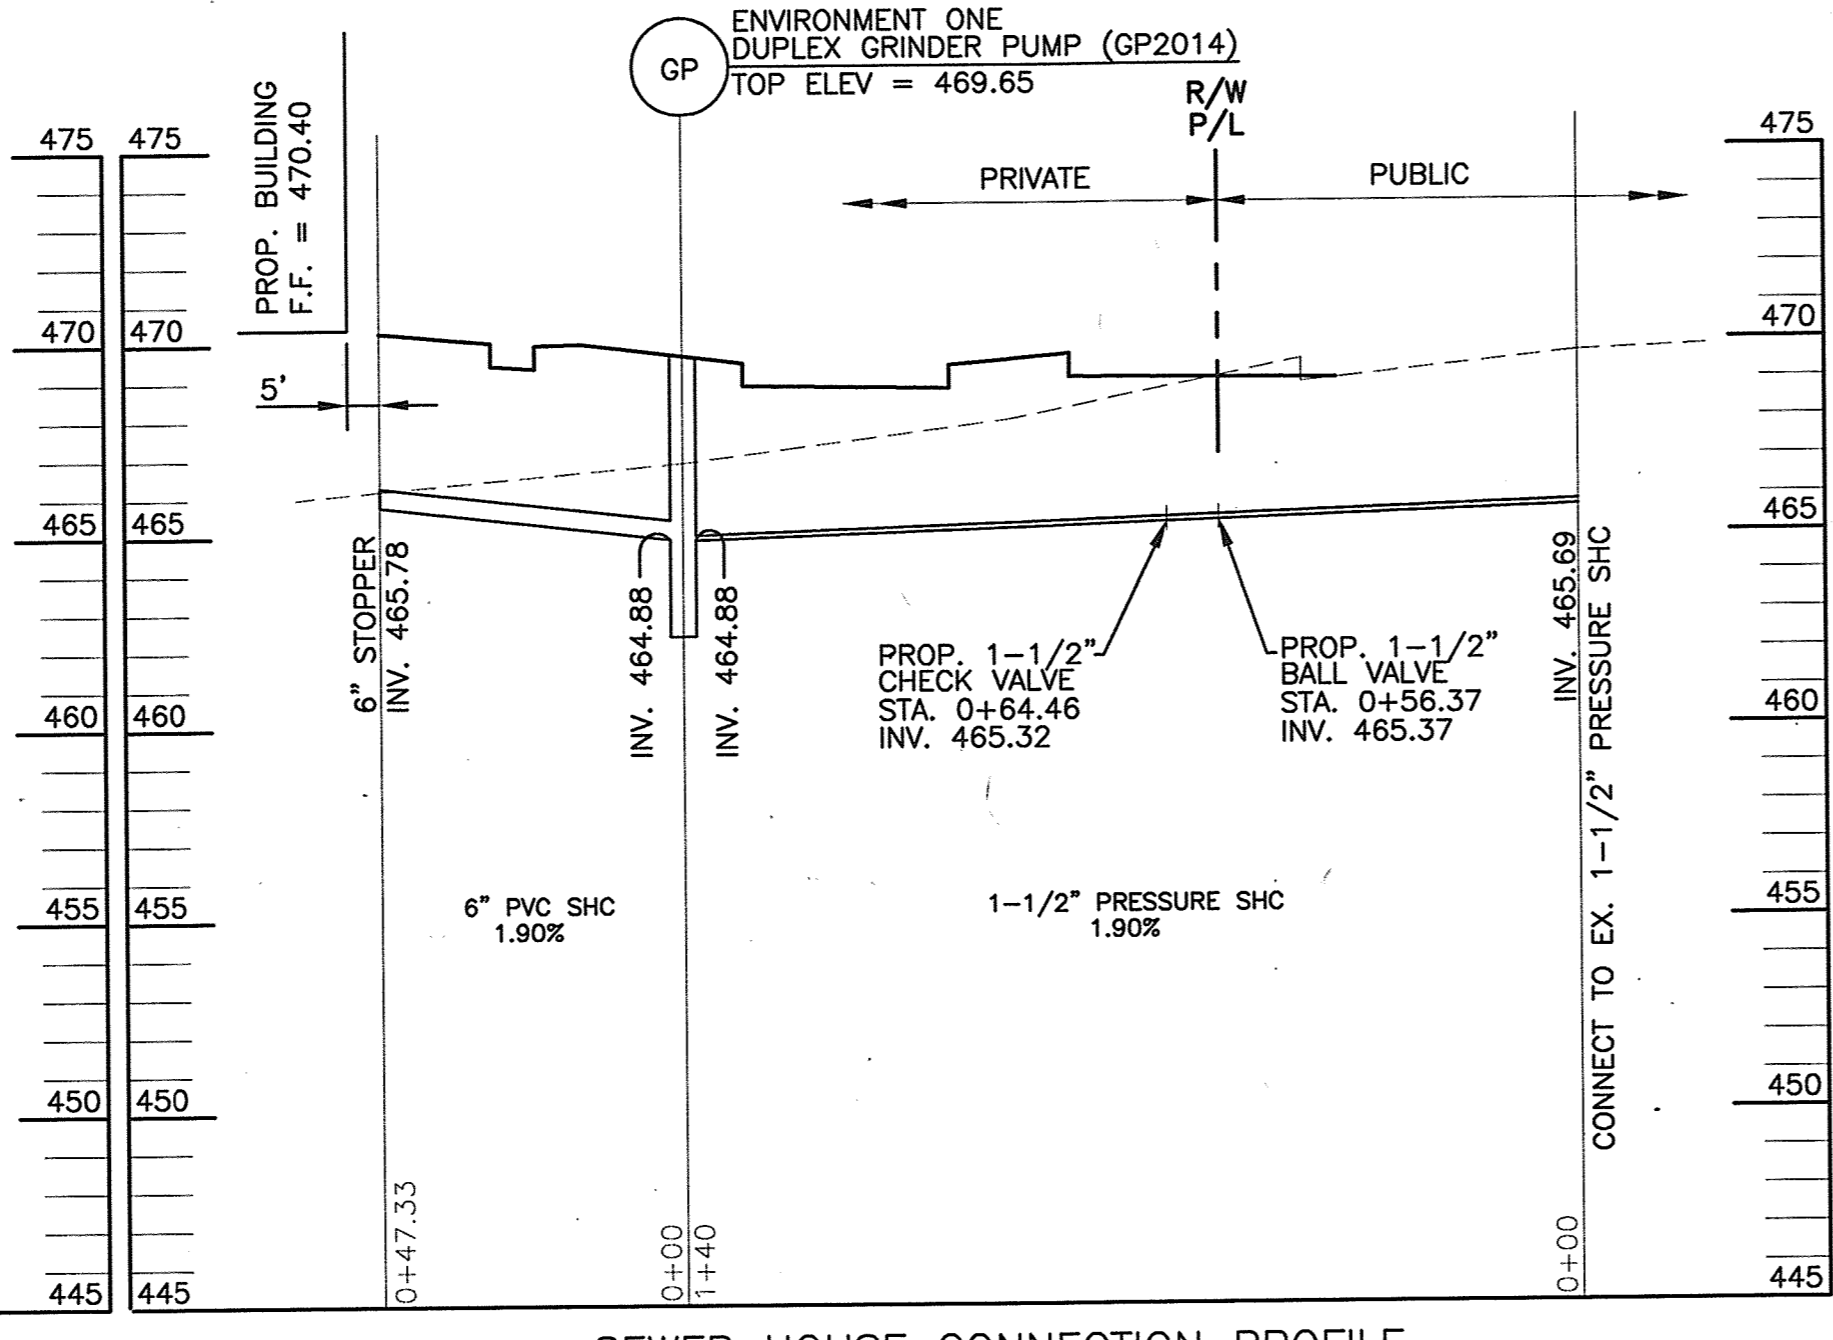

SEWER HOUSE CONNECTION PROFILE
SCALE: HORIZONTAL 1" = 30'
VERTICAL 1" = 5'


OPERATION AND MAINTENANCE SCHEDULE FOR PRIVATELY OWNED AND MAINTAINED UNDERGROUND STORMWATER FILTRATION SYSTEM (F-2)

1. THE SEDIMENT CHAMBER OUTLET DEVICES SHALL BE CLEANED AND/OR REPAIRED WHEN DRAW-DOWN TIMES WITHIN THE CHAMBER EXCEED 36 HOURS.
2. DEBRIS AND LITTER SHALL BE REMOVED AS NECESSARY TO ENSURE PROPER OPERATION OF THE SYSTEM.
3. SEDIMENT SHALL BE CLEANED OUT OF THE SEDIMENTATION CHAMBER WHEN IT ACCUMULATES TO A DEPTH OF 6 INCHES. VEGETATION WITHIN THE SEDIMENT CHAMBER SHALL BE LIMITED TO A HEIGHT OF 18 INCHES.
4. WHEN WATER PONDS ON THE SURFACE OF THE FILTER BED FOR MORE THAN 72 HOURS, THE TOP FEW INCHES OF DISCOLORED MATERIAL SHALL BE REPLACED WITH FRESH MATERIAL. PROPER CLEANING AND DISPOSAL OF THE REMOVED MATERIALS AND LIQUID MUST BE FOLLOWED BY THE OWNER.
5. A LOG BOOK SHALL BE MAINTAINED TO DETERMINE THE RATE AT WHICH THE FACILITY DRAINS.
6. THE MAINTENANCE LOG BOOK SHALL BE AVAILABLE TO HOWARD COUNTY FOR INSPECTION TO ENSURE COMPLIANCE WITH OPERATION AND MAINTENANCE CRITERIA.
7. ONCE THE PERFORMANCE CHARACTERISTICS OF THE INFILTRATION SYSTEM HAVE BEEN VERIFIED, THE MONITORING SCHEDULE CAN BE REDUCED TO AN ANNUAL BASIS UNLESS THE PERFORMANCE DATA INDICATES THAT A MORE FREQUENT SCHEDULE IS REQUIRED.

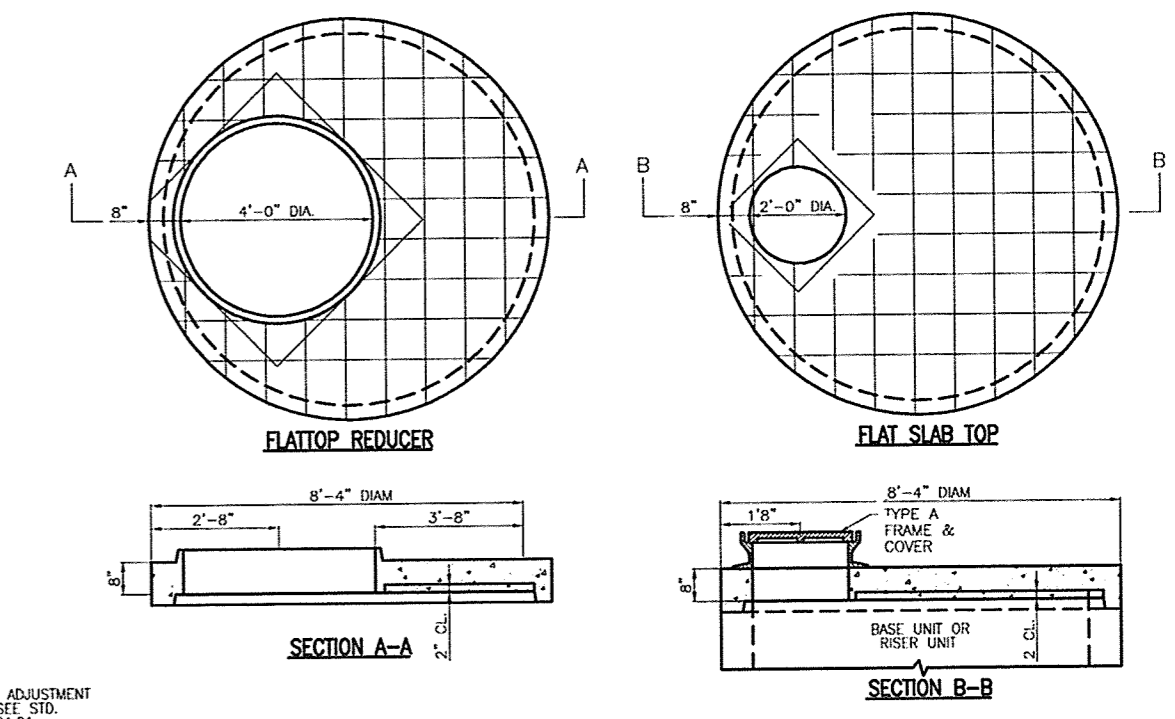


UNDERGROUND SAND FILTER CONSTRUCTION SPECIFICATIONS


1. PROVIDE MANHOLE AND/OR GRATES TO ALL UNDERGROUND AND BELOW GRADE STRUCTURES. MANHOLES SHALL BE IN COMPLIANCE WITH STANDARD SPECIFICATIONS FOR EACH COUNTY, BUT DIAMETERS SHOULD BE 30" MINIMUM TO COMPLY WITH OSHA CONFINED SPACE REQUIREMENTS). ALUMINUM AND STEEL LOUVERED DOORS ARE ALSO ACCEPTABLE. TEN INCH WIDE (MINIMUM) MANHOLE STEPS (12" O.C.) SHALL BE CAST IN PLACE OR DRILLED AND MORTARED INTO THE WALL BELOW EACH MANHOLE. A 5' MINIMUM HEIGHT CLEARANCE (FROM THE TOP OF THE SAND LAYER TO THE BOTTOM OF THE UPPER/SURFACE SLAB) IS REQUIRED FOR ALL PERMANENT UNDERGROUND STRUCTURES. LIFT RINGS ARE TO BE SUPPLIED TO REMOVE/REPLACE TOP SLABS ON PRE-FABRICATED STRUCTURES. MANHOLE COVERS SHOULD ALLOW FOR PROPER VENTILATION.
2. UNDERGROUND SANDFILTERS SHOULD BE CONSTRUCTED WITH A GATE VALVE LOCATED JUST ABOVE THE TOP OF THE FILTER BED FOR DEWATERING IN THE EVENT THAT CLOGGING OCCURS.
3. UNDERGROUND SAND BEDS SHALL BE PROTECTED FROM TRASH ACCUMULATION BY A WIDE MESH GEOTEXTILE SCREEN TO BE PLACED ON THE SURFACE OF THE SAND BED. SCREEN IS TO BE ROLLED UP, REMOVED, CLEANED AND RE-INSTALLED DURING MAINTENANCE OPERATIONS.

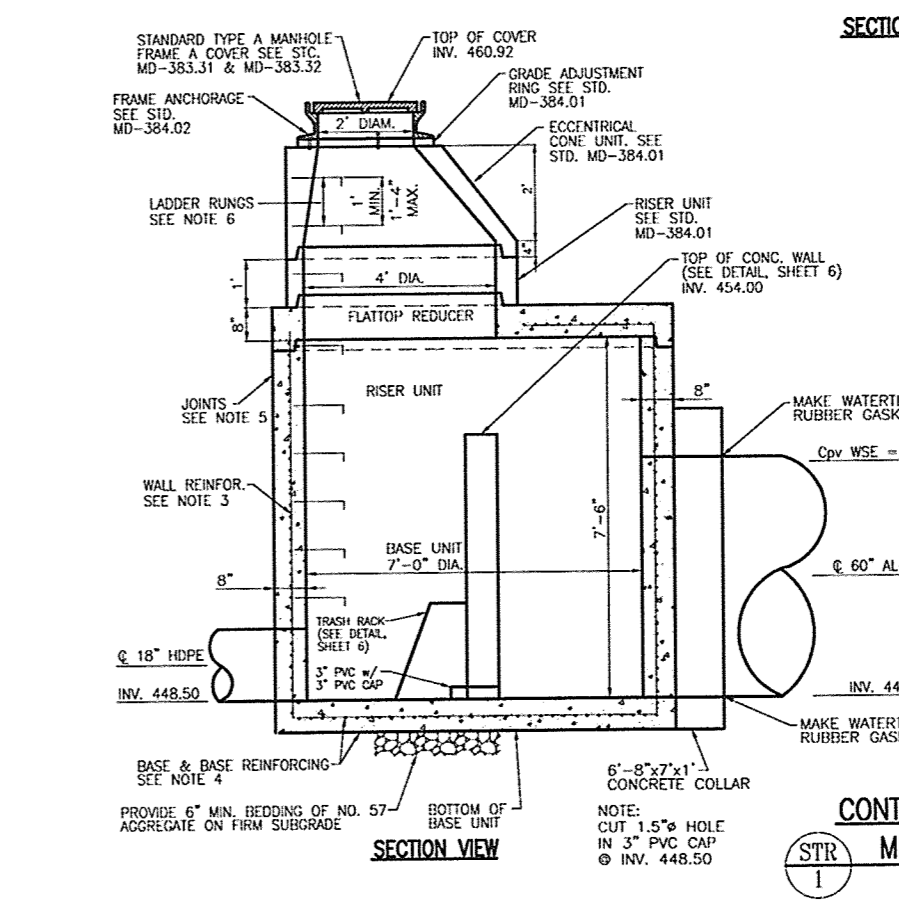

- CONTROL STRUCTURE NOTES:**
1. MANHOLES SHALL BE CONSTRUCTED IN ACCORDANCE WITH AASHTO M 190.
 2. CONCRETE SHALL BE MIN. NO. 6 (4500 P.S.I.).
 3. WALL REINFORCEMENT FOR BASE UNITS AND RISER UNITS SHALL BE REINFORCEMENT BARS OR WELDED WIRE FABRIC WITH A MINIMUM AREA OF 0.2 IN²/FT FOR THE 8" DIAMETER MANHOLES. WELDED WIRE FABRIC SHALL CONFORM TO ASTM A 185 AND A 52.
 4. BASE REINFORCEMENT TO BE REINFORCEMENT BARS OR WELDED WIRE FABRIC WITH A MINIMUM AREA OF 0.27 IN²/FT. THE BASE SHALL BE CAST MONOLITHIC WITH THE BASE UNIT OR JOINTED PER MANUFACTURER'S DESIGN.
 5. THE MANUFACTURER SHALL FORM MALE AND FEMALE ENDS OF JOINTS USING THEIR OWN DESIGN. THE JOINTS SHALL BE SEALED BY THE CONTRACTOR AND MADE WATER-TIGHT USING AN APPROPRIATE MORTAR RUBBER O-RING GASKETS MEETING ASTM C541 AND C 443 OR FLEXIBLE PLASTIC GASKETS MEETING AASHTO M 198 TYPE B.
 6. LADDER RUNGS SHALL BE INSTALLED IN VERTICAL ALIGNMENT WITH THE BASE UNIT OR RISER UNIT IF LESS THAN 6" ADDITIONAL NO. 3 BARS ARE REQUIRED AROUND OPENINGS.
 7. WHEN THE DISTANCE BETWEEN MULTIPLE PIPE OPENINGS IN EACH SECTION FOR HANDLING, NO. 3 BARS ARE REQUIRED AROUND OPENINGS.
 8. LIFT RINGS OR LIFT EYES SHALL BE PROVIDED IN EACH SECTION FOR HANDLING.
 9. MIX NO. 2 CONCRETE OR BRICK CHANNEL SHALL BE PROVIDED IN THE FIELD AND SHALL SLOPE 2" PER FOOT TOWARD OUTLET OR AS DIRECTED BY THE ENGINEER.
 10. THE DROP STONE LANDING SHALL BE USED ONLY WHEN THERE ARE PIPES CONNECTED TO THE RISER UNITS. SEE STD. MD-384.13 FOR DETAILS.
 11. MINIMUM DEPTH PAYMENT FOR EACH SHALL BE 10'-1" MEASURED FROM THE BOTTOM OF THE BASE UNIT TO THE TOP OF THE MANHOLE COVER. VERTICAL DEPTH PAYMENT FOR UNDER FOOT SHALL INCLUDE ALL DEBRIS IN EXCESS OF 10'-1" THE COST OF THE DROP STONE LANDING, NO. 57 AGGREGATE GROUT, SEALANT, AND ALL NECESSARY APPURTENANCES SHALL BE INCIDENTAL TO THE PRICE BID.
- CAST-IN-PLACE CONTROL STRUCTURE NO. 1**
MD SHA STD. 384.07
SCALE: 1/4" = 1"

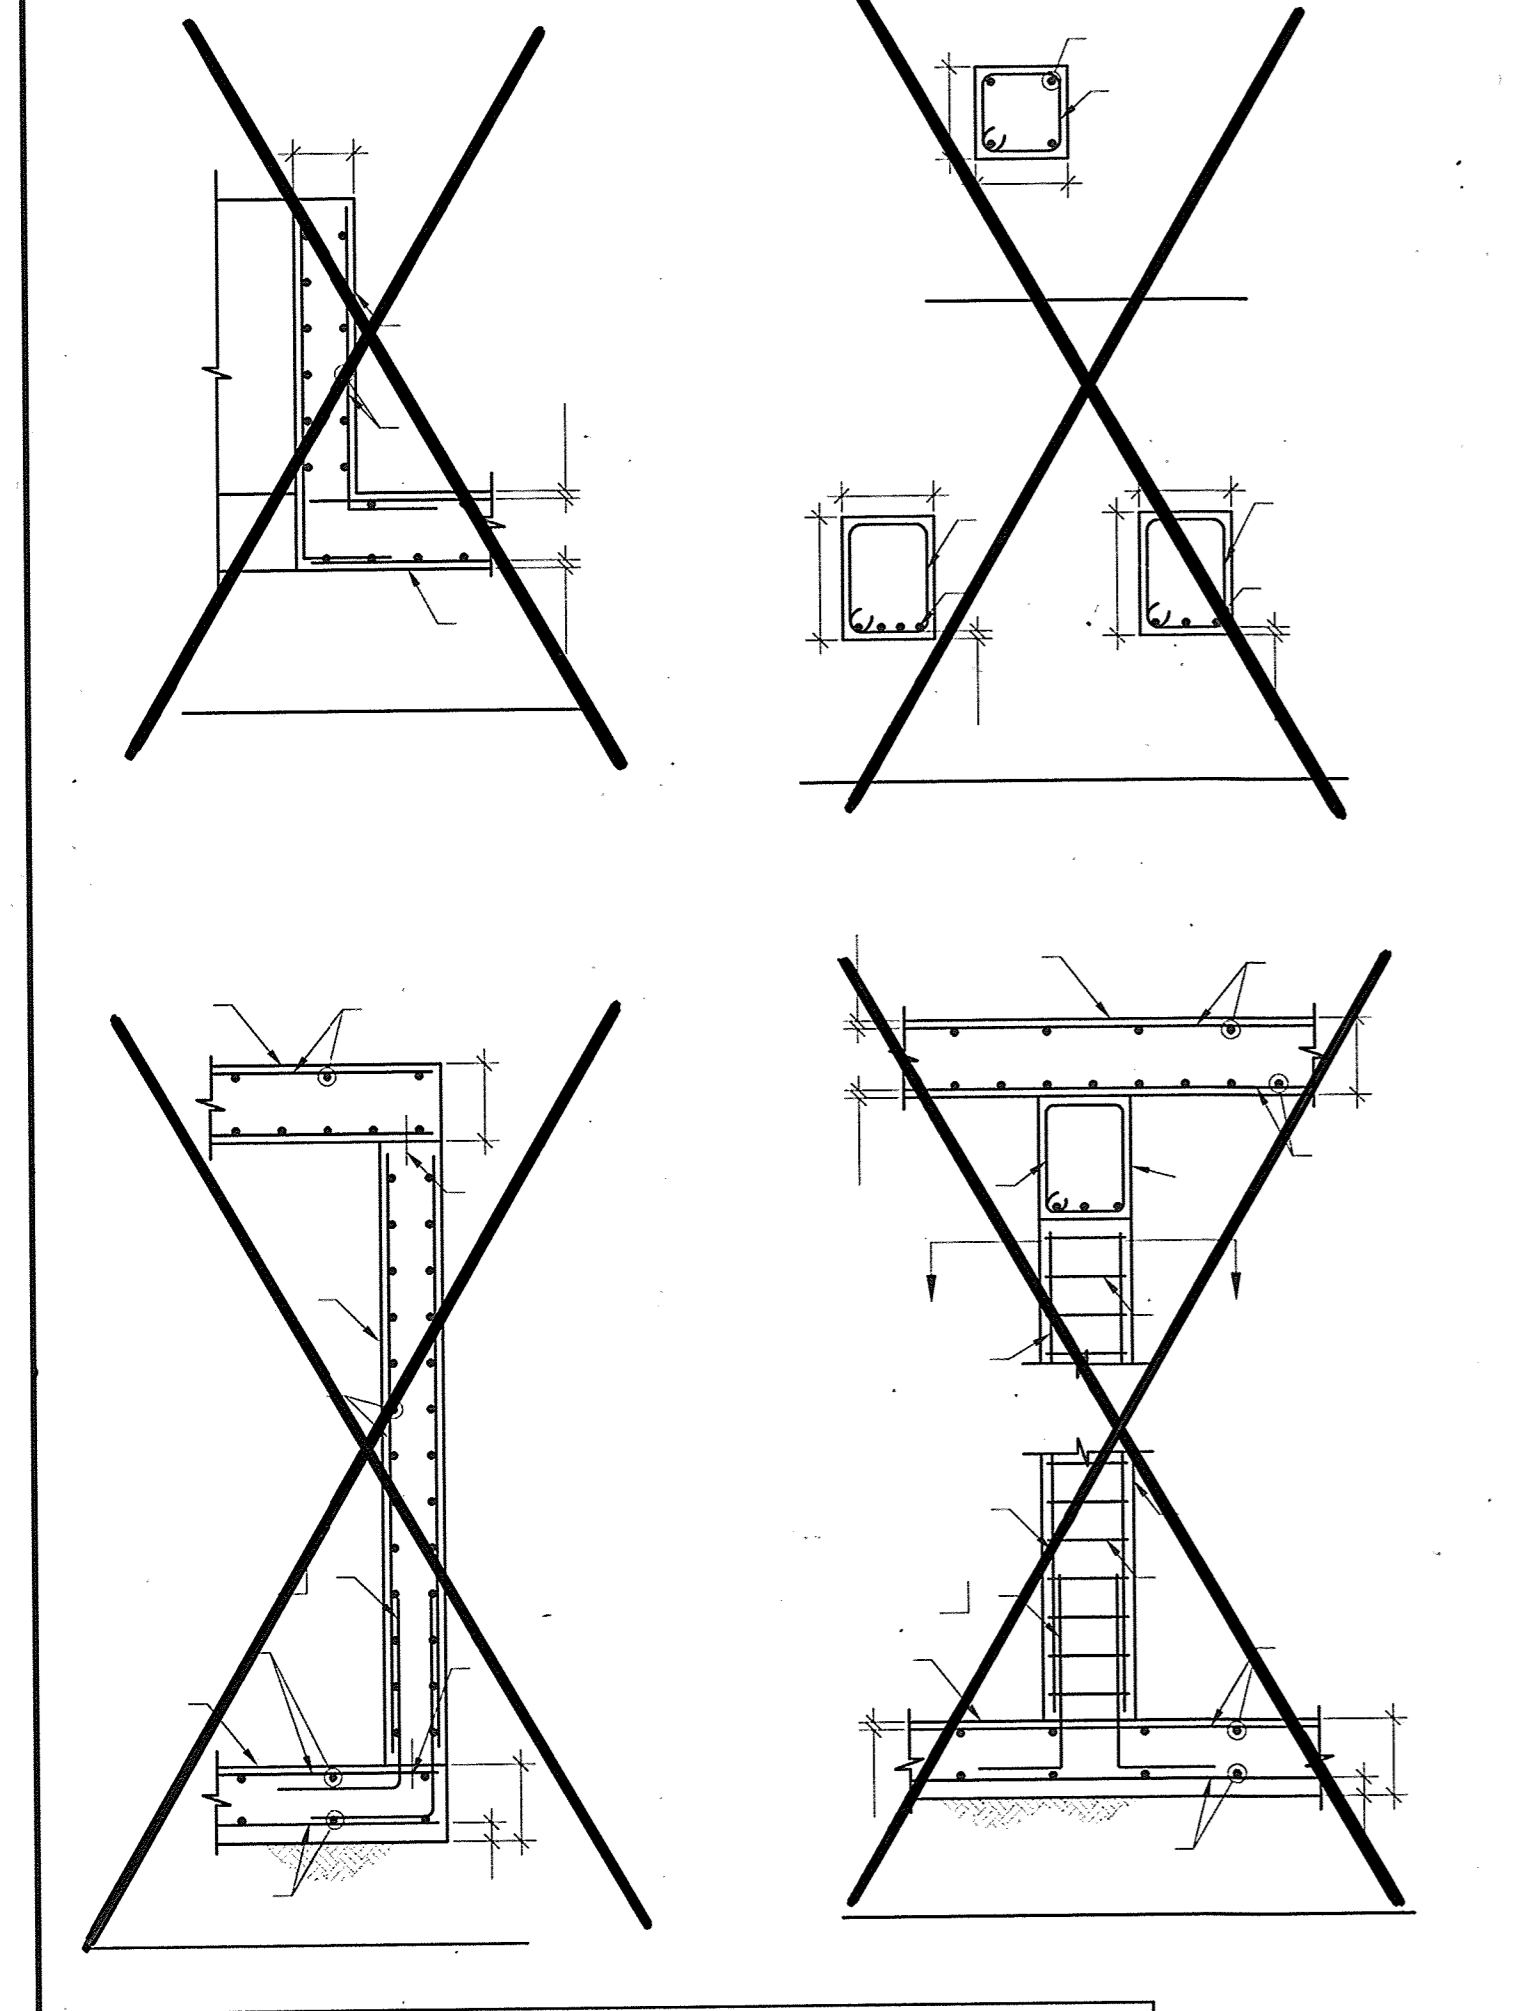

- CONCRETE**
1. ALL FOOTINGS, FOUNDATIONS AND INTERIOR SLABS SHALL BE NORMAL WT CONCRETE WITH A COMPRESSIVE STRENGTH EQUAL TO AT LEAST 3000 PSI WITHIN 28 DAYS AFTER CURING. THE WATER/CEMENT RATIO SHALL BE NO GREATER THAN 0.50 AND SLUMP SHALL BE 3 IN. OR LESS. MIN CEMENT CONTENT SHALL BE 504 LBS PER CU YARD.
 2. UNLESS OTHERWISE NOTED, ALL CONSTRUCTION JOINTS SHALL BE KEPT WITH A KEY 1-1/2 IN. DEEP AND A LENGTH 2 IN. LESS THAN THE MEMBER, AND A NOTH 1/2 OF THE MEMBER. REINFORCING SHALL BE CONTINUOUS THRU JOINTS.
 3. ALL CONCRETE WORK SHALL BE PLACED, CURED, STRIPPED AND PROTECTED AS DIRECTED BY THE SPECIFICATIONS AND ACI STANDARDS AND PRACTICES.
 4. BEFORE CONCRETE IS PLACED CHECK WITH ALL TRADES TO INSURE PROPER PLACEMENT OF ALL OPENINGS, SLEEVES, PIPES, CONDUITS, BOLTS, INSERTS, ETC. RELATIVE TO WORK.
 5. CONTRACTOR IS RESPONSIBLE FOR ALL SHORING AND FORMWORK.
 6. REFER TO CIVIL DRAWINGS FOR MOLDING, GROOVES, ORNAMENT, CLIPS OR GROUNDS, REQUIRED TO BE ENCASED IN CONCRETE AND FLOOR LOCATION OF FLOOR FINISHES AND SLAB DEPRESSIONS.
 7. CONCRETE DESIGN AND DETAILING SHALL CONFORM TO THE REQUIREMENTS OF ACI 318-02. CONTRACTOR SHALL SUBMIT MIX DESIGN ACCOMPANIED BY APPROPRIATE GRAPHS AND BACKGROUND DATA FOR APPROVAL. MIX DESIGN SHALL INDICATE 7 AND 28 DAY STRENGTHS, CEMENT CONTENT, AIR CONTENT, WATER/CEMENT RATIO, AMOUNT OF FINE AND COARSE AGGREGATES, AND ADMIXTURES. MINIMUM ULTIMATE COMPRESSIVE STRENGTH OF CONCRETE IN 28 DAYS SHALL BE AS FOLLOWS, UNLESS NOTED OTHERWISE:
 SLABS ON GRADE 3000 PSI
 FOOTINGS AND PILE CAPS 3000 PSI
 PEA-GRAVEL CONCRETE (OR GROUT) 3000 PSI (FOR FILLING CMU UNITS)
 ALL OTHER CONCRETE 3000 PSI
 8. ALL EXTERIOR CONCRETE AND CONCRETE EXPOSED TO WEATHER SHALL BE AIR-ENTRAINED.
 9. CONTRACTOR TO SUPPLY SHOP DRAWINGS OF ALL STRUCTURAL COMPONENTS FOR APPROVAL PRIOR TO CONSTRUCTION.
 10. USE OF ADMIXTIVES SHALL NOT BE PERMITTED UNLESS SPECIFICALLY APPROVED BY THE STRUCTURAL ENGINEER.
 11. THE CONCRETE SUBCONTRACTOR SHALL NOT REPRODUCE ANY PORTION OF THE STRUCTURAL CONTRACT DRAWINGS FOR UTILIZATION AS SHOP DRAWINGS.
- REINFORCING STEEL**
1. REINFORCING BARS SHALL BE DEFORMED BILLET STEEL CONFORMING TO ASTM A615 (GRADE 60). ALL WELDED WIRE FABRIC SHALL CONFORM TO ASTM A-185. BARS SHALL BE BRANDED BY THE MANUFACTURER WITH BAR SIZE AND GRADE OF STEEL AND CERTIFIED MILL REPORTS SHALL BE SUBMITTED FOR RECORD. REINFORCING STEEL SHALL BE ORDERED IN ACCORDANCE WITH THE ACI MANUAL OF STANDARD PRACTICE FOR DETAILING REINFORCED CONCRETE STRUCTURES, LATEST EDITION. PROVIDE CORNER BARS AT JUNCTIONS OF CONCRETE WALLS AND WALL FOOTINGS AND LAP CORNER BARS TO BE PLACED AS HORIZONTAL WALL REINFORCING UNLESS SHOWN OTHERWISE. WHERE CONTINUOUS BARS ARE CALLED FOR, THEY SHALL RUN CONTINUOUSLY AROUND CORNERS AND LAPPED AS NECESSARY. PROVIDE STANDARD HOOKS AT DISCONTINUOUS ENDS. TENSION AND COMPRESSION LAP SPLICES SHALL NOT BE LESS THAN THE SPLICE LENGTHS AS GIVEN IN ACI-318. GENERALLY LAP TOP BARS AT MID SPAN AND BOTTOM BARS AT SUPPORTS. PROVIDE LACING ACCESSORIES IN ACCORDANCE WITH ACI RECOMMENDATIONS.
 2. ALL REINFORCING TO BE LAPPED 48 X BAR SIZE. STAGG ALL LAPS IN THE SLAB.
- FOOTINGS**
1. ALL FOOTINGS ARE BASED ON AN ALLOWABLE SOIL BEARING CAPACITY OF 3000 PSF. ANY SOIL CONDITION ENCOUNTERED DURING EXCAVATION THAT IS CONTRARY TO THOSE USED FOR DESIGN OF FOOTINGS AS OUTLINED IN WORKING DRAWINGS SHALL BE BROUGHT TO THE ATTENTION OF THE ENGINEER BEFORE PROCEEDING.
 2. BOTTOM OF ALL EXTERIOR FOOTINGS SHALL BE A MINIMUM OF 2'-6" BELOW FINISHED EXTERIOR GRADE UNLESS A LOWER ELEVATION IS NOTED. FOOTING ELEVATIONS NOTED ARE ESTIMATED BASED ON AVAILABLE GEOTECHNICAL AND GRADING INFORMATION. ALL FOOTINGS ADJACENT TO EXISTING FOOTINGS SHALL BE LOWERED TO MATCH EXISTING FOOTING ELEVATION.
 3. ALL FOUNDATION SUBGRADES SHALL BE INSPECTED AND APPROVED UNDER THE SUPERVISION OF A REGISTERED PROFESSIONAL ENGINEER PRIOR TO BEING CONCRETED. FOOTINGS MAY BE LOWERED TO ACHIEVE BEARING CAPACITY.


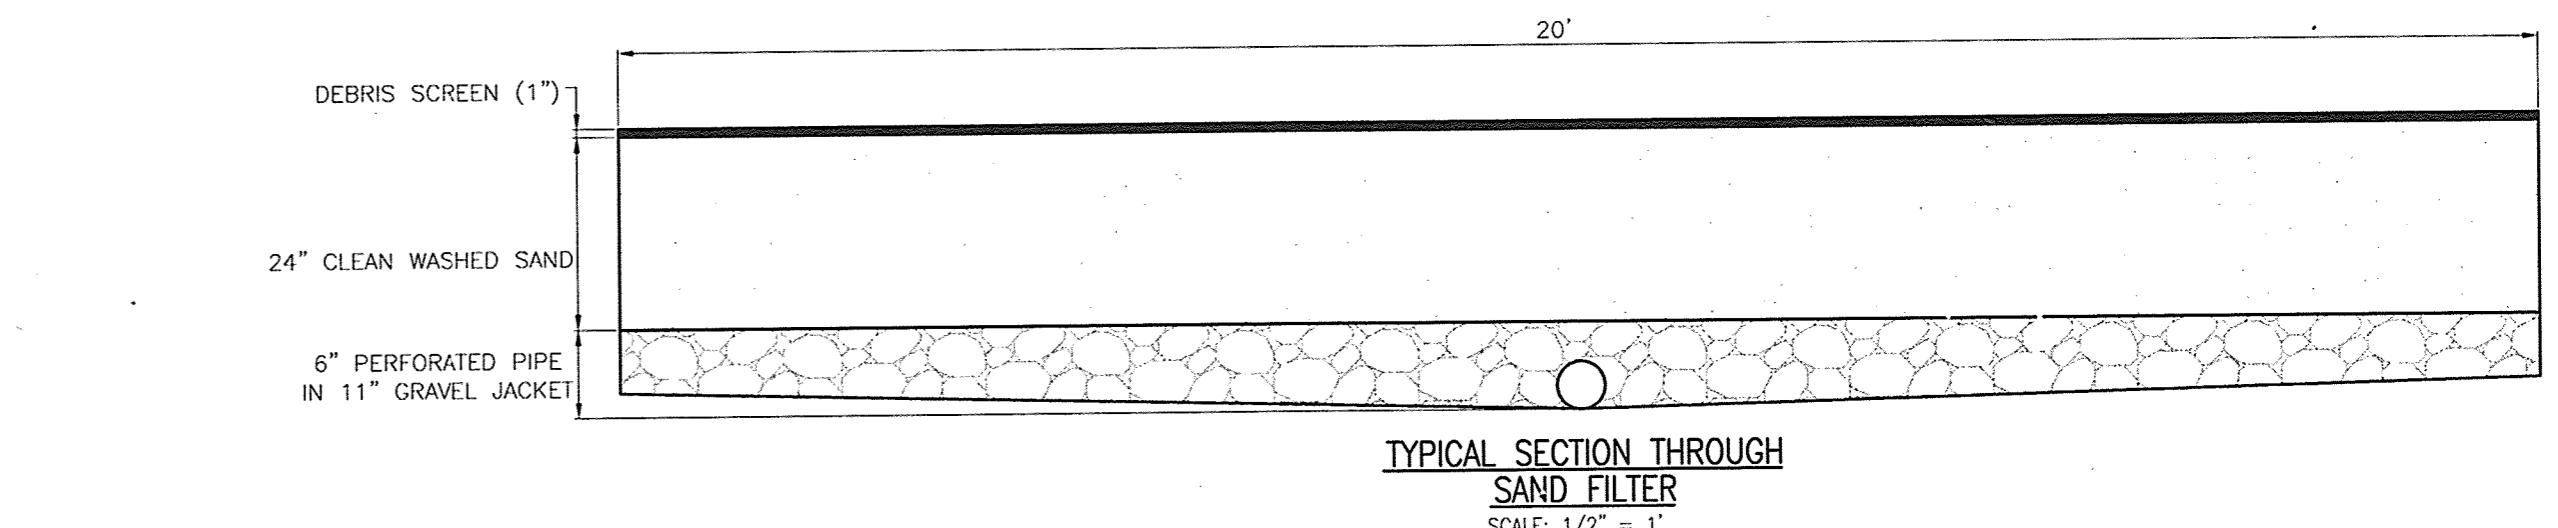


APPROVED: HOWARD COUNTY DEPARTMENT OF PLANNING AND ZONING

CHIEF, DEVELOPMENT ENGINEERING DIVISION: *[Signature]* 12/2/03

CHIEF, DIVISION OF LAND DEVELOPMENT: *[Signature]* 12/1/03

DIRECTOR: *[Signature]* 12/2/03

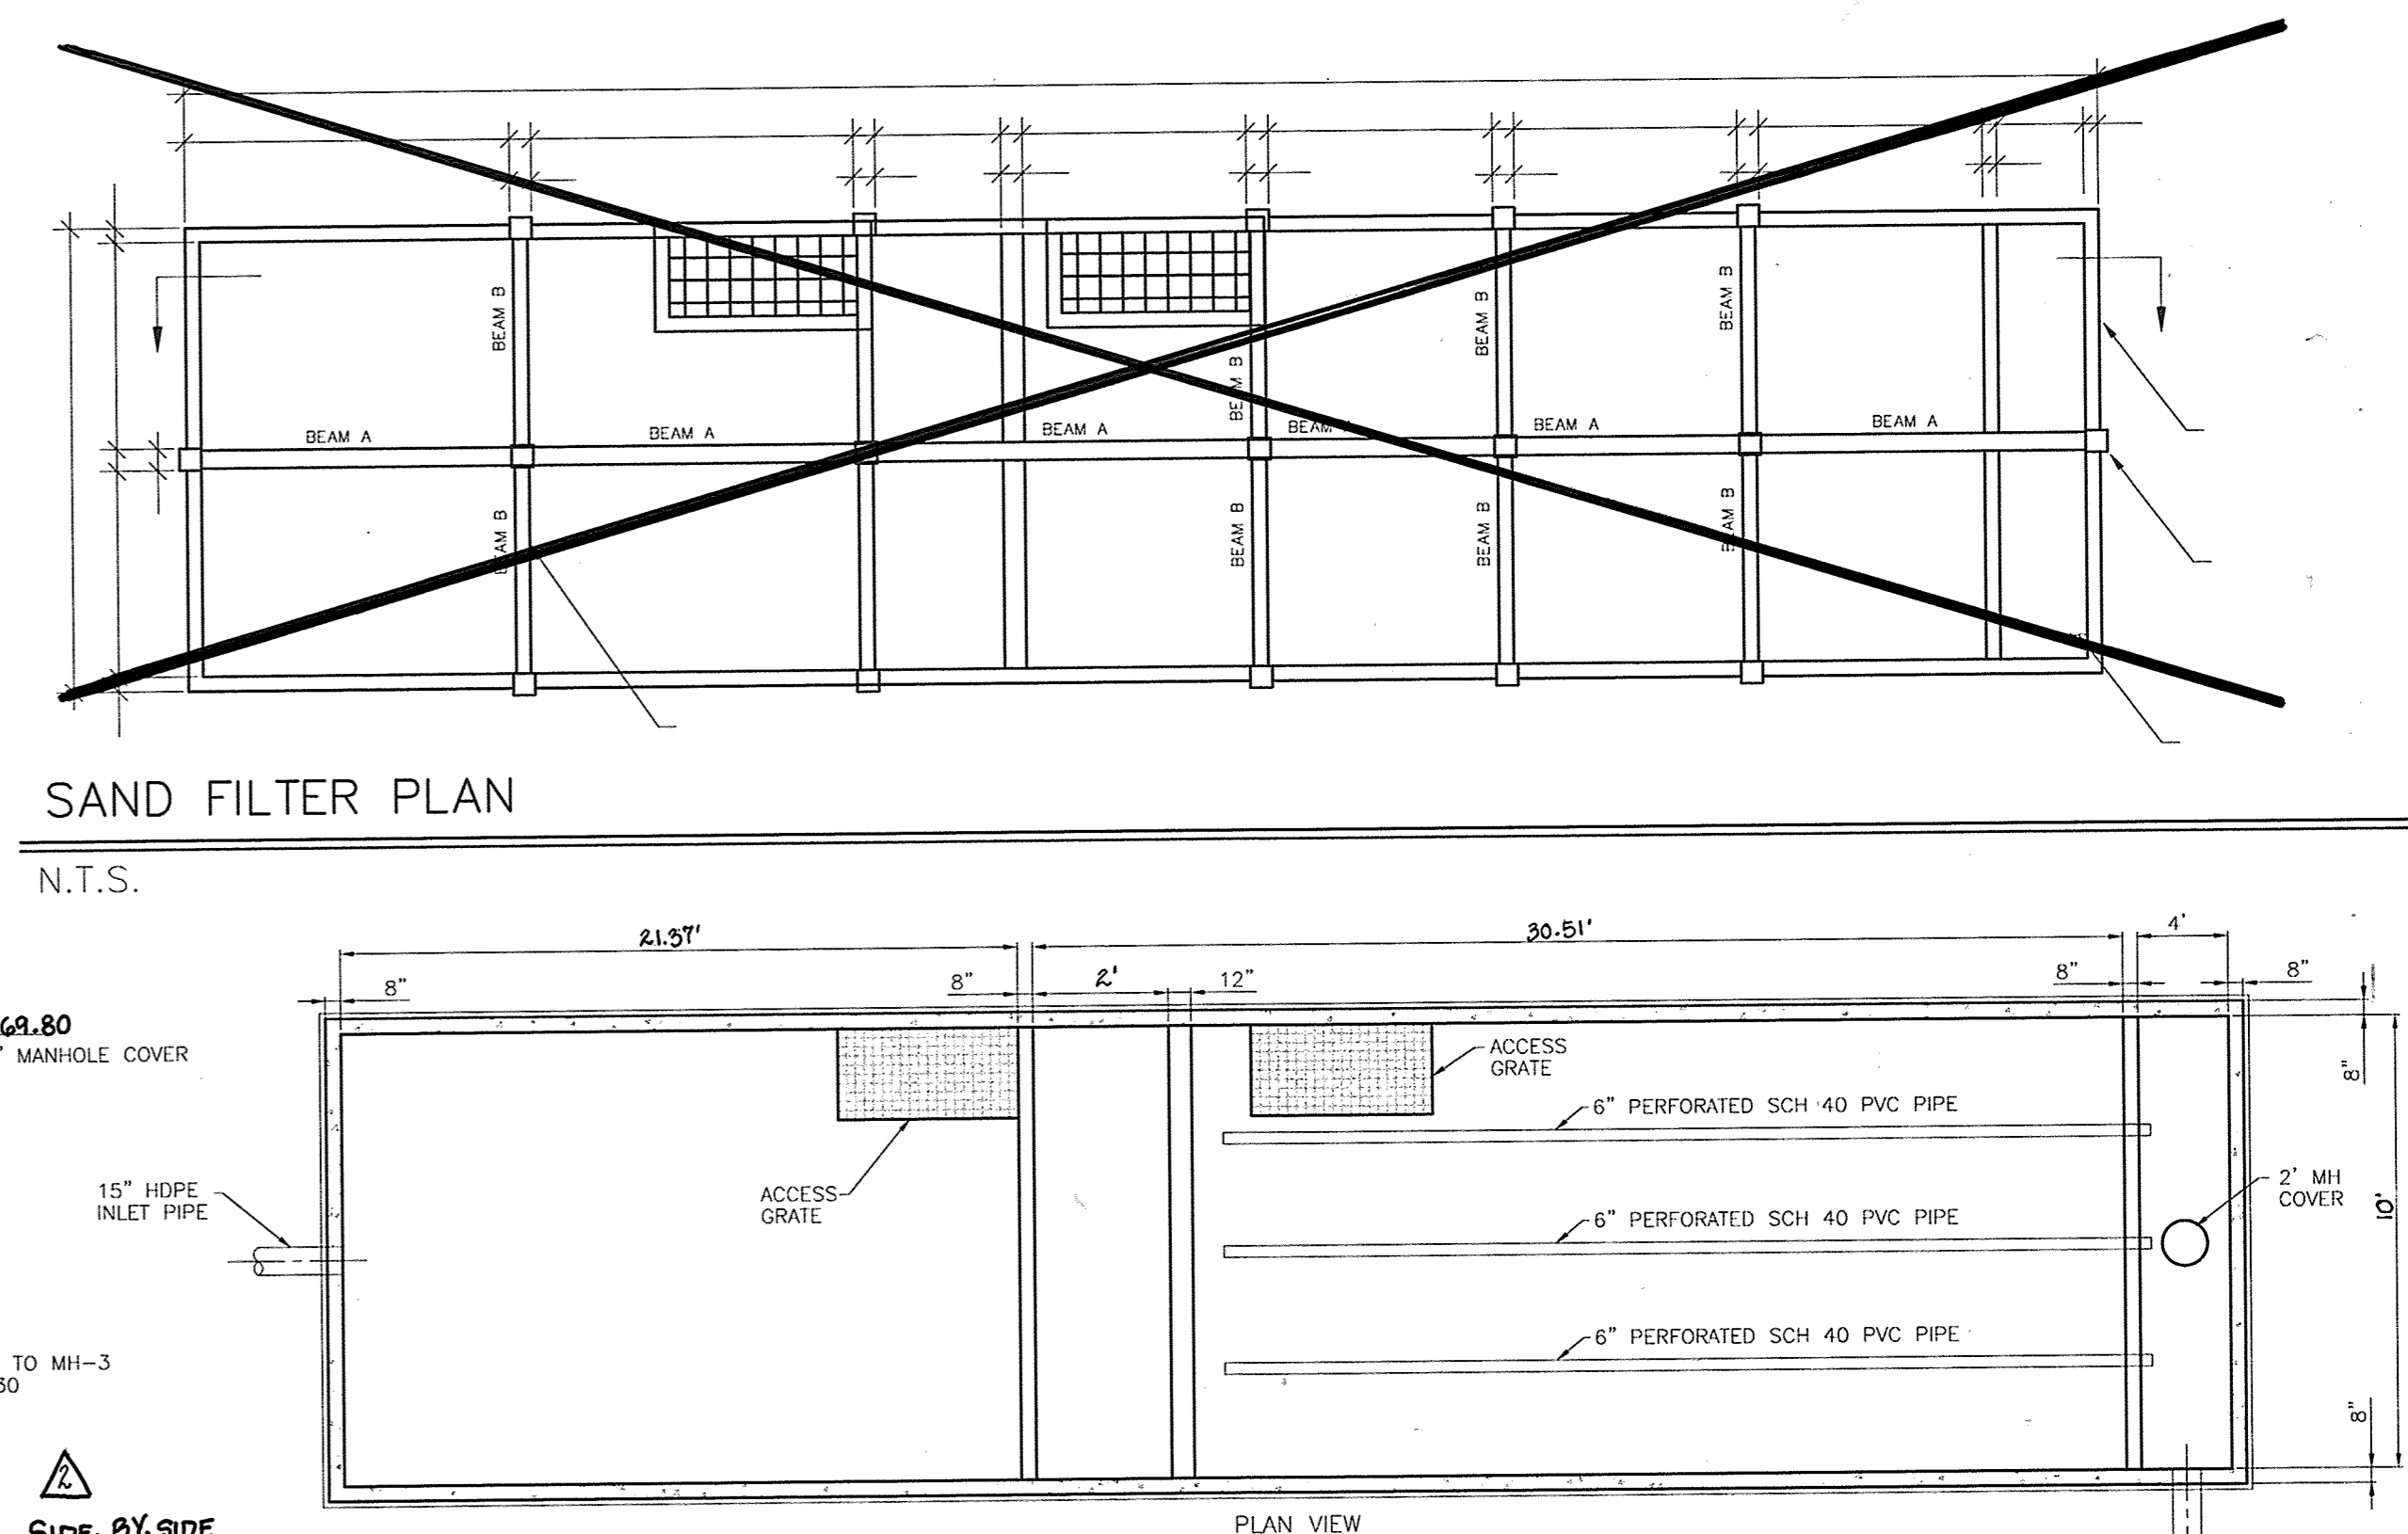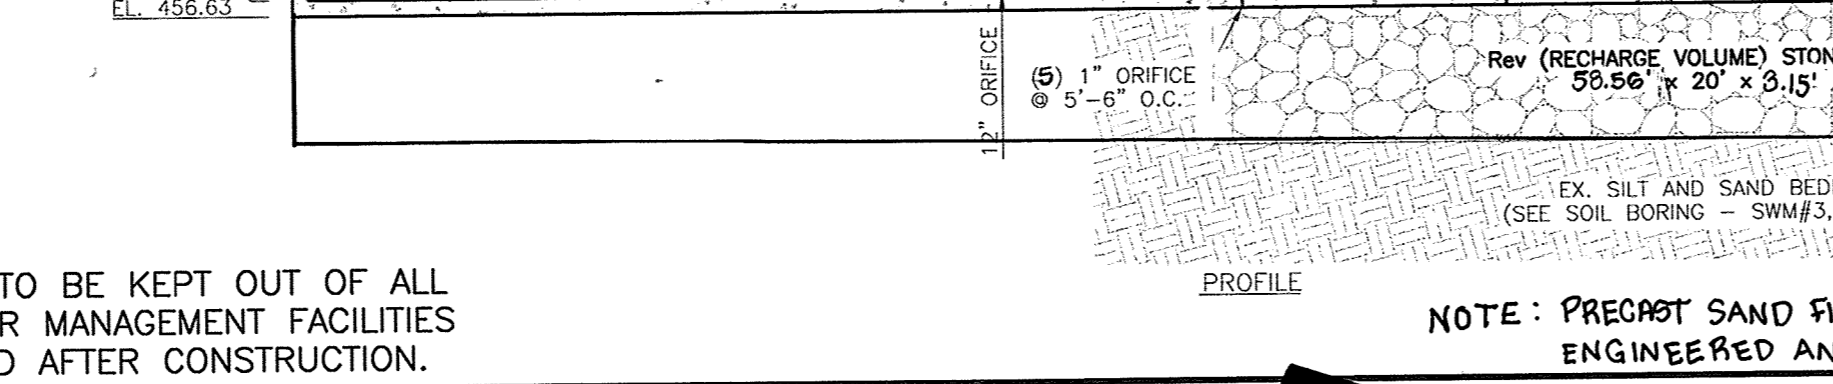

REV#	DATE	DESCRIPTION
3	5-21-20	REVISE THE PLAN TO REFLECT ADDITION OF A 2,526 SF SHOWROOM, ADDITION OF 1,620 SF OF NEW PAVEMENT AND APPOINTMENT. SEE MODIFICATIONS.
2	10-24-05	REVISE SANDFILTER; REVISE WHC; ADD SANDWICH SEPARATOR; REVISE VEHICLE DISPLAY AREA.
1	03-28-05	REVISE BUILDING FOOTPRINT ASSOCIATED ORDINANCE CHANGES, TITLE AND PROJECT NAME CHANGES.

OWNER/DEVELOPER

1318 COMPANY LLC
10400 AUTO PARK DRIVE
BETHESDA, MD 20817

VOGEL ENGINEERING

TIMMONS GROUP

3300 NORTH RIDGE ROAD, SUITE 110, ELLICOTT CITY, MD 21143
P: 410.461.7666 F: 410.461.8961 www.timmons.com

FREDERICK WARD ASSOCIATES, INC.

7125 RIVERWOOD DRIVE
COLUMBIA, MARYLAND 21046-2354
410.720.6226 fax

REGIONAL OFFICES: BEL AIR, MARYLAND AND WARRENTON, VIRGINIA

ARCHITECTS | ENGINEERS | PLANNERS | SURVEYORS
www.frederickward.com


(REVISED) SITE DEVELOPMENT PLAN
STORMWATER MANAGEMENT NOTES AND DETAILS
WATER & SEWER PROFILES AND DETAILS
COLEMAN LANDROVER/JAGUAR

TAX MAP #34 BLOCK #6
5TH ELECTION DISTRICT

STATE OF MARYLAND
ROBERT H. VOGEL, PE No. 16193
REGISTERED PROFESSIONAL ENGINEER

DATE: SEPT 2003
SCALE: 1"=30'
DESIGN BY: MMR
CHECKED BY: RHW
DRAWN BY: DZ

DRAWING NO.: 2024096.00
SHEET 5 OF 7
FVA JOB NUMBER: 2024096.00
SDP-03-93

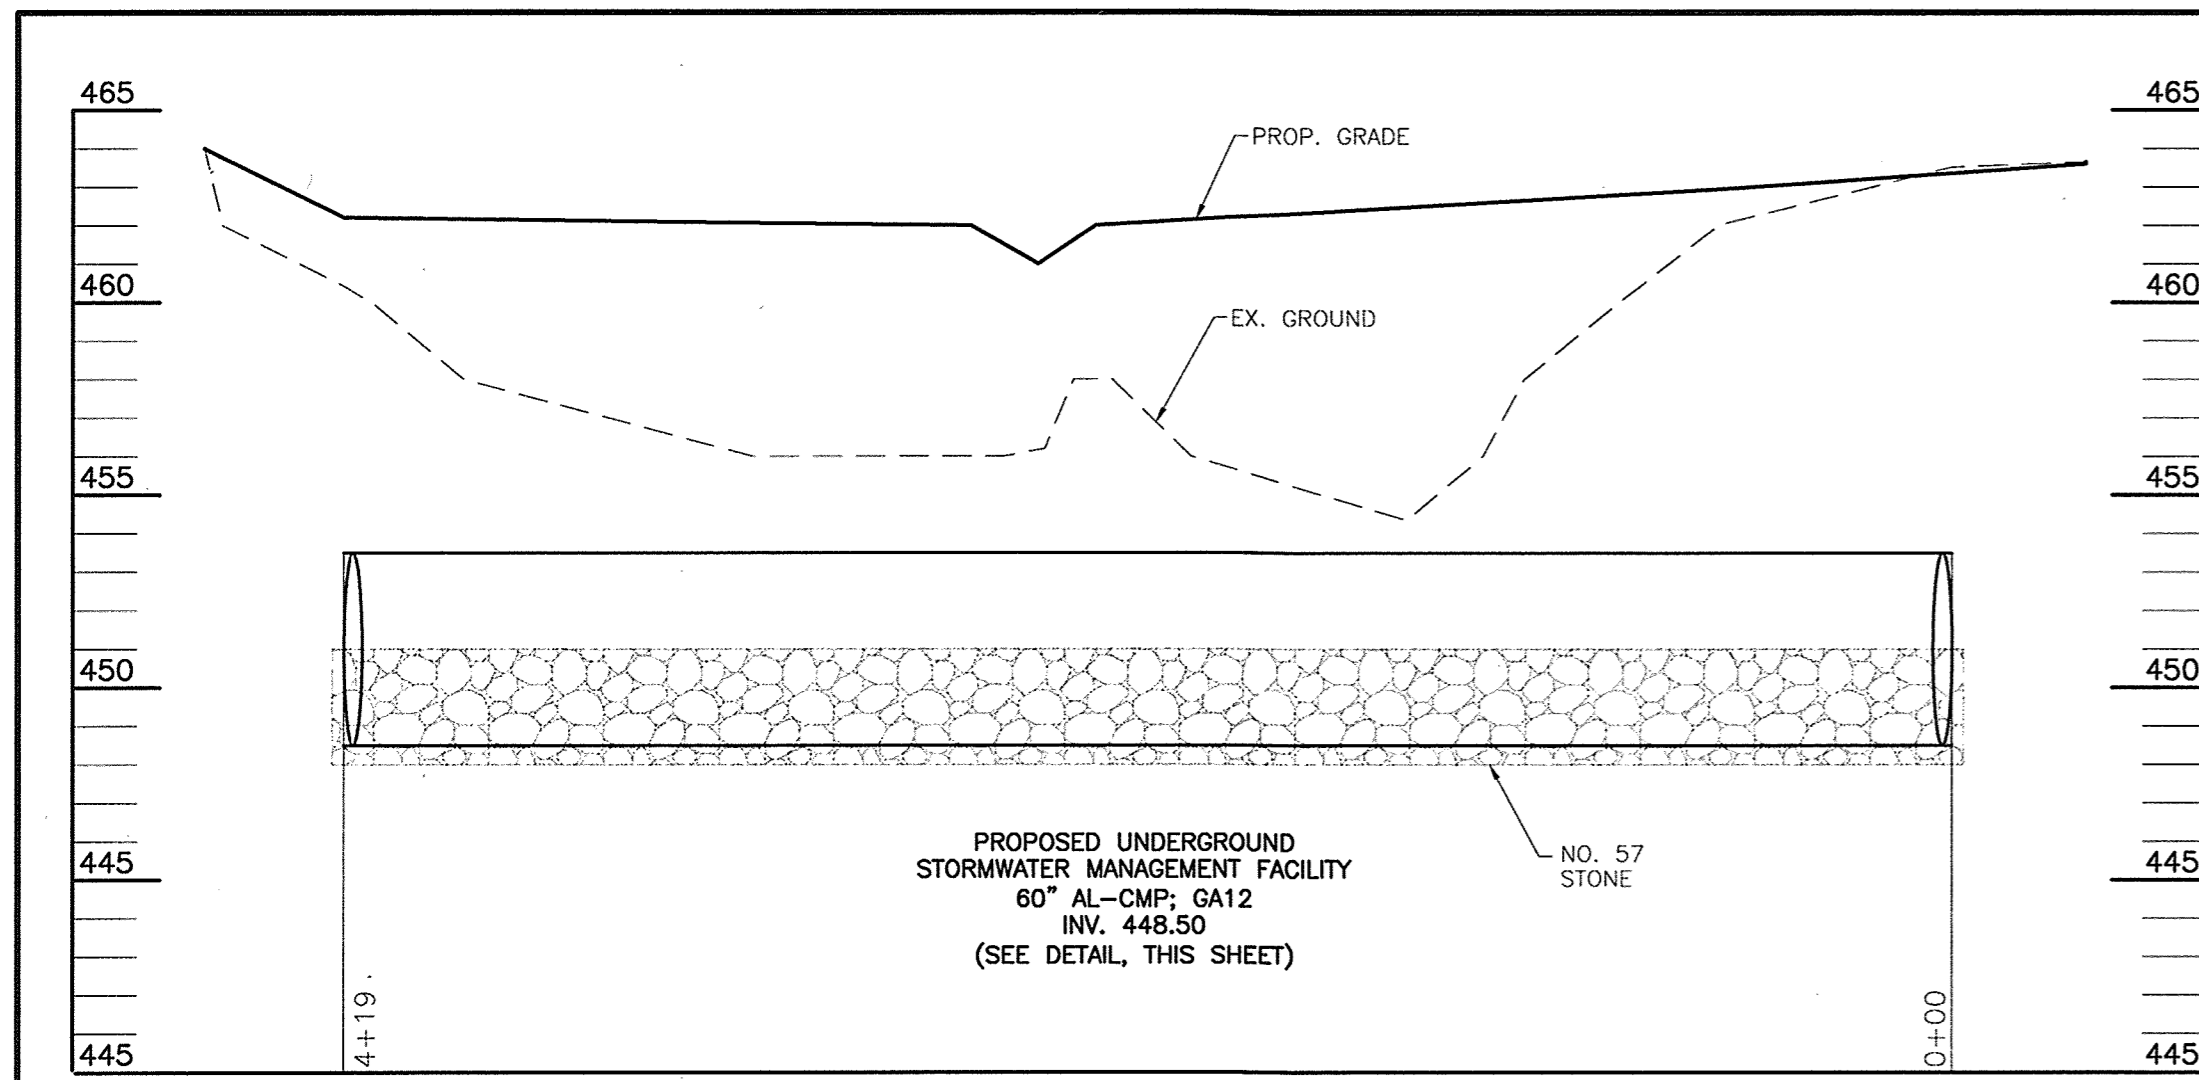


UNDERGROUND STORMWATER MANAGEMENT FACILITY PROFILE
 SCALE: HORIZONTAL 1" = 5'
 VERTICAL 1" = 5'

OPERATION AND MAINTENANCE SCHEDULE FOR PRIVATELY OWNED AND MAINTAINED UNDERGROUND FACILITIES

- THE UNDERGROUND STORMWATER MANAGEMENT FACILITY IS PRIVATELY OWNED AND IT SHALL BE THE RESPONSIBILITY OF THE OWNER TO PERIODICALLY INSPECT AND CLEAN THE FACILITY TO MAINTAIN ITS OPERATION AND FUNCTION.
- THE UNDERGROUND STORMWATER MANAGEMENT FACILITY SHALL BE INSPECTED YEARLY AT A MINIMUM AND AFTER ESPECIALLY SEVERE STORM EVENTS.
- WHEN SEDIMENT ACCUMULATION OF MORE THAN 2" IS OBSERVED OR ANY DEBRIS THAT MIGHT OBSTRUCT THE OUTFALL IS OBSERVED, THE FACILITY MUST BE CLEANED AT THE POINT OF DEBRIS ACCUMULATION.
- THE FACILITY SHALL BE CLEANED IMMEDIATELY AFTER PETROLEUM SPILLS. THE OWNER SHALL CONTACT THE APPROPRIATE REGULATORY AGENCIES NOTIFYING THEM OF THE SPILL AND CLEANUP OPERATION.
- THE SEDIMENT AND DEBRIS SHALL BE REMOVED FROM THE UNDERGROUND STORMWATER MANAGEMENT FACILITY BY VACUUM TRUCK OR OTHER MANUAL MEANS. THE OWNER SHALL FOLLOW PROPER CLEANING AND DISPOSAL OF THE REMOVED MATERIAL AND LIQUID.
- THE INLET AND OUTLET PIPES SHALL BE CHECKED FOR ANY OBSTRUCTIONS AT LEAST ONCE EVERY SIX (6) MONTHS. IF OBSTRUCTIONS ARE FOUND, THE OWNER SHALL HAVE THEM REMOVED AND PROPERLY DISPOSED OF.


UNDERGROUND DETENTION SYSTEM CROSS SECTION #1 (ACCESS MH-B TO MH-A)

SCALE: 1/8" = 1"

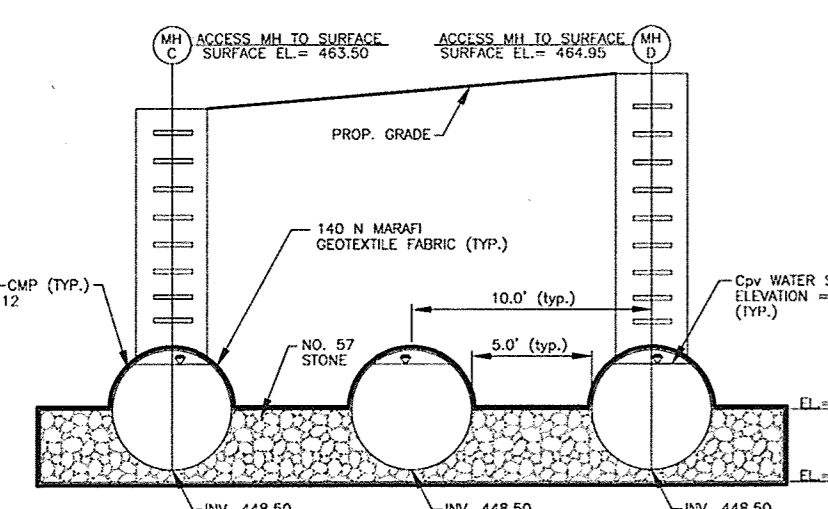


UNDERGROUND DETENTION SYSTEM CROSS SECTION #2 (ACCESS MH-C TO MH-D)

SCALE: 1/8" = 1"

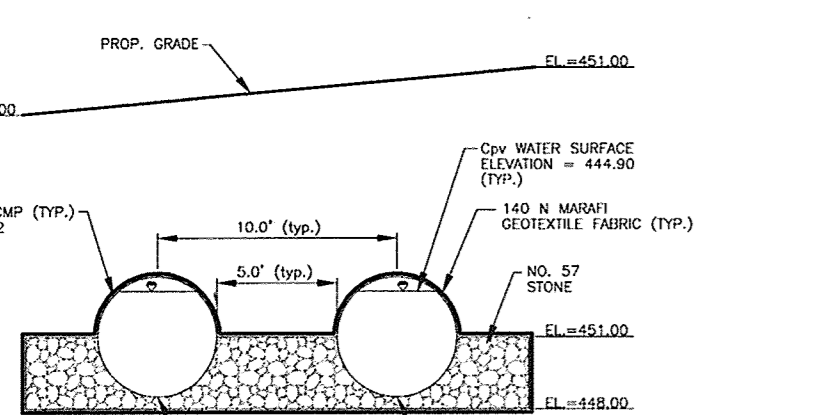

UNDERGROUND DETENTION SYSTEM CROSS SECTION #3 (SECTION AT BEND)

SCALE: 1/8" = 1"

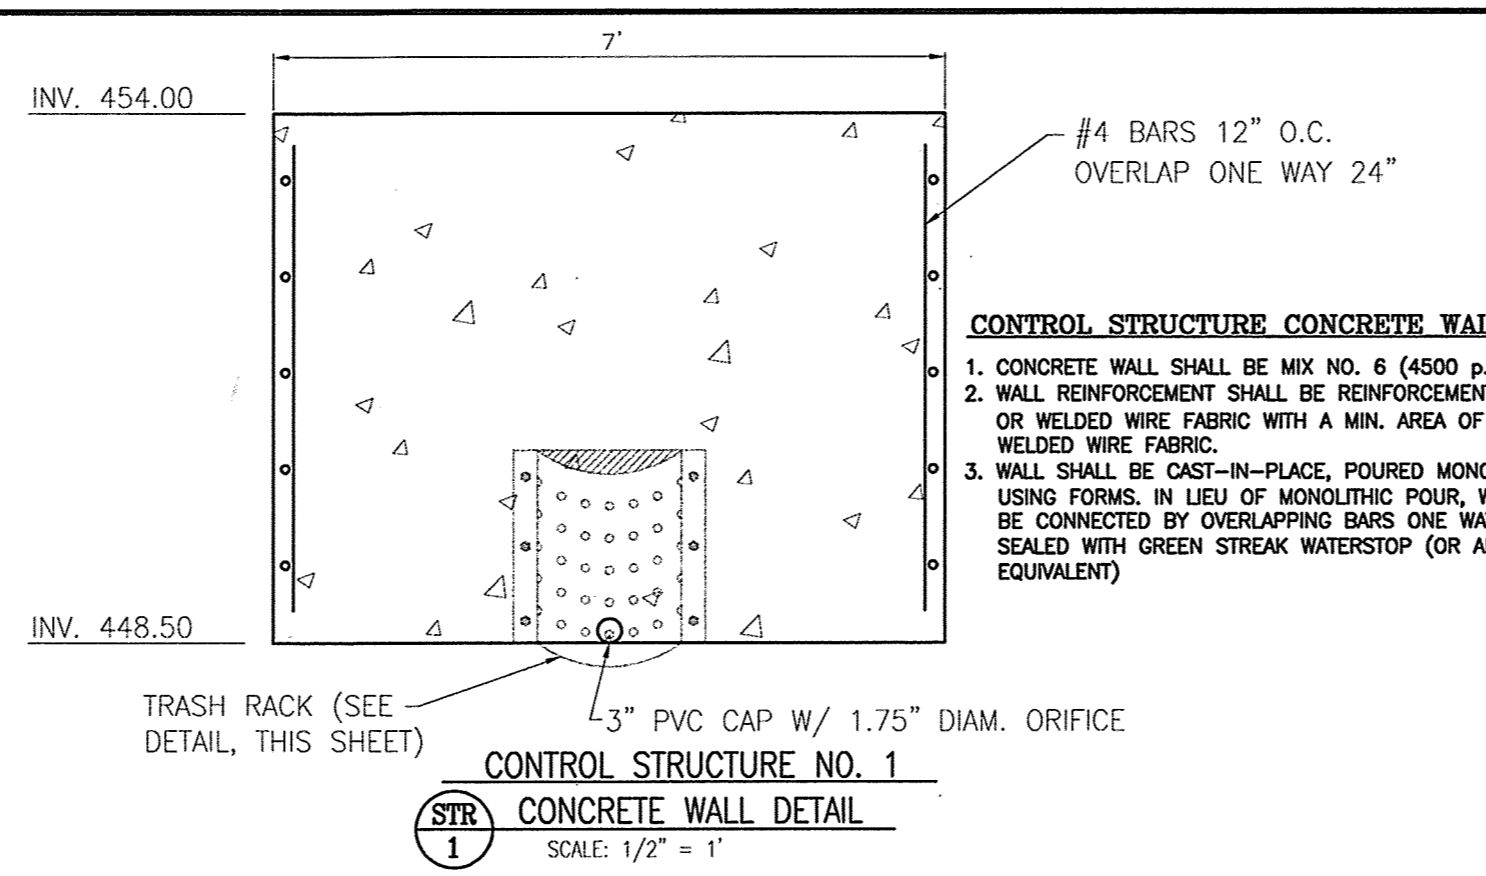

- CONTROL STRUCTURE CONCRETE WALL NOTES**
- CONCRETE WALL SHALL BE MIX NO. 6 (4500 p.s.i.)
 - WALL REINFORCEMENT SHALL BE REINFORCEMENT BARS OR WELDED WIRE FABRIC WITH A MIN. AREA OF 0.21 IN.²/FT. WELDED WIRE FABRIC.
 - WALL SHALL BE CAST-IN-PLACE, POURED MONOLITHIC CONCRETE USING FORMS. IN LIEU OF MONOLITHIC POUR, WALL SHALL BE CONNECTED BY OVERLAPPING BARS ONE WAY 24", AND SEALED WITH GREEN STREAK WATERSTOP (OR APPROVED EQUIVALENT)


MATERIAL	SPECIFICATION	SIZE	NOTES
PLANTINGS	SEE APPENDIX A, TABLE A1	N/A	PLANTINGS ARE SITE-SPECIFIC
PLANTING SOIL	USDA 35-600 (0-60%) SAND, 35-500 (60-70%) SILT, 30-500 (70-100%) CLAY	N/A	USDA SOIL TYPES LOAMY SAND, SANDY LOAM OR LOAM
MULCH	SHREDDED HARDWOOD	N/A	AGED 6 MONTHS, MINIMUM
PEA GRAVEL DIAPHRAGM AND CURTAIN DRAIN	PEA GRAVEL: ASTM D-448 (30-45) WASHED COBBLES	PEA GRAVEL NO. 6	FOR USE AS NECESSARY BENEATH UNDERGROUNDS ONLY
GEOTEXTILE	GLASS FIBER APPARENT OPENING SIZE (ASTM D-4751), GRAB TENSILE STRENGTH (ASTM D-4633), PUNCTURE RESISTANCE (ASTM D-4833)	N/A	FOR USE AS NECESSARY BENEATH UNDERGROUNDS ONLY FOR MBRT: PE TYPE 1 NONWOVEN
UNDERGROUND GRAVEL	ASTM D-43	0.375" TO 0.75"	FOR MBRT: PERFORATED PIPE SHALL BE WRAPPED WITH 1/2-INCH GALVANIZED HARDWARE CLOTH FOR MBRT: USE NO. 57 AND NO. 6 AGGREGATE (3/8 TO 3/4)
UNDERGROUND PIPING	F 758, TYPE PS 28 OR ASTM D-278	4" TO 6" RIGID SCHEDULE 40 PVC OR HDPE	3/8" PER FOR 6" O.C. HOLES PER FOR MIN. OF 3' OF GRAVEL OVER PIPES; NOT NECESSARY UNDERNEATH PIPES
POURED IN PLACE CONCRETE (IF REQUIRED)	MISHA MIX NO. 3, 1:2:3.50 P/P @ 28 DAYS, MINIMUM HEIGHT, AIR-ENTRAINED, REINFORCING TO MEET ASTM-615-60	N/A	ON-SITE TESTING OF POURED-IN-PLACE CONCRETE REQUIRED: 28 DAY STRENGTH AND SLUMP TEST. ALL CONCRETE DESIGN (CAST-IN-PLACE OR PRE-CAST) NOT USING PREVIOUSLY APPROVED STAIR OR LOCK. MIXTURE DESIGN SHALL BE APPROVED BY A PROFESSIONAL STRUCTURAL ENGINEER LICENSED IN THE STATE OF MARYLAND - DESIGN TO INCLUDE MIXING AND CURING, SENSITIVE LEARNING (1+10 OR 1+20) ALLOWABLE HORIZONTAL LOADING BASED ON SOIL PRESSURE; AND ANALYSIS OF POTENTIAL CRACKING
SAND (1" DEEP)	ASTM D-6 OR ASTM C-33	0.02" TO 0.04"	SAND SUBSTITUTIONS SUCH AS DIAMINE AND GRANITEGEO ARE NOT ACCEPTABLE. NO CALCIUM CARBONATE OR POLYMERIC SAND SUBSTITUTIONS ARE ACCEPTABLE. NO "TRUCK DUST" CAN BE USED FOR SAND

OPERATION AND MAINTENANCE SCHEDULE FOR BIO-RETENTION AREAS

- ANNUAL MAINTENANCE OF PLANT MATERIAL, MULCH LAYER AND SOIL LAYER IS REQUIRED. MAINTENANCE OF MULCH AND SOIL IS LIMITED TO CORRECTING AREAS OF EROSION OR WASH OUT. ANY MULCH REPLACEMENT SHALL BE DONE IN THE SPRING. PLANT MATERIAL SHALL BE CHECKED FOR DISEASE AND INSECT INFESTATION AND MAINTENANCE WILL ADDRESS DEAD MATERIAL AND PRUNING.
- SCHEDULE OF PLANT INSPECTION WILL BE TWICE A YEAR IN SPRING AND FALL. THIS INSPECTION WILL INCLUDE REMOVAL OF DEAD AND DISEASED VEGETATION CONSIDERED BEYOND TREATMENT, OF ALL DEFICIENT STAGES AND WIRES.
- MULCH SHALL BE INSPECTED EACH SPRING. REMOVE PREVIOUS MULCH LAYER BEFORE APPLYING NEW LAYER EVERY 2 TO 3 YEARS.
- SOIL EROSION TO BE ADDRESSED ON AN AS NEEDED WITH A MINIMUM OF ONCE PER MONTH AND AFTER HEAVY STORM EVENTS.

NOTE: CONTRACTOR SHALL ENSURE THAT THE S.W.M. FACILITY IS WATER TIGHT.

- ALL PIPE CONNECTIONS AT STRUCTURES SHALL BE CEMENTED TO ENSURE WATER TIGHT CONNECTION.
- ALL ACCOMP PIPE JOINTS SHALL USE 1/2" WIDE HUGGER BAND WITH "OT" RING GASKETS.
- TEES AND ELBOWS TO BE FACTORY FABRICATED WELDS, ONE PIECE.
- TRENCH BEDDING TO BE IN ACCORDANCE WITH RECOMMENDATIONS FROM THE GEOTECHNICAL ENGINEER IN THE FIELD.
- PROVIDE WATER TIGHT JOINTS AT ALL PIPE CONNECTIONS. (FOR REINFORCED CONCRETE PIPE, ASTM C-361, RUBBER GASKET PIPE).

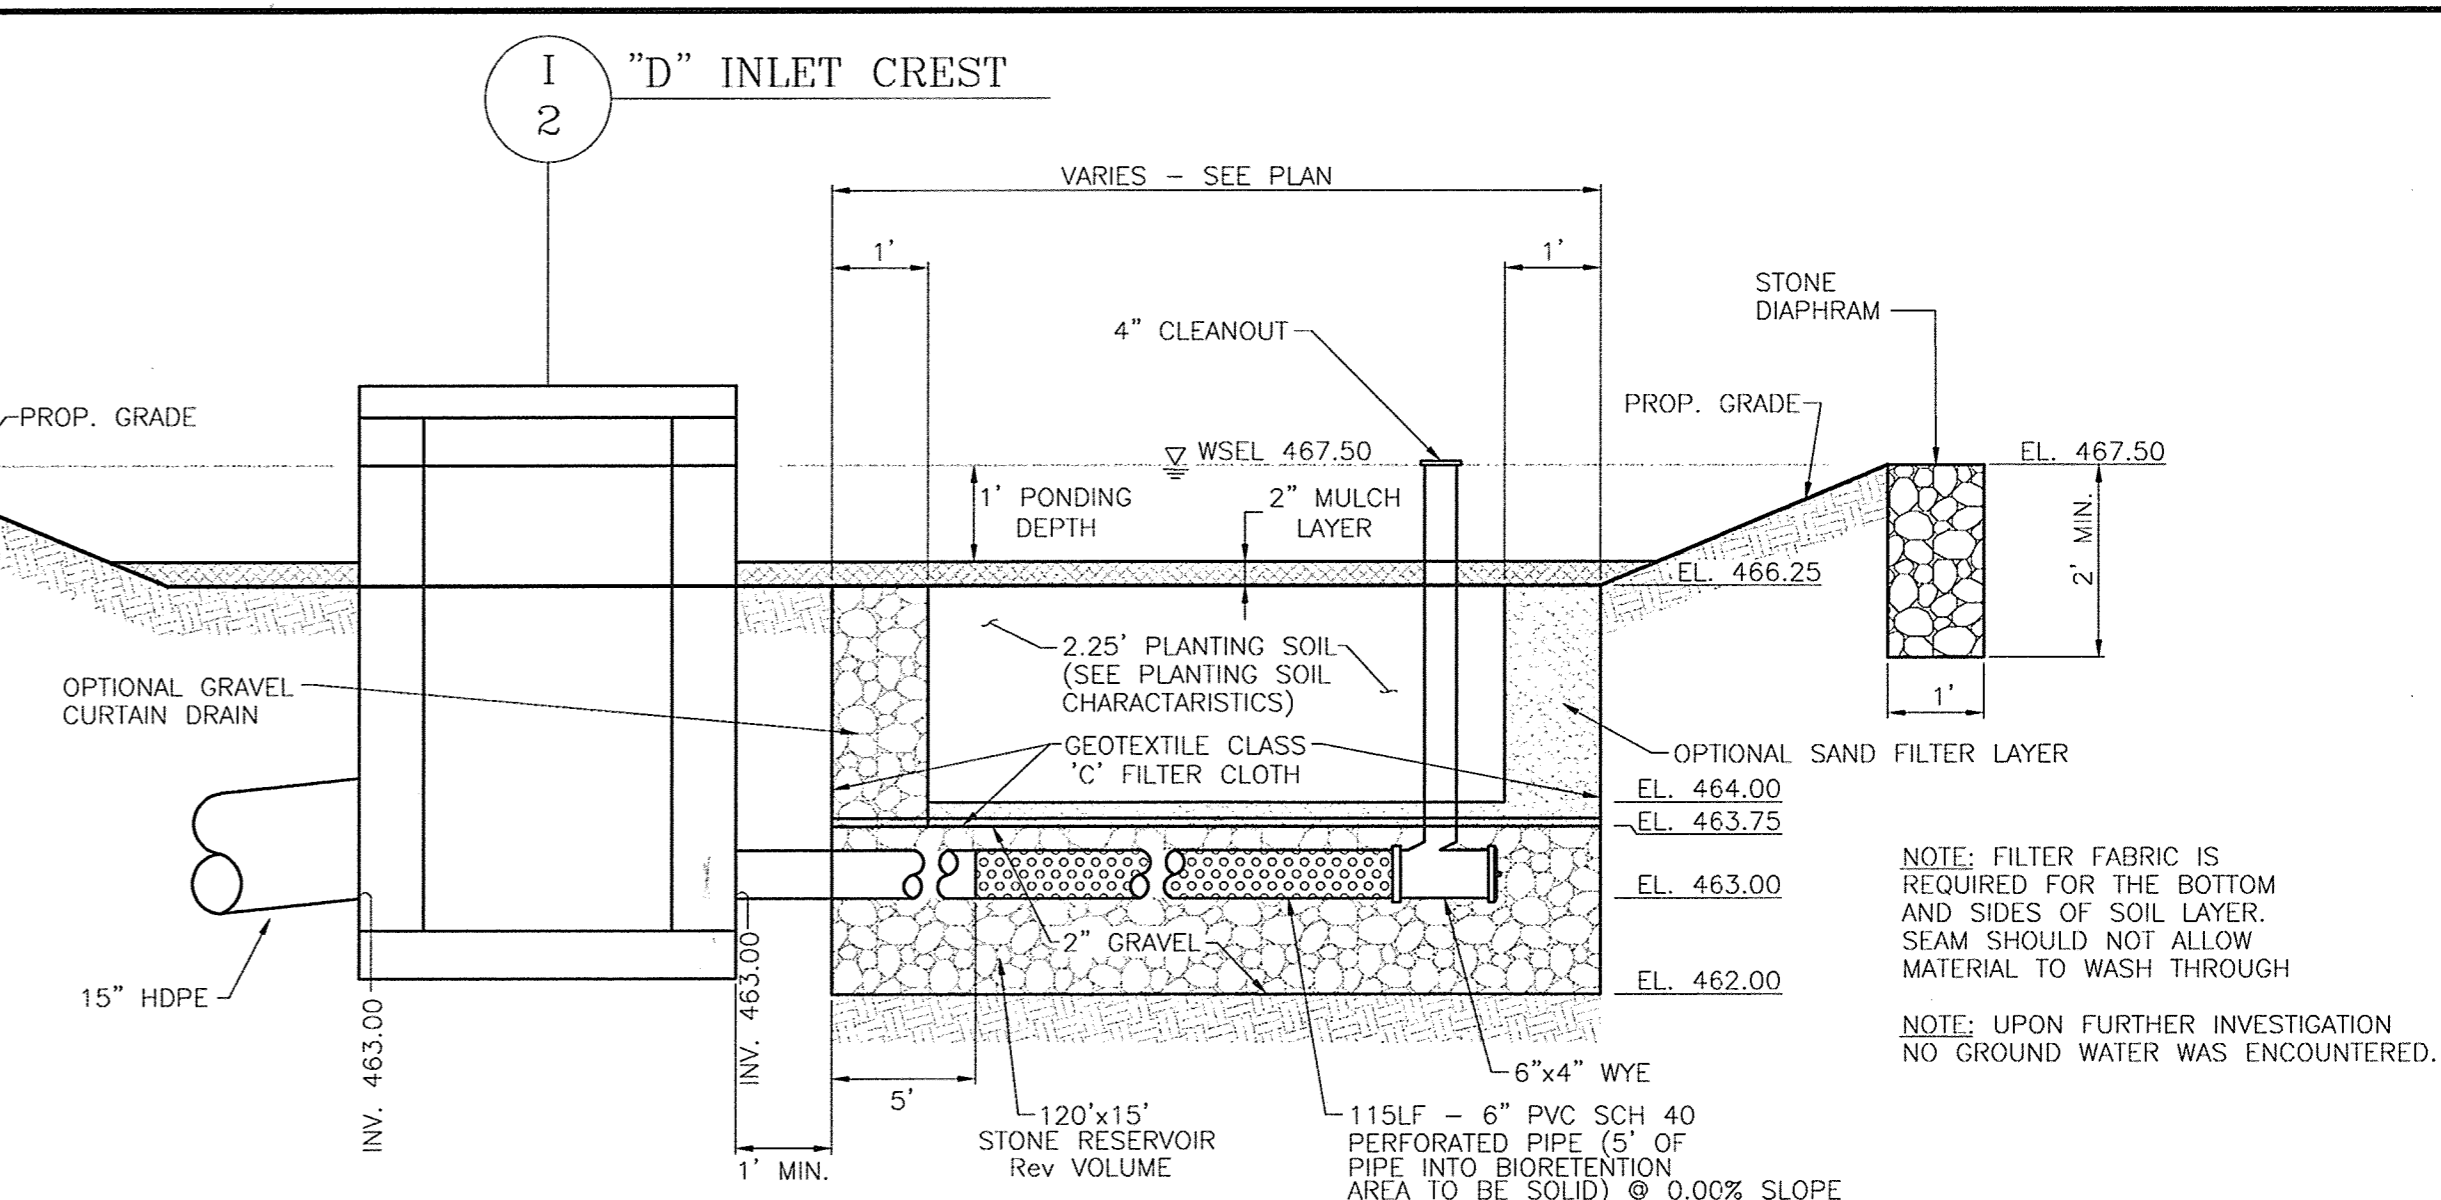

BIORETENTION AREA DETAIL

SCALE: 1/2" = 1"

Appendix B.3. Construction Specifications for Sand Filters, Bioretention and Open Channels

Specifications for Bioretention

The allowable materials to be used in bioretention area are detailed in Table B.3.2.

1. Material Specifications

The soil shall be a uniform mix, free of stones, stumps, roots or other similar objects larger than two inches. No other materials or substances shall be mixed or dumped within the bioretention area that may be harmful to plant growth or prove a hindrance to the planting or maintenance operations. The design of equipment with screen traps or high pressure lines will cause excessive compaction resulting in reduced infiltration rates and is not acceptable. Compaction will significantly contribute to design failure.

The planting soil must be tested and shall meet the following criteria:

pH range: 5.2 - 7.0
 organic matter: 1.5 - 3% (by weight)
 phosphorus: 35 to 60 lb/acre
 potassium: 40 to 80 lb/acre
 soluble sulfur: 10 to 15 lb/acre

All bioretention areas shall have a minimum of one test. Each test shall consist of both the standard soil test for pH, phosphorus, and potassium and additional test of organic matter, and soluble salts. A textural analysis shall be performed for each location where the soil will be used. Since different lab calibrates their testing equipment differently, all testing results shall come from the same testing facility. Should the pH fall out of the acceptable range, it may be modified (higher) with lime or (lower) with iron sulfate plus sulfur.

2. Plant Installation

It is very important to minimize compaction of both the base of the bioretention area and the required bedding. When possible, use hoses to remove ground soil. If bioretention areas are precast panels, the contractor should use wide track or marsh track equipment or light weight equipment with narrow tracks. Compaction of the soil by heavy equipment will significantly contribute to design failure.

When backfilling the bioretention area, the soil shall be placed in lifts 12" to 18". Do not use heavy equipment within the bioretention basin. Heavy equipment can be used around the perimeter of the basin to supply soil and sand. Grade bioretention materials with light equipment such as a constant torque roller or a dozer/loader with marsh tires during the entire planting process.

Grasses and legume seed shall be drilled into the soil to a depth of at least one inch. Grass and legume plants shall be planted following the non-grass ground cover planting specifications.

3. Compaction


The topsoil specifications provide enough organic material to adequately supply nutrients from natural cycling. The primary function of the bioretention structure is to improve water quality. Adding fertilizer does not improve water quality. This soil. Only one fertilizer or wood chips or mulch are used to amend the soil. Avoid urea fertilizer at a rate of 2 pounds of nitrogen per 1000 square feet.

4. Underdrains

Underdrains are to be placed on a 3'-0" wide section filter fabric. Fabric is placed next, followed by the gravel bedding. The ends of underdrain pipes must be placed in the bioretention area. The pipes shall be supported by the bedding. The main collector pipe for underdrain systems shall be constructed of a minimum slope of 0.5%. Observation well and/or clean-out pipes must be provided (one minimum per every 1000 square feet of surface area).


5. Miscellaneous

The bioretention facility may not be constructed until all contributing drainage area has been stabilized.

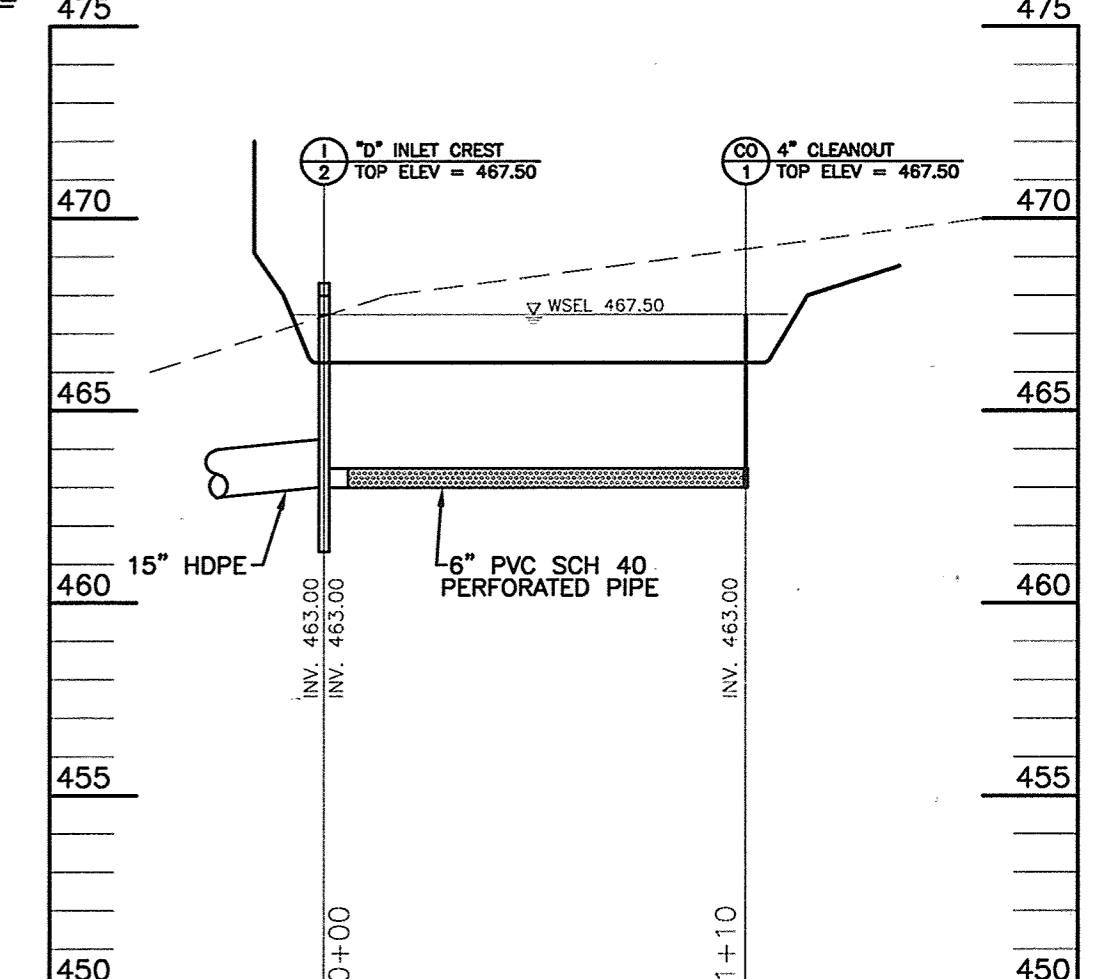


BIORETENTION PROFILE

SCALE: HORIZONTAL 1" = 5'
 VERTICAL 1" = 5'

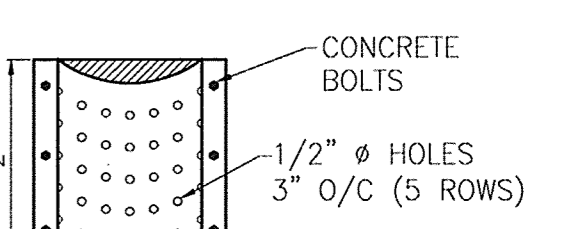

CONTROL STRUCTURE TRASH RACK DETAIL

SCALE: 1/2" = 1"

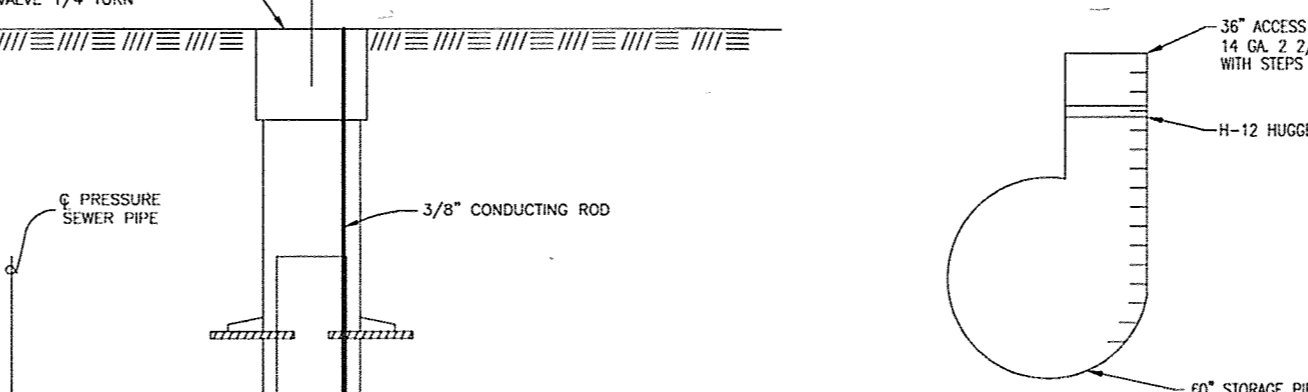

TYPICAL ACCESS MANHOLE DETAIL FOR UNDERGROUND S.W.M. FACILITY

(NOT TO SCALE)

SWM #	TOP ELEVATION	SOIL BORING DETAIL	(NOT TO SCALE)
B-1	470.0	Soil Profile 1: 0.5' topsoil, 1.5' fill (tan, sandy, silt, trace clay, silt, to moist, loose to medium dense), 2.5' fill (tan, sandy, silt, trace clay, silt, to moist, loose to medium dense), 11.5' sand (tan, silty, trace decomposed rock, dry, medium dense (M)), 2.0' gravel (tan, silty, dry to moist, medium dense (M)), 2.0' gravel (tan, silty, dry to moist, medium dense (M))	
B-2	467.5	Soil Profile 2: 0.5' topsoil, 1.5' fill (tan, sandy, silt, trace clay, silt, to moist, loose to medium dense), 2.5' fill (tan, sandy, silt, trace clay, silt, to moist, loose to medium dense), 11.5' sand (tan, silty, trace decomposed rock, dry, medium dense (M)), 2.0' gravel (tan, silty, dry to moist, medium dense (M)), 2.0' gravel (tan, silty, dry to moist, medium dense (M))	
B-3	465.0	Soil Profile 3: 0.5' topsoil, 1.5' fill (tan, sandy, silt, trace clay, silt, to moist, loose to medium dense), 2.5' fill (tan, sandy, silt, trace clay, silt, to moist, loose to medium dense), 11.5' sand (tan, silty, trace decomposed rock, dry, medium dense (M)), 2.0' gravel (tan, silty, dry to moist, medium dense (M)), 2.0' gravel (tan, silty, dry to moist, medium dense (M))	
B-4	462.5	Soil Profile 4: 0.5' topsoil, 1.5' fill (tan, sandy, silt, trace clay, silt, to moist, loose to medium dense), 2.5' fill (tan, sandy, silt, trace clay, silt, to moist, loose to medium dense), 11.5' sand (tan, silty, trace decomposed rock, dry, medium dense (M)), 2.0' gravel (tan, silty, dry to moist, medium dense (M)), 2.0' gravel (tan, silty, dry to moist, medium dense (M))	
B-5	460.0	Soil Profile 5: 0.5' topsoil, 1.5' fill (tan, sandy, silt, trace clay, silt, to moist, loose to medium dense), 2.5' fill (tan, sandy, silt, trace clay, silt, to moist, loose to medium dense), 11.5' sand (tan, silty, trace decomposed rock, dry, medium dense (M)), 2.0' gravel (tan, silty, dry to moist, medium dense (M)), 2.0' gravel (tan, silty, dry to moist, medium dense (M))	
B-6	457.5	Soil Profile 6: 0.5' topsoil, 1.5' fill (tan, sandy, silt, trace clay, silt, to moist, loose to medium dense), 2.5' fill (tan, sandy, silt, trace clay, silt, to moist, loose to medium dense), 11.5' sand (tan, silty, trace decomposed rock, dry, medium dense (M)), 2.0' gravel (tan, silty, dry to moist, medium dense (M)), 2.0' gravel (tan, silty, dry to moist, medium dense (M))	
B-7	455.0	Soil Profile 7: 0.5' topsoil, 1.5' fill (tan, sandy, silt, trace clay, silt, to moist, loose to medium dense), 2.5' fill (tan, sandy, silt, trace clay, silt, to moist, loose to medium dense), 11.5' sand (tan, silty, trace decomposed rock, dry, medium dense (M)), 2.0' gravel (tan, silty, dry to moist, medium dense (M)), 2.0' gravel (tan, silty, dry to moist, medium dense (M))	
B-8	452.5	Soil Profile 8: 0.5' topsoil, 1.5' fill (tan, sandy, silt, trace clay, silt, to moist, loose to medium dense), 2.5' fill (tan, sandy, silt, trace clay, silt, to moist, loose to medium dense), 11.5' sand (tan, silty, trace decomposed rock, dry, medium dense (M)), 2.0' gravel (tan, silty, dry to moist, medium dense (M)), 2.0' gravel (tan, silty, dry to moist, medium dense (M))	
B-9	450.0	Soil Profile 9: 0.5' topsoil, 1.5' fill (tan, sandy, silt, trace clay, silt, to moist, loose to medium dense), 2.5' fill (tan, sandy, silt, trace clay, silt, to moist, loose to medium dense), 11.5' sand (tan, silty, trace decomposed rock, dry, medium dense (M)), 2.0' gravel (tan, silty, dry to moist, medium dense (M)), 2.0' gravel (tan, silty, dry to moist, medium dense (M))	

BALL VALVE CONNECTION DETAIL

SCALE: N.T.S.

(REVISED) SITE DEVELOPMENT PLAN
 STORMWATER MANAGEMENT
 NOTES AND DETAILS
 COLEMAN LANDROVER/JAGUAR



DATE: SEPT 2003	DRAWING NO.:
SCALE: AS SHOWN	
DESIGN BY: MMR	SHEET: 6 OF 7
CHECKED BY: RHV	FVA JOB NUMBER:
DRAWN BY: DZ	2024096.00
SDP-03-93	

OWNER/DEVELOPER
 1318 COMPANY LLC
 10400 AUTO PARK DRIVE
 BETHESDA, MD 20817

VOGEL ENGINEERING
 TIMMONS GROUP
 3300 NORTH RIDGE ROAD, SUITE 110, ELLICOTT CITY, MD 211043
 P: 410.461.7666 F: 410.461.8961 www.timmons.com

FREDERICK WARD ASSOCIATES, INC.
 ARCHITECTS PLANNERS SURVEYORS



NOTE: DEBRIS IS TO BE KEPT OUT OF ALL STORMWATER MANAGEMENT FACILITIES DURING AND AFTER CONSTRUCTION.

APPROVED: HOWARD COUNTY DEPARTMENT OF PLANNING AND ZONING

CHIEF, DEVELOPMENT ENGINEERING DIVISION: [Signature] DATE: 12/26/03
 CHIEF, DIVISION OF LAND DEVELOPMENT: [Signature] DATE: 12/17/03
 DIRECTOR: [Signature] DATE: 12/23/03

REV#	DATE	DESCRIPTION
3	5-21-20	REVISE THE PLAN TO REFLECT ADDITION OF A 2.526 SF SUBSTORMWATER ADJUNCTION OF 1,620 SF OF NEW PLANTS AND ADDITIONAL SITE MODIFICATIONS
1	03-28-05	REVISE BUILDING FOOTPRINT, ASSUMED GRADING CHANGES, TITLE AND PROJECT NAME CHANGES

M:\PROJECTS\2019159\BREV\DWG\WC_Mitidibish1\0006.dwg Thu Oct 16 11:05:29 2003 M.A.N.

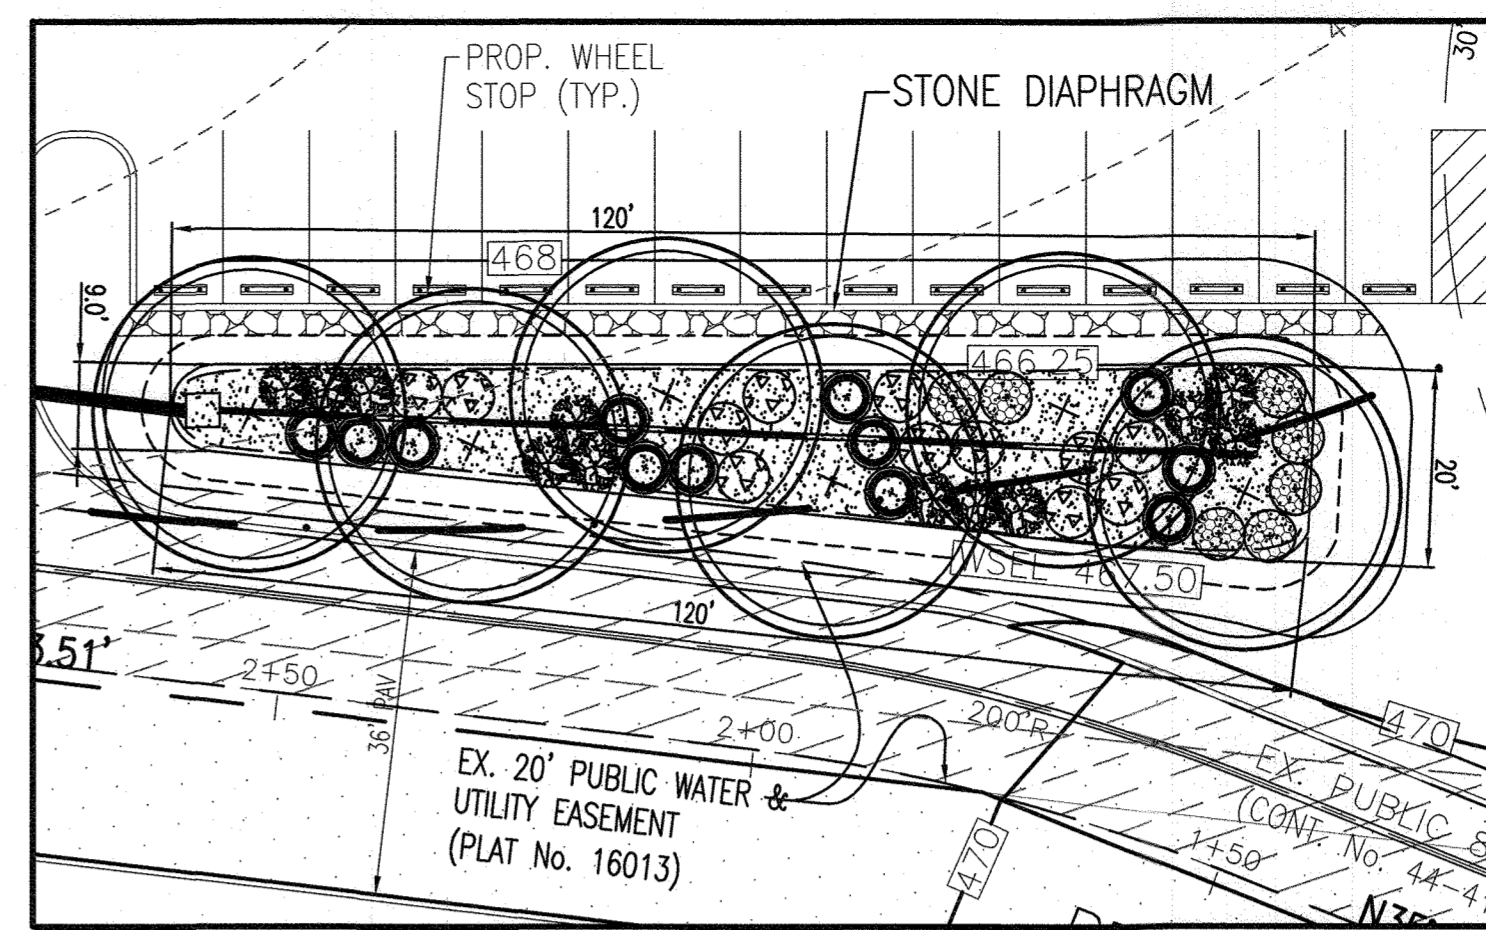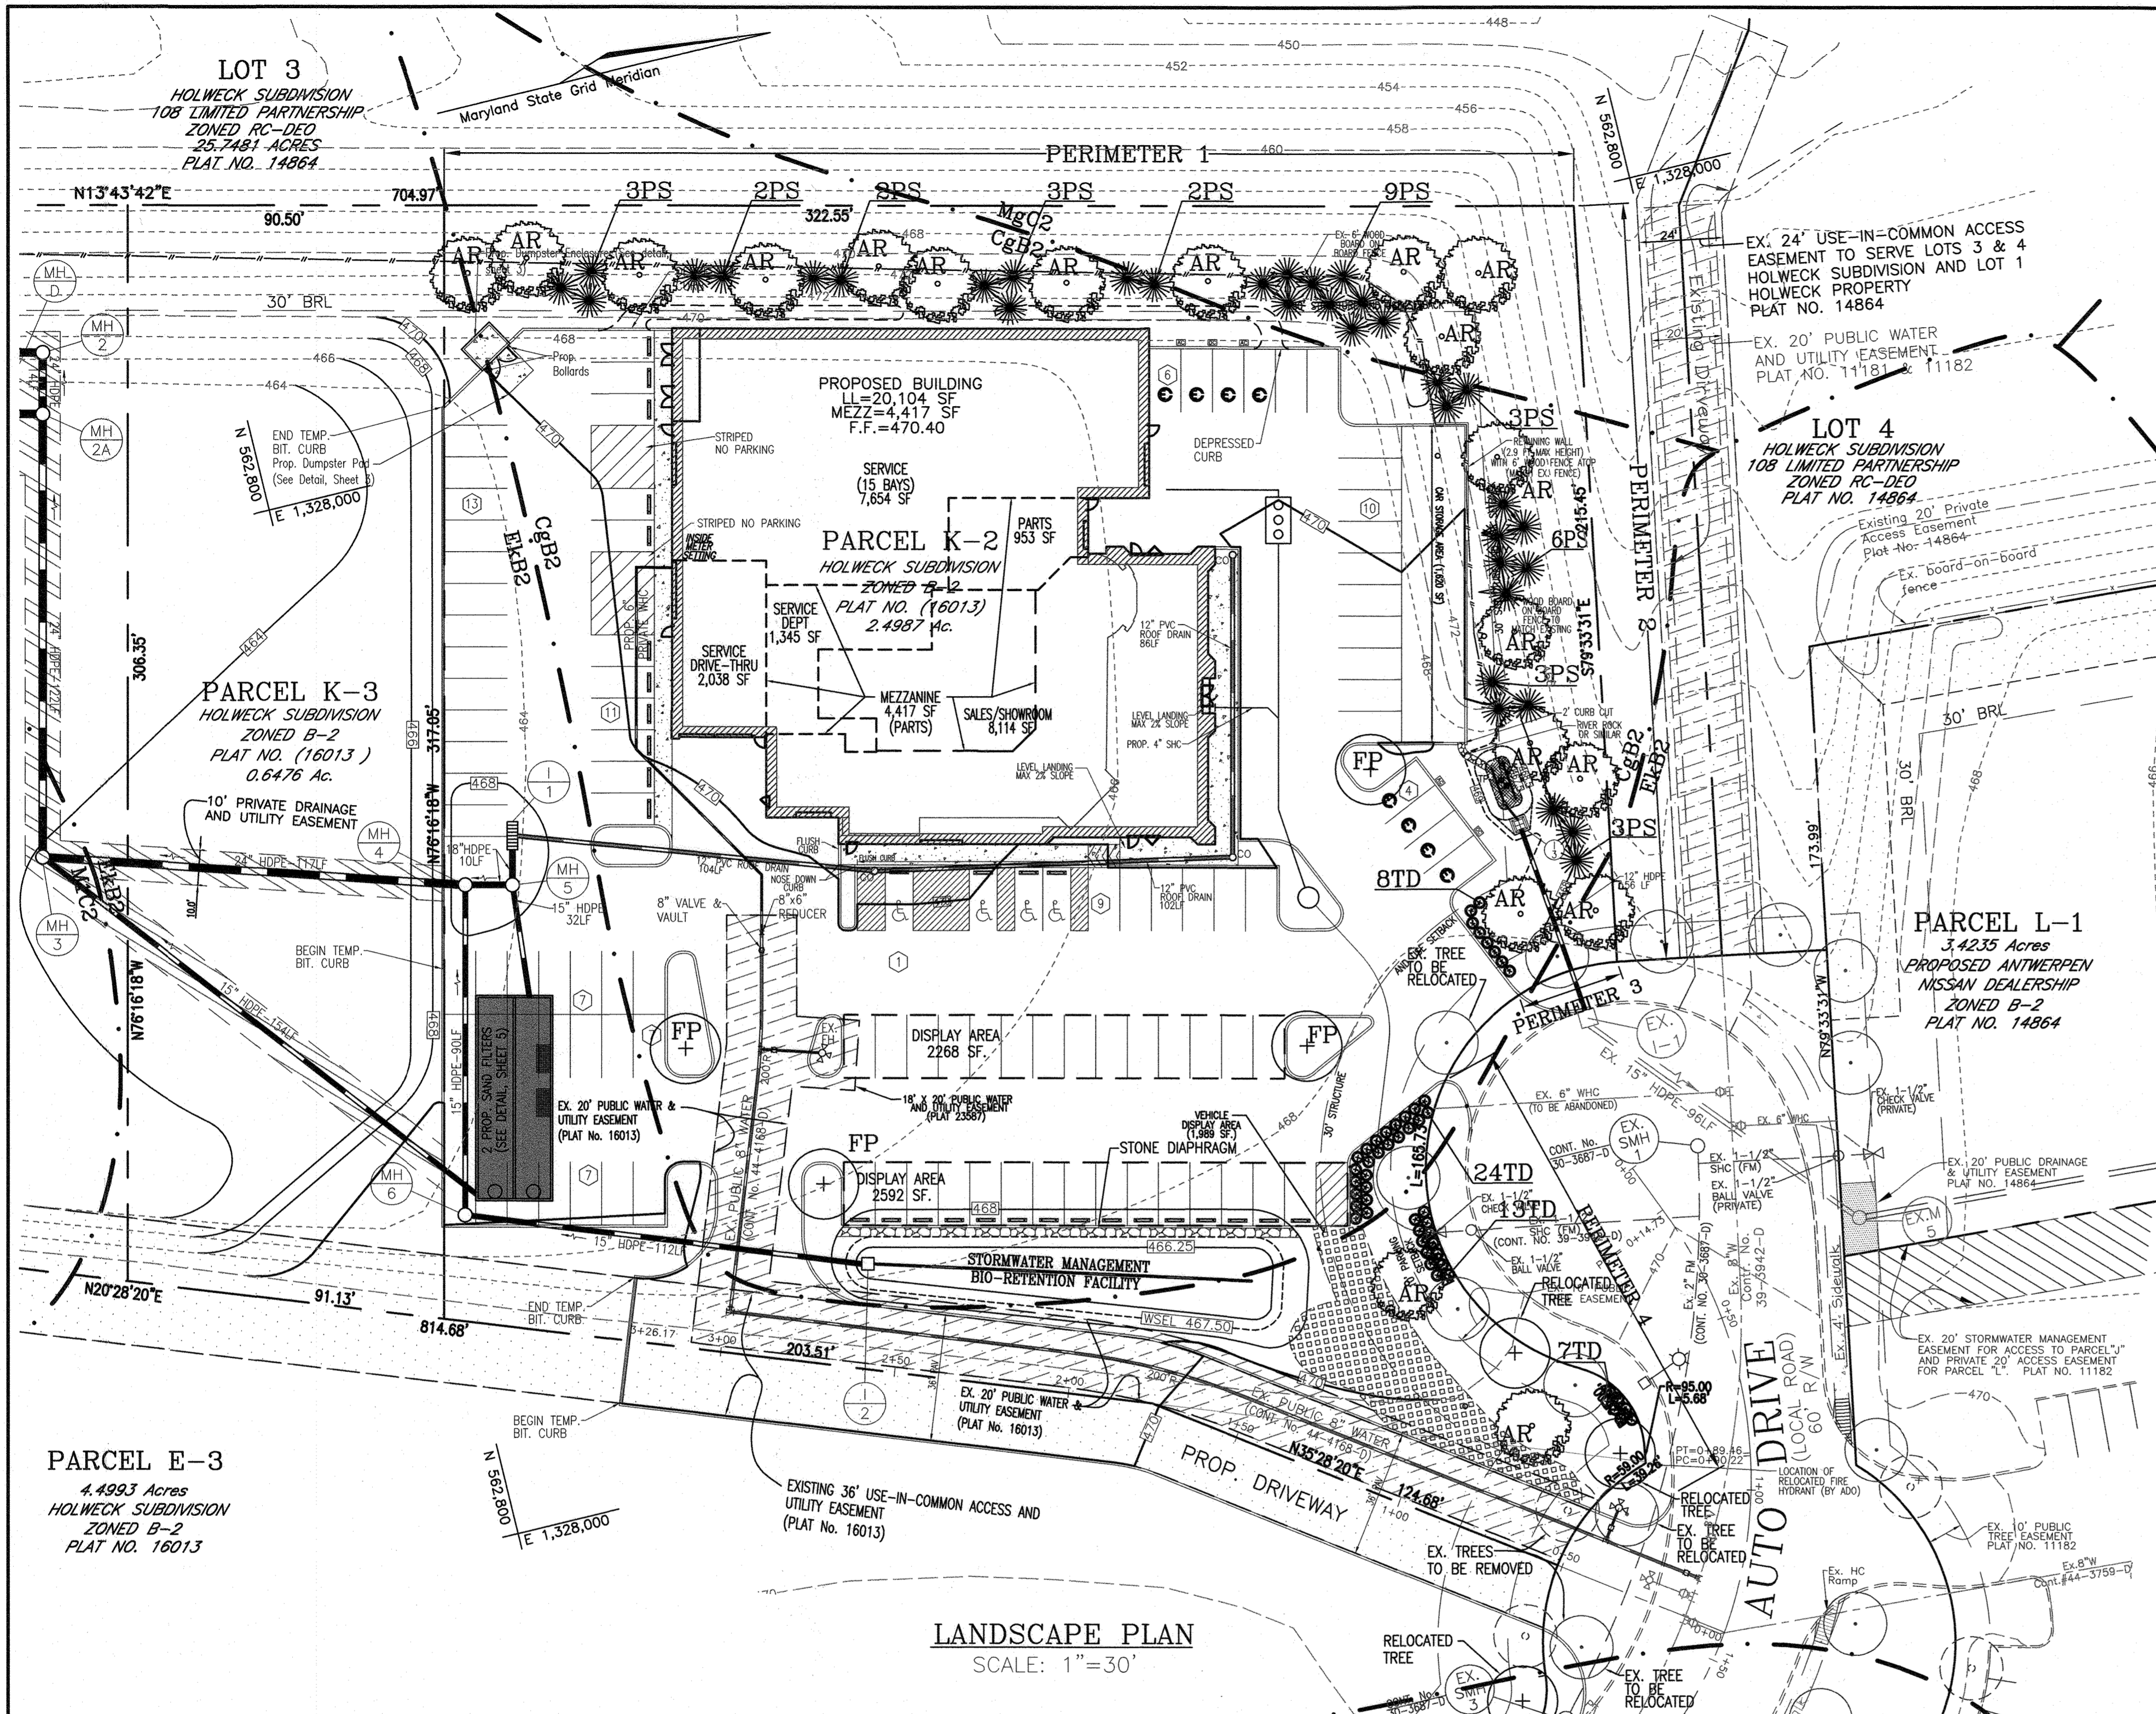

BIO RETENTION LANDSCAPING
SCALE: 1"=20'

SCHEDULE D - STORMWATER MANAGEMENT AREA LANDSCAPING

LINEAR FEET OF PERIMETER	269 LF
CREDIT FOR EXISTING VEGETATION (NO, YES AND LINEAR FEET)	NO
CREDIT FOR OTHER LANDSCAPING (NO, YES AND %)	YES, 100%
NUMBER OF TREES REQUIRED (SHADE TREES, EVERGREEN TREES)	6 (C BUFFER), 6 SHADE TREES, 7 EVERGREEN TREES
NUMBER OF TREES PROVIDED (SHADE TREES, EVERGREEN TREES)	SEE BIORETENTION PLANT LIST

*SURETY FOR BIORETENTION PROVIDED IN THE DED COST ESTIMATE

BIORETENTION PLANTING REQUIREMENTS

NR	AREA	STEMS REQUIRED	STEMS PROVIDED
1	1924 SF	45	49
3	98 SF	3	4

BIORETENTION AREAS ARE LANDSCAPED BASED ON A MINIMUM DENSITY OF 1000 STEMS PER PLANTED ACRE (0.225 STEMS PER SQUARE FOOT).

BIORETENTION PLANTING SCHEDULE

KEY	SPEC	BOTANICAL NAME	SIZE	REMARKS
1	6	CLADOSTIS LUTA 'WHITEHAWK'	1 1/2" - 2" CAL.	B & B
2	8	LEL EXERA COMPACTA	3 GALLON	CONT.
3	13	YUCCA FILIFERA	5 GALLON	CONT.
4	13	PHODODENDRON HY. 'SANDY' OR 'WHITE ROSEBUD'	3 GALLON	CONT.
5	1276	LARIX MURRAYI 'NANUS'	2" POT	1" O.C.

LANDSCAPE SCHEDULE NOTE:


- ALL PLANT MATERIALS SHALL BE FULL AND HEAVY, BE WELL FORMED AND SYMMETRICAL, CONFORM TO THE MOST CURRENT AN SPECIFICATIONS AND BE INSTALLED IN ACCORDANCE WITH LCMW PLANTING SPECIFICATIONS.
- CONTRACTOR SHALL VERIFY LOCATION OF ALL UNDERGROUND UTILITIES PRIOR TO DIGGING.
- FINAL LOCATION OF PLANT MATERIAL MAY NEED TO VARY TO MEET FINAL FIELD CONDITIONS. TREES SHALL NOT BE PLANTED IN THE BOTTOM OF DRAINAGE SWALES.
- CONTRACTOR SHALL VERIFY PLANT QUANTITIES PRIOR TO BIDDING. IF PLAN DIFFERS FROM LANDSCAPE SCHEDULE, THE PLAN SHALL GOVERN.
- FINANCIAL SURETY FOR THE REQUIRED LANDSCAPING SHALL BE POSTED WITH THE DEVELOPER'S AGREEMENT, IN THE AMOUNT OF \$12,360.00 FOR 23 SHADE TREES, 28 EVERGREEN TREES AND 42 SHRUBS.
- FILTER AREA SHALL BE 50% COVERED BY PLANTINGS AT FULL GROWTH.

GENERAL NOTES:


- THIS PLAN HAS BEEN PREPARED IN ACCORDANCE WITH THE PROVISIONS OF SECTION 16.124 OF THE HOWARD COUNTY CODE AND THE LANDSCAPE MANUAL. THE REQUIRED PARKING AND PERIMETER LANDSCAPING WILL BE BONDED PER THIS SUBMISSION.
- THE FUTURE SITE DEVELOPMENT PLANS FOR PARCELS K-3 AND K-4 WILL ADDRESS THE LANDSCAPE REQUIREMENTS FOR EACH PARCEL.

LEGEND:


- EXISTING CONTOUR
- PROPOSED CONTOUR
- PROPOSED SPOT ELEVATION
- EXISTING SPOT ELEVATION
- EXISTING CURB AND GUTTER
- PROPOSED CURB AND GUTTER
- EXISTING GUY WIRE
- EXISTING UTILITY POLE
- EXISTING LIGHT POLE
- EXISTING MAILBOX
- EXISTING SIGN
- EXISTING BOLLARD
- EXISTING SANITARY MANHOLE
- EXISTING SANITARY LINE
- EXISTING CLEANOUT
- EXISTING FIRE HYDRANT
- EXISTING WATER LINE
- EXISTING SO MANHOLE
- EXISTING STORM DRAIN
- EXISTING FENCE
- PROPERTY LINE
- RIGHT-OF-WAY LINE
- SOLS BOUNDARY
- PROPOSED SIDEWALK
- PROPOSED STORM DRAIN INLET
- PROPOSED LIGHT POLE
- PROPOSED SHADE TREE
- PROPOSED EVERGREEN TREE
- PROPOSED SHRUB
- PROP. ELECTRIC CHARGING STATION
- PROP. ELECTRIC VEHICLE SPACE

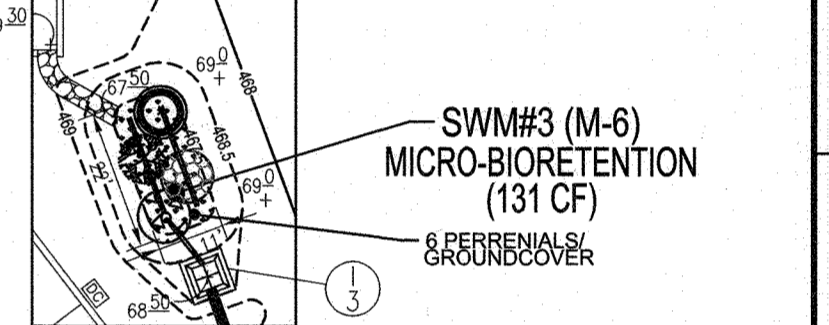


MBR LANDSCAPING (SWM#3)
SCALE: 1"=20'

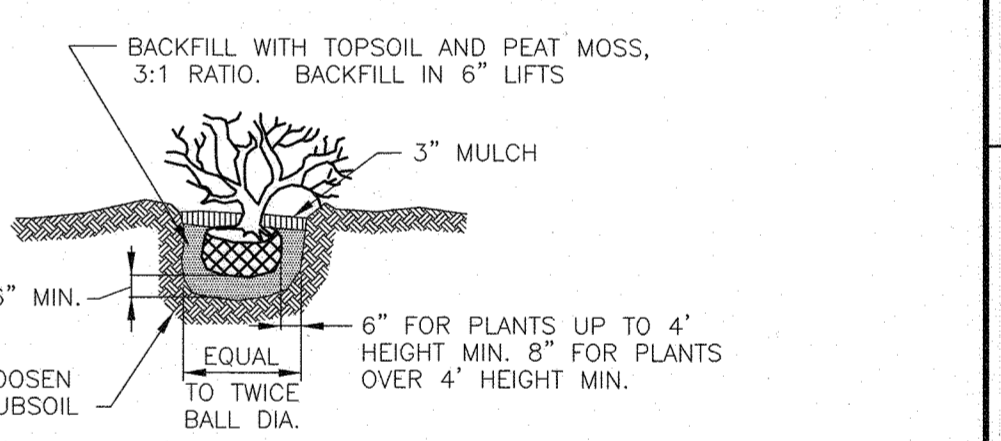

SHRUB PLANTING DETAIL
NOT TO SCALE

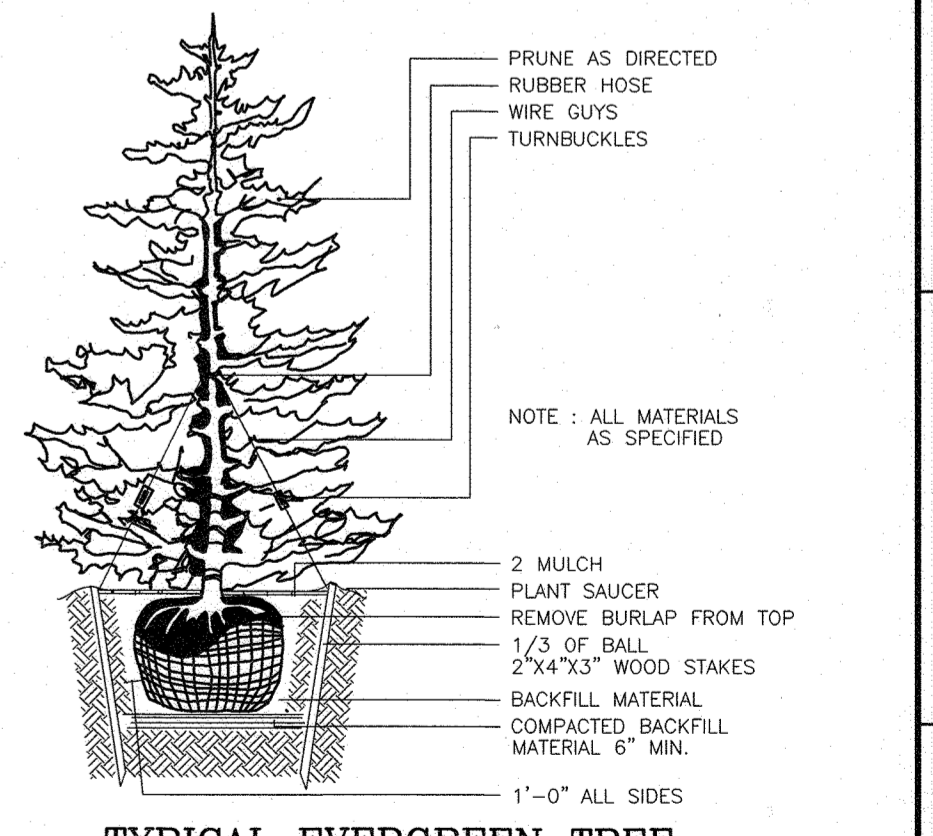

TYPICAL EVERGREEN TREE PLANTING DETAIL
NOT TO SCALE

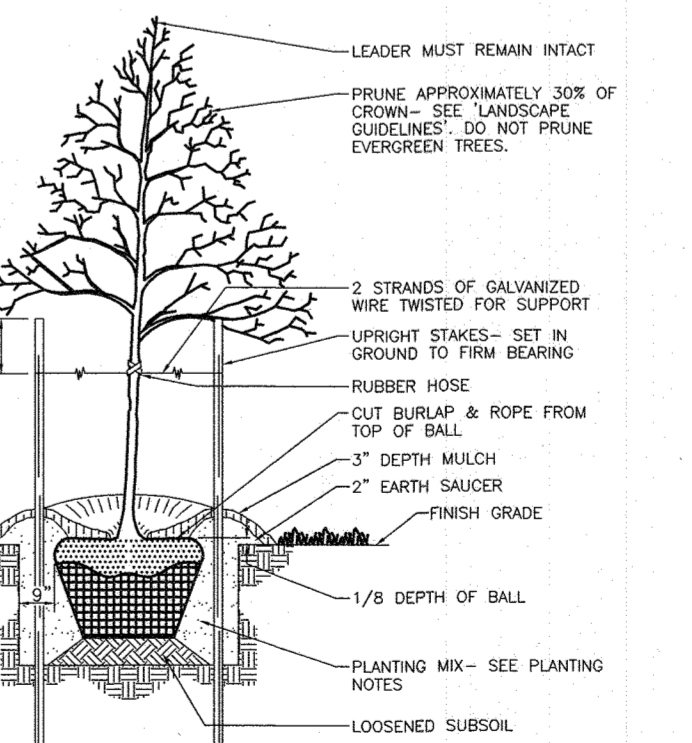

TREE PLANTING AND STAKING
DECIDUOUS TREES UP TO 2-1/2" CALIPER
NOT TO SCALE

DEVELOPER'S/BUILDER'S CERTIFICATE

I/WE CERTIFY THAT THE LANDSCAPING SHOWN ON THIS PLAN WILL BE DONE ACCORDING TO THE PLAN, SECTION 16.124 OF THE HOWARD COUNTY CODE AND THE HOWARD COUNTY LANDSCAPE MANUAL. I/WE FURTHER CERTIFY THAT UPON COMPLETION, A CERTIFICATION OF LANDSCAPE INSTALLATION, ACCOMPANIED BY AN EXECUTED ONE (1) YEAR GUARANTEE OF PLANT MATERIALS, WILL BE SUBMITTED TO THE DEPARTMENT OF PLANNING AND ZONING.

Signature: [Signature] DATE: 2/2/24

APPROVED: HOWARD COUNTY DEPARTMENT OF PLANNING AND ZONING
Director: [Signature] DATE: 4-23-21
Chief, Development Engineering Division: [Signature] DATE: 4-8-21
Chief, Division of Land Development: [Signature] DATE: 4/23/21

SCHEDULE A PERIMETER LANDSCAPE EDGE

CATEGORY	ADJACENT TO ROADWAYS	ADJACENT TO PERIMETER PROPERTIES
Perimeter/Frontage Designation	3	4
Perimeter/Frontage Designation	E	C
Linear Feet of Roadway Frontage/Perimeter	30	135
Credit for Existing Vegetation (Yes, No, Linear Feet)	No	No
Credit for Wall, Fence or Berm (Yes, No, Linear Feet)	No	No
Number of Plants Required (Shade Trees, Evergreen Trees)	1:40 1, 1:40 3*	1:40 9, 1:20 17
Number of Plants Provided (Shade Trees, Evergreen Trees)	1:4 8, 1:4 34	10 10, 21 15
Other Trees (2:1 Substitution)	8	44*

*10 shrubs substituted for 1 shade tree in perimeter 4.

LANDSCAPE SCHEDULE

KEY	QUAN.	BOTANICAL NAME	SIZE	REM
AR	19	ACER RUERUM 'OCTOBER GLORY'	2 1/2" - 3" CAL.	B & B
FP	4	FRAXINUS P. 'MARSHALLS' SEEDLESS'	2 1/2" - 3" CAL.	B & B
PS	36	PINUS STROBUS	6" - 8" HT.	B & B
TD	44	TAXUS X MEDIA 'DENSIFORMIS'	36" HT.	B & B OR CONT.

SCHEDULE B PARKING LOT INTERNAL LANDSCAPING

Number of parking spaces	75
Number of trees and islands required	4
Number of trees and islands provided	4
Shade Trees	4
Other Trees (2:1 Substitution)	-

REVISIONS

REV#	DATE	DESCRIPTION
3	05-21-20	REVISE THE PLAN TO REFLECT ADDITION OF 2,528 SFT SHOWROOM, ADDITION OF 1,620 SFT OF NEW PAVEMENT AND ADDITIONAL SITE MODIFICATIONS
1	03-28-05	REVISE BUILDING FOOTPRINT, ASSOCIATED GRADING CHANGES, TITLE AND PROJECT NAME CHANGES


OWNER/DEVELOPER

1318 COMPANY LLC
10400 AUTO PARK DRIVE
BETHESDA, MD 20817

VOGEL ENGINEERING

TIMMONS GROUP

3300 NORTH RIDGE ROAD, SUITE 110, ELLICOTT CITY, MD 21043
P: 410.461.7666 F: 410.461.8961 www.timmons.com

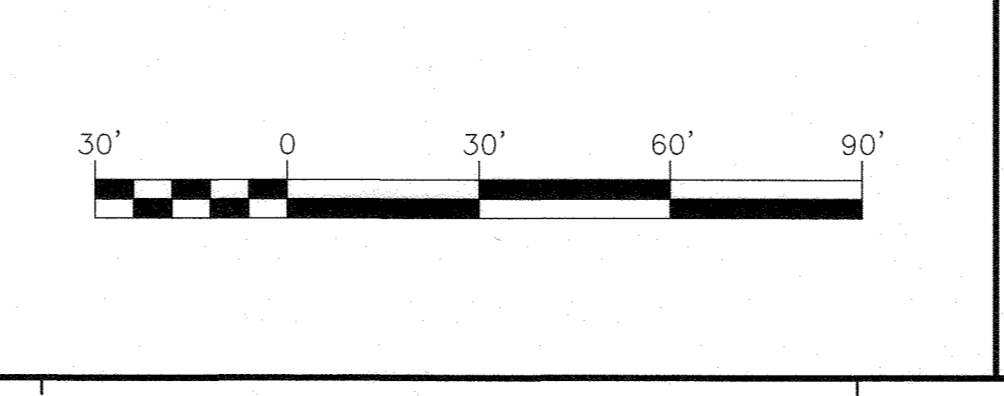

REVISED SITE DEVELOPMENT PLAN
LANDSCAPE PLAN
COLEMAN LANDROVER/JAGUAR

TAX MAP #34 BLOCK #6
5TH ELECTION DISTRICT

PARCEL K-2
HOWARD COUNTY, MARYLAND

STATE OF MARYLAND
ROBERT HARRIS VOGEL
PROFESSIONAL ENGINEER

DESIGN BY: RHW/DZE
DRAWN BY: VE+TO
CHECKED BY: RHW
DATE: JULY 2020
SCALE: AS SHOWN
W.O. NO.: 03-40

PROFESSIONAL CERTIFICATE
I HEREBY CERTIFY THAT THESE DOCUMENTS WERE PREPARED OR APPROVED BY ME, AND THAT I AM A DULY LICENSED PROFESSIONAL ENGINEER UNDER THE LAWS OF THE STATE OF MARYLAND, LICENSE NO. 18183, EXPIRATION DATE: 09-27-2022

7 SHEET OF 7
SDP-03-93