


General Notes

- All construction shall be in accordance with the latest standards and specifications of Howard County plus MSHA standards and specifications if applicable.
- The contractor shall notify the Department of Public Works, Bureau of Engineering/Construction Inspection Division at (410) 313-1800 at least 48 hours prior to the start of work.
- The contractor shall notify "Miss Utility" at 1-800-251-TTTT at least 48 hours prior to any excavation work.
- The contractor shall notify the Howard County Department of Public Works, Bureau of Utilities at (410) 313-4900 at least five (5) working days prior to starting any excavation work.
- Traffic control devices, markings and signing shall be in accordance with the latest edition of the Manual of Uniform Traffic Control Devices (MUTCD). All street and regulatory signs shall be in place before the placement of any asphalt.
- Proposed Use: Office (1 story - no mezzanines), Religious Facilities + Accessory Retail
- All plan dimensions are to face of curb or face of building unless otherwise noted. Dimensions are measured perpendicular or radially between items unless otherwise noted.
- Existing topography is shown per field run survey information by Gutschick, Little & Weber, P.A. in March, 2004 & from design plans for construction.
- Coordinates and bearings are based upon the Howard County Geodetic Control which is based upon the Maryland State Plane Coordinate System. Howard County Monument Nos. 2243002 and 2243003 were used for this project.
- Water and sewer service is public.
- All existing water and sewer is per Contract 24-1440-D, 24-1587-D & 20-1347-D
- All existing public storm drain is per F-87-63 & F-86-126.
- See trench bedding class "C" for storm drains.
- Recording reference: Plat No. 17094
- Existing utilities are based on approved design plans for construction and field location by Gutschick, Little & Weber, P.A.
- There is no floodplain on site.
- There are no streams, wetlands, or steep slopes on the site.
- Building setbacks and building restrictions are per Plat No. 1429B
- This site is exempt from the Forest Conservation requirements of Section 16.1200 of the Howard County Code by Section 16.1202(b)(1)(V).
- In case of discrepancies between the plat and the plans, the plat shall govern.
- No clearing, grading or construction is permitted within any wetland, wetlands buffer, 50' stream buffer or floodplain.
- All outdoor lighting shall comply with the requirements of zoning section 134. See sheet 3 Lighting Fixture Schedule.
- The Landscape Plan was prepared according to the Alternative Compliance Section of the Landscape Manual.
- Stormwater Management, for quality and quantity, is being provided in a regional facility which was constructed under F-97-9B. An Amendment to the Stormwater Management Report for Columbia Gateway was prepared under F-00-74. This Amendment indicates that the regional facility satisfies the Stormwater Management needs for this parcel.
- There are no known cemeteries, grave sites or historic structures located on the subject property.
- There are no scenic roads within or adjacent to the subject property.
- Because this plan submission is non-residential use, a noise study is not required.
- Building will have automatic fire protection sprinkler system.
- All curb radii are 5' R, unless otherwise noted.
- This site is subject to a 10' parking and fence setback.
- A shared parking easement for Parcels N-9 through N-11 has been recorded in the Land Records of Howard County, Maryland in Liber 5102 Folio 273.

SITE DEVELOPMENT PLAN


COLUMBIA GATEWAY

PARCEL N-13

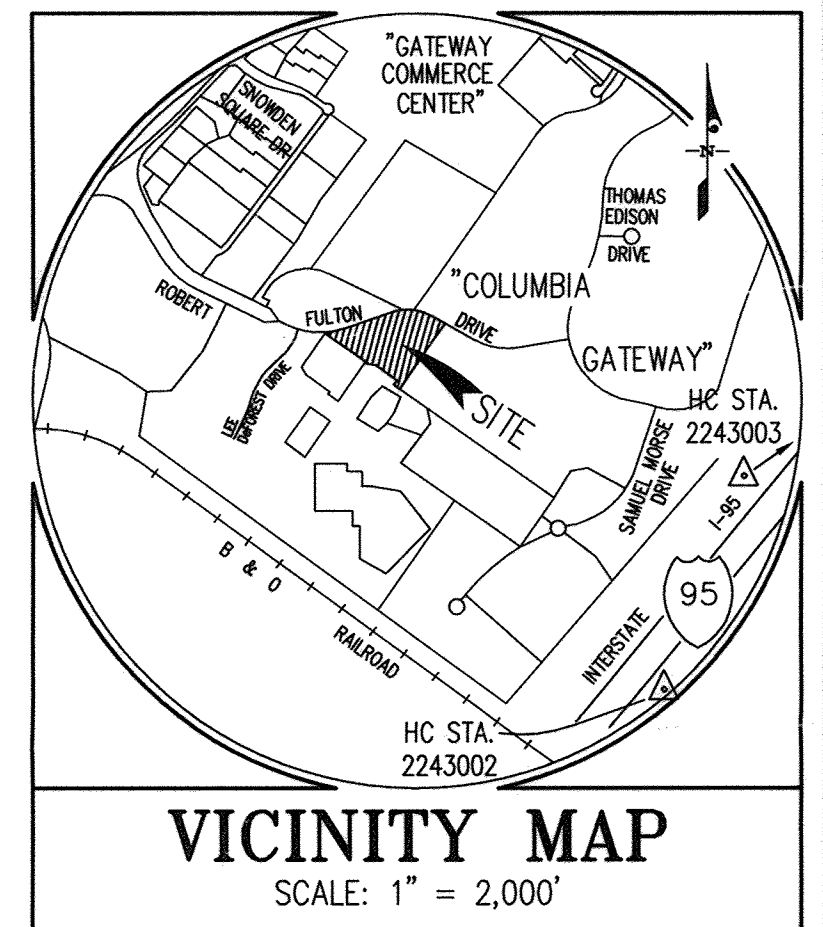

BENCHMARKS

2243002	ELEV. = XXX.XX
STANDARD DISC ON CONCRETE MONUMENT	
2243003	ELEV. = XXX.XX
STANDARD DISC ON CONCRETE MONUMENT	

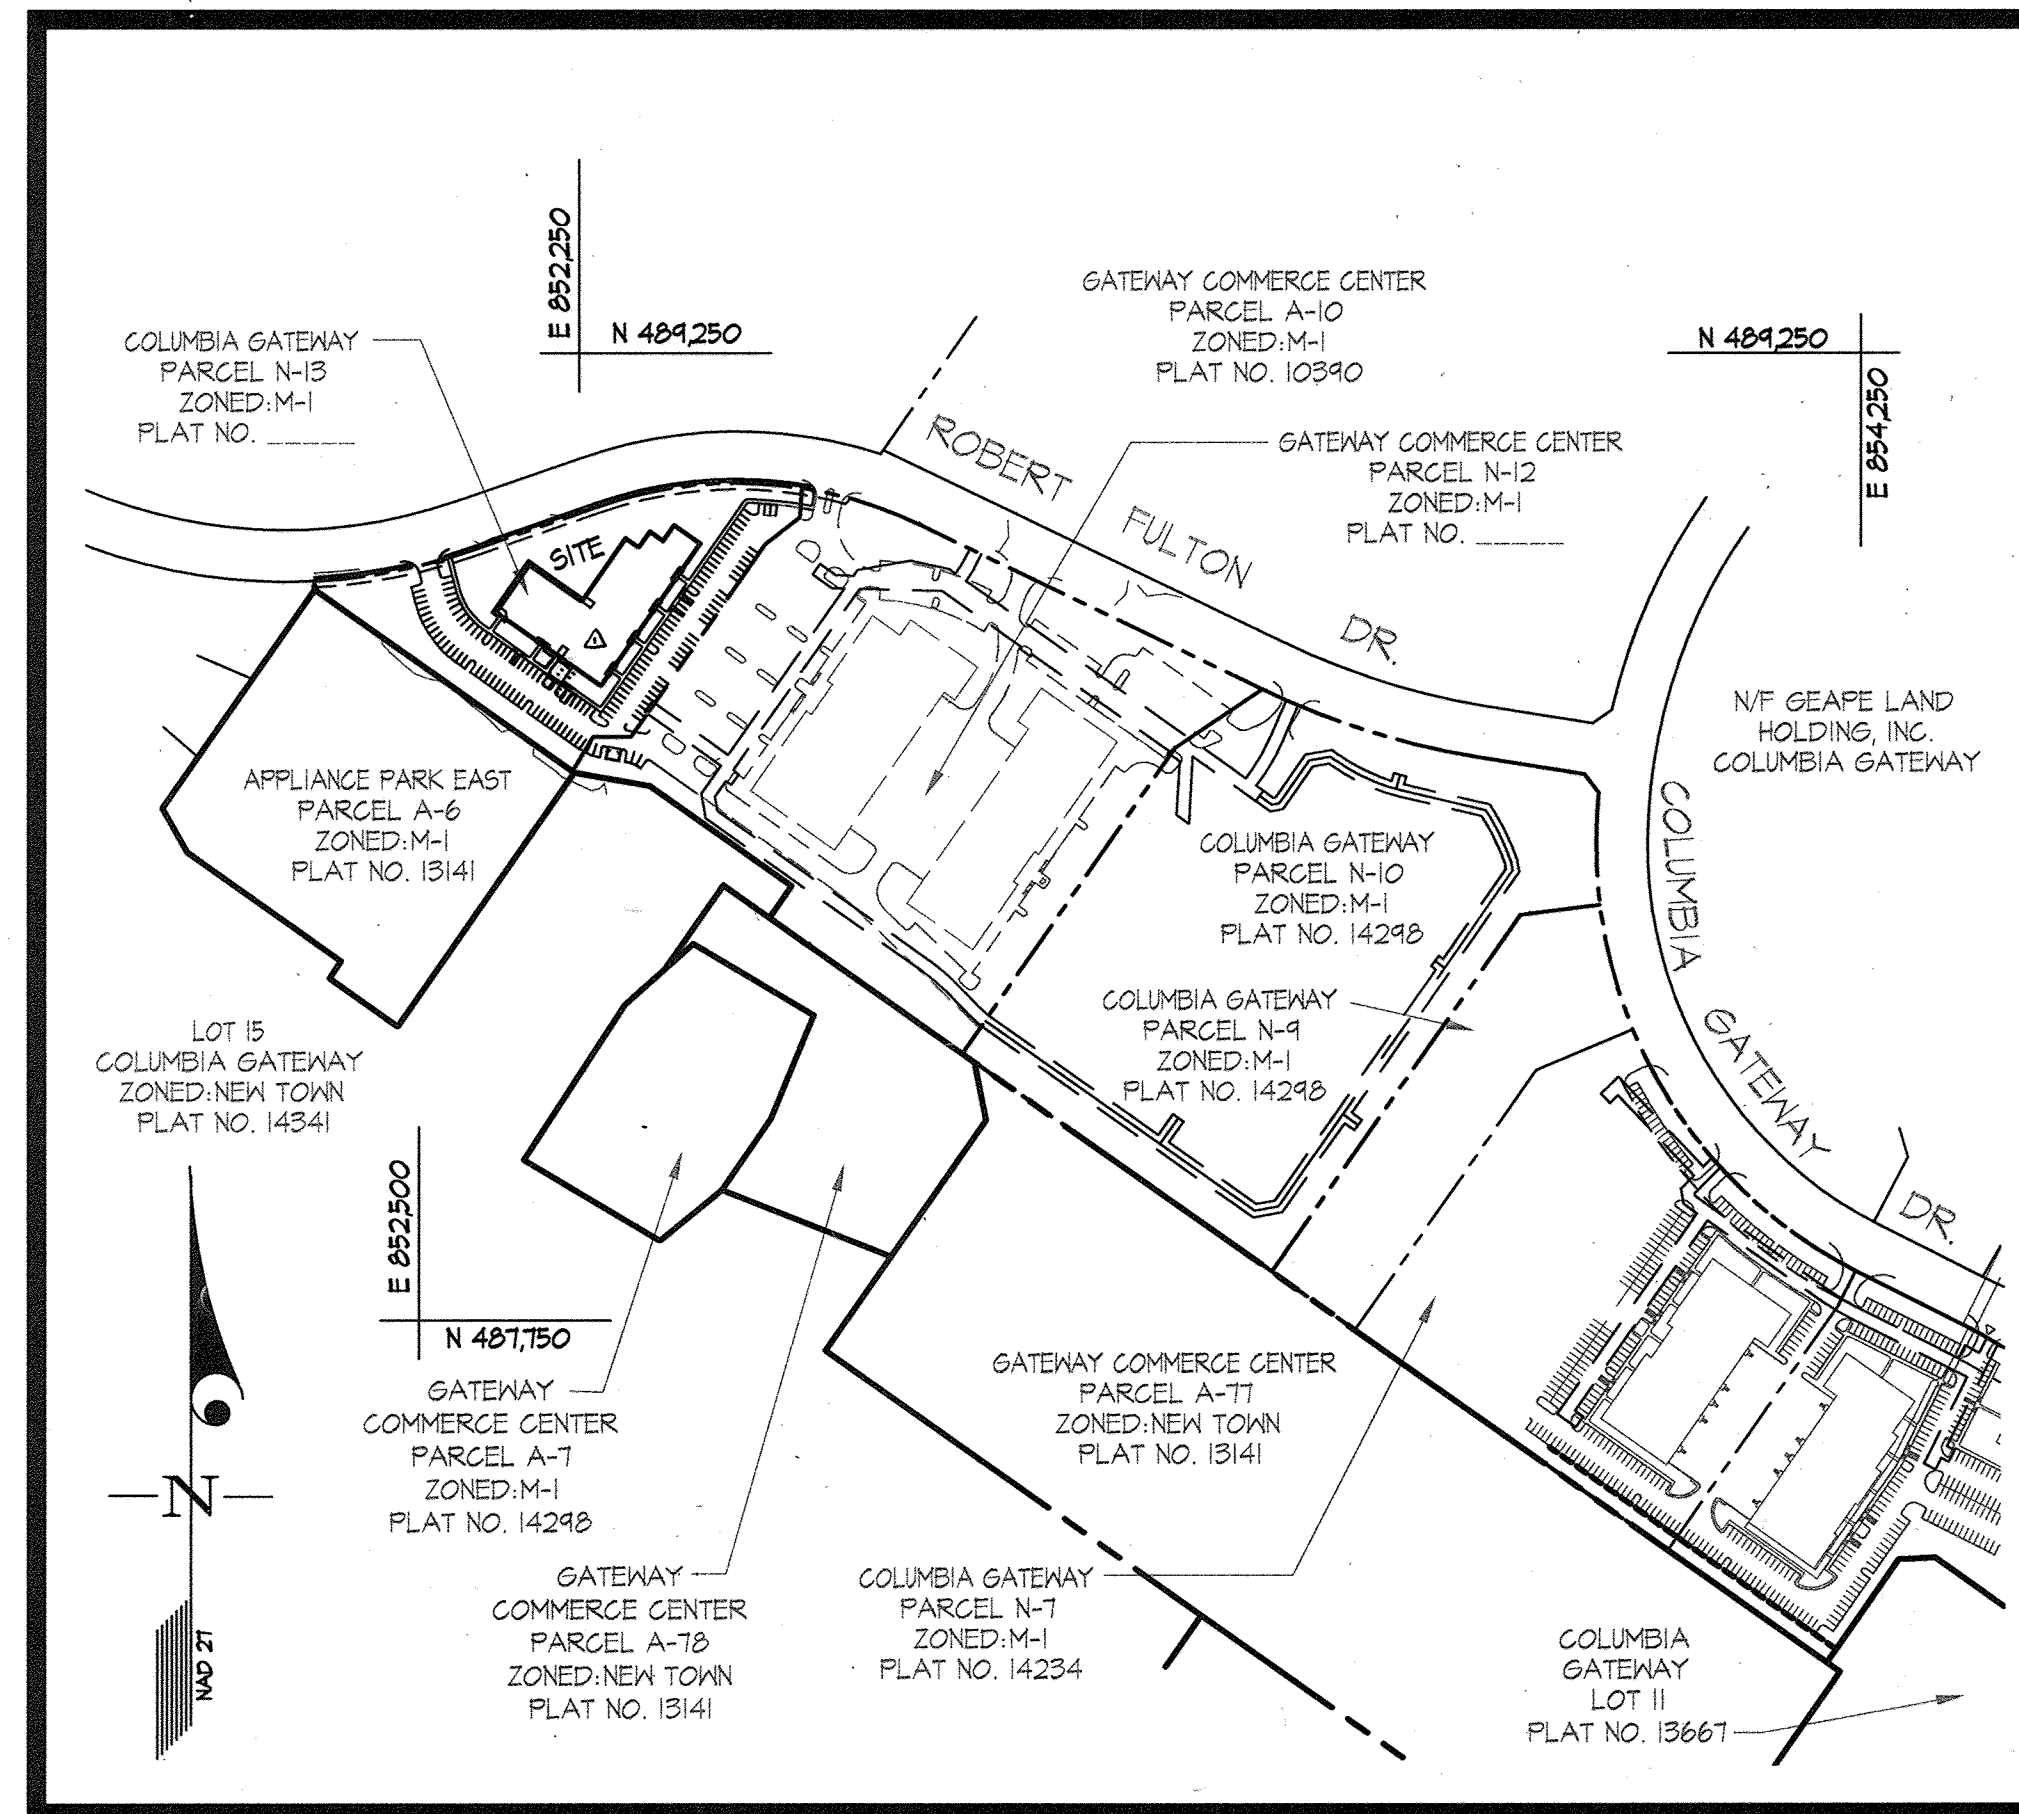

KEY MAP

SCALE: 1" = 300'

LEGEND

--- 366 ---	EX. CONTOUR
--- 300 ---	PROP. CONTOUR
(+)	EX. TREES
---	EX. STORM DRAIN
---	PROP. STORM DRAIN
---	LIMIT OF SUBMISSION
8'S --- 8'S	EX. SANITARY SEWER
Ex. 8" W	EX. WATERLINE
---	PROP. SANITARY SEWER
---	PROPOSED WATERLINE
---	EX. CURB & GUTTER
---	CONCRETE CURB & GUTTER
---	PROPOSED REVERSE CURB & GUTTER
---	CONCRETE SIDEWALK
---	DUMPSTER OR UTILITY PAD
---	EX. EASEMENTS
x 78 88	TOP OF PAVING SPOT SHOT
(6)	NUMBER OF PARKING SPACES
---	PROP. LIGHT FIXTURE & POLE
---	EX. LIGHT FIXTURE & POLE
---	HANDICAP CURB RAMP (SEE DETAIL SHEET 3)
---	ENTRANCE

Site Analysis Data Chart

- Gross Area Parcel N-13: 160,880 SF or 3.81 Ac.
- Limit of Disturbed Area = 152,460 SF or 3.50 Ac.
- Zoning: M-1
- Proposed Use: 1 STORY OFFICE, INDUSTRIAL AND INDUSTRIALISTIC FACILITY, Religious Facilities, and Accessory Retail - including Indoor Athletic Facility
- Gross Floor Area: 32,850 SF
- No. of standard parking spaces required: 112 spaces
- No. of handicap spaces required: 6 spaces (2 van space).
- No. of standard parking spaces provided: 144 spaces.
- No. of handicap spaces provided: 6 spaces (4 van spaces).
- Total parking spaces provided: 150 spaces.
- Building Percent Coverage: 32,850/160,880 = 19.5%
- Project background: See Dept. of Planning & Zoning File Numbers: F-86-22, S-84-44, F-85-55, F-85-63, F-86-17, F-86-63, F-86-182, F-87-46, F-88-41, F-89-175, F-91-16, F-92-15, F-97-48, F-99-156, F-00-11 & 01-24, F-05-26, F-00-148, F-00-160.
- Gross Floor Area: 32,850 SF
- Light Manufacturing / Office: 15,517 SF
- Accessory Retail: 2,000 SF
- Religious Facilities: 15,333 SF (4,922 sq. ft. Assembly Area)
- Parking Requirements:
 - Light Manufacturing / Office (3.3 spaces per 1000 sq. ft.): 52 spaces
 - Accessory Retail (2.5 spaces per 1000 sq. ft.): 10 spaces
 - Religious Facilities (1.0 spaces per 1000 sq. ft. in the Assembly Area): 50 spaces
 - Total Required Spaces = 112 spaces
 - Parking Provided = 150 spaces
- NOTE: THIS PARKING ANALYSIS ASSUMES THAT THE PRIMARY USE OF THE RELIGIOUS FACILITY IS FOR SERVICES ON THE WEEKENDS IF THE CHURCH ACTIVITIES CHANGE TO ADD ADDITIONAL USES SUCH AS 5 DAY A WEEK DAYCARE OR SCHOOL, A NEW REPLY MUST BE SUBMITTED TO HOWARD COUNTY.
- Gross Floor Area 32,850 SF
- Office/Industrial 28,566 SF
- Indoor Athletic Facility 4,284 SF (Area of Assembly) (3,300 SF)
- PARKING REQUIREMENTS
- Office/Industrial 28,566 SF 3.3 SPACES/1,000 = 91.5 SPACES
- Indoor Recreation 4,284 SF (3,300 SF Assembly Area) 10 SPACES/1,000 = 33 SPACES
- 32,850 SF TOTAL PARKING REQUIRED = 128 150 PROVIDED

- Sheet Index**
- Cover Sheet
 - Site Development Plan
 - Site Details & Paving Plan
 - Site & Handicap Accessibility Details
 - Storm Drain/Utility Profiles
 - Sediment Control Plan/Drainage Area Map
 - Sediment Control Notes & Details
 - Landscape/Perimeter Planting Plan
 - Landscape Notes, Details, Plant List & Schedules
 - Striping Plan

APPROVED: HOWARD COUNTY DEPARTMENT OF PLANNING & ZONING

Mark J. Leagle, Director, 12/3/04

Chief, Division of Land Development, 12/3/04

Chief, Development Engineering Division, 11/22/04

STATE OF MARYLAND BOARD OF ARCHITECTS

10177

MICHAEL WYNE CAMPBELL

STATE OF MARYLAND

GLWGUTSCHICK LITTLE & WEBER, P.A.

CIVIL ENGINEERS, LAND SURVEYORS, LAND PLANNERS, LANDSCAPE ARCHITECTS

3909 NATIONAL DRIVE - SUITE 250 - BURTONSVILLE OFFICE PARK

BURTONSVILLE, MARYLAND 20886

TEL: 301-421-4024 BALT: 410-880-1820 DC/VA: 301-989-2524 FAX: 301-421-4186

DATE	REVISION	BY	APP'R.
7/22/15	Show 2000 SF necessary retail, new sprinkler room & door locations. Revised required parking accordingly.	JNG	
1/28/17	Religious Facilities added as a use. Parking tabulation revised.	JL	
1/28/17	Delete Religious Facilities. Add Indoor Athletic Facility. Parking tabulation revised.	MC	
1/28/17	REVISE NOTATION OF OFFICE/LIGHT MANUFACTURING TO OFFICE/INDUSTRIAL. REVISE PARKING CALC.	MC	

PREPARED FOR:

GATEWAY 67 LLC

8815 CENTRE PARK DRIVE, SUITE 400

COLUMBIA, MD. 21045

PH: 410-992-7348

ATTN: MR. ROGER WAESCHE

COVER SHEET

COLUMBIA GATEWAY



PARCEL N-13

Plat No. 17094

WATER CODE:		SEWER CODE:		ADDRESS CHART	
506	4900000	PARCEL NUMBER	STREET ADDRESS		
		N-13	8681 ROBERT FULTON DRIVE		
SUBDIVISION NAME:			SECTION/AREA		PARCELS
COLUMBIA GATEWAY					P/O F 670
PLAT NO.	ZONE	TAX MAP	BLOCK	ELEC. DIST.	CENSUS TRACT
17094	M-1	42	11	6	6061.03
SCALE		ZONING		G. L. W. FILE NO.	
AS SHOWN		M-1		04032	
DATE		TAX MAP - GRID		SHEET	
Sept., 2004		42 - 12		1 OF 10	

ELECTION DISTRICT No. 6

HOWARD COUNTY, MARYLAND

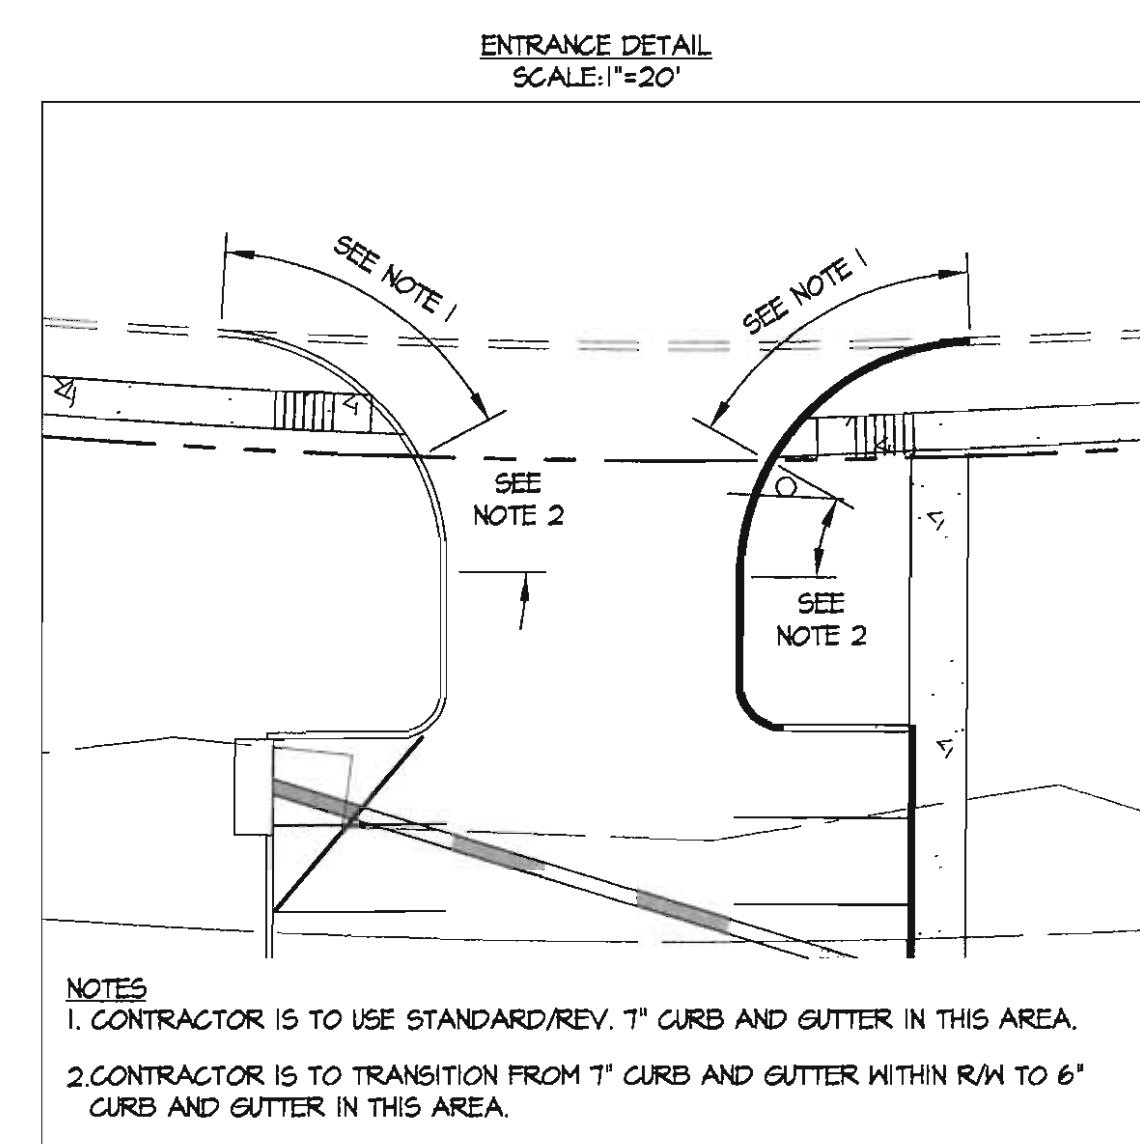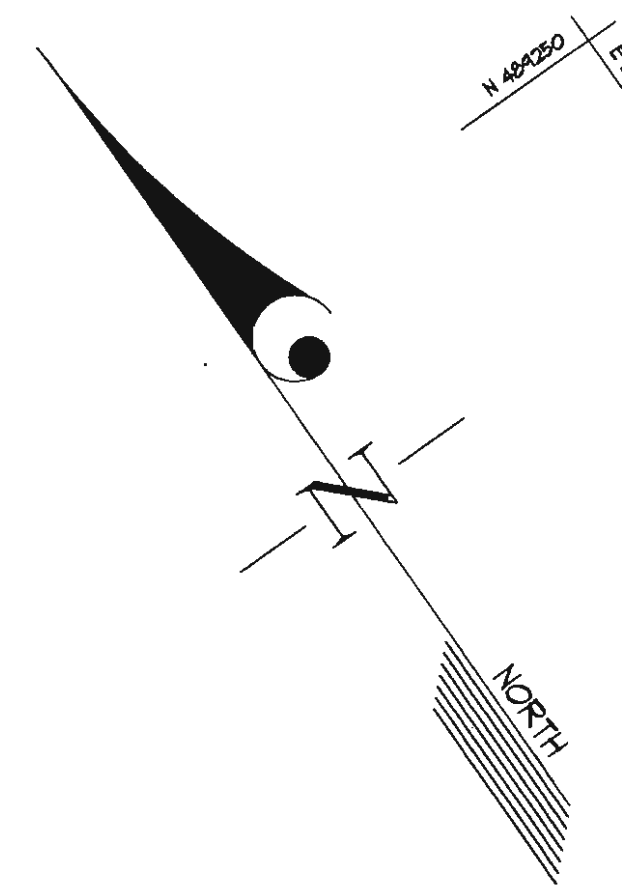

APPROVED: HOWARD COUNTY DEPARTMENT OF PLANNING & ZONING

Director: *Howard K. Leight* Date: 12/1/11

Chief, Division of Land Development: *Cindy Harris* Date: 12/1/11

Chief, Development Engineering Division: *Michael K. ...* Date: 11/22/11

L:\CAD\DRAWINGS\04032\SDP\04032SP2.dwg 10/7/2011 11:07:28 AM 111

GLWGUTSCHICK LITTLE & WEBER, P.A.
CIVIL ENGINEERS, LAND SURVEYORS, LAND PLANNERS, LANDSCAPE ARCHITECTS
3909 NATIONAL DRIVE - SUITE 250 - BURTONSVILLE OFFICE PARK
BURTONSVILLE, MARYLAND 20866
TEL: 301-421-4024 BAL: 410-880-1820 DC/VA: 301-989-2524 FAX: 301-421-4186

DES. DEV	DRN. JAU	CHK. DEV	DATE	REVISION	BY	APP'R

PREPARED FOR:
GATEWAY 67 LLC
8815 CENTRE PARK DRIVE, SUITE 400
COLUMBIA, MD. 21045
PH.: 410-992-7348
ATTN: MR. ROGER WAESCHE

SITE DEVELOPMENT PLAN
COLUMBIA GATEWAY
PARCEL N-13
Plat No. 17094



ELECTION DISTRICT No. 6

HOWARD COUNTY, MARYLAND

SCALE	ZONING	G. L. W. FILE NO.
1"=40'	M-1	04032
DATE	TAX MAP - GRID	SHEET
Sept., 2004	42 - 12	2 OF 10


Drawings\04032\SDP\04032SP2.dwg DES. DEV DRN. JAU CHK. DEV DATE REVISION BY APP'R

SDP-04-148

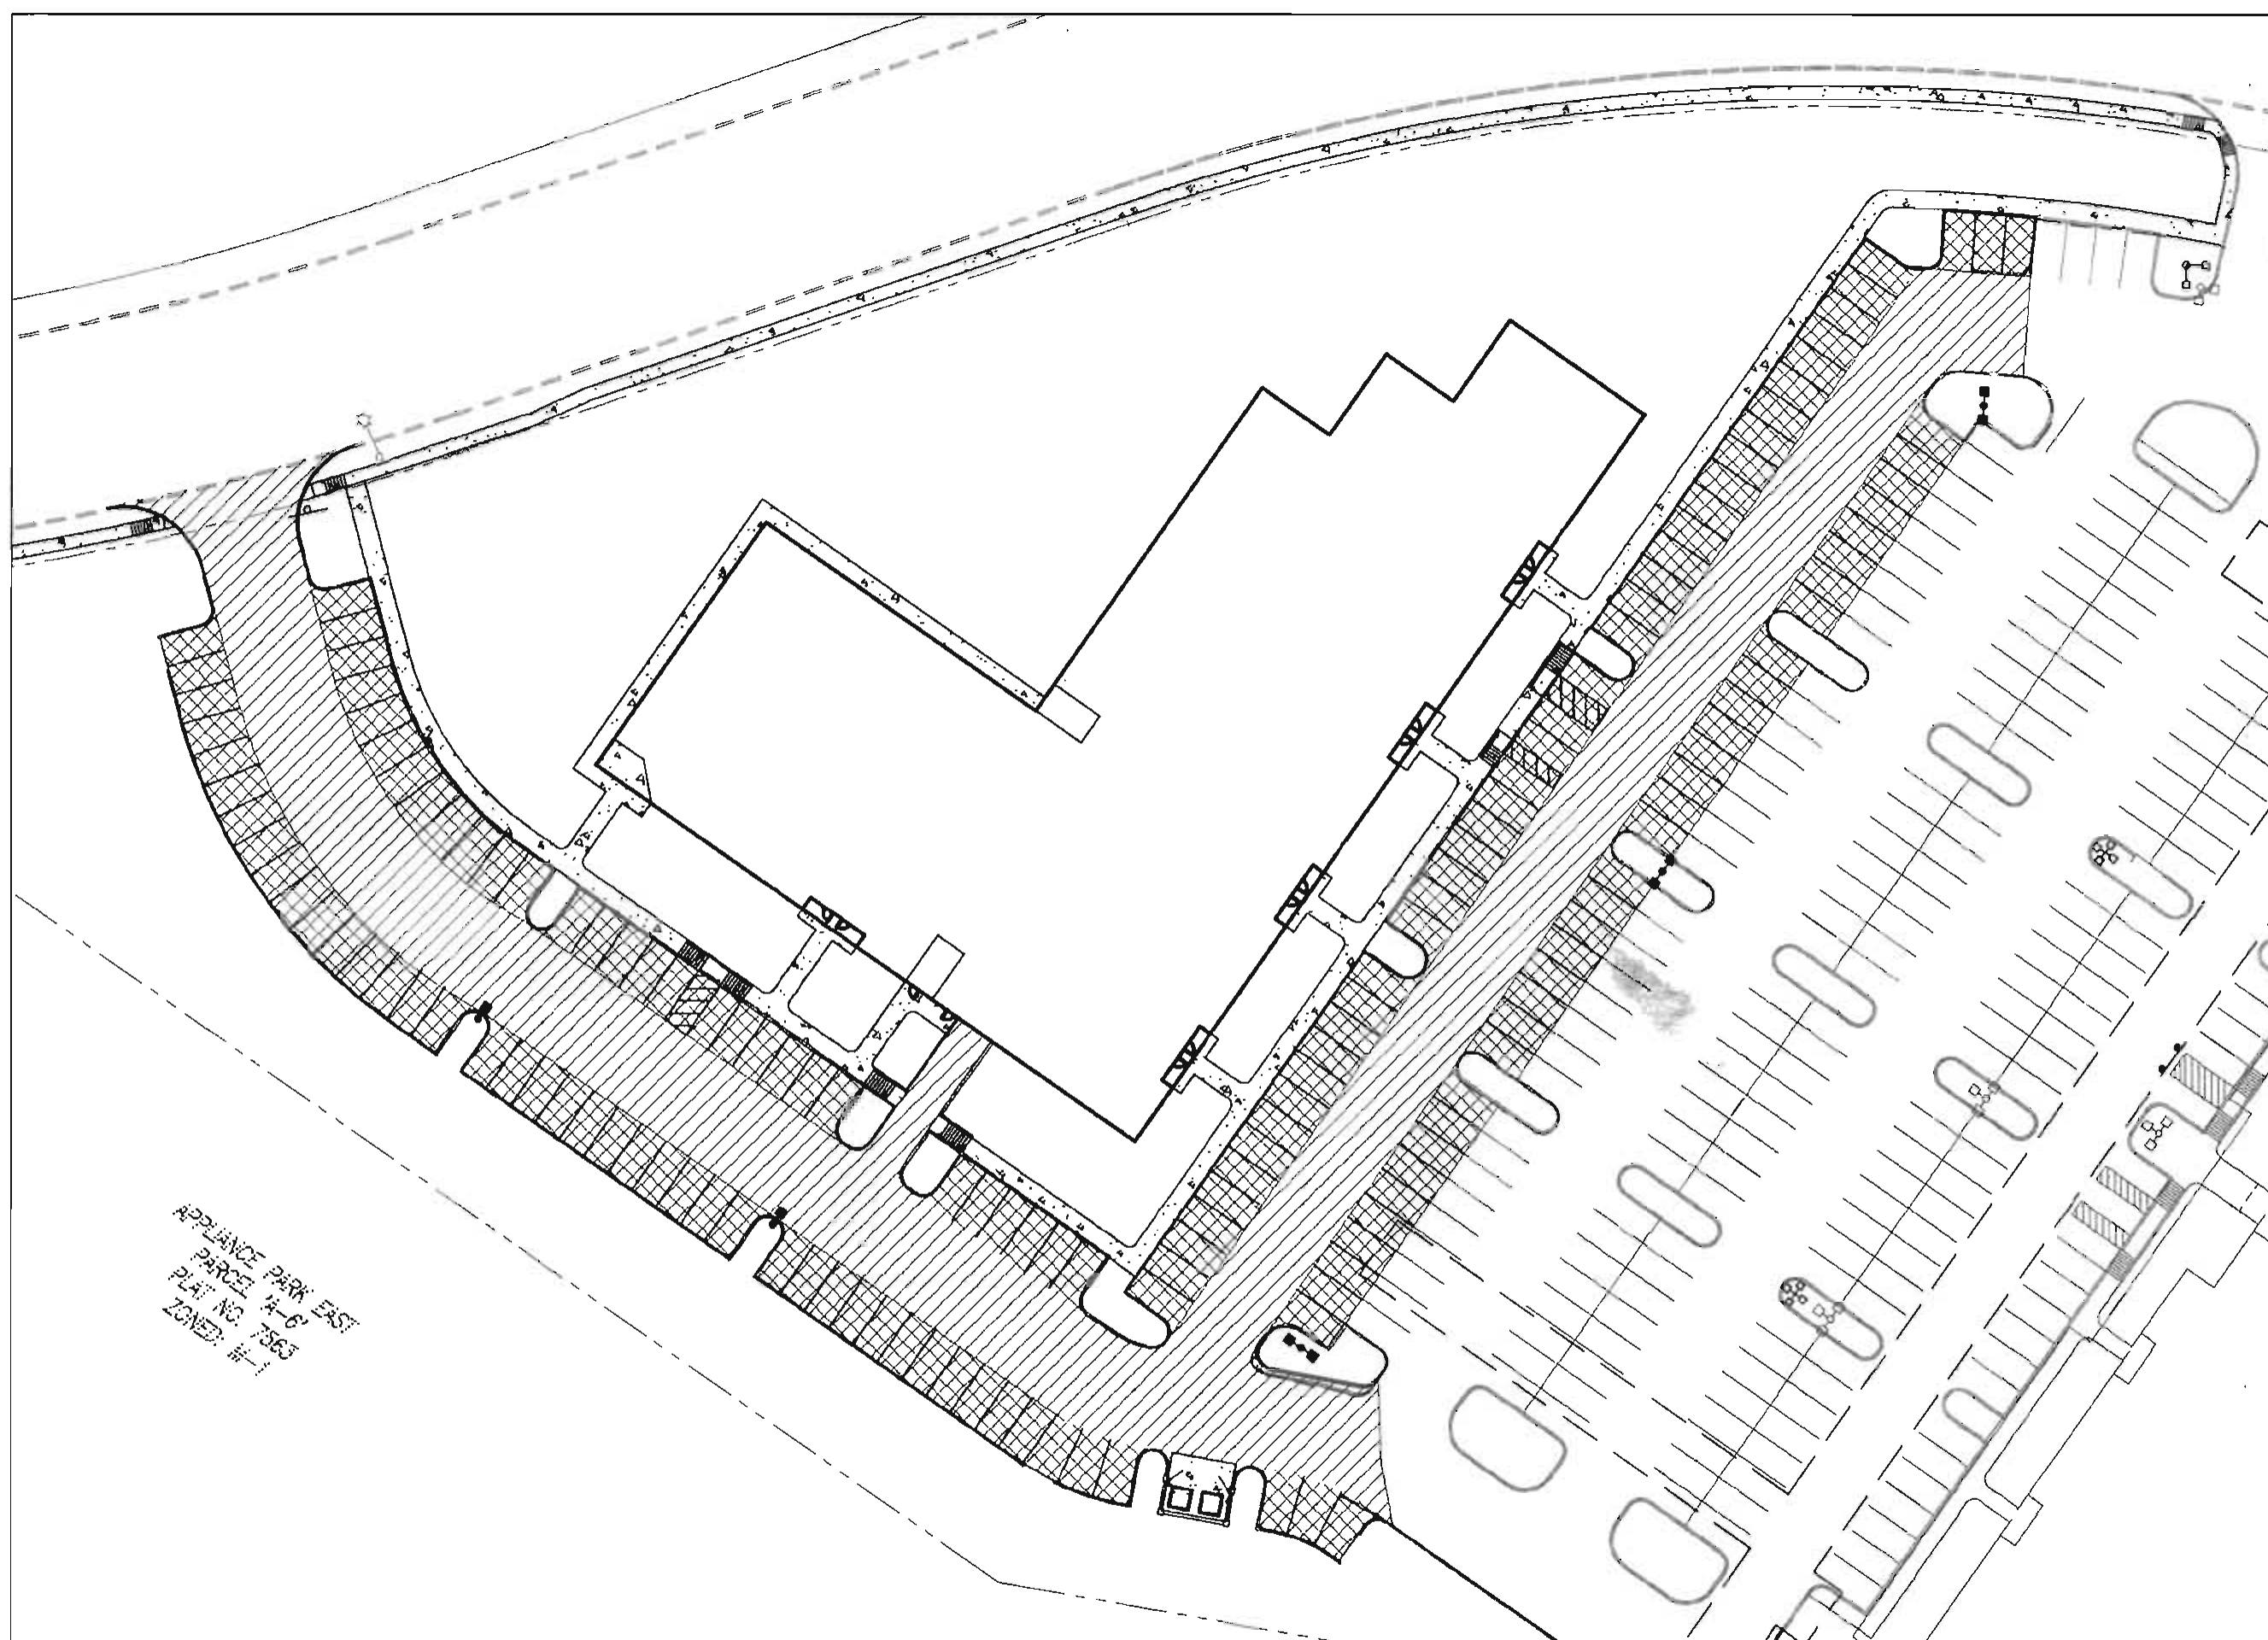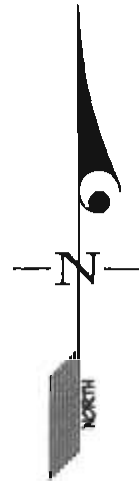


PAVING PLAN
SCALE: 1"=50'


LIGHT INFORMATION		
Symbol	Description	Quantity
■-■-■	Twin Type III, with horizontal 400 Watt high pressure sodium lamp on a 30 foot round tapered steel pole. (brown) Ecolume ECA-182-3H-400HPS-BRP or approved equal.	3
■-■	Single Type III, with horizontal 400 Watt high pressure sodium lamp on a 30 foot round tapered steel pole. (brown) Ecolume ECA-181-3H-400HPS-BRP or approved equal.	2

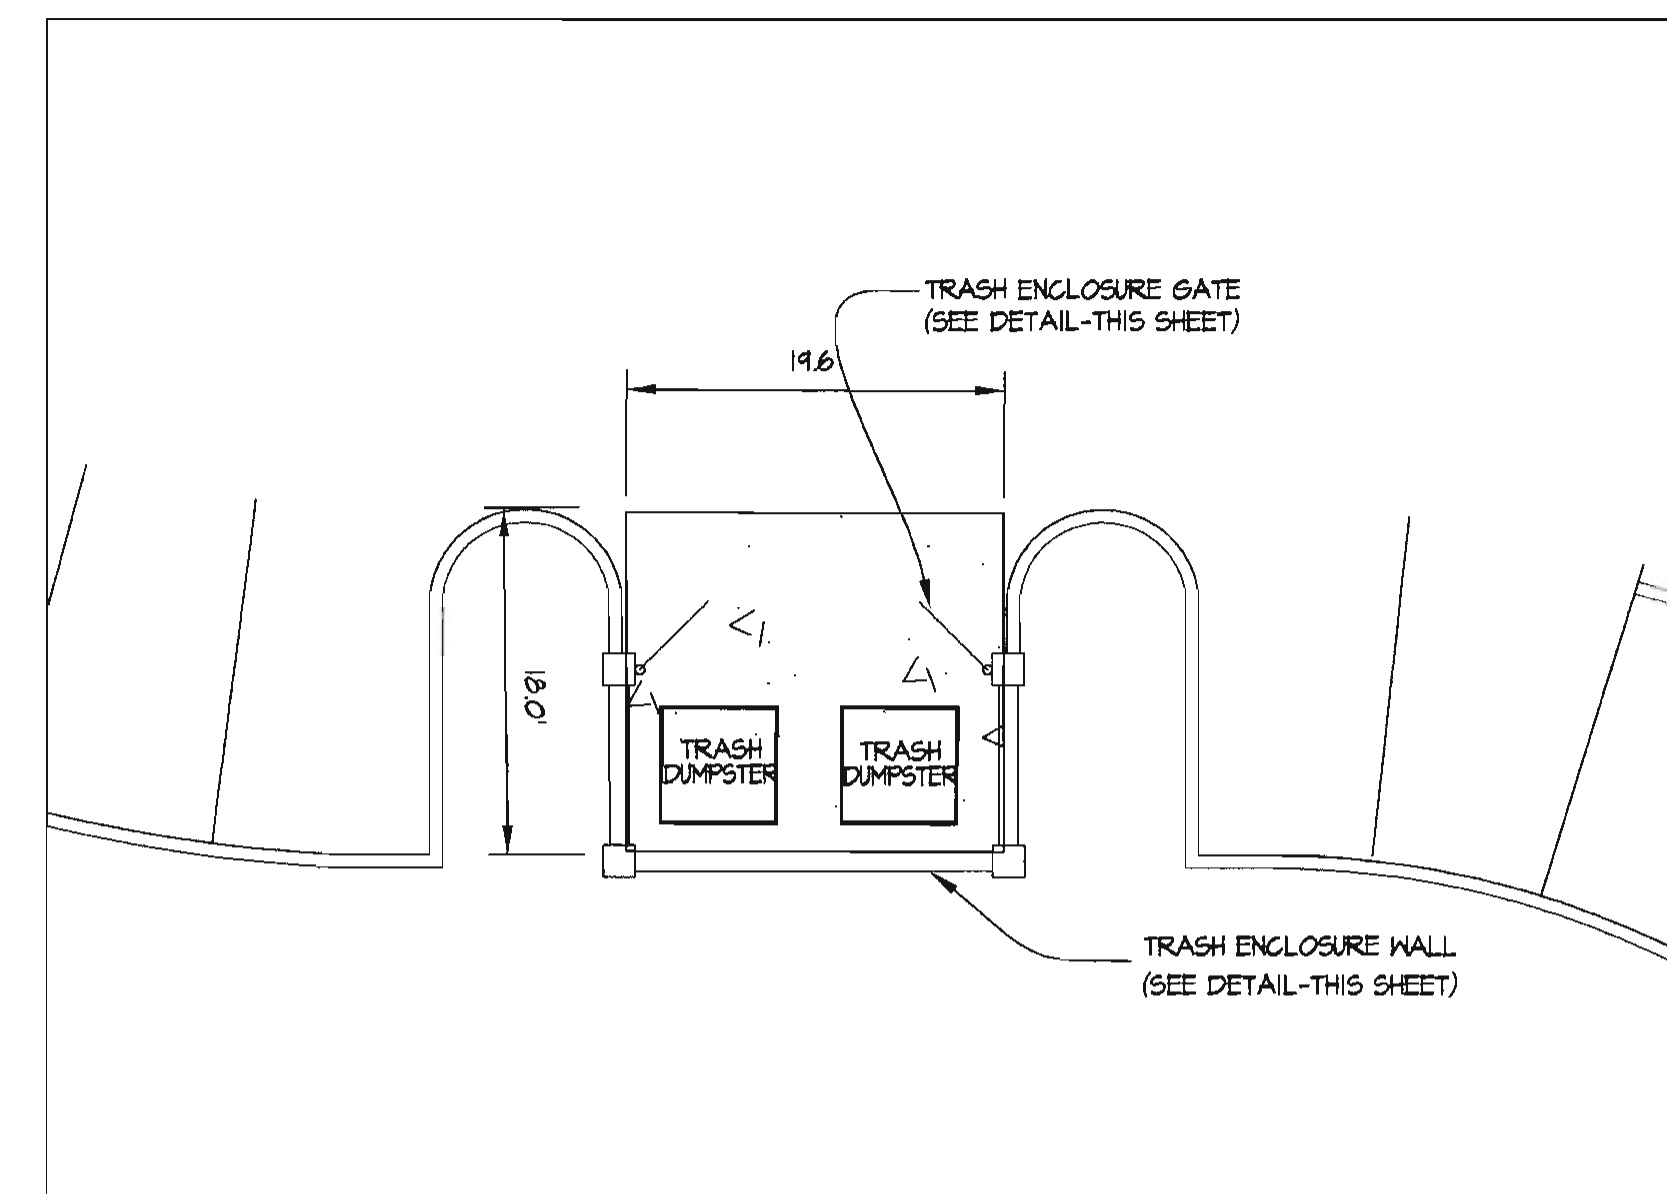


Trash Enclosure
1"=10'

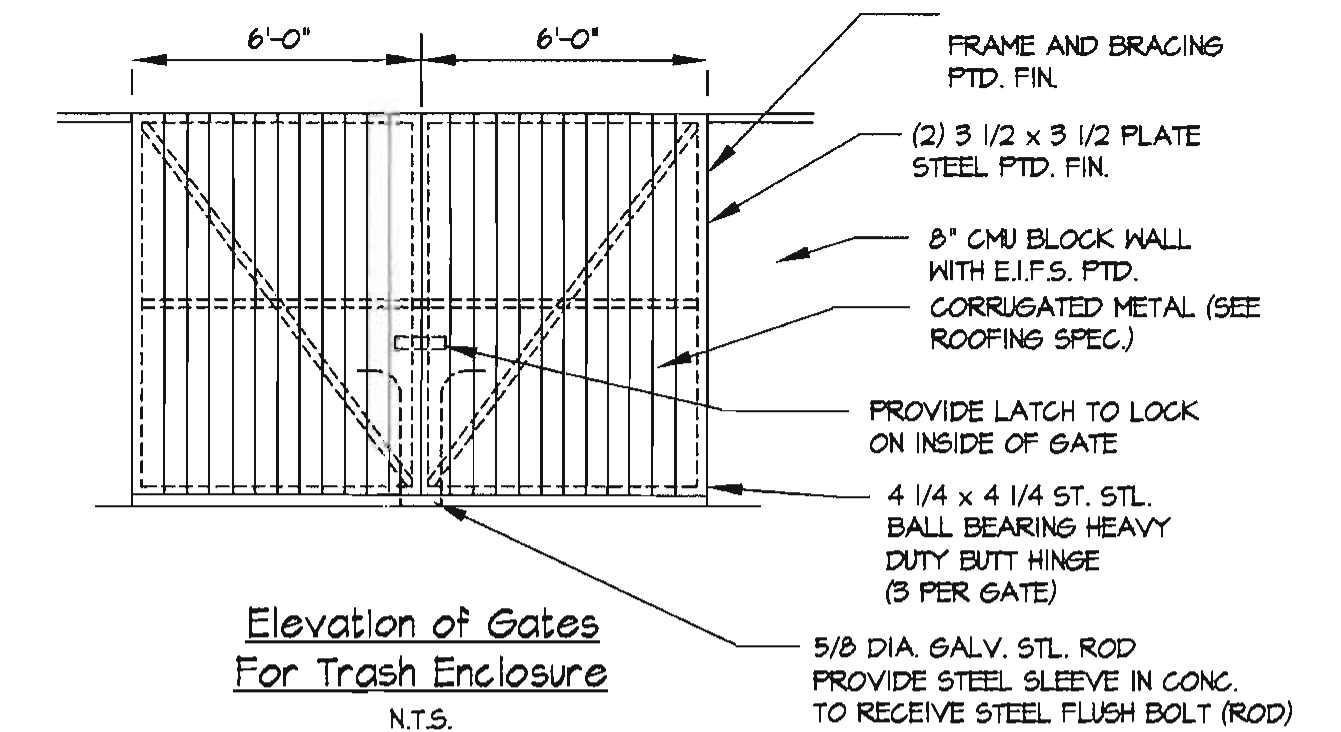

Elevation of Gates
For Trash Enclosure
N.T.S.

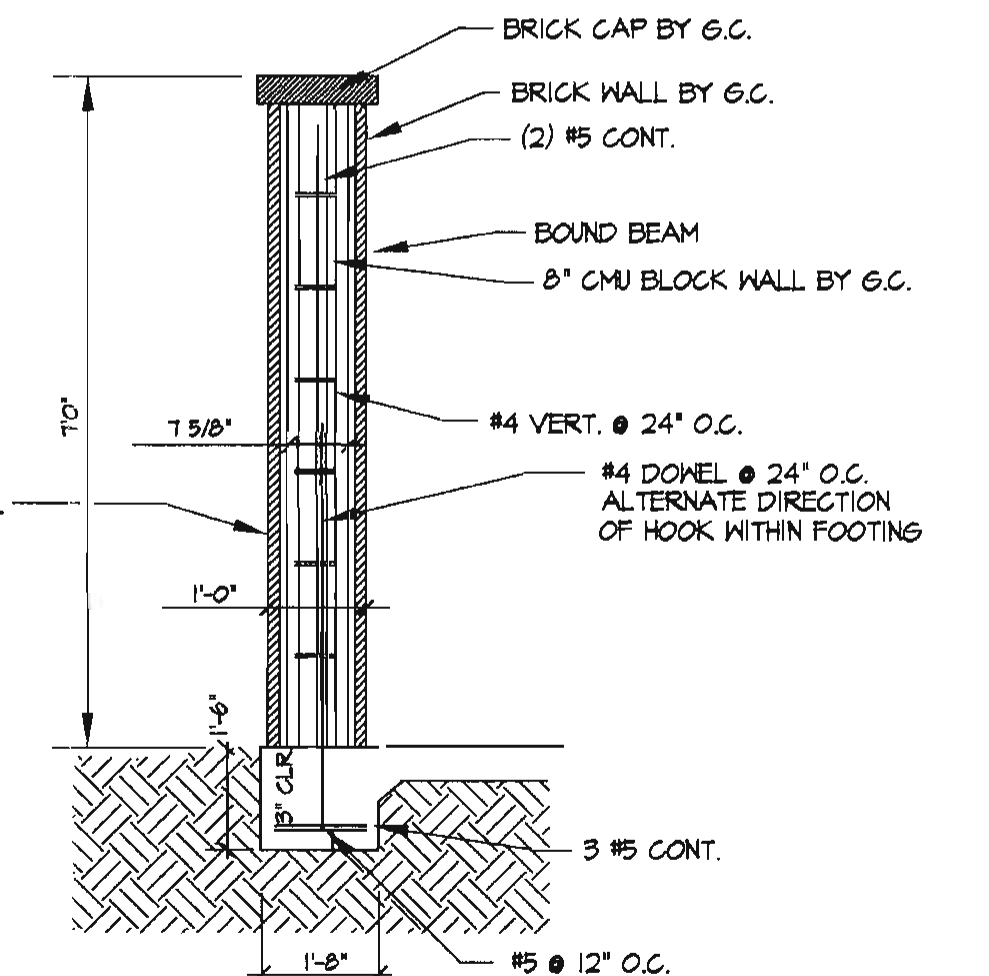


Section of Stone Wall
For Trash Enclosure
N.T.S.

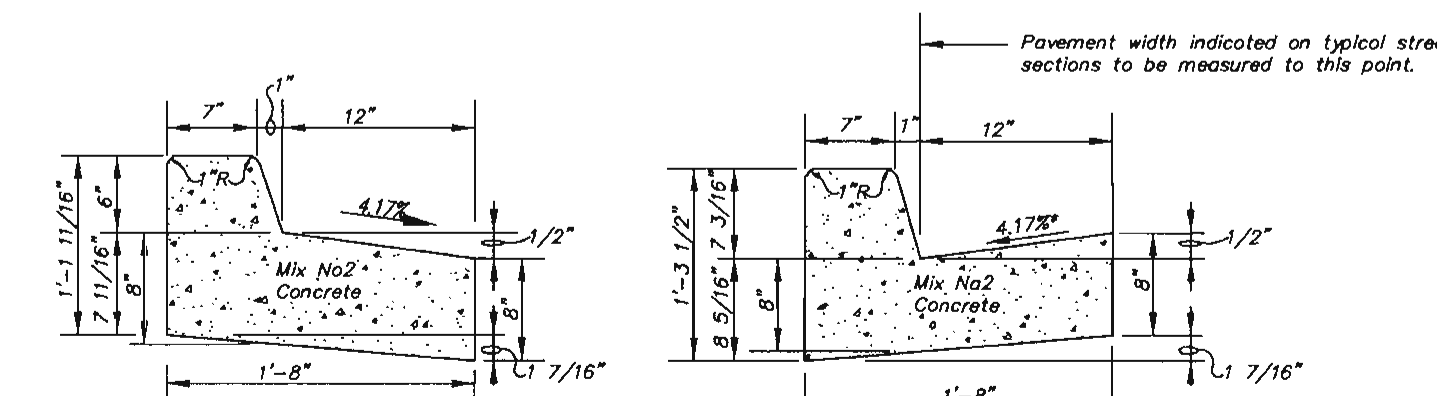



Reverse 7" Combination
Curb & Gutter
N.T.S.

Standard 7" Combination
Curb & Gutter
N.T.S.

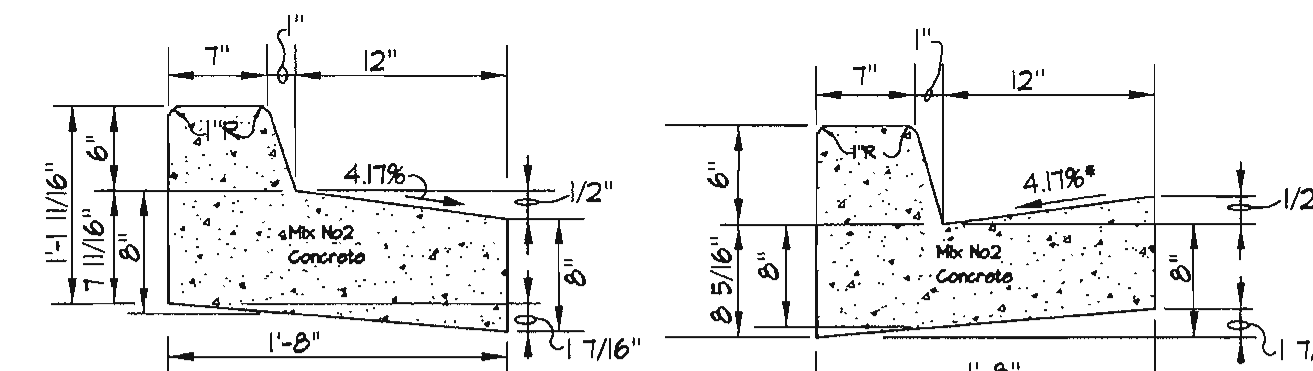


Reverse 6" Combination Curb & Gutter
N.T.S.


Standard 6" Combination Curb & Gutter
N.T.S.

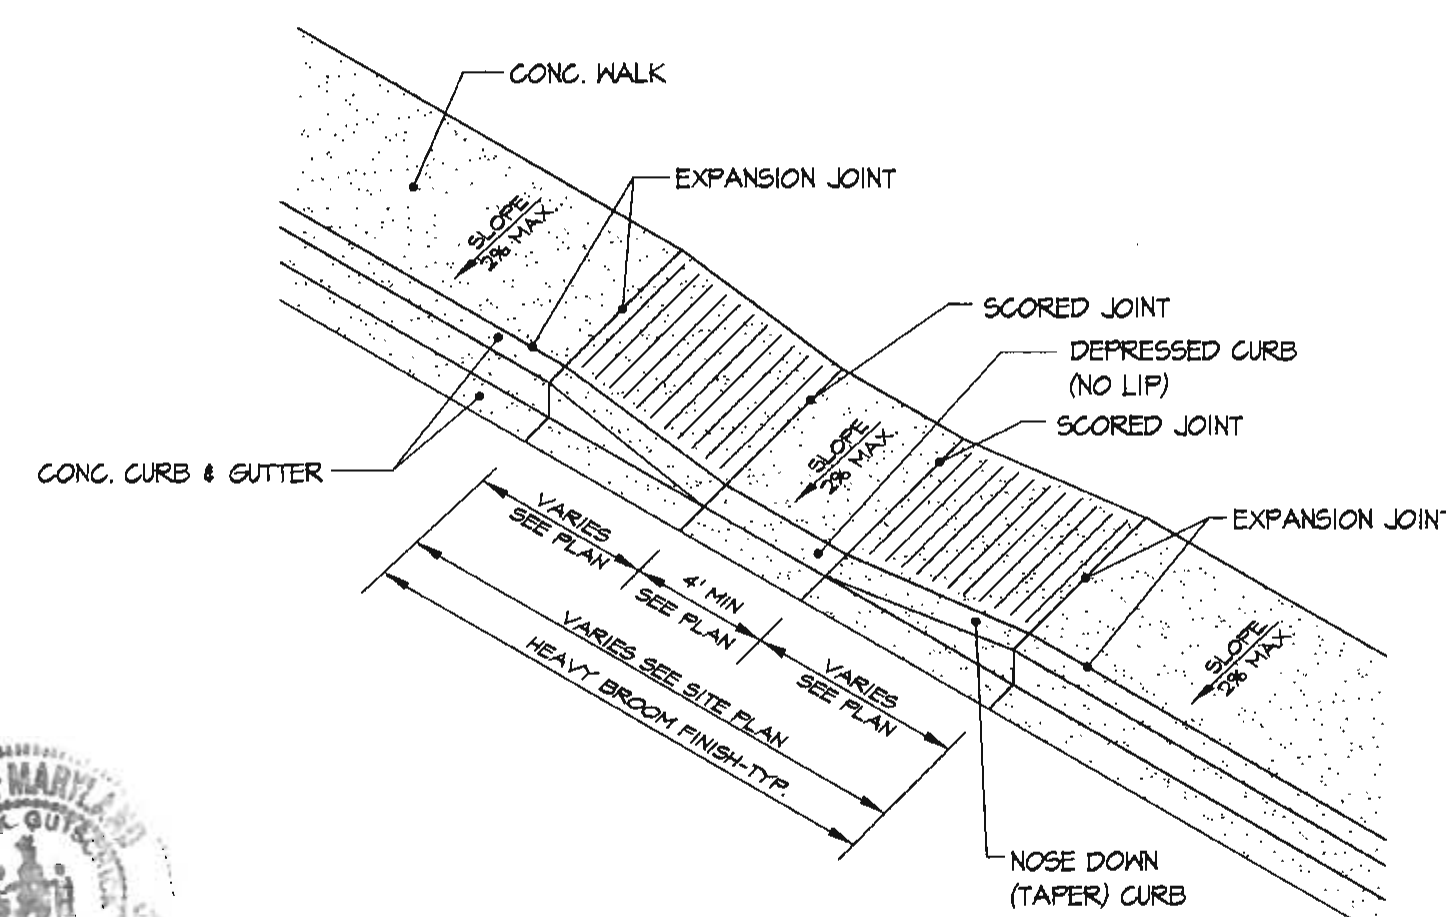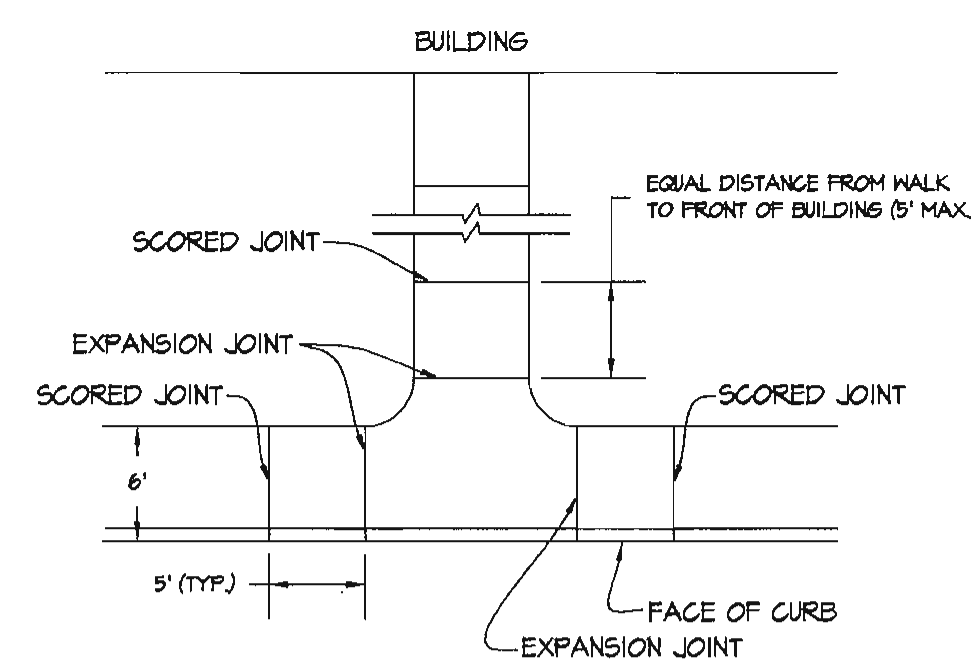


TYPE-A HANDICAP RAMP DETAIL
NO SCALE

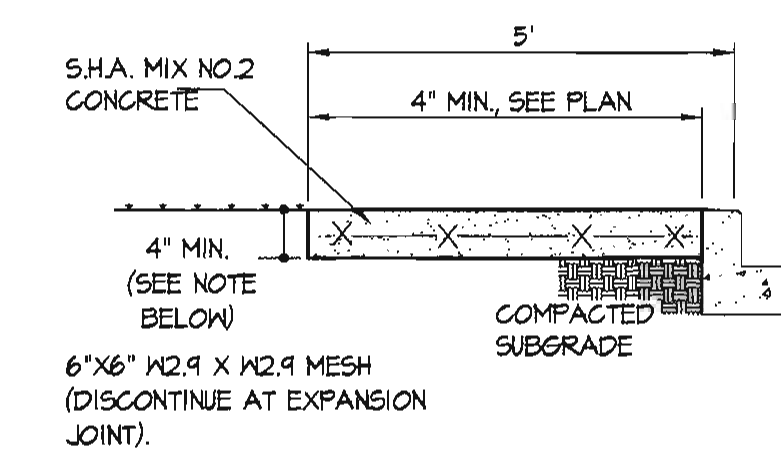


TYPICAL SIDEWALK SECTION
NO SCALE

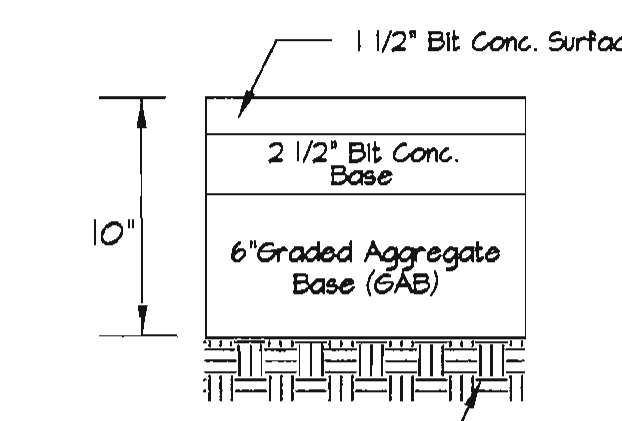


Granular Base Alternative
Approved subgrade

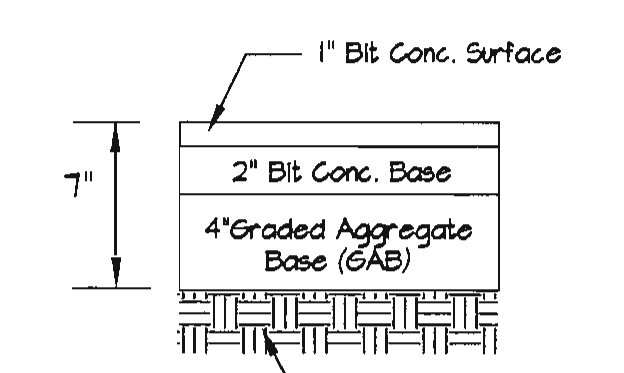

Granular Base Alternative
Approved subgrade

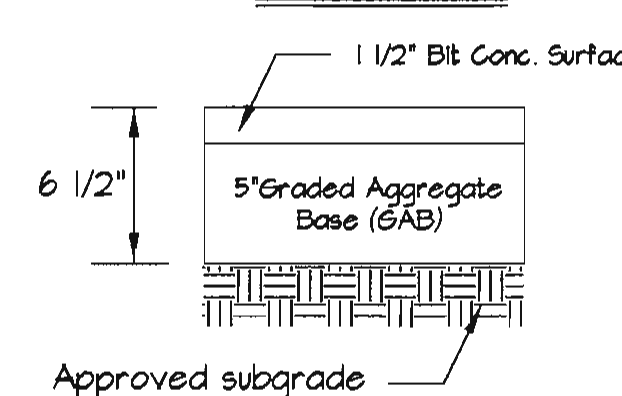

Full Depth Bituminous Concrete Alternative
Approved subgrade

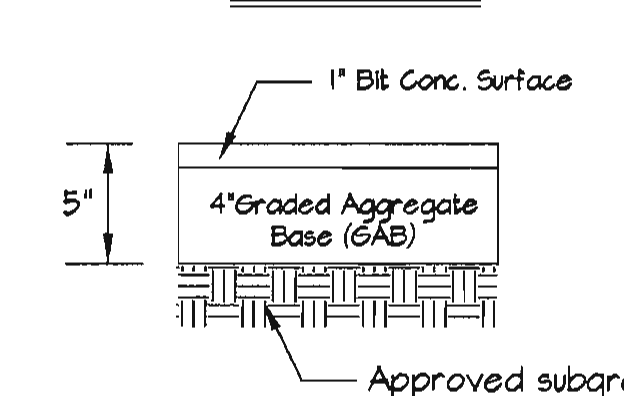

Full Depth Bituminous Concrete Alternative
Approved subgrade

P-2 Granular Base
N.T.S.

P-1 Granular Base
N.T.S.

Note:
Depending on the CBR values obtained in the field, the paving sections may be revised, if approved by a professional soils engineer. These substitutions must also be approved by the Howard County Dept. of Public Works.

APPROVED: HOWARD COUNTY DEPARTMENT OF PLANNING & ZONING
 Director: [Signature] Date: 12/15/04
 Chief, Division of Land Development: [Signature] Date: 12/13/04
 Chief, Development Engineering Division: [Signature] Date: 11/22/04




GLWGUTSCHICK LITTLE & WEBER, P.A.
 CIVIL ENGINEERS, LAND SURVEYORS, LAND PLANNERS, LANDSCAPE ARCHITECTS
 3909 NATIONAL DRIVE - SUITE 250 - BURTONSVILLE OFFICE PARK
 BURTONSVILLE, MARYLAND 20866
 TEL: 301-421-4024 BALT: 410-886-1820 DC/VA: 301-989-2524 FAX: 301-421-4186


PREPARED FOR:
 GATEWAY 67 LLC
 8815 CENTRE PARK DRIVE, SUITE 400
 COLUMBIA, MD. 21045
 PH.: 410-992-7348
 ATTN: MR. ROGER WAESCHE

SITE DETAILS & PAVING PLAN
COLUMBIA GATEWAY
 PARCEL N-13
 Plat No. 17094


SCALE	ZONING	G. L. W. FILE No.
AS SHOWN	M-1	04032
DATE	TAX MAP - GRID	SHEET
Sept., 2004	42 - 12	3 OF 10

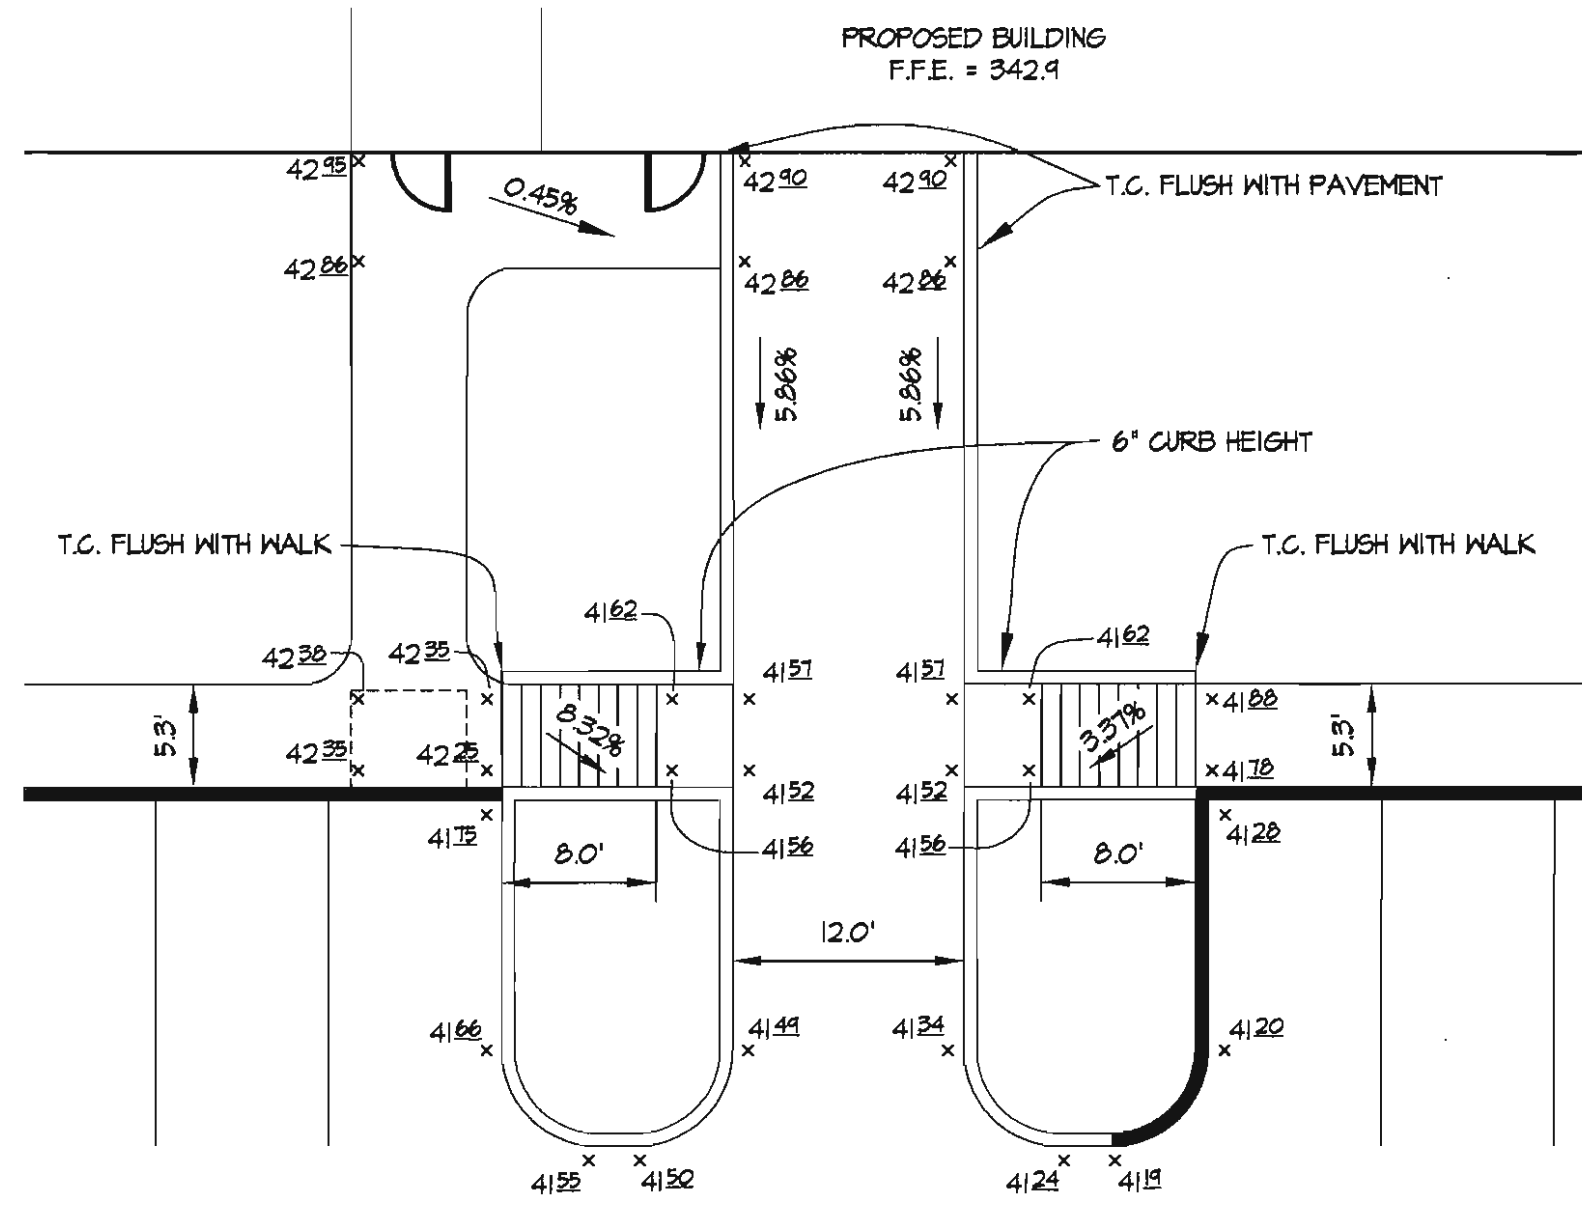


LOADING AREA DETAIL
SCALE: 1"=10'

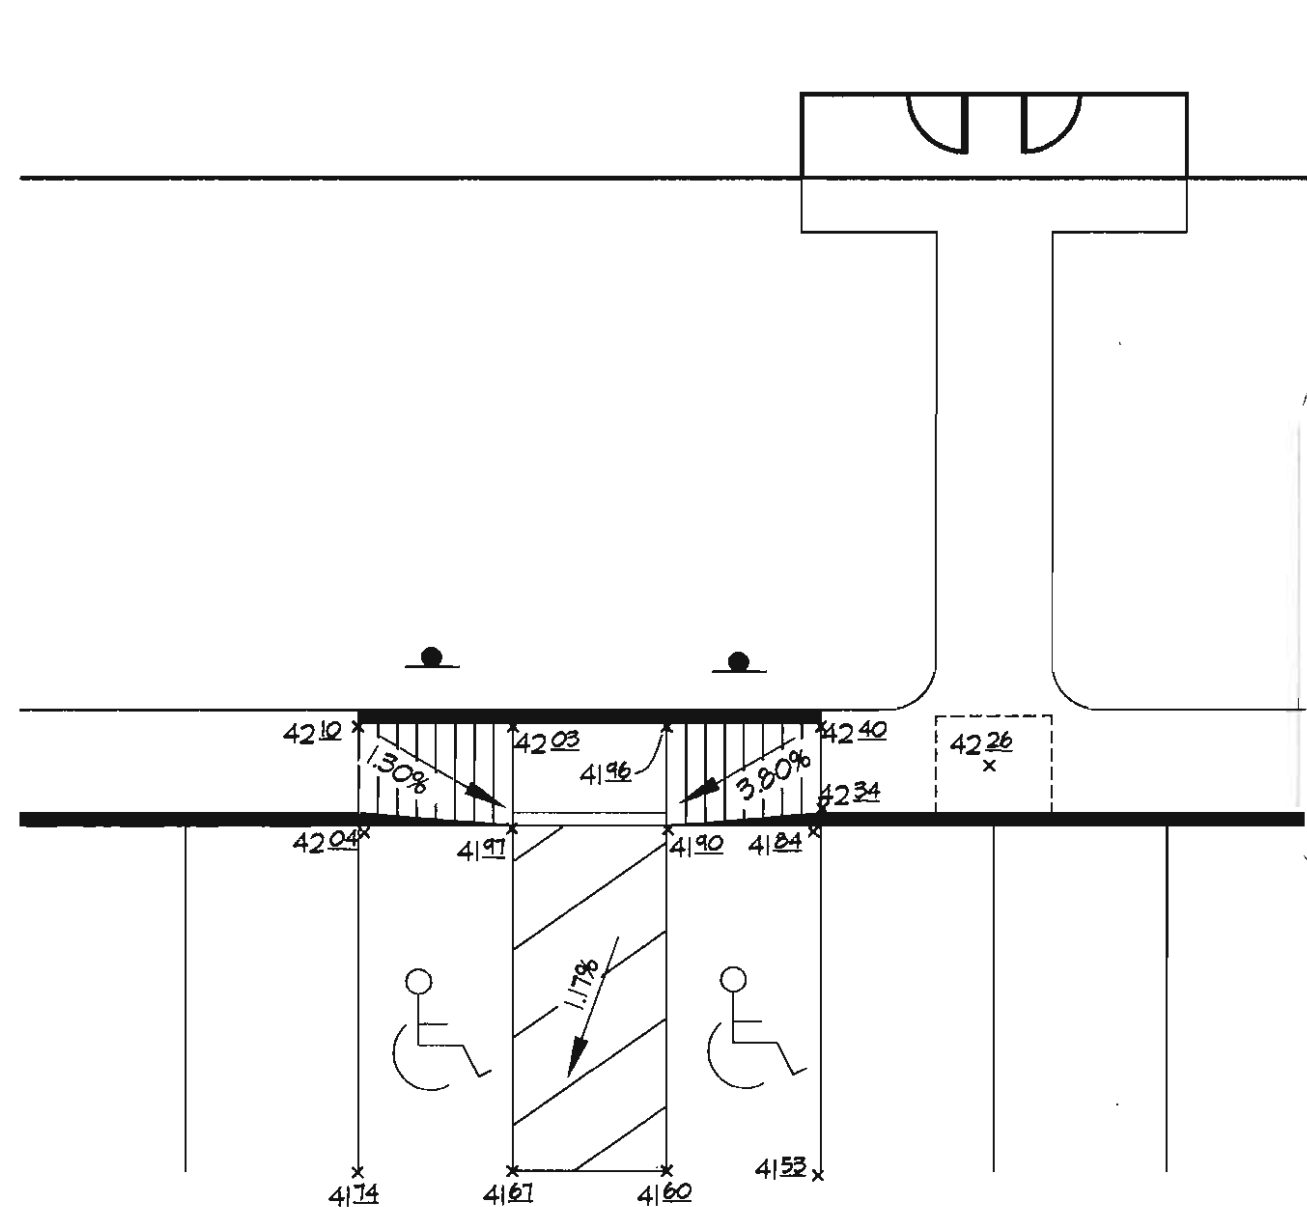




HANDICAP PARKING DETAIL (SW SIDE OF BUILDING)
SCALE: 1"=10'

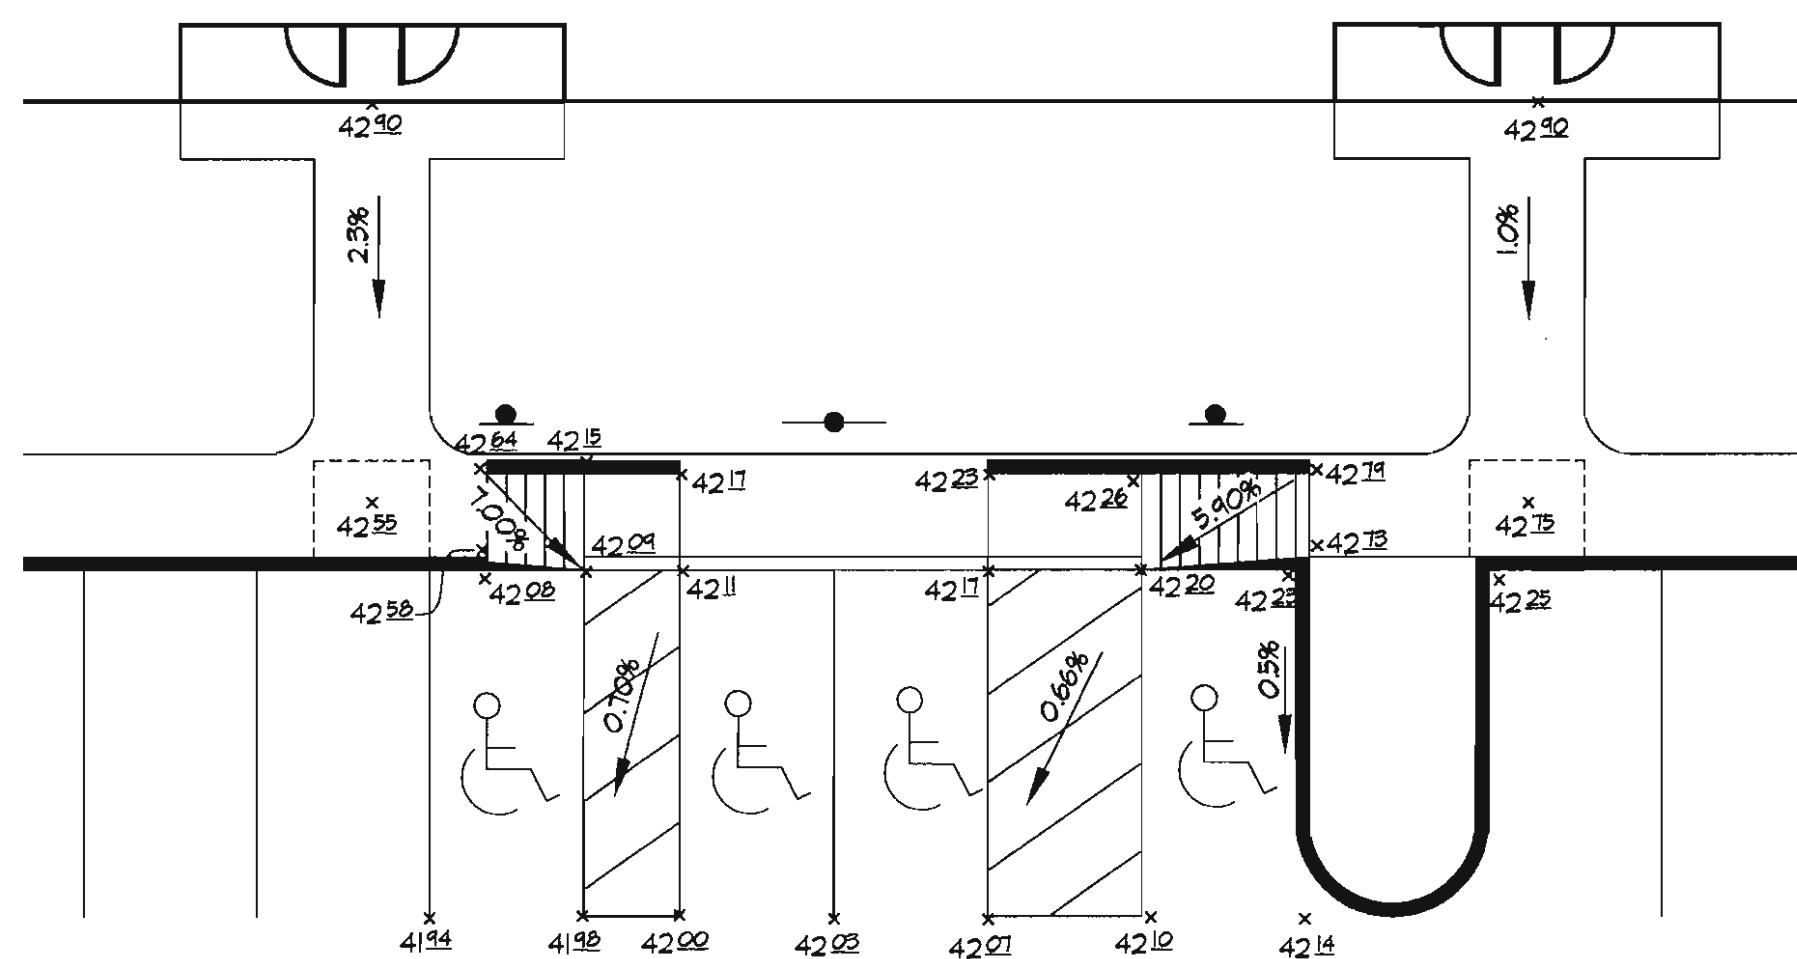

HANDICAP PARKING DETAIL (SE SIDE OF BUILDING)
SCALE: 1"=10'

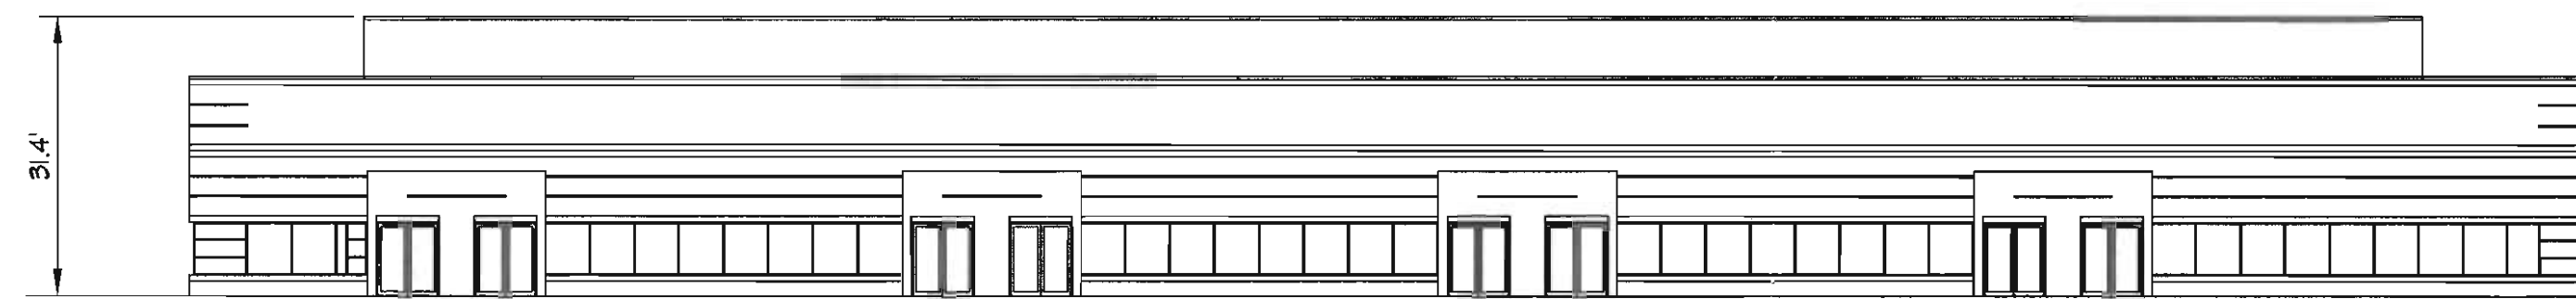

BUILDING 'K' ELEVATION

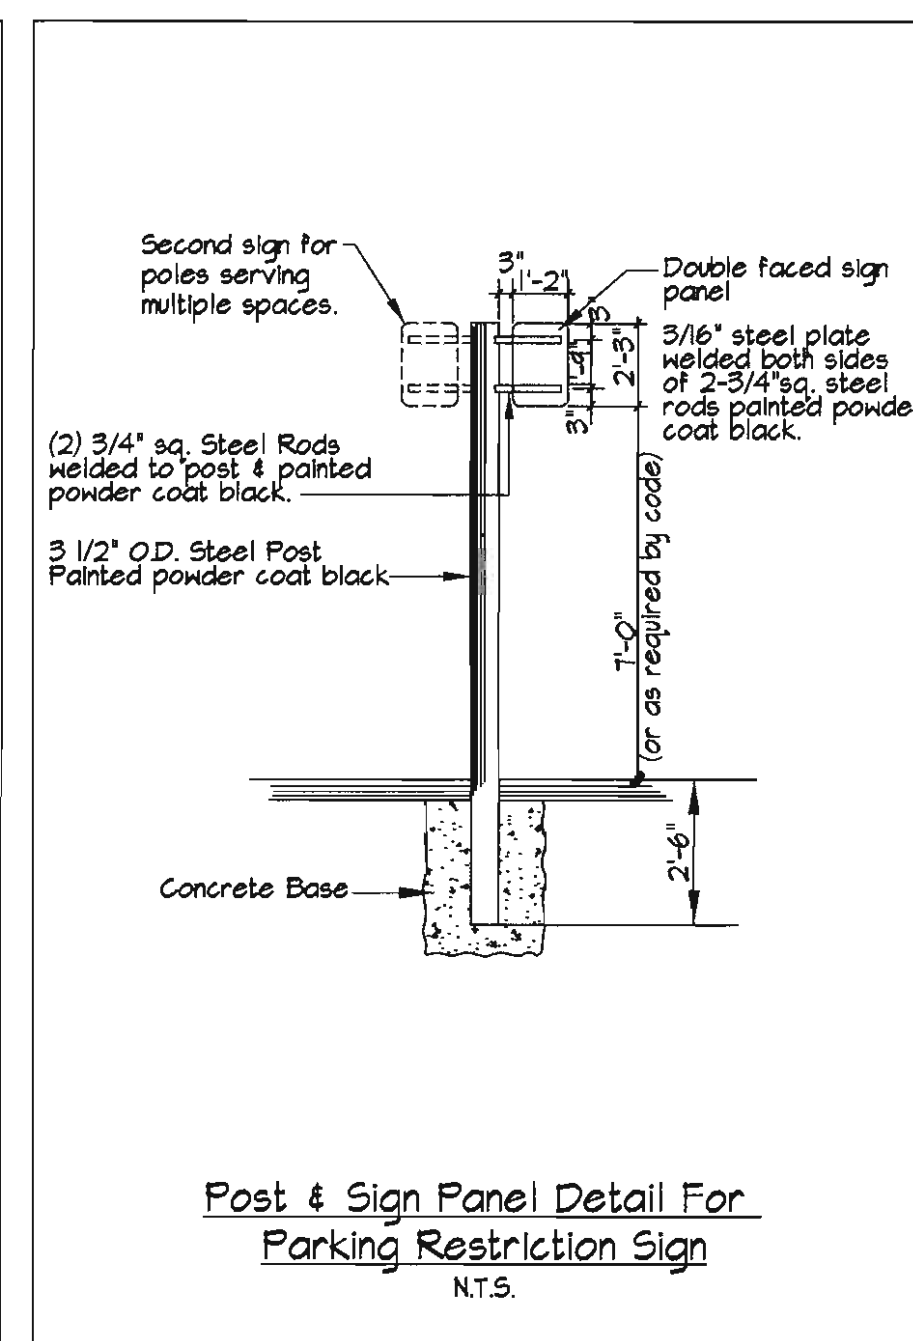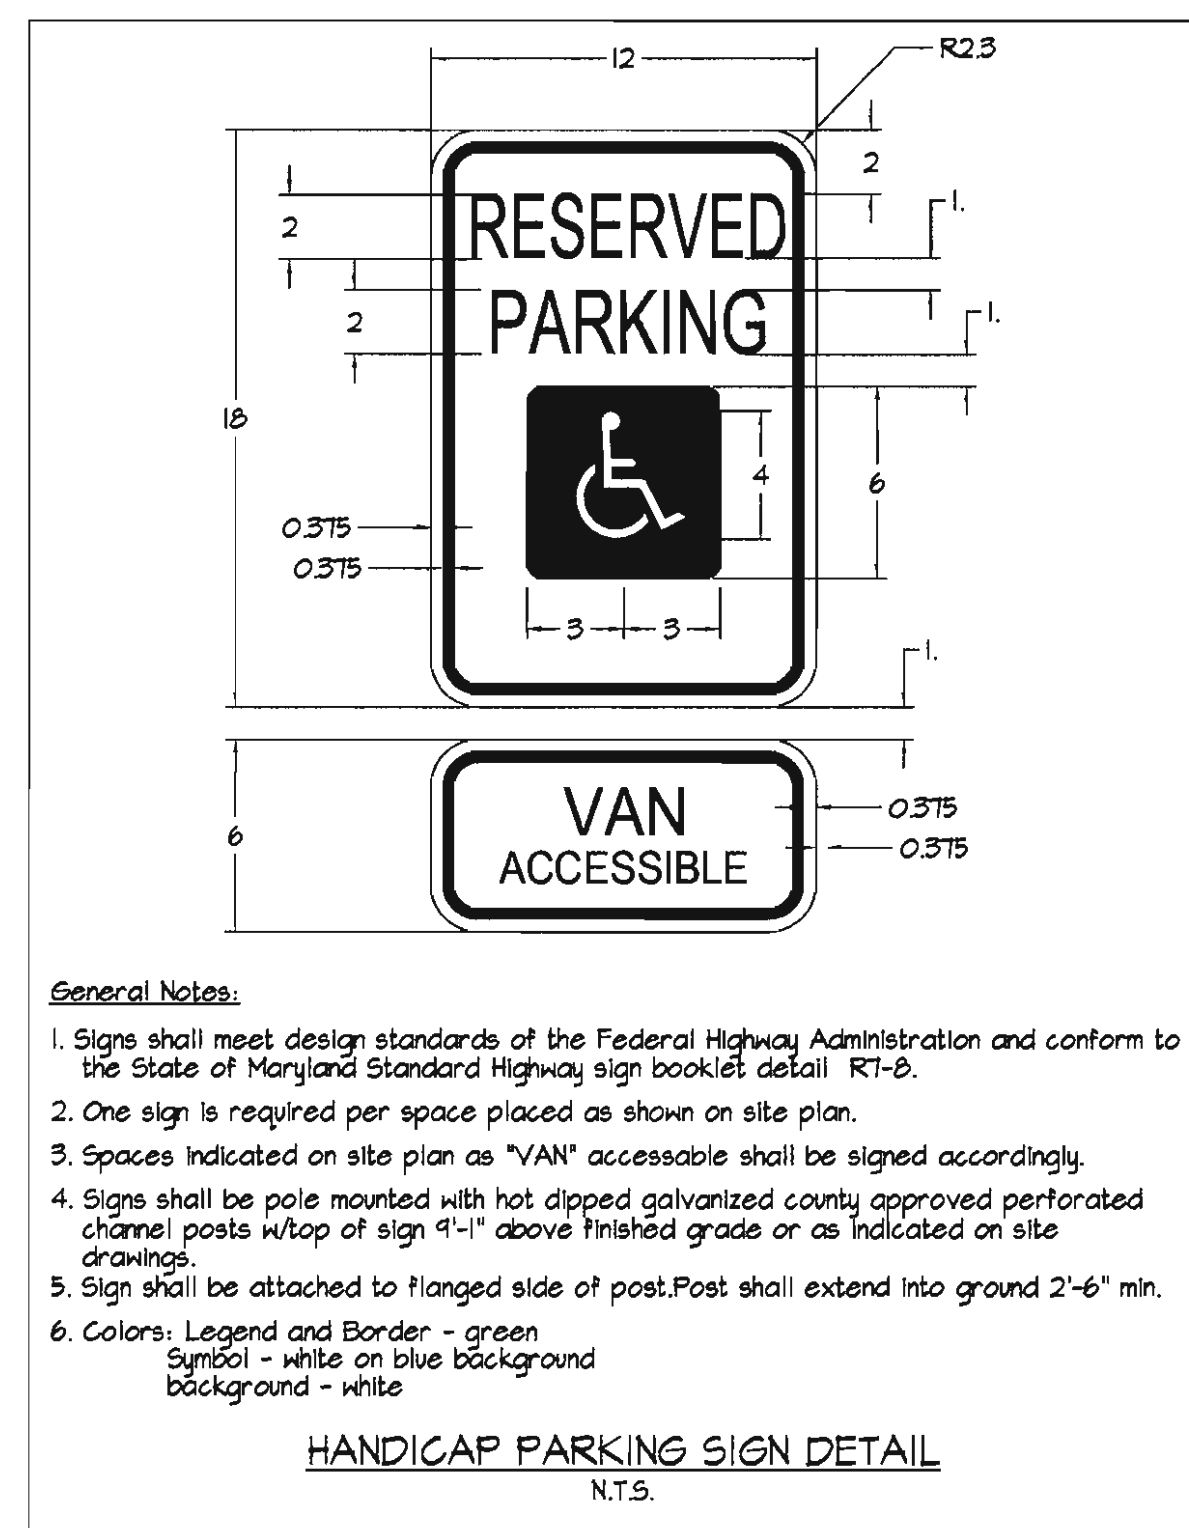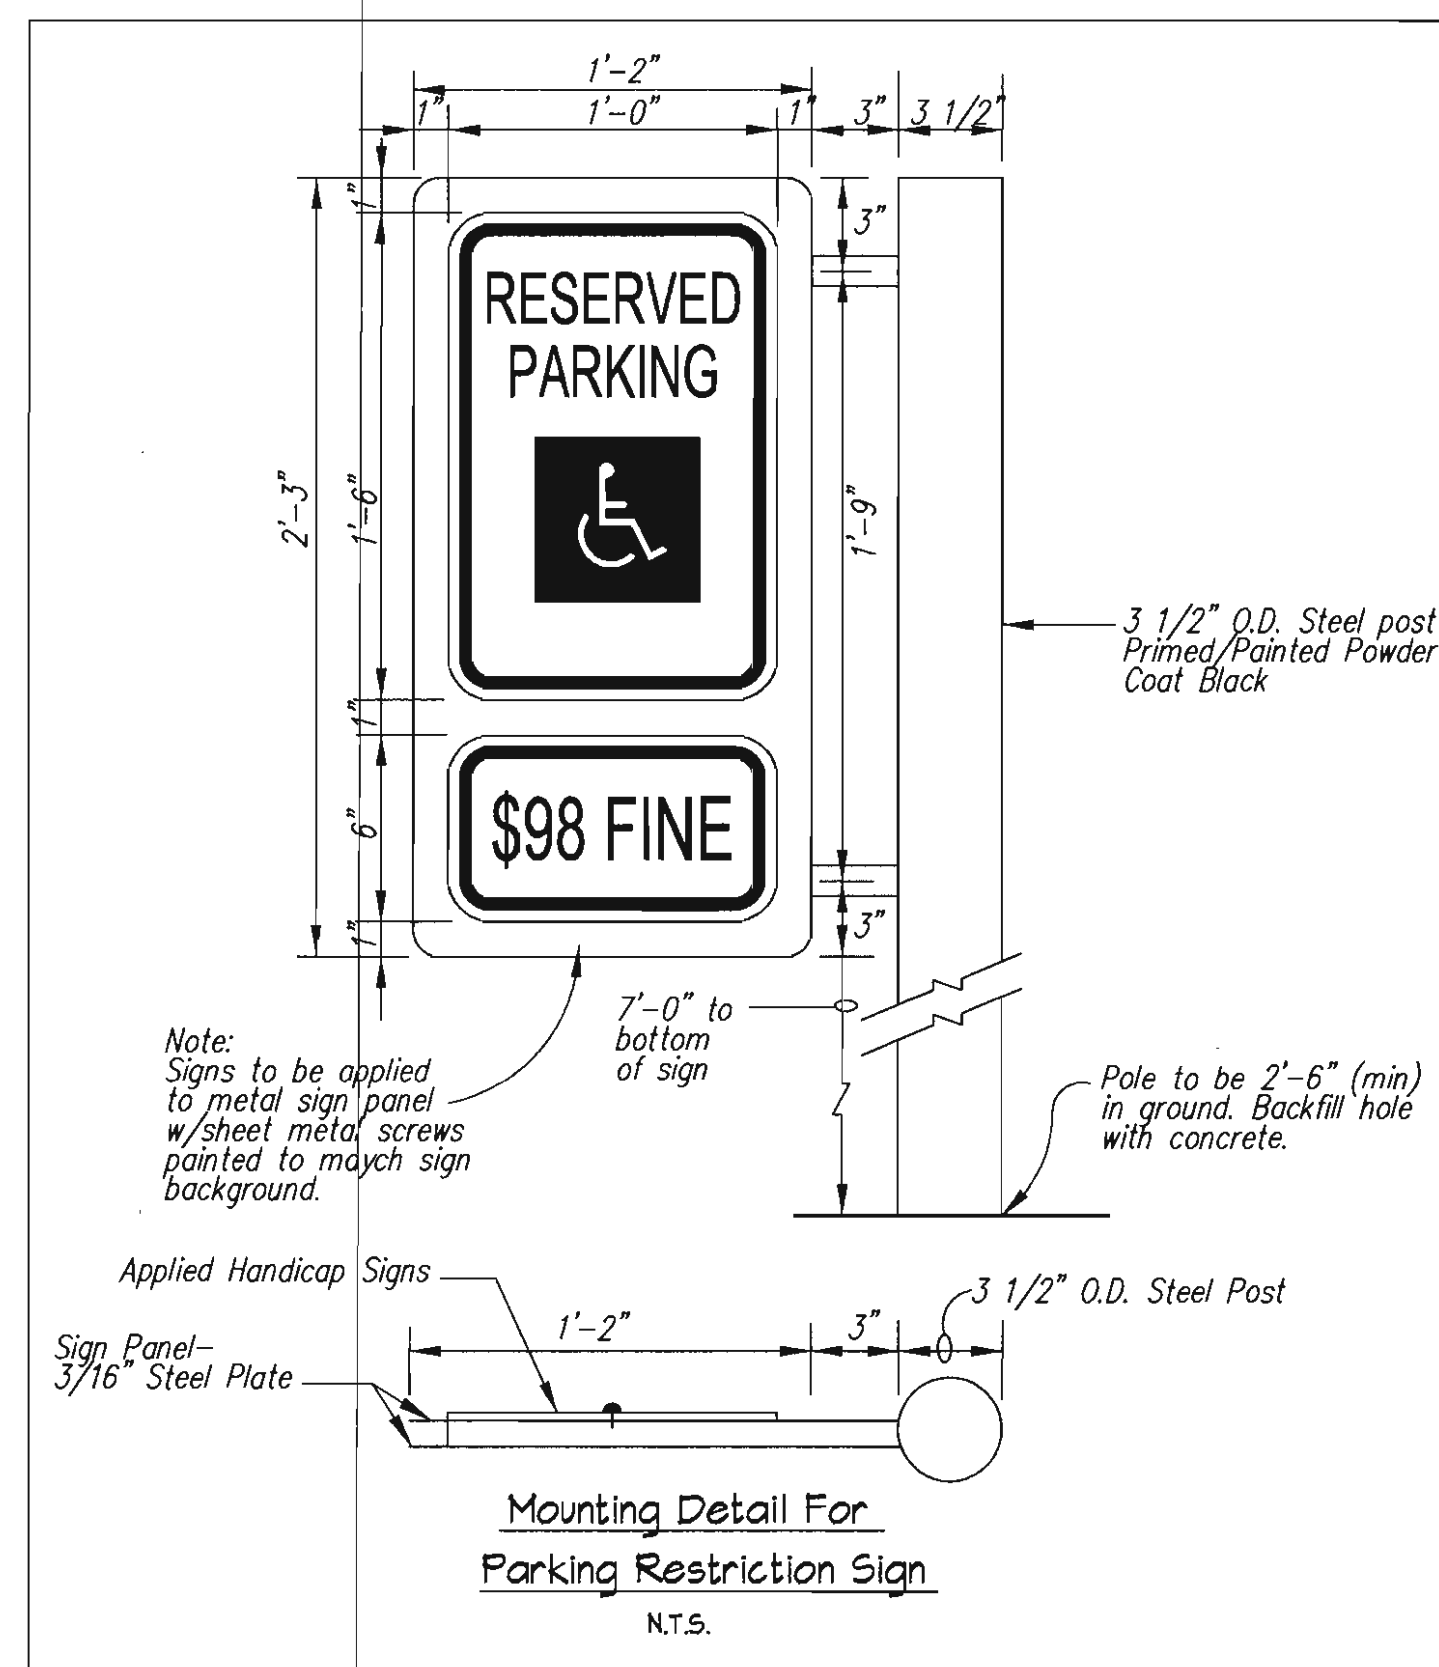

APPROVED: HOWARD COUNTY DEPARTMENT OF PLANNING & ZONING
 Director: *David DeLoach* Date: 12/21/04
 Chief, Division of Land Development: *Cindy Hanotte* Date: 12/21/04
 Chief, Development Engineering Division: *Mike Amussen* Date: 11/22/04



GLWGUTSCHICK LITTLE & WEBER, P.A.
 CIVIL ENGINEERS, LAND SURVEYORS, LAND PLANNERS, LANDSCAPE ARCHITECTS
 3909 NATIONAL DRIVE - SUITE 250 - BURTONSVILLE OFFICE PARK
 BURTONSVILLE, MARYLAND 20886
 TEL: 301-421-4024 BALT: 410-880-1820 DC/VA: 301-989-2524 FAX: 301-421-4186

PREPARED FOR:
 GATEWAY 67 LLC
 CENTRE PARK DRIVE, SUITE 400
 COLUMBIA, MD. 21045
 PH.: 410-992-7348
 ATTN: MR. ROGER WAESCHE


SITE & HANDICAP ACCESSIBILITY DETAILS
COLUMBIA GATEWAY
PARCEL N-13
 Plat No. 17094

SCALE	ZONING	G. L. W. FILE No.
AS SHOWN	M-1	04032
DATE	TAX MAP - GRID	SHEET
Sept., 2004	42 - 12	4 OF 10

ELECTION DISTRICT No. 6

HOWARD COUNTY, MARYLAND

DRAINAGE AREA INFORMATION			
STRUCTURE NO.	AREA	'C' VALUE	% IMP.
I-1	0.23 AC.	0.69	64%
I-2	0.43 AC.	0.80	79%
I-3	0.28 AC.	0.81	80%
I-4	0.12 AC.	0.24	0%
I-5	0.40 AC.	0.24	0%

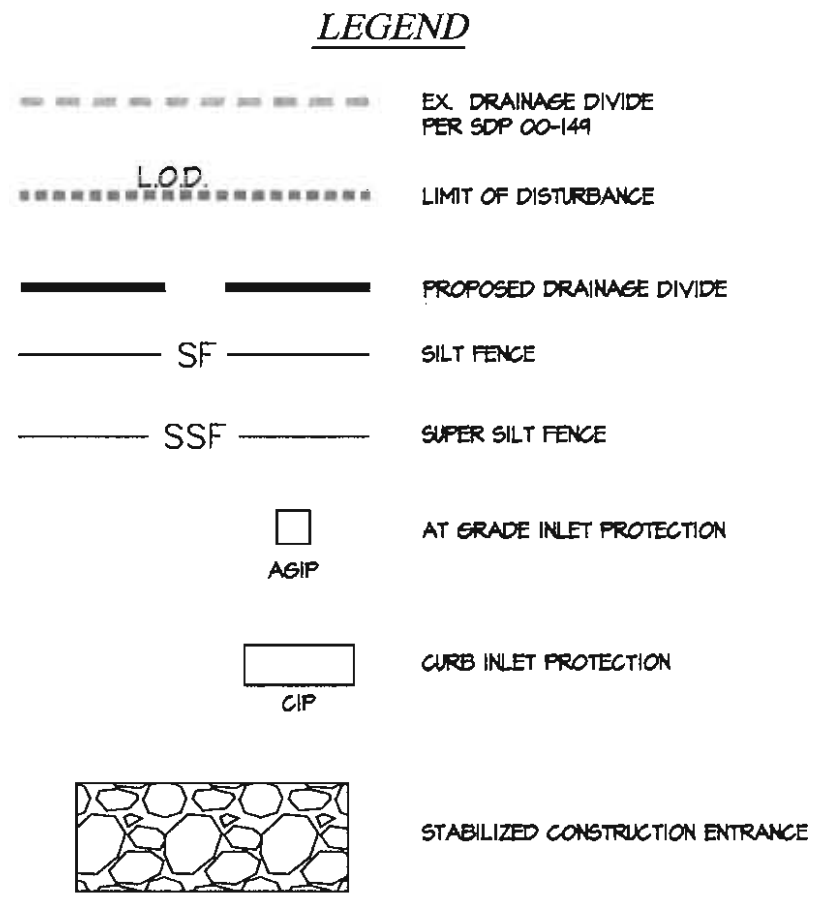

WHERE L.O.D. IS NOT SHOWN, THE SEDIMENT CONTROL DEVICES SHALL INDICATE THE LIMIT OF DISTURBANCE.
 DUE TO MASS GRADING, 'C' SOILS WERE USED FOR STORM DRAIN DESIGN.



ENGINEER'S CERTIFICATE

"I certify that this plan for erosion and sediment control represents a practical and workable plan based on my personal knowledge of the site conditions and that it was prepared in accordance with the requirements of the Howard Soil Conservation District."

Signature of Engineer: *Ch...* Date: 10/28/04

DEVELOPER'S/BUILDER'S CERTIFICATE

"We certify that all development and/or construction will be done according to this plan, and that any responsible personnel involved in the construction project will have a Certificate of Attendance at a Maryland Department of the Environment Approved Training Program for the Control of Sediment and Erosion before beginning the project. I also authorize periodic on-site inspection."

Signature of Developer/Builder: *Roger A. Waesche, Jr.* Date: 10/28/04
 Roger A. Waesche, Jr., Senior Vice President of Gateway 67, LLC


These plans have been reviewed for the Howard Soil Conservation District and meet the technical requirements.

Signature: *Jim Meyer* Date: 11/16/04
 Natural Resources Conservation Service

This Development Plan is approved for Soil Erosion and Sediment Control by the Howard Soil Conservation District.

Signature: *John R. Roberts* Date: 11/16/04
 Howard S.C.D.

APPROVED: HOWARD COUNTY DEPARTMENT OF PLANNING & ZONING
 Director: *Dan...* Date: 12/2/04
 Chief, Division of Land Development: *C. Ham...* Date: 12/3/04
 Chief, Development Engineering Division: *M. K...* Date: 11/22/04

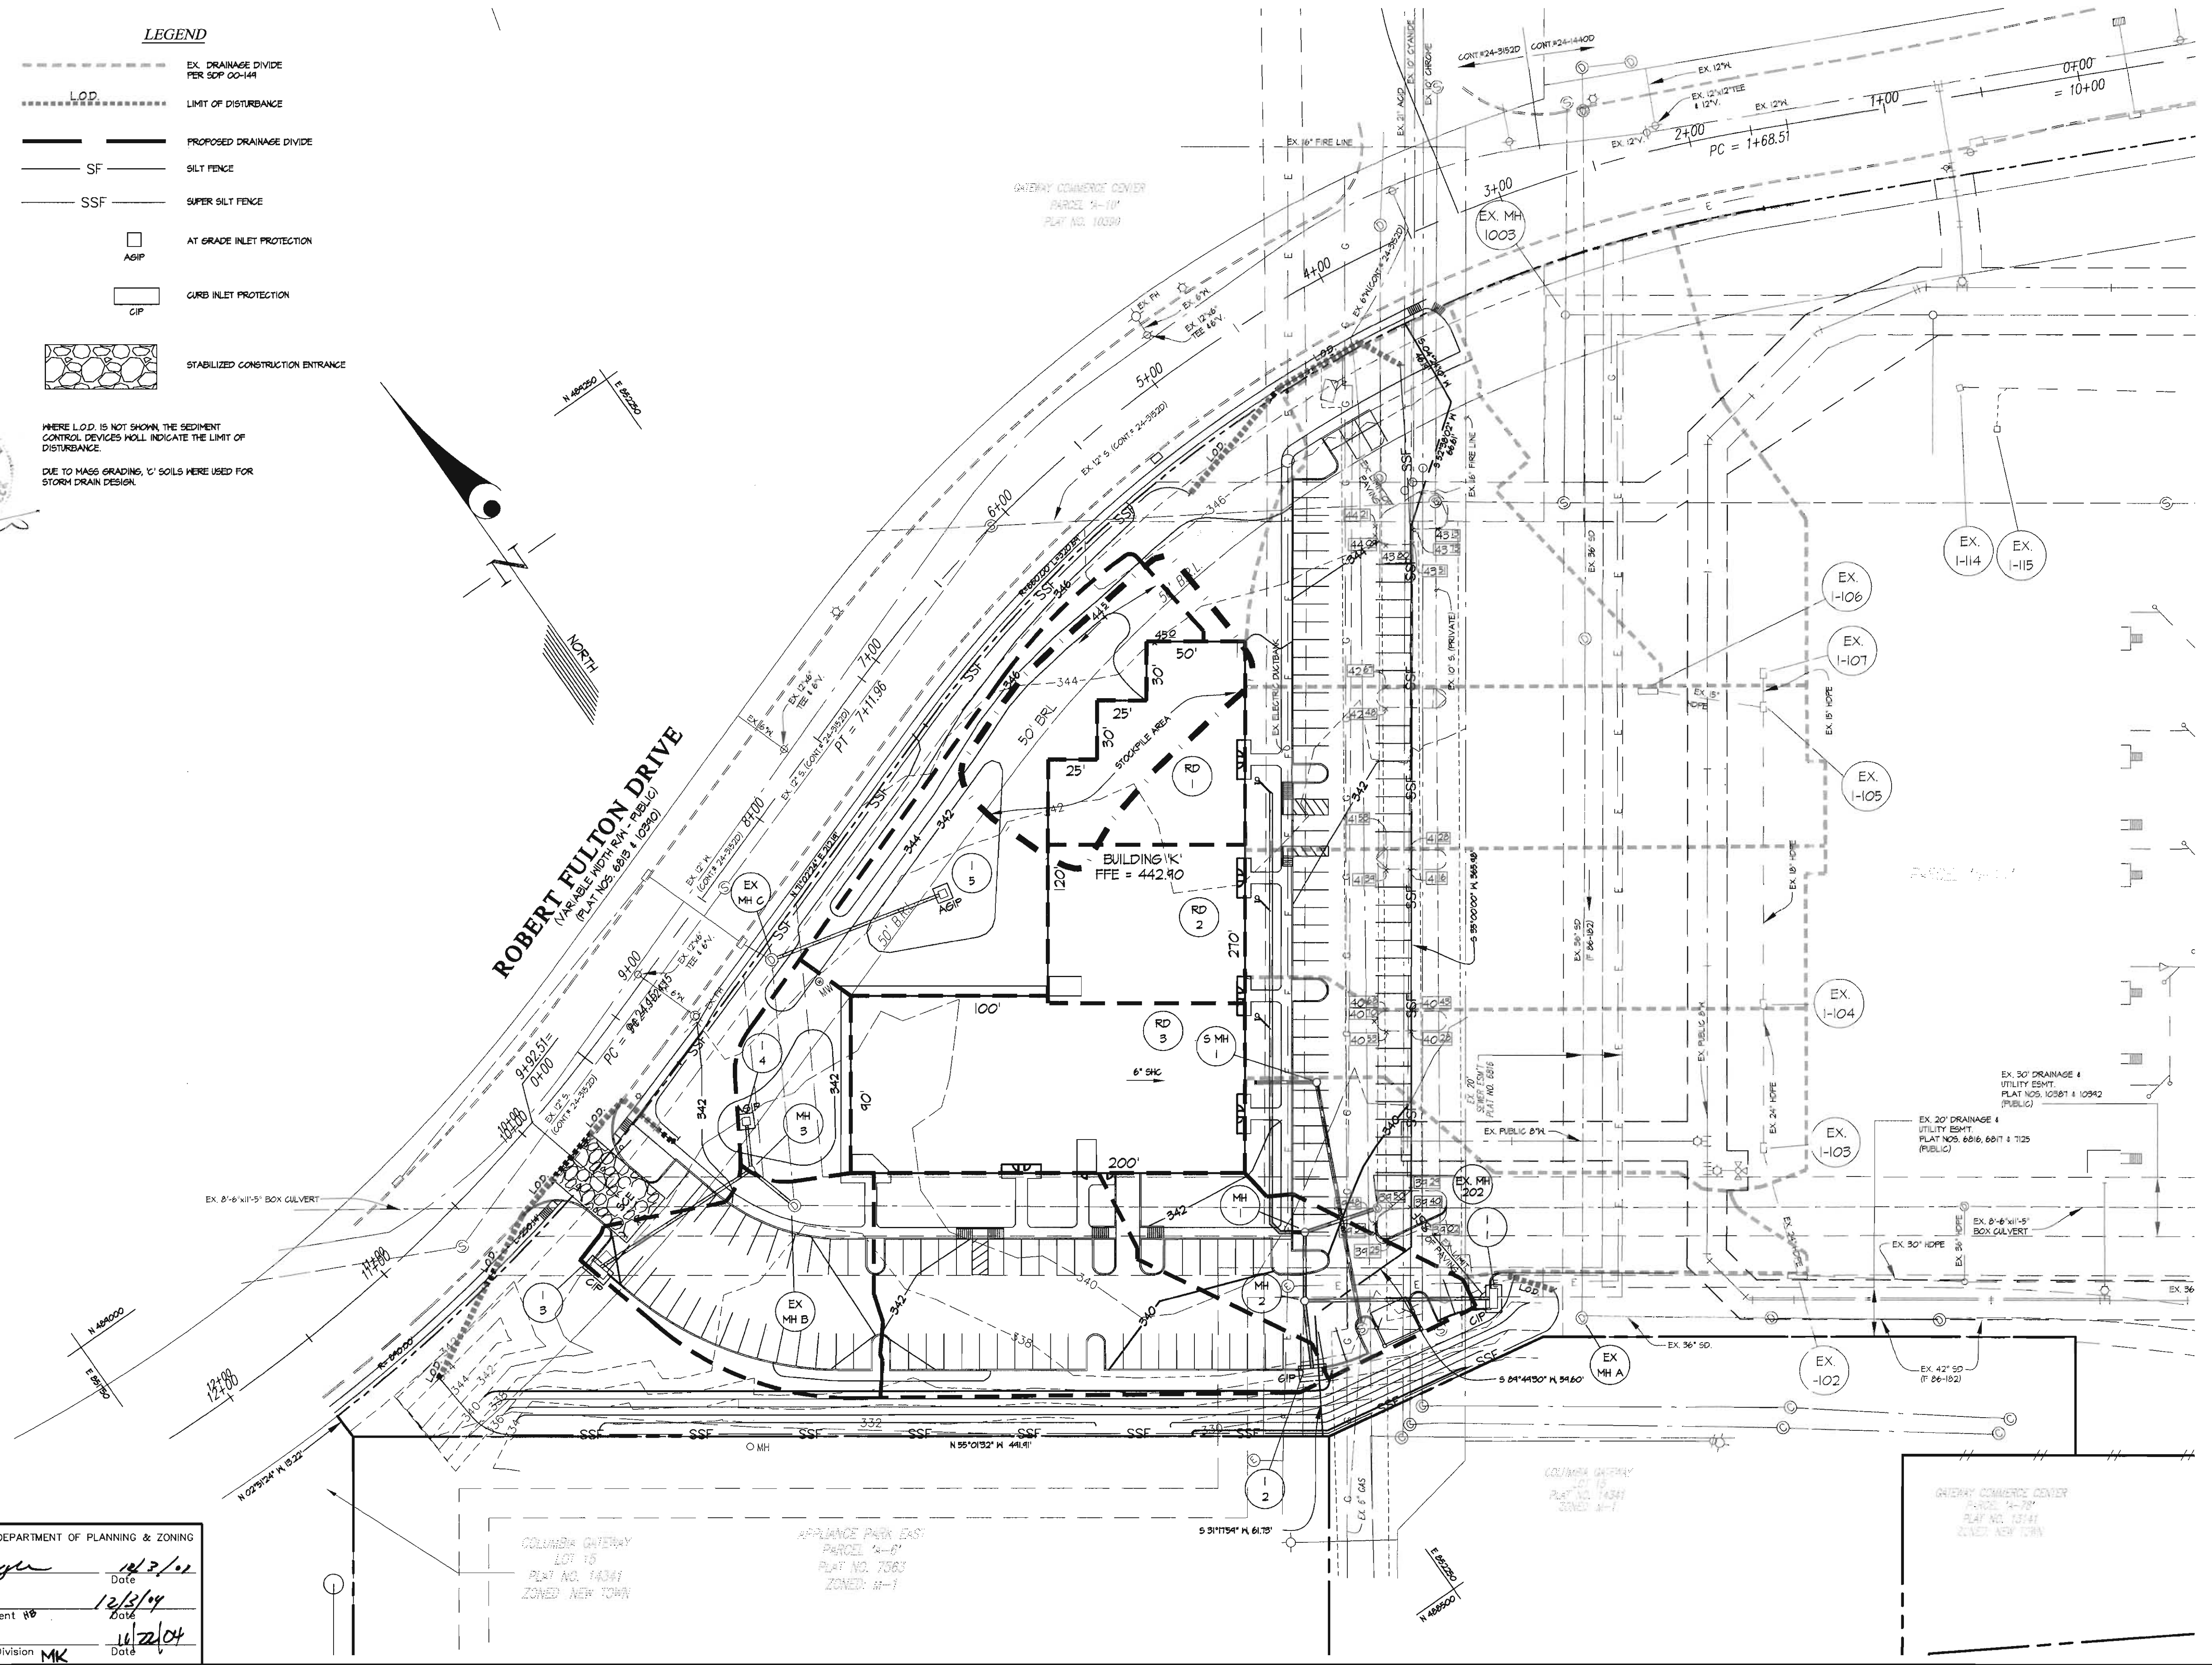






GLWGUTSCHICK LITTLE & WEBER, P.A.
 CIVIL ENGINEERS, LAND SURVEYORS, LAND PLANNERS, LANDSCAPE ARCHITECTS
 3909 NATIONAL DRIVE - SUITE 250 - BURTONSVILLE OFFICE PARK
 BURTONSVILLE, MARYLAND 20886
 TEL: 301-421-4024 BALT: 410-880-1820 DC/VA: 301-989-2524 FAX: 301-421-4186

PREPARED FOR:
 GATEWAY 67 LLC
 8815 CENTRE PARK DRIVE, SUITE 400
 COLUMBIA, MD. 21045
 PH.: 410-992-7348
 ATTN: MR. ROGER WAESCHE

SEDIMENT CONTROL PLAN/DRAINAGE AREA MAP
COLUMBIA GATEWAY
PARCEL N-13
 Plat No. 17094

SCALE	ZONING	G. L. W. FILE No.
1" = 40'	M-1	04032
DATE	TAX MAP - GRID	SHEET
Sept., 2004	42 - 12	6 OF 10

L:\CADD\DRAWINGS\04032\SDP\04032SP6.dwg 10/28/2004 01:58:06 PM C01

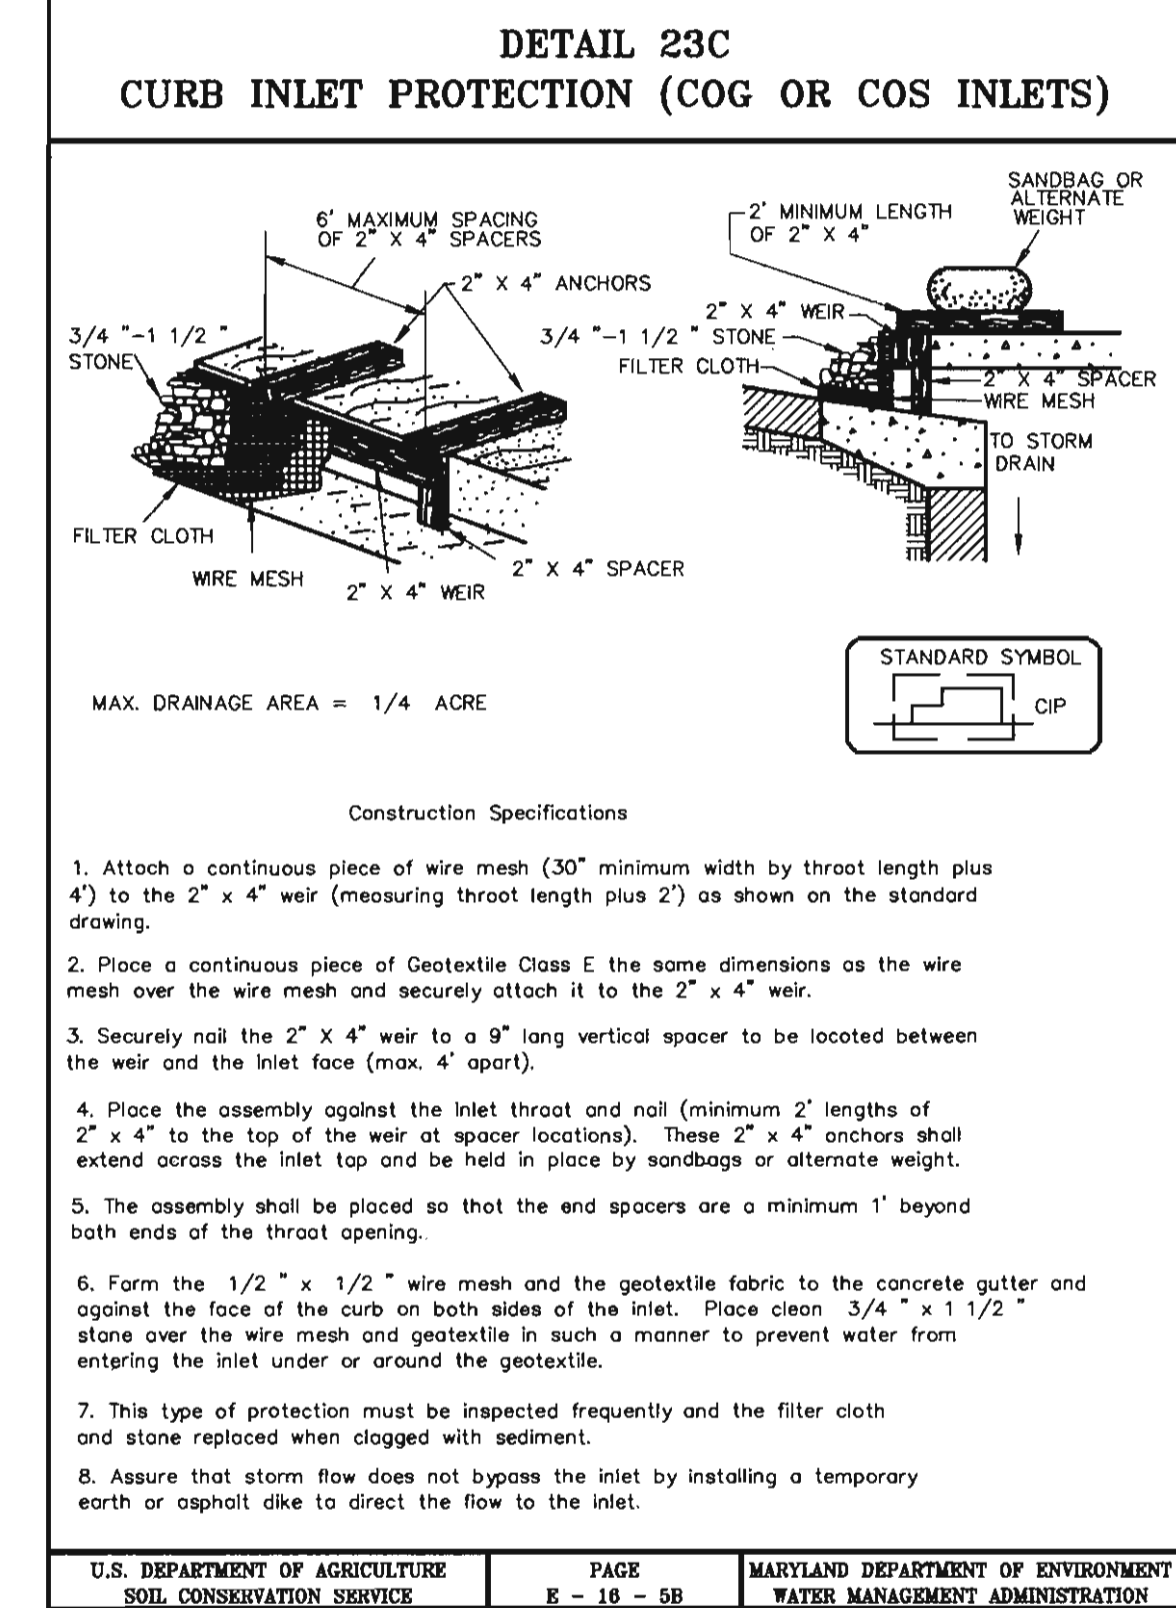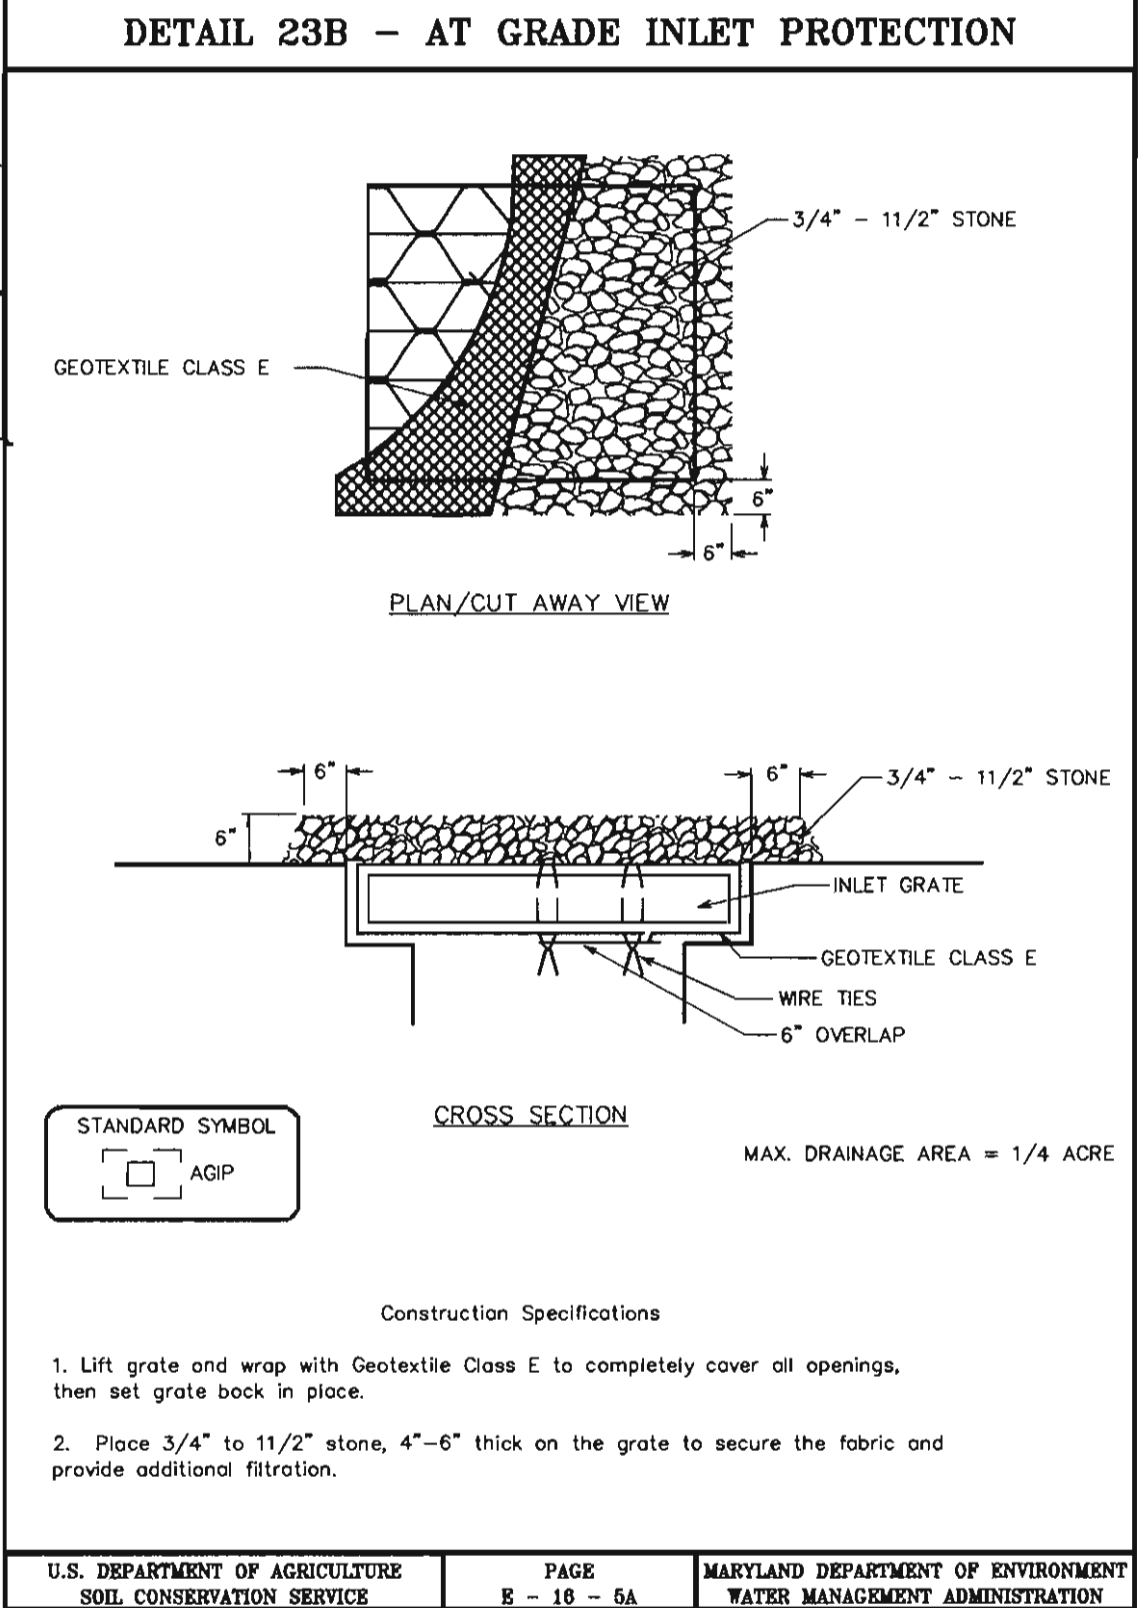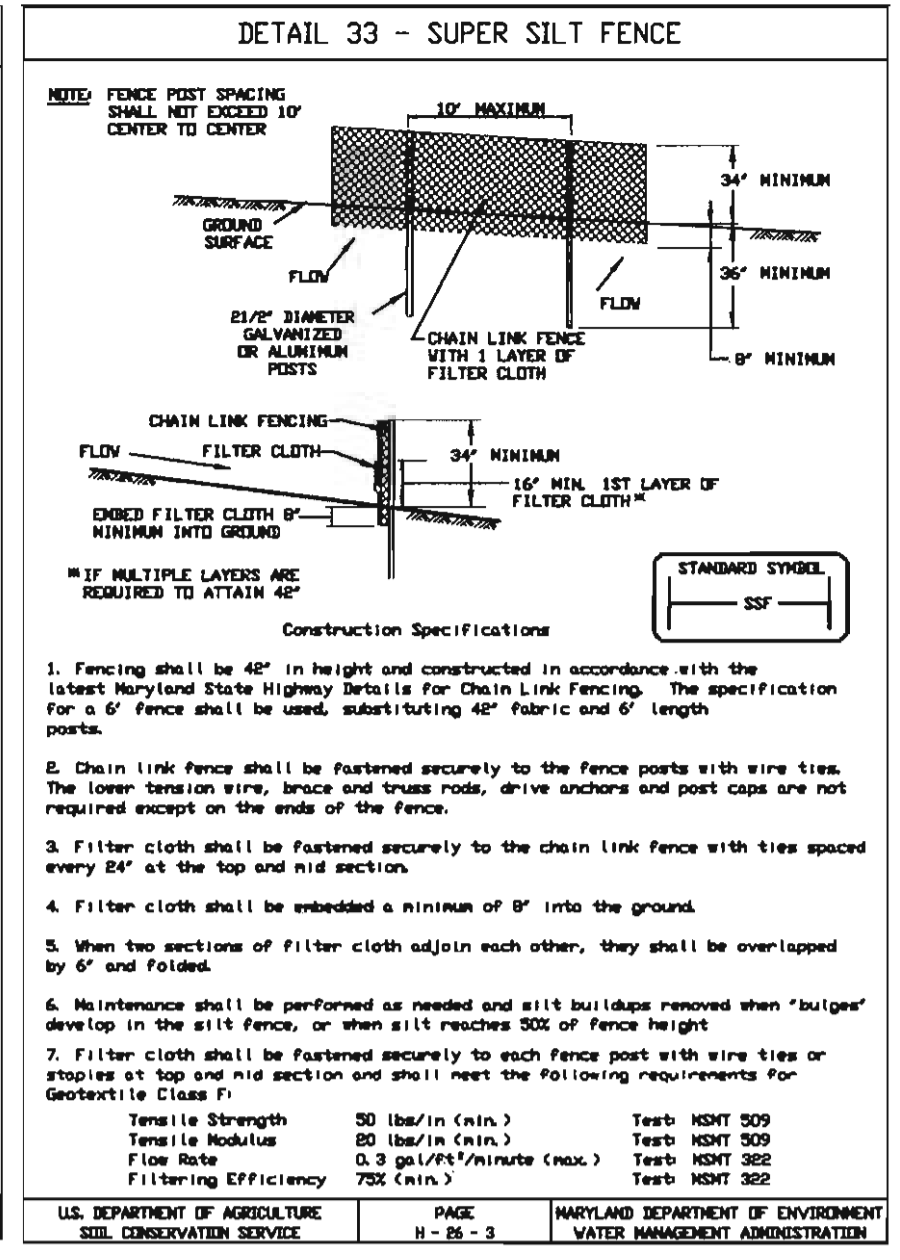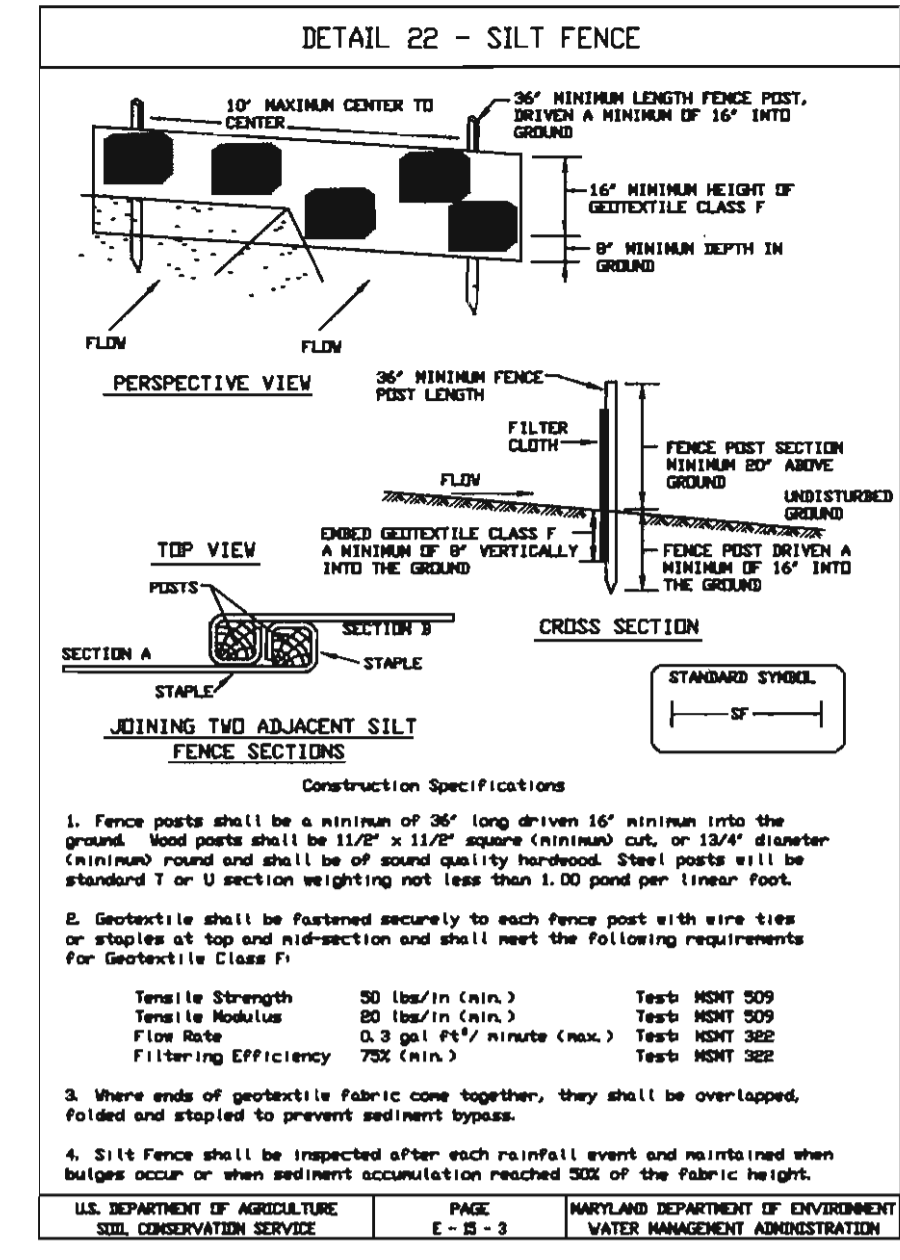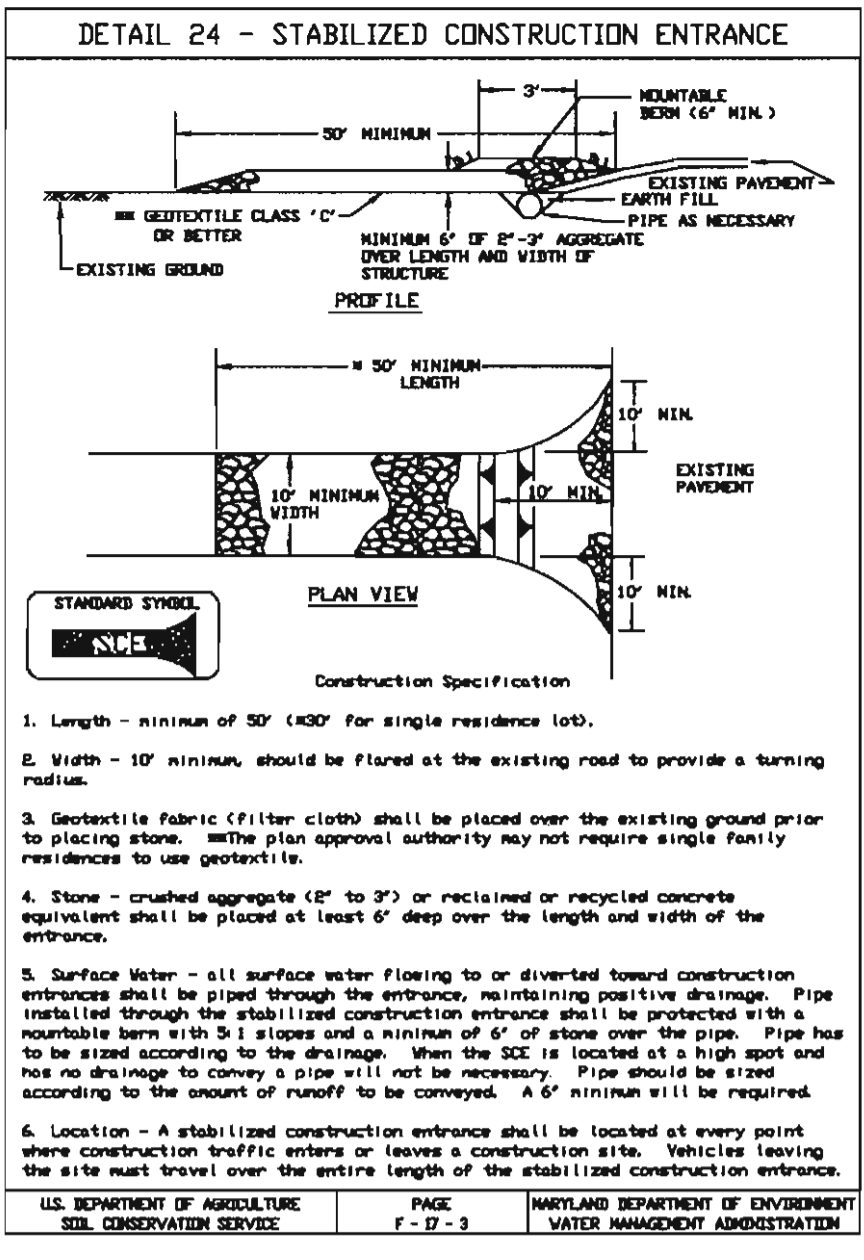

PERMANENT SEEDING NOTES

Apply to graded or cleared area not subject to immediate further disturbance where a permanent long-lived vegetative cover is needed.

Seedbed Preparation: Loosen upper three inches of soil by raking, discing or other acceptable means before seeding (unless previously loosened).

Soil Amendments: In lieu of soil test recommendations, use one of the following schedules:

- Preferred - Apply 2 tons per acre dolomitic limestone (92 lbs/1000 square feet) and 600 lbs per acre 10-10-10 fertilizer (14 lbs/1000 sq ft) before seeding. Harrow or disc into upper three inches of soil. At time of seeding, apply 400 lbs per acre 30-0-0 ureaformal fertilizer (9 lbs/1000 sq ft).
- Acceptable - Apply 2 tons per acre dolomitic limestone (92 lbs/1000 square feet) and 1000 lbs per acre 10-10-10 fertilizer (23 lbs/1000 sq ft) before seeding. Harrow or disc into upper three inches of soil.

Seeding: For the periods March 1 thru April 30, and August 1 thru October 15, seed with 60 lbs per acre (1.4 lbs/1000 sq ft) of Kentucky 31 Tall Fescue. For the period May 1 thru July 31, seed with 60 lbs Kentucky 31 Tall Fescue per acre and 2 lbs per acre (.05 lbs/1000 sq ft) of weeping lovegrass. During the period of October 16 thru February 28, protect site by Option (1) 2 tons per acre of well anchored straw mulch and seed as soon as possible in the spring. Option (2) Use sod. Option (3) Seed with 60 lbs/acre Kentucky 31 Tall Fescue and mulch with 2 tons/acre well anchored straw.

Mulching: Apply 1-1/2 to 2 tons per acre (70 to 90 lbs/1000 sq ft) of unrotted small grain straw immediately after seeding. Anchor mulch immediately after application using mulch anchoring tool or 218 gallons per acre (5 gal/1000 sq ft) of emulsified asphalt on flat areas. On slopes 8 ft or higher, use 348 gallons per acre (8 gal/1000 sq ft) for anchoring.

Maintenance: Inspect all seeded areas and make needed repairs, replacements and reseedings.

TEMPORARY SEEDING NOTES

Apply to graded or cleared areas likely to be redisturbed where a short-term vegetative cover is needed.

Seedbed Preparation: Loosen upper three inches of soil by raking, discing or other acceptable means before seeding (unless previously loosened).

Soil Amendments: Apply 600 lbs per acre 10-10-10 fertilizer (14 lbs/1000 sq ft).

Seeding: For periods March 1 thru April 30 and from August 15 thru October 15, seed with 2-1/2 bushel per acre of annual ryegrass (3.2 lbs/1000 sq ft). For the period May 1 thru August 14, seed with 3 lbs per acre of weeping lovegrass (.07 lbs/1000 sq ft). For the period November 16 thru February 28, protect site by applying 2 tons per acre of well anchored straw mulch and seed as soon as possible in the spring, or use sod.

Mulching: Apply 1-1/2 to 2 tons per acre (70 to 90 lbs/1000 sq ft) of unrotted, weed-free, small grain straw immediately after seeding. Anchor mulch immediately after application using mulch anchoring tool or 218 gal per acre (5 gal/1000 sq ft) of emulsified asphalt on flat areas. On slopes, 8 ft or higher, use 348 gal per acre (8 gal/1000 sq ft) for anchoring.

Refer to the 1994 MARYLAND STANDARDS AND SPECIFICATIONS FOR SOIL EROSION AND SEDIMENT CONTROL for rate and methods not covered.

SEDIMENT CONTROL NOTES

- A minimum of 24 hours notice must be given to the Howard County Office of Inspection and Permits prior to the start of any construction. (410) 313-1855.
- All vegetative and structural practices are to be installed according to the provisions of this plan and are to be in conformance with the 1994 MARYLAND STANDARDS AND SPECIFICATIONS FOR SOIL EROSION AND SEDIMENT CONTROL.
- Following initial soil disturbance or redisturbance, permanent or temporary stabilization shall be completed within: a) 7 calendar days for all perimeter sediment control structures, dikes and perimeter slopes and all slopes greater than 3:1, b) 14 days as to all other disturbed or graded areas on the project site.
- All sediment traps/basins shown must be fenced and warning signs posted around their perimeter in accordance with Vol. 1, Chapter 12, of the HOWARD COUNTY DESIGN MANUAL, Storm Drainage.
- All disturbed areas must be stabilized within the time period specified above in accordance with the 1983 MARYLAND STANDARDS AND SPECIFICATIONS FOR SOIL EROSION AND SEDIMENT CONTROL for permanent seedings, sod, temporary seeding and mulching (Sec. G). Temporary stabilization, with mulch alone, can only be done when recommended seeding dates do not allow for proper germination and establishment of grasses.
- All sediment control structures are to remain in place and are to be maintained in operative condition until permission for their removal has been obtained from the Howard County Sediment Control Inspector.
- Site Analysis:

Total Area of Site	: 3.87 Acres±
Area Disturbed	: 3.50 Acres±
Area to be roofed or paved	: 2.05 Acres±
Area to be vegetatively stabilized	: 1.45 Acres±
Total Cut	: 329 Cu. Yds.
Total Fill	: 8619 Cu. Yds.

 Off-site waste/borrow area location: To be determined
- Any sediment control practice which is disturbed by grading activity for placement of utilities must be repaired on the same day of disturbance.
- Additional sediment control must be provided, if deemed necessary by the Howard County DPW Sediment Control Inspector.
- On all sites with disturbed areas in excess of 2 acres, approval of the inspection agency shall be requested upon completion of installation of perimeter erosion and sediment controls, but before proceeding with any other earth disturbance or grading. Other building or grading inspection approvals may not be authorized until this initial approval by the inspection agency is made.
- Trenches for the construction of utilities is limited to 3 pipe lengths or that which shall be backfilled and stabilized within one working day, whichever is shorter.

SEQUENCE OF CONSTRUCTION

- OBTAIN GRADING PERMIT AND ARRANGE PRE-CONSTRUCTION MEETING WITH SEDIMENT CONTROL INSPECTOR. (1 DAY)
- INSTALL STABILIZED CONSTRUCTION ENTRANCE AND SILT FENCE/SUPER SILT FENCE. (2 DAYS)
- CONSTRUCT THE WATER FROM THE EXISTING STUB AND THE SEWER FROM THE EXISTING MANHOLE TO WITHIN 5 FEET OF THE BUILDING. INSTALL THE STORM DRAIN SYSTEM. (5 DAYS)
- GRADE SITE.
- CONSTRUCT BUILDING.
- FINE GRADE SITE.
- INSTALL CURB AND GUTTER, SIDEWALK, AND BASE PAVING. STABILIZE REMAINING AREAS WITH GRASS, SEED, AND MULCH. (7 DAYS)
- WHEN AREAS DRAINING TO THE SEDIMENT CONTROL DEVICES HAVE BEEN STABILIZED AND PERMISSION IS GRANTED BY THE SEDIMENT CONTROL INSPECTOR, REMOVE SEDIMENT CONTROL DEVICES. (1 WEEK)
- INSTALL SURFACE PAVING. (1 WEEK)
- INSTALL LANDSCAPING. (1 WEEK)
- REMOVE ANY REMAINING SEDIMENT CONTROL DEVICES AND STABILIZE AREAS AS NECESSARY. (3 DAYS)

DEVELOPER'S/BUILDER'S CERTIFICATE

"I/We certify that all development and/or construction will be done according to this plan, and that any responsible personnel involved in the construction project will have a Certificate of Attendance at a Maryland Department of the Environment Approved Training Program for the Control of Sediment and Erosion before beginning the project. I also authorize periodic on-site inspection by the HSCD."

These plans have been reviewed for the Howard Soil Conservation District and meet the technical requirements.

ENGINEER'S CERTIFICATE

"I certify that this plan for erosion and sediment control represents a practical and workable plan based on my personal knowledge of the site conditions and that it was prepared in accordance with the requirements of the Howard Soil Conservation District."



Signature: Roger A. Waesche, Jr.
Senior Vice President of Gateway 67, LLC
Date: 10/28/04

Signature: Jim Meyer
Natural Resources Conservation Service
Date: 11/11/04

This Development Plan is approved for Soil Erosion and Sediment Control by the Howard Soil Conservation District.
Signature: [Illegible]
Date: 11/16/04

APPROVED: HOWARD COUNTY DEPARTMENT OF PLANNING & ZONING
Director: Mark D. Leyle, 10/21/04
Chief, Division of Land Development: Cindy Harvitt, 10/21/04
Chief, Development Engineering Division: [Illegible], 11/22/04

GLWGUTSCHICK LITTLE & WEBER, P.A.
CIVIL ENGINEERS, LAND SURVEYORS, LAND PLANNERS, LANDSCAPE ARCHITECTS
3909 NATIONAL DRIVE - SUITE 250 - BURTONSVILLE OFFICE PARK
BURTONSVILLE, MARYLAND 20866
TEL: 301-421-4024 BAL: 410-880-1820 DC/VA: 301-989-2524 FAX: 301-421-4186

PREPARED FOR:
GATEWAY 67 LLC
8815 CENTRE PARK DRIVE, SUITE 400
COLUMBIA, MD. 21045
PH.: 410-992-7348
ATTN: MR. ROGER WAESCHE



SEDIMENT CONTROL NOTES & DETAILS
COLUMBIA GATEWAY
PARCEL N-13
Plat No. 17094

SCALE	ZONING	G. L. W. FILE NO.
NO SCALE	M-1	04032
DATE	TAX MAP - GRID	SHEET
Sept., 2004	42 - 12	7 OF 10

U.S. DEPARTMENT OF AGRICULTURE SOIL CONSERVATION SERVICE	PAGE 1	MARYLAND DEPARTMENT OF ENVIRONMENT WATER MANAGEMENT ADMINISTRATION	PAGE 1
--	--------	--	--------

PLANT SCHEDULE

TYPE	SYMBOL	QUANT.	NAME (BOTANICAL/COMMON)	SIZE	COMMENTS
CANOPY SHADE TREE	RS	13	ACER RUBRUM 'RED SUNSET' / RED SUNSET RED MAPLE	2.5"-3" CAL.	B4B
	SS	4	ACER RUBRUM 'SCARLET SENTINEL' / SCARLET SENTINEL RED MAPLE	2.5"-3" CAL.	B4B
	P	20	PLATANUS x ACERIFOLIA 'BLOODGOOD' / BLOODGOOD LONDON PLANETREE	2.5"-3" CAL.	B4B
	Q	7	QUERCUS PHELLOS / WILLOW OAK	2.5"-3" CAL.	B4B
EVERGREEN TREE	PS	43	PINUS STROBUS / EASTERN WHITE PINE	10' HT. MIN.	B4B, WITH INTACT CENTRAL LEADER
	PO	27	PICEA OMERIKA / ABIES	10' HT. MIN.	B4B, WITH INTACT CENTRAL LEADER
ORNAMENTAL TREE	MZ	4	MALUS 'ZUMI' / ZUMI CRABAPPLE	2" CAL MIN.	B4B
	PP	11	PURPLE LEAF PLUM	2" CAL MIN.	B4B
	SI	126	COTONEASTER DAMMERII 'CORAL BEAUTY' / CORAL BEAUTY COTONEASTER COTONEASTER HORIZONTALIS 'TOM THUMB' / TOM THUMB COTONEASTER JUNIFERUS HORIZONTALIS VAR. / JUNIFER VAR. 'BAR HARBOR' 'ANDORRA', 'WILTONI BLUE RUG'	ALL 18" - 24" SPREAD	ALL CONTAINERIZED

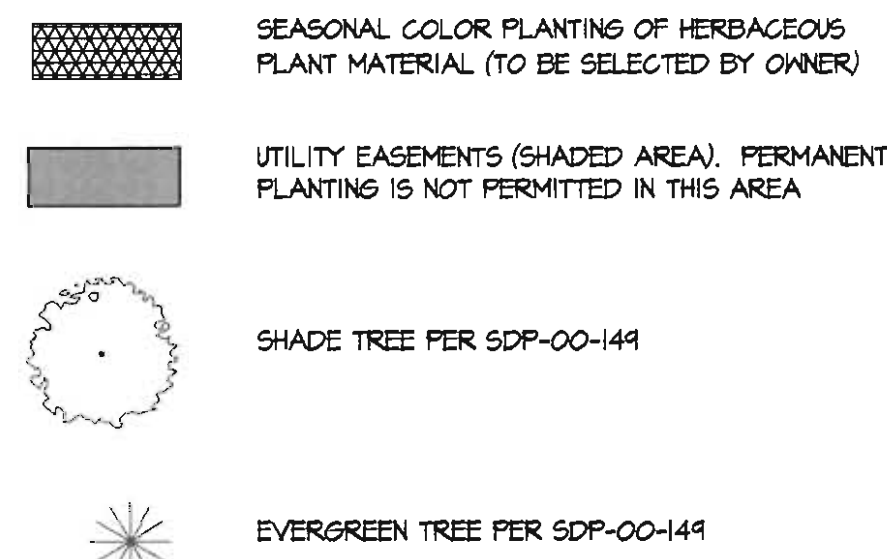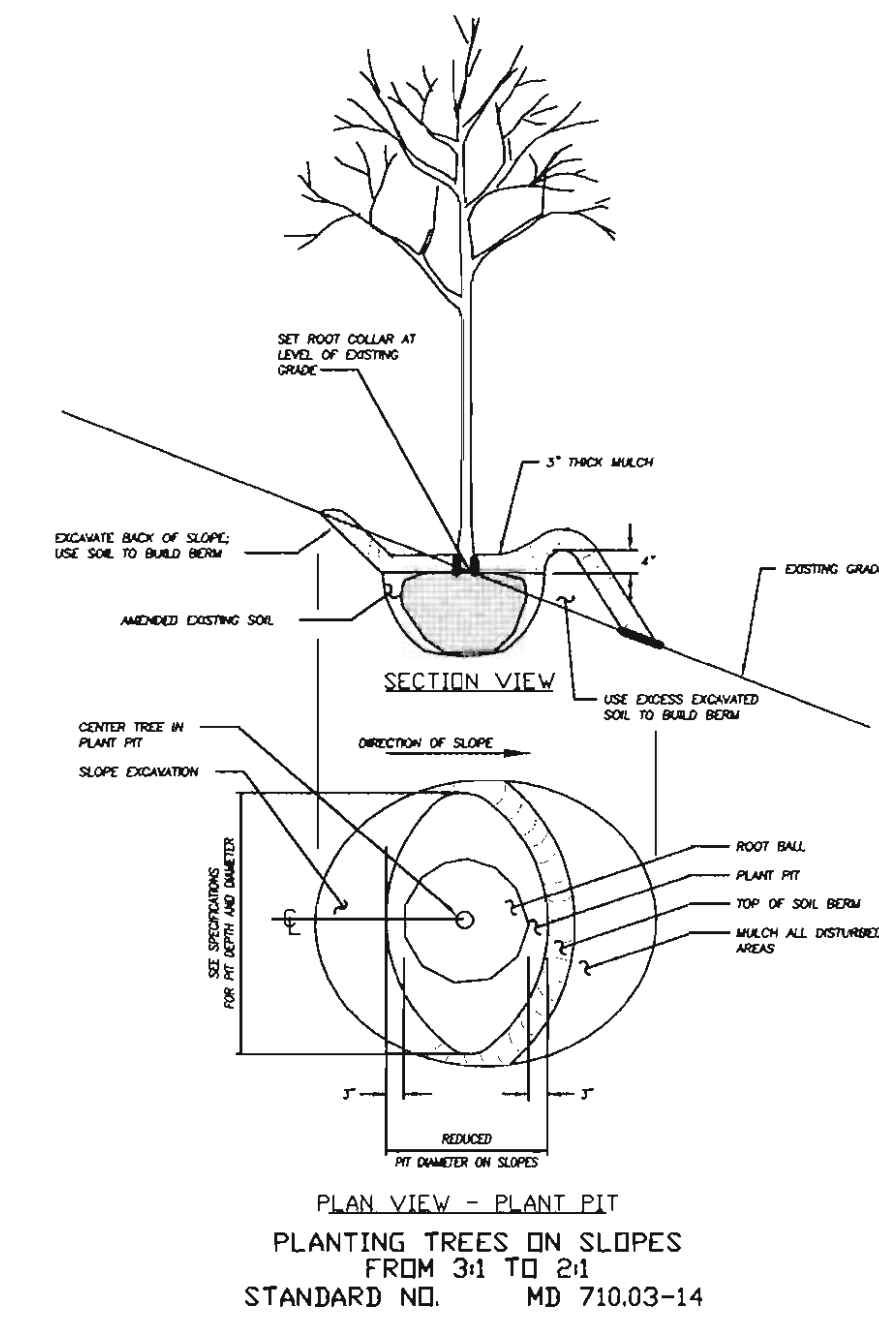

THE OWNER SHALL BE RESPONSIBLE FOR THE RESTORATION OF ANY LANDSCAPING DISTURBED BY STORM DRAIN MAINTENANCE OPERATIONS BY THE DEPARTMENT OF PUBLIC WORKS.

DEVELOPER'S/BUILDER'S CERTIFICATE

I/WE CERTIFY THAT THE LANDSCAPING SHOWN ON THIS PLAN WILL BE DONE ACCORDING TO THE PLAN, SECTION 16.124 OF THE HOWARD COUNTY CODE AND THE HOWARD COUNTY LANDSCAPE MANUAL. I/WE FURTHER CERTIFY THAT UPON COMPLETION A LETTER OF LANDSCAPE INSTALLATION, ACCOMPANIED BY AN EXECUTED ONE YEAR GUARANTEE OF PLANT MATERIALS, WILL BE SUBMITTED TO THE DEPARTMENT OF PLANNING AND ZONING.

Roger A. Waesche, Jr.
NAME: Roger A. Waesche, Jr. DATE: 10/28/04
Senior Vice President of Gutzsche, LLC



APPROVED: HOWARD COUNTY DEPARTMENT OF PLANNING & ZONING

Mark D. Taylor 10/28/04
Director Date

Cynthia Hamrick 10/28/04
Chief, Division of Land Development Date

Michael D. Williams 11/22/04
Chief, Development Engineering Division Date

APPLIANCE PARK EAST
PARCEL 'A-6'
PLAT NO. 7563

APPLIANCE PARK EAST
PARCEL 'A-6'
PLAT NO. 13141
ZONED: M-1

COLUMBIA GATEWAY
LOT 15
PLAT NO. 14341
ZONED: NEH TOWN

GATEWAY COMMERCE CENTER
PARCEL 'A-10'
PLAT NO. 10390
ZONED: NEH TOWN

THIS PLAN IS FOR PLANTING PURPOSES ONLY!

GLWGUTSCHICK LITTLE & WEBER, P.A.
CIVIL ENGINEERS, LAND SURVEYORS, LAND PLANNERS, LANDSCAPE ARCHITECTS
3909 NATIONAL DRIVE - SUITE 250 - BURTONSVILLE OFFICE PARK
BURTONSVILLE, MARYLAND 20866
TEL: 301-421-4024 BALT: 410-880-1820 DC/VA: 301-988-2524 FAX: 301-421-4186

PREPARED FOR:
GATEWAY 67 LLC
8815 CENTRE PARK DRIVE, SUITE 400
COLUMBIA, MD, 21045
PH: 410-992-7348
ATTN: MR. ROGER WAESCHE


LANDSCAPE/PERIMETER PLANTING PLAN
COLUMBIA GATEWAY
PARCEL N-13
Plat No. 17097

SCALE	ZONING	G. L. W. FILE No.
1"=40'	M-1	04032
DATE	TAX MAP - GRID	SHEET
Sept., 2004	42 - 12	8 OF 10

Drawings\04032\SDP\04032SP8.dwg	DES. DEV	DRN. JAU	CHK. DEV	DATE	REVISION	BY	APPR.
---------------------------------	----------	----------	----------	------	----------	----	-------

ELECTION DISTRICT No. 6

HOWARD COUNTY, MARYLAND

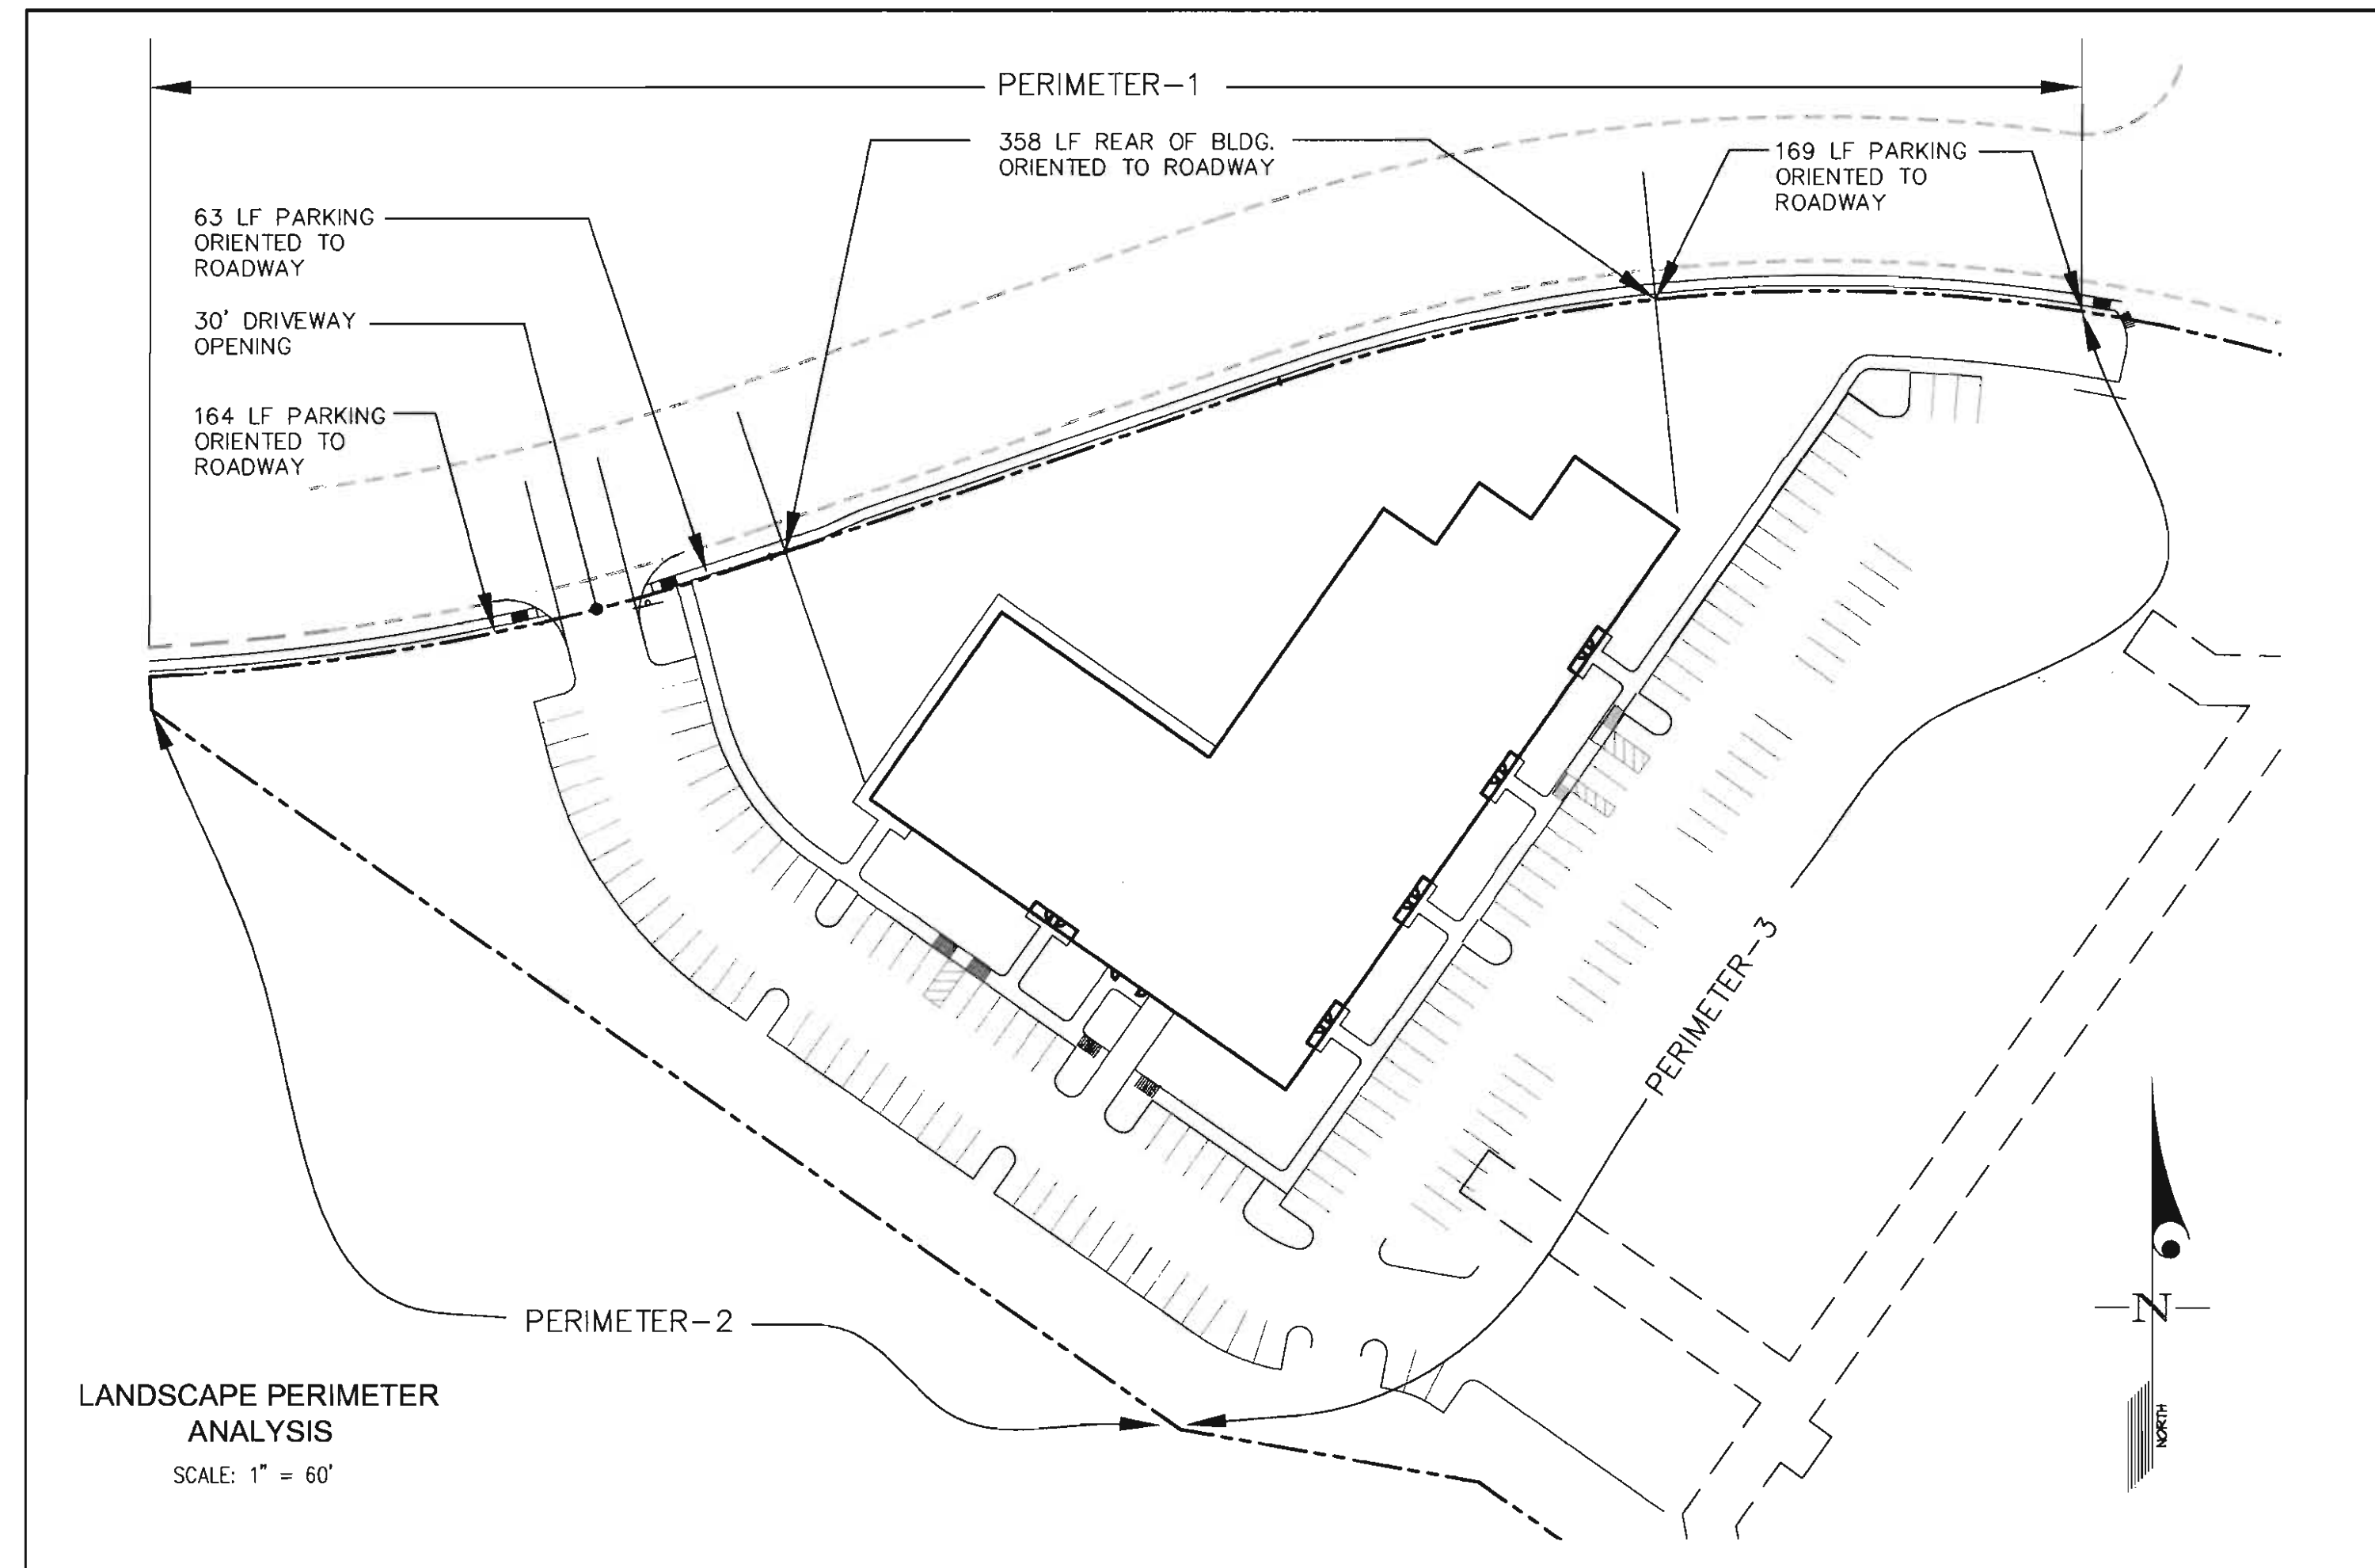

LANDSCAPE PERIMETER ANALYSIS
SCALE: 1" = 60'

LANDSCAPING NOTES

- This plan has been prepared in accordance with Section 16.124 of the Howard County Code and Chapter VI (Alternative Compliance) of the Howard County Landscape Manual.
- Contractor shall notify all utilities at least (5) five days before starting work. All General Notes, especially those regarding utilities, on Sheet 1 shall apply.
- Field verify underground utility locations and existing conditions before starting planting work. Contact engineer / landscape architect if any relocations are required.
- Plant quantities shown on Plant List are provided for the convenience of the contractor only. If discrepancies exist between quantities shown on the plan and those shown on the plant list, the quantities on the plan shall take precedence.
- All plant material shall be full, heavy, well formed, and symmetrical, and conform to the A.A.N. Specifications, and be installed in accordance with project specifications.
- No substitution shall be made without written consent of the owner or his representative.
- All areas disturbed by construction activities but not otherwise planted, paved, or mulched shall be seeded or sodded in accordance with the project specifications.
- The contractor shall notify the owner in writing if he/she encounters soil drainage conditions which may be detrimental to the growth of the plants.
- All exposed earth within limits of planting beds shall be mulched with shredded hardwood mulch per Planting Details.
- Planting is NOT PERMITTED within utility easements.
- The owner, tenant, and/or their agents shall be responsible for maintenance of the required landscaping, including both plant materials and berms, fences and walls. All plant materials shall be maintained in good growing condition, and when necessary, replaced with new materials to ensure continued compliance with applicable regulations. All other required landscaping shall be permanently maintained in good condition, and, when necessary, repaired and replaced.
- "Schedule A - Perimeter Landscape Edge" and "Schedule B - Parking Lot Internal Landscaping" are provided for landscape surety calculation purposes only. Financial surety for the required landscaping shall be posted with the grading permit application in the amount of \$16,470.00 for the following:
 \$ 2,970.00 for 99 shrubs at \$30/shrub
 \$10,500.00 for 36 shade trees at \$300/tree
 \$ 2,700.00 for 18 evergreen trees at \$150/tree
 \$16,470.00 total landscape surety

13. Tabulation for landscape shown:
Required planting by HRD for 3.87 acres of R&D/OFFICE at 24 trees / acre = 93 trees (or equivalent)
Planting provided:
Shade Trees (existing and proposed): 50
Ornamental Trees: 16 = 8 E.S.T. (equivalent shade tree)
Evergreen Trees 70 = 35 E.S.T.
TOTAL EQUIVALENT SHADE TREE = 93

SCHEDULE-A: PERIMETER LANDSCAPE EDGE				
PERIMETER No.	1	2	3	
USE SITUATION	PARKING ADJ. TO ROADWAY	REAR OF BLDG. TO ROADWAY	COMMERCIAL TO COMMERCIAL	INTERNAL PERIMETER
LANDSCAPE TYPE	E	C	A	
LINEAR FEET OF ROADWAY FRONTAGE/PERIMETER	396 LF	358 LF	508	
CREDIT FOR EXISTING VEGETATION	NONE	NONE	NONE	
CREDIT FOR WALL, FENCE OR BERM	NONE	NONE	NONE	
NUMBER OF PLANTS REQUIRED	10	9	9	
SHADE TREES	N/A	18	N/A	
EVERGREEN TREES	99	N/A	N/A	
SHRUBS				
NUMBER OF PLANTS PROVIDED	OVER 10 SHADE TREES, 18 EVERGREEN TREES AND 99 SHRUBS (OR EQUIVALENT SUBSTITUTIONS) ARE PLANTED BY ALTERNATIVE COMPLIANCE	3 SHADE TREES ARE PROVIDED. THE REMAINING 6 SHADE TREES ARE SUBSTITUTED WITH OVER 12 EVERGREEN TREES		

SCHEDULE-B: PARKING LOT INTERNAL LANDSCAPING	
NUMBER OF PARKING SPACES	144
NUMBER OF SHADE TREES REQUIRED (1 PER 10 SPACES FOR RESIDENTIAL, 1 PER 20 SPACES FOR COMMERCIAL)	8
NUMBER OF TREES PROVIDED	14 PARKING LOT ISLANDS ARE PROVIDED. 12 OF THE ISLANDS ARE PLANTED WITH SHADE TREES (11-RS & 1-Q).
SHADE TREES	
OTHER TREES (2:1 SUBSTITUTION)	

PLANT MATERIALS AND PLANTING METHODS

A. Plant Materials

The landscape contractor shall furnish and install and/or dig, ball, burlap and transport all of the plant materials called for on drawings and/or listed in the Plant Schedule.

- Plant Names**
Plant names used in the Plant Schedule shall conform with "Standardized Plant Names," latest edition.
- Plant Standards**
All plant material shall be equal to or better than the requirements of the "USA Standard for Nursery Stock" latest edition, as published by the American Association of Nurserymen (hereafter referred to as AAN Standards). All plants shall be typical of their species and variety, shall have a normal habit of growth and shall be first quality, sound, vigorous, well-branched and with healthy, well-furnished root systems. They shall be free of disease, insect pests and mechanical injuries.
All plants shall be nursery grown and shall have been grown under the same climate conditions as the location of this project for at least two years before planting. Neither heeled-in plants nor plants from cold storage will be accepted.
- Plant Measurements**
All plants shall conform to the measurements specified in the Plant Schedule as approved by the ARC.
 a. Caliper measurements shall be taken six inches (6") above grade for trees under four-inch (4") caliper and twelve (12") above grade for trees four inches (4") in caliper and over.
 b. Minimum branching height for all trees shall be six feet (6'), maximum eight feet (8').
 c. Minimum size for planting shade trees shall be 3-3" caliper, 14'-16' in height.
 d. Minimum size for planting minor or intermediate focus trees (pines, crabapples, etc.) shall be 3-3" caliper, 10'-12' in height.
 e. Minimum size for planting shrubs shall be 18" - 24" spread unless noted otherwise.
 f. Caliper, height, spread and size of ball shall be generally as follows:

CALIPER	HEIGHT	SPREAD	SIZE OF BALL
3" - 3.5"	14' - 16'	6' - 8'	32" diameter
3.5" - 4"	14' - 16'	8' - 10'	36" diameter
4" - 4.5"	16' - 18'	8' - 10'	40" diameter
4.5" - 5"	16' - 17'	10' - 12'	44" diameter
5" - 5.5"	16' - 20'	10' - 12'	48" diameter
5.5" - 6"	18' - 20'	12' - 14'	52" diameter

All plant material shall generally average the median for the size ranges indicated above as indicated in the "AAN Standards".

4. Plant Identification

Legible labels shall be attached to all shade trees, minor trees, specimen shrubs and bundles or boxes of other plant material giving the botanical and common names, size and quantity of each. Each shipment of plants shall bear certificates of inspection as required by Federal, State and County authorities.

5. Plant Inspection

The ARC may, upon request by the builder or developer, at least ten (10) days prior to the installation of any proposed plant material, inspect all proposed plant material at the source of origin.

B. Planting Methods

All proposed plant materials that meet the specifications in Section A are to be planted in accordance with the following methods during the proper planting seasons as described in the following:

- Planting Seasons**
The planting of deciduous trees, shrubs and vines shall be from March 1st to June 15th and from September 15th to December 15th. Planting of deciduous material may be continued during the winter months providing there is no frost in the ground and frost-free topsoil planting mixtures are used.
The planting of evergreen material shall be from March 15th to June 15th and from August 15th to December 1st. No planting shall be done when ground is frozen or excessively moist. No frozen or wet topsoil shall be used at any time.
- Digging**
All plant material shall be dug, balled and burlapped (B&B) in accordance with the "AAN Standards".
- Excavation of Plant Pits**
The landscape contractor shall excavate all plant pits, vine pits, hedge trenches and shrub beds in accordance with the following schedule:
 a. Locations of all proposed plant material shall be staked and approved in the field by the landscape architect before any of the proposed plant material is installed by the landscape contractor.
 b. All pits shall be generally circular in outline, vertical sides; depth shall not be less than 6" deeper than the root ball, diameter shall not be less than two times the diameter of the root ball as set forth in the following schedule.

c. If areas are designated as shrub beds or hedge trenches, they shall be excavated to at least 18" depth minimum. Areas designated for ground covers and vines shall be excavated to at least 12" in depth minimum.

PLANT SIZE	ROOT BALL	PIT DIAMETER	PIT DEPTH
3" - 3.5" cal.	32"	64"	28"
3.5" - 4" cal.	36"	72"	32"
4" - 4.5" cal.	40"	80"	36"
4.5" - 5" cal.	44"	88"	40"
5" - 5.5" cal.	48"	96"	44"
5.5" - 6" cal.	52"	104"	48"

A 20% compaction figure of the soil to be removed is assumed and will be allowed in calculation of extra topsoil. The tabulated pit sizes are for purposes of uniform calculation and shall not override the specified depths below the bottoms of the root balls.

4. Staking, Guying and Wrapping

All plant material shall be staked or guyed, and wrapped in accordance with the following specifications:

- Stakes: Shall be sound wood 2" x 2" rough sawn oak or similar durable woods, or lengths, minimum 7'-0" for major trees and 5'-0" minimum for minor trees.
- Wire and Cable: Wire shall be #10 galvanized or bethonized annealed steel wire. For trees over 3" caliper, provide 5/16" turn buckles, eye and eye with 4" take-up. For trees over 5" caliper, provide 3/16", 7 strand cable coium plated steel, with galvanized "eye" thimbles of wire and hose on trees up to 3" in caliper.
- Hose: Shall be new, 2 ply reinforced rubber hose, minimum 1/2" I.D. "Plastic Lock Ties" or "Paul's Trees Braces" may be used in place of wire and hose on trees up to 3" in caliper.
- All trees under 3" in caliper are to be planted and staked in accordance with the attached "Typical Tree Staking Detail". All trees over 3" in caliper are to be planted and guyed in accordance with the attached "Typical Tree Guying Detail".

5. Plant Pruning, Edging and Mulching

a. Each tree, shrub or vine shall be pruned in an appropriate manner to its particular requirements, in accordance with accepted standard practices. Broken or bruised branches shall be removed with clean cuts flush with the adjacent trunk or branches. All cuts over 1" in diameter shall be painted with an approved antiseptic tree wound dressing.

6. Plant Inspection and Acceptance

The ARC shall be responsible for inspecting all planting projects on a periodic basis to assure that all work is proceeding in accordance with the approved plans and specifications.

7. Plant Guarantee

All plant material shall be guaranteed for the duration of one full growing season, after final inspection and acceptance of the work in the planting project. Plants shall be alive and in satisfactory growing condition at the end of the guarantee period.


a. For this purpose, the "growing season" shall be that period between the end of the "Spring" planting season, and the commencement of the "Fall" planting season.

b. Guarantee for planting performed after the specified end of the "Spring" planting season, shall be extended through the end of the next following "Spring" planting season.


Sodding

All sodding shall be in accordance to the "Landscape Specification Guidelines for Baltimore-Washington Metropolitan Areas" latest edition, approved by Landscape Contractors Association of Metropolitan Washington and the American Society of Landscape Architects.


All sod shall be strongly rooted sod, not less than two years old and free of weeds and undesirable native grasses. Provide only sod capable of growth development when planted and in strips not more than 18" wide x 4" long. Provide sod composed or principally of improved strain Kentucky bluegrass, such as, Columbia, Victa, or Escort.

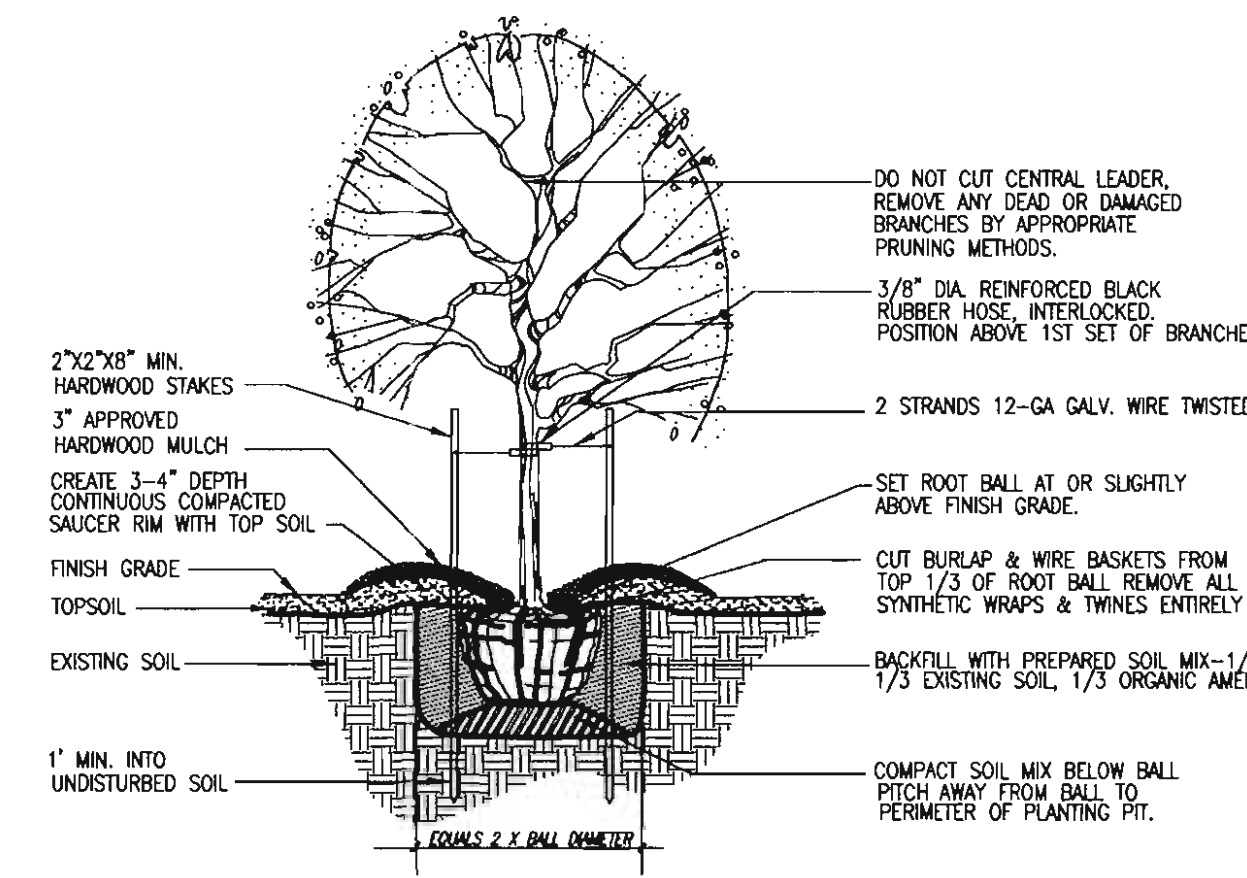


DECIDUOUS TREE PLANTING DETAIL
FOR PLANTING MATERIAL UP TO 3 1/2" CALIPER
N/S

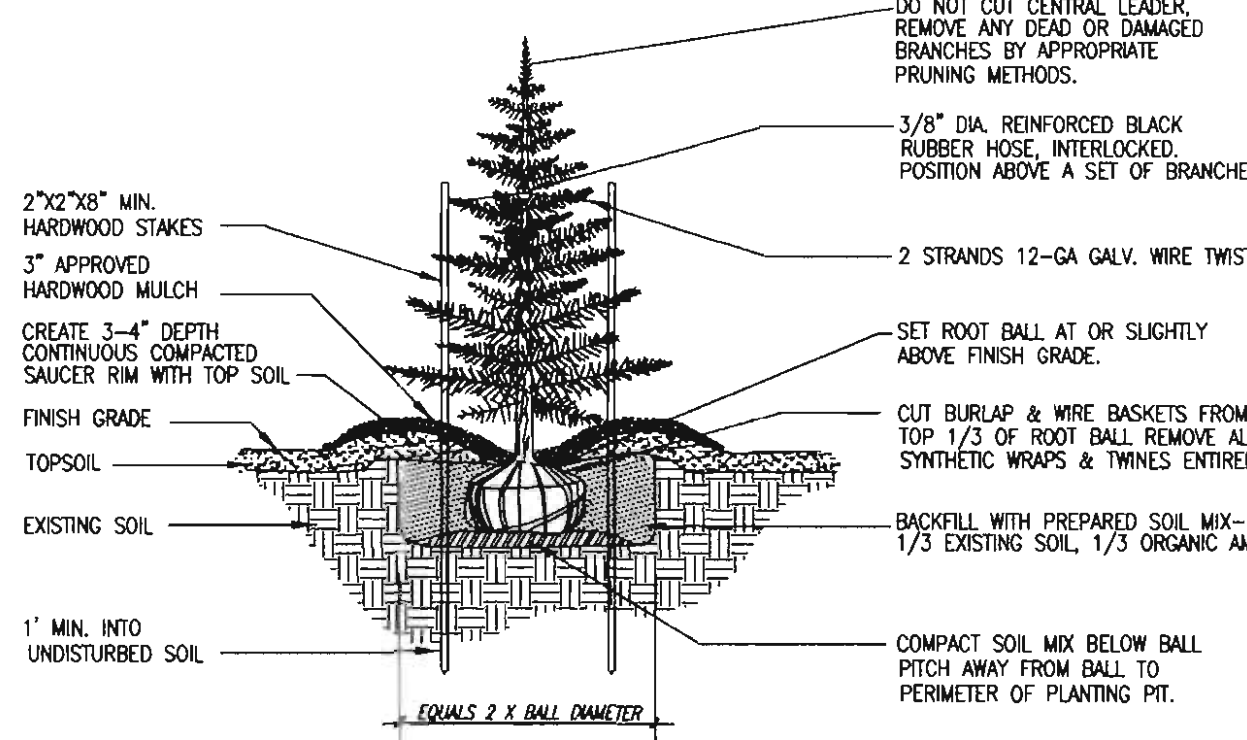

EVERGREEN TREE PLANTING DETAIL
N/S

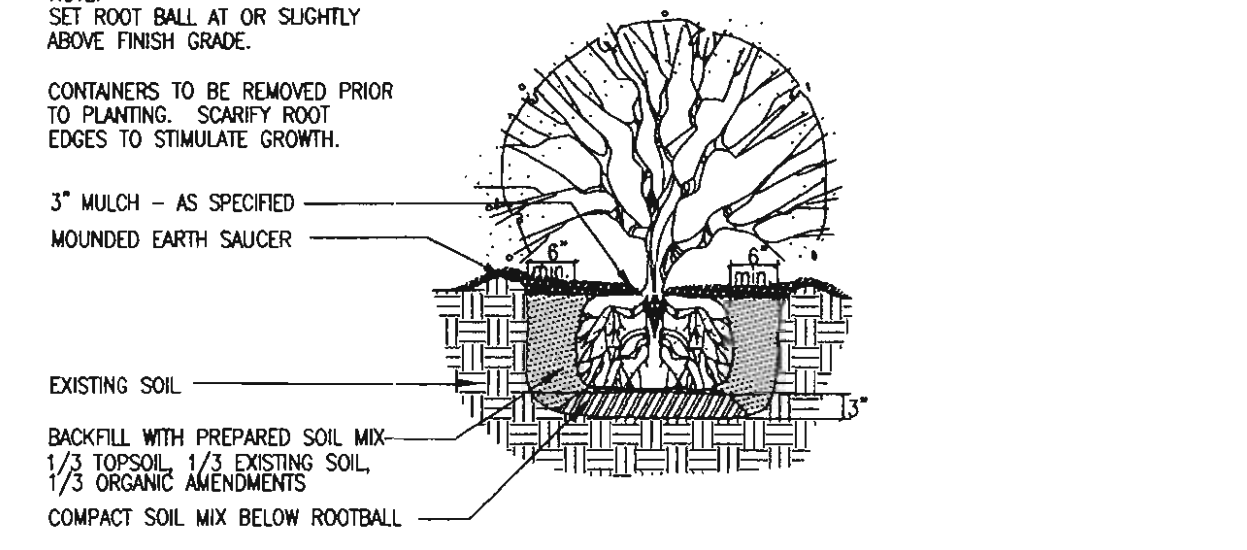

SHRUB PLANTING DETAIL
N/S

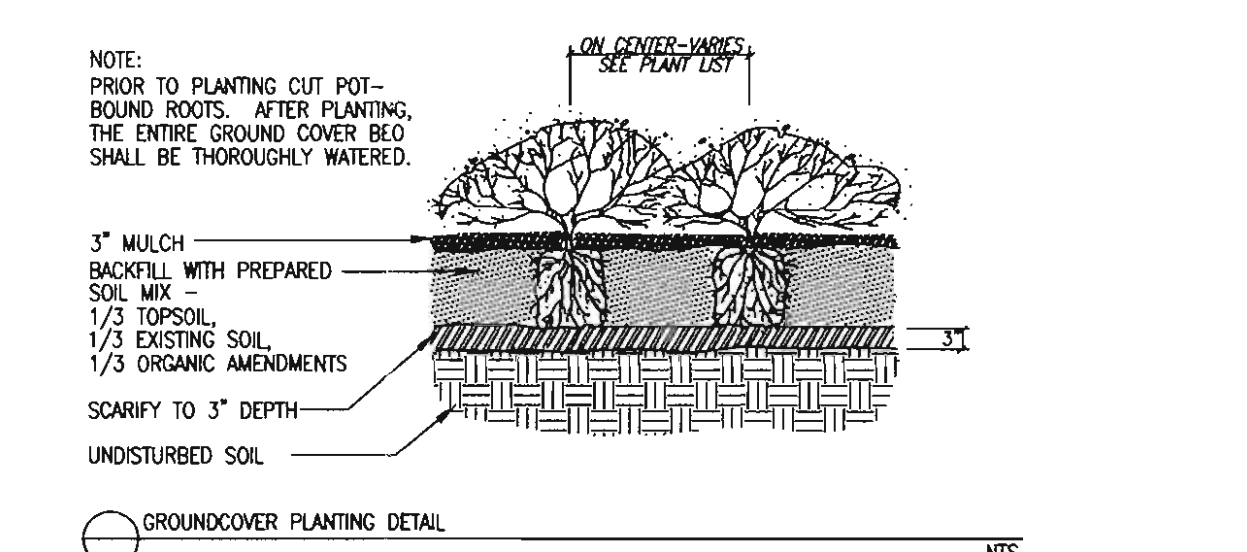

GROUNDCOVER PLANTING DETAIL
N/S

APPROVED: HOWARD COUNTY DEPARTMENT OF PLANNING & ZONING
 Director: [Signature] Date: 12/3/04
 Chief, Division of Land Development: [Signature] Date: 12/3/04
 Chief, Development Engineering Division: [Signature] Date: 11/22/04

GLWGUTSCHICK LITTLE & WEBER, P.A.
 CIVIL ENGINEERS, LAND SURVEYORS, LAND PLANNERS, LANDSCAPE ARCHITECTS
 3909 NATIONAL DRIVE - SUITE 250 - BURTONTOWN OFFICE PARK
 BURTONTOWN, MARYLAND, 20866
 TEL: 301-421-4024 BNL: 410-989-1820 DLK: 301-989-2524 FAX: 301-421-4196

DATE	REVISION	BY	APPR.

PREPARED FOR:
 GATEWAY 67 LLC
 8815 CENTRE PARK DRIVE, SUITE 400
 COLUMBIA, MD. 21045
 PH.: 410-992-7348
 ATTN: MR. ROGER WAESCHE

LANDSCAPE NOTES, DETAILS, PLANT LIST & SCHEDULES
COLUMBIA GATEWAY
PARCEL N-13
 Plat No. 17094


SCALE	ZONING	G. L. W. FILE No.
NO SCALE	M-1	04032
DATE	TAX MAP - GRID	SHEET
Sept., 2004	42 - 12	9 OF 10

PAVEMENT MARKING NOTES

1. ALL PAVEMENT MARKINGS TO BE APPLIED USING "SETFAST PREMIUM ALKYD TRAFFIC PAINT" BY SHERWIN WILLIAMS OR APPROVED EQUAL.
2. EXISTING PAVEMENT MARKINGS THAT ARE IN CONFLICT WITH THE PROPOSED PAVEMENT MARKINGS FOR THIS CONTRACT WILL BE REMOVED BY THE CONTRACTOR BY ANY METHOD WHICH IS APPROVED BY THE COUNTY INSPECTOR.

- (A) - PAVEMENT LINES - 4" X 10' WHITE SKIP
- (B) - PAVEMENT SYMBOL - LEFT TURN/RIGHT TURN ARROW
- (C) - PAVEMENT LINES - 4" SOLID YELLOW

FINAL STRIPING IS SHOWN HEREON. CONTRACTOR SHALL INSPECT EXISTING STRIPING PATTERNS TO DETERMINE CHANGES REQUIRED TO IMPLEMENT THIS PLAN.

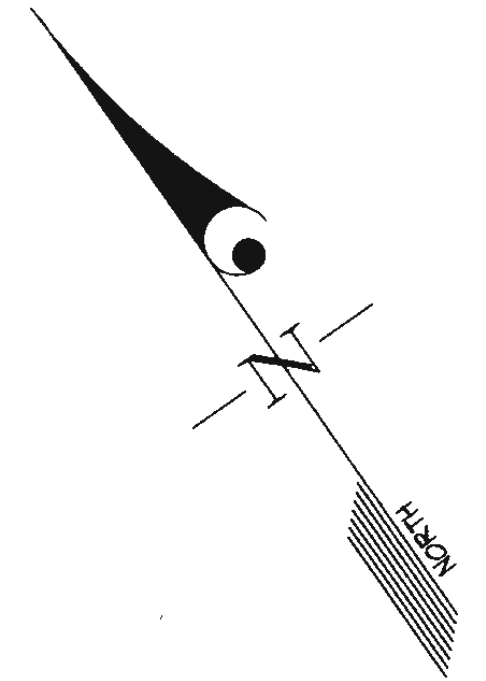

ROBERT FULTON DRIVE
(PARALLEL WITH RW - 100' WIDE)
 (PLANT 100' EMB 1 (2000))

- (A) - Pavement Lines 4"x10' White Skip (TYP)
- (B) - Pavement Left Turn/Right Turn Arrow (TYP)
- (C) - Pavement Lines 4" Solid Yellow (TYP)



APPROVED: HOWARD COUNTY DEPARTMENT OF PLANNING & ZONING

Mark D. Doyle 12/2/07
 Director Date

Cindy Harshbarger 12/2/07
 Chief, Division of Land Development Date

[Signature] 11/22/07
 Chief, Development Engineering Division MK Date

GLWGUTSCHICK LITTLE & WEBER, P.A.
 CIVIL ENGINEERS, LAND SURVEYORS, LAND PLANNERS, LANDSCAPE ARCHITECTS
 3909 NATIONAL DRIVE - SUITE 250 - BURTONSVILLE OFFICE PARK
 BURTONSVILLE, MARYLAND 20866
 TEL: 301-421-4024 BAL: 410-880-1820 DC/VA: 301-989-2524 FAX: 301-421-4186

PREPARED FOR:
 GATEWAY 67 LLC
 8815 CENTRE PARK DRIVE, SUITE 400
 COLUMBIA, MD. 21045
 PH.: 410-992-7348
 ATTN: MR. ROGER WAESCHE

STRIPING PLAN
COLUMBIA GATEWAY
PARCEL N-13
 Plat No. 17094

SCALE	ZONING	G. L. W. FILE No.
1"=40'	M-1	04032
DATE	TAX MAP - GRID	SHEET
Sept., 2004	42 - 12	10 OF 10

DES. DEV	DRN. JAU	CHK. DEV	DATE	REVISION	BY	APPR.

ELECTION DISTRICT No. 6

HOWARD COUNTY, MARYLAND

I:\Drawings\04032\SDP\04032SP10.dwg 10/26/2007 11:07:20 AM LUT


General Notes

- All construction shall be in accordance with the latest standards and specifications of Howard County plus MSHA standards and specifications if applicable.
- The contractor shall notify the Department of Public Works, Bureau of Engineering/Construction Inspection Division at (410) 315-1980 at least 48 hours prior to the start of work.
- The contractor shall notify "Miss Utility" at 1-800-251-TTTT at least 48 hours prior to any excavation work.
- The contractor shall notify the Howard County Department of Public Works, Bureau of Utilities at (410) 315-4900 at least five (5) working days prior to starting any excavation work.
- Traffic control devices, markings and signing shall be in accordance with the latest edition of the Manual of Uniform Traffic Control Devices (MUTCD). All street and regulatory signs shall be in place before the placement of any asphalt.
- Proposed Use: Office (1 story - no mezzanines)
- All plan dimensions are to face of curb or face of building unless otherwise noted. Dimensions are measured perpendicular or radially between items unless otherwise noted.
- Existing topography is shown per field run survey information by Gutschick, Little & Weber, P.A. in March, 2004 & from design plans for construction.
- Coordinates and bearings are based upon the Howard County Geodetic Control which is based upon the Maryland State Plane Coordinate System. Howard County Monument Nos. 2243002 and 2243003 were used for this project.
- Water and sewer service is public.
- All existing water and sewer is per Contract 24-1440-D, 24-1587-D & 20-1347-D
- All existing public storm drain is per F-87-63 & F-86-128.
- See trench bedding class "C" for storm drains.
- Recording reference: Plat No. 17094
- Existing utilities are based on approved design plans for construction and field location by Gutschick, Little & Weber, P.A.
- There is no floodplain on site.
- There are no streams, wetlands, or steep slopes on the site.
- Building setbacks and building restrictions are per Plat No. 14298
- This site is exempt from the Forest Conservation requirements of Section 16.1200 of the Howard County Code by Section 16.1202(b)(1)(iv).
- In case of discrepancies between the plat and the plans, the plat shall govern.
- No clearing, grading or construction is permitted within any wetland, wetlands buffer, 50' stream buffer or floodplain.
- All outdoor lighting shall comply with the requirements of zoning section 134. See sheet 3 Lighting Fixture Schedule.
- The Landscape Plan was prepared according to the Alternative Compliance Section of the Landscape Manual.
- Stormwater Management, for quality and quantity, is being provided in a regional facility, which was constructed under F-41-48. An Amendment to the Stormwater Management Report for Columbia Gateway was prepared under F-00-74. This Amendment indicates that the regional facility satisfies the Stormwater Management needs for this parcel.
- There are no known cemeteries, grave sites or historic structures located on the subject property.
- There are no scenic roads within or adjacent to the subject property.
- Because this plan submission is non-residential use, a noise study is not required.
- Building will have automatic fire protection sprinkler system.
- All curb radii are 5' R, unless otherwise noted.
- This site is subject to a 10' parking and fence setback.
- A shared parking easement for Parcels N-4 through N-11 has been recorded in the Land Records of Howard County, Maryland in Liber 5182 Folio 273.

SITE DEVELOPMENT PLAN


COLUMBIA GATEWAY

PARCEL N-13

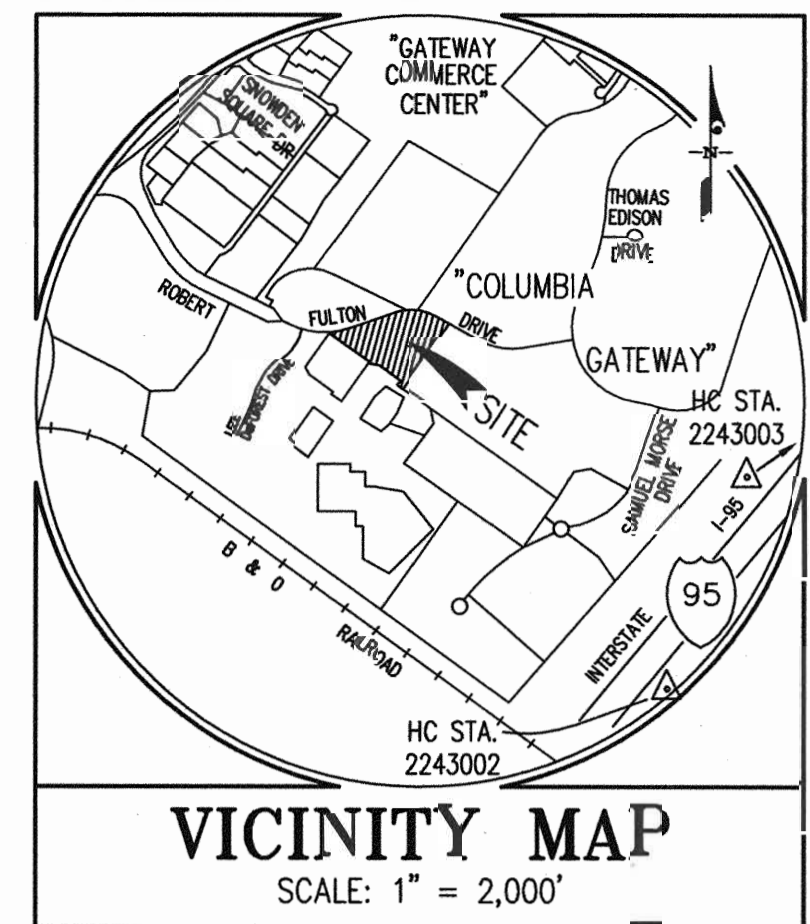

VICINITY MAP
SCALE: 1" = 2,000'

BENCHMARKS
2243002 ELEV. = xxx.xx
STANDARD DISC ON CONCRETE MONUMENT
2243003 ELEV. = xxx.xx
STANDARD DISC ON CONCRETE MONUMENT

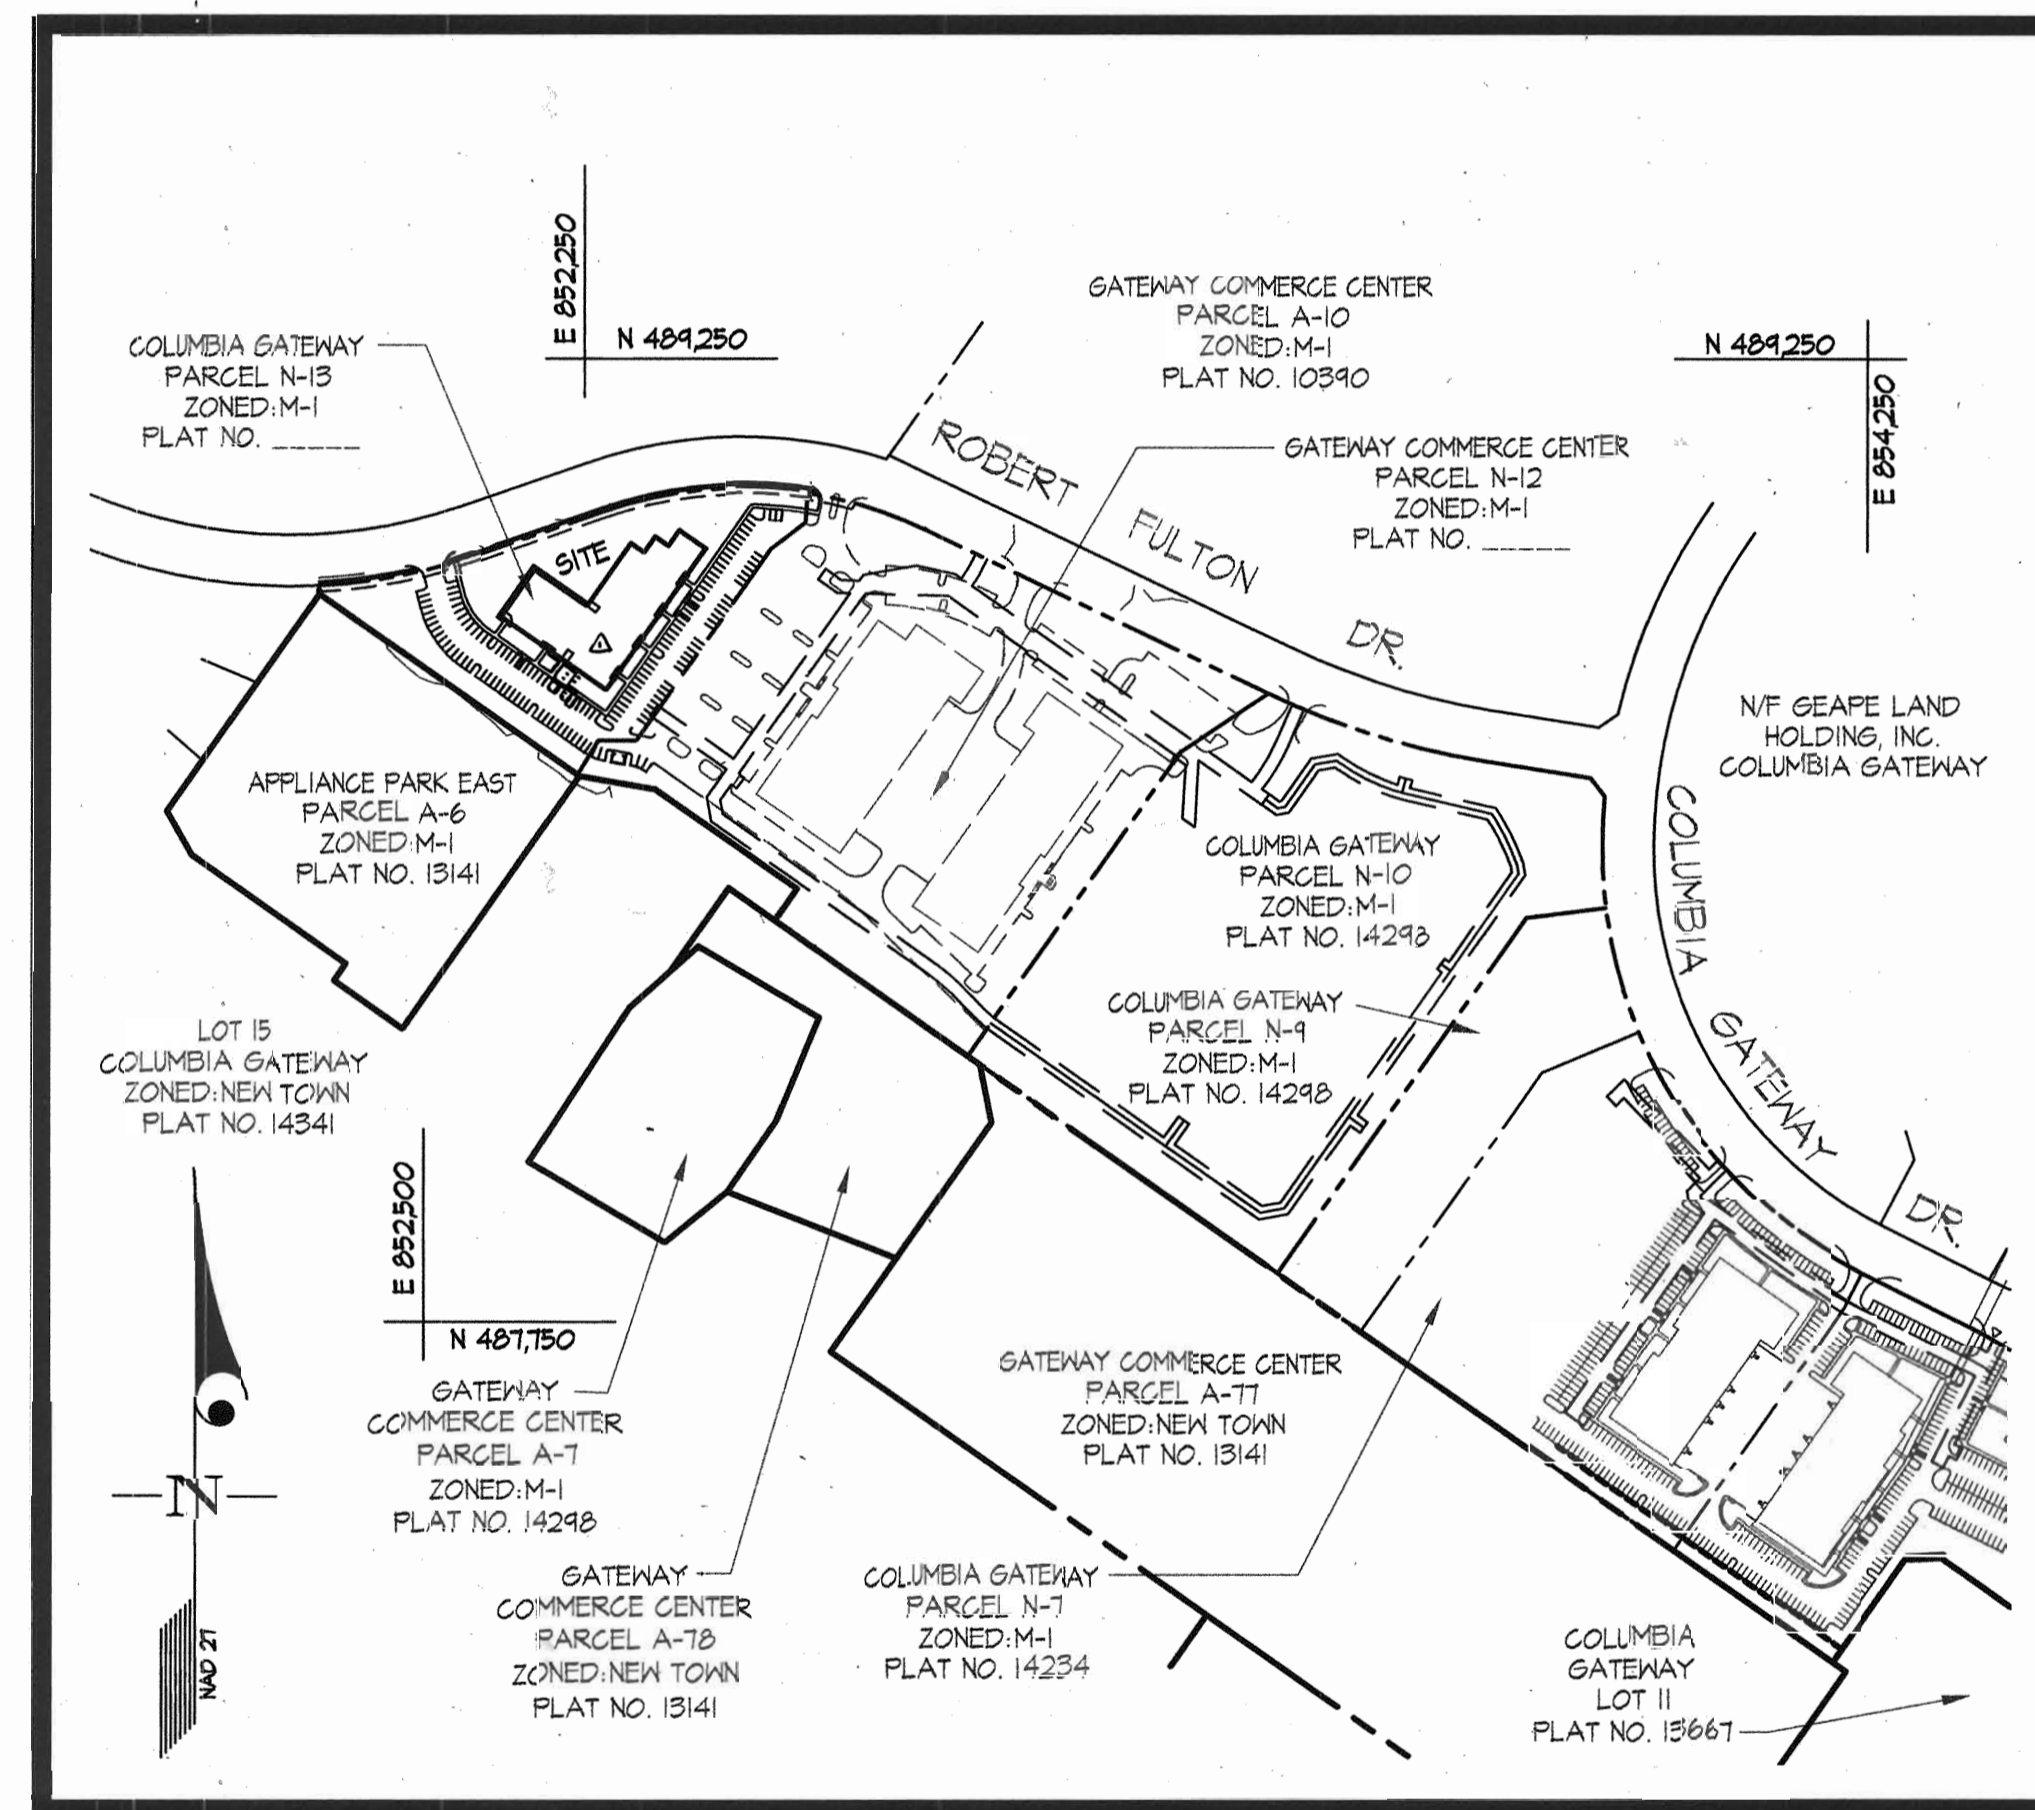

KEY MAP

SCALE: 1" = 300'

LEGEND

- 366 --- EX. CONTOUR
- 300 --- PROP. CONTOUR
- (+) EX. TREES
- EX. STORM DRAIN
- PROP. STORM DRAIN
- LIMIT OF SUBMISSION
- 8" S --- 8" S EX. SANITARY SEWER
- PROP. 8" S --- EX. WATERLINE
- PROP. SANITARY SEWER
- PROPOSED WATERLINE
- EX. CURB & GUTTER
- CONCRETE CURB & GUTTER
- PROPOSED REVERSE CURB & GUTTER
- CONCRETE SIDEWALK
- DUMPSTER OR UTILITY PAD
- EX. EASEMENTS
- x 78.88 TOP OF PAVING SPOT SHOT
- (6) NUMBER OF PARKING SPACES
- PROP. LIGHT FIXTURE & POLE
- EX. LIGHT FIXTURE & POLE
- HANDICAP CURB RAMP (SEE DETAIL SHEET 3)
- ENTRANCE

Site Analysis Data Chart

- Gross Area Parcel N-13: 168,880 SF or 3.87 Ac.
- Limit of Disturbed Area = 152,460 SF or 3.50 Ac.
- Zoning: M-1
- Proposed Use: 1 story office, light manufacturing, and accessory retail building
- Gross Floor Area: 32,850 SF
- No. of standard parking spaces required: 112 spaces
- No. of handicap spaces required: 6 spaces (2 van space).
- No. of standard parking spaces provided: 144 spaces.
- No. of handicap spaces provided: 6 spaces (4 van spaces).
- Total parking spaces provided: 150 spaces.
- Building Percent Coverage: 32,850/168,880 = 19.5%
- Project background: See Dept. of Planning & Zoning File Numbers: P-86-22, S-84-44, F-85-55, F-85-65, F-86-17, F-86-63, F-86-182, F-87-46, F-88-41, F-88-175, F-91-16, F-92-15, F-91-48, F-91-156, F-00-11 & 6P-01-24, F-05-26, F-00-148, F-00-160.

Gross Floor Area: 32,850 s.f.
Light Manufacturing / office: 30,850 s.f.
Accessory Retail: 2,000 s.f.

Parking Requirements:
For Light Manufacturing / office (@ 3.3 space per 1000 s.f.): 102 spaces
For Accessory Retail (@ 5.0 space per 1000 s.f.): 10 spaces
112 spaces

Sheet Index

- Cover Sheet
- Site Development Plan
- Site Details & Paving Plan
- Site & Handicap Accessibility Details
- Storm Drain/Utility Profiles
- Sediment Control Plan/Drainage Area Map
- Sediment Control Notes & Details
- Landscape/Perimeter Planting Plan
- Landscape Notes, Details, Plant List & Schedules
- Striping Plan

APPROVED: HOWARD COUNTY DEPARTMENT OF PLANNING & ZONING
 Director: *Frank J. Eagle* 12/3/04
 Chief, Division of Land Development: *Conrad Hamrick* 12/3/04
 Chief, Development Engineering Division: *MK* 11/22/04



GLWGUTSCHICK LITTLE & WEBER, P.A.
 CIVIL ENGINEERS, LAND SURVEYORS, LAND PLANNERS, LANDSCAPE ARCHITECTS
 3909 NATIONAL DRIVE - SUITE 250 - BURTONSVILLE OFFICE PARK
 BURTONSVILLE, MARYLAND 20866
 TEL: 301-421-4024 BALT: 410-150-1820 DC/VA: 301-989-2524 FAX: 301-421-4186

DES. DEV	DRN. JAU	CHK. DEV	DATE	REVISION	BY	APPR
				Show 2000 sf accessory retail, new sprinkler room & door locations. Revised required parking accordingly.	JNG	


PREPARED FOR:
 GATEWAY 67 LLC
 8815 CENTRE PARK DRIVE, SUITE 400
 COLUMBIA, MD. 21045
 PH.: 410-992-7348
 ATTN: MR. ROGER WAESCHE

COVER SHEET
 COLUMBIA GATEWAY
 PARCEL N-13
 Plat No. 17094

ADDRESS CHART					
PARCEL NUMBER	STREET ADDRESS				
N-13	8681 ROBERT FULTON DRIVE				
SUBDIVISION NAME:		SECTION/AREA	PARCELS P/O P 670		
COLUMBIA GATEWAY					
PLAT No.	ZONE	TAX MAP	BLOCK	ELEC. DIST.	CENSUS TRACT
17094	M-1	42	11	6	6067.03
SCALE		ZONING	G. L. W. FILE No.		
AS SHOWN		M-1	04032		
DATE		TAX MAP - GRID	SHEET		
Sept., 2004		42 - 12	1 OF 10		


ELECTION DISTRICT No. 6

HOWARD COUNTY, MARYLAND

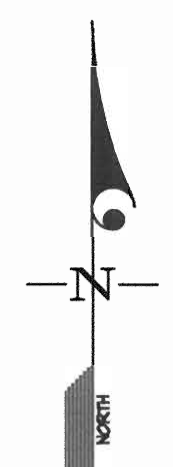



LEGEND

	P-1 PAVING
	P-2 PAVING
	CONCRETE

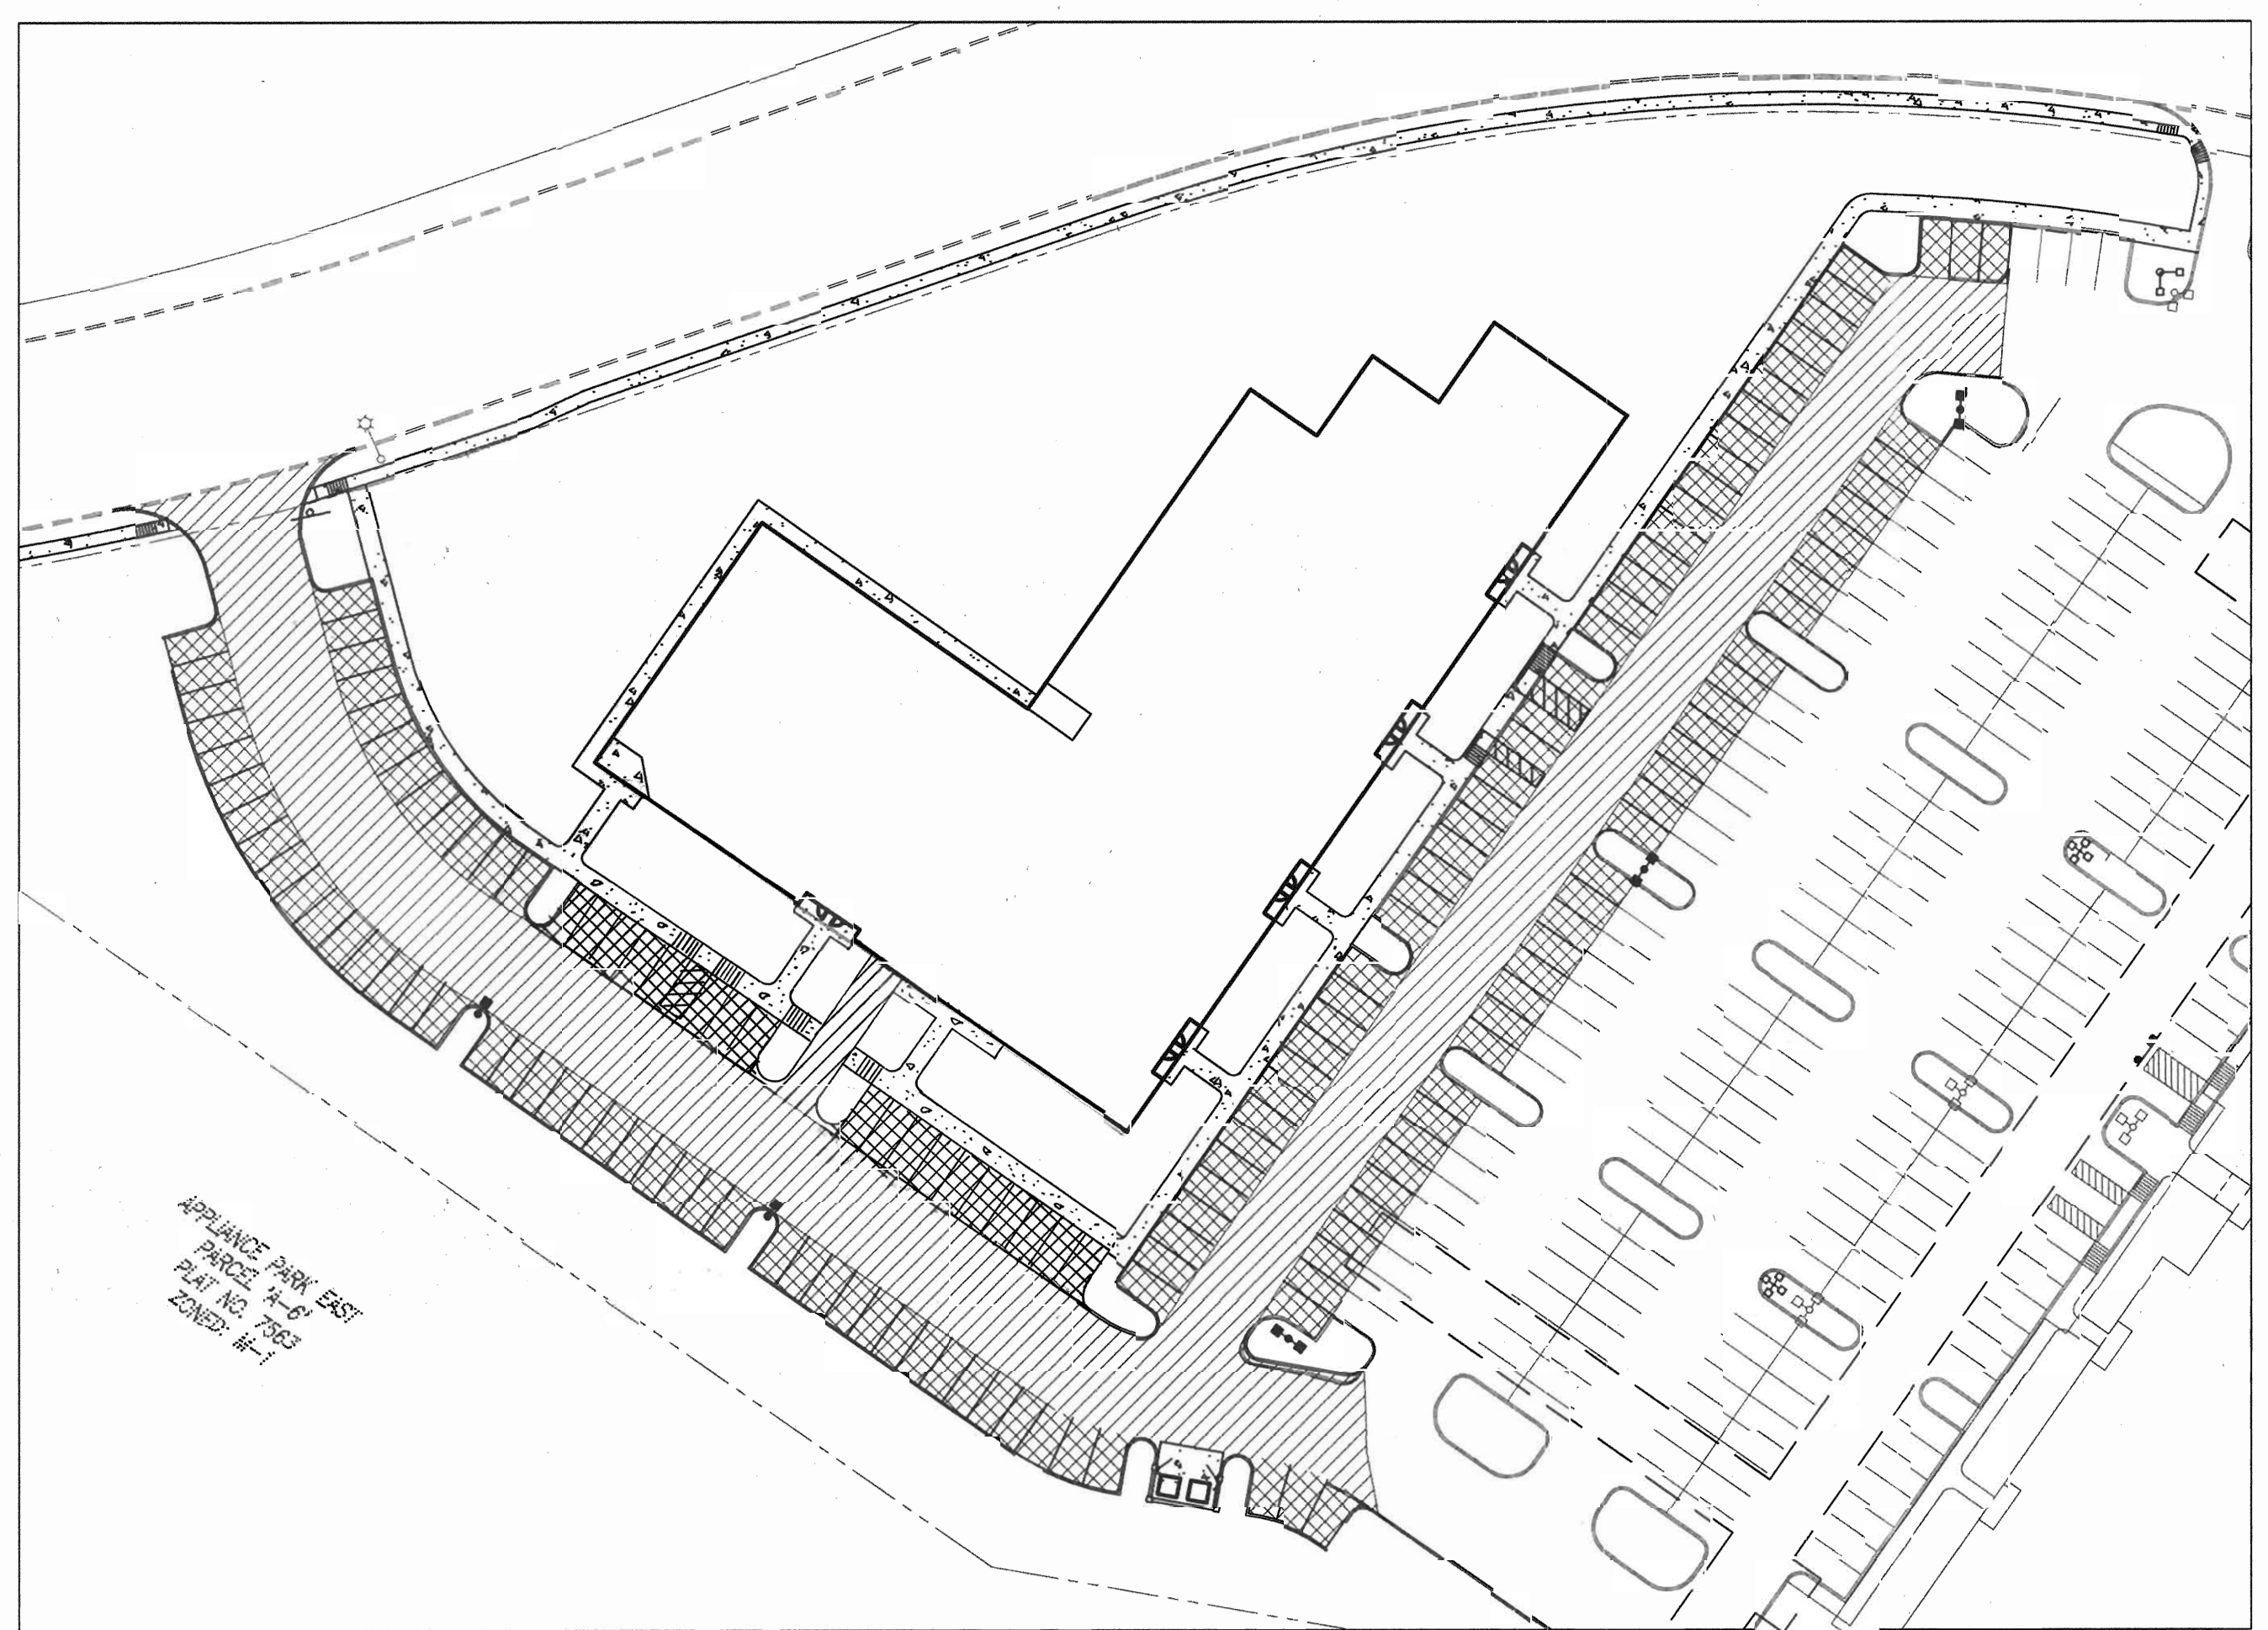


PAVING PLAN
SCALE: 1"=50'


Symbol	Description	Quantity
	Twin Type II, with horizontal 400 Watt high pressure sodium lamp on a 30 foot round tapered steel pole. (brown) Ecolume ECA-182-3H-400HPS-BRP or approved equal.	3
	Single Type III, with horizontal 400 Watt high pressure sodium lamp on a 30 foot round tapered steel pole. (brown) Ecolume ECA-181-3H-400HPS-BRP or approved equal.	2

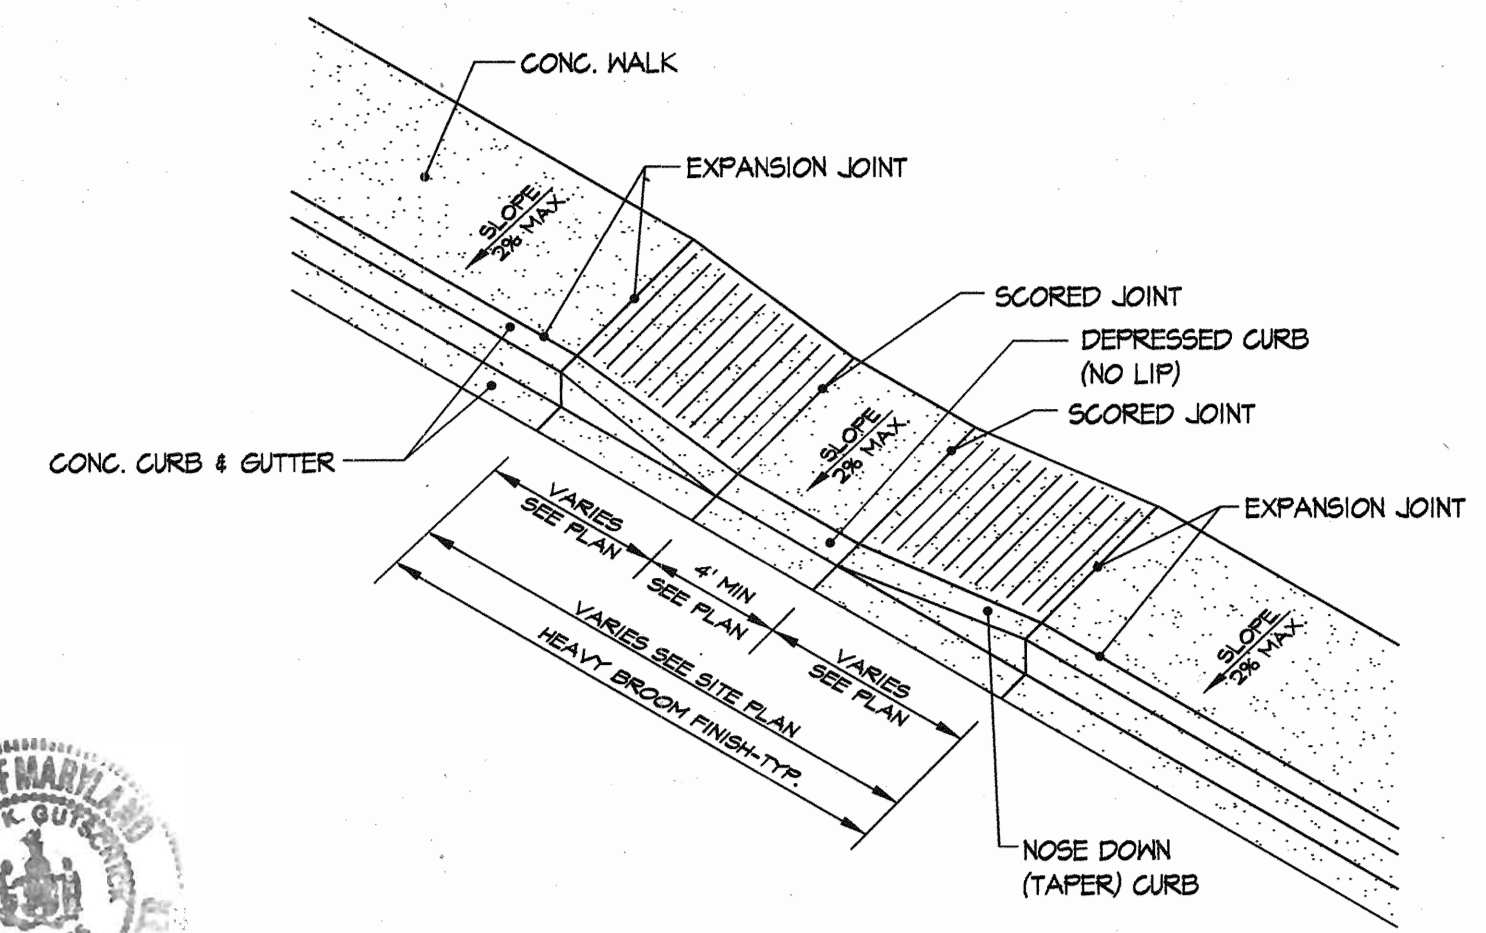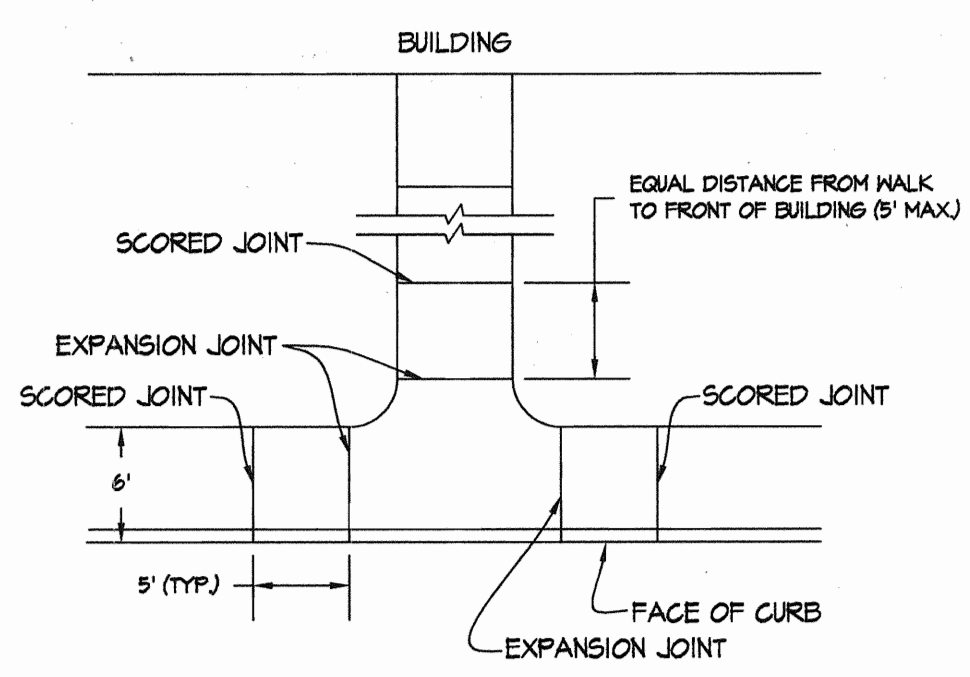


TYPE-A HANDICAP RAMP DETAIL
NO SCALE

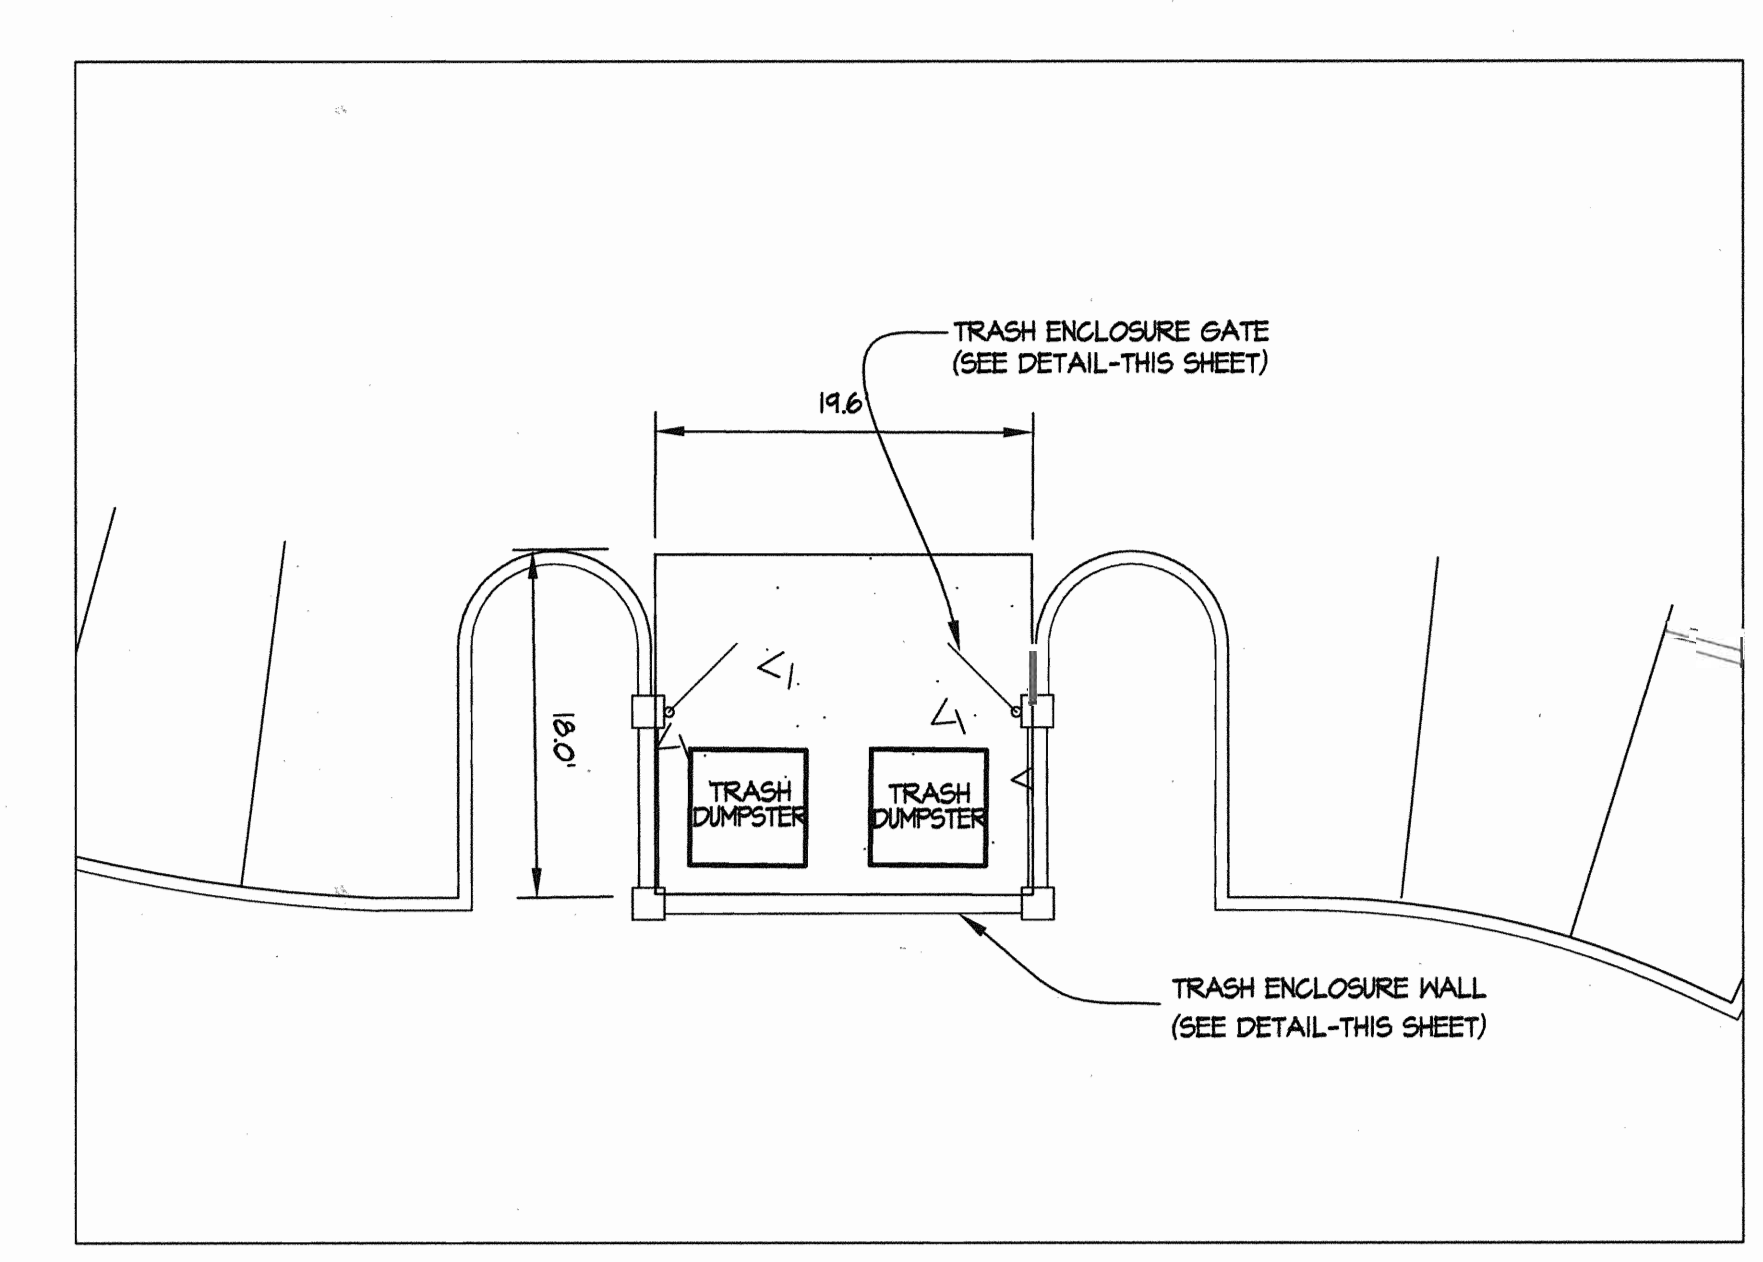


Trash Enclosure
1"=10'

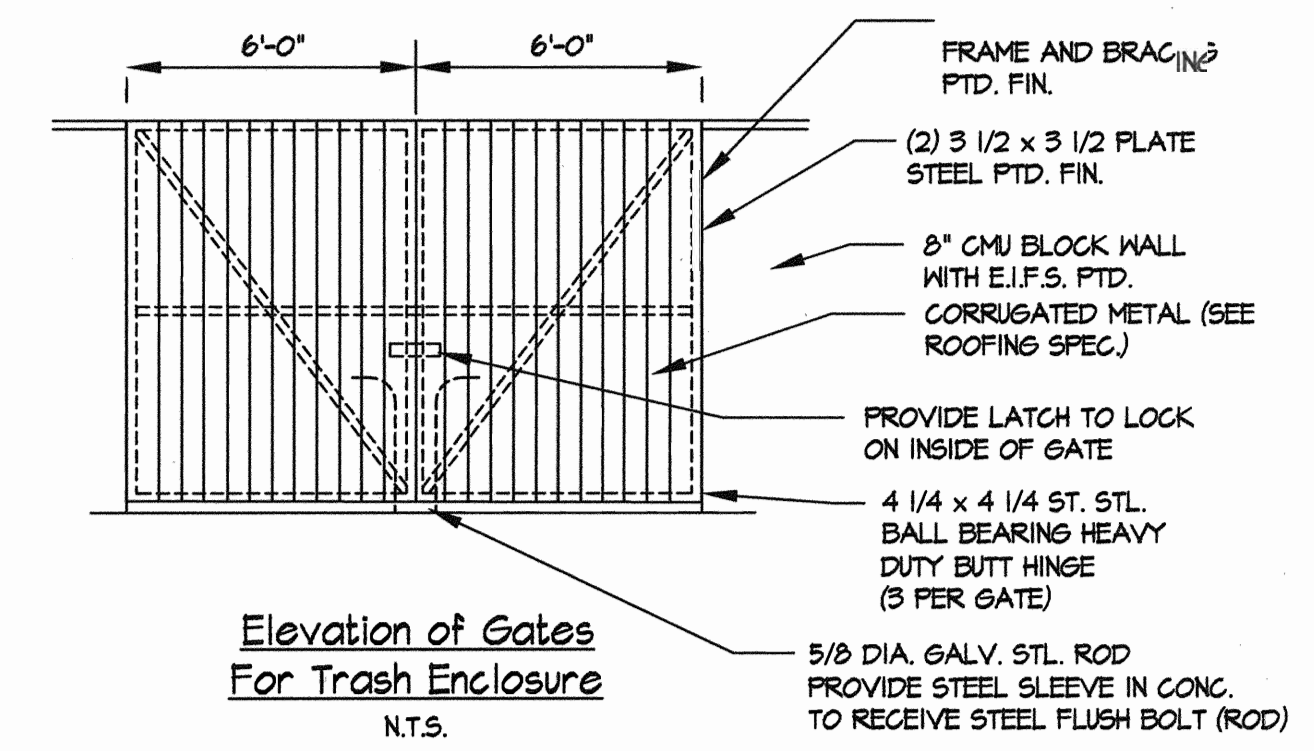


Elevation of Gates For Trash Enclosure
N.T.S.

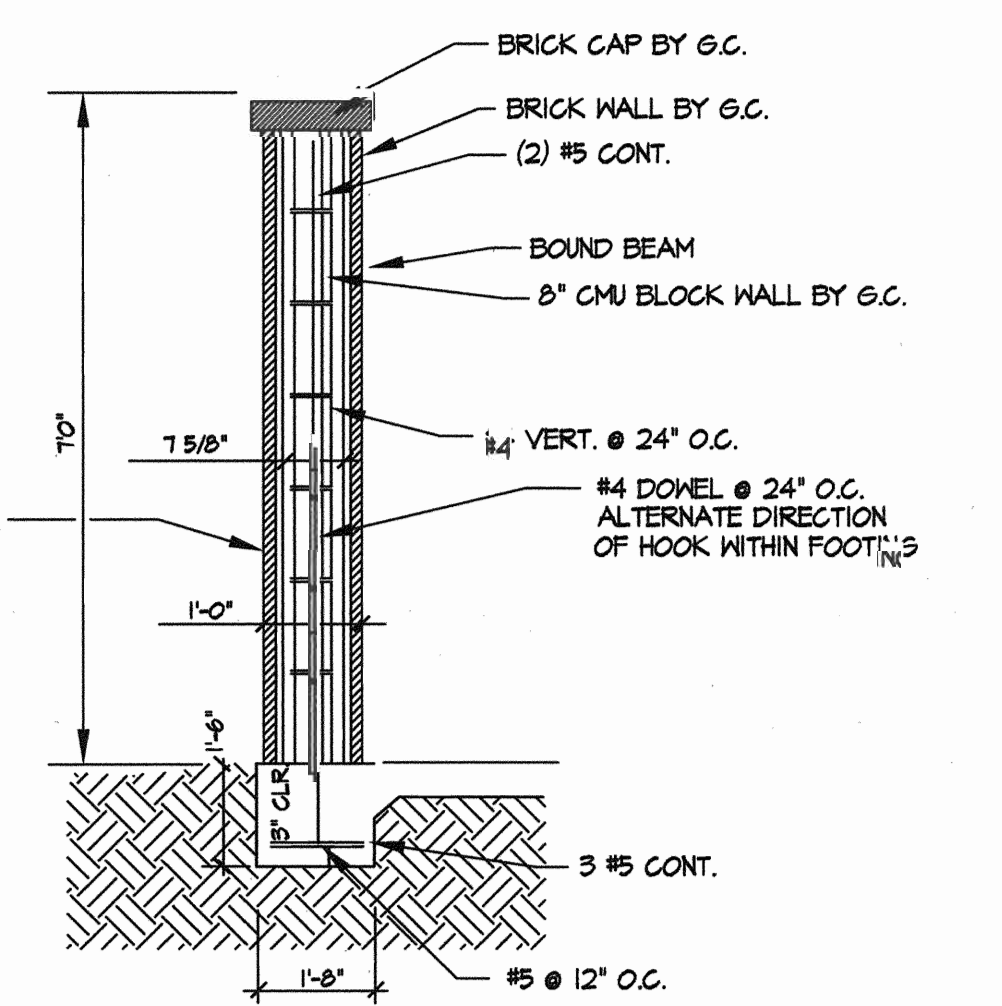


Section of Stone Wall For Trash Enclosure
N.T.S.

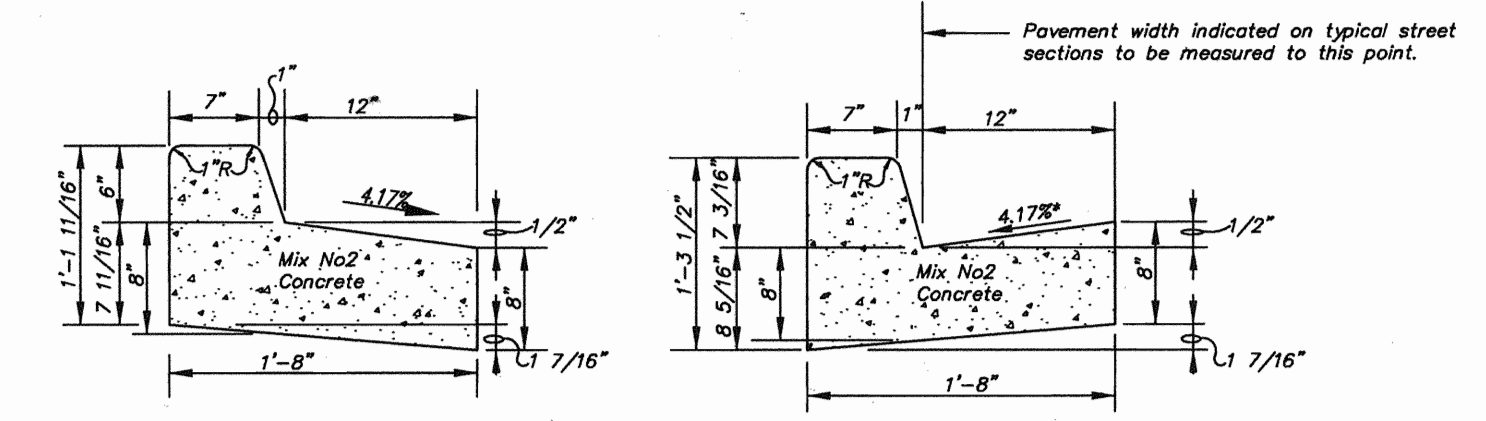


Reverse 7" Combination Curb & Gutter N.T.S.
Standard 7" Combination Curb & Gutter N.T.S.

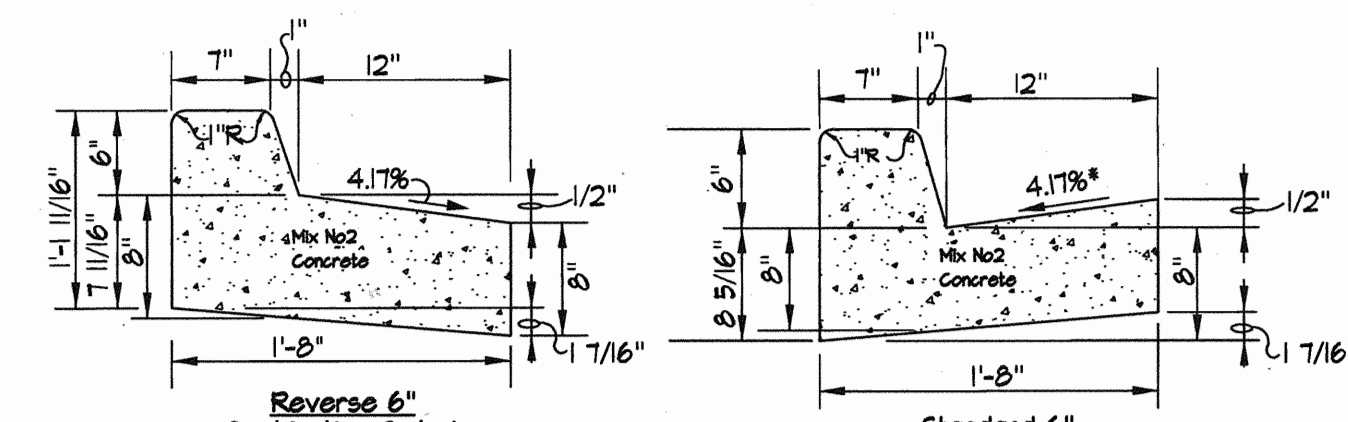

Reverse 6" Combination Curb & Gutter N.T.S.
Standard 6" Combination Curb & Gutter N.T.S.

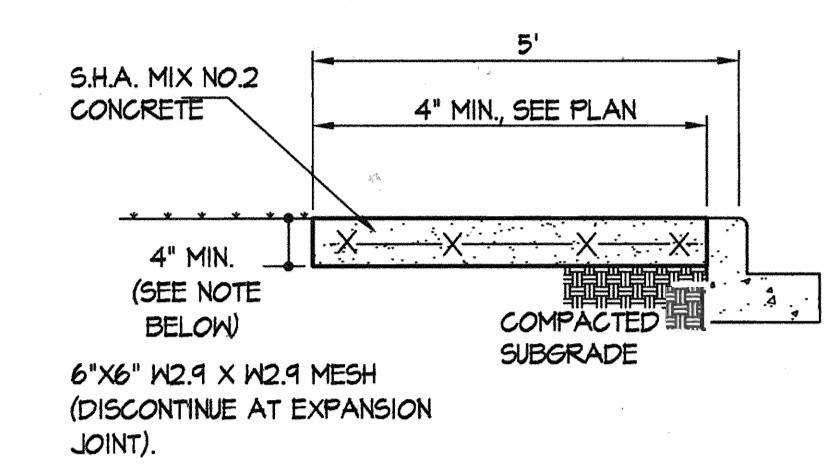

TYPICAL SIDEWALK SECTION
NO SCALE

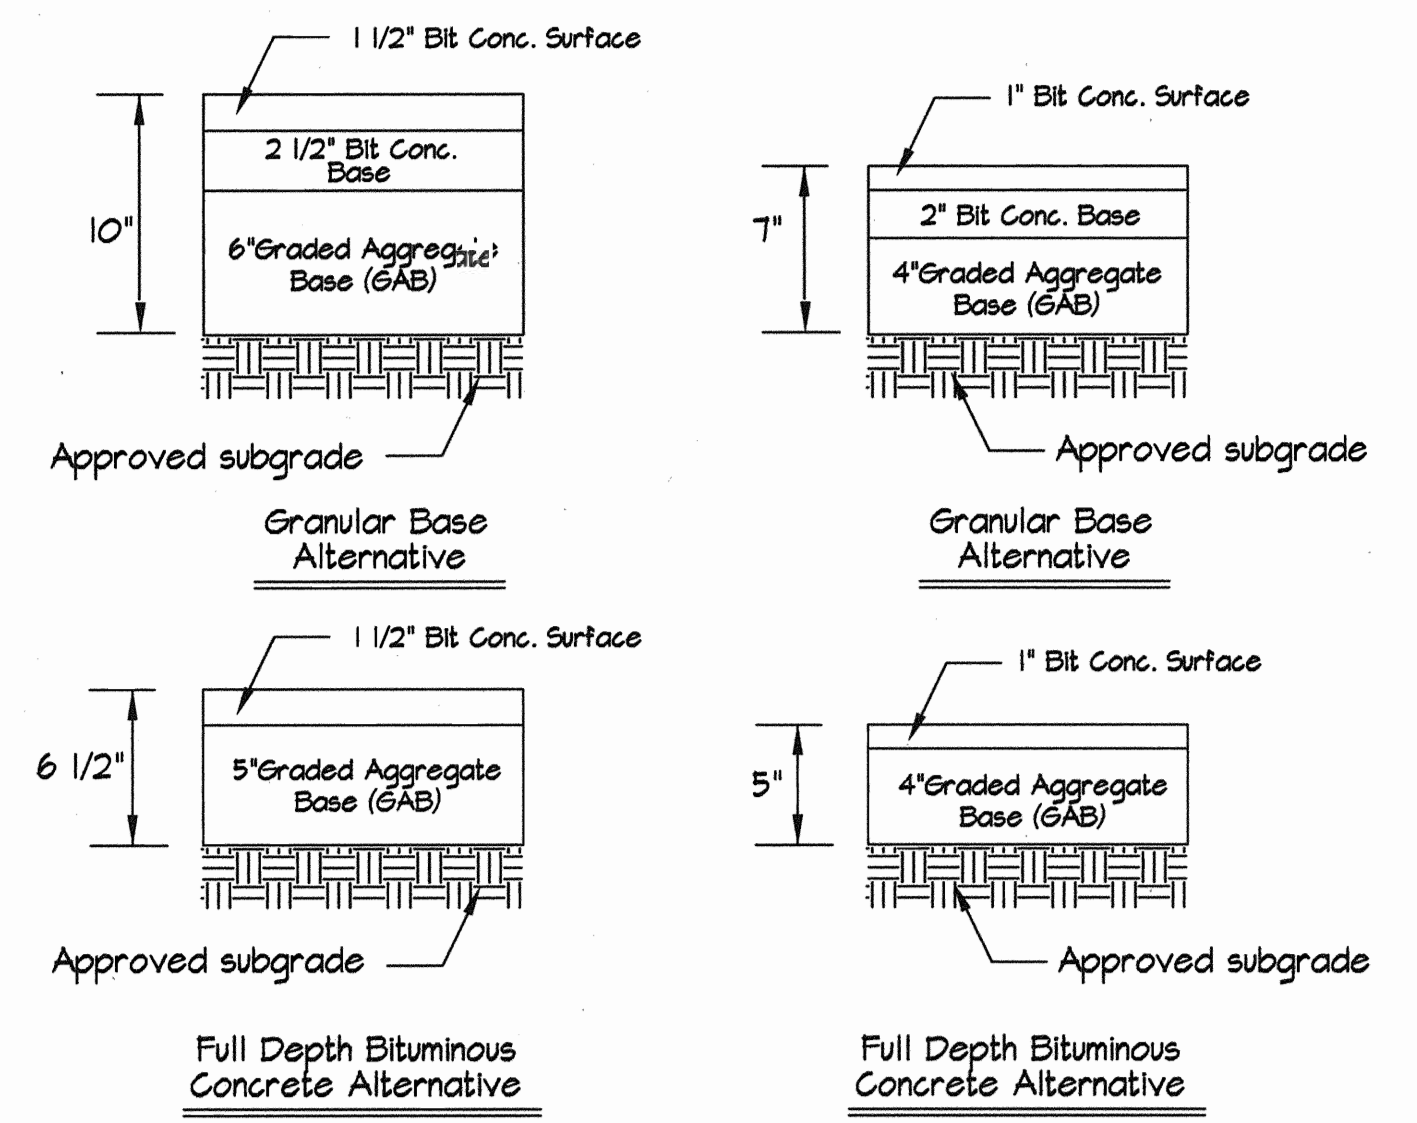

P-2 Granular Base N.T.S.
P-1 Granular Base N.T.S.

Note: Depending on the CBR values obtained in the field, the paving sections may be revised, if approved by a professional soils engineer. These substitutions must also be approved by the Howard County Dept. of Public Works.

APPROVED: HOWARD COUNTY DEPARTMENT OF PLANNING & ZONING

Howard County Seal

Cindy Hammonds
Chief, Division of Land Development
Date: 12/3/04

MK
Chief, Development Engineering Division
Date: 11/21/04



GIW GUTSCHICK LITTLE & WEBER, P.A.
CIVIL ENGINEERS, LAND SURVEYORS, LAND PLANNERS, LANDSCAPE ARCHITECTS
3909 NATIONAL DRIVE - SUITE 250 - BURTONSVILLE OFFICE PARK
BURTONSVILLE, MARYLAND 20866
TEL: 301-421-4024 BAL: 410-880-1820 DC/VA: 301-989-2524 FAX: 301-421-4186









DATE	REVISION	BY	APP'R.
12/21/05	2	JING	

PREPARED FOR:
GATEWAY 67 LLC
8815 CENTRE PARK DRIVE, SUITE 400
COLUMBIA, MD. 21045
PH.: 410-992-7348
ATTN: MR. ROGER WAESCHE

SITE DETAILS & PAVING PLAN
COLUMBIA GATEWAY
PARCEL N-13
Plot No. 17094
ELECTION DISTRICT No. 6
HOWARD COUNTY, MARYLAND

SCALE	ZONING	G. L. W. FILE No.
AS SHOWN	M-1	04032
DATE	TAX MAP - GRID	SHEET
Sept., 2004	42 - 12	3 OF 10

L:\CADD\DRAWINGS\04032\sdps\04032sp3.dwg 10/28/2004 10:44:02 AM EDT

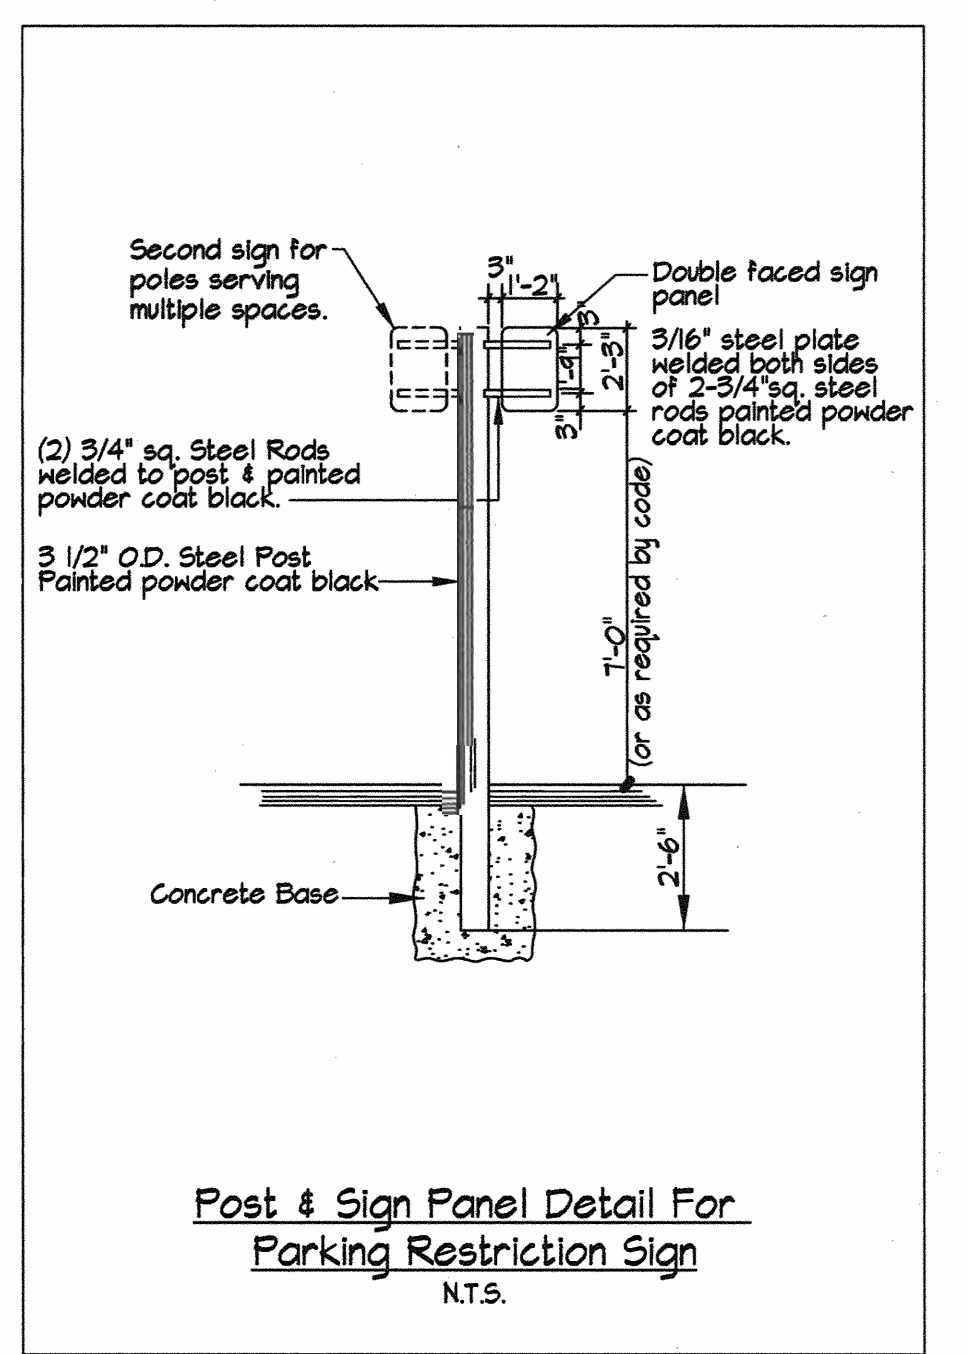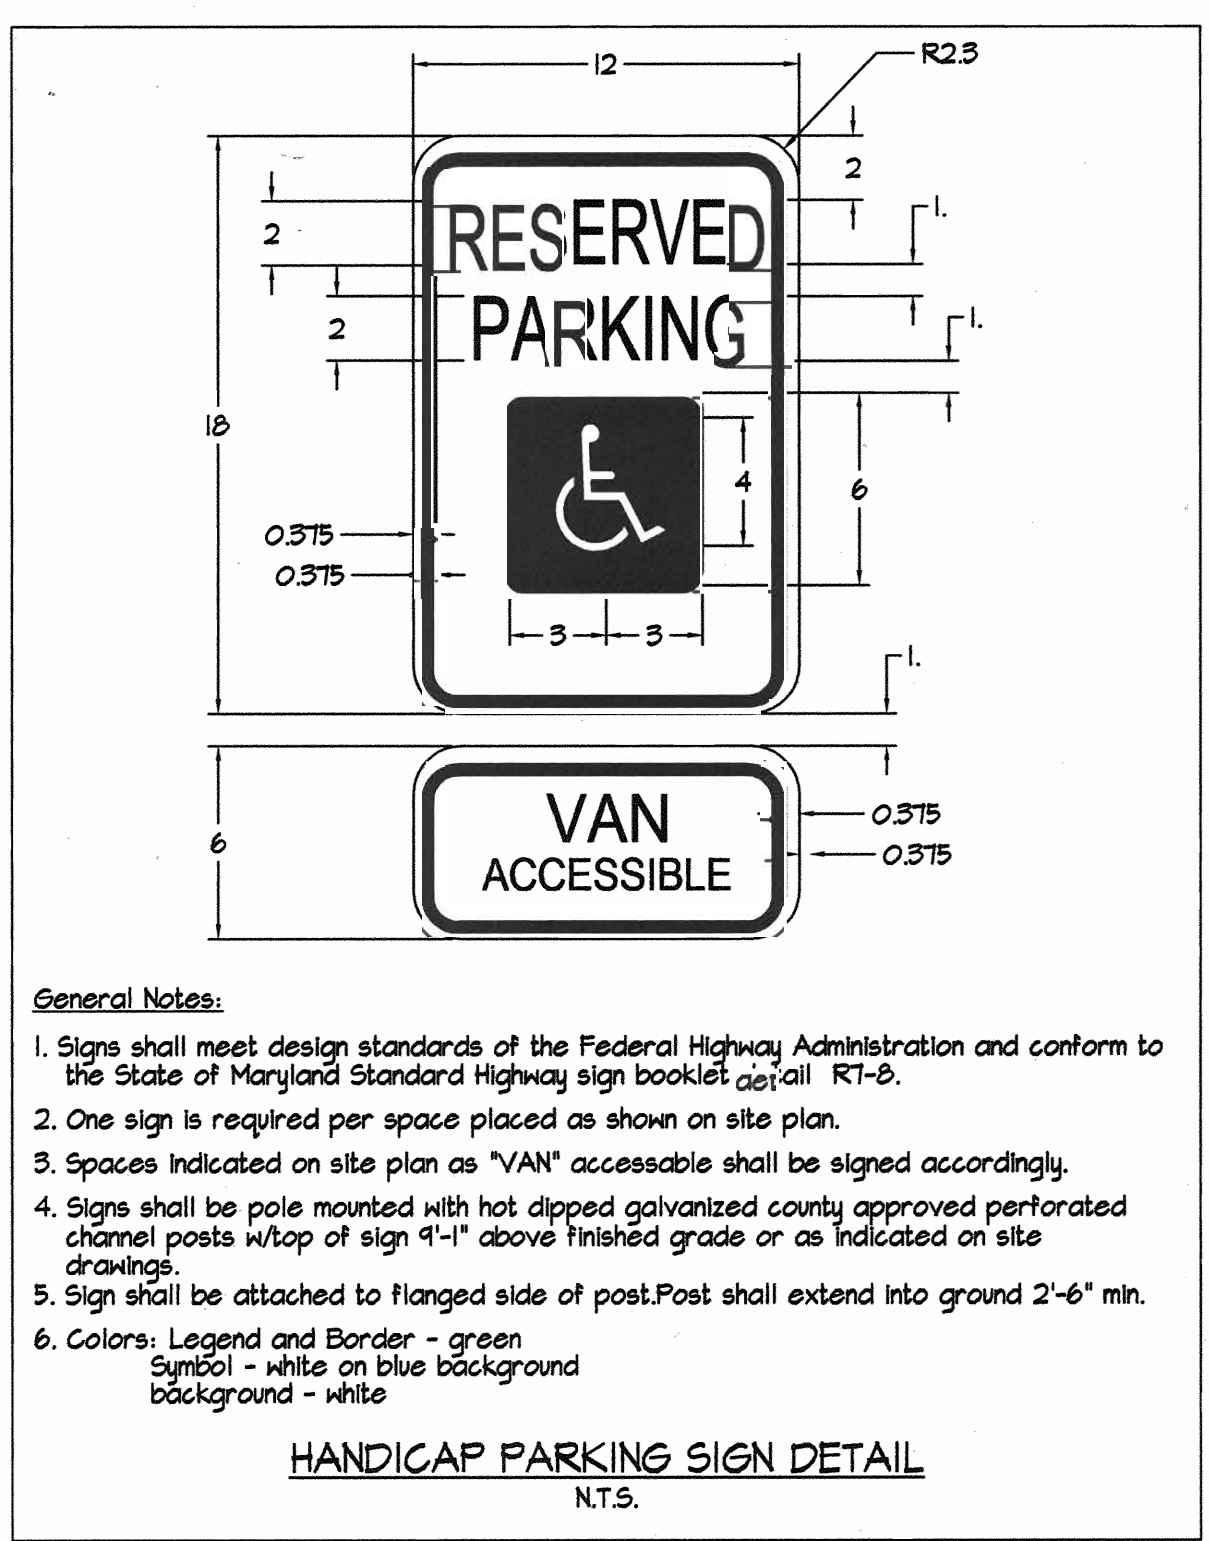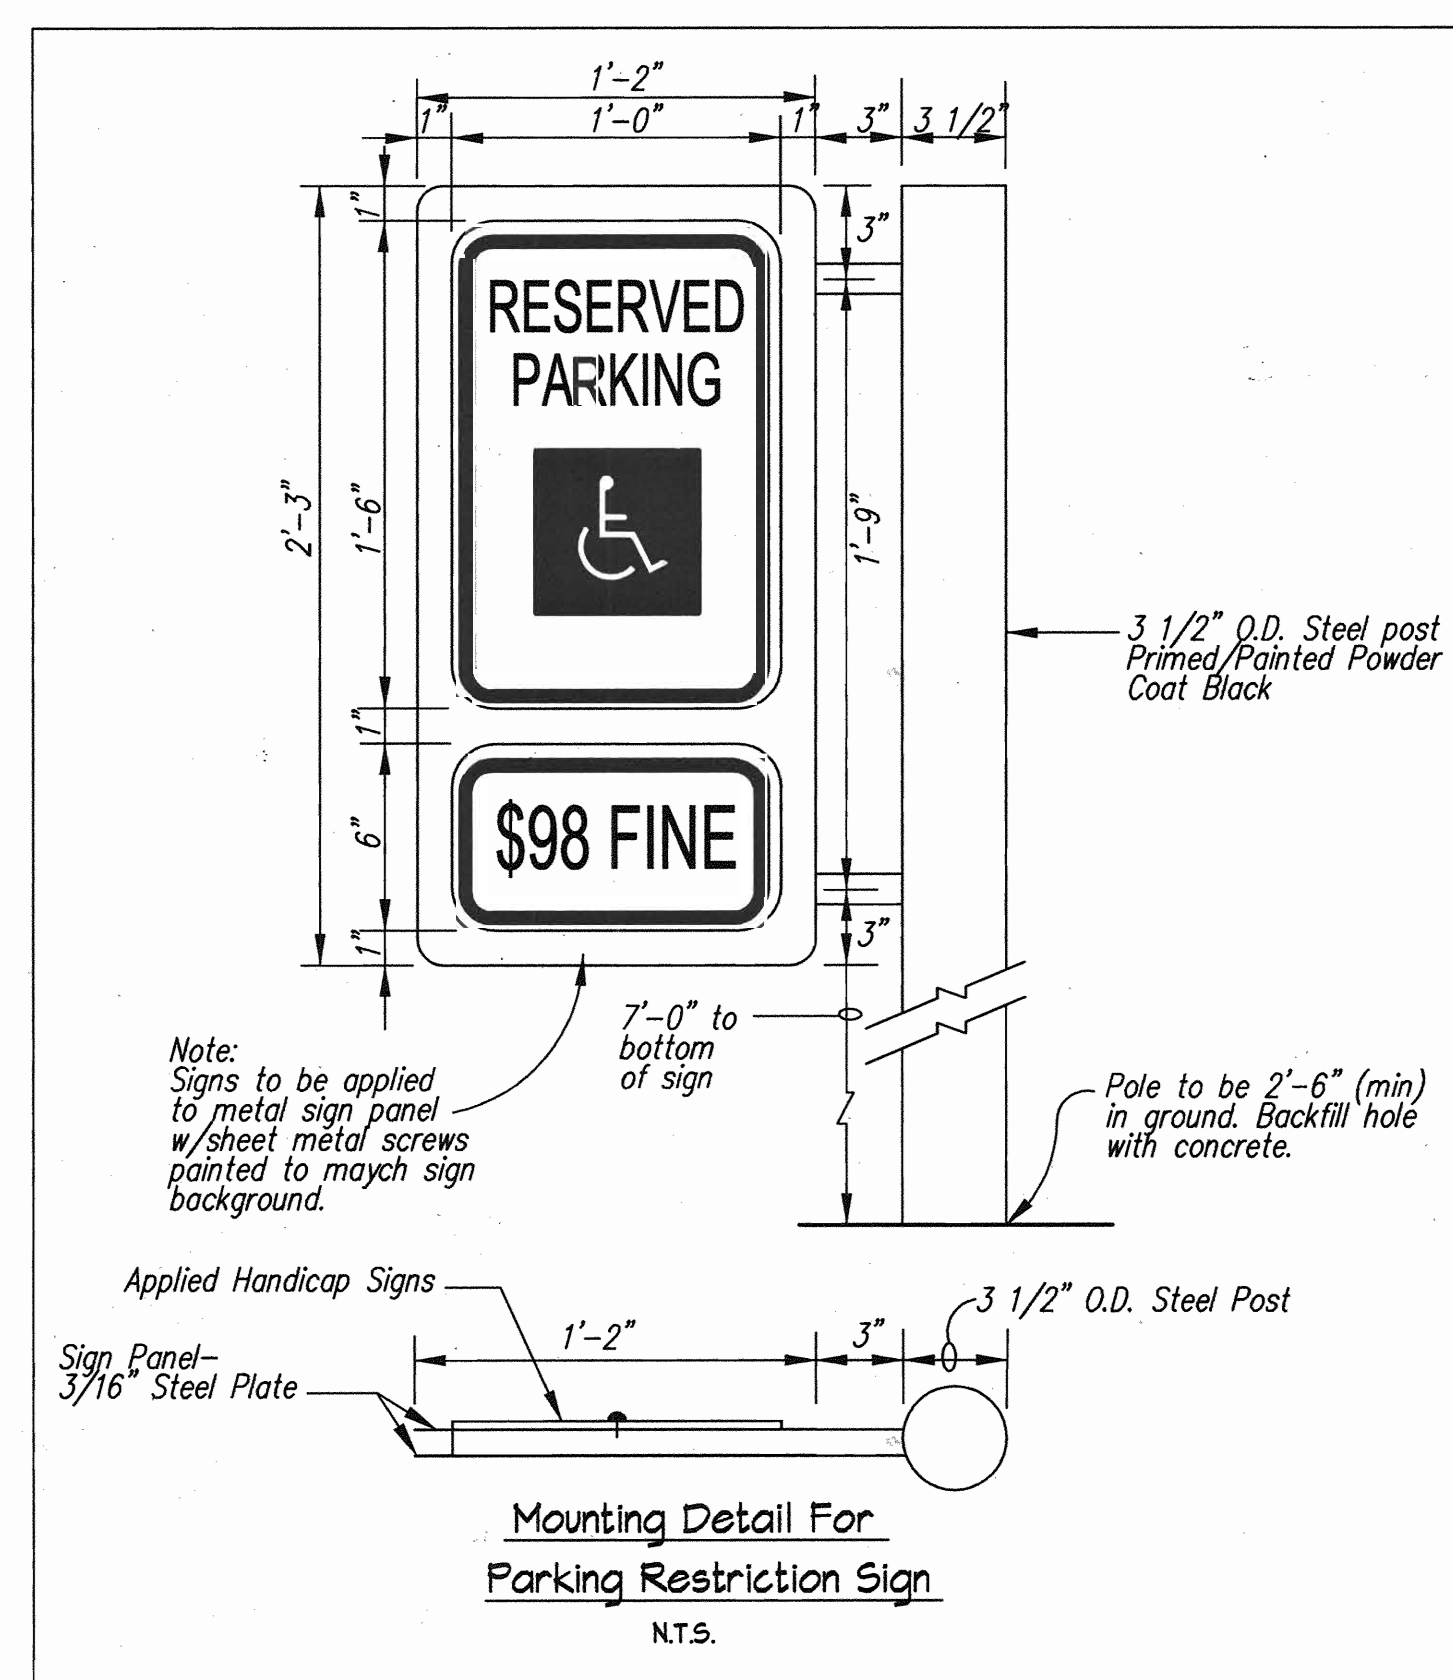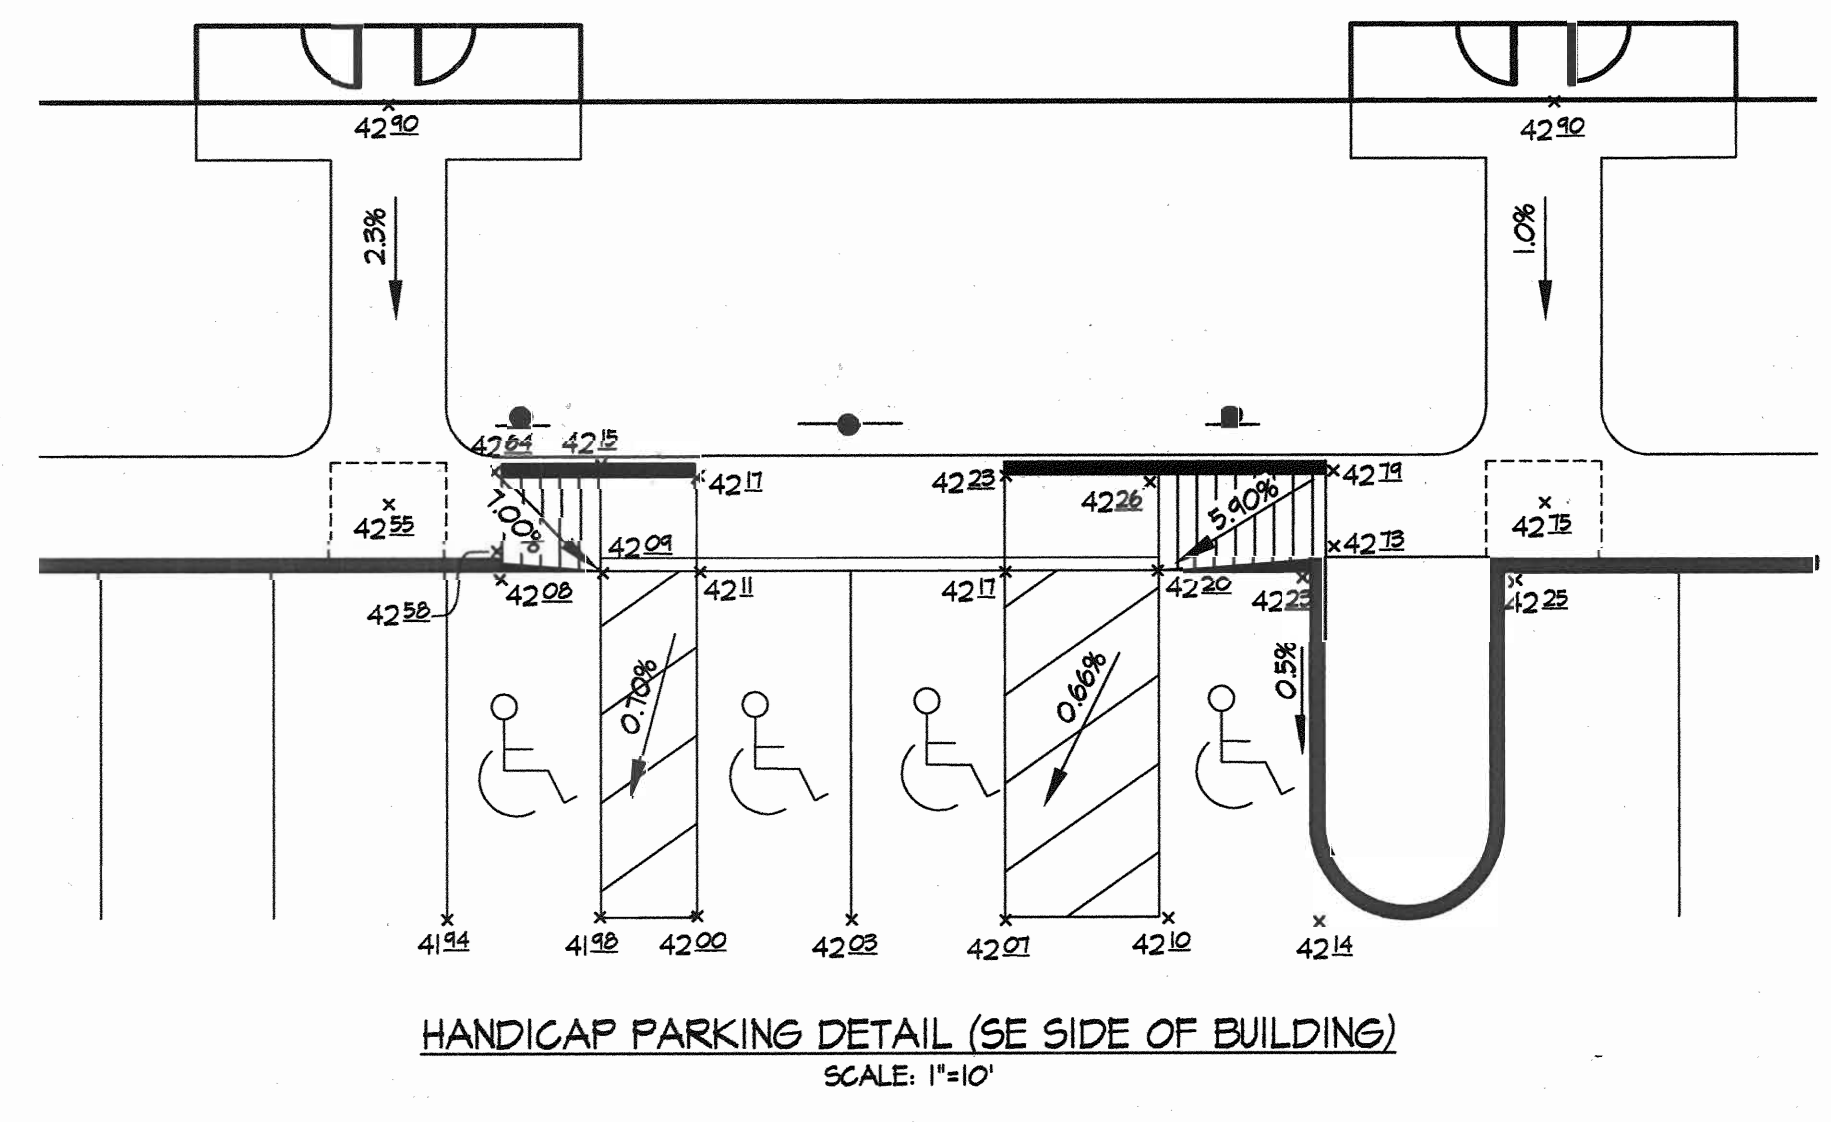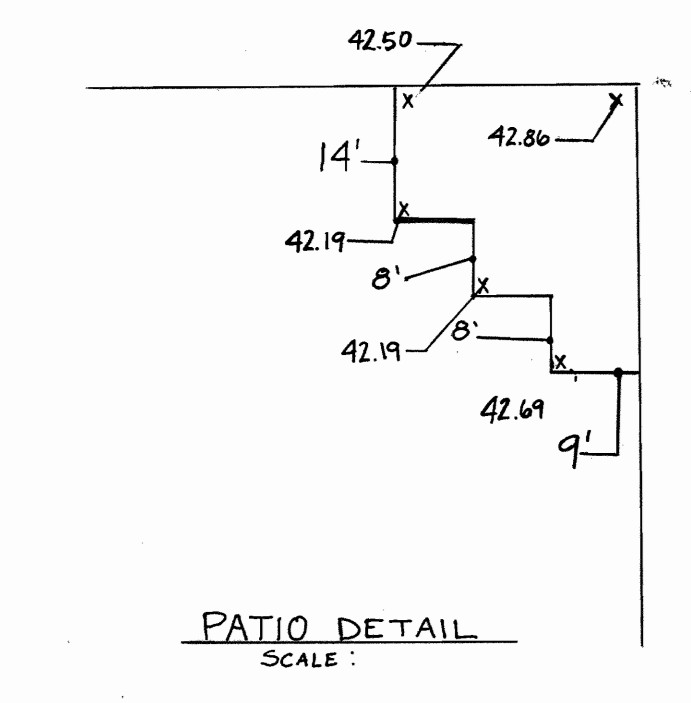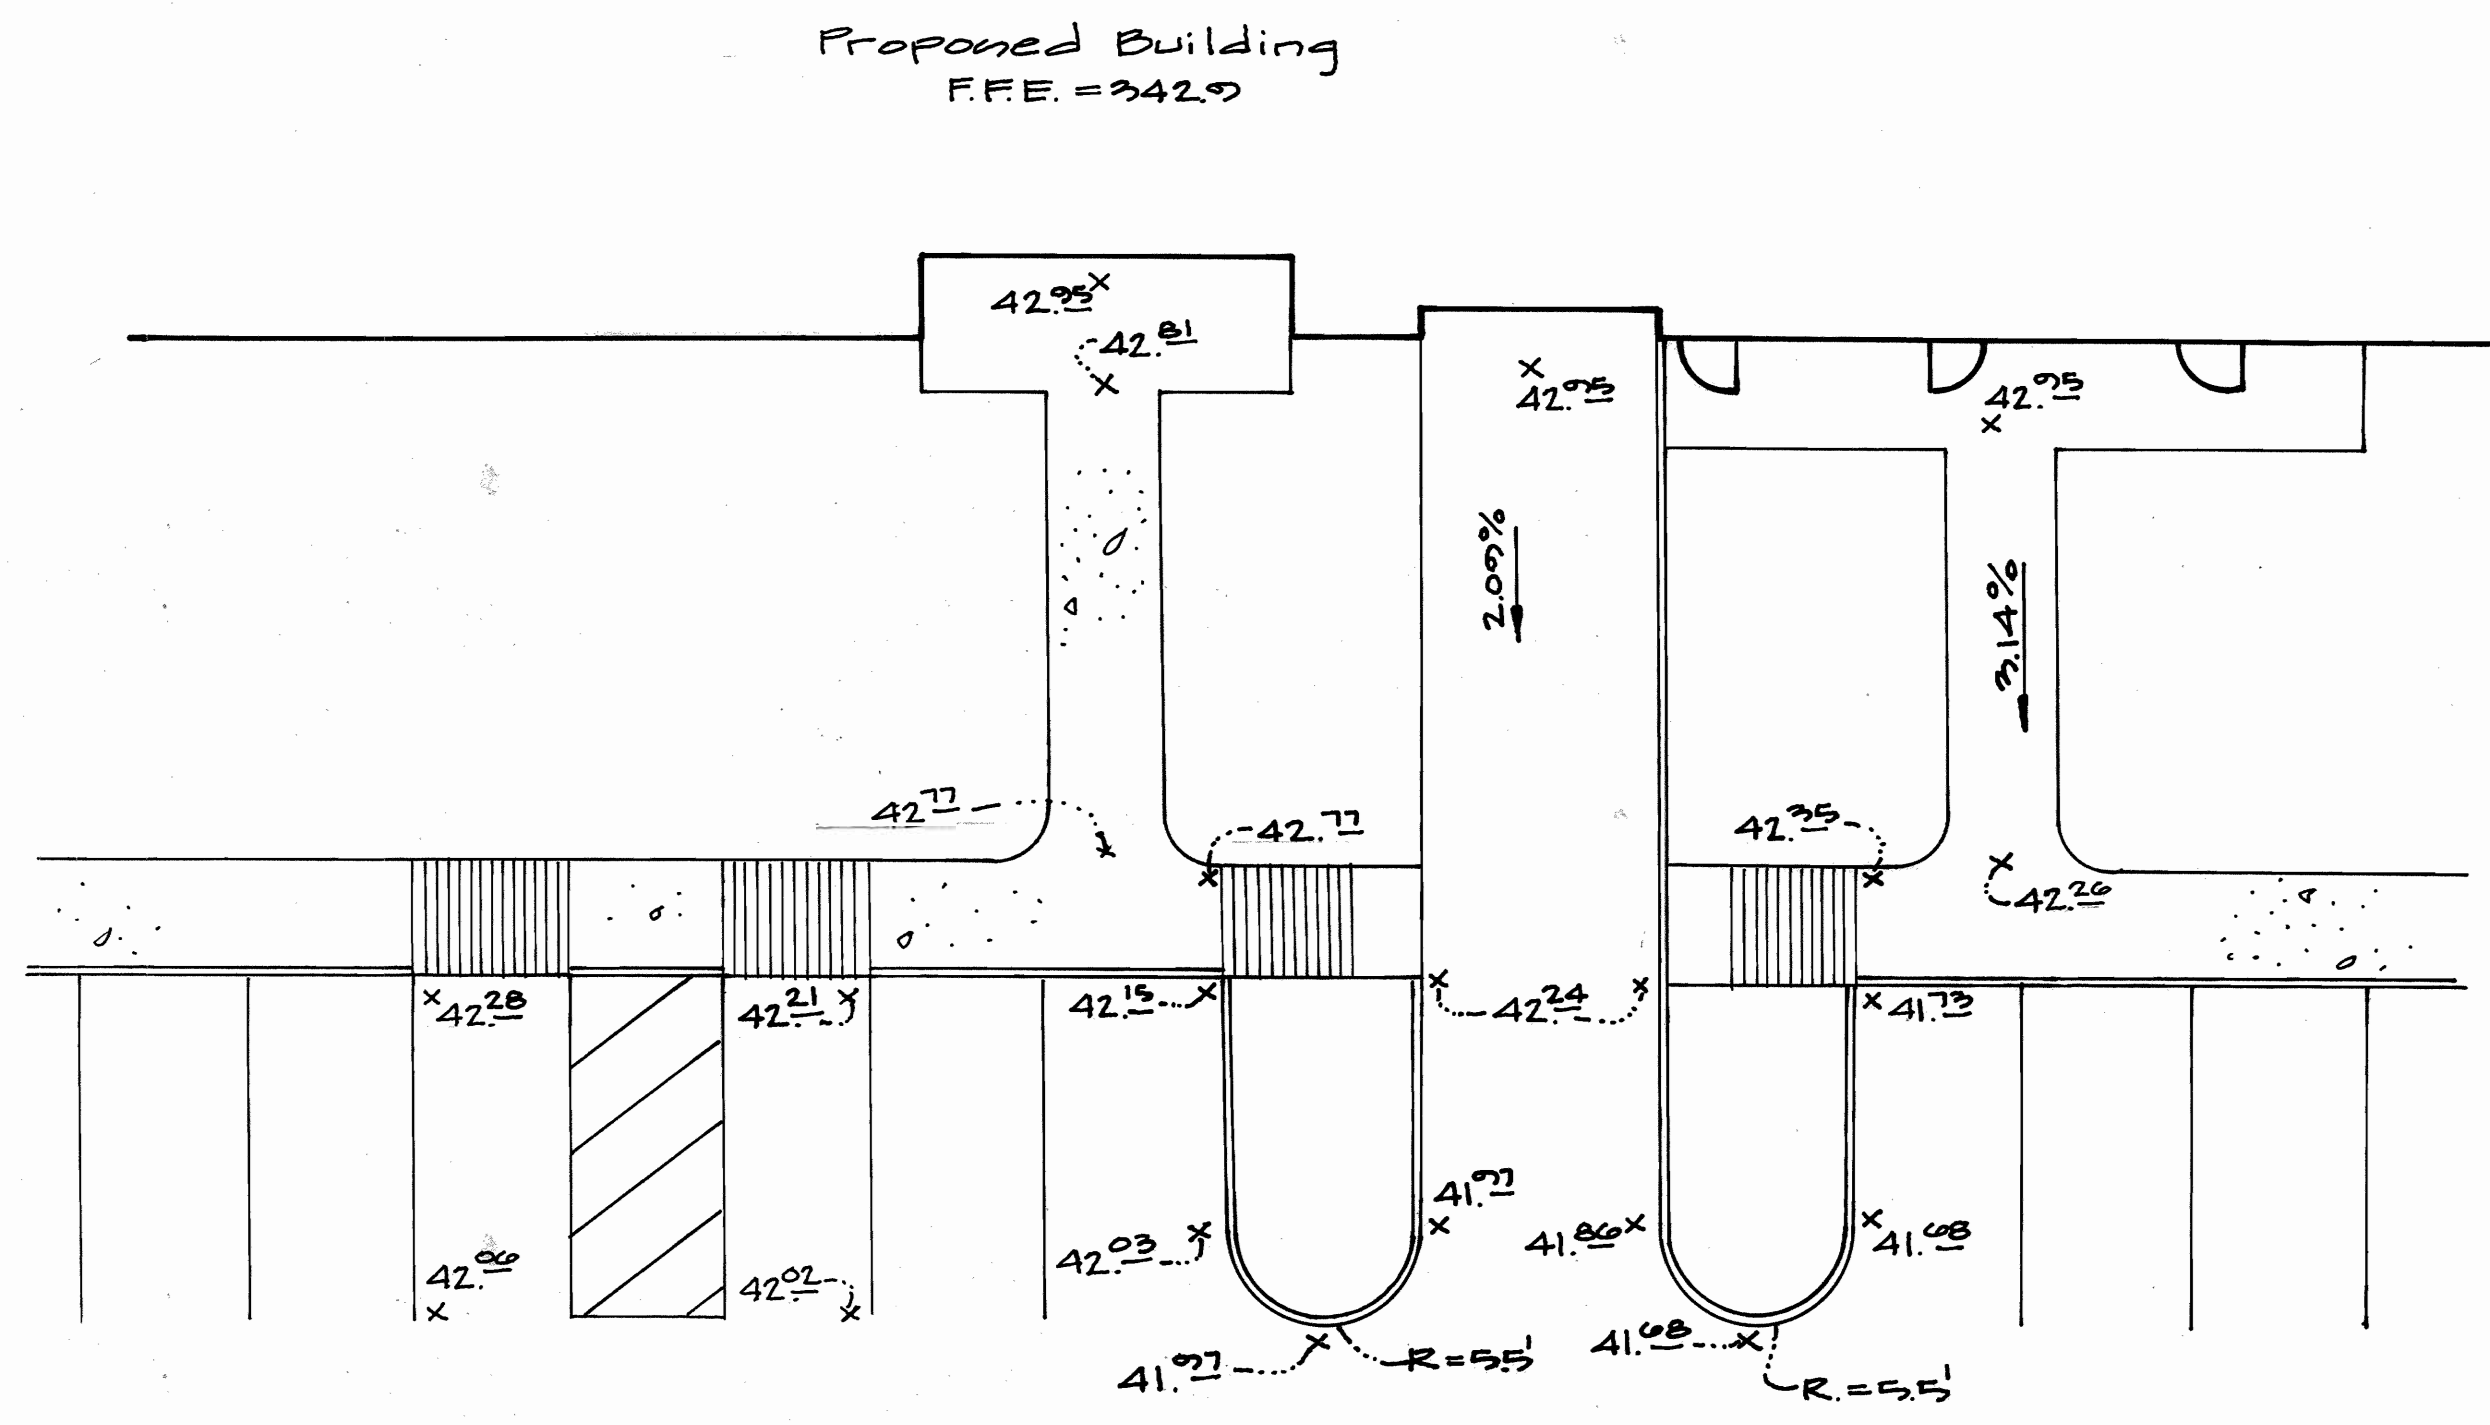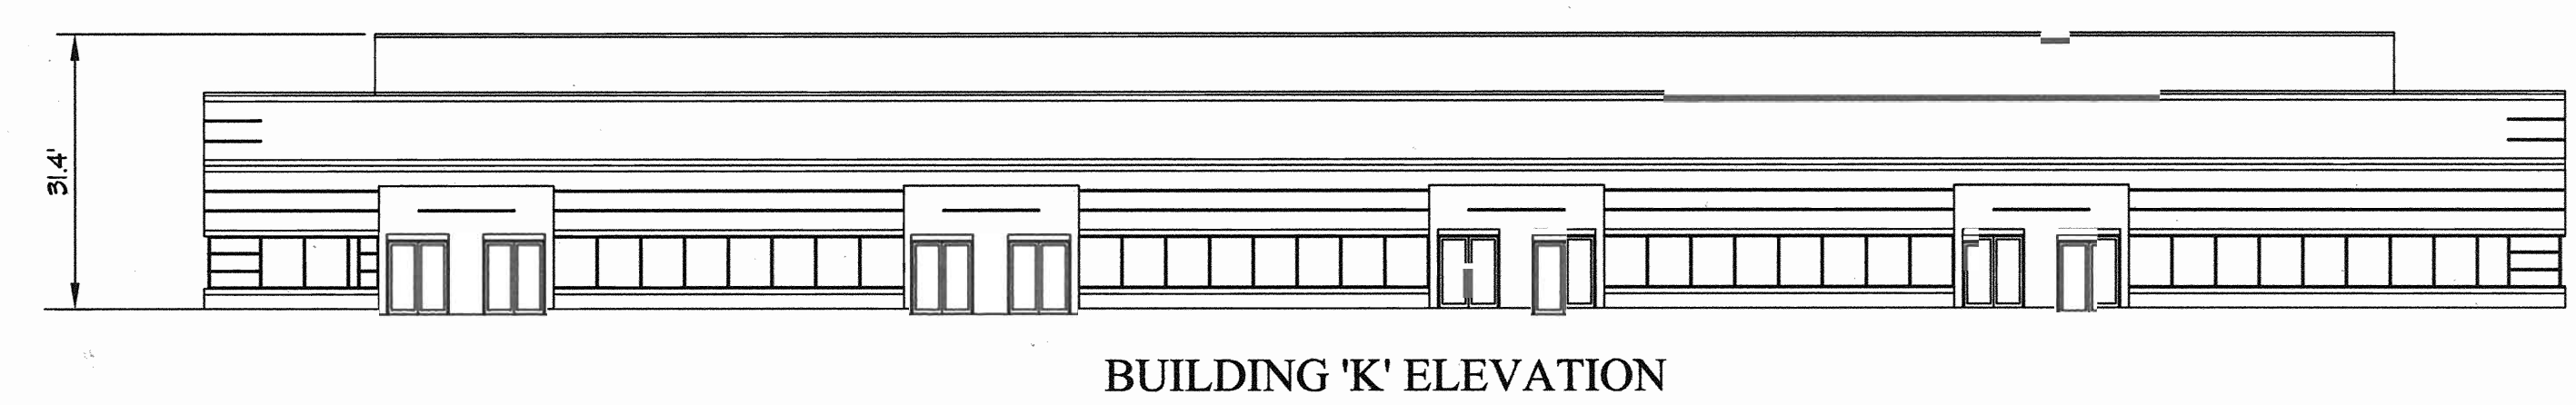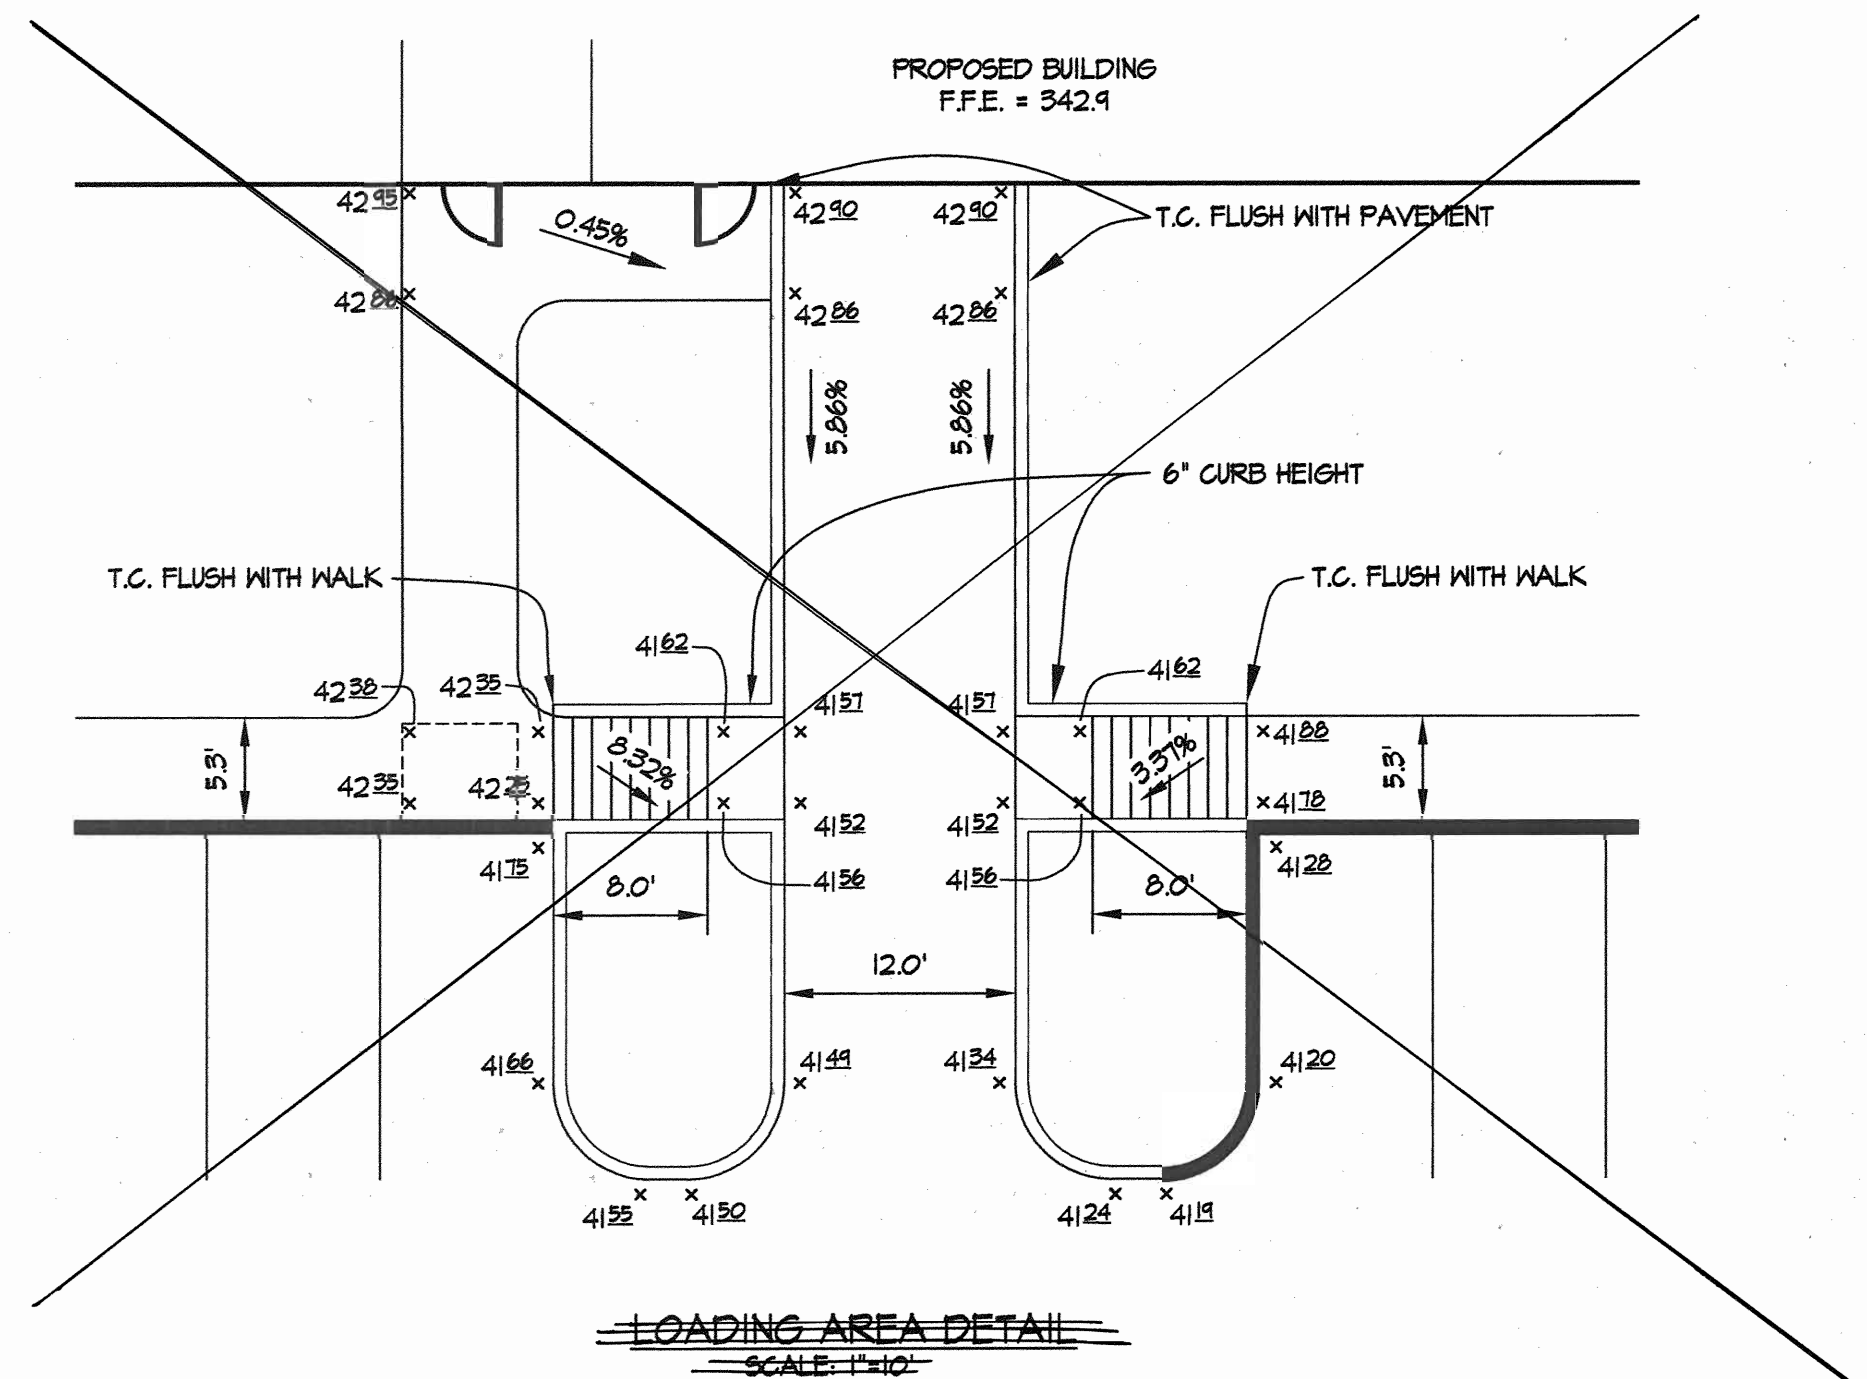

APPROVED: HOWARD COUNTY DEPARTMENT OF PLANNING & ZONING

Director: *Frank D. Layton* Date: 12/10/04

Chief, Division of Land Development: *Cynthia Krametz* Date: 12/10/04

Chief, Development Engineering Division: *MK* Date: 11/22/04



GLW GUTSCHICK LITTLE & WEBER, P.A.
CIVIL ENGINEERS, LAND SURVEYORS, LAND PLANNERS, LANDSCAPE ARCHITECTS
3909 NATIONAL DRIVE - SUITE 250 - BURTONSVILLE OFFICE PARK
BURTONSVILLE, MARYLAND 20866
TEL: 301-421-4024 BALT: 410-880-1820 DC/VA: 301-999-2524 FAX: 301-421-4186







DATE	REVISION	BY	APP'R.
7/27/05	Revise detail for handicap access for new overhead door location.	JMG	

PREPARED FOR:
GATEWAY 67 LLC
8815 CENTRE PARK DRIVE, SUITE 400
COLUMBIA, MD. 21045
PH.: 410-992-7348
ATTN: MR. ROGER WAESCHE

SITE & HANDICAP ACCESSIBILITY DETAILS
COLUMBIA GATEWAY
PARCEL N-13
Plot No. 1709y
ELECTION DISTRICT No. 6
HOWARD COUNTY, MARYLAND

SCALE	ZONING	G. L. W. FILE No.
AS SHOWN	M-1	04032
DATE	TAX MAP - GRID	SHEET
Sept., 2004	42 - 12	4 OF 10

L:\CADD\DRAWINGS\04032\sdp's\04032sp4.dwg 10/28/2004 11:09:49 AM EDT

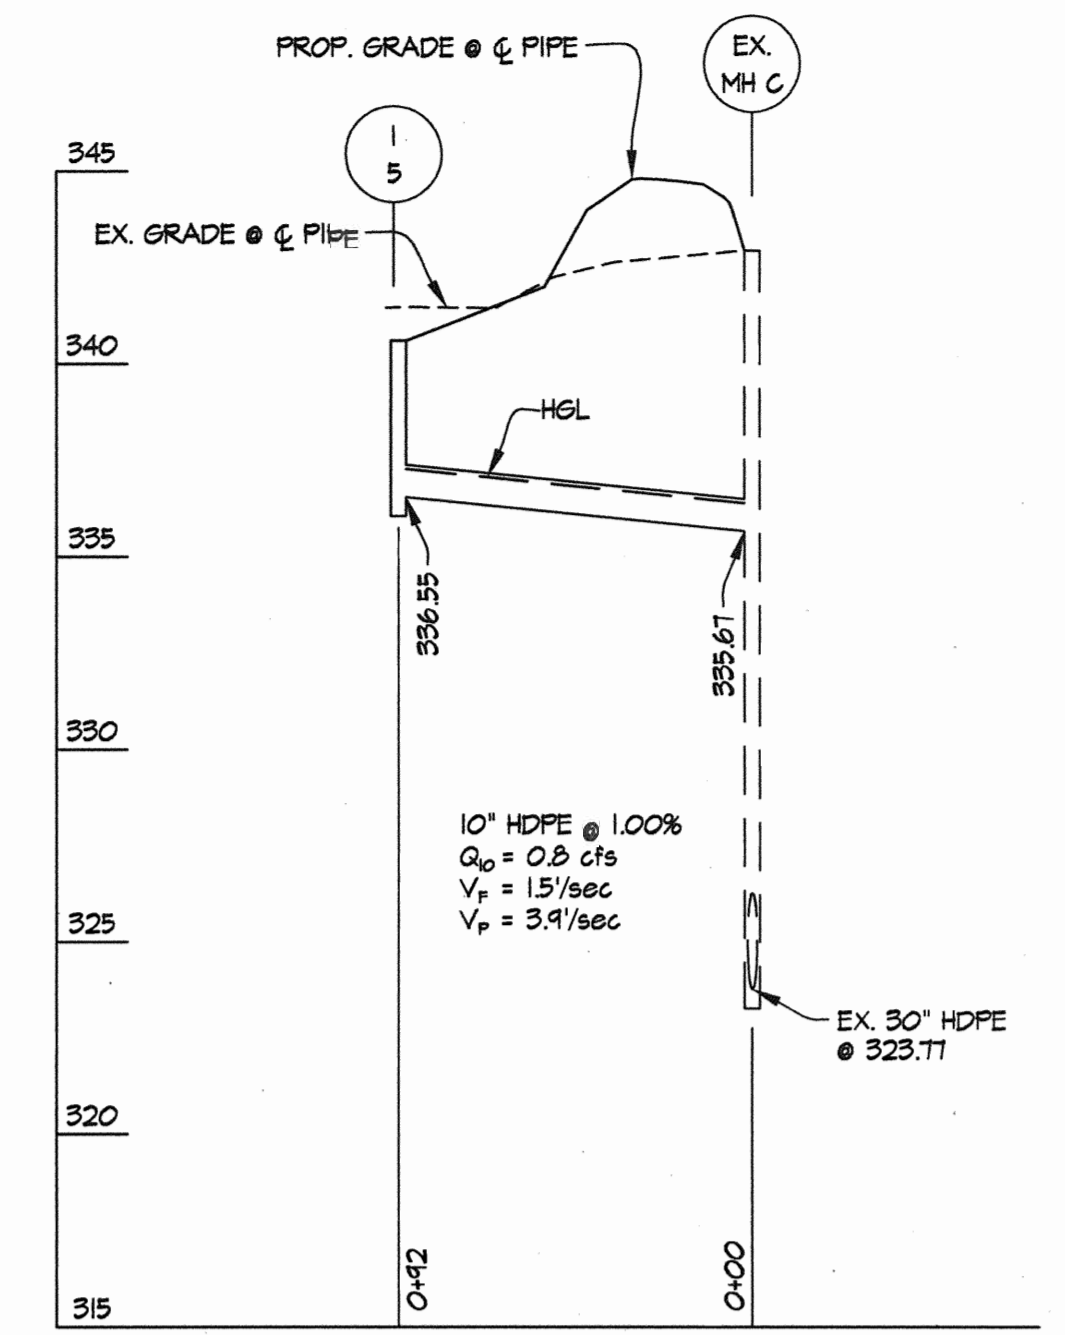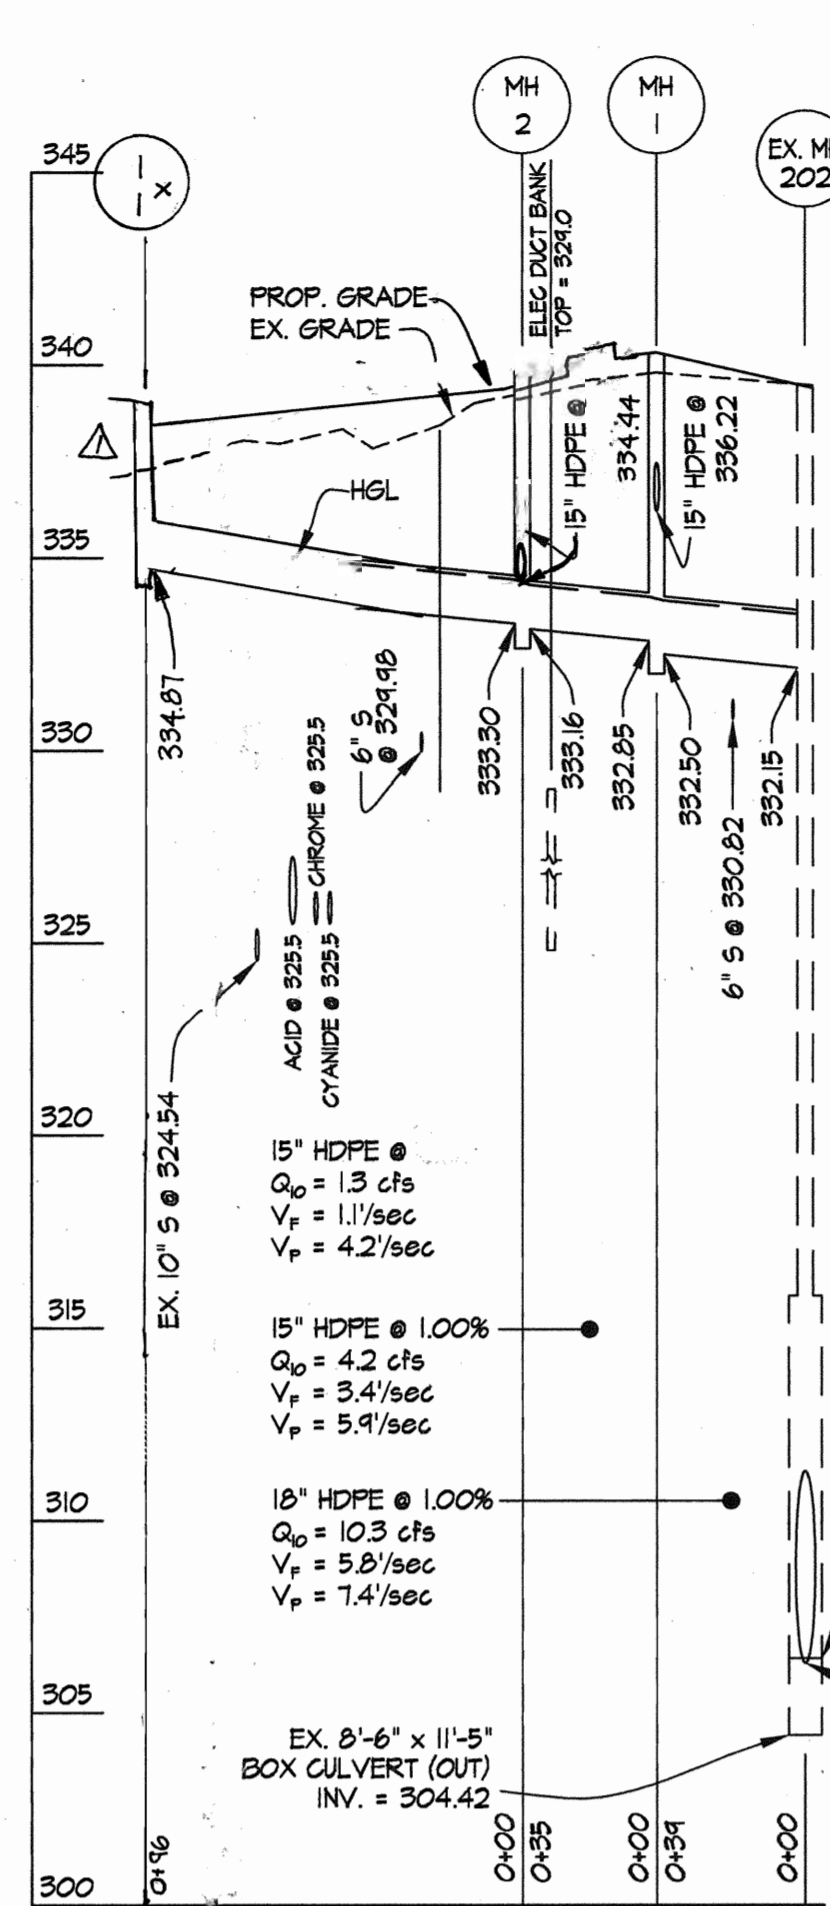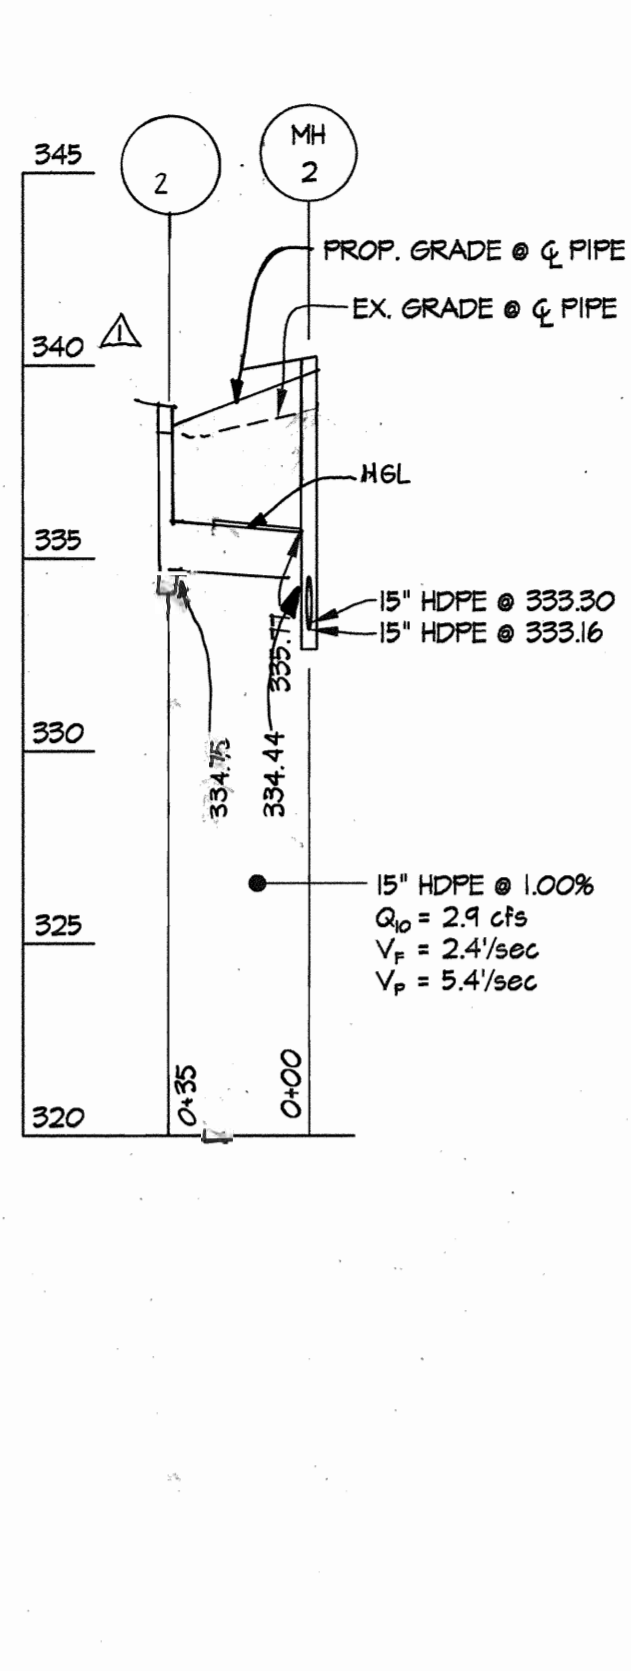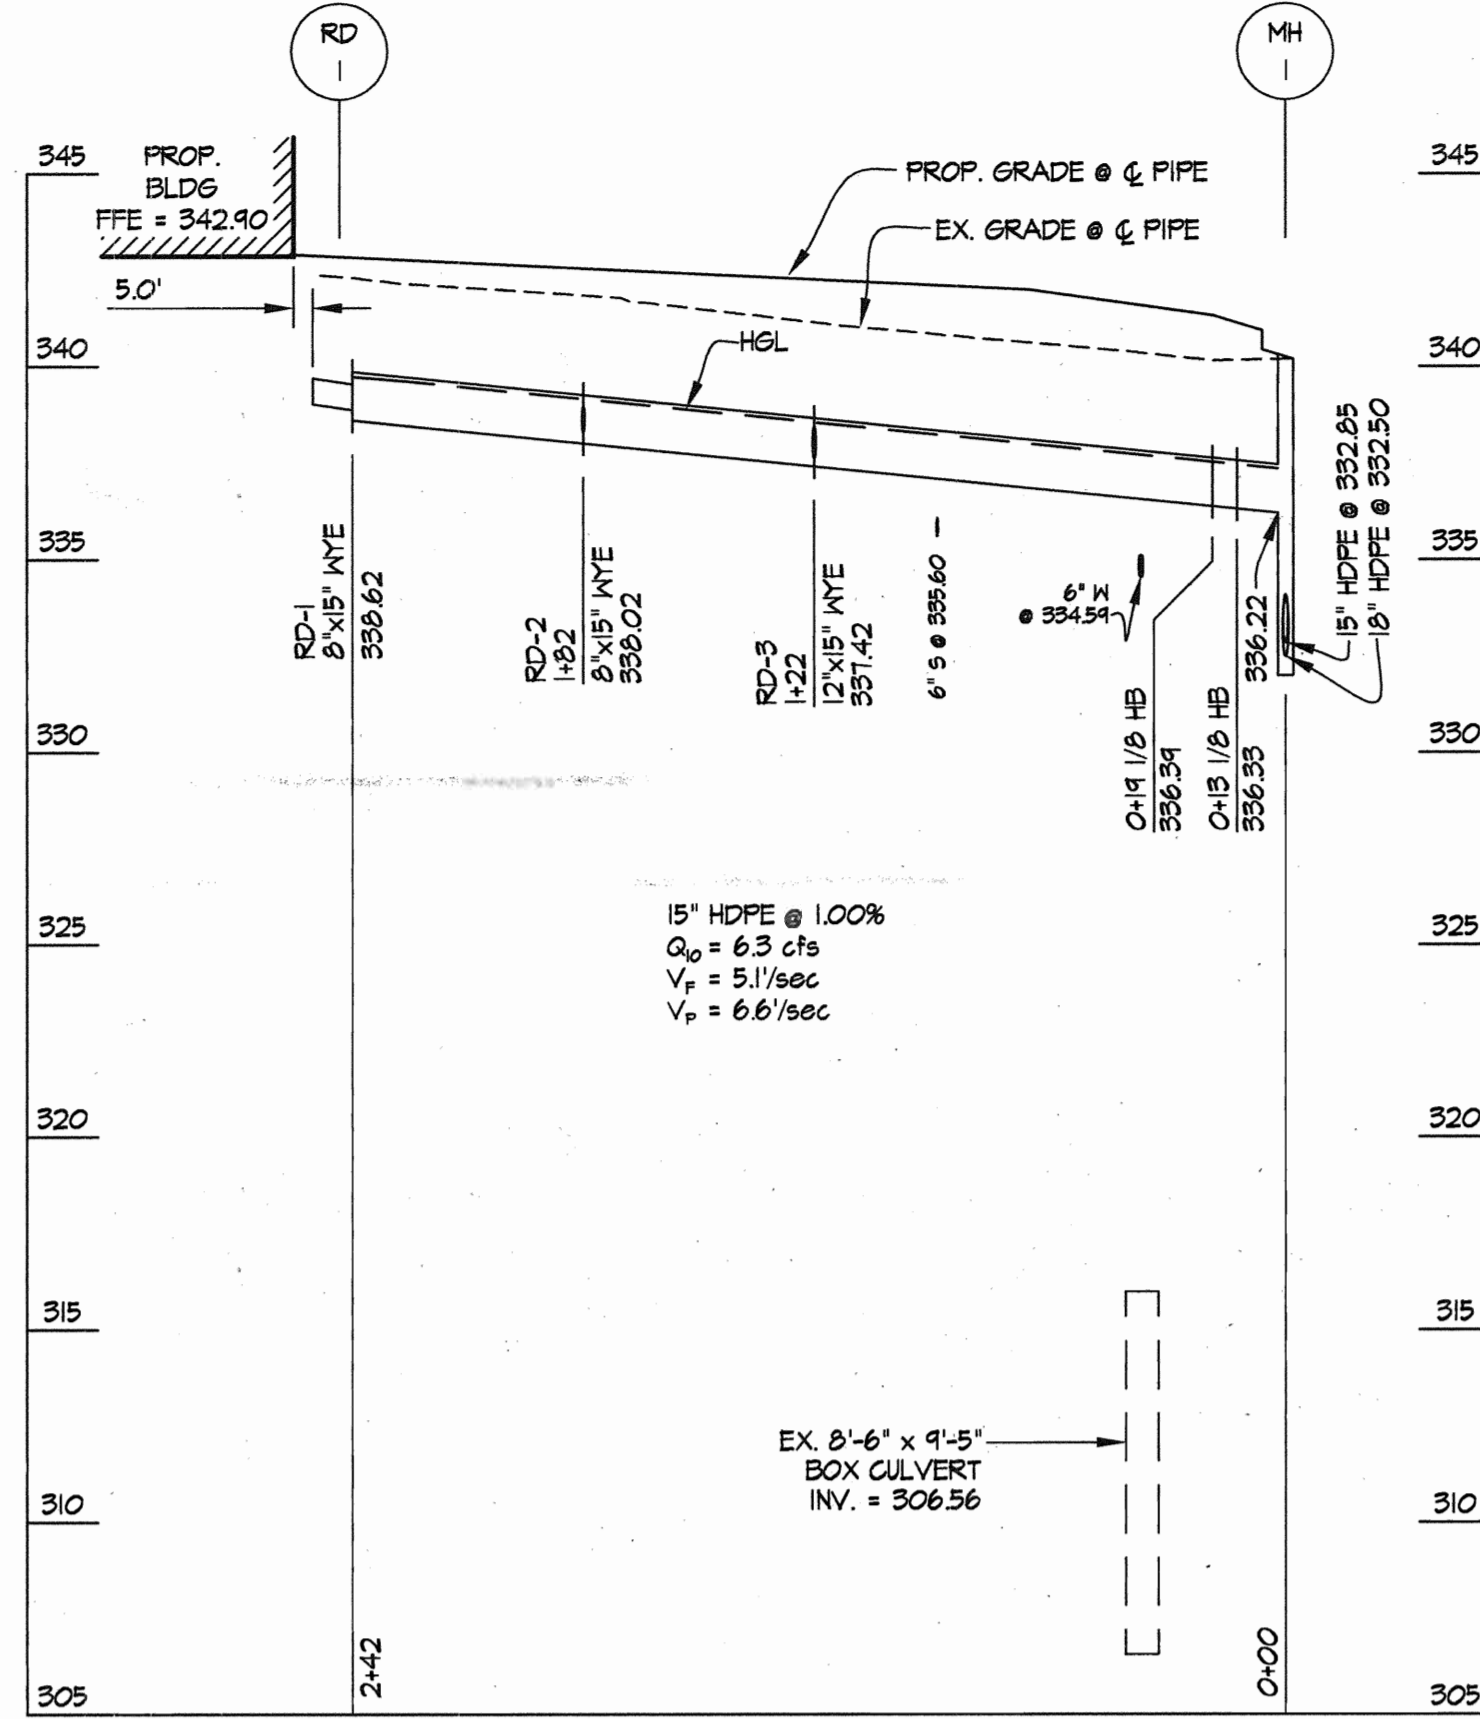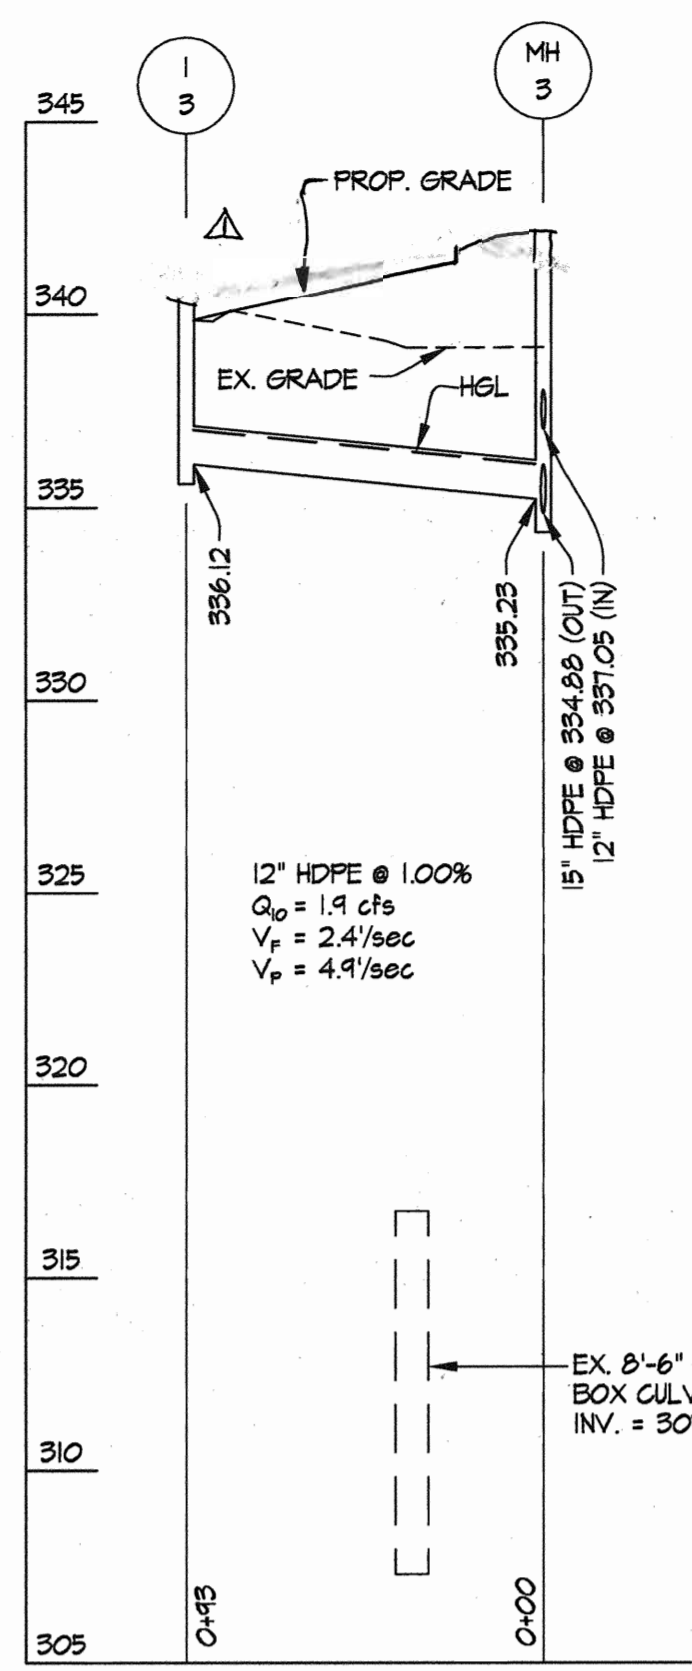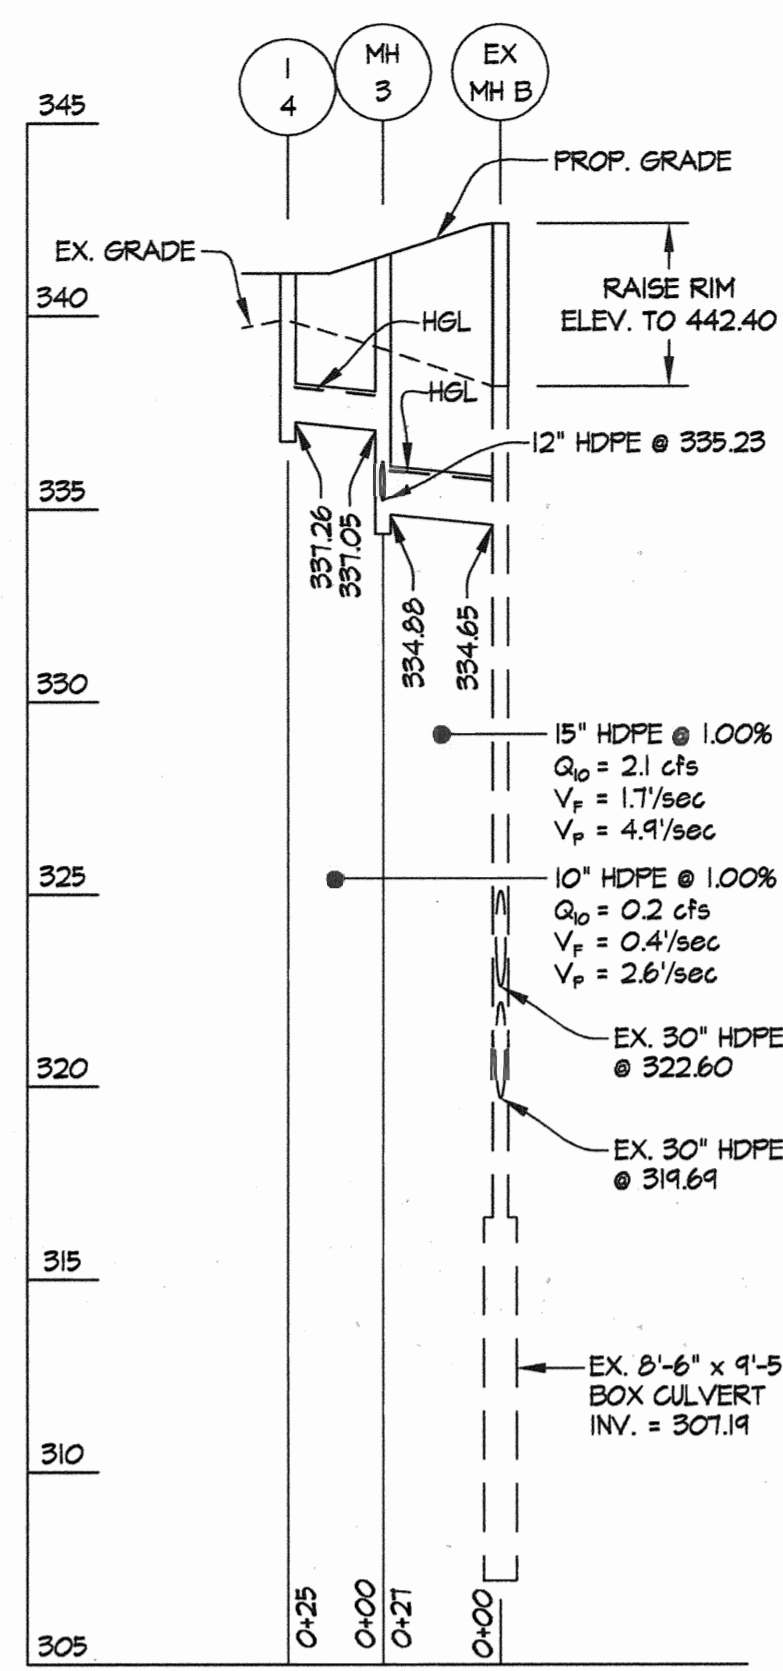

STRUCTURE SCHEDULE									
NO	TYPE	WIDTH (INSIDE)	TOP ELEVATION		INVERT ELEVATION		STD. DETAIL	LOCATIONS	REMARKS
			UPPER	LOWER	UPPER	LOWER			
1-1	A-10 INLET	3'-0"	339.20	339.12	---	334.87	HO. CO. SD-4.41	N 488,619 E 852,335	
1-2	A-10 INLET	3'-0"	---	339.00	---	334.75	HO. CO. SD-4.41	N 488,640 E 852,253	
1-3	A-5 INLET	3'-0"	340.23	340.17	---	336.12	HO. CO. SD-4.40	N 488,882 E 851,889	
1-4	YARD INLET	18"	---	341.10	---	337.26	HO. CO. SD-4.14	N 488,900 E 852,092	
1-5	YARD INLET	18"	---	340.60	---	336.55	HO. CO. SD-4.14	N 488,938 E 852,240	
MH-1	STANDARD MANHOLE	5'-0"	---	340.50	336.22	332.50	HO. CO. 6-5.12	N 488,692 E 852,292	
MH-2	STANDARD MANHOLE	5'-0"	---	339.59	334.44	333.16	HO. CO. 6-5.12	N 488,663 E 852,272	
MH-3	STANDARD MANHOLE	4'-0"	---	342.42	331.05	334.88	HO. CO. 6-5.12	N 488,879 E 852,080	

COORDINATE POINT GIVEN IS TO THE CENTERLINE OF STRUCTURE AT THE FACE OF CURB FOR INLETS AND TO THE CENTERLINE OF STRUCTURE FOR MANHOLES AND YARD INLETS.
NOTE: ALL WATER AND SEWER CROSSINGS SHOWN ARE PER CONTRACT: 24-413D



PIPE SCHEDULE			
SIZE	TYPE	QUANTITY (L.F.)	REMARKS
8"	HDPE	20'	
10"	HDPE	109'	
12"	HDPE	99'	
15"	HDPE	340'	
18"	HDPE	35'	

HDPE indicates High Density Polyethylene pipe, such as N-13 by ADS, or H-G by Hancox or an approved equal.
Trench bedding to be provided per Howard County Detail G 2.01.
Trench for P.V.C. pipe and H.D.P.E."

APPROVED: HOWARD COUNTY DEPARTMENT OF PLANNING & ZONING
 Director: *[Signature]* Date: 10/2/04
 Chief, Division of Land Development: *[Signature]* Date: 10/2/04
 Chief, Development Engineering Division: *[Signature]* Date: 10/2/04



PROFILES
SCALE: 1"=50' HORIZONTAL
1"=5' VERTICAL

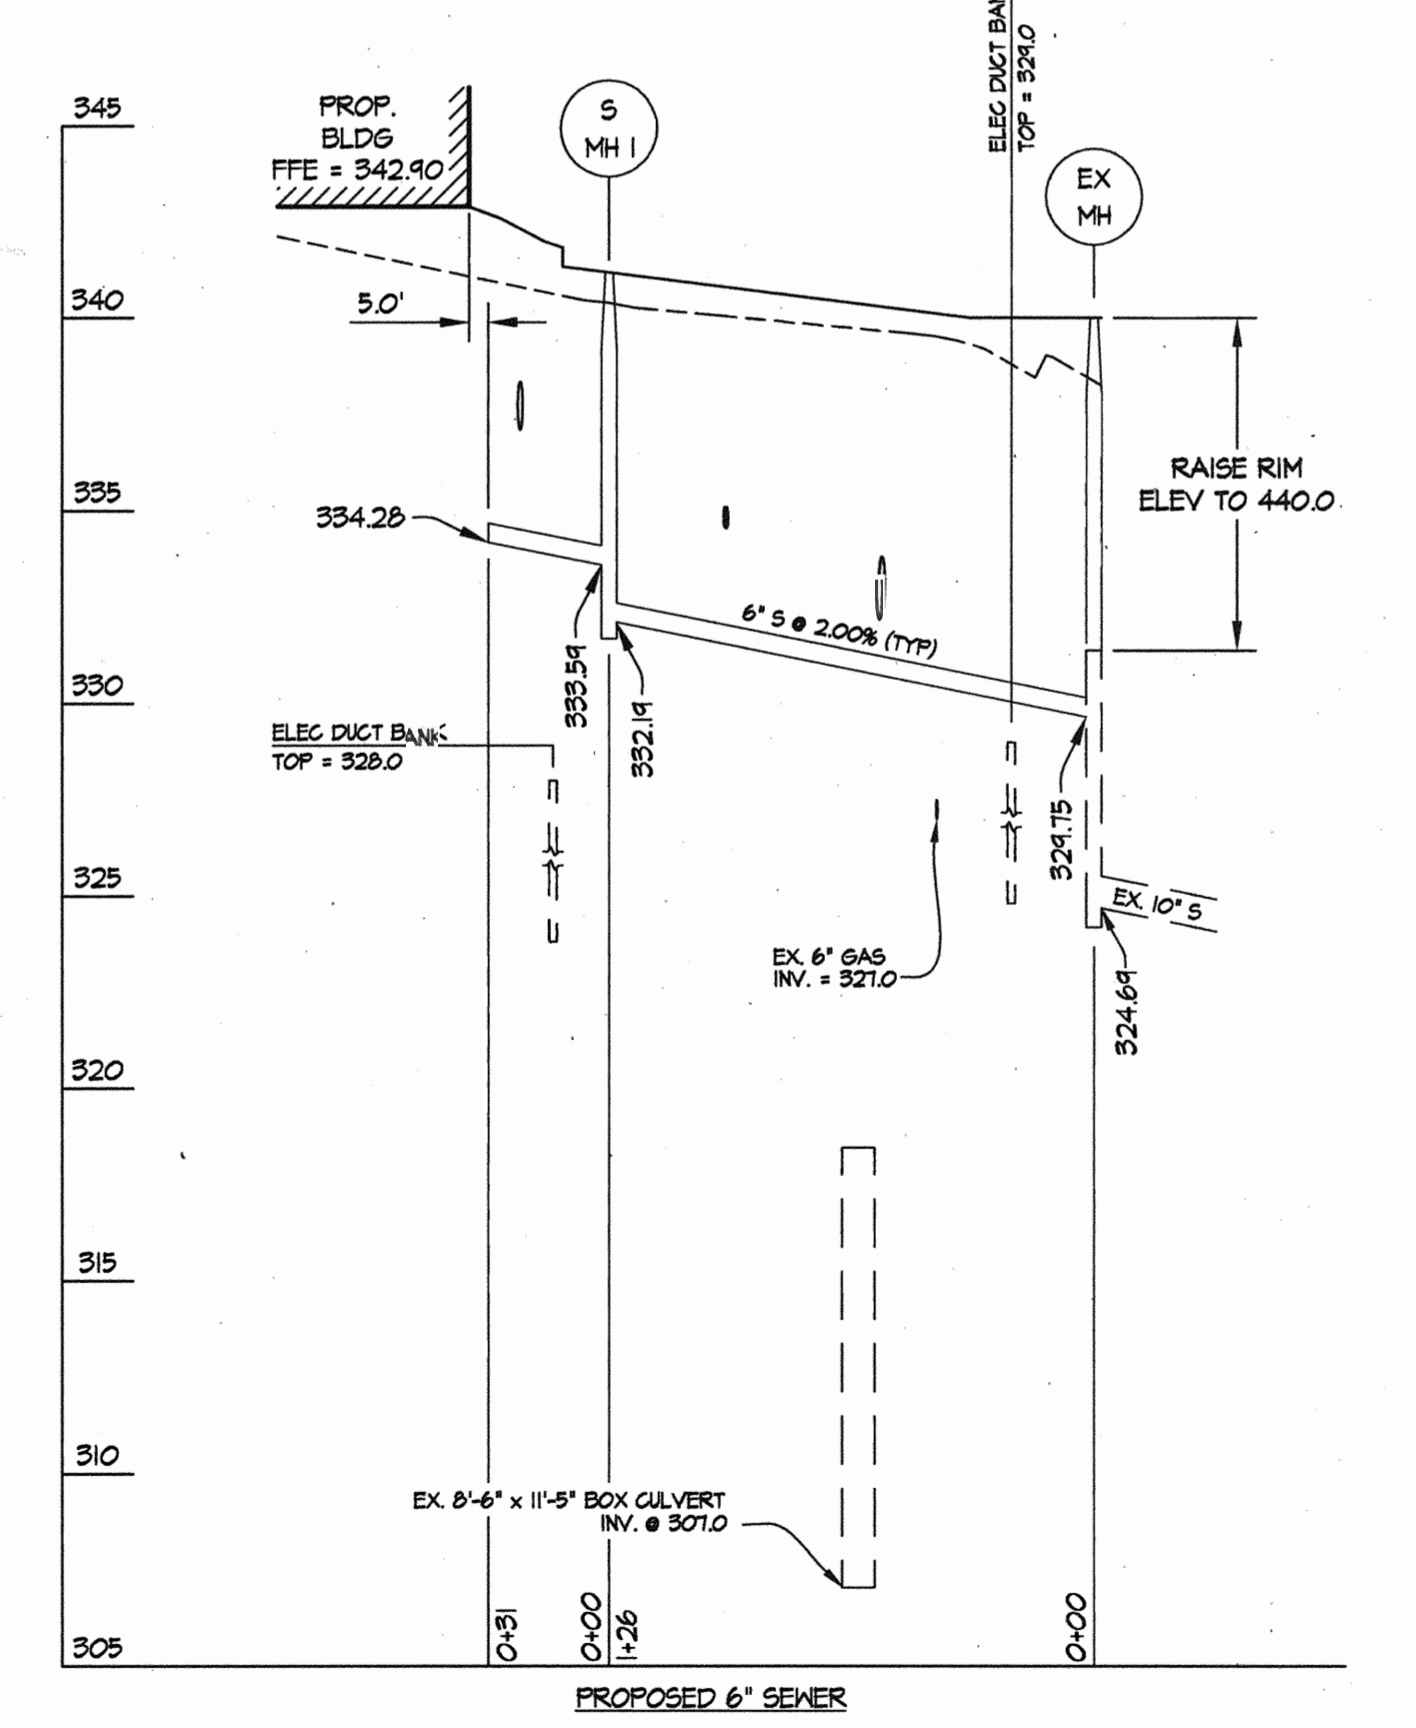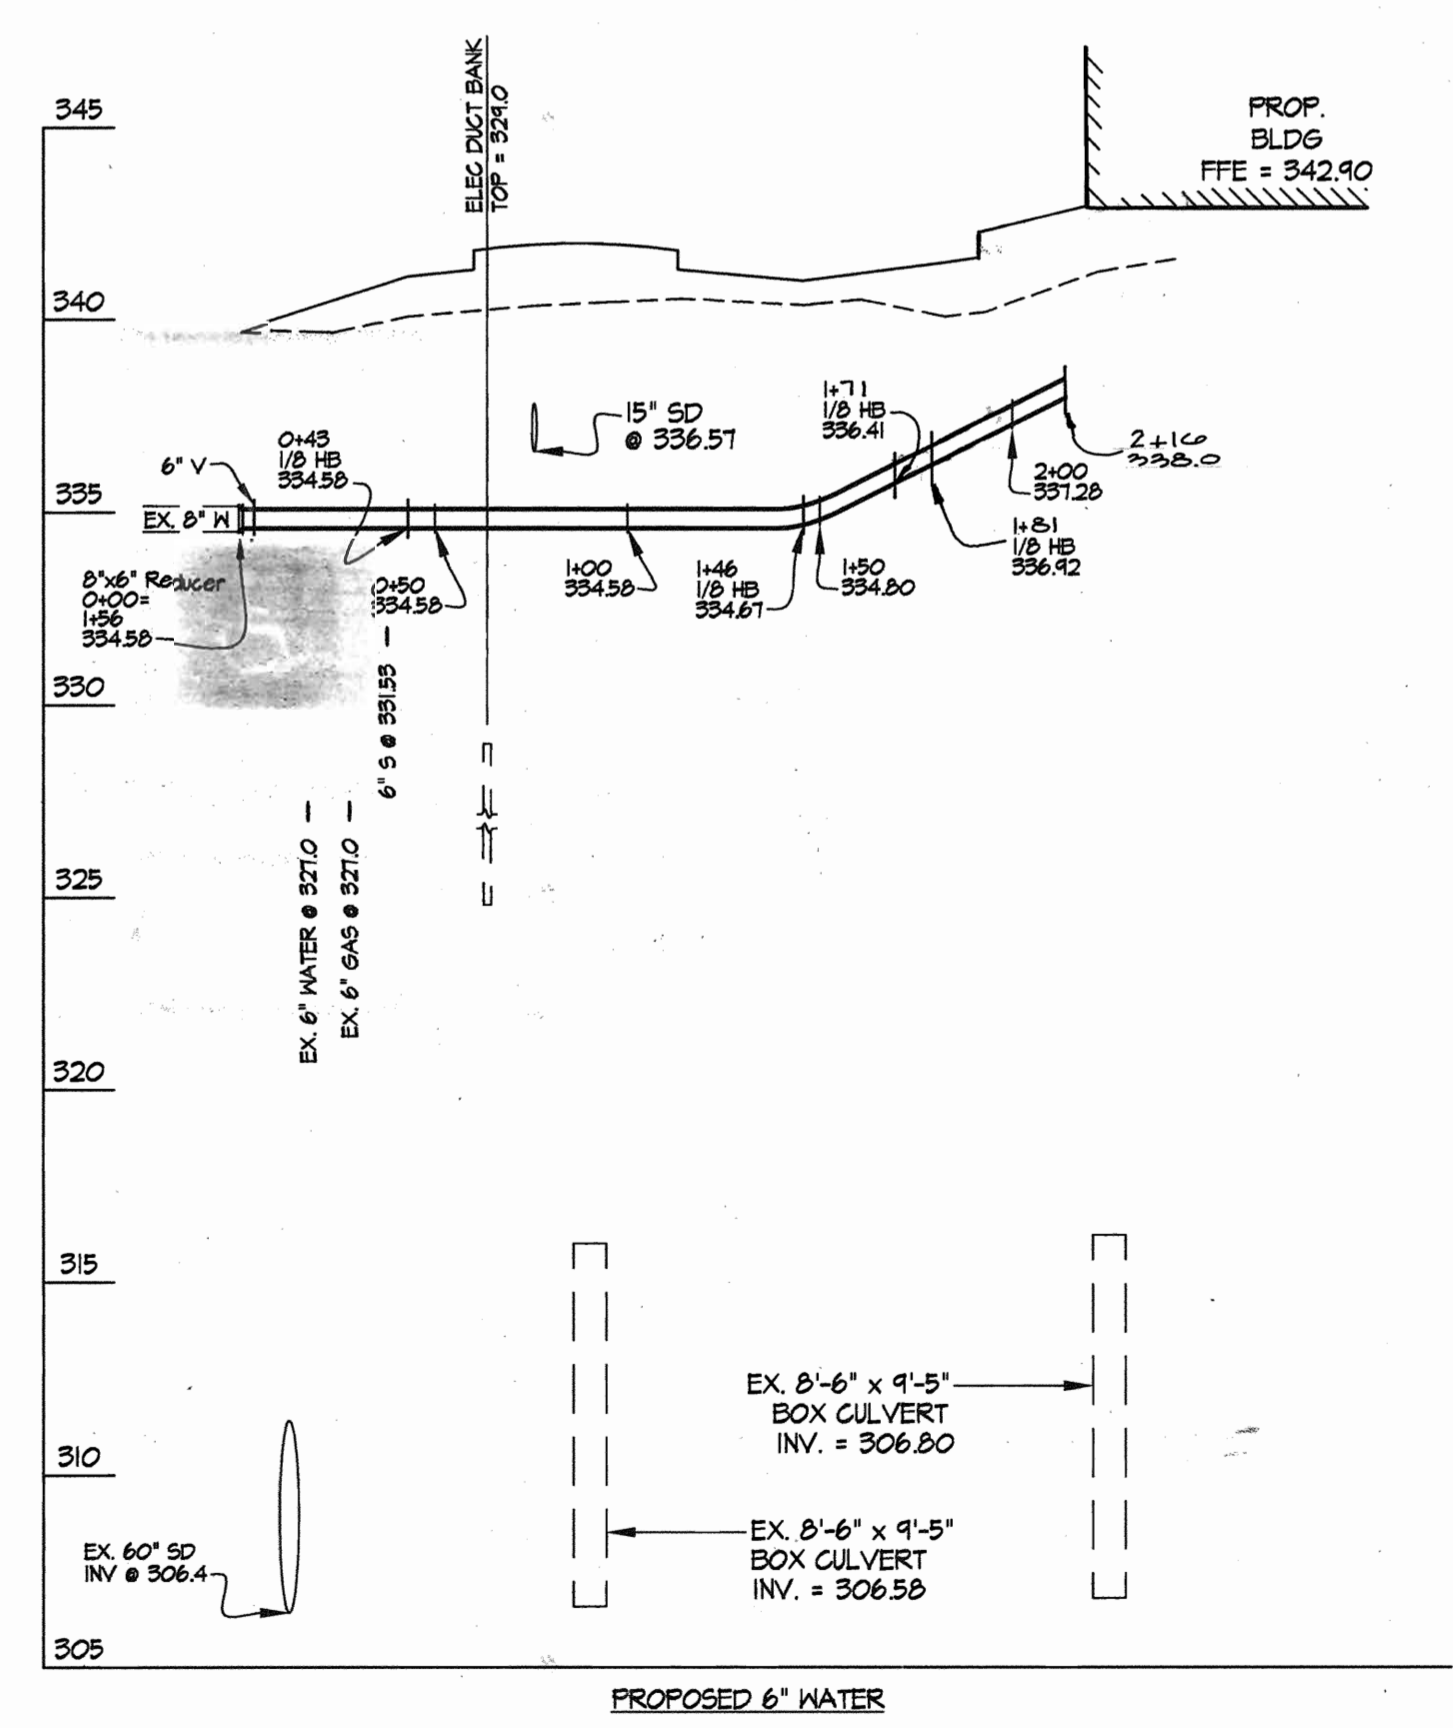

GLWGUTSCHICK LITTLE & WEBER, P.A.
CIVIL ENGINEERS, LAND SURVEYORS, LAND PLANNERS, LANDSCAPE ARCHITECTS
3909 NATIONAL DRIVE - SUITE 250 - BURTONSVILLE OFFICE PARK
BURTONSVILLE, MARYLAND 20886
TEL: 301-421-4024 BALT: 410-980-1820 DC/VA: 301-989-2524 FAX: 301-421-4186

DATE	REVISION	BY	APPR.
7/27/05	Revise storm drain runs 1-1 to MH2, 1-2 to MH2 and 1-3 to MH3. Revise structure schedule.	JNG	


PREPARED FOR:
GATEWAY 67 LLC
8815 CENTRE PARK DRIVE, SUITE 400
COLUMBIA, MD. 21045
PH.: 410-992-7348
ATTN: MR. ROGER WAESCHE

STORM DRAIN/UTILITY PROFILES
COLUMBIA GATEWAY
PARCEL N-13
Plot No. 17094
ELECTION DISTRICT No. 6

SCALE	ZONING	G. L. W. FILE No.
AS SHOWN	M-1	04032
DATE	TAX MAP - GRID	SHEET
Sept., 2004	42 - 12	5 OF 10

L:\CADD\DRAWINGS\04032\sdps\04032SP5.dwg 10/28/2004 11:03:14 AM EDT

DRAINAGE AREA INFORMATION			
STRUCTURE NO.	AREA	'C' VALUE	% IMP.
1-1	0.23 AC.	0.69	64%
1-2	0.43 AC.	0.80	79%
1-3	0.28 AC.	0.81	80%
1-4	0.12 AC.	0.24	0%
1-5	0.40 AC.	0.24	0%

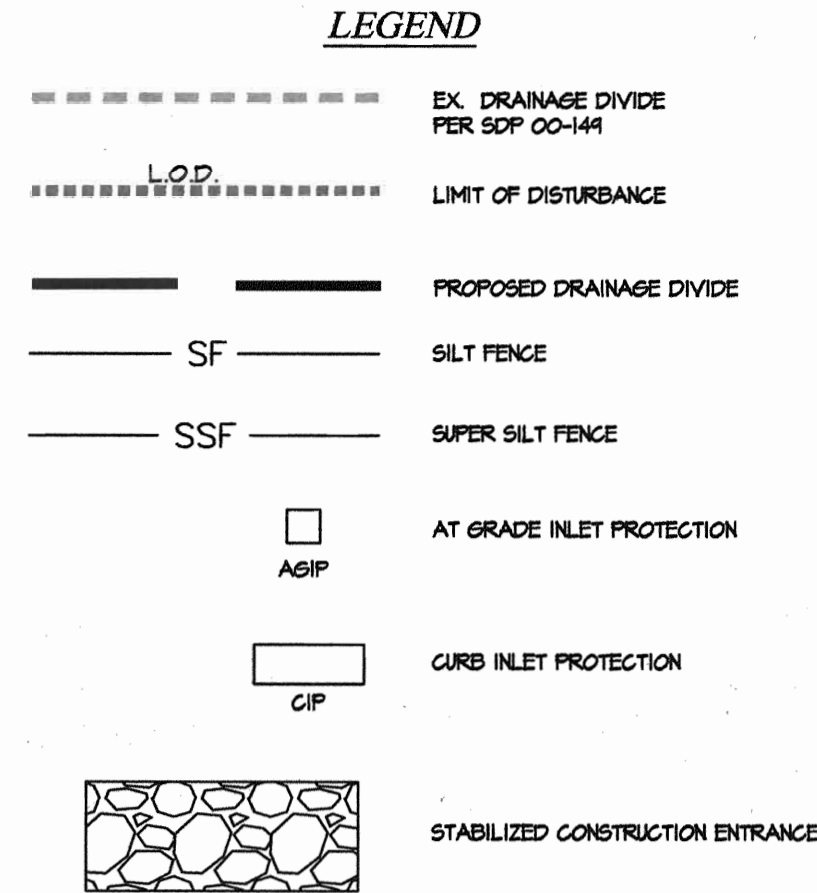

WHERE L.O.D. IS NOT SHOWN, THE SEDIMENT CONTROL DEVICES SHALL INDICATE THE LIMIT OF DISTURBANCE.
 DUE TO MASS GRADINGS, 'C' SOILS WERE USED FOR STORM DRAIN DESIGN.



ENGINEER'S CERTIFICATE

I certify that this plan for erosion and sediment control represents a practical and workable plan based on my personal knowledge of the site conditions and that it was prepared in accordance with the requirements of the Howard Soil Conservation District.

[Signature]
 Signature of Engineer Date 10/28/04

DEVELOPER'S/BUILDER'S CERTIFICATE

I/We certify that all development and/or construction will be done according to this plan, and that any responsible personnel involved in the construction project will have a Certificate of Attendance at a Maryland Department of the Environment Approved Training Program for the Control of Sediment and Erosion before beginning the project. I also authorize periodic on-site inspection.

[Signature]
 Signature of Developer/Builder Date 10/28/04
 Roger A. Waesche, Sr.
 Senior Vice President of Gateway 67, LLC

These plans have been reviewed for the Howard Soil Conservation District and meet the technical requirements.

[Signature]
 Natural Resources Conservation Service Date 11/6/04

This Development Plan is approved for Soil Erosion and Sediment Control by the Howard Soil Conservation District.

[Signature]
 Howard S.C.D. Date 11/6/04

APPROVED: HOWARD COUNTY DEPARTMENT OF PLANNING & ZONING

[Signature] Director Date 12/2/04
[Signature] Chief, Division of Land Development Date 12/3/04
[Signature] Chief, Development Engineering Division Date 11/22/04

ROBERT FULTON DRIVE
 (VARIABLE WIDTH WITH ADJ. PUBLIC)
 (PLAT NOS. 8818 & 10940)

COLUMBIA GATEWAY LOT 15
 PLAT NO. 14341
 ZONED: NEW TOWN

APPLIANCE PINK EAST
 PARCEL 'A-6'
 PLAT NO. 7363
 ZONED: M-1

SEDIMENT CONTROL PLAN/DRAINAGE AREA MAP
COLUMBIA GATEWAY
PARCEL N-13
 Plat No. 17094

Note: This Plan is For Sediment Control and Drainage Area Purposes Only!!

L:\CADD\DRAWINGS\04032\SDP\04032SP6.dwg 10/28/2004 01:58:06 PM EDT






GLW GUTSCHICK LITTLE & WEBER, P.A.
 CIVIL ENGINEERS, LAND SURVEYORS, LAND PLANNERS, LANDSCAPE ARCHITECTS
 3909 NATIONAL DRIVE - SUITE 250 - BURTONSVILLE OFFICE PARK
 BURTONSVILLE, MARYLAND 20886
 TEL: 301-421-4024 BALT: 410-980-1820 DC/VA: 301-989-2524 FAX: 301-421-4186

DATE	REVISION	BY	APPR.
7/28/05	Revise access to reflect new overhead door location		

PREPARED FOR:
 GATEWAY 67 LLC
 8815 CENTRE PARK DRIVE, SUITE 400
 COLUMBIA, MD. 21045
 PH.: 410-992-7348
 ATTN: MR. ROGER WAESCHE

SELECTION DISTRICT NO. 6
 HOWARD COUNTY, MARYLAND

SCALE	ZONING	G. L. W. FILE NO.
1"=40'	M-1	04032
DATE	TAX MAP - GRID	SHEET
Sept., 2004	42 - 12	6 OF 10

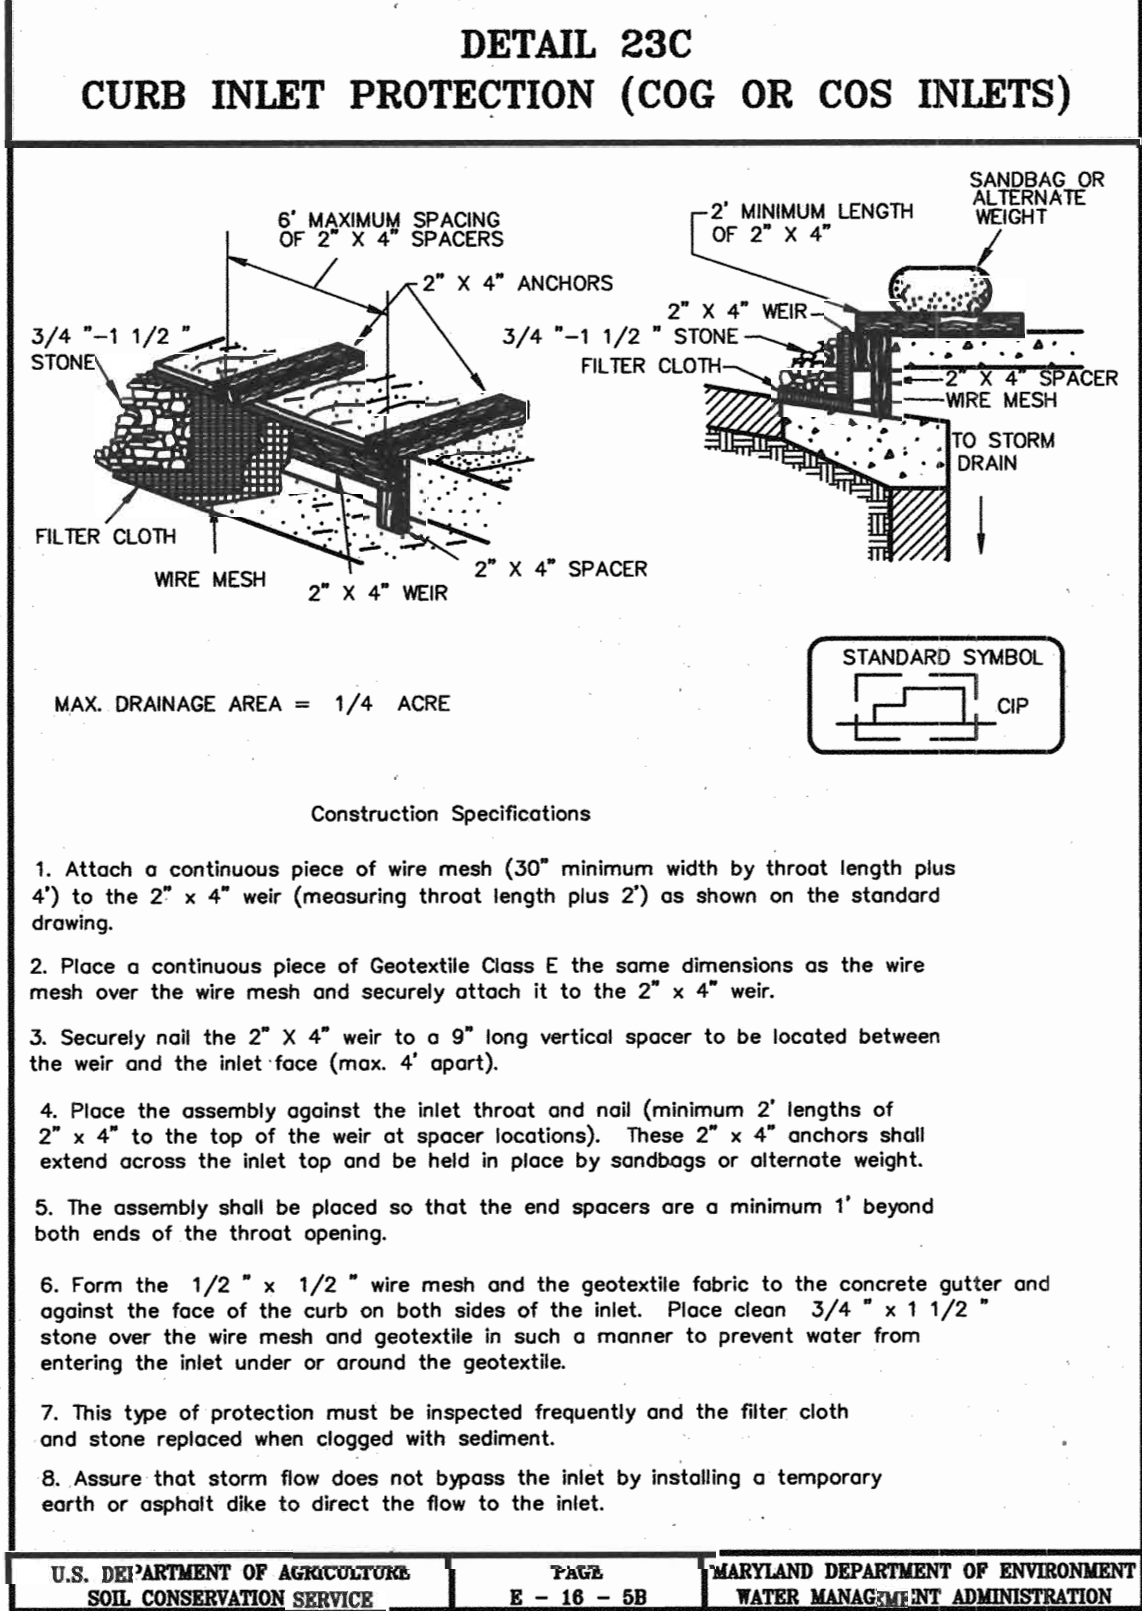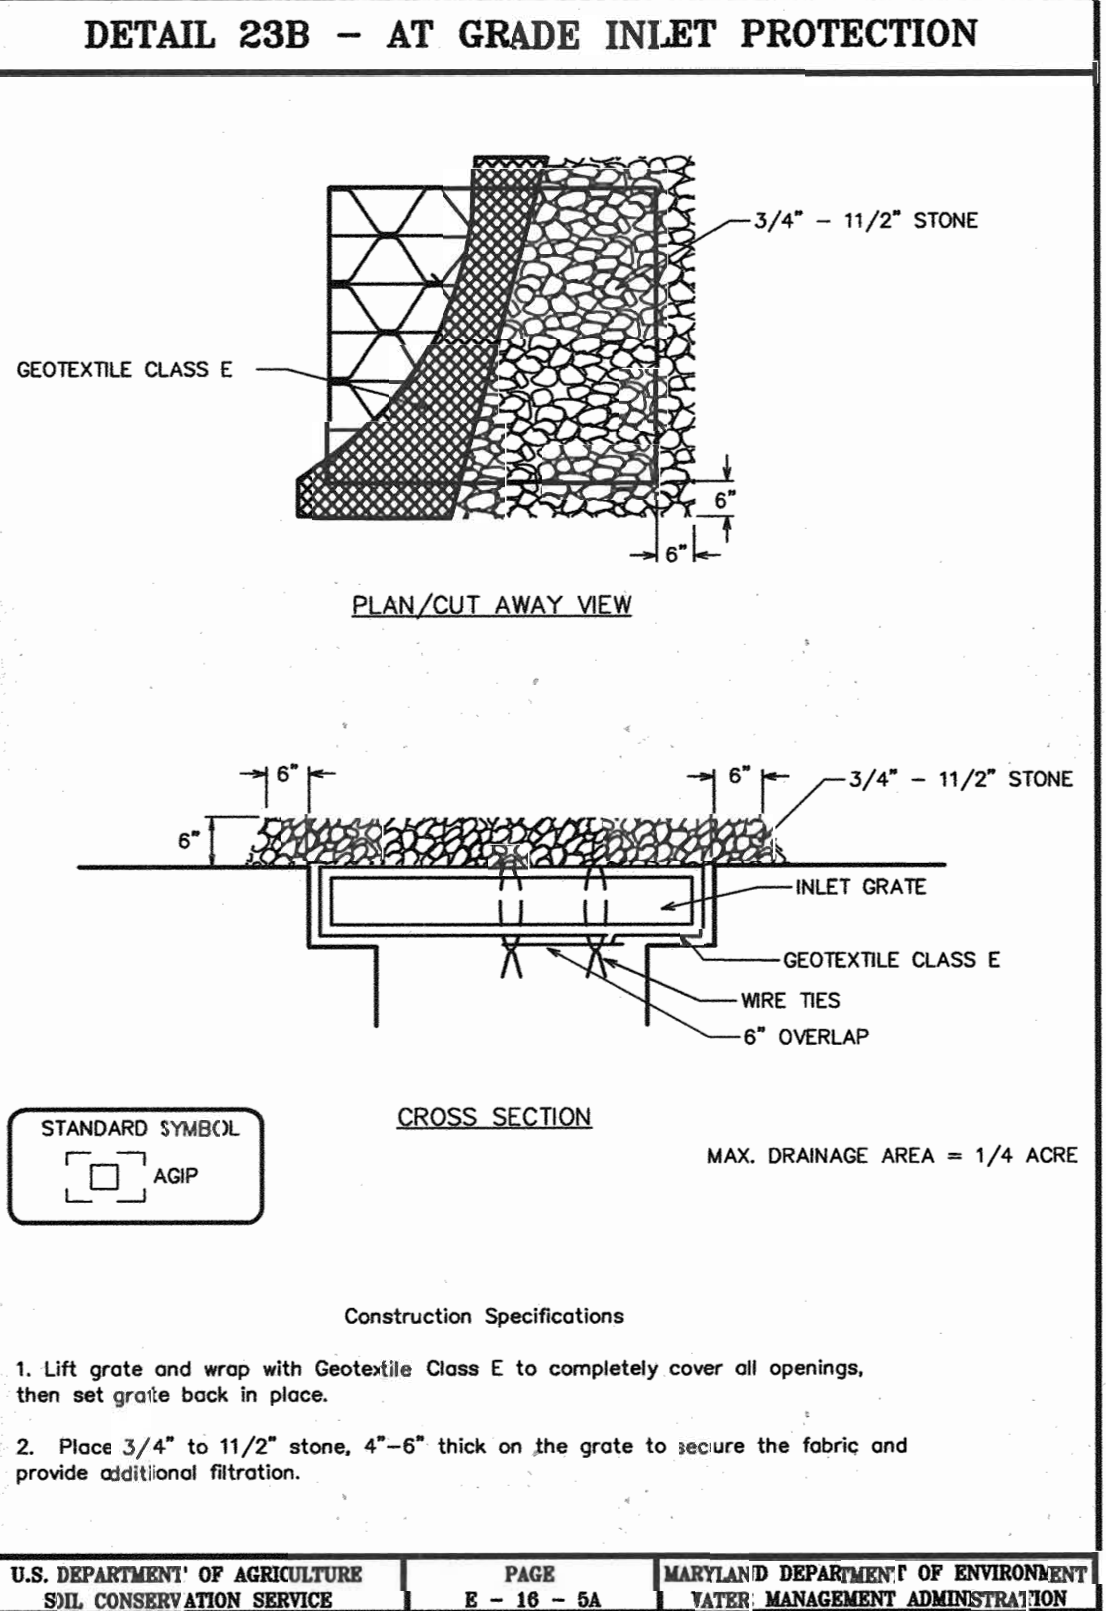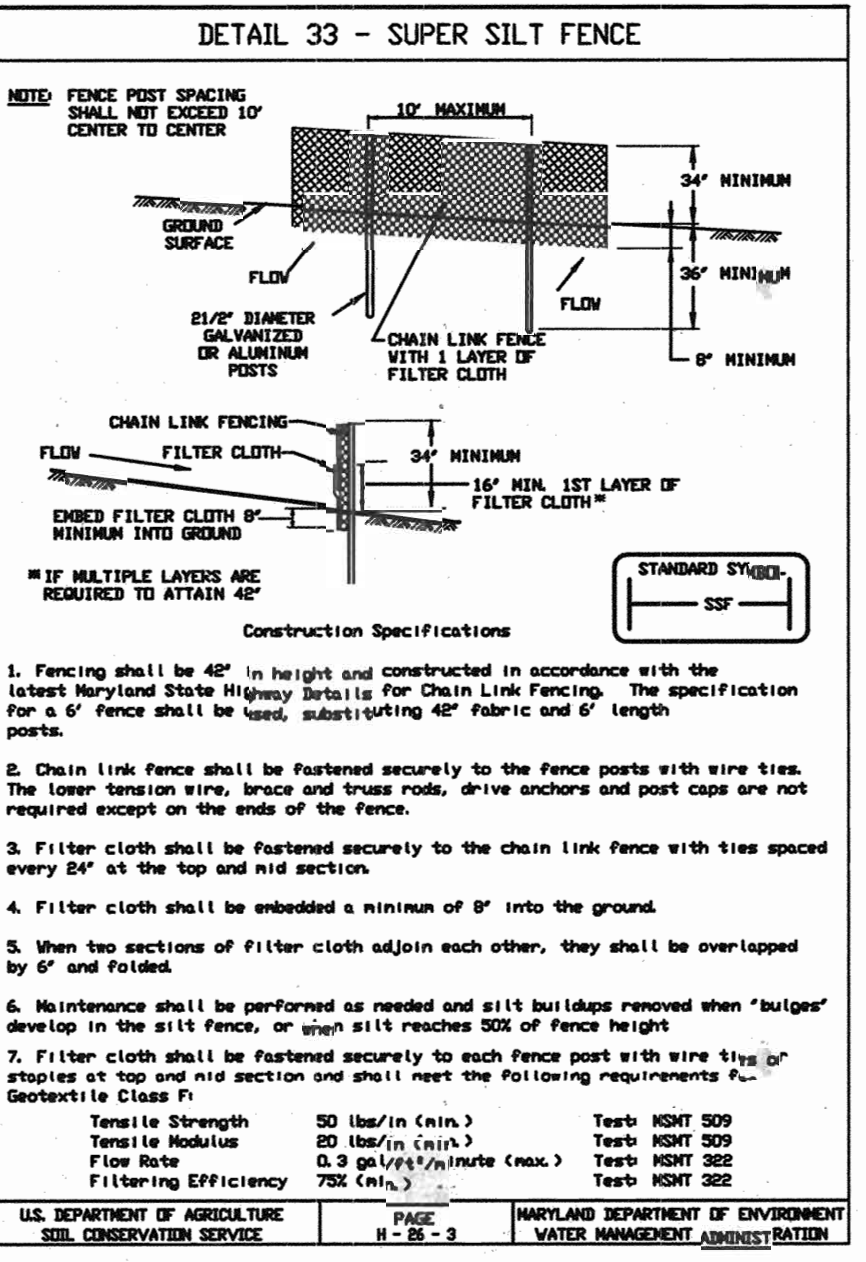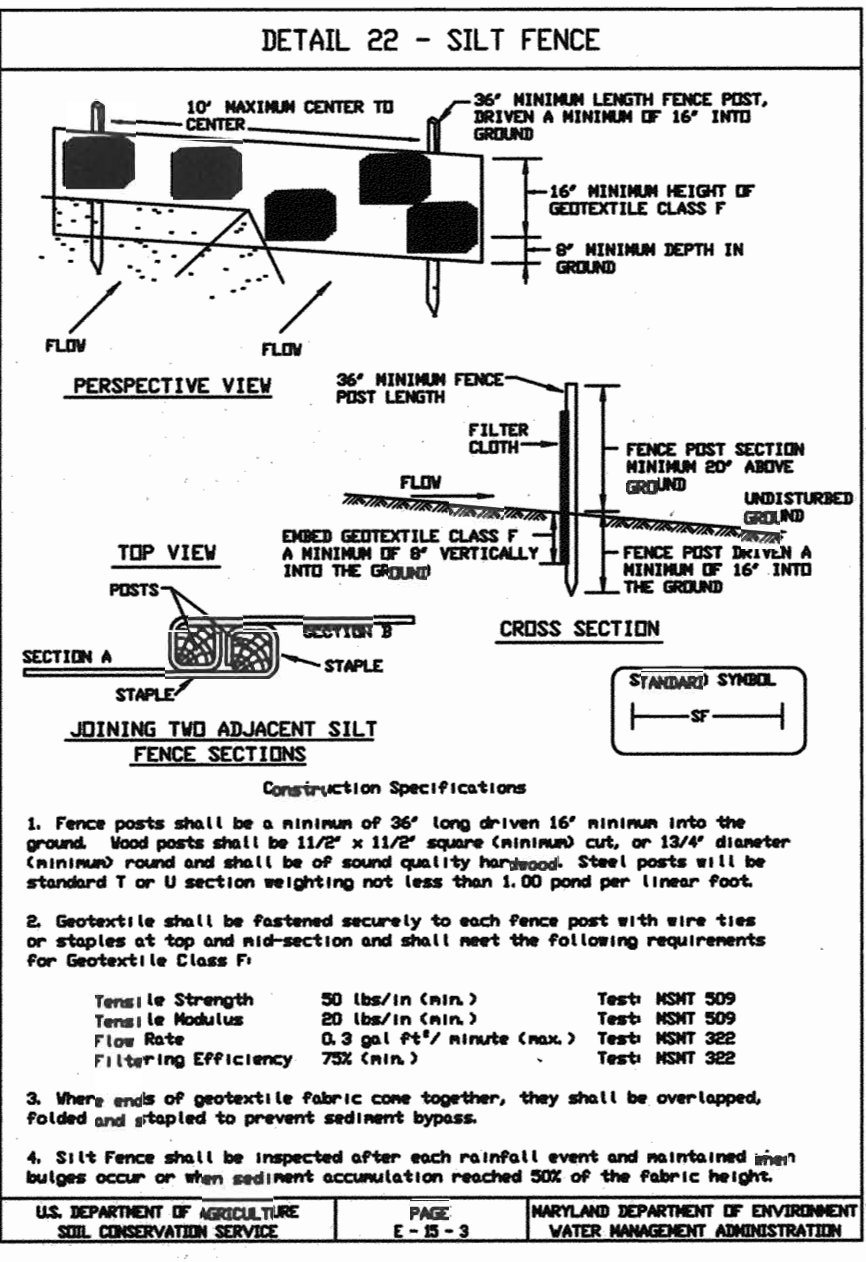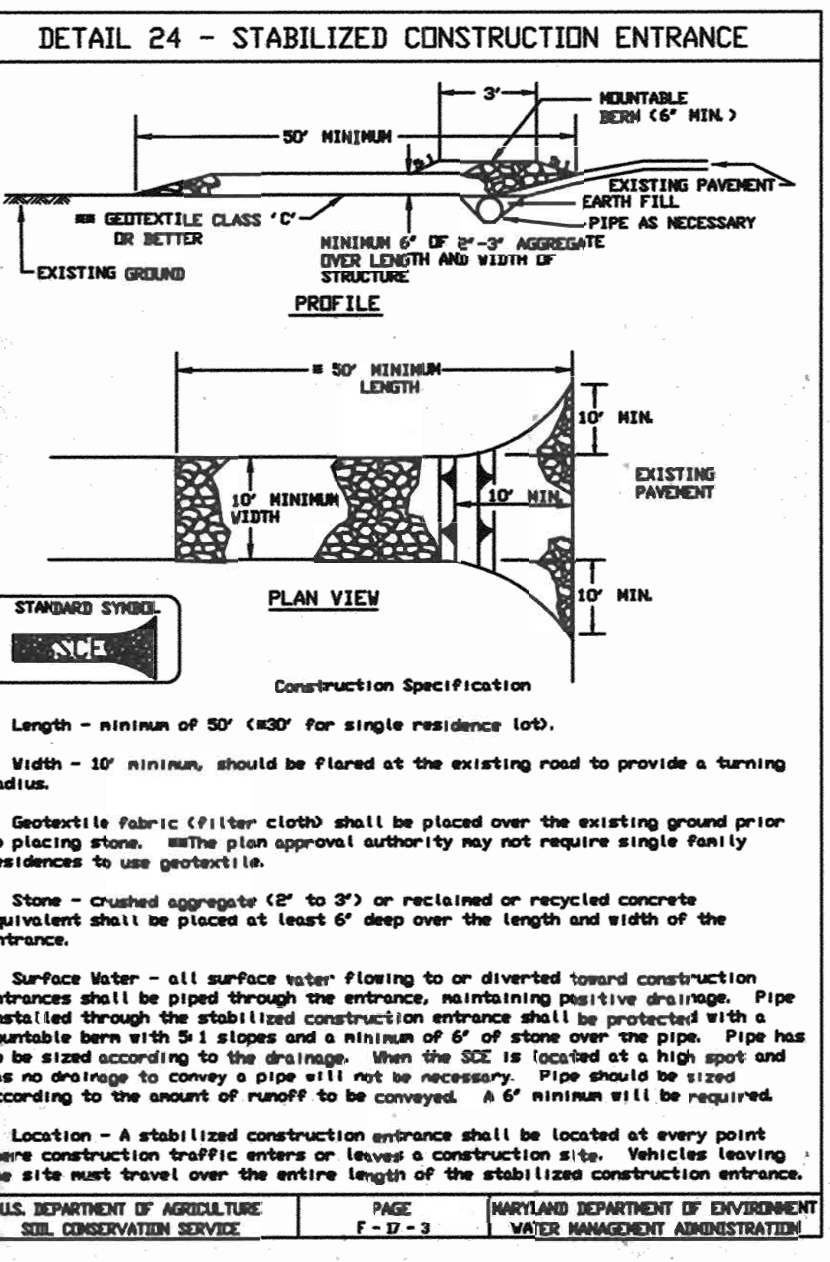

PERMANENT SEEDING NOTES

Apply to graded or cleared area not subject to immediate further disturbance where a permanent long-lived vegetative cover is needed.

Seedbed Preparation: Loosen upper three inches of soil by raking, discing or other acceptable means before seeding (unless previously loosened).

Soil Amendments: In lieu of soil test recommendations, use one of the following schedules:

- Preferred** - Apply 2 tons per acre dolomitic limestone (92 lbs/1000 square feet) and 600 lbs per acre 10-10-10 fertilizer (14 lbs/1000 sq ft) before seeding. Harrow or disc into upper three inches of soil. At time of seeding, apply 400 lbs per acre 30-0-0 ureaform fertilizer (9 lbs/1000 sq ft).
- Acceptable** - Apply 2 tons per acre dolomitic limestone (92 lbs/1000 sq ft) and 1000 lbs per acre 10-10-10 fertilizer (23 lbs/1000 sq ft) before seeding. Harrow or disc into upper three inches of soil.

Seeding: For the periods March 1 thru April 30, and August 1 thru October 15, seed with 60 lbs per acre (1.4 lbs/1000 sq ft) of Kentucky 31 Tall Fescue. For the period May 1 thru July 31, seed with 60 lbs Kentucky 31 Tall Fescue per acre and 2 lbs per acre (0.5 lbs/1000 sq ft) of weeping lovegrass. During the period of October 16 thru February 28, protect site by Option (1) 2 tons per acre of well anchored straw mulch and seed as soon as possible in the spring. Option (2) Use sod. Option (3) Seed with 60 lbs/acre Kentucky 31 Tall Fescue and mulch with 2 tons/acre well anchored straw.

Mulching: Apply 1-1/2 to 2 tons per acre (70 to 90 lbs/1000 sq ft) of unrotted small grain straw immediately after seeding. Anchor mulch immediately after application using mulch anchoring tool or 218 gallons per acre (5 gal/1000 sq ft) of emulsified asphalt on flat areas. On slopes 8 feet or higher, use 348 gallons per acre (8 gal/1000 sq ft) for anchoring.

Maintenance: Inspect all seeded areas and make needed repairs, replacements and reseedings.

TEMPORARY SEEDING NOTES

Apply to graded or cleared areas likely to be redistributed where a short-term vegetative cover is needed.

Seedbed Preparation: Loosen upper three inches of soil by raking, discing or other acceptable means before seeding (unless previously loosened).

Soil Amendments: Apply 600 lbs per acre 10-10-10 fertilizer (14 lbs/1000 sq ft).

Seeding: For periods March 1 thru April 30 and from August 15 thru October 15, seed with 2-1/2 bushel per acre of annual rye (3.2 lbs./1000 sq ft.). For the period May 1 thru August 14, seed with 3 lbs per acre of weeping lovegrass (.07 lbs/1000 sq ft). For the period November 16 thru February 28, protect site by applying 2 tons per acre of well anchored straw mulch and seed as soon as possible in the spring, or use sod.

Mulching: Apply 1-1/2 to 2 tons per acre (70 to 90 lbs/1000 sq ft) of unrotted, weed-free, small grain straw immediately after seeding. Anchor mulch immediately after application using mulch anchoring tool or 218 gal per acre (5 gal/1000 sq ft) of emulsified asphalt on flat areas. On slopes 8 ft or higher, use 348 gal per acre (8 gal/1000 sq ft) for anchoring.

Refer to the 1994 MARYLAND STANDARDS AND SPECIFICATIONS FOR SOIL EROSION AND SEDIMENT CONTROL for rate and methods not covered.

SEDIMENT CONTROL NOTES

- A minimum of 24 hours notice must be given to the Howard County Office of Inspection and Permits prior to the start of any construction. (410) 313-1855.
- All vegetative and structural practices are to be installed according to the provisions of this plan and are to be in conformance with the 1994 MARYLAND STANDARDS AND SPECIFICATIONS FOR SOIL EROSION AND SEDIMENT CONTROL.
- Following initial soil disturbance or redistribution, permanent or temporary stabilization shall be completed within: a) 7 calendar days for all perimeter sediment control structures, dikes and perimeter slopes and all slopes greater than 3:1, b) 14 days as to all other disturbed or graded areas on the project site.
- All sediment traps/basins shown must be fenced and warning signs posted around their perimeter in accordance with Vol. 1, Chapter 12, of the HOWARD COUNTY DESIGN MANUAL, Storm Drainage.
- All disturbed areas must be stabilized within the time period specified above in accordance with the 1994 MARYLAND STANDARDS AND SPECIFICATIONS FOR SOIL EROSION AND SEDIMENT CONTROL for permanent seedings, sod, temporary seeding and mulching (Sec. G). Temporary stabilization, with mulch alone, can only be done when recommended seeding dates do not allow for proper germination and establishment of grasses.
- All sediment control structures are to remain in place and are to be maintained in operative condition until permission for their removal has been obtained from the Howard County Sediment Control Inspector.
- Site Analysis:**

Total Area of Site	: 3.87 Acres±
Area Disturbed	: 3.50 Acres±
Area to be roofed or paved	: 2.05 Acres±
Area to be vegetatively stabilized	: 1.45 Acres±
Total Cut	: 329 Cu. Yds.
Total Fill	: 8619 Cu. Yds.

 Off-site waste/borrow area location: To be determined.
- Any sediment control practice which is disturbed by grading activity for placement of utilities must be repaired on the same day of disturbance.
- Additional sediment control must be provided, if deemed necessary by the Howard County DPW Sediment Control Inspector.
- On all sites with disturbed areas in excess of 2 acres, approval of the inspection agency shall be requested upon completion of installation of perimeter erosion and sediment controls, but before proceeding with any other earth disturbance or grading. Other building or grading inspection approvals may not be authorized until this initial approval by the inspection agency is made.
- Trenches for the construction of utilities is limited to 3 pipe lengths or that which shall be backfilled and stabilized within one working day, whichever is shorter.

SEQUENCE OF CONSTRUCTION

- OBTAIN GRADING PERMIT AND ARRANGE PRE-CONSTRUCTION MEETING WITH SEDIMENT CONTROL INSPECTOR. (1 DAY)
- INSTALL STABILIZED CONSTRUCTION ENTRANCE AND SILT FENCE/SUPER SILT FENCE. (2 DAYS)
- CONSTRUCT THE WATER FROM THE EXISTING STUB AND THE SEWER FROM THE EXISTING MANHOLE TO WITHIN 5 FEET OF THE BUILDING. INSTALL THE STORM DRAIN SYSTEM. (5 DAYS)
- GRADE SITE.
- CONSTRUCT BUILDING.
- FINE GRADE SITE.
- INSTALL CURB AND CUTTER, SIDEWALK, AND BASE PAVING. STABILIZE REMAINING AREAS WITH GRASS, SEED, AND MULCH. (7 DAYS)
- WHEN AREAS DRAINING TO THE SEDIMENT CONTROL DEVICES HAVE BEEN STABILIZED AND PERMISSION IS GRANTED BY THE SEDIMENT CONTROL INSPECTOR, REMOVE SEDIMENT CONTROL DEVICES. (1 WEEK)
- INSTALL SURFACE PAVING. (1 WEEK)
- INSTALL LANDSCAPING. (1 WEEK)
- REMOVE ANY REMAINING SEDIMENT CONTROL DEVICES AND STABILIZE AREAS AS NECESSARY. (3 DAYS)

APPROVED: HOWARD COUNTY DEPARTMENT OF PLANNING & ZONING

Director: *[Signature]* Date: 10/28/04

Chief, Division of Land Development: *[Signature]* Date: 10/28/04

Chief, Development Engineering Division: *[Signature]* Date: 10/28/04



ENGINEER'S CERTIFICATE

I certify that this plan for erosion and sediment control represents a practical and workable plan based on my personal knowledge of the site conditions and that it was prepared in accordance with the requirements of the Howard Soil Conservation District.

[Signature] Date: 10/28/04

DEVELOPER'S/BUILDER'S CERTIFICATE

I/We certify that all development and/or construction will be done according to this plan, and that any responsible personnel involved in the construction project will have a Certificate of Attendance at a Maryland Department of the Environment Approved Training Program for the Control of Sediment and Erosion before beginning the project. I also authorize periodic on-site inspection by the HSCD.

[Signature] Date: 10/28/04

[Signature] Date: 11/10/04

These plans have been reviewed for the Howard Soil Conservation District and meet the technical requirements.

This Development Plan is approved for Soil Erosion and Sediment Control by the Howard Soil Conservation District.

[Signature] Date: 11/10/04

GLW GUTSCHICK LITTLE & WEBER, I.A.
 CIVIL ENGINEERS, LAND SURVEYORS, LAND PLANNERS, LANDSCAPE ARCHITECTS
 3909 NATIONAL DRIVE - SUITE 200 - BURTONSVILLE OFFICE PARK
 BURTONSVILLE, MARYLAND 20866
 TEL: 301-421-4024 FAX: 301-421-4186

REVISION	DATE	BY	APP'R.
JNG			

PREPARED FOR:
 GATEWAY 67 LLC
 8815 CENTRE PARK DRIVE, SUITE 400
 COLUMBIA, MD. 21045
 PH.: 410-992-7348
 ATTN: MR. ROGER WAESCHE

SEDIMENT CONTROL NOTES & DETAILS

COLUMBIA GATEWAY
 PARCEL N-13
 Plat No. 17094


ELECTION DISTRICT No. 6

HOWARD COUNTY, MARYLAND

SCALE	ZONING	G. L. W. FILE NO.
NO SCALE	M-1	64032
DATE	TAX MAP - GRID	SHEET
Sept., 2004	42 - 12	7 OF 10

PLANT SCHEDULE

TYPE	SYMBOL	QUANT.	NAME (BOTANICAL/COMMON)	SIZE	COMMENTS
CANOPY SHADE TREE	RS	13	ACER RUBRUM 'RED SUNSET' / RED SUNSET RED MAPLE	2.5'-3" GAL.	B4B
	SS	9	ACER RUBRUM 'SCARLET SENTINEL' / SCARLET SENTINEL RED MAPLE	2.5'-3" GAL.	B4B
	P	20	PLATANUS x ACERIFOLIA 'BLOODGOOD' / BLOODGOOD LONDON PLANETREE	2.5'-3" GAL.	B4B
	Q	7	QUERCUS PHELLOS / WILLOW OAK	2.5'-3" GAL.	B4B
EVERGREEN TREE	PS	43	PINUS STROBUS / EASTERN WHITE PINE	10' HT. MIN.	B4B, WITH INTACT CENTRAL LEADER
	PO	27	PICEA OMERIKA / ABIES	10' HT. MIN.	B4B, WITH INTACT CENTRAL LEADER
ORNAMENTAL TREE	MZ	9	MALUS 'ZUMI' / ZUMI CRABAPPLE	2" GAL MIN.	B4B
	PP	11	PURPLE LEAF PLUM	2" GAL MIN.	B4B
	SI	126	COTONEASTER DAMMERII 'CORAL BEAUTY' / CORAL BEAUTY COTONEASTER COTONEASTER HORIZONTALIS 'TOM THUMB' / TOM THUMB COTONEASTER JUNIFERUS HORIZONTALIS VAR. / JUNIFER VAR. 'BAR HARBOR', 'ANDORRA', 'WILTON BLUE RUS'	ALL 10" - 24" SPREAD	ALL CONTAINERIZED

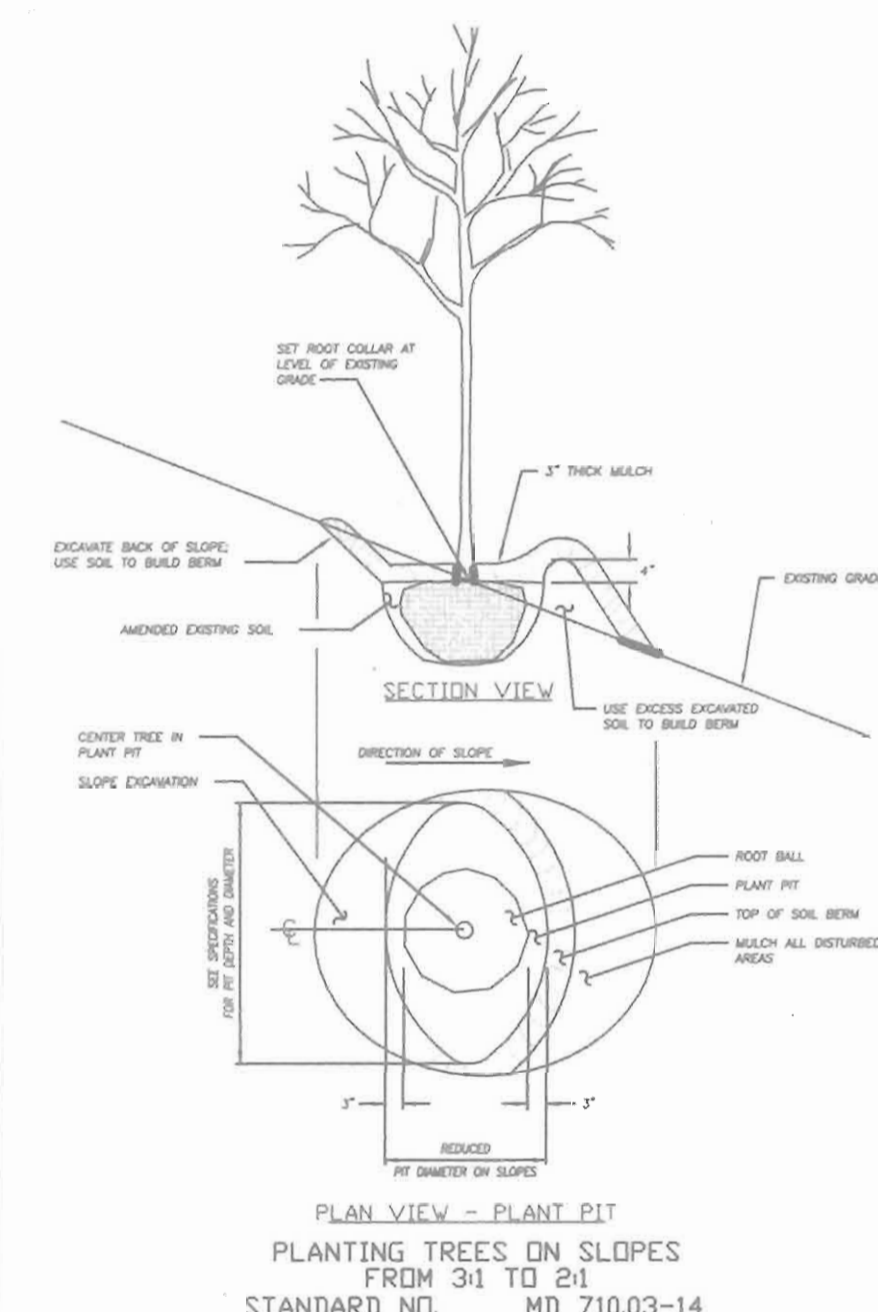

- SEASONAL COLOR PLANTING OF HERBACEOUS PLANT MATERIAL (TO BE SELECTED BY OWNER)
- UTILITY EASEMENTS (SHADED AREA). PERMANENT PLANTING IS NOT PERMITTED IN THIS AREA
- SHADE TREE PER SDP-00-144
- EVERGREEN TREE PER SDP-00-144

THE OWNER SHALL BE RESPONSIBLE FOR THE RESTORATION OF ANY LANDSCAPING DISTURBED BY STORM DRAIN MAINTENANCE OPERATIONS BY THE DEPARTMENT OF PUBLIC WORKS.

DEVELOPER'S/BUILDER'S CERTIFICATE

I/WE CERTIFY THAT THE LANDSCAPING SHOWN ON THIS PLAN WILL BE DONE ACCORDING TO THE PLAN, SECTION 16.124 OF THE HOWARD COUNTY CODE AND THE HOWARD COUNTY LANDSCAPE MANUAL. I/WE FURTHER CERTIFY THAT UPON COMPLETION A LETTER OF LANDSCAPE INSTALLATION, ACCOMPANIED BY AN EXECUTED ONE YEAR GUARANTEE OF PLANT MATERIALS, WILL BE SUBMITTED TO THE DEPARTMENT OF PLANNING AND ZONING.

Roger A. Waesche, Jr.
NAME: Roger A. Waesche, Jr. DATE: 10/28/04
Senior Vice President of Gateway 67, LLC



APPROVED: HOWARD COUNTY DEPARTMENT OF PLANNING & ZONING

Mark DeLoye 10/28/04
Director Date

Chris Hamrick 10/28/04
Chief, Division of Land Development Date

Chris Hamrick 10/28/04
Chief, Development Engineering Division Date

APPLIANCE PARK EAST
PARCEL 'A-6'
PLAT NO. T563

APPLIANCE PARK EAST
PARCEL 'A-6'
PLAT NO. 15141
ZONED: M-1


COLUMBIA GATEWAY
LOT 15
PLAT NO. 14341
ZONED: NEW TOWN

GATEWAY COMMERCE CENTER
PARCEL 'A-10'
PLAT NO. 10340
ZONED: NEW TOWN

GLWGUTSCHICK LITTLE & WEBER, P.A. CIVIL ENGINEERS, LAND SURVEYORS, LAND PLANNERS, LANDSCAPE ARCHITECTS 3909 NATIONAL DRIVE - SUITE 250 - BURTONSVILLE OFFICE PARK BURTONSVILLE, MARYLAND 20886 TEL: 301-421-4024 BALT: 410-880-1820 DC/VA: 301-989-2524 FAX: 301-421-4186	7/28/05	Revise access to reflect new overhead door location and revised landscaping accordingly.	JNG			PREPARED FOR: GATEWAY 67 LLC 8815 CENTRE PARK DRIVE, SUITE 400 COLUMBIA, MD. 21045 PH.: 410-992-7348 ATTN: MR. ROGER WAESCHE	LANDSCAPE/PERIMETER PLANTING PLAN COLUMBIA GATEWAY PARCEL N-13 Plat No. 17094	SCALE	ZONING	G. L. W. FILE No.
								1"=40'	M-1	04032
								DATE	TAX MAP - GRID	SHEET
								Sept., 2004	42 - 12	8 OF 10

Drawings\04032\SDP\04032SP8.dwg DES. DEV DRN. JAU CHK. DEV DATE REVISION BY APP'R ELECTION DISTRICT No. 6 HOWARD COUNTY, MARYLAND SDP-04-148

THIS PLAN IS FOR PLANTING PURPOSES ONLY!

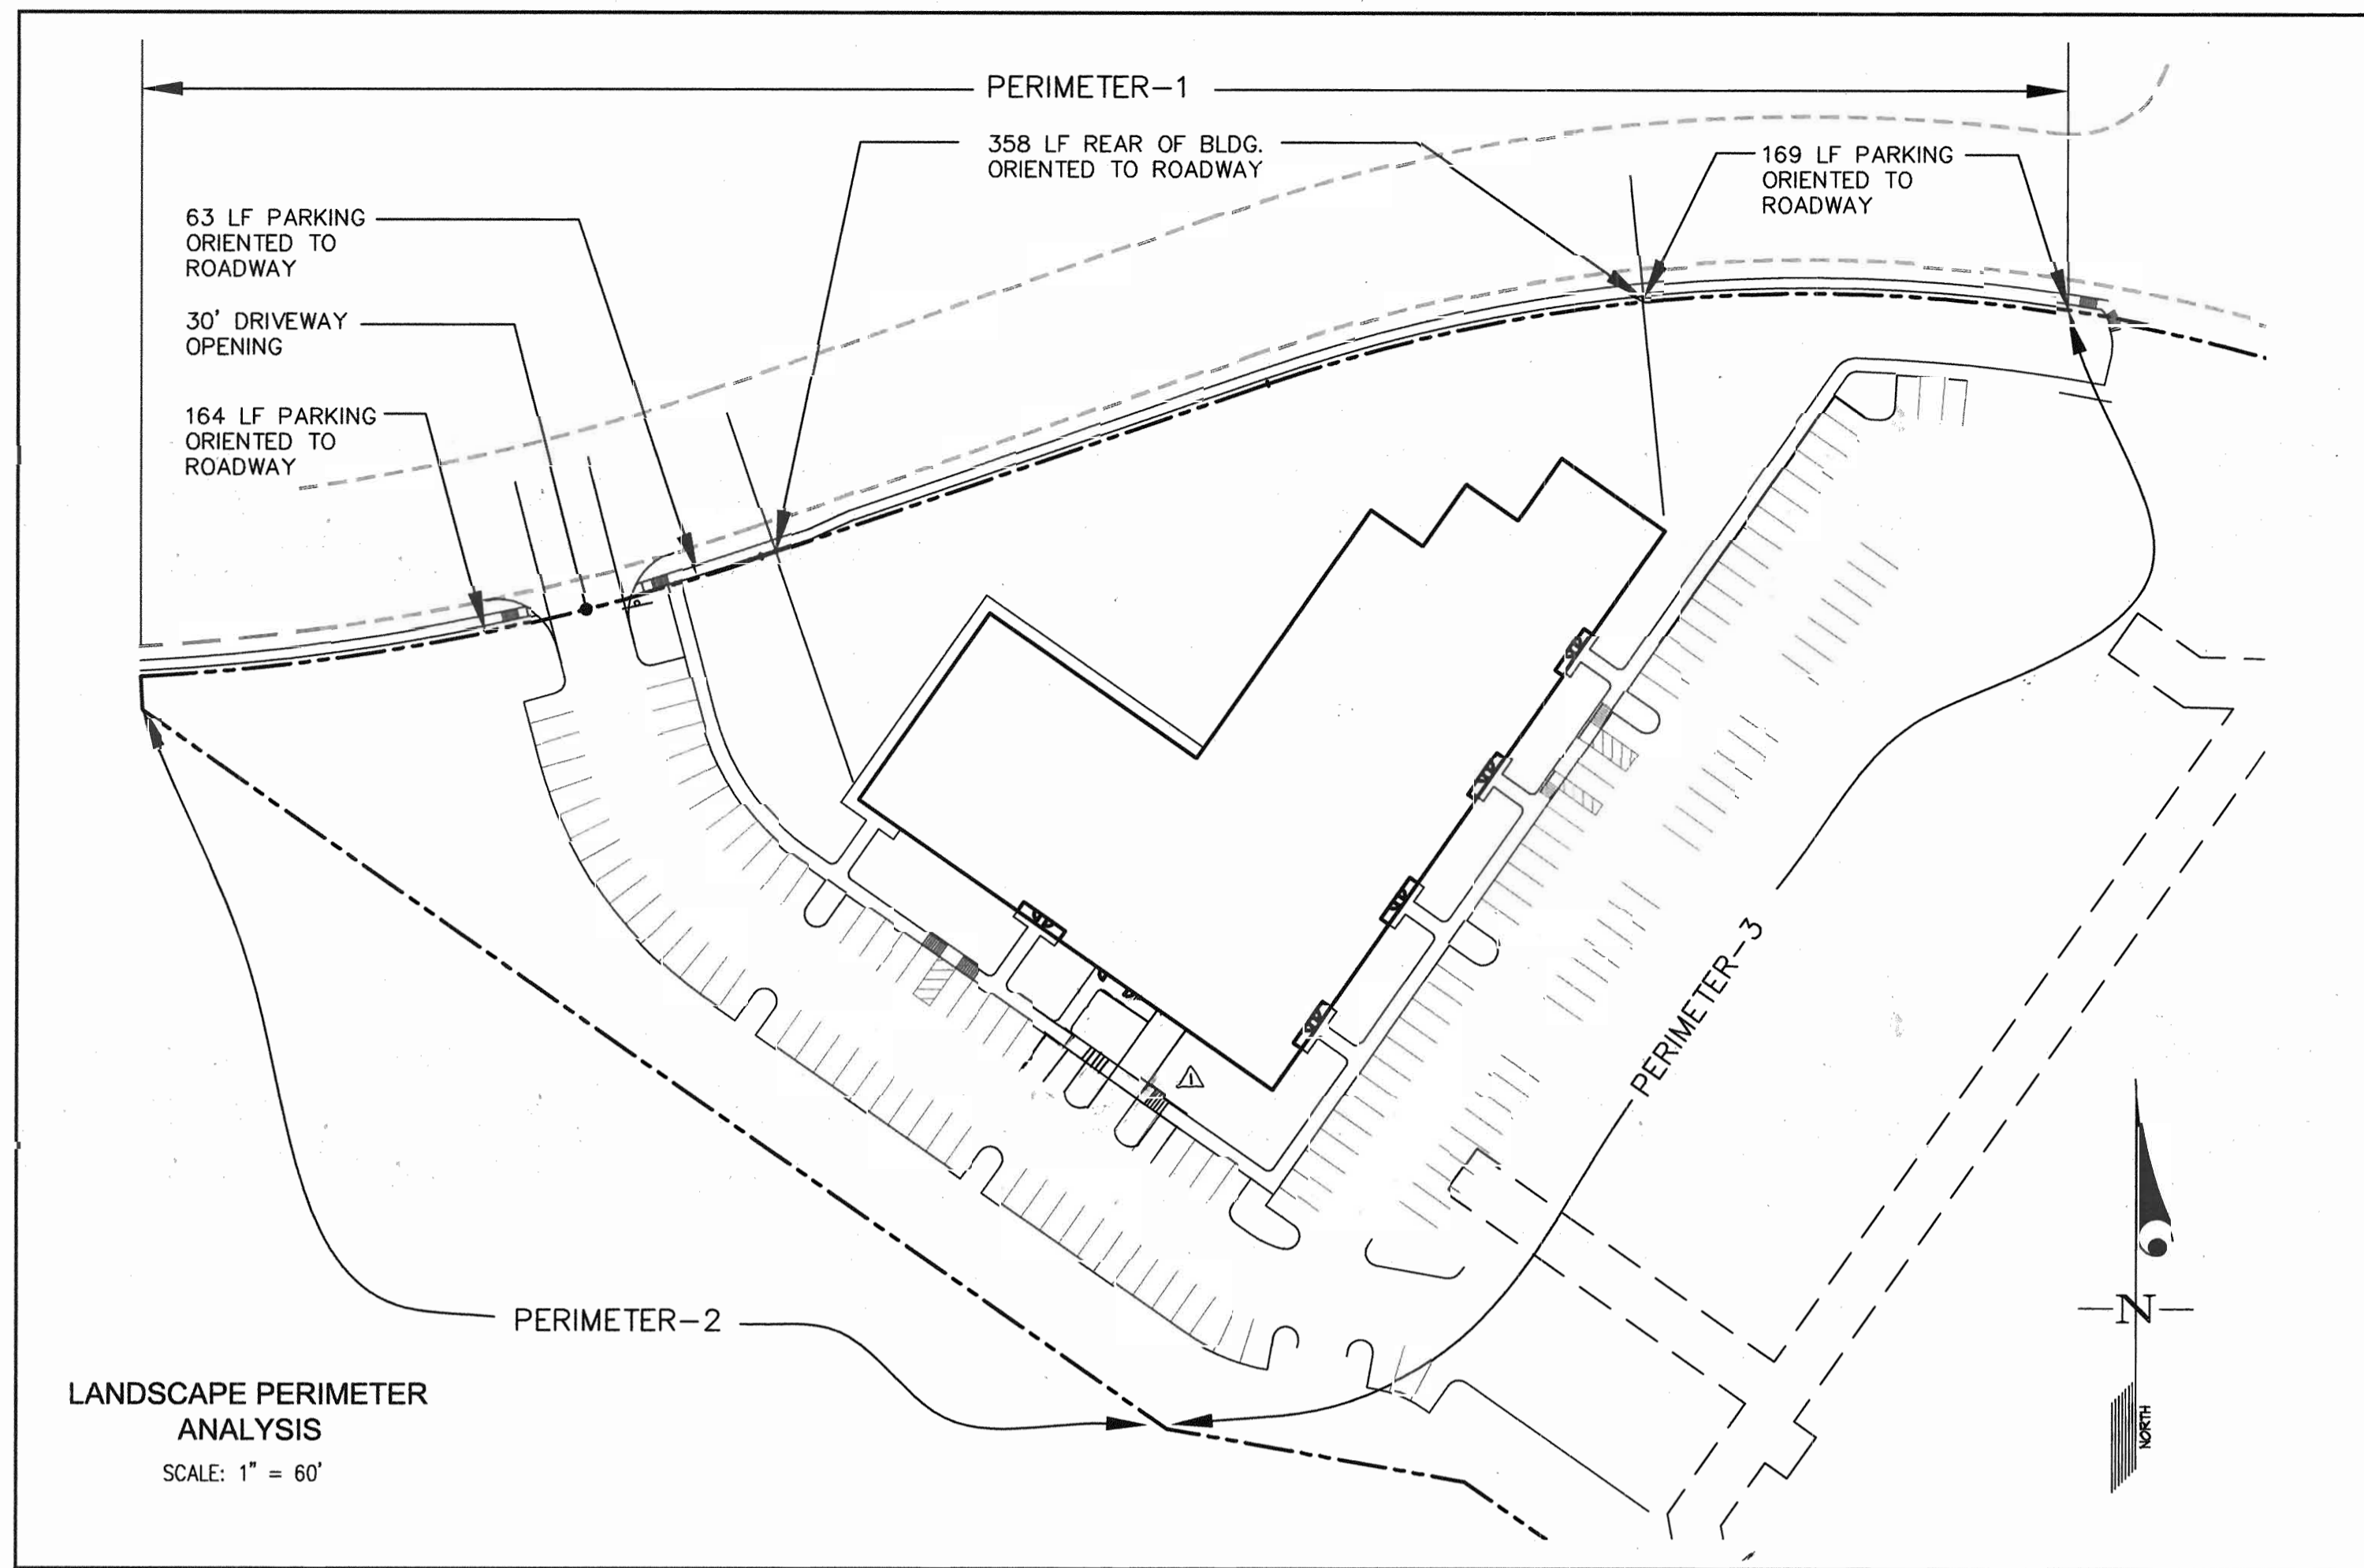

PLANT MATERIALS AND PLANTING METHODS

A. Plant Materials

The landscape contractor shall furnish and install and/or dig, ball, burlap and transport all of the plant materials called for on drawings and/or listed in the Plant Schedule.

- Plant Names**
Plant names used in the Plant Schedule shall conform with "Standardized Plant Names," latest edition.
- Plant Standards**
All plant material shall be equal to or better than the requirements of the "USA Standard for Nursery Stock" latest edition, as published by the American Association of Nurserymen (hereafter referred to as AAN Standards). All plants shall be typical of their species and variety, shall have a normal habit of growth and shall be first quality, sound, vigorous, well-branched and with healthy, well-furnished root systems. They shall be free of disease, insect pests and mechanical injuries.

c. If areas are designated as shrub beds or hedge trenches, they shall be excavated to at least 18" depth minimum. Areas designated for ground covers and vines shall be excavated to at least 12" in depth minimum.

PLANT SIZE	ROOT BALL	PIT	DEPTH
3" - 3.5" col.	32"	64"	28"
3.5" - 4" col.	36"	72"	32"
4" - 4.5" col.	40"	80"	36"
4.5" - 5" col.	44"	88"	40"
5" - 5.5" col.	48"	96"	44"
5.5" - 6" col.	52"	104"	48"

A 20% compaction figure of the soil to be removed is assumed and will be allowed in calculation of extra topsoil. The tabulated pit sizes are for purposes of uniform calculation and shall not override the specified depths below the bottoms of the root balls.

- Plant Measurements**
All plants shall conform to the measurements specified in the Plant Schedule as approved by the ARC.

- Caliper measurements shall be taken six inches (6") above grade for trees under four-inch (4") caliper and twelve (12") above grade for trees four inches (4") in caliper and over.
 - Minimum branching height for all trees shall be six feet (6'), maximum eight feet (8').
 - Minimum size for planting shade trees shall be 3-3" caliper, 14'-16" in height.
 - Minimum size for planting minor or intermediate focus trees (pines, crabapples, etc.) shall be 3-3" caliper, 10'-12" in height.
 - Minimum size for planting shrubs shall be 18" x 24" spread unless noted otherwise.
 - Caliper, height, spread and size of ball shall be generally as follows:
- | CALIPER | HEIGHT | SPREAD | SIZE OF BALL |
|-----------|---------|---------|--------------|
| 3" - 3.5" | 14'-16" | 6'-8" | 32" diameter |
| 3.5" - 4" | 14'-16" | 8'-10" | 36" diameter |
| 4" - 4.5" | 16'-18" | 8'-10" | 40" diameter |
| 4.5" - 5" | 16'-17" | 10'-12" | 44" diameter |
| 5" - 5.5" | 16'-20" | 10'-12" | 48" diameter |
| 5.5" - 6" | 18'-20" | 12'-14" | 52" diameter |

All plant material shall generally average the median for the size ranges indicated above as indicated in the "AAN Standards".

B. Planting Methods





- Plant Identification**
Legible labels shall be attached to all shade trees, minor trees, specimen shrubs and bundles or boxes of other plant material giving the botanical and common names, size and quantity of each. Each shipment of plants shall bear certificates of inspection as required by Federal, State and County authorities.
- Plant Inspection**
The ARC may, upon request by the builder or developer, at least ten (10) days prior to the installation of any proposed plant material, inspect all proposed plant material at the source of origin.

All proposed plant materials that meet the specifications in Section A are to be planted in accordance with the following methods during the proper planting seasons as described in the following:

- Planting Seasons**
The planting of deciduous trees, shrubs and vines shall be from March 1st to June 15th and from September 15th to December 15th. Planting of deciduous material may be continued during the winter months providing there is no frost in the ground and frost-free topsoil planting mixtures are used.
The planting of evergreen material shall be from March 15th to June 15th and from August 15th to December 1st. No planting shall be done when ground is frozen or excessively moist. No frozen or wet topsoil shall be used at any time.
- Digging**
All plant material shall be dug, balled and burlapped (B&B) in accordance with the "AAN Standards".
- Excavation of Plant Pits**
The landscaping contractor shall excavate all plant pits, vine pits, hedge trenches and shrub beds in accordance with the following schedule:

Sodding
All sodding shall be in accordance to the "Landscape Specification Guidelines for Baltimore-Washington Metropolitan Area" latest edition, approved by the Landscape Contractors Association of Metropolitan Washington and the American Society of Landscape Architects.

- Locations of all proposed plant material shall be staked and approved in the field by the landscape architect before any of the proposed plant material is installed by the landscape contractor.
- All pits shall be generally circular in outline, vertical sides; depth shall not be less than 6" deeper than the root ball; diameter shall not be less than two times the diameter of the root ball as set forth in the following schedule.

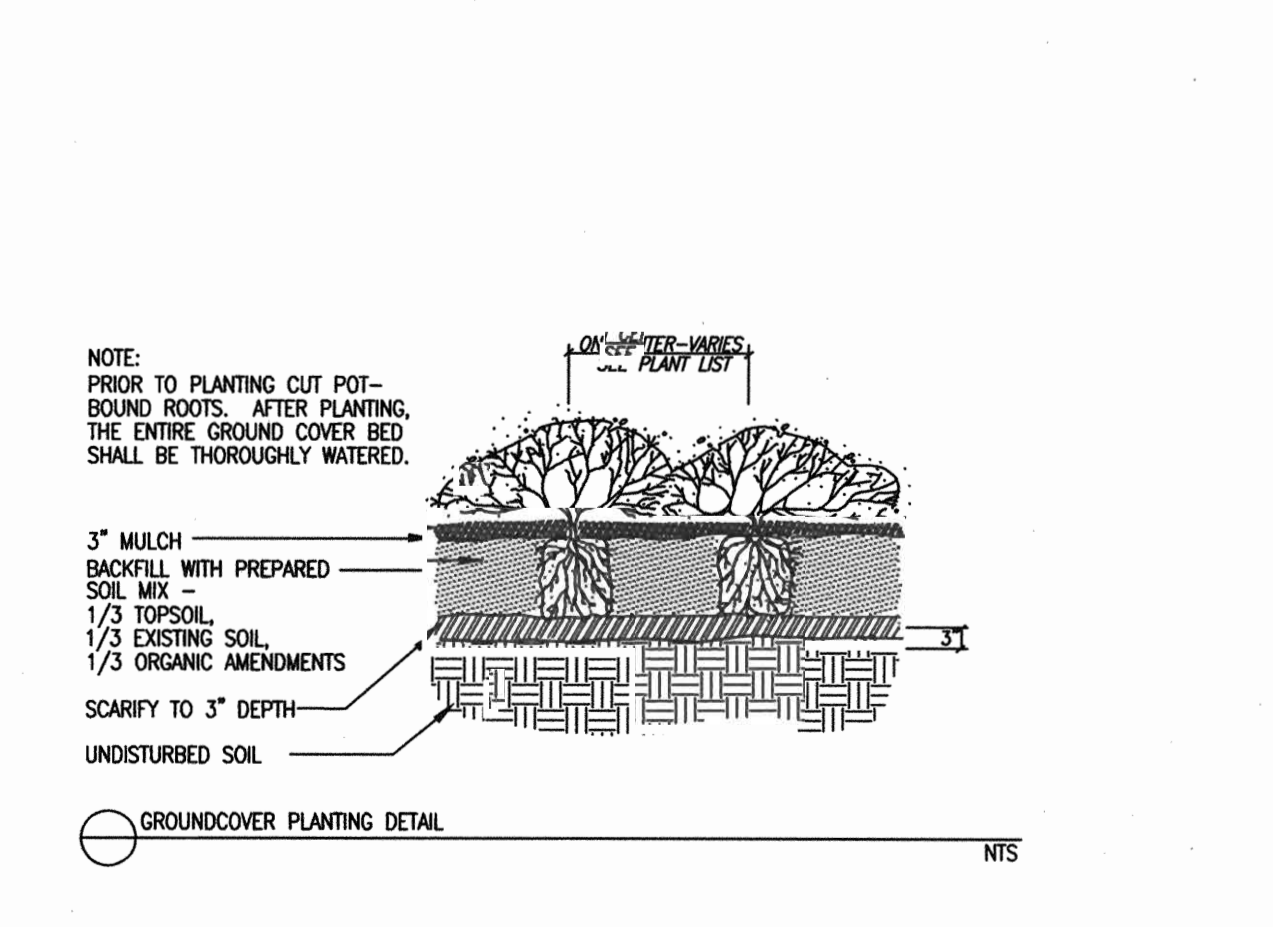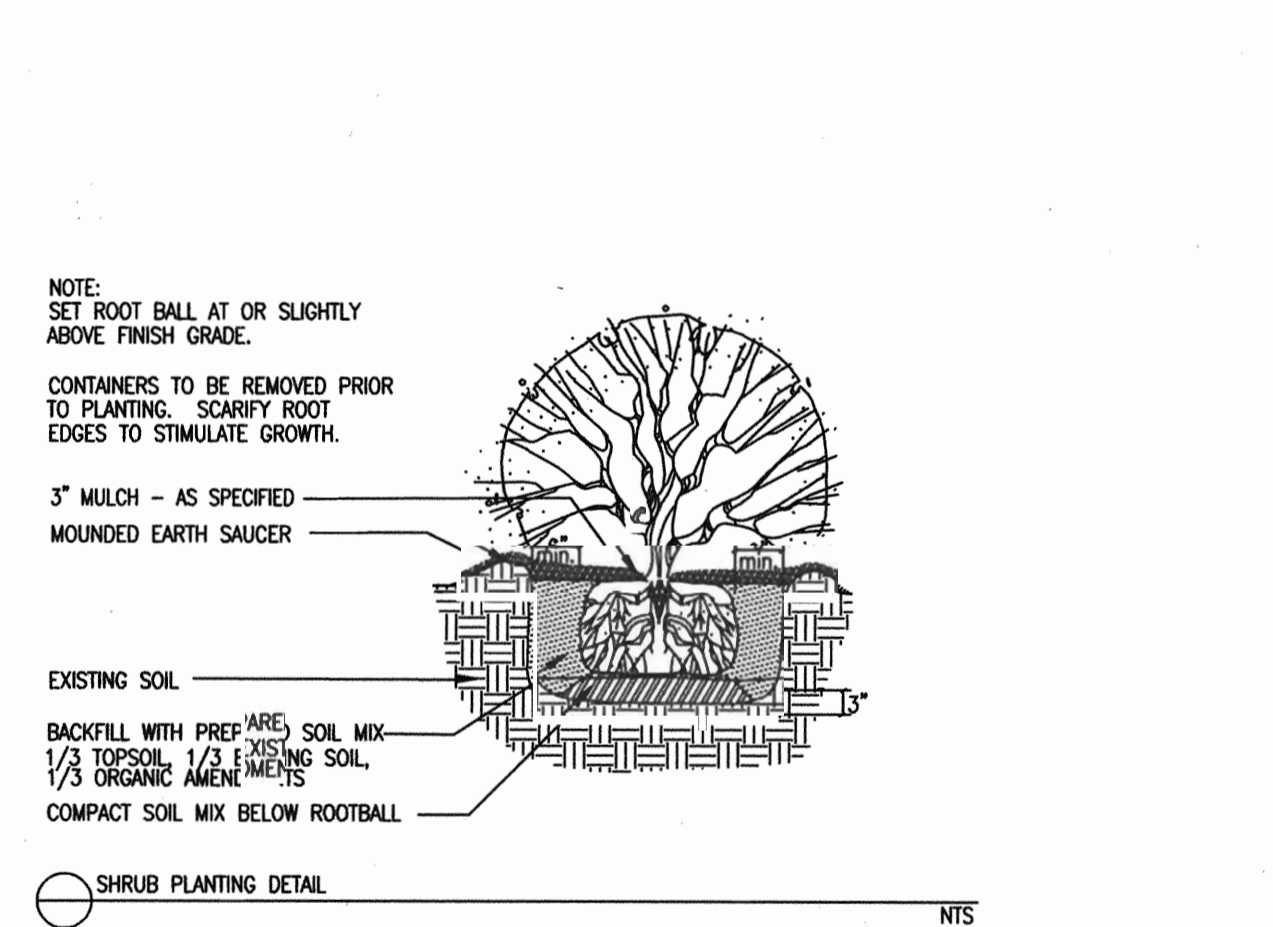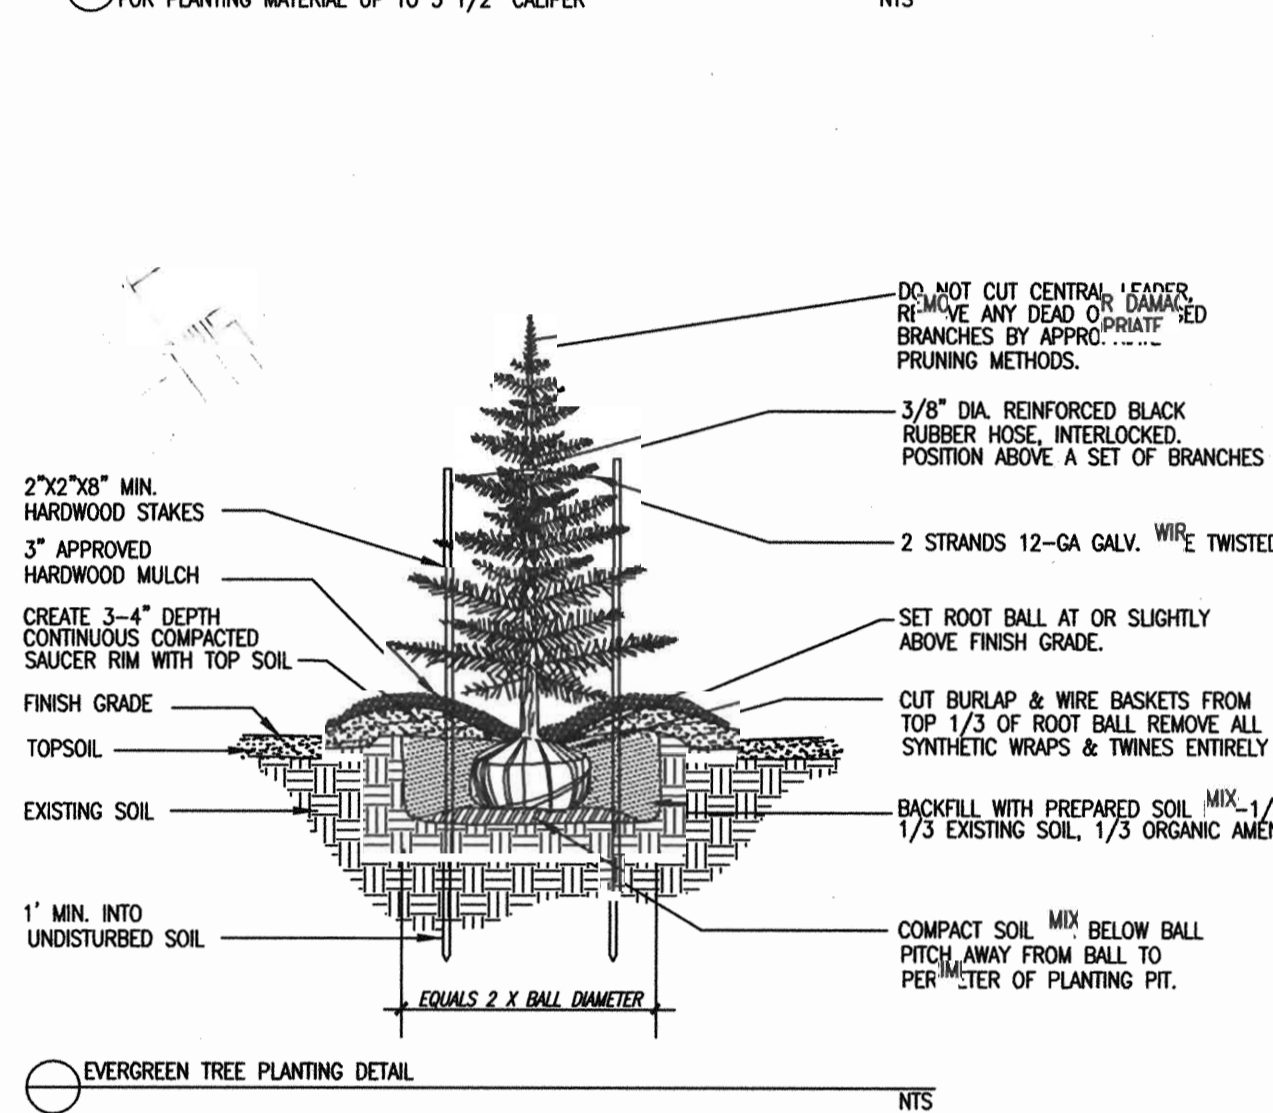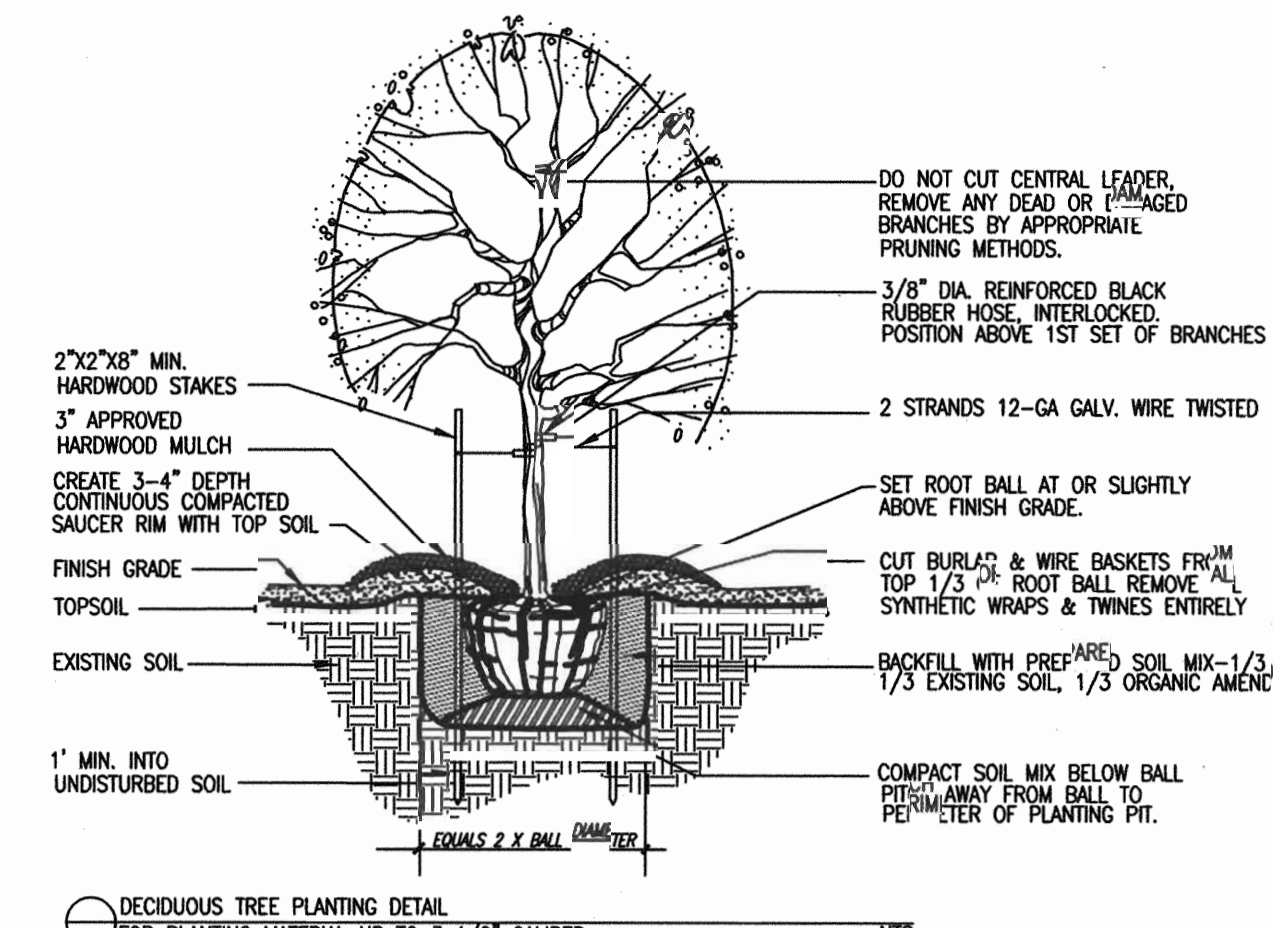

LANDSCAPING NOTES

- This plan has been prepared in accordance with Section 16.124 of the Howard County Code and Chapter VI (Alternative Compliance) of the Howard County Landscape Manual.
- Contractor shall notify all utilities at least (5) five days before starting work. All General Notes, especially those regarding utilities, on Sheet 1 shall apply.
- Field verify underground utility locations and existing conditions before starting planting work. Contact engineer / landscape architect if any relocations are required.
- Plant quantities shown on Plant List are provided for the convenience of the contractor only. If discrepancies exist between quantities shown on the plan and those shown on the plant list, the quantities on the plan shall take precedence.
- All plant material shall be full, healthy, well formed, and symmetrical, and conform to the A.A.N. Specifications, and be installed in accordance with project specifications.
- No substitution shall be made without written consent of the owner or his representative.
- All areas disturbed by construction activities but not otherwise planted, paved, or mulched shall be seeded or sodded in accordance with the project specifications.
- The contractor shall notify the owner in writing if he/she encounters soil drainage conditions which may be detrimental to the growth of the plants.
- All exposed earth within limits of planting beds shall be mulched with shredded hardwood mulch per Planting Details.
- Planting is NOT PERMITTED within utility easements.
- The owner, tenant, and/or their agents shall be responsible for maintenance of the required landscaping, including both plant materials and berms, fences and walls. All plant materials shall be maintained in good growing condition, and when necessary, replaced with new materials to ensure continued compliance with applicable regulations. All other required landscaping shall be permanently maintained in good condition, and, when necessary, repaired and replaced.

12. "Schedule A - Perimeter Landscape Edge" and "Schedule B - Parking Lot Internal Landscaping" are provided for landscape surety calculation purposes only. Financial surety for the required landscaping shall be posted with the grading permit application in the amount of \$16,470.00 for the following:

- \$ 2,970.00 for 99 shrubs at \$30/shrub
- \$10,800.00 for 36 shade trees at \$300/tree
- \$ 2,700.00 for 18 evergreen trees at \$150/tree
- \$16,470.00 total landscape surety

13. Tabulation for landscape shown:

Required planting by HRD for 3.87 acres of RMD/OFFICE at 24 trees / acre = 93 trees (or equivalent)	Planting provided: Shade Trees (existing and proposed): 50 Ornamental Trees: 16 = 8 E.S.T. (equivalent shade tree) Evergreen Trees 70 = 35 E.S.T.
TOTAL EQUIVALENT SHADE TREE = 93	

SCHEDULE-A: PERIMETER LANDSCAPE EDGE

PERIMETER No.	1	2	3	INTERNAL PERIMETER
USE SITUATION	PARKING ADJ. TO ROADWAY	REAR OF BLDG. TO ROADWAY	COMMERCIAL TO COMMERCIAL	
LANDSCAPE TYPE	E	C	A	
LINEAR FEET OF ROADWAY FRONTAGE/PERIMETER	396 LF	358 LF	508	
CREDIT FOR EXISTING VEGETATION	NONE	NONE	NONE	
CREDIT FOR WALL, FENCE OR BERM	NONE	NONE	NONE	
NUMBER OF PLANTS REQUIRED				
SHADE TREES	N/A	9	9	
EVERGREEN TREES	N/A	18	N/A	
SHRUBS	99	N/A	N/A	
NUMBER OF PLANTS PROVIDED				
SHADE TREES	OVER 10 SHADE TREES, 18 EVERGREEN TREES AND 99 SHRUBS (OR EQUIVALENT SUBSTITUTIONS) ARE PLANTED BY ALTERNATIVE COMPLIANCE		3 SHADE TREES ARE PROVIDED, THE REMAINING 6 SHADE TREES ARE SUBSTITUTED WITH OVER 12 EVERGREEN TREES	

SCHEDULE-B: PARKING LOT INTERNAL LANDSCAPING

NUMBER OF PARKING SPACES	144
NUMBER OF SHADE TREES REQUIRED (1 PER 10 SPACES FOR RESIDENTIAL; 1 PER 20 SPACES FOR COMMERCIAL)	8
NUMBER OF TREES PROVIDED	14 PARKING LOT ISLANDS ARE PROVIDED. 12 OF THE ISLANDS ARE PLANTED WITH SHADE TREES (11-RS & 1-O).
SHADE TREES	
OTHER TREES (2:1 SUBSTITUTION)	

APPROVED: HOWARD COUNTY DEPARTMENT OF PLANNING & ZONING
Director: *Mark A. Weger* Date: 12/2/04
Chief, Division of Land Development: *Cindy Hammett* Date: 12/3/04
Chief, Development Engineering Division: *Mike Damman* Date: 11/22/04

GLWGUTSCHICK LITTLE & WEBER, P.A.
CIVIL ENGINEERS, LAND SURVEYORS, LAND PLANNERS, LANDSCAPE ARCHITECTS
3909 NATIONAL DRIVE - SUITE 250 - BURTONSVILLE OFFICE PARK
BURTONSVILLE, MARYLAND 20866
TEL: 301-421-4024 BAL: 410-880-1820 DC/VA: 301-989-2524 FAX: 301-421-4186

DATE	REVISION	BY	APP'D.
7/28/05	Revise access to reflect new overhead door location.	JNG	

PREPARED FOR:
GATEWAY 67 LLC
8815 CENTRE PARK DRIVE, SUITE 400
COLUMBIA, MD. 21045
PH.: 410-992-7348
ATTN: MR. ROGER WAESCHE

LANDSCAPE NOTES, DETAILS, PLANT LIST & SCHEDULES
COLUMBIA GATEWAY
PARCEL 1N13
PLOT No. 17099


SCALE	ZONING	G. L. W. FILE No.
NO SCALE	M-1	04032
DATE	TAX MAP - GRID	SHEET
Sept., 2004	42 - 12	9 OF 10

PAVEMENT MARKING NOTES

1. ALL PAVEMENT MARKINGS TO BE APPLIED USING "SETFAST PREMIUM ALKYD TRAFFIC PAINT" BY SHERWIN WILLIAMS OR APPROVED EQUAL.
2. EXISTING PAVEMENT MARKINGS THAT ARE IN CONFLICT WITH THE PROPOSED PAVEMENT MARKINGS FOR THIS CONTRACT WILL BE REMOVED BY THE CONTRACTOR BY ANY METHOD WHICH IS APPROVED BY THE COUNTY INSPECTOR.

- (A) - PAVEMENT LINES - 4" X 10' WHITE SKIP
- (B) - PAVEMENT SYMBOL - LEFT TURN/RIGHT TURN ARROW
- (C) - PAVEMENT LINES - 4" SOLID YELLOW

FINAL STRIPING IS SHOWN HEREON. CONTRACTOR SHALL INSPECT EXISTING STRIPING PATTERNS TO DETERMINE CHANGES REQUIRED TO IMPLEMENT THIS PLAN.

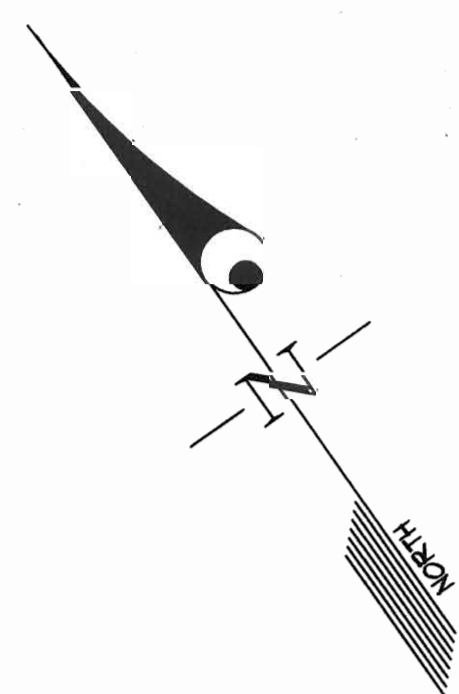

ROBERT FULTON DRIVE
(MARKABLE NORTHWAY - PUBLIC)
 (P.L. NO. 103-889 - 10/28/04)

GATEWAY COMMERCE CENTER
 PARCEL "A-10"
 PLAT NO. 10389

PARCEL "A-11"



APPROVED: HOWARD COUNTY DEPARTMENT OF PLANNING & ZONING

<i>Paul D. English</i>	10/2/04
Director	Date
<i>Cindy Hancock</i>	10/2/04
Chief, Division of Land Development	Date
<i>Michael J. ...</i>	10/2/04
Chief, Development Engineering Division	Date

COLUMBIA GATEWAY
 LOT 15
 PLAT NO. 14341
 ZONED: NEW TOWN

APPLIANCE PARK EAST
 PARCEL "A-8"
 PLAT NO. 7563
 ZONED: M-1

COLUMBIA GATEWAY
 LOT 15
 PLAT NO. 14341
 ZONED: M-1

GATEWAY COMMERCE CENTER
 PARCEL "A-7"
 PLAT NO. 13141
 ZONED: NEW TOWN

GLW GUTSICHICK LITTLE & WEBER, P.A.
 CIVIL ENGINEERS, LAND SURVEYORS, LAND PLANNERS, LANDSCAPE ARCHITECTS
 3909 NATIONAL DRIVE - SUITE 250 - BURTONSVILLE OFFICE PARK
 BURTONSVILLE, MARYLAND 20866
 TEL: 301-421-4024 BAL: 410-88-0-1820 DC/VA: 301-989-2524 FAX: 301-421-4186

DATE	REVISION	BY	APP'D
7/28/05	Revise access to reflect new overhead door location.	JNL	

PREPARED FOR:
 GATEWAY 67 LLC
 8815 CENTRE PARK DRIVE, SUITE 400
 COLUMBIA, MD. 21045
 PH.: 410-992-7348
 ATTN: MR. ROGER WAESCHE


STRIPING PLAN
COLUMBIA GATEWAY
 PARCEL N-13
 Plat No. 17094

SCALE	ZONING	G. L. W. FILE NO.
1"=40'	M-1	04032
DATE	TAX MAP - GRID	SHEET
Sept., 2004	42 - 12	10 OF 10

ELECTION DISTRICT No. 6

HOWARD COUNTY, MARYLAND

L:\CADD\DRAWINGS\04032\SDP\04032SP2.dwg 10/28/2004 11:02:28 AM EDT

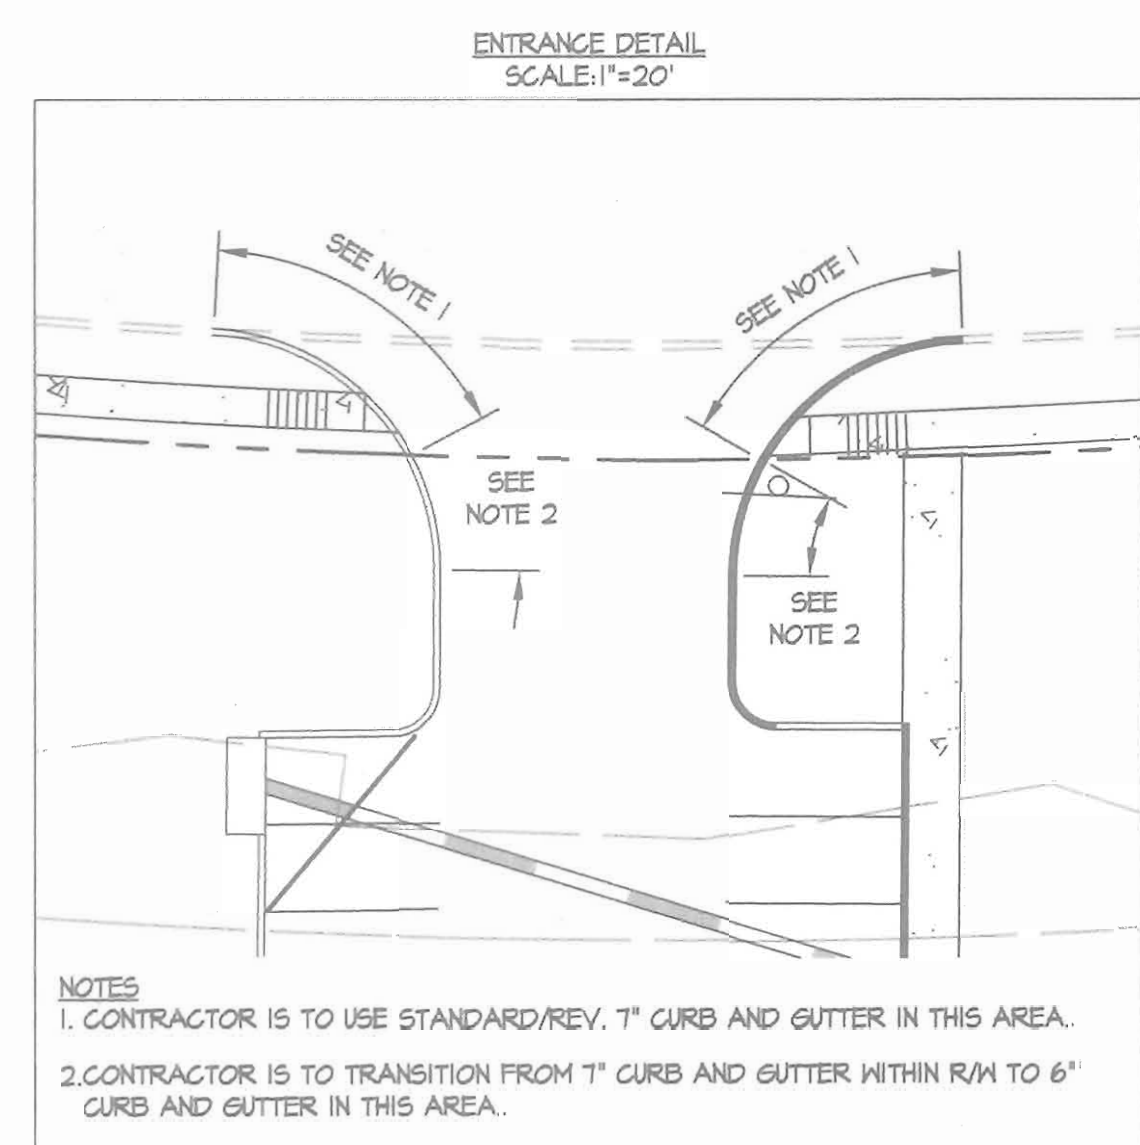

NOTES
 1. CONTRACTOR IS TO USE STANDARD/REV. 7" CURB AND GUTTER IN THIS AREA.
 2. CONTRACTOR IS TO TRANSITION FROM 7" CURB AND GUTTER WITHIN R/W TO 6" CURB AND GUTTER IN THIS AREA.



APPROVED: HOWARD COUNTY DEPARTMENT OF PLANNING & ZONING
 Director: *David DeLoach* Date: 12/1/04
 Chief, Division of Land Development: *Cindy Hammett* Date: 12/1/04
 Chief, Development Engineering Division: *Michael McKinnon* Date: 11/22/04

GLW GUTSCHICK LITTLE & WEBER, P.A.
 CIVIL ENGINEERS, LAND SURVEYORS, LAND PLANNERS, LANDSCAPE ARCHITECTS
 3909 NATIONAL DRIVE - SUITE 250 - BURTONSVILLE OFFICE PARK
 BURTONSVILLE, MARYLAND 20886
 TEL: 301-421-4024 BALT: 410-880-1820 DC/VA: 301-989-2524 FAX: 301-421-4186

DATE	REVISION	BY	APP'R.
7/27/05	Show 2000 SF. accessory retail, new sprinkler room & door locations.	JNG	
8/25/05	Revised and added existing water and sewer information.	dev	

PREPARED FOR:
 GATEWAY 67 LLC
 8815 CENTRE PARK DRIVE, SUITE 400
 COLUMBIA, MD. 21045
 PH.: 410-992-7348
 ATTN: MR. ROGER WAESCHE

SITE DEVELOPMENT PLAN
COLUMBIA GATEWAY
PARCEL N-13
 Plat No. 17094
 ELECTION DISTRICT No. 6
 HOWARD COUNTY, MARYLAND

SCALE	ZONING	G. L. W. FILE NO.
1"=40'	M-1	04032
DATE	TAX MAP - GRID	SHEET
Sept., 2004	42 - 12	2 OF 10

