


BENCH MARKS
 T.P. 3166 ELEV. 315.38
 N. 173.996.1586
 E. 419.619.2145
 LOC. NEAR THE INTERSECTION
 OF GORMAN RD. & STEVENS ROAD.
 T.P. 3167 ELEV. 339.00
 N. 174440.1549
 E. 419.864.0345
 LOC. NEAR I-95 BRIDGE
 ALONG GORMAN ROAD

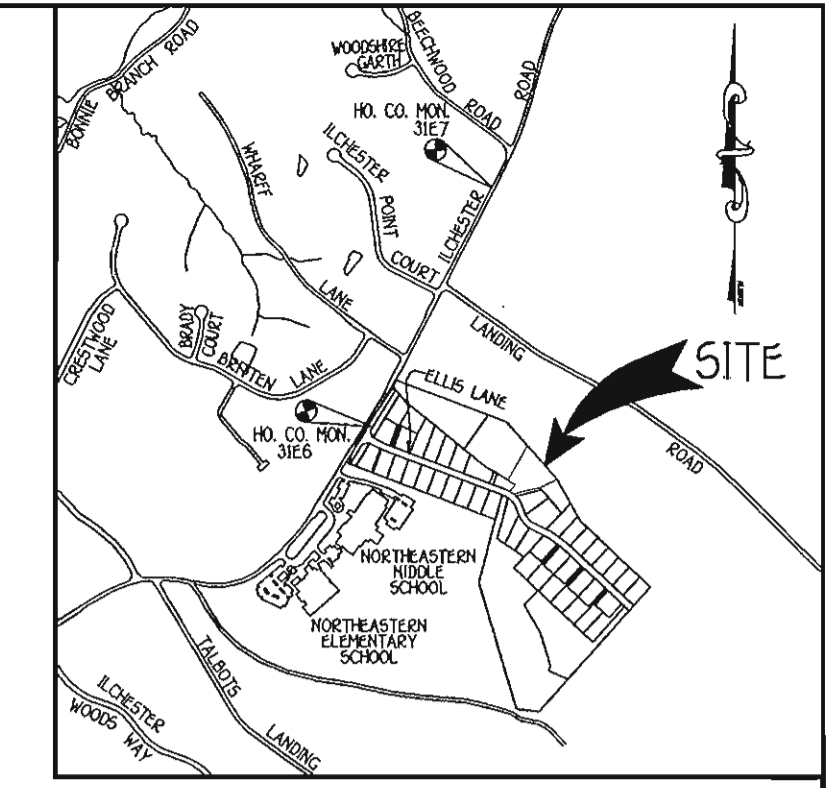

- GENERAL NOTES**
- SUBJECT PROPERTY ZONED R-20 PER 2/02/04 COMPREHENSIVE REZONING PLAN.
 - TOTAL AREA OF BUILDABLE LOTS 1.0893 ACRES.
 - TOTAL NUMBER OF LOTS SUBMITTED 2 SINGLE FAMILY.
 - THE CONTRACTOR SHALL NOTIFY THE CONSTRUCTION INSPECTION DIVISION AT (410)313-1800 AT LEAST 50 WORKING DAYS PRIOR TO THE START OF WORK.
 - THE CONTRACTOR SHALL NOTIFY "MISS UTILITY" AT 1-800-257-7777 AT LEAST 48 HOURS PRIOR TO ANY EXCAVATION WORK.
 - THIS PROJECT IS SUBJECT TO HOWARD COUNTY FILES: F-02-05-F-03-170, WAS CONT. #14-3976-D, & F-03-214, F-03-171.
 - THIS PLAN IS BASED ON A FIELD RUN BOUNDARY SURVEY PERFORMED ON OR ABOUT DECEMBER 22, 1997 BY FISHER COLLINS & CARTER, INC.
 - HORIZONTAL AND VERTICAL CONTROL DATUM IS BASED ON NAD 83, MARYLAND COORDINATE SYSTEM AS PROJECTED BY HOWARD COUNTY GEODETIC CONTROL STATIONS.
 - HOWARD COUNTY MONUMENT 3167 N. 173996.1586 E. 419619.2145
 - HOWARD COUNTY MONUMENT 3167 N. 174440.1549 E. 419864.0345
 - ANY DAMAGE TO THE COUNTY'S RIGHT-OF-WAY SHALL BE CORRECTED AT THE DEVELOPER'S EXPENSE.
 - THIS PLAN IS FOR HOUSE SITING AND GRADING ONLY. IMPROVEMENTS SHOWN WITHIN THE RIGHTS-OF-WAY OF THIS S.D.P. ARE NOT USED FOR CONSTRUCTION. FOR CONSTRUCTION SEE APPROVED ROAD CONSTRUCTION PLANS F-02-05, AND/OR APPROVED WATER AND SEWER PLANS CONTRACT NO. 14-3976-D.
 - CONTRACTOR WILL CHECK SEWER HOUSE CONNECTION ELEVATION AT EASEMENT LINE PRIOR TO CONSTRUCTION.
 - THE STORMWATER QUANTITY & QUALITY MANAGEMENT FOR THIS SUBDIVISION IS PROVIDED IN THE STORMWATER MANAGEMENT POND IN THE GLYNCHESTER FARM II (F-02-05) SUBDIVISION.
 - LANDSCAPING IN ACCORDANCE WITH SECTION 16.124 OF THE HOWARD COUNTY CODE AND LANDSCAPE MANUAL SHALL BE PROVIDED AS SHOWN ON THIS SITE PLAN. SECURITY FOR 3 SHADE TREES LOCATED ON LOT 3 AND 5 SHADE TREES LOCATED ON LOT 4, FOR A TOTAL OF 8 SHADE TREES, IN THE AMOUNT OF \$2,400.00 SHALL BE POSTED WITH THE GRADING PERMIT.
 - THIS SITE IS EXEMPT FROM FOREST CONSERVATION OBLIGATIONS PER F-05-17 IN ACCORDANCE WITH SECTION 16.1202B(1)(iv) OF THE FOREST CONSERVATION MANUAL SINCE IT IS A MINOR RESUBDIVISION WHICH DOES NOT CREATE ANY ADDITIONAL LOTS AND HAS NO FURTHER SUBDIVISION POTENTIAL.
 - FOR DRIVEWAY ENTRANCE DETAILS REFER TO HO. CO. DES. MAN. VOL. IV DETAILS R.6.05.
 - SITE DEVELOPMENT PLAN FOR SINGLE FAMILY DETACHED UNITS.
 - THIS PLAN IS SUBJECT TO THE AMENDED FIFTH EDITION OF THE SUBDIVISION REGULATIONS IN ACCORDANCE WITH SECTION 129 (A)(1) OF THE H.C.O.C. ZONING REGULATION. BATWINDROWS, CHIMNEYS OR EXTERIOR STAIRWAYS NOT MORE THAN 16 FEET IN WIDTH MAY PROJECT NOT MORE THAN 4 FEET INTO ANY SETBACK, PORCHES OR DECKS, OPEN OR ENCLOSED MAY PROJECT NOT MORE THAN 10 FEET INTO THE FRONT OR REAR YARD SETBACKS.
 - REFUSE COLLECTION, SNOW REMOVAL AND ROAD MAINTENANCE TO BE PROVIDED AT THE JUNCTION OF THE PIPE/LAG STEM AND THE ROAD RIGHT-OF-WAY AND NOT ON THE FLAG/PIPE STEM DRIVEWAY.
 - USE-IN-COMMON DRIVEWAYS SHALL BE PROVIDED PRIOR TO ISSUANCE OF A USE AND OCCUPANCY PERMIT TO ENSURE SAFE ACCESS FOR FIRE AND EMERGENCY VEHICLES PER THE FOLLOWING (MINIMUM) REQUIREMENTS:
 A) WIDTH - 12 FEET (14 FEET SERVING MORE THAN ONE RESIDENCE)
 B) SURFACE - SIX (6) INCHES OF COMPACTED CRUSHER RUN BASE WITH TAR AND CHIP COATING (1-1/2" MINIMUM)
 C) GEOMETRY - MAXIMUM 15% GRADE, MAXIMUM 10% GRADE CHANGE AND 45-FOOT TURNING RADIUS
 D) STRUCTURE - (GULCHES/BRIDGES) - CAPABLE OF SUPPORTING 25 GROSS TONS (NETS-LOADING)
 E) DRAINAGE ELEMENTS - CAPABLE OF SAFELY PASSING 100 YEAR FLOOD WITH NO MORE THAN 1 FOOT DEPTH OVER SURFACE
 F) STRUCTURE CLEARANCES - MINIMUM 12 FEET
 G) MAINTENANCE - SUFFICIENT TO ENSURE ALL WEATHER USE
 - ACCESS TO LOTS 3 & 4 OF THE YAW PROPERTY SHALL BE IN ACCORDANCE WITH THE EXISTING 10' WIDE USE-IN-COMMON ACCESS EASEMENT AS SHOWN ON THE FINAL PLAN FOR F-02-05, GLYNCHESTER FARM. UNTIL SUCH TIME AS ELLIS LANE IS CONSTRUCTED, UPON CONSTRUCTION OF ELLIS LANE, INGRESS/EGRESS TO LOTS 3 & 4 WILL BE DIRECTLY FROM ELLIS LANE VIA THE 30' WIDE USE-IN-COMMON ACCESS EASEMENT DESIGNED TO SERVE THOSE LOTS EXCLUSIVELY AND USE OF THE 10' WIDE USE-IN-COMMON ACCESS EASEMENT WILL BE ABANDONED.
 - NO CEMETARIES EXIST ON SITE BY VISUAL OBSERVATION.
 - A WETLANDS REPORT WAS PREPARED BY AMERICAN LAND CONCEPTS ON MAY 20, 2003. NO WETLANDS EXIST ON-SITE.
 - HOMEOWNER ASSOCIATION DOCUMENTS FOR THE GLYNCHESTER FARM SUBDIVISION HAVE BEEN FILED WITH THE MD DEPARTMENT OF ASSESSMENTS AND TAXATION AS RECORDING NUMBER 000414840 ON 7-18-03.
 - Per plat # 10346 recorded on 11-25-03, the 10' wide access easement on the Yaw Property shall remain in place until such time as all lots of the access easement contingent upon the dedication of Ellis Lane to Howard County.

ADDRESS CHART

LOT NUMBER	STREET ADDRESS
3	4951 ELLIS LANE
4	4953 ELLIS LANE

LEGEND

SYMBOL	DESCRIPTION
---	EXISTING CONTOUR 2' INTERVAL
+362.2	SPOT ELEVATION
---	PROPOSED WALKOUT
---	SUPER SILT FENCE
---	SILT FENCE/TREE PROTECTION
---	LIMIT OF DISTURBANCE
---	EXISTING PERIMETER SHADE TREES F-02-05
---	EXISTING STREET TREE PER F-02-05

INDEX CHART

SHEET	DESCRIPTION
SHEET 1	SITE, LANDSCAPE & SEDIMENT/EROSION CONTROL PLAN
SHEET 2	SEDIMENT/EROSION CONTROL NOTES & DETAILS

BUILDER/DEVELOPER'S CERTIFICATE

I/WE CERTIFY THAT THE REQUIRED LANDSCAPING WILL BE DONE ACCORDING TO THE PLAN SECTION 16.124 OF THE HOWARD COUNTY SUBDIVISION AND LAND DEVELOPMENT REGULATIONS AND THE LANDSCAPE MANUAL. I/WE FURTHER CERTIFY THAT UPON COMPLETION A CERTIFICATION OF LANDSCAPE INSTALLATION ACCOMPANIED BY AN EXECUTED ONE YEAR GUARANTEE OF PLANT MATERIALS, WILL BE SUBMITTED TO THE DEPARTMENT OF PLANNING AND ZONING.

Bob Padgett 8-12-04
 BOB PADGETT DATE

ENGINEER'S CERTIFICATE

I certify that this plan for erosion and sediment control represents a practical and workable plan based on my personal knowledge of the site conditions and that it was prepared in accordance with the requirements of the Howard Soil Conservation District.

Earl D. Collins 8-12-04
 EARL D. COLLINS DATE

BUILDER/DEVELOPER'S CERTIFICATE

I/WE CERTIFY THAT ALL DEVELOPMENT AND CONSTRUCTION WILL BE DONE ACCORDING TO THIS PLAN, FOR SEDIMENT AND EROSION CONTROL AND THAT ANY RESPONSIBLE PERSONNEL INVOLVED IN THE CONSTRUCTION PROJECT WILL HAVE A CERTIFICATE OF ATTENDANCE AT A DEPARTMENT OF THE ENVIRONMENT APPROVED TRAINING PROGRAM FOR THE CONTROL OF SEDIMENT AND EROSION BEFORE BEGINNING THE PROJECT. I ALSO AUTHORIZE PERIODIC ON-SITE INSPECTION BY THE HOWARD SOIL CONSERVATION DISTRICT.

Bob Padgett 8-12-04
 BOB PADGETT DATE

Reviewed for HOWARD SCD and meets Technical Requirements.

John R. Robertson 8/23/04
 JOHN R. ROBERTSON DATE

This development plan is approved for soil erosion and sediment control by the HOWARD SOIL CONSERVATION DISTRICT.

John R. Robertson 8/23/04
 JOHN R. ROBERTSON DATE

OWNER/BUILDER/DEVELOPER

RYLAND GROUP
 7250 PARKWAY DRIVE
 SUITE 520
 HANOVER, MARYLAND 21076
 410-712-7012

APPROVED: HOWARD COUNTY DEPARTMENT OF PLANNING AND ZONING

Cindy Hamilton 10/8/04
 CINDY HAMILTON DATE

Mark R. Wolfe 9/9/04
 MARK R. WOLFE DATE

Mark R. Wolfe 10/12/04
 MARK R. WOLFE DATE

PROJECT: YAW PROPERTY SECTION: N/A LOTS NO.: 3 & 4

PLAT: 16937 BLOCK NO.: 16 ZONE: R-20 TAX/ZONE: 31 ELEC. DIST.: FIRST CENSUS TR.: 6011.01

WATER CODE: G-09 SEWER CODE: 1254550

SITE DEVELOPMENT, LANDSCAPE & SEDIMENT/EROSION CONTROL PLAN




SINGLE FAMILY DETACHED

YAW PROPERTY

LOTS 3 & 4


TAX MAP NO: 31 PARCEL NO: 239 & 242 GRID NO: 16
 FIRST ELECTION DISTRICT: HOWARD COUNTY, MARYLAND
 SCALE: 1" = 30' DATE: JUNE, 2004
 SHEET 1 OF 2

SDP-04-100

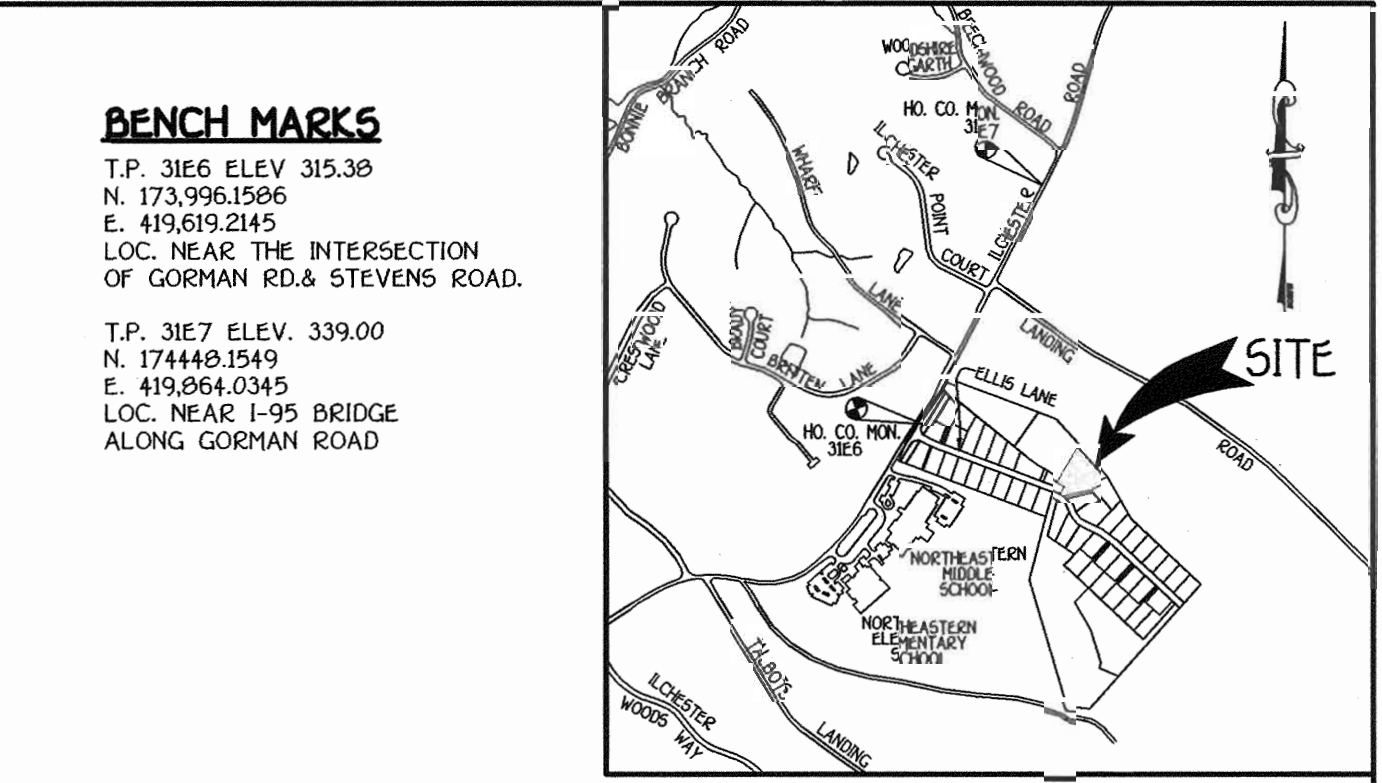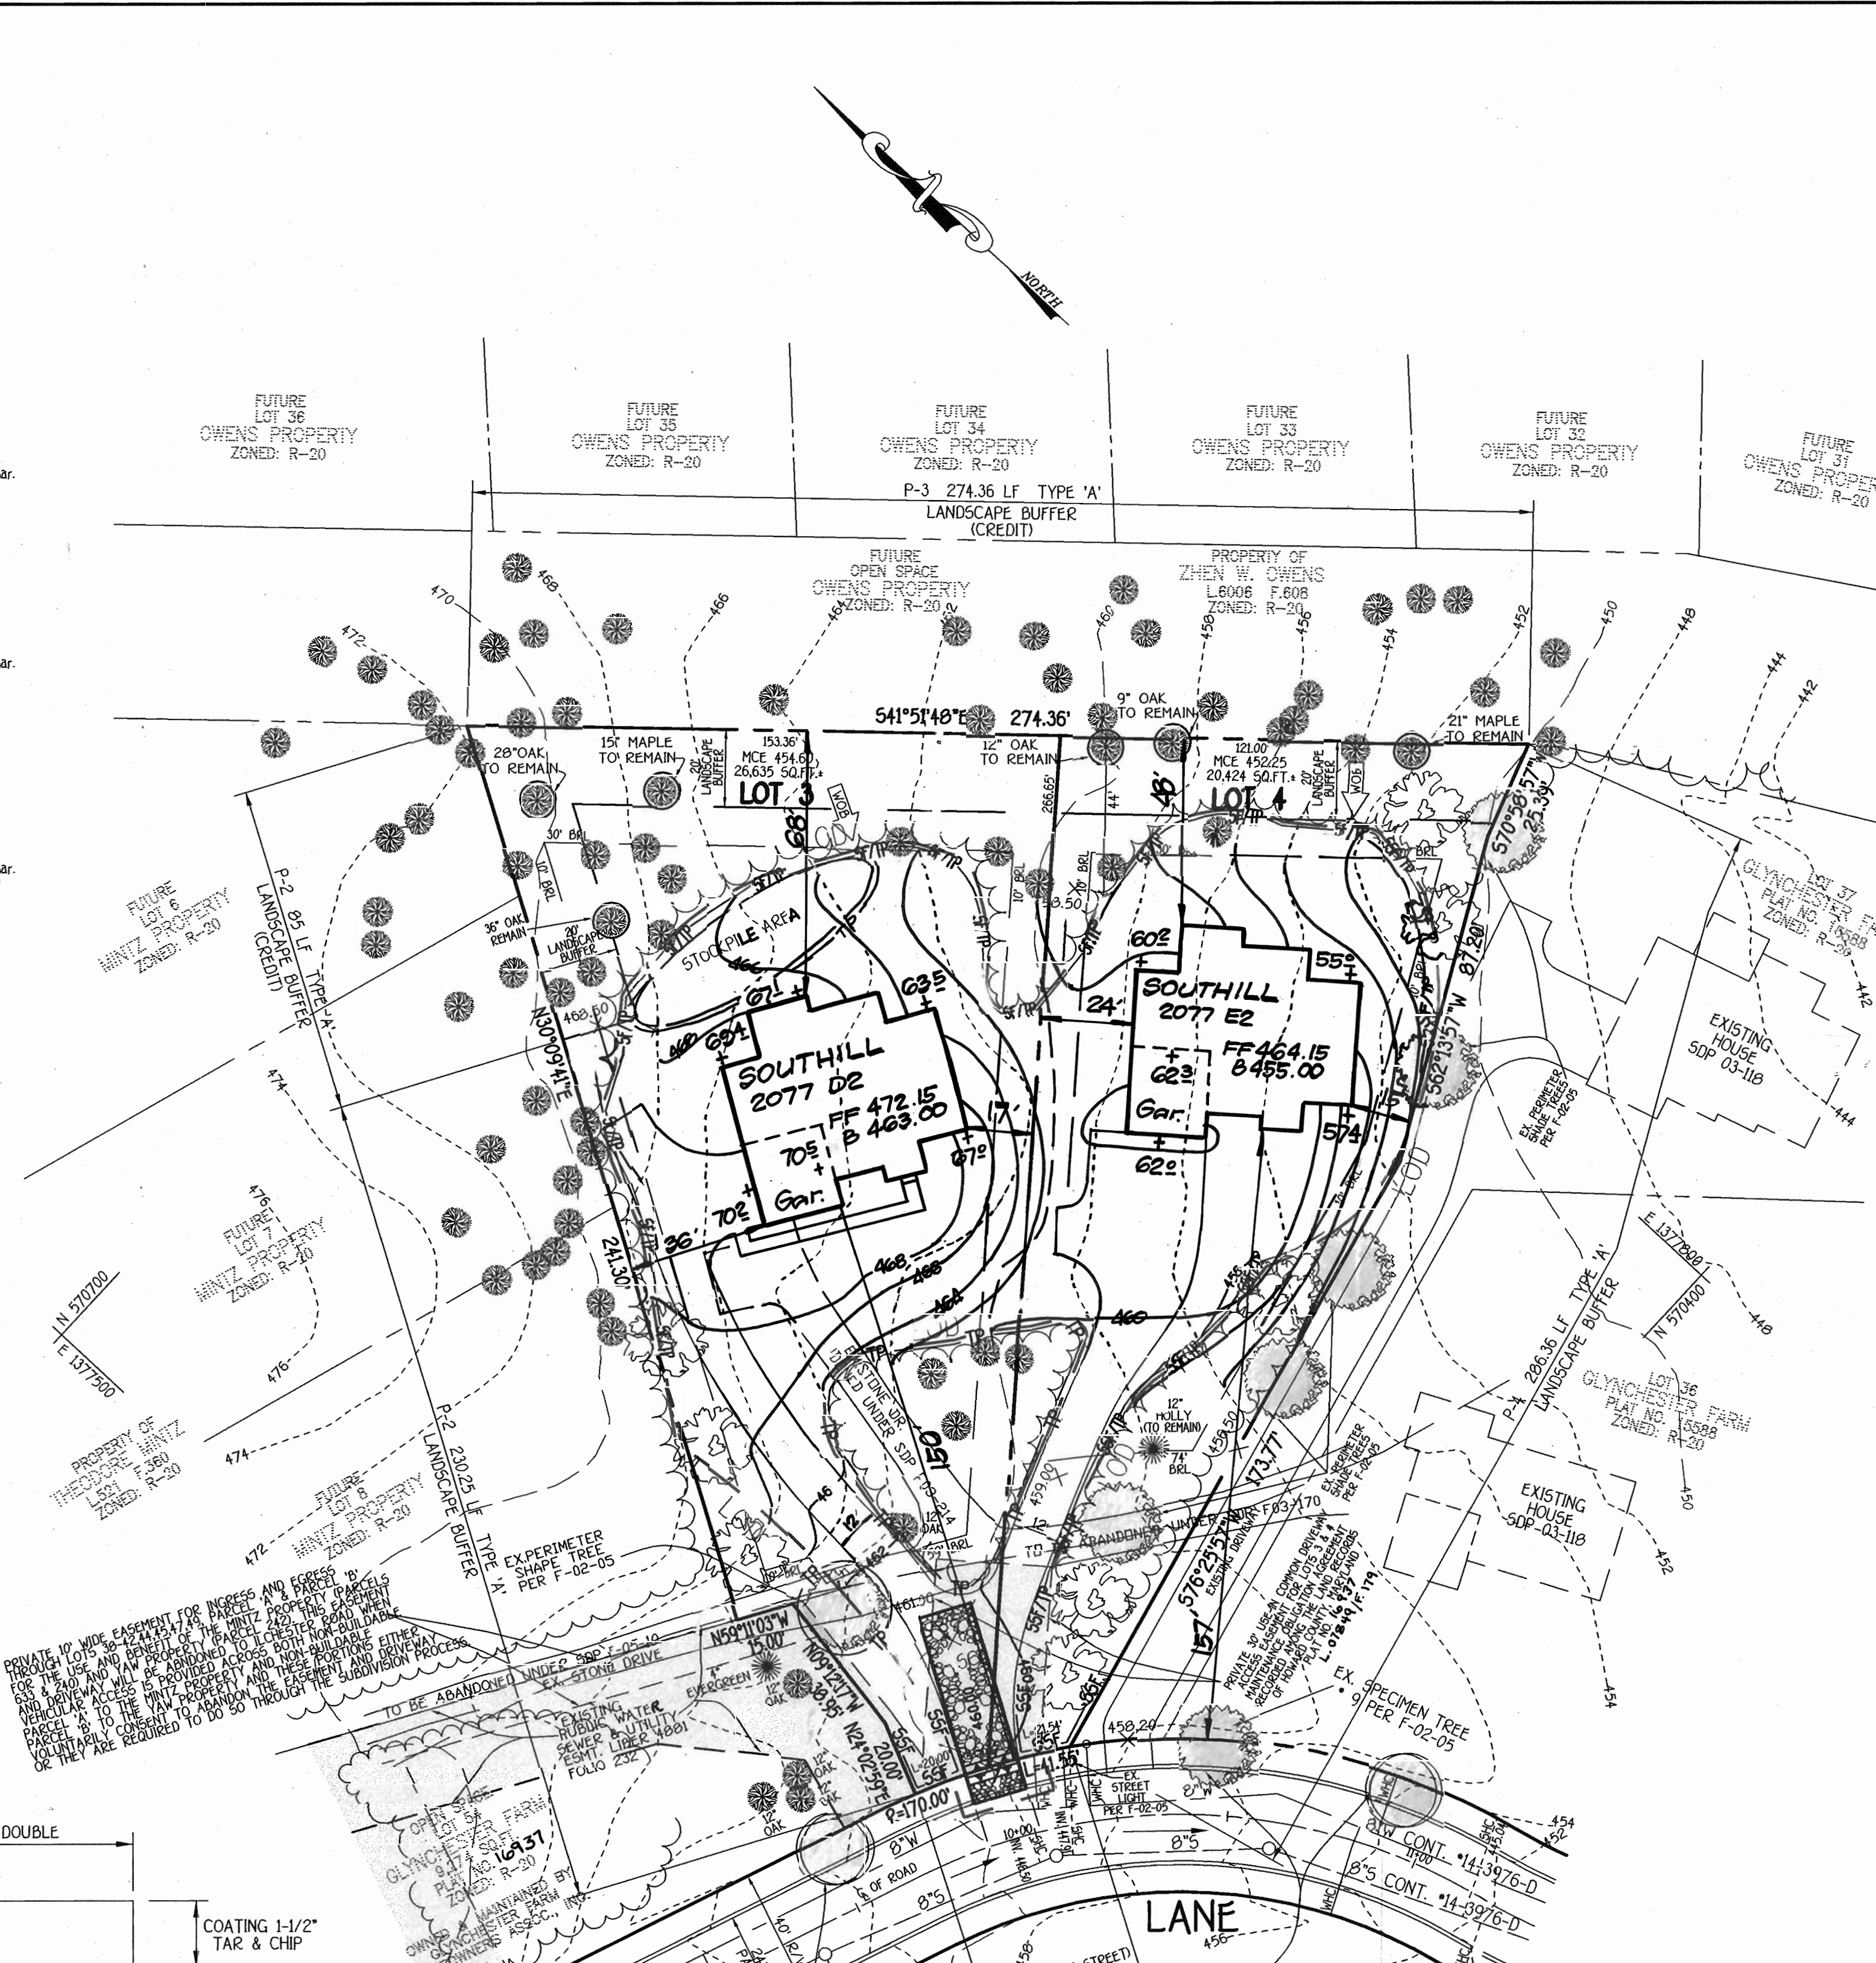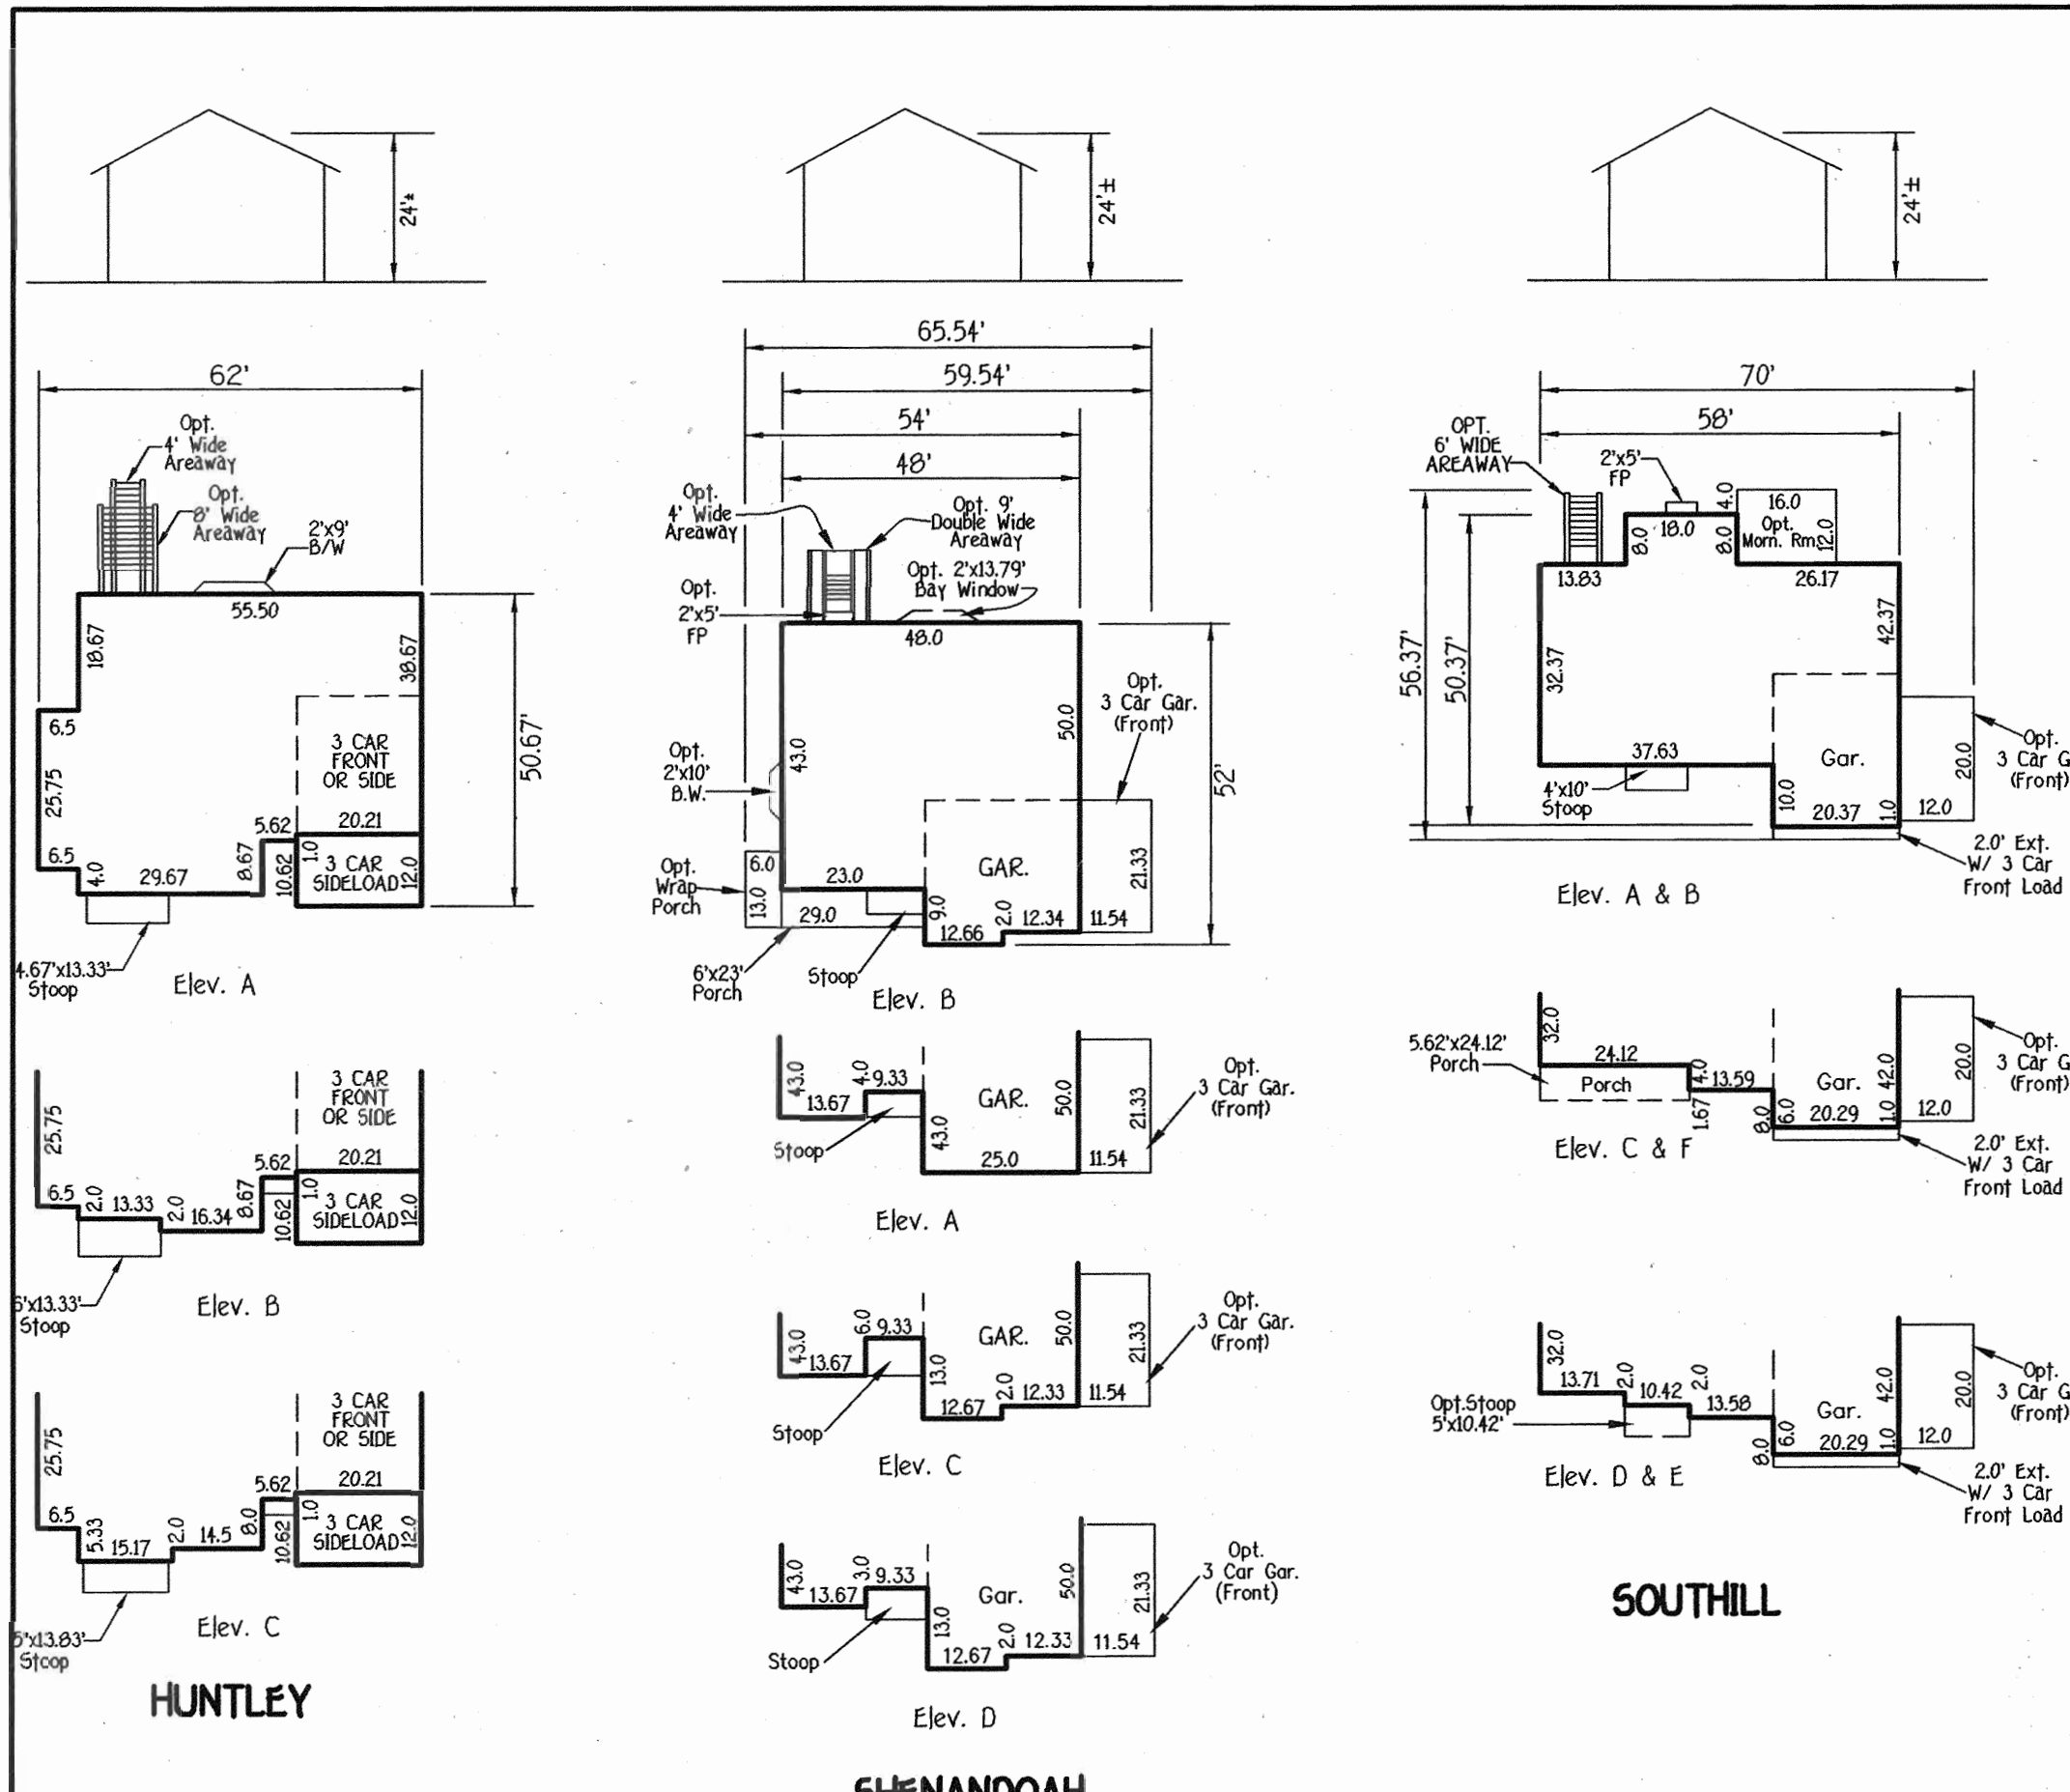

BENCH MARKS
 T.P. 3167 ELEV. 315.30
 N. 173.996.1506
 E. 419.619.2145
 LOC. NEAR THE INTERSECTION
 OF GORMAN RD. & STEVENS ROAD.
 T.P. 3167 ELEV. 339.00
 N. 174449.1549
 E. 419.664.0345
 LOC. NEAR I-95 BRIDGE
 ALONG GORMAN ROAD

- GENERAL NOTES**
- SUBJECT PROPERTY ZONED R-20 PER 2/02/04 COMPREHENSIVE REZONING PLAN.
 - TOTAL AREA OF BUILDABLE LOTS 1.0883 ACRES.
 - TOTAL NUMBER OF LOTS SUBMITTED 2 SINGLE FAMILY.
 - THE CONTRACTOR SHALL NOTIFY THE CONSTRUCTION INSPECTION DIVISION AT (410)313-1800 AT LEAST (5) FIVE WORKING DAYS PRIOR TO THE START OF WORK.
 - THE CONTRACTOR SHALL NOTIFY "MISS UTILITY" AT 1-800-257-7777 AT LEAST 48 HOURS PRIOR TO ANY EXCAVATION WORK.
 - THIS PROJECT IS SUBJECT TO HOWARD COUNTY FILES: F-02-05, F-03-170, W&S CONT. #14-3976-D, & F-03-214, F-03-171.
 - THIS PLAN IS BASED ON A FIELD RUN BOUNDARY SURVEY PERFORMED ON OR ABOUT DECEMBER 22, 1997 BY FISHER COLLINS & CARTER, INC.
 - HORIZONTAL AND VERTICAL CONTROL DATUM IS BASED ON NAD 83, MARYLAND COORDINATE SYSTEM AS PROJECTED BY HOWARD COUNTY GEODETIC CONTROL STATIONS.
 - HOWARD COUNTY MONUMENT 3167 N 173996.1506 E 419619.2145
 HOWARD COUNTY MONUMENT 3167 N 174449.1549 E 419664.0345
 - ANY DAMAGE TO THE COUNTY'S RIGHT-OF-WAY SHALL BE CORRECTED AT THE DEVELOPER'S EXPENSE.
 - THIS PLAN IS FOR HOUSE SITING AND GRADING ONLY. IMPROVEMENTS SHOWN WITHIN THE RIGHTS-OF-WAY OF THIS S.D.P. ARE NOT USED FOR CONSTRUCTION FOR CONSTRUCTION SEE APPROVED ROAD CONSTRUCTION PLANS F-02-05, AND/OR APPROVED WATER AND SEWER PLANS CONTRACT NO. 14-3976-D.
 - CONTRACTOR WILL CHECK SEWER HOUSE CONNECTION ELEVATION AT EASEMENT LINE PRIOR TO CONSTRUCTION.
 - THE STORMWATER QUANTITY & QUALITY MANAGEMENT FOR THIS SUBDIVISION IS PROVIDED IN THE STORMWATER MANAGEMENT POND IN THE GLYNCHESTER FARM IF-02-05 SUBDIVISION.
 - LANDSCAPING IN ACCORDANCE WITH SECTION 16.124 OF THE HOWARD COUNTY CODE AND LANDSCAPE MANUAL SHALL BE PROVIDED AS SHOWN ON THIS SITE PLAN. SURETY FOR 3 SHADE TREES LOCATED ON LOT 3 AND 5 SHADE TREES LOCATED ON LOT 4, FOR A TOTAL OF 8 SHADE TREES, IN THE AMOUNT OF \$2,400.00 SHALL BE POSTED WITH THE GRADING PERMIT.
 - THIS SITE IS EXEMPT FROM FOREST CONSERVATION OBLIGATIONS PER F-05-17 IN ACCORDANCE WITH SECTION 16.1202(B)(iv)(v) OF THE FOREST CONSERVATION MANUAL SINCE IT IS A MINOR RESUBDIVISION WHICH DOES NOT CREATE ANY ADDITIONAL LOTS AND HAS NO FURTHER SUBDIVISION POTENTIAL.
 - FOR DRIVEWAY ENTRANCE DETAILS REFER TO HO. CO. DES. MAN. VOL. IV DETAILS R.6.05.
 - SITE DEVELOPMENT PLAN FOR SINGLE FAMILY DETACHED UNITS.
 - THIS PLAN IS SUBJECT TO THE AMENDED FIFTH EDITION OF THE SUBDIVISION REGULATIONS.
 - IN ACCORDANCE WITH SECTION 12B (A)(1) OF THE HOVOC ZONING REGULATION, BAYWINDOWS, CHIMNEYS OR EXTERIOR STAIRWAYS NOT MORE THAN 16 FEET IN WIDTH MAY PROJECT NOT MORE THAN 4 FEET INTO ANY SETBACK, PORCHES OR DECKS, OPEN OR ENCLOSED MAY PROJECT NOT MORE THAN 10 FEET INTO THE FRONT OR REAR YARD SETBACKS.
 - REFUSE COLLECTION, SNOW REMOVAL AND ROAD MAINTENANCE TO BE PROVIDED AT THE JUNCTION OF THE PIPE/FLAG STEM AND THE ROAD RIGHT-OF-WAY AND NOT INTO THE FLAG/PIPE STEM DRIVEWAY.
 - USE-IN-COMMON DRIVEWAYS SHALL BE PROVIDED PRIOR TO ISSUANCE OF A USE AND OCCUPANCY PERMIT TO ENSURE SAFE ACCESS FOR FIRE AND EMERGENCY VEHICLES PER THE FOLLOWING (MINIMUM) REQUIREMENTS:
 A) WIDTH - 12 FEET (4 FEET SERVING MORE THAN ONE RESIDENCE)
 B) SURFACE - SIX (6) INCHES OF COMPACTED CRUSHER RUN BASE WITH TAR AND CHIP COATING (1-1/2" MINIMUM)
 C) GEOMETRY - MAXIMUM 15% GRADE, CHANGE AND 45-FOOT TURNING RADIUS
 D) STRUCTURE - (CULVERTS/BRIDGES) - CAPABLE OF SUPPORTING 25 GROSS TONS (825-LOADING)
 E) DRAINAGE ELEMENTS - CAPABLE OF SUPPORTING 100 YEAR FLOOD WITH NO LEAKING
 F) FOOT DEPTH OVER SURFACE
 G) STRUCTURE CLEARANCES - MINIMUM 12 FEET
 H) MAINTENANCE - SUFFICIENT TO ENSURE ALL WEATHER USE
 - ACCESS TO LOTS 3 & 4 OF THE YAW PROPERTY SHALL BE IN ACCORDANCE WITH THE EXISTING 10' WIDE USE-IN-COMMON ACCESS EASEMENT AS SHOWN ON THE FINAL PLAN FOR F-02-05, GLYNCHESTER FARM, UNTIL SUCH TIME AS ELLIS LANE IS CONSTRUCTED. UPON CONSTRUCTION OF ELLIS LANE, INGRESS/EGRESS TO LOTS 3 & 4 WILL BE DIRECTLY FROM ELLIS LANE, VIA THE 30' WIDE USE-IN-COMMON ACCESS EASEMENT DESIGNED TO SERVE THESE LOTS EXCLUSIVELY AND USE OF THE 10' WIDE USE-IN-COMMON ACCESS EASEMENT WILL BE ABANDONED.
 - NO CEMETARIES EXIST ON SITE BY VISUAL OBSERVATION.
 - A WETLANDS REPORT WAS PREPARED BY AMERICAN LAND CONCEPTS ON MAY 20, 2003. NO WETLANDS EXIST ON-SITE.
 - HOMELAND ASSOCIATION DOCUMENTS FOR THE GLYNCHESTER FARM SUBDIVISION HAVE BEEN FILED WITH THE MD DEPARTMENT OF ASSESSMENTS AND TAXATION AS RECORDING NUMBER 00691740 ON 7-10-03.
 - Per plat #16346 recorded on 11-25-03, the two lots comprising the Yaw Property (Parcel #42) have approved all rights to the access easement contingent upon the dedication of Ellis Lane to Howard County.

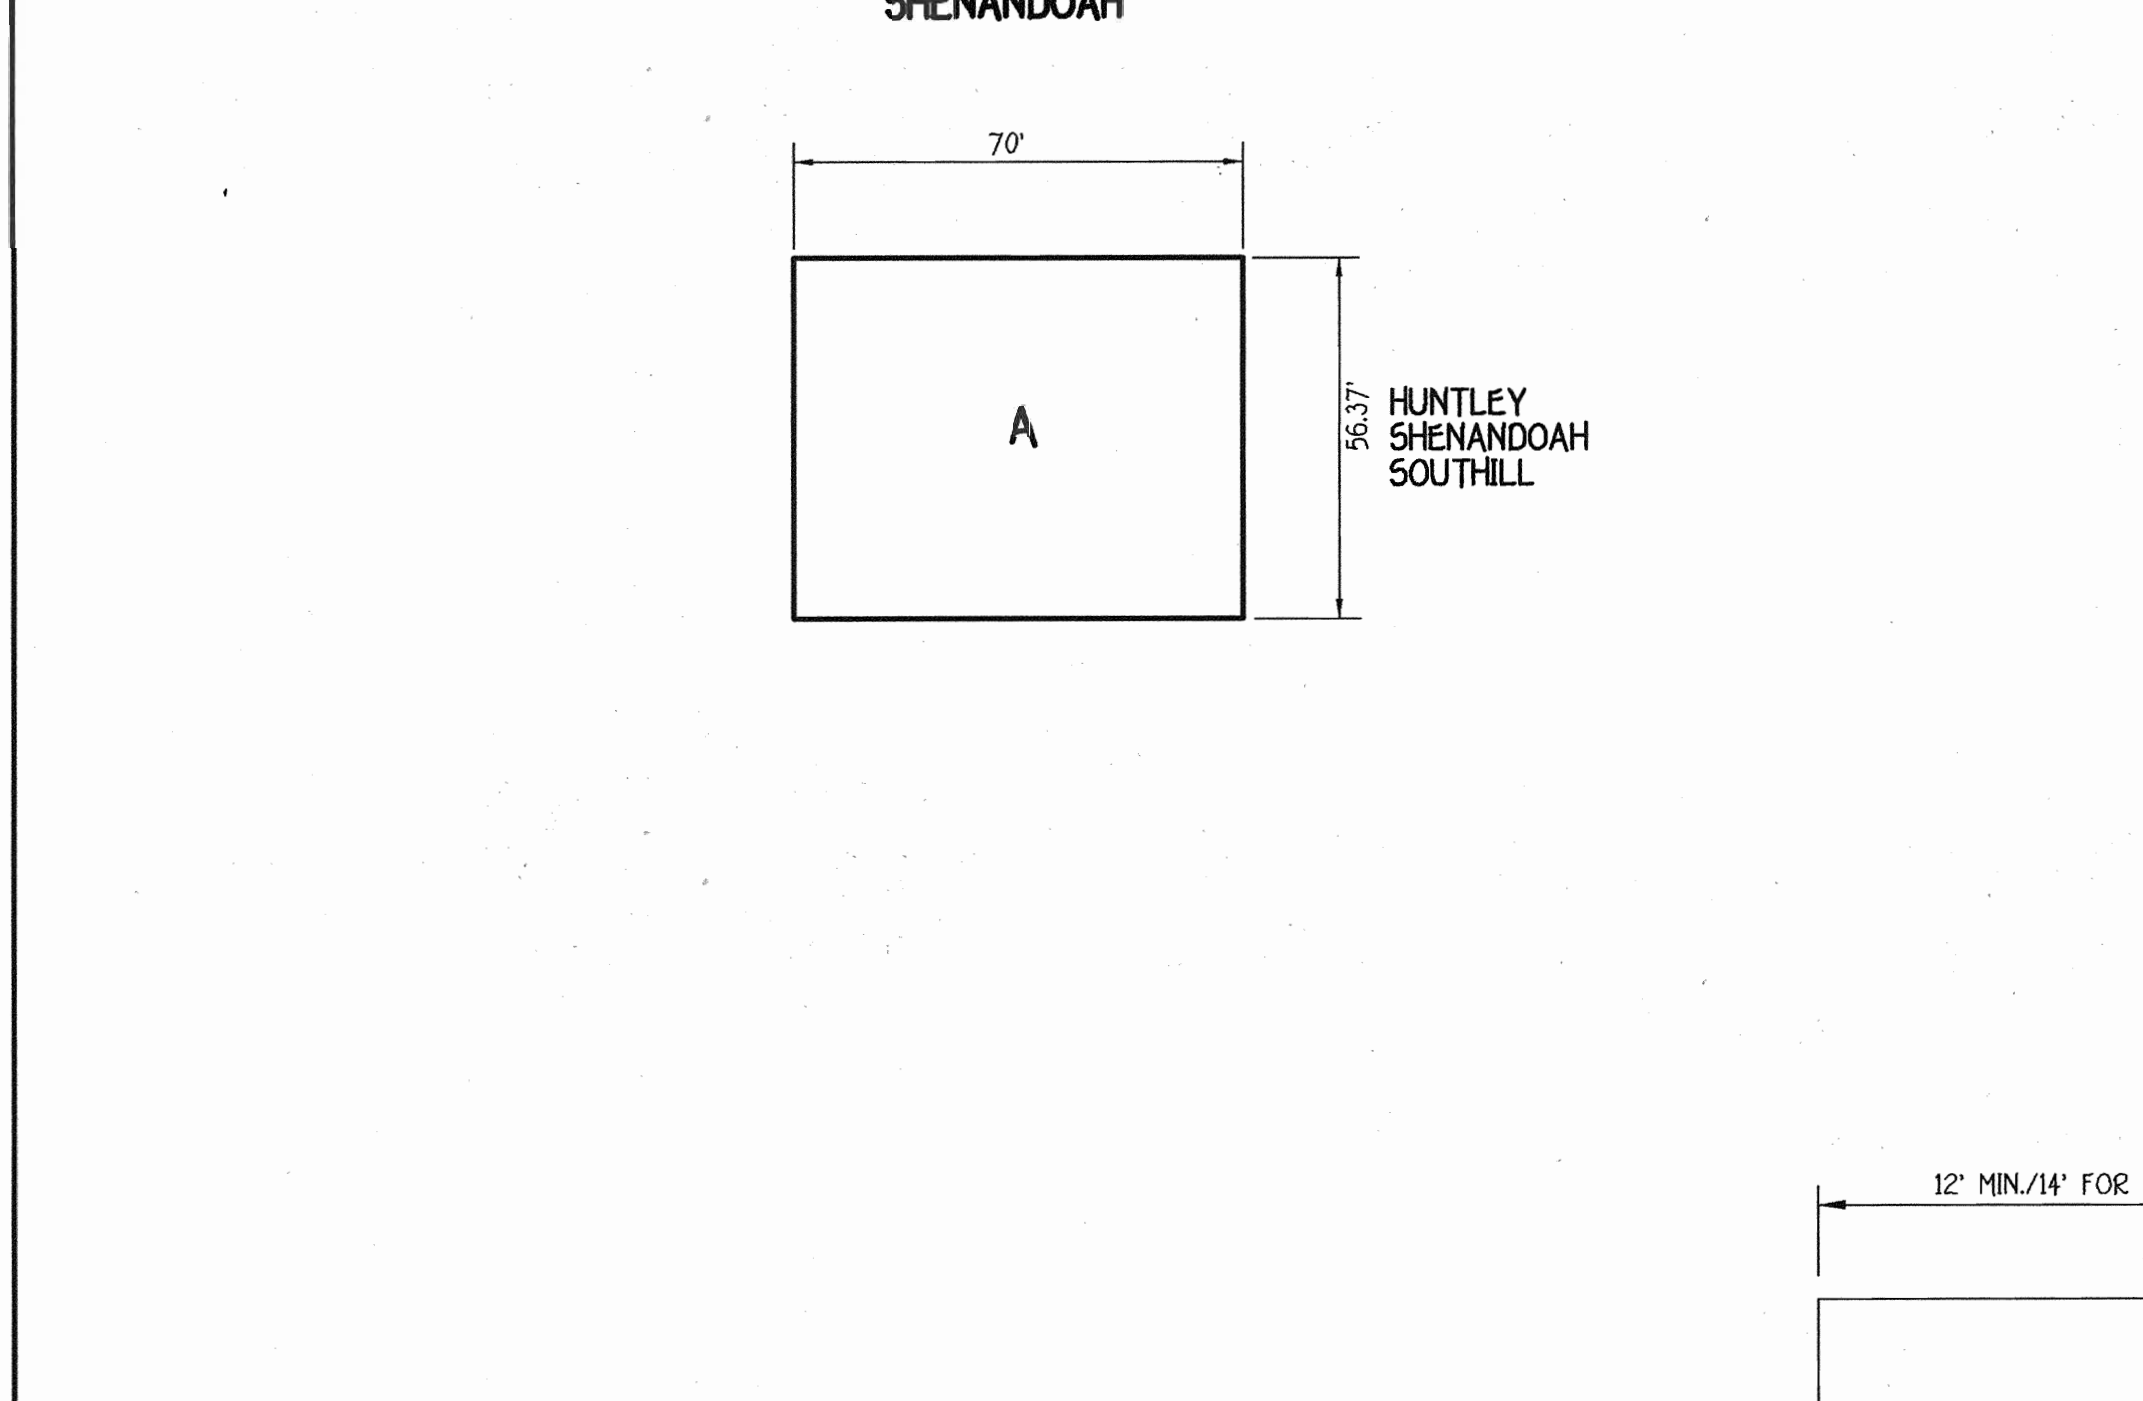

BUILDER/DEVELOPER'S CERTIFICATE
 I/WE CERTIFY THAT THE REQUIRED LANDSCAPING WILL BE DONE ACCORDING TO THE PLAN, SECTION 16.124 OF THE HOWARD COUNTY SUBDIVISION AND LAND DEVELOPMENT REGULATIONS AND THE LANDSCAPE MANUAL. I/WE FURTHER CERTIFY THAT UPON COMPLETION, A CERTIFICATION OF LANDSCAPE INSTALLATION ACCOMPANIED BY AN EXECUTED ONE YEAR GUARANTEE OF PLANT MATERIALS, WILL BE SUBMITTED TO THE DEPARTMENT OF PLANNING AND ZONING.
 Bob Padgett 8-12-04
 BOB PADGETT DATE

ADDRESS CHART

LOT NUMBER	STREET ADDRESS
3	4951 ELLIS LANE
4	4953 ELLIS LANE

INDEX CHART

SHEET	DESCRIPTION
SHEET 1	SITE, LANDSCAPE & SEDIMENT/EROSION CONTROL PLAN
SHEET 2	SEDIMENT/EROSION CONTROL NOTES & DETAILS

LEGEND

SYMBOL	DESCRIPTION
---	EXISTING CONTOUR 2' INTERVAL
+362.2	SPOT ELEVATION
---	PROPOSED WALKOUT
---	SUPER SILT FENCE
---	SILT FENCE/TREE PROTECTION
---	LIMIT OF DISTURBANCE
○	EXISTING PERIMETER SHADE TREES F-02-05
○	EXISTING STREET TREE PER F-02-05

FISHER, COLLINS & CARTER, INC.
 3708 ENGINEERING CENTER AVENUE, 3 & 4 FLOOR
 CENTENNIAL SQUARE OFFICE PARK - 10772 BALTIMORE NATIONAL FREE
 ELLEOTT CITY, MARYLAND 21112
 (410) 481-2505

ENGINEER'S CERTIFICATE
 I certify that this plan for erosion and sediment control represents a practical and workable plan based on my personal knowledge of the site conditions and that it was prepared in accordance with the requirements of the Howard Soil Conservation District.
 Earl D. Collins 8-12-04
 Signature of Engineer EARL D. COLLINS DATE

BUILDER/DEVELOPER'S CERTIFICATE
 I/WE certify that all development and construction will be done according to this plan for sediment and erosion control and that any responsible personnel involved in the construction project will have a Certificate of Attendance at a Department of the Environment Approved Training Program for the Control of Sediment and Erosion before beginning the project. I also authorize periodic on-site inspection by the Howard Soil Conservation District.
 Bob Padgett 8-12-04
 Signature of Developer BOB PADGETT DATE

OWNER/BUILDER/DEVELOPER
 RYLAND GROUP
 7250 PARKWAY DRIVE
 SUITE 520
 HANOVER, MARYLAND 21076
 410-712-7012

1 Rev. hse. & grd. lots 3 & 4 to show As-Built Conditions 3-22-05

ENGINEER'S CERTIFICATE
 I certify that this plan for erosion and sediment control represents a practical and workable plan based on my personal knowledge of the site conditions and that it was prepared in accordance with the requirements of the Howard Soil Conservation District.
 Jim Myers 8/23/04
 Signature of Engineer JIM MYERS DATE

BUILDER/DEVELOPER'S CERTIFICATE
 I/WE certify that all development and construction will be done according to this plan for sediment and erosion control and that any responsible personnel involved in the construction project will have a Certificate of Attendance at a Department of the Environment Approved Training Program for the Control of Sediment and Erosion before beginning the project. I also authorize periodic on-site inspection by the Howard Soil Conservation District.
 John K. Volante 8/23/04
 Signature of Builder/Developer JOHN K. VOLANTE DATE

OWNER/BUILDER/DEVELOPER
 RYLAND GROUP
 7250 PARKWAY DRIVE
 SUITE 520
 HANOVER, MARYLAND 21076
 410-712-7012

APPROVED: HOWARD COUNTY DEPARTMENT OF PLANNING AND ZONING
 Chief, Division of Land Development 10/8/04
 Chief, Development Engineering Division 9/10/04
 Director - Department of Planning and Zoning 8/12/04

SITE DEVELOPMENT, LANDSCAPE & SEDIMENT/EROSION CONTROL PLAN
 SINGLE FAMILY DETACHED
YAW PROPERTY
 LOTS 3 & 4
 TAX MAP NO: 31 PARCEL NO: 239 & 242 GRID NO: 16
 FIRST ELECTION DISTRICT HOWARD COUNTY, MARYLAND
 SCALE: 1" = 30' DATE: JUNE, 2004
 SHEET 1 OF 2

SDP-04-100