



- PLANTING NOTES**
- ALL PLANT MATERIALS SHALL BE FULL AND HEAVY, BE WELL FORMED AND SYMMETRICAL AND CONFORM TO THE MOST CURRENT AAS SPECIFICATIONS.
 - CONTRACTOR SHALL VERIFY LOCATION OF ALL UNDERGROUND UTILITIES PRIOR TO DIGGING.
 - FINAL LOCATION OF PLANT MATERIAL MAY NEED TO VARY TO MEET FINAL FIELD CONDITIONS. TREES SHALL NOT BE PLANTED IN THE BOTTOM OF DRAINAGE SWALES.

QTY.	KEY	BOTANICAL NAME	COMMON NAME	SIZE/ROOT
5	AC	ACER CAMPESTRE	HEDGE MAPLE	2-1/2" - 3", 12'-14' / B & B
7	AR1	ACER RUBRUM 'OCTOBER GLORY'	RED MAPLE	2-1/2" - 3", 12'-14' / B & B
9	TO	THUGA OCCIDENTALIS 'TECHNY'	MISSION ARBORVITAE	7'-8' / B & B
2	CK	CORNUS KOUSA	KOUSA DOGWOOD	2" - 2-1/2" CAL. B & B
11	CA	CLETHRA ALNIFOLIA 'HUMMINGBIRD'	HUMMINGBIRD SUMMERSWEET	24" - 30" Ht. B & B
3	IG	ILEX GLABRA 'COMPACTA'	COMPACT INKBERRY	24" - 30" Ht. B & B
4	JC	JUNIPERUS CHINENSIS 'PITZERIANA COMPACTA'	COMPACT PITZTER JUNIPER	24" - 30" Ht. B & B

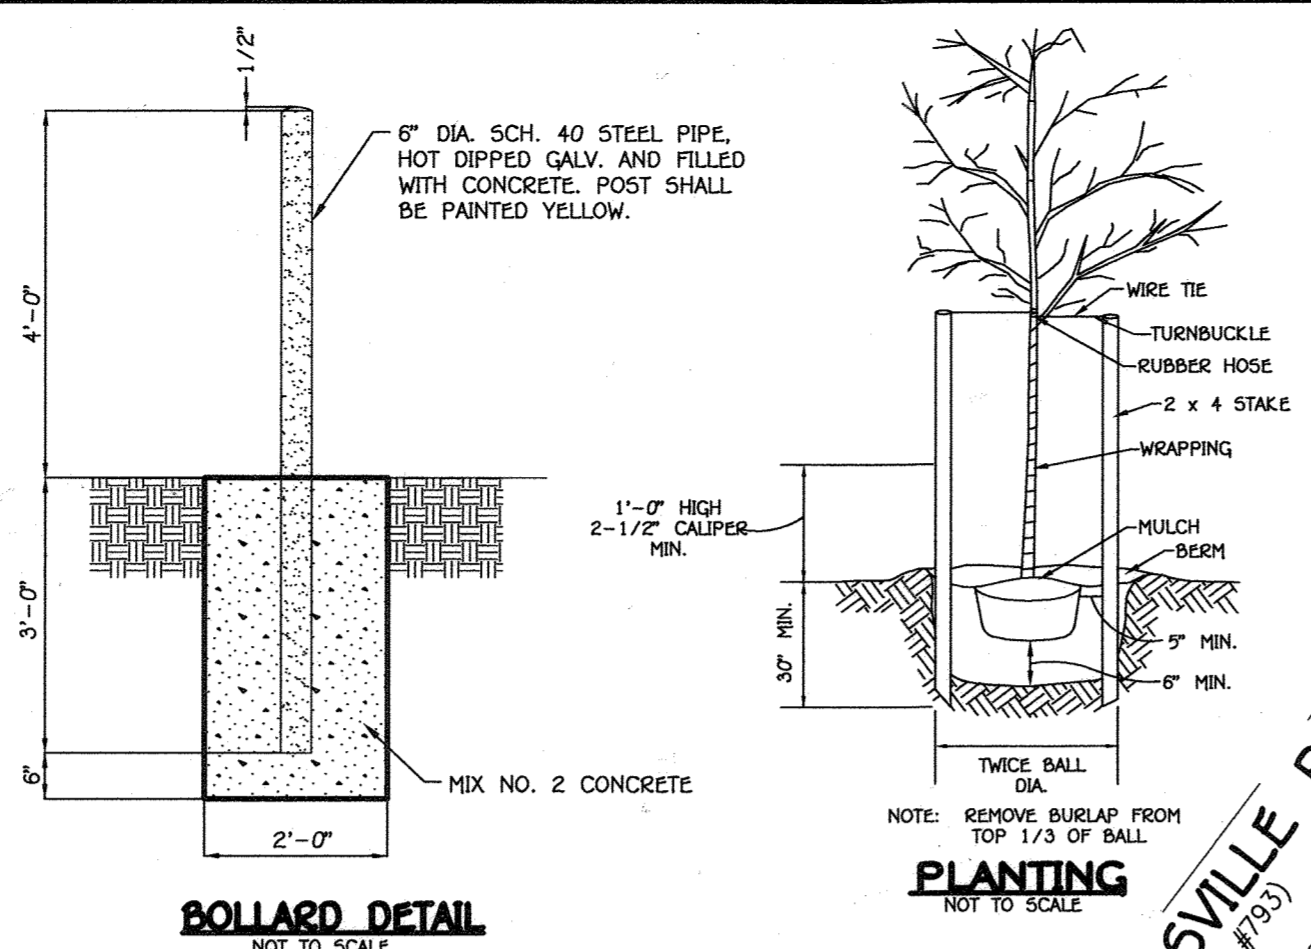

SYMBOL		DESCRIPTION	SYMBOL		DESCRIPTION	SYMBOL		DESCRIPTION
---	---	EXISTING CONTOUR 2' INTERVAL	---	---	DRAINAGE LIMITS	○	○	DOOR LOCATION
---	---	EXISTING CONTOUR 10' INTERVAL	---	---	L.O.D. LIMIT OF DISTURBANCE	○	○	EXISTING PARKING SPACES
---	---	PROPOSED CONTOUR 2' INTERVAL	---	---	EXISTING GASMAIN	○	○	STORMWATER MANAGEMENT DEVICE
---	---	PROPOSED CONTOUR 10' INTERVAL	---	---	EXISTING TREE LINE	○	○	STORM DRAIN
---	---	SUPER SILT FENCE	---	---	OVERHEAD UTILITY	○	○	STABILIZED CONSTRUCTION ENTRANCE

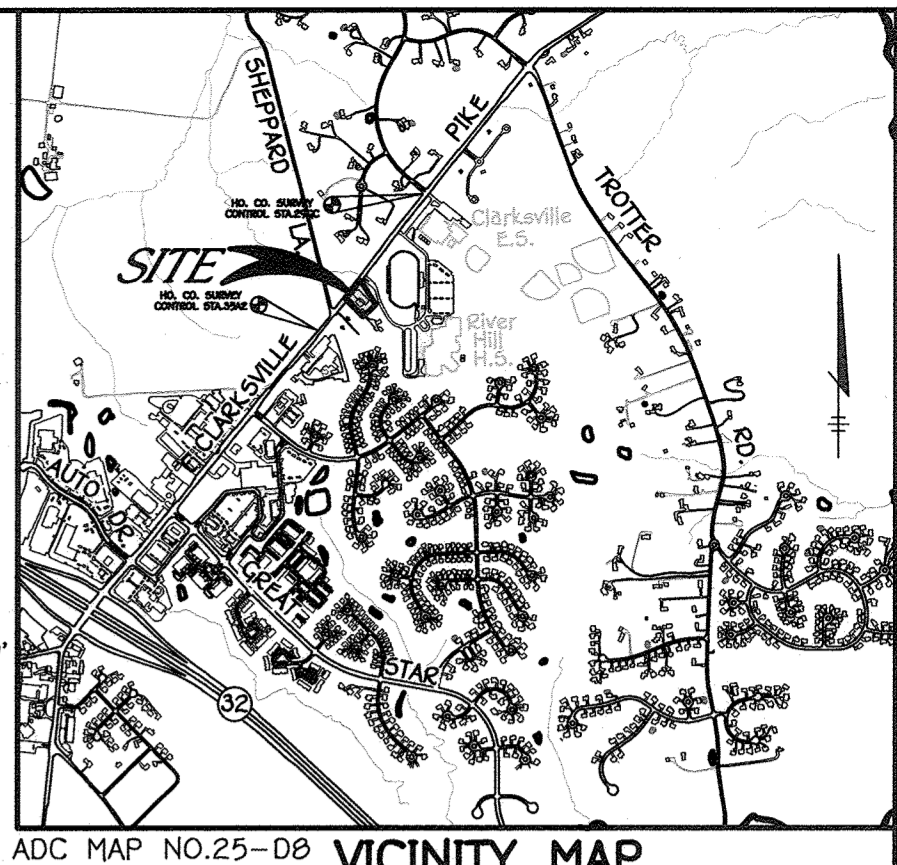

PERIMETER TYPE	SCHEDULE A PERIMETER LANDSCAPE EDGE					
	'B'	'E'	'B'	'A'	'C'	'B'
CATEGORY	Adjacent to Roadways					Adjacent to Perimeter Properties
LINEAR FEET OF ROADWAY FRONTAGE/PERIMETER	(1) 82'	(2) 31'	(3) 87'	(4) 279'	(5) 178'	(6) 231'
CREDIT FOR EXISTING VEGETATION						
SHADE TREES	1	0	0	0	1	1
EVERGREEN TREES	0	0	0	0	2	4
SHRUBS	10	0	20	0	0	0
CREDIT FOR WALL, FENCE OR BERM (YES, NO, LINEAR FEET) (DESCRIBE IF NEEDED)	NO	NO	NO	NO	NO	NO
NUMBER OF PLANTS REQUIRED						
SHADE TREES	2 (1:50)	1 (1:40)	2 (1:50)	5 (1:60)	5 (1:40)	5 (1:50)
EVERGREEN TREES	2 (1:40)	0	2 (1:40)	0	9 (1:20)	6 (1:40)
SHRUBS	0	0 (1:4)	0	0	0	0
NUMBER OF PLANTS PROVIDED						
SHADE TREES	1	0	0	4	3	4
EVERGREEN TREES	2	0	0	0	0	2
OTHER TREES (2:1 SUBSTITUTION)	0	0	0	0	0	0
SHRUBS (10:1 SUBSTITUTION)	0	0	0	0	0	0

1. THERE ARE 19 EXISTING SHRUBS IN THE TYPE 'B' BUFFER ALONG THE ROAD, 10 OF WHICH ARE BEING USED TO SUBSTITUTE FOR ONE OF THE REQUIRED 2 SHADE TREES.

2. TO NEW SHRUBS ARE BEING SUBSTITUTED FOR THE 1 REQUIRED SHADE TREE.

3. 20 OF THE 22 EXISTING SHRUBS WILL BE CREDITED TOWARDS THE TWO REQUIRED SHADE TREE PLANTINGS.

4. THERE IS 1 EXISTING SHADE TREE AND 2 ORNAMENTAL TREES THAT ARE BEING SUBSTITUTED FOR 2 OF THE 5 REQUIRED SHADE TREES IN THE (S) BUFFER.

5. THERE ARE 6 EXISTING EVERGREEN TREES THAT ARE BEING CREDITED TOWARDS THE REQUIRED 9 EVERGREENS. NONE VERIFIED AS BEING IN THE BUFFER.

6. THERE IS 1 EXISTING SHADE TREE IN THE (B) BUFFER THAT IS BEING SUBSTITUTED FOR 1 OF THE 5 REQUIRED SHADE TREES.

Lutfi's International Day Spa and Salon													
DATA SUMMARY OF Lutfi's International Day Spa and Salon										ESD SUMMARY TABLE No. 1			
Gross Area of Site:										1.18 Acres	Date: 04-1-16		
Developable Area:										1.18 Acres	Page 1 of 1		
Pre-Developed Conditions Composite RCNw:										65			
Target PE for overall project:										1.8 Inches			
Target ESDvol for overall project:										0.080 Ac. Ft. 3,467 Cu. Ft.			
D.A. No.	Area (Sq. Ft.)	Imp. Area	Lawn Area	% of Total Site Area	ESD	Filter Area (Sq. Ft.)	100% ESDvol Required (CF)	ESD Surface Stor. Prov.	ESD Stone/Sand Filter Media	Rev. Prox. (CF)	ESDvol Prox. (CF)	% IMP	PE
1	345	345	0	0.87	M-5	128	50	128	51	51	51	100%	1.8
2	864	864	0	1.88	M-5	392	123	392	157	157	157	100%	1.8
3	305	305	0	0.59	M-5	128	44	128	51	51	51	100%	1.8
4	302	302	0	0.58	M-5	128	43	128	51	51	51	100%	1.8
5	828	828	0	1.61	M-5	200	68	200	80	80	80	100%	1.8
6	323	323	0	0.62	M-5	128	51	128	51	51	51	100%	1.8
7	1788	1788	0	3.43	M-6	142	252	305	305	305	305	100%	2.7
Sub	4735	4735	0	(see B.)		1,248	631	1,409	746	441	746		
Total	0.11	0.11	0.00	(see B.)									

*** SITE ANALYSIS DATA CHART (UPDATED DEC. 2017)**


F) FLOOR SPACE ON EACH LEVEL OF BUILDING (BY USE):

FIRST FLOOR AREA:
 EXISTING: 2,897 SF (SALON)
 TO BE RAZED: 276 SF (SALON)
 PROPOSED (NEW CONSTRUCTION): 4,731 SF (480 SF SALON; 890 SF OFFICE; 3,373 SF OFFICE OR RETAIL)

SECOND FLOOR AREA:
 EXISTING: 1,000 SF (101 SF SALON; 899 SF DAY SPA)
 1,788 SF (BUSINESS STORAGE)
 10,120 SF (3,190 SF SALON; 899 SF DAY SPA; 890 SF OFFICE; 3,373 SF OFFICE OR RETAIL); 1,788 SF (BUSINESS STORAGE)

H) NUMBER OF PARKING SPACES REQUIRED: 99 P.S.
 GROUPED BY USES:
 1) SALON: 3,190 SF @ 5 PER 1,000 SQ. FT. = 16 SPACES
 2) DAY SPA: 899 SF @ 3.3 PER 1,000 SQ. FT. = 3 SPACES
 3) OFFICE: 890 SF @ 3.3 PER 1,000 SQ. FT. = 3 SPACES
 4) RETAIL: 3,373 SF @ 5 PER 1,000 SQ. FT. = 17 SPACES
 5) SECOND FLOOR RETENTION (BUSINESS STORAGE) = 0 SPACES REQUIRED
 TOTAL REQUIRED = 43 SPACES REQUIRED

G) LOFT AREA: 1,200 SF @ 3.3 PER 1,000 SQ. FT. = 4 SF

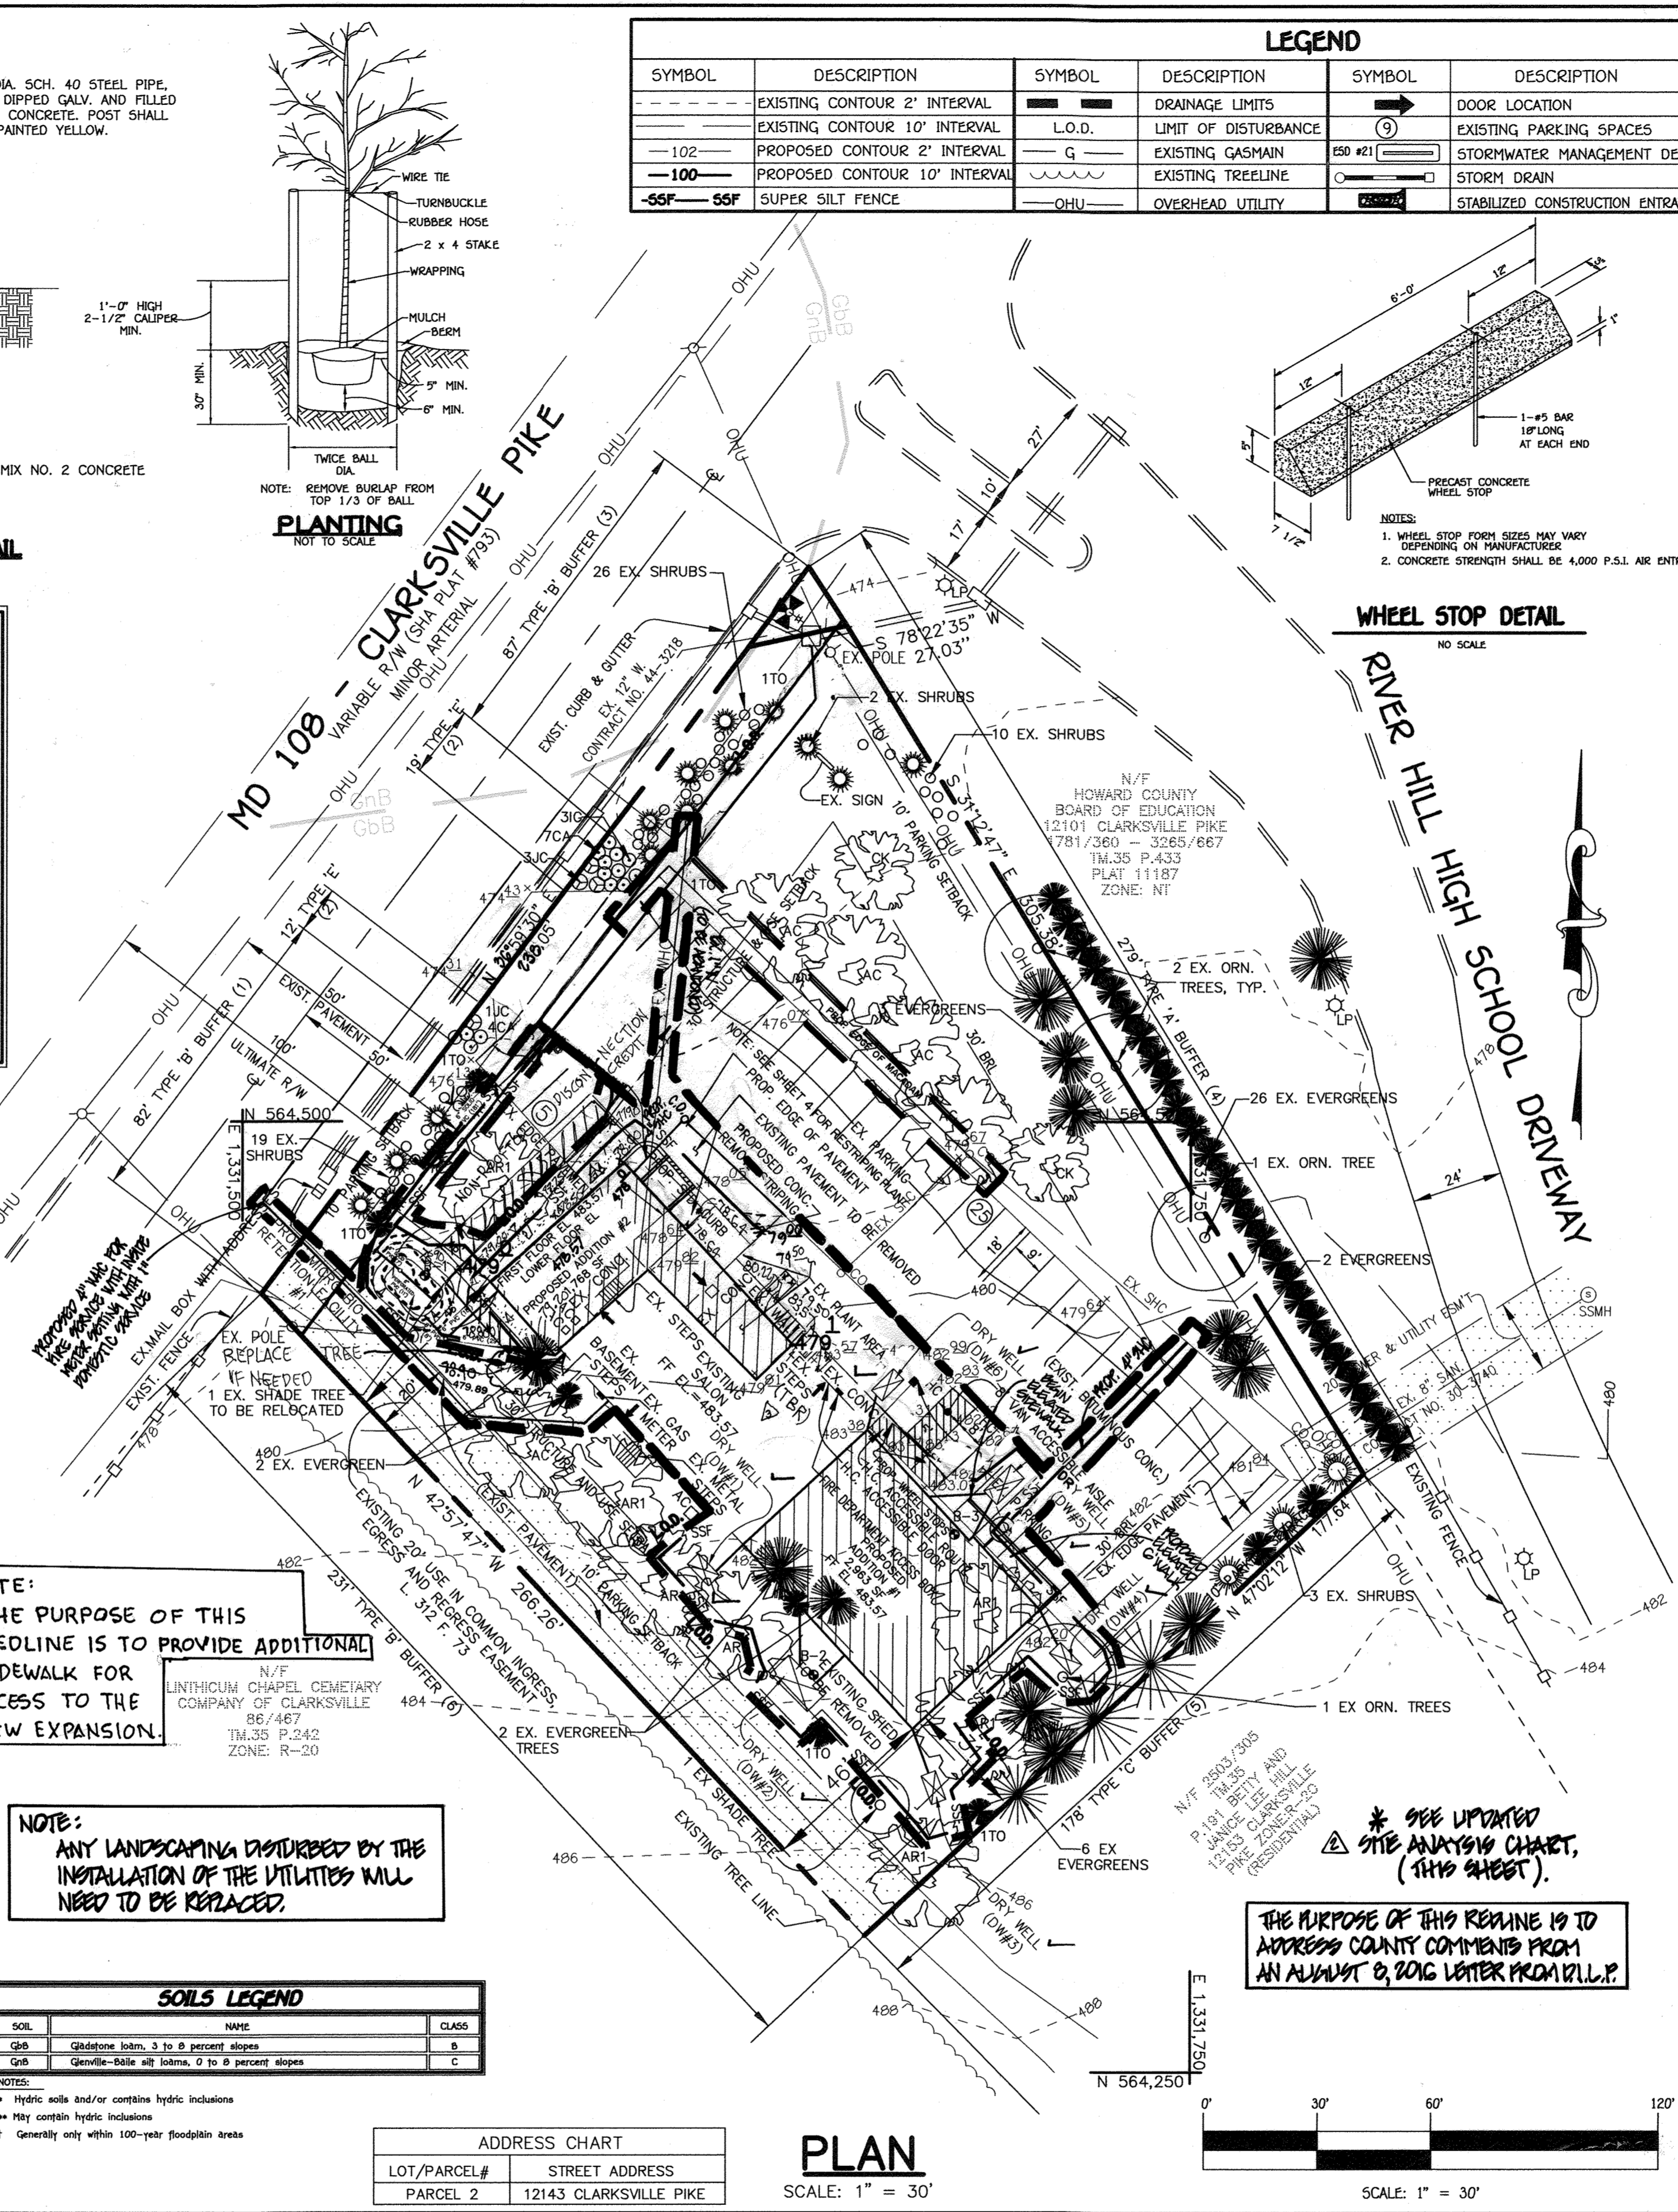

SOILS LEGEND		
SOIL	NAME	CLASS
CL	Claystone loam, 3 to 8 percent slopes	B
GS	Gentle-slopes, 8 to 15 percent slopes	B
CS	Gentle-slopes, 15 to 25 percent slopes	C

ADDRESS CHART	
LOT/PARCEL#	STREET ADDRESS
PARCEL 2	12143 CLARKSVILLE PIKE

PLAN
SCALE: 1" = 30'

FISHER, COLLINS & CARTER, INC.
 CIVIL ENGINEERING CONSULTANTS & LAND SURVEYORS
 CENTENNIAL SQUARE OFFICE PARK - 10272 BALTIMORE NATIONAL PIKE
 ELLETT CITY, MARYLAND 21042
 (410) 461-0292

4 ADDITIONAL SHEET FOR PARKING RESTRICTION 2/14/20
 FOR ADDITIONAL LOFT AREA REQUIRED PARKING
 5 THE REDLINE IS FOR PROVIDING ADDITIONAL SIDEWALK 5/19/17
 6 REWROTE SITE ANALYSIS CHART TO REFLECT UPDATED FLOOR AREA 10/17/17
 7 Access to building, skunk fire & domestic line shown SHC (see 6/12/17)
 NO. REVISION DATE

ENGINEER'S CERTIFICATE
 "I certify that this plan for erosion and sediment control represents a practical and workable plan based on my personal knowledge of the site conditions and that it was prepared in accordance with the requirements of the Howard Soil Conservation District."

John R. Robertson
 Signature of Engineer 6/17/16 Date

BUILDER/DEVELOPER'S CERTIFICATE
 "I/We certify that all development and construction will be done according to this plan, for sediment and erosion control and that any responsible personnel involved in the construction project will have a Certificate of Attendance at a Department of the Environment Approved Training Program for the Control of Sediment and Erosion before beginning the project. I also authorize periodic on-site inspection by the Howard Soil Conservation District."

John R. Robertson
 Signature of Developer 6/17/16 Date

OWNER/DEVELOPER
 MR. LUTFI ON
 10295 CRIMSON TREE COURT
 COLUMBIA, MD. 21044
 410-531-3300

APPROVED: HOWARD COUNTY DEPARTMENT OF PLANNING AND ZONING
John R. Robertson
 Chief, Division of Land Development 7-21-16 Date
John R. Robertson
 Chief, Development Engineering Division 7-13-16 Date
Walter J. J. J.
 Director, Department of Planning and Zoning 7-25-16 Date

PROJECT	SECTION	PARCEL NO.			
LUTFI'S INTERNATIONAL SALON AND SPA	N/A	2			
LIBER/FOLIO	BLOCK NO.	ZONE	TAX/ZONE	ELEC. DIST.	CENSUS TR.
2497/357	N/A	B-1	35	5TH	605501

SOP AND SEC PLAN - REVISED SITE DEVELOPMENT PLAN

LUTFI'S INTERNATIONAL SALON AND SPA EXPANSION
 12143 CLARKSVILLE PIKE

TAX MAP NO: 35 PARCEL NO: 2 GRID NO: 1
 5TH ELECTION DISTRICT HOWARD COUNTY, MARYLAND
 SCALE: AS SHOWN DATE: MAY 24, 2016
 SHEET 1 OF 4

"AS-BUILT" SDP-07-121

SOIL PREPARATION, TOPSOILING AND SOIL AMENDMENTS (B-4-2)

- 1. Temporary Stabilization
a. Seeded preparation consists of loosening soil to a depth of 3 to 5 inches by means of suitable agricultural or construction equipment...
b. Apply fertilizer and lime as prescribed on the plans.
c. Incorporate lime and fertilizer into the top 3 to 5 inches of soil by disking or other suitable equipment.

B. Topsoiling

- 1. Topsoil to be placed over prepared subsoil prior to establishment of permanent vegetation...
2. Topsoil shall be placed on an existing site only if used provided it meets the standards as set forth in these specifications...
3. Topsoiling is limited to areas having 2:1 or flatter slopes where:

- a. The texture of the exposed subsoil/parent material is not adequate to produce vegetative growth.
b. The soil material is so shallow that the rooting zone is not deep enough to support plants or furnish continuing supplies of moisture and plant nutrients.
c. The original soil to be vegetated contains material toxic to plant growth.

- 4. Areas having slopes steeper than 2:1 require special consideration and design.
5. Topsoil Specifications: Soil to be used as topsoil must meet the following criteria:
a. Topsoil must be a loam, sandy loam, clay loam, silt loam, sandy clay loam, or loamy sand.

- 6. Topsoil must be free of noxious plants or plant parts such as Bermuda grass, quack grass, Johnson grass, and other weeds.
7. Topsoil shall be stockpiled and preserved on-site for redistribution until final grade.

C. Soil Amendments (Fertilizer and Lime Specifications)

- 1. Soil tests must be performed to determine the exact ratio and application rates for both lime and fertilizer on sites having disturbed areas of 5 acres or more.
2. Fertilizers must be uniform in composition, free flowing and suitable for accurate application by chemical equipment.

TEMPORARY SEEDING NOTES (B-4-4)

- 1. Select one or more of the species or mixtures listed in Table B.3 for the appropriate Plant Hardiness Zone...
2. For areas having soil pits performed, use and show the recommended rates by the testing agency.

Table with 4 columns: Species, Application Rate (lb/ac), Seeding Dates, Seeding Depth. Rows include BARLEY, OATS, and RYE.

Table with 4 columns: Hardness Zone, Species, Application Rate (lb/ac), Seeding Dates, Seeding Depth, Lime Rate, Fertilizer Rate.

AS-BUILT CERTIFICATION FOR PSWM
I hereby certify that the facility shown on the plan was constructed as shown on the 'AS BUILT' plans and complies with the approved plans and specifications.

Table with 2 columns: NO., REVISION. Row 1: 1 ADD ADDITIONAL SHEET FOR PARKING RESTRIPING FOR ADDITIONAL LOFT AREA REQUIRED PARKING.

PERMANENT SEEDING NOTES (B-4-5)

- 1. General Use
a. Select one or more of the species or mixtures listed in Table B.3 for the appropriate Plant Hardiness Zone...
b. Additional planting specifications for exceptional sites such as shorelines, stream banks, or dunes...
c. For sites having disturbed areas over 5 acres, use and show the rates recommended by the soil testing agency.

- 2. Turfgrass Mixtures
a. Areas where turfgrass may be desired include lawns, parks, playgrounds, and commercial sites which require a medium to high level of maintenance.
b. Select one or more of the species or mixtures listed below based on the site conditions or purpose.


- 3. Tall Fescue/Kentucky Bluegrass: Full Sun Mixture: For use in areas that require intensive management...
4. Tall Fescue/Kentucky Bluegrass: Full Sun Mixture: For use in areas with shade in Bluegrass lawns.

Table with 4 columns: Hardness Zone, Species, Application Rate (lb/ac), Seeding Dates, Seeding Depth, Lime Rate, Fertilizer Rate.

Table with 4 columns: Species, Application Rate (lb/ac), Seeding Dates, Seeding Depth, Lime Rate, Fertilizer Rate.

STANDARD STABILIZATION NOTE

- 1. FOLLOWING INITIAL SOIL DISTURBANCE OR RE-DISTURBANCE, PERMANENT OR TEMPORARY STABILIZATION MUST BE COMPLETED WITHIN:
a.) THREE (3) CALENDAR DAYS AS TO THE SURFACE OF ALL PERIMETER DIKES, SHALLOWS, DITCHES, PERIMETER SLOPES AND ALL SLOPES STEEPER THAN 3 HORIZONTAL TO 1 VERTICAL (3:1); AND
b.) SEVEN (7) CALENDAR DAYS AS TO ALL OTHER DISTURBED OR GRADED AREAS ON THE PROJECT SITE NOT UNDER ACTIVE GRADING.

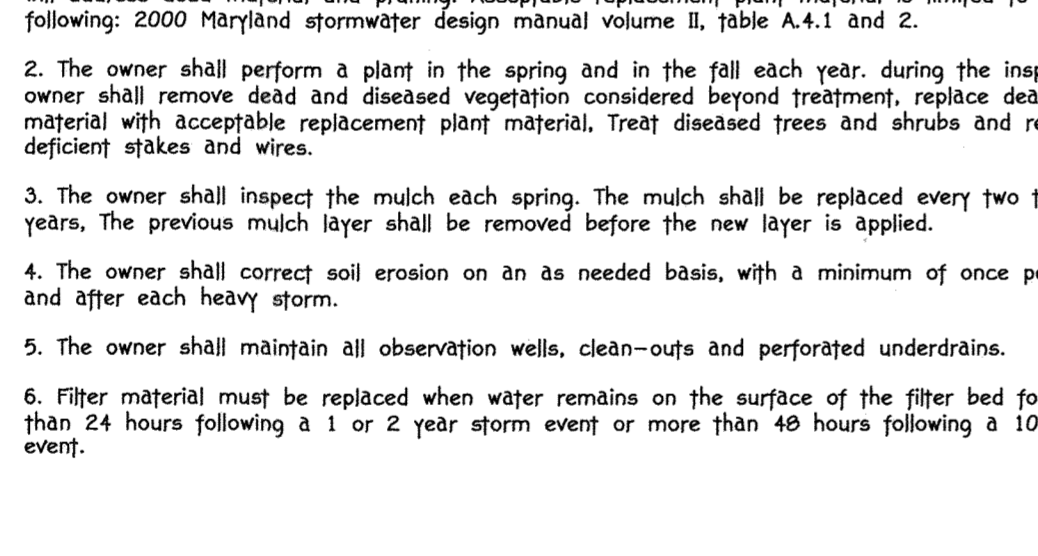

(FACILITY Nos. 1) MICRO BIO-RETENTION (M-6) SECTION @ 2ND STAGE ONE WEIR

ENGINEER'S CERTIFICATE
I certify that this plan, detailing erosion and sediment control represents a practical and workable plan based on a description of the site conditions and that it was prepared in accordance with the requirements of the Howard Soil Conservation District.

BUILDER/DEVELOPER'S CERTIFICATE
I/we certify that all development and construction will be done according to this plan, for sediment and erosion control and that any responsible personnel involved in the construction project will have a Certificate of Attendance at a Department of the Environment Approved Training Program for the Control of Sediment and Erosion before beginning the project.

HOWARD SOIL CONSERVATION DISTRICT (HSCD) STANDARD SEDIMENT CONTROL NOTES

- 1. A pre-construction meeting must occur with the Howard County Department of Public Works, Construction Inspection Division (CID), 410-513-1855 after the future L.O.D and protected areas are marked clearly in the field.
2. Upon completion of the installation of perimeter erosion and sediment controls, but before proceeding with any other earth disturbance or grading.
3. Prior to the start of another phase of construction or opening of another grading unit, d. Prior to the removal or modification of sediment control practices.



- 4. All disturbed areas must be established within the time period specified above in accordance with the 2011 MARYLAND STANDARDS AND SPECIFICATIONS FOR SOIL EROSION AND SEDIMENT CONTROL for topsoil (Sec. B-4-2), permanent seeding (Sec. B-4-5), temporary seeding (Sec. B-4-4) and mulching (Sec. B-4-3).
5. All sediment control structures are to remain in place, and are to be maintained in operative condition until their removal has been obtained from the CID.

- 6. Site Analysis:
Total Area of Site: 1.18 ACRES
Area Disturbed: 0.29 ACRES
Area to be roofed or paved: 0.11 ACRES
Area to be vegetatively stabilized: 0.18 ACRES
Total Cut: 350 CU.YDS.
Total Fill: N/A.

- 7. Any sediment control practice which is disturbed by grading activity for placement of utilities must be repaired on the same day of disturbance.
8. Additional sediment control must be provided, if deemed necessary by the CID. The site and all controls shall be inspected by the contractor weekly, and the next day after each rain event.







- 9. Trenches for the construction of utilities is limited to three pipe lengths or that which can and shall be back-filled and stabilized by the end of each utility, whichever is shorter.
10. Any major changes or revisions to the plan or sequence of construction must be reviewed and approved by the HSCD prior to proceeding with construction.

- 11. Disturbance shall not occur outside the L.O.D. A project is to be sequenced so that grading activities begin on one grading unit (minimum acreage of 20 ac. per grading unit) at a time.
12. Wash water from any equipment, vehicles, wheels, pavement, and other sources must be treated in a sediment basin or other approved washout structure.

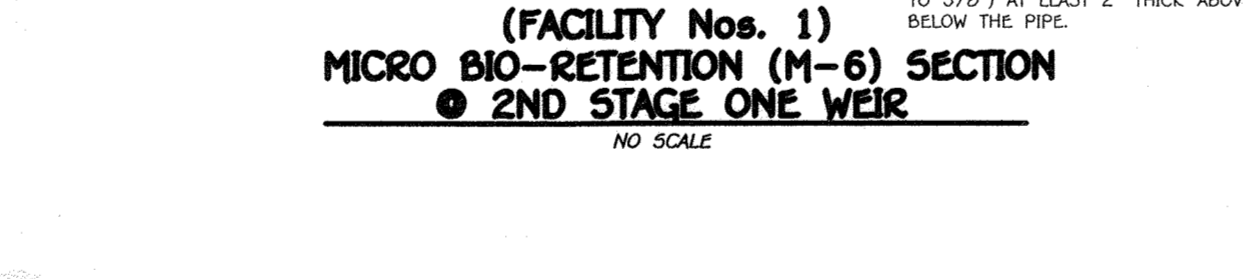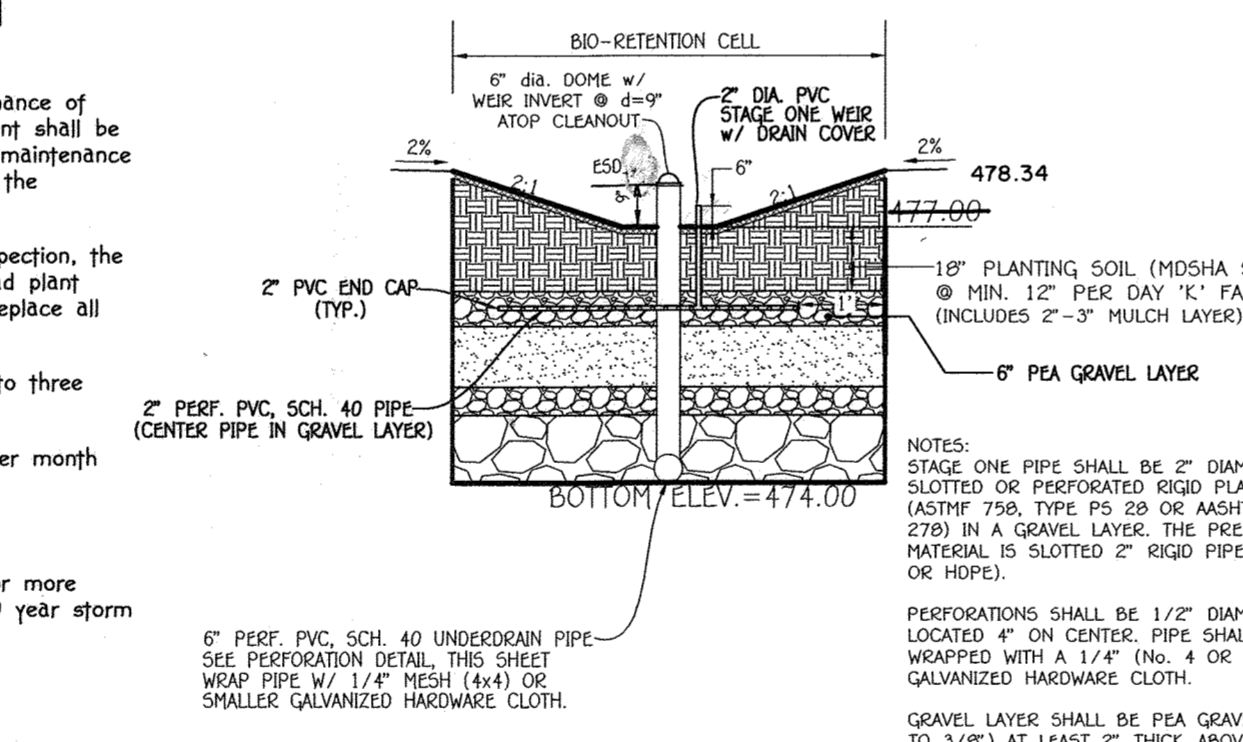







ENGINEER'S CERTIFICATE
This development plan is approved for soil erosion and sediment control by the HOWARD SOIL CONSERVATION DISTRICT.

DETAIL E-2 SILT FENCE ON PAVEMENT

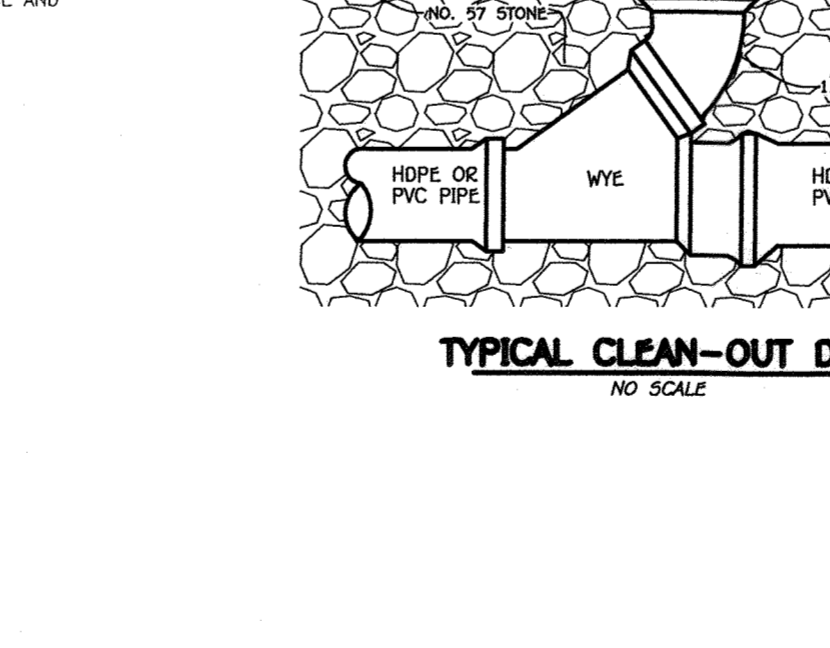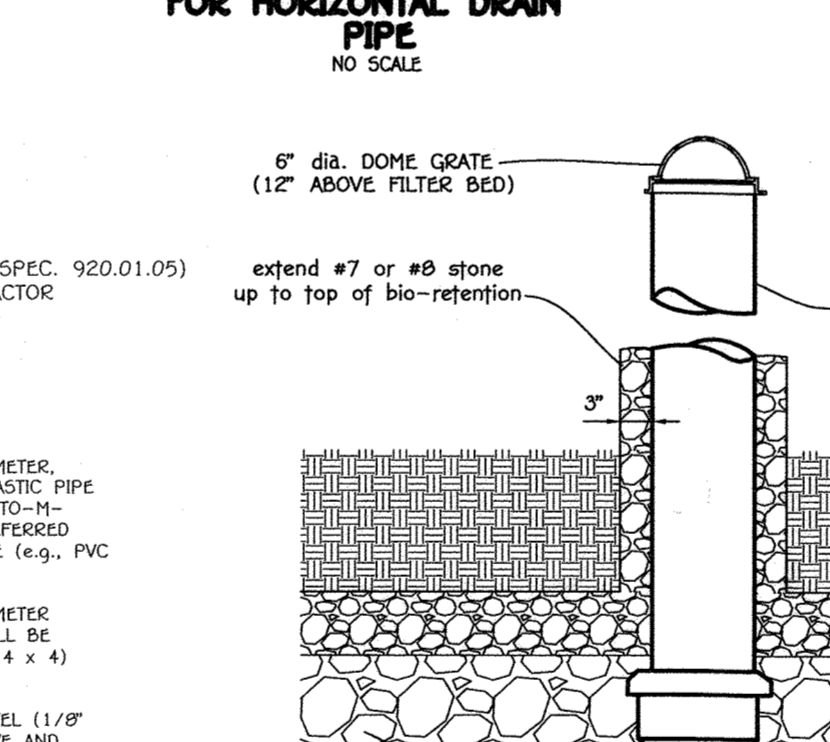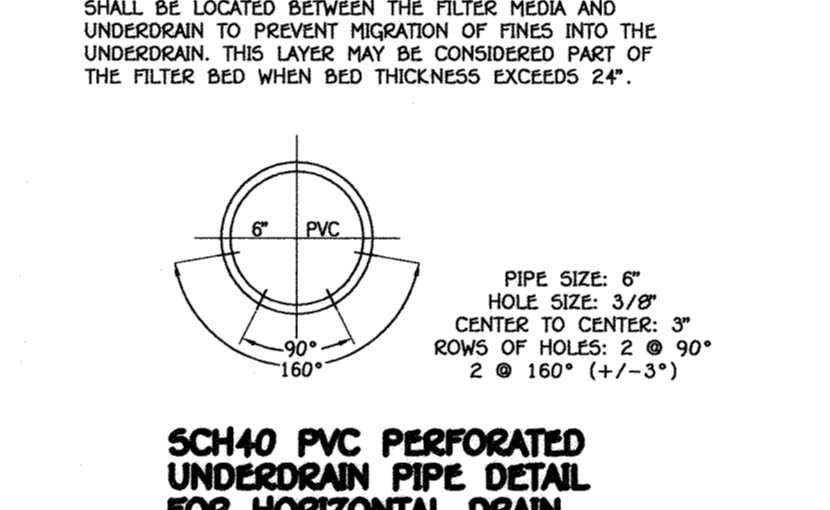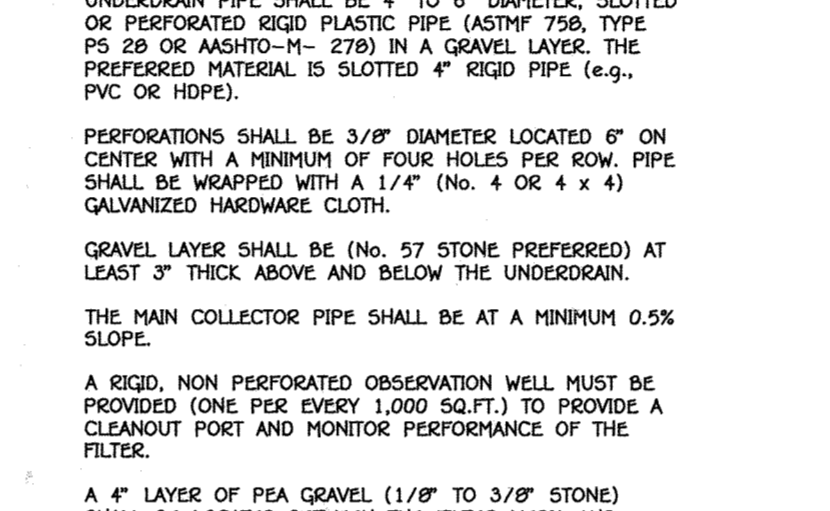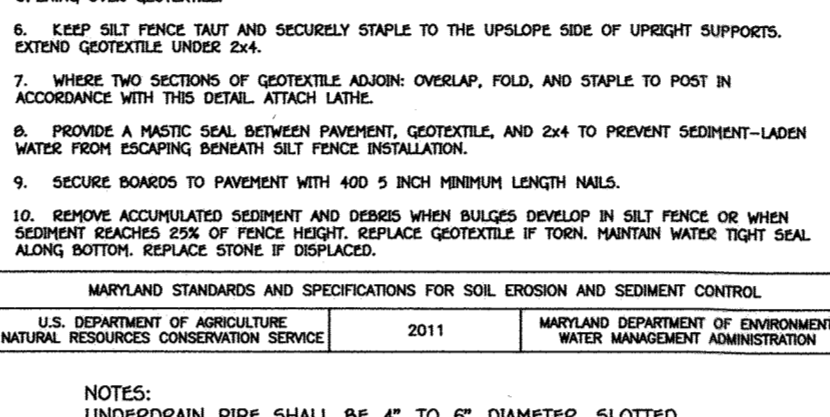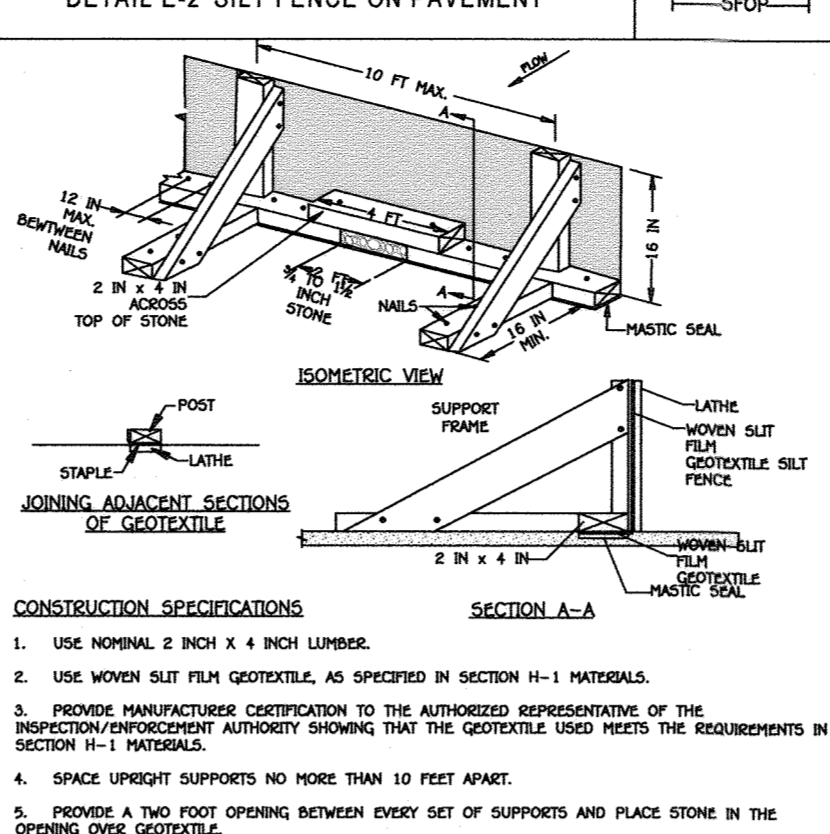







OWNER/DEVELOPER
MR. LUFTI ON
10295 CRIMSON TREE COURT
COLUMBIA, MD. 21044
410-531-3300

DETAIL B-1 STABILIZED CONSTRUCTION ENTRANCE

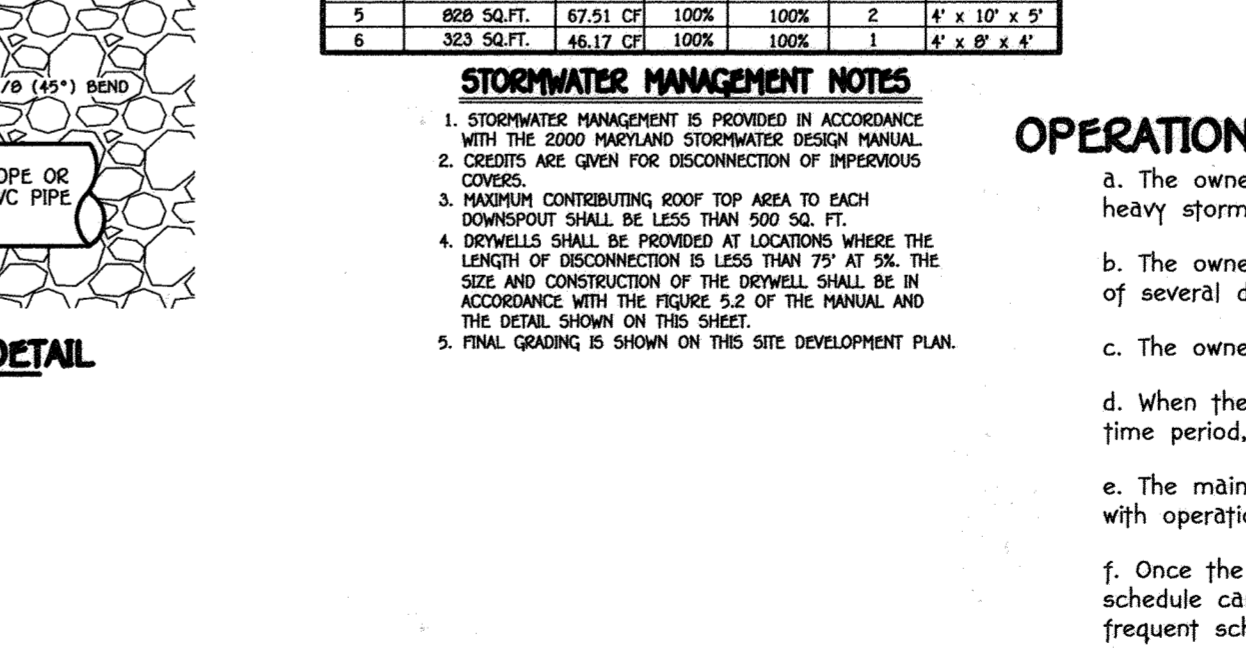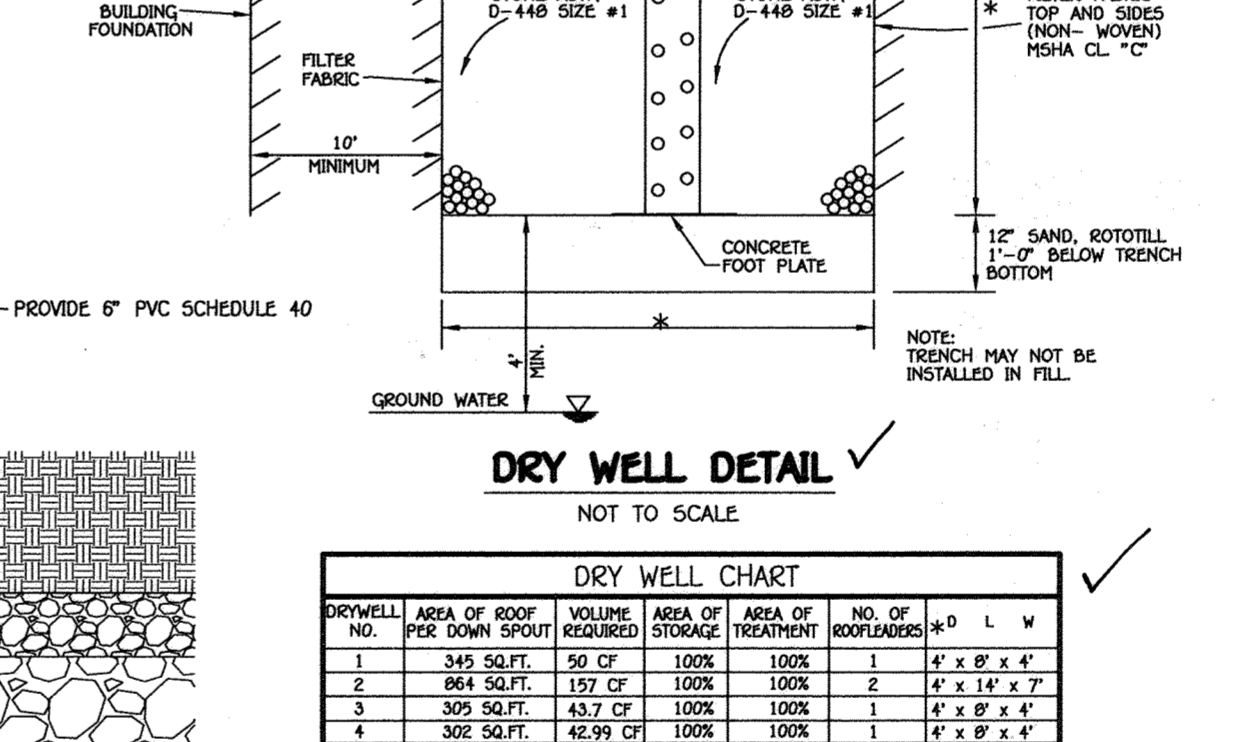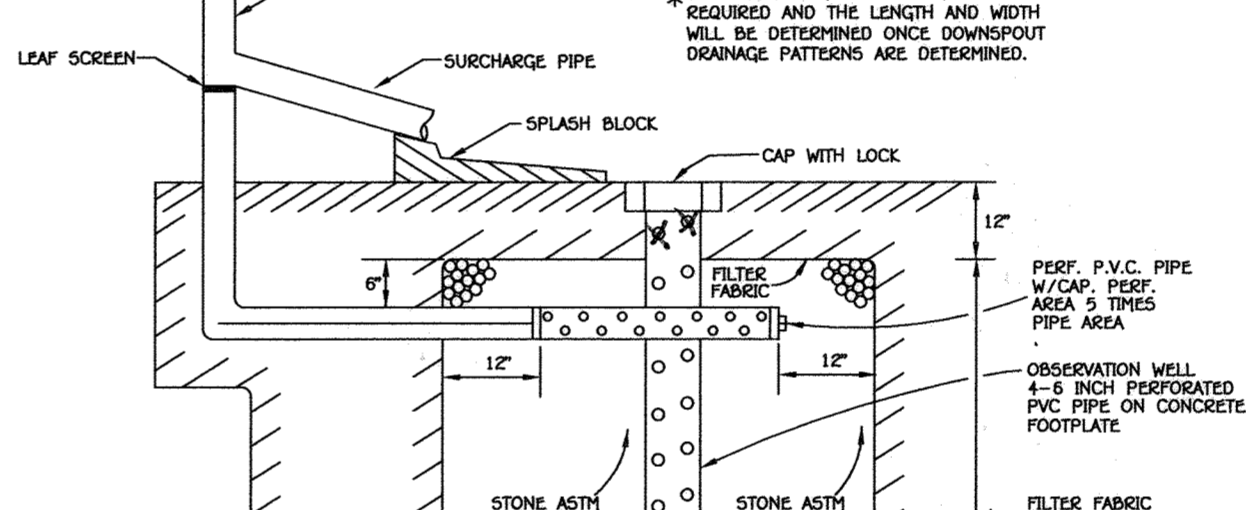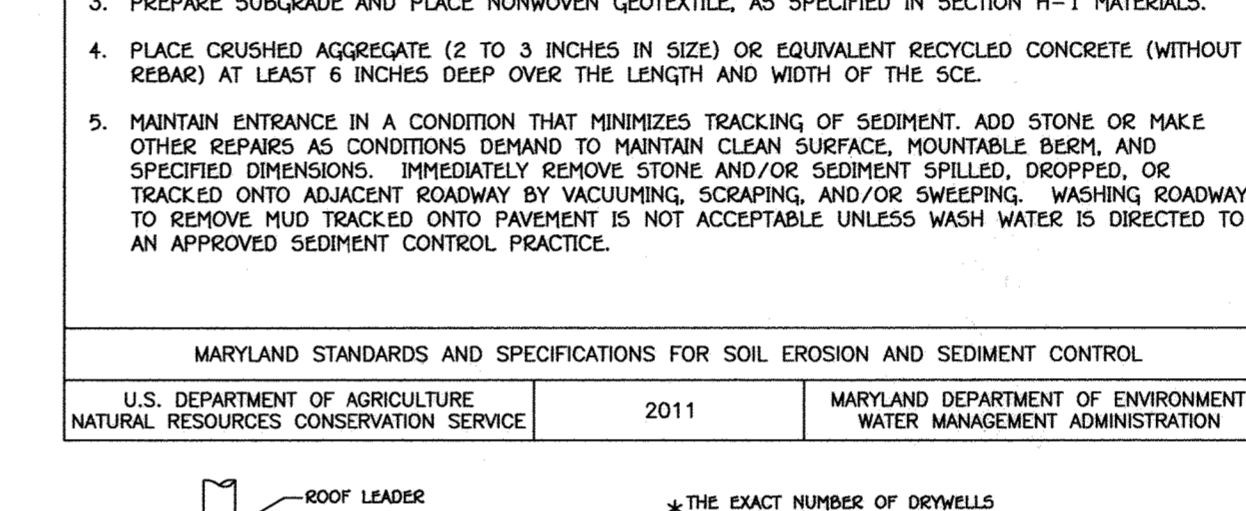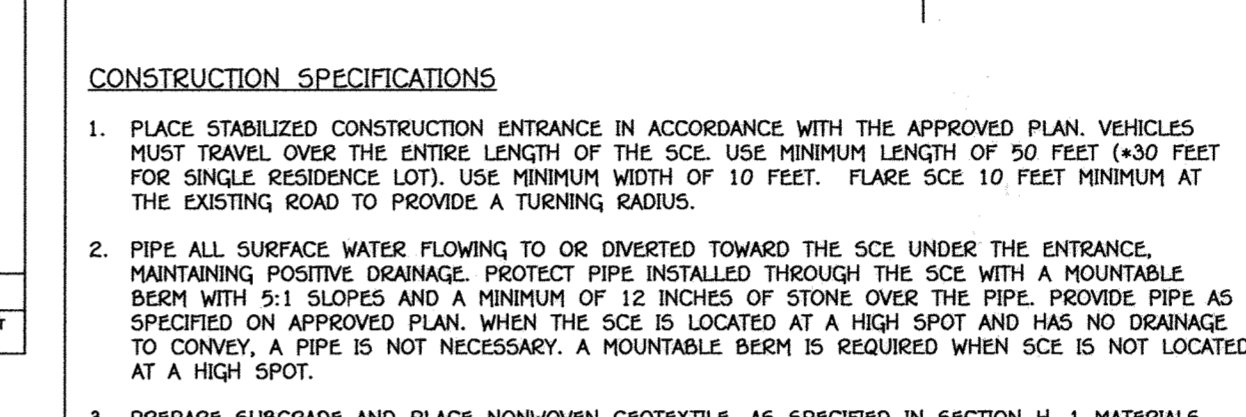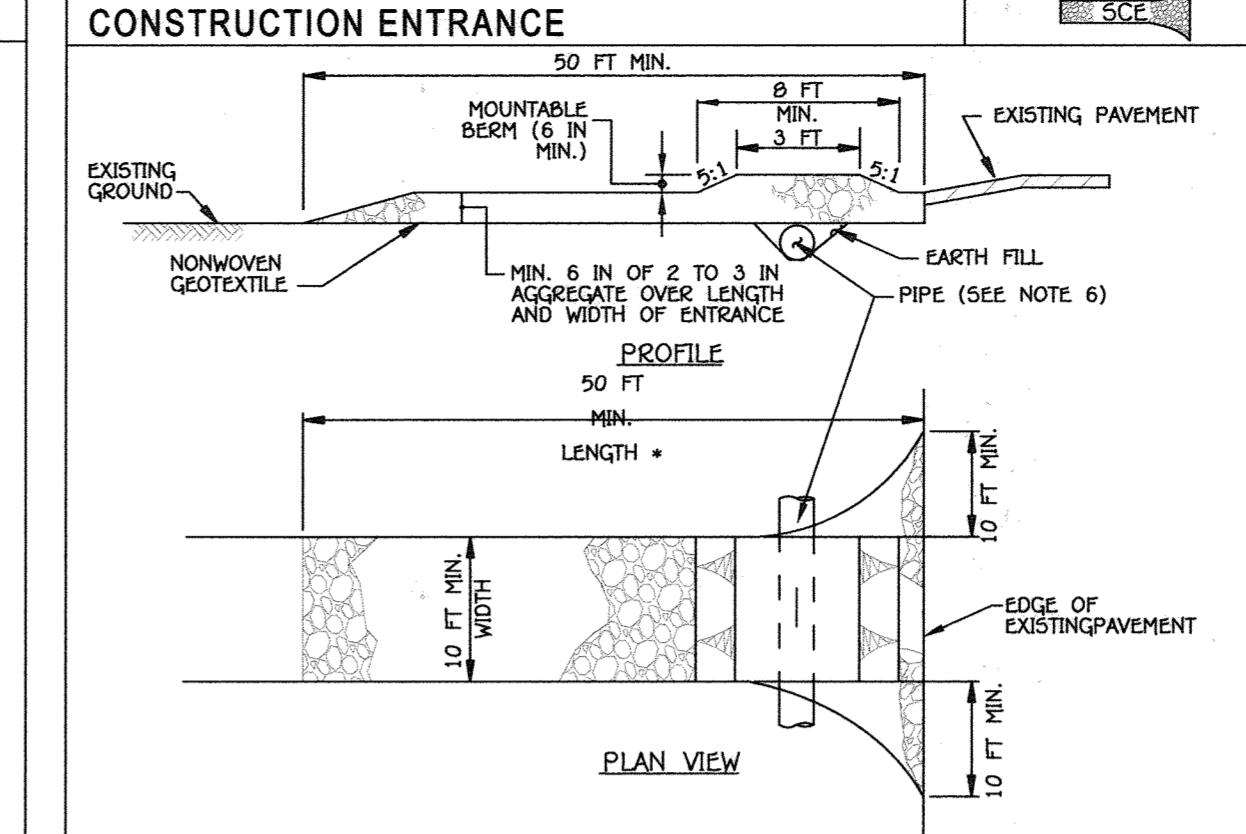

APPROVED: HOWARD COUNTY DEPARTMENT OF PLANNING AND ZONING
Chief, Division of Land Development: 7-20-16
Chief, Development Engineering Division: 7-25-16

CHAIN LINK FENCE WITH WOVEN MONOFILAMENT GEOTEXTILE

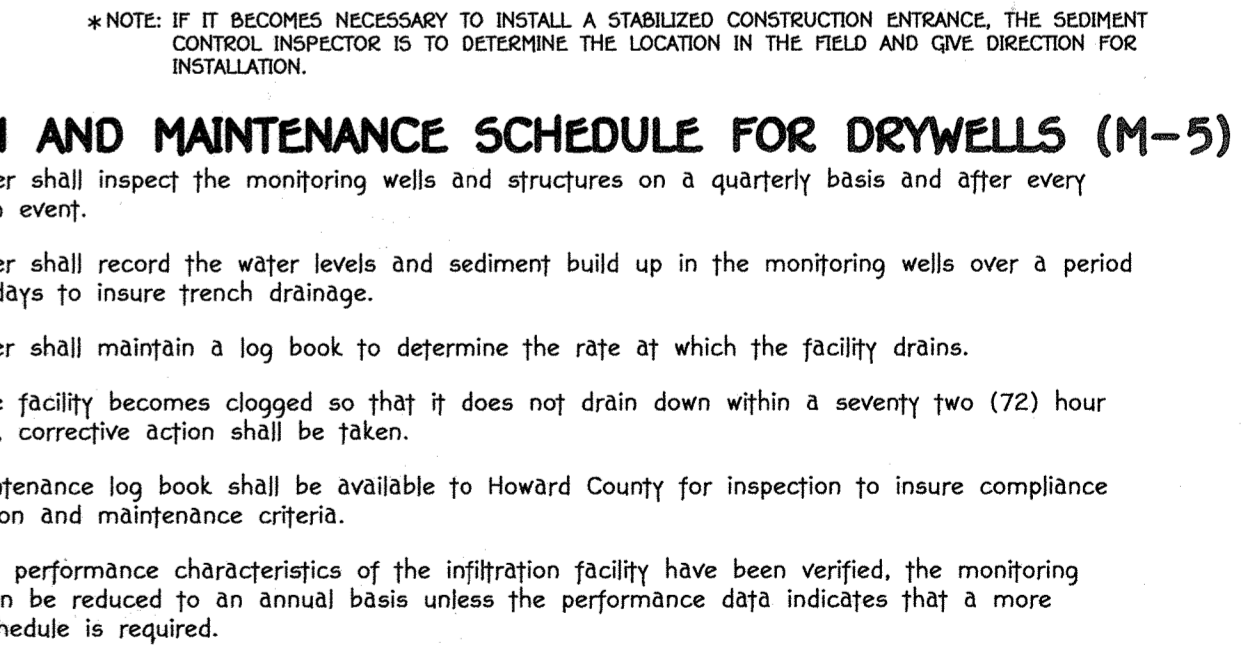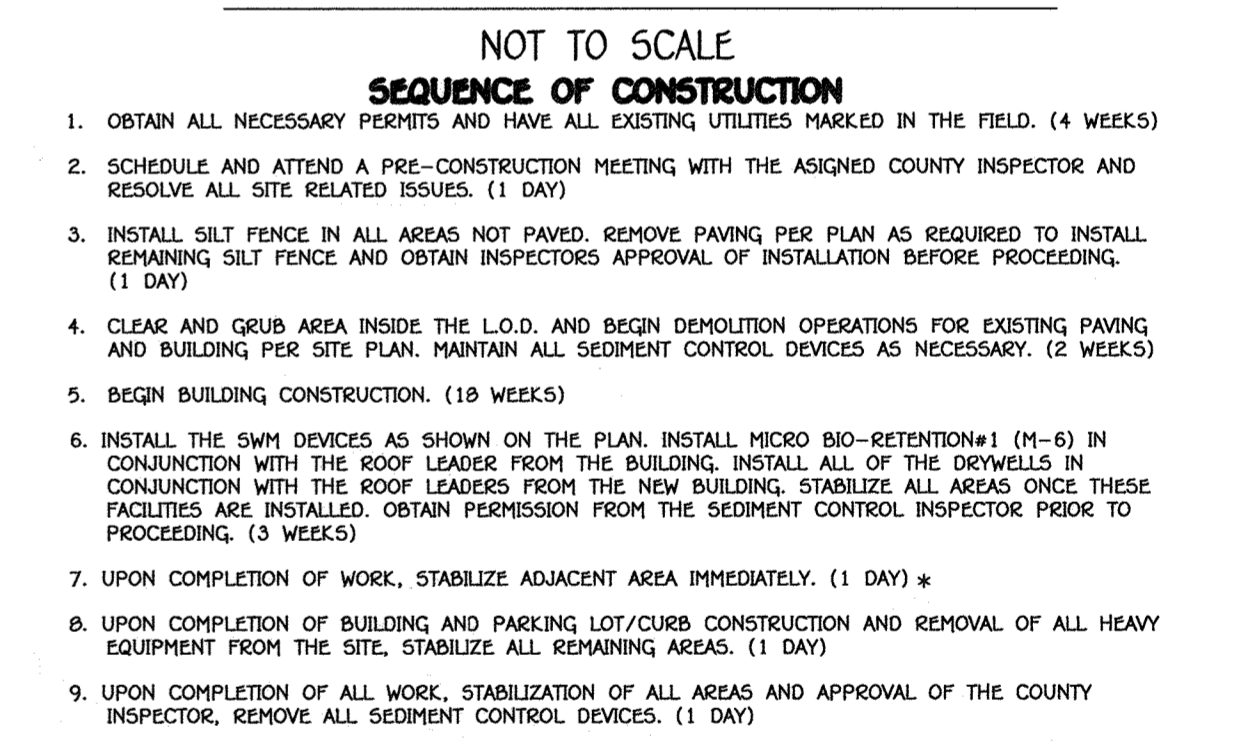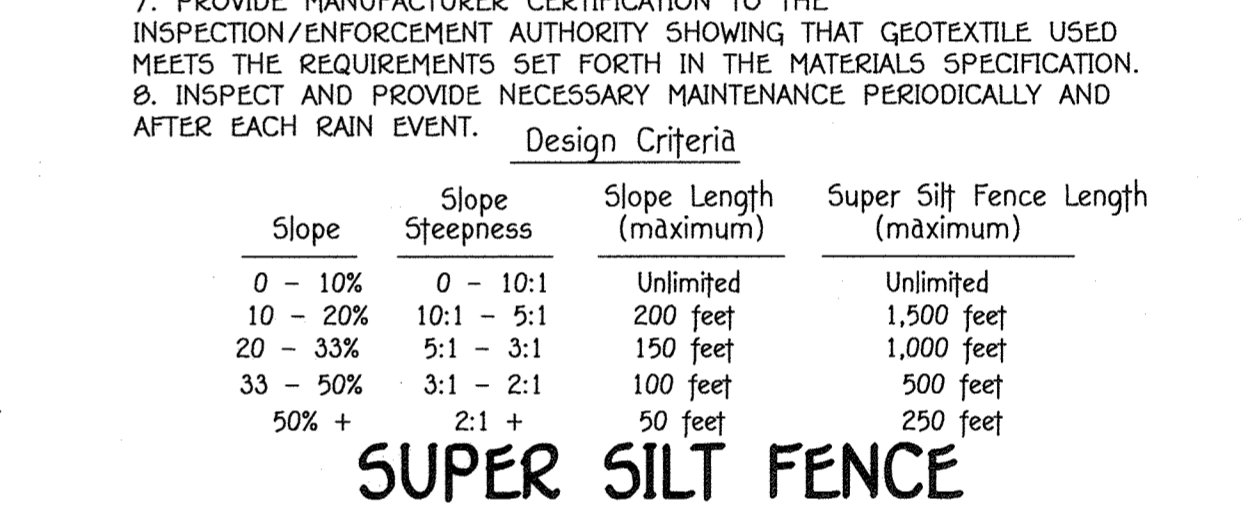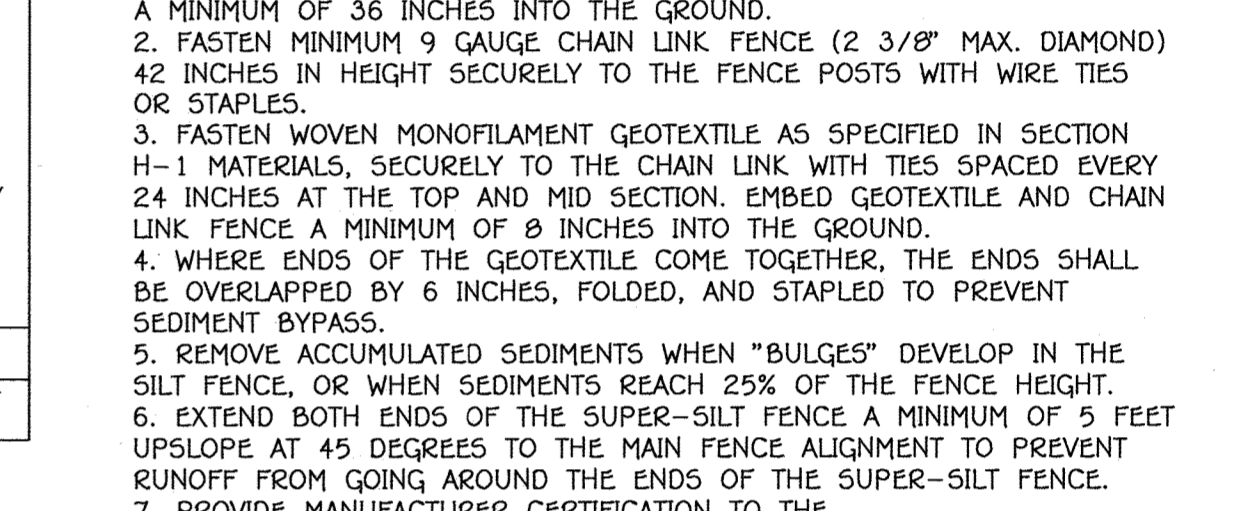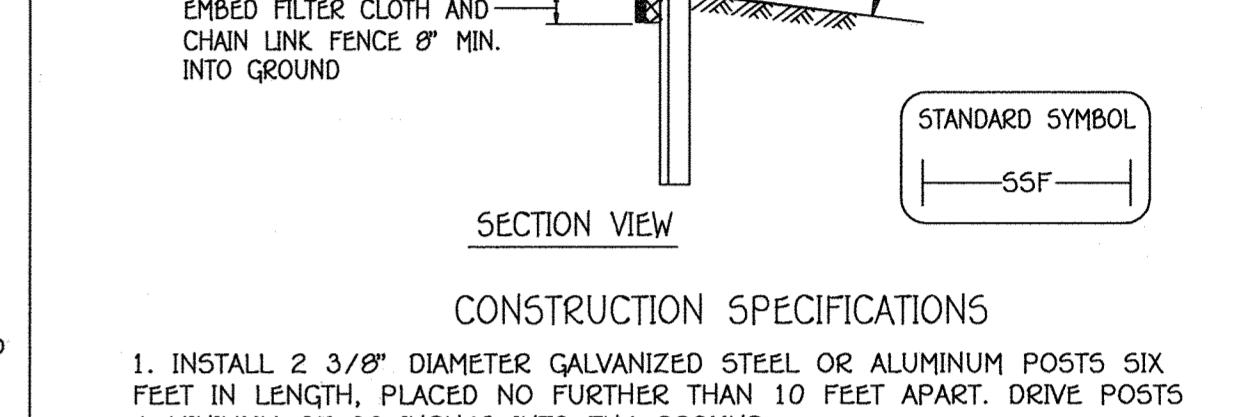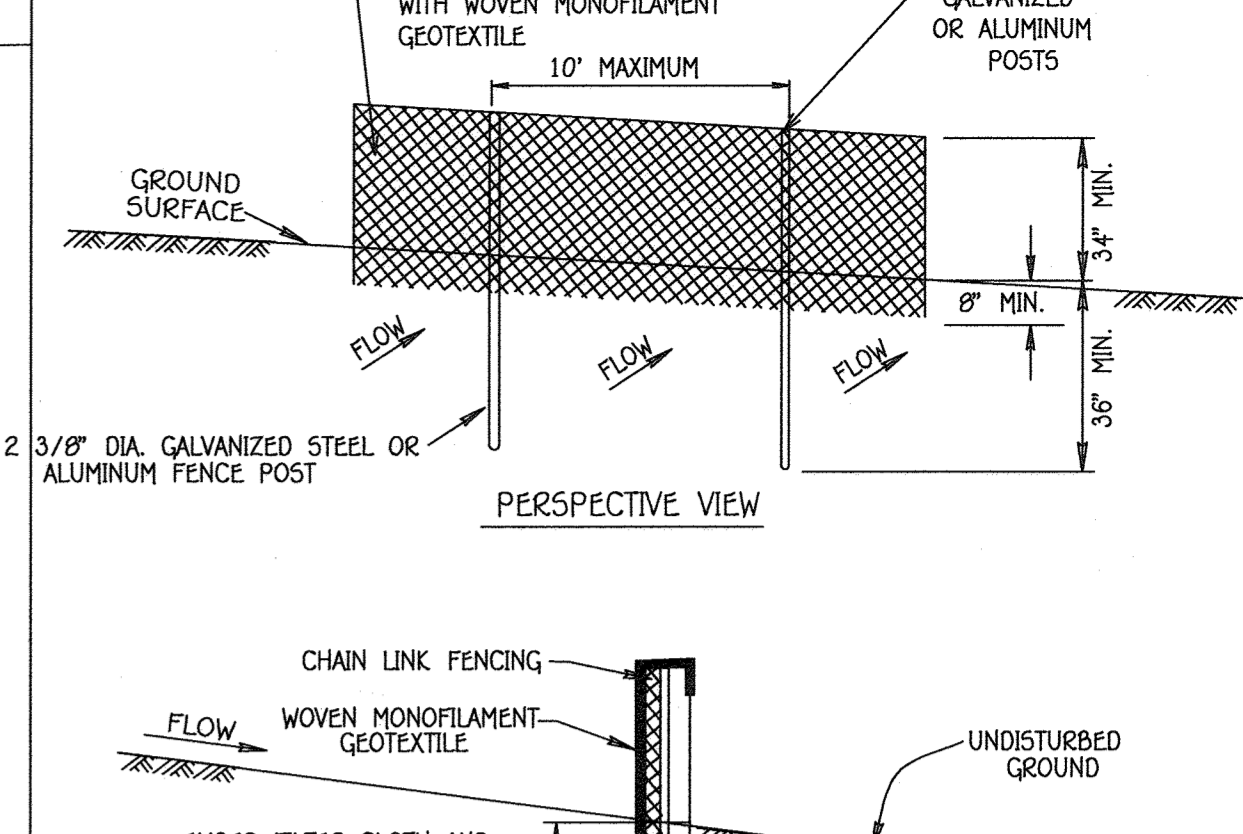

REVISID SITE DEVELOPMENT PLAN
SEDIMENT CONTROL NOTES & DETAILS
LUTTI'S INTERNATIONAL SALON AND SPA EXPANSION
12143 CLARKSVILLE PIKE
TAX MAP NO: 35 PARCEL NO: 2 GRID NO: 1

MD 108 - CLARKSVILLE PIKE
 VARIABLE RIGHT-OF-WAY PLAT #793

NOTE:
 ANY LANDSCAPING DISTURBED BY THE
 INSTALLATION OF THE PAVING WILL
 NEED TO BE REPLACED.

N/F
 LINTHICUM CHAPEL CEMETARY
 COMPANY OF CLARKSVILLE
 86,467
 TM.35 P.242
 ZONE: R-20


N/F
 HOWARD COUNTY
 BOARD OF EDUCATION
 12101 CLARKSVILLE PIKE
 1781,360 - 3265,667
 TM.35 P.433
 PLAT 11187
 ZONE: NT

N/F 2503/305
 TM.35
 P.191 BETTY AND
 JANICE LEE HILL
 12193 CLARKSVILLE
 PIKE ZONE-R-20
 (RESIDENTIAL)


NOTE THE EXISTING PARKING LOT OUTLINE
 IS BASED ON FIELD RUN TOPO PROVIDED
 BY F.C.C. ON OR ABOUT JANUARY 17, 2020.

PLAN
 SCALE: 1" = 30'

THE PURPOSE OF THIS REDLINE IS TO
 WIDENING THE EXISTING PARKING LOT AND
 RESTRIPE TO PROVIDE THE 4 EXTRA SPACES
 NEEDED FOR THE LOFT AREA.

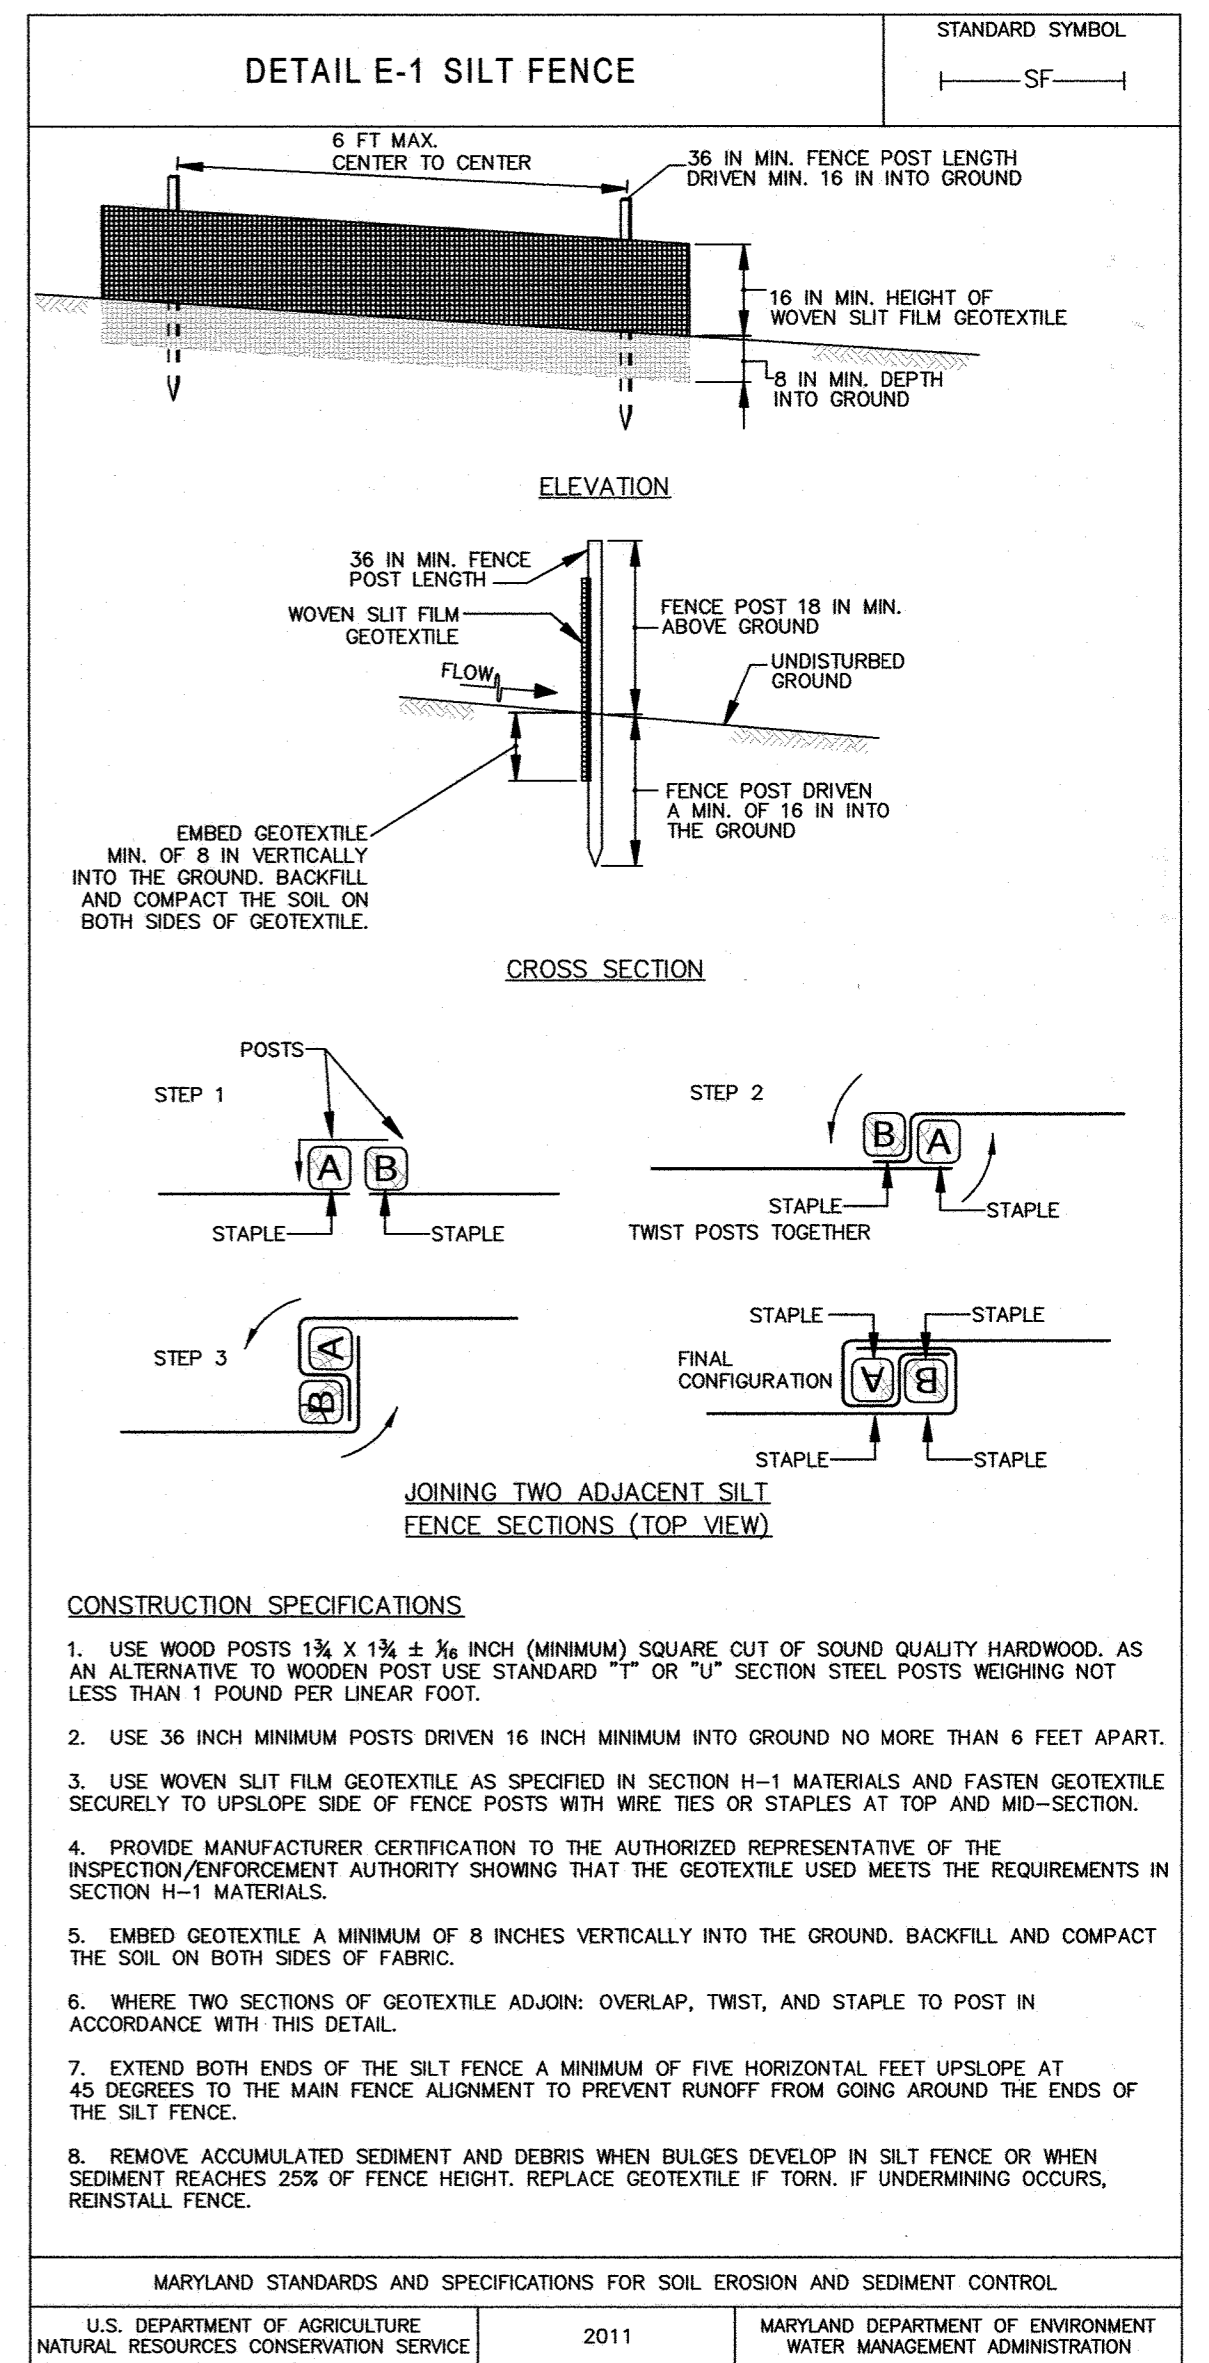

SECTION NUMBER	ROAD AND STREET CLASSIFICATION	CALIFORNIA BEARING RATIO (CBR)					
		3 TO <5	5 TO <7	≥7	3 TO <5	5 TO <7	≥7
P-2	PARKING DRIVE ACCESS: RESIDENTIAL AND NON-RESIDENTIAL WITH NO MORE THAN 10 HEAVY TRUCKS PER DAY LOCAL ROADS: ACCESS PLACE, ACCESS STREET CUL-DE-SACS: RESIDENTIAL	PAVEMENT MATERIAL (INCHES)					
		MIN HMA WITH GAB					
		HMA WITH CONSTANT GAB					
		SUPERPAVE ASPHALT MIX FINAL SURFACE 5.5 MM PG 64-22, LEVEL 1 (ESAL)	1.5	1.5	1.5	1.5	1.5
SUPERPAVE ASPHALT MIX INTERMEDIATE SURFACE 9.5 MM PG 64-22S, LEVEL 1 (ESAL)	1.5	1.5	1.5	1.5	1.5	1.5	
SUPERPAVE ASPHALT MIX BASE 19.0 MM PG 64-22S, LEVEL 1 (ESAL)	2.0	2.0	2.0	3.5	2.0	2.0	
GRADED AGGREGATE BASE (GAB)	8.0	4.0	3.0	4.0	4.0	4.0	

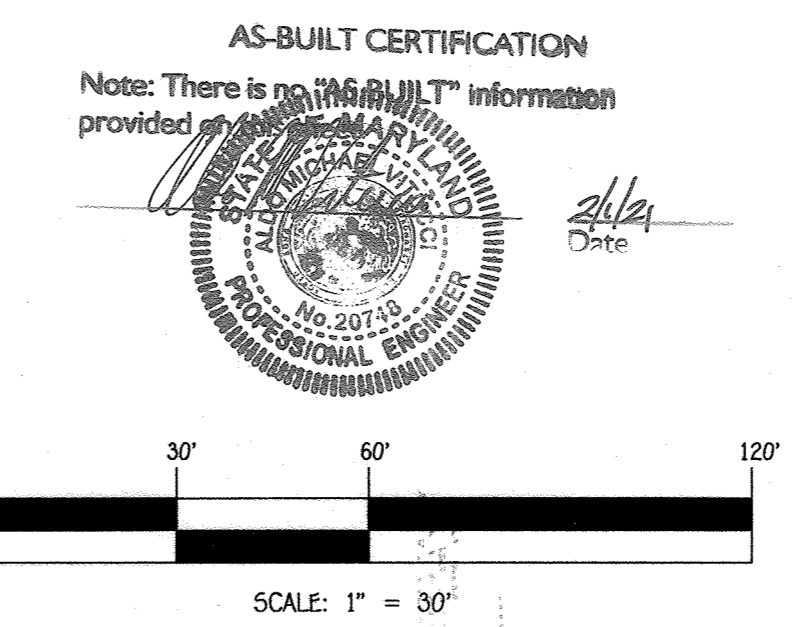

NO.	REVISION	DATE
1	ADD THIS SHEET FOR PARKING WIDENING AND RESTRIPE FOR ADDITIONAL LOFT AREA REQUIRED SPACES	2/6/20

ENGINEER'S CERTIFICATE
 "I certify that the design and sediment control represents a practical and workable plan based on the personal knowledge of the site conditions and that it was prepared in accordance with the requirements of the Howard Soil Conservation District."
 Signature: [Signature] Date: 02/06/2020
 ENGINEER/DEVELOPER'S CERTIFICATE
 "I/we certify that the development and construction will be done according to this plan, for sediment and erosion control and that any responsible personnel involved in the construction project will have a Certificate of Attendance at a Department of the Environment Approved Training Program for the Control of Sediment and Erosion before beginning the project. I also authorize periodic on-site inspection by the Howard Soil Conservation District."
 Signature of Developer: [Signature] Date: 2/6/2020

APPROVED: HOWARD COUNTY DEPARTMENT OF PLANNING AND ZONING
 Chief, Division of Land Development: [Signature] Date: 2/6/2020
 Chief, Development Engineering Division: [Signature] Date: 2/27/2020
 Director, Department of Planning and Zoning: [Signature]
 OWNER/DEVELOPER
 MR. LUTFI ON
 10295 CRIMSON TREE COURT
 COLUMBIA, MD. 21044
 410-531-3300

PROJECT	SECTION	PARCEL NO.			
LUTFI'S INTERNATIONAL SALON AND SPA	N/A	2			
LIBER/FOLIO	BLOCK NO.	ZONE	TAX/ZONE	ELEC. DIST.	CENSUS TR.
2487/357	N/A	B-1	35	5TH	605501

PARKING LOT WIDENING AND RESTRIPE
LUTFI'S INTERNATIONAL SALON AND SPA EXPANSION
 12143 CLARKSVILLE PIKE
 TAX MAP NO: 35 PARCEL NO.: 2 GRID NO.: 1
 5TH ELECTION DISTRICT HOWARD COUNTY, MARYLAND
 SCALE: AS SHOWN DATE: FEBRUARY 6, 2020
 SHEET 4 OF 4