- I. ALL CONSTRUCTION SHALL BE IN ACCORDANCE WITH THE LATEST STANDARDS AND SPECIFICATIONS OF HOWARD COUNTY PLUS MSHA STANDARDS AND SPECIFICATIONS IF APPLICABLE.
- 2. THE CONTRACTOR SHALL NOTIFY THE DEPARTMENT OF PUBLIC WORKS, BUREAU OF ENGINEERING, CONSTRUCTION INSPECTION DIVISION AT (410) 313-1880 AT LEAST FIVE (5) WORKING DAYS PRIOR TO THE START OF WORK.
- THE CONTRACTOR SHALL NOTIFY "MISS UTILITY" AT 1-800-257-7777 AT LEAST 48 HOURS PRIOR TO ANY EXCAVATION WORK BEING DONE.

4. PROJECT BACKGROUND

TAX MAP #46, GRIDS 3 \$ 4 MXD-3 ZONING:

STH ELECTION DISTRICT PARCEL B-II AREA:

- THE CONTRACTOR SHALL NOTIFY THE HOWARD COUNTY DEPARTMENT OF PUBLIC WORKS, BUREAU OF UTILITIES AT (410) 313-4900 AT LEAST FIVE (5) WORKING DAYS PRIOR TO STARTING ANY EXCAVATION WORK.
- 7. ALL PLAN DIMENSIONS ARE TO FACE OF BUILDING UNLESS OTHERWISE NOTED. DIMENSIONS ARE MEASURED PERPENDICULAR OR RADIALLY BETWEEN ITEMS UNLESS OTHERWISE NOTED
- EXISTING TOPOGRAPHY IS SHOWN PER FIELD RUN SURVEY INFORMATION BY GUTSCHICK, LITTLE & WEBER, P.A. & BY DESIGN GRADES FROM DESIGN PLANS FOR CONSTRUCTION.
- 9. COORDINATES AND BEARINGS ARE BASED UPON THE '83 MD STATE COORDINATE SYSTEM (NAD '83) AS PROJECTED BY HOWARD COUNTY GEODETIC CONTROL STATIONS NO. 41EA, 41EB, 41GA AND NO. 46B2.
- SITE IS BEING DEVELOPED UNDER MXD-3 REGULATIONS, PER ZB995M, APPROVED ON 2/8/OI AND ZB-1039M APPROVED 03/20/06 AND THE COMPREHENSIVE ZONING PLAN DATED 02/02/04. UNDERLYING ZONING IS RR-DEO AND THE COMP LITE ZONING REGULATION AMENDMENTS DATED 07/28/06.
- THE PREVIOUS DEPARTMENT OF PLANNING AND ZONING FILE NUMBERS S OI-17, S-06-16, ZB-995M, ZB-1039M, PB-353, PB-378, P-07-18, F-08-54, F-08-55, SDP-07-43, WP-05-12, WP-07-122, WP-08-04, SDP-08-056 and F-08-105.
- 12. WATER AND SEMER SERVICE IS PUBLIC.
- 13. FOR EXISTING PUBLIC WATER AND SEWER SEE CONTRACTS 24-4498-D, 44-3305-D and 24-4543-D
- 5. STORMWATER MANAGEMENT, FOR BOTH QUALITY AND QUANTITY, FOR THE DEVELOPMENT PROPOSED BY THESE PLANS WILL BE SATISFIED BY TWO REGIONAL FACILITIES BEING CONSTRUCTED UNDER F-08-55 AND AN EXISTING FACILITY CONSTRUCTED UNDER F-03-07. THE EXISTING FACILITY AND THE FACILITY ON OPEN SPACE LOT 3 WILL BE PUBLICLY OWNED AND MAINTAINED. THE FACILITY ON OPEN SPACE LOT 2 WILL BE PRIVATELY OWNED AND MAINTAINED. THE RECHARGE REQUIREMENTS FOR THIS DEVELOPMENT WILL BE PROVIDED IN A PRIVATELY OWNED AND MAINTAINED FACILITY ON PARCEL B-5. THE RECHARGE FACILITY WILL BE AN INFILTRATION TRENCH IN ACCORDANCE WITH THE DESIGN OF F-08-055
- 16, EXISTING UTILITIES ARE BASED ON APPROVED DESIGN PLANS FOR CONSTRUCTION AND FIELD LOCATION BY GUTSCHICK, LITTLE & WEBER, P.A.
- THERE ARE NO KNOWN CEMETERIES, GRAVE SITES OR HISTORIC STRUCTURES LOCATED ON THE SUBJECT PROPERTY.
- B. THERE ARE NO SCENIC ROADS WITHIN OR ADJACENT TO THE SUBJECT PROPERTY
- 19. THERE IS NO FLOODPLAIN WITHIN PARCELS B-6 THRU B-11.
- 20. THERE ARE NO WETLANDS WITHIN PARCEL B-6 THRU B-11
- 21. AS A COMMERCIAL DEVELOPMENT, A NOISE STUDY IS NOT REQUIRED FOR THIS SDP.
- 22. BUILDING SETBACKS AND BUILDING RESTRICTIONS ARE IN ACCORDANCE WITH THE APPROVED DEVELOPMENT CRITERIA PER S-06-16.
- THE RESIDENTIAL LOTS, PARCELS AND EMPLOYMENT USE STRUCTURES DEVELOPED OR PROPOSED ON THE ORIGINAL 501 AGRES TRACT FOR MAPLE LAWN FARMS ARE GRANDFATHERED TO THE FOURTH EDITION OF THE SUBDIVISION AND LAND DEVELOPMENT REGULATIONS AS DEVELOPED UNDER 5-01-17, PB CASE 353 AND ZB CASE NO. 995M. HOWEVER, THE PROPOSED REGIDENTIAL AND EMPLOYMENT USES THAT ARE TO BE DEVELOPED UNDER AMENDED CSP, 5-06-16 AND ZB CASE NO. 1039M FOR THE FORMER MESSEL AND OLIVER PROPERTIES ARE SUBJECT TO THE AMENDED FIFTH EDITION OF THE SUBDIVISION AND REGULATIONS PER COUNCIL BILL NO.45-2003 AND THE ZONING REGULATIONS PER COUNCIL BILL NO. 75-2003.
- 24. THE TRAFFIC STUDY (APFO) WAS APPROVED AS PART OF SKETCH PLAN 5-06-016.
- 25. FOREST CONSERVATION FOR THIS SITE HAS BEEN PROVIDED UNDER F-08-54. THE GRADING WORK UNDER THIS SDP SHALL BE COORDINATED WITH THE FOREST AND LANDSCAPE PLANTING IN OPEN LOT # UNDER F-08-54.
- 26. THE WATER METER IS LOCATED INSIDE THE BUILDING. A FIRE SPRINKLER SYSTEM IS NOT REQUIRE FOR A BUILDING UNDER 5,000 S.F.
- 27. THE SHARED ACCESS AND PARKING AGREEMENT FOR PARCELS B6 THRU BII IS RECORDED AT L.TTB9 F.353
- 28 ALL EXTERIOR LIGHT FIXTURES SHALL BE ORIENTED TO DIRECT LIGHT INWARDS AND DOWNWARDS AWAY FROM ALL ADJOINING RESIDENTIAL USE AREAS AND PUBLIC ROADS IN ACCORDANCE WITH SECTION 134 OF THE HOWARD COUNTY ZONING REGULATIONS.
- 29. SEE SHEET 5 FOR LANDSCAPE/SURETY REQUIREMENTS.
- 30. ON APRIL 24, 2008 THE PLANNING BOARD OF HOWARD COUNTY APPROVED THIS SDP.

- ON AUGUST 20, 2004, MP 05-12 WAS GRANTED, ALLOWING THE FOLLOWING
- DEVELOPMENT OR SUBDIVISION IN A CEMETERY (WAIVER FROM SECTION 16.1304) REMOVAL OF HUMAN REMAINS FROM A CEMETERY PRIOR TO DEVELOPMENT (WAIVER FROM SECTION 16.1306)

- WAIVER REQUEST FROM SECTION 16,146 REQUIREMENT FOR A PRELIMINARY PLAN PRIOR TO THE PLAT APPROVAL, WAS APPROVED BY THE
- DEPARTMENT OF PLANNING AND ZONING UNDER THE CONDITIONS OF WP-07-122(\*\*\*\*), WHICH WAS GRANTED ON JUNE 19, 2007 SUBJECT TO THE I. COMPLIANCE WITH THE SRC COMMENTS ISSUED FOR THE FINAL PLAN, F-07-183 AND THE RED-LINE REVISION OF SDP-05-36.
- 2. COMPLIANCE WITH THE COMMENTS DATED JUNE 14, 2001 FROM DEVELOPMENT ENGINEERING DIVISION: I. ADDED PARCEL C-20 TO PURPOSE NOTE.
- 2. APPROVED BECAUSE IT DOES NOT HAVE AN EFFECT ON STORMWATER MANAGEMENT, OR APFO. 3. THIS PLAN ONLY ALLOWS FOR THE CONSTRUCTION OF AN ADDITION OF A PARKING LOT.

- ON AUGUST 8, 2007, MP-08-04 WAS GRANTED TO WAIVE SECTION 16.121(E)(I) WHICH REQUIRES OPEN SPACE LOTS (OPEN SPACE LOTS I THRU 4) TO HAVE A MINIMUM OF 40 FEET OF FRONTAGE ONTO A PUBLIC ROAD FOR ACCESS BY PEDESTRIANS AND MAINTENANCE VEHICLES.
- THE APPROVAL IS SUBJECT TO THE FOLLOWING CONDITIONS: BOLLARD MARKERS OR SOME FORM OF PERMANENT SIGNAGE SHALL BE INSTALLED AT THE PUBLIC OR PRIVATE ROAD FRONTAGES TO IDENTIFY PEDESTRIAN AND VEHICULAR ACCESS TO OPEN SPACE LOTS I THRU 4 AND FOR OPEN SPACE LOTS 2 AND 4 AT THE SWM ACCESS EASEMENT TO IDENTIFY MAINTENANCE VEHICLE ACCESS TO THE SWM FACILITIES.
- SUBJECT TO THE SRC COMMENTS ISSUED FOR PRELIMINARY PLAN P-07-18 THE MINIMUM PUBLIC ROAD FRONTAGE FOR HOA OPEN SPACE LOT 2 SHALL BE INCREASED IN WIDTH FROM THE 19 FEET PRESENTLY PROPOSED
- ON THE WAIVER PLAN EXHIBIT TO A MINIMUM OF 20 FEET IN WIDTH. 4. A 20' WIDE MINIMUM UNRESTRICTED PUBLIC OR PRIVATE ROAD ACCESS MUST BE PROVIDED TO SERVE AS AN ENTRANCEWAY LEADING INTO HOA OPEN SPAGE LOT 4 (FUTURE HOA RECREATIONAL BALL FIELDS) TO ACCOMMODATE PEDESTRIAN ACCESS AND PERIODIC ACCESS FOR
- THE PROCESSING OF THIS WAIVER REQUEST FOR THE MINIMUM OPEN SPACE FRONTAGE REQUIREMENTS FOR OPEN SPACE LOTS I THRU 4 AS SHOWN ON P-07-18 SHALL BE CONSIDERED AS A TEMPORARY DEFERRAL OF THE PUBLIC OR PRIVATE FRONTAGE REQUIREMENT UNTIL THE FINAL SUBDIVISION PLANS ARE SUBMITTED FOR THIS PROJECT.

# PLANNING BOARD OF HOWARD COUNTY

APPROVED: HOWARD COUNTY DEPARTMENT OF PLANNING & ZONING

GLWGUTSCHICK LITTLE &WEBER, P.A.

CIVIL ENGINEERS, LAND SURVEYORS, LAND PLANNERS, LANDSCAPE ARCHITECTS

3909 NATIONAL DRIVE - SUITE 250 - BURTONSVILLE OFFICE PARK

BURTONSVILLE, MARYLAND 20866

TEL: 301-421-4024 BALT: 410-880-1820 DC/VA: 301-989-2524 FAX: 301-421-4186

Chief, Development Engineering Division 🕊

Professional Certification - Liberary pertity that these documents were prepared or approved by me, and that I am a duly licensed professional engineer under the laws

\_ Evolvation Data: 7/9/19



PERSONAL SERVICE BUSINESSES. DESIGNATED RETAIL CENTERS MAY INCLUDE RETAIL STORES, PERSONAL SERVICE ESTABLISHMENTS, AND SIMILAR USES, AS WELL AS FAST FOOD RESTAURANTS AND A GASOLINE SERVICE STATION; HOWEVER FOR ALL RETAIL CENTERS THE TOTAL SQUARE FOOT AREA WHICH MAY BE USED FOR RETAIL AND PERSONAL SERVICE BUSINESS SHALL NOT EXCEED 181590 (300 SQUARE FEET PER GROSS ACRE). NO INDIVIDUAL RETAIL ESTABLISHMENT WITHIN THE MXD-3 DISTRICT SHALL HAVE A GROSS FLOOR AREA GREATER THAN 65,000 SQUARE FEET, RETAIL AND PERSONAL SERVICES AND OTHER ALLOWED USES, SUCH AS RESTAURANTS AND A GASOLINE SERVICE STATION MAY ALSO BE LOCATED WITHIN OTHER DESIGNATED EMPLOYMENT AREAS OUTSIDE OF A RETAIL CENTER.

30/17 A VERIZON WIRELESS EQUIPMENT + ANTENNAS ADDED TO NEW LIGHT POLE

SECTION 128.F SHALL APPLY TO EMPLOYMENT LAND USE AREAS. NO COVERAGE REQUIREMENT IS IMPOSED IN EMPLOYMENT LAND USE AREAS.

OVERALL LIMIT IS 0.35 CALCULATED ON THE TOTAL ACREAGE FOR ALL EMPLOYMENT LAND USE AREAS.

AND TELEPHONE EXCHANGES, BUT NO STAND-ALONE COMMERCIAL COMMUNICATIONS TOWERS.

COMMERCIAL DEVELOPMENT DESIGN CRITERIA PER S-06-16

MAXIMUM BUILDING HEIGHT SHALL BE LIMITED TO 120' UNLESS APPROVED TO BE GREATER ON A SITE DEVELOPMENT PLAN BY THE HOWARD COUNTY

. COMMERCIAL BUILDINGS IN THE BUSINESS DISTRICT LOCATED BETWEEN 300 FEET AND 500 FEET FROM MD ROUTE 216 SHALL NOT EXCEED FOUR

· COMMERCIAL BUILDINGS IN THE BUSINESS DISTRICT BEYOND 500 FEET FROM MD ROUTE 216 SHALL NOT EXCEED EIGHT STORIES ABOVE THE

. COMMERCIAL BUILDINGS IN THE WESTSIDE DISTRICT BEYOND 300 FEET FROM MD ROUTE 216 SHALL NOT EXCEED FOUR STORIES ABOVE THE

EMPLOYMENT USES PERMITTED ONLY WITHIN M-I ZONING DISTRICT SHALL NOT BE PERMITTED. ALL USES PERMITTED AS A MATTER OF RIGHT IN THE

MOVIE THEATERS, LEGITIMATE THEATERS AND DINNER THEATERS, PUBLIC UTILITY USES (EXCLUDING STAND-ALONE COMMUNICATION TOWERS), GROUP

THE FOLLOWING ADDITIONAL USES NOT REFERRED TO OR INCLUDED IN THE ABOVE USES, WHICH ARE ALLOWED BY SPECIAL EXCEPTION IN THE POR.

B-I AND M-I DISTRICTS, WILL BE PERMITTED AS A MATTER OF RIGHT IN THE EMPLOYMENT LAND USE AREAS, AND ARE SPECIFICALLY APPROVED BY

· PUBLIC UTILITY USES, LIMITED TO THE FOLLOWING: UTILITY SUBSTATIONS, ABOVE GROUND PIPELINES, PUMPING STATIONS, TELEPHONE STATIONS,

NO MORE THAN 15% OF THE TOTAL EMPLOYMENT LAND USE AREA MAY BE DEVOTED TO WAREHOUSE AND LIGHT MANUFACTURING USES.

· A MAXIMUM OF ONE GASOLINE SERVICE STATION IS PERMITTED. THE GASOLINE SERVICE STATION MAY INCLUDE A CAR WASH, CAR REPAIR

. NO SINGLE RETAIL CENTER SHALL CONTAIN MORE THAN 150,000 SQUARE FEET OF GROSS FLOOR AREA DESIGNATED FOR USE BY RETAIL AND

PREPARED FOR:

MAPLE LAWN FARMS, LLC.

SUITE 300 WOODHOLME CENTER

1829 REISTERSTOWN RD

BALTIMORE, MD 21208

ATTN: CHARLIE O'DONOVAN

410-484-8400

THE PLANNING BOARD ON THIS AMENDED COMPREHENSIVE SKETCH PLAN, PROVIDED, HOWEVER, THAT QUARRIES, TEMPORARY WRECKED VEHICLE

POR, B-I AND M-I DISTRICTS, AS PER PETITIONER'S PDP EXHIBIT 18, WITHOUT REGARD TO ANY LIMITATIONS OR RESTRICTIONS ON RETAIL OR

PERSONAL SERVICE USES OTHERWISE PERMITTED IN SUCH DISTRICTS; FAST FOOD, CONVENIENCE STORES, COUNTRY CLUBS AND GOLF COURSES,

CARE FACILITIES, HOUSING FOR THE ELDERLY AND/OR HANDICAPPED PERSONS, NURSING HOMES AND SHELTERED HOUSING, PARCEL A-2 MAY

CONTAIN LIVE-WORK UNITS AS DEFINED IN THE OTHER RESIDENTIAL (OR) SECTION, ACCESSORY STRUCTURES AND ACCESSORY USES ARE ALSO

. COMMERCIAL BUILDINGS AT THE CORNER OF JOHNS HOPKINS ROAD AND MAPLE LAWN BOULEVARD SHALL NOT EXCEED THREE STORIES;

. COMMERCIAL BUILDINGS EAST OF MAPLE LAWN BOULEVARD AT THE FOCAL POINT SHALL NOT EXCEED FOUR STORIES.

. COMMERCIAL BUILDINGS IN THE BUSINESS DISTRICT WITHIN 300 FEET OF MD ROUTE 216 SHALL NOT EXCEED ONE STORY.

• COMMERCIAL BUILDINGS IN THE WESTSIDE DISTRICT WITHIN 300 FEET OF MD ROUTE 216 SHALL NOT EXCEED TWO STORIES.

NO MINIMUM OR MAXIMUM PARCEL SIZES APPLY IN THE EMPLOYMENT LAND USE AREAS

PLANNING BOARD. ADDITIONALLY, THE FOLLOWING SHALL APPLY:

THE FOLLOWING USES ARE PERMITTED IN EMPLOYMENT LAND USE AREAS:

PUBLIC SCHOOL BUILDINGS-TEMPORARY CONVERSION TO OTHER USES

• CEMETERIES, MAUSOLEUMS & CREMATORIUMS ARE NOT PERMITTED

STORAGE AND YARD WASTE SHALL NOT BE ALLOWED:

THEATERS, LEGITIMATE AND DINNER


THE FOLLOWING USE RESTRICTIONS ALSO APPLY:

FACILITIES, AND/OR CONVENIENCE STORE FOOD.

HIGHEST ADJOINING GRADE.

# SITE DEVELOPMENT PLAN MAPLE LAWN FARMS

# Westside District - Area 1 Parcel B-11 (Bank)

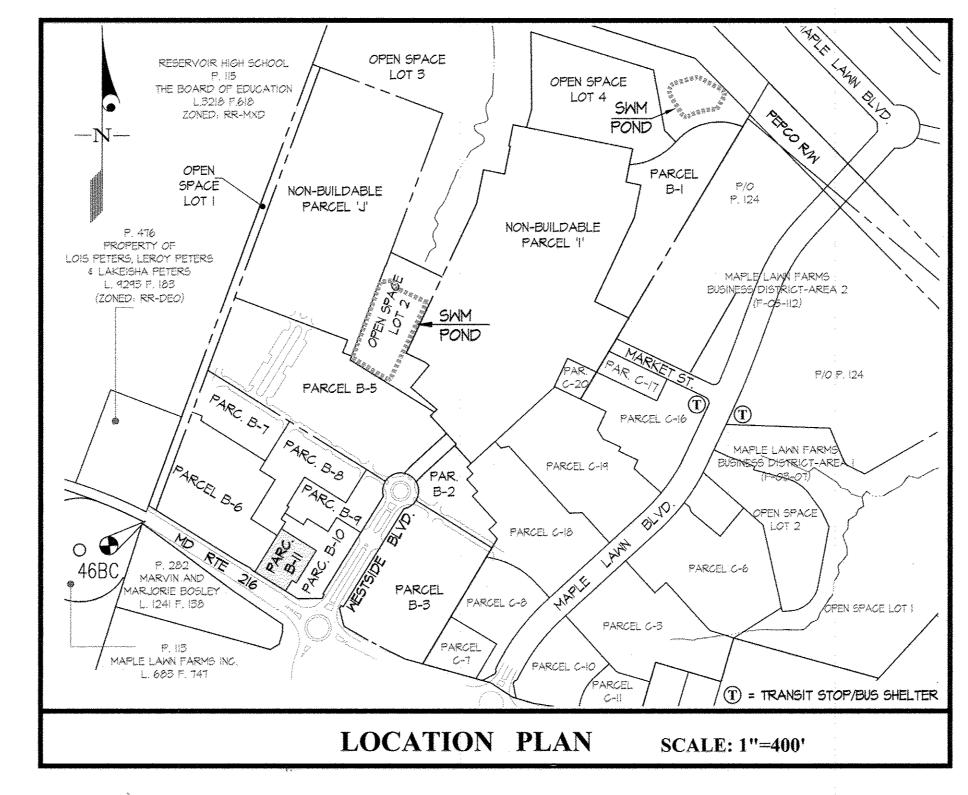

### SITE INDEX

### - COVER SHEET

- 2 SITE DEVELOPMENT PLAN and SITE DETAILS 3 - SITE DETAILS and UTILITY PROFILES
- 4 SEDIMENT CONTROL PLAN and NOTES & DETAILS
- 5 LANDSCAPE PLAN and NOTES & DETAILS

### SITE ANALYSIS DATA

GROSS AREA OF PARCEL B-II = 0.8011 AC

- 2. LIMIT OF DISTURBED AREA = 0.47± AC.
- 3. ZONING: MXD-3.
- 4. PROPOSED USE: COMMERCIAL BANK
- 5. BUILDING COVERAGE: (% OF GROSS ACREAGE) 1,701 S.F. CANOPY 6,155 S.F. OR 17.6% OF SITE (PARCEL B-11)
- 6. FLOOR AREA RATIO (F.A.R.) CALCULATIONS 4,454 S.F. BLDG / 34,895 S.F. (Parcel B-II area = 0.13 F.A.R.)

- SETBACKS (ALSO SEE "PROJECT BOUNDARY SETBACKS") HE MINIMUM SETBACK FOR EMPLOYMENT/COMMERCIAL STRUCTURES SHALL BE AS FOLLOWS:
- 50' FROM THE BOUNDARY LINE ALONG JOHNS HOPKING ROAD OR ROUTE 216
- . 10' FROM THE RIGHT-OF-WAY OF MAPLE LAWN BOULEVARD . NO SETBACK IS REQUIRED FROM THE RIGHT-OF-WAY OF ANY INTERNAL PUBLIC OR PRIVATE ROADS OTHER
- THAN FOR MAPLE LAWN BOULEVARD AS NOTED ABOVE. . IO' FROM ANY OTHER PROPERTY LINE

### PARKING SETBACKS

- 15' TO PUBLIC RIGHT-OF-WAY OF MAPLE LAWN BOULEVARD (EXCEPT FOR PARALLEL PARKING ADJACENT TO ROADWAY)
- . 10' TO ANY OTHER PROPERTY OR BOUNDARY LINE (EXCEPT FOR PARALLEL PARKING ADJACENT TO ROADWAY, OR WHERE A PARCEL LINE LIES WITHIN A USE-IN-COMMON PARKING AREA SERVING MULTIPLE PARCELS.) • 20' TO PROJECT BOUNDARY LINE ALONG JOHNS HOPKINS OR ROUTE 216

### EXCEPTIONS TO SETBACK REQUIREMENTS

- STRUCTURES MAY BE LOCATED ANYWHERE WITHIN SETBACK AREAS IN ACCORDANCE WITH A SITE DEVELOPMENT PLAN APPROVED BY THE HOWARD COUNTY
- EXCEPT FOR THE FOLLOWING, SECTION 128, A.I APPLIES: A. BAY WINDOWS, EAVES, FRENCH BALCONIES, PORTICOS, CORNICES, AWNINGS, SIGNS, AND SIMILAR ARCHITECTURAL ELEMENTS MAY ENCROACH FULLY INTO
- B. ARCADES MAY ENCROACH INTO ANY SETBACK TO WITHIN I' OF THE PROPERTY LINE. WHERE SUCH ARCADES ARE PROPOSED, THE FRONT FA7ADE MAY ALIGN, VERTICALLY, WITH THE FRONT OF THE ARCADE, THEREBY REDUCING THE REQUIRED FRONT SETBACK ACCORDINGLY. AN ARCADE IS AN ARCHED BUILDING, OR PORTION OF A BUILDING, OR GALLERY OFTEN COVERED WITH A ROOF STRUCTURE OR BUILDING SUPPORTED BY A SERIES OF ARCHES AND/OR COLUMNS ON PIERS.

- a. A MINIMUM OF FIVE PARKING SPACES SHALL BE PROVIDED FOR EACH 1,000 SQUARE FEET OF NET LEASABLE AREA DEVOTED TO COMMERCIAL RETAIL b. A MINIMUM OF 3.3 PARKING SPACES SHALL BE PROVIDED FOR EACH LOOD SQUARE FEET OF NET LEASABLE AREA THAT IS DEVOTED TO OFFICE OR
- RESEARCH AND DEVELOPMENT USES. NO PARKING REQUIREMENT IS IMPOSED UPON ANY RESTAURANT, COFFEE SHOP OR SIMILAR FACILITY CONSTRUCTED WITHIN BUILDINGS WHICH PRIMARILY
- SERVES TENANTS AND EMPLOYEES OF SUCH BUILDINGS, OR NEIGHBORING BUILDINGS ACCESSIBLE BY PEDESTRIANS. d. ONE PARKING SPACE SHALL BE PROVIDED FOR EACH BEDROOM CONTAINED WITHIN ANY HOTEL, INN OR SIMILAR FACILITY AND ONE PARKING SPACE
- SHALL BE PROVIDED FOR EACH FIVE EMPLOYEES OF SUCH FACILITY. ONE PARKING SPACE SHALL BE PROVIDED FOR EACH THREE SEATS WITHIN ANY RESTAURANT, COFFEE SHOP OR SIMILAR FACILITY CONSTRUCTED WITHIN A HOTEL, INN OR SIMILAR FACILITY OR AS A FREESTANDING STRUCTURE AND ONE PARKING SPACE SHALL BE PROVIDED FOR EACH FIVE EMPLOYEES OF
- ONE PARKING SPACE SHALL BE PROVIDED FOR EACH TWO BEDS IN ANY HOSPITAL OR CLINIC; ONE PARKING SPACE SHALL BE PROVIDED FOR EACH EMPLOYEE ON A MAJOR SHIFT; AND EIGHT PARKING SPACES SHALL BE PROVIDED FOR EACH DOCTOR TREATING OUTPATIENTS ON A MAJOR SHIFT. INDUSTRIAL USES: 0.5 SPACES PER 1,000 SQUARE FEET OF NET LEASABLE AREA

'FLEX' SPACE (INDUSTRIAL/OFFICE) 2.5 SPACES PER I,000 SQUARE FEET OF NET LEASABLE AREA OTHER INDUSTRIAL 2.0 SPACES PER 1,000 SQUARE FEET OF NET LEASABLE AREA.

RECREATIONAL USES:

10,0 SPACES PER 1,000 SQUARE FEET OF NET LEASABLE AREA SWIMMING POOL, COMMUNITY 1.0 SPACE PER SEVEN PERSONS PERMITTED IN THE POOL AT ONE TIME BY THE DEPT. OF HEALTH

HEALTH CLUB TENNIS COURT

2.0 SPACES PER COURT "NET LEASEABLE AREA" IS DEFINED AS 90% OF THE GROSS FLOOR AREA (AFTER DEDUCTING ANY FLOORS DEVOTED TO STORAGE AND COMMON USES). UNLESS A MORE PRECISE VALUE IS DETERMINED BY REDUCING THE GROSS FLOOR AREA BY AREAS DEVOTED TO PARKING, VEHICULAR CIRCULATION,

REQUIRED MINIMUM PARKING FOR ALL SUCH COMMERCIAL AND EMPLOYMENT USES SHALL BE MET OFF-STREET. ADDITIONAL PARKING MAY BE ACCOMMODATED ON-STREET, IN PARALLEL PARKING WITHIN PUBLIC ROAD RIGHTS-OF-WAY, PARALLEL SPACES LOCATED ON PAVED AREAS ADJACENT TO PUBLICLY MAINTAINED ROADWAYS OR ORIENTED DIAGONALLY OR AT RIGHT ANGLES TO SUCH ROADWAYS, IN AND/OR OUT OF THE PUBLIC R/W.

OFFICE BUILDING STORAGE AREAS, EQUIPMENT AND MECHANICAL ROOMS/AREAS, LOCKER AND SHOWER FACILITIES, ENTRANCE FOYERS/ATRIA, AND

REDUCTIONS IN PARKING REQUIREMENTS ARE PERMITTED PURSUANT TO THE HOWARD COUNTY ZONING REGULATIONS SECTIONS 133.D.8 (PARKING STUDIES), 133.E.I (SHARED PARKING) AND 133.E.2 (TRIP REDUCTION PLANS).

### **COVER SHEET**

MAPLE LAWN FARMS WESTSIDE DISTRICT - AREA 1 PARCEL B-11 (Bank) PLAT No. 19902/03, TAX MAP PARCEL No. 116 LIME KILN ADC MAP 18 K5 \$ K6 **VICINITY MAP** ADC MAP I SCALE: I" = 2000' A5 & A6

ELEV. = 472.16 N = 539.925.13 E=1.337.205.77 STANDARD DISC ON CONCRETE MONUMENT 46BD ELEV. = 431.17 N = 538,656.76 E=1,339,461.55 STANDARD DISC ON CONCRETE MONUMENT

FLOOR AREA RATIO (F.A.R.) TRACKING CHART								
PZ FILE No.	PARCEL AREA	FLOOR AREA	F.A.R.					
P-04-44 (Office Bldg. I)	4.40 AC. (191,550 S.F.)	93,945 S.F.	0.49					
2-04-96 (Retail Bldg.   & Bank)	3.17 AC. (137,933 S.F.)	24,088 S.F.	0.17					
P-05-08 (Retail Bldg. 2 \$ Gas Station)	3.20 AC. (139,520 S.F.)	22,218 S.F.	0.16					
P-05-036 (Office Bldg. 2)	4.24 AC. (184,802 S.F.)	93,945 S.F.	0.51					
P-05-047 (Office Bldg. 3 & M&T BANK)	5.58 AC. (243,230 S.F.)	123,740 S.F.	0.51					
PP-06-067 (Office Bldg. 4)	4.78 AC. (208 <sub>,</sub> 087 S.F.)	100,288 S.F.	0.48					
P-06-148 (Medical \$ 3 Office Bldgs.)	8.54 AC. (371,950 S.F.)	121,620 S.F.	0.33					
PP-07-02 (Bank, School, Retail, & Restaurant)	7.36 AC. (320,659 S.F.)	45,225 S.F.	0.14					
P-08-056 (Grocery Store - Parcel B-6)	4.24 AC. (184,615 S.F.)	49,815 S.F.	0.27					
is SDP (Bank, Parcel B-II)	0.80 AC. (34,895 S.F.)	4,454 S.F.	0.13					
SUB-TOTAL	46.31 AC. (2,017,241 S.F.)	679,338 S.F.	0.34					
MPLOYMENT AREA RECORDED AS R/W	13.60 AC. ①							
TAL AREA TO BE RECORDED AS EMPLOYMENT	122.00 AC. ①	15.60 AC.	0.I3					
OTAL RECORDED EMPLOYMENT REMAINING	62.09 AC.							

(I) AREAS TO DATE BASED ON F-08-54 OVERALL TRACKING CHART.

	PARKING TABULATION						
· · · · · · · · · · · · · · · · · · ·	PARKIN	G GENERATION	DATA				
	HARRIS TEETER (SDP-08-056)	BANK (THIS SDP)					
NET FLOOR AREA (in S.F.)	45,020 S.F.	4,009 S.F.					
REQUIRED PARKING RATIO	5 per 1000	5 per 1000					
REQUIRED PARKING SPACES	225	21					
PARKING SPACES PROVIDED	232	21*					
PARKING RATIO PROVIDED	5.15 per 1000	5.23 per 1000	inginisti manih Colombia da Arabinan La manin and and and and and and and and and an				

(1) AS DEFINED BY BOMA (BUILDING OWNERS AND MANAGERS ASSOCIATION) GUIDELINES (approx. 91% of gross S.F.) \* THERE ARE 19 SPACES ON PARCEL B-11. THE 21 SPACES INCLUDES 2 PARKING SPACES FROM ADJOINING PARCELS THRU A RECORDED SHARED ACCESS & PARKING AGREEMENT.

PARKING DISTRIBUTION								
PARCEL NUMBER	B-6	B-7	B-8	B-9	B-10	B-II	RUNNING TOTA	
PARALLEL SPACES	5	1	10	0	0	0	26	
9'x18' SPACES (90°)	219	38	108	85	34	17	501	
HANDICAP SPACES	8	w/ other SDP	w/other SDP	w/ other SDP	w/ other SDP	2	10	
RUNNING TOTAL	252	49	118	85	34	19	537	

SEE SDP-08-056 FOR THE COMPLETE PARKING LAYOUT FOR PARCEL B-6. PARTIAL PARKING LAYOUT FOR THE OTHER PARCELS ARE ALSO SHOWN ON SDP-08-056. THE SHARED ACCESS AND PARKING AGREEMENT IS RECORDED

-	BUILDING ADDRESS: 1	3190 WESTSIDE	BOULEVARD			
	SUBDIVISION NAME: MAPLE LAWN FARMS	and the second s	SECTION/A WESTSIDE DIS	REA STRICT/AREA I		PARCEL B-II
	PLAT Nos. 19902/03	ZONE MXD-3	TAX MAP	BLOCK 3 \$ 4	ELEC. DIST.	CENSUS TRACT
January	WATER CODE: E2I		SENER COI 1695000	<b>9</b> E:		
			SCALE		70NING	G I W FIIF No

MXD-3TAX MAP - GRID HOWARD COUNTY, MARYLAND

L:\CADD\DRAWINGS\03067\07070\SDP\07070-CS.dwg | DES. MBT | DRN. KLP | CHK. BY APP'R

XPIRATION DATE: MAY 26, 2008

PROFESSIONAL CERTIFICATION


HEREBY CERTIFY THAT THESE PLANS


WERE PREPARED OR APPROVED BY

ME. AND THAT I AM A DULY LICENSED

PROFESSIONAL ENGINEER UNDER THE

LAWS OF THE STATE OF MARYLAND, LICENSE NO. 12975

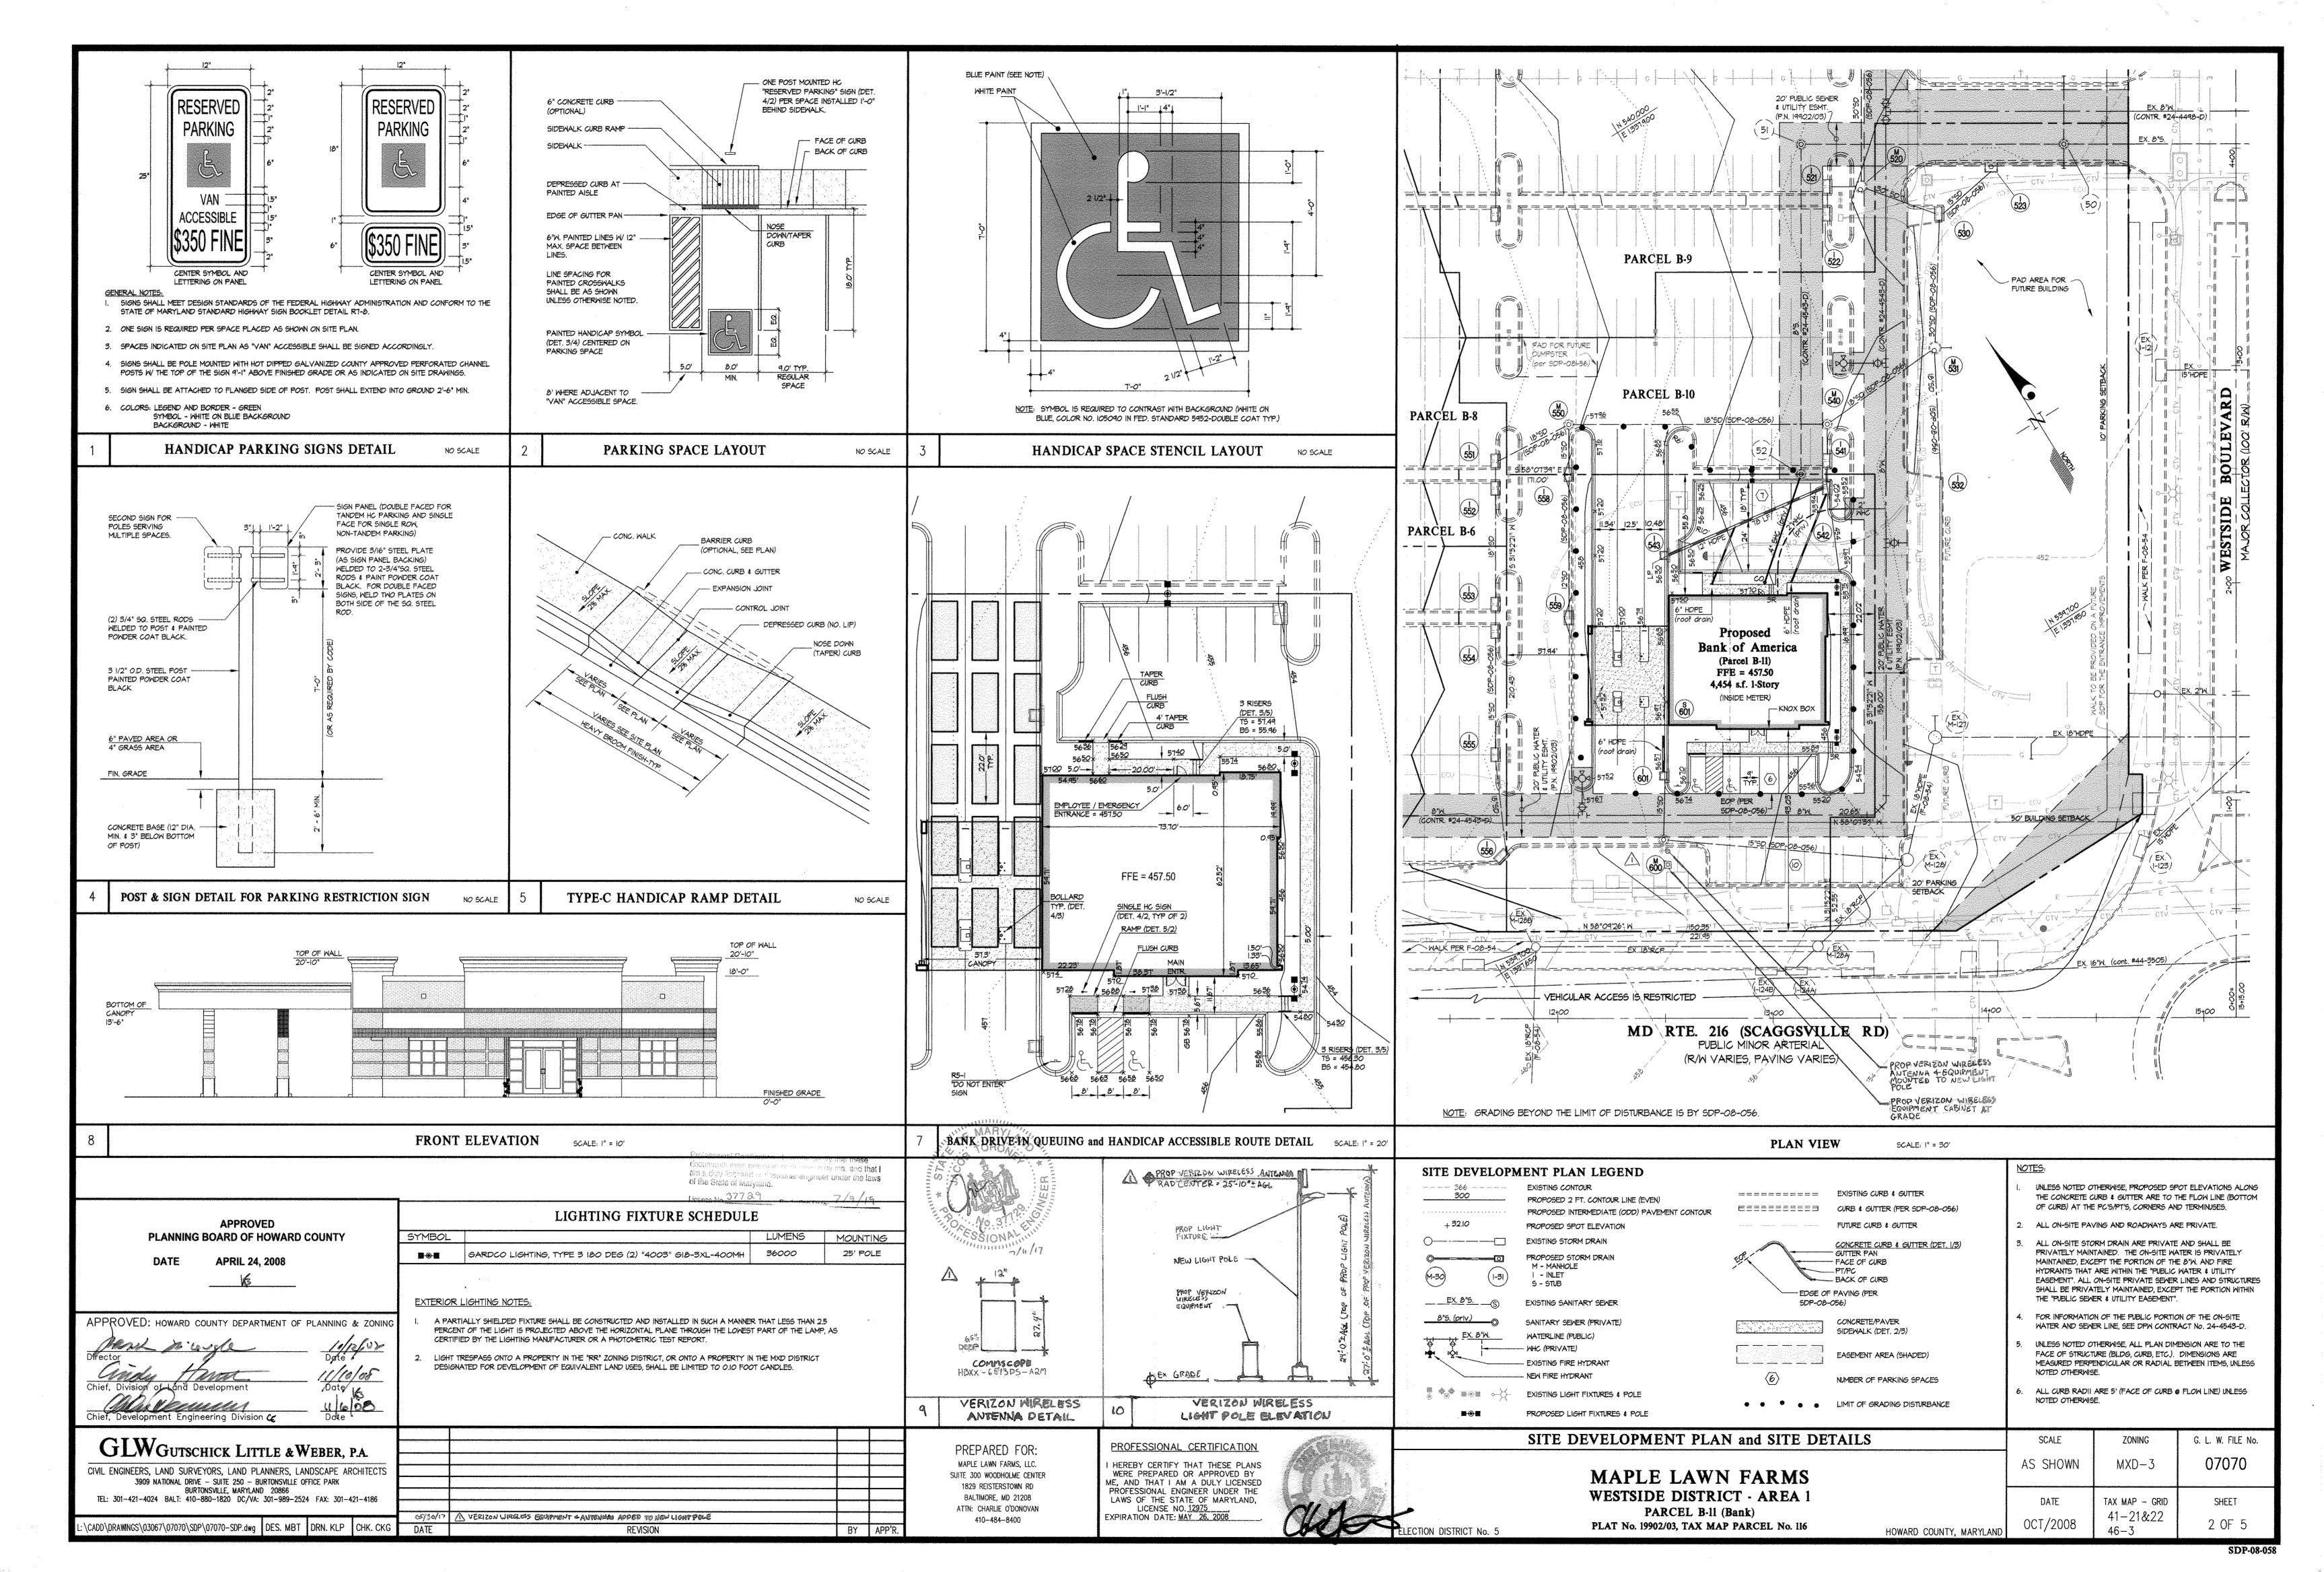

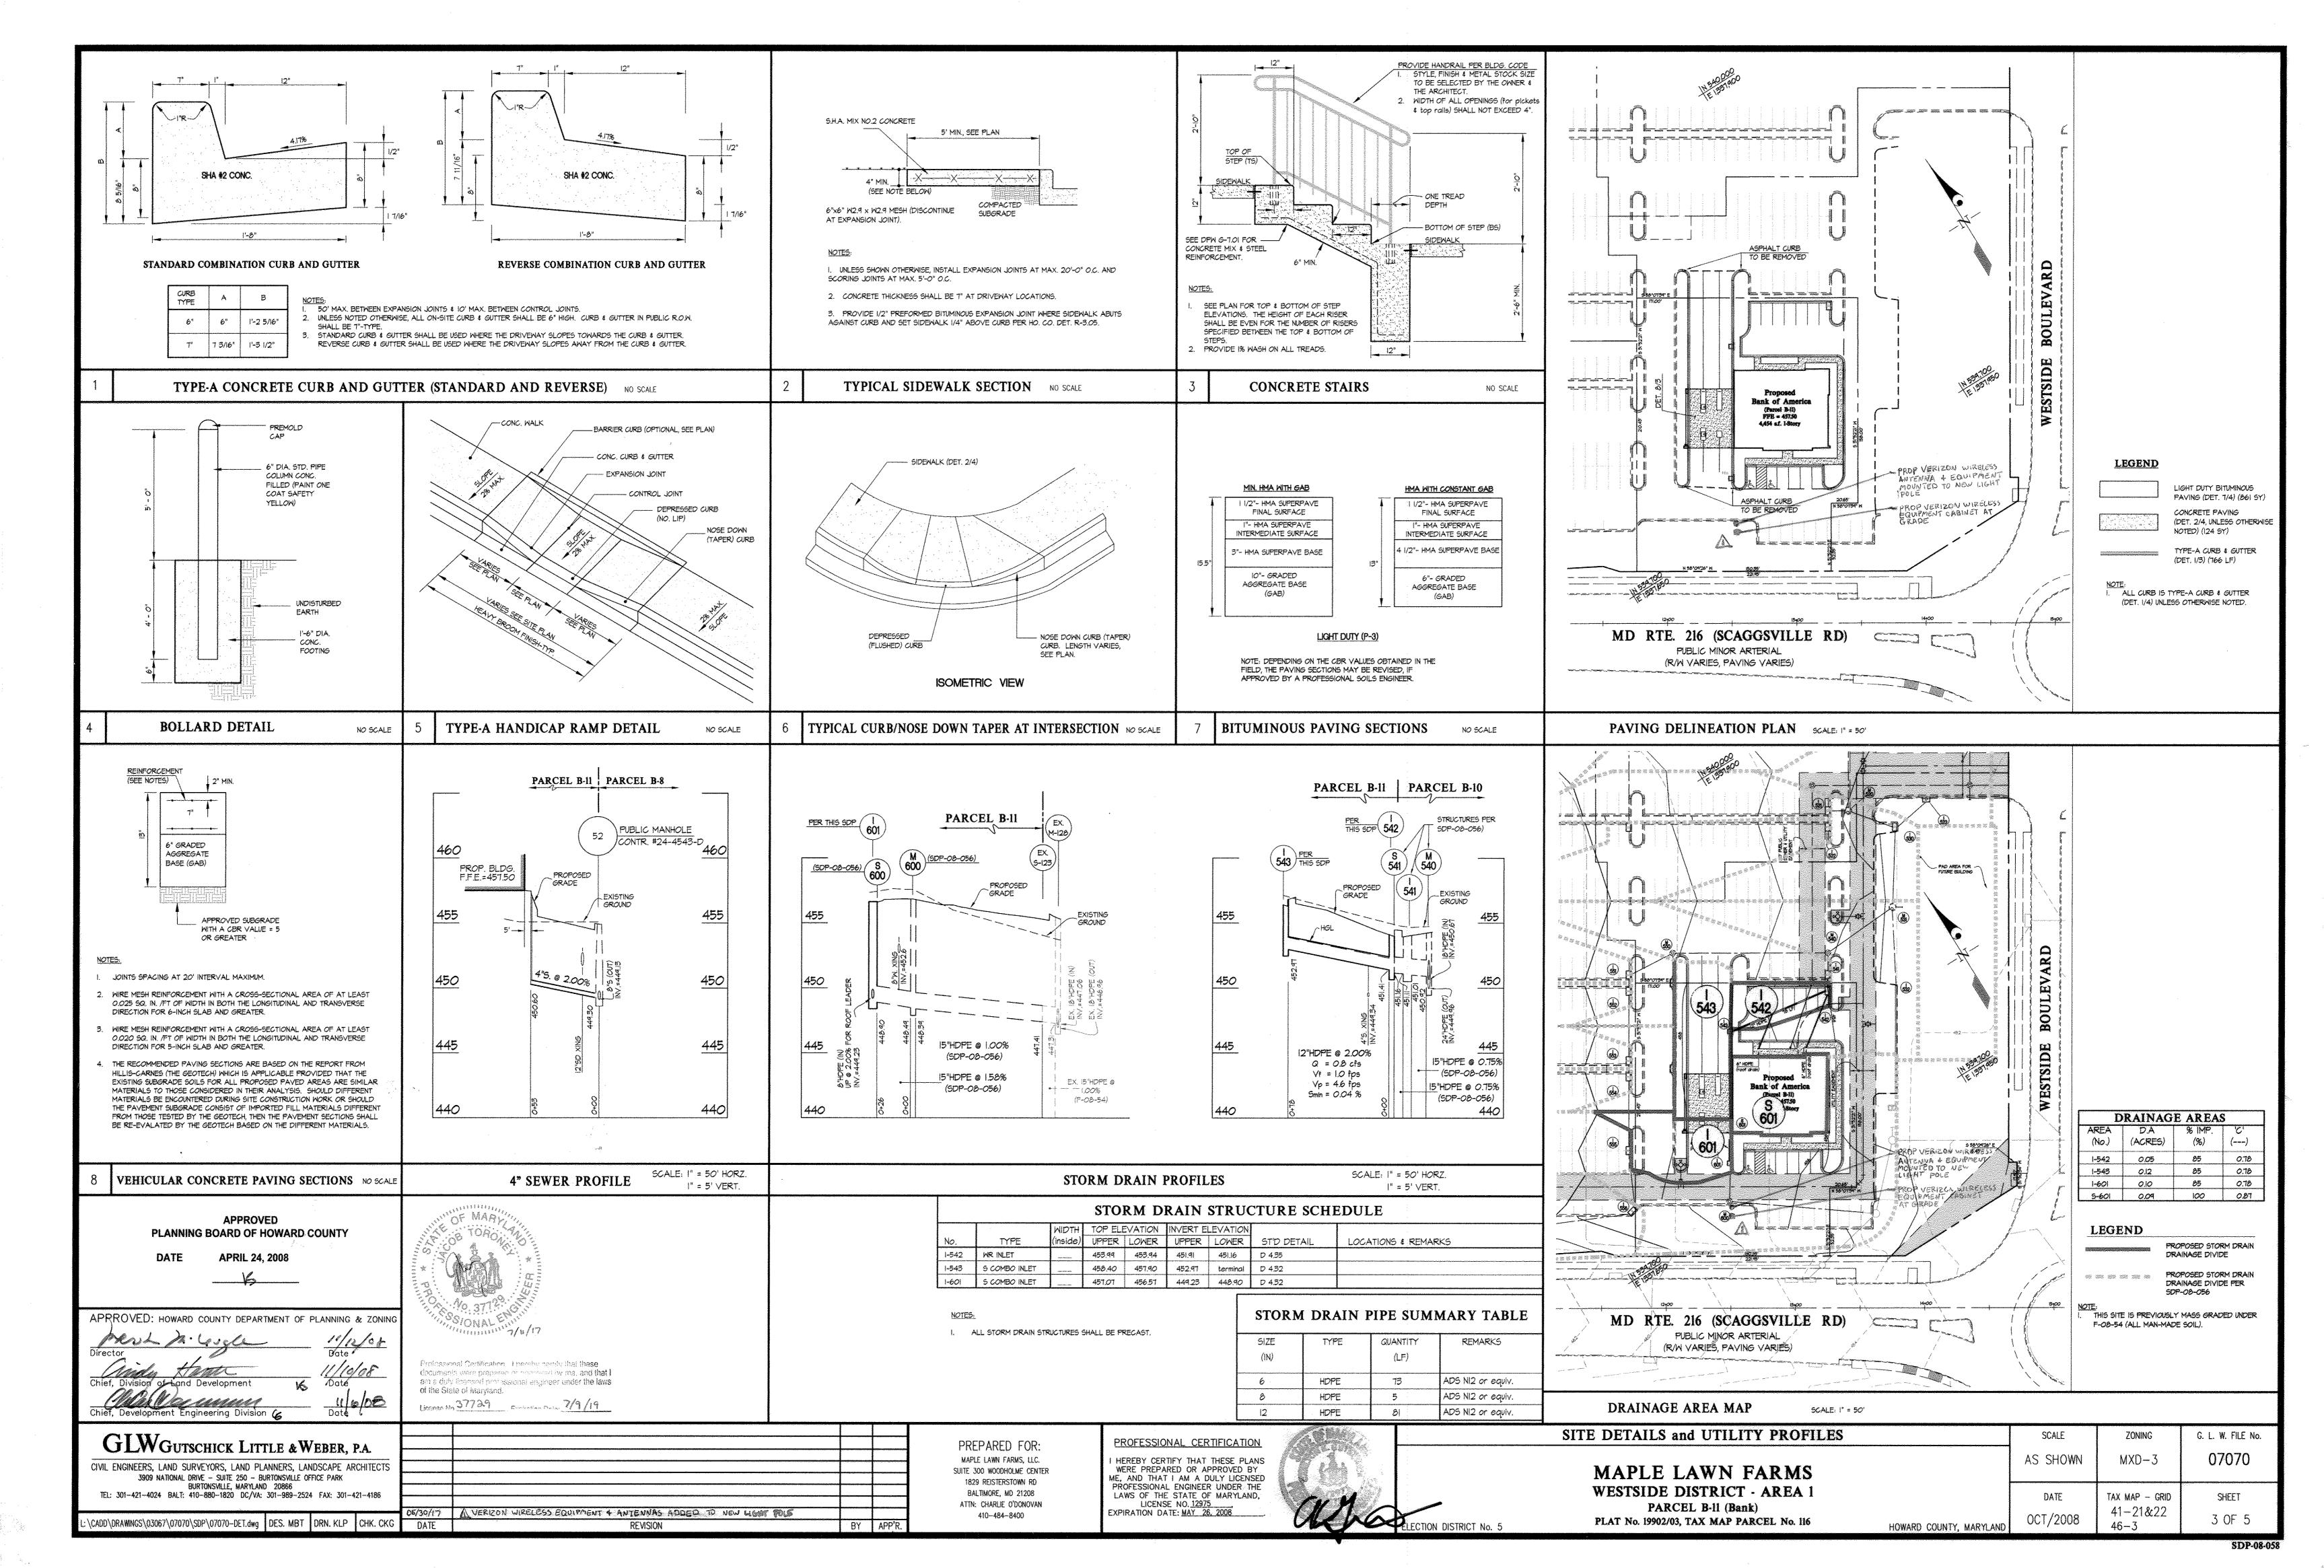

### PERMANENT SEEDING NOTES

APPLY TO GRADED OR CLEARED AREA NOT SUBJECT TO IMMEDIATE FURTHER DISTURBANCE WHERE A PERMANENT LONG-LIVED VEGETATIVE COVER IS NEEDED. SEEDBED PREPARATION: LOOSEN UPPER THREE INCHES OF SOIL BY RAKING, DISCING OR OTHER ACCEPTABLE MEANS BEFORE SEEDING

(UNLESS PREVIOUSLY LOOSENED).

SOIL AMENDMENTS: IN LIEU OF SOIL TEST RECOMMENDATIONS, USE ONE OF THE FOLLOWING SCHEDULES

PREFERRED - APPLY 2 TONS PER ACRE DOLOMITIC LIMESTONE (92 LBS/1000 SQUARE FEET) AND 600 LBS PER ACRE 10-10-10 FERTILIZER (14 LBS/1000 SQ FT) BEFORE SEEDING. HARROW OR DISC INTO UPPER THREE INCHES OF SOIL. AT TIME OF SEEDING, APPLY 400 LBS PER ACRE 50-0-0 UREA-FORM FERTILIZER (9 LBS/1000 SQ FT).

2) ACCEPTABLE - APPLY 2 TONS PER ACRE DOLOMITIC LIMESTONE (92 LBS/1000 SQ FT) AND 1000 LBS PER ACRE OF 10-10-10 FERTILIZER (23 LBS/1000 SQ FT) BEFORE SEEDING. HARROW OR DISC INTO UPPER THREE INCHES OF SOIL.

SEEDING: FOR THE PERIODS MARCH | THRU APRIL 30, AND AUGUST | THRU OCTOBER 15. SEED WITH 60 LBS PER ACRE (1.4 LBS/1000 SQ FT) OF KENTUCKY 31 TALL FESCUE. FOR THE PERIOD MAY I THRU JULY 31, SEED WITH 60 LBS KENTUCKY 31 TALL FESCUE PER ACRE AND 2 LBS PER ACRE (.05 LBS/1000 SQ FT) OF WEEPING LOVEGRASS. DURING THE PERIOD OF OCTOBER 16 THRU FEBRUARY 28, PROTECT SITE BY: OPTION (1) 2 TONS PER ACRE OF WELL ANCHORED STRAW MULCH AND SEED AS SOON AS POSSIBLE IN THE SPRING. OPTION (2) USE SOD. OPTION (3) SEED WITH 60 LBS/ACRE KENTUCKY 31 TALL FESCUE AND MULCH WITH 2 TONS/ACRE WELL ANCHORED STRAW.

MULCHING: APPLY 1-1/2 TO 2 TONS PER ACRE (TO TO 90 LBS/1000 50 FT) OF UNROTTED SMALL GRAIN STRAW IMMEDIATELY AFTER SEEDING. ANCHOR MULCH IMMEDIATELY AFTER APPLICATION USING MULCH ANCHORING TOOL OR 218 GALLONS PER ACRE (5 GAL/1000 SQ FT) OF EMULSIFIED ASPHALT ON FLAT AREAS. ON SLOPES 8 FEET OR HIGHER. USE 348 GALLONS PER AGRE (8 GAL/1000 SQ FT) FOR ANCHORING.

MAINTENANCE: INSPECT ALL SEEDED AREAS AND MAKE NEEDED REPAIRS REPLACEMENTS AND RESEEDINGS

### **TEMPORARY SEEDING NOTES**

APPLY TO GRADED OR CLEARED AREAS LIKELY TO BE REDISTURBED WHERE A SHORT-TERM VEGETATIVE COVER IS NEEDED.

SEEDBED PREPARATION: LOOSEN UPPER THREE INCHES OF SOIL BY RAKING, DISCING OR OTHER ACCEPTABLE MEANS BEFORE SEEDING (UNLESS PREVIOUSLY LOOSENED).

SOIL AMENDMENTS: APPLY 600 LBS PER ACRE 10-10-10 FERTILIZER (14 LBS/1000 SQ FT).

SEEDING: FOR PERIODS MARCH I THRU APRIL 30 AND FROM AUGUST 15 THRU OCTOBER 15, SEED WITH 2-1/2 BUSHEL PER ACRE OF ANNUAL RYE (3.2 LBS /IOOO SQFT ) FOR THE PERIOD MAY I THRU AUGUST 14. SEED WITH 3 LBS PER ACRE OF WEEPING LOVEGRASS (.OT LBS/1000 SQ FT). FOR THE PERIOD NOVEMBER 16 THRU FEBRUARY 26, PROTECT SITE BY APPLYING 2 TONS PER ACRE OF WELL ANCHORED STRAW MULCH AND SEED AS SOON AS POSSIBLE IN THE SPRING, OR USE SOD.

MULCHING: APPLY 1-1/2 TO 2 TONS PER ACRE (TO TO 40 LB5/1000 50 FT) OF UNROTTED, WEED-FREE, SMALL GRAIN STRAW IMMEDIATELY AFTER SEEDING, ANCHOR MULCH IMMEDIATELY AFTER APPLICATION USING MULCH ANCHORING TOOL OR 218 GAL PER ACRE (5 GAL/1000 SQ FT) OF EMULSIFIED ASPHALT ON FLAT AREAS. ON SLOPES, 8 FT OR HIGHER, USE 348 GAL PER ACRE (8 GAL/1000 SQ FT) FOR ANCHORING.

THIS DEVELOPMENT PLAN IS APPROVED FOR SOIL EROSION AND SEDIMENT CONTROL BY THE HOWARD SOIL CONSERVATION DISTRICT.

PLANNING BOARD OF HOWARD COUNTY

APPROVED: HOWARD COUNTY DEPARTMENT OF PLANNING & ZONIN

Chief, Division of Land Development Chief, Development Engineering Division CE

GLWGUTSCHICK LITTLE & WEBER, PA

CIVIL ENGINEERS, LAND SURVEYORS, LAND PLANNERS, LANDSCAPE ARCHITECT 3909 NATIONAL DRIVE - SUITE 250 - BURTONSVILLE OFFICE PARK BURTONSVILLE, MARYLAND 20866 TEL: 301-421-4024 BALT: 410-880-1820 DC/VA: 301-989-2524 FAX: 301-421-4186

\CADD\DRAWNGS\03067\07070\SDP\07070-SNE.dwg | DES. MBT | DRN. KLP | CHK. CKI

### STANDARD AND SPECIFICATIONS FOR TOPSOIL

### DEFINITION

PLACEMENT OF TOPSOIL OVER A PREPARED SUBSOIL PRIOR TO ESTABLISHMENT OF PERMANENT VEGETATION.

TO PROVIDE A SUITABLE SOIL MEDIUM FOR VEGETATIVE GROWTH. SOILS OF CONCERN HAVE LOW MOISTURE CONTENT, LOW NUTRIENT LEVELS, LOW PH, MATERIALS TOXIC TO PLANTS, AND/OR UNACCEPTABLE SOIL GRADATION.

### CONDITIONS WHERE PRACTICE

- THIS PRACTICE IS LIMITED TO AREAS HAVING 2:1 OR FLATTER SLOPE WHERE: A. THE TEXTURE OF THE EXPOSED SUBSOIL/PARENT MATERIAL IS NOT ADEQUATE TO PRODUCE VEGETATIVE GROWTH
- B. THE SOIL MATERIAL IS SO SHALLOW THAT THE ROOTING ZONE IS NOT DEEP ENOUGH TO SUPPORT PLANTS OR FURNISH CONTINUING SUPPLIED OF MOISTURE AND PLANT NUTRIENTS.
- C. THE ORIGINAL SOIL TO BE VEGETATED CONTAINS MATERIAL TOXIC TO PLANT
- D. THE SOIL IS SO ACIDIC THAT TREATMENT WITH LIMESTONE IS NOT FEASIBLE. FOR THE PURPOSE OF THESE STANDARDS AND SPECIFICATIONS, AREAS HAVING SLOPES STEEPER THAN 2:1 REQUIRE SPECIAL CONSIDERATION AND DESIGN FOR ADEQUATE STABILIZATION. AREAS HAVING SLOPES STEEPER THAN 2:1 SHALL HAVE THE APPROPRIATE STABILIZATION SHOWN ON THE PLANS.

### CONSTRUCTION AND MATERIAL SPECIFICATIONS

TOPSOIL SALVAGED FROM THE EXISTING SITE MAY BE USED PROVIDED THAT IT MEETS THE STANDARDS AS SET FORTH IN THESE SPECIFICATIONS, TYPICALLY, THE DEPTH OF TOPSOIL TO BE SALVAGED FOR A GIVEN SOIL TYPE CAN BE FOUND IN THE RESPECTIVE SOIL PROFILE SECTION IN THE SOIL SURVEY PUBLISHED BY USDA-SCS IN COOPERATION WITH MARYLAND AGRICULTURAL EXPERIMENTAL STATION.

- TOPSOIL SPECIFICATIONS SOIL TO BE USED AS TOPSOIL MUST MEET THE FOLLOWING:
- A. TOPSOIL SHALL BE A LOAM, SANDY LOAM, CLAY LOAM, SILT LOAM, SANDY CLAY LOAM, LOAMY SAND, OTHER SOILS MAY BE USED IF RECOMMENDED BY A AGRONOMIST OR SOIL SCIENTIST AND APPROVED BY THE APPROPRIATE APPROVAL AUTHORITY. REGARDLESS, TOPSOIL SHALL NOT BE A MIXTURE OF CONTRASTING TEXTURED SUBSOILS AND SHALL CONTAIN LESS THAN 5% BY VOLUME OF CINDERS, STONES, SLAG, COARSE FRAGMENTS, GRAVEL, STICKS, ROOTS, TRASH, OR OTHER MATERIALS LARGER THAN I 1/2" IN DIAMETER.
- B. TOPSOIL MUST BE FREE OF PLANT PARTS SUCH AS BERMUDA GRASS, QUACKGRASS, JOHNSONGRASS, NUTSEDGE, POISON IVY, THISTLE, OR OTHERS AS

C. WHERE THE SUBSOIL IS EITHER HIGHLY ACIDIC OR COMPOSED OF HEAVY CLAYS, GROUND LIMESTONE SHALL BE SPREAD AT THE RATE IF 4-8 TONS/ACRE (200-400 POUNDS PER 1,000 SQUARE FEET) PRIOR TO THE PLACEMENT OF TOPSOIL. LIME SHALL BE DISTRIBUTED UNIFORMLY OVER DESIGNATED AREAS AND WORKED INTO THE SOIL IN CONJUNCTION WITH TILLAGE OPERATIONS AS DESCRIBED IN THE FOR SHES HAVING DISTURBED AREAS UNDER 5 ACRES:

A. PLACE TOPSOIL (IF REQUIRED) AND APPLY SOIL AMENDMENTS AS SPECIFIED IN 20.0 VEGETATIVE STABILIZATION - SECTION I - VEGETATIVE STABILIZATION METHODS AND MATERIALS (OR SEE SEEDING NOTES).

### . FOR SITES HAVING DISTURBED AREAS OVER 5 ACRES:

A. ON SOIL MEETING TOPSOIL SPECIFICATIONS, OBTAIN TEST RESULTS DICTATING FERTILIZER & LIME AMENDMENTS REQUIRED TO BRING THE SOIL INTO COMPLIANCE WITH THE FOLLOWING:

- PH FOR TOPSOIL SHALL BE BETWEEN 6.0 AND 7.5. IF THE TESTED SOIL DEMONSTRATES A PH OF LESS THAN 6.0, SUFFICIENT LIME SHALL BE PRESCRIBED TO RAISE THE PH TO 6.5 OR HIGHER. 2. ORGANIC CONTENT OF TOPSOIL SHALL BE NOT LESS THAN 1.5 PERCENT BY
- 3. TOPSOIL HAVING SOLUBLE SALT GREATER THAN 500 PARTS PER MILL SHALL NOT BE USED. 4. NO SOD OR SEED SHALL BE PLACED ON SOIL WHICH HAS BEEN WITH SOIL

STERILANTS OR CHEMICALS USED FOR WEED CONTROL UNTIL SUFFICIENT TIME HAS ELAPSED (14 DAYS MIN.) TO PERMIT DISSIPATION OF PHOTO-TOXIC NOTE: TOPSOIL SUBSTITUTES OR AMENDMENTS, AS RECOMMENDED BY A QUALIFIED AGRONOMIST OR SOIL SCIENTIST AND APPROVED BY THE APPROPRIATE APPROVAL

- AUTHORITY, MAY BE USED IN LIEU OF NATURAL TOPSOIL. B. PLACE TOPSOIL (IF REQUIRED) AND APPLY SOIL AMENDMENTS AS SPECIFIED IN 2.0 VEGETATIVE STABILIZATION - SECTION I - VEGETATIVE STABILIZATION METHODS
- AND MATERIALS (OR SEE SEEDING NOTES). TOPSOIL APPLICATION
- A. WHEN TOPSOILLING, MAINTAIN NEEDED EROSION AND SEDIMENT CONTROL PRACTICES SUCH AS DIVERSION, GRADE STABILIZATION STRUCTURES, EARTH DIKES, SLOPE SILT FENCE AND SEDIMENT TRAPS AND BASINS.
- B. GRADES ON THE AREAS TO BE TOPSOILED, WHICH HAVE BEEN PREVIOUSLY ESTABLISHED, SHALL BE MAINTAINED, ALBEIT 4"-8" HIGHER IN ELEVATION.
- C. TOPSOIL SHALL BE UNIFORMLY DISTRIBUTED IN A 4'-8' LAYER AND LIGHTLY COMPACTED TO A MINIMUM THICKNESS OF 4". SPREADING SHALL BE PERFORMED IN SUCH A MANNER THAT SODDING OR SEEDING CAN PROCEED WITH A MINIMUM OF ADDITIONAL SOIL PREPARATION AND TILLAGE. ANY IRREGULARITIES IN THE SURFACE RESULTING FROM TOPSOILLING OR OTHER OPERATIONS SHALL BE CORRECTED IN ORDER TO PREVENT THE FORMATION OF DEPRESSIONS OR WATER
- D. TOPSOIL SHALL NOT BE PLACED WHILE THE TOPSOIL OR SUBSOIL IS FROZEN OR MUDDY CONDITION, WHEN THE SUBSOIL IS EXCESSIVELY WET OR IN A CONDITION THAT MAY OTHERWISE BE DETRIMENTAL TO PROPER GRADING AND SEEDBED
- ALTERNATIVE FOR PERMANENT SEEDING INSTEAD OF APPLYING THE FULL AMOUNTS OF LIME AND COMMERCIAL FERTILIZER, COMPOSTED SLUDGE AND AMENDMENTS MAY BE PPLIED AS SPECIFIED BELOW. A. COMPOSTED SLUDGE MATERIAL FOR USE AS A SOIL CONDITIONER FOR SITES
- HAVING DISTURBED AREAS OVER 5 ACRES SHALL BE TESTED TO PRESCRIBE AMENDMENTS AND FOR SITES HAVING DISTURBED AREAS UNDER 5 ACRES SHALL CONFORM TO THE FOLLOWING REQUIREMENTS: COMPOSTED SLUDGE SHALL BE SUPPLIED BY, OR ORIGINATE FROM, A PERSON OR PERSONS THAT ARE PERMITTED (AT THE TIME OF ACQUISITION OF
- THE COMPOST) BY THE MARYLAND DEPARTMENT OF THE ENVIRONMENT UNDER COMAR 26.04.06. 2. COMPOSTED SLUDGE SHALL CONTAIN AT LEAST I PERCENT NITROGEN, 15 PERCENT PHOSPHORUS, AND 0.2 PERCENT POTASSIUM AND HAVE A PH OF 1.0 TO 8.0. IF COMPOST DOES NOT MEET THESE REQUIREMENTS, THE

APPROPRIATE CONSTITUENTS MUST BE ADDED TO MEET THE REQUIREMENTS


- PRIOR TO USE. 3. COMPOSTED SLUDGE SHALL BE APPLIED AT A RATE OF I TON/1,000 SQUARE FEET
- B. COMPOSTED SLUDGE SHALL BE AMENDED WITH A POTASSIUM FERTILIZER APPLIED AT A RATE OF 4LB/1,000 SQUARE FEET, AND 1/3 THE NORMAL LIME APPLICATION RATE REFERENCES: GUIDELINE SPECIFICATIONS, SOIL PREPARATION AND SODDING. MD-VA

## DEVELOPER'S/BUILDER'S CERTIFICATE

PUB. #1, COOPERATIVE EXTENSION SERVICE, UNIVERSITY OF MARYLAND AND VIRGINIA

POLYTECHNIC INSTITUTES. REVISED 1973.

"I/WE CERTIFY THAT ALL DEVELOPMENT AND/OR CONSTRUCTION WILL BE DONE ACCORDING TO THIS PLAN, AND THAT ANY RESPONSIBLE PERSONNEL INVOLVED IN THE CONSTRUCTION PROJECT WILL HAVE A CERTIFICATE OF ATTENDANCE AT A MARYLAND DEPARTMENT OF THE ENVIRONMENT APPROVED TRAINING PROGRAM FOR THE CONTROL OF SEDIMENT AND EROSION BEFORE BEGINNING THE PROJECT. I ALSO AUTHORIZE PERIODIC ON-SITE INSPECTION BY THE HSCD."

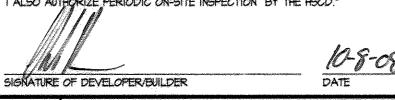

A verizon wireless equipment & antennas added to New Light Pole

REVISION

THE HOWARD SOIL CONSERVATION DISTRICT."

ENGINEER'S CERTIFICATE

BY APP'R

"I CERTIFY THAT THIS PLAN FOR EROSION AND SEDIMENT CONTROL REPRESENTS A

PRACTICAL AND WORKABLE PLAN BASED ON MY PERSONAL KNOWLEDGE OF THE SITE

CONDITIONS AND THAT IT WAS PREPARED IN ACCORDANCE WITH THE REQUIREMENTS OF

SEDIMENT CONTROL NOTES

I. A MINIMUM OF 24 HOURS NOTICE MUST BE GIVEN TO THE HOWARD COUNTY

2. ALL VEGETATIVE AND STRUCTURAL PRACTICES ARE TO BE INSTALLED

CONFORMANCE WITH THE 1994 MARYLAND STANDARDS AND SPECIFICATIONS

3. FOLLOWING INITIAL SOIL DISTURBANCE OR REDISTURBANCE, PERMANENT

DIKES AND PERIMETER SLOPES AND ALL SLOPES GREATER THAN 3.1, B) 14

DAYS AS TO ALL OTHER DISTURBED OR GRADED AREAS ON THE PROJECT

OFFICE OF INSPECTION AND PERMITS PRIOR TO THE START OF ANY

ACCORDING TO THE PROVISIONS OF THIS PLAN AND ARE TO BE IN

FOR SOIL EROSION AND SEDIMENT CONTROL AND REVISIONS THERETO.

OR TEMPORARY STABILIZATION SHALL BE COMPLETED WITHIN: A) 7

CALENDAR DAYS FOR ALL PERIMETER SEDIMENT CONTROL STRUCTURES.

4. ALL SEDIMENT TRAPS/BASING SHOWN MUST BE FENCED AND WARNING

SIGNS POSTED AROUND THEIR PERIMETER IN ACCORDANCE WITH VOL. I,

CHAPTER 12, OF THE HOWARD COUNTY DESIGN MANUAL, STORM DRAINAGE.

5. ALL DISTURBED AREAS MUST BE STABILIZED WITHIN THE TIME PERIOD

SPECIFIED ABOVE IN ACCORDANCE WITH THE 1994 MARYLAND STANDARDS AND SPECIFICATIONS FOR SOIL EROSION AND SEDIMENT CONTROL FOR

PERMANENT SEEDINGS, SOD, TEMPORARY SEEDINGS AND MULCHING (SEC. G)

TEMPORARY STABILIZATION, WITH MULCH ALONE, CAN ONLY BE DONE WHEN

RECOMMENDED SEEDING DATES DO NOT ALLOW FOR PROPER GERMINATION

6. ALL SEDIMENT CONTROL STRUCTURES ARE TO REMAIN IN PLACE AND

8. ANY SEDIMENT CONTROL PRACTICE WHICH IS DISTURBED BY GRADING

ACTIVITY FOR PLACEMENT OF UTILITIES MUST BE REPAIRED ON THE SAME

NECESSARY BY THE HOWARD COUNTY DPW SEDIMENT CONTROL INSPECTOR.

CONTROLS, BUT BEFORE PROCEEDING WITH ANY OTHER EARTH DISTURBANCE

OR GRADING. OTHER BUILDING OR GRADING INSPECTION APPROVALS MAY

4. ADDITIONAL SEDIMENT CONTROL MUST BE PROVIDED, IF DEEMED

IO. ON ALL SITES WITH DISTURBED AREAS IN EXCESS OF 2 ACRES. APPROVAL OF THE INSPECTION AGENCY SHALL BE REQUESTED UPON

COMPLETION OF INSTALLATION OF PERIMETER EROSION AND SEDIMENT

NOT BE AUTHORIZED UNTIL THIS INITIAL APPROVAL BY THE INSPECTION

II. TRENCHES FOR THE CONSTRUCTION OF UTILITIES IS LIMITED TO 3 PIPE

LENGTHS OR THAT WHICH SHALL BE BACKFILLED AND STABILIZED WITHIN I

I, APPLY FOR A GRADING PERMIT AND ARRANGE FOR THE PRE-CONSTRUCTION

SDP-08-056 AND THE ROAD CONSTRUCTION PLANS F-08-54 \$ 55.

RUN FROM THOSE BASIN TO PARCELS B6 - BII ARE OPERATIONAL.

6. INSTALL CURB/GUTTER AND BASE PAVING. DURATION: 2-3 DAYS.

MEETING WITH THE SEDIMENT CONTROL INSPECTOR. OBTAIN THE GRADING PERMIT

THE WORK ON THIS SOP SHALL BE CONCURRENT WITH THE GRADING WORK UNDER

3. MAKE SURE THE SEDIMENT CONTROL BASINS PER F-08-54 \$ 55 AND THE STORM

4. SINCE THE GRADING WORK UNDER THIS 5DP IS CONCURRENT WITH 5DP-08-056 AND

OF THE SEDIMENT CONTROL INSPECTION. DURATION: I DAY IF APPLICABLE

CONSTRUCT THE BANK BUILDING AND INSTALL UTILITIES (STORM DRAIN, WHC, SHC,

GAS, ELECTRIC, ETC.). DURATION: 6 MONTHS BUILDING CONSTRUCTION AND 2-3

5. OBTAIN PERMISSION FROM THE INSPECTOR TO GRADE THE SITE IN ORDER TO

7. INSTALL LANDSCAPING, SURFACE PAVING COURSE, SIDEWALK AND STRIPE THE

9. COMPLETE BUILDING INTERIOR WORK AND OBTAIN USE & OCCUPANCY PERMIT

8. FLUSH AND PUMP CLEAN ALL STORM DRAIN SYSTEM ONCE THE LOD AREA FOR THIS

F-08-54 \$ 55, THE INSTALLATION OF THE SCE \$ SILT FENCE IS AT THE DISCRETION

F-08-54, F-08-55 AND SDP-08-056. COORDINATE THIS SDP WORK WITH THOSE OF

0.83± ACRES

0.47± ACRES

0.40± ACRES

0.011 ACRES

190± CU. YDS.

190± CU. YDS.

ARE TO BE MAINTAINED IN OPERATIVE CONDITION UNTIL PERMISSION

FOR THEIR REMOVAL HAS BEEN OBTAINED FROM THE HOWARD COUNTY

CONSTRUCTION (410) 313-1855

AND ESTABLISHMENT OF GRASSES.

SEDIMENT CONTROL INSPECTOR.

AREA TO BE ROOFED OR PAVED

AREA TO BE VEGETATIVELY STABILIZED

WORKING DAY, WHICHEVER IS SHORTER.

SEQUENCE OF CONSTRUCTION

AT THE MEETING (I DAY).

DAYS UTILITY INSTALLATION.

PARKING SPACES, DURATION: 3-4 DAYS.

SDP IS STABILIZED. DURATION: I DAY.

OFF-SITE WASTE/BORROW AREA LOCATION :

TOTAL AREA OF SITE

AREA DISTURBED

TOTAL FILL

PREPARED FOR: MAPLE LAWN FARMS, LLC. SUITE 300 WOODHOLME CENTER 1829 REISTERSTOWN RD BALTIMORE, MD 21208 ATTN: CHARLIE O'DONOVAN

410-484-8400

Professional Certification - Enoraby coming that these


of the State of Maryland.


License No. 37729

documents were prepared or approved by me, and that I

am a duly licensed professional engineer under the laws

PROFESSIONAL CERTIFICATION HEREBY CERTIFY THAT THESE PLANS WERE PREPARED OR APPROVED BY ME, AND THAT I AM A DULY LICENSED PROFESSIONAL ENGINEER UNDER THE LAWS OF THE STATE OF MARYLAND, LICENSE NO. 12975

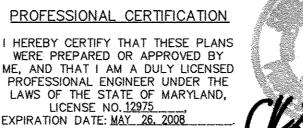

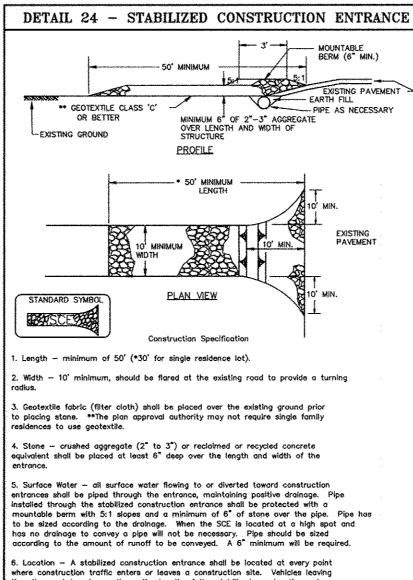

the site must travel over the entire length of the stabilized construction entrance F - 17 - 3 WATER MANAGEMENT ADMINISTRATION SOIL CONSERVATION SERVICE DETAIL 22 - SILT FENCE — 36" MINIMUM LENGTH FENCE POST, DRIVEN A MINIMUM OF 16" INTO GROUND 36" MINIMUM FENCE -POST LENGTH PERSPECTIVE VIEW

MINIMUM 20" ABOVE GROUND EMBED GEOTEXTILE CLASS F A MINIMUM OF 8" VERTICALLY FENCE POST DRIVEN A MINIMUM OF 16" INTO CROSS SECTION STANDARD SYMBOL

\_\_\_\_SF \_\_\_\_

JOINING TWO ADJACENT SILT FENCE SECTIONS

. Fence posts shall be a minimum of 36" long driven 16" minimum into the ground. Wood posts shall be  $1\ 1/2^* \times 1\ 1/2^*$  square (minimum) cut, or  $1\ 3/4^*$  diameter (minimum) round and shall be of sound quality hardwood. Steel posts will be standard T or U section weighting not less than 1.00 pand per linear foot.

2. Geotextile shall be fastened securely to each fence post with wire ties or staples at top and mid-section and shall meet the following requirements 50 lbs/in (min.) Tensile Modulus 20 lbs/in (min.) Test: MSMT 509

0.3 gal ft / minute (max.) Test: MSMT 32 Filtering Efficiency 75% (min.) 3. Where ends of geotextile fabric come together, they shall be overlapped.

4. Silt Fence shall be inspected after each rainfall event and maintained when

### DUST CONTROL

### <u>Definition</u> Controlling dust blowing and movement on construction sites and roads.

To prevent blowing and movement of dust from exposes soil surfaces, reduce on and off-site

damage, health hazards, and improve traffic safety. Conditions Where Practice Applies

This practice is applicable to areas subject to dust blowing and movements where on and off-site damage is likely without treatment.

### Temporary Methods

- Mulches See standards for vegetative stabilization with mulches only. Mulch should be crimped or tacked to prevent blowing.
- Vegetative Cover See standards for temporary vegetative cover.
- Tillage To roughen surface and bring clods to the surface. This is an emergency measure which should be used before soil blowing starts. Begin plowing on windward side of site. Chisel-type plaws spaces about 12" apart, spring-toothed harrows, and similar plows are examples of equipment which may produce the
- Irrigation This is generally done as an emergency treatment. Site is sprinkled with water until the surface is moist. Repeat as needed. At no time should the site be irrigated to the point that runoff begins to flow.
- Barriers Solid board fences, silt fences, burlap fences, straw bales, and similar material can be used to control air currents and soil blowing. Barriers placed at right angles to prevailing currents at intervals of about 10 times their height are effective in controlling soil blowing.
- 6. Calcium Chloride Apply at rates that will keep surface moist. May need retreatment.
- 1. Permanent Vegetation See standards for permanent vegetative cover, and permanent stabilization with sod. Existing trees or large shrubs may afford valuable protection if left in place.
- Topsoiling Covering with less erosive soil materials. See standards for topsoiling. 3. Stone - Cover surface with crushed stone or coarse gravel.

1. Agriculture Handbook 346, Wind Erosion Forces in the United States and Their Use

2. Agriculture Information Bulletin 354. How to Control Wind Erosion, USDA\_ARS.

PAD AREA FOR -FUTURE BUILDING PAD FOR FUTURE DUMPSTER (per SDP-08-56) Proposed Bank of America (Parcel B-11) FFE = 457.50 4,454 s.f. 1-Story EX. 18"HDPE K PER F-08-54 \ EX. 16°W. (cont. #44-3505) EQUIPMENT CABINET AT MD RTE. 216 (SCAGGSVILLE RD) PUBLIC MINOR ARTERIAL (R/W VARIES, PAVING VARIES)

20' PUBLIC SEWER & UTILITY ESMT.

(P.N. 19902/03) /

### LEGEND PROPOSED SPOT ELEVATION EXISTING CONTOUR PROPOSED CONTOUR THIS PHASE PROPOSED SILT FENCE

LIMIT OF DISTURBANCE

STABILIZED CONSTRUCTION

- TEMPORARY SWM IS PROVIDED BY THE EXISTING BASIN/SWM FACILITY CONSTRUCTED UNDER F-03-07 AND F-08-54 & 55.
- 2. COORDINATE THE CONSTRUCTION WORK ON THIS PLAN SET WITH F-08-54 & 55.

SDP-08-058


*⋣⋜⋸⋪⋸*⋷⋸⋸⋒⋶⋜⋜⋐

CONTR. #24-4

3. GRADING BEYOND THE L.O.D. IS BY SDP-08-056.

## THIS PLAN IS FOR SEDIMENT CONTROL PURPOSES ONLY

SEDIMENT CONTROL PLAN and NOTES & DETAILS ZONING G. L. W. FILE No. 1" = 30'07070 MXD-3MAPLE LAWN FARMS **WESTSIDE DISTRICT - AREA 1** SHEET TAX MAP — GRID PARCEL B-11 (Bank) 41-21&22 4 OF 5 PLAT No. 19902/03, TAX MAP PARCEL No. 116 HOWARD COUNTY, MARYLAND

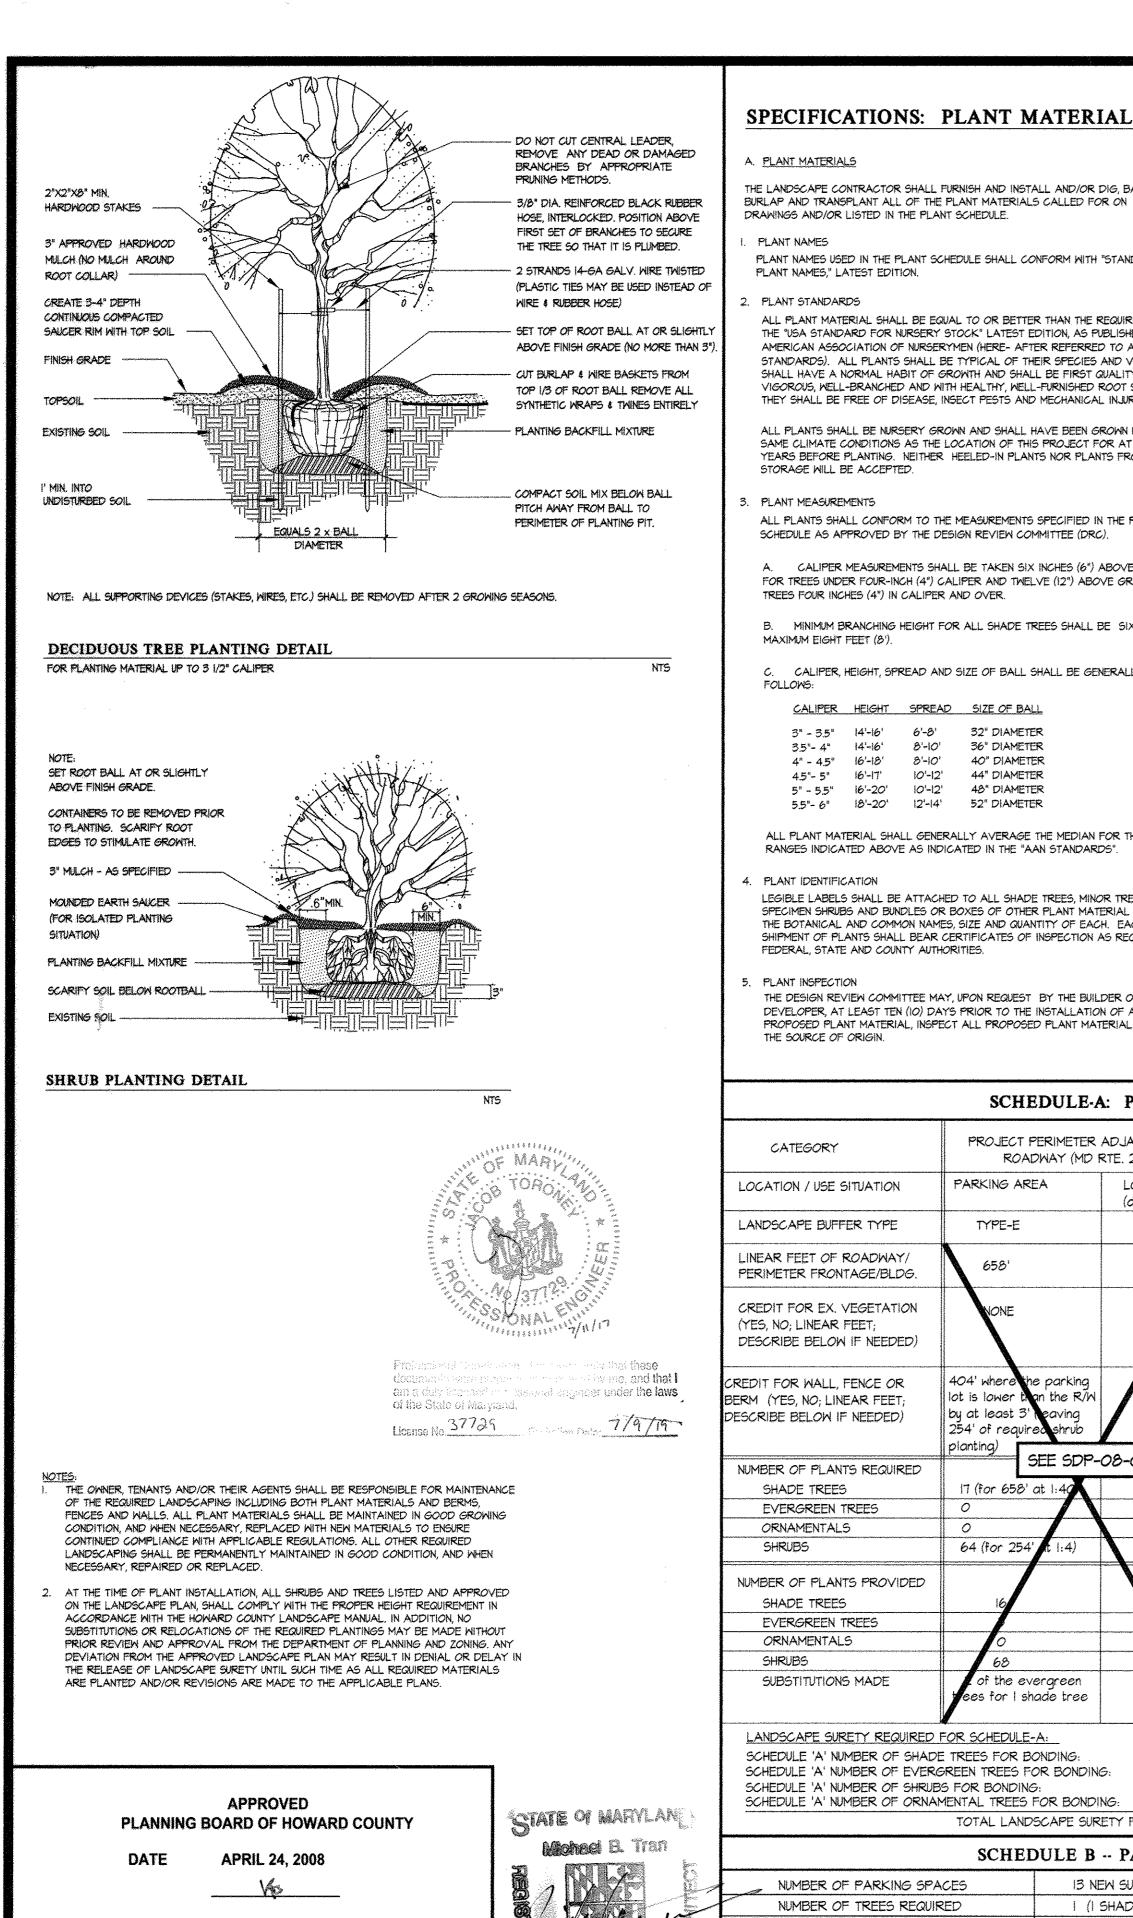

LOCATION / USE SITUATION LANDSCAPE BUFFER TYPE LINEAR FEET OF ROADWAY PERIMETER FRONTAGE/BLDG. CREDIT FOR EX. VEGETATION (YES, NO; LINEAR FEET; DESCRIBE BELOW IF NEEDED) REDIT FOR WALL, FENCE OR BERM (YES, NO; LINEAR FEET; DESCRIBE BELOW IF NEEDED) NUMBER OF PLANTS REQUIRED SHADE TREES EVERGREEN TREES **ORNAMENTALS** NUMBER OF PLANTS PROVIDED SHADE TREES

### SPECIFICATIONS: PLANT MATERIALS AND PLANTING METHODS

A. PLANT MATERIALS

THE LANDSCAPE CONTRACTOR SHALL FURNISH AND INSTALL AND/OR DIG, BALL, BURLAP AND TRANSPLANT ALL OF THE PLANT MATERIALS CALLED FOR ON DRAWINGS AND/OR LISTED IN THE PLANT SCHEDULE.

PLANT NAMES USED IN THE PLANT SCHEDULE SHALL CONFORM WITH "STANDARDIZED PLANT NAMES," LATEST EDITION,

, PLANT STANDARDS

ALL PLANT MATERIAL SHALL BE EQUAL TO OR BETTER THAN THE REQUIREMENTS OF THE "USA STANDARD FOR NURSERY STOCK" LATEST EDITION, AS PUBLISHED BY THE AMERICAN ASSOCIATION OF NURSERYMEN (HERE- AFTER REFERRED TO AS AAN STANDARDS). ALL PLANTS SHALL BE TYPICAL OF THEIR SPECIES AND VARIETY, SHALL HAVE A NORMAL HABIT OF GROWTH AND SHALL BE FIRST QUALITY, SOUND. VIGOROUS, WELL-BRANCHED AND WITH HEALTHY, WELL-FURNISHED ROOT SYSTEMS. THEY SHALL BE FREE OF DISEASE, INSECT PESTS AND MECHANICAL INJURIES.

ALL PLANTS SHALL BE NURSERY GROWN AND SHALL HAVE BEEN GROWN UNDER THE SAME CLIMATE CONDITIONS AS THE LOCATION OF THIS PROJECT FOR AT LEAST TWO YEARS BEFORE PLANTING. NEITHER HEELED-IN PLANTS NOR PLANTS FROM COLD STORAGE WILL BE ACCEPTED.

. PLANT MEASUREMENTS

ALL PLANTS SHALL CONFORM TO THE MEASUREMENTS SPECIFIED IN THE PLANT SCHEDULE AS APPROVED BY THE DESIGN REVIEW COMMITTEE (DRC).

A. CALIPER MEASUREMENTS SHALL BE TAKEN SIX INCHES (6") ABOVE GRADE FOR TREES UNDER FOUR-INCH (4") CALIPER AND TWELVE (12") ABOVE GRADE FOR TREES FOUR INCHES (4") IN CALIPER AND OVER.

B. MINIMUM BRANCHING HEIGHT FOR ALL SHADE TREES SHALL BE SIX FEET (6'),

CALIPER, HEIGHT, SPREAD AND SIZE OF BALL SHALL BE GENERALLY AS

1 0 L	LUMU:			
	CALIPER	HEIGHT	SPREAD	SIZE OF BALL
	3" - 3.5"	14'-16'	6'-8'	32" DIAMETER
	35"- 4"	4'-16'	8'-10'	36" DIAMETER
	4" - 4.5"	16'-18'	8'-10'	40" DIAMETER
	4.5"- 5"	16'-17'	10'-12'	44" DIAMETER
	5" - 55"	16'-20'	10'-12'	48" DIAMETER
	5.5"- 6"	18'-20'	12'-14'	52" DIAMETER

ALL PLANT MATERIAL SHALL GENERALLY AVERAGE THE MEDIAN FOR THE SIZE RANGES INDICATED ABOVE AS INDICATED IN THE "AAN STANDARDS".

4. PLANT IDENTIFICATION

LEGIBLE LABELS SHALL BE ATTACHED TO ALL SHADE TREES, MINOR TREES, SPECIMEN SHRUBS AND BUNDLES OR BOXES OF OTHER PLANT MATERIAL GIVING THE BOTANICAL AND COMMON NAMES, SIZE AND QUANTITY OF EACH. EACH SHIPMENT OF PLANTS SHALL BEAR CERTIFICATES OF INSPECTION AS REQUIRED BY FEDERAL, STATE AND COUNTY AUTHORITIES.

THE DESIGN REVIEW COMMITTEE MAY, UPON REQUEST BY THE BUILDER OR DEVELOPER, AT LEAST TEN (IO) DAYS PRIOR TO THE INSTALLATION OF ANY PROPOSED PLANT MATERIAL, INSPECT ALL PROPOSED PLANT MATERIAL AT THE SOURCE OF ORIGIN.

TYPE-E

404' where the parking

lot is lower than the R/W

254' of required shrul

17 (for 658' at 1:

of the evergreen

ees for I shade tree

by at least 3'

64 (for 254

plantina)

B. PLANTING METHODS

ALL PROPOSED PLANT MATERIALS THAT MEET THE SPECIFICATIONS IN SECTION A ARE TO BE PLANTED IN ACCORDANCE WITH THE FOLLOWING METHODS DURING THE PROPER PLANTING SEASONS AS DESCRIBED IN THE FOLLOWING:

I. PLANTING SEASONS

THE PLANTING OF DECIDUOUS TREES, SHRUBS AND VINES SHALL BE FROM MARCH IST TO JUNE 15TH AND FROM SEPTEMBER 15TH TO DECEMBER 15TH, PLANTING OF DECIDUOUS MATERIAL MAY BE CONTINUED DURING THE WINTER MONTHS PROVIDING THERE IS NO FROST IN THE GROUND AND FROST-FREE TOPSOIL PLANTING MIXTURES ARE USED.

THE PLANTING OF EVERGREEN MATERIAL SHALL BE FROM MARCH 15TH TO JUNE 15TH AND FROM AUGUST 15TH TO DECEMBER 1ST. NO PLANTING SHALL BE DONE WHEN THE GROUND IS FROZEN OR EXCESSIVELY MOIST. NO FROZEN OR WET TOPSOIL SHALL BE USED AT ANY TIME.

ALL PLANT MATERIAL SHALL BE DUG, BALLED AND BURLAPPED (B&B) IN ACCORDANCE WITH THE "AAN STANDARDS".

3. EXCAVATION OF PLANT PITS

THE LANDSCAPING CONTRACTOR SHALL EXCAVATE ALL PLANT PITS, VINE PITS, HEDGE TRENCHES AND SHRUB BEDS IN ACCORDANCE WITH THE FOLLOWING SCHEDULE:

A. LOCATIONS OF ALL PROPOSED PLANT MATERIAL SHALL BE STAKED AND APPROVED IN THE FIELD BY THE LANDSCAPE ARCHITECT BEFORE ANY OF THE PROPOSED PLANT MATERIAL IS INSTALLED BY THE LANDSCAPE CONTRACTOR.

ALL PITS SHALL BE GENERALLY CIRCULAR IN OUTLINE, VERTICAL SIDES; DEPTH SHALL NOT BE LESS THAN 6" DEEPER THAN THE ROOT BALL, DIAMETER SHALL NOT BE LESS THAN TWO TIMES THE DIAMETER OF THE ROOT BALL AS SET FORTH IN THE FOLLOWING SCHEDULE.

IF AREAS ARE DESIGNATED AS SHRUB BEDS OR HEDGE TRENCHES, THEY SHALL BE EXCAVATED TO AT LEAST 18" DEPTH MINIMUM. AREAS DESIGNATED FOR GROUND COVERS AND VINES SHALL BE EXCAVATED TO AT LEAST 12" IN DEPTH MINIMUM.

D. DIAMETER AND DEPTH OF TREE PITS SHALL GENERALLY BE AS FOLLOWS:

PLANT SIZE	ROOT BALL	PIT DIA.	PIT DEPTH
3" - 3.5"CAL.	32"	64"	28"
35"- 4" CAL.	36"	72"	32"
4" - 4.5"CAL.	40"	80"	36"
4.5"- 5" CAL.	44 <sup>#</sup>	88"	40"
5" - 5.5"CAL.	48 <sup>∉</sup>	96"	44*
55"-6" CAL.	52"	104"	48"

A 20 % COMPACTION FIGURE OF THE SOIL TO BE REMOVED IS ASSUMED AND WILL BE ALLOWED IN CALCULATION OF EXTRA TOPSOIL. THE TABULATED PIT SIZES ARE FOR PURPOSES OF UNIFORM CALCULATION AND SHALL NOT OVERRIDE THE SPECIFIED DEPTHS BELOW THE BOTTOMS OF THE ROOT BALLS.

4. STAKING, GUYING AND WRAPPING

BUILDING LENGTH (REAR & SIDES)

I SHRUB PER 4 LF OF BLDG LENGTH /

200 LF (74' rear + 2 x 63' sides)

SIDES & REAR OF STORE BLDG

NONE

N/A

N/A

50

N/A

0.00

0.00

0 x \$ 300 =

0 x \$ 150 =

13 NEW SURFACE PARKING SPACES.

I (I SHADE TREE PER 20 PARKING SPACES)

TOTAL LANDSCAPE SURETY FOR SCHEDULE-A \$1,500.00

OVER

THE SURETY FOR THE REQUIRED PLANTING PER SCHEDULE-B IS: I tree x \$300/tree = \$300.00

(ALL LANDSCAPE PLANTING ABOVE THE MINIMUM IS VOLUNTARY AND NOT MANDATORY)

50 x \$ 30 = 1,500.00

0 x \$ 150 = 0.00

SCHEDULE B -- PARKING LOT INTERNAL LANDSCAPING

SCHEDULE-A: PERIMETER LANDSCAPE EDGE

(dumpster)

TYPE-D

PROJECT PERIMETER ADJACENT TO

ROADWAY (MD RTE. 216)

SEE SDP-08-056

ALL PLANT MATERIAL SHALL BE STAKED OR GUYED, AND WRAPPED IN ACCORDANCE WITH THE FOLLOWING SPECIFICATIONS:

A. STAKES: SHALL BE SOUND WOOD 2" X 2" ROUGH SAWN OAK OR SIMILAR DURABLE WOODS, OR LENGTHS, MINIMUM 1'-O" FOR MAJOR TREES AND 5'-O" MINIMUM FOR MINOR TREES.

PLANTING PER THE MLF

LANDSCAPE DESIGN

CRITERIA (PART-F)

B. WIRE AND CABLE: WIRE SHALL BE #10 GA. GALVANIZED OR BETHANIZED ANNEALED STEEL WIRE. FOR TREES OVER 3" CALIPER, PROVIDE 5/16" TURN BUCKLES, EYE AND EYE WITH 4" TAKE-UP. FOR TREES OVER 5" CALIPER, PROVIDE 3/16", 7 STRAND CABLE CADMIUM PLATED STEEL, WITH GALVANIZED "EYE" THIMBLES OF WIRE AND HOSE ON TREES UP TO 3" IN CALIPER.

C. HOSE: SHALL BE NEW, 2 PLY REINFORCED RUBBER HOSE, MINIMUM 1/2" I.D. "PLASTIC LOCK TIES" OR "PAUL'S TREES BRACES" MAY BE USED IN PLACE OF WIRE AND HOSE ON TREES UP TO 3" IN CALIPER.

D. ALL TREES UNDER 3" IN CALIPER ARE TO BE PLANTED AND STAKED IN ACCORDANCE WITH THE ATTACHED PLANTING DETAILS.

5. PLANT PRUNING, EDGING AND MULCHING

A. EACH TREE, SHRUB OR VINE SHALL BE PRUNED IN AN APPROPRIATE MANNER TO ITS PARTICULAR REQUIREMENTS, IN ACCORDANCE WITH ACCEPTED STANDARD PRACTICE. BROKEN OR BRUISED BRANCHES SHALL BE REMOVED WITH CLEAN CUTS FLUSH WITH THE ADJACENT TRUNK OR BRANCHES. ALL CUTS OVER I" IN DIAMETER SHALL BE PAINTED WITH AN APPROVED ANTISEPTIC TREE WOUND DRESSING.

B. ALL TRENCHES AND SHRUB BEDS SHALL BE EDGED AND CULTIVATED TO THE LINES SHOWN ON THE DRAWING. THE AREAS AROUND ISOLATED PLANTS SHALL BE EDGED AND CULTIVATED TO THE FULL DIAMETER OF THE PIT. SOD WHICH HAS BEEN REMOVED AND STACKED SHALL BE USED TO TRIM THE EDGES OF ALL EXCAVATED AREAS TO THE NEAT LINES OF THE PLANT PIT SAUCERS, THE EDGES OF SHRUB AREAS, HEDGE TRENCHES AND VINE POCKETS.

C. AFTER CULTIVATION, ALL PLANT MATERIALS SHALL BE MULCHED WITH A 3" LAYER OF FINE, SHREDDED PINE BARK, PEAT MOSS, OR ANOTHER APPROVED MATERIAL OVER THE ENTIRE AREA OF THE BED OR SAUCER.

6. PLANT INSPECTION AND ACCEPTANCE

THE DESIGN REVIEW COMMITTEE SHALL BE RESPONSIBLE FOR INSPECTING ALL PLANTING PROJECTS ON A PERIODIC BASIS TO ASSURE THAT ALL WORK IS PROCEEDING IN ACCORDANCE WITH THE APPROVED PLANS AND SPECIFICATIONS.

ALL PLANT MATERIAL SHALL BE GUARANTEED FOR THE DURATION OF ONE FULL GROWING SEASON, AFTER FINAL INSPECTION AND ACCEPTANCE OF THE WORK IN THE PLANTING PROJECT. PLANTS SHALL BE ALIVE AND IN SATISFACTORY

GROWING CONDITION AT THE END OF THE GUARANTEE PERIOD.

A. FOR THIS PURPOSE, THE "GROWING SEASON" SHALL BE THAT PERIOD BETWEEN THE END OF THE "SPRING" PLANTING SEASON, AND THE COMMENCEMENT OF THE "FALL" PLANTING SEASON.

B. GUARANTEE FOR PLANTING PERFORMED AFTER THE SPECIFIED END OF THE "SPRING" PLANTING SEASON, SHALL BE EXTENDED THROUGH THE END OF THE NEXT FOLLOWING "SPRING" PLANTING SEASON.

ALL SODDING SHALL BE IN ACCORDANCE TO THE "LANDSCAPE SPECIFICATION GUIDELINES FOR BALTIMORE-WASHINGTON METROPOLITAN AREAS" LATEST EDITION, APPROVED BY THE LANDSCAPE CONTRACTORS ASSOCIATION OF METROPOLITAN WASHINGTON AND THE AMERICAN SOCIETY OF LANDSCAPE ARCHITECTS.

ALL SOD SHALL BE STRONGLY ROOTED SOD, NOT LESS THAN TWO YEARS OLD AND FREE OF WEEDS AND UNDESIRABLE NATIVE GRASSES. PROVIDE ONLY SOD CAPABLE OF GROWTH DEVELOPMENT WHEN PLANTED AND IN STRIPS NOT MORE THAN 18" WIDE X 4" LONG. PROVIDE SOD COMPOSED PRINCIPALLY OF IMPROVED STRAIN KENTUCKY BLUEGRASS, SUCH AS, COLUMBIA, VICTA, OR ESCORT.

### LANDSCAPE NOTES THIS PLAN HAS BEEN PREPARED IN ACCORDANCE WITH SECTION 16.124 OF THE HOWARD COUNTY CODE & CHAPTER VI OF THE HOWARD COUNTY LANDSCAPE MANUAL (ALTERNATIVE COMPLIANCE) PLUS THE LANDSCAPE DESIGN CRITERIA OF 5-06-16 AND CONTRACTOR SHALL NOTIFY ALL UTILITIES AT LEAST (5) FIVE DAYS BEFORE STARTING WORK. ALL GENERAL NOTES, ESPECIALLY THOSE REGARDING UTILITIES, ON

SHEET NO.1 SHALL APPLY. 3. FIELD VERIFY UNDERGROUND UTILITY LOCATIONS AND EXISTING CONDITIONS BEFORE STARTING PLANTING WORK. CONTACT CONSTRUCTION MANAGER OR OWNER IF ANY RELOCATIONS ARE REQUIRED.

4. PLANT QUANTITIES SHOWN ON THE PLANT LIST ARE PROVIDED FOR THE CONVENIENCE OF THE CONTRACTOR ONLY. IF DISCREPANCIES EXIST BETWEEN QUANTITIES SHOWN ON THE PLAN AND THOSE SHOWN ON THE PLANT LIST, THE QUANTITIES ON THE PLAN SHALL TAKE PRECEDENCE.

5. ALL PLANT MATERIAL SHALL BE FULL, HEAVY, WELL FORMED, SYMMETRICAL, AND CONFORM TO THE A.A.N. SPECIFICATIONS. ALL PLANT MATERIAL SHALL BE INSTALLED IN ACCORDANCE WITH THE PROJECT SPECIFICATIONS AND THIS PLAN.

COUNTY DPZ AND THE OWNER OR HIS REPRESENTATIVE. ALL AREAS DISTURBED BY CONSTRUCTION ACTIVITIES BUT NOT OTHERWISE PLANTED, PAVED, OR MULCHED SHALL BE SODDED OR SEEDED IN ACCORDANCE WITH THE PERMANENT SEEDING SPECIFICATION. A MINIMUM OF 4" OF TOPSOIL SHALL BE

6. NO SUBSTITUTION SHALL BE MADE WITHOUT PRIOR APPROVAL FROM HOWARD

PROVIDED TO ALL PLANTING AREAS (FOR TOPSOIL SPEC. SEE SHEET 5). THE CONTRACTOR SHALL NOTIFY THE OWNER IN WRITING IF HE/SHE ENCOUNTERS SOIL DRAINAGE CONDITIONS THAT MAY BE DETRIMENTAL TO THE GROWTH OF THE

9. ALL EXPOSED EARTH WITHIN THE LIMITS OF PLANTING BEDS SHALL BE MULCHED WITH SHREDDED HARDWOOD MULCH PER THE PLANTING DETAILS.

IO. DO NOT PLANT WITHIN THE PUBLIC WATER, SEWER AND UTILITY EASEMENT.

SCHEDULES "A" AND "B" ARE PROVIDED FOR LANDSCAPE SURETY CALCULATION PURPOSES. FINANCIAL SURETY FOR THE REQUIRED LANDSCAPING SHALL BE POSTED WITH THE GRADING PERMIT FOR BUILDING CONSTRUCTION IN THE AMOUNT OF \$ 1,800.00 FOR THE FOLLOWING REQUIRED PLANT QUANTITIES:


> 50 SHRUBS AT \$30/SHRUB = \$1,500.00 O EVERGREEN TREES AT \$150/TREE = N/A

FOR LANDSCAPE INSPECTION TO OBTAIN THE RELEASE OF THE SURETY, CONTACT HOWARD COUNTY DEPT. OF PLANNING & ZONING AT 410-313-2350.

### DEVELOPER'S/BULDER'S CERTIFICATE

I/WE CERTIFY THAT THE LANDSCAPING SHOWN ON THIS PLAN WILL BE DONE ACCORDING TO THE PLAN, SECTION 16.124 OF THE HOWARD COUNTY CODE AND THE HOWARD COUNTY LANDSCAPE MANUAL AND THE MLF LANDSCAPE DESIGN CRITERIA. I/WE FURTHER CERTIFY THAT UPON COMPLETION A LETTER OF LANDSCAPE INSTALLATION, ACCOMPANIED BY AN EXECUTED ONE YEAR GUARANTEE OF PLANT MATERIALS, WILL BE SUBMITTED TO THE DEPARTMENT OF PLANNING AND ZONING.



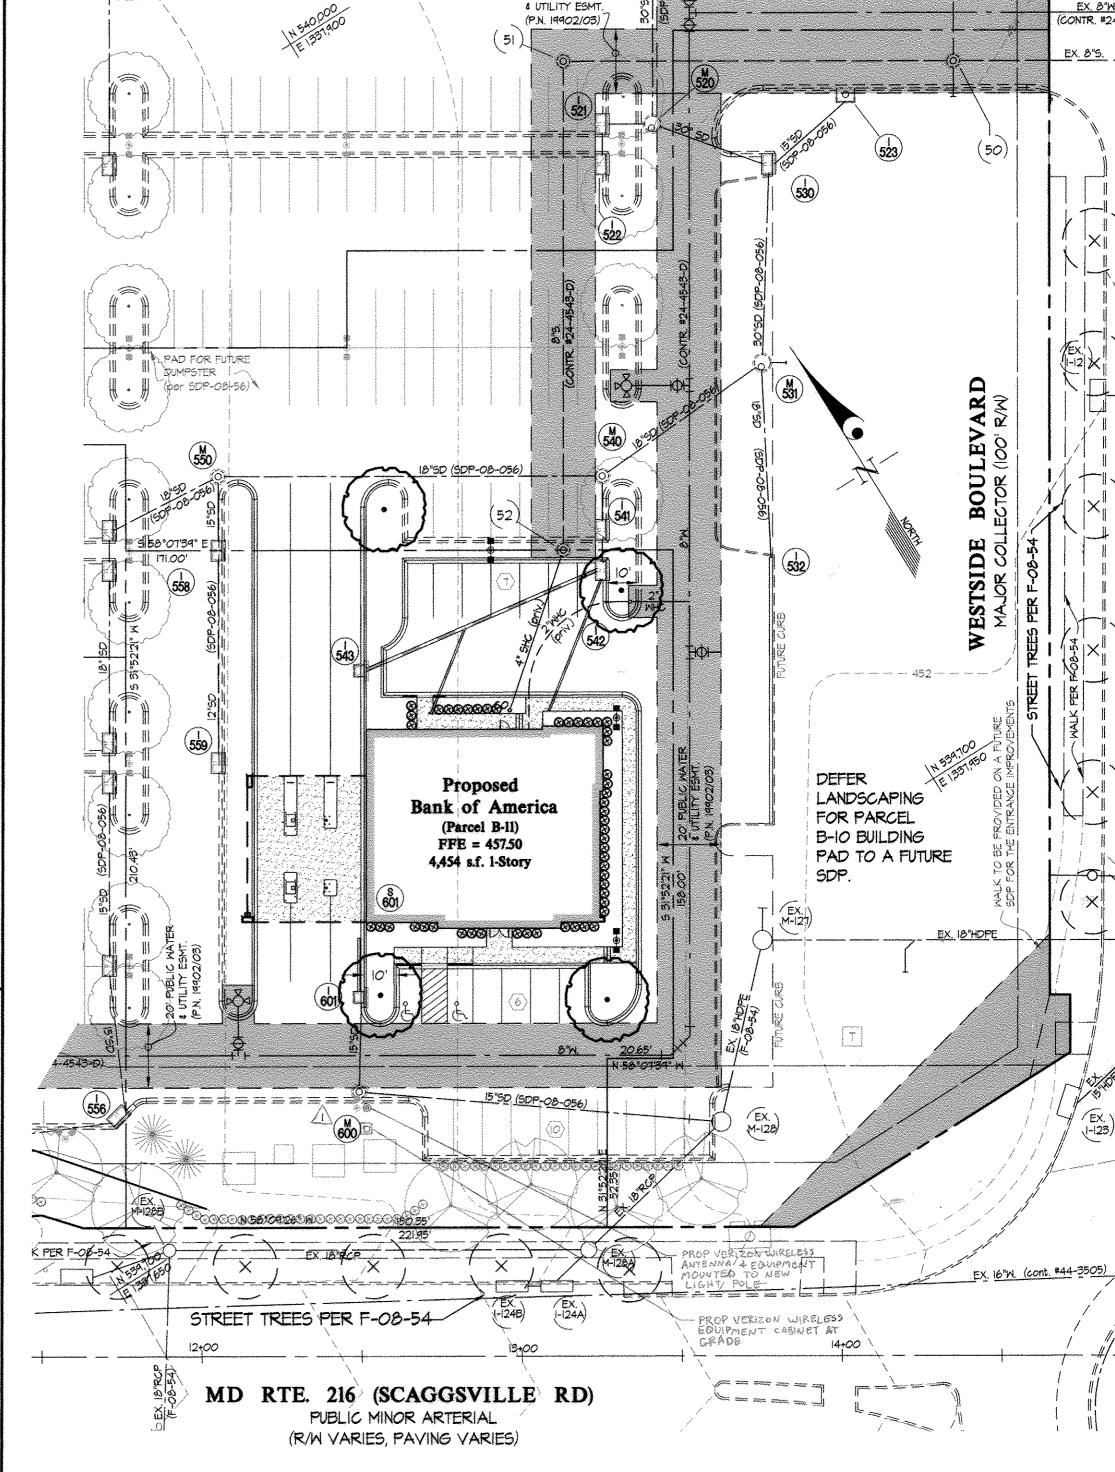

	PLANTING LEGEND				
SYMBOL	QUANT.	SIZE	NAME (BOTANICAL/COMMON) OF PLANTS FOR SELECTION BY OWNER/BUYER	COMMENTS	SHRUB
SHADE TREE  SHRUB	4	25" - 3" CAL.	CHOOSE FROM THE FOLLOWING: ACER RUBRUM 'OCTOBER GLORY' / OCTOBER GLORY RED MAPLE QUERCUS PALUSTRIS / PIN OAK ZELKOVA SERRATA 'VILLAGE GREEN' / VILLAGE GREEN ZELKOVA	ALL B4B	CANOPY SHADE TR
⊗	50	ALL 24" - 30" SPREAD	CHOOSE FROM THE FOLLOWING FOR BUILDING FOUNDATION PLANTING: AZALEA VAR.: 'GIMPO PINK', 'GUMPO WHITE', 'KAEMPO' COTONEASTER DAMMERII 'CORAL BEAUTY' CORAL BEAUTY COTONEASTER COTONEASTER HORIZONTALIS 'TOM THUMB' / TOM THUMB COTONEASTER JUNIPERUS HORIZONTALIS VAR. / JUNIPER VAR.: 'BAR HARBOR', 'ANDORRA', 'WILTONI BLUE RUG' JUNIPERUS PROCUMBENS 'NANA' / DWARF JAPANESE GARDEN JUNIPER	ALL CONTAINERIZED.	TREES & SHRUBS PER SDP-08-056

THIS PLAN IS FOR PLANTING PURPOSES ONLY

ANDSCAPE PLAN and NOTES & DETAILS		SCALE	ZONING	G. L. W. FILE N
MAPLE LAWN FARMS		1" = 30'	MXD-3	07070
WESTSIDE DISTRICT - AREA 1 PARCEL B-11 (Bank)		DATE	TAX MAP - GRID	SHEET
PLAT No. 19902/03, TAX MAP PARCEL No. 116	HOWARD COUNTY, MARYLAND	OCT/2008	41-21&22 46-3	5 OF 5

GLWGUTSCHICK LITTLE &WEBER, P.A.

Will Market and the second second

Chief, Development Engineering Division

APPROVED: HOWARD COUNTY DEPARTMENT OF PLANNING & ZONIN

CIVIL ENGINEERS, LAND SURVEYORS, LAND PLANNERS, LANDSCAPE ARCHITECTS 3909 NATIONAL DRIVE - SUITE 250 - BURTONSVILLE OFFICE PARK BURTONSVILLE, MARYLAND 20866 TEL: 301-421-4024 BALT: 410-880-1820 DC/VA: 301-989-2524 FAX: 301-421-4186

\CADD\DRAWNGS\03067\07070\SDP\07070-LS.dwg | DES. MBT | DRN. KLP | CHK. CKG

30/17 A VERIZON WIRELESS EQUIPMENT & ANTENNAS APOED TO NEW LIGHT POLE REVISION BY APP'R.

NUMBER OF TREES PROVIDED

OTHER TREES (2:1 substitution)

SHADE TREES

PREPARED FOR: MAPLE LAWN FARMS, LLC. SUITE 300 WOODHOLME CENTER 1829 REISTERSTOWN RD BALTIMORE, MD 21208 ATTN: CHARLIE O'DONOVAN 410-484-8400

LECTION DISTRICT No. 5