

SHEET INDEX	
NO.	DESCRIPTION
1	COVER SHEET
2	SITE DEVELOPMENT PLAN - GRADING PLAN
3	SEDIMENT & EROSION CONTROL PLAN
4	SEDIMENT & EROSION CONTROL PLAN, NOTES AND DETAILS AND WHC PROFILE AND SHC PROFILE
5	SEDIMENT & EROSION CONTROL NOTES
6	STORM DRAINAGE AREA MAP, SOILS MAP AND SOING LOGS
7	STORM DRAIN PROFILES, NOTES AND DETAILS
8	STORM DRAIN PROFILES, NOTES AND DETAILS
9	WATER QUALITY FACILITY 1 AND #2 NOTES AND DETAILS
10	WATER QUALITY FACILITY 3 NOTES AND DETAILS
11	LANDSCAPE PLAN, NOTES AND DETAILS


# COLUMBIA JUNCTION

## SECTION 3 - LOT 'A'-2

### 6th ELECTION DISTRICT


### HOWARD COUNTY, MARYLAND

# REVISED SITE DEVELOPMENT PLAN

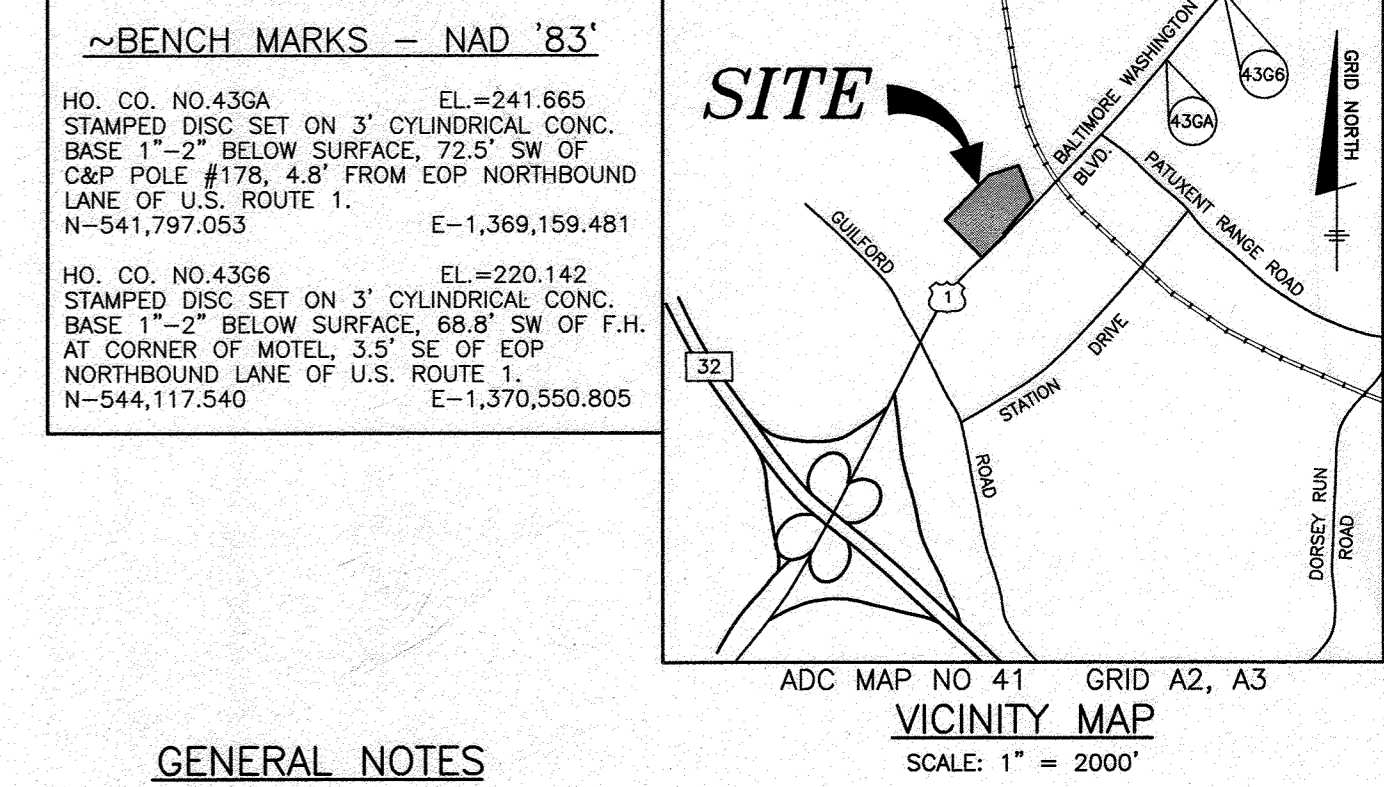


### LEGEND

SOILS CLASSIFICATION	ChB2	PROPOSED FIRE HYDRANT	
SOILS DELINEATION		PROPOSED FENCE	
EXISTING CONTOURS (AERIAL 12/02)		PROPOSED SIDEWALK	
PROPOSED CONTOURS	999	PROP. CROSS WALK	
EXISTING WOODS LINE		LOADING AREA	
PROPOSED WOODS LINE		NO PARKING AREA	
PROPOSED STRUCTURE		HANDICAP ACCESS	
STABILIZED CONSTRUCTION ENTRANCE		PUBLIC UTILITY EASEMENT	
LIMIT OF DISTURBANCE		RELOCATABLE PRIVATE ACCESS EASEMENT	
SILT FENCE DIVERSION	SFD		
SUPER SILT FENCE	SSF		
INLET PROTECTION			
PROP. PARKING LOT LIGHT			
PROP. SOIL BORING			

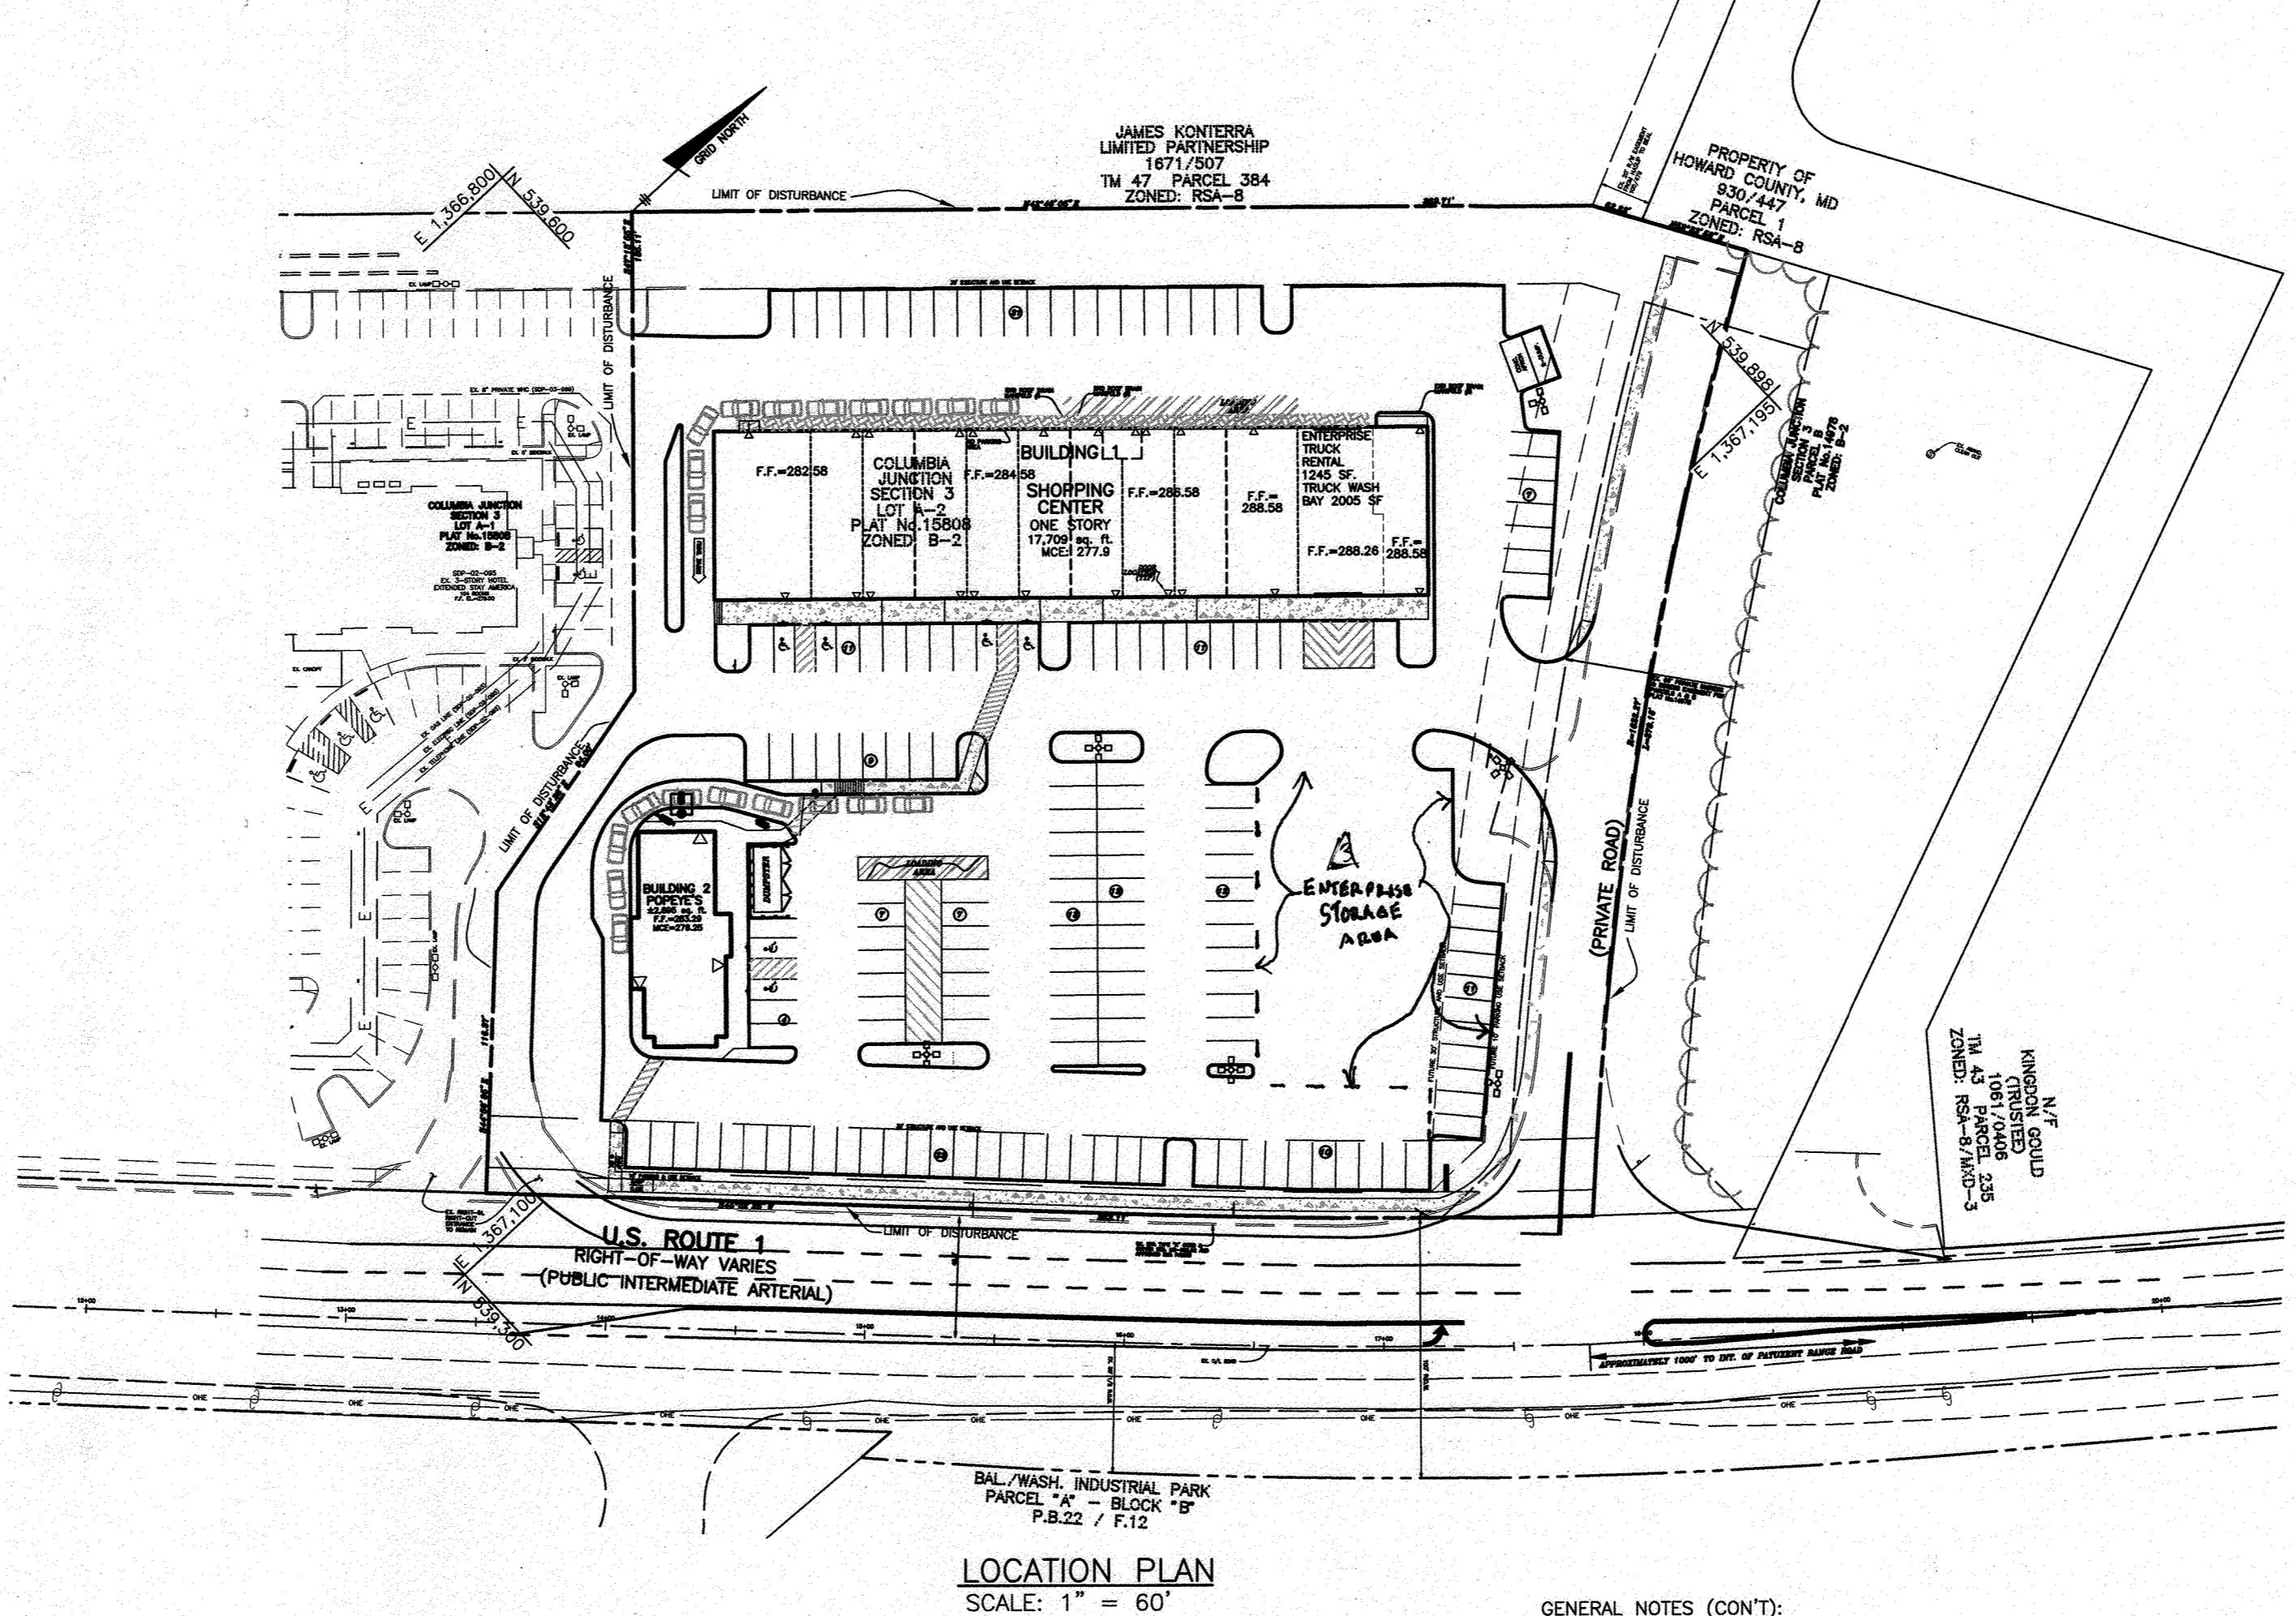


- ### GENERAL NOTES
- ALL CONSTRUCTION SHALL BE IN ACCORDANCE WITH THE LATEST STANDARDS AND SPECIFICATIONS OF HOWARD COUNTY, PLUS MSHA STANDARDS AND SPECIFICATIONS, IF APPLICABLE.
  - THE CONTRACTOR SHALL NOTIFY THE DEPARTMENT OF PUBLIC WORKS, CONSTRUCTION INSPECTION DIVISION AT 410-313-1880 AT LEAST FIVE(5) WORKING DAYS PRIOR TO THE START OF WORK.
  - THE CONTRACTOR SHALL NOTIFY "MISS UTILITY" AT 1-800-257-7777 AT LEAST 48 HOURS PRIOR TO ANY EXCAVATION WORK.
  - TRAFFIC CONTROL DEVICES, MARKINGS AND SIGNING SHALL BE IN ACCORDANCE WITH THE MOST CURRENT EDITION OF THE MANUAL ON UNIFORM TRAFFIC CONTROL DEVICES (MUTCD). ALL STREET AND REGULATORY SIGNS SHALL BE IN PLACE PRIOR TO THE PLACEMENT OF ANY ASPHALT.
  - ALL DIMENSIONS ARE TO THE FACE OF CURB UNLESS OTHERWISE NOTED.
  - THE CONTOURS SHOWN HEREON HAVE BEEN TAKEN FROM FIELD RUN TOPOGRAPHIC SURVEYS AT 2' INTERVALS PREPARED BY BENCHMARK ENGINEERING, INC. ON OR ABOUT AUGUST 27, 2007.
  - THE COORDINATES SHOWN HEREON ARE BASED UPON THE HOWARD COUNTY GEODETIC CONTROL WHICH IS BASED UPON THE MARYLAND STATE PLANE COORDINATES SYSTEM. HOWARD COUNTY MONUMENT NOS. 430A & 430B WERE USED FOR THIS PROJECT.
  - WATER AND SEWER FOR THIS PROJECT IS PUBLIC, CONTRACT No. 24-3901-D.
  - SUBJECT PROPERTY ZONED B-2 PER 10-18-1993 COMPREHENSIVE ZONING PLAN AND LIES WITHIN THE METROPOLITAN WATER AND SEWER DISTRICT.
  - STORMWATER MANAGEMENT SHALL BE PROVIDED FOR THIS PROJECT BASED ON GUIDELINES ESTABLISHED BY THE 2000 MARYLAND STORMWATER DESIGN MANUAL VOLUMES I & II. QUALITY CONTROL SHALL BE PROVIDED BY: AN UNDERGROUND SAND FILTERS (F-2) AND AN UNDERGROUND STONE REV. CHAMBER, QUANTITY CONTROL FOR PARCEL 'A' WAS PREVIOUSLY PROVIDED WITHIN THE SWMF CONSTRUCTED AS PART OF F-88-160.
  - THE UNDERGROUND SAND FILTERS (F-2) AND UNDERGROUND STONE REV. CHAMBER SWM FACILITIES SHALL BE PRIVATELY OWNED AND MAINTAINED BY THE H.O.A. THE EXISTING EXTENDED DETENTION POND (P-3) SHALL BE PRIVATELY OWNED AND JOINTLY MAINTAINED BY THE H.O.A.
  - TRAFFIC STUDY WAS PREPARED BY MARS GROUP DATED JANUARY, 2008 AND AS PART OF THIS PLAN.
  - THE FOREST CONSERVATION REQUIREMENT FOR THIS SITE WERE PREVIOUSLY PROVIDED BY A FEE-IN-LIEU PAYMENT FOR 102,366 S.F. OF TOTAL REFORESTATION, PAID ALONG WITH SITE DEVELOPMENT PLAN. SDP-01-103.
  - THERE ARE NO WETLANDS, WETLANDS BUFFERS, STREAMS, STREAM BUFFERS, FLOODPLAIN OR STEEP SLOPES LOCATED ON THIS SITE.
  - EXISTING UTILITIES SHOWN WERE LOCATED BY RECORD DRAWINGS AND FIELD LOCATIONS.
  - UNLESS NOTED AS "PRIVATE", ALL EASEMENTS ARE PUBLIC.
  - CONTRACTOR SHALL ADJUST ALL UTILITIES AND RIM ELEVATIONS AS NEEDED TO MATCH THIS PLAN.
  - ALL PROPOSED EXTERIOR LIGHTING SHALL BE DIRECTED/REFLECTED AWAY FROM ALL ADJACENT PUBLIC ROADS AND RESIDENTIAL ZONING DISTRICTS IN ACCORDANCE WITH SECTION 134 OF THE HOWARD COUNTY ZONING REGULATIONS.
  - THIS PLAN HAS BEEN PREPARED IN ACCORDANCE WITH THE PROVISIONS OF SECTION 16.124 OF THE HOWARD COUNTY CODE AND THE LANDSCAPE MANUAL.
  - FINANCIAL SURETY FOR THE REQUIRED LANDSCAPING IN THE AMOUNT OF \$17,160.00 WAS POSTED AS PART OF THE DPW DEVELOPERS AGREEMENT FOR THIS SITE PLAN.
  - WP-99-35 WAS CONSIDERED AND DENIED ON 12/3/98, WHICH REQUESTED A WAIVER OF SECTION 16.144(a) AND (f) TO REQUIRE SUBMISSION OF A SKETCH PLAN AND PRELIMINARY PLAN FOR THE PROPOSED SUBDIVISION OF PARCELS 90, 91 AND 114.
  - THE ACCESS ROAD FOR THE SITE IS INTENDED TO BECOME A PUBLIC ROAD W/66' RIGHT-OF-WAY IN THE FUTURE. AN AGREEMENT WILL BE RECORDED TO ENSURE THAT BOTH THE OWNERS OF PARCELS 'A' AND 'B' WILL ALLOW FOR THE FUTURE ROAD R/W DEDICATION.
  - TO THE BEST OF OUR KNOWLEDGE THERE ARE NO CEMETERY LOCATIONS ON-SITE.
  - PREVIOUS DEPARTMENT OF PLANNING AND ZONING REFERENCE NUMBERS INCLUDE: SP-99-011, WP-99-35, F-01-087, SDP-01-103, F-88-160, F-02-169 AND PLATS 15807-15808, 22372, 23871.
  - PRIVATE REFUSE STORAGE AND DISPOSAL IS BEING PROVIDED FOR BUILDING #1 AND #2.
  - WP-09-019 WAS DENIED ON 10/10/2008, WHICH REQUESTED A WAIVER OF SECTION 16.124(b)(1)(iii) TO ALLOW THE PLANTING OF PERIMETER LANDSCAPING IN AN EXISTING PUBLIC EASEMENT ADJACENT TO US ROUTE 1.
  - THE STRIPING INDICATED WITHIN US ROUTE 1 IS IN ACCORDANCE WITH A STRIPING PLAN APPROVED SEPTEMBER, 2016. THE STRIPING WORK WILL BE PERFORMED UNDER A DISTRICT PERMIT ISSUED TO SECURITY DEVELOPMENT, INC. SEPTEMBER, 2016.
  - HEALTH DEPARTMENT APPROVAL OF THIS SITE DEVELOPMENT PLAN DOES NOT ENSURE APPROVAL OF ASSOCIATED BUILDING PERMIT APPLICATIONS. PERMIT PLANS FOR CERTAIN FACILITIES SUCH AS FOOD SERVICE OR POOLS WILL REQUIRE REVIEW AND APPROVAL BY THE HEALTH DEPARTMENT.
  - A BUILDING PERMIT IS REQUIRED FOR THE FENCE. CONTACT FIRE MARSHAL ABOUT THE NEED FOR A KNOX BOX (40-313-6040).

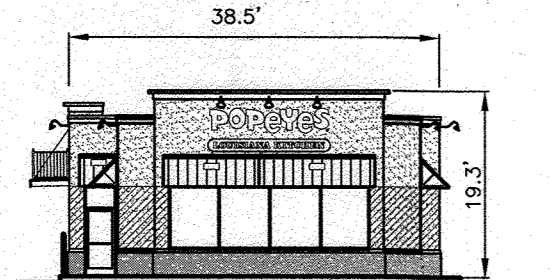

### SITE DATA TABULATION

GENERAL SITE DATA	
1. PRESENT ZONING:	B-2
2. APPLICABLE DPZ FILE REFERENCES:	SP-99-011, WP-99-35, F-01-087, SDP-01-103, F-88-160, F-02-169 AND PLATS 15807-15808, PLAT 22372, WP-09-230, WP-11-097, WP-12-078, WP-13-113, WP-15-141
3. PROPOSED USE OF SITE:	RETAIL/COMMERCIAL
4. PROPOSED WATER	<input checked="" type="checkbox"/> PUBLIC
5. PROPOSED SEWER	<input checked="" type="checkbox"/> PUBLIC
AREA TABULATION	
1. TOTAL AREA OF SITE	3.68± Ac.
2. AREA OF 100 YR. FLOODPLAIN	N/A
3. NET AREA OF SITE	3.68± Ac.
4. AREA OF THIS PLAN SUBMISSION	3.68± Ac.
5. APPROXIMATE LIMIT OF DISTURBANCE	3.68± Ac.
6. BUILDING COVERAGE OF SITE (PERMITTED)	N/A
7. BUILDING COVERAGE OF SITE (PROPOSED)	20,404 s.f.
OPEN SPACE DATA	
1. OPEN SPACE ON SITE(0.0%)	N/A
2. AREA OF RECREATION OPEN SPACE REQUIRED BY SUBDIVISION & LAND DEVELOPMENT REGULATIONS	N/A
ACRES REQUIRED	N/A
ACRES PROVIDED	N/A
PARKING SPACE DATA	
1. FLOOR SPACE ON EACH LEVEL PER BUILDING(S) PER USE	20,404 S.F.
2. MAXIMUM NUMBER OF EMPLOYEES, TENANTS ON-SITE PER USE	N/A
3. NUMBER OF PARKING SPACES REQUIRED BY ZONING REGULATIONS AND/OR FDP CRITERIA	107
SHOPPING CENTER -17,709sf (6,1000sf)	
FAST FOOD-2,695sf (14,1000sf)	38
TOTAL PARKING SPACES REQUIRED	145
4. TOTAL NUMBER OF PARKING SPACES PROVIDED ON-SITE	148
5. TOTAL NUMBER OF SERVICE PARKING SPACES PROVIDED ON-SITE	N/A
6. NUMBER OF HANDICAPPED PARKING SPACES PROVIDED ON-SITE	6

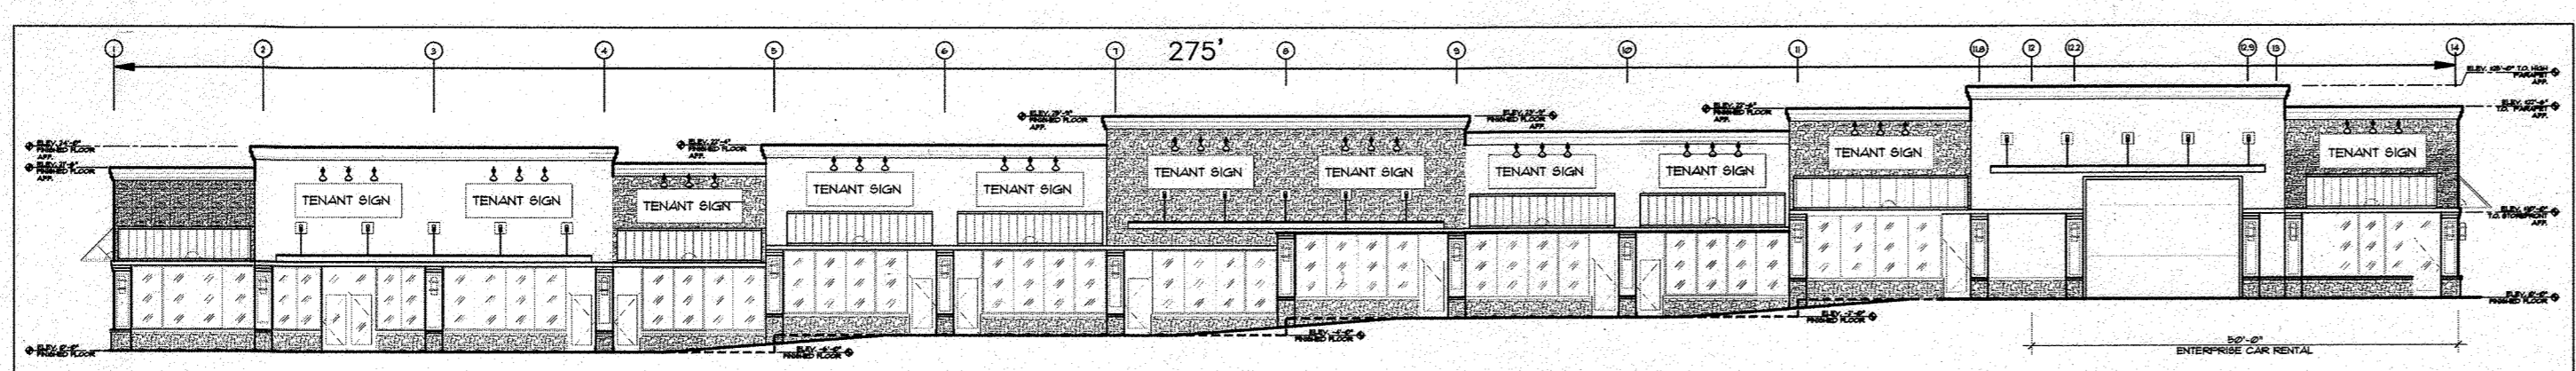

GENERAL NOTES (CON'T):

30. WP-15-141, A WAIVER TO SECTIONS 16.156(a)(1)(i), 16.156(a)(1)(ii) AND 16.156(a)(2), TO REACTIVATE SDP-08-100. THE APPROVAL WAS SUBJECT TO A REQUIREMENT TO INITIATE CONSTRUCTION ON OR BEFORE JUNE 8, 2016, AND APPLY FOR ALL PERMITS ONE OR BEFORE JUNE 8, 2017. IT WAS NOTED THAT IF THE CONSTRUCTION MUST BE COMPLETED BY MAY 4, 2017 TO MAINTAIN GRANDFATHERING. IT WAS ALSO NOTED THAT MAJOR CHANGES TO THE SDP MAY REQUIRE A NEW SITE DEVELOPMENT PLAN.

"NO AS-BUILT INFORMATION IS PROVIDED ON THIS SHEET"

Professional Certification. I hereby certify that these documents were prepared or approved by me, and that I am a duly licensed professional engineer under the laws of the State of Maryland.

License No. 21443 Expiration Date: 12-21-20



Specify parking in fenced-in area 7/2/24 BEI  
Add general note #30.

APPROVED: FOR PUBLIC WATER AND PUBLIC SEWER SYSTEMS:  
HOWARD COUNTY HEALTH DEPARTMENT

*Richard J. Davis* 2/8/17  
HOWARD COUNTY HEALTH OFFICER DATE

APPROVED: HOWARD COUNTY DEPARTMENT OF PLANNING AND ZONING

*Chad Clark* 2-2-17  
CHIEF, DEVELOPMENT ENGINEERING DIVISION #68 DATE

*Kathleen O'Connell* 4-17-17  
CHIEF, DIVISION OF LAND DEVELOPMENT DATE

*Walter J. Jyllie* 4-17-17  
DIRECTOR DATE

PERMIT INFORMATION CHART					
SUBDIVISION NAME	LOT/PARCEL#	ZONE			
COLUMBIA JUNCTION SECTION 3	LOT A-2	B-2			
PLAT Nos. 15808, 22372	BLOCK No. 6	SEC./AREA 3	TAX MAP 48	ELEC. DIST. 6th	CENSUS 6069.01
WATER CODE B-03	SEWER CODE 4250000				

ADDRESS CHART	
BLDG. NO.	STREET ADDRESS
1	8530 WASH. BLVD. (U.S. RTE. 1)
2	8520 WASH. BLVD. (U.S. RTE. 1)

NO.	DATE	REVISION
3	1-31-18	REVISED TO SHOW ENTERPRISE STORAGE AREA
2	DEC 16	REVISE BY SHEET SUBSTITUTION TO REVISE ROOF DRAINS, SEWER HOUSE CONNECTION AND PAVE OUTPANEL.
1	FEB 16	REVISE BY SHEET SUBSTITUTION POPEYE'S BUILDING FOOTPRINT AND ASSOCIATED ITEMS

**BENCHMARK ENGINEERING, INC.**

ENGINEERS & LAND SURVEYORS & PLANNERS

6480 BALTIMORE NATIONAL PIKE & SUITE 315 ELLICOTT CITY, MARYLAND 21043  
(P) 410-465-8105 (F) 410-465-8844  
WWW.BEI-CVLENGINEERING.COM

Professional Certification. I hereby certify that these documents were prepared or approved by me, and that I am a duly licensed professional engineer under the laws of the State of Maryland, License No. 28376, Expiration Date: 01-01-2017

DEVELOPER:	COLUMBIA JUNCTION DEV. LLC 100 MENLO PARK DRIVE, SUITE 500 EDISON, NEW JERSEY 08837 201-314-6049	PROJECT:	COLUMBIA JUNCTION SECTION 3 - LOT 'A'-2 (RETAIL CENTER)
LOCATION:	TAX MAP 48 - BLOCK 1 PARCEL 548 6th ELECTION DISTRICT HOWARD COUNTY, MARYLAND	TITLE:	COVER SHEET
DATE:	JANUARY, 2017	PROJECT NO.	1221
Design: DAM/AAM	Draft:HP/AAM	Check: CAM/AAM	SCALE: AS SHOWN
		DRAWING 1 OF 11	

JAMES KONIENKA  
LIMITED PARTNERSHIP  
1671/507  
IN 47 PARCEL 384  
ZONED: RSA-3

NOTE:  
A KNOX BOX (FIRE DEPARTMENT ACCESS BOX) IS REQUIRED TO BE PLACED ON THE FRONT OF THE BUILDING. IT SHALL BE PLACED TO THE RIGHT OF THE MAIN ENTRANCE AT A RANGE OF 4'-5' IN HEIGHT AND NO MORE THAN 6' LATERALLY FROM THE DOOR. THE KNOX BOX LOCATION SHALL BE SHOWN ON THE PLAN, AS WELL AS, ADDRESSED BY GENERAL NOTE ON THE PLAN. THE BOX SHALL BE ELECTRONICALLY SUPERVISED TO NOTIFY THE OWNER THAT IT IS BEING ELECTRONICALLY SUPERVISED (INTEGRATED WITH THE FIRE ALARM SYSTEM).  
NFFPA-118.2.2.1.

NOTE: FOR DETAIL OF THE HANDICAPPED PARKING AT BUILDING #2 SEE SHEET NO. 3 OF 11.

NOTE: SPRINKLER SYSTEM TO BE INSTALLED FOR BUILDING #2

LEGEND

SOILS CLASSIFICATION	ChB2	PROPOSED FIRE HYDRANT	
SOILS DELINEATION		PROPOSED FENCE	
EXISTING CONTOURS (AERIAL 12/02)		PROPOSED SIDEWALK	
PROPOSED CONTOURS		PROP. CROSS WALK	
EXISTING WOODS LINE		LOADING AREA	
PROPOSED WOODS LINE		NO PARKING AREA	
PROPOSED STRUCTURE		HANDICAP ACCESS	
STABILIZED CONSTRUCTION ENTRANCE		PUBLIC UTILITY EASEMENT	
LIMIT OF DISTURBANCE		RELOCATABLE PRIVATE ACCESS EASEMENT	
SILT FENCE DIVERSION			
SUPER SILT FENCE			
INLET PROTECTION			
PROP. PARKING LOT LIGHT			
PROP. SOIL BORING			

NOTE: PROPOSED PRIVATE WATER METER TO HAVE INSIDE LOCATION FOR BUILDING #1 AND #2.

PARKING LOT LIGHT SCHEDULE

SYMBOL	DESCRIPTION	LOCATION
	(3)150 WATT HPS VAPOR WITH 1" BLACK FIBERGLASS POLE	N 539823.3768 E 1367132.7595
	(5)150 WATT HPS VAPOR WITH 1" BLACK FIBERGLASS POLE	N 539467.8618 E 1367159.6206 N 539617.0979 E 1367118.1915 N 539725.5468 E 1367230.0171 N 539586.7231 E 1367243.3922 N 539569.3938 E 1367244.1531

APPROVED: FOR PUBLIC WATER AND PUBLIC SEWER SYSTEMS:  
HOWARD COUNTY HEALTH DEPARTMENT

*Richard A. Davis*  
HOWARD COUNTY HEALTH OFFICER  
DATE: 2/1/17

APPROVED: HOWARD COUNTY DEPARTMENT OF PLANNING AND ZONING

*Phil Clark*  
CHIEF, DEVELOPMENT ENGINEERING DIVISION  
DATE: 2-21-17


*Krist Salcedo*  
CHIEF, DIVISION OF LAND DEVELOPMENT  
DATE: 4-17-17

*Valerie Zylber*  
DIRECTOR  
DATE: 4-17-17

WALL ELEVATION/GEOMETRY PLAN  
SCALE: 1" = 10'

AS-BUILT CERTIFICATION  
I hereby certify, by my seal, that to the best of my knowledge and belief the facilities shown on this "AS-BUILT" Plan meet the Approved Plans and Specifications  
Donald Mason, P.E.  
Date: 3/29/19

Professional Certification. I hereby certify that these documents were prepared or approved by me, and that I am a duly licensed professional engineer under the laws of the State of Maryland.  
License No. 21443 Expiration Date: 12-21-20

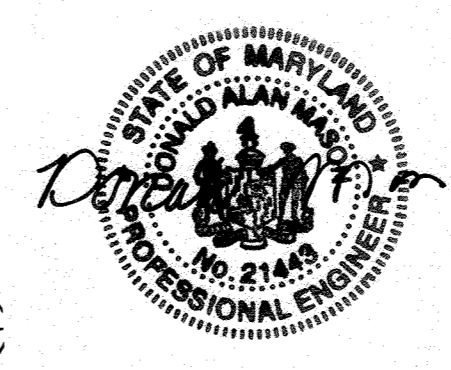


NO.	DATE	REVISION
5	5-15-19	REVISE DRAWING FROM BID 1 - UPDATE BOLLARD LOCATIONS TO DOCUMENT AS-BUILT CONDITION.
4	1-31-18	REVISED TO ADD ENTERPRISE PARKING/STORAGE AREA AND EXTEND PRIVATE WHC (BID. 1)
3	02-23-2017	REMOVE PDC CONNECTION SPRINKLER NOTES FOR BLDG #2
2	DEC 16	SHEET SUBSTITUTION TO REVISE ROOF, DRAINS, SEWER HOSE CONNECTION AND PAVE OUTPARCEL.
1	FEB 16	REVISE BY SHEET SUBSTITUTION POPEY'S BUILDING FOOTPRINT AND ASSOCIATED ITEMS

**BENCHMARK**  
ENGINEERS & LAND SURVEYORS & PLANNERS  
**ENGINEERING, INC.**  
8480 BALTIMORE NATIONAL PIKE & SUITE 315 ELLICOTT CITY, MARYLAND 21043  
(P) 410-465-8105 (F) 410-465-8644  
WWW.BEI-CIVILENGINEERING.COM

Professional Certification. I hereby certify that these documents were prepared or approved by me, and that I am a duly licensed professional engineer under the laws of the State of Maryland, License No. 28376, Expiration Date: 01-01-17.





DEVELOPER:	COLUMBIA JUNCTION DEV. LLC 100 MENLO PARK DRIVE, SUITE 500 EDISON, NEW JERSEY 08837 201-314-6049	PROJECT:	COLUMBIA JUNCTION SECTION 3 / LOT A-2 (RETAIL CENTER)
LOCATION:	TAX MAP 48 - BLOCK 1 PARCEL 548 6th ELECTION DISTRICT HOWARD COUNTY, MARYLAND	TITLE:	REVISED SITE DEVELOPMENT PLAN GRADING PLAN
DATE:	JANUARY, 2017	PROJECT NO.:	1221
Design: DAM/AAM	Draft: HP/AAM	Check: CAM/AAM	SCALE: 1" = 20'
		DRAWING 2 OF 11	

AS-BUILT SDP-08-100

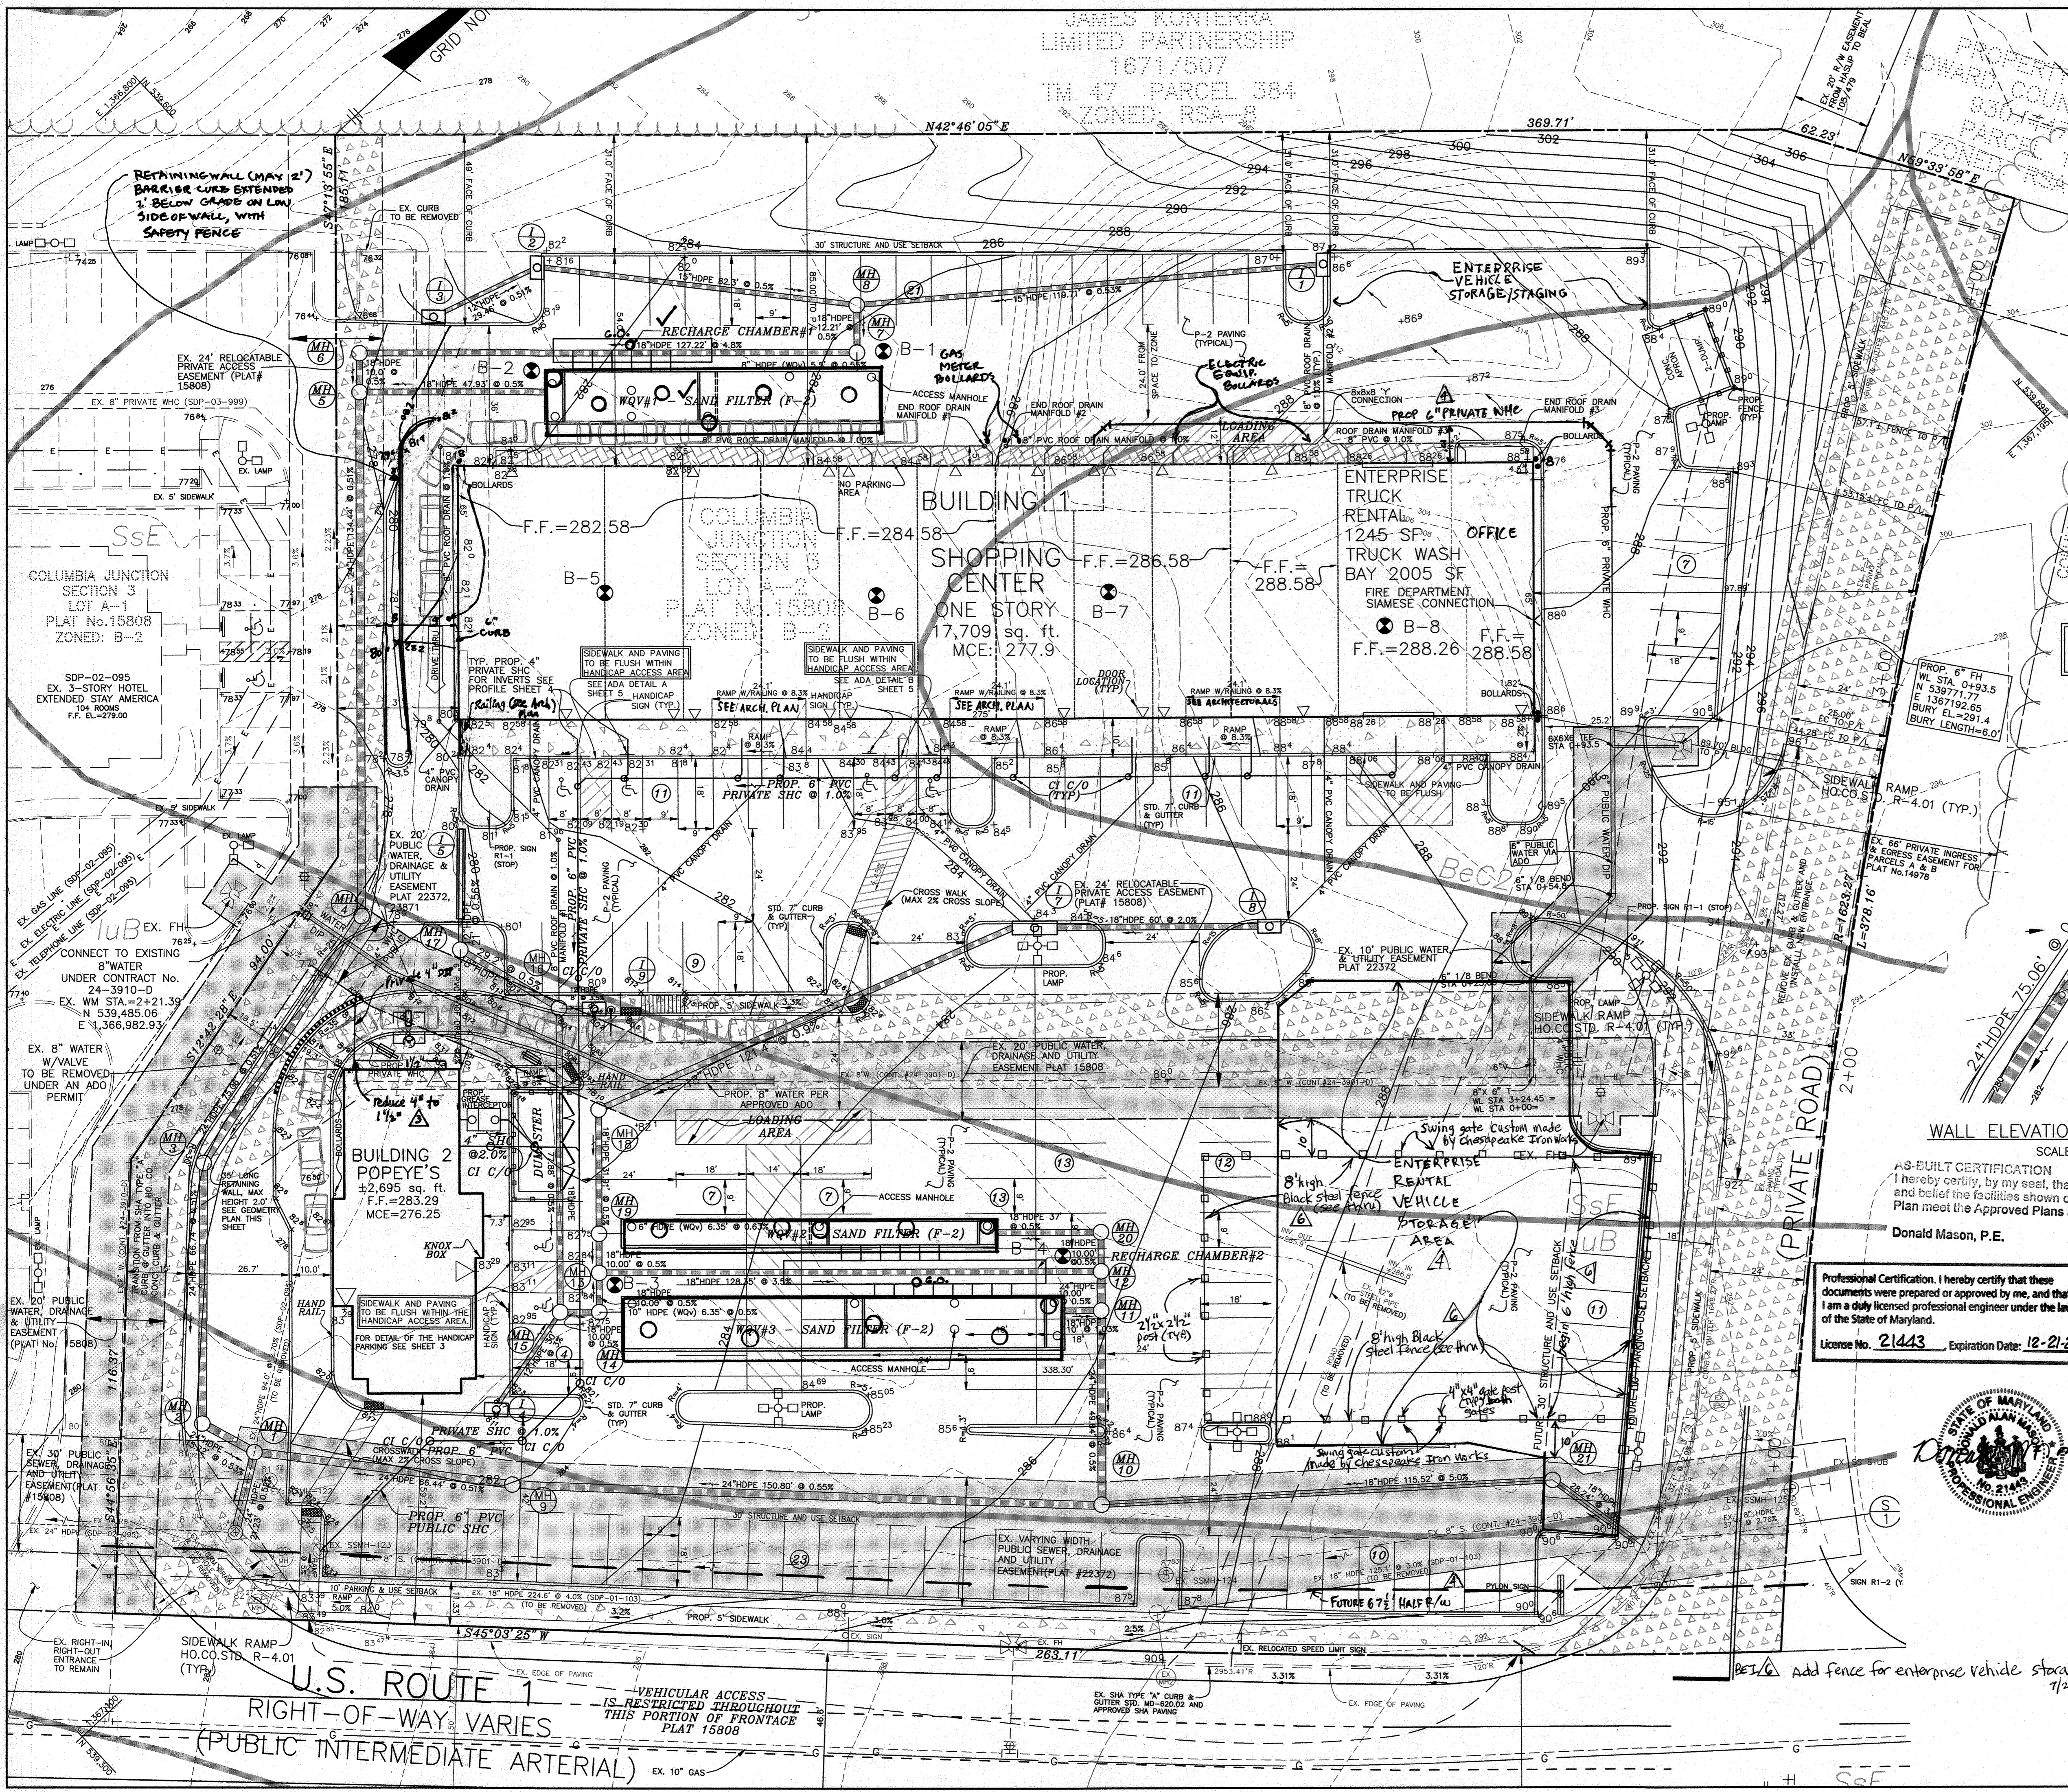

U.S. ROUTE 1  
RIGHT-OF-WAY VARIES  
(PUBLIC INTERMEDIATE ARTERIAL)

VEHICULAR ACCESS IS RESTRICTED THROUGHOUT THIS PORTION OF FRONTAGE PLAT 15808

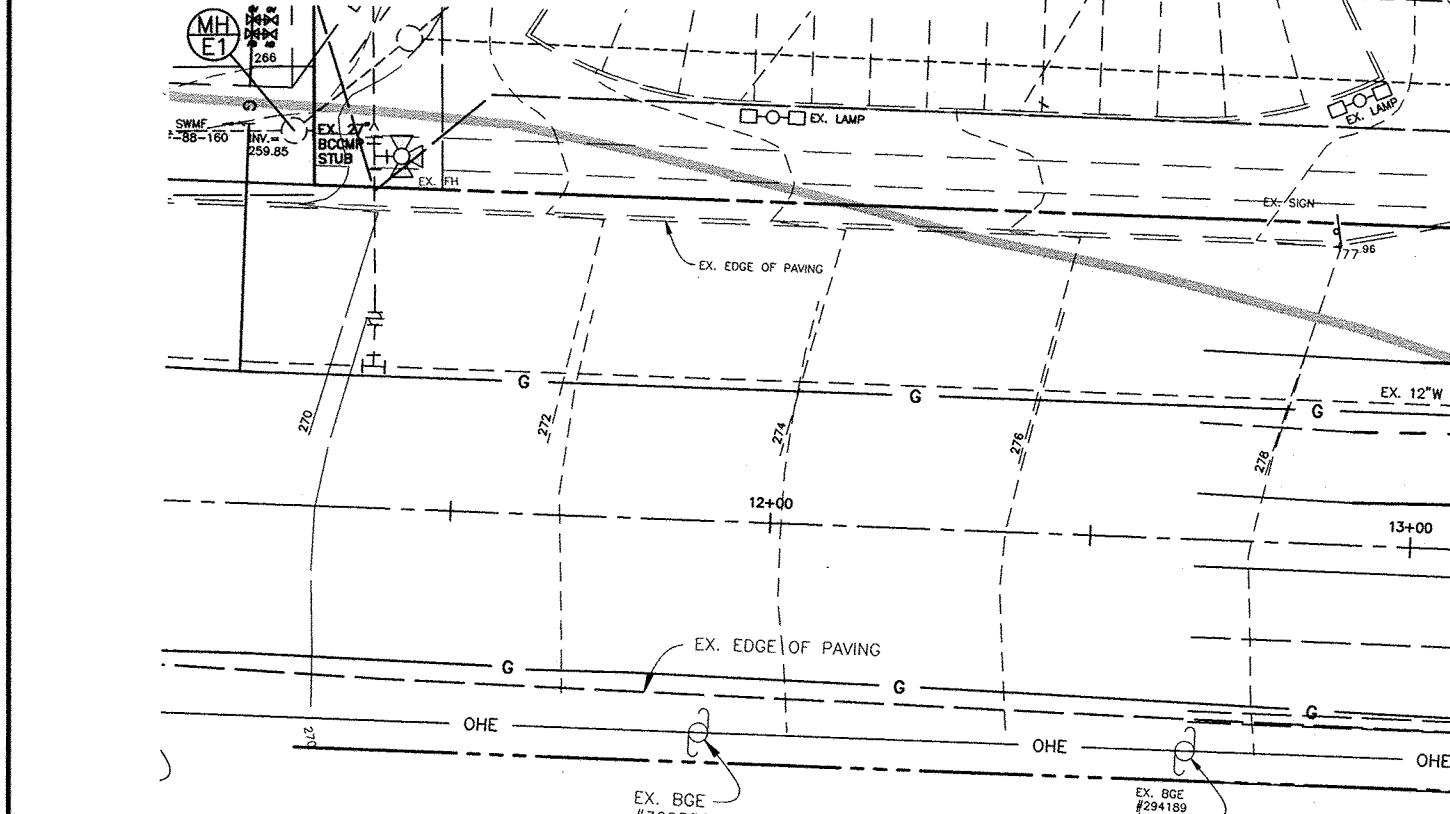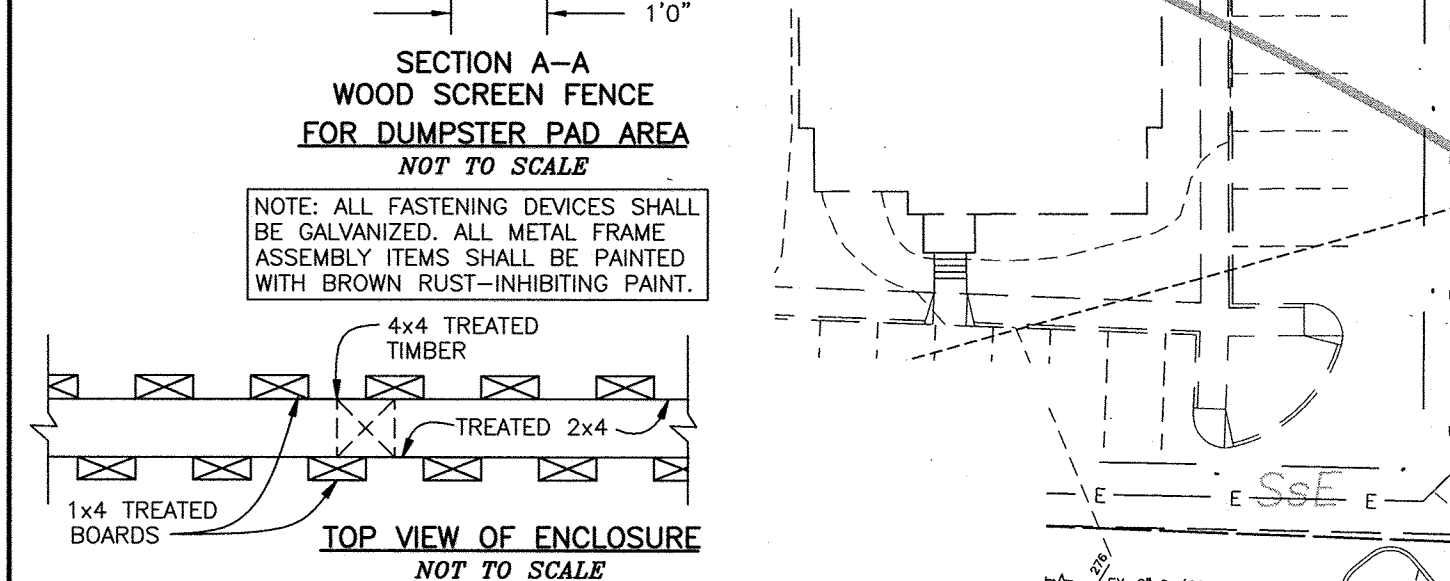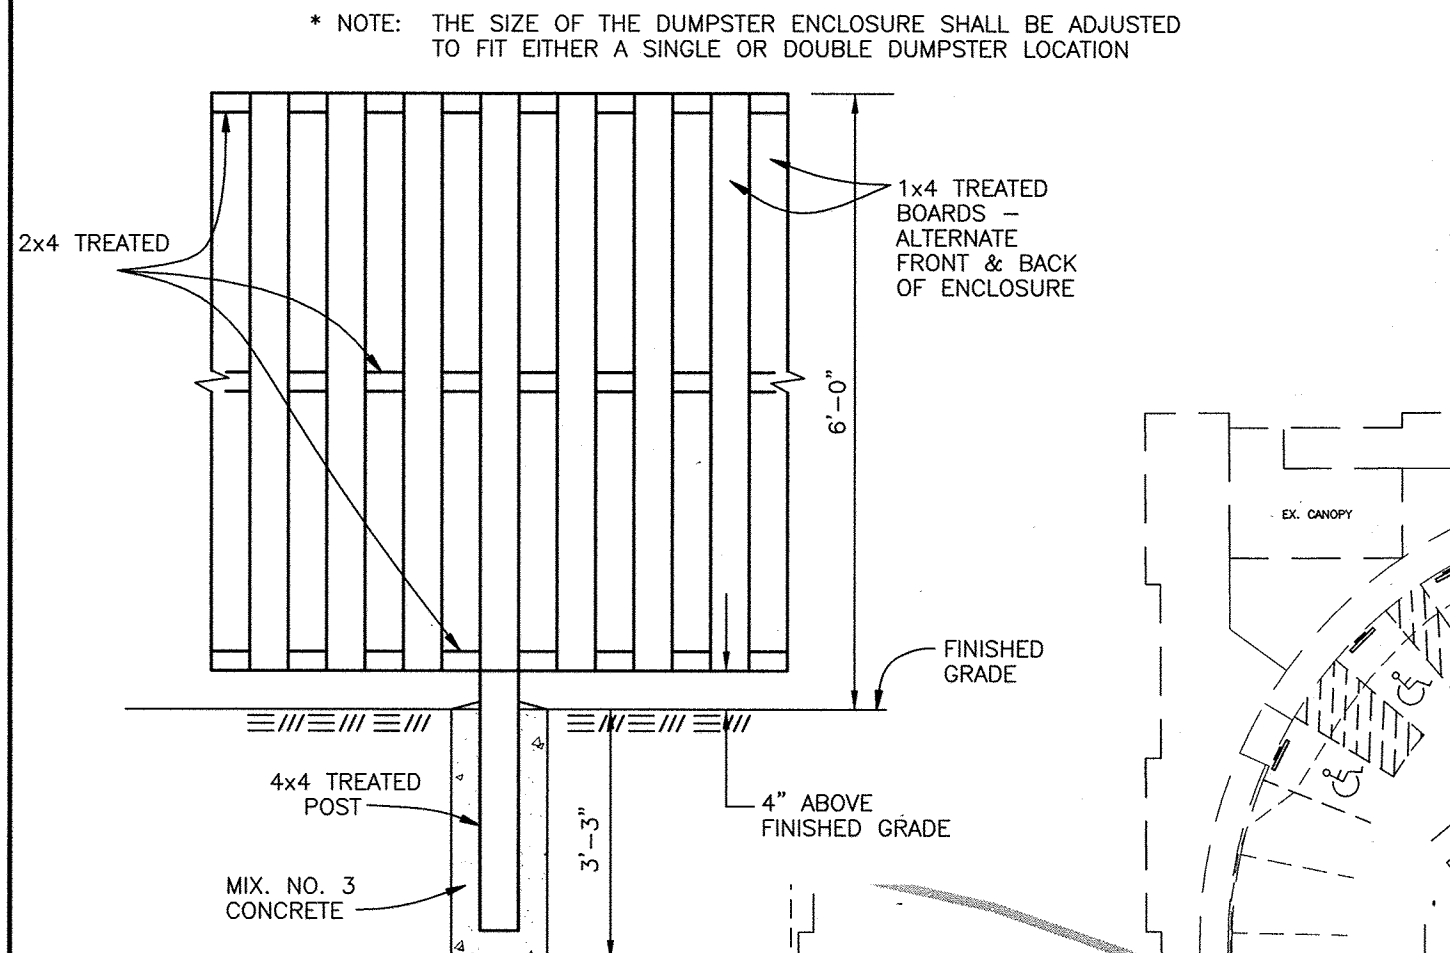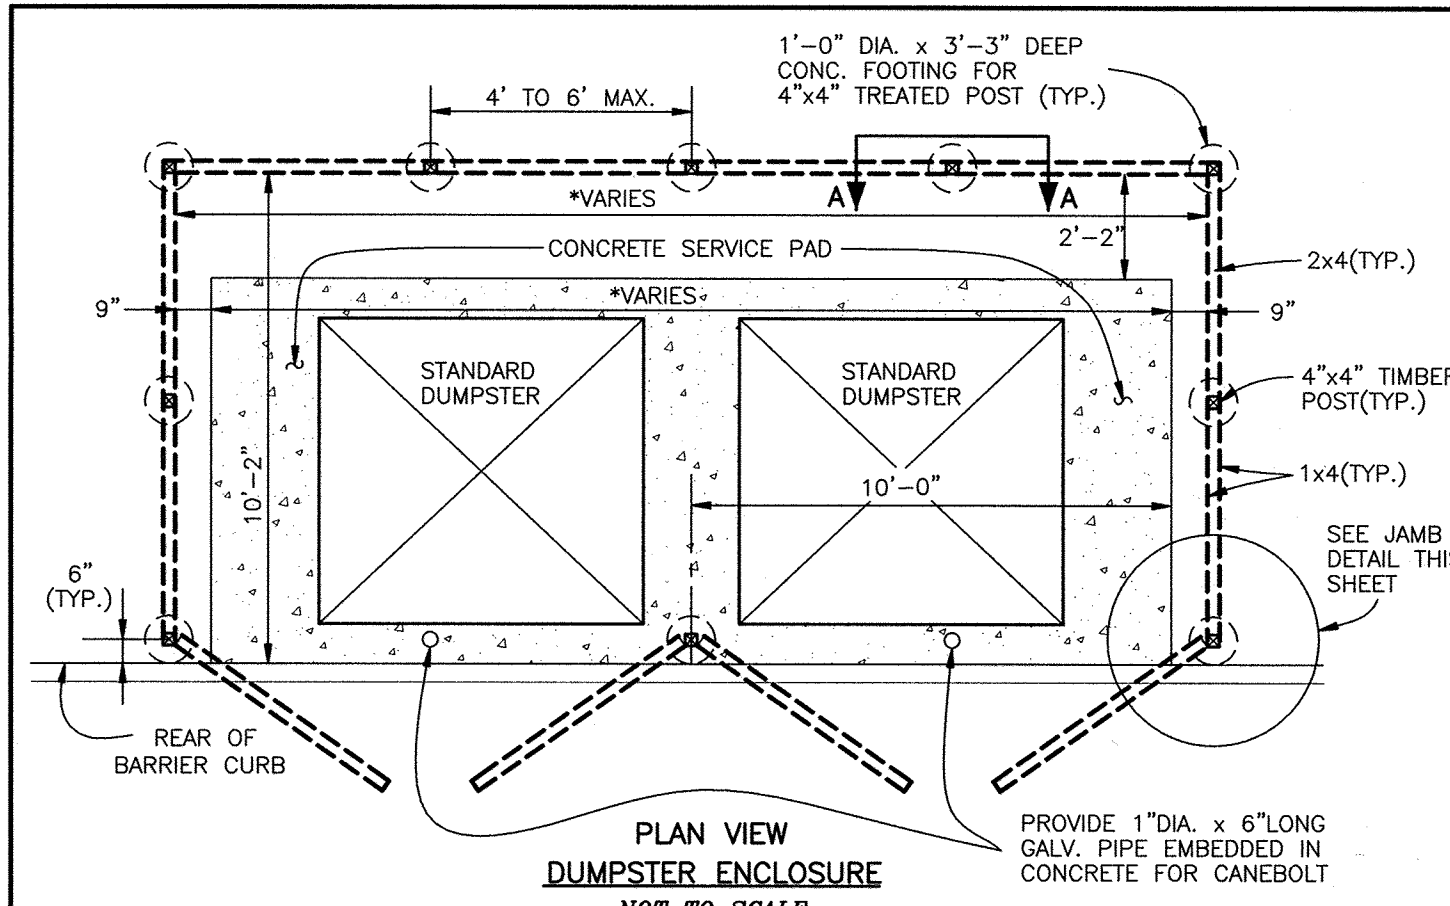





NOTE: TEMPORARY SWM IS BEING PROVIDED WITHIN THE SWM FACILITY BUILT UNDER F-88-160 (COLUMBIA JUNCTION SECTION 2 - AREA 1). THIS DESIGN WAS BASED ON A COMMERCIAL AND BUSINESS CURVE NUMBER WHICH HAS A HIGHER VALUE THAN NEWLY GRADED LAND EVEN WITH THE CHANGE IN THE HYDROLOGIC SOILS GROUP.

SEDIMENT CONTROL LOCATION AND IMPLEMENTATION SHOWN ON THIS PLAN IS SUBJECT TO REVISIONS IN THE FIELD AT THE DISCRETION OF THE SEDIMENT CONTROL INSPECTOR.

ALL SEDIMENT CONTROL FEATURES SHALL BE INSTALLED IN ACCORDANCE WITH STANDARD DETAILS SHOWN IN THE 2011 MARYLAND STANDARDS AND SPECIFICATIONS FOR SOIL EROSION AND SEDIMENT CONTROL.

MAP SYMBOL	SOIL GROUP	SOIL TYPE
BsB2	C	BELTSVILLE SILT LOAM, 1 TO 5 PERCENT SLOPES, MODERATELY ERODED
BsC2	C	BELTSVILLE SILT LOAM, 5 TO 10 PERCENT SLOPES, MODERATELY ERODED
IuB	C	IUKA LOAM, LOCAL ALLUVIUM, 1 TO 5 PERCENT SLOPES
Sid2	B	SASSAFRAS LOAM, 10 TO 15 PERCENT SLOPES, MODERATELY ERODED
SsE	B	SASSAFRAS SOILS, 15 TO 40 PERCENT SLOPES

\* INDICATES HYDRIC SOILS  
TAKEN FROM SOILS SURVEY, ISSUED JULY 1968, MAP NO. 25

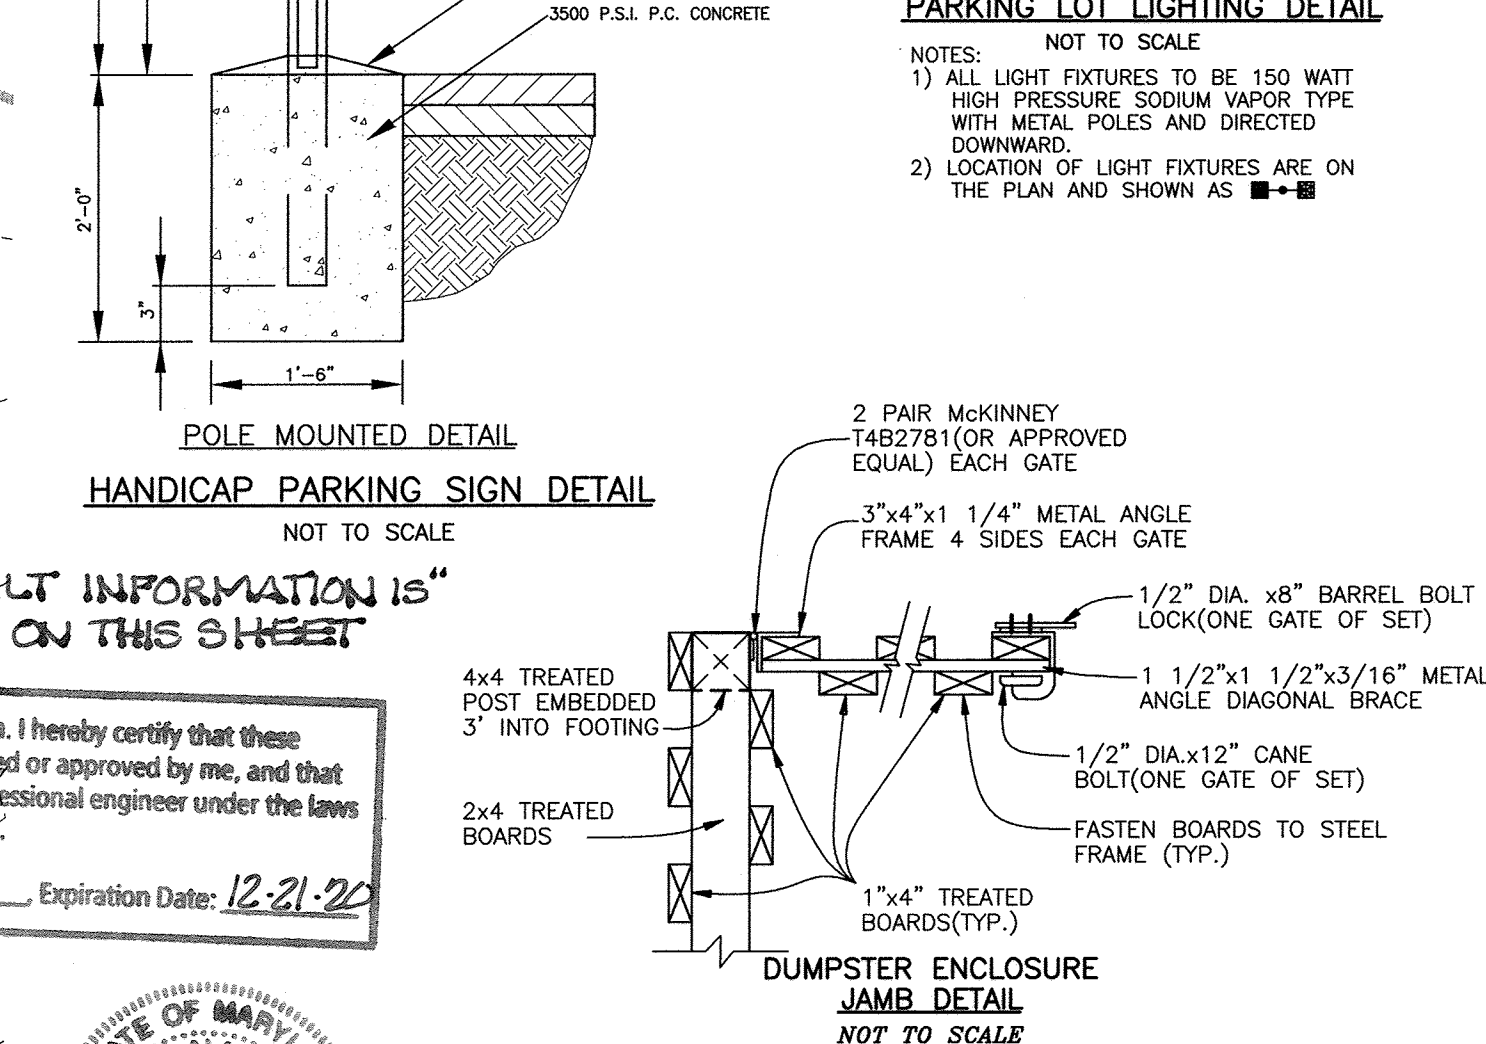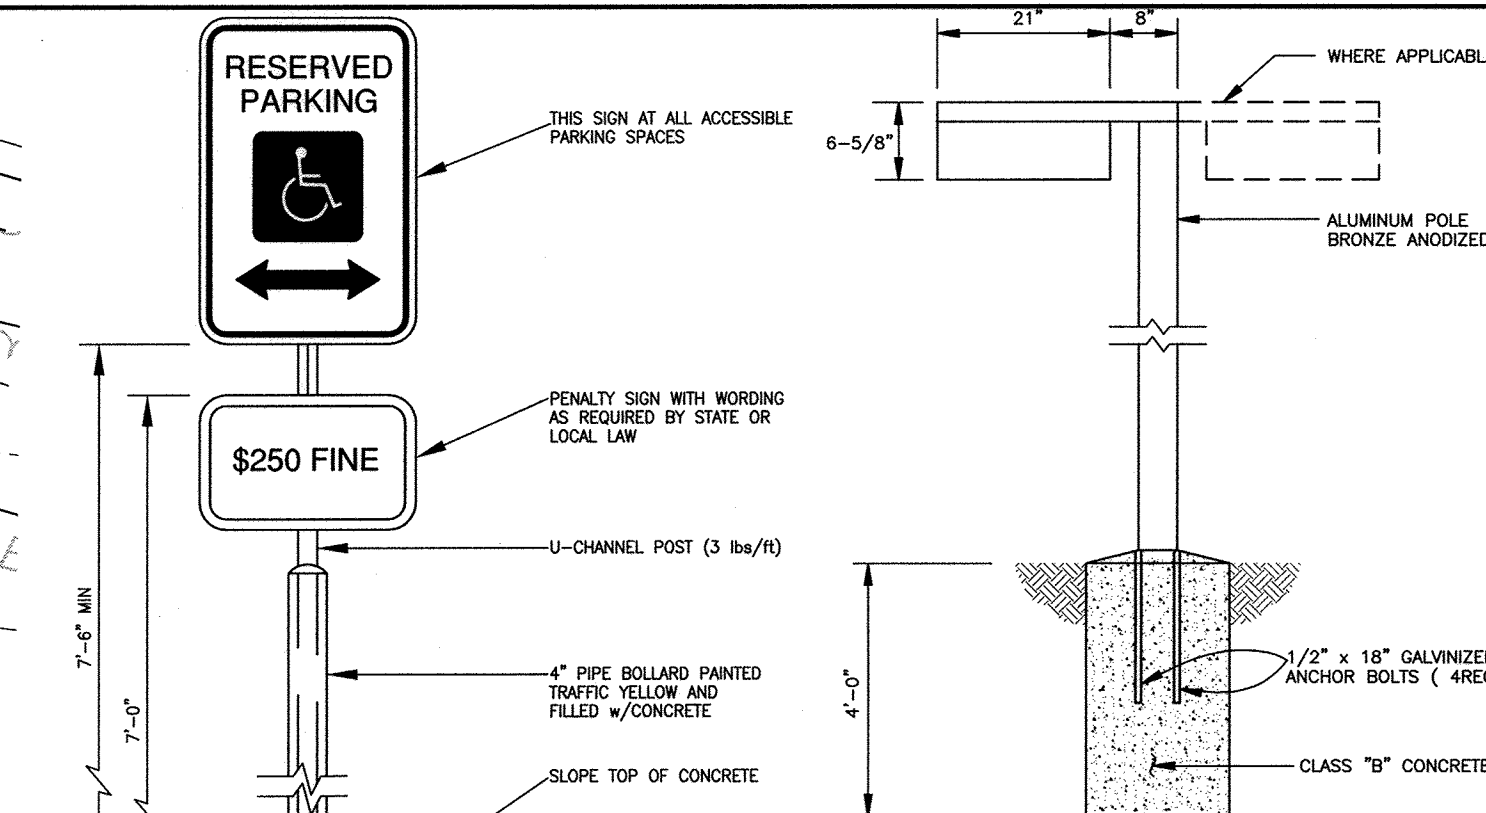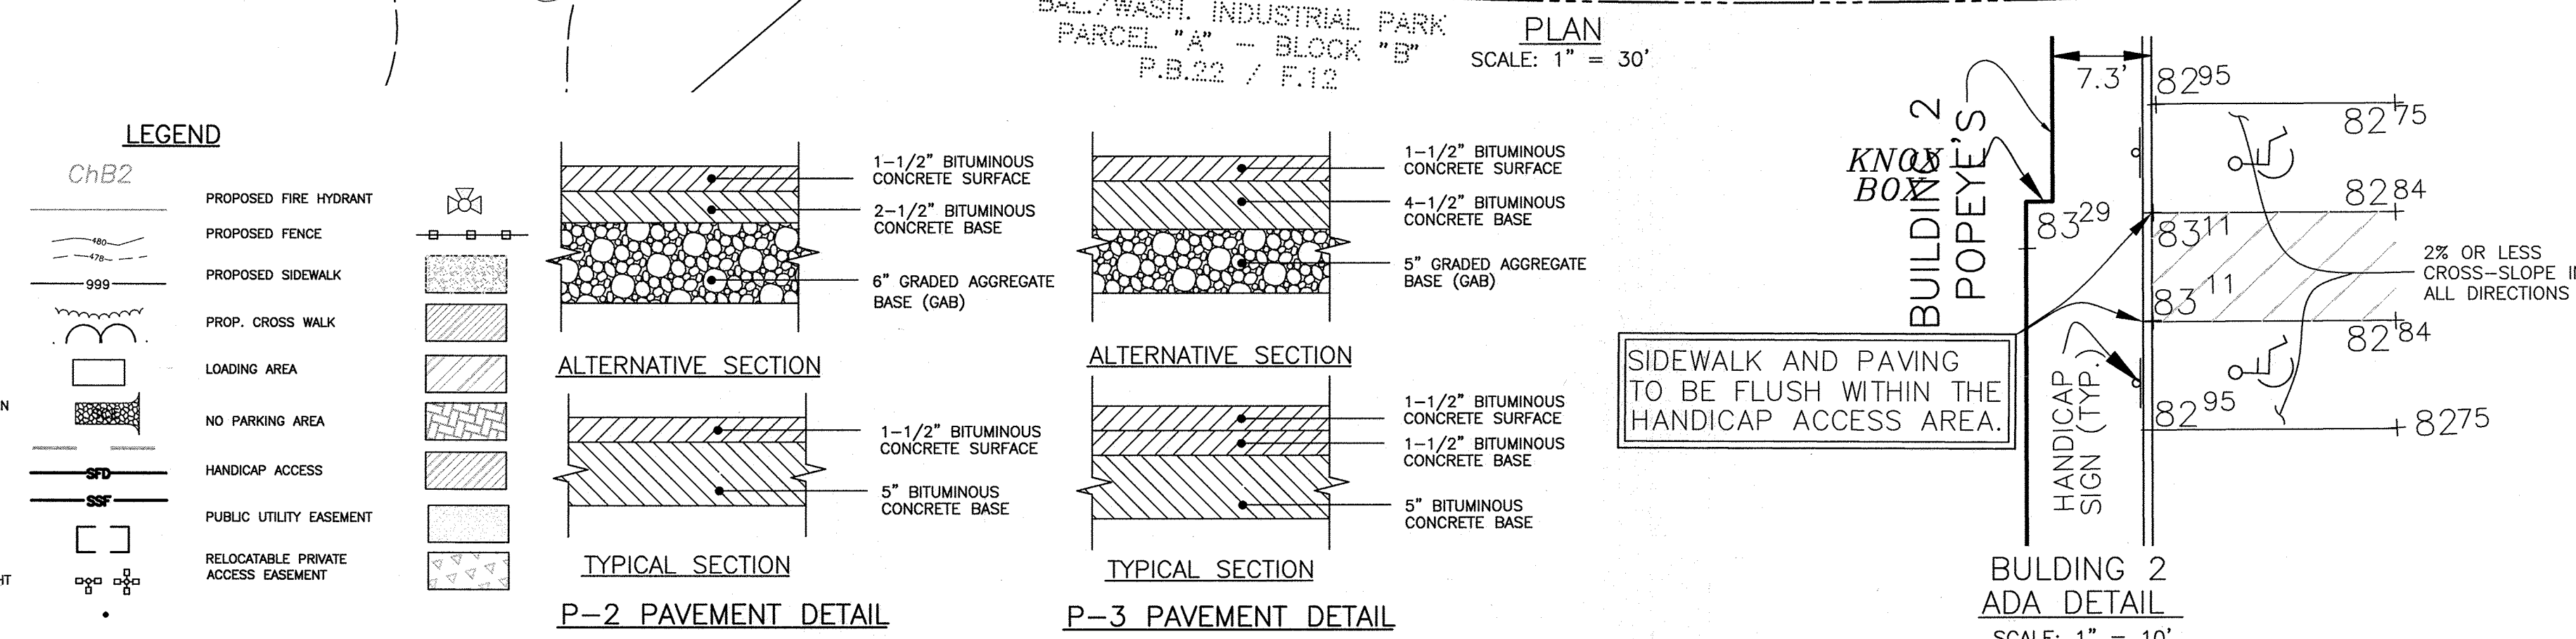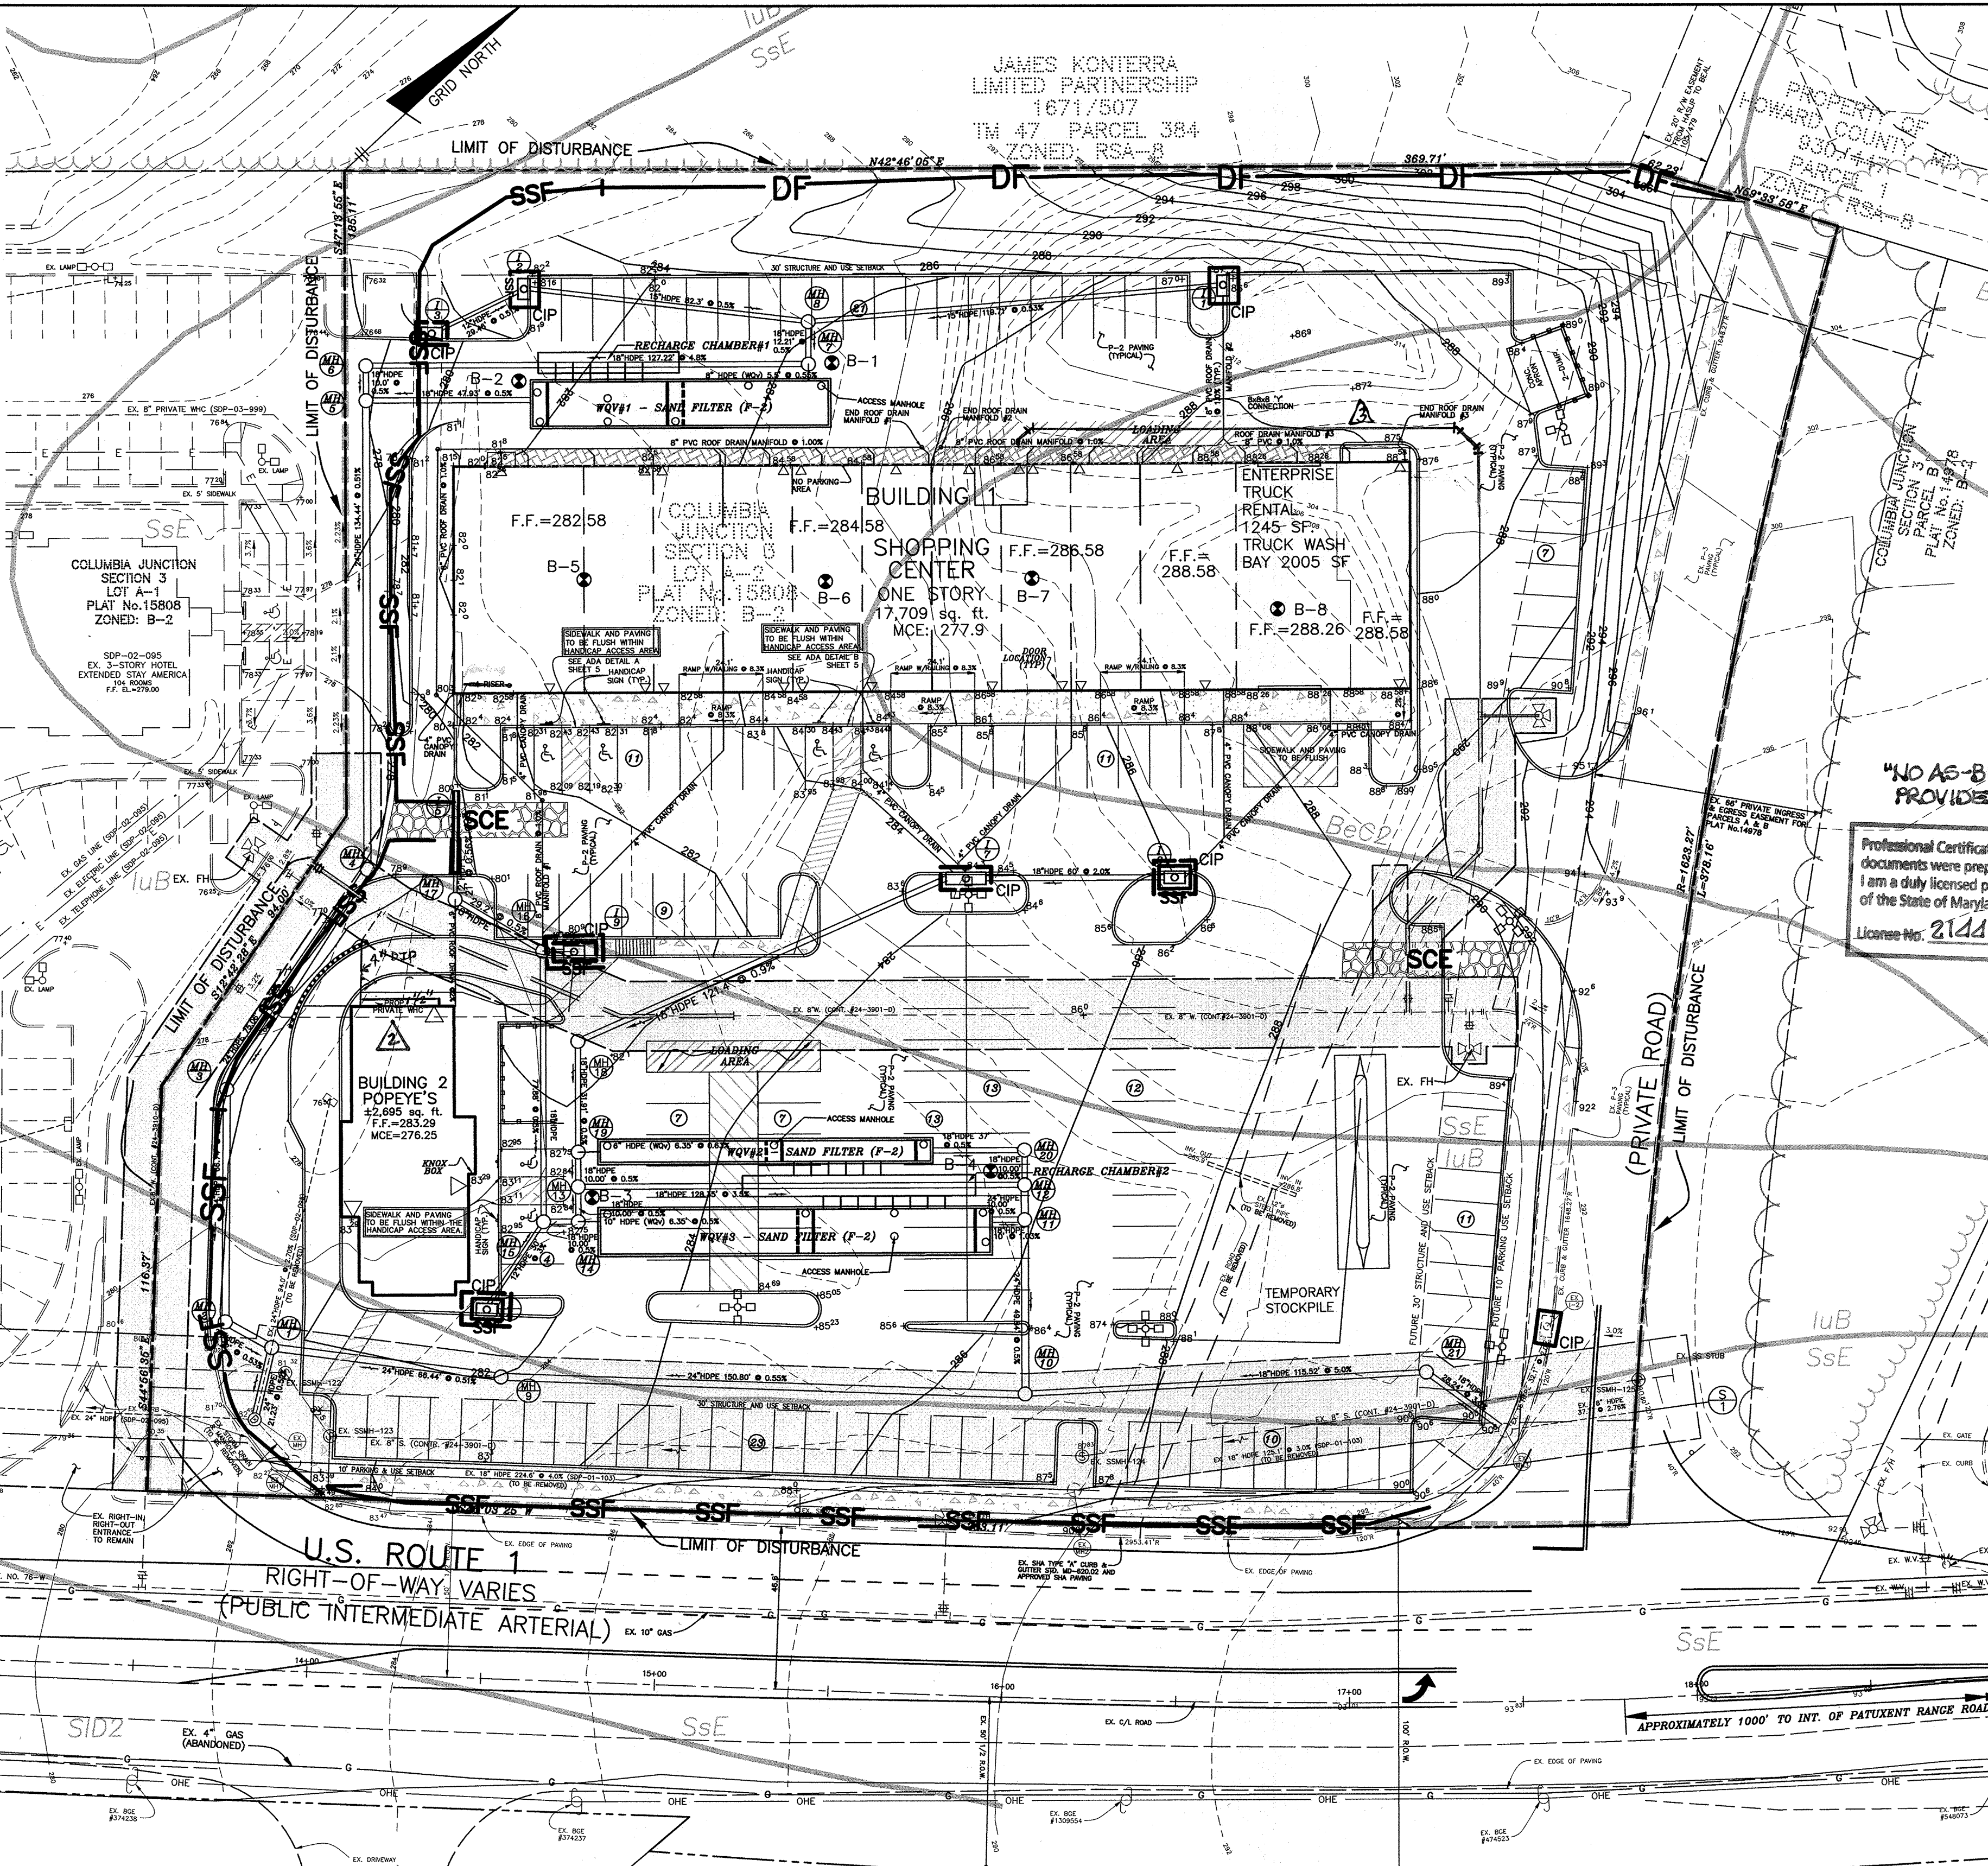

"NO AS-BUILT INFORMATION IS PROVIDED ON THIS SHEET"

Professional Certification. I hereby certify that these documents were prepared or approved by me, and that I am a duly licensed professional engineer under the laws of the State of Maryland.  
License No. 21413 Expiration Date: 12-21-22

STATE OF MARYLAND PROFESSIONAL ENGINEER  
3/21/19

1081/0406  
714 AS PARCEL 235  
ZONED: RSA-B/AMD-3

ENGINEER'S CERTIFICATE  
I HEREBY CERTIFY THAT THIS PLAN HAS BEEN DESIGNED IN ACCORDANCE WITH CURRENT MARYLAND EROSION AND SEDIMENT CONTROL LAWS, REGULATIONS, AND STANDARDS, THAT IT REPRESENTS A PRACTICAL AND WORKABLE PLAN BASED ON MY PERSONAL KNOWLEDGE OF THE SITE, AND THAT IT WAS PREPARED IN ACCORDANCE WITH THE REQUIREMENTS OF THE HOWARD SOIL CONSERVATION DISTRICT.  
25 Jan 17  
ALICE A. MILLER, P.E. (MD. P.E. 28376)

DEVELOPER'S CERTIFICATE  
I/WE CERTIFY THAT ALL DEVELOPMENT AND CONSTRUCTION WILL BE DONE ACCORDING TO THIS PLAN OF DEVELOPMENT FOR SEDIMENT AND EROSION CONTROL, AND THAT ALL RESPONSIBLE PERSONNEL INVOLVED IN THE CONSTRUCTION PROJECT WILL HAVE A CERTIFICATE OF ATTENDANCE AT A DEPARTMENT OF THE ENVIRONMENT APPROVED TRAINING PROGRAM FOR THE CONTROL OF SEDIMENT AND EROSION BEFORE BEGINNING THE PROJECT. I ALSO AUTHORIZE PERIODIC ON-SITE INSPECTION BY THE HOWARD SOIL CONSERVATION DISTRICT.  
11/26/17  
COLUMBIA JUNCTION DEV. LLC.

APPROVED: HOWARD COUNTY DEPARTMENT OF PLANNING AND ZONING  
2/14/17  
HOWARD COUNTY DEPARTMENT OF PLANNING AND ZONING

4-21-17  
4-17-17  
4-17-17

NO.	DATE	REVISION
1	FEB 16	REVISE BY SHEET SUBSTITUTION POPEYE'S BUILDING FOOTPRINT AND ASSOCIATED ITEMS
2	02/27/2017	REMOVE REFERENCE FROM 4" W/S TO 1 1/2" W/S
3	1-31-18	REVISED TO EXTEND PRIVATE W/M

**BENCHMARK ENGINEERING, INC.**  
8480 BALTIMORE NATIONAL PIKE SUITE 315 • ELICOTT CITY, MARYLAND 21043  
(P) 410-465-6105 (F) 410-465-6844  
WWW.BE-CMENGINEERING.COM






DEVELOPER: COLUMBIA JUNCTION DEV. LLC  
100 MENLO PARK DRIVE, SUITE 500, EDISON, NEW JERSEY 08837 201-314-6049

PROJECT: COLUMBIA JUNCTION SECTION 3 / LOT A-2 (RETAIL CENTER)

LOCATION: TAX MAP 48 - BLOCK 1 PARCEL 548 6TH ELECTION DISTRICT HOWARD COUNTY, MARYLAND

TITLE: REVISED SITE DEVELOPMENT PLAN SEDIMENT AND EROSION CONTROL PLAN, NOTES AND DETAILS

DATE: JANUARY, 2017 PROJECT NO. 1221  
Design: DAM/AAM Draft: HP/AAM Check: CAM/AAM SCALE: 1" = 30' DRAWING 3 OF 11

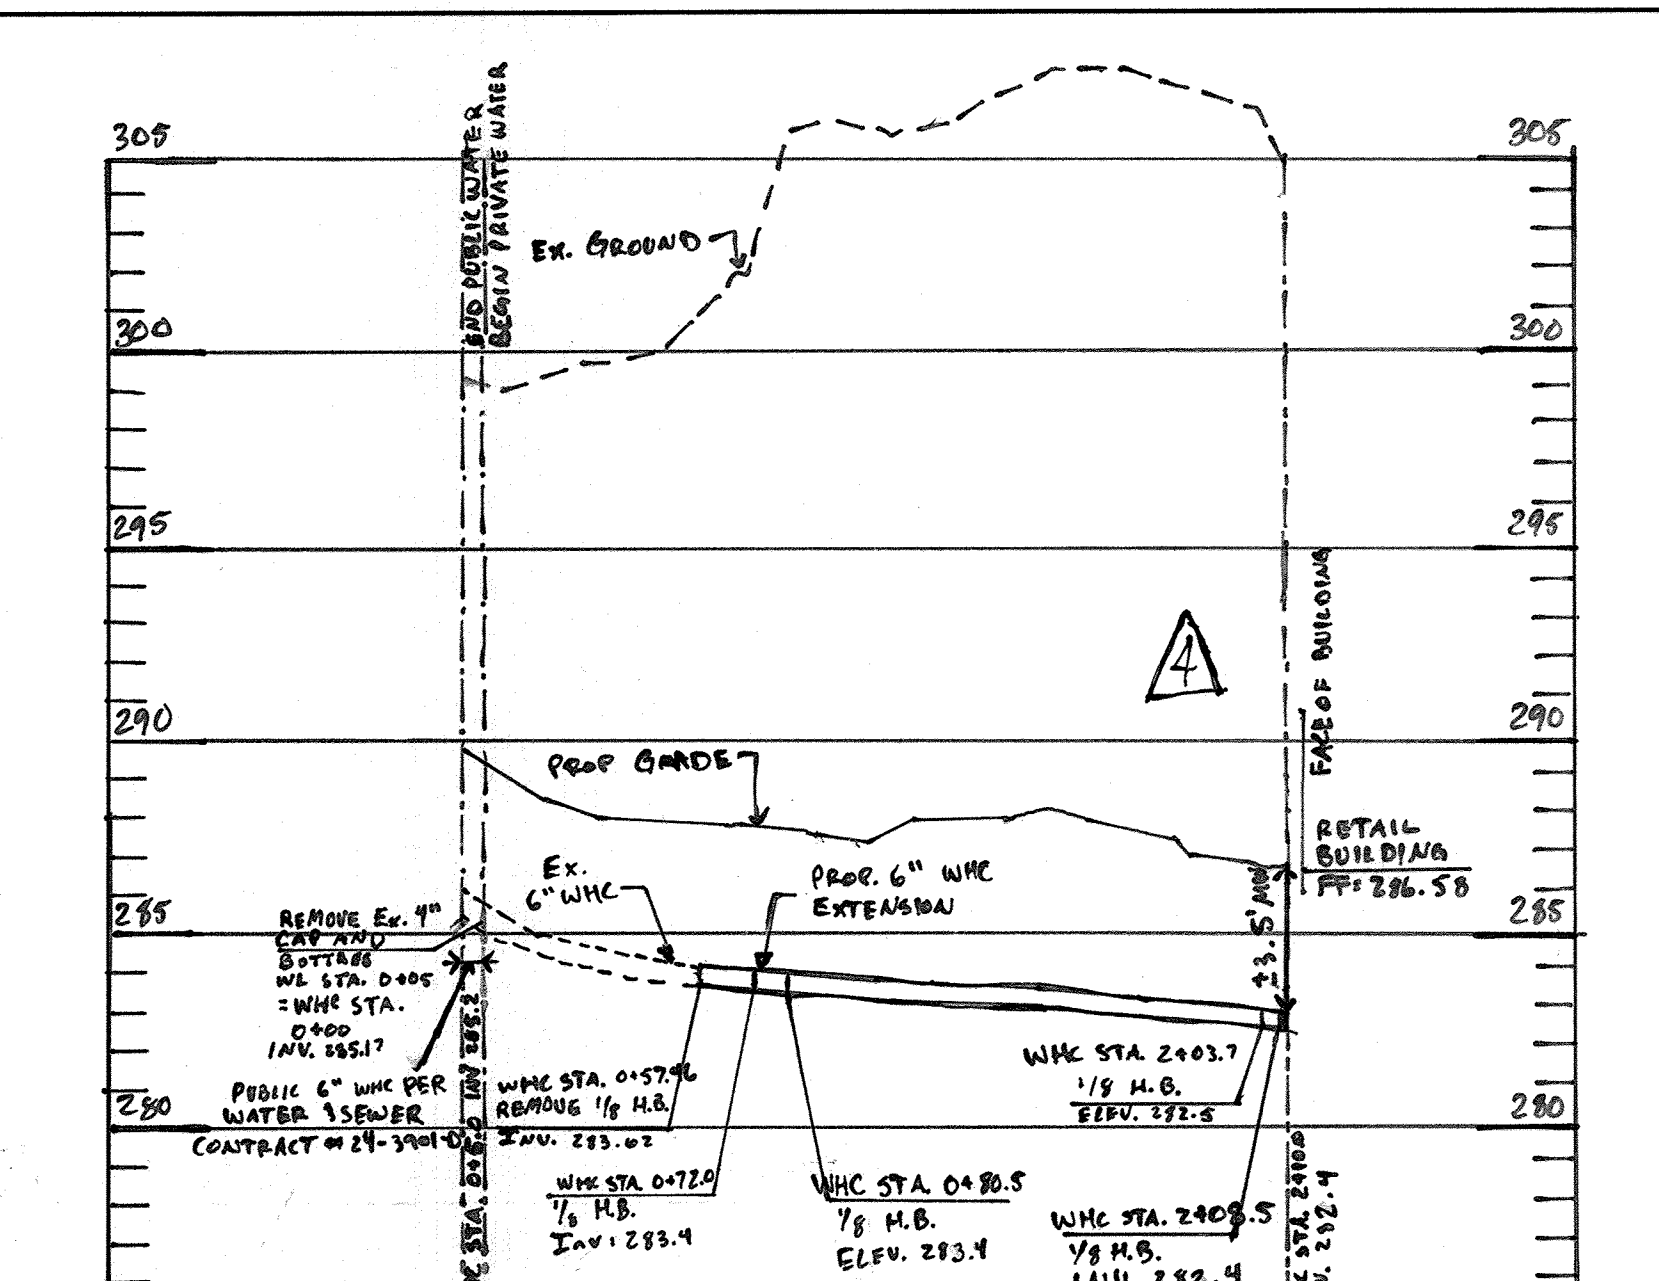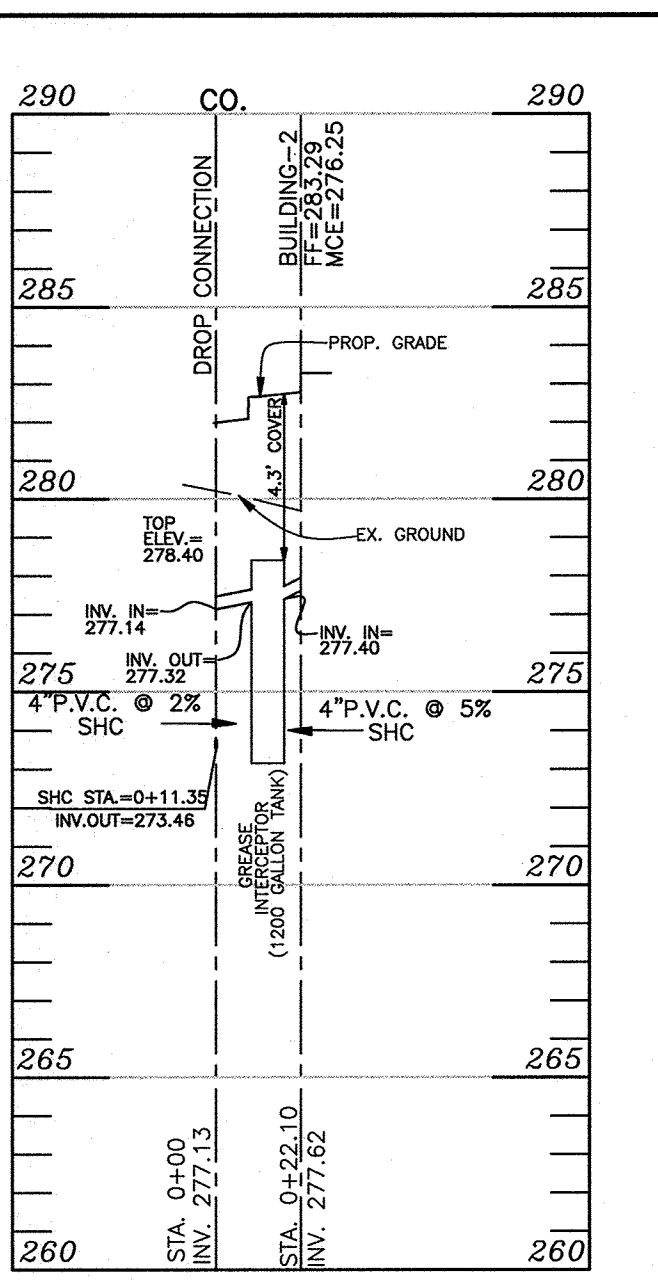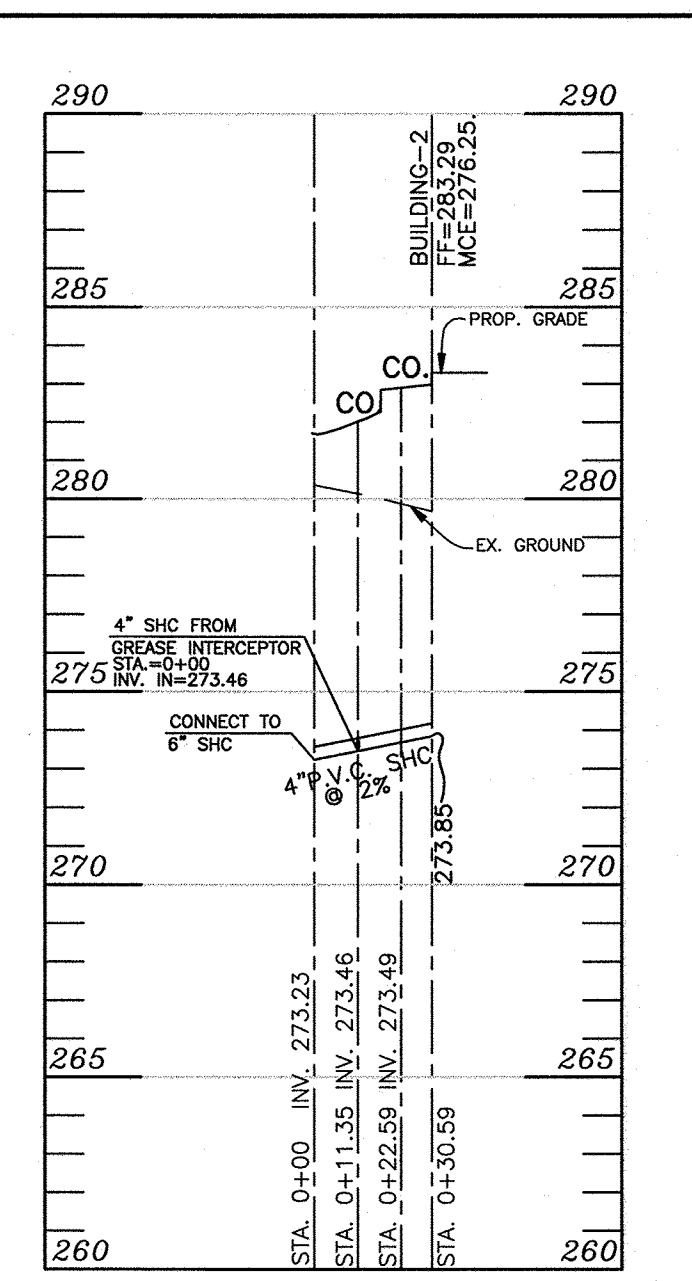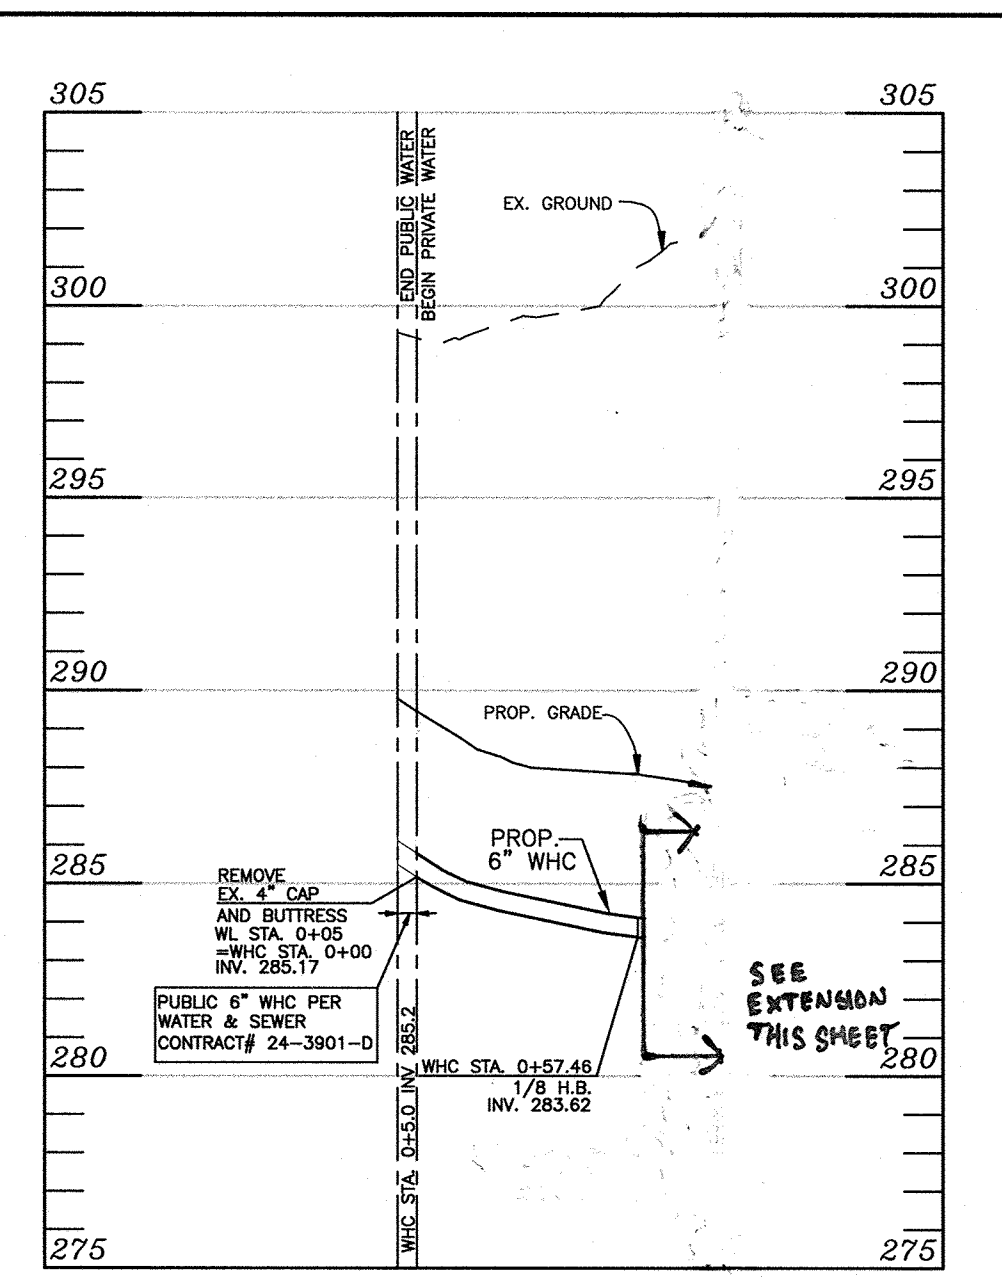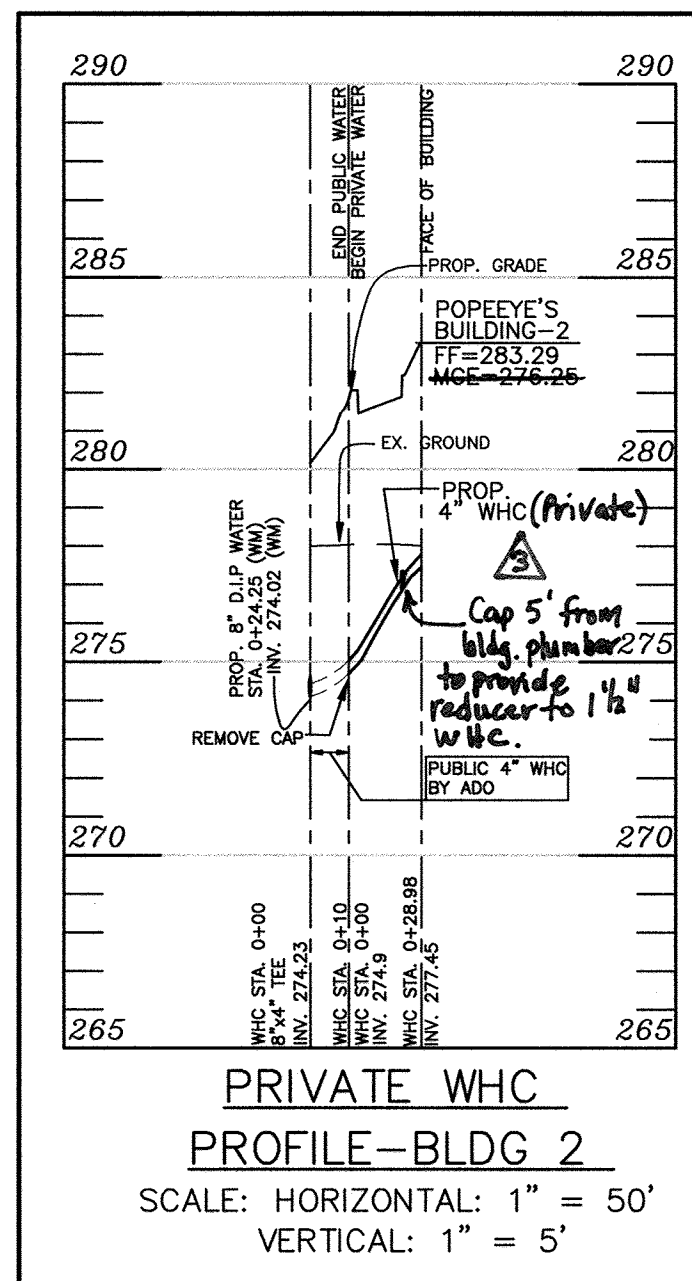

**PRIVATE WHC  
PROFILE-BLDG 2**  
SCALE: HORIZONTAL: 1" = 50'  
VERTICAL: 1" = 5'

**PRIVATE 6" WATER HOUSE CONNECTION**  
SCALE: HORIZONTAL: 1" = 50'  
VERTICAL: 1" = 5'

**PRIVATE SEWER HOUSE CONNECTION FROM BLDG-2**  
SCALE: HORIZONTAL: 1" = 50'  
VERTICAL: 1" = 5'

**PRIVATE SHC- FROM GREASE INTERCEPTOR TO BLDG-2**  
SCALE: HORIZONTAL: 1" = 50'  
VERTICAL: 1" = 5'

**PRIVATE 6" WATER HOUSE CONNECTION**  
SCALE: HORIZONTAL: 1" = 50'  
VERTICAL: 1" = 5'





SEDIMENT CONTROL LOCATION AND IMPLEMENTATION SHOWN ON THIS PLAN IS SUBJECT TO REVISIONS IN THE FIELD AT THE DISCRETION OF THE SEDIMENT CONTROL INSPECTOR

ALL SEDIMENT CONTROL FEATURES SHALL BE INSTALLED IN ACCORDANCE WITH STANDARD DETAILS SHOWN IN THE 2011 MARYLAND STANDARDS AND SPECIFICATIONS FOR SOIL EROSION AND SEDIMENT CONTROL.

**NOTE: FOR GREASE INTERCEPTOR DETAIL SEE SHEET NO. 8 OF 11**

 NOTE: ALL CLEANOUT FRAMES AND LIDS TO BE CAST IRON

QUANTITIES	
ITEMS	QUANTITIES ESTIMATED
4" WHC	19 L.F.
6" WHC	80 L.F.
4" SHC	143 L.F.
6" SHC	409 L.F.
SEWER CLEANOUT	17 EACH

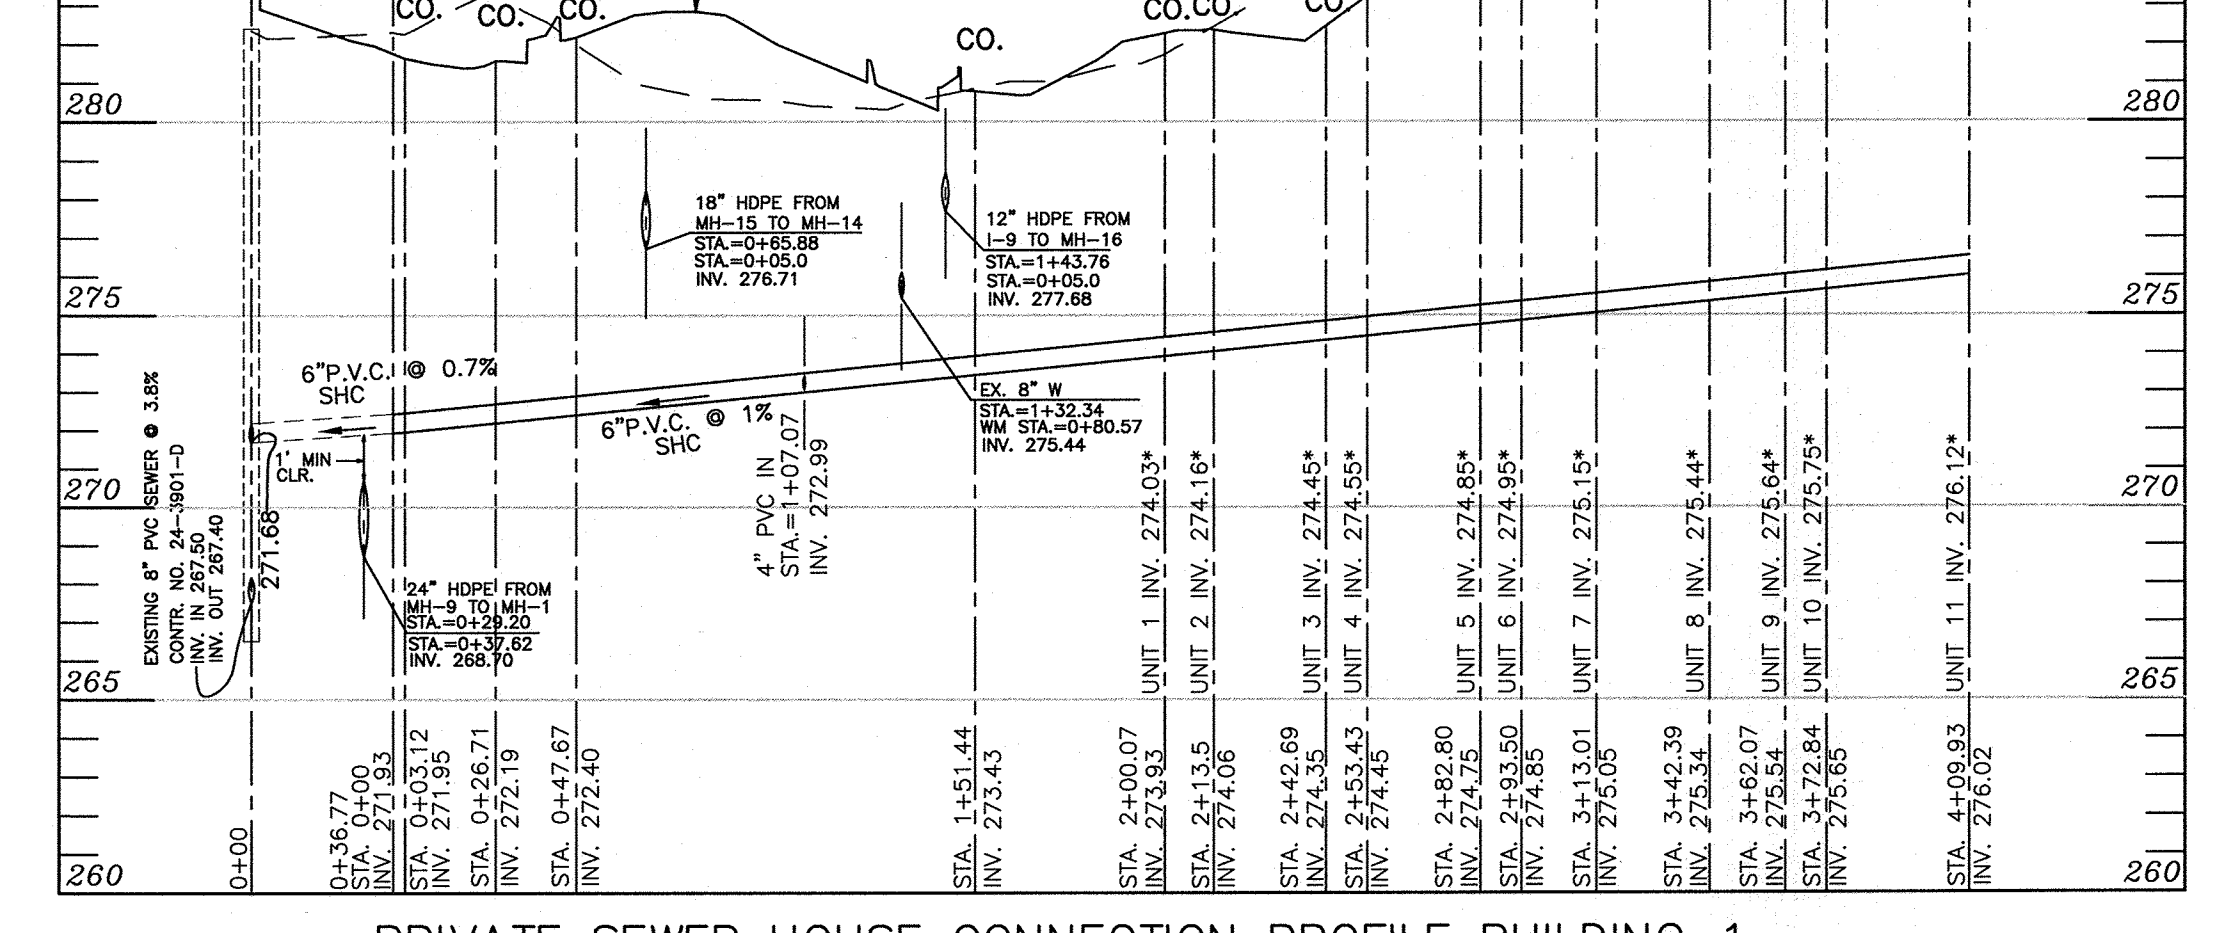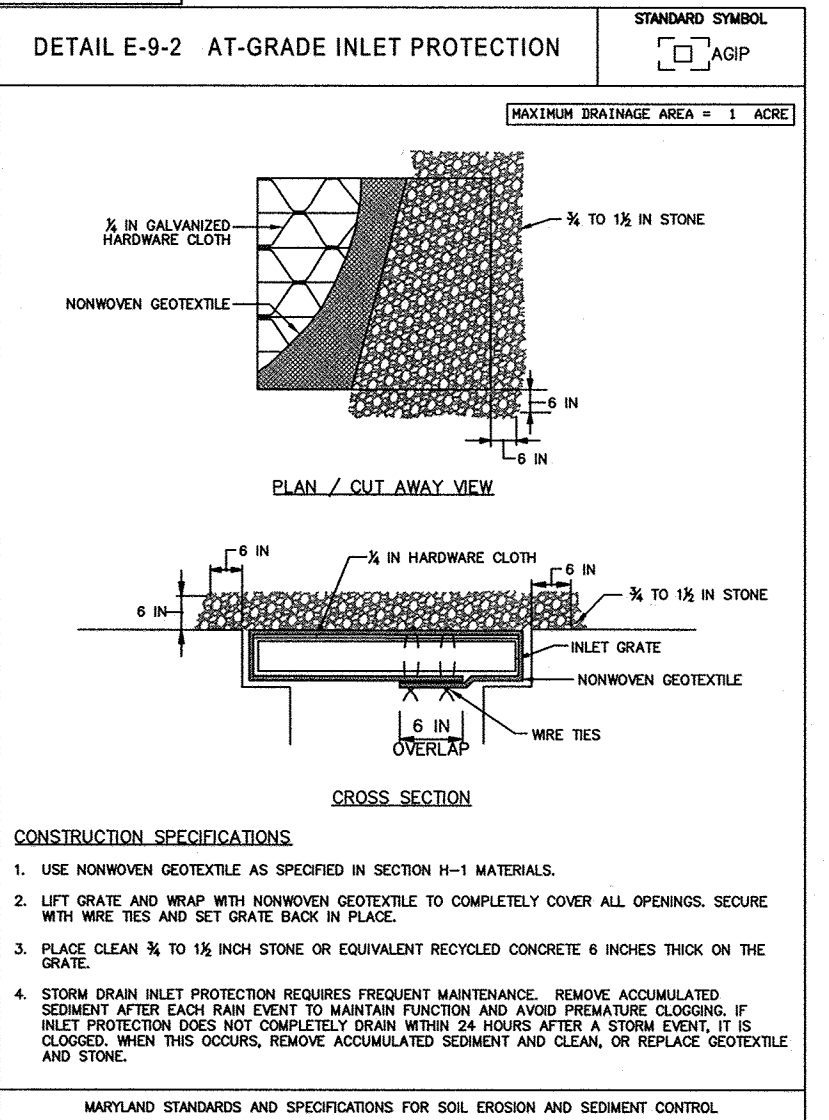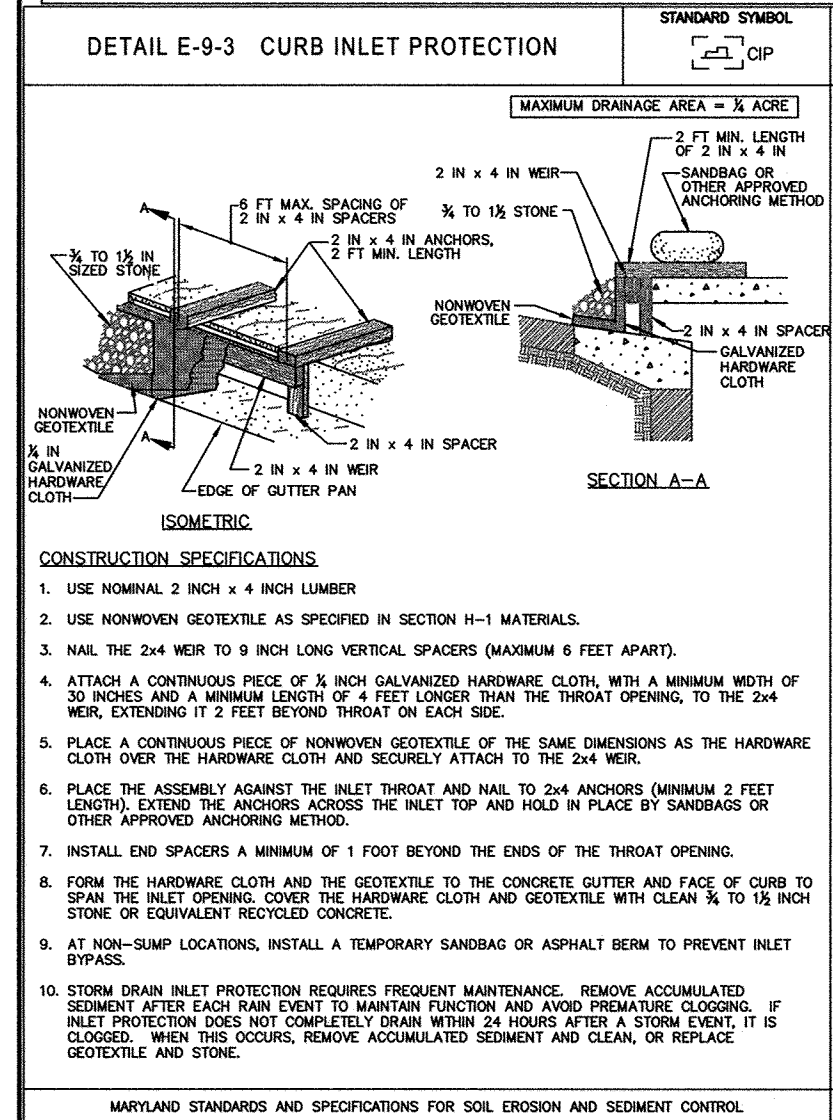







**PRIVATE SEWER HOUSE CONNECTION PROFILE BUILDING-1**  
SCALE: HORIZONTAL: 1" = 50'  
VERTICAL: 1" = 5'

"NO AS-BUILT INFORMATION IS PROVIDED ON THIS SHEET"



Professional Certification. I hereby certify that these documents were prepared or approved by me, and that I am a duly licensed professional engineer under the laws of the State of Maryland.

License No. 21113, Expiration Date: 12-21-20

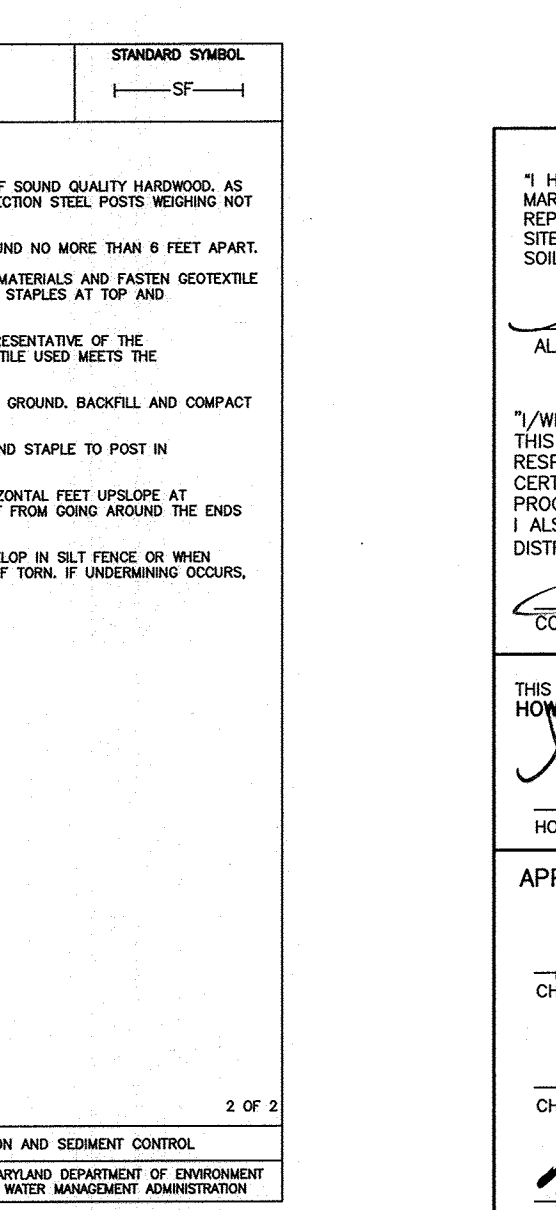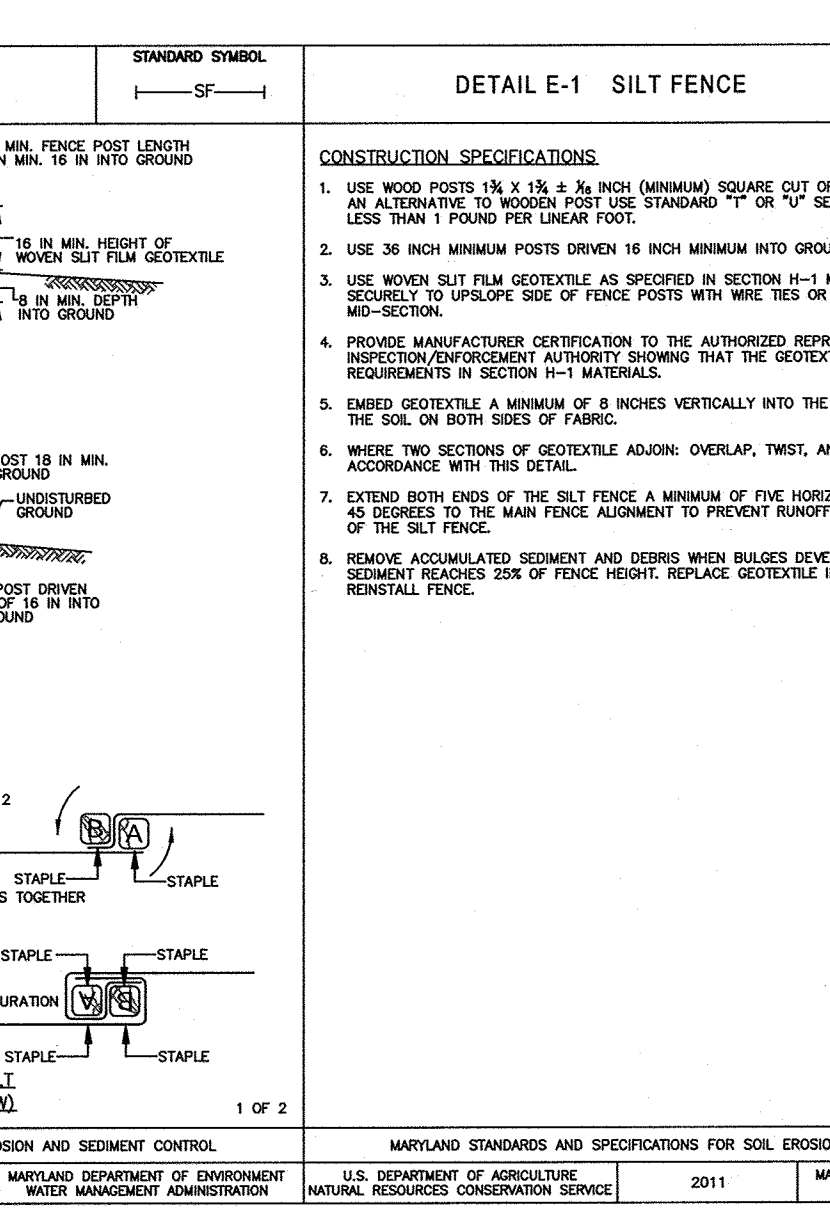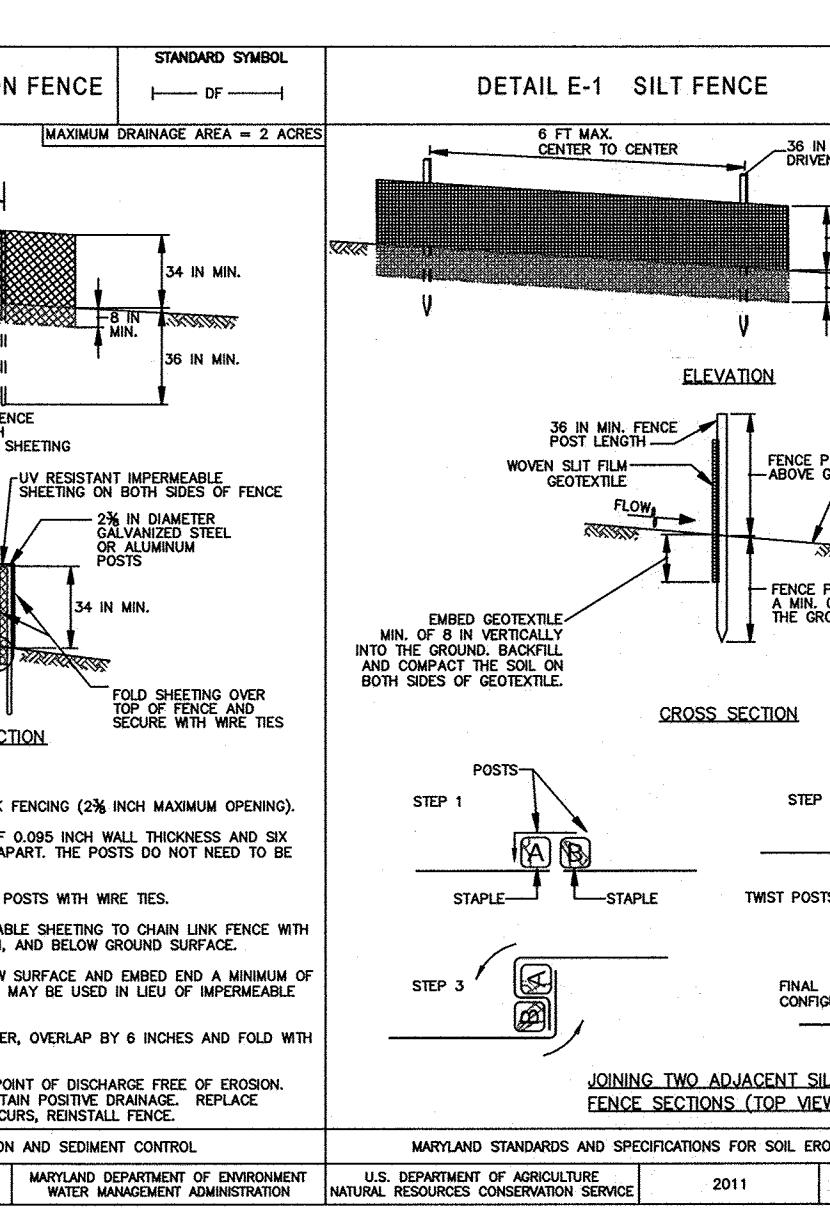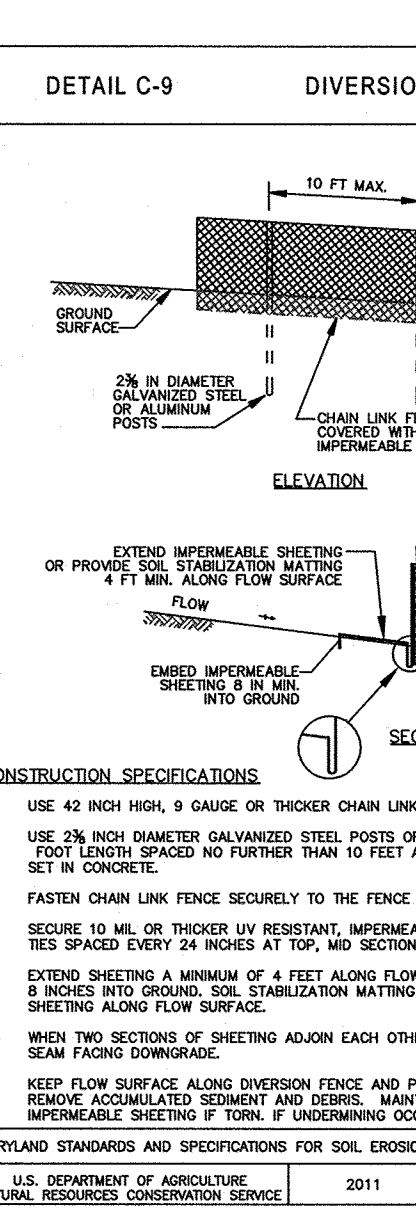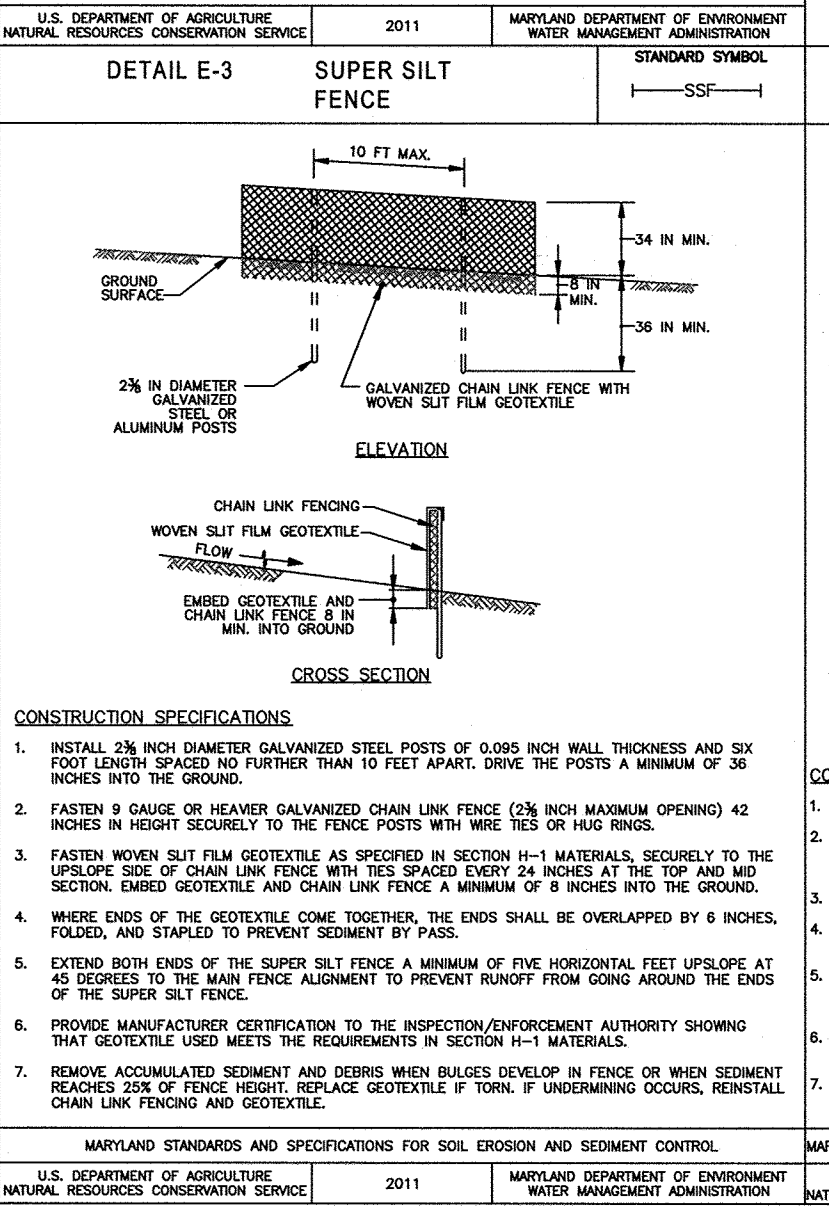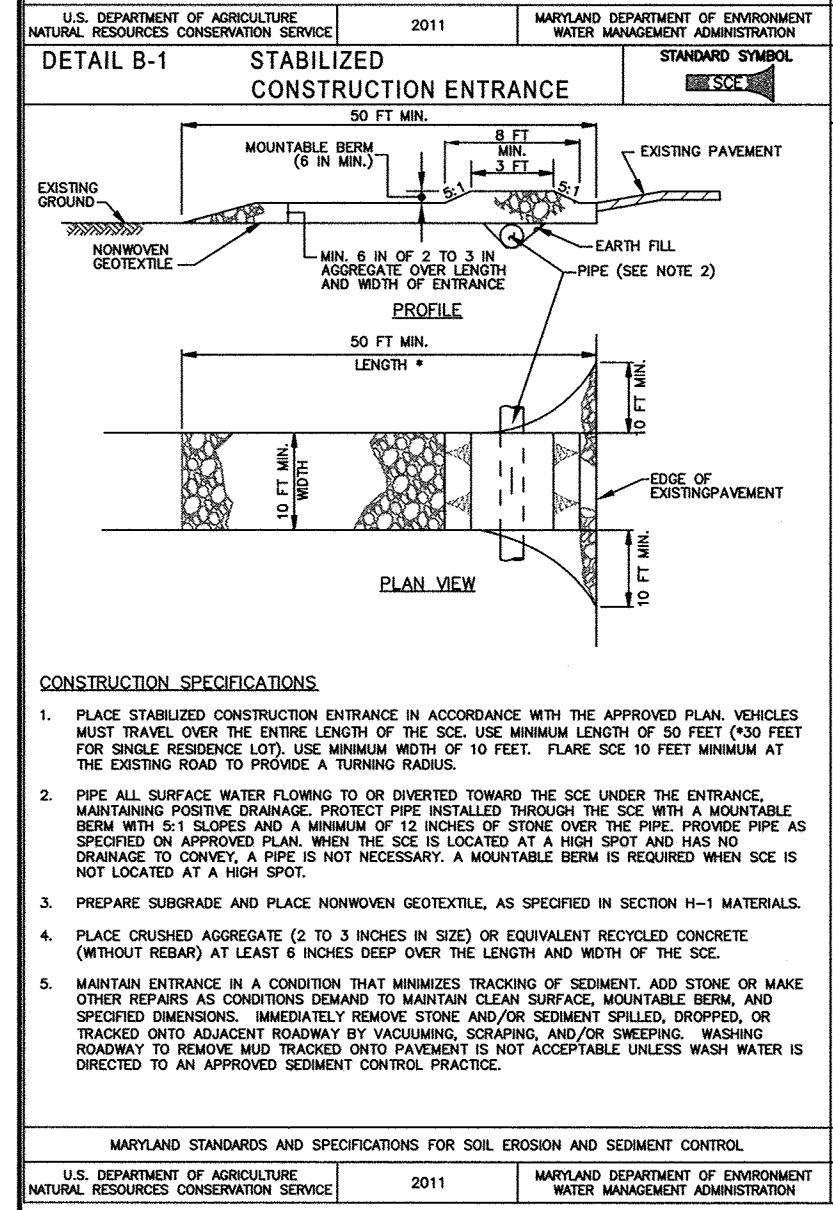

**ENGINEER'S CERTIFICATE**

I HEREBY CERTIFY THAT THIS PLAN HAS BEEN PREPARED IN ACCORDANCE WITH CURRENT MARYLAND EROSION AND SEDIMENT CONTROL LAWS, REGULATIONS, AND STANDARDS, THAT IT REPRESENTS A PRACTICAL AND WORKABLE PLAN BASED ON MY PERSONAL KNOWLEDGE OF THE SITE, AND THAT IT WAS PREPARED IN ACCORDANCE WITH THE REQUIREMENTS OF THE HOWARD COUNTY CONSERVATION DISTRICT.

Alice A. Miller, P.E. (MD. PE. 28376)

25 Jan 17

**DEVELOPER'S CERTIFICATE**

I/WE CERTIFY THAT ALL DEVELOPMENT AND CONSTRUCTION WILL BE DONE ACCORDING TO THIS PLAN OF DEVELOPMENT FOR SEDIMENT AND EROSION CONTROL, AND THAT ALL RESPONSIBLE PERSONNEL INVOLVED IN THE CONSTRUCTION PROJECT WILL HAVE A CERTIFICATE OF ATTENDANCE AT A DEPARTMENT OF THE ENVIRONMENT APPROVED TRAINING PROGRAM FOR THE CONTROL OF SEDIMENT AND EROSION BEFORE BEGINNING THE PROJECT. I ALSO AUTHORIZE PERIODIC ON-SITE INSPECTION BY THE HOWARD COUNTY CONSERVATION DISTRICT.

22 Jan 17

22 Jan 17

4-17-17

4-17-17

APPROVED: HOWARD COUNTY DEPARTMENT OF PLANNING AND ZONING

- SEQUENCE OF CONSTRUCTION**
1. NOTIFY SEDIMENT CONTROL DIVISION 48 HOURS PRIOR TO START OF CONSTRUCTION
  2. OBTAIN GRADING PERMIT AND REQUEST A PRECONSTRUCTION MEETING WITH THE HOWARD COUNTY SEDIMENT CONTROL INSPECTOR (INSPECTOR) 48 HOURS BEFORE ANY CONSTRUCTION ACTIVITIES. (DAY 1)
  3. INSTALL ALL STABILIZED CONSTRUCTION ENTRANCE, SUPER SILT FENCE AND DIVERSION FENCE. (DAY 2-5)
  4. CLEAR AND GRUB SITE. (DAY 6-8)
  5. MASS GRADE SITE AND STABILIZE IN ACCORDANCE WITH TEMPORARY SEEDING NOTES. (DAY 9-15)
  6. INSTALL STORM DRAIN FROM EXISTING MH TO EXISTING MH3. REMOVE EXISTING MH1 AND EXISTING MH2. BLOCK UNUSED OPENINGS IN EX. MH AND EX. MH3. (DAY 15-20)
  7. CONSTRUCT UNDERGROUND STORMWATER FACILITIES. (MAY OCCUR SIMULTANEOUSLY WITH UTILITY AND STORM DRAIN CONSTRUCTION) BLOCK ALL INLETS UNTIL SITE IS FULLY STABILIZED. (DAY 21-45)
  8. INSTALL STORM DRAINS, BLOCKING OUTLETS TO UNDERGROUND SWM FACILITIES. AS INLET CONSTRUCTION COMMENCES, IMMEDIATELY INSTALL INLET PROTECTION AS SPECIFIED. INLETS 1-4, 1-8 AND 1-9 SHOULD BE WRAPPED IN SUPER SILT FENCE IN ADDITION TO INLET PROTECTION. INSTALLATION OF TRENCH DRAIN 1-5 SHALL BE DELAYED UNTIL THE DRAINAGE AREA IS STABILIZED WITH STONE BASE. (DAY 24-45)
  9. INSTALL CURB & GUTTER AND PAVING, AND STABILIZE ISLANDS IN ACCORDANCE WITH PERMANENT SEEDING NOTES (DAY 46-97)
  10. INSTALL FILTER MEDIA IN SAND FILTERS, AND REMOVE BLOCKING FROM DIVERSION MANHOLES AND INLET PIPES. (DAY 97-102)
  11. UPON APPROVAL OF THE HOWARD COUNTY SEDIMENT CONTROL INSPECTOR, REMOVE SEDIMENT CONTROL DEVICES, AND STABILIZE DISTURBED AREAS IN ACCORDANCE WITH THE PERMANENT SEEDING NOTES. (DAY 102-104)

- STANDARD SEDIMENT CONTROL NOTES**
1. A PRE-CONSTRUCTION MEETING MUST OCCUR WITH THE HOWARD COUNTY DEPARTMENT OF PUBLIC WORKS, CONSTRUCTION INSPECTION DIVISION (CID) 10-315-1855 AFTER THE FUTURE LOD AND PROTECTED AREAS ARE MARKED CLEARLY IN THE FIELD. A MINIMUM OF 48 HOURS NOTICE TO CID MUST BE GIVEN AT THE FOLLOWING STAGES:
    - A. PRIOR TO THE START OF EARTH DISTURBANCE.
    - B. UPON COMPLETION OF THE INSTALLATION OF PERIMETER EROSION AND SEDIMENT CONTROLS, BUT BEFORE PROCEEDING WITH ANY OTHER EARTH DISTURBANCE OR GRADING.
    - C. PRIOR TO THE START OF ANOTHER PHASE OF CONSTRUCTION OR OPENING OF ANOTHER GRADING UNIT.
    - D. PRIOR TO THE REMOVAL OR MODIFICATION OF SEDIMENT CONTROL PRACTICES.
  2. AGENCY IS MADE OF OTHER RELATED STATE AND FEDERAL PERMITS SHALL BE REFERENCED, TO ENSURE COORDINATION AND TO AVOID CONFLICTS WITH THIS PLAN.
  3. ALL VEGETATIVE AND STRUCTURAL PRACTICES ARE TO BE INSTALLED ACCORDING TO THE PROVISIONS OF THIS PLAN AND ARE TO BE IN CONFORMANCE WITH THE 2011 MARYLAND STANDARDS AND SPECIFICATIONS FOR SOIL EROSION AND SEDIMENT CONTROL, AND REVISIONS THEREOF.
  4. FOLLOWING INITIAL SOIL DISTURBANCE OR RE-DISTURBANCE, PERMANENT OR TEMPORARY STABILIZATION IS REQUIRED WITHIN THREE (3) CALENDAR DAYS AS TO THE SURFACE OF ALL PERIMETER CONTROLS, DIKES, SWALES, DITCHES, PERIMETER SLOPES, AND ALL SLOPES STEEPER THAN 3 HORIZONTAL TO 1 VERTICAL (3:1); AND SEVEN (7) CALENDAR DAYS AS TO ALL OTHER DISTURBED AREAS ON THE PROJECT SITE EXCEPT FOR THOSE AREAS UNDER ACTIVE GRADING.
  5. ALL DISTURBED AREAS MUST BE STABILIZED WITHIN THE TIME PERIOD SPECIFIED ABOVE IN ACCORDANCE WITH THE 2011 MARYLAND STANDARDS AND SPECIFICATIONS FOR SOIL EROSION AND SEDIMENT CONTROL, FOR TOPSOIL (SEC. B-4-2), PERMANENT SEEDING (SEC. B-4-3), TEMPORARY SEEDING (SEC. B-4-4) AND MULCHING (SEC. B-4-5). TEMPORARY STABILIZATION WITH MULCH ALONE CAN ONLY BE APPLIED BETWEEN THE FALL AND SPRING SEEDING DATES IF THE GROUND IS FIRM, INCREASING STABILIZATION (SEC. B-4-1) SPECIFICATIONS SHALL BE ENFORCED IN AREAS WITH >15' OF CUT AND/OR FILL, STOCKPILES (SEC. B-4-8) IN EXCESS OF 20 FT. MUST BE BENCHED WITH STABLE CUTS. ALL CONCENTRATED FLOW, STEEP SLOPES, AND HIGHLY ERODIBLE AREAS SHALL RECEIVE SOIL STABILIZATION MATTING (SEC. B-4-6).
  6. ALL SEDIMENT CONTROL STRUCTURES ARE TO REMAIN IN PLACE, AND ARE TO BE MAINTAINED IN OPERATIVE CONDITION UNTIL PERMISSION FOR THEIR REMOVAL HAS BEEN OBTAINED FROM THE CID.
  7. SITE ANALYSIS:
 

TOTAL AREA OF SITE:	3.68 ACRES
AREA TO BE ROOFED OR PAVED:	2.46 ACRES
AREA TO BE DISTURBED:	1.22 ACRES
TOTAL CUT:	19,746 CU. YDS.
TOTAL FILL:	0 CU. YDS.
  8. OFFSITE WASTE/BORROW AREA LOCATION: TO BE DETERMINED BY CONTRACTOR
  9. ANY SEDIMENT CONTROL PRACTICE WHICH IS DISTURBED BY GRADING ACTIVITY FOR PLACEMENT OF UTILITIES MUST BE REPAIRED ON THE SAME DATE OF DISTURBANCE.
  10. ADDITIONAL SEDIMENT CONTROL MUST BE PROVIDED, IF DEEMED NECESSARY BY THE CID. THE SITE AND ALL CONTROLS SHALL BE INSPECTED BY THE CONTRACTOR WEEKLY, AND THE NEXT DAY AFTER EACH RAIN EVENT. A WRITTEN REPORT BY THE CONTRACTOR, MADE AVAILABLE UPON REQUEST, IS PART OF EVERY INSPECTION AND SHOULD INCLUDE:
    - INSPECTION DATE
    - INSPECTION TYPE (ROUTINE, PRE-STORM EVENT, DURING RAIN EVENT)
    - NAME AND TITLE OF INSPECTOR
    - WEATHER INFORMATION (CURRENT CONDITIONS AS WELL AS TIME AND AMOUNT OF LAST RECORDED PRECIPITATION)
    - BRIEF DESCRIPTION OF PROJECT'S STATUS (E.G. PERCENT COMPLETE) AND/OR CURRENT ACTIVITIES
    - EVIDENCE OF SEDIMENT DISCHARGES
    - IDENTIFICATION OF PLAN DEFICIENCIES
    - IDENTIFICATION OF SEDIMENT CONTROLS THAT REQUIRE MAINTENANCE
    - IDENTIFICATION OF MISSING OR IMPROPERLY INSTALLED SEDIMENT CONTROLS
    - COMPLIANCE STATUS REGARDING THE SEQUENCE OF CONSTRUCTION AND STABILIZATION REQUIREMENTS
    - PHOTOGRAPHS
    - MONITORING/SAMPLING
    - MAINTENANCE AND/OR CORRECTIVE ACTION PERMITTED
    - OTHER INSPECTION ITEMS AS REQUIRED BY THE GENERAL PERMIT FOR STORMWATER ASSOCIATED WITH CONSTRUCTION ACTIVITIES (MPODES, MDE).
  11. DISTURBANCE SHALL NOT OCCUR OUTSIDE THE L.O.D. A PROJECT IS TO BE SEQUENCED SO THAT GRADING ACTIVITIES BEGIN ON ONE GRADING UNIT (MAXIMUM INCREASE OF 20 AC. PER GRADING UNIT) AT A TIME. WORK MAY PROCEED TO A SUBSEQUENT GRADING UNIT WHEN AT LEAST 50 PERCENT OF THE DISTURBED AREA IN THE PRECEDING GRADING UNIT HAS BEEN STABILIZED AND APPROVED BY THE CID. UNLESS OTHERWISE SPECIFIED AND APPROVED BY THE CID, NO MORE THAN 30 ACRES CUMULATIVELY MAY BE DISTURBED AT A GIVEN TIME.
  12. WASH WATER FROM ANY EQUIPMENT, VEHICLES, WHEELS, PAVEMENT, AND OTHER SOURCES MUST BE TREATED IN A SEDIMENT BASIN OR OTHER APPROVED WASHOUT STRUCTURE.
  13. TOPSOIL SHALL BE STOCKPILED AND PRESERVED ON-SITE FOR REDISTRIBUTION ONTO FINAL GRADE.
  14. ALL SILT FENCE AND SUPER SILT FENCE SHALL BE PLACED ON-THE-COUNTOUR, AND BE IMBRICATED AT 25' MINIMUM INTERVALS, WITH LOWER ENDS CURLED UPWARD.
  15. STREAM CHANNELS MUST NOT BE DISTURBED DURING THE FOLLOWING RESTRICTED TIME PERIODS (INCLUSIVE):
    - USE I AND IP MARCH 1 - JUNE 15
    - USE II AND IP OCTOBER 1 - APRIL 30
    - USE IV MARCH 1 - MAY 31
  16. A COPY OF THIS PLAN, THE 2011 MARYLAND STANDARDS AND SPECIFICATIONS FOR SOIL EROSION AND SEDIMENT CONTROL, AND ASSOCIATED PERMITS SHALL BE ON-SITE AND AVAILABLE WHEN THE SITE IS ACTIVE.

NO.	DATE	REVISION
4	1-31-18	REVISE WMC BLD. 1
3	02-27-20	SHOW PRIVATE 4" WPC STOPPING 5' FROM BLDG. - REDUCE TO 1 1/2" WMC
2	DEC 16	SHEET SUBSTITUTION TO REVISE ROOF DRAINS, SEWER HOUSE CONNECTION AND PAVE OUTCROP.
1	FEB 16	REVISE BY SHEET SUBSTITUTION POPEY'S BUILDING FOOTPRINT AND ASSOCIATED ITEMS

DEVELOPER: COLUMBIA JUNCTION DEV. LLC  
100 MENLO PARK DRIVE, SUITE 500  
EDISON, NEW JERSEY 08837  
201-314-6049

PROJECT: COLUMBIA JUNCTION SECTION 3 / LOT A-2 (RETAIL CENTER)

LOCATION: TAX MAP 48 - BLOCK 1 PARCEL 548  
6th ELECTION DISTRICT  
HOWARD COUNTY, MARYLAND

TITLE: REVISED SITE DEVELOPMENT PLAN  
SEDIMENT AND EROSION CONTROL  
PLAN, NOTES AND DETAILS  
AND WHC PROFILE AND SHC PROFILE

DATE: JANUARY, 2017 PROJECT NO. 1221  
SCALE: AS SHOWN DRAWING 4 OF 11

Design: DAM/AAM Draft: HP/AAM Check: CAM/AAM

**AS-BUILT** SDP-08-100

**B-4 STANDARDS AND SPECIFICATIONS FOR VEGETATIVE STABILIZATION**  
**Definition**  
 Using vegetation as cover to protect exposed soil from erosion.  
**Purpose**  
 To promote the establishment of vegetation on exposed soil.  
**Conditions Where Practice Applies**  
 On all disturbed areas not stabilized by other methods. This specification is divided into sections on incremental stabilization; soil preparation, soil amendments and topsoiling; seeding and mulching; temporary stabilization; and permanent stabilization.  
**Effects on Water Quality and Quantity**  
 Stabilization practices are used to promote the establishment of vegetation on exposed soil. When soil is stabilized with vegetation, the soil is less likely to erode and more likely to allow infiltration of rainfall, thereby reducing sediment loads and runoff to downstream areas.  
 Planting vegetation in disturbed areas will have an effect on the water budget, especially on volumes and rates of runoff, infiltration, evaporation, transpiration, percolation, and groundwater recharge. Over time, vegetation will increase organic matter content and improve the water holding capacity of the soil and subsequent plant growth.  
 Vegetation will help reduce the movement of sediment, nutrients, and other chemicals carried by runoff to receiving waters. Plants will also help protect groundwater supplies by assimilating those substances present within the root zone.  
 Sediment control practices must remain in place during grading, seedbed preparation, seeding, mulching, and vegetative establishment.  
**Adequate Vegetative Establishment**  
 Inspect seeded areas for vegetative establishment and make necessary repairs, replacements, and reseedings within the planting season.  
 1. Adequate vegetative stabilization requires 95 percent groundcover.  
 2. If an area has less than 40 percent groundcover, reestablish following the original recommendations for lime, fertilizer, seedbed preparation, and seeding.  
 3. If an area has between 40 and 94 percent groundcover, over-seed and fertilize using half of the rates originally specified.  
 4. Maintenance fertilizer rates for permanent seeding are shown in Table B.6.

**B-4-1 STANDARDS AND SPECIFICATIONS FOR INCREMENTAL STABILIZATION**  
**Definition**  
 Establishment of vegetative cover on cut and fill slopes.  
**Purpose**  
 To provide timely vegetative cover on cut and fill slopes as work progresses.  
**Conditions Where Practice Applies**  
 Any cut or fill slope greater than 15 feet in height. This practice also applies to stockpiles.  
**Criteria**  
**A. Incremental Stabilization - Cut Slopes**  
 1. Excavate and stabilize cut slopes in increments not to exceed 15 feet in height. Prepare seedbed and apply seed and mulch on all cut slopes as the work progresses.  
 2. Construction sequence example (Refer to Figure B.1):  
 a. Construct and stabilize all temporary swales or dikes that will be used to convey runoff around the excavation.  
 b. Perform Phase 1 excavation, prepare seedbed, and stabilize.  
 c. Perform Phase 2 excavation, prepare seedbed, and stabilize. Overseed Phase 1 areas as necessary.  
 d. Perform final phase excavation, prepare seedbed, and stabilize. Overseed previously seeded areas as necessary.  
 Note: Once excavation has begun the operation should be continuous from grubbing through the completion of grading and placement of topsoil (if required) and permanent seed and mulch. Any interruptions in the operation or completing the operation out of the seeding season will necessitate the application of temporary stabilization.  
**B. Incremental Stabilization - Fill Slopes**  
 1. Construct and stabilize fill slopes in increments not to exceed 15 feet in height. Prepare seedbed and apply seed and mulch on all slopes as the work progresses.  
 2. Stabilize slopes immediately when the vertical height of a lift reaches 15 feet, or when the grading operation ceases as prescribed in the plans.  
 3. At the end of each day, install temporary water conveyance practice(s), as necessary, to intercept surface runoff and convey it down the slope in a non-erosive manner.  
 4. Construction sequence example (Refer to Figure B.2):  
 a. Construct and stabilize all temporary swales or dikes that will be used to divert runoff around the fill. Construct silt fence on low side of fill unless other methods shown on the plans address this area.  
 b. At the end of each day, install temporary water conveyance practice(s), as necessary, to intercept surface runoff and convey it down the slope in a non-erosive manner.  
 c. Place Phase 1 fill, prepare seedbed, and stabilize.  
 d. Place Phase 2 fill, prepare seedbed, and stabilize.  
 e. Place final phase fill, prepare seedbed, and stabilize. Overseed previously seeded areas as necessary.  
 Note: Once the placement of fill has begun the operation should be continuous from grubbing through the completion of grading and placement of topsoil (if required) and permanent seed and mulch. Any interruptions in the operation or completing the operation out of the seeding season will necessitate the application of temporary stabilization.

**B-4-2 STANDARDS AND SPECIFICATIONS FOR SOIL PREPARATION, TOPSOILING, AND SOIL AMENDMENTS**  
**Definition**  
 The process of preparing the soils to sustain adequate vegetative stabilization.  
**Purpose**  
 To provide a suitable soil medium for vegetative growth.  
**Conditions Where Practice Applies**  
 Where vegetative stabilization is to be established.  
**Criteria**  
**A. Soil Preparation**  
 1. Temporary Stabilization  
 a. Seedbed preparation consists of loosening soil to a depth of 3 to 5 inches by means of suitable agricultural or construction equipment, such as disc harrows or chisel plows or rippers mounted on construction equipment. After the soil is loosened, it must not be rolled or dragged smooth but left in the roughened condition. Slopes 3:1 or flatter are to be tracked with ridges running parallel to the contour of the slope.  
 b. Apply fertilizer and lime as prescribed on the plans.  
 c. Incorporate lime and fertilizer into the top 3 to 5 inches of soil by disking or other suitable means.  
 2. Permanent Stabilization  
 a. A soil test is required for any earth disturbance of 5 acres or more. The minimum soil conditions required for permanent vegetative establishment are:  
 i. Soil pH between 6.0 and 7.0.  
 ii. Soluble salts less than 500 parts per million (ppm).  
 iii. Soil contains less than 40 percent clay but enough fine grained material (greater than 30 percent silt plus clay) to provide the capacity to hold a moderate amount of moisture. An exception: if lovegrass will be planted, then a sandy soil (less than 30 percent silt plus clay) would be acceptable.  
 iv. Soil contains 1.5 percent minimum organic matter by weight.  
 v. Soil contains sufficient pore space to permit adequate root penetration.  
 b. Application of amendments or topsoil is required on site soils do not meet the above conditions.  
 c. Graded areas must be maintained in a true and even grade as specified on the approved plan, then scarified or otherwise loosened to a depth of 3 to 5 inches.  
 d. Apply soil amendments as specified on the approved plan or as indicated by the results of a soil test.  
 e. Mix soil amendments into the top 3 to 5 inches of soil by disking or other suitable means. Rake lawn areas to smooth the surface, remove large objects like stones and branches, and ready the area for seed application. Loosen surface soil by dragging with a heavy chain or other equipment to roughen the surface where site conditions will not permit normal seedbed preparation. Track slopes 3:1 or flatter with tracked equipment leaving the soil in an irregular condition with ridges running parallel to the contour of the slope. Leave the top 1 to 3 inches of soil loose and friable. Seeding/loosening may be unnecessary on newly disturbed areas.  
**B. Topsoiling**  
 1. Topsoil is placed over prepared subsoil prior to establishment of permanent vegetation. The purpose is to provide a suitable soil medium for vegetative growth. Soils of concern have low moisture content, low nutrient levels, low pH, materials toxic to plants, and/or unacceptable soil gradation.  
 2. Topsoil salvaged from an existing site may be used provided it meets the standards as set forth in these specifications. Typically, the depth of topsoil to be salvaged for a given soil type can be found in the representative soil profile section in the Soil Survey published by USDA-NRCS.  
 3. Topsoiling is limited to areas having 2:1 or flatter slopes where:  
 a. The texture of the exposed subsoil/parent material is not adequate to produce vegetative growth.  
 b. The soil material is so shallow that the rooting zone is not deep enough to support plants or furnish confining supplies of moisture and plant nutrients.  
 c. The original soil to be vegetated contains material toxic to plant growth.  
 d. The soil is so acidic that treatment with limestone is not feasible.  
 4. Areas having slopes steeper than 2:1 require special consideration and design.  
 5. Topsoil Specifications: Soil to be used as topsoil must meet the following criteria:  
 a. Topsoil must be a loam, sandy loam, clay loam, silt loam, sandy clay loam, or loamy sand. Other soils may be used if recommended by an agronomist or soil scientist and approved by the appropriate approval authority. Topsoil must not be a mixture of contrasting textured subsoils and must contain less than 5 percent by volume of cinders, stones, silt, coarse fragments, gravel, sticks, roots, trash, or other materials larger than 1 1/2 inches in diameter.

**B-4-3 STANDARDS AND SPECIFICATIONS FOR SEEDING AND MULCHING**  
**Definition**  
 The application of seed and mulch to establish vegetative cover.  
**Purpose**  
 To protect disturbed soils from erosion during and at the end of construction.  
**Conditions Where Practice Applies**  
 To the surface of all perimeter controls, slopes, and any disturbed area not under active grading.  
**Criteria**  
**A. Seeding**  
 1. Specifications  
 a. All seed must meet the requirements of the Maryland State Seed Law. All seed must be subject to re-testing by a recognized seed laboratory. All seed used must have been tested within the 6 months immediately preceding the date of sowing such material on any project. Refer to Table B.4 regarding the quality of seed. Seed tags must be available upon request to the inspector to verify type of seed and seeding rate.  
 b. Mulch alone may be applied between the fall and spring seeding dates only if the ground is frozen. The appropriate seeding method must be applied when the ground thaws.  
 c. Inoculants: The inoculant for treating legume seed in the seed mixtures must be a pure culture of nitrogen fixing bacteria prepared specifically for the species. Inoculants must not be used later than the date indicated on the container. Add fresh inoculants as directed on the package. Use four times the recommended rate when hydroseeding. Note: It is very important to keep inoculant as cool as possible upon use. Temperatures above 75 to 80 degrees Fahrenheit can weaken bacteria and make the inoculant less effective.  
 d. Soil or seed must not be placed on soil which has been treated with soil sterilants or chemicals used for weed control until sufficient time has elapsed (14 days min.) to permit dissipation of phytotoxic materials.  
 2. Application  
 a. Dry Seeding: This includes use of conventional drop or broadcast spreaders.  
 i. Incorporate seed into the subsoil at the rates prescribed on Temporary Seeding Table B.1, Permanent Seeding Table B.3, or site-specific seeding summaries.  
 ii. Apply seed in two directions, perpendicular to each other. Apply half the seeding rate in each direction. Roll the seeded area with a weighted roller to provide good seed to soil contact.  
 b. Drill or Cultipacker Seeding: Mechanized seeders that apply and cover seed with soil.  
 i. Cultipacker seeders are required to bury the seed in such a fashion as to provide at least 1/4 inch of soil covering. Seedbed must be firm after planting.  
 ii. Apply seed in two directions, perpendicular to each other. Apply half the seeding rate in each direction.  
 c. Hydroseeding: Apply seed uniformly with hydroseeder (slurry includes seed and fertilizer).  
 i. If fertilizer is being applied at the time of seeding, the application rates should not exceed the following: nitrogen, 100 pounds per acre total of soluble nitrogen; P2O5 (phosphorus), 200 pounds per acre; K2O (potassium), 200 pounds per acre.  
 ii. Lime: Use only ground agricultural limestone (up to 3 tons per acre may be applied by hydroseeding). Normally, not more than 2 tons are applied by hydroseeding at any one time. Do not use burnt or hydrated lime when hydroseeding.  
 iii. Mix seed and fertilizer on site and seed immediately and without interruption.  
 iv. When hydroseeding do not incorporate seed into the soil.  
**B. Mulching**  
 1. Mulch Materials (in order of preference)  
 a. Straw consisting of thoroughly threshed wheat, rye, oat, or barley and reasonably bright in color. Straw is to be free of noxious weed seeds as specified in the Maryland Seed Law and not musty, moldy, caked, decayed, or excessively dusty. Note: Use only sterile straw mulch in areas where one species of grass is desired.  
 b. Wood Cellulose Fiber Mulch (WCFM) consisting of specially prepared wood cellulose processed into a uniform fibrous physical state.  
 i. WCFM is to be dyed green or contain a green dye in the package that will provide an appropriate color to facilitate visual inspection of the uniformly spread slurry.  
 ii. WCFM, including dye, must contain no germination or growth inhibiting factors.  
 iii. WCFM materials are to be manufactured and processed in such a manner that the wood cellulose fiber mulch will remain in uniform suspension in water under agitation and will blend with seed, fertilizer and other additives to form a homogeneous slurry. The mulch material must provide a blotter-like ground cover, on application, having moisture absorption and percolation properties and must cover and hold grass seed in contact with the soil without inhibiting the growth of the grass seedlings.  
 iv. WCFM material must not contain elements or compounds at concentration levels that will be phytotoxic.  
 v. WCFM must conform to the following physical requirements: fiber length of approximately 10 millimeters, diameter approximately 1 millimeter, pH range of 4.0 to 8.5, ash content of 1.6 percent maximum and water holding capacity of 50 percent minimum.  
 2. Application  
 a. Apply mulch to all seeded areas immediately after seeding.  
 b. When straw mulch is used, spread it over all seeded areas at a rate of 2 tons per acre to a uniform loose depth of 1 to 2 inches. Apply mulch to achieve a uniform distribution and depth so that the soil surface is not exposed. When using a mulch anchoring tool, increase the application rate to 2.5 tons per acre.  
 c. Wood cellulose fiber used as mulch must be applied at a net dry weight of 1500 pounds per acre. Mix the wood cellulose fiber with water to attain a mixture with a maximum of 50 pounds of wood cellulose fiber per 100 gallons of water.  
 3. Anchoring  
 a. Perform mulch anchoring immediately following application of mulch to minimize loss by wind or water. This may be done by one of the following methods (listed by preference), depending upon the size of the area and erosion hazard:  
 i. A mulch anchoring tool is a tractor drawn implement designed to punch and anchor mulch into the soil surface a minimum of 2 inches. This practice is most effective on large areas, but is limited to flatter slopes where equipment can operate safely. If used on sloping land, this practice should follow the contour.  
 ii. Wood cellulose fiber may be used for anchoring straw. Apply the fiber binder at a net dry weight of 750 pounds per acre. Mix the wood cellulose fiber with water at a maximum of 50 pounds of wood cellulose fiber per 100 gallons of water.  
 iii. Striped binders such as Acrylic DLR (Agra-Tack), DCA-75, Petrosel, Terra Tax II, Terra Tack AP or other approved equal may be used. Follow application rates as specified by the manufacturer. Application of liquid binders needs to be heavier at the edges where wind catches mulch, such as in valleys and on crests of banks. Use of asphalt binders is strictly prohibited.  
 iv. Lightweight plastic netting may be stapled over the mulch according to manufacturer recommendations. Netting is usually available in rolls 4 to 15 feet wide and 300 to 3,000 feet long.


SEDIMENT CONTROL LOCATION AND IMPLEMENTATION SHOWN ON THIS PLAN IS SUBJECT TO REVISIONS IN THE FIELD AT THE DISCRETION OF THE SEDIMENT CONTROL INSPECTOR.  
 ALL SEDIMENT CONTROL FEATURES SHALL BE INSTALLED IN ACCORDANCE WITH STANDARD DETAILS SHOWN IN THE 1994 MARYLAND STANDARDS AND SPECIFICATIONS FOR SOIL EROSION AND SEDIMENT CONTROL.  
 2011

**B-4-4 STANDARDS AND SPECIFICATIONS FOR TEMPORARY STABILIZATION**  
**Definition**  
 To stabilize disturbed soils with vegetation for up to 6 months.  
**Purpose**  
 To use fast growing vegetation that provides cover on disturbed soils.  
**Conditions Where Practice Applies**  
 Exposed soils where ground cover is needed for a period of 6 months or less. For longer duration of time, permanent stabilization practices are required.  
**Criteria**  
 1. Select one or more of the species or seed mixtures listed in Table B.1 for the appropriate Plant Hardiness Zone (from Figure B.3), and enter them in the Temporary Seeding Summary below along with application rates, seeding dates and seeding depths. If this Summary is not put on the plan and completed, then Table B.1 plus fertilizer and lime rates must be put on the plan.  
 2. For sites having soil tests performed, use and show the recommended rates by the testing agency. Soil tests are not required for Temporary Seeding Summary.  
 3. When stabilization is required outside of a seeding season, apply seed and mulch or straw mulch alone as prescribed in Section B-4-3.A.1.b and maintain until the next seeding season.

**B-4-5 STANDARDS AND SPECIFICATIONS FOR PERMANENT STABILIZATION**  
**Definition**  
 To stabilize disturbed soils with permanent vegetation.  
**Purpose**  
 To use long-lived perennial grasses and legumes to establish permanent ground cover on disturbed soils.  
**Conditions Where Practice Applies**  
 Exposed soils where ground cover is needed for 6 months or more.  
**Criteria**  
**A. Seed Mixtures**  
 1. General Use  
 a. Select one or more of the species or mixtures listed in Table B.3 for the appropriate Plant Hardiness Zone (from Figure B.3) and based on the site condition or purpose found on Table B.2. Enter selected mixture(s), application rates, and seeding dates in the Permanent Seeding Summary. The Summary is to be placed on the plan.  
 b. Additional planning specifications for exceptional sites such as shorelines, stream banks, or dunes or for special purposes such as wildlife or aesthetic treatment may be found in USDA-NRCS Technical Field Office Guide, Section 342 - Critical Area Planting.  
 c. For sites having disturbed areas over 5 acres, use and show the rates recommended by the soil testing agency.  
 d. For areas receiving low maintenance, apply urea form fertilizer (46-0-0) at 3 1/2 pounds per 1000 square feet (150 pounds per acre) at the time of seeding in addition to the soil amendments shown in the Permanent Seeding Summary.  
 2. Turfgrass Mixtures  
 a. Areas where turfgrass may be desired include lawns, parks, playgrounds, and commercial sites which will receive a medium to high level of maintenance.  
 b. Select one or more of the species or mixtures listed below based on the site conditions or purpose. Enter selected mixture(s), application rates, and seeding dates in the Permanent Seeding Summary. The summary is to be placed on the plan.  
 i. Kentucky Bluegrass: Full Sun Mixture: For use in areas that receive intensive management. Irrigation required in the areas of central Maryland and Eastern Shore. Recommended Certified Kentucky Bluegrass Seeding Rate: 1.5 to 2.0 pounds per 1000 square feet. One or more cultivars may be blended.  
 ii. Tall Fescue/Kentucky Bluegrass: Full Sun Mixture: For use in drought prone areas and/or for areas receiving low to medium management in full sun to medium shade. Recommended mixture includes: Certified Tall Fescue/Cultivar 95 to 100 percent, Certified Kentucky Bluegrass Cultivar 0 to 5 percent. Seeding Rate: 1 1/2 to 2 pounds per 1000 square feet.  
 iii. Kentucky Bluegrass/Perennial Ryegrass: Full Sun Mixture: For use in full sun areas where rapid establishment is necessary and medium to intensive management. Certified Perennial Ryegrass/Cultivar/Certified Kentucky Bluegrass Seeding Rate: 2 pounds mixture per 1000 square feet. Choose a minimum of three Kentucky Bluegrass Cultivars with each ranging from 10 to 35 percent of the total mixture by weight.  
 iv. Kentucky Bluegrass/Perennial Ryegrass: Shade Mixture: For use in areas with shade in Bluegrass lawns. For establishment in high quality, intensively managed turf area. Mixture includes Certified Kentucky Bluegrass Cultivar 30 to 40 percent and Certified Fine Fescue and 60 to 70 percent. Seeding Rate: 1 1/2 to 3 pounds per 1000 square feet.  
 Notes: Select turfgrass varieties from those listed in the most current University of Maryland Publication, Agronomy Memo #77, "Turfgrass Cultivar Recommendations for Maryland" Choose certified material. Certified material is the best guarantee of cultivar purity. The certification program of the Maryland Department of Agriculture, Turf and Seed Section, provides a reliable means of consumer protection and assures a pure genetic line.  
 c. Ideal Times of Seeding for Turfgrass: Full Sun Mixture: March 15 to June 1, August 1 to October 1 (Hardiness Zones: 5b, 6a) Central MD; March 1 to May 15, August 15 to October 15 (Hardiness Zone: 6b) Southern MD; Eastern Shore: March 1 to May 15, August 15 to October 15 (Hardiness Zones: 6a, 7a)  
 d. Till areas to receive seed by disking or other approved methods to a depth of 2 to 4 inches, level and rake the areas to prepare a proper seedbed. Remove stones and debris over 1 1/2 inches in diameter. The resulting seedbed must be in such condition that future mowing of grasses will pose no difficulty.  
 e. If soil moisture is deficient, supply new seedlings with adequate water for plant growth (1/2 to 1 inch every 3 to 4 days depending on soil texture) until they are firmly established. This is not especially true when seedlings are made late in the planting season, in abnormally dry or hot seasons, or on adverse sites.  
 f. Sod: To provide quick cover on disturbed areas (2:1 grade or flatter).

**B-4-8 STANDARDS AND SPECIFICATIONS FOR STOCKPILE AREA**  
**Definition**  
 A mound or pile of soil protected by appropriately designed erosion and sediment control measures.  
**Purpose**  
 To provide a designated location for the temporary storage of soil that controls the potential for erosion, sedimentation, and changes to drainage patterns.  
**Conditions Where Practice Applies**  
 Stockpile areas are utilized when it is necessary to salvage and store soil for later use.  
**Criteria**  
 1. The stockpile location and all related sediment control practices must be clearly indicated on the erosion and sediment control plan.  
 2. The footprint of the stockpile must be sized to accommodate the anticipated volume of material and based on a slope ratio no steeper than 2:1. Benching must be provided in accordance with Section B-3 Land Grading.  
 3. Runoff from the stockpile area must drain to a suitable sediment control practice.  
 4. Access the stockpile area from the up-slope side.  
 5. Clear water runoff into the stockpile area must be minimized by use of a diversion device such as a ditch and dike, temporary swale or diversion fence. Diversion devices must be made for discharging concentrated flow in a non-erosive manner.  
 6. Where runoff concentrates along the toe of the stockpile fill, an appropriate erosion/sediment control practice must be used to intercept the discharge.  
 7. Stockpiles must be stabilized in accordance with the 37 day stabilization requirement as well as Standard B-4-1 Incremental Stabilization and Standard B-4-4 Temporary Stabilization.  
 8. If the stockpile is located on an impervious surface, a liner should be provided below the stockpile to facilitate cleaning. Stockpiles containing contaminated material must be covered with impermeable sheeting.  
**Maintenance**  
 The stockpile area must continuously meet the requirements for Adequate Vegetative Establishment in accordance with Section B-4 Vegetative Stabilization. Side slopes must be maintained at no steeper than a 2:1 ratio. The stockpile area must be kept free of erosion. If the vertical height of a stockpile exceeds 20 feet for 2:1 slopes, 30 feet for 3:1 slopes, or 40 feet for 4:1 slopes, benching must be provided in accordance with Section B-3 Land Grading.

**H-5 STANDARDS AND SPECIFICATIONS FOR DUST CONTROL**  
**Definition**  
 Controlling the suspension of dust particles from construction activities.  
**Purpose**  
 To prevent blowing and movement of dust from exposed soil surfaces to reduce on and off-site damage including health and traffic hazards.  
**Conditions Where Practice Applies**  
 Areas subject to dust blowing and movement where on and off-site damage is likely without treatment.  
**Specifications**  
 1. **Mulches:** See Section B-4-2 Soil Preparation, Topsoiling, and Soil Amendments, Section B-4-3 Seeding and Mulching, and Section B-4-4 Temporary Stabilization. Mulch must be anchored to prevent blowing.  
 2. **Vegetative Cover:** See Section B-4-4 Temporary Stabilization.  
 3. **Tillage:** Till to roughen surface and bring clods to the surface. Begin plowing on windward side of site. Chisel-type plows spaced about 12 inches apart, spring-toothed harrows, and similar plows are examples of equipment that may produce the desired effect.  
 4. **Irrigation:** Sprinkle site with water until the surface is moist. Repeat as needed. The site must not be irrigated to the point that runoff occurs.  
 5. **Barriers:** Solid board fences, silt fences, snow fences, burlap fences, straw bales, and similar material can be used to control air currents and soil blowing.  
 6. **Chemical Treatment:** Use of chemical treatment requires approval by the appropriate plan review authority.

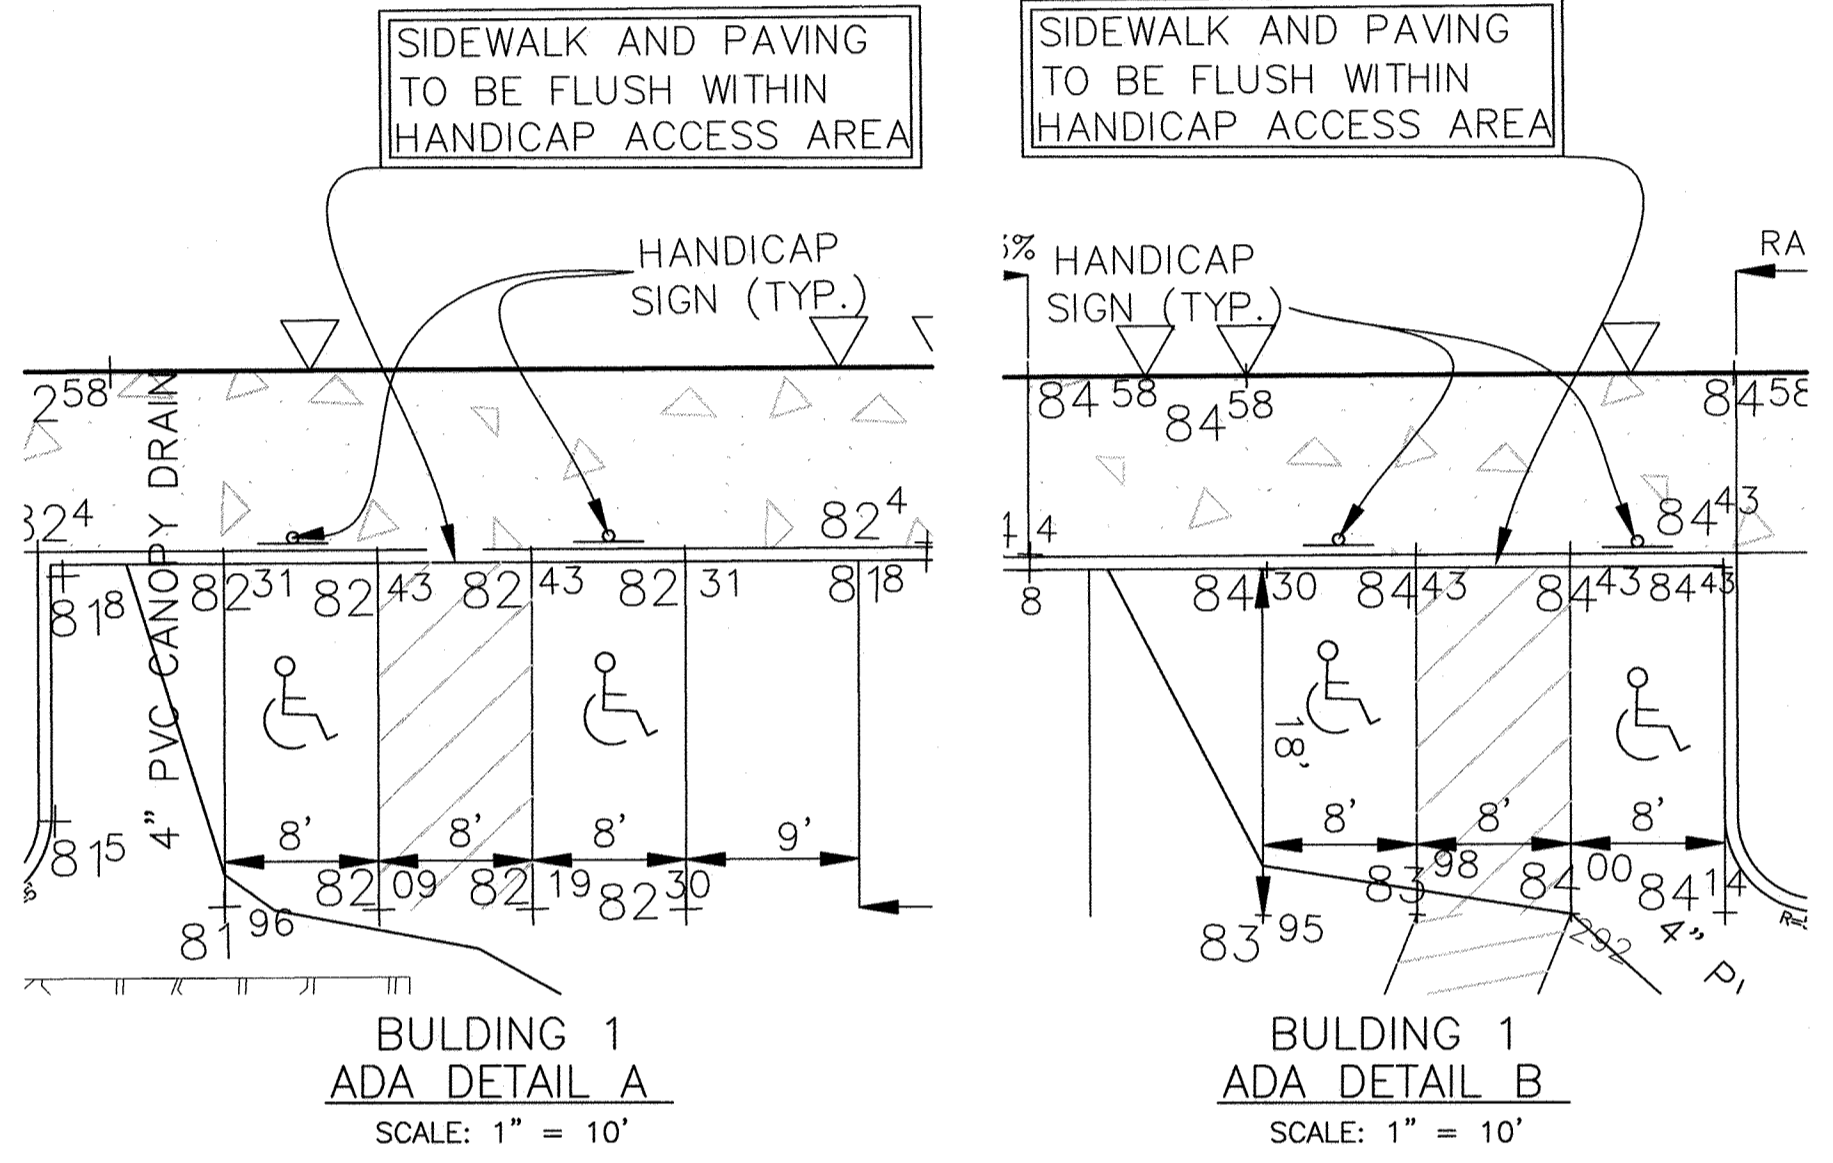

"NO AS-BUILT INFORMATION IS PROVIDED ON THIS SHEET"



Professional Certification. I hereby certify that these documents were prepared or approved by me, and that I am a duly licensed professional engineer under the laws of the State of Maryland.  
 License No. 21443, Expiration Date: 12-21-20

ENGINEER'S CERTIFICATE  
 I CERTIFY THAT THIS PLAN FOR SEDIMENT AND EROSION CONTROL REPRESENTS A PRACTICAL AND WORKABLE PLAN BASED ON MY PERSONAL KNOWLEDGE OF THE SITE CONDITIONS AND THAT IT WAS PREPARED IN ACCORDANCE WITH THE REQUIREMENTS OF THE HOWARD SOIL CONSERVATION DISTRICT.  
 Alice A. Miller, P.E. # 28376  
 25 Jan 17  
 ENGINEER - ALICE A. MILLER, P.E. # 28376  
 DATE

DEVELOPER'S CERTIFICATE  
 I/WE CERTIFY THAT ALL DEVELOPMENT AND CONSTRUCTION WILL BE DONE ACCORDING TO THIS PLAN FOR SEDIMENT AND EROSION CONTROL AND THAT ALL PERSONNEL INVOLVED IN THE CONSTRUCTION PROJECT WILL HAVE A CERTIFICATE OF ATTENDANCE AT A DEPARTMENT OF THE ENVIRONMENT APPROVED TRAINING PROGRAM FOR THE CONTROL OF SEDIMENT AND EROSION BEFORE BEGINNING THE PROJECT. I ALSO AUTHORIZE PERIODIC ON-SITE INSPECTION BY THE HOWARD SOIL CONSERVATION DISTRICT.  
 Alice R. Pouth  
 1-26-17  
 COLUMBIA JUNCTION DEV. LLC.  
 DATE

THIS DEVELOPMENT PLAN IS APPROVED FOR SOIL EROSION AND SEDIMENT CONTROL BY THE HOWARD SOIL CONSERVATION DISTRICT.  
 John P. Poth  
 2/14/17  
 HOWARD SCD  
 DATE

APPROVED: HOWARD COUNTY DEPARTMENT OF PLANNING AND ZONING  
 Chief, Development Engineering Division  
 2-21-17  
 DATE  
 Chief, Division of Land Development  
 4-27-17  
 DATE  
 Director  
 4-17-17  
 DATE

1 DEC 16 SHEET SUBSTITUTION TO REVISE ROOF DRAINS, SEWER HOUSE CONNECTION AND PAVE OUTPARCEL.  
 NO. DATE REVISION


DEVELOPER: COLUMBIA JUNCTION DEV. LLC  
 100 MENLO PARK DRIVE, SUITE 500  
 EDISON, NEW JERSEY 08837  
 201-314-6049

PROJECT: COLUMBIA JUNCTION SECTION 3 / LOT A-2 (RETAIL CENTER)

LOCATION: TAX MAP 48 - BLOCK 1  
 PARCEL 548  
 6TH ELECTION DISTRICT  
 HOWARD COUNTY, MARYLAND

TITLE: REVISED SITE DEVELOPMENT PLAN  
 SEDIMENT AND EROSION CONTROL  
 PLAN, NOTES AND DETAILS  
 AND WMC PROFILE AND SHC PROFILE

DATE: JANUARY, 2017 PROJECT NO. 1221  
 SCALE: AS SHOWN DRAWING 5 OF 11

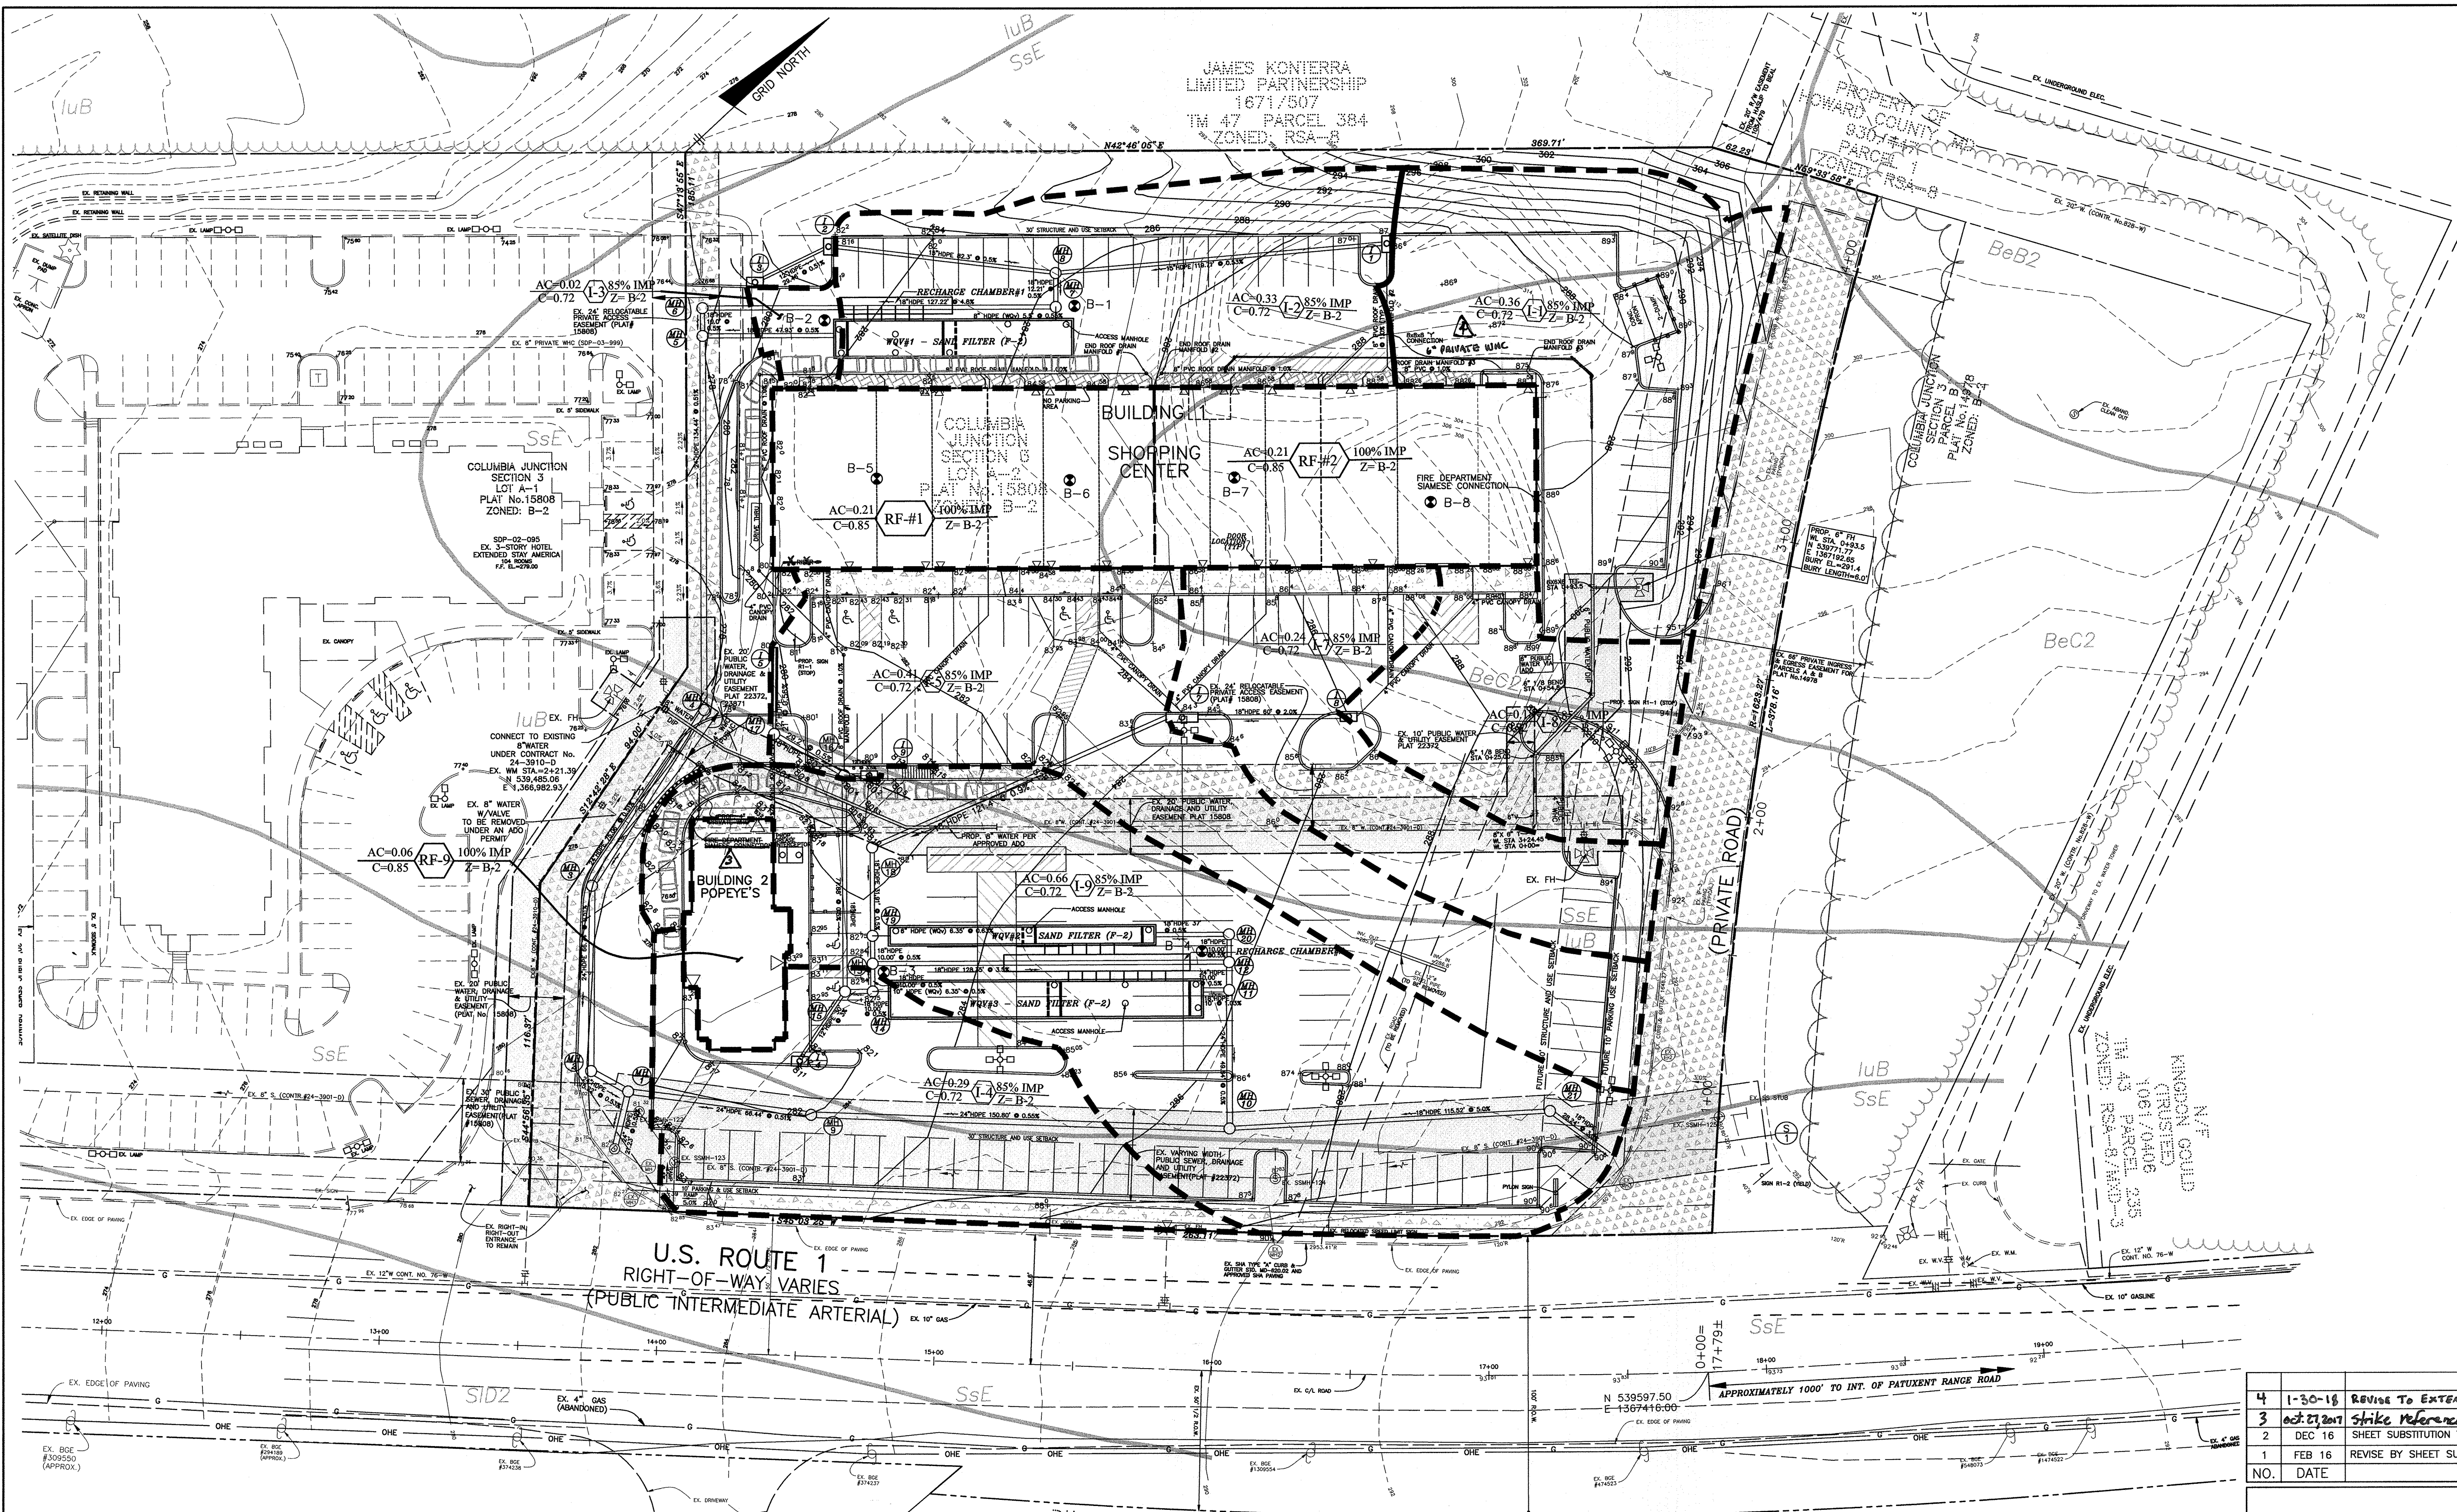

STORM DRAIN RUNOFF

INLET	DA (Ac.)	C	%IMP	ZONE
I-1	0.36	0.72	85	B-2
I-2	0.33	0.72	85	B-2
I-3	0.02	0.72	85	B-2
I-4	0.36	0.72	85	B-2
I-5	0.39	0.72	85	B-2
I-7	0.18	0.72	85	B-2
I-8	0.37	0.72	85	B-2
I-9	0.55	0.72	85	B-2
RF-#1	0.21	0.85	100	B-2
RF-#2	0.21	0.85	100	B-2

APPROVED: DEPARTMENT OF PLANNING AND ZONING

*Ketleshook* 4-17-17  
 CHIEF, DIVISION OF LAND DEVELOPMENT DATE

*John Chumble* 7-21-17  
 CHIEF, DEVELOPMENT ENGINEERING DIVISION DATE

*N. Valdivia* 4-17-17  
 DIRECTOR DATE

NO.	DATE	REVISION
4	1-30-18	REVISE TO EXTEND PRIVATE WMC (BLDG 1)
3	02-21-2017	Strike reference to FBC and WHE SIZE
2	DEC 16	SHEET SUBSTITUTION TO REVISE ROOF DRAINS, SEWER HOUSE CONNECTION AND PAVE OUTPARCEL.
1	FEB 16	REVISE BY SHEET SUBSTITUTION POPEYE'S BUILDING FOOTPRINT AND ASSOCIATED ITEMS

SOILS LEGEND

MAP SYMBOL	SOIL TYPE	MAPPING UNIT
BeB2	C	BELTSVILLE SILT LOAM - 1 TO 5 PERCENT SLOPES - MODERATELY ERODED
BeC2	C	BELTSVILLE SILT LOAM - 5 TO 10 PERCENT SLOPES - MODERATELY ERODED
IuB	C	IUKA LOAM - LOCAL ALLUVIUM - 1 TO 5 PERCENT SLOPES
S102	B	SASSAFRAS LOAM - 10 TO 15 PERCENT SLOPES - MODERATELY ERODED
SSE	B	SASSAFRAS SOILS - 15 TO 40 PERCENT SLOPES

PLAN  
 SCALE: 1" = 30'



Professional Certification. I hereby certify that these documents were prepared or approved by me, and that I am a duly licensed professional engineer under the laws of the State of Maryland.  
 License No. 21443, Expiration Date: 12-31-20

**BENCHMARK ENGINEERING, INC.**  
 8480 BALTIMORE NATIONAL PIKE & SUITE 315 A ELLOTT CITY, MARYLAND 21043  
 (P) 410-466-8100 (F) 410-466-8644  
 WWW.BE-ENGINEERING.COM


DEVELOPER: COLUMBIA JUNCTION DEV. LLC  
 100 MENLO PARK DRIVE, SUITE 500  
 EDISON, NEW JERSEY 08837  
 201-314-6049

PROJECT: COLUMBIA JUNCTION SECTION 3 / LOT A-2 (RETAIL CENTER)

LOCATION: TAX MAP 48 - BLOCK 1  
 PARCEL 54B  
 6th ELECTION DISTRICT  
 HOWARD COUNTY, MARYLAND


TITLE: REVISED SITE DEVELOPMENT PLAN  
 STORM DRAIN DRAINAGE AREA MAP,  
 SOILS MAP AND BORING LOGS

DATE: JANUARY, 2017 PROJECT NO. 1221  
 SCALE: 1" = 30' DRAWING 6 OF 11

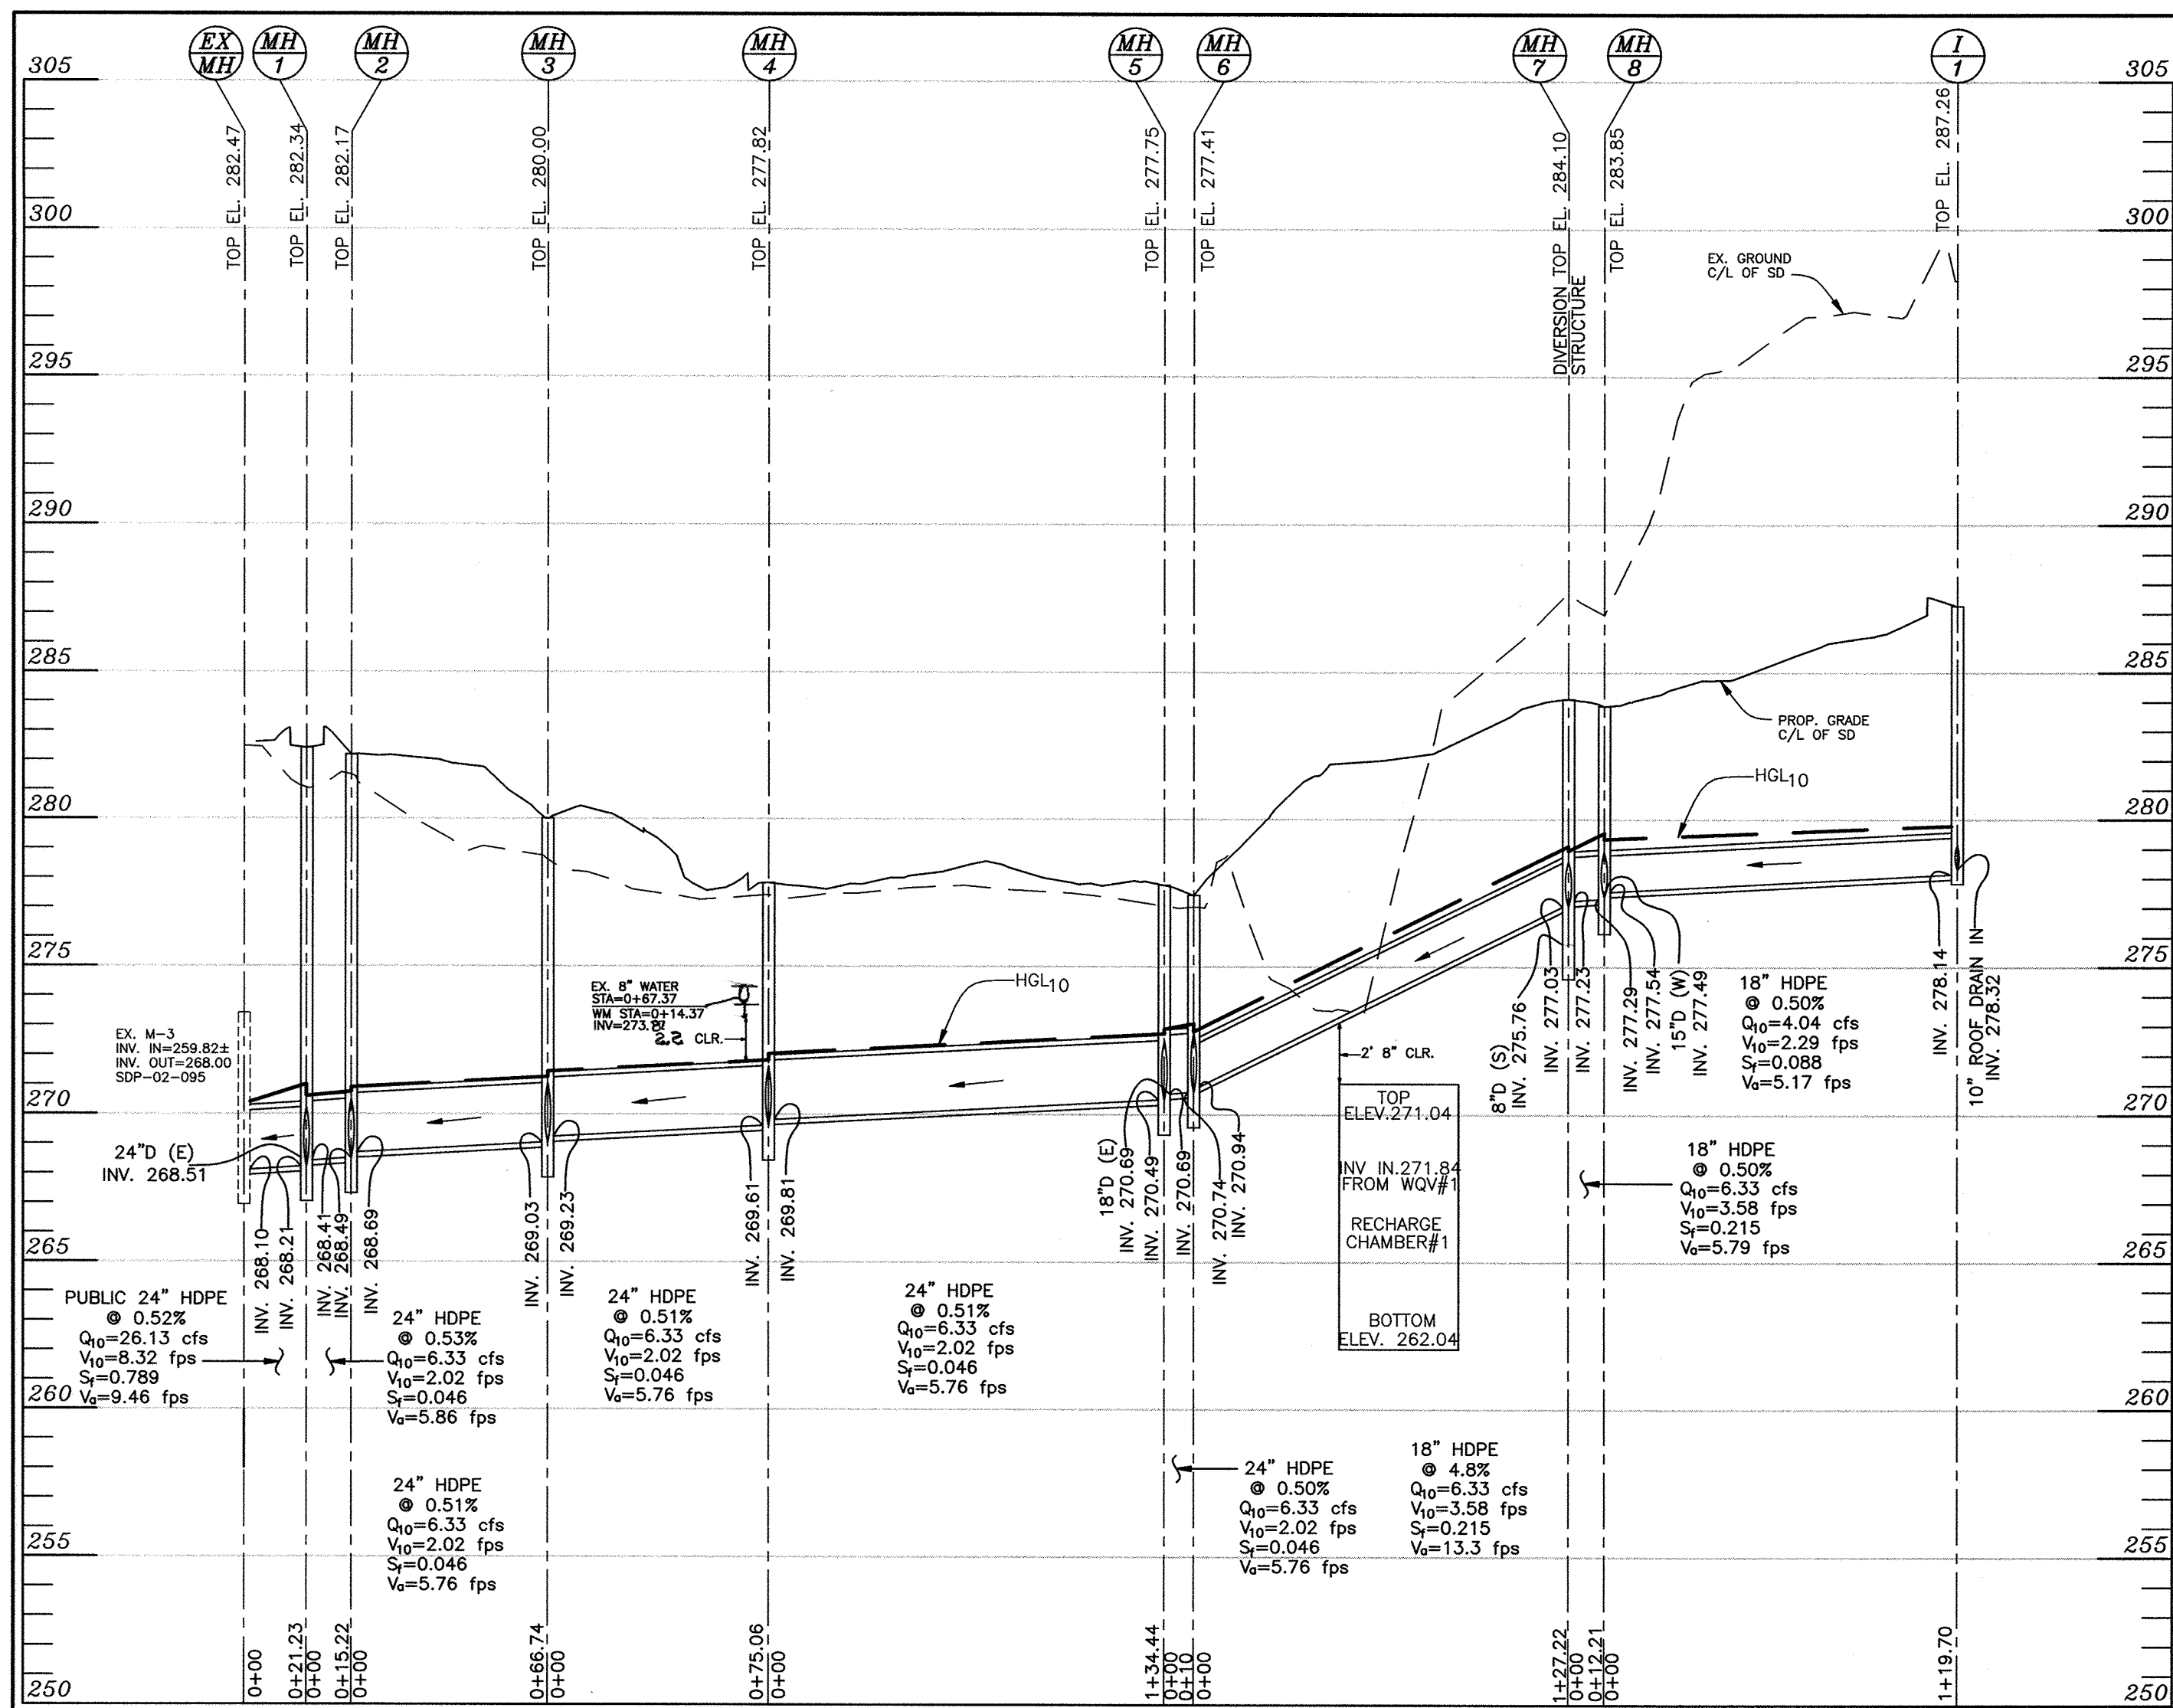


STORM DRAIN PROFILE FROM EX MH TO I-1


NOTE: ALL STORM DRAIN PRIVATE UNLESS NOTED OTHERWISE ON THE PROFILES.

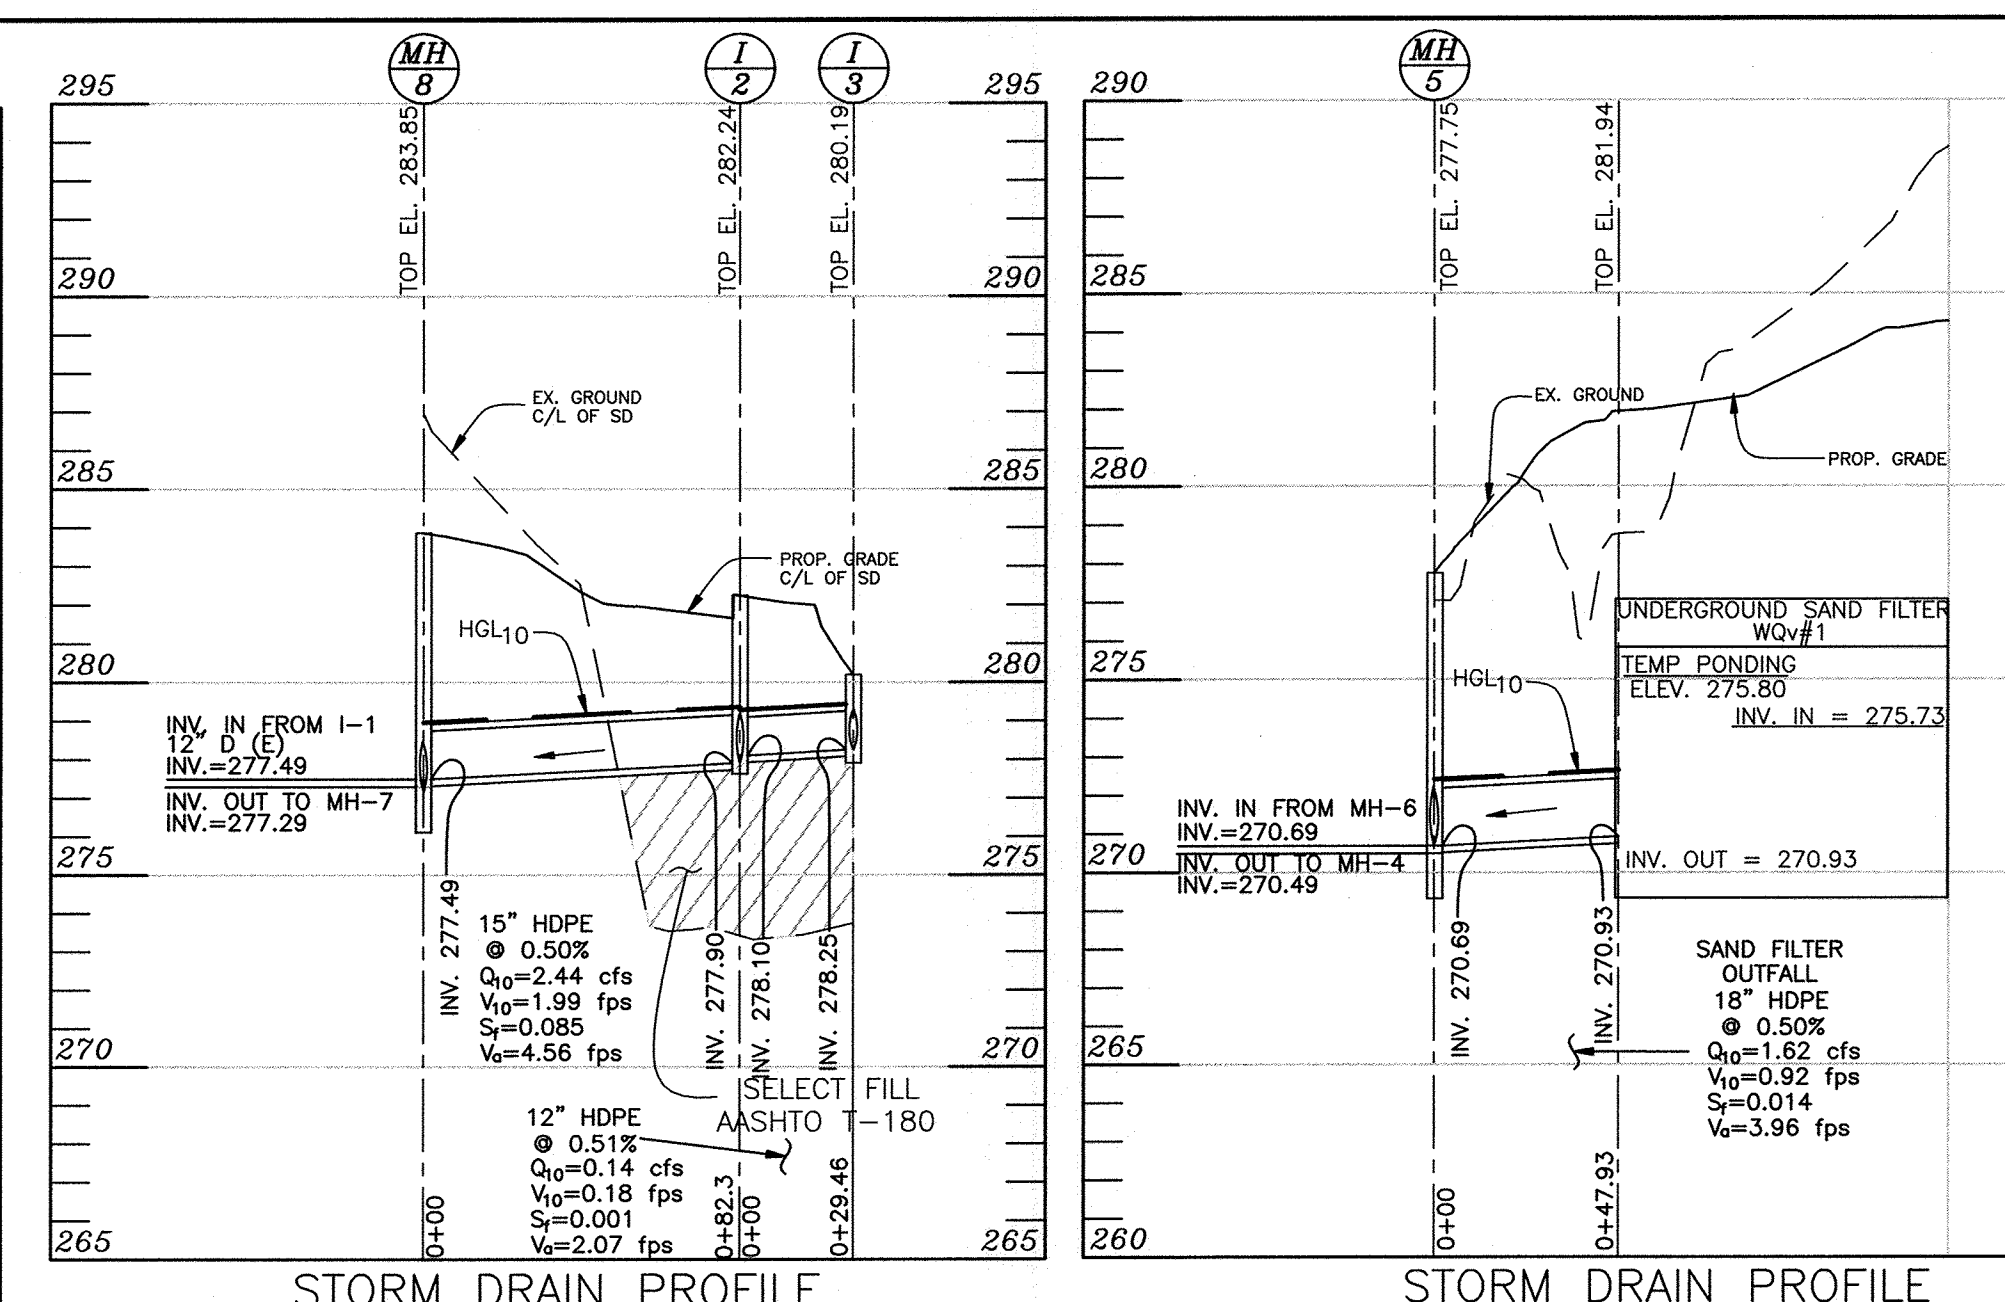


STORM DRAIN PROFILE FROM MH-8 TO I-3

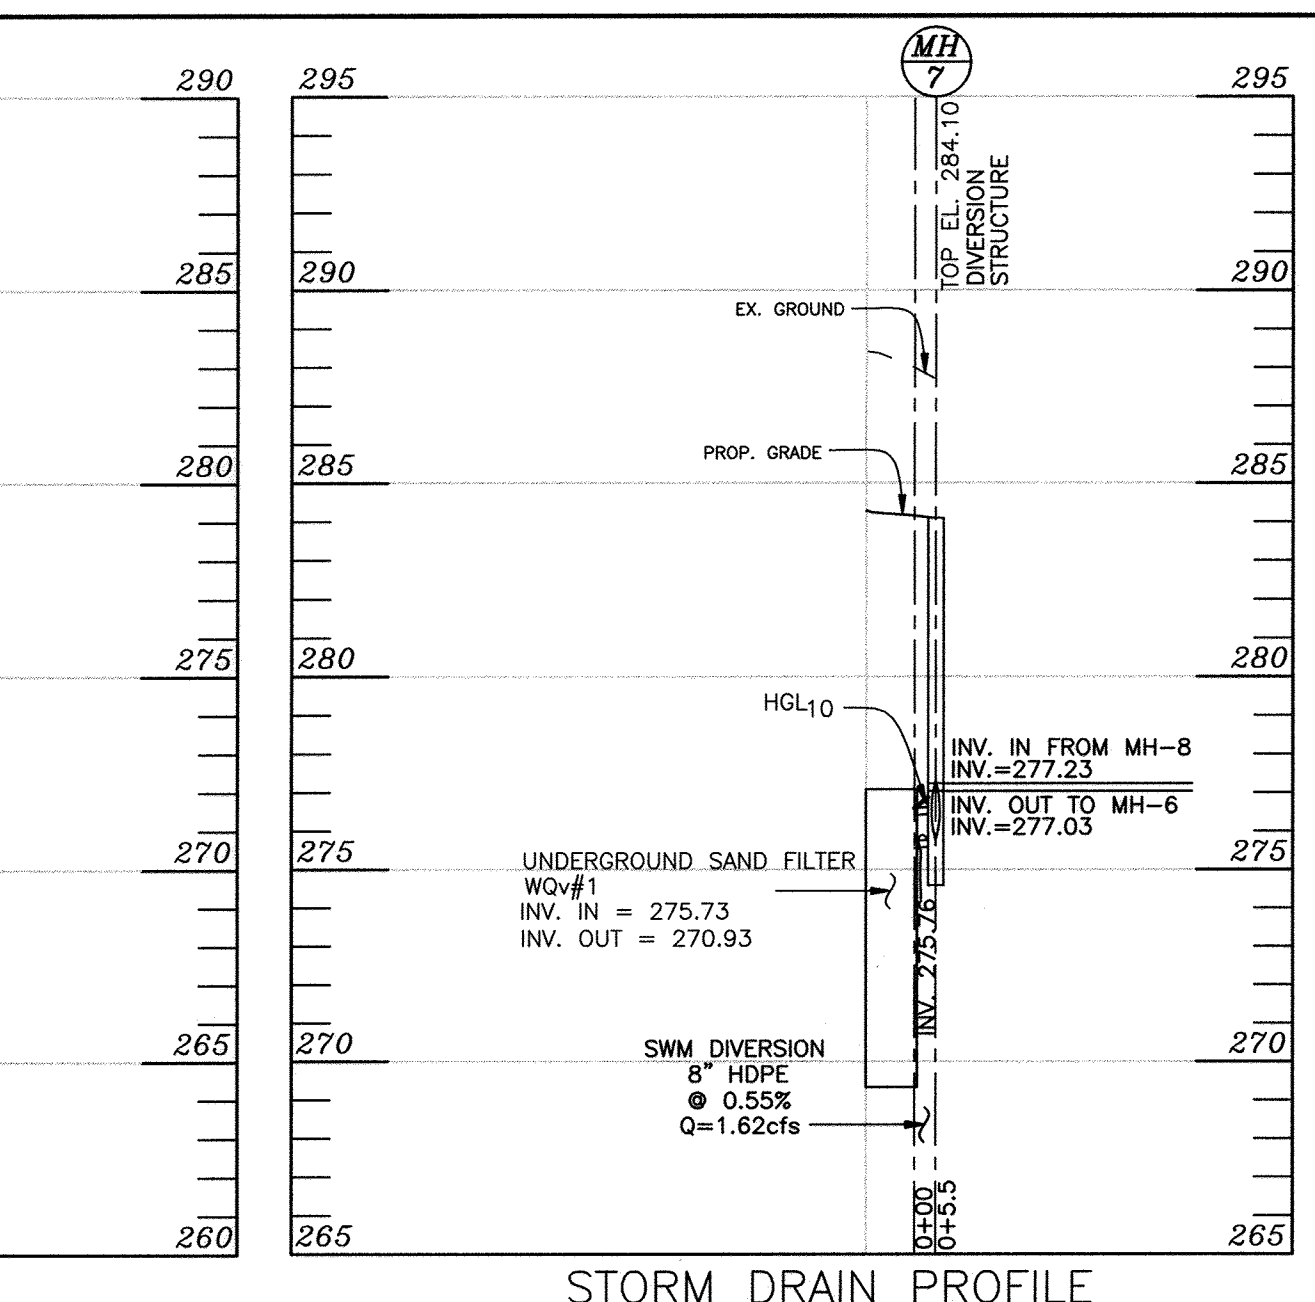


STORM DRAIN PROFILE FROM MH-5 TO WQV#1

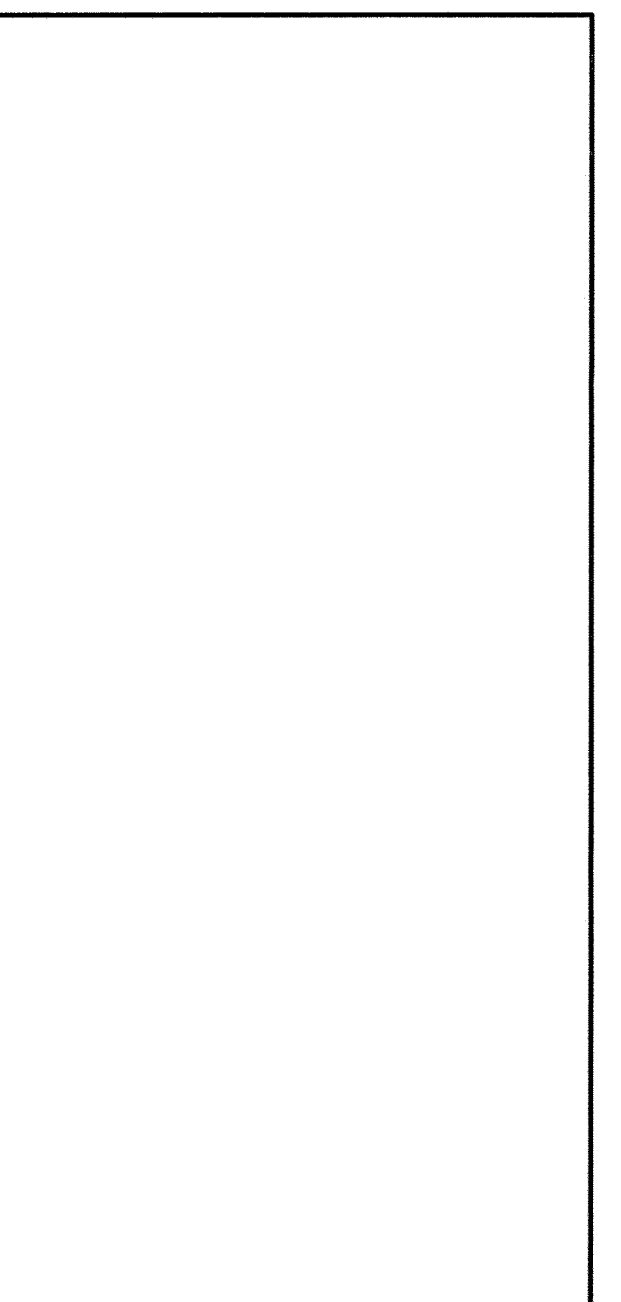


STORM DRAIN PROFILE FROM WQV#1 TO MH-7

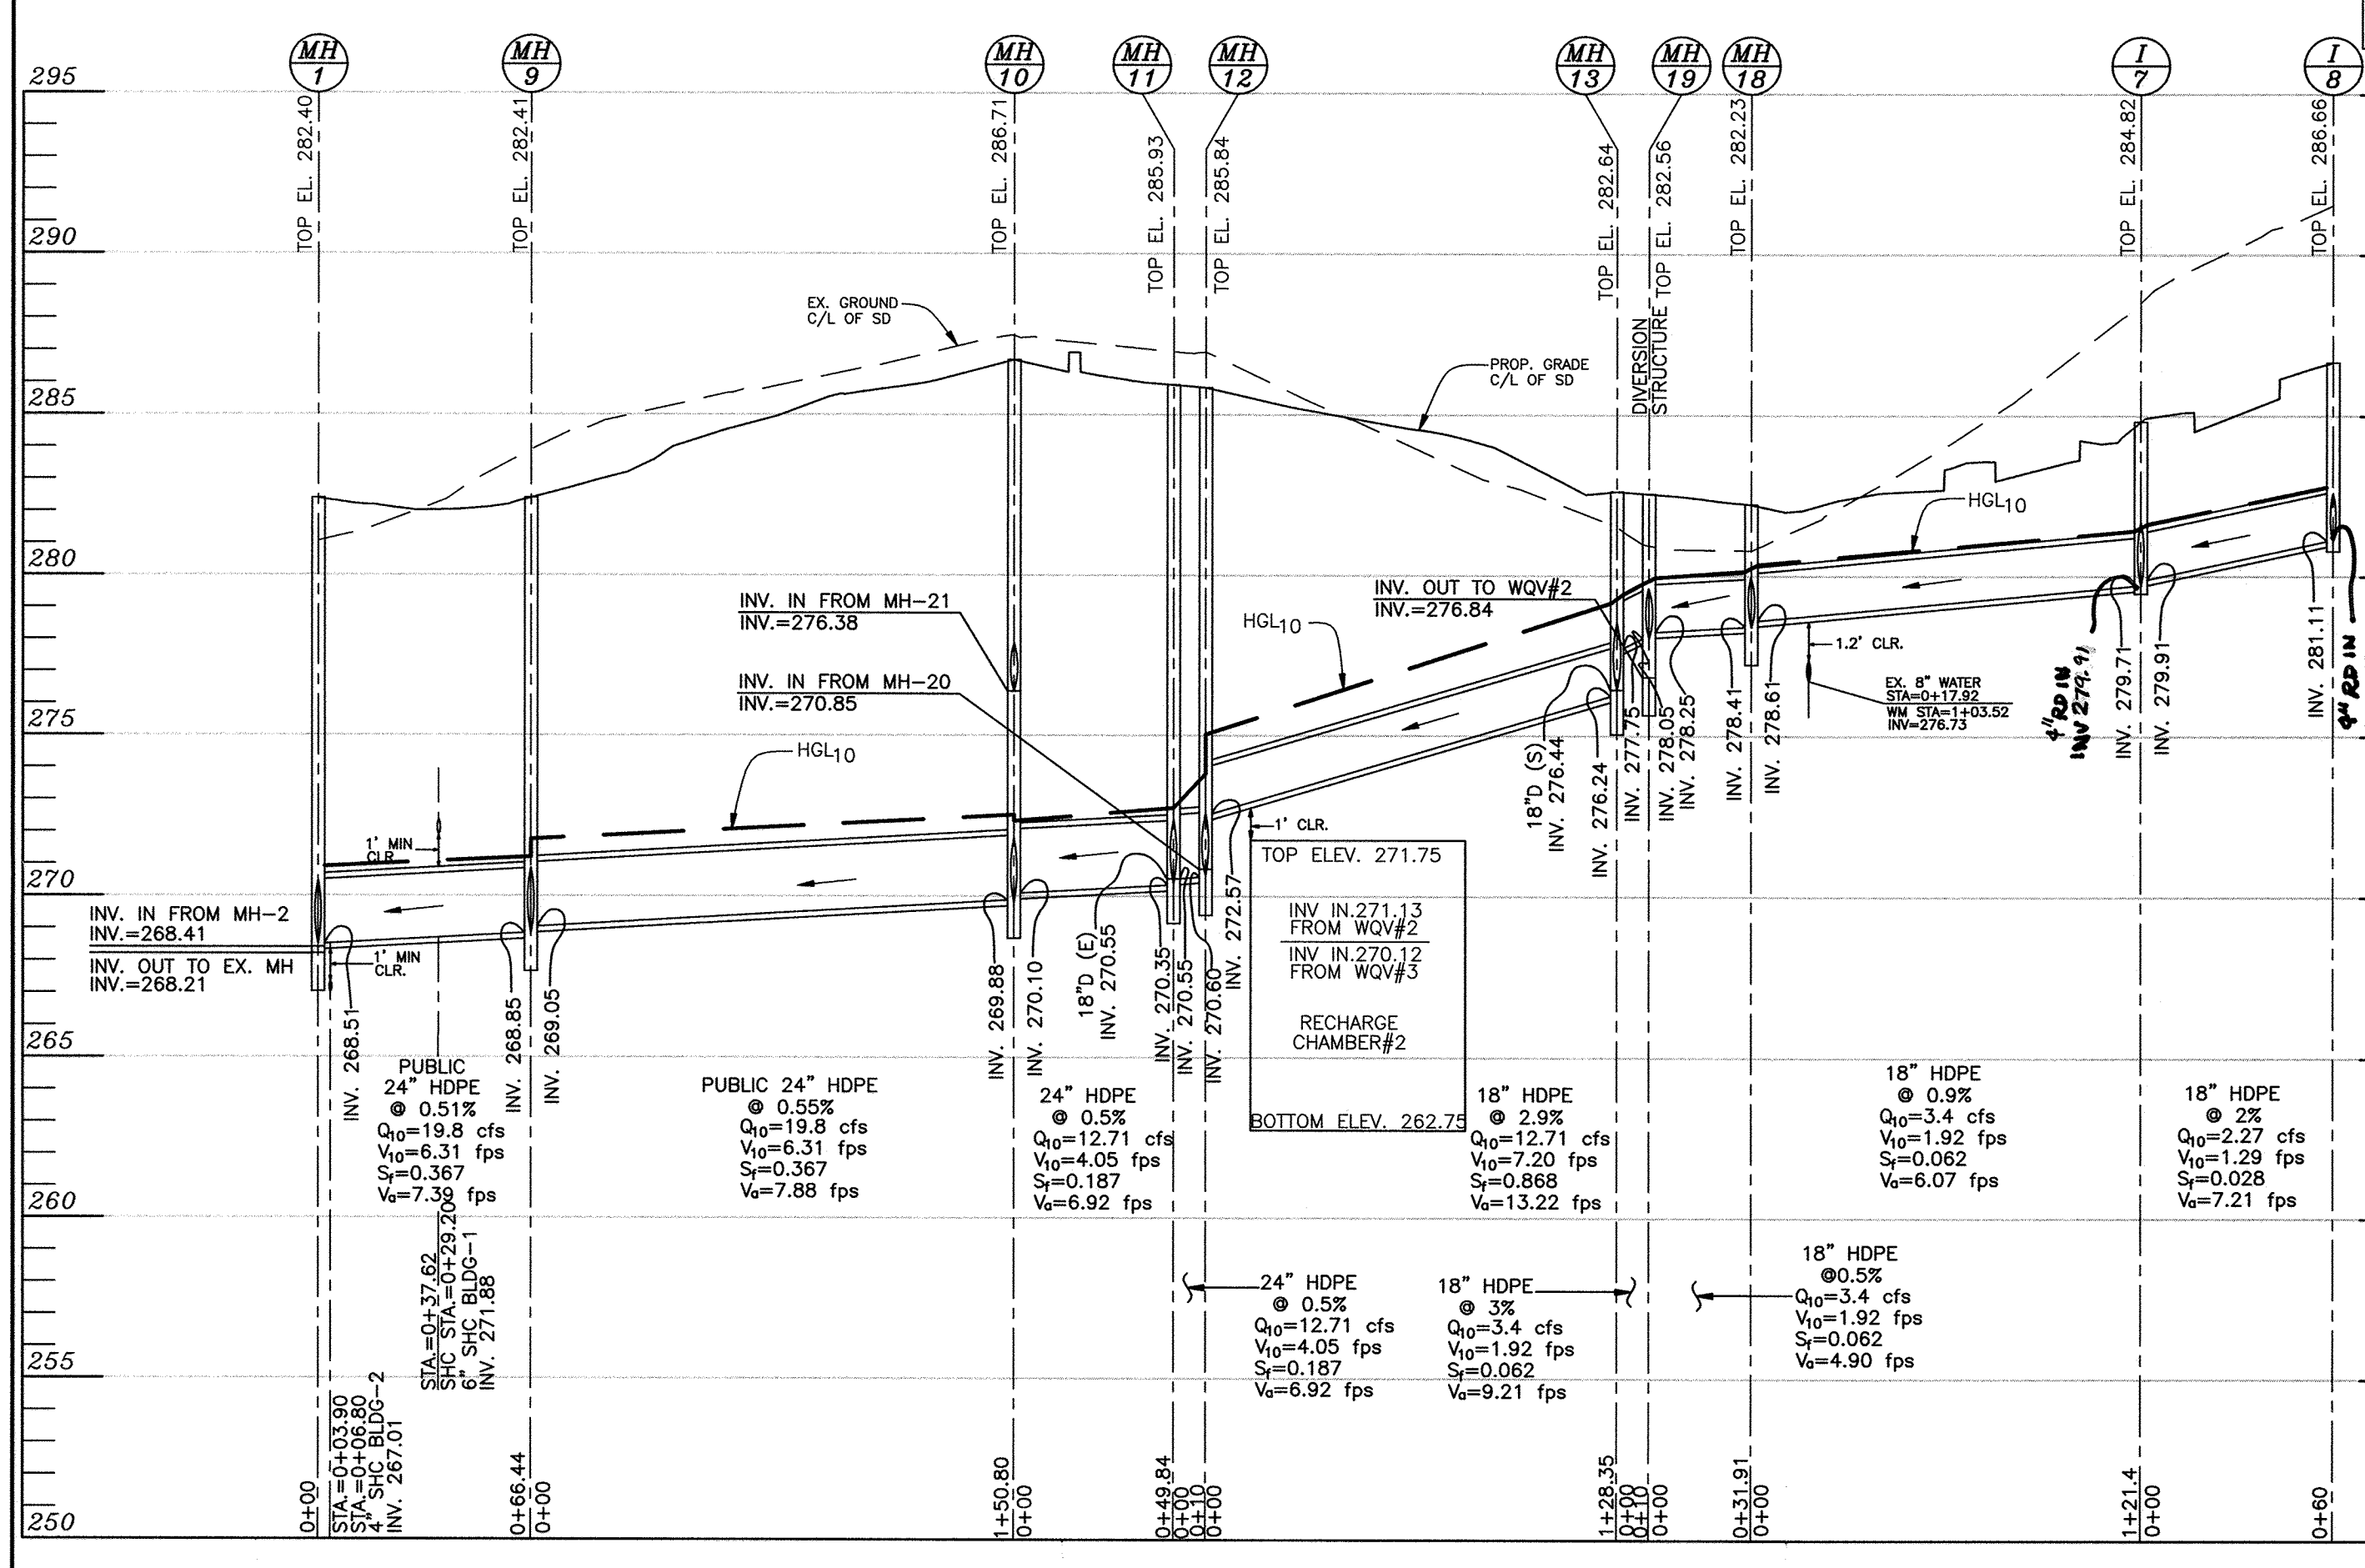

STORM DRAIN PROFILE FROM MH-1 TO I-8

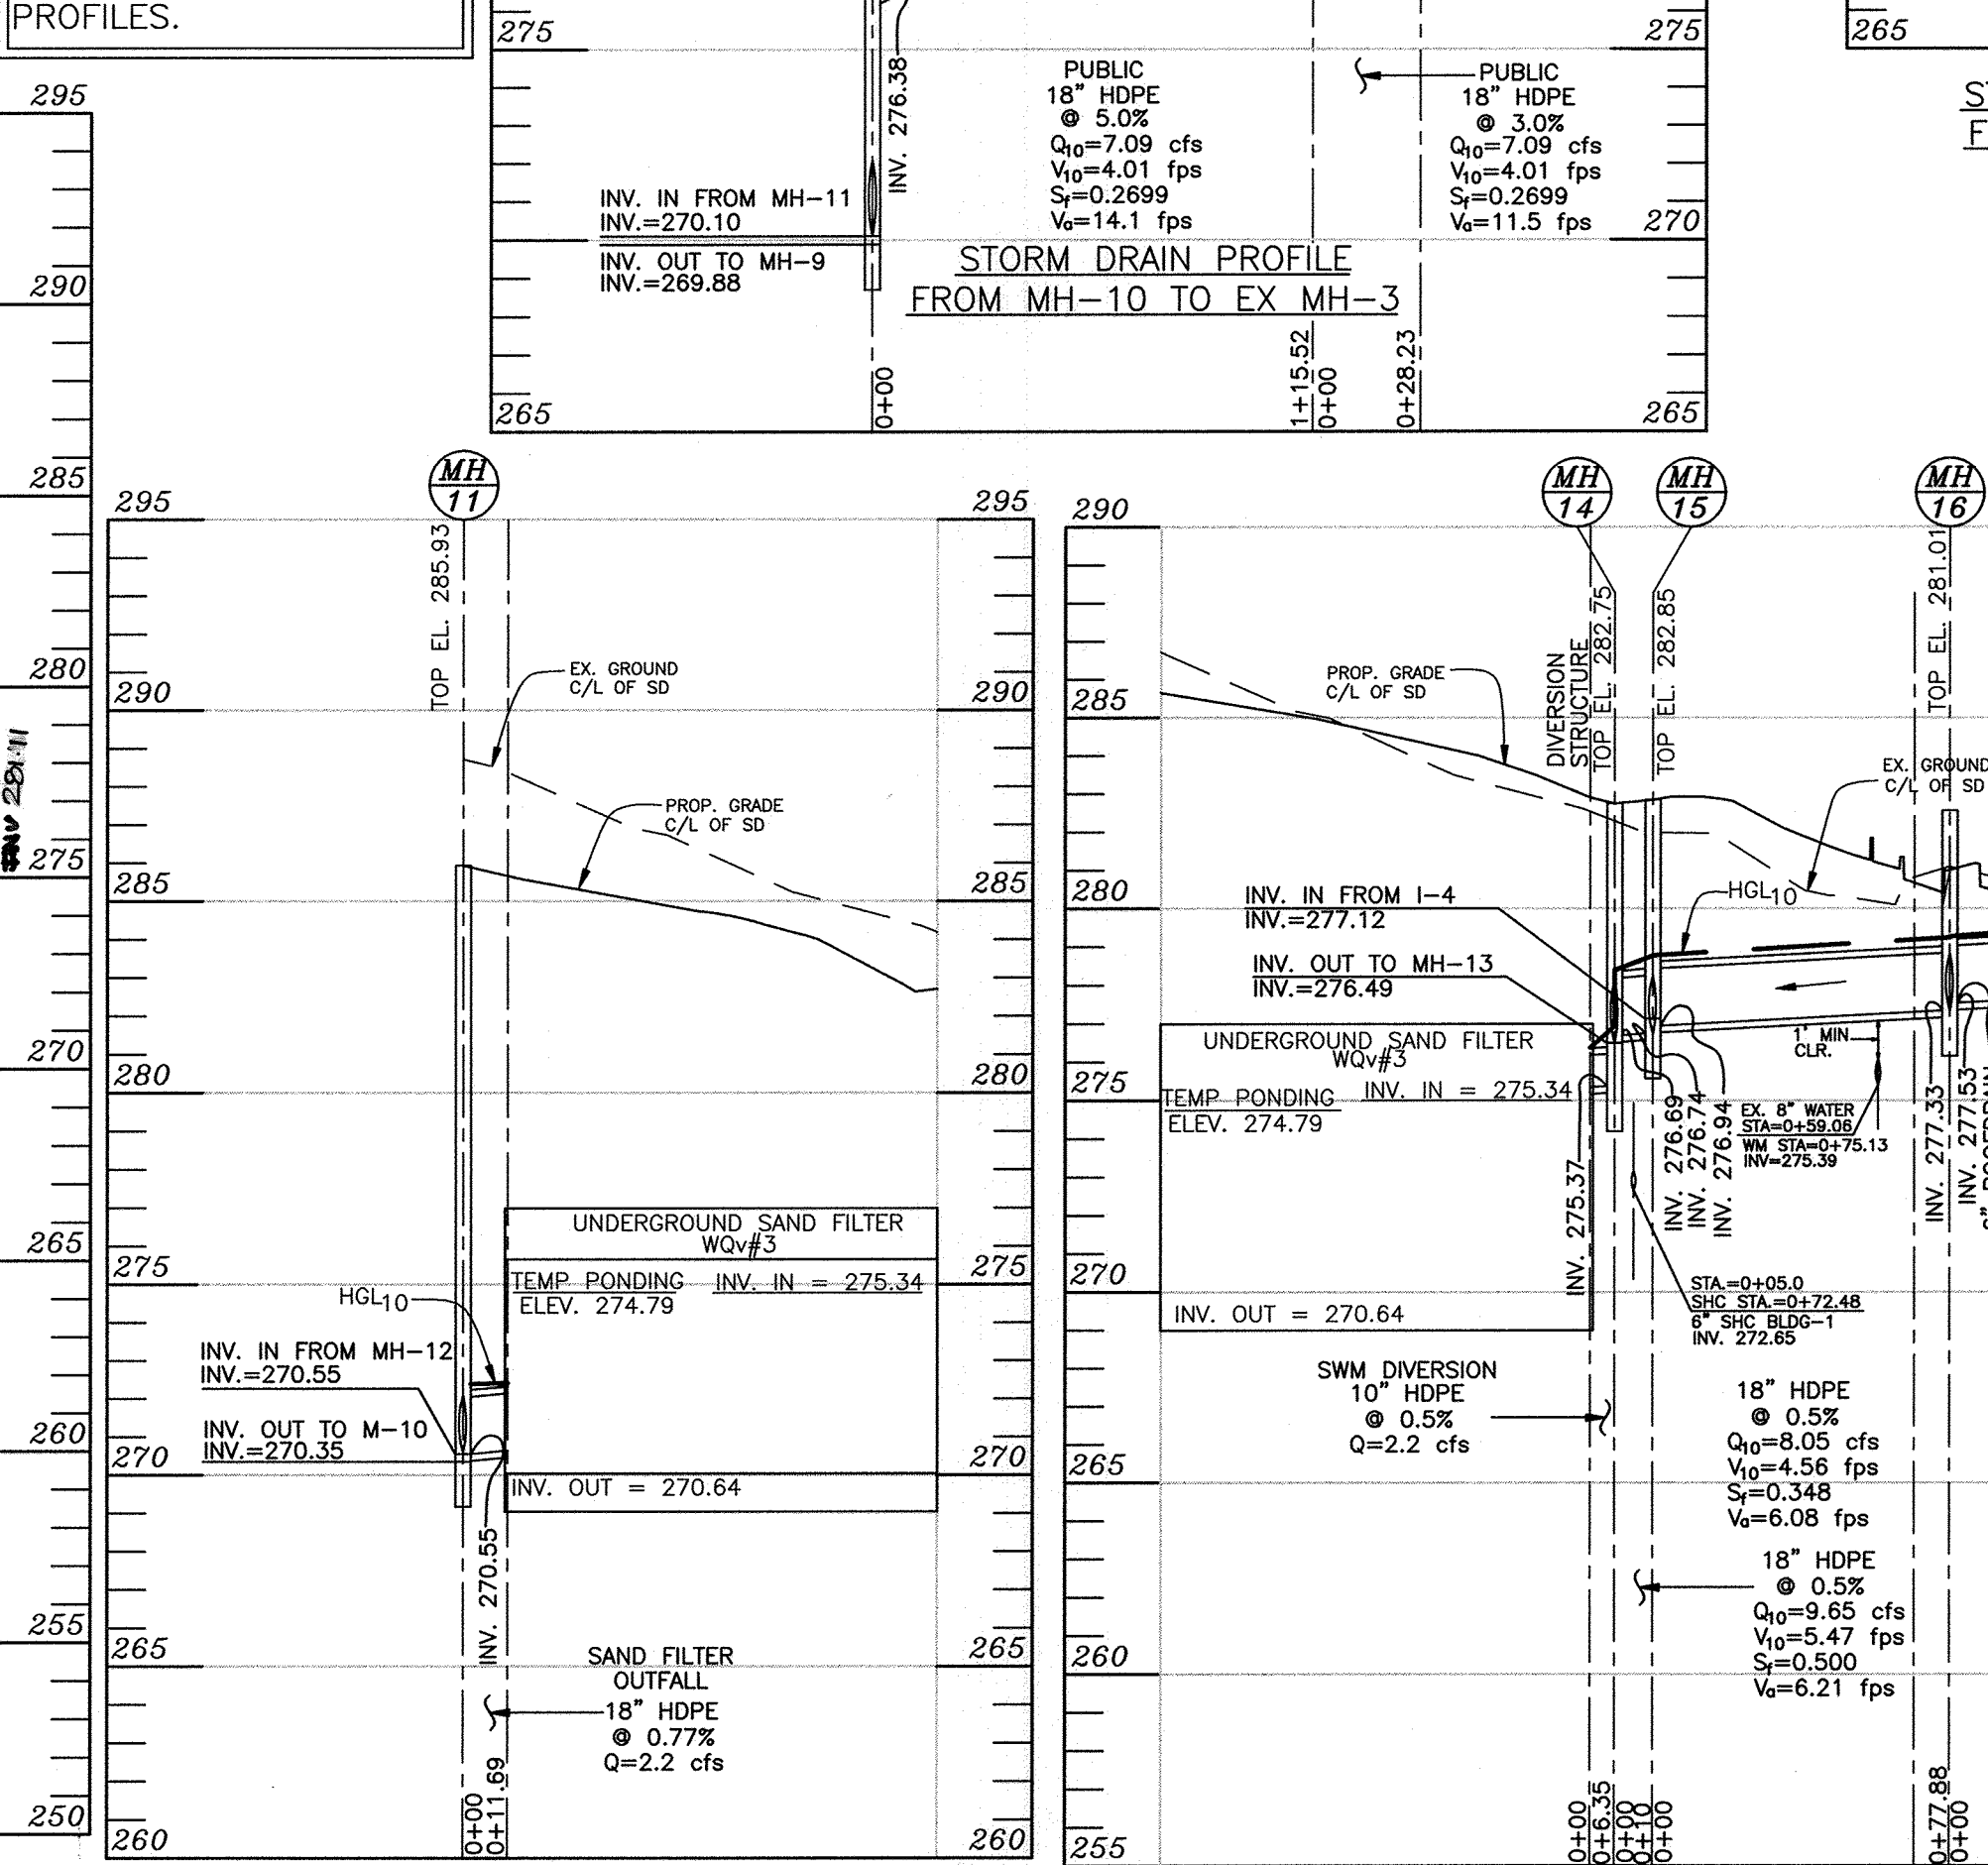


STORM DRAIN PROFILE FROM MH-11 TO WQV#3

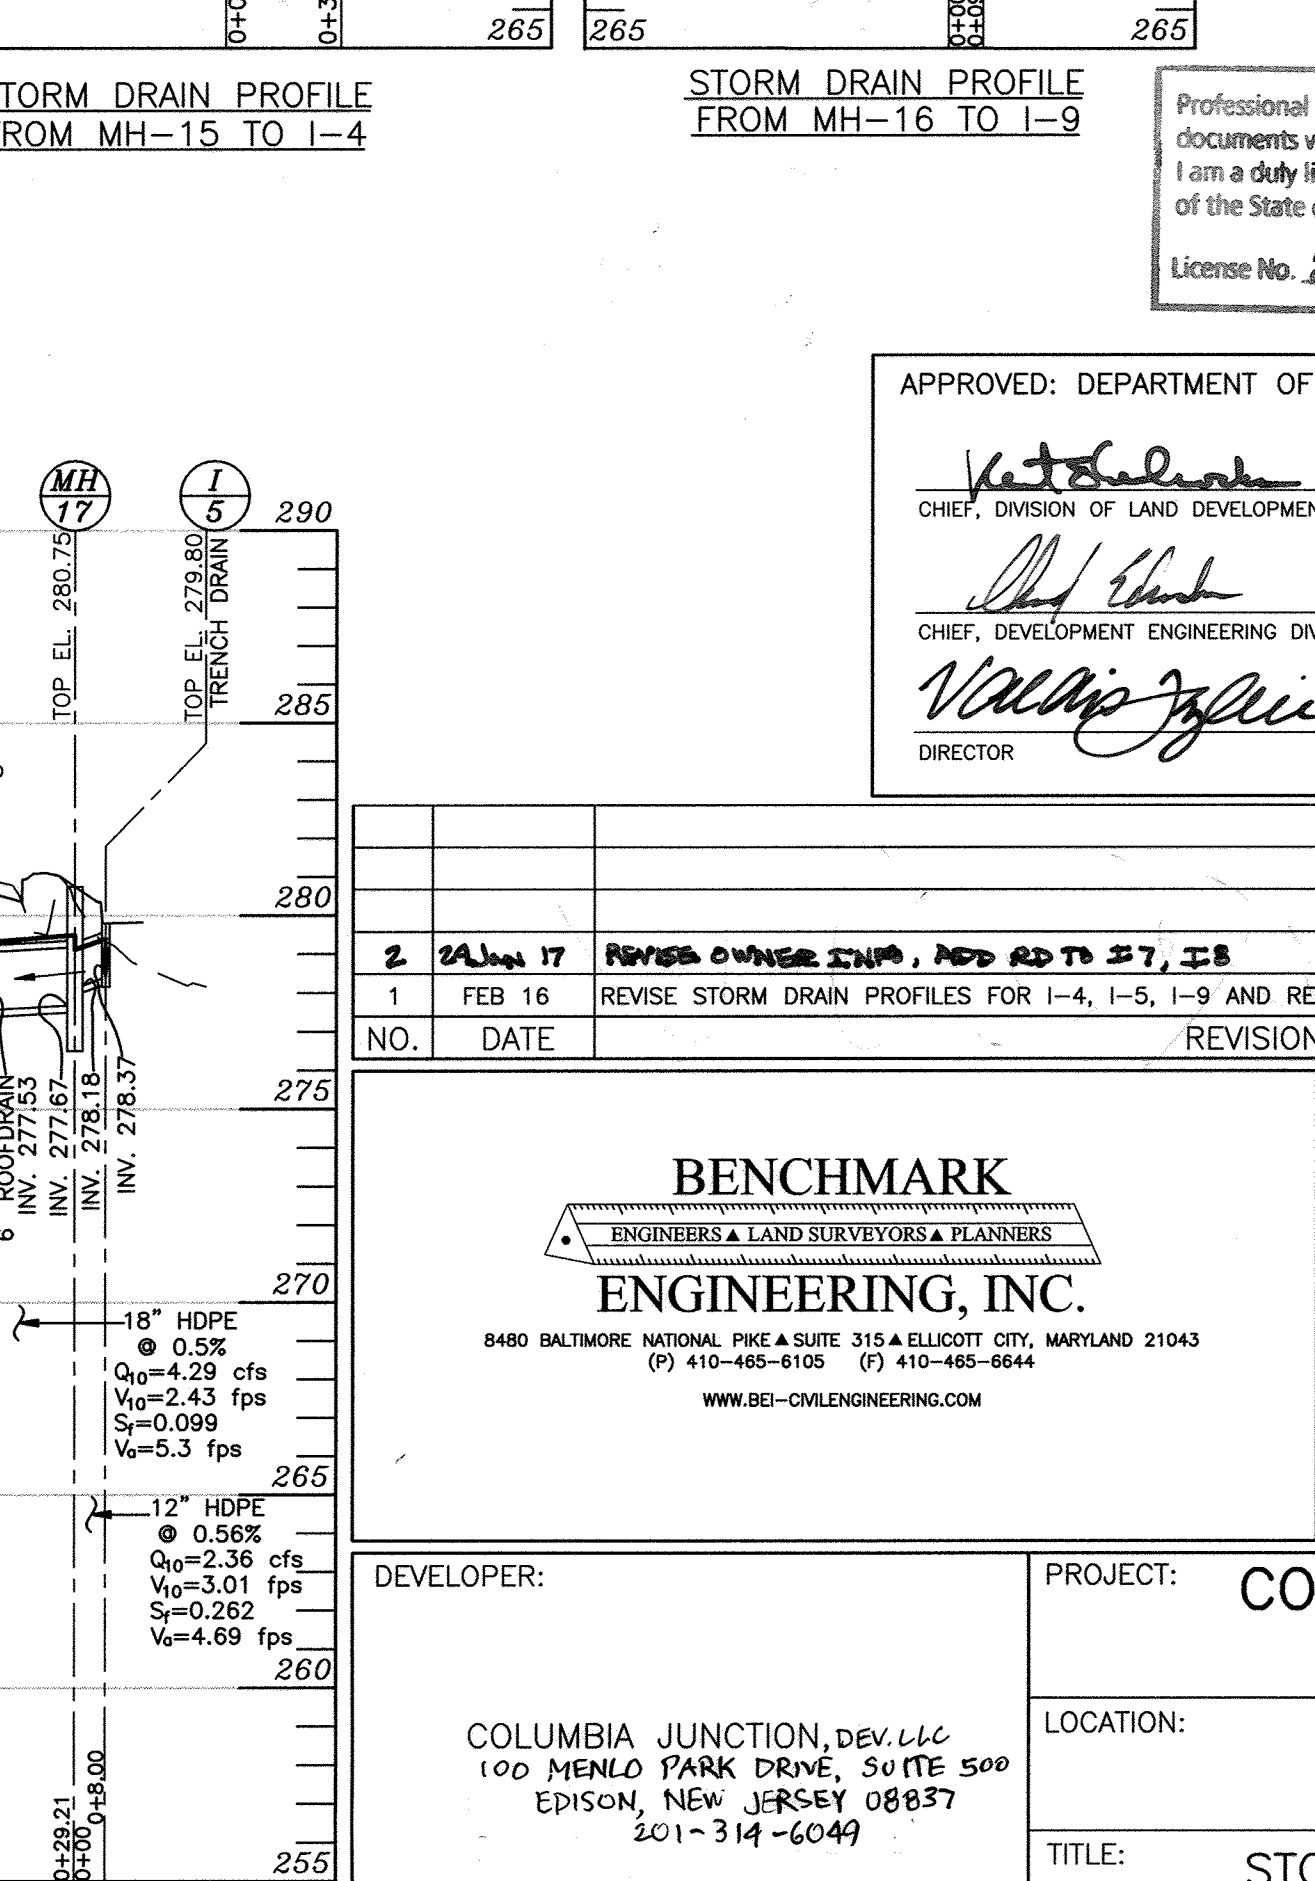

STORM DRAIN PROFILE FROM MH-14 TO I-5

NO AS-BUILT INFORMATION IS PROVIDED ON THIS SHEET

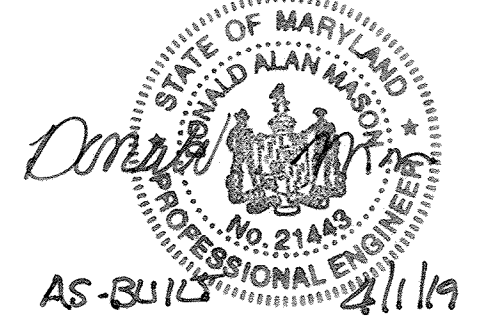

Professional Certification. I hereby certify that these documents were prepared or approved by me, and that I am a duly licensed professional engineer under the laws of the State of Maryland.  
License No. 21143, Expiration Date: 12-21-20

APPROVED: DEPARTMENT OF PLANNING AND ZONING  
Kathleen [Signature] 5-25-16  
CHIEF, DIVISION OF LAND DEVELOPMENT  
[Signature] 5-19-16  
CHIEF, DEVELOPMENT ENGINEERING DIVISION  
Valerie [Signature] 5-25-16  
DIRECTOR

NO.	DATE	REVISION
2	2/24/17	REVISE OWNER INP, ADD RD TO 27, IS
1	FEB 16	REVISE STORM DRAIN PROFILES FOR I-4, I-5, I-9 AND REMOVE I-6





**BENCHMARK ENGINEERING, INC.**  
ENGINEERS & LAND SURVEYORS & PLANNERS  
8480 BALTIMORE NATIONAL PIKE & SUITE 315 • ELLOTT CITY, MARYLAND 21043  
(P) 410-465-8105 (F) 410-465-6644  
WWW.BE-CIVILENGINEERING.COM

DEVELOPER: COLUMBIA JUNCTION, DEV. LLC  
100 MENLO PARK DRIVE, SUITE 500  
EDISON, NEW JERSEY 08837  
201-314-6049

PROJECT: COLUMBIA JUNCTION SECTION 3 / LOT A-2 (RETAIL CENTER)  
LOCATION: TAX MAP 48 - BLOCK 1  
PARCEL 548  
6TH ELECTION DISTRICT  
HOWARD COUNTY, MARYLAND

TITLE: STORM DRAIN PROFILES, NOTES AND DETAILS  
DATE: APRIL, 2016 PROJECT NO. 1221  
SCALE: AS SHOWN DRAWING 7 OF 11

Design: DAM Draft: HP Check: DAM/brc SCALE: AS SHOWN DRAWING 7 OF 11

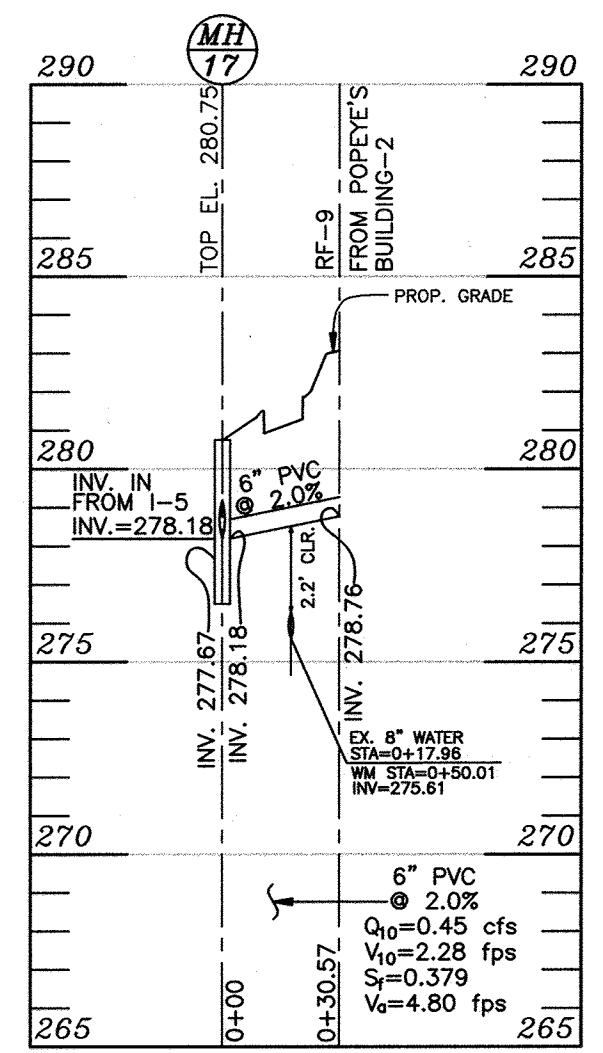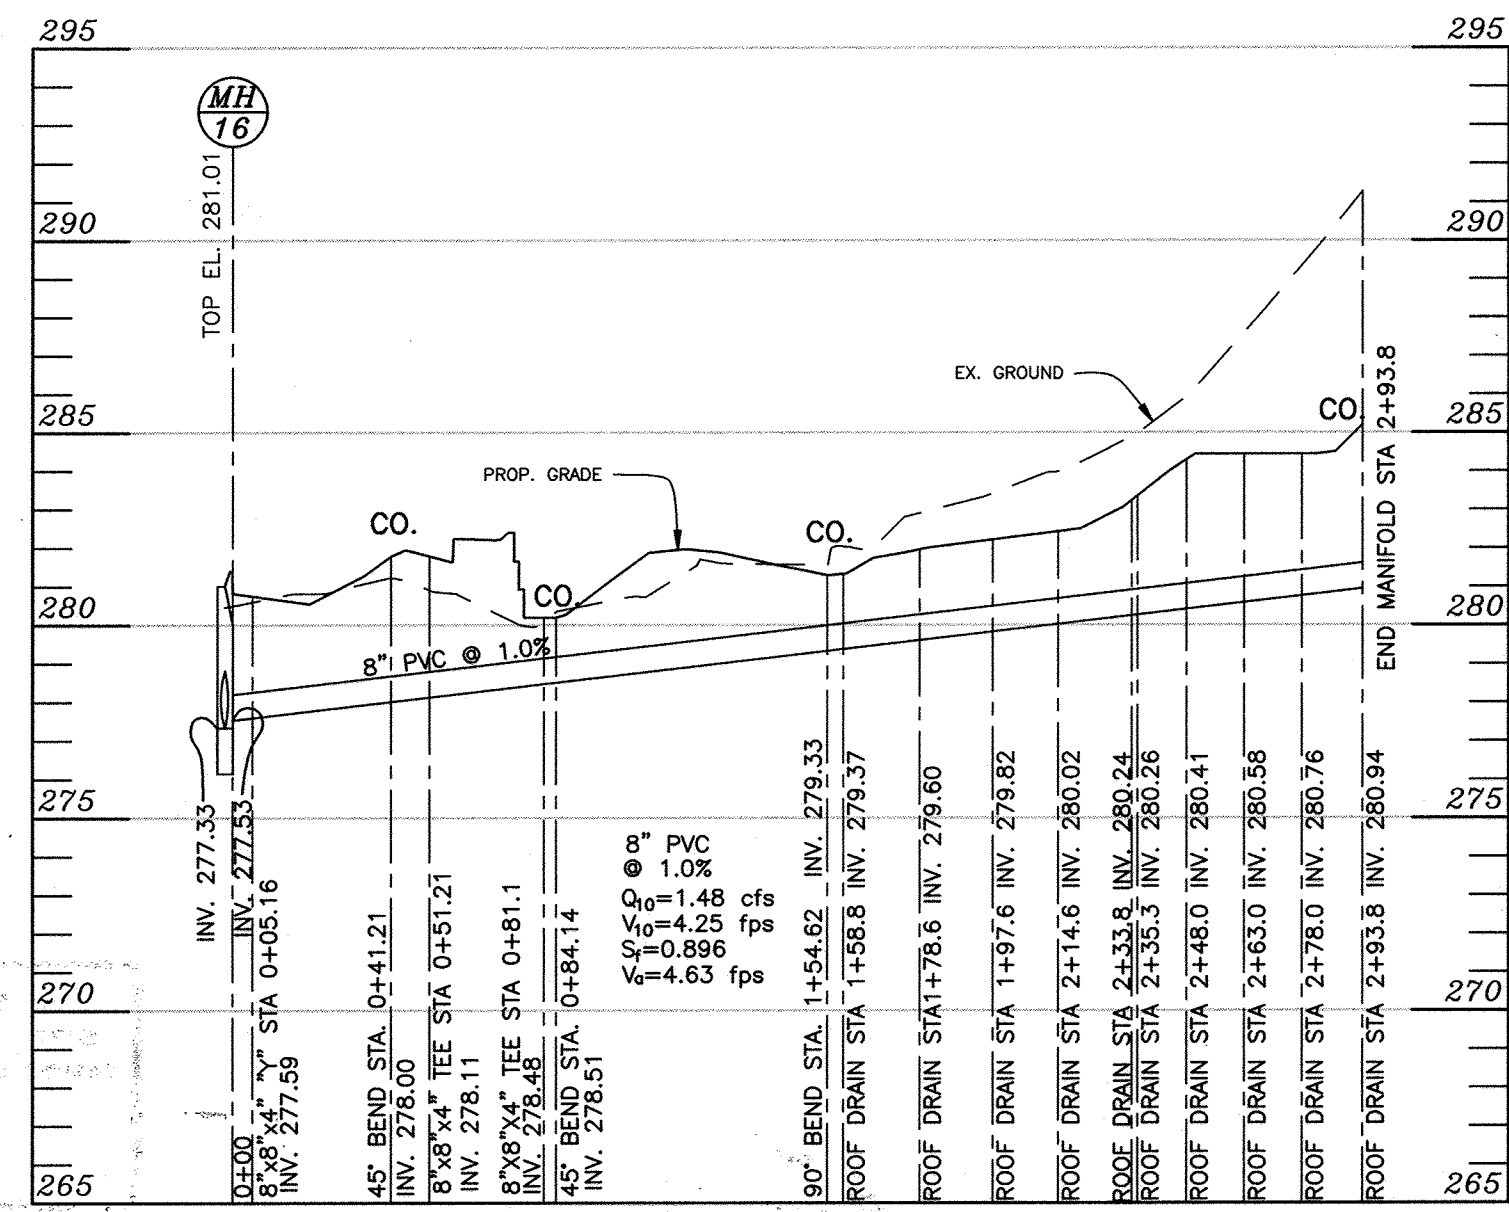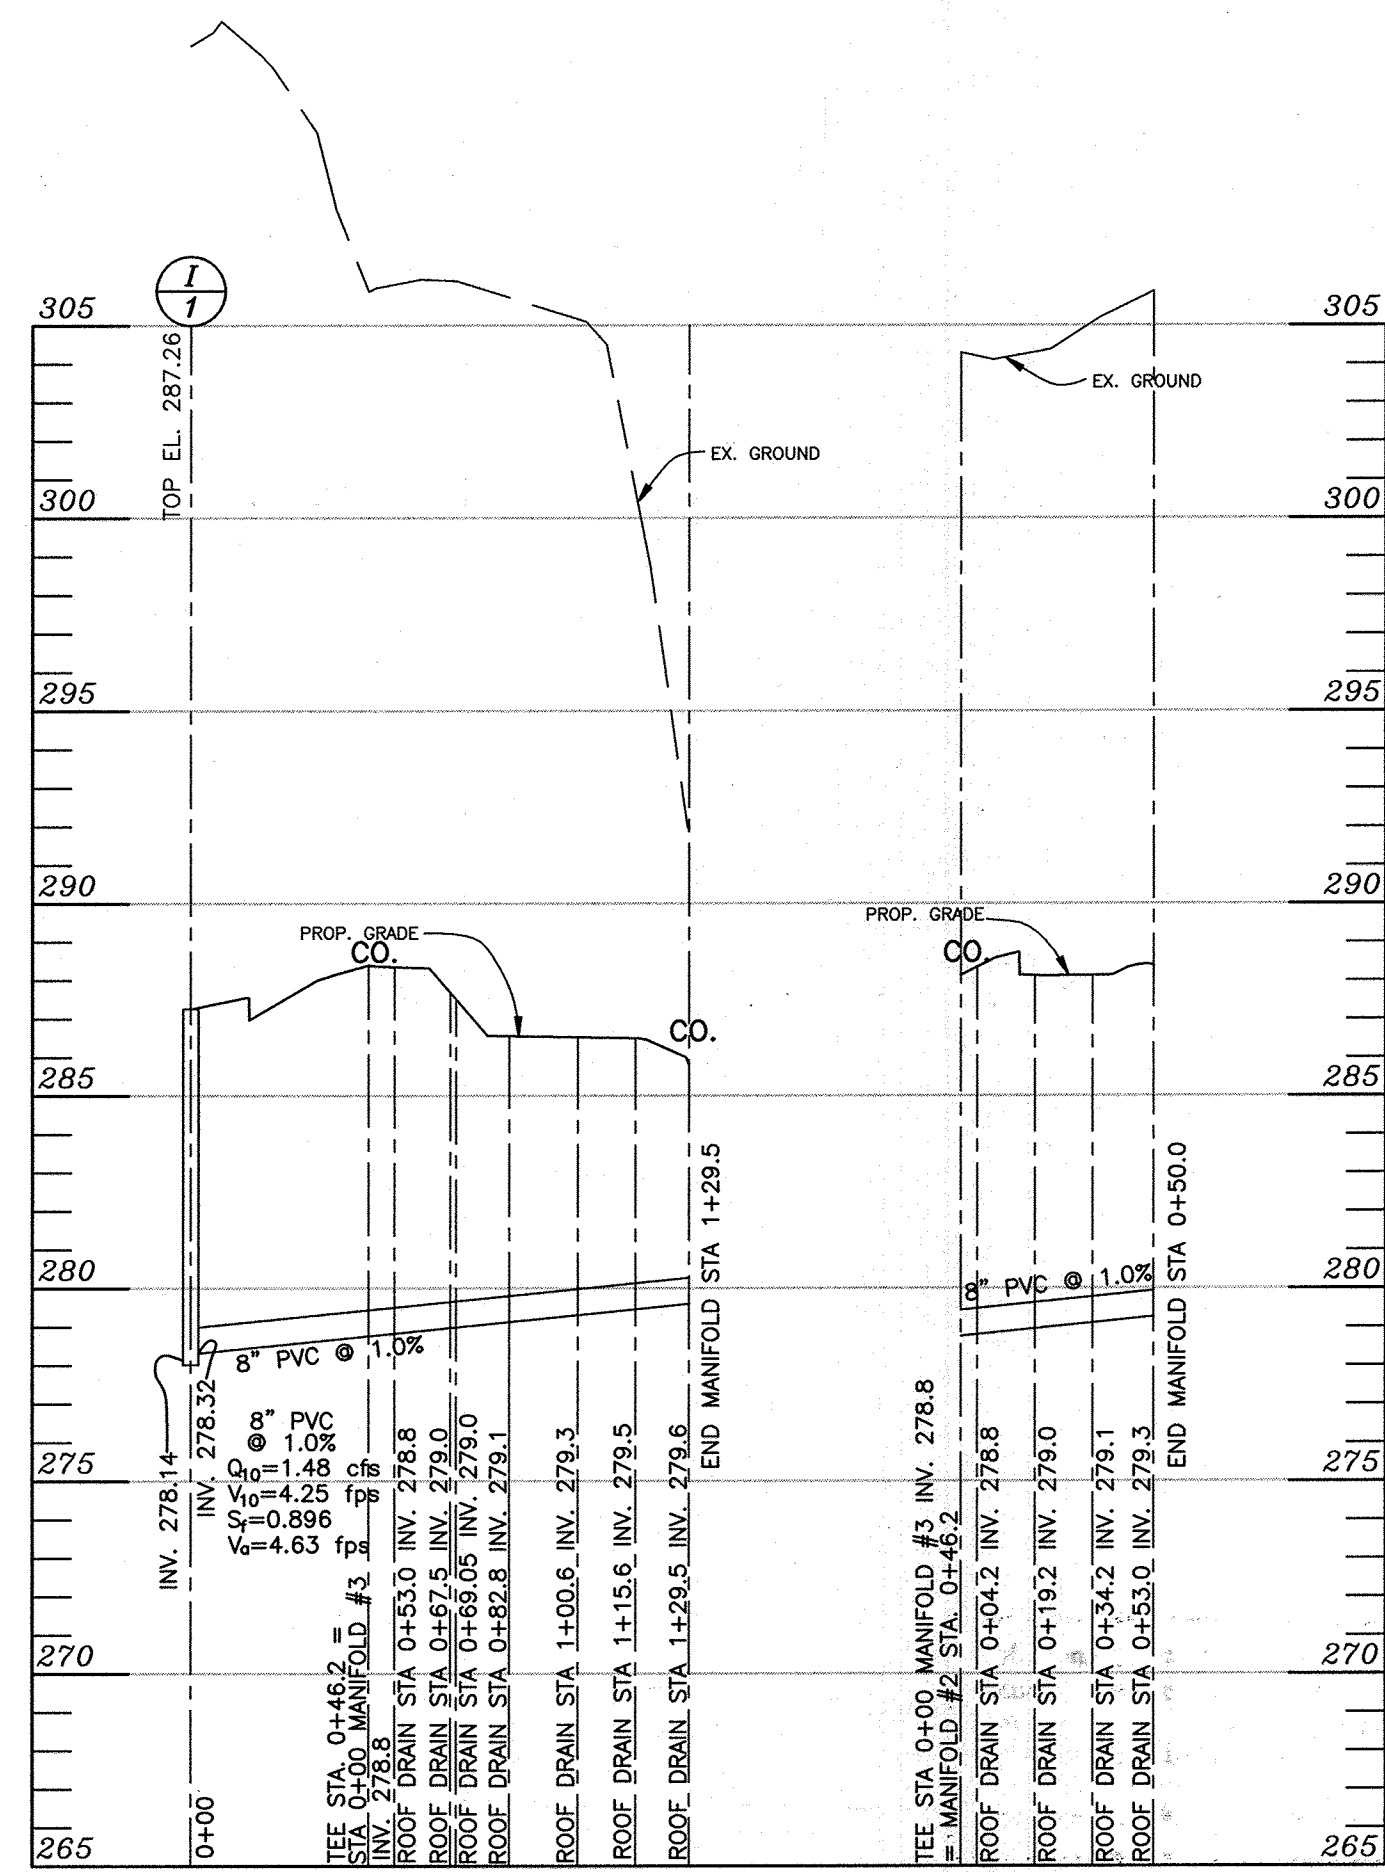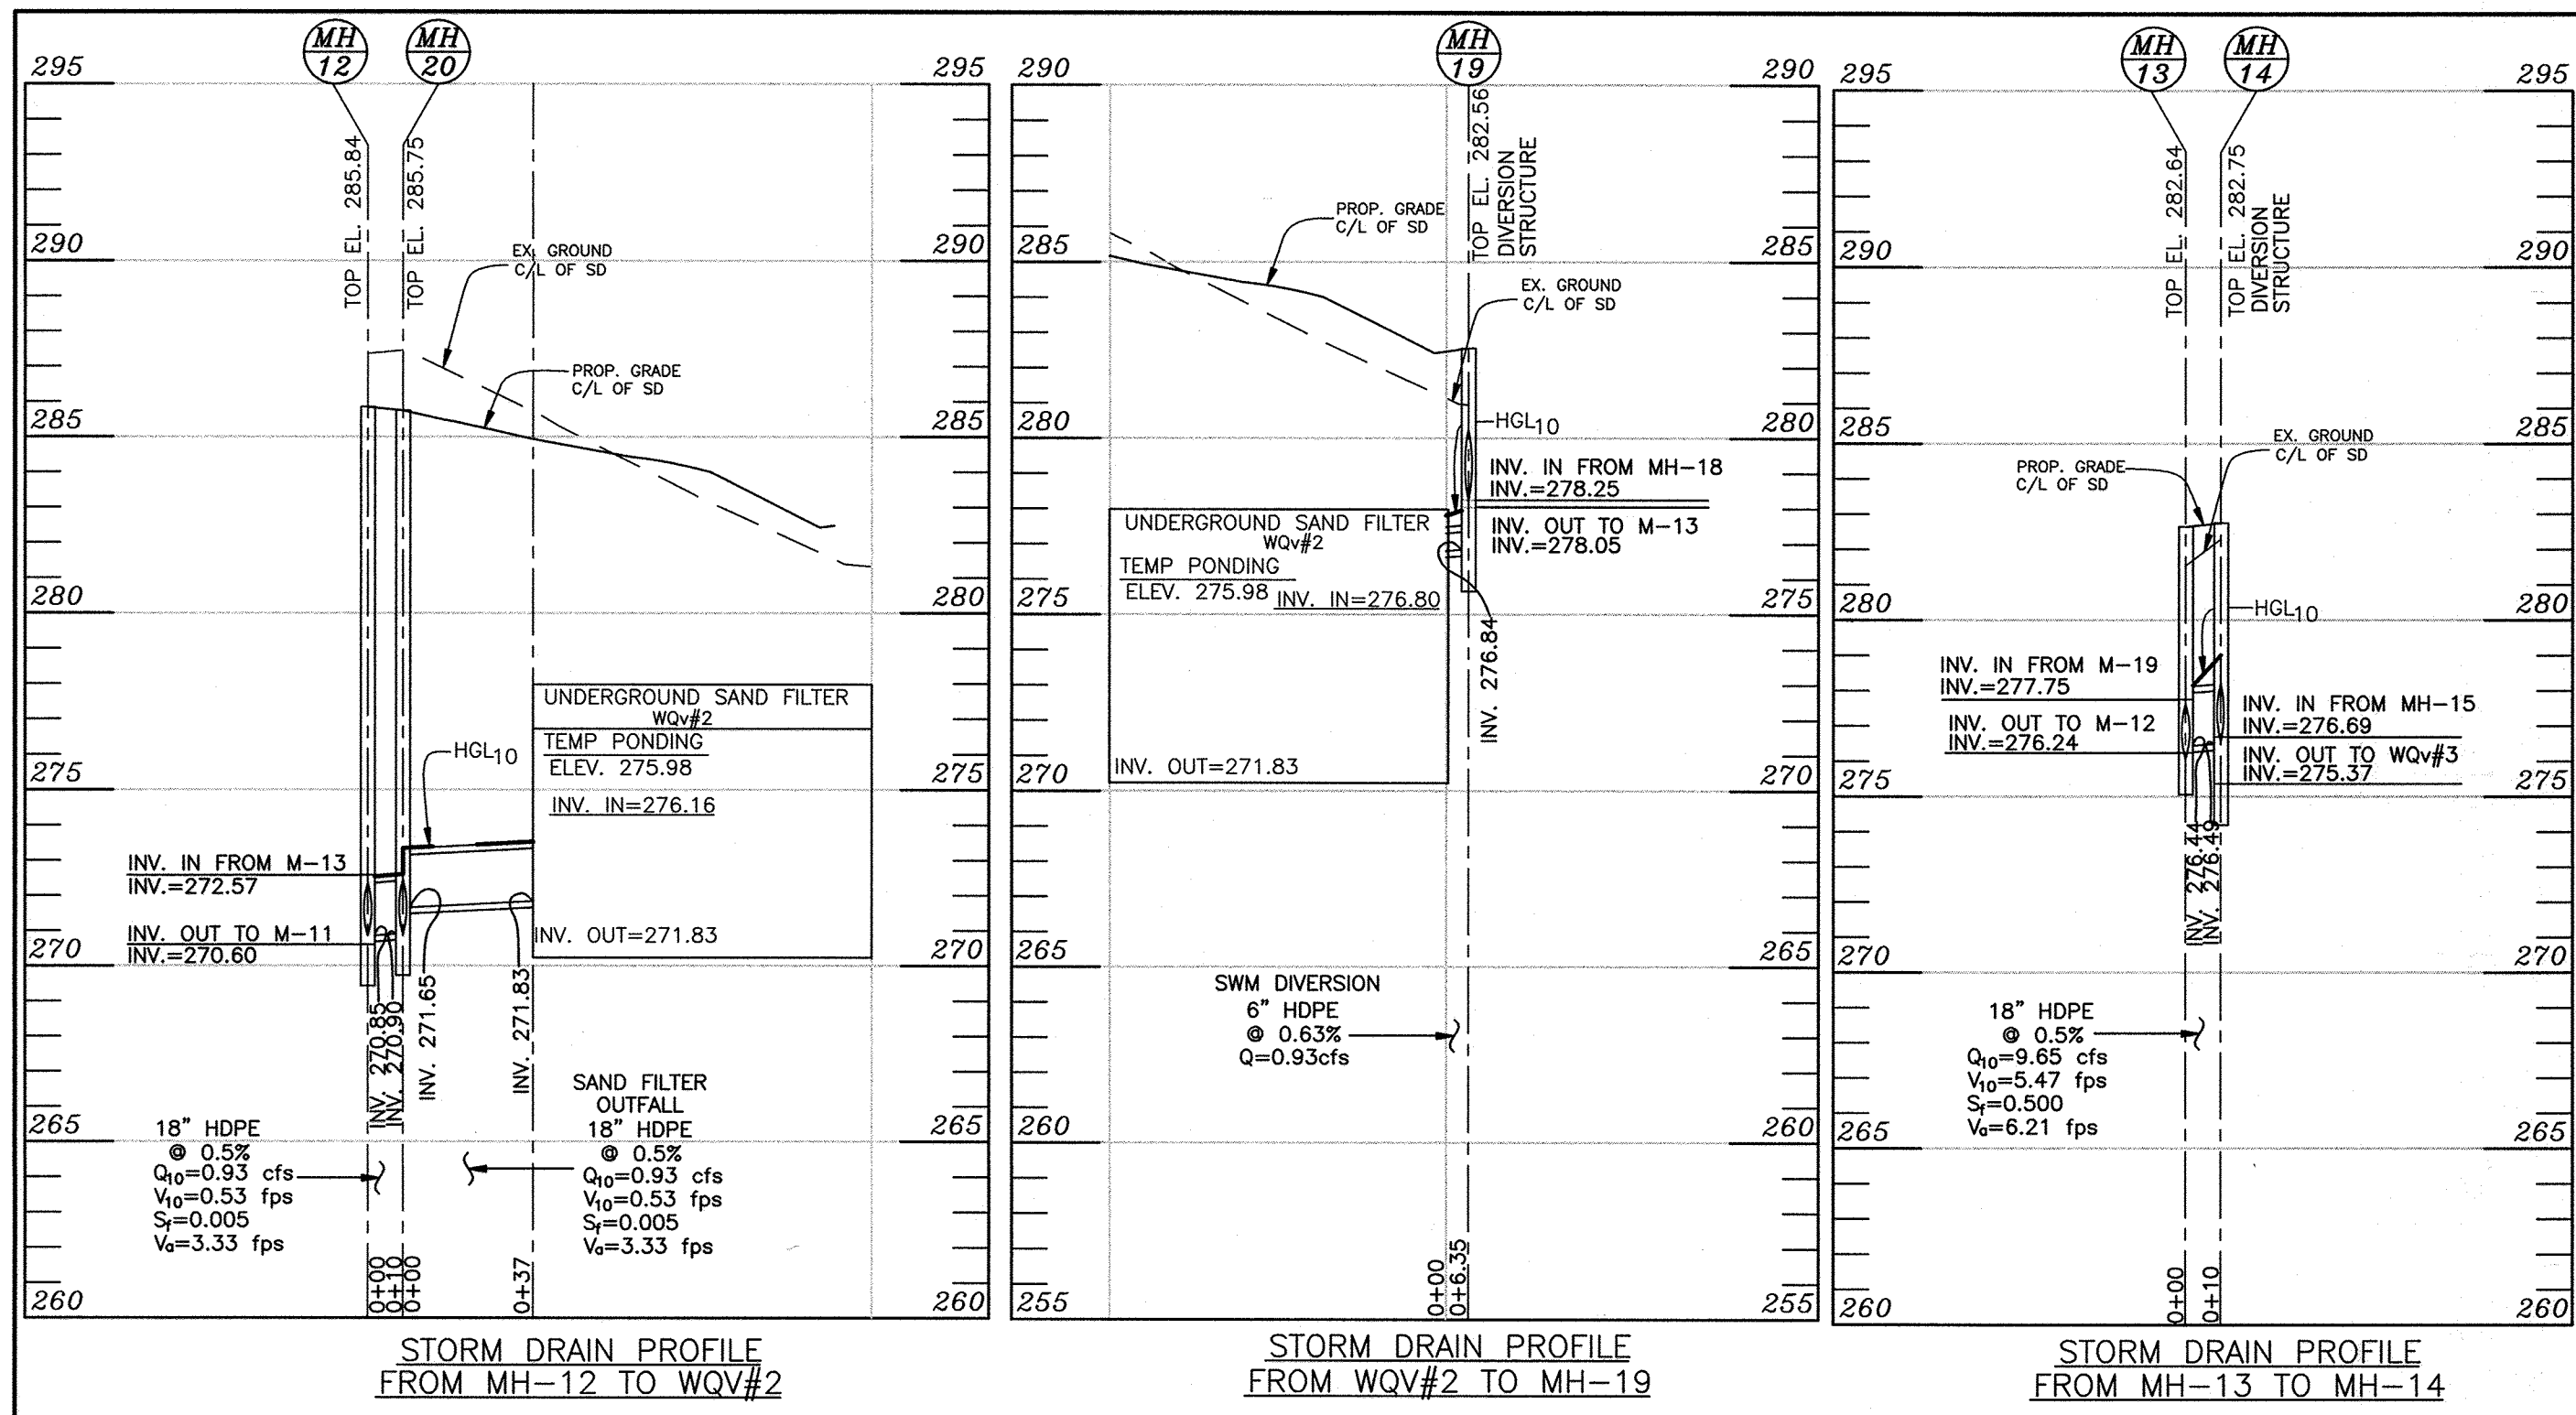

ROOF DRAIN MANIFOLD #2 FROM I-1 TO BUILDING #1

ROOF DRAIN MANIFOLD #3 FROM I-1 TO BUILDING #1

ROOF DRAIN MANIFOLD #1 FROM M-16 TO BUILDING #1

ROOF DRAIN PROFILE FROM M-17 TO BUILDING #2



STORM DRAIN PROFILE SCALE: HORIZONTAL: 1" = 50' VERTICAL: 1" = 5'

AS-BUILT CERTIFICATION I hereby certify, by my seal, that to the best of my knowledge and belief the facilities shown on this "AS-BUILT" Plan meet the Approved Plans and Specifications

Donald Mason, P.E.

Date: 4/11/19

NOTE: ALL STORM DRAIN PRIVATE UNLESS NOTED OTHERWISE ON THE PROFILES.

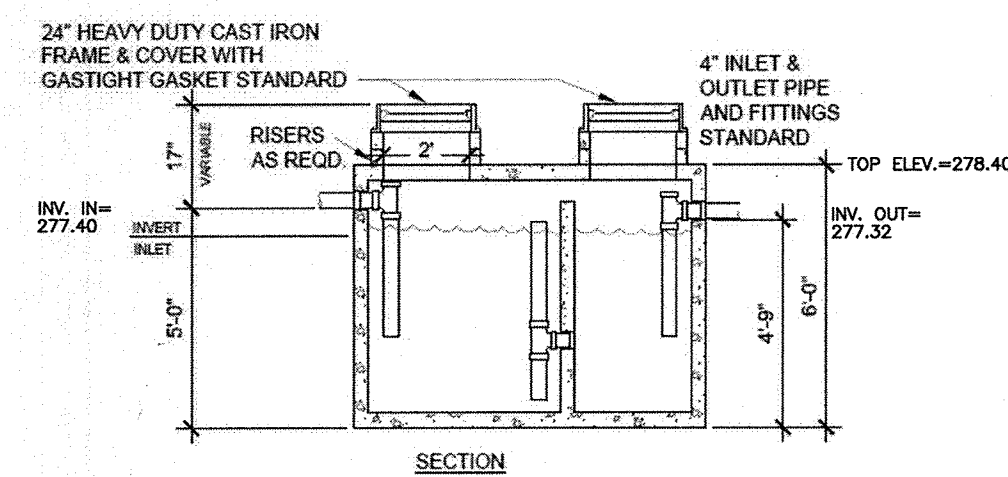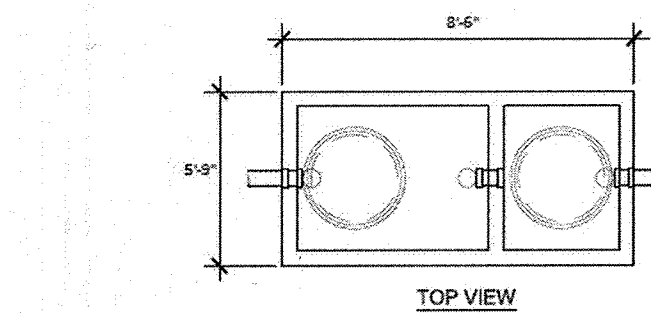

EXTERIOR GREASE TRAP

Professional Certification. I hereby certify that these documents were prepared or approved by me, and that I am a duly licensed professional engineer under the laws of the State of Maryland. License No. 21443, Expiration Date: 12-21-20



APPROVED: DEPARTMENT OF PLANNING AND ZONING  
 Chief, Division of Land Development  
 Chief, Development Engineering Division  
 Director

STRUCTURE SCHEDULE										
NO.	TYPE	LOCATION	THROAT INV.	INVERT IN	INVERT OUT	TOP ELEV.	HO. CO. STD.	REMARKS	MAINT.	
MH-1	STD. PRE-CAST	N 539,381.98 E 1,367,076.78		268.41	268.21	282.34	Ho.Co.STD. G-5.12	-	PUBLIC	
MH-2	STD. PRE-CAST	N 539,377.21 E 1,367,062.32		268.69	268.49	282.17	Ho.Co.STD. G-5.12	-	PRIVATE	
MH-3	STD. PRE-CAST	N 539,422.98 E 1,367,013.74		269.23	269.03	280.00	Ho.Co.STD. G-5.12	-	PRIVATE	
MH-4	STD. PRE-CAST	N 539,495.66 E 1,366,995.02		269.81	269.61	277.82	Ho.Co.STD. G-5.12	-	PRIVATE	
MH-5	STD. PRE-CAST	N 539,586.95 E 1,366,896.33		270.69	270.49	277.75	Ho.Co.STD. G-5.12	-	PRIVATE	
MH-6	STD. PRE-CAST	N 539,593.74 E 1,366,888.99		270.94	270.74	277.41	Ho.Co.STD. G-5.12	-	PRIVATE	
MH-7	STD. PRE-CAST	N 539,687.13 E 1,366,975.37		277.23	275.76	277.03	284.10	Ho.Co.STD. G-5.12	-	PRIVATE
MH-8	STD. PRE-CAST	N 539,695.42 E 1,366,966.41		277.49	277.29	283.85	Ho.Co.STD. G-5.12	-	PRIVATE	
MH-9	STD. PRE-CAST	N 539,424.54 E 1,367,127.80		269.05	268.85	282.41	Ho.Co.STD. G-5.12	-	PUBLIC	
MH-10	STD. PRE-CAST	N 539,531.39 E 1,367,234.19		270.10	276.38	269.88	286.71	Ho.Co.STD. G-5.12	-	PUBLIC
MH-11	STD. PRE-CAST	N 539,565.28 E 1,367,197.64		270.55	270.35	285.93	Ho.Co.STD. G-5.12	-	PRIVATE	
MH-12	STD. PRE-CAST	N 539,572.07 E 1,367,190.30		270.85	272.57	276.60	285.84	Ho.Co.STD. G-5.12	-	PRIVATE
MH-13	STD. PRE-CAST	N 539,477.85 E 1,367,103.15		277.75	276.44	276.24	282.64	Ho.Co.STD. G-5.12	-	PRIVATE
MH-14	STD. PRE-CAST	N 539,471.06 E 1,367,110.49		276.69	275.37	276.49	282.75	Ho.Co.STD. G-5.12	-	PRIVATE
MH-15	STD. PRE-CAST	N 539,463.72 E 1,367,103.70		276.94	277.12	276.74	282.85	Ho.Co.STD. G-5.12	-	PRIVATE
MH-16	STD. PRE-CAST	N 539,516.60 E 1,367,046.52		277.53	277.53	277.33	281.01	Ho.Co.STD. G-5.12	-	PRIVATE
MH-17	STD. PRE-CAST	N 539,508.25 E 1,367,018.53		278.18	277.53	277.67	280.75	Ho.Co.STD. G-5.12	-	PRIVATE
MH-18	STD. PRE-CAST	N 539,506.31 E 1,367,072.38		278.61	278.41	282.23	Ho.Co.STD. G-5.12	-	PRIVATE	
MH-19	STD. PRE-CAST	N 539,484.64 E 1,367,095.80		278.25	278.05	276.84	282.56	Ho.Co.STD. G-5.12	-	PRIVATE
MH-20	STD. PRE-CAST	N 539,578.86 E 1,367,182.96		271.65	270.90	285.75	Ho.Co.STD. G-5.12	-	PRIVATE	
MH-21	STD. PRE-CAST	N 539,619.91 E 1,367,308.41		282.36	282.16	290.71	Ho.Co.STD. G-5.12	-	PUBLIC	
I-1	"A"-5"	N 539,789.79 E 1,367,040.07		-	278.12	287.26	Ho.Co.STD. D-4.01	-	PRIVATE	
I-2	"A"-5"	N 539,642.09 E 1,366,963.74		278.10	277.90	282.24	Ho.Co.STD. D-4.01	-	PRIVATE	
I-3	"A"-5"	N 539,613.94 E 1,366,895.07		-	278.25	280.19	Ho.Co.STD. D-4.01	-	PRIVATE	
I-4	"A"-5"	N 539,433.42 E 1,367,112.16		-	278.01	281.67	Ho.Co.STD. D-4.01	-	PRIVATE	
I-5	TRENCH DRAIN	N 539,521.65 E 1,367,004.36		-	278.37	279.50	Ho.Co.STD. D-4.15	-	PRIVATE	
I-7	"A"-10"	N 539,619.75 E 1,367,114.31		-	279.91	279.71	284.82	Ho.Co.STD. D-4.03	-	PRIVATE
I-8	"A"-5"	N 539,663.79 E 1,367,155.05		-	281.11	286.66	Ho.Co.STD. D-4.01	-	PRIVATE	
I-9	"A"-5"	N 539,522.22 E 1,367,053.62		-	277.87	280.80	Ho.Co.STD. D-4.01	-	PRIVATE	


PIPE SCHEDULE

SIZE	LENGTH	TYPE & CLASS	OWNED & MAINT.
24"	240'	HDPE HI-Q	PUBLIC
18"	144'	HDPE HI-Q	PUBLIC


PIPE SCHEDULE

SIZE	LENGTH	TYPE & CLASS	OWNED & MAINT.
24"	360'	HDPE HI-Q	PRIVATE
18"	845'	HDPE HI-Q	PRIVATE
15"	82'	HDPE HI-Q	PRIVATE
12"	77'	HDPE HI-Q	PRIVATE
10"	7'	HDPE HI-Q	PRIVATE
8"	6'	HDPE HI-Q	PRIVATE
6"	17'	HDPE HI-Q	PRIVATE
6"	150'	PVC	PRIVATE
8"	473'	PVC	PRIVATE


NOTE: WATER AND SEWER CONTRACT NO. 24-4519-D.

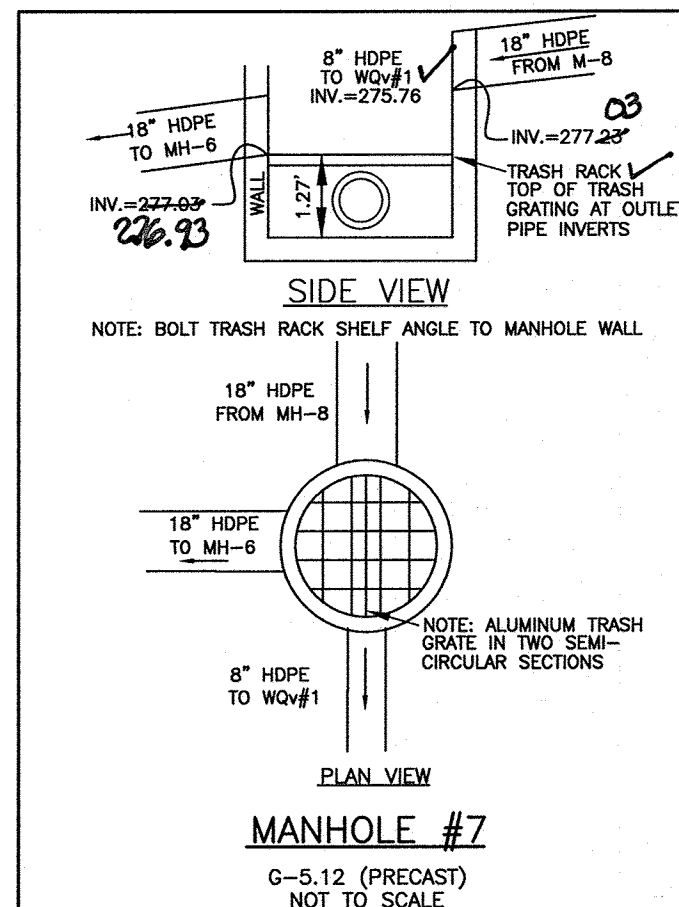

MANHOLE #7

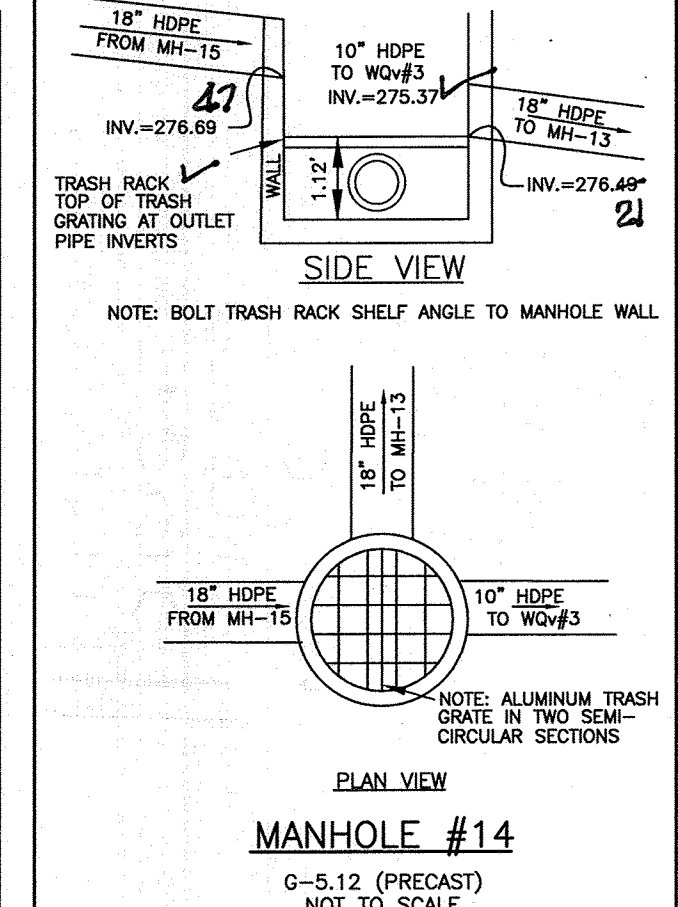

MANHOLE #14

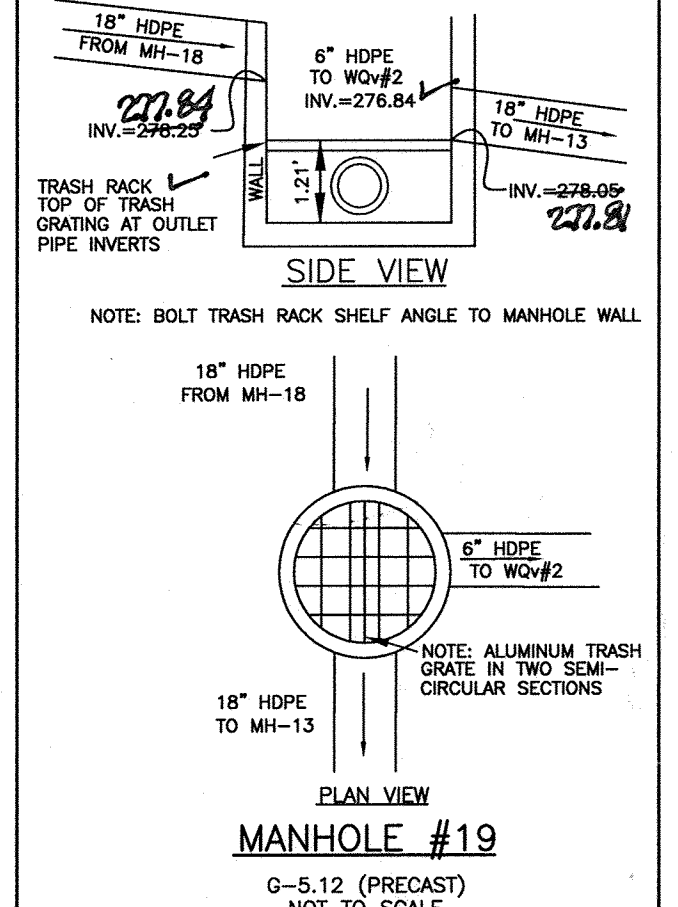

MANHOLE #19

DIVERSION STRUCTURE DETAILS

NO.	DATE	REVISION
2	DEC 16	SHEET SUBSTITUTION TO REVISE ROOF DRAINS, SEWER HOUSE CONNECTION AND PAVE OUTPARCEL
1	FEB 16	RELOCATE ROOF DRAIN FOR BUILDING #2 AND REVISE STRUCTURE SCHEDULE

**BENCHMARK ENGINEERING, INC.**  
 ENGINEERS & LAND SURVEYORS & PLANNERS  
 8480 BALTIMORE NATIONAL PIKE & SUITE 315 ELLICOTT CITY, MARYLAND 21043  
 (P) 410-485-6108 (F) 410-485-6644  
 www.beg-civilengineering.com

DEVELOPER: COLUMBIA JUNCTION DEV. LLC  
 100 MENLO PARK DRIVE, SUITE 500  
 EDISON, NEW JERSEY 08837  
 201-314-6049

PROJECT: COLUMBIA JUNCTION SECTION 3 / LOT A-2 (RETAIL CENTER)

LOCATION: TAX MAP 48 - BLOCK 1  
 PARCEL 548  
 6th ELECTION DISTRICT  
 HOWARD COUNTY, MARYLAND

TITLE: REVISED SITE DEVELOPMENT PLAN STORM DRAIN PROFILES, NOTES AND DETAILS


DATE: JANUARY, 2017 PROJECT NO. 1221

Design: DAM/AAM Draft: HP/AAM Check: CAM/AAM SCALE: AS SHOWN DRAWING 8 OF 11

AS-BUILT

SDP-08-100



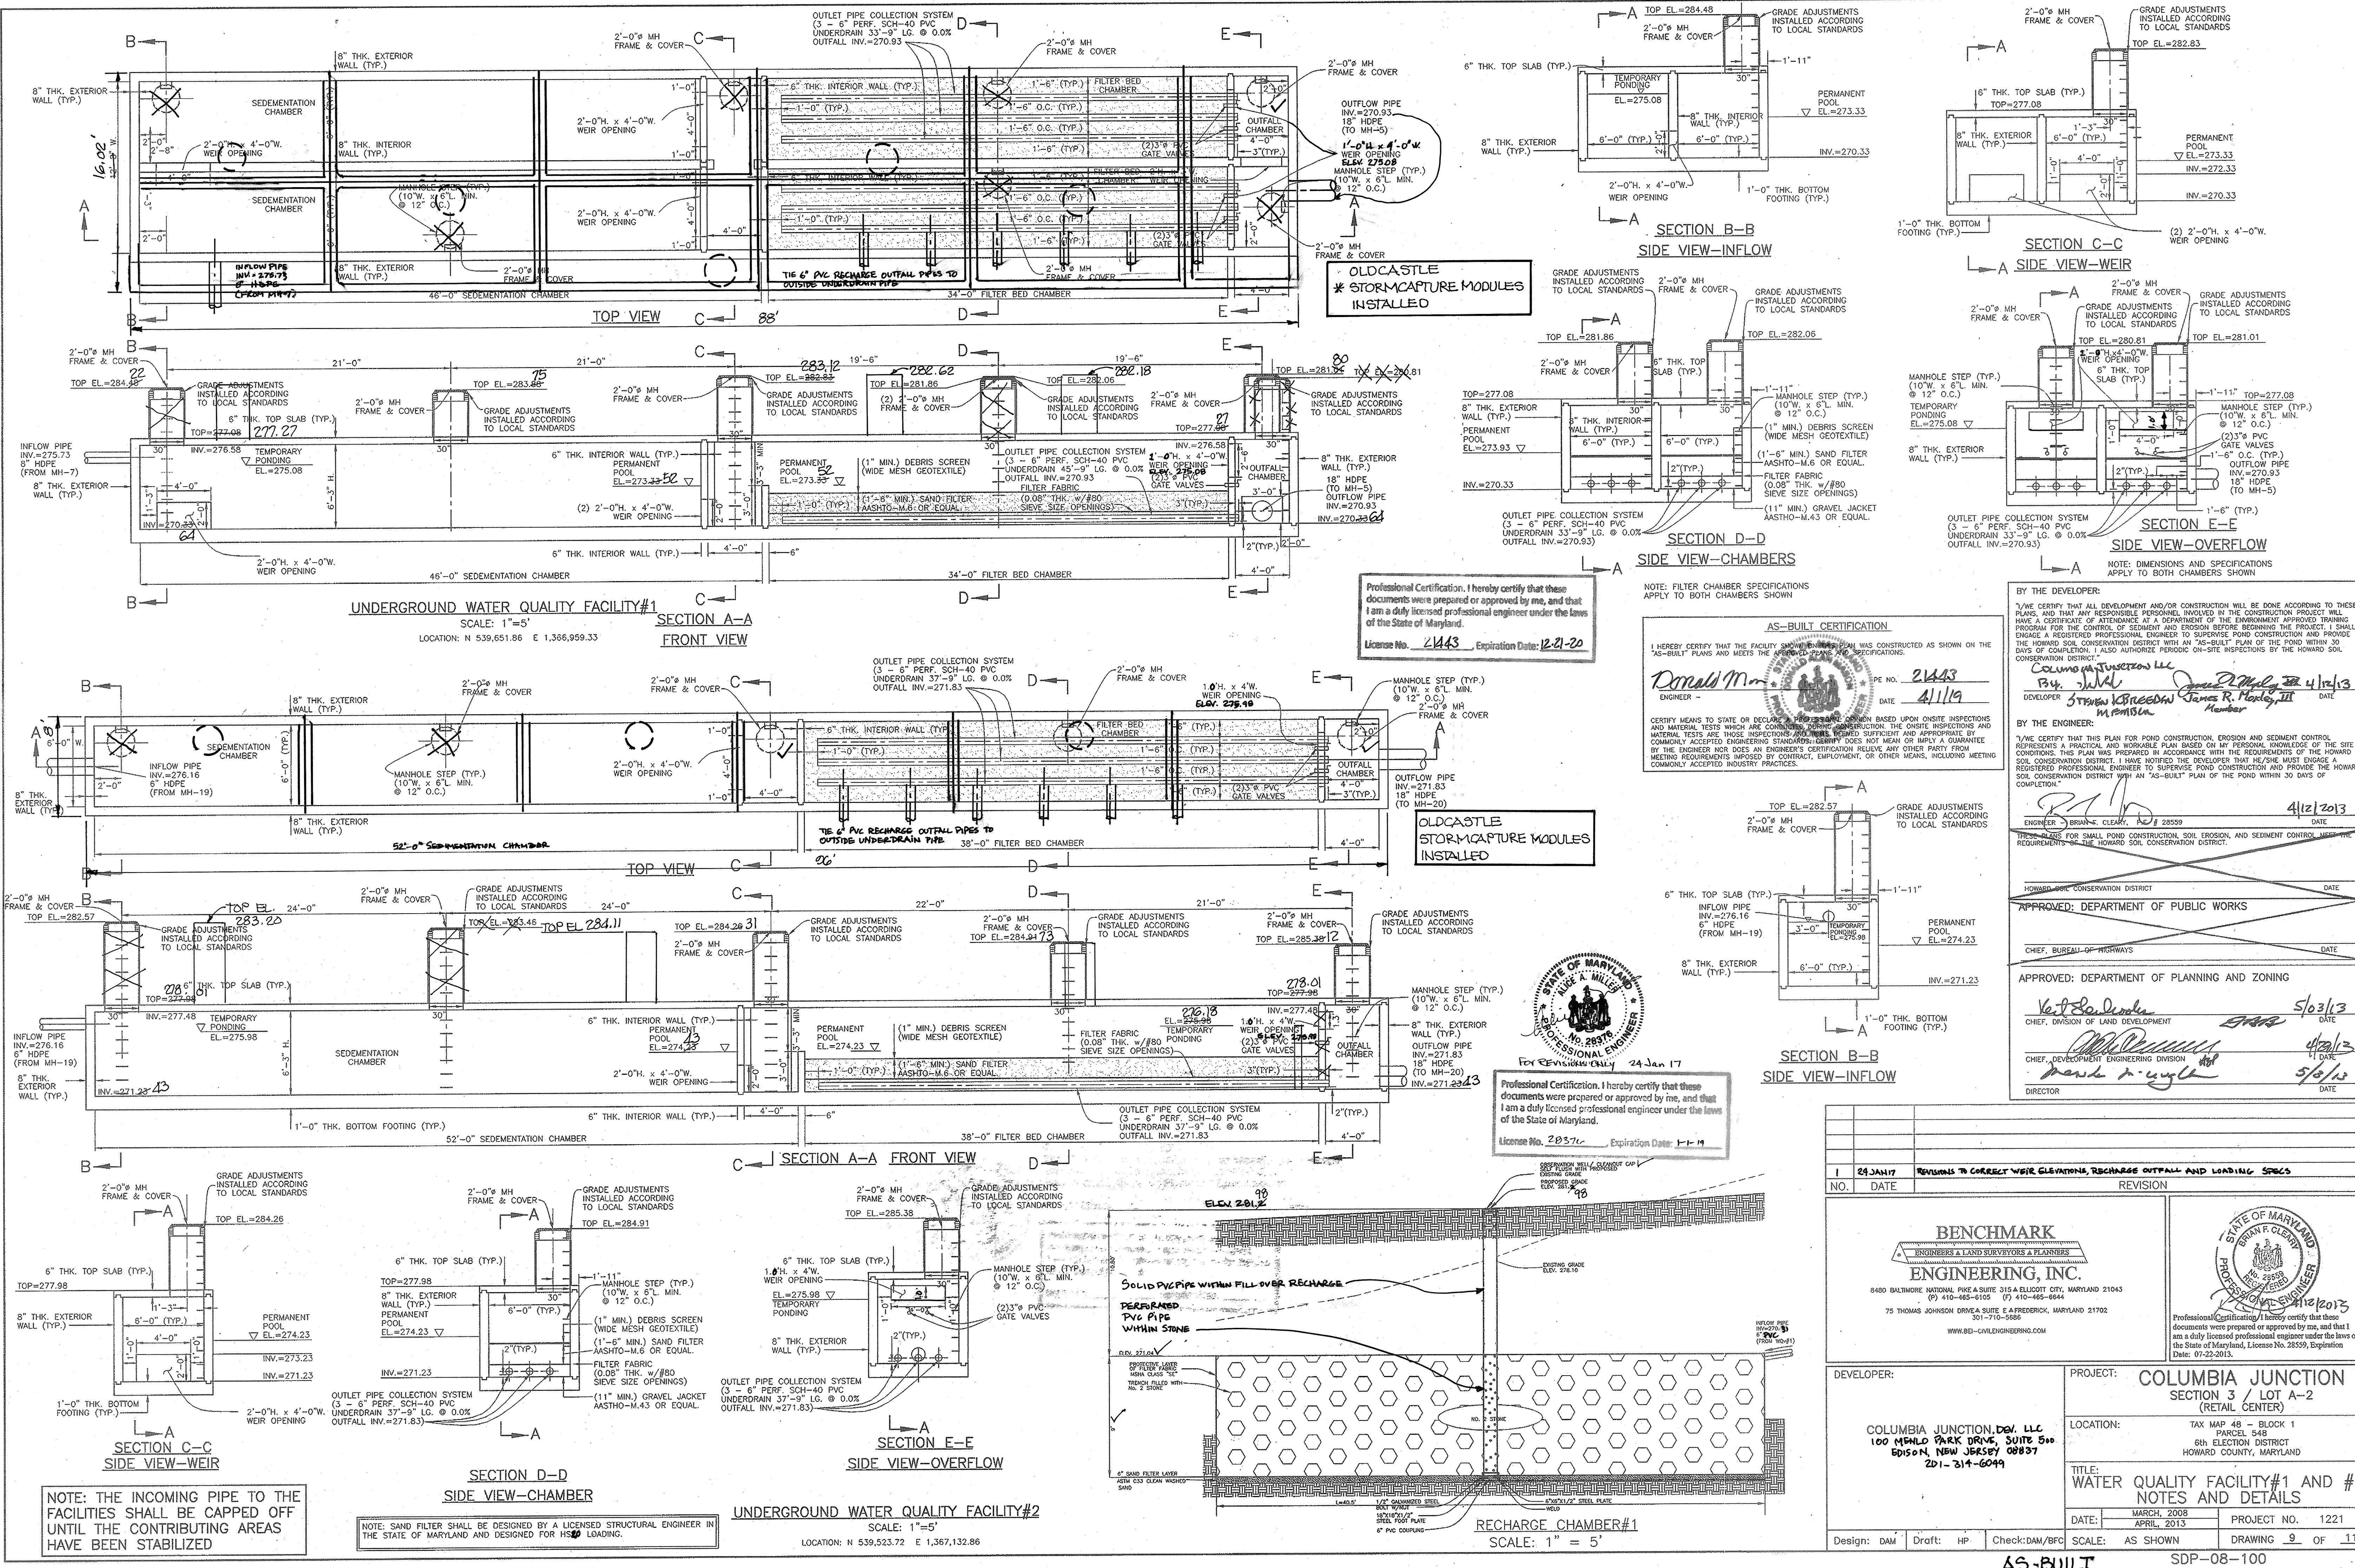

**UNDERGROUND WATER QUALITY FACILITY#1**  
 SCALE: 1"=5'  
 LOCATION: N 539,651.86 E 1,366,959.33

**UNDERGROUND WATER QUALITY FACILITY#2**  
 SCALE: 1"=5'  
 LOCATION: N 539,523.72 E 1,367,132.86

Professional Certification. I hereby certify that these documents were prepared or approved by me, and that I am a duly licensed professional engineer under the laws of the State of Maryland.  
 License No. 21443 Expiration Date: 12-21-20

**AS-BUILT CERTIFICATION**  
 I HEREBY CERTIFY THAT THE FACILITY SHOWN ON THESE AS-BUILT PLANS AND MEETS THE APPLICABLE CODES AND SPECIFICATIONS.  
 Donald M. [Signature] PE No. 21443 DATE 4/11/19  
 ENGINEER

**STATE OF MARYLAND**  
 PROFESSIONAL ENGINEER  
 License No. 28371 Expiration Date: 1-1-14

BY THE DEVELOPER:  
 I/WE CERTIFY THAT ALL DEVELOPER AND/OR CONSTRUCTION WILL BE DONE ACCORDING TO THESE PLANS, AND THAT ANY RESPONSIBLE PERSONNEL INVOLVED IN THE CONSTRUCTION PROJECT WILL HAVE A CERTIFICATE OF ATTENDANCE AT A DEPARTMENT OF THE ENVIRONMENT APPROVED TRAINING PROGRAM FOR THE CONTROL OF SEDIMENT AND EROSION BEFORE BEGINNING THE PROJECT. I SHALL EMPLOY A REGISTERED PROFESSIONAL ENGINEER TO SUPERVISE POND CONSTRUCTION AND PROVIDE THE HOWARD SOIL CONSERVATION DISTRICT WITH AN "AS-BUILT" PLAN OF THE POND WITHIN 30 DAYS OF COMPLETION. I ALSO AUTHORIZE PERIODIC ON-SITE INSPECTIONS BY THE HOWARD SOIL CONSERVATION DISTRICT.

BY THE ENGINEER:  
 I/WE CERTIFY THAT THIS PLAN FOR POND CONSTRUCTION, EROSION AND SEDIMENT CONTROL REPRESENTS A PRACTICAL AND WORKABLE PLAN BASED ON MY PERSONAL KNOWLEDGE OF THE SITE CONDITIONS. THIS PLAN WAS PREPARED IN ACCORDANCE WITH THE REQUIREMENTS OF THE HOWARD SOIL CONSERVATION DISTRICT. I HAVE NOTIFIED THE DEVELOPER THAT HE/SHE MUST EMPLOY A REGISTERED PROFESSIONAL ENGINEER TO SUPERVISE POND CONSTRUCTION AND PROVIDE THE HOWARD SOIL CONSERVATION DISTRICT WITH AN "AS-BUILT" PLAN OF THE POND WITHIN 30 DAYS OF COMPLETION.


APPROVED: DEPARTMENT OF PUBLIC WORKS  
 APPROVED: DEPARTMENT OF PLANNING AND ZONING

NO.	DATE	REVISION
1	29JAN17	REVISED TO CORRECT WEIR ELEVATIONS, RECHARGE OUTFALL AND LOADING SPACES

**BENCHMARK ENGINEERING, INC.**  
 ENGINEERS & LAND SURVEYORS & PLANNERS  
 8480 BALTIMORE NATIONAL PIKE SUITE 315 & ELICOTT CITY, MARYLAND 21043  
 (P) 410-468-4105 (F) 410-468-4644  
 75 THOMAS JOHNSON DRIVE SUITE 2 A FREDERICK, MARYLAND 21702  
 301-710-5886  
 WWW.BE-CIVILENGINEERING.COM

Professional Certification. I hereby certify that these documents were prepared or approved by me, and that I am a duly licensed professional engineer under the laws of the State of Maryland, License No. 28559, Expiration Date: 07-22-2013.

DEVELOPER:	COLUMBIA JUNCTION, INC. 100 HANCOCK PARK DRIVE, SUITE 500 EDISON, NJ 08857, 201-314-6044
PROJECT:	COLUMBIA JUNCTION SECTION 3 / LOT A-2 (RETAIL CENTER)
LOCATION:	TAX MAP 48 - BLOCK 1 PARCEL 548 6TH ELECTION DISTRICT HOWARD COUNTY, MARYLAND
TITLE:	WATER QUALITY FACILITY#1 AND #2 NOTES AND DETAILS
DATE:	MARCH, 2008 APRIL, 2013
PROJECT NO.:	1221
Design:	DAM HP Check: DAM/BFC
Draft:	HP
Scale:	AS SHOWN
Sheet:	DRAWING 9 OF 11

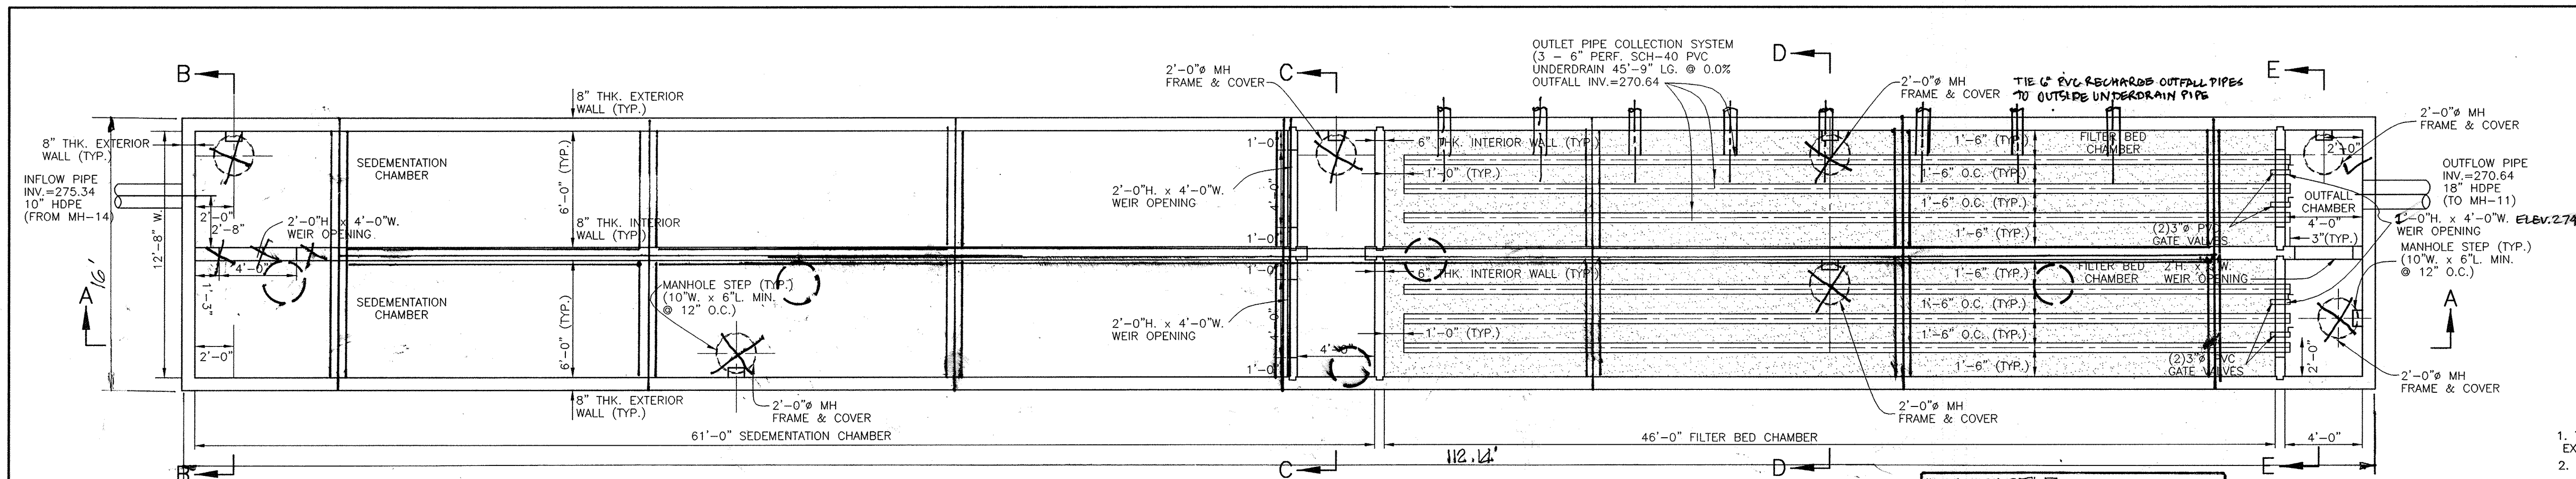

MATERIAL	SPECIFICATION	SIZE	NOTES
NON-REBAR STEEL	ASTM A-36	N/A	STRUCTURAL STEEL TO BE HOT-DIPPED GALVANIZED ASTM A-133
GRAVEL	ASTM D-448	NO. 8	PEA GRAVEL; WASHED COBBLES
GEOTEXTILE	ASTM D-4751	0.87 THK. EQUIVALENT OPENING SIZE OF #80 SIEVE	MUST MAINTAIN 125 GPM / SQ. FT. FLOW RATE. NOTE: A PEA GRAVEL LAYER MAY BE SUBSTITUTED FOR GEOTEXTILES MEANT TO "SEPERATE" SAND FILTER LAYERS
UNDERDRAIN PIPING	ASTM D-4333	0.375" TO 0.750"	3/8" PERF. @ 6" O.C. 4 HOLES PER ROW. MINIMUM OF 3" OF GRAVEL OVER PIPES, NOT INCLUDING UNDERDRAIN PIPING
POURED-IN-PLACE CONC. (IF REQUIRED)	ASTM C-1500	N/A	ON-SITE TESTING OF POURED-IN-PLACE CONC. REQUIRED; 28 DAY STRENGTH TEST AND SLUMP TEST. ALL CONC. DESIGN (CAST IN PLACE OR PRE-CAST) NOT USING PREVIOUSLY APPROVED STATE OR LOCAL STANDARDS. STANDARDS REQUIRES DESIGN DRAWINGS SEALED AND APPROVED BY A PROFESSIONAL STRUCTURAL ENGINEER LICENSED IN THE STATE OF MARYLAND.
SAND (2.0' DEEP)	ASTM M-63	0.02" TO 0.04"	SAND SUBSTITUTIONS SUCH AS DUNESAND AND DRYSTONE#10 ARE NOT ACCEPTABLE. NO CALCIUM CARBONATE OR EOLKIMIC SAND SUBSTITUTIONS ARE ACCEPTABLE. NO "ROCK JUST" CAN BE USED FOR SAND.

**OPERATION & MAINTENANCE SCHEDULE FOR PRIVATELY OWNED AND MAINTAINED UNDERGROUND STORMWATER FILTRATION SYSTEMS SAND FILTER (WQV#1, WQV#2, WQV#3)**

1. THE SEDIMENT CHAMBER OUTLET DEVICES SHALL BE CLEANED AND/OR REPAIRED WHEN DRAWDOWN TIMES WITHIN THE CHAMBER EXCEEDS 36 HOURS.
2. DEBRIS & LITTER SHALL BE REMOVED AS NECESSARY TO INSURE PROPER OPERATION OF THE SYSTEM.
3. SEDIMENT SHALL BE CLEANED-OUT OF THE SEDIMENTATION CHAMBER WHEN IT ACCUMULATES TO A DEPTH OF 6 INCHES.
4. WHEN WATER PONDS ON THE SURFACE OF THE FILTER BED FOR MORE THAN 72 HOURS, THE TOP FEW INCHES OF DISCOLORED MATERIAL SHALL BE REPLACED WITH FRESH MATERIAL. PROPER CLEANING AND DISPOSAL OF THE REMOVED MATERIALS & LIQUIDS MUST BE FOLLOWED BY THE OWNER.
5. A LOGBOOK SHALL BE MAINTAINED TO DETERMINE THE RATE AT WHICH THE FACILITY DRAINS.
6. THE MAINTENANCE LOGBOOK SHALL BE AVAILABLE TO HOWARD COUNTY FOR INSPECTION TO INSURE COMPLIANCE WITH OPERATION AND MAINTENANCE CRITERIA.
7. ONCE THE PERFORMANCE CHARACTERISTICS OF THE INFILTRATION SYSTEM HAVE BEEN VERIFIED, THE MONITORING SCHEDULE CAN BE REDUCED TO AN ANNUAL BASIS UNLESS THE PERFORMANCE DATA INDICATED THAT A MORE FREQUENT SCHEDULE IS REQUIRED.

**AS-BUILT CERTIFICATION**

I HEREBY CERTIFY THAT THE FACILITY SHOWN ON THIS PLAN WAS CONSTRUCTED AS SHOWN ON THE "AS-BUILT" PLANS AND MEETS THE APPROVED PLANS AND SPECIFICATIONS.

ENGINEER: \_\_\_\_\_ PE NO. \_\_\_\_\_ DATE: \_\_\_\_\_

CERTIFY MEANS TO STATE OR DECLARE A PROFESSIONAL OPINION BASED UPON ON-SITE INSPECTIONS AND MATERIAL TESTS WHICH ARE CONDUCTED DURING CONSTRUCTION. THE ON-SITE INSPECTIONS AND MATERIAL TESTS ARE THOSE INSPECTIONS AND TESTS DEEMED SUFFICIENT AND APPROPRIATE BY COMMONLY ACCEPTED ENGINEERING STANDARDS. CERTIFY DOES NOT MEAN OR IMPLY A GUARANTEE BY THE ENGINEER NOR DOES AN ENGINEER'S CERTIFICATION RELIEVE ANY OTHER PARTY FROM MEETING REQUIREMENTS IMPOSED BY CONTRACT, EMPLOYMENT, OR OTHER MEANS, INCLUDING MEETING COMMONLY ACCEPTED ENGINEERING PRACTICES.

BY THE DEVELOPER:  
I, THE DEVELOPER, CERTIFY THAT ALL DEVELOPMENT AND/OR CONSTRUCTION HAS BEEN DONE ACCORDING TO THESE PLANS, AND THAT ANY RESPONSIBLE PERSONNEL INVOLVED IN THE CONSTRUCTION PROJECT WILL HAVE A CERTIFICATE OF ATTENDANCE AT A DEPARTMENT OF THE ENVIRONMENT APPROVED TRAINING PROGRAM FOR THE CONTROL OF SEDIMENT AND EROSION BEFORE BEGINNING THE PROJECT. I SHALL ENGAGE A REGISTERED PROFESSIONAL ENGINEER TO SUPERVISE POND CONSTRUCTION AND PROVIDE THE HOWARD SOIL CONSERVATION DISTRICT WITH AN "AS-BUILT" PLAN OF THE POND WITHIN 30 DAYS OF COMPLETION. I ALSO AUTHORIZE PERIODIC ON-SITE INSPECTIONS BY THE HOWARD SOIL CONSERVATION DISTRICT.

DEVELOPER: *STEVEN K. BREWER* DATE: *4/12/13*

BY THE ENGINEER:  
I, THE ENGINEER, CERTIFY THAT THIS PLAN FOR POND CONSTRUCTION, EROSION AND SEDIMENT CONTROL REPRESENTS A PRACTICAL AND WORKABLE PLAN BASED ON MY PERSONAL KNOWLEDGE OF THE SITE CONDITIONS. THIS PLAN WAS PREPARED IN ACCORDANCE WITH THE REQUIREMENTS OF THE HOWARD SOIL CONSERVATION DISTRICT. I HAVE NOTIFIED THE DEVELOPER THAT HE/SHE MUST ENGAGE A REGISTERED PROFESSIONAL ENGINEER TO SUPERVISE POND CONSTRUCTION AND PROVIDE THE HOWARD SOIL CONSERVATION DISTRICT WITH AN "AS-BUILT" PLAN OF THE POND WITHIN 30 DAYS OF COMPLETION.

ENGINEER: *BRUCE A. CLEAR* DATE: *4/12/2013*


THESE PLANS FOR SMALL POND CONSTRUCTION, SOIL EROSION, AND SEDIMENT CONTROL MEET THE REQUIREMENTS OF THE HOWARD SOIL CONSERVATION DISTRICT.

APPROVED: DEPARTMENT OF PUBLIC WORKS  
CHIEF BUREAU OF HIGHWAYS


APPROVED: DEPARTMENT OF PLANNING AND ZONING  
CHIEF, DIVISION OF LAND DEVELOPMENT

APPROVED: *Paul D. Loyell* DATE: *5/3/13*


CHIEF, DEVELOPMENT ENGINEERING DIVISION

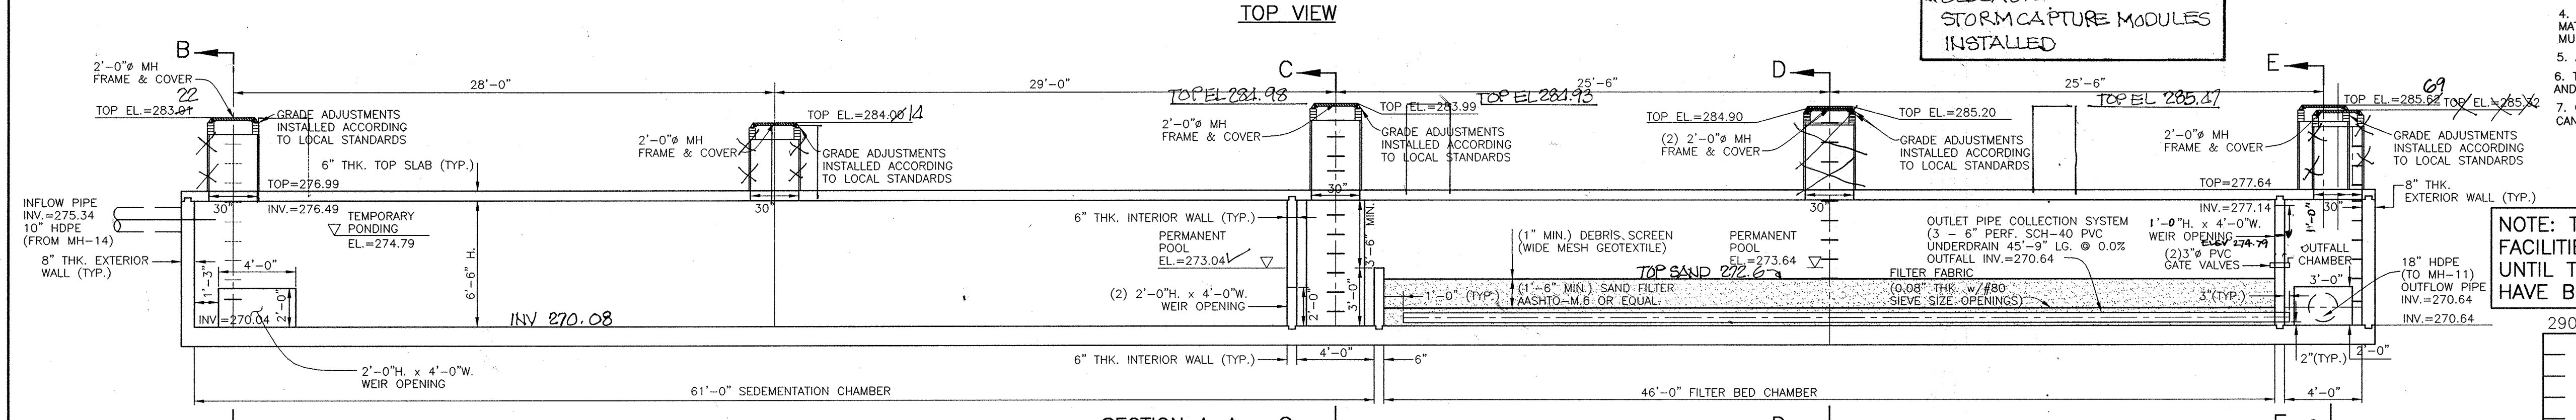


SECTION A-A FRONT VIEW

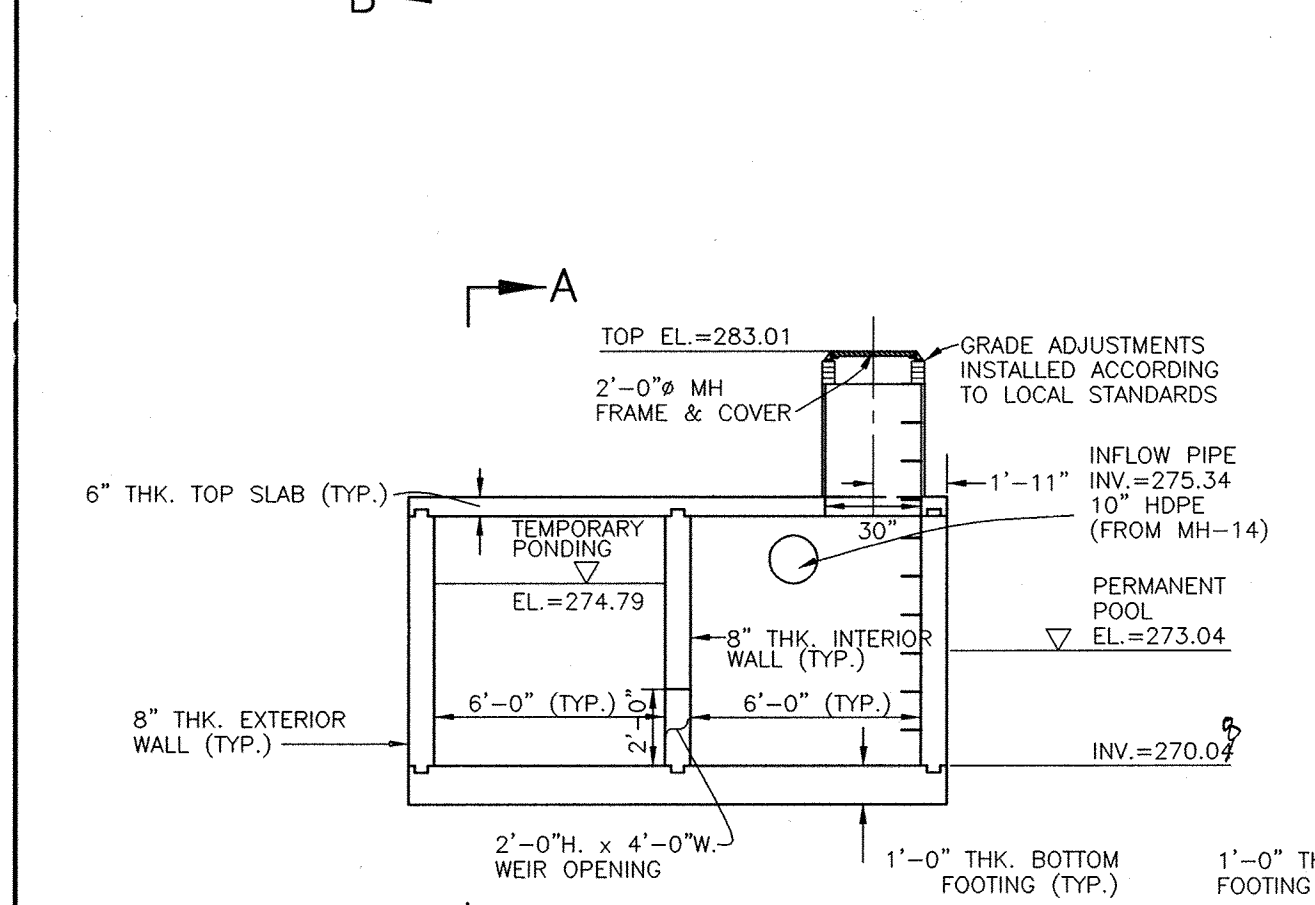


SECTION B-B SIDE VIEW-INFLOW

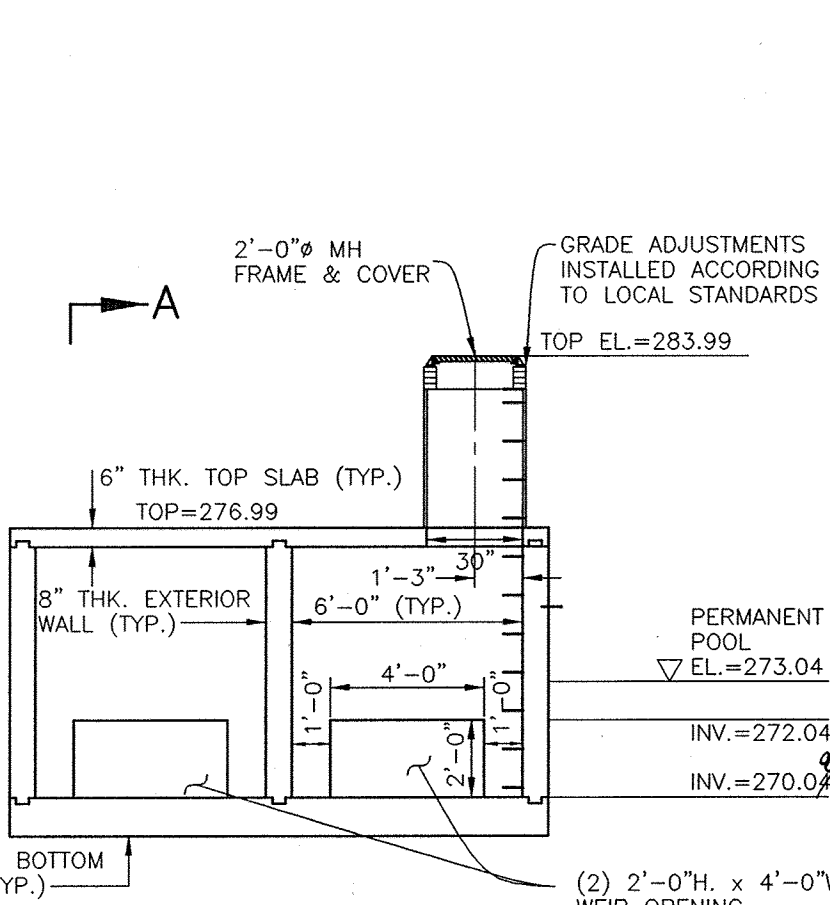

SECTION C-C SIDE VIEW-WEIR

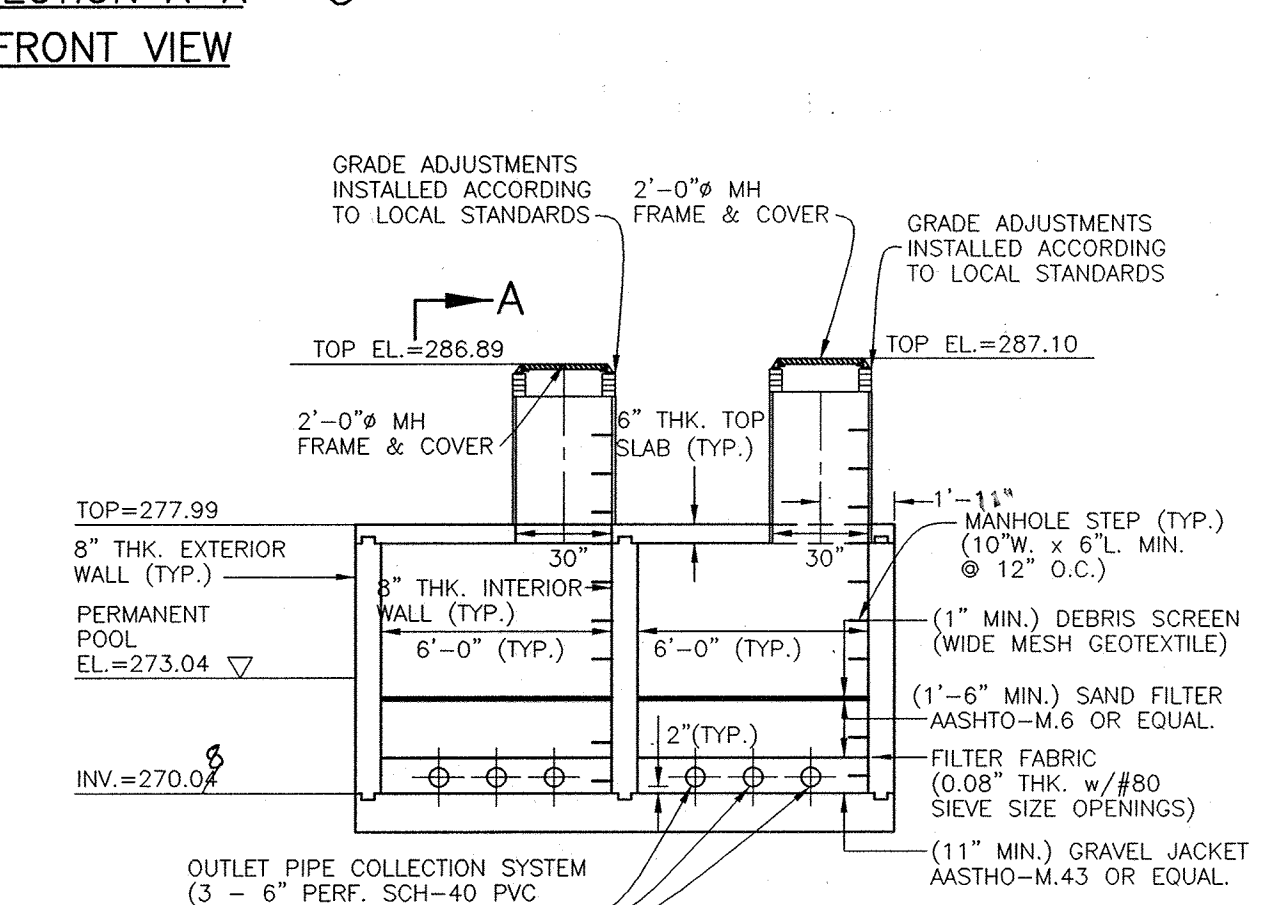


SECTION D-D SIDE VIEW-CHAMBERS

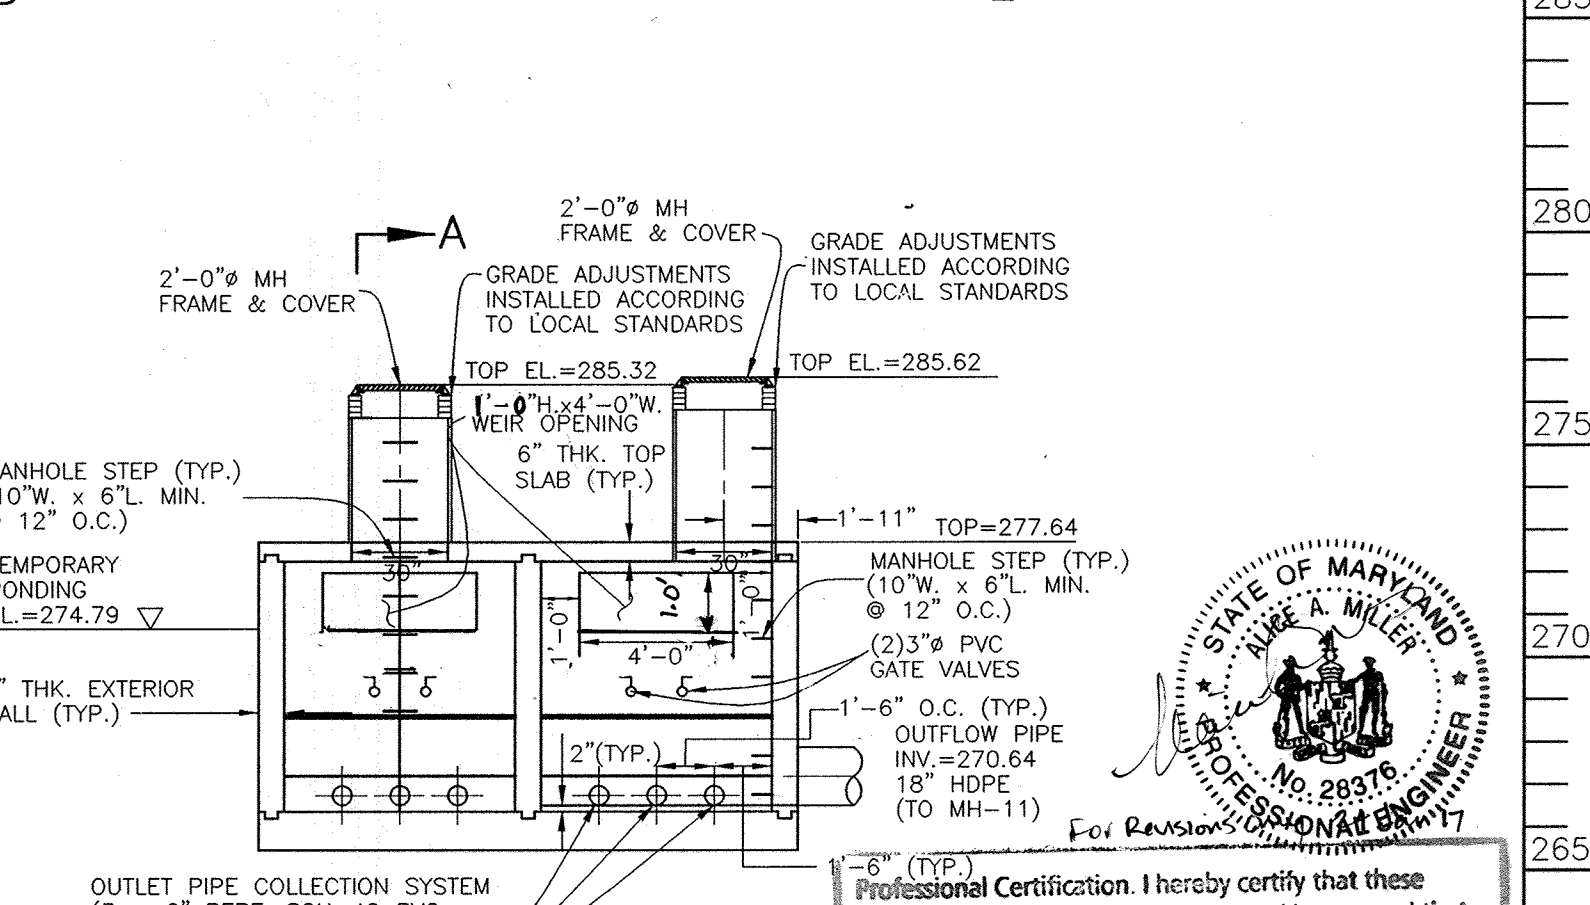

SECTION E-E SIDE VIEW-OVERFLOW

NOTE: THE INCOMING PIPE TO THE FACILITIES SHALL BE CAPPED OFF UNTIL THE CONTRIBUTING AREAS HAVE BEEN STABILIZED

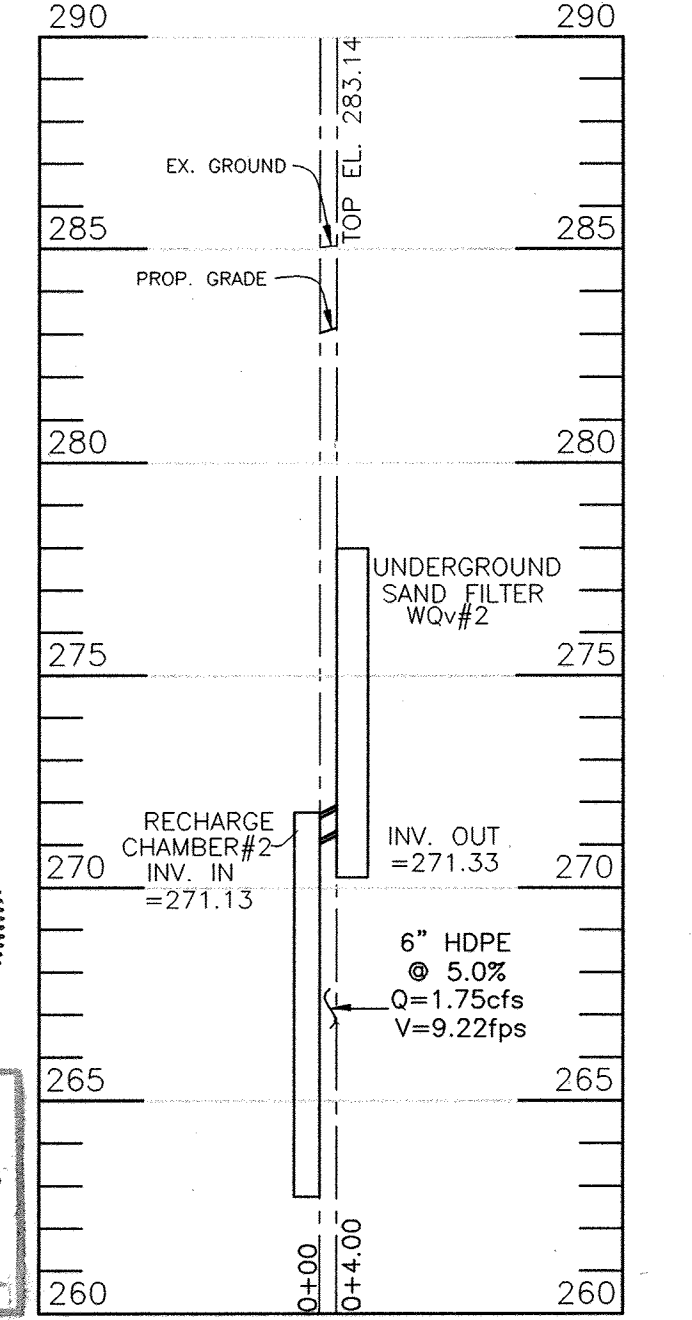


STORM DRAIN PROFILE FROM REV#2 TO WQV#2

SCALE: HORIZONTAL: 1"=50' VERTICAL: 1"=5'

**UNDERGROUND WATER QUALITY FACILITY #3**


SCALE: 1"=5'  
LOCATION: N 539,514.56 E 1,367,155.28

NOTE: SAND FILTER SHALL BE DESIGNED BY A LICENSED STRUCTURAL ENGINEER IN THE STATE OF MARYLAND AND DESIGNED FOR HS20 LOADING.

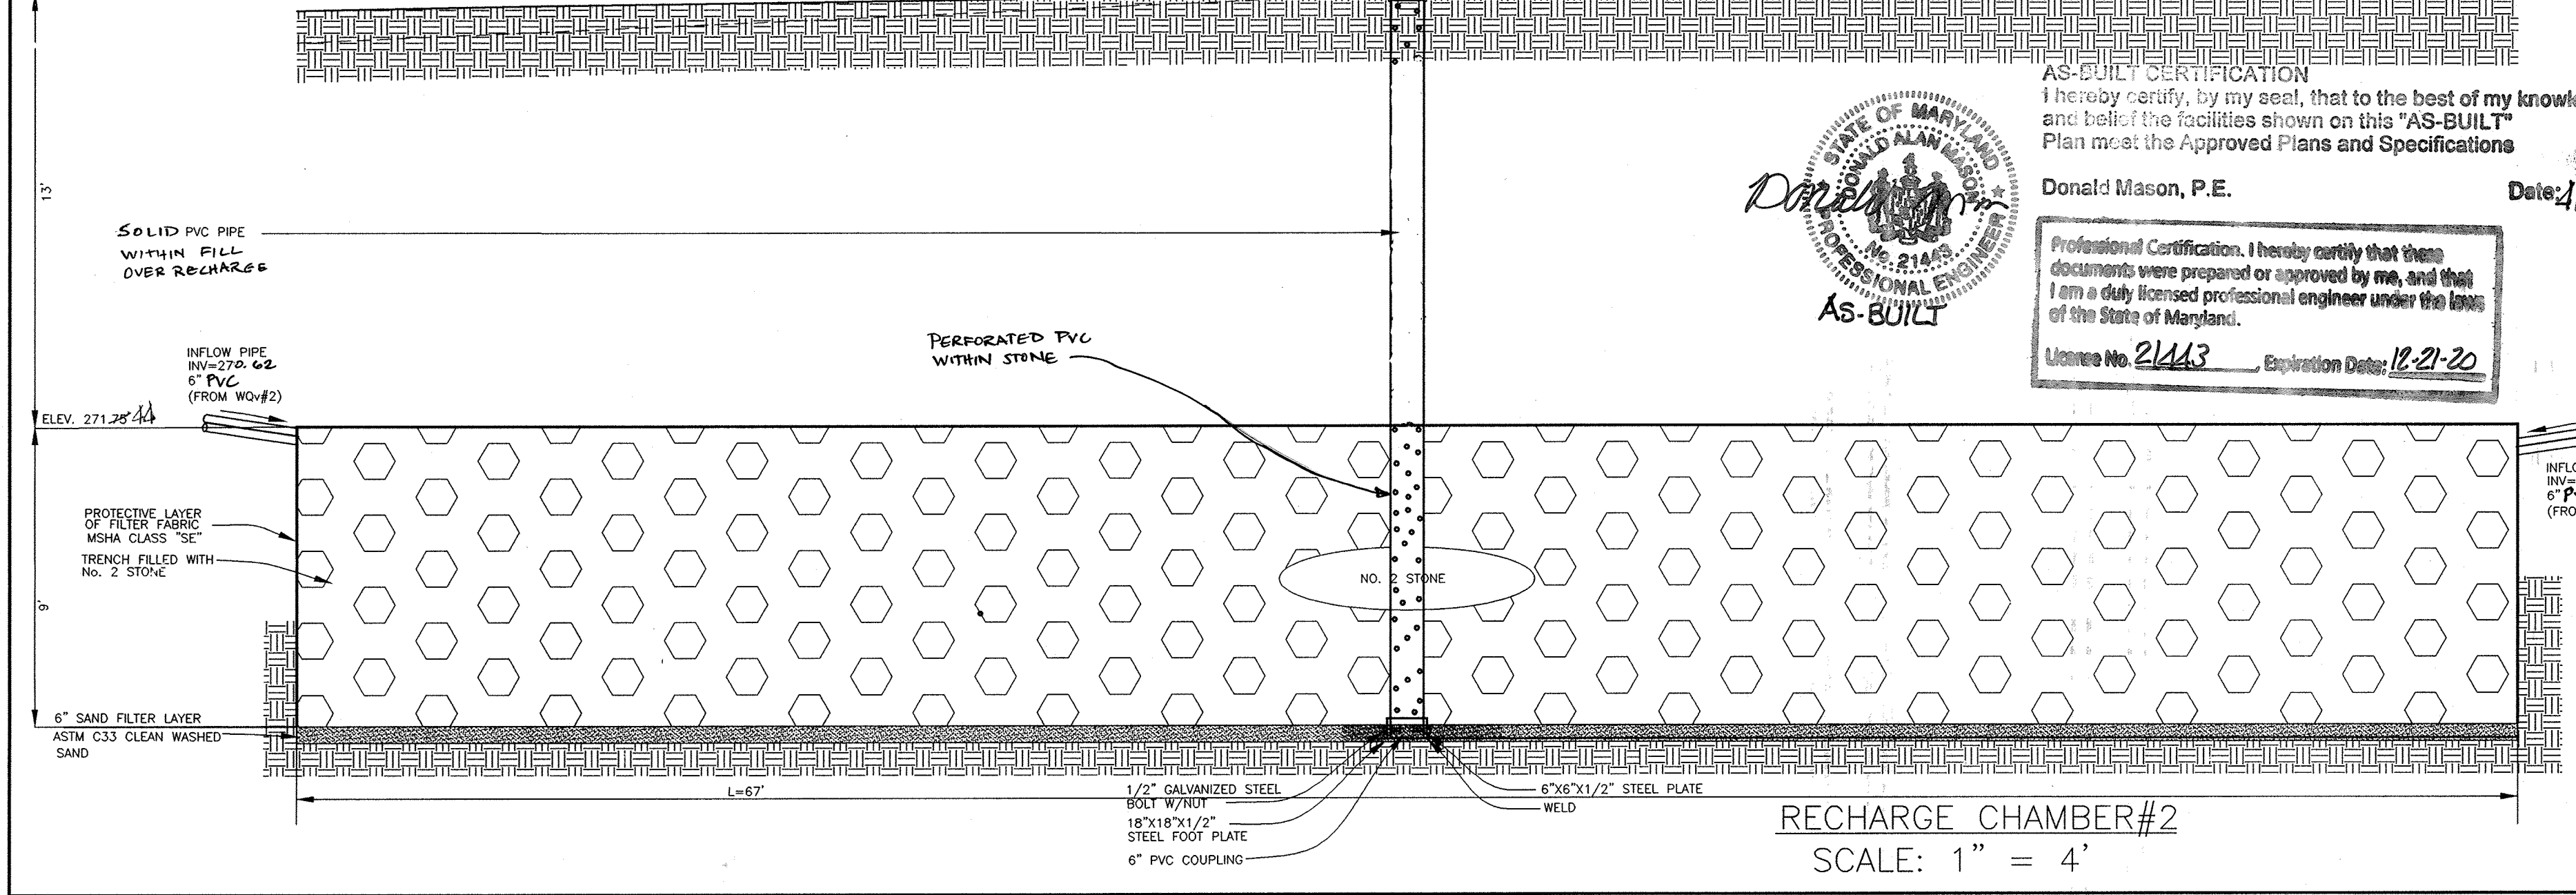

RECHARGE CHAMBER#2

SCALE: 1" = 4'

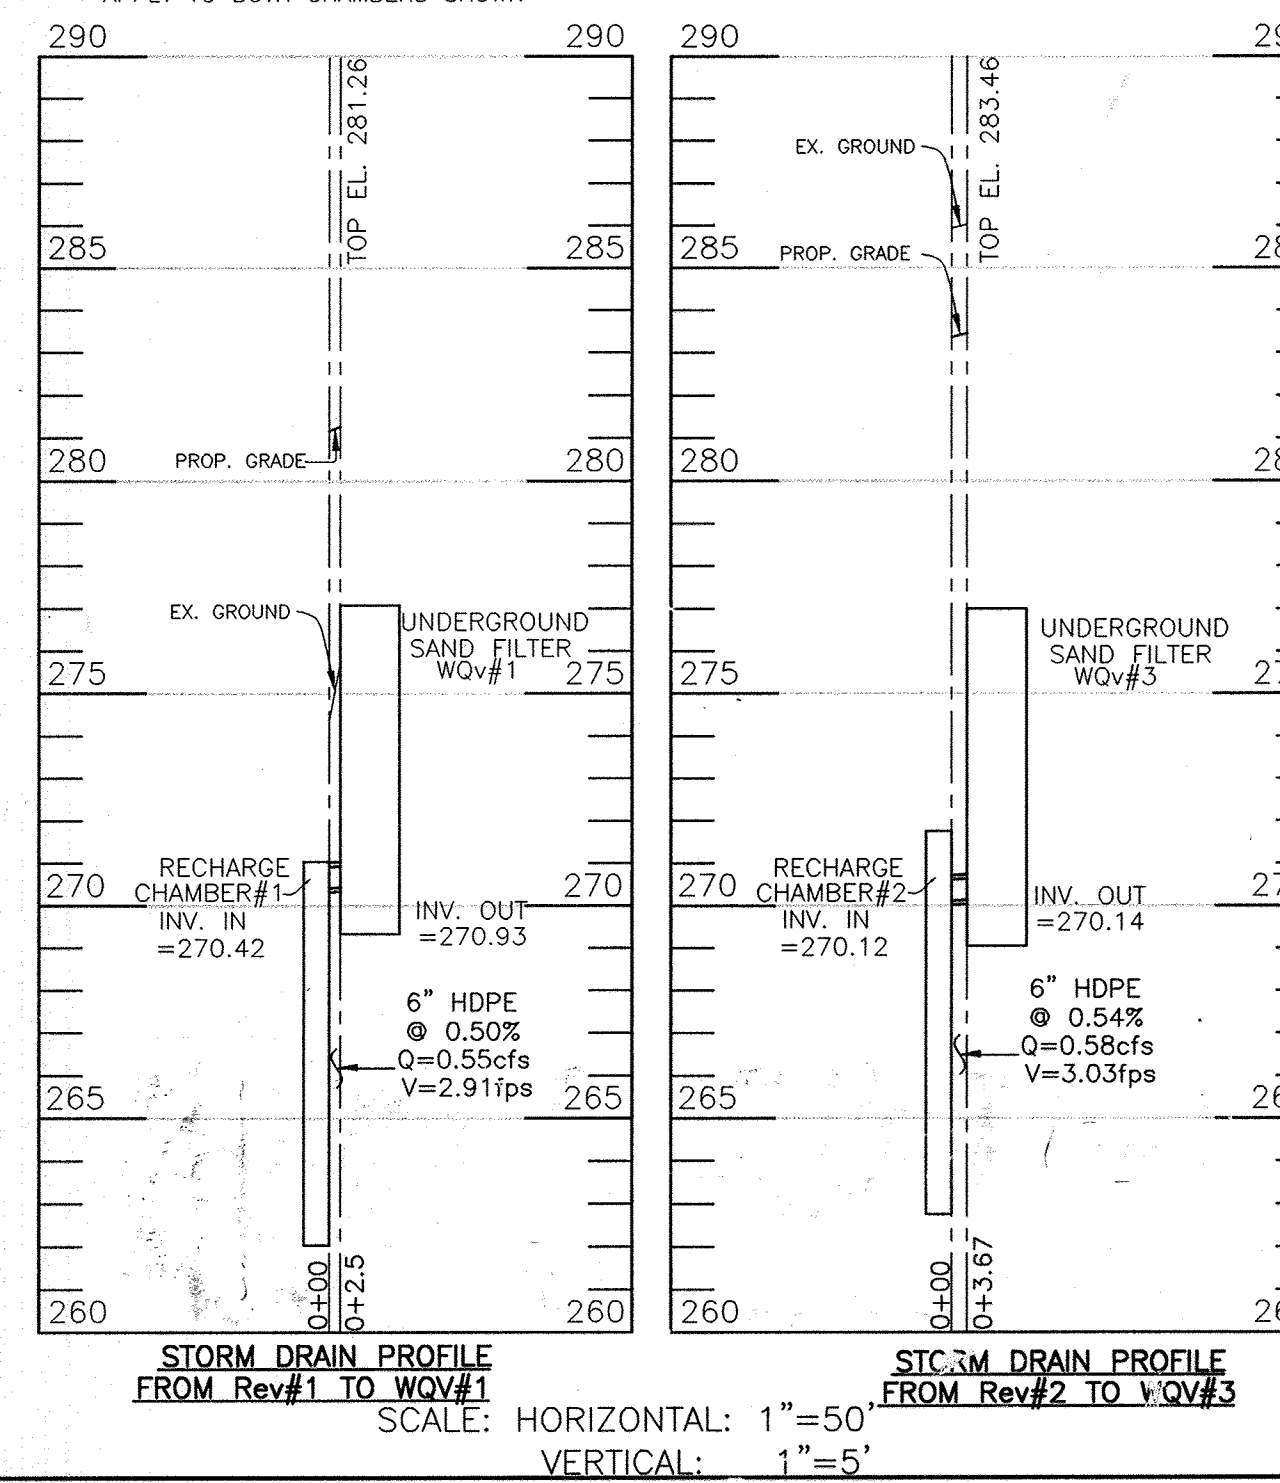

STORM DRAIN PROFILE FROM REV#1 TO WQV#1

SCALE: HORIZONTAL: 1"=50' VERTICAL: 1"=5'

STORM DRAIN PROFILE FROM REV#2 TO WQV#3

SCALE: HORIZONTAL: 1"=50' VERTICAL: 1"=5'

**AS-BUILT CERTIFICATION**  
I hereby certify, by my seal, that to the best of my knowledge and belief the facilities shown on this "AS-BUILT" Plan meet the Approved Plans and Specifications.

Donald Mason, P.E. Date: *4/11/19*

Professional Certification. I hereby certify that these documents were prepared or approved by me, and that I am a duly licensed professional engineer under the laws of the State of Maryland.  
License No. *21443* Expiration Date: *12-21-20*

NO.	DATE	REVISIONS TO CORRECT THEIR ELEVATIONS, RECHARGE OUTFALL AND LOADING SPECS	REVISION
1	2/21/17		

**BENCHMARK ENGINEERING, INC.**  
840 BALTIMORE NATIONAL PIKE SUITE 315 ELICOTT CITY, MARYLAND 21043  
(P) 410-465-8105 (F) 410-465-8144  
75 THOMAS JOHNSON DRIVE SUITE E & F FREDERICK, MARYLAND 21702  
301-710-5686  
WWW.BE-CIVILENGINEERING.COM

DEVELOPER: **COLUMBIA JUNCTION SECTION 3 / LOT A-2 (RETAIL CENTER)**

LOCATION: TAX MAP 48 - BLOCK 1 PARCEL 548 6TH ELECTION DISTRICT HOWARD COUNTY, MARYLAND

TITLE: **WATER QUALITY FACILITY #3 NOTES AND DETAILS**

DATE: MARCH, 2008 PROJECT NO. 1221  
APRIL, 2013

Design: DAM Draft: W Check: DAM/BFC SCALE: AS SHOWN DRAWING 10 OF 11

