


SITE DEVELOPMENT PLAN

THE HILLSIDE AT ROCKY GORGE VII


LOTS 1 THRU 10 AND OPEN SPACE LOT 11

BENCHMARKS (NAD 83):
 STATION 477T1
 NORTHING: 535,143.322 EASTING: 1,346,960.276
 ELEVATION: 404.04
 STATION 477T2
 NORTHING: 534,509.424 EASTING: 1,347,851.039
 ELEVATION: 401.10

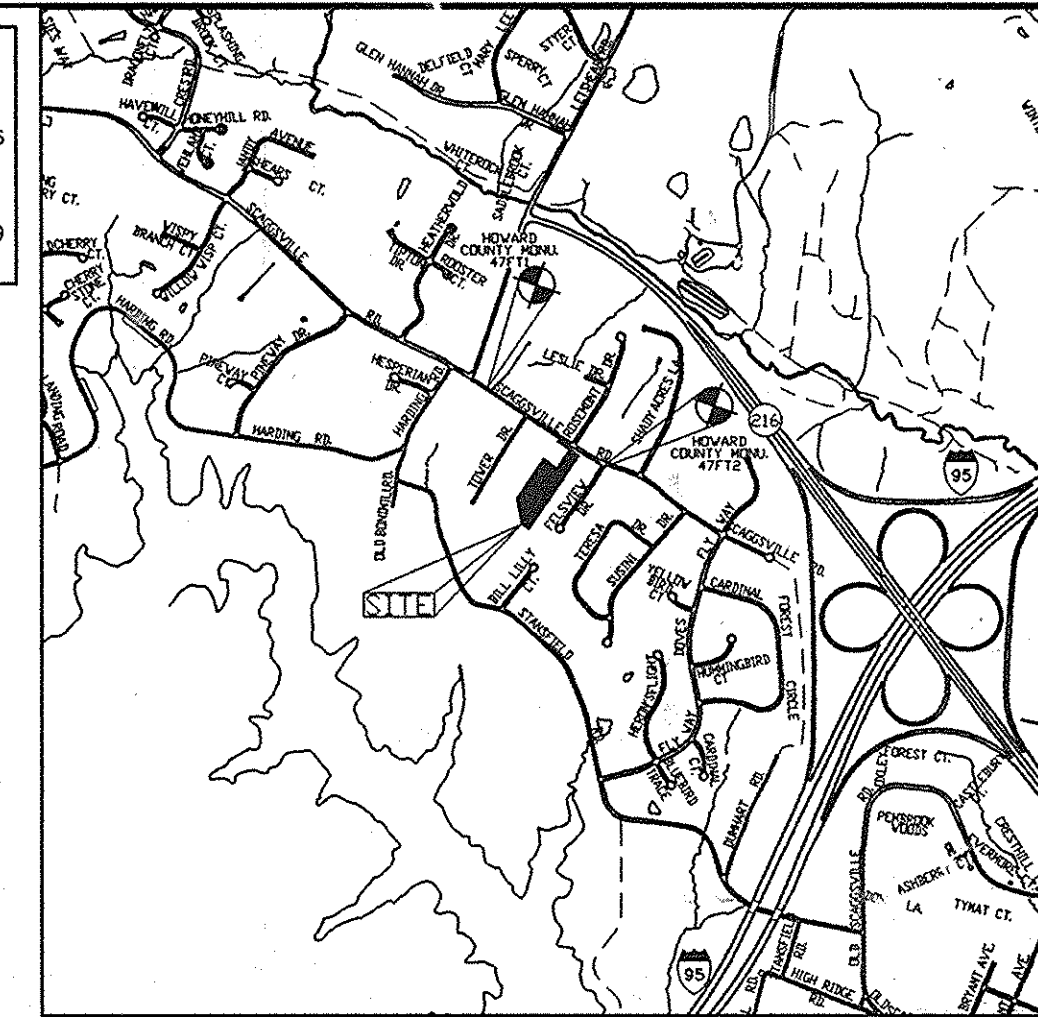

SITE ANALYSIS DATA CHART

- A) TOTAL PROJECT AREA: 3.60 AC ±
- B) AREA OF THIS PLAN SUBMISSION: 3.60 AC ±
- C) APPROXIMATE LIMIT OF DISTURBANCE: 3.03 AC (EXCLUDING LOT 10)
- D) PI USE/V ZONING: R-20
- E) PROPOSED USE OF SITE: RESIDENTIAL SINGLE FAMILY DETACHED UNITS
- F) FLOOR SPACE PER LOT: N/A
- G) TOTAL NUMBER OF UNITS ALLOWED AS SHOWN ON FINAL PLAT(S): 10
- H) TOT. NUMBER OF UNITS PROPOSED: 10
- I) OPEN SPACE ON-SITE: 0.00 AC. PERCENTAGE OF GROSS AREA: 0%
- J) AREA OF RECREATIONAL OPEN SPACE REQUIRED: 0.00 AC. AREA OF RECREATIONAL OPEN SPACE PROVIDED: 0.00 AC.
- K) BUILDING COVERAGE OF SITE: N/A. PERCENTAGE OF GROSS AREA: 0%
- L) APPLICABLE DPZ FILE REFERENCES: SP-04-05, F-07-77, CONTRACT # 24-4464-D
- M) PROPOSED WATER AND SEWER SYSTEMS: PUBLIC PRIVATE
- N) **LOD ACREAGE FOR LOT 10: 0.35AC ±**

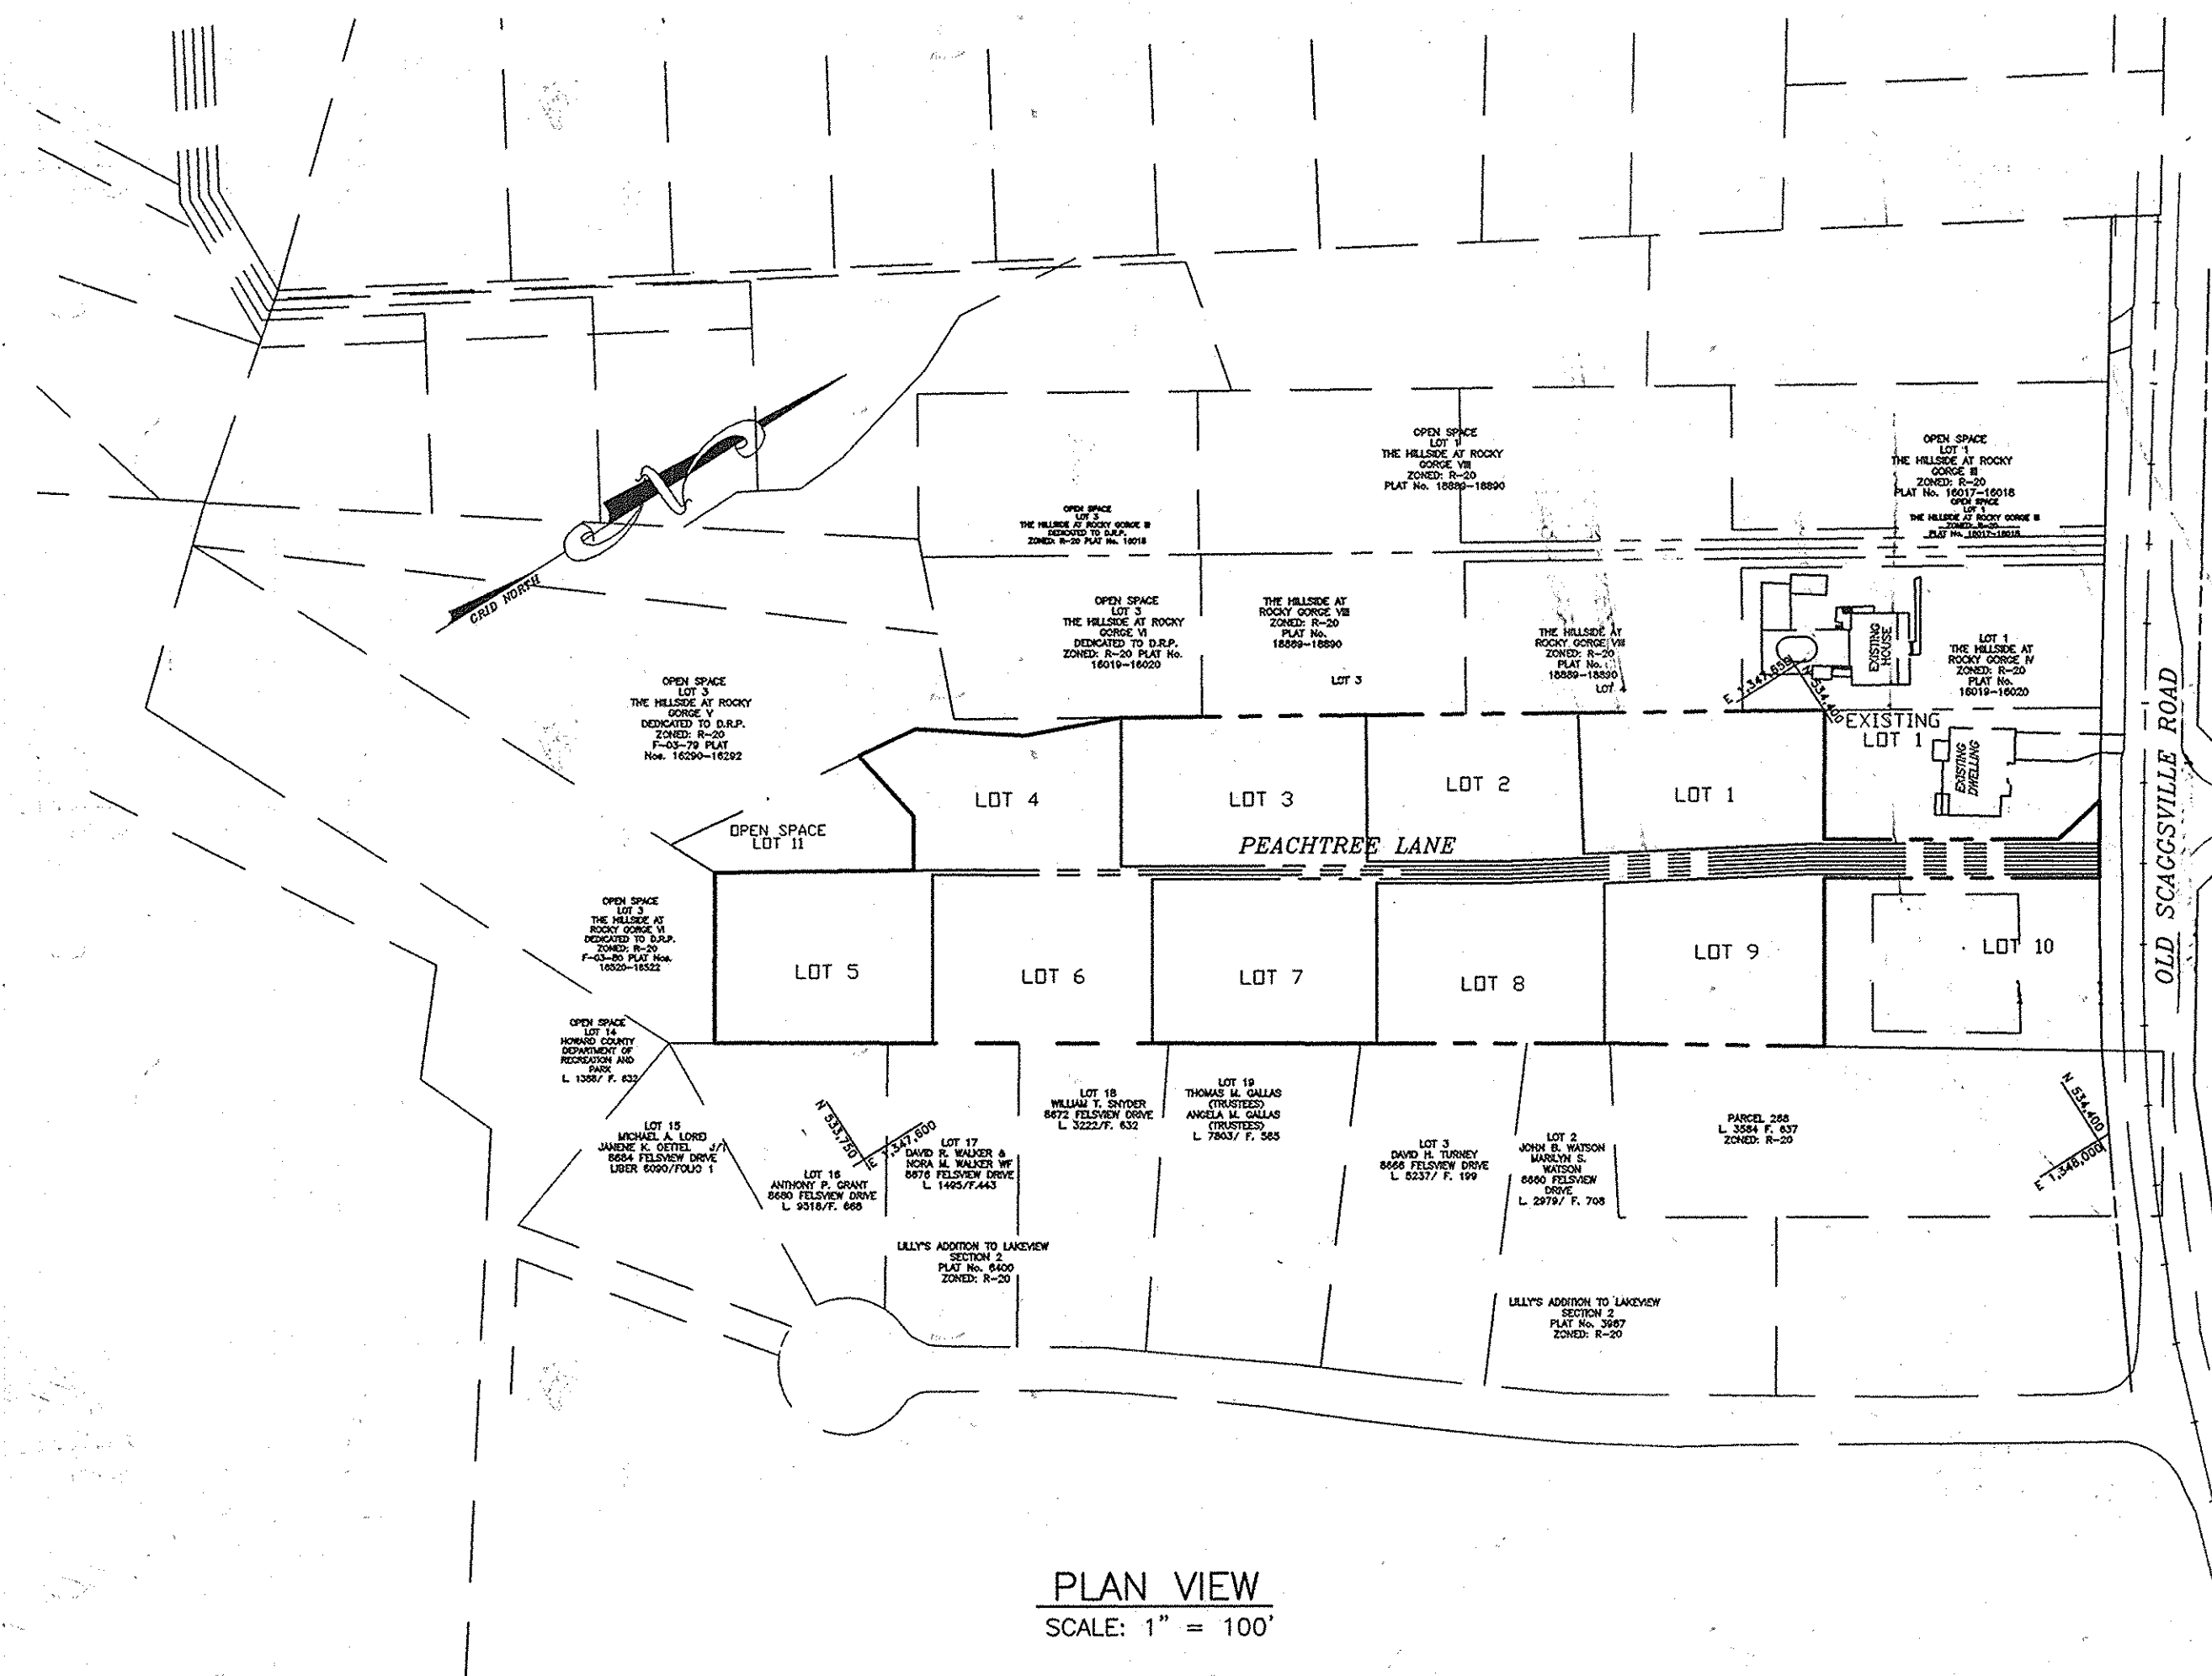

PLAN VIEW
 SCALE: 1" = 100'

LEGEND






- EXISTING CONTOURS PER F-05-012
- - - PROPOSED CONTOURS
- ~ ~ ~ EXISTING TREELINE
- 30' BRL --- BUILDING RESTRICTION LINE
- INDICATES A WALK-OUT BASEMENT
- FF=350.90, BF=341.98 --- FIRST FLOOR ELEVATION, BASEMENT FLOOR ELEVATION
- ECM (EROSION CONTROL MATTING)
- LOD --- LIMIT OF DISTURBANCE
- SOIL BOUNDARY
- + 715 --- SPOT ELEVATION
- SUPER SILT FENCE
- EXISTING PRIVATE EASEMENTS
- PRIVATE ACCESS PLACE EASEMENT
- EXISTING PUBLIC ACCESS JO. OPEN SPACE LOT 3
- EXISTING PUBLIC EASEMENT
- EXISTING PAVING
- EXISTING ACCESS EASEMENT
- SEDIMENT CONTROL ENTRANCE
- INLET PROTECTION
- TEMPORARY STOCKPILE AREA

- 25. A BUILDING PERMIT FOR CONSTRUCTION OF THE HOUSE ON LOT 10 MUST BE APPLIED FOR WITHIN ONE YEAR FROM THE REDLINE REVISION APPROVAL DATE ON OR BEFORE NOVEMBER 3, 2010.
- 26. WITHIN 18 MONTHS FROM COMPLETION OF THE CONSTRUCTION OF THE HOUSE ON LOT 10, THE PROPERTY OWNER SHALL CONTACT THE LANDSCAPE COORDINATOR BY EMAIL AT J.WHEELER@HOWARDCOUNTYMD.GOV TO SCHEDULE AN INSPECTION TO VERIFY LANDSCAPE PLANTINGS AND TO PROCESS THE LANDSCAPE SURETY RELEASE.
- 27. THE BUILDER/OWNER IS ADVISED TO REMEMBER TO EMAIL THIS DIVISION TO PROCESS THE LANDSCAPE SURETY RELEASE. BE SURE TO ATTACH A COPY OF THE LANDSCAPE INSPECTION FEE RECEIPT AND A ONE YEAR LANDSCAPE GUARANTEE WITH THE REQUEST.



GENERAL NOTES

1. THE SUBJECT PROPERTY IS ZONED R-20 PER THE 2-20-04 COMPREHENSIVE ZONING PLAN.
2. THE CONTRACTOR SHALL NOTIFY THE DEPARTMENT OF PUBLIC WORKS CONSTRUCTION INSPECTION DIVISION AT (410)313-1880 AT LEAST FIVE(5) WORKING DAYS PRIOR TO THE START OF WORK.
3. THE CONTRACTOR SHALL NOTIFY "MISS UTILITY" AT 1-800-257-7777 AT LEAST 48 HOURS PRIOR TO ANY EXCAVATION WORK.
4. EXISTING TOPOGRAPHY SHOWN HEREON WAS TAKEN FROM THE GRADING PLAN UNDER F-07-77. CONTOUR INTERVAL IS 2 FEET.
5. HORIZONTAL AND VERTICAL DATUM ARE NAD '83 - MONUMENTS 477T1 AND 477T2.
6. EXISTING UTILITIES SHOWN HAVE BEEN TAKEN FROM CONTRACT DRAWINGS #24-4464-D AND ROAD CONSTRUCTION PLANS F-07-77. IF NECESSARY, CONTRACTOR SHALL ADJUST ANY OR ALL STRUCTURE TOP ELEVATIONS TO MATCH SGP GRADES.
7. THERE ARE NO WETLANDS, WETLANDS BUFFERS, STREAMS, STREAM BUFFERS OR 100-YEAR FLOODPLAIN LOCATED ON THESE LOTS.
8. IN ACCORDANCE WITH SECTION 12B OF THE HOWARD COUNTY ZONING REGULATIONS, BAY WINDOWS, CHIMNEYS OR EXTERIOR STAIRWAYS NOT MORE THAN 16 FEET IN WIDTH MAY PROJECT NOT MORE THAN 4 FEET INTO ANY SETBACKS, PORCHES OR DECKS, OPEN OR ENCLOSED MAY PROJECT NOT MORE THAN 10 FEET INTO THE FRONT OR REAR YARD SETBACK.
9. [WOB] INDICATES WALKOUT BASEMENT.
10. PREVIOUS HOWARD COUNTY FILE NUMBERS: F-03-79, F-03-08, SP-04-05, S-03-18, F-07-77, CONT. #24-4464-D
11. THE STAKING OF FOUNDATIONS PRIOR TO CONSTRUCTION TO ENSURE COMPLIANCE WITH REGULATORY BUILDING RESTRICTION LINES IS RECOMMENDED.
12. ANY DAMAGE TO THE COUNTY'S RIGHT-OF-WAY SHALL BE CORRECTED AT THE BUILDERS EXPENSE.
13. "BRL" INDICATES BUILDING RESTRICTION LINE.
14. FOR DRIVEWAY ENTRANCE DETAIL SEE HOWARD COUNTY STANDARD DETAILS R-6.1 & R-6.05.
15. HOUSES/GARAGES WILL BE SITED ON LOTS SO THAT A SECOND CAR, IF PARKED IN THE DRIVEWAY, WILL NOT OVERHANG INTO THE PRIVATE ACCESS PLACE DRIVEWAY (18" MINIMUM CLEARANCE).
16. DRIVEWAY SLOPES SHOWN ARE AVERAGE. THE SLOPE AT THE OUTSIDE EDGES COULD BE FLATTER OR STEEPER DEPENDING ON GRADE OF ROADWAY.
17. DRIVEWAYS SHALL BE PROVIDED PRIOR TO ISSUANCE OF A USE AND OCCUPANCY PERMIT FOR ANY NEW DWELLINGS TO INSURE SAFE ACCESS FOR FIRE AND EMERGENCY VEHICLES PER THE FOLLOWING MINIMUM REQUIREMENTS:
 1. WIDTH - 12' (14' SERVING MORE THAN ONE RESIDENCE);
 2. SURFACE - 6" OF COMPACTED CRUSHER RUN BASE W/TAR AND CHIP COATING (1-1/2" MIN.);
 3. GEOMETRY - MAX. 15% GRADE, MAX. 10% GRADE CHANGE AND MIN. 45' TURNING RADIUS;
 4. STRUCTURES (CULVERTS/BRIDGES) - CAPABLE OF SUPPORTING 25 GROSS TONS (H25 LOADING);
 5. DRAINAGE ELEMENTS - CAPABLE OF SAFELY PASSING 100-YEAR FLOOD WITH NO MORE THAN 1 FOOT DEPTH OVER DRIVEWAY SURFACE;
 6. MAINTENANCE - SUFFICIENT TO INSURE ALL WEATHER USE.
18. THIS PLAN CONFORMS WITH THE AMENDED 5th EDITION OF THE HOWARD COUNTY SUBDIVISION AND LAND DEVELOPMENT REGULATIONS. THE DEVELOPER SHALL APPLY FOR BUILDING PERMITS FOR ALL LOTS AS SHOWN ON THIS SITE DEVELOPMENT PLAN WITHIN FIVE YEARS OF SIGNATURE APPROVAL OF THIS PLAN.
19. STREET TREES SHALL BE PROVIDED IN ACCORDANCE WITH THE APPROVED ROAD CONSTRUCTION DRAWINGS (F-07-77). SURETY HAS BEEN POSTED WITH THE DEVELOPER'S AGREEMENT.
20. THE PRIVATE ACCESS PLACE MAINTENANCE AGREEMENT FOR LOTS 1 THRU 11 HAS BEEN RECORDED IN THE LAND RECORDS OF HOWARD COUNTY, MARYLAND IN LIBER 11346 AT FOLIO 646.
21. FOR FLAG OR PIPE STEM LOTS, REFUSE COLLECTION, SNOW REMOVAL AND ROAD MAINTENANCE ARE PROVIDED TO THE JUNCTION OF THE FLAG OR PIPE STEM AND ROAD RIGHT-OF-WAY LINE AND NOT ONTO THE FLAG OR PIPE STEM LOTS DRIVEWAY.
22. FINANCIAL SURETY FOR THE REQUIRED LANDSCAPING, REFUSE PAD SCREENING AND THE PRIVATE ACCESS PLACE STREET TREE PLANTING WILL BE POSTED AS PART OF THE DEVELOPER'S AGREEMENT UNDER PLAT F-07-77 IN THE AMOUNT OF \$10,590.00 (32 SHADE TREES @ \$300.00 EACH, 5 EVERGREEN TREES @ \$150.00 EACH, AND 8 SHRUBS @ \$30.00 EACH).
23. THE STORMWATER MANAGEMENT IS BEING PROVIDED AS PER F-07-77. THIS PLAN IS EXEMPT FROM PROVIDING SP-1 MANAGEMENT. W/O AND REV ARE PROVIDED THRU THE GRASS CHANNELS, POCKET SAND FILTER AND SHEET FLOW TO BUFFER CREEKS.
24. THE FOREST CONSERVATION OBLIGATIONS FOR THIS SITE HAVE BEEN FULFILLED UNDER F-03-79 (HILLSIDE AT ROCKY GORGE V) BY RETENTION OF 0.91 ACRE IN AN EASEMENT ON OPEN SPACE LOT 3, PLAT 16292 AND UNDER F-03-80 (HILLSIDE AT ROCKY GORGE VI) BY RETENTION OF 0.94 ACRE IN AN EASEMENT ON OPEN SPACE LOT 3, PLAT 16522.

Professional Certification. I hereby certify that these documents were prepared or approved by me, and that I am a duly licensed professional engineer under the laws of the State of Maryland.
 License No. 45577, Expiration Date: 06-28-16

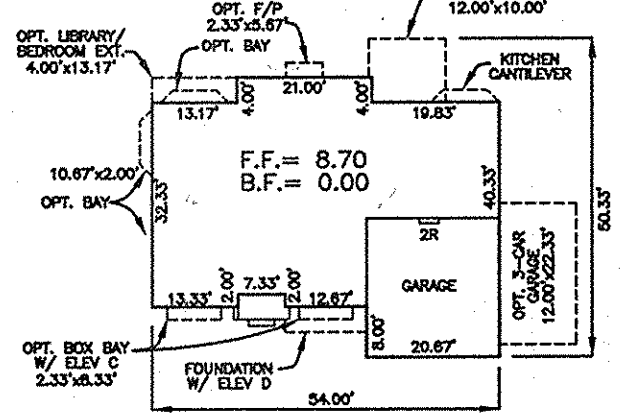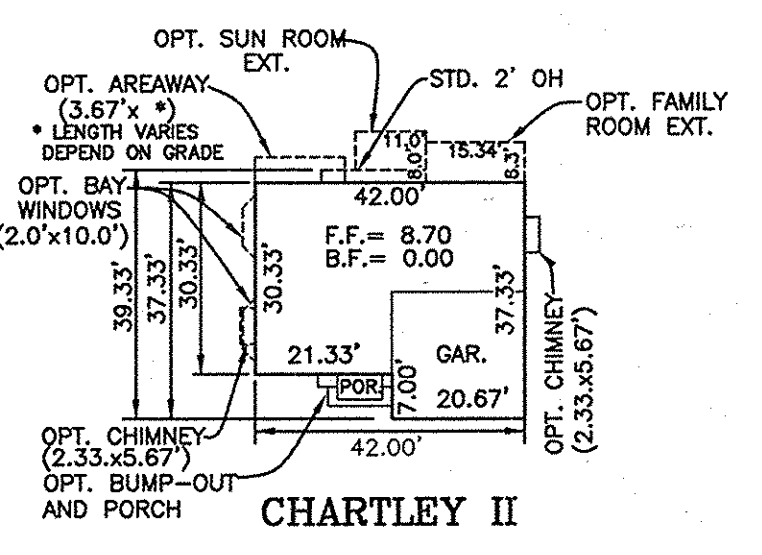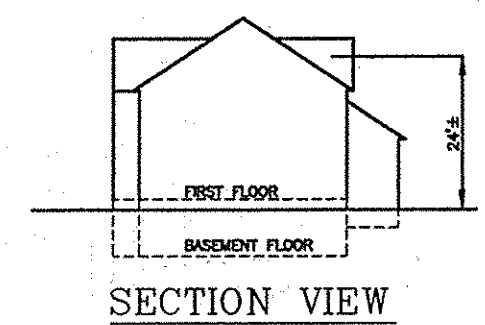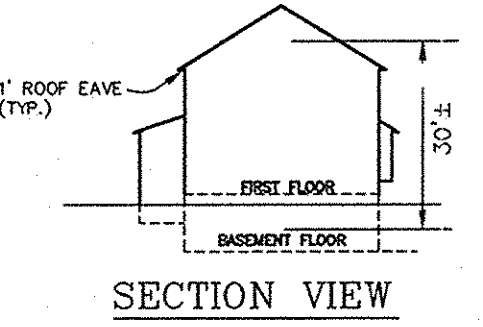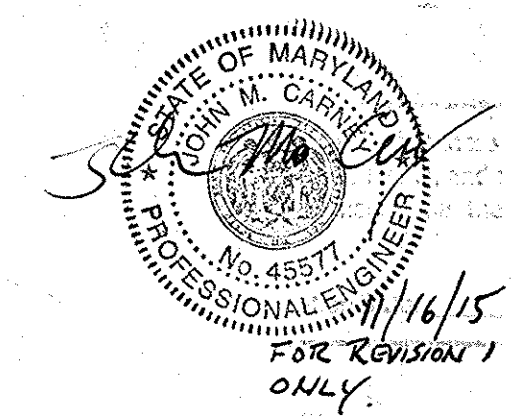

HOUSE FOOTPRINT SCALE: 1"=30'

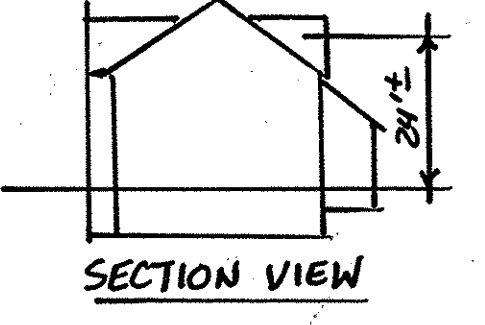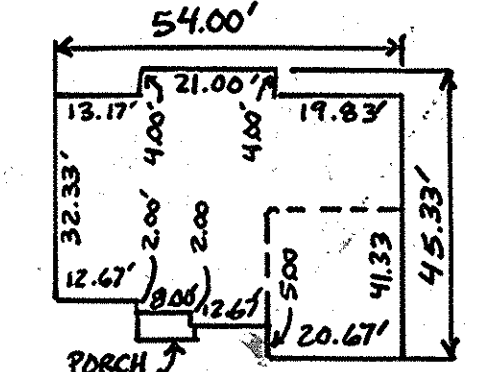

LOT NUMBER	GROSS AREA	PIPESTEM AREA	MINIMUM LOT SIZE
1	13,625± s.f.	751± s.f.	12,874± s.f.
2	12,953± s.f.	850± s.f.	12,103± s.f.
3	15,336± s.f.	1,207± s.f.	14,129± s.f.
4	13,713± s.f.	1,613± s.f.	12,100± s.f.
5	16,208± s.f.	1,923± s.f.	14,285± s.f.
6	15,709± s.f.	1,561± s.f.	14,148± s.f.
7	15,303± s.f.	1,191± s.f.	14,112± s.f.
8	14,850± s.f.	816± s.f.	14,034± s.f.
9	14,458± s.f.	453± s.f.	14,005± s.f.

LOT NUMBER	STREET ADDRESS
1	8706 PEACHTREE LANE
2	8710 PEACHTREE LANE
3	8714 PEACHTREE LANE
4	8718 PEACHTREE LANE
5	8723 PEACHTREE LANE
6	8719 PEACHTREE LANE
7	8715 PEACHTREE LANE
8	8711 PEACHTREE LANE
9	8707 PEACHTREE LANE

NO.	DESCRIPTION
1	TITLE SHEET
2	SITE DEVELOPMENT, GRADING AND LANDSCAPE PLAN
3	SEDIMENT & EROSION CONTROL PLAN
4	SEDIMENT & EROSION CONTROL NOTES AND DETAILS

APPROVED: HOWARD COUNTY DEPARTMENT OF PLANNING AND ZONING
 [Signatures and dates: 5/20/09, 5/27/09, 5/27/09]

BENCHMARK ENGINEERS, INC.
 ENGINEERS & LAND SURVEYORS & PLANNERS
 8480 BALTIMORE NATIONAL PIKE # SUITE 418
 ELLICOTT CITY, MARYLAND 21043
 PHONE: 410-465-6105 FAX: 410-465-6844
 www.benchmark-engineering.com

OWNER/DEVELOPER: SCAGGSVILLE ROAD INVESTMENT, LLD
 C/O BRIAN D. BOY (MEMBER)
 9695 NORFOLK AVENUE
 LAUREL, MARYLAND 20723
 410-792-2565


PROJECT: THE HILLSIDE AT ROCKY GORGE VII
 LOTS 1 THRU 10 AND OPEN SPACE LOT 11
 (SINGLE FAMILY DETACHED)

LOCATION: TAX MAP: 46 PARCELS: 92 & 149
 GRID: 18 ZONED: R-20
 8th ELECTION DISTRICT
 HOWARD COUNTY, MARYLAND

TITLE: SITE DEVELOPMENT PLAN
 TITLE SHEET

DATE: MAY, 2009 PROJECT NO. 2095
 SCALE: AS SHOWN SHEET 1 OF 4

DESIGN: WEO DRAFT: WEO CHECK: DAM

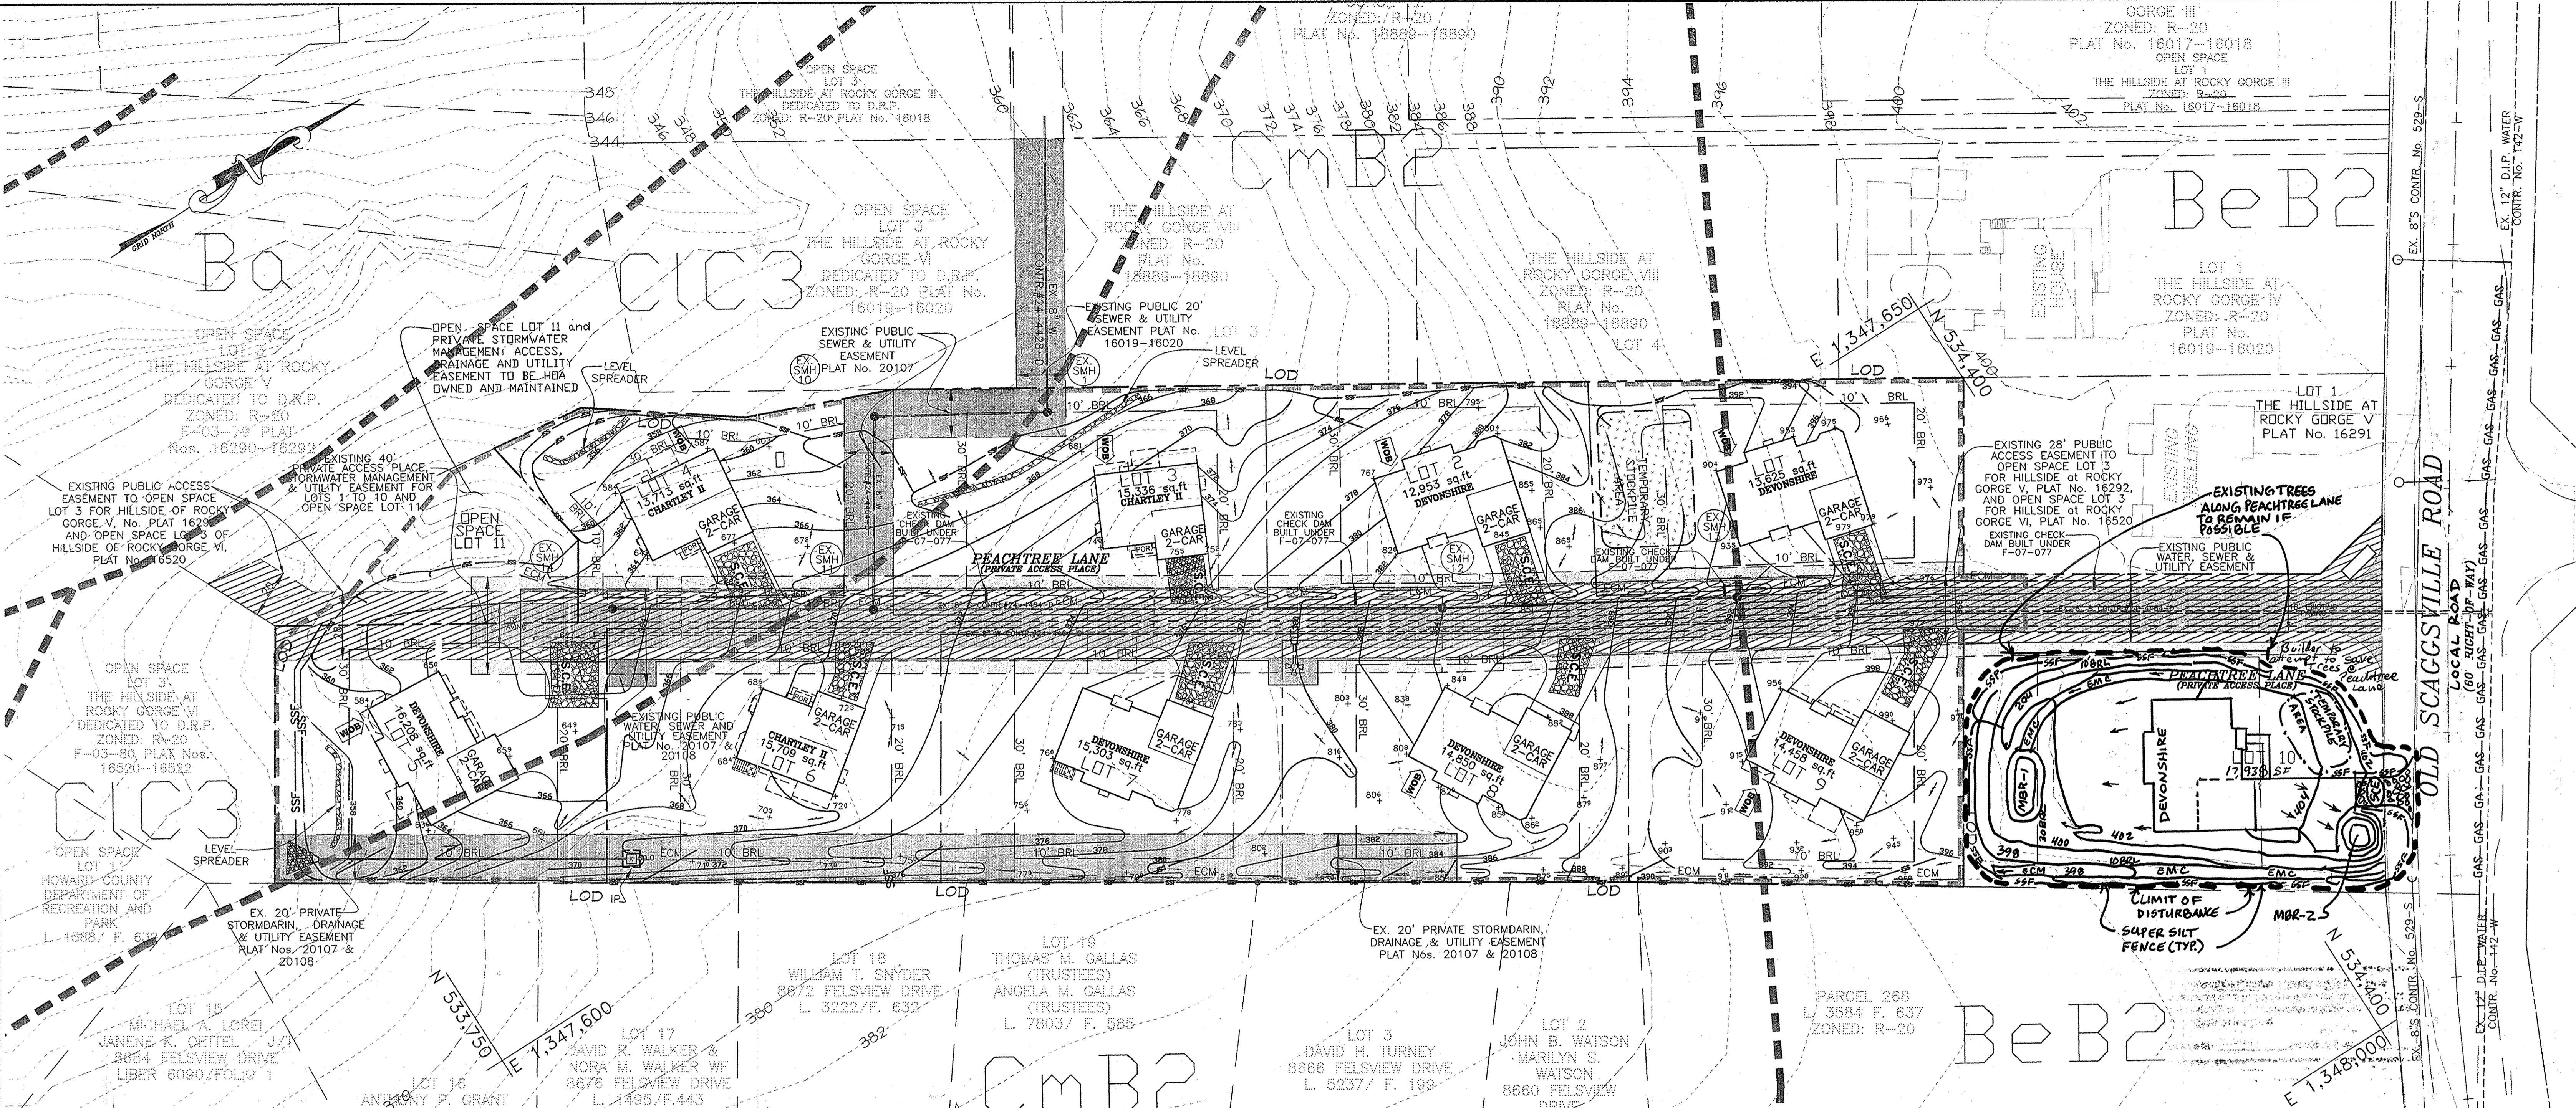

ENGINEER'S CERTIFICATE
 I HEREBY CERTIFY THAT THIS PLAN FOR SEDIMENT AND EROSION CONTROL REPRESENTS A PRACTICAL AND WORKABLE PLAN BASED ON MY PERSONAL KNOWLEDGE OF THE SITE CONDITIONS AND THAT IT WAS PREPARED IN ACCORDANCE WITH THE REQUIREMENTS OF THE HOWARD SOIL CONSERVATION DISTRICT.
 ENGINEER: *DR. DANIEL P. WEAVER, P.E.* # 36443-2
 DATE: 4/20/2009

DEVELOPER'S CERTIFICATE
 I HEREBY CERTIFY THAT ALL DEVELOPMENT AND CONSTRUCTION WILL BE DONE ACCORDING TO THIS PLAN FOR SEDIMENT AND EROSION CONTROL, AND THAT ALL RESPONSIBLE PERSONNEL INVOLVED IN THE CONSTRUCTION PROJECT WILL HAVE A CERTIFICATE OF ATTENDANCE AT A DEPARTMENT OF THE ENVIRONMENT APPROVED TRAINING PROGRAM FOR THE CONTROL OF SEDIMENT AND EROSION BEFORE BEGINNING THE PROJECT. I ALSO AUTHORIZE PERIODIC ON-SITE INSPECTION BY THE HOWARD SOIL CONSERVATION DISTRICT.
 DEVELOPER: *BRANDON D. BOY*
 DATE: 4/30/09

APPROVED: HOWARD COUNTY DEPARTMENT OF PLANNING AND ZONING
 CHIEF, DEVELOPMENT ENGINEERING DIVISION: *Ed DeWanna* 5/1/09
 CHIEF, DIVISION OF LAND DEVELOPMENT: *Coltman* 5/2/09
 DIRECTOR: *Thomas F. Spitzer* 5/13/09

A TEMPORARY STOCKPILE WILL BE LOCATED ON LOT 1



NOTE: SEE MDE DETAIL B-4-G-C FOR EROSION CONTROL MATTING

ROCKY GORGE LOT 10 MICRO-BIORETENTION (M-B) PLANTING SCHEDULE

PLANTS	MBR-1	MBR-2
VINCA MINOR (COMMON PERIWINKLE)	16	5
ADUGA REPTANS (CREEPING BUGLEWEED)	14	4
IRIS VERSICOLOR (IRIS)	7	2
HERMEROCALLIS (SP) (DAY LILY)	5	1
ACER RUBRUM (RED MAPLE)	1	1

PLAN VIEW
 SCALE: 1" = 30'

Professional Certification. I hereby certify that these documents were prepared or approved by me, and that I am a duly licensed professional engineer under the laws of the State of Maryland.
 License No. 45577 Expiration Date: 06-08-16

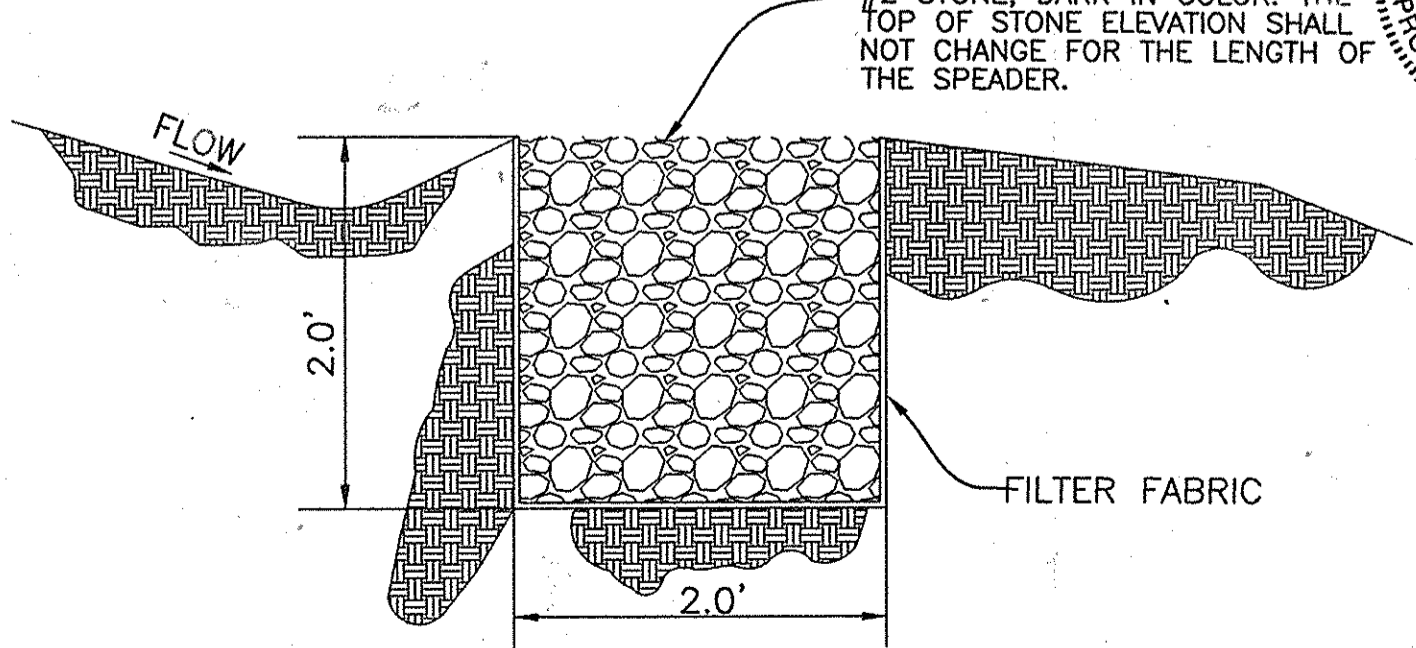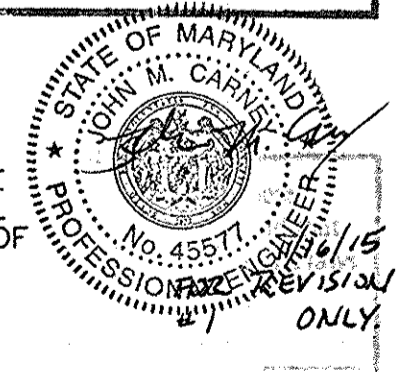

TYPICAL LEVEL SPREADER CROSS SECTION NOT TO SCALE

LEGEND

- EXISTING CONTOURS PER F-00-012
- PROPOSED CONTOURS
- EXISTING TREELINE
- 30' BRL - BUILDING RESTRICTION LINE
- INDICATES A WALK-OUT
- FF=350.90 - FIRST FLOOR ELEVATION
- BF=341.98 - BASEMENT FLOOR ELEVATION
- ECM (EROSION CONTROL MATTING)
- LOD - LIMIT OF DISTURBANCE
- SOIL BOUNDARY
- SPOT ELEVATION
- SUPER SILT FENCE
- EXISTING PRIVATE EASEMENTS
- PRIVATE ACCESS PLACE EASEMENT
- EXISTING PUBLIC ACCESS TO OPEN SPACE LOT 3
- EXISTING PUBLIC EASEMENT
- EXISTING PAVING
- EXISTING ACCESS EASEMENT
- SEDIMENT CONTROL ENTRANCE
- INLET PROTECTION
- TEMPORARY STOCKPILE AREA

SOILS LEGEND

MAP SYMBOL	SOIL GROUP	SOIL TYPE
Ba	D	BAILE SILT LOAM
BeB2	C	BELTSVILLE SILT LOAM, 1 TO 5 PERCENT SLOPES, MODERATELY ERODED
C1C3	B	CHILLUM GRAVELLY LOAM, 5 TO 10 PERCENT SLOPES, SEVERELY ERODED
CmB2	B	CHILLUM SILT LOAM, 1 TO 5 PERCENT SLOPES, MODERATELY ERODED

* INDICATES HYDRIC SOILS
 TAKEN FROM SOILS SURVEY, ISSUED JULY 1968, MAP NO. 25

BENCHMARK ENGINEERING, INC.

8480 BALTIMORE NATIONAL PIKE A SUITE 418
 ELLICOTT CITY, MARYLAND 21043
 phone: 410-465-6105 A fax: 410-465-6644
 www.bei-civilengineering.com

OWNER: SCAGGSVILLE ROAD INVESTMENT, LLD
 C/O BRIAN D. BOY (MEMBER)
 9695 NORFOLK AVENUE
 LAUREL, MARYLAND 20723
 410-792-2565

BUILDER: CORNERSTONE HOMES, L.L.C.
 9695 NORFOLK AVENUE
 LAUREL, MARYLAND 20723
 410-792-2565

PROJECT: THE HILLSIDE AT ROCKY GORGE VII
 LOTS 1 THRU 10 AND OPENSPACE LOT 11
 (SINGLE FAMILY DETACHED)

LOCATION: TAX MAP: 46 PARCELS: 92 & 14
 GRID: 18 ZONED: R-20
 6th ELECTION DISTRICT
 HOWARD COUNTY, MARYLAND

TITLE: SEDIMENT AND EROSION CONTROL, SWM
 PLAN AND SOILS MAP

DATE: MAY, 2009 PROJECT NO: 2095
 SCALE: AS SHOWN SHEET 3 OF 4

DESIGN: WEO DRAFT: WEO CHECK: DAM

NO.	DATE	REVISION
1	11-13-15	SHOW DEVONSHIRE ON LOT 10, REVISE GRADES

SEDIMENT CON.ROL NOTES

- A MINIMUM OF 24 HOURS NOTICE MUST BE GIVEN TO THE HOWARD COUNTY DEPARTMENT OF INSPECTION, LICENSES AND PERMITS, SLIDMENT CONTROL DIVISION PRIOR TO THE START OF ANY CONSTRUCTION, (410-313-1859).
- ALL VEGETATIVE AND STRUCTURAL PRACTICES ARE TO BE INSTALLED ACCORDING TO THE PROVISIONS OF THIS PLAN AND ARE TO BE IN CONFORMANCE WITH THE MOST CURRENT "MARYLAND STANDARDS AND SPECIFICATION FOR SOIL EROSION AND SEDIMENT CONTROL", REVISIONS THERETO.
- FOLLOWING INITIAL SOIL DISTURBANCE OR REDISTURBANCE, PERMANENT OR TEMPORARY STABILIZATION SHALL BE COMPLETED WITHIN: A) 7 CALENDAR DAYS FOR ALL PERIMETER SEDIMENT CONTROL STRUCTURES, DENSE PERIMETER SLOPES, AND ALL SLOPES GREATER THAN 3:1, B) 14 DAYS AS TO ALL OTHER DISTURBED OR GRADED AREAS ON THE PROJECT SITE.
- ALL SEDIMENT TRAPS/BASINS SHOWN MUST BE VENCED AND WARNING SIGNS POSTED AROUND THEIR PERIMETER IN ACCORDANCE WITH VOL. 1, CHAPTER 12, OF THE HOWARD COUNTY DESIGN MANUAL, STORM DRAINAGE.
- ALL DISTURBED AREAS MUST BE STABILIZED WITHIN THE TIME PERIOD SPECIFIED ABOVE IN ACCORDANCE WITH THE 1924 "MARYLAND STANDARDS AND SPECIFICATIONS FOR SOIL EROSION AND SEDIMENT CONTROL FOR MULCHING (SEC. 51) SOD (SEC. 54), TEMPORARY SEEDING (SEC. 50) AND PERMANENT (SEC. 52), TEMPORARY STABILIZATION WITH MULCH ALONE CAN ONLY BE DONE WHEN RECOMMENDED SEEDING DATES DO NOT ALLOW FOR PROPER GERMINATION AND ESTABLISHMENT OF GRASSES.
- ALL SEDIMENT CONTROL STRUCTURES ARE TO REMAIN IN PLACE AND ARE TO BE MAINTAINED IN OPERATIVE CONDITION UNTIL PERMITS FOR THEIR REMOVAL HAS BEEN OBTAINED FROM THE HOWARD COUNTY SEDIMENT CONTROL INSPECTOR.
- SIT ANALYSES:

TOTAL AREA OF SITE (THIS SUBMISSION)	3.45 ACRES
AREA DISTURBED	3.03 ACRES
AREA TO BE ROOFED OR PAVED	0.99 ACRES
AREA TO BE VEGETATIVELY STABILIZED	2.00 ACRES
TOTAL CUT	6,823 CY
TOTAL FILL	5,364 CY
OFFSITE STE/BORROW AREA LOCATION	*

*IT IS THE RESPONSIBILITY OF THE CONTRACTOR TO IDENTIFY THE SPILL/BORROW SITE AND NOTIFY MD GAIN APPROVAL FROM THE SEDIMENT CONTROL INSPECTOR OF THE SITE AND THE GRADING PERMIT NUMBER AT THE TIME OF CONSTRUCTION.

- ANY SEDIMENT CONTROL PRACTICE WHICH IS DISTURBED BY GRADING ACTIVITY FOR PLACEMENT OF UTILITIES MUST BE REPAIRED ON THE SAME DAY OF DISTURBANCE.
- ADDITIONAL SEDIMENT CONTROL MUST BE PROVIDED, IF DEEMED NECESSARY BY THE HOWARD COUNTY SEDIMENT CONTROL INSPECTOR.
- ON ALL SITES WITH DISTURBED AREAS IN EXCESS OF 2 ACRES, APPROVAL OF THE INSPECTION AGENCY SHALL BE REQUESTED UPON COMPLETION OF INSTALLATION OF PERIMETER EROSION AND SEDIMENT CONTROLS, BUT BEFORE PROCEEDING WITH ANY OTHER EARTH DISTURBANCE OR GRADING, OTHER BUILDING OR GRADING INSPECTION APPROVALS MAY NOT BE AUTHORIZED UNTIL THIS INITIAL APPROVAL BY THE INSPECTION AGENCY IS MADE.
- TRENCHES FOR THE CONSTRUCTION OF UTILITIES IS LIMITED TO THREE PIPE LENGTHS OR THAT WHICH CAN BE BACK FILLED AND STABILIZED WITHIN ONE WORKING DAY, WHICHEVER IS SHORTER.

PERMANENT SEEDBED PREPARATIONS

SEEDBED PREPARATION: LOOSEN UPPER THREE INCHES OF SOIL BY RAKING, DISCING OR OTHER ACCEPTABLE MEANS BEFORE SEEDING, IF NOT PREVIOUSLY LOOSENED.

SOIL AMENDMENTS: IN LIEU OF SOIL TEST RECOMMENDATIONS, USE ON OF THE FOLLOWING SCHEDULES:

- PREFERRED - APPLY 2 TONS PER ACRE DOLOMITIC LIMESTONE (92 LBS/1000 SQ FT) AND 100 LBS PER ACRE 10-10-10 FERTILIZER (14 LBS/1000 SQ FT) BEFORE SEEDING. HARROW OR DISC INTO UPPER THREE INCHES OF SOIL AT TIME OF SEEDING. APPLY 400 LBS PER ACRE 30-0-0 UREAFORM FERTILIZER (9 LBS/1000 SQ FT).
- ACCEPTABLE - APPLY 2 TONS PER ACRE DOLOMITIC LIMESTONE (92 LBS/1000 SQ FT) AND 1000 LBS PER ACRE 10-10-10 FERTILIZER (23 LBS/1000 SQ FT) BEFORE SEEDING. HARROW OR DISC INTO UPPER THREE INCHES OF SOIL.

SEEDING: FOR THE PERIODS MARCH 1 THROUGH APRIL 30 AND AUGUST 1 THROUGH OCTOBER 15, SEED WITH 60 LBS PER ACRE (14 LBS/1000 SQ FT) OF KENTUCKY 31 TALL FESCUE PER ACRE AN; 2 LBS PER ACRE (.05 LBS/1000 SQ FT) OF WEeping LOVEGRASS. DURING THE PERIOD OF OCTOBER 16 THROUGH FEBRUARY 20, PROJECT SITE BY: OPTION (1) 2 TONS PER ACRE OF WELL ANCHORED STRAW MULCH AND SEED AS SOON AS POSSIBLE IN THE SPRING. OPTION (2) USE SOD. OPTION (3) SEED WITH 60 LBS PER ACRE OF KENTUCKY 31 TALL FESCUE AND MULCH WITH 2 TONS PER ACRE OF WELL ANCHORED STRAW.

MULCHING: APPLY 1-1/2 TO 2 TONS PER ACRE (70 TO 90 LBS/1000 SQ FT) OF UNROTTED SMALL GRAIN STRAW IMMEDIATELY AFTER SEEDING. ANCHOR MULCH IMMEDIATELY AFTER APPLICATION USING MULCH ANCHORING TOOL OR 218 GALLONS PER ACRE (5 GAL/1000 SQ FT) OF EMULSIFIED ASPHALT ON FLAT AREAS, ON SLOPES 8 FT. OR HIGHER, USE 348 GALLONS PER ACRE (8 GAL/1000 SQ FT) FOR ANCHORING.

MAINTENANCE: INSPECT ALL SEEDED AREAS AND MAKE NEEDED REPAIRS, REPLACEMENTS AND RESEEDINGS.

TEMPORARY SEEDBED PREPARATIONS

APPLY TO GRADED OR CLEARED AREAS LIKELY TO BE REDISTURBED WHERE A SHORT-TERM VEGETATIVE COVER IS NEEDED.

SEEDBED PREPARATION: LOOSEN UPPER THREE INCHES OF SOIL BY RAKING, DISCING OR OTHER ACCEPTABLE MEANS BEFORE SEEDING, IF NOT PREVIOUSLY LOOSENED.

SOIL AMENDMENTS: APPLY 600 LBS PER ACRE 10-10-10 FERTILIZER (14 LBS/1000 SQ FT).

SEEDING: FOR PERIOD MARCH 1 THROUGH APRIL 30 AND FROM AUGUST 1 THROUGH OCTOBER 15, SEED WITH 2-1/2 BUSHELS PER ACRE OF ANNUAL RYE (3.2 LBS/1000 SQ FT) FOR THE PERIOD MAY 1 THROUGH AUGUST 14, SEED WITH 3 LBS PER ACRE OF WEeping LOVEGRASS (.07 LBS/1000 SQ FT). FOR THE PERIOD NOVEMBER 16 THROUGH FEBRUARY 28, PROJECT SITE BY APPLYING 2 TONS PER ACRE OF WELL ANCHORED STRAW MULCH AND SEED AS SOON AS POSSIBLE IN THE SPRING, OR USE SOD.

MULCHING: APPLY 1-1/2 TO 2 TONS PER ACRE (70 TO 90 LBS/1000 SQ FT) OF UNROTTED SMALL GRAIN STRAW IMMEDIATELY AFTER SEEDING. ANCHOR MULCH IMMEDIATELY AFTER APPLICATION USING MULCH ANCHORING TOOL OR 218 GALLONS PER ACRE (5 GAL/1000 SQ FT) OF EMULSIFIED ASPHALT ON FLAT AREAS, ON SLOPES 8 FT. OR HIGHER, USE 348 GALLONS PER ACRE (8 GAL/1000 SQ FT) FOR ANCHORING.

REFER TO THE 1994 MARYLAND STANDARDS AND SPECIFICATIONS FOR SOIL EROSION AND SEDIMENT CONTROL FOR RATE AND METHODS NOT COVERED.

TOPSOIL SPECIFICATIONS

- Topsoil salvaged from the existing site may be used provided that it meets standards as set forth in these specifications. Typically, the depth of topsoil to be salvaged for a given soil type can be found in the representative soil profile section in the Soil Survey published by USDA-SCS in cooperation with Maryland Agricultural Experiment Station.
- Topsoil Specifications - Soil to be used as topsoil must meet the following:
 - Topsoil shall be a loam, sandy loam, clay loam, silt loam, sandy clay loam, loamy sand. Other soils may be used if recommended by an agronomist or soil scientist and approved by the appropriate approval authority. Regardless, topsoil shall not be a mixture of contrasting texture subsoils and shall contain less than 5% by volume of cinders, stones, slag, coarse fragments, gravel, sticks, roots, trash, or other materials larger than 1-1/2" in diameter.
 - Topsoil must be free of plants or plant parts such as Bermuda grass, quack grass, Johnson grass, nutgrass, poison ivy, thistle, or others as specified.
 - When the subsoil is either highly acidic or composed of heavy clays, ground limestone shall be spread at the rate of 4-8 tons/acre (200-400 pounds per 1,000 square feet) prior to the placement of topsoil. Lime shall be distributed uniformly over designated areas and worked into the soil in conjunction with tillage operations as described in the following procedures.
- For sites having disturbed areas under 5 acres:
 - Place topsoil (if required) and apply soil amendments as specified in 20.0 Vegetative Stabilization - Section I - Vegetative Stabilization Methods and Materials.
- For sites having disturbed areas over 5 acres:
 - On soil meeting Topsoil specifications, obtain test results dictating fertilizer and lime amendments required to bring the soil into compliance with the following:
 - pH for topsoil shall be between 6.0 and 7.5. If the tested soil demonstrates a pH of less than 6.0, sufficient lime shall be prescribed to raise the pH to 6.5 or higher.
 - Organic content or topsoil shall be not less than 1.5 percent by weight.
 - Topsoil having soluble salt content greater than 500 parts per million shall not be used.
 - No sod or seed shall be placed on soil which has been treated with soil sterilants or chemicals used for weed control until sufficient time has elapsed (14 days min.) to permit dissipation of phytotoxic materials.

- Note: Topsoil substitutes or amendments, as recommended by a qualified agronomist or soil scientist and approved by the appropriate approval authority, may be used in lieu of natural topsoil.
- Place topsoil (if required) and apply soil amendments as specified in 20.0 Vegetative Stabilization - Section I - Vegetative Stabilization Methods and Materials.

- When topsoiling, maintain needed erosion and sediment control practices such as diversions, grade stabilization structures, earth dikes, slope silt fence and sediment traps and basins.
- Grades on the areas to be topsoiled, which have been previously established, shall be maintained, albeit 4" - 8" higher in elevation.
- Topsoil shall be uniformly distributed in a 4" - 8" layer and lightly compacted to a minimum thickness of 4". Spreading shall be performed in such a manner that the sodding or seeding can proceed with a minimum of additional soil preparation and tillage. Any irregularities in the surface resulting from topsoiling or other operations shall be corrected in order to prevent the formation of depressions or water pockets.
- Topsoil shall not be placed while the topsoil or subsoil is in a frozen or muddy condition, when the subsoil is excessively wet or in a condition that may otherwise be detrimental to proper grading and seedbed preparation.


SEQUENCE OF CONSTRUCTION

- NOTIFY SEDIMENT CONTROL DIVISION 48 HOURS PRIOR TO START OF CONSTRUCTION
- DAY 1-1) OBTAIN GRADING PERMIT.
- DAY 2-6) 2) INSTALL SEDIMENT CONTROLS THAT ARE NOTED TO BE INSTALLED UNDER THIS S.D.P.
- DAY 7-10) 3) EXCAVATE FOR FOUNDATIONS, ROUGH GRADE AND STABILIZE IN ACCORDANCE WITH TEMPORARY SEEDBED NOTES.
- DAY 11-80) 4) CONSTRUCT HOUSES, BACKFILL AND CONSTRUCT DRIVEWAYS.
- DAY 81-85) 5) FINAL GRADE, INSTALL LEVEL SPREADERS AND STABILIZE IN ACCORDANCE WITH PERMANENT SEEDBED NOTES AND FLUSH STORM DRAIN SYSTEM.
- DAY 86-89) 6) WITH THE APPROVAL OF THE HOWARD COUNTY SEDIMENT CONTROL INSPECTOR, REMOVE SEDIMENT CONTROL DEVICES AND STABILIZE ANY REMAINING DISTURBED AREAS.

* - INDICATES SINGLE HOUSE CONSTRUCTION.

NOTE: EROSION CONTROL MATTING SHALL BE PLACED IN SWALES WHERE DEEMED NECESSARY UNTIL VEGETATION IS ESTABLISHED OR SOIL SOD SHOULD BE USED.


DETAIL 24 - STABILIZED CONSTRUCTION ENTRANCE

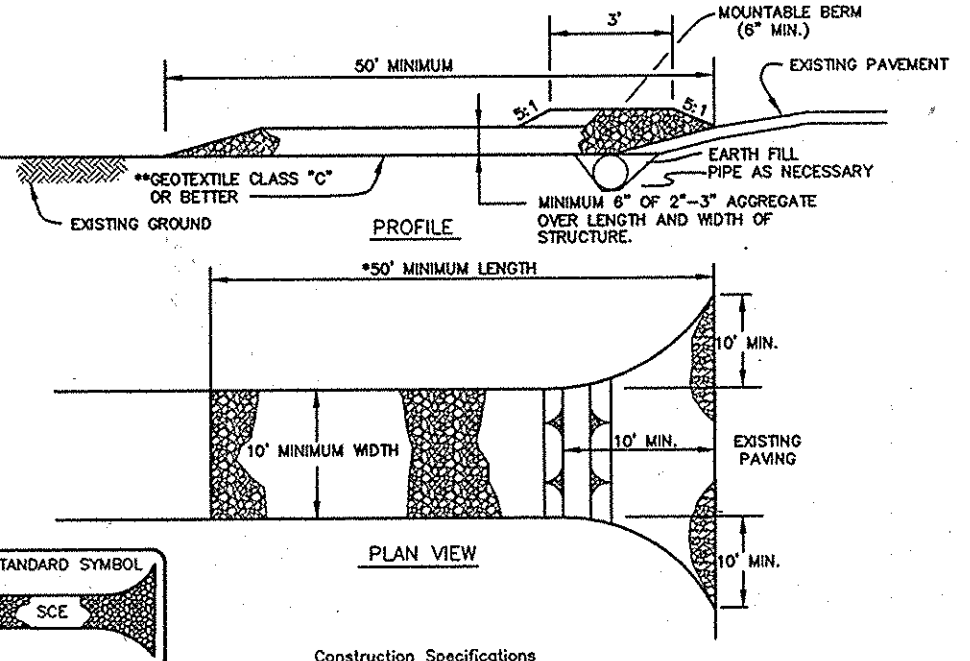

- CONSTRUCTION SPECIFICATIONS**
- Length - minimum of 50' (*30' for single residence lot).
 - Width - 10' minimum, should be flared at the existing road to provide a turning radius.
 - Geotextile fabric (filter cloth) shall be placed over the existing ground prior to placing stones. **The plan approval authority may require single family residence to use geotextile.
 - Stones - crushed aggregate (2" to 3") or reclaimed or recycled concrete equivalent shall be placed at least 6" deep over the length and width of the entrance.
 - Surface Water - all surface water flowing to or diverted toward construction entrances shall be piped through the entrance, maintaining positive drainage. Pipe installed through the stabilized construction entrance shall be protected with a minimum 6" slope and a minimum of 6" of stone over the pipe. Pipe has to be sized according to the drainage. When the SCE is located at a high spot and has no drainage to convey a pipe will not be necessary. Pipe should be sized according to the amount of runoff to be conveyed. A 6" minimum will be required.
 - Location - A stabilized construction entrance shall be located at every point where construction traffic enters or leaves a construction site. Vehicles leaving the site must travel over the entire length of the stabilized construction entrance.

U.S. DEPARTMENT OF AGRICULTURE SOIL CONSERVATION SERVICE PAGE F 17 - 3 MARYLAND DEPARTMENT OF ENVIRONMENT WATER MANAGEMENT ADMINISTRATION


DETAIL 33 - SUPER SILT FENCE

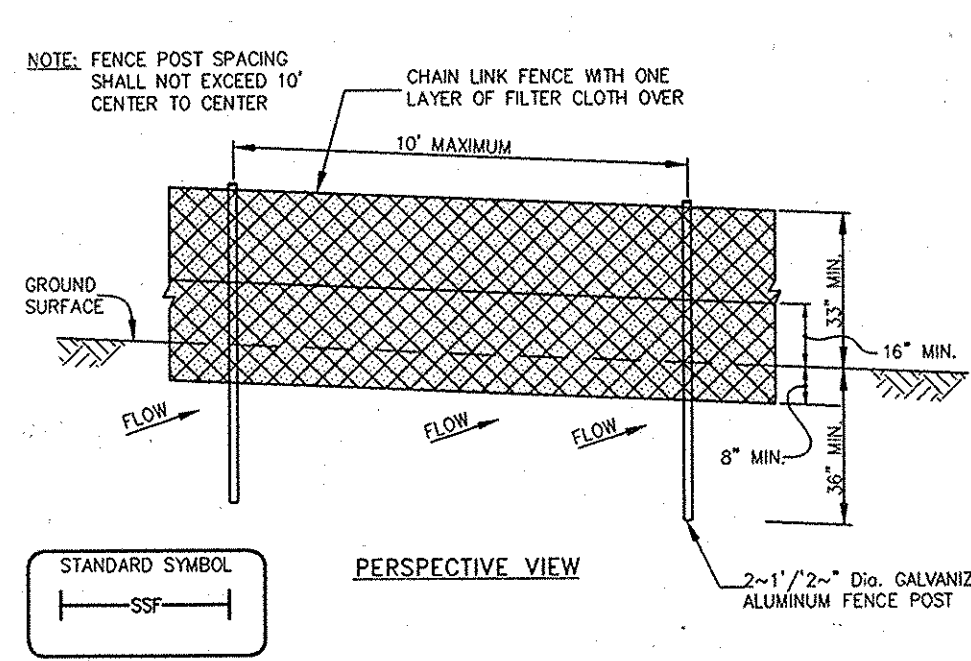

- CONSTRUCTION SPECIFICATIONS**
- Chain link fence with one layer of filter cloth over it.
 - 2x4" ALUMINUM FENCE POST.
 - 16" MIN. SPACING BETWEEN POSTS.
 - EMBED FILTER CLOTH 2" MIN. INTO GROUND.

U.S. DEPARTMENT OF AGRICULTURE SOIL CONSERVATION SERVICE PAGE H 28 - 3 MARYLAND DEPARTMENT OF ENVIRONMENT WATER MANAGEMENT ADMINISTRATION

DETAIL 30 - EROSION CONTROL MATTING

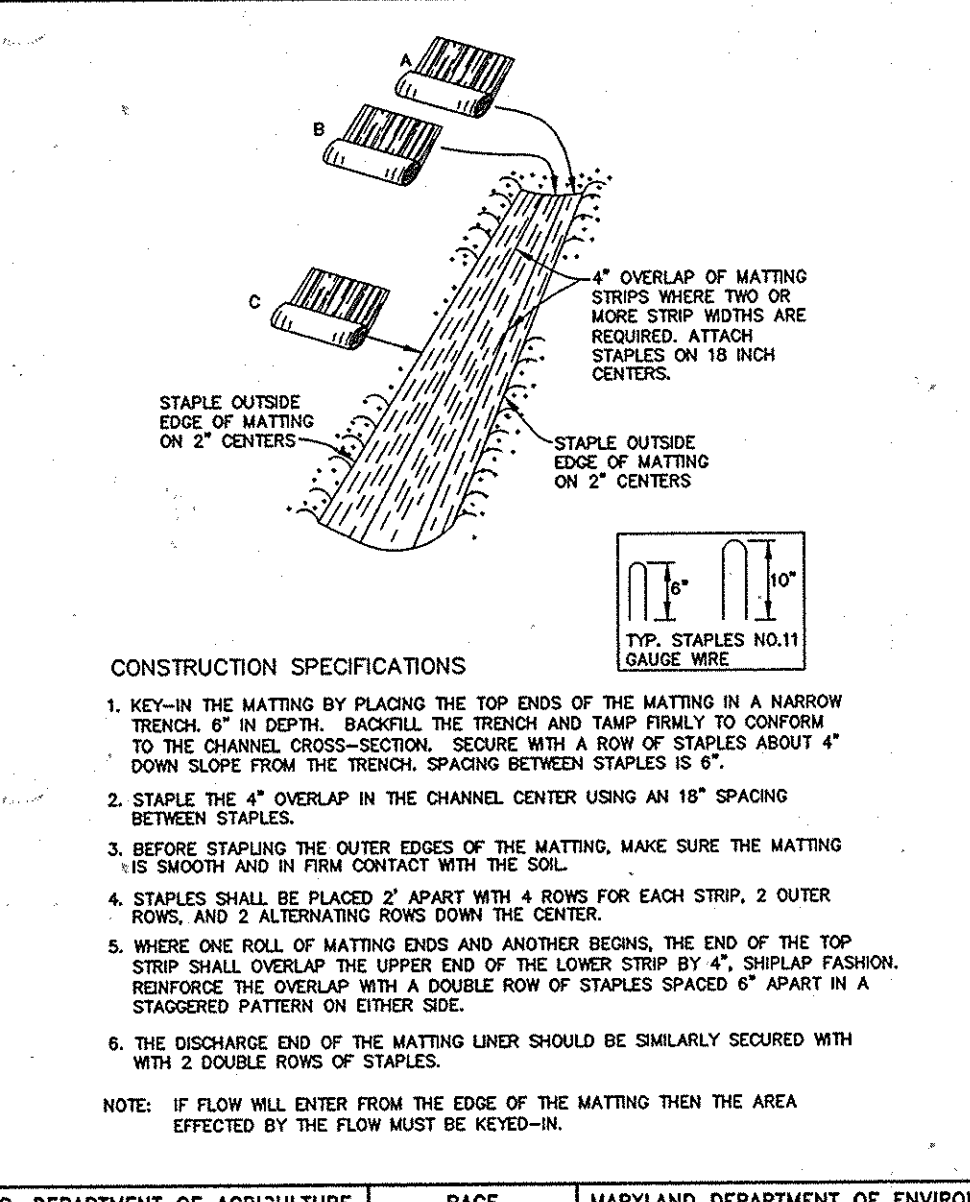

- CONSTRUCTION SPECIFICATIONS**
- SEWING THE MATTING BY PLACING THE TOP EDGES OF THE MATTING IN A NARROW TRENCH 6" IN DEPTH. BACKFILL THE TRENCH AND TAMP FIRMLY TO CONFORM TO THE CHANNEL CROSS-SECTION. SECURE WITH A ROW OF STAPLES ALONG 4" DOWN SIDE FROM THE TRENCH. SPACING BETWEEN STAPLES IS 6".
 - STAPLE THE 4" OVERLAP IN THE CHANNEL CENTER USING AN 18" SPACING BETWEEN STAPLES.
 - BEFORE STAPLING THE OUTER EDGES OF THE MATTING, MAKE SURE THE MATTING IS SMOOTH AND IN FIRM CONTACT WITH THE SOIL.
 - STAPLES SHALL BE PLACED 2' APART WITH 4 ROWS FOR EACH STRIP, 2 OUTER ROWS, AND 2 ALTERNATING ROWS OF STAPLES.
 - WHERE ONE ROLL OF MATTING ENDS AND ANOTHER BEGINS, THE END OF THE TOP STRIP SHALL OVERLAP THE UPPER END OF THE LOWER STRIP BY 4", SHIPLAP FASHION. REINFORCE THE OVERLAP WITH A DOUBLE ROW OF STAPLES SPACED 6' APART IN A STAGGERED PATTERN ON EITHER SIDE.
 - THE DISCHARGE END OF THE MATTING LINER SHOULD BE SIMILARLY SECURED WITH 2 DOUBLE ROWS OF STAPLES.

NOTE: IF FLOW WILL ENTER FROM THE EDGE OF THE MATTING THEN THE AREA EFFECTED BY THE FLOW MUST BE KEYED-IN.

U.S. DEPARTMENT OF AGRICULTURE SOIL CONSERVATION SERVICE PAGE G 22 - 2 MARYLAND DEPARTMENT OF ENVIRONMENT WATER MANAGEMENT ADMINISTRATION

SUPER SILT FENCE

- CONSTRUCTION SPECIFICATIONS**
- Fencing shall be 42" in height and constructed in accordance with the latest Maryland State Highway Details for Chain Link Fencing. The specification for a 6' fence shall be used, substituting 42" fabric and 6' length posts.
 - Chain link fence shall be fastened securely to the fence posts with wire ties. The lower tension wire, brace and truss rods, drive anchors and post caps are not required except on the ends of the fence.
 - Filter cloth shall be fastened securely to the chain link fence with ties spaced every 24" at the top and mid section.
 - Filter cloth shall be embedded a minimum of 8" into the ground.
 - When two sections of filter cloth adjoin each other, they shall be overlapped by 6" and folded.
 - Maintenance shall be performed as needed, and silt buildups removed when "bulges" develop in the silt fence, or when silt reaches 50% of fence height.
 - Filter cloth shall be fastened securely to each fence post with wire ties or staples of top and mid section and shall meet the following requirements for Geotextile Class F:


Tensile Strength	50 lbs/in (min.)	Test: MSMT 509
Tensile Modulus	20 lbs/in (min.)	Test: MSMT 508
Flow Rate	0.3 gpl/fl /minute (max.)	Test: MSMT 322
Filtering Efficiency	75% (min.)	Test: MSMT 322

SUPER SILT FENCE DESIGN CRITERIA

Slope	Slope Steepness	Slope Length (maximum)	Silt Fence Length (maximum)
0 - 10%	0 - 10:1	Unlimited	Unlimited
10 - 20%	10:1 - 5:1	200 feet	1,500 feet
20 - 33%	5:1 - 3:1	100 feet	1,000 feet
33 - 50%	3:1 - 2:1	100 feet	500 feet
50% +	2:1 +	50 feet	250 feet

U.S. DEPARTMENT OF AGRICULTURE SOIL CONSERVATION SERVICE PAGE E 26 - 3A MARYLAND DEPARTMENT OF ENVIRONMENT WATER MANAGEMENT ADMINISTRATION

DETAIL 22 - SILT FENCE

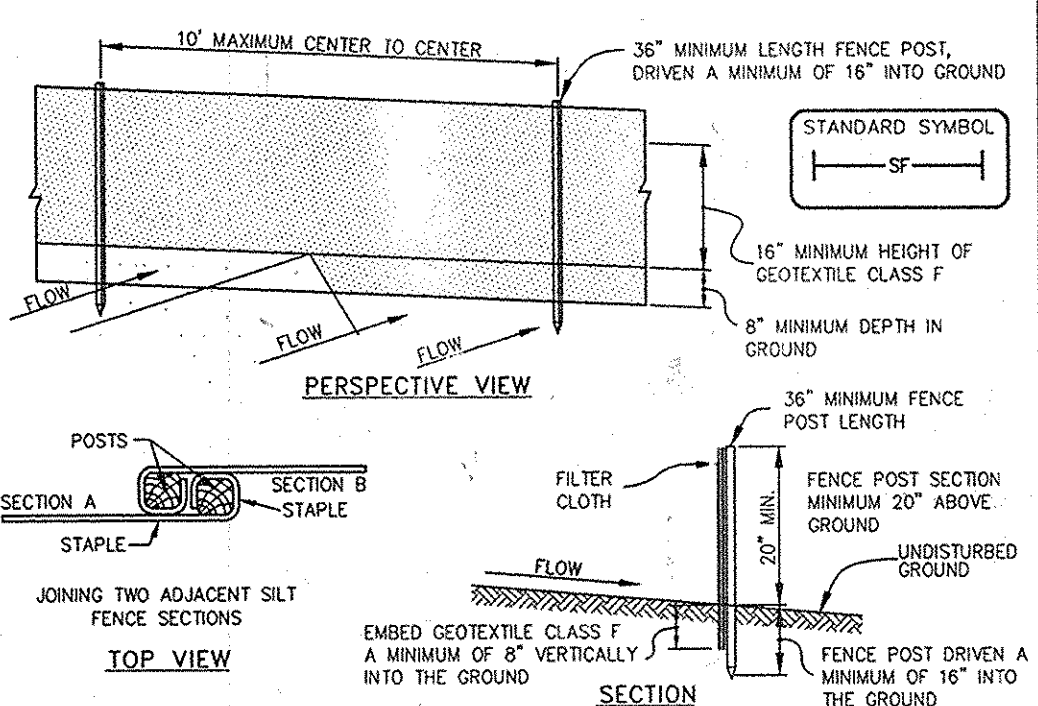


CONSTRUCTION NOTES FOR FABRICATED SILT FENCE

- Fence posts shall be a minimum of 36" long driven 16" minimum into the ground. Posts shall be 11/2" x 11/2" square (minimum) cut, or 1 3/4" diameter (minimum) round and shall be of sound quality hardwood. Steel posts will be standard I or U section weighing not less than 1.00 pound per linear foot.
- Geotextile shall be fastened securely to each fence post with wire ties or staples at top and mid-section and shall meet the following requirements for Geotextile Class F:
- Tensile Strength 50 lbs/in (min.) Test: MSMT 509
- Tensile Modulus 20 lbs/in (min.) Test: MSMT 508
- Flow Rate 0.3 gpl/fl /minute (max.) Test: MSMT 322
- Filtering Efficiency 75% (min.) Test: MSMT 322
- Where ends of geotextile fabric come together, they shall be overlapped, folded and stapled to prevent sediment bypass.
- Silt Fence shall be inspected after each rainfall event and maintained when bulges occur or when sediment accumulation reaches 50% of the fabric height.


U.S. DEPARTMENT OF AGRICULTURE SOIL CONSERVATION SERVICE PAGE E 15 - 3 MARYLAND DEPARTMENT OF ENVIRONMENT WATER MANAGEMENT ADMINISTRATION

HO. CO. APPROVED SIGN DESIGN AND INSTALLATION DETAIL

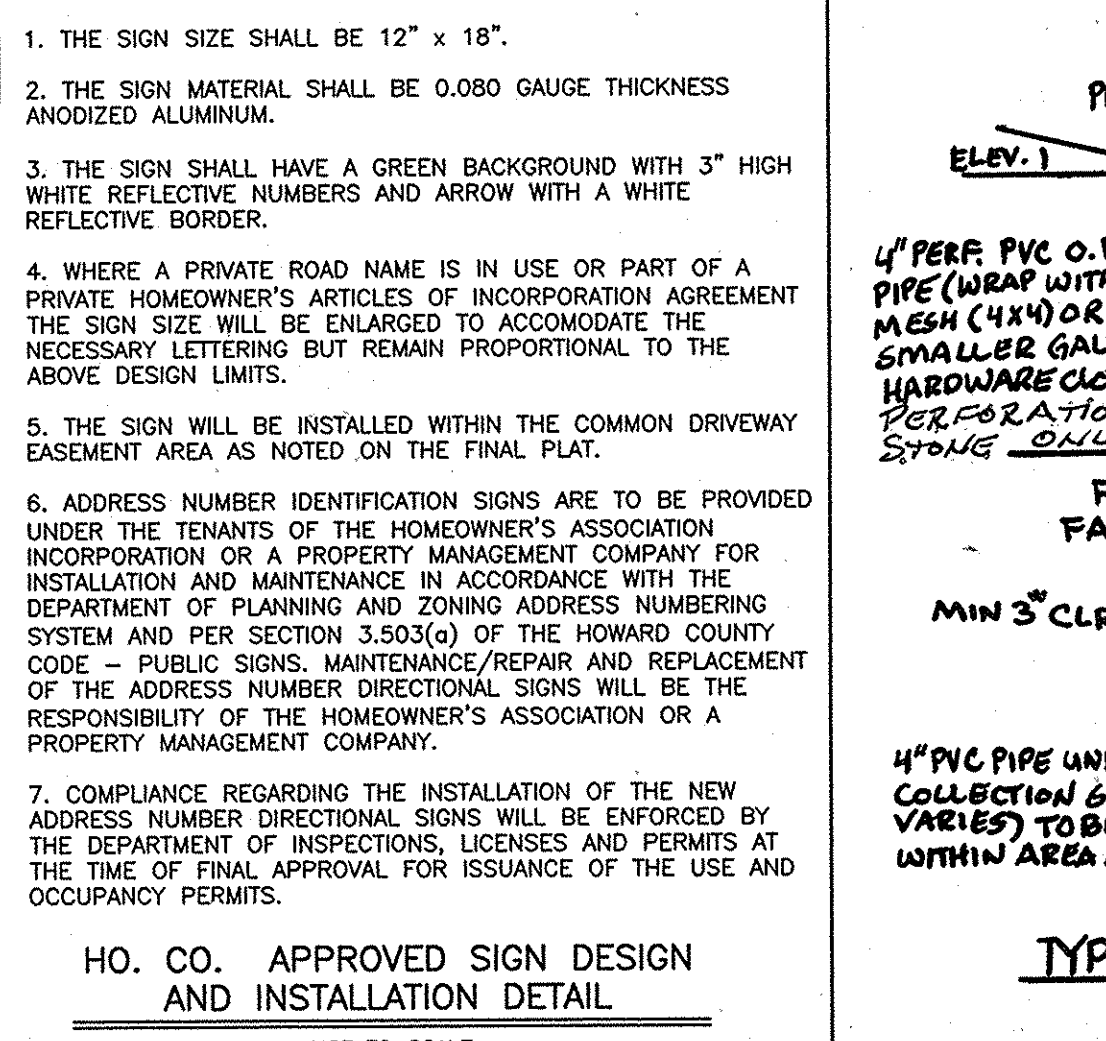

- THE FOLLOWING STANDARD SIGN DESIGN SPECIFICATIONS SHALL APPLY:
- THE SIGN SIZE SHALL BE 12" x 18".
 - THE SIGN MATERIAL SHALL BE 0.080 GAUGE THICKNESS ANODIZED ALUMINUM.
 - THE SIGN SHALL HAVE A GREEN BACKGROUND WITH 3" HIGH WHITE REFLECTIVE NUMBERS AND ARROW WITH A WHITE REFLECTIVE BORDER.
 - WHERE A PRIVATE ROAD NAME IS IN USE OR PART OF A PRIVATE HOMEOWNER'S ARTICLES OF INCORPORATION AGREEMENT THE SIGN SIZE WILL BE ENLARGED TO ACCOMMODATE THE NECESSARY LETTERING BUT REMAIN PROPORTIONAL TO THE ABOVE DESIGN LIMITS.
 - THE SIGN WILL BE INSTALLED WITHIN THE COMMON DRIVEWAY EASEMENT AREA AS NOTED ON THE FINAL PLAN.
 - ADDRESS NUMBER IDENTIFICATION SIGNS ARE TO BE PROVIDED UNDER THE TENANTS OF THE HOMEOWNER'S ASSOCIATION FOR INCORPORATION OR A PROPERTY MANAGEMENT COMPANY FOR INSTALLATION AND MAINTENANCE IN ACCORDANCE WITH THE DEPARTMENT OF PLANNING AND ZONING ADDRESS NUMBERING SYSTEM AND PER SECTION 3.503(a) OF THE HOWARD COUNTY CODE - PUBLIC SIGNS, MAINTENANCE/REPAIR AND REPLACEMENT OF THE ADDRESS NUMBER DIRECTIONAL SIGNS WILL BE THE RESPONSIBILITY OF THE HOMEOWNER'S ASSOCIATION OR A PROPERTY MANAGEMENT COMPANY.
 - COMPLIANCE REGARDING THE INSTALLATION OF THE NEW ADDRESS NUMBER DIRECTIONAL SIGNS WILL BE ENFORCED BY THE DEPARTMENT OF INSPECTIONS, LICENSES AND PERMITS AT THE TIME OF FINAL APPROVAL FOR ISSUANCE OF THE USE AND OCCUPANCY PERMITS.

NOT TO SCALE

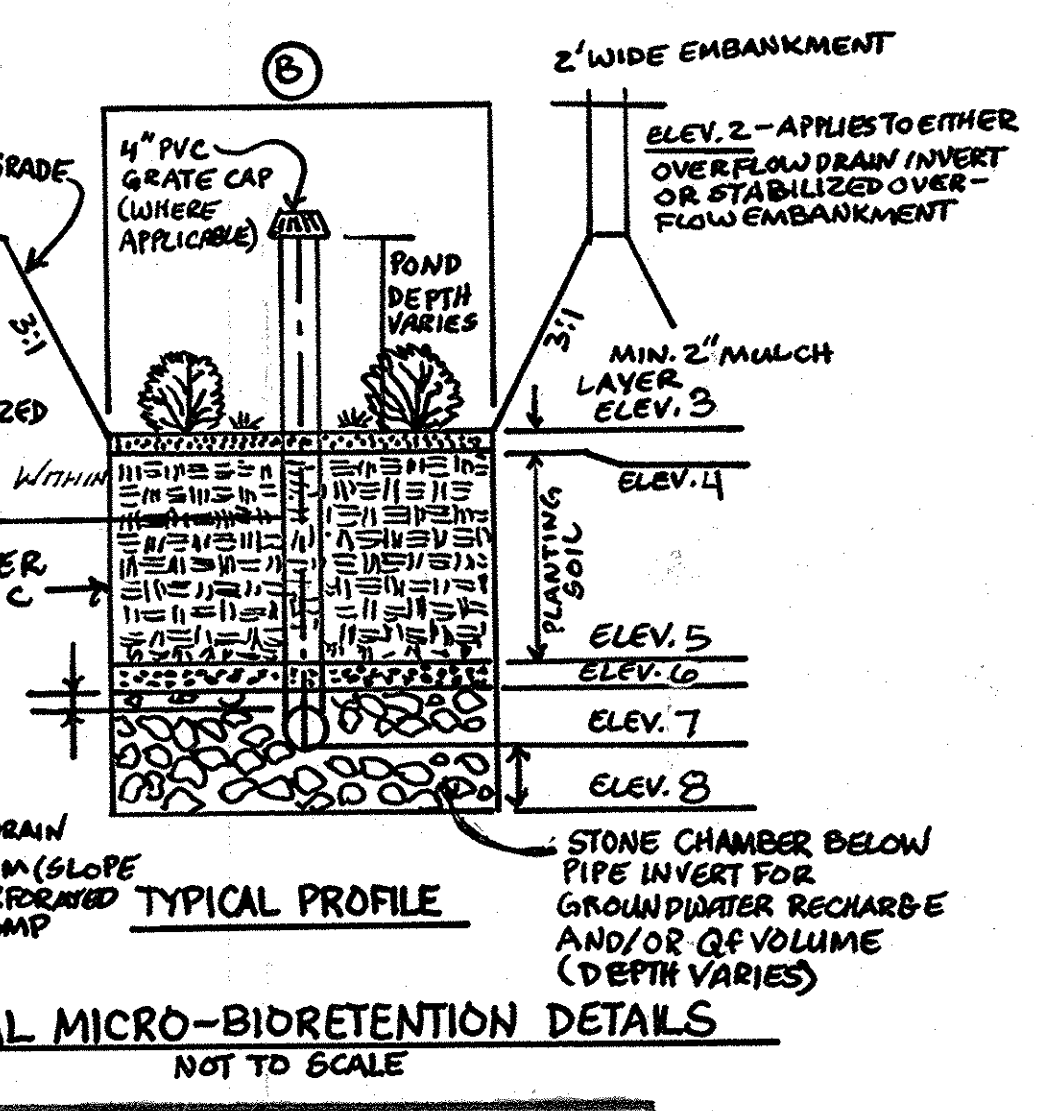

TYPICAL MICRO-BIORETENTION DETAILS

NOT TO SCALE

Professional Certification. I hereby certify that these documents were prepared or approved by me, and that I am a duly licensed professional engineer under the laws of the State of Maryland.
License No. 45572, Expiration Date: 06-08-15



FOR REVIEWS ONLY

CONSTRUCTION SPECIFICATIONS FOR IPD-1

- A. A swale, ditchline or yard inlet protection
- Excavate completely around inlet to a depth of 18" below notch elevation.
 - Drive 2 x 4 post 1' into ground at four corners of inlet. Place nail strips between posts on ends of inlet. Assemble top portion of 2 x 4 frame using overlap joint shown. Top of frame (weir) must be 6" below edge of roadway adjacent to inlet.
 - Stretch wire mesh lightly around frame and fasten securely. Ends must meet post.
 - Stretch filter cloth lightly over wire mesh, the cloth must extend from top of frame to 18" below inlet notch elev. fasten securely to frame. Ends must meet at post, be overlapped and folded, then fastened down.
 - Backfill ground inlet in compacted 6" layers until layer of earth is even with notch elevation on ends and top elevation on sides. If the inlet is not in a low point, construct a compacted earth dike in the ditchline below it. The top of this dike is to be at least 6" higher than the top of frame (weir).
 - This structure must be inspected frequently and the filter fabric replaced when clogged.
- B. curb inlet protection.
- Attach a continuous piece of wire mesh (30" min. width by throat length plus 4") to the 2"x4" weir (measuring throat length plus 2") as shown on the standard drawing.
 - Place a piece of approved filter cloth (40-85 sieve) of the same dimensions as the wire mesh and securely attach to the 2"x4" weir.
 - Securely nail the 2"x4" weir to 9" long vertical spacers to be located between the weir and inlet face (max. 6" apart).
 - Place the assembly against the inlet throat and nail (min. 2" lengths of 2"x4" to the top of the weir spacer locations. These 2"x4" anchors shall extend across the inlet top and be held in place by sandbags or alternate weight.
 - The assembly shall be placed so that the end spacers are a minimum 1" beyond both ends of the throat opening.
 - From the wire mesh and filter cloth to the concrete gutter and against the face of curb on both sides of the inlet. Place clean 2" stone over the wire mesh and filter fabric in such a manner as to prevent water from entering the inlet under or around the filter cloth.
 - This type of protection must be inspected frequently and the filter cloth and stone replaced when clogged with sediment.
 - Assure that storm flow does not bypass inlet by installing temporary earth or asphalt dikes directing flow into inlet.

ROCKY GORGE LOT 10 MICRO-BIORETENTION CMB DESIGN ELEVATION

MB-1	(M-G)	MB-2	(M-G)
MICRO-BIORETENTION		MICRO-BIORETENTION	
ELEVATION 1	401.25	ELEVATION 1	402.25
ELEVATION 2	401.25	ELEVATION 2	402.25
ELEVATION 3	400.25	ELEVATION 3	401.25
ELEVATION 4	400.08	ELEVATION 4	401.08
ELEVATION 5	398.08	ELEVATION 5	399.08
ELEVATION 6	397.75	ELEVATION 6	398.75
ELEVATION 7	397.17	ELEVATION 7	398.17
ELEVATION 8	396.92	ELEVATION 8	397.92
DIMENSIONS		DIMENSIONS	
A WIDTH	7.50'	A WIDTH	7.02'
B LENGTH	22.50'	B LENGTH	8.02'
BOTTOM RADII	2.0'	BOTTOM RADII	2.0'

ENGINEER'S CERTIFICATE


"I CERTIFY THAT THIS PLAN FOR SEDIMENT AND EROSION CONTROL REPRESENTS A PRACTICAL AND WORKABLE PLAN BASED ON MY PERSONAL KNOWLEDGE OF THE SITE CONDITIONS AND THAT IT WAS PREPARED IN ACCORDANCE WITH THE REQUIREMENTS OF THE HOWARD COUNTY DESIGN DISTRICT."
ENGINEER: W. M. CIVIL ENGINEERING, Inc. DATE: 4/30/09

DEVELOPER'S CERTIFICATE


"I HEREBY CERTIFY THAT ALL DEVELOPMENT AND CONSTRUCTION WILL BE DONE ACCORDING TO THIS PLAN FOR SEDIMENT AND EROSION CONTROL, AND THAT ALL RESPONSIBLE PERSONNEL INVOLVED IN THE CONSTRUCTION PROJECT WILL HAVE A CERTIFICATE OF ATTENDANCE AT A DEPARTMENT OF THE ENVIRONMENT APPROVED TRAINING PROGRAM FOR THE CONTROL OF SEDIMENT AND EROSION BEFORE BEGINNING THE PROJECT. I ALSO AUTHORIZE PERIODIC ON-SITE INSPECTION BY THE HOWARD COUNTY SEDIMENT CONTROL DIVISION."
DEVELOPER: CORNERSTONE HOMES, INC. DATE: 4/30/09

APPROVED: HOWARD COUNTY DEPARTMENT OF PLANNING AND ZONING
DATE: 5/20/09
DATE: 5/27/09
DATE: 5/27/09

SWALE INLET PROTECTION DETAIL

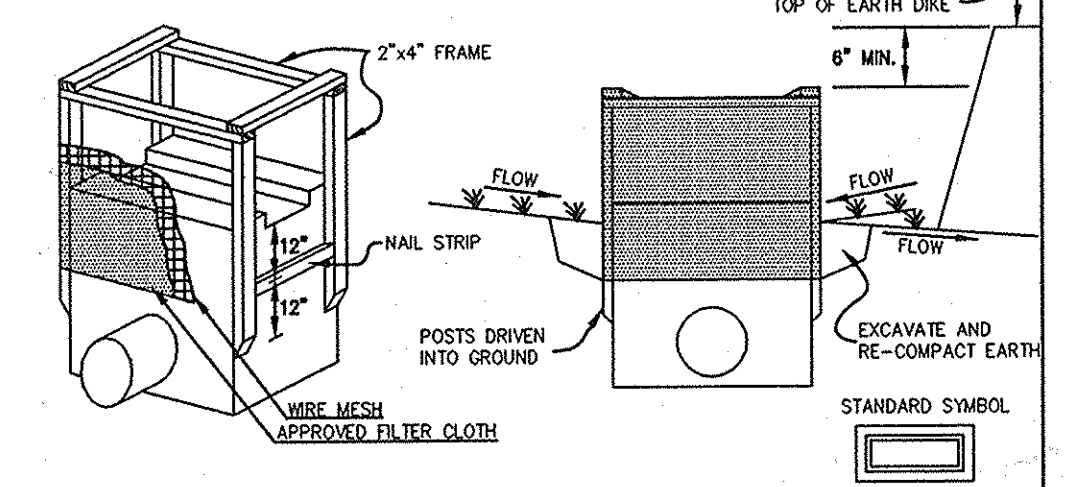

CURB INLET PROTECTION DETAIL

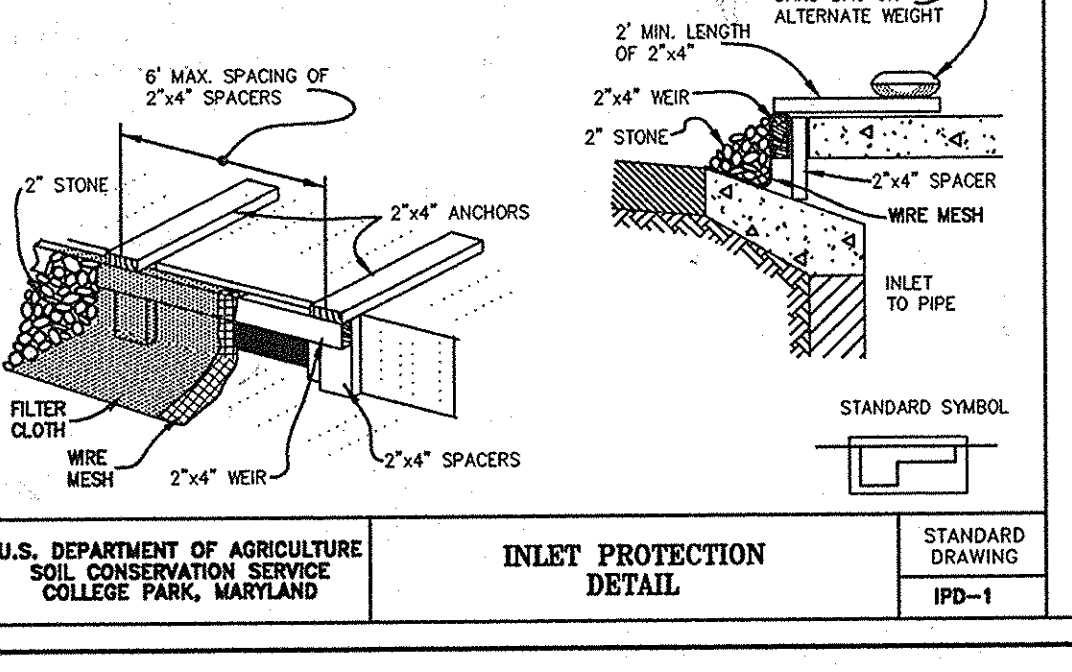

U.S. DEPARTMENT OF AGRICULTURE SOIL CONSERVATION SERVICE COLLEGE PARK, MARYLAND IPD-1