


CONSTRUCTION NOTES

- No sediment and erosion control devices may be removed without prior approval from the Howard County Inspector.
- Stabilize any disturbed areas as soon as possible by permanent or temporary means.
- All temporary stock piles and excess material shall be removed to an approved spoil site. All borrow material shall be obtained from an approved site.
- It shall be the responsibility of the contractor or subcontractor to notify the engineer of any deviation to these plans prior to any change being made. Any changes in these plans without the written consent of the engineer for said changes, the engineer shall be responsible for the contractor or subcontractor.
- UTILITIES shown on these plans are in accordance with the best information available for the contractor. The contractor shall be responsible for locating and protecting all existing services and mains (public or private). The contractor shall obtain the services of a private utility locator for the protection of existing private services and mains. The owners and engineer assume no responsibility for accuracy or completeness of the information shown. Existing main or service shall be carefully protected. Any damage to these caused by the work shall be immediately repaired to the satisfaction of the engineer by the contractor at the contractor's expense, using materials of the kinds damaged.
- The contractor shall call "MISS UTILITY", 1-800-257-7777, a minimum of 48 hours in advance of any excavation, boring, and/or digging to determine the location of underground utilities.
- The contractor shall grade all areas within the area of construction and shall warp paving as necessary to insure positive drainage.
- The Contractor shall be responsible for coordination of his construction with the construction by other contractors and subcontractors.
- All soil erosion measures shall be in accordance with the "1994 MARYLAND STANDARDS AND SPECIFICATIONS FOR SOIL EROSION AND SEDIMENT CONTROL".
- Failure to specifically mention items which would normally be required to complete the work and develop this site in accordance with approved plans, shall not relieve the contractor from performing such work. This work shall be part of the contractors base bid.


SITE DEVELOPMENT PLAN FOR HIGHS AT NORMANDY 2nd ELECTION DISTRICT HOWARD COUNTY, MARYLAND

LEGEND

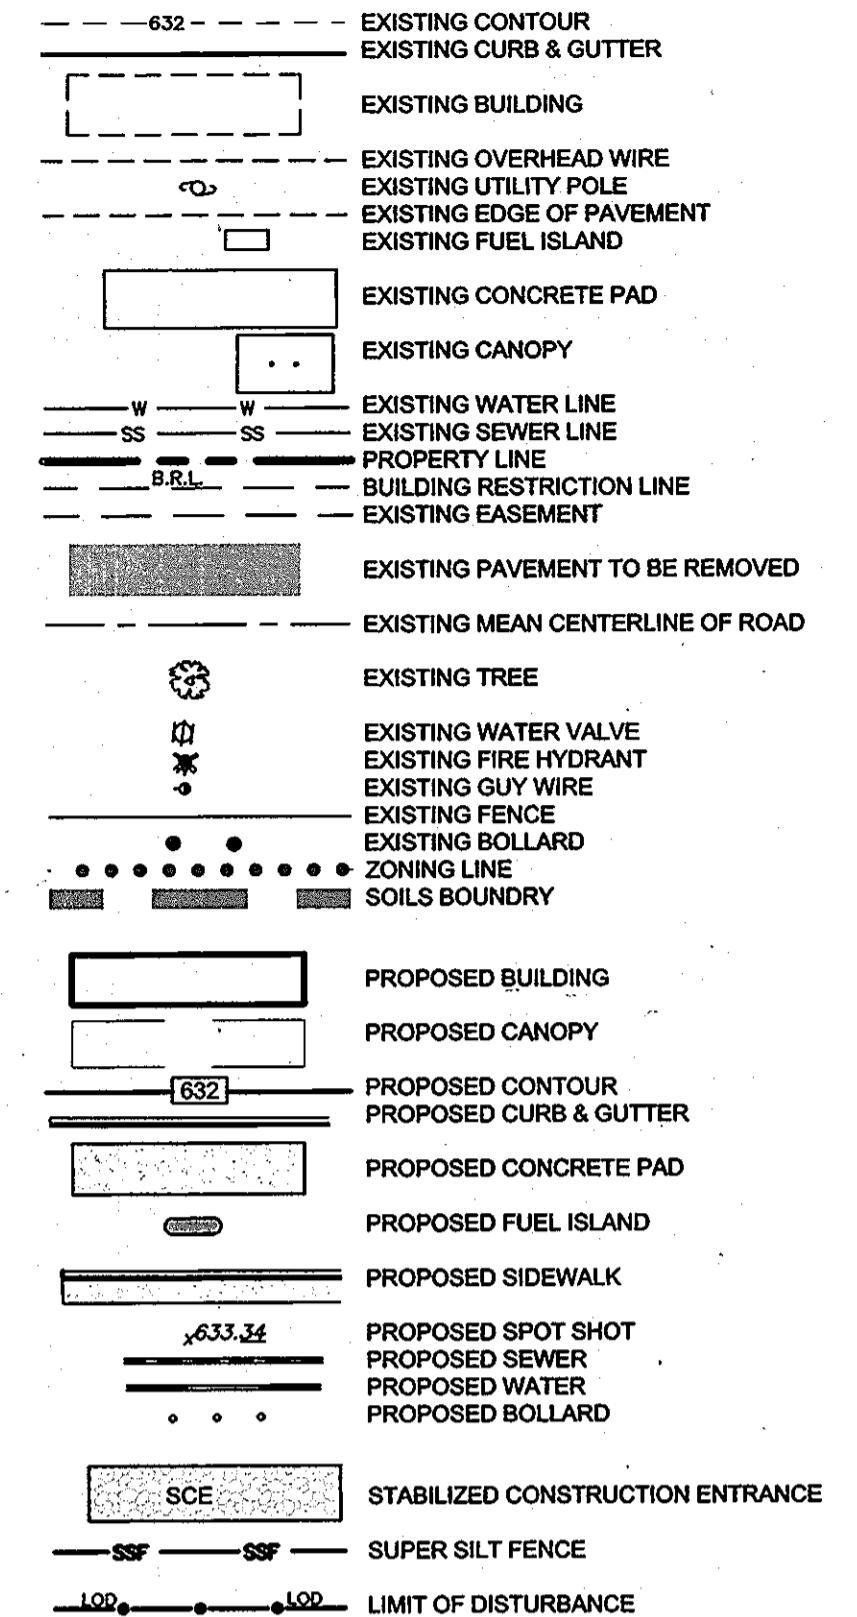


GENERAL NOTES NON-RESIDENTIAL SITE DEVELOPMENT PLAN

- All construction shall be in accordance with the latest standards and specifications of Howard County plus MSHA standards and specifications if applicable.
- The contractor shall notify the Department of Public Works/Bureau of Engineering/Construction Inspection Division at (410) 313-1880 at least five (5) working days prior to the start of work.
- The contractor shall notify "Miss Utility" at 1-800-257-7777 at least 48 hours prior to any excavation work being done.
- Traffic control devices, markings and signing shall be in accordance with the latest edition of the Manual of Uniform Traffic Control Devices (MUTCD). All street and regulatory signs shall be in place prior to the placement of any asphalt.
- All plan dimensions are to face of curb unless otherwise noted.
- The existing topography is taken from field survey with two foot contour intervals prepared by Messick and Associates dated 1/9/08
- The coordinates shown herein are based upon the Howard County Geodetic Control which is based upon the Maryland State Plane Coordinate System. Howard County Monument Nos. 24C2 and 18G1 were used in this project.
- Water is private.
- Sewer is private.
- This is a redevelopment site. Stormwater management is a water quality underground sand filter. Owned and maintained by Highs of Baltimore.
- Existing utilities are based on a survey performed by Messick and Associates & record files provided by Howard County
- There is no floodplain on this site.
- There are no wetlands on this site.
- The traffic study for this project was prepared by Traffic Concepts Inc. dated 5/21/08 and was approved on 09/28/09.
- All outdoor lighting shall comply with the requirements of zoning section 134.
- In accordance with sub section 16.1202 (b)(1)(ii), this plan is exempt from compliance with the requirements of the forest conservation act. Because the LOD shown does not exceed the LOD shown on SDP-72-12 for the site which was approved prior to 1/23/92.
- A decision was rendered on conditional use case BA-08-045C December 3rd 2008. The conditional use order can be found to the left of these General Notes.
- Street light placement and the type of fixture and pole shall be accordance with the Howard County Design Manual, Volume III (1993) and as modified by "Guidelines for Street Lights in Residential Developments (June 1993)." A minimum spacing of 20' shall be maintained between any streetlight and any tree.
- All sign posts used for traffic control signs installed in the County right-of-way shall be mounted on a 2" galvanized steel, perforated, square tube post (14 gauge) inserted into a 2-1/2" galvanized steel, perforated, square tube sleeve (12 gauge)-3' long. A galvanized steel pole cap shall be mounted on top of each post.
- Storm water management will be controlled by a onsite sand filter to be owned and maintained by High's of Baltimore Inc.
- The floodplain study for this project was prepared by Messick and Associates dated 6/20/09 and was approved on 09/28/09.
- The Knox box is located on the front of the building, to the right of the entrance 4' to 5' in height and no more than 6' laterally from the door. The box shall be electronically supervised to notify the owner that it is being accessed (integrated with the fire alarm system). NFPA-182.2.1.
- This property is a part of a recorded subdivision as shown on plat F-98-33, Normandy Shopping Center, Parcels A and C.

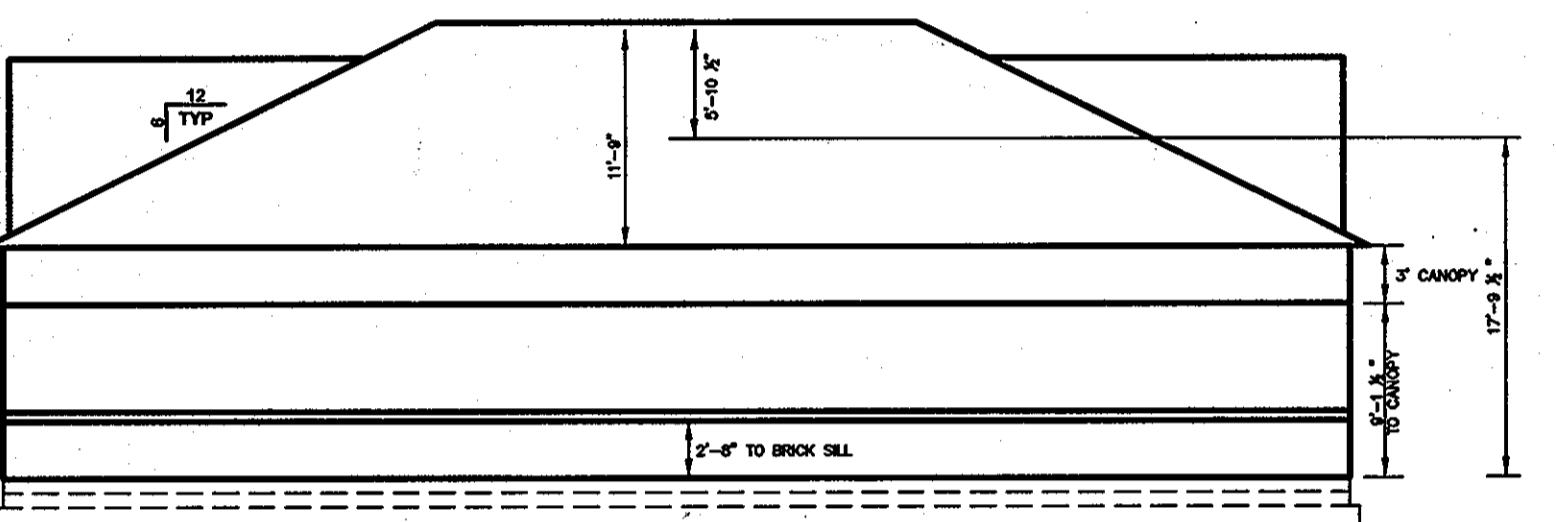

BUILDING ELEVATION

SCALE: 1" = 20'

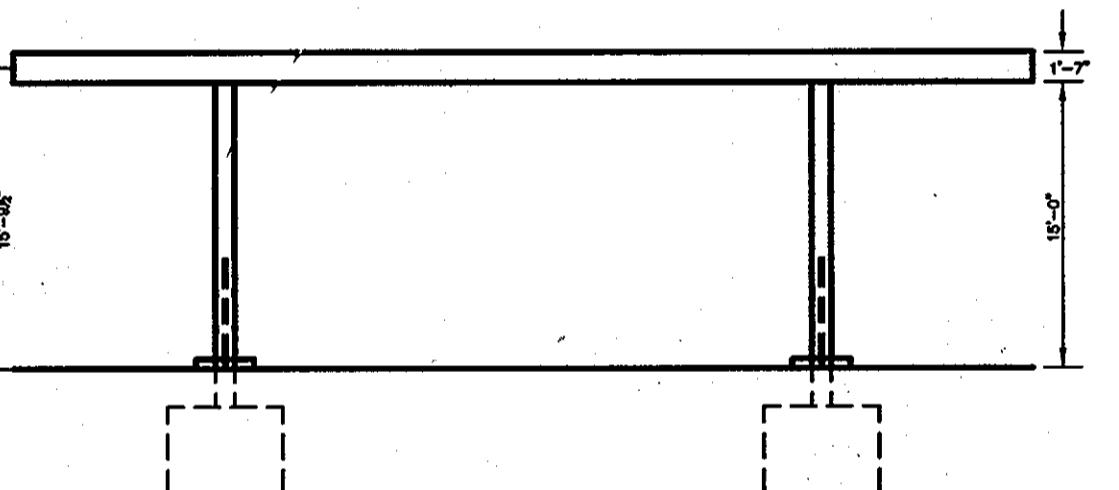

CANOPY ELEVATION

SCALE: 1" = 20'

High's of Baltimore conditional use decision BOA Case No. 08-045C	
ORDER	
Based upon the foregoing, it is this 3rd day of December 2008, by the Howard County Board of Appeals Hearing Examiner, ORDERED:	
That the petition of High's of Baltimore, Inc. for a gasoline service station conditional use and convenience store on the same site, in a B-2 (Business: General) Zoning District is hereby GRANTED;	
Provided, however, that:	
1. The conditional use will apply only to the uses and structures as described in the petition and Conditional Use Plan submitted, and not to any other activities, uses, structures, or additions on the Property.	
2. All dumpster pads shall be enclosed with a fence.	
3. Outside operations are limited to dispensing gasoline, diesel fuel, pressurized air, vacuuming, and kerosene.	
4. All outside sales of propane shall be screened.	
5. The Air/Vacuum/Kerosene dispensing area shall be screened.	
6. The parking space adjacent to the Air/Vacuum/Kerosene dispensing area shall be eliminated.	
7. Abandonment. The premises (including landscaping) of all gasoline service station, if not in continuous operation or abandoned shall be maintained in the same manner as is required under these regulations for operating gasoline service stations.	
8. Violation of the use. The gasoline service station conditional use shall become void upon notice of abandonment by the owner. If notice of abandonment is not received, but it is determined by the Department of Planning and Zoning that the gasoline service station has not been in continuous operation for a period of twelve months, a revocation hearing shall be initiated by the Department of Planning and Zoning in accordance with the procedures set forth in Section 131.L. For purposes of this subsection, "continuous operation" shall mean operation as a gasoline service station at least eight hours per day, five days per week.	
9. Removal. If the gasoline service station is abandoned and the conditional use becomes void as provided above, all gasoline pumps, pump island canopies, and other improvements (not including buildings) shall be removed from the site within six months of the date the conditional use becomes void.	

THE PRIVATE IMPROVEMENTS WERE CONSTRUCTED
AND LOCATED IN ACCORDANCE WITH THE APPROVED
PLANS AND SPECIFICATIONS, EXCEPT AS OTHERWISE
NOTED IN RED

4/5/12

SHEET INDEX

- TITLE SHEET
- EXISTING CONDITIONS PLAN
- SITE DEMOLITION PLAN
- GRADING, SEDIMENT AND EROSION CONTROL PLAN
- SITE DEVELOPMENT PLAN
- STORMWATER MANAGEMENT PLAN, DETAILS & SITE DETAILS
- STORM WATER MANAGEMENT NOTES & GREASE TRAP DETAILS
- STORM WATER MANAGEMENT DRAINAGE AREA MAP
- SITE DETAILS
- STORM DRAIN PROFILES & DRAINAGE AREA MAP
- SEDIMENT CONTROL NOTES & DETAILS
- LANDSCAPE PLAN

#1 Revised Parking Calculations
9/15/10 (WAN)

APPROVED: DEPARTMENT OF PLANNING AND ZONING	3/12/10
Chief, Development Engineering Division	DATE
Kent Sheehan	4-12-10
Chief, Division of Land Development	DATE
Monica Butler	4/12/10
DIRECTOR	DATE
APPROVED: FOR PUBLIC WATER AND PUBLIC SEWERAGE SYSTEMS	
Brian Wilson for Peter Balsilow	3/26/2010
COUNTY HEALTH OFFICER	DATE
HOWARD COUNTY HEALTH DEPARTMENT	1/10

MESSICK & ASSOCIATES*
CONSULTING ENGINEERS
SURVEYORS & PLANNERS
2120 RENARD COURT
ANNAPOLIS, MARYLAND 21401
(410) 266-3212 * FAX (410) 266-3502

* MESSICK GROUP INC T/A MESSICK AND ASSOCIATES

2/22/10

MESSICK & ASSOCIATES
CONSULTING ENGINEERS
SURVEYORS & PLANNERS
2120 RENARD COURT
ANNAPOLIS, MARYLAND 21401
(410) 266-3212 * FAX (410) 266-3502

Professional Engineer, Registered in the State of Maryland, certifies that this document was prepared under my direction and that I am a duly licensed professional engineer under the laws of the State of Maryland.

License No. 21591 Expiration Date: 5/14/2011

OWNER:
THE NORMANDY VENTURE LIMITED PARTNERSHIP
P.O. BOX 1424
ELLIOTT CITY, MD. 21041-1424

DEVELOPER:
HIGH'S OF BALTIMORE INC.
7477 NEW RIDGE ROAD
HANOVER, MARYLAND 20794
410-859-3636



PERMIT INFORMATION CHART

SUBDIVISION NAME	SECT./AREA	PARCEL
NORMANDY SHOPPING CENTER	N/A	75 PARCEL B
PLAT NO.	BLOCK #	ZONING
13067	19	B-2
		18
WATER CODE		2nd
PUBLIC		6026
SEWER CODE		PUBLIC

ADDRESS CHART

3095 ROGERS AVENUE
ELLIOTT CITY, MD. 21043

PROJECT	HIGH'S @ NORMANDY
NORMANDY SHOPPING CENTER, P/O PARCEL B	NEW BUILDING, GAS PUMPS & PARKING LOT EXPANSION
TITLE	THE NORMANDY VENTURE LIMITED PARTNERSHIP
SITE DEVELOPMENT PLAN	
F-98-33, BA 08-045C, SDP 88-89, SDP 88-205, SDP 84-297, SDP 79-140, SDP 77-15, SDP 72-12	
TITLE SHEET	
TAX MAP 18, GRID 19, PARCEL 75, P/O PARCEL B	
ELECTION DISTRICT NO. 2	LIBER 172
DATE: MARCH 09, 2009	DESIGN BY: WAN DRAWN BY: BPO
HOWARD COUNTY MARYLAND	SCALE: AS SHOWN
SHEET 1 OF 12	SDP-09-049

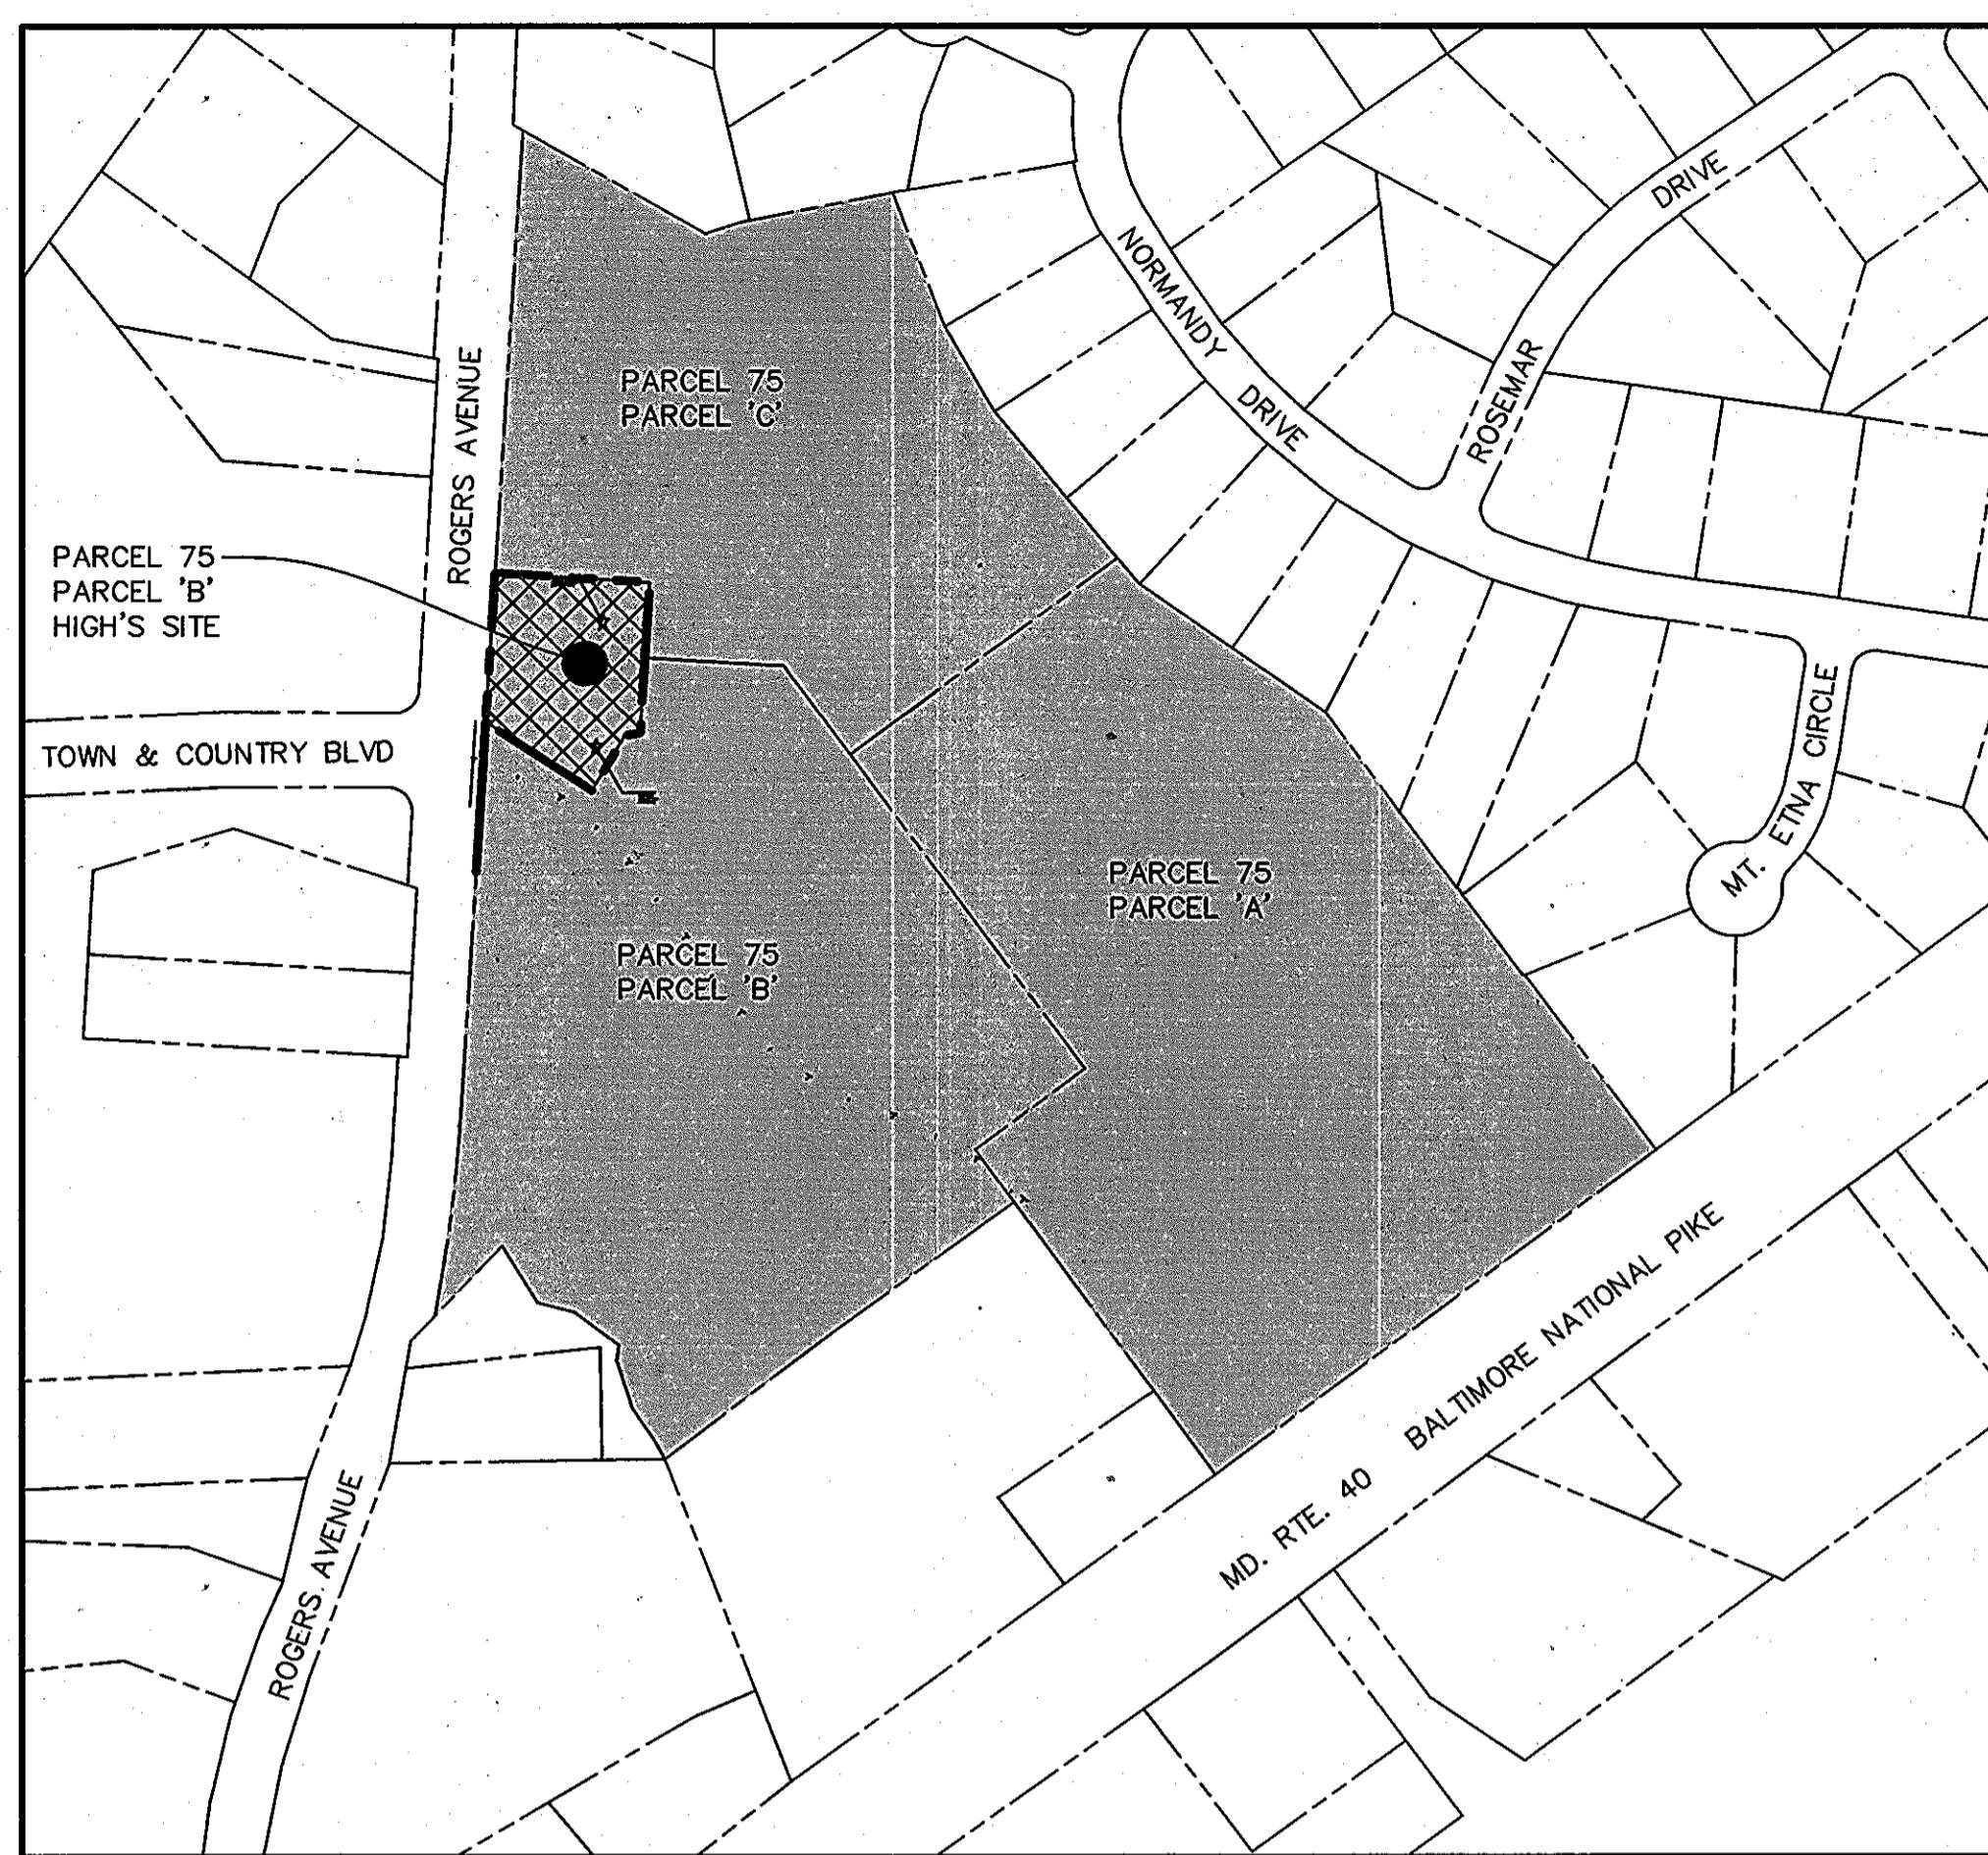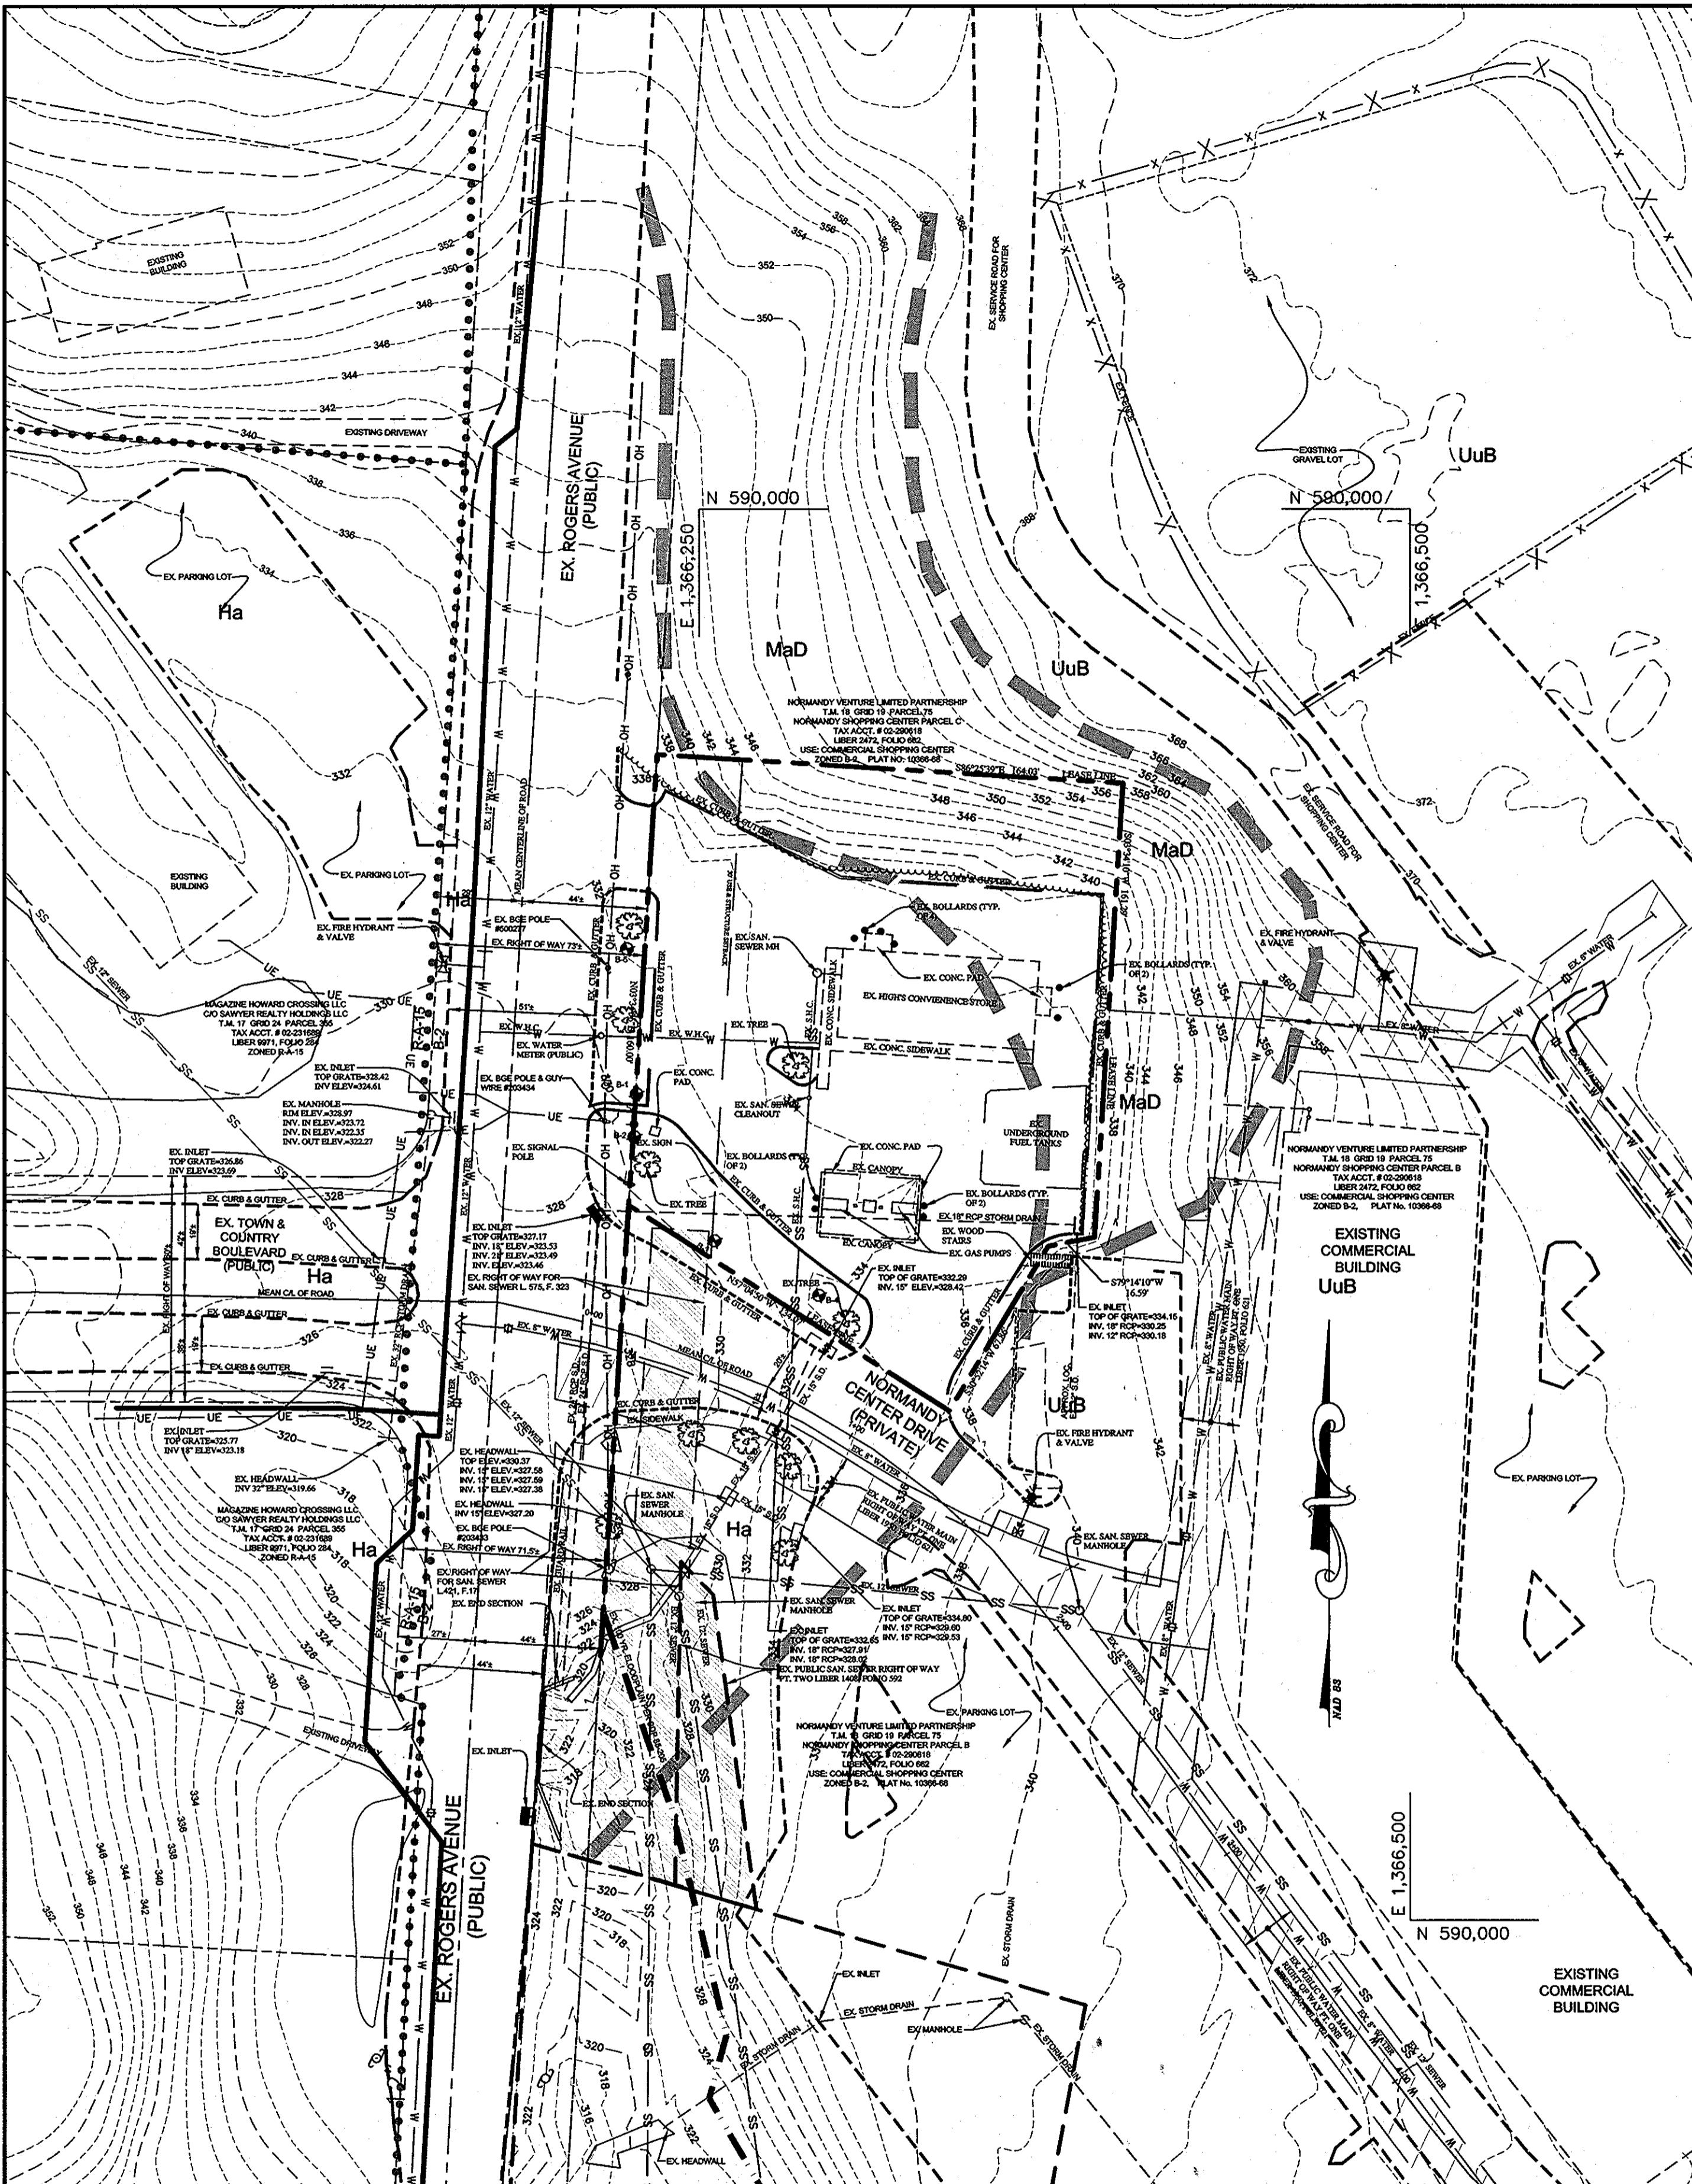

LEGEND

632	EXISTING CONTOUR
- - -	EXISTING CURB & GUTTER
[dashed line]	EXISTING BUILDING
[dashed line]	EXISTING OVERHEAD WIRE
[dashed line]	EXISTING UTILITY POLE
[dashed line]	EXISTING EDGE OF PAVEMENT
[dashed line]	EXISTING FUEL ISLAND
[dashed line]	EXISTING CONCRETE PAD
[dashed line]	EXISTING CANOPY
W W W	EXISTING WATER LINE
SS SS SS	EXISTING SEWER LINE
B.R.L.	PROPERTY LINE
- - -	BUILDING RESTRICTION LINE
- - -	EXISTING EASEMENT
[solid black box]	EXISTING PAVEMENT TO BE REMOVED
— — —	EXISTING MEAN CENTERLINE OF ROAD
— — —	EXISTING TREE
— — —	EXISTING WATER VALVE
— — —	EXISTING FIRE HYDRANT
— — —	EXISTING GUY WIRE
— — —	EXISTING FENCE
— — —	EXISTING BOLLARD
— — —	EXISTING OVERHEAD WIRE
— — —	EXISTING UNDERGROUND ELECTRIC
— — —	ZONING LINE
— — —	SOILS BOUNDARY

SITE LOCATION PLAN

SCALE: 1" = 100'


PLAN

SCALE: 1" = 40'

APPROVED: DEPARTMENT OF PLANNING AND ZONING <i>[Signature]</i> DATE 3/12/10	APPROVED: FOR PUBLIC WATER AND PUBLIC SEWERAGE SYSTEMS <i>[Signature]</i> DATE 4/12/10
CHIEF, DEVELOPMENT ENGINEERING DIVISION <i>[Signature]</i> DATE 4-12-10	CHIEF, DIVISION OF LAND DEVELOPMENT <i>[Signature]</i> DATE 4/12/10
DIRECTOR <i>[Signature]</i> DATE 4/12/10	
B. Wilson for Peter Beilenson 3/26/2010 COUNTY HEALTH OFFICER HOWARD COUNTY HEALTH DEPARTMENT DATE 7/7/10	

MESSICK & ASSOCIATES *
CONSULTING ENGINEERS
SURVEYORS & PLANNERS
2120 RENARD COURT
ANAPOLIS, MARYLAND 21401
(410) 266-3212 * FAX (410) 266-3502

* MESSICK GROUP INC. T/A MESSICK AND ASSOCIATES

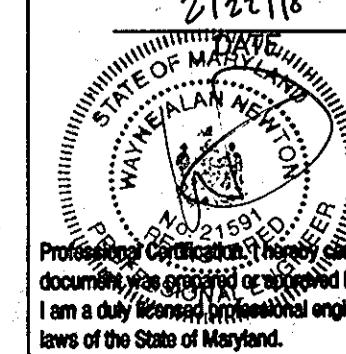

STATE OF MARYLAND
WALTER MILLEN NEVISON
GOVERNOR

License No. 21691

Expiration Date: 5/14/2011

RECORD DRAWING MARCH 2012

OWNER:
THE NORMANDY VENTURE LIMITED PARTNERSHIP
P.O. BOX 1424
ELLIOTT CITY, MD. 21041-1424

DEVELOPER:
HIGH'S OF BALTIMORE INC.
7477 NEW RIDGE ROAD
HANOVER, MARYLAND 20794
410-859-3636


PROJECT HIGH'S @ NORMANDY
NORMANDY SHOPPING CENTER, P/O PARCEL B
NEW BUILDING, GAS PUMPS & PARKING LOT EXPANSION

TITLE THE NORMANDY VENTURE LIMITED PARTNERSHIP
SITE DEVELOPMENT PLAN

F-98-33, BA 08-045C, SDP 86-89, SDP 85-205, SDP 84-297, SDP 79-140, SDP 77-15, SDP 72-12

EXISTING CONDITIONS PLAN
TAX MAP 18, GRID 19, PARCEL 75, P/O PARCEL B
ELECTION DISTRICT NO. 2 LIBER 2472 FOLIO 662 PLAT M.D.R. NO. 10367
DATE: MARCH 2009 DESIGN: WAN DRAWN BY: BPO
HOWARD COUNTY MARYLAND SCALE: AS SHOWN SHEET 2 OF 12

SDP-09-044

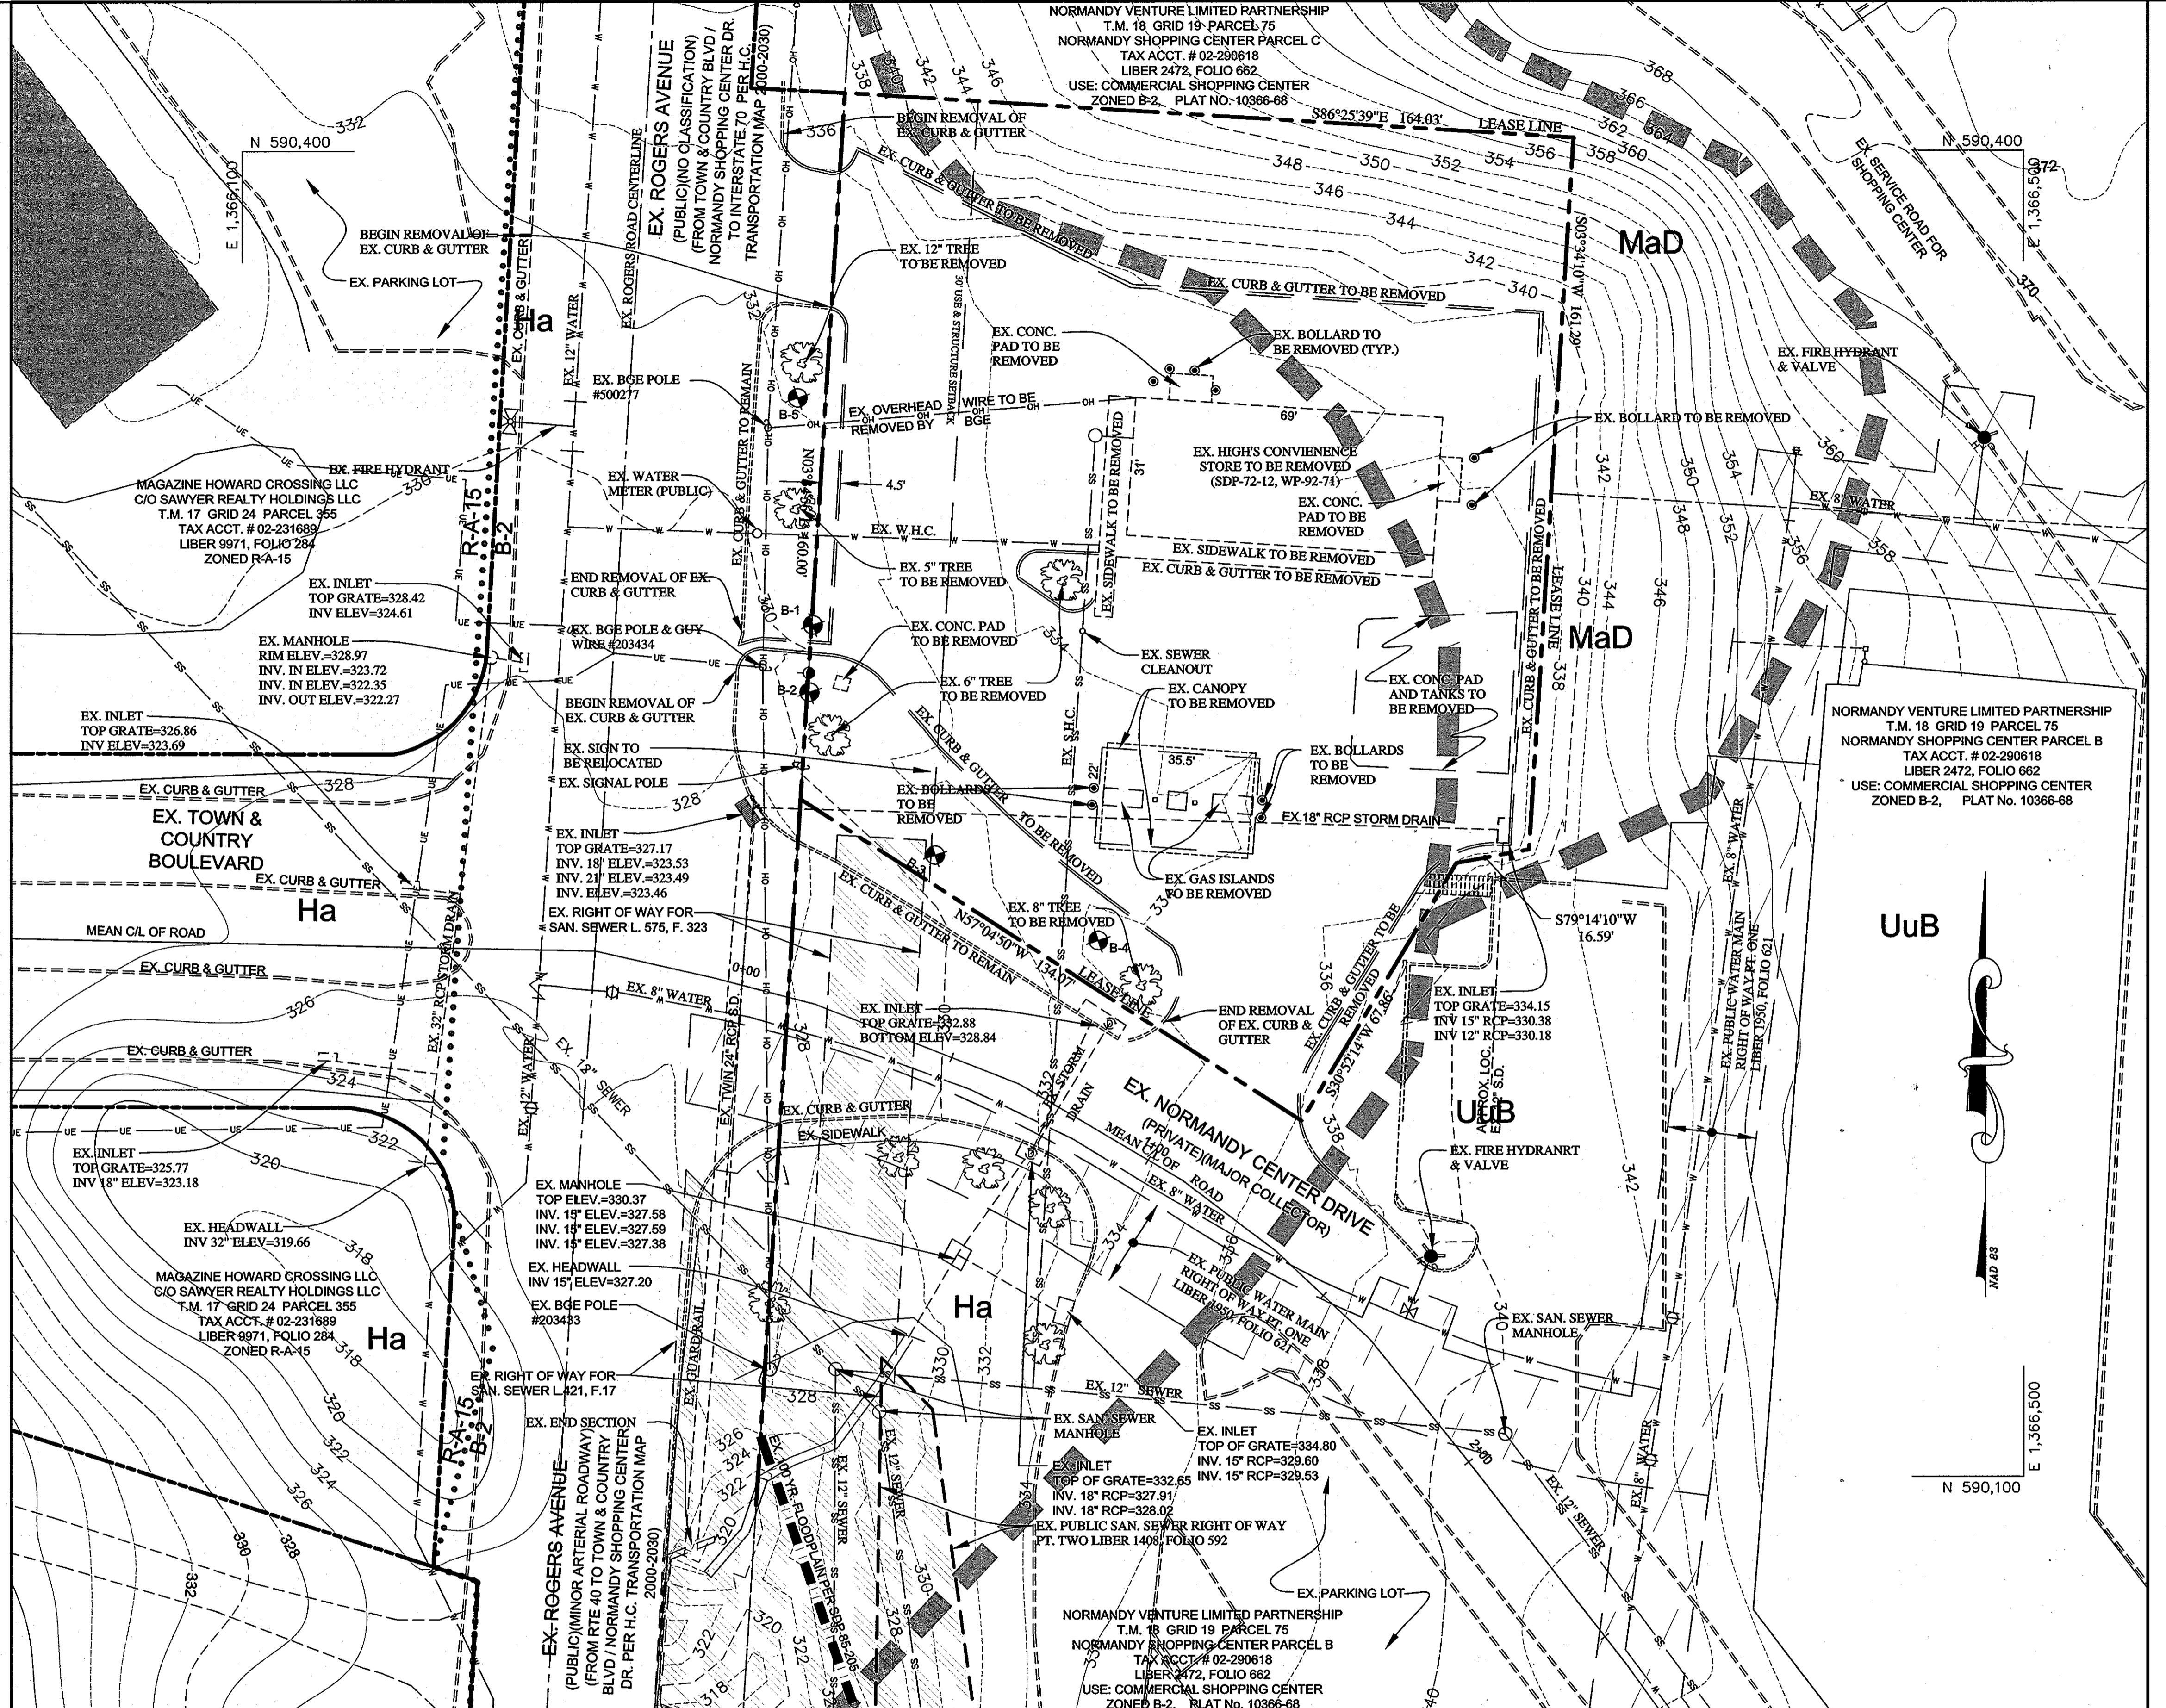

PLAN

SCALE: 1" = 20' RECORD DRAWING MARCH 2012

APPROVED: DEPARTMENT OF PLANNING AND ZONING	
	DATE 8/12/10
CHIEF, DEVELOPMENT ENGINEERING DIVISION NY	DATE 4-12-10
	DATE 4/12/10
CHIEF, DIVISION OF LAND DEVELOPMENT	
	DATE 4/12/10
DIRECTOR	
APPROVED: FOR PUBLIC WATER AND PUBLIC SEWERAGE SYSTEMS	
	DATE 3/26/10
COUNTY HEALTH OFFICER HOWARD COUNTY HEALTH DEPARTMENT	



MESSICK & ASSOCIATES*
CONSULTING ENGINEERS
SURVEYORS & PLANNERS
2120 RENARD COURT
ANNE ARUNDEL COUNTY, MARYLAND 21401
(410) 266-3212 * FAX (410) 266-3501

* MESSICK GROUP INC. T/A MESSICK AND ASSOCIATES (410) 266-3212 * FAX (410) 266-3501
ANNEAPOLIS, MARYLAND 21401

OWNER:
THE NORMANDY VENTURE LIMITED PARTNERSHIP
P.O. BOX 1424
ELLICOTT CITY, MD. 21041-1424

DEVELOPER:
HIGHS OF BALTIMORE INC.
7477 NEW RIDGE ROAD
HANOVER, MARYLAND 20794
410-859-3636

PROJECT HIGH'S @ NORMANDY
NORMANDY SHOPPING CENTER, P/O PARCEL B
NEW BUILDING, GAS PUMPS & PARKING LOT EXPANSION


TITLE THE NORMANDY VENTURE LIMITED PARTNERSHIP
SITE DEVELOPMENT PLAN

F-98-33, BA 08-045C, SDP 86-89, SDP 85-205, SDP 84-297, SDP 79-140, SDP 77-15, SDP 72-12

SITE DEMOLITION PLAN

TAX MAP 18, GRID 19, PARCEL 75, P/O PARCEL B
ELECTION DISTRICT NO. 2 LIBER 2472 FOLIO 662 PLAT M.D.R. NO. 10367
DATE: MARCH 2009 DESIGN BY: WAN DRAWN BY: BPO
HOWARD COUNTY MARYLAND SCALE: AS SHOWN SHEET 3 OF 12

SDP-09-049

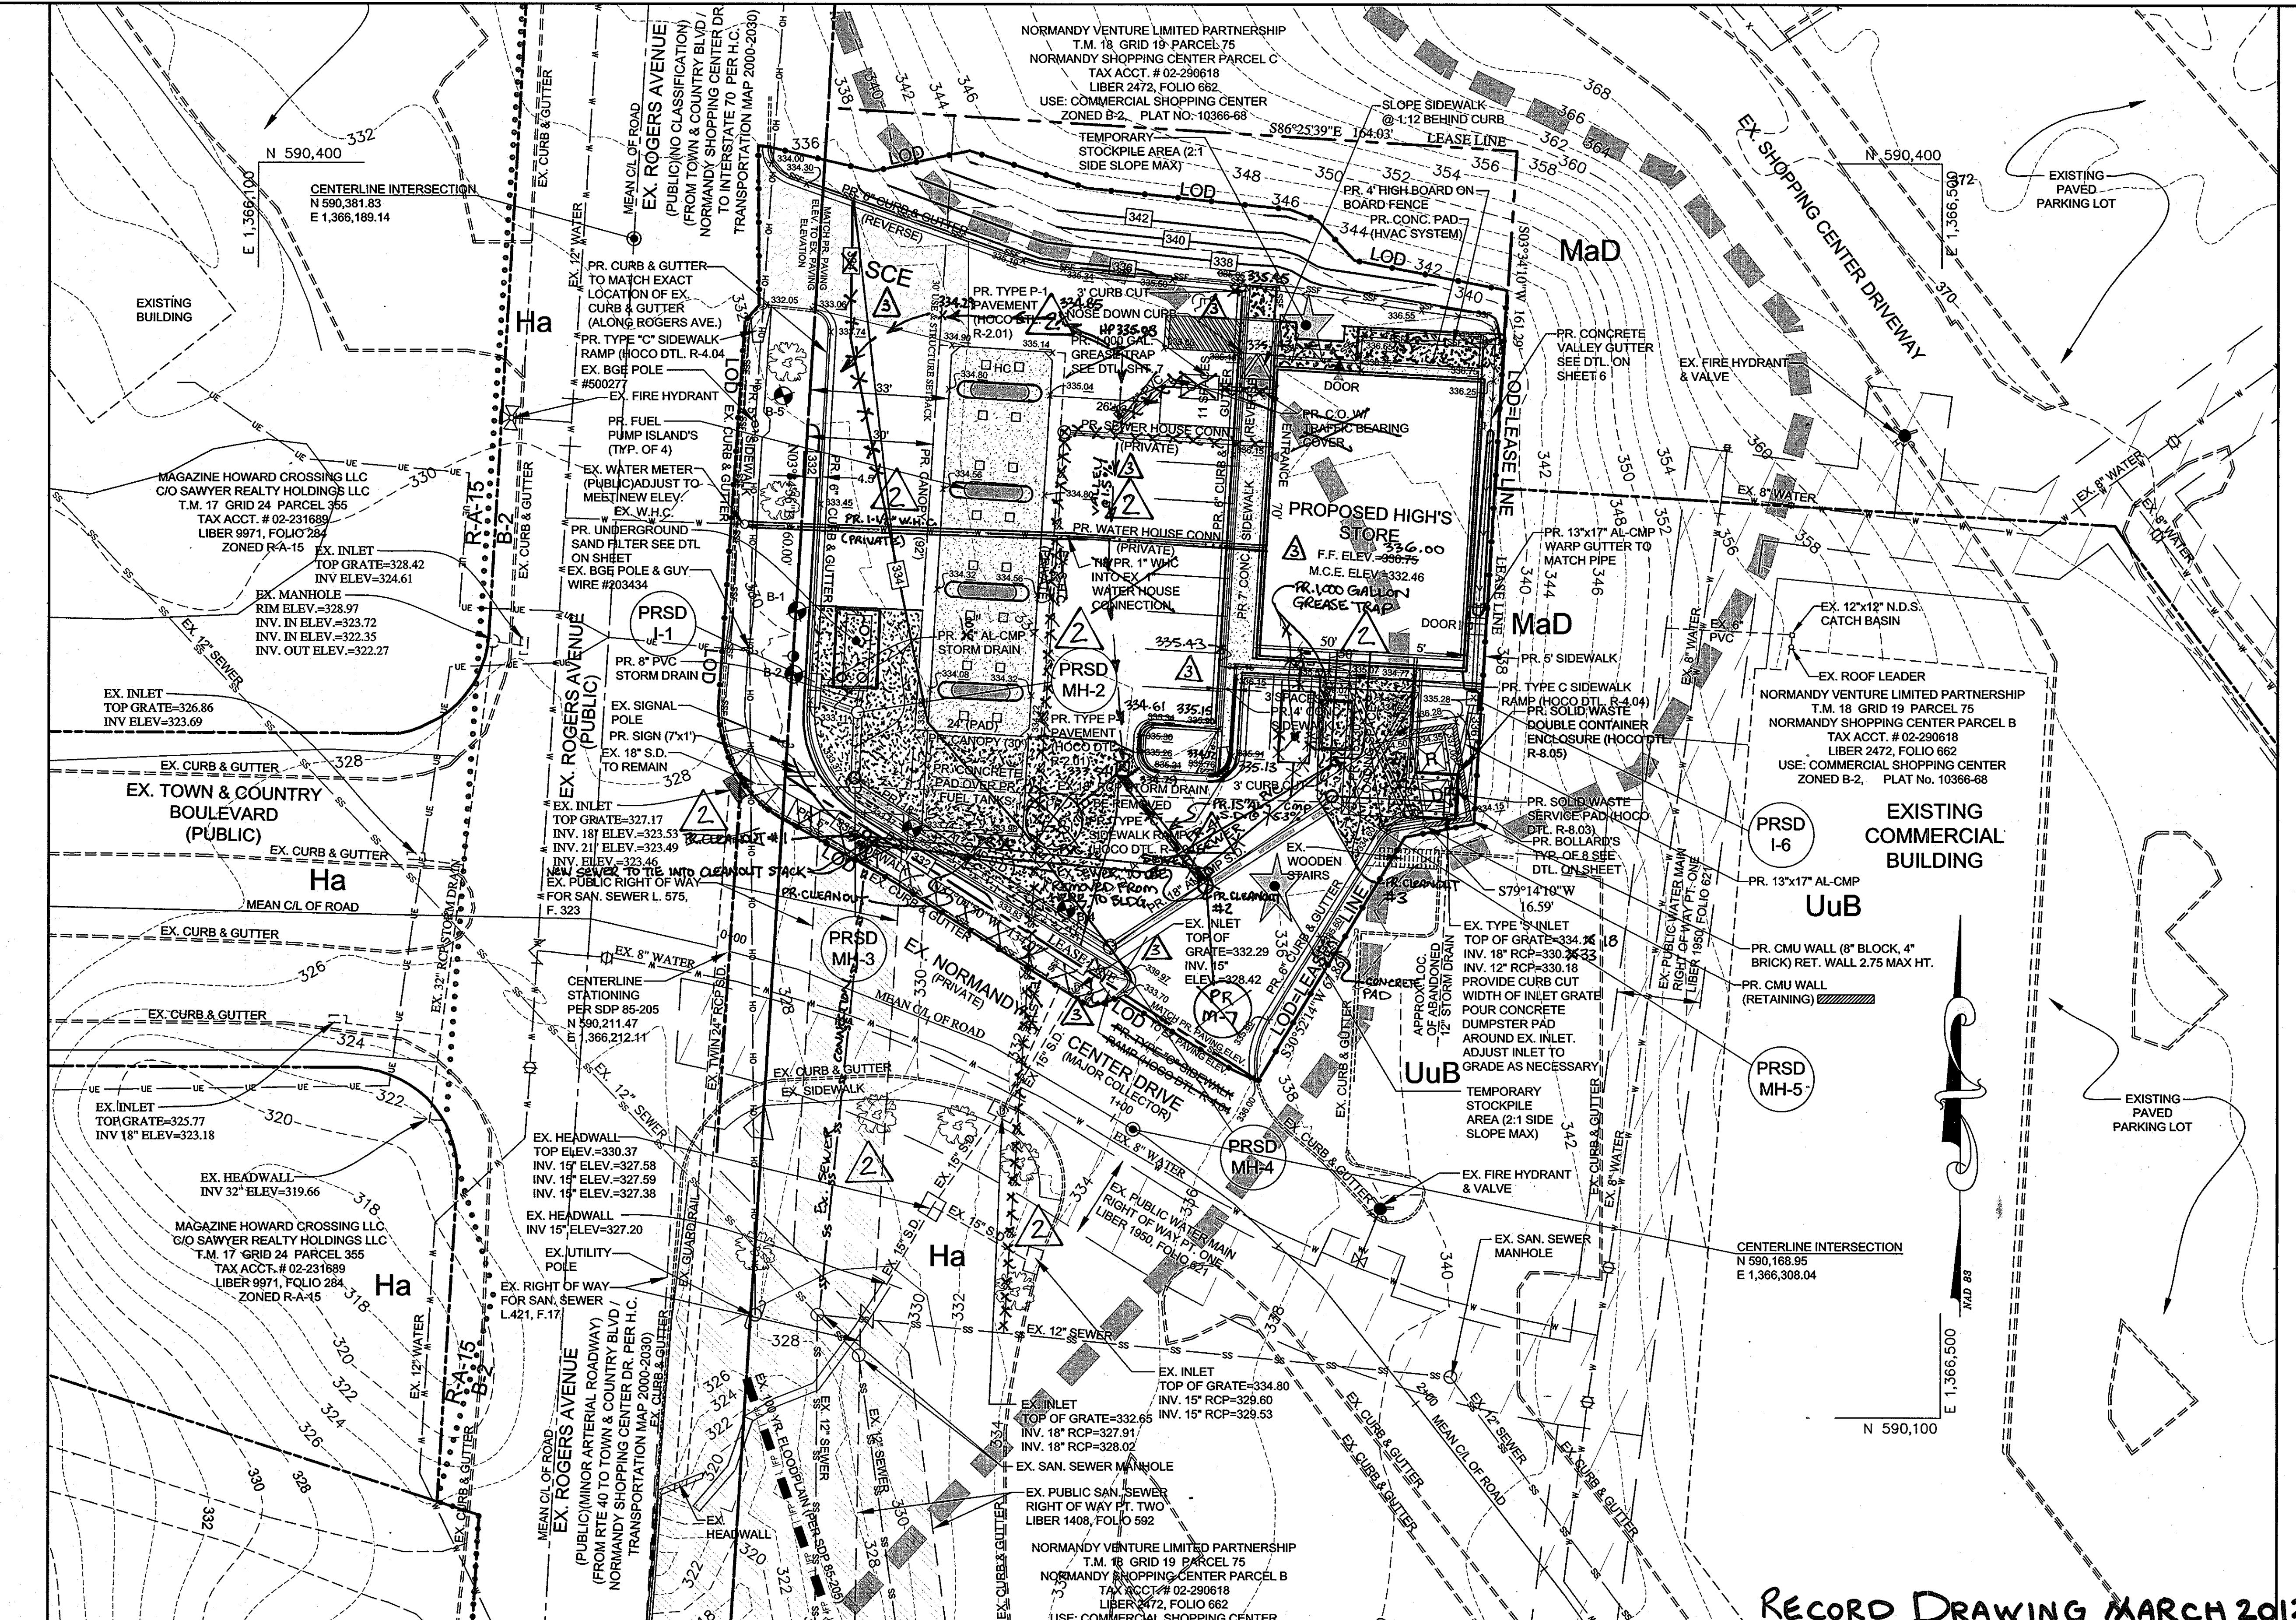

DATE	#	REVISION DESCRIPTION
8/15/11	3	REMOVED SIDEWALK ALONG NORMANDY CENTER DR., ADDED STORM DRAIN, REVISED SITE GRADES TO MEET AS-BUILT FLOOR ELEV. REV

APPROVED: DEPARTMENT OF PLANNING AND ZONING	
<u>John DeMuro</u>	<u>9/23/10</u>
CHIEF, DEVELOPMENT ENGINEERING DIVISION N.Y.	DATE
<u>Kent Schlueter</u>	<u>10/07/10</u>
CHIEF, DIVISION OF LAND DEVELOPMENT	DATE
<u>Thomas E. Butler</u>	<u>10/17/10</u>
DIRECTOR	DATE
APPROVED: FOR PUBLIC WATER AND PUBLIC SEWERAGE SYSTEMS	
<u>Bethany Peter Belsen</u>	<u>10/14/2011</u>
COUNTY HEALTH OFFICER HOWARD COUNTY HEALTH DEPARTMENT	DATE

MESSICK & ASSOCIATES *
CONSULTING ENGINEERS
SURVEYORS & PLANNERS
2120 RENARD COURT
ANNAPOLIS, MARYLAND 21401



MESSICK GROUP INC. T/A MESSICKS AND ASSOCIATES

A circular stamp with a decorative border containing the text "STATE OF MARYLAND" at the top and "PROFESSIONAL ENGINEER" at the bottom. The center of the stamp contains the text "WAYNE A. DATE" above "NEWTON" and "REGISTRATION NO. 21356" below it. The date "JULY 2000" is stamped diagonally across the center.

OWNER:
THE NORMANDY VENTURE LIMITED PARTNERSHIP
P.O. BOX 1424
ELLIOTT CITY, MD. 21041-1424

DEVELOPER:
HIGHS OF BALTIMORE INC.
7477 NEW RIDGE ROAD
HANOVER, MARYLAND 20794
410-859-3636

REVISION DESCRIPTION REvised SOP 8/15

DATE	#	REVISION DESCRIPTION	REVISED SDP	8/15/11
6/27/11	2	RELOCATED SEWER CONNECTION TO MATCH EXIST FIELD CONDITIONS & SHOW REPLACEMENT OF W.H.C.	REVISED SDP	6/27/11
9/15/10	1	Relocate Building, Revised dumpster with 2' high retain. wall, Adhdsl Inlet	Revised SDP	9/15/10

JECT HIGH'S @ NORMANDY
NORMANDY SHOPPING CENTER, P/O PARCEL B
NEW BUILDING, GAS PUMPS & PARKING LOT EXPANSION

E THE NORMANDY VENTURE LIMITED PARTNERSHIP
SITE DEVELOPMENT PLAN

F-98-33, BA 08-045C, SDP 86-89, SDP 85-205, SDP 84-297, SDP 79-140, SDP 77-15, SDP 72-12

GRADING, SEDIMENT & EROSION CONTROL PLAN

TAX MAP 18, GRID 19, PARCEL 75, P/O PARCEL B
ELECTION DISTRICT NO. 2 LIBER 2472 FOLIO 662 PLAT M.D.R. NO. 10367
DATE: MARCH 2009 DESIGN BY: WAN DRAWN BY: BPO
HOWARD COUNTY MARYLAND SCALE: AS SHOWN SHEET 4 OF 12

LEGEND

	EXISTING CONTOUR
	EXISTING CURB & GUTTER
	EXISTING BUILDING
	EXISTING OVERHEAD WIRE
	EXISTING UTILITY POLE
	EXISTING EDGE OF PAVEMENT
	EXISTING FUEL ISLAND
	EXISTING CONCRETE PAD
	EXISTING CANOPY
	EXISTING WATER LINE EXISTING SEWER LINE PROPERTY LINE BUILDING RESTRICTION LINE EXISTING EASEMENT
	EXISTING PAVEMENT TO BE REMOVED
	EXISTING MEAN CENTERLINE OF ROAD
	EXISTING TREE
	EXISTING WATER VALVE
	EXISTING FIRE HYDRANT
	EXISTING GUY WIRE
	EXISTING FENCE
	EXISTING BOLLARD
	EXISTING OVERHEAD WIRE
	EXISTING UNDERGROUND ELECTRIC
	ZONING LINE SOILS BOUNDARY
	PROPOSED BUILDING
	PROPOSED CANOPY
	PROPOSED CONTOUR PROPOSED CURB & GUTTER
	PROPOSED CONCRETE PAD
	PROPOSED FUEL ISLAND
	PROPOSED SIDEWALK
	PROPOSED SPOT SHOT PROPOSED SEWER PROPOSED WATER PROPOSED BOLLARD
	STABILIZED CONSTRUCTION ENTRANCE
	SUPER SILT FENCE
	LIMIT OF DISTURBANCE

DETAIL SCHEDULE

DETAIL	DETAIL REFERENCE	SHEET REF.
ENT SECTION (TYPE P-1)	H0.CO. DTL. R-2.01	SEE SHEET 10
CRETE SIDEWALK SECTION	H0.CO. DTL. R-3.05	SEE SHEET 10
WASTE SERVICE PAD (MODIFIED)	H0.CO. DTL. R-8.03	SEE SHEET 10
BINATION CURB & GUTTER DETAIL	H0.CO. DTL. R-9.01	SEE SHEET 10
E COMBINATION CURB & GUTTER DETAIL	H0.CO. DTL. R-9.01	SEE SHEET 10
SED CURB DETAIL	H0.CO. DTL. R-9.01	SEE SHEET 10
& GUTTER TANSITION	H0.CO. DTL. R-3.02	SEE SHEET 10
CURB OPENING DETAIL	--	SEE SHEET 10
SYSTEM ENCLOSURE BLOW-UP		SEE SHEET 10
ON BOARD FENCE DETAIL (ENCE & DUMPSTER ENCLOSURE)	--	SEE SHEET 10
AP RAMPS (TYPE C)	H0.CO. DTL. R-4.04	SEE SHEET 10
ZED CONSTRUCTION ENTRANCE	SCD DETAIL 24	SEE SHEET 11
GATE FENCE	GOF DETAIL 77	SEE SHEET 11

HANDICAP ACCESS NOTE:
ALL PATRONS INCLUDING ONE'S WITH DISABILITIES SHALL ACCESS THE STORE THROUGH THE MAIN ENTRANCE LOCATED ON THE FRONT OF THE BUILDING.

DEVELOPERS CERTIFICATE :

WE CERTIFY THAT ALL DEVELOPMENT AND CONSTRUCTION
WILL BE DONE ACCORDING TO THIS PLAN FOR SEDIMENT &
EROSION CONTROL, AND THAT ANY RESPONSIBLE
PERSONNEL INVOLVED IN THE CONSTRUCTION PROJECT WILL
HAVE A CERTIFICATE OF ATTENDANCE AT A DEPARTMENT
OF THE ENVIRONMENT APPROVED TRAINING PROGRAM FOR
THE CONTROL OF SEDIMENT & EROSION BEFORE
BEGINNING THE PROJECT. I ALSO AUTHORIZE PERIODIC ON-
SITE INSPECTIONS BY THE HOWARD SOIL CONSERVATION

STRICT.
Brian Darnell, VP 9/15/00
DEVELOPER: BRIAN DARNELL (HIGH'S OF BALTIMORE, INC.) DATE

GINEERS CERTIFICATE :
CERTIFY THAT THIS PLAN FOR SEDIMENT AND EROSION
NTROL REPRESENTS A PRACTICAL AND WORKABLE PLAN
SED ON MY PERSONAL KNOWLEDGE OF THE SITE
NDITIONS AND THAT IT WAS PREPARED IN ACCORDANCE
H THE REQUIREMENTS OF THE HOWARD SOIL
NSERVATION DISTRICT.

9/15/10
ENGINEER: WAYNE A. NEWTON (MESSICK & ASSOC.) DATE
S DEVELOPMENT PLAN IS APPROVED FOR SOIL EROSION
D SEDIMENT CONTROL BY THE HOWARD SOIL
NSERVATION DISTRICT
John L. Hunter 9/27/10



WARD SOIL CONSERVATION DISTRICT DATE

HIGH S @ NORMANDY
SHOPPING CENTER, P/O PARCEL B
G. GAS PUMPS & PARKING LOT EXPANSION

**NDY VENTURE LIMITED PARTNERSHIP
SITE DEVELOPMENT PLAN
P 86-89, SDP 85-205, SDP 84-297, SDP 79-140, SDP 77-15, SDP 72-12**

SEDIMENT & EROSION CONTROL PLAN

P 18, GRID 19, PARCEL 75, P/O PARCEL B
LIBER 2472 FOLIO 662 PLAT M.D.R. NO. 10367
RCH 2009 DESIGN BY: WAN DRAWN BY: BPO
RYLAND SCALE: AS SHOWN SHEET 4 OF 12

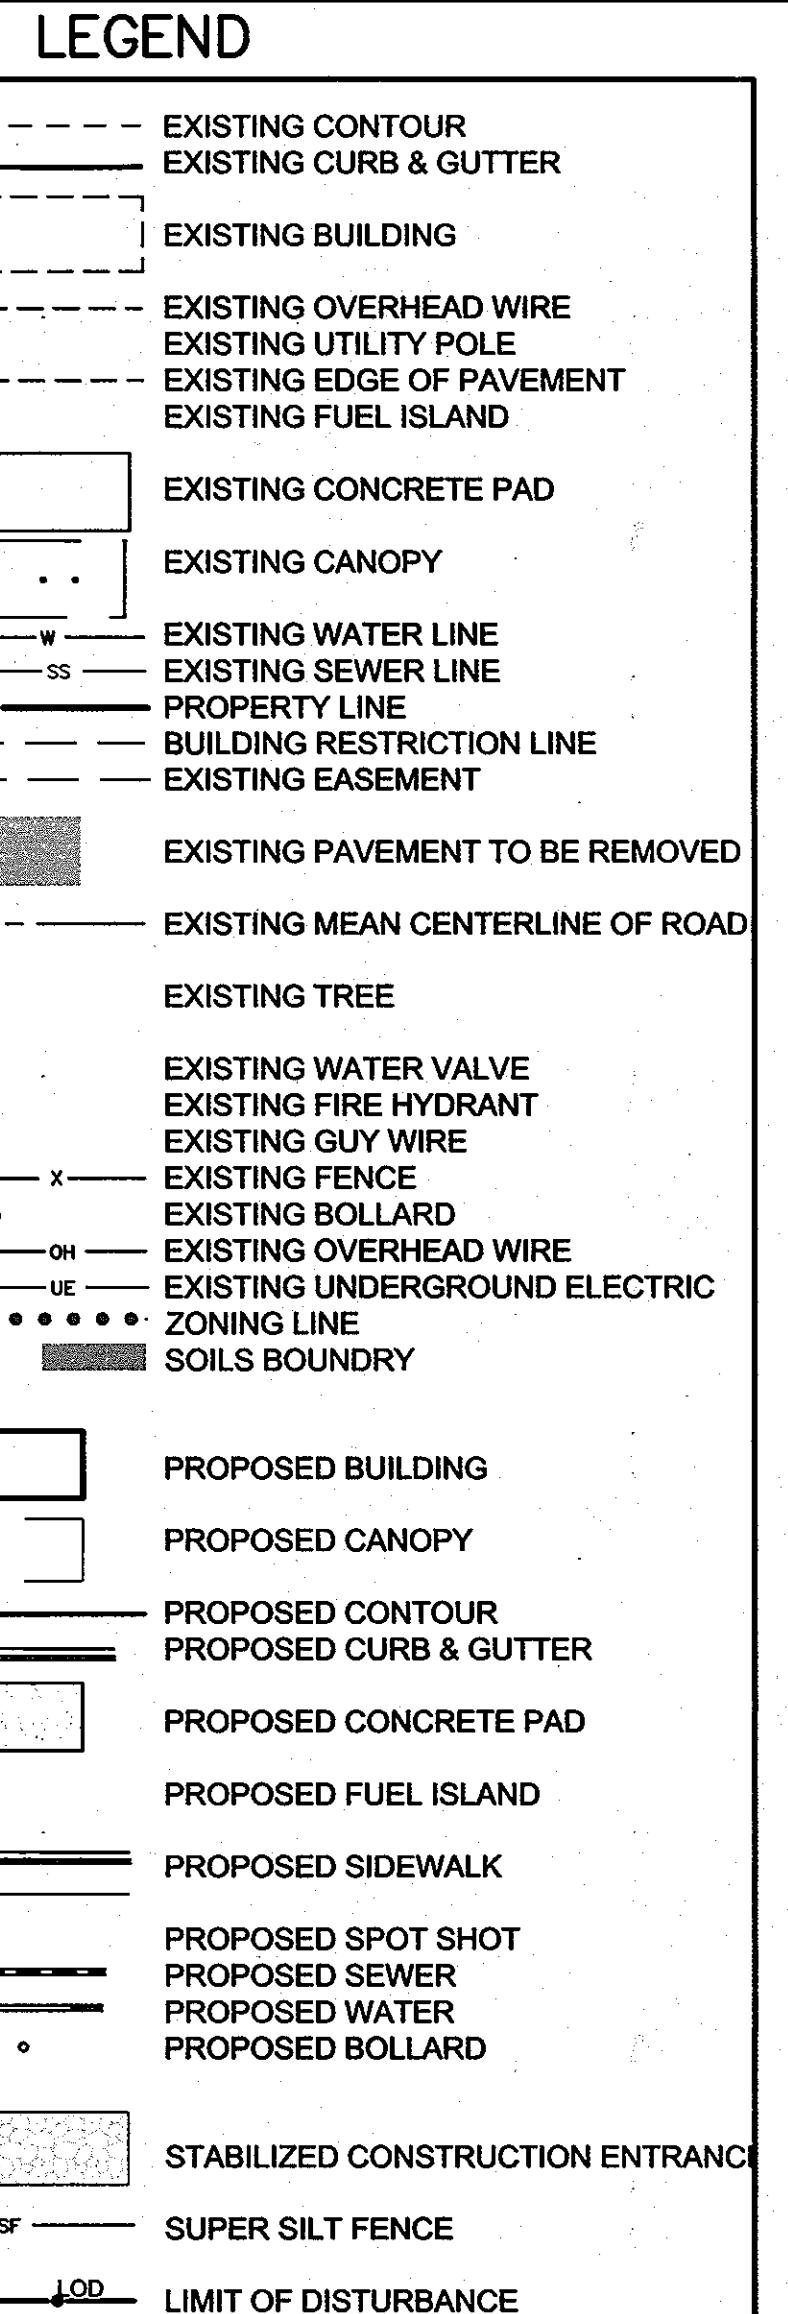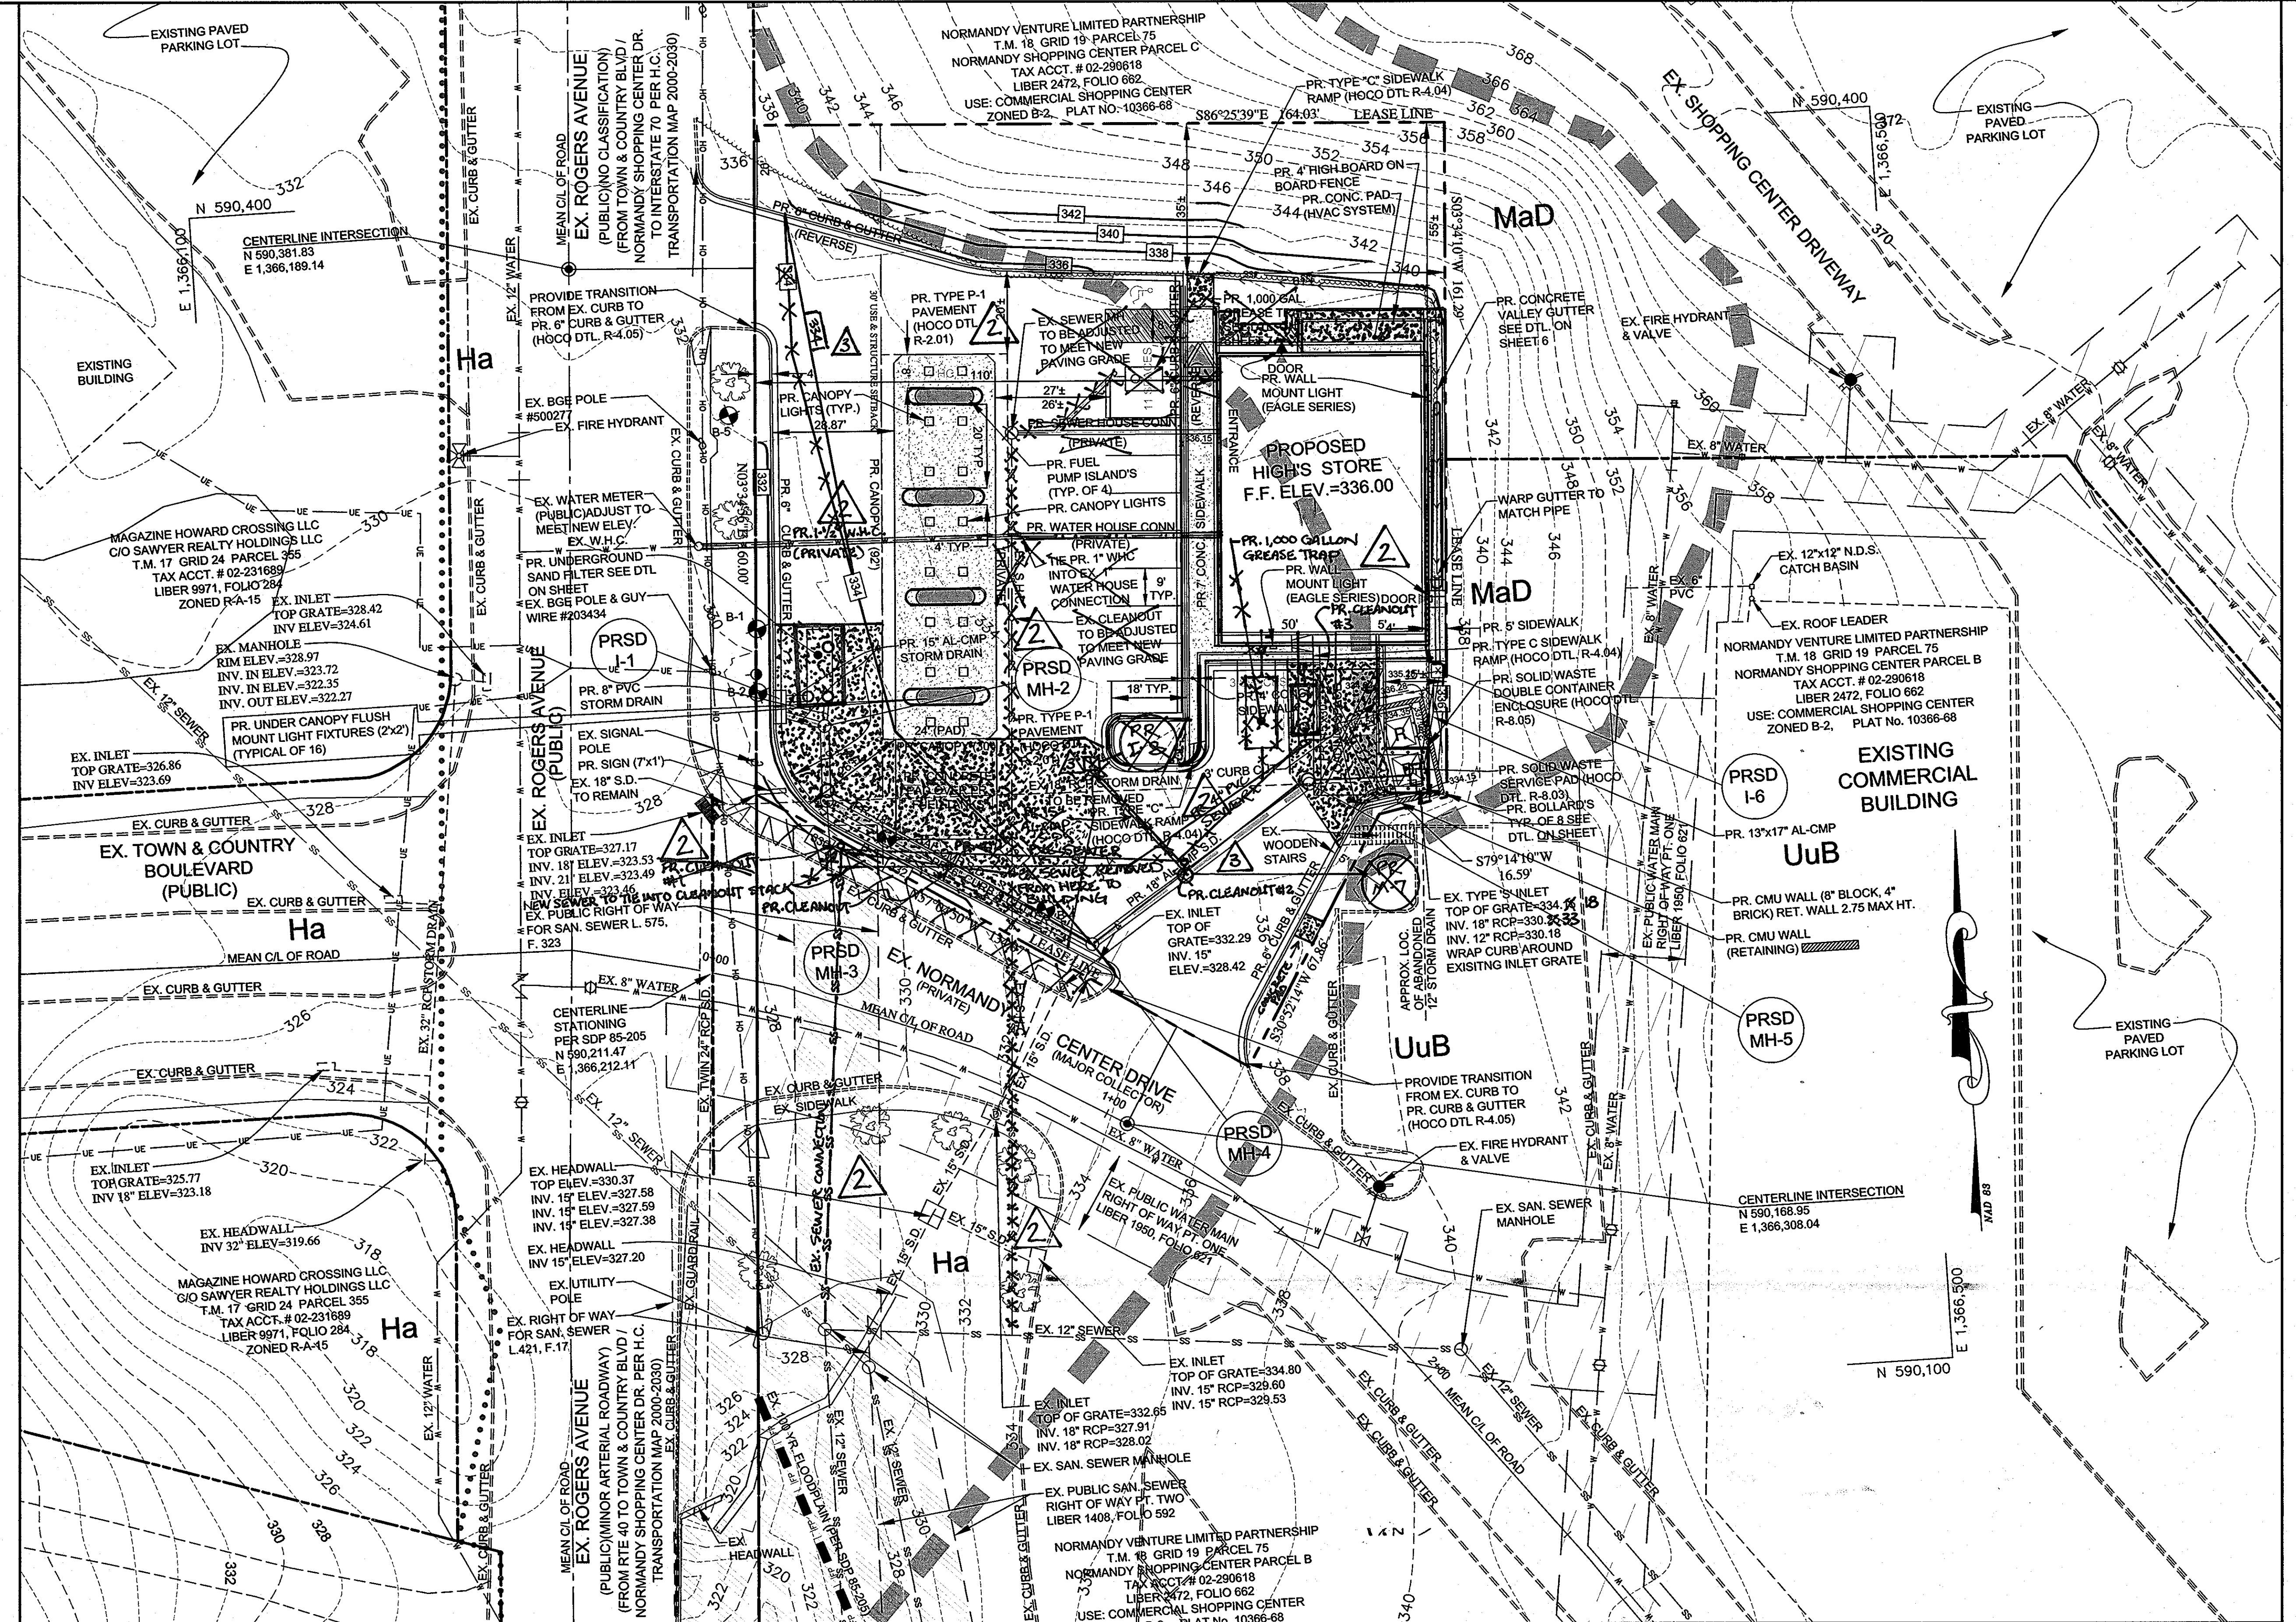

HANDICAP ACCESS NOTE:
ALL PATRONS INCLUDING ONE'S WITH DISABILITIES SHALL ACCESS THE STORE THROUGH THE MAIN ENTRANCE LOCATED ON THE FRONT OF THE BUILDING.

DETAIL SCHEDULE

DETAIL	DETAIL REFERENCE	sheet ref.
PAVEMENT SECTION (TYPE P-1)	HO.O. DTL. R-2.01	SEE SHEET 10
4" CONCRETE SIDEWALK SECTION	HO.O. DTL. R-3.01	SEE SHEET 10
SOLID WASTE SERVICE PAD (MODIFIED)	HO.O. DTL. R-8.01	SEE SHEET 10
6" COMBINATION CURB & GUTTER DETAIL	HO.O. DTL. R-9.01	SEE SHEET 10
REVERSE COMBINATION CURB & GUTTER DETAIL	HO.O. DTL. R-9.01	SEE SHEET 10
DEPRESSED CURB DETAIL	HO.O. DTL. R-9.01	SEE SHEET 10
CURB & GUTTER TRANSITION	HO.CO. DTL. R-3.02	SEE SHEET 10
2" WIDE CURB OPENING DETAIL	--	SEE SHEET 10
HVAC SYSTEM ENCLOSURE BLOW UP	--	SEE SHEET 10
BOARD ON BOARD FENCE DETAIL (FOR FENCE & DUMPSTER ENCLOSURE)	--	SEE SHEET 10
HANDICAP RAMPS (TYPE C)	HO.O. DTL. R-4.04	SEE SHEET 10
STABILIZED CONSTRUCTION ENTRANCE	SCE DTL. 24	SEE SHEET 11
SUPER SILT FENCE	SCE DTL. 33	SEE SHEET 11

DATE	#	REVISION DESCRIPTION	PLAN
8/15/11	3	REMOVED SIDEWALK ALONG NORMANDY CENTER DR. ADDED STORM DRAIN, REVISED SITE GRADES TO MEET AS-BUILT FLOOR ELEV.	REVISED SDP 8/15/11 SCALE: 1" = 20'


DATE	#	REVISION DESCRIPTION
6/27/11	2	RELOCATED SEWER CONNECTION TO MATCH EXISTING FIELD CONDITIONS FOR REPLACEMENT OF W.H.C.

REVISED SDP 6/27/11

9/15/11 RECORD DRAWING MARCH 2012



APPROVED: DEPARTMENT OF PLANNING AND ZONING
[Signature] DATE 9/28/10
CDEV, DEVELOPMENT ENGINEERING DIVISION NY
Kat Shalow DATE 10/10/10
CDEV, DIVISION OF LAND DEVELOPMENT
DIRECTOR DATE 10/10/10
APPROVED: FOR PUBLIC WATER AND PUBLIC SEWERAGE SYSTEMS
[Signature] DATE 10/10/10
Barbara Bester Biderman 10/10/2010
HOWARD COUNTY HEALTH DEPARTMENT DATE 7/9/10

MESSICK & ASSOCIATES *
CONSULTING ENGINEERS
SURVEYORS & PLANNERS
2100 RENARD COURT
ANNAPOLIS, MARYLAND 21401
(410) 266-3212 * FAX (410) 266-3502
* MESSICK GROUP INC T/A MESSICK AND ASSOCIATES

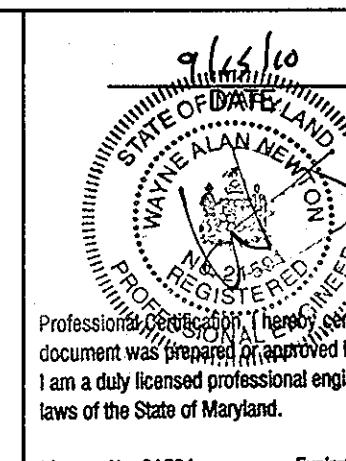


OWNER:
THE NORMANDY VENTURE LIMITED PARTNERSHIP
P.O. BOX 1424
ELICOTT CITY, MD. 21041-1424
DEVELOPER:
HIGH'S OF BALTIMORE INC.
7477 NEW RIDGE ROAD
HANOVER, MARYLAND 20794
410-859-3636
Professional Engineer I declare that this document was prepared under my direction, and that I am a duly licensed professional engineer under the laws of the State of Maryland.
License No. 21591 Expiration Date: 5/14/2011

PROJECT HIGH'S @ NORMANDY
NORMANDY SHOPPING CENTER, P/O PARCEL B
NEW BUILDING, GAS PUMPS & PARKING LOT EXPANSION
TITLE THE NORMANDY VENTURE LIMITED PARTNERSHIP
SITE DEVELOPMENT PLAN
F-98-33, BA 08-0453, SDP 86-89, SDP 85-205, SDP 84-297, SDP 79-140, SDP 77-15, SDP 72-12
SITE DEVELOPMENT PLAN
TAX MAP 18, GRID 19, PARCEL 75, P/O PARCEL B
ELECTION DISTRICT NO. 2 LIBER 2472 FOJO 662 PLAT M.D.R. NO. 10367
DATE: MARCH 2009 DESIGN BY: WAN DRAWN BY: BPO
HOWARD COUNTY MARYLAND SHEET 5 OF 12
SDP-09-049

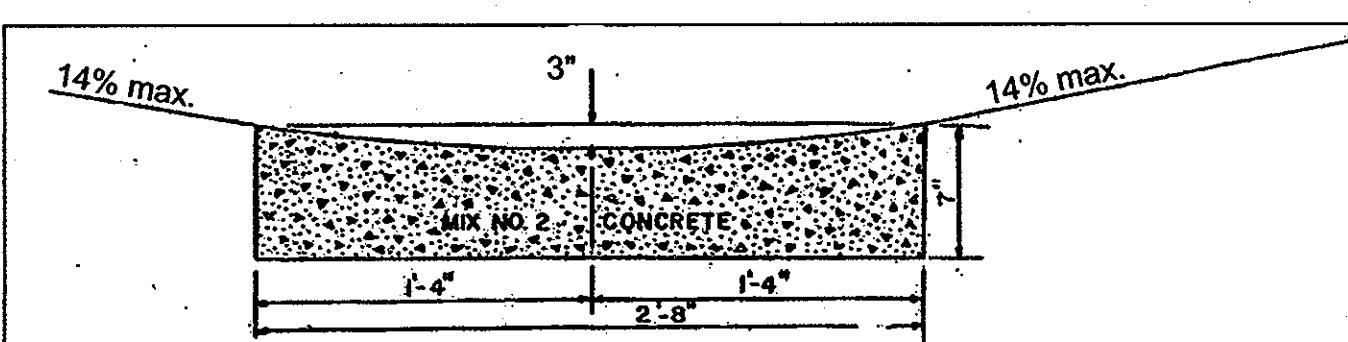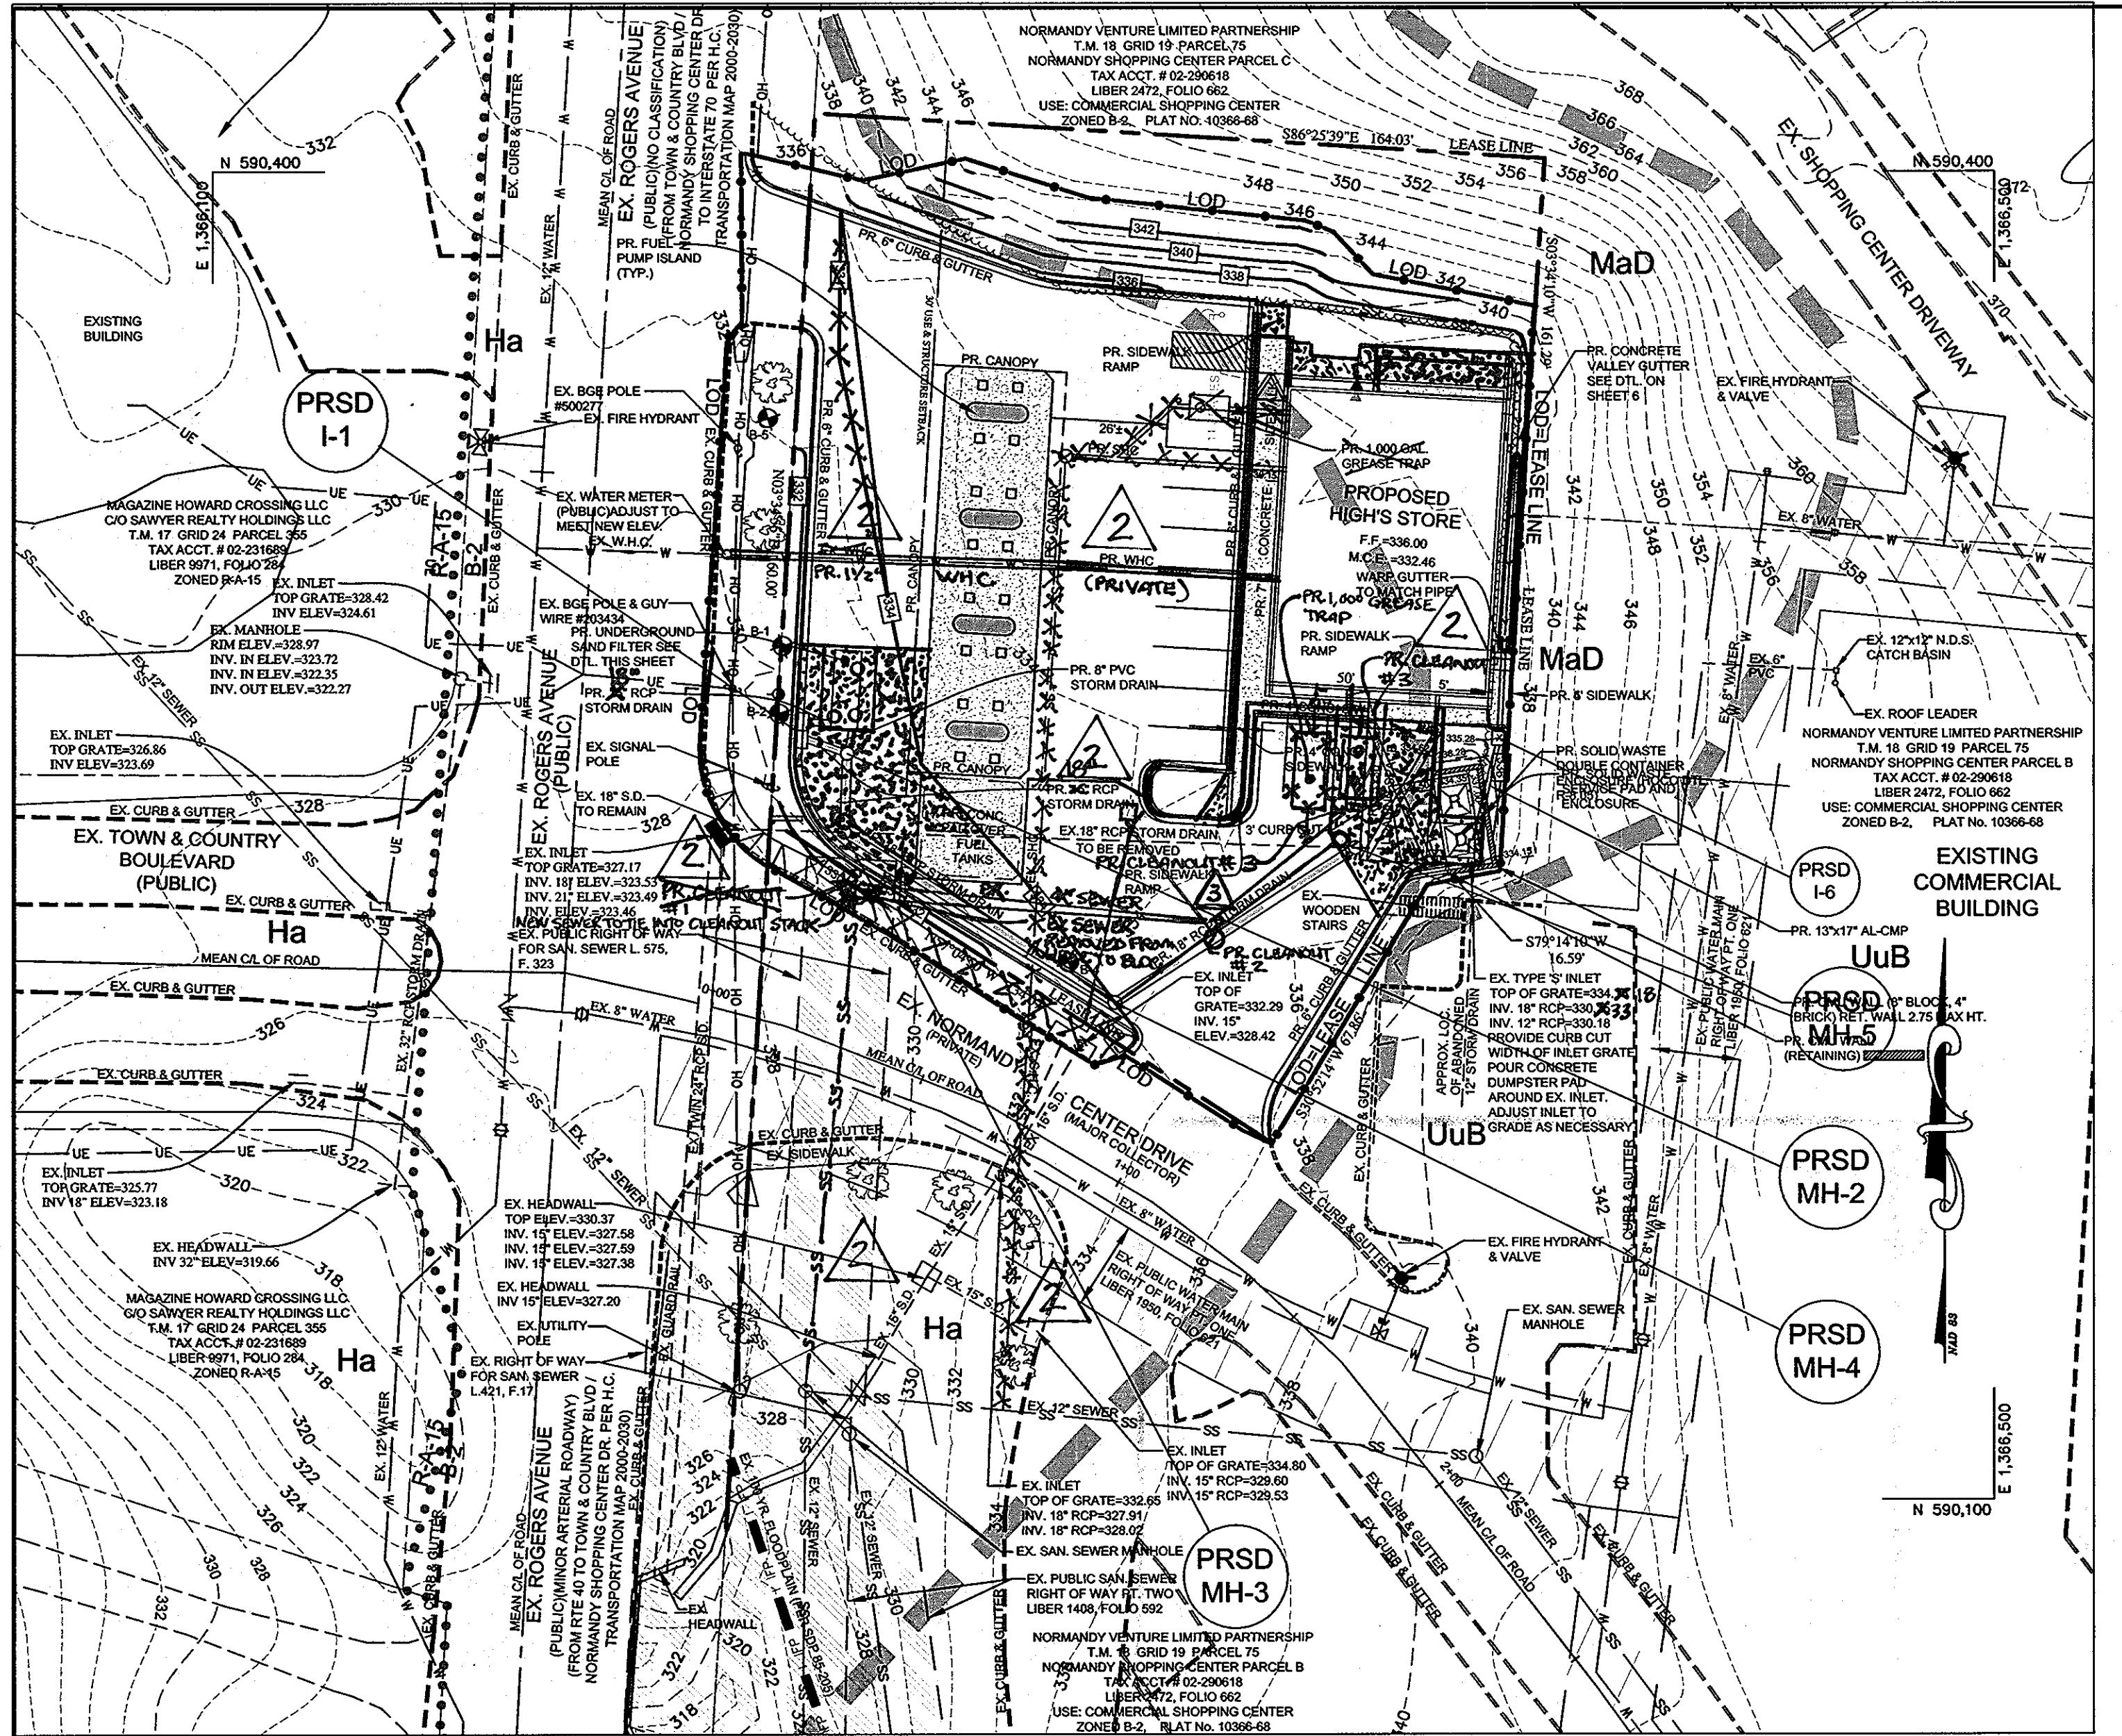


DATE	#	REVISION DESCRIPTION
8/15/11	3	REMOVED SIDEWALK ALONG NORMANDY CENTER DR. ADDED STORM DRAIN, REVISED SITE GRADES TO MEET AS-BUILT FLOOR ELEV.


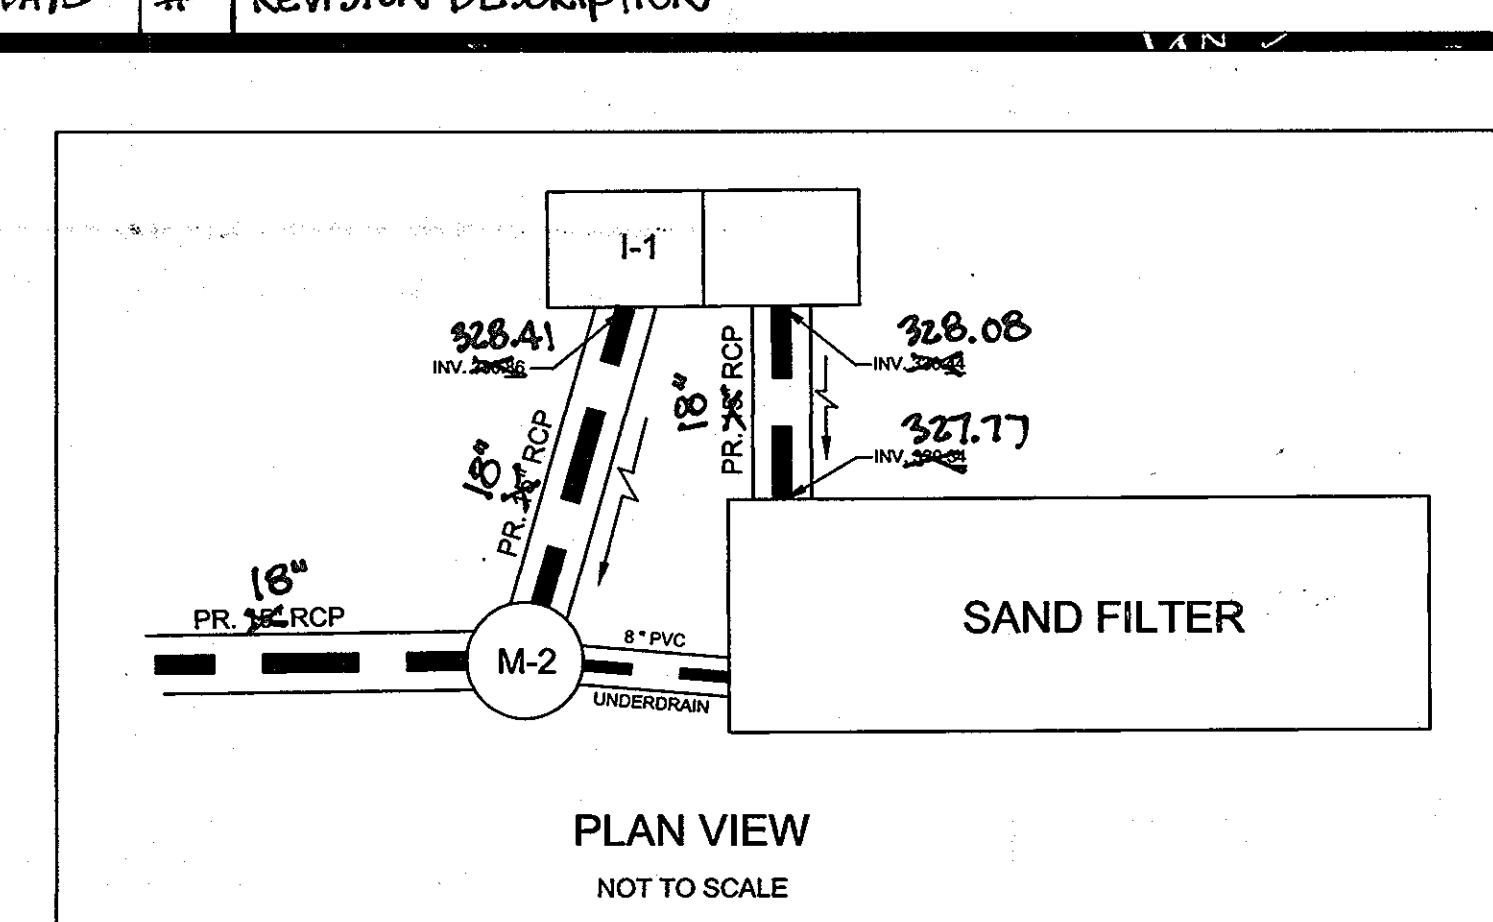


MESSICK & ASSOCIATES * CONSULTING ENGINEERS SURVEYORS & PLANNERS 2120 RENARD COURT ANNAPOLIS, MARYLAND 21401 (410) 266-3212 * FAX (410) 266-3502

* MESSICK GROUP INC T/A MESSICK AND ASSOCIATES

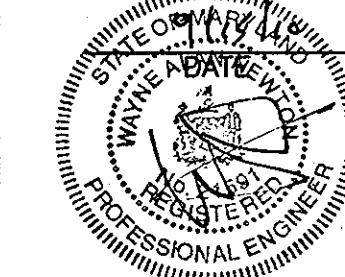


Professional Certification: I hereby certify that this document was prepared or approved by me, and that I am a duly licensed professional engineer under the laws of the State of Maryland.
License No. 21591
Expiration Date: 5/14/2011

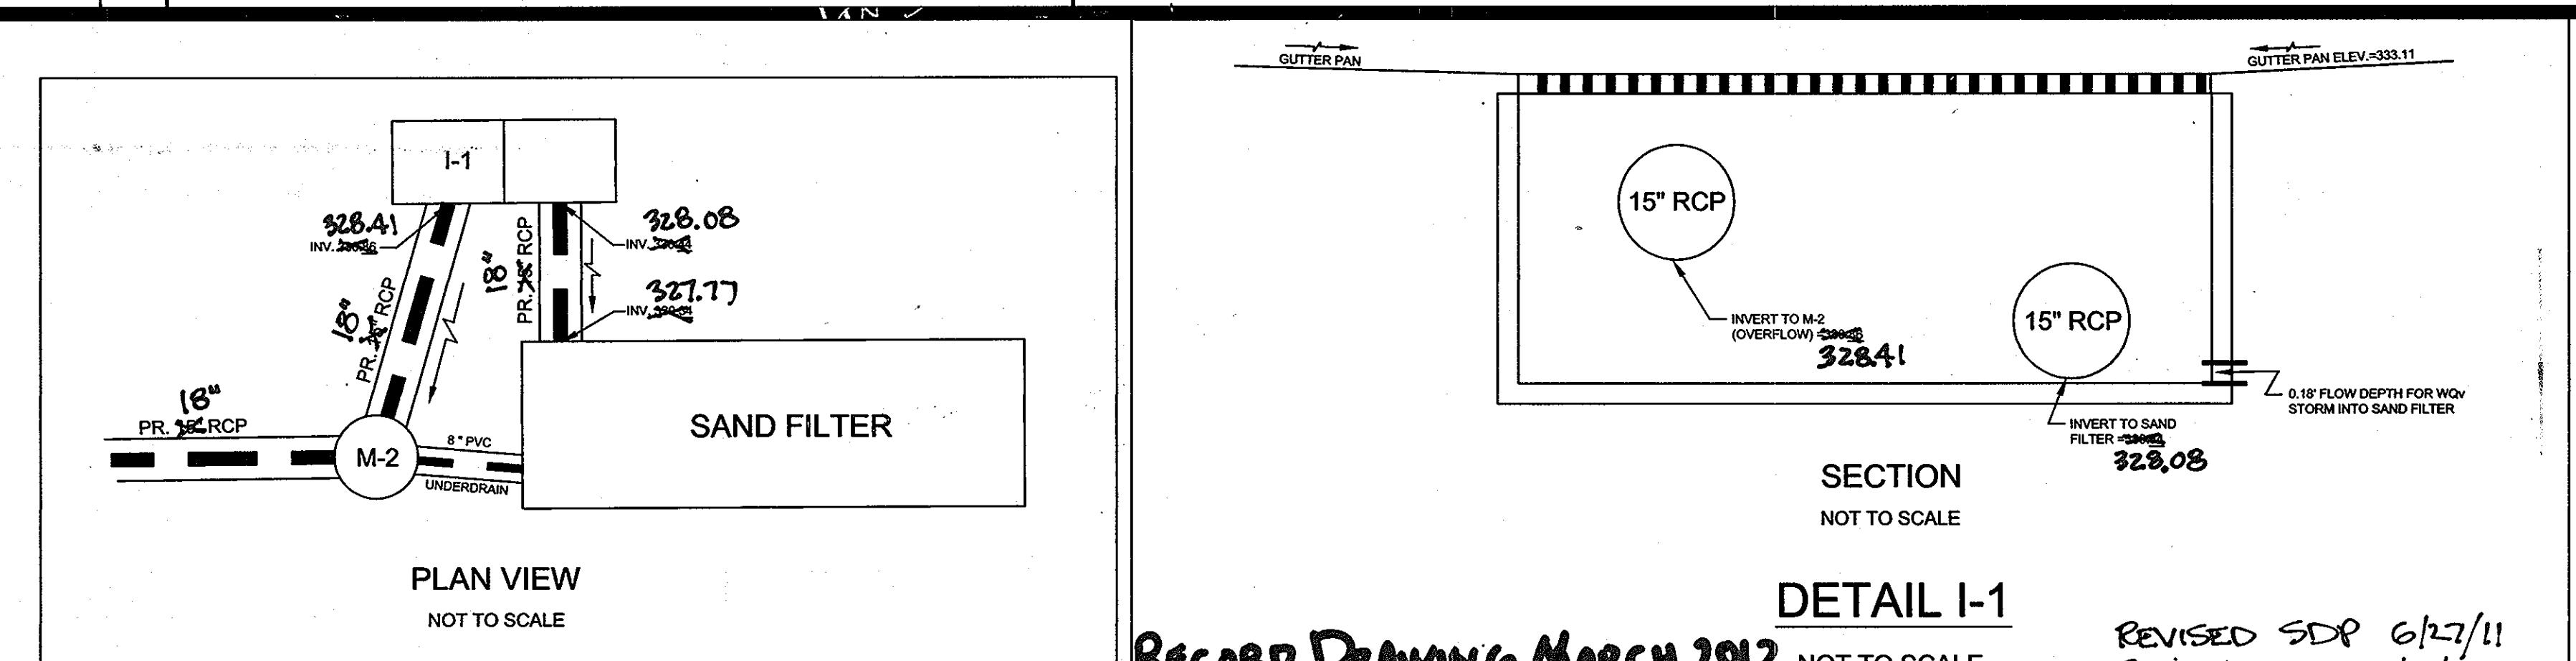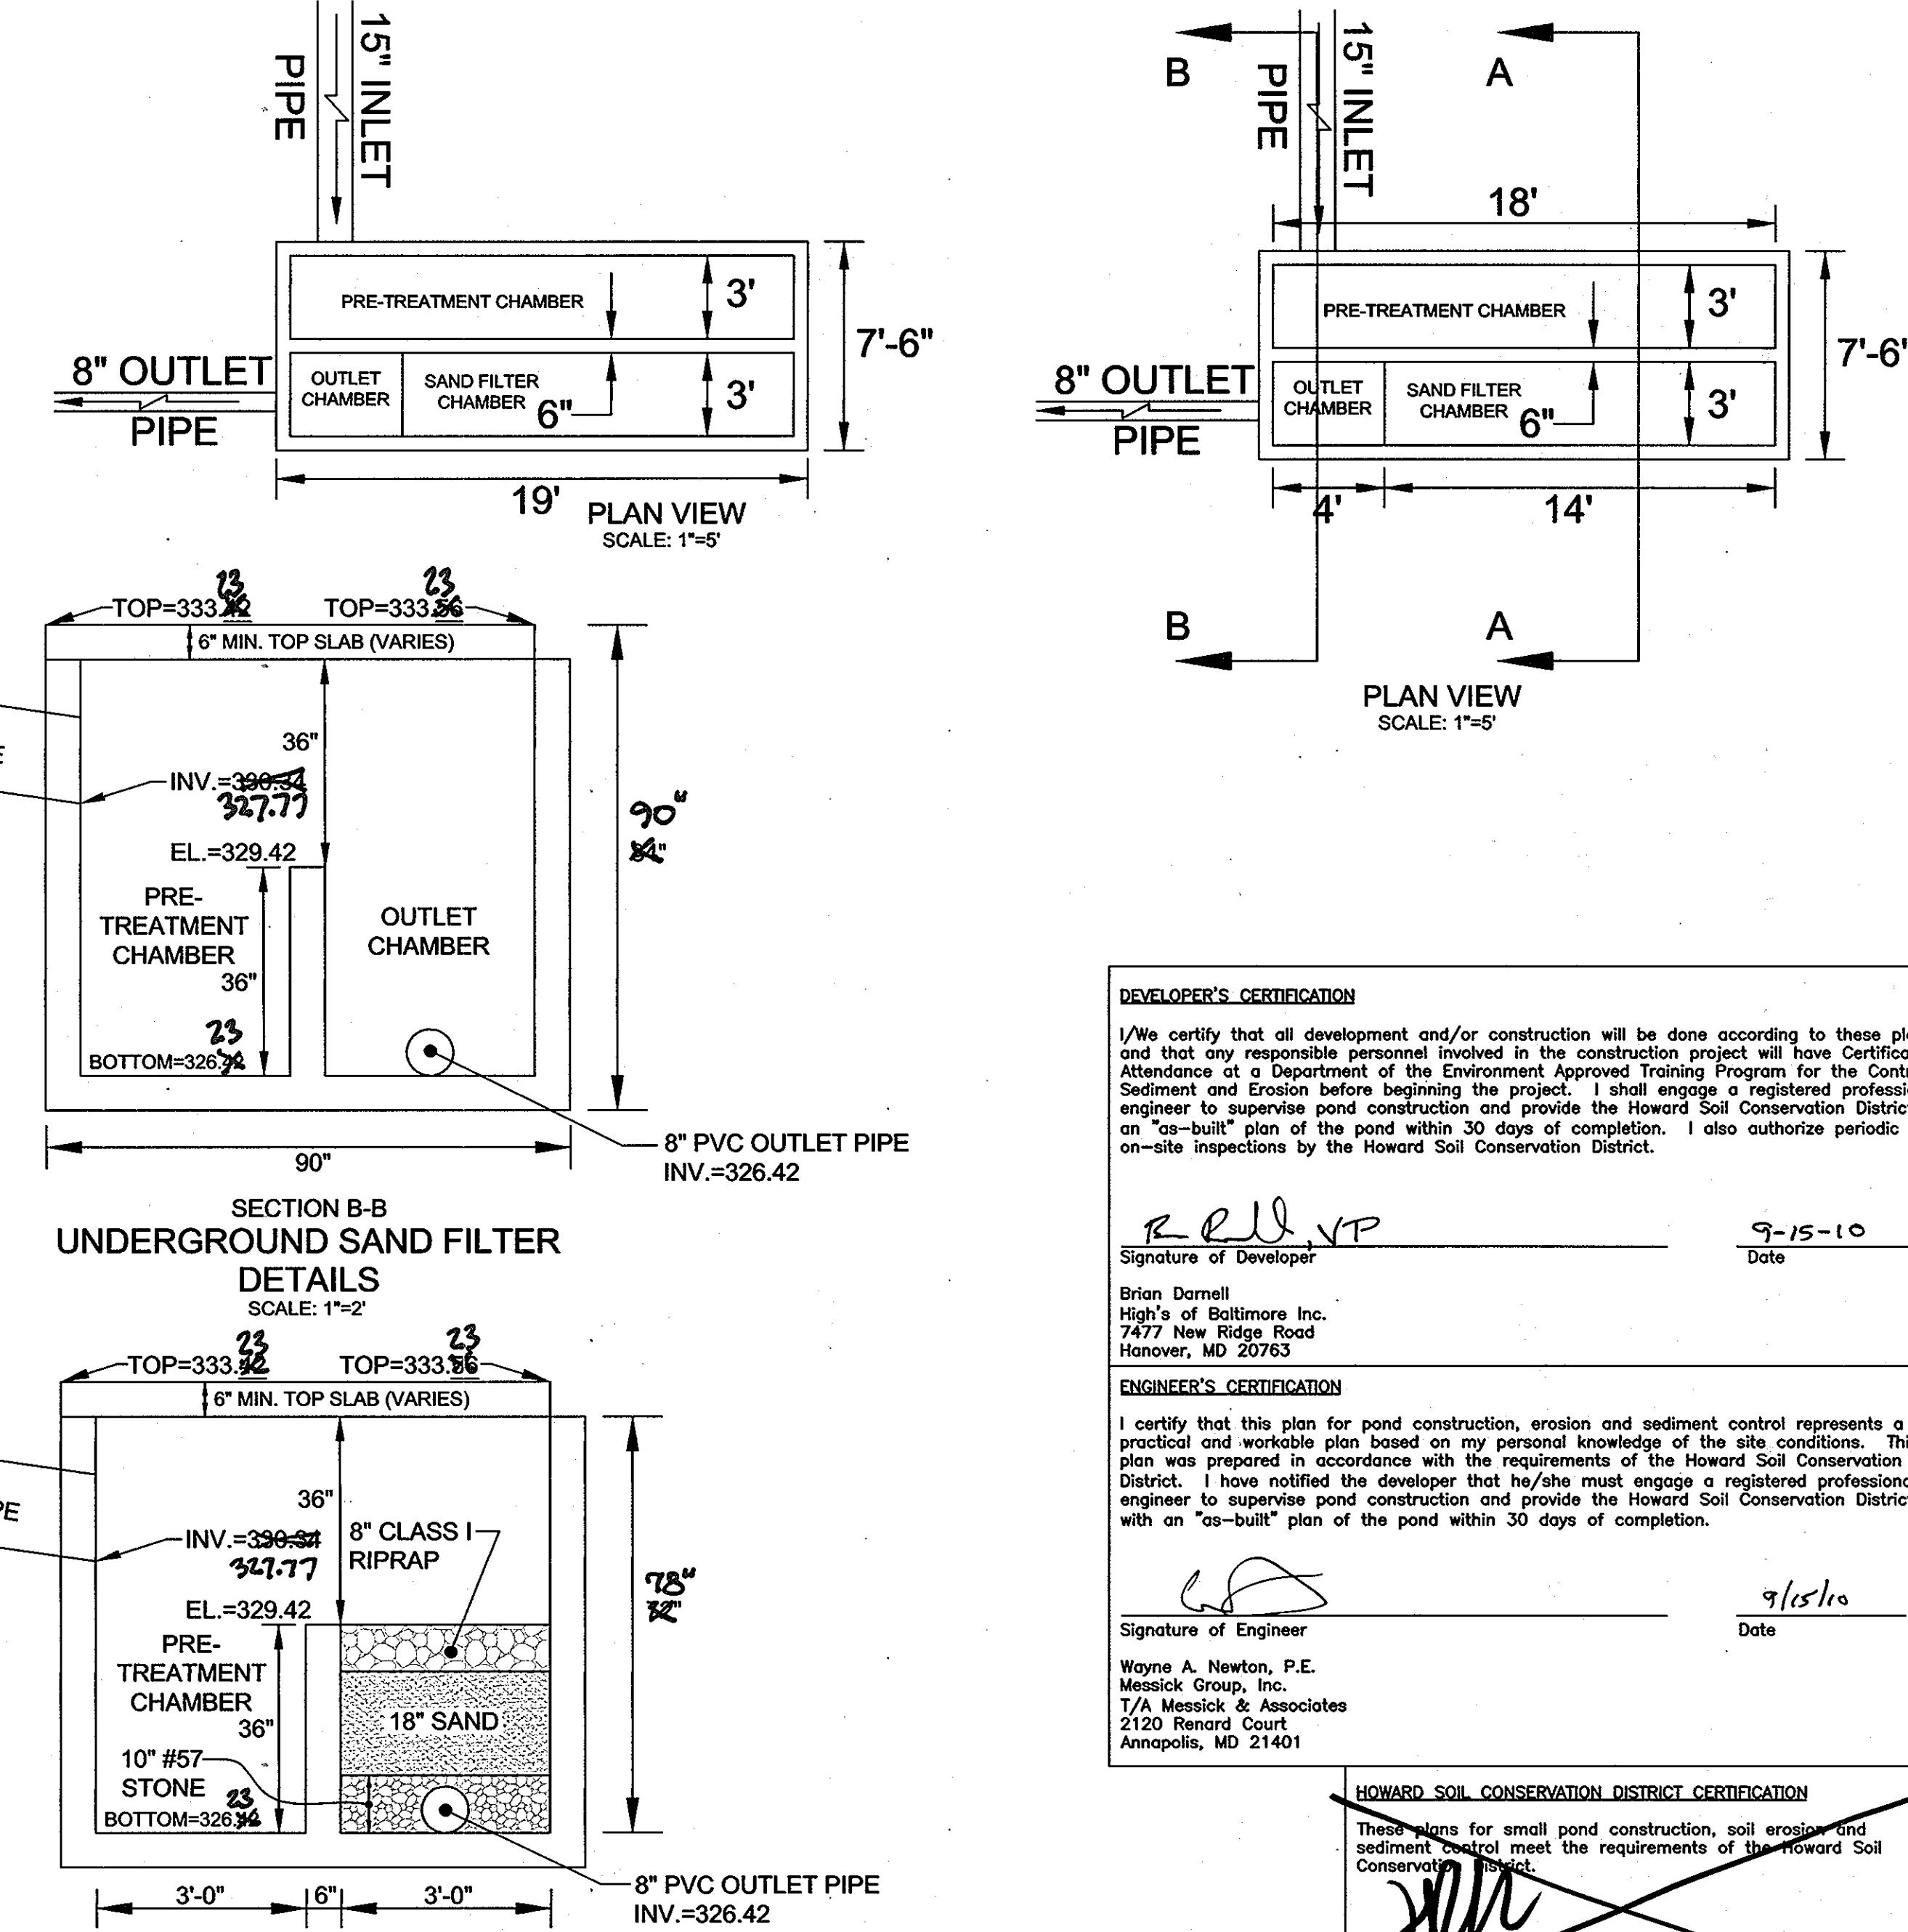

PROJECT	HIGH'S @ NORMANDY NORMANDY SHOPPING CENTER, P/O PARCEL B NEW BUILDING, GAS PUMPS & PARKING LOT EXPANSION
TITLE	THE NORMANDY VENTURE LIMITED PARTNERSHIP SITE DEVELOPMENT PLAN
F-98-33, BA 08-0450, SDP 86-89, SDP 85-205, SDP 84-297, SDP 79-140, SDP 77-15, SDP 72-12	

STORMWATER MANAGEMENT PLAN
TAX MAP 18, GRID 19, PARCEL 75, P/O PARCEL B
ELECTION DISTRICT NO. 2 LIBER 2472 FOLIO 662 PLAT M.D.R. NO. 10367
HOWARD COUNTY MARYLAND DATE: MARCH 2009 DESIGN BY: WAN DRAWN BY: BPO
SCALE: AS SHOWN SHEET 6 OF 12

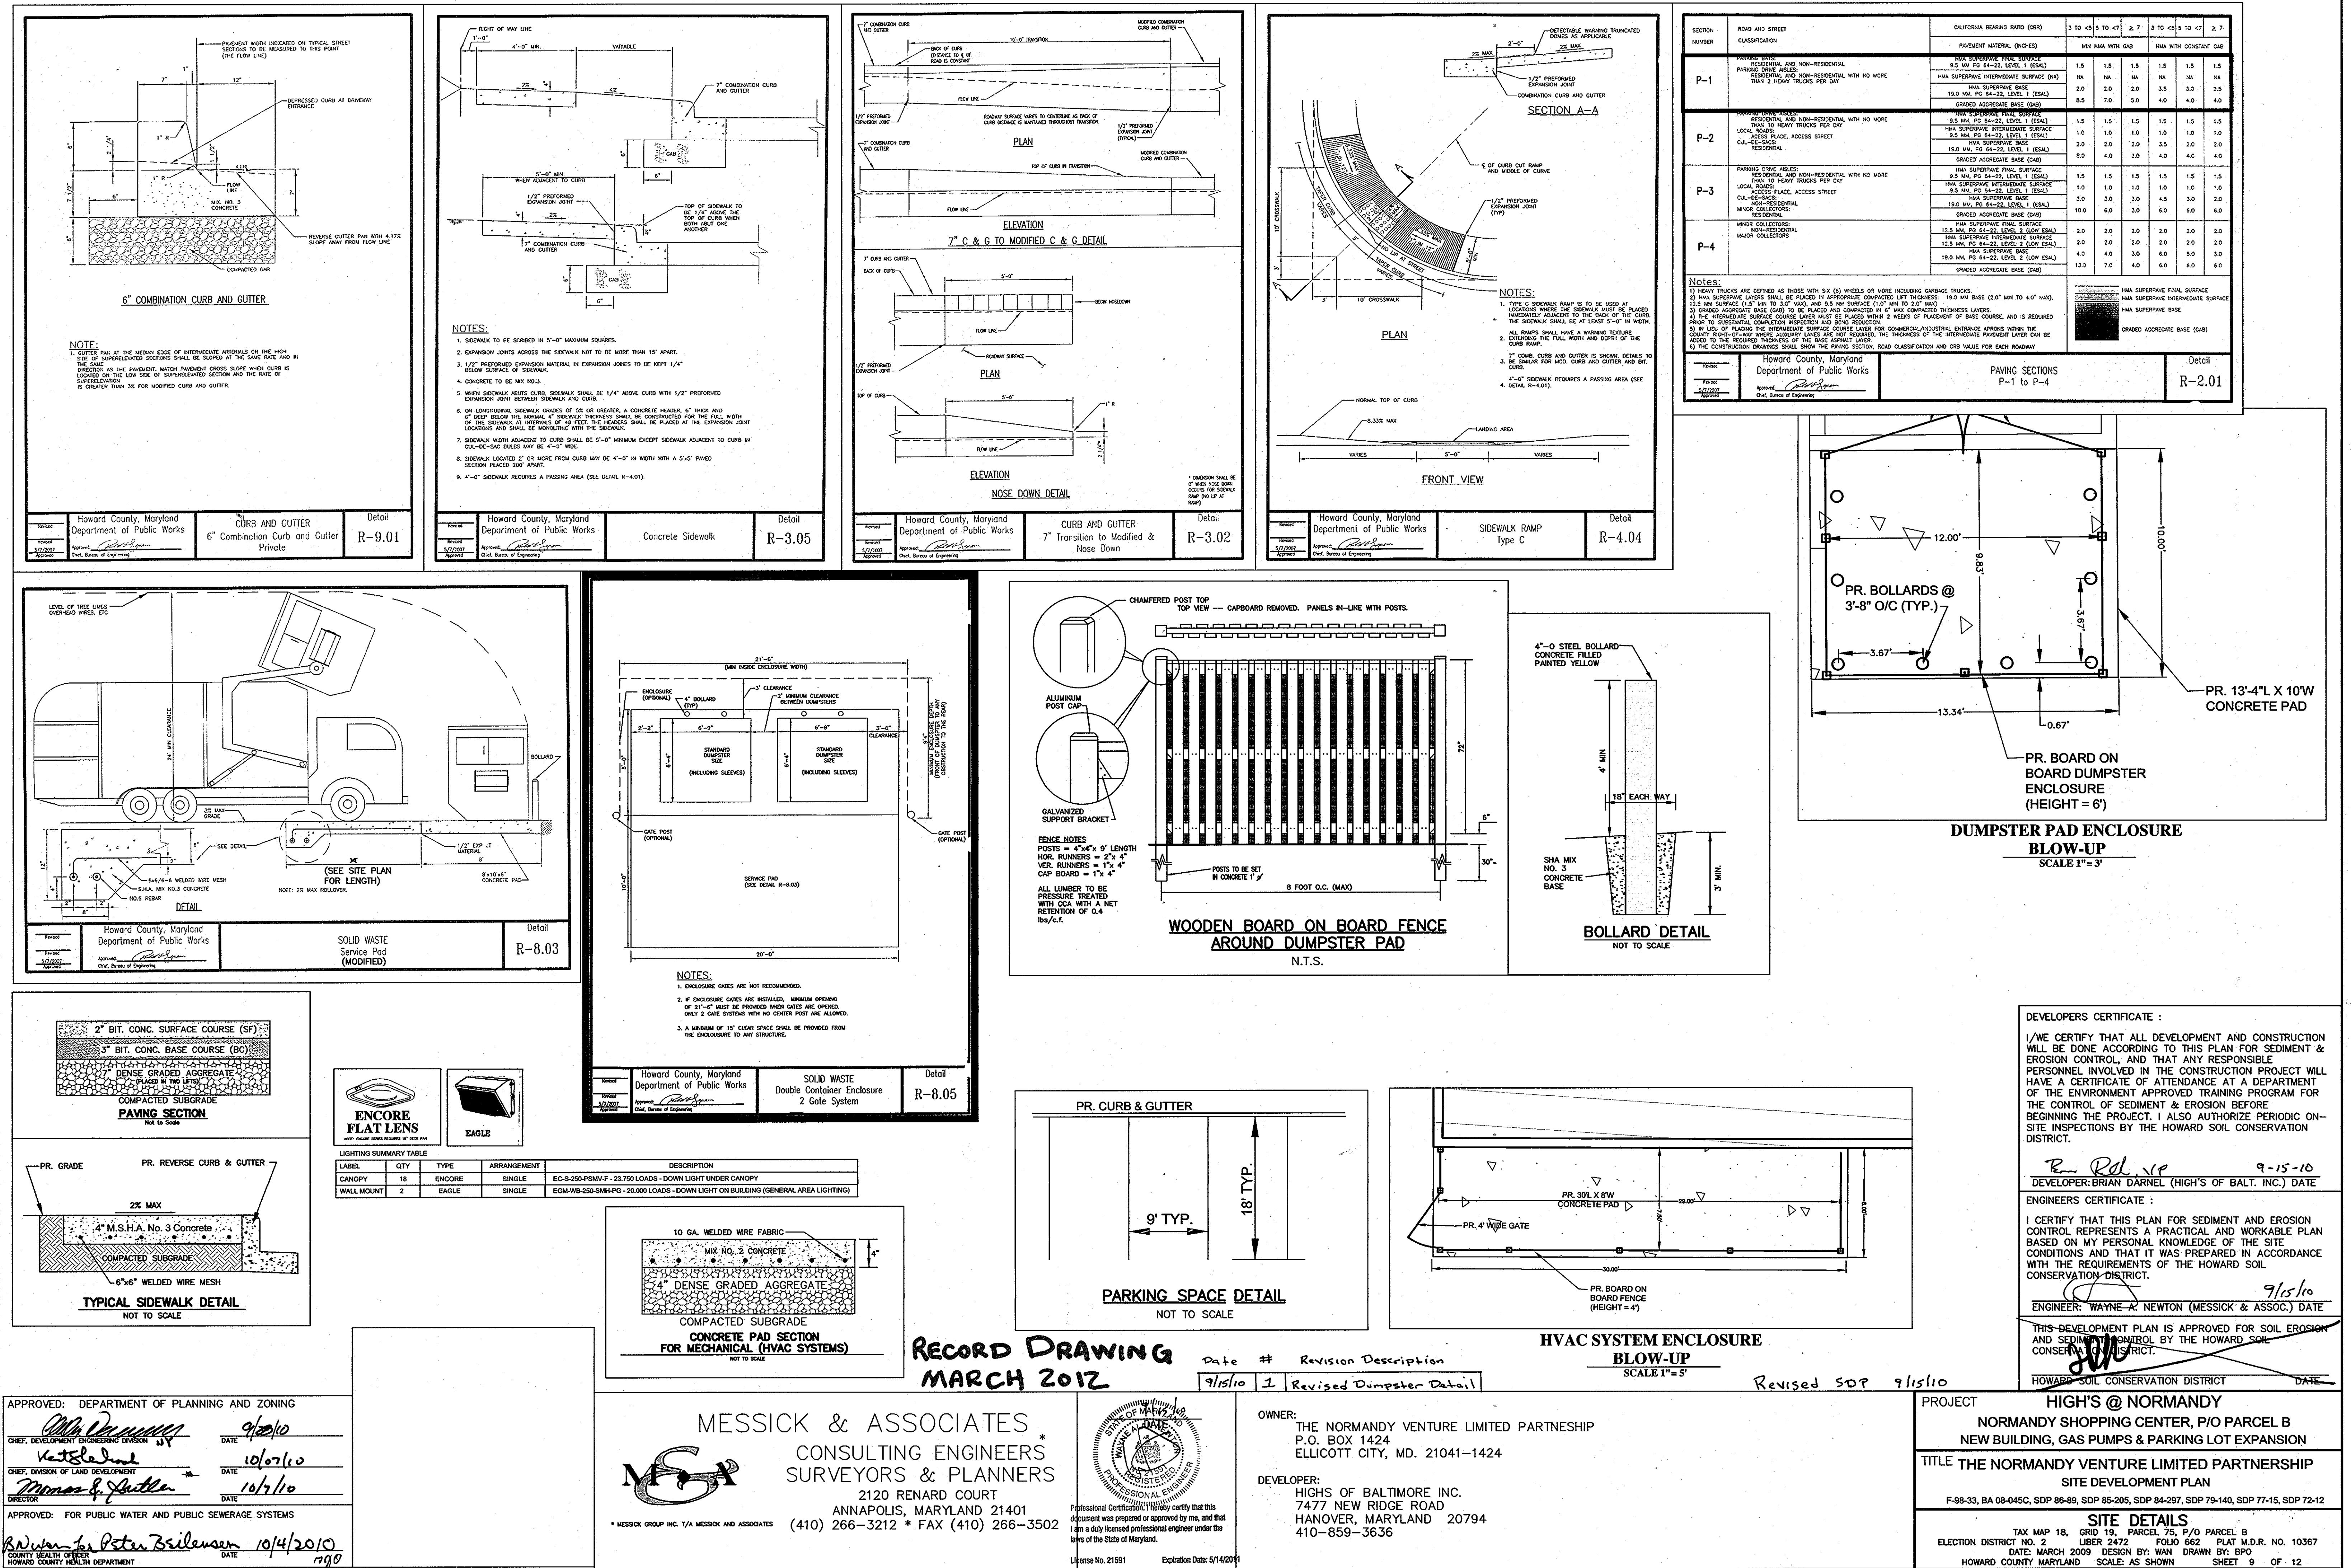

TEMPORARY SEEDING NOTES

Apply to graded or cleared areas likely to be redisturbed where a short-term vegetative cover is needed.

Seeded Preparation: Loosen upper three inches of soil by raking, discing or other acceptable means before seeding, if not previously loosened.

Soil Amendments: Apply 600 lbs. per acre 10-10-10 fertilizer (14 lbs. per 1000 sq. ft.)

Seeding: For periods March 1 thru April 30 and from August 15 thru November 15, seed with 2-1/2 bushels per acre of annual rye (3.2 lbs./per 1000 sq. ft.) For the period May 1 thru August 14, seed with 3 lbs. per acre of weeping lovegrass (0.07 lbs. per 1000 sq. ft.) For the period November 16 thru February 28, protect site by applying 2 tons per acre of well anchored straw mulch and seed as soon as possible in the spring, or anchor.

Mulching: Apply 1-1/2 to 2 tons per acre (70 to 90 lbs. per 1000 sq. ft.) of unrotted small grain straw immediately after seeding. Anchor mulch immediately after application using mulch anchoring tool or 218 gal. per acre (5 gal. per 1000 sq.ft.) of emulsified asphalt on flat areas. On slopes, 8 ft. or higher, use 347 gal. per acre (8 gal. per 1000 sq.ft.) for anchoring.

Refer to the 1983 Maryland Standards and Specifications for Soil Erosion and Sediment Control for rate and methods not covered.

PERMANENT SEEDING NOTES

Apply to graded or cleared areas not subject to immediate further disturbance where a permanent long-lived vegetative cover is needed.

Seeded Preparation: Loosen upper three inches of soil by raking, discing or other acceptable means before seeding, if not previously loosened.

Soil Amendments: In lieu of soil test recommendations, use one of the following schedules:

1) Preferred - Apply 2 tons per acre dolomitic limestone (92 lbs. per 1000 sq.ft.) and 600 lbs. per acre 10-10-10 fertilizer (14 lbs. per 1000 sq.ft.) before seeding. Harrow or disc into upper three inches of soil. At time of seeding, apply 400 lbs. per acre 30-0-0 ureaform fertilizer (9 lbs. per 1000 sq.ft.).

2) Acceptable - Apply 2 tons per acre dolomitic limestone (92 lbs. per 1000 sq.ft.) 1000 lbs. per acre 10-10-10 fertilizer (25 lbs. per 1000 sq. ft.) before seeding. Harrow or disc into upper three inches of soil.

Seeding: for the period March 1 thru April 30 and from August 1 thru October 15, seed with 60 lbs. per acre (1.4 lbs. per 1000 square feet) of Kentucky 31 Tall Fescue. For the period May 1 thru July 31, seed with 60 lbs Kentucky 31 Tall Fescue per acre and 2 lbs. per acre (0.05 lbs. per 1000 sq.ft.) of weeping lovegrass. During the period October 16 thru February 28, protect site by one of the following options:

1) 2 tons per acre of well-anchored mulch straw and seed as soon as possible in the spring.

2) Use sod.

3) Seed with 60 lbs. per acre Kentucky 31 Tall Fescue and mulch with 2 tons per acre well anchored straw.

Mulching: Apply 1-1/2 to 2 tons per acre (70 to 90 lbs. per 1000 sq. ft.) of unrotted small grain straw immediately after seeding. Anchor mulch immediately after application using mulch anchoring tool or 218 gal. per acre (5 gal. per 1000 sq.ft.) of emulsified asphalt on flat areas. On slopes, 8 ft. or higher, use 347 gal. per acre (8 gal. per 1000 sq.ft.) for anchoring.

Maintenance: Inspect all seeded areas and make needed repairs, replacements, and reseedings.

BORROW SITE INFORMATION

The name and/or location of a borrow site is not known at this time. The contractor shall submit all necessary paper work or information to Howard SCD or its legal representative for approval.

21.0 Standard and Specifications for Topsoil

Definition

Placement of topsoil over a prepared subsoil prior to establishment of permanent vegetation.

Purpose

To provide a suitable soil medium for vegetative growth. Soils of concern have low moisture content, low nutrient levels, low pH, materials toxic to plants, and/or unacceptable soil gradation.

Conditions Where Practice Applies

This practice is limited to areas having 2:1 or flatter slopes where:

- The texture of the exposed subsoil/parent material is not adequate to produce vegetative growth.

b. The soil material is so shallow that the rooting zone is not deep enough to support plants or furnish continuing supplies of moisture and plant nutrients.

c. The original soil to be vegetated contains material toxic to plant growth.

d. The soil is so acidic that treatment with limestone is not feasible.

II. For the purpose of these Standards and Specifications, areas having slopes steeper than 2:1 require special consideration and design for appropriate stabilization. Areas having slopes steeper than 2:1 shall have the appropriate stabilization shown on the plans.

Construction and Material Specifications

I. Topsoil salvaged from the existing site may be used provided that it meets the standards as set forth in these specifications. Typically, the topsoil to be salvaged will be salvaged for a specific type as specified in the representative soil profile section in the Soil Survey published by USDA-SCS in cooperation with Maryland Agricultural Experiment Station.

II. Topsoils Specifications - Soil to be used as topsoil must meet the following:

I. Topsoil shall be a loam, sandy loam, clay loam, silt loam, sandy clay loam, loamy sand. Other soils may be used if recommended by an agronomist or soil scientist and approved by the appropriate soil conservation district. Required topsoil shall not be a mixture of contrasting textured subsoils and shall contain less than 5% by volume of cinders, stones, slag, coarse fragments, gravel, sticks, roots, trash, or other materials larger than 1-1/2" in diameter.

II. Topsoil must be free of plants or plant parts such as bermuda grass, quackgrass, Johnson grass, nutgrass, poison ivy, thistle, or other as specified.

III. Where subsoil is either highly acidic or composed of heavy clays, ground limestone shall be spread at the rate of 4-8 tons/acre (200-400 pounds per 1,000 square feet) prior to placing the topsoil. Limestone shall be distributed uniformly over disturbed areas and worked into the soil in conjunction with tillage operations as described in the following procedures.

For sites having disturbed areas under 5 acres:

I. Place topsoil (if required) and apply soil amendments as specified in 20.0 Vegetative Stabilization - Section I - Vegetative Stabilization Methods and Materials.

III. For sites having disturbed areas over 5 acres:

I. Place topsoil (if required) and apply soil amendments as specified in 20.0 Vegetative Stabilization - Section I - Vegetative Stabilization Methods and Materials.

IV. Composted sludge shall be applied at a rate of 1 ton/1,000 square feet.

V. Composted sludge shall be amended with a potassium fertilizer applied at the rate of 4 lb./1,000 square feet, and 1/3 the normal lime application rate.

I. On soil meeting topsoil specifications, obtain test results dictating fertilizer and lime amendments required to bring the soil into compliance with the following:

a. pH for topsoil shall be between 6.0 and 7.5. If the tested soil demonstrates a pH of less than 6.0, sufficient lime shall be prescribed to raise the pH to 6.5 or higher.

b. Organic content of topsoil shall be not less than 1.5 percent by weight.

c. Topsoil having soluble salt content greater than 500 parts per million shall not be used.

d. No sod or seed shall be placed on soil which has been treated with soil sterilants or chemicals for weed control until sufficient time has elapsed (14 days minimum) to permit dissipation of phyto-toxic materials.

Notes: Topsoil substitutes to amendments, as recommended by a qualified agronomist or soil scientist and approved by the appropriate approval authority may be used in lieu of natural topsoil.

II. Place topsoil (if required) and apply soil amendments as specified in 20.0 Vegetative Stabilization - Section I - Vegetative Stabilization Methods and Materials.

V. Topsoil Application

I. When topsoiling, maintain needed erosion and sediment control practices such as diversions, Grade Stabilization Structures, Earth Dikes, Slope Silt Fence and Sediment Traps and Basins.

II. Grades on the areas to be topsoiled, which have been previously established, shall be maintained, albeit 4" - 8" higher in elevation.

III. Topsoil shall be uniformly distributed in a 4" - 8" layer and lightly compacted to a minimum thickness of 4". Spreading shall be performed in such a manner that sodding or seeding can proceed with a minimum of disturbance to the surface and drainage. Any irregularities in the surface resulting from topsoiling or other operations shall be corrected in order to prevent the formation of depressions or water pockets.

IV. Topsoil shall not be placed while the topsoil or subsoil is in a frozen or muddy condition, when the subsoil is excessively wet or in a condition that may otherwise be detrimental to proper grading and seedbed preparation.

V. Alternative for permanent seeding - instead of applying the full amounts of lime and commercial fertilizer, composted sludge and amendments may be applied as specified below:

Composted sludge material for use as a soil amendment for sites having disturbed areas over 5 acres shall be tested to prescribe amendments and for site having disturbed areas under 5 acres shall conform to the following requirements:

a. Composted sludge shall be supplied by, or originate from, a person or persons that are permitted (at the time of acquisition of the compost) by the Maryland Department of the Environment under COMAR 26.04.05.

b. Composted sludge shall contain at least 1 percent nitrogen, 1.5 percent phosphorus, and 0.2 percent potassium and have a pH of 7.0 to 8.0. If compost does not meet these requirements, the appropriate constituents must be added to meet the requirements prior to use.

c. Composted sludge shall be applied at a rate of 1 ton/1,000 square feet.

d. Composted sludge shall be amended with a potassium fertilizer applied at the rate of 4 lb./1,000 square feet, and 1/3 the normal lime application rate.

References: Guideline Specifications, Soil Preparation and Sodding. MD-VA, Pub. #1, Cooperative Extension Service, University of Maryland and Virginia Polytechnic Institutes. Revised 1973.

SEDIMENT CONTROL NOTES

1. A MINIMUM OF 48 HOURS NOTICE MUST BE GIVEN TO THE HOWARD COUNTY DEPARTMENT OF INSPECTIONS, LICENSES, AND PERMITS, SEDIMENT CONTROL DIVISION PRIOR TO THE START OF ANY CONSTRUCTION (410) 313-1855.

2. ALL VEGETATIVE AND STRUCTURAL PRACTICES ARE TO BE INSTALLED ACCORDING TO THE PROVISIONS OF THIS PLAN AND ARE TO BE IN CONFORMANCE WITH THE MARYLAND STANDARDS AND SPECIFICATIONS FOR SOIL AND EROSION CONTROL, AND REVISIONS THERETO.

3. FOLLOWING INITIAL SOIL DISTURBANCE OR REDISTURBANCE, PERMANENT OR TEMPORARY STABILIZATION SHALL BE COMPLETED WITHIN (A) CALENDAR DAYS FROM PERMIT APPROVAL DATE, CONSTRUCTION, DIKES, PERIMETER SLOPES AND ALL SLOPES GREATER THAN 3:1; (B) 14 DAYS AS TO OTHER DISTURBED OR GRADED AREAS ON THE PROJECT SITE.

4. ALL SEDIMENT TRAPS/BASINS SHOWN MUST BE FENCED AND WARNING SIGNS POSTED AROUND THE PERIMETER IN ACCORDANCE WITH VOL 1, CHAPTER 12.1 OF THE HOWARD COUNTY DESIGN MANUAL, STORM DRAINAGE.

5. ALL DISTURBED AREAS MUST BE STABILIZED WITHIN THE TIME PERIOD SPECIFIED ABOVE IN ACCORDANCE WITH THE 1994 MARYLAND STANDARDS AND SPECIFICATIONS FOR SOIL AND EROSION CONTROL FOR PERMANENT SEEDINGS (SEC. 51), SOD (SEC. 54), TEMPORARY SEEDINGS (SEC.50) AND MULCHING (SEC. 52). TEMPORARY STABILIZATION WITH MULCH ALONE CAN ONLY BE DONE WHEN RECOMMENDED SEEDING DATES DO NOT ALLOW FOR PROPER GERMINATION AND ESTABLISHMENT OF GRASSES.

6. ALL SEDIMENT CONTROL STRUCTURES ARE TO REMAIN IN PLACE AND ARE TO BE MAINTAINED IN OPERATIVE CONDITION UNTIL PERMISSION FOR THEIR REMOVAL HAS BEEN OBTAINED FROM THE HOWARD COUNTY SEDIMENT CONTROL INSPECTOR.

7. SITE ANALYSIS

TOTAL SITE AREA	0.7173 ACRES
AREA DISTRIBUTED	0.6734 ACRES
AREA TO BE ROOFED AND PAVED	0.5468 ACRES
AREA TO BE VEGETATIVELY STABILIZED	0.1266 ACRES
TOTAL CUT	350± CU. YDS.
TOTAL FILL (contractor to check quantities)	950± CU. YDS.
OFFSITE WASTE/BORROW AREA LOCATION	A SITE WITH AN ACTIVE GRAZING PERMIT, APPROVED BY THE COUNTY INSPECTOR

8. ANY SEDIMENT CONTROL PRACTICE WHICH IS DISTURBED BY GRADING ACTIVITY FOR PLACEMENT OF UTILITIES MUST BE REPAVED ON THE DAY OF DISTURBANCE.


9. ADDITIONAL SEDIMENT CONTROLS MUST BE PROVIDED, IF DEEMED NECESSARY BY THE HOWARD COUNTY SEDIMENT CONTROL INSPECTOR.

10. SITE GRADING WILL BEGIN ONLY AFTER ALL PERIMETER SEDIMENT CONTROL MEASURES HAVE BEEN INSTALLED AND ARE IN A FUNCTIONING CONDITION.


11. ON ALL SITES WITH DISTURBED AREAS IN EXCESS OF 2 AC., APPROVAL OF THE INSPECTION AGENCY SHALL BE REQUESTED UPON COMPLETION OF INSTALLATION OF PERIMETER EROSION AND SEDIMENT CONTROLS, BUT BEFORE PROCEEDING WITH ANY ADDITIONAL DISTURBANCE. GRAZING, GRAVEL SPREADING, BUILDING OR GRAVING INSPECTION APPROVALS MAY NOT BE AUTHORIZED UNTIL THIS INITIAL APPROVAL BY THE INSPECTION AGENCY IS MADE.

12. TRENCHES FOR THE CONSTRUCTION OF UTILITIES IS LIMITED TO THREE PIPE LENGTHS OR THAT WHICH CAN BE BACKFILLED AND STABILIZED BY THE END OF EACH WORKING DAY, WHICHEVER IS SHORTER.

DETAIL 23A - STANDARD INLET PROTECTION

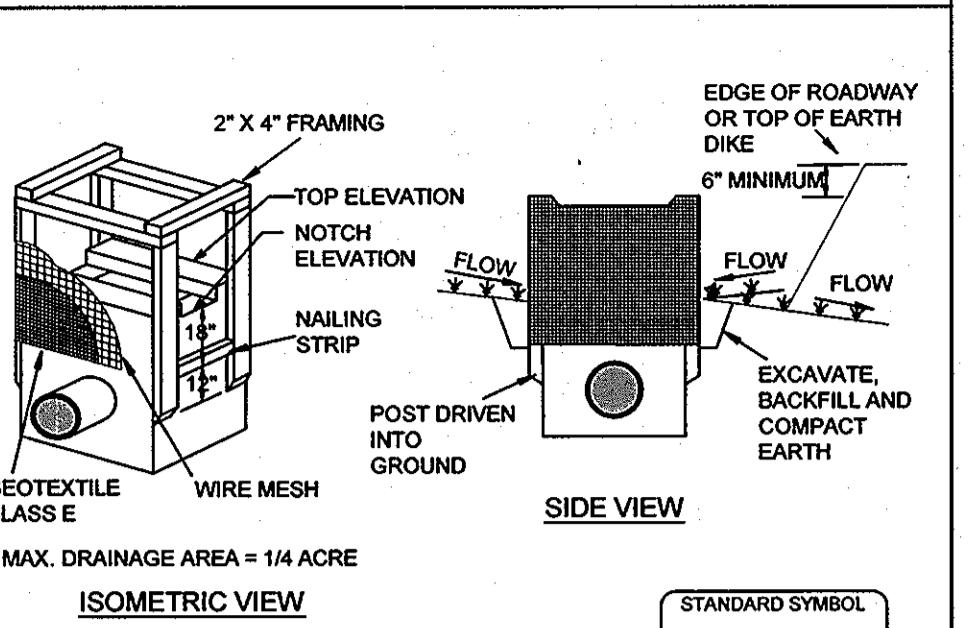

DETAIL 23C - CURB INLET PROTECTION (COG OR COS INLETS)

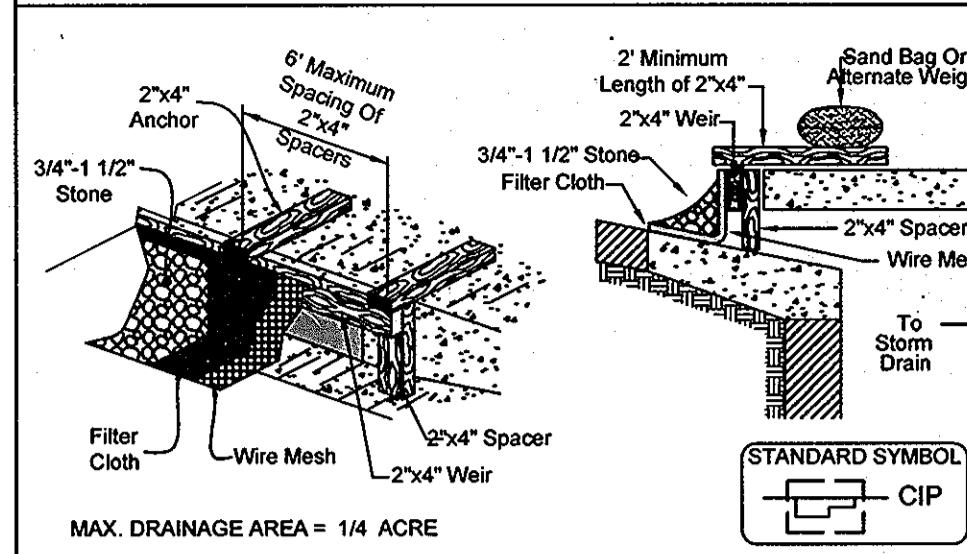

CONSTRUCTION SPECIFICATIONS

- Excavate completely around the inlet to a depth of 18" below the notch elevation.
- Drive the 2x4 construction grade lumber posts 1' into the ground at each corner of the inlet. Place nail strips between the posts on the ends of the inlet. Assemble the top portion of the 2x4 frame using the overlap joint shown on Detail 23A. The top of the frame (weir) must be 6" below adjacent grade when flooding and safety issues may arise.
- Securely nail the 2x4' weir to a 9" long vertical spacer between the weirs. The ends of the spacers must meet at a post, be overlapped and folded, then fastened down.
- Stretch the 1/2" x 1/2" wire mesh tightly around the frame and fasten securely. The ends must meet and overlap at a post.
- Stretch the Geotextile Class E tightly over the wire mesh with the geotextile extending from the top of the frame to 18" below the inlet notch elevation. Fasten the geotextile firmly to the frame. The ends of the geotextile must meet at a post, be overlapped and folded, then fastened down.
- Backfill around the inlet in compacted 6" layers until the layer of earth is level with the notch elevation on the ends and top elevation on the sides.
- If the inlet is not in a sum, construct a compacted earth dike across the ditch line directly below it. The top of the earth dike should be at least 6" higher than the top of the frame.
- The structure must be inspected periodically and after each rain and the geotextile replaced when it becomes clogged.
- Assure that storm flow does not bypass the inlet by installing a temporary earth or asphalt dike to direct the flow to the inlet.

U.S. DEPARTMENT OF AGRICULTURE
SOIL CONSERVATION SERVICE


PAGE E-18-5 MARYLAND DEPARTMENT OF ENVIRONMENT
WATER MANAGEMENT ADMINISTRATION

SEQUENCE OF CONSTRUCTION

- Contractor shall obtain all necessary approvals and the grading permit prior to beginning construction. The contractor shall notify the Howard County Department of Inspections & Permits, Mississ. at least 48 hours prior to beginning construction.
- The contractor shall schedule a pre construction meeting with the respective agencies to review the plans and permits.
- Clear or grub site as shown on the plans.
- Clear and grub only the areas necessary for the installation of super silt fence.
- Clear and grub site as needed.
- Remove Existing gravel, pavement & buildings. Strip and stockpile topsoil.
- Rough grade site. Remove and replace unsuitable soil with select fill.
- Install utilities & Begin Building Construction.
- Install tanks and pump islands.
- Remove existing drainage structures, install new storm drain & the underground stormwater management system. Immediately upon completion of storm drain, install the inlet protection devices.
- Install curb and gutter and dense graded aggregate in parking lot and drive aisles.
- Install bimini concrete, concrete aprons, concrete dumpster pad or similar pads.
- Place and fine grade topsoil as needed to provide positive drainage. Stabilize with seed and mulch.
- Install landscaping.
- Stabilize all remaining disturbed areas with seed & mulch.
- With the sediment control inspectors approval, remove all temporary sediment controls, mark out outer structure. Re-stabilize all minor disturbance an vegetation growth is not established.

*Can be done concurrently

DETAIL 24 - STABILIZED CONSTRUCTION ENTRANCE

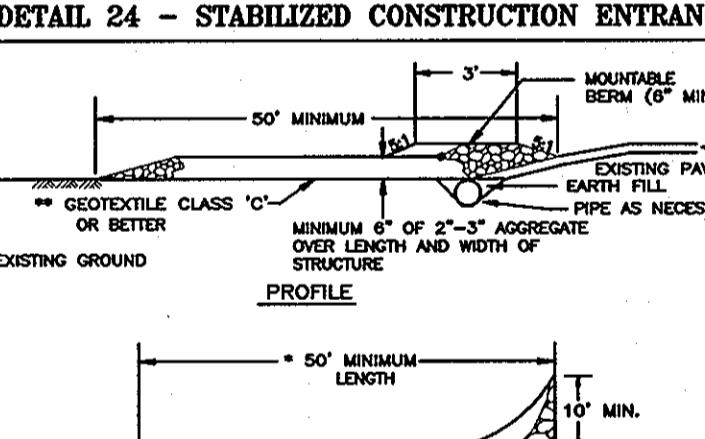

DETAIL 33

