

NO	DESCRIPTION
1	TITLE SHEET
2	OVERALL SITE DEVELOPMENT PLAN
3	EXISTING CONDITIONS & SOILS PLAN
4	DEMOLITION PLAN
5	SITE DEVELOPMENT PLAN
6	GRADING AND SEDIMENT CONTROL PLAN
7	SEDIMENT & EROSION CONTROL DETAILS
8	STORMWATER MANAGEMENT PLAN AND DETAILS
9	UTILITY PLAN
10	UTILITY PROFILES
11	LANDSCAPE PLAN
12	LANDSCAPE & FOREST CONSERVATION NOTES AND DETAILS
13	SITE DETAILS
14	SOIL BORING LOGS
15	RETAINING WALL PLANS & ELEVATIONS
16	EXTERIOR ELEVATIONS AND BUILDING SECTIONS
17	RETAINING WALL GENERAL NOTES
18	RETAINING WALL SECTIONS

# SITE DEVELOPMENT PLAN

# ST. PAUL'S CATHOLIC CHURCH


# EVANGELIZATION CENTER

## CLASSROOM FACILITY

### PARCELS 61, 120, & 121

### 2ND ELECTION DISTRICT

### HOWARD COUNTY, MARYLAND

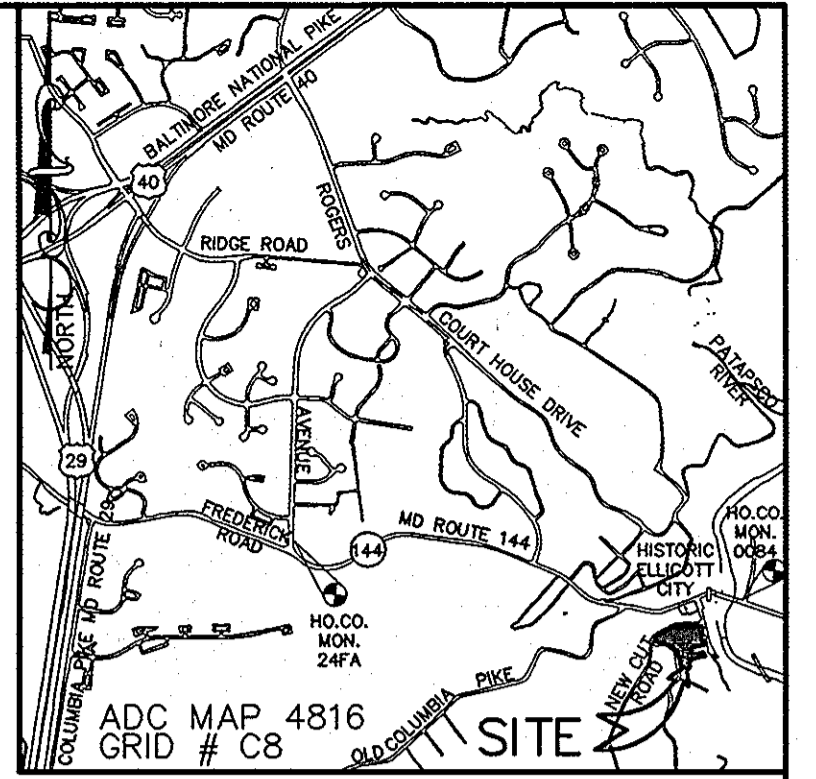

VICINITY MAP  
SCALE: 1" = 200'

COPYRIGHT ADC THE MAP PEOPLE, PERMITTED USE  
NO. 2081197  
HOWARD COUNTY ADC MAP 4816 GRID C8

#### BENCHMARKS

HOWARD COUNTY SURVEY CONTROL: 0084  
ELEVATION 124.948'  
N 583,158.761 E 1,370,739.978  
LOCATION IS ±14' NORTH OF FREDERICK ROAD AND ±15'  
WEST OF OELLA AVENUE.

HOWARD COUNTY SURVEY CONTROL: 24FA  
ELEVATION 282.884'  
N 583,751.413 E 1,366,091.862  
LOCATION IS ±14' EAST OF ROGERS AVENUE NEAR THE  
INTERSECTION WITH FREDERICK ROAD.


#### SITE ANALYSIS DATA CHART

AREA OF SITE:	2.76 ACRES (120,053 SF) (INCLUDES ENTIRE CAMPUS)
LIMIT OF DISTURBED AREA:	0.27 ACRES ± (11,962 SF)
PRESENT ZONING:	HO (HISTORIC OFFICE DISTRICT)
EXISTING USES:	CHURCH & CHURCH OFFICES
PROPOSED USES:	CHURCH, EVANGELIZATION CENTER, & CHURCH OFFICES
FLOOR AREA OF PROPOSED BUILDING:	LOWER LEVEL FLOOR: 3,229 SF (CLASSROOM: 1,406 SF, UTILITY AREA: 269 SF, COMMON AREA 1,554 SF) MAIN LEVEL FLOOR: 3,219 SF (CLASSROOM: 1,448 SF, UTILITY AREA: 91 SF, COMMON AREA 1,680 SF) TOTAL: 6,448 SF
BUILDING HEIGHT:	MAXIMUM ALLOWABLE HEIGHT: 40'-0" HEIGHT OF PROPOSED BUILDING: 27'-10 3/8"
PARKING TABULATION:	65 SPACES
EXISTING PARKING:	NO ADDITIONAL PARKING PROPOSED WITH THIS PLAN (SEE GENERAL NOTE #32)
PROPOSED PARKING:	
EXISTING FLOOR AREA RATIO:	37,095 SF/120,053 SF = 0.31
PROPOSED FLOOR AREA RATIO:	41,128 SF/120,053 SF = 0.34

## AS-BUILT

#### GENERAL NOTES

- ALL CONSTRUCTION SHALL BE IN ACCORDANCE WITH THE LATEST STANDARDS AND SPECIFICATIONS OF HOWARD COUNTY PLUS MSHA STANDARDS AND SPECIFICATIONS, IF APPLICABLE.
- THE CONTRACTOR SHALL NOTIFY THE DEPARTMENT OF PUBLIC WORKS/BUREAU OF ENGINEERING/ CONSTRUCTION INSPECTION DIVISION AT (410) 313-1880 AT LEAST FIVE (5) WORKING DAYS PRIOR TO THE START OF WORK.
- THE CONTRACTOR SHALL NOTIFY "MISS UTILITY" AT 1-800-257-7777 AT LEAST 48 HOURS PRIOR TO ANY EXCAVATION WORK BEING DONE.
- TRAFFIC CONTROL DEVICES, MARKINGS, AND SIGNING SHALL BE IN ACCORDANCE WITH THE LATEST EDITION OF THE MANUAL ON UNIFORM TRAFFIC CONTROL DEVICES (MUTCD). ALL STREET AND REGULATORY SIGNS SHALL BE IN PLACE PRIOR TO THE PLACEMENT OF ANY ASPHALT.
- ALL PLAN DIMENSIONS ARE TO FACE OF CURB UNLESS OTHERWISE NOTED.
- THE EXISTING TOPOGRAPHY IS TAKEN FROM AVAILABLE HOWARD COUNTY RECORDS AND FIELD RUN SURVEY WITH MAXIMUM TWO FOOT CONTOUR INTERVALS PREPARED BY PATTON HARRIS RUST & ASSOCIATES DATED NOVEMBER 2008.
- THE COORDINATES SHOWN HEREON ARE IN MARYLAND COORDINATE SYSTEM NAD 83/91 BASED ON THE HOWARD COUNTY GEODETIC CONTROL. HOWARD COUNTY MONUMENT NOS. 0084 AND 25CA WERE USED FOR THIS PROJECT. THE ELEVATIONS ARE IN NAVD88 BASED ON THE SAME CONTROL MONUMENT.
- WATER IS PUBLIC. CONTRACT #661-W&S & #38-W.
- SEWER IS PUBLIC. CONTRACT #541-S.
- STORM WATER MANAGEMENT FOR THE SITE IS PROVIDED BY A GREEN ROOF AND RAIN GARDEN.
- APPROXIMATE LOCATION OF EXISTING UTILITIES ARE SHOWN. THE CONTRACTOR SHALL TAKE ALL NECESSARY PRECAUTIONS TO PROTECT THE EXISTING UTILITIES AND MAINTAIN UNINTERRUPTED SERVICE. ANY DAMAGE INCURRED DUE TO CONTRACTOR'S OPERATION SHALL BE REPAIRED IMMEDIATELY AT THE CONTRACTOR'S EXPENSE. EXISTING UTILITIES ARE SHOWN BASED ON THE BEST AVAILABLE INFORMATION.
- A 100-YEAR FLOODPLAIN STUDY FOR THIS PROJECT IS NOT REQUIRED.
- NO WETLANDS ARE FOUND ON THIS PROJECT PER FIELD VISIT ON SEPTEMBER 28, 2006 BY PHRA.
- THE BOUNDARY SURVEY FOR THIS PROJECT WAS PREPARED BY PATTON HARRIS RUST & ASSOCIATES DATED NOVEMBER 2008.
- SUBJECT PROPERTY ZONED HO PER 02-02-04 COMPREHENSIVE ZONING PLAN AND THE COMP LITE ZONING AMENDMENTS DATED 7/28/06.
- THE CONTRACTOR SHALL TEST PIT EXISTING UTILITIES AT LEAST (5) DAYS BEFORE STARTING WORK SHOWN ON THESE DRAWINGS.
- CONTRACTOR IS SOLELY RESPONSIBLE FOR CONSTRUCTION MEANS, METHODS, TECHNIQUES, SEQUENCES, PROCEDURES, AND SAFETY PRECAUTIONS AND PROGRAMS.
- PIPE SHALL NOT BE INSTALLED BY THE CONTRACTOR UNTIL THE LENGTH CALLED FOR AT EACH STATION HAS BEEN APPROVED BY THE ENGINEER IN THE FIELD.
- NO PIPE SHALL BE LAID UNTIL LINES OF EXCAVATION HAVE BEEN BROUGHT WITHIN 6" OF FINISHED GRADE.
- ALL PIPE ELEVATIONS SHOWN ARE INVERT ELEVATIONS.
- PROFILE STATIONS SHALL BE ADJUSTED AS NECESSARY TO CONFORM TO PLAN DIMENSIONS.
- ALL FILL AREAS WITHIN ROADWAY AND UNDER STRUCTURES TO BE COMPACTED TO A MINIMUM OF 95% COMPACTION OF AASHTO T180.
- SITE LIGHTING IS PROPOSED WITH THIS PLAN AS APPROVED BY THE HISTORIC DISTRICT COMMISSION. LIGHT LOCATIONS ARE SHOWN ON THE SITE DEVELOPMENT PLAN.
- BASED ON AVAILABLE COUNTY MAPS AND RECORDS, THERE ARE HISTORIC STRUCTURES LOCATED ON THE SUBJECT PROPERTY. THE HISTORIC STRUCTURES ARE ST. PAUL'S CATHOLIC CHURCH (HO #547), CROGHAN HALL (HO #548), DOHONY HALL (HO #76), OLD ST. PETER'S RECTORY (HO #591), AND ST. PETER'S PARISH HOUSE (HO #298).
- ALL PAVING IS TO BE HOWARD COUNTY P-2 PAVING OR AS RECOMMENDED BY PROFESSIONAL GEOTECHNICAL ENGINEER.
- SEE SITE DETAILS SHEET FOR CURB AND GUTTER AND SIDEWALK DETAILS.
- ALL SIGN POSTS USED FOR TRAFFIC CONTROL SIGNS SHALL BE MOUNTED ON A 2" GALVANIZED STEEL, PERFORATED, SQUARE TUBE POST (14 GAUGE) INSERTED INTO A 2-1/2" GALVANIZED STEEL, PERFORATED, SQUARE TUBE SLEEVE (12 GAUGE) - 3' LONG. A GALVANIZED STEEL POLE CAP SHALL BE MOUNTED ON THE TOP OF EACH POST.
- OVERHEAD 80E POWER LINES ARE LOCATED IN THE VICINITY OF THE PROPOSED DEVELOPMENT.
- THIS PROJECT COMPLIES WITH THE REQUIREMENTS OF SECTION 16.1200 OF THE HOWARD COUNTY CODE FOR FOREST CONSERVATION FOR 0.04 ACRES OF AFFORESTATION PROVIDED BY A FEE-IN-LIEU IN THE AMOUNT OF \$1,307.00 AT \$0.75/SF.
- THIS PLAN HAS BEEN PREPARED IN ACCORDANCE WITH THE PROVISIONS OF SECTION 16.124 OF THE HOWARD COUNTY CODE AND THE LANDSCAPE MANUAL. FINANCIAL SURETY FOR THE REQUIRED LANDSCAPING HAS BEEN POSTED AS PART OF THE DPW DEVELOPER'S AGREEMENT IN THE AMOUNT OF \$4,200.00 FOR 8 SHADE TREES, 0 ORNAMENTAL TREES, 12 EVERGREEN TREES AND 0 SHRUBS.
- NO TRAFFIC STUDY IS REQUIRED WITH THIS PLAN AS NO INCREASE IN PEAK TRIPS WILL BE GENERATED WITH THIS PLAN. THE FUNCTIONS THAT THIS BUILDING PROVIDES ARE ALREADY PROVIDED ELSEWHERE ON THE CAMPUS, AND WILL BE MOVED FROM THEIR CURRENT SUBSTANDARD LOCATIONS TO THIS NEW SPACE. DUE TO THE ACTIVITIES THAT THE NEW BUILDING WILL HOUSE, THE NEW BUILDING WILL BE UTILIZED AT OFF-PEAK HOURS, GENERALLY IN THE EVENINGS OR ON SUNDAY MORNINGS, AND SO WILL NOT CONTRIBUTE TO PEAK HOUR TRAFFIC.
- NO ADDITIONAL PARKING IS PROPOSED OR REQUIRED WITH THE EVANGELIZATION CENTER EXPANSION IN ACCORDANCE WITH THE REQUIREMENTS OF SECTION 114.2.6 OF THE ZONING REGULATIONS. THE EXISTING PARKING IS SUFFICIENT FOR THE PROPOSED STRUCTURE. USE OF THE PROPOSED FACILITY WILL OCCUR WHEN OTHER FACILITIES ARE NOT AT PEAK USE OR WILL BE USED BY USERS ALREADY AT THE SITE USING ONE OF THE OTHER SITE FACILITIES.
- NO DUMPSTER IS PROPOSED FOR THIS PROJECT. ALL TRASH FROM THE PROPOSED BUILDING WILL BE ACCOMMODATED IN THE EXISTING WASTE FACILITIES.
- THIS PROJECT IS SUBJECT TO THE FOLLOWING DPZ FILES: WP-90-047, SDP-91-104, WP-91-148, WP-94-059, WP-95-118, WP-10-017, & WP-10-156. WP-95-118 WAS FILED TO WAIVE THE SDP REQUIREMENTS FOR A SCHOOL ADDITION (SECTION 16.155.3.1) AND WAS APPROVED ON MAY 19, 1995. WP-91-148 WAS FILED TO GRADE WITHIN STEEP SLOPES. ALL FILES FOR WP-91-148 HAVE BEEN DISCARDED BY HOWARD COUNTY. WP-91-104 WAS FILED TO WAIVE SDP REQUIREMENTS FOR A PARKING LOT. ALL FILES FOR WP-91-104 HAVE BEEN DISCARDED BY HOWARD COUNTY. WP-94-059 WAS FILED TO WAIVE SDP REQUIREMENTS FOR A SCHOOL ADDITION. ALL FILES FOR WP-94-059 HAVE BEEN DISCARDED BY HOWARD COUNTY. WP-00-17 WAS FILED TO WAIVE SDP REQUIREMENTS FOR A NON-RESIDENTIAL ADDITION (SECTION 16.155.3.1) AND WAS APPROVED ON OCTOBER 6, 1999. ALL FILES FOR WP-90-047 HAVE BEEN DISCARDED BY HOWARD COUNTY.
- THE REQUIRED HISTORIC DISTRICT (HDC) MEETING FOR NEW DEVELOPMENT LOCATED WITHIN AN HISTORIC IN HOWARD COUNTY, MARYLAND WAS HELD ON FEBRUARY 3, 2010 CONCERNING THE PROPOSED DEVELOPMENT. THE HDC MEETING MINUTES ARE INCLUDED AND ARE ON FILE WITH THIS SUBMISSION.
- THE PROPOSED BUILDING IS TO BE FULLY SPRINKLERED.
- THE EVANGELIZATION CENTER EXPANSION IS NOT REQUIRED BY HOWARD COUNTY REGULATIONS TO MEET GREEN BUILDING DESIGN STANDARDS.
- ALL EXTERIOR LIGHT FIXTURES SHALL BE ORIENTED TO DIRECT LIGHT INWARDS AND DOWNWARDS ON-SITE AWAY FROM ALL ADJOINING RESIDENTIAL PROPERTIES AND PUBLIC ROADS AND SHALL BE IN COMPLIANCE WITH THE LIGHT TRESPASS LIMIT OF 0.5 FOOT CANDLES ONTO ANY OTHER ADJOINING PROPERTY ZONED OR USED FOR RESIDENTIAL PURPOSES IN ACCORDANCE WITH SECTION 134 OF THE HOWARD COUNTY ZONING REGULATIONS.
- CONSTRUCTION ON THIS SITE HAS BEEN DESIGNED TO BE IN ACCORDANCE WITH SECTION 114.2.D.2.e OF THE HO (HISTORIC OFFICE) DISTRICT OF THE ZONING REGULATIONS. THE PROPOSED EVANGELIZATION CENTER HAS A FRONT YARD EQUAL IN DEPTH TO THE FRONT YARD OF THE MAIN PART OF THE EXISTING CHURCH OFFICES WHICH IS THE NEAREST STRUCTURE ON THE SAME SIDE OF THE STREET.
- 5,880 SF OF ON-SITE AND OFF-SITE CONTIGUOUS 25% OR GREATER STEEP SLOPES EXIST WITHIN THE PROJECT AREA. THE STEEP SLOPES ARE UNREGULATED SINCE THEIR CONTIGUOUS ON-SITE AND OFF-SITE AREA IS LESS THAN 20,000 SF IN SIZE.
- BURIAL GROUNDS AND CEMETERIES DO NOT EXIST ON SITE.
- A SCENIC ROAD EXHIBIT IS ON FILE WITH THIS SUBMISSION. THIS SITE HAS BEEN DESIGNED IN ACCORDANCE WITH THE REQUIREMENTS OF SECTION 16.125 - PROTECTION OF SCENIC ROADS - OF THE SUBDIVISION REGULATIONS.
- WAIVER PETITION WP-10-156 WAS APPROVED ON MAY 27, 2010 TO WAIVE SECTION 16.1202.1.111 FOREST CONSERVATION - LIMITATION ON SITE AREA TO EXCLUDE PREVIOUSLY DEVELOPED AREAS. APPROVAL OF THE WAIVER PETITION IS SUBJECT TO THE FOLLOWING CONDITIONS:
  - THE FOREST CONSERVATION OBLIGATION FOR THIS SITE SHALL BE LIMITED TO THE 0.28± ACRES OF DISTURBANCE AND THAT THE CORRESPONDING OBLIGATION SHALL BE SATISFIED BY THE PAYMENT OF A FEE-IN-LIEU.
  - COMPLIANCE WITH ALL SRC AGENCY COMMENTS GENERATED WITH THE REVIEW OF THE SITE DEVELOPMENT PLAN, SDP-10-069.

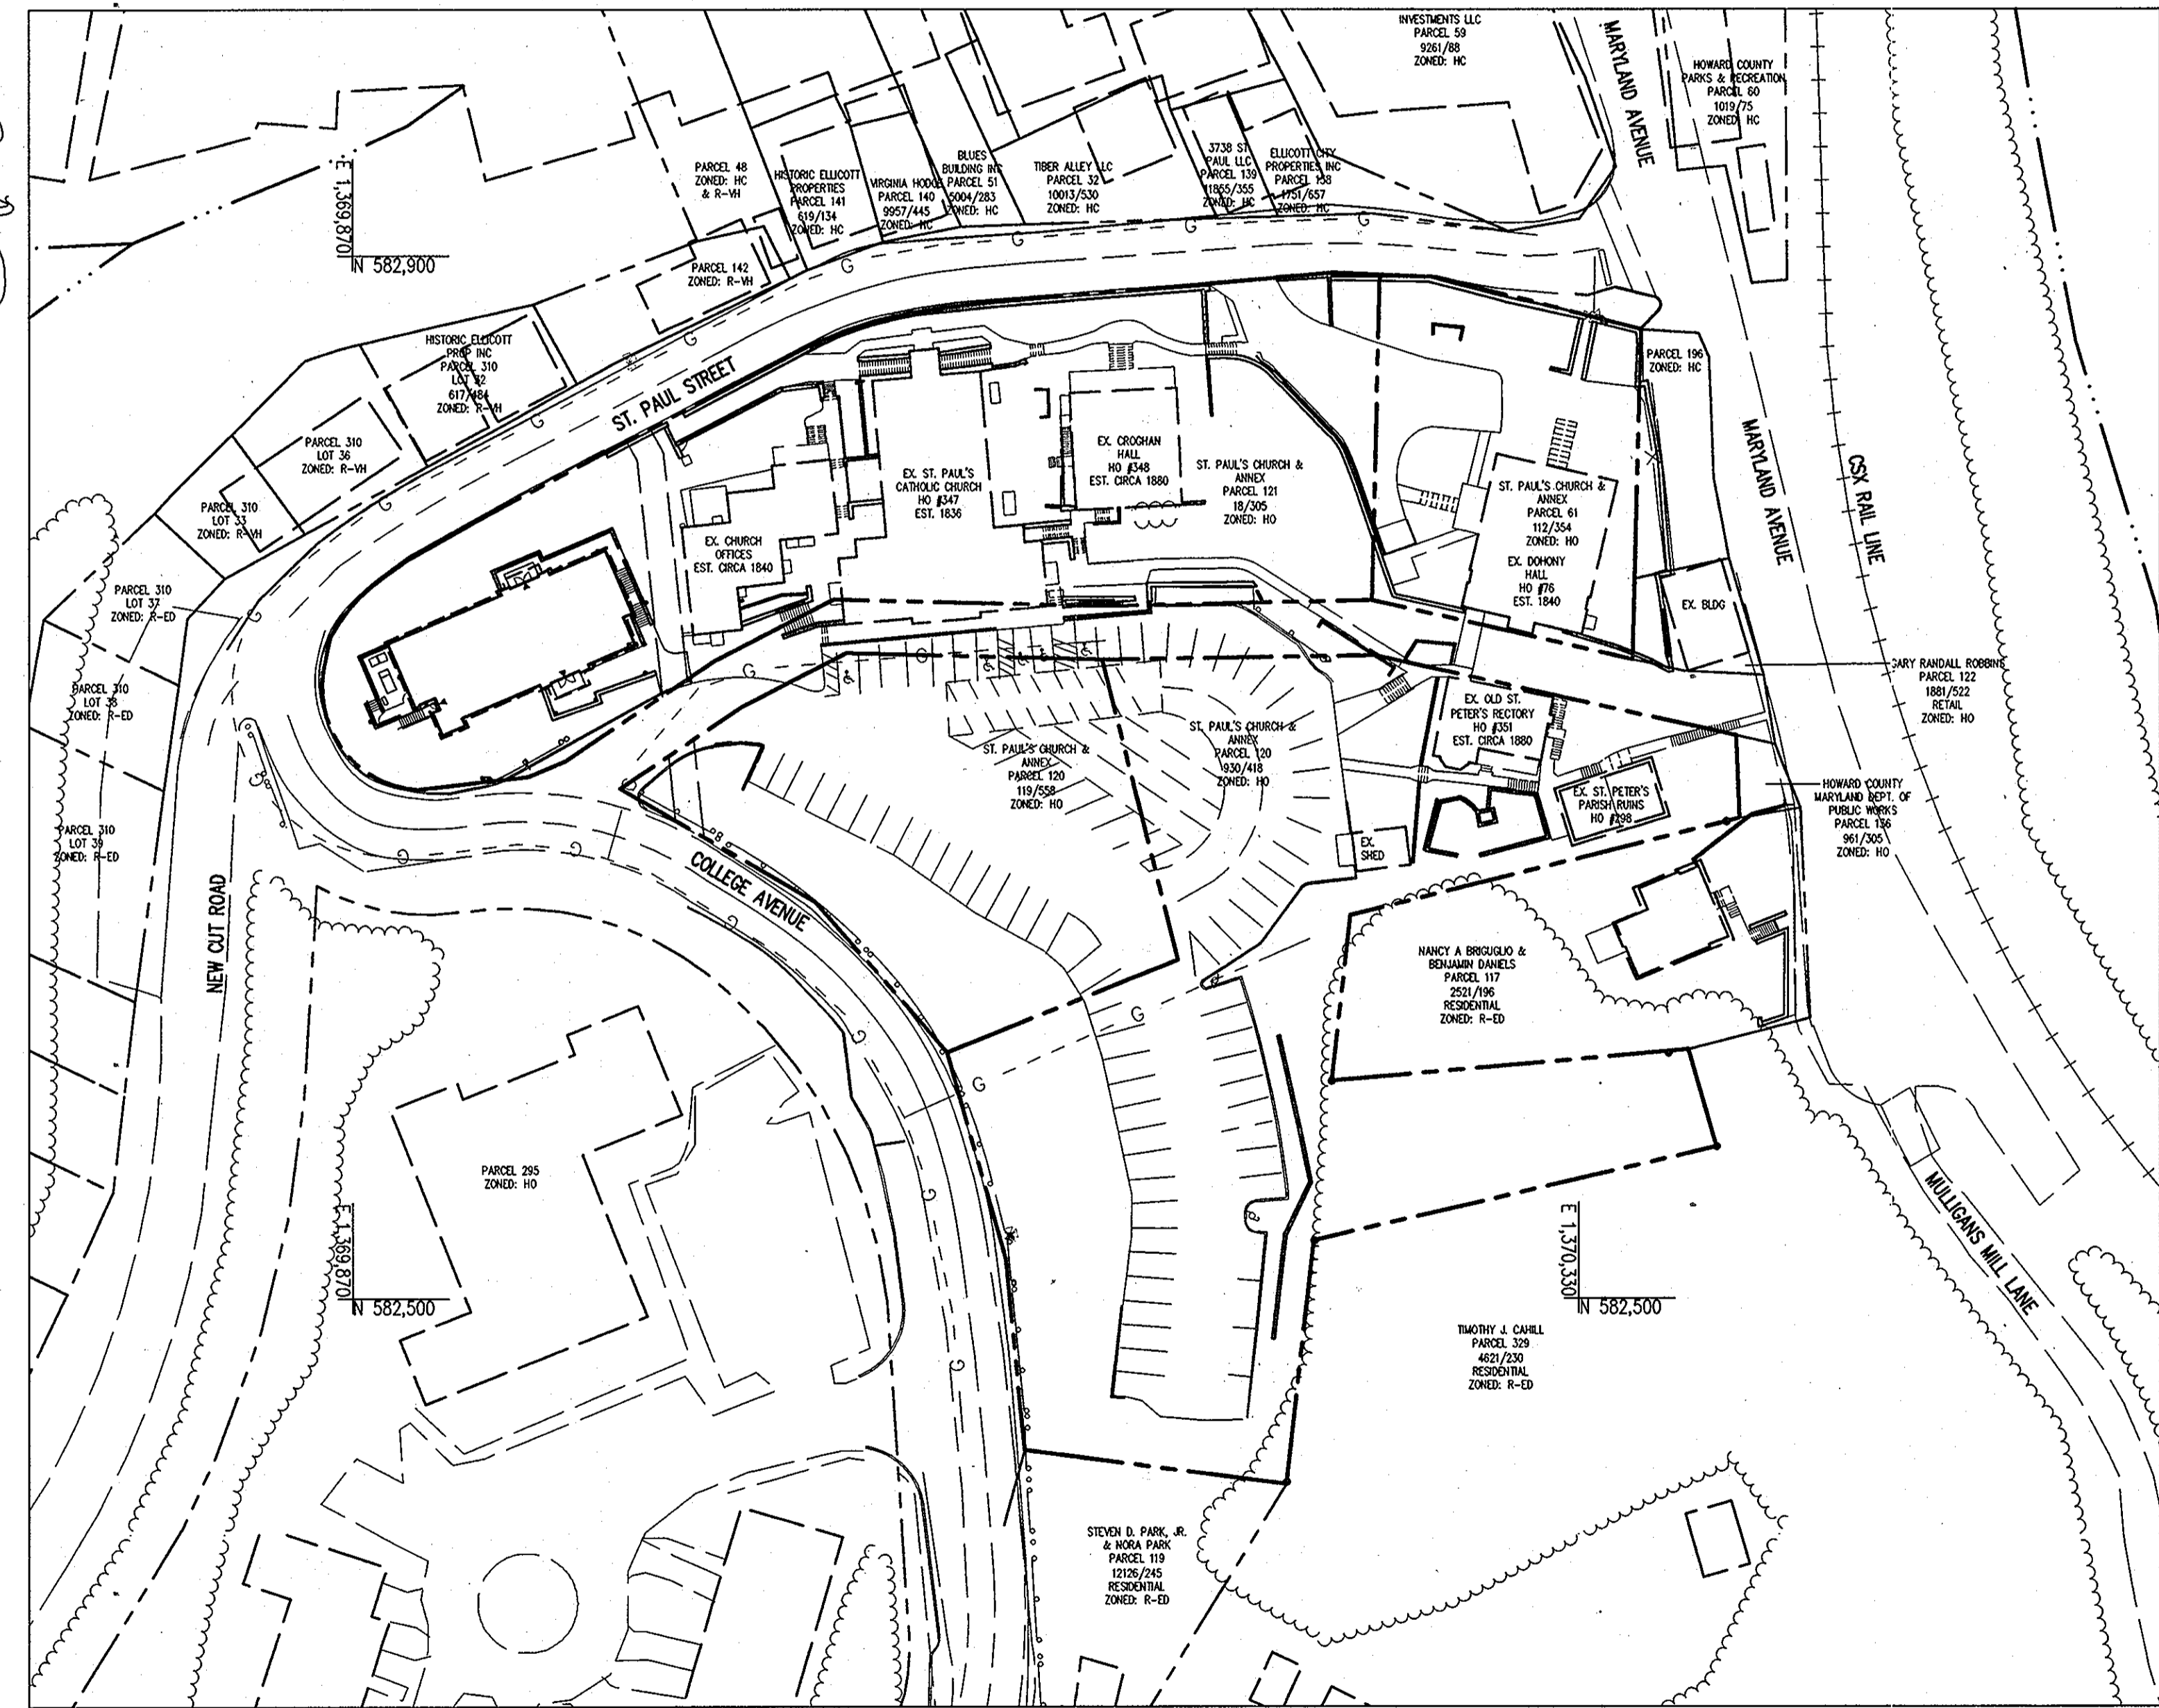


PLAN  
SCALE: 1" = 50'

**AS-BUILT CERTIFICATION**

I HEREBY CERTIFY THAT THE FACILITY SHOWN ON THIS PLAN WAS CONSTRUCTED AS SHOWN ON THE "AS-BUILT" PLANS AND MEETS THE APPROVED PLANS AND SPECIFICATIONS.

JAMES A. RUFF  
PRINTED NAME  
#21774  
MD PE NO.  
10/23/12  
DATE

STATE OF MARYLAND  
PROFESSIONAL ENGINEER  
LICENSE NO. 21774  
EXPIRATION DATE: 11-10-2013

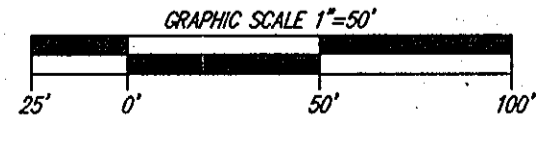

I HEREBY CERTIFY THAT THESE DOCUMENTS WERE PREPARED OR APPROVED BY ME, AND THAT I AM A DULY LICENSED PROFESSIONAL ENGINEER UNDER THE LAWS OF THE STATE OF MARYLAND, LICENSE NO. 21774. EXPIRATION DATE: 11-10-2013

SEE SHEET 16 FOR ARCHITECTURAL ELEVATIONS.

CALL "MISS UTILITY" AT LEAST 48 HOURS IN ADVANCE OF CONSTRUCTION AT 1-800-257-7777


#### PERMIT INFORMATION CHART

PARCEL NUMBER	STREET ADDRESS
121	3765 ST. PAUL STREET

DEVELOPMENT	SECT./AREA	PARCEL			
ST. PAUL'S CATHOLIC CHURCH EVANGELIZATION CENTER		61, 120, & 121			
PLAT NO. OR L/F	GRID #	ZONING	TAX MAP NO.	ELECT. DIST.	CENSUS TRACT
00832/0029		HO	25-A	2	602700


**Patton Harris Rust & Associates**  
Engineers, Surveyors, Planners, Landscape Architects.  
8818 Centre Park Drive  
Columbia, MD 21045  
T 410.997.8900  
F 410.997.9282

DESIGNED BY: JSN  
DRAWN BY: JSN  
PROJECT NO: 14867-1-0  
DATE: SEPTEMBER 13, 2010  
SCALE: 1"=50'  
DRAWING NO. 1 OF 18

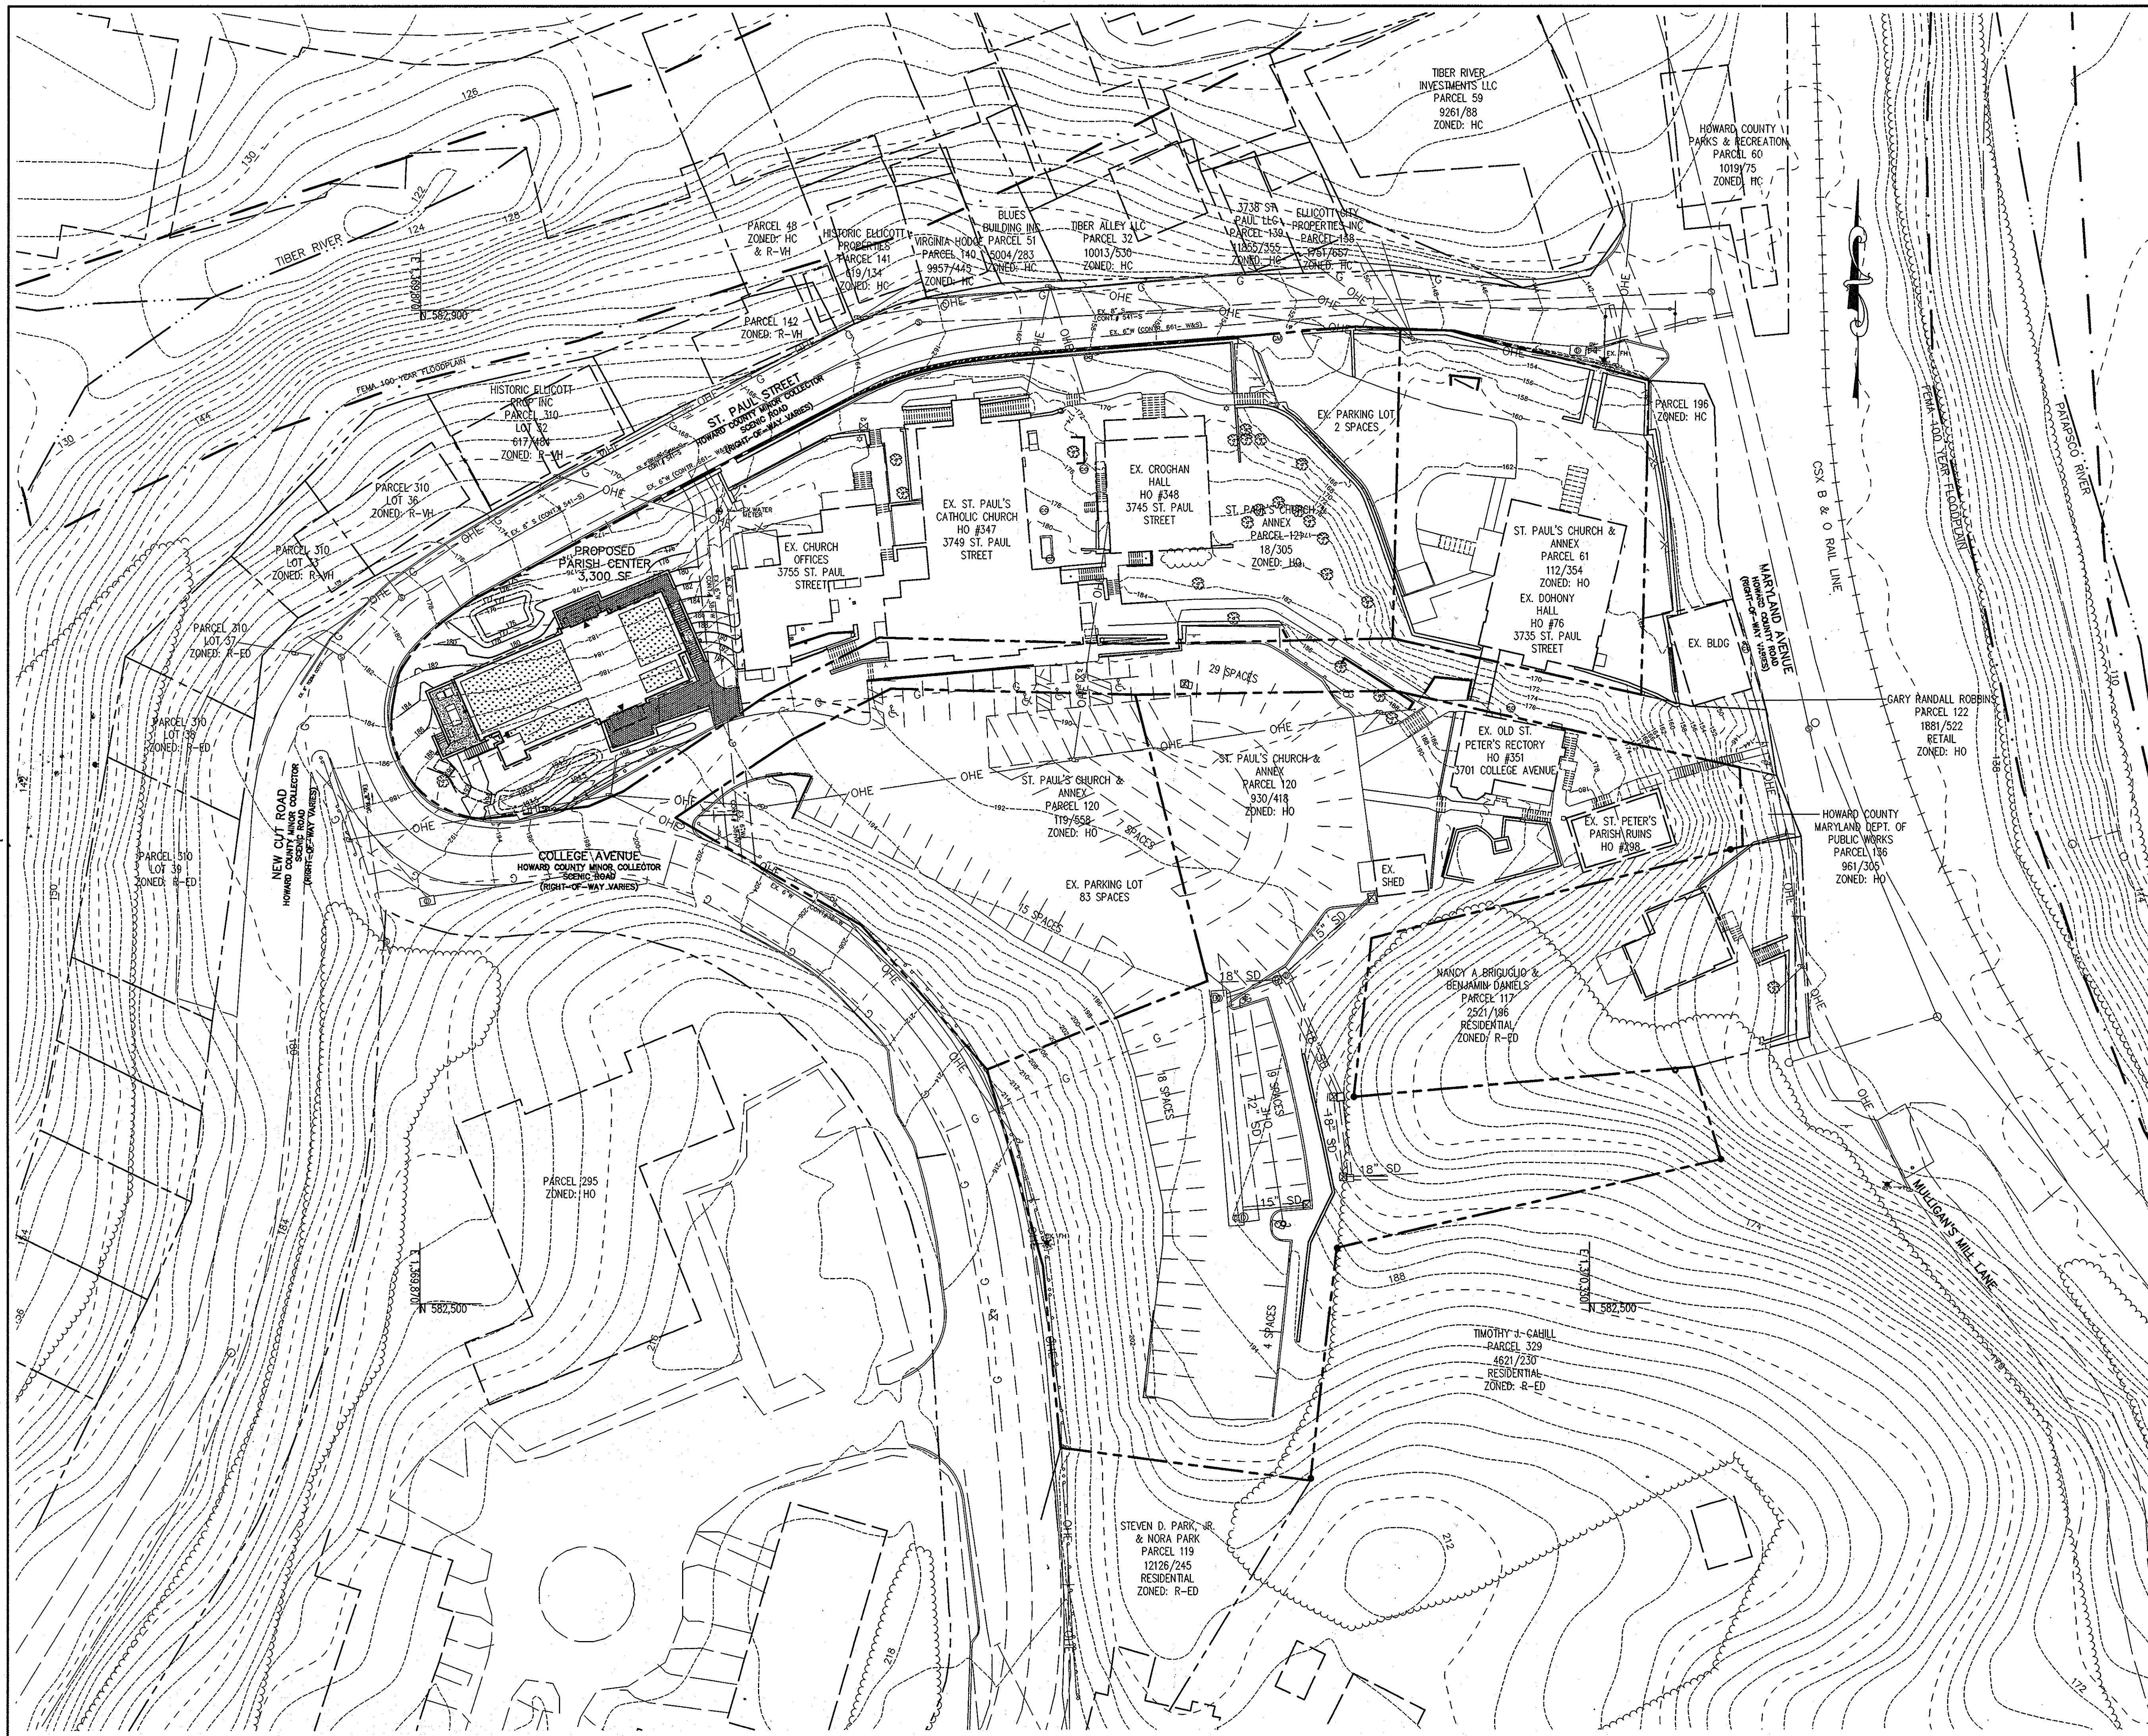

**LEGEND**

EXISTING 2' CONTOUR	---	302
EXISTING 10' CONTOUR	---	300
PROPOSED 2' CONTOUR	---	302
PROPOSED 10' CONTOUR	---	300
PROPERTY LINE AND RIGHT OF WAY	---	
EX. TREELINE	---	
EX. FIRE HYDRANT	⊕	
EX. OVERHEAD WIRES	---	OHE
EX. BUILDING	---	
PROP. BUILDING	---	
EX. CURB & GUTTER	---	
PROP. CURB & GUTTER	---	
EX. STORM DRAIN	---	
EX. SEWER	---	
EX. WATER METER	⊕	
PROPOSED GREEN ROOF	---	

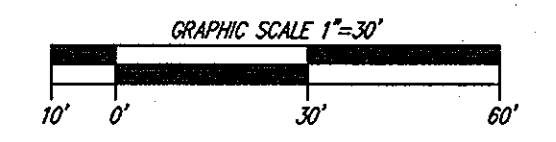

CALL "MISS UTILITY" AT LEAST 48 HOURS IN ADVANCE OF CONSTRUCTION AT 1-800-257-7777

APPROVED : HOWARD COUNTY DEPARTMENT OF PLANNING AND ZONING.

*Thomas S. Butler* 12/21/10  
 DIRECTOR DATE  
*Shel Chanda* 12/15/10  
 CHIEF, DEVELOPMENT ENGINEERING DIVISION HCP DATE  
*Kevin S. DeLoach* 12-21-10  
 CHIEF, DIVISION OF LAND DEVELOPMENT DATE

DATE	NO.	REVISION

OWNER  
 DOUG JOHNSON  
 ST. PAUL'S CHURCH & ANNEX  
 3675 COLLEGE AVE  
 ELLICOTT CITY MD 21043-4655  
 (410) 547-5340

DEVELOPER  
 DOUG JOHNSON  
 ST. PAUL'S CHURCH & ANNEX  
 3675 COLLEGE AVE  
 ELLICOTT CITY MD 21043-4655  
 (410) 547-5340

PROJECT **ST. PAUL'S CATHOLIC CHURCH EVANGELIZATION CENTER**

AREA TAX MAP 25-A PARCELS 61, 120, & 121  
 2nd ELECTION DISTRICT ZONED HO  
 HOWARD COUNTY, MARYLAND

TITLE  
**OVERALL SITE DEVELOPMENT PLAN**

**Patton Harris Rust & Associates**  
 Engineers, Surveyors, Planners, Landscape Architects.  
 8818 Centre Park Drive  
 Columbia, MD 21045  
 T 410.997.8900  
 F 410.997.9282

SEAL  
  
 DESIGNED BY JSN  
 DRAWN BY: JSN  
 PROJECT NO : 14867-1-0  
 DATE : SEPTEMBER 13, 2010  
 SCALE : 1"=30'  
 DRAWING NO. 2 OF 18



**LEGEND**

- EXISTING 2' CONTOUR
- EXISTING 10' CONTOUR
- PROPERTY LINE AND RIGHT OF WAY
- EX. TREELINE
- EX. FIRE HYDRANT
- EX. OVERHEAD WIRES
- EX. BUILDING
- EX. SOILS
- EX. CURB & GUTTER
- EX. STORM DRAIN
- EX. SEWER
- EX. WATER METER
- 15-25% SLOPES
- >25% SLOPES
- EXISTING TREES
- EXISTING PUBLIC SHA RIGHT-OF-WAY

**GENERAL NOTES**

1. THERE IS NO EXISTING FOREST ON SITE.
2. THERE ARE NO SPECIMEN TREES ON SITE.
3. THERE ARE NO STREAMS OR WETLANDS ON SITE.
4. THERE ARE NO REGULATED 25% STEEP SLOPES ON SITE.
5. THE EXISTING CAMPUS IS COMPRISED OF EXISTING LAMN AREA AND SCATTERED TREES. TREE TYPES INCLUDE CEDAR, SPRUCE, MAPLES, AND OTHER TYPICAL LANDSCAPE PLANT VARIETIES.

**SOILS CHART**

MAP SYMBOL	NAME	STRUCTURAL LIMITATIONS Dwellings w/ Basements	EROSION HAZARD	HYDRIC (Yes/No)	SLOPE (%)
LeC	Legore Silt Loam	Somewhat limited	Moderate	No	8-15
MgD	Manor-Bannertown Sandy Loams	Very limited	High	No	15-25
MgF	Manor-Bannertown Sandy Loams	Very limited	High	No	25-65

SOURCE: SOIL INFORMATION TAKEN FROM THE NATURAL RESOURCES CONSERVATION SERVICE WEB SOIL SURVEY.

APPROVED : HOWARD COUNTY DEPARTMENT OF PLANNING AND ZONING.

*Thomas E. Buttle* 12/10  
 DIRECTOR DATE

*Paul Church* 12/15/10  
 CHIEF, DEVELOPMENT ENGINEERING DIVISION DATE

*Kent S. Deane* 12-21-10  
 CHIEF, DIVISION OF LAND DEVELOPMENT DATE

DATE	NO.	REVISION

OWNER  
 DOUG JOHNSON  
 ST. PAUL'S CHURCH & ANNEX  
 3675 COLLEGE AVE  
 ELLICOTT CITY MD 21043-4655  
 (410) 547-5340

DEVELOPER  
 DOUG JOHNSON  
 ST. PAUL'S CHURCH & ANNEX  
 3675 COLLEGE AVE  
 ELLICOTT CITY MD 21043-4655  
 (410) 547-5340

PROJECT **ST. PAUL'S CATHOLIC CHURCH EVANGELIZATION CENTER**

AREA TAX MAP 25-A PARCELS 61, 120, & 121  
 2nd ELECTION DISTRICT ZONED HO  
 HOWARD COUNTY, MARYLAND


TITLE **EXISTING CONDITIONS & SOILS PLAN**


**Patton Harris Rust & Associates**  
 Engineers, Surveyors, Planners, Landscape Architects.  
 8818 Centre Park Drive  
 Columbia, MD 21045  
 T 410.997.8900  
 F 410.997.9282

SEAL

DESIGNED BY : JSN  
 DRAWN BY : JSN  
 PROJECT NO : 148671-0  
 DATE : SEPTEMBER 13, 2010  
 SCALE : 1"=10'  
 DRAWING NO. 3 OF 18


CALL "MISS UTILITY" AT LEAST 48 HOURS IN ADVANCE OF CONSTRUCTION AT 1-800-257-7777

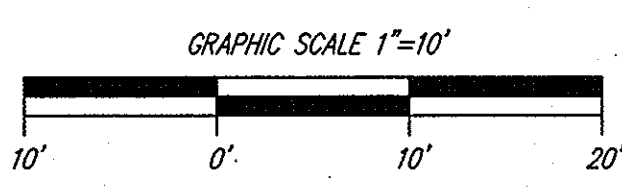

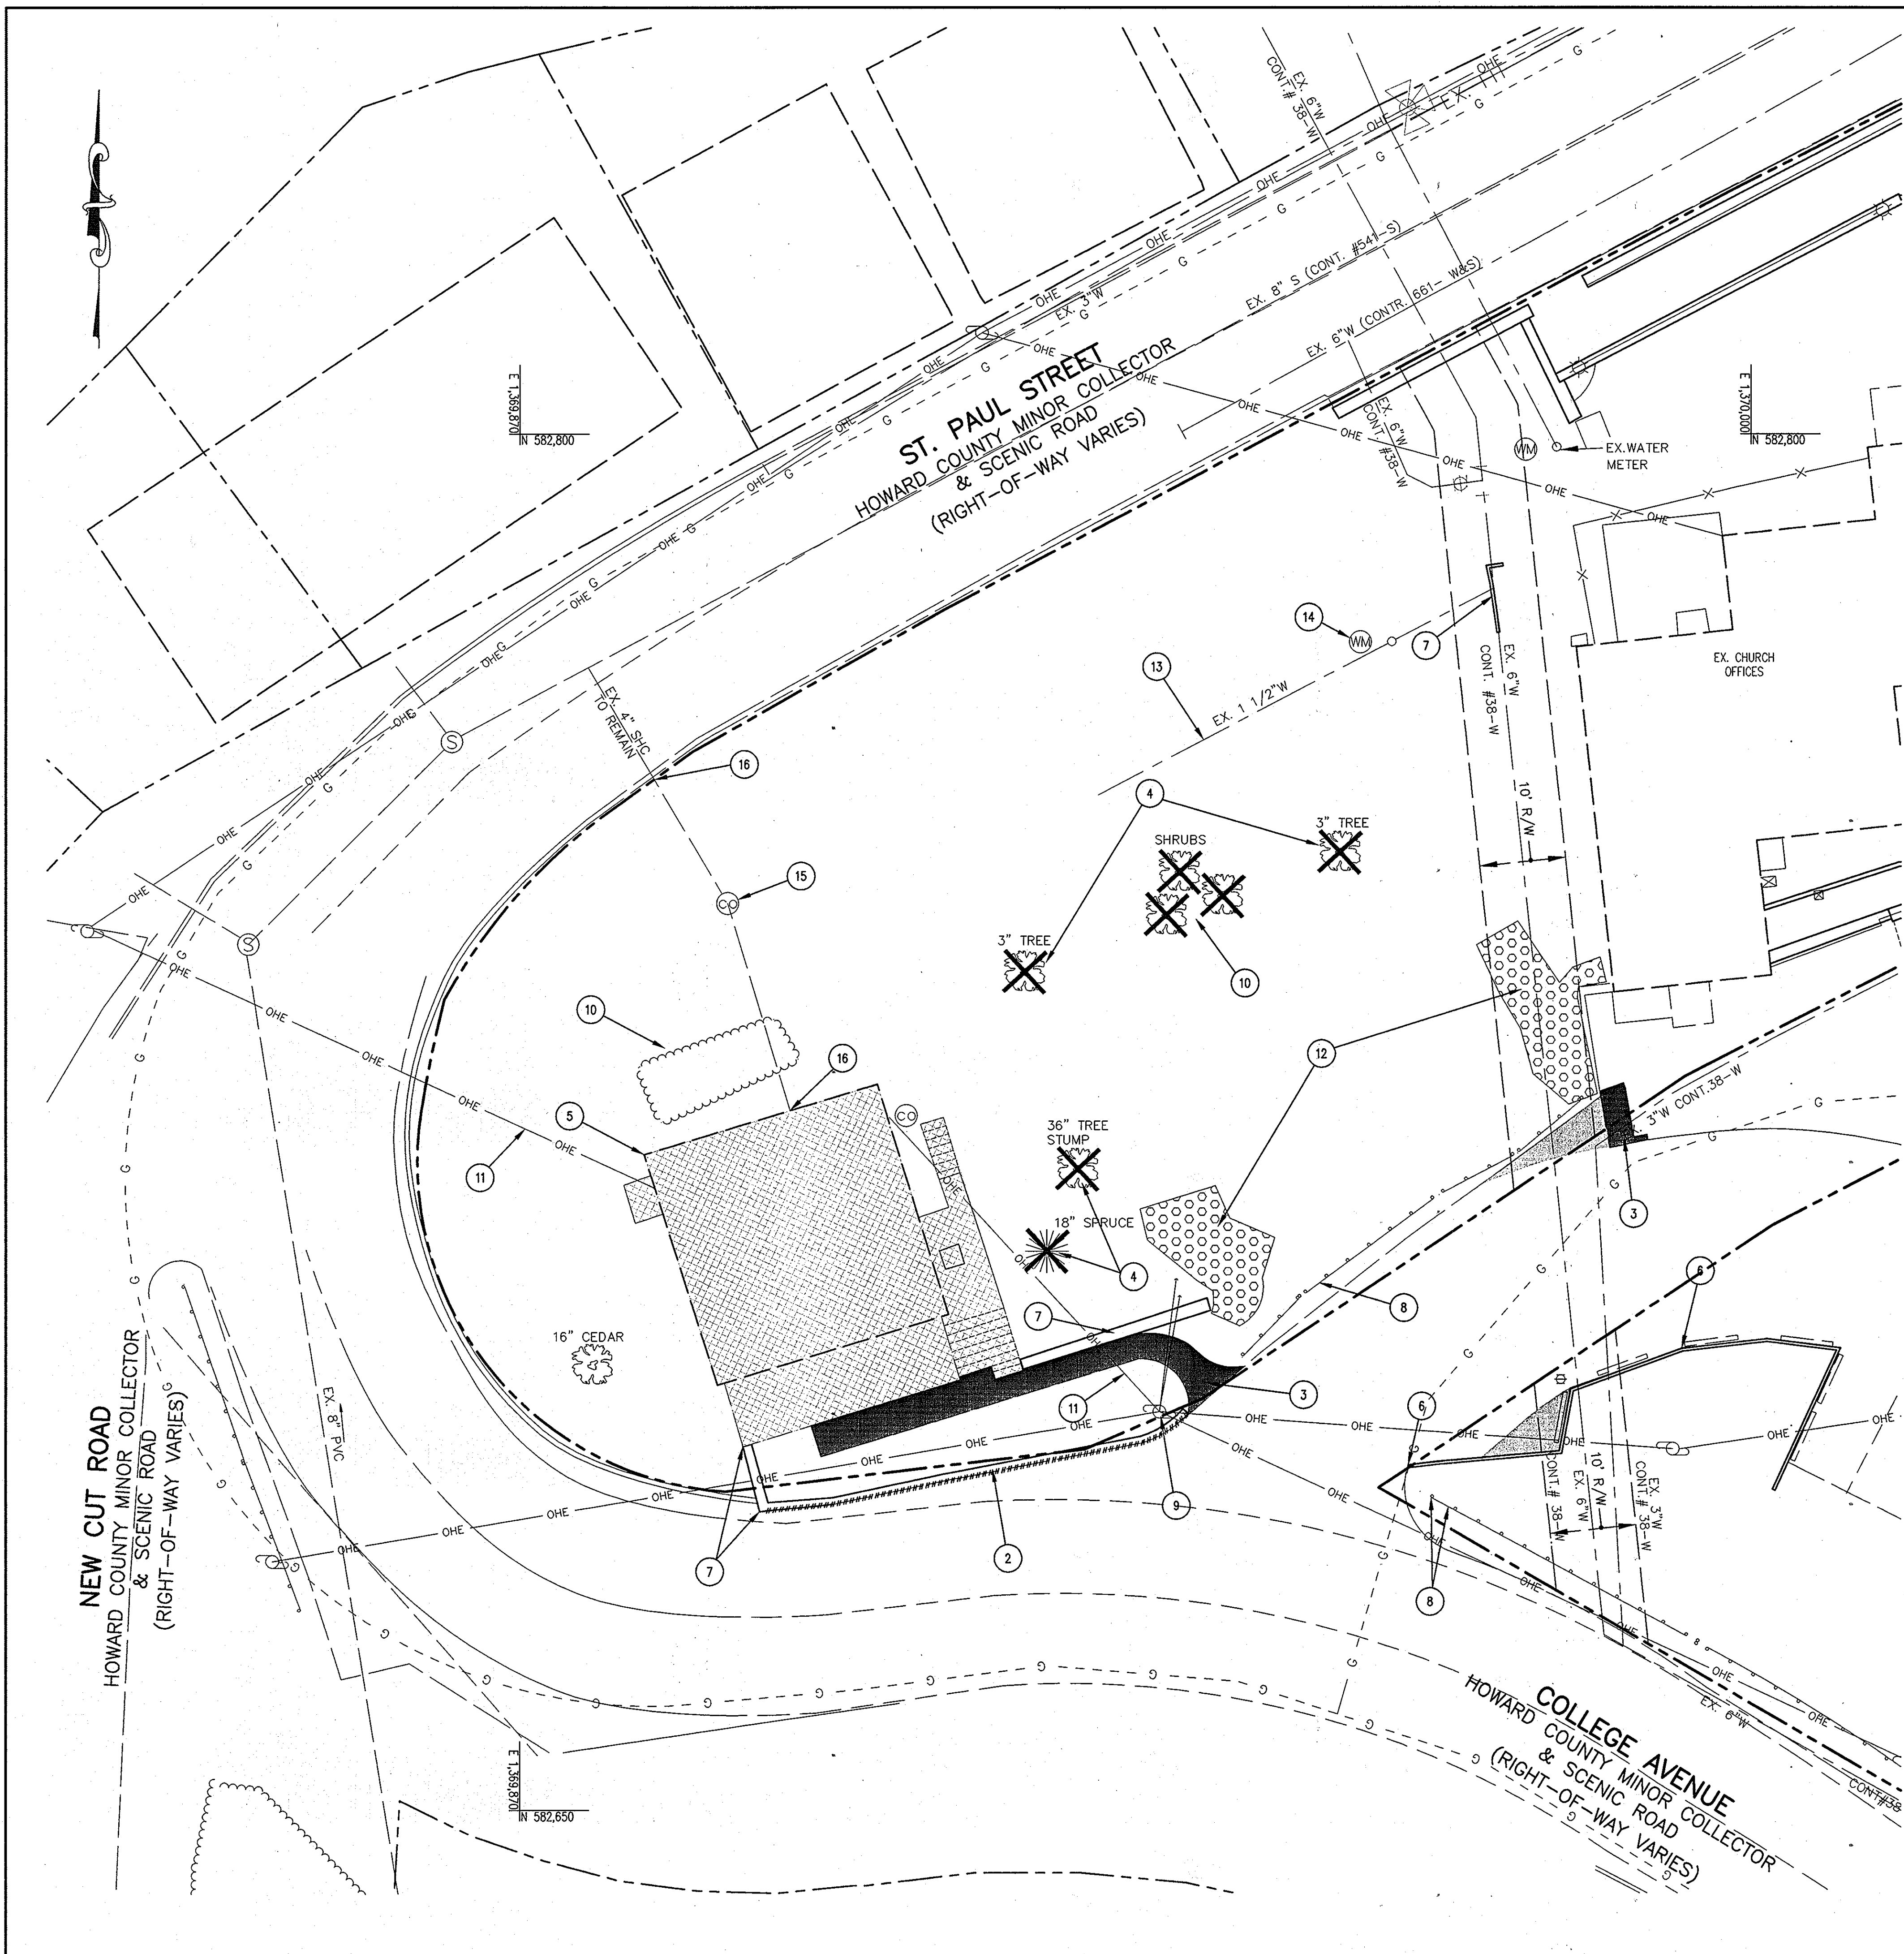

**DEMOLITION KEY:**


- |                                     |  |
|-------------------------------------|--|
| 1 REMOVE EXISTING BITUMINOUS PAVING | 9 RELOCATE EXISTING UTILITY POLE   |
| 2 REMOVE EXISTING CONCRETE CURB     | 10 REMOVE EXISTING SHRUBS  |
| 3 REMOVE EXISTING SIDEWALK          | 11 ABANDON EXISTING UTILITY SERVICE  |
| 4 REMOVE EXISTING TREE              | 12 REMOVE EXISTING RIP RAP   |
| 5 REMOVE EXISTING BUILDING          | 13 REMOVE EXISTING WATER LINE TO MAIN  |
| 6 REMOVE EXISTING TIMBER WALL       | 14 REMOVE EXISTING WATER METER   |
| 7 REMOVE EXISTING RETAINING WALL    | 15 REMOVE EXISTING CLEANOUT  |
| 8 REMOVE EXISTING GAIRD RAIL        | 16 REMOVE EXISTING 4" SEWER HOUSE CONNECTION TO RIGHT-OF-WAY FOR ST. PAUL STREET |

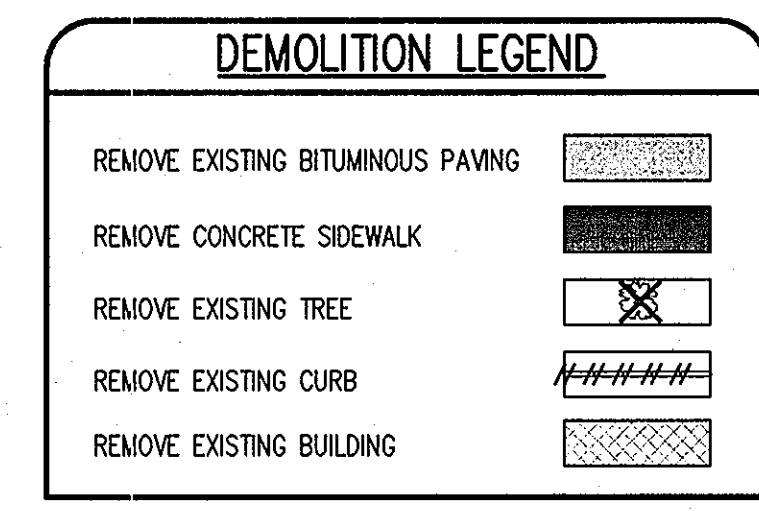

**DEMOLITION NOTES:**

- ALL MATERIALS DEMOLISHED, UNLESS IDENTIFIED TO BE SALVAGED (CONCRETE, PAVING, AND OTHER DEBRIS) SHALL BE REMOVED FROM THE SITE AND DISPOSED OF PER FEDERAL, STATE AND LOCAL REGULATIONS. ALL COSTS OF HAULING, DISPOSAL AND TIPPING FEES ARE THE RESPONSIBILITY OF THE CONTRACTOR AS PART OF THE BASE BID. ITEMS TO BE DEMOLISHED SHALL BE DISPOSED OF IN SUCH A MANNER AS TO MEET APPLICABLE LEED CERTIFICATION REQUIREMENTS.
- ALL MATERIALS IDENTIFIED TO BE SALVAGED/RELOCATED SHALL BE REMOVED WITH CARE TO MINIMIZE DAMAGE AND SHALL BE STORED ON SITE FOR REUSE OR FOR RETRIEVAL BY OWNER OR OWNER AGENT.
- ALL QUANTITIES OF DEMOLITION SHALL BE DETERMINED BY THE CONTRACTOR AND COVERED IN THE BASE BID. CONTRACTOR SHALL MAKE NECESSARY SITE INSPECTIONS PRIOR TO BID TO VERIFY ALL QUANTITIES TO HIS SATISFACTION.
- CONTRACTOR SHALL REFER TO SEPARATE PLANS IN THE CIVIL SERIES (SITE PLAN, STORMWATER MANAGEMENT PLAN, UTILITY PLAN, SEDIMENT CONTROL PLAN, ETC.) TO DETERMINE APPROPRIATE SEQUENCE OF ALL DEMOLITION ACTIVITIES.
- REFER TO SEPARATE PLANS FOR SEDIMENT AND EROSION CONTROL REQUIREMENTS.
- EXISTING UTILITY LINES HAVE BEEN SHOWN USING THE BEST AVAILABLE RECORDS OBTAINED FROM HOWARD COUNTY AND FIELD EVIDENCE. PRIOR TO COMMENCEMENT OF WORK, CONTRACTOR SHALL CALL MISS UTILITY TO LOCATE ALL UNDERGROUND UTILITY LINES AND SUPPLEMENT THOSE MARKINGS BY ENGAGING A PRIVATE UTILITY LOCATING COMPANY (AT CONTRACTOR'S EXPENSE) TO ENSURE THAT ALL EXISTING UTILITIES HAVE BEEN MARKED.
- ALL PAVEMENT TO BE REMOVED SHALL BE RECYCLED TO THE EXTENT REQUIRED BY GENERAL PROJECT CONDITIONS (LEED CERTIFICATION REQUIRED).
- THE TOTAL IMPERVIOUS AREA TO BE DEMOLISHED IS 0.03 AC (1,378 SF).
- EXISTING UTILITY POLE TO BE RELOCATED BY OTHERS. CONTRACTOR SHALL COORDINATE WITH UTILITY OWNERS.
- WATER METERS TO BE DISPOSED OF ACCORDING TO HOWARD COUNTY REQUIREMENTS.

CALL "MISS UTILITY" AT LEAST 48 HOURS IN ADVANCE OF CONSTRUCTION AT 1-800-257-7777

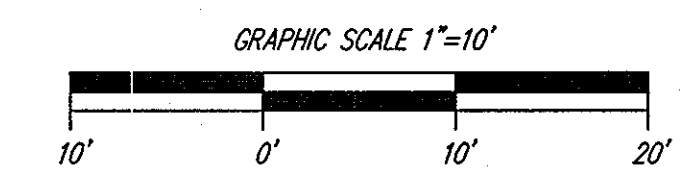

APPROVED : HOWARD COUNTY DEPARTMENT OF PLANNING AND ZONING.

*Mona E. Suttler* 12/21/10  
DIRECTOR DATE

*Paul Stedman* 12/15/10  
CHIEF, DEVELOPMENT ENGINEERING DIVISION DATE

*Walt Stedman* 12-21-10  
CHIEF, DIVISION OF LAND DEVELOPMENT DATE

DATE	NO.	REVISION

OWNER  
DOUG JOHNSON  
ST. PAUL'S CHURCH & ANNEX  
3675 COLLEGE AVE  
ELLICOTT CITY MD 21043-4655  
(410) 547-5340

DEVELOPER  
DOUG JOHNSON  
ST. PAUL'S CHURCH & ANNEX  
3675 COLLEGE AVE  
ELLICOTT CITY MD 21043-4655  
(410) 547-5340

PROJECT **ST. PAUL'S CATHOLIC CHURCH EVANGELIZATION CENTER**


AREA TAX MAP 25-A PARCELS 61, 120, & 121  
2nd ELECTION DISTRICT ZONED HO  
HOWARD COUNTY, MARYLAND

TITLE **DEMOLITION PLAN**

**Patton Harris Rust & Associates**  
Engineers, Surveyors, Planners, Landscape Architects.  
8818 Centre Park Drive  
Columbia, MD 21045  
T 410.997.8900  
F 410.997.9282


SEAL

DESIGNED BY : JSN  
DRAWN BY : JSN  
PROJECT NO : 14867-1-0  
DATE : SEPTEMBER 13, 2010  
SCALE : 1"=10'  
DRAWING NO. 4 OF 18

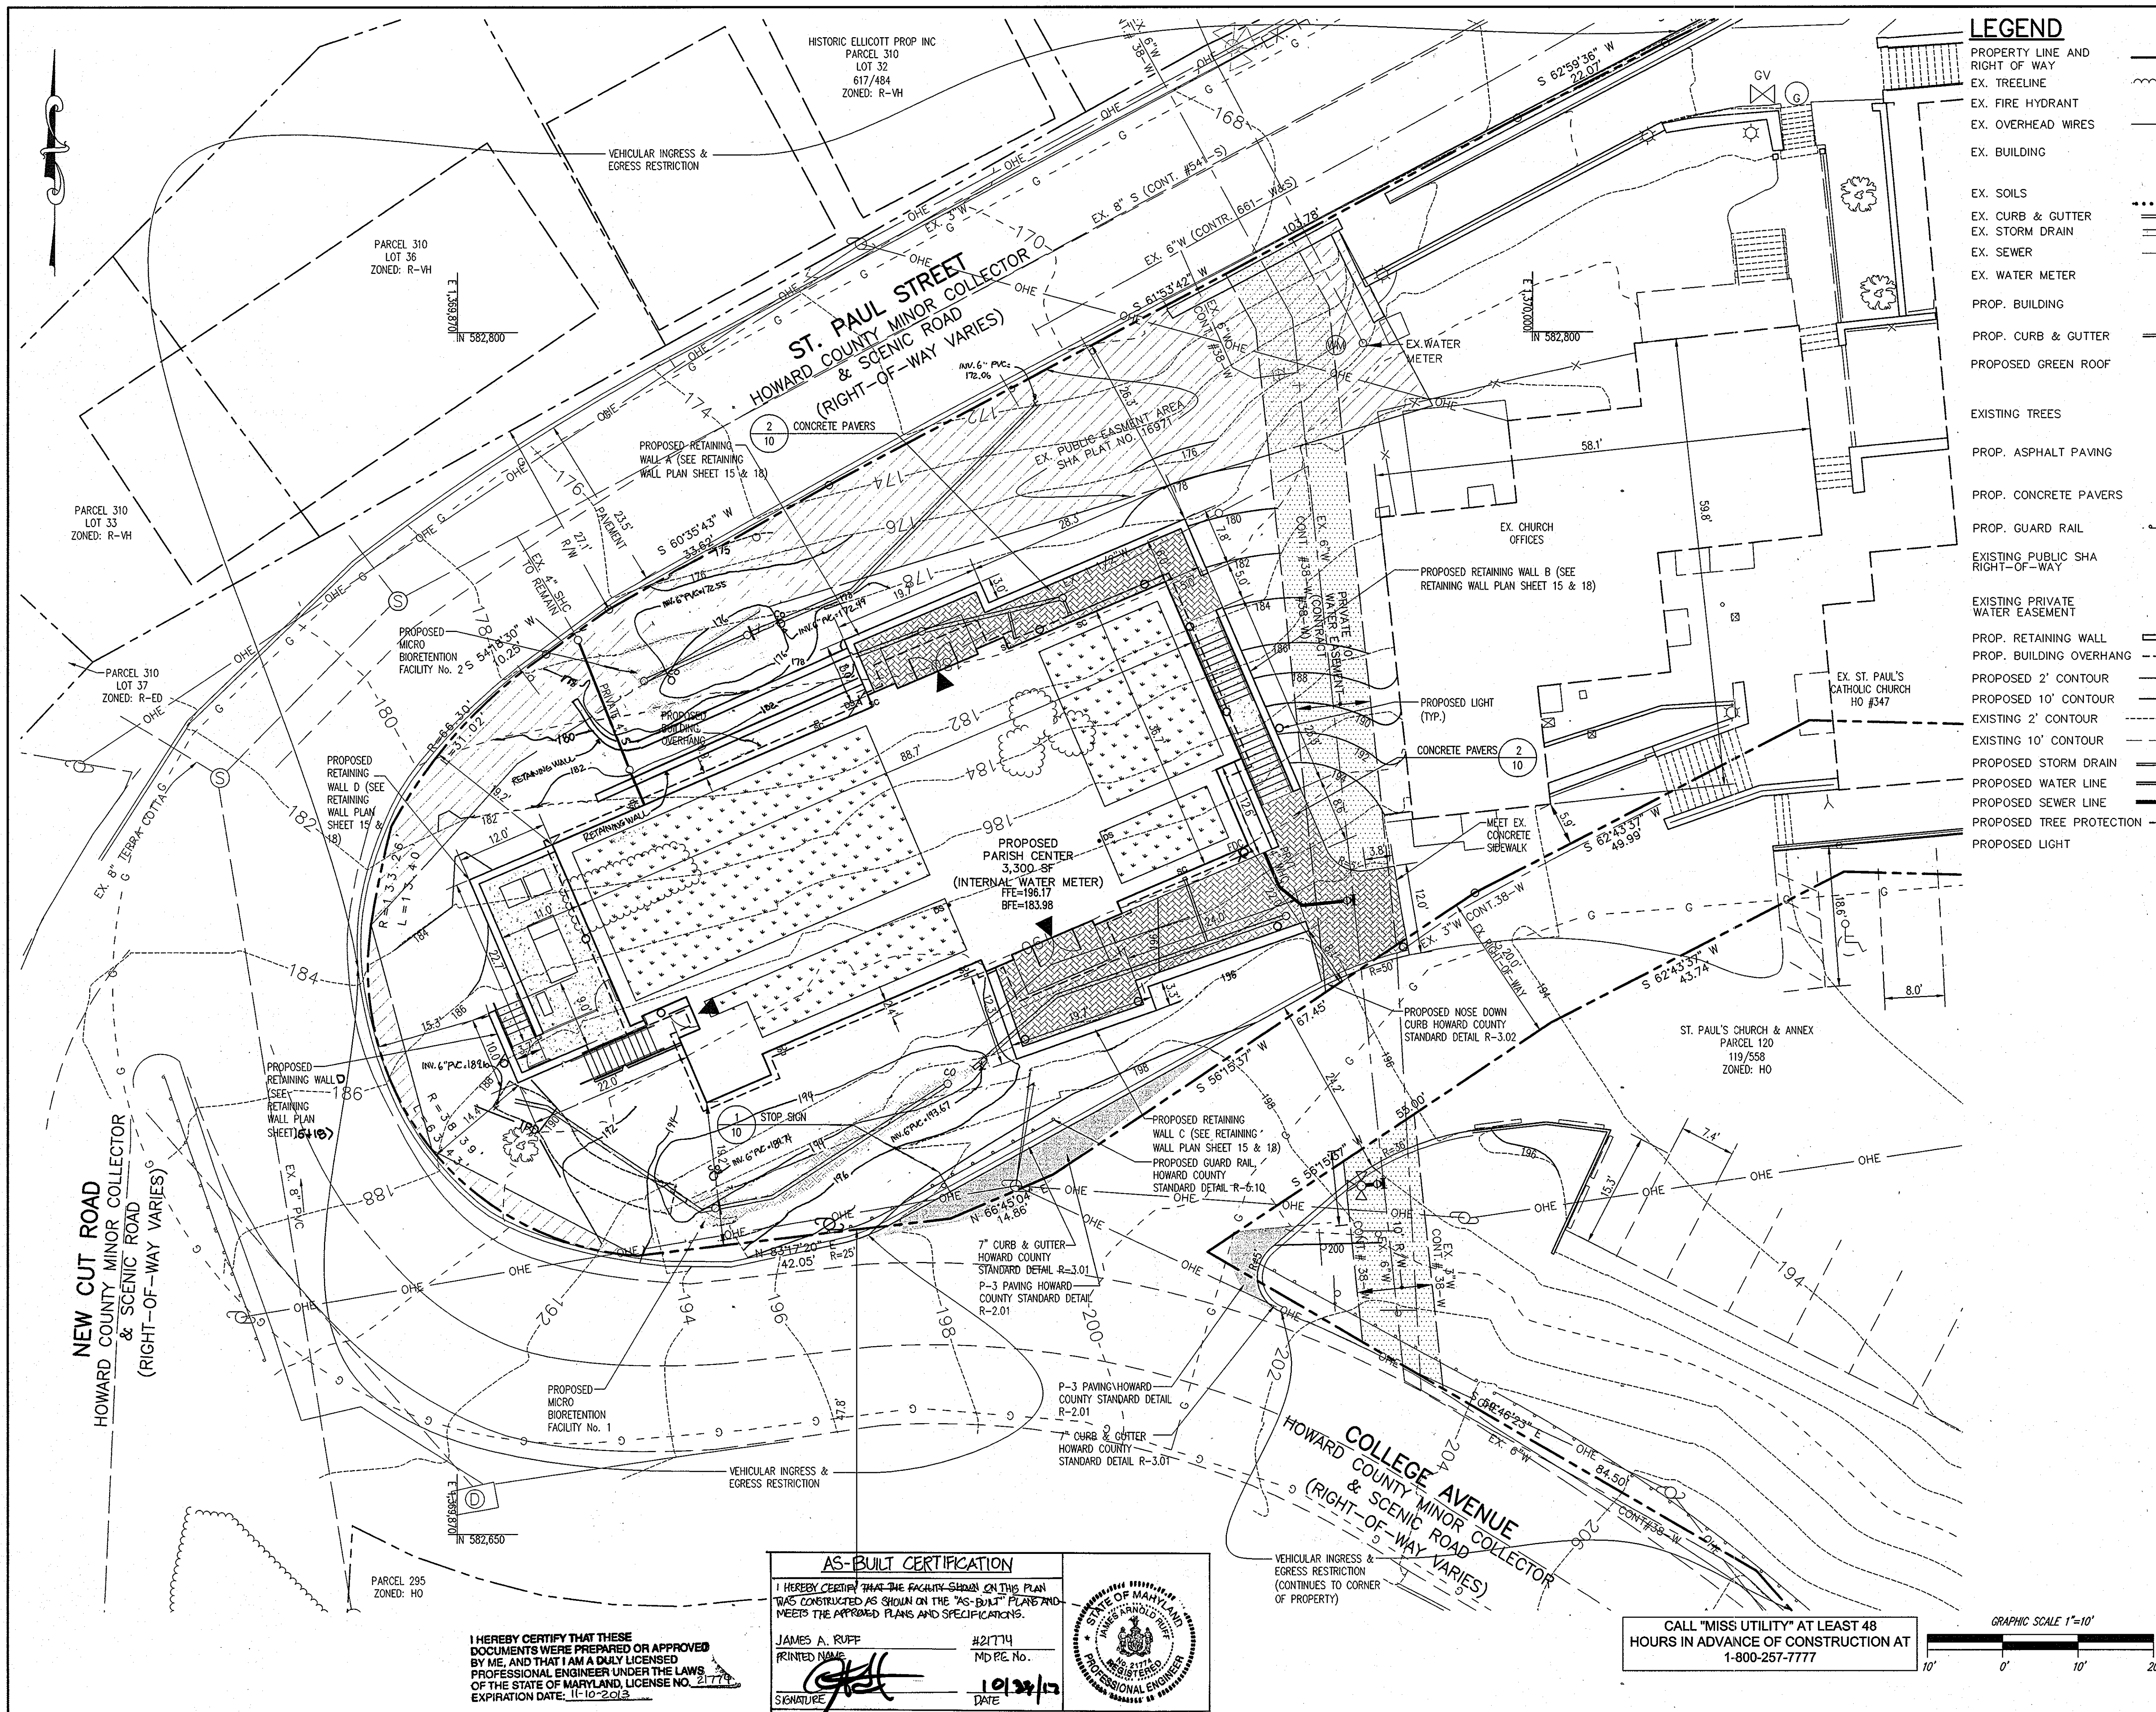

**LEGEND**

- PROPERTY LINE AND RIGHT OF WAY
- EX. TREELINE
- EX. FIRE HYDRANT
- EX. OVERHEAD WIRES
- EX. BUILDING
- EX. SOILS
- EX. CURB & GUTTER
- EX. STORM DRAIN
- EX. SEWER
- EX. WATER METER
- PROP. BUILDING
- PROP. CURB & GUTTER
- PROPOSED GREEN ROOF
- EXISTING TREES
- PROP. ASPHALT PAVING
- PROP. CONCRETE PAVERS
- PROP. GUARD RAIL
- EXISTING PUBLIC SHA RIGHT-OF-WAY
- EXISTING PRIVATE WATER EASEMENT
- PROP. RETAINING WALL
- PROP. BUILDING OVERHANG
- PROPOSED 2' CONTOUR
- PROPOSED 10' CONTOUR
- EXISTING 2' CONTOUR
- EXISTING 10' CONTOUR
- PROPOSED STORM DRAIN
- PROPOSED WATER LINE
- PROPOSED SEWER LINE
- PROPOSED TREE PROTECTION
- PROPOSED LIGHT

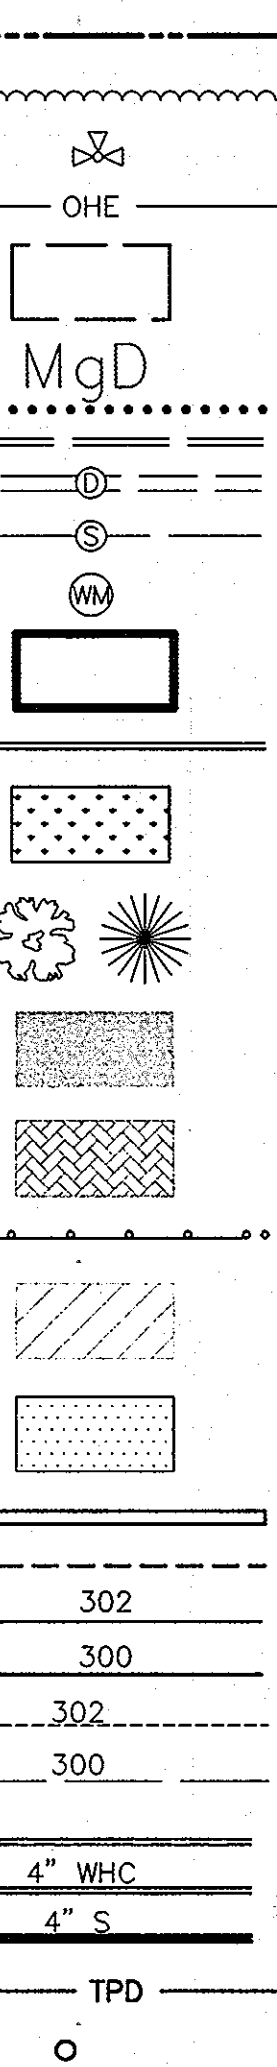

**AS-BUILT**

APPROVED : HOWARD COUNTY DEPARTMENT OF PLANNING AND ZONING.

*Thomas J. Ruttle* 12/21/10 DATE  
DIRECTOR

*John E. Smith* 12-15-10 DATE  
CHIEF, DEVELOPMENT ENGINEERING DIVISION

*Kevin J. Shindler* 12-21-10 DATE  
CHIEF, DIVISION OF LAND DEVELOPMENT

DATE	NO.	REVISION

OWNER

DOUG JOHNSON  
ST. PAUL'S CHURCH & ANNEX  
3675 COLLEGE AVE  
ELLCOTT CITY MD 21043-4655  
(410) 547-5340

DEVELOPER

DOUG JOHNSON  
ST. PAUL'S CHURCH & ANNEX  
3675 COLLEGE AVE  
ELLCOTT CITY MD 21043-4655  
(410) 547-5340

PROJECT **ST. PAUL'S CATHOLIC CHURCH EVANGELIZATION CENTER**

AREA TAX MAP 25-A PARCELS 61, 120, & 121  
2nd ELECTION DISTRICT ZONED HO  
HOWARD COUNTY, MARYLAND

TITLE **SITE DEVELOPMENT PLAN**

**Patton Harris Rust & Associates**  
Engineers, Surveyors, Planners, Landscape Architects.  
8818 Centre Park Drive  
Columbia, MD 21045  
T 410.997.8900  
F 410.997.9282

DESIGNED BY : JSN  
DRAWN BY : JSN  
PROJECT NO : 14867-1-0  
DATE : SEPTEMBER 13, 2010  
SCALE : 1"=10'  
DRAWING NO. 5 OF 18

**AS-BUILT CERTIFICATION**


I HEREBY CERTIFY THAT THE FACILITY SHOWN ON THIS PLAN WAS CONSTRUCTED AS SHOWN ON THE "AS-BUILT" PLANS AND MEETS THE APPROVED PLANS AND SPECIFICATIONS.

JAMES A. RUFF #21774  
PRINTED NAME MD PE No.  
*[Signature]* 10/22/10  
SIGNATURE DATE

I HEREBY CERTIFY THAT THESE DOCUMENTS WERE PREPARED OR APPROVED BY ME, AND THAT I AM A DAILY LICENSED PROFESSIONAL ENGINEER UNDER THE LAWS OF THE STATE OF MARYLAND, LICENSE NO. 21774, EXPIRATION DATE: 11-10-2012.

CALL "MISS UTILITY" AT LEAST 48 HOURS IN ADVANCE OF CONSTRUCTION AT 1-800-257-7777

GRAPHIC SCALE 1"=10'

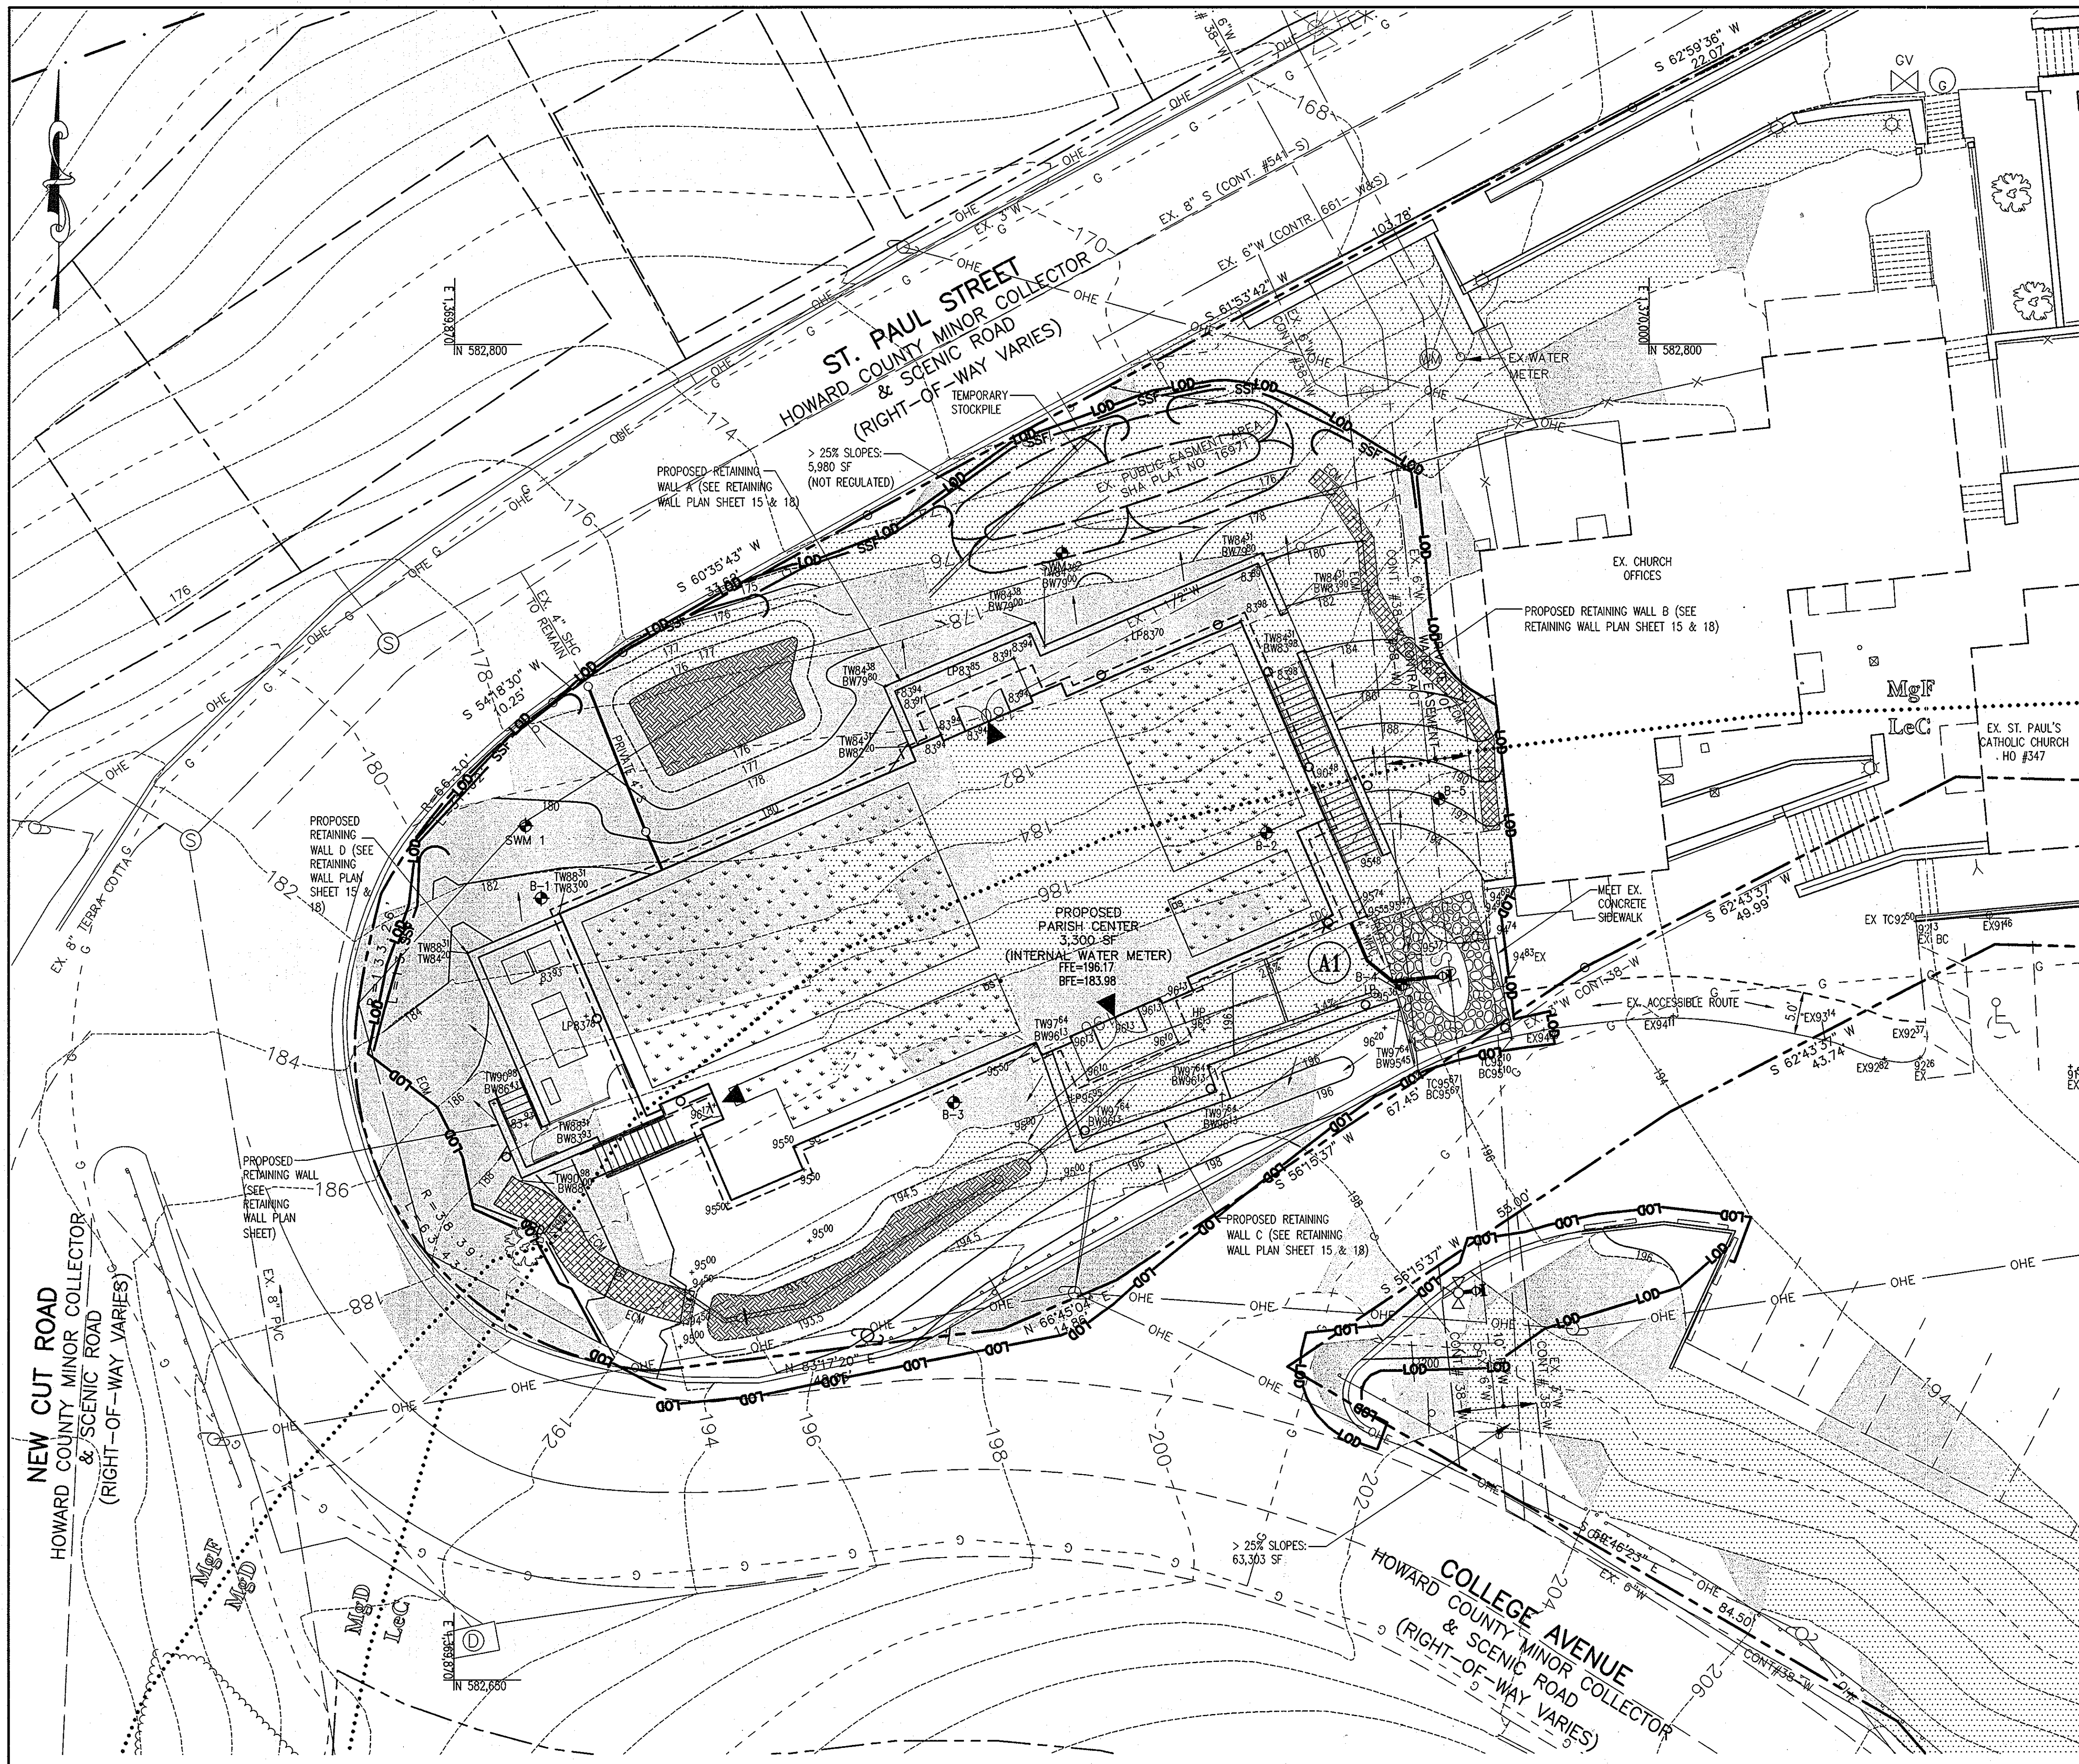

**LEGEND**

EXISTING 2' CONTOUR	---
EXISTING 10' CONTOUR	---
PROPERTY LINE AND RIGHT OF WAY	---
EX. TRELINE	---
EX. FIRE HYDRANT	⊗
EX. OVERHEAD WIRES	OHE
EX. BUILDING	▭
EX. SOILS	MgD
EX. CURB & GUTTER	---
EX. STORM DRAIN	---
EX. POWER POLE	---
SUPER SILT FENCE	SSF
EROSION CONTROL MATTING (ECM)	ECM
PROPOSED GREEN ROOF	---
SOIL BORINGS	B-4
EX. SEWER	---
EX. WATER METER	---
PROP. BUILDING	▭
PROP. CURB & GUTTER	---
PROPOSED 2' CONTOUR	---
PROPOSED 10' CONTOUR	---
LIMIT OF DISTURBANCE	---
15-25% SLOPES	---
>25% SLOPES	---
EX. GAUDDRAIL	---
STABILIZED CONSTRUCTION ENTRANCE	SCE
PROP. TREE PROTECTION	TPD

**NOTE:**  
A DOUBLE ROW OF SUPER SILT FENCE IS TO BE PLACED ALONG ST. PAUL STREET AT THE DIRECTION OF THE SEDIMENT CONTROL INSPECTOR.

**BY THE DEVELOPER:**  
I/WE CERTIFY THAT ALL DEVELOPMENT AND CONSTRUCTION WILL BE DONE ACCORDING TO THIS PLAN, AND THAT ANY RESPONSIBLE PERSONNEL INVOLVED IN THE CONSTRUCTION PROJECT WILL HAVE A CERTIFICATE OF ATTENDANCE AT A DEPARTMENT OF THE ENVIRONMENT APPROVED TRAINING PROGRAM FOR THE CONTROL OF SEDIMENT AND EROSION BEFORE BEGINNING THE PROJECT. I ALSO AUTHORIZE PERIODIC ON-SITE INSPECTIONS BY THE HOWARD SOIL CONSERVATION DISTRICT.  
*Michael P. Rozanski*  
DEVELOPER  
Near Rev. Mitchell T. Rozanski, Vice-Parish

**BY THE ENGINEER:**  
I CERTIFY THAT THIS PLAN FOR EROSION AND SEDIMENT CONTROL REPRESENTS A PRACTICAL AND WORKABLE PLAN BASED ON MY PERSONAL KNOWLEDGE OF THE SITE CONDITIONS AND THAT IT WAS PREPARED IN ACCORDANCE WITH THE REQUIREMENTS OF THE HOWARD SOIL CONSERVATION DISTRICT.  
*John R. Robinson*  
ENGINEER

THIS DEVELOPMENT PLAN IS APPROVED FOR SOIL EROSION AND SEDIMENT CONTROL BY THE HOWARD SOIL CONSERVATION DISTRICT.  
*John R. Robinson*  
HOWARD SOIL CONSERVATION DISTRICT

APPROVED: HOWARD COUNTY DEPARTMENT OF PLANNING AND ZONING.  
*Thomas J. Swindle*  
DIRECTOR

*John P. Swindle*  
CHIEF, DEVELOPMENT ENGINEERING DIVISION  
*West Swindle*  
CHIEF, DIVISION OF LAND DEVELOPMENT

DATE	NO.	REVISION

**OWNER**  
DOUG JOHNSON  
ST. PAUL'S CHURCH & ANNEX  
3675 COLLEGE AVE  
ELLCOTT CITY MD 21043-4655  
(410) 547-5340

**DEVELOPER**  
DOUG JOHNSON  
ST. PAUL'S CHURCH & ANNEX  
3675 COLLEGE AVE  
ELLCOTT CITY, MD 21043-4655  
(410) 547-5340

**PROJECT** ST. PAUL'S CATHOLIC CHURCH EVANGELIZATION CENTER  
**AREA** TAX MAP 25-A PARCELS 61, 120, & 121  
2nd ELECTION DISTRICT ZONED HO  
HOWARD COUNTY, MARYLAND

**TITLE** GRADING AND SEDIMENT CONTROL PLAN


**Patton Harris Rust & Associates**  
Engineers, Surveyors, Planners, Landscape Architects.  
**PHRA**  
8818 Centre Park Drive  
Columbia, MD 21045  
T 410.997.8900  
F 410.997.9282

**DESIGNED BY:** JSN  
**DRAWN BY:** JSN  
**PROJECT NO:** 14867-1-0  
**DATE:** SEPTEMBER 13, 2010  
**SCALE:** 1"=10'  
**DRAWING NO.:** 6 OF 18


**SOILS CHART**

MAP SYMBOL	NAME	STRUCTURAL LIMITATIONS Dwellings w/ Basements	EROSION HAZARD	HYDRIC (Yes/No)	SLOPE (%)
LeC	Legore Silt Loam	Somewhat limited	Moderate	No	8-15
MgD	Manor-Bannertown Sandy Loams	Very limited	High	No	15-25
MgF	Manor-Bannertown Sandy Loams	Very limited	High	No	25-65

SOURCE: SOIL INFORMATION TAKEN FROM THE NATURAL RESOURCES CONSERVATION SERVICE WEB SOIL SURVEY.

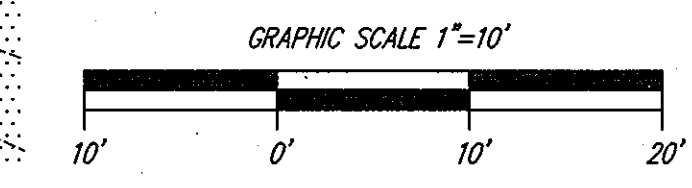

CALL "MISS UTILITY" AT LEAST 48 HOURS IN ADVANCE OF CONSTRUCTION AT 1-800-257-7777

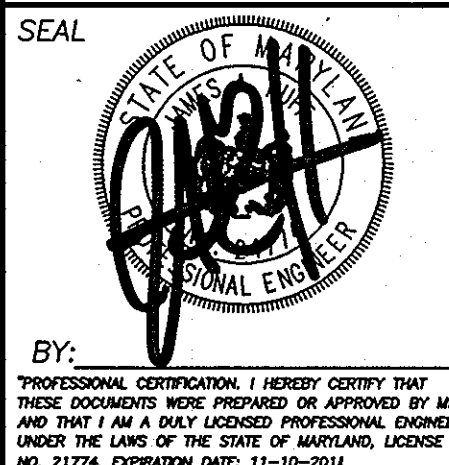

**STANDARD SEDIMENT CONTROL NOTES**

1. A MINIMUM OF 48 HOURS NOTICE MUST BE GIVEN TO THE HOWARD COUNTY DEPARTMENT OF INSPECTIONS, LICENSES AND PERMITS, SEDIMENT CONTROL DIVISION PRIOR TO THE START OF ANY CONSTRUCTION (313-1855).
2. ALL VEGETATIVE AND STRUCTURAL PRACTICES ARE TO BE INSTALLED ACCORDING TO THE PROVISIONS OF THIS PLAN AND ARE TO BE IN CONFORMANCE WITH THE 1994 MARYLAND STANDARDS AND SPECIFICATIONS FOR SOIL EROSION AND SEDIMENT CONTROL AND REVISIONS THEREOF.
3. FOLLOWING INITIAL SOIL DISTURBANCE OR RE-DISTURBANCE, PERMANENT OR TEMPORARY STABILIZATION SHALL BE COMPLETED WITHIN: A) 7 CALENDAR DAYS FOR ALL PERIMETER SEDIMENT CONTROL STRUCTURES, DIKES, PERIMETER SLOPES, AND ALL SLOPES STEEPER THAN 3:1, B) 14 DAYS AS 3:1, B) 14 DAYS AS 1:1 TO ALL OTHER DISTURBED OR GRADED AREAS ON THE PROJECT SITE.
4. ALL SEDIMENT TRAPS/BASINS SHOWN MUST BE FENCED AND WARNING SIGNS POSTED AROUND THE PERIMETER IN ACCORDANCE WITH VOL. 1, CHAPTER 7, OF THE HOWARD COUNTY DESIGN MANUAL, STORM DRAINAGE.
5. ALL DISTURBED AREAS MUST BE STABILIZED WITHIN THE TIME PERIOD SPECIFIED ABOVE IN ACCORDANCE WITH THE 1994 MARYLAND STANDARDS AND SPECIFICATIONS FOR SOIL EROSION AND SEDIMENT CONTROL FOR PERMANENT SEEDING, SO2, TEMPORARY SEEDING AND MULCHING (SEC. C.), TEMPORARY STABILIZATION WITH MULCH ALONE SHALL ONLY BE DONE WHEN RECOMMENDED SEEDING DATES DO NOT ALLOW FOR PROPER GERMINATION AND ESTABLISHMENT OF GRASSES.
6. ALL SEDIMENT CONTROL STRUCTURES ARE TO REMAIN IN PLACE AND ARE TO BE MAINTAINED IN OPERATIVE CONDITION UNTIL PERMISSION FOR THEIR REMOVAL HAS BEEN OBTAINED FROM THE HOWARD COUNTY SEDIMENT CONTROL INSPECTOR.
7. SITE ANALYSIS:
 

TOTAL AREA OF SITE	2.76 ACRES
AREA DISTURBED	0.27 ACRES
AREA TO BE PAVED/ROOFED	0.15 ACRES
AREA TO BE VEGETATIVELY STABILIZED	0.13 ACRES
TOTAL CUT	460 CU. YARDS
TOTAL FILL	180 CU. YARDS
8. ANY SEDIMENT CONTROL PRACTICE WHICH IS DISTURBED BY GRADING ACTIVITY FOR PLACEMENT OF UTILITIES MUST BE REPAIRED ON THE SAME DAY OF DISTURBANCE.
9. ADDITIONAL SEDIMENT CONTROLS MUST BE PROVIDED, IF DEEMED NECESSARY BY THE HOWARD COUNTY SEDIMENT CONTROL INSPECTOR.
10. ON ALL SITES WITH DISTURBED AREAS IN EXCESS OF 2 ACRES, APPROVAL OF THE INSPECTION AGENCY SHALL BE OBTAINED UPON COMPLETION OF INSTALLATION OF PERIMETER EROSION AND SEDIMENT CONTROLS, BUT BEFORE PROCEEDING WITH ANY OTHER EARTH DISTURBANCE OR GRADING. OTHER BUILDING OR GRADING INSPECTION APPROVALS MAY NOT BE AUTHORIZED UNTIL THIS INITIAL APPROVAL BY THE INSPECTION AGENCY IS MADE.
11. TRENCHES FOR THE CONSTRUCTION OF UTILITIES IS LIMITED TO THREE PIPE LENGTHS OR THAT WHICH SHALL BE BACK-FILLED AND STABILIZED WITHIN ONE WORKING DAY, WHICHEVER IS SHORTER.
12. SITE GRADING WILL BEGIN ONLY AFTER ALL PERIMETER SEDIMENT CONTROL MEASURES HAVE BEEN INSTALLED AND ARE IN A FUNCTIONING CONDITION.
13. SEDIMENT WILL BE REMOVED FROM TRAPS WHEN ITS DEPTH REACHES CLEAN OUT ELEVATION SHOWN ON THE PLANS.
14. CUT AND FILL QUANTITIES PROVIDED UNDER SITE ANALYSIS DO NOT REPRESENT BID QUANTITIES. THESE QUANTITIES DO NOT DISTINGUISH BETWEEN TOPSOIL, STRUCTURAL FILL OR EMBANKMENT MATERIAL, NOR DO THEY REFLECT CONSIDERATION OF UNDERCUTTING OR REMOVAL OF UNSUITABLE MATERIAL. THE CONTRACTOR SHALL FAMILIARIZE HIMSELF WITH SITE CONDITIONS WHICH MAY AFFECT THE WORK.

15. TRENCHES FOR THE CONSTRUCTION OF UTILITIES IS LIMITED TO THREE PIPE LENGTHS OR THAT WHICH SHALL BE BACK-FILLED AND STABILIZED WITHIN ONE WORKING DAY, WHICHEVER IS SHORTER.
16. SITE GRADING WILL BEGIN ONLY AFTER ALL PERIMETER SEDIMENT CONTROL MEASURES HAVE BEEN INSTALLED AND ARE IN A FUNCTIONING CONDITION.
17. SEDIMENT WILL BE REMOVED FROM TRAPS WHEN ITS DEPTH REACHES CLEAN OUT ELEVATION SHOWN ON THE PLANS.
18. CUT AND FILL QUANTITIES PROVIDED UNDER SITE ANALYSIS DO NOT REPRESENT BID QUANTITIES. THESE QUANTITIES DO NOT DISTINGUISH BETWEEN TOPSOIL, STRUCTURAL FILL OR EMBANKMENT MATERIAL, NOR DO THEY REFLECT CONSIDERATION OF UNDERCUTTING OR REMOVAL OF UNSUITABLE MATERIAL. THE CONTRACTOR SHALL FAMILIARIZE HIMSELF WITH SITE CONDITIONS WHICH MAY AFFECT THE WORK.

**TEMPORARY SEEDING NOTES**

APPLY TO GRADED OR CLEARED AREAS LIKELY TO BE REDISTURBED WHERE A SHORT-TERM VEGETATIVE COVER IS NEEDED. WHERE AREAS WILL NOT BE DISTURBED AGAIN IN THE SHORT TERM, USE PERMANENT SEEDING AS NOTED BELOW.

SEEDBED PREPARATION: LOOSEN UPPER THREE INCHES OF SOIL BY RAKING, DISCING OR OTHER ACCEPTABLE MEANS BEFORE SEEDING, IF NOT PREVIOUSLY LOOSENED.

SOIL AMENDMENTS: APPLY 600 LBS. PER ACRE 10-10-10 FERTILIZER (14 LBS. PER 1000 SQ.FT.).

SEEDING: FOR PERIODS MARCH 1 THRU APRIL 30 AND FROM AUGUST 15 THRU NOVEMBER 15, SEED WITH 2-1/2 BUSHELS PER ACRE OF ANNUAL RYE (3.2 LBS. PER 1000 SQ.FT.). FOR THE PERIOD MAY 1 THRU AUGUST 14, SEED WITH 10 LBS. PER ACRE OF FOXTAIL MILLET. FOR THE PERIOD NOVEMBER 16 THRU FEBRUARY 28, PROTECT SITE BY APPLYING 2 TONS PER ACRE OF WELL ANCHORED STRAW MULCH AND SEED AS SOON AS POSSIBLE IN THE SPRING, OR USE SOD.

MULCHING: APPLY 1-1/2 TO 2 TONS PER ACRE (70 TO 90 LBS. PER 1000 SQ.FT.) OF UNROTTED SMALL GRAIN STRAW IMMEDIATELY AFTER SEEDING. ANCHOR MULCH IMMEDIATELY AFTER APPLICATION USING MULCH ANCHORING TOOL OR 218 GAL. PER ACRE (5 GAL. PER 1000 SQ.FT.) OF EMULSIFIED ASPHALT ON FLAT AREAS. ON SLOPES, 8 FT. OR HIGHER, USE 347 GAL. PER ACRE (8 GAL. PER 1000 SQ.FT.) FOR ANCHORING.

REFER TO THE 1994 MARYLAND STANDARDS AND SPECIFICATIONS FOR SOIL EROSION AND SEDIMENT CONTROL FOR RATE AND METHODS NOT COVERED.

**PERMANENT SEEDING NOTES**

APPLY TO GRADED OR CLEARED AREAS NOT SUBJECT TO IMMEDIATE FURTHER DISTURBANCE WHERE A PERMANENT LONG-LIVED VEGETATIVE COVER IS NEEDED.

SEEDBED PREPARATION: LOOSEN UPPER THREE INCHES OF SOIL BY RAKING, DISCING OR OTHER ACCEPTABLE MEANS BEFORE SEEDING, IF NOT PREVIOUSLY LOOSENED.

SOIL AMENDMENTS: IN LIEU OF SOIL TEST RECOMMENDATIONS, USE ONE OF THE FOLLOWING SCHEDULES:

- 1) PREFERRED - APPLY 2 TONS PER ACRE DOLOMITIC LIMESTONE (92 LBS. PER 1000 SQ.FT.) AND 600 LBS. PER ACRE 10-10-10 FERTILIZER (14 LBS. PER 1000 SQ.FT.) BEFORE SEEDING. HARROW OR DISC INTO UPPER THREE INCHES OF SOIL. AT TIME OF SEEDING, APPLY 400 LBS. PER ACRE 30-0-0 UREAFORM FERTILIZER (9 LBS. PER 1000 SQ.FT.).
- 2) ACCEPTABLE - APPLY 2 TONS PER ACRE DOLOMITIC LIMESTONE (92 LBS. PER 1000 SQ.FT.) AND 1000 LBS. PER ACRE 10-10-10 FERTILIZER (23 LBS. PER 1000 SQ.FT.) BEFORE SEEDING. HARROW OR DISC INTO UPPER THREE INCHES OF SOIL.

SEEDING: FOR THE PERIOD MARCH 1 THRU APRIL 30 AND FROM AUGUST 15 THRU OCTOBER 15, SEED WITH FOLLOWING MIXTURE: 100% TALL TURF TYPE FESCUE (3 WAY BLEND) AT 6 LBS./1000 SF. ALL SEED VARIETIES MUST BE SELECTED FROM LIST OF RECOMMENDED CULTIVARS OF TURF-TYPE TALL FESCUES AS INDICATED BY THE UNIVERSITY OF MARYLAND AGRONOMY NIMED 77 (REVISED MAY 1995) OR MOST CURRENT EDITION. SEED MIX SHALL CONSIST OF A THREE-WAY BLEND (34% 338, AND 33%) OF TURF-TYPE TALL FESCUES FROM ABOVE UNIVERSITY OF MARYLAND LIST OR RECOMMENDED CULTIVARS. DURING THE PERIOD OCTOBER 16 THRU FEBRUARY 28, PROTECT SITE BY ONE OF THE FOLLOWING OPTIONS:

- 1) 2 TONS PER ACRE OF WELL-ANCHORED MULCH STRAW AND SEED AS SOON AS POSSIBLE IN THE SPRING.
- 2) USE SOD.
- 3) SEED AND MULCH WITH 2 TONS PER ACRE WELL ANCHORED STRAW.

MULCHING: APPLY 1-1/2 TO 2 TONS PER ACRE (70 TO 90 LBS. PER 1000 SQ.FT.) OF UNROTTED SMALL GRAIN STRAW IMMEDIATELY AFTER SEEDING. ANCHOR MULCH IMMEDIATELY AFTER APPLICATION USING MULCH ANCHORING TOOL OR 218 GAL. PER ACRE (5 GAL. PER 1000 SQ.FT.) OF EMULSIFIED ASPHALT ON FLAT AREAS. ON SLOPES, 8 FT. OR HIGHER, USE 347 GAL. PER ACRE (8 GAL. PER 1000 SQ.FT.) FOR ANCHORING.

MAINTENANCE: INSPECT ALL SEEDBED AREAS AND MAKE NEEDED REPAIRS, REPLACEMENTS AND RESEEDINGS.

**21.0 STANDARD AND SPECIFICATIONS FOR TOPSOIL**

**DEFINITION:**  
PLACEMENT OF TOPSOIL OVER A PREPARED SUBSOIL PRIOR TO ESTABLISHMENT OF PERMANENT VEGETATION.

**PURPOSE:**  
TO PROVIDE A SUITABLE SOIL MEDIUM FOR VEGETATIVE GROWTH. SOILS OF CONCERN HAVE LOW MOISTURE CONTENT, LOW NUTRIENT LEVELS, LOW PH, MATERIALS TOXIC TO PLANTS, AND/OR UNACCEPTABLE SOIL GRADATION.

**CONDITIONS WHERE PRACTICE APPLIES:**  
I. THIS PRACTICE IS LIMITED TO AREAS HAVING 2:1 OR FLATTER SLOPES WHERE:  
--a. THE TEXTURE OF THE EXPOSED SUBSOIL/PARENT MATERIAL IS NOT ADEQUATE TO PRODUCE VEGETATIVE GROWTH.  
--b. THE SOIL MATERIAL IS SO SHALLOW THAT THE ROOTING ZONE IS NOT DEEP ENOUGH TO SUPPORT PLANTS OR FURNISH CONTINUING SUPPLIES OF MOISTURE AND PLANT NUTRIENTS.  
--c. THE ORIGINAL SOIL TO BE VEGETATED CONTAINS MATERIAL TOXIC TO PLANT GROWTH.  
--d. THE SOIL IS SO ACIDIC THAT TREATMENT WITH LIMESTONE IS NOT FEASIBLE.

II. FOR THE PURPOSE OF THESE STANDARDS AND SPECIFICATIONS, AREAS HAVING SLOPES STEEPER THAN 2:1 REQUIRE SPECIAL CONSIDERATION AND DESIGN FOR ADEQUATE STABILIZATION. AREAS HAVING SLOPES STEEPER THAN 2:1 SHALL HAVE THE APPROPRIATE STABILIZATION SHOWN ON THE PLANS.

**CONSTRUCTION AND MATERIAL SPECIFICATIONS:**  
I. TOPSOIL SALVAGED FROM THE EXISTING SITE MAY BE USED PROVIDED THAT IT MEETS THE STANDARDS AS SET FORTH IN THESE SPECIFICATIONS. TYPICALLY, THE DEPTH OF TOPSOIL TO BE SALVAGED FOR A GIVEN SOIL TYPE CAN BE FOUND IN THE REPRESENTATIVE SOIL PROFILE SECTION IN THE SOIL SURVEY PUBLISHED BY USDA-SCS IN COOPERATION WITH MARYLAND AGRICULTURAL EXPERIMENTATION STATION.  
II. TOPSOIL SPECIFICATIONS - SOIL TO BE USED AS TOPSOIL MUST MEET THE FOLLOWING:  
--a. TOPSOIL SHALL BE A LOAM, SANDY LOAM, CLAY LOAM, SANDY CLAY LOAM, LOAMY SAND. OTHER SOILS MAY BE USED IF RECOMMENDED BY AN AGRONOMIST OR SOIL SCIENTIST AND APPROVED BY THE APPROPRIATE APPROVAL AUTHORITY. REGARDLESS, TOPSOIL SHALL NOT BE A MIXTURE OF CONTRASTING TEXTURED SUBSOILS AND SHALL CONTAIN LESS THAN 5% BY VOLUME OF CONDEERS, STONES, SLAG, COARSE FRAGMENTS, GRAVEL, STICKS, ROOTS, TRASH, OR OTHER MATERIALS LARGER THAN 1-1/2" IN DIAMETER.  
--b. TOPSOIL MUST BE FREE OF PLANTS OR PLANT PARTS SUCH AS BERMUDA GRASS, QUACKGRASS, JOHNSONGRASS, NUTSEDGE, POISON IVY, THISTLE, OR OTHERS AS SPECIFIED.  
--c. WHERE SUBSOIL IS EITHER HIGHLY ACIDIC OR COMPOSED OF HEAVY CLAYS, GROUND LIMESTONE SHALL BE SPREAD AT THE RATE OF 4-8 TONS/ACRE (200-400 POUNDS PER 1,000 SQUARE FEET) PRIOR TO THE PLACEMENT OF TOPSOIL. LIME SHALL BE DISTRIBUTED UNIFORMLY OVER DESIGNATED AREAS AND WORKED INTO THE SOIL IN CONJUNCTION WITH TILLAGE OPERATIONS AS DESCRIBED IN THE FOLLOWING PROCEDURES.  
III. FOR SITES HAVING DISTURBED AREAS UNDER 5 ACRES:  
--a. PLACE TOPSOIL (IF REQUIRED) AND APPLY SOIL AMENDMENTS AS SPECIFIED IN 20.0 VEGETATIVE STABILIZATION - SECTION I - VEGETATIVE STABILIZATION METHODS AND MATERIALS.  
III. FOR SITES HAVING DISTURBED AREAS OVER 5 ACRES:  
--a. ON SOIL MEETING TOPSOIL SPECIFICATIONS, OBTAIN TEST RESULTS DICTATING FERTILIZER AND LIME AMENDMENTS REQUIRED TO BRING THE SOIL INTO COMPLIANCE WITH THE FOLLOWING:  
--b. PH FOR TOPSOIL SHALL BE BETWEEN 6.0 AND 7.5. IF THE TESTED SOIL DEMONSTRATES A PH OF LESS THAN 6.0, SUFFICIENT LIME SHALL BE PRESCRIBED TO RAISE THE PH TO 6.5 OR HIGHER.  
--c. ORGANIC CONTENT OF TOPSOIL SHALL BE NOT LESS THAN 1.5 PERCENT BY WEIGHT.  
--d. TOPSOIL HAVING SODIUM SALTY CONTENT GREATER THAN 500 PARTS PER MILLION SHALL NOT BE USED.  
--e. NO SOD OR SEED SHALL BE PLACED ON SOIL WHICH HAS BEEN TREATED WITH SOIL STERILANTS OR CHEMICALS USED FOR WEED CONTROL UNTIL SUFFICIENT TIME HAS ELAPSED (14 DAYS MIN.) TO PERMIT DISPERSION OF PHYTO-TOXIC MATERIALS.  
NOTE: TOPSOIL SUBSTITUTES TO AMENDMENTS, AS RECOMMENDED BY A QUALIFIED AGRONOMIST OR SOIL SCIENTIST AND APPROVED BY THE APPROPRIATE APPROVAL AUTHORITY MAY BE USED IN LIEU OF NATURAL TOPSOIL.  
--f. PLACE TOPSOIL (IF REQUIRED) AND APPLY SOIL AMENDMENTS AS SPECIFIED IN 20.0 VEGETATIVE STABILIZATION - SECTION I - VEGETATIVE STABILIZATION METHODS AND MATERIALS.  
V. TOPSOIL APPLICATION  
--a. WHEN TOPSOILING, MAINTAIN NEEDED EROSION AND SEDIMENT CONTROL PRACTICES SUCH AS DIVERSIONS, GRADE STABILIZATION STRUCTURES, EARTH DIKES, SLOPE SILT FENCE AND SEDIMENT TRAPS AND BASINS.  
--b. GRADES ON THE AREAS TO BE TOPSOILED, WHICH HAVE BEEN PREVIOUSLY ESTABLISHED, SHALL BE MAINTAINED, ALBERT 4" - 8" HIGHER IN ELEVATION.  
--c. TOPSOIL SHALL BE UNIFORMLY DISTRIBUTED IN A 4" - 8" LAYER AND LIGHTLY COMPACTED TO A MINIMUM THICKNESS OF 4". SPREADING SHALL BE PERFORMED IN SUCH A MANNER THAT SODDING OR SEEDING CAN PROCEED WITH A MINIMUM OF ADDITIONAL SOIL PREPARATION AND TILLAGE. ANY IRREGULARITIES IN THE SURFACE RESULTING FROM TOPSOILING OR OTHER OPERATIONS SHALL BE CORRECTED IN ORDER TO PREVENT THE FORMATION OF DEPRESSIONS OR WATER POCKETS.  
--d. TOPSOIL SHALL NOT BE PLACED WHILE THE TOPSOIL OR SUBSOIL IS IN A FROZEN OR MUDDY CONDITION, WHEN THE SUBSOIL IS EXCESSIVELY WET OR IN A CONDITION THAT MAY OTHERWISE BE DETRIMENTAL TO PROPER GRADING AND SEEDBED PREPARATION.  
VI. ALTERNATIVE FOR PERMANENT SEEDING - INSTEAD OF APPLYING THE FULL AMOUNTS OF LIME AND COMMERCIAL FERTILIZER, COMPOSTED SLUDGE AND AMENDMENTS MAY BE APPLIED AS SPECIFIED BELOW:  
--a. COMPOSTED SLUDGE MATERIAL FOR USE AS A SOIL CONDITIONER FOR SITES HAVING DISTURBED AREAS OVER 5 ACRES SHALL BE TESTED TO PRESCRIBE AMENDMENTS AND FOR SITE HAVING DISTURBED AREAS UNDER 5 ACRES SHALL CONFORM TO THE FOLLOWING REQUIREMENTS:  
--b. COMPOSTED SLUDGE SHALL BE SUPPLIED BY, OR ORIGINATE FROM, A PERSON OR PERSONS THAT ARE PERMITTED (AT THE TIME OF ACQUISITION OF THE COMPOST) BY THE MARYLAND DEPARTMENT OF THE ENVIRONMENT UNDER COMAR 26.04.06.  
--c. COMPOSTED SLUDGE SHALL CONTAIN AT LEAST 1 PERCENT NITROGEN, 1.5 PERCENT PHOSPHORUS, AND 0.2 PERCENT POTASSIUM AND HAVE A PH OF 7.0 TO 8.0. IF COMPOST DOES NOT MEET THESE REQUIREMENTS, THE APPROPRIATE CONSTITUENTS MUST BE ADDED TO MEET THE REQUIREMENTS PRIOR TO USE.  
--d. COMPOSTED SLUDGE SHALL BE APPLIED AT A RATE OF 1 TON/1,000 SQUARE FEET.  
--e. COMPOSTED SLUDGE SHALL BE AMENDED WITH A POTASSIUM FERTILIZER APPLIED AT THE RATE OF 4 LB./1,000 SQUARE FEET, AND 1/3 THE NORMAL LIME APPLICATION RATE. REFERENCES: GUIDELINE SPECIFICATIONS, SOIL PREPARATION AND SODDING, MD-10A, PUB. #1, COOPERATIVE EXTENSION SERVICE, UNIVERSITY OF MARYLAND AND VIRGINIA POLYTECHNIC INSTITUTES, REVISED 1973.

**EROSION CONTROL MATTING**


**Construction Specifications**

1. Key-in the matting by placing the top ends of the matting in a narrow trench, 6" in depth. Backfill the trench and tamp firmly to conform to the channel cross-section. Secure with a row of staples about 4" down slope from the trench. Spacing between staples is 6".
2. Staple the 4" overlap in the channel center using an 18" spacing between staples.
3. Before stapling the outer edges of the matting, make sure the matting is smooth and in firm contact with the soil.
4. Staples shall be placed 2' apart with 4 rows for each strip, 2 outer rows, and 2 alternating rows down the center.
5. Where one roll of matting ends and another begins, the end of the top strip shall overlap the upper end of the lower strip by 4", shiplap fashion. Reinforce the overlap with a double row of staples spaced 6" apart in a staggered pattern on either side.
6. The discharge end of the matting liner should be similarly secured with 2 double rows of staples.

Note: If flow will enter from the edge of the matting then the area effected by the flow must be keyed-in.


U.S. DEPARTMENT OF AGRICULTURE SOIL CONSERVATION SERVICE	PAGE 6 - 22 - 2A	MARYLAND DEPARTMENT OF ENVIRONMENT WATER MANAGEMENT ADMINISTRATION
---	---------------------	---

**DETAIL 24 - STABILIZED CONSTRUCTION ENTRANCE**

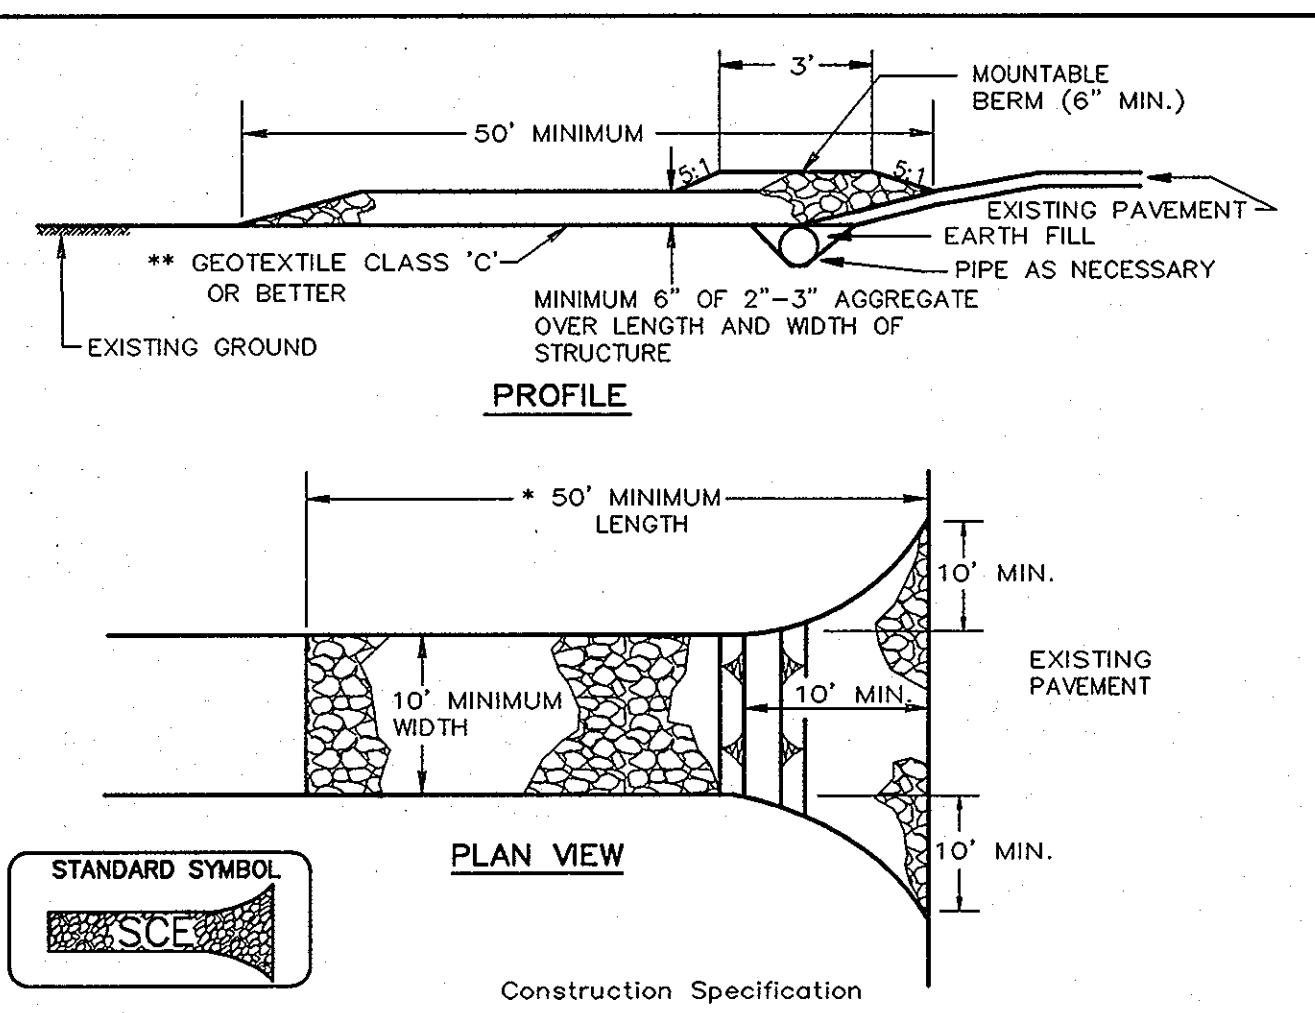

1. Length - minimum of 50' (\*30' for single residence lot).
  2. Width - 10' minimum, should be flared at the existing road to provide a turning radius.
  3. Geotextile fabric (filter cloth) shall be placed over the existing ground prior to placing stone. \*\*The plan approval authority may not require single family residences to use geotextile.
  4. Stone - crushed aggregate (2" to 3") or reclaimed or recycled concrete equivalent shall be placed at least 6" deep over the length and width of the entrance.
  5. Surface Water - all surface water flowing to or diverted toward construction entrances shall be piped through the entrance, maintaining positive drainage. Pipe installed through the stabilized construction entrance shall be protected with a mountable berm with 5:1 slopes and a minimum of 6" of stone over the pipe. Pipe has to be sized according to the drainage. When the SCE is located at a high spot and has no drainage to convey a pipe will not be necessary. Pipe should be sized according to the amount of runoff to be conveyed. A 6" minimum will be required.
  6. Location - A stabilized construction entrance shall be located at every point where construction traffic enters or leaves a construction site. Vehicles leaving the site must travel over the entire length of the stabilized construction entrance.
- |   |                    |   |
|---|--------------------|---|
| U.S. DEPARTMENT OF AGRICULTURE<br>SOIL CONSERVATION SERVICE | PAGE<br>F - 17 - 3 | MARYLAND DEPARTMENT OF ENVIRONMENT<br>WATER MANAGEMENT ADMINISTRATION |
|---|--------------------|---|

**DETAIL 30 - EROSION CONTROL MATTING**

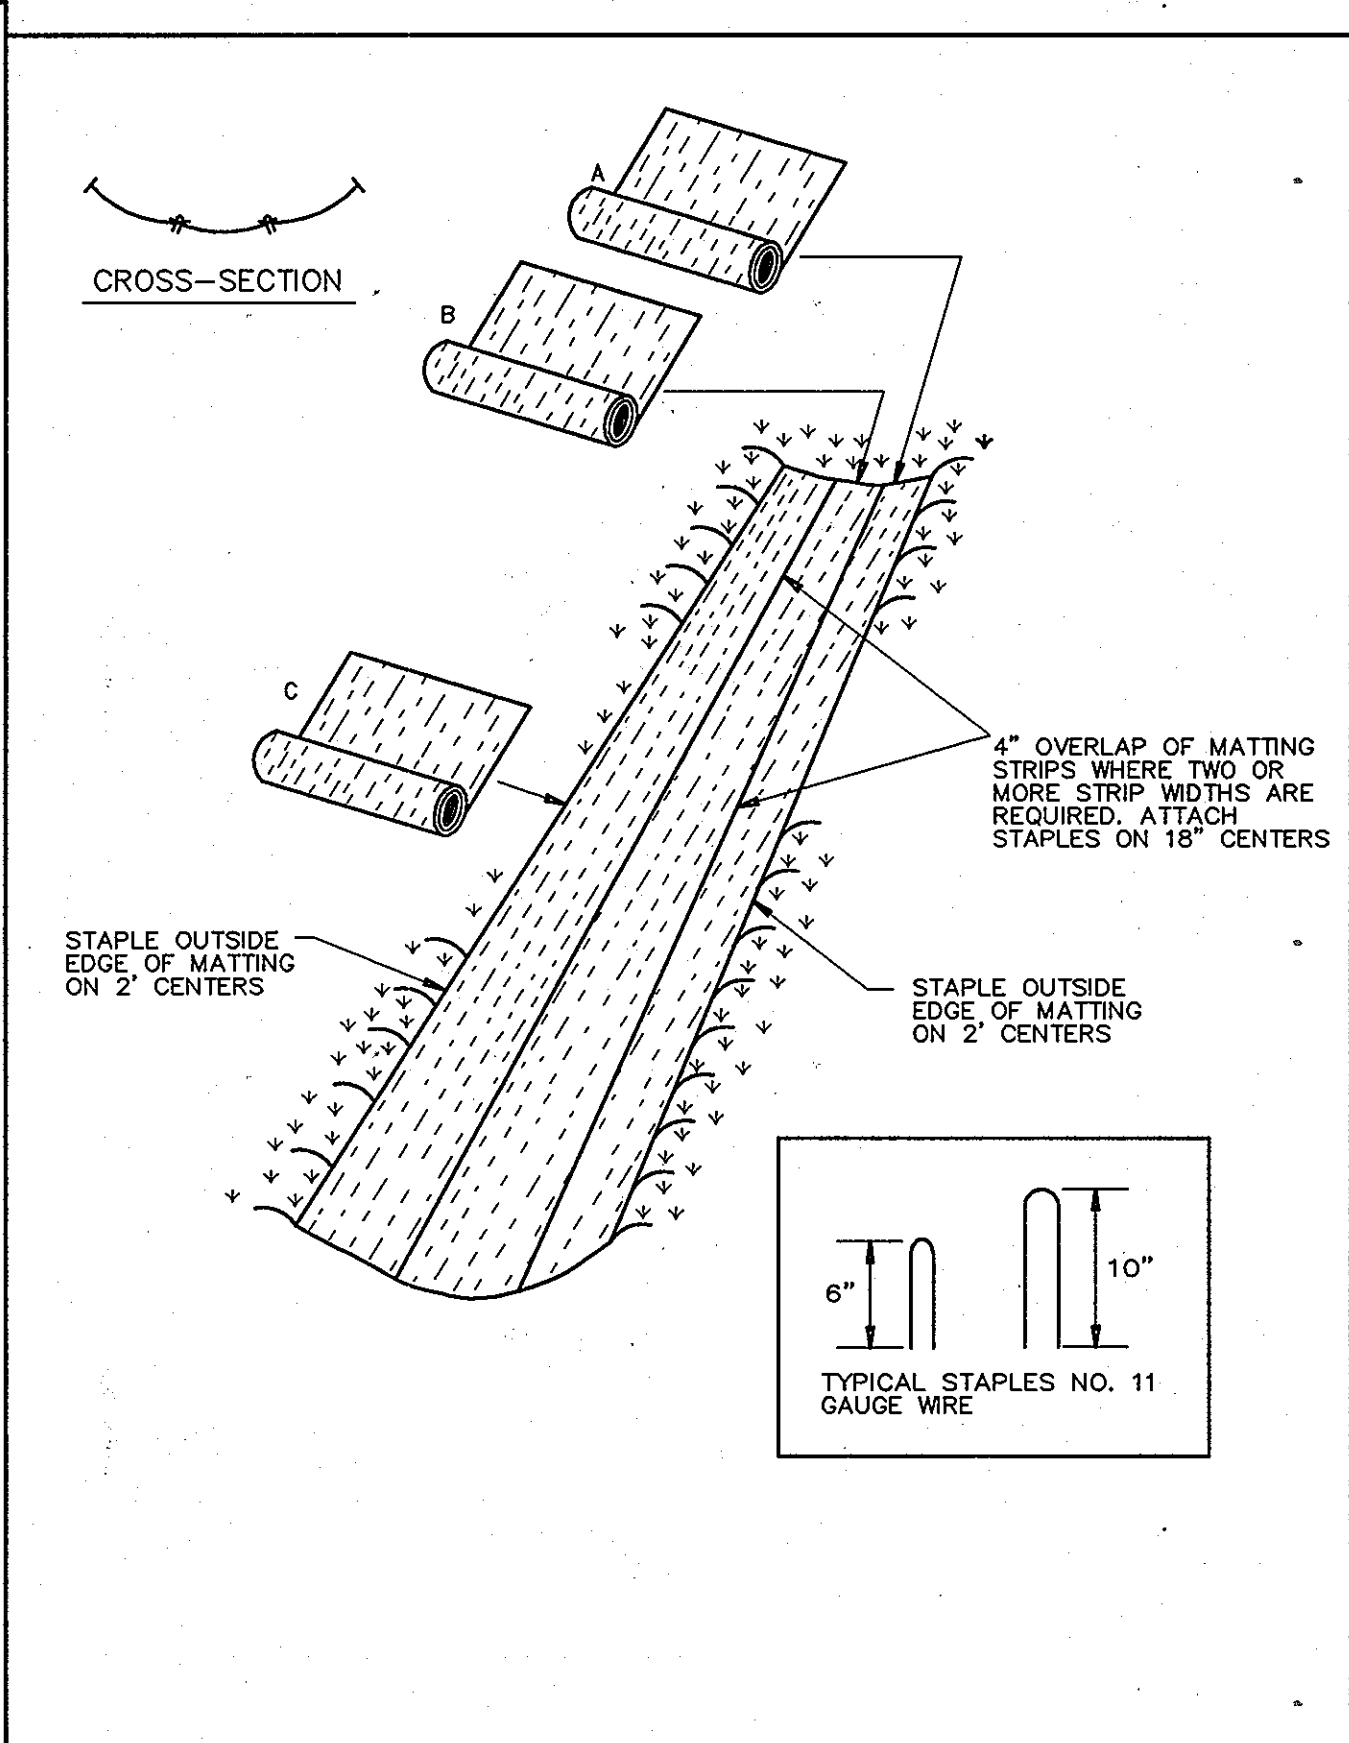

U.S. DEPARTMENT OF AGRICULTURE SOIL CONSERVATION SERVICE	PAGE 6 - 22 - 2	MARYLAND DEPARTMENT OF ENVIRONMENT WATER MANAGEMENT ADMINISTRATION
---	--------------------	---

**30.0 - DUST CONTROL**

**DEFINITION:**  
CONTROLLING DUST BLOWING AND MOVEMENT ON CONSTRUCTION SITES AND ROADS.

**PURPOSE:**  
TO PREVENT BLOWING AND MOVEMENT OF DUST FROM EXPOSED SOIL SURFACES, REDUCE ON AND OFF-SITE DAMAGE, HEALTH HAZARDS, AND IMPROVE TRAFFIC SAFETY.

**CONDITIONS WHERE PRACTICE APPLIES:**  
THIS PRACTICE IS APPLICABLE TO AREAS SUBJECT TO DUST BLOWING AND MOVEMENT WHERE ON OFF-SITE DAMAGE IS LIKELY WITHOUT TREATMENT.

**TEMPORARY METHODS**

1. MULCHES - SEE STANDARDS FOR VEGETATIVE STABILIZATION WITH MULCHES ONLY. MULCH SHOULD BE CRIMPED OR TACKED TO PREVENT BLOWING.
2. VEGETATIVE COVER - SEE STANDARDS FOR TEMPORARY VEGETATIVE COVER.
3. TILLAGE - TO ROUGHEN SURFACE AND BRING CLODS TO THE SURFACE. THIS IS AN EMERGENCY MEASURE WHICH SHOULD BE USED BEFORE SOIL BLOWING STARTS. BEGIN PLOWING ON WINDWARD SIDE OF SITE. CHISEL-TYPE PLOWS SPACED ABOUT 12' APART, SPRING-TOOTHED HARROWS, AND SIMILAR PLOWS ARE EXAMPLES OF EQUIPMENT WHICH MAY PRODUCE THE DESIRED EFFECT.
4. IRRIGATION - THIS IS GENERALLY DONE AS AN EMERGENCY TREATMENT. SITE IS SPRINKLED WITH WATER UNTIL THE SURFACE IS MOIST. REPEAT AS NEEDED. AT NO TIME SHOULD THE SITE BE IRRIGATED TO THE POINT THAT RUNOFF BEGINS TO FLOW.
5. BARRIERS - SOLID BOARD FENCES, SILT FENCES, SNOW FENCES, BURLAP FENCES, STRAW BALES, AND SIMILAR MATERIAL CAN BE USED TO CONTROL AIR CURRENTS AND SOIL BLOWING. BARRIERS PLACED AT RIGHT ANGLES TO PREVAILING CURRENTS AT INTERVALS OF ABOUT 10 TIMES THEIR HEIGHT ARE EFFECTIVE IN CONTROLLING SOIL BLOWING.
6. CALCIUM CHLORIDE - APPLY AT RATES THAT WILL KEEP SURFACE MOIST. MAY NEED RETREATMENT.

**PERMANENT METHODS**


1. PERMANENT VEGETATION - SEE STANDARDS FOR PERMANENT VEGETATIVE COVER, AND PERMANENT STABILIZATION WITH SOD. EXISTING TREES OR LARGE SHRUBS MAY AFFORD VALUABLE PROTECTION IF LEFT IN PLACE.
2. TOPSOILING - COVERING WITH LESS EROSION SOIL MATERIALS. SEE STANDARDS FOR TOPSOILING.
3. STONE - COVER SURFACE WITH CRUSHED STONE OR COARSE GRAVEL.

**REFERENCES**

1. AGRICULTURE HANDBOOK 346. WIND EROSION FORCES IN THE UNITED STATES AND THEIR USES IN PREDICTING SOIL LOSS.
2. AGRICULTURE INFORMATION BULLETIN 354. HOW TO CONTROL WIND EROSION, USDA-ARS.

U.S. DEPARTMENT OF AGRICULTURE SOIL CONSERVATION SERVICE	PAGE H - 30 - 1	MARYLAND DEPARTMENT OF ENVIRONMENT WATER MANAGEMENT ADMINISTRATION
---	--------------------	---

**DETAIL 33 - SUPER SILT FENCE**

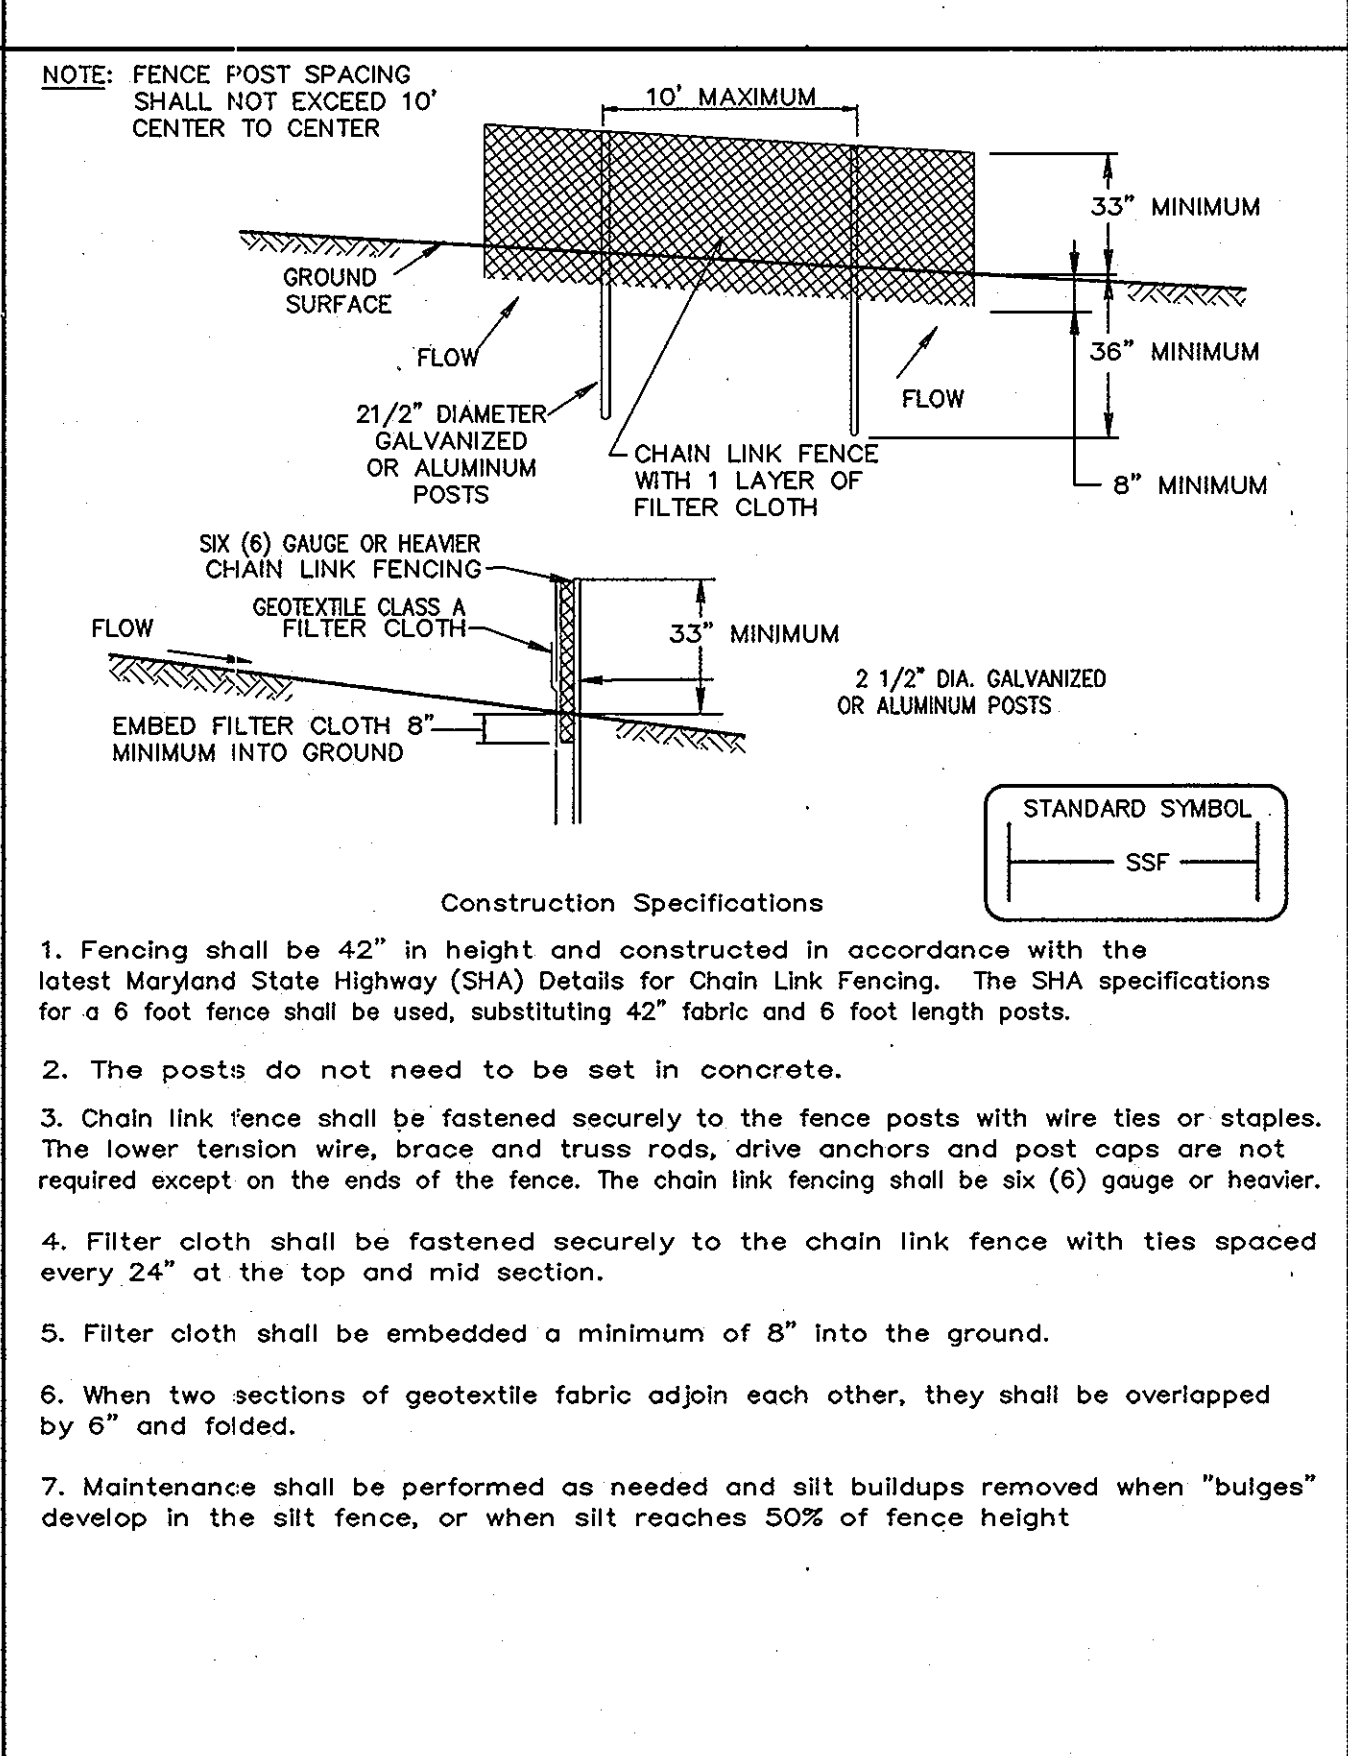

U.S. DEPARTMENT OF AGRICULTURE SOIL CONSERVATION SERVICE	PAGE H - 28 - 3	MARYLAND DEPARTMENT OF ENVIRONMENT WATER MANAGEMENT ADMINISTRATION
---	--------------------	---

**SEQUENCE OF CONSTRUCTION**

1. OBTAIN GRADING PERMIT.
2. INSTALL PERIMETER CONTROLS, STABILIZED CONSTRUCTION ENTRANCE, AND SUPER SILT FENCE (3 DAYS).
3. BEGIN ROUGH GRADING AND DEMOLITION (2 WEEKS).
4. AS SUBGRADE ELEVATIONS ARE ESTABLISHED, INSTALL WATER AND SEWER (3 WEEKS).
5. UPON COMPLETION OF UTILITY SYSTEMS, OBTAIN APPROVALS FROM INSPECTORS.
6. PROVIDE TEMPORARY AND PERMANENT SEEDING TO ESTABLISH VEGETATION ON DISTURBED STEEP SLOPE AREA.
7. BEGIN STRUCTURAL RETAINING WALLS AND BUILDING CONSTRUCTION (6 MONTHS).
8. INSTALL STORM WATER MANAGEMENT FACILITIES, AND MICRO BIOTENTION FACILITY AS INDICATED ON PLANS (3 WEEKS).
9. UPON COMPLETION OF STORM WATER MANAGEMENT FACILITIES, OBTAIN APPROVALS FROM INSPECTOR.
10. UPON COMPLETION OF BUILDING EXTERIOR, PERFORM FINE GRADING AROUND BUILDING AND INSTALL EROSION CONTROL, MATTING AND LANDSCAPING (1 DAY).
11. UPON COMPLETION OF FINE GRADING, INSTALL CURB, CUTTER, AND BASE PAVING AS REQUIRED (2 WEEKS).
12. APPLY TOPSOIL AND STABILIZE DISTURBED AREAS IN ACCORDANCE WITH PERMANENT SEEDING NOTES (2 DAYS).
13. UPON PERMISSION OF COUNTY SEDIMENT CONTROL INSPECTOR, REMOVE ALL REMAINING SEDIMENT CONTROL DEVICES AND STABILIZE DISTURBED AREAS IN ACCORDANCE WITH PERMANENT SEEDING NOTES (1 DAY).

BY THE DEVELOPER:

I/WE CERTIFY THAT ALL DEVELOPMENT AND CONSTRUCTION WILL BE DONE ACCORDING TO THIS PLAN, AND THAT ANY RESPONSIBLE PERSONNEL INVOLVED IN THE CONSTRUCTION PROJECT WILL HAVE A CERTIFICATE OF ATTENDANCE AT A DEPARTMENT OF THE ENVIRONMENT APPROVED TRAINING PROGRAM FOR THE CONTROL OF SEDIMENT AND EROSION BEFORE BEGINNING THE PROJECT. I ALSO AUTHORIZE PERIODIC ON-SITE INSPECTIONS BY THE HOWARD SOIL CONSERVATION DISTRICT.

*Michael T. Rozański*  
DEVELOPER  
DATE: 12/17/10

BY THE ENGINEER:

I CERTIFY THAT THIS PLAN FOR EROSION AND SEDIMENT CONTROL REPRESENTS A PRACTICAL AND WORKABLE PLAN BASED ON MY PERSONAL KNOWLEDGE OF THE SITE CONDITIONS AND THAT IT WAS PREPARED IN ACCORDANCE WITH THE REQUIREMENTS OF THE HOWARD SOIL CONSERVATION DISTRICT.

*John R. Roberts*  
ENGINEER  
DATE: 12/17/10

APPROVED: HOWARD COUNTY DEPARTMENT OF PLANNING AND ZONING.

*Thomas J. Buttle*  
DIRECTOR  
DATE: 12/21/10

*John R. Roberts*  
CHIEF, DEVELOPMENT ENGINEERING DIVISION  
DATE: 12/21/10

*John R. Roberts*  
CHIEF, DIVISION OF LAND DEVELOPMENT  
DATE: 12/21/10

DATE	NO.	REVISION

**OWNER**  
DOUG JOHNSON  
ST. PAUL'S CHURCH & ANNEX  
3675 COLLEGE AVE  
ELLCOTT CITY MD 21043-4655  
(410) 547-5340

**DEVELOPER**  
DOUG JOHNSON  
ST. PAUL'S CHURCH & ANNEX  
3675 COLLEGE AVE  
ELLCOTT CITY MD 21043-4655  
(410) 547-5340

**PROJECT**  
ST. PAUL'S CATHOLIC CHURCH EVANGELIZATION CENTER

**AREA**  
TAX MAP 25-A PARCELS 61, 120, & 121  
2nd ELECTION DISTRICT ZONED HO  
HOWARD COUNTY, MARYLAND

**TITLE**  
SEDIMENT & EROSION CONTROL DETAILS

**Patton Harris Rust & Associates**  
Engineers, Surveyors, Planners, Landscape Architects.  
8818 Centre Park Drive  
Columbia, MD 21045  
T 410.997.8900  
F 410.997.9282

DESIGNED BY: JSN  
DRAWN BY: JSN  
PROJECT NO: 14867-1-0  
DATE: SEPTEMBER 13, 2010  
SCALE: AS SHOWN  
DRAWING NO. 7 OF 18

**BIOFILTRATION SPECIFICATIONS**

1. THE UNDERDRAIN PIPE MUST BE 6-INCH DIAMETER SCHEDULE 40 OR STRONGER PERFORATED PVC PIPE AT 0.00% SLOPE. THREE INCHES OF GRAVEL MUST BE PLACED UNDER THE PIPE, WITH A MINIMUM OF 6 INCHES OF GRAVEL OVER THE PIPE. PERFORATIONS MUST BE 3/8 INCH IN DIAMETER AND MUST BE LOCATED 4 INCHES ON CENTER, EVERY 90 DEGREES AROUND THE PIPE. PERFORATED PIPE MUST BEGIN AT LEAST 5 FT. INSIDE THE FILTER MEDIA. FILTER FABRIC MUST NOT BE WRAPPED AROUND THE UNDERDRAIN PIPE.
2. 4" INCH CLEAN-OUTS SHOULD BE USED. CLEANOUTS FOR EACH PIPE SHOULD EXTEND 6 INCHES ABOVE THE TOP OF THE PLANTING MEDIA AND HAVE A REMOVABLE CAP.
3. THE GRAVEL LAYER SURROUNDING THE UNDERDRAIN PIPES MUST MEET MSHA SIZE #7 (TABLE 901A), AND MUST PROVIDE A MINIMUM OF 6 INCHES COVER OVER THE PIPE, AND MINIMUM 3 INCHES UNDER THE PIPE. NO GEOTEXTILE OR FILTER FABRIC IS ALLOWED ANYWHERE WITHIN THE FILTER MEDIA (STONE OR SAND).
4. A MINIMUM 6-INCH FINE AGGREGATE SAND LAYER SHALL BE PROVIDED BELOW THE SOIL FILTER/PLANTING MEDIA. A SAND WINDOW SHALL EXTEND FROM THE SAND FILTER TO THE SURFACE OF THE PLANTING MEDIA. THE SAND WINDOW MUST BE ASTM C33 FINE AGGREGATE CONCRETE SAND. MANUFACTURED SAND OR STONE DUST IS NOT ACCEPTABLE.
5. THE PLANTING MEDIA SHALL CONSIST OF 1/3 PERLITE, 1/3 COMPOST AND 1/3 TOPSOIL. THE PERLITE SHALL BE COARSE GRADE HORTICULTURAL PERLITE. THE COMPOST SHALL BE HIGH GRADE COMPOST FREE OF STONES AND PARTIALLY COMPOSTED WOODY MATERIAL. THE SOIL SHALL MEET THE FOLLOWING MINIMUM CRITERIA: CONTAIN NO MORE THAN 10% CLAY, 30-50% SILT AND 35-60% SAND. THE SOIL SHALL BE FREE OF STONES, STUMPS, ROOTS OR OTHER SIMILAR OBJECTS LARGER THAN 2 INCHES. THE FIRST LAYER OF THE PLANTING MEDIA SHALL BE LIGHTLY TILLED TO MIX IT INTO THE SAND LAYER, SO NOT TO CREATE A DEFINITIVE BOUNDARY. THE PLANTING MATERIAL SHALL BE FLOODED AFTER PLACEMENT. ANY SETTLEMENT THAT OCCURS SHALL BE FILLED BACK TO THE DESIGN ELEVATION.
6. THE SURFACE MULCH LAYER WILL CONSIST OF STANDARD FINE SHREDDED AGED HARDWOOD MULCH. THE MULCH SHOULD BE UNIFORMLY TO A DEPTH OF 2 TO 3 INCHES. YEARLY REPLISHING MAY BE NECESSARY. PINE BARK IS NOT ACCEPTABLE.

**BIORETENTION AREA OPERATION AND MAINTENANCE SCHEDULE**

1. ANNUAL MAINTENANCE OF PLANT MATERIAL, MULCH LAYER AND SOIL LAYER IS REQUIRED. MAINTENANCE OF MULCH AND SOIL IS LIMITED TO CORRECTING AREAS OF EROSION OR WASH OUT. ANY MULCH REPLACEMENT SHALL BE DONE IN THE SPRING. PLANT MATERIAL SHALL BE CHECKED FOR DISEASE AND INSECT INFESTATION AND MAINTENANCE WILL ADDRESS DEAD MATERIAL AND PRUNING.
2. SCHEDULE OF PLANTING INSPECTION WILL BE TWICE A YEAR IN SPRING AND FALL. THIS INSPECTION WILL INCLUDE REMOVAL OF DEAD AND DISEASE VEGETATION CONSIDERED BEYOND TREATMENT, TREATMENT OF ALL DISEASED TREES AND SHRUBS AND REPLACEMENT OF ALL DEFICIENT STAKES AND WIRES.
3. MULCH SHALL BE INSPECTED EACH SPRING. REMOVE PREVIOUS MULCH LAYER BEFORE APPLYING NEW LAYER ONCE EVERY 2 TO 3 YEARS.
4. SOIL EROSION TO BE ADDRESSED ON AS NEEDED BASIS, WITH A MINIMUM OF ONCE A MONTH AND AFTER HEAVY STORMS.


**OBSERVATION WELL CAP (NOT TO SCALE)**

I HEREBY CERTIFY THAT THESE DOCUMENTS WERE PREPARED OR APPROVED BY ME, AND THAT I AM A DULY LICENSED PROFESSIONAL ENGINEER UNDER THE LAWS OF THE STATE OF MARYLAND, LICENSE NO. 21774, EXPIRATION DATE: 11-10-2013.

**AS-BUILT CERTIFICATION**


I HEREBY CERTIFY THAT THE FACILITY SHOWN ON THIS PLAN WAS CONSTRUCTED AS SHOWN ON THE "AS-BUILT" PLANS AND MEETS THE APPROVED PLANS AND SPECIFICATIONS.

JAMES A. RUFF #21774  
 PRINTED NAME MB PE. No.  
 SIGNATURE DATE 10/27/12

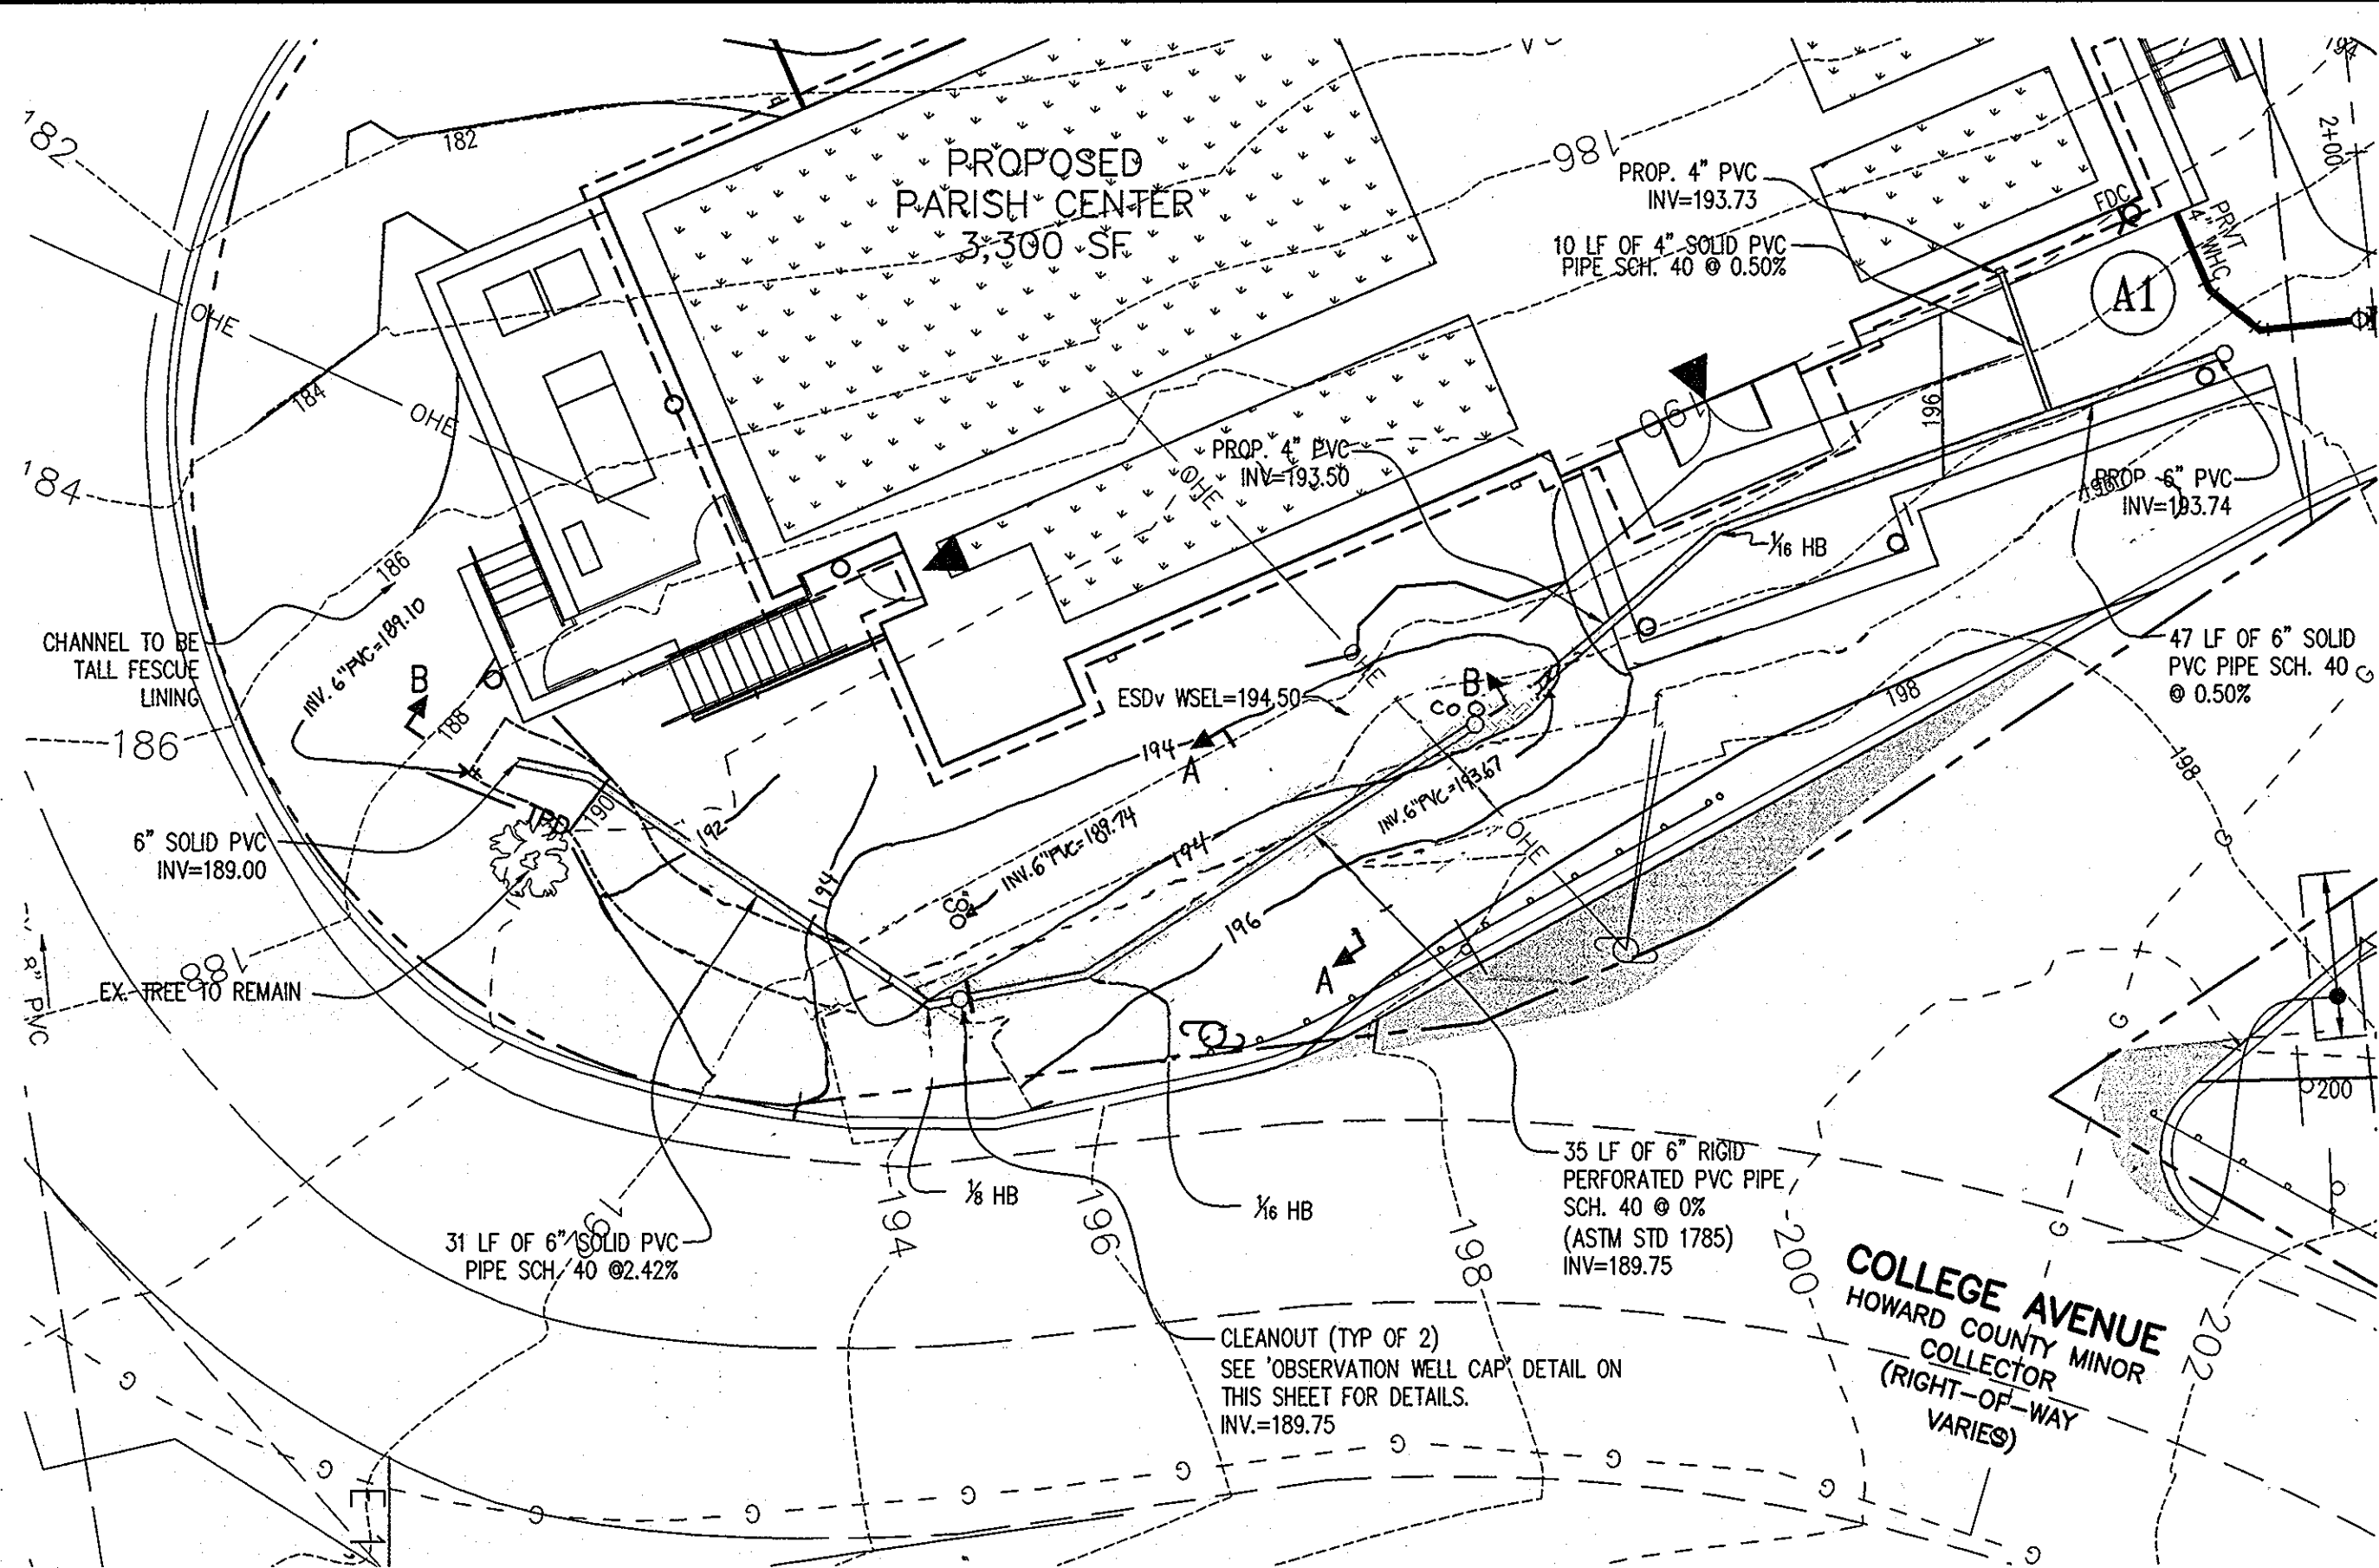


**MICRO-BIORETENTION FACILITY NO. 1**

SCALE: 1"=10'

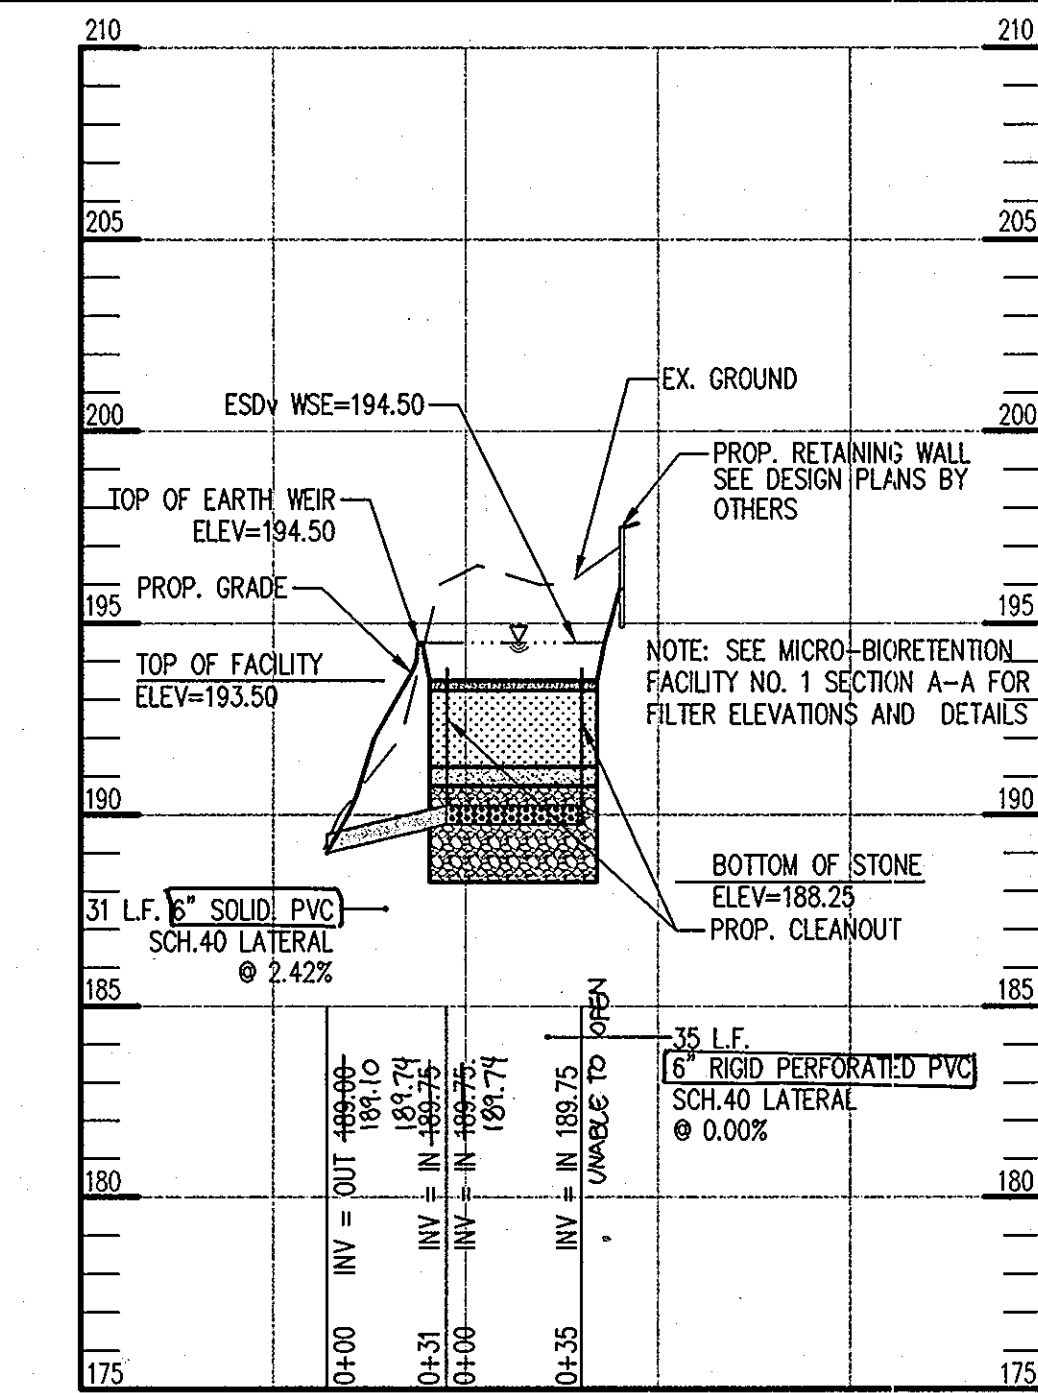

**PROFILE THROUGH MICRO-BIORETENTION FACILITY NO. 1-SECTION B-B**

SCALE: HOR: 1"=50'  
 VERT: 1"=5'

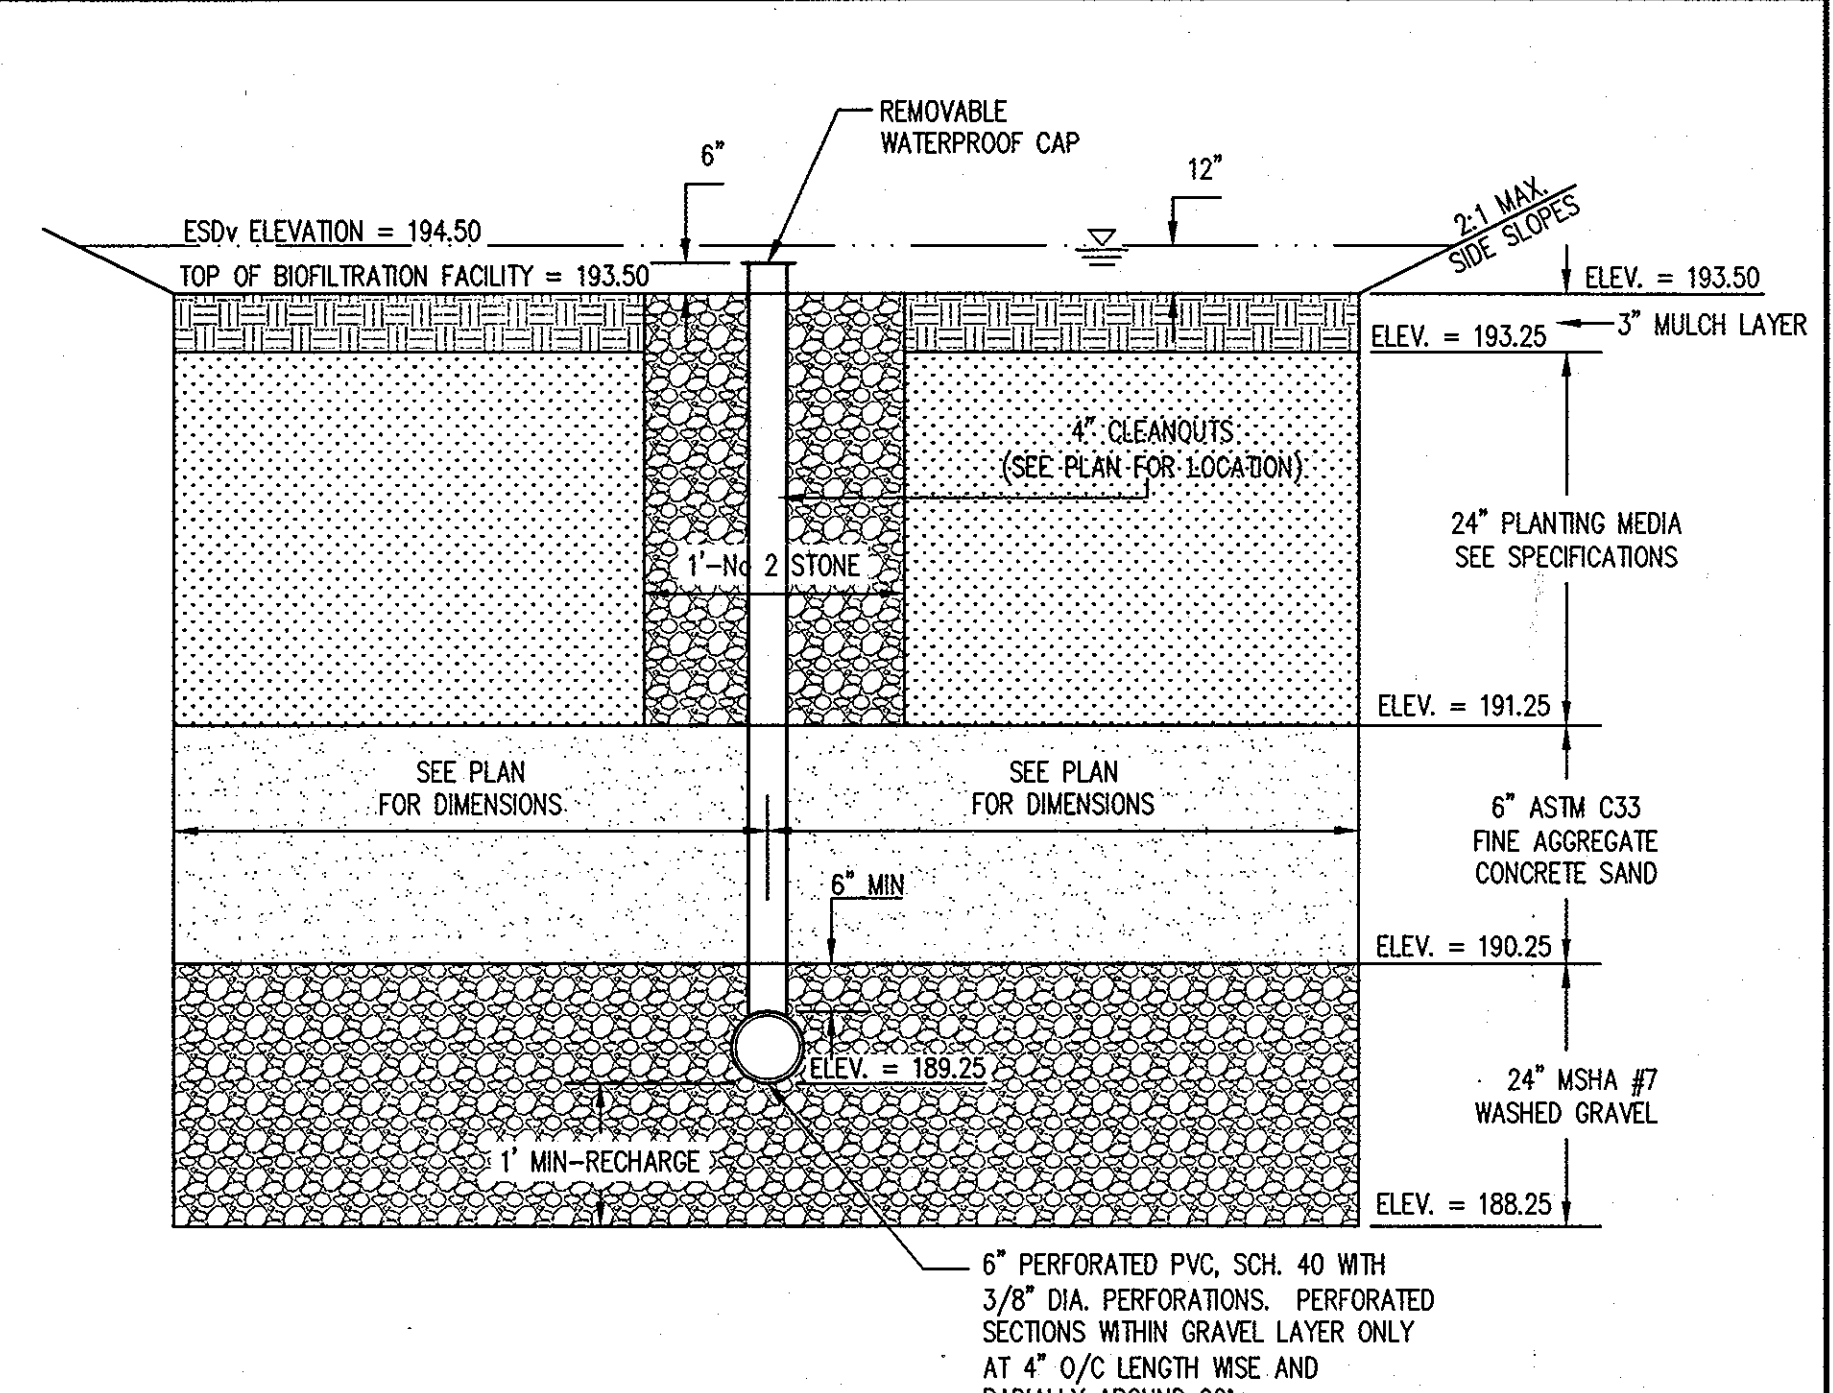

**MICRO-BIORETENTION FACILITY NO. 1 SECTION A-A**


NOT TO SCALE

STORM DRAIN PIPE SCHEDULE		
SIZE	TYPE	LINEAR FOOTAGE
4"	SOLID PVC SCH 40	17
6"	SOLID PVC SCH 40	157
6"	RIGID PERFORATED PVC SCH 40	50

STRUCTURE SCHEDULE					
NUMBER	TYPE	LOCATION		TOP ELEVATION	REMARKS
		STATION	OFFSET		
A1	NYLOPLAST INLINE DRAIN BASIN	SEE	PLAN	195.36	10" Ø STANDARD DUCTILE IRON GRATE
A2	NYLOPLAST INLINE DRAIN BASIN	SEE	PLAN	183.70	10" Ø STANDARD DUCTILE IRON GRATE
A3	NYLOPLAST INLINE DRAIN BASIN	SEE	PLAN	183.85	10" Ø STANDARD DUCTILE IRON GRATE


**NOTES**

- 1) ALL STRUCTURES ARE ADS NYLOPLAST STANDARDS UNLESS NOTED OTHERWISE. CONTRACTOR MAY USE PRECAST STRUCTURE WHERE AVAILABLE TO MEET THE STANDARD STRUCTURE SPECIFIED.
- 2) ELEVATIONS ARE GIVEN TO TOP OF GRATE INLETS.
- 3) PIPE LENGTHS ARE GIVEN TO THE CENTER OF THE STRUCTURE. CONTRACTOR SHALL ADJUST LENGTH TO OBTAIN ACTUAL PIPE LENGTHS.

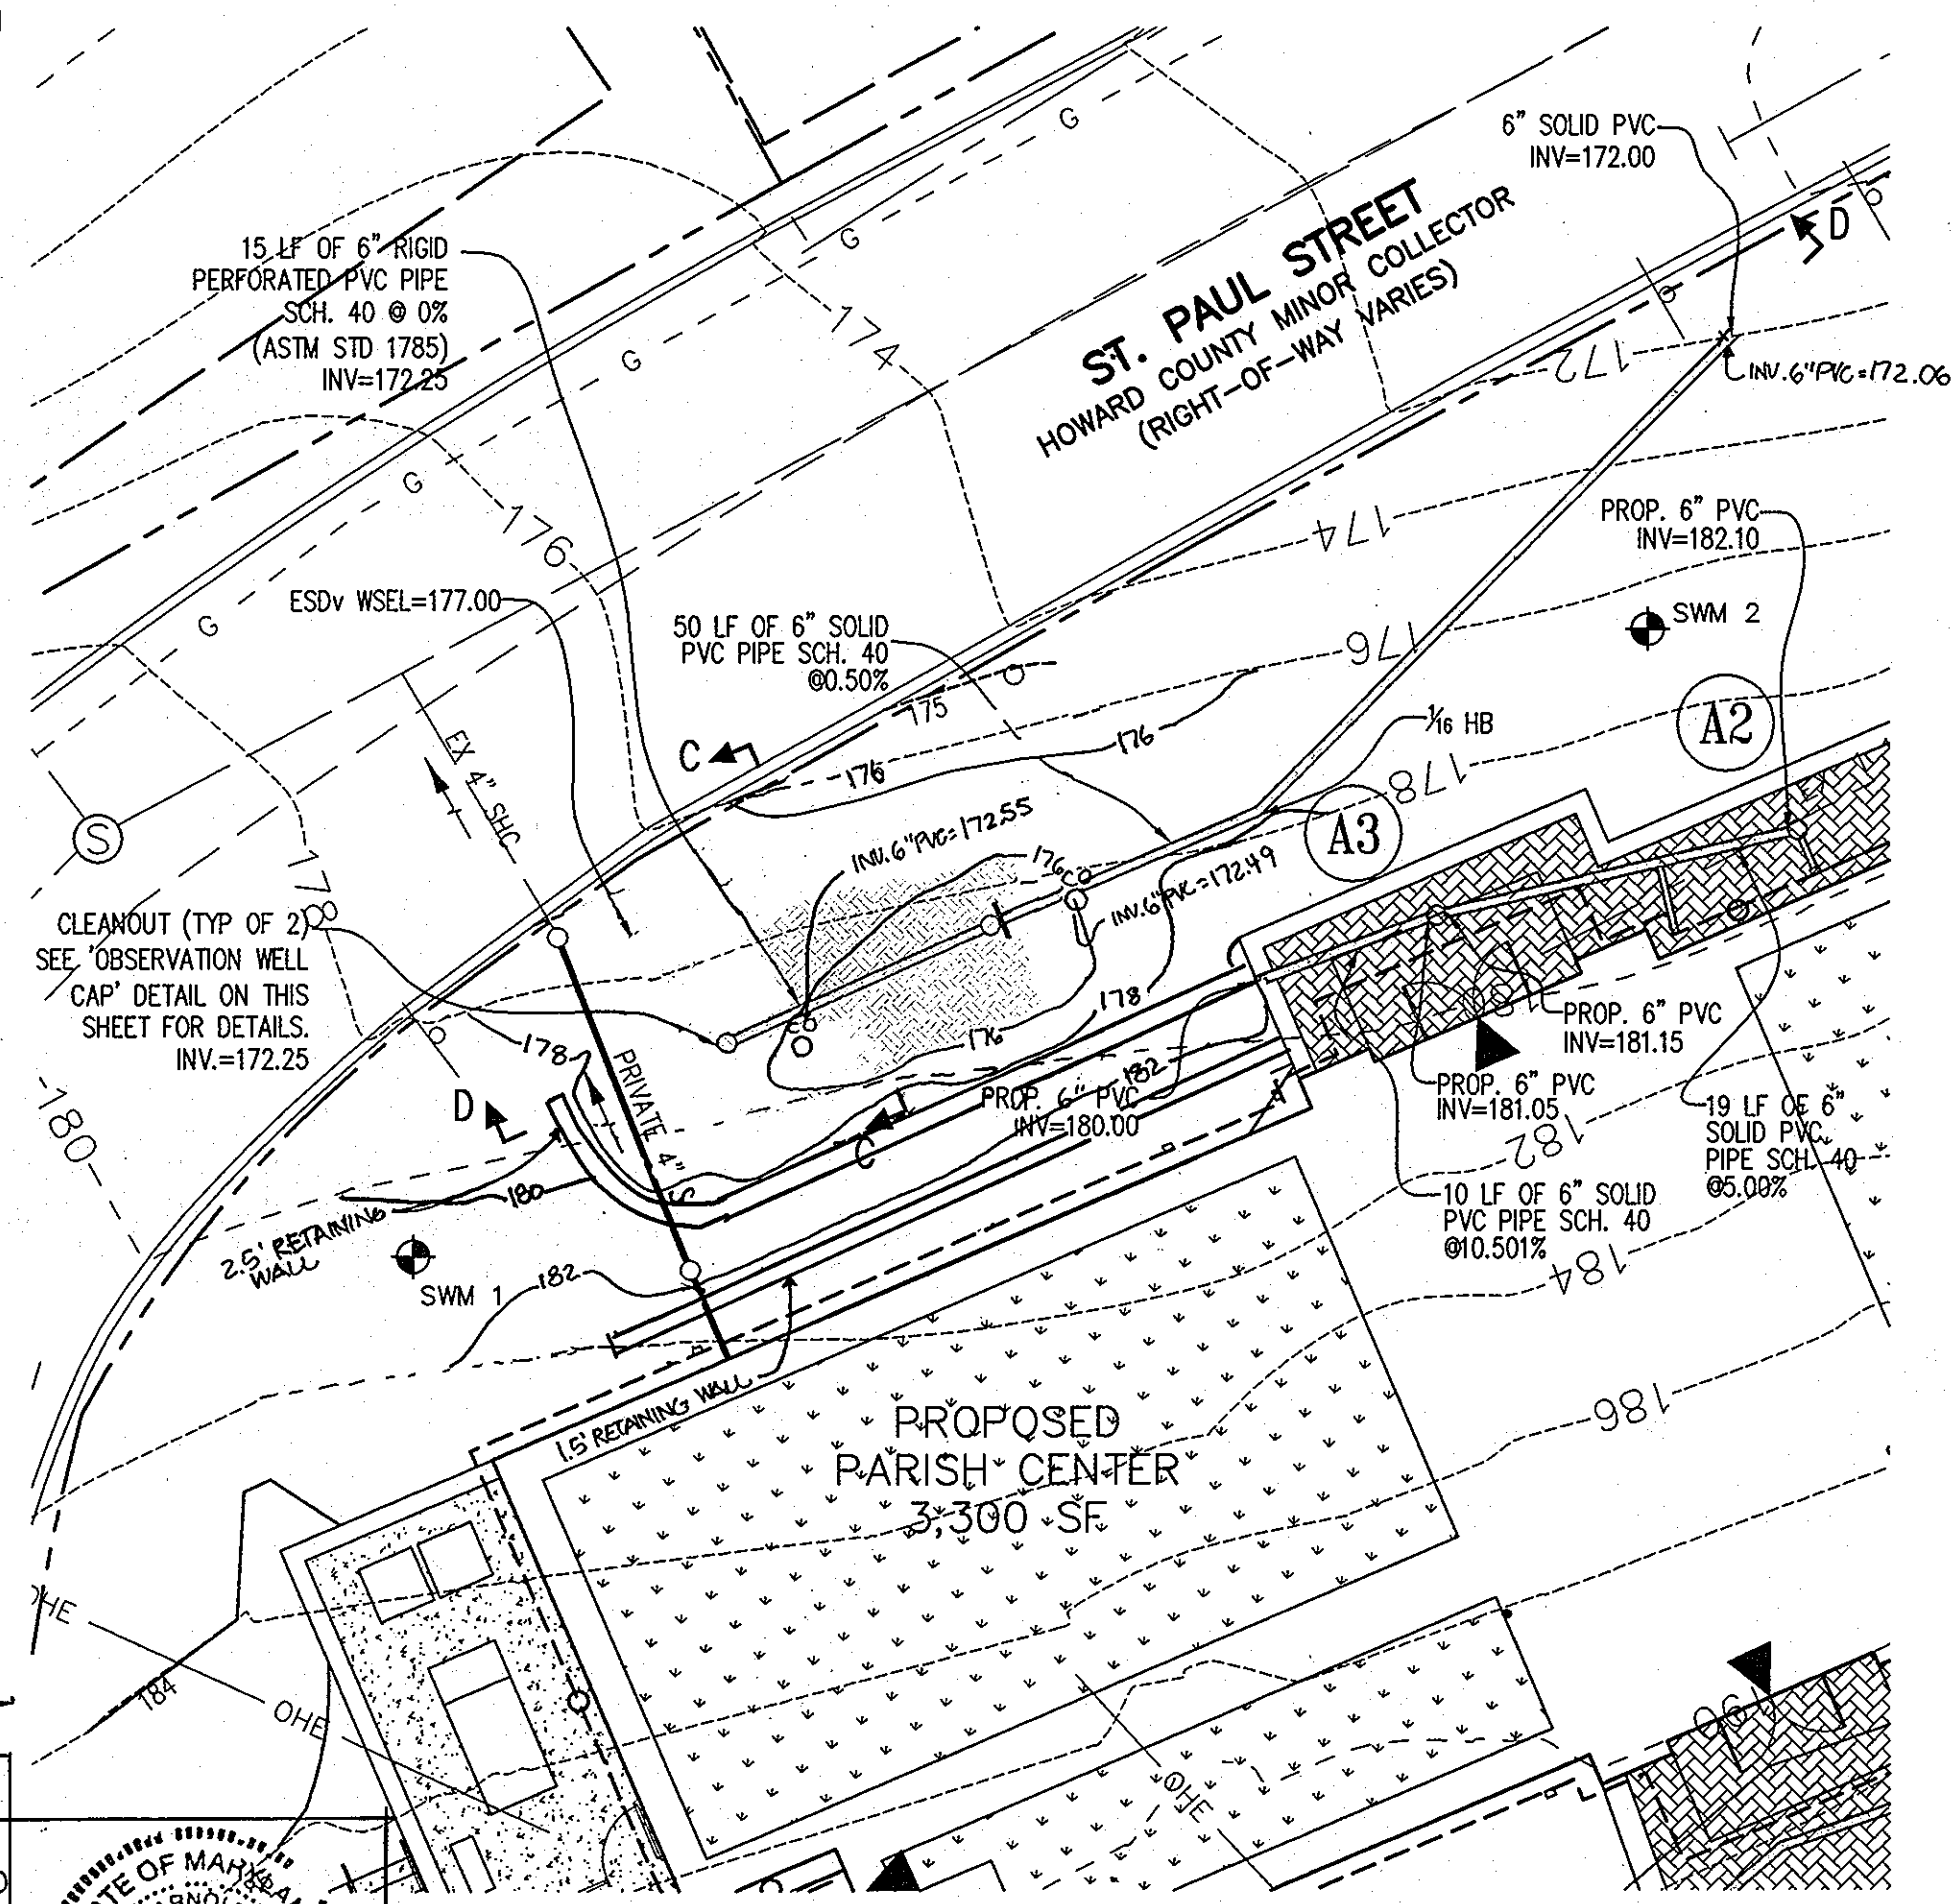


**MICRO-BIORETENTION FACILITY NO. 2**

SCALE: 1"=10'

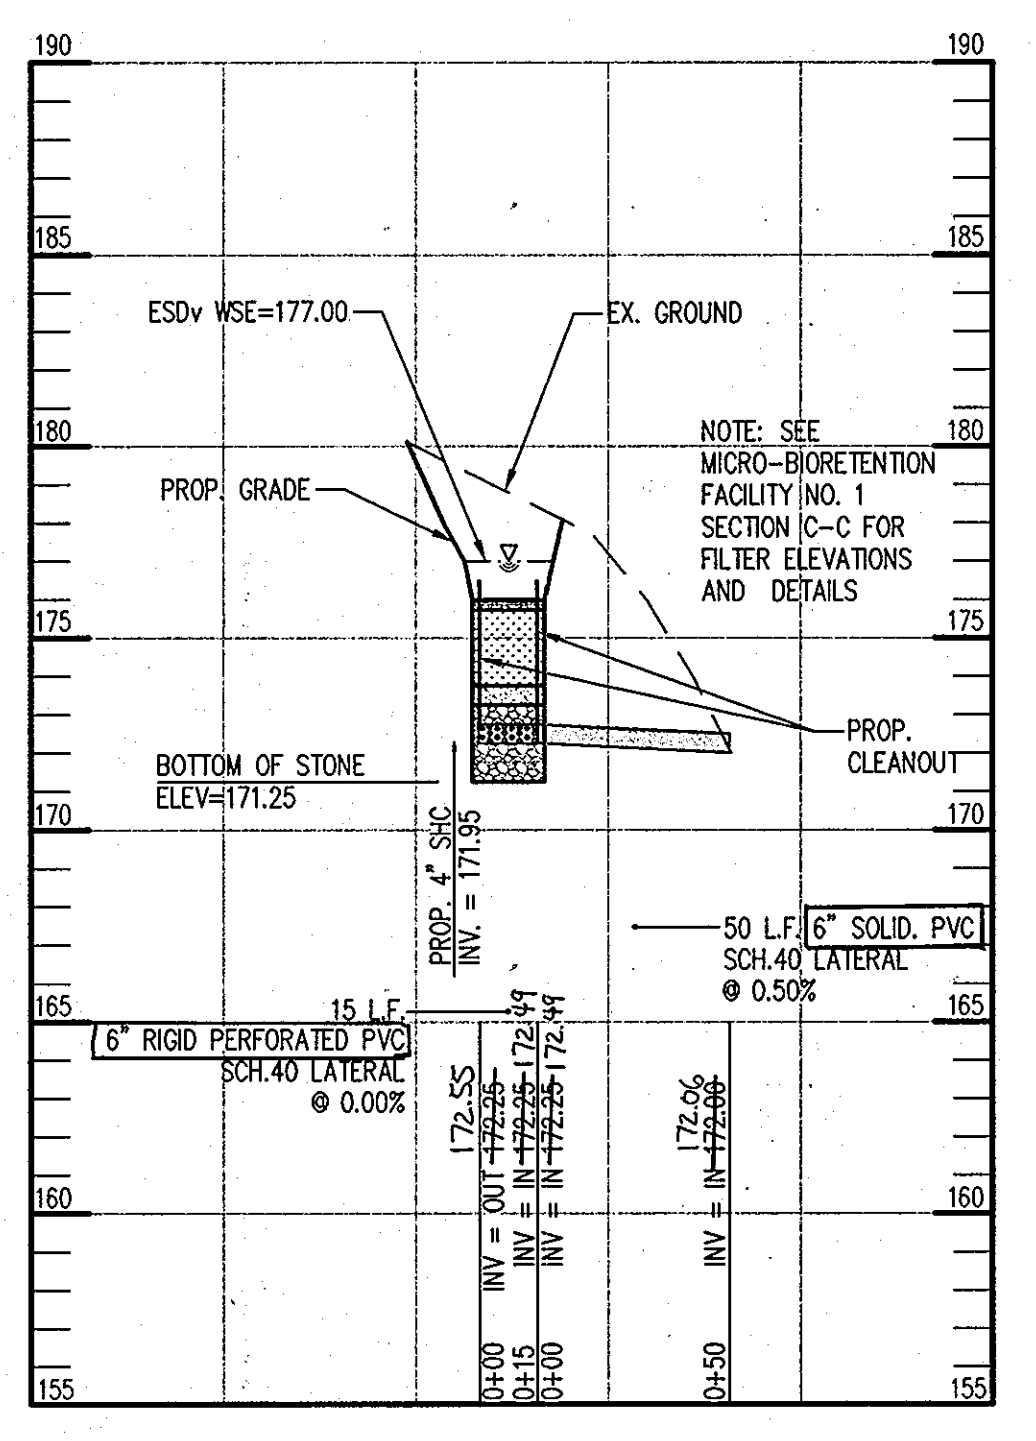

**PROFILE THROUGH MICRO-BIORETENTION FACILITY NO. 2-SECTION D-D**

SCALE: HOR: 1"=50'  
 VERT: 1"=5'

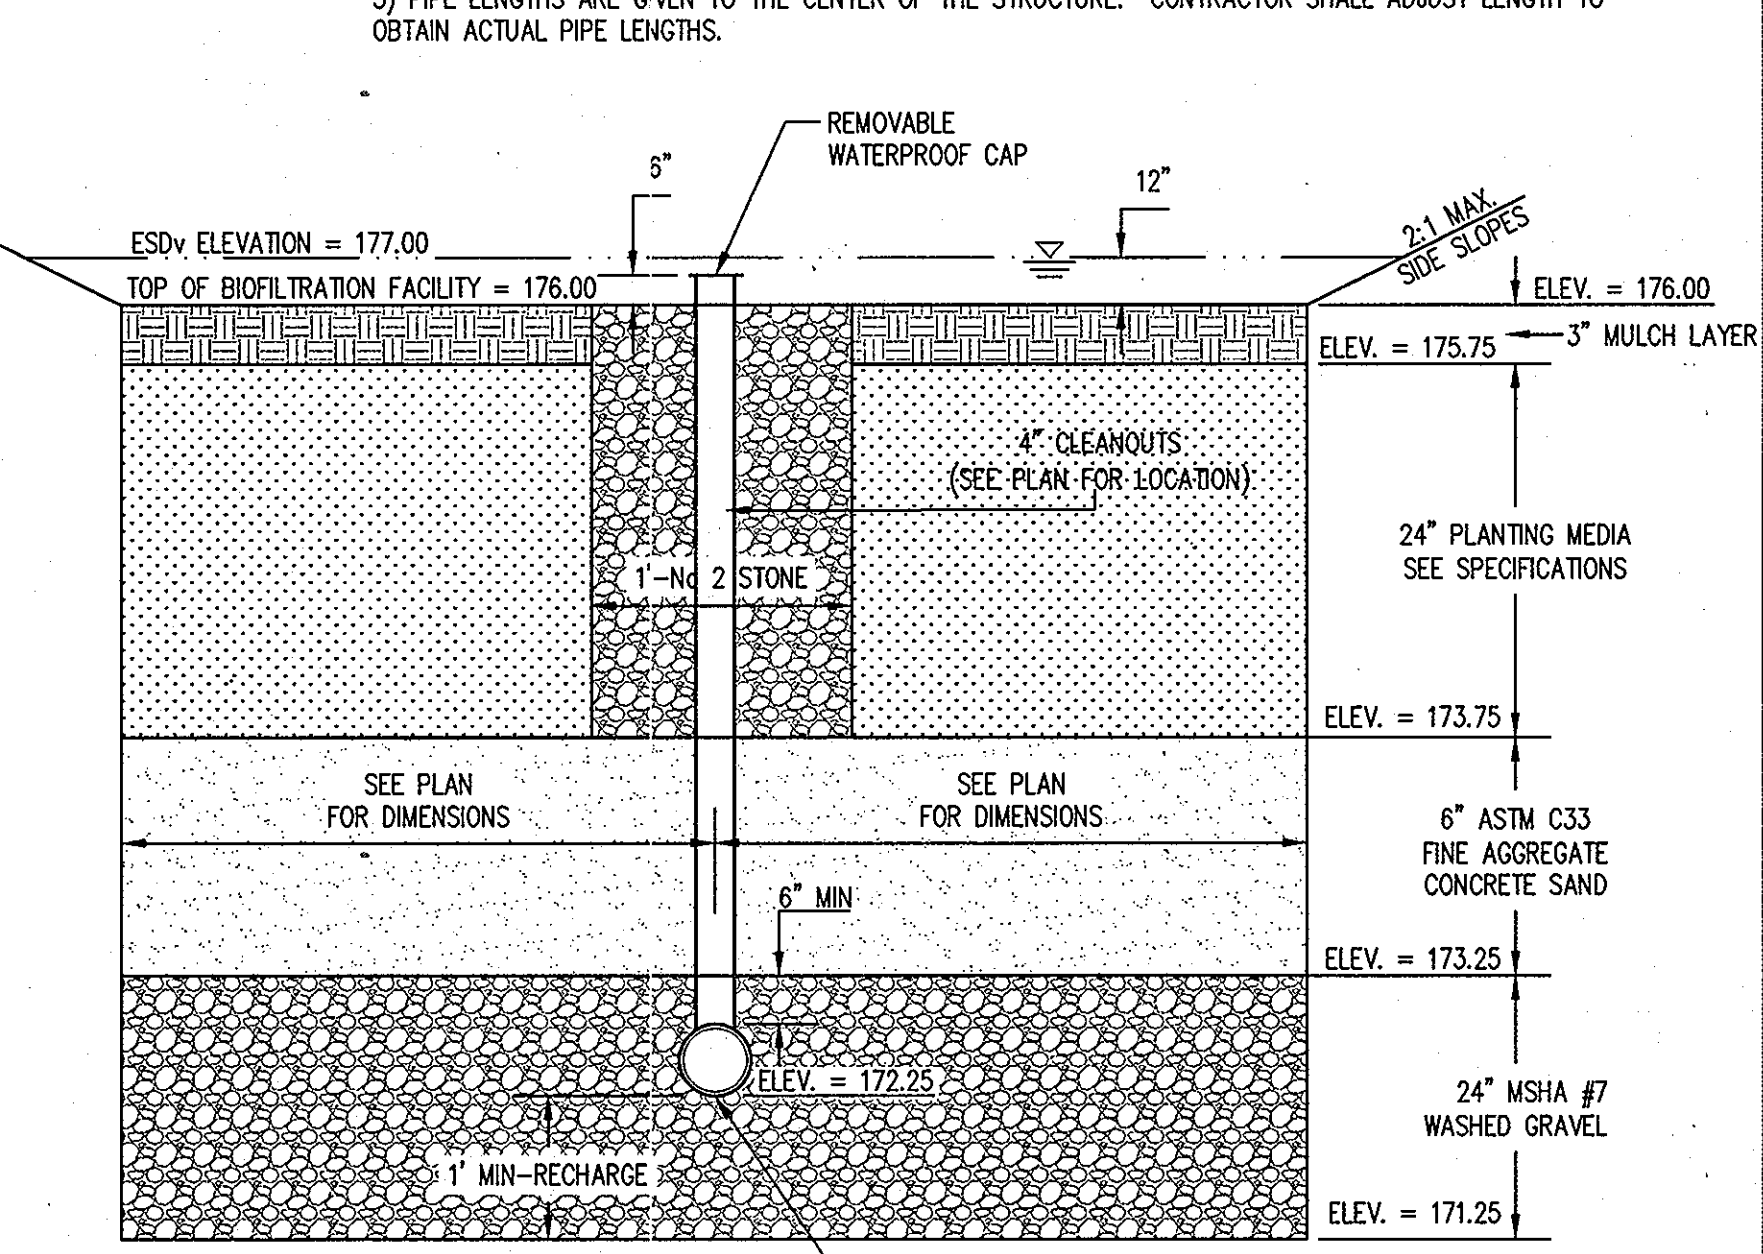

**MICRO-BIORETENTION FACILITY NO. 2 SECTION A-A**

NOT TO SCALE

**AS-BUILT**

APPROVED: HOWARD COUNTY DEPARTMENT OF PLANNING AND ZONING.

Thomas E. Butler 12/21/10  
 DIRECTOR DATE  
 David Edmund 12-15-10  
 CHIEF, DEVELOPMENT ENGINEERING DIVISION 1/6 P DATE  
 Kent Shadlock 12-21-10  
 CHIEF, DIVISION OF LAND DEVELOPMENT DATE

DATE	NO.	REVISION

**OWNER**  
 DOUG JOHNSON  
 ST. PAUL'S CHURCH & ANNEX  
 3675 COLLEGE AVE  
 ELLICOTT CITY MD 21043-4655  
 (410) 547-5340

**DEVELOPER**  
 DOUG JOHNSON  
 ST. PAUL'S CHURCH & ANNEX  
 3675 COLLEGE AVE  
 ELLICOTT CITY MD 21043-4655  
 (410) 547-5340

**PROJECT** ST. PAUL'S CATHOLIC CHURCH EVANGELIZATION CENTER  
**AREA** TAX MAP 25-A PARCELS 61, 120, & 121  
 2nd ELECTION DISTRICT ZONED HO  
 HOWARD COUNTY, MARYLAND


**TITLE** STORMWATER MANAGEMENT PLAN AND DETAILS

**Patton Harris Rust & Associates**  
 Engineers, Surveyors, Planners, Landscape Architects.  
 8818 Centre Park Drive  
 Columbia, MD 21045  
 T 410.997.8900  
 F 410.997.9282

DESIGNED BY: SER  
 DRAWN BY: JSN  
 PROJECT NO: 14867-1-0  
 DATE: SEPTEMBER 13, 2010  
 SCALE: SEE PLAN  
 DRAWING NO. 8 OF 18


BY: [Signature]  
 PROFESSIONAL CERTIFICATION: I HEREBY CERTIFY THAT THESE DOCUMENTS WERE PREPARED OR APPROVED BY ME, AND THAT I AM A DULY LICENSED PROFESSIONAL ENGINEER UNDER THE LAWS OF THE STATE OF MARYLAND, LICENSE NO. 21774, EXPIRATION DATE: 11-10-2013.



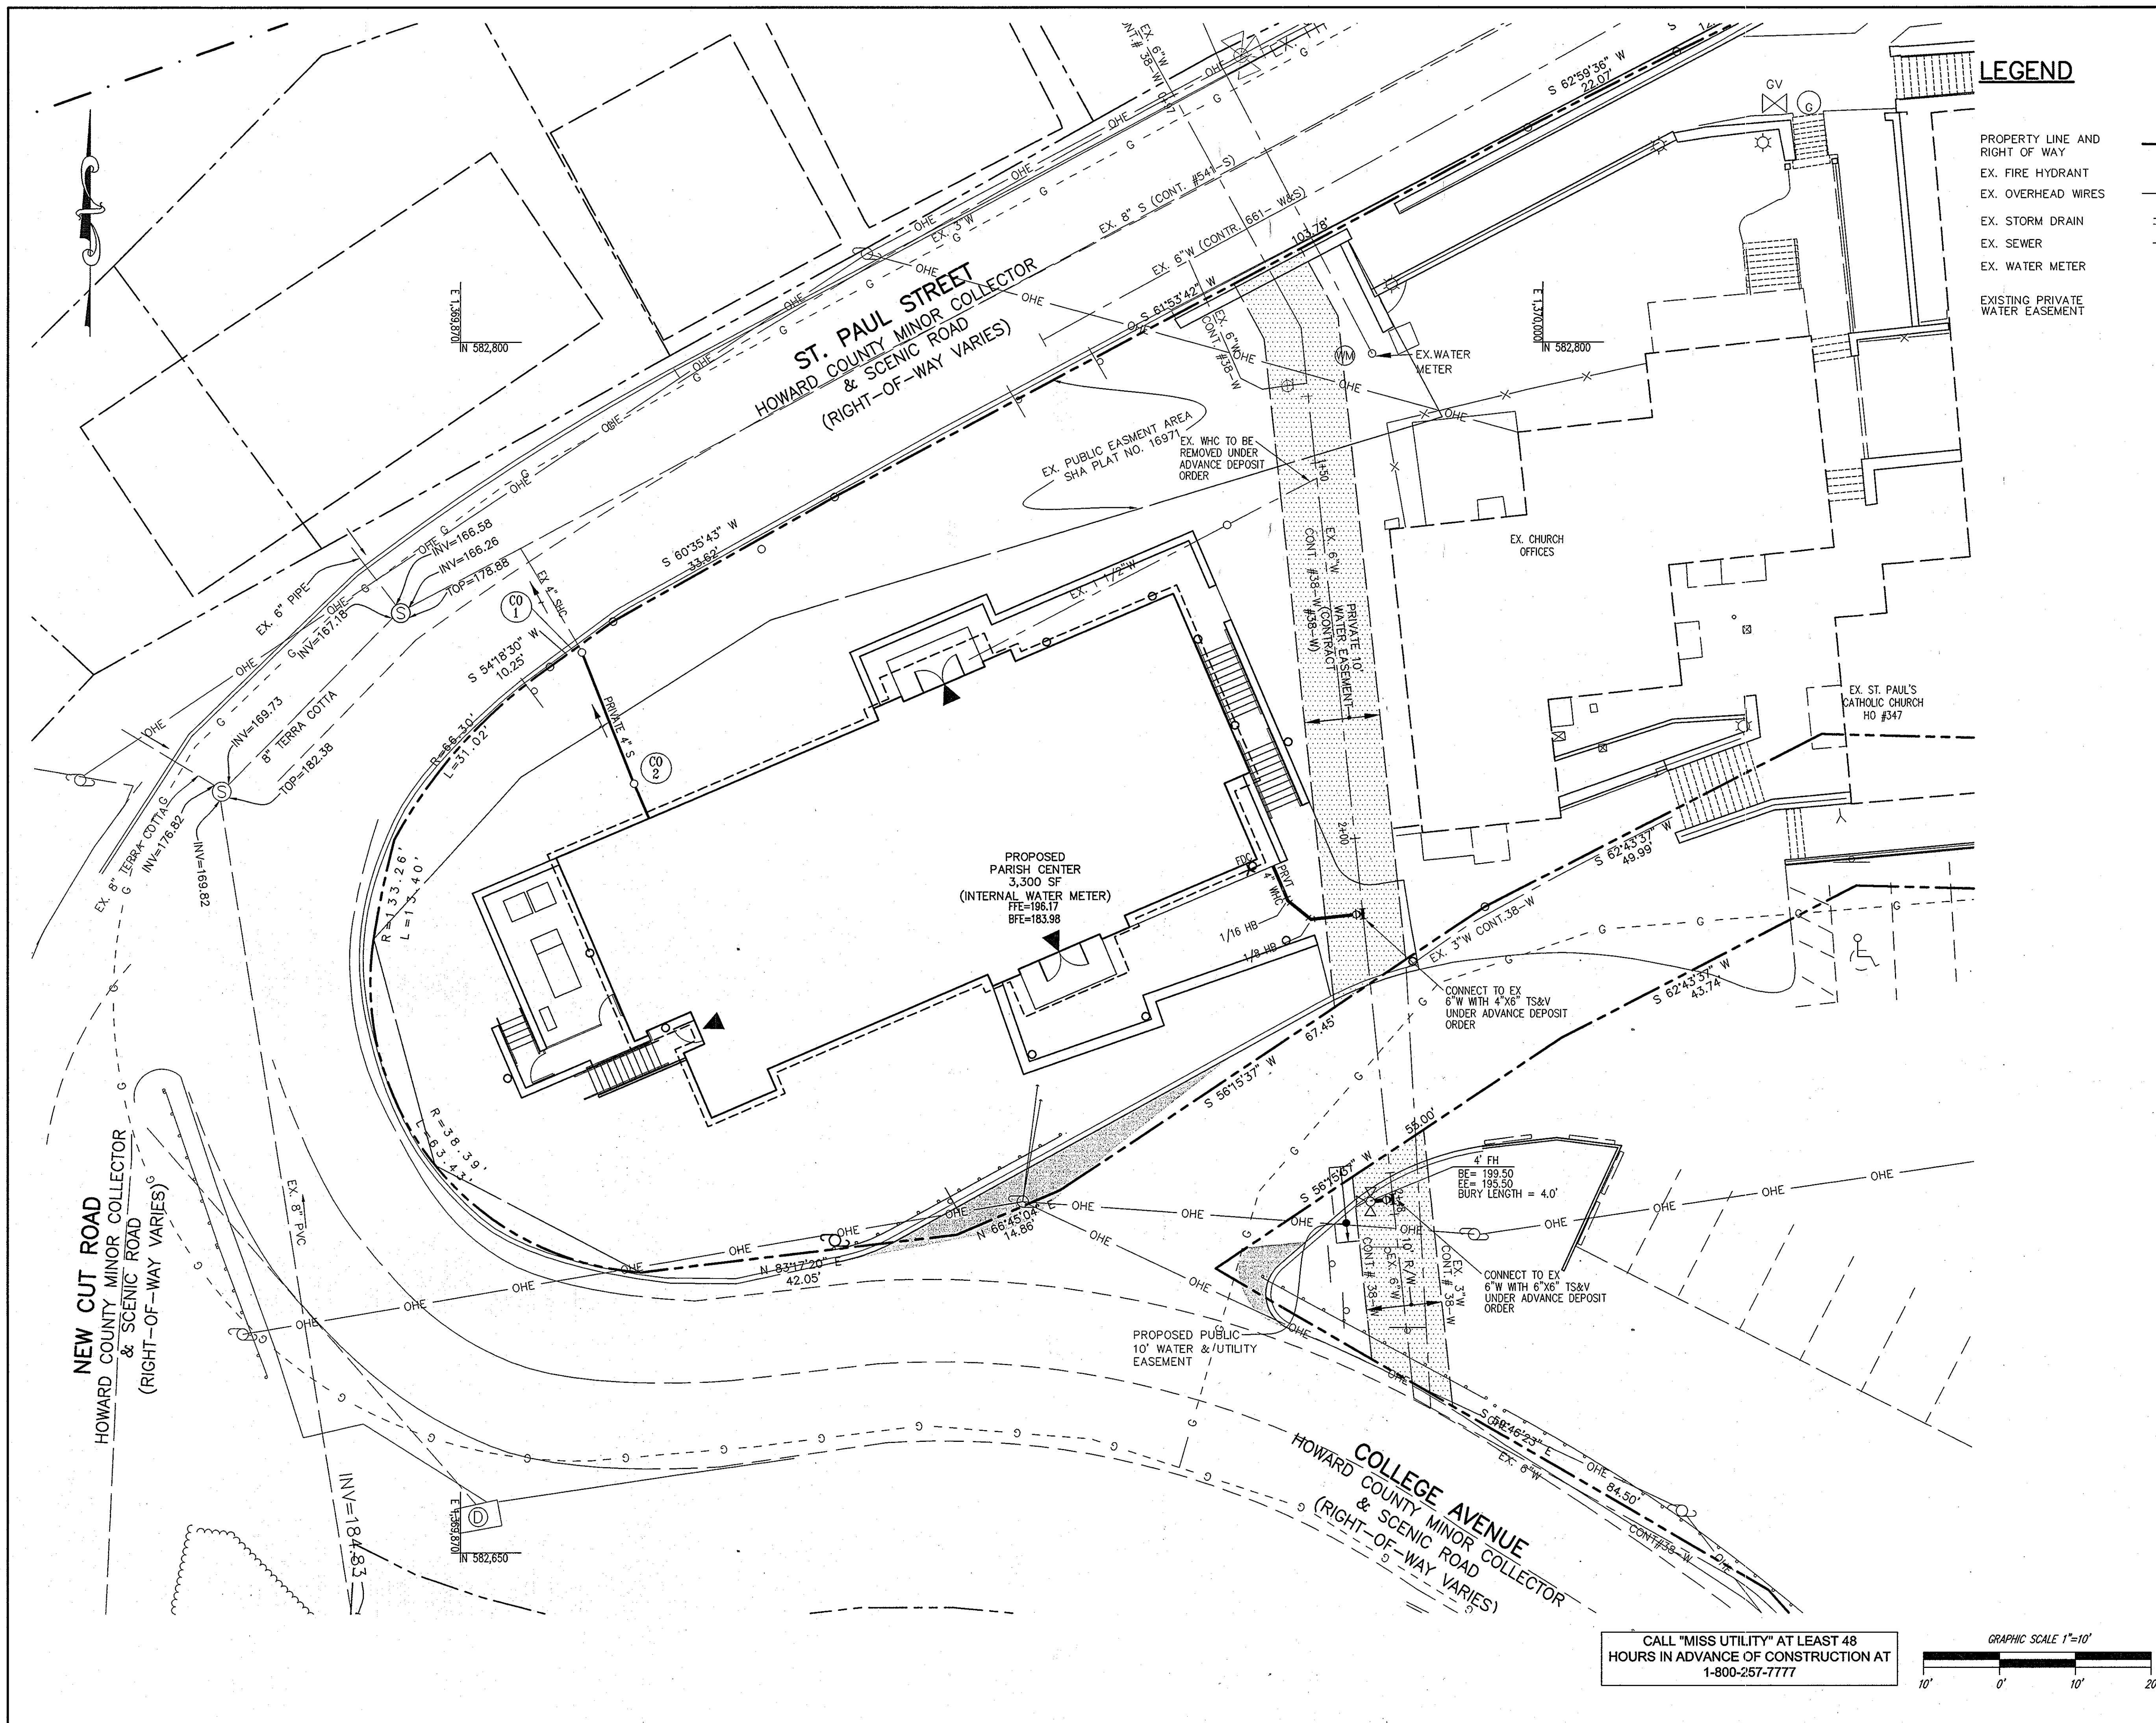

**LEGEND**

- PROPERTY LINE AND RIGHT OF WAY
- EX. FIRE HYDRANT
- EX. OVERHEAD WIRES
- EX. STORM DRAIN
- EX. SEWER
- EX. WATER METER
- EXISTING PRIVATE WATER EASEMENT

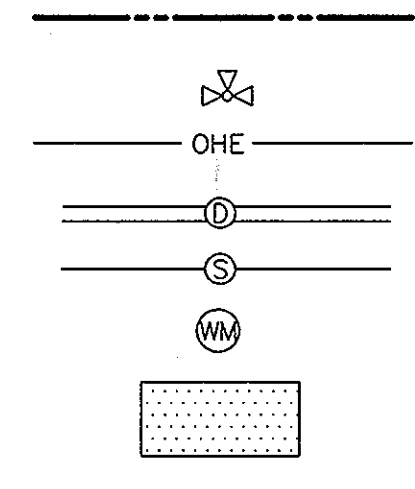

APPROVED : HOWARD COUNTY DEPARTMENT OF PLANNING AND ZONING.

*James & Butler* 12/21/10  
 DIRECTOR DATE  
*Shel Edmond* 12-15-10  
 CHIEF, DEVELOPMENT ENGINEERING DIVISION HSP DATE  
*Kevin Shadlock* 12-21-10  
 CHIEF, DIVISION OF LAND DEVELOPMENT DATE

DATE	NO.	REVISION

OWNER  
 DOUG JOHNSON  
 ST. PAUL'S CHURCH & ANNEX  
 3675 COLLEGE AVE  
 ELLICOTT CITY MD 21043-4655  
 (410) 547-5340

DEVELOPER  
 DOUG JOHNSON  
 ST. PAUL'S CHURCH & ANNEX  
 3675 COLLEGE AVE  
 ELLICOTT CITY MD 21043-4655  
 (410) 547-5340

PROJECT **ST. PAUL'S CATHOLIC CHURCH EVANGELIZATION CENTER**

AREA TAX MAP 25-A PARCELS 61, 120, & 121  
 2nd ELECTION DISTRICT ZONED HO  
 HOWARD COUNTY, MARYLAND


TITLE **UTILITY PLAN**


**Patton Harris Rust & Associates**  
 Engineers, Surveyors, Planners, Landscape Architects.  
 8818 Centre Park Drive  
 Columbia, MD 21045  
 T 410.997.8900  
 F 410.997.9282

SEAL  
  
 BY: *James A. Rust*

DESIGNED BY : JSN  
 DRAWN BY: JSN  
 PROJECT NO : 14867-1-0  
 DATE : SEPTEMBER 13, 2010  
 SCALE : 1"=10'  
 DRAWING NO. 9 OF 18

CALL "MISS UTILITY" AT LEAST 48 HOURS IN ADVANCE OF CONSTRUCTION AT 1-800-257-7777

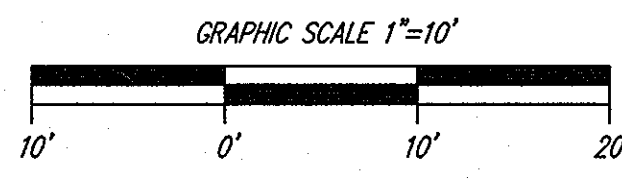

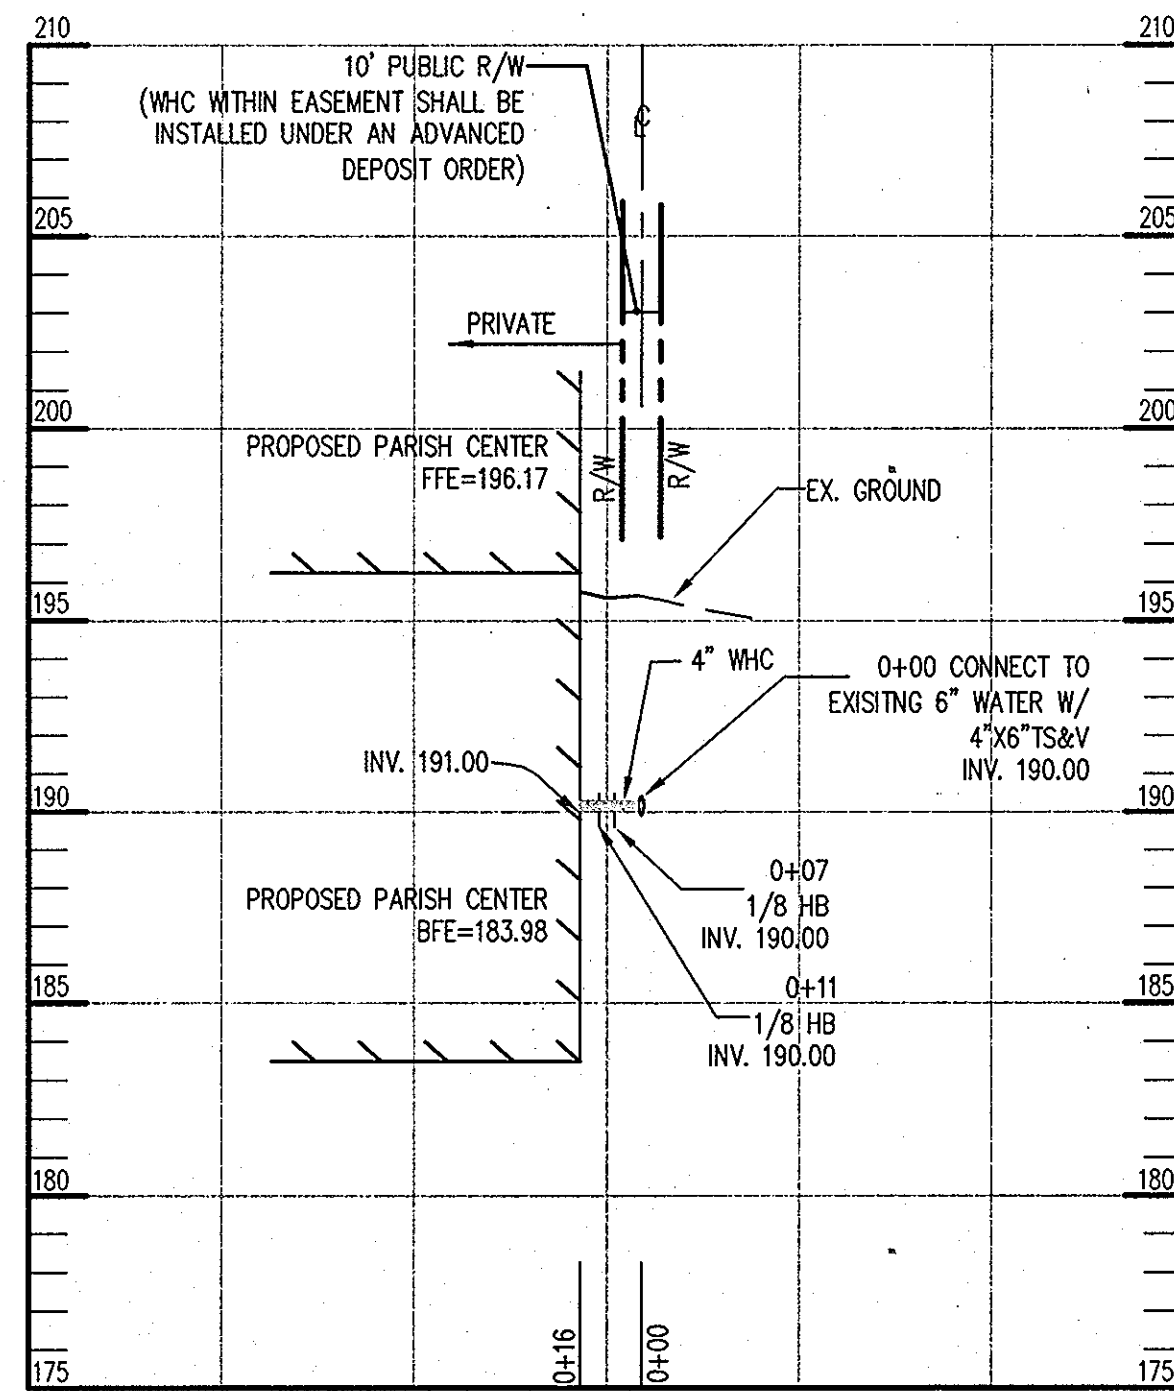

**WATER PROFILE**

SCALE : HOR: 1"=50'  
VERT: 1"=5'


WATER AND SEWER PIPE SCHEDULE		
SIZE	TYPE	LINEAR FOOTAGE
4" SEWER	PVC	23 LF (PRIVATE)
4" WATER	DIP	5 LF (PUBLIC) 11 LF (PRIVATE)

WATER FITTING SCHEDULE		
QUANTITY	SIZE	TYPE
1	4"	1/8 HB
1	4"	1/16 HB
1	-	4"x6" TS&V
1	-	6"x8" TS&V
1	6"	FH

STRUCTURE SCHEDULE FOR PRIVATE SEWER							
NUMBER	TYPE	LOCATION		TOP ELEVATION	PIPE INVERTS		REMARKS
		NORTHING	EASTING		INVERT IN	INVERT OUT	
CO-1	CLEANOUT	582775.34	1369883.58	177.00	171.35	165.51	HOWARD COUNTY STANDARD DETAIL S-3.21
CO-2	CLEANOUT	582756.38	1369889.52	180.00	174.95	174.95	


**NOTES**

- 1) ALL STRUCTURES ARE HOWARD COUNTY STANDARDS UNLESS NOTED OTHERWISE. CONTRACTOR MAY USE PRECAST STRUCTURE WHERE AVAILABLE TO MEET THE STANDARD STRUCTURE SPECIFIED.
- 2) STATIONS ARE GIVEN TO CENTER OF STRUCTURE FOR ALL STRUCTURES.
- 3) ELEVATIONS ARE GIVEN TO TOP LID FOR MANHOLES.
- 4) PIPE LENGTHS ARE GIVEN TO THE CENTER OF THE STRUCTURE. CONTRACTOR SHALL ADJUST LENGTH TO OBTAIN ACTUAL PIPE LENGTHS.

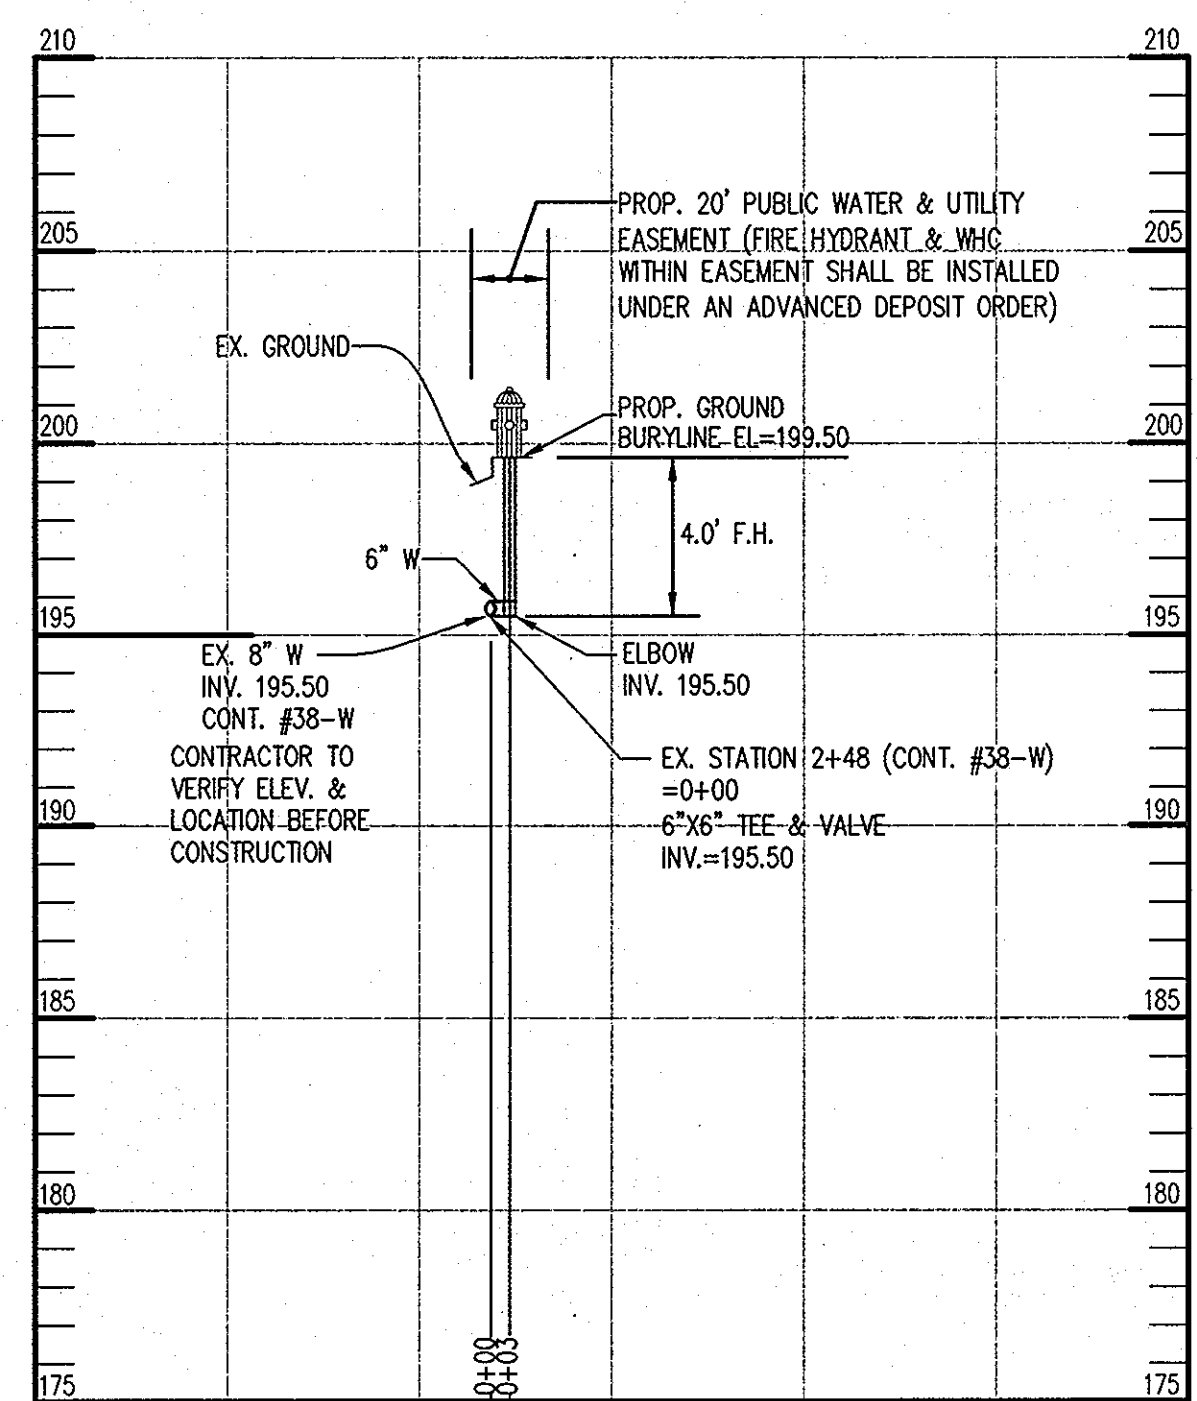

**WATER PROFILE**

SCALE : HOR: 1"=50'  
VERT: 1"=5'

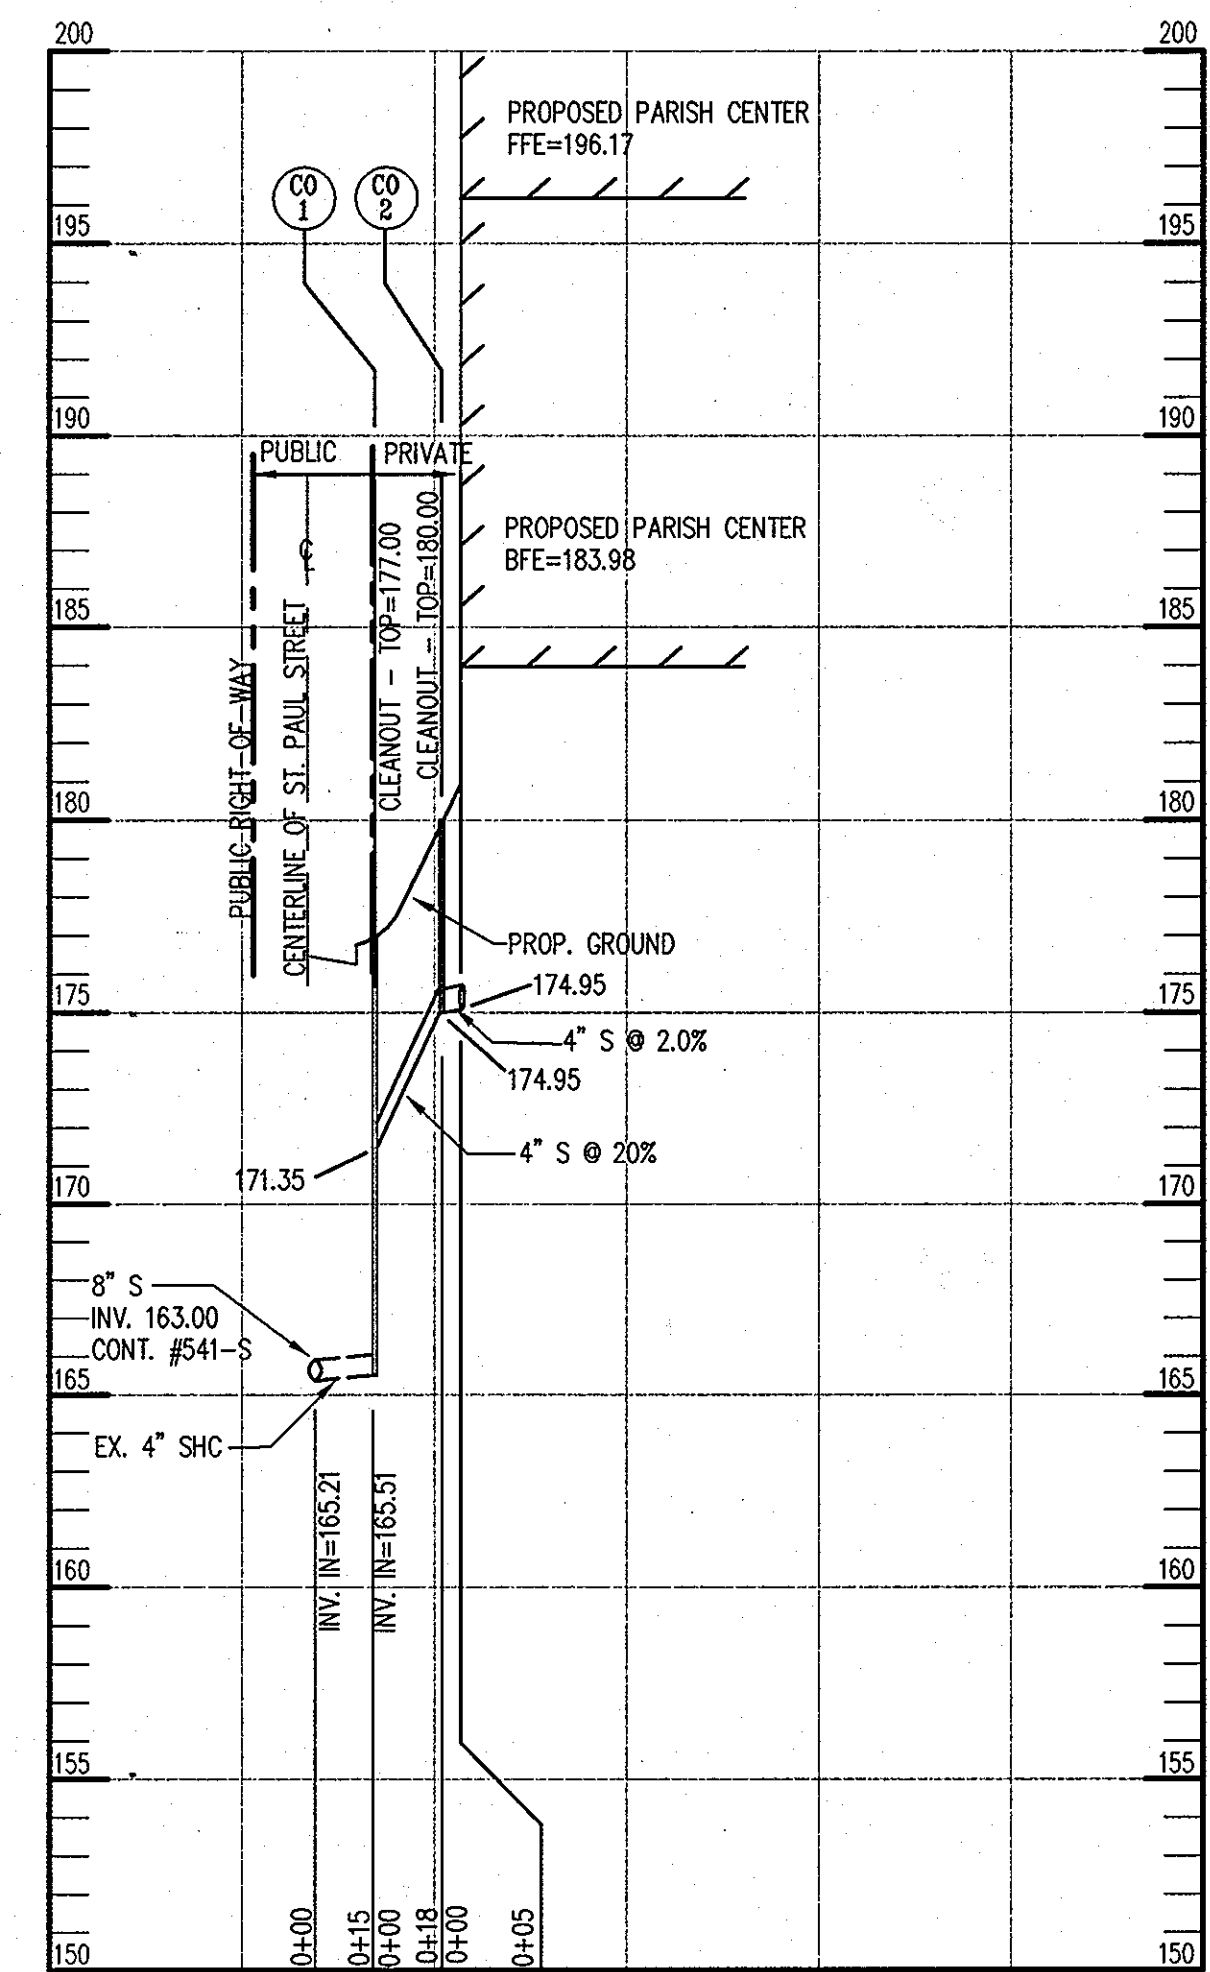

**SEWER PROFILE**

SCALE : HOR: 1"=50'  
VERT: 1"=5'

APPROVED : HOWARD COUNTY DEPARTMENT OF PLANNING AND ZONING.

*Morgan G. Rutler* 12/21/10  
DIRECTOR DATE

*David Edwards* 12-15-10  
CHIEF, DEVELOPMENT ENGINEERING DIVISION HSP DATE

*Kent Schulz* 12-21-10  
CHIEF, DIVISION OF LAND DEVELOPMENT DATE

DATE	NO.	REVISION

**OWNER**  
DOUG JOHNSON  
ST. PAUL'S CHURCH & ANNEX  
3675 COLLEGE AVE  
ELLICOTT CITY MD 21043-4655  
(410) 547-5340

**DEVELOPER**  
DOUG JOHNSON  
ST. PAUL'S CHURCH & ANNEX  
3675 COLLEGE AVE  
ELLICOTT CITY MD 21043-4655  
(410) 547-5340


**PROJECT** ST. PAUL'S CATHOLIC CHURCH EVANGELIZATION CENTER  
**AREA** TAX MAP 25-A PARCELS 61, 120, & 121  
2nd ELECTION DISTRICT ZONED HO  
HOWARD COUNTY, MARYLAND

**TITLE** UTILITY PROFILES

**Patton Harris Rust & Associates**  
Engineers, Surveyors, Planners, Landscape Architects.  
8818 Centre Park Drive  
Columbia, MD 21045  
T 410.997.8900  
F 410.997.9282

SEAL  
STATE OF MARYLAND  
JAMES A. RUST  
REGISTERED PROFESSIONAL ENGINEER  
NO. 21774, EXPIRATION DATE: 11-10-2011

DESIGNED BY : JSN  
DRAWN BY : JSN  
PROJECT NO : 14867-1-0  
DATE : SEPTEMBER 13, 2010  
SCALE : AS SHOWN  
DRAWING NO. 10 OF 18

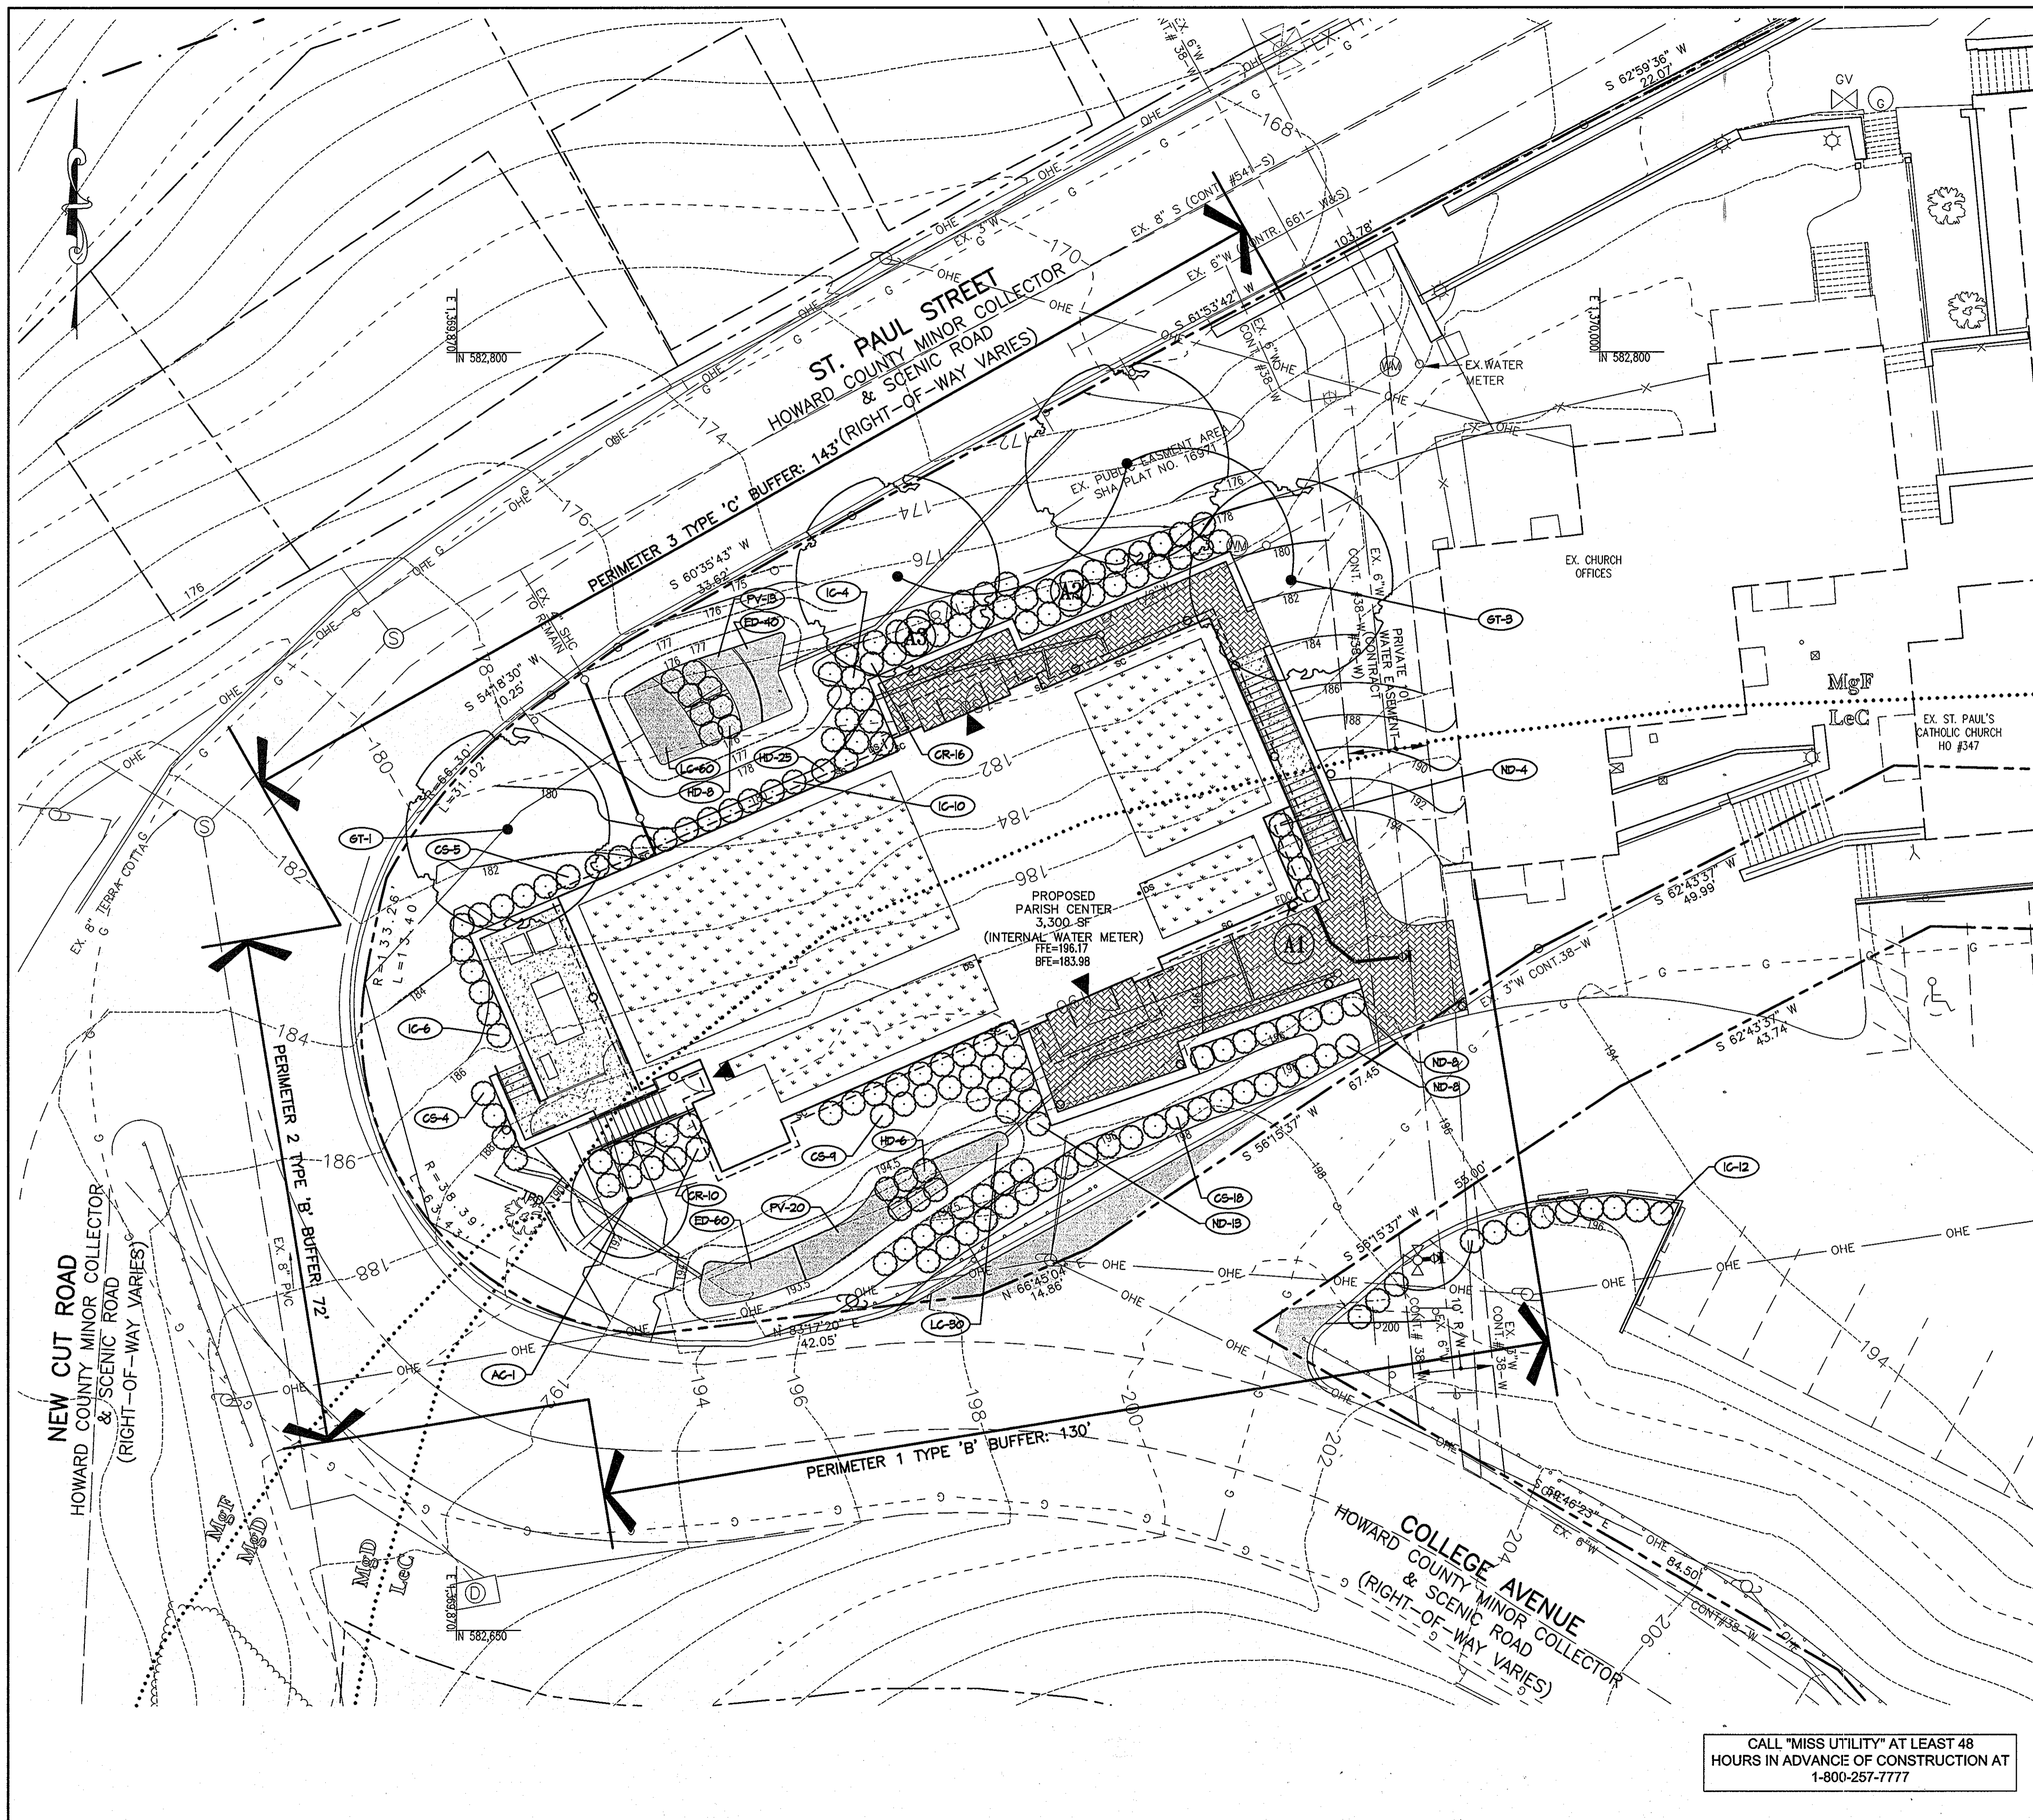

**LEGEND**

EXISTING 2' CONTOUR	---
EXISTING 10' CONTOUR	---
PROPERTY LINE AND RIGHT OF WAY	---
EX. TREELINE	---
EX. FIRE HYDRANT	⊕
EX. OVERHEAD WIRES	OHE
EX. BUILDING	▭
EX. SOILS	MgD
EX. CURB & GUTTER	---
EX. STORM DRAIN	---
EX. SEWER	---
EX. WATER METER	⊕
PROP. BUILDING	▭
PROP. CURB & GUTTER	---
PROPOSED 2' CONTOUR	---
PROPOSED 10' CONTOUR	---
PROPOSED GREEN ROOF	▨
PROPOSED SHADE TREE	⊙
PROPOSED ORNAMENTAL TREE	⊙
PROPOSED SHRUB	⊙
EXISTING TREES	⊙

APPROVED : HOWARD COUNTY DEPARTMENT OF PLANNING AND ZONING.

*Thomas R. Ruttle* 12/21/10  
DIRECTOR DATE

*Paul Elbert* 12-19-10  
CHIEF, DEVELOPMENT ENGINEERING DIVISION H&P DATE

*Kat Stalder* 12-21-10  
CHIEF, DIVISION OF LAND DEVELOPMENT DATE



DATE	NO.	REVISION
OWNER		
DOUG JOHNSON ST. PAUL'S CHURCH & ANNEX 3675 COLLEGE AVE ELLICOTT CITY MD 21043-4655 (410) 547-5340		
DEVELOPER		
DOUG JOHNSON ST. PAUL'S CHURCH & ANNEX 3675 COLLEGE AVE ELLICOTT CITY MD 21043-4655 (410) 547-5340		
PROJECT <b>ST. PAUL'S CATHOLIC CHURCH EVANGELIZATION CENTER</b>		
AREA TAX MAP 25-A PARCELS 61, 120, & 121 2nd ELECTION DISTRICT ZONED HO HOWARD COUNTY, MARYLAND		
TITLE <b>LANDSCAPE PLAN</b>		

**Patton Harris Rust & Associates**  
Engineers, Surveyors, Planners, Landscape Architects.  
8818 Centre Park Drive  
Columbia, MD 21045  
T 410.997.8900  
F 410.997.9282

**PHRA**

DESIGNED BY : JSN  
DRAWN BY : JSN  
PROJECT NO : 14867-1-0  
DATE : SEPTEMBER 13, 2010  
SCALE : 1"=10'  
DRAWING NO. 11 OF 18

CALL "MISS UTILITY" AT LEAST 48 HOURS IN ADVANCE OF CONSTRUCTION AT 1-800-257-7777

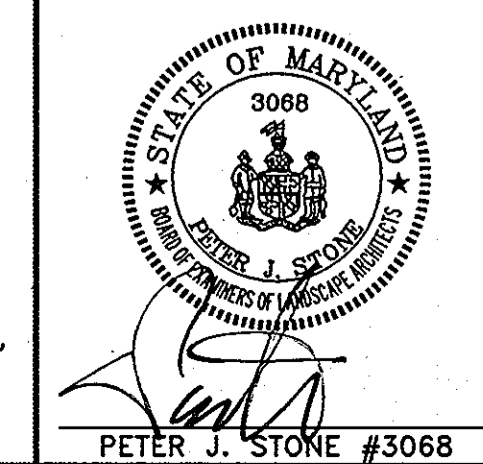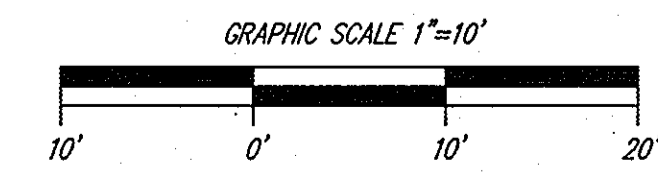

**PLANTING SPECIFICATIONS**

- Plants, related material, and operations shall meet the detailed description, as given on the plans and as described herein. Where discrepancies exist between Standards & Guidelines referenced within these specifications and the Howard County Landscape Manual, the latter takes precedence.
- All plant material, unless otherwise specified, that is not nursery grown, uniformly branched, does not have a vigorous root system, and does not conform to the most recent edition of the American Association of Nurserymen (AAN) Standards will be rejected. Plant material that is not healthy, vigorous, free from defects, decay, disfiguring roots, sunscald injuries, abrasions of the bark, plant disease, insect pest eggs, borers and all forms of insect infestations or objectionable disfigurements will be rejected. Plant material that is weak or which has been cut back from larger grades to meet specified requirements will be rejected. Trees with forked leaders will be rejected. All B & B plants shall be freshly dug; no healed-in plants or plants from cold storage will be accepted.
- Unless otherwise specified, all general conditions, planting operations, details and planting specifications shall conform to the most recent edition of the "Landscape Specification Guidelines by the Landscape Contractors Association of MD, DC, & VA", (hereinafter "Landscape Guidelines") approved by the Landscape Contractors Association of Metropolitan Washington and the Potomac Chapter of the American Society of Landscape Architects.
- Contractor shall guarantee all plant material for a period of one year after date of acceptance in accordance with the appropriate section on the Landscape Guidelines. Contractor's attention is directed to the maintenance requirements found within the one year specifications including watering and replacement of specified plant material.
- Contractor shall be responsible for notifying all relevant and appropriate utility companies, utility contractors, and "Miss Utility" a minimum of 48 hours prior to the beginning of any work. Contractor may make minor adjustments in spacing and location of plant material to avoid conflicts with utilities. Major changes will require the approval of the landscape architect. Damage to existing structure and utilities shall be repaired at the expense of the Contractor.
- Protection of existing vegetation to remain shall be accomplished via the temporary installation of 4 foot high snow fence at the drip line, see detail.
- Contractor is responsible for installing all material in the proper planting season for each plant type. All planting is to be completed within growing season of completion of site construction. Do not plant Pinus strobus or Xcupressacyparis leylandii between November 15 and March 15. Landscape plants are not to be installed before site is graded to final grade.
- Contractor to regrade, fine grade, sod, hydroseed and straw mulch all areas disturbed by their work.
- Bid shall be based on actual site conditions. No extra payment shall be made for work arising from actual site conditions differing from those indicated on drawings and specifications.
- Plant quantities are provided for the convenience of the contractor only. If discrepancies exist between quantities shown on plan and those shown on the plant list, the quantities on the plan take precedence. Where discrepancies on the plan exist between the symbols and the callout leader, the number of symbols take precedence.
- All shrubs and groundcover areas shall be planted in continuous planting beds, prepared as specified, unless otherwise indicated on plans. (See Specification 13). Beds to be mulched with minimum 2" and maximum 3" of composted, double-shredded hardwood mulch throughout.
- Positive drainage shall be maintained on planting beds (minimum 2 percent slope).
- Bed preparation shall be as follows: Till into a minimum depth of 6" 1 yard of Compro or Leafgro per 200 SF of planting bed, and 1 yard of topsoil per 100 SF of bed. Add 3 lbs of standard 5-10-5 fertilizer per cubic yard of planting mix and till. Ericaceous plants (Azaleas, Rhododendrons, etc.): top dress after planting with iron sulfate or comparable product according to package directions. Taxus baccata 'Repandens' (English weeping yews): Top dress after planting with 1/4 to 1/2 cup lime each.
- Planting mix: For trees not in a prepared bed, mix 50% Compro or Leafgro with 50% soil from tree hole to use as backfill, see tree planting detail.
- Weed & insect control: Incorporate a pre-emergent herbicide into the planting bed following recommended rates on the label. For tree planting, apply a pre-emergent on top of soil and root ball before mulching. Caution: For areas to be planted with a ground cover, be sure to carefully check the chemical used to assure its adaptability to the specific groundcover to be treated. Maintain the mulch weed-free for the extent of the warranty period. Under no circumstances is a pesticide containing chlorpyrifos to be used as a means of pest control.
- Water: All plant material planted shall be watered thoroughly the day of planting. All plant material not yet planted shall be properly protected from drying out until planted. At a minimum, water unplanted plant material daily and as necessary to avoid desiccation.
- Pruning: Do not heavily prune trees and shrubs at planting. Prune only broken, dead, or diseased branches.
- All areas within contract limits disturbed during or prior to construction not designated to receive plants and mulch shall be fine graded, grass seed planted, and covered with straw mulch.

PLANT SCHEDULE					
SYMBOL	QTY.	SCIENTIFIC/COMMON NAME	SIZE	ROOT	REMARKS
<b>SHADE TREES</b>					
GT	4	GLEDTISIA TRIACANTHOS INERMIS 'IMPERIAL' IMPERIAL THORNLESS HONEY LOCUST	2.5-3" CAL.	B&B	AS SHOWN
<b>ORNAMENTAL TREES</b>					
AC	1	AMELANCHIER CANADENSIS SHADBLOW SERVICEBERRY	8-10' HT.	B&B	AS SHOWN
<b>SHRUBS</b>					
CS	36	COTONEASTER SALICIFOLIUS 'REPENS' MILLOWLEAF COTONEASTER	18-24" HT.	CONT.	AS SHOWN
CR	26	CORNUS SERICEA REDOSIER DOGWOOD	18-24" HT.	CONT.	AS SHOWN
IC	32	ILEX CORNUTA 'DWARF BURFORD' DWARF BURFORD HOLLY	18-24" HT.	CONT.	AS SHOWN
HD	39	HYPERICUM DENSIFLORUM DENSE ST. JOHN'S WORT	12-18" HT.	CONT.	AS SHOWN
ND	33	NANDINA DOMESTICA 'HARBOR DWARF' HARBOR DWARF NANDINA	18-24" HT.	CONT.	AS SHOWN
<b>PERENNIALS</b>					
ED	100	EUPATORIUM DUBIUM JOE-PYE WEED	2 1/2" PEAT POT	FULL FLAT	FULL FLATS 12" O.C.
LC	90	LOBELIA CARDINALIS CARDINAL FLOWER	2 1/2" PEAT POT	FULL FLAT	FULL FLATS 12" O.C.
<b>GRASSES</b>					
PV	33	PANICUM VIRGATUM VIRGINIA SWITCHGRASS	2 GAL.	CONT.	FULL SHAPE 3' O.C.

SOILS CHART					
MAP SYMBOL	NAME	STRUCTURAL LIMITATIONS	EROSION HAZARD	HYDRIC (Yes/No)	SLOPE (%)
LeC	Legore Silt Loam	Dwellings w/ Basements	Moderate	No	8-15
MgD	Manor-Bannertown Sandy Loams	Somewhat limited	High	No	15-25
MgF	Manor-Bannertown Sandy Loams	Very limited	High	No	25-65

SOURCE: SOIL INFORMATION TAKEN FROM THE NATURAL RESOURCES CONSERVATION SERVICE WEB SOIL SURVEY.

SCHEDULE A - PERIMETER LANDSCAPE EDGE				
	ADJACENT TO ROADS	ADJACENT TO ROADS	ADJACENT TO ROADS	TOTAL NUMBER OF PLANTS
PERIMETER	1	2	3	
LANDSCAPE TYPE	B	B	C	
LINEAR FEET OF ROADWAY FRONTAGE / PERIMETER	130' ±	72' ±	143' ±	
CREDIT FOR EXISTING VEGETATION (YES, NO, LINEAR FEET) (DESCRIBE BELOW IF NEEDED)	NO	NO	NO	
CREDIT FOR WALL, FENCE, BERM OR DRIVE AISLE (YES/NO/LINEAR FEET)	NO	NO	NO	
LINEAR FEET REMAINING	130' ±	72' ±	143' ±	
TOTAL NUMBER OF PLANTS REQUIRED				8
SHADE TREES	3	1	4	12
EVERGREEN TREES	3	2	7	0
SHRUBS	0	0	0	0
TOTAL NUMBER OF PLANTS PROVIDED				4
SHADE TREES	0	0	4	0
EVERGREEN TREES	0	1	0	1
SMALL FLOWERING TREES	0	0	0	0
SHRUBS	60	20	60	140

**SUBSTITUTION NOTES:**

PERIMETER 1: 30 SHRUBS HAVE BEEN SUBSTITUTED FOR 3 SHADE TREES & 30 SHRUBS HAVE BEEN SUBSTITUTED FOR 3 EVERGREEN TREES.

PERIMETER 2: 1 FLOWERING TREE BEEN SUBSTITUTED FOR 1 EVERGREEN TREE & 20 SHRUBS HAVE BEEN SUBSTITUTED FOR 1 SHADE TREE AND 1 EVERGREEN TREE.

PERIMETER 3: 1 SHADE TREE HAS BEEN SUBSTITUTED FOR 2 EVERGREEN TREES & 60 SHRUBS HAVE BEEN SUBSTITUTED FOR 5 EVERGREEN TREES & 1 SHADE TREE.

### Howard County Forest Conservation Worksheet

Project Name: St. Paul's Catholic Church  
County File #: SDP-10-069  
Date: February 3, 2010

Net Tract Area  
A. Total Tract Area  
B. Floodplain Area  
C. Net Tract Area (A-B-C)

Land Use Category: IDA  
D. Afforestation Threshold (Net Tract Area X 15%)  
E. Conservation Threshold (Net Tract Area X 20%)

Existing Forest Cover  
F. Existing Forest Cover within the Net Tract Area  
G. Area of Forest Above Conservation Threshold  
If the Existing Forest Cover (F) is greater than Conservation Threshold (G), then G = Existing Forest Cover (F) - Conservation Threshold (E); Otherwise G = 0

Break Even Point  
H. Break Even (Amount of forest that must be retained so that no mitigation is required)  
(1) If the area of forest above the Conservation Threshold (G) is greater than zero, then H = (0.2 X the area of forest above Conservation Threshold (G)) + the Conservation Threshold (E)  
(2) If the area of forest above the Conservation Threshold (G) is equal to zero, then H = Existing Forest Cover (F)

Proposed Forest Clearing  
I. Total Area of Forest to be Cleared  
J. Total Area of Forest to be Retained  
K = Existing Forest Cover (F) - forest to be cleared (J)


Planting Requirements  
L. If the Total Area of Forest to be Cleared (K) is at or above the Break Even Point (H), no planting is required and no further calculations are necessary (L=0, M=0, N=0, P=0); If not, calculate the planting requirement below:  
L. Reforestation for Clearing Above the Conservation Threshold  
(1) If the total area of forest to be retained (K) is greater than the Conservation Threshold (E), then L = the area of forest to be cleared (J) X 0.25;  
(2) If the forest to be retained (K) is less than or equal to the Conservation Threshold (E), then L = area of forest above Conservation Threshold (G) X 0.25  
M. Reforestation for Clearing Below the Conservation Threshold  
(1) If Existing Forest Cover (F) is greater than Conservation Threshold (E) and the forest to be retained (K) is less than or equal to the Conservation Threshold (E), then M = 2.0 X (the Conservation Threshold (E) - the forest to be retained (K))  
(2) If Existing Forest (F) is less than or equal to the Conservation Threshold (E), then M = 2.0 X Forest to be cleared (J).  
N. Credit for Retention Above the Conservation Threshold  
If the area of forest to be retained (K) is greater than the Conservation Threshold (E), then N = K - E  
P. Total Reforestation Required P = L + M - N  
Q. Total Afforestation Required  
(1) If Existing Forest Cover (F) is less than the Afforestation Threshold (D) then Q = the Afforestation Threshold (D) - the Existing Forest Cover (F)  
R. Total Planting Requirement R = P + Q

**FOREST CONSERVATION GENERAL NOTES**

- THE EXISTING TOPOGRAPHY IS TAKEN FROM AVAILABLE HOWARD COUNTY RECORDS AND FIELD RUN SURVEY WITH MAXIMUM TWO FOOT CONTOUR INTERVALS PREPARED BY PATTON HARRIS RUST & ASSOCIATES DATED NOVEMBER 2008. THE BOUNDARY SURVEY FOR THIS PROJECT WAS PREPARED BY PATTON HARRIS RUST & ASSOCIATES DATED NOVEMBER 2008.
- NO CRITICAL HABITATS OF RARE, THREATENED OR ENDANGERED SPECIES WERE OBSERVED.
- NO TREES, SHRUBS, OR PLANTS IDENTIFIED AS RARE, THREATENED OR ENDANGERED SPECIES WERE OBSERVED.
- THERE ARE NO KNOWN CEMETERIES OR BURIAL PLOTS LOCATED ON THE SITE, ACCORDING TO THE HOWARD COUNTY CEMETERIES INVENTORY.
- SEVEN EXISTING BUILDINGS ARE PRESENT ON THE SITE.
- THE SOILS ON SITE ARE LEGORE SILT LOAM (8-15% SLOPES) - LeC, MANOR-BANNERTOWN SANDY LOAMS (15-25% SLOPES) - MgD, AND MANOR-BANNERTOWN SANDY LOAMS (25-65% SLOPES) - MgF ACCORDING TO THE NATURAL RESOURCES CONSERVATION SERVICE WEB SOIL SURVEY.
- THERE IS NO EXISTING FOREST COVER ON THE SITE, THEREFORE NO FOREST STAND DELINEATION (FSD) WAS CONDUCTED FOR THIS PROJECT.
- THE HOWARD COUNTY FOREST CONSERVATION MANUAL SUPERCEDES ANY DISCREPANCIES BETWEEN THE MANUAL AND THESE PLANS.
- THIS PROJECT COMPLIES WITH THE REQUIREMENTS OF SECTION 16.1200 OF THE HOWARD COUNTY CODE FOR FOREST CONSERVATION FOR 0.04 ACRES OF AFFORESTATION PROVIDED BY A FEE-IN-LIEU IN THE AMOUNT OF \$1,307.00 AT \$0.75/SF.

**GENERAL LANDSCAPE NOTES:**

- THIS PLAN HAS BEEN PREPARED IN ACCORDANCE WITH THE PROVISIONS OF SECTION 16.124 OF THE HOWARD COUNTY CODE AND THE LANDSCAPE MANUAL.
- FINANCIAL SURETY FOR THE REQUIRED LANDSCAPING MUST BE POSTED AS PART OF THE DEVELOPER'S AGREEMENT IN THE AMOUNT OF \$4,200.00.  
8 SHADE TREES @ \$300 = \$2,400.00  
0 ORNAMENTAL TREES @ \$150 = \$0  
12 EVERGREEN TREES @ \$150 = \$1,800.00  
0 SHRUBS @ \$30 = \$0
- THIS PLAN IS FOR LANDSCAPING PURPOSES ONLY.
- CONTRACTOR IS SOLELY RESPONSIBLE FOR CONSTRUCTION MEANS, METHODS, TECHNIQUES, SEQUENCES, PROCEDURES, AND SAFETY PRECAUTIONS AND PROGRAMS.
- ALL MATERIAL SELECTED SHALL BE EQUAL TO OR BETTER THAN THE REQUIREMENTS OF THE "USA STANDARD FOR NURSERY STOCK", LATEST EDITION, AS PUBLISHED BY THE AMERICAN ASSOCIATION OF NURSERYMEN.
- ALL MATERIAL SHALL BE PLANTED IN ACCORDANCE WITH THE MINIMUM STANDARDS CITED IN THE LATEST EDITION OF "LANDSCAPE SPECIFICATION GUIDELINES" PUBLISHED BY THE LANDSCAPE CONTRACTORS ASSOCIATION.
- AT THE TIME OF INSTALLATION, ALL SHRUBS AND OTHER PLANTINGS SHALL BE OF THE PROPER HEIGHT AND/OR SPREAD REQUIREMENTS IN ACCORDANCE WITH THIS PLAN AND THE HOWARD COUNTY LANDSCAPE MANUAL.
- NO SUBSTITUTIONS OR RELOCATION OF PLANTS MAY BE MADE WITHOUT PRIOR APPROVAL FROM THE DEPARTMENT OF PLANNING AND ZONING OF HOWARD COUNTY. ANY DEVIATION FROM THIS LANDSCAPE PLAN MAY RESULT IN A REQUIREMENT FOR SUBMITTAL OF AN OFFICIAL "REDLINE REVISION" TO THE SITE DEVELOPMENT PLAN(S) AND/OR DENIAL IN THE RELEASE OF LANDSCAPE SURETY.
- NO SUBSTITUTIONS OR RELOCATION OF PLANTS MAY BE MADE WITHOUT PRIOR APPROVAL FROM THE DEPARTMENT OF PLANNING AND ZONING OF HOWARD COUNTY. ANY DEVIATION FROM THIS LANDSCAPE PLAN MAY RESULT IN A REQUIREMENT FOR SUBMITTAL OF AN OFFICIAL "REDLINE REVISION" TO THE SITE DEVELOPMENT PLAN(S) AND/OR DENIAL IN THE RELEASE OF LANDSCAPE SURETY.
- THIS EXPANSION IS LESS THAN 50% OF THE SITE AREA, LANDSCAPING IS REQUIRED FOR THE EVANGELIZATION CENTER EXPANSION ONLY.

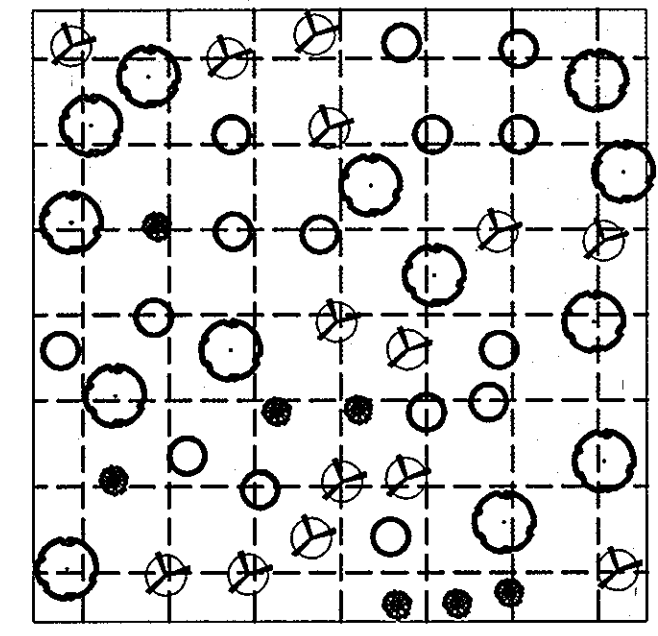

**NOTES**

- RANDOMLY LOCATE GROUPS OF PLANT SPECIES, TAKING CARE NOT TO PLANT IN SUCCESSION MORE THAN 4 OF THE SAME SPECIES.
- THIS DETAIL PROVIDES A HYPOTHETICAL GRAPHIC DEPICTION OF A PROPOSED LAYOUT FOR FIVE DIFFERENT PLANT SPECIES (A-E). IT IS NOT MEANT TO BE FOLLOWED EXACTLY. THE PURPOSE IS TO ACHIEVE THE APPEARANCE OF RANDOM SPACING.
- SEE PLANT LIST FOR ACTUAL NUMBER OF PLANT SPECIES. SEE PLANT LIST FOR ON-CENTER SPACING REQUIREMENTS.


**DEVELOPER'S/BUILDER'S CERTIFICATE:**

I/WE CERTIFY THAT THE LANDSCAPING SHOWN ON THIS PLAN WILL BE DONE ACCORDING TO THE PLAN, SECTION 16.124 OF THE HOWARD COUNTY CODE AND THE HOWARD COUNTY LANDSCAPE MANUAL. I/WE FURTHER CERTIFY THAT UPON COMPLETION, A LETTER OF LANDSCAPE INSTALLATION, ACCOMPANIED BY AN EXECUTED ONE YEAR GUARANTEE OF PLANT MATERIALS, WILL BE SUBMITTED TO THE DEPARTMENT OF PLANNING AND ZONING.

*Mitchell T. Rozanski*  
SIGNATURE DATE  
MUST REV MITCHELL T. ROZANSKI, VICE-PRES.

GREEN ROOF PLANT SCHEDULE					
AS	-	ALLIUM SCHOENOPRASSUM CHIVES	2 1/2" PEAT POT	FULL FLAT	2" O.C.
DN	-	DELOSPERMA NUBIGENUM 'BASUTOLAND' YELLOW ICE PLANT	2 1/2" PEAT POT	FULL FLAT	10" O.C.
SK	-	SEDUM KAMTSCHATICUM RUSSIAN STONECROP	2 1/2" PEAT POT	FULL FLAT	10" O.C.
SS	-	SEDUM SPURIMUM 'FULDAGLUT' TWO ROW STONECROP	2 1/2" PEAT POT	FLAT	8" O.C.
TC	-	TALINUM CALYXINUM FLAME FLOWER	2 1/2" PEAT POT	FULL FLAT	7" O.C.

- NOTES:**
- THE ABOVE GREEN ROOF PLANT SCHEDULE WAS TAKEN FROM EMORY KNOLL FARMS, INC. (www.greenroofplants.com).
  - PLANTS SHOWN IN THE ABOVE SCHEDULE ARE CONCEPTUAL AND MAY VARY WITH FINAL DESIGN, DEPENDING ON THE PARTICULAR GREEN ROOF SUPPLIER, AND THE AVAILABILITY OF PARTICULAR PLANTS AT THE TIME OF INSTALLATION. PLANTS TO BE SELECTED SHALL HAVE A HISTORY OF BEING USED FOR GREEN ROOFS, AND SHALL BE ACQUIRED FROM AN EXPERIENCED GREEN ROOF PLANT SUPPLIER. FINAL PLANT LIST SHALL BE APPROVED BY LANDSCAPE ARCHITECT/ARCHITECT.

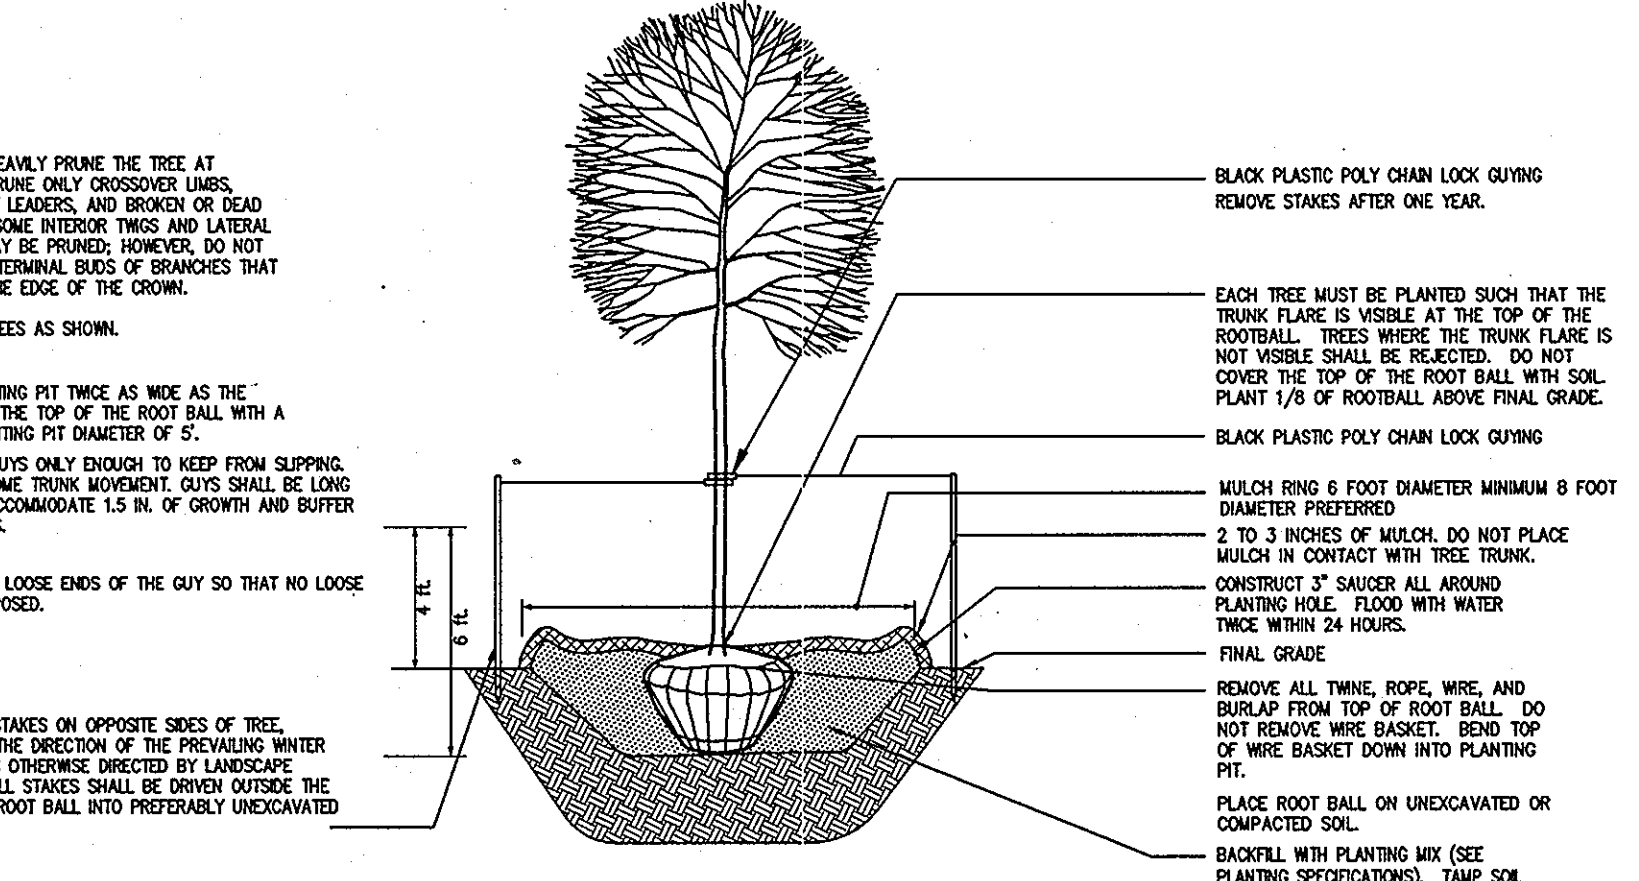


APPROVED: HOWARD COUNTY DEPARTMENT OF PLANNING AND ZONING.

*Thomas E. Butler* 12/21/10  
DIRECTOR DATE

*Paul Gardner* 12/15/10  
CHIEF, DEVELOPMENT ENGINEERING DIVISION DATE


*Kate Shadlock* 12-21-10  
CHIEF, DIVISION OF LAND DEVELOPMENT DATE

DATE	NO.	REVISION
<b>OWNER</b>		
DOUG JOHNSON ST. PAUL'S CHURCH & ANNEX 3675 COLLEGE AVE ELLCOTT CITY MD 21043-4655 (410) 547-5340		
<b>DEVELOPER</b>		
DOUG JOHNSON ST. PAUL'S CHURCH & ANNEX 3675 COLLEGE AVE ELLCOTT CITY MD 21043-4655 (410) 547-5340		
<b>PROJECT</b>		
ST. PAUL'S CATHOLIC CHURCH EVANGELIZATION CENTER		
<b>AREA</b>		
TAX MAP 25-A PARCELS 61, 120, & 121 2nd ELECTION DISTRICT ZONED HO HOWARD COUNTY, MARYLAND		
<b>TITLE</b>		
LANDSCAPE & FOREST CONSERVATION NOTES AND DETAILS		
Patton Harris Rust & Associates Engineers, Surveyors, Planners, Landscape Architects. 8818 Centre Park Drive Columbia, MD 21045 T 410.997.8900 F 410.997.9282		
<b>DESIGNED BY:</b> JSN		
<b>DRAWN BY:</b> JSN		
<b>PROJECT NO:</b> 14867-1-0		
<b>DATE:</b> SEPTEMBER 13, 2010		
<b>SCALE:</b> AS SHOWN		
<b>DRAWING NO. 12 OF 18</b>		

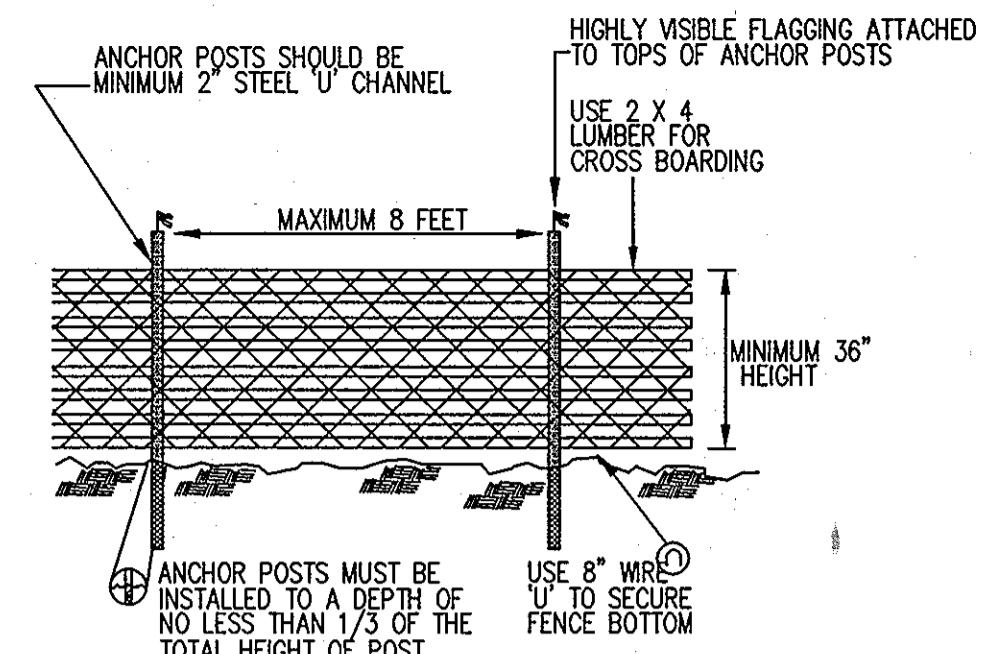


- NOTES:
1. BLAZE ORANGE OR BLUE PLASTIC MESH FENCE FOR FOREST PROTECTION DEVICE, ONLY.
  2. SUPER SILT FENCE MAY BE SUBSTITUTED FOR TREE PROTECTION FENCING.
  3. BOUNDARIES OF RETENTION AREA WILL BE ESTABLISHED AS PART OF THE FOREST CONSERVATION PLAN REVIEW PROCESS.
  4. BOUNDARIES OF RETENTION AREA SHOULD BE STAKED AND FLAGGED PRIOR TO INSTALLING DEVICE.
  5. AVOID DAMAGE TO CRITICAL ROOT ZONE. DO NOT DAMAGE OR SEVER LARGE ROOTS WHEN INSTALLING POSTS.
  6. PROTECTION SIGNS ARE REQUIRED, SEE SIGN DETAIL.
  7. FENCING SHALL BE MAINTAINED THROUGHOUT CONSTRUCTION.


1 TREE PROTECTION FENCING  
13 NOT TO SCALE

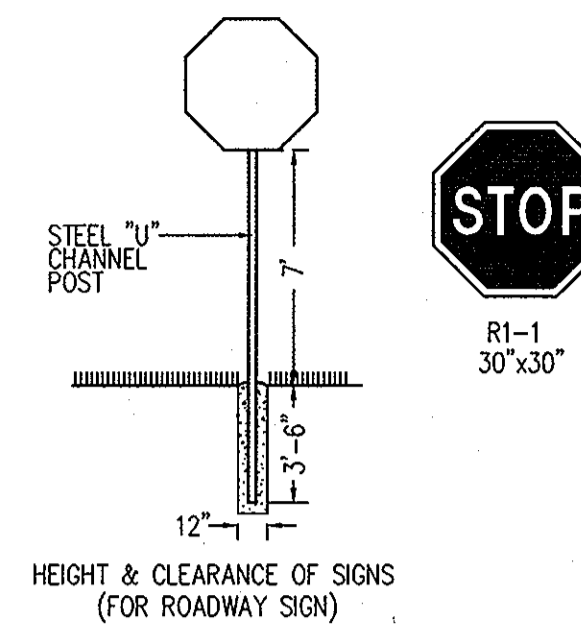

2 STOP SIGN DETAIL  
13 NOT TO SCALE

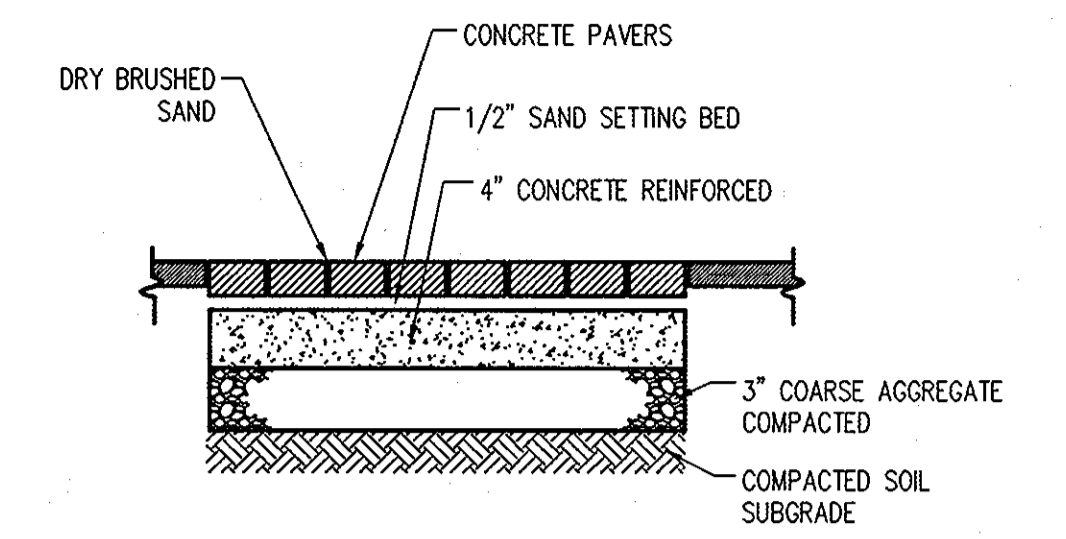

3 CONCRETE PAVERS  
13 NOT TO SCALE

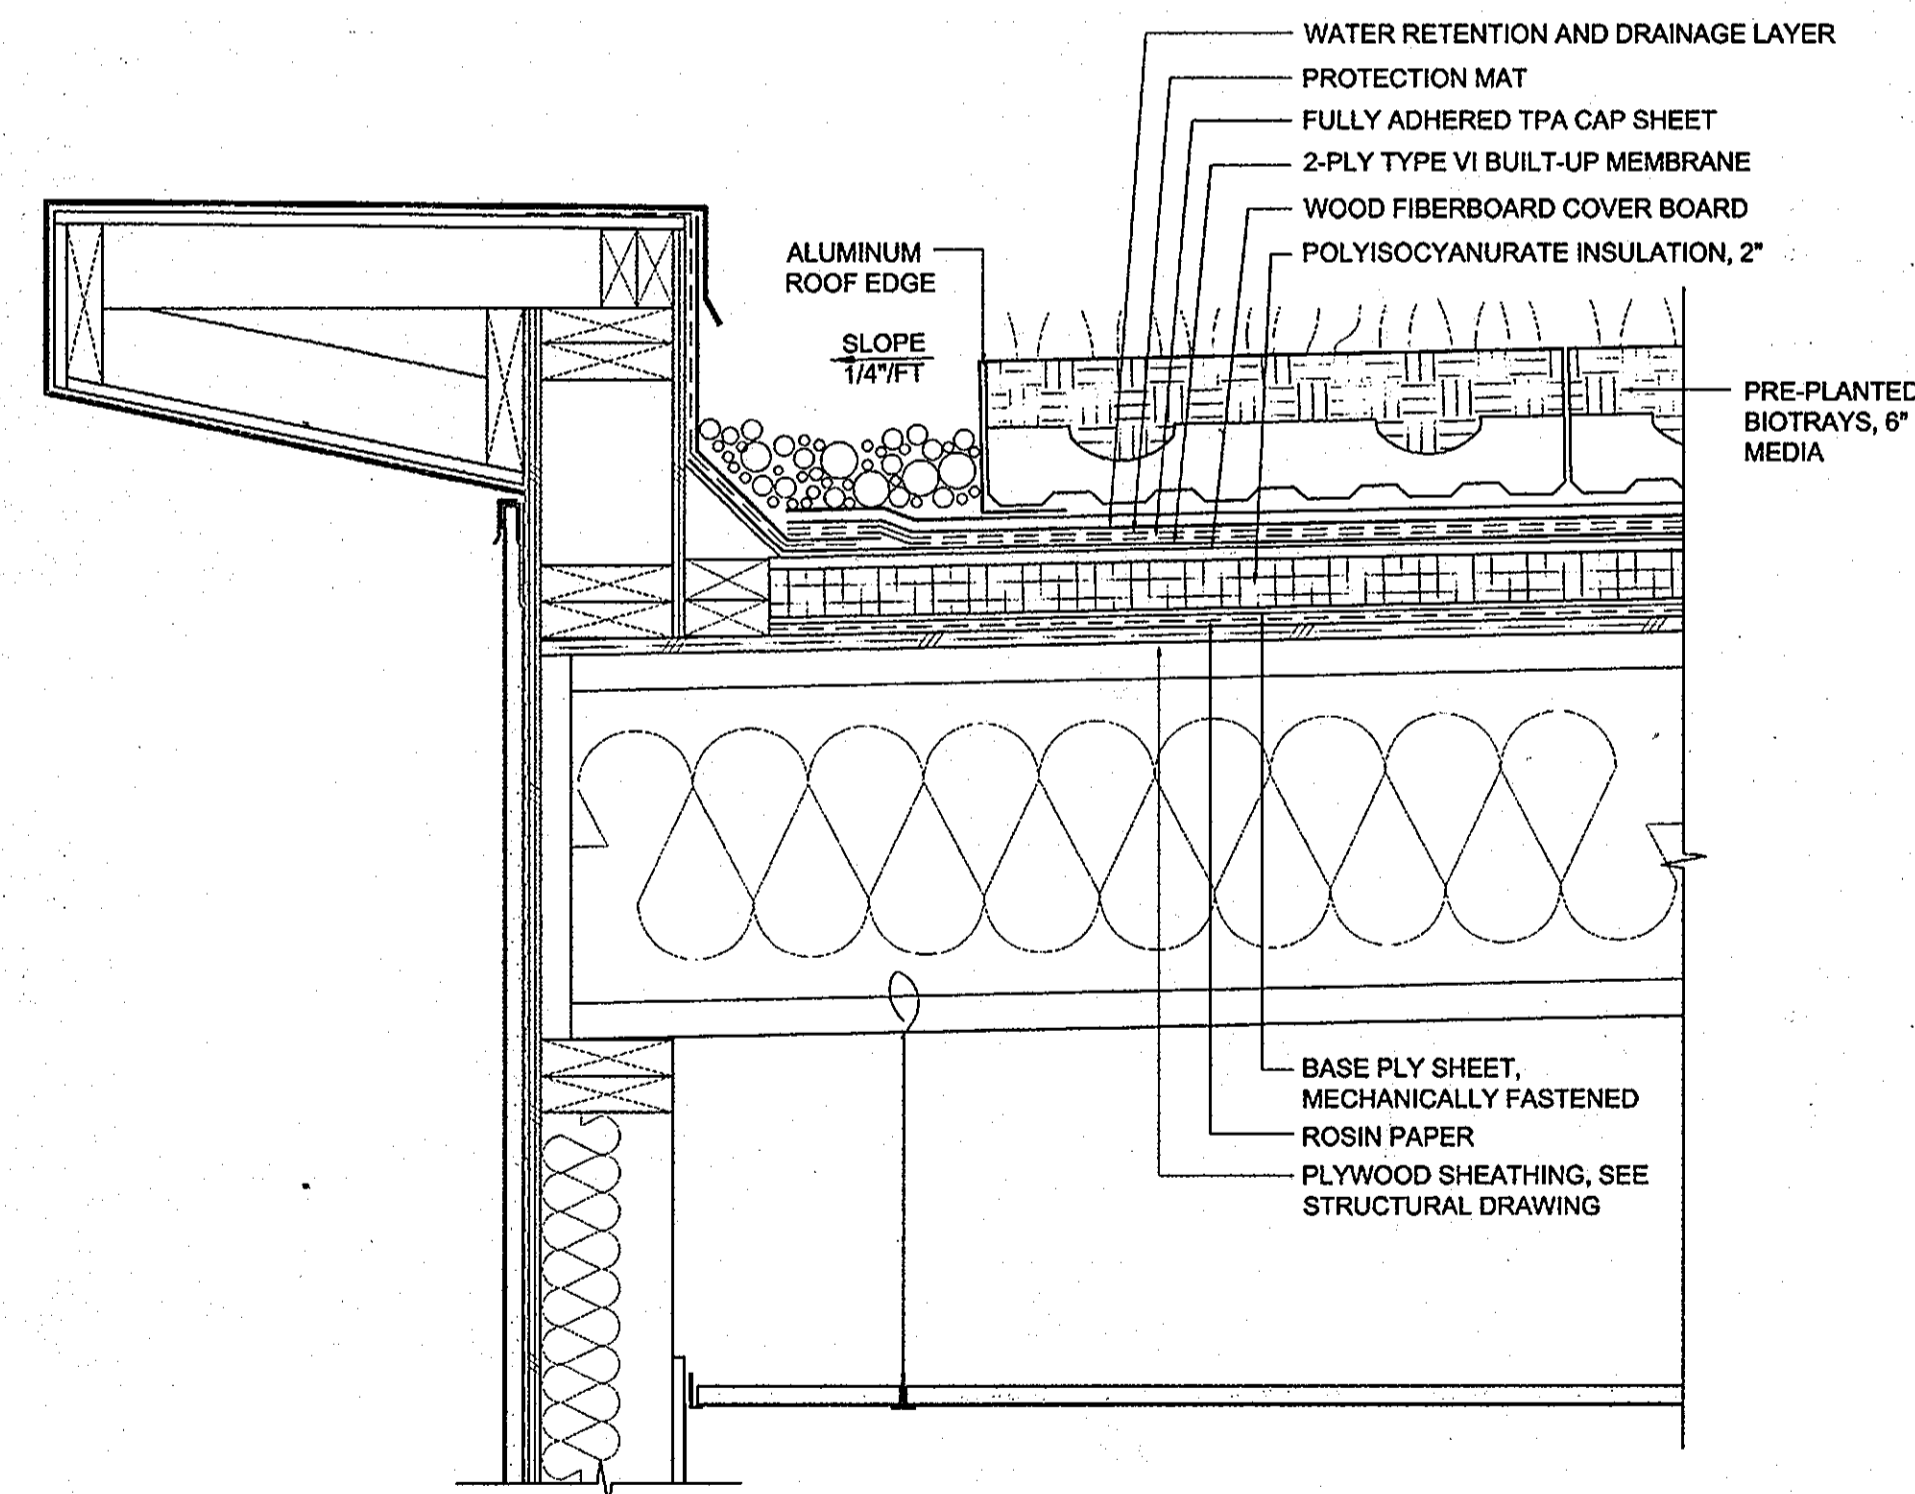

NOTE:  
ENGINEER SEAL ON THIS SHEET DOES NOT COVER THE STRUCTURAL OR ARCHITECTURAL DESIGN OF BUILDING RELATED ELEMENTS SUCH AS THOSE SHOWN IN THIS DETAIL.

ARCHITECTURAL REGISTRATION BOARD  
7286-A  
STATE OF MARYLAND

APPROVED : HOWARD COUNTY DEPARTMENT OF PLANNING AND ZONING.

DIRECTOR

DATE

CHIEF, DEVELOPMENT ENGINEERING DIVISION

DATE

CHIEF, DIVISION OF LAND DEVELOPMENT

DATE

Project # 0608-03  
Scale: 1/2" = 1'-0"  
Date: 5/10/10

Sheet # SKA-051010-A  
SDP-10-069

St. Paul's Church Evangelization Center  
3675 College Avenue, Ellicott City, MD 21043

VEGETATIVE ROOF DETAIL

FENYA BAILEY  
ARCHITECTS  
Phone: 410.436.8877  
Fax: 410.436.8878

OPERATION AND MAINTENANCE SCHEDULE FOR PRIVATELY OWNED AND MAINTAINED GREEN ROOF

THE FOLLOWING OPERATION AND MAINTENANCE SCHEDULE SHALL BE IMPLEMENTED TO THE FUNCTION OF THE GREEN ROOF SYSTEM IN ACCORDANCE WITH THE RECOMMENDATIONS OF THE "GREEN ROOF SYSTEM DISTRIBUTOR":

- WEED - ON AN ANNUAL BASIS REMOVE UNWANTED PLANT MATERIAL.
- REPLACE - REPLACE FAILED PLANT MATERIAL WHEN THE FAILED PLANT AREA EXCEEDS FIVE PERCENT (5%) OF THE ROOF AREA.
- IRRIGATE - A NEWLY INSTALLED ROOF SHOULD BE IRRIGATED DURING THE FIRST GROWING SEASON. SATURATE THE GREEN ROOF AT LEAST ONCE A WEEK DURING THE FIRST GROWING SEASON. AFTER VEGETATION IS ESTABLISHED, IRRIGATION MAY BE REQUIRED PERIODICALLY. DURING DRY PERIODS.
- NUTRIENT - THE APPLICATION OF A SLOW-RELEASE FERTILIZER IN THE SPRING IS RECOMMENDED ON AN ANNUAL BASIS.
- INSPECT FOR DRAINAGE - AFTER EACH SIGNIFICANT RAINFALL INSPECT DOWNSPOUTS OR DRAINAGE CHANNELS/COURSES FOR CLOGS.
- INSPECT FOR LEAKS - AFTER EACH SIGNIFICANT RAINFALL INSPECT THE GREEN ROOF FOR LEAKS.

APPROVED : HOWARD COUNTY DEPARTMENT OF PLANNING AND ZONING.

*Thomas E. Fudler* 12/21/10  
DIRECTOR DATE

*John Clark* 12-15-10  
CHIEF, DEVELOPMENT ENGINEERING DIVISION HSP DATE

*Kevin DeWilde* 12-21-10  
CHIEF, DIVISION OF LAND DEVELOPMENT DATE

DATE NO. REVISION

OWNER DOUG JOHNSON  
ST. PAUL'S CHURCH & ANNEX  
3675 COLLEGE AVE  
ELLICOTT CITY MD 21043-4655  
(410) 547-5340

DEVELOPER DOUG JOHNSON  
ST. PAUL'S CHURCH & ANNEX  
3675 COLLEGE AVE  
ELLICOTT CITY MD 21043-4655  
(410) 547-5340

PROJECT ST. PAUL'S CATHOLIC CHURCH EVANGELIZATION CENTER

AREA TAX MAP 25-A PARCELS 61, 120, & 121  
2nd ELECTION DISTRICT ZONED HO  
HOWARD COUNTY, MARYLAND

TITLE SITE DETAILS

Patton Harris Rust & Associates  
Engineers, Surveyors, Planners, Landscape Architects.  
PHRA  
8818 Centre Park Drive  
Columbia, MD 21045  
T 410.997.8900  
F 410.997.9282

SEAL

DESIGNED BY : JSN

DRAWN BY: JSN








PROJECT NO : 14867-1-0

DATE : SEPTEMBER 13, 2010

SCALE : AS SHOWN

DRAWING NO. 13 OF 18

BY: *[Signature]*  
PROFESSIONAL CERTIFICATION: I HEREBY CERTIFY THAT THESE DOCUMENTS WERE PREPARED OR APPROVED BY ME AND THAT I AM A DULY LICENSED PROFESSIONAL ENGINEER UNDER THE LAWS OF THE STATE OF MARYLAND, LICENSE NO. 21774, EXPIRATION DATE: 11-10-2011

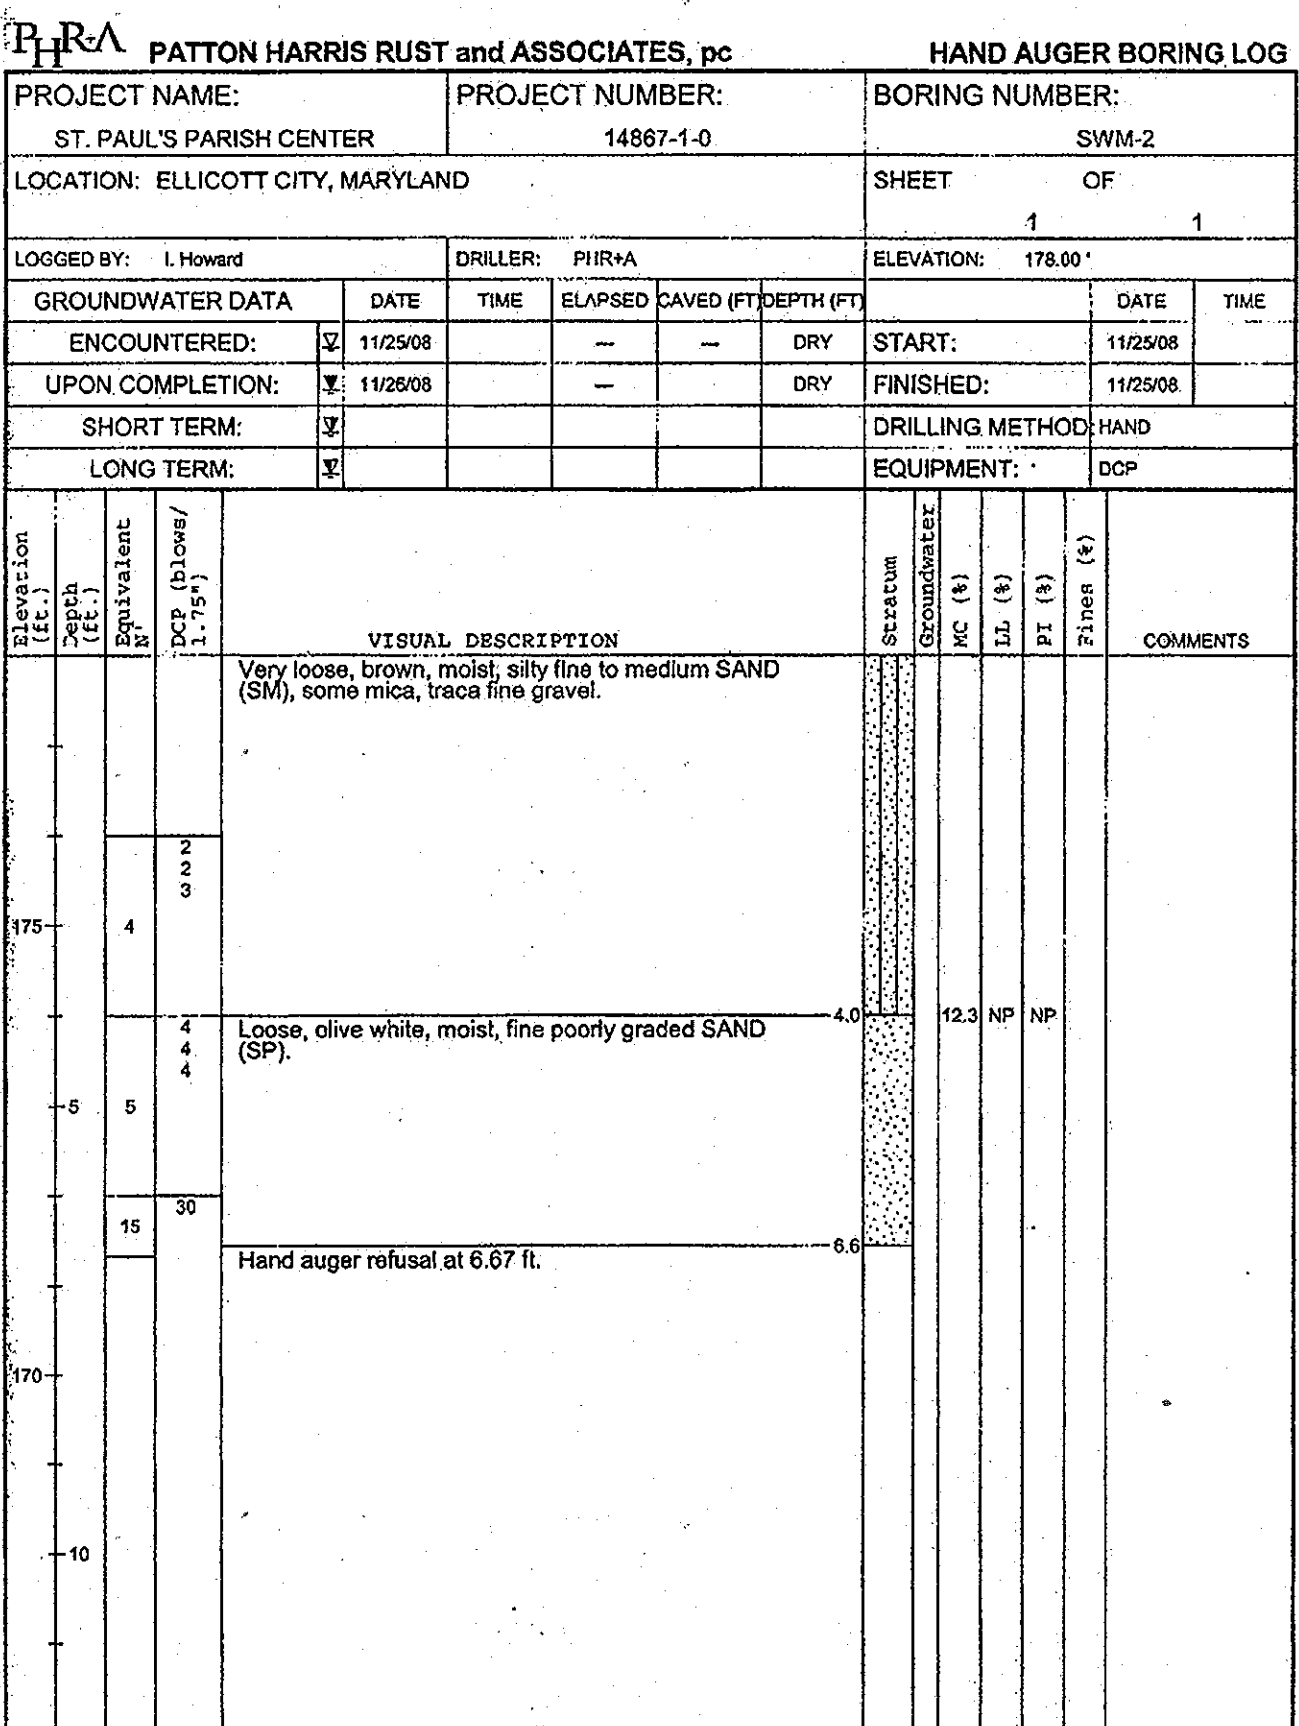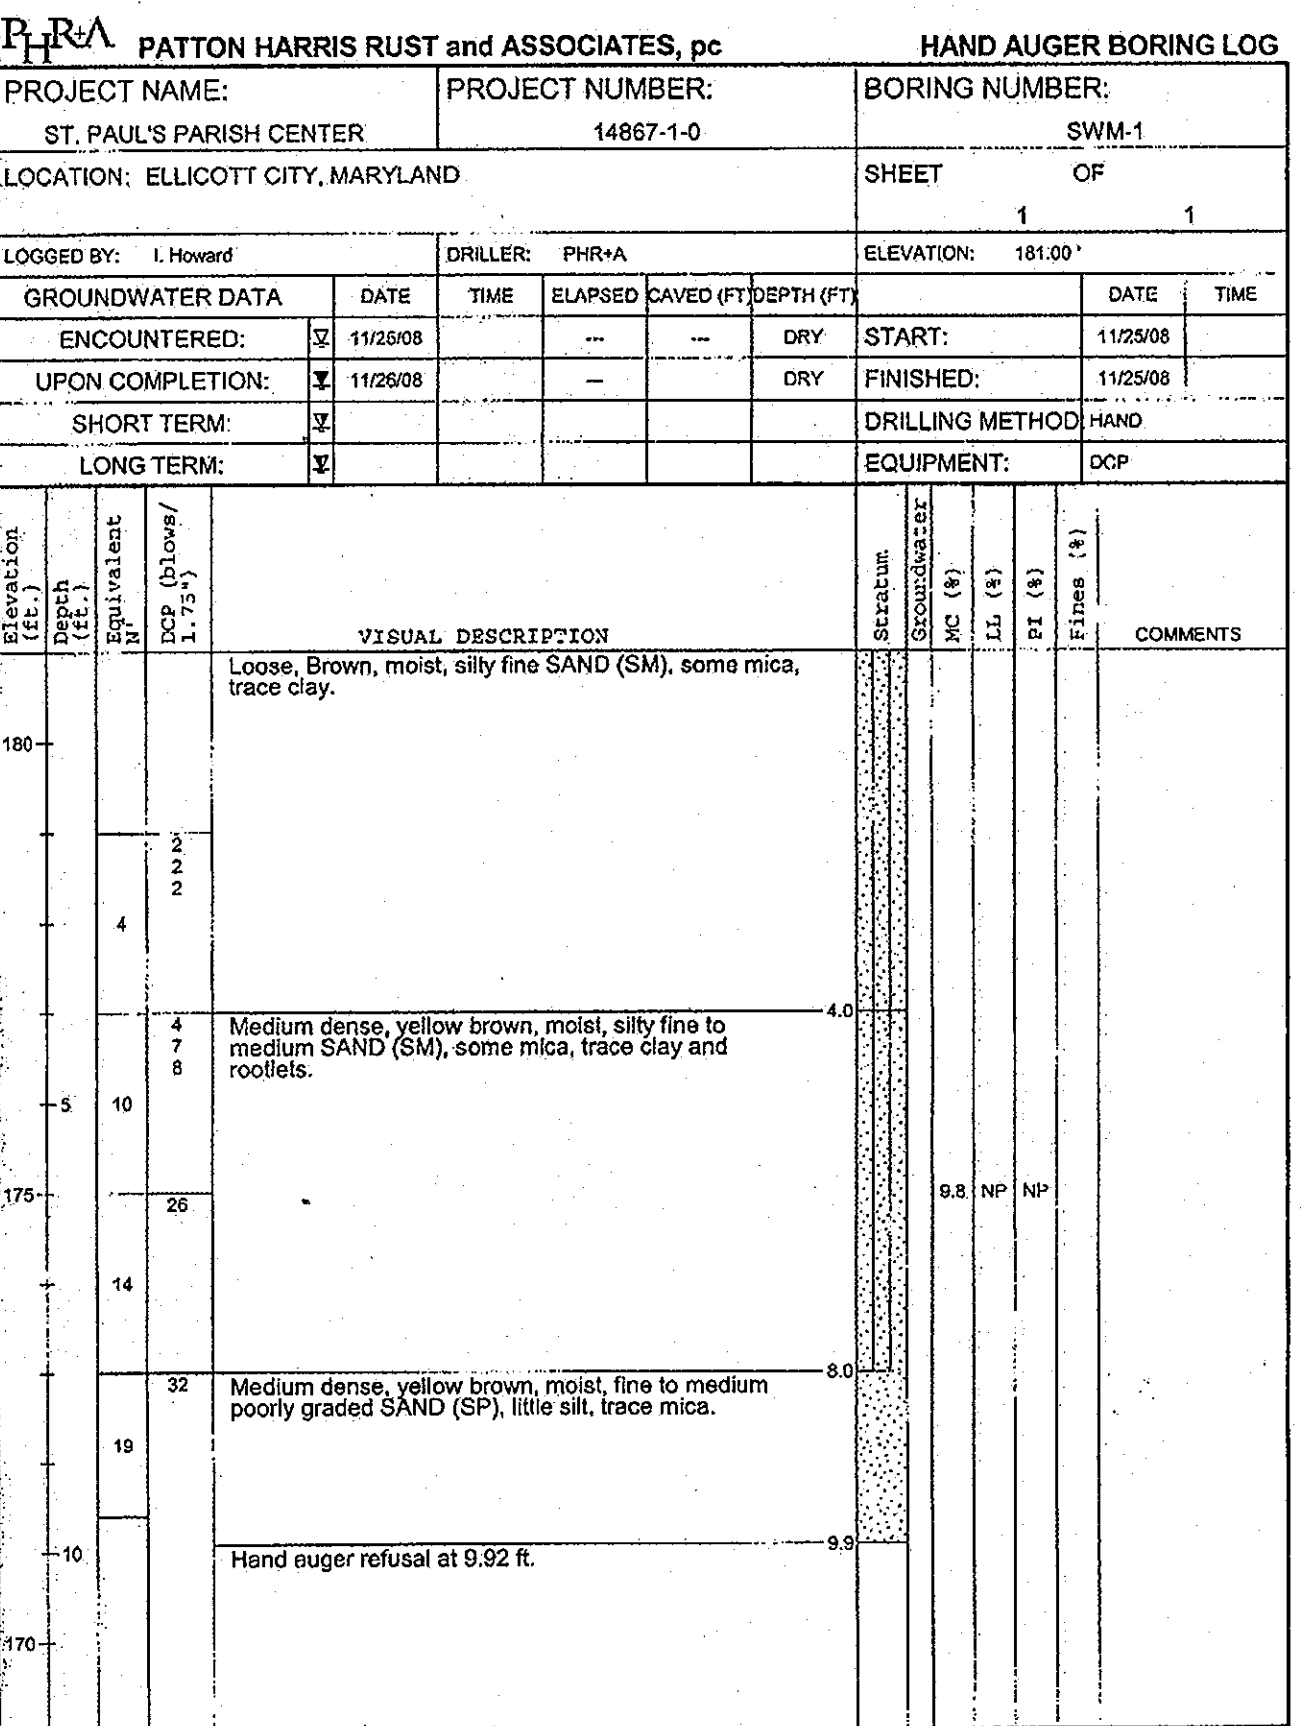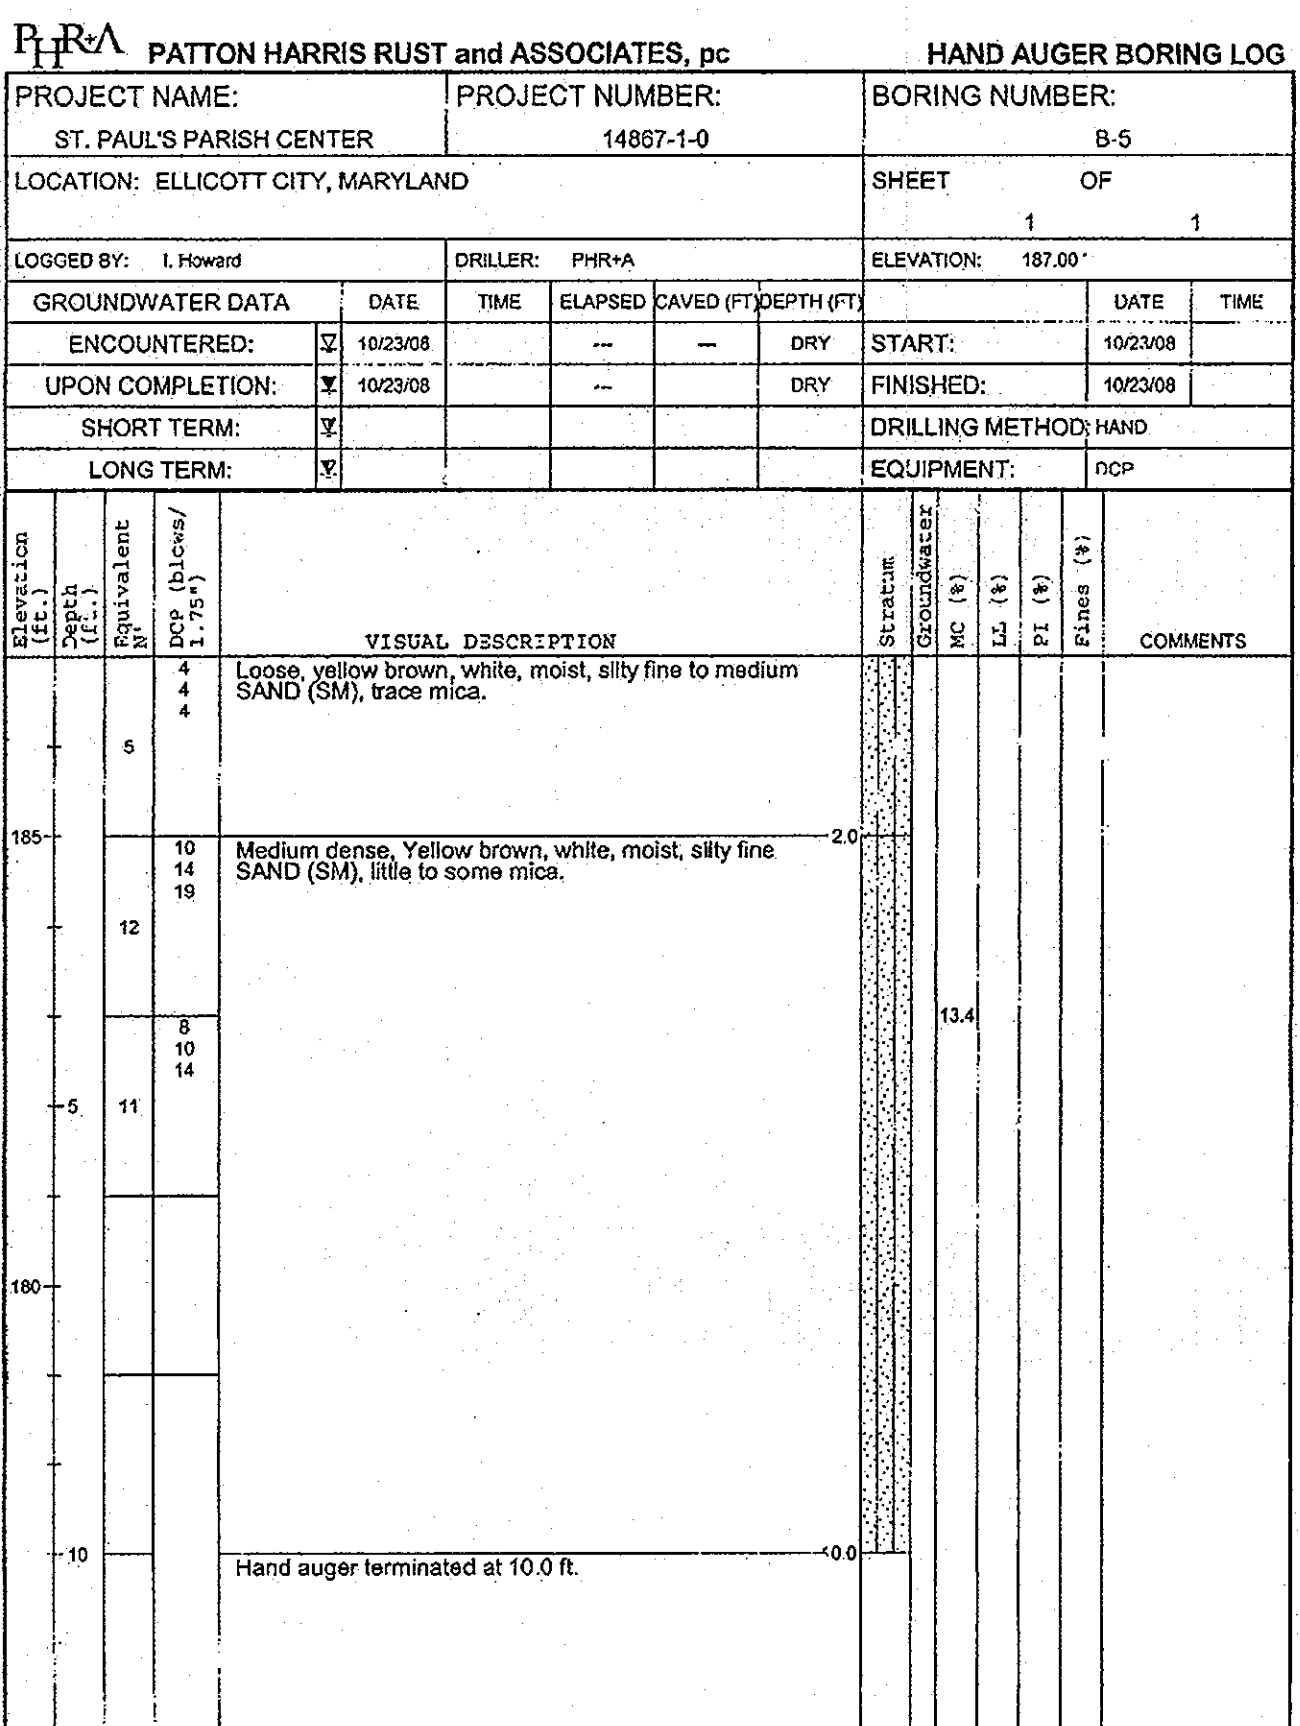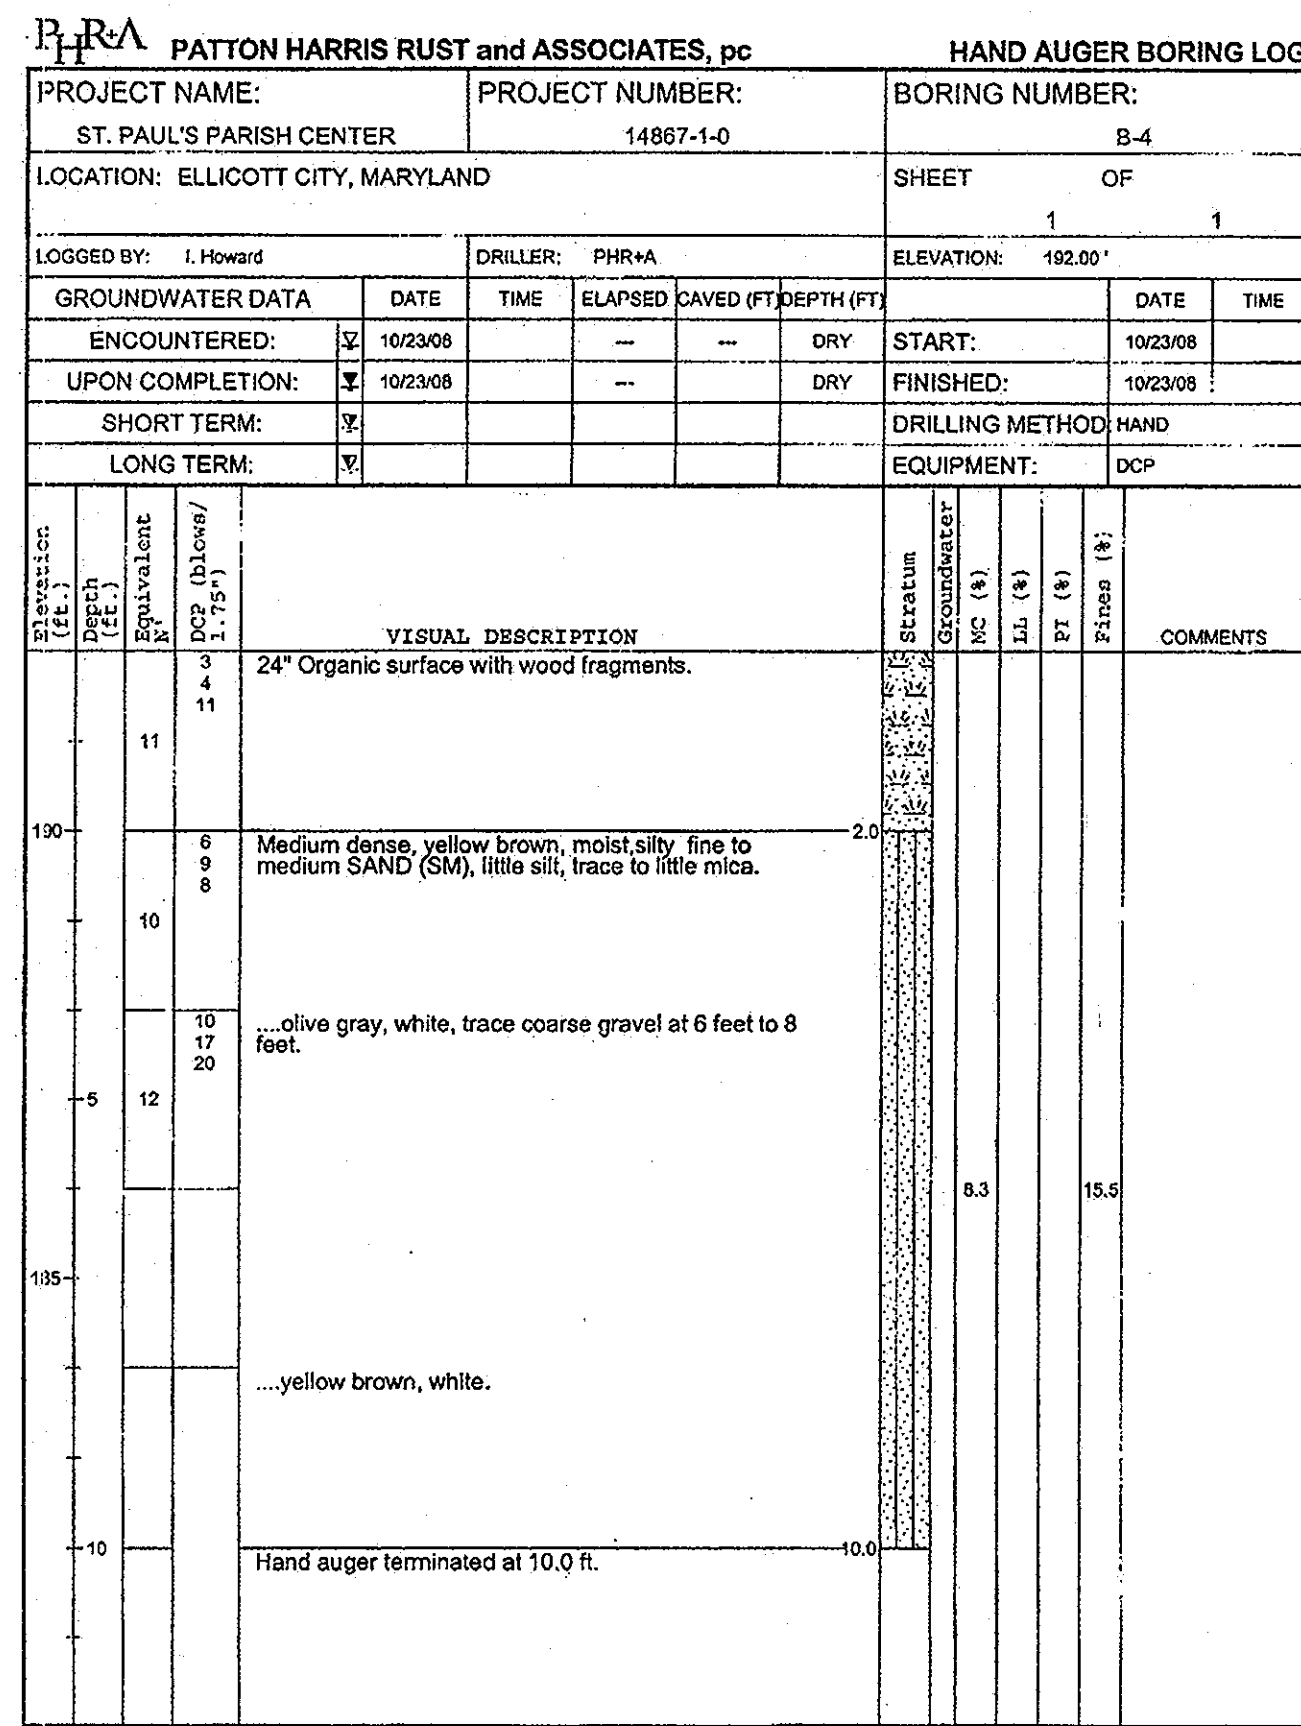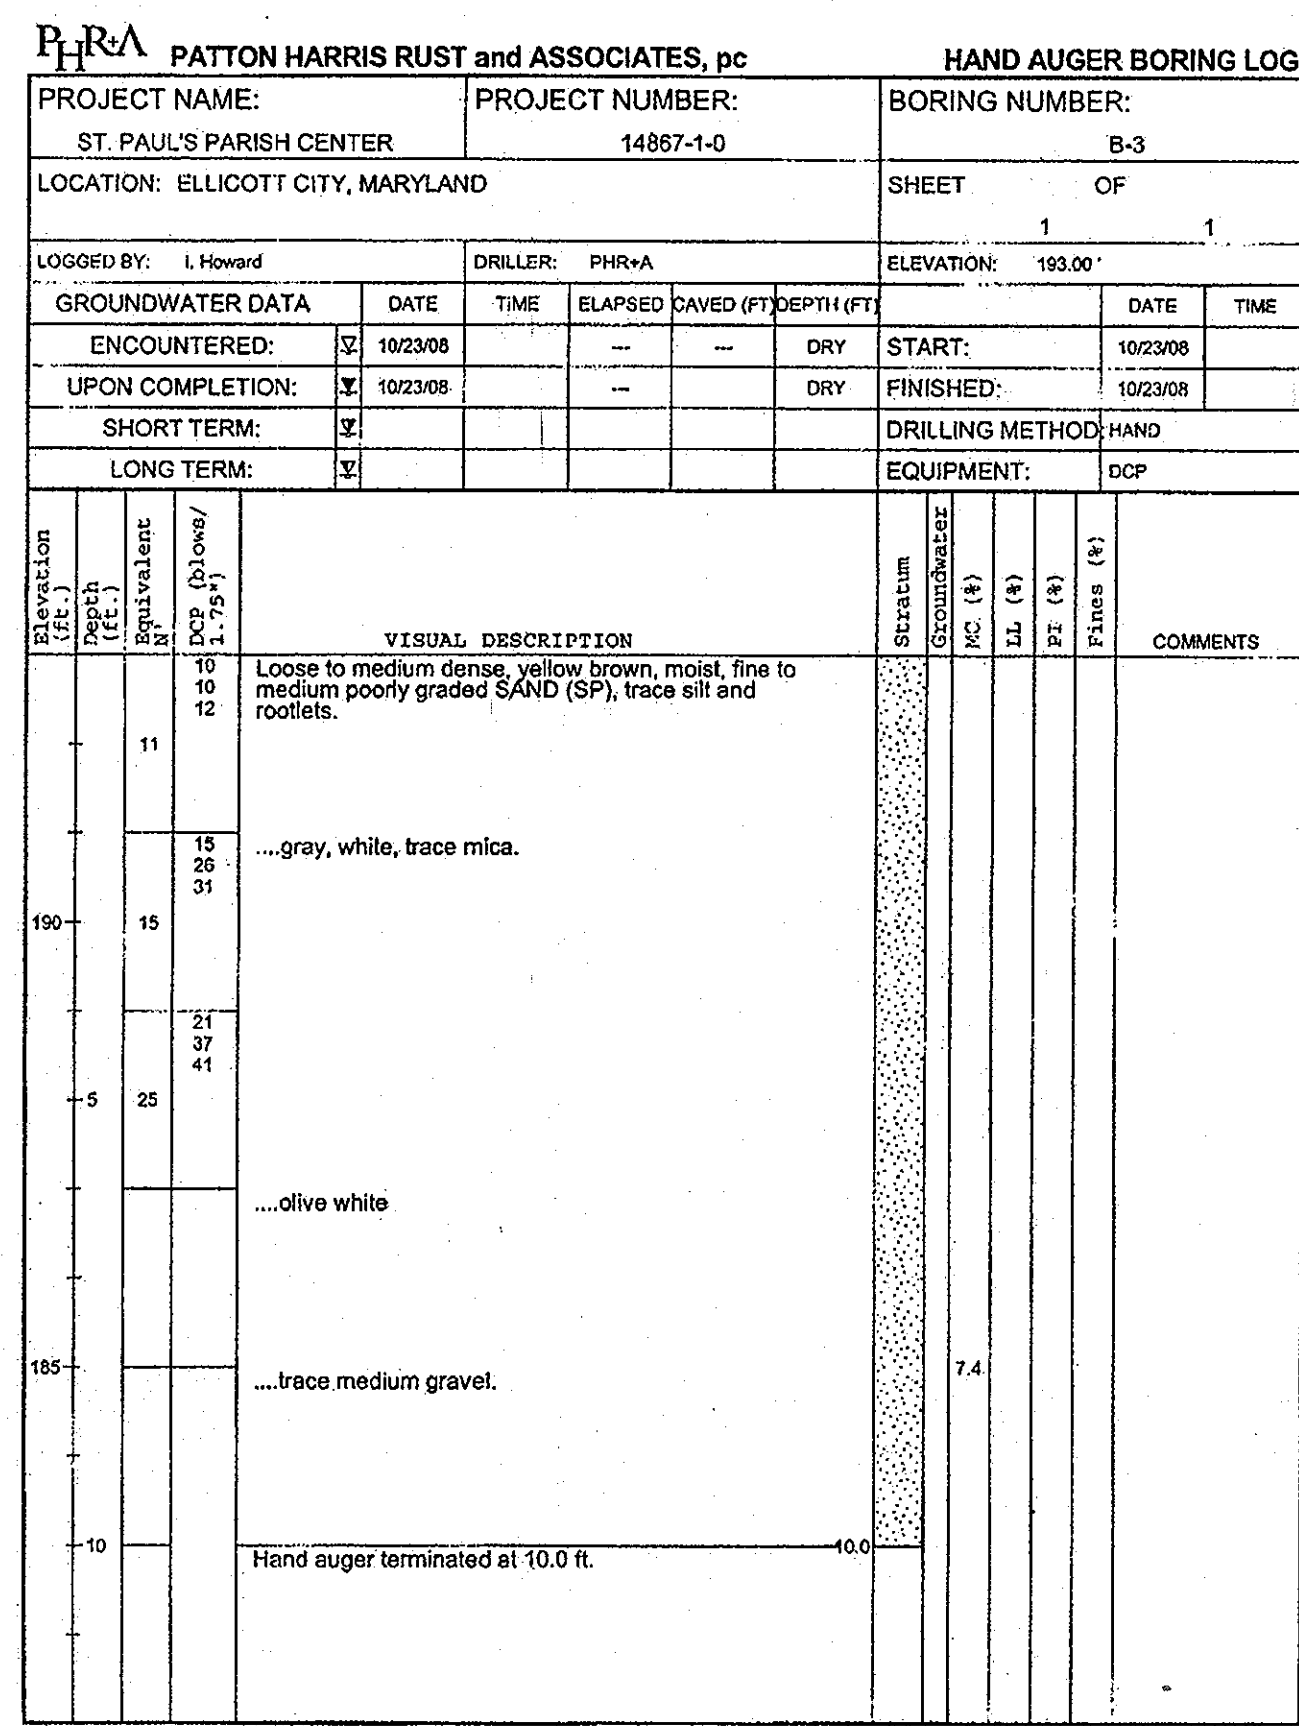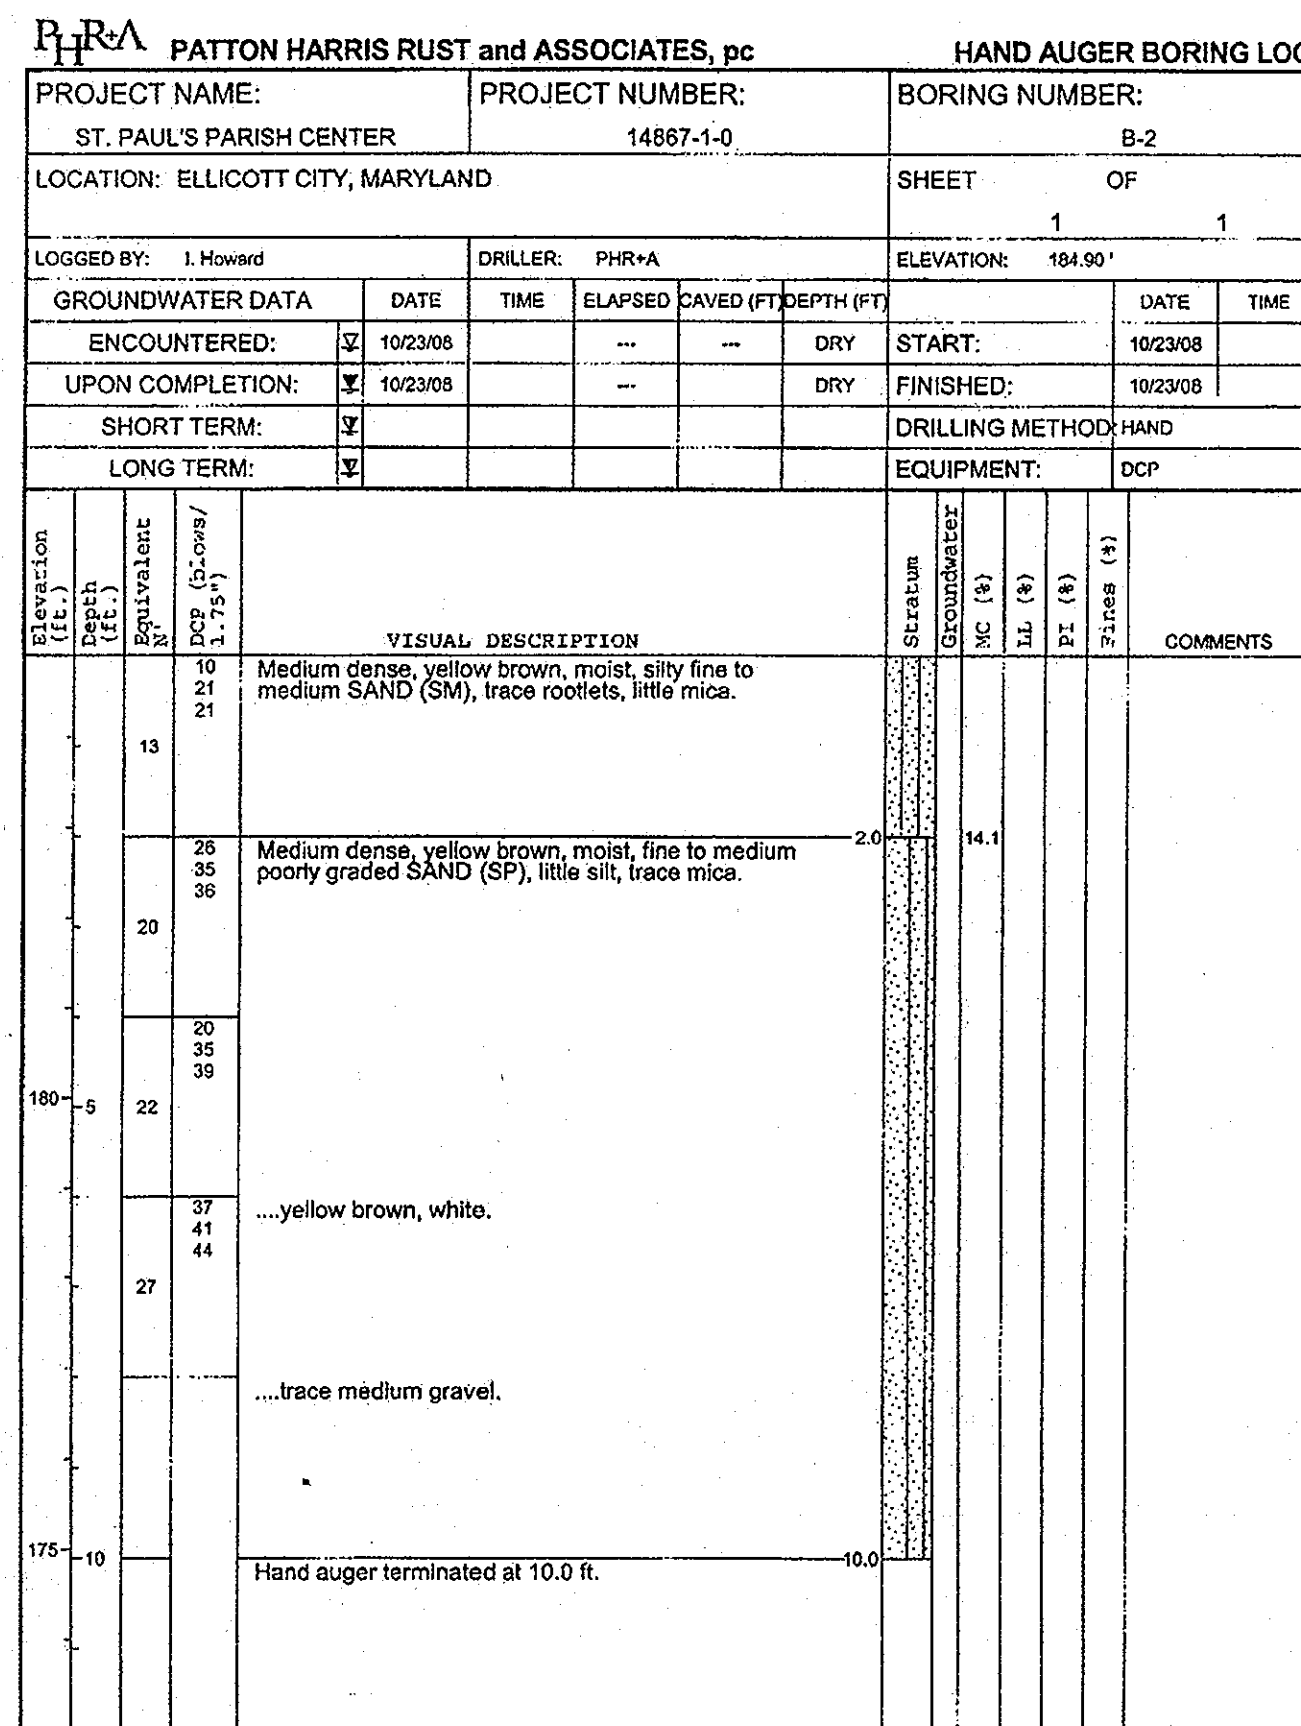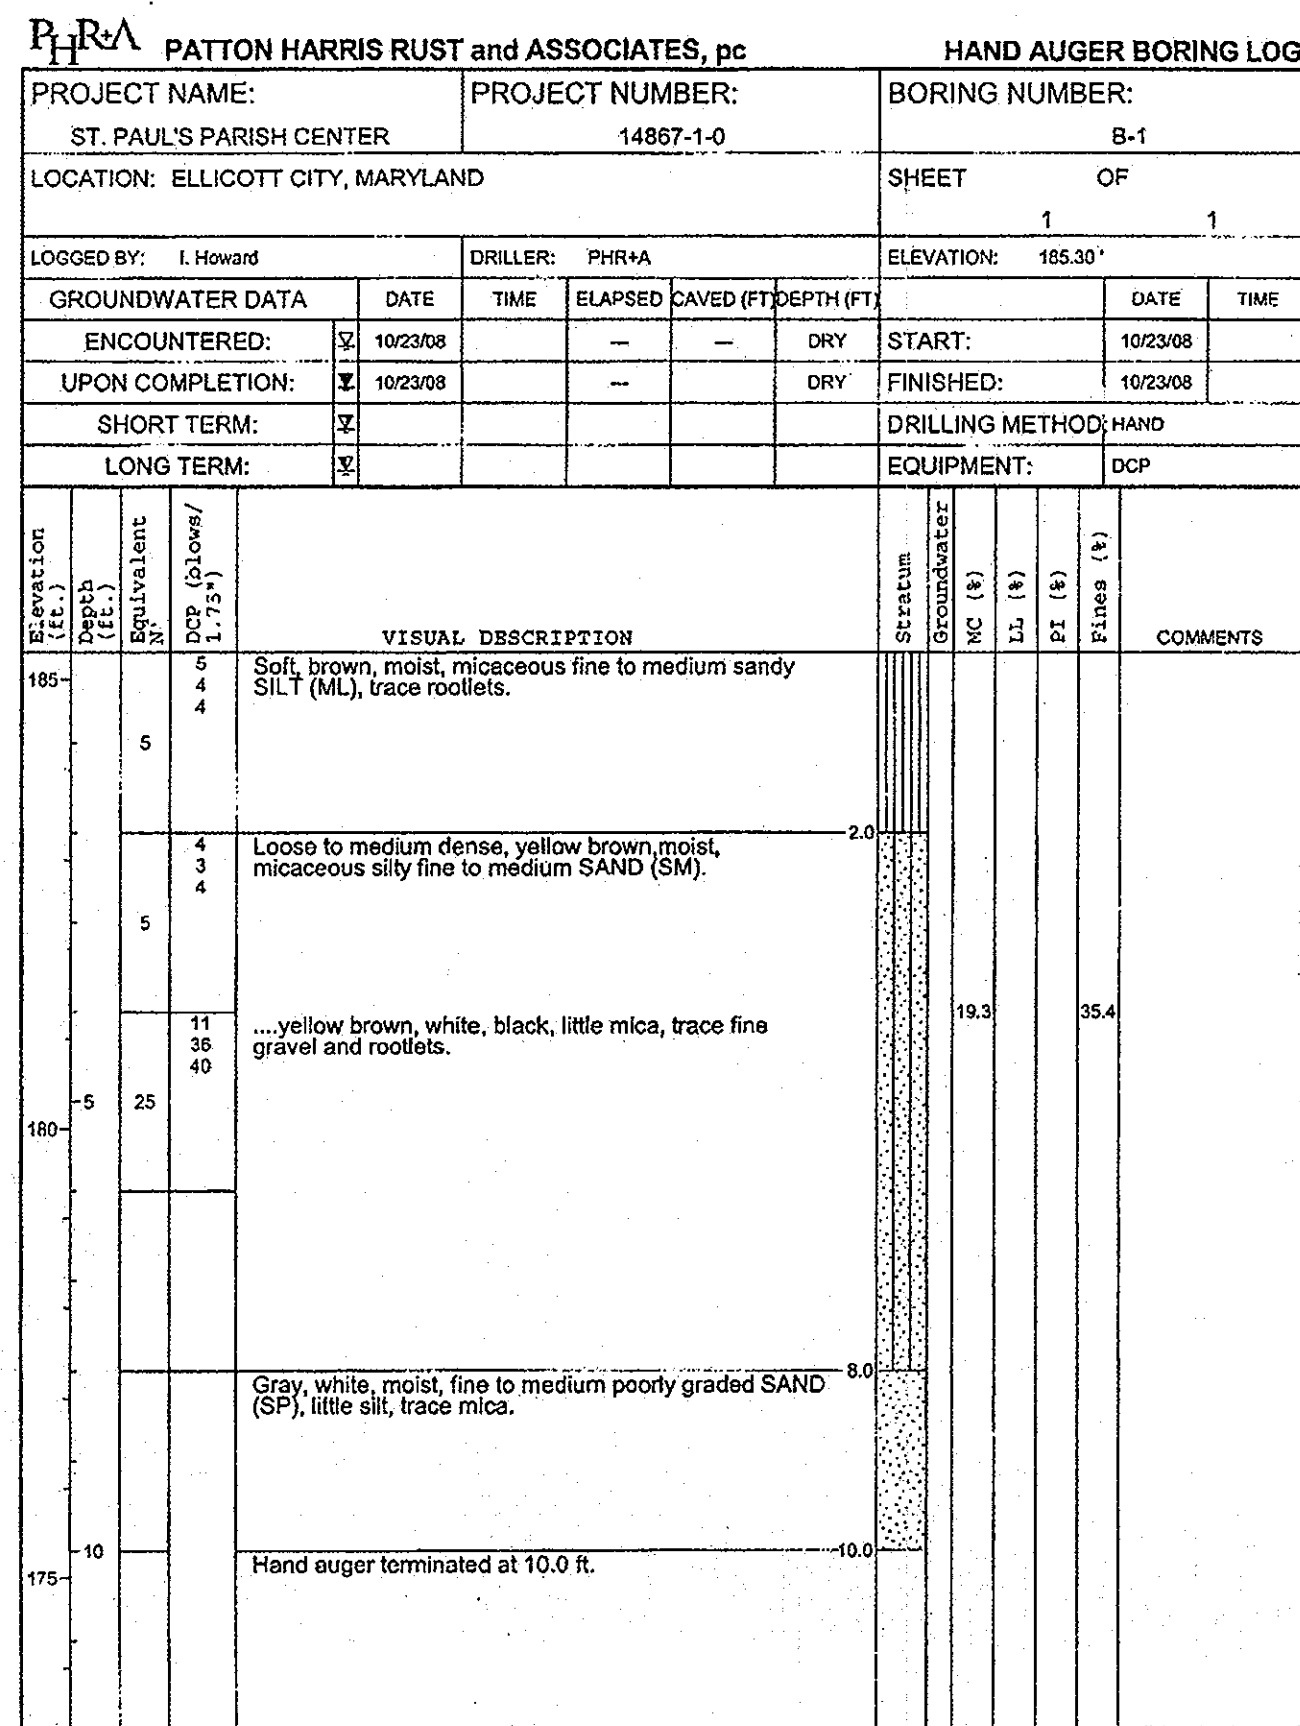

NOTE: REFER TO GEOTECHNICAL REPORT FOR COMPLETE SET OF SITE AND BUILDING SOIL BORINGS.

APPROVED: HOWARD COUNTY DEPARTMENT OF PLANNING AND ZONING.

*Mona E. Hittle* 12/2/10  
DIRECTOR DATE

*Paul Smith* 12-15-10  
CHIEF, DEVELOPMENT ENGINEERING DIVISION DATE

*Kevin Calverley* 12-24-10  
CHIEF, DIVISION OF LAND DEVELOPMENT DATE

DATE	NO.	REVISION

OWNER: DOUG JOHNSON  
ST. PAUL'S CHURCH & ANNEX  
3675 COLLEGE AVE  
ELLICOTT CITY MD 21043-4655  
(410) 547-5340

DEVELOPER: DOUG JOHNSON  
ST. PAUL'S CHURCH & ANNEX  
3675 COLLEGE AVE  
ELLICOTT CITY MD 21043-4655  
(410) 547-5340

PROJECT: ST. PAUL'S CATHOLIC CHURCH EVANGELIZATION CENTER

AREA: TAX MAP 25-A PARCELS 61, 120, & 121  
2nd ELECTION DISTRICT ZONED HO  
HOWARD COUNTY, MARYLAND

TITLE: SOIL BORING LOGS

Patton Harris Rust & Associates  
Engineers, Surveyors, Planners, Landscape Architects.  
**PHRA**  
8818 Centre Park Drive  
Columbia, MD 21045  
T 410.997.8900  
F 410.997.9282

SEAL: STATE OF MARYLAND  
JAMES A. RUFFALO  
PROFESSIONAL ENGINEER  
DESIGNED BY: JSN  
DRAWN BY: JSN  
PROJECT NO: 14867-1-0  
DATE: SEPTEMBER 13, 2010  
SCALE: AS SHOWN  
DRAWING NO. 14 OF 18









