

INDEX OF DRAWINGS

NO.	DESCRIPTION
1	COVER SHEET
2	SITE DEVELOPMENT, SEDIMENT CONTROL PLANS AND SOIL MAP
3	SEDIMENT CONTROL NOTES AND DETAILS

ADDRESS CHART

LOT #	ADDRESS
1	5809 MARBUCK WAY
2	6229 MONTGOMERY ROAD
3	5811 MARBUCK WAY
4	5815 MARBUCK WAY
5	5819 MARBUCK WAY
6	5823 MARBUCK WAY
7	5827 MARBUCK WAY
8	5831 MARBUCK WAY

SITE DEVELOPMENT PLAN

MARBUCK ESTATES

LOTS 1 THRU 8

FIRST ELECTION DISTRICT

HOWARD COUNTY, MARYLAND

GENERAL NOTES


- THE CONTRACTOR SHALL NOTIFY THE DEPARTMENT OF PUBLIC WORKS/CONSTRUCTION INSPECTIONS AT (410) 313-1880 AT LEAST FIVE (5) WORKING DAYS PRIOR TO THE START OF WORK.
- THE CONTRACTOR SHALL NOTIFY "MISS UTILITY" AT 1-800-257-7777 AT LEAST 48 HOURS PRIOR TO ANY EXCAVATION WORK BEING DONE.
- THE EXISTING TOPOGRAPHY IS TAKEN FROM FIELD RUN SURVEY WITH MAXIMUM TWO FOOT CONTOUR INTERVALS PREPARED BY MILDENBERG, BOENDER AND ASSOC. INC. PERFORMED ON OR ABOUT SEPTEMBER 2003.
- COORDINATES BASED ON NAD 83 (HORIZONTAL) AND NVD 89 (VERTICAL) MARYLAND COORDINATE SYSTEM AS PROJECTED BY HOWARD COUNTY GEODETIC CONTROL STATIONS NO.37BA & 37BB
STA. No. 37BA N 563,785.618 E 1,376,343.172 ELEV. 394.786
STA. No. 37BB N 563,663.415 E 1,378,040.471 ELEV. 373.822
- STORMWATER MANAGEMENT REQUIREMENTS HAVE BEEN SATISFIED VIA ON-SITE NON-STRUCTURAL CREDIT, THE ROOFTOP DISCONNECTION CREDIT, THE NON-ROOFTOP DISCONNECTION CREDIT AND USE OF RAINGARDENS IN ACCORDANCE WITH THE 2000 MARYLAND STORMWATER DESIGN MANUAL AS APPROVED UNDER F-10-107.
- EXISTING UTILITIES ARE BASED ON ACTUAL FIELD LOCATIONS, IN COMBINATION WITH EXISTING WATER AND SEWER CONTRACTS.
- ANY DAMAGE TO THE COUNTY RIGHT-OF-WAY SHALL BE CORRECTED AT THE DEVELOPER'S EXPENSE.
- SEWER HOUSE CONNECTION ELEVATIONS SHOWN ARE LOCATED AT THE PROPERTY LINE OR EASEMENT LINE.
- FOR DRIVEWAY ENTRANCE DETAILS, REFER TO HOWARD COUNTY DESIGN MANUAL, VOLUME IV, STANDARD DETAIL R-6.06.
- SITE ANALYSIS DATA CHART:
LOCATION: TAX MAP 37 PARCEL 47, DEED REFERENCE: L 9862 F. 52
ZONING: R-20 (ZONING MAP DATED JULY 28, 2006)
ELECTION DISTRICT: 1ST
TOTAL PROJECT AREA: 4.99 ACRES ±
AREA OF PLAN SUBMISSION: 4.09 ACRES ±
LIMIT OF DISTURBED AREA: 3.37 ACRES ±
PROPOSED USE FOR SITE: RESIDENTIAL
TOTAL NUMBER OF UNITS: 8
TYPE OF PROPOSED UNIT: SFD
DPZ FILES: SP-05-007, WP-05-78, WP-10-60, F-10-107
- SUBJECT PROPERTY ZONED R-20 RESIDENTIAL PER THE 02/02/04 COMPREHENSIVE ZONING PLAN AND PER THE COMP LITE ZONING AMENDMENT EFFECTIVE 7/28/06.
 - IN ACCORDANCE WITH SECTION 12B OF THE HOWARD COUNTY ZONING REGULATIONS, BAY WINDOWS, CHIMNEYS OR EXTERIOR STAIRWAYS NOT MORE THAN 18 FEET IN WIDTH MAY PROJECT NOT MORE THAN 4 FEET INTO ANY SETBACKS, PORCHES OR DECKS, OPEN OR ENCLOSED MAY PROJECT NOT MORE THAN 10 FEET INTO THE FRONT OR REAR YARD SETBACK.
 - NO GRADING, REMOVAL OF VEGETATIVE COVER OR TREES, OR PLACEMENT OF NEW PAVING OR STRUCTURES IS PERMITTED WITHIN THE LIMITS OF WETLANDS, STREAM(S), OR THEIR BUFFERS, FOREST CONSERVATION EASEMENT AREAS AND 100-YEAR FLOODPLAIN.
 - DRIVEWAYS SHALL BE PROVIDED PRIOR TO ISSUANCE OF A USE AND OCCUPANCY PERMIT FOR ANY NEW DWELLINGS TO ENSURE SAFE ACCESS FOR FIRE AND EMERGENCY VEHICLES PER THE FOLLOWING MINIMUM REQUIREMENTS:
 - WIDTH - 12 FEET (16 FEET SERVING MORE THAN ONE RESIDENCE).
 - SURFACE - 6 INCHES OF COMPACTED CRUSHER RUN BASE WITH TAR AND CHIP COATING (1-1/2 INCH MINIMUM).
 - GEOMETRY - MAXIMUM 15% GRADE, MAXIMUM 10% GRADE CHANGE AND MINIMUM OF 45-FOOT TURNING RADIUS.
 - STRUCTURES (CULVERTS/BRIDGES) - CAPABLE OF SAFELY PASSING 100-YEAR FLOOD WITH NO MORE THAN 1 FOOT DEPTH OVER DRIVEWAY SURFACE.
 - MAINTENANCE - SUFFICIENT TO ENSURE ALL WEATHER USE.
- PUBLIC WATER AND SEWER WILL BE UTILIZED. LOTS 1 THRU 8 WILL BE SERVICED UNDER CONTRACT # 14-4678-D.
- FOR FLAG OR PIPESTEM LOTS, REFUSE COLLECTION, SNOW REMOVAL AND ROAD MAINTENANCE ARE PROVIDED TO THE JUNCTION OF THE FLAG OR PIPESTEM LOT DRIVEWAY RIGHT-OF-WAY LINE AND ROAD RIGHT-OF-WAY LINE AND NOT ONTO THE PIPESTEM LOT DRIVEWAY RIGHT-OF-WAY LINE.
- MINIMUM LOT SIZE AND OPEN SPACE REQUIREMENTS SHOWN ABOVE ARE IN ACCORDANCE WITH SECTION 16.121(a)(2) OF THE HOWARD COUNTY SUBDIVISION REGULATIONS, 5th ED.
- BASED ON AVAILABLE COUNTY DATA, NO HISTORIC STRUCTURES OR BURIAL GROUNDS EXIST ON SITE.
- NO STEEP SLOPES OR FLOODPLAINS EXIST ON SITE.
- THE FOREST CONSERVATION REQUIREMENTS PER SECTION 16.1202 OF THE HOWARD COUNTY CODE HAVE BEEN SATISFIED UNDER F-10-107.
- THE LANDSCAPING REQUIREMENTS WERE SATISFIED WITH F-10-107.
- THE OWNER, TENANT AND/OR THEIR AGENTS SHALL BE RESPONSIBLE FOR MAINTENANCE OF THE REQUIRED LANDSCAPING PLANT MATERIALS, BERMS, FENCES AND WALLS (AS REQUIRED UNDER F-10-107) ALL PLANT MATERIALS SHALL BE MAINTAINED IN GOOD GROWING CONDITION, AND WHEN NECESSARY, REPLACED WITH NEW MATERIALS TO ENSURE CONTINUED COMPLIANCE WITH APPLICABLE REGULATIONS. ALL OTHER REQUIRED LANDSCAPING SHALL BE PERMANENTLY MAINTAINED IN GOOD CONDITION, AND WHEN NECESSARY, REPAIRED OR REPLACED.
- STORMWATER MANAGEMENT IS PROVIDED IN ACCORDANCE WITH THE 2000 MARYLAND STORMWATER DESIGN MANUAL VOLUME I & II. IT WAS DETERMINED THAT THIS PROJECT MET THE CRITERIA OUTLINED IN THE MDE STORMWATER MANAGEMENT REGULATION GUIDANCE FOR IMPLEMENTATION FOR ACCEPTANCE OF THE 2000 DESIGN CRITERIA AND GRANTED A WAIVER. THIS PLAN RECEIVED PRELIMINARY APPROVAL (SP-05-007) ON MARCH 10, 2006. THIS PLAN IS ALSO SUBJECT TO THE EXPIRATION OF THIS WAIVER UNLESS ALL STORMWATER MANAGEMENT IS CONSTRUCTED BY MAY 4, 2017.
- A PRIVATE RANGE OF ADDRESS SIGN ASSEMBLY SHALL BE FABRICATED AND INSTALLED BY HOWARD COUNTY BUREAU OF HIGHWAYS AT THE DEVELOPERS/OWNERS EXPENSE. CONTACT HOWARD COUNTY TRAFFIC DIVISION AT 410-313-5752 FOR DETAILS AND COST ESTIMATES.
- STORMWATER MANAGEMENT IS PROVIDED IN ACCORDANCE WITH THE 2000 MARYLAND MANUAL VOLUME I AND II. IT WAS DETERMINED THAT THIS PROJECT MET THE CRITERIA OUTLINED IN THE MDE STORMWATER MANAGEMENT REGULATIONS GUIDANCE FOR IMPLEMENTATION FOR ACCEPTANCE OF THE 2000 DESIGN CRITERIA AND GRANTED AS ADMINISTRATION WAIVER. THIS PLAN RECEIVED PRELIMINARY APPROVAL (SP-05-007) ON MARCH 10, 2006. THIS PLAN RECEIVED PLAT APPROVAL (F-10-107) ON APRIL 18, 2011. EXPIRATION OF ADMINISTRATIVE WAIVERS FOR GRANDFATHERING SHALL BE MAY 04, 2015 IF THE DEVELOPER DOES NOT RECEIVE FINAL APPROVAL (SIGNED BY SCD) PRIOR TO THIS DATE SO THAT GRADING PERMIT MAY BE OBTAINED AND THE PROJECT CONTINUES TO CONSTRUCTION COMPLETION. THIS PLAN IS ALSO SUBJECT TO THE EXPIRATION OF THE WAIVER UNLESS ALL STORMWATER MANAGEMENT IS CONSTRUCTED BY MAY 04, 2017.

PERMIT INFORMATION BLOCK

SUBDIVISION NAME: MARBUCK ESTATES		SECTION/AREA: N/A	PARCEL: 47	
LOTS 1 THRU 8				
PLAT NO. 21546-11	BLOCK(S) 5	ZONING R-20	TAX MAP NO. 37	ELECTION DISTRICT 1ST
			CENSUS TRACT 601101	

LEGEND

- USE IN COMMON PUBLIC ROAD AND PRIVATE DRIVEWAY
- PRIVATE USE-IN-COMMON ACCESS EASEMENT FOR LOTS 3-8 & PRIVATE WATER, SEWER AND UTILITY EASEMENT FOR LOTS 7 & 8. PRIVATE INGRESS & EGRESS EASEMENT TO OPEN SPACE LOT 9 FOR LOTS 1-8. PRIVATE DRAINAGE, STORMWATER MANAGEMENT AND RETAINING WALL EASEMENT.
- PUBLIC WATER, SEWER AND UTILITY EASEMENT
- EROSION CONTROL MATTING
- TREES PROVIDED UNDER F-10-107
- EXISTING TREELINE
- DENOTES EXISTING POWER POLE
- LIMIT OF DISTURBANCE
- EXISTING SUPER SILT FENCE
- RAINGARDEN
- EXISTING STREET TREES PROVIDED UNDER F-10-107

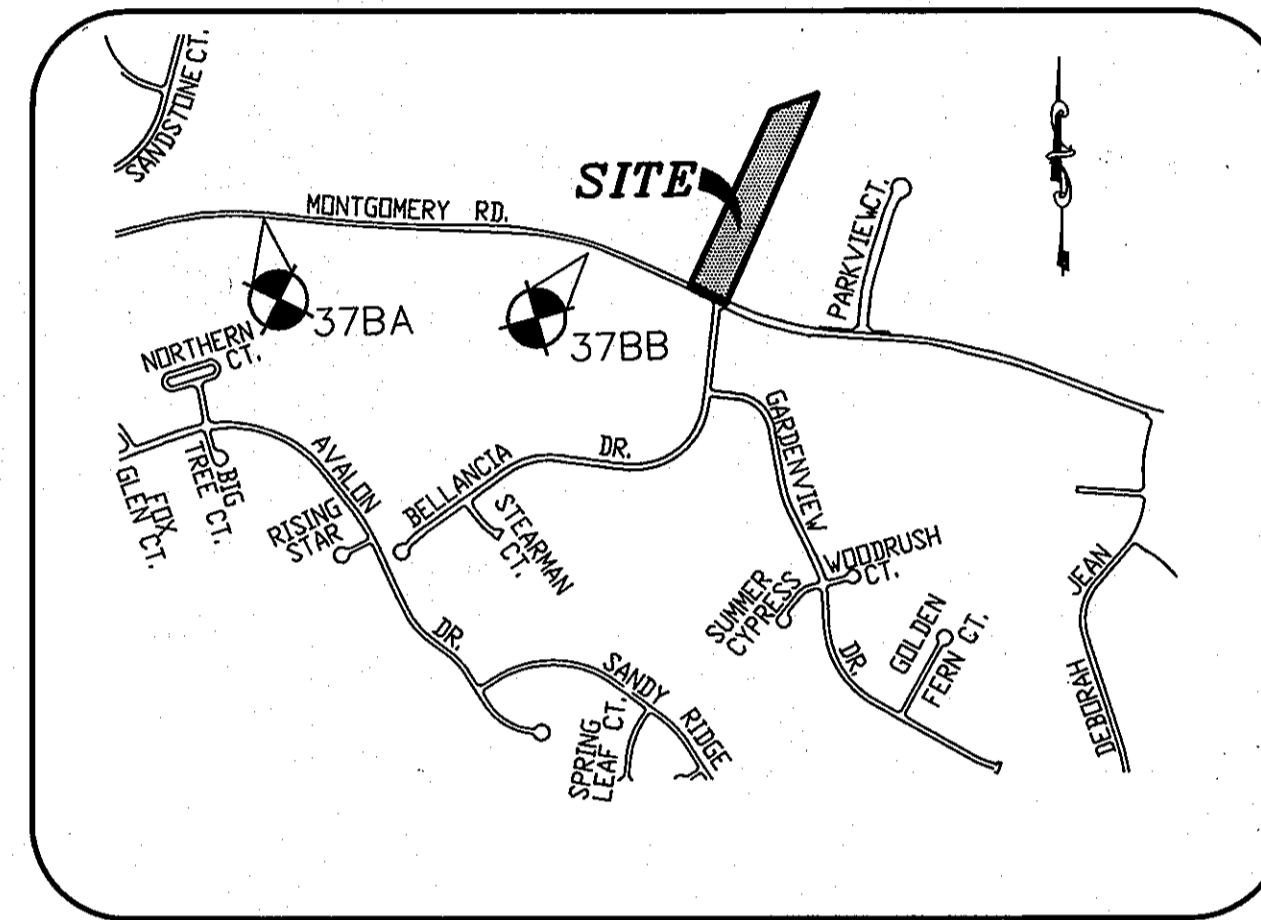

VICINITY MAP

SCALE: 1"=1000'
ADC MAP: 4936 H6

STORMWATER MANAGEMENT PRACTICES

LOT #	ADDRESS	GREEN ROOF	PERMEABLE PAVEMENTS	REINFORCED TURF	DISCONNECTION OF ROOFTOP RUNOFF	DISCONNECTION OF NON-ROOFTOP RUNOFF	SHEETFLOW TO CONSERVATION AREAS	RAINWATER HARVESTING	SUBMERGED GRAVEL WETLANDS	LANDSCAPE INFILTRATION	INFILTRATION BERMS	DRY WELLS	MICRO-BIORETENTION	RAIN - GARDENS	SWALES	ENHANCED FILTERS
		A-1 (Y/N)	A-2 (Y/N)	A-3 (Y/N)	N-1 (NUMBER)	N-2 (Y/N)	N-3 (Y/N)	M-1 (NUMBER)	M-2 (NUMBER)	M-3 (NUMBER)	M-4 (NUMBER)	M-5 (NUMBER)	M-6 (NUMBER)	M-7 (NUMBER)	M-8 (NUMBER)	M-9 (NUMBER)
1	MONTGOMERY ROAD	N	N	N	0	Y	N	0	0	0	0	0	0	1	0	0
2	MONTGOMERY ROAD	N	N	N	0	Y	N	0	0	0	0	0	0	0	0	0
3	MONTGOMERY ROAD	N	N	N	0	N	N	0	0	0	0	0	0	1	1	0
4	MONTGOMERY ROAD	N	N	N	0	N	N	0	0	0	0	0	0	1	1	0
5	MONTGOMERY ROAD	N	N	N	0	N	N	0	0	0	0	0	0	1	1	0
6	MONTGOMERY ROAD	N	N	N	0	Y	N	0	0	0	0	0	0	2	0	0
7	MONTGOMERY ROAD	N	N	N	0	Y	N	0	0	0	0	0	0	2	0	0
8	MONTGOMERY ROAD	N	N	N	0	Y	N	0	0	0	0	0	0	2	0	0

NOTE: NO OPTIONS SHALL BE ALLOWED FOR MODELS: ALEXIS MARIE, CHAMBERLAIN III, UNLESS A REDLINE IS APPROVED SHOWING ADDITIONAL STORMWATER MANAGEMENT MEASURES.

OWNER/DEVELOPER

DORSEY FAMILY HOMES
10717 BIRMINGHAM WAY SUITE B
WOODSTOCK, MARYLAND 21163
410-465-7200

DEVELOPERS CERTIFICATE

I CERTIFY THAT ALL DEVELOPMENT AND CONSTRUCTION WILL BE DONE ACCORDING TO THIS PLAN, AND THAT ANY RESPONSIBLE PERSONNEL INVOLVED IN THE CONSTRUCTION PROJECT WILL HAVE A CERTIFICATE OF ATTENDANCE AT A DEPARTMENT OF THE ENVIRONMENT APPROVED TRAINING PROGRAM FOR THE CONTROL OF SEDIMENT AND EROSION BEFORE BEGINNING THE PROJECT. HOWARD SOIL CONSERVATION DISTRICT IS AUTHORIZED TO PERIODIC ON-SITE INSPECTION.

Robert L. Dorsey Jr. 6-29-2011
SIGNATURE OF DEVELOPER DATE
PRINTED NAME OF DEVELOPER

ENGINEER'S CERTIFICATE

I CERTIFY THAT THIS PLAN FOR EROSION AND SEDIMENT CONTROL REPRESENTS A PRACTICAL AND WORKABLE PLAN BASED ON MY PERSONAL KNOWLEDGE OF THE SITE CONDITIONS AND THAT IT WAS PREPARED IN ACCORDANCE WITH THE REQUIREMENTS OF THE NATURAL RESOURCE CONSERVATION SERVICE.



R. Jacob Hikmat, PE 6/19/11
SIGNATURE OF ENGINEER DATE
PRINTED NAME OF ENGINEER

THIS DEVELOPMENT PLAN IS APPROVED FOR SOIL EROSION AND SEDIMENT CONTROL BY THE HOWARD SOIL CONSERVATION DISTRICT.


John R. Robertson 7/12/11
SIGNATURE OF HOWARD SOIL CONSERVATION DISTRICT DATE

APPROVED: DEPARTMENT OF PLANNING AND ZONING
Christy Edwards 7-15-11
CHIEF, DEVELOPMENT ENGINEERING DIVISION DATE
West S. Edwards 7-19-11
CHIEF, DIVISION OF LAND DEVELOPMENT DATE
Mark S. Doyle 7/19/11
DIRECTOR DATE


I HEREBY CERTIFY THAT THESE DOCUMENTS WERE PREPARED OR APPROVED BY ME AND THAT I AM A DULY LICENSED PROFESSIONAL ENGINEER UNDER THE LAWS OF THE STATE OF MARYLAND, LICENSE NO. 17942, EXP DATE 9/3/12.

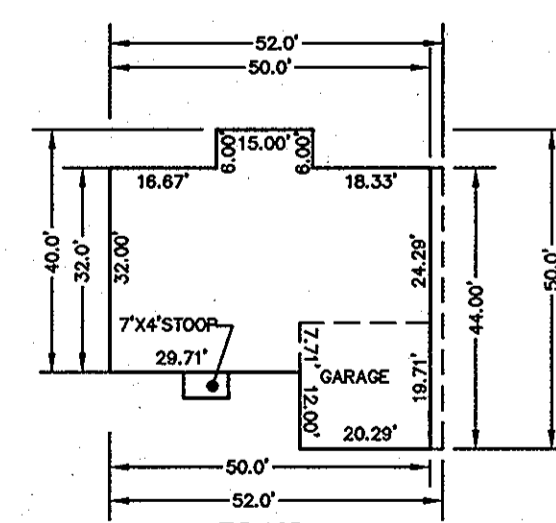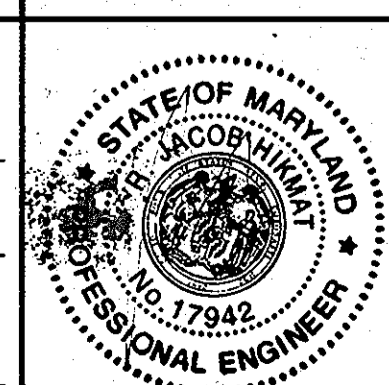


ALEXIS MARIE

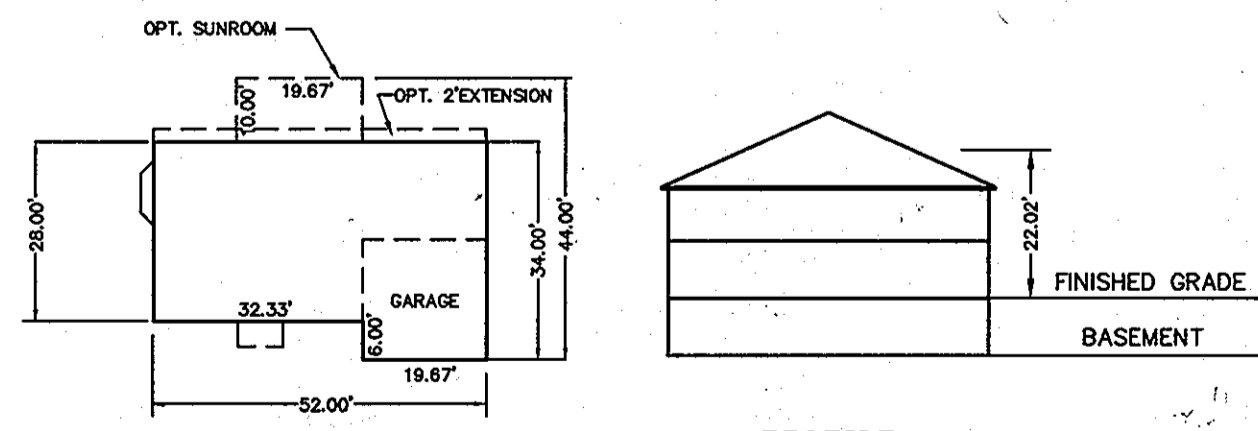


ARMISTEAD III

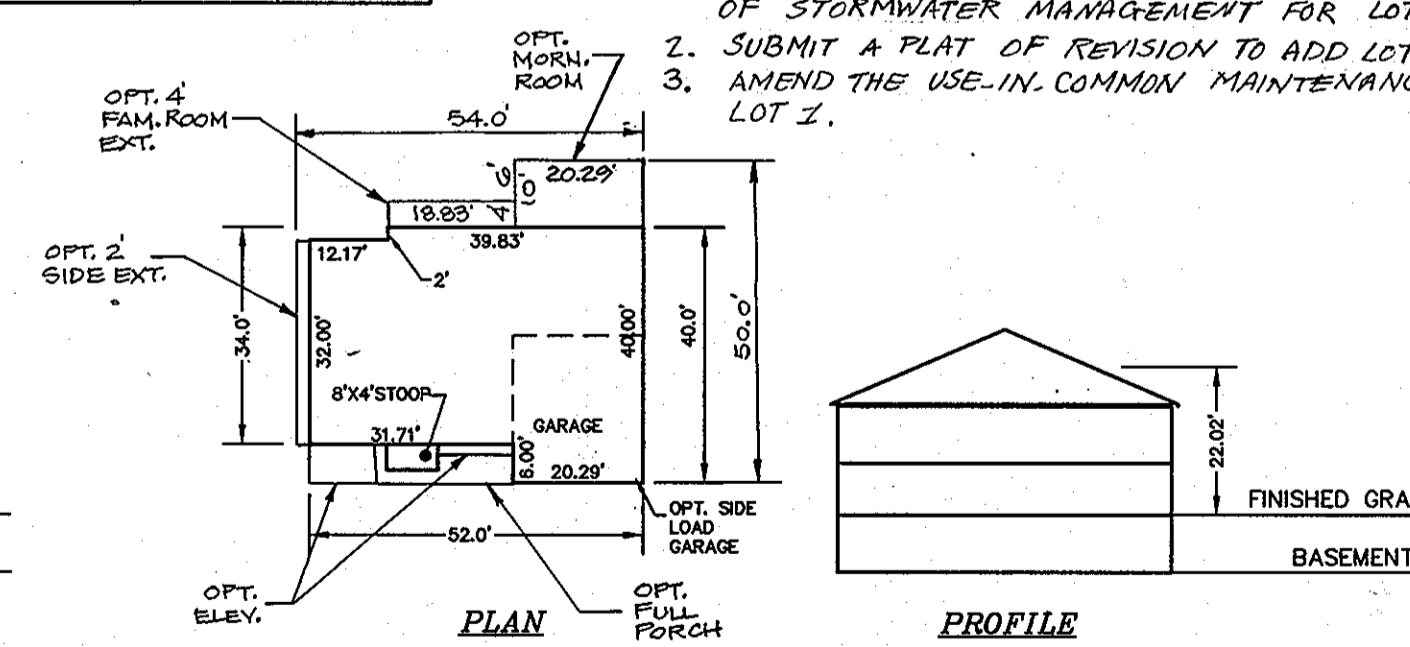


CHAMBERLAIN III

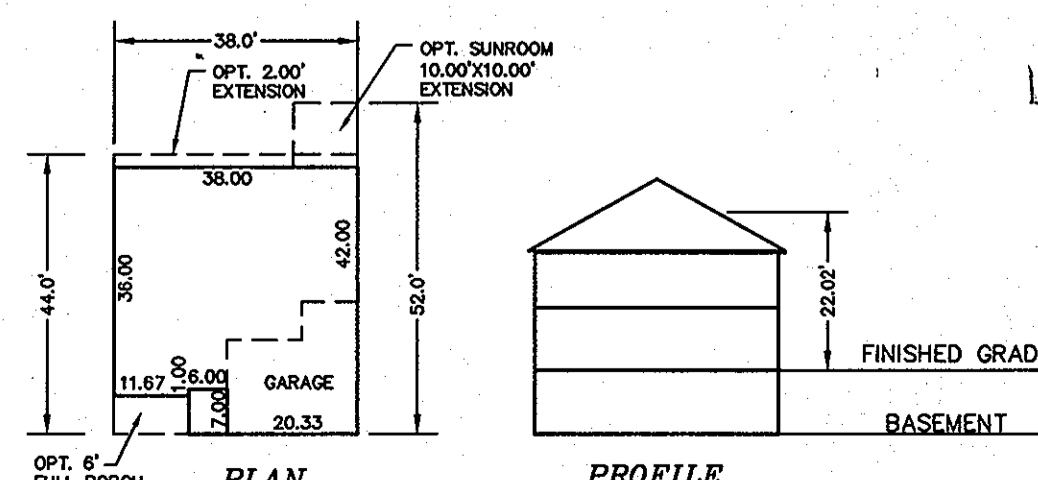

CARROLL

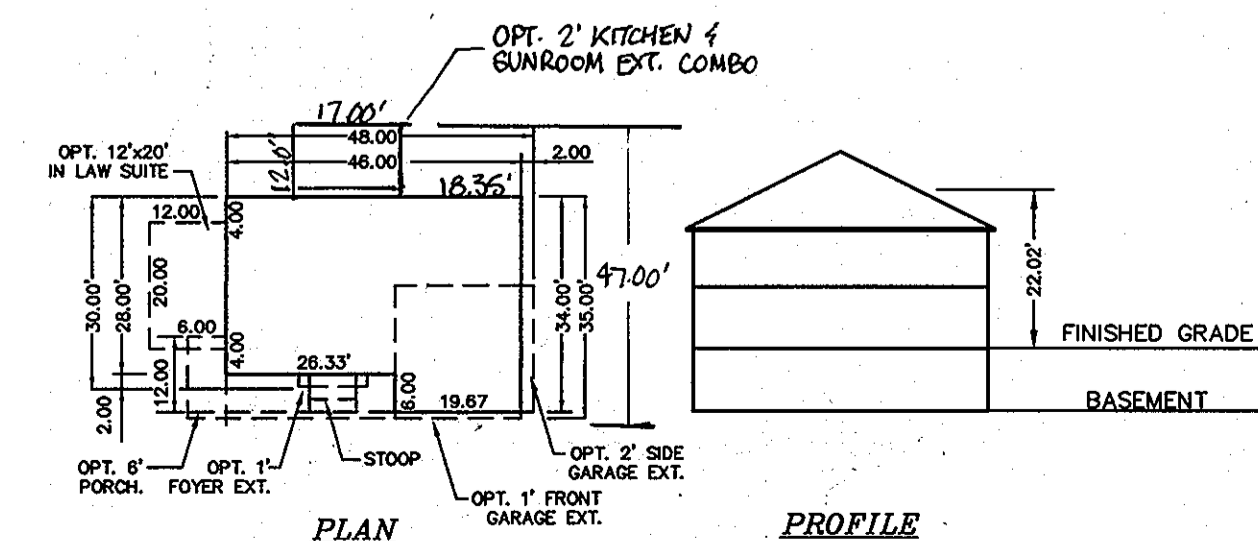

GILMOR III

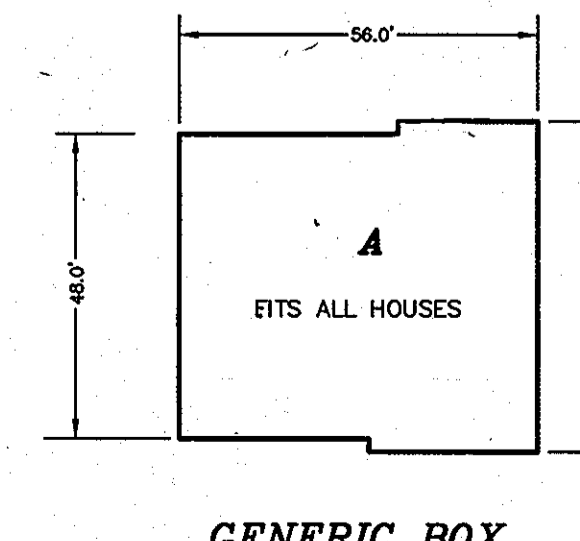

GENERIC BOX

Project	10-022	date	JULY 2011
Illustration	MM	engineering	MM
scale	AS SHOWN	approval	MM




ADD 2 ARCH & SURVEYOR EXTS. COMB TO CHANGE III	12/06/12	date	12/06/12
REVISE CHANGE III PERMIT # GEN-BOX	01/02/11	description	01/02/11
ADD GENERAL NOTE 23.	10/18/11	revisions	10/18/11

MARBUCK ESTATES
 LOTS 1 THRU 8
 TAX MAP 37 GRID 5, PARCEL 47
 HOWARD COUNTY, MARYLAND
 FIRST ELECTION DISTRICT
 COVER SHEET

MILDENBERG, BOENDER & ASSOC., INC.
 Engineers Planners Surveyors
 6800 Deerpath Road, Suite 150, Belkridge, Maryland 20715
 (410) 997-0996 Fax

SOILS DESCRIPTION

SYMBOL	DESCRIPTION
Bec3	BELTSVILLE SILT LOAM, 5% TO 10% SLOPES, SEVERELY ERODED (TYPE C)
OmB2	CHILLUM SILT LOAM, 1% TO 5% SLOPES, MODERATELY ERODED (TYPE C)
Fa	FALLSINGTON LOAM (TYPE D)
EaB	EVESBORO LOAMY SAND, 1% TO 5% SLOPES (TYPE B)
EvC	EVESBORO LOAMY SAND, 5% TO 15% SLOPES (TYPE B)
SiC2	SASSAFRAS GRAVELLY SAND LOAM, 5% TO 10% SLOPES, MODERATELY ERODED (TYPE B)
SiB2	SASSAFRAS LOAM, 1% TO 5% SLOPES, MODERATELY ERODED (TYPE B)
SiD2	SASSAFRAS LOAM, 10% TO 15% SLOPES, MODERATELY ERODED (TYPE B)
luB	IUKA LOAM, LOCAL ALLUVIUM, 1% TO 5% SLOPES (TYPE B)

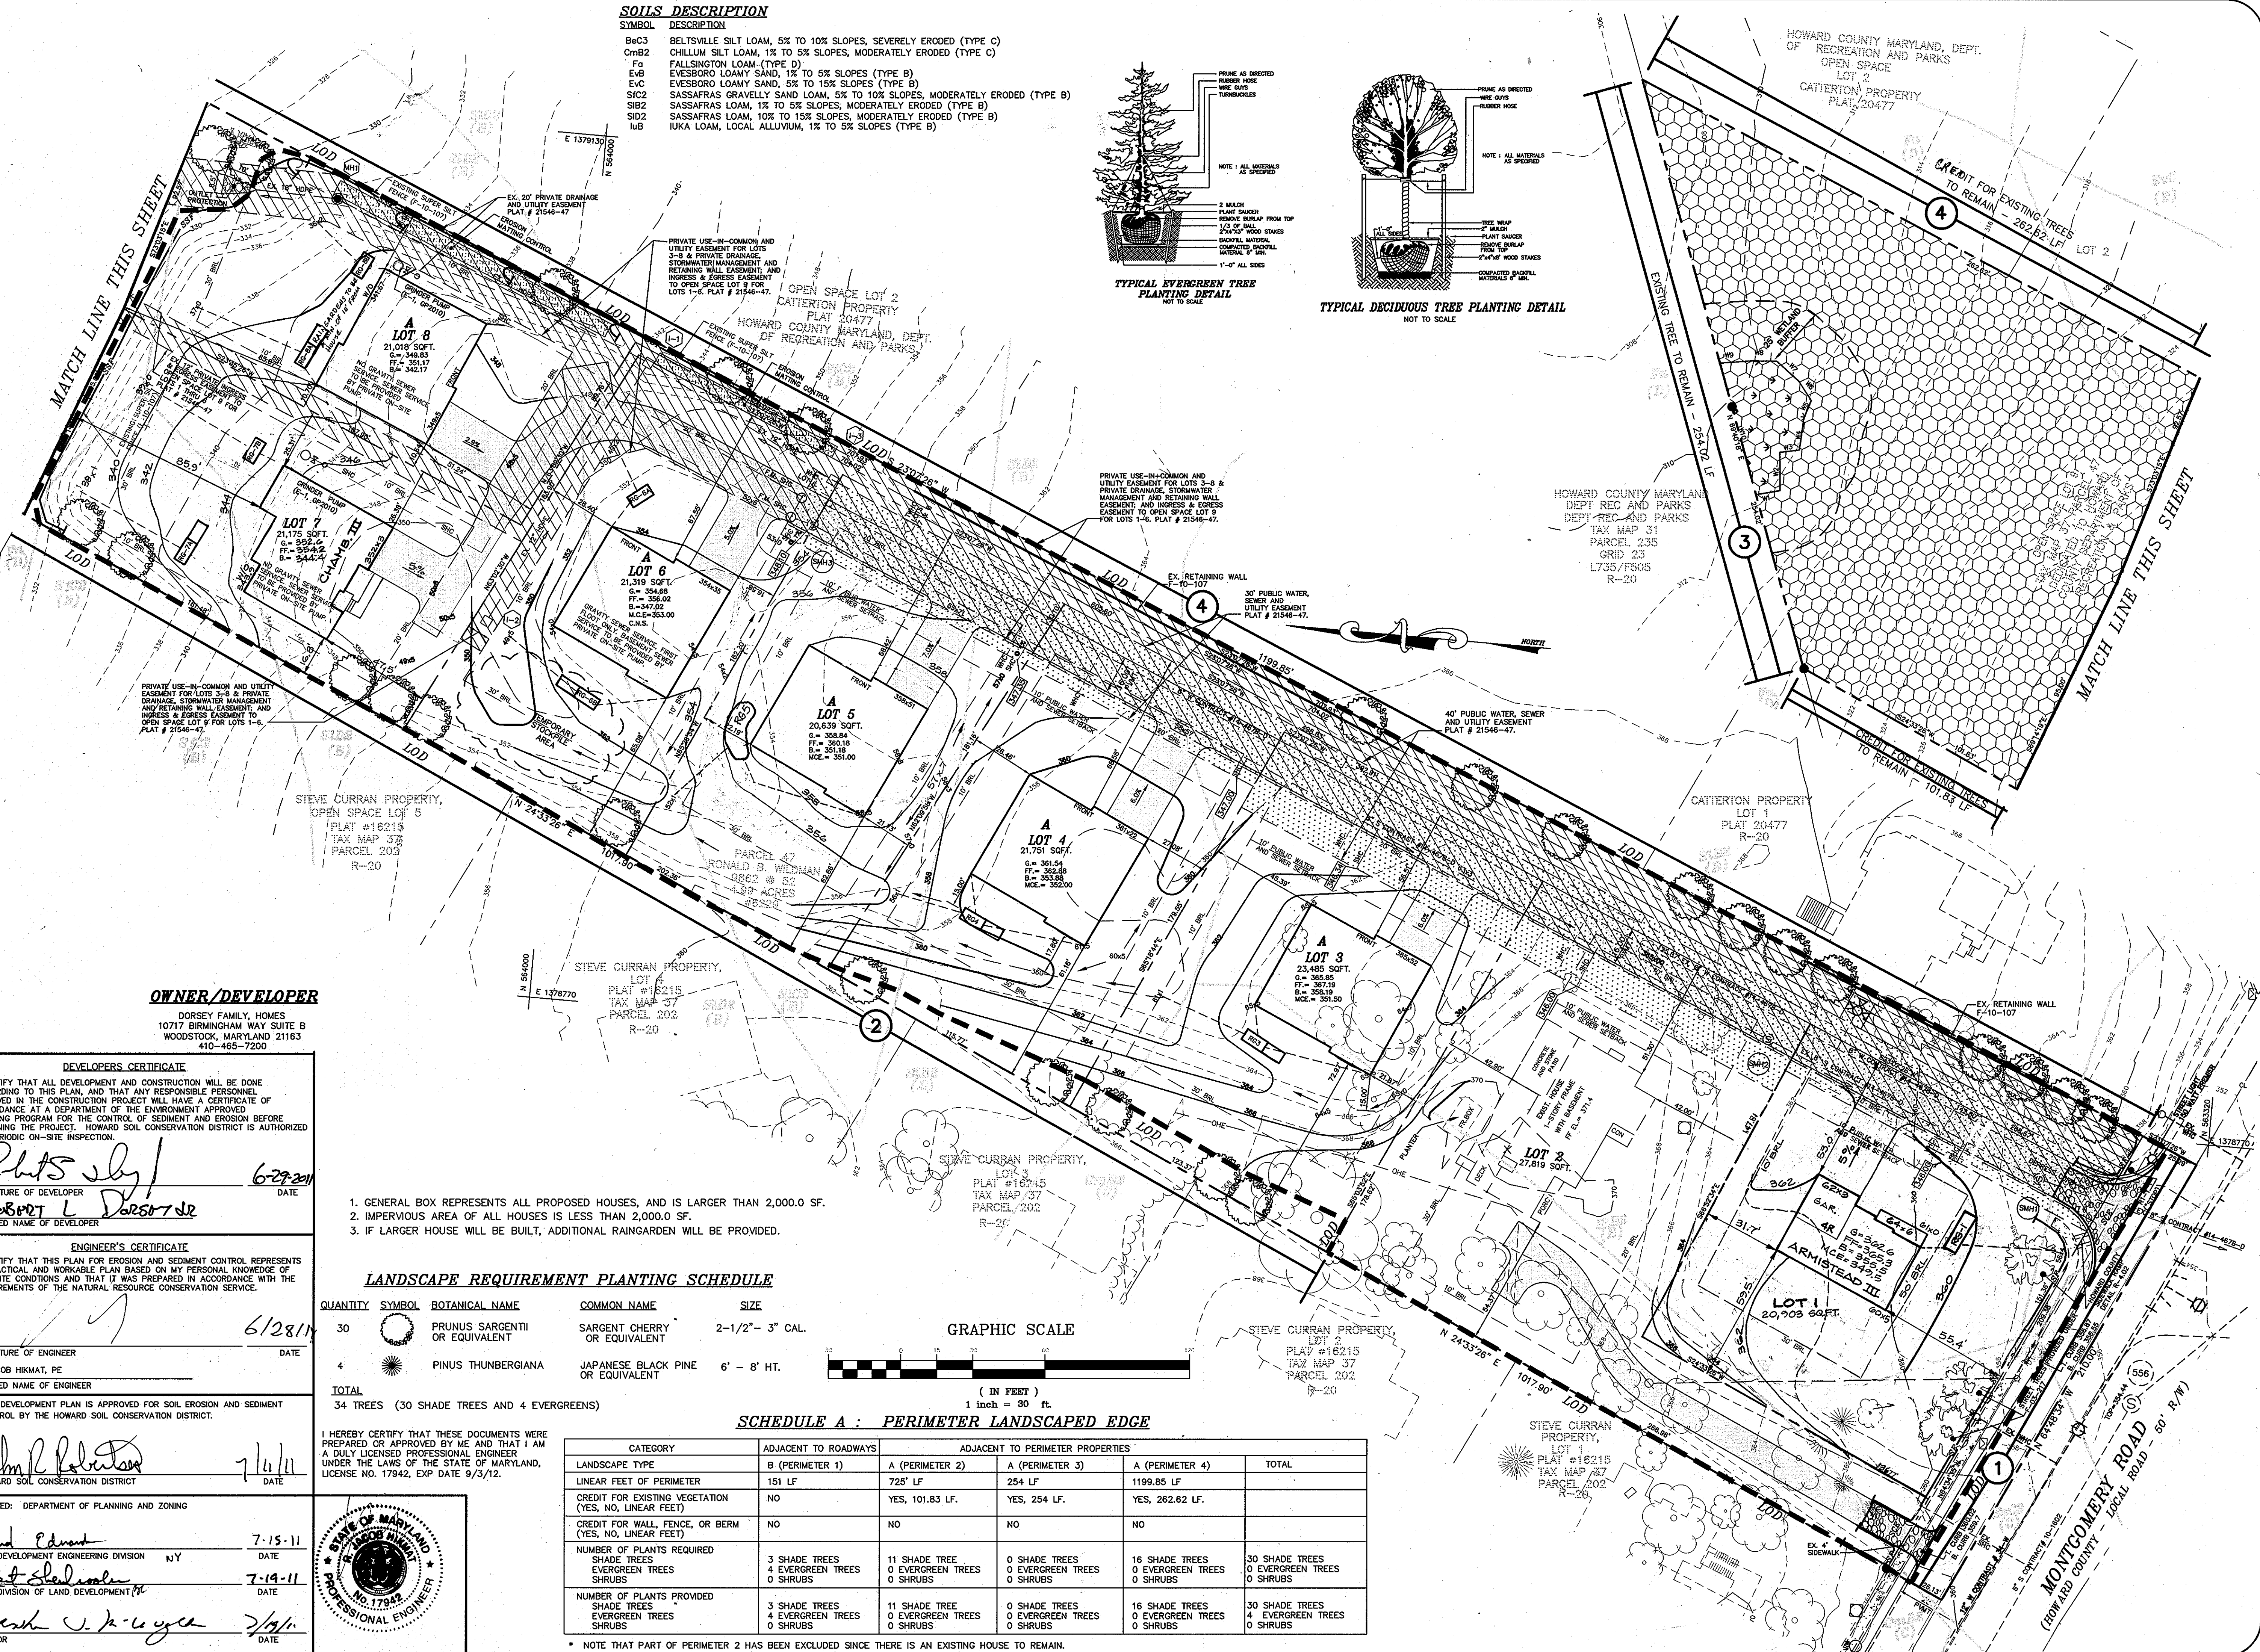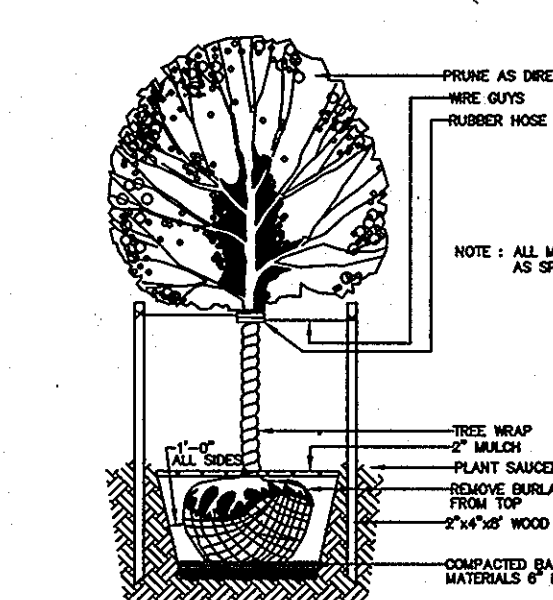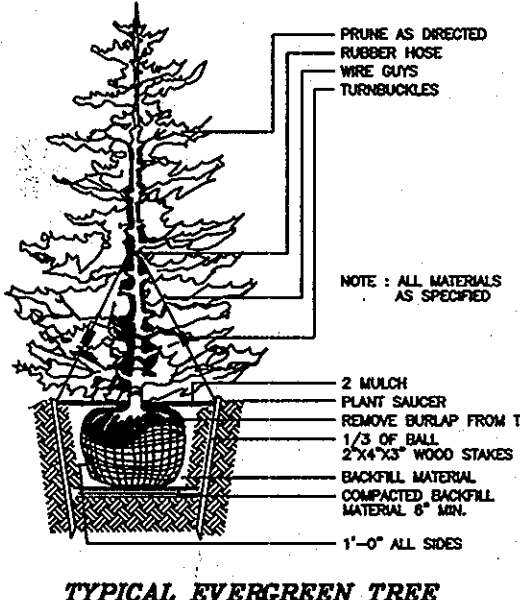

OWNER/DEVELOPER
 DORSEY FAMILY, HOMES
 10717 BIRMINGHAM WAY SUITE B
 WOODSTOCK, MARYLAND 21183
 410-465-7200

DEVELOPERS CERTIFICATE
 I CERTIFY THAT ALL DEVELOPMENT AND CONSTRUCTION WILL BE DONE ACCORDING TO THIS PLAN, AND THAT ANY RESPONSIBLE PERSONNEL INVOLVED IN THE CONSTRUCTION PROJECT WILL HAVE A CERTIFICATE OF ATTENDANCE AT A DEPARTMENT OF THE ENVIRONMENT APPROVED TRAINING PROGRAM FOR THE CONTROL OF SEDIMENT AND EROSION BEFORE BEGINNING THE PROJECT. HOWARD SOIL CONSERVATION DISTRICT IS AUTHORIZED TO PERIODIC ON-SITE INSPECTION.
 Signature: Robert L. Dorsey, Jr.
 DATE: 6-29-2011

ENGINEER'S CERTIFICATE
 I CERTIFY THAT THIS PLAN FOR EROSION AND SEDIMENT CONTROL REPRESENTS A PRACTICAL AND WORKABLE PLAN BASED ON MY PERSONAL KNOWLEDGE OF THE SITE CONDITIONS AND THAT IT WAS PREPARED IN ACCORDANCE WITH THE REQUIREMENTS OF THE NATURAL RESOURCE CONSERVATION SERVICE.
 Signature: John R. Boender
 DATE: 6/28/11

APPROVED: DEPARTMENT OF PLANNING AND ZONING
 Signature: [Official Seal]
 DATE: 7-15-11
 Signature: [Official Seal]
 DATE: 7-19-11
 Signature: [Official Seal]
 DATE: 7/19/11

- GENERAL BOX REPRESENTS ALL PROPOSED HOUSES, AND IS LARGER THAN 2,000.0 SF.
- IMPERVIOUS AREA OF ALL HOUSES IS LESS THAN 2,000.0 SF.
- IF LARGER HOUSE WILL BE BUILT, ADDITIONAL RAINGARDEN WILL BE PROVIDED.

LANDSCAPE REQUIREMENT PLANTING SCHEDULE

QUANTITY	SYMBOL	BOTANICAL NAME	COMMON NAME	SIZE
30	(Symbol)	PRUNUS SARGENTI OR EQUIVALENT	SARGENT CHERRY OR EQUIVALENT	2-1/2" - 3" CAL.
4	(Symbol)	PINUS THUNBERGIANA	JAPANESE BLACK PINE OR EQUIVALENT	6' - 8' HT.
TOTAL				34 TREES (30 SHADE TREES AND 4 EVERGREENS)



SCHEDULE A : PERIMETER LANDSCAPED EDGE

CATEGORY	ADJACENT TO ROADWAYS		ADJACENT TO PERIMETER PROPERTIES		TOTAL
	B (PERIMETER 1)	A (PERIMETER 2)	A (PERIMETER 3)	A (PERIMETER 4)	
LINEAR FEET OF PERIMETER	151 LF	725 LF	254 LF	1199.85 LF	
CREDIT FOR EXISTING VEGETATION (YES, NO, LINEAR FEET)	NO	YES, 101.83 LF.	YES, 254 LF.	YES, 262.62 LF.	
CREDIT FOR WALL, FENCE, OR BERM (YES, NO, LINEAR FEET)	NO	NO	NO	NO	
NUMBER OF PLANTS REQUIRED	3 SHADE TREES 4 EVERGREEN TREES 0 SHRUBS	11 SHADE TREE 0 EVERGREEN TREES 0 SHRUBS	0 SHADE TREES 0 EVERGREEN TREES 0 SHRUBS	16 SHADE TREES 0 EVERGREEN TREES 0 SHRUBS	30 SHADE TREES 4 EVERGREEN TREES 0 SHRUBS
NUMBER OF PLANTS PROVIDED	3 SHADE TREES 4 EVERGREEN TREES 0 SHRUBS	11 SHADE TREE 0 EVERGREEN TREES 0 SHRUBS	0 SHADE TREES 0 EVERGREEN TREES 0 SHRUBS	16 SHADE TREES 0 EVERGREEN TREES 0 SHRUBS	30 SHADE TREES 4 EVERGREEN TREES 0 SHRUBS

* NOTE THAT PART OF PERIMETER 2 HAS BEEN EXCLUDED SINCE THERE IS AN EXISTING HOUSE TO REMAIN.

PROJECT	DATE	DESCRIPTION	BY	APPROVAL
10-022	JULY, 2011	illustration	MM	MM

NO.	DATE	DESCRIPTION	REVISIONS
5	12/16/12	REV. USE & ORD. LOT 1 TO REFLECT AS-BUILT COND.	
4	7/24/12	REV. GRP 1 & 2 TO REFLECT AS-BUILT COND.	
3	12/10/11	REV. GRP 5 LAYOUT, GRP 5 LOTS TO REFLECT AS-BUILT COND.	
2	12/10/11	REVISED GEN. BOX, ENLARGE RAIN GARDENS	
1	10/19/11	RECORDED ZONING & REVISED GRADING	

MARBUCK ESTATES
 LOTS 1 THRU 8
 TAX MAP 37 GRID 5, PARCEL 47
 HOWARD COUNTY, MARYLAND
 FIRST ELECTION DISTRICT
 SITE DEVELOPMENT, SEDIMENT CONTROL PLANS AND SOIL MAP

MILDENBERG, BOENDER & ASSOC., INC.
 Engineers Planners Surveyors
 6800 Deerpath Road, Suite 650, Elkridge, Maryland 21075
 (410) 987-0296 Fax

