











GENERAL NOTES

- ALL CONSTRUCTION SHALL BE IN ACCORDANCE WITH THE LATEST STANDARDS AND SPECIFICATIONS OF HOWARD COUNTY PLUS MSHA STANDARDS AND SPECIFICATIONS AS APPLICABLE.
- EXISTING TOPOGRAPHY SHOWN ONSITE AND BOUNDARY ARE BASED ON A FIELD RUN BOUNDARY SURVEY PERFORMED BY BENCHMARK ENGINEERING, INC. IN DECEMBER 2011. CONTOUR INTERVAL IS 2'.
- THE COORDINATES SHOWN HEREON ARE BASED UPON THE HOWARD COUNTY GEODETIC CONTROL WHICH IS BASED UPON THE MARYLAND STATE COORDINATE SYSTEM. HOWARD COUNTY MONUMENT NOS. 48DB AND 48DC WERE USED FOR THIS PROJECT.
- WATER AND SEWER ARE PUBLIC AND WILL CONNECT TO IMPROVEMENTS PROVIDED UNDER SEWER CONTRACT NUMBER 20-326 AND WATER CONTRACT 870-W. THE DRAINAGE AREA IS LITTLE PATUXENT.
- EXISTING UTILITIES SHOWN ARE BASED ON CONTRACT DRAWINGS, HOWARD COUNTY GIS AND FIELD SURVEYED LOCATIONS.
- CONTRACTOR SHALL VERIFY ALL UTILITY LOCATIONS PRIOR TO ANY CONSTRUCTION ACTIVITY AND SHALL ADJUST ALL UTILITIES AND RIM ELEVATIONS AS NEEDED TO MATCH THIS PLAN.
- THERE ARE NO WETLANDS, WETLAND BUFFERS, STREAMS, STREAM BUFFERS, STEEP SLOPES (25% OR GREATER) OR 100-YEAR FLOODPLAINS ON THE SITE.
- A NOISE STUDY IS NOT REQUIRED FOR COMMERCIAL PROJECTS.
- THE SUBJECT PROPERTY IS ZONED M-2 PER THE 2-2-2004 COMPREHENSIVE ZONING PLAN AND THE "COMP LITE" ZONING AMENDMENTS EFFECTIVE 7-28-2006.
- TO THE BEST OF OUR KNOWLEDGE, THERE ARE NO BURIAL GROUNDS, CEMETERIES OR HISTORIC STRUCTURES LOCATED ON THIS SITE.
- THIS PROJECT IS LOCATED WITHIN THE METROPOLITAN DISTRICT.
- LANDSCAPING FOR THIS PARCEL IS PROVIDED IN ACCORDANCE WITH A CERTIFIED LANDSCAPE PLAN INCLUDED WITH THIS SITE DEVELOPMENT PLAN SET IN ACCORDANCE WITH SECTION 16.124 OF THE HOWARD COUNTY CODE AND THE LANDSCAPE MANUAL. FINANCIAL SURETY FOR THE REQUIRED PERIMETER LANDSCAPING HAS BEEN POSTED AS PART OF THE DPW DEVELOPER'S AGREEMENT FOR THE AMOUNT OF \$5,250.00 (\$4,800.00 FOR THE 16 REQUIRED SHADE TREES, \$450.00 FOR THE REQUIRED 3 EVERGREENS).
- PREVIOUS HOWARD COUNTY FILE NUMBERS: ECP-12-041
- THE CONTRACTOR SHALL NOTIFY "MISS UTILITY" AT 1-800-257-7777 AT LEAST 48 HOURS PRIOR TO ANY EXCAVATION WORK BEING DONE.
- THE CONTRACTOR SHALL NOTIFY THE DEPARTMENT OF PUBLIC WORKS/BUREAU OF ENGINEERING/CONSTRUCTION INSPECTION DIVISION AT 410-313-1880 AT LEAST FIVE (5) WORKING DAYS PRIOR TO THE START OF WORK.
- ALL EXTERIOR LIGHTING SHALL BE IN ACCORDANCE WITH THE HOWARD COUNTY DESIGN MANUAL VOLUME III (1993), ZONING SECTION 134 AND AS SHOWN ON THESE PLANS. ALL EXTERIOR LIGHT FIXTURES SHALL BE ORIENTED TO DIRECT LIGHT INWARDS AND DOWNWARDS ONE FOOT AWAY FROM ALL ADJACENT RESIDENTIAL PROPERTIES AND PUBLIC ROADS IN ACCORDANCE WITH SECTION 134 OF THE HOWARD COUNTY ZONING REGULATIONS.
- TRAFFIC CONTROL DEVICES, MARKINGS AND SIGNING SHALL BE IN ACCORDANCE WITH THE LATEST EDITION OF THE MANUAL OF UNIFORM TRAFFIC CONTROL DEVICES (MUTCD). ALL STREET AND REGULATORY SIGNS SHALL BE IN PLACE PRIOR TO PLACEMENT OF ANY ASPHALT.
- ALL SIGN POSTS USED FOR TRAFFIC CONTROL SIGNS INSTALLED IN THE COUNTY RIGHT-OF-WAY SHALL BE MOUNTED ON A 2" GALVANIZED STEEL PERFORATED, SQUARE TUBE POST (14 GAUGE) INSERTED INTO A 2.5" GALVANIZED STEEL PERFORATED SQUARE TUBE SLEEVE (12 GAUGE)-3" LONG. A GALVANIZED STEEL POLE CAP SHALL BE MOUNTED ON TOP OF EACH POST.
- THE FOREST CONSERVATION ACT OBLIGATION FOR THIS PROJECT WILL BE MET BY PAYMENT OF FEE-IN-LIEU IN THE AMOUNT OF \$4,901 FOR AN OBLIGATION OF 0.15 ACRES. (6,534 S.F. X \$0.75 = \$4,901)
- SHO ELEVATION SHOWN IS LOCATED AT THE PROPERTY LINE.
- A TRAFFIC STUDY DATED SEPTEMBER, 2012, WAS PREPARED FOR THIS PROJECT BY MARS GROUP, INC. AND WAS APPROVED FEBRUARY 7, 2013 PER DPZ LETTER.
- ALL PLAN DIMENSIONS ARE TO FACE OF CURB UNLESS OTHERWISE NOTED.
- "BR" INDICATES BUILDING RESTRICTION LINE.
- ANY DAMAGE TO THE COUNTY'S RIGHT-OF-WAY SHALL BE CORRECTED AT THE BUILDER'S AND/OR DEVELOPER'S EXPENSE.
- THIS PLAN CONFORMS WITH THE AMENDED 5th EDITION OF THE HOWARD COUNTY SUBDIVISION AND LAND DEVELOPMENT REGULATIONS. THE DEVELOPER SHALL APPLY FOR BUILDING PERMITS FOR THIS SITE DEVELOPMENT PLAN WITHIN ONE YEAR OF SIGNATURE APPROVAL OF THIS PLAN.
- STORMWATER MANAGEMENT SHALL BE PROVIDED FOR THIS PROJECT BASED ON GUIDELINES ESTABLISHED BY THE STORMWATER MANAGEMENT ACT OF 2009. TREATMENT FOR THIS PROJECT SHALL BE PROVIDED BY ONE BIOTRETATION FACILITY, PERMEABLE PAVEMENT AND THREE DRY WELLS. STORMWATER MANAGEMENT FACILITIES SHALL BE PRIVATELY OWNED AND MAINTAINED.
- DRIVEWAY CONSTRUCTION SHALL BE IN CONFORMANCE WITH HOWARD COUNTY STANDARD R-6.10.
- WATER METER SHALL BE PRIVATE, AND OUTSIDE SETTING.
- HANDICAP PARKING ACCESS AISLE SHALL BE SLOPED TO MEET SIDEWALK ELEVATION BUT NOT EXCEED 2% IN ANY DIRECTION.
- NO GRADING, REMOVAL OF VEGETATIVE COVER OR TREES, PAVING AND NEW STRUCTURES SHALL BE PERMITTED WITHIN THE REQUIRED WETLANDS, STREAM OR THEIR BUFFERS, FOREST CONSERVATION AREAS AND 100-YEAR FLOODPLAIN.
- THE EXISTING WELL IS TO BE PROPERLY ABANDONED BY A LICENSED WELL DRILLER AND A CERTIFICATION SHALL BE PROVIDED TO THE HOWARD COUNTY HEALTH DEPARTMENT BEFORE SIGNATURE APPROVAL OF THIS PLAN.
- A KNOX BOX SHALL BE INSTALLED WITHIN 6' OF THE FRONT DOOR AT A RANGE OF 4' TO 5' IN HEIGHT. THE BOX SHALL BE ELECTRONICALLY SUPERVISED TO NOTIFY THE OWNER THAT IT IS BEING ACCESSED.
- CONTRACTOR SHALL BE RESPONSIBLE TO COORDINATE WITH UTILITY COMPANIES TO SCHEDULE BRACING OF POLES FOR WORK WITHIN 5.0' OF ANY POLE.
- STREET LIGHT PLACEMENT AND THE TYPE OF FIXTURE AND POLE SHALL BE IN ACCORDANCE WITH THE HOWARD COUNTY DESIGN MANUAL, VOLUME III (1993) AND AS MODIFIED BY "GUIDELINES FOR STREET LIGHTS IN RESIDENTIAL DEVELOPMENTS (JUNE 1993)". A MINIMUM SPACING OF 20' SHALL BE MAINTAINED BETWEEN ANY STREETLIGHT AND ANY TREE.

SITE DEVELOPMENT PLAN L&R BUILDINGS L. 13356 F. 0464 6TH ELECTION DISTRICT HOWARD COUNTY, MARYLAND

BENCH MARKS--(NAD'83)

HO. CO. #48DB STANDARD DISC ON CONC. MONUMENT N 536,575.7003	ELEV. 238.836 CONC. MONUMENT E 1,371,005.7944
HO. CO. #48DC STANDARD DISC ON CONC. MONUMENT N 534,290.4821	ELEV. 209.014 CONC. MONUMENT E 1,371,119.4255

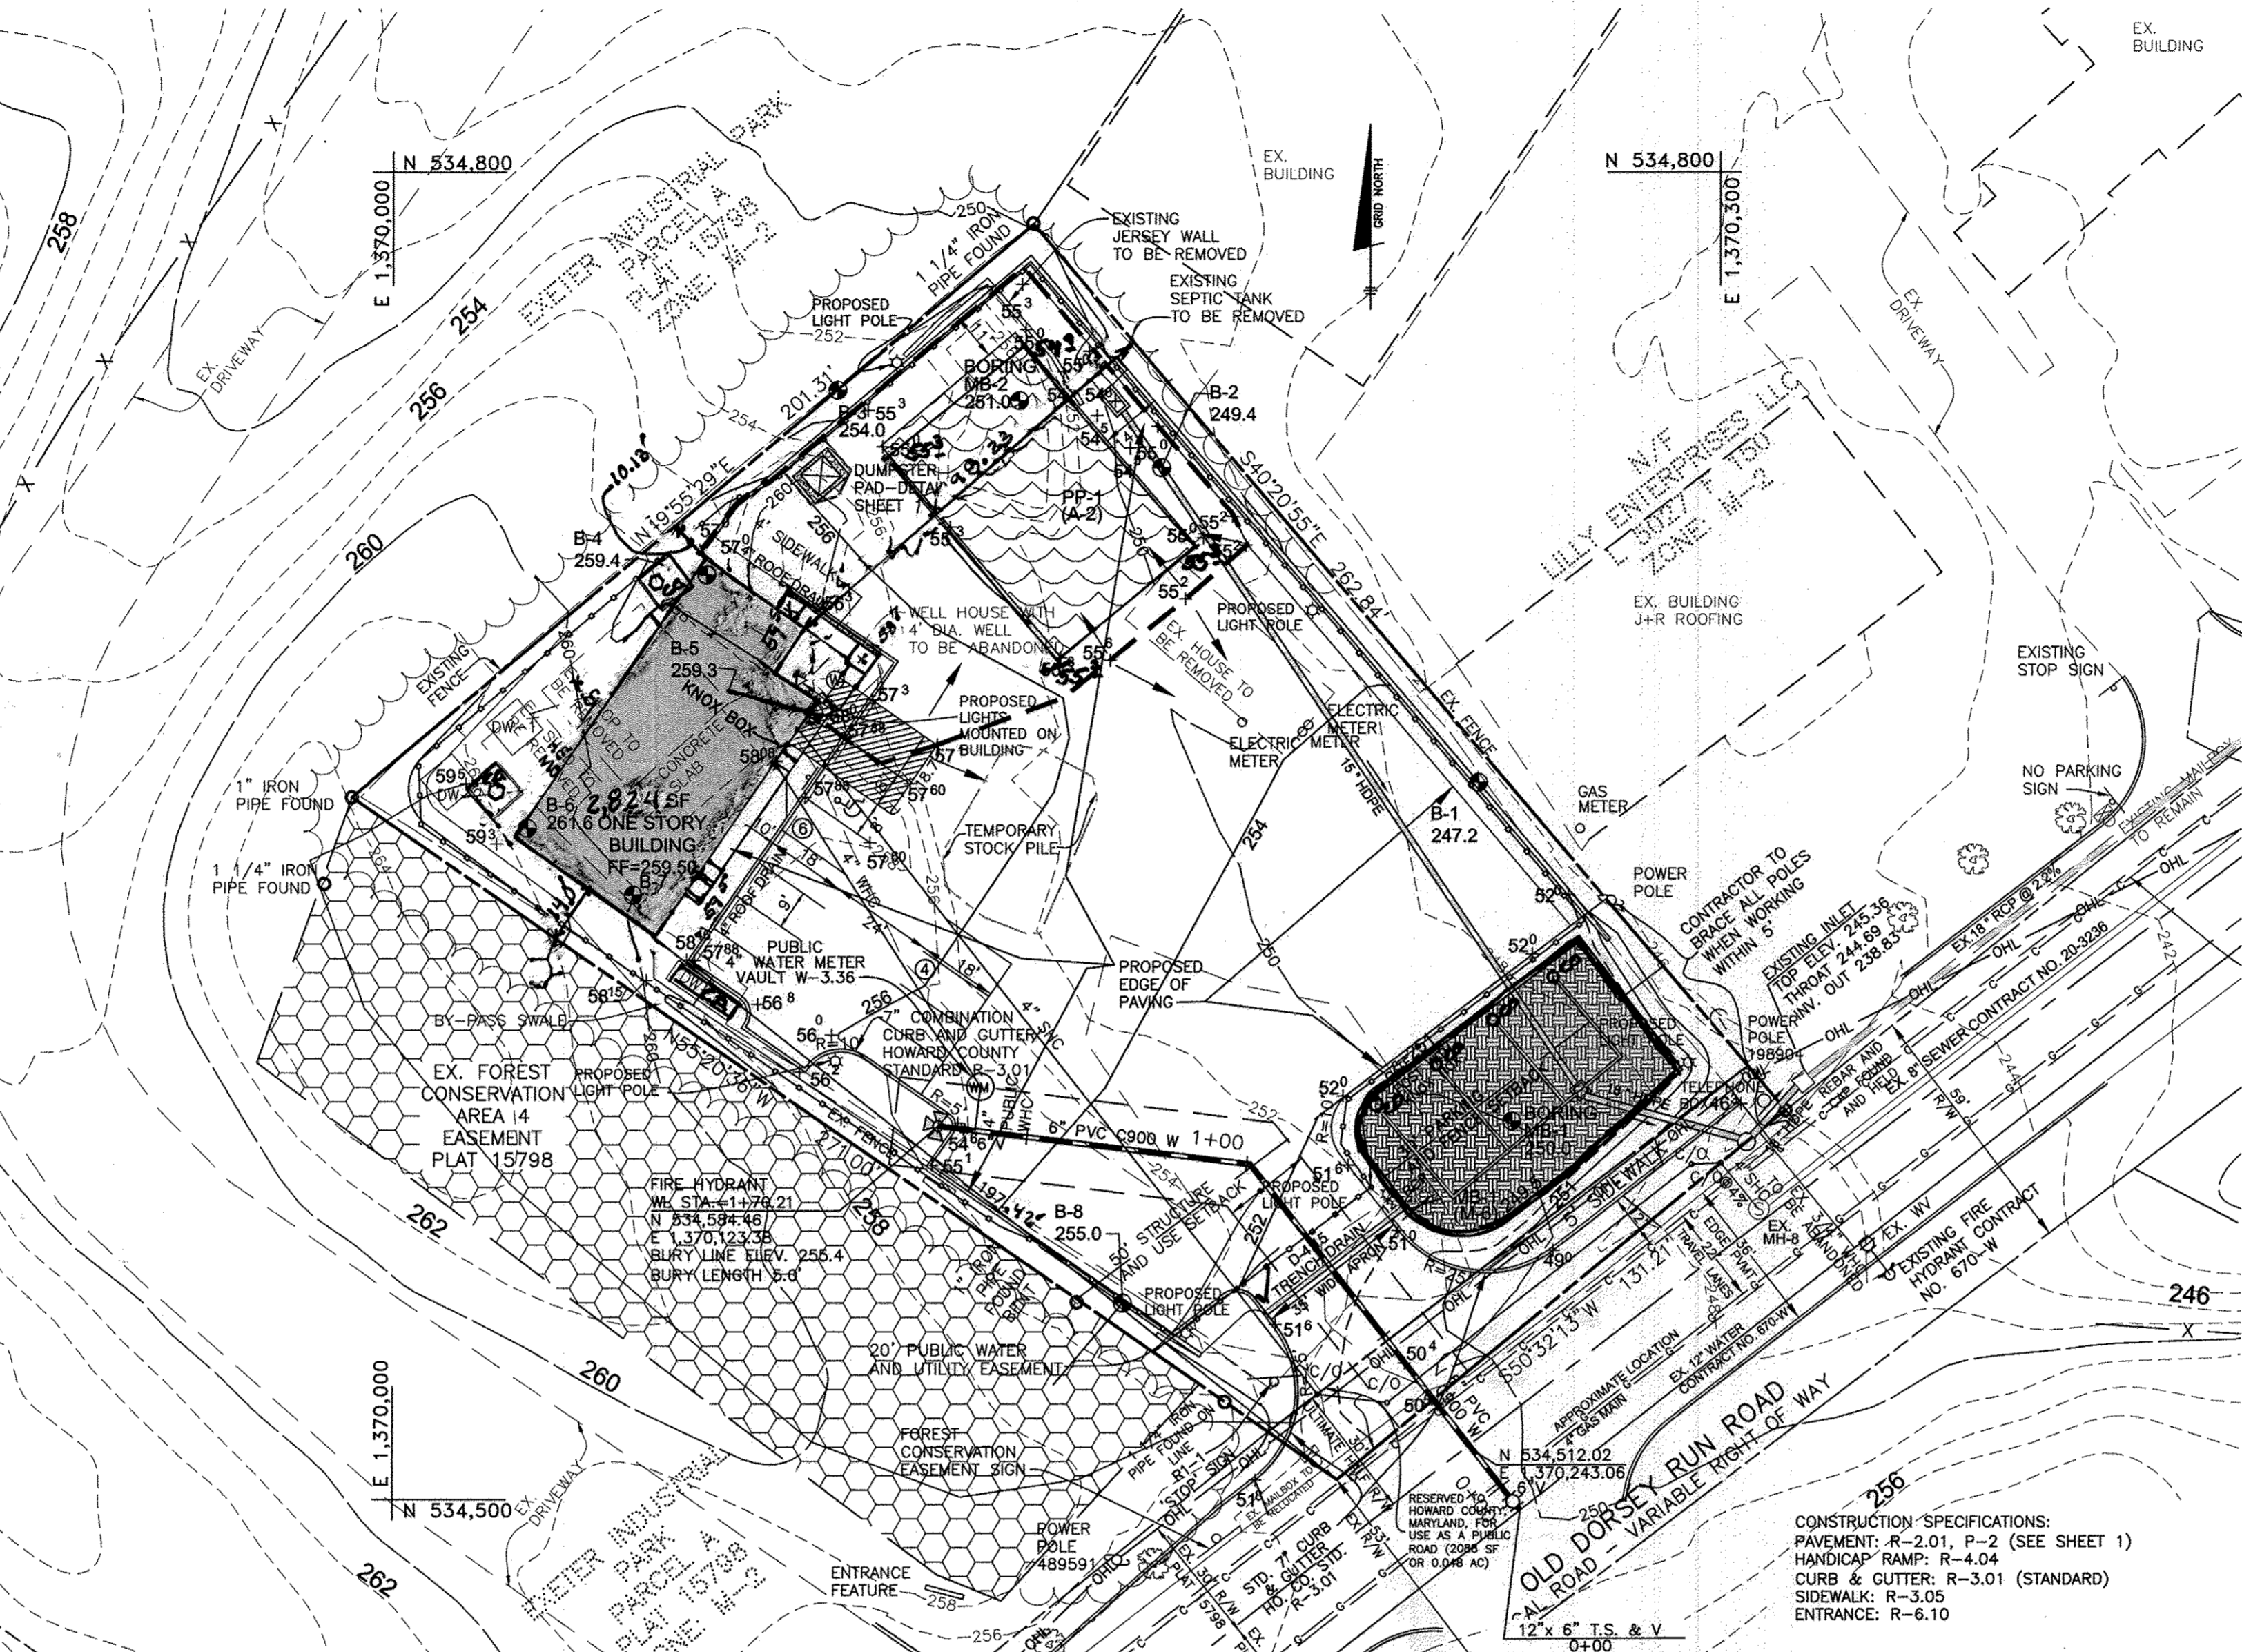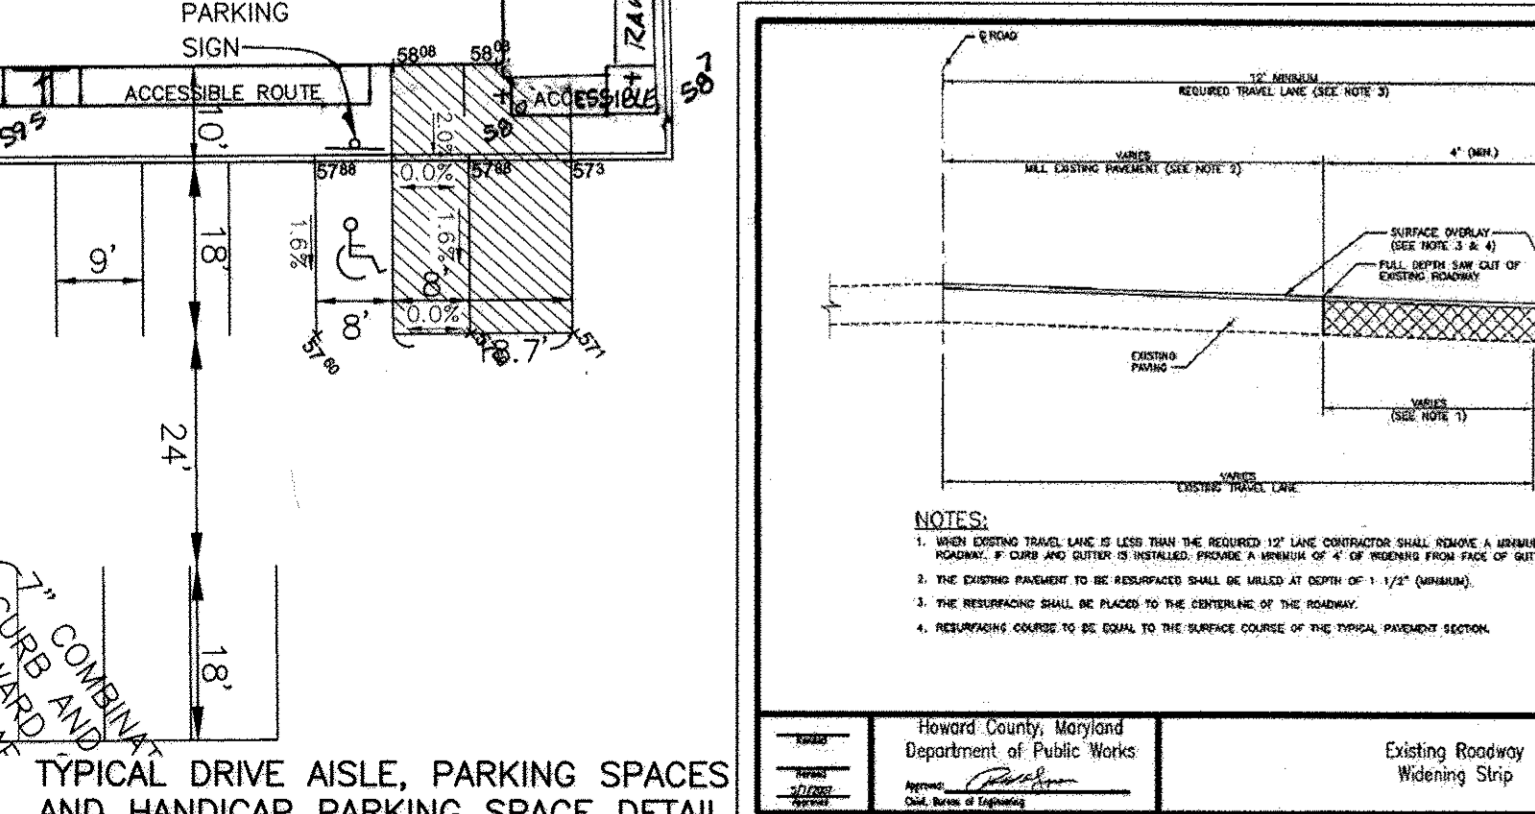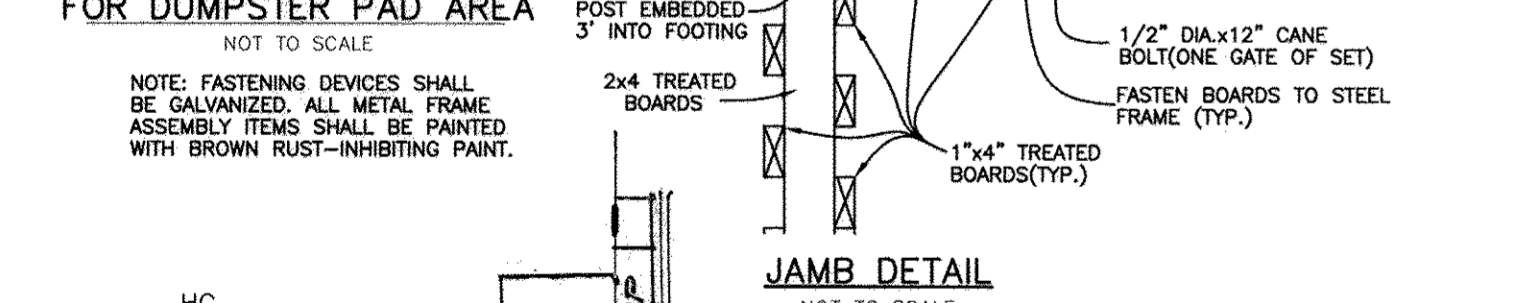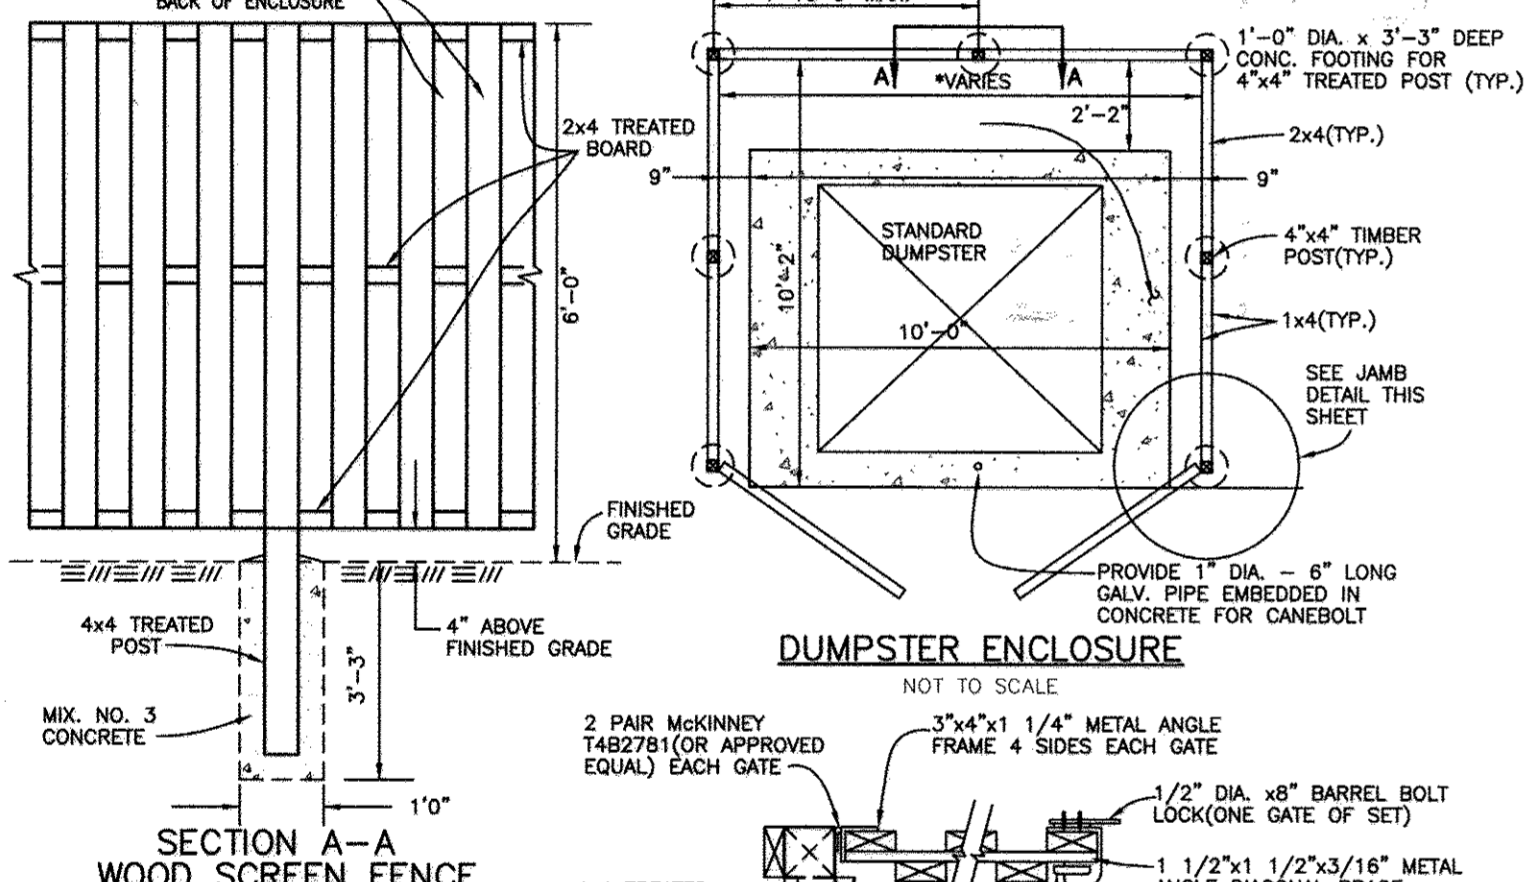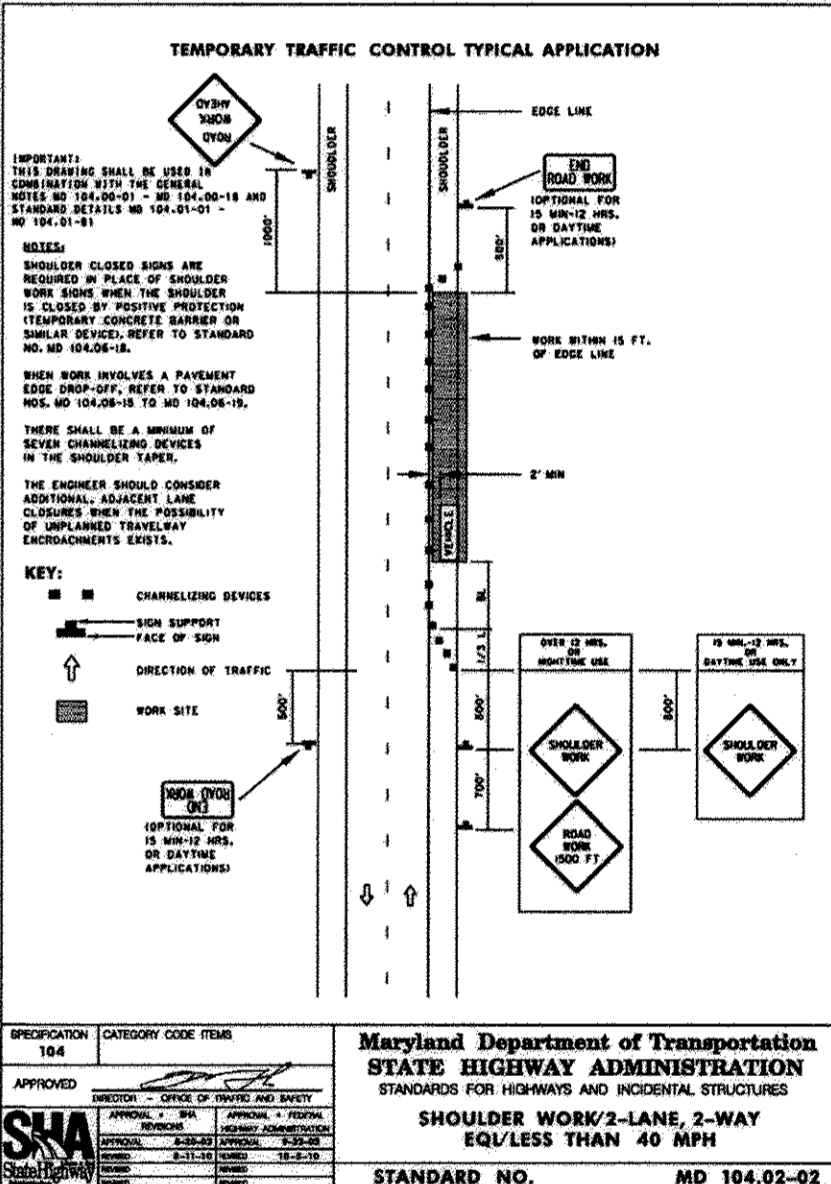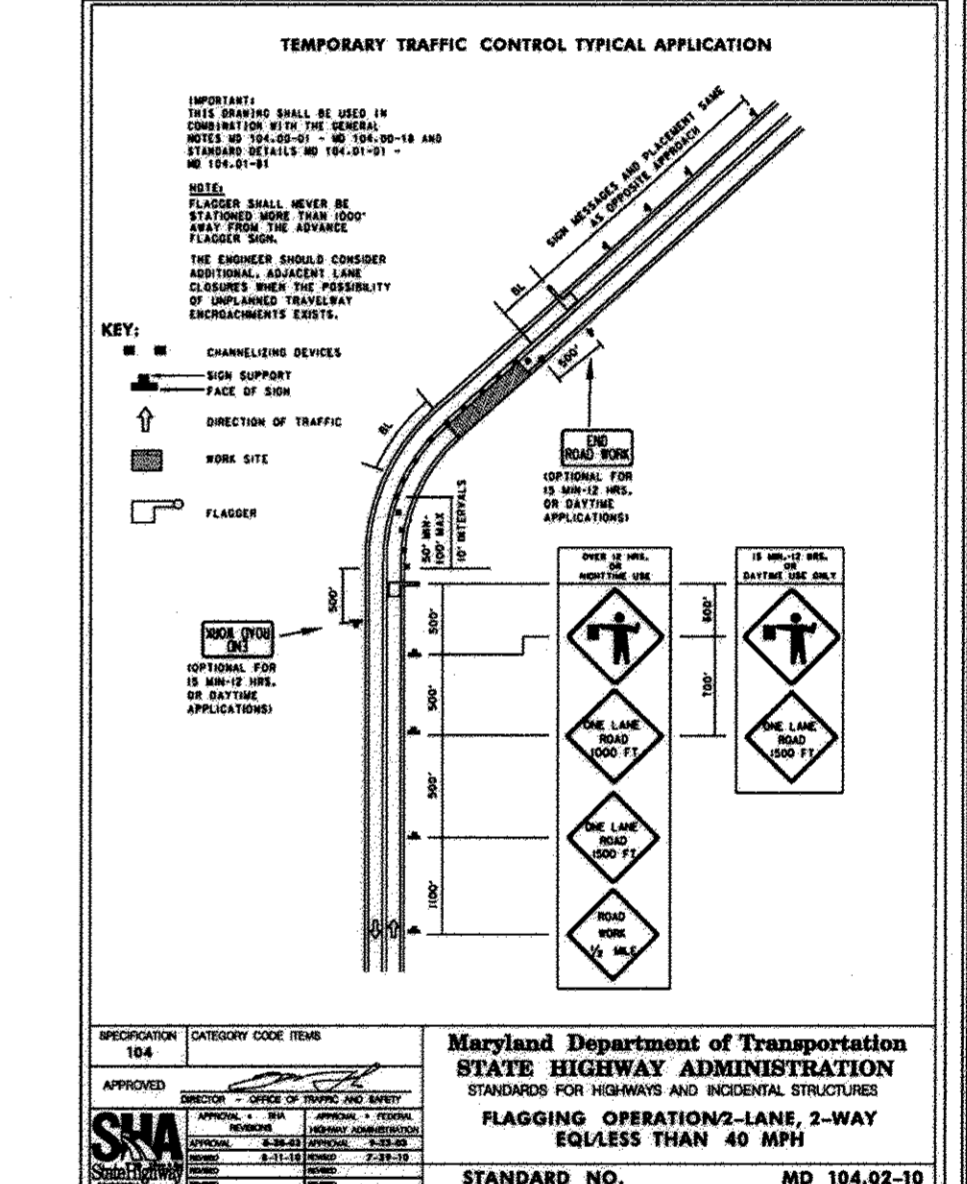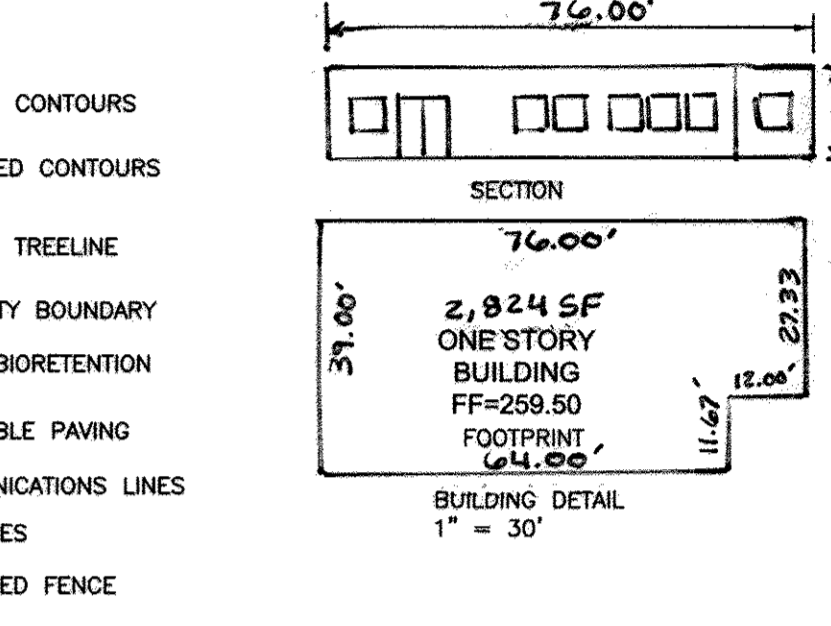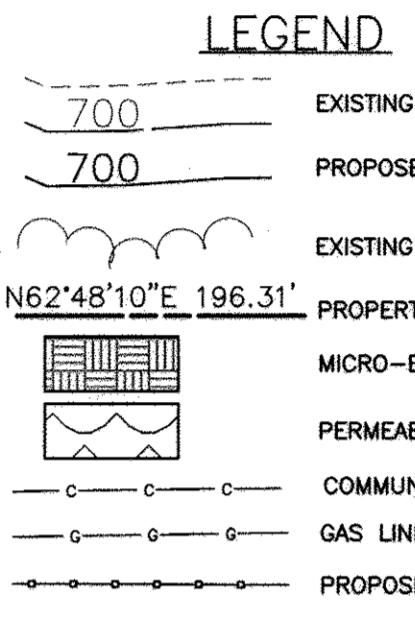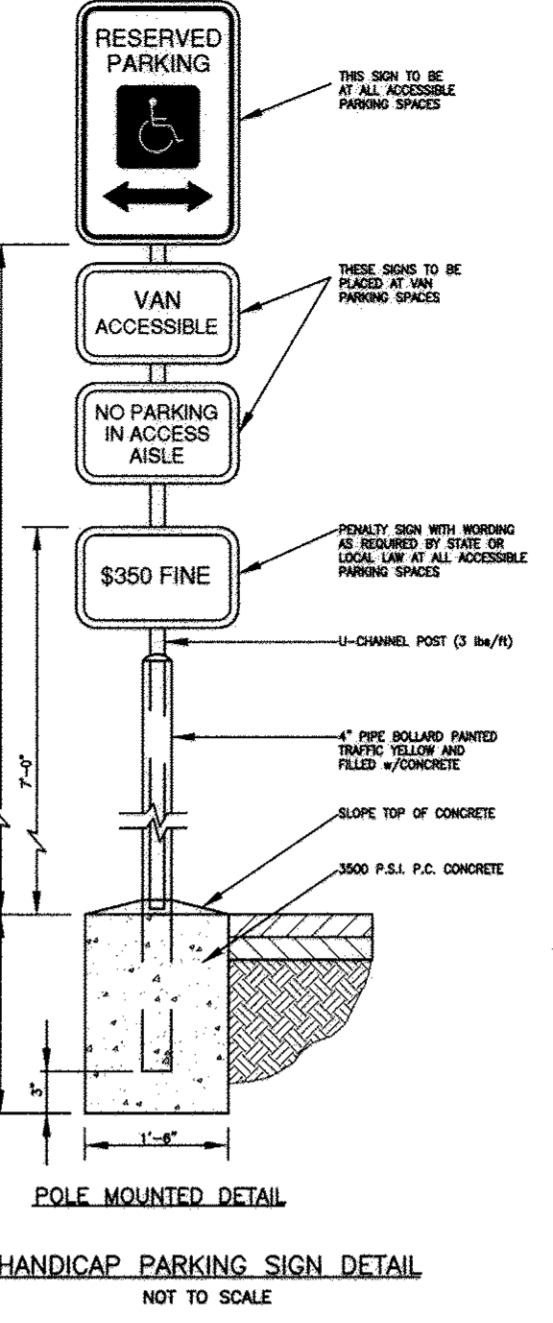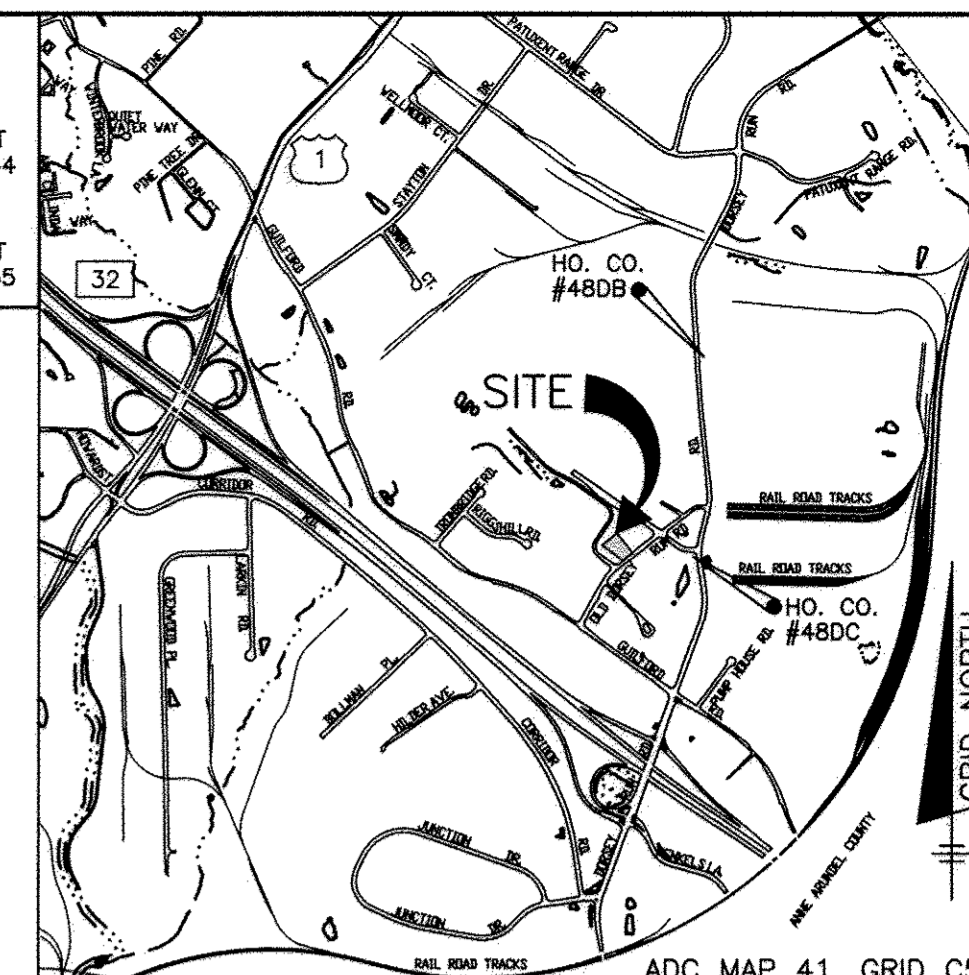

BORING LOG

Station	Depth	Description of Materials	Remarks
249.1	0.0	Topsoil	
249.1	1.0	Dark orange-brown fine to coarse sand with gravel, some silty fine to medium sand with gravel, some very loose (SM) SAND; SANDY LOAM	
249.1	2.0	Orange-brown fine to coarse sand GRAVEL with some clayey sil. clump. loose (SM) USDA: SANDY LOAM	
249.1	3.0	Dark orange-brown to off-white fine SAND with some silty fines to clay, medium coarse (SM) USDA: SANDY LOAM	
249.1	4.0	Dark orange-brown to off-white fine SAND with some silty fines to clay, medium coarse (SM) USDA: SANDY LOAM	
249.1	5.0	Dark orange-brown to off-white fine SAND with some silty fines to clay, medium coarse (SM) USDA: SANDY LOAM	
249.1	6.0	Dark orange-brown to off-white fine SAND with some silty fines to clay, medium coarse (SM) USDA: SANDY LOAM	
249.1	7.0	Dark orange-brown to off-white fine SAND with some silty fines to clay, medium coarse (SM) USDA: SANDY LOAM	
249.1	8.0	Dark orange-brown to off-white fine SAND with some silty fines to clay, medium coarse (SM) USDA: SANDY LOAM	
249.1	9.0	Dark orange-brown to off-white fine SAND with some silty fines to clay, medium coarse (SM) USDA: SANDY LOAM	
249.1	10.0	Dark orange-brown to off-white fine SAND with some silty fines to clay, medium coarse (SM) USDA: SANDY LOAM	
249.1	11.0	Dark orange-brown to off-white fine SAND with some silty fines to clay, medium coarse (SM) USDA: SANDY LOAM	
249.1	12.0	Dark orange-brown to off-white fine SAND with some silty fines to clay, medium coarse (SM) USDA: SANDY LOAM	
249.1	13.0	Dark orange-brown to off-white fine SAND with some silty fines to clay, medium coarse (SM) USDA: SANDY LOAM	
249.1	28.0	Dark orange-brown to off-white fine SAND with some silty fines to clay, medium coarse (SM) USDA: SANDY LOAM	
249.1	29.0	Dark orange-brown to off-white fine SAND with some silty fines to clay, medium coarse (SM) USDA: SANDY LOAM	
249.1	30.0	Dark orange-brown to off-white fine SAND with some silty fines to clay, medium coarse (SM) USDA: SANDY LOAM	

BORING LOG

Station	Depth	Description of Materials	Remarks
249.2	0.0	Topsoil	
249.2	1.0	Dark orange-brown fine to coarse sand with gravel, more, very loose (SM) SAND; SANDY LOAM	
249.2	2.0	Orange-brown fine to coarse sand GRAVEL with some clayey sil. clump. loose (SM) USDA: SANDY LOAM	
249.2	3.0	Dark orange-brown to off-white fine SAND with some silty fines to clay, medium coarse (SM) USDA: SANDY LOAM	
249.2	4.0	Dark orange-brown to off-white fine SAND with some silty fines to clay, medium coarse (SM) USDA: SANDY LOAM	
249.2	5.0	Dark orange-brown to off-white fine SAND with some silty fines to clay, medium coarse (SM) USDA: SANDY LOAM	
249.2	6.0	Dark orange-brown to off-white fine SAND with some silty fines to clay, medium coarse (SM) USDA: SANDY LOAM	
249.2	7.0	Dark orange-brown to off-white fine SAND with some silty fines to clay, medium coarse (SM) USDA: SANDY LOAM	
249.2	8.0	Dark orange-brown to off-white fine SAND with some silty fines to clay, medium coarse (SM) USDA: SANDY LOAM	
249.2	9.0	Dark orange-brown to off-white fine SAND with some silty fines to clay, medium coarse (SM) USDA: SANDY LOAM	
249.2	10.0	Dark orange-brown to off-white fine SAND with some silty fines to clay, medium coarse (SM) USDA: SANDY LOAM	
249.2	11.0	Dark orange-brown to off-white fine SAND with some silty fines to clay, medium coarse (SM) USDA: SANDY LOAM	
249.2	26.0	Dark orange-brown to off-white fine SAND with some silty fines to clay, medium coarse (SM) USDA: SANDY LOAM	
249.2	27.0	Dark orange-brown to off-white fine SAND with some silty fines to clay, medium coarse (SM) USDA: SANDY LOAM	
249.2	28.0	Dark orange-brown to off-white fine SAND with some silty fines to clay, medium coarse (SM) USDA: SANDY LOAM	
249.2	29.0	Dark orange-brown to off-white fine SAND with some silty fines to clay, medium coarse (SM) USDA: SANDY LOAM	
249.2	30.0	Dark orange-brown to off-white fine SAND with some silty fines to clay, medium coarse (SM) USDA: SANDY LOAM	

PAVEMENT DETAIL

NOTE: PAVEMENT SECTION THICKNESS IS BASED ON HOWARD COUNTY'S "P-2" WITH AN ESTIMATED CBR VALUE OF 3 TO 7. CONTRACTOR SHOULD CONFIRM AND ADJUST THICKNESS OR MOISTURE SUBSTRATE AS NECESSARY.

SITE ANALYSIS DATA CHART

A) PROJECT AREA	1.00 AC.±
B) AREA OF PLAN SUBMISSION:	1.00 AC.±
C) LIMIT OF DISTURBANCE AREA:	1.00 AC.±
D) PRESENT ZONING:	M-2
E) PROPOSED USE FOR SITES:	CONTRACTOR OFFICE
F) OFFICE SPACE:	29,23 SF
G) NUMBER OF PARKING SPACES REQUIRED BY HOWARD COUNTY ZONING REGULATIONS (PER SECTION 133.0.3.0. OF THE ZONING REGULATIONS AT 3.3 SPACES PER 1000 SQ FT TOTAL REQUIRED):	9 SPACES
H) NUMBER OF PARKING SPACES PROVIDED ON SITE (INCLUDING 1 HANDICAPPED PARKING SPACE):	10 SPACES
I) BUILDING COVERAGE OF SITE:	6%
J) APPLICABLE DPZ FILE REFERENCES:	ECP-12-041
K) ANY OTHER INFORMATION WHICH MAY BE RELEVANT:	N/A

ADDRESS CHART


BUILDING	STREET ADDRESS
1	8594 OLD DORSEY RUN ROAD

PERMIT INFORMATION CHART

SUBDIVISION NAME:	SECTION/AREA:	LOT/PARCEL#
L&R BUILDINGS	-	P. 22

INfiltration RATES

TEST MB-1	6.0 INCHES/HR
TEST MB-2	24.0 INCHES/HR

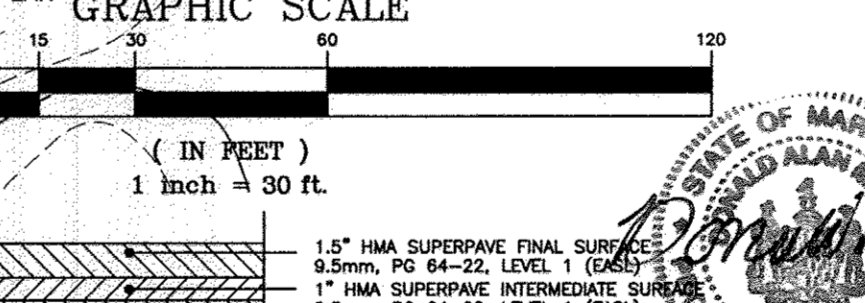

AS-BUILT CERTIFICATION
I hereby certify, by my seal, that to the best of my knowledge and belief the facilities shown on this "AS-BUILT" Plan meet the Approved Plans and Specifications.
Date: 1-12-18
Seal: [Professional Engineer Seal]

REVISION

NO.	DATE	REVISION
2	10-29-15	CHANGE BUILDING FOOTPRINT/LOCATION, ADJUST SITE ANALYSIS & ADJUST HANDICAP ACCESS ROUTES
1	3-19-15	CHANGE BUILDING, WALLS AND SWM PRACTICES

BENCHMARK ENGINEERING, INC.
8480 BALTIMORE NATIONAL PIKE SUITE 315 & ELLICOTT CITY, MARYLAND 21043
(P) 410-465-6105 (F) 410-465-6544
WWW.BEI-ENGINEERING.COM

L&R BUILDINGS
L. 13356 F. 0464

OWNER/DEVELOPER:
L&R BUILDINGS, LLC
11404 GALT AVENUE
SILVER SPRING, MD 20902
717-600-6171
ATT: LUIS RIVERA
240-372-2283

REVISED SITE DEVELOPMENT AND GRADING PLAN

DATE: NOVEMBER, 2014
MARCH, 2015
PROJECT NO. 2437

DESIGN: AAM DRAFT: AAM CHECK: JC SCALE: 1" = 30' SHEET 1 OF 6

SHEET INDEX

NO.	DESCRIPTION
1	SITE DEVELOPMENT AND GRADING PLAN
2	LANDSCAPE PLAN, STORMWATER MANAGEMENT NOTES AND DETAILS, WATER AND SEWER HOUSE CONNECTION PROFILES
3	SEDIMENT AND EROSION CONTROL PLAN, NOTES AND DETAILS, DRAINAGE AREA MAPS AND STORM DRAIN PROFILES
4-6	RETAINING WALL DESIGN

SEDIMENT CONTROL NOTES

1. A MINIMUM OF 24 HOURS NOTICE MUST BE GIVEN TO THE HOWARD COUNTY DEPARTMENT OF INSPECTION, LICENSES AND PERMITS, SEDIMENT CONTROL DIVISION PRIOR TO THE START OF ANY CONSTRUCTION, (313-1850).

2. ALL VEGETATIVE AND STRUCTURAL PRACTICES ARE TO BE INSTALLED ACCORDING TO THE PROVISIONS OF THIS PLAN AND ARE TO BE IN CONFORMANCE WITH THE MOST CURRENT REVISIONS THEREOF.

3. FOLLOWING INITIAL SOIL DISTURBANCE OR RESTORATION, PERMANENT OR TEMPORARY STABILIZATION SHALL BE COMPLETED WITHIN 48 HOURS OF THE DATE OF APPROVED PERMITS. SEDIMENT CONTROL STRUCTURES, DIKES, PERIMETER SLOPES AND ALL SLOPES GREATER THAN 3:1, 7 DAYS AS TO ALL OTHER DISTURBED OR GRADED AREAS ON THE PROJECT SITE.

4. ALL SEDIMENT TRAPS/BASINS SHOWN MUST BE FENCED AND WARNING SIGNS POSTED AROUND THEIR PERIMETER IN ACCORDANCE WITH VOL. 1, CHAPTER 12, OF THE HOWARD COUNTY DESIGN MANUAL, STORM DRAINAGE.

5. ALL DISTURBED AREAS MUST BE STABILIZED WITHIN THE TIME PERIOD SPECIFIED ABOVE IN ACCORDANCE WITH THE 2011 MARYLAND STANDARDS AND SPECIFICATIONS FOR SOIL EROSION AND SEDIMENT CONTROL FOR PERMANENT SEEDINGS (SEC. 51) SOD (SEC. 52), TEMPORARY SEEDING (SEC. 50) AND MULCHING (SEC. 53), TEMPORARY STABILIZATION WITH MULCH ALONE CAN ONLY BE DONE WHEN RECOMMENDED SEEDING DATES DO NOT ALLOW FOR PROPER GERMINATION AND ESTABLISHMENT OF GRASSES. PERMANENT SEDIMENT CONTROL STRUCTURES MUST REMAIN IN PLACE UNDER ALL CONDITIONS UNTIL OPERATIVE CONSTRUCTION UNTIL PERMITS FOR THEIR REMOVAL HAS BEEN OBTAINED FROM THE HOWARD COUNTY SEDIMENT CONTROL INSPECTOR.

6. SITE ANALYSIS:

TOTAL AREA OF SITE	1.00	ACRES
AREA DISTURBED	1.08	ACRES
AREA TO BE ROOFED OR PAVED	0.80	ACRES
AREA TO BE VEGETATIVELY STABILIZED	0.28	ACRES
TOTAL CUT	1103	CY

7. ALL QUANTITIES ARE FOR SEDIMENT CONTROL PURPOSES ONLY. CONTRACTOR SHALL FURNISH THEIR OWN EARTHWORK CALCULATIONS FOR SITE BALANCING.

8. ANY SLOPE CONTROL STRUCTURE DISTURBED BY GRADING ACTIVITY FOR PLACEMENT OF UTILITIES MUST BE REPAIRED ON THE SAME DAY OF DISTURBANCE.

9. ADDITIONAL SEDIMENT CONTROL MUST BE PROVIDED, IF DEEMED NECESSARY BY THE HOWARD COUNTY SEDIMENT CONTROL INSPECTOR.

10. ON ALL SITES WITH DISTURBED AREAS IN EXCESS OF 2 ACRES, APPROVAL OF THE INSPECTION AGENCY SHALL BE REQUESTED UPON COMPLETION OF INSTALLATION OF PERIMETER EROSION AND SEDIMENT CONTROLS, BUT BEFORE PROCEEDING WITH ANY OTHER EARTH DISTURBANCE OR GRADING. OTHER BUILDING OR GRADING INSPECTION PERMITS SHALL BE AUTHORIZED UNTIL THIS INITIAL APPROVAL BY THE INSPECTION AGENCY IS MADE.

11. TRENCHES FOR THE CONSTRUCTION OF UTILITIES IS LIMITED TO THREE PIPE LENGTHS OR THAT WHICH CAN BE BACK FILLED AND STABILIZED WITHIN ONE WORKING DAY, WHICHEVER IS SHORTER.

B-4-8 STANDARDS AND SPECIFICATIONS FOR STOCKPILE AREA

Definition: A mound or pile of soil protected by appropriately designed erosion and sediment control measures.

Purpose: To provide a designated location for the temporary storage of soil that controls the potential for erosion, sedimentation, and changes to drainage patterns.

Conditions Where Practice Applies: Exposed soils where ground cover is needed for 6 months or more.

Stockpile areas are utilized when it is necessary to salvage and store soil for later use.

Criteria: 1. The stockpile location and all related sediment control practices must be clearly indicated on the erosion and sediment control plan.

2. The footprint of the stockpile must be sized to accommodate the anticipated volume of material and based on a side slope ratio no steeper than 2:1. Benching must be provided in accordance with Section B-3 Land Grading.

3. Runoff from the stockpile area must drain to a suitable sediment control practice.

4. Access to the stockpile area must be maintained with a minimum thickness of 4 inches. Spreading is to be performed in such a manner that seeding or seeding can proceed with a minimum of additional soil preparation and fill. Any irregularities in the surface must be smoothed and graded to prevent the formation of depressions or water pockets.

5. Topsoil must not be placed if the topsoil or subsoil is in a frozen or muddy condition, when the subsoil is excessively wet or in a condition that may seed or germinate.

6. Topsoil Application

7. Erosion and sediment control practices must be maintained when applying topsoil.

8. Access the stockpile area in a 5 to 6 inch layer and apply a minimum thickness of 4 inches. Spreading is to be performed in such a manner that seeding or seeding can proceed with a minimum of additional soil preparation and fill. Any irregularities in the surface must be smoothed and graded to prevent the formation of depressions or water pockets.

9. Topsoil must not be placed if the topsoil or subsoil is in a frozen or muddy condition, when the subsoil is excessively wet or in a condition that may seed or germinate.

10. Topsoil Application

11. Erosion and sediment control practices must be maintained when applying topsoil.

B-4-1 STANDARDS AND SPECIFICATIONS FOR SEEDING AND MULCHING

1. Specifications

2. Application

3. Seeding

4. Mulching

5. WCM Material

6. WCM Material

SEQUENCE OF CONSTRUCTION

NOTIFY SEDIMENT CONTROL DIVISION 48 HOURS PRIOR TO START OF CONSTRUCTION

- OBTAIN GRADING PERMIT (DAY 1)
- INSTALL STABILIZED CONSTRUCTION ENTRANCE AND SUPER SILT FENCES.
- ON APPROVAL OF THE HOWARD COUNTY SEDIMENT CONTROL INSPECTOR, BRING SITE TO GRADE AND STABILIZE IN ACCORDANCE WITH TEMPORARY SEEDING NOTES. UTILIZE DUST CONTROL (DAY 2-20)
- INSTALL STORM DRAINS, UTILITIES, FINAL GRADE AND PAVING. INSTALL PERMEABLE PAVING ONLY AFTER THE STORM DRAIN AND CURB AND GUTTER PERMANENT SEEDING (DAY 21-60)
- WHEN CONTRIBUTING AREAS TO MICRO-BIORETENTION FACILITY ARE STABILIZED, INSTALL PLANTING SOIL, EROSION CONTROL MATTING AND PERMANENT SEEDING (DAY 61-66)
- ON APPROVAL OF THE HOWARD COUNTY SEDIMENT CONTROL INSPECTOR, REMOVE SEDIMENT CONTROL DEVICES, AND STABILIZED TURBULENT AREAS IN ACCORDANCE WITH THE PERMANENT SEEDING NOTES. (DAY 67-70)

ENGINEER'S CERTIFICATE

I HEREBY CERTIFY THAT THIS PLAN FOR SEDIMENT AND EROSION CONTROL REPRESENTS PRACTICAL AND WORKABLE PLAN BASED ON MY PERSONAL KNOWLEDGE OF THE SITE CONDITIONS AND THAT IT WAS PREPARED IN ACCORDANCE WITH THE REQUIREMENTS OF THE HOWARD COUNTY CONSERVATION DISTRICT.

John M. ... 3/25/15
ENGINEER

DEVELOPER'S CERTIFICATE

"I WE CERTIFY THAT ALL DEVELOPMENT AND CONSTRUCTION WILL BE DONE ACCORDING TO THIS PLAN FOR DEVELOPMENT FOR SEDIMENT AND EROSION CONTROL, AND THAT ALL RESPONSIBLE PERSONNEL INVOLVED IN THE CONSTRUCTION PROJECT WILL HAVE A CERTIFICATE OF ATTENDANCE AT A DEPARTMENT OF THE ENVIRONMENT TRAINING PROGRAM FOR THE CONTROL OF SEDIMENT AND EROSION BEFORE BEGINNING THE PROJECT. I ALSO AUTHORIZE PERSONNEL ON-SITE INSPECTION BY THE HOWARD COUNTY CONSERVATION DISTRICT."

John M. ... 4/14/15
DEVELOPER

APPROVED: DEPARTMENT OF PLANNING AND ZONING
... 5-28-15
CHIEF, DIVISION OF LAND DEVELOPMENT

... 5-28-2015
CHIEF, DEVELOPMENT ENGINEERING DIVISION

SOILS LEGEND

SYMBOL	SOIL	SOIL TYPE
SfC	B	SASSPARILLA AND CROOM SOIL, 5 TO 10 PERCENT SLOPES
Ebc	A	EVERSHORE LOAMY SAND, 2 TO 10 PERCENT SLOPES
Uhd	D	URBAN LAND - UDHORTENS COMPLEX, 0 TO 15 PERCENT SLOPES

STORM DRAIN AREA DATA

INLET NO.	ZONING	AREA (AC)	CFactor	IMPERVIOUS
1-1	MB-1	M-2	0.57	78
1-2	MB-2	M-2	0.23	68
EX. INLET	M-2	M-2	0.44	31
T-1	M-2	M-2	0.15	93

STORM DRAIN STRUCTURE SCHEDULE

NO.	LOCATION	INV. IN.	INV. OUT.	TOP ELEV.	HO. CO.	STD.	OWNER	NOTE
I-1	N 534,592.57	E 1,370,268.58	241.87	251.3	D-4.10	PRIVATE		
I-2	N 534,748.52	E 1,370,162.94	245.00	254.6	D-4.23	PRIVATE	22'	BASE
M-1	N 534,580.81	E 1,370,360.10	239.90	246.2	G-5.12	PUBLIC		
T-1	N 534,563.48	E 1,370,225.42	250.97	249.59	VARIES	D-4.15	PRIVATE	
E-1	N 534,568.60	E 1,370,232.10	-	249.50	-	D-5.51	PRIVATE	

PIPE SCHEDULE

SIZE	LENGTH	TYPE & CLASS	OWNER
12"	5' LF	RCP	PRIVATE
15"	182' LF	HDPE	PRIVATE
18"	37' LF	HDPE	PRIVATE
18"	15' LF	HDPE	PUBLIC

STORM DRAIN PROFILES

1"=50' HORIZONTAL
1"=5' VERTICAL

PRIVATE 15" HDPE
Q₁₀=1.30 cfs
V=10.0 fps
Sf=0.04%

PRIVATE 18" HDPE
Q₁₀=1.30 cfs
V=8.00 fps
Sf=0.04%

PRIVATE 18" HDPE
Q₁₀=1.30 cfs
V=10.15 fps
Sf=0.17%

PUBLIC 18" HDPE
Q₁₀=4.34 cfs
V=10.15 fps
Sf=0.17%

PRIVATE 12" RCP
Q₁₀=1.02 cfs
V=1.30 fps
Sf=0.08%

PRIVATE 18" RCP
Q₁₀=5.22 cfs
V=7.94 fps
Sf=0.25%

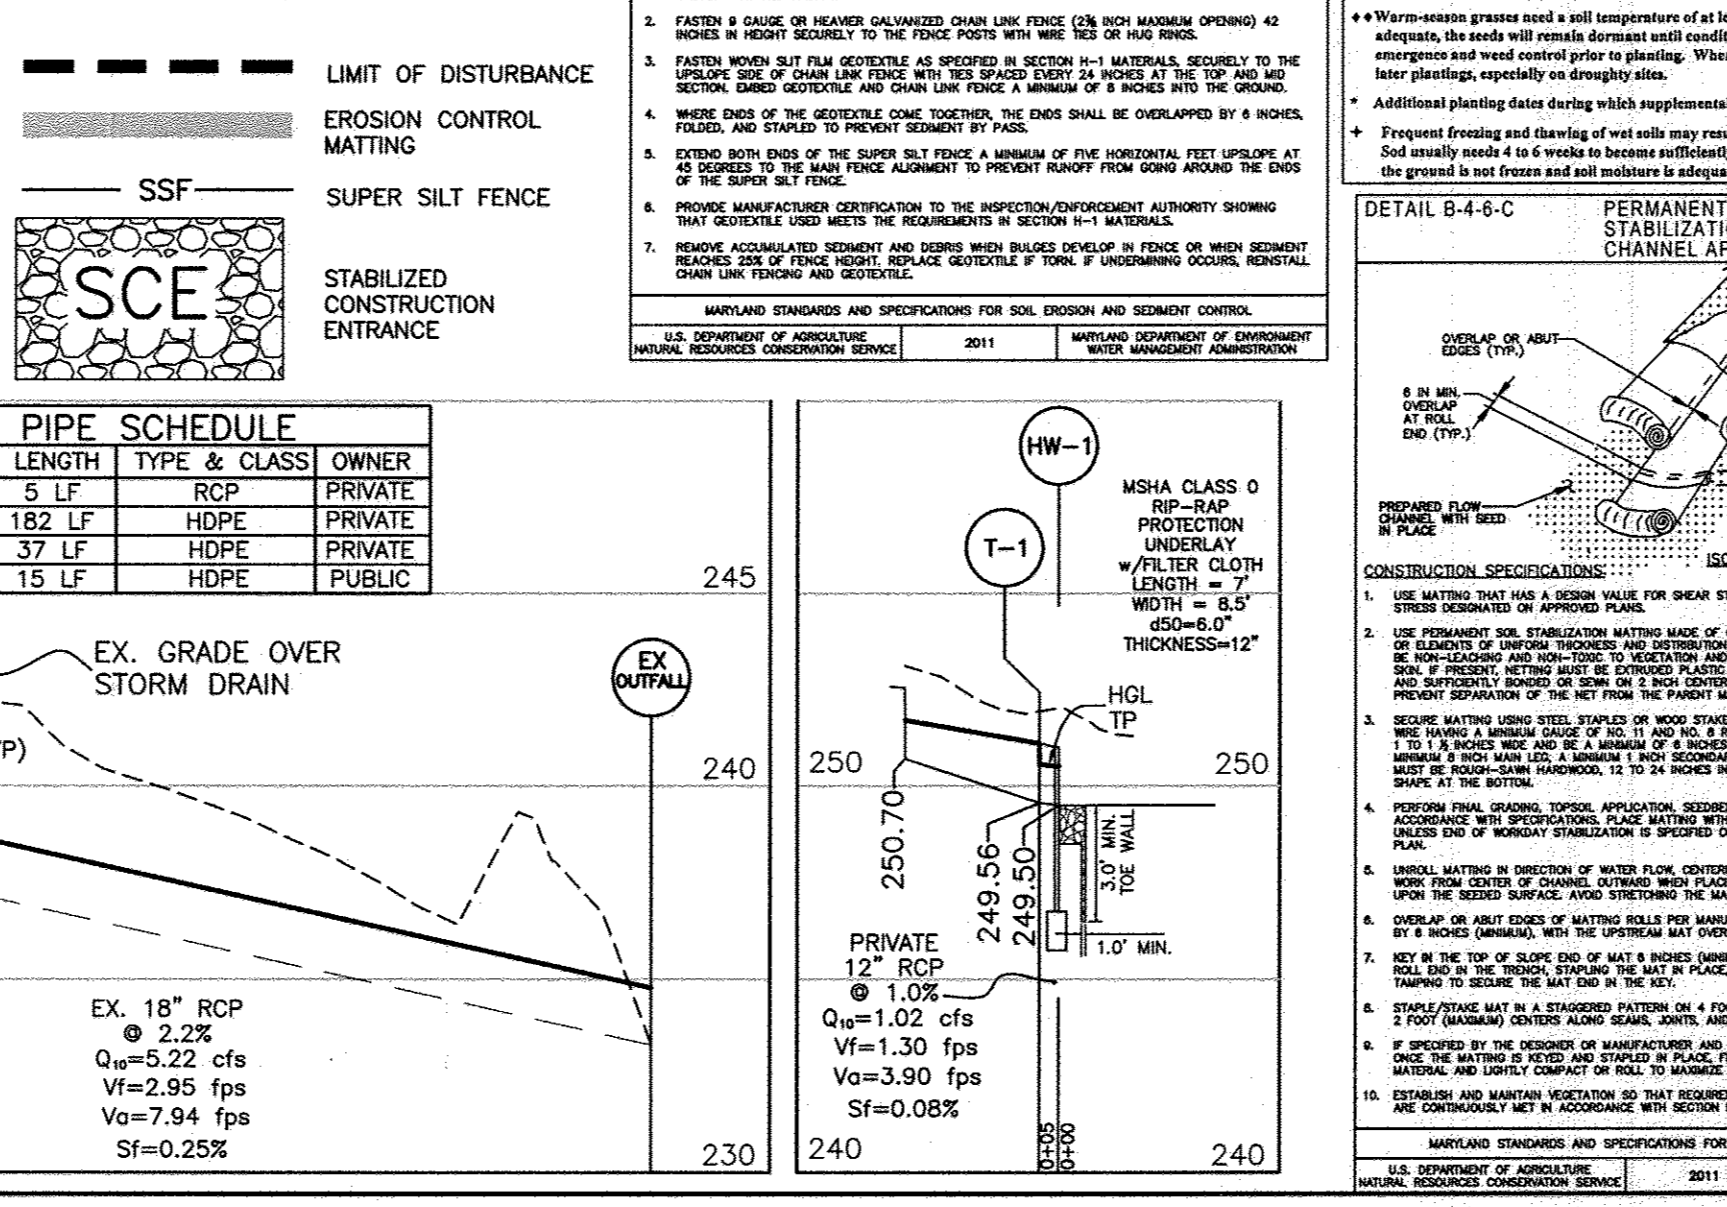
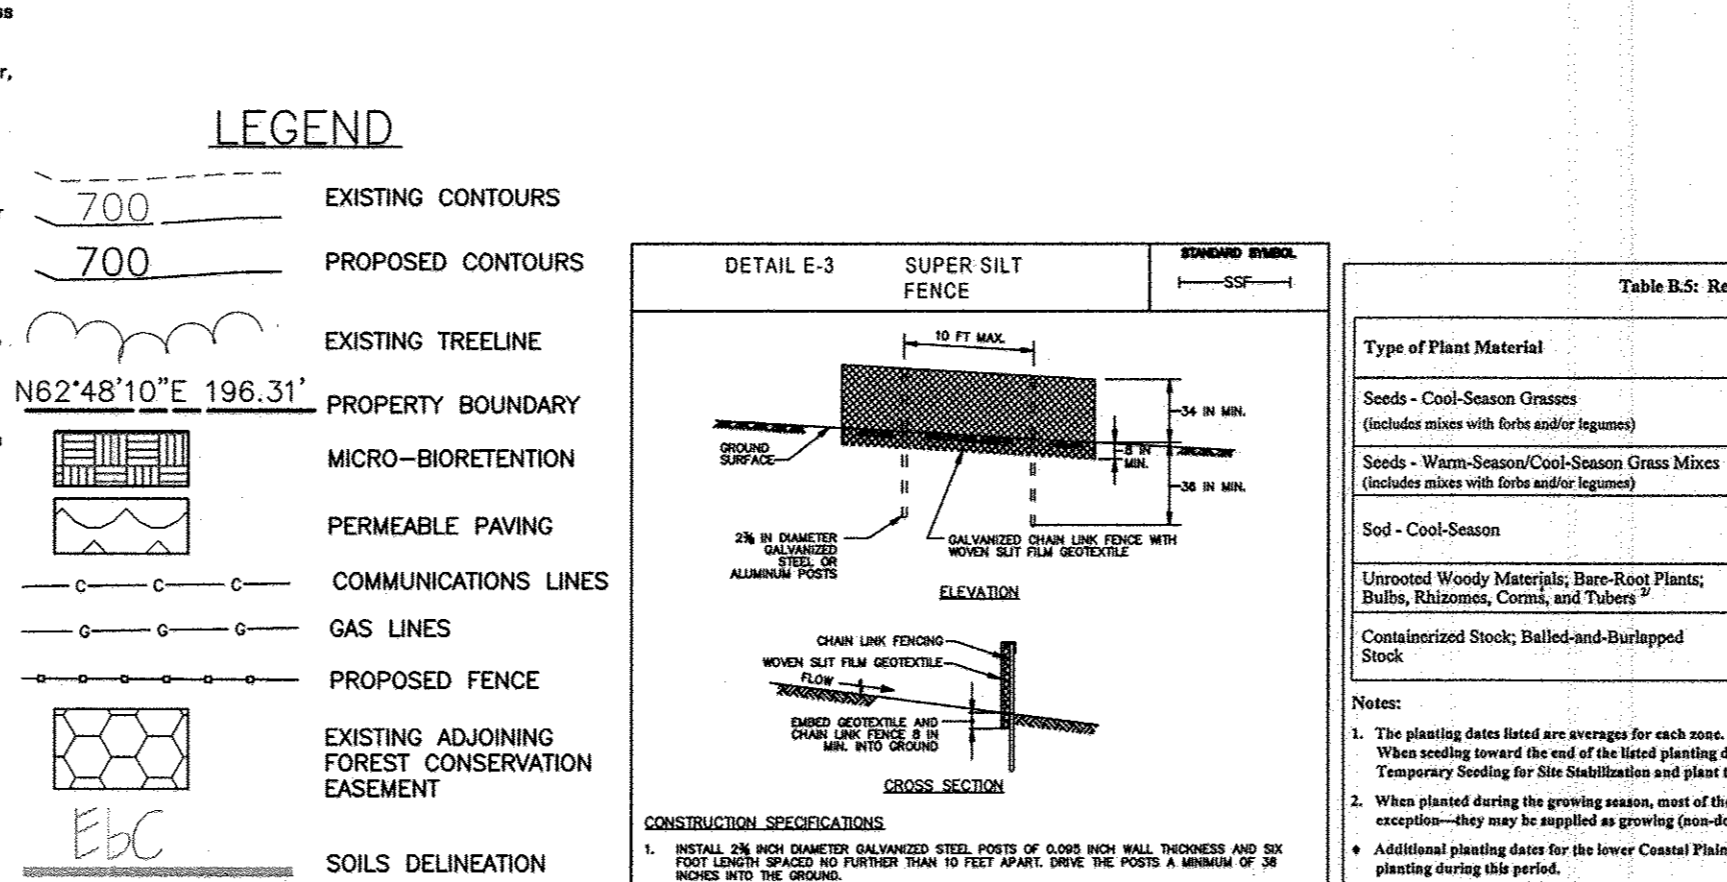
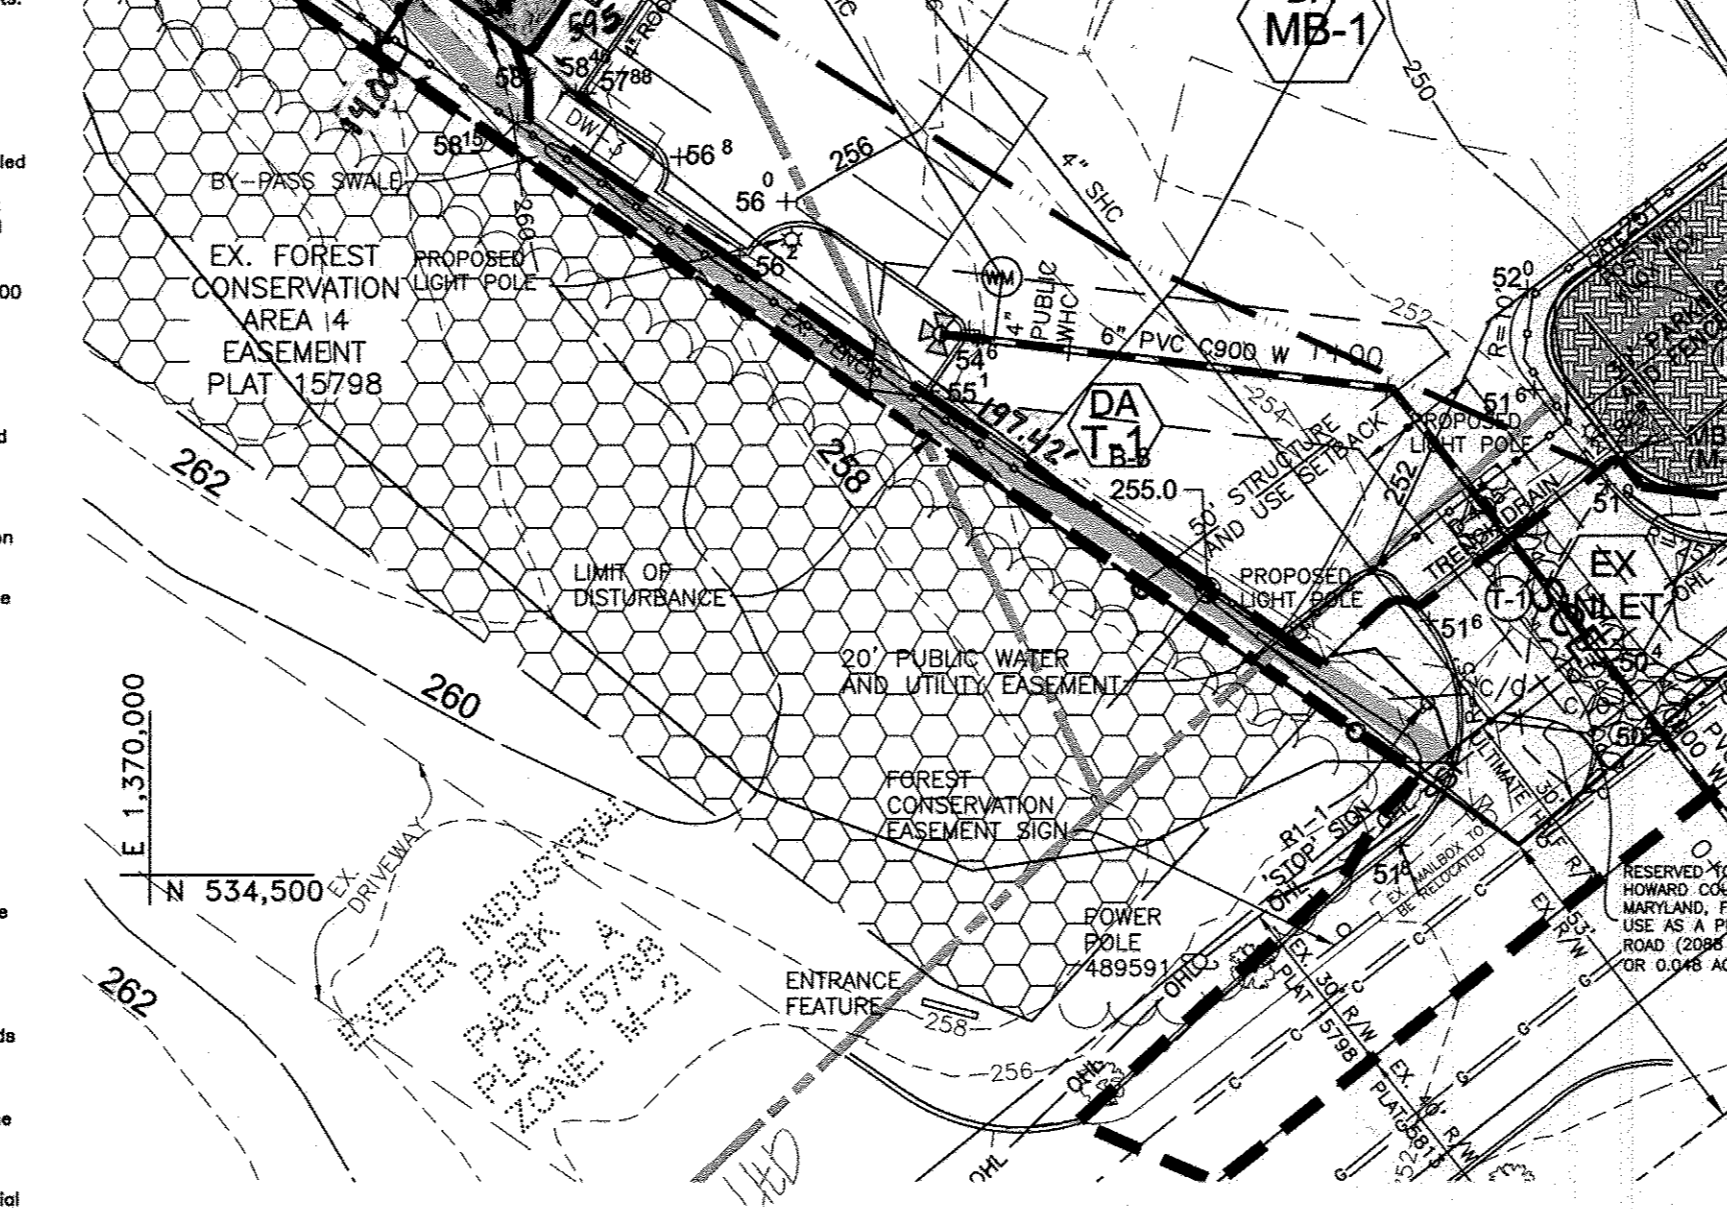
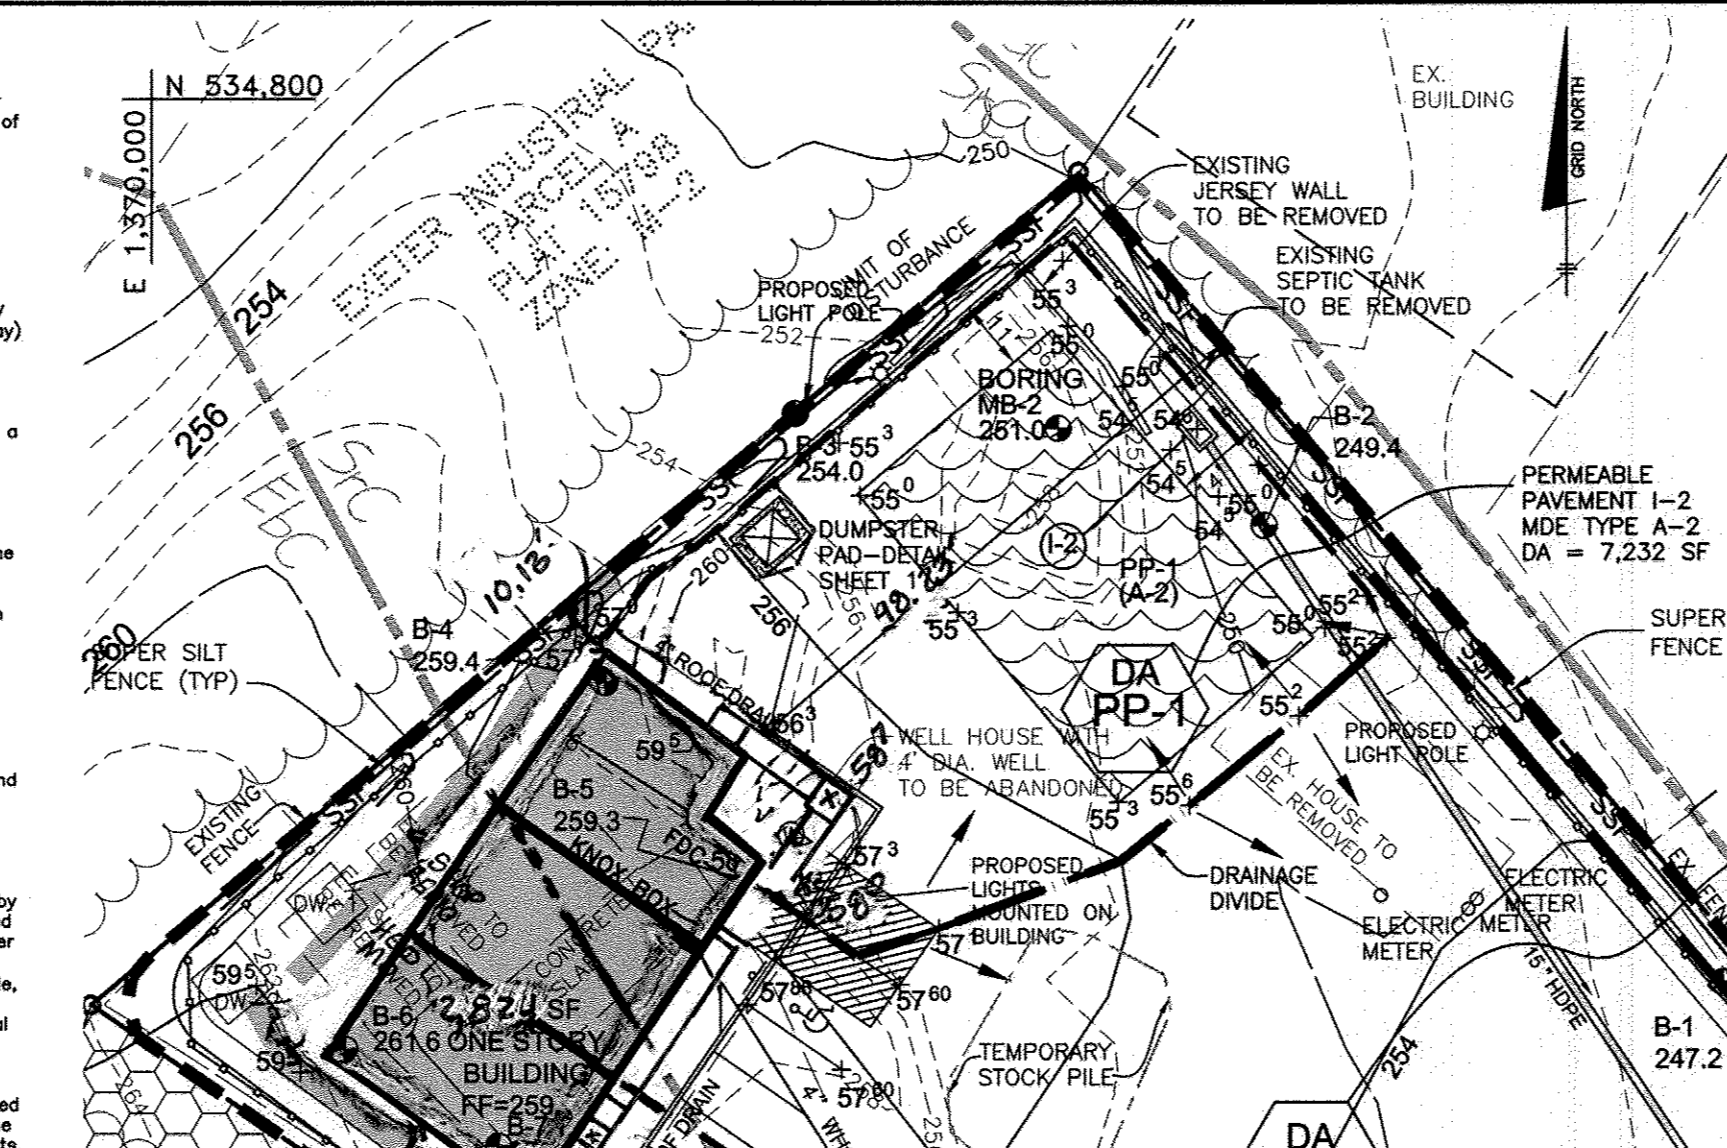
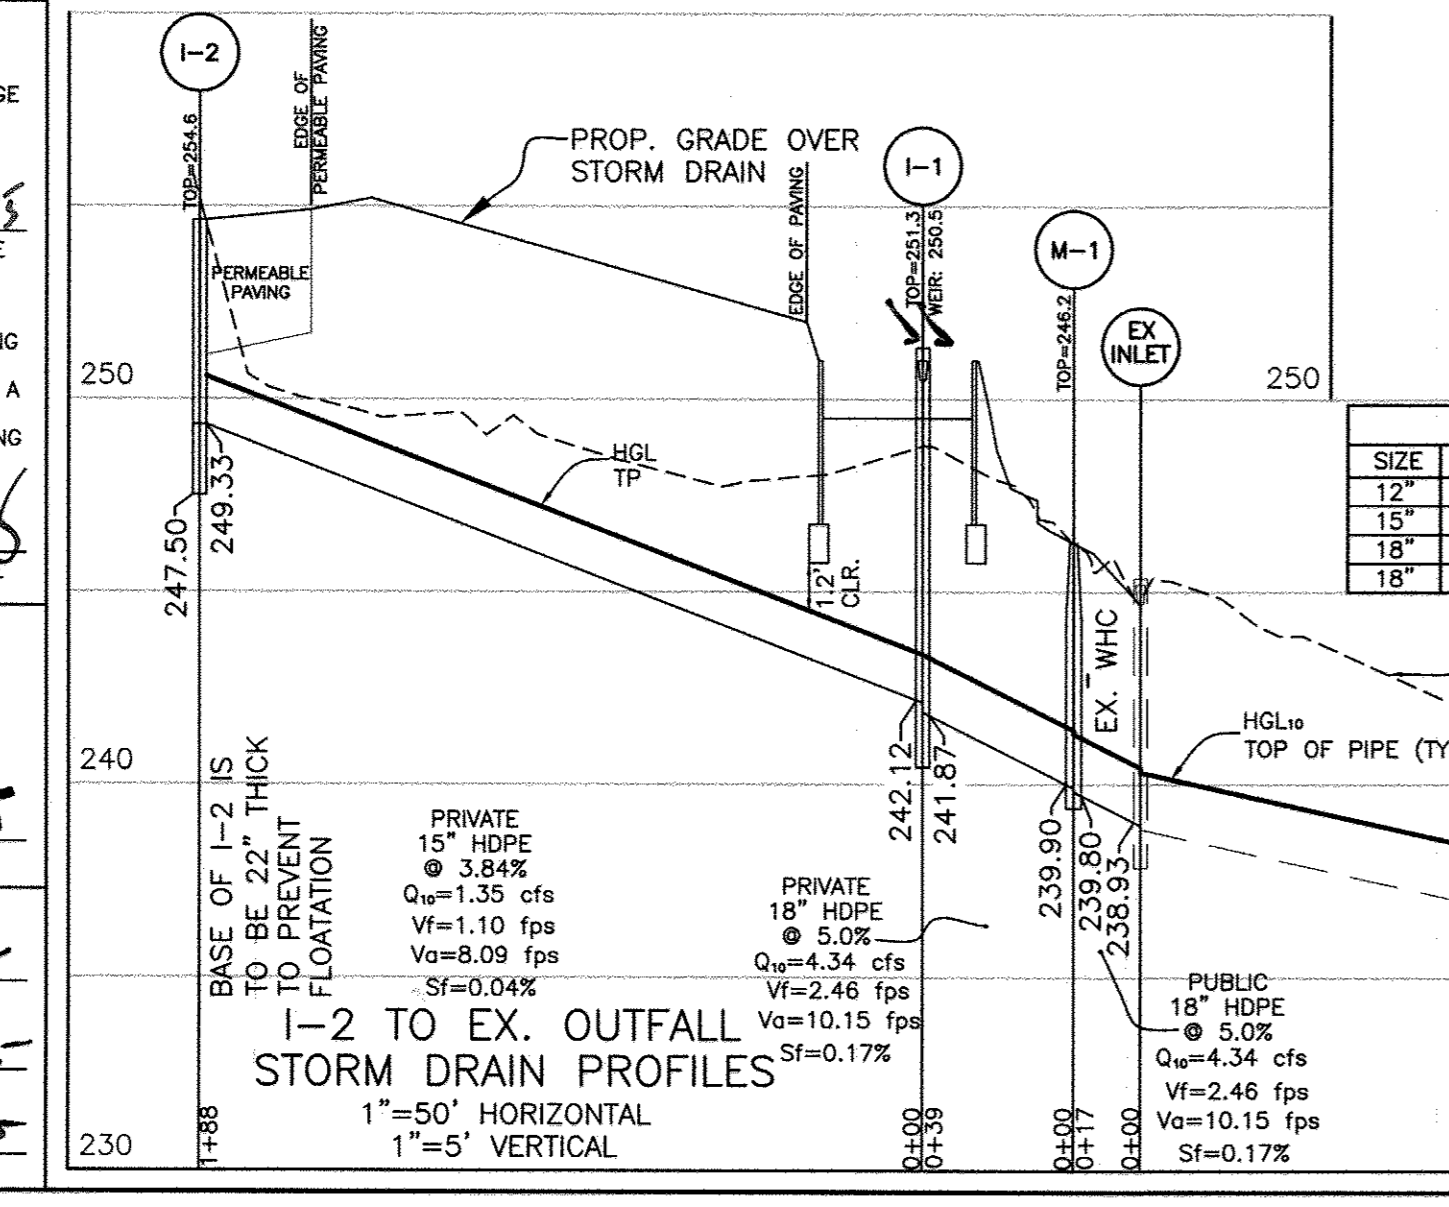
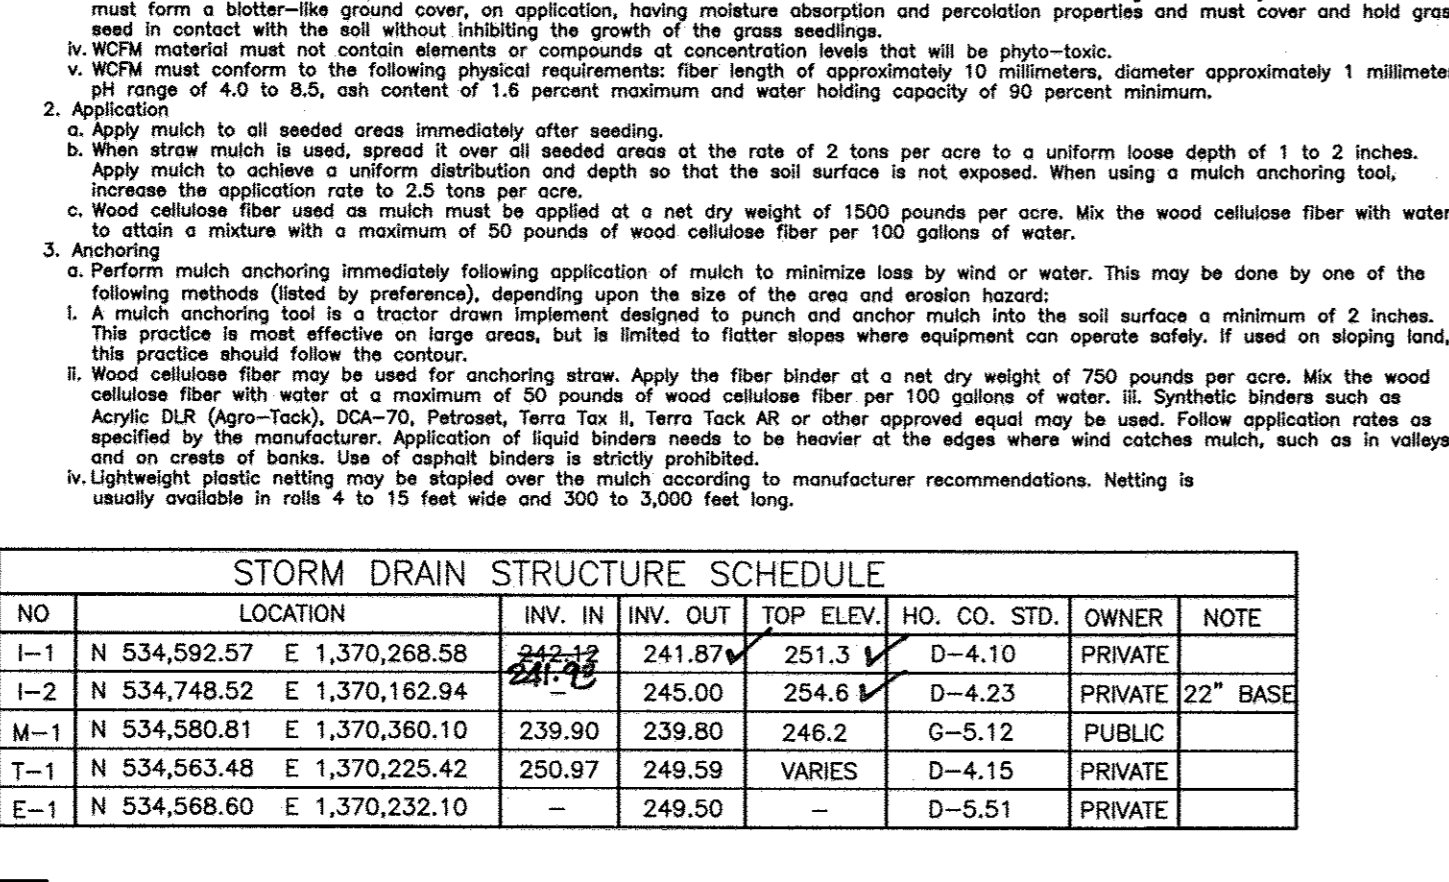
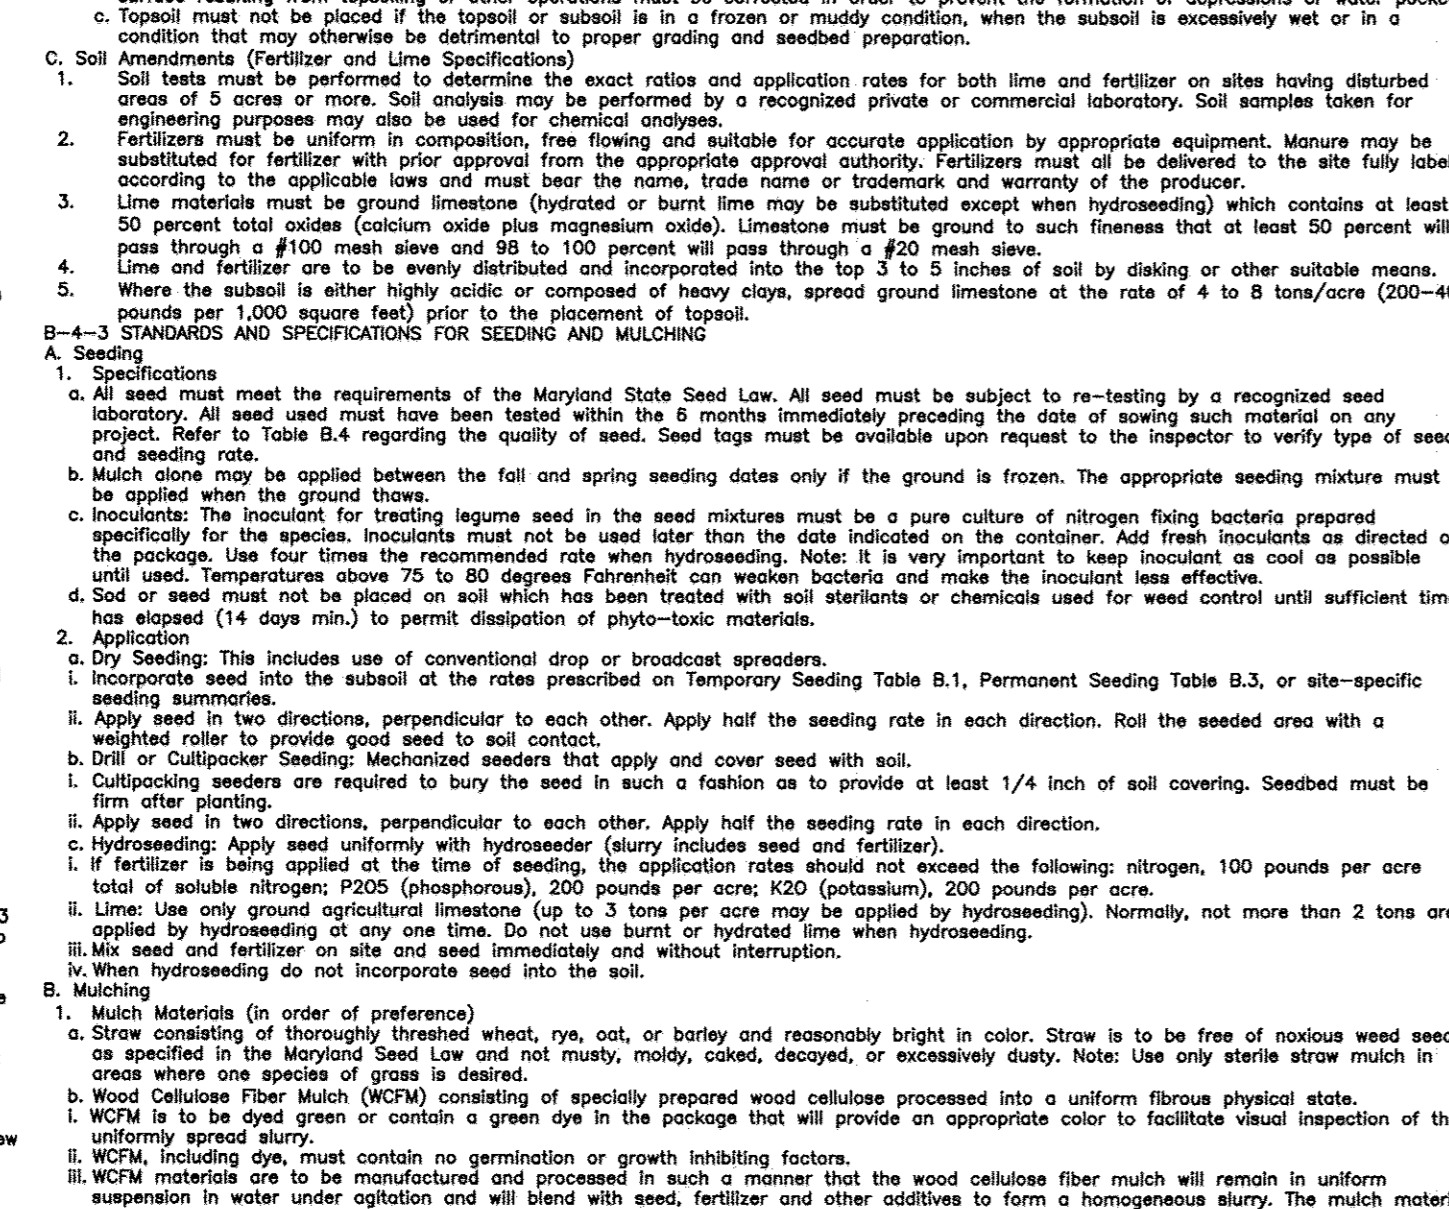
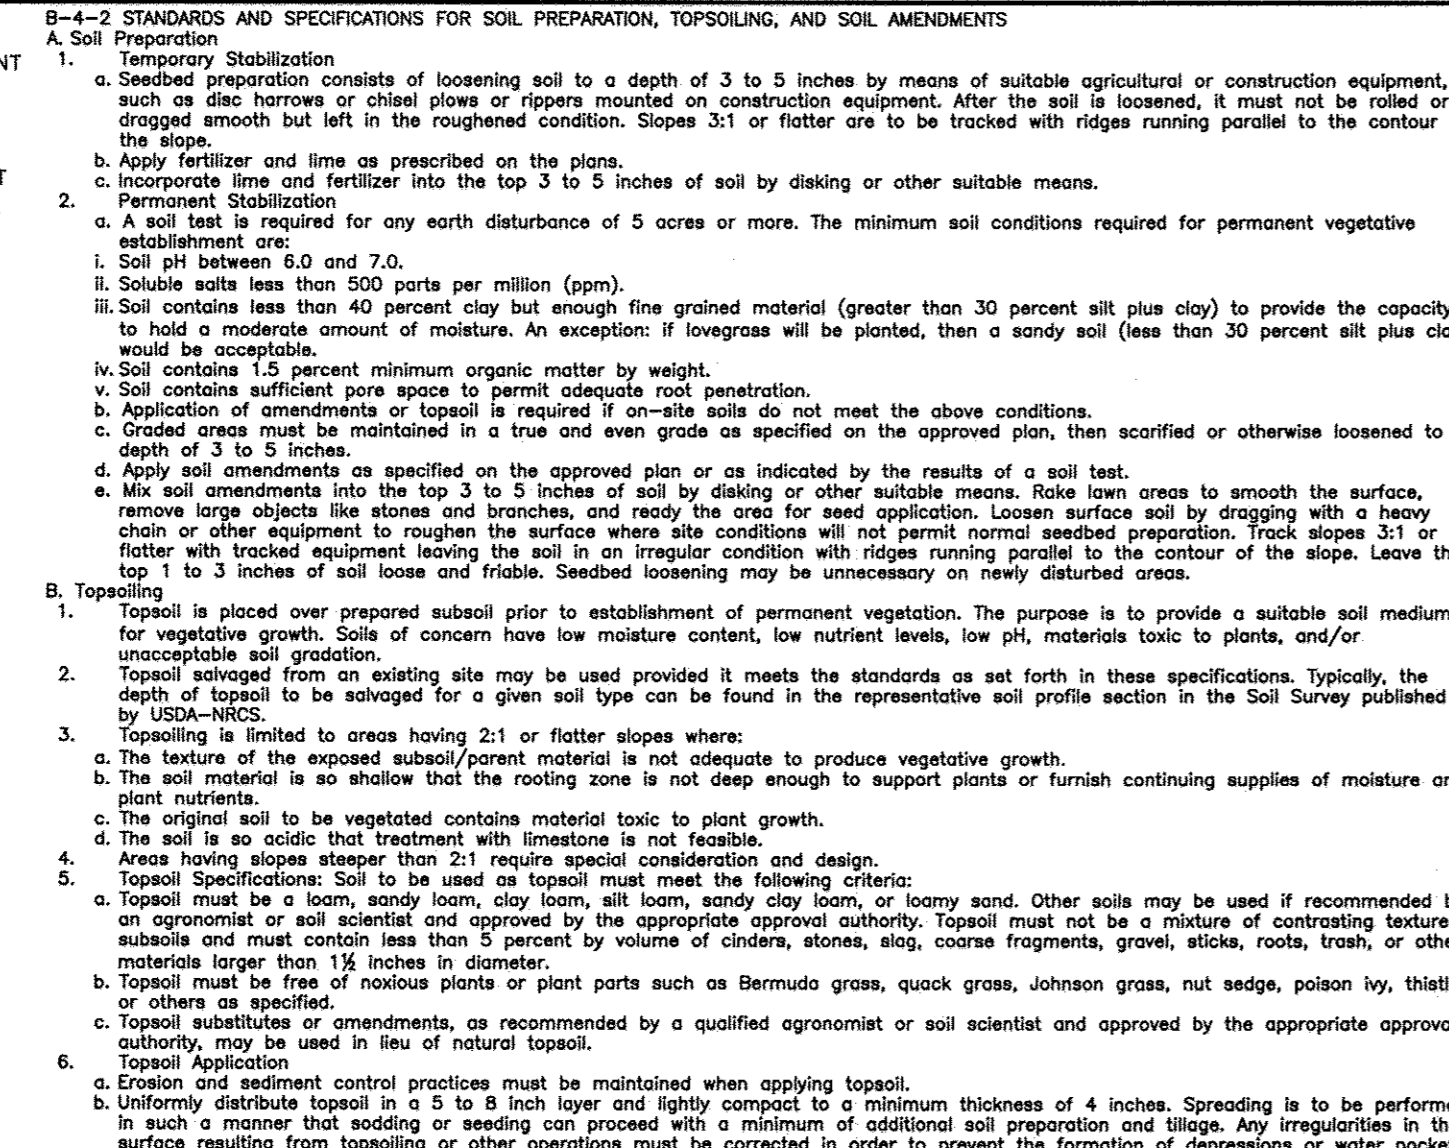


Table B.1: Temporary Seeding for Site Stabilization

Plant Species	Seeding Rate		Seeding Depth		Recommended Seeding Dates by Plant Hardiness Zone	
	lb/acre	lb/1000 sq ft	(inches)	(inches)	Zone 6a	Zone 6b
Cool-Season Grasses	40	1.0	0.5	1.0	Mar 15 to May 31; Aug 1 to Sep 30	Mar 15 to May 31; Aug 1 to Sep 30
Warm-Season Grasses	56	2.2	1.0	1.0	May 15 to May 31; Aug 1 to Sep 30	May 15 to May 31; Aug 1 to Sep 30
Ornamental Grasses	72	1.7	1.0	1.0	Mar 15 to May 31; Aug 1 to Sep 30	Mar 15 to May 31; Aug 1 to Sep 30
Wildflower Mixtures	120	2.8	1.0	1.0	Mar 15 to May 31; Aug 1 to Sep 30	Mar 15 to May 31; Aug 1 to Sep 30
Perennial Legumes	112	2.8	1.0	1.0	Mar 15 to May 31; Aug 1 to Sep 30	Mar 15 to May 31; Aug 1 to Sep 30
Forage Legumes	30	0.7	0.5	1.0	Jan 1 to Jun 31	May 15 to Jun 31
Forage Legumes	20	0.5	0.5	1.0	May 15 to Jun 31	May 15 to Jun 31

Table B.2: Recommended Planting Dates for Permanent Cover in Maryland

Type of Plant Material	Plant Hardiness Zones		Zone 6a	Zone 6b
Seeds - Cool-Season Grasses	Mar 15 to May 31	Aug 1 to Oct 15	Feb 15 to May 31	Aug 1 to Sep 30
Seeds - Warm-Season Grasses	May 15 to May 31	Aug 1 to Sep 30	May 15 to May 31	Aug 1 to Sep 30
Seeds - Cool-Season Grasses	Mar 15 to May 31	Aug 1 to Oct 15	Feb 15 to May 31	Aug 1 to Sep 30
Seeds - Warm-Season Grasses	May 15 to May 31	Aug 1 to Sep 30	May 15 to May 31	Aug 1 to Sep 30
Seeds - Cool-Season Grasses	Mar 15 to May 31	Aug 1 to Oct 15	Feb 15 to May 31	Aug 1 to Sep 30
Seeds - Warm-Season Grasses	May 15 to May 31			

SPECIFICATIONS
MODULAR CONCRETE BLOCK RETAINING WALL

PART 1: GENERAL
1.01 DESCRIPTION
A. WORK SHALL CONSIST OF FURNISHING AND CONSTRUCTION OF A MODULAR RETAINING WALL SYSTEM IN ACCORDANCE WITH THESE SPECIFICATIONS AND IN REASONABLY CLOSE CONFORMITY WITH THE LINES, GRADES, DESIGN, AND DIMENSIONS SHOWN ON THE PLANS.
B. WORK INCLUDES PREPARING FOUNDATION SOIL, FURNISHING AND INSTALLING LEVELING PAD, UNIT DRAINAGE FILL AND BACKFILL TO THE LINES AND GRADES SHOWN ON THE CONSTRUCTION DRAWINGS.
C. WORK INCLUDES FURNISHING AND INSTALLING GEOGRID SOIL REINFORCEMENT OF THE TYPE, SIZE, LOCATION, AND LENGTHS DESIGNATED ON THE CONSTRUCTION DRAWINGS.

1.02 DELIVERY, STORAGE AND HANDLING
A. CONTRACTOR SHALL CHECK ALL MATERIALS UPON DELIVERY TO ASSURE THAT THE PROPER TYPE, GRADE, COLOR, AND CERTIFICATION HAS BEEN RECEIVED.
B. CONTRACTOR SHALL PROTECT ALL MATERIALS FROM DAMAGE DUE TO JOB SITE CONDITIONS AND IN ACCORDANCE WITH MANUFACTURER'S RECOMMENDATIONS. DAMAGED MATERIALS SHALL NOT BE INCORPORATED INTO THE WORK.

PART 2: PRODUCTS
2.01 MODULAR CONCRETE RETAINING WALL UNITS
A. MODULAR CONCRETE UNITS SHALL CONFORM TO THE FOLLOWING ARCHITECTURAL REQUIREMENTS:
FACE COLOR - COLOR MAY BE SPECIFIED BY THE OWNER.
FACE FINISH - SCULPTURED ROCK FACE IN ANGRULAR TRIPLINER OR FLAT CONFIGURATION. OTHER FACE FINISHES WILL NOT BE ALLOWED WITHOUT WRITTEN APPROVAL OF OWNER.
BOND CONFIGURATION - RUNNING WITH BONDS NOMINALLY LOCATED AT MIDPOINT VERTICALLY ADJACENT UNITS, IN BOTH STRAIGHT AND CURVED ALIGNMENTS.
EXPOSED SURFACES OF UNITS SHALL BE FREE OF CHIPS, CRACKS OR OTHER IMPERFECTIONS AS VIEWED FROM A DISTANCE OF 10 FEET UNDER DIFFUSED LIGHTING.
B. MODULAR CONCRETE MATERIALS SHALL CONFORM TO THE REQUIREMENTS OF ASTM C1372 - STANDARD SPECIFICATIONS FOR SEGMENTAL RETAINING WALL UNITS.
C. MODULAR CONCRETE UNITS SHALL CONFORM TO THE FOLLOWING STRUCTURAL AND GEOMETRIC REQUIREMENTS MEASURED IN ACCORDANCE WITH APPROPRIATE REFERENCES:
COMPRESSIVE STRENGTH = 3000 PSI MINIMUM.
ABSORPTION = 8% MAXIMUM (6% IN NORTHERN STATES) FOR STANDARD WEIGHT AGGREGATES.
DIMENSIONAL TOLERANCES = ±1/8" FROM NOMINAL UNIT DIMENSIONS NOT INCLUDING ROUGH SPLIT FACE, ±1/16"
UNIT HEIGHT - TOP AND BOTTOM PLANES; UNIT SIZE - 8" (H) X 18" (W) X 12" (D) MINIMUM.

2.02 SHEAR CONNECTORS (IF APPLICABLE)
A. SHEAR CONNECTORS SHALL BE 1/2 INCH DIAMETER THERMOSET ISOPHTHALIC POLYESTER RESIN-PROTRUDED FIBERGLASS REINFORCEMENT RODS OR EQUIVALENT TO PROVIDE CONNECTION BETWEEN VERTICALLY AND HORIZONTALLY ADJACENT UNITS. STRENGTH OF SHEAR CONNECTORS BETWEEN VERTICAL ADJACENT UNITS SHALL BE APPLICABLE OVER A DESIGN TEMPERATURE OF 10 DEGREES F TO +100 DEGREES F. B. SHEAR CONNECTORS SHALL BE CAPABLE OF HOLDING THE GEOGRID IN THE PROPER DESIGN POSITION DURING GRID PRE-TENSIONING AND BACKFILLING.

2.03 BASE LEVELING PAD MATERIAL
A. MATERIAL SHALL CONSIST OF A COMPACTED #57 CRUSHED STONE BASE AS SHOWN ON THE CONSTRUCTION DRAWINGS.
2.04 UNIT DRAINAGE FILL
A. UNIT DRAINAGE FILL SHALL CONSIST OF #57 CRUSHED STONE.
2.05 REINFORCED BACKFILL
A. REINFORCED BACKFILL SHALL TYPE SM. BE FREE OF DEBRIS AND MEET THE FOLLOWING GRADATION TESTED IN ACCORDANCE WITH ASTM D-422 AND MEET OTHER PROPERTIES SHOWN ON THE PLAN:

SIEVE SIZE	PERCENT PASSING
2 INCH	100-75
3/4 INCH	100-75
NO. 40	0-60
NO. 200	0-35

PLASTICITY INDEX (PI) <10 AND LIQUID LIMIT <35 PER ASTM D-4318.
B. MATERIAL CAN BE SITE EXCAVATED SOILS WHERE THE ABOVE REQUIREMENTS CAN BE MET. UNSUITABLE SOILS FOR BACKFILL (HIGH PLASTIC CLAYS OR ORGANIC SOILS) SHALL NOT BE USED IN THE REINFORCED SOIL MASS.
2.06 GEOGRID SOIL REINFORCEMENT
A. GEOSYNTHETIC REINFORCEMENT SHALL CONSIST OF GEOGRIDS MANUFACTURED SPECIFICALLY FOR SOIL


2.07 DRAINAGE PIPE
A. THE DRAINAGE PIPE SHALL BE PERFORATED CORRUGATED HDPE PIPE MANUFACTURED IN ACCORDANCE WITH ASTM D-1248.
PART 3 EXECUTION
3.01 EXCAVATION
A. CONTRACTOR SHALL EXCAVATE TO THE LINES AND GRADES SHOWN ON THE CONSTRUCTION DRAWINGS. OWNER'S REPRESENTATIVE SHALL BE RESPONSIBLE FOR INSPECTING AND APPROVING THE EXCAVATION PRIOR TO PLACEMENT OF LEVELING MATERIAL OR FILL SOILS.
3.02 BASE LEVELING PAD
A. LEVELING PAD MATERIAL SHALL BE PLACED TO THE LINES AND GRADES SHOWN ON THE CONSTRUCTION DRAWINGS. TO A MINIMUM THICKNESS OF 6 INCHES AND EXTEND LATERALLY A MINIMUM OF 6" IN FRONT AND BEHIND THE MODULAR WALL UNIT.
B. LEVELING PAD SHALL BE PREPARED TO INSURE FULL CONTACT TO THE BASE SURFACE OF THE CONCRETE UNITS.
3.03 MODULAR UNIT INSTALLATION
A. FIRST COURSE OF UNITS SHALL BE PLACED ON THE LEVELING PAD AT THE APPROPRIATE LINE AND GRADE. ALIGNMENT AND LEVEL SHALL BE CHECKED IN ALL DIRECTIONS AND INSURE THAT ALL UNITS ARE IN FULL CONTACT WITH THE BASE AND PROPERLY SEATED.
B. PLACE THE FRONT OF UNITS SIDE-BY-SIDE. DO NOT LEAVE GAPS BETWEEN ADJACENT UNITS. LAYOUT OF CORNERS AND CURVES SHALL BE IN ACCORDANCE WITH MANUFACTURER'S RECOMMENDATIONS.
C. INSTALL SHEAR/CONNECTING DEVICES PER MANUFACTURER'S RECOMMENDATIONS.
D. PLACE AND COMPACT DRAINAGE FILL WITHIN AND BEHIND WALL UNITS. PLACE AND COMPACT BACKFILL SOIL BEHIND DRAINAGE FILL. FOLLOW WALL ERECTION AND DRAINAGE FILL CLOSELY WITH STRUCTURE BACKFILL.
E. MAXIMUM STACKED VERTICAL HEIGHT OF WALL UNITS PRIOR TO UNIT DRAINAGE FILL AND BACKFILL PLACEMENT AND COMPACTION, SHALL NOT EXCEED THREE COURSES.
3.04 STRUCTURAL GEOGRID INSTALLATION
A. GEOGRID SHALL BE ORIENTED WITH THE HIGHEST STRENGTH AXIS PERPENDICULAR TO THE WALL ALIGNMENT.
B. GEOGRID REINFORCEMENT SHALL BE PLACED AT THE STRENGTHS, LENGTHS, AND ELEVATIONS SHOWN ON THE CONSTRUCTION DRAWINGS OR AS DIRECTED BY THE ENGINEER.
C. THE GEOGRID SHALL BE LAID HORIZONTALLY ON COMPACTED BACKFILL AND ATTACHED TO THE MODULAR WALL UNITS. PLACE THE NEXT COURSE OF MODULAR CONCRETE UNITS OVER THE GEOGRID. THE GEOGRID SHALL BE PULLED TAUT, AND ANCHORED PRIOR TO BACKFILL PLACEMENT ON THE GEOGRID.

3.05 REINFORCED BACKFILL PLACEMENT
A. REINFORCED BACKFILL SHALL BE PLACED, SPREAD, AND COMPACTED IN SUCH A MANNER THAT MINIMIZES THE DEVELOPMENT OF SLACK IN THE GEOGRID AND INSTALLATION DAMAGE.
B. REINFORCED BACKFILL SHALL BE PLACED AND COMPACTED IN LIFTS NOT TO EXCEED 6 INCHES WHERE HAND COMPACTION IS USED, OR 8-10 INCHES WHERE HEAVY COMPACTION EQUIPMENT IS USED. LIFT THICKNESS SHALL BE DECREASED TO ACHIEVE THE REQUIRED DENSITY AS REQUIRED.
C. REINFORCED BACKFILL SHALL BE COMPACTED TO 95% OF THE MAXIMUM DENSITY AS DETERMINED BY ASTM D698. THE MOISTURE CONTENT OF THE BACKFILL MATERIAL PRIOR TO AND DURING COMPACTION SHALL BE UNIFORMLY DISTRIBUTED THROUGHOUT EACH LAYER AND SHALL BE +3% TO -3% OF OPTIMUM.
D. ONLY LIGHTWEIGHT HAND-OPERATED EQUIPMENT SHALL BE ALLOWED WITHIN 3 FEET FROM THE TAIL OF THE MODULAR CONCRETE UNIT.
E. TRACKED CONSTRUCTION EQUIPMENT SHALL NOT BE OPERATED DIRECTLY UPON THE GEOGRID REINFORCEMENT. A MINIMUM FILL THICKNESS OF 6 INCHES IS REQUIRED PRIOR TO OPERATION OF TRACKED VEHICLES OVER THE GEOGRID. TRACKED VEHICLE TURNING SHOULD BE KEPT TO A MINIMUM TO PREVENT TRACKS FROM DISPLACING THE FILL AND DAMAGING THE GEOGRID.
F. RUBBER Tired EQUIPMENT MAY PASS OVER GEOGRID REINFORCEMENT AT SLOW SPEEDS, LESS THAN 10 MPH. SUDDEN BRAKING AND SHARP TURNING SHALL BE AVOIDED.
G. AT THE END OF EACH DAY'S OPERATION, THE CONTRACTOR SHALL SLOPE THE LAST LIFT OF REINFORCED BACKFILL AWAY FROM THE WALL UNITS TO DIRECT RUNOFF AWAY FROM WALL FACE. THE CONTRACTOR SHALL NOT ALLOW SURFACE RUNOFF FROM ADJACENT AREAS TO ENTER THE WALL CONSTRUCTION SITE.
3.06 CAP INSTALLATION
A. CAP UNITS SHALL BE GLUED TO UNDERLYING UNITS WITH AN ALL-WEATHER ADHESIVE RECOMMENDED BY THE MANUFACTURER.
3.07 FIELD QUALITY CONTROL
A. THE OWNER SHALL ENGAGE INSPECTION AND TESTING SERVICES, INCLUDING INDEPENDENT LABORATORIES, TO PROVIDE QUALITY ASSURANCE AND TESTING SERVICES DURING CONSTRUCTION.
B. AS A MINIMUM, QUALITY ASSURANCE TESTING SHOULD INCLUDE FOUNDATION SOIL INSPECTION, SOIL AND BACKFILL TESTING, VERIFICATION OF DESIGN PARAMETERS, AND OBSERVATION OF CONSTRUCTION FOR GENERAL COMPLIANCE WITH DESIGN DRAWINGS AND SPECIFICATIONS.

REINFORCEMENT APPLICATIONS AND SHALL BE MANUFACTURED FROM HIGH TENACITY POLYESTER YARN.
2.07 DRAINAGE PIPE
A. THE DRAINAGE PIPE SHALL BE PERFORATED CORRUGATED HDPE PIPE MANUFACTURED IN ACCORDANCE WITH ASTM D-1248.
PART 3 EXECUTION
3.01 EXCAVATION
A. CONTRACTOR SHALL EXCAVATE TO THE LINES AND GRADES SHOWN ON THE CONSTRUCTION DRAWINGS. OWNER'S REPRESENTATIVE SHALL BE RESPONSIBLE FOR INSPECTING AND APPROVING THE EXCAVATION PRIOR TO PLACEMENT OF LEVELING MATERIAL OR FILL SOILS.
3.02 BASE LEVELING PAD
A. LEVELING PAD MATERIAL SHALL BE PLACED TO THE LINES AND GRADES SHOWN ON THE CONSTRUCTION DRAWINGS. TO A MINIMUM THICKNESS OF 6 INCHES AND EXTEND LATERALLY A MINIMUM OF 6" IN FRONT AND BEHIND THE MODULAR WALL UNIT.
B. LEVELING PAD SHALL BE PREPARED TO INSURE FULL CONTACT TO THE BASE SURFACE OF THE CONCRETE UNITS.
3.03 MODULAR UNIT INSTALLATION
A. FIRST COURSE OF UNITS SHALL BE PLACED ON THE LEVELING PAD AT THE APPROPRIATE LINE AND GRADE. ALIGNMENT AND LEVEL SHALL BE CHECKED IN ALL DIRECTIONS AND INSURE THAT ALL UNITS ARE IN FULL CONTACT WITH THE BASE AND PROPERLY SEATED.
B. PLACE THE FRONT OF UNITS SIDE-BY-SIDE. DO NOT LEAVE GAPS BETWEEN ADJACENT UNITS. LAYOUT OF CORNERS AND CURVES SHALL BE IN ACCORDANCE WITH MANUFACTURER'S RECOMMENDATIONS.
C. INSTALL SHEAR/CONNECTING DEVICES PER MANUFACTURER'S RECOMMENDATIONS.
D. PLACE AND COMPACT DRAINAGE FILL WITHIN AND BEHIND WALL UNITS. PLACE AND COMPACT BACKFILL SOIL BEHIND DRAINAGE FILL. FOLLOW WALL ERECTION AND DRAINAGE FILL CLOSELY WITH STRUCTURE BACKFILL.
E. MAXIMUM STACKED VERTICAL HEIGHT OF WALL UNITS PRIOR TO UNIT DRAINAGE FILL AND BACKFILL PLACEMENT AND COMPACTION, SHALL NOT EXCEED THREE COURSES.
3.04 STRUCTURAL GEOGRID INSTALLATION
A. GEOGRID SHALL BE ORIENTED WITH THE HIGHEST STRENGTH AXIS PERPENDICULAR TO THE WALL ALIGNMENT.
B. GEOGRID REINFORCEMENT SHALL BE PLACED AT THE STRENGTHS, LENGTHS, AND ELEVATIONS SHOWN ON THE CONSTRUCTION DRAWINGS OR AS DIRECTED BY THE ENGINEER.
C. THE GEOGRID SHALL BE LAID HORIZONTALLY ON COMPACTED BACKFILL AND ATTACHED TO THE MODULAR WALL UNITS. PLACE THE NEXT COURSE OF MODULAR CONCRETE UNITS OVER THE GEOGRID. THE GEOGRID SHALL BE PULLED TAUT, AND ANCHORED PRIOR TO BACKFILL PLACEMENT ON THE GEOGRID.


HOWARD COUNTY GENERAL NOTES:

- No trees shall be planted within 10 feet of the top of the retaining wall.
- Retaining walls shall only be constructed under the observation of a registered professional engineer and a (NICET, WACEL, or equiv.) certified soils technician.
- The required bearing pressure beneath the wall system shall be verified in the field by a certified soils technician. Testing documentation must be provided to the Howard County Inspector prior to start of construction. The required bearing test shall be the Dynamic Cone Penetrometer test ASTM STP-399.
- The suitability of fill material shall be confirmed by the on-site soils technician. Each 8" lift must be compacted to a minimum 95% standard proctor density and the testing report shall be made available to the Howard County Inspector upon completion of construction.
- Walls shall not be constructed on uncertified fill materials.
- Walls shall not be constructed within a Howard Co. right-of-way or easement.

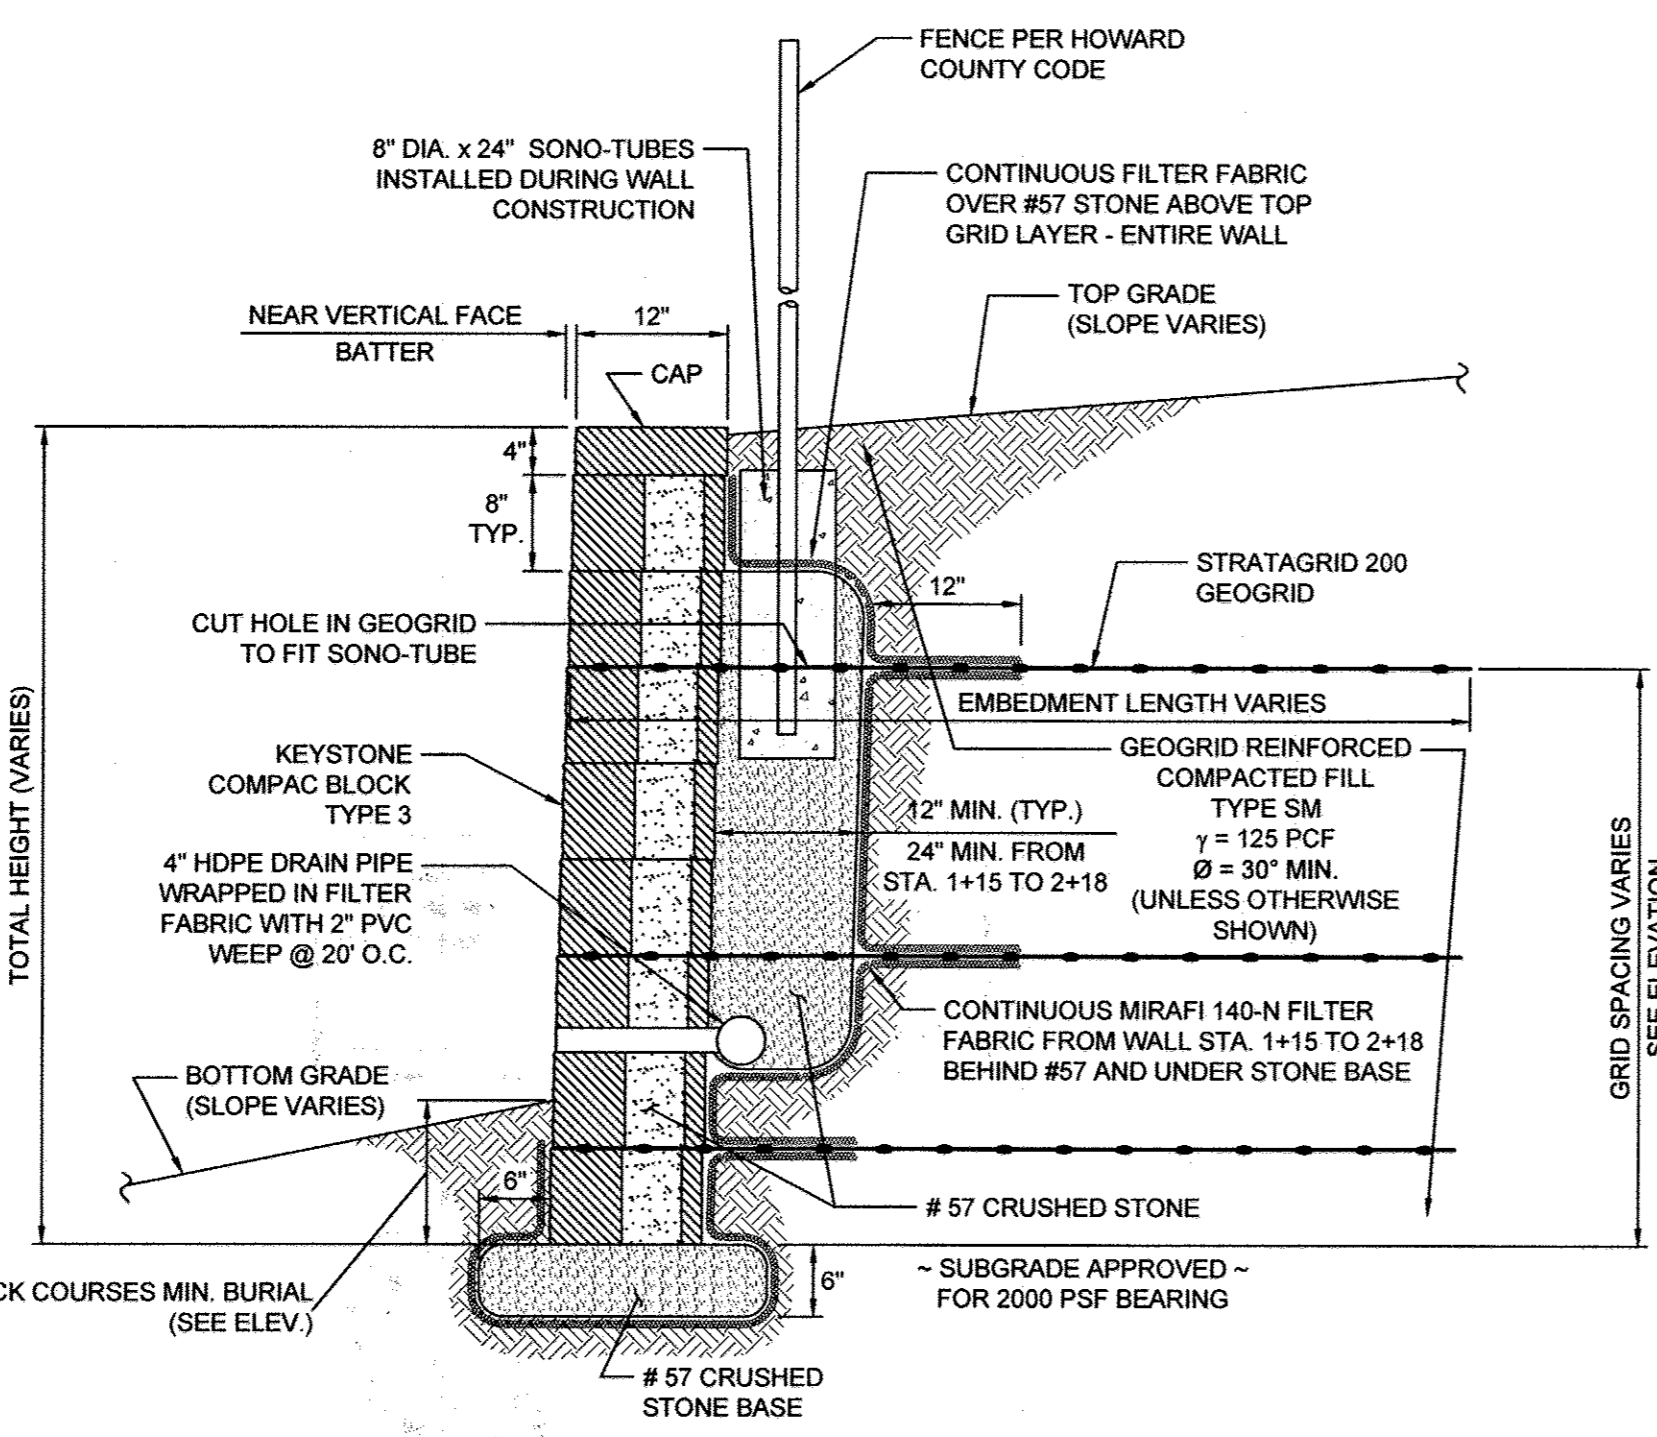

TYPICAL MODULAR BLOCK WALL SECTION
N.T.S.

APPROVED: DEPARTMENT OF PLANNING AND ZONING
K. A. ...
CHIEF, DIVISION OF LAND DEVELOPMENT
5-28-15
DATE
CHIEF, DEVELOPMENT ENGINEERING DIVISION
M. A. ...
DATE
5-28-2015
DIRECTOR

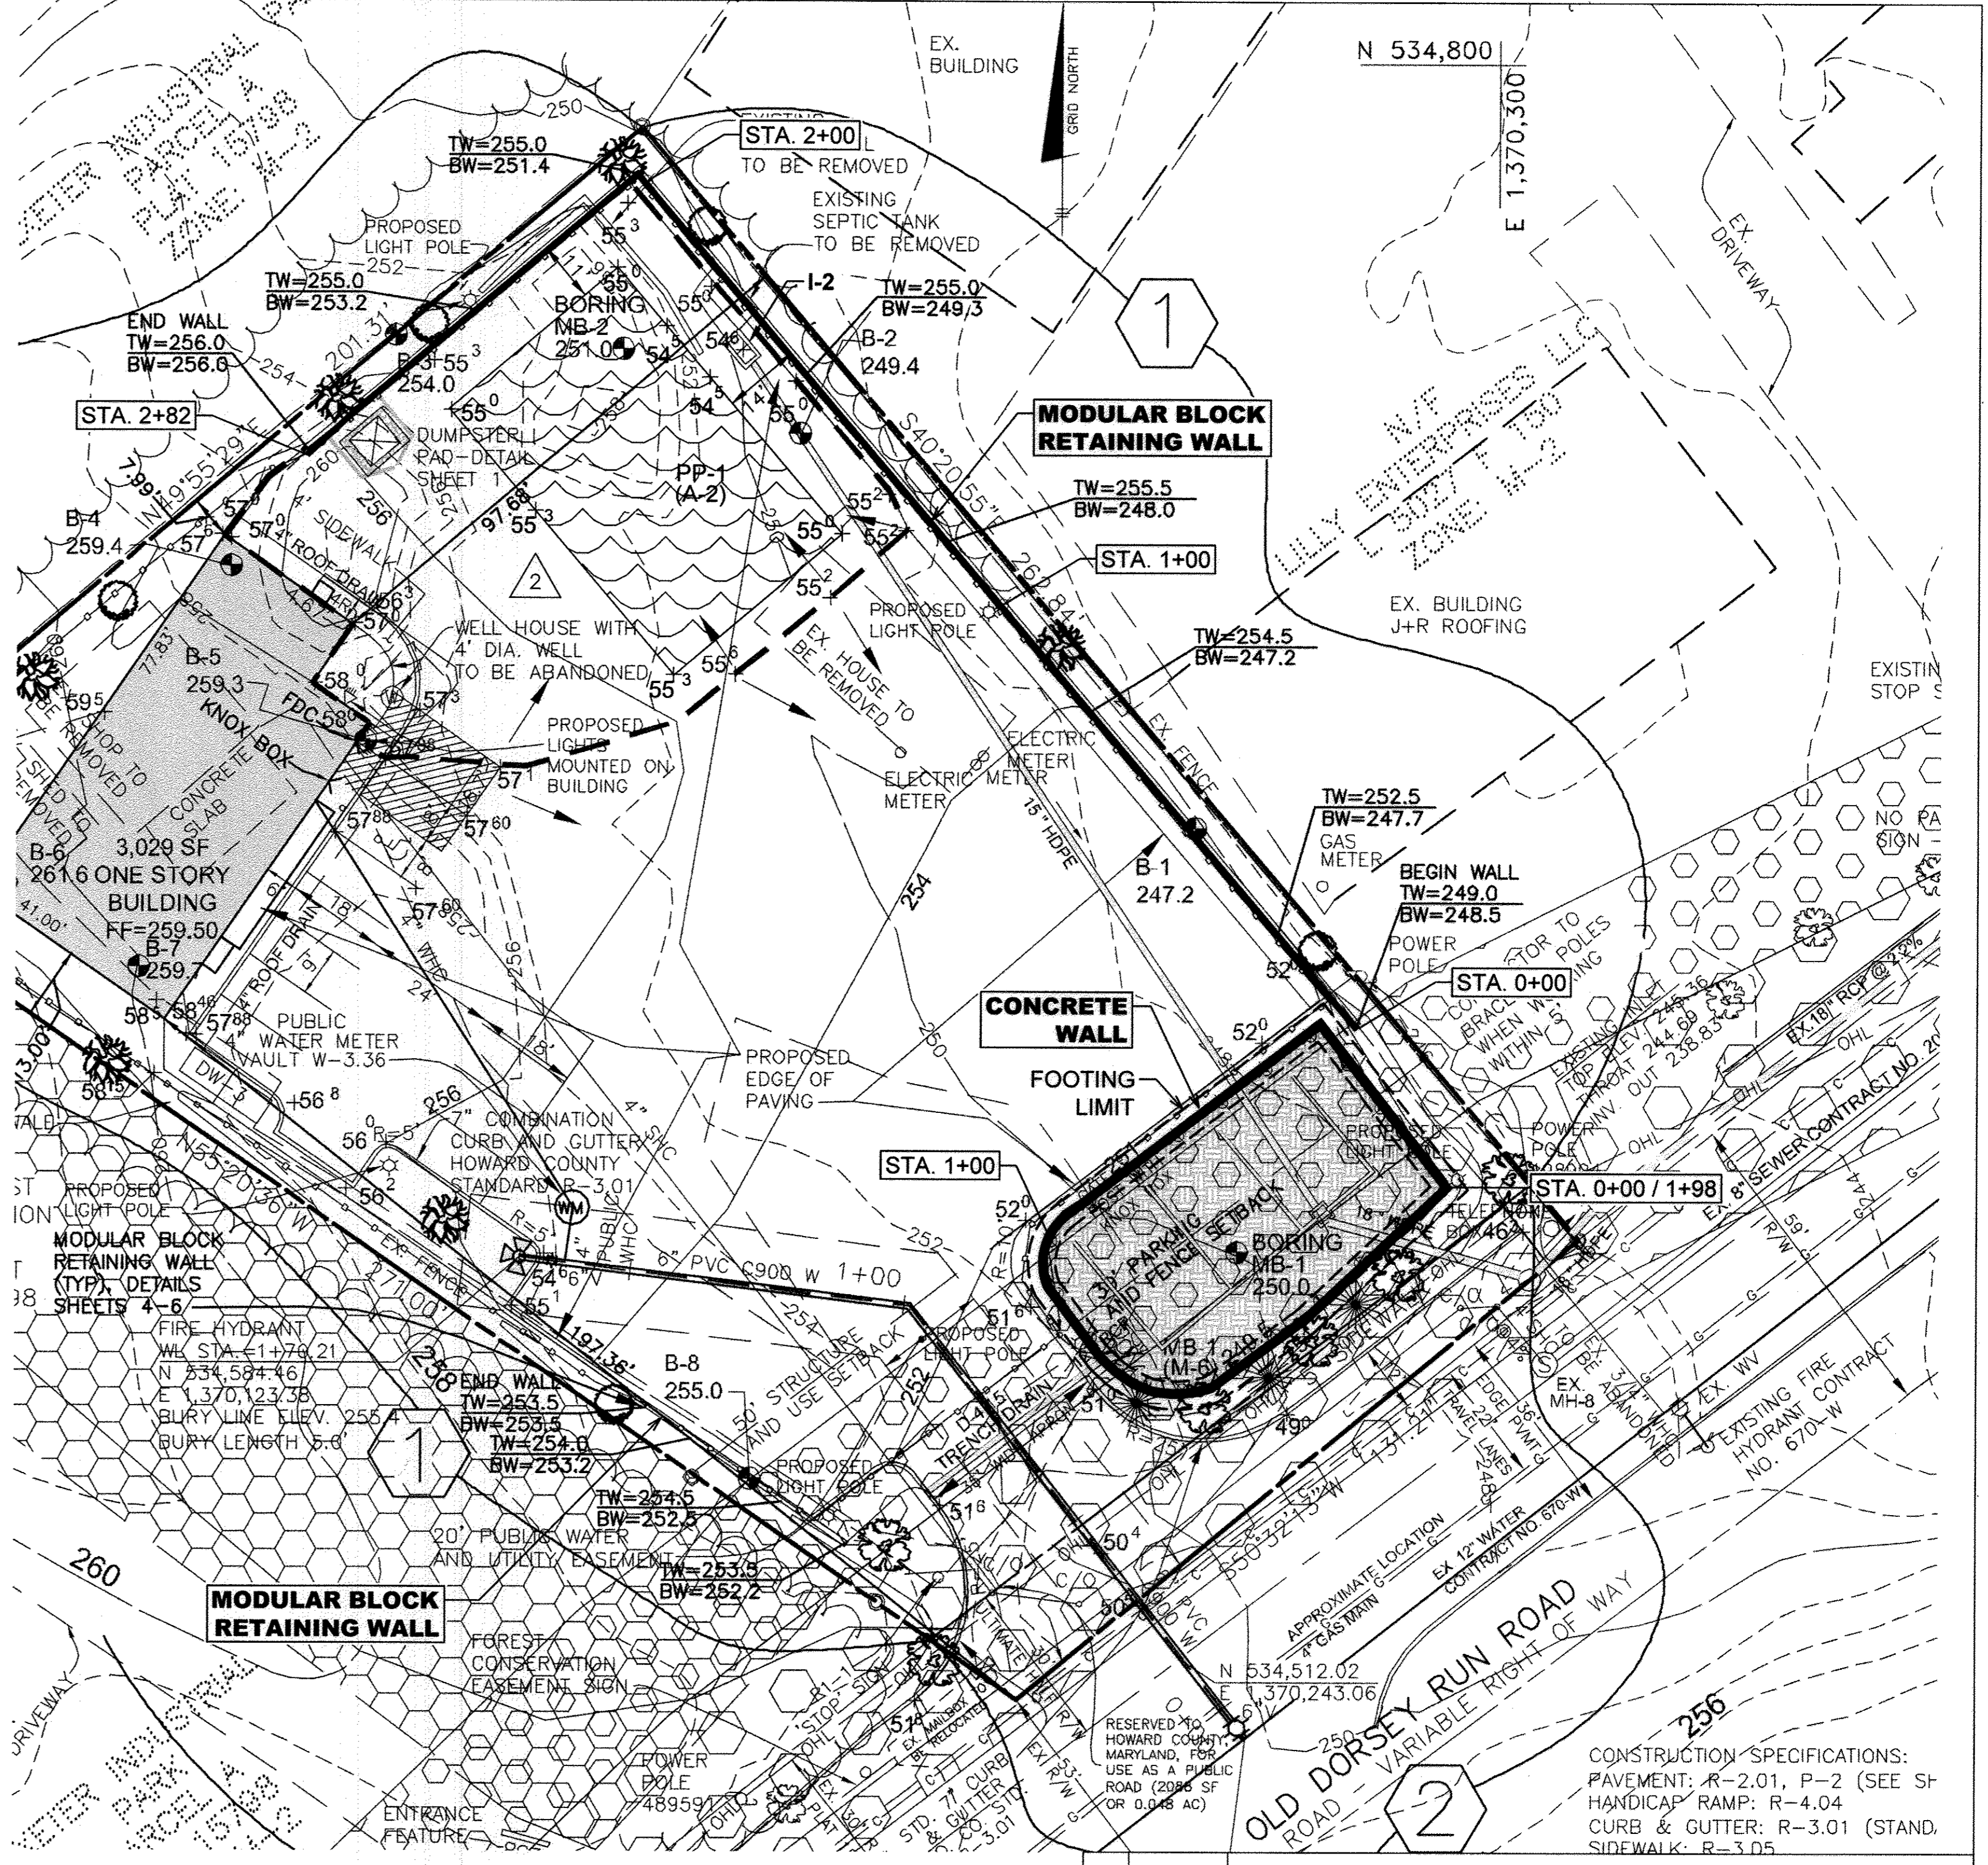

RETAINING WALL LOCATION PLAN
1" = 20'

Professional Certification. I hereby certify that these documents were prepared or approved by me, and that I am a duly licensed professional engineer under the laws of the State of Maryland.
License No. 21443 Expiration Date: 12-21-19

NO.	DATE	REVISION
2	05/08/15	RELOCATE POROUS PAVEMENT AREA
1	12/12/14	REPLACEMENT SHEET - REVISE PERIMETER WALL & ADD SWM CONCRETE WALL

HILLIS-CARNES ENGINEERING ASSOCIATES
10975 Galt Road, Suite A Annapolis Junction, Maryland
(410) 880-4788 WWW.HCEA.COM Fax: (410) 880-4986

L&R BUILDINGS
L. 13356 F. 0464
TAX MAP: 48, GRID: 14, PARCEL: 22
6th ELECTION DISTRICT
HOWARD COUNTY, MARYLAND


REVISD SITE DEVELOPMENT PLAN
RETAINING WALL LOCATION PLAN
AND MODULAR BLOCK WALL
CONSTRUCTION DETAILS

DATE: DECEMBER 2014 PROJECT NO. 12341A
DESIGN/JUC/RWS DRAFT: HM CHECK: JUC SCALE: AS SHOWN SHEET 4 OF 6

OWNER/DEVELOPER:
L&R BUILDINGS, LLC
11404 GALT AVENUE
SILVER SPRING, MD 20902
717-600-6171
ATT: LUIS RIVERA
240-372-2283

AS-BUILT

"NO AS-BUILT INFORMATION"
SHOW ON THIS PLAN

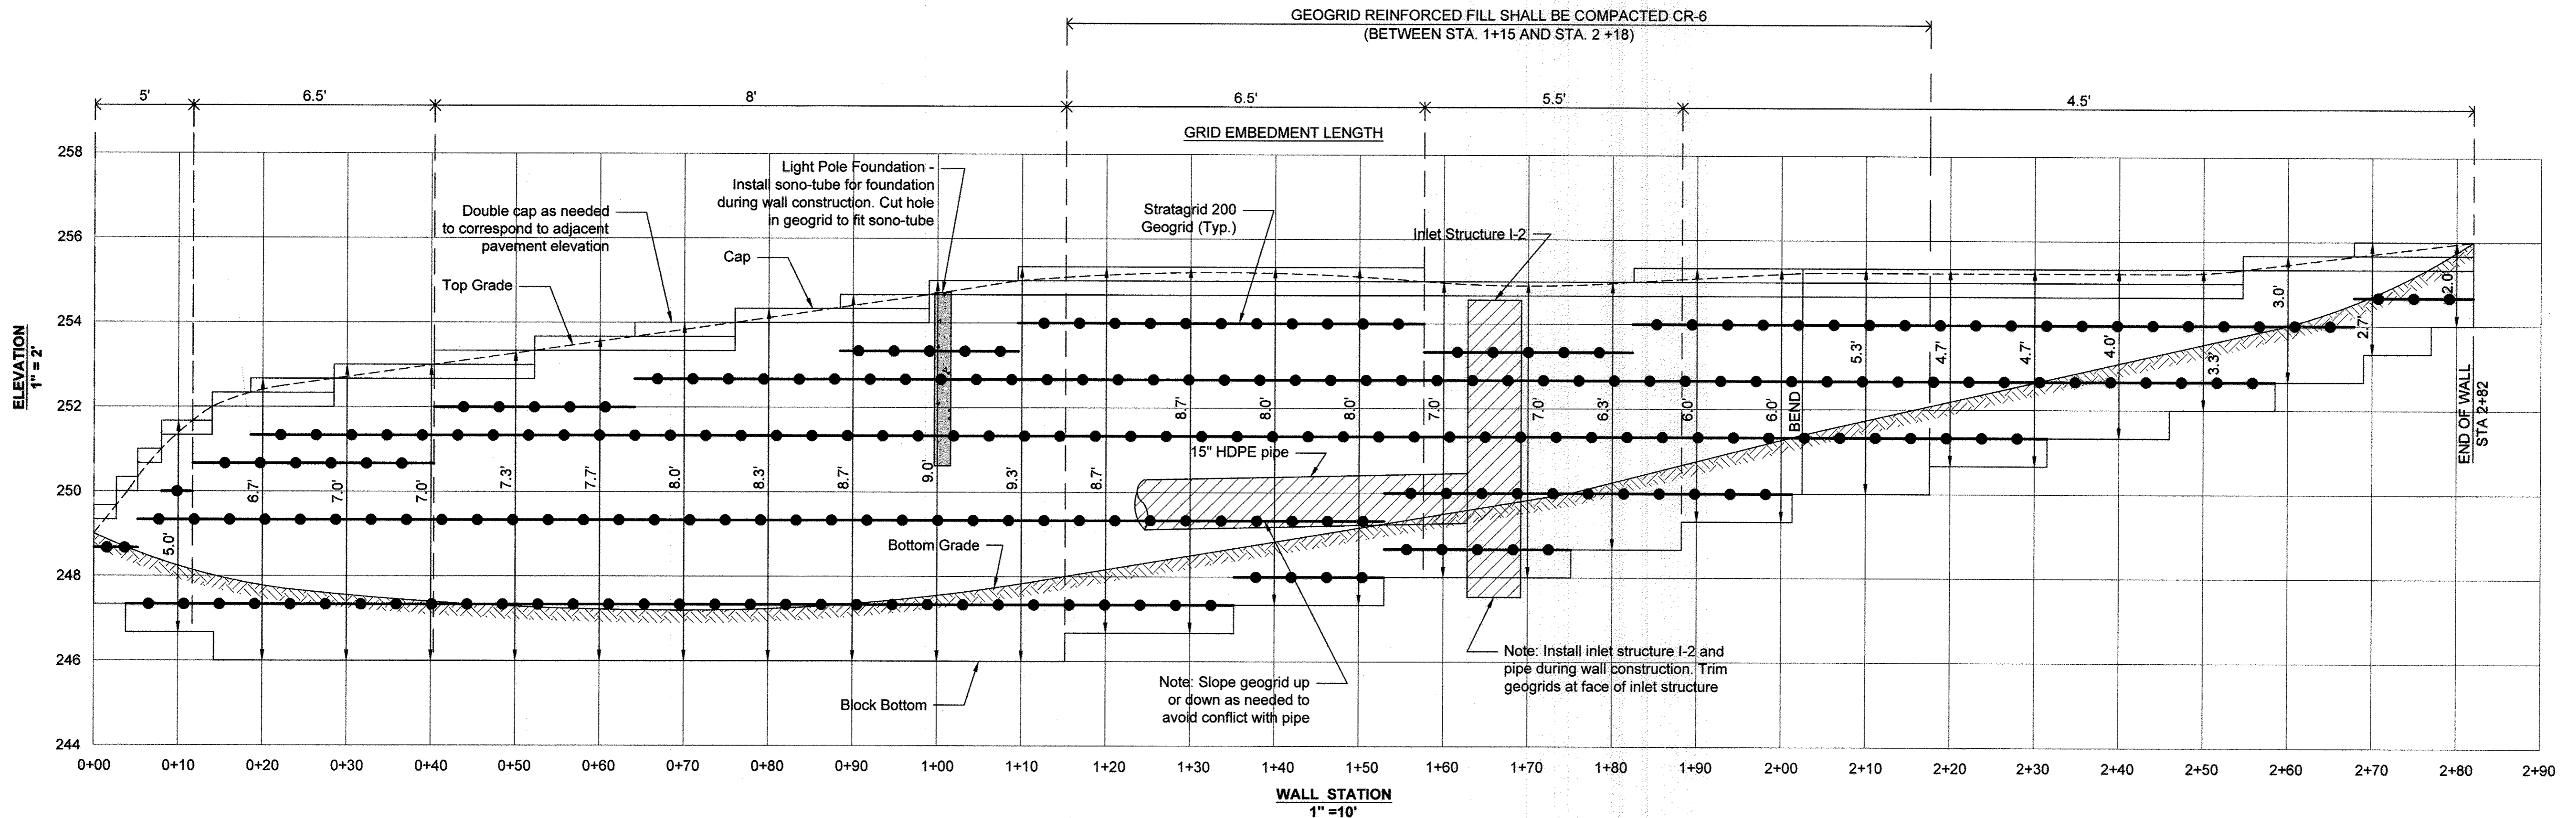

MODULAR BLOCK RETAINING WALL ELEVATION

Professional Certification. I hereby certify that these documents were prepared or approved by me, and that I am a duly licensed professional engineer under the laws of the State of Maryland.
 License No. 21443, Expiration Date: 12-21-18




NO AS-BUILT INFORMATION SHOWN ON THIS PLAN

1 12/12/14		REPLACEMENT SHEET -- REVISE PERIMETER WALL & ADD SWM CONCRETE WALL
NO.	DATE	REVISION
 10975 Guilford Road, Suite A Annapolis Junction, Maryland (410) 860-4788 WWW.HCEA.COM Fax: (410) 860-4098		
OWNER/DEVELOPER:		L&R BUILDINGS L. 13356 F. 0464
L&R BUILDINGS, LLC 11404 GALT AVENUE SILVER SPRING, MD 20902 717-600-6171 ATT: LUIS RIVERA 240-372-2283		TAX MAP: 48, GRID: 14, PARCEL: 22 6th ELECTION DISTRICT HOWARD COUNTY, MARYLAND
DATE: DECEMBER 2014		PROJECT NO. 12341A
DESIGN: JJC/RWS	DRAFT: HM	CHECK: JJC
SCALE: AS SHOWN		SHEET 5 OF 6


AS-BUILT

SDP-13-003

APPROVED: DEPARTMENT OF PLANNING AND ZONING
 Chief, Division of Land Development
 DATE: 5-28-15
 Chief, Development Engineering Division
 DATE: 5-28-2015
 Director

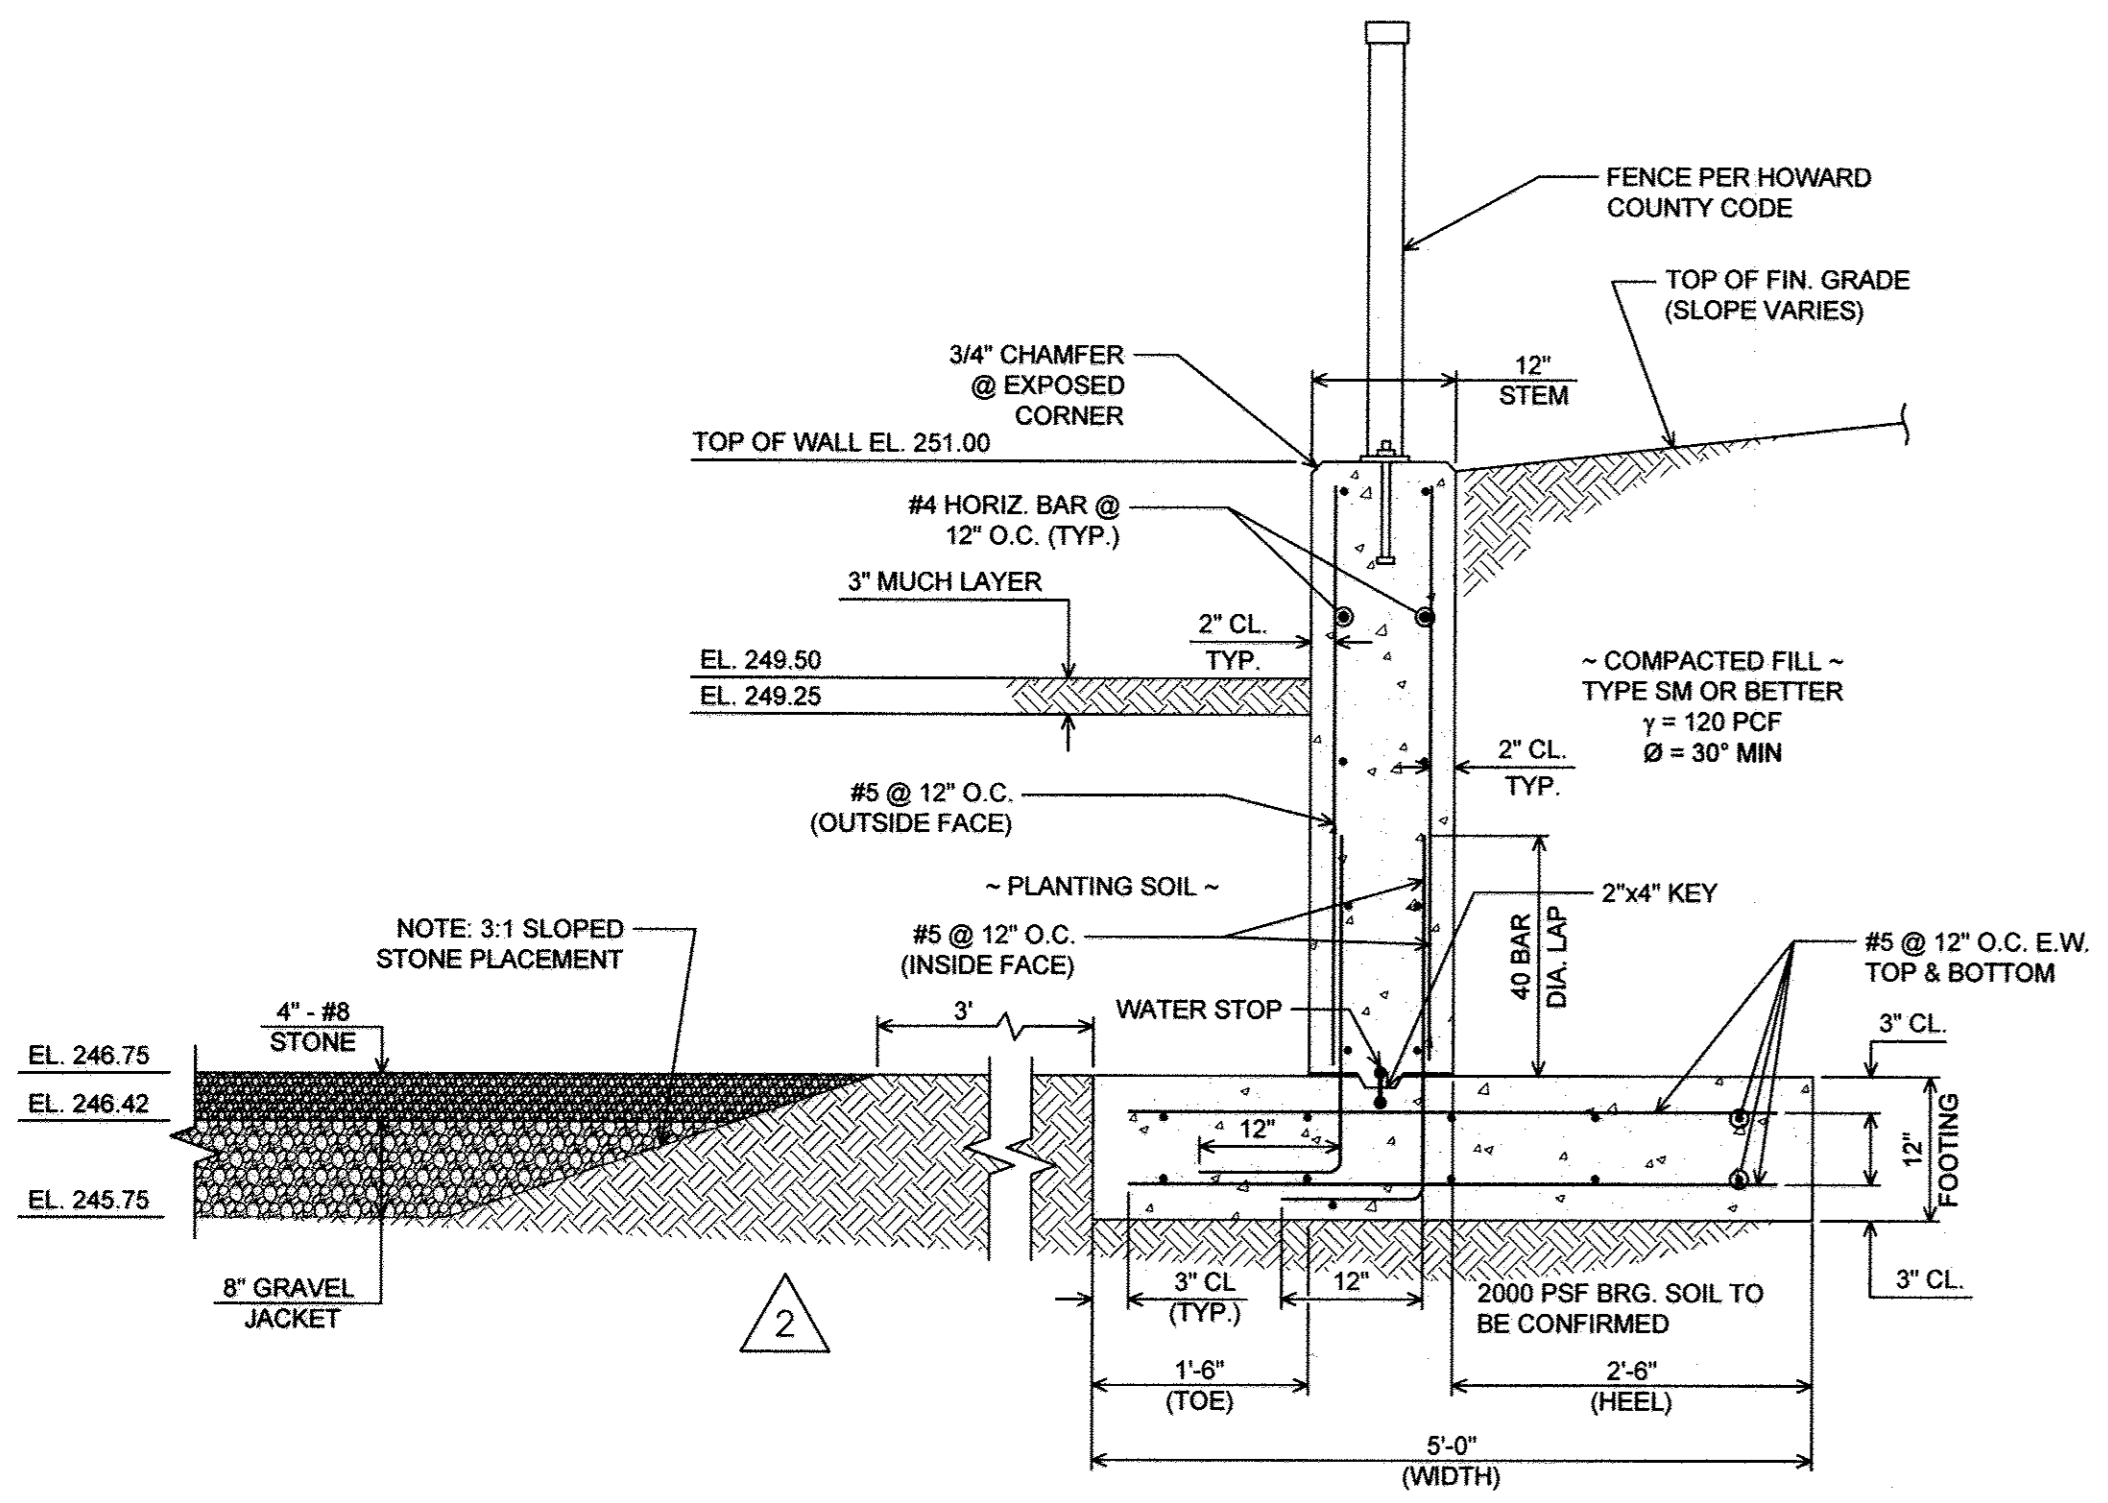


CONCRETE WALL - SECTION A-A (TYP.)
MICRO-BIORETENTION MB-1 (M-6)
 3/4" = 1'-0"

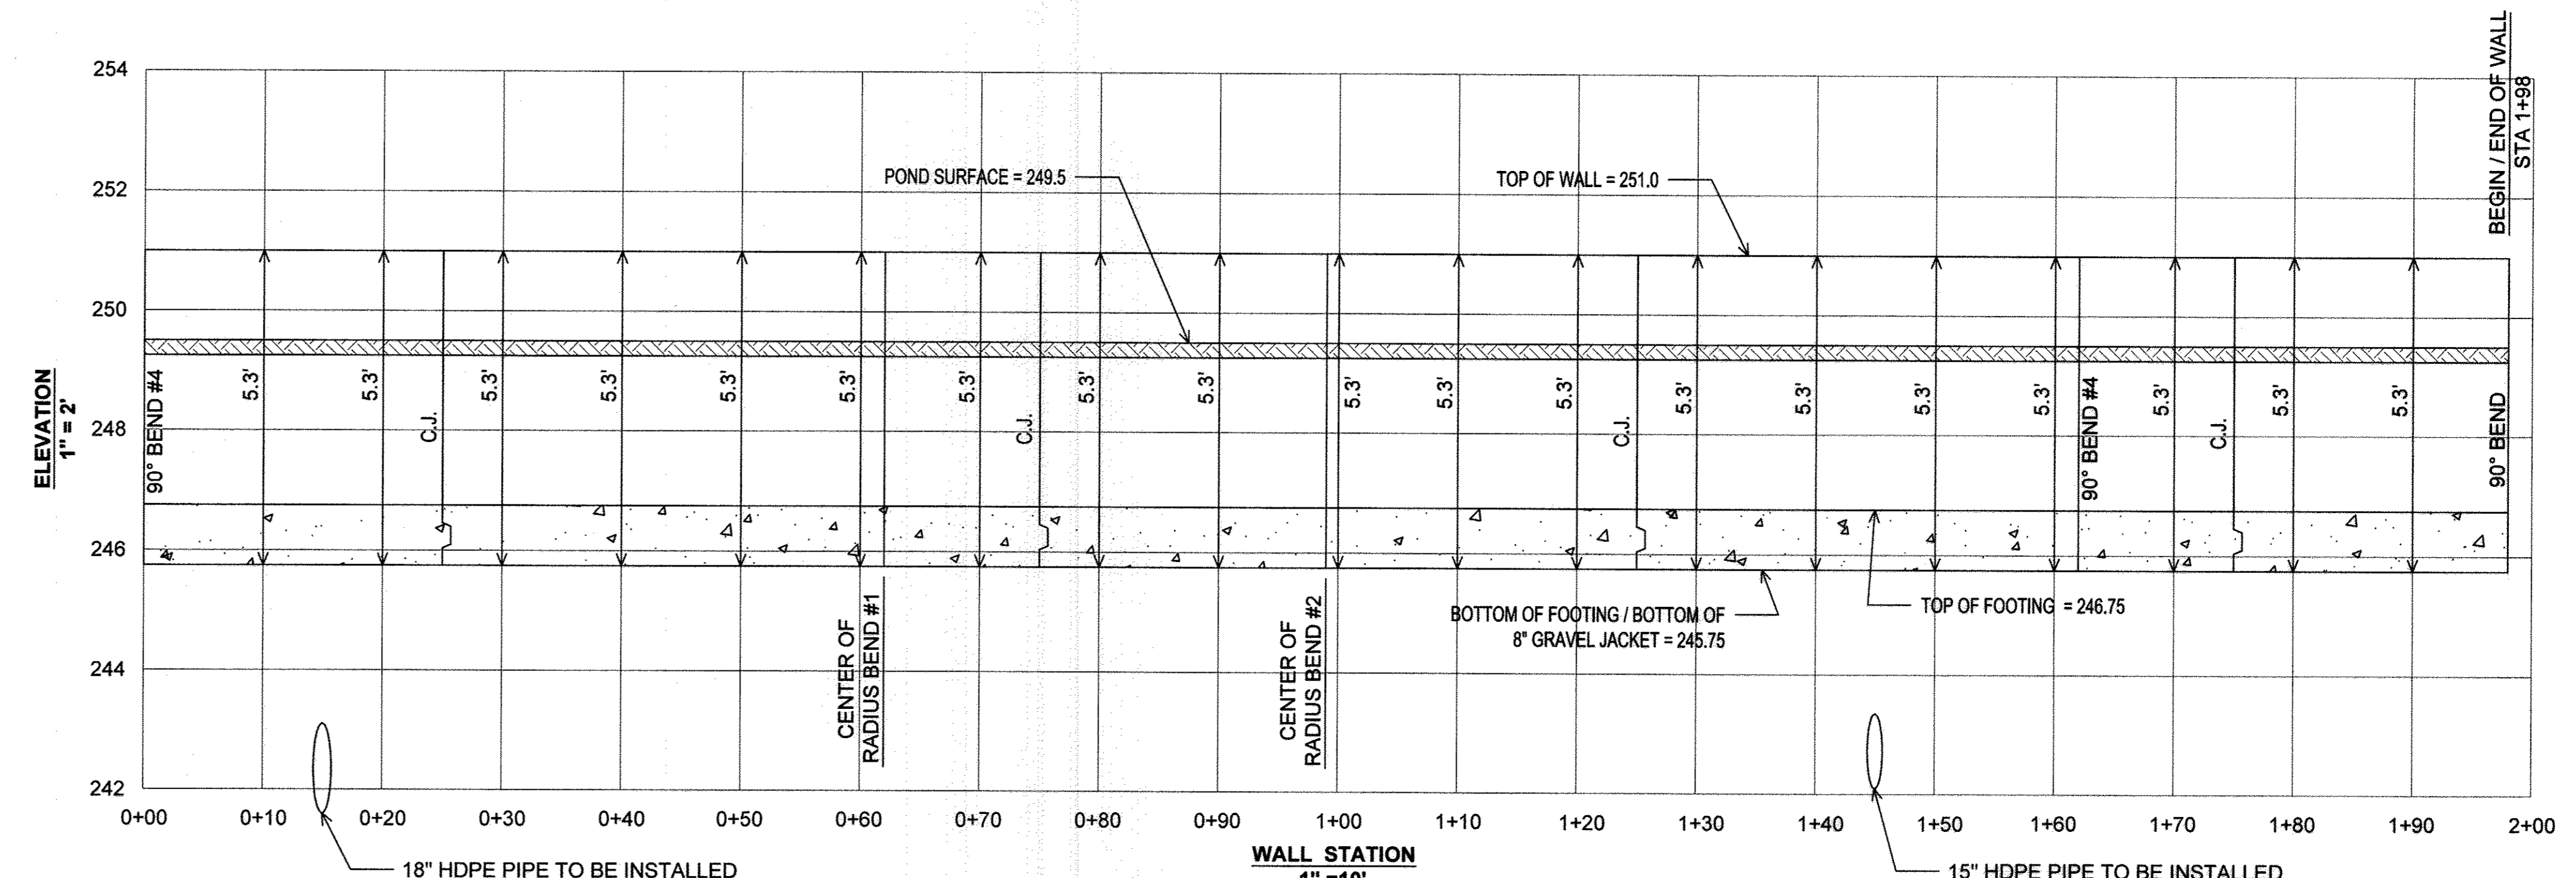


CONCRETE RETAINING WALL ELEVATION
MICRO-BIORETENTION MB-1 (M-6)

- GENERAL NOTES:**
1. ALL RETAINING WALL CONCRETE SHALL BE 4000 PSI WITH AIR ENTRAINMENT.
 2. REINFORCING STEEL SHALL CONFORM TO ASTM A-615 GRADE 60.
 3. CONCRETE WORK SHALL COMPLY WITH THE LATEST ACI 318 BUILDING CODE FOR CONCRETE STRUCTURES.
 4. ALL REBAR SPLICES NOT SHOWN SHALL BE A MINIMUM OF 40 BAR DIAM.
 5. ALL WALL EXPOSED SURFACES SHALL BE MORTAR PATCHED AND SACK-RUBBED FINISHED WITH GROUT AND BURLAP. (RUB FINISH PER OWNER'S SPECIFICATIONS).
 6. ALL DIMENSIONS, ROUNDED BEND CORNERS WITH RADIUS, ANGLES AT BENDS AND LOCATIONS SHALL BE ESTABLISHED FROM BENCHMARK ENGINEERING'S SITE DEVELOPMENT AND GRADING PLAN AND SHALL BE FIELD VERIFIED.
 7. REFER TO GEOTECHNICAL EVALUATION FOR SITE PREPARATION AND EARTHWORK RECOMMENDATIONS.
 8. RETAINING WALL SHALL ONLY BE CONSTRUCTION UNDER THE OBSERVATION OF A REGISTERED PROFESSIONAL ENGINEER AND A (NICET, WACEL OR EQUIVALENT) CERTIFIED SOILS TECHNICIAN.
 9. THE DESIGN BEARING PRESSURE OF 2000 PSF BENEATH THE FOOTING OF THE WALL SHALL BE VERIFIED IN THE FIELD BY A CERTIFIED SOILS TECHNICIAN. TESTING DOCUMENTATION SHALL BE PROVIDED TO THE HOWARD COUNTY INSPECTOR PRIOR TO THE START OF CONSTRUCTION. THE REQUIRED TEST PROCEDURE SHALL BE THE DYNAMIC CONE PENETROMETER TEST ASTM STP-399.
 10. THE SUITABILITY OF FILL MATERIAL SHALL BE CONFIRMED BY THE ONSITE SOILS TECHNICIAN. EACH (8) INCH LIFT SHALL BE COMPACTED TO A MINIMUM OF 95% STANDARD PROCTOR DENSITY (T-99) AND THE TESTING REPORT SHALL BE MADE AVAILABLE TO THE HOWARD COUNTY INSPECTOR UPON COMPLETION OF CONSTRUCTION.

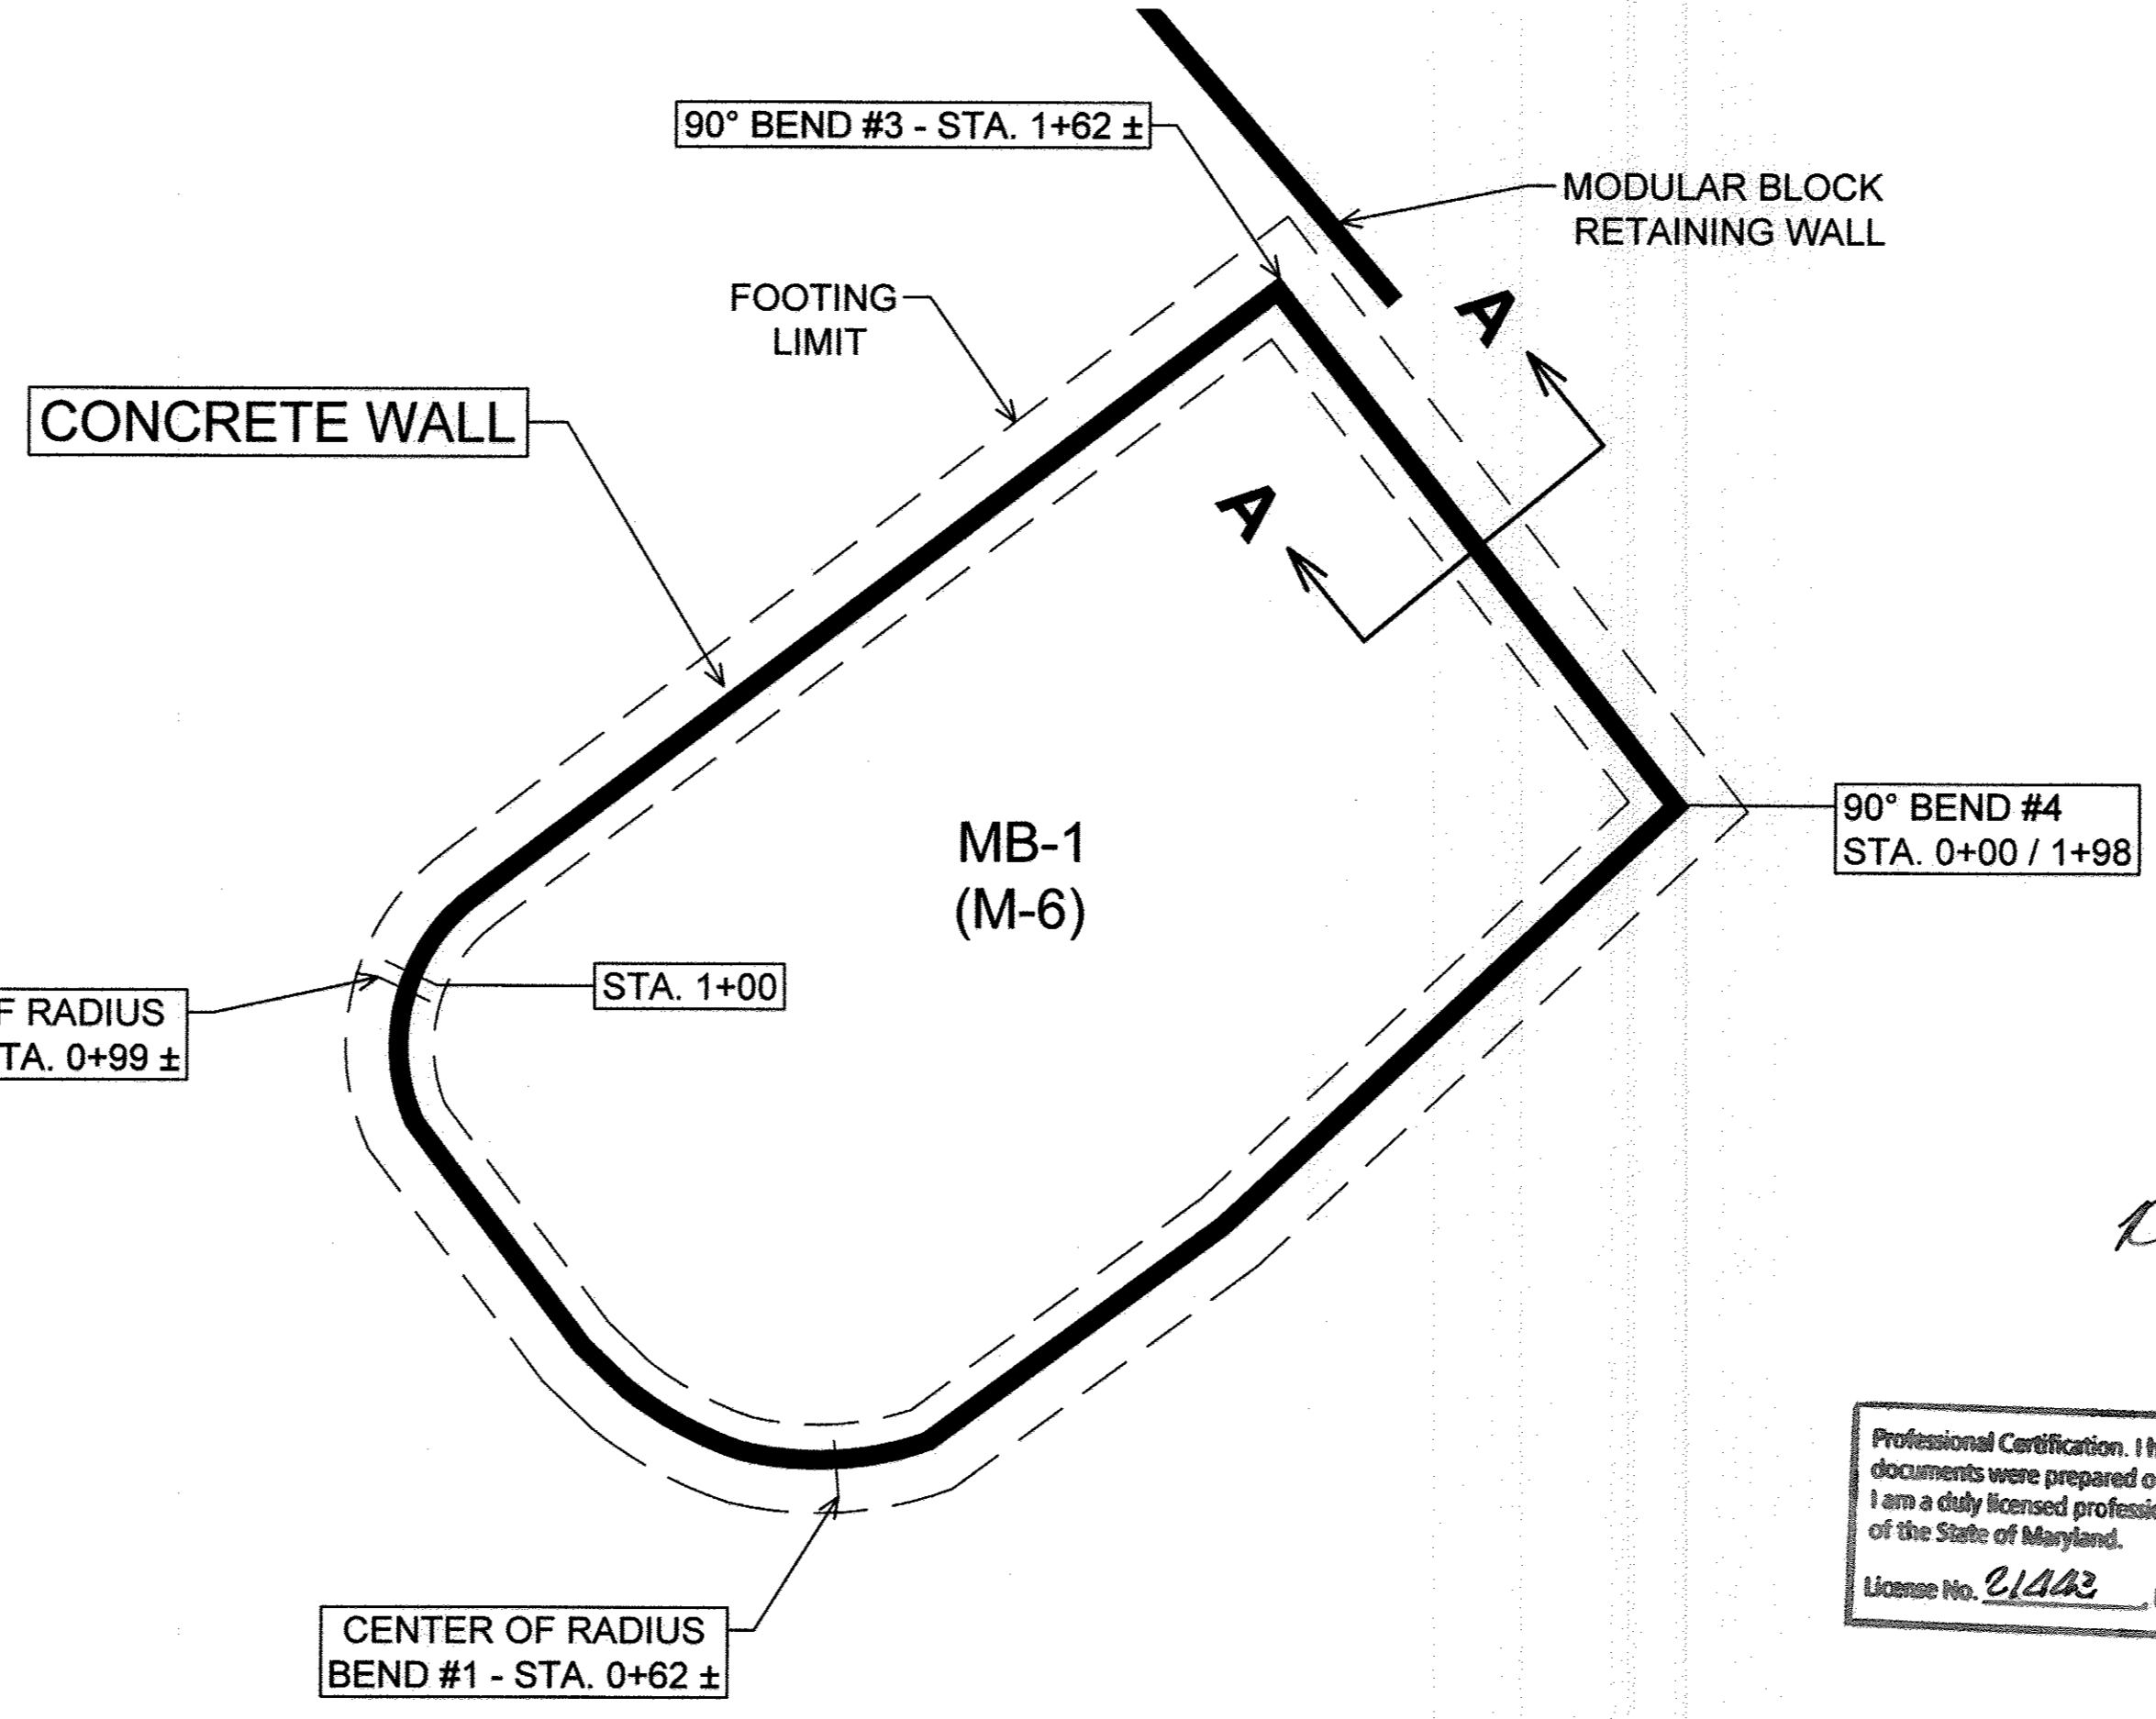

CONCRETE WALL PLAN
MICRO-BIORETENTION MB-1 (M-6)
 1" = 10'

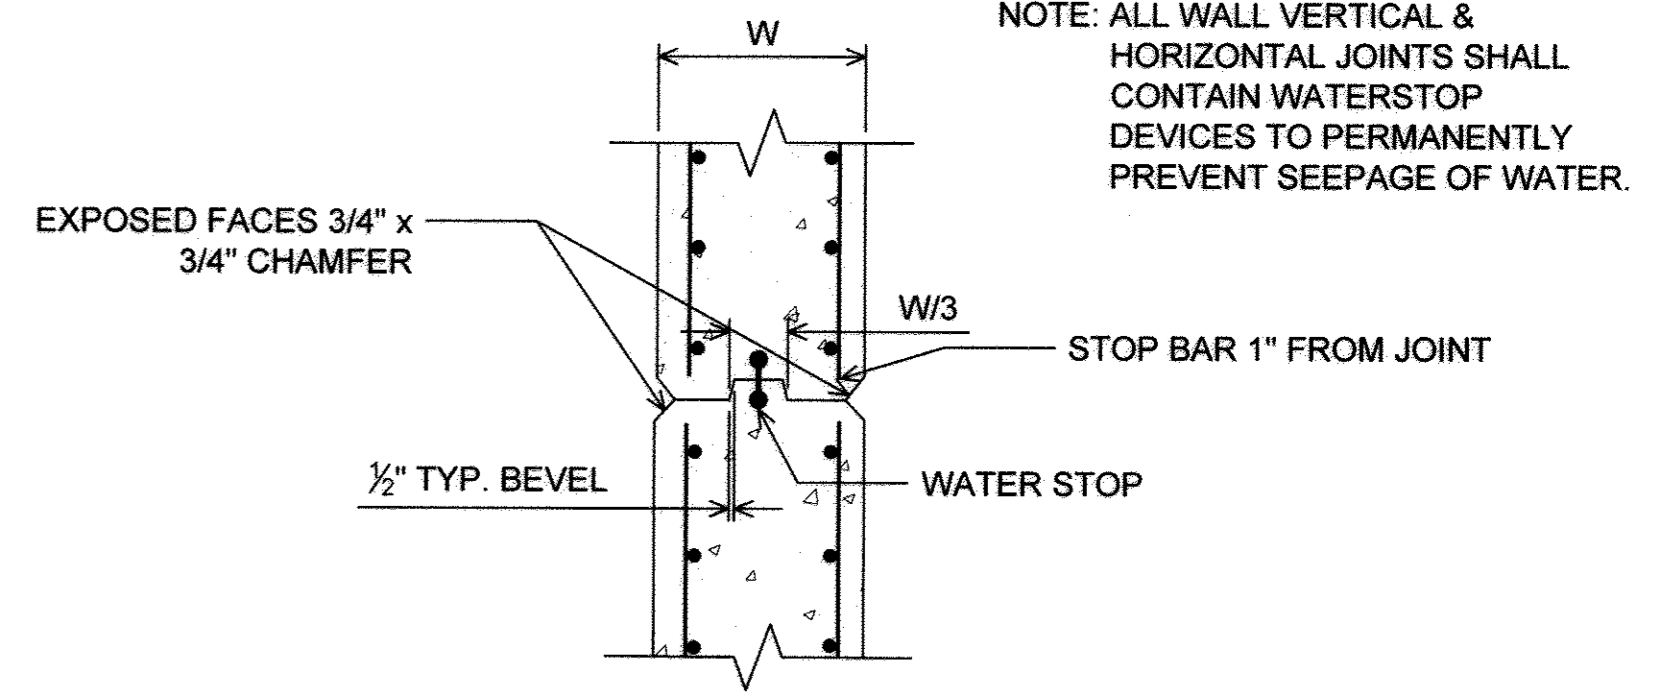

CONCRETE WALL STEM VERTICAL CONTRACTION
JOINT C.J. DETAIL (PLAN VIEW)
 NOT TO SCALE

APPROVED: DEPARTMENT OF PLANNING AND ZONING
Katsch... 5-28-15
 CHIEF, DIVISION OF LAND DEVELOPMENT
 DATE
 CHIEF, DEVELOPMENT ENGINEERING DIVISION
... 5-28-2015
 DIRECTOR
 DATE

Professional Certification. I hereby certify that these documents were prepared or approved by me, and that I am a duly licensed professional engineer under the laws of the State of Maryland.
 License No. 211403 Expiration Date: 12-21-18

NO AS-BUILT INFORMATION SHOWN ON THIS PLAN

NO.	DATE	REVISION
2	05/08/15	PROVIDED OFFSET FOR STORAGE STONE PLACEMENT
1	12/12/14	REPLACEMENT SHEET - REVISE PERIMETER WALL & ADD SWM CONCRETE WALL

HILLIS-CARNES
ENGINEERING ASSOCIATES
 10975 Guilford Road, Suite A Annapolis Junction, Maryland
 (410) 880-4788 WWW.HCEA.COM Fax: (410) 880-4096

OWNER/DEVELOPER:		L&R BUILDINGS L. 13356 F. 0464	
L&R BUILDINGS, LLC 11404 GALT AVENUE SILVER SPRING, MD 20902 717-600-6171 ATT: LUIS RIVERA 240-372-2283		TAX MAP: 48, GRID: 14, PARCEL: 22 6th ELECTION DISTRICT HOWARD COUNTY, MARYLAND	
REVISED SITE DEVELOPMENT PLAN CONCRETE RETAINING WALL DETAILS			
DESIGN: JJC/RWS	DRAFT: HM	CHECK: JJC	SCALE: AS SHOWN
DATE: DECEMBER 2014	PROJECT NO. 12341A	SHEET 6 OF 6	