

SHEET INDEX	
SHEET TITLE	SHEET NUMBER
COVER SHEET	1
GENERAL NOTES AND LEGEND	2
SITE DEMOLITION PLAN	3
SITE DEVELOPMENT PLAN	4
GRADING PLAN	5
UTILITY PLAN	6
EROSION AND SEDIMENT CONTROL PLAN PHASE I	7
EROSION AND SEDIMENT CONTROL PLAN PHASE II	8
EROSION AND SEDIMENT CONTROL NOTES	9
EROSION AND SEDIMENT CONTROL DETAILS	10-11
WILDERNESS LANE PLAN AND PROFILE	12
KNOWLEDGE DRIVE AND SIMPLICITY COURT PLAN AND PROFILES	13
LANDSCAPE PLAN	14
LANDSCAPE NOTES AND DETAILS	15-16
FOREST CONSERVATION PLAN	17
FOREST CONSERVATION NOTES AND DETAILS	18
STORMDRAIN PROFILES	19-20
BUILDING ELEVATIONS AND FOOTPRINTS	21
DRAINAGE AREAS TO EROSION AND SEDIMENT CONTROL MEASURES	22
SVM DRAINAGE AREAS TO ESD MEASURES	23
STORMDRAIN DRAINAGE AREAS	24
MICROBIORETENTION FACILITY DETAILS	25-29
SVM DETAILS	30
BORING PLAN	31
BORING LOGS	32
SITE DETAILS	33-34
CONCRETE RETAINING WALL PLAN AND DETAILS	35

ADDRESS CHART	
UNIT #	STREET ADDRESS
1	9804 WILDERNESS LANE
2	9806 WILDERNESS LANE
3	9810 WILDERNESS LANE
4	9812 WILDERNESS LANE
5	9814 WILDERNESS LANE
6	9816 WILDERNESS LANE
7	9818 WILDERNESS LANE
8	9820 WILDERNESS LANE
9	9830 WILDERNESS LANE
10	9832 WILDERNESS LANE
11	9834 WILDERNESS LANE
12	9836 WILDERNESS LANE
13	9840 WILDERNESS LANE
14	9842 WILDERNESS LANE
15	9844 WILDERNESS LANE
16	9846 WILDERNESS LANE
17	9850 WILDERNESS LANE
18	9852 WILDERNESS LANE
19	9854 WILDERNESS LANE
20	9856 WILDERNESS LANE
21	9866 WILDERNESS LANE
22	9870 WILDERNESS LANE
23	9874 WILDERNESS LANE
24	9878 WILDERNESS LANE
25	9882 WILDERNESS LANE
26	9796 KNOWLEDGE DRIVE
27	9780 KNOWLEDGE DRIVE
28	9776 KNOWLEDGE DRIVE
29	9772 KNOWLEDGE DRIVE
30	9768 KNOWLEDGE DRIVE
31	9766 KNOWLEDGE DRIVE
32	9764 KNOWLEDGE DRIVE
33	9762 KNOWLEDGE DRIVE
34	9760 KNOWLEDGE DRIVE
35	9758 KNOWLEDGE DRIVE
36	9754 KNOWLEDGE DRIVE
37	9752 KNOWLEDGE DRIVE
38	9750 KNOWLEDGE DRIVE
39	9746 KNOWLEDGE DRIVE
40	9746 KNOWLEDGE DRIVE
41	9742 KNOWLEDGE DRIVE
42	9740 KNOWLEDGE DRIVE
43	9738 KNOWLEDGE DRIVE
44	9736 KNOWLEDGE DRIVE
45	9734 KNOWLEDGE DRIVE
46	9732 KNOWLEDGE DRIVE
47	9728 KNOWLEDGE DRIVE
48	9726 KNOWLEDGE DRIVE
49	9724 KNOWLEDGE DRIVE
50	9722 KNOWLEDGE DRIVE
51	9720 KNOWLEDGE DRIVE
52	9901 SIMPLICITY COURT
53	9903 SIMPLICITY COURT
54	9905 SIMPLICITY COURT
55	9907 SIMPLICITY COURT
56	9906 SIMPLICITY COURT
57	9904 SIMPLICITY COURT
58	9902 SIMPLICITY COURT
59	9805 WILDERNESS LANE
60	9829 WILDERNESS LANE
61	9831 WILDERNESS LANE
62	9833 WILDERNESS LANE
63	9835 WILDERNESS LANE
64	9837 WILDERNESS LANE
65	9839 WILDERNESS LANE
66	9843 WILDERNESS LANE
67	9845 WILDERNESS LANE
68	9847 WILDERNESS LANE
69	9849 WILDERNESS LANE
70	9851 WILDERNESS LANE
71	9853 WILDERNESS LANE
72	9857 WILDERNESS LANE
73	9859 WILDERNESS LANE
74	9861 WILDERNESS LANE
75	9863 WILDERNESS LANE
76	9865 WILDERNESS LANE
77	9869 WILDERNESS LANE
78	9871 WILDERNESS LANE
79	9873 WILDERNESS LANE
80	9781 KNOWLEDGE DRIVE
81	9759 KNOWLEDGE DRIVE
82	9757 KNOWLEDGE DRIVE
83	9755 KNOWLEDGE DRIVE
84	9753 KNOWLEDGE DRIVE
85	9751 KNOWLEDGE DRIVE
86	9747 KNOWLEDGE DRIVE
87	9745 KNOWLEDGE DRIVE
88	9743 KNOWLEDGE DRIVE
89	9741 KNOWLEDGE DRIVE
90	9739 KNOWLEDGE DRIVE
91	9737 KNOWLEDGE DRIVE
92	9733 KNOWLEDGE DRIVE
93	9731 KNOWLEDGE DRIVE
94	9729 KNOWLEDGE DRIVE
95	9727 KNOWLEDGE DRIVE
96	9725 KNOWLEDGE DRIVE
97	9723 KNOWLEDGE DRIVE
O.S. LOT 98	9816 WILDERNESS LANE (COMMUNITY CENTER)

SITE DEVELOPMENT PLAN FOR WALDEN WOODS

PLANNED SENIOR COMMUNITY (PSC) - AGE RESTRICTED ADULT HOUSING

LOCATION OF SITE 6TH ELECTION DISTRICT TAX MAP 47, GRID 2, TM PARCEL 4, LOTS 1-97, OPEN SPACE LOT 98 HOWARD COUNTY, MARYLAND 20723

STREET SIGN CHART				
STREET NAME	STATION	OFFSET	POSTED SIGN	SIGN CODE
WILDERNESS LANE	10+50.45	28.6' RT	STREET NAME (STRAPPED TO LIGHT POLE)	
WILDERNESS LANE	10+59	22' LT	STOP	R1-1
WILDERNESS LANE	21+00	22.5' RT	STREET NAME	
WILDERNESS LANE	11+00	20' RT	25 MPH	R2-1
KNOWLEDGE DRIVE	10+45	16' LT	STOP	R1-1
KNOWLEDGE DRIVE	10+35	17.5' LT	STREET NAME (STRAPPED TO LIGHT POLE)	
SIMPLICITY COURT	10+20.86	21' RT	STREET NAME (STRAPPED TO LIGHT POLE)	
SIMPLICITY COURT	10+20.82	18.81' LT	STOP	R1-1

STREET LIGHT CHART				
STREET NAME	STATION	OFFSET	FIXTURE POLE TYPE	COMMENTS
WILDERNESS LANE	10+50.45	28.6' RT	150-WATT H.P.S. VAPOR PREMIER POST TOP MOUNTED ON A 14-FOOT BLACK FIBERGLASS POLE	PRIVATE; TO BE INSTALLED BY BGE
WILDERNESS LANE	20+76.44	30.56' LT	150-WATT H.P.S. VAPOR PREMIER POST TOP MOUNTED ON A 14-FOOT BLACK FIBERGLASS POLE	PRIVATE; TO BE INSTALLED BY BGE
KNOWLEDGE DRIVE	10+35	17.5' LT	150-WATT H.P.S. VAPOR PREMIER POST TOP MOUNTED ON A 14-FOOT BLACK FIBERGLASS POLE	PRIVATE; TO BE INSTALLED BY BGE
SIMPLICITY COURT	10+20.86	21' RT	150-WATT H.P.S. VAPOR PREMIER POST TOP MOUNTED ON A 14-FOOT BLACK FIBERGLASS POLE	PRIVATE; TO BE INSTALLED BY BGE

PERMIT INFORMATION CHART					
SUBDIVISION NAME	SECTION/AREA	LOT/PARCEL NO.	PLAT # OR L/F	GRID #	ZONING
WALDEN WOODS	N/A	4			
			5192	2	PSC
				47	
				6	
					6068.21

ADDRESS CHART	
UNIT #	STREET ADDRESS
COMMUNITY CENTER (LOT 98)	9816 WILDERNESS LANE

APPROVED
PLANNING BOARD OF HOWARD COUNTY
PB406
DATE **10/08/2014**



APPROVED: DEPARTMENT OF PLANNING AND ZONING
Chad E. ... 10-21-15
CHIEF-DEVELOPMENT ENGINEERING DIVISION

APPROVED: DEPARTMENT OF PLANNING AND ZONING
Michael ... 10-23-15
CHIEF-DIVISION OF LAND DEVELOPMENT

OPEN SPACE TABULATION	
GROSS ACREAGE =	18.61± AC
OPEN SPACE REQUIRED =	6.51 AC. (35%)
OPEN SPACE PROVIDED =	11.21 AC. (60%)
PROPOSED DISTURBANCE AREA =	14.80 AC.

DENSITY TABULATION	
GROSS ACREAGE =	18.61± AC.
FLOODPLAIN =	0.35 AC.
STEEP SLOPES =	0.30 AC.
NET ACREAGE =	17.96 AC.
ALLOWABLE UNITS =	(8 PER NET AC.)
TOTAL ALLOWABLE UNITS =	143
PROPOSED UNITS =	97
* EXCLUSIVE OF FLOODPLAIN	

PARKING ANALYSIS	
PARKING REQUIRED:	
87 TOWNHOME UNITS x 2 SP/UNIT =	174 SPACES
10 SFD UNITS x 2 SP/UNIT =	20 SPACES
SFD GUEST SPACES (10 LOTS X 0.5 SP/LOT) =	5 SPACES
SFA GUEST SPACES (87 LOTS X 0.35 SP/LOT) =	28 SPACES
OVERFLOW SPACES (87 UNITS X 0.5 SP/UNIT) =	43 SPACES
TOTAL SPACES REQUIRED =	274 SPACES
PARKING PROPOSED:	
97 UNITS x 2 SP/GARAGE =	194 SPACES
17 UNITS x 2 SP/DRIVEWAY =	34 SPACES
COMMON/GUEST SPACES (INCLUDING 3 ADA SPACES) =	42 SPACES
TOTAL SPACES PROVIDED =	430 SPACES

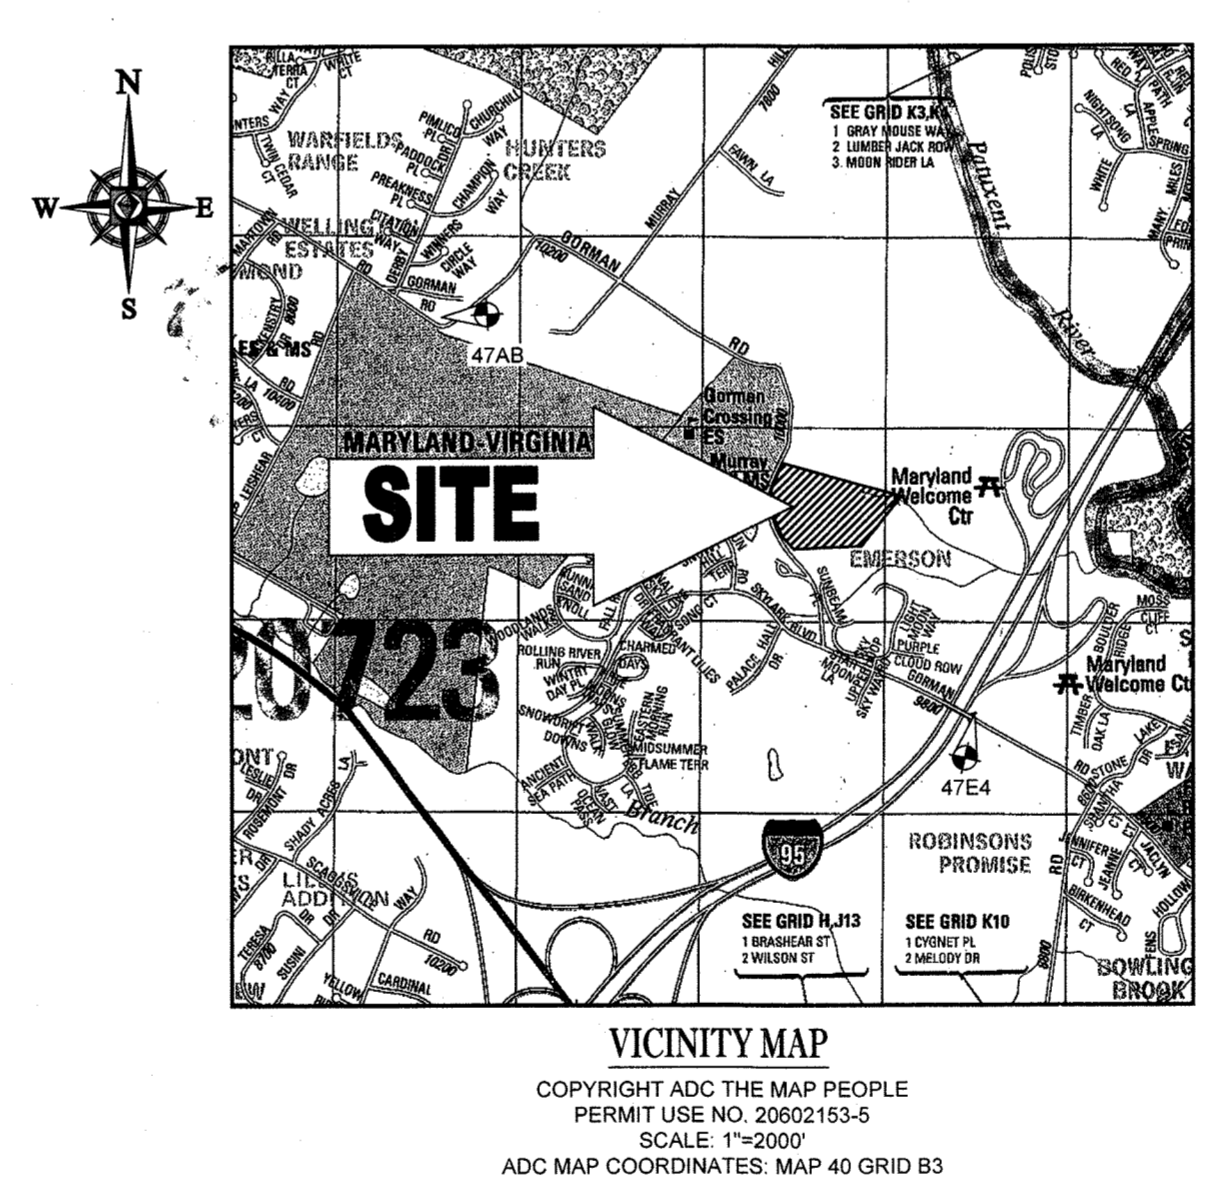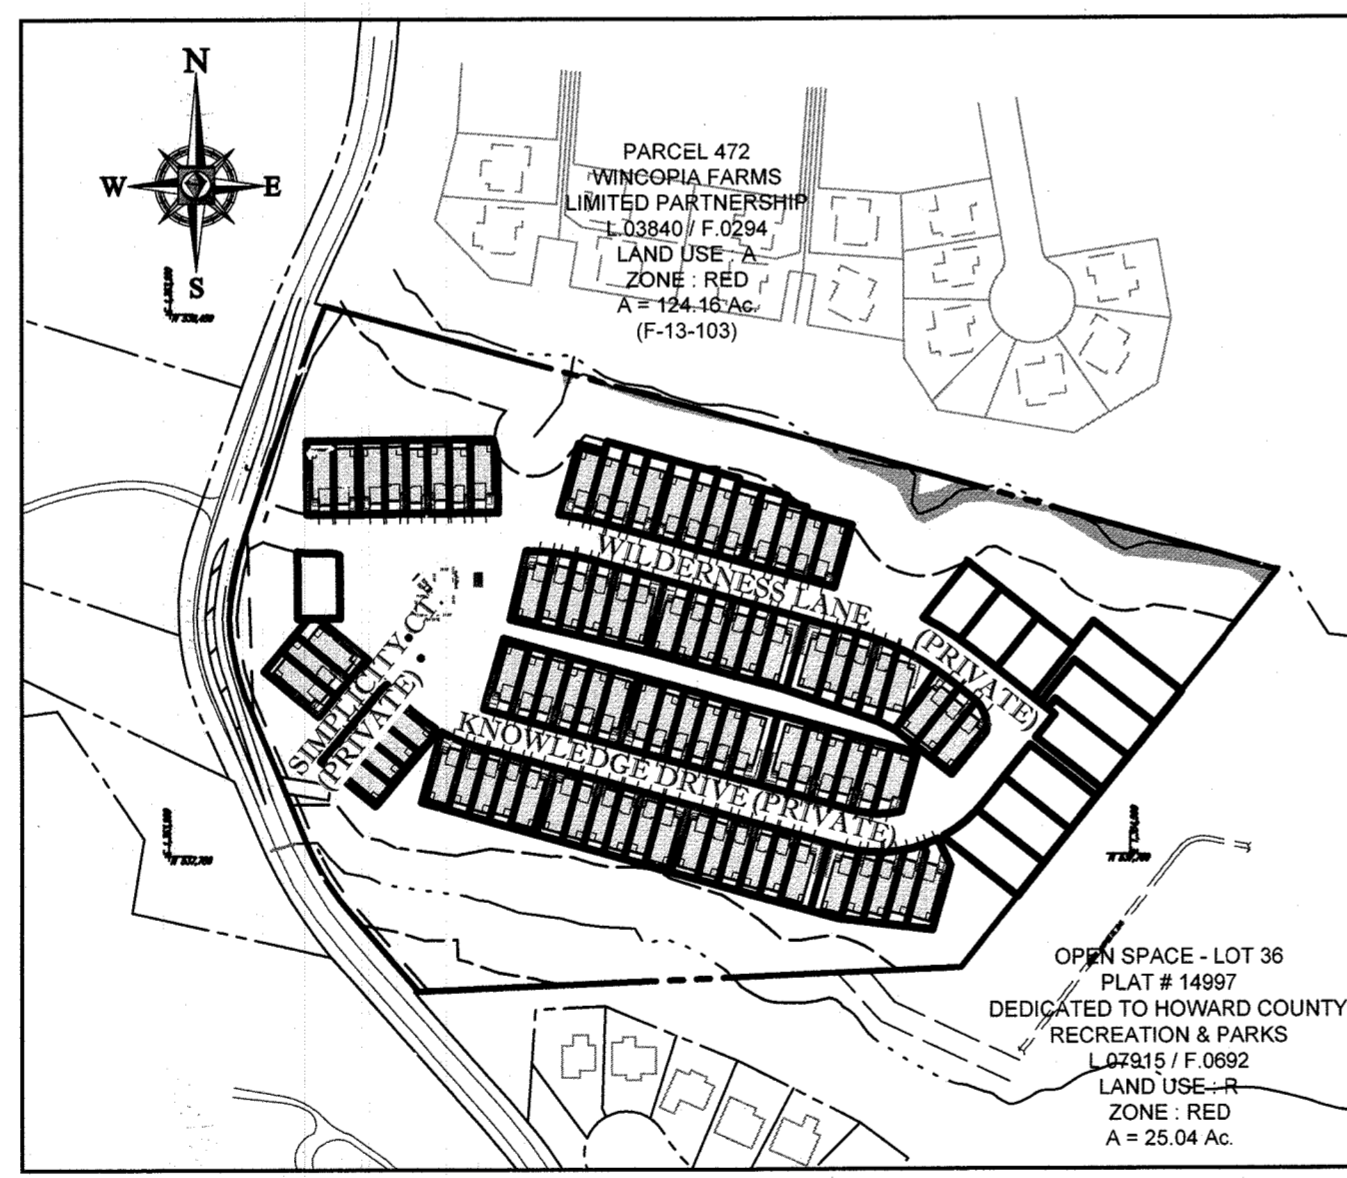

NOTE: THERE IS NO AS-BUILT INFORMATION PROVIDED ON THIS SITE.

Professional L.S. # 10849 Exp. 2/28/20
AS-BUILT DATE: **7/21/15**
Shensberger & Sons

8/31/15 REVISION TO UPDATE CLUBHOUSE/COMMUNITY CENTER AND SURROUNDING AREA.

PREPARED BY

BOHLER ENGINEERING

901 DULANEY VALLEY ROAD, SUITE 801
TOWSON, MARYLAND 21204
Phone: (410) 821-7900
Fax: (410) 821-7987
www.BohlerEngineering.com

CONTACT: BRANDON R. ROWE, P.E.

GENERAL NOTES

- THE PROPERTY IS ZONED PSC PER THE OCTOBER 6, 2013 COMPREHENSIVE ZONING REGULATIONS, Z.B. CASE 1041M DATED MAY 16, 2005 AND Z.B. CASE 1101M DATED JULY 31, 2012.
- PROPOSED USE FOR SITE AND STRUCTURES: AGE RESTRICTED TOWNHOME (SFA) AND SINGLE FAMILY UNITS (SFD).
- TOTAL AREA OF PROPERTY = 18.61 AC.
- TOTAL AREA OF FLOOD PLAIN = 0.35 AC.
- TOTAL AREA SLOPES IN EXCESS OF 25% = 0.30 AC.
- NET TRACT AREA = 17.96 AC.
TOTAL AREA OF DISTURBANCE = 14.80 ± AC.
TOTAL AREA OF HOUSES = 3.54 ± AC.
- TOTAL NUMBER OF BUILDABLE UNITS ALLOWED = 143 UNITS (8 PER NET ACRE)
- TOTAL NUMBER OF PROPOSED BUILDABLE UNITS = 87 UNITS
A. NUMBER OF SINGLE FAMILY ATTACHED (TOWNHOUSES) = 87 UNITS
B. NUMBER OF SINGLE FAMILY DETACHED = 10 UNITS
- TOTAL AREA OF ROADWAY DEDICATION = 0.08 AC. DEDICATED UNDER F-13-032.
- THE CONTRACTOR SHALL NOTIFY THE CONSTRUCTION INSPECTION DIVISION AT (410) 313-1880 AT LEAST (5) WORKING DAYS PRIOR TO THE START OF WORK.
- THE CONTRACTOR SHALL NOTIFY "MISS UTILITY" AT 1-800-257-7777 AT LEAST 48 HOURS PRIOR TO ANY EXCAVATION WORK.
- PUBLIC WATER AND PUBLIC SEWER TO BE UTILIZED. EXISTING UTILITIES ARE BASED ON CURRENT HOWARD COUNTY CONTRACT DRAWINGS.
EX. 12" WATER - CONTRACT NO. 44-3874
EX. 12" WATER - CONTRACT NO. 34-4338-D
EX. 8" SEWER - CONTRACT NO. 20-3733
- WETLANDS AND STREAM BUFFERS WERE DELINEATED BY ECO-SCIENCE PROFESSIONALS ON APRIL 9, 2012.
- THE PROPERTY SHOWN IS LOCATED WITHIN THE METROPOLITAN DISTRICT.
- THE BOUNDARY AND TOPOGRAPHY IS BASED ON A FIELD MONUMENTED SURVEY PERFORMED BY JOHN C. MELLEMA SR. INC. IN AUGUST, 2004.
- IN ACCORDANCE WITH SECTION 128 OF THE HOWARD COUNTY ZONING REGULATIONS, BAY WINDOWS, CHIMNEYS OR EXTERIOR STAIRWAYS NOT MORE THAN 16 FEET IN WIDTH MAY PROJECT NOT MORE THAN 4 FEET INTO ANY SETBACKS, PORCHES OR DECKS. OPEN OR ENCLOSED MAY PROJECT NOT MORE THAN 10 FEET INTO THE FRONT OR REAR YARD SETBACK EXTERIOR STAIRWAYS OR RAMPS, ABOVE OR BELOW GROUND LEVEL MAY PROJECT UP TO 10 FEET INTO A FRONT SETBACK OR PROJECT BOUNDARY SETBACK OR UP TO 18 FEET INTO A REAR SETBACK.
- A STRUCTURE AND USE SETBACK LINE HAS BEEN ESTABLISHED PER SECT. 127.1.F.2
HOWARD COUNTY CONTRACT DRAWINGS.
A. WIDTH - 12 (15) SERVING MORE THAN ONE RESIDENCE
B. SURFACE - SIX (6) INCHES OF COMPACTED CRUSHER RUN BASE WITH TAR AND CHIP COATING (1 1/2" MIN.)
C. GEOMETRY - MAXIMUM 15% GRADE, MAXIMUM 10% GRADE CHANGE AND 45 FOOT TURNING RADIUS
D. STRUCTURES (CULVERTS/BRIDGES) - CAPABLE OF SUPPORTING 25 GROSS TONS (M25-LOADING)
E. DRAINAGE ELEMENTS - CAPABLE OF SAFELY PASSING 100 YEAR FLOOD WITH NO MORE THAN 1 FOOT DEPTH OVER DRIVEWAY.
F. STRUCTURE CLEARANCES - MINIMUM 12 FEET
G. MAINTENANCE - SUFFICIENT TO INSURE ALL WEATHER USE.
- REFUSE COLLECTION, SNOW REMOVAL AND PRIVATE ROAD MAINTENANCE WILL BE PROVIDED BY THE HOMEOWNERS ASSOCIATION. REFUSE COLLECTION TO BE PROVIDED BY PRIVATE CONTRACTOR.
- THIS PROJECT IS SUBJECT TO THE AMENDED SUBDIVISION AND LAND DEVELOPMENT REGULATIONS ADOPTED PER COUNCIL BILL 45-2003 EFFECTIVE OCTOBER 2, 2003, THE ZONING REGULATIONS PER COUNCIL BILL NO. 75-2003 ADOPTED 2/2/04 AND THE OCTOBER 6, 2013 COMPREHENSIVE ZONING REGULATIONS.
- ALL ROADS AND PARKING AREAS ARE TO BE PRIVATELY MAINTAINED BY THE HOA.
- HORIZONTAL AND VERTICAL CONTROL DATUM IS BASED ON HOWARD COUNTY GEODETIC CONTROL STATIONS:
HOWARD COUNTY MONUMENT 47E4 N 535946 138 E 1355431 199 ELEV. = 338.18 FT
HOWARD COUNTY MONUMENT 47A8 N 540058 246 E 135005 038 ELEV. = 397.57 FT.
- THE FOREST CONSERVATION REQUIREMENTS PER SECTION 16.1202 OF THE HOWARD COUNTY CODE AND THE FOREST CONSERVATION MANUAL FOR THIS PROJECT HAS BEEN FULFILLED BY RETENTION OF EXISTING FOREST IN THE AMOUNT OF 3.2 ACRES AND 2.0 ACRES OF REFORESTATION FOR THE FOREST CONSERVATION EASEMENT AREA OF 5.2 ACRES. THE SURETY AMOUNT FOR OFF-SITE REFORESTATION IS \$ 0.00. AND ON-SITE REFORESTATION IS \$22,673.00 FOR A TOTAL SURETY AMOUNT OF \$22,673.00 WHICH WILL BE PART OF THE DEVELOPER SURETY SHEETS 17 & 18. OFFSITE MITIGATION TO BE PROVIDED AT CHELSEA KNOLLS FOREST CONSERVATION BANK (SDP-14-032).
- SIDEWALKS ARE TO BE PROVIDED OR CONSTRUCTED ON ONE SIDE OF THE PROPOSED ROAD. WAIVER WP-13-093 WAS APPROVED ON MAY 14, 2013 TO ELIMINATE SIDEWALK ALONG PORTIONS OF GORMAN ROAD AND ONE SIDE OF THE PROPOSED ROADS.
- TOTAL NUMBER OF "MODERATE INCOME HOUSING UNITS" REQUIRED FOR THIS SITE PER THE (PSC) ZONING DISTRICT IS 10%
A) TOTAL NUMBER OF "M.I.H.U." REQUIRED = 10
B) THE DEVELOPER WILL PAY A FEE-IN-LIEU TO THE COUNTY TO SATISFY THE M.I.H.U. REQUIREMENTS
- STORMWATER MANAGEMENT FACILITIES ARE NON MD-378 FACILITIES, AND WILL BE PRIVATELY OWNED AND MAINTAINED.
- ANY DAMAGE TO THE COUNTY'S RIGHT-OF-WAY SHALL BE CORRECTED AT THE DEVELOPER'S EXPENSE.
- ALL CONSTRUCTION SHALL BE IN ACCORDANCE WITH THE LATEST STANDARDS AND SPECIFICATIONS OF HOWARD COUNTY PLUS MSHA STANDARDS AND SPECIFICATIONS IF APPLICABLE.
- ALL EXISTING STRUCTURES SHALL BE RAZED. THE FOUR (4) EXISTING DWELLING UNITS MUST BE RAZED PRIOR TO PLAC REORDINATION.
- THERE ARE NO HISTORIC STRUCTURES OR CEMETERIES LOCATED ON THIS PROPERTY.
- THIS PSC DISTRICT IS SUBJECT TO COMPLIANCE WITH THE DECISION AND ORDER ISSUED FOR ZB CASE NO. 1041M APPROVED BY THE HOWARD COUNTY ZONING BOARD ON MAY 16, 2005 AND REAPPROVED ON JULY 31, 2012 PER ZONING CASE ZB-1101M. TO CREATE A PSC OVERLAY ZONE ON THIS PROPERTY. NO CONDITIONS WERE IMPOSED.
- NO CLEARING, GRADING OR CONSTRUCTION IS PERMITTED WITHIN FLOODPLAIN, WETLANDS, STREAMS AND THEIR BUFFERS AND FOREST CONSERVATION EASEMENTS, EXCEPT AS PERMITTED BY WP-12-151. WP-12-011 WAS APPROVED ON MAY 29, 2012 WHICH WAIVED SECTION 16.116(A)(2)(iii) ALLOWING FOR DISTURBANCE WITHIN THE STREAM BUFFER AS SHOWN ON PLAN.
- ALL PLAN DIMENSIONS ARE TO FACE OF CURB UNLESS OTHERWISE NOTED.
- THIS PLAN HAS BEEN PREPARED IN ACCORDANCE WITH THE PROVISION OF SECTION 16.124 OF THE HOWARD COUNTY CODE AND LANDSCAPE MANUAL. FINANCIAL SURETY FOR THE REQUIRED LANDSCAPING HAS BEEN POSTED AS PART OF THE DEVELOPER'S AGREEMENT IN THE AMOUNT OF \$112,050 FOR ADDITIONAL DETAIL SEE SHEET 16.
- A NOISE STUDY PERFORMED ON THE EMERSON SITE INDICATED THE 65DBA LINE TO BE 500 FT. EAST OF THIS PROPERTY. SEE F-01-140 SHEET 11 OF 25.
- PARKING IS ONLY ALLOWED WITHIN GARAGES, MARKED PARKING SPACES OR DRIVEWAYS. PARKING IS PROHIBITED ALONG CURBS.
- NO PHASING IS PROPOSED.

THIS PROJECT COMPLIES WITH THE COMMUNITY BUILDING REQUIREMENT PER THE PSC ZONING REGULATIONS OF 20 SQUARE FEET PER UNIT (RE. SECT 127.1.B.8.a) OR 1,940 SQUARE FEET BY PROVIDING A COMMUNITY CENTER BUILDING OF 2,560 SQUARE FEET IN SIZE.

THIS PLAN INCLUDES RECREATION AND COMMUNITY ACTIVITY AREAS FOR RESIDENTS PER THE PSC ZONING REGULATIONS SUCH AS PATHWAYS, OUTDOOR SEATING AREAS, AND A COMMUNITY CENTER.

HOMEOWNER'S OR CONDOMINIUM ASSOCIATION FOR THIS PROJECT HAS BEEN OR WILL BE ESTABLISHED PRIOR TO SFP SIGNATURE APPROVAL WITH SFP SIGNATURE APPROVAL WITH THE STATE DEPARTMENT OF ASSESSMENT AND TAXATION ON **10/23/15** RECORDED AS **10-23-15** (TO BE PROVIDED)

ALL SIGN POSTS USED FOR TRAFFIC CONTROL SIGNS INSTALLED IN THE COUNTY RIGHT-OF-WAY SHALL BE MOUNTED ON A 2" GALVANIZED STEEL PERFORATED SQUARE TUBE POST (14 GAUGE), INSERTED INTO A 2-1/2" GALVANIZED STEEL PERFORATED SQUARE TUBE SLEEVE (12 GAUGE) - 3" LONG A GALVANIZED STEEL POLE CAP SHALL BE MOUNTED ON TOP OF EACH POST. THE ANCHOR SHALL NOT EXTEND MORE THAN TWO PERFORATIONS ABOVE GROUND LEVEL.

STREET LIGHTS WILL BE REQUIRED IN THIS DEVELOPMENT IN ACCORDANCE WITH THE DESIGN MANUAL. STREET LIGHTS PLACEMENTS AND THE TYPE OF FIXTURES AND POLE SELECTED SHALL BE IN ACCORDANCE WITH THE LATEST HOWARD COUNTY DESIGN MANUAL, VOLUME III (1998) AND AS MODIFIED BY GUIDELINES FOR THE STREET LIGHTS IN RESIDENTIAL DEVELOPMENTS (JUNE 1993). THE JUNE 1993 POLICY INCLUDING GUIDELINES FOR LATERAL AND LONGITUDINAL PLACEMENT. A MINIMUM SPACING OF 20' SHALL BE MAINTAINED BETWEEN ANY STREETLIGHT AND ANY TREE.

THIS PROJECT WILL COMPLY WITH THE UNIVERSAL DESIGN STANDARDS FOR AGE RESTRICTED ADULT HOUSING IN HOWARD COUNTY.

THE ARH DOCUMENTS ARE RECORDED AT LIBER **1183** FOLIO **138**

NO BUILDING PERMITS WILL BE ISSUED UNTIL ALL EXISTING DWELLINGS, WELLS, AND SEPTIC SYSTEMS HAVE BEEN ABANDONED IN COMPLIANCE WITH HEALTH DEPARTMENT REGULATIONS.

A WAIVER PETITION (WP-13-093) TO ALLOW REMOVAL OF TWO CHAMPION TREES WAS APPROVED BY HOWARD COUNTY DIVISION OF LAND DEVELOPMENT ON MAY 14, 2013.

A DESIGN MANUAL WAIVER REQUEST TO REDUCE MINIMUM HORIZONTAL CURVE RADI FOR ROADS WAS SUBMITTED TO HOWARD COUNTY DEVELOPMENT ENGINEERING DIVISION ON NOV. 29, 2012, AND A WAIVER TO ALLOW STORMDRAIN STRUCTURES IN PUBLIC WATER AND SEWER EASEMENTS WAS APPROVED BY HOWARD COUNTY DEPARTMENT OF PUBLIC WORKS ON FEB. 19, 2013.

PROPERTY WAS PREVIOUSLY PROPOSED FOR DEVELOPMENT AS WESTOVER GLEN (SDP-06-039 AND F-06-170) BUT WAS NOT RECORDED.

A PRIVATE RANGE OF ADDRESS SIGNS SHALL BE FABRICATED AND INSTALLED BY HOWARD COUNTY BUREAU OF HIGHWAYS AT THE DEVELOPERS/OWNERS EXPENSE. CONTACT HOWARD COUNTY TRAFFIC DIVISION AT 410-313-2430 FOR DETAILS AND COST ESTIMATE. THE R1-1 (STOP) SIGNS AND THE STREET NAME SIGN (SNS) ASSEMBLIES FOR THIS DEVELOPMENT MUST BE INSTALLED BEFORE THE BASE PAVING IS COMPLETED. b) THE TRAFFIC CONTROL DEVICE SHOWN ON THE PLANS ARE APPROXIMATE AND MUST BE FIELD APPROVED BY HOWARD COUNTY TRAFFIC DIVISION (410-313-2430) PRIOR TO THE INSTALLATION OF ANY OF THE TRAFFIC CONTROL DEVICES. c) ALL TRAFFIC CONTROL DEVICES AND THEIR LOCATIONS SHALL BE IN ACCORDANCE WITH THE LATEST EDITION OF THE MARYLAND MANUAL ON UNIFORM TRAFFIC CONTROL DEVICES.

STORMWATER MANAGEMENT FACILITIES WILL BE PROVIDED IN ACCORDANCE WITH CURRENT MDE AND HOWARD COUNTY STANDARDS UTILIZING BIO-RETENTION FACILITIES, SAND FILTERS, AND DRY WELLS. THE BIO-RETENTION FACILITIES AND SAND FILTERS WILL BE JOINTLY MAINTAIN BY HOWARD COUNTY AND THE HOA. THE COUNTY WILL MAINTAIN THE INLET STRUCTURE AND THE HOA WILL MAINTAIN THE UNDERDRAINS, MEDIA, PLANTINGS, ETC. WITHIN THE EASEMENTS. THE DRY WELLS WILL BE PRIVATELY MAINTAINED BY THE INDIVIDUAL HOMEOWNERS.

A WAIVER PETITION (WP-14-148) TO LAND A PHASED GRADING PERMIT WAS APPROVED BY HOWARD COUNTY DIVISION OF LAND DEVELOPMENT ON JULY 8, 2014 SUBJECT TO THE FOLLOWING CONDITIONS:

A. PETITIONERS MAY COMMENCE ACTIVITIES ONLY UPON APPROVAL OF A GRADING PLAN BY THE HOWARD COUNTY DEPARTMENT OF INSPECTIONS, LICENSES AND PERMITS.

B. PETITIONERS MAY COMMENCE PROPOSED PHASE 2 ACTIVITIES ONLY UPON PLANNING BOARD APPROVAL. BY VOTE, OF PLANNING BOARD CASE NUMBER PB 406 SITE DEVELOPMENT PLAN SDP-13-023 ON JULY 17, 2014.

C. THE DPV DEVELOPER AGREEMENT AND PAYMENT OF ALL REQUIRED FEES AND SURETIES ASSOCIATED WITH F-13-032 SHALL BE COMPLETED BY THE PETITIONER PRIOR TO INITIATION OF THE GORMAN ROAD IMPROVEMENTS AND WATER AND SEWER IMPROVEMENTS WITH THE RIGHT-OF-WAY.

D. PETITIONERS SHALL SEAL ALL EXISTING WELLS AND PROPERLY ABANDON ALL EXISTING SEPTIC SYSTEMS PRIOR TO GRADING OPERATIONS IN ACCORDANCE WITH THE ATTACHED HEALTH DEPARTMENT COMMENTS.

51. Per the Conditions of WP-13-093, Revision 19 on this plan, shows the Pathway Connection From the Walden Woods Subdivision (SDP13-023) to the Emerson Subdivision (F-01-140)

FOR REVISION 2 ONLY

FOR REVISION 19 ONLY

NO.	DATE	REVISION DESCRIPTION
19	11/21/15	Pathway Connection to Emerson
20	12/11/15	Revised Clubhouse/Community Center
21	8/31/15	Revised Clubhouse/Community Center

OWNER: M/I HOMES OF DC, LLC
21355 BANTON CIRCLE, SUITE 220
STERLING, VA 20156
CONTACT: CINDY HUNTZBERRY
PHONE: 443-677-9803

DEVELOPER: SOMERWORTH II, L.C.
5704 DORSEY HALL DRIVE, SUITE 205
ELLCOTT CITY, MD 21042
CONTACT: JASON VAN KIRK
PHONE: (410) 720-3021

PROJECT: REVISED SITE DEVELOPMENT PLAN
WALDEN WOODS

TAX MAP: 47 GRID: 2 ZONED: PSC
PARCEL: 4, LOTS 1-97, OPEN SPACE LOTS 98 - 102
6TH ELECTION DISTRICT, HOWARD COUNTY, MARYLAND


TITLE: COVER SHEET

BOHLER ENGINEERING
901 DULANEY VALLEY ROAD, SUITE 801
TOWSON, MARYLAND 21204
Phone: (410) 821-7900
Fax: (410) 821-7987
www.BohlerEngineering.com

CHECKED BY: BRR
DESIGNED BY: BRR
DRAWN BY: RMS/AVG
PROJECT NO.: MD112149
DATE: 10/27/14
SCALE: AS NOTED
DRAWING NO.: 1 OF 35

PROFESSIONAL CERTIFICATION
I, BRANDON R. ROWE, HEREBY CERTIFY THAT THESE DOCUMENTS WERE PREPARED OR APPROVED BY ME, AND THAT I AM A DULY LICENSED PROFESSIONAL ENGINEER UNDER THE LAWS OF THE STATE OF MARYLAND. LICENSE NO. 43808, EXPIRATION DATE: 7/30/215

BRANDON R. ROWE
PROFESSIONAL ENGINEER NO. 43808

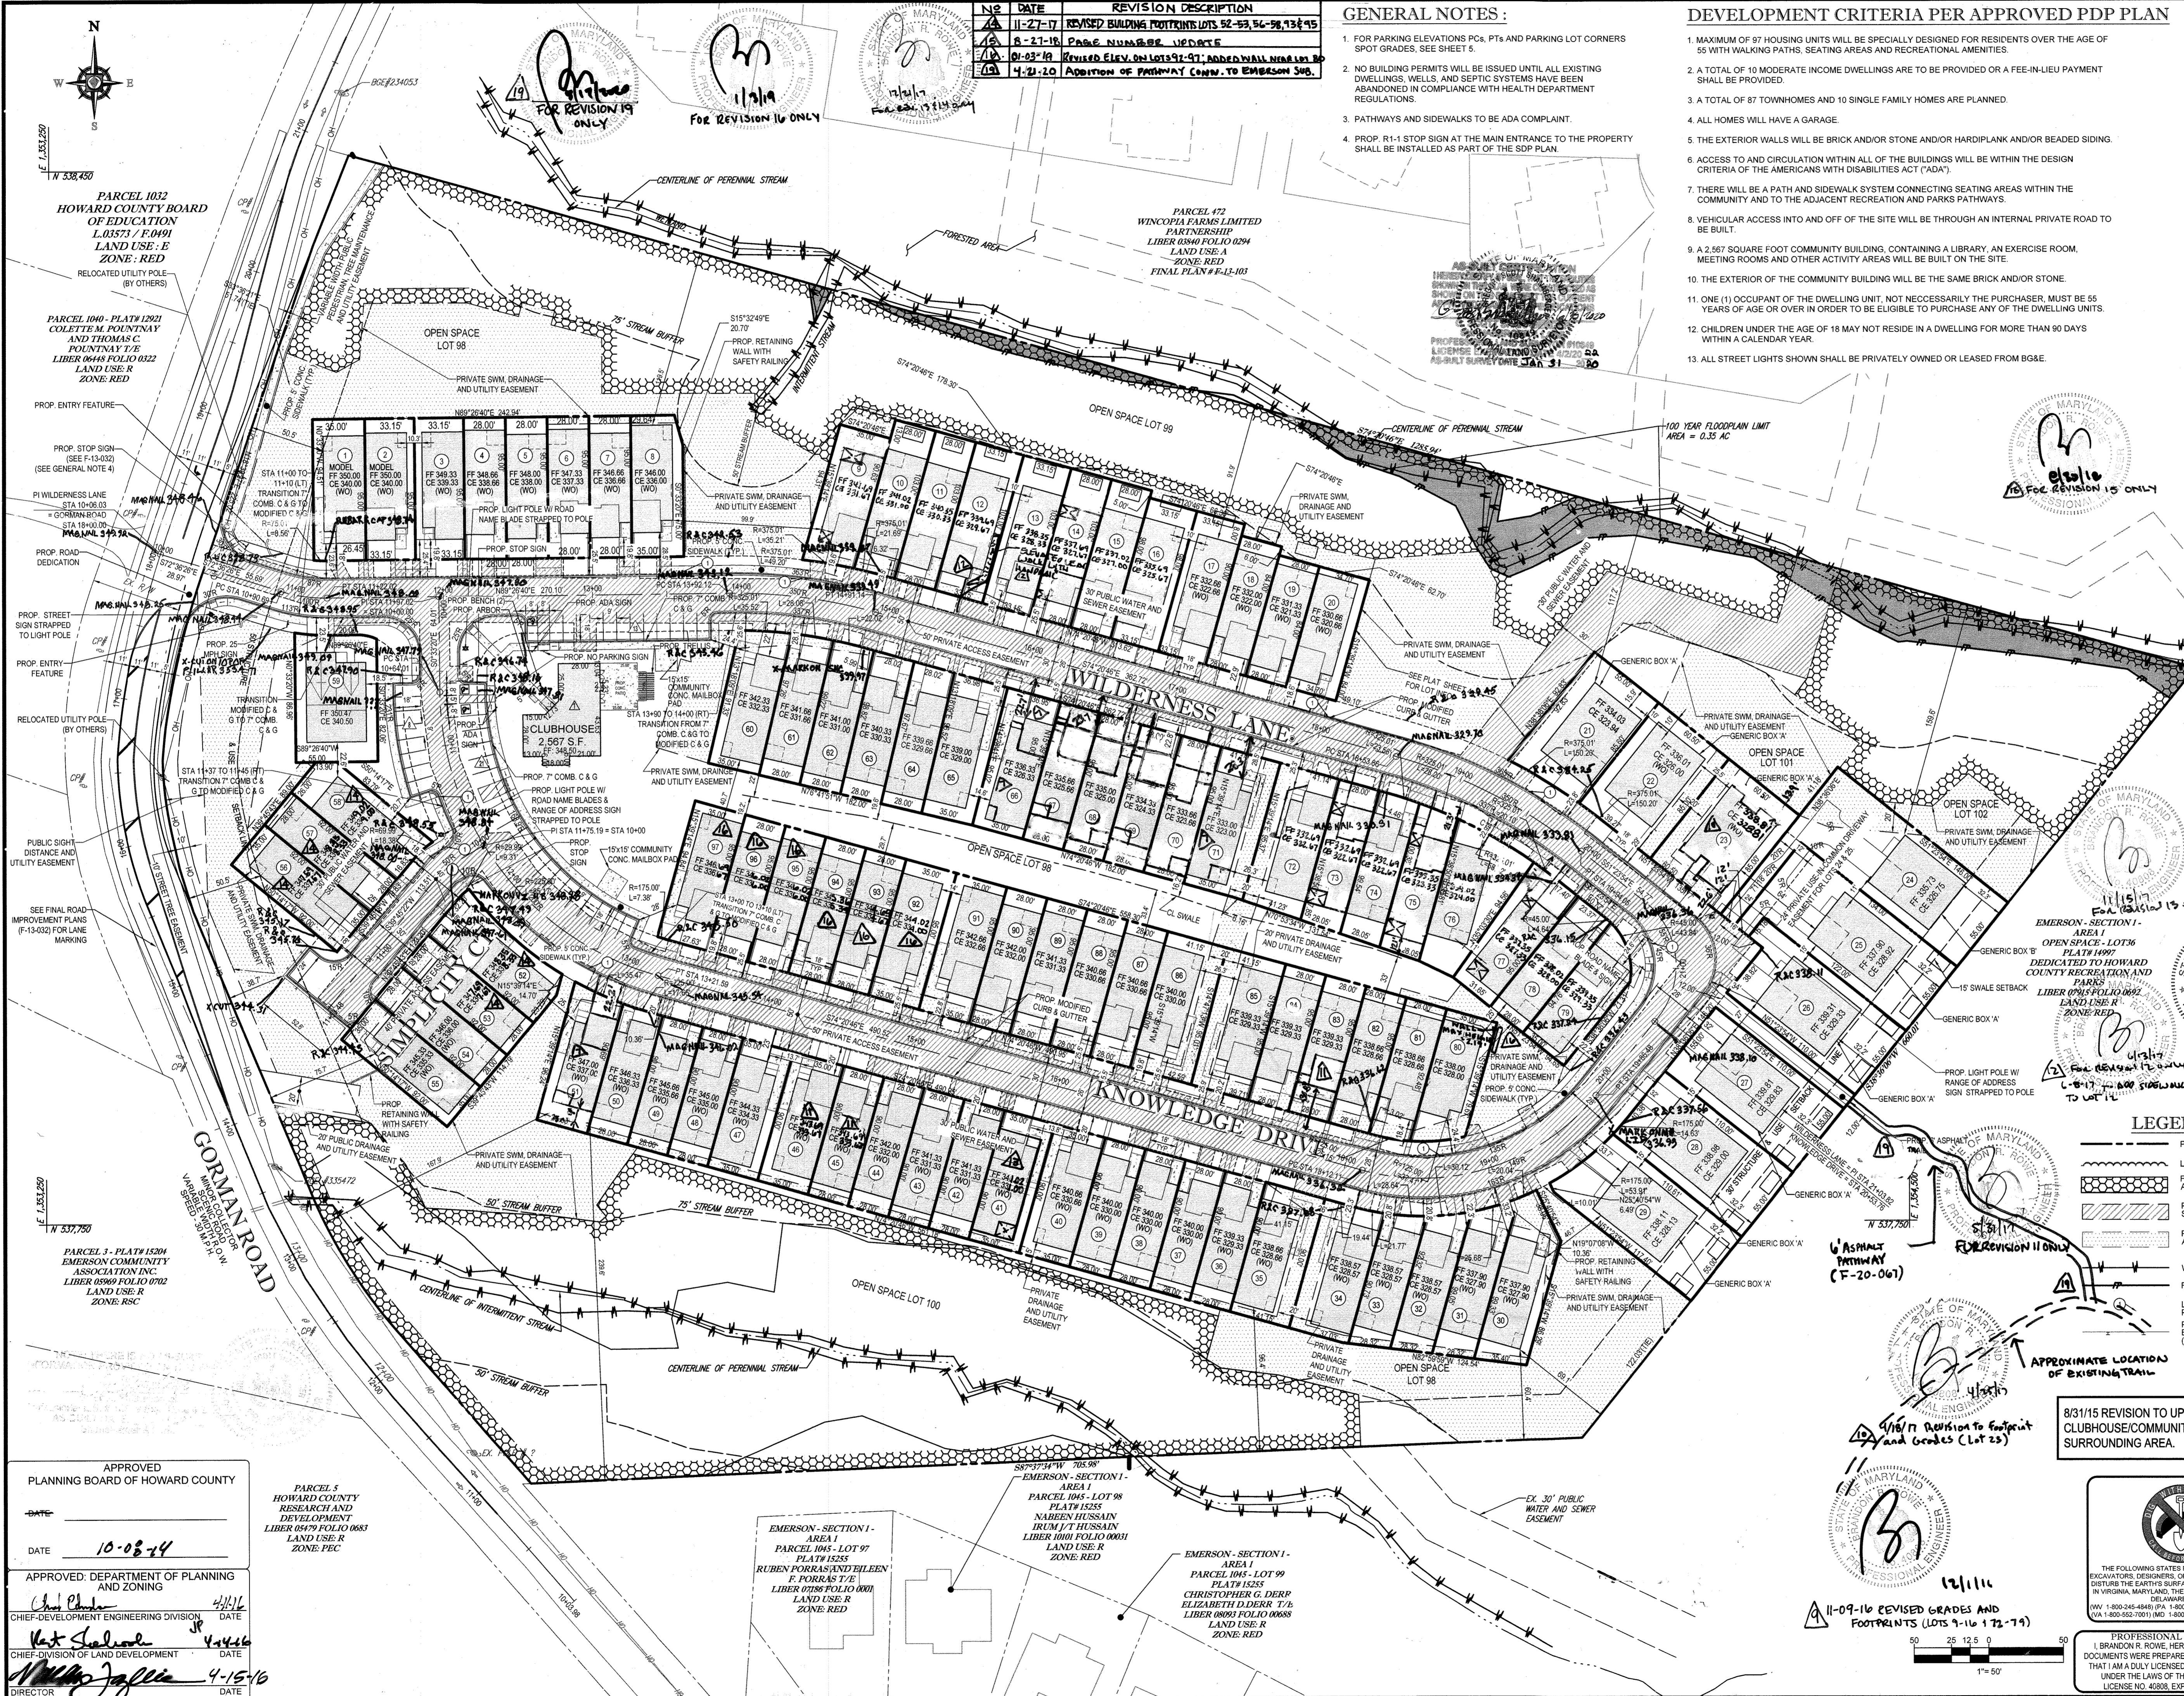

NO.	DATE	REVISION DESCRIPTION
1	11-27-17	REVISED BUILDING FOOTPRINTS LOTS 52-53, 56-58, 93&95
2	8-27-18	PAGE NUMBER UPDATE
3	01-03-19	REVISED ELEV. ON LOTS 91-97, ADDITIONAL NEARBY
4	4-21-20	ADDITION OF PATHWAY CONN. TO EMERSON SUB.

- GENERAL NOTES:**
- FOR PARKING ELEVATIONS PCL, PTs AND PARKING LOT CORNERS SPOT GRADES, SEE SHEET 5.
 - NO BUILDING PERMITS WILL BE ISSUED UNTIL ALL EXISTING DWELLINGS, WELLS, AND SEPTIC SYSTEMS HAVE BEEN ABANDONED IN COMPLIANCE WITH HEALTH DEPARTMENT REGULATIONS.
 - PATHWAYS AND SIDEWALKS TO BE ADA COMPLAINT.
 - PROP. R-11 STOP SIGN AT THE MAIN ENTRANCE TO THE PROPERTY SHALL BE INSTALLED AS PART OF THE SDP PLAN.

- DEVELOPMENT CRITERIA PER APPROVED PDP PLAN**
- MAXIMUM OF 97 HOUSING UNITS WILL BE SPECIALLY DESIGNED FOR RESIDENTS OVER THE AGE OF 55 WITH WALKING PATHS, SEATING AREAS AND RECREATIONAL AMENITIES.
 - A TOTAL OF 10 MODERATE INCOME DWELLINGS ARE TO BE PROVIDED OR A FEE-IN-LIEU PAYMENT SHALL BE PROVIDED.
 - A TOTAL OF 87 TOWNHOMES AND 10 SINGLE FAMILY HOMES ARE PLANNED.
 - ALL HOMES WILL HAVE A GARAGE.
 - THE EXTERIOR WALLS WILL BE BRICK AND/OR STONE AND/OR HARDPLANK AND/OR BEADED SIDING.
 - ACCESS TO AND CIRCULATION WITHIN ALL OF THE BUILDINGS WILL BE WITHIN THE DESIGN CRITERIA OF THE AMERICANS WITH DISABILITIES ACT (ADA).
 - THERE WILL BE A PATH AND SIDEWALK SYSTEM CONNECTING SEATING AREAS WITHIN THE COMMUNITY AND TO THE ADJACENT RECREATION AND PARKS PATHWAYS.
 - VEHICULAR ACCESS INTO AND OFF OF THE SITE WILL BE THROUGH AN INTERNAL PRIVATE ROAD TO BE BUILT.
 - A 2,567 SQUARE FOOT COMMUNITY BUILDING, CONTAINING A LIBRARY, AN EXERCISE ROOM, MEETING ROOMS AND OTHER ACTIVITY AREAS WILL BE BUILT ON THE SITE.
 - THE EXTERIOR OF THE COMMUNITY BUILDING WILL BE THE SAME BRICK AND/OR STONE.
 - ONE (1) OCCUPANT OF THE DWELLING UNIT, NOT NECESSARILY THE PURCHASER, MUST BE 55 YEARS OF AGE OR OVER IN ORDER TO BE ELIGIBLE TO PURCHASE ANY OF THE DWELLING UNITS.
 - CHILDREN UNDER THE AGE OF 18 MAY NOT RESIDE IN A DWELLING FOR MORE THAN 90 DAYS WITHIN A CALENDAR YEAR.
 - ALL STREET LIGHTS SHOWN SHALL BE PRIVATELY OWNED OR LEASED FROM BG&E.

AMENDED DEVELOPMENT CRITERIA PER ZONING, SECTION 127.1.B, C, D, F (1-5).

- A. PERMITTED USES:**
- AGE-RESTRICTED ADULT HOUSING.
- B. ACCESSORY USES:**
- SERVICES AND BUSINESSES THAT SERVE THE RESIDENTS OF THE PSC DISTRICT, INCLUDING RECREATIONAL, EDUCATIONAL, HEALTH, PERSONAL, PROFESSIONAL AND BUSINESS SERVICES.
 - HOME OCCUPATIONS, SUBJECT TO THE REQUIREMENTS OF SECTION 128 C.1.
 - COMMUNITY CENTER ALLOWS CUSTOMARY COMMUNITY ACTIVITIES INCLUDING BUT NOT LIMITED TO RECREATIONAL, SOCIAL AND EDUCATIONAL ACTIVITIES SUCH AS PICNICS, RUMMAGE SALES, CAKE SALES, DANCES, AND OTHER SIMILAR ACTIVITIES.
- C. BULK REGULATIONS:**
- MAXIMUM DENSITY IS 8.0 DWELLING UNITS PER NET ACRE.
 - MAXIMUM UNITS PER STRUCTURE:
 - a. SINGLE FAMILY ATTACHED = 8 UNITS PER STRUCTURE
 - b. BUILDING LENGTH = 320 FEET FOR SFA
 - MAXIMUM HEIGHT SHALL NOT EXCEED:
 - a. APARTMENTS AND GARDEN CONDOMINIUMS = 60 FT. (max.)
 - b. SINGLE FAMILY ATTACHED AND DETACHED = 34 FEET (max.)
 - c. ACCESSORY STRUCTURE = 15 FEET
 - MINIMUM DISTANCES BETWEEN RESIDENTIAL UNITS (ALL STYLES), EXCEPT IMPROVEMENTS MAY BE LOCATED ANYWHERE WITHIN SUCH SETBACK AREAS IF IN ACCORDANCE WITH A SITE DEVELOPMENT PLAN APPROVED BY THE PLANNING BOARD:
 - a. FACE TO FACE = 30 FEET
 - b. FACE TO SIDE/REAR TO SIDE = 10 FEET
 - c. SIDE TO SIDE = 10 FEET
 - d. REAR TO REAR = 25 FEET
 - e. REAR TO FACE = 20 FEET
 - MINIMUM DISTANCES BETWEEN RESIDENTIAL UNITS (ALL STYLES) AND EDGE OF PRIVATE ROAD ROADWAY, EXCEPT IMPROVEMENTS MAY BE LOCATED ANYWHERE WITHIN SUCH SETBACK AREAS IF IN ACCORDANCE WITH A SITE DEVELOPMENT PLAN APPROVED BY THE PLANNING BOARD:
 - a. RESIDENTIAL FRONT = 18 FEET (AS MEASURED FROM GARAGE DOOR ONLY)
 - b. RESIDENTIAL SIDE = 10 FEET
 - c. RESIDENTIAL REAR = 30 FEET
 - d. RESIDENTIAL ACCESSORY STRUCTURE = 10 FEET (EXCEPT RECREATIONAL AMENITIES)
 - GARDEN CONDOMINIUM = 10 FEET
 - MINIMUM DISTANCES BETWEEN COMMUNITY BUILDING, AND CASEROO STRUCTURES AND EDGE OF PRIVATE ROADWAY AND/OR PARKING AREAS = 10 FEET
 - BUILDING COVERAGE - NO COVERAGE REQUIREMENTS ARE IMPOSED OTHER THAN COMPLYING WITH THE 35% MINIMUM OPEN SPACE REQUIREMENTS FOR THE PSC DISTRICT:
 - a. FROM ARTERIAL OR COLLECTOR PUBLIC STREET:
 - RIGHT-OF-WAY = 50 FEET
 - FROM OTHER PUBLIC RIGHT-OF-WAY = 40 FEET
 - b. FROM RESIDENTIAL LOTS IN RC, RR, R-ED, R-20, R-12 OR R-SC DISTRICTS:
 - EXCEPT STRUCTURES CONTAINING APARTMENTS, ASSISTED LIVING FACILITIES OR NURSING FACILITIES = 75 FEET
 - R-20, R-12 & PSC DISTRICTS = 30 FEET
 - FROM OTHER DISTRICTS OTHER THAN RC, RR, R-ED, R-20, R-12 OR R-SC DISTRICTS = 30 FEET
- D. OTHER PROVISIONS:**
- THE PROVISIONS OF SECTION 128 (SUPPLEMENTAL ZONING DISTRICT REGULATIONS) AND SECTION 133 (OFF-STREET PARKING AND LOADING FACILITIES) PER APPROVED FEBRUARY 2, 2004 ZONING REGULATIONS SHALL APPLY IN THE PSC DISTRICT.
 - THE PLAN ALLOWS FOR SOME FLEXIBILITY IN THE EXACT LOCATION AND DENSITY OF LAND USES.
- E. LANDSCAPING AND SCREENING:**
- THE MINIMUM LANDSCAPING AND SCREENING REQUIREMENTS SHALL BE IN ACCORDANCE WITH THE SUBDIVISION REGULATIONS, THE ZONING REGULATIONS AND THE HOWARD COUNTY LANDSCAPING MANUAL.
- F. PARKING STANDARDS:**
- | | |
|---|-------------------|
| 87 TOWNHOME UNITS X 2 SP/UNIT = | 174 SPACES |
| 10 SFD UNITS X 2 SP/UNIT = | 20 SPACES |
| 870 GUEST SPACES (10 LOTS X 0.5 SP/LOT) = | 435 SPACES |
| 570 GUEST SPACES (87 LOTS X 0.3 SP/LOT) = | 25 SPACES |
| OVERFLOW SPACES (97 UNITS X 0.5 SP/UNITS) = | 49 SPACES |
| TOTAL SPACES REQUIRED = | 274 SPACES |

LEGEND

- PROPERTY LINE
- LIMITS OF CLEARING
- FOREST CONSERVATION AREA
- PUBLIC WATER AND SEWER EASEMENT
- PRIVATE SWM, DRAINAGE AND UTILITY EASEMENT
- WETLAND LIMITS
- FLOODPLAIN LIMITS
- LIMITS OF CURB PAINTED ROAD
- PROP. ROAD END BARRICADE (R-5-11)

11-10-17 REVISED LOT GRADING & FF EL.

00-08-17 REVISED SIDEWALK GRADING ON LOT 12

1/2016 REVISION TO REVISE SFD GENERIC FOOTPRINT AND FFICE ELEVATIONS

NO.	DATE	REVISION DESCRIPTION
1	04-6-17	REVISED FOOTPRINT FOR LOTS 3-4 AND 10
2	02-11-16	REVISED SFD GENERIC FOOTPRINT
3	10-27-15	UPDATED GRADING FOR LOTS 17-20
4	03-31-15	REVISED CLUBHOUSE/COMMUNITY CENTER

APPROVED
PLANNING BOARD OF HOWARD COUNTY

DATE: _____
DATE: 10-08-14

APPROVED: DEPARTMENT OF PLANNING AND ZONING

DATE: 4/11/16

CHIEF-DEVELOPMENT ENGINEERING DIVISION

DATE: 4/15/16

CHIEF-DIVISION OF LAND DEVELOPMENT

DATE: _____

DIRECTOR

PARCEL 5
HOWARD COUNTY
RESEARCH AND
DEVELOPMENT
LIBER 05479 FOLIO 0683
LAND USE: R
ZONE: PEC

EMERSON - SECTION 1 -
AREA 1
PARCEL 1045 - LOT 97
PLAT 15255
RUBEN PORRAS AND ELLEN
F. PORRAS T/E
LIBER 0708 FOLIO 0001
LAND USE: R
ZONE: RED

EMERSON - SECTION 1 -
AREA 1
PARCEL 1045 - LOT 98
PLAT 15255
NABEEN HUSSAIN
IRUM / T HUSSAIN
LIBER 1001 FOLIO 0003
LAND USE: R
ZONE: RED

EMERSON - SECTION 1 -
AREA 1
PARCEL 1045 - LOT 99
PLAT 15255
CHRISTOPHER G. DERR
ELIZABETH D. DERR T/E
LIBER 0805 FOLIO 0068
LAND USE: R
ZONE: RED

OWNER:
M/I HOMES OF DC, LLC
21355 RIDGETOP CIRCLE, SUITE 220
STERLING, VA 20166
CONTACT: CINDY HUNTZBERRY
PHONE: 443-677-9803

DEVELOPER:
SOMERWORTH II, L.C.
5704 DORSEY HALL DRIVE, SUITE 205
ELLCOTT CITY, MD 21142
CONTACT: JASON VAN KIRK
PHONE: (410) 720-3021

PROJECT: REVISED SITE DEVELOPMENT PLAN
WILDEN WOODS

TAX MAP: 47 GRID: 2 ZONED: PSC
PARCEL 4, LOTS 1-97, OPEN SPACE LOTS 98 - 102
6TH ELECTION DISTRICT, HOWARD COUNTY, MARYLAND

TITLE: **SITE DEVELOPMENT PLAN**


BOHLER ENGINEERING

901 DULANEY VALLEY ROAD, SUITE 801
TOWSON, MARYLAND 21284
Phone: (410) 821-7900
Fax: (410) 821-7987
www.BohlerEngineering.com

CHECKED BY: BRR
DESIGNED BY: BRR
DRAWN BY: RMS/JAG
PROJECT NO.: MD112149
DATE: 6/23/14
SCALE: 1" = 50'
DRAWING NO.: 4 OF 38



PROFESSIONAL CERTIFICATION
I, BRANDON R. ROWE, HEREBY CERTIFY THAT THESE DOCUMENTS WERE PREPARED OR APPROVED BY ME, AND THAT I AM A DULY LICENSED PROFESSIONAL ENGINEER UNDER THE LAWS OF THE STATE OF MARYLAND, LICENSE NO. 40808, EXPIRATION DATE: 7/31/2015

11-09-10 REVISED GRADES AND FOOTPRINTS (LOTS 9-16 & 72-79)

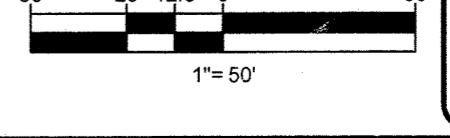


NO.	DATE	REVISION DESCRIPTION
1	11-27-17	REVISED BUILDING FOOTPRINTS FOR LOTS 52-59 & 61-63
2	8-27-18	PAGE NUMBER UPDATE
3	12-06-18	REVISED GRADING ON LOT 56
4	01-03-19	REVISED ELEV. ON LOT 91-97, ADDED WILDERNESS LOT 50
5	03-26-19	REVISED GARAGE ELEV. ON LOTS 92-94

U-21-20 ADDED PATHWAY CONN. TO EMERSON SUE.

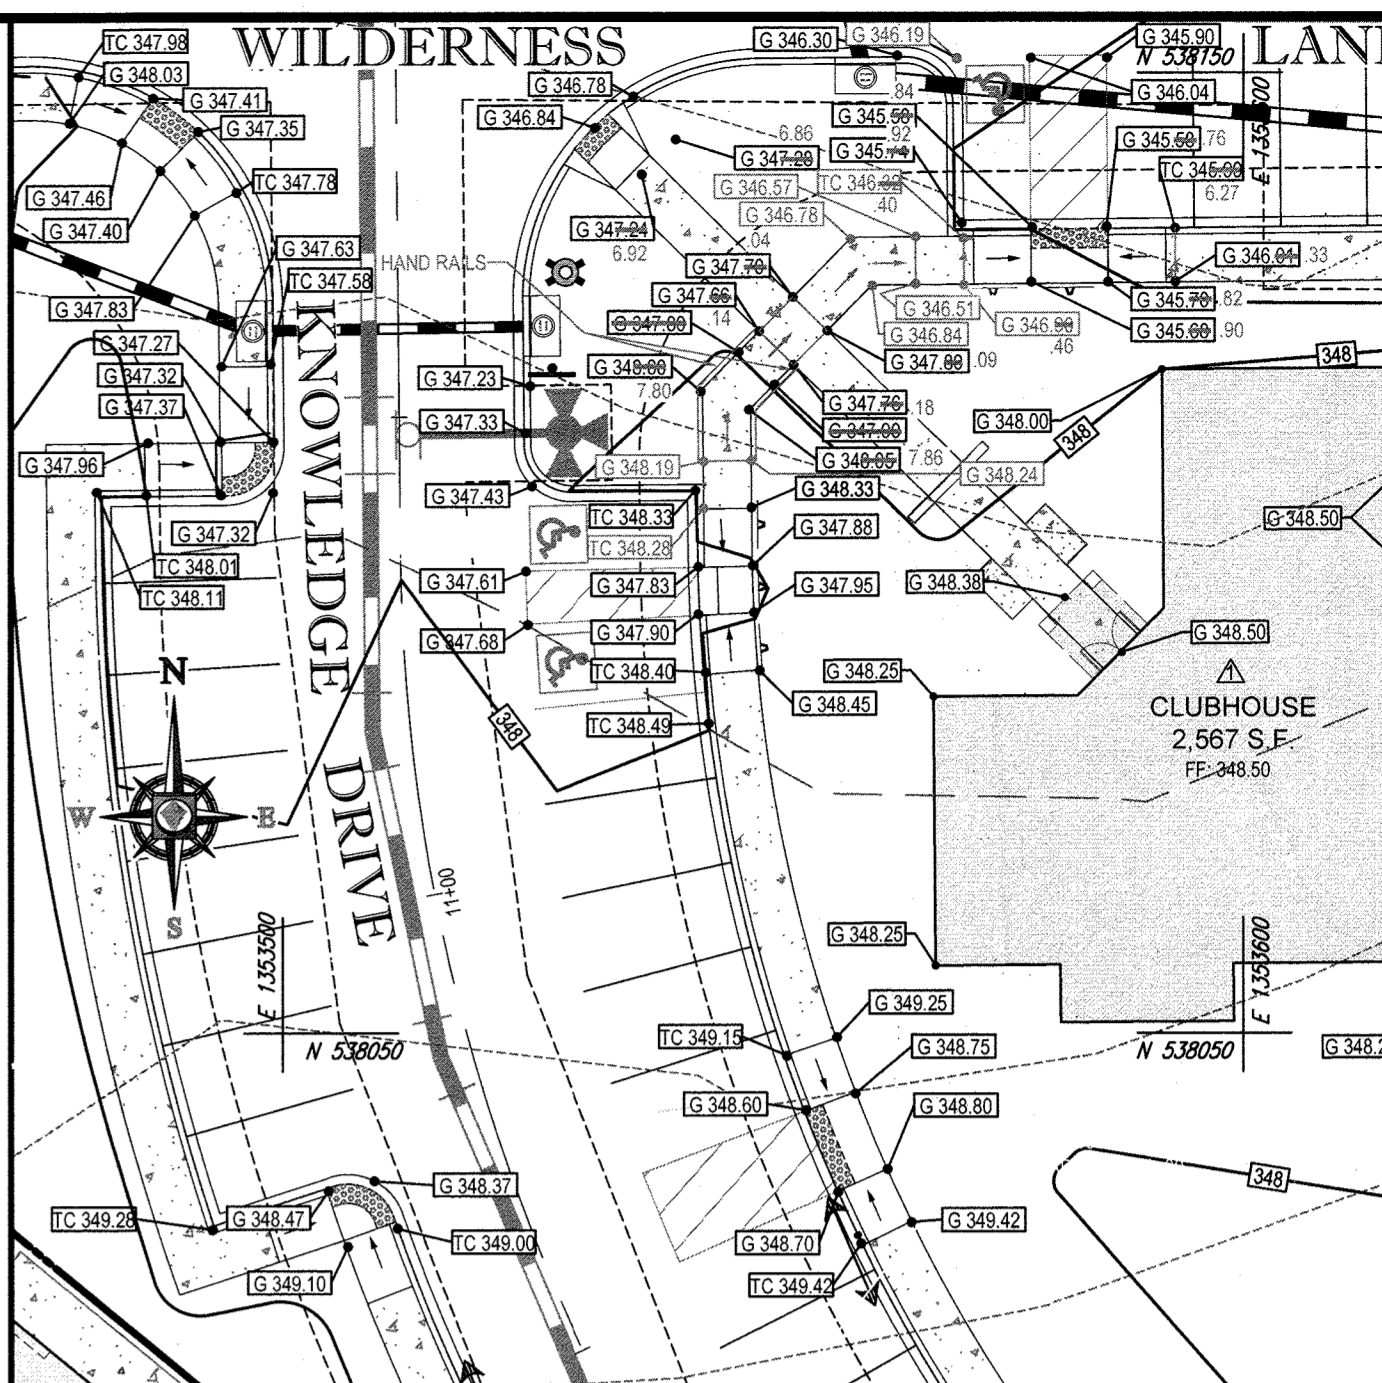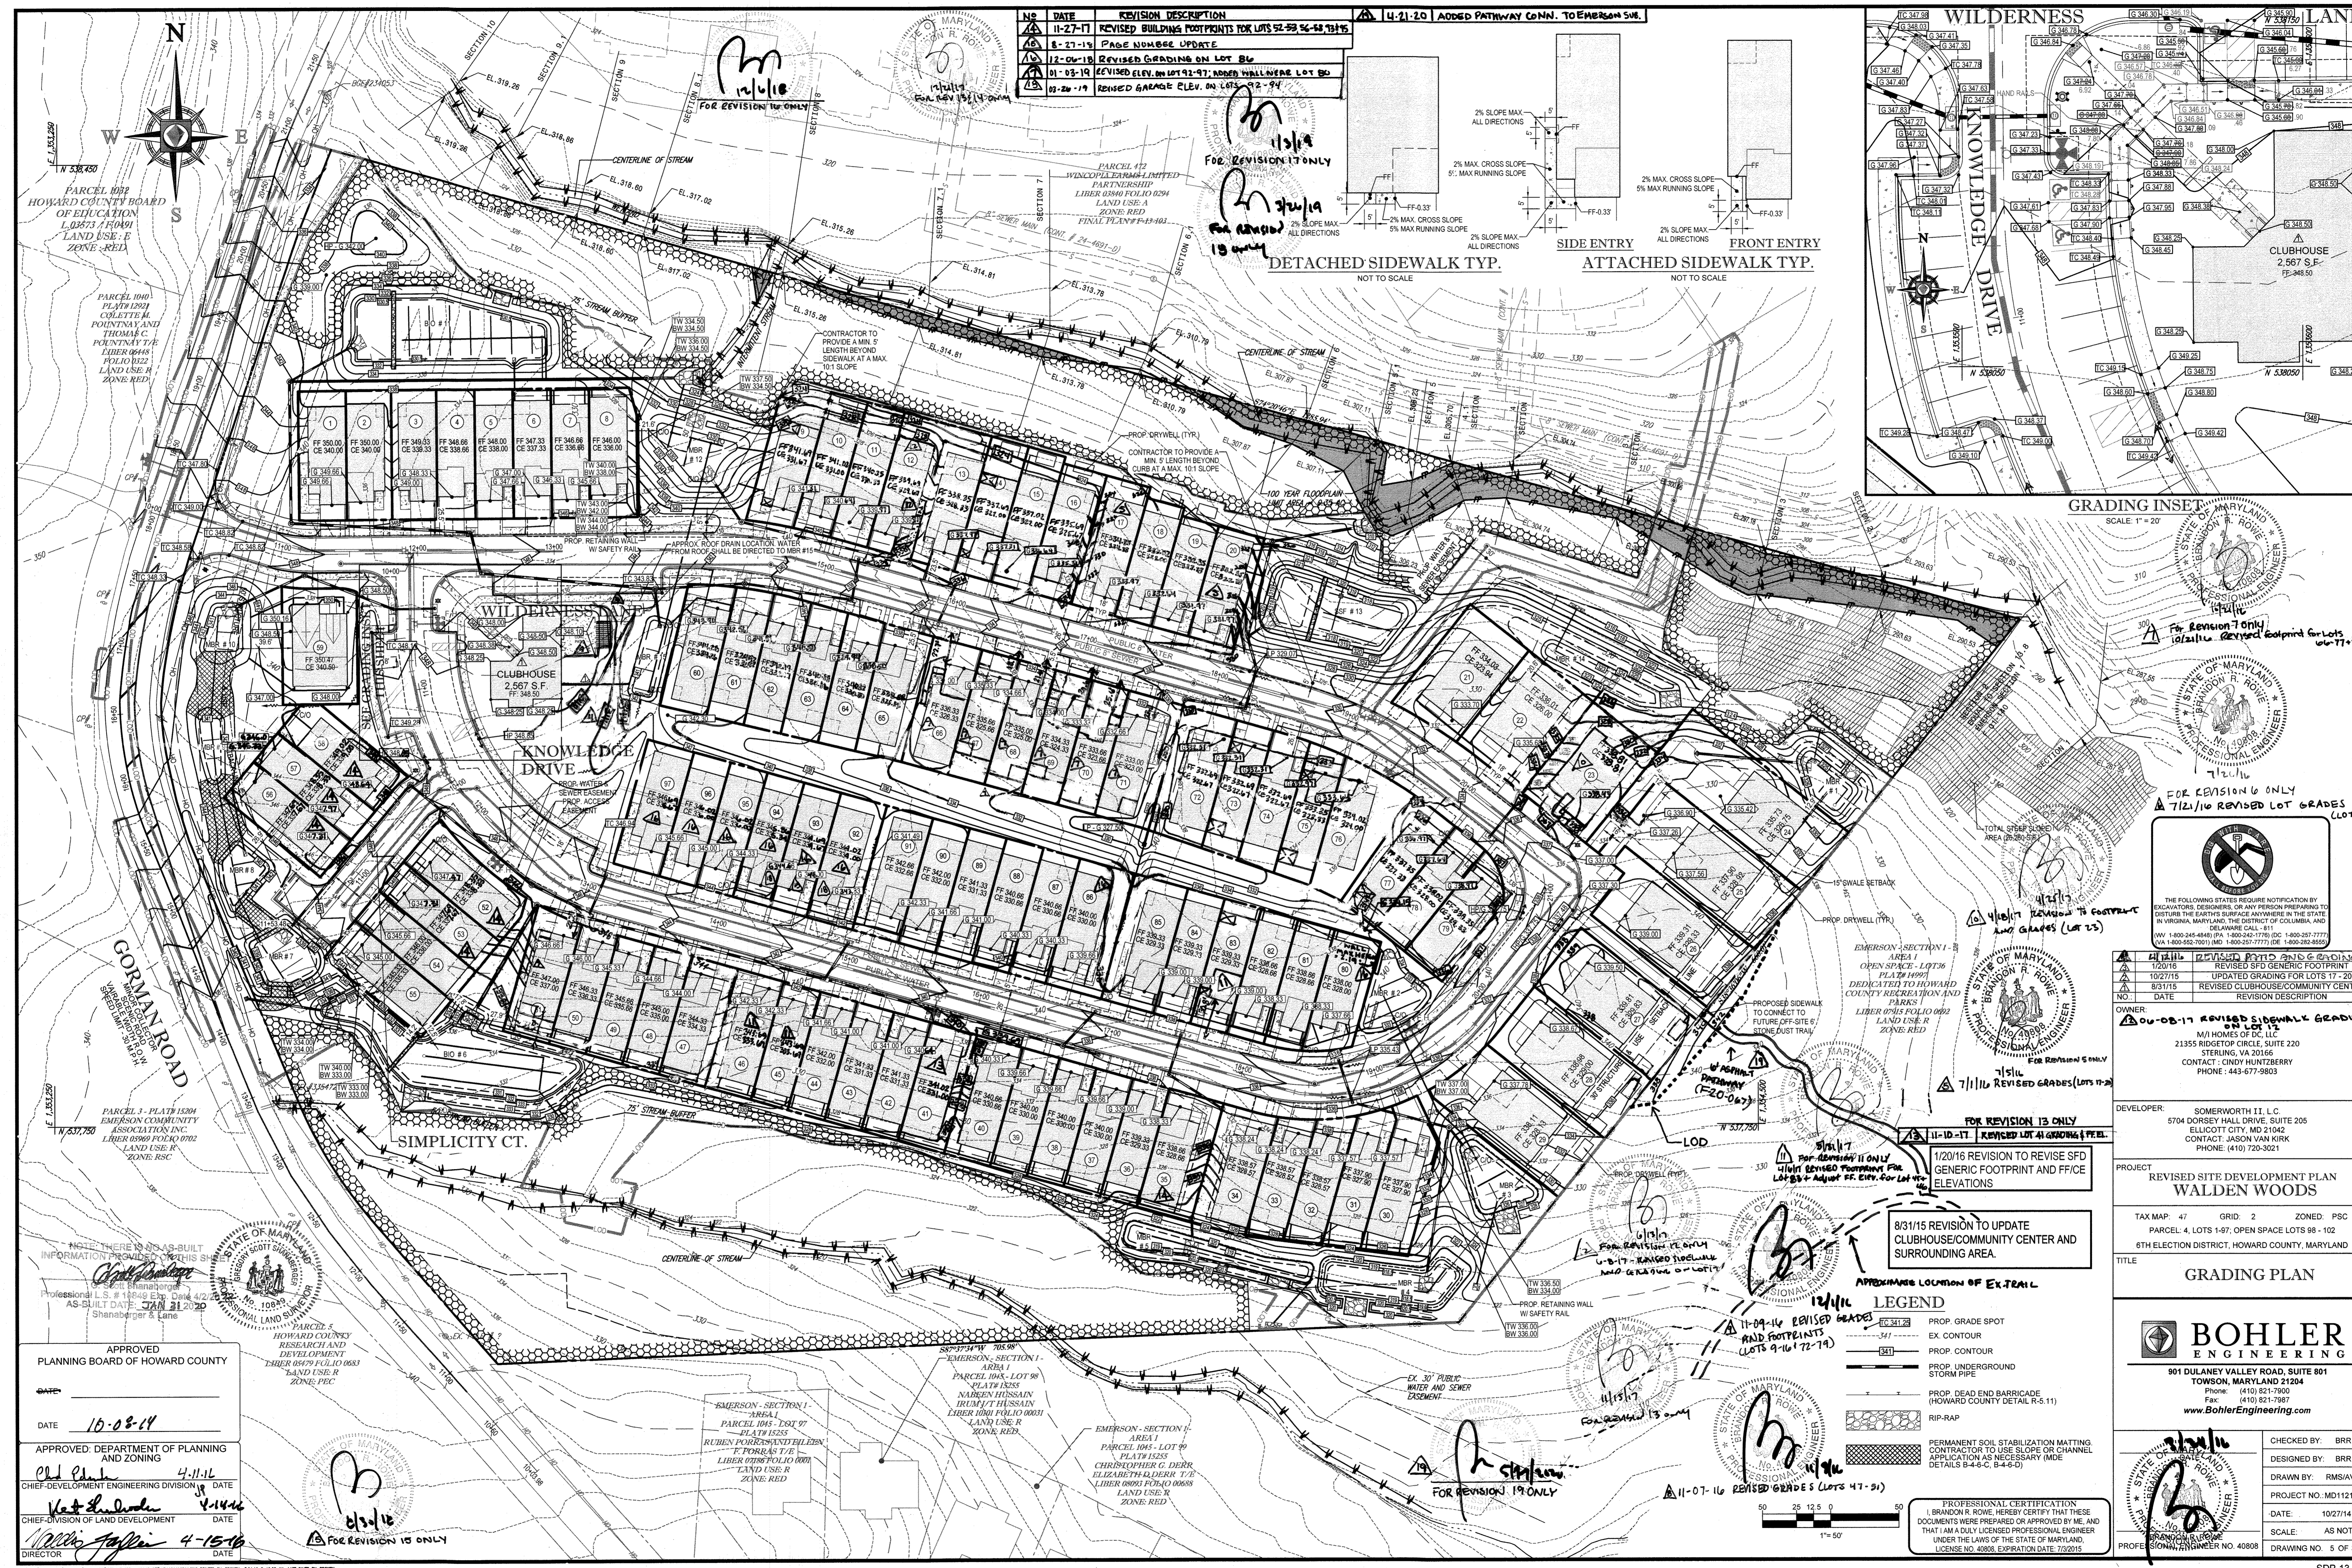

GRADING INSET
SCALE: 1" = 20'

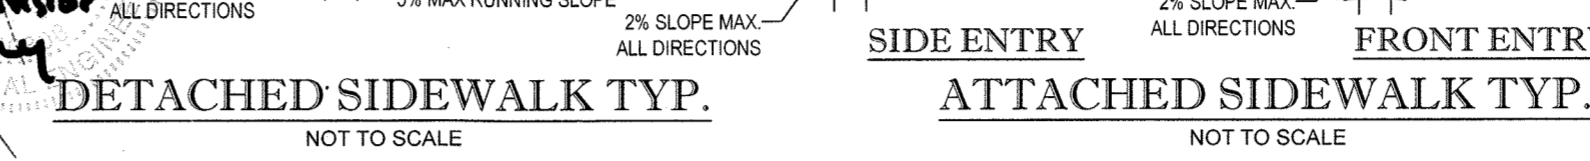

FOR REVISION 7 ONLY
12/11/16 REVISED FOOTPRINT FOR LOTS 17-20

FOR REVISION 6 ONLY
7/11/16 REVISED LOT GRADES (LOT 27)

THE FOLLOWING STATES REQUIRE NOTIFICATION BY EXCAVATORS, DESIGNERS, OR ANY PERSON PREPARING TO DISTURB THE EARTH'S SURFACE ANYWHERE IN THE STATE OF VIRGINIA, MARYLAND, THE DISTRICT OF COLUMBIA, AND DELAWARE CALL - 811
MD 1-800-245-4848 (PA) 1-800-267-7770 (DC) 1-800-257-7777 (VA) 1-800-552-7001 (MD) 1-800-257-7777 (DE) 1-800-282-8559

EMERSON - SECTION 1 - AREA 1
OPEN SPACE - LOT 76
PLAT 1699
DEDICATED TO HOWARD COUNTY RECREATION AND PARKS
LIBER 0549 FOLIO 002
LAND USE: R
ZONE: RED

OWNER:
M/HOMES OF DC, LLC
21355 RIDGETOP CIRCLE, SUITE 220
STERLING, VA 20155
CONTACT: CINDY HUNTZBERG
PHONE: 443-677-9803

DEVELOPER:
SOMERWORTH II, L.C.
5704 DORSEY HALL DRIVE, SUITE 205
STERLING, VA 20155
CONTACT: JASON VAN KIRK
PHONE: (410) 720-3021

PROJECT:
REVISED SITE DEVELOPMENT PLAN
WILDERNESS WOODS

TAX MAP: 47 GRID: 2 ZONED: PSC
PARCEL: 4, LOTS 1-97, OPEN SPACE LOTS 98-102
6TH ELECTION DISTRICT, HOWARD COUNTY, MARYLAND

TITLE:
GRADING PLAN

BOHLER ENGINEERING
901 DULANEY VALLEY ROAD, SUITE 801
TOWSON, MARYLAND 21284
Phone: (410) 821-7900
Fax: (410) 821-7987
www.BohlerEngineering.com

CHECKED BY:	BRR
DESIGNED BY:	BRR
DRAWN BY:	RMS/AG
PROJECT NO.:	MD112149
DATE:	10/27/14
SCALE:	AS NOTED
DRAWING NO.:	5 OF 35

APPROVED
PLANNING BOARD OF HOWARD COUNTY
DATE: 10-08-14
APPROVED: DEPARTMENT OF PLANNING AND ZONING
DATE: 4-11-16
CHIEF-DEVELOPMENT ENGINEERING DIVISION
DATE: 4-14-16
CHIEF-DIVISION OF LAND DEVELOPMENT
DATE: 4-15-16
DIRECTOR



FOR REVISION 15 ONLY
10/15/16

FOR REVISION 19 ONLY
11/15/17

FOR REVISION 13 ONLY
11-09-16 REVISED GRADES AND FOOTPRINTS (LOTS 9-16 17-19)

FOR REVISION 11 ONLY
8/31/15 REVISION TO UPDATE CLUBHOUSE/COMMUNITY CENTER AND SURROUNDING AREA

FOR REVISION 10 ONLY
11-10-17 REVISED LOT 41 GRADING & FEEL

FOR REVISION 5 ONLY
7/11/16 REVISED LOT GRADES (LOTS 17-20)

FOR REVISION 7 ONLY
4/11/17 REVISED TO CORRECT LOT 25 GRADES (LOT 25)

FOR REVISION 6 ONLY
7/11/16 REVISED LOT GRADES (LOT 27)

FOR REVISION 5 ONLY
7/11/16 REVISED LOT GRADES (LOTS 17-20)

FOR REVISION 10 ONLY
11-10-17 REVISED LOT 41 GRADING & FEEL

FOR REVISION 11 ONLY
8/31/15 REVISION TO UPDATE CLUBHOUSE/COMMUNITY CENTER AND SURROUNDING AREA

FOR REVISION 13 ONLY
11-09-16 REVISED GRADES AND FOOTPRINTS (LOTS 9-16 17-19)

FOR REVISION 19 ONLY
11-15-17

FOR REVISION 15 ONLY
10/15/16

FOR REVISION 10 ONLY
11-10-17 REVISED LOT 41 GRADING & FEEL

FOR REVISION 11 ONLY
8/31/15 REVISION TO UPDATE CLUBHOUSE/COMMUNITY CENTER AND SURROUNDING AREA

FOR REVISION 13 ONLY
11-09-16 REVISED GRADES (LOTS 9-16 17-19)

FOR REVISION 19 ONLY
11-15-17

PROFESSIONAL CERTIFICATION
I, BRANDON R. ROWE, HEREBY CERTIFY THAT THESE DOCUMENTS WERE PREPARED OR APPROVED BY ME, AND THAT I AM A DULY LICENSED PROFESSIONAL ENGINEER UNDER THE LAWS OF THE STATE OF MARYLAND, LICENSE NO. 4088, EXPIRATION DATE: 7/31/2015

PROFESSIONAL ENGINEER NO. 4088

SDP-13-023

B-4.1 STANDARDS AND SPECIFICATIONS FOR VEGETATIVE STABILIZATION

DEFINITION USING VEGETATION AS COVER TO PROTECT EXPOSED SOIL FROM EROSION

PURPOSE TO PROMOTE THE ESTABLISHMENT OF VEGETATION ON EXPOSED SOIL

CONDITIONS WHERE PRACTICE APPLIES ON ALL DISTURBED AREAS NOT STABILIZED BY OTHER METHODS...

EFFECTS ON WATER QUALITY AND QUANTITY STABILIZATION PRACTICES ARE USED TO PROMOTE THE ESTABLISHMENT OF VEGETATION ON EXPOSED SOIL...

PLANTING VEGETATION IN DISTURBED AREAS WILL HAVE AN EFFECT ON THE WATER BUDGET...

VEGETATION WILL HELP REDUCE THE MOVEMENT OF SEDIMENT, NUTRIENTS, AND OTHER CHEMICALS...

SEDIMENT CONTROL PRACTICES MUST REMAIN IN PLACE DURING GRADING, SEEDBED PREPARATION, SEEDING, MULCHING, AND VEGETATIVE ESTABLISHMENT.

ADEQUATE VEGETATIVE ESTABLISHMENT

INSPECT SEEDING AREAS FOR VEGETATIVE ESTABLISHMENT AND MAKE NECESSARY REPAIRS, REPLACEMENTS, AND RESEEDINGS WITHIN THE PLANTING SEASON.

- 1. ADEQUATE VEGETATIVE STABILIZATION REQUIRES 95 PERCENT GROUND COVER.
2. IF AN AREA HAS LESS THAN 40 PERCENT GROUND COVER, RE-STABILIZE FOLLOWING THE ORIGINAL RECOMMENDATIONS FOR LIME, FERTILIZER, SEEDBED PREPARATION, AND SEEDING.
3. IF AN AREA HAS BETWEEN 40 AND 94 PERCENT GROUND COVER, OVER-SEED AND FERTILIZE USING HALF OF THE RATES ORIGINALLY SPECIFIED.
4. MAINTENANCE FERTILIZER RATES FOR PERMANENT SEEDING ARE SHOWN IN TABLE B.6.

B-4.1 STANDARDS AND SPECIFICATIONS FOR INCREMENTAL STABILIZATION

DEFINITION ESTABLISHMENT OF VEGETATIVE COVER ON CUT AND HILL SLOPES.

PURPOSE TO PROVIDE TIMELY VEGETATIVE COVER ON CUT AND HILL SLOPES AS WORK PROGRESSES.

CONDITIONS WHERE PRACTICE APPLIES ANY CUT OR HILL SLOPE GREATER THAN 15 FEET IN HEIGHT, THIS PRACTICE ALSO APPLIES TO STOCKPILES.

CRITERIA A. INCREMENTAL STABILIZATION - CUT SLOPES

- 1. EXCAVATE AND STABILIZE CUT SLOPES IN INCREMENTS NOT TO EXCEED 15 FEET IN HEIGHT. PREPARE SEEDBED AND APPLY SEED AND MULCH ON ALL CUT SLOPES AS THE WORK PROGRESSES.
2. CONSTRUCTION SEQUENCE EXAMPLE (REFER TO FIGURE B.1):
a. CONSTRUCT AND STABILIZE ALL TEMPORARY SWALES OR DIKES THAT WILL BE USED TO CONVEY RUNOFF AROUND THE EXCAVATION.
b. PERFORM PHASE 1 EXCAVATION, PREPARE SEEDBED, AND STABILIZE.
c. PERFORM PHASE 2 EXCAVATION, PREPARE SEEDBED, AND STABILIZE. OVERSEED PHASE 1 AREAS AS NECESSARY.
d. PERFORM FINAL PHASE EXCAVATION, PREPARE SEEDBED, AND STABILIZE. OVERSEED PREVIOUSLY SEEDED AREAS AS NECESSARY.

NOTE: ONCE EXCAVATION HAS BEGUN THE OPERATION SHOULD BE CONTINUOUS FROM GRUBBING THROUGH THE COMPLETION OF GRADING AND PLACEMENT OF TOPSOIL (IF REQUIRED) AND PERMANENT SEED AND MULCH. ANY INTERRUPTIONS IN THE OPERATION OR COMPLETING THE OPERATION OUT OF THE SEEDING SEASON WILL NECESSITATE THE APPLICATION OF TEMPORARY STABILIZATION.



FIGURE B.1: INCREMENTAL STABILIZATION - CUT

B. INCREMENTAL STABILIZATION - HILL SLOPES

- 1. CONSTRUCT AND STABILIZE HILL SLOPES IN INCREMENTS NOT TO EXCEED 15 FEET IN HEIGHT. PREPARE SEEDBED AND MULCH ON ALL SLOPES AS THE WORK PROGRESSES. STABILIZE SLOPES IMMEDIATELY WHEN THE VERTICAL HEIGHT OF A LIFT REACHES 15 FEET, OR WHEN THE GRADING OPERATION CEASES AS PRESCRIBED IN THE PLANS.
2. AT THE END OF EACH DAY, INSTALL TEMPORARY WATER CONVEYANCE PRACTICE(S), AS NECESSARY, TO INTERCEPT SURFACE RUNOFF AND CONVEY IT DOWN THE SLOPE IN A NON-EROSIVE MANNER.
3. CONSTRUCTION SEQUENCE EXAMPLE (REFER TO FIGURE B.2):
a. CONSTRUCT AND STABILIZE ALL TEMPORARY SWALES OR DIKES THAT WILL BE USED TO DIVERT RUNOFF AROUND THE HILL. CONSTRUCT SILT FENCE ON LOW SIDE OF HILL UNLESS OTHER METHODS SHOWN ON THE PLANS ADDRESS THIS AREA.
b. AT THE END OF EACH DAY, INSTALL TEMPORARY WATER CONVEYANCE PRACTICE(S), AS NECESSARY, TO INTERCEPT SURFACE RUNOFF AND CONVEY IT DOWN THE SLOPE IN A NON-EROSIVE MANNER.
c. PLACE PHASE 1 FILL, PREPARE SEEDBED, AND STABILIZE.
d. PLACE PHASE 2 FILL, PREPARE SEEDBED, AND STABILIZE.
e. PLACE FINAL PHASE FILL, PREPARE SEEDBED, AND STABILIZE. OVERSEED PREVIOUSLY SEEDED AREAS AS NECESSARY.

NOTE: ONCE THE PLACEMENT OF FILL HAS BEGUN THE OPERATION SHOULD BE CONTINUOUS FROM GRUBBING THROUGH THE COMPLETION OF GRADING AND PLACEMENT OF TOPSOIL (IF REQUIRED) AND PERMANENT SEED AND MULCH. ANY INTERRUPTIONS IN THE OPERATION OR COMPLETING THE OPERATION OUT OF THE SEEDING SEASON WILL NECESSITATE THE APPLICATION OF TEMPORARY STABILIZATION.



FIGURE B.2: INCREMENTAL STABILIZATION - HILL

B-4.2 STANDARDS AND SPECIFICATIONS FOR SOIL PREPARATION, TOPSOILING, AND SOIL AMENDMENTS

DEFINITION THE PROCESS OF PREPARING THE SOILS TO SUSTAIN ADEQUATE VEGETATIVE STABILIZATION.

PURPOSE TO PROVIDE A SUITABLE SOIL MEDIUM FOR VEGETATIVE GROWTH.

CONDITIONS WHERE PRACTICE APPLIES WHERE VEGETATIVE STABILIZATION IS TO BE ESTABLISHED.

CRITERIA A. SOIL PREPARATION

- 1. TEMPORARY STABILIZATION
a. SEEDBED PREPARATION CONSISTS OF LOOSENING SOIL TO A DEPTH OF 3 TO 5 INCHES BY MEANS OF SUITABLE AGRICULTURAL OR CONSTRUCTION EQUIPMENT, SUCH AS DISC HARROWS OR CHURNERS MOUNTED ON CONSTRUCTION EQUIPMENT. AFTER THE SOIL IS LOOSENED, IT MUST NOT BE ROLLED OR DRAGGED SMOOTH BUT LEFT IN THE ROUGHENED CONDITION. SLOPES OF 1:1 OR FLATTER ARE TO BE TRACKED WITH RIDGES RUNNING PARALLEL TO THE CONTOUR OF THE SLOPE.
b. APPLY FERTILIZER AND LIME AS PRESCRIBED ON THE PLANS.

APPROVED: DEPARTMENT OF PLANNING AND ZONING

APPROVED: PLANNING BOARD OF HOWARD COUNTY

DATE: 10/08/2014

- 2. PERMANENT STABILIZATION
a. A SOIL TEST IS REQUIRED FOR ANY EARTH DISTURBANCE OF 5 ACRES OR MORE. THE MINIMUM SOIL CONDITIONS REQUIRED FOR PERMANENT VEGETATIVE ESTABLISHMENT ARE:
i. SOIL PH BETWEEN 6.0 AND 7.0.
ii. SOLUBLE SALTS LESS THAN 500 PARTS PER MILLION (PPM).
iii. SOIL CONTAINS LESS THAN 40 PERCENT CLAY BUT ENOUGH FINE GRAINED MATERIAL TO FORM A HOMOGENEOUS SLURRY. THE MULCH MATERIAL MUST FORM A BLOTTER-LIKE GROUND COVER ON APPLICATION, HAVING MOISTURE-RETENTIVE AND NON-EROSIVE PROPERTIES AND HOLD GRASS SEED IN CONTACT WITH THE SOIL WITHOUT INHIBITING THE GROWTH OF THE GRASS SEEDLINGS.
iv. SOIL CONTAINS 1.5 PERCENT MINIMUM ORGANIC MATTER BY WEIGHT.
v. SOIL CONTAINS SUFFICIENT PORE SPACE TO PERMIT ADEQUATE ROOT PENETRATION.
b. APPLICATION OF AMENDMENTS OR TOPSOIL IS REQUIRED IF ON-SITE SOILS DO NOT MEET THE ABOVE CONDITIONS.
c. GRADED AREAS MUST BE MAINTAINED IN A TRUE AND EVEN GRADE AS SPECIFIED ON THE SURVEY PLAN, THEN SCARIFIED OR OTHERWISE LOOSENED TO A DEPTH OF 3 TO 5 INCHES.
d. APPLY SOIL AMENDMENTS AS SPECIFIED ON THE APPROVED PLAN OR AS INDICATED BY THE RESULTS OF A SOIL TEST.
e. MIX SOIL AMENDMENTS INTO THE TOP 3 TO 5 INCHES OF SOIL BY DISKING OR OTHER SUITABLE MEANS. RAKE LAVES ARE TO BE USED TO SMOOTH THE SURFACE. REMOVE LARGE OBJECTS LIKE STONES AND BRANCHES, AND READY THE AREA FOR SEED APPLICATION. LOOSEN SURFACE SOIL BY DRAGGING WITH A HEAVY CHAIN OR OTHER EQUIPMENT TO ROUGHEN THE SURFACE WHERE SITE CONDITIONS WILL NOT PERMIT NORMAL SEEDBED PREPARATION. TRACK SLOPES 3:1 OR FLATTER WITH TRACKED EQUIPMENT LEAVING THE SOIL IN AN IRREGULAR CONDITION WITH RIDGES RUNNING PARALLEL TO THE CONTOUR OF THE SLOPE. LEAVE THE TOP 1 TO 3 INCHES OF SOIL LOOSE AND FRIABLE. SEEDBED LOOSENING MAY BE UNNECESSARY ON NEWLY DISTURBED AREAS.

- 3. ANCHORING
a. PERFORM MULCH ANCHORING IMMEDIATELY FOLLOWING APPLICATION OF MULCH TO MINIMIZE WIND OR WATER EROSION. THIS MAY BE DONE BY ONE OF THE FOLLOWING METHODS (LISTED BY PREFERENCE), DEPENDING UPON THE SIZE OF THE AREA AND EROSION HAZARD:
i. A MULCH ANCHORING TOOL IS A TRACTOR DRAWN IMPLEMENT DESIGNED TO PUNCH AND ANCHOR MULCH INTO THE SOIL SURFACE A MINIMUM OF 2 INCHES. THIS TOOL IS AVAILABLE FROM A LIMITED NUMBER OF MANUFACTURERS. IT IS USED ON SLOPING LAND, THIS PRACTICE SHOULD FOLLOW THE CONTOUR.
ii. WOOD CELLULOSE FIBER MAY BE USED FOR ANCHORING STRAW. APPLY THE FIBER BINDER AT A RATE OF 2 TO 4 POUNDS PER 100 GALLONS OF WATER. MIX THE WOOD CELLULOSE FIBER WITH WATER AT A MAXIMUM OF 50 POUNDS OF WOOD CELLULOSE FIBER PER 100 GALLONS OF WATER.
iii. SYNTHETIC BINDERS SUCH AS ACRYLIC DLR (AGRO-TACK), DCA-70, PETROSET, TERRA TACK, TERRA TACK OR OTHER APPROVED EQUAL MAY BE USED. FOLLOW APPLICATION RATES AS SPECIFIED ON THE MANUFACTURER'S APPLICATION OF LIQUID BINDERS. BINDERS SHOULD BE HEAVIER AT THE EDGES WHERE WIND CATCHES MULCH, SUCH AS IN VALLEYS AND ON CRESTS OF BANKS. USE OF ASPHALT BINDERS IS STRICTLY PROHIBITED.
iv. LIGHTWEIGHT PLASTIC NETTING MAY BE STAPLED OVER THE MULCH ACCORDING TO MANUFACTURER RECOMMENDATIONS. NETTING IS USUALLY AVAILABLE IN ROLLS 4 TO 15 FEET WIDE AND 300 TO 3,000 FEET LONG.

- 4. APPLICATION
a. APPLY MULCH TO ALL SEEDED AREAS IMMEDIATELY AFTER SEEDING.
b. STRAW MULCH IS USED, SPREAD IT OVER ALL SEEDED AREAS AT THE RATE OF 2 TONS PER ACRE TO A UNIFORM LOOSE DEPTH OF 1 TO 2 INCHES. APPLY MULCH TO ACHIEVE A UNIFORM DISTRIBUTION AND DEPTH SO THAT THE SOIL SURFACE IS NOT EXPOSED. WHEN USING A MULCH ANCHORING TOOL, INCREASE THE APPLICATION RATE TO 2.5 TONS PER ACRE.
c. WOOD CELLULOSE FIBER USED AS MULCH MUST BE APPLIED AT A NET DRY WEIGHT OF 1500 POUNDS PER ACRE. MIX THE WOOD CELLULOSE FIBER WITH WATER TO ATTAIN A MIXTURE WITH A MAXIMUM OF 50 POUNDS OF WOOD CELLULOSE FIBER PER 100 GALLONS OF WATER.

- 5. TOPSOILING
1. TOPSOIL IS PLACED OVER PREPARED SUBSOIL PRIOR TO ESTABLISHMENT OF PERMANENT VEGETATION. THE PRACTICE IS SUITABLE FOR AREAS WITH VEGETATIVE ESTABLISHMENT CONCERN OF LOW MOISTURE CONTENT, LOW NUTRIENT LEVELS, LOW PH, MATERIALS TOXIC TO PLANTS, AND/OR UNACCEPTABLE SOIL GRAIN DISTRIBUTION. TOPSOIL IS OBTAINED FROM AN EXISTING SITE THAT MEETS THE STANDARDS AS SET FORTH IN THESE SPECIFICATIONS. TYPICALLY, THE DEPTH OF TOPSOIL TO BE PLACED OVER THE SUBSOIL SHOULD BE 4 INCHES. THE REPRESENTATIVE SOIL PROFILE SECTION IN THE SOIL SURVEY PUBLISHED BY USDA-NRCS.
2. TOPSOILING IS LIMITED TO AREAS HAVING 2:1 OR FLATTER SLOPES WHERE:
a. THE TEXTURE OF THE EXPOSED SUBSOIL MATERIAL IS NOT ADEQUATE TO PRODUCE VEGETATIVE GROWTH.
b. THE SOIL MATERIAL IS SO SHALLOW THAT THE ROOTING ZONE IS NOT DEEP ENOUGH TO SUPPORT PLANTS OR FLURISH CONTINUING SURVIVAL OF MOISTURE AND PLANT NUTRIENTS.
c. THE ORIGINAL SOIL TO BE VEGETATED CONTAINS MATERIAL TOXIC TO PLANT GROWTH.
d. THE SOIL IS SO ACIDIC THAT TREATMENT WITH LIMESTONE IS NOT FEASIBLE.
e. AREAS HAVING SLOPES STEEPER THAN 2:1 REQUIRE SPECIAL CONSIDERATION AND DESIGN.
3. TOPSOILING SPECIFICATIONS: SOIL TO BE USED AS TOPSOIL MUST MEET THE FOLLOWING CRITERIA:
a. TOPSOIL MUST BE A LOAM, SANDY LOAM, CLAY LOAM, SILT LOAM, SANDY CLAY LOAM, OR LOAMY SAND. OTHER SOILS MAY BE USED IF RECOMMENDED BY AN AGRONOMIST OR SOIL SCIENTIST AND APPROVED BY THE APPROPRIATE APPROVAL AUTHORITY. TOPSOIL MUST NOT BE A MIXTURE OF CONTAMINATED MATERIALS AND MUST CONTAIN LESS THAN 5 PERCENT BY VOLUME OF CONCRETE, STONES, SLAG, CEMENT FRAGMENTS, GRAVEL, STICKS, ROOTS, TRASH, OR OTHER MATERIALS LARGER THAN 1/4 INCHES IN DIAMETER.
b. TOPSOIL MUST BE FREE OF NOXIOUS PLANTS OR PLANT PARTS SUCH AS BERBERIS, GASS, QUACK GRASS, JOHNSON GRASS, NUT SEDGE, POISON IVY, THISTLE, OR OTHERS AS SPECIFIED.
c. TOPSOIL SUBSTITUTES OR AMENDMENTS, AS RECOMMENDED BY A QUALIFIED AGRONOMIST OR SOIL SCIENTIST AND APPROVED BY THE APPROPRIATE APPROVAL AUTHORITY, MAY BE USED IN LIEU OF NATURAL TOPSOIL.
4. TOPSOIL APPLICATION
a. EROSION AND SEDIMENT CONTROL PRACTICES MUST BE MAINTAINED WHEN APPLYING TOPSOIL.
b. UNIFORMLY DISTRIBUTE TOPSOIL IN A 5 TO 10 INCH LAYER AND LIGHTLY COMPACT TO A MINIMUM THICKNESS OF 4 INCHES. SPREADING IS TO BE PERFORMED IN SUCH A MANNER THAT SODDING OR SEEDING CAN PROCEED WITH A MINIMUM OF ADDITIONAL SOIL PREPARATION AND TILLAGE. ANY IRREGULARITIES IN THE SURFACE RESULTING FROM TOPSOILING OR OTHER OPERATIONS MUST BE CORRECTED IN ORDER TO PREVENT THE FORMATION OF DEPRESSIONS OR WATER POCKETS.
c. TOPSOIL MUST NOT BE PLACED IF THE TOPSOIL OR SUBSOIL IS IN A FROZEN OR MUDDY CONDITION, WHEN THE SUBSOIL IS EXCESSIVELY WET OR IN A CONDITION THAT MAY OTHERWISE BE DETRIMENTAL TO PROPER GRADING AND SEEDBED PREPARATION.

- 6. SOIL AMENDMENTS (FERTILIZER AND LIME SPECIFICATIONS)
1. SOIL TESTS MUST BE PERFORMED TO DETERMINE THE EXACT RATIOS AND APPLICATION RATES FOR BOTH LIME AND FERTILIZER. SOIL TESTS MUST BE PERFORMED ON SITES HAVING DISTURBED AREAS OF 5 ACRES OR MORE. SOIL ANALYSIS MAY BE PERFORMED BY A RECOGNIZED PRIVATE OR COMMERCIAL LABORATORY. SOIL SAMPLES TAKEN FOR ENGINEERING PURPOSES MAY ALSO BE USED FOR CHEMICAL ANALYSIS.
2. FERTILIZERS MUST BE UNIFORM IN COMPOSITION, FREE FLOWING AND SUITABLE FOR ACCURATE APPLICATION BY APPROPRIATE EQUIPMENT. MANURE MAY BE SUBSTITUTED FOR FERTILIZERS WITH PRIOR APPROVAL FROM THE APPROPRIATE APPROVAL AUTHORITY. FERTILIZERS MUST ALL BE DELIVERED TO THE SITE FULLY LABELED ACCORDING TO THE APPLICABLE LAWS AND MUST BEAR THE NAME, TRADE NAME OR TRADEMARK AND WARRANTY OF THE PRODUCER.
3. LIME MATERIALS MUST BE GROUND LIMESTONE (HYDRATED OR BURNT LIME MAY BE SUBSTITUTED EXCEPT WHEN HYDROSEEDING) WHICH CONTAINS AT LEAST 50 PERCENT TOTAL OXIDES (CALCIUM OXIDE PLUS MAGNESIUM OXIDE). LIMESTONE MUST BE GROUND TO SUCH FINENESS THAT AT LEAST 85 PERCENT WILL PASS THROUGH A #20 MESH SIEVE.
4. LIME AND FERTILIZER ARE TO BE EVENLY DISTRIBUTED AND INCORPORATED INTO THE TOP 3 TO 5 INCHES OF SOIL BY DISKING OR OTHER SUITABLE MEANS.
5. WHERE THE SUBSOIL IS EITHER HIGHLY ACIDIC OR COMPOSED OF HEAVY CLAYS, SPREAD GROUND LIMESTONE AT THE RATE OF 4 TO 6 TONS/ACRE (200-400 POUNDS PER 1,000 SQUARE FEET) PRIOR TO THE PLACEMENT OF TOPSOIL.

B-4.3 STANDARDS AND SPECIFICATIONS FOR SEEDING AND MULCHING

DEFINITION THE APPLICATION OF SEED AND MULCH TO ESTABLISH VEGETATIVE COVER.

PURPOSE TO PROTECT DISTURBED SOILS FROM EROSION DURING AND AT THE END OF CONSTRUCTION.

CONDITIONS WHERE PRACTICE APPLIES TO THE SURFACE OF ALL PERIMETER CONTROLS, SLOPES, AND ANY DISTURBED AREA NOT UNDER ACTIVE GRADING.

CRITERIA A. SEEDING

- 1. SPECIFICATIONS
a. ALL SEED MUST MEET THE REQUIREMENTS OF THE MARYLAND STATE SEED LAW. ALL SEED MUST BE SUBJECT TO RE-TESTING BY A RECOGNIZED SEED LABORATORY. ALL SEED USED MUST HAVE BEEN TESTED WITHIN THE 6 MONTHS IMMEDIATELY PRECEDING THE DATE OF SOWING SUCH MATERIAL ON ANY PROJECT. REFER TO TABLE B.4 REGARDING THE QUALITY OF SEED. SEED TAGS MUST BE AVAILABLE UPON REQUEST TO THE INSPECTOR TO VERIFY TYPE OF SEED AND SEEDING RATE.
b. MULCH ALONE MAY BE USED TO PROTECT DISTURBED AREAS. MULCHING SEEDING DATES ONLY IF THE GROUND IS FROZEN. THE APPROPRIATE SEEDING MIXTURE MUST BE APPLIED WHEN THE GROUND THAW.
c. INOCULANTS: THE INOCULANT FOR TREATING LEGUME SEED IN THE SEED MIXTURES MUST BE A PURE CULTURE OF NITROGEN FIXING BACTERIA PREPARED SPECIFICALLY FOR THE SPECIES. INOCULANTS MUST NOT BE USED AFTER THE DATE OF EXPIRATION ON THE CONTAINER. ADD FRESH INOCULANTS AS DIRECTED ON THE PACKAGE. USE FOUR TIMES THE RECOMMENDED RATE WHEN HYDROSEEDING. NOTE: IT IS VERY IMPORTANT TO KEEP INOCULANT COOL AS POSSIBLE UNTIL USED. TEMPERATURES ABOVE 75 TO 80 DEGREES FAHRENHEIT CAN WEAKEN BACTERIA AND MAKE THE INOCULANT LESS EFFECTIVE.
d. SOD OR SEED MUST NOT BE PLACED ON SOIL WHICH HAS BEEN TREATED WITH SOIL STERILANTS OR CHEMICALS USED FOR WEED CONTROL UNTIL SUFFICIENT TIME HAS ELAPSED (14 DAYS MIN.) TO PERMIT DISSIPATION OF THE WEEDICIDE.
2. APPLICATION
a. DRY SEEDING: THIS INCLUDES USE OF CONVENTIONAL DROP OR BROADCAST SPREADERS.
i. INCORPORATE SEED INTO THE SUBSOIL AT THE RATES PRESCRIBED ON TEMPORARY SEEDING TABLE B.1. PERMANENT SEEDING TABLE B.3, OR SITE-SPECIFIC SEEDING SUMMARIES.
ii. APPLY SEED IN TWO DIRECTIONS, PERPENDICULAR TO EACH OTHER. APPLY HALF THE SEEDING RATE IN EACH DIRECTION.
b. DRILL OR CULTRIPACKER SEEDING: MECHANIZED SEEDERS THAT APPLY AND COVER SEED WITH SOIL.
i. CULTRIPACKER SEEDERS ARE REQUIRED TO BURY THE SEED IN SUCH A FASHION AS TO PROVIDE AT LEAST 1/4 INCH OF SOIL COVERING THE SEED. SEEDING MUST BE PERFORMED IN TWO DIRECTIONS, PERPENDICULAR TO EACH OTHER. APPLY HALF THE SEEDING RATE IN EACH DIRECTION.
ii. HYDROSEEDING: APPLY SEED UNIFORMLY WITH HYDROSEEDER (SLURRY INCLUDES SEED AND FERTILIZER).
i. IF FERTILIZER IS BEING APPLIED AT THE TIME OF SEEDING, THE APPLICATION RATES SHOULD NOT EXCEED THE FOLLOWING: NITROGEN, 100 POUNDS PER ACRE; TOTAL COUT SOLUBLE NITROGEN, 200 (PHOSPHOROUS), 200 POUNDS PER ACRE; P2O5 (POTASSIUM), 200 POUNDS PER ACRE.
ii. LIME: USE ONLY GROUND AGRICULTURAL LIMESTONE (UP TO 3 TONS PER ACRE MAY BE APPLIED BY HYDROSEEDING). NORMALLY, NOT MORE THAN 2 TONS ARE APPLIED BY HYDROSEEDING AT ANY ONE TIME. DO NOT USE BURNT OR HYDRATED LIME WHEN HYDROSEEDING.
iii. MIX SEED AND FERTILIZER ON SITE AND USE IMMEDIATELY AND WITHOUT INTERCEPTION.
iv. WHEN HYDROSEEDING DO NOT INCORPORATE SEED INTO THE SOIL.
3. MULCHING
a. MULCH MATERIALS (IN ORDER OF PREFERENCE)
i. STRAW CONSISTING OF THRESHED WHEAT, RYE, OAT, OR BARLEY AND REASONABLY BRIGHT IN COLOR. STRAW IS TO BE FREE OF NOXIOUS WEED SEEDS AS SPECIFIED IN THE MARYLAND SEED LAW AND NOT MUSTY, MOLDY, CAKED, DECAYED, OR EXCESSIVELY DUSTY. NOTE: USE ONLY STERILE STRAW MULCH IN AREAS WHERE ONE SPECIES OF GRASS IS DESIRED.
ii. KENTUCKY BLUEGRASS: FULL SUN MIXTURE: FOR USE IN AREAS THAT RECEIVE INTENSIVE MANAGEMENT. IRRIGATION REQUIRED IN THE AREAS OF CENTRAL MARYLAND AND EASTERN SHORE. RECOMMENDED CERTIFIED KENTUCKY BLUEGRASS CULTIVARS SEEDING RATE: 1.5 TO 2.0 POUNDS PER 1,000 SQUARE FEET. CHOOSE A MINIMUM OF THREE KENTUCKY BLUEGRASS CULTIVARS WITH EACH RANGING FROM 10 TO 35 PERCENT OF THE TOTAL MIXTURE BY WEIGHT.
iii. KENTUCKY BLUEGRASS/PRENNIAL RYE: FULL SUN MIXTURE: FOR USE IN FULL SUN AREAS WHERE RAPID ESTABLISHMENT IS NECESSARY AND WHEN TURF WILL RECEIVE INTENSIVE MANAGEMENT. RECOMMENDED CERTIFIED PRENNIAL RYEGRASS/CERTIFIED KENTUCKY BLUEGRASS SEEDING RATE: 2 POUNDS MIXTURE PER 1,000 SQUARE FEET. CHOOSE A MINIMUM OF THREE KENTUCKY BLUEGRASS CULTIVARS WITH EACH RANGING FROM 10 TO 35 PERCENT OF THE TOTAL MIXTURE BY WEIGHT.

- iii. TALL FESCUE/KENTUCKY BLUEGRASS: FULL SUN MIXTURE: FOR USE IN DROUGHT PRONE AREAS AND/OR FOR AREAS REQUIRING LOW TO MODERATE MANAGEMENT IN FULL SUN TO MEDIUM SHADE. RECOMMENDED MIXTURE INCLUDES: CERTIFIED TALL FESCUE CULTIVARS 95 TO 100 PERCENT, CERTIFIED KENTUCKY BLUEGRASS CULTIVARS 5 TO 5 PERCENT. SEEDING RATE: 3 TO 8 POUNDS PER 1000 SQUARE FEET. ONE OR MORE CULTIVARS MAY BE BLENDED.
iv. KENTUCKY BLUEGRASS/FINE FESCUE: MATURE MIXTURE: FOR USE IN AREAS WITH SHADY TO FULL SUN. RECOMMENDED MIXTURE INCLUDES: CERTIFIED KENTUCKY BLUEGRASS CULTIVARS 30 TO 40 PERCENT, CERTIFIED FINE FESCUE AND 60 TO 70 PERCENT. SEEDING RATE: 1 1/2 TO 3 POUNDS PER 1000 SQUARE FEET.
NOTES:
SELECT TURFGRASS VARIETIES FROM THOSE LISTED IN THE MOST CURRENT UNIVERSITY OF MARYLAND PUBLICATION, AGRONOMY MEMO #77, "TURFGRASS CULTIVAR RECOMMENDATIONS FOR MARYLAND".
CHOOSE CERTIFIED MATERIAL. CERTIFIED MATERIAL IS THE BEST GUARANTEE OF CULTIVAR PURITY. THE CERTIFICATION PROGRAM OF THE MARYLAND DEPARTMENT OF AGRICULTURE, TURF AND SEED SECTION, PROVIDES A RELIABLE MEANS OF CONSUMER PROTECTION AND ASSURES A PURE GENETIC LINE.
c. IDEAL TIMES OF SEEDING FOR TURF GRASS MIXTURES:
WESTERN MD: MARCH 15 TO JUNE 1, AUGUST 1 TO OCTOBER 1 (HARDINESS ZONES: 5B, 6A)
CENTRAL MD: MARCH 1 TO MAY 15, AUGUST 15 TO OCTOBER 15 (HARDINESS ZONE: 6B)
SOUTHERN MD: EASTERN SHORE: MARCH 1 TO MAY 15, AUGUST 15 TO OCTOBER 15 (HARDINESS ZONES: 7A, 7B)
d. TILL AREAS TO RECEIVE SEED BY DISKING OR OTHER APPROVED METHODS TO A DEPTH OF 2 TO 4 INCHES. LEVEL AND RAKE THE AREAS TO PREPARE A PROPER SEEDBED. MOISTURE WILL BE REQUIRED TO PREPARE A PROPER SEEDBED. MOISTURE MUST BE IN SUCH CONDITION THAT FUTURE SEEDING WILL BE EASIER.
e. IF SOIL MOISTURE IS DEFICIENT, SUPPLY NEW SEEDINGS WITH ADEQUATE WATER FOR PLANT GROWTH (1/2 TO 1 INCH EVERY 3 TO 4 DAYS DEPENDING ON SOIL TYPE). THEY ARE FIRM TO ESTABLISHMENT. SEEDING SHOULD BE DONE EARLY IN THE PLANTING SEASON, IN ABNORMALLY DRY OR HOT SEASONS, OR ON ADVERSE SITES.

- 4. APPLICATION
a. APPLY MULCH TO ALL SEEDED AREAS IMMEDIATELY AFTER SEEDING.
b. STRAW MULCH IS USED, SPREAD IT OVER ALL SEEDED AREAS AT THE RATE OF 2 TONS PER ACRE TO A UNIFORM LOOSE DEPTH OF 1 TO 2 INCHES. APPLY MULCH TO ACHIEVE A UNIFORM DISTRIBUTION AND DEPTH SO THAT THE SOIL SURFACE IS NOT EXPOSED. WHEN USING A MULCH ANCHORING TOOL, INCREASE THE APPLICATION RATE TO 2.5 TONS PER ACRE.
c. WOOD CELLULOSE FIBER USED AS MULCH MUST BE APPLIED AT A NET DRY WEIGHT OF 1500 POUNDS PER ACRE. MIX THE WOOD CELLULOSE FIBER WITH WATER TO ATTAIN A MIXTURE WITH A MAXIMUM OF 50 POUNDS OF WOOD CELLULOSE FIBER PER 100 GALLONS OF WATER.

- 5. ANCHORING
a. PERFORM MULCH ANCHORING IMMEDIATELY FOLLOWING APPLICATION OF MULCH TO MINIMIZE WIND OR WATER EROSION. THIS MAY BE DONE BY ONE OF THE FOLLOWING METHODS (LISTED BY PREFERENCE), DEPENDING UPON THE SIZE OF THE AREA AND EROSION HAZARD:
i. A MULCH ANCHORING TOOL IS A TRACTOR DRAWN IMPLEMENT DESIGNED TO PUNCH AND ANCHOR MULCH INTO THE SOIL SURFACE A MINIMUM OF 2 INCHES. THIS TOOL IS AVAILABLE FROM A LIMITED NUMBER OF MANUFACTURERS. IT IS USED ON SLOPING LAND, THIS PRACTICE SHOULD FOLLOW THE CONTOUR.
ii. WOOD CELLULOSE FIBER MAY BE USED FOR ANCHORING STRAW. APPLY THE FIBER BINDER AT A RATE OF 2 TO 4 POUNDS PER 100 GALLONS OF WATER. MIX THE WOOD CELLULOSE FIBER WITH WATER AT A MAXIMUM OF 50 POUNDS OF WOOD CELLULOSE FIBER PER 100 GALLONS OF WATER.
iii. SYNTHETIC BINDERS SUCH AS ACRYLIC DLR (AGRO-TACK), DCA-70, PETROSET, TERRA TACK, TERRA TACK OR OTHER APPROVED EQUAL MAY BE USED. FOLLOW APPLICATION RATES AS SPECIFIED ON THE MANUFACTURER'S APPLICATION OF LIQUID BINDERS. BINDERS SHOULD BE HEAVIER AT THE EDGES WHERE WIND CATCHES MULCH, SUCH AS IN VALLEYS AND ON CRESTS OF BANKS. USE OF ASPHALT BINDERS IS STRICTLY PROHIBITED.
iv. LIGHTWEIGHT PLASTIC NETTING MAY BE STAPLED OVER THE MULCH ACCORDING TO MANUFACTURER RECOMMENDATIONS. NETTING IS USUALLY AVAILABLE IN ROLLS 4 TO 15 FEET WIDE AND 300 TO 3,000 FEET LONG.

B-4.4 STANDARDS AND SPECIFICATIONS FOR TEMPORARY STABILIZATION

DEFINITION TO STABILIZE DISTURBED SOILS WITH VEGETATION FOR UP TO 6 MONTHS.

PURPOSE TO USE FAST GROWING VEGETATION THAT PROVIDES COVER ON DISTURBED SOILS.

CONDITIONS WHERE PRACTICE APPLIES EXPOSED SOILS WHERE GROUND COVER IS NEEDED FOR A PERIOD OF 6 MONTHS OR LESS. FOR LONGER DURATION OF TIME, PERMANENT STABILIZATION PRACTICES ARE REQUIRED.

CRITERIA 1. SELECT ONE OR MORE OF THE SPECIES OR SEED MIXTURES LISTED IN TABLE B.1 FOR THE APPROPRIATE PLANT HARDINESS ZONE (FROM FIGURE B.3), AND ENTER THEM IN THE TEMPORARY SEEDING SUMMARY BELOW ALONG WITH APPLICATION RATES, SEEDING DATES AND SEEDING DEPTHS. (THIS SUMMARY IS NOT PUT ON THE PLAN AND COMPLETED, THEN TABLE B.1 PLUS FERTILIZER AND LIME RATES MUST BE PUT ON THE PLAN.
2. FOR SITES HAVING SOIL TESTS PERFORMED, USE AND SHOW THE RECOMMENDED RATES BY THE TESTING AGENCY. SOIL TESTS ARE NOT REQUIRED FOR TEMPORARY SEEDING.
3. WHEN STABILIZATION IS REQUIRED OUTSIDE OF A SEEDING SEASON, APPLY SEED AND MULCH OR STRAW MULCH ALONE AS PRESCRIBED IN SECTION B.4-3.1, B AND MAINTAIN UNTIL THE NEXT SEEDING SEASON.

TEMPORARY SEEDING SUMMARY TABLE with columns: NO., SPECIES, APPLICATION RATE (LB/AC), SEEDING DATES, SEEDING DEPTHS, FERTILIZER RATE (10-20-20), LIME RATE

COOL SEASON GRASSES

Table with 7 rows of cool season grasses including Annual Ryegrass, Barley, Oats, Wheat, Cereal Rye, Foxtail Millet, and Pearl Millet.

WARM SEASON GRASSES

Table with 2 rows of warm season grasses including Foxtail Millet and Pearl Millet.

B-4.5 STANDARDS AND SPECIFICATIONS FOR PERMANENT STABILIZATION

DEFINITION TO STABILIZE DISTURBED SOILS WITH PERMANENT VEGETATION.

PURPOSE TO USE LONG-LEAF PERENNIAL GRASSES AND LEGUMES TO ESTABLISH PERMANENT GROUND COVER ON DISTURBED SOILS.

CONDITIONS WHERE PRACTICE APPLIES EXPOSED SOILS WHERE GROUND COVER IS NEEDED FOR 6 MONTHS OR MORE.

CRITERIA A. SEED MIXTURES

- 1. GENERAL USE
a. SELECT ONE OR MORE OF THE SPECIES OR MIXTURES LISTED IN TABLE B.3 FOR THE APPROPRIATE PLANT HARDINESS ZONE (FROM FIGURE B.3) AND BASED ON THE SITE CONDITIONS OR PURPOSES FOUND ON TABLE B.2, ENTER THE RECOMMENDED MIXTURE APPLICATION RATES, AND SEEDING DATES IN THE PERMANENT SEEDING SUMMARY. THE SUMMARY IS TO BE PLACED ON THE PLAN.
b. ADDITIONAL PLANTING SPECIFICATIONS FOR EXCEPTIONAL SITES SUCH AS SHORELINES, STREAM BANKS, OR DUNES OR FOR SPECIAL PURPOSES SUCH AS WILDLIFE OR AESTHETIC TREATMENT MAY BE FOUND IN USDA-NRCS TECHNICAL FIELD OFFICE GUIDE, SECTION 342- CRITICAL AREA PLANTING.
c. FOR SITES HAVING DISTURBED AREA OVER 5 ACRES, USE AND SHOW THE RATES RECOMMENDED BY THE SOIL TESTING AGENCY.
d. FOR AREAS RECEIVING LOW MAINTENANCE, APPLY UREA FORM FERTILIZER (46-0-0) AT 3 1/2 POUNDS PER 1,000 SQUARE FEET (150 POUNDS PER ACRE) AT THE TIME OF SEEDING IN ADDITION TO THE SOIL AMENDMENTS SHOWN IN THE PERMANENT SEEDING SUMMARY.
2. TURFGRASS MIXTURES
a. AREAS WHERE TURFGRASS MAY BE DESIRED INCLUDE LAWNS, PARKS, PLAYGROUNDS, AND COMMERCIAL SITES WHICH WILL RECEIVE A MEDIUM TO HIGH LEVEL OF MAINTENANCE.
b. SELECT ONE OR MORE OF THE SPECIES OR MIXTURES LISTED BELOW BASED ON THE SITE CONDITIONS OR PURPOSES FOUND ON TABLE B.2, ENTER THE RECOMMENDED MIXTURE APPLICATION RATES, AND SEEDING DATES IN THE PERMANENT SEEDING SUMMARY. THE SUMMARY IS TO BE PLACED ON THE PLAN.
i. KENTUCKY BLUEGRASS: FULL SUN MIXTURE: FOR USE IN AREAS THAT RECEIVE INTENSIVE MANAGEMENT. IRRIGATION REQUIRED IN THE AREAS OF CENTRAL MARYLAND AND EASTERN SHORE. RECOMMENDED CERTIFIED KENTUCKY BLUEGRASS CULTIVARS SEEDING RATE: 1.5 TO 2.0 POUNDS PER 1,000 SQUARE FEET. CHOOSE A MINIMUM OF THREE KENTUCKY BLUEGRASS CULTIVARS WITH EACH RANGING FROM 10 TO 35 PERCENT OF THE TOTAL MIXTURE BY WEIGHT.
ii. KENTUCKY BLUEGRASS/PRENNIAL RYE: FULL SUN MIXTURE: FOR USE IN FULL SUN AREAS WHERE RAPID ESTABLISHMENT IS NECESSARY AND WHEN TURF WILL RECEIVE INTENSIVE MANAGEMENT. RECOMMENDED CERTIFIED PRENNIAL RYEGRASS/CERTIFIED KENTUCKY BLUEGRASS SEEDING RATE: 2 POUNDS MIXTURE PER 1,000 SQUARE FEET. CHOOSE A MINIMUM OF THREE KENTUCKY BLUEGRASS CULTIVARS WITH EACH RANGING FROM 10 TO 35 PERCENT OF THE TOTAL MIXTURE BY WEIGHT.

PERMANENT SEEDING SUMMARY

PERMANENT SEEDING SUMMARY TABLE with columns: NO., SPECIES, APPLICATION RATE (LB/AC), SEEDING DATES, SEEDING DEPTHS, N, P2O5, K2O, LIME RATE

FOR THE PERIOD 5/1 TO 8/14 ADD 6.0 LBS/AC. FOXTAIL OR PEARL MILLET TO PERMANENT MIX # 9, AND 2.25 LBS/AC. FOXTAIL OR PEARL MILLET TO MIX NO. 5

SOD: TO PROVIDE QUICK COVER ON DISTURBED AREAS (2:1 GRADE OR FLATTER).

- 1. GENERAL SPECIFICATIONS
a. CLASS OF TURFGRASS SOD MUST BE MARYLAND STATE CERTIFIED. SOD LABELS MUST BE MADE AVAILABLE TO THE JOB FOREMAN AND INSPECTOR.
b. SOD MUST BE MACHINE CUT AT A UNIFORM SOIL THICKNESS OF 3/4 INCH, PLUS OR MINUS 1/8 INCH, AT THE TIME OF CUTTING. MEASUREMENT FOR THICKNESS MUST EXCLUDE TOP GROWTH AND THATCH. BROKEN PADS AND TORN OR UNEVEN ENDS WILL NOT BE ACCEPTABLE.
c. STANDARD SIZE SECTIONS OF SOD MUST BE STRONG ENOUGH TO SUPPORT THEIR OWN WEIGHT AND RETAIN THEIR SIZE AND SHAPE WHEN SUSPENDED VERTICALLY WITH A FIRM GRASP ON THE UPPER 10 PERCENT OF THE SECTION.
d. SOD MUST NOT BE HARVESTED OR TRANSPORTED WHEN MOISTURE CONTENT (EXCESSIVELY DRY OR WET) MAY ADVERSELY AFFECT ITS SURVIVAL.
e. SOD MUST BE HARVESTED, DELIVERED, AND INSTALLED WITHIN A PERIOD OF 36 HOURS. SOD NOT TRANSPORTED WITHIN THIS PERIOD MUST BE APPROVED BY AN AGRONOMIST OR SOIL SCIENTIST PRIOR TO ITS INSTALLATION.
2. SOD INSTALLATION
a. DURING PERIODS OF EXCESSIVELY HIGH TEMPERATURE OR IN AREAS HAVING DRY SUBSOIL, LIGHTLY IRRIGATE THE SUBSOIL IMMEDIATELY PRIOR TO LAYING THE SOD.
b. LAY THE FIRST ROW OF SOD IN A STRAIGHT LINE WITH SUBSEQUENT ROWS LAYED PARALLEL TO IT AND TIGHTLY WEDGED AGAINST EACH OTHER. STAGGER JOINTS TO PROMOTE MOISTURE RETENTION. STRETCHED OR OVERLAPPED AND THAT ALL JOINTS ARE BUTTED TIGHT IN ORDER TO PREVENT VOIDS WHICH WOULD CAUSE AIR DRYING OF THE ROOTS.
c. WHEREVER POSSIBLE, LAY SOD WITH THE LONG EDGES PARALLEL TO THE CONTOUR AND WITH STAGGERED JOINTS. ROLL AND TAMP PEG OR OTHERWISE SECURE TO PREVENT SLIPPAGE ON SLOPES. ENSURE SOIL CONTACT EXISTS BETWEEN SOD ROOTS AND THE UNDERLYING SOIL SURFACE.
d. WATER THE SOD IMMEDIATELY FOLLOWING ROLLING AND TAMPING UNTIL THE UNDERSIDE OF THE NEW SOD PAD AND SOIL SURFACE BELOW THE SOD ARE THOROUGHLY WET. COMPLETE THE OPERATIONS OF LAYING, TAMPING AND IRRIGATING FOR ANY PIECE OF SOD WITHIN EIGHT HOURS.
3. SOD MAINTENANCE
a. IN THE ABSENCE OF ADEQUATE RAINFALL, WATER DAILY DURING THE FIRST WEEK OR AS OFTEN AND SUFFICIENTLY AS NECESSARY TO MAINTAIN MOIST SOIL TO A DEPTH OF 4 INCHES. WATER SOD DURING THE HEAT OF THE DAY TO PREVENT WILTING.
b. AFTER THE FIRST WEEK, SOD WATERING IS REQUIRED AS NECESSARY TO MAINTAIN ADEQUATE MOISTURE CONTENT.
c. DO NOT MOW UNTIL THE SOD IS FIRMLY ROOTED. NO MORE THAN 1/4 OF THE GRASS LEAF MUST BE REMOVED BY THE INITIAL CUTTING OR SUBSEQUENT CUTTINGS. MAINTAIN A GRASS HEIGHT OF AT LEAST 3 INCHES UNLESS OTHERWISE SPECIFIED.

B-4.6 STANDARDS AND SPECIFICATIONS FOR SOIL STABILIZATION MATTING

DEFINITION MATERIAL USED TO TEMPORARILY OR PERMANENTLY STABILIZE CHANNELS OR STEEP SLOPES UNTIL GROUND COVER IS ESTABLISHED.

PURPOSE TO PROTECT THE SOILS UNTIL VEGETATION IS ESTABLISHED.

CONDITIONS WHERE PRACTICE APPLIES ON NEWLY SEEDED SURFACES TO PREVENT THE APPLIED SEED FROM WASHING OUT, IN CHANNELS AND ON STEEP SLOPES WHERE THE FLOW HAS VELOCITIES OR CONVEYS CLEAR WATER. ON TEMPORARY SWALES, EARTH DIKES, AND PERIMETER DIKE SWALES AS REQUIRED BY THE RESPECTIVE DESIGN STANDARD, AND ON STREAM BANKS WHERE MOVING WATER IS LIKELY TO WASH OUT NEW VEGETATIVE PLANTINGS.

MAINTENANCE VEGETATION MUST BE ESTABLISHED AND MAINTAINED SO THAT THE REQUIREMENTS FOR ADEQUATE VEGETATIVE ESTABLISHMENT ARE CONTINUOUSLY MET IN ACCORDANCE WITH SECTION B-4 VEGETATIVE STABILIZATION.

HOWARD SOIL CONSERVATION DISTRICT STANDARD SEDIMENT CONTROL NOTES

1. A MINIMUM OF 48 HOURS NOTICE MUST BE GIVEN TO THE HOWARD COUNTY DEPARTMENT OF INSPECTIONS, LICENSES AND PERMITS, SEDIMENT CONTROL DIVISION PRIOR TO THE START OF ANY CONSTRUCTION (316-1655).

2. ALL VEGETATIVE AND STRUCTURAL PRACTICES ARE TO BE INSTALLED ACCORDING TO THE PROVISIONS OF THIS PLAN AND ARE TO BE IN CONFORMANCE WITH THE MOST CURRENT MARYLAND STANDARDS AND SPECIFICATIONS FOR SOIL EROSION AND SEDIMENT CONTROL, AND REVISIONS THERETO.

3. FOLLOWING INITIAL SOIL DISTURBANCE OR RE-DISTURBANCE, PERMANENT OR TEMPORARY STABILIZATION SHALL BE COMPLETED WITHIN A 3 CALENDAR DAYS FOR ALL PERIMETER SEDIMENT CONTROL STRUCTURES, DIKES, PERIMETER SLOPES AND ALL SLOPES GREATER THAN 5:1, 6:1 DAYS AS TO ALL OTHER DISTURBED OR GRADED AREAS ON THE PROJECT SITE.

DETAIL B-4-6-A TEMPORARY SOIL STABILIZATION MATTING CHANNEL APPLICATION

STANDARD SYMBOL
TSSMC - * * lb/ft²
(* INCLUDE SHEAR STRESS)

CONSTRUCTION SPECIFICATIONS

- USE MATTING THAT HAS A DESIGN VALUE FOR SHEAR STRESS EQUAL TO OR HIGHER THAN THE SHEAR STRESS DESIGNATED ON APPROVED PLANS.
- USE TEMPORARY SOIL STABILIZATION MATTING MADE OF DEGRADABLE (LASTS 6 MONTHS MINIMUM) NATURAL OR MAN-MADE FIBERS (MOSTLY ORGANIC). MAT MUST HAVE UNIFORM THICKNESS AND DISTRIBUTION OF FIBERS THROUGHOUT AND BE SMOLDER RESISTANT. CHEMICALS USED IN THE MAT MUST BE NON-LEACHING AND NON-TOXIC TO VEGETATION AND SEED GERMINATION AND NON-HARMFUL TO THE SKIN. IF PRESENT, NETTING MUST BE EXTRUDED PLASTIC WITH A MAXIMUM MESH OPENING OF 2 1/2 INCHES AND SUFFICIENTLY BONDED OR SEWN ON 2 INCH CENTERS ALONG LONGITUDINAL AXIS OF THE MATERIAL TO PREVENT SEPARATION OF THE NET FROM THE PARENT MATERIAL.
- SECURE MATTING USING STEEL STAPLES, WOOD STAKES, OR BIODEGRADABLE EQUIVALENT. STAPLES MUST BE "U" OR "T" SHAPED STEEL WIRE HAVING A MINIMUM GAUGE OF NO. 11 AND NO. 8 RESPECTIVELY. "U" SHAPED STAPLES MUST AVERAGE 1 TO 1 1/2 INCHES WIDE AND BE A MINIMUM OF 6 INCHES LONG. "T" SHAPED STAPLES MUST AVERAGE 1 TO 1 1/2 INCHES WIDE AND BE A MINIMUM OF 6 INCHES LONG. "T" SHAPED STAPLES MUST HAVE A MINIMUM 8 INCH MAIN LEG, A MINIMUM 1 INCH SECONDARY LEG, AND A MINIMUM 4 INCH HEAD. WOOD STAKES MUST BE ROUGH-SAWN HARDWOOD, 1 1/2 TO 2 INCHES IN LENGTH, 1 1/2 INCH IN CROSS SECTION, AND WEDGE SHAPED AT THE BOTTOM.
- PERFORM FINAL GRADING, TOPSOIL APPLICATION, SEEDBED PREPARATION, AND PERMANENT SEEDING IN ACCORDANCE WITH SPECIFICATIONS. PLACE MATTING WITHIN 48 HOURS OF COMPLETING SEEDING OPERATIONS UNLESS END OF WORKDAY STABILIZATION IS SPECIFIED ON THE APPROVED EROSION AND SEDIMENT CONTROL PLAN.
- UNROLL MATTING DOWNSLOPE. LAY MAT SMOOTHLY AND FIRMLY UPON THE SEEDBED SURFACE. AVOID STRETCHING THE MATTING.
- OVERLAP OR ABUT ROLL EDGES PER MANUFACTURER RECOMMENDATIONS. OVERLAP ROLL ENDS BY 6 INCHES (MINIMUM), WITH THE UPSTREAM MAT OVERLAPPING ON TOP OF THE DOWNSLOPE MAT.
- KEY-IN UPSTREAM END OF EACH MAT ROLL BY DIGGING A 6 INCH (MINIMUM) TRENCH AT THE UPSTREAM END OF THE MATTING, PLACING THE ROLL END IN THE TRENCH, REPLACING THE EXCAVATED MATERIAL, AND TAMPING TO SECURE THE MAT END.
- OVERLAP OR ABUT THE ROLL EDGES PER MANUFACTURER RECOMMENDATIONS. OVERLAP ROLL ENDS BY 6 INCHES (MINIMUM), WITH THE UPSTREAM MAT OVERLAPPING ON TOP OF THE NEXT DOWNSLOPE MAT.
- STAPLE/TAKE MAT IN A STAGGERED PATTERN ON 4 FOOT (MAXIMUM) CENTERS THROUGHOUT AND 2 FOOT (MAXIMUM) CENTERS ALONG SEAMS, JOINTS, AND ROLL ENDS.
- ESTABLISH AND MAINTAIN VEGETATION SO THAT REQUIREMENTS FOR ADEQUATE VEGETATIVE ESTABLISHMENT ARE CONTINUOUSLY MET IN ACCORDANCE WITH SECTION B-4 VEGETATIVE STABILIZATION.

DETAIL B-4-6-C PERMANENT SOIL STABILIZATION MATTING CHANNEL APPLICATION

STANDARD SYMBOL
PSSMC - * * lb/ft²
(* INCLUDE SHEAR STRESS)

CONSTRUCTION SPECIFICATIONS

- USE MATTING THAT HAS A DESIGN VALUE FOR SHEAR STRESS EQUAL TO OR HIGHER THAN THE SHEAR STRESS DESIGNATED ON APPROVED PLANS.
- USE PERMANENT SOIL STABILIZATION MATTING MADE OF OPEN WEAVE SYNTHETIC, NON-DEGRADABLE FIBERS OR ELEMENTS OF UNIFORM THICKNESS AND DISTRIBUTION THROUGHOUT. CHEMICALS USED IN THE MAT MUST BE NON-LEACHING AND NON-TOXIC TO VEGETATION AND SEED GERMINATION AND NON-HARMFUL TO THE SKIN. IF PRESENT, NETTING MUST BE EXTRUDED PLASTIC WITH A MAXIMUM MESH OPENING OF 2 1/2 INCHES AND SUFFICIENTLY BONDED OR SEWN ON 2 INCH CENTERS ALONG LONGITUDINAL AXIS OF THE MATERIAL TO PREVENT SEPARATION OF THE NET FROM THE PARENT MATERIAL.
- SECURE MATTING USING STEEL STAPLES OR WOOD STAKES. STAPLES MUST BE "U" OR "T" SHAPED STEEL WIRE HAVING A MINIMUM GAUGE OF NO. 11 AND NO. 8 RESPECTIVELY. "U" SHAPED STAPLES MUST AVERAGE 1 TO 1 1/2 INCHES WIDE AND BE A MINIMUM OF 6 INCHES LONG. "T" SHAPED STAPLES MUST AVERAGE 1 TO 1 1/2 INCHES WIDE AND BE A MINIMUM OF 6 INCHES LONG. "T" SHAPED STAPLES MUST HAVE A MINIMUM 8 INCH MAIN LEG, A MINIMUM 1 INCH SECONDARY LEG, AND A MINIMUM 4 INCH HEAD. WOOD STAKES MUST BE ROUGH-SAWN HARDWOOD, 1 1/2 TO 2 INCHES IN LENGTH, 1 1/2 INCH IN CROSS SECTION, AND WEDGE SHAPED AT THE BOTTOM.
- PERFORM FINAL GRADING, TOPSOIL APPLICATION, SEEDBED PREPARATION, AND PERMANENT SEEDING IN ACCORDANCE WITH SPECIFICATIONS. PLACE MATTING WITHIN 48 HOURS OF COMPLETING SEEDING OPERATIONS, UNLESS END OF WORKDAY STABILIZATION IS SPECIFIED ON THE APPROVED EROSION AND SEDIMENT CONTROL PLAN.
- UNROLL MATTING IN DIRECTION OF WATER FLOW, CENTERING THE FIRST ROLL ON THE CHANNEL CENTERLINE. WORK FROM CENTER OF CHANNEL OUTWARD WHEN PLACING ROLLS. LAY MATTING SMOOTHLY AND FIRMLY UPON THE SEEDBED SURFACE. AVOID STRETCHING THE MATTING.
- OVERLAP OR ABUT EDGES OF MATTING ROLLS PER MANUFACTURER RECOMMENDATIONS. OVERLAP ROLL ENDS BY 6 INCHES (MINIMUM), WITH THE UPSTREAM MAT OVERLAPPING ON TOP OF THE NEXT DOWNSLOPE MAT.
- KEY-IN THE TOP OF SLOPE END OF MAT 6 INCHES (MINIMUM) BY DIGGING A TRENCH, PLACING THE MATTING ROLL END IN THE TRENCH, STAPLING THE MAT IN PLACE, REPLACING THE EXCAVATED MATERIAL, AND TAMPING TO SECURE THE MAT END IN THE KEY.
- STAPLE/TAKE MAT IN A STAGGERED PATTERN ON 4 FOOT (MAXIMUM) CENTERS THROUGHOUT AND 2 FOOT (MAXIMUM) CENTERS ALONG SEAMS, JOINTS, AND ROLL ENDS.
- IF SPECIFIED BY THE DESIGNER OR MANUFACTURER AND DEPENDING ON THE TYPE OF MAT BEING INSTALLED, ONCE THE MATTING IS KEPT AND STAPLED IN PLACE, FILL THE MAT VOIDS WITH TOP SOIL OR GRANULAR MATERIAL AND LIGHTLY COMPACT OR ROLL TO MAXIMIZE SOIL/MAT CONTACT WITHOUT CRUSHING MAT.
- ESTABLISH AND MAINTAIN VEGETATION SO THAT REQUIREMENTS FOR ADEQUATE VEGETATIVE ESTABLISHMENT ARE CONTINUOUSLY MET IN ACCORDANCE WITH SECTION B-4 VEGETATIVE STABILIZATION.

DETAIL B-1 STABILIZED CONSTRUCTION ENTRANCE

STANDARD SYMBOL
SCE

CONSTRUCTION SPECIFICATIONS

- PLACE STABILIZED CONSTRUCTION ENTRANCE IN ACCORDANCE WITH THE APPROVED PLAN. VEHICLES MUST TRAVEL OVER THE ENTIRE LENGTH OF THE SCE. USE MINIMUM LENGTH OF 80 FEET (30 FEET FOR SINGLE RESIDENCE LOTS). USE MINIMUM WIDTH OF 10 FEET. FLARE SCE 10 FEET MINIMUM AT THE EXISTING ROAD TO PROVIDE A TURNING RADIUS.
- PIPE ALL SURFACE WATER FLOWING TO OR DIVERTED TOWARD THE SCE UNDER THE ENTRANCE, MAINTAINING POSITIVE DRAINAGE. PROTECT PIPE INSTALLED THROUGH THE SCE WITH A MOUNTABLE BERM WITH 5:1 SLOPES AND A MINIMUM OF 12 INCHES OF STONE OVER THE PIPE. PROVIDE PIPE AS SPECIFIED ON APPROVED PLAN. WHEN THE SCE IS LOCATED AT A HIGH SPOT AND HAS NO DRAINAGE TO CONVEY A PIPE IS NOT NECESSARY. A MOUNTABLE BERM IS REQUIRED WHEN SCE IS NOT LOCATED AT A HIGH SPOT.
- PREPARE SUBGRADE AND PLACE NONWOVEN GEOTEXTILE, AS SPECIFIED IN SECTION H-1 MATERIALS.
- PLACE CRUSHED AGGREGATE (2 TO 3 INCHES IN SIZE) OR EQUIVALENT RECYCLED CONCRETE (WITHOUT REBAR) AT LEAST 8 INCHES DEEP OVER THE LENGTH AND WIDTH OF THE SCE.
- MOUNTABLE ENTRANCE IN A CONDITION THAT MINIMIZES TRACKING OF SEDIMENT. ADD STONE OR MAKE OTHER REPAIRS AS CONDITIONS DEMAND TO MAINTAIN CLEAN SURFACE. MOUNTABLE BERM, AND SPECIFIED DIMENSIONS. IMMEDIATELY REMOVE STONE AND/OR SEDIMENT SPILLED, DROPPED, OR TRACKED ONTO ADJACENT ROADWAY BY VACUUMING, SCRAPING, AND/OR SWEEPING. WASHING ROADWAY TO REMOVE MUD TRACKED ONTO PAVEMENT IS NOT ACCEPTABLE UNLESS WASH WATER IS DIRECTED TO AN APPROVED SEDIMENT CONTROL PRACTICE.

DETAIL E-1 SILT FENCE

STANDARD SYMBOL
SF

CONSTRUCTION SPECIFICATIONS

- USE WOOD POSTS 1 1/2 X 1 1/2 INCH (MINIMUM) SQUARE CUT OF SOUND QUALITY HARDWOOD, AS AN ALTERNATIVE TO WOODEN POSTS USE STANDARD "T" OR "U" SECTION STEEL POSTS WEIGHING NOT LESS THAN 1 POUND PER LINEAR FOOT.
- USE 36 INCH MINIMUM POSTS DRIVEN 16 INCH MINIMUM INTO GROUND NO MORE THAN 6 FEET APART.
- USE WOVEN SILT FILM GEOTEXTILE AS SPECIFIED IN SECTION H-1 MATERIALS AND FASTEN GEOTEXTILE SECURELY TO UPSLOPE SIDE OF FENCE POSTS WITH WIRE TIES OR STAPLES AT TOP AND MID-SECTION.
- PROVIDE MANUFACTURER CERTIFICATION TO THE AUTHORIZED REPRESENTATIVE OF THE INSPECTION/ENFORCEMENT AUTHORITY SHOWING THAT THE GEOTEXTILE USED MEETS THE REQUIREMENTS IN SECTION H-1 MATERIALS.
- EMBED GEOTEXTILE A MINIMUM OF 8 INCHES VERTICALLY INTO THE GROUND, BACKFILL AND COMPACT THE SOIL ON BOTH SIDES OF FABRIC.
- EXTEND BOTH ENDS OF THE SILT FENCE A MINIMUM OF FIVE HORIZONTAL FEET UPSLOPE AT 45 DEGREES TO THE MAIN FENCE ALIGNMENT TO PREVENT RUNOFF FROM GOING AROUND THE ENDS OF THE SILT FENCE.
- REMOVE ACCUMULATED SEDIMENT AND DEBRIS WHEN BULGES DEVELOP IN SILT FENCE OR WHEN SEDIMENT REACHES 25% OF FENCE HEIGHT. REPLACE GEOTEXTILE IF TORN. IF UNDERMINING OCCURS, REINSTALL FENCE.

DETAIL E-1 SILT FENCE

STANDARD SYMBOL
SF

CONSTRUCTION SPECIFICATIONS

- USE WOOD POSTS 1 1/2 X 1 1/2 INCH (MINIMUM) SQUARE CUT OF SOUND QUALITY HARDWOOD, AS AN ALTERNATIVE TO WOODEN POSTS USE STANDARD "T" OR "U" SECTION STEEL POSTS WEIGHING NOT LESS THAN 1 POUND PER LINEAR FOOT.
- USE 36 INCH MINIMUM POSTS DRIVEN 16 INCH MINIMUM INTO GROUND NO MORE THAN 6 FEET APART.
- USE WOVEN SILT FILM GEOTEXTILE AS SPECIFIED IN SECTION H-1 MATERIALS AND FASTEN GEOTEXTILE SECURELY TO UPSLOPE SIDE OF FENCE POSTS WITH WIRE TIES OR STAPLES AT TOP AND MID-SECTION.
- PROVIDE MANUFACTURER CERTIFICATION TO THE AUTHORIZED REPRESENTATIVE OF THE INSPECTION/ENFORCEMENT AUTHORITY SHOWING THAT THE GEOTEXTILE USED MEETS THE REQUIREMENTS IN SECTION H-1 MATERIALS.
- EMBED GEOTEXTILE A MINIMUM OF 8 INCHES VERTICALLY INTO THE GROUND, BACKFILL AND COMPACT THE SOIL ON BOTH SIDES OF FABRIC.
- EXTEND BOTH ENDS OF THE SILT FENCE A MINIMUM OF FIVE HORIZONTAL FEET UPSLOPE AT 45 DEGREES TO THE MAIN FENCE ALIGNMENT TO PREVENT RUNOFF FROM GOING AROUND THE ENDS OF THE SILT FENCE.
- REMOVE ACCUMULATED SEDIMENT AND DEBRIS WHEN BULGES DEVELOP IN SILT FENCE OR WHEN SEDIMENT REACHES 25% OF FENCE HEIGHT. REPLACE GEOTEXTILE IF TORN. IF UNDERMINING OCCURS, REINSTALL FENCE.

DETAIL B-4-6-B TEMPORARY SOIL STABILIZATION MATTING SLOPE APPLICATION

STANDARD SYMBOL
TSSMS - * * lb/ft²
(* INCLUDE SHEAR STRESS)

CONSTRUCTION SPECIFICATIONS

- USE MATTING THAT HAS A DESIGN VALUE FOR SHEAR STRESS EQUAL TO OR HIGHER THAN THE SHEAR STRESS DESIGNATED ON APPROVED PLANS.
- USE TEMPORARY SOIL STABILIZATION MATTING MADE OF DEGRADABLE (LASTS 6 MONTHS MINIMUM) NATURAL OR MAN-MADE FIBERS (MOSTLY ORGANIC). MAT MUST HAVE UNIFORM THICKNESS AND DISTRIBUTION OF FIBERS THROUGHOUT AND BE SMOLDER RESISTANT. CHEMICALS USED IN THE MAT MUST BE NON-LEACHING AND NON-TOXIC TO VEGETATION AND SEED GERMINATION AND NON-HARMFUL TO THE SKIN. IF PRESENT, NETTING MUST BE EXTRUDED PLASTIC WITH A MAXIMUM MESH OPENING OF 2 1/2 INCHES AND SUFFICIENTLY BONDED OR SEWN ON 2 INCH CENTERS ALONG LONGITUDINAL AXIS OF THE MATERIAL TO PREVENT SEPARATION OF THE NET FROM THE PARENT MATERIAL.
- SECURE MATTING USING STEEL STAPLES, WOOD STAKES, OR BIODEGRADABLE EQUIVALENT. STAPLES MUST BE "U" OR "T" SHAPED STEEL WIRE HAVING A MINIMUM GAUGE OF NO. 11 AND NO. 8 RESPECTIVELY. "U" SHAPED STAPLES MUST AVERAGE 1 TO 1 1/2 INCHES WIDE AND BE A MINIMUM OF 6 INCHES LONG. "T" SHAPED STAPLES MUST AVERAGE 1 TO 1 1/2 INCHES WIDE AND BE A MINIMUM OF 6 INCHES LONG. "T" SHAPED STAPLES MUST HAVE A MINIMUM 8 INCH MAIN LEG, A MINIMUM 1 INCH SECONDARY LEG, AND A MINIMUM 4 INCH HEAD. WOOD STAKES MUST BE ROUGH-SAWN HARDWOOD, 1 1/2 TO 2 INCHES IN LENGTH, 1 1/2 INCH IN CROSS SECTION, AND WEDGE SHAPED AT THE BOTTOM.
- PERFORM FINAL GRADING, TOPSOIL APPLICATION, SEEDBED PREPARATION, AND PERMANENT SEEDING IN ACCORDANCE WITH SPECIFICATIONS. PLACE MATTING WITHIN 48 HOURS OF COMPLETING SEEDING OPERATIONS UNLESS END OF WORKDAY STABILIZATION IS SPECIFIED ON THE APPROVED EROSION AND SEDIMENT CONTROL PLAN.
- UNROLL MATTING DOWNSLOPE. LAY MAT SMOOTHLY AND FIRMLY UPON THE SEEDBED SURFACE. AVOID STRETCHING THE MATTING.
- OVERLAP OR ABUT ROLL EDGES PER MANUFACTURER RECOMMENDATIONS. OVERLAP ROLL ENDS BY 6 INCHES (MINIMUM), WITH THE UPSTREAM MAT OVERLAPPING ON TOP OF THE DOWNSLOPE MAT.
- KEY-IN THE UPSLOPE END OF MAT 6 INCHES (MINIMUM) BY DIGGING A TRENCH, PLACING THE MATTING ROLL END IN THE TRENCH, STAPLING THE MAT IN PLACE, REPLACING THE EXCAVATED MATERIAL, AND TAMPING TO SECURE THE MAT END IN THE KEY.
- STAPLE/TAKE MAT IN A STAGGERED PATTERN ON 4 FOOT (MAXIMUM) CENTERS THROUGHOUT AND 2 FOOT (MAXIMUM) CENTERS ALONG SEAMS, JOINTS, AND ROLL ENDS.
- ESTABLISH AND MAINTAIN VEGETATION SO THAT REQUIREMENTS FOR ADEQUATE VEGETATIVE ESTABLISHMENT ARE CONTINUOUSLY MET IN ACCORDANCE WITH SECTION B-4 VEGETATIVE STABILIZATION.

DETAIL B-4-6-D PERMANENT SOIL STABILIZATION MATTING SLOPE APPLICATION

STANDARD SYMBOL
PSSMS - * * lb/ft²
(* INCLUDE SHEAR STRESS)

CONSTRUCTION SPECIFICATIONS

- USE MATTING THAT HAS A DESIGN VALUE FOR SHEAR STRESS EQUAL TO OR HIGHER THAN THE SHEAR STRESS DESIGNATED ON APPROVED PLANS.
- USE PERMANENT SOIL STABILIZATION MATTING MADE OF OPEN WEAVE SYNTHETIC, NON-DEGRADABLE FIBERS OR ELEMENTS OF UNIFORM THICKNESS AND DISTRIBUTION THROUGHOUT. CHEMICALS USED IN THE MAT MUST BE NON-LEACHING AND NON-TOXIC TO VEGETATION AND SEED GERMINATION AND NON-HARMFUL TO THE SKIN. IF PRESENT, NETTING MUST BE EXTRUDED PLASTIC WITH A MAXIMUM MESH OPENING OF 2 1/2 INCHES AND SUFFICIENTLY BONDED OR SEWN ON 2 INCH CENTERS ALONG LONGITUDINAL AXIS OF THE MATERIAL TO PREVENT SEPARATION OF THE NET FROM THE PARENT MATERIAL.
- SECURE MATTING USING STEEL STAPLES OR WOOD STAKES. STAPLES MUST BE "U" OR "T" SHAPED STEEL WIRE HAVING A MINIMUM GAUGE OF NO. 11 AND NO. 8 RESPECTIVELY. "U" SHAPED STAPLES MUST AVERAGE 1 TO 1 1/2 INCHES WIDE AND BE A MINIMUM OF 6 INCHES LONG. "T" SHAPED STAPLES MUST AVERAGE 1 TO 1 1/2 INCHES WIDE AND BE A MINIMUM OF 6 INCHES LONG. "T" SHAPED STAPLES MUST HAVE A MINIMUM 8 INCH MAIN LEG, A MINIMUM 1 INCH SECONDARY LEG, AND A MINIMUM 4 INCH HEAD. WOOD STAKES MUST BE ROUGH-SAWN HARDWOOD, 1 1/2 TO 2 INCHES IN LENGTH, 1 1/2 INCH IN CROSS SECTION, AND WEDGE SHAPED AT THE BOTTOM.
- PERFORM FINAL GRADING, TOPSOIL APPLICATION, SEEDBED PREPARATION, AND PERMANENT SEEDING IN ACCORDANCE WITH SPECIFICATIONS. PLACE MATTING WITHIN 48 HOURS OF COMPLETING SEEDING OPERATIONS, UNLESS END OF WORKDAY STABILIZATION IS SPECIFIED ON THE APPROVED EROSION AND SEDIMENT CONTROL PLAN.
- UNROLL MATTING DOWN SLOPE. LAY MATTING SMOOTHLY AND FIRMLY UPON THE SEEDBED SURFACE. AVOID STRETCHING THE MATTING.
- OVERLAP OR ABUT EDGES OF MATTING ROLLS PER MANUFACTURER RECOMMENDATIONS. OVERLAP ROLL ENDS BY 6 INCHES (MINIMUM), WITH THE UPSTREAM MAT OVERLAPPING ON TOP OF THE DOWNSLOPE MAT.
- KEY-IN THE TOP OF SLOPE END OF MAT 6 INCHES (MINIMUM) BY DIGGING A TRENCH, PLACING THE MATTING ROLL END IN THE TRENCH, STAPLING THE MAT IN PLACE, REPLACING THE EXCAVATED MATERIAL, AND TAMPING TO SECURE THE MAT END IN THE KEY.
- STAPLE/TAKE MAT IN A STAGGERED PATTERN ON 4 FOOT (MAXIMUM) CENTERS THROUGHOUT AND 2 FOOT (MAXIMUM) CENTERS ALONG SEAMS, JOINTS, AND ROLL ENDS.
- IF SPECIFIED BY THE DESIGNER OR MANUFACTURER AND DEPENDING ON THE TYPE OF MAT BEING INSTALLED, ONCE THE MATTING IS KEPT AND STAPLED IN PLACE, FILL THE MAT VOIDS WITH TOP SOIL OR GRANULAR MATERIAL AND LIGHTLY COMPACT OR ROLL TO MAXIMIZE SOIL/MAT CONTACT WITHOUT CRUSHING MAT.
- ESTABLISH AND MAINTAIN VEGETATION SO THAT REQUIREMENTS FOR ADEQUATE VEGETATIVE ESTABLISHMENT ARE CONTINUOUSLY MET IN ACCORDANCE WITH SECTION B-4 VEGETATIVE STABILIZATION.

DETAIL B-3-1 BENCHING

STANDARD SYMBOL
BENCHING

CONSTRUCTION SPECIFICATIONS

- USE FILL MATERIAL FREE OF BRUSH, RUBBISH, ROCKS, LOGS, STUMPS, BUILDING DEBRIS, AND OTHER OBJECTIONABLE MATERIALS THAT WOULD INTERFERE WITH OR PREVENT CONSTRUCTION OF SATISFACTORY FILLS.
- DO NOT INCORPORATE FROZEN, SOFT, MUCKY, OR HIGHLY COMPRESSIBLE MATERIALS INTO FILL SLOPES OR STRUCTURAL FILLS. DO NOT PLACE FILL ON A FROZEN FOUNDATION.
- PLACE ALL FILL IN LOOSE LIFTS NOT TO EXCEED 8 INCHES AND THEN COMPACT.
- COMPACT ALL FILLS AS REQUIRED TO REDUCE EROSION, SLIPAGE, SETTLEMENT, OR OTHER RELATED PROBLEMS. COMPACT FILL INTENDED TO SUPPORT BUILDINGS, STRUCTURES, CONDUITS, ETC., IN ACCORDANCE WITH LOCAL REQUIREMENTS OR CODES.
- HANDLE SLOPES OR SPRINGS ENCOUNTERED DURING CONSTRUCTION IN ACCORDANCE WITH SECTION H-2 SUBSURFACE DRAINS OR OTHER APPROVED METHODS.
- MAINTAIN LINE, GRADE, AND CROSS SECTION OF BENCHING. STABILIZE IN ACCORDANCE WITH THE 37 DAY STABILIZATION CRITERIA OR AS SPECIFIED ON THE APPROVED EROSION AND SEDIMENT CONTROL PLAN. INSTALLATION OF EROSION CONTROL MATTINGS MAY BE NECESSARY IN BENCHSWALE INVERTS. CONTINUOUSLY MEET REQUIREMENTS FOR ADEQUATE VEGETATIVE ESTABLISHMENT IN ACCORDANCE WITH SECTION B-4 VEGETATIVE STABILIZATION.
- KEEP ALL BENCHES FREE OF SEDIMENT DURING ALL PHASES OF DEVELOPMENT.

DETAIL C-1 EARTH DIKE

STANDARD SYMBOL
A-1
DIKE SEPARATION (See B-3)

CONSTRUCTION SPECIFICATIONS

- REMOVE AND DISPOSE OF ALL TREES, BRUSH, STUMPS, OBSTRUCTIONS, AND OTHER OBJECTIONABLE MATERIAL, SO AS NOT TO INTERFERE WITH PROPER FUNCTION OF EARTHDIKE.
- EXCAVATE OR SHAPE EARTH DIKE TO LINE, GRADE, AND CROSS SECTION AS SPECIFIED. BANK PROJECTIONS OR OTHER IRREGULARITIES ARE NOT ALLOWED.
- COMPACT FILL.
- CONSTRUCT FLOW CHANNEL ON AN UNINTERRUPTED, CONTINUOUS GRADE, ADJUSTING THE LOCATION DUE TO FIELD CONDITIONS AS NECESSARY TO MAINTAIN POSITIVE DRAINAGE.
- PROVIDE OUTLET PROTECTION AS REQUIRED ON APPROVED PLAN.
- STABILIZE EARTH DIKE WITHIN THREE DAYS OF INSTALLATION. STABILIZE FLOW CHANNEL FOR CLEAR WATER DIVERSION WITHIN 24 HOURS OF INSTALLATION.
- MAINTAIN LINE, GRADE, AND CROSS SECTION. REMOVE ACCUMULATED SEDIMENT AND DEBRIS, AND MAINTAIN POSITIVE DRAINAGE. KEEP EARTH DIKE AND POINT OF DISCHARGE FREE OF EROSION, AND CONTINUOUSLY MEET REQUIREMENTS FOR ADEQUATE VEGETATIVE ESTABLISHMENT IN ACCORDANCE WITH SECTION B-4 VEGETATIVE STABILIZATION.
- UPON REMOVAL OF EARTH DIKE, GRADE AREA FLUSH WITH EXISTING GROUND. WITHIN 24 HOURS OF REMOVAL STABILIZE DISTURBED AREA WITH TOPSOIL, SEED, AND MULCH, OR AS SPECIFIED ON APPROVED PLAN.

DETAIL G-2-4 BAFFLE BOARDS

STANDARD SYMBOL
BB

CONSTRUCTION SPECIFICATIONS

- REMOVE AND DISPOSE OF ALL TREES, BRUSH, STUMPS, OBSTRUCTIONS, AND OTHER OBJECTIONABLE MATERIAL, SO AS NOT TO INTERFERE WITH PROPER FUNCTION OF EARTHDIKE.
- EXCAVATE OR SHAPE EARTH DIKE TO LINE, GRADE, AND CROSS SECTION AS SPECIFIED. BANK PROJECTIONS OR OTHER IRREGULARITIES ARE NOT ALLOWED.
- COMPACT FILL.
- CONSTRUCT FLOW CHANNEL ON AN UNINTERRUPTED, CONTINUOUS GRADE, ADJUSTING THE LOCATION DUE TO FIELD CONDITIONS AS NECESSARY TO MAINTAIN POSITIVE DRAINAGE.
- PROVIDE OUTLET PROTECTION AS REQUIRED ON APPROVED PLAN.
- STABILIZE EARTH DIKE WITHIN THREE DAYS OF INSTALLATION. STABILIZE FLOW CHANNEL FOR CLEAR WATER DIVERSION WITHIN 24 HOURS OF INSTALLATION.
- MAINTAIN LINE, GRADE, AND CROSS SECTION. REMOVE ACCUMULATED SEDIMENT AND DEBRIS, AND MAINTAIN POSITIVE DRAINAGE. KEEP EARTH DIKE AND POINT OF DISCHARGE FREE OF EROSION, AND CONTINUOUSLY MEET REQUIREMENTS FOR ADEQUATE VEGETATIVE ESTABLISHMENT IN ACCORDANCE WITH SECTION B-4 VEGETATIVE STABILIZATION.
- UPON REMOVAL OF EARTH DIKE, GRADE AREA FLUSH WITH EXISTING GROUND. WITHIN 24 HOURS OF REMOVAL STABILIZE DISTURBED AREA WITH TOPSOIL, SEED, AND MULCH, OR AS SPECIFIED ON APPROVED PLAN.

MARYLAND STANDARDS AND SPECIFICATIONS FOR SOIL EROSION AND SEDIMENT CONTROL

U.S. DEPARTMENT OF AGRICULTURE NATURAL RESOURCES CONSERVATION SERVICE 2011 MARYLAND DEPARTMENT OF ENVIRONMENT WATER MANAGEMENT ADMINISTRATION

MARYLAND STANDARDS AND SPECIFICATIONS FOR SOIL EROSION AND SEDIMENT CONTROL

U.S. DEPARTMENT OF AGRICULTURE NATURAL RESOURCES CONSERVATION SERVICE 2011 MARYLAND DEPARTMENT OF ENVIRONMENT WATER MANAGEMENT ADMINISTRATION

B-4-7 STANDARDS AND SPECIFICATIONS FOR HEAVY USE AREA PROTECTION

DEFINITION
THE STABILIZATION OF AREAS FREQUENTLY AND INTENSIVELY USED BY SURFACING WITH SUITABLE MATERIALS (E.G., MULCH AND AGGREGATE).

PURPOSE
TO PROVIDE A STABLE, NON-ERODING SURFACE FOR AREAS FREQUENTLY USED AND TO IMPROVE THE WATER QUALITY FROM THE RUNOFF OF THESE AREAS.

CONDITIONS WHERE PRACTICE APPLIES
THIS PRACTICE APPLIES TO INTENSIVELY USED AREAS (E.G., EQUIPMENT AND MATERIAL STORAGE, STAGING AREAS, HEAVILY USED TRAVEL LANES).

CRITERIA

- A MINIMUM 4-INCH BASE COURSE OF CRUSHED STONE OR OTHER SUITABLE MATERIALS INCLUDING WOOD CHIPS OVER NONWOVEN GEOTEXTILE SHOULD BE PROVIDED AS SPECIFIED IN SECTION H-1 MATERIALS.
- SELECT THE STABILIZING MATERIAL BASED ON THE INTENDED USE, DESIRED MAINTENANCE FREQUENCY, AND RUNOFF CONTROL.
- THE TRANSPORT OF SEDIMENTS, NUTRIENTS, OILS, CHEMICALS, PARTICULATE MATTER ASSOCIATED WITH VEHICULAR TRAFFIC AND EQUIPMENT, AND MATERIAL STORAGE NEEDS TO BE CONSIDERED IN THE SELECTION OF MATERIAL. ADDITIONAL CONTROL MEASURES MAY BE NECESSARY TO CONTROL SOME OF THESE POTENTIAL POLLUTANTS.
- SURFACE EROSION CAN BE A PROBLEM ON LARGE HEAVY USE AREAS. IN THESE SITUATIONS MEASURES TO REDUCE THE FLOW LENGTH OF RUNOFF OR EROSION VELOCITIES NEED TO BE CONSIDERED.

MAINTENANCE
THE HEAVY USE AREAS MUST BE MAINTAINED IN A MANNER THAT MINIMIZES EROSION. THIS MAY REQUIRE ADDING SUITABLE MATERIAL, AS SPECIFIED ON THE APPROVED PLANS, TO MAINTAIN A CLEAN SURFACE.

B-4-7 STANDARDS AND SPECIFICATIONS FOR STOCKPILE AREA

DEFINITION
A MOUND OR PILE OF SOIL PROTECTED BY APPROPRIATELY DESIGNED EROSION AND SEDIMENT CONTROL MEASURES.

PURPOSE
TO PROVIDE A DESIGNATED LOCATION FOR THE TEMPORARY STORAGE OF SOIL THAT CONTROLS THE POTENTIAL FOR EROSION, SEDIMENTATION, AND CHANGES TO DRAINAGE PATTERNS.

CONDITIONS WHERE PRACTICE APPLIES
STOCKPILE AREAS ARE UTILIZED WHEN IT IS NECESSARY TO SALVAGE AND STORE SOIL FOR LATER USE.

CRITERIA

- THE STOCKPILE LOCATION AND ALL RELATED SEDIMENT CONTROL PRACTICES MUST BE CLEARLY IDENTIFIED ON THE EROSION AND SEDIMENT CONTROL PLAN.
- THE FOOTPRINT OF THE STOCKPILE MUST BE SIZED TO ACCOMMODATE THE ANTICIPATED VOLUME OF MATERIAL AND BASED ON A SIDE SLOPE RATIO NO STEEPER THAN 2:1. BENCHING MUST BE PROVIDED IN ACCORDANCE WITH SECTION B-3 LAND GRADING.
- RUNOFF FROM THE STOCKPILE AREA MUST DRAIN TO A SUITABLE SEDIMENT CONTROL PRACTICE.
- ACCESS THE STOCKPILE AREA FROM THE UPGRADE SIDE.
- CLEAR WATER RUNOFF INTO THE STOCKPILE AREA MUST BE MINIMIZED BY USE OF A DIVERSION DEVICE SUCH AS AN EARTH DIKE, TEMPORARY SWALE OR DIVERSION FENCE. PROVISIONS MUST BE MADE FOR DISCHARGING CONCENTRATED FLOW IN A NONEROSIVE MANNER.
- WHERE RUNOFF CONCENTRATES ALONG THE TOE OF THE STOCKPILE, FILL AN APPROPRIATE EROSION/SEDIMENT CONTROL PRACTICE MUST BE USED TO INTERCEPT THE DISCHARGE.
- STOCKPILES MUST BE STABILIZED IN ACCORDANCE WITH THE 37 DAY STABILIZATION REQUIREMENT AS WELL AS STANDARD B-4-1 INCREMENTAL STABILIZATION AND STANDARD B-4-4 TEMPORARY STABILIZATION.
- IF THE STOCKPILE IS LOCATED ON AN IMPERVIOUS SURFACE, A LINER SHOULD BE PROVIDED BELOW THE STOCKPILE TO FACILITATE CLEANUP. STOCKPILES CONTAINING CONTAMINATED MATERIAL MUST BE COVERED WITH IMPERMEABLE SHEETING.

MAINTENANCE
THE STOCKPILE AREA MUST CONTINUOUSLY MEET THE REQUIREMENTS FOR ADEQUATE VEGETATIVE ESTABLISHMENT IN ACCORDANCE WITH SECTION B-4 VEGETATIVE STABILIZATION. SIDE SLOPES MUST BE MAINTAINED AT NO STEEPER THAN A 2:1 RATIO. THE STOCKPILE AREA MUST BE KEPT FREE OF EROSION. IF THE VERTICAL HEIGHT OF A STOCKPILE EXCEEDS 20 FEET FOR 1:1 SLOPES, 30 FEET FOR 2:1 SLOPES, OR 40 FEET FOR 4:1 SLOPES, BENCHING MUST BE PROVIDED IN ACCORDANCE WITH SECTION B-3 LAND GRADING.

ENGINEER'S CERTIFICATE

I HEREBY CERTIFY THAT THIS PLAN FOR EROSION AND SEDIMENT CONTROL REPRESENTS A PRACTICABLE AND WORKABLE PLAN BASED ON MY PERSONAL KNOWLEDGE OF THE SITE CONDITIONS AND IT WAS PREPARED IN ACCORDANCE WITH THE REQUIREMENTS OF THE HOWARD COUNTY SOIL CONSERVATION DISTRICT.

SIGNATURE OF ENGINEER: *[Signature]* DATE: 10/20/14

DEVELOPER'S CERTIFICATE

"I HEREBY CERTIFY THAT ALL DEVELOPMENT AND CONSTRUCTION WILL BE DONE ACCORDING TO THIS PLAN, AND THAT ANY RESPONSIBLE PERSONNEL INVOLVED IN THE CONSTRUCTION PROJECT WILL HAVE A CERTIFICATE OF ATTENDANCE AT A DEPARTMENT OF THE ENVIRONMENT APPROVED TRAINING PROGRAM FOR THE CONTROL OF SEDIMENT AND EROSION BEFORE BEGINNING THE PROJECT. I ALSO AUTHORIZE PERIODIC ON-SITE INSPECTIONS BY THE HOWARD COUNTY SOIL CONSERVATION DISTRICT."

SIGNATURE OF DEVELOPER: *[Signature]* DATE: 11-3-14

PROFESSIONAL CERTIFICATION

I, BRUNO R. ROWE, HEREBY CERTIFY THAT THESE DOCUMENTS WERE PREPARED OR APPROVED BY ME, AND THAT I AM A DULY LICENSED PROFESSIONAL ENGINEER UNDER THE LAWS OF THE STATE OF MARYLAND, LICENSE NO. 40808, EXPIRATION DATE: 12/31/15.

BOHLER ENGINEERING

901 DULANEY VALLEY ROAD, SUITE 801
TOWSON, MARYLAND 21284
Phone: (410) 821-7900
Fax: (410) 821-7987
www.BohlerEngineering.com

CHECKED BY: BRR
DESIGNED BY: BRR
DRAWN BY: RMS/AVG
PROJECT NO.: MD112149
DATE: 10/27/14
SCALE: AS NOTED
DRAWING NO.: 10 OF 35

MARYLAND STANDARDS AND SPECIFICATIONS FOR SOIL EROSION AND SEDIMENT CONTROL

U.S. DEPARTMENT OF AGRICULTURE NATURAL RESOURCES CONSERVATION SERVICE 2011 MARYLAND DEPARTMENT OF ENVIRONMENT WATER MANAGEMENT ADMINISTRATION

WALDEN WOODS


TAX MAP: 47 GRID: 2 ZONED: PSC
PARCEL: 4, LOTS 1-97, OPEN SPACE LOTS 98 - 102
6TH ELECTION DISTRICT, HOWARD COUNTY, MARYLAND

EROSION AND SEDIMENT CONTROL NOTES AND DETAILS












BOHLER ENGINEERING

901 DULANEY VALLEY ROAD, SUITE 801
TOWSON, MARYLAND 21284
Phone: (410) 821-7900
Fax: (410) 821-7987
www.BohlerEngineering.com


CHECKED BY: BRR
DESIGNED BY: BRR
DRAWN BY: RMS/AVG
PROJECT NO.: MD112149
DATE: 10/27/14
SCALE: AS NOTED
DRAWING NO.: 10 OF 35

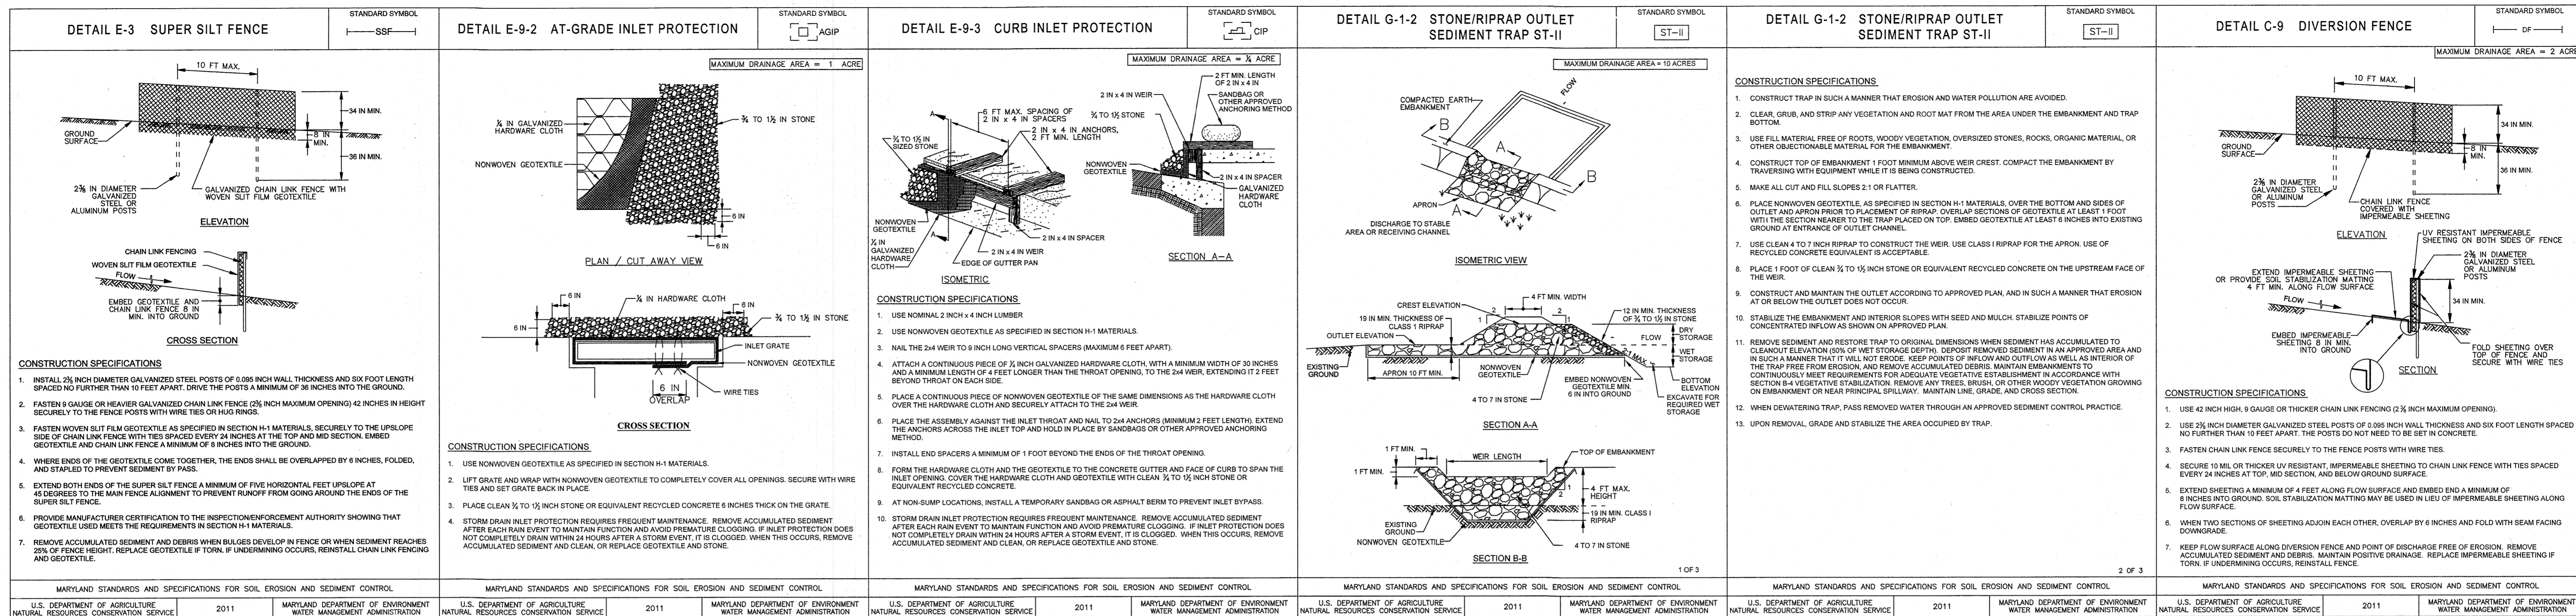

MARYLAND STANDARDS AND SPECIFICATIONS FOR SOIL EROSION AND SEDIMENT CONTROL	MARYLAND STANDARDS AND SPECIFICATIONS FOR SOIL EROSION AND SEDIMENT CONTROL	MARYLAND STANDARDS AND SPECIFICATIONS FOR SOIL EROSION AND SEDIMENT CONTROL	MARYLAND STANDARDS AND SPECIFICATIONS FOR SOIL EROSION AND SEDIMENT CONTROL	MARYLAND STANDARDS AND SPECIFICATIONS FOR SOIL EROSION AND SEDIMENT CONTROL	MARYLAND STANDARDS AND SPECIFICATIONS FOR SOIL EROSION AND SEDIMENT CONTROL
U.S. DEPARTMENT OF AGRICULTURE NATURAL RESOURCES CONSERVATION SERVICE	U.S. DEPARTMENT OF AGRICULTURE NATURAL RESOURCES CONSERVATION SERVICE	U.S. DEPARTMENT OF AGRICULTURE NATURAL RESOURCES CONSERVATION SERVICE	U.S. DEPARTMENT OF AGRICULTURE NATURAL RESOURCES CONSERVATION SERVICE	U.S. DEPARTMENT OF AGRICULTURE NATURAL RESOURCES CONSERVATION SERVICE	U.S. DEPARTMENT OF AGRICULTURE NATURAL RESOURCES CONSERVATION SERVICE
2011	2011	2011	2011	2011	2011
MARYLAND DEPARTMENT OF ENVIRONMENT WATER MANAGEMENT ADMINISTRATION	MARYLAND DEPARTMENT OF ENVIRONMENT WATER MANAGEMENT ADMINISTRATION	MARYLAND DEPARTMENT OF ENVIRONMENT WATER MANAGEMENT ADMINISTRATION	MARYLAND DEPARTMENT OF ENVIRONMENT WATER MANAGEMENT ADMINISTRATION	MARYLAND DEPARTMENT OF ENVIRONMENT WATER MANAGEMENT ADMINISTRATION	MARYLAND DEPARTMENT OF ENVIRONMENT WATER MANAGEMENT ADMINISTRATION

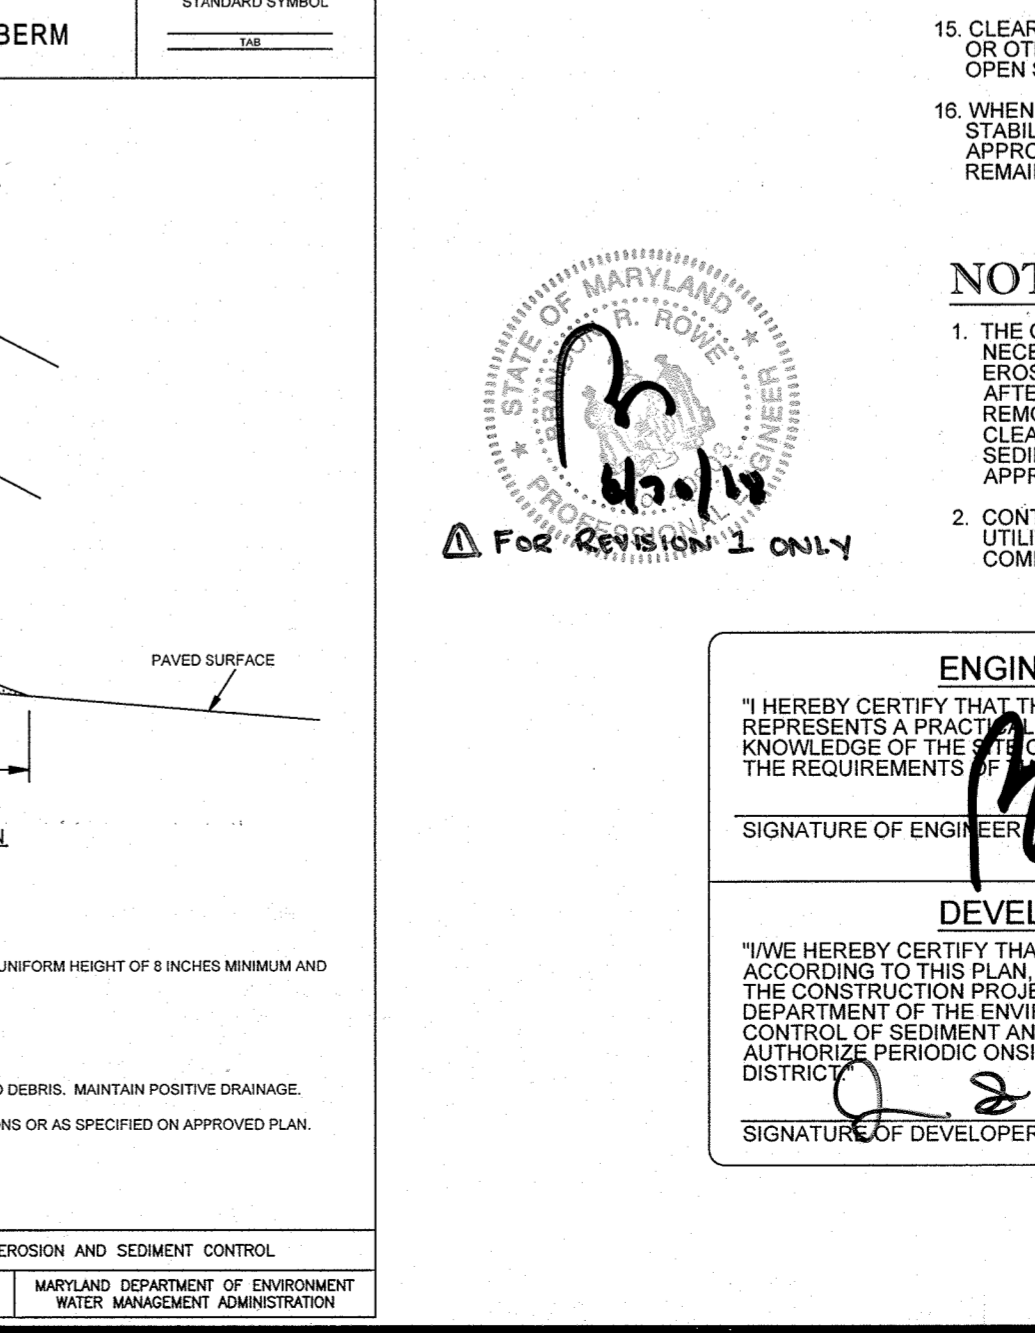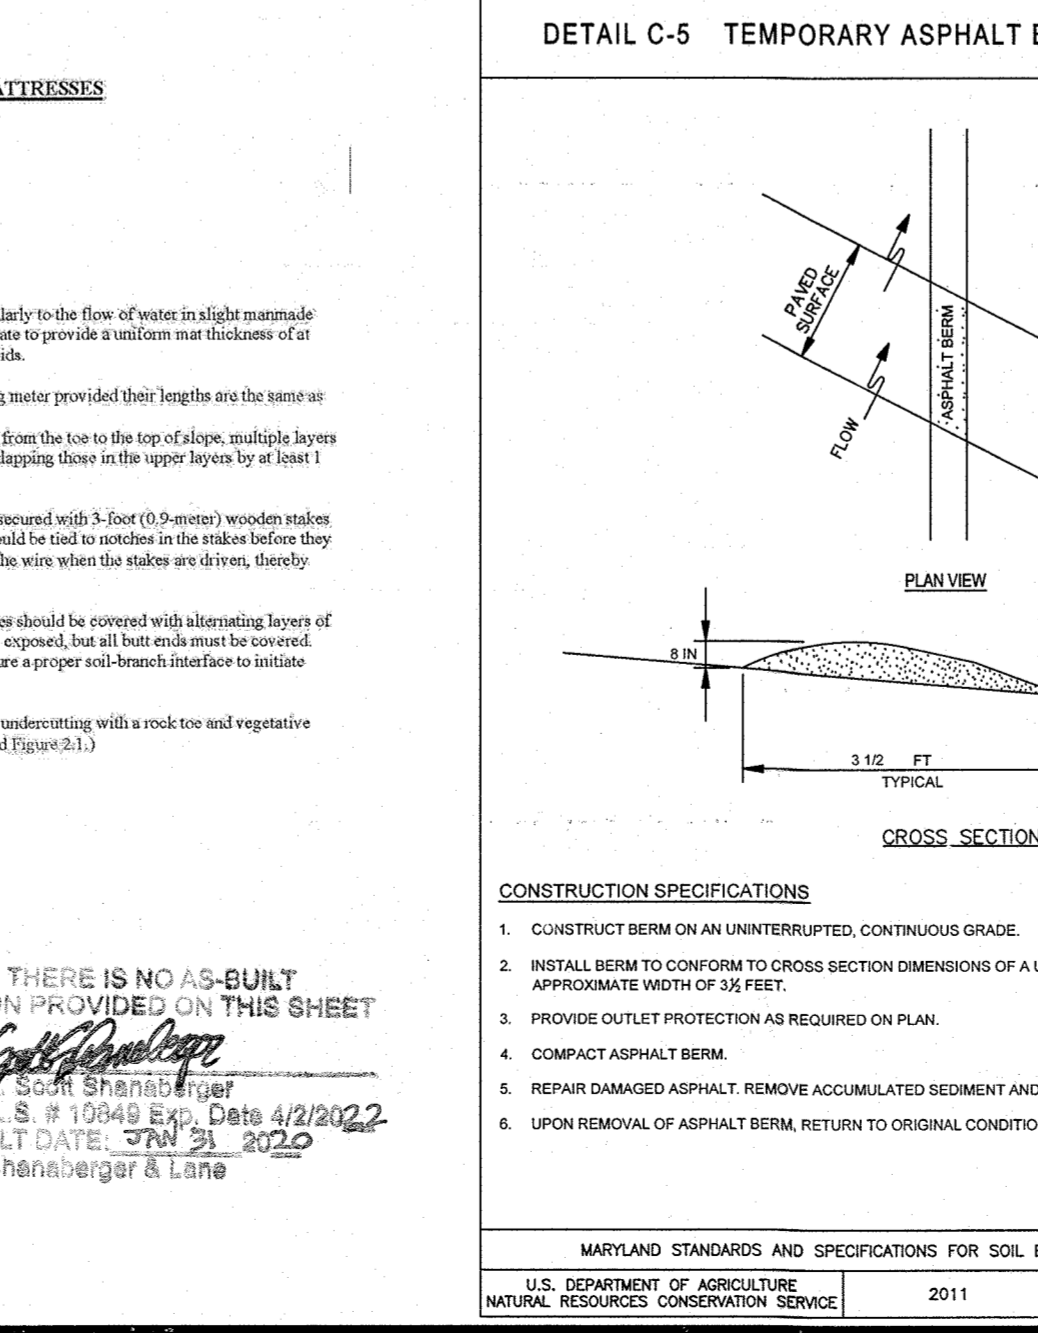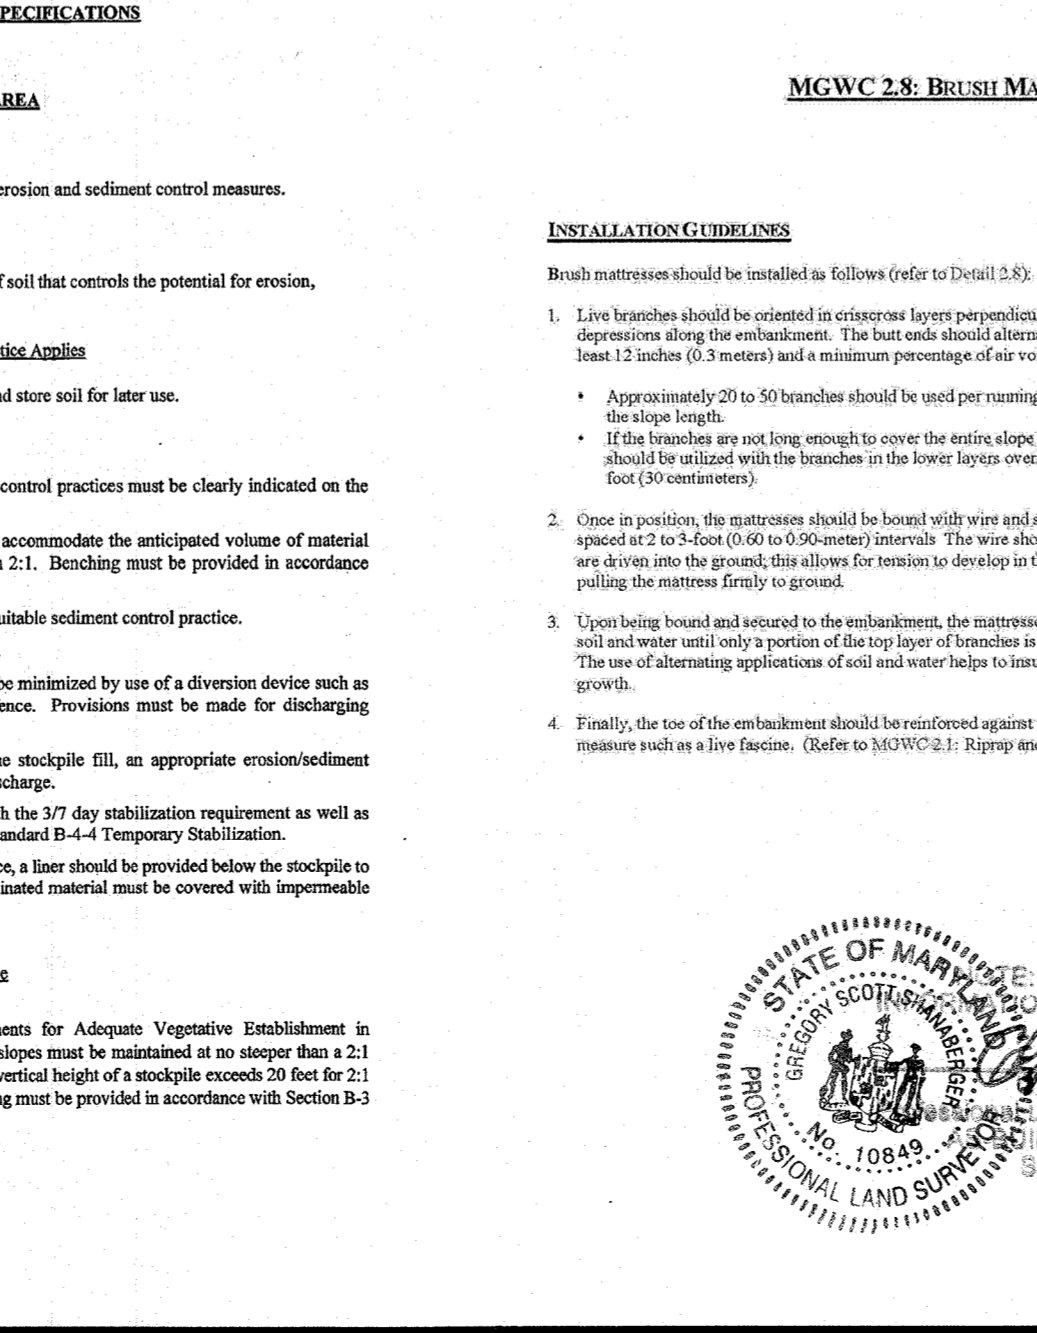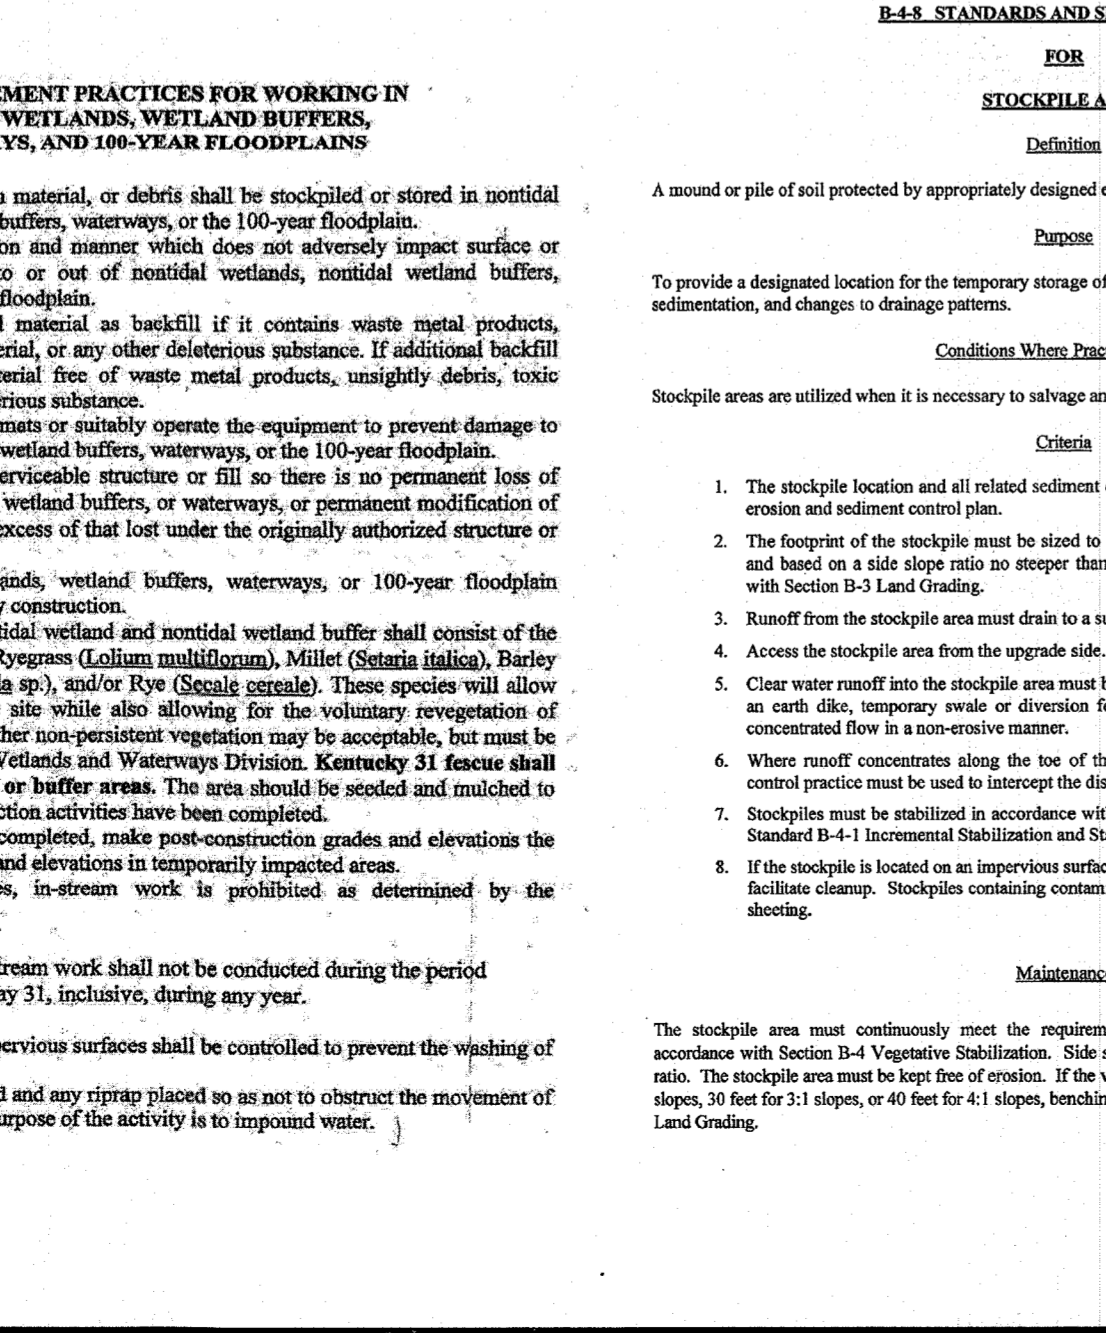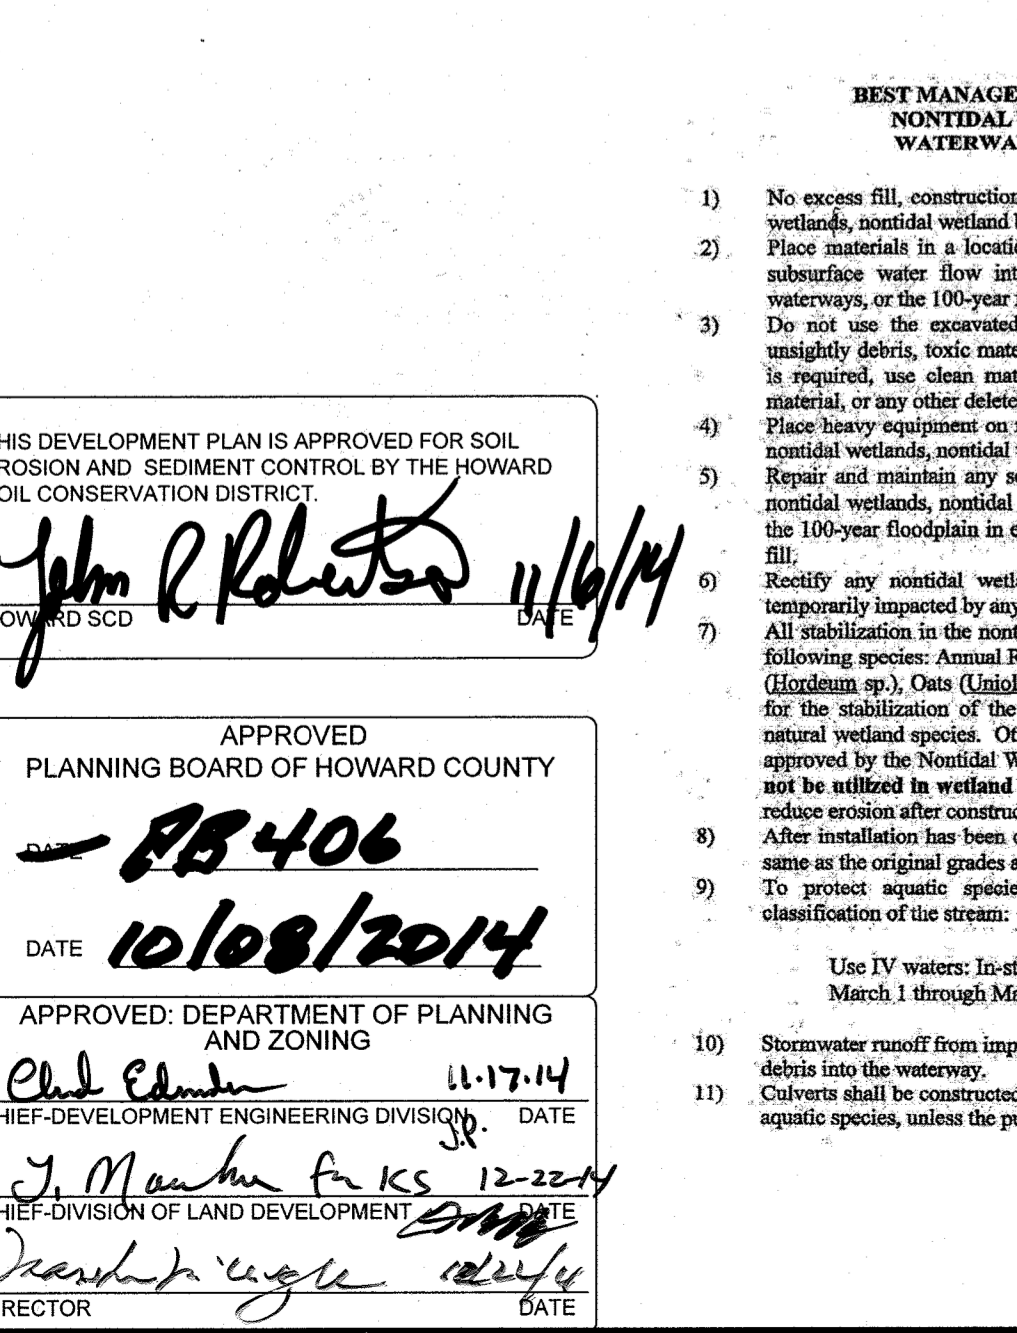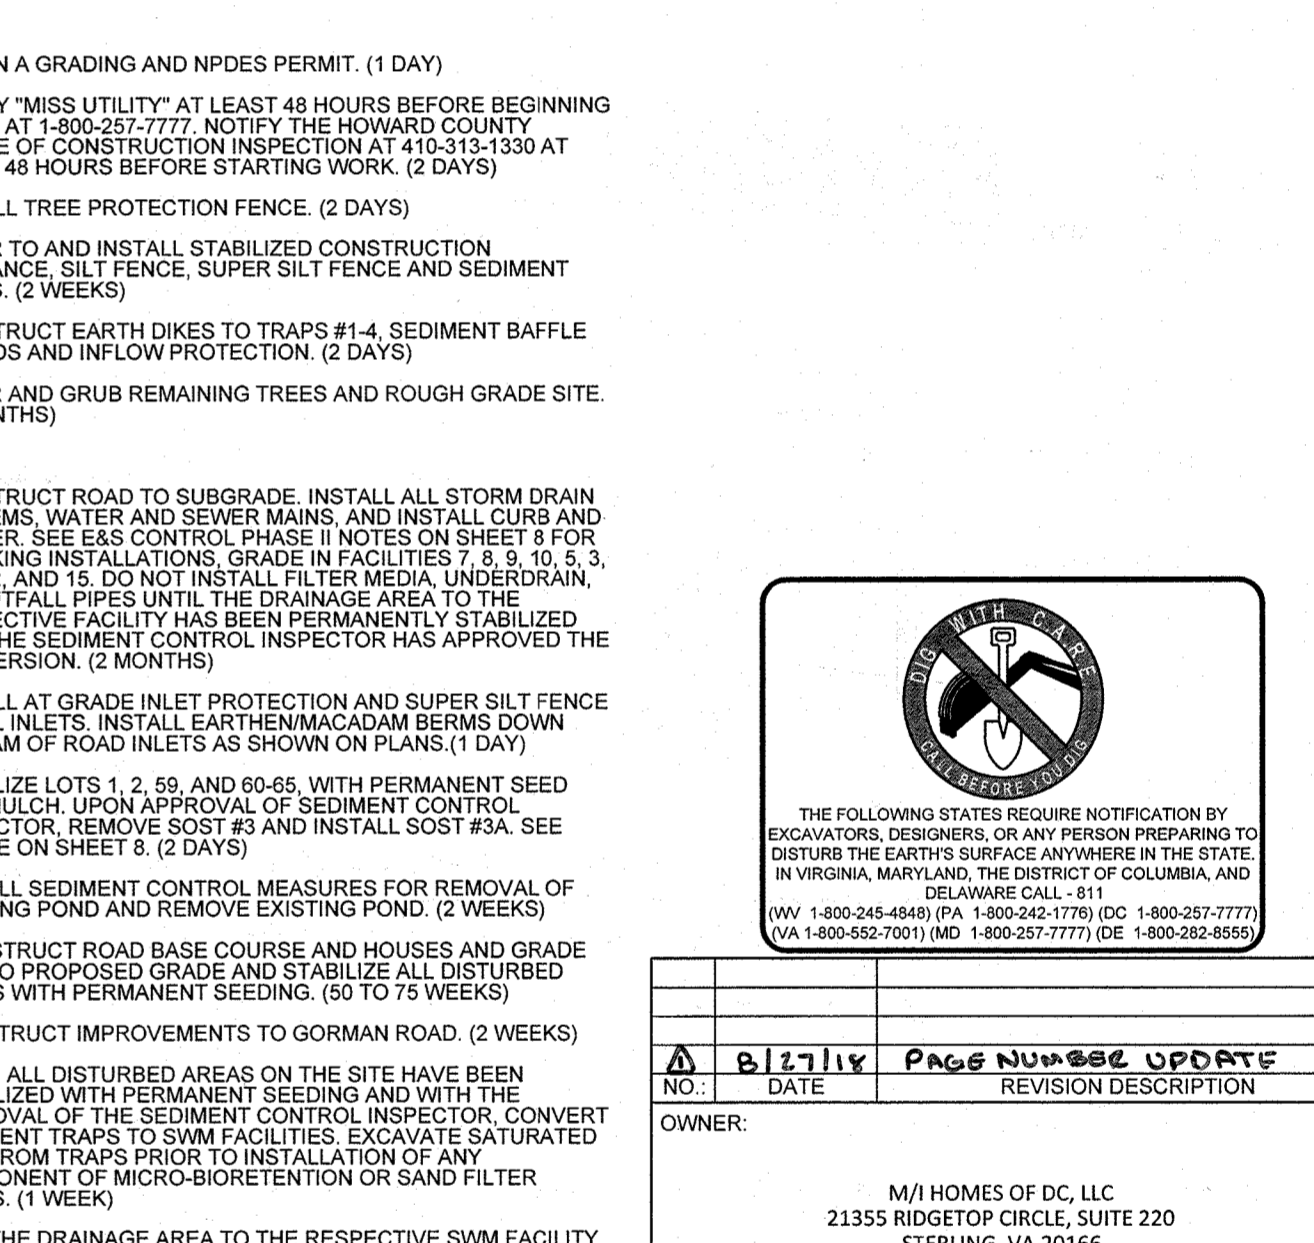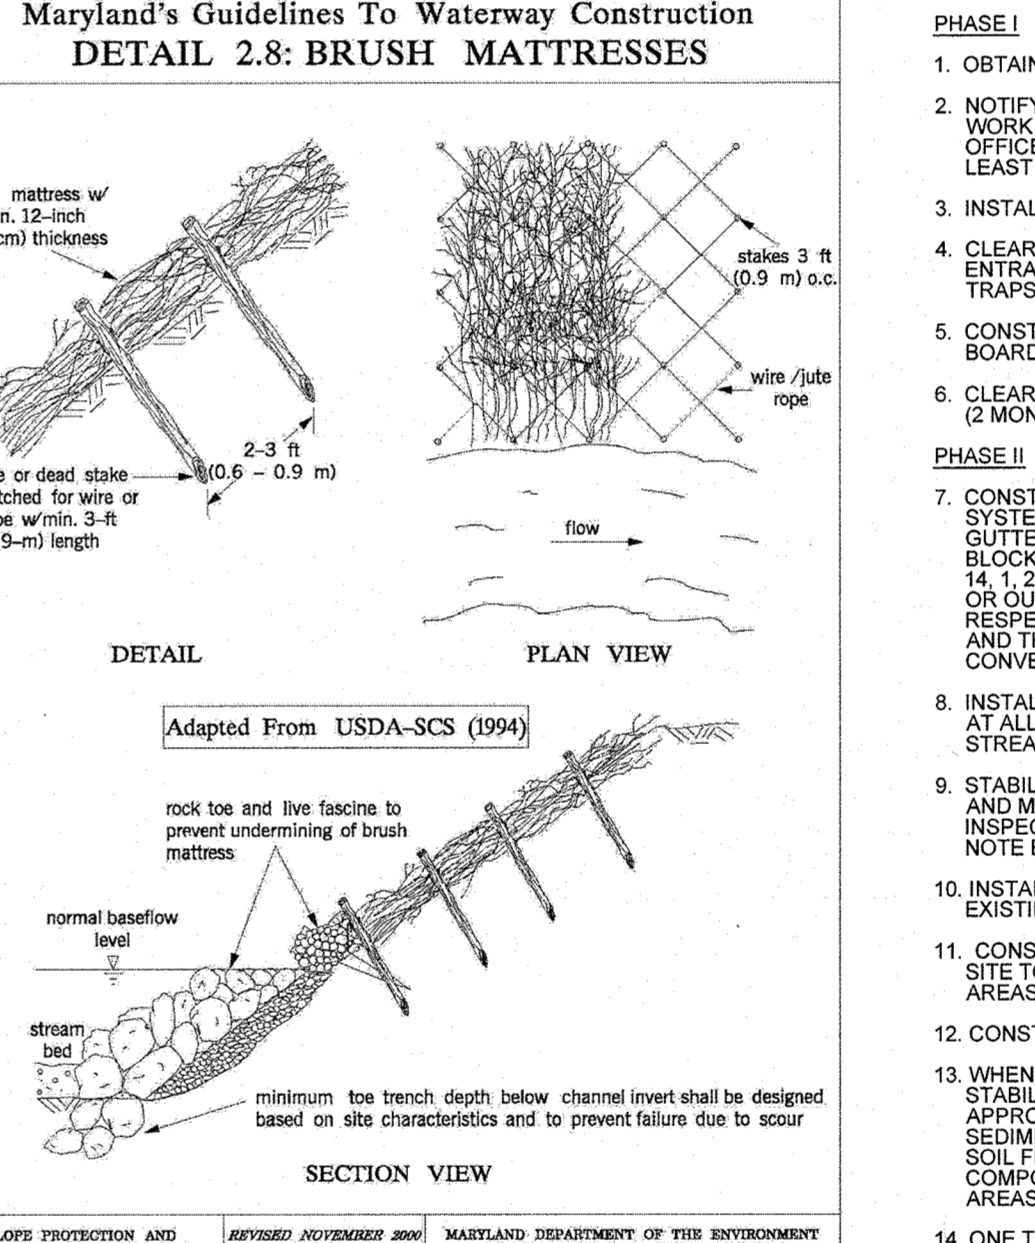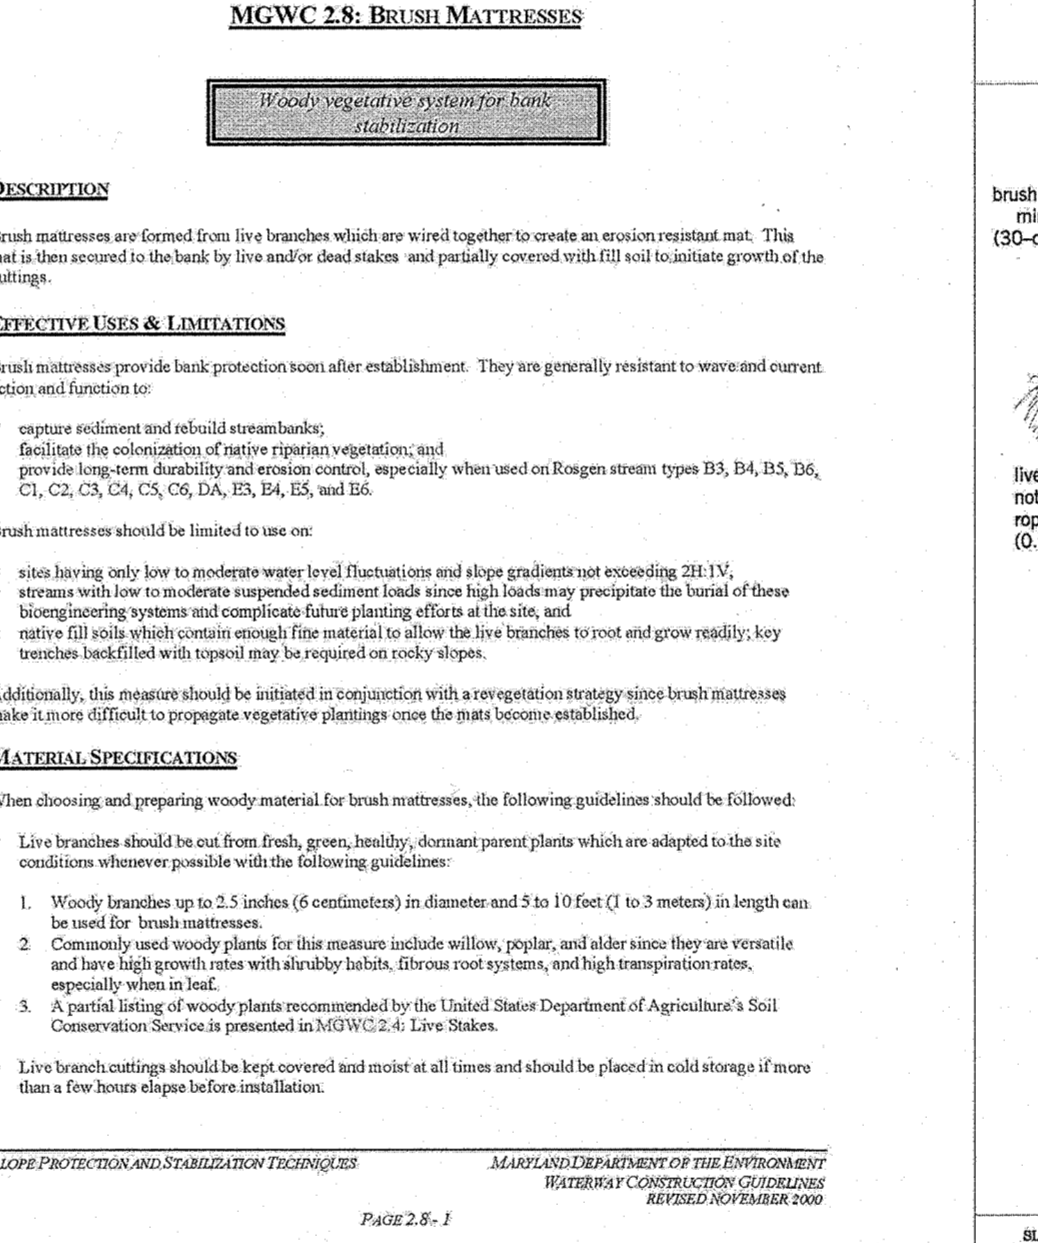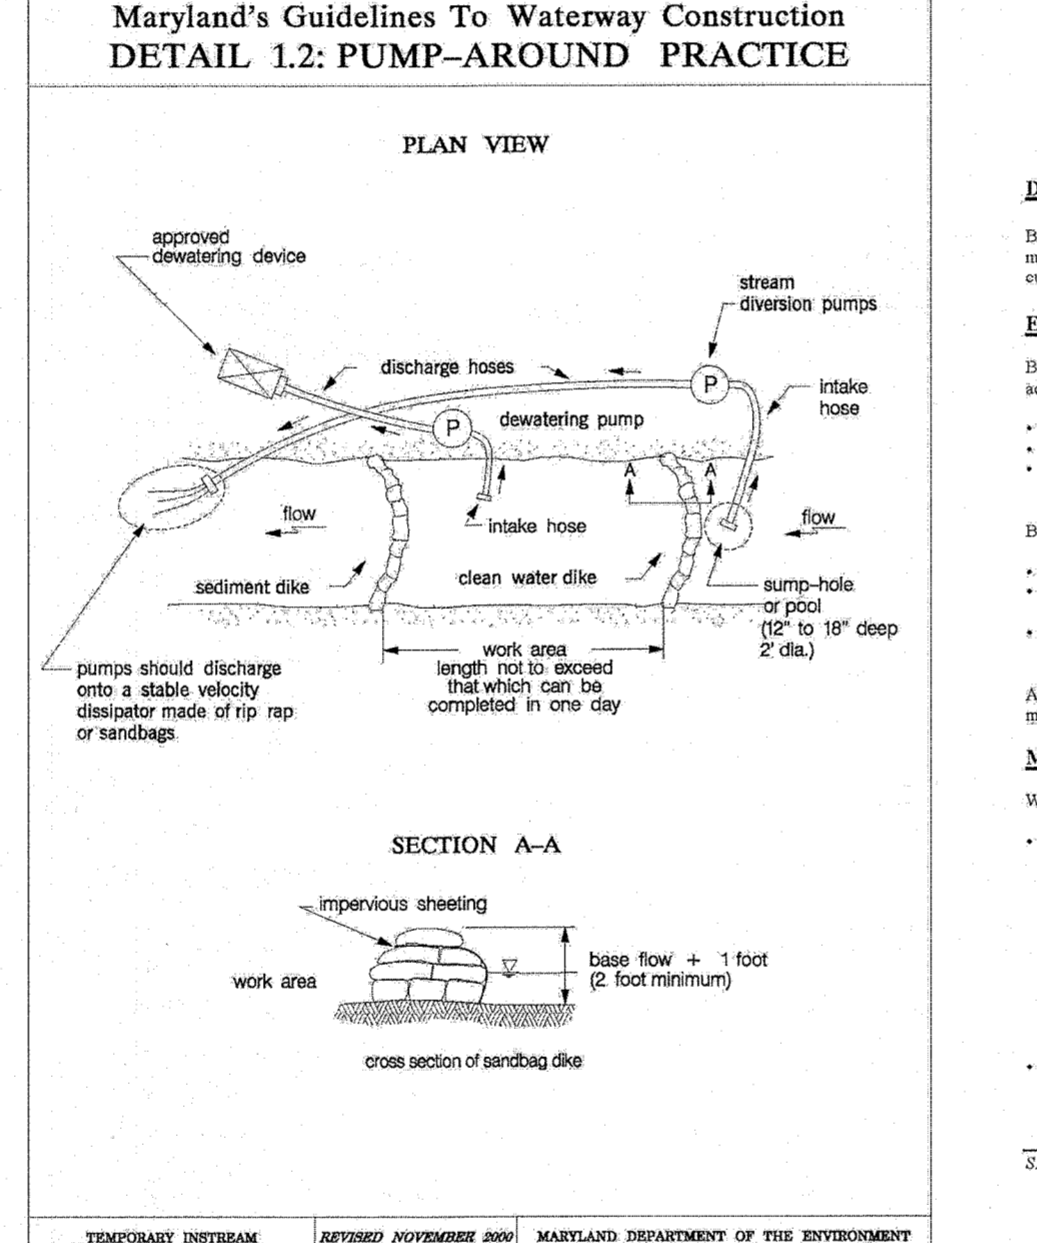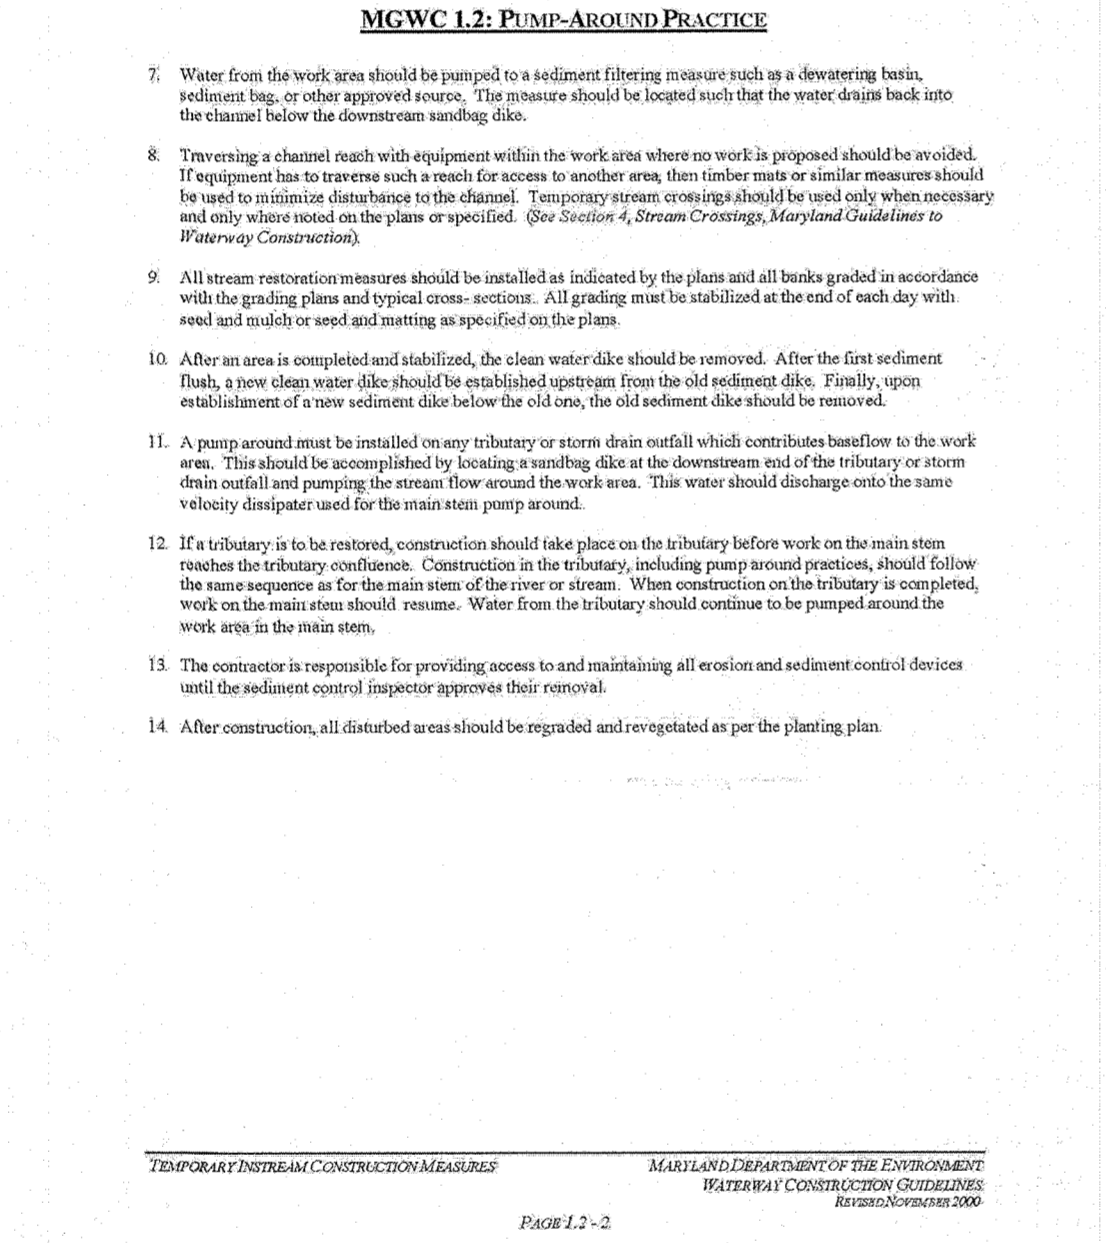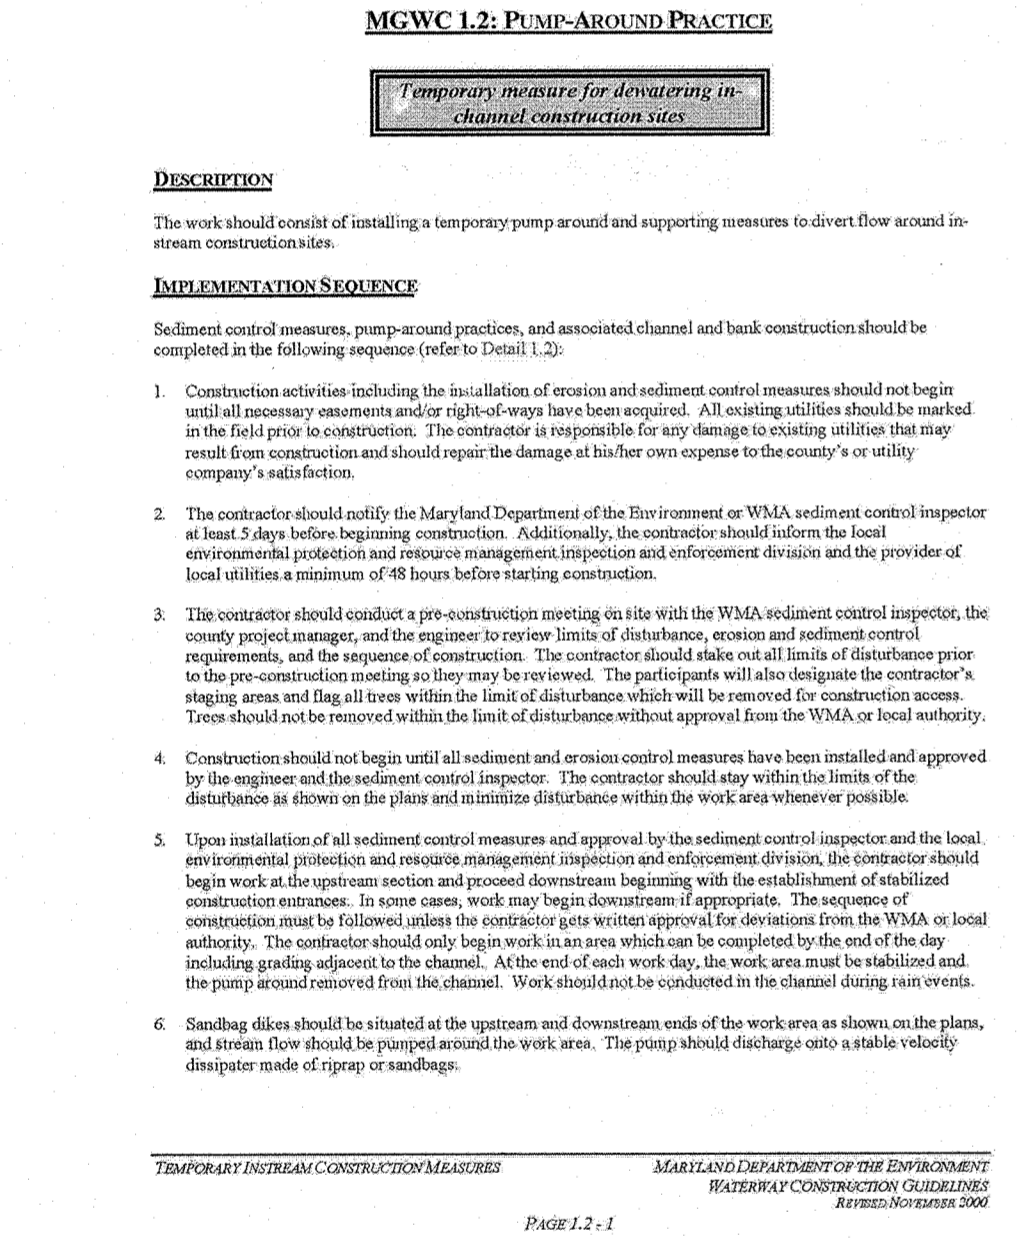


WALDEN WOODS
 TAX MAP: 47 GRID: 2 ZONED: PSC
 PARCEL: 4, LOTS 1-97, OPEN SPACE LOTS 88-102
 6TH ELECTION DISTRICT, HOWARD COUNTY, MARYLAND
 TITLE: **EROSION AND SEDIMENT CONTROL NOTES AND DETAILS**
 DEVELOPER: SOMERWORTH II, L.C.
 5704 DORSEY HALL DRIVE, SUITE 205
 ELLICOTT CITY, MD 21042
 CONTACT: JASON VAN KIRK
 PHONE: (410) 720-3021
 PROJECT: WALDEN WOODS
 M/HOMES OF DC, LLC
 21355 RIDGETOP CIRCLE, SUITE 220
 SHELTON, VA 20156
 CONTACT: GINDY HUNT-BERRY
 PHONE: 443-677-9803
 ENGINEER'S CERTIFICATE:
 I HEREBY CERTIFY THAT THIS PLAN FOR EROSION AND SEDIMENT CONTROL REPRESENTS A PROFESSIONAL ENGINEER'S DESIGN AND THAT THESE DOCUMENTS WERE PREPARED OR APPROVED BY ME, AND THAT I AM A DULY LICENSED PROFESSIONAL ENGINEER UNDER THE LAWS OF THE STATE OF MARYLAND.
 SIGNATURE OF ENGINEER: [Signature] DATE: 10/24/14
 DEVELOPER'S CERTIFICATE:
 I HEREBY CERTIFY THAT ALL DEVELOPMENT AND CONSTRUCTION WILL BE DONE ACCORDING TO THIS PLAN, AND THAT ANY RESPONSIBLE PERSONNEL INVOLVED IN THE CONSTRUCTION PROJECT WILL HAVE A CERTIFICATE OF ATTENDANCE AT A COURSE OF TRAINING APPROVED BY THE DEPARTMENT OF THE ENVIRONMENT AND NATURAL RESOURCES FOR THE CONTROL OF SEDIMENT AND EROSION BEFORE BEGINNING THE PROJECT. I ALSO HEREBY CERTIFY THAT I HAVE BEEN ADVISED BY THE HOWARD COUNTY SOIL CONSERVATION DISTRICT THAT THESE DOCUMENTS WERE PREPARED OR APPROVED BY ME, AND THAT I AM A DULY LICENSED PROFESSIONAL ENGINEER UNDER THE LAWS OF THE STATE OF MARYLAND.
 SIGNATURE OF DEVELOPER: [Signature] DATE: 10-3-14
 BOHLER ENGINEERING
 901 DULANEY VALLEY ROAD, SUITE 801
 TOWSON, MARYLAND 21284
 Phone: (410) 821-7900
 Fax: (410) 821-7987
 www.BohlerEngineering.com
 CHECKED BY: BRR
 DESIGNED BY: BRR
 DRAWN BY: RMS/AVG
 PROJECT NO: MD112419
 DATE: 10/27/14
 SCALE: AS NOTED
 DRAWING NO: 11 OF 35
 PROFESSIONAL ENGINEER NO. 40808

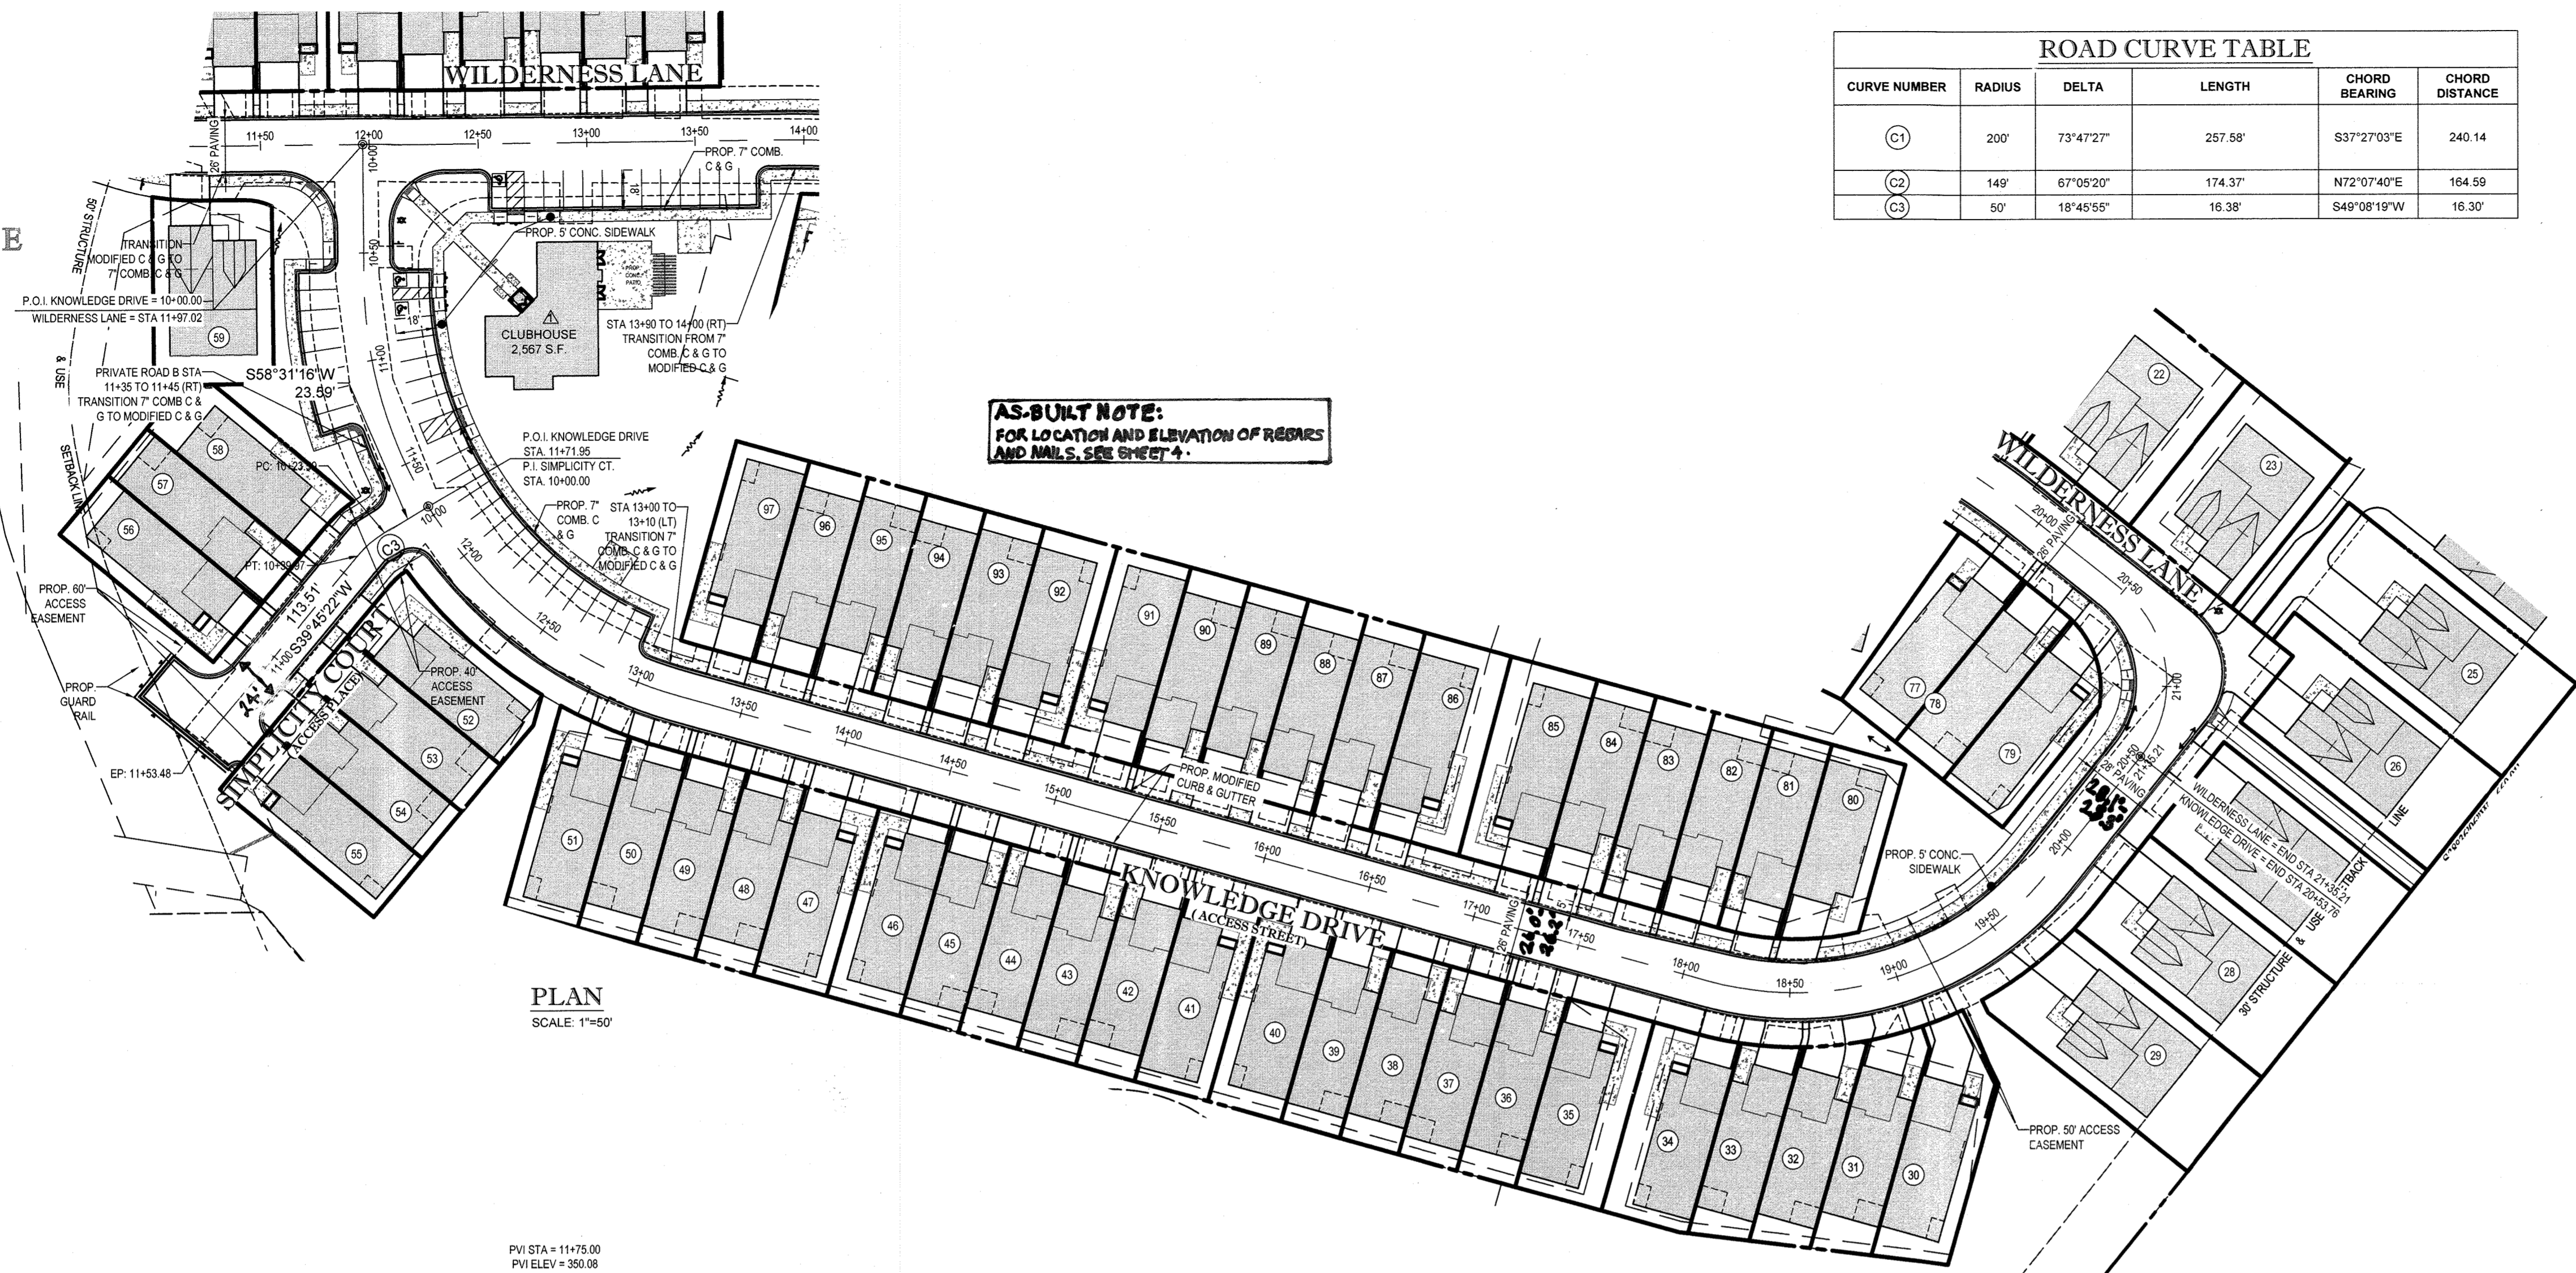

AS-BUILT NOTE:
FOR LOCATION AND ELEVATION OF REBAR
AND NAILS, SEE SHEET 4.


ROAD CURVE TABLE					
CURVE NUMBER	RADIUS	DELTA	LENGTH	CHORD BEARING	CHORD DISTANCE
(C1)	200'	73°47'27"	257.58'	S37°27'03"E	240.14
(C2)	149'	67°08'20"	174.37'	N72°07'40"E	164.59
(C3)	50'	18°45'55"	16.38'	S49°08'19"W	16.30'

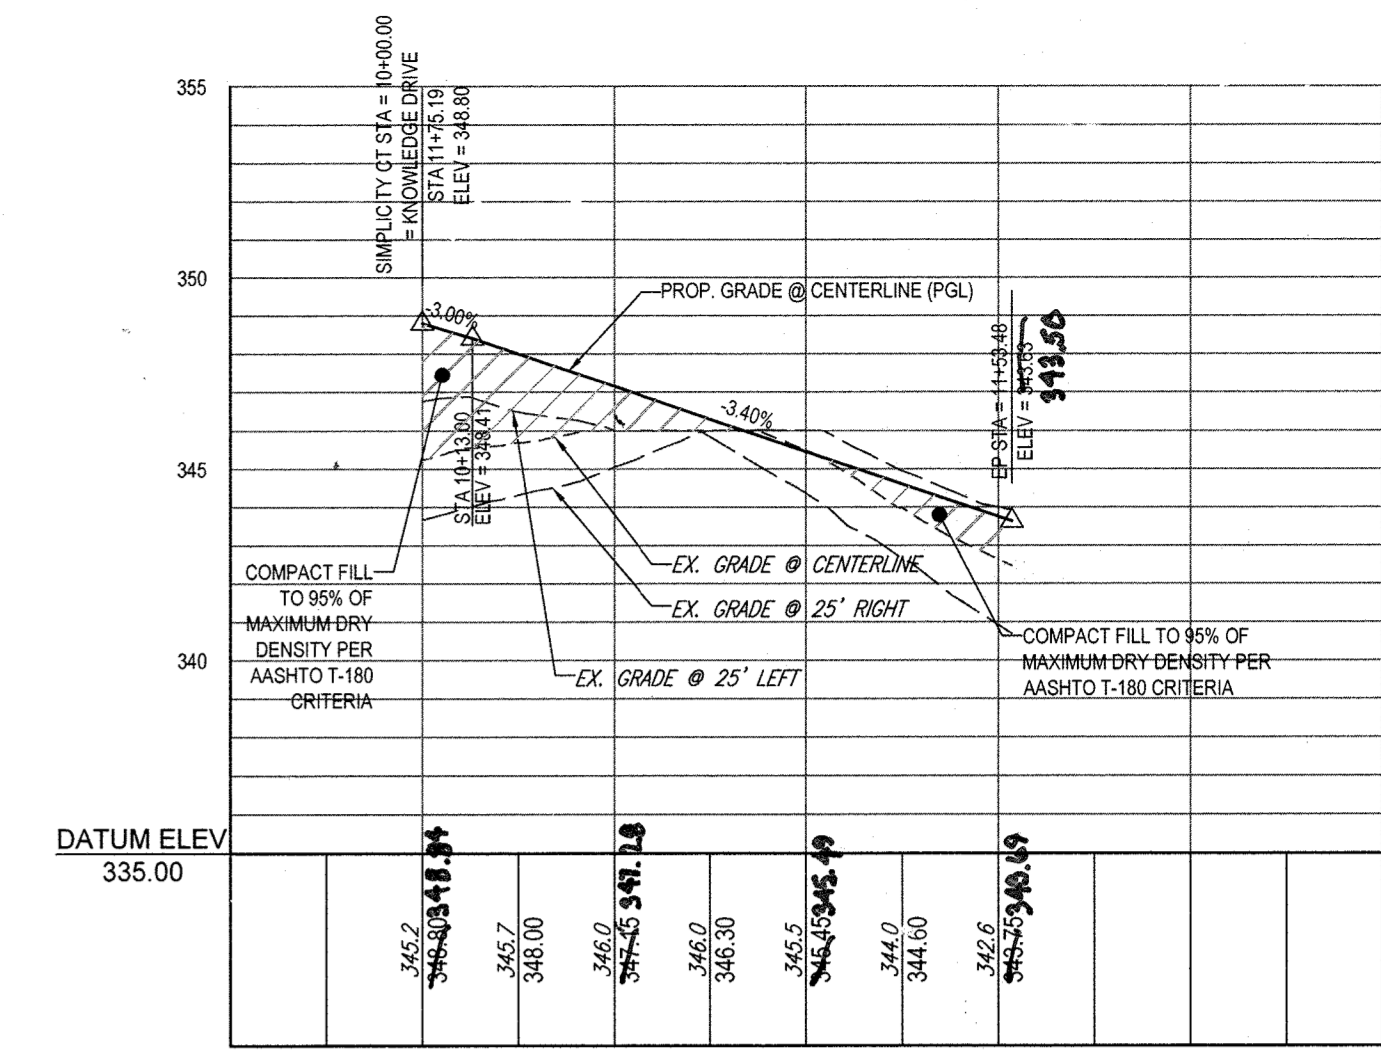

LENGTH: 153.48'
SIMPLICITY COURT PROFILE
SCALE: 1"=50' HORIZONTAL
1"=5' VERTICAL
DESIGN SPEED = 25 MPH

6/30/15
FOR REVISION 2 ONLY

8/31/15 REVISION TO UPDATE
CLUBHOUSE/COMMUNITY CENTER AND
SURROUNDING AREA.

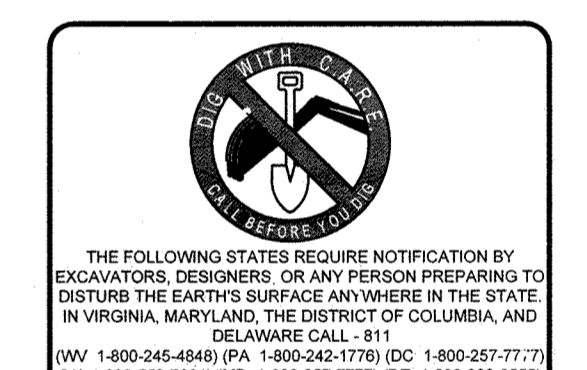

NO.	DATE	REVISION DESCRIPTION
1	8/31/15	REVISION TO UPDATE CLUBHOUSE/COMMUNITY CENTER AND SURROUNDING AREA

OWNER: M/I HOMES OF DC, LLC
21355 RIDGETOP CIRCLE, SUITE 220
STERLING, VA 20166
CONTACT: CINDY HUNTZBERRY
PHONE: 443-677-9803

DEVELOPER: SOMERWORTH II, L.C.
5704 DORSEY HALL DRIVE, SUITE 205
ELICOTT CITY, MD 21042
CONTACT: JASON VAN KIRK
PHONE: (410) 720-3021


PROJECT: REVISED SITE DEVELOPMENT PLAN
WALDEN WOODS

TAX MAP: 47 GRID: 2 ZONED: PSC
PARCEL: 4, LOTS 1-97, OPEN SPACE LOTS 98 - 102
6TH ELECTION DISTRICT, HOWARD COUNTY, MARYLAND


TITLE: **KNOWLEDGE DRIVE AND SIMPLICITY COURT PLAN AND PROFILES**

BOHLER ENGINEERING
901 DULANEY VALLEY ROAD, SUITE 901
TOWSON, MARYLAND 21284
Phone: (410) 821-7900
Fax: (410) 821-7987
www.BohlerEngineering.com

CHECKED BY: BRR
DESIGNED BY: BRR
DRAWN BY: RMS/AVG
PROJECT NO. MD12145
DATE: 10/27/14
SCALE: AS NOTED
DRAWING NO. 13 OF 35

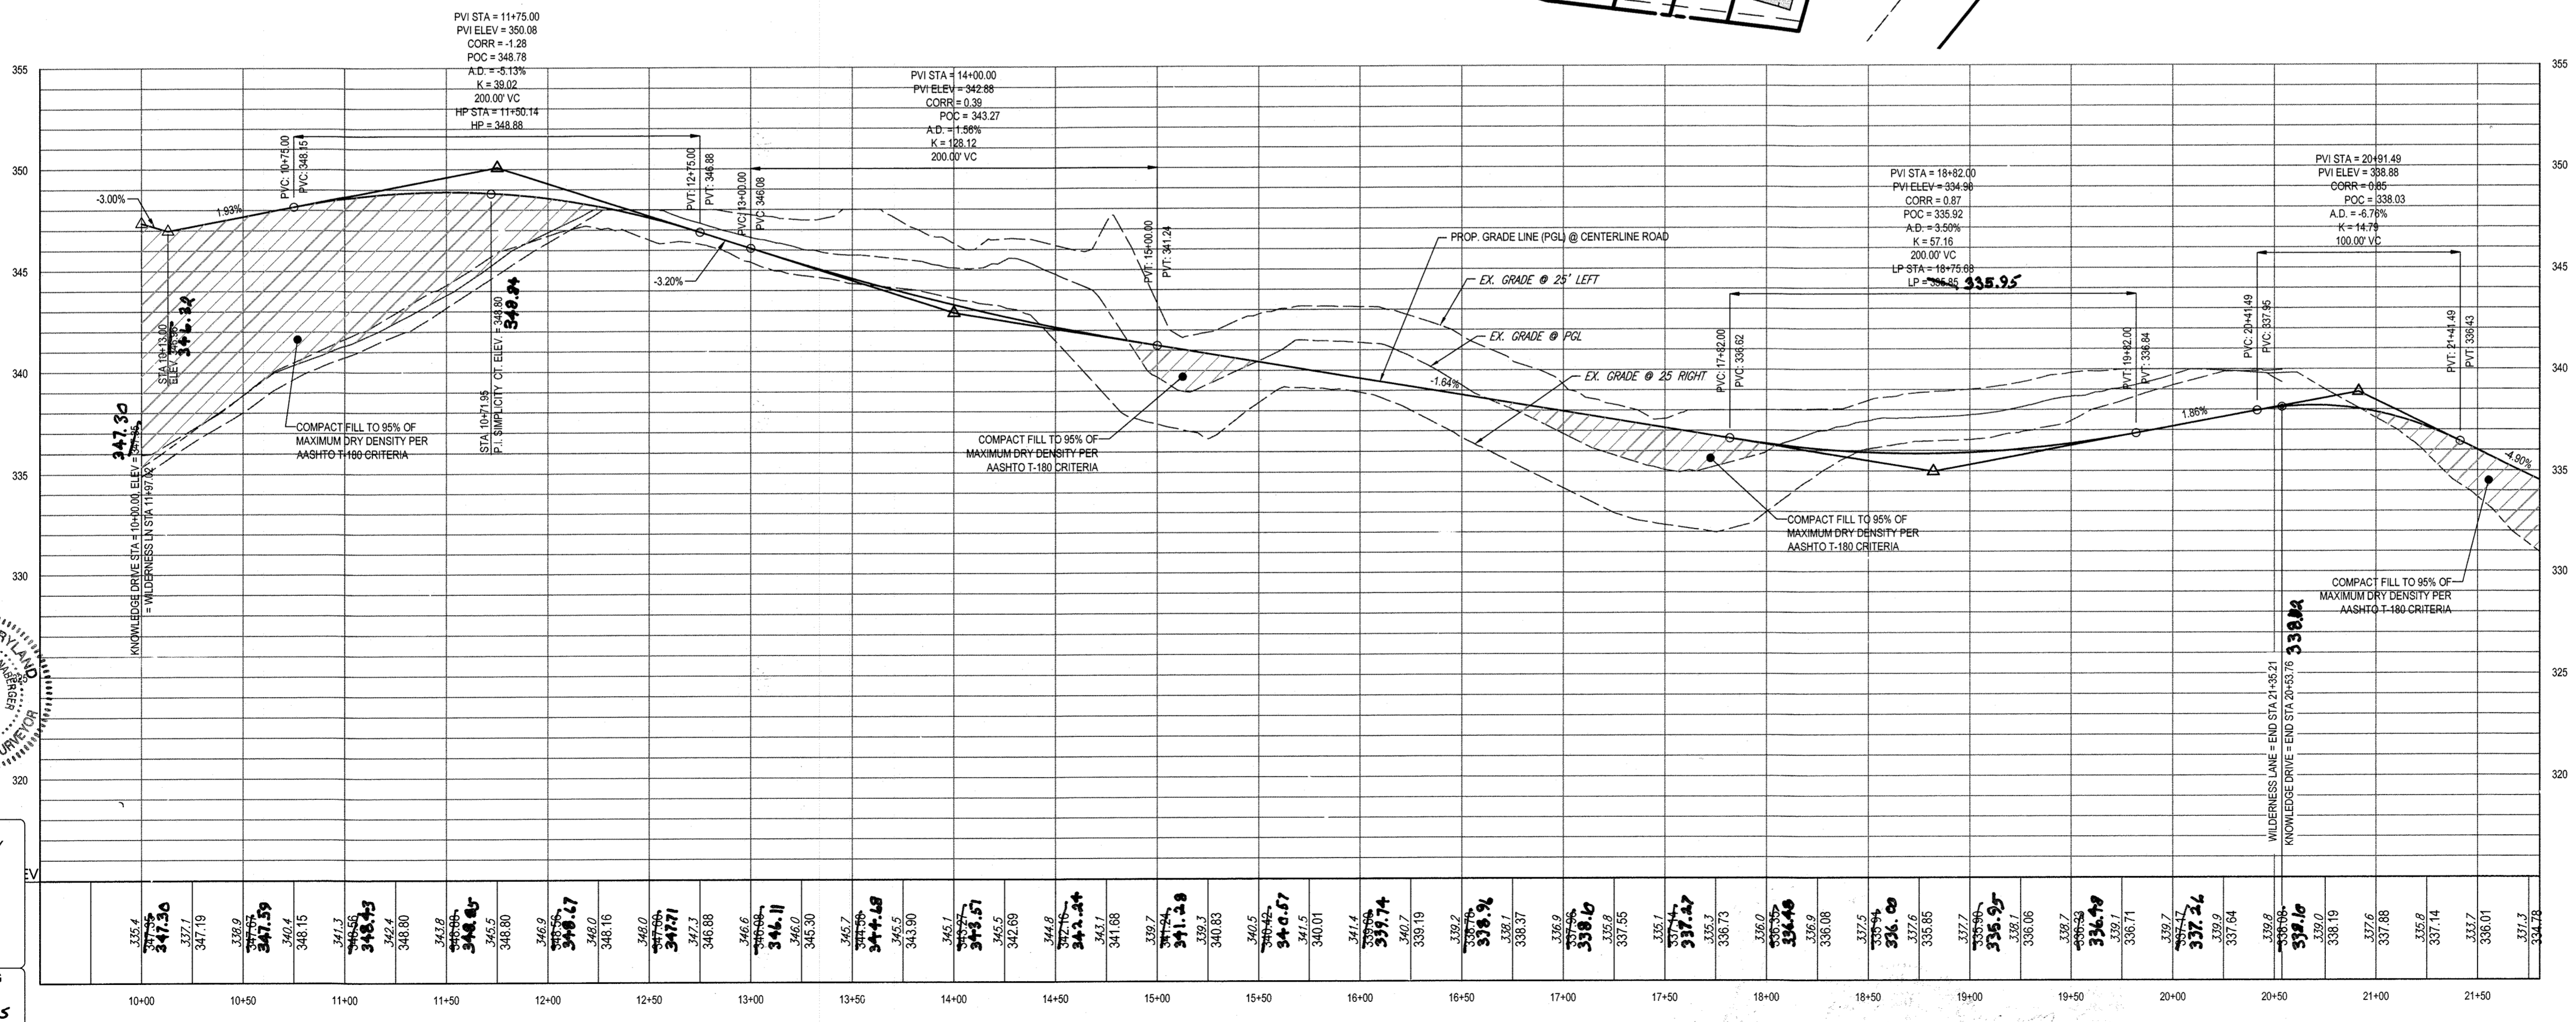

LENGTH: 1053.76
KNOWLEDGE DRIVE PROFILE
SCALE: 1"=50' HORIZONTAL
1"=5' VERTICAL
DESIGN SPEED = 25 MPH

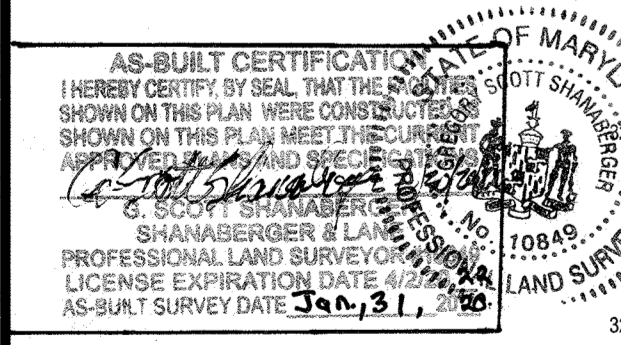


APPROVED
PLANNING BOARD OF HOWARD COUNTY

18406
DATE: 10/08/2014

APPROVED: DEPARTMENT OF PLANNING AND ZONING
10-21-15
10-22-15
10-23-15


PROFESSIONAL CERTIFICATION
BRANDON S. ROWE, HEREBY CERTIFY THAT THESE DOCUMENTS WERE PREPARED OR APPROVED BY ME, AND THAT I AM A DULY LICENSED PROFESSIONAL ENGINEER UNDER THE LAWS OF THE STATE OF MARYLAND, LICENSE NO. 40889, EXPIRATION DATE: 7/20/16.

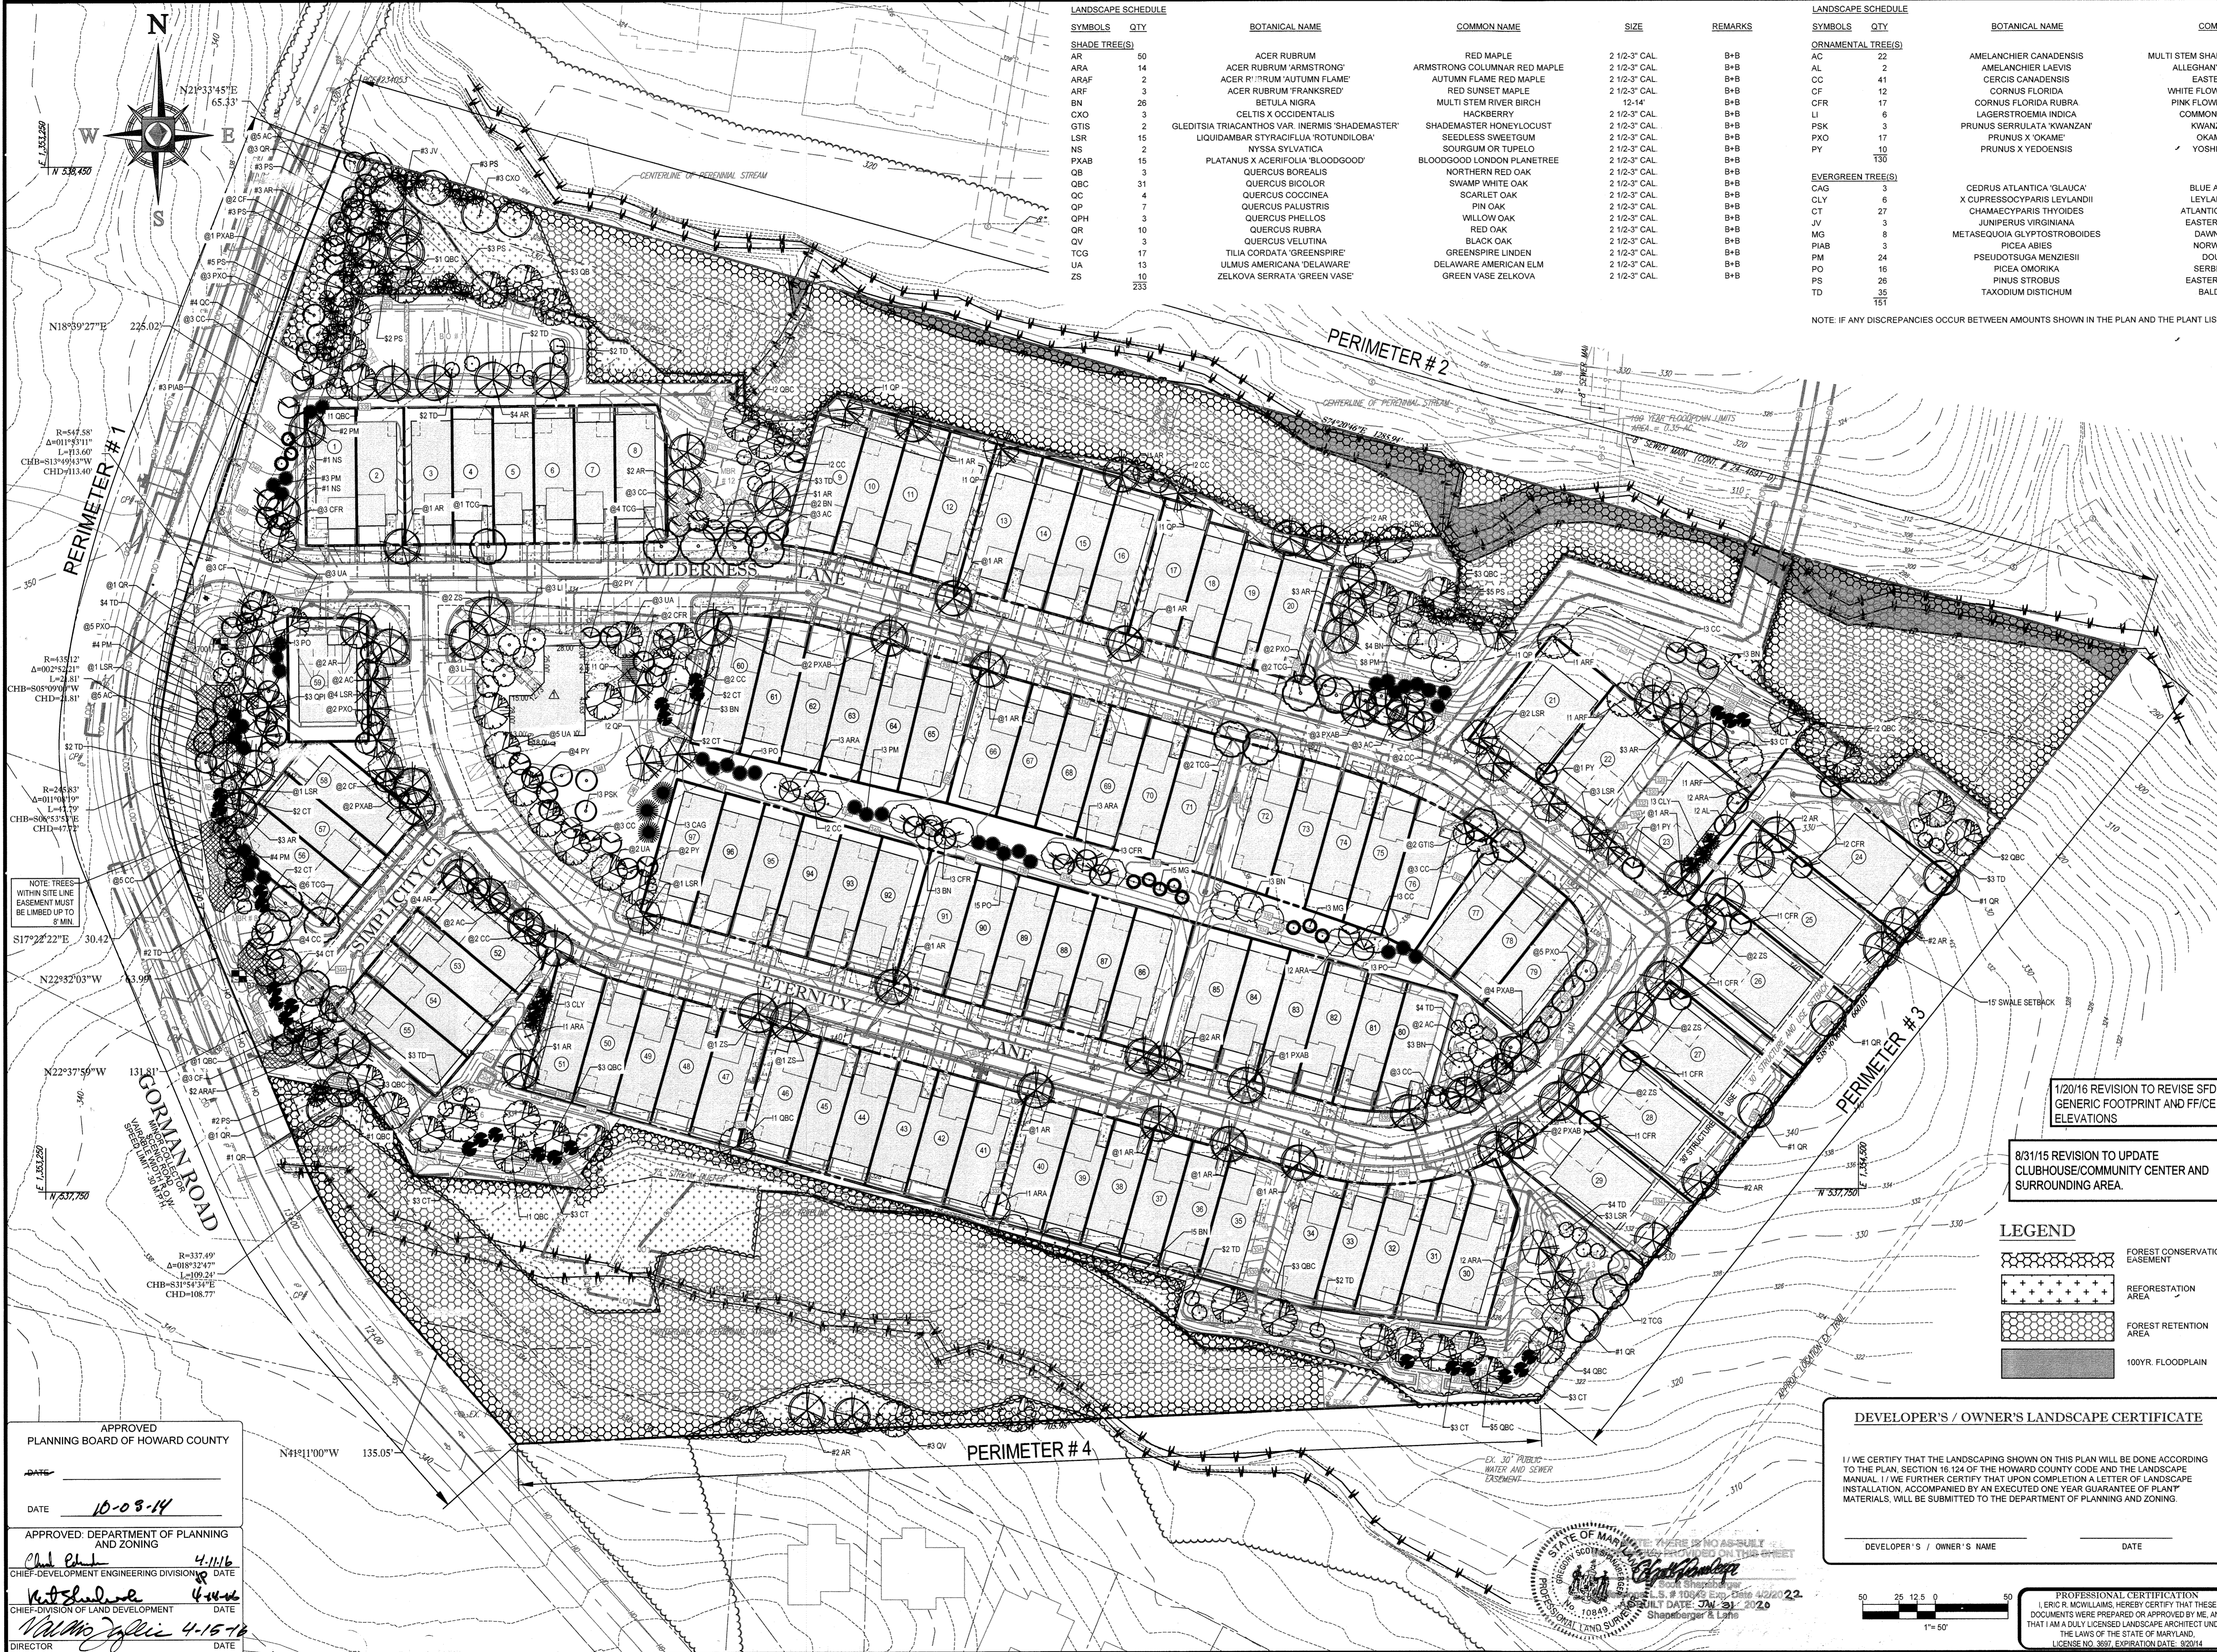

SYMBOLS	QTY	BOTANICAL NAME	COMMON NAME	SIZE	REMARKS
SHADE TREE(S)					
AR	50	ACER RUBRUM	RED MAPLE	2 1/2-3" CAL	B+B
ARA	14	ACER RUBRUM 'ARMSTRONG'	ARMSTRONG COLUMNAR RED MAPLE	2 1/2-3" CAL	B+B
ARAF	2	ACER 'FRUM 'AUTUMN FLAME'	AUTUMN FLAME RED MAPLE	2 1/2-3" CAL	B+B
ARF	3	ACER RUBRUM 'FRANKSRED'	RED SUNSET MAPLE	2 1/2-3" CAL	B+B
BN	26	BETULA NIGRA	MULTI STEM RIVER BIRCH	12-14"	B+B
CXO	3	CELTIS X OCCIDENTALIS	HACKBERRY	2 1/2-3" CAL	B+B
GTIS	2	GLEDITSIA TRIACANTHOS VAR. INERMIS 'SHADEMASTER'	SHADEMASTER HONEYLOCUST	2 1/2-3" CAL	B+B
LSR	15	LIQUIDAMBAR STYRACIFLUA 'ROTUNDILOBA'	SEEDLESS SWEETGUM	2 1/2-3" CAL	B+B
NS	2	NYSSA SYLVATICA	SOURGUM OR TUPelo	2 1/2-3" CAL	B+B
PXAB	15	PLATANUS X ACERIFOLIA 'BLOODGOOD'	BLOODGOOD LONDON PLANETREE	2 1/2-3" CAL	B+B
OB	3	QUERCUS BOREALIS	NORTHERN RED OAK	2 1/2-3" CAL	B+B
OBC	31	QUERCUS BICOLOR	SWAMP WHITE OAK	2 1/2-3" CAL	B+B
OC	4	QUERCUS COCCINEA	SCARLET OAK	2 1/2-3" CAL	B+B
OP	7	QUERCUS PALUSTRIS	PIN OAK	2 1/2-3" CAL	B+B
OPH	3	QUERCUS PHELLOS	WILLOW OAK	2 1/2-3" CAL	B+B
OR	10	QUERCUS RUBRA	RED OAK	2 1/2-3" CAL	B+B
OV	3	QUERCUS VELITINA	BLACK OAK	2 1/2-3" CAL	B+B
TGC	17	TILIA CORDATA 'GREENSPIRE'	GREENSPIRE LINDEN	2 1/2-3" CAL	B+B
UA	13	ULMUS AMERICANA 'DELAWARE'	DELAWARE AMERICAN ELM	2 1/2-3" CAL	B+B
ZS	10	ZELKOVA SERRATA 'GREEN VASE'	GREEN VASE ZELKOVA	2 1/2-3" CAL	B+B
	233				

SYMBOLS	QTY	BOTANICAL NAME	COMMON NAME	SIZE	REMARKS
ORNAMENTAL TREE(S)					
AC	22	AMELANCHIER CANADENSIS	MULTI STEM SHADLOW SERVICEBERRY	8-10'	B+B
AL	2	AMELANCHIER LAEVIS	ALLEGHANY SERVICEBERRY	8-10'	B+B
CC	41	CERCIS CANADENSIS	EASTERN REDBUD	2-2 1/2" CAL	B+B
CF	12	CORNUS FLORIDA	WHITE FLOWERING DOGWOOD	2-2 1/2" CAL	B+B
CFR	17	CORNUS FLORIDA RUBRA	PINK FLOWERING DOGWOOD	2-2 1/2" CAL	B+B
LI	6	LAGERSTROEMIA INDICA	COMMON CRAPEMYRTLE	8-10'	B+B
PSK	3	PRUNUS SERRULATA 'KWAZAN'	KWAZAN CHERRY	2-2 1/2" CAL	B+B
PXO	17	PRUNUS X 'OKAME'	OKAME CHERRY	2-2 1/2" CAL	B+B
PY	10	PRUNUS X 'YEDONENSIS'	YOSHINO CHERRY	2-2 1/2" CAL	B+B
EVERGREEN TREE(S)					
CAC	3	CEDRUS ATLANTICA 'OLAUCA'	BLUE ATLAS CEDAR	7-8'	B+B
CLY	6	X CUPRESSOCYPARIS LEYLANDII	LEYLAND CYPRESS	6-7'	B+B
CT	27	CHAMAECYPARIS THYOIDES	ATLANTIC WHITE CEDAR	8-7'	B+B
JV	3	JUNIPERUS VIRGINIANA	EASTERN RED CEDAR	8-10'	B+B
MG	8	METASEQUOIA GLYPTOSTROBODES	DAWN REDWOOD	6-8'	B+B
PIAB	3	PICEA ABIES	NORWAY SPRUCE	6-7'	B+B
PM	24	PSEUDOTSUGA MENZIESII	DOUGLAS FIR	6-7'	B+B
PO	15	PICEA OMBRIKA	SERBIAN SPRUCE	6-7'	B+B
PS	26	PINUS STROBUS	EASTERN WHITE PINE	6-7'	B+B
TD	35	TAXODIUM DISTICHUM	BALD CYPRESS	8-10'	B+B
	151				

NOTE: IF ANY DISCREPANCIES OCCUR BETWEEN AMOUNTS SHOWN IN THE PLAN AND THE PLANT LIST, THE PLAN SHALL DICATE.

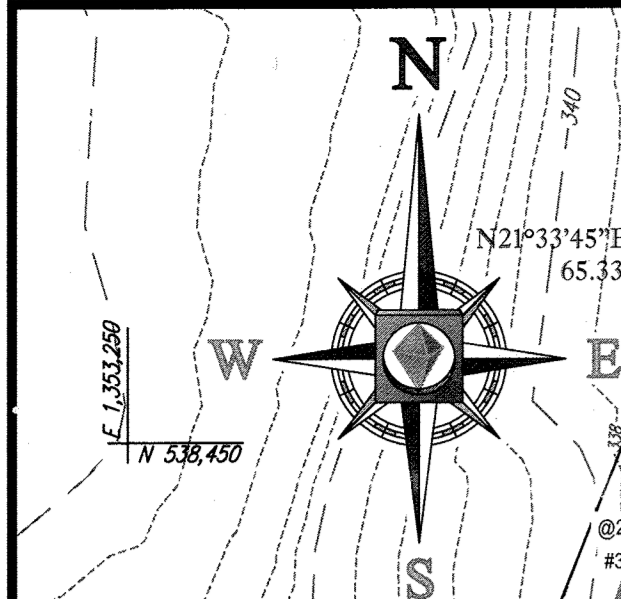


NOTE: TREES WITHIN SITE LINE EASEMENT MUST BE LIMBED UP TO 6" MIN.

APPROVED
PLANNING BOARD OF HOWARD COUNTY

DATE: 10-08-14

APPROVED: DEPARTMENT OF PLANNING AND ZONING
Chief-Development Engineering Division
Chief-Division of Land Development

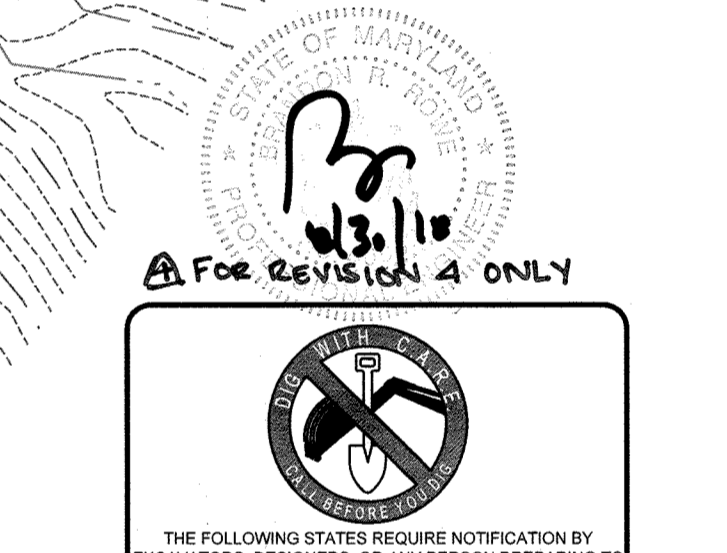

NO.	DATE	REVISION DESCRIPTION
1	1/20/16	REVISED SFD GENERIC FOOTPRINT
2	10/27/15	UPDATED GRADING FOR LOTS 17 - 20
3	8/31/15	REVISED CLUBHOUSE/COMMUNITY CENTER

OWNER: M/I HOMES OF DC, LLC
21355 RIDGETOP CIRCLE, SUITE 220
STERLING, VA 20166
CONTACT: CINDY HUNZIBERRY
PHONE: 443-677-9803

DEVELOPER: SOMERWORTH II, L.C.
5704 DORSEY HALL DRIVE, SUITE 205
ELLCOTT CITY, MD 21042
CONTACT: JASON VAN KIRK
PHONE: (410) 720-3021

PROJECT: REVISED SITE DEVELOPMENT PLAN
WALDEN WOODS

TAX MAP: 47 GRID: 2 ZONED: PSC
PARCEL: 4, LOTS 1-97; OPEN SPACE LOTS 98 - 102
6TH ELECTION DISTRICT, HOWARD COUNTY, MARYLAND

TITLE: **LANDSCAPE PLAN**

DEVELOPER'S / OWNER'S LANDSCAPE CERTIFICATE

I / WE CERTIFY THAT THE LANDSCAPING SHOWN ON THIS PLAN WILL BE DONE ACCORDING TO THE PLAN, SECTION 16.124 OF THE HOWARD COUNTY CODE AND THE LANDSCAPE MANUAL. I / WE FURTHER CERTIFY THAT UPON COMPLETION A LETTER OF LANDSCAPE INSTALLATION, ACCOMPANIED BY AN EXECUTED ONE YEAR GUARANTEE OF PLANT MATERIALS, WILL BE SUBMITTED TO THE DEPARTMENT OF PLANNING AND ZONING.

DEVELOPER'S / OWNER'S NAME: _____ DATE: _____

PROFESSIONAL CERTIFICATION

ERIC R. MCWILLIAMS, HEREBY CERTIFY THAT THESE DOCUMENTS WERE PREPARED OR APPROVED BY ME, AND THAT I AM A DULY LICENSED LANDSCAPE ARCHITECT UNDER THE LAWS OF THE STATE OF MARYLAND.
LICENSE NO. 3897, EXPIRATION DATE: 8/31/14

CHECKED BY: BRR
DESIGNED BY: ERM
DRAWN BY: RMS/AVG
PROJECT NO.: MD112149
DATE: 10/27/14
SCALE: 1"=50'
DRAWING NO.: 14 OF 35


LANDSCAPE SPECIFICATIONS

- SCOPE OF WORK**
THE LANDSCAPE CONTRACTOR SHALL BE REQUIRED TO PERFORM ALL CLEARING, FINISHED GRADING, SOIL PREPARATION, PERMANENT SEEDING OR SOODING, PLANTING AND MULCHING INCLUDING ALL LABOR, MATERIALS, TOOLS AND EQUIPMENT NECESSARY FOR THE COMPLETION OF THIS PROJECT, UNLESS OTHERWISE CONTRACTED BY THE GENERAL CONTRACTOR.
- MATERIALS**
 - GENERAL - ALL HARDSCAPE MATERIALS SHALL MEET OR EXCEED SPECIFICATIONS AS OUTLINED IN THE STATE DEPARTMENT OF TRANSPORTATION'S SPECIFICATIONS.
 - TOPSOIL - NATURAL, FRIABLE, LOAMY SILT SOIL HAVING AN ORGANIC CONTENT NOT LESS THAN 5%, A PH RANGE BETWEEN 4.5-7.0. IT SHALL BE FREE OF DEBRIS, ROCKS LARGER THAN ONE INCH (1"), WOOD, ROOTS, VEGETABLE MATTER AND CLAY CLOUDS.
 - LAWN - ALL DISTURBED AREAS ARE TO BE TREATED WITH A MINIMUM SIX INCH (6") THICK LAYER OF TOPSOIL OR AS DIRECTED BY THE LOCAL ORDINANCE OR CLIENT, AND SEEDED OR SOODING IN ACCORDANCE WITH THE PERMANENT STABILIZATION METHODS INDICATED WITHIN THE SOIL EROSION AND SEDIMENT CONTROL NOTES.
 - LAWN SEED MIXTURE SHALL BE FRESH, CLEAN NEW CROP SEED.
 - SOD SHALL BE STRONGLY ROOTED, WEED AND DISEASE/FEST FREE WITH A UNIFORM THICKNESS.
 - SOD INSTALLED ON SLOPES GREATER THAN 4:1 SHALL BE FEGGED TO HOLD SOD IN PLACE.
 - MULCH - THE MULCH AROUND THE PERIMETER OF THE BUILDING SHALL BE A 3" LAYER OF DOUBLE SHREDDED BLACK CEDAR MULCH ONLY. ALL OTHER AREAS SHALL BE MULCHED WITH A 3" LAYER OF DOUBLE SHREDDED DARK BROWN HARDWOOD BARK MULCH, UNLESS OTHERWISE STATED ON THE LANDSCAPE PLAN.
 - FERTILIZER
 - FERTILIZER SHALL BE DELIVERED TO THE SITE MIXED AS SPECIFIED IN THE ORIGINAL UNOPENED STANDARD BAGS SHOWING WEIGHT, ANALYSIS AND NAME OF MANUFACTURER. FERTILIZER SHALL BE STORED IN A WEATHERPROOF PLACE SO THAT IT CAN BE KEPT DRY PRIOR TO USE.
 - FOR THE PURPOSE OF BIDDING, ASSUME THAT FERTILIZER SHALL BE 10% NITROGEN, 6% PHOSPHORUS AND 4% POTASSIUM BY WEIGHT. A FERTILIZER SHOULD NOT BE SELECTED WITHOUT A SOIL TEST PERFORMED BY A CERTIFIED SOIL LABORATORY.
 - PLANT MATERIAL
 - ALL PLANTS SHALL IN ALL CASES CONFORM TO THE REQUIREMENTS OF THE 'AMERICAN STANDARD FOR NURSERY STOCK' (ANSI Z60.1), LATEST EDITION, AS PUBLISHED BY THE AMERICAN NURSERY & LANDSCAPE ASSOCIATION.
 - IN ALL CASES, BOTANICAL NAMES SHALL TAKE PRECEDENCE OVER COMMON NAMES FOR ANY AND ALL PLANT MATERIAL.
 - PLANTS SHALL BE LEGIBLY TAGGED WITH THE PROPER NAME AND SIZE. TAGS ARE TO REMAIN ON AT LEAST ONE PLANT OF EACH SPECIES FOR VERIFICATION PURPOSES DURING THE FINAL INSPECTION.
 - TREES WITH ABRASION OF THE BARK, SUN SCALDS, DISFIGURATION OR FRESH CUTS OF LIMBS OVER 1", WHICH HAVE NOT BEEN COMPLETELY CALLED, SHALL BE REJECTED. PLANTS SHALL NOT BE BOUND WITH WIRE OR ROPE AT ANY TIME SO AS TO DAMAGE THE BARK OR BREAK BRANCHES.
 - ALL PLANTS SHALL BE TYPES OF THEIR KIND AND SHALL HAVE A NORMAL HABIT OF GROWTH. WELL DEVELOPED BRANCHES, DENSELY FOLIATED, VIGOROUS ROOT SYSTEMS AND BE FREE OF DISEASE, INSECTS, PESTS, EGGS OR LARVAE.
 - CALIPER MEASUREMENTS OF NURSERY GROWN TREES SHALL BE TAKEN AT A POINT ON THE TRUNK SIX INCHES (6") ABOVE THE NATURAL GRADE FOR TREES UP TO AND INCLUDING A FOUR INCH (4") CALIPER SIZE. IF THE CALIPER AT SIX INCHES (6") ABOVE THE GROUND EXCEEDS FOUR INCHES (4") IN CALIPER, THE CALIPER SHOULD BE MEASURED AT A POINT 12" ABOVE THE NATURAL GRADE.
 - SHRUBS SHALL BE MEASURED TO THE AVERAGE HEIGHT OR SPREAD OF THE SHRUB, AND NOT TO THE LONGEST BRANCH.
 - TREES AND SHRUBS SHALL BE HANDLED WITH CARE BY THE ROOT BALL.
- GENERAL WORK PROCEDURES**
 - CONTRACTOR TO UTILIZE WORKMANLIKE INDUSTRY STANDARDS IN PERFORMING ALL LANDSCAPE CONSTRUCTION. THE SITE IS TO BE LEFT IN A CLEAN STATE AT THE END OF EACH WORKDAY. ALL DEBRIS, MATERIALS AND TOOLS SHALL BE PROPERLY STORED, STOCKPILED OR DISPOSED OF.
 - WASTE MATERIALS AND DEBRIS SHALL BE COMPLETELY DISPOSED OF AT THE CONTRACTOR'S EXPENSE. DEBRIS SHALL NOT BE BURIED, INCLUDING ORGANIC MATERIALS, BUT SHALL BE REMOVED COMPLETELY FROM THE SITE.
- SITE PREPARATIONS**
 - BEFORE AND DURING PRELIMINARY GRADING AND FINISHED GRADING, ALL WEEDS AND GRASSES SHALL BE DUG UP BY THE ROOTS AND DISPOSED OF IN ACCORDANCE WITH GENERAL WORK PROCEDURES OUTLINED HEREIN.
 - ALL EXISTING TREES TO REMAIN SHALL BE PRUNED TO REMOVE ANY DAMAGED BRANCHES. THE ENTIRE LIMB OF ANY DAMAGED BRANCH SHALL BE CUT OFF AT THE TRUNK. CONTRACTOR SHALL ENSURE THAT CUTS ARE SMOOTH AND STRAIGHT. ANY EXPOSED ROOTS SHALL BE CUT BACK WITH CLEAN, SHARP TOOLS AND TOPSOIL SHALL BE PLACED AROUND THE REMAINDER OF THE ROOTS. EXISTING TREES SHALL BE MONITORED ON A REGULAR BASIS FOR ADDITIONAL ROOT OR BRANCH DAMAGE AS A RESULT OF CONSTRUCTION. ROOTS SHALL NOT BE LEFT EXPOSED FOR MORE THAN ONE (1) DAY. CONTRACTOR SHALL WATER EXISTING TREES AS NEEDED TO PREVENT SHOCK OR DECLINE.
 - CONTRACTOR SHALL ARRANGE TO HAVE A UTILITY STAKE-OUT TO LOCATE ALL UNDERGROUND UTILITIES PRIOR TO INSTALLATION OF ANY LANDSCAPE MATERIAL. UTILITY COMPANIES SHALL BE CONTACTED THREE (3) DAYS PRIOR TO THE BEGINNING OF WORK.
- TREE PROTECTION**
 - CONTRACTOR SHALL BE RESPONSIBLE FOR THE PROTECTION OF ALL EXISTING TREES TO REMAIN. A TREE PROTECTION ZONE SHALL BE ESTABLISHED AT THE DRIP LINE OR 15 FEET FROM THE TRUNK OR AT THE LIMIT OF CONSTRUCTION DISTURBANCE, WHICHEVER IS GREATER. LOCAL STANDARDS THAT MAY REQUIRE A MORE STRICT TREE PROTECTION ZONE SHALL BE HONORED.
 - A FORTY-EIGHT INCH (48") HIGH WOODEN SNOW FENCE OR ORANGE COLORED HIGH-DENSITY 'VISI-FENCE', OR APPROVED EQUAL, MOUNTED ON STEEL POSTS SHALL BE PLACED ALONG THE BOUNDARY OF THE TREE PROTECTION ZONE. POSTS SHALL BE LOCATED AT A MAXIMUM OF EIGHT FEET (8') ON CENTER OR AS INDICATED WITHIN THE TREE PROTECTION DETAIL.
 - WHEN THE TREE PROTECTION FENCING HAS BEEN INSTALLED, IT SHALL BE INSPECTED BY THE APPROVING AGENCY PRIOR TO DEMOLITION, GRADING, TREE CLEARING OR ANY OTHER CONSTRUCTION. THE FENCING ALONG THE TREE PROTECTION ZONE SHALL BE REGULARLY INSPECTED BY THE LANDSCAPE CONTRACTOR AND MAINTAINED UNTIL ALL CONSTRUCTION ACTIVITY HAS BEEN COMPLETED.
 - AT NO TIME SHALL MACHINERY, DEBRIS, FALLEN TREES OR OTHER MATERIALS BE PLACED, STOCKPILED OR LEFT STANDING IN THE TREE PROTECTION ZONE.
- SOIL MODIFICATIONS**
 - CONTRACTOR SHALL ATTAIN A SOIL TEST FOR ALL AREAS OF THE SITE PRIOR TO CONDUCTING ANY PLANTING. SOIL TESTS SHALL BE PERFORMED BY A CERTIFIED SOIL LABORATORY.
 - LANDSCAPE CONTRACTOR SHALL REPORT ANY SOIL OR DRAINAGE CONDITIONS CONSIDERED DETRIMENTAL TO THE GROWTH OF PLANT MATERIAL. SOIL MODIFICATIONS, AS SPECIFIED HEREIN, MAY NEED TO BE CONDUCTED BY THE LANDSCAPE CONTRACTOR DEPENDING ON SITE CONDITIONS.
 - THE FOLLOWING AMENDMENTS AND QUANTITIES ARE APPROXIMATE AND ARE FOR BIDDING PURPOSES ONLY. COMPOSITION OF AMENDMENTS SHOULD BE REVISED DEPENDING ON THE OUTCOME OF A TOPSOIL ANALYSIS PERFORMED BY A CERTIFIED SOIL LABORATORY.
 - TO INCREASE A SANDY SOIL'S ABILITY TO RETAIN WATER AND NUTRIENTS, THOROUGHLY TILL ORGANIC MATTER INTO THE TOP 6-12". USE COMPOSTED BARK, COMPOSTED LEAF MULCH OR PEAT MOSS. ALL PRODUCTS SHOULD BE COMPOSTED TO A DARK COLOR AND BE FREE OF PIECES WITH IDENTIFIABLE LEAF OR WOOD STRUCTURE. AVOID MATERIAL WITH A PH HIGHER THAN 7.5.
 - TO INCREASE DRAINAGE, MODIFY HEAVY CLAY OR SILT (MORE THAN 40% CLAY OR SILT) BY ADDING COMPOSTED PINE BARK (UP TO 30% BY VOLUME) AND/OR AGRICULTURAL GYPSUM. COARSE SAND MAY BE USED IF ENOUGH IS ADDED TO BRING THE SAND CONTENT TO MORE THAN 60% OF THE TOTAL MIX. SUBSURFACE DRAINAGE LINES MAY NEED TO BE ADDED TO INCREASE DRAINAGE.
 - MODIFY EXTREMELY SANDY SOILS (MORE THAN 85%) BY ADDING ORGANIC MATTER AND/OR DRY, SHREDDED CLAY LOAM UP TO 30% OF THE TOTAL MIX.
- FINISHED GRADING**
 - UNLESS OTHERWISE CONTRACTED, THE LANDSCAPE CONTRACTOR SHALL BE RESPONSIBLE FOR THE INSTALLATION OF TOPSOIL AND THE ESTABLISHMENT OF FINE-GRADING WITHIN THE DISTURBANCE AREA OF THE SITE.
 - LANDSCAPE CONTRACTOR SHALL VERIFY THAT SUBGRADE FOR INSTALLATION OF TOPSOIL HAS BEEN ESTABLISHED. THE SUBGRADE OF THE SITE MUST MEET THE FINISHED GRADE LESS THE REQUIRED TOPSOIL THICKNESS (1").
 - ALL LAWN AND PLANTING AREAS SHALL BE GRADED TO A SMOOTH, EVEN AND UNIFORM PLANE WITH NO ABRUPT CHANGE OF SURFACE AS DEPICTED WITHIN THIS SET OF CONSTRUCTION PLANS, UNLESS OTHERWISE DIRECTED BY THE PROJECT ENGINEER OR LANDSCAPE ARCHITECT.
 - ALL PLANTING AREAS SHALL BE GRADED AND MAINTAINED TO ALLOW FREE FLOW OF SURFACE WATER IN AND AROUND THE PLANTING BEDS. STANDING WATER SHALL NOT BE PERMITTED IN PLANTING BEDS.
- TOPSOILING**
 - CONTRACTOR SHALL PROVIDE A SIX INCH (6") THICK MINIMUM LAYER OF TOPSOIL, OR AS DIRECTED BY THE LOCAL ORDINANCE OR CLIENT, IN ALL PLANTING AREAS. TOPSOIL SHOULD BE SPREAD OVER A PREPARED SURFACE IN A UNIFORM LAYER TO ACHIEVE THE DESIRED COMPACTED THICKNESS.
 - ON-SITE TOPSOIL MAY BE USED TO SUPPLEMENT THE TOTAL AMOUNT REQUIRED. TOPSOIL FROM THE SITE MAY BE REJECTED IF IT HAS NOT BEEN PROPERLY REMOVED, STORED AND PROTECTED PRIOR TO CONSTRUCTION.
 - CONTRACTOR SHALL FURNISH TO THE APPROVING AGENCY AN ANALYSIS OF BOTH IMPORTED AND ON-SITE TOPSOIL TO BE UTILIZED IN ALL PLANTING AREAS. THE PH AND NUTRIENT LEVELS MAY NEED TO BE ADJUSTED THROUGH SOIL MODIFICATIONS AS NEEDED TO ACHIEVE THE REQUIRED LEVELS AS SPECIFIED IN THE MATERIALS SECTION ABOVE.
 - ALL PLANTING AND LAWN AREAS ARE TO BE CULTIVATED TO A DEPTH OF SIX INCHES (6"). ALL DEBRIS EXPOSED FROM EXCAVATION AND CULTIVATION SHALL BE DISPOSED OF IN ACCORDANCE WITH GENERAL WORK PROCEDURES SECTION ABOVE. THE FOLLOWING SHALL BE TILLED INTO THE TOP FOUR INCHES (4") IN TWO DIRECTIONS (QUANTITIES BASED ON A 1,000 SQUARE FOOT AREA):
 - 20 POUNDS 'GROW POWER' OR APPROVED EQUAL.
 - 20 POUNDS NITRO-FORM (COURSE) 38-0-0 BLUE CHIP.
 - THE SPREADING OF TOPSOIL SHALL NOT BE CONDUCTED UNDER MUDDY OR FROZEN CONDITIONS.


APPROVED: DEPARTMENT OF PLANNING AND ZONING
 11-17-14
 APPROVED: PLANNING BOARD OF HOWARD COUNTY
 10/08/2014

- PLANTING**
 - INSOFAE THAT IT IS FEASIBLE, PLANT MATERIAL SHALL BE PLANTED ON THE DAY OF DELIVERY. IN THE EVENT THAT THIS IS NOT POSSIBLE, LANDSCAPE CONTRACTOR SHALL PROTECT UNINSTALLED PLANT MATERIAL. PLANTS SHALL NOT REMAIN UNPLANTED FOR LONGER THAN A THREE DAY PERIOD AFTER DELIVERY. PLANTS THAT WILL NOT BE PLANTED FOR A PERIOD OF TIME GREATER THAN THREE DAYS SHALL BE HEALED IN WITH TOPSOIL OR MULCH TO HELP PRESERVE ROOT MOISTURE.
 - PLANTING OPERATIONS SHALL BE PERFORMED DURING PERIODS WITHIN THE PLANTING SEASON WHEN WEATHER AND SOIL CONDITIONS ARE SUITABLE AND IN ACCORDANCE WITH ACCEPTED LOCAL PRACTICE. PLANTS SHALL NOT BE INSTALLED IN TOPSOIL THAT IS IN A MUDDY OR FROZEN CONDITION.
 - ANY INJURED ROOTS OR BRANCHES SHALL BE PRUNED TO MAKE CLEAN-CUT ENDS PRIOR TO PLANTING INCLUDING CLEAN, SHARP TOOLS. ONLY INJURED OR DISEASED BRANCHING SHALL BE REMOVED.
 - ALL PLANTING CONTAINERS AND NON-BIODEGRADABLE MATERIALS SHALL BE REMOVED FROM ROOT BALLS DURING PLANTING. NATURAL FIBER BURLAP MUST BE CUT FROM AROUND THE TRUNK OF THE TREE AND FOLDED DOWN AGAINST THE ROOT BALL PRIOR TO BACKFILLING.
 - POSITION TREES AND SHRUBS AT THEIR INTENDED LOCATIONS AS PER THE PLANS AND SECURE THE APPROVAL OF THE LANDSCAPE ARCHITECT PRIOR TO EXCAVATING PITS, MAKING NECESSARY ADJUSTMENTS AS DIRECTED.
 - PRIOR TO THE ISSUANCE OF ANY CERTIFICATE OF OCCUPANCY, THE PROPOSED LANDSCAPE, AS SHOWN ON THE APPROVED LANDSCAPE PLAN, MUST BE INSTALLED, INSPECTED AND APPROVED BY THE APPROVING AGENCY. THE APPROVING AGENCY SHALL TAKE INTO ACCOUNT SEASONAL CONSIDERATIONS IN THIS REGARD AS FOLLOWS: THE PLANTING OF TREES, SHRUBS, VINES OR GROUND COVER SHALL OCCUR ONLY DURING THE FOLLOWING PLANTING SEASONS:
 - PLANTS: MARCH 15 TO DECEMBER 15
 - LAWN: MARCH 15 TO JUNE 15 OR SEPT. 1 TO DECEMBER 1
 - PLANTINGS REQUIRED FOR A CERTIFICATE OF OCCUPANCY SHALL BE PROVIDED DURING THE NEXT APPROPRIATE SEASON AT THE MUNICIPALITY'S DISCRETION. CONTRACTOR SHOULD CONTACT APPROVING AGENCY FOR POTENTIAL SUBSTITUTIONS.
 - FURTHERMORE, THE FOLLOWING TREE VARIETIES ARE UNUSUALLY SUSCEPTIBLE TO WINTER DAMAGE. WITH TRANSPLANT SHOCK AND THE SEASONAL LACK OF NITROGEN AVAILABILITY, THE RISK OF PLANT DEATH IS GREATLY INCREASED. IT IS NOT RECOMMENDED THAT THESE SPECIES BE PLANTED DURING THE FINAL PLANTING SEASON:

ACER RUBRUM	PLATANUS X ACERIFOLIA
BETULA VARIETIES	POPULUS VARIETIES
CARPINUS VARIETIES	PRUNUS VARIETIES
CRATAEGUS VARIETIES	PYRUS VARIETIES
KOELREUTERIA	QUERCUS VARIETIES
LIQUIDAMBER SYRACIFLUA	TILIA TOMENTOSA
LIRODENDRON TULPIFERA	ZELKOVA VARIETIES

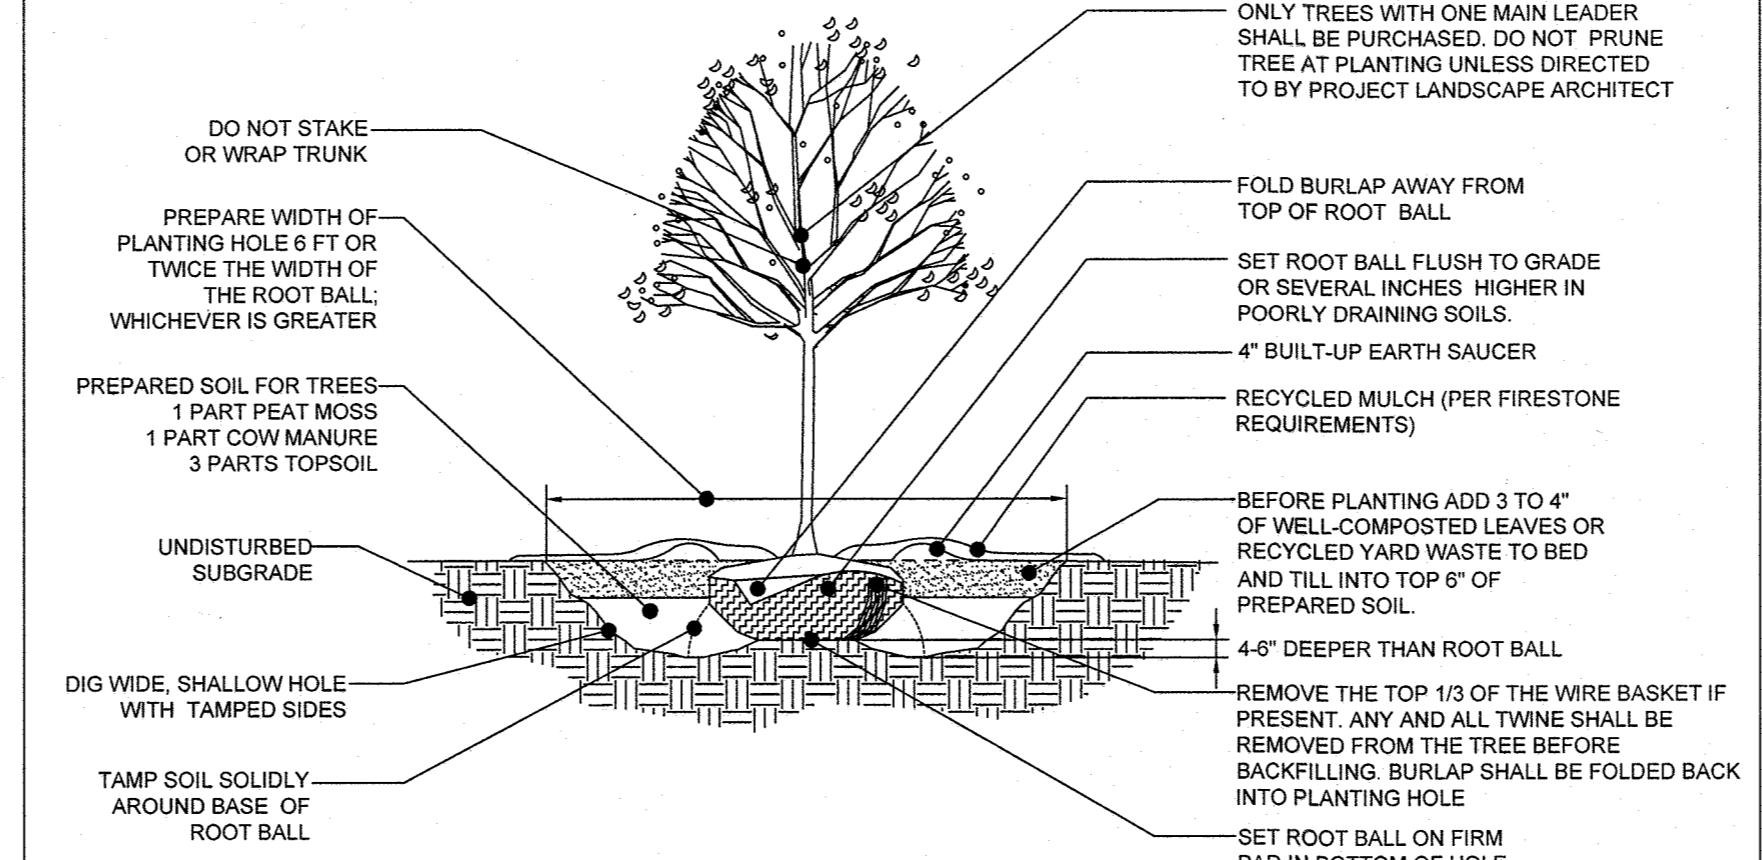

REFERENCE: ARCHITECTURAL GRAPHIC STANDARDS 1998 CUMULATIVE SUPPLEMENT
DECIDUOUS TREE PLANTING DETAIL
 NOT TO SCALE


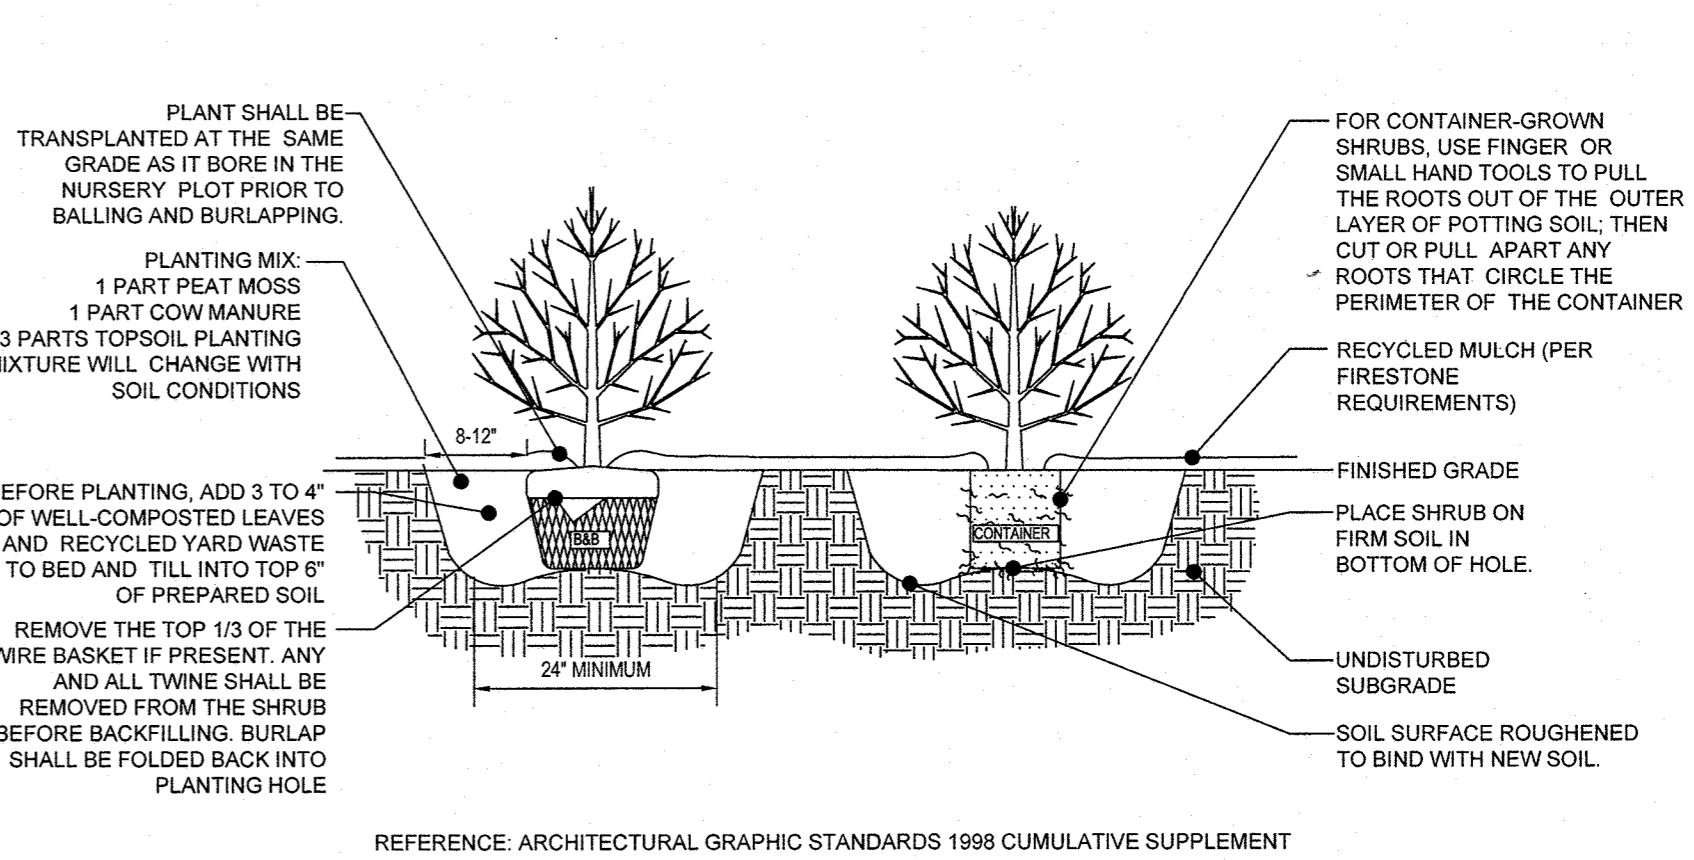


REFERENCE: ARCHITECTURAL GRAPHIC STANDARDS 1998 CUMULATIVE SUPPLEMENT
DECIDUOUS AND EVERGREEN SHRUB PLANTING DETAIL
 NOT TO SCALE

TABLE B.3.2 MATERIALS SPECIFICATIONS FOR BIORETENTION

MATERIAL	SPECIFICATIONS	SIZE	NOTES
PLANTINGS	SEE APPENDIX A, TABLE A.4	N/A	PLANTINGS ARE SITE-SPECIFIC
PLANTING SOIL	SAND 35-50% SILT 30-50% CLAY 10-25%	N/A	USDA SOIL TYPES LOAMY SAND, SANDY LOAM OR LOAM
MULCH	SHREDDED HARDWOOD		AGED 6 MONTHS, MINIMUM
PEA GRAVEL, DIAPHRAGM AND CURTAIN DRAIN	PEA GRAVEL: ASTM #48 ORNAMENTAL STONE: WASHED COBBLES	PEA GRAVEL: NO. 8 STONE: 2" TO 5"	
GEOTEXTILE	CLASS "C" - APPARENT OPENING SIZE (ASTM-D-4751), GRAB TENSILE STRENGTH (ASTM-D-4832), PUNCTURE RESISTANCE (ASTM-D-4833)	N/A	FOR USE AS NECESSARY BENEATH UNDERDRAINS ONLY
UNDERDRAIN GRAVEL	AASHTO M-43	1/2" TO 3/4"	
UNDERDRAIN PIPING	F 758, TYPE PS 28 OR AASHTO M-278	4" TO 6"	RIGID SCHEDULE 40 PVC OR SDR35
POURED IN PLACE CONCRETE (IF REQUIRED)	MSHA MIX NO. 3, F _c = 3500 PSI @ 28 DAYS, NORMAL WEIGHT, AIR-ENTRAINED, REINFORCING TO MEET ASTM-F16-90	N/A	ON-SITE TESTING OF POURED-IN-PLACE CONCRETE REQUIRED; 28 DAY STRENGTH AND SLUMP TEST; ALL CONCRETE DESIGN (CAST-IN-PLACE OR PRE-CAST) NOT USING UNUSUALLY APPROVED STATE OR LOCAL STANDARDS REQUIRES DESIGN SEAL AND APPROVAL BY A PROFESSIONAL STRUCTURAL ENGINEER LICENSED IN THE STATE OF MARYLAND. DESIGN TO INCLUDE MEETING ACI CODE 350 R/89, VERTICAL LOADING (H-10 OR H-20); ALLOWABLE HORIZONTAL LOADING (BASED ON PRESSURES); AND ANALYSIS OR POTENTIAL CRACKING
SAND (1" DEEP)	AASHTO M-60 OR ASTM-C-33	0.02" TO 0.04"	SAND SUBSTITUTIONS SUCH AS DABASE AND GRAYSTONE ARE NOT ACCEPTABLE. NO CALCIUM CARBONATE OR DOLOMITIC SAND SUBSTITUTIONS ARE ACCEPTABLE. NO "ROCK DUST" CAN BE USED FOR SAND.

- SEEDING SPECIFICATIONS**
- PRIOR TO SEEDING, AREA IS TO BE TOPSOILED, FINE GRADED, AND RAKED OF ALL DEBRIS LARGER THAN 2" DIAMETER.
 - PRIOR TO SEEDING, CONSULT MANUFACTURER'S RECOMMENDATIONS AND INSTRUCTIONS.
- | | |
|-----------------------|-----------------------|
| PERENNIAL RYEGRASS | 1/2 LB/1,000 SQ FT |
| KENTUCKY BLUEGRASS | 1 LB/1,000 SQ FT |
| RED FESCUE | 1 1/2 LBS/1,000 SQ FT |
| SPREADING FESCUE | 1 1/2 LBS/1,000 SQ FT |
| FERTILIZER (20-10-10) | 14 LBS/1,000 SQ FT |
| MULCH | 90 LBS/1,000 SQ FT |
- GERMINATION RATES WILL VARY AS TO TIME OF YEAR FOR SOILING. CONTRACTOR TO IRRIGATE SEEDED AREA UNTIL AN ACCEPTABLE STAND OF COVER IS ESTABLISHED BY OWNER.

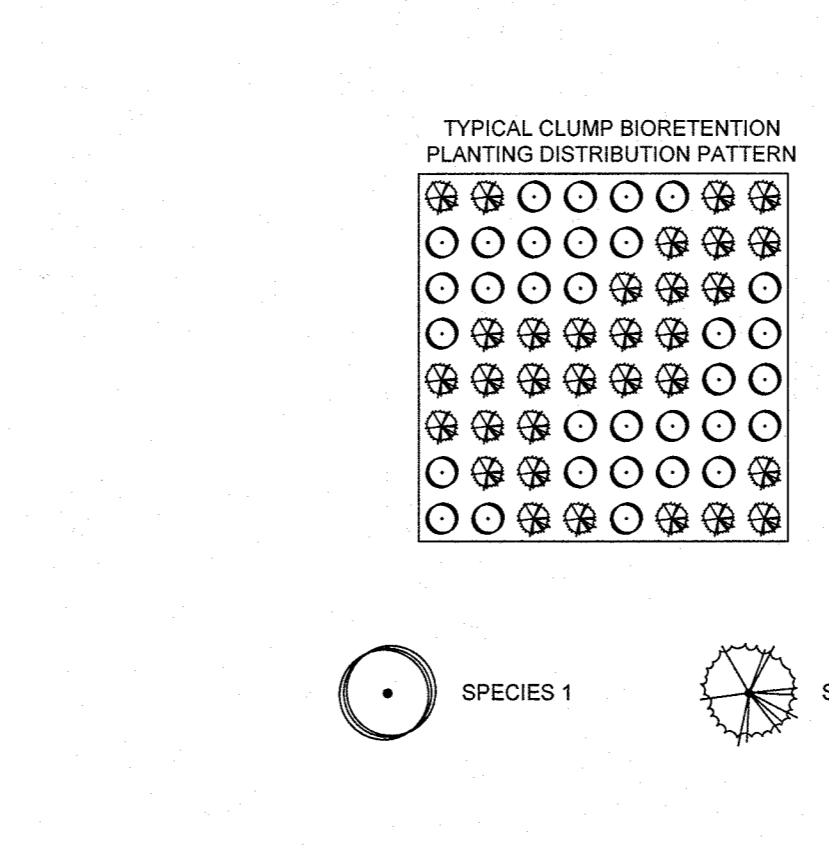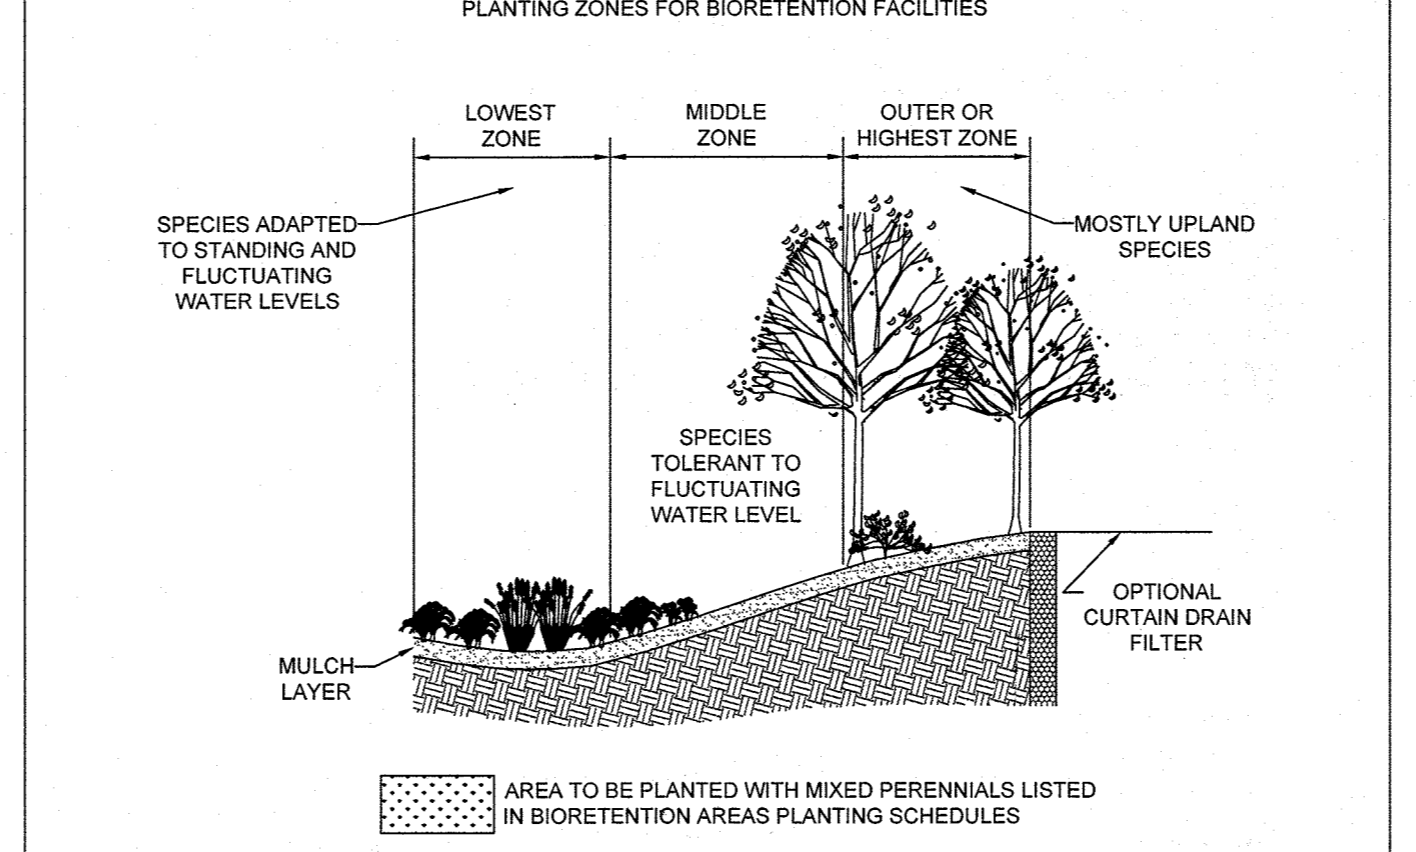


- NOTES:**
- HERBACEOUS PERENNIALS TO BE PLANTED 18" O.C. IN GROUPS BETWEEN 15 TO 20 PLUGS
 - LANDSCAPE CONTRACTOR TO GROUP LIKE PLANTS TOGETHER IN EACH BED AS SHOWN IN PLANTING DISTRIBUTION PATTERN DETAIL.
 - ALL BIORETENTION AREAS ARE TO BE MULCHED WITH A 3" LAYER OF DOUBLE SHREDDED HARDWOOD BARK MULCH.
 - WHEN BACKFILLING THE BIORETENTION FACILITY, PLACE SOIL IN LIFTS 12" TO 18". DO NOT USE HEAVY EQUIPMENT WITHIN THE BIORETENTION BASIN. HEAVY EQUIPMENT CAN BE USED AROUND THE PERIMETER OF THE BASIN TO SUPPLY SOILS AND SAND. GRADE BIORETENTION MATERIALS WITH LIGHT EQUIPMENT SUCH AS A COMPACT LOADER OR A DOZER/LOADER WITH MARKS TRACKS. (SEE ALSO CONST. SPECS. ON SHEET 25 FOR ADDITIONAL REQUIREMENTS.)

NOTE: NATURALLY OCCURRING POPULATIONS TEND TO BE FOUND IN INFORMAL GROUPINGS. A CLUSTER OF PLANTS IS REALLY A MOSAIC OF DIFFERENT SPECIES GROUPS. THE OBJECTIVE IS TO SELECT THE APPROPRIATE SPECIES AND DISTRIBUTION PATTERN FOR A CHOSEN SITE THAT MIMIC NATURAL PATTERNS.

TYPICAL PLANTING FOR BIORETENTION AREAS
 NOT TO SCALE

BIORETENTION PLANTING DISTRIBUTION PATTERN DETAIL
 NOT TO SCALE

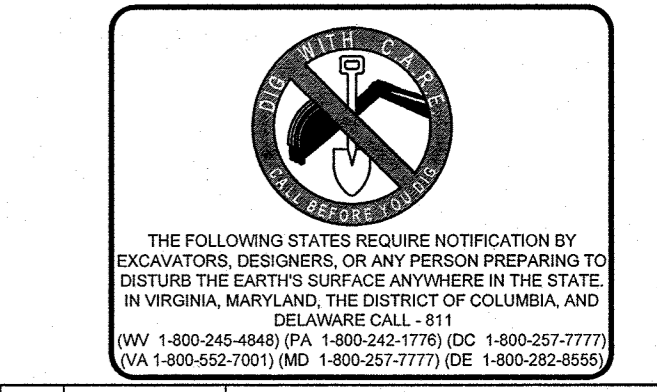

NO.	DATE	REVISION DESCRIPTION
1	4/27/19	PAGE NUMBER UPDATE

OWNER: M/H HOMES OF DC, LLC
 21355 RIDGETOP CIRCLE, SUITE 220
 STERLING, VA 20166
 CONTACT: GINDY HUNTERBERRY
 PHONE: 443-677-9803

DEVELOPER: SOMERWORTH II, L.C.
 5704 DORSEY HALL DRIVE, SUITE 205
 ELLICOTT CITY, MD 21042
 CONTACT: JASON VAN KIRK
 PHONE: (410) 720-3201

PROJECT: WALDEN WOODS

TAX MAP: 47 GRID: 2 ZONED: PSC
 PARCEL: 4 LOTS 1-97, OPEN SPACE LOTS 98 - 102
 6TH ELECTION DISTRICT, HOWARD COUNTY, MARYLAND

TITLE: LANDSCAPE NOTES AND DETAILS

BOHLER ENGINEERING
 901 DULANEY VALLEY ROAD, SUITE 801
 TOWSON, MARYLAND 21284
 Phone: (410) 821-7900
 Fax: (410) 821-7987
 www.BohlerEngineering.com


CHECKED BY: BRR
 DESIGNED BY: BRR
 DRAWN BY: RMS/AVG
 PROJECT NO.: MD112149
 DATE: 10/27/14
 SCALE: AS NOTED
 DRAWING NO. 15 OF 25

DEVELOPER'S / OWNER'S LANDSCAPE CERTIFICATE

I/WE CERTIFY THAT THE LANDSCAPING SHOWN ON THIS PLAN WILL BE DONE ACCORDING TO THE PLAN, SECTION 16-124 OF THE HOWARD COUNTY CODE AND THE LANDSCAPE MANUAL. I/WE FURTHER CERTIFY THAT UPON COMPLETION A LETTER OF LANDSCAPE INSTALLATION, ACCOMPANIED BY AN EXECUTED ONE YEAR GUARANTEE OF PLANT MATERIALS, WILL BE SUBMITTED TO THE DEPARTMENT OF PLANNING AND ZONING.

DEVELOPER'S/OWNER'S NAME: *[Signature]* DATE: 11-3-14

PROFESSIONAL CERTIFICATION
 I, ERIC R. MCWILLIAMS, HEREBY CERTIFY THAT THESE DOCUMENTS WERE PREPARED OR APPROVED BY ME, AND THAT I AM A DULY LICENSED LANDSCAPE ARCHITECT UNDER THE LAWS OF THE STATE OF MARYLAND. LICENSE NO. 9897. EXPIRATION DATE: 3/31/14

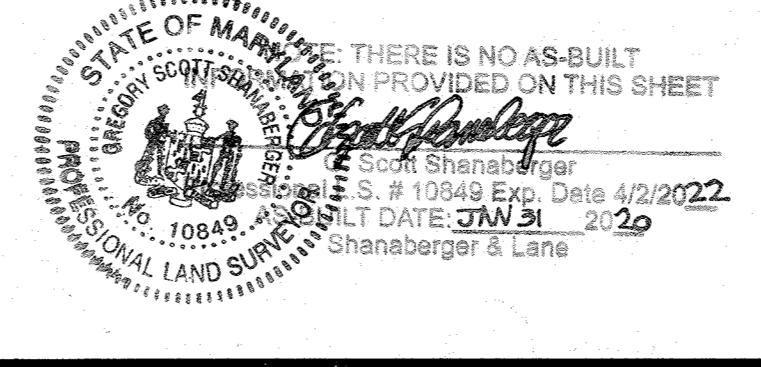

BIORETENTION AREAS PLANTING SCHEDULES																		
				FACILITY/SIZE (S.F.)														
SPECIES		CONTAINER SIZE	SPACING	#1	#2	#3	#4	#5	#6	#7	#8	#9	#10	#11	#12	#14	#15	TOTAL
BOTANICAL NAME	COMMON NAME			704	1456	1232	1800	1053	5900	1330	895	550	716	6868	1206	800	630	
SHRUBS																		
ALNUS RUGOSA	SPECKLED ALDER	2 GAL. CONT.	3' O.C.	10	25	20	30	20	110	25	15	10	12	110	25	15	12	439
ARONIA ARBUTIFOLIA	CHOKEBERRY	2 GAL. CONT.	3' O.C.	10	25	25	35	20	110	25	15	10	12	110	25	15	12	449
CORNUS AMMOMUM	SILKY DOGWOOD	2 GAL. CONT.	3' O.C.	20	30	25	35	20	110	25	18	10	15	110	25	15	12	470
HERBACEOUS																		
ASTER NOVAE-ANGLIAE	NEW ENGLAND ASTER	PLUG	18" O.C.	20	25	30	45	15	110	30	20	15	15	110	20	25	15	495
IRIS VERSICOLOR	BLUE FLAG	PLUG	18" O.C.	20	25	25	45	15	110	30	20	15	15	110	20	25	15	490
LOBELIA CARDINALIS	CARDINAL FLOWER	PLUG	18" O.C.	20	25	25	45	15	110	30	25	15	15	110	20	25	15	495
CYPERUS PSEUDOVEGETUS	MARSH FLATSEDEGE	PLUG	18" O.C.	20	30	25	45	15	110	30	20	10	15	110	20	30	15	495
RUDBECKIA LACINIATA	TALL CONEFLOWER	PLUG	18" O.C.	-	30	30	45	-	110	-	-	10	-	110	-	-	-	335
JUNCUS EFFUSUS	SOFT RUSH	PLUG	18" O.C.	35	80	85	85	50	225	70	45	30	35	250	75	40	35	1120
SCIRPUS ACUTUS	HARDSTEMMED BULLRUSH	PLUG	18" O.C.	35	80	85	85	50	225	70	45	30	35	250	75	40	35	1120
SOLIDAGO SEMPERVIRENS	GOLDEN ROD	PLUG	18" O.C.	20	-	-	-	-	110	35	-	-	15	110	-	30	15	335
HIBISCUS MOSCHEUTOS	SWAMP ROSEMALLOW	PLUG	18" O.C.	-	30	-	-	15	110	-	25	-	-	110	25	-	-	315

SCHEDULE 'A' PERIMETER LANDSCAPE EDGE											
PERIMETER	CATEGORY (P = PROPERTIES, R = ROADWAYS)	LANDSCAPE TYPE	LINEAR FEET OF ROADWAY FRONTAGE/PERIMETER	CREDIT FOR EX. VEGETATION (YES/NO; LF) (DESCRIBE BELOW IF NEEDED)	CREDIT FOR FENCE/WALL/BERM (YES/NO; LF) (DESCRIBE BELOW IF NEEDED)	NUMBER OF PLANTS REQUIRED			NUMBER OF PLANTS PROVIDED		
						EVERGREEN TREES	SHADE TREES	SHRUBS	EVERGREEN TREES	SHADE TREES	SHRUBS
#1	R	C	983 LF	(261) 722	NO (0)	37	19	0	37	19	0
#2	P	A	1,286 LF	(1,136) 150	NO (0)	0	3	0	0	3	0
#3	P	A	660 LF	(160) 500	NO (0)	0	8	0	0	8	0
#4	P	A	712 LF	(452) 260	NO (0)	0	5	0	0	5	0
TOTAL						37	30	0	37	30	0

SYMBOL DESIGNATES PERIMETER LANDSCAPE EDGE PLANTINGS

SCHEDULE 'C' RESIDENTIAL DEVELOPMENT INTERNAL LANDSCAPING			
NUMBER OF DWELLING UNITS	87 TOWNHOMES (SFA) + 10 SINGLE FAMILY DWELLINGS = 97 UNITS		
NUMBER OF TREES REQUIRED (1:DU SFA)	87 TREES		
NUMBER OF TREES PROVIDED (2:1 RATIO EVERGREEN TO SHADE)	36 EVERGREEN / 28 SMALL DECIDUOUS	SHADE	TOTAL EQUIVALENT TREES
	32 EQUIVALENT TREES	55	87

SYMBOL DESIGNATES INTERNAL LANDSCAPING REQUIREMENTS

RELEASE OF SURETY WILL NOT BE GRANTED UNTIL ALL LANDSCAPING SHOWN ON THESE PLANS HAS BEEN COMPLETED IN ACCORDANCE WITH THE APPROVED LANDSCAPE PLAN. SURETY FOR LANDSCAPING SHALL BE BASED ON THE TOTAL NUMBER OF REQUIRED NEW TREES (SHADE, ORNAMENTAL AND EVERGREEN) OR COMPARABLE ELEMENTS SHOWN ON THE LANDSCAPE PLAN. THE UNIT PRICES TO BE USED FOR ESTABLISHING SURETY REQUIREMENTS SHALL BE IN ACCORDANCE WITH THE ADOPTED COUNTY FEE SCHEDULE WHICH IS \$300.00 PER SHADE TREE, \$150.00 PER EVERGREEN/ORNAMENTAL TREE, \$30.00 PER SHRUB, \$10.00 PER LINEAR FEET OF FENCING AND \$20.00 PER LINEAR FEET OF WALL.

BASED ON ALL THE PLANTING SCHEDULE, THE SURETY FOR REQUIRED LANDSCAPING IS THE FOLLOWING:

233 SHADE TREES X \$300.00 = \$69,900.00 (STREET TREES = 130)
 130 ORNAMENTAL TREES X \$150.00 = \$19,500
 151 EVERGREEN TREES X \$150.00 = \$22,650
 TOTAL = \$112,050.00

NOTE: THE LANDSCAPING SURETY WILL BE POSTED WITH THE DEVELOPER'S AGREEMENT.

SCHEDULE 'D' STORMWATER MANAGEMENT BIORETENTION FACILITY #1	
LINEAR FEET OF PERIMETER	108 FT
NUMBER OF TREES REQUIRED (SHADE TREE = 1.50) (EVERGREEN TREE = 1.40)	2 3
CREDIT FOR EX. VEGETATION	YES - 33%
CREDIT FOR OTHER LANDSCAPING	NO

SCHEDULE 'D' STORMWATER MANAGEMENT BIORETENTION FACILITY #10	
LINEAR FEET OF PERIMETER	105 FT
NUMBER OF TREES REQUIRED (SHADE TREE = 1.50) (EVERGREEN TREE = 1.40)	3 4
CREDIT FOR EX. VEGETATION	NO
CREDIT FOR OTHER LANDSCAPING	NO

SCHEDULE 'D' STORMWATER MANAGEMENT BIORETENTION FACILITY #2	
LINEAR FEET OF PERIMETER	171 FT
NUMBER OF TREES REQUIRED (SHADE TREE = 1.50) (EVERGREEN TREE = 1.40)	3 4
CREDIT FOR EX. VEGETATION	NO
CREDIT FOR OTHER LANDSCAPING	NO

SCHEDULE 'D' STORMWATER MANAGEMENT BIORETENTION FACILITY #11	
LINEAR FEET OF PERIMETER	427 FT
NUMBER OF TREES REQUIRED (SHADE TREE = 1.50) (EVERGREEN TREE = 1.40)	8 11
CREDIT FOR EX. VEGETATION	NO
CREDIT FOR OTHER LANDSCAPING	NO

SCHEDULE 'D' STORMWATER MANAGEMENT BIORETENTION FACILITY #3	
LINEAR FEET OF PERIMETER	152 FT
NUMBER OF TREES REQUIRED (SHADE TREE = 1.50) (EVERGREEN TREE = 1.40)	3 4
CREDIT FOR EX. VEGETATION	NO
CREDIT FOR OTHER LANDSCAPING	NO

SCHEDULE 'D' STORMWATER MANAGEMENT BIORETENTION FACILITY #12	
LINEAR FEET OF PERIMETER	147 FT
NUMBER OF TREES REQUIRED (SHADE TREE = 1.50) (EVERGREEN TREE = 1.40)	3 3
CREDIT FOR EX. VEGETATION	YES - 35%
CREDIT FOR OTHER LANDSCAPING	NO

SCHEDULE 'D' STORMWATER MANAGEMENT BIORETENTION FACILITY #4	
LINEAR FEET OF PERIMETER	221 FT
NUMBER OF TREES REQUIRED (SHADE TREE = 1.50) (EVERGREEN TREE = 1.40)	5 6
CREDIT FOR EX. VEGETATION	NO
CREDIT FOR OTHER LANDSCAPING	NO

SCHEDULE 'D' STORMWATER MANAGEMENT BIORETENTION FACILITY #13	
LINEAR FEET OF PERIMETER	289 FT
NUMBER OF TREES REQUIRED (SHADE TREE = 1.50) (EVERGREEN TREE = 1.40)	10 13
CREDIT FOR EX. VEGETATION	YES - 18%
CREDIT FOR OTHER LANDSCAPING	NO

SCHEDULE 'D' STORMWATER MANAGEMENT BIORETENTION FACILITY #5	
LINEAR FEET OF PERIMETER	286 FT
NUMBER OF TREES REQUIRED (SHADE TREE = 1.50) (EVERGREEN TREE = 1.40)	3 4
CREDIT FOR EX. VEGETATION	YES - 50%
CREDIT FOR OTHER LANDSCAPING	NO

SCHEDULE 'D' STORMWATER MANAGEMENT BIORETENTION FACILITY #14	
LINEAR FEET OF PERIMETER	159 FT
NUMBER OF TREES REQUIRED (SHADE TREE = 1.50) (EVERGREEN TREE = 1.40)	3 3
CREDIT FOR EX. VEGETATION	YES - 42%
CREDIT FOR OTHER LANDSCAPING	NO

SCHEDULE 'D' STORMWATER MANAGEMENT BIORETENTION FACILITY #6	
LINEAR FEET OF PERIMETER	604 FT
NUMBER OF TREES REQUIRED (SHADE TREE = 1.50) (EVERGREEN TREE = 1.40)	8 9
CREDIT FOR EX. VEGETATION	YES - 40%
CREDIT FOR OTHER LANDSCAPING	NO

SCHEDULE 'D' STORMWATER MANAGEMENT BIORETENTION FACILITY #15	
LINEAR FEET OF PERIMETER	136 FT
NUMBER OF TREES REQUIRED (SHADE TREE = 1.50) (EVERGREEN TREE = 1.40)	3 4
CREDIT FOR EX. VEGETATION	NO
CREDIT FOR OTHER LANDSCAPING	NO

SCHEDULE 'D' STORMWATER MANAGEMENT BIORETENTION FACILITY #7	
LINEAR FEET OF PERIMETER	132 FT
NUMBER OF TREES REQUIRED (SHADE TREE = 1.50) (EVERGREEN TREE = 1.40)	4 4
CREDIT FOR EX. VEGETATION	NO
CREDIT FOR OTHER LANDSCAPING	NO

SCHEDULE 'D' STORMWATER MANAGEMENT BIORETENTION FACILITY #16	
LINEAR FEET OF PERIMETER	121 FT
NUMBER OF TREES REQUIRED (SHADE TREE = 1.50) (EVERGREEN TREE = 1.40)	3 4
CREDIT FOR EX. VEGETATION	NO
CREDIT FOR OTHER LANDSCAPING	NO

SCHEDULE 'D' STORMWATER MANAGEMENT BIORETENTION FACILITY #8	
LINEAR FEET OF PERIMETER	121 FT
NUMBER OF TREES REQUIRED (SHADE TREE = 1.50) (EVERGREEN TREE = 1.40)	3 4
CREDIT FOR EX. VEGETATION	NO
CREDIT FOR OTHER LANDSCAPING	NO

SCHEDULE 'D' STORMWATER MANAGEMENT BIORETENTION FACILITY #17	
LINEAR FEET OF PERIMETER	109 FT
NUMBER OF TREES REQUIRED (SHADE TREE = 1.50) (EVERGREEN TREE = 1.40)	3 4
CREDIT FOR EX. VEGETATION	NO
CREDIT FOR OTHER LANDSCAPING	NO

SCHEDULE 'D' STORMWATER MANAGEMENT BIORETENTION FACILITY #9	
LINEAR FEET OF PERIMETER	109 FT
NUMBER OF TREES REQUIRED (SHADE TREE = 1.50) (EVERGREEN TREE = 1.40)	3 4
CREDIT FOR EX. VEGETATION	NO
CREDIT FOR OTHER LANDSCAPING	NO

SCHEDULE 'D' STORMWATER MANAGEMENT BIORETENTION FACILITY #18	
LINEAR FEET OF PERIMETER	121 FT
NUMBER OF TREES REQUIRED (SHADE TREE = 1.50) (EVERGREEN TREE = 1.40)	3 4
CREDIT FOR EX. VEGETATION	NO
CREDIT FOR OTHER LANDSCAPING	NO


STREET TREE CHART		
STREET NAME	REQUIRED	PROVIDED
GORMAN ROAD (983 FT - 265 EXISTING FOREST TO REMAIN = 718)	18 TREES	18 TREES
ROAD A (1,104 FT)	56 TREES	43 SHADE; 26 ORNAMENTAL & EVERGREEN = 56 EQUIVALENT
ROAD B (1,109 FT)	56 TREES	42 SHADE; 28 ORNAMENTAL & EVERGREEN = 56 EQUIVALENT
TOTAL TREES	130 TREES	130 EQUIVALENT TREES

DEVELOPER'S / OWNER'S LANDSCAPE CERTIFICATE

I/WE CERTIFY THAT THE LANDSCAPING SHOWN ON THIS PLAN WILL BE DONE ACCORDING TO THE PLAN, SECTION 16.124 OF THE HOWARD COUNTY CODE AND THE LANDSCAPE MANUAL. I/WE FURTHER CERTIFY THAT UPON COMPLETION A LETTER OF LANDSCAPE INSTALLATION, ACCOMPANIED BY AN EXECUTED ONE YEAR GUARANTEE OF PLANT MATERIALS, WILL BE SUBMITTED TO THE DEPARTMENT OF PLANNING AND ZONING.

DEVELOPER'S / OWNER'S NAME: J. & V. [Signature] DATE: 11-3-14

PROFESSIONAL CERTIFICATION
 I, ERIC R. MCWILLIAMS, HEREBY CERTIFY THAT THESE DOCUMENTS WERE PREPARED OR APPROVED BY ME, AND THAT I AM A DULY LICENSED LANDSCAPE ARCHITECT UNDER THE LAWS OF THE STATE OF MARYLAND.
 LICENSE NO. 9871 EXPIRATION DATE: 8/2014

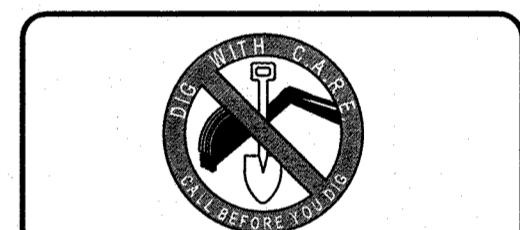

THE FOLLOWING STATES REQUIRE NOTIFICATION BY EXCAVATORS, DESIGNERS, OR ANY PERSON PREPARING TO DISTURB THE EARTH'S SURFACE ANYWHERE IN THE STATE OF VIRGINIA, MARYLAND, THE DISTRICT OF COLUMBIA, AND DELAWARE CALL - 811
 (VA 1-800-245-4444) (PA 1-800-245-1779) (DC 1-800-257-7777) (MD 1-800-552-7001) (DE 1-800-257-7777) (DE 1-800-282-6556)

NO.	DATE	REVISION DESCRIPTION
1	11/11/14	PAGE NUMBER UPDATE

OWNER: M/I HOMES OF DC, LLC
 21355 RIDGETOP CIRCLE, SUITE 220
 STERLING, VA 20156
 CONTACT: CINDY HUNTZBERRY
 PHONE: 443-677-9803

DEVELOPER: SOMERWORTH II, L.C.
 5704 DORSEY HALL DRIVE, SUITE 205
 ELLICOTT CITY, MD 21042
 CONTACT: JASON VAN KIRK
 PHONE: (410) 720-3021

PROJECT: WALDEN WOODS

TAX MAP: 47 GRID: 2 ZONED: PSC
 PARCEL: 4, LOTS 1-97, OPEN SPACE LOTS 98 - 102
 6TH ELECTION DISTRICT, HOWARD COUNTY, MARYLAND

TITLE: LANDSCAPE NOTES AND DETAILS

BOHLER ENGINEERING
 901 DULANEY VALLEY ROAD, SUITE 801
 TOWSON, MARYLAND 21284
 Phone: (410) 821-7900
 Fax: (410) 821-7987
 www.BohlerEngineering.com

CHECKED BY: BRR
 DESIGNED BY: BRR
 DRAWN BY: RMS/AVG
 PROJECT NO.: MD112149
 DATE: 10/27/14
 SCALE: NOT TO SCALE
 DRAWING NO. 16 OF 35

APPROVED
 PLANNING BOARD OF HOWARD COUNTY
88406
 DATE: 10/08/2014

APPROVED: DEPARTMENT OF PLANNING AND ZONING
[Signature] 11-17-14
 CHIEF-DEVELOPMENT ENGINEERING DIVISION DATE

[Signature] 12-22-14
 CHIEF-DIVISION OF LAND DEVELOPMENT DATE

[Signature]
 DIRECTOR DATE

STATE OF MARYLAND
 GREEN SCOTT SIGNATURE
 ERIC R. MCWILLIAMS
 LICENSE NO. 9871
 EXPIRES 8/2014
 REGISTERED LANDSCAPE ARCHITECT

STATE OF MARYLAND
 REGISTERED LANDSCAPE ARCHITECT
[Signature]
 11/3/14
 For Revision 1 ONLY

FOREST CONSERVATION PLANTING SPECIFICATIONS

1. SCOPE OF WORK:
THE LANDSCAPE CONTRACTOR SHALL BE REQUIRED TO PERFORM ALL CLEARING, FINISHED GRADING, SOIL PREPARATION, PERMANENT SEEDING OR SODDING, PLANTING AND MULCHING INCLUDING ALL LABOR, MATERIALS, TOOLS AND EQUIPMENT NECESSARY FOR THE COMPLETION OF THIS PROJECT, UNLESS OTHERWISE CONTRACTED BY THE GENERAL CONTRACTOR.

2. MATERIALS
A. GENERAL - ALL HARDSCAPE MATERIALS SHALL MEET OR EXCEED SPECIFICATIONS AS OUTLINED IN THE STATE DEPARTMENT OF TRANSPORTATION'S SPECIFICATIONS.
B. TOPSOIL - NATURAL, FRIABLE, LOAMY SILT SOIL HAVING AN ORGANIC CONTENT NOT LESS THAN 5% (A PH RANGE BETWEEN 4.5-7.0, IT SHALL BE FREE OF DEBRIS, ROCKS LARGER THAN ONE INCH (1"), WOOD, ROOTS, VEGETABLE MATTER AND CLAY CLUMPS.

C. LAWN - ALL DISTURBED AREAS ARE TO BE TREATED WITH A MINIMUM SIX INCH (6") THICK LAYER OF TOPSOIL, OR AS DIRECTED BY THE LOCAL ORDINANCE OR CLIENT, AND SEEDED OR SODDED IN ACCORDANCE WITH THE PERMANENT STABILIZATION METHODS INDICATED WITHIN THE SOIL EROSION AND SEDIMENT CONTROL NOTES.
1. LAWN SEED MIXTURE SHALL BE FRESH, CLEAN NEW CROP SEED.
2. SOO SHALL BE STRONGLY ROOTED, WEED AND DISEASE-FREE WITH A UNIFORM THICKNESS.
3. SOO INSTALLED ON SLOPES GREATER THAN 4:1 SHALL BE PEGGED TO HOLD SOO IN PLACE.

D. MULCH - THE MULCH AROUND THE PERIMETER OF THE BUILDING SHALL BE A 3" LAYER OF DOUBLE SHREDDED BLACK CEDAR MULCH ONLY, ALL OTHER AREAS SHALL BE MULCHED WITH A 3" LAYER OF DOUBLE SHREDDED DARK BROWN HARDWOOD BARK MULCH, UNLESS OTHERWISE STATED ON THE LANDSCAPE PLAN.

E. FERTILIZER
1. FERTILIZER SHALL BE DELIVERED TO THE SITE MIXED AS SPECIFIED IN THE ORIGINAL UNOPENED STANDARD BAGS SHOWING HEIGHT, ANALYSIS AND NAME OF MANUFACTURER. FERTILIZER SHALL BE STORED IN A WEATHERPROOF PLACE SO THAT IT CAN BE KEPT DRY PRIOR TO USE.
2. FOR THE PURPOSE OF BIDDING, ASSUME THAT FERTILIZER SHALL BE 10% NITROGEN, 6% PHOSPHORUS AND 4% POTASSIUM BY WEIGHT. A FERTILIZER SHOULD NOT BE SELECTED WITHOUT A SOIL TEST PERFORMED BY A CERTIFIED SOIL LABORATORY.

F. PLANT MATERIAL
1. ALL PLANTS SHALL IN ALL CASES CONFORM TO THE REQUIREMENTS OF THE 'AMERICAN STANDARD FOR NURSERY STOCK' (ANSI Z60.1, LATEST EDITION, AS PUBLISHED BY THE AMERICAN NURSERY & LANDSCAPE ASSOCIATION)
2. IN ALL CASES, BOTANICAL NAMES SHALL TAKE PRECEDENCE OVER COMMON NAMES FOR ANY AND ALL PLANT MATERIAL.
3. PLANTS SHALL BE LEGIBLY TAGGED WITH THE PROPER NAME AND SIZE. TAGS ARE TO REMAIN ON AT LEAST ONE PLANT OF EACH SPECIES FOR VERIFICATION PURPOSES DURING THE FINAL INSPECTION.
4. TREES WITH BRUISES OR SUN SCALDS, DISFIGURATION OR FRESH CUTS OF LIMBS OVER 1/4", WHICH HAVE NOT BEEN COMPLETELY CALLED, SHALL BE REJECTED. PLANTS SHALL NOT BE BOUND WITH WIRE OR ROPE AT ANY TIME SO AS TO DAMAGE THE BARK OR BREAK BRANCHES.
5. ALL PLANTS SHALL BE TYPICAL OF THEIR SPECIES OR VARIETY AND SHALL HAVE A NORMAL HABIT OF GROWTH: WELL DEVELOPED BRANCHES, DENSELY FOLIATED, VIGOROUS ROOT SYSTEMS AND BE FREE OF DISEASE, INSECTS, PESTS, EGGS OR LARVAE.
6. CALIPER MEASUREMENTS OF NURSERY GROWN TREES SHALL BE TAKEN AT A POINT ON THE TRUNK SIX INCHES (6") ABOVE THE NATURAL GRADE FOR TREES UP TO AND INCLUDING A FOUR INCH (4") CALIPER SIZE. IF THE CALIPER AT SIX INCHES (6") ABOVE THE GROUND EXCEEDS FOUR INCHES (4") IN CALIPER, THE CALIPER SHOULD BE MEASURED AT A POINT 12" ABOVE THE NATURAL GRADE.
7. SHRUBS SHALL BE MEASURED TO THE AVERAGE HEIGHT OR SPREAD OF THE SHRUB, AND NOT TO THE LONGEST BRANCH.
8. TREES AND SHRUBS SHALL BE HANDLED WITH CARE BY THE ROOT BALL.

3. GENERAL WORK PROCEDURES
A. CONTRACTOR TO UTILIZE WORKMANLIKE INDUSTRY STANDARDS IN PERFORMING ALL LANDSCAPE CONSTRUCTION. THE SITE IS TO BE LEFT IN A CLEAN STATE AT THE END OF EACH WORKDAY. ALL DEBRIS, MATERIALS AND TOOLS SHALL BE PROPERLY STORED, STOCKPILED OR DISPOSED.
B. WASTE MATERIALS AND DEBRIS SHALL BE COMPLETELY DISPOSED OF AT THE CONTRACTOR'S EXPENSE. DEBRIS SHALL NOT BE BURIED, INCLUDING ORGANIC MATERIALS, BUT SHALL BE REMOVED COMPLETELY FROM THE SITE.

4. SITE PREPARATIONS
A. BEFORE AND DURING PRELIMINARY GRADING AND FINISHED GRADING, ALL WEEDS AND GRASSES SHALL BE DUG OUT BY THE ROOTS AND DISPOSED OF IN ACCORDANCE WITH GENERAL WORK PROCEDURES OUTLINED HEREIN.
B. ALL EXISTING TREES TO REMAIN SHALL BE PRUNED TO REMOVE ANY DAMAGED BRANCHES. THE ENTIRE LIMB OF ANY DAMAGED BRANCH SHALL BE CUT OFF AT THE TRUNK. CONTRACTOR SHALL ENSURE THAT CUTS ARE SMOOTH AND STRAIGHT. ANY EXPOSED ROOTS SHALL BE CUT BACK WITH CLEAN, SHARP TOOLS AND TOPSOIL SHALL BE PLACED AROUND THE REMAINDER OF THE ROOTS. EXISTING TREES SHALL BE MONITORED ON A REGULAR BASIS FOR ADDITIONAL ROOT OR BRANCH DAMAGE AS A RESULT OF CONSTRUCTION. ROOTS SHALL NOT BE LEFT EXPOSED FOR MORE THAN ONE (1) DAY. CONTRACTOR SHALL WATER EXISTING TREES AS NEEDED TO PREVENT SHOCK OR DRY.

C. CONTRACTOR SHALL ARRANGE TO HAVE A UTILITY STAKE-OUT TO LOCATE ALL UNDERGROUND UTILITIES PRIOR TO INSTALLATION OF ANY LANDSCAPE MATERIAL. UTILITY COMPANIES SHALL BE CONTACTED THREE (3) DAYS PRIOR TO THE BEGINNING OF WORK.
D. CONTRACTOR SHALL BE RESPONSIBLE FOR THE PROTECTION OF ALL EXISTING TREES TO REMAIN. A TREE PROTECTION ZONE SHALL BE ESTABLISHED AT THE DRIP LINE OR 15 FEET FROM THE TRUNK OR AT THE LIMIT OF CONSTRUCTION DISTURBANCE, WHICHEVER IS GREATER. LOCAL STANDARDS THAT MAY REQUIRE A MORE STRICT TREE PROTECTION ZONE SHALL BE HONORED.

A. FORTY-EIGHT INCH (48") HIGH WOODEN SNOW FENCE OR ORANGE COLORED HIGH-DENSITY 'YIP-FENCE', OR APPROVED EQUAL, MOUNTED ON STEEL POSTS SHALL BE PLACED ALONG THE BOUNDARY OF THE TREE PROTECTION ZONE. POSTS SHALL BE LOCATED AT A MAXIMUM OF EIGHT FEET (8') ON CENTER OR AS INDICATED WITHIN THE TREE PROTECTION DETAIL.
C. WHEN THE TREE PROTECTION FENCING HAS BEEN INSTALLED, IT SHALL BE INSPECTED BY THE APPROVING AGENCY PRIOR TO DEMOLITION GRADING, TREE CLEARING OR ANY OTHER CONSTRUCTION. THE FENCING ALONG THE TREE PROTECTION ZONE SHALL BE REGULARLY INSPECTED BY THE LANDSCAPE CONTRACTOR AND MAINTAINED UNTIL ALL CONSTRUCTION ACTIVITY HAS BEEN COMPLETED.
D. AT NO TIME SHALL MACHINERY, DEBRIS, FALLEN TREES OR OTHER MATERIALS BE PLACED, STOCKPILED OR LEFT STANDING IN THE TREE PROTECTION ZONE.

5. SOIL MODIFICATIONS
A. CONTRACTOR SHALL ATAIN A SOIL TEST FOR ALL AREAS OF THE SITE PRIOR TO CONDUCTING ANY PLANTING. SOIL TESTS SHALL BE PERFORMED BY A CERTIFIED SOIL LABORATORY.
B. LANDSCAPE CONTRACTOR SHALL REPORT ANY SOIL OR DRAINAGE CONDITIONS CONSIDERED DETRIMENTAL TO THE GROWTH OF PLANT MATERIAL. SOIL MODIFICATIONS, AS SPECIFIED HEREIN, MAY NEED TO BE CONDUCTED BY THE LANDSCAPE CONTRACTOR DEPENDING ON SITE CONDITIONS.
C. THE FOLLOWING AMENDMENTS AND QUANTITIES ARE APPROXIMATE AND ARE FOR BIDDING PURPOSES ONLY. COMPOSITION OF AMENDMENTS SHOULD BE REVISED DEPENDING ON THE OUTCOME OF A TOPSOIL ANALYSIS PERFORMED BY A CERTIFIED SOIL LABORATORY.
1. TO INCREASE A SANDY SOIL'S ABILITY TO RETAIN WATER AND NUTRIENTS, THOROUGHLY TILL ORGANIC MATTER INTO THE TOP 6"-12". USE COMPOSTED BARK, COMPOSTED LEAF MULCH OR PEAT MOSS. ALL PRODUCTS SHOULD BE COMPOSTED TO A DARK COLOR AND BE FREE OF PIECES WITH IDENTIFIABLE LEAF OR WOOD STRUCTURE. AVOID MATERIAL WITH A PH HIGHER THAN 7.5.
2. TO INCREASE DRAINAGE, MODIFY HEAVY CLAY OR SILT (MORE THAN 40% CLAY OR SILT) BY ADDING COMPOSTED PINE BARK (UP TO 30% BY VOLUME) AND/OR AGRICULTURAL GYPSUM. COARSE SAND MAY BE USED IF ENOUGH IS ADDED TO BRING THE SAND CONTENT TO MORE THAN 60% OF THE TOTAL MIX. SUBSURFACE DRAINAGE LINES MAY NEED TO BE ADDED TO INCREASE DRAINAGE.
3. MODIFY EXTREMELY SANDY SOILS (MORE THAN 85%) BY ADDING ORGANIC MATTER AND/OR DRY, SHREDDED CLAY LOAM UP TO 30% OF THE TOTAL MIX.

7. FINISHED GRADING
A. UNLESS OTHERWISE CONTRACTED, THE LANDSCAPE CONTRACTOR SHALL BE RESPONSIBLE FOR THE INSTALLATION OF TOPSOIL AND THE ESTABLISHMENT OF FINE GRADING WITHIN THE DISTURBANCE AREA OF THE SITE.
B. LANDSCAPE CONTRACTOR SHALL VERIFY THAT SUBGRADE FOR INSTALLATION OF TOPSOIL HAS BEEN ESTABLISHED. THE SUBGRADE OF THE SITE MUST MEET THE FINISHED GRADE LESS THE REQUIRED TOPSOIL THICKNESS (1").
C. ALL LAWN AND PLANTING AREAS SHALL BE GRADED TO A SMOOTH, EVEN AND UNIFORM PLANE WITH NO ABRUPT CHANGE OF SURFACE AS DEPICTED WITHIN THIS SET OF CONSTRUCTION PLANS, UNLESS OTHERWISE DIRECTED BY THE PROJECT ENGINEER OR LANDSCAPE ARCHITECT.
D. ALL PLANTING AREAS SHALL BE GRADED AND MAINTAINED TO ALLOW FREE FLOW OF SURFACE WATER IN AND AROUND THE PLANTING BEDS. STANDING WATER SHALL NOT BE PERMITTED IN PLANTING BEDS.

8. TOPSOILING
A. CONTRACTOR SHALL FURNISH TO THE APPROVING AGENCY AN ANALYSIS OF BOTH IMPORTED AND ON-SITE TOPSOIL TO BE UTILIZED IN ALL PLANTING AREAS. PH AND NUTRIENT LEVELS MAY NEED TO BE ADJUSTED THROUGH SOIL MODIFICATIONS AS NEEDED TO ACHIEVE THE REQUIRED LEVELS AS SPECIFIED IN THE MATERIALS SECTION ABOVE.
D. ALL PLANTING AND LAWN AREAS ARE TO BE CULTIVATED TO A DEPTH OF SIX INCHES (6"). ALL DEBRIS EXPOSED FROM EXCAVATION AND CULTIVATION SHALL BE DISPOSED OF IN ACCORDANCE WITH GENERAL WORK PROCEDURES SECTION ABOVE. THE FOLLOWING SHALL BE TILLED INTO THE TOP FOUR INCHES (4") IN TWO DIRECTIONS (QUANTITIES BASED ON A 1,000 SQUARE FOOT AREA).
1. 20 POUNDS 'GROW POWER' OR APPROVED EQUAL.
2. 20 POUNDS NITRO-FORM (COURSE) 30-0-40 BLUE CHIP.
E. THE SPREADING OF TOPSOIL SHALL NOT BE CONDUCTED UNDER MUDDY OR FROZEN CONDITIONS.

9. PLANTING
A. INSURE THAT IT IS FEASIBLE. PLANT MATERIAL SHALL BE PLANTED ON THE DAY OF DELIVERY. IN THE EVENT THAT THIS IS NOT POSSIBLE, LANDSCAPE CONTRACTOR SHALL PROTECT UNINSTALLED PLANT MATERIAL. PLANTS SHALL NOT REMAIN UNPLANTED FOR LONGER THAN A THREE DAY PERIOD AFTER DELIVERY. PLANTS THAT WILL NOT BE PLANTED FOR A PERIOD OF TIME GREATER THAN THREE DAYS SHALL BE HEALED IN WITH TOPSOIL OR MULCH TO HELP PRESERVE ROOT MOISTURE.
B. PLANTING OPERATIONS SHALL BE PERFORMED DURING PERIODS WITHIN THE PLANTING SEASON WHEN WEATHER AND SOIL CONDITIONS ARE SUITABLE AND IN ACCORDANCE WITH ACCEPTED LOCAL PRACTICE. PLANTS SHALL NOT BE INSTALLED IN TOPSOIL THAT IS IN A MUDDY OR FROZEN CONDITION.
C. ANY INJURED ROOTS OR BRANCHES SHALL BE PRUNED TO MAKE CLEAN-CUT ENDS PRIOR TO PLANTING UTILIZING CLEAN, SHARP TOOLS. ONLY INJURED OR DISEASED BRANCHING SHALL BE REMOVED.
D. ALL PLANTING CONTAINERS AND NON-BIODEGRADABLE MATERIALS SHALL BE REMOVED FROM ROOT BALLS DURING PLANTING. NATURAL FIBER BURLAP MUST BE CUT FROM AROUND THE TRUNK OF THE TREE AND FOLDED DOWN AGAINST THE ROOT BALL PRIOR TO BACKFILLING.
E. POSITION TREES AND SHRUBS AT THEIR INTENDED LOCATIONS AS PER THE PLANS AND SECURE THE APPROVAL OF THE LANDSCAPE ARCHITECT PRIOR TO EXCAVATING PITS, MAKING NECESSARY ADJUSTMENTS AS DIRECTED.
F. PRIOR TO THE ISSUANCE OF ANY CERTIFICATE OF OCCUPANCY, THE PROPOSED LANDSCAPE, AS SHOWN ON THE APPROVED LANDSCAPE PLAN, MUST BE INSTALLED, INSPECTED AND APPROVED BY THE APPROVING AGENCY. THE APPROVING AGENCY SHALL TAKE INTO ACCOUNT SEASONAL CONSIDERATIONS IN THIS REGARD AS FOLLOWS: THE PLANTING OF TREES, SHRUBS, VINES OR GROUND COVER SHALL OCCUR ONLY DURING THE FOLLOWING PLANTING SEASONS:
1. PLANTS: MARCH 15 TO DECEMBER 15
2. LAWN: MARCH 15 TO JUNE 15 OR SEPT. 1 TO DECEMBER 1
G. PLANTINGS REQUIRED FOR A CERTIFICATE OF OCCUPANCY SHALL BE PROVIDED DURING THE NEXT APPROPRIATE SEASON AT THE MUNICIPALITY'S DISCRETION. CONTRACTOR SHOULD CONTACT APPROVING AGENCY FOR POTENTIAL SUBSTITUTIONS.
H. FURTHERMORE, THE FOLLOWING TREE VARIETIES ARE UNUSUALLY SUSCEPTIBLE TO WINTER DAMAGE, WITH TRANSIENT SHOCK AND THE SEASONAL LACK OF WATER AVAILABILITY. THE RISK OF PLANT DEATH IS GREATLY INCREASED. IT IS NOT RECOMMENDED THAT THESE SPECIES BE PLANTED DURING THE FINAL PLANTING SEASON:
ACER RUBRUM PLATANUS X ACERIFOLIA
BETULA PULCHRA PRUNUS VARIETIES
CARPINUS VARIETIES PRUNUS VARIETIES
CRATAEGUS VARIETIES PYRUS VARIETIES
KOELERIA VARIETIES QUERCUS VARIETIES
LIQUIDAMBER STRYACIFLUA TILIA TOMENTOSA
LIRIODENDRON TULIPIFERA ZELKOVA VARIETIES

I. PLANTING PITS SHALL BE DUG WITH LEVEL BOTTOMS, WITH THE WIDTH TWICE THE DIAMETER OF ROOT BALL. THE ROOT BALL SHALL REST ON UNDISTURBED GRADE. EACH PLANT PIT SHALL BE BACKFILLED IN LAYERS WITH THE FOLLOWING PREPARED SOIL MIXED THOROUGHLY:
+ 1 PART PEAT MOSS
+ 1 PART COMPOSTED COV MANURE BY VOLUME
+ 3 PARTS TOPSOIL BY VOLUME
+ 21 GRAMS AGRIFORM PLANTING TABLETS (OR APPROVED EQUAL) AS FOLLOWS:
A) 2 TABLETS PER 1 GALLON PLANT
B) 3 TABLETS PER 3 GALLON PLANT
C) 4 TABLETS PER 15 GALLON PLANT
D) LARGER PLANTS: 2 TABLETS PER 1/4" CALIPER OF TRUNK
J. FILL PREPARED SOIL AROUND BALL OF PLANT HALF-WAY AND INSERT PLANT TABLETS. COMPLETE BACKFILL AND WATER THOROUGHLY.
K. ALL PLANTS SHALL BE PLANTED SO THAT THE TOP OF THE ROOT BALL, THE POINT AT WHICH THE ROOT FLARE BEGINS, IS SET AT GROUND LEVEL AND IN THE CENTER OF THE PIT. NO SOIL IS TO BE PLACED DIRECTLY ON TOP OF THE ROOT BALL.
L. ALL PROPOSED TREES DIRECTLY ADJACENT TO WALKWAYS OR DRIVEWAYS SHALL BE PRUNED AND MAINTAINED TO A MINIMUM BRANCHING HEIGHT OF 7' FROM GRADE.
M. GROUND COVER AREAS SHALL RECEIVE A 1/2" LAYER OF HUMUS RAKED INTO THE TOP 1" OF PREPARED SOIL PRIOR TO PLANTING. ALL GROUND COVER AREAS SHALL BE WEEDED AND TREATED WITH A PRE-EMERGENT CHEMICAL AS PER MANUFACTURER'S RECOMMENDATION.
N. NO PLANT, EXCEPT GROUND COVERS, GRASSES OR VINES, SHALL BE PLANTED LESS THAN TWO FEET (2') FROM EXISTING STRUCTURES AND SIDEWALKS.
O. ALL PLANTING AREAS AND PLANTING PITS SHALL BE MULCHED AS SPECIFIED HEREIN TO FILL THE ENTIRE BED AREA OR SAUCER. NO MULCH IS TO TOUCH THE TRUNK OF THE TREE OR SHRUB.
P. ALL PLANTING AREAS SHALL BE WATERED IMMEDIATELY UPON INSTALLATION IN ACCORDANCE WITH THE WATERING SPECIFICATIONS AS LISTED HEREIN.

10. TRANSPLANTING (WHEN REQUIRED)
A. ALL TRANSPLANTS SHALL BE DUG WITH INTACT ROOT BALLS CAPABLE OF SUSTAINING THE PLANT.
B. IF PLANTS ARE TO BE STOCKPILED BEFORE REPLANTING, THEY SHALL BE HEALED IN WITH MULCH OR SOIL, ADEQUATELY WATERED AND PROTECTED FROM EXTREME HEAT, SUN, AND WIND.
C. PLANTS SHALL NOT BE DUG FOR TRANSPLANTING BETWEEN APRIL 10 AND JUNE 30.
D. UPON REPLANTING, BACKFILL SOIL SHALL BE AMENDED WITH FERTILIZER AND ROOT GROWTH HORMONE.
E. TRANSPLANTS SHALL BE GUARANTEED FOR THE LENGTH OF THE GUARANTEE PERIOD SPECIFIED HEREIN.
F. IF TRANSPLANTS DIE, SHRUBS AND TREES LESS THAN SIX INCHES (6") DBH SHALL BE REPLACED IN KIND. TREES GREATER THAN SIX INCHES (6") DBH MAY BE REQUIRED TO BE REPLACED IN ACCORDANCE WITH THE MUNICIPALITY'S TREE REPLACEMENT GUIDELINES.

11. WATERING
A. NEW PLANTINGS OR LAWN AREAS SHALL BE ADEQUATELY IRRIGATED BEGINNING IMMEDIATELY AFTER PLANTING. WATER SHALL BE APPLIED TO EACH TREE AND SHRUB IN SUCH MANNER AS NOT TO DISTURB BACKFILL AND TO THE EXTENT THAT ALL MATERIALS IN THE PLANTING HOLES ARE THOROUGHLY SATURATED. WATERING SHALL CONTINUE AT LEAST UNTIL PLANTS ARE ESTABLISHED.
B. SITE OWNER SHALL PROVIDE WATER IF AVAILABLE ON SITE AT TIME OF PLANTING. IF WATER IS NOT AVAILABLE ON SITE, CONTRACTOR SHALL SUPPLY ALL NECESSARY WATER. THE USE OF WATERING BAGS IS RECOMMENDED FOR ALL NEWLY PLANTED TREES.
C. IF AN IRRIGATION SYSTEM HAS BEEN INSTALLED ON THE SITE, IT SHALL BE USED TO WATER PROPOSED PLANT MATERIAL, BUT ANY FAILURE OF THE SYSTEM DOES NOT ELIMINATE THE CONTRACTOR'S RESPONSIBILITY OF MAINTAINING THE DESIRED MOISTURE LEVEL FOR VIGOROUS, HEALTHY GROWTH.

12. GUARANTEE
A. THE LANDSCAPE CONTRACTOR SHALL GUARANTEE ALL PLANTS FOR A PERIOD OF ONE (1) YEAR FROM APPROVAL OF LANDSCAPE INSTALLATION BY THE APPROVING AGENCY. CONTRACTOR SHALL GUARANTEE THE OWNER WITH A MAINTENANCE BOND FOR TEN PERCENT (10%) OF THE VALUE OF THE LANDSCAPE INSTALLATION WHICH WILL BE RELEASED AT THE CONCLUSION OF THE GUARANTEE PERIOD AND WHEN A FINAL INSPECTION HAS BEEN COMPLETED AND APPROVED BY THE OWNER OR AUTHORIZED REPRESENTATIVE.
B. ANY DEAD OR DYING PLANT MATERIAL SHALL BE REPLACED FOR THE LENGTH OF THE GUARANTEE PERIOD. REPLACEMENT OF PLANT MATERIAL SHALL BE CONDUCTED AT THE FIRST SUCCEEDING PLANTING SEASON. ANY DEBRIS SHALL BE DISPOSED OF OFF-SITE, WITHOUT EXCEPTION.
C. TREES AND SHRUBS SHALL BE MAINTAINED BY THE CONTRACTOR DURING CONSTRUCTION AND THROUGHOUT THE 90 DAY MAINTENANCE PERIOD AS SPECIFIED HEREIN. CULTIVATION, WEEDING, WATERING AND THE PREVENTATIVE TREATMENTS SHALL BE PERFORMED AS NECESSARY TO KEEP PLANT MATERIAL IN GOOD CONDITION AND FREE OF INSECTS AND DISEASE.
D. LAWNS SHALL BE MAINTAINED THROUGH WATERING, FERTILIZING, WEEDING, MOWING, TRIMMING AND OTHER OPERATIONS SUCH AS ROLLING, REGARDING AND REPLANTING AS REQUIRED TO ESTABLISH A SMOOTH, ACCEPTABLE LAWN, FREE OF ERODED OR BARE AREAS.

13. CLEANUP
A. UPON THE COMPLETION OF ALL LANDSCAPE INSTALLATION AND BEFORE THE FINAL ACCEPTANCE, THE CONTRACTOR SHALL REMOVE ALL UNUSED MATERIALS, EQUIPMENT AND DEBRIS FROM THE SITE. ALL PAVED AREAS ARE TO BE CLEANED.
B. THE SITE SHALL BE CLEANED AND LEFT IN A NEAT AND ACCEPTABLE CONDITION AS APPROVED BY THE OWNER OR AUTHORIZED REPRESENTATIVE.

14. INSPECTION
A. THE CONTRACTOR SHALL BE RESPONSIBLE FOR THE PROTECTION OF ALL EXISTING TREES TO REMAIN. A TREE PROTECTION ZONE SHALL BE ESTABLISHED AT THE DRIP LINE OR 15 FEET FROM THE TRUNK OR AT THE LIMIT OF CONSTRUCTION DISTURBANCE, WHICHEVER IS GREATER. LOCAL STANDARDS THAT MAY REQUIRE A MORE STRICT TREE PROTECTION ZONE SHALL BE HONORED.
B. FORTY-EIGHT INCH (48") HIGH WOODEN SNOW FENCE OR ORANGE COLORED HIGH-DENSITY 'YIP-FENCE', OR APPROVED EQUAL, MOUNTED ON STEEL POSTS SHALL BE PLACED ALONG THE BOUNDARY OF THE TREE PROTECTION ZONE. POSTS SHALL BE LOCATED AT A MAXIMUM OF EIGHT FEET (8') ON CENTER OR AS INDICATED WITHIN THE TREE PROTECTION DETAIL.
C. WHEN THE TREE PROTECTION FENCING HAS BEEN INSTALLED, IT SHALL BE INSPECTED BY THE APPROVING AGENCY PRIOR TO DEMOLITION GRADING, TREE CLEARING OR ANY OTHER CONSTRUCTION. THE FENCING ALONG THE TREE PROTECTION ZONE SHALL BE REGULARLY INSPECTED BY THE LANDSCAPE CONTRACTOR AND MAINTAINED UNTIL ALL CONSTRUCTION ACTIVITY HAS BEEN COMPLETED.
D. AT NO TIME SHALL MACHINERY, DEBRIS, FALLEN TREES OR OTHER MATERIALS BE PLACED, STOCKPILED OR LEFT STANDING IN THE TREE PROTECTION ZONE.

15. SOIL MODIFICATIONS
A. CONTRACTOR SHALL ATAIN A SOIL TEST FOR ALL AREAS OF THE SITE PRIOR TO CONDUCTING ANY PLANTING. SOIL TESTS SHALL BE PERFORMED BY A CERTIFIED SOIL LABORATORY.
B. LANDSCAPE CONTRACTOR SHALL REPORT ANY SOIL OR DRAINAGE CONDITIONS CONSIDERED DETRIMENTAL TO THE GROWTH OF PLANT MATERIAL. SOIL MODIFICATIONS, AS SPECIFIED HEREIN, MAY NEED TO BE CONDUCTED BY THE LANDSCAPE CONTRACTOR DEPENDING ON SITE CONDITIONS.
C. THE FOLLOWING AMENDMENTS AND QUANTITIES ARE APPROXIMATE AND ARE FOR BIDDING PURPOSES ONLY. COMPOSITION OF AMENDMENTS SHOULD BE REVISED DEPENDING ON THE OUTCOME OF A TOPSOIL ANALYSIS PERFORMED BY A CERTIFIED SOIL LABORATORY.
1. TO INCREASE A SANDY SOIL'S ABILITY TO RETAIN WATER AND NUTRIENTS, THOROUGHLY TILL ORGANIC MATTER INTO THE TOP 6"-12". USE COMPOSTED BARK, COMPOSTED LEAF MULCH OR PEAT MOSS. ALL PRODUCTS SHOULD BE COMPOSTED TO A DARK COLOR AND BE FREE OF PIECES WITH IDENTIFIABLE LEAF OR WOOD STRUCTURE. AVOID MATERIAL WITH A PH HIGHER THAN 7.5.
2. TO INCREASE DRAINAGE, MODIFY HEAVY CLAY OR SILT (MORE THAN 40% CLAY OR SILT) BY ADDING COMPOSTED PINE BARK (UP TO 30% BY VOLUME) AND/OR AGRICULTURAL GYPSUM. COARSE SAND MAY BE USED IF ENOUGH IS ADDED TO BRING THE SAND CONTENT TO MORE THAN 60% OF THE TOTAL MIX. SUBSURFACE DRAINAGE LINES MAY NEED TO BE ADDED TO INCREASE DRAINAGE.
3. MODIFY EXTREMELY SANDY SOILS (MORE THAN 85%) BY ADDING ORGANIC MATTER AND/OR DRY, SHREDDED CLAY LOAM UP TO 30% OF THE TOTAL MIX.

17. FINISHED GRADING
A. UNLESS OTHERWISE CONTRACTED, THE LANDSCAPE CONTRACTOR SHALL BE RESPONSIBLE FOR THE INSTALLATION OF TOPSOIL AND THE ESTABLISHMENT OF FINE GRADING WITHIN THE DISTURBANCE AREA OF THE SITE.
B. LANDSCAPE CONTRACTOR SHALL VERIFY THAT SUBGRADE FOR INSTALLATION OF TOPSOIL HAS BEEN ESTABLISHED. THE SUBGRADE OF THE SITE MUST MEET THE FINISHED GRADE LESS THE REQUIRED TOPSOIL THICKNESS (1").
C. ALL LAWN AND PLANTING AREAS SHALL BE GRADED TO A SMOOTH, EVEN AND UNIFORM PLANE WITH NO ABRUPT CHANGE OF SURFACE AS DEPICTED WITHIN THIS SET OF CONSTRUCTION PLANS, UNLESS OTHERWISE DIRECTED BY THE PROJECT ENGINEER OR LANDSCAPE ARCHITECT.
D. ALL PLANTING AREAS SHALL BE GRADED AND MAINTAINED TO ALLOW FREE FLOW OF SURFACE WATER IN AND AROUND THE PLANTING BEDS. STANDING WATER SHALL NOT BE PERMITTED IN PLANTING BEDS.

18. TOPSOILING
A. CONTRACTOR SHALL FURNISH TO THE APPROVING AGENCY AN ANALYSIS OF BOTH IMPORTED AND ON-SITE TOPSOIL TO BE UTILIZED IN ALL PLANTING AREAS. PH AND NUTRIENT LEVELS MAY NEED TO BE ADJUSTED THROUGH SOIL MODIFICATIONS AS NEEDED TO ACHIEVE THE REQUIRED LEVELS AS SPECIFIED IN THE MATERIALS SECTION ABOVE.
D. ALL PLANTING AND LAWN AREAS ARE TO BE CULTIVATED TO A DEPTH OF SIX INCHES (6"). ALL DEBRIS EXPOSED FROM EXCAVATION AND CULTIVATION SHALL BE DISPOSED OF IN ACCORDANCE WITH GENERAL WORK PROCEDURES SECTION ABOVE. THE FOLLOWING SHALL BE TILLED INTO THE TOP FOUR INCHES (4") IN TWO DIRECTIONS (QUANTITIES BASED ON A 1,000 SQUARE FOOT AREA).
1. 20 POUNDS 'GROW POWER' OR APPROVED EQUAL.
2. 20 POUNDS NITRO-FORM (COURSE) 30-0-40 BLUE CHIP.
E. THE SPREADING OF TOPSOIL SHALL NOT BE CONDUCTED UNDER MUDDY OR FROZEN CONDITIONS.

19. PLANTING
A. INSURE THAT IT IS FEASIBLE. PLANT MATERIAL SHALL BE PLANTED ON THE DAY OF DELIVERY. IN THE EVENT THAT THIS IS NOT POSSIBLE, LANDSCAPE CONTRACTOR SHALL PROTECT UNINSTALLED PLANT MATERIAL. PLANTS SHALL NOT REMAIN UNPLANTED FOR LONGER THAN A THREE DAY PERIOD AFTER DELIVERY. PLANTS THAT WILL NOT BE PLANTED FOR A PERIOD OF TIME GREATER THAN THREE DAYS SHALL BE HEALED IN WITH TOPSOIL OR MULCH TO HELP PRESERVE ROOT MOISTURE.
B. PLANTING OPERATIONS SHALL BE PERFORMED DURING PERIODS WITHIN THE PLANTING SEASON WHEN WEATHER AND SOIL CONDITIONS ARE SUITABLE AND IN ACCORDANCE WITH ACCEPTED LOCAL PRACTICE. PLANTS SHALL NOT BE INSTALLED IN TOPSOIL THAT IS IN A MUDDY OR FROZEN CONDITION.
C. ANY INJURED ROOTS OR BRANCHES SHALL BE PRUNED TO MAKE CLEAN-CUT ENDS PRIOR TO PLANTING UTILIZING CLEAN, SHARP TOOLS. ONLY INJURED OR DISEASED BRANCHING SHALL BE REMOVED.
D. ALL PLANTING CONTAINERS AND NON-BIODEGRADABLE MATERIALS SHALL BE REMOVED FROM ROOT BALLS DURING PLANTING. NATURAL FIBER BURLAP MUST BE CUT FROM AROUND THE TRUNK OF THE TREE AND FOLDED DOWN AGAINST THE ROOT BALL PRIOR TO BACKFILLING.
E. POSITION TREES AND SHRUBS AT THEIR INTENDED LOCATIONS AS PER THE PLANS AND SECURE THE APPROVAL OF THE LANDSCAPE ARCHITECT PRIOR TO EXCAVATING PITS, MAKING NECESSARY ADJUSTMENTS AS DIRECTED.
F. PRIOR TO THE ISSUANCE OF ANY CERTIFICATE OF OCCUPANCY, THE PROPOSED LANDSCAPE, AS SHOWN ON THE APPROVED LANDSCAPE PLAN, MUST BE INSTALLED, INSPECTED AND APPROVED BY THE APPROVING AGENCY. THE APPROVING AGENCY SHALL TAKE INTO ACCOUNT SEASONAL CONSIDERATIONS IN THIS REGARD AS FOLLOWS: THE PLANTING OF TREES, SHRUBS, VINES OR GROUND COVER SHALL OCCUR ONLY DURING THE FOLLOWING PLANTING SEASONS:
1. PLANTS: MARCH 15 TO DECEMBER 15
2. LAWN: MARCH 15 TO JUNE 15 OR SEPT. 1 TO DECEMBER 1
G. PLANTINGS REQUIRED FOR A CERTIFICATE OF OCCUPANCY SHALL BE PROVIDED DURING THE NEXT APPROPRIATE SEASON AT THE MUNICIPALITY'S DISCRETION. CONTRACTOR SHOULD CONTACT APPROVING AGENCY FOR POTENTIAL SUBSTITUTIONS.
H. FURTHERMORE, THE FOLLOWING TREE VARIETIES ARE UNUSUALLY SUSCEPTIBLE TO WINTER DAMAGE, WITH TRANSIENT SHOCK AND THE SEASONAL LACK OF WATER AVAILABILITY. THE RISK OF PLANT DEATH IS GREATLY INCREASED. IT IS NOT RECOMMENDED THAT THESE SPECIES BE PLANTED DURING THE FINAL PLANTING SEASON:
ACER RUBRUM PLATANUS X ACERIFOLIA
BETULA PULCHRA PRUNUS VARIETIES
CARPINUS VARIETIES PRUNUS VARIETIES
CRATAEGUS VARIETIES PYRUS VARIETIES
KOELERIA VARIETIES QUERCUS VARIETIES
LIQUIDAMBER STRYACIFLUA TILIA TOMENTOSA
LIRIODENDRON TULIPIFERA ZELKOVA VARIETIES

I. PLANTING PITS SHALL BE DUG WITH LEVEL BOTTOMS, WITH THE WIDTH TWICE THE DIAMETER OF ROOT BALL. THE ROOT BALL SHALL REST ON UNDISTURBED GRADE. EACH PLANT PIT SHALL BE BACKFILLED IN LAYERS WITH THE FOLLOWING PREPARED SOIL MIXED THOROUGHLY:
+ 1 PART PEAT MOSS
+ 1 PART COMPOSTED COV MANURE BY VOLUME
+ 3 PARTS TOPSOIL BY VOLUME
+ 21 GRAMS AGRIFORM PLANTING TABLETS (OR APPROVED EQUAL) AS FOLLOWS:
A) 2 TABLETS PER 1 GALLON PLANT
B) 3 TABLETS PER 3 GALLON PLANT
C) 4 TABLETS PER 15 GALLON PLANT
D) LARGER PLANTS: 2 TABLETS PER 1/4" CALIPER OF TRUNK
J. FILL PREPARED SOIL AROUND BALL OF PLANT HALF-WAY AND INSERT PLANT TABLETS. COMPLETE BACKFILL AND WATER THOROUGHLY.
K. ALL PLANTS SHALL BE PLANTED SO THAT THE TOP OF THE ROOT BALL, THE POINT AT WHICH THE ROOT FLARE BEGINS, IS SET AT GROUND LEVEL AND IN THE CENTER OF THE PIT. NO SOIL IS TO BE PLACED DIRECTLY ON TOP OF THE ROOT BALL.
L. ALL PROPOSED TREES DIRECTLY ADJACENT TO WALKWAYS OR DRIVEWAYS SHALL BE PRUNED AND MAINTAINED TO A MINIMUM BRANCHING HEIGHT OF 7' FROM GRADE.
M. GROUND COVER AREAS SHALL RECEIVE A 1/2" LAYER OF HUMUS RAKED INTO THE TOP 1" OF PREPARED SOIL PRIOR TO PLANTING. ALL GROUND COVER AREAS SHALL BE WEEDED AND TREATED WITH A PRE-EMERGENT CHEMICAL AS PER MANUFACTURER'S RECOMMENDATION.
N. NO PLANT, EXCEPT GROUND COVERS, GRASSES OR VINES, SHALL BE PLANTED LESS THAN TWO FEET (2') FROM EXISTING STRUCTURES AND SIDEWALKS.
O. ALL PLANTING AREAS AND PLANTING PITS SHALL BE MULCHED AS SPECIFIED HEREIN TO FILL THE ENTIRE BED AREA OR SAUCER. NO MULCH IS TO TOUCH THE TRUNK OF THE TREE OR SHRUB.
P. ALL PLANTING AREAS SHALL BE WATERED IMMEDIATELY UPON INSTALLATION IN ACCORDANCE WITH THE WATERING SPECIFICATIONS AS LISTED HEREIN.

20. TRANSPLANTING (WHEN REQUIRED)
A. ALL TRANSPLANTS SHALL BE DUG WITH INTACT ROOT BALLS CAPABLE OF SUSTAINING THE PLANT.
B. IF PLANTS ARE TO BE STOCKPILED BEFORE REPLANTING, THEY SHALL BE HEALED IN WITH MULCH OR SOIL, ADEQUATELY WATERED AND PROTECTED FROM EXTREME HEAT, SUN, AND WIND.
C. PLANTS SHALL NOT BE DUG FOR TRANSPLANTING BETWEEN APRIL 10 AND JUNE 30.
D. UPON REPLANTING, BACKFILL SOIL SHALL BE AMENDED WITH FERTILIZER AND ROOT GROWTH HORMONE.
E. TRANSPLANTS SHALL BE GUARANTEED FOR THE LENGTH OF THE GUARANTEE PERIOD SPECIFIED HEREIN.
F. IF TRANSPLANTS DIE, SHRUBS AND TREES LESS THAN SIX INCHES (6") DBH SHALL BE REPLACED IN KIND. TREES GREATER THAN SIX INCHES (6") DBH MAY BE REQUIRED TO BE REPLACED IN ACCORDANCE WITH THE MUNICIPALITY'S TREE REPLACEMENT GUIDELINES.

21. WATERING
A. NEW PLANTINGS OR LAWN AREAS SHALL BE ADEQUATELY IRRIGATED BEGINNING IMMEDIATELY AFTER PLANTING. WATER SHALL BE APPLIED TO EACH TREE AND SHRUB IN SUCH MANNER AS NOT TO DISTURB BACKFILL AND TO THE EXTENT THAT ALL MATERIALS IN THE PLANTING HOLES ARE THOROUGHLY SATURATED. WATERING SHALL CONTINUE AT LEAST UNTIL PLANTS ARE ESTABLISHED.
B. SITE OWNER SHALL PROVIDE WATER IF AVAILABLE ON SITE AT TIME OF PLANTING. IF WATER IS NOT AVAILABLE ON SITE, CONTRACTOR SHALL SUPPLY ALL NECESSARY WATER. THE USE OF WATERING BAGS IS RECOMMENDED FOR ALL NEWLY PLANTED TREES.
C. IF AN IRRIGATION SYSTEM HAS BEEN INSTALLED ON THE SITE, IT SHALL BE USED TO WATER PROPOSED PLANT MATERIAL, BUT ANY FAILURE OF THE SYSTEM DOES NOT ELIMINATE THE CONTRACTOR'S RESPONSIBILITY OF MAINTAINING THE DESIRED MOISTURE LEVEL FOR VIGOROUS, HEALTHY GROWTH.

22. GUARANTEE
A. THE LANDSCAPE CONTRACTOR SHALL GUARANTEE ALL PLANTS FOR A PERIOD OF ONE (1) YEAR FROM APPROVAL OF LANDSCAPE INSTALLATION BY THE APPROVING AGENCY. CONTRACTOR SHALL GUARANTEE THE OWNER WITH A MAINTENANCE BOND FOR TEN PERCENT (10%) OF THE VALUE OF THE LANDSCAPE INSTALLATION WHICH WILL BE RELEASED AT THE CONCLUSION OF THE GUARANTEE PERIOD AND WHEN A FINAL INSPECTION HAS BEEN COMPLETED AND APPROVED BY THE OWNER OR AUTHORIZED REPRESENTATIVE.
B. ANY DEAD OR DYING PLANT MATERIAL SHALL BE REPLACED FOR THE LENGTH OF THE GUARANTEE PERIOD. REPLACEMENT OF PLANT MATERIAL SHALL BE CONDUCTED AT THE FIRST SUCCEEDING PLANTING SEASON. ANY DEBRIS SHALL BE DISPOSED OF OFF-SITE, WITHOUT EXCEPTION.
C. TREES AND SHRUBS SHALL BE MAINTAINED BY THE CONTRACTOR DURING CONSTRUCTION AND THROUGHOUT THE 90 DAY MAINTENANCE PERIOD AS SPECIFIED HEREIN. CULTIVATION, WEEDING, WATERING AND THE PREVENTATIVE TREATMENTS SHALL BE PERFORMED AS NECESSARY TO KEEP PLANT MATERIAL IN GOOD CONDITION AND FREE OF INSECTS AND DISEASE.
D. LAWNS SHALL BE MAINTAINED THROUGH WATERING, FERTILIZING, WEEDING, MOWING, TRIMMING AND OTHER OPERATIONS SUCH AS ROLLING, REGARDING AND REPLANTING AS REQUIRED TO ESTABLISH A SMOOTH, ACCEPTABLE LAWN, FREE OF ERODED OR BARE AREAS.

23. CLEANUP
A. UPON THE COMPLETION OF ALL LANDSCAPE INSTALLATION AND BEFORE THE FINAL ACCEPTANCE, THE CONTRACTOR SHALL REMOVE ALL UNUSED MATERIALS, EQUIPMENT AND DEBRIS FROM THE SITE. ALL PAVED AREAS ARE TO BE CLEANED.
B. THE SITE SHALL BE CLEANED AND LEFT IN A NEAT AND ACCEPTABLE CONDITION AS APPROVED BY THE OWNER OR AUTHORIZED REPRESENTATIVE.

24. INSPECTION
A. THE CONTRACTOR SHALL BE RESPONSIBLE FOR THE PROTECTION OF ALL EXISTING TREES TO REMAIN. A TREE PROTECTION ZONE SHALL BE ESTABLISHED AT THE DRIP LINE OR 15 FEET FROM THE TRUNK OR AT THE LIMIT OF CONSTRUCTION DISTURBANCE, WHICHEVER IS GREATER. LOCAL STANDARDS THAT MAY REQUIRE A MORE STRICT TREE PROTECTION ZONE SHALL BE HONORED.
B. FORTY-EIGHT INCH (48") HIGH WOODEN SNOW FENCE OR ORANGE COLORED HIGH-DENSITY 'YIP-FENCE', OR APPROVED EQUAL, MOUNTED ON STEEL POSTS SHALL BE PLACED ALONG THE BOUNDARY OF THE TREE PROTECTION ZONE. POSTS SHALL BE LOCATED AT A MAXIMUM OF EIGHT FEET (8') ON CENTER OR AS INDICATED WITHIN THE TREE PROTECTION DETAIL.
C. WHEN THE TREE PROTECTION FENCING HAS BEEN INSTALLED, IT SHALL BE INSPECTED BY THE APPROVING AGENCY PRIOR TO DEMOLITION GRADING, TREE CLEARING OR ANY OTHER CONSTRUCTION. THE FENCING ALONG THE TREE PROTECTION ZONE SHALL BE REGULARLY INSPECTED BY THE LANDSCAPE CONTRACTOR AND MAINTAINED UNTIL ALL CONSTRUCTION ACTIVITY HAS BEEN COMPLETED.
D. AT NO TIME SHALL MACHINERY, DEBRIS, FALLEN TREES OR OTHER MATERIALS BE PLACED, STOCKPILED OR LEFT STANDING IN THE TREE PROTECTION ZONE.


25. SOIL MODIFICATIONS
A. CONTRACTOR SHALL ATAIN A SOIL TEST FOR ALL AREAS OF THE SITE PRIOR TO CONDUCTING ANY PLANTING. SOIL TESTS SHALL BE PERFORMED BY A CERTIFIED SOIL LABORATORY.
B. LANDSCAPE CONTRACTOR SHALL REPORT ANY SOIL OR DRAINAGE CONDITIONS CONSIDERED DETRIMENTAL TO THE GROWTH OF PLANT MATERIAL. SOIL MODIFICATIONS, AS SPECIFIED HEREIN, MAY NEED TO BE CONDUCTED BY THE LANDSCAPE CONTRACTOR DEPENDING ON SITE CONDITIONS.
C. THE FOLLOWING AMENDMENTS AND QUANTITIES ARE APPROXIMATE AND ARE FOR BIDDING PURPOSES ONLY. COMPOSITION OF AMENDMENTS SHOULD BE REVISED DEPENDING ON THE OUTCOME OF A TOPSOIL ANALYSIS PERFORMED BY A CERTIFIED SOIL LABORATORY.
1. TO INCREASE A SANDY SOIL'S ABILITY TO RETAIN WATER AND NUTRIENTS, THOROUGHLY TILL ORGANIC MATTER INTO THE TOP 6"-12". USE COMPOSTED BARK, COMPOSTED LEAF MULCH OR PEAT MOSS. ALL PRODUCTS SHOULD BE COMPOSTED TO A DARK COLOR AND BE FREE OF PIECES WITH IDENTIFIABLE LEAF OR WOOD STRUCTURE. AVOID MATERIAL WITH A PH HIGHER THAN 7.5.
2. TO INCREASE DRAINAGE, MODIFY HEAVY CLAY OR SILT (MORE THAN 40% CLAY OR SILT) BY ADDING COMPOSTED PINE BARK (UP TO 30% BY VOLUME) AND/OR AGRICULTURAL GYPSUM. COARSE SAND MAY BE USED IF ENOUGH IS ADDED TO BRING THE SAND CONTENT TO MORE THAN 60% OF THE TOTAL MIX. SUBSURFACE DRAINAGE LINES MAY NEED TO BE ADDED TO INCREASE DRAINAGE.
3. MODIFY EXTREMELY SANDY SOILS (MORE THAN 85%) BY ADDING ORGANIC MATTER AND/OR DRY, SHREDDED CLAY LOAM UP TO 30% OF THE TOTAL MIX.

27. FINISHED GRADING
A. UNLESS OTHERWISE CONTRACTED, THE LANDSCAPE CONTRACTOR SHALL BE RESPONSIBLE FOR THE INSTALLATION OF TOPSOIL AND THE ESTABLISHMENT OF FINE GRADING WITHIN THE DISTURBANCE AREA OF THE SITE.
B. LANDSCAPE CONTRACTOR SHALL VERIFY THAT SUBGRADE FOR INSTALLATION OF TOPSOIL HAS BEEN ESTABLISHED. THE SUBGRADE OF THE SITE MUST MEET THE FINISHED GRADE LESS THE REQUIRED TOPSOIL THICKNESS (1").
C. ALL LAWN AND PLANTING AREAS SHALL BE GRADED TO A SMOOTH, EVEN AND UNIFORM PLANE WITH NO ABRUPT CHANGE OF SURFACE AS DEPICTED WITHIN THIS SET OF CONSTRUCTION PLANS, UNLESS OTHERWISE DIRECTED BY THE PROJECT ENGINEER OR LANDSCAPE ARCHITECT.
D. ALL PLANTING AREAS SHALL BE GRADED AND MAINTAINED TO ALLOW FREE FLOW OF SURFACE WATER IN AND AROUND THE PLANTING BEDS. STANDING WATER SHALL NOT BE PERMITTED IN PLANTING BEDS.

28. TOPSOILING
A. CONTRACTOR SHALL FURNISH TO THE APPROVING AGENCY AN ANALYSIS OF BOTH IMPORTED AND ON-SITE TOPSOIL TO BE UTILIZED IN ALL PLANTING AREAS. PH AND NUTRIENT LEVELS MAY NEED TO BE ADJUSTED THROUGH SOIL MODIFICATIONS AS NEEDED TO ACHIEVE THE REQUIRED LEVELS AS SPECIFIED IN THE MATERIALS SECTION ABOVE.
D. ALL PLANTING AND LAWN AREAS ARE TO BE CULTIVATED TO A DEPTH OF SIX INCHES (6"). ALL DEBRIS EXPOSED FROM EXCAVATION AND CULTIVATION SHALL BE DISPOSED OF IN ACCORDANCE WITH GENERAL WORK PROCEDURES SECTION ABOVE. THE FOLLOWING SHALL BE TILLED INTO THE TOP FOUR INCHES (4") IN TWO DIRECTIONS (QUANTITIES BASED ON A 1,000 SQUARE FOOT AREA).
1. 20 POUNDS 'GROW POWER' OR APPROVED EQUAL.
2. 20 POUNDS NITRO-FORM (COURSE) 30-0-40 BLUE CHIP.
E. THE SPREADING OF TOPSOIL SHALL NOT BE CONDUCTED UNDER MUDDY OR FROZEN CONDITIONS.

29. PLANTING
A. INSURE THAT IT IS FEASIBLE. PLANT MATERIAL SHALL BE PLANTED ON THE DAY OF DELIVERY. IN THE EVENT THAT THIS IS NOT POSSIBLE, LANDSCAPE CONTRACTOR SHALL PROTECT UNINSTALLED PLANT MATERIAL. PLANTS SHALL NOT REMAIN UNPLANTED FOR LONGER THAN A THREE DAY PERIOD AFTER DELIVERY. PLANTS THAT WILL NOT BE PLANTED FOR A PERIOD OF TIME GREATER THAN THREE DAYS SHALL BE HEALED IN WITH TOPSOIL OR MULCH TO HELP PRESERVE ROOT MOISTURE.
B. PLANTING OPERATIONS SHALL BE PERFORMED DURING PERIODS WITHIN THE PLANTING SEASON WHEN WEATHER AND SOIL CONDITIONS ARE SUITABLE AND IN ACCORDANCE WITH ACCEPTED LOCAL PRACTICE. PLANTS SHALL NOT BE INSTALLED IN TOPSOIL THAT IS IN A MUDDY OR FROZEN CONDITION.
C. ANY INJURED ROOTS OR BRANCHES SHALL BE PRUNED TO MAKE CLEAN-CUT ENDS PRIOR TO PLANTING UTILIZING CLEAN, SHARP TOOLS. ONLY INJURED OR DISEASED BRANCHING SHALL BE REMOVED.
D. ALL PLANTING CONTAINERS AND NON-BIODEGRADABLE MATERIALS SHALL BE REMOVED FROM ROOT BALLS DURING PLANTING. NATURAL FIBER BURLAP MUST BE CUT FROM AROUND THE TRUNK OF THE TREE AND FOLDED DOWN AGAINST THE ROOT BALL PRIOR TO BACKFILLING.
E. POSITION TREES AND SHRUBS AT THEIR INTENDED LOCATIONS AS PER THE PLANS AND SECURE THE APPROVAL OF THE LANDSCAPE ARCHITECT PRIOR TO EXCAVATING PITS, MAKING NECESSARY ADJUSTMENTS AS DIRECTED.
F. PRIOR TO THE ISSUANCE OF ANY CERTIFICATE OF OCCUPANCY, THE PROPOSED LANDSCAPE, AS SHOWN ON THE APPROVED LANDSCAPE PLAN, MUST BE INSTALLED, INSPECTED AND APPROVED BY THE APPROVING AGENCY. THE APPROVING AGENCY SHALL TAKE INTO ACCOUNT SEASONAL CONSIDERATIONS IN THIS REGARD AS FOLLOWS: THE PLANTING OF TREES, SHRUBS, VINES OR GROUND COVER SHALL OCCUR ONLY DURING THE FOLLOWING PLANTING SEASONS:
1. PLANTS: MARCH 15 TO DECEMBER 15
2. LAWN: MARCH 15 TO JUNE 15 OR SEPT. 1 TO DECEMBER 1
G. PLANTINGS REQUIRED FOR A CERTIFICATE OF OCCUPANCY SHALL BE PROVIDED DURING THE NEXT APPROPRIATE SEASON AT THE MUNICIPALITY'S DISCRETION. CONTRACTOR SHOULD CONTACT APPROVING AGENCY FOR POTENTIAL SUBSTITUTIONS.
H. FURTHERMORE, THE FOLLOWING TREE VARIETIES ARE UNUSUALLY SUSCEPTIBLE TO WINTER DAMAGE, WITH TRANSIENT SHOCK AND THE SEASONAL LACK OF WATER AVAILABILITY. THE RISK OF PLANT DEATH IS GREATLY INCREASED. IT IS NOT RECOMMENDED THAT THESE SPECIES BE PLANTED DURING THE FINAL PLANTING SEASON:
ACER RUBRUM PLATANUS X ACERIFOLIA
BETULA PULCHRA PRUNUS VARIETIES
CARPINUS VARIETIES PRUNUS VARIETIES
CRATAEGUS VARIETIES PYRUS VARIETIES
KOELERIA VARIETIES QUERCUS VARIETIES
LIQUIDAMBER STRYACIFLUA TILIA TOMENTOSA
LIRIODENDRON TULIPIFERA ZELKOVA VARIETIES

I. PLANTING PITS SHALL BE DUG WITH LEVEL BOTTOMS, WITH THE WIDTH TWICE THE DIAMETER OF ROOT BALL. THE ROOT BALL SHALL REST ON UNDISTURBED GRADE. EACH PL

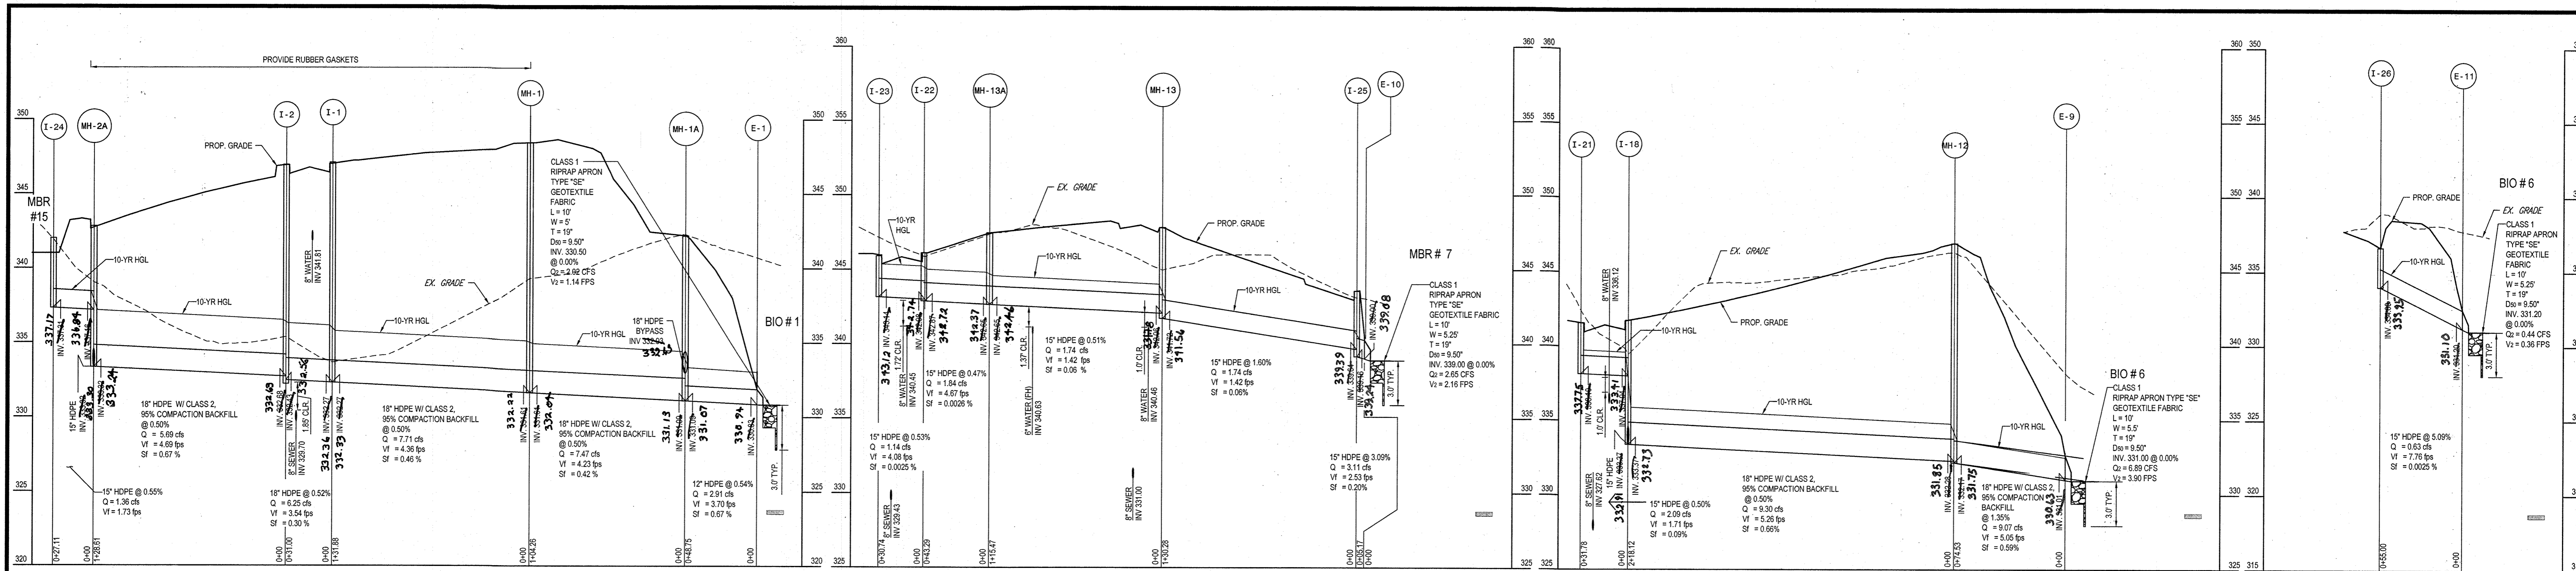


I-24 TO E-1 STORM DRAIN PROFILE
SCALE: 1"=50' HORIZONTAL
1"=5' VERTICAL


I-23 TO E-10 STORM DRAIN PROFILE
SCALE: 1"=50' HORIZONTAL
1"=5' VERTICAL

I-21 TO E-9 STORM DRAIN PROFILE
SCALE: 1"=50' HORIZONTAL
1"=5' VERTICAL


I-26 TO E-11 STORM DRAIN PROFILE
SCALE: 1"=50' HORIZONTAL
1"=5' VERTICAL

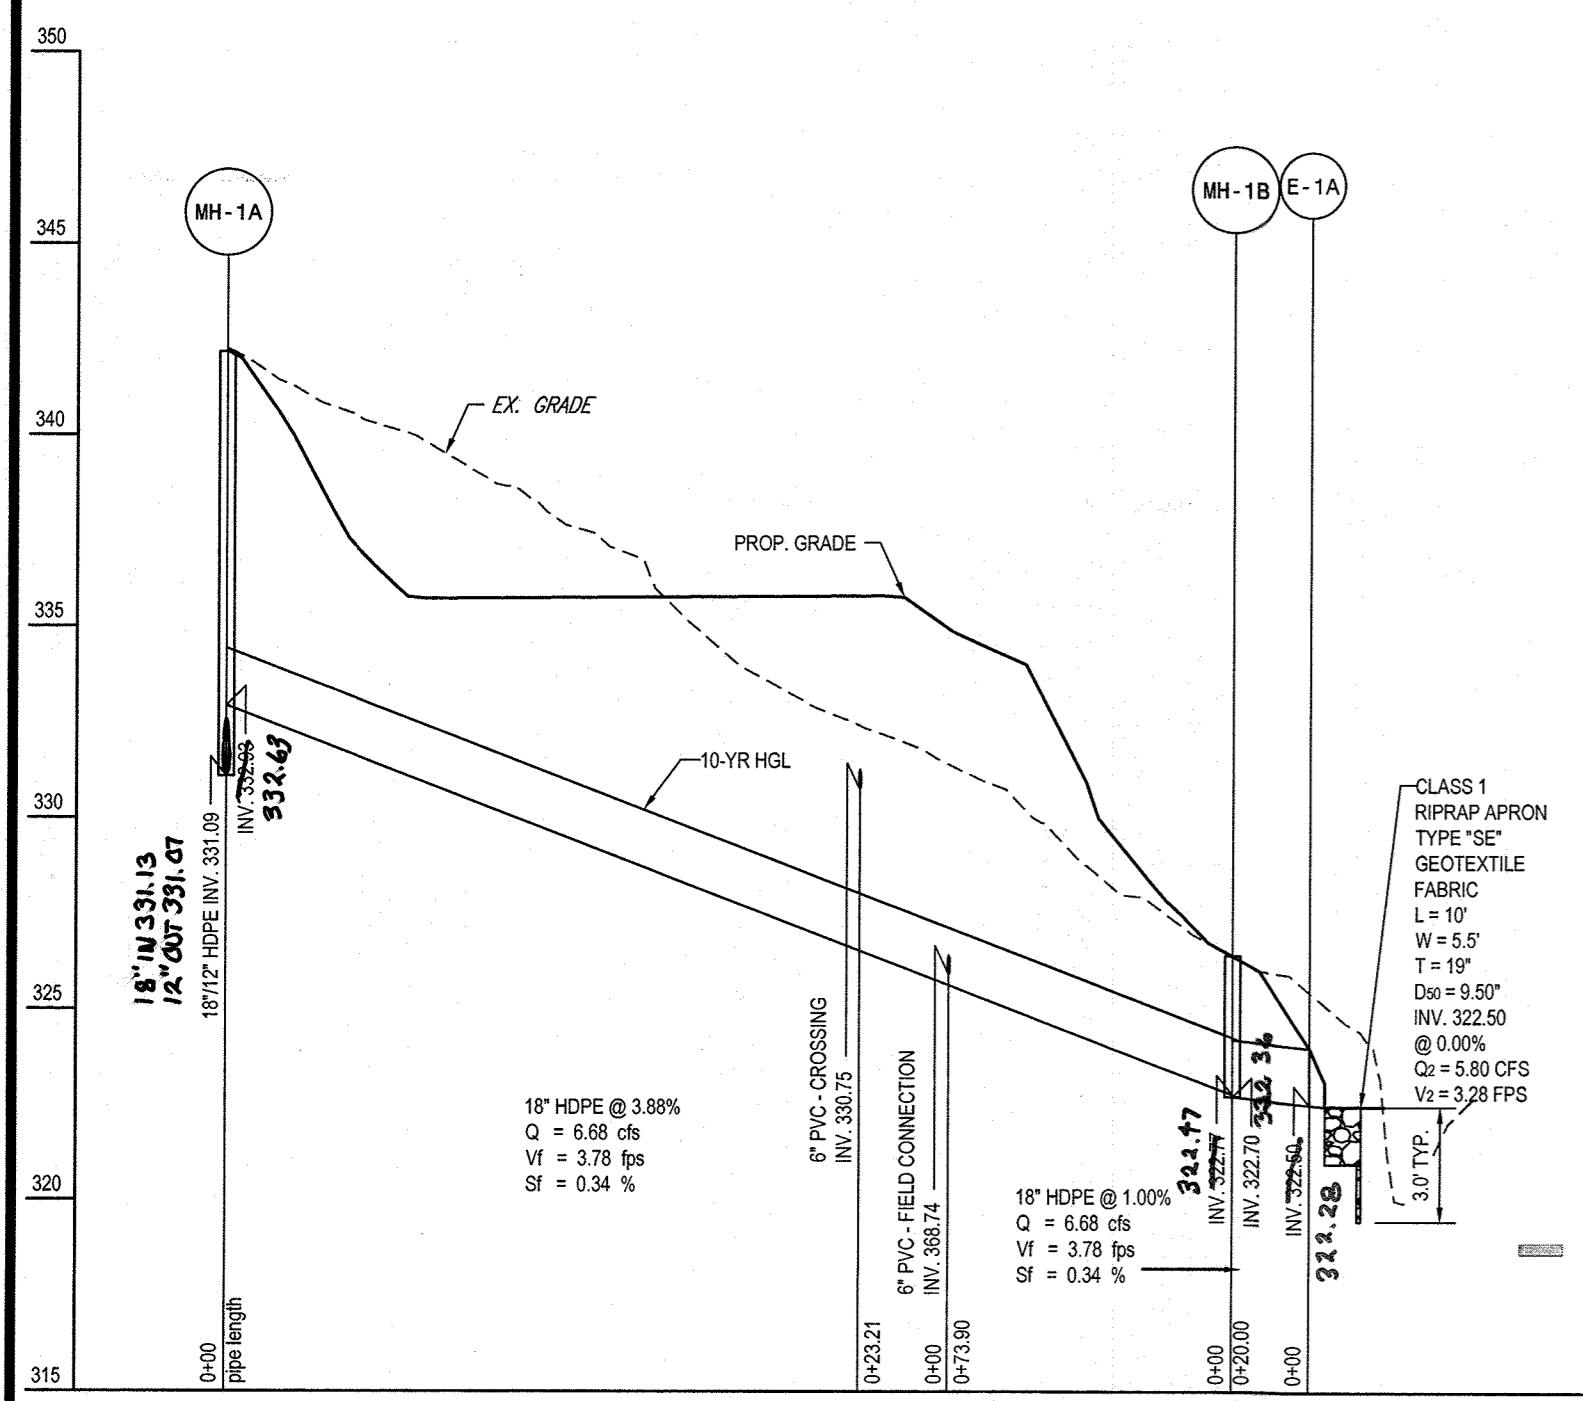


MH-A1 TO E-A1 - STORM DRAIN PROFILE
SCALE: 1"=50' HORIZONTAL
1"=5' VERTICAL

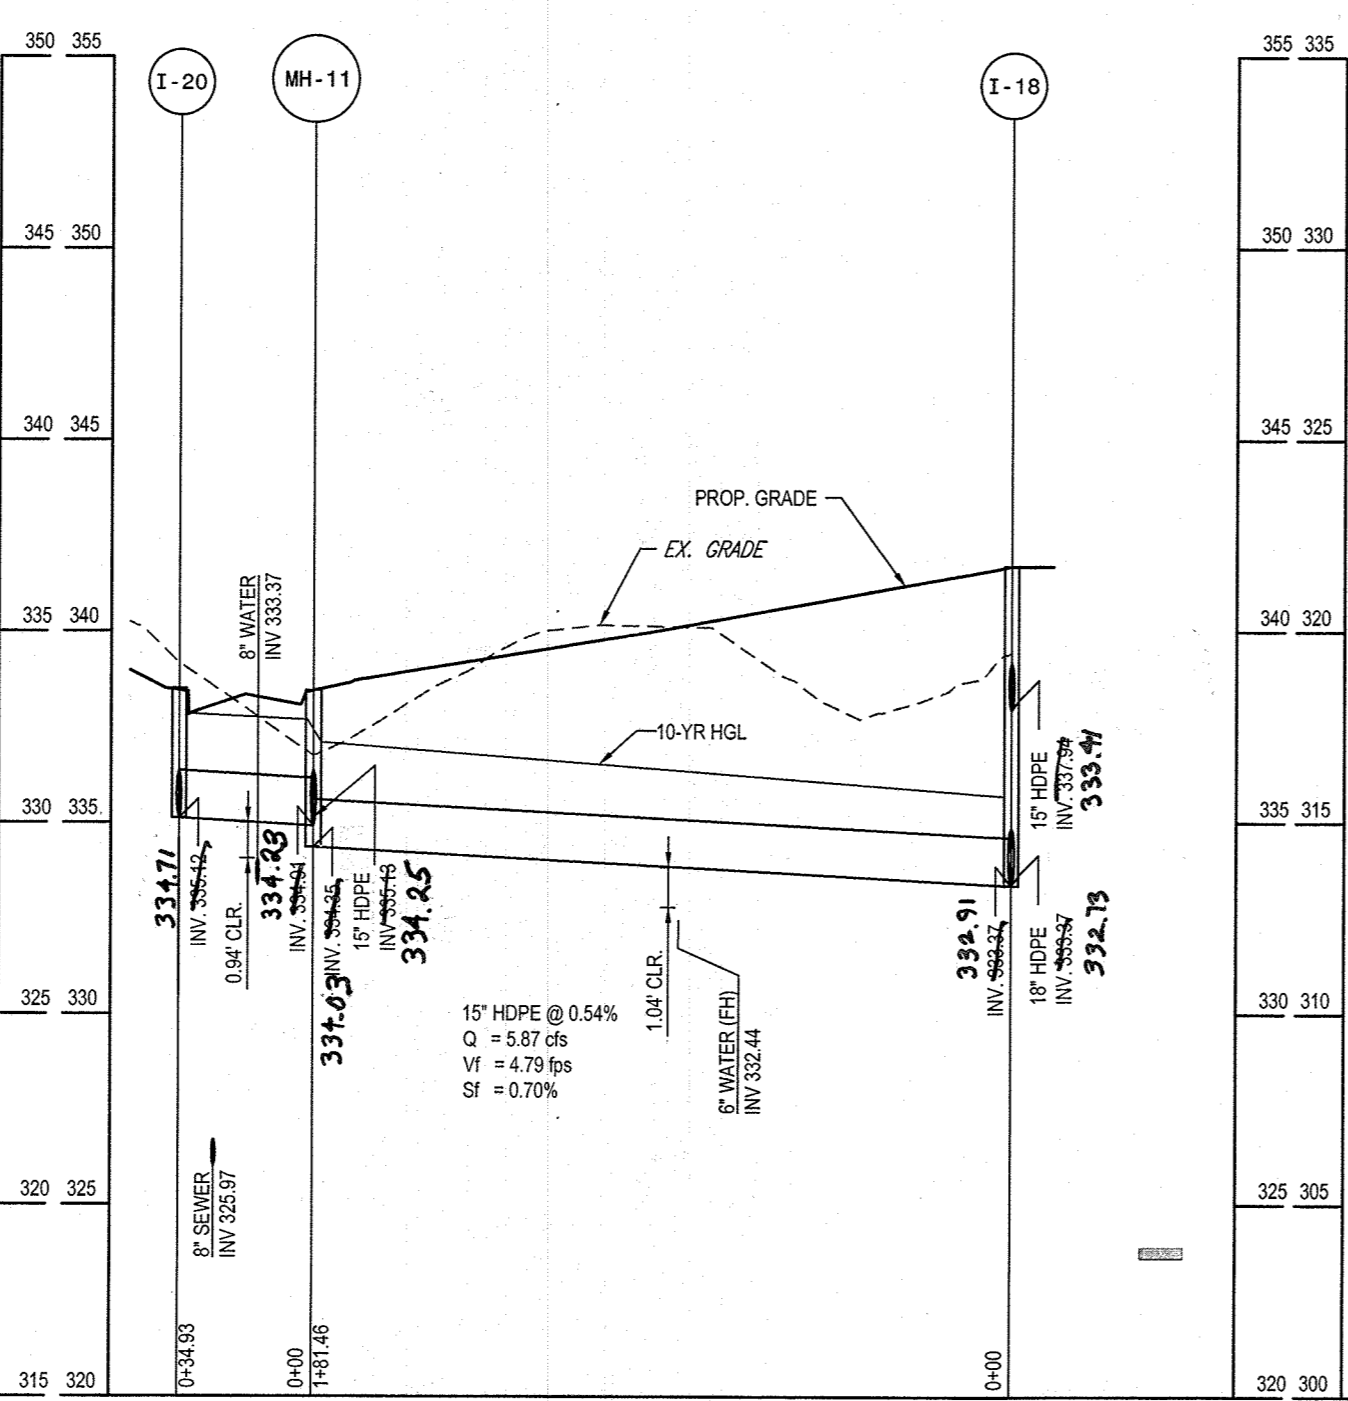


I-20 TO I-18 STORM DRAIN PROFILE
SCALE: 1"=50' HORIZONTAL
1"=5' VERTICAL

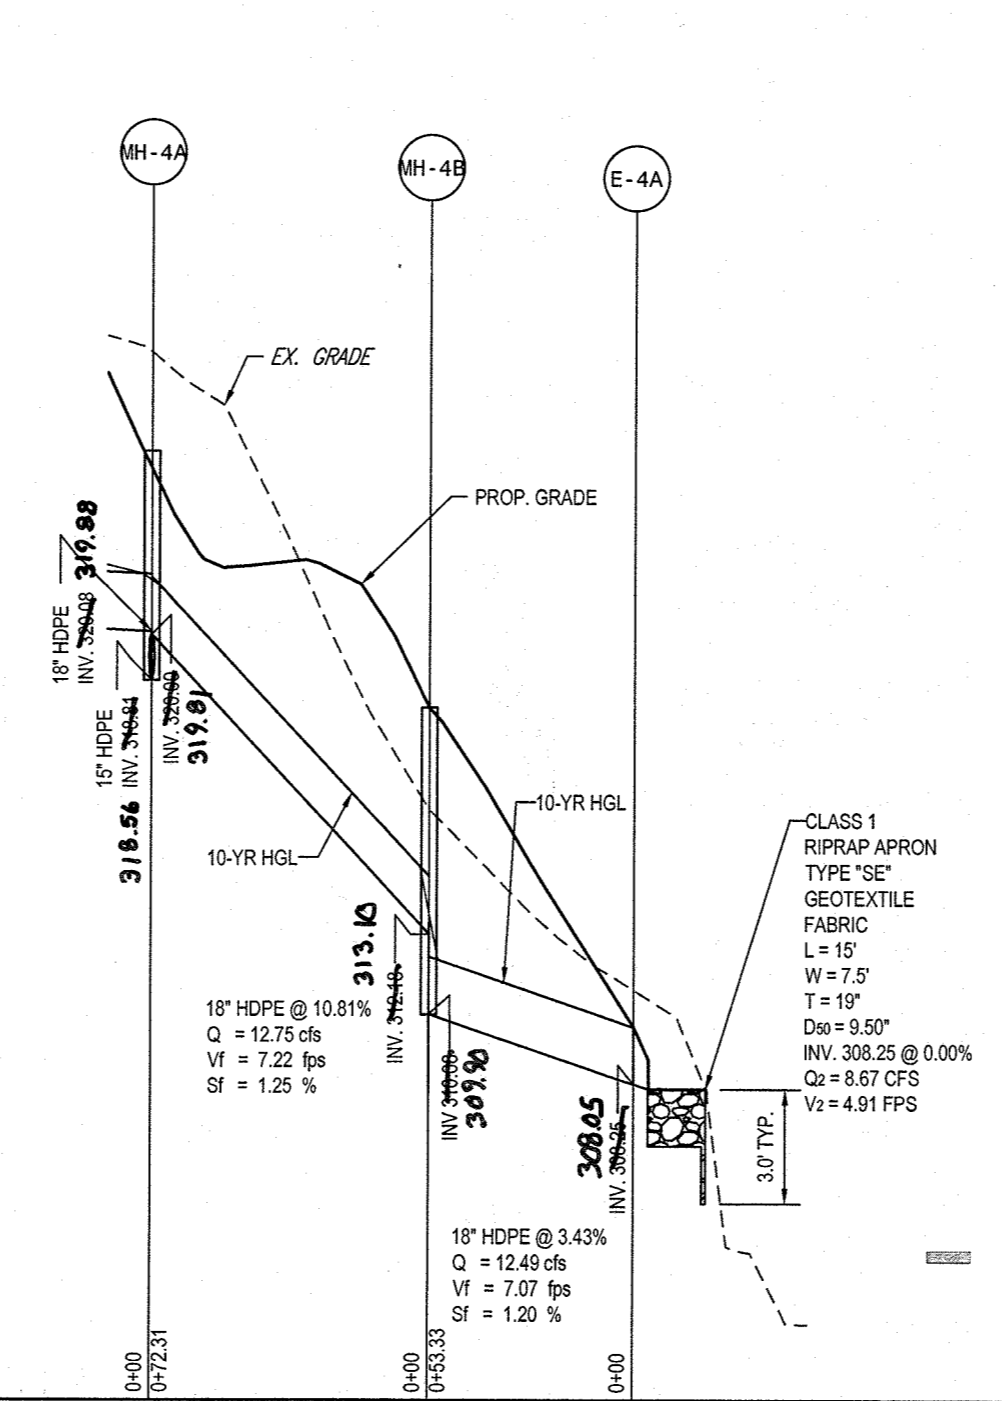


MH-4A TO E-4A STORM DRAIN PROFILE
SCALE: 1"=50' HORIZONTAL
1"=5' VERTICAL

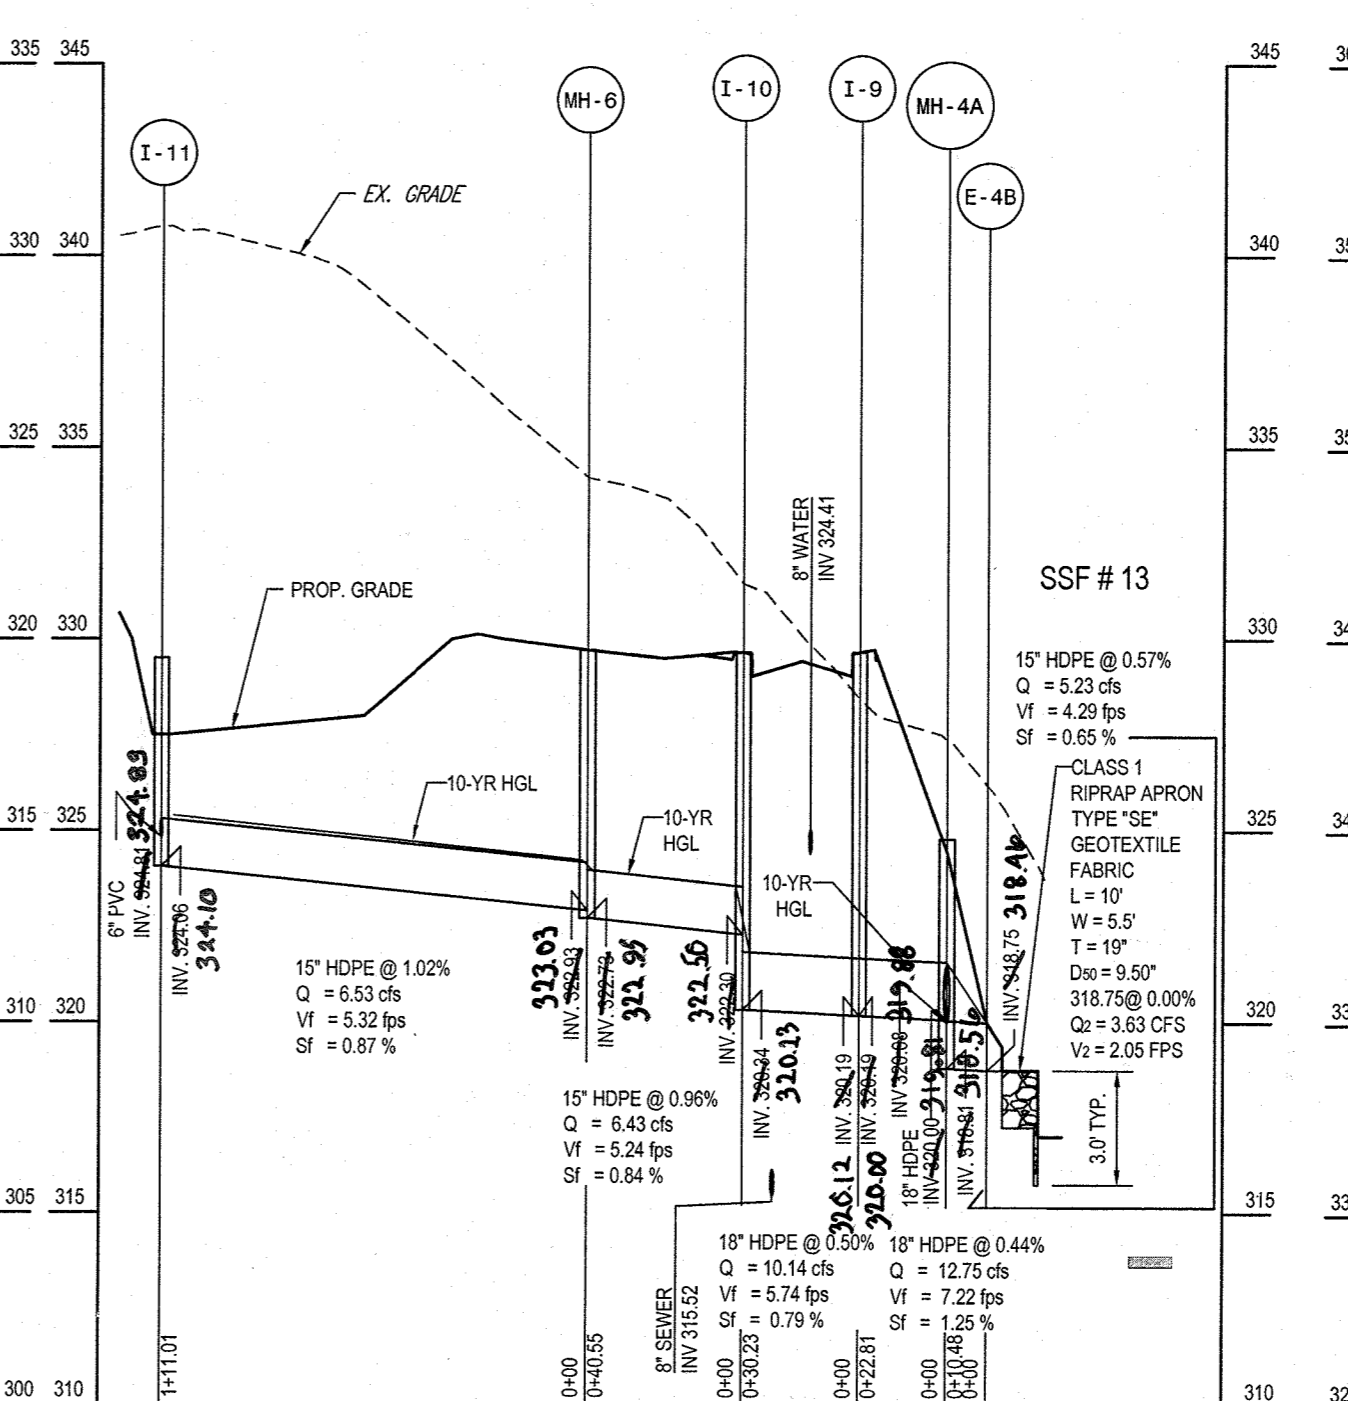

I-11 TO E-4B STORM DRAIN PROFILE
SCALE: 1"=50' HORIZONTAL
1"=5' VERTICAL

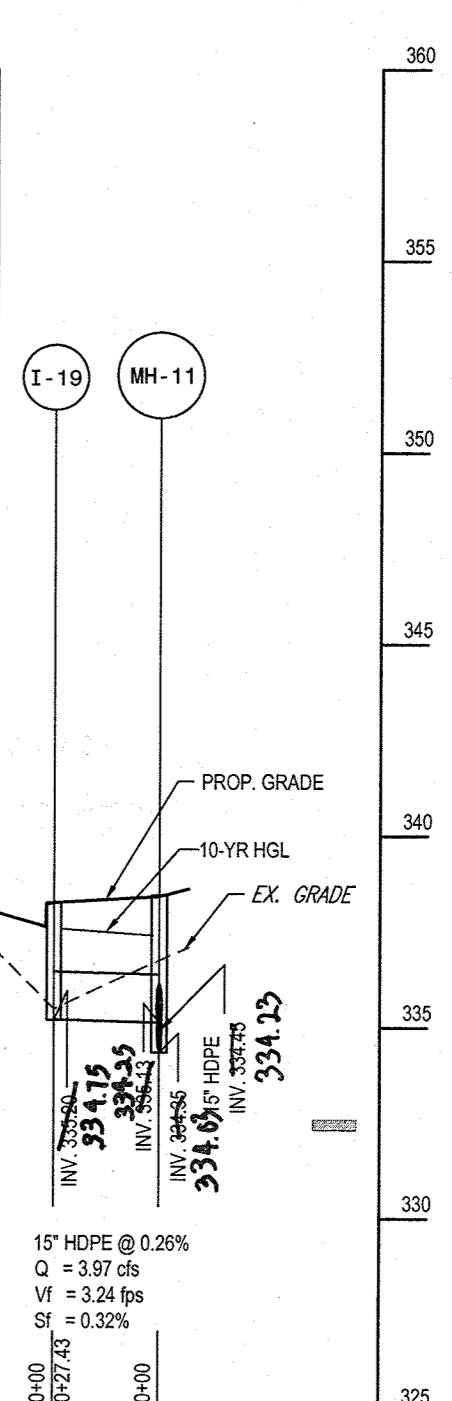

I-19 TO MH-11 STORM DRAIN PROFILE
SCALE: 1"=50' HORIZONTAL
1"=5' VERTICAL

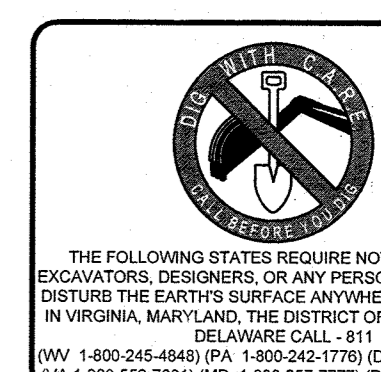

THE FOLLOWING STATES REQUIRE NOTIFICATION BY EXCAVATORS, DESIGNERS, OR ANY PERSON PREPARING TO DISTURB THE EARTH'S SURFACE ANYWHERE IN THE STATE IN VIRGINIA, MARYLAND, THE DISTRICT OF COLUMBIA, AND DELAWARE CALL: 811 (MW 1-800-245-4649) (PA 1-800-245-1770) (DC 1-800-251-7777) (MD 1-800-852-7001) (MD 1-800-251-7777) (DE 1-800-282-8555)

NO.	DATE	REVISION DESCRIPTION
1	12/11/14	PAGE NUMBER UPDATE


OWNER:
M/I HOMES OF DC, LLC
21355 RIDGETOP CIRCLE, SUITE 220
STERLING, VA 20155
CONTACT: CINDY HUNTZBERG
PHONE: 443-677-9803

DEVELOPER:
SOMERWORTH II, L.C.
5704 DORSEY HALL DRIVE, SUITE 205
ELLCOTT CITY, MD 21045
CONTACT: JASON VAN KIRK
PHONE: (410) 720-3021

PROJECT: WALDEN WOODS

TAX MAP: 47 **GRID:** 2 **ZONED:** PSC
PARCEL: 4, LOTS 1-97, OPEN SPACE LOTS 98 - 102
6TH ELECTION DISTRICT, HOWARD COUNTY, MARYLAND

TITLE: STORM DRAIN PROFILE

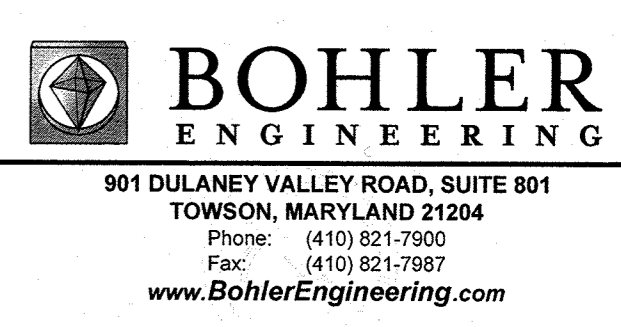



CHECKED BY:	BRR
DESIGNED BY:	BRR
DRAWN BY:	RMS/AVG
PROJECT NO.:	MD112149
DATE:	10/27/14
SCALE:	1"=50'
DRAWING NO.:	19 OF 35

APPROVED
PLANNING BOARD OF HOWARD COUNTY
FB406
DATE: **10/08/2014**


APPROVED: DEPARTMENT OF PLANNING AND ZONING
Chad Cook 11-17-14
CHIEF-DEVELOPMENT ENGINEERING DIVISION

J. Munch for **KS** 12-22-14
CHIEF-DIVISION OF LAND DEVELOPMENT

Handwritten signature 10/27/14
DIRECTOR

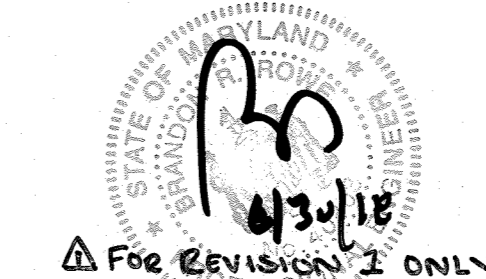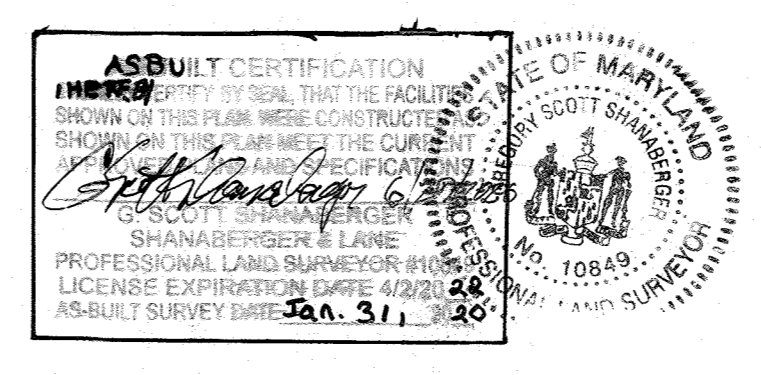

NOTE: CLASS 3 BACKFILL TO BE USED FOR PIPE INSTALLATION UNLESS OTHERWISE NOTED.

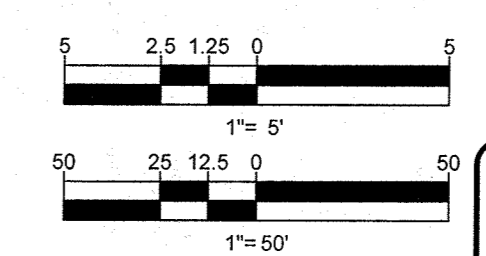


PROFESSIONAL CERTIFICATION
I, BRANDON R. ROWE, HEREBY CERTIFY THAT THESE DOCUMENTS WERE PREPARED OR APPROVED BY ME, AND THAT I AM A FULLY LICENSED PROFESSIONAL ENGINEER UNDER THE LAWS OF THE STATE OF MARYLAND, LICENSE NO. 40808, EXPIRATION DATE: 7/31/2015

STORM STRUCTURE SCHEDULE


NAME	TYPE (HO. CO. STD.)	TOP ELEVATION	INV. IN	INV. OUT	ROAD NAME	ROAD STATION & OFFSET
E-1	HDPE END SECTION		336.42	330.94	WILDERNESS LN	N 538314.742 E 1353462.464
E-1A	HDPE END SECTION		334.29	331.29	WILDERNESS LN	N 538292.874 E 1353702.746
E-2	HDPE END SECTION		341.91	338.91	WILDERNESS LN	10+82.52 13.00 R
E-3	HDPE END SECTION		330.89	327.89	WILDERNESS LN	N 538279.945 E 1353737.465
E-4A	HDPE END SECTION		308.05	305.05	WILDERNESS LN	N 538198.848 E 1354159.796
E-4B	HDPE END SECTION		318.10	315.10	WILDERNESS LN	N 538107.944 E 1354152.744
E-5	HDPE END SECTION		323.17	320.17	WILDERNESS LN	N 538007.944 E 1354338.744
E-5A	HDPE END SECTION		324.05	321.05	WILDERNESS LN	N 538008.944 E 1354529.744
E-6	HDPE END SECTION		325.91	322.91	ETERNITY LN	N 537726.744 E 1354217.744
E-8	HDPE END SECTION		318.85	315.85	ETERNITY LN	N 537835.944 E 1354252.744
E-9	HDPE END SECTION		318.98	315.98	ETERNITY LN	N 537897.944 E 1354062.744
E-10	HDPE END SECTION		326.42	323.42	ETERNITY LN	N 537897.944 E 1353994.744
E-11	HDPE END SECTION		329.03	326.03	GORMAN ROAD	N 537726.744 E 1354217.744
I-1	A-5 INLET (D4.0)	347.05	344.05	341.05	WILDERNESS LN	10+774.000 E 1353994.744 10+37.0, 13.0 L.
I-2	A-5 INLET (D4.0)	346.90	343.90	340.90	WILDERNESS LN	12+45.54 13.00 R
I-3	A-5 INLET (D4.0)	348.37	345.37	342.37	WILDERNESS LN	10+774.000 E 1353994.744 10+15.1, 13.0 R
I-4	A-5 INLET (D4.0)	347.45	344.45	341.45	WILDERNESS LN	10+774.000 E 1353994.744
I-5	A-5 INLET (D4.0)	347.65	344.65	341.65	ETERNITY LN	10+774.000 E 1353994.744
I-6	A-5 INLET (D4.0)	347.65	344.65	341.65	ETERNITY LN	10+774.000 E 1353994.744 10+37.0, 13.0 L.
I-7	A-5 INLET (D4.0)	347.65	344.65	341.65	WILDERNESS LN	10+774.000 E 1353994.744
I-8	A-5 INLET (D4.0)	347.65	344.65	341.65	WILDERNESS LN	15+90.54 13.00 R
I-9	A-10 INLET (D4.0)	347.65	344.65	341.65	WILDERNESS LN	18+296.54 13.00 R
I-10	A-10 INLET (D4.0)	349.64	346.64	343.64	WILDERNESS LN	18+296.54 13.00 R
I-11	D INLET (D4.10)	348.38	345.38	342.38	WILDERNESS LN	17+80.54 13.00 R
I-12	A-5 INLET (D4.0)	348.80	345.80	342.80	WILDERNESS LN	17+80.54 13.00 R
I-13	A-5 INLET (D4.0)	348.80	345.80	342.80	WILDERNESS LN	20+35.54 13.00 R
I-14	A-10 INLET (D4.0)	348.02	345.02	342.02	ETERNITY LN	18+70.54 13.00 R
I-15	A-10 INLET (D4.0)	349.97	346.97	343.97	ETERNITY LN	18+70.54 13.00 R
I-16	A-5 INLET (D4.0)	347.40	344.40	341.40	ETERNITY LN	17+48.54 13.00 R
I-17	A-5 INLET (D4.0)	347.40	344.40	341.40	ETERNITY LN	17+48.54 13.00 R
I-18	A-5 INLET (D4.0)	341.65	338.65	335.65	ETERNITY LN	17+48.54 13.00 R
I-19	A-5 INLET (D4.0)	340.40	337.40	334.40	ETERNITY LN	16+95.54 13.00 R
I-20	A-5 INLET (D4.0)	340.24	337.24	334.24	ETERNITY LN	16+95.54 13.00 R
I-21	A-5 INLET (D4.0)	340.57	337.57	334.57	ETERNITY LN	14+95.54 13.00 L
I-22	A-5 INLET (D4.0)	340.95	337.95	334.95	ETERNITY LN	13+09.54 13.00 R
I-23	A-5 INLET (D4.0)	340.95	337.95	334.95	ETERNITY LN	13+10.54 13.00 L
I-24	D INLET (D4.10)	340.24	337.24	334.24	WILDERNESS LN	13+77.54 13.00 R
I-25	A-5 INLET (D4.0)	340.99	337.99	334.99	SIMPLICITY CT	10+00.000 E 1353994.744 10+37.0, 13.0 R
I-25A	YARD INLET (D4.14)	340.99	337.99	334.99	SIMPLICITY CT	10+00.000 E 1353994.744
I-26	YARD INLET	340.99	337.99	334.99	GORMAN ROAD	10+00.000 E 1353994.744
MH-1	STD MANHOLE (65.12)	348.71	345.71	342.71	WILDERNESS LN	11+00.54 27.82 L
MH-1A	STD MANHOLE (65.12)	342.05	339.05	336.05	MD112149-124 TO E-1	N 538314.742 E 1353462.464 10+37.0, 13.0 R
MH-1B	STD MANHOLE (65.12)	342.05	339.05	336.05	GORMAN ROAD	N 538292.874 E 1353702.746
MH-2A	STD MANHOLE (65.12)	343.32	340.32	337.32	WILDERNESS LN	13+13.54 2.2 L
MH-3	STD MANHOLE (65.12)	346.10	343.10	340.10	WILDERNESS LN	11+17.54 13.00 R
MH-4	STD MANHOLE (65.12)	340.92	337.92	334.92	WILDERNESS LN	14+33.54 13.00 L
MH-4A	STD MANHOLE (65.12)	342.73	339.73	336.73	WILDERNESS LN	18+70.54 13.00 L
MH-4B	STD MANHOLE (65.12)	348.02	345.02	342.02	WILDERNESS LN	18+70.54 13.00 L
MH-5	SHALLOW MANHOLE (65.12)	349.32	346.32	343.32	WILDERNESS LN	15+52.54 27.82 L
MH-6	STD MANHOLE (65.12)	349.36	346.36	343.36	WILDERNESS LN	15+52.54 27.82 L
MH-7	STD MANHOLE (65.12)	348.78	345.78	342.78	WILDERNESS LN	20+35.54 13.00 R
MH-8	STD MANHOLE (65.12)	343.43	340.43	337.43	ETERNITY LN	19+28.54 55.00 R
MH-9	STD MANHOLE (65.12)	345.02	342.02	339.02	ETERNITY LN	17+94.54 112.94 R
MH-10	STD MANHOLE (65.12)	348.74	345.74	342.74	ETERNITY LN	16+77.54 13.00 R
MH-11	STD MANHOLE (65.12)	348.77	345.77	342.77	ETERNITY LN	16+77.54 13.00 R
MH-12	STD MANHOLE (65.12)	346.51	343.51	340.51	ETERNITY LN	12+73.54 25.45 R
MH-13	STD MANHOLE (65.12)	348.20	345.20	342.20	SIMPLICITY CT	10+00.000 E 1353994.744
MH-13A	STD MANHOLE (65.12)	347.22	344.22	341.22	ETERNITY LN	12+64.54 14.62 R

AS-BUILT ELEVATIONS OF INLETS ARE CL TOP CURB, TOP OF GRATE, OR TOP OF SLAB


* ALL (4) SIDES OF INLET SHALL BE OPEN

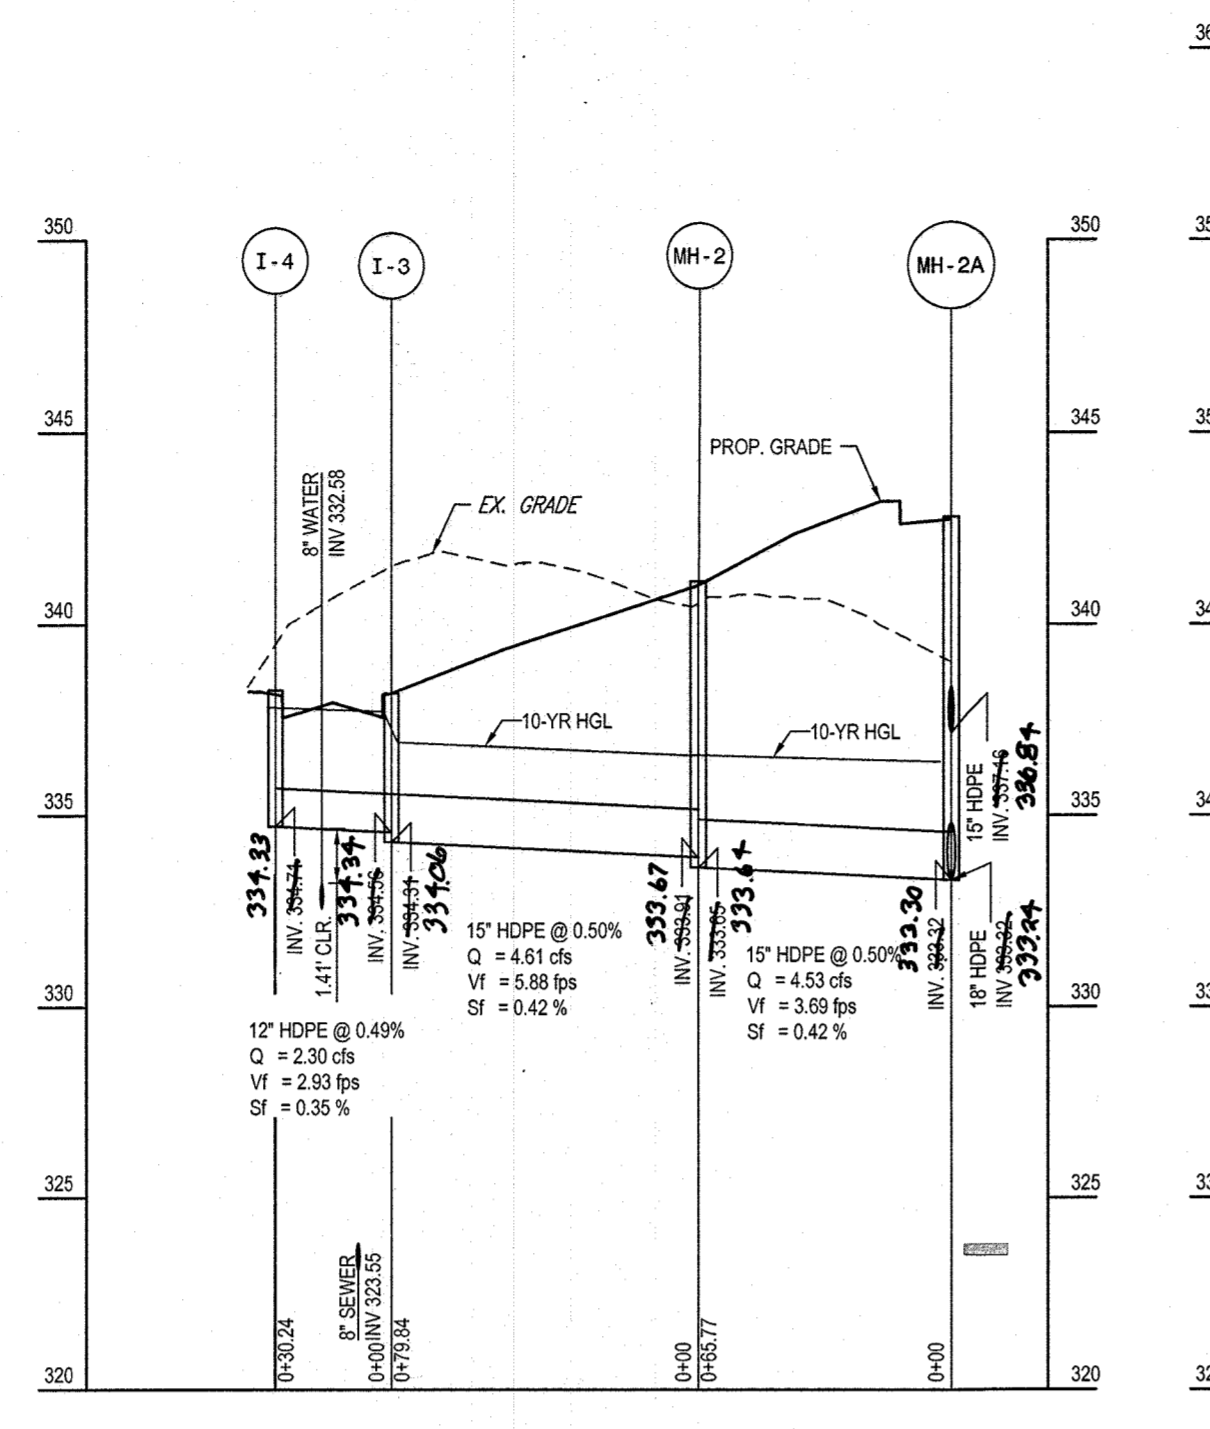


I-4 TO MH-2A STORM DRAIN PROFILE
SCALE: 1"=50' HORIZONTAL
1"=5' VERTICAL

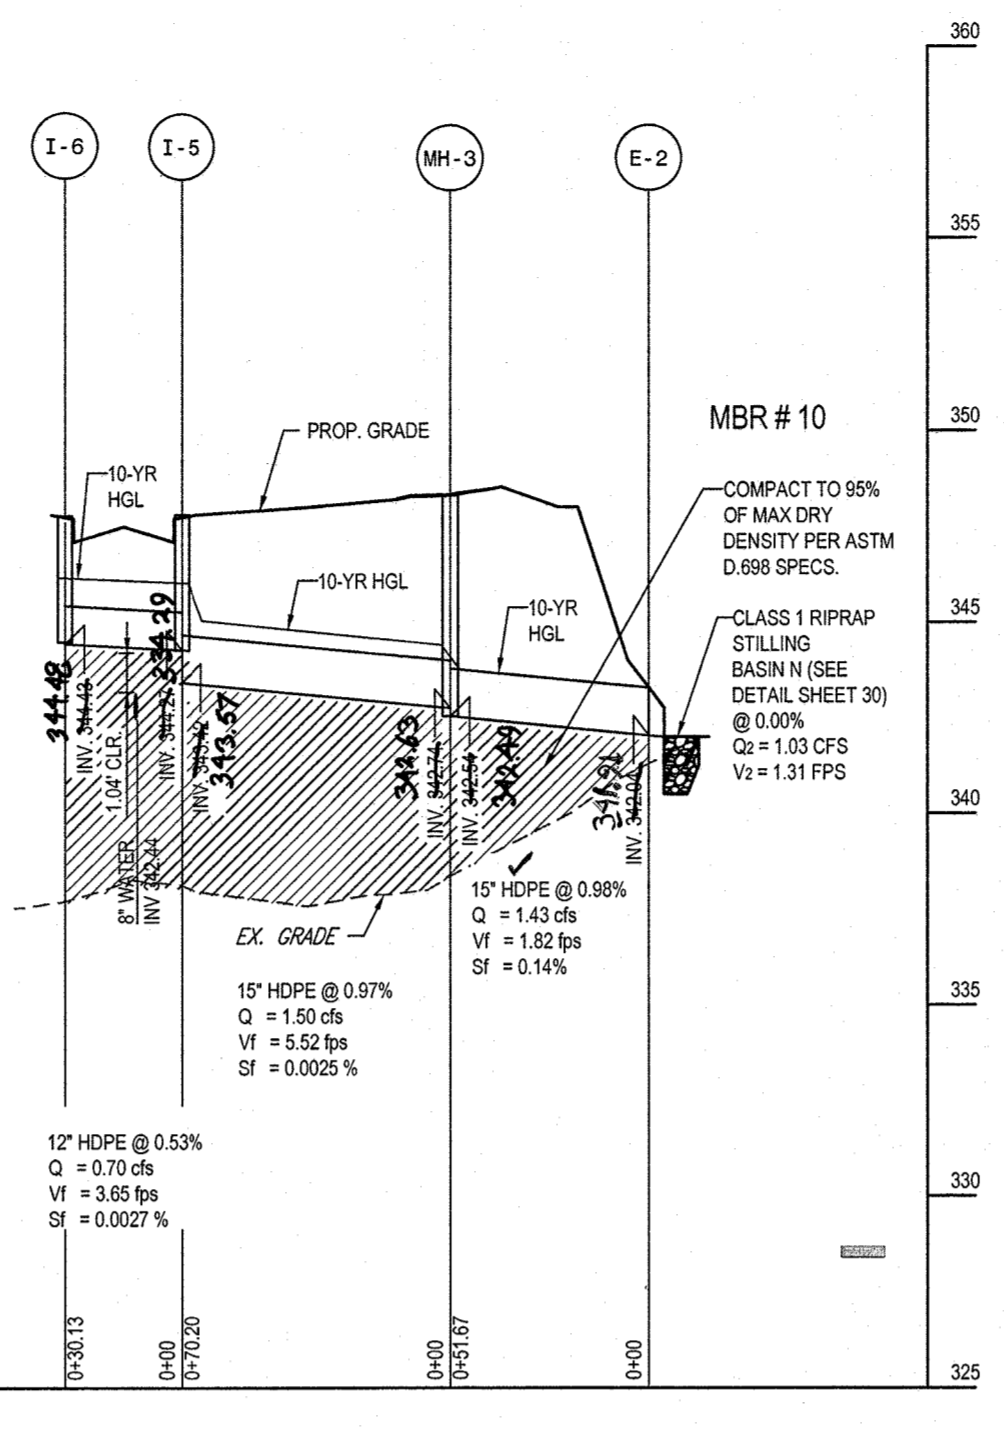


I-6 TO E-2 STORM DRAIN PROFILE
SCALE: 1"=50' HORIZONTAL
1"=5' VERTICAL

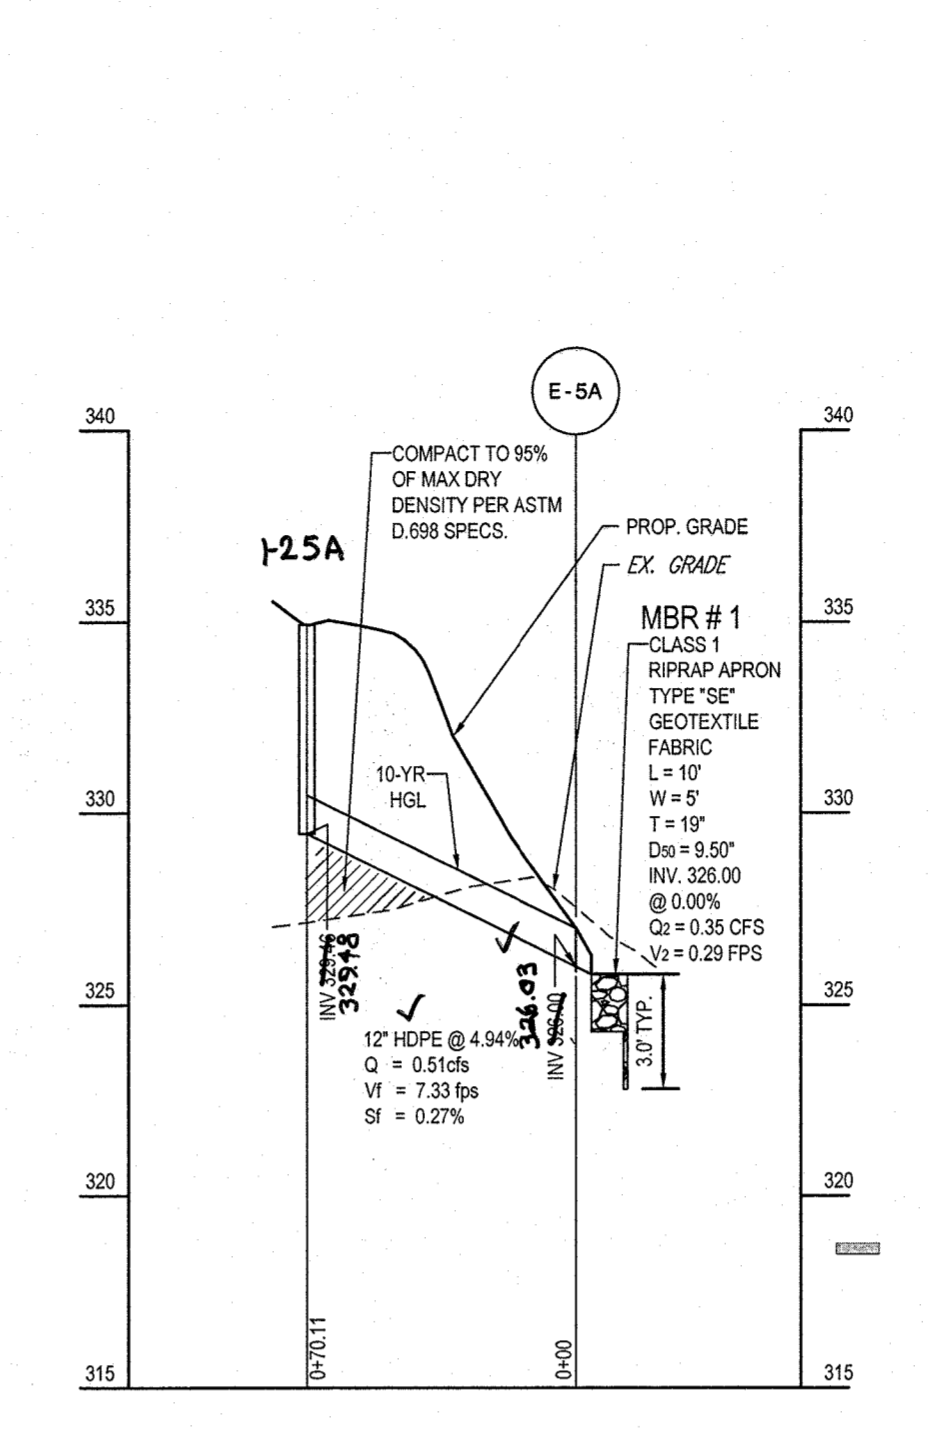


I-25A TO E-5A STORM DRAIN PROFILE
SCALE: 1"=50' HORIZONTAL
1"=5' VERTICAL

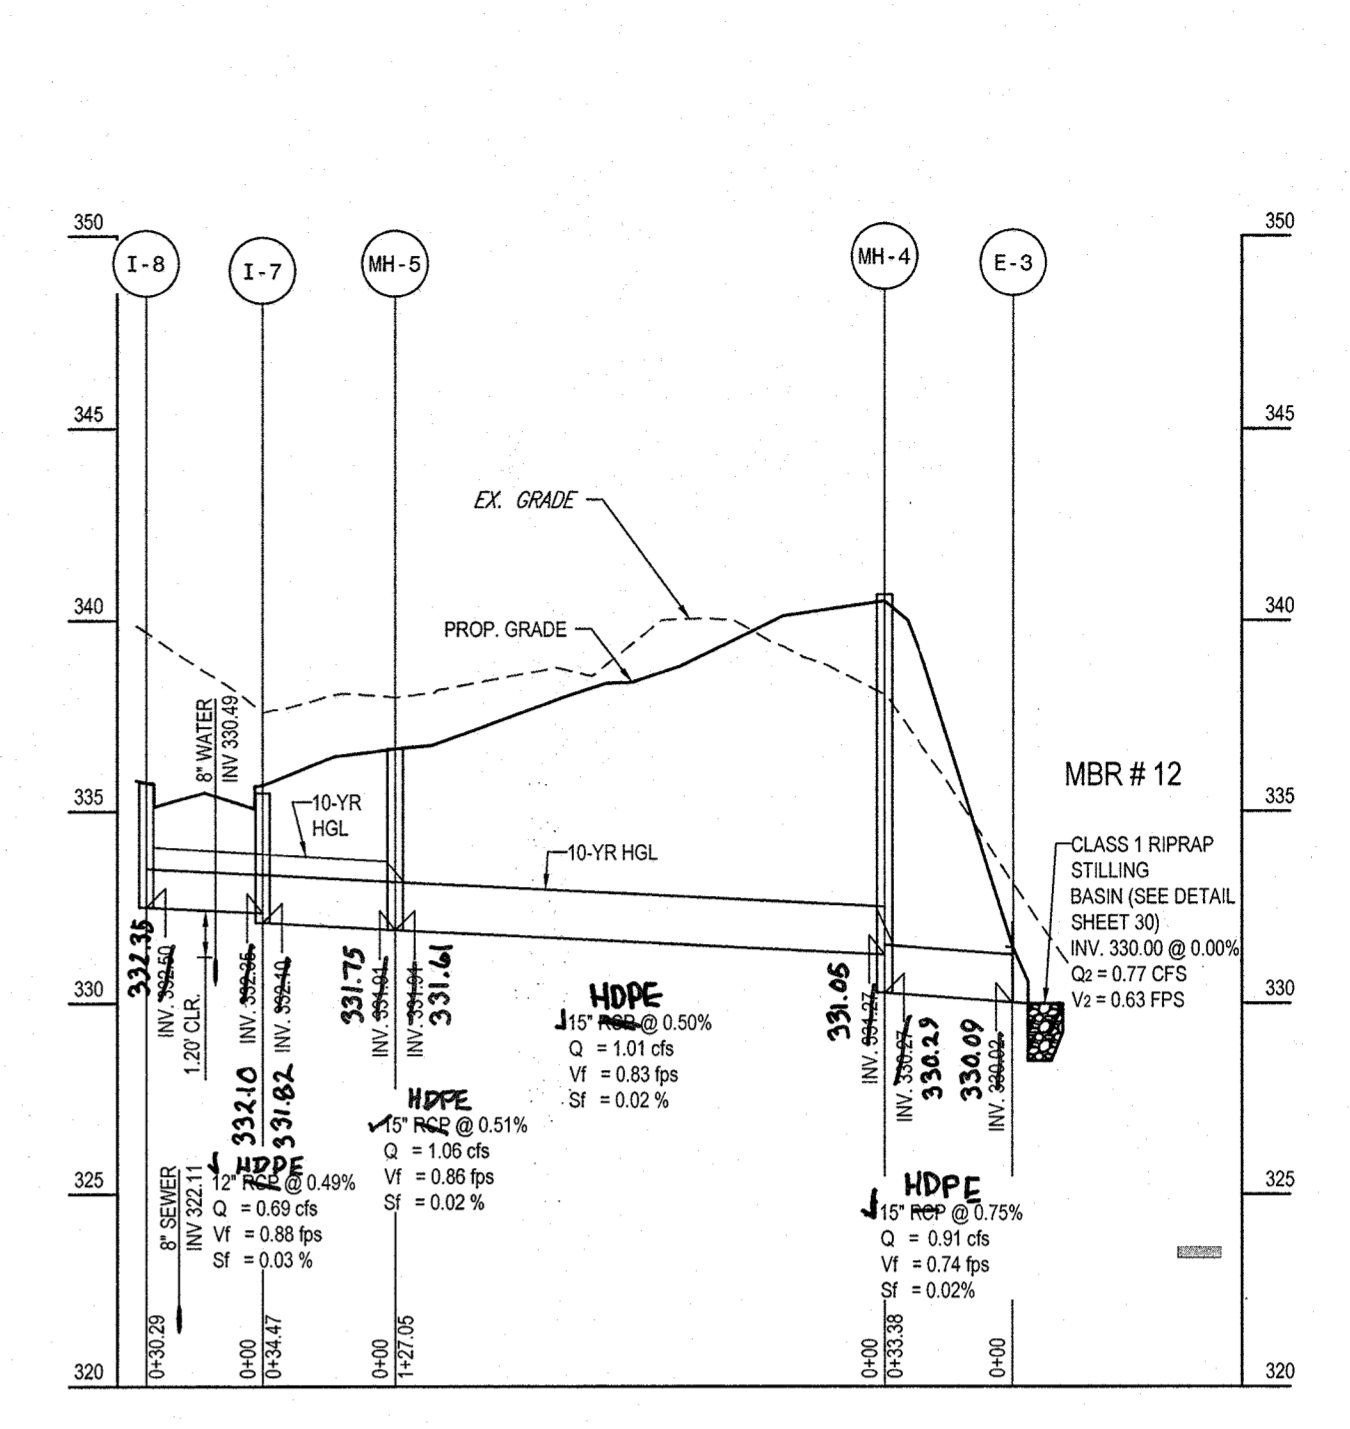


I-8 TO E-3 STORM DRAIN PROFILE
SCALE: 1"=50' HORIZONTAL
1"=5' VERTICAL

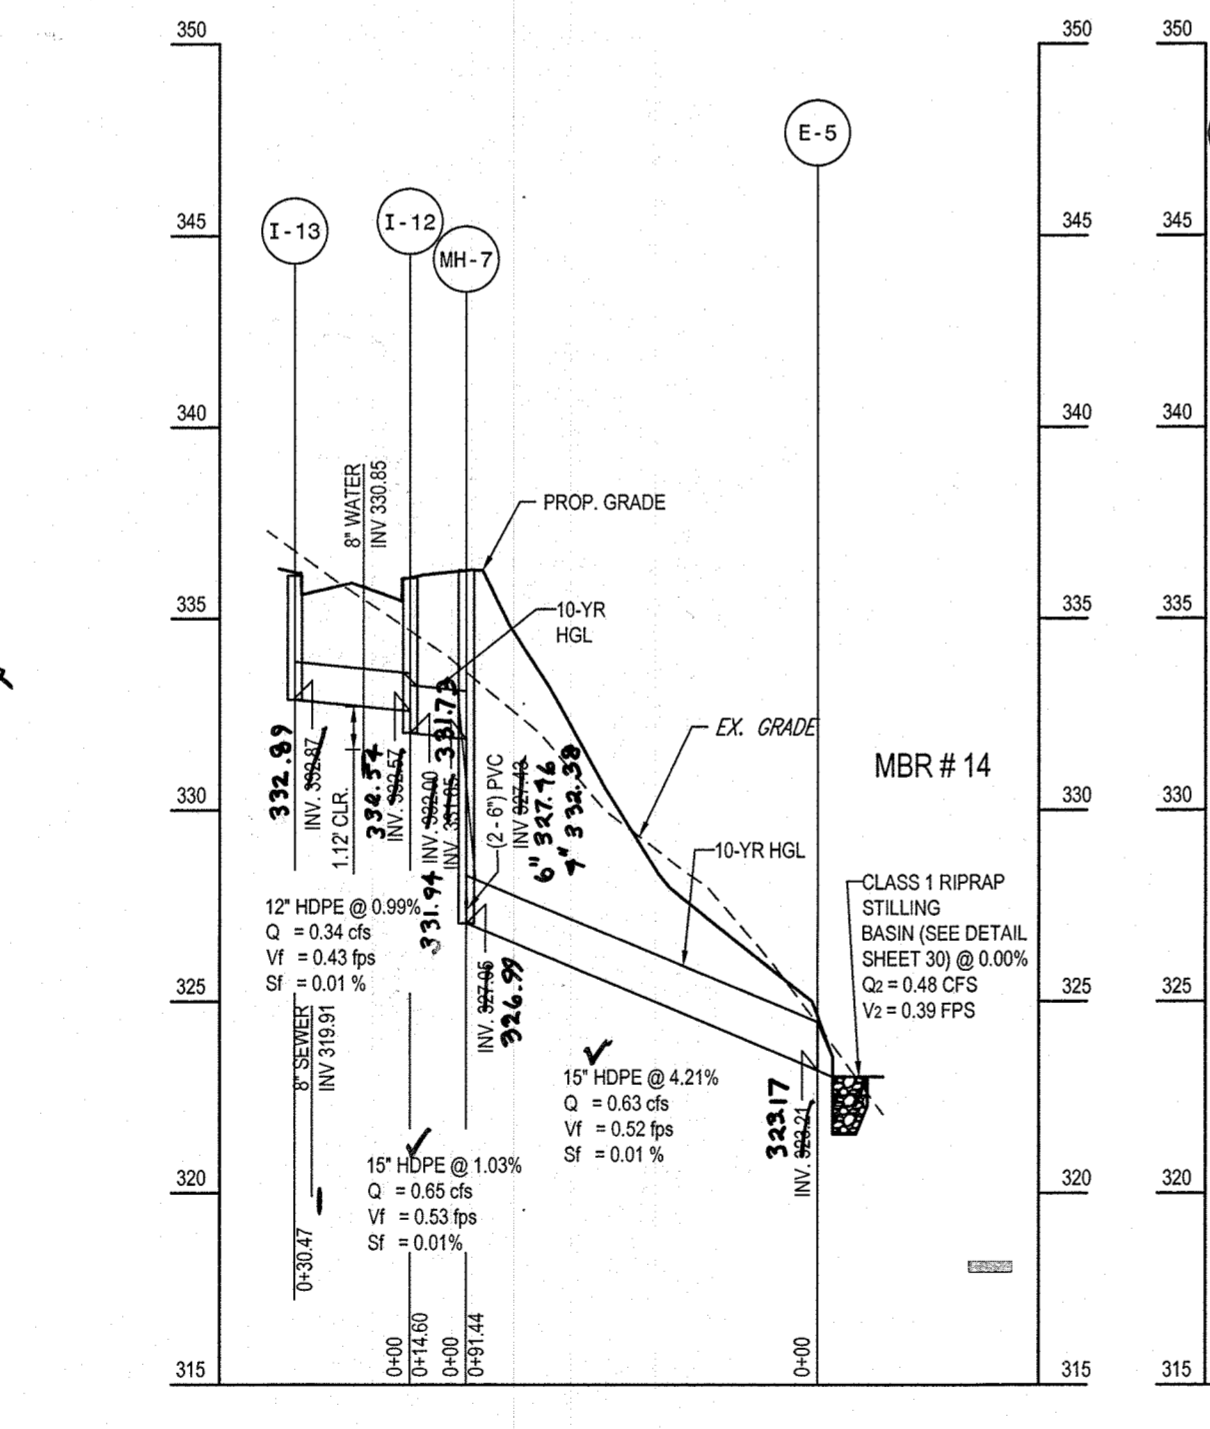


I-13 TO E-5 STORM DRAIN PROFILE
SCALE: 1"=50' HORIZONTAL
1"=5' VERTICAL

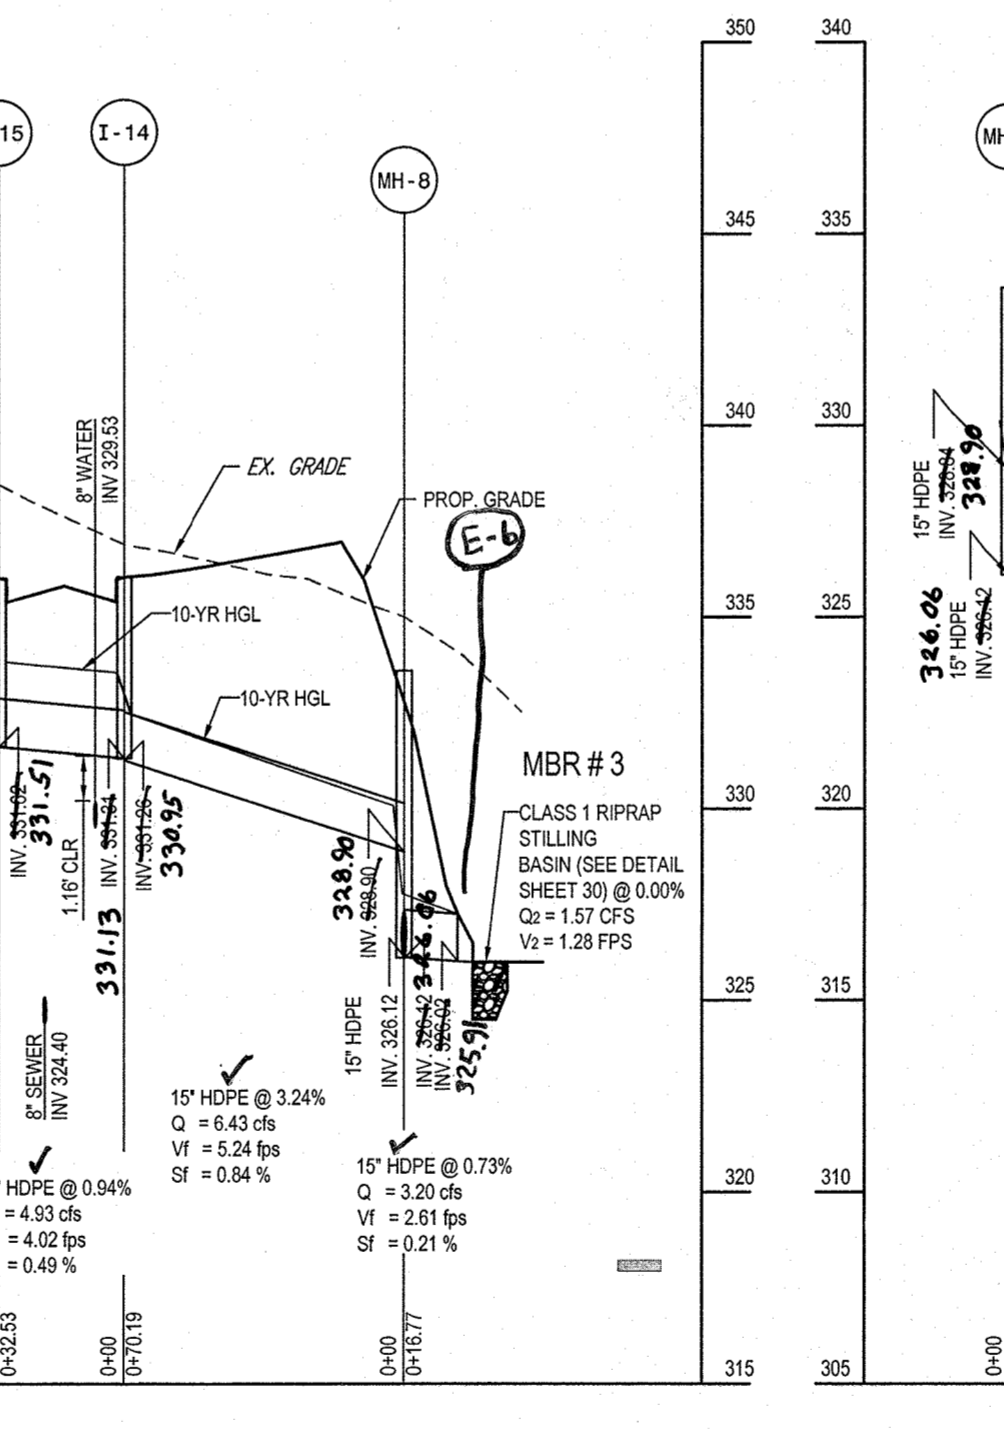

I-15 TO E-6 STORM DRAIN PROFILE
SCALE: 1"=50' HORIZONTAL
1"=5' VERTICAL

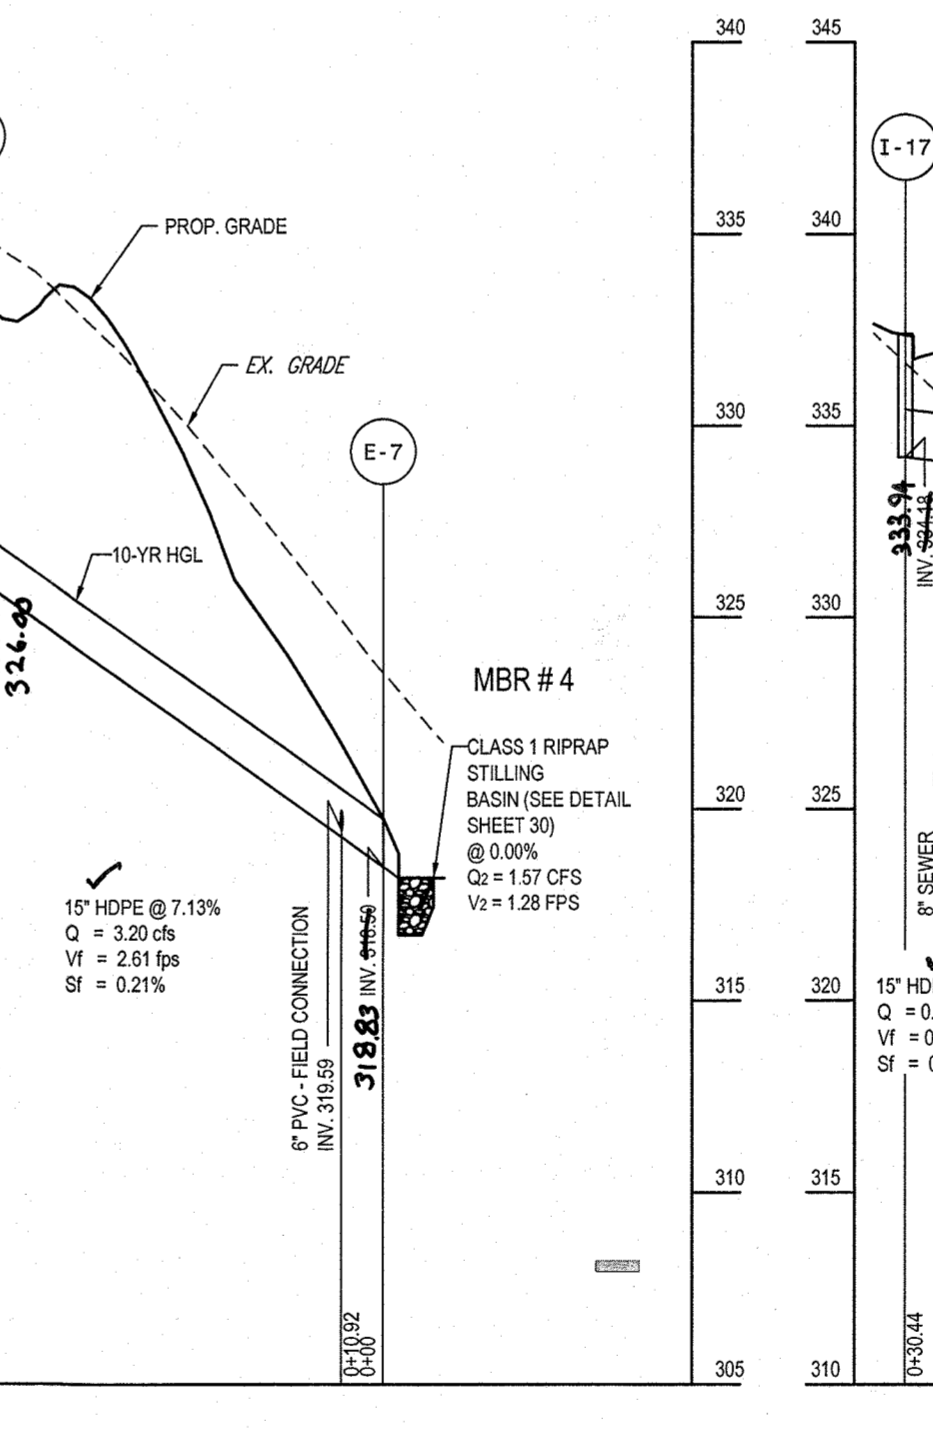

MH-8 TO E-7 STORM DRAIN PROFILE
SCALE: 1"=50' HORIZONTAL
1"=5' VERTICAL

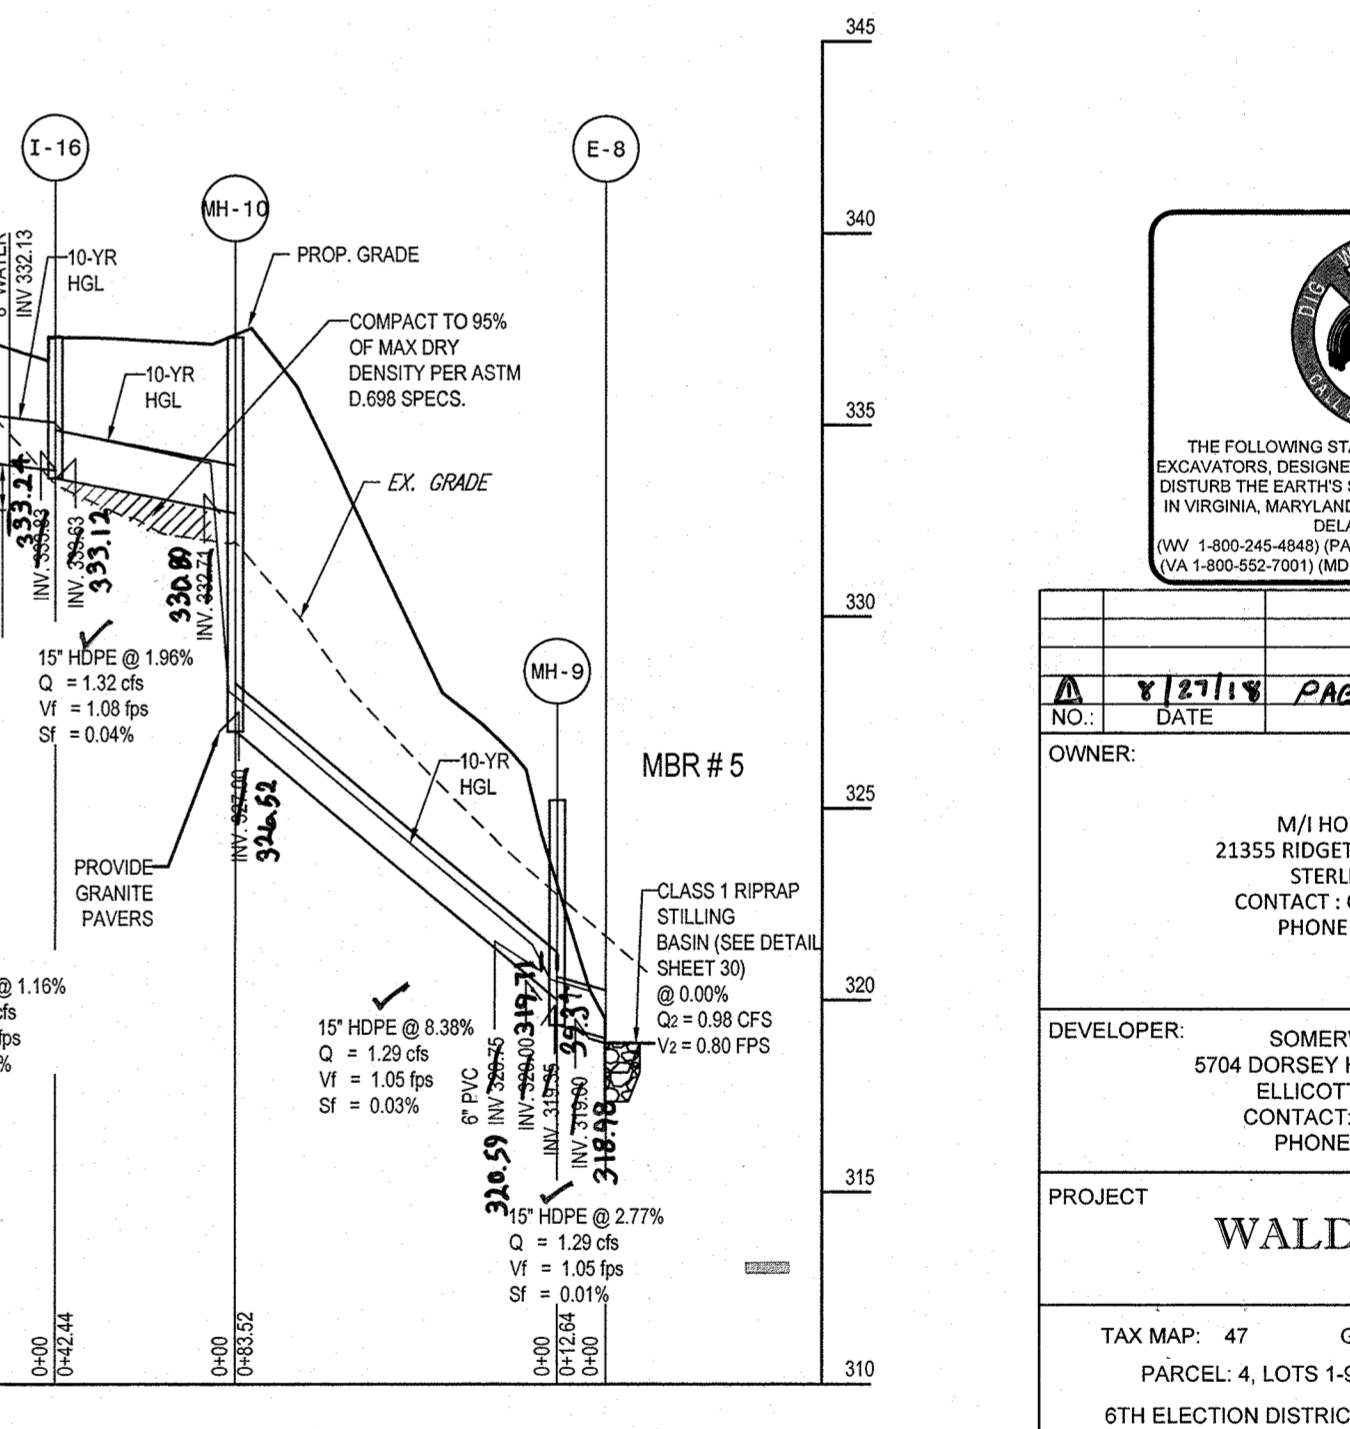

I-17 TO E-8 STORM DRAIN PROFILE
SCALE: 1"=50' HORIZONTAL
1"=5' VERTICAL

APPROVED
PLANNING BOARD OF HOWARD COUNTY
DATE **08/06**
DATE **10/08/2014**
APPROVED: DEPARTMENT OF PLANNING AND ZONING
Chad E. ... 4-17-14
CHIEF-DEVELOPMENT ENGINEERING DIVISION
J. ... 12-22-14
CHIEF-DIVISION OF LAND DEVELOPMENT
...

AS-BUILT CERTIFICATE
I HEREBY CERTIFY THAT THE INFORMATION SHOWN ON THIS PLAN IS ACCURATE AND CORRECT AS SHOWN ON THE FIELD.
...
PROFESSIONAL LAND SURVEYOR
NO. 10849
EXPIRES 12/31/2015

STATE OF MARYLAND
ENGINEER
...
10/3/10
FOR REVISION 3 ONLY
NOTE: CLASS 3 BACKFILL TO BE USED FOR PIPE INSTALLATION UNLESS OTHERWISE NOTED.

PROFESSIONAL CERTIFICATION
I, BRANDON R. ROWE, HEREBY CERTIFY THAT THESE DOCUMENTS WERE PREPARED OR APPROVED BY ME, AND THAT I AM A DULY LICENSED PROFESSIONAL ENGINEER UNDER THE LAWS OF THE STATE OF MARYLAND. LICENSE NO. 48088, EXPIRATION DATE: 7/31/15

THE FOLLOWING STATES REQUIRE NOTIFICATION BY EXCAVATORS, DESIGNERS, OR ANY PERSON PREPARING TO DISTURB THE EARTH'S SURFACE ANYWHERE IN THE STATE OF VIRGINIA, MARYLAND, THE DISTRICT OF COLUMBIA, AND DELAWARE CALL - 811 (TOLL FREE 1-800-485-4848) OR 1-800-240-3700 (DC 1-800-257-7777) (VA 1-800-552-7001) (MD 1-800-257-7777) (DE 1-800-282-8556)

NO.	DATE	PAGE NUMBER	UPDATE	REVISION DESCRIPTION
1		1		

OWNER: M/I HOMES OF DC, LLC
21355 RIDGETOP CIRCLE, SUITE 220
STERLING, VA 20156
CONTACT: CINDY HUNTZBERG
PHONE: 443-677-9803


DEVELOPER: SOMERWORTH II, L.C.
5704 DORSEY HALL DRIVE, SUITE 205
ELLCOTT CITY, MD 21042
CONTACT: JASON VAN KIRK
PHONE: (410) 720-3021

PROJECT: WALDEN WOODS
TAX MAP: 47 GRID: 2 ZONED: PSC
PARCEL: 4 LOTS 1-97, OPEN SPACE LOTS 98 - 102
6TH ELECTION DISTRICT, HOWARD COUNTY, MARYLAND


TITLE: STORM DRAIN PROFILE

BOHLER ENGINEERING
901 DULANEY VALLEY ROAD, SUITE 801
TOWSON, MARYLAND 21284
Phone: (410) 821-7900
Fax: (410) 821-7987
www.BohlerEngineering.com


CHECKED BY: BRR
DESIGNED BY: BRR
DRAWN BY: RMS/AVG
PROJECT NO.: MD112149
DATE: 10/27/14
SCALE: 1"=50'
DRAWING NO. 20 OF 35

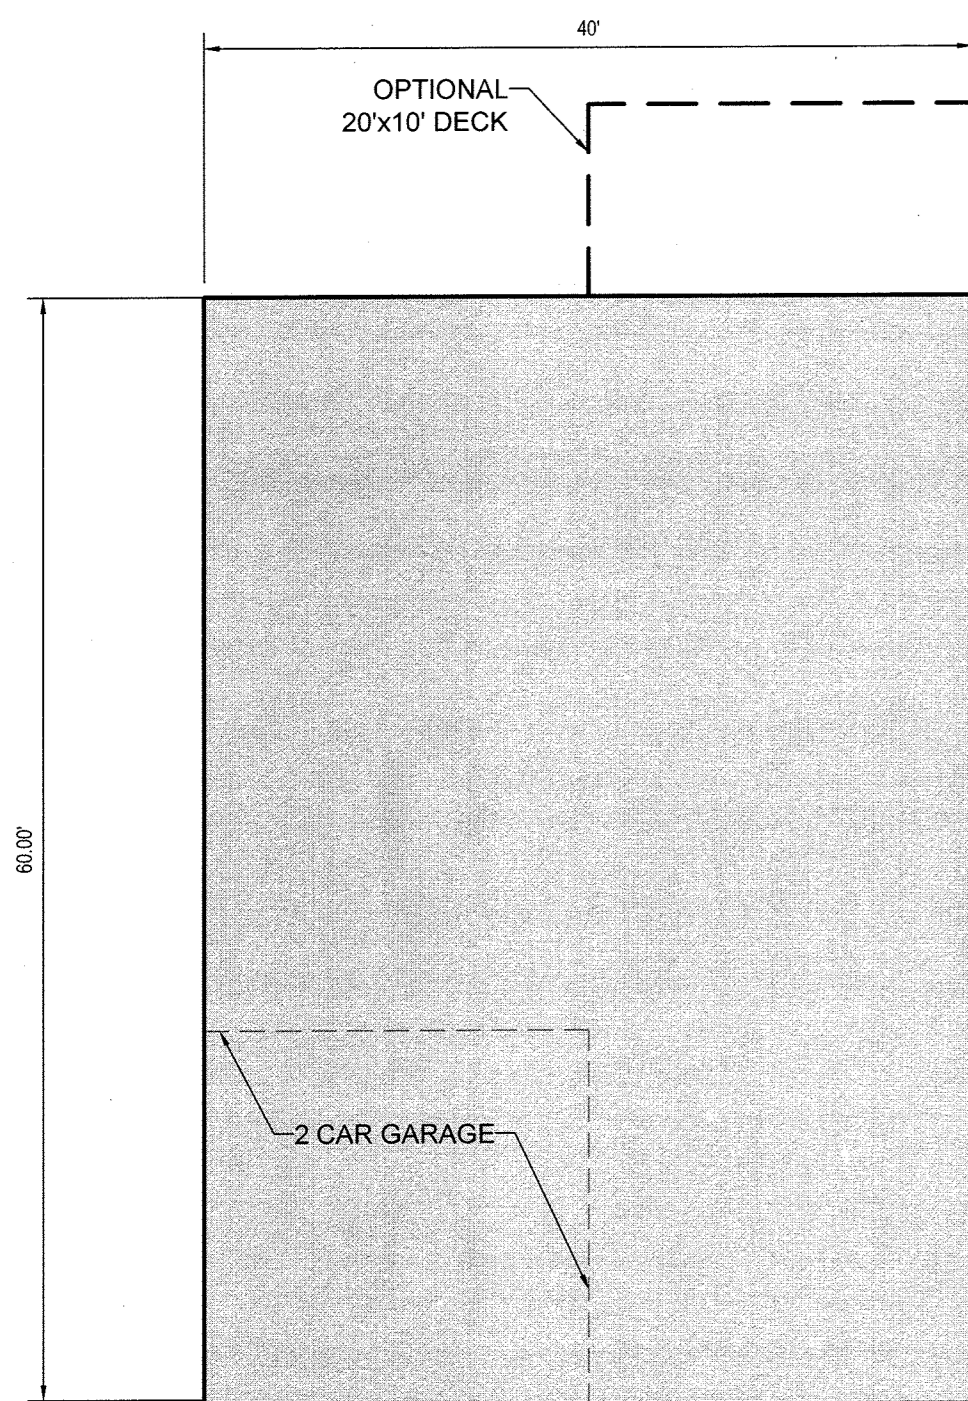

GENERIC BOX 'A'
SINGLE FAMILY DETACHED
SCALE: 1" = 10'

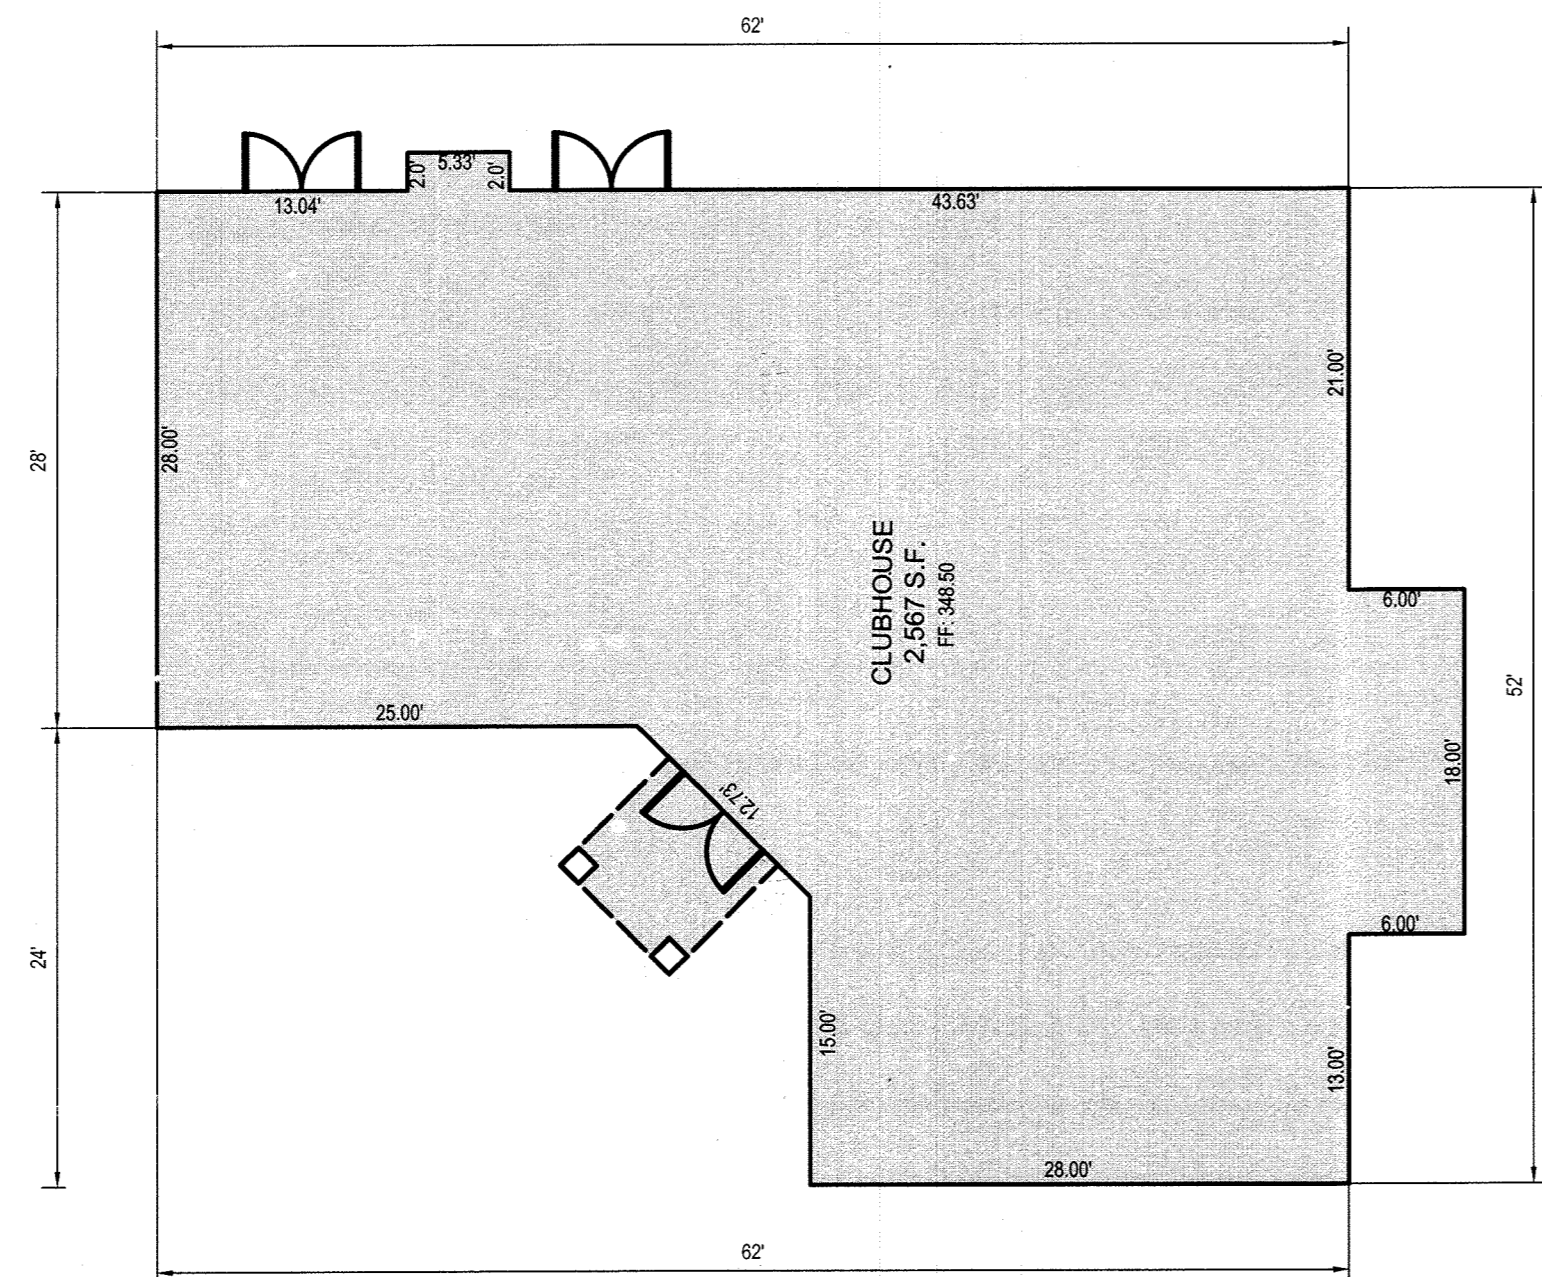


COMMUNITY CENTER
SCALE: 1" = 10'

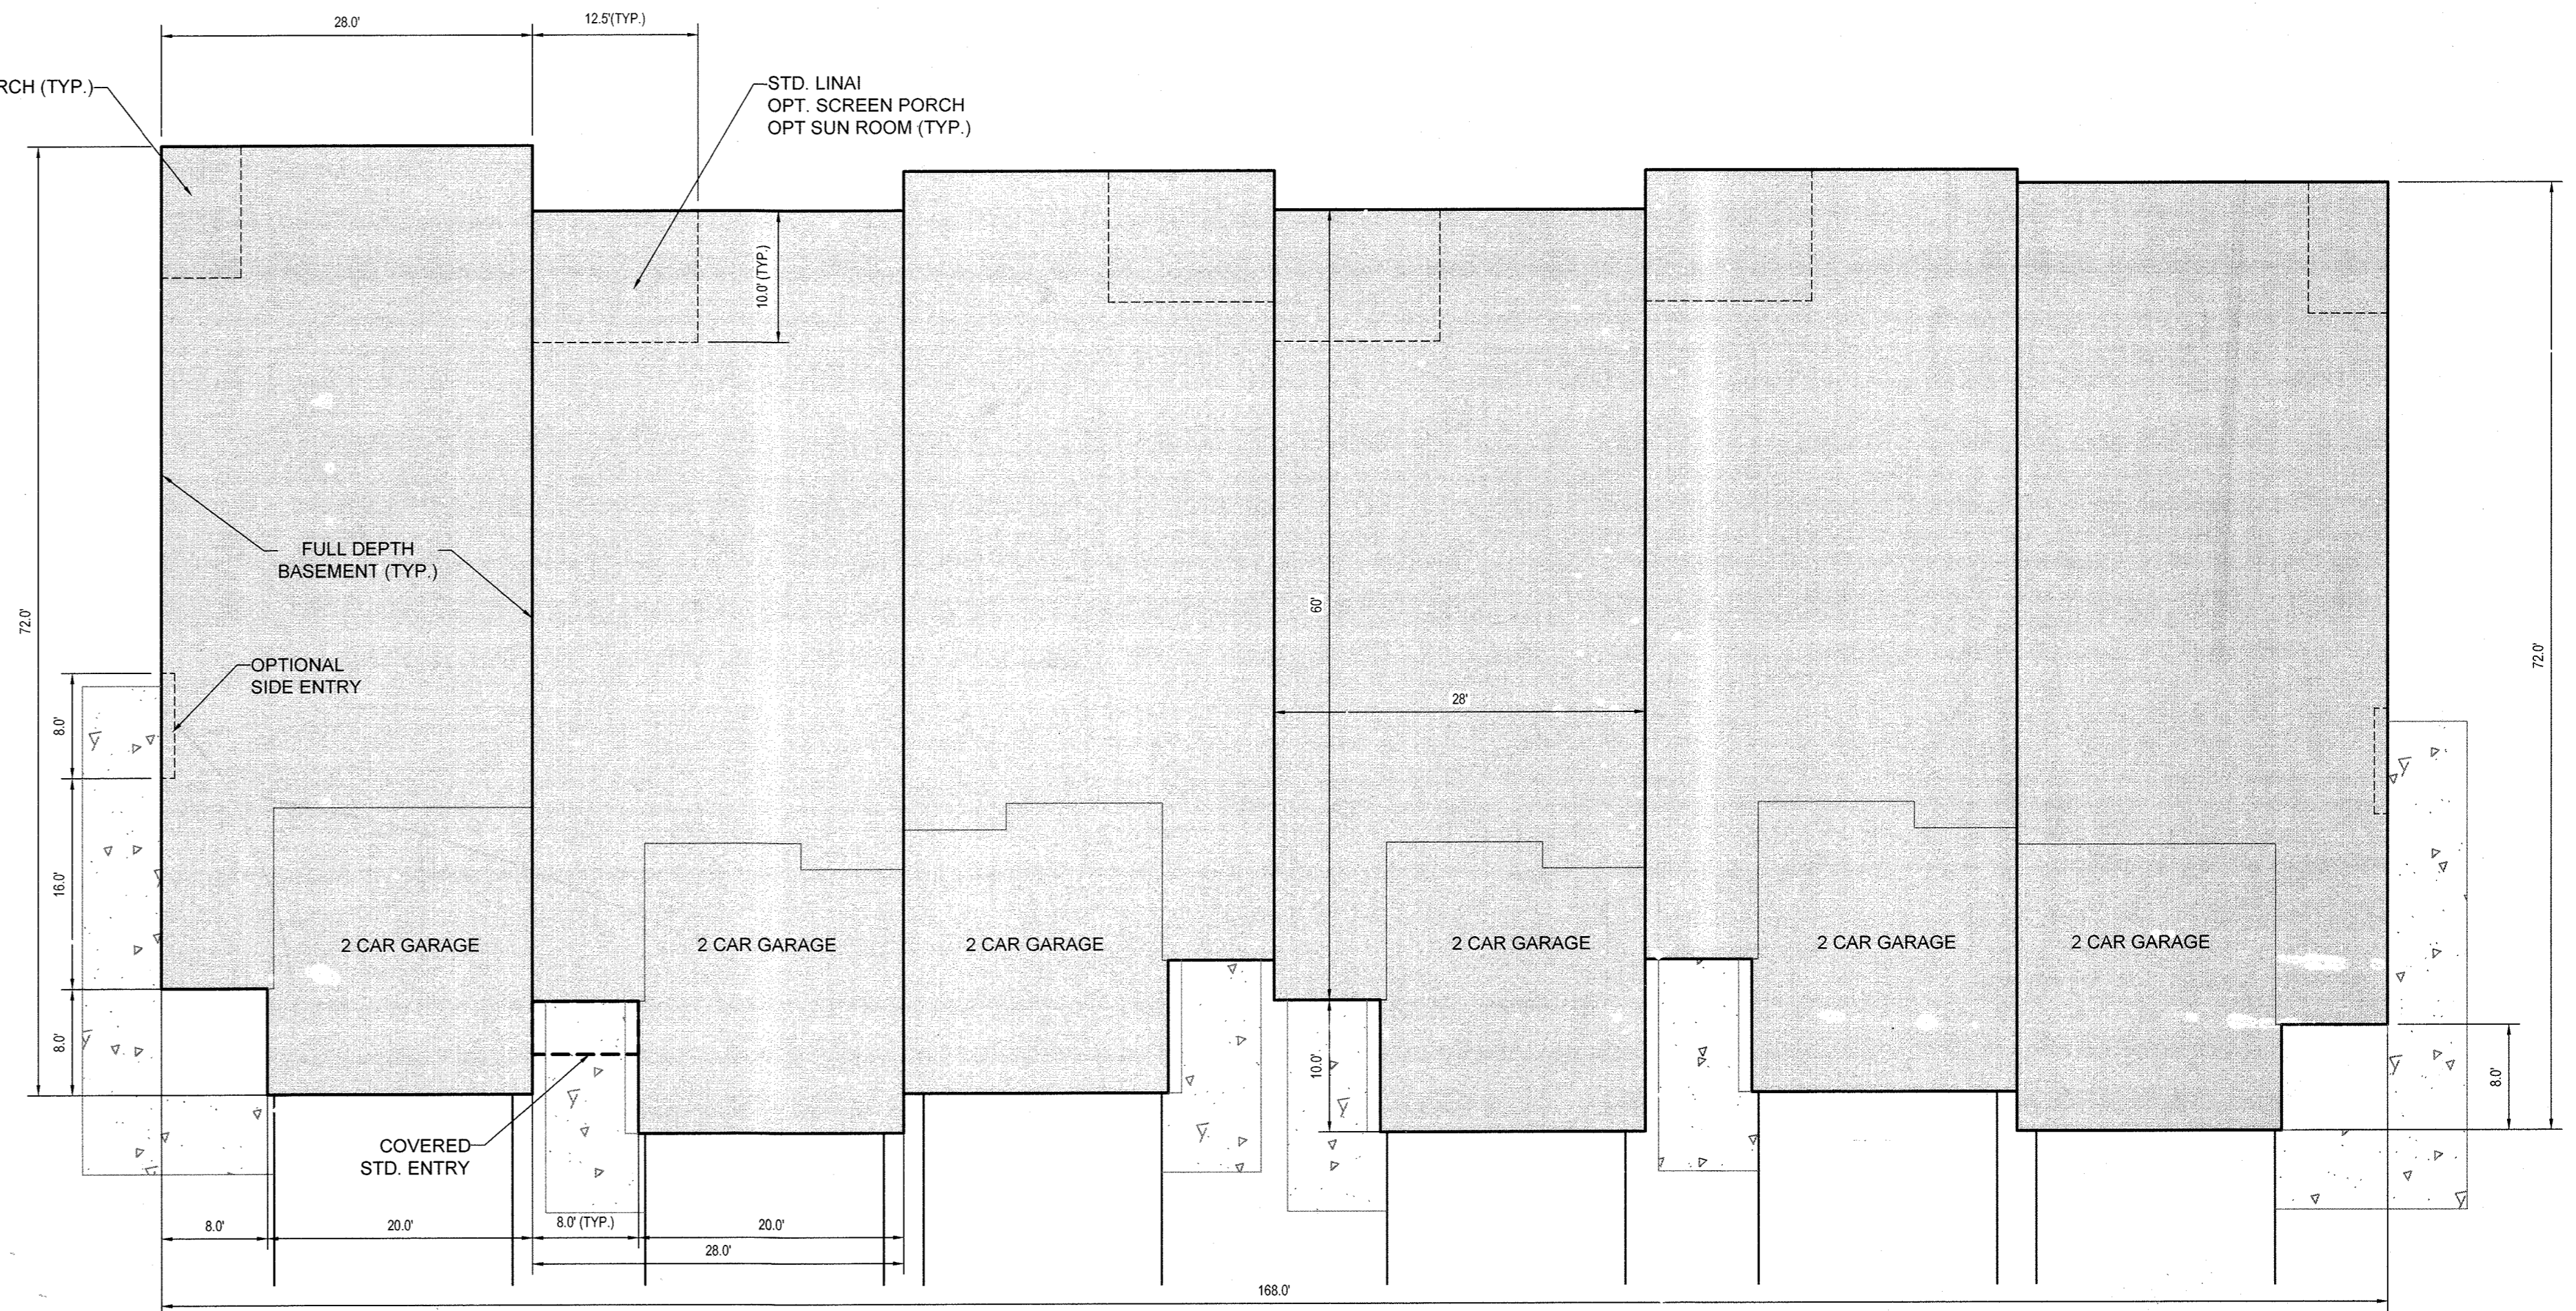


SINGLE FAMILY ATTACHED
SCALE: 1" = 10'

* LOTS 52, 58, AND 80 HAVE MODIFIED BUILDING FOOTPRINTS

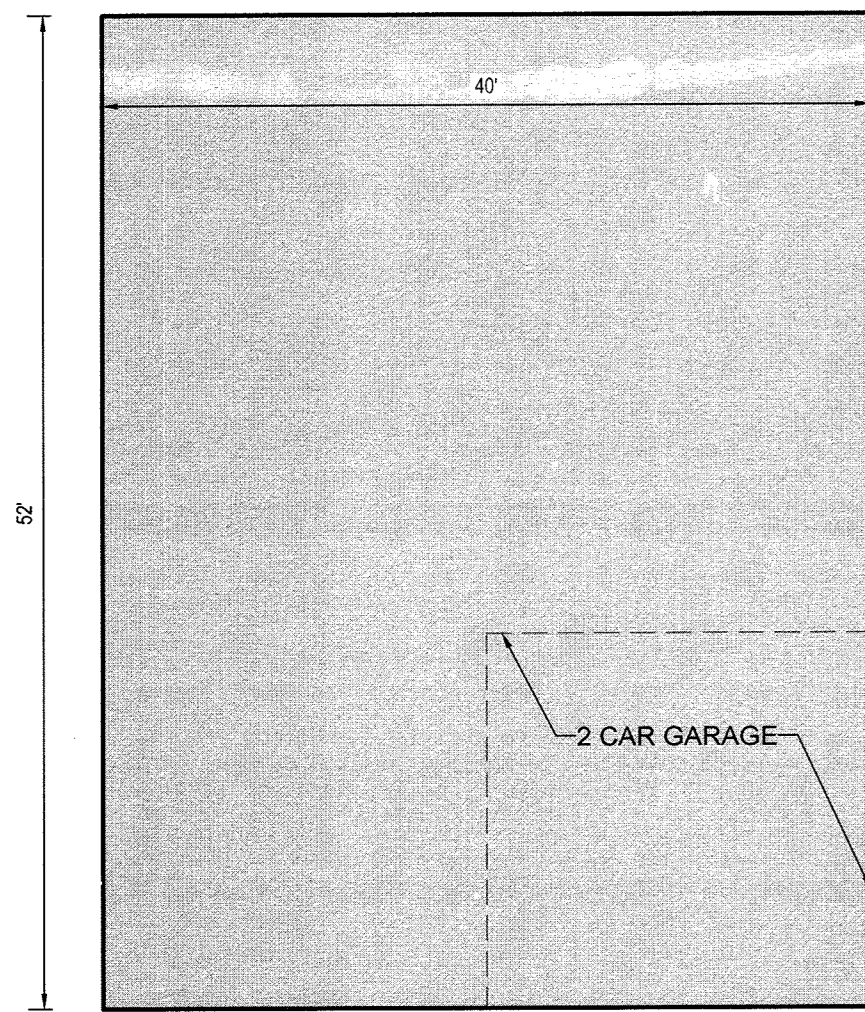


GENERIC BOX 'B'
SINGLE FAMILY DETACHED
SCALE: 1" = 10'

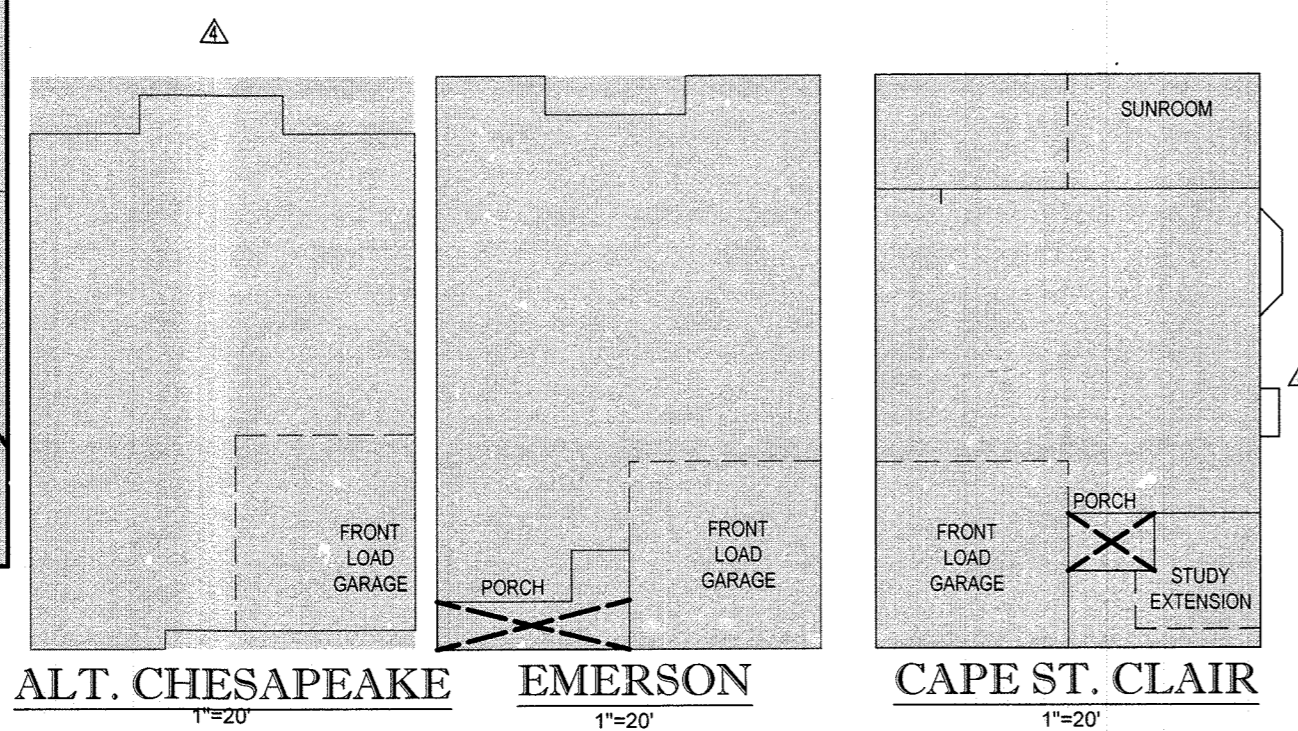


ALT. CHESAPEAKE
SCALE: 1" = 20'

EMERSON
SCALE: 1" = 20'

CAPE ST. CLAIR
SCALE: 1" = 20'

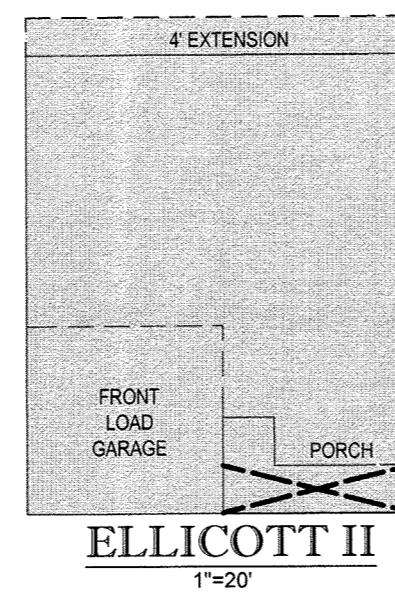

ELLICOTT II
SCALE: 1" = 20'

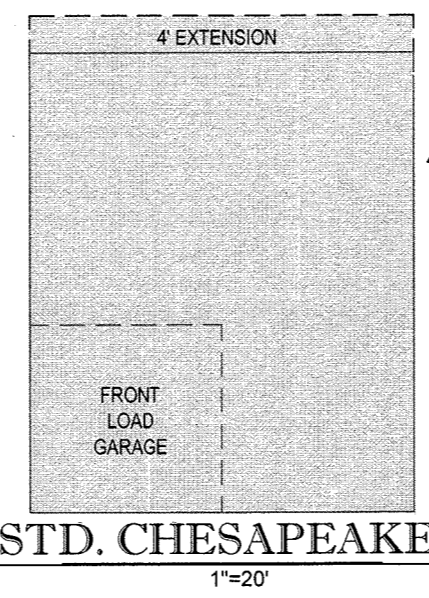

STD. CHESAPEAKE
SCALE: 1" = 20'

GENERIC FOOTPRINT	HOUSE OPTIONS							
	UNIT NAME							
	STD. CHESAPEAKE		ELLICOTT II		CAPE ST. CLAIR		EMERSON	
BASE	4' EXTENSION	BASE	4' EXTENSION	BASE	SUNROOM	STUDY EXTENSION	BASE	
A	Y	Y	Y	Y	Y	Y	Y	
B	Y	Y	Y	Y	Y	N	Y	

GENERIC FOOTPRINT	UNIT NAME
A	ALT. CHESAPEAKE
B	BASE



8/17/16 REVISION TO ADD ALT CHESAPEAKE FOOTPRINT
1/20/16 REVISION TO REVISE SFD GENERIC FOOTPRINT AND FF/ICE ELEVATIONS

NO.	DATE	REVISION DESCRIPTION
7/18/16		REVISED CHESAPEAKE FOOTPRINT
1/20/16		REVISED SFD GENERIC FOOTPRINT
10/27/15		UPDATED GRADING FOR LOTS 17 - 20
8/31/15		REVISED CLUBHOUSE/COMMUNITY CENTER

OWNER:
M/I HOMES OF DC, LLC
21355 RIDGETOP CIRCLE, SUITE 220
STERLING, VA 20156
CONTACT: CINDY HUNTZBERRY
PHONE: 443-677-9803

DEVELOPER:
SOMERWORTH II, L.C.
5704 DORSEY HALL DRIVE, SUITE 205
ELLICOTT CITY, MD 21042
CONTACT: JASON VAN KIRK
PHONE: (410) 720-3021

PROJECT:
REVISED SITE DEVELOPMENT PLAN
WALDEN WOODS


TAX MAP: 47 GRID: 2 ZONED: PSC
PARCEL: 4, LOTS 1-97, OPEN SPACE LOTS 98 - 102
6TH ELECTION DISTRICT, HOWARD COUNTY, MARYLAND

TITLE:
BUILDING ELEVATIONS
AND FOOT PRINTS

BOHLER ENGINEERING
901 DULANEY VALLEY ROAD, SUITE 801
TOWSON, MARYLAND 21284
Phone: (410) 821-7900
Fax: (410) 821-7987
www.BohlerEngineering.com



SINGLE FAMILY DETACHED - FRONT ELEVATION
NOT TO SCALE

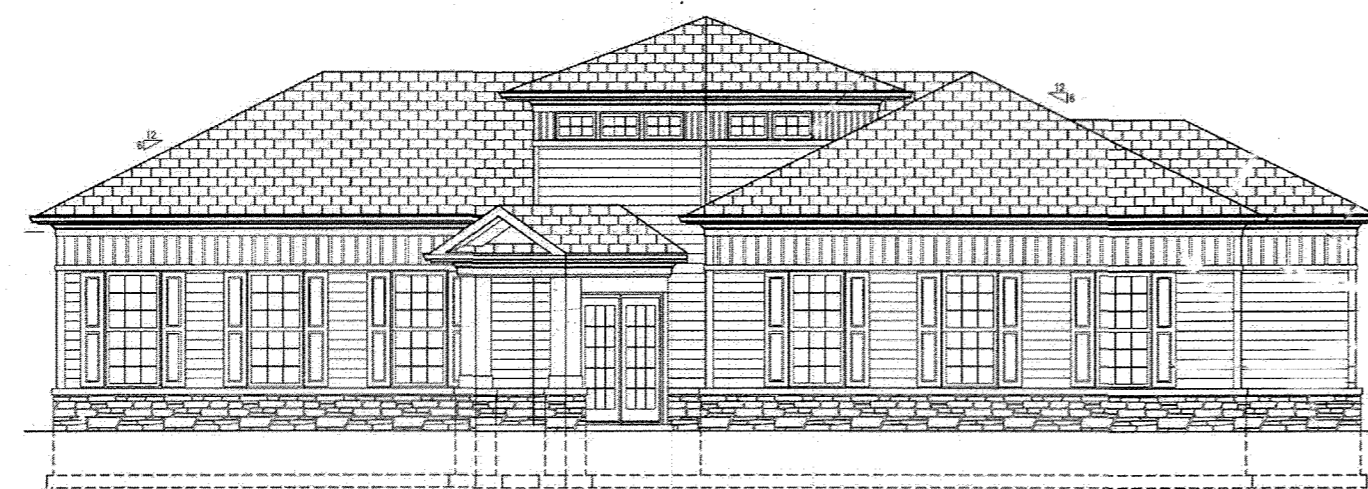


COMMUNITY CENTER - SIDE ELEVATION
NOT TO SCALE



SINGLE FAMILY ATTACHED - FRONT ELEVATION
NOT TO SCALE

APPROVED: DEPARTMENT OF PLANNING AND ZONING
DATE: 9-22-16
CHIEF-DEVELOPMENT ENGINEERING DIVISION


APPROVED: PLANNING BOARD OF HOWARD COUNTY
DATE: 10/08/2014
DATE: 9-26-16
DATE: 9-20-16
DATE: PB 406 DAA

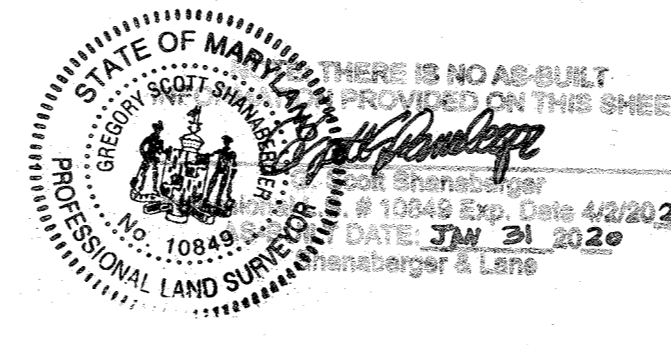

8/31/15 REVISION TO UPDATE CLUBHOUSE/COMMUNITY CENTER AND SURROUNDING AREA.

PROFESSIONAL CERTIFICATION
I, BRANDON R. ROWE, HEREBY CERTIFY THAT THESE DOCUMENTS WERE PREPARED OR APPROVED BY ME, AND THAT I AM A DULY LICENSED PROFESSIONAL ENGINEER UNDER THE LAWS OF THE STATE OF MARYLAND, LICENSE NO. 40808, EXPIRATION DATE: 7/31/15.

CHECKED BY:	BRR
DESIGNED BY:	BRR
DRAWN BY:	RMS/AVG
PROJECT NO.:	MD112149
DATE:	10/27/14
SCALE:	AS NOTED
DRAWING NO.:	21 OF 36

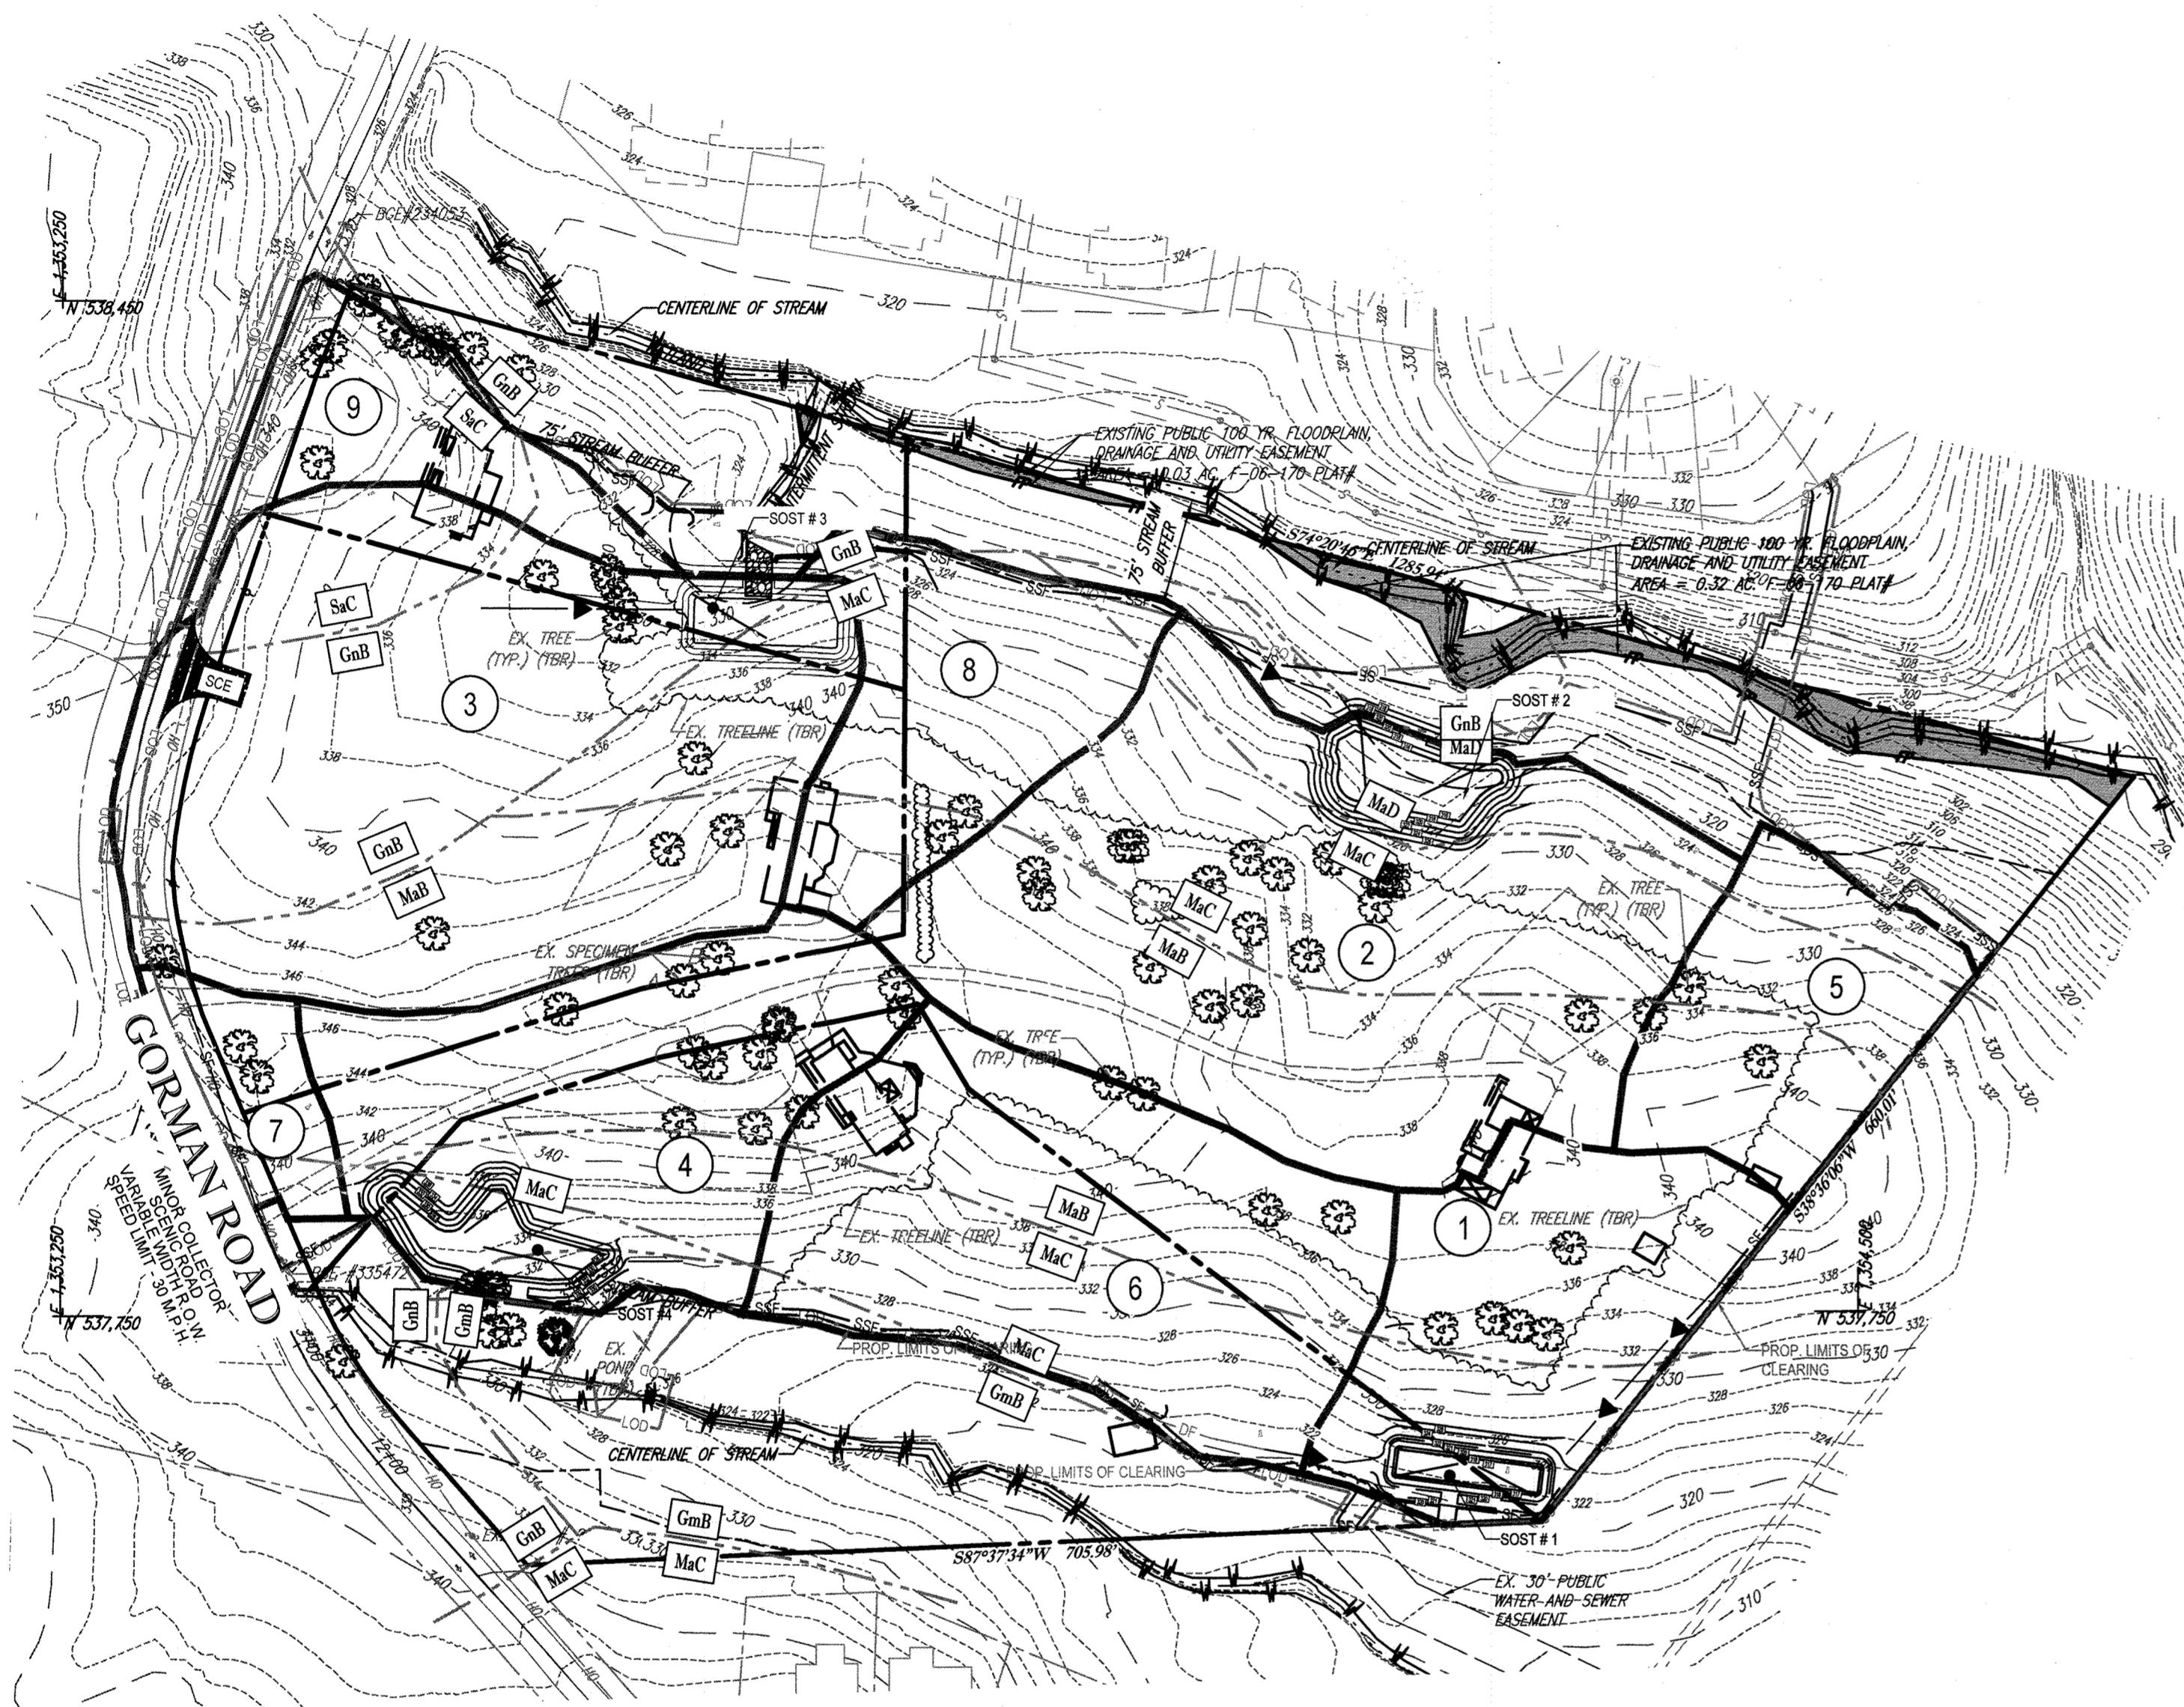

PREDEVELOPMENT DRAINAGE AREAS TO EROSION AND SEDIMENT CONTROL MEASURES

SCALE: 1"=100'

- 1 AREA 1 - SEDIMENT TRAP # 1
TOTAL AREA = 1.27 AC
- 2 AREA 2 - SEDIMENT TRAP # 2
TOTAL AREA = 3.17 AC
- 3 AREA 3 - SEDIMENT TRAP # 3
TOTAL AREA = 3.10 AC
- 4 AREA 4 - SEDIMENT TRAP # 4
TOTAL AREA = 1.80 AC
- 5 AREA 5 - SUPER SILT FENCE
TOTAL AREA = 0.83 AC
- 6 AREA 6 - SUPER SILT FENCE
TOTAL AREA = 2.00 AC
- 7 AREA 7 - SUPER SILT FENCE
TOTAL AREA = 0.33 AC
- 8 AREA 8 - SUPER SILT FENCE
TOTAL AREA = 1.11 AC
- 9 AREA 9 - SUPER SILT FENCE
TOTAL AREA = 0.66 AC

LEGEND



- DRAINAGE DIVIDE
- DRAINAGE AREA LABEL



POSTDEVELOPMENT DRAINAGE AREAS TO EROSION AND SEDIMENT CONTROL MEASURES

SCALE: 1"=100'

- 1 AREA 1 - SEDIMENT TRAP # 1
TOTAL AREA = 2.0 AC
- 2 AREA 2 - SEDIMENT TRAP # 2
TOTAL AREA = 3.2 AC
- 3 AREA 3 - SEDIMENT TRAP # 3
TOTAL AREA = 0.85 AC
- 3A AREA 3A - SEDIMENT TRAP # 3A
TOTAL AREA = 1.80 AC
- 4 AREA 4 - SEDIMENT TRAP # 4
TOTAL AREA = 1.93 AC
- 5 AREA 5 - SUPER SILT FENCE
TOTAL AREA = 1.27 AC
- 6 AREA 6 - SUPER SILT FENCE
TOTAL AREA = 1.34 AC
- 7 AREA 7 - SUPER SILT FENCE
TOTAL AREA = 0.37 AC
- 8 AREA 8 - SUPER SILT FENCE
TOTAL AREA = 0.50 AC
- 9 AREA 9 - SUPER SILT FENCE
TOTAL AREA = 0.32 AC
- 10 AREA 10 - SEDIMENT CIP
TOTAL AREA = 0.35 AC

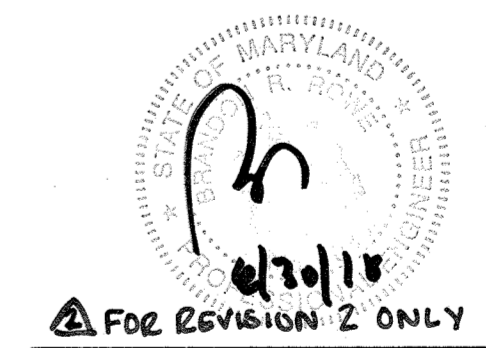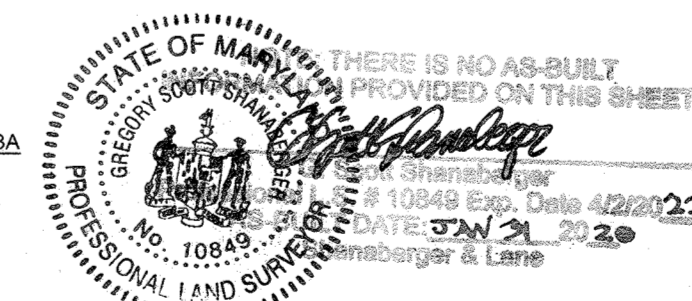

8/31/15 REVISION TO UPDATE CLUBHOUSE/COMMUNITY CENTER AND SURROUNDING AREA.

ENGINEER'S CERTIFICATE


"I HEREBY CERTIFY THAT THIS PLAN FOR EROSION AND SEDIMENT CONTROL REPRESENTS A PRACTICAL AND WORKABLE PLAN BASED ON MY PERSONAL KNOWLEDGE OF THE SITE CONDITIONS AND IT WAS PREPARED IN ACCORDANCE WITH THE REQUIREMENTS OF THE HOWARD SOIL CONSERVATION DISTRICT."

SIGNATURE OF ENGINEER _____ DATE _____


DEVELOPER'S CERTIFICATE

"I/WE HEREBY CERTIFY THAT ALL DEVELOPMENT AND CONSTRUCTION WILL BE DONE ACCORDING TO THIS PLAN, AND THAT ANY RESPONSIBLE PERSONNEL INVOLVED IN THE CONSTRUCTION PROJECT WILL HAVE A CERTIFICATE OF ATTENDANCE AT A DEPARTMENT OF THE ENVIRONMENT APPROVED TRAINING PROGRAM FOR THE CONTROL OF SEDIMENT AND EROSION BEFORE BEGINNING THE PROJECT. I ALSO AUTHORIZE PERIODIC ONSITE INSPECTION BY THE HOWARD SOIL CONSERVATION DISTRICT."

SIGNATURE OF DEVELOPER _____ DATE _____

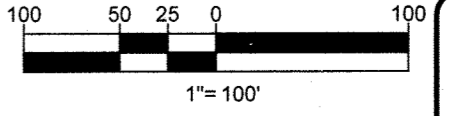

PROFESSIONAL CERTIFICATION
BRANDON R. ROWE, HEREBY CERTIFY THAT THESE DOCUMENTS WERE PREPARED OR APPROVED BY ME, AND THAT I AM A DULY LICENSED PROFESSIONAL ENGINEER UNDER THE LAWS OF THE STATE OF MARYLAND. LICENSE NO. 40808, EXPIRATION DATE: 7/31/15.

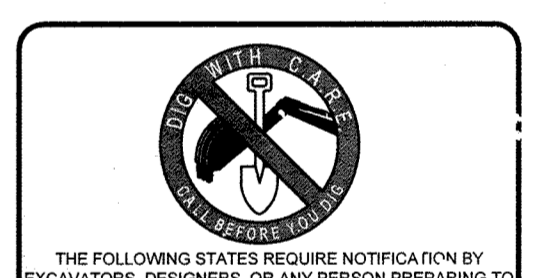

THE FOLLOWING STATES REQUIRE NOTIFICATION BY EXCAVATORS, DESIGNERS, OR ANY PERSON PREPARING TO DISTURB THE EARTH'S SURFACE ANYWHERE IN THE STATE: IN VIRGINIA, MARYLAND, THE DISTRICT OF COLUMBIA, AND DELAWARE CALL - 811 (WV 1-800-345-4348; PA 1-800-282-1770; DC 1-800-257-7777; VA 1-800-552-7001; MD 1-800-257-7777; DE 1-800-282-8555)

NO.	DATE	REVISION DESCRIPTION
1	8/31/15	PAGE NUMBER UPDATE
2	8/31/15	REVISED CLUBHOUSE/COMMUNITY CENTER

OWNER: M/I HOMES OF DC, LLC
21355 RIDGETOP CIRCLE, SUITE 220
STERLING, VA 20156
CONTACT: CINDY HUNTZBERRY
PHONE: 443-677-9803

DEVELOPER: SOMERWORTH II, L.C.
5704 DORSEY HALL DRIVE, SUITE 205
ELLCOTT CITY, MD 21042
CONTACT: JASON VAN KIRK
PHONE: (410) 720-3021

PROJECT: REVISED SITE DEVELOPMENT PLAN
WALDEN WOODS

TAX MAP: 47 GRID: 2 ZONED: PSC
PARCEL: 4, LOTS 1-97, OPEN SPACE LOTS 98 - 102
6TH ELECTION DISTRICT, HOWARD COUNTY, MARYLAND

TITLE: DRAINAGE AREAS TO EROSION AND SEDIMENT CONTROL MEASURES



901 DULANEY VALLEY ROAD, SUITE 801
TOWSON, MARYLAND 21284
Phone: (410) 821-7900
Fax: (410) 821-7987
www.BohlerEngineering.com


CHECKED BY: BRR
DESIGNED BY: BRR
DRAWN BY: RMS/AVG
PROJECT NO.: MD112149
DATE: 10/27/14
SCALE: 1"=100'
DRAWING NO.: 22 OF 35

APPROVED
PLANNING BOARD OF HOWARD COUNTY
AB406
DATE **10/08/2014**

APPROVED: DEPARTMENT OF PLANNING AND ZONING
Paul E. ... 10-21-15
CHIEF-DEVELOPMENT ENGINEERING DIVISION 8 DATE

W. ... 10-23-15
CHIEF-DIVISION OF LAND DEVELOPMENT DATE

W. ... 10-23-15
DIRECTOR DATE

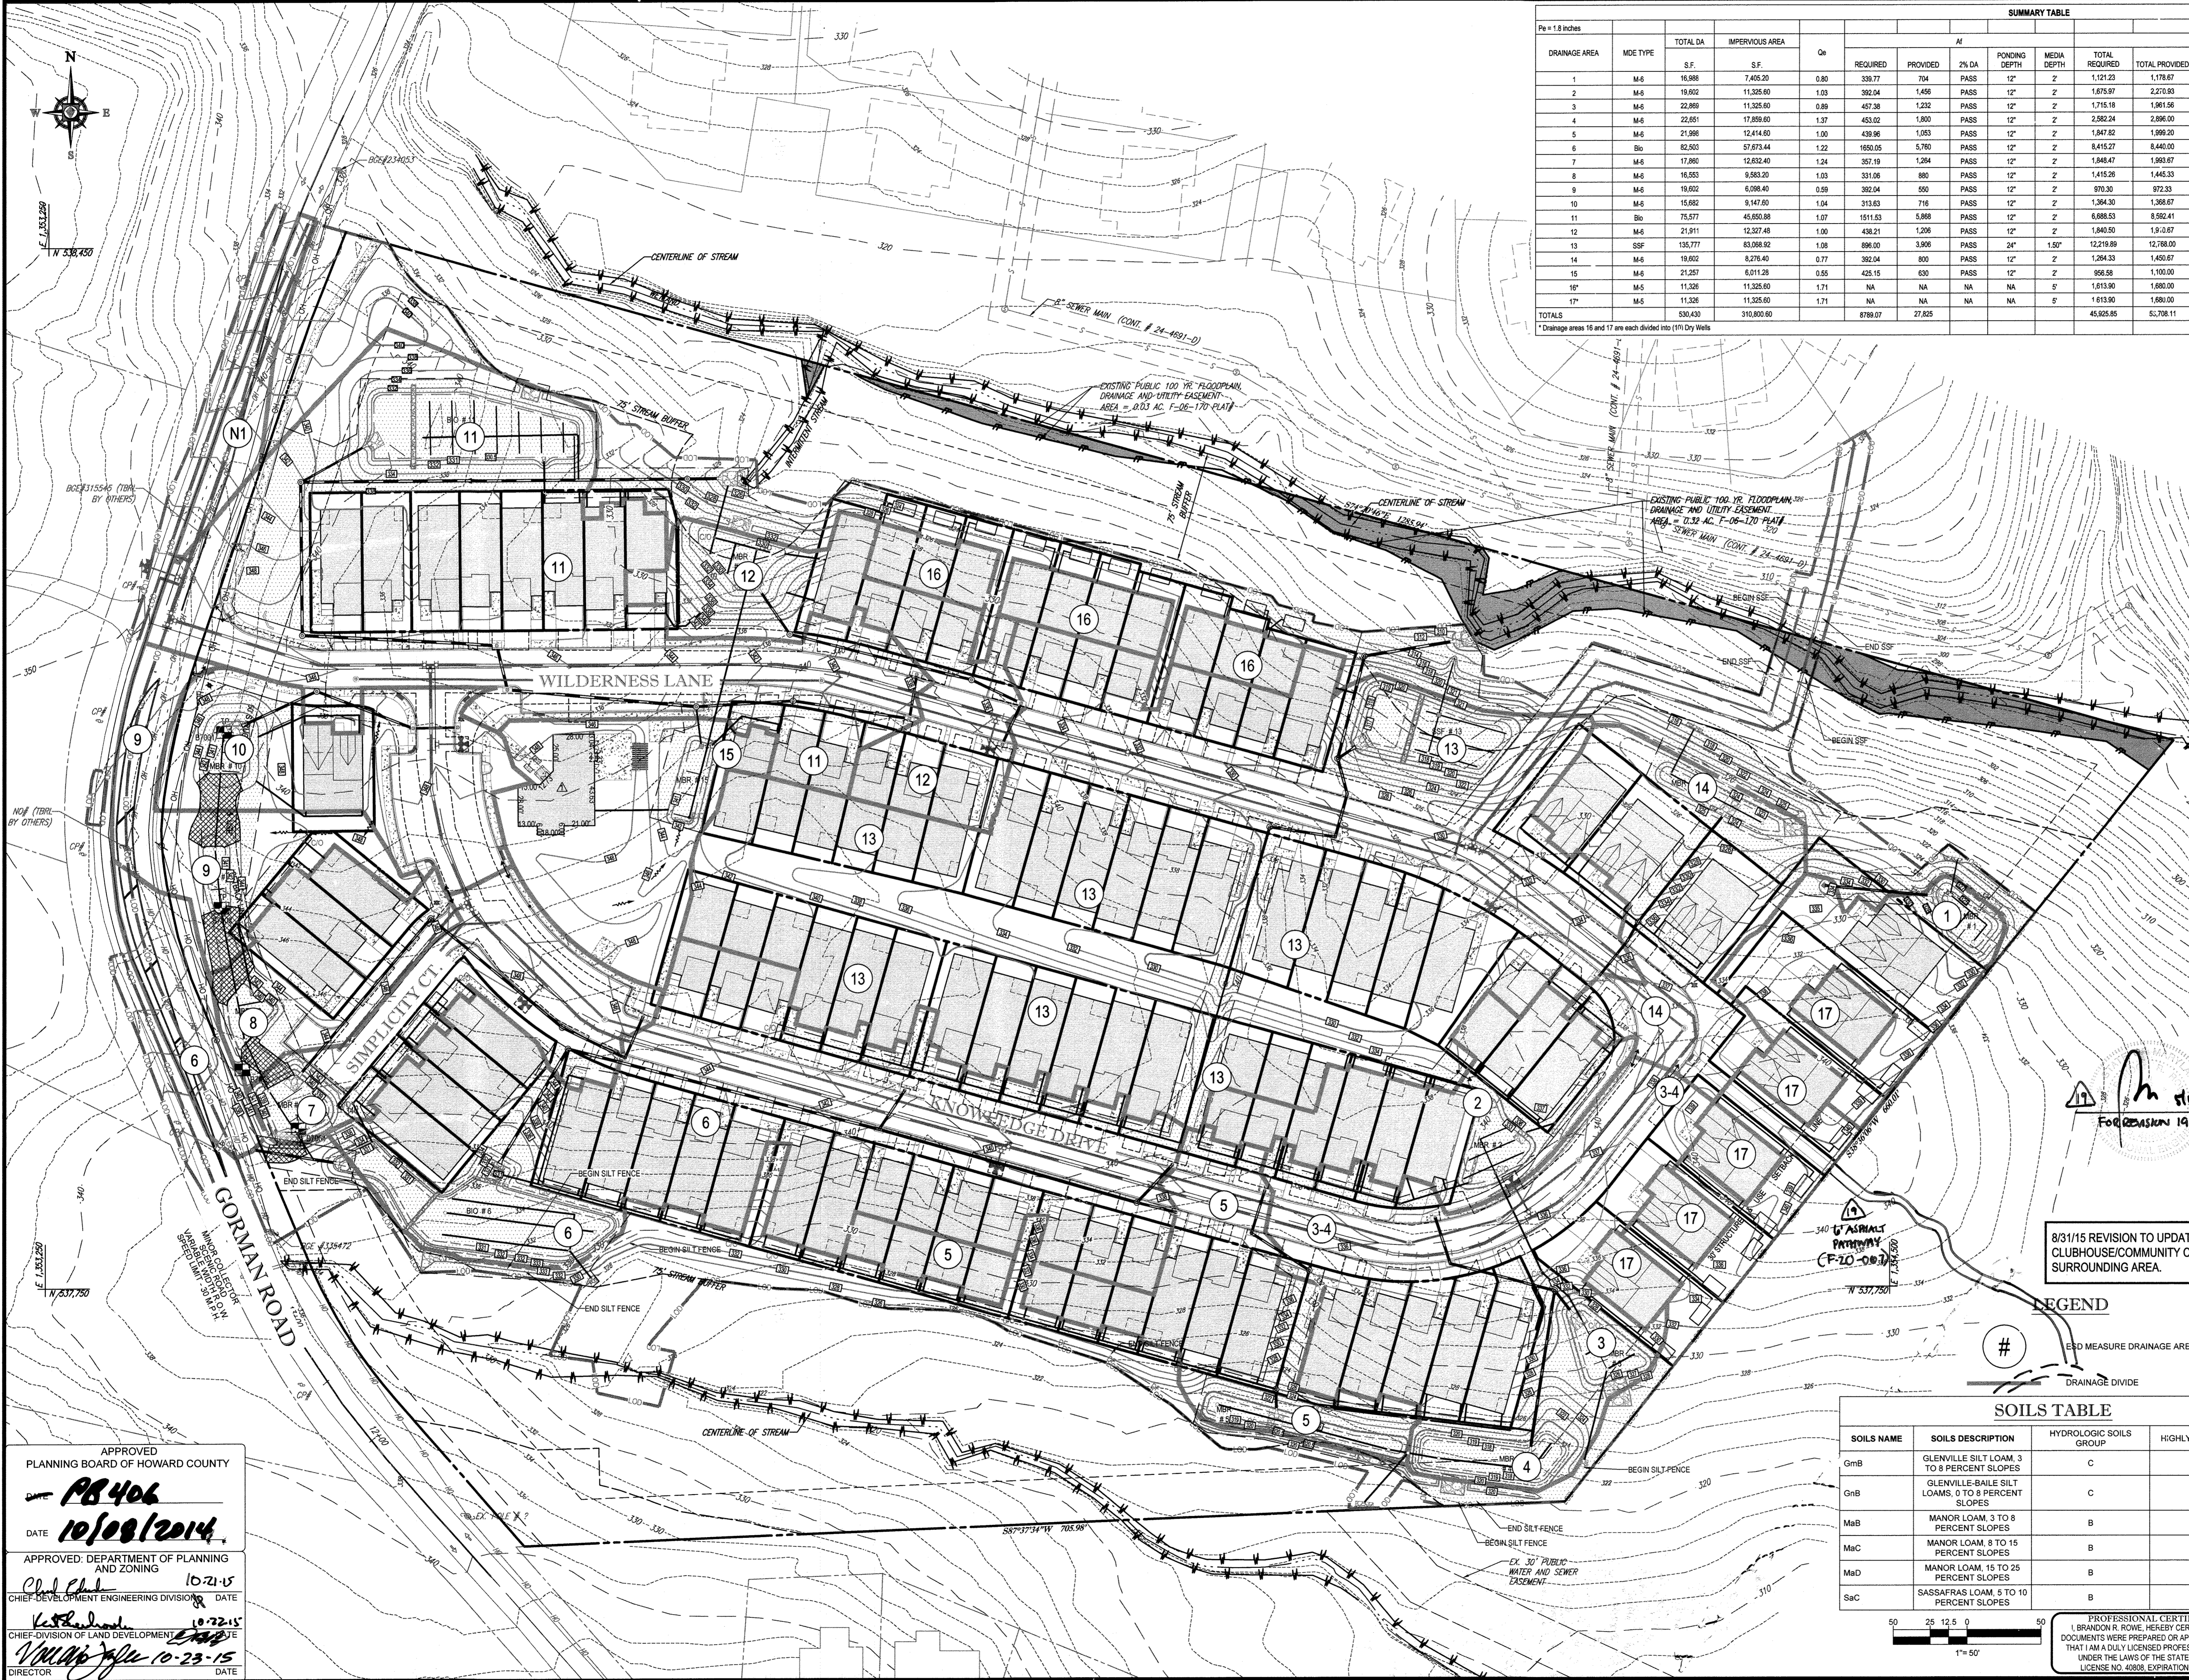

SUMMARY TABLE														Rev			
DRAINAGE AREA	MDE TYPE	TOTAL DA		IMPERVIOUS AREA	Cp	AI		PONDING DEPTH	MEDIA DEPTH	TOTAL REQUIRED	TOTAL PROVIDED	PONDING REQUIRED (75%)	PONDING PROVIDED	75% ESD PROVIDED	Pp PROVIDED	REQUIRED	PROVIDED
		S.F.	%			REQUIRED	PROVIDED									REQUIRED	PROVIDED
1	MA6	16,988	7,405.20	0.80	338.77	704	PASS	12"	2"	1,121.23	1,178.67	840.93	884.00	PASS	1.8"		140.8
2	MA6	19,602	11,325.60	1.03	392.04	1,456	PASS	12"	2"	1,675.97	2,270.93	1,256.98	1,703.20	PASS	2.4"		291.2
3	MA6	22,869	11,325.60	0.86	457.36	1,232	PASS	12"	2"	1,715.16	1,961.56	1,286.38	1,471.17	PASS	2.0"		248.4
4	MA6	22,651	17,859.60	1.37	453.02	1,800	PASS	12"	2"	2,582.24	2,866.00	1,936.68	2,172.00	PASS	2.0"		360.0
5	MA6	21,968	12,414.60	1.00	439.96	1,053	PASS	12"	2"	1,847.82	1,999.20	1,385.86	1,496.40	PASS	1.9"		210.6
6	MA6	82,503	57,873.44	1.22	1,650.05	5,760	PASS	12"	2"	8,415.27	8,440.00	6,311.45	6,330.00	PASS	1.8"		1,152.0
7	MA6	17,860	12,832.40	1.24	357.19	1,264	PASS	12"	2"	1,846.47	1,963.67	1,386.35	1,465.25	PASS	1.9"		252.7
8	MA6	16,553	9,583.20	1.03	331.06	880	PASS	12"	2"	1,415.26	1,445.33	1,061.45	1,094.00	PASS	1.8"		176.0
9	MA6	19,602	6,098.40	0.59	392.04	950	PASS	12"	2"	970.30	972.33	727.72	729.25	PASS	1.8"		110.0
10	MA6	15,682	9,147.60	1.04	313.63	716	PASS	12"	2"	1,364.30	1,368.67	1,023.22	1,026.50	PASS	1.8"		143.2
11	MA6	21,911	45,850.88	1.07	1,511.53	5,888	PASS	12"	2"	6,888.53	8,952.41	5,016.40	6,444.31	PASS	2.3"		1,173.5
12	MA6	21,911	12,327.48	1.00	438.21	1,208	PASS	12"	2"	1,840.50	1,910.67	1,380.37	1,433.00	PASS	1.8"		241.2
13	SF8	135,777	83,068.82	1.08	896.00	3,908	PASS	24"	1.50"	12,219.89	12,788.00	9,154.92	9,576.00	PASS	1.8"		781.2
14	MA6	19,602	8,276.40	0.77	392.04	800	PASS	12"	2"	1,394.33	1,450.67	948.25	1,088.00	PASS	2.0"		160.0
15	MA6	21,257	6,011.38	0.55	425.15	630	PASS	12"	2"	956.56	1,100.00	717.43	825.00	PASS	2.0"		126.0
16	MA5	11,326	11,325.60	1.71	NA	NA	NA	NA	NA	1,613.90	1,680.00	NA	NA	NA	1.8"		160.0
17	MA5	11,326	11,325.60	1.71	NA	NA	NA	NA	NA	1,613.90	1,680.00	NA	NA	NA	1.8"		126.0
TOTALS		530,430	310,800.60		8769.07	27,825				45,825.85	53,708.11					3,702	5564.9

* Drainage areas 16 and 17 are each divided into (1) Dry Wells

FOR REVISION 2 ONLY

PROFESSIONAL LAND SURVEYOR
 STATE OF MARYLAND
 No. 12865
 1985
 NOTE: THERE IS NO AS-BUILT DATA PROVIDED ON THIS SHEET
 DATE 4/22/22

THE FOLLOWING STATES REQUIRE NOTIFICATION BY EXCAVATORS, DESIGNERS, OR ANY PERSON PREPARING TO DISTURB THE EARTH'S SURFACE ANYWHERE IN THE STATE IN VIRGINIA, MARYLAND, THE DISTRICT OF COLUMBIA, AND DELAWARE CALL - 811 (TOLL FREE) 1-800-245-4848 (PA 1-800-245-7770) (DC 1-800-257-7777) (VA 1-800-552-7001) (MD 1-800-257-7777) (DE 1-800-282-8525)

OWNER: M/I HOMES OF DC, LLC
 21355 RIDGETOP CIRCLE, SUITE 220
 STERLING, VA 20166
 CONTACT: CINDY HUNTZBERY
 PHONE: 443-677-9803

DEVELOPER: SOMERWORTH II, L.C.
 5704 DORSEY HALL DRIVE, SUITE 205
 ELLICOTT CITY, MD 21042
 CONTACT: JASON VAN KIRK
 PHONE: (410) 720-3231

PROJECT: REVISED SITE DEVELOPMENT PLAN
 WILDEN WOODS

TAX MAP: 47 GRID 2 ZONED: PSC
 PARCEL: 4, LOTS 1-97, OPEN SPACE LOTS 98 - 102
 6TH ELECTION DISTRICT, HOWARD COUNTY, MARYLAND

TITLE: SWM DRAINAGE AREAS TO ESD MEASURES


BOHLER ENGINEERING
 901 DULANEY VALLEY ROAD, SUITE 801
 TOWSON, MARYLAND 21284
 Phone: (410) 821-7900
 Fax: (410) 821-7987
 www.BohlerEngineering.com

CHECKED BY: BRR
 DESIGNED BY: BRR
 DRAWN BY: RMS/AVG
 PROJECT NO.: MD112149
 DATE: 10/27/14
 SCALE: 1"=50'
 DRAWING NO.: 23 OF 35

8/31/15 REVISION TO UPDATE CLUBHOUSE/COMMUNITY CENTER AND SURROUNDING AREA.

LEGEND
 # ESD MEASURE DRAINAGE AREA LABEL
 --- DRAINAGE DIVIDE

SOILS NAME	SOILS DESCRIPTION	HYDROLOGIC SOILS GROUP	HIGHLY ERODIBLE SOIL
GmB	GLENVILLE SILT LOAM, 3 TO 8 PERCENT SLOPES	C	NO
GhB	GLENVILLE-BAILE SILT LOAMS, 0 TO 8 PERCENT SLOPES	C	YES
MaB	MANOR LOAM, 3 TO 8 PERCENT SLOPES	B	NO
MaC	MANOR LOAM, 8 TO 15 PERCENT SLOPES	B	NO
MaD	MANOR LOAM, 15 TO 25 PERCENT SLOPES	B	NO
SaC	SASSAFRAS LOAM, 5 TO 10 PERCENT SLOPES	B	NO

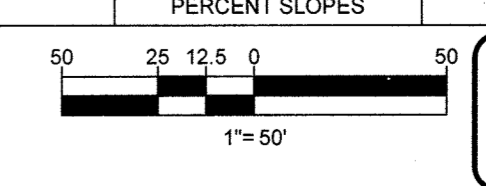

APPROVED
 PLANNING BOARD OF HOWARD COUNTY
 PB406
 DATE 10/08/2014

APPROVED: DEPARTMENT OF PLANNING AND ZONING
 10-21-15
 DATE 10-22-15

CHIEF-DEVELOPMENT ENGINEERING DIVISION
 DATE 10-23-15


CHIEF-DIVISION OF LAND DEVELOPMENT
 DATE 10-23-15

DIRECTOR



HYDROLOGIC TABLE									
INLET NUMBER	AREA (AC)	IMP. %	C FACTOR	C X AREA	TC (MIN)	I _n (CFS)	Q _u (CFS)	ZONE	
I-1	0.26	82	0.73	0.19	5.0	8.50	1.61	PSC	
I-2	0.12	72	0.87	0.08	5.0	8.50	0.68	PSC	
I-3	0.37	82	0.74	0.27	5.0	8.50	2.33	PSC	
I-4	0.35	86	0.76	0.27	5.0	8.50	2.26	PSC	
I-5	0.15	65	0.63	0.09	5.0	8.50	0.80	PSC	
I-6	0.14	59	0.59	0.08	5.0	8.50	0.70	PSC	
I-7	0.10	78	0.52	0.05	5.0	8.50	0.44	PSC	
I-8	0.11	81	0.73	0.08	5.0	8.50	0.68	PSC	
I-9	0.48	78	0.71	0.34	5.0	8.50	2.90	PSC	
I-10	0.64	84	0.75	0.48	5.0	8.50	4.08	PSC	
I-11	1.58	48	0.52	0.82	6.0	8.00	6.57	PSC	
I-12	0.06	75	0.69	0.04	5.0	8.50	0.35	PSC	
I-13	0.06	80	0.67	0.04	5.0	8.50	0.34	PSC	
I-14	0.48	72	0.67	0.32	5.0	8.50	2.73	PSC	
I-15	0.27	87	0.77	0.21	5.0	8.50	1.77	PSC	
I-16	0.11	87	0.78	0.09	5.0	8.50	0.73	PSC	
I-17	0.11	81	0.73	0.08	5.0	8.50	0.68	PSC	
I-18	0.30	81	0.74	0.22	5.0	8.50	1.89	PSC	
I-19	0.31	82	0.73	0.23	5.0	8.50	1.92	PSC	
I-20	0.33	78	0.71	0.23	5.0	8.50	1.99	PSC	
I-21	0.3*	89	0.79	0.24	5.0	8.50	2.08	PSC	
I-22	0.14	60	0.59	0.08	5.0	8.50	0.70	PSC	
I-23	0.16	97	0.84	0.13	5.0	8.50	1.14	PSC	
I-24	0.43	31	0.37	0.16	5.0	8.50	1.35	PSC	
I-25	0.31	85	0.78	0.24	5.0	8.50	2.00	PSC	
I-25A	0.10	50	0.55	0.06	5.0	8.50	0.47	PSC	


For Revision 19 ONLY

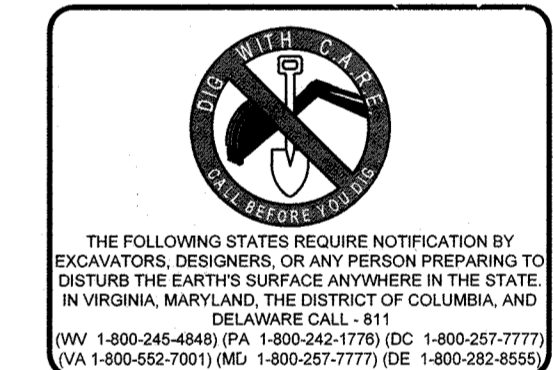

NO. 19	4-21-20	PATHWAY + EMERGENCY SUBDIVISION
NO. 2	12/11/13	PAGE NUMBER UPDATE
NO. 3	03/11/15	REVISED CLUBHOUSE/COMMUNITY CENTER
NO. 4	DATE	REVISION DESCRIPTION
OWNER:		
M/H HOMES OF DC, LLC 21355 RIDGETOP CIRCLE, SUITE 220 STERLING, VA 20156 CONTACT: CINDY HUNZIBERRY PHONE: 443-677-9803		
DEVELOPER:		
SOMERWORTH II, L.C. 5704 DORSEY HALL DRIVE, SUITE 205 ELICOTT CITY, MD 21042 CONTACT: JASON VAN KIRK PHONE: (410) 720-3021		
PROJECT:		
REVISED SITE DEVELOPMENT PLAN WALDEN WOODS		
TAX MAP: 47	GRID: 2	ZONED: PSC
PARCEL 4, LOTS 1-97, OPEN SPACE LOTS 98 - 102 6TH ELECTION DISTRICT, HOWARD COUNTY, MARYLAND		
TITLE:		
STORM DRAIN DRAINAGE AREAS		













8/31/15 REVISION TO UPDATE CLUBHOUSE/COMMUNITY CENTER AND SURROUNDING AREA.

SOILS TABLE			
SOILS NAME	SOILS DESCRIPTION	HYDROLOGIC SOILS GROUP	HIGHLY ERODIBLE SOIL
GmB	GLENVILLE SILT LOAM, 3 TO 8 PERCENT SLOPES	C	NO
GnB	GLENVILLE-SALE SILT LOAMS, 0 TO 8 PERCENT SLOPES	C	YES
MaB	MANOR LOAM, 3 TO 8 PERCENT SLOPES	B	NO
MaC	MANOR LOAM, 8 TO 15 PERCENT SLOPES	B	NO
MaD	MANOR LOAM, 15 TO 25 PERCENT SLOPES	B	NO
SaC	SASSAFRAS LOAM, 5 TO 10 PERCENT SLOPES	B	NO

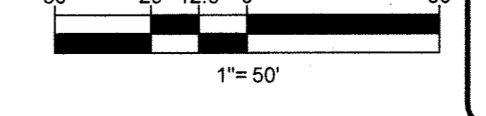

PROFESSIONAL CERTIFICATION
I, BRANDON R. ROWE, HEREBY CERTIFY THAT THESE DOCUMENTS WERE PREPARED OR APPROVED BY ME, AND THAT I AM A DULY LICENSED PROFESSIONAL ENGINEER UNDER THE LAWS OF THE STATE OF MARYLAND, LICENSE NO. 40808, E-PIRATION DATE: 7/31/2015

APPROVED
PLANNING BOARD OF HOWARD COUNTY
CB 406
DATE **10/08/2014**
APPROVED: DEPARTMENT OF PLANNING AND ZONING
DATE **10-21-15**
CHIEF DEVELOPMENT ENGINEERING DIVISION
DATE **10-22-15**
CHIEF DIVISION OF LAND DEVELOPMENT
DATE **10-23-15**
DIRECTOR

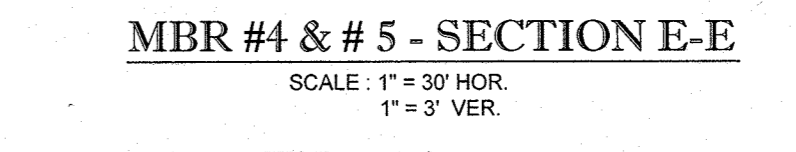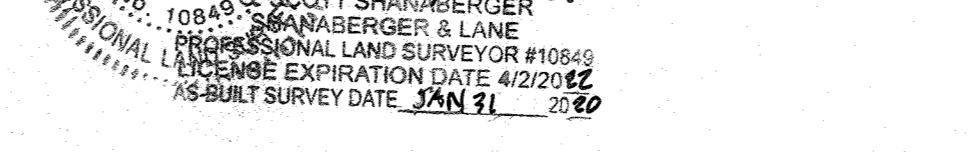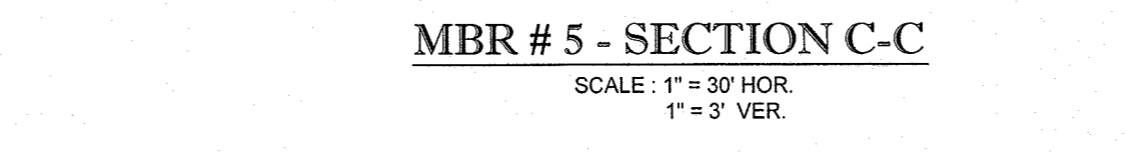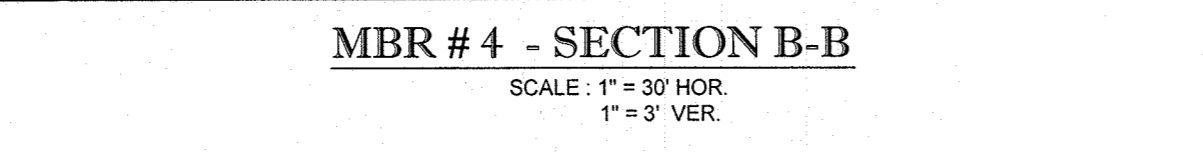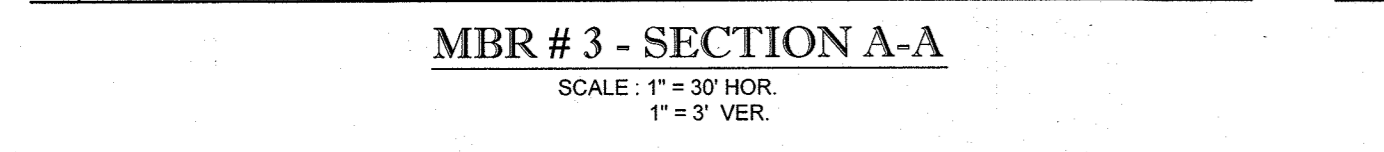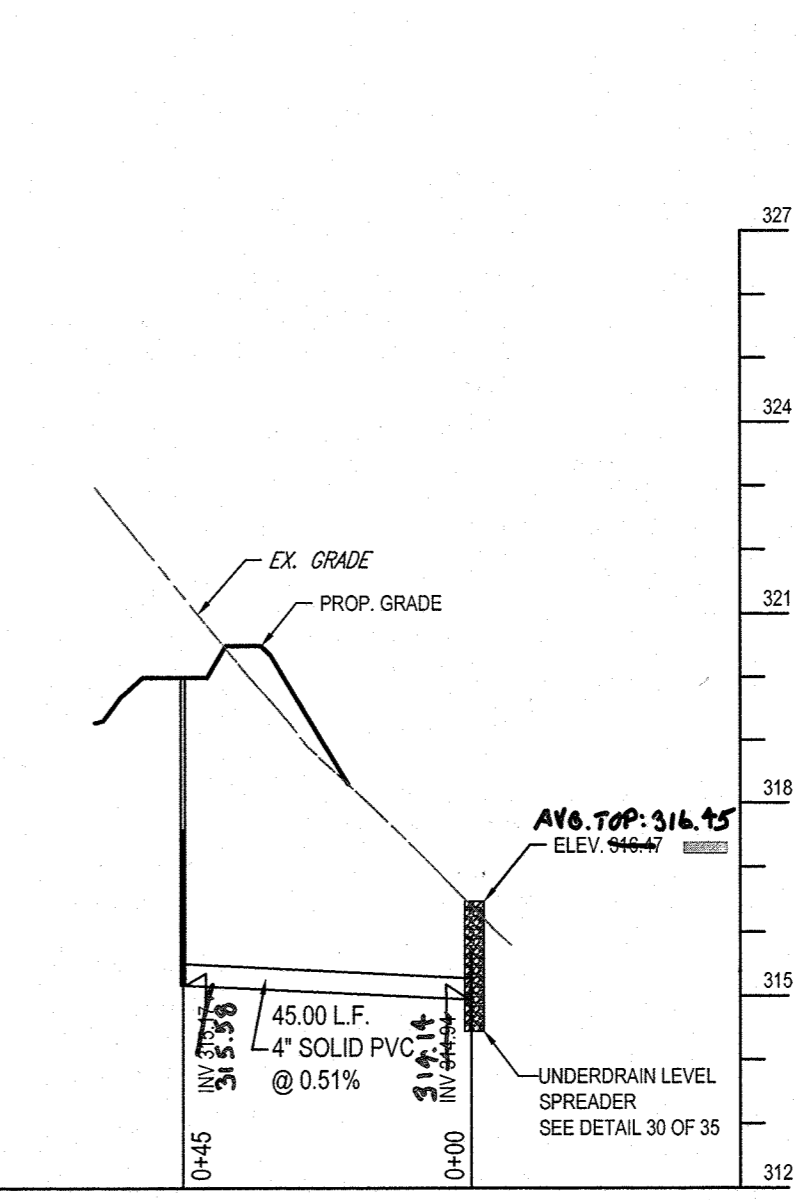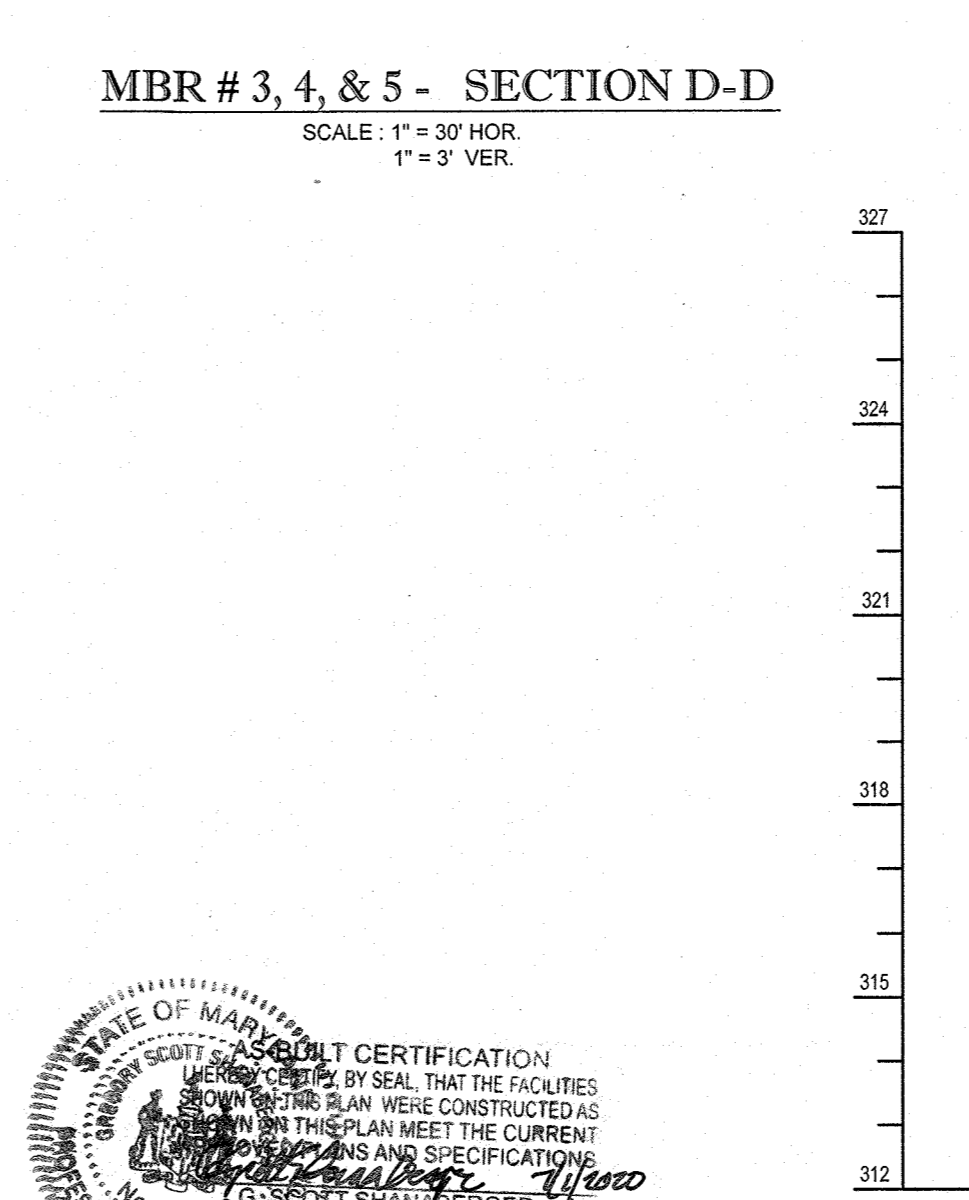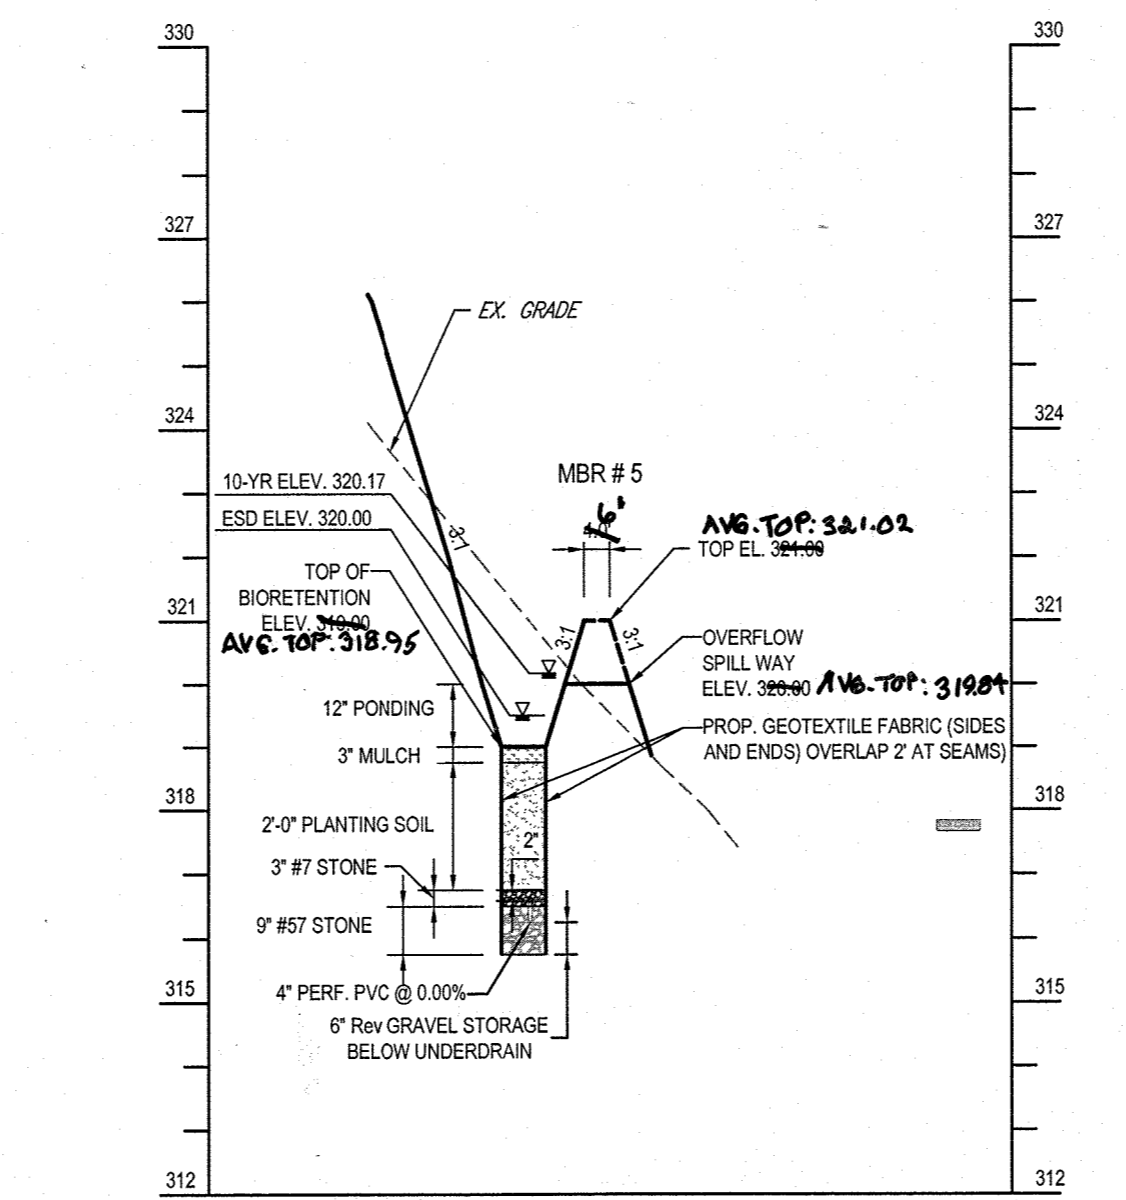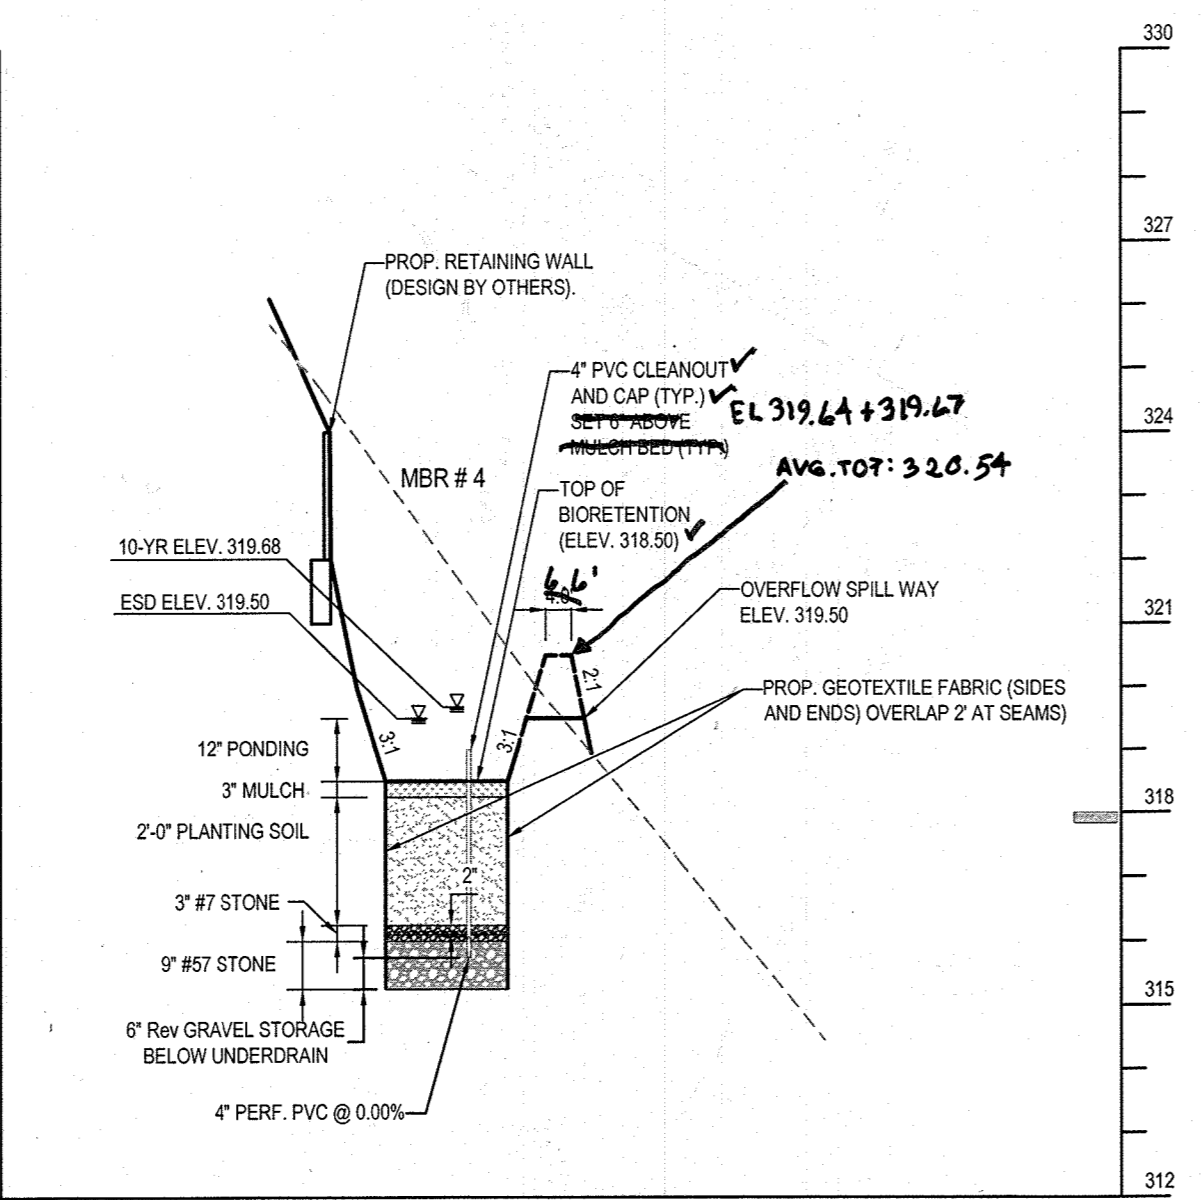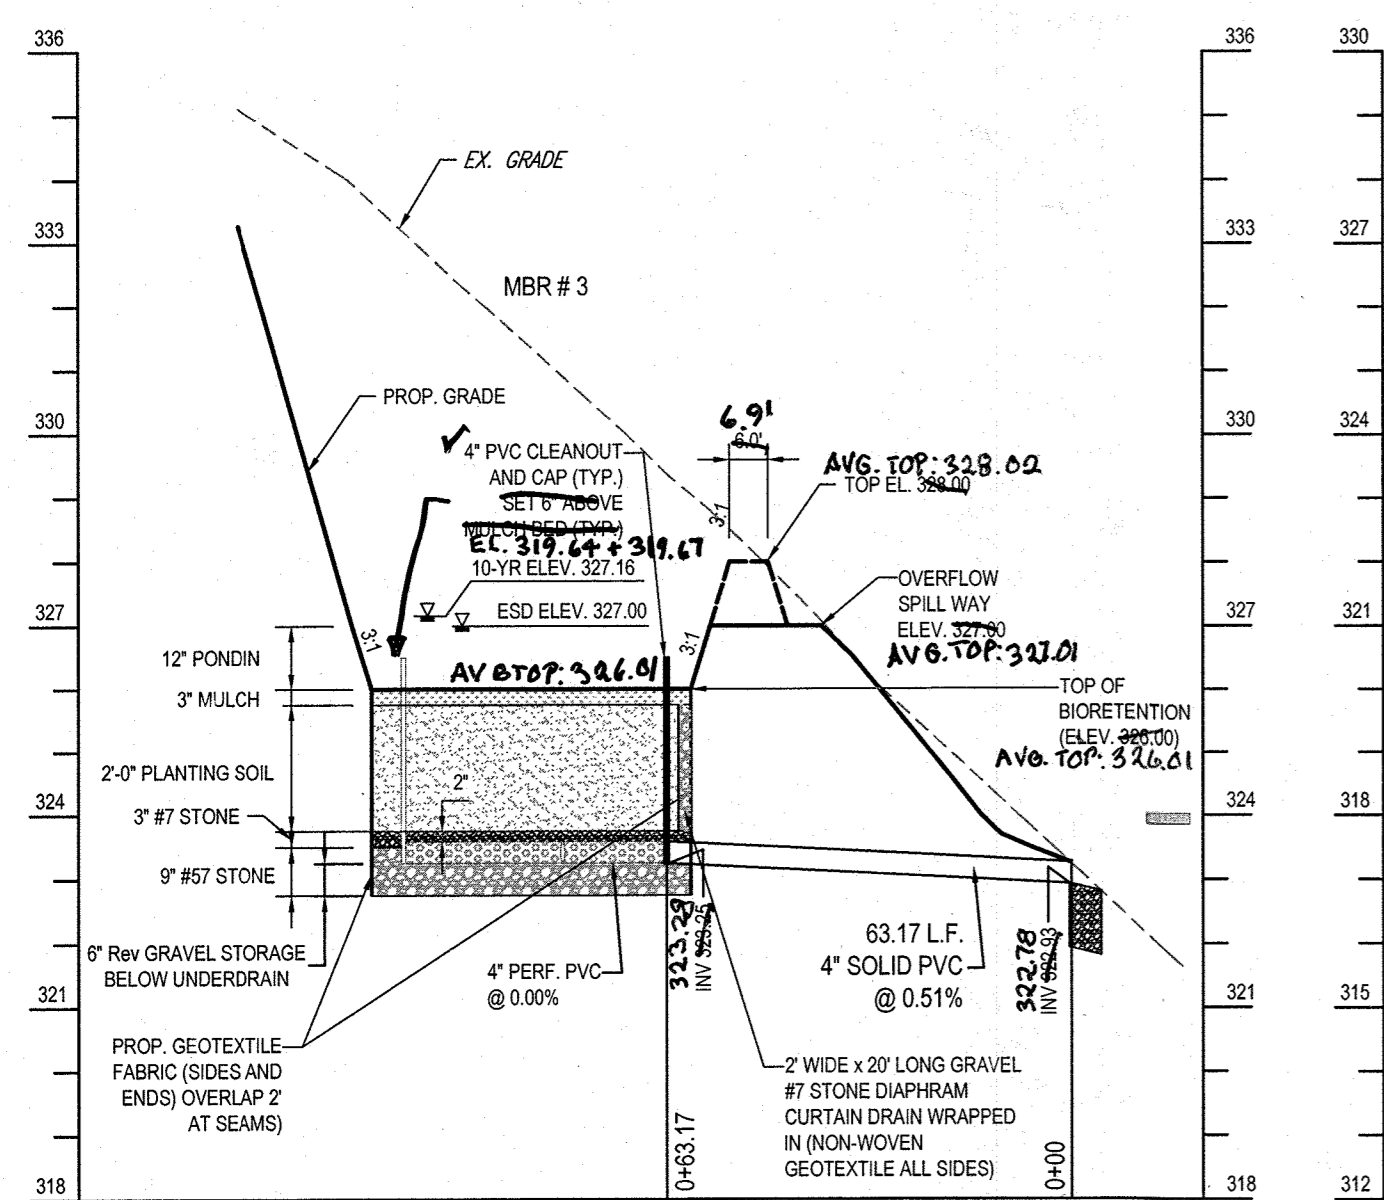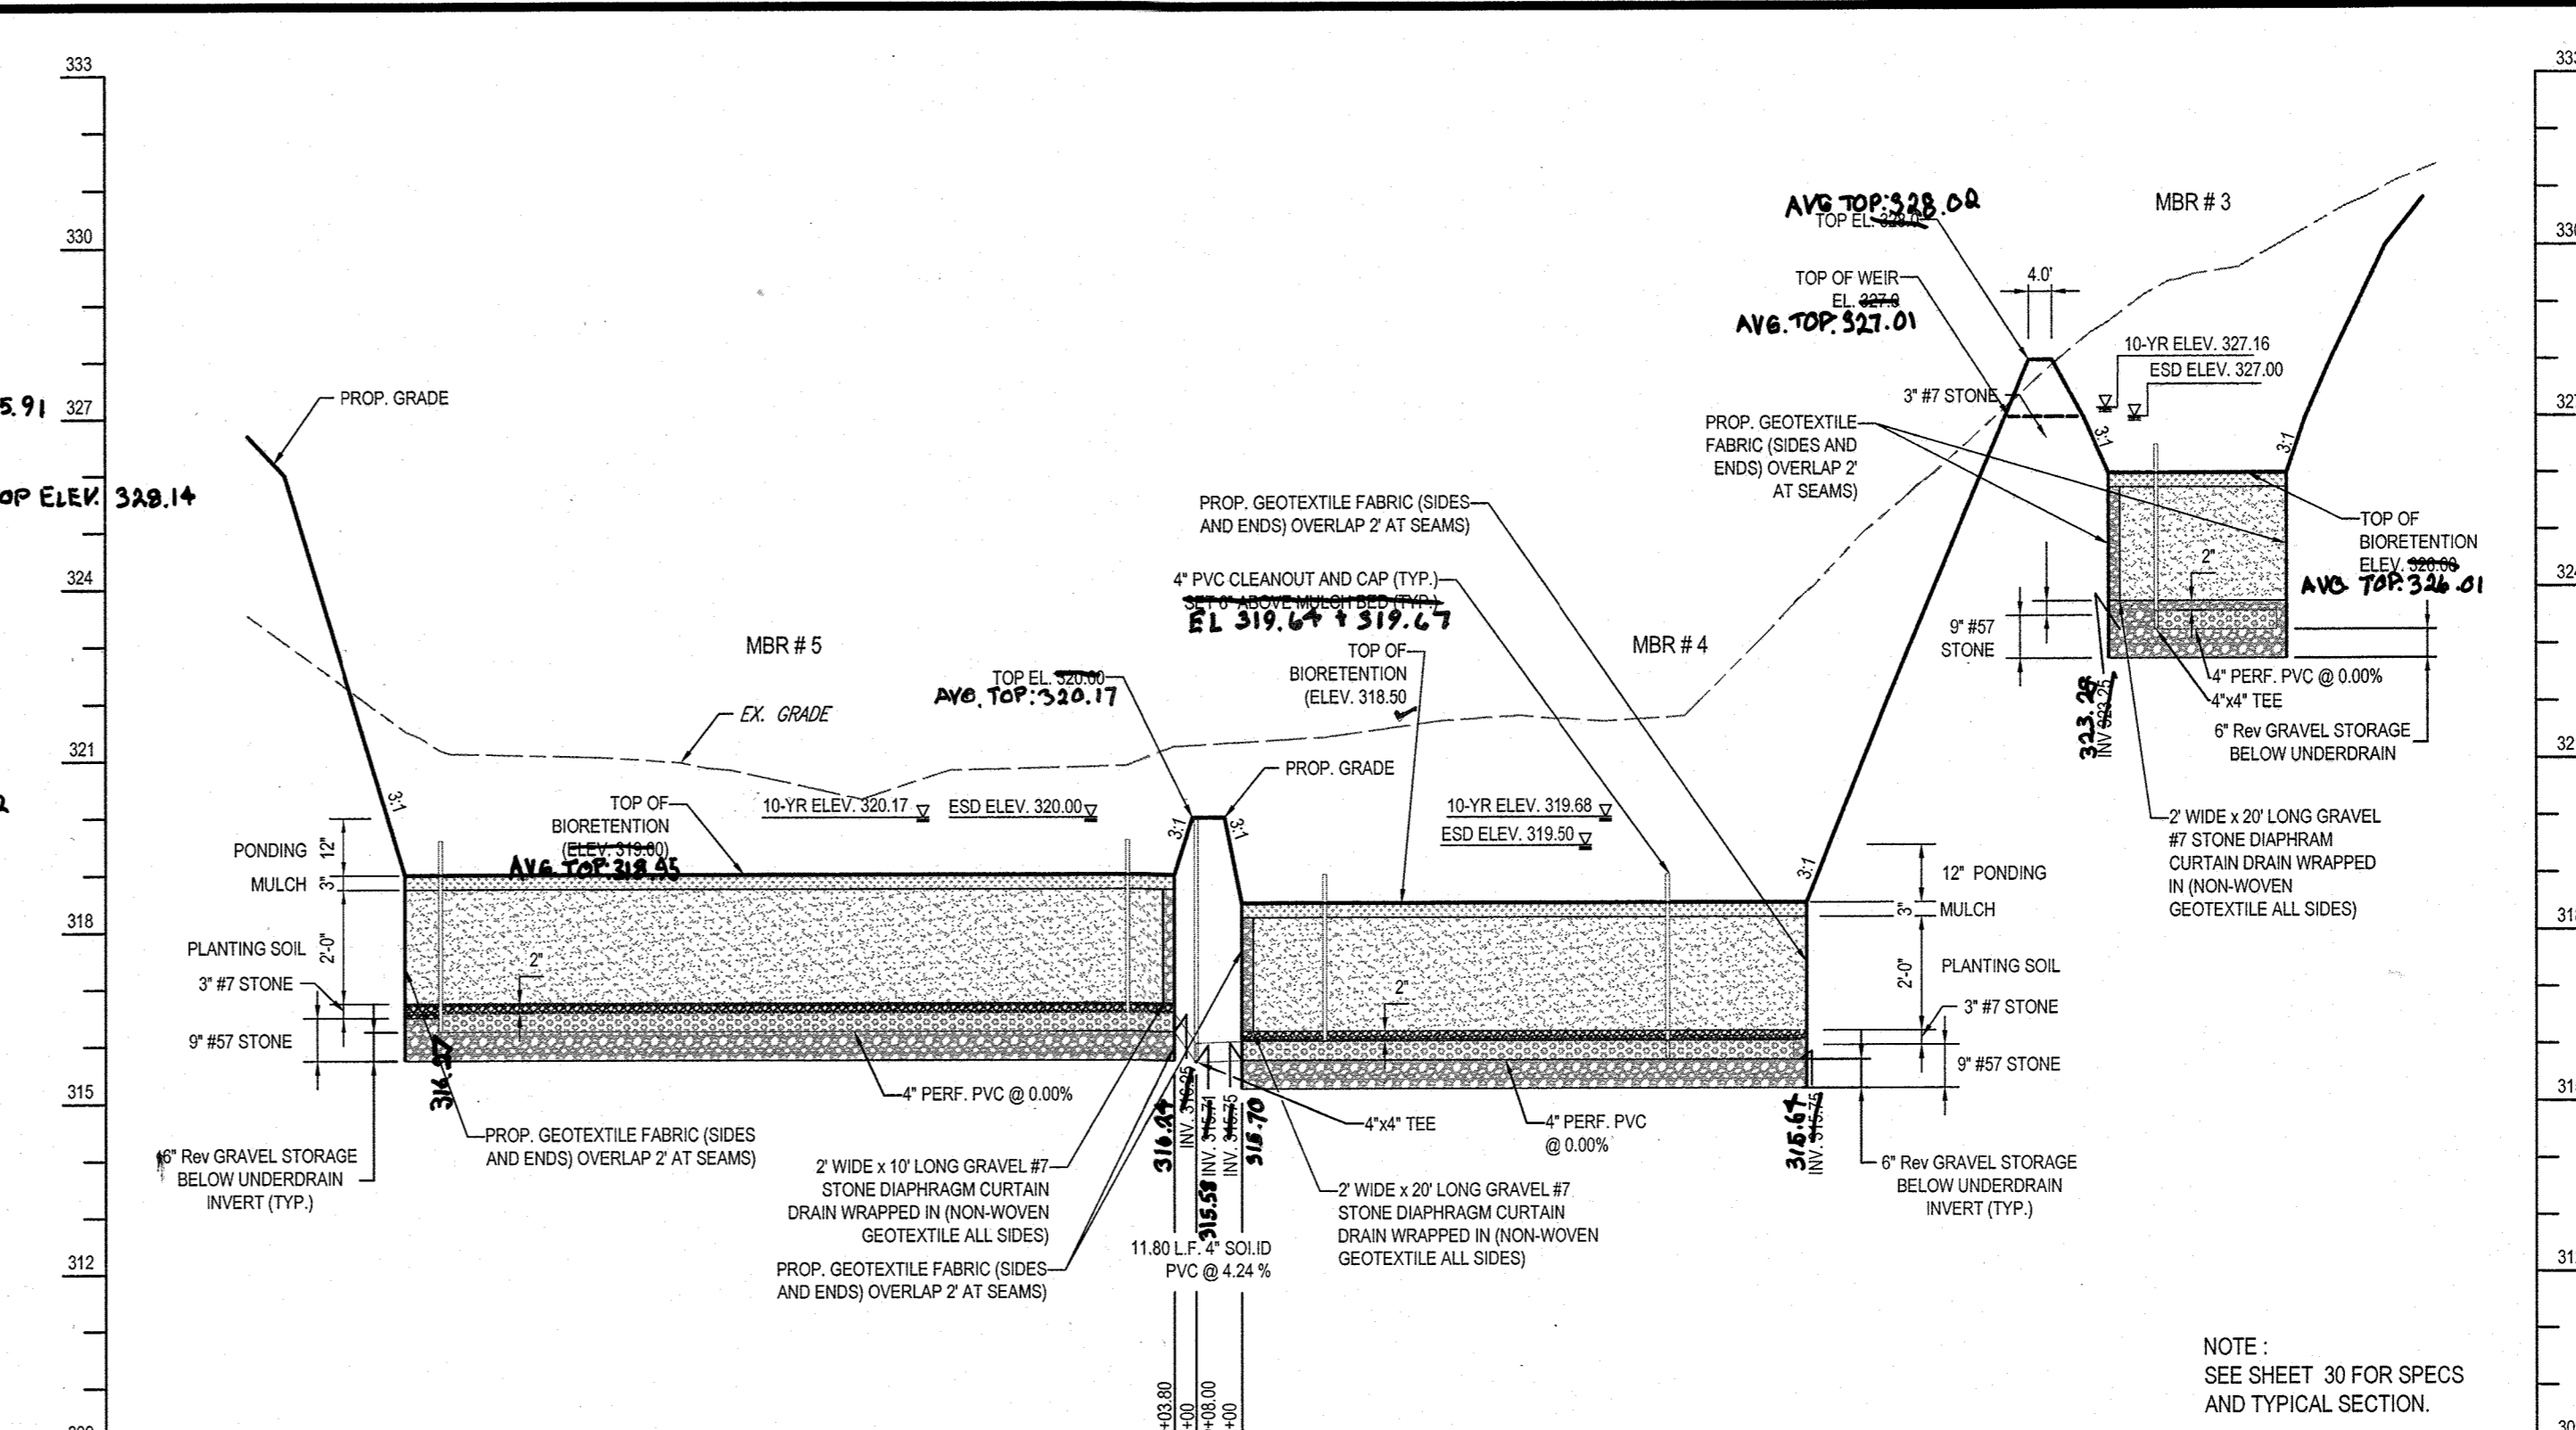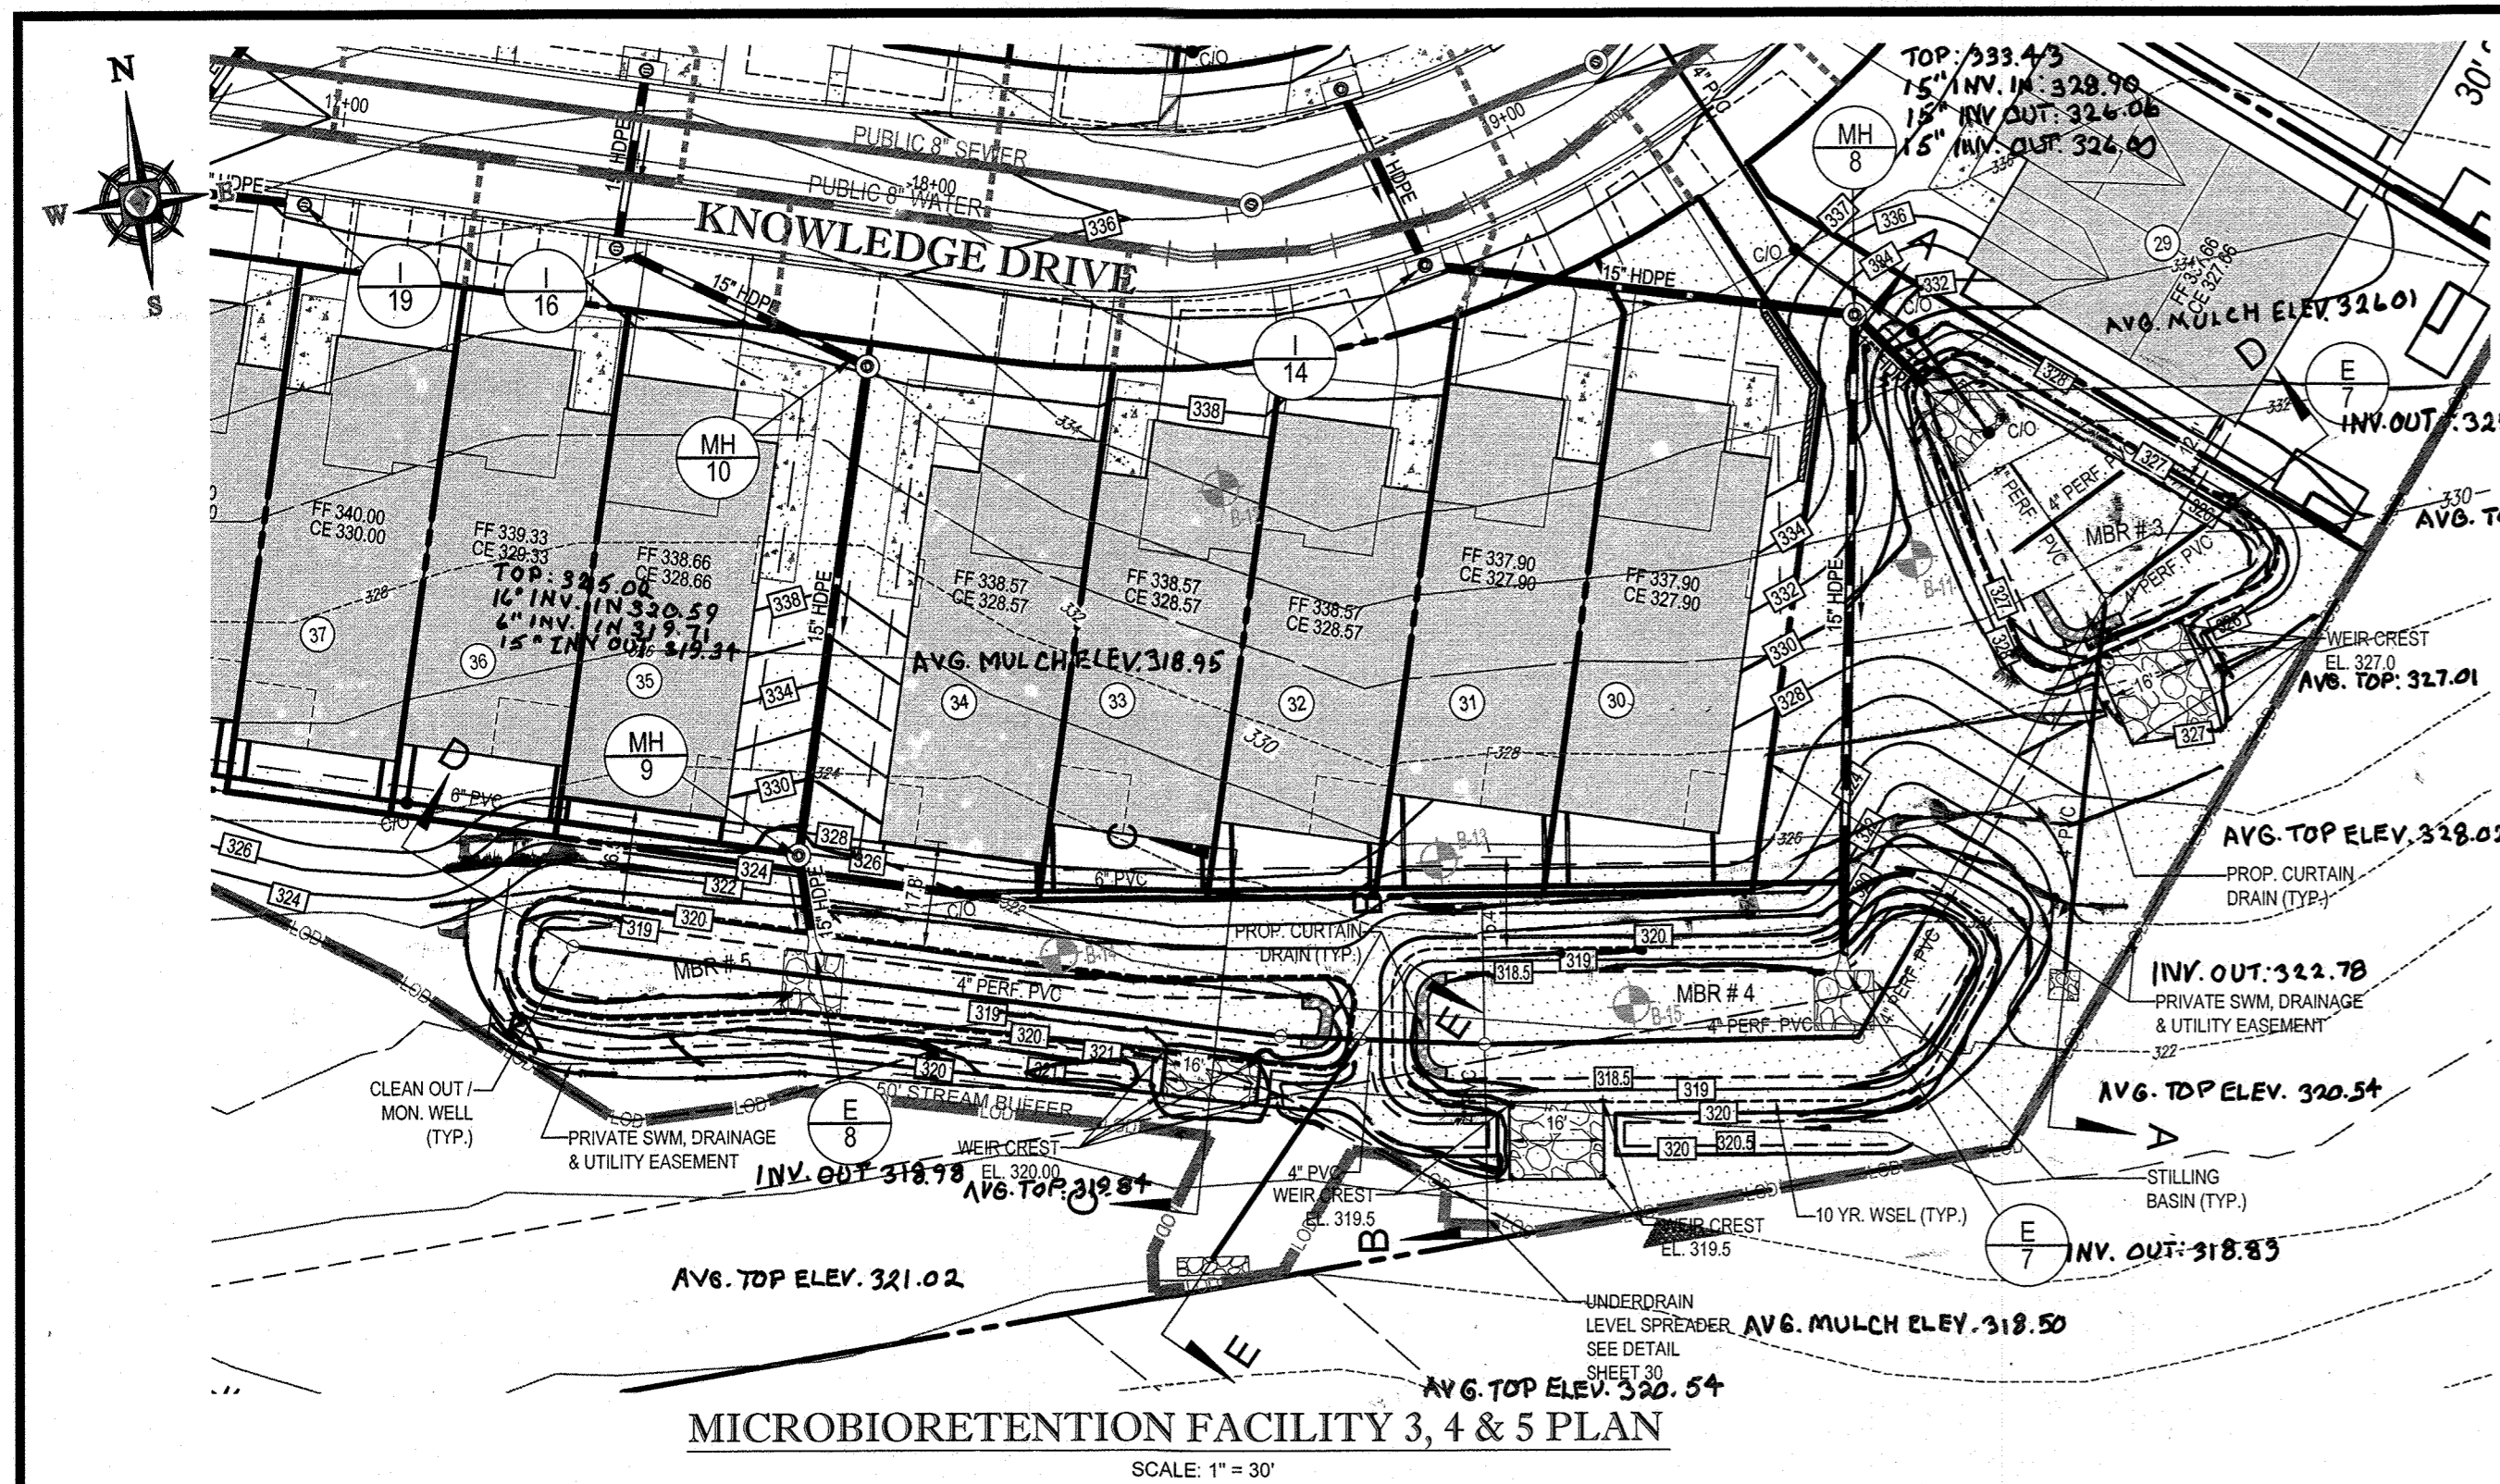

Construction Specifications for Environmental Site Design Practices

Base Course - The base course shall be AASHTO No. 3 or 4 course aggregate with an assumed open pore space of 30% (n = 0.30).

3. **Reinforced Turf**

Reinforced Grass Pavement (RGP) - Whether used with grass or gravel, the RGP thickness shall be at least 1 1/2" thick with a load capacity capable of supporting the traffic and vehicle types that will be carried.

B-4-C Specifications for Micro-Bioretention, Rain Gardens, Landscape Infiltration & Infiltration Berms

1. **Material Specifications**

The allowable materials to be used in these practices are detailed in Table B-4.1.

2. **Filtering Media or Planting Soil**

The soil shall be a uniform mix, free of stones, stumps, roots or other similar objects larger than two inches. No other materials or substances shall be mixed or dumped within the micro-bioretention practice that may be harmful to plant growth, or prove a hindrance to the planting or maintenance operations. The planting soil shall be free of Bermuda grass, Quackgrass, Johnson grass, or other noxious weeds as specified under COMAR 15.08.01.05.

The planting soil shall be tested and shall meet the following criteria:

- Soil Component - Loamy Sand or Sandy Loam (USDA Soil Textural Classification)
- Organic Content - Minimum 10% by dry weight (ASTM D 2974). In general, this can be met with a mixture of loamy sand (60%-65%) and compost (35% to 40%) or sandy loam (30%), coarse sand (30%), and compost (40%).
- Clay Content - Media shall have a clay content of less than 5%.
- pH Range - Should be between 5.5 - 7.0. Amendments (e.g., lime, iron sulfate plus sulfur) may be mixed into the soil to increase or decrease pH.

There shall be at least one soil test per project. Each test shall consist of both the standard soil test for pH, and additional tests of organic matter, and soluble salts. A textual analysis is required from the site stockpiled topsoil. If topsoil is imported, then a texture analysis shall be performed for each location where the topsoil was excavated.

3. **Compaction**

It is very important to minimize compaction of both the base of bioretention practices and the required backfill. When possible, use excavation hoses to remove original soil. If practices are

Construction Specifications for Environmental Site Design Practices

excavated using a loader, the contractor should use wide track or marsh track equipment, or light equipment with turf tires. Use of equipment with narrow tracks or narrow tires, rubber tires with large lugs, or high-pressure tires will cause excessive compaction resulting in reduced infiltration rates and is not acceptable. Compaction will significantly contribute to design failure.

Compaction can be alleviated at the base of the bioretention facility by using a primary tilling operation such as a chisel plow, ripper, or subsoiler. These tilling operations are to refracture the soil profile through the 12 inch compaction zone. Substitute methods must be approved by the engineer. Rototillers typically do not till deep enough to reduce the effects of compaction from heavy equipment.

Rototill 2 to 3 inches of sand into the base of the bioretention facility before backfilling the optional sand layer. Pump any ponded water before preparing (rototilling) base.

When backfilling the topsoil over the sand layer, first place 3 to 4 inches of topsoil over the sand, then rototill the sand/topsoil to create a gradation zone. Backfill the remainder of the topsoil to final grade.

When backfilling the bioretention facility, place soil in lifts 12" to 18". Do not use heavy equipment within the bioretention basin. Heavy equipment can be used around the perimeter of the basin to supply soils and sand. Grade bioretention materials with light equipment such as a compact loader or a dozer/loader with marsh tracks.

4. **Plant Material**

Recommended plant material for micro-bioretention practices can be found in Appendix A, Section A.2.3.

5. **Plant Installation**

Compost is a better organic material source, is less likely to float, and should be placed in the invert and other low areas. Mulch should be placed in surrounding to a uniform thickness of 2" to 3". Shredded or chipped hardwood mulch is the only accepted mulch. Fine mulch and wood chips will float and move to the perimeter of the bioretention area during a storm event and are not acceptable. Shredded mulch must be well aged (6 to 12 months) for acceptance.

Rootstock of the plant material shall be kept moist during transport and on-site storage. The plant root ball should be planted so 1/8" of the ball is above final grade surface. The diameter of the planting pit shall be at least six inches larger than the diameter of the planting ball. Set and maintain the plant straight during the entire planting process. Thoroughly water ground bed cover after installation.

Construction Specifications for Environmental Site Design Practices

Trees shall be braced using 2" by 2" stakes only as necessary and for the first growing season only. Stakes are to be equally spaced on the outside of the tree ball.

Grasses and legume seed should be drilled into the soil to a depth of at least one inch. Grass and legume plugs shall be planted following the non-grass ground cover planting specifications.

The topsoil specifications provide enough organic material to adequately supply nutrients from natural cycling. The primary function of the bioretention structure is to improve water quality. Adding fertilizers, deficits, or, at a minimum, impedes this goal. Only add fertilizer if wood chips or mulch are used to amend the soil. Rototill urea fertilizer at a rate of 2 pounds per 1000 square feet.

6. **Underdrains**

Underdrains should meet the following criteria:

- Pipes - Should be 4" to 6" diameter, slotted or perforated rigid plastic pipe (ASTM F 758, Type PS 25, or AASHTO M-278) in a gravel layer. The preferred material is slotted, 4" rigid pipe (e.g., PVC or HDPE).
- Perforations - If perforated pipe is used, perforations should be 3/8" diameter located 6" on center with a minimum of four holes per row. Pipe shall be wrapped with a 3/4" (No. 4 or 4x4) galvanized undermesh hardware cloth.
- Gravel - The gravel layer (No. 57 stone preferred) shall be at least 3" thick above and below the underdrain.
- The main collector pipe shall be at a minimum 0.5% slope.
- A rigid, non-perforated observation well must be provided (one per every 1,000 square feet) to provide a clean-out post and monitor performance of the filter.
- A 4" layer of pea gravel (1/4" to 1/2" stone) shall be located between the filter media and underdrain to prevent migration of fines into the underdrain. This layer may be considered part of the filter bed when bed thickness exceeds 24".

The main collector pipe for underdrain systems shall be constructed at a minimum slope of 0.5%. Observation wells and/or clean-out pipes must be provided (one minimum per every 1000 square feet of surface area).

7. **Miscellaneous**

These practices may not be constructed until all contributing drainage area has been stabilized.

Table B-4.1 Materials Specifications for Micro-Bioretention, Rain Gardens & Landscape Infiltration

Material	Specification	Size	Notes
Plantings	see Appendix A, Table A.4	n/a	plantings are site-specific
Planting soil (2" to 4" deep)	loamy sand (60-65%) & compost (35-40%) or sandy loam (30%) & coarse sand (30%) & compost (40%)	n/a	USDA soil types loamy sand or sandy loam, clay content < 5%
Organic content	Min. 10% by dry weight (ASTM D 2974)	n/a	aged 6 months, minimum; no pine or wood chips
Mulch	shredded hardwood	NO. 8 OR NO. 9 (1 1/8" TO 3/8")	
Pea gravel diaphragm	pea gravel: ASTM D-448	NO. 8 OR NO. 9 (1 1/8" TO 3/8")	
Curtain drain	conglomerate stone: washed cobbles	stone: 2" to 5"	
Geotextile		n/a	PB Type 1 nonwoven
Gravel (underdrains and infiltration berms)	AASHTO M-63	NO. 57 OR NO. 6 (3/8" TO 3/4")	
Underdrain piping	F 758, Type PS 25 or AASHTO M-278	4" to 6" rigid schedule 40 PVC or HDPE	Slotted or perforated pipe; 3/8" perf. @ 6" on center, 4 holes per row; minimum of 2" of gravel over pipes; not necessary undermesh hardware cloth
Poured in place concrete (if required)	MSHA Mix No. 3, f'c = 3500 psi @ 28 days, normal weight, air-entrained, reinforcing to meet ASTM A-615-60	n/a	on-site testing of precast in-place concrete required; 28 day strength and slump test; all concrete design (cast-in-place or pre-cast) not using previously approved State or local standards requires design drawings sealed and approved by a professional structural engineer licensed in the State of Maryland - design to include meeting ACI Code 350.1(R)9; vertical loading (15-10 or 15-30) allowable horizontal loading (based on soil pressure); and analysis of potential cracking
Sand	AASHTO M-66 or ASTM C-33	0.02" to 0.04"	Sand substitutions such as Diabase and Graystone (AASHTO #10) are not acceptable. No calcium carbide or dolomitic sand substitutions are acceptable. No "rock dust" can be used for sand.

STATE OF MARYLAND
Professional Engineer
Brandon R. Rowe
License No. 43808
Expiration Date 7/31/2015

FOR REVISION 2 ONLY

BOHLER ENGINEERING
901 DULANEY VALLEY ROAD, SUITE 801
TOWSON, MARYLAND 21284
Phone: (410) 821-7800
Fax: (410) 821-7887
www.BohlerEngineering.com

PROFESSIONAL CERTIFICATION
I, BRANDON R. ROWE, HEREBY CERTIFY THAT THESE DOCUMENTS WERE PREPARED OR APPROVED BY ME, AND THAT I AM A DULY LICENSED PROFESSIONAL ENGINEER UNDER THE LAWS OF THE STATE OF MARYLAND, LICENSE NO. 43808, EXPIRATION DATE: 7/31/2015

OWNER: M/H HOMES OF DC, LLC
21355 RIDGETOP CIRCLE, SUITE 220
STERLING, VA 20166
CONTACT: CINDY HUNTZBERRY
PHONE: 443-677-9803


DEVELOPER: SOMERWORTH II, L.C.
5704 DORSEY HALL DRIVE, SUITE 205
ELLICOTT CITY, MD 21042
CONTACT: JASON VAN KIRK
PHONE: (410) 720-3021

PROJECT: WALDEN WOODS


TAX MAP: 47 **GRID:** 2 **ZONED:** PSC
PARCEL: 4, LOTS 1-97, OPEN SPACE LOTS 98 - 102
6TH ELECTION DISTRICT, HOWARD COUNTY, MARYLAND

TITLE: MICROBIORETENTION FACILITY DETAILS


CHECKED BY: BRR
DESIGNED BY: BRR
DRAWN BY: RMS/AVG
PROJECT NO.: MD112149
DATE: 10/27/14
SCALE: AS NOTED
DRAWING NO. 25 OF 35

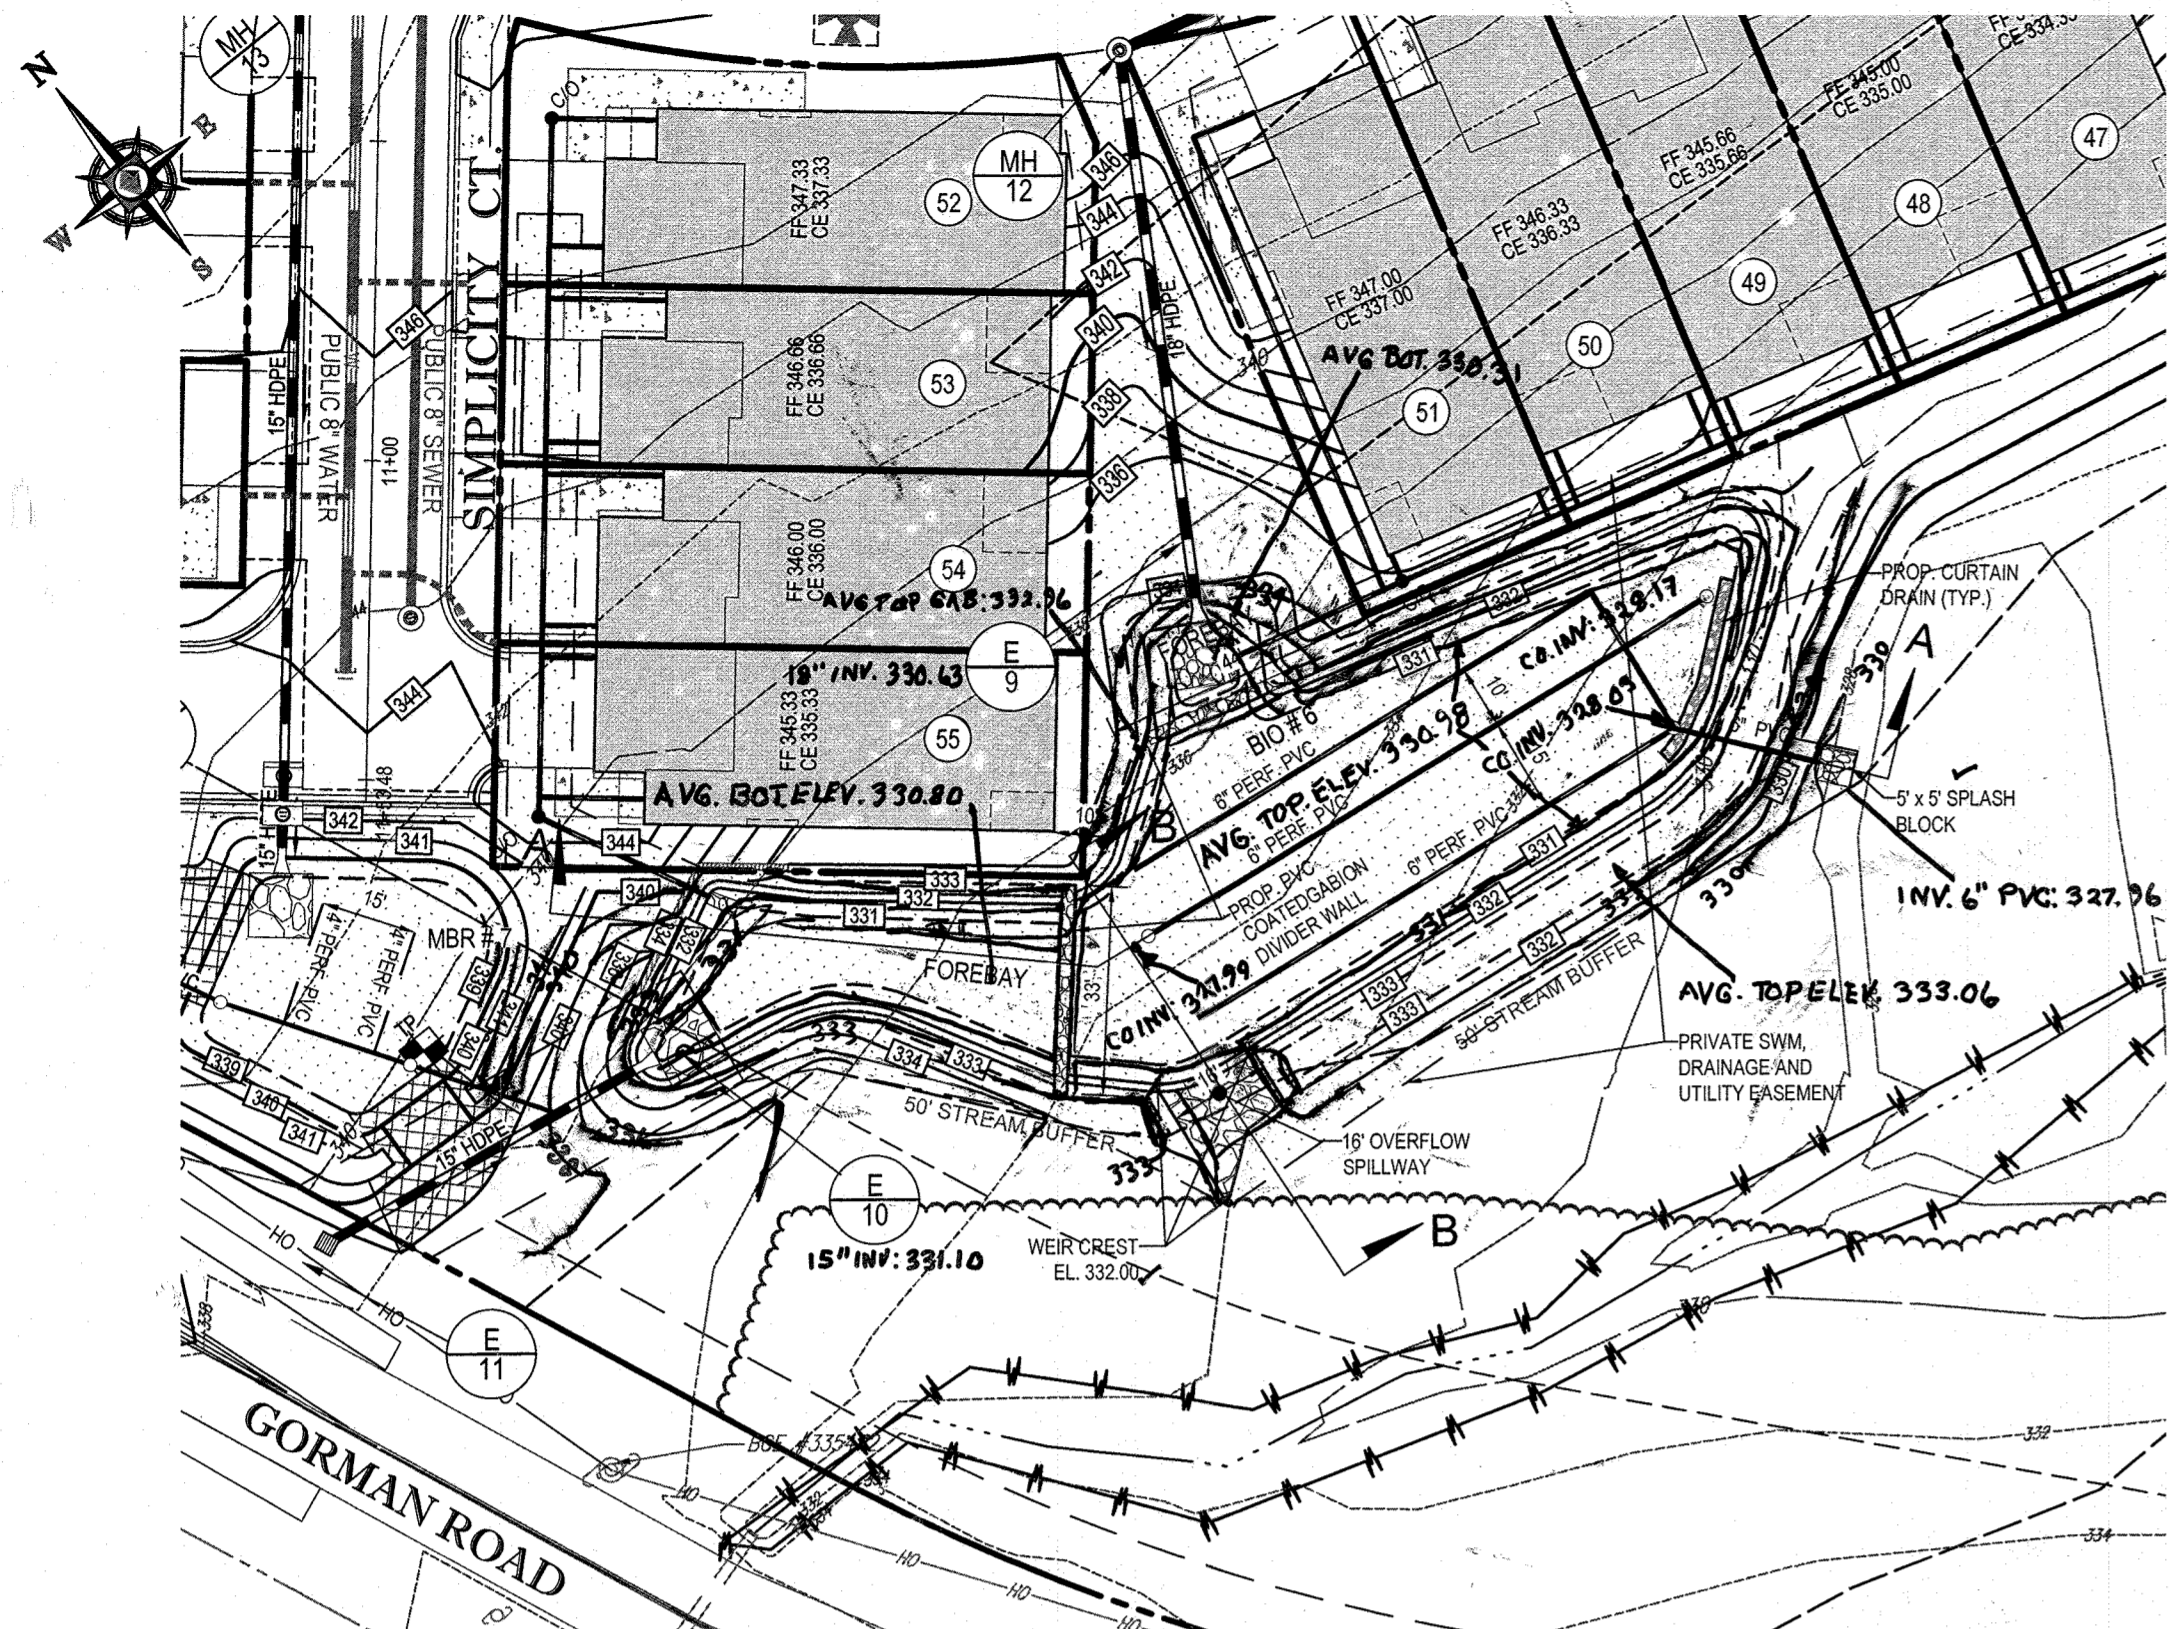


BIORETENTION FACILITY #6 - PLAN
SCALE: 1" = 30'

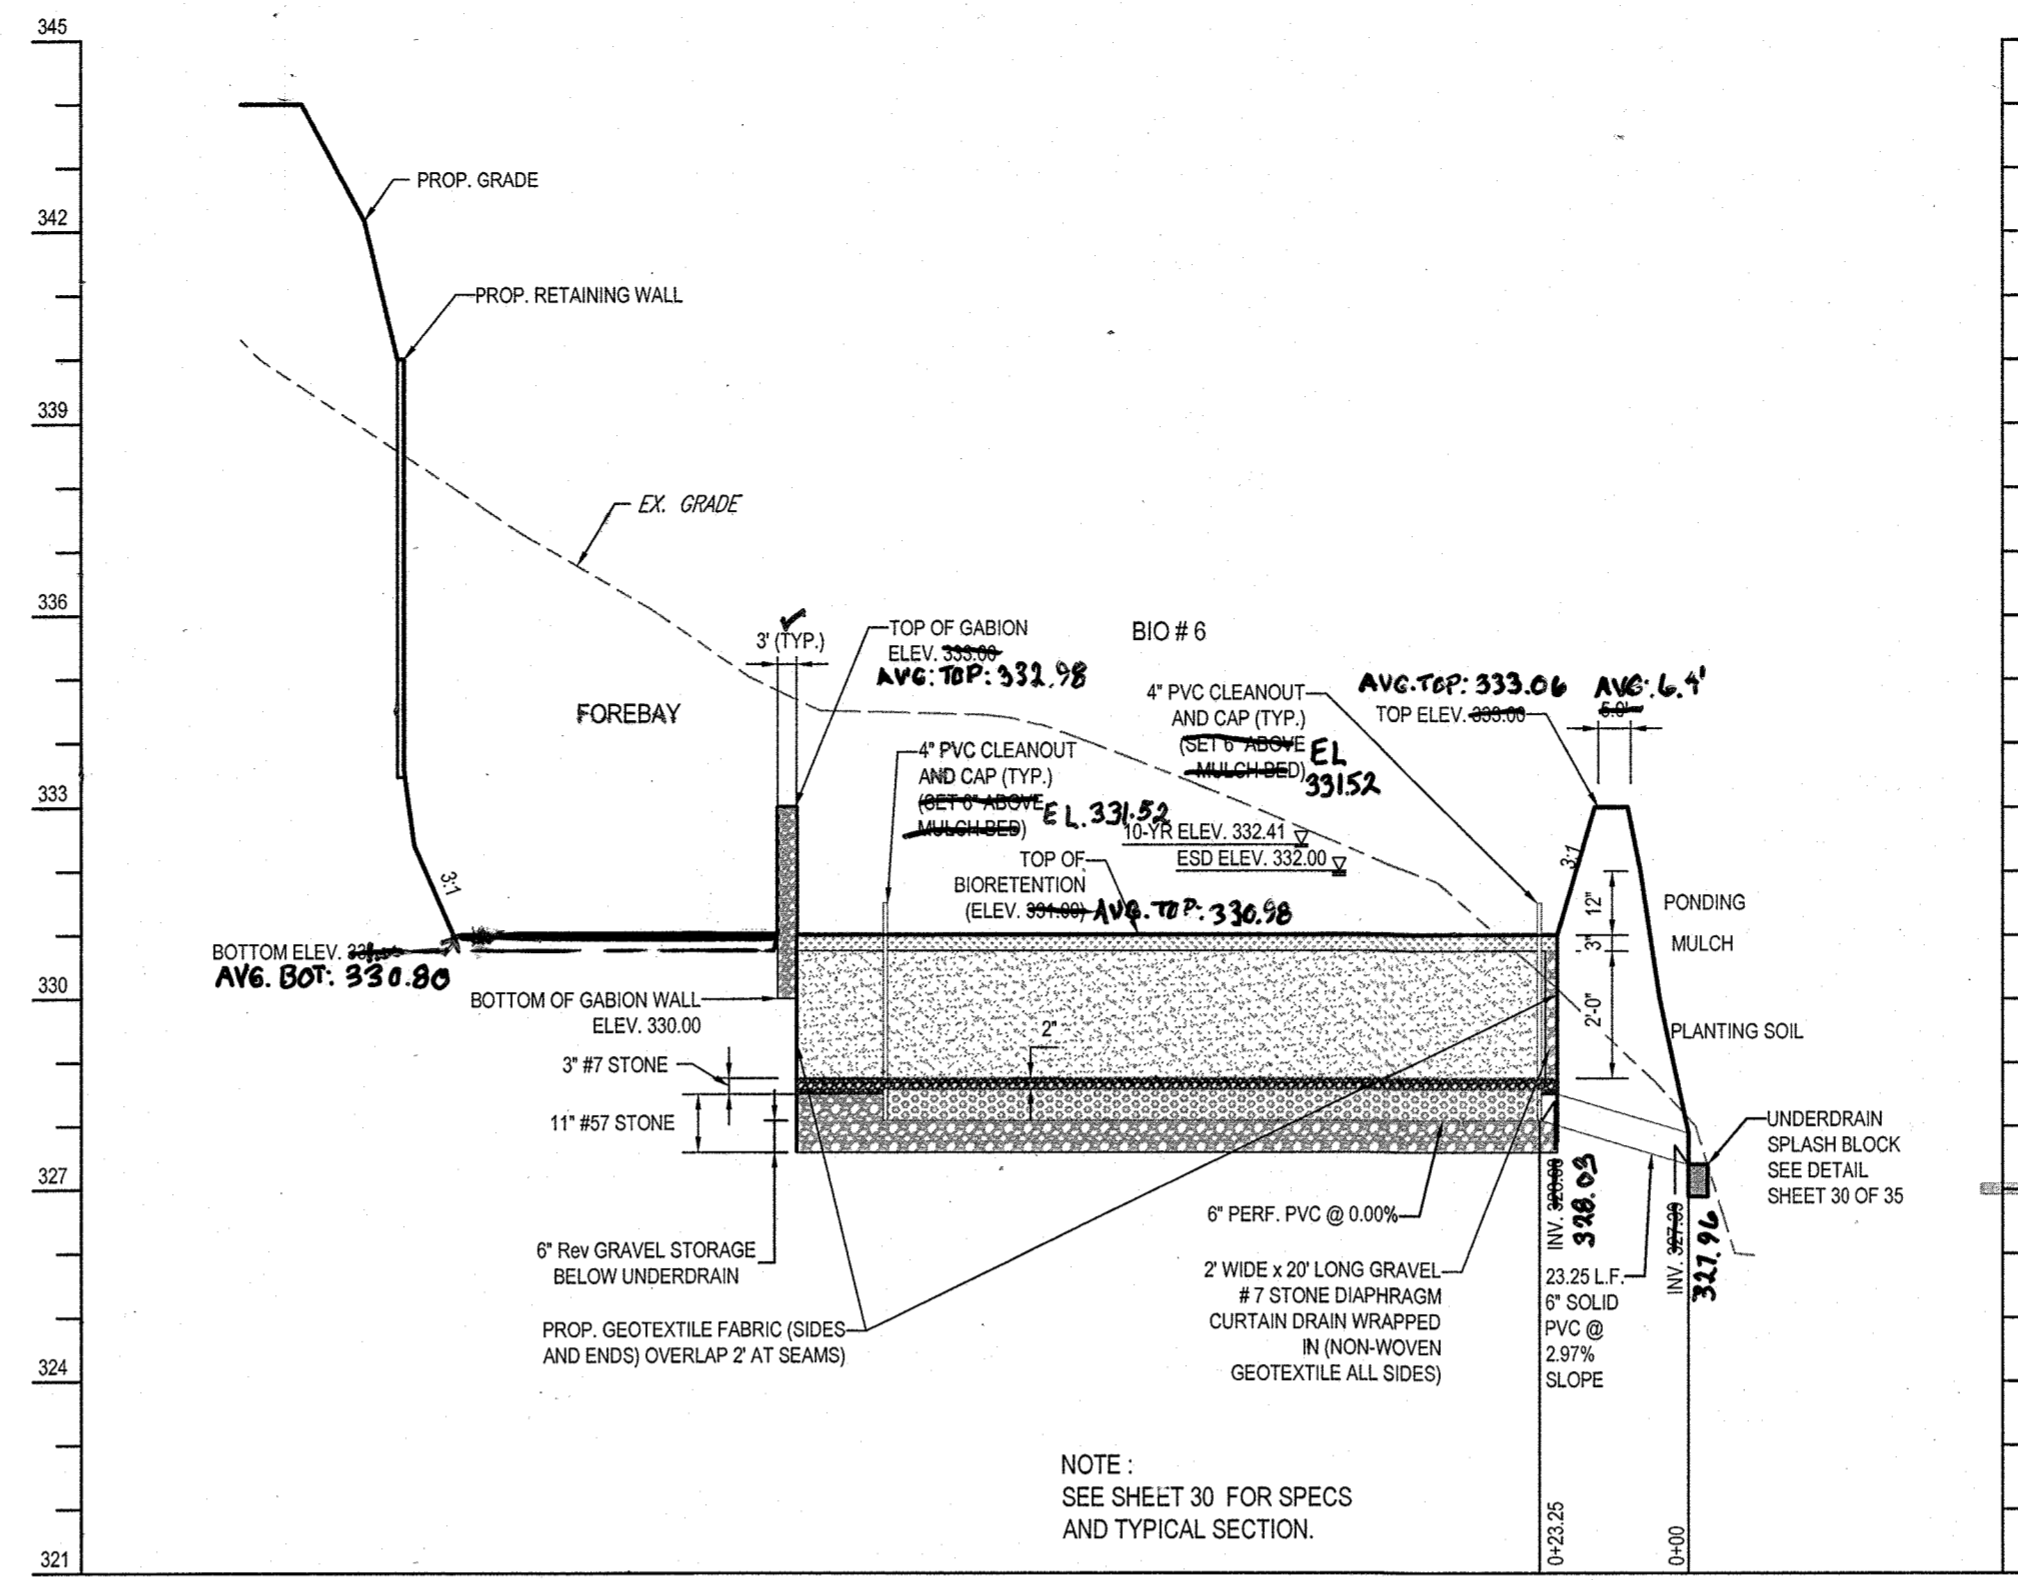


BIO #6 - SECTION A-A
SCALE: 1" = 30' HOR.
1" = 3' VER.

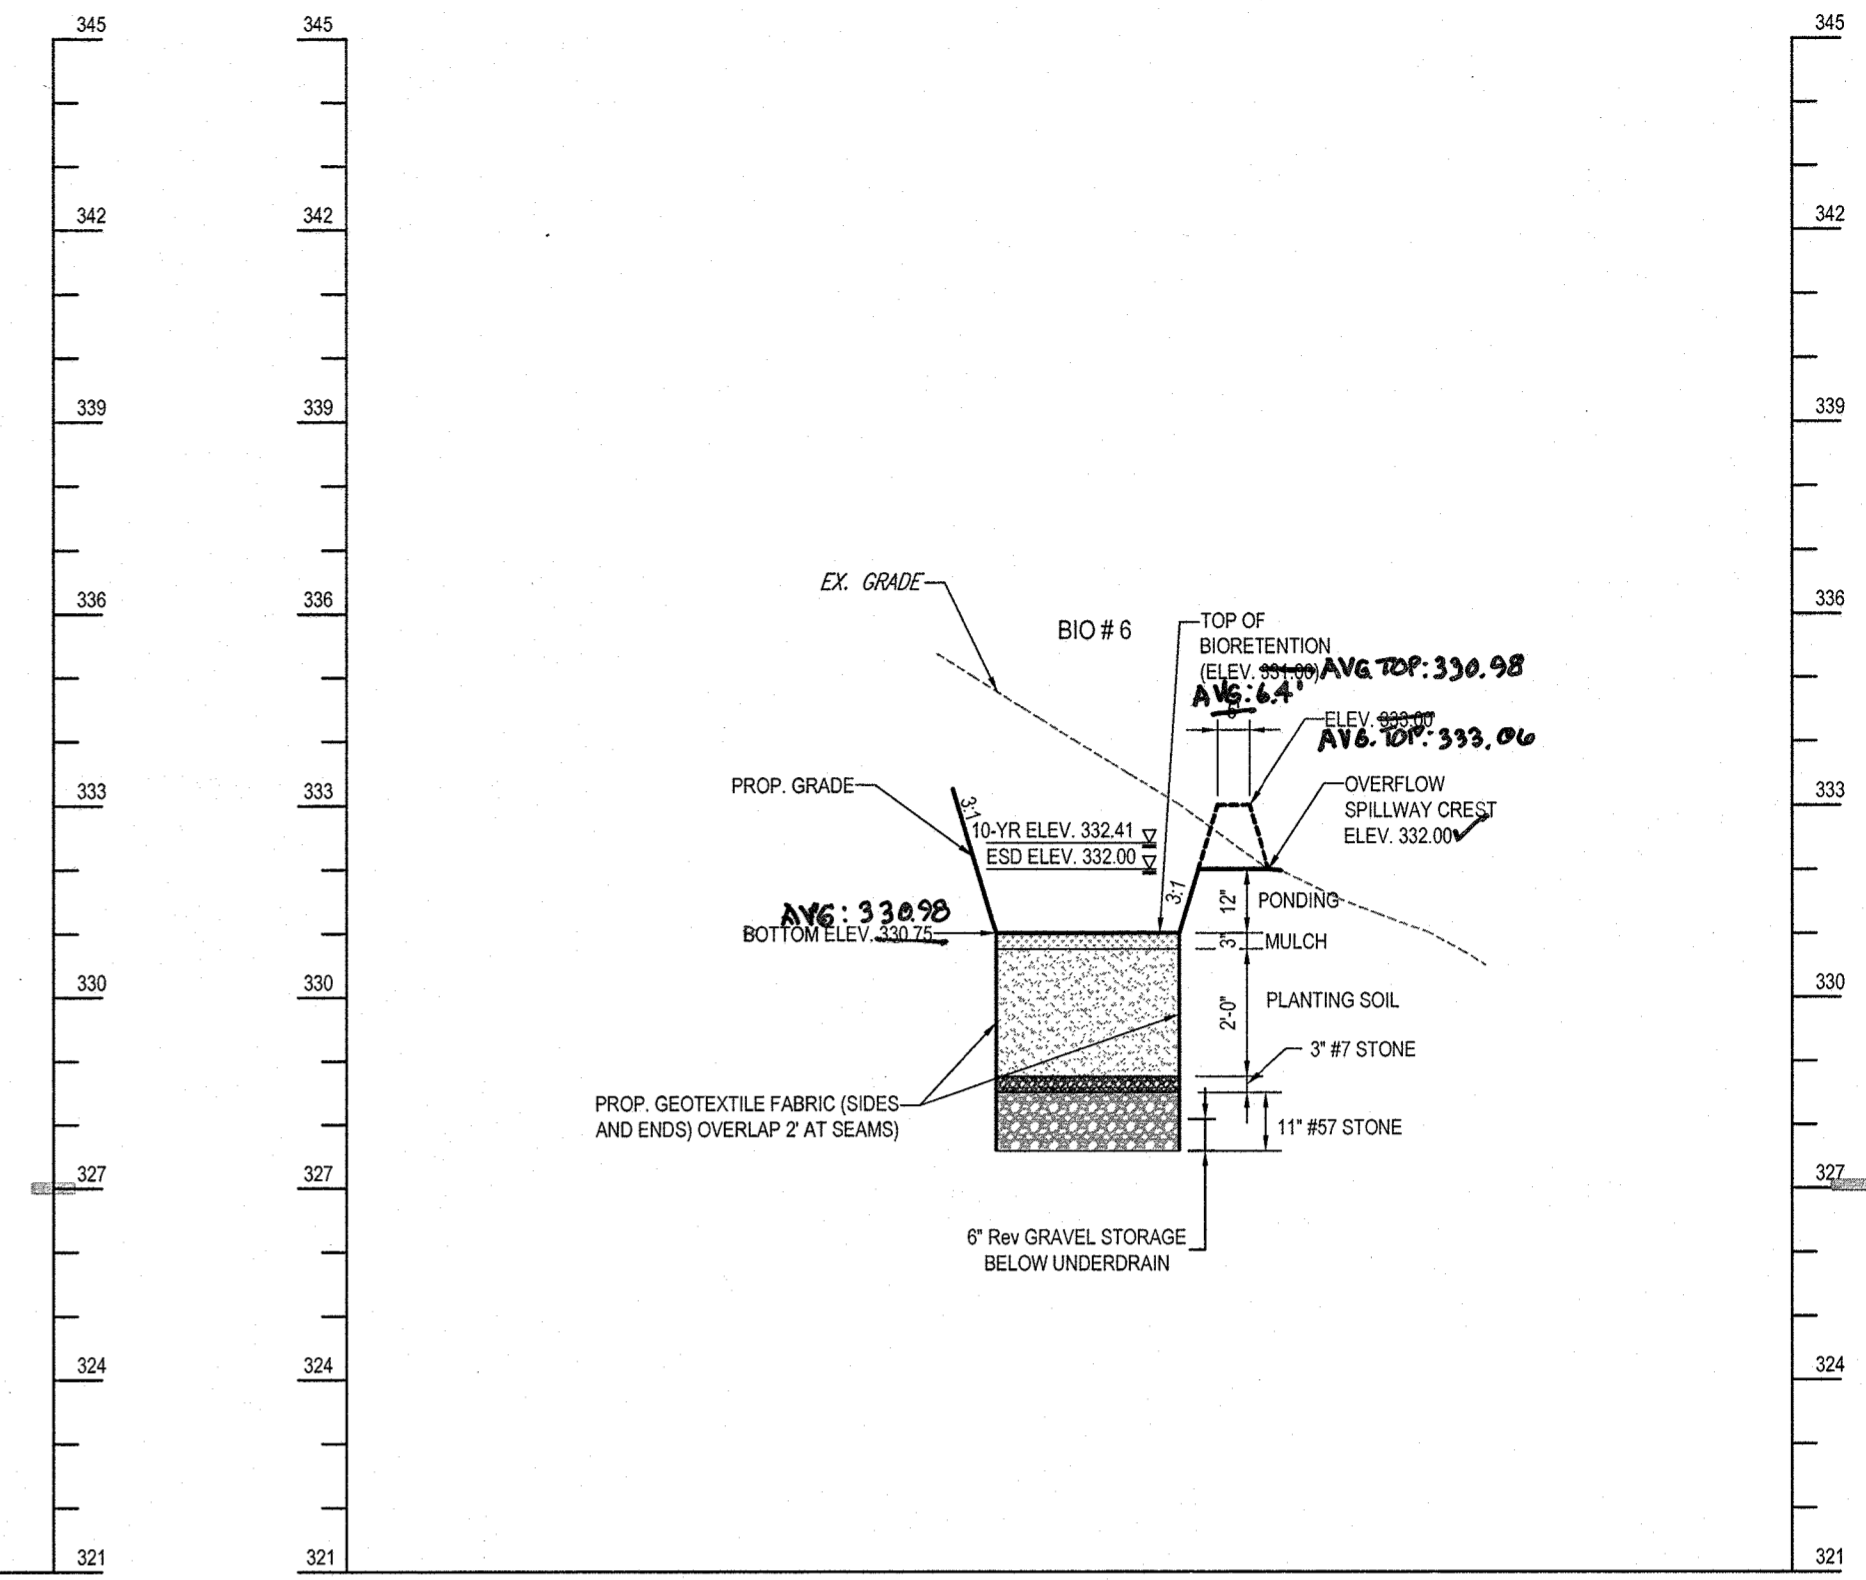

BIO #6 - SECTION B-B
SCALE: 1" = 30' HOR.
1" = 3' VER.

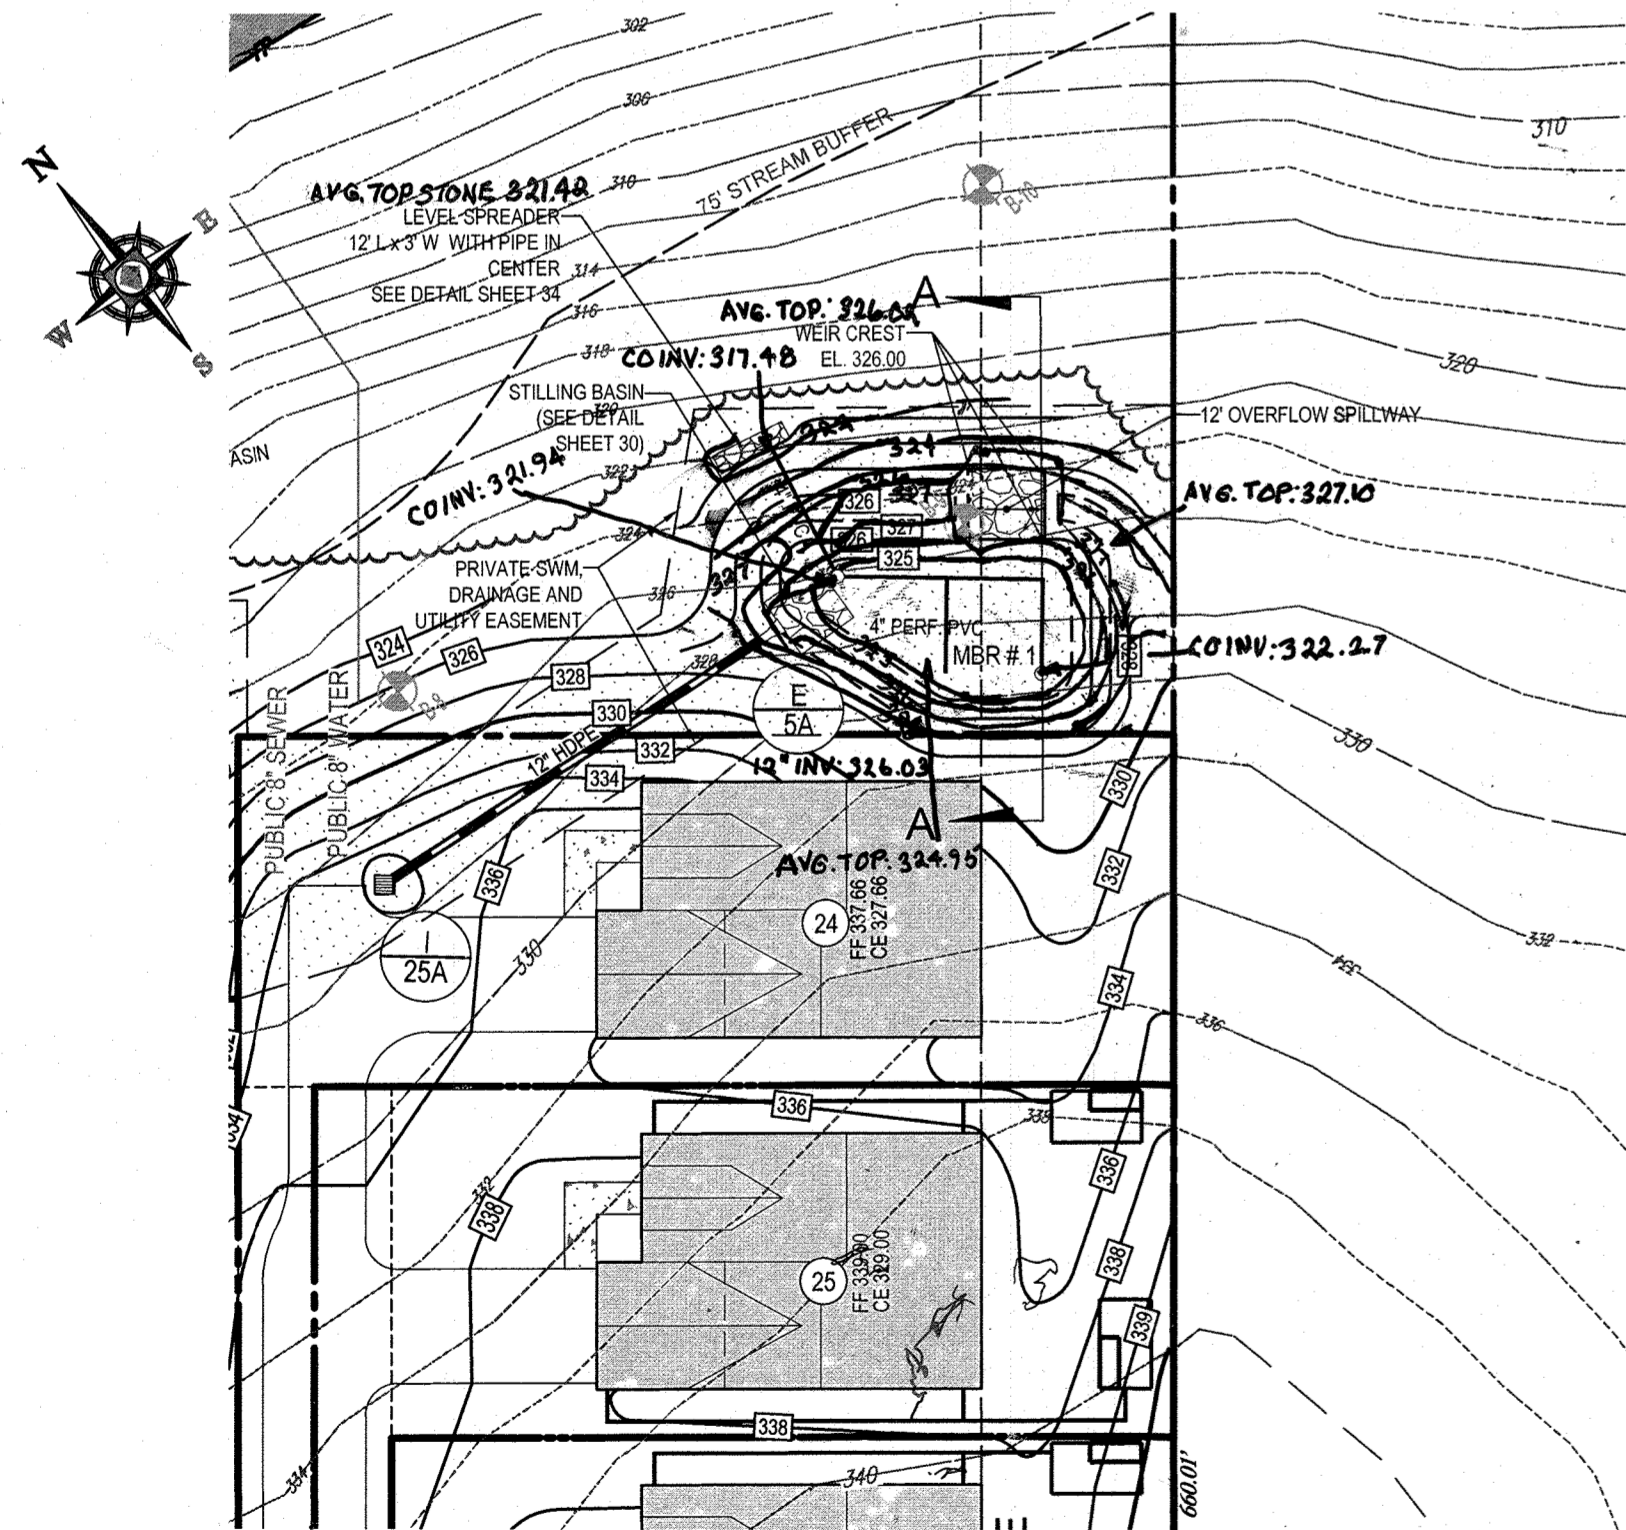

MICROBIORETENTION FACILITY #1 PLAN
SCALE: 1" = 30'

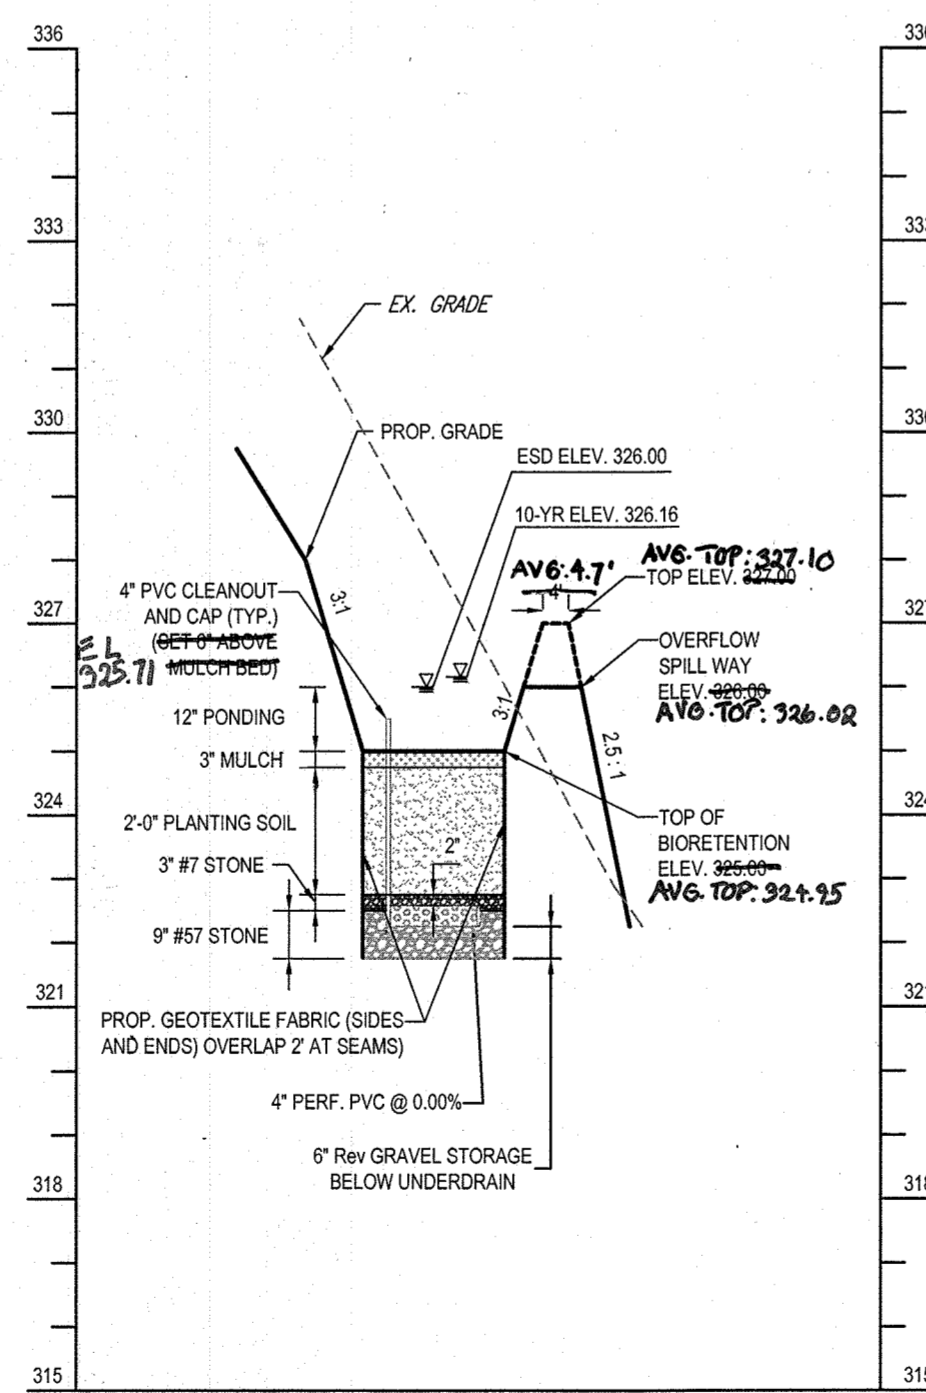


MBR #1 - SECTION A-A
SCALE: 1" = 30' HOR.
1" = 3' VER.

APPROVED: DEPARTMENT OF PLANNING AND ZONING
Chad Edmister 11-17-14
 CHIEF-DEVELOPMENT ENGINEERING DIVISION, DATE


APPROVED: PLANNING BOARD OF HOWARD COUNTY
J. M. Maerhaas for KS 12-22-14 **PR406**
 CHIEF-DIVISION OF LAND DEVELOPMENT, DATE

Frank Tozole 10/08/2014
 DIRECTOR, DATE

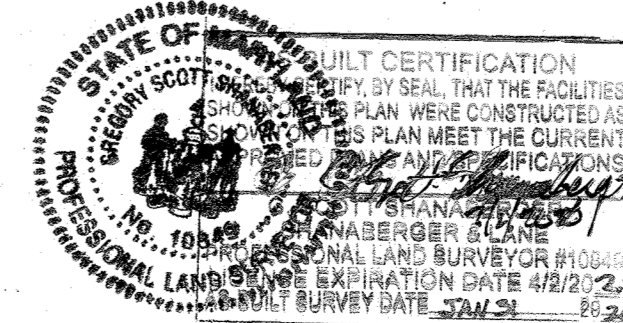

BR
 10/20/14
 FOR REVISION 1 ONLY

PROFESSIONAL CERTIFICATION
 I, BRANDON R. ROWE, HEREBY CERTIFY THAT THESE DOCUMENTS WERE PREPARED OR APPROVED BY ME, AND THAT I AM A DULY LICENSED PROFESSIONAL ENGINEER UNDER THE LAWS OF THE STATE OF MARYLAND.
 LICENSE NO. 40808 EXPIRATION DATE: 7/31/2015

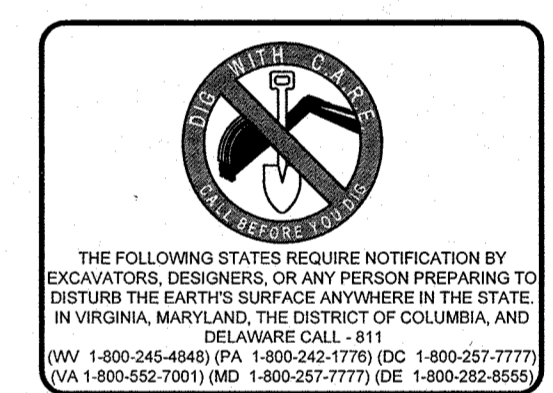

NO.	DATE	PAGE NUMBER	REVISION DESCRIPTION
1	10/27/14	26	UPDATE

OWNER:
 M/I HOMES OF DC, LLC
 21355 RIDGETOP CIRCLE, SUITE 220
 STERLING, VA 20166
 CONTACT: CINDY HUNTZBERRY
 PHONE: 443-677-9803

DEVELOPER:
 SOMERWORTH II, L.C.
 5704 DORSEY HALL DRIVE, SUITE 205
 ELLICOTT CITY, MD 21042
 CONTACT: JASON VAN KIRK
 PHONE: (410) 720-5021


PROJECT: **WALDEN WOODS**

TAX MAP: 47 GRID: 2 ZONED: PSC
 PARCEL: 4, LOTS 1-97, OPEN SPACE LOTS 98 - 102
 6TH ELECTION DISTRICT, HOWARD COUNTY, MARYLAND

TITLE: **MICROBIORETENTION FACILITY DETAILS**


BOHLER ENGINEERING
 901 DULANEY VALLEY ROAD, SUITE 801
 TOWSON, MARYLAND 21284
 Phone: (410) 821-7900
 Fax: (410) 821-7987
 www.BohlerEngineering.com

CHECKED BY:	BRR
DESIGNED BY:	BRR
DRAWN BY:	RMS/AVG
PROJECT NO.:	MD112149
DATE:	10/27/14
SCALE:	AS NOTED
DRAWING NO.:	26 OF 35

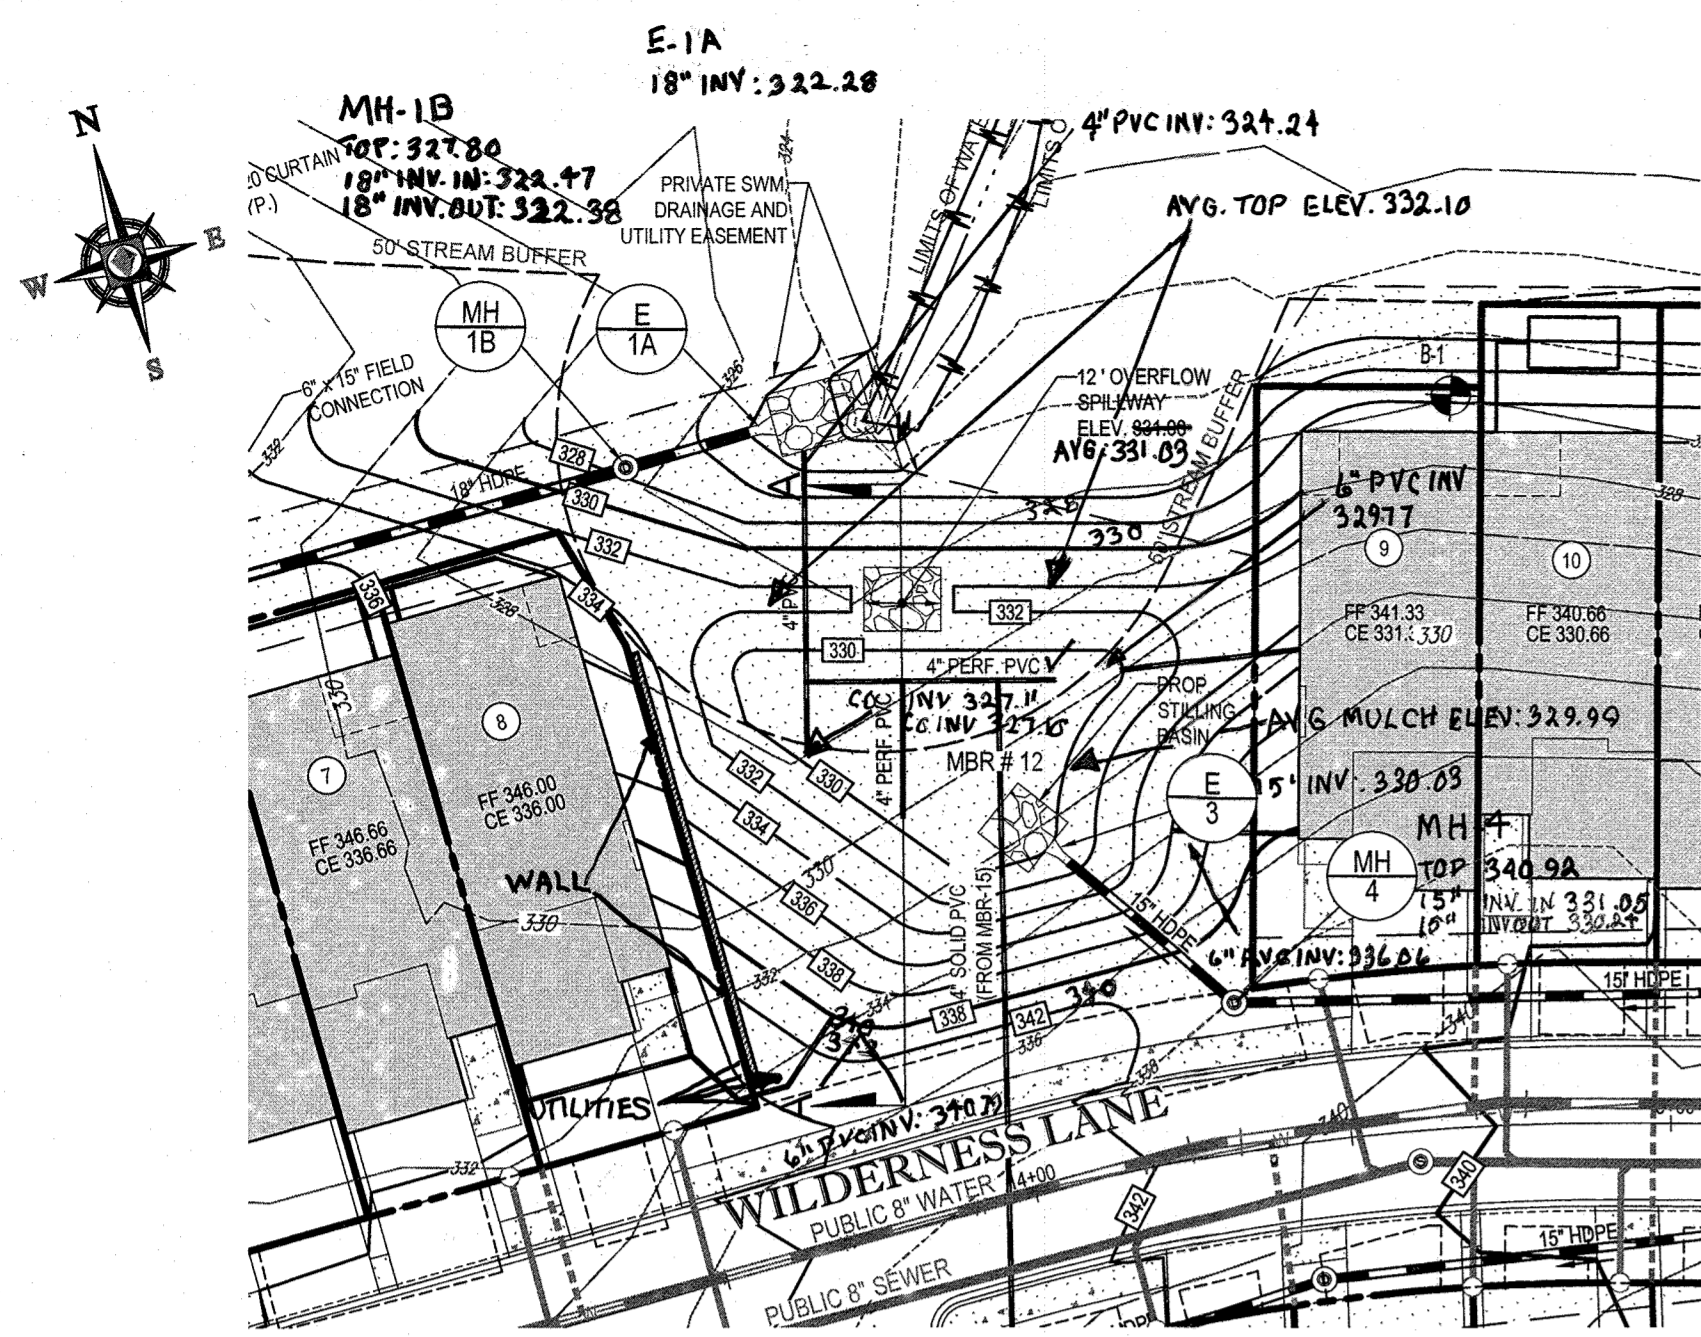


MICROBIORETENTION FACILITY 12 - PLAN

SCALE: 1" = 30'

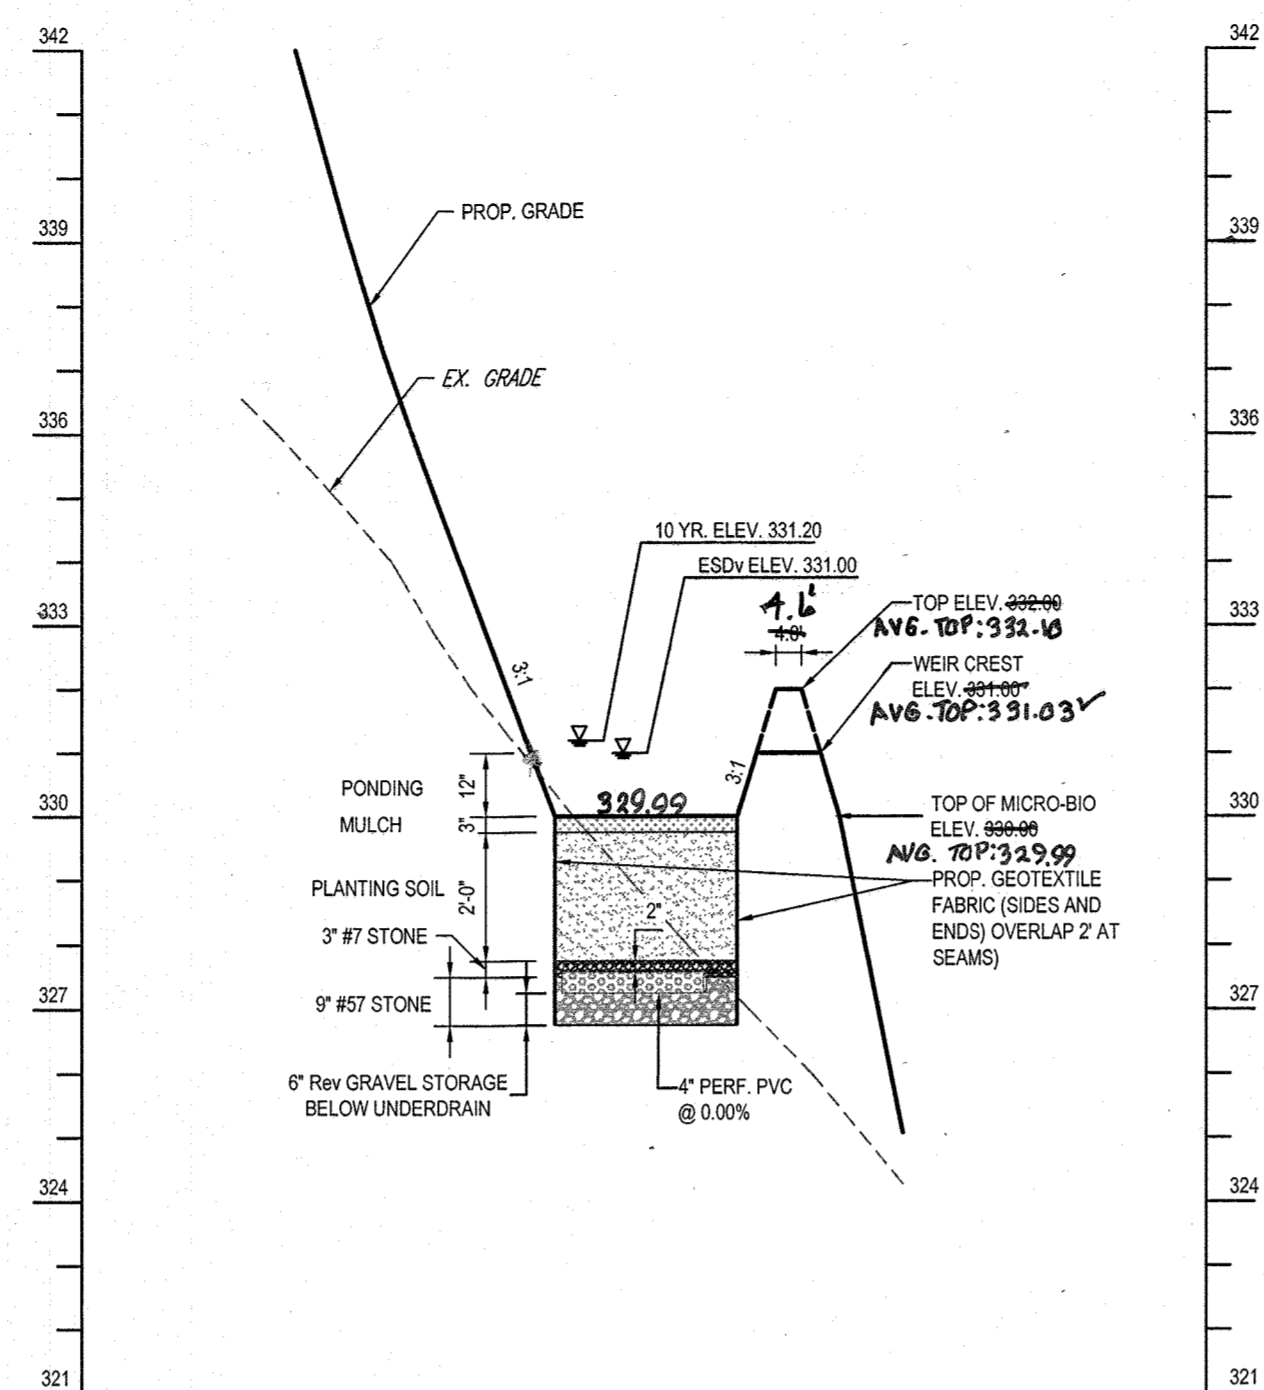


MBR # 12 - SECTION A-A

SCALE: 1" = 30' HOR.
1" = 3' VER.

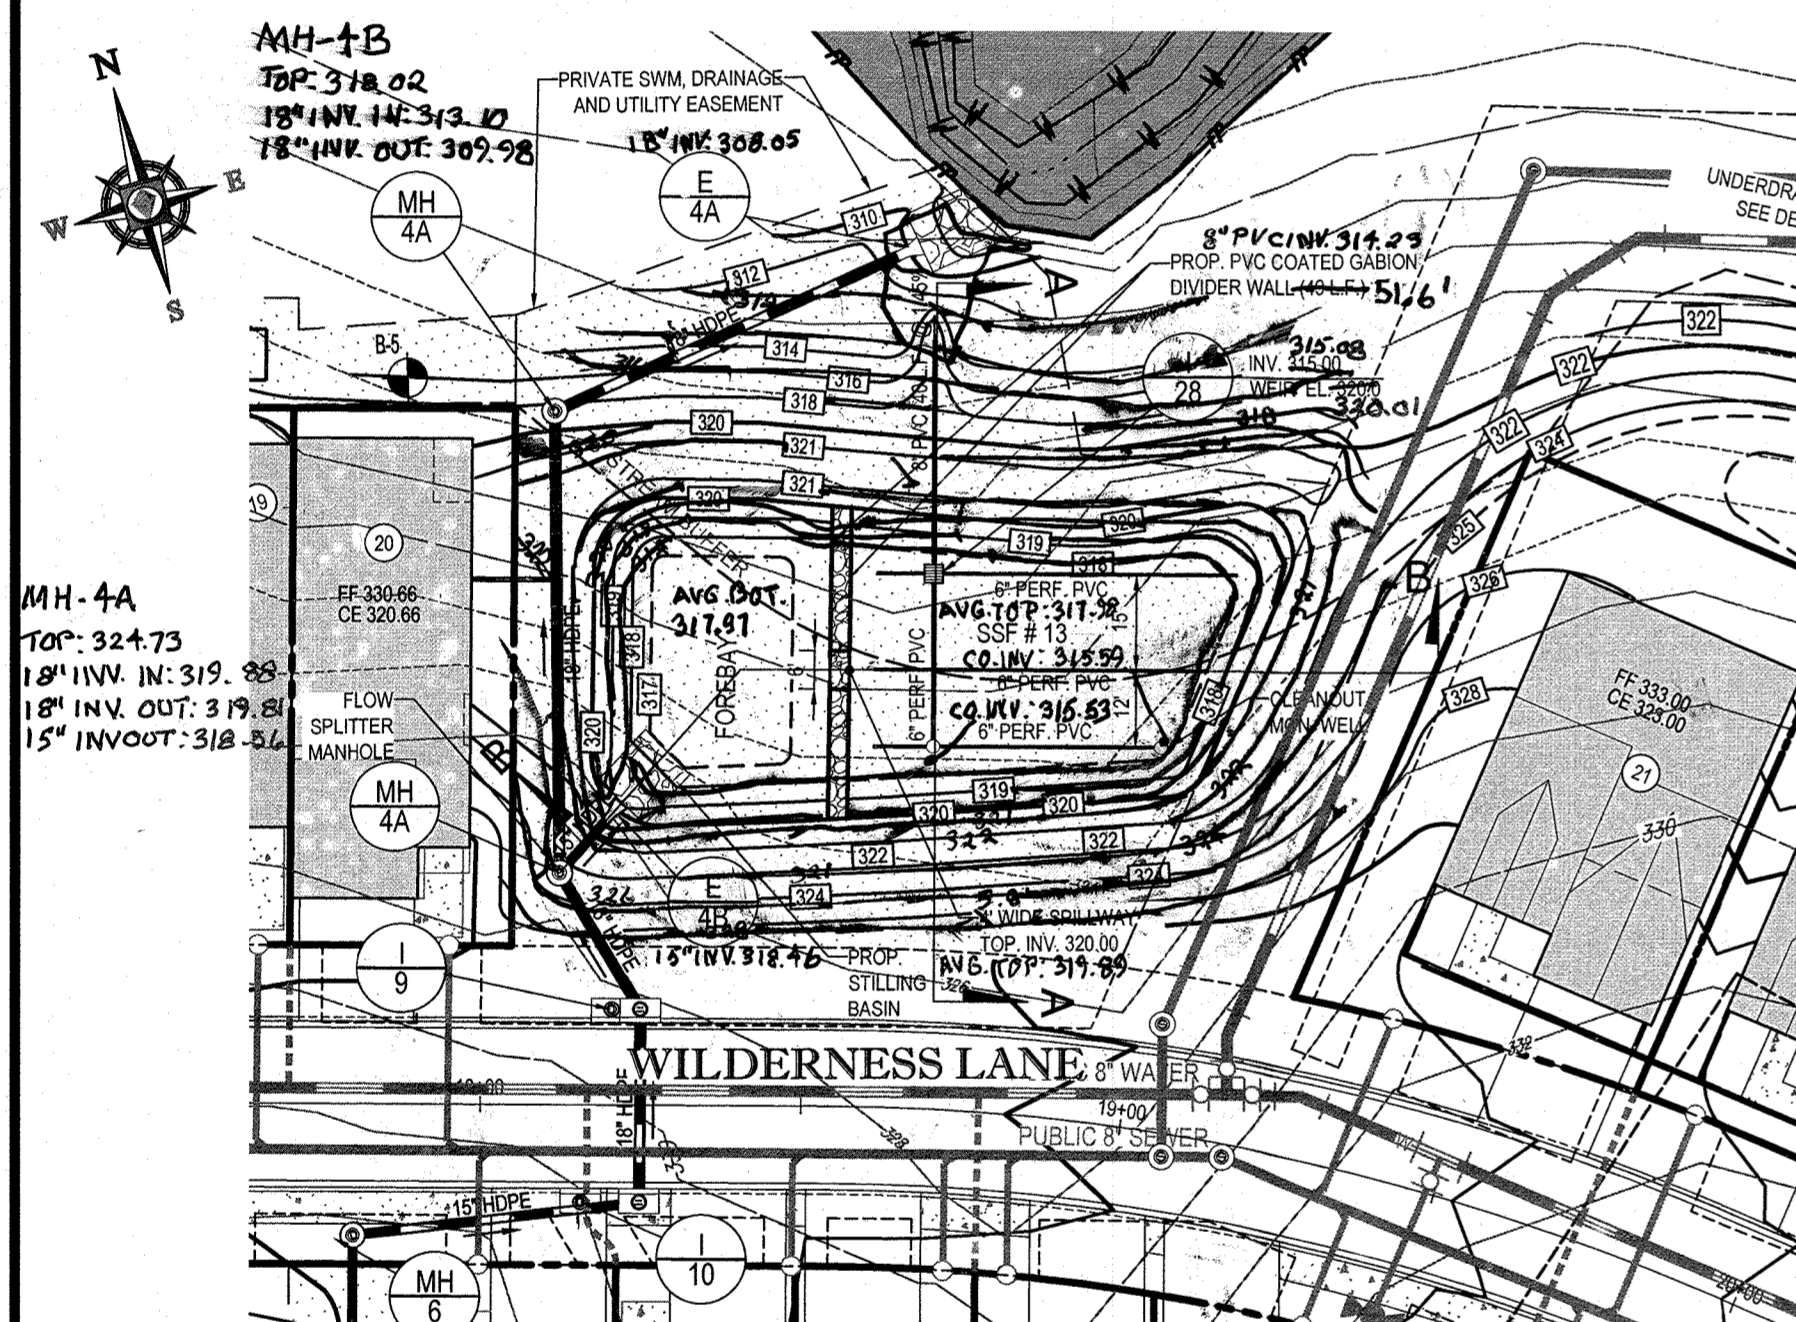


SURFACE SAND FILTER FACILITY 13 - PLAN

SCALE: 1" = 30'

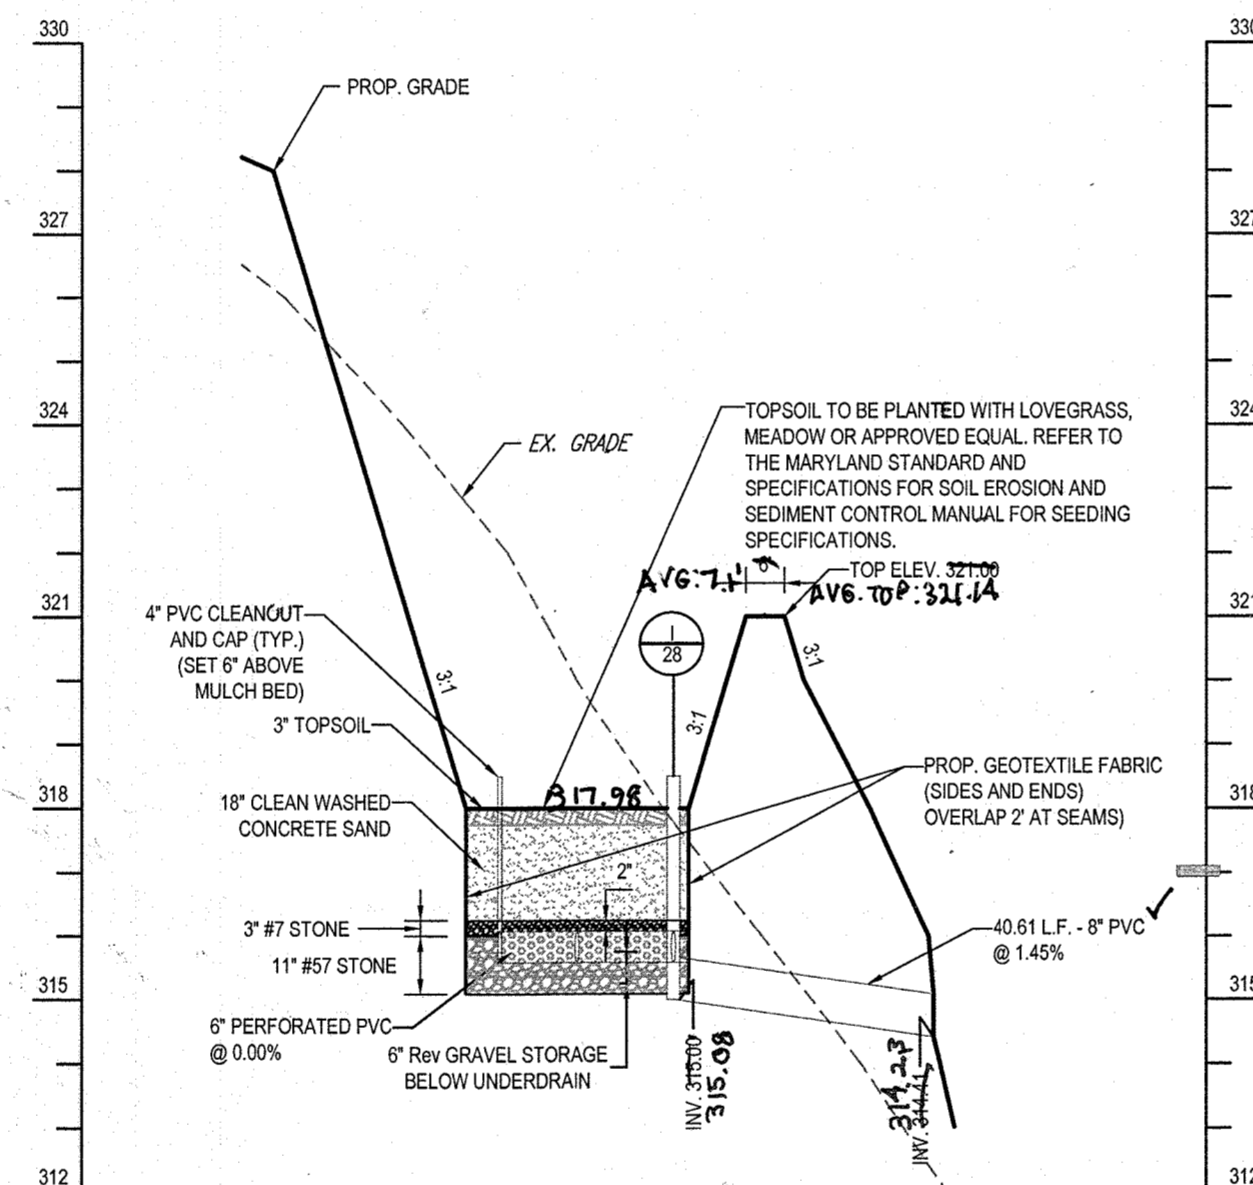


SSF # 13 - SECTION A-A

SCALE: 1" = 30' HOR.
1" = 3' VER.

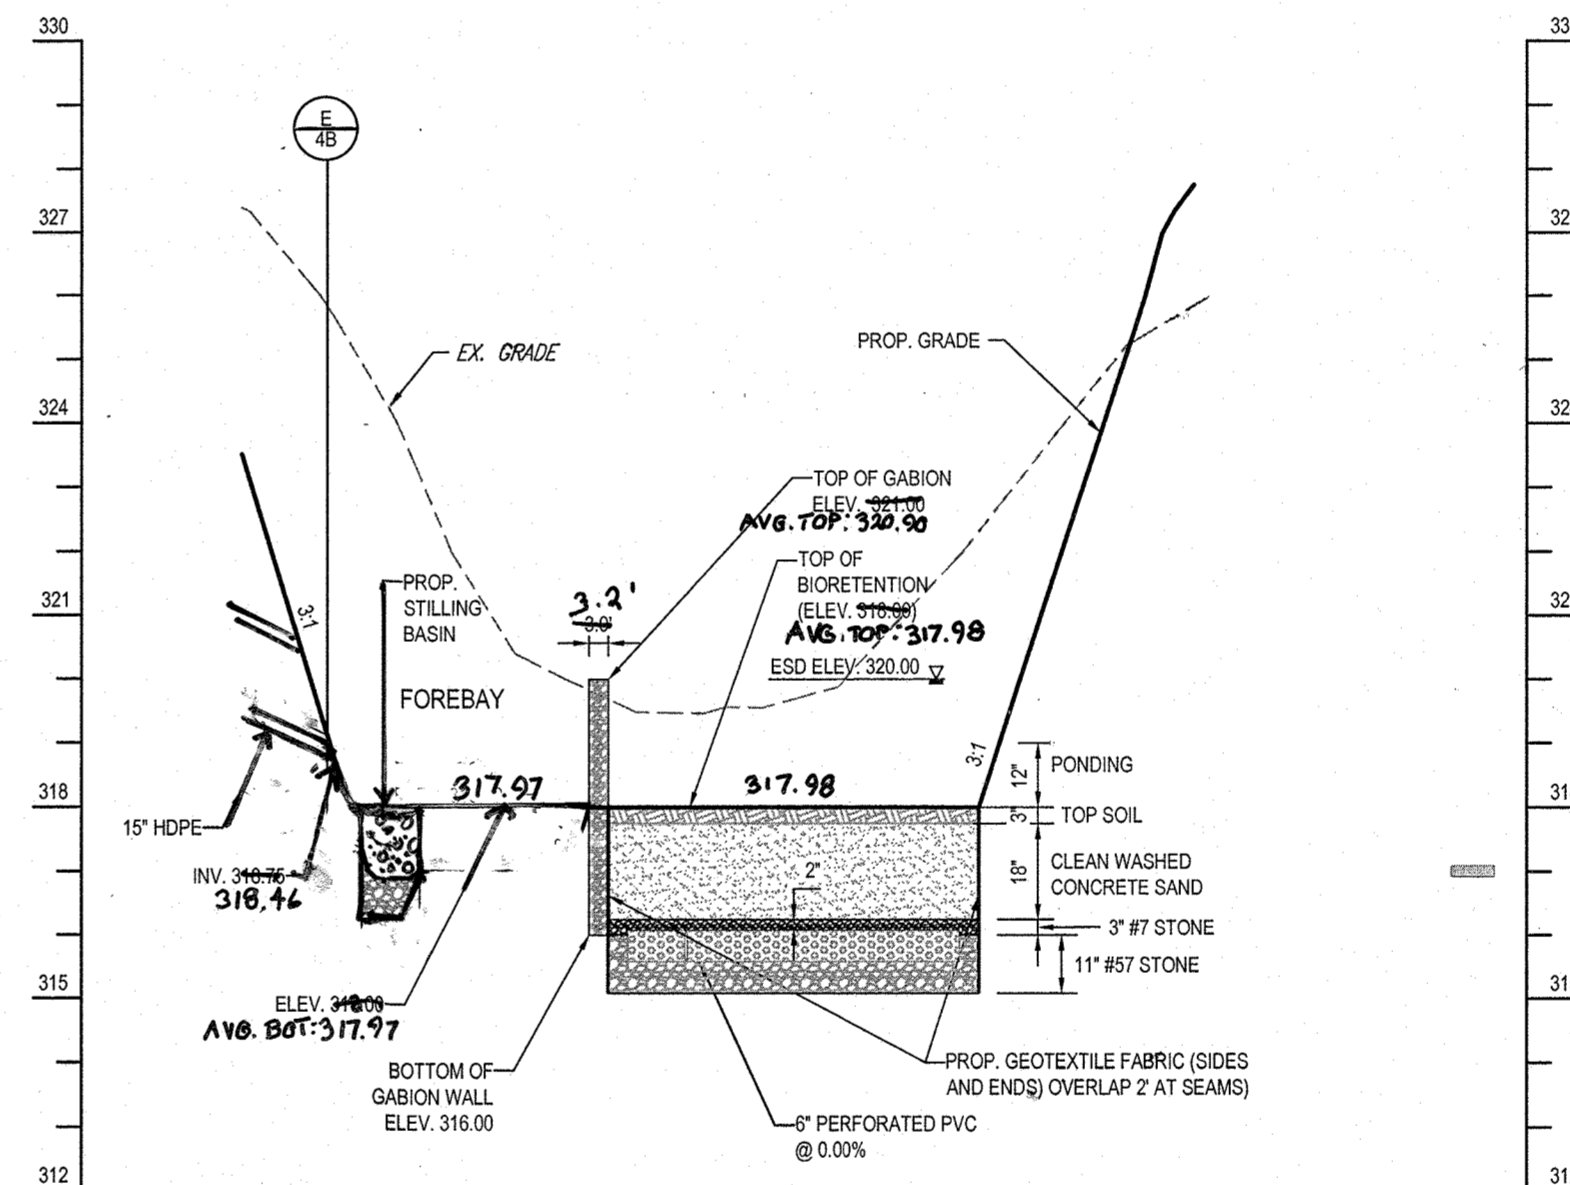


SSF # 13 - SECTION B-B

SCALE: 1" = 30' HOR.
1" = 3' VER.

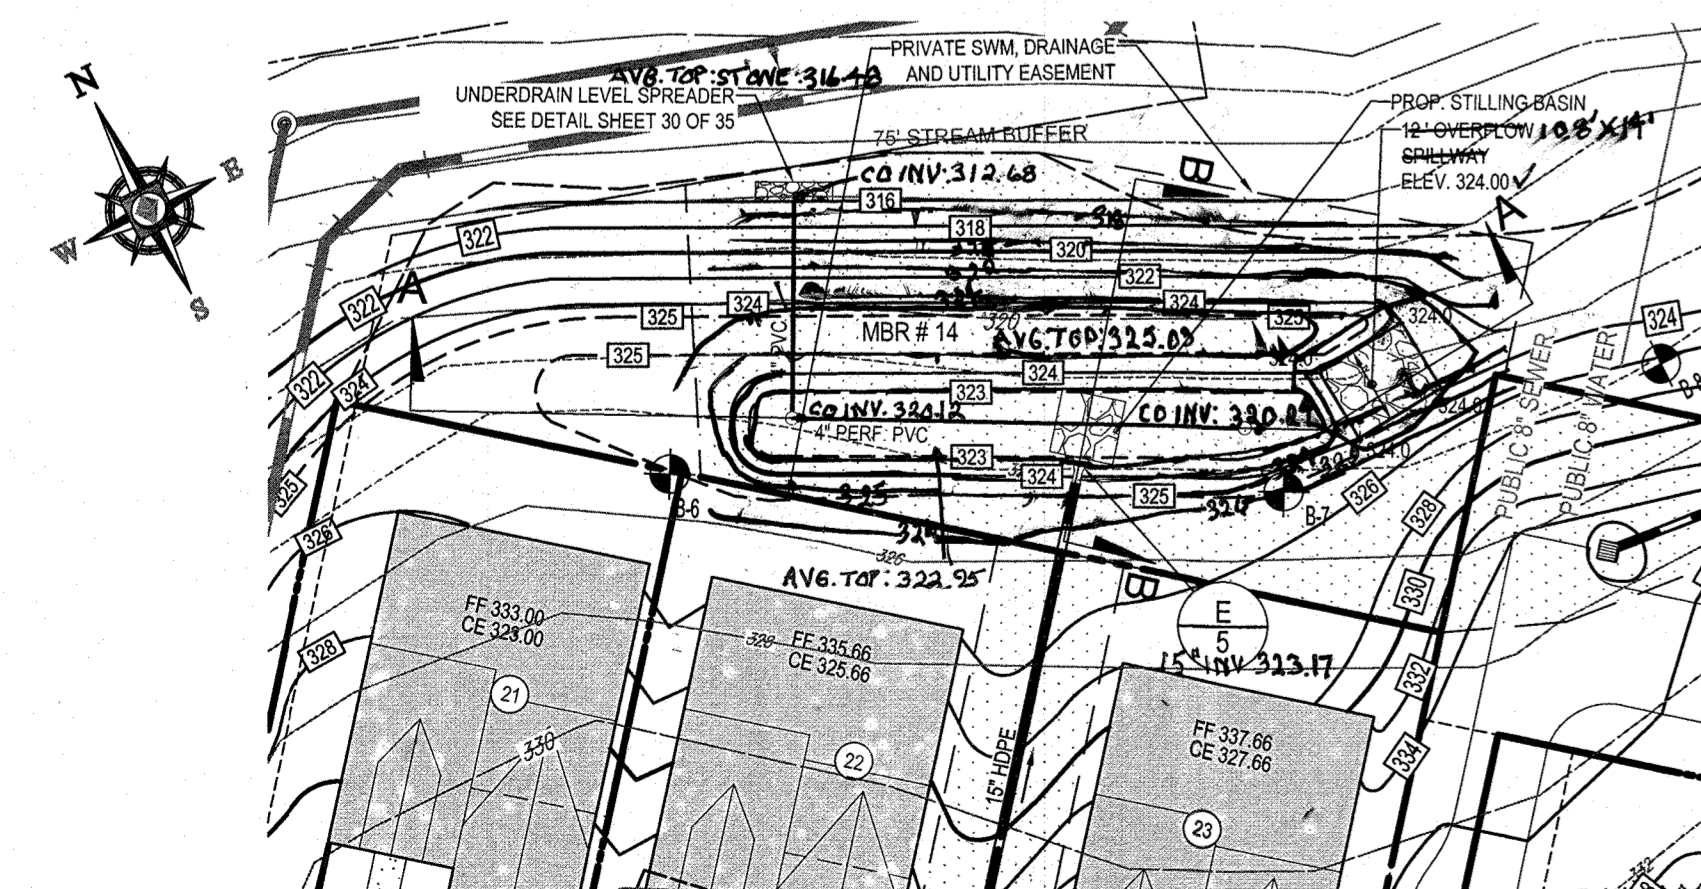


MICROBIORETENTION FACILITY 14 PLAN

SCALE: 1" = 30'

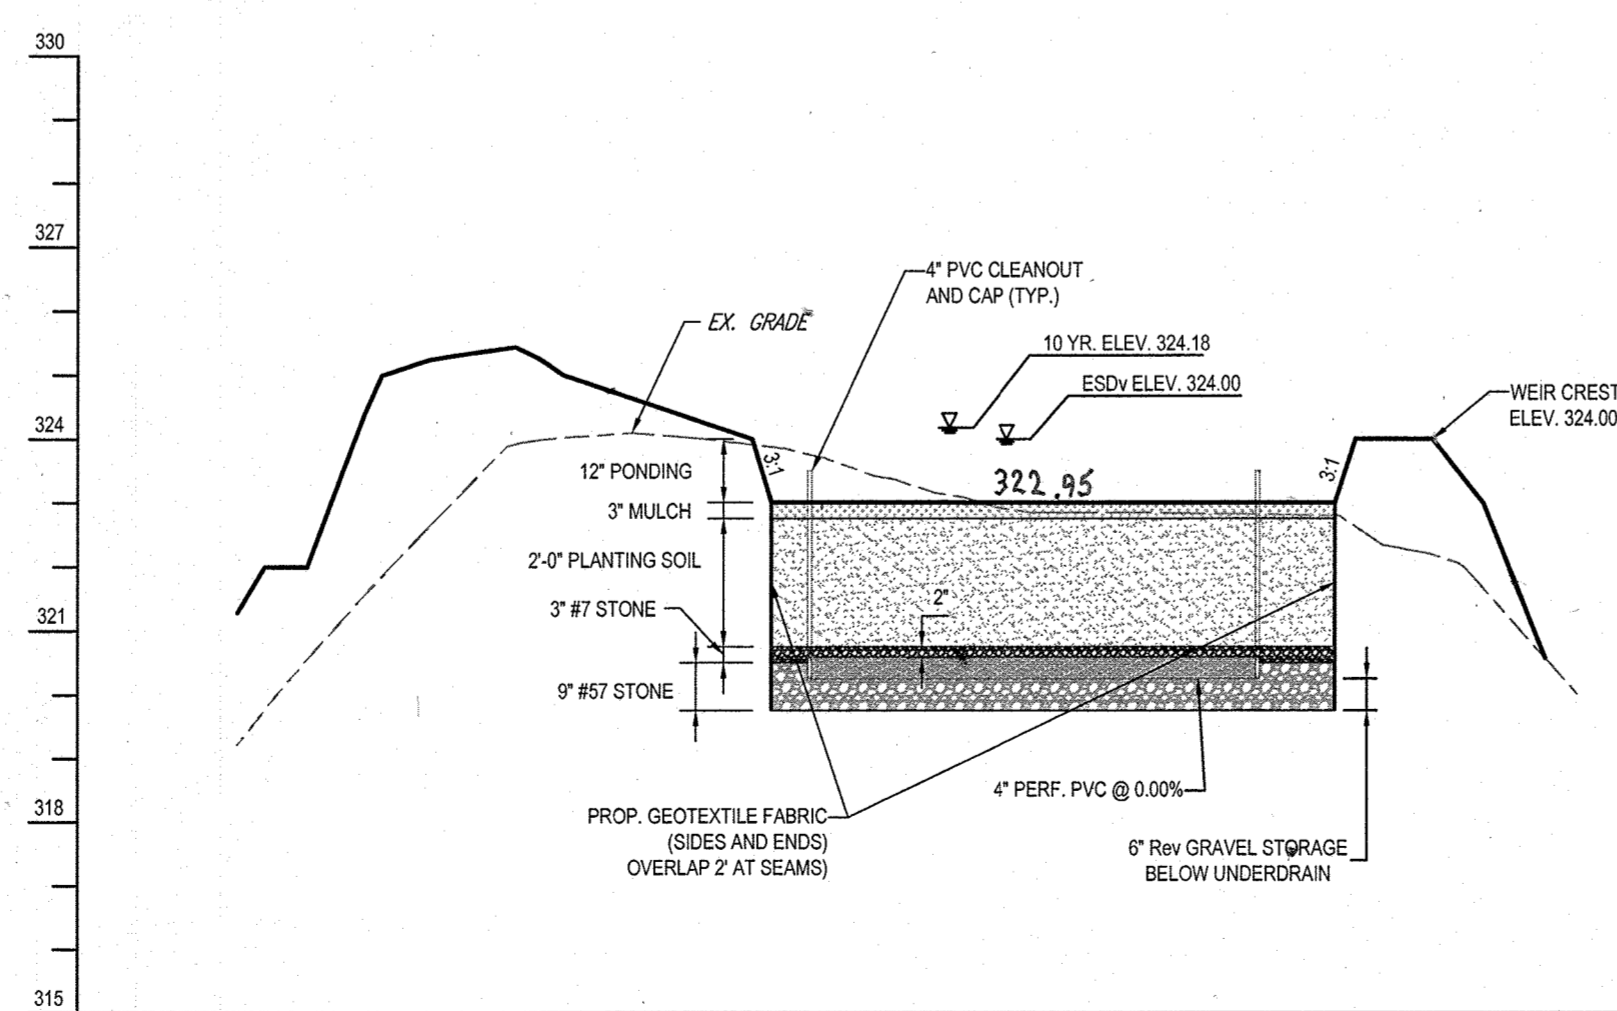

MBR # 14 - SECTION A-A

SCALE: 1" = 30' HOR.
1" = 3' VER.


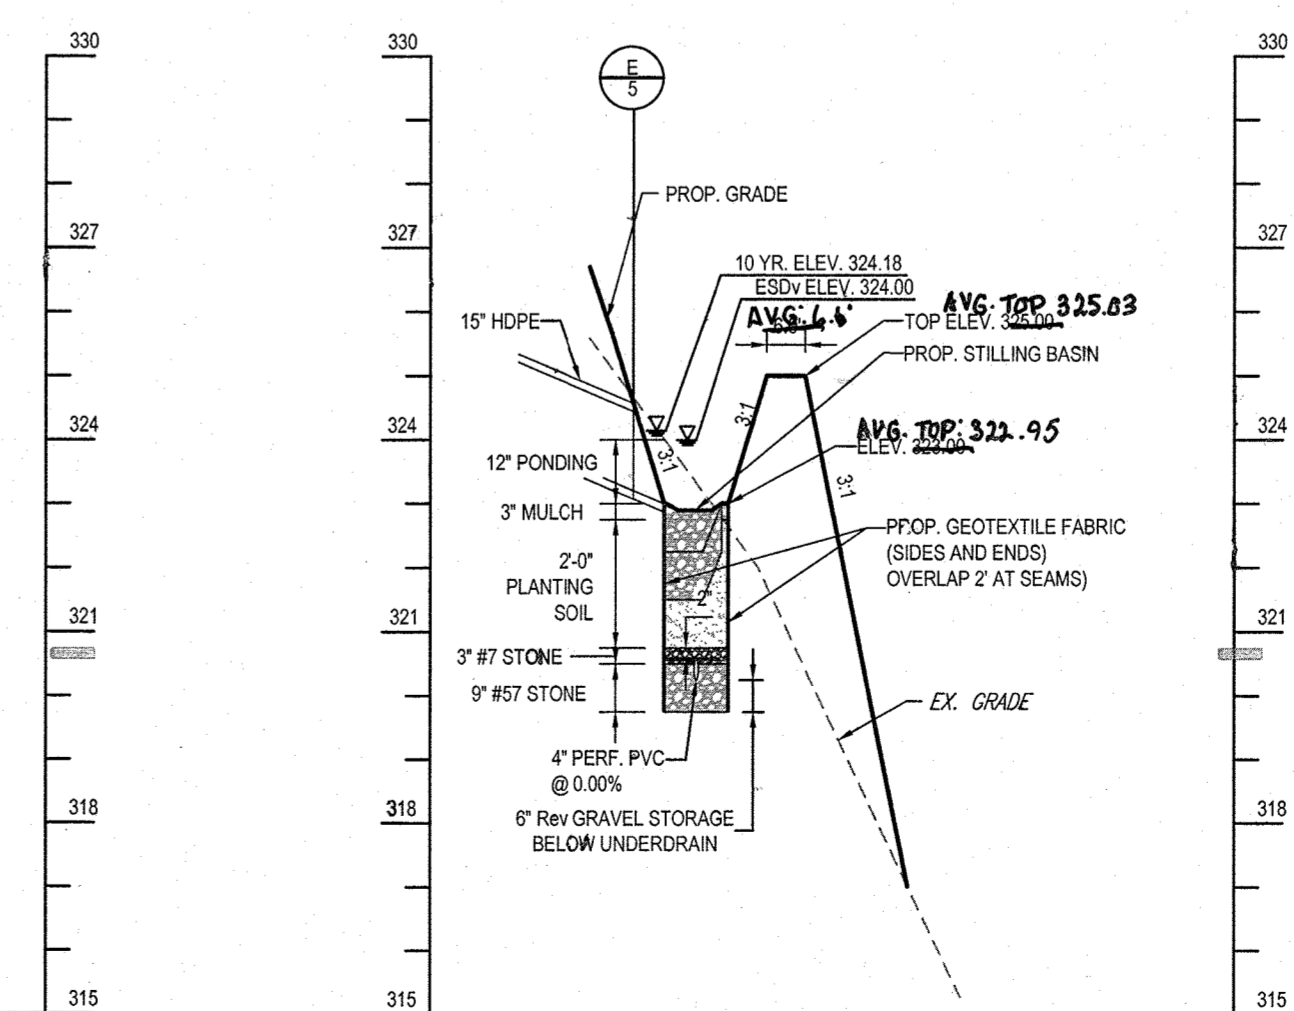


MBR # 14 - SECTION B-B

SCALE: 1" = 30' HOR.
1" = 3' VER.

APPROVED: DEPARTMENT OF PLANNING AND ZONING
DATE 11/2/14
CHIEF-DEVELOPMENT ENGINEERING DIVISION
DATE 12-22-14
CHIEF-DIVISION OF LAND DEVELOPMENT
DATE 10/08/2014
DIRECTOR

APPROVED: PLANNING BOARD OF HOWARD COUNTY
DATE 10/08/2014

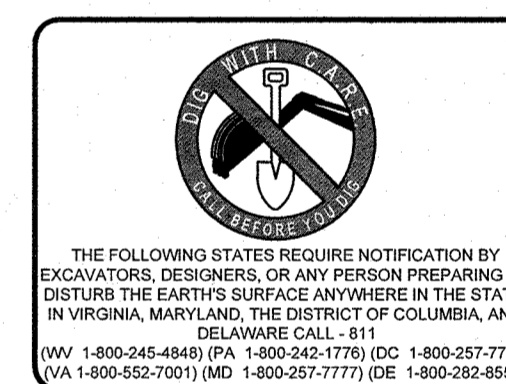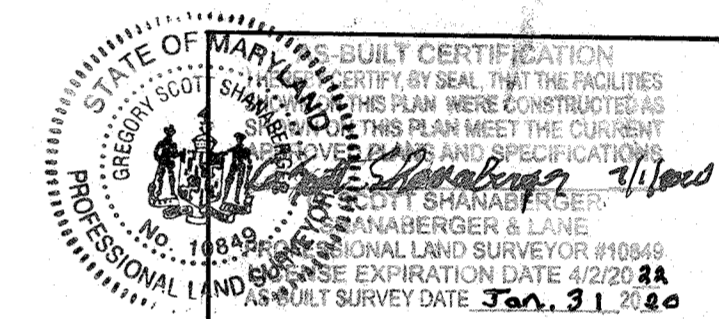

NO.	DATE	REVISION DESCRIPTION
A	11/2/14	PAGE NUMBER UPDATE

OWNER:
M/I HOMES OF DC, LLC
21355 RIDGETOP CIRCLE, SUITE 220
STERLING, VA 20156
CONTACT: CINDY HUNTZBERRY
PHONE: 443-677-9803

DEVELOPER:
SOMERWORTH II, L.C.
5704 DORSEY HALL DRIVE, SUITE 205
ELLCOTT CITY, MD 21042
CONTACT: JASON VAN KIRK
PHONE: (410) 720-3021

PROJECT: WALDEN WOODS

TAX MAP: 47 GRID: 2 ZONED: PSC
PARCEL: 4, LOTS 1-87, OPEN SPACE LOTS 98 - 102
6TH ELECTION DISTRICT, HOWARD COUNTY, MARYLAND


TITLE: MICROBIORETENTION FACILITY DETAILS




901 DULANEY VALLEY ROAD, SUITE 801
TOWSON, MARYLAND 21284
Phone: (410) 821-7900
Fax: (410) 821-7987
www.BohlerEngineering.com

CHECKED BY: BRR
DESIGNED BY: BRR
DRAWN BY: RMS/AVG
PROJECT NO.: MD112149
DATE: 10/27/14
SCALE: AS NOTED
DRAWING NO. 28 OF 35


PROFESSIONAL CERTIFICATION
I, BRANDON R. ROWE, HEREBY CERTIFY THAT THESE DOCUMENTS WERE PREPARED OR APPROVED BY ME, AND THAT I AM A DULY LICENSED PROFESSIONAL ENGINEER UNDER THE LAWS OF THE STATE OF MARYLAND, LICENSE NO. 40808, EXPIRATION DATE: 7/3/2015

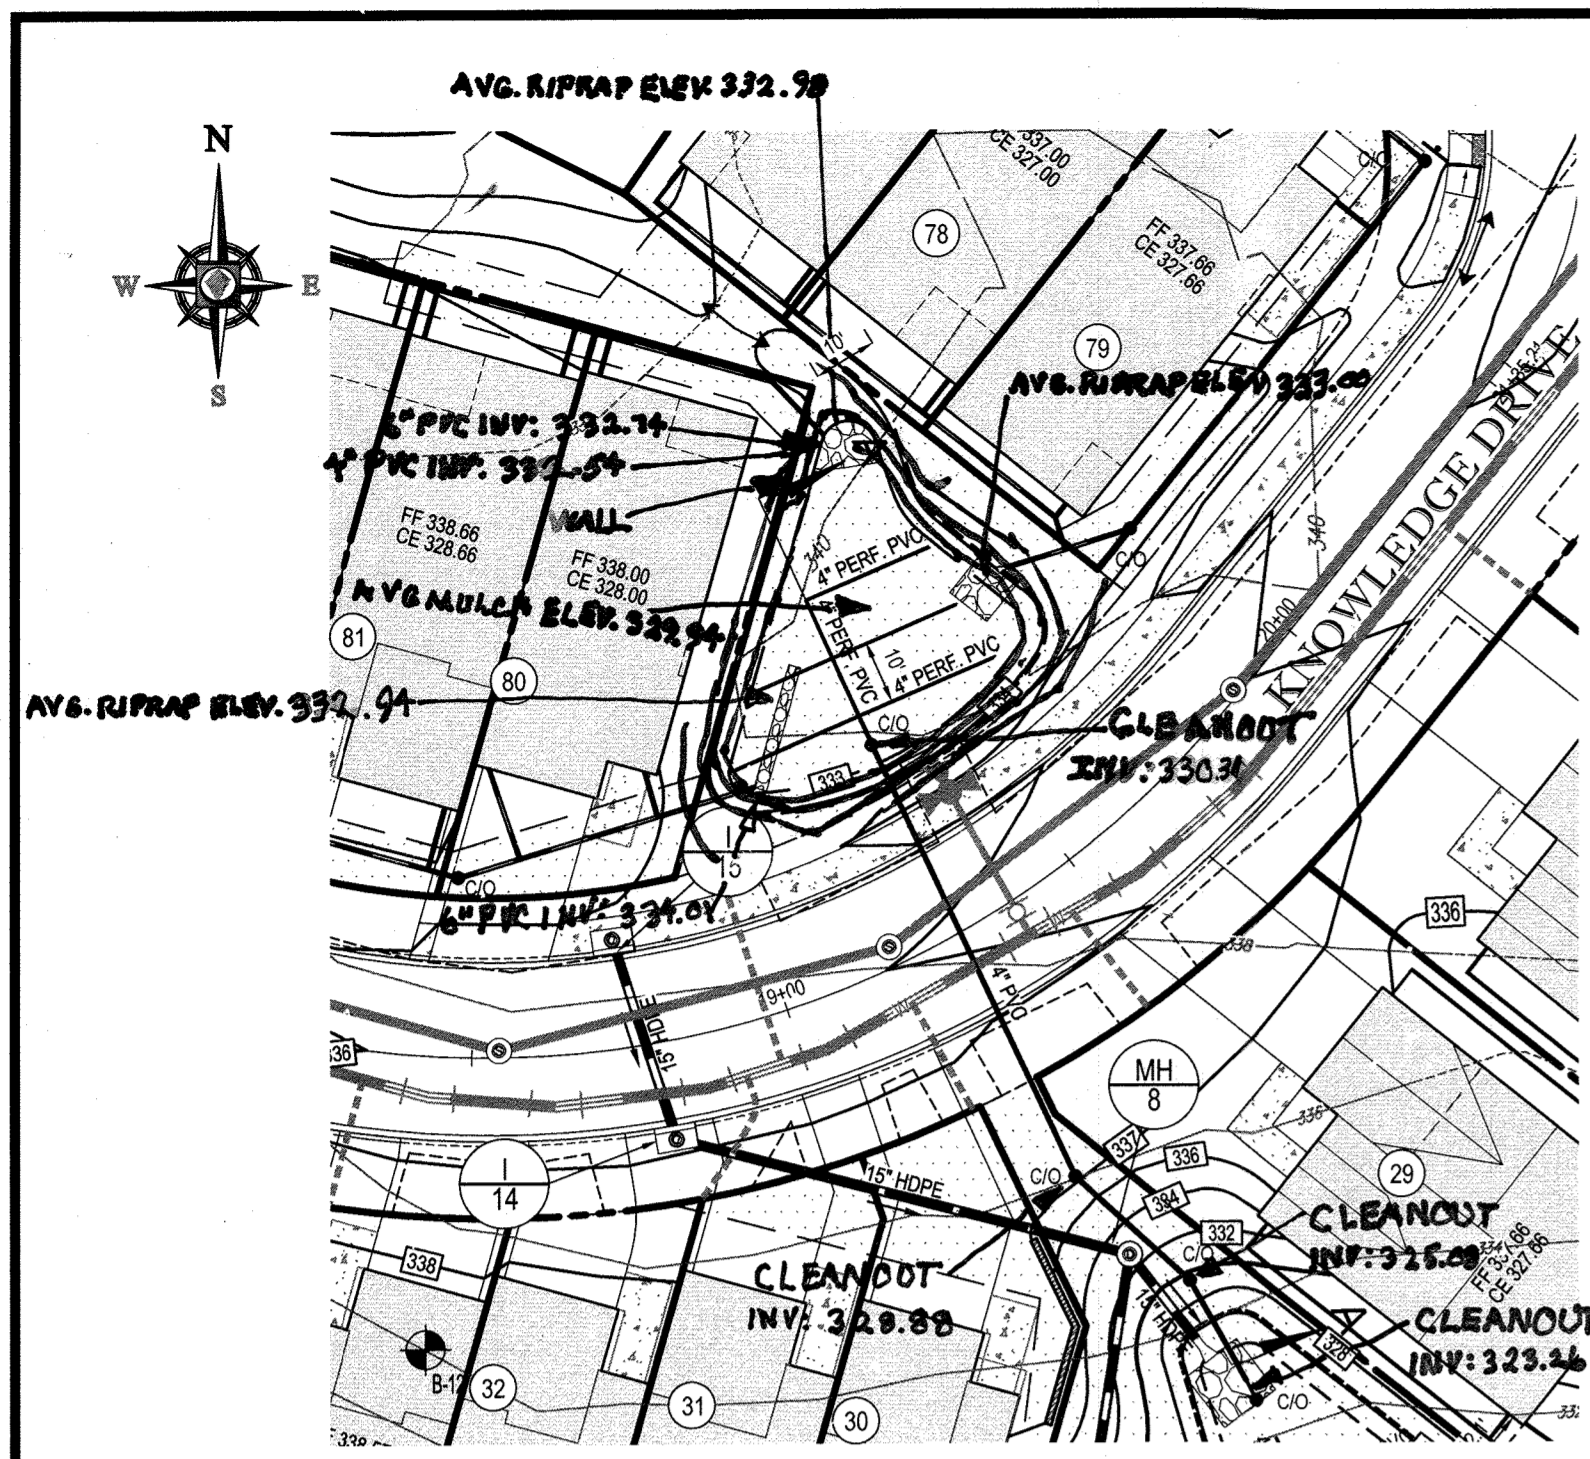


MICROBIORETENTION FACILITY 2 - PLAN
SCALE: 1" = 30'

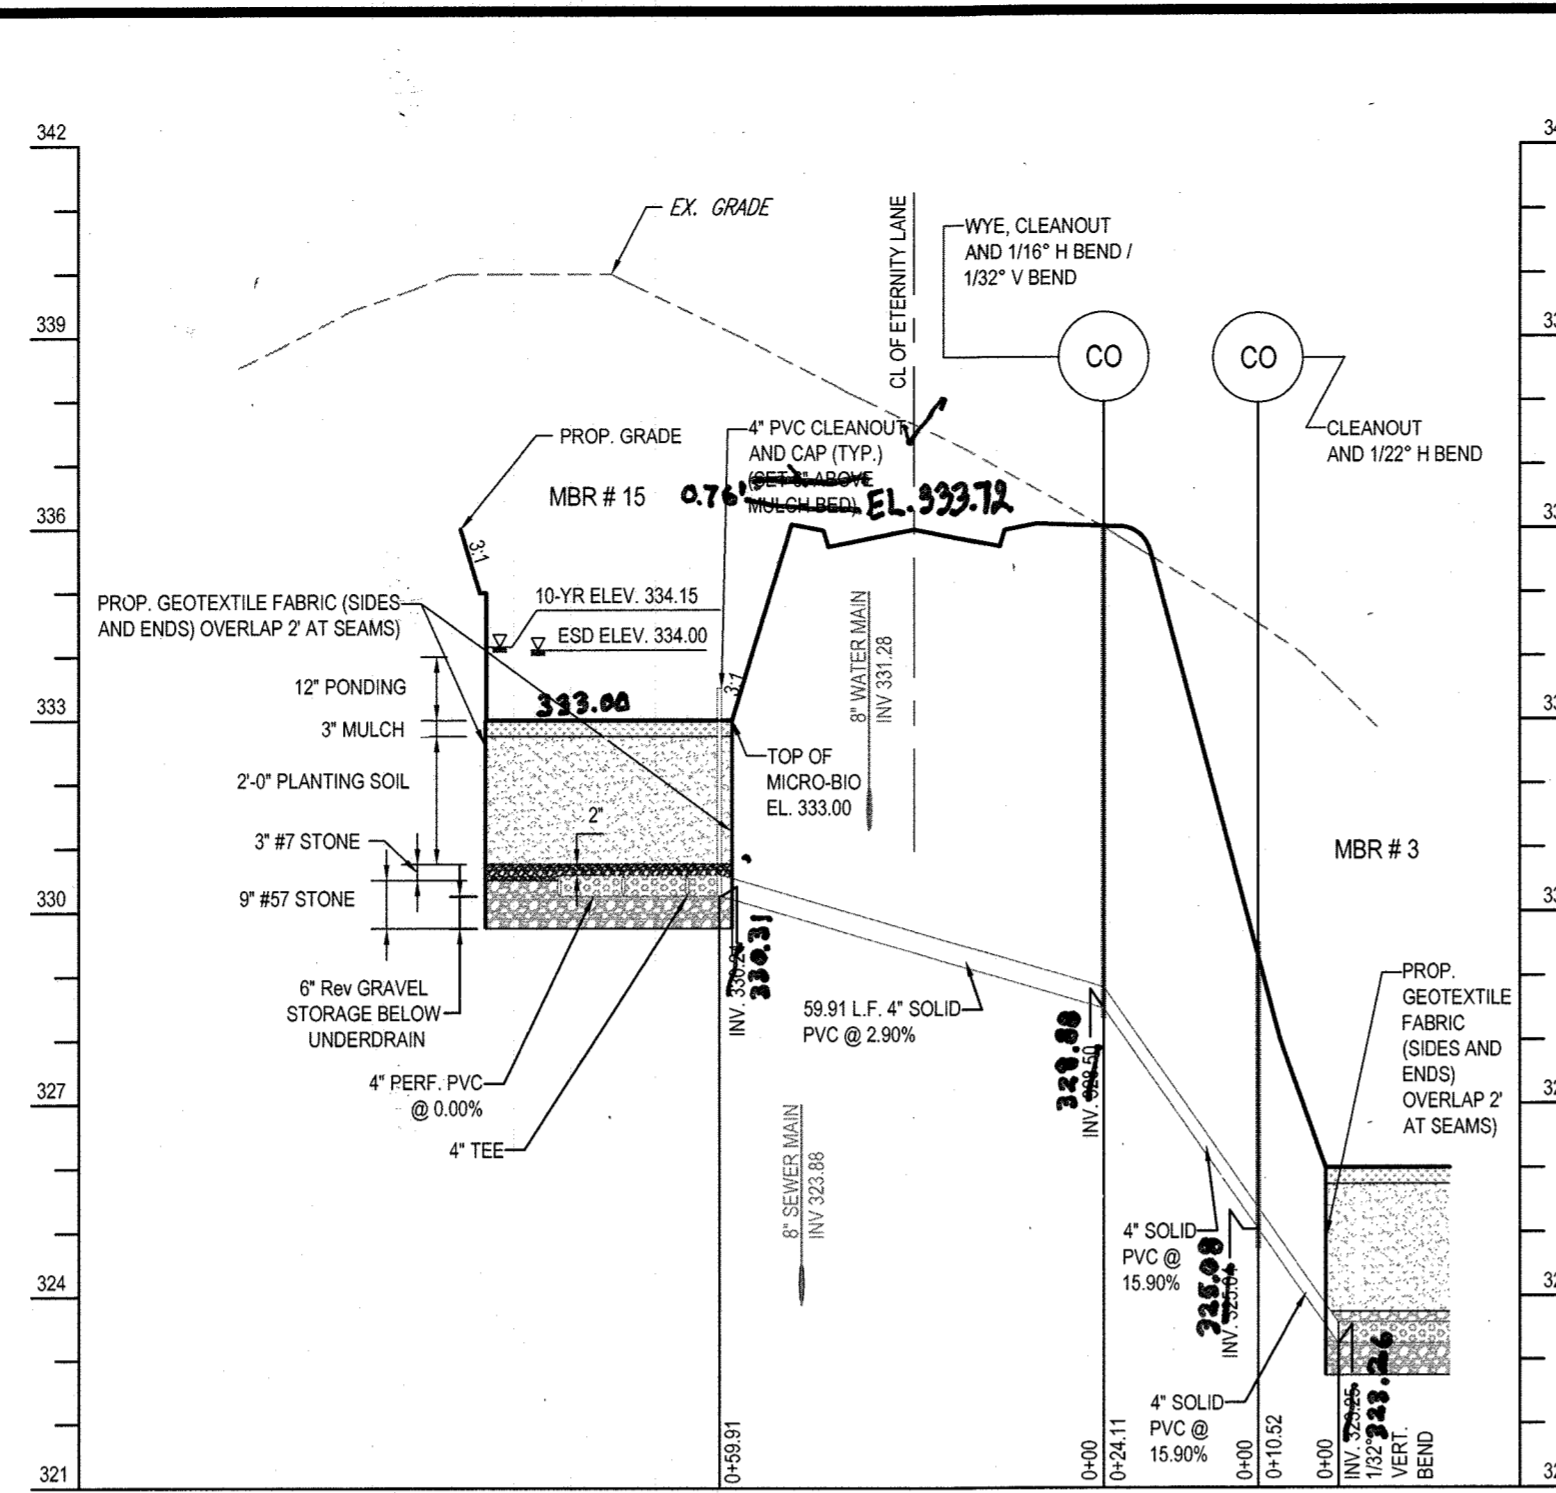


MBR # 2 - SECTION A-A
SCALE: 1" = 30' HOR.
1" = 3' VER.

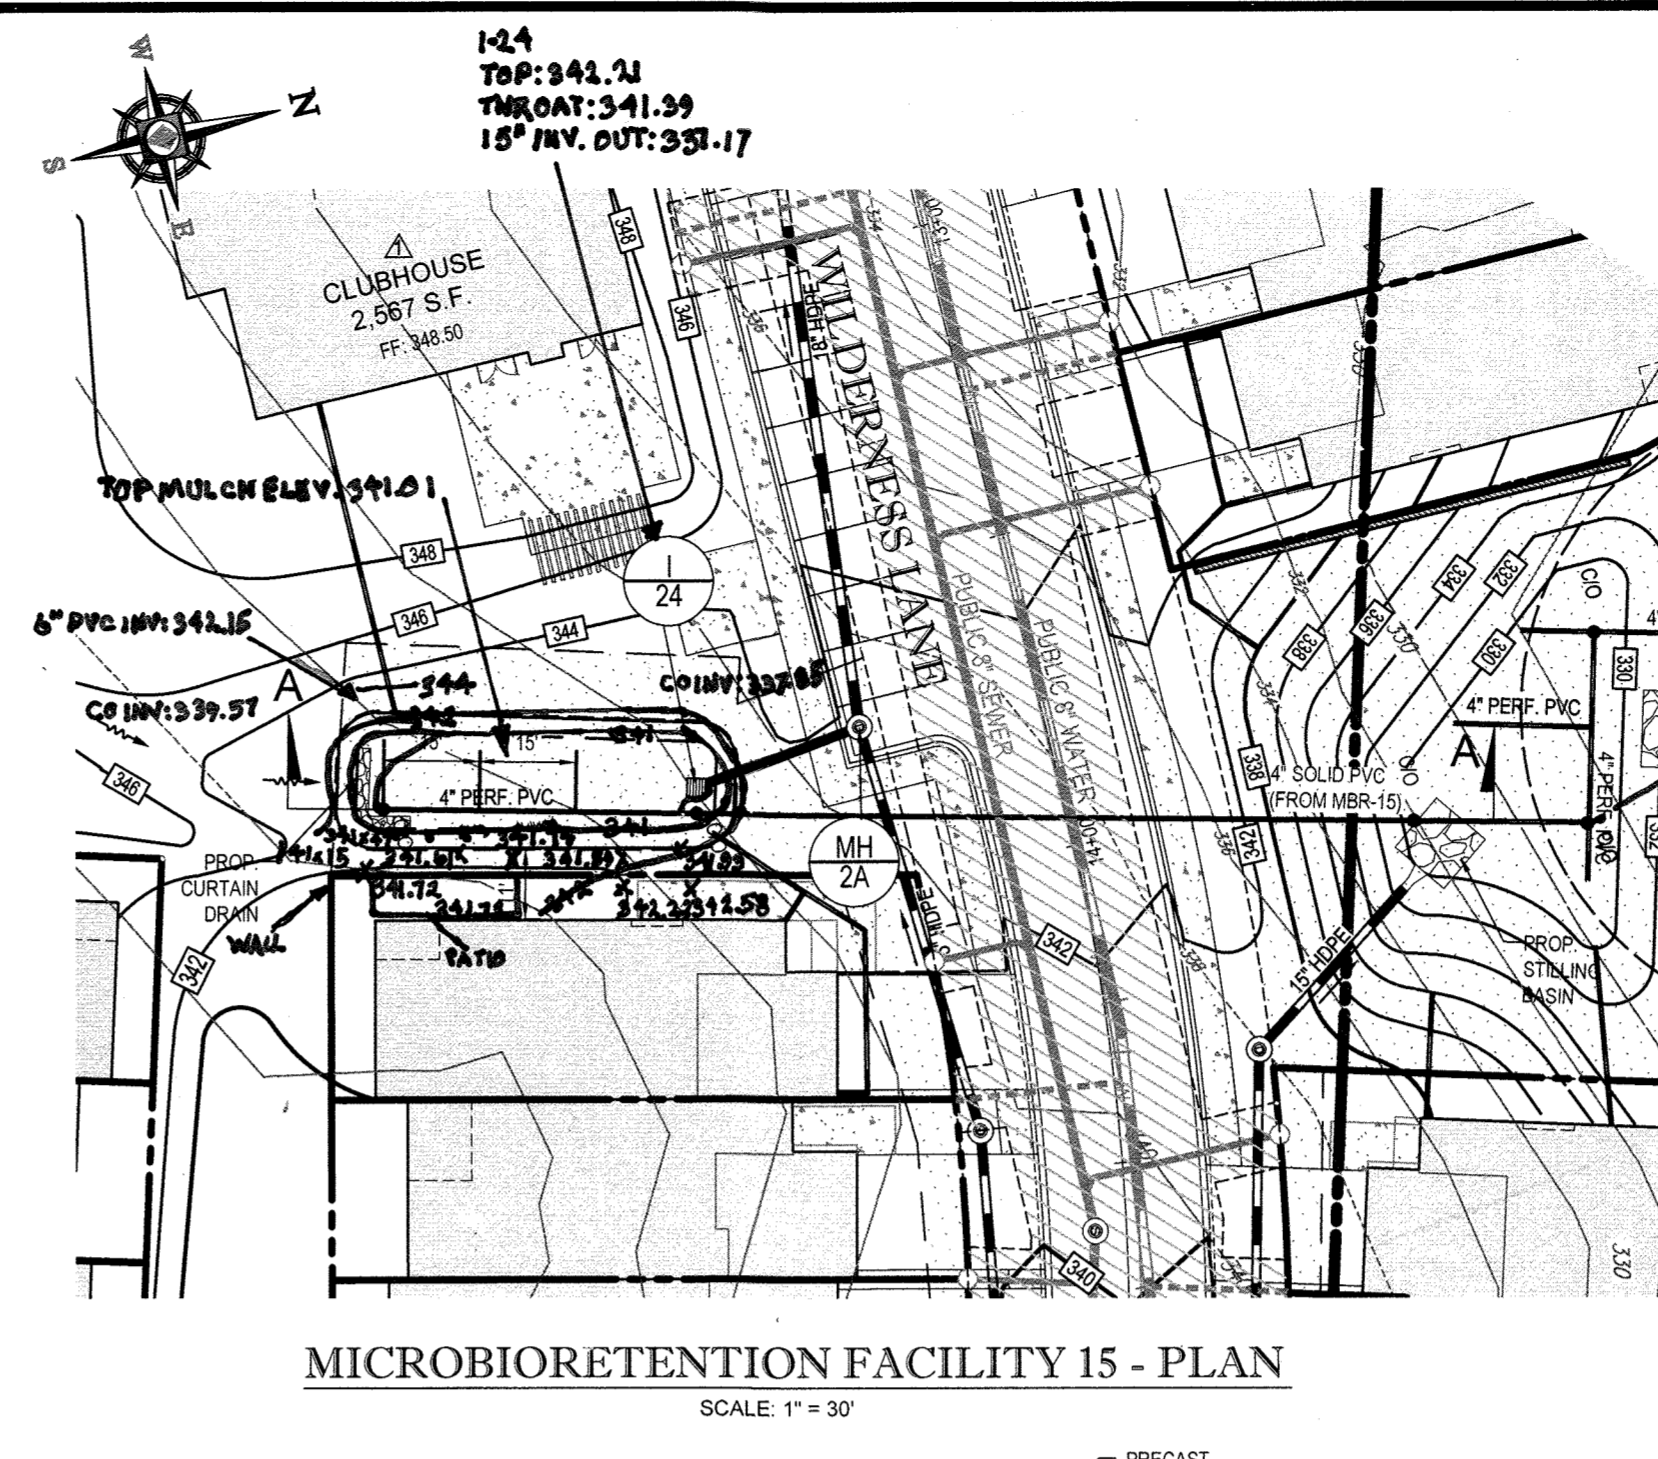


MICROBIORETENTION FACILITY 15 - PLAN
SCALE: 1" = 30'

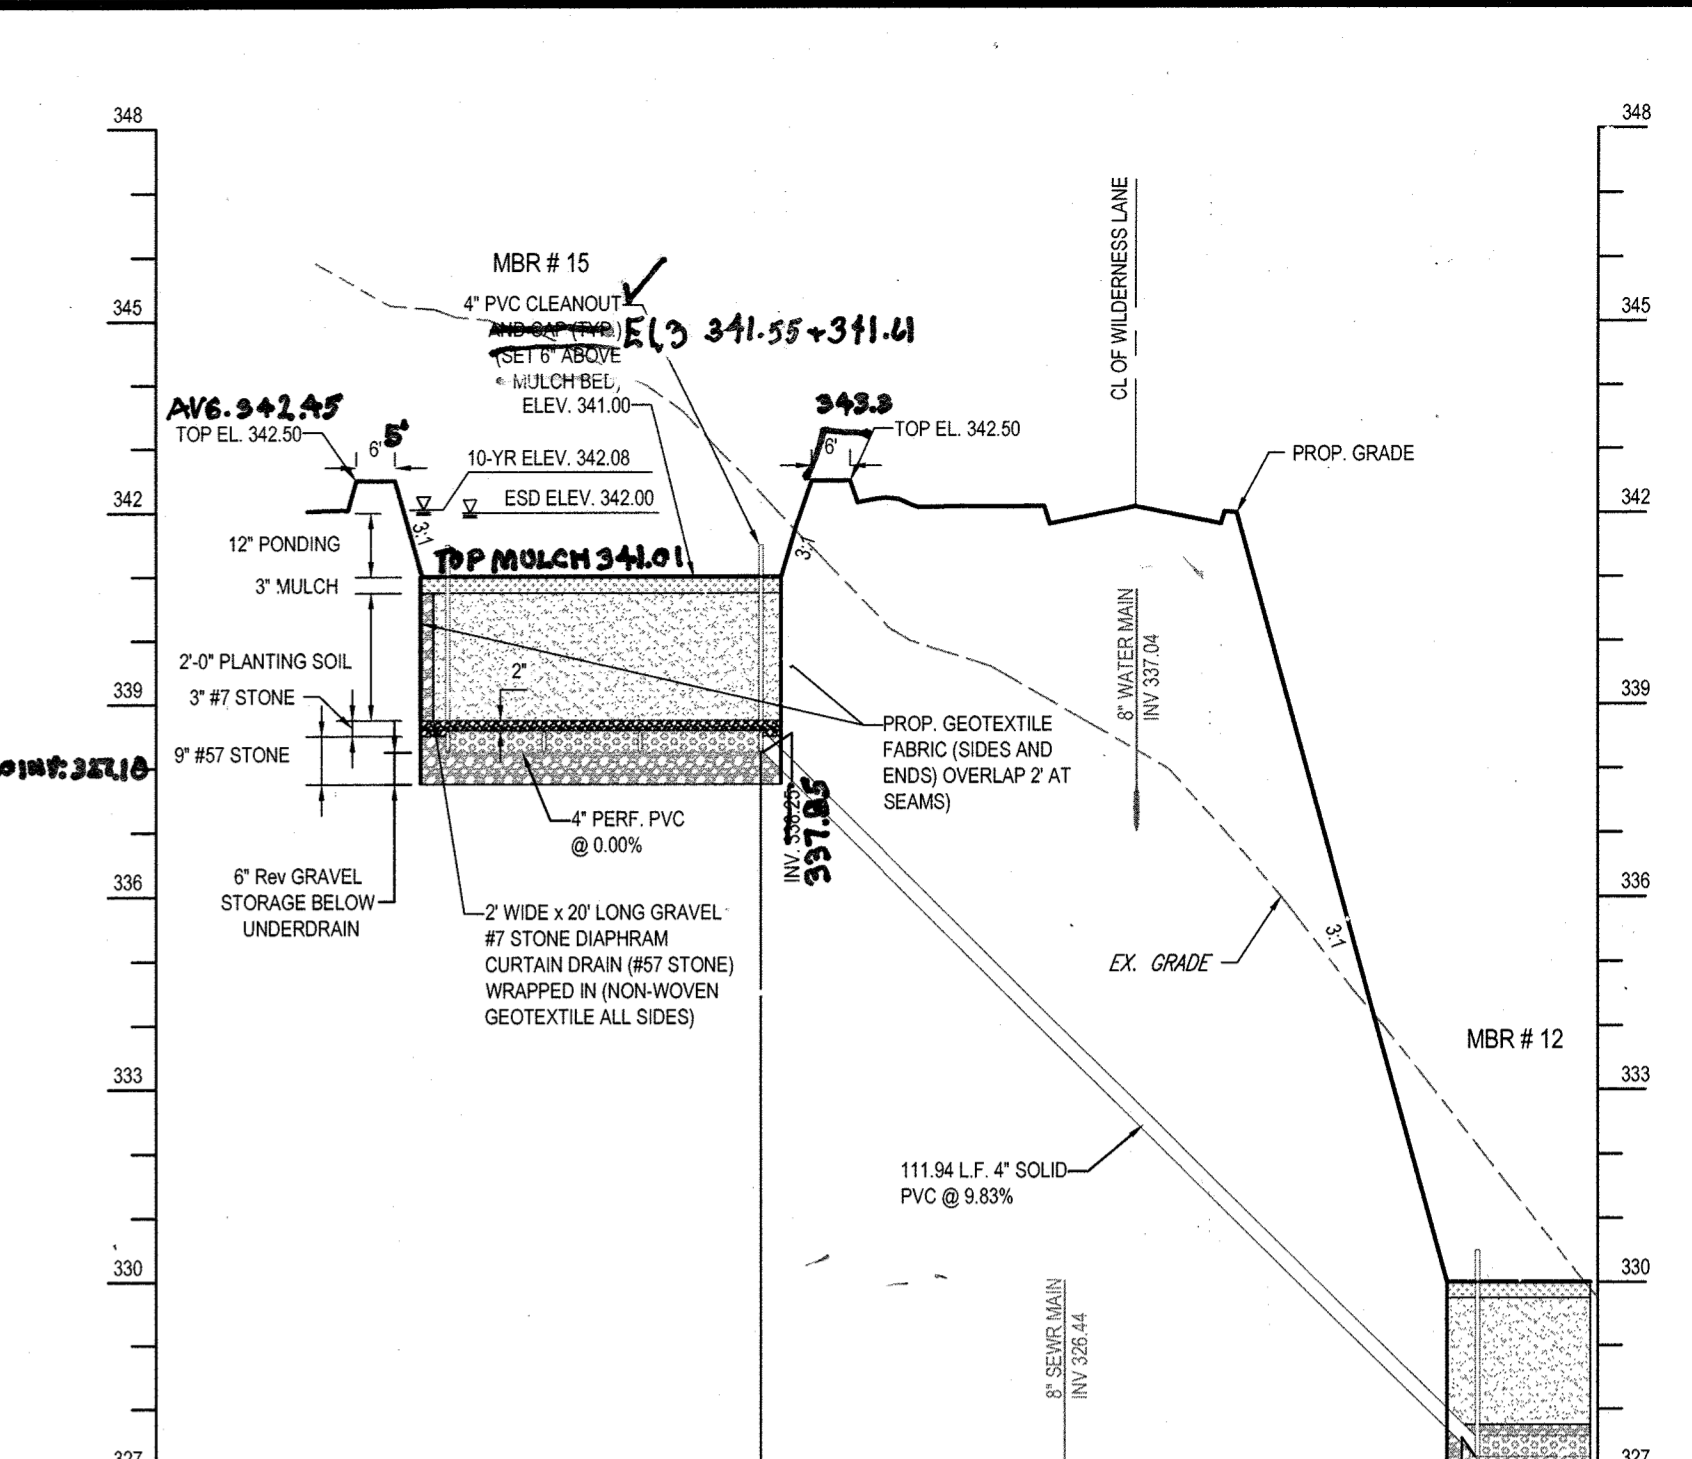

MBR # 15 - SECTION A-A
SCALE: 1" = 30' HOR.
1" = 3' VER.

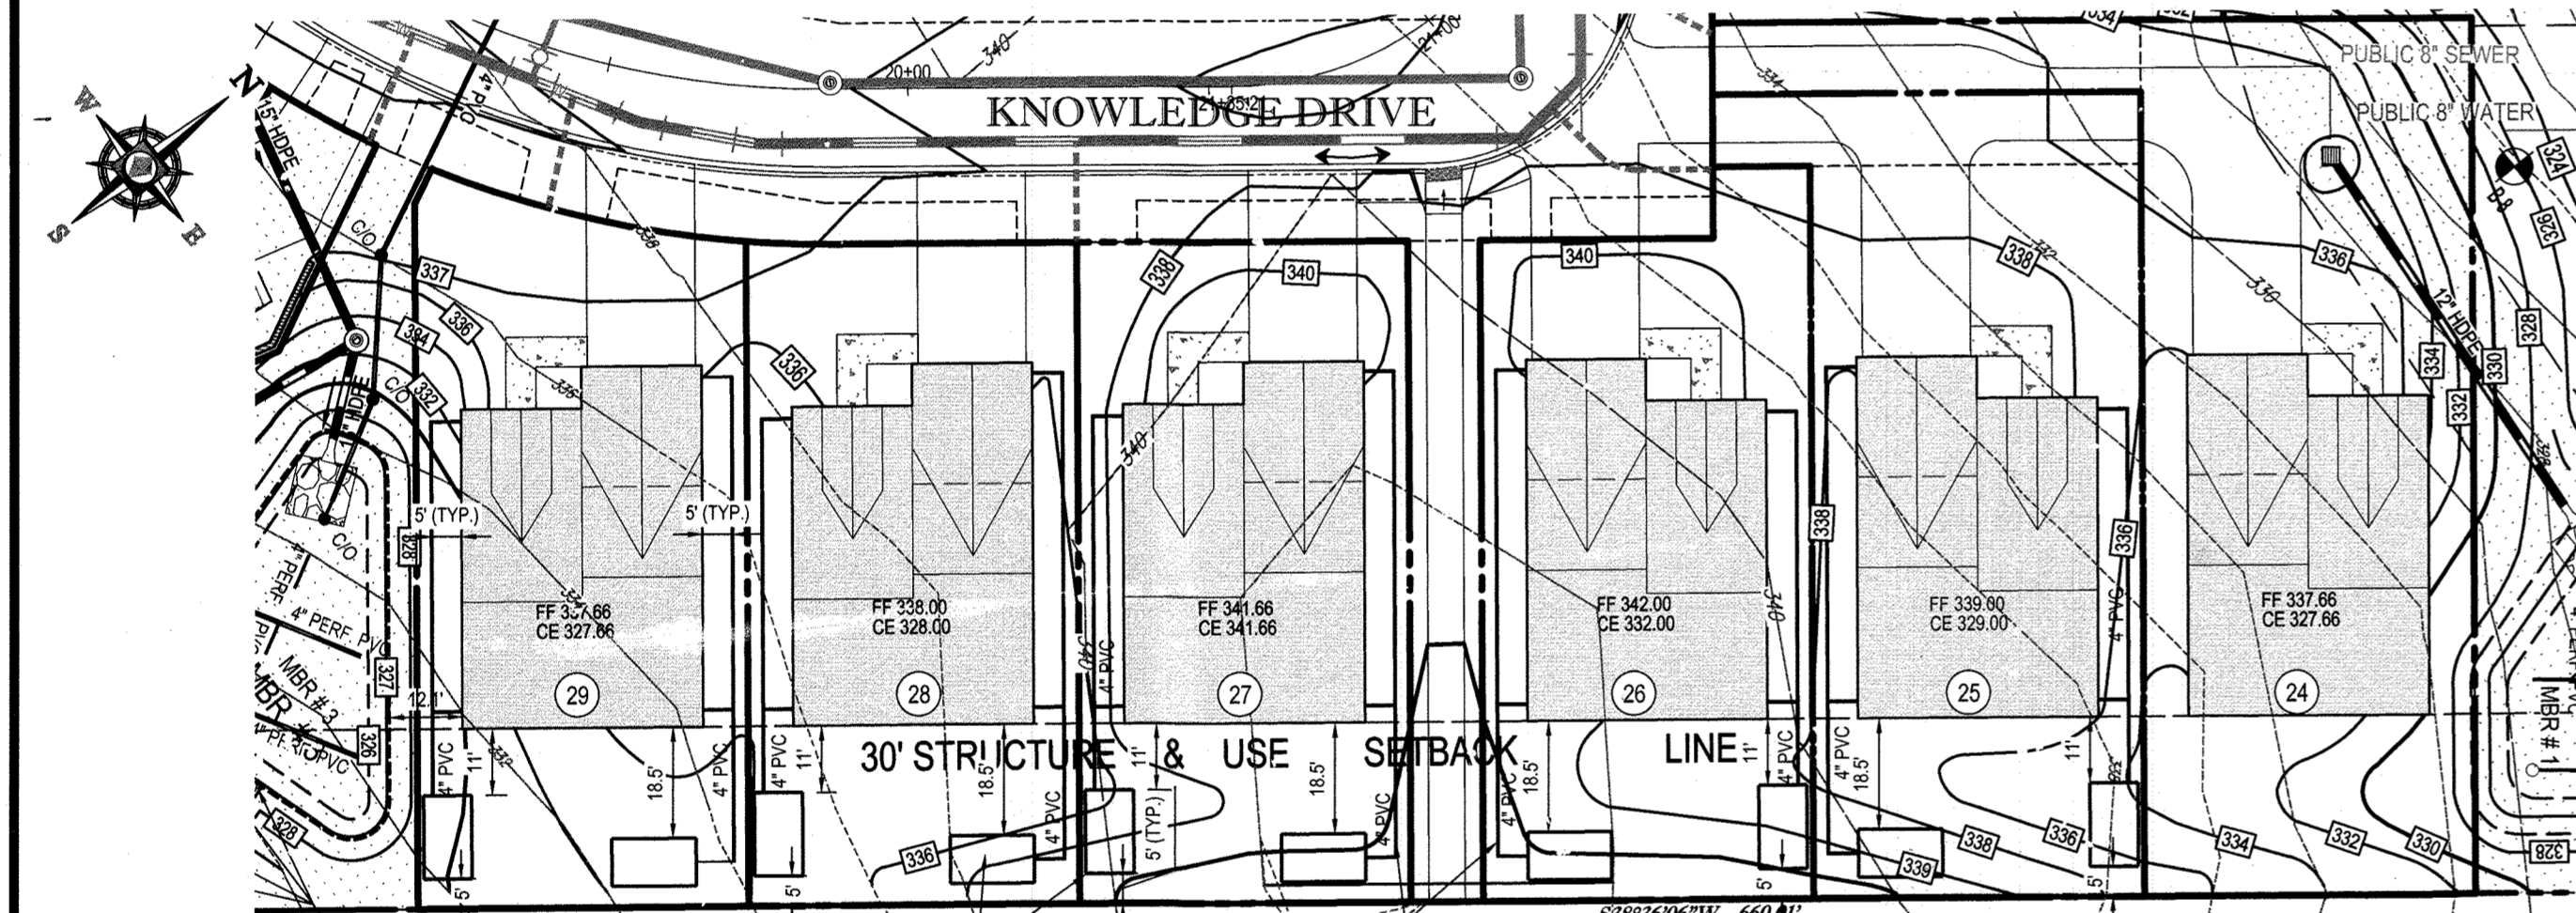

DRY WELL (DA #2) - PLAN
SCALE: 1" = 30'

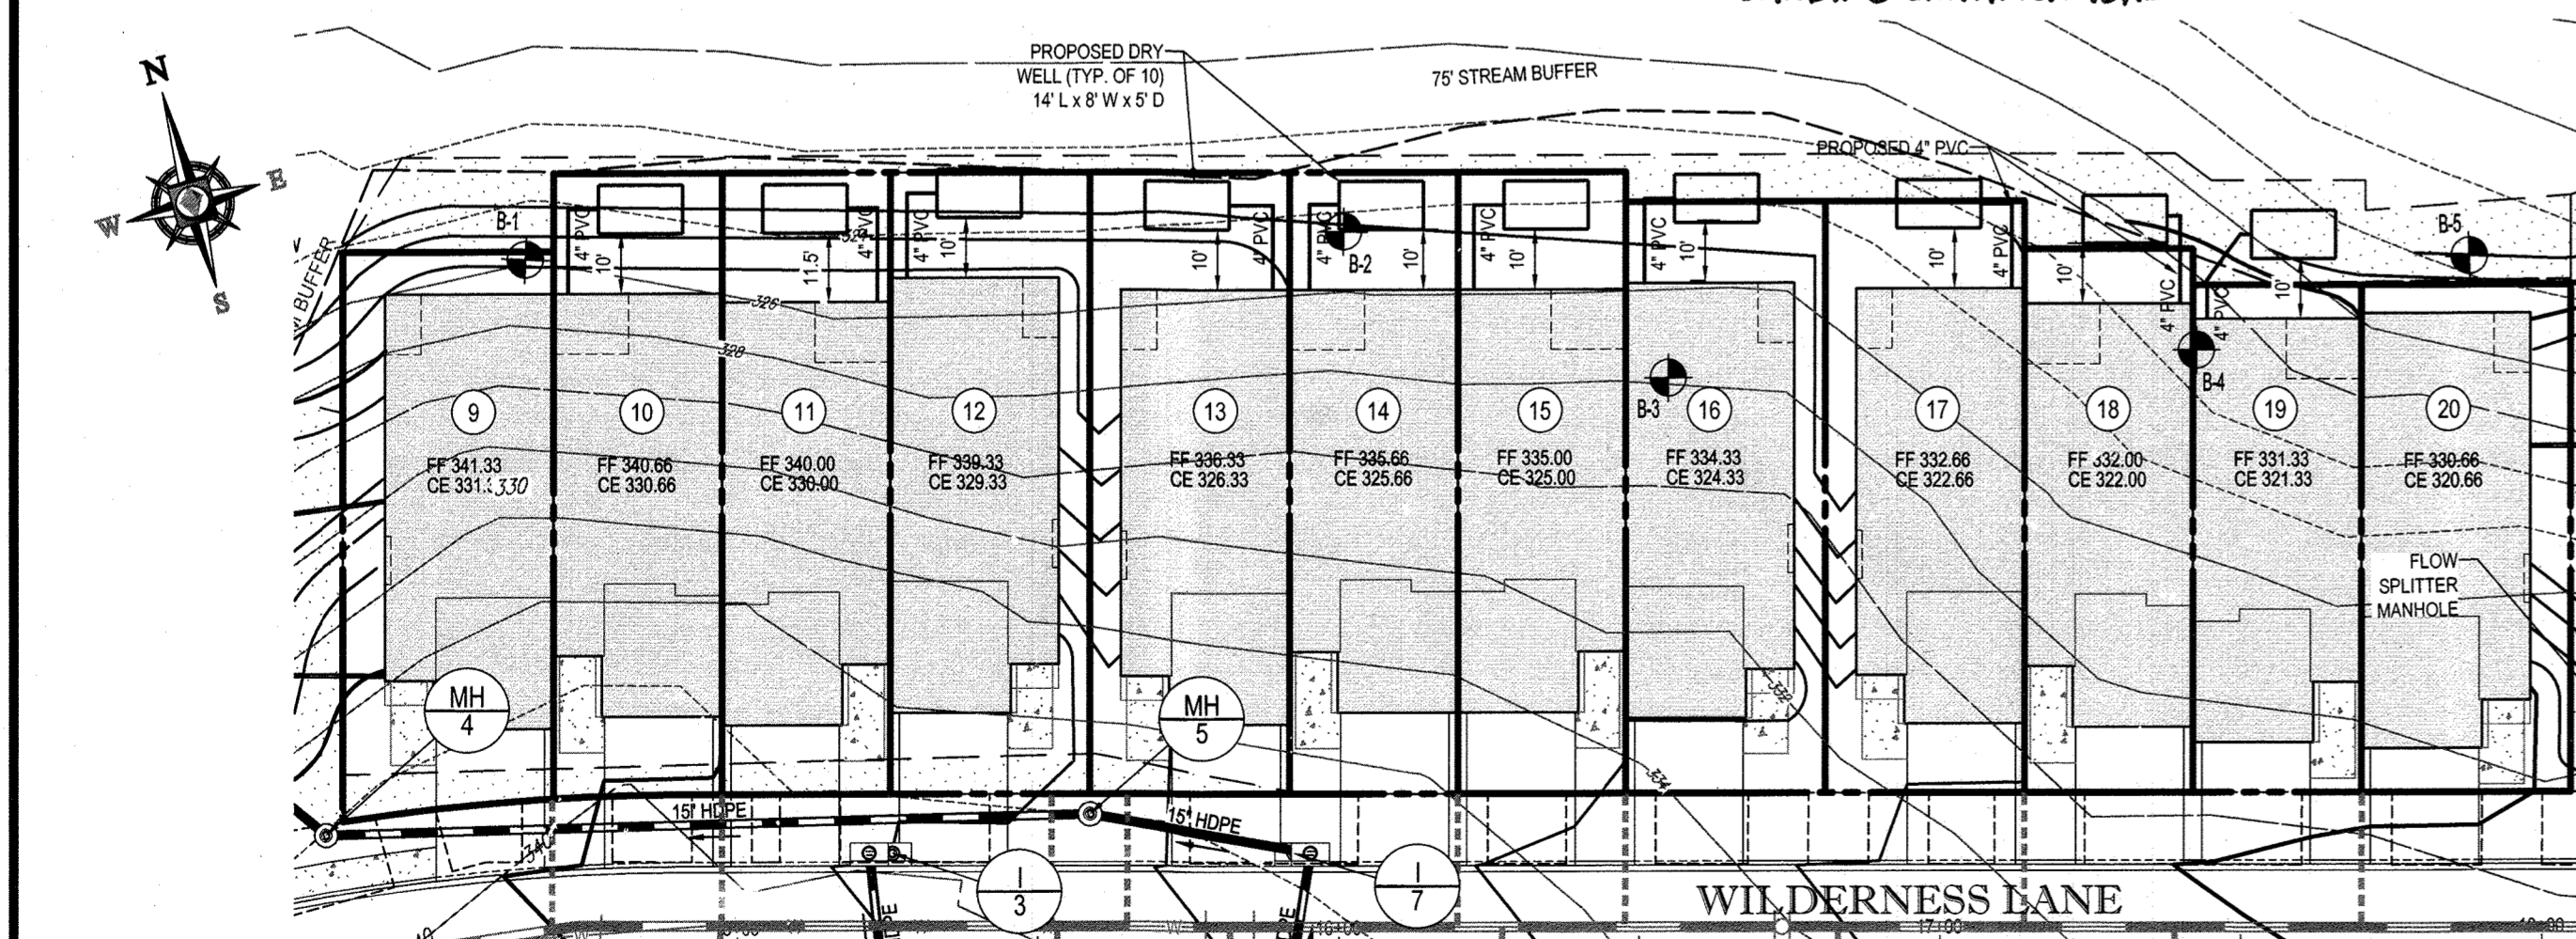

DRY WELL (DA #17) - PLAN
SCALE: 1" = 30'


DRYWELL LOCATIONS ARE SHOWN ON INDIVIDUAL LOT GRADING CERTIFICATIONS

[OPERATION AND MAINTENANCE SCHEDULE FOR LANDSCAPE INFILTRATION (M-3) MICRO-BIORETENTION (M-6), RAIN GARDENS (M-7), BIORETENTION SWALE (M-8), ENHANCED FILTERS (M-9)]


- The Owner shall maintain the plant material, mulch layer and soil layer annually. Maintenance of mulch and soil is limited to correcting areas of erosion or wash out. Any much replacement shall be done in the spring. Plant material shall be checked for disease and insect infestation and maintenance will address dead material and pruning. Acceptable replacement plant material is limited to the following: 2000 Maryland Stormwater Design Manual Volume II, Table A.4.1 and 2.
 - The Owner shall perform a plant in the spring and in the fall of each year. During the inspection, the Owner shall remove dead and diseased vegetation considered beyond treatment, replace dead plant material with acceptable replacement plant material, treat diseased trees and shrubs, and replace all deficient stakes and wires.
 - The Owner shall inspect the mulch each spring. The mulch shall be replaced every two to three years. The previous mulch layer shall be removed before the new layer is applied.
 - The Owner shall correct soil erosion on an as needed basis, with a minimum of once per month and after each heavy storm.
- STORMWATER INFILTRATION TRENCHES (I-1), DRY WELLS (M-5)**
- The Owner shall inspect the monitoring wells and structures on a quarterly basis and after every heavy storm event.
 - The Owner shall record the water levels and sediment build up in the monitoring wells over a period of several days to insure trench drainage.
 - The Owner shall maintain a log book to determine the rate at which the facility drains.
 - When the facility becomes clogged so that it does not drain down within a seventy two (72) hour time period, corrective action shall be taken.
 - The maintenance log book shall be available to Howard County for inspection to insure compliance with operation and maintenance criteria.
 - Once the performance characteristics of the infiltration facility have been verified, the monitoring schedule can be reduced to an annual basis unless the performance data indicates that a more frequent schedule is required.

SURFACE STORMWATER FILTRATION SYSTEMS (F-1, F-4, AND F-5)


- The Owner shall inspect the stormwater wetland facility annually and after every heavy storm. Inspections shall be performed during wet weather to determine if the facility is functioning properly.
- The Owner shall mow the top and side slopes of the embankment a minimum of once per year, when vegetation reaches 18" in height or as needed.
- The Owner shall mow filters that have a grass cover a minimum of three (3) times per growing season to maintain a maximum grass height of less than 12 inches.
- The Owner shall remove any debris and litter from the facility.
- The Owner shall repair any erosion in the facility as soon as it is noticed.
- The Owner shall remove silt when it exceeds four (4) inches deep in the forebay.
- When water ponds on the surface of the filter bed for more than seventy-two (72) hours, the Owner shall replace the top few inches of discolored material with fresh material. Proper cleaning and disposal of the removed materials and liquid must be followed by the Owner.
- The Owner shall maintain a log book to determine the rate at which the facility drains.
- The maintenance log book shall be available to Howard County for inspection to insure compliance with operation and maintenance criteria.
- Once the performance characteristics of the infiltration system have been verified, the monitoring schedule can be reduced to an annual basis unless the performance data indicates that a more frequent schedule is required.

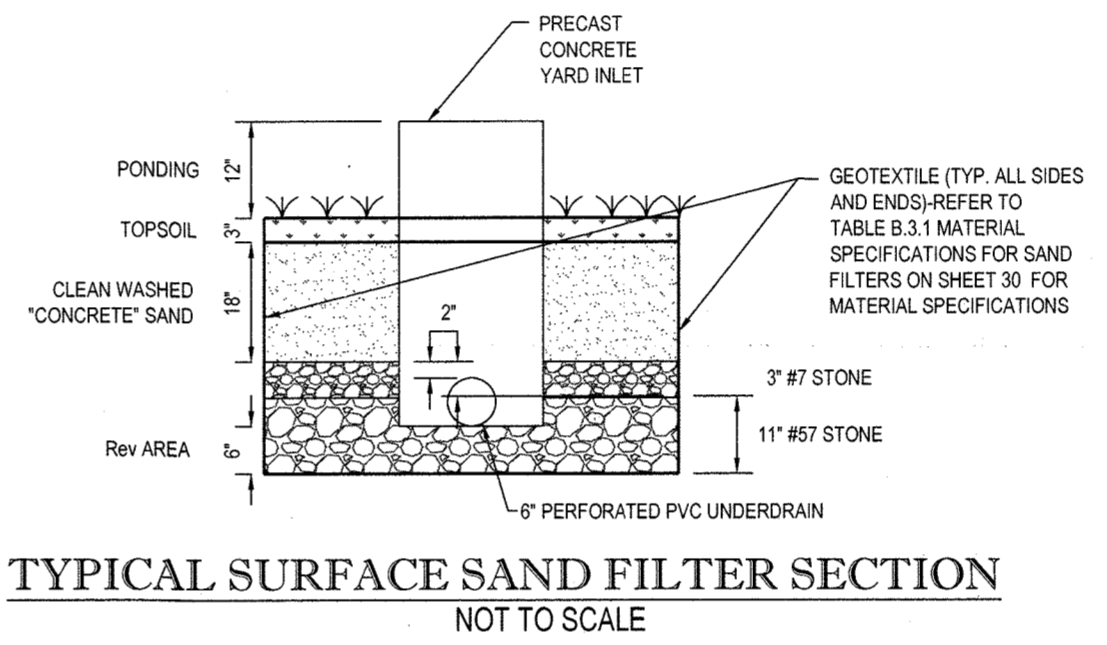


TYPICAL SURFACE SAND FILTER SECTION
NOT TO SCALE

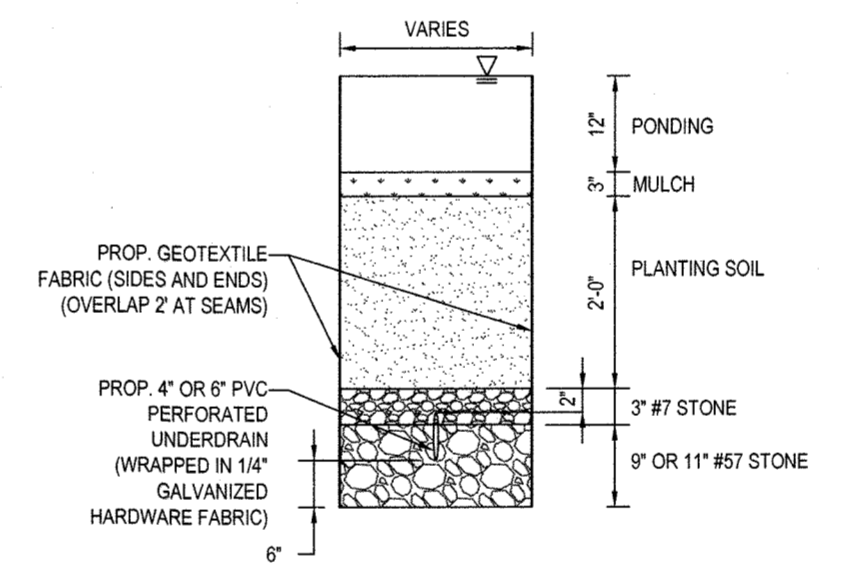

TYPICAL BIORETENTION FACILITY SECTION
NOT TO SCALE

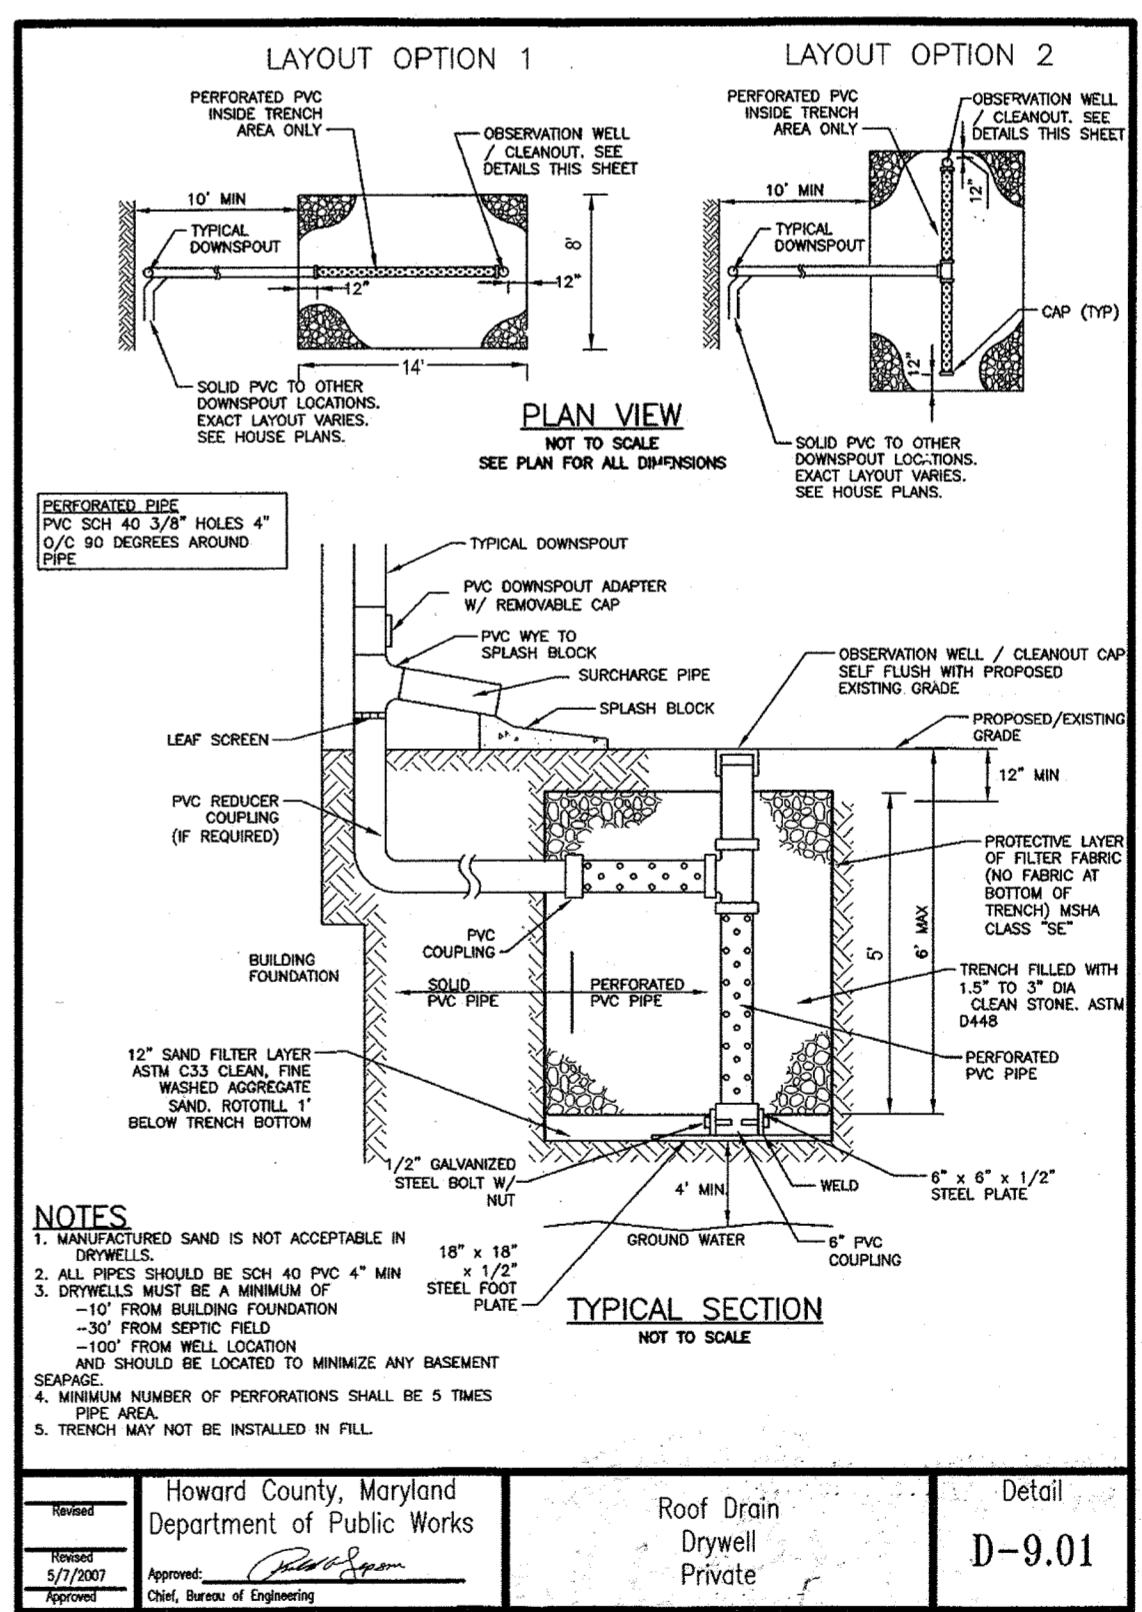


DRY WELL DETAIL
NTS

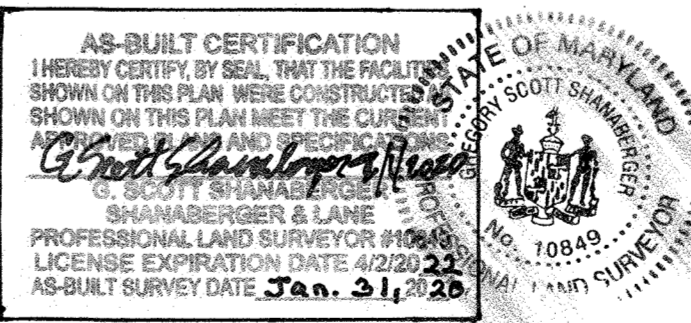


Howard County, Maryland Department of Public Works	Roof Drain Drywell Private	Detail D-9.01
---	----------------------------------	------------------

8/31/15 REVISION TO UPDATE CLUBHOUSE/COMMUNITY CENTER AND SURROUNDING AREA.

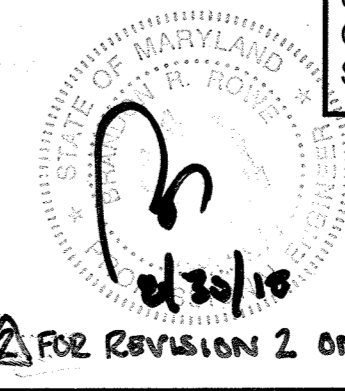

PROFESSIONAL CERTIFICATION
I, BRANDON R. ROWE, HEREBY CERTIFY THAT THESE DOCUMENTS WERE PREPARED OR APPROVED BY ME, AND THAT I AM A DULY LICENSED PROFESSIONAL ENGINEER UNDER THE LAWS OF THE STATE OF MARYLAND, LICENSE NO. 40808, EXPIRATION DATE: 7/31/2015

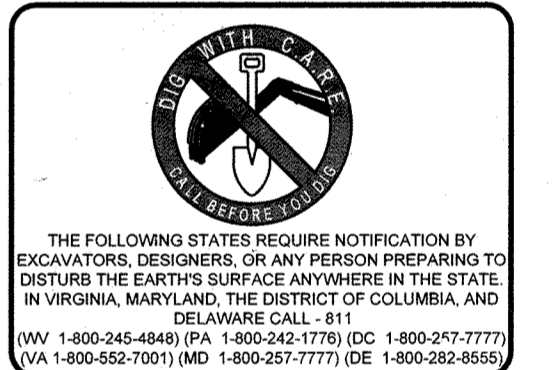

NO.	DATE	REVISION DESCRIPTION
1	8/31/15	REVISED TO UPDATE CLUBHOUSE/COMMUNITY CENTER

OWNER: M/I HOMES OF DC, LLC
21355 RIDGETOP CIRCLE, SUITE 220
STERLING, VA 20166
CONTACT: CINDY HUNTZBERG
PHONE: 443-677-9803

DEVELOPER: SOMERWORTH II, L.C.
5704 DORSEY HALL DRIVE, SUITE 205
ELLCOTT CITY, MD 21042
CONTACT: JASON VAN KIRK
PHONE: (410) 720-3021

TITLE: MICROBIORETENTION FACILITY DETAILS

BOHLER ENGINEERING
901 DULANEY VALLEY ROAD, SUITE 801
TOWSON, MARYLAND 21284
Phone: (410) 821-7900
Fax: (410) 821-7987
www.BohlerEngineering.com


CHECKED BY: BRR	DESIGNED BY: BRR
DRAWN BY: RMS/AVG	PROJECT NO.: MD112149
DATE: 10/27/14	SCALE: AS NOTED
DATE: 10-23-15	DRAWING NO. 29 OF 35

APPROVED: DEPARTMENT OF PLANNING AND ZONING
10-21-15
CHIEF-DEVELOPMENT ENGINEERING DIVISION

APPROVED: PLANNING BOARD OF HOWARD COUNTY
10/22/15
CHIEF-DIVISION OF LAND DEVELOPMENT


DATE: 10-23-15
DIRECTOR

DATE: 10/22/15
DATE: 10/08/2014

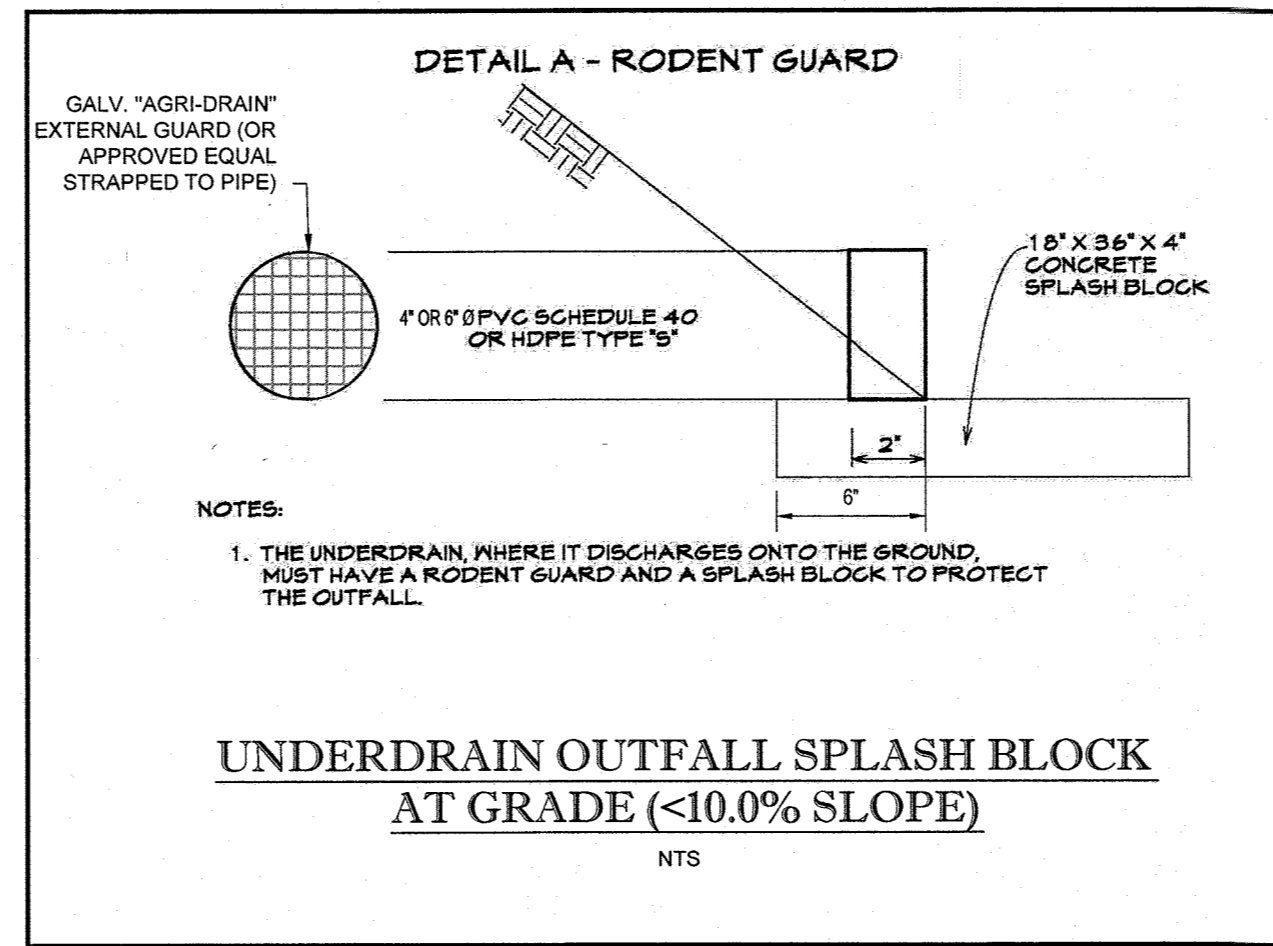


UNDERDRAIN OUTFALL SPLASH BLOCK AT GRADE (<10.0% SLOPE)

NTS

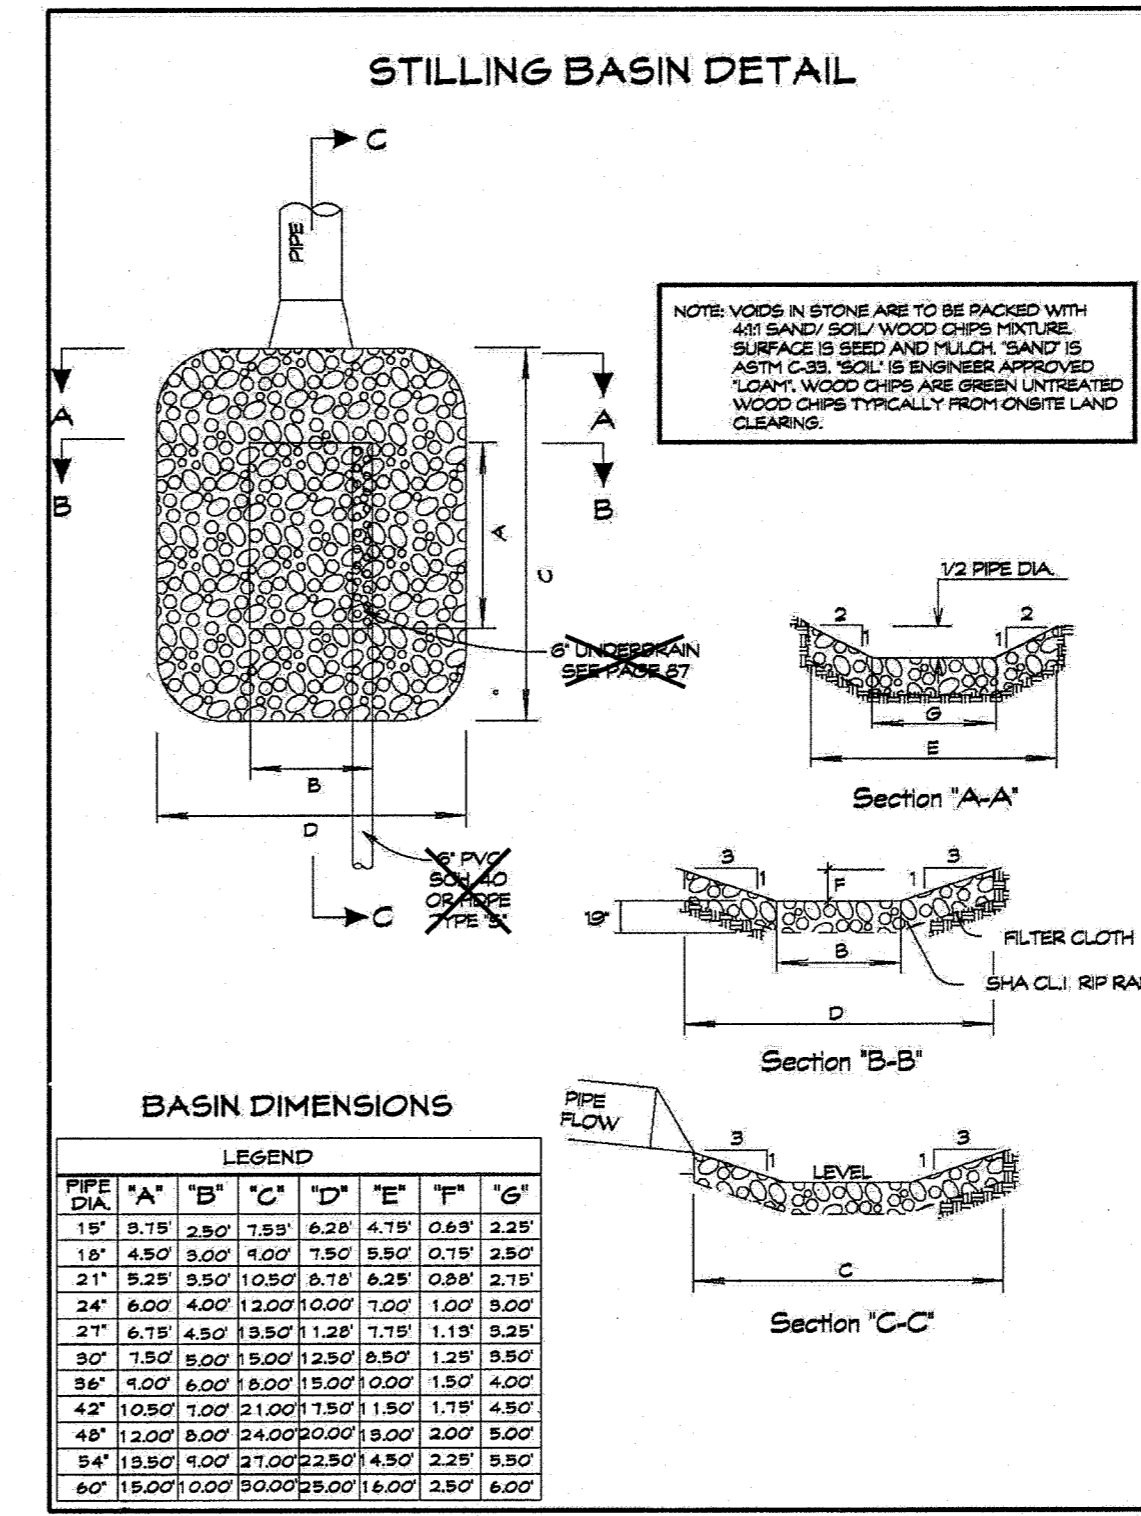

BASIN DIMENSIONS

PIPE DIA.	A*	B*	C*	D*	E*	F*	G*
18"	3.75	3.00	1.50	0.25	4.75	0.60	2.25
18"	4.50	3.00	1.50	0.25	5.50	0.75	2.50
21"	5.25	3.50	1.75	0.25	6.25	0.80	2.75
24"	6.00	4.00	2.00	0.25	7.00	1.00	3.00
27"	6.75	4.50	2.25	0.25	7.75	1.10	3.25
30"	7.50	5.00	2.50	0.25	8.50	1.20	3.50
36"	9.00	6.00	3.00	0.25	10.00	1.50	4.00
42"	10.50	7.00	3.50	0.25	11.50	1.75	4.50
48"	12.00	8.00	4.00	0.25	13.00	2.00	5.00
54"	13.50	9.00	4.50	0.25	14.50	2.25	5.50
60"	15.00	10.00	5.00	0.25	16.00	2.50	6.00

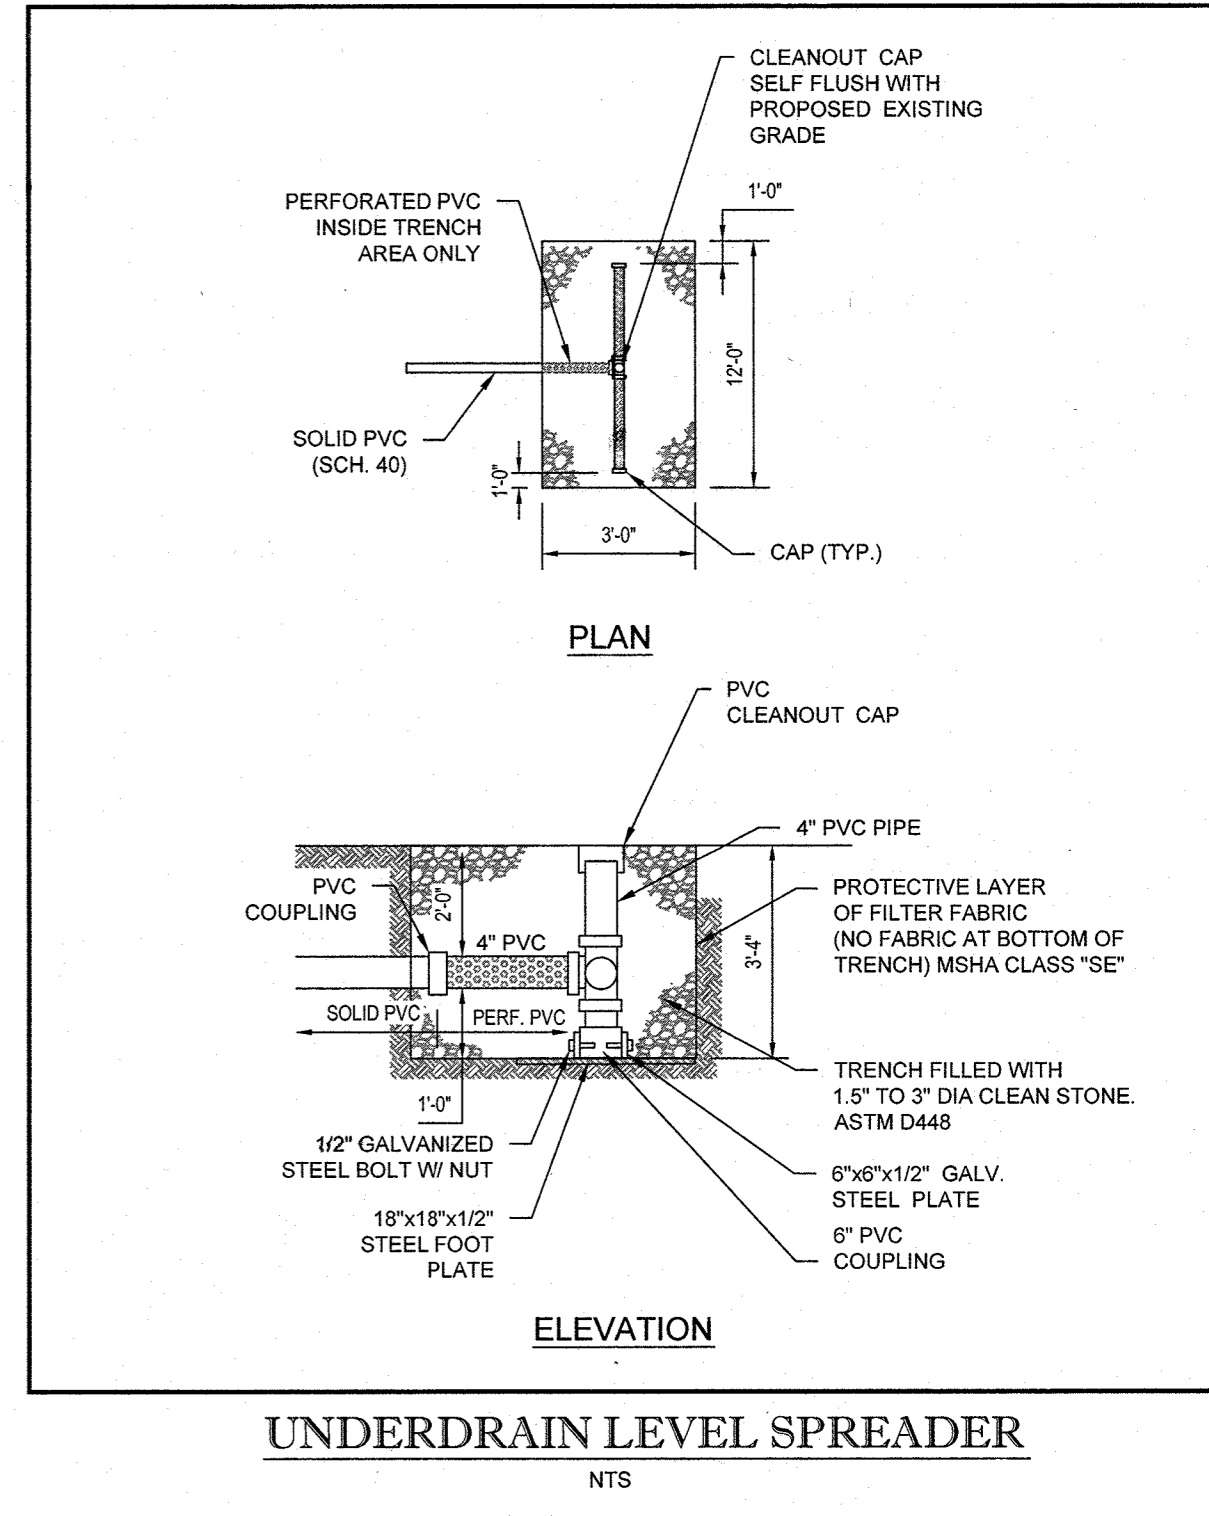

UNDERDRAIN LEVEL SPREADER

NTS

Appendix B.3. Construction Specifications for Sand Filters, Bioretention and Open Channels

B.3.A Sand Filter Specifications

1. Material Specifications for Sand Filters

The allowable materials for sand filter construction are detailed in Table B.3.1.

2. Sand Filter Testing Specifications

Underground sand filters, facilities within sensitive groundwater aquifers, and filters designed to serve urban hot spots are to be tested for water tightness prior to placement of filter media. Entrances and exits should be plugged and the system completely filled with water to demonstrate water tightness. Water tightness means no leakage for a period of 8 hours.

All overflow weirs, multiple orifices and flow distribution slots are to be field-tested to verify adequate distribution of flows.

3. Sand Filter Construction Specifications

Provide sufficient maintenance access (i.e., 12-foot-wide road with legally recorded easement). Vegetated access slopes are to be a maximum of 10%; gravel slopes to 15%; paved slopes to 25%.

Absolutely no runoff is to enter the filter until all contributing drainage areas have been stabilized. Surface of filter bed is to be level.

All underground sand filters should be clearly delineated with signs so that they may be located when maintenance is due.

Surfa.c sand filters may be planted with appropriate grasses; see Appendix A.

"Pocket" sand filters (and residential bioretention facilities treating areas larger than an acre) shall be sized with a stone "window" that covers approximately 10% of the filter area. This "window" shall be filled pea gravel (3/4 inch stone).

Appendix B.3. Construction Specifications for Sand Filters, Bioretention and Open Channels

4. Specifications Pertaining to Underground Sand Filters (F-2)

Provide manhole and/or grates to all underground and below grade structures. Manholes shall be in compliance with standard specifications for each county but diameters should be 30" minimum (to comply with OSHA confined space requirements). Aluminum and steel louvered doors are also acceptable. Ten inch wide (minimum) manhole steps (12" o.c.) shall be cast in place or drilled and mortared into the wall below each manhole. A 5' minimum height clearance from the top of the sand layer to the bottom of the upper/surface slab) is required for all permanent underground structures. Lift rings are to be supplied to remove/replace top slabs on pre-fabricated structures. Manhole covers should allow for proper ventilation.

Underground sand filters should be constructed with a gate valve located just above the top of the filter bed for dewatering in the event that clogging occurs.

Underground sand beds shall be protected from trash accumulation by a wide mesh geotextile screen to be placed on the surface of the sand bed; screen is to be rolled up, removed, cleaned and re-installed during maintenance operations.

B.3.1


B.3.2

Table B.3.1 Material Specifications for Sand Filters


Material	Specification Test Method	Size	Notes
sand	clean AASHTO-M-6 or ASTM-C-33 concrete sand	0.075" to 0.04"	Sand substitutions such as Diabase and Graystone #10 are not acceptable. No calcium carbonated or dolomitic sand substitutions are acceptable. No "rock dust" can be used for sand.
peat	ash content < 15% pH range: 5.2 to 4.9 loose bulk density 0.12 to 0.15 g/cc	n/a	The material must be reed-sedge hemis peat, shredded, uncompacted, uniform, and clean.
leaf compost	AASHTO-M-43	0.375" to 0.75"	n/a
underdrain gravel	AASHTO-M-43	0.375" to 0.75"	n/a
geotextile fabric (if required)	ASTM-D-4833 (puncture strength-125 lb.) ASTM-D-4632 (Tensile Strength-300 lb.)	0.08" thick equivalent opening size of #60 sieve	Must maintain 125 gpm per sq. ft. flow rate. Note: a 4" pea gravel layer may be substituted for geotextiles meant to "separate" sand filter layers.
impermeable liner (if required)	ASTM-D-4833 (thickness) ASTM-D-112 (tensile strength 1,100 lb., elongation 200%) ASTM-D-624 (Tear resistance - 150 lb./in.) ASTM-D-471 (water absorption: < 8 to 2% mass)	30 mil thickness	Liner to be ultraviolet resistant. A geotextile fabric should be used to protect the liner from puncture.
underdrain piping	F-758, Type PS 28 or AASHTO-M-278	4" - 6" rigid schedule 40 PVC or SDR35	3/8" perf. @ 6" on center, 4 holes per row; minimum of 3" of gravel over pipes; not necessary underdrain pipes
concrete (cast-in-place)	MSHA Standards and Specs. Section 902, Min No. 3, f'c = 3500 psi, normal weight, air-entrained; re-reinforcing to meet ASTM-615-00	n/a	on-site testing of poured-in-place concrete required. 28 day strength and slump test; all concrete design (cast-in-place or pre-cast) not using previously approved State or local standards requires design drawings sealed and approved by a professional structural engineer licensed in the State of Maryland.
concrete (pre-cast)	per pre-cast manufacturer	n/a	SEE ABOVE NOTE
non-rebar steel	ASTM A-36	n/a	structural steel to be hot-dipped galvanized ASTM-A-123

B.3.3

Appendix B.3. Construction Specifications for Sand Filters, Bioretention and Open Channels

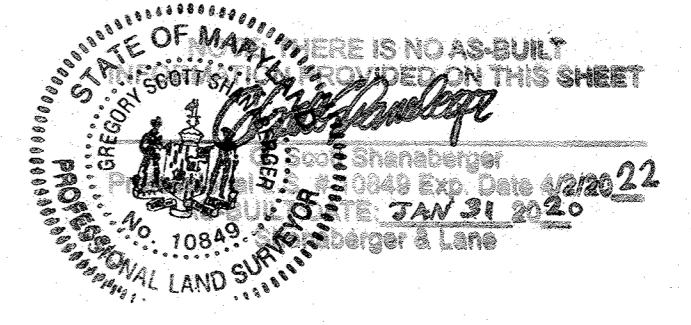

PROFESSIONAL CERTIFICATION
I, BRANDON R. ROVÉ, HEREBY CERTIFY THAT THESE DOCUMENTS WERE PREPARED OR APPROVED BY ME, AND THAT I AM A DULY LICENSED PROFESSIONAL ENGINEER UNDER THE LAWS OF THE STATE OF MARYLAND, LICENSE NO. 40808, EXPIRATION DATE: 7/2015

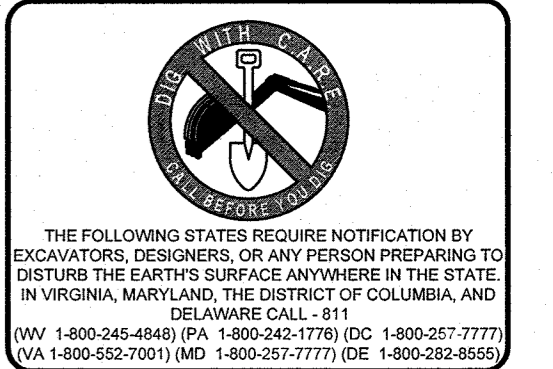


THE FOLLOWING STATES REQUIRE NOTIFICATION BY EXCAVATORS, DESIGNERS, OR ANY PERSON PREPARING TO DISTURB THE EARTH'S SURFACE ANYWHERE IN THE STATE OF MARYLAND: VIRGINIA, MARYLAND, THE DISTRICT OF COLUMBIA, AND DELAWARE. CALL 1-811 (MD 1-800-245-4548) (PA 1-800-242-1776) (DC 1-800-257-7777) (VA 1-800-692-7001) (MD 1-800-237-7777) (DE 1-800-293-8955)

NO.	DATE	REVISION DESCRIPTION
Δ	8/27/14	PAGE NUMBER UPDATE
OWNER:		
M/I HOMES OF DC, LLC 21355 RIDGETOP CIRCLE, SUITE 220 STERLING, VA 20166 CONTACT: CINDY HUNTZBERRY PHONE: 443-677-9803		
DEVELOPER:		
SOMERWORTH II, L.C. 5704 DORSEY HALL DRIVE, SUITE 205 ELLCOTT CITY, MD 21042 CONTACT: JASON VAN KIRK PHONE: (410) 720-3021		
PROJECT:		
WALDEN WOODS		
TAX MAP: 47 GRID: 2 ZONED: PSC PARCEL: 4, LOTS 1-97, OPEN SPACE LOTS 98 - 102 6TH ELECTION DISTRICT, HOWARD COUNTY, MARYLAND		
TITLE:		
SWM DETAILS		
 BOHLER ENGINEERING 901 DULANEY VALLEY ROAD, SUITE 801 TOWSON, MARYLAND 21284 Phone: (410) 821-7900 Fax: (410) 821-7987 www.BohlerEngineering.com		
CHECKED BY:	BRR	
DESIGNED BY:	BRR	
DRAWN BY:	RMS/AVG	
PROJECT NO.:	MD112149	
DATE:	10/27/14	
SCALE:	AS NOTED	
PROFESSIONAL ENGINEER	NO. 40808	DRAWING NO. 30 OF 33

APPROVED
PLANNING BOARD OF HOWARD COUNTY
PR406
DATE 10/08/2014
APPROVED: DEPARTMENT OF PLANNING AND ZONING
Chief Clerk
DATE 11-17-14
CHIEF-DEVELOPMENT ENGINEERING DIVISION
I. Mankoff for KC 12-22-14
CHIEF-DIVISION OF LAND DEVELOPMENT
Mark Mungin 12/22/14
DIRECTOR

APPROVED
PLANNING BOARD OF HOWARD COUNTY
DATE 11-17-14
CHIEF-DEVELOPMENT ENGINEERING DIVISION
I. Mankoff for KC 12-22-14
CHIEF-DIVISION OF LAND DEVELOPMENT
Mark Mungin 12/22/14
DIRECTOR

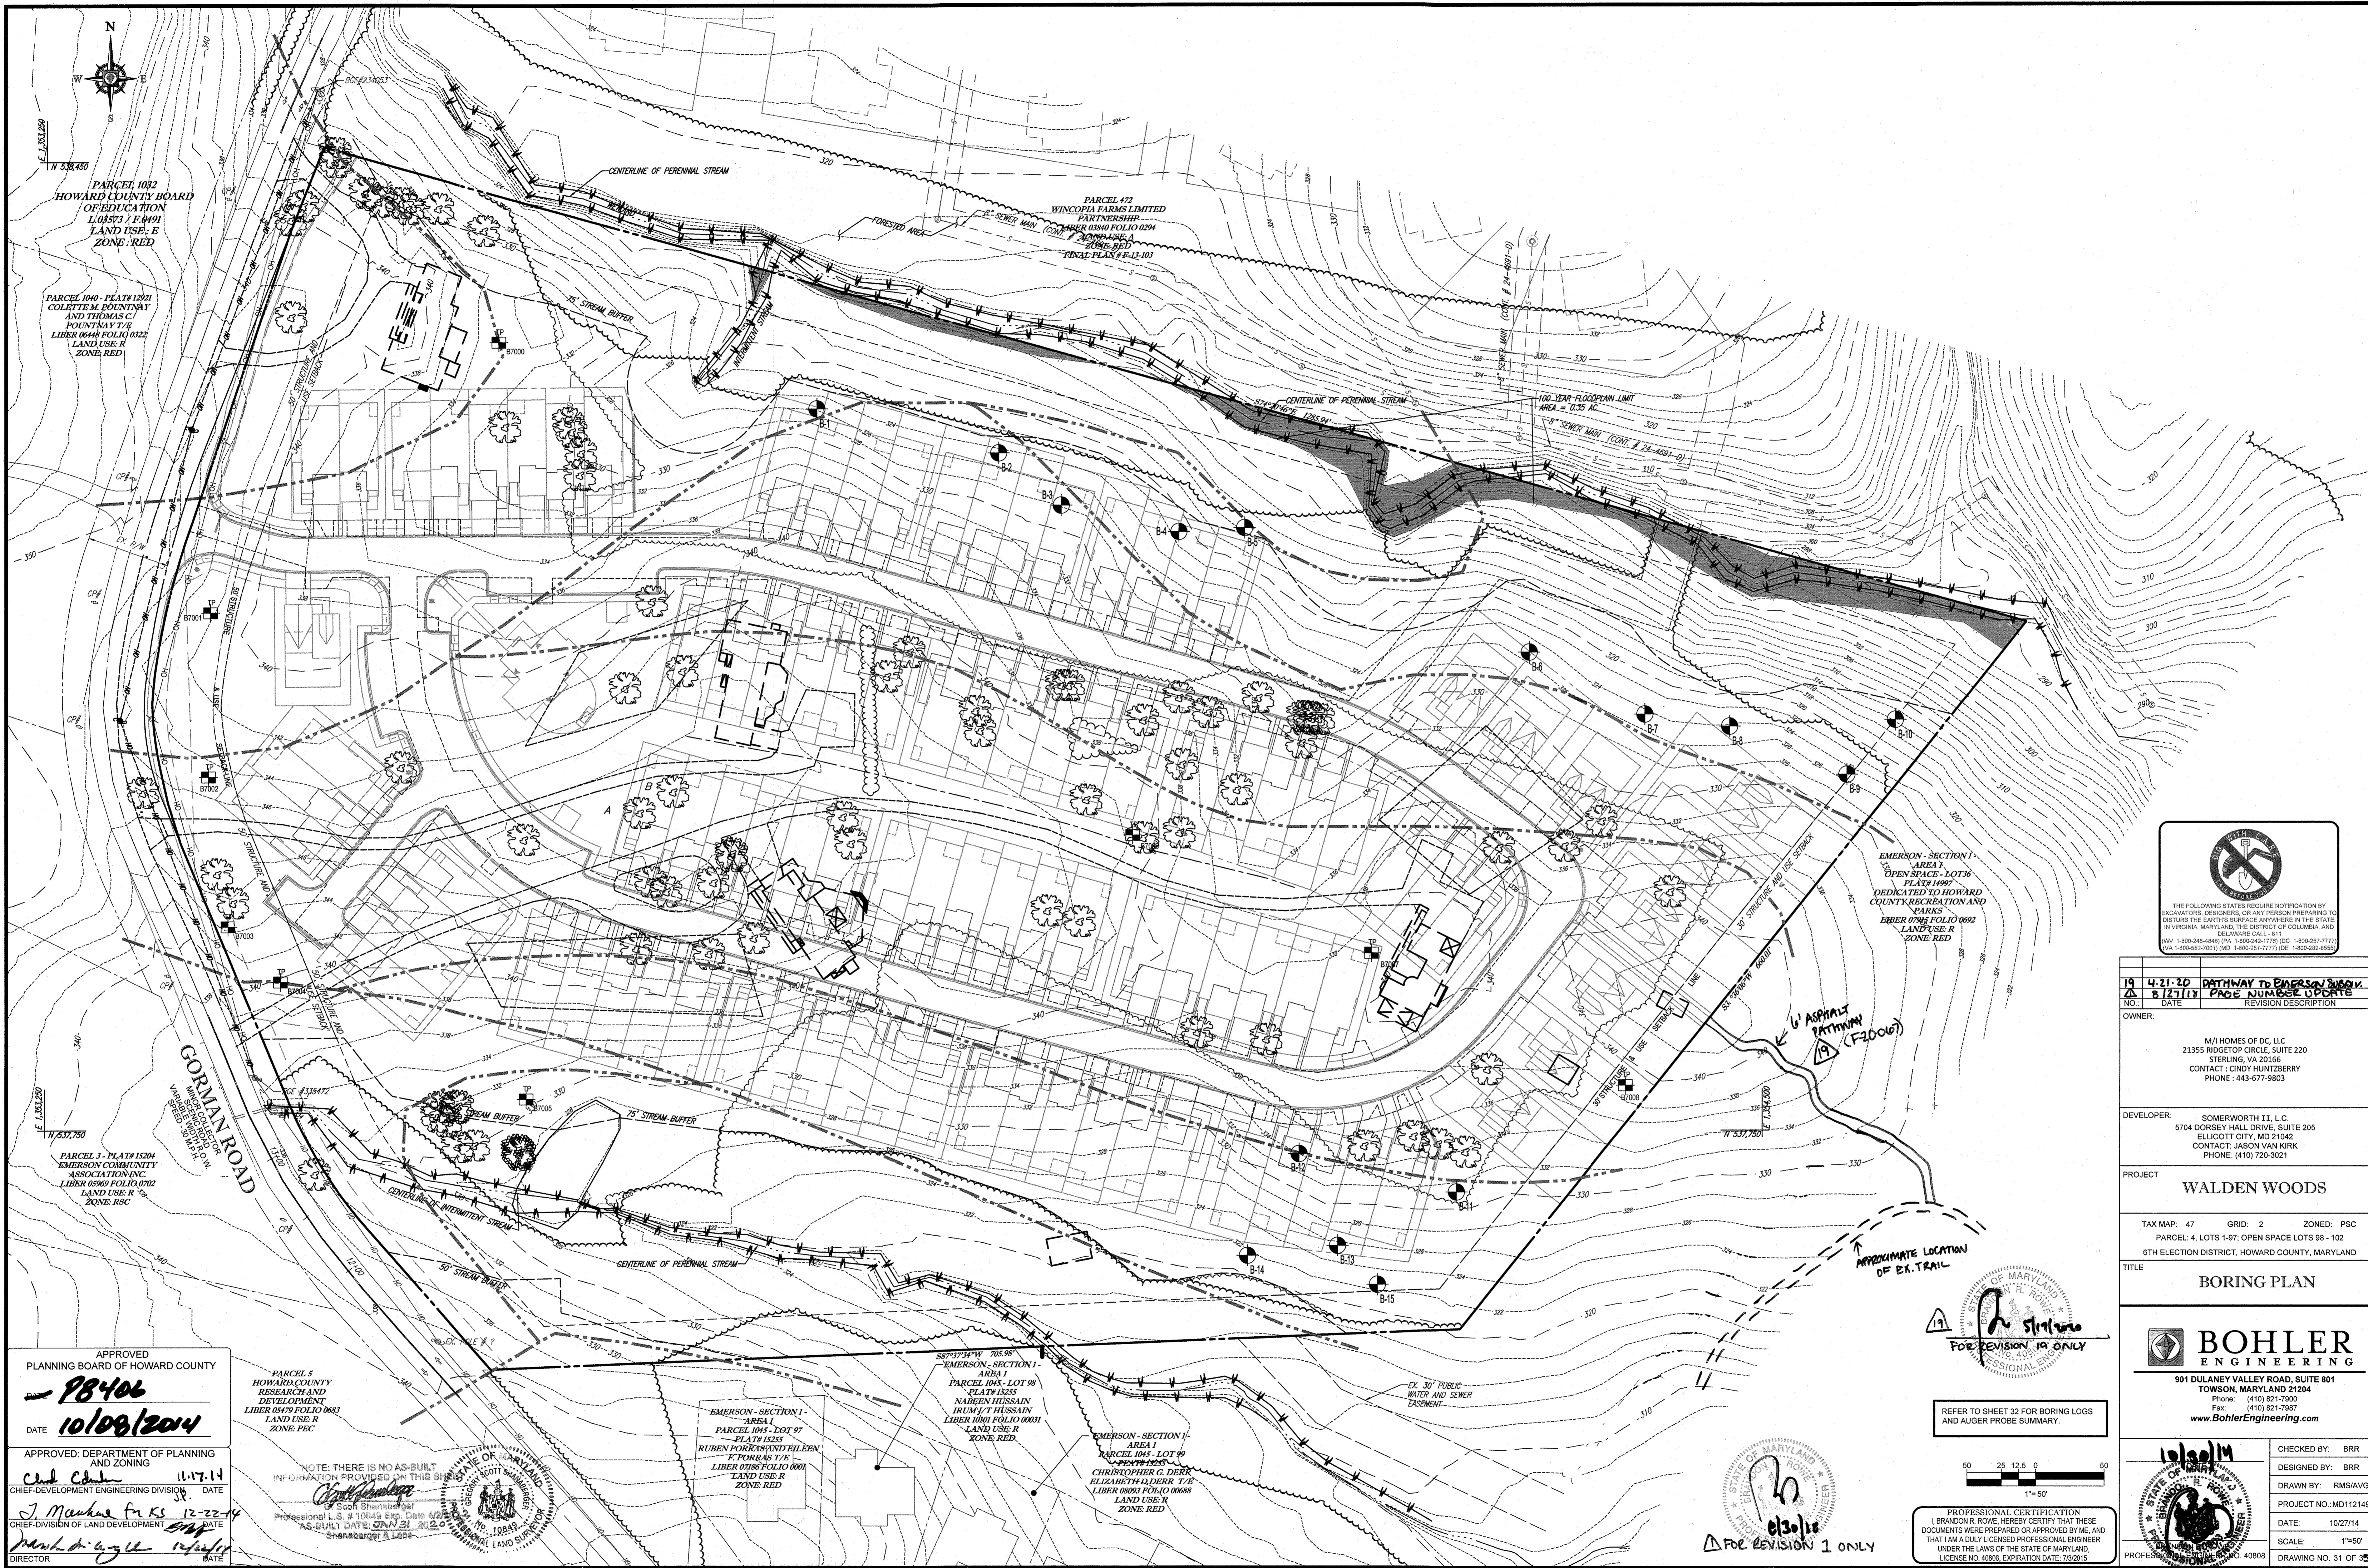

PARCEL 1032
HOWARD COUNTY BOARD
OF EDUCATION
L.03573 / F.0491
LAND USE: E
ZONE: RED

PARCEL 1040 - PLATS 12021
COLETTE M. BOUNTNEY
AND THOMAS C.
BOUNTNEY T/E
LIBER 0648 FOLIO 0022
LAND USE: R
ZONE: RED

PARCEL 472
WINCOPIA FARMS LIMITED
PARTNERSHIP
LIBER 0890 FOLIO 0294
LAND USE: A
ZONE: RED
FINAL PLAN # R-11-103

PARCEL 3 - PLAT 15204
EMERSON COMMUNITY
ASSOCIATION INC.
LIBER 0569 FOLIO 0702
LAND USE: R
ZONE: RESC

EMERSON - SECTION I
AREA I
OPEN SPACE - LOT 36
PLAT 16997
DEDICATED TO HOWARD
COUNTY RECREATION AND
PARKS
LIBER 0962 FOLIO 0692
LAND USE: R
ZONE: RED

EMERSON - SECTION I -
AREA I
PARCEL 1045 - LOT 97
- PLAT 15355
RUBEN FORRAS AND EILEEN
F. FORRAS T/E
LIBER 0985 FOLIO 0001
LAND USE: R
ZONE: RED

EMERSON - SECTION I -
AREA I
PARCEL 1045 - LOT 98
- PLAT 15355
NAREEN HUSSAIN
KUMI T/HUSSAIN
LIBER 1001 FOLIO 0001
LAND USE: R
ZONE: RED


EMERSON - SECTION I -
AREA I
PARCEL 1045 - LOT 99
- PLAT 15355
CHRISTOPHER G. DERR
ELIZABETH D. DERR T/E
LIBER 0893 FOLIO 0688
LAND USE: R
ZONE: RED

PARCEL 5
HOWARD COUNTY
RESEARCH AND
DEVELOPMENT
LIBER 0597 FOLIO 0881
LAND USE: R
ZONE: PEC

NOTE: THERE IS NO AS-BUILT
INFORMATION PROVIDED ON THIS SHEET
DATE: 01/14/2014



APPROVED
PLANNING BOARD OF HOWARD COUNTY
88406
DATE 10/08/2014
APPROVED: DEPARTMENT OF PLANNING
AND ZONING
11-17-14
DATE
CHIEF-DEVELOPMENT ENGINEERING DIVISION
DATE
CHIEF-DIVISION OF LAND DEVELOPMENT
DATE
DIRECTOR

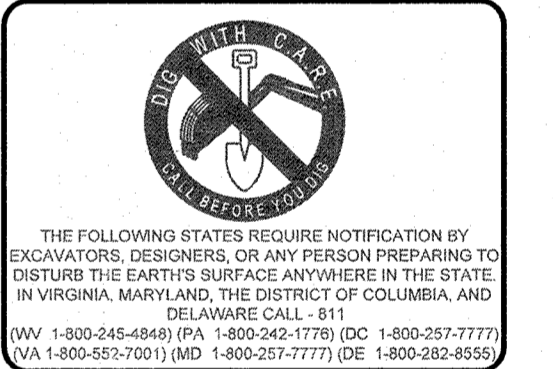

19	4-21-20	PATHWAY TO EMERSON SUBDIV.
NO.	DATE	REVISION DESCRIPTION
1	8/27/18	PAGE NUMBER UPDATE

OWNER:
M/I HOMES OF DC, LLC
21355 RIDGETOP CIRCLE, SUITE 220
STERLING, VA 20166
CONTACT: CINDY HUNTZBERRY
PHONE: 443-677-9803

DEVELOPER:
SOMERWORTH II, L.C.
5704 DORSEY HALL DRIVE, SUITE 205
ELLICOTT CITY, MD 21042
CONTACT: JASON VAN KIRK
PHONE: (410) 720-3021

PROJECT
WALDEN WOODS


TAX MAP: 47 GRID: 2 ZONED: PSC
PARCEL: 4, LOTS 1-97, OPEN SPACE LOTS 98 - 102
6TH ELECTION DISTRICT, HOWARD COUNTY, MARYLAND

TITLE
BORING PLAN


BOHLER
ENGINEERING
901 DULANEY VALLEY ROAD, SUITE 801
TOWSON, MARYLAND 21284
Phone: (410) 821-7900
Fax: (410) 821-7987
www.BohlerEngineering.com

CHECKED BY: BRR
DESIGNED BY: BRR
DRAWN BY: RMS/AVG
PROJECT NO.: MD112149
DATE: 10/27/14
SCALE: 1"=50'
DRAWING NO. 31 OF 35

REFER TO SHEET 32 FOR BORING LOGS
AND AUGER PROBE SUMMARY.

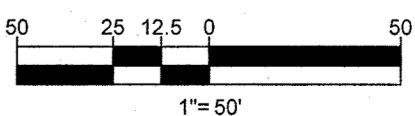

PROFESSIONAL CERTIFICATION
I, BRANDON R. ROWE, HEREBY CERTIFY THAT THESE
DOCUMENTS WERE PREPARED OR APPROVED BY ME, AND
THAT I AM A DULY LICENSED PROFESSIONAL ENGINEER
UNDER THE LAWS OF THE STATE OF MARYLAND,
LICENSE NO. 40808, EXPIRATION DATE: 7/3/2015
















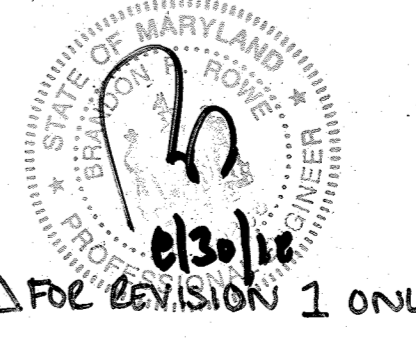


FOR REVISION 1 ONLY

WALDEN WOODS

HC PROJECT NO. 12399A
TABLE 1 - AUGER PROBE SUMMARY

Table with columns: BORING, SURFACE ELEVATION, BORING DEPTH (PROPOSED, DRILLED), AT COMPLETION (WATER (FT), CAVE-IN (FT)), AFTER 24 HOURS (WATER (FT), CAVE-IN (FT)). Rows B-7000 to B-7008.

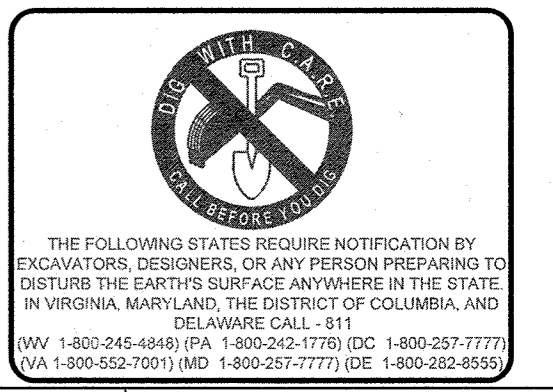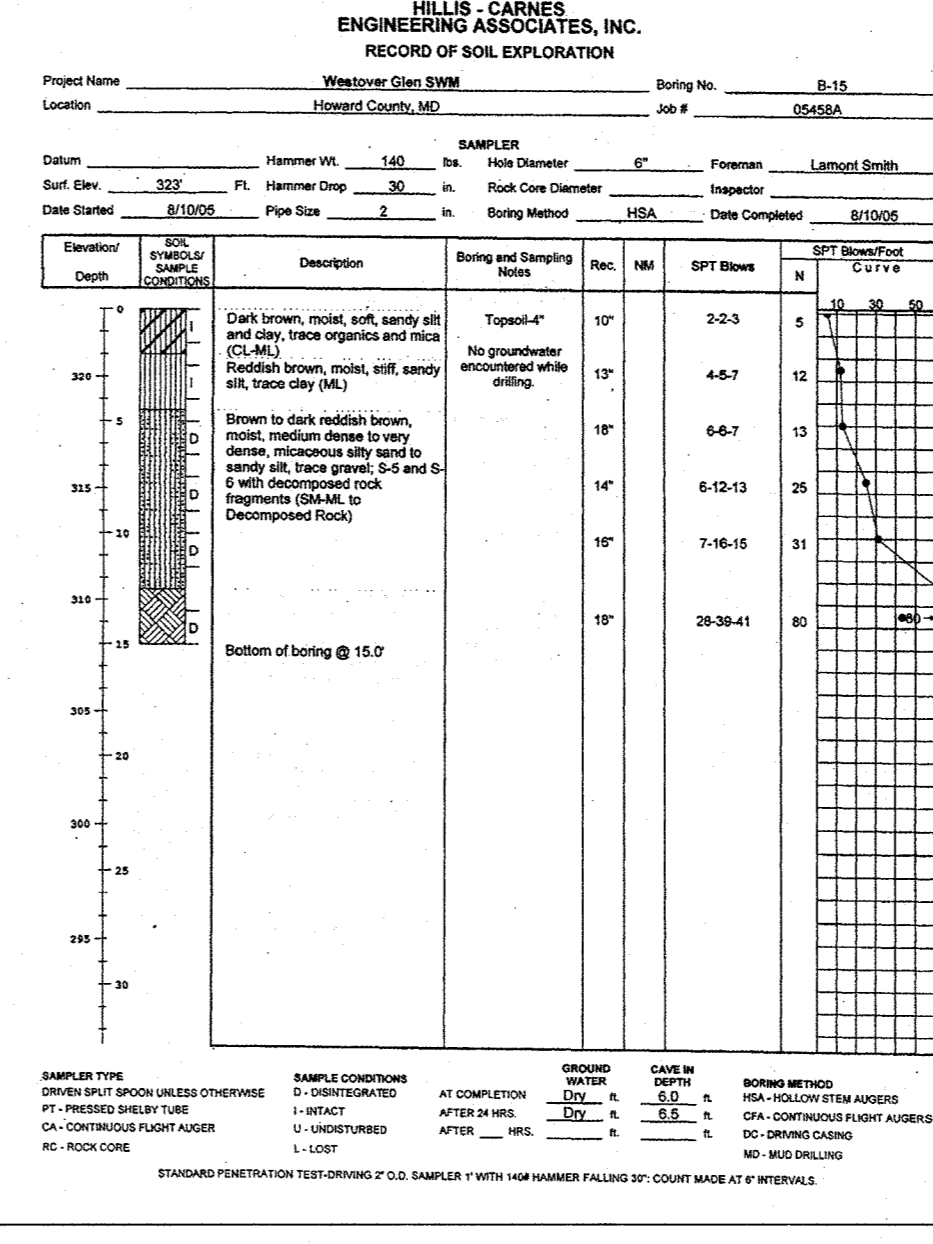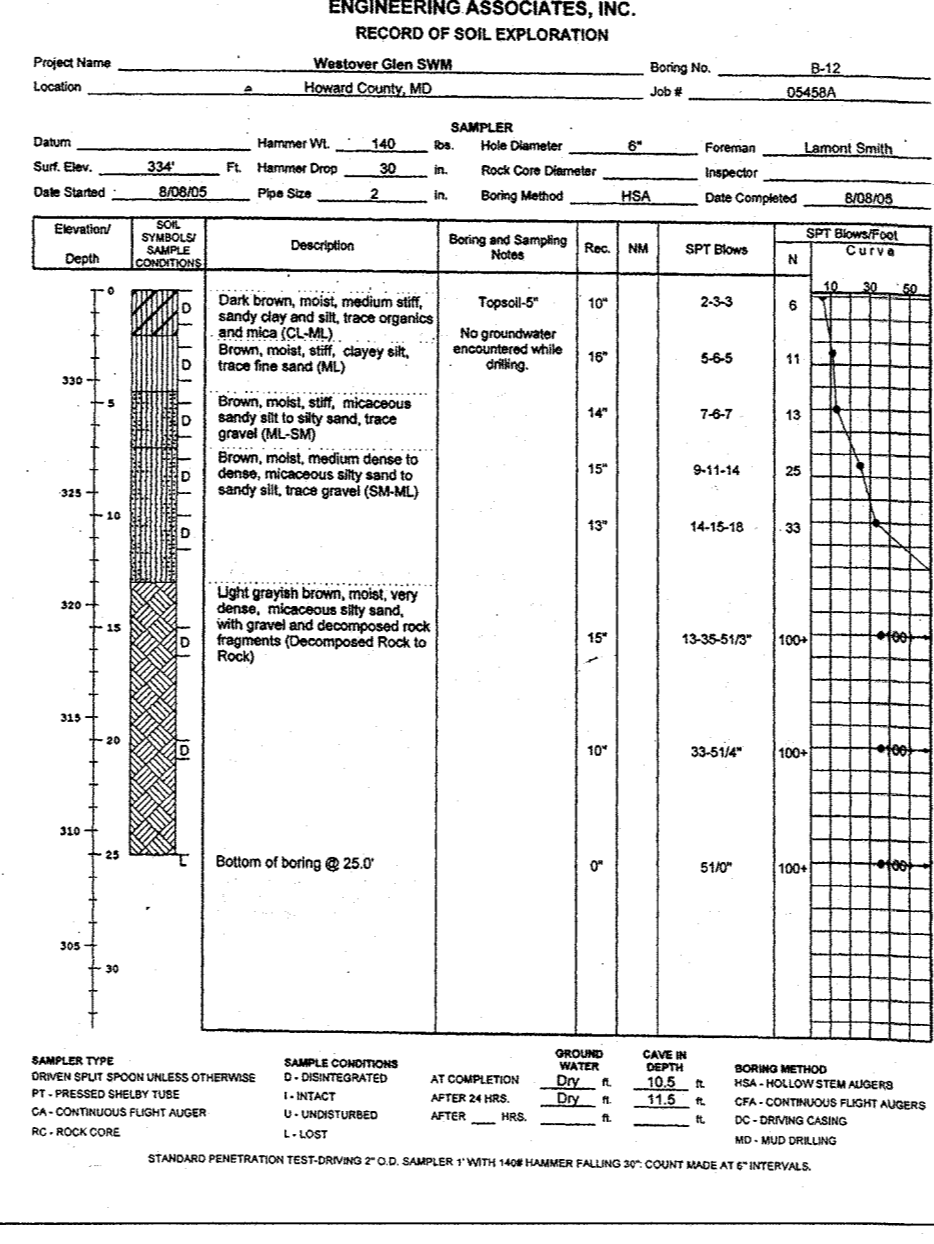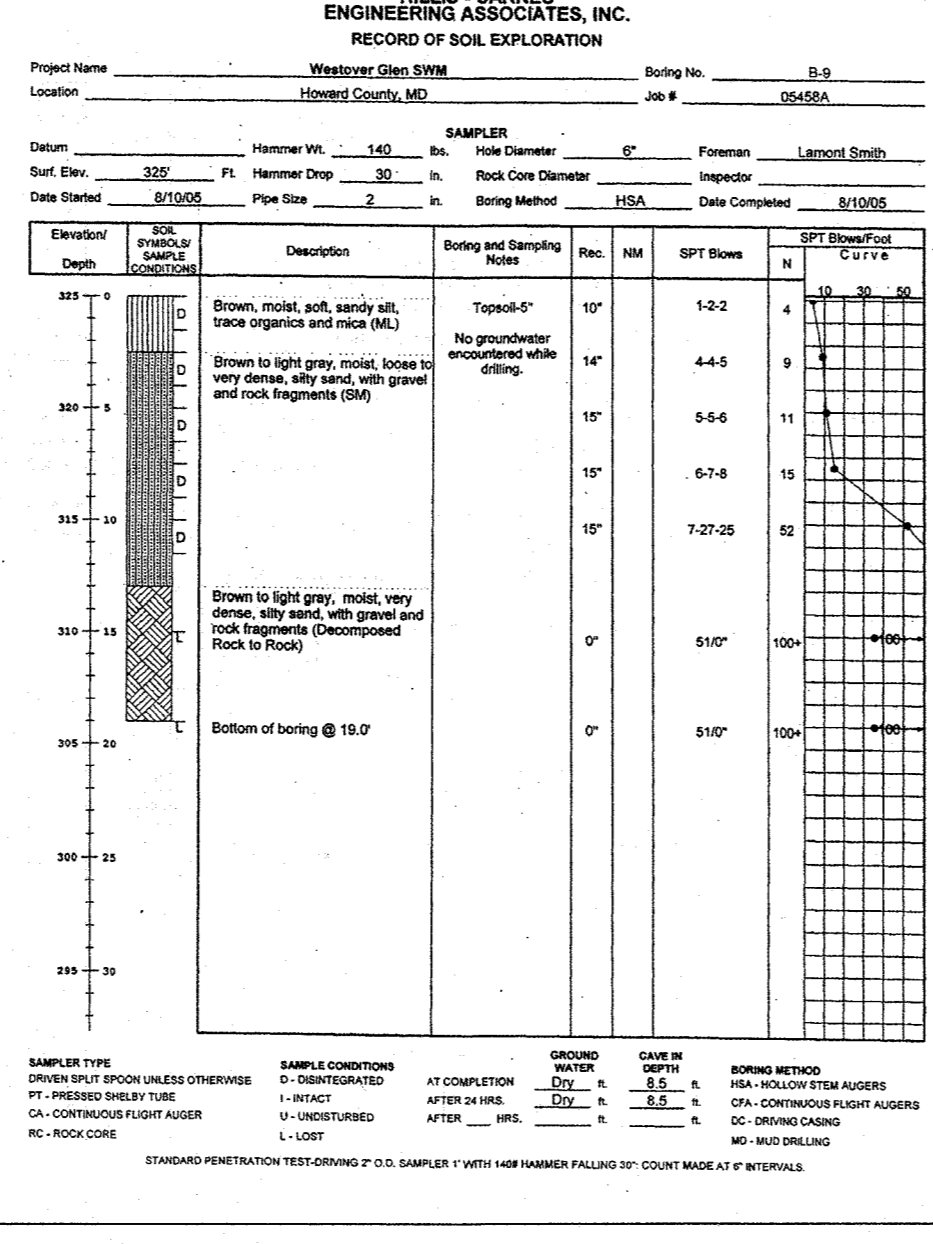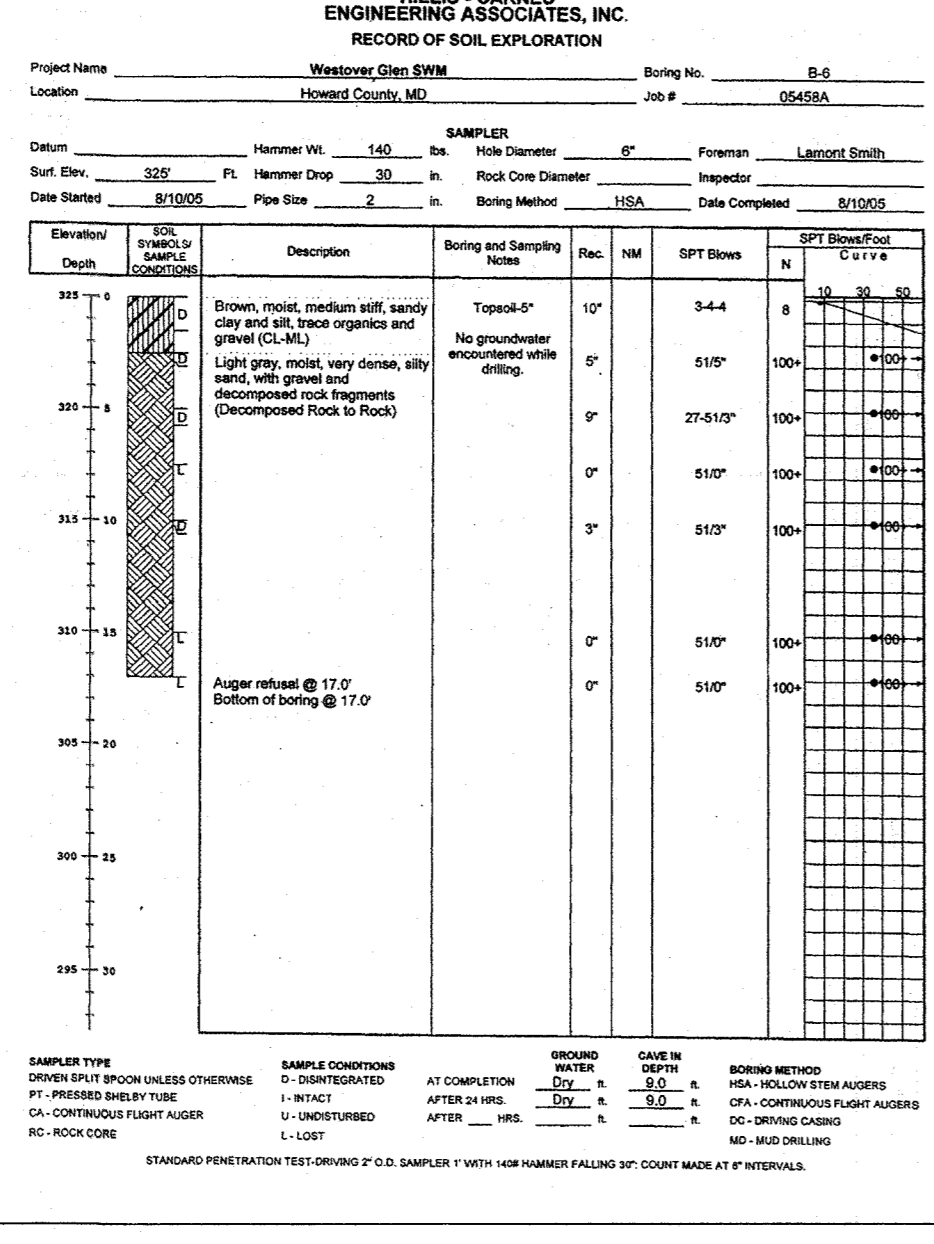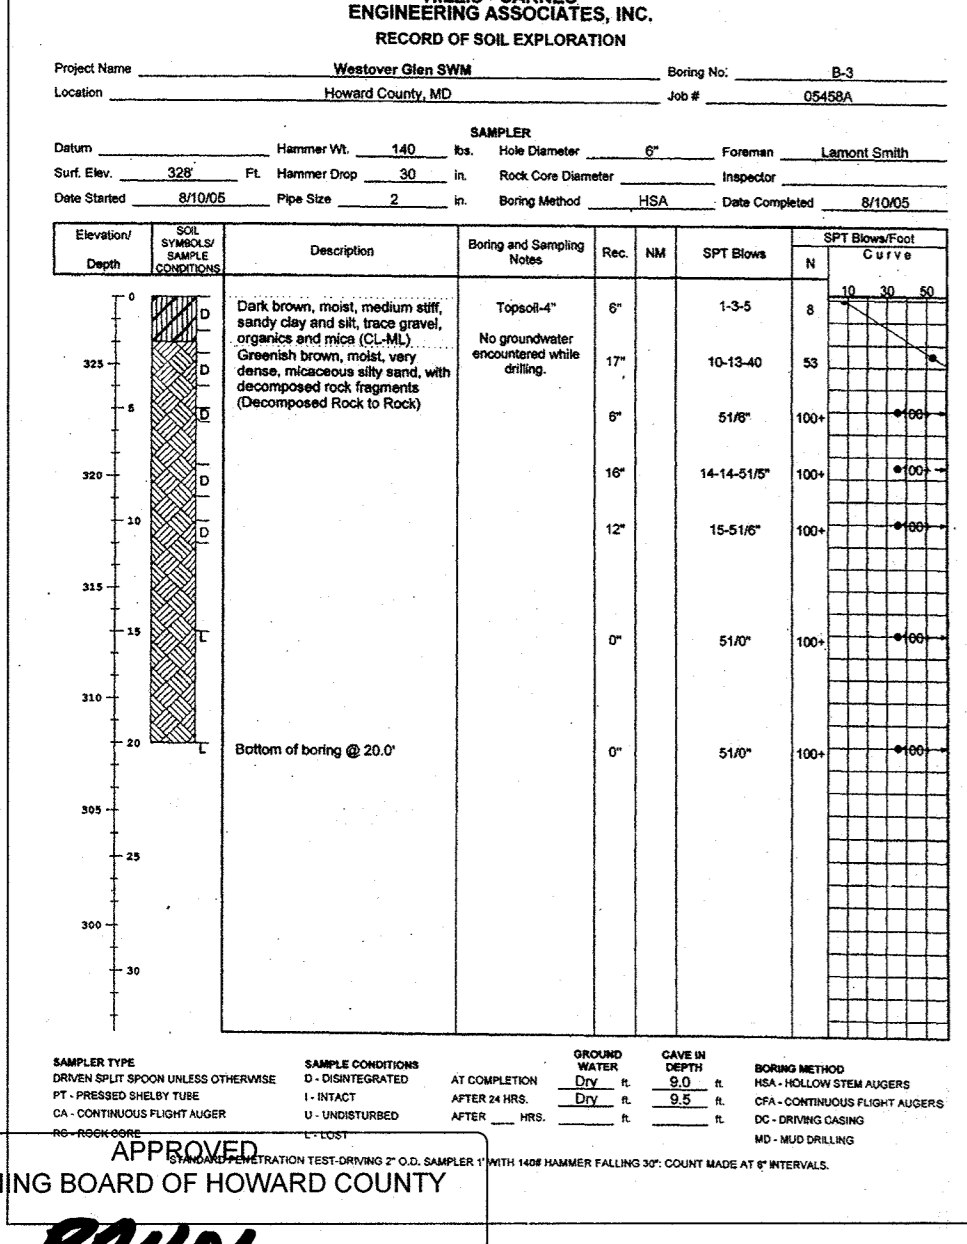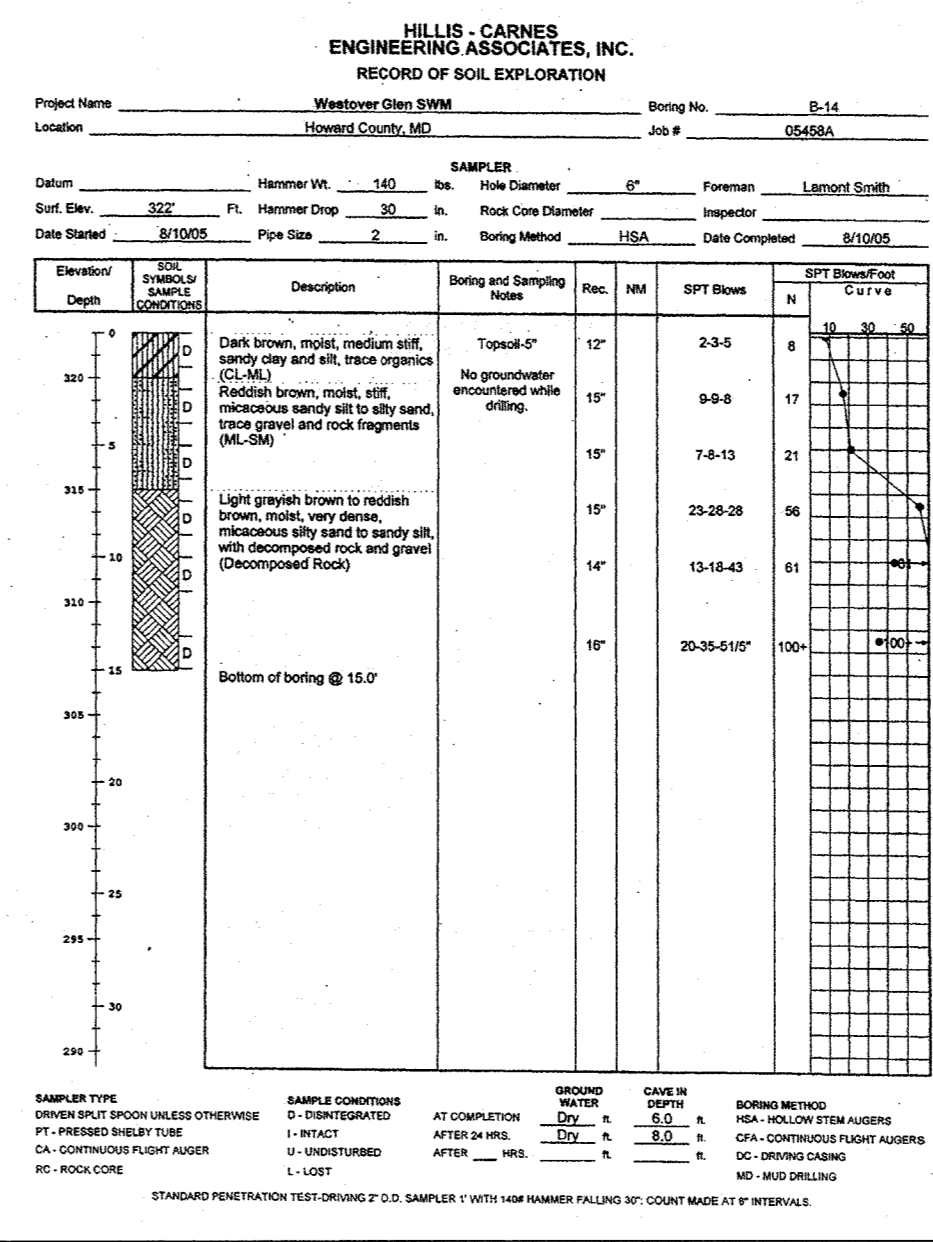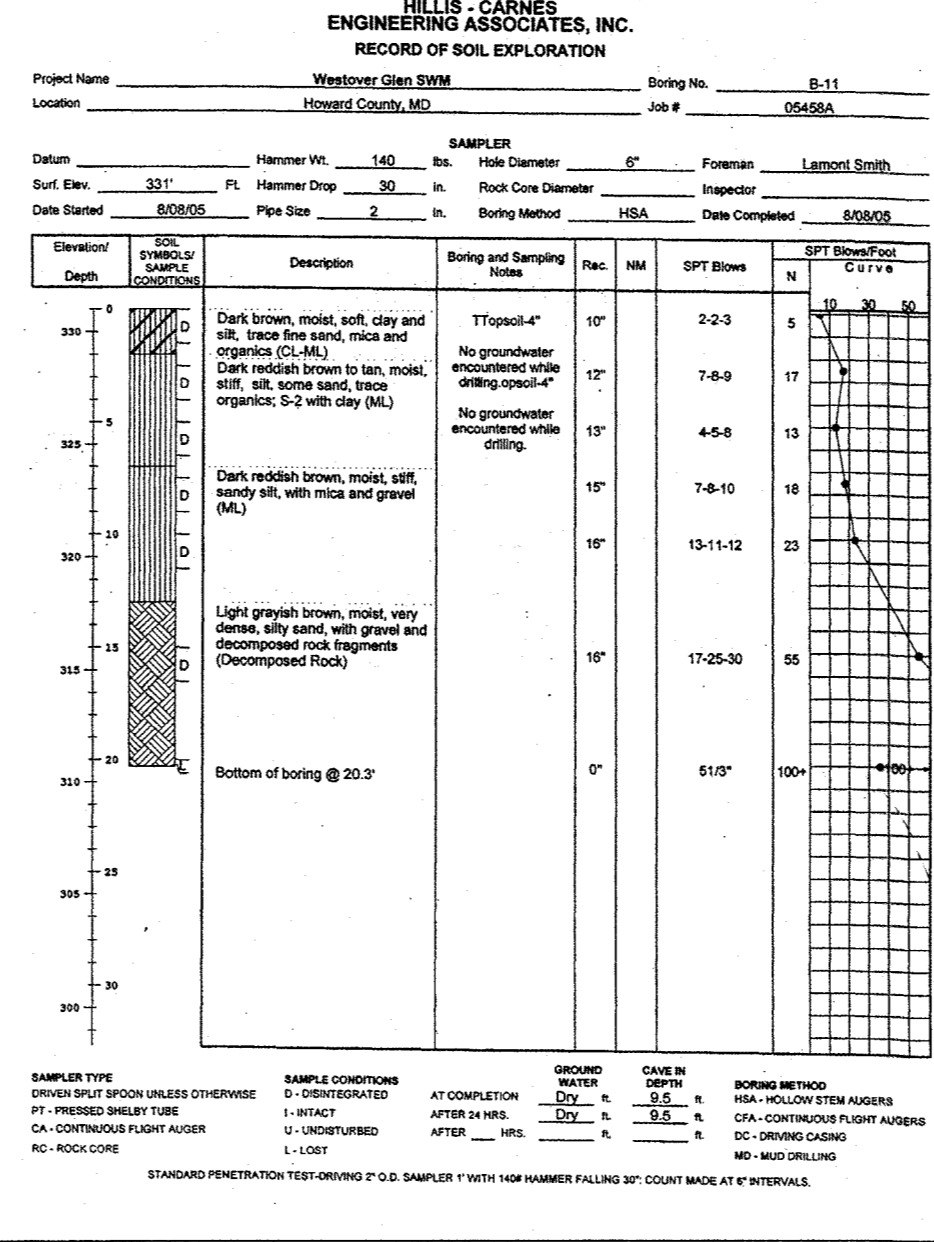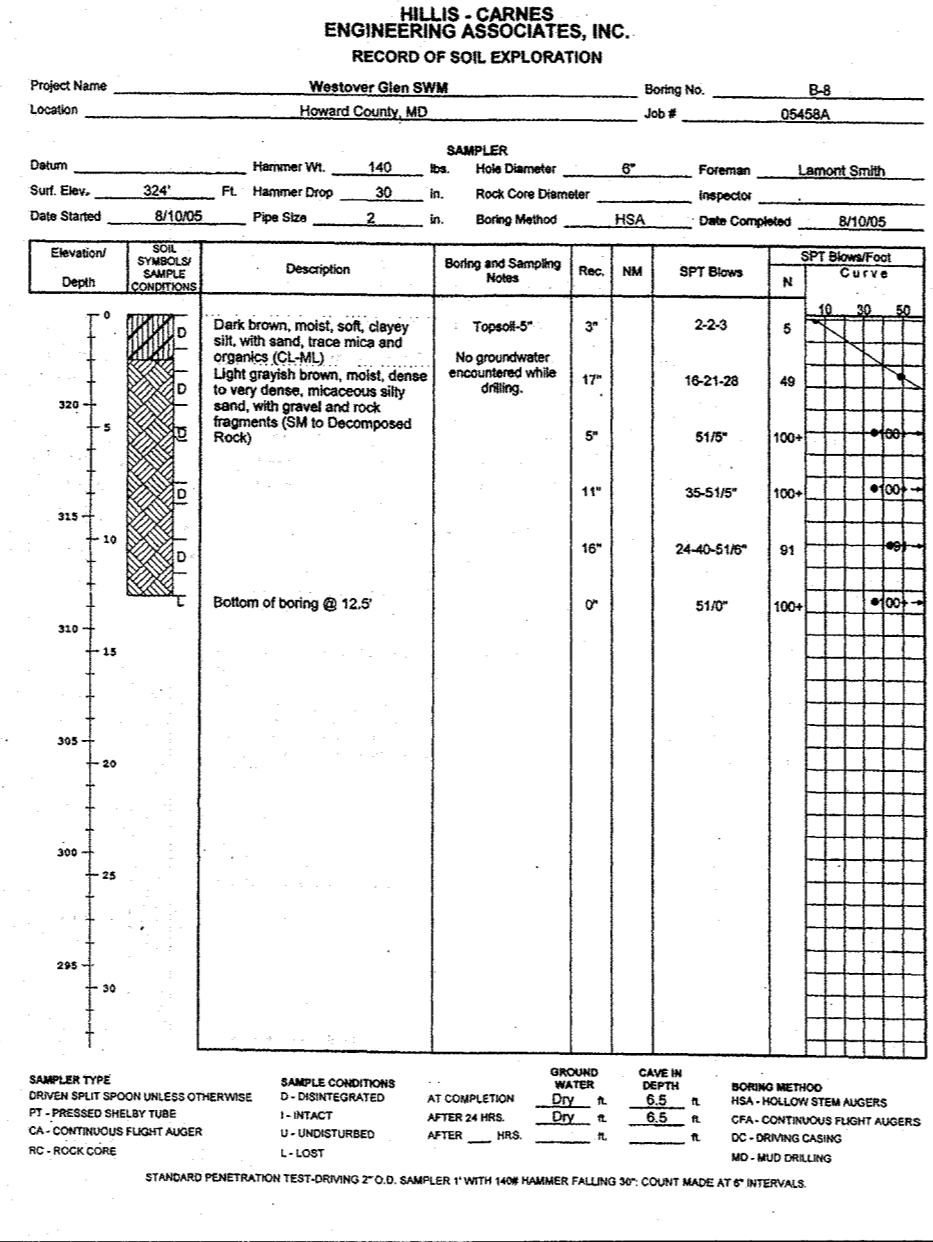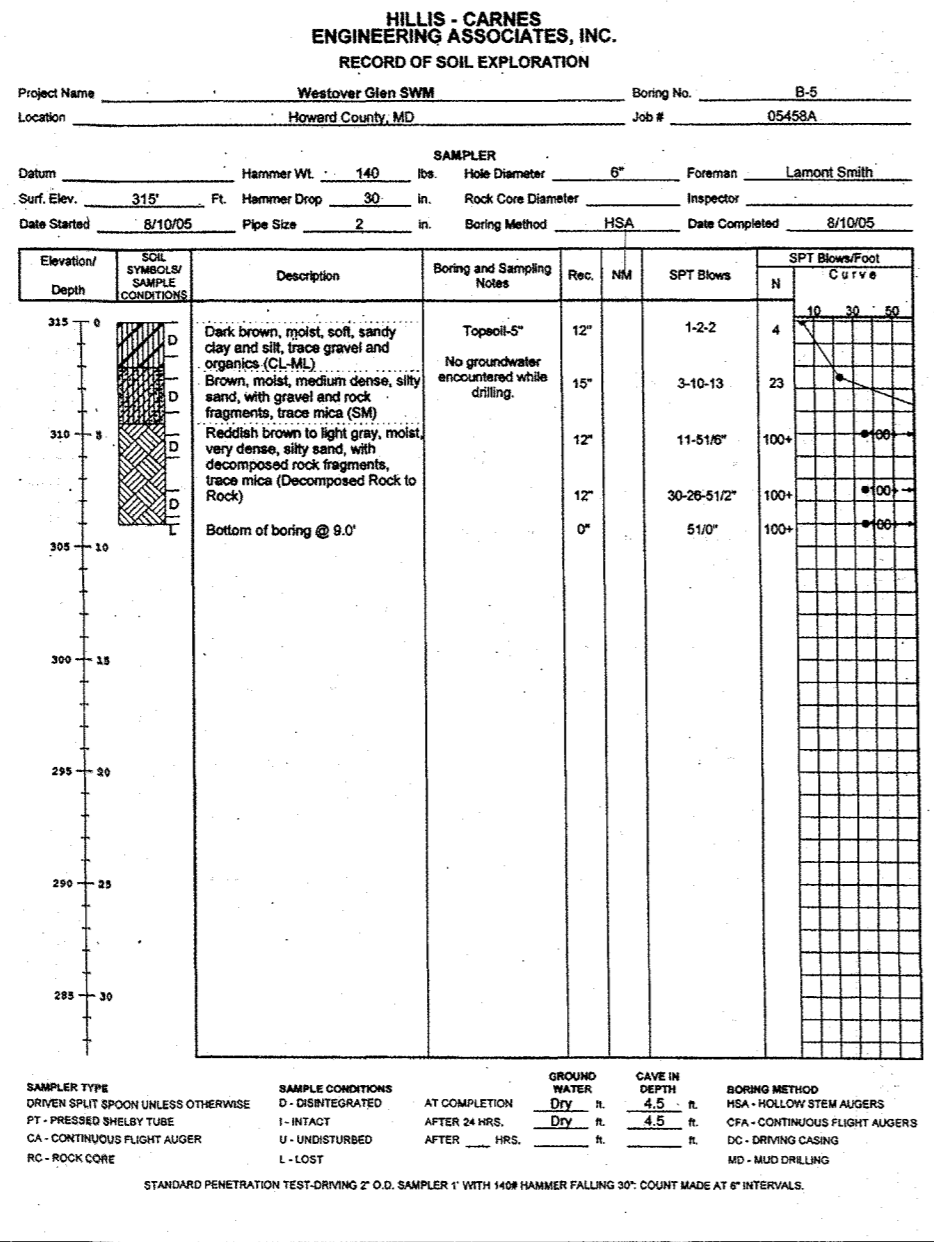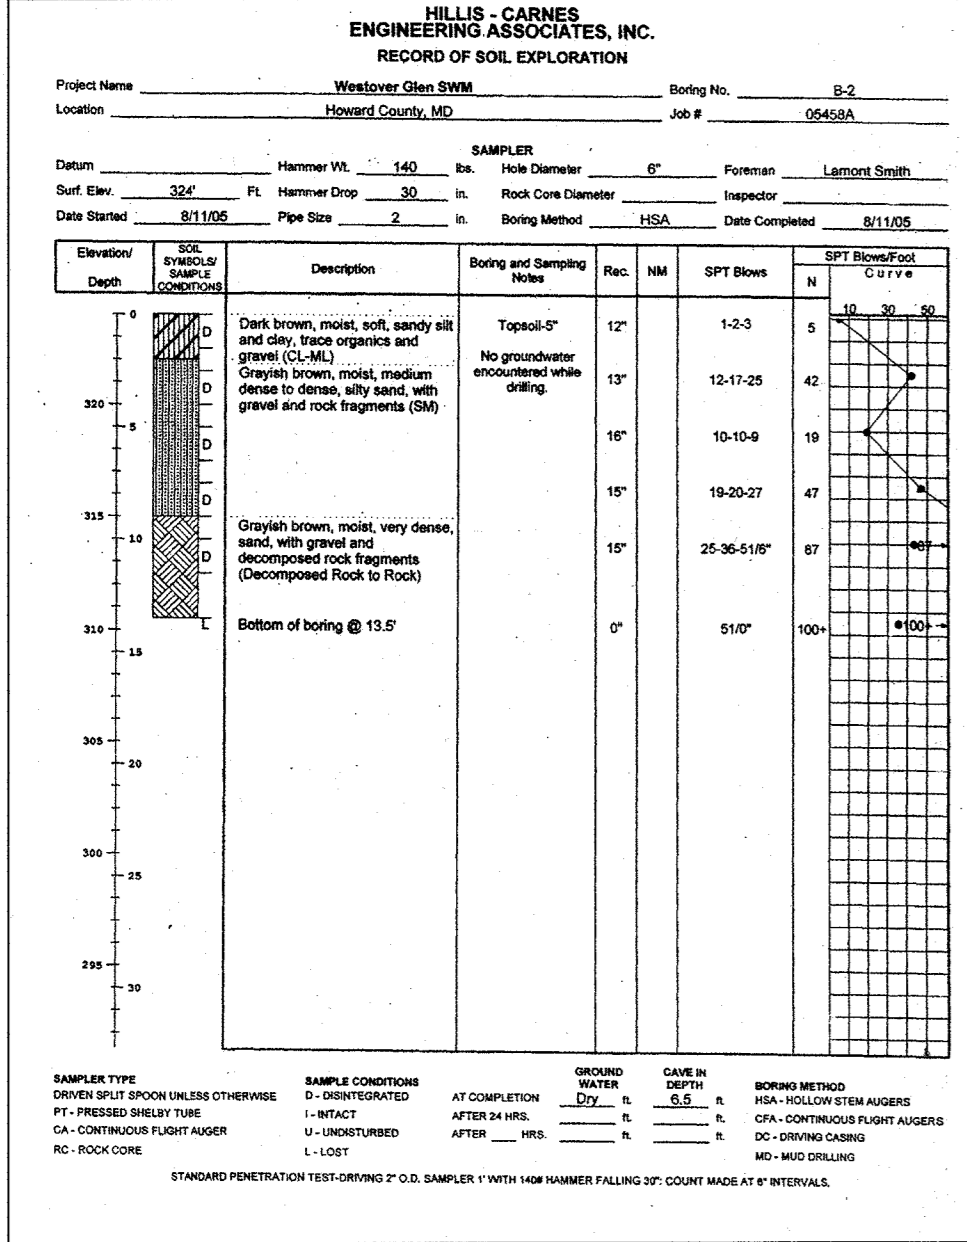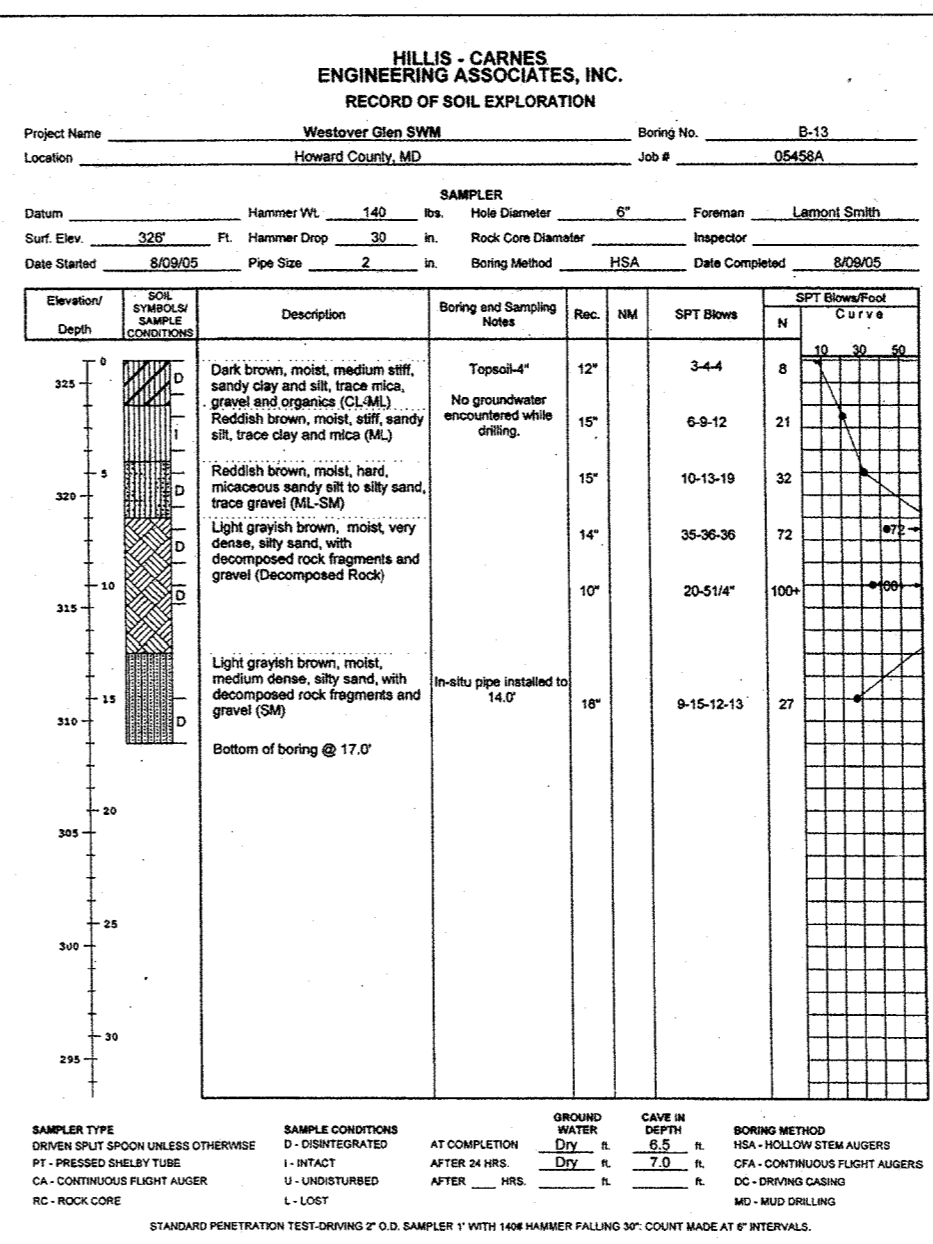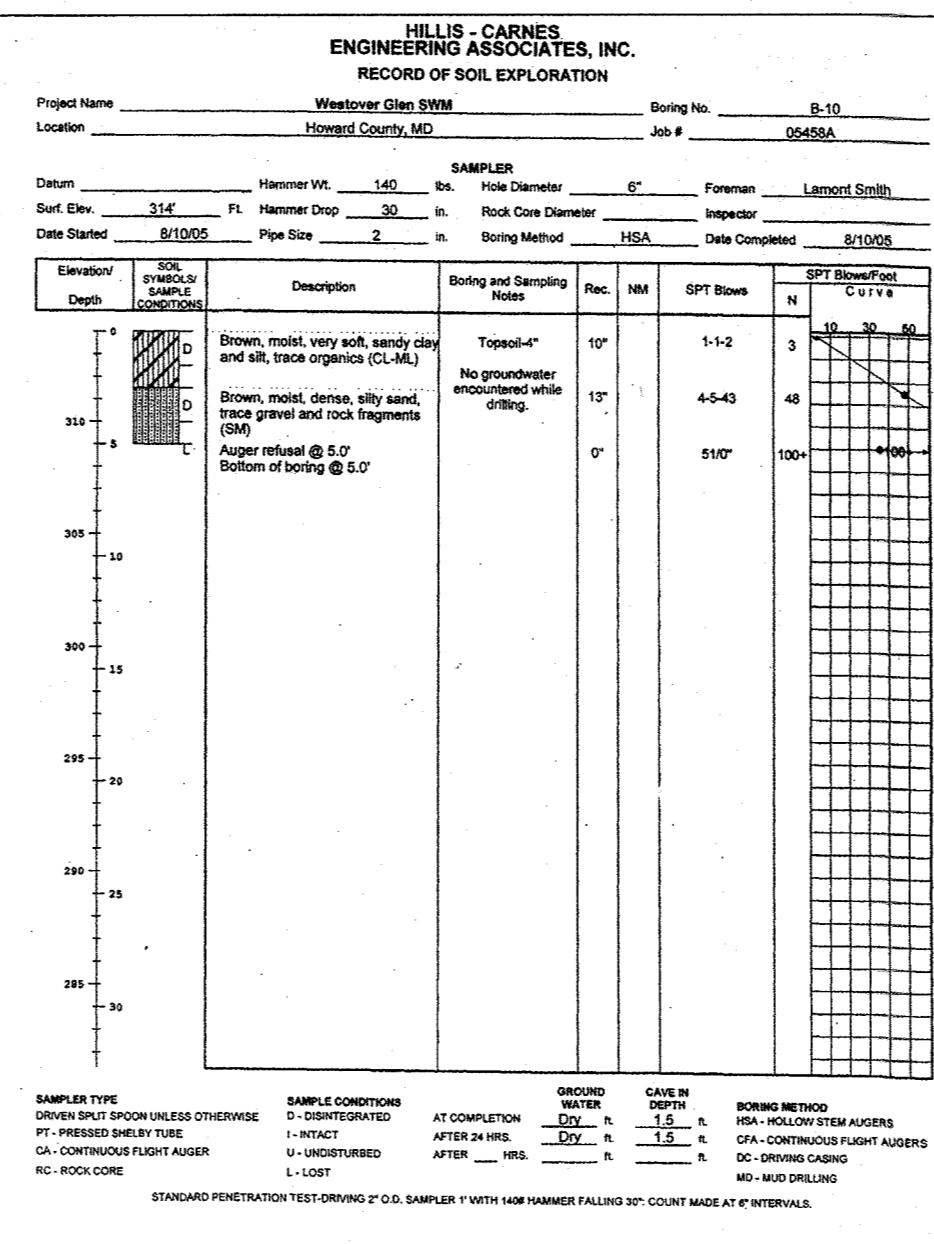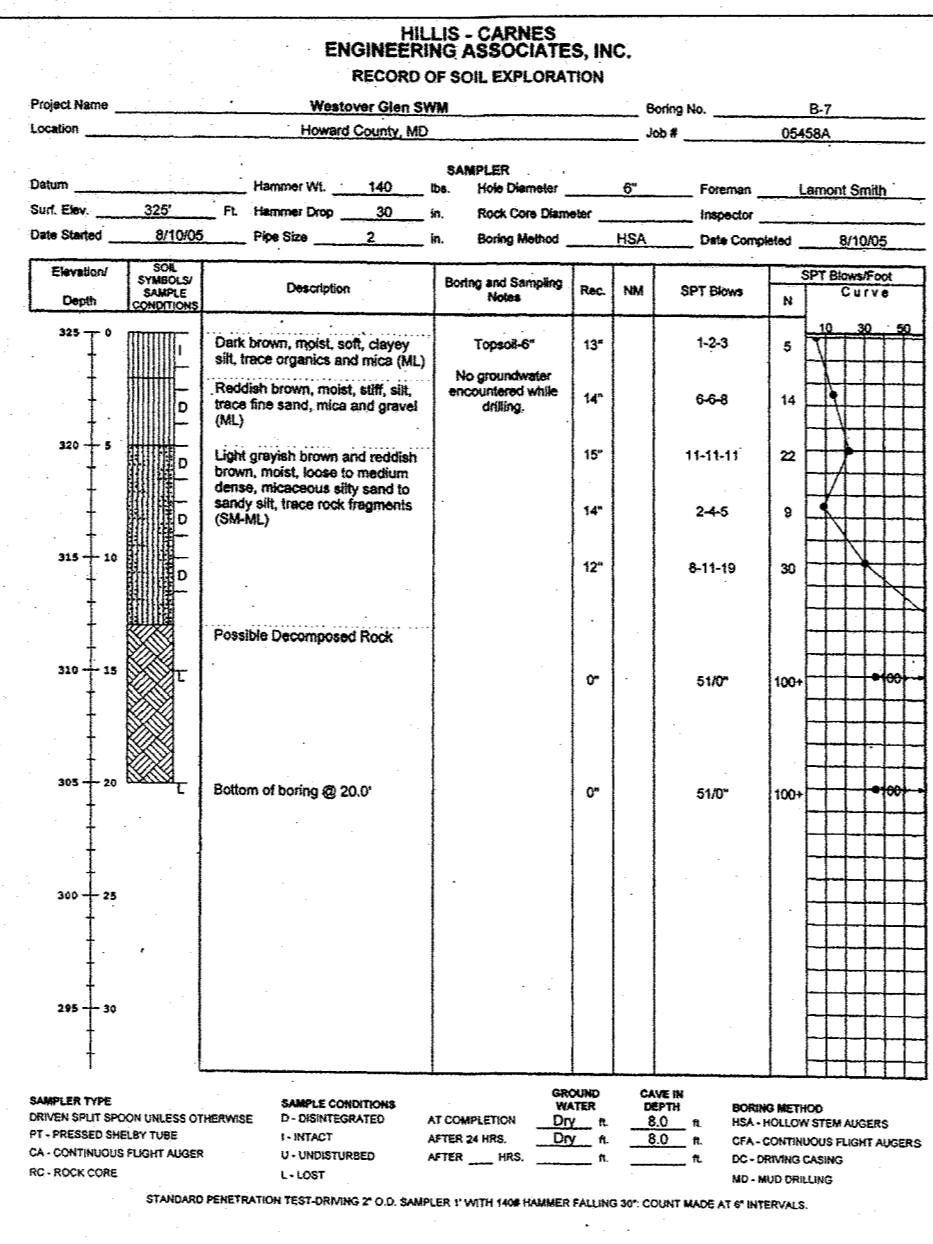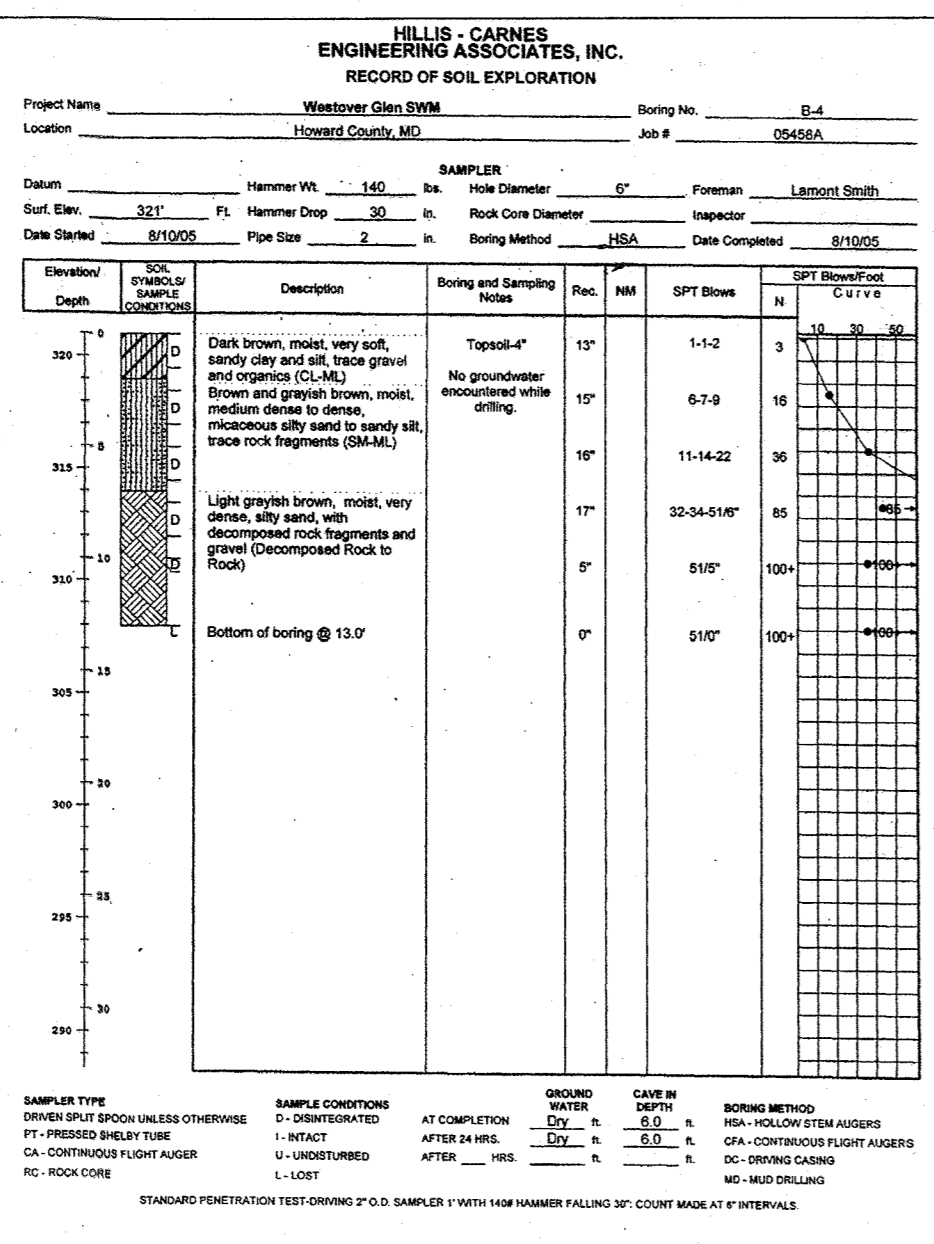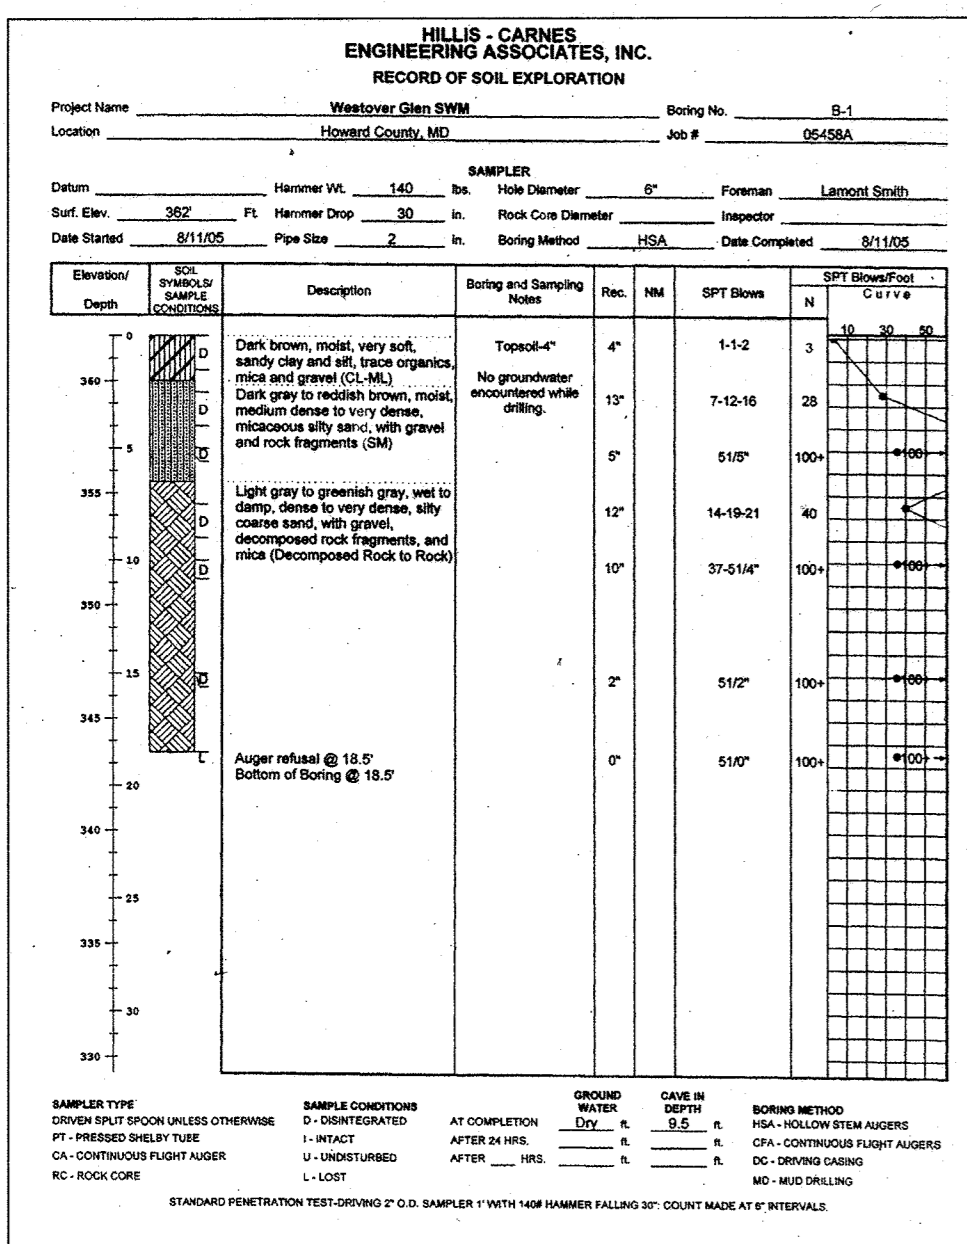

NO. 1 DATE 8/17/14 PAGE NUMBER UPDATE REVISION DESCRIPTION

OWNER: M/HOMES OF DC, LLC
21355 RIDGETOP CIRCLE, SUITE 220
STERLING, VA 20166
CONTACT: CINDY HUNTZBERRY
PHONE: 443-677-9803

DEVELOPER: SOMERWORTH II, L.C.
5704 DORSEY HALL DRIVE, SUITE 205
ELICOTT CITY, MD 21042
CONTACT: JASON VAN KERSK
PHONE: (410) 720-3021


PROJECT: WALDEN WOODS
TAX MAP: 47 GRID: 2 ZONED: PSC
PARCEL: 4, LOTS 1-97, OPEN SPACE LOTS 98 - 102
6TH ELECTION DISTRICT, HOWARD COUNTY, MARYLAND

TITLE: BORING LOGS




CHECKED BY: BRR
DESIGNED BY: BRR
DRAWN BY: RMS/AVG
PROJECT NO. MD11249
DATE: 10/27/14
SCALE: AS NOTED
DRAWING NO. 32 OF 35


APPROVED: BOARD OF PLANNING AND ZONING
DATE 10/08/2014
APPROVED: DEPARTMENT OF PLANNING AND ZONING
DATE 11-17-14
DATE 12-22-14
DATE 12-22-14

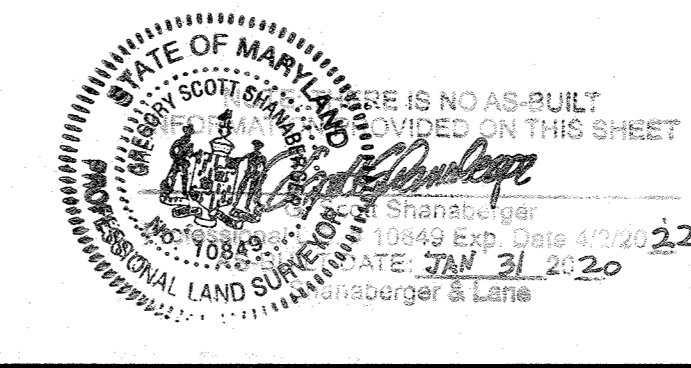

PROFESSIONAL CERTIFICATION
I, BRANDON R. ROWE, HEREBY CERTIFY THAT THESE DOCUMENTS WERE PREPARED OR APPROVED BY ME, AND THAT I AM A DULY LICENSED PROFESSIONAL ENGINEER UNDER THE LAWS OF THE STATE OF MARYLAND, LICENSE NO. 14000, EXPIRATION DATE: 12/31/15

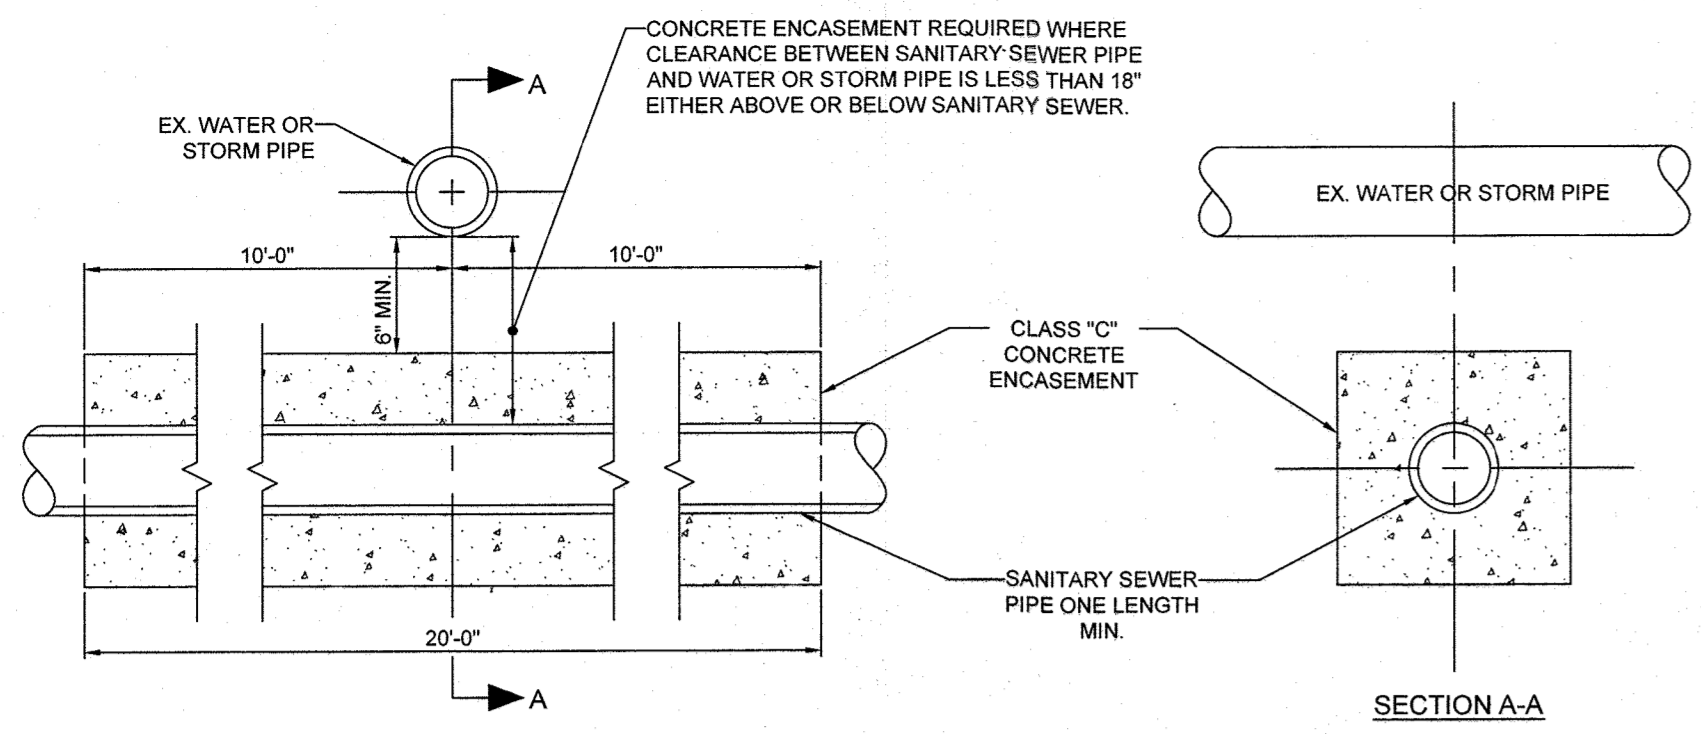


CONCRETE ENCASEMENT DETAIL
NOT TO SCALE

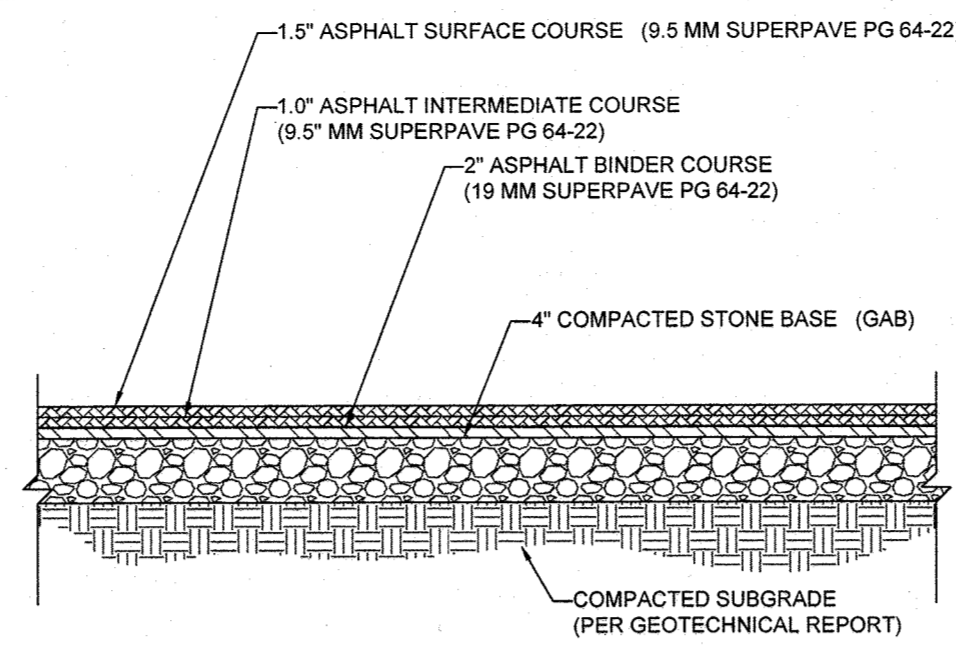


NOTE:
1. SECTION SHOWN IS BASED ON AN ANTICIPATED CBR OF 5 ANY COUNTY P-2 STANDARD PAVING SECTION. FINAL DESIGN TO BE PROVIDED ONCE FINAL CBR'S ARE AVAILABLE ON COMPACTED SUB-BASE.

ASPHALT PAVEMENT SECTION
NOT TO SCALE

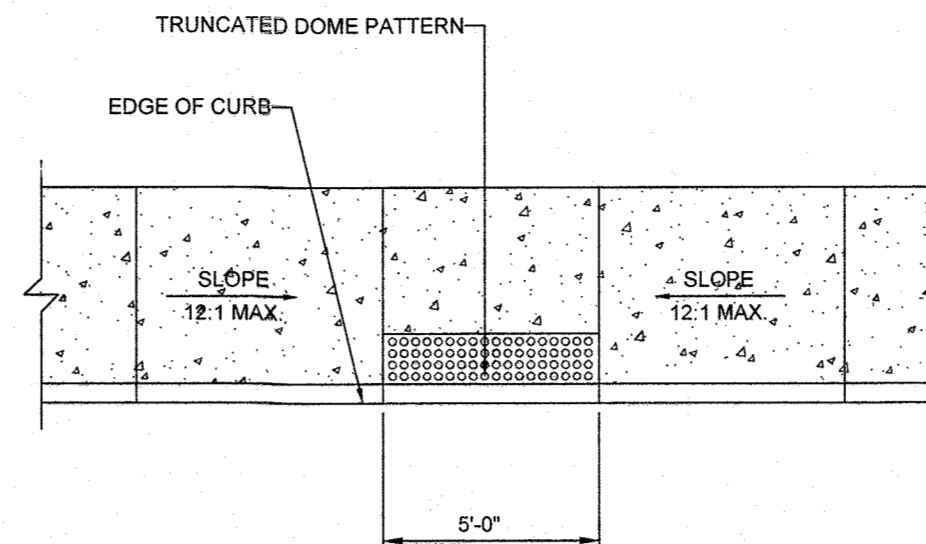


NOTE:
ADA ACCESSIBLE RAMP CONSTRUCTION SHALL CONFORM TO CURRENT ADA ACCESSIBLE GUIDELINES.


ADA ACCESSIBLE RAMP DETAIL
NOT TO SCALE

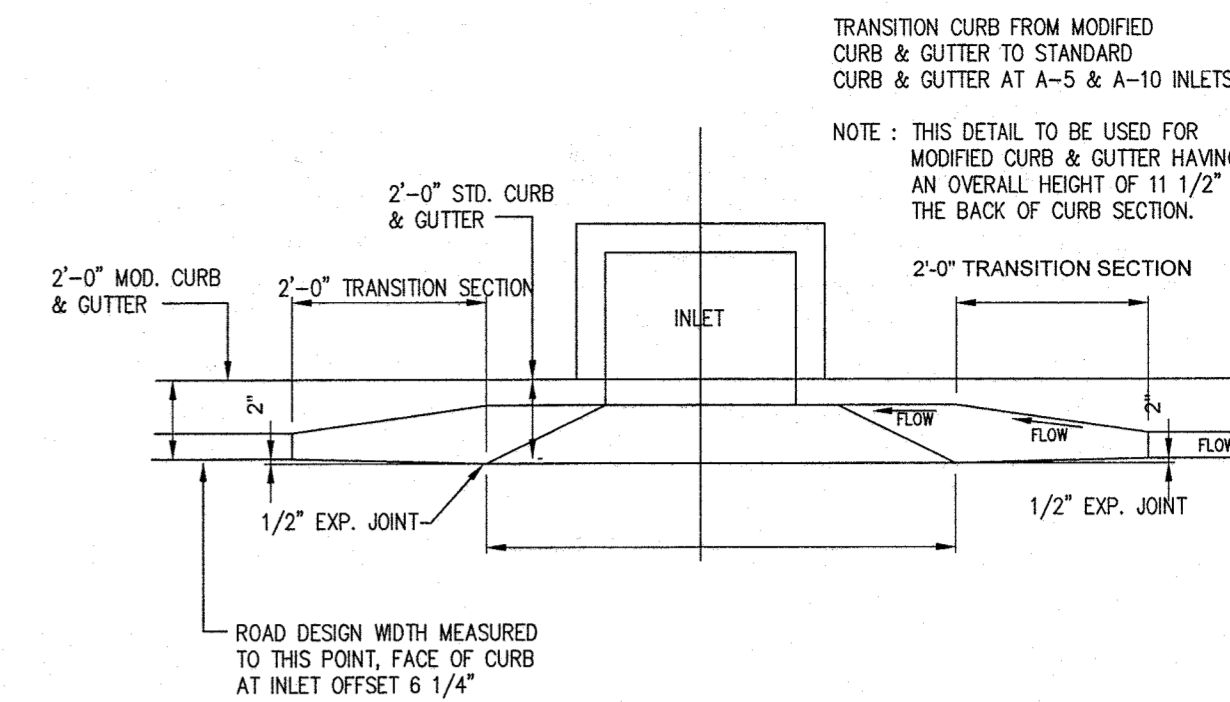

CONCRETE CURB & GUTTER TRANSITION
NOT TO SCALE

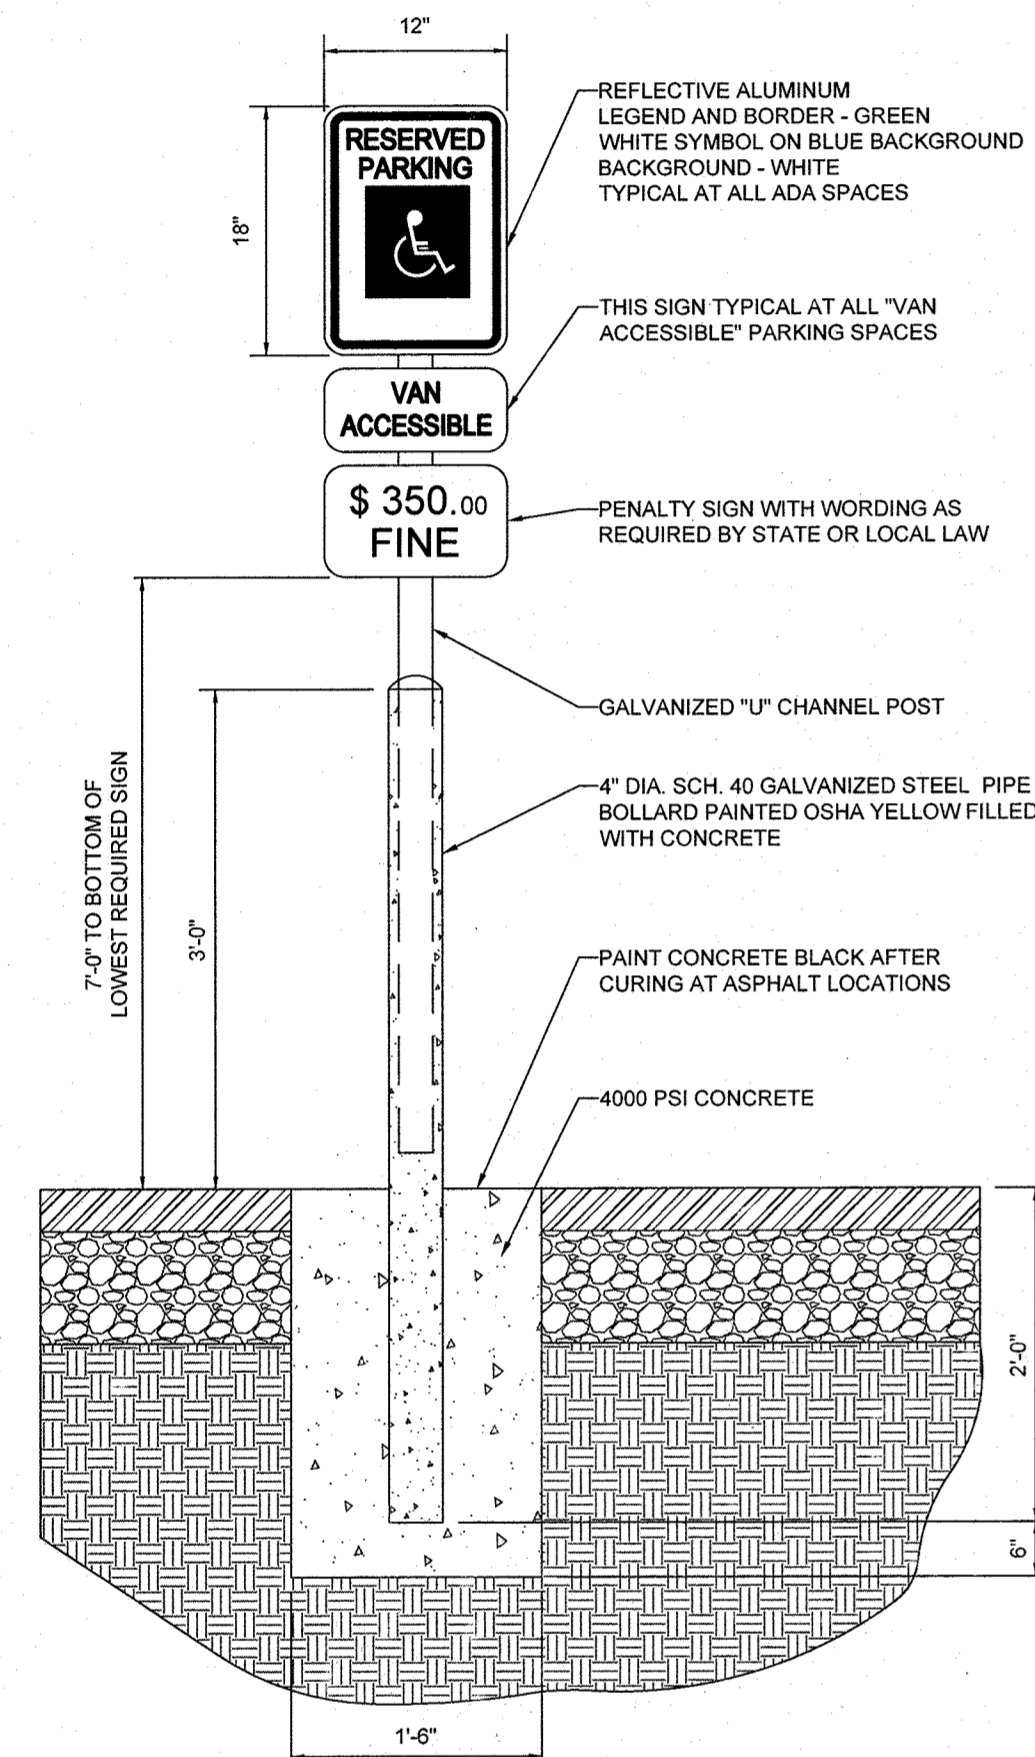


BOLLARD MOUNTED ADA PARKING SIGN DETAIL
NOT TO SCALE

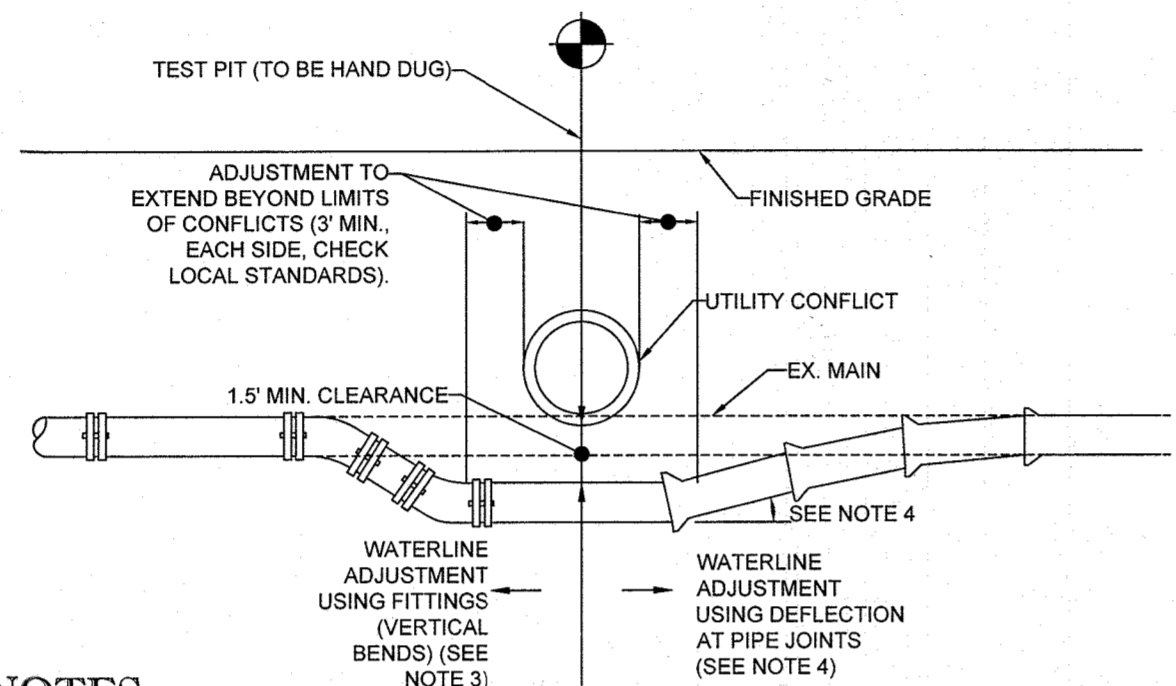


NOTES:
1. CONTRACTOR TO COORDINATE WATERLINE ADJUSTMENT WITH APPROPRIATE INSPECTOR, BASED UPON LOCAL JURISDICTIONAL REQUIREMENTS AND FIELD CONDITIONS.
2. CONTRACTOR TO HAND DIG TEST PIT AT ANTICIPATED CROSSING LOCATION TO DETERMINE EXISTING WATERLINE DEPTH, TOTAL WATERLINE DEFLECTION REQUIRED, AND BEST METHOD FOR WATERLINE ADJUSTMENT.
3. VERTICAL BENDS (INSTALLED PER LOCAL STANDARDS) AS REQUIRED.
4. PIPE DEFLECTION AT JOINTS (PER LOCAL STANDARDS)


WATERLINE ADJUSTMENT DETAIL
NOT TO SCALE

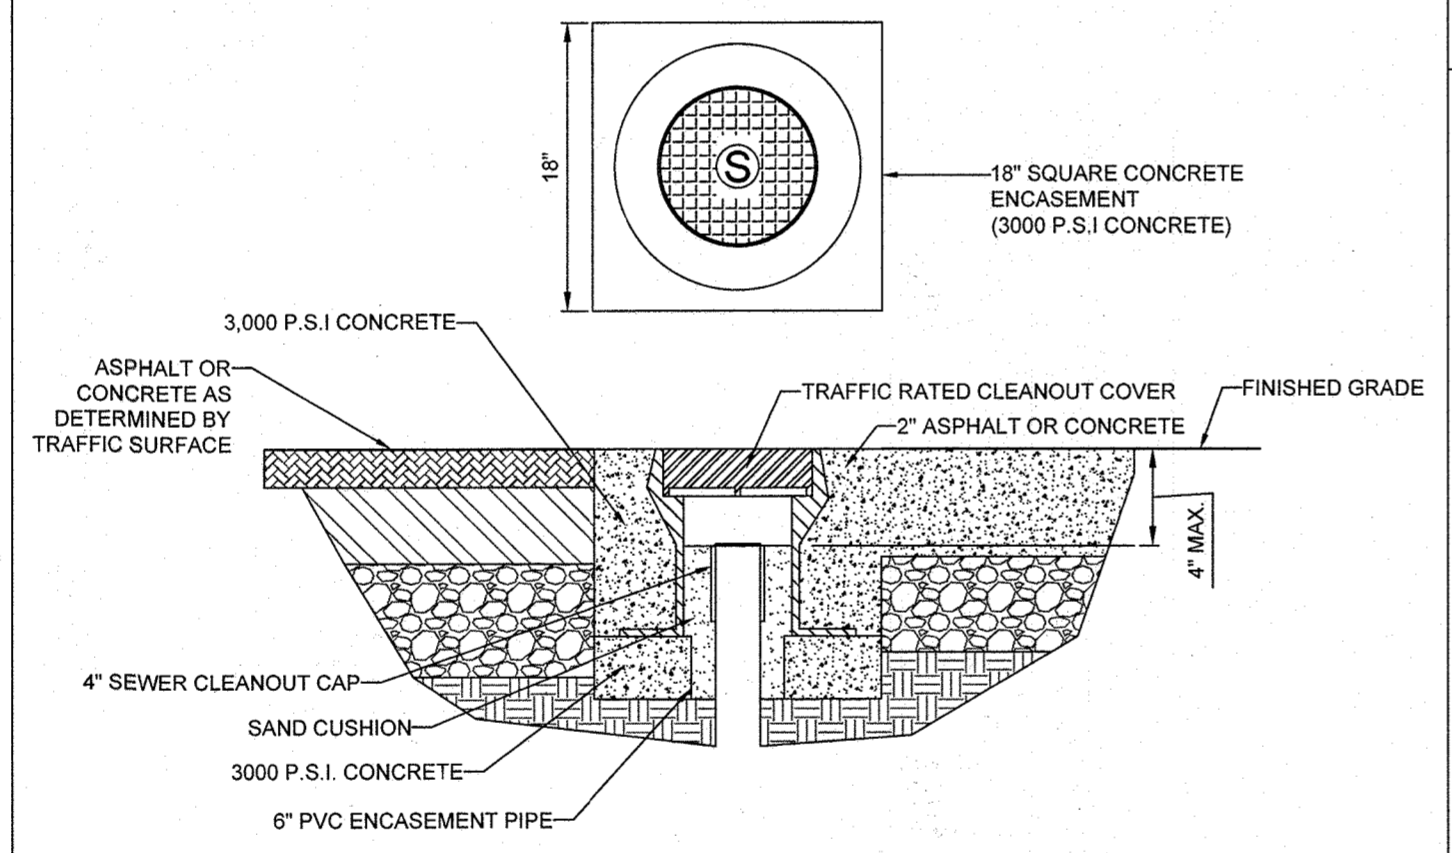


TRAFFIC RATED CLEANOUT DETAIL
NOT TO SCALE

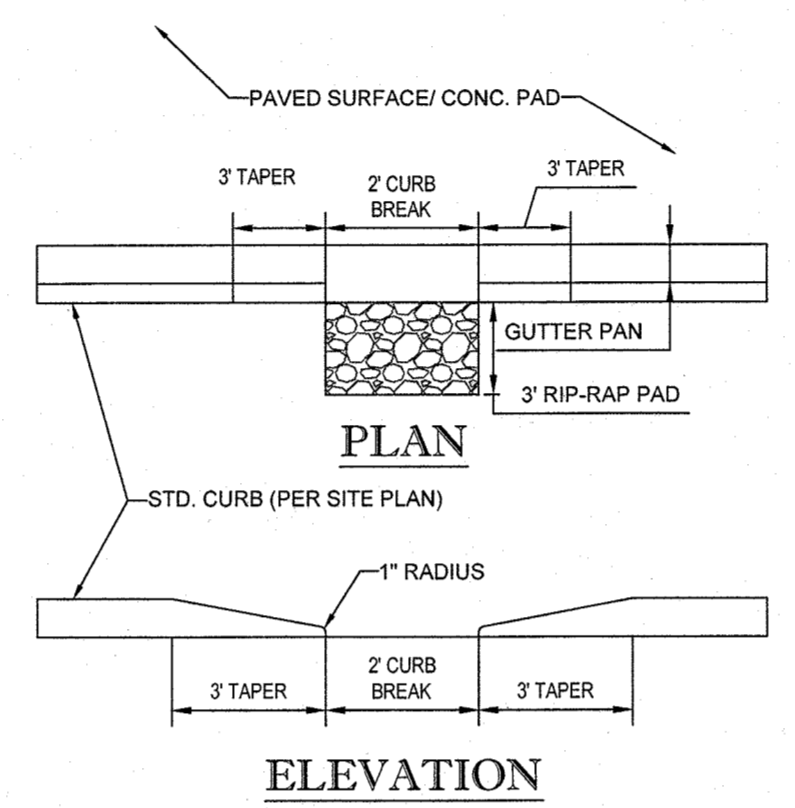

CURB BREAK DETAIL
NOT TO SCALE

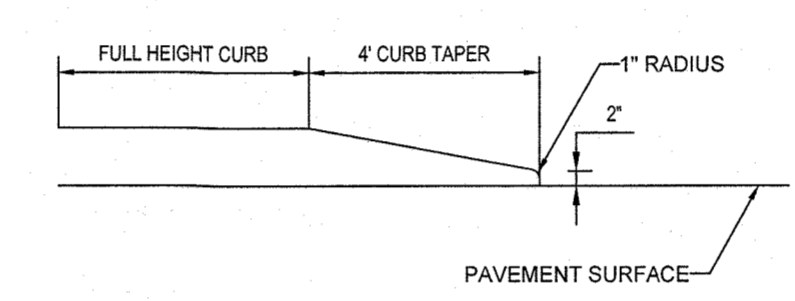


CURB TAPER DETAIL
NOT TO SCALE

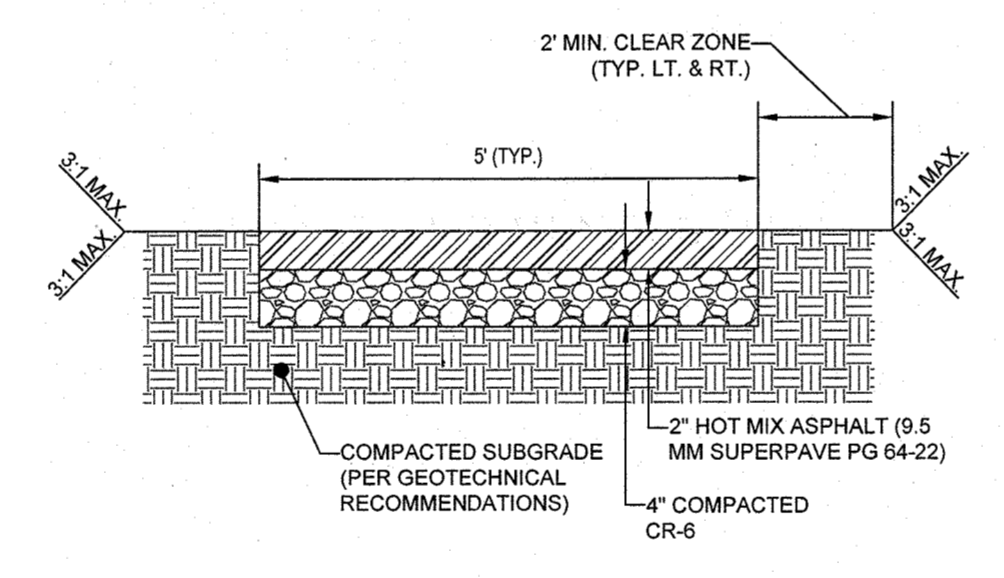


NOTE:
1. TRAIL CROSS SLOPE NOT TO EXCEED 2.00%.

ASPHALT TRAIL DETAIL
NOT TO SCALE

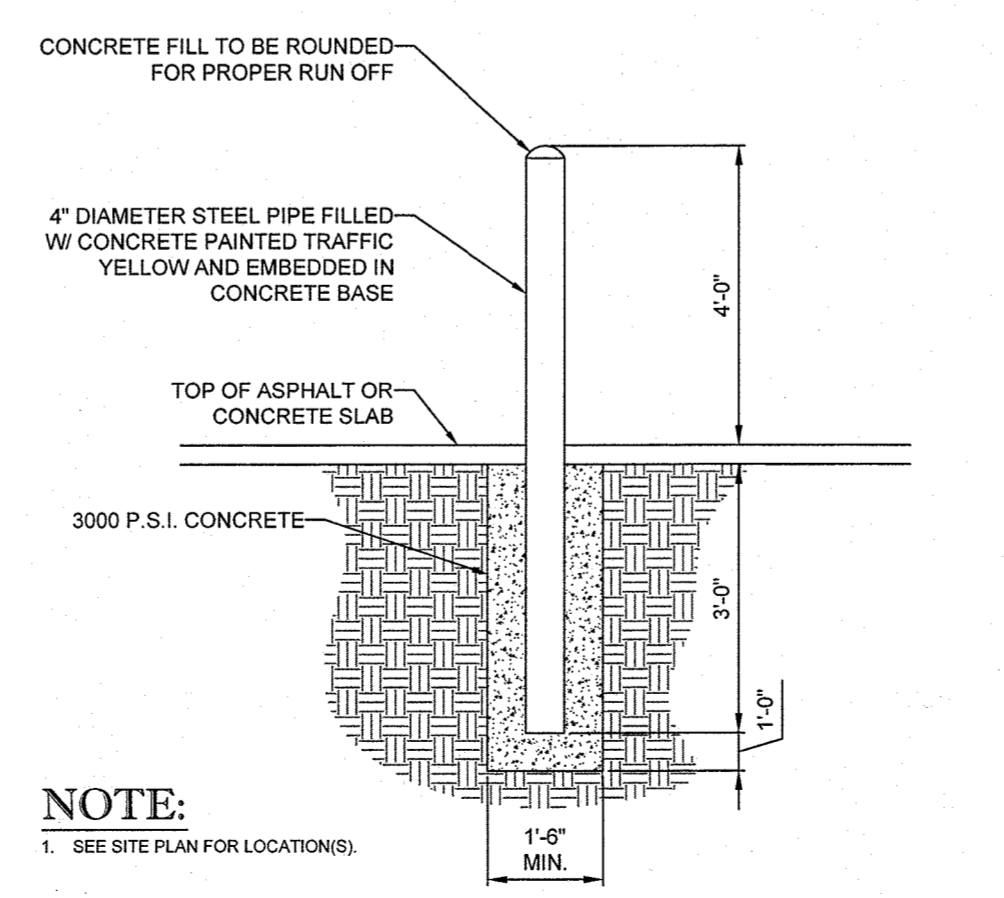


NOTE:
1. SEE SITE PLAN FOR LOCATION(S).


BOLLARD DETAIL
NOT TO SCALE

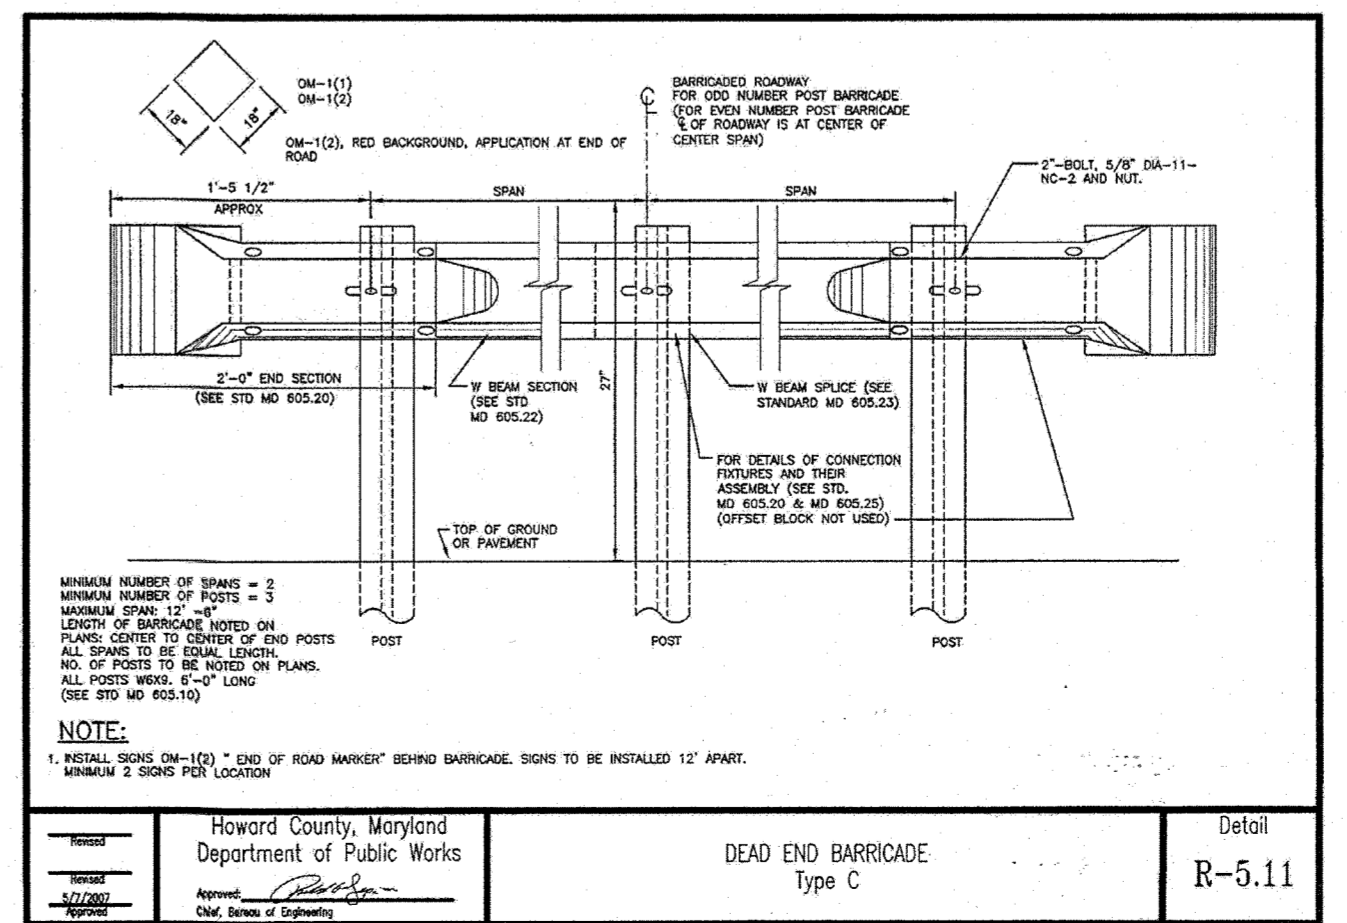

Howard County, Maryland
Department of Public Works
Type C
Detail
R-5.11

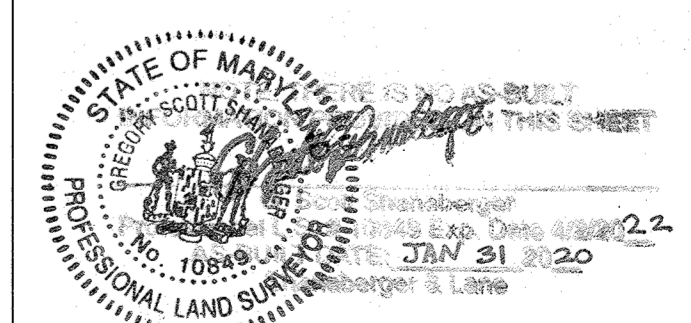

FOR REVISION 2 ONLY
PROFESSIONAL CERTIFICATION
I, BRANDON R. ROWE, HEREBY CERTIFY THAT THESE DOCUMENTS WERE PREPARED OR APPROVED BY ME AND THAT I AM A DULY LICENSED PROFESSIONAL ENGINEER UNDER THE LAWS OF THE STATE OF MARYLAND, LICENSE NO. 40808 EXPIRATION DATE: 7/31/2015

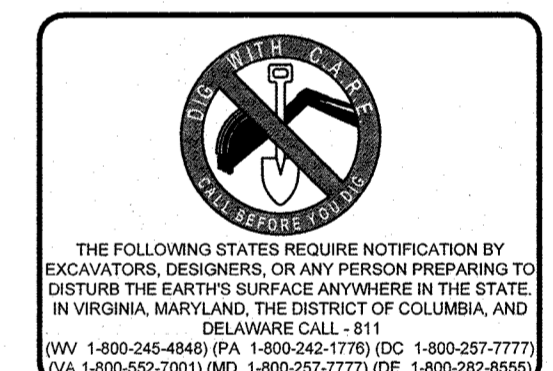

THE FOLLOWING STATES REQUIRE NOTIFICATION BY EXCAVATORS, DESIGNERS, OR ANY PERSON PREPARING TO EXCAVATE THE EARTH'S SURFACE ANYWHERE IN THE STATE OF VIRGINIA, MARYLAND, THE DISTRICT OF COLUMBIA, AND DELAWARE CALL: 811 (WV 1-800-248-4848) (PA 1-800-242-1778) (DC 1-800-257-7777) (VA 1-800-552-7001) (MD 1-800-267-7777) (DE 1-800-282-8555)

NO.	DATE	REVISION DESCRIPTION
1	8/17/13	PAGE NUMBER UPDATE

OWNER:
M/H HOMES OF DC, LLC
21355 RIDGETOP CIRCLE, SUITE 220
STERLING, VA 20166
CONTACT: CINDY HUNTZBERRY
PHONE: 443-677-9803

DEVELOPER:
SOMERWORTH II, L.C.
5704 DORSEY HALL DRIVE, SUITE 205
ELLICOTT CITY, MD 21042
CONTACT: JASON VAN KIRK
PHONE: (410) 720-3021


PROJECT:
WALDEN WOODS
TAX MAP: 47 GRID: 2 ZONED: PSC
PARCEL: 4, LOTS 1-97, OPEN SPACE LOTS 98 - 102
6TH ELECTION DISTRICT, HOWARD COUNTY, MARYLAND

TITLE:
SITE DETAILS


BOHLER ENGINEERING
901 DULANEY VALLEY ROAD, SUITE 801
TOWSON, MARYLAND 21284
Phone: (410) 821-7900
Fax: (410) 821-7987
www.BohlerEngineering.com

CHECKED BY: BRR
DESIGNED BY: BRR
DRAWN BY: RMS/AVG
PROJECT NO.: MD112149
DATE: 10/27/14
SCALE: NOT TO SCALE
DRAWING NO. 33 OF 35


APPROVED
PLANNING BOARD OF HOWARD COUNTY
DATE: 10/09/2014
APPROVED: DEPARTMENT OF PLANNING AND ZONING
DATE: 11-17-14
CHIEF-DEVELOPMENT ENGINEERING DIVISION
CHIEF-DIVISION OF LAND DEVELOPMENT
DIRECTOR

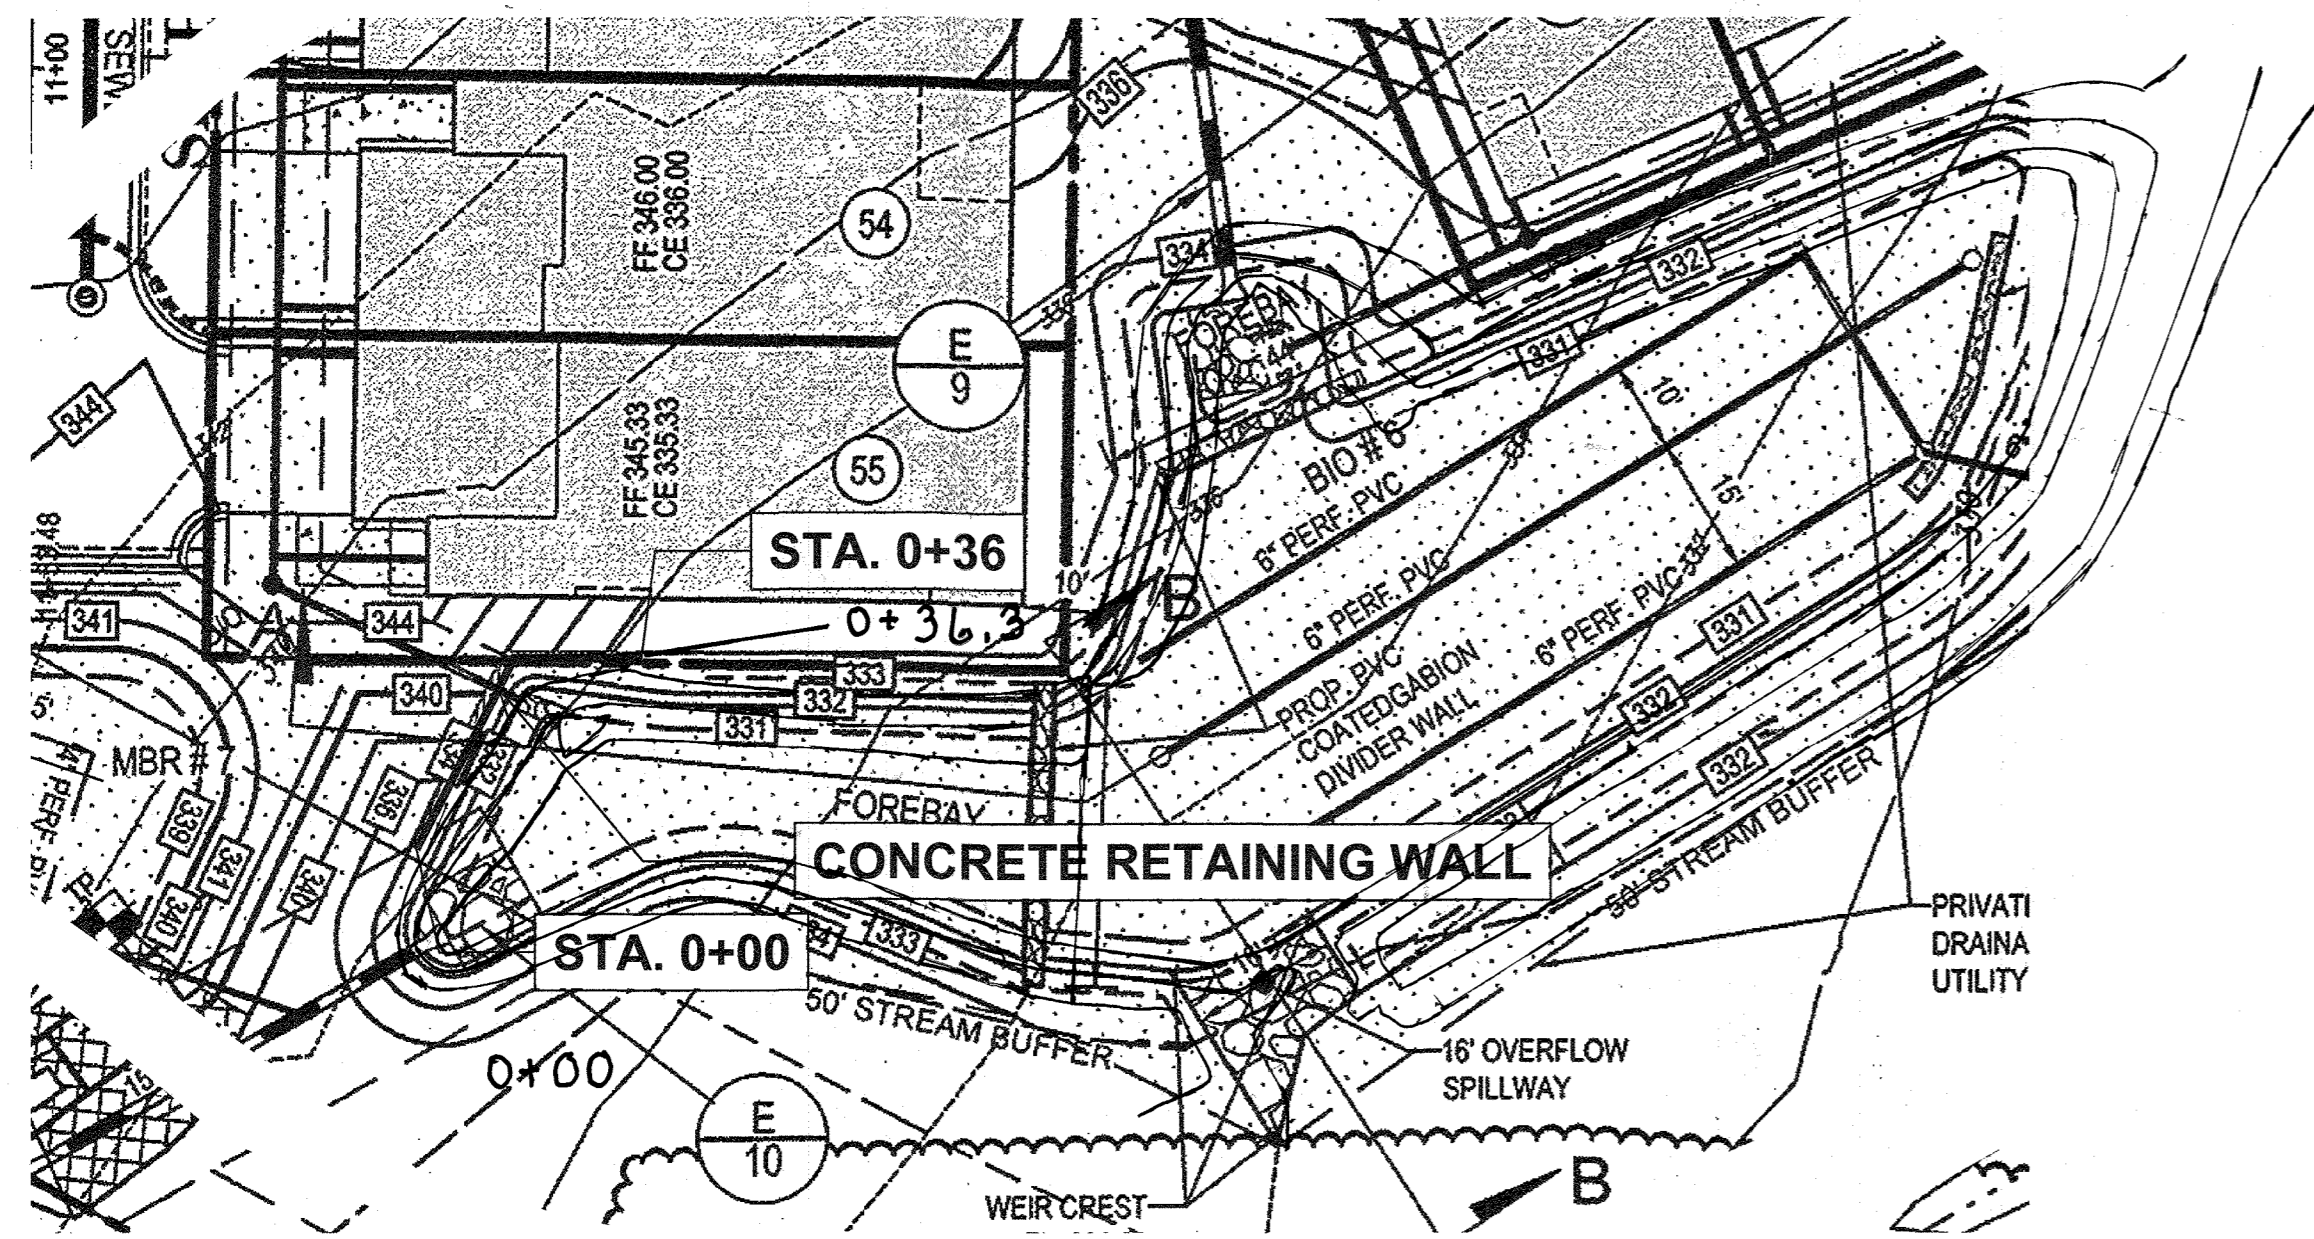

WALL LOCATION PLAN
1" = 20'

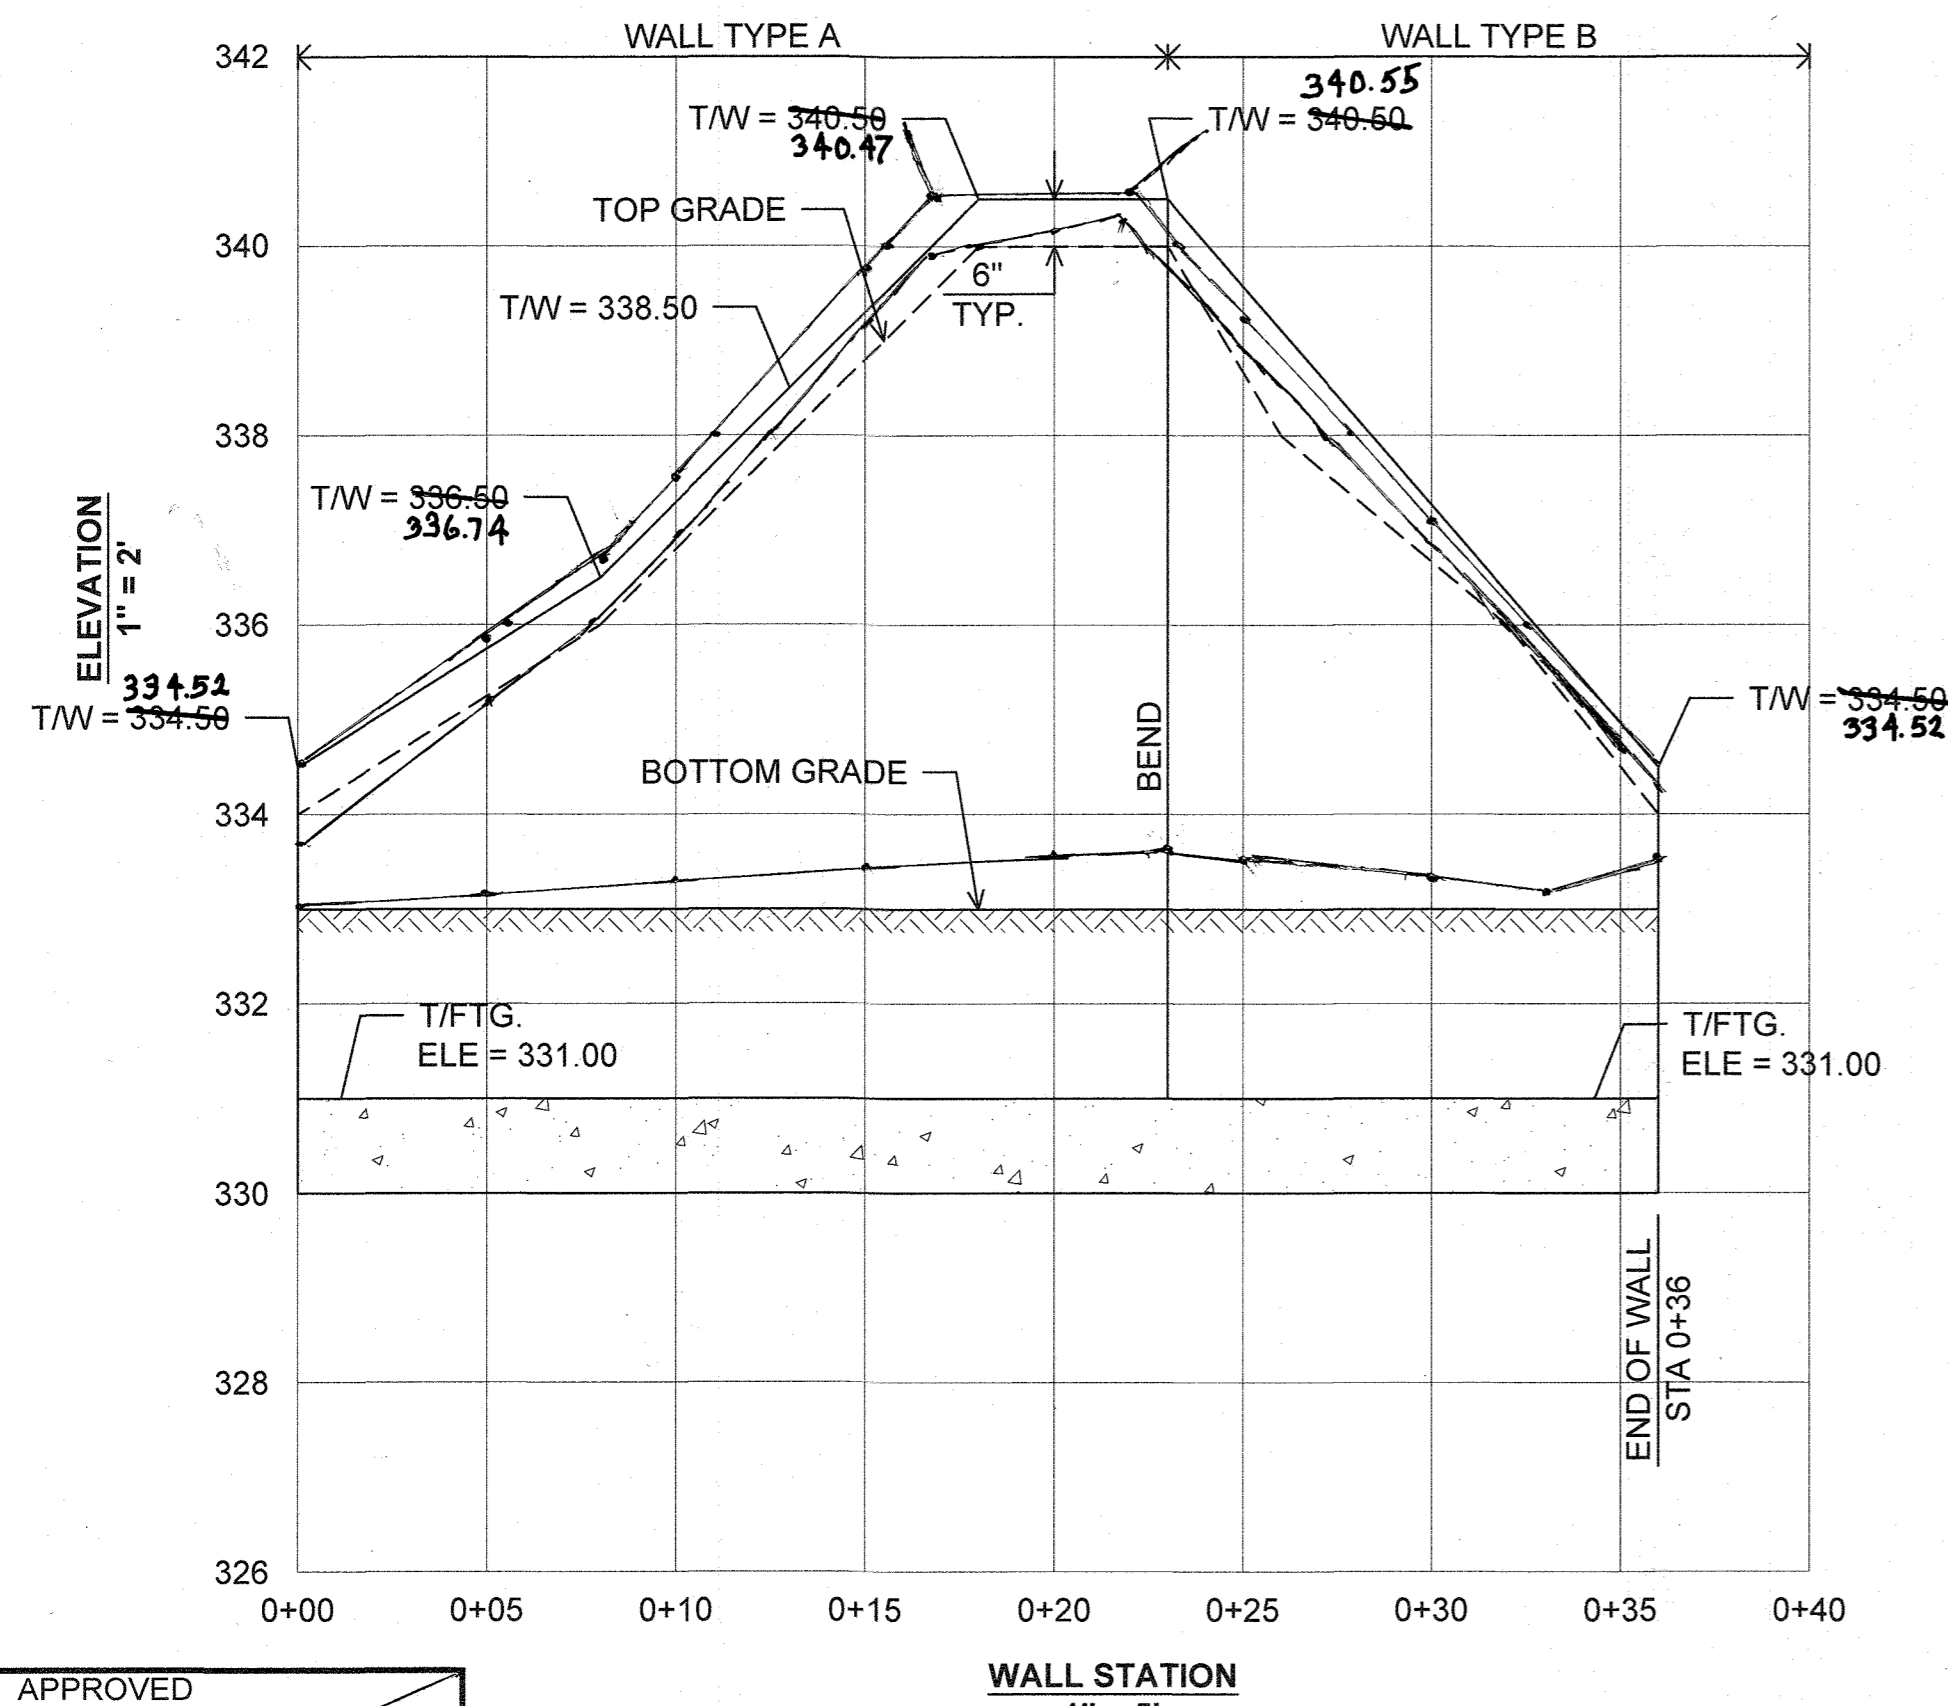


WALL ELEVATION
1" = 5'

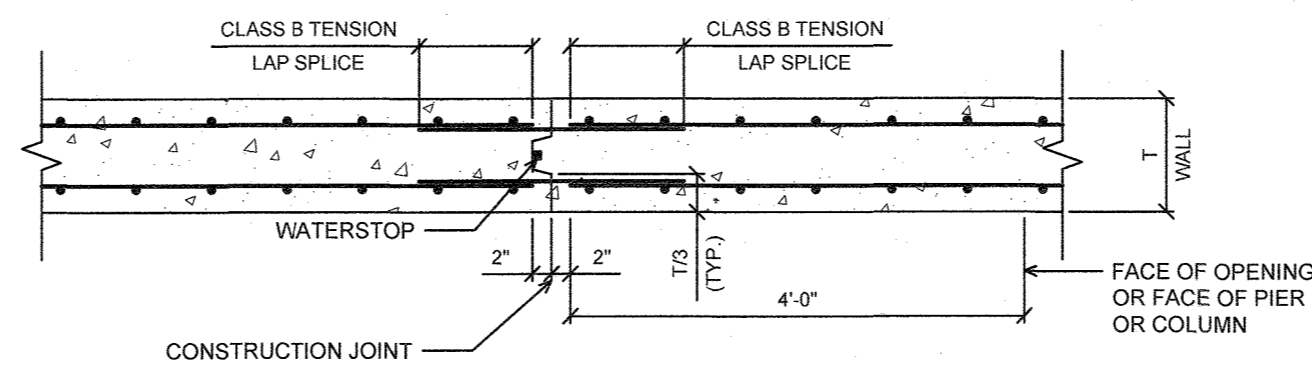


TYPICAL VERTICAL CONSTRUCTION JOINT IN WALL
NOT TO SCALE

NOTES:
PROVIDE CONTROL JOINTS AT LOCATIONS INDICATED ON PLAN OR ARCHITECTURAL DRAWINGS. PROVIDE AT 20'-0" O.C. MAXIMUM WHERE NOT SHOWN, BUT NO CLOSER THAN 12" FROM COLUMNS, PIERS OR OPENINGS.

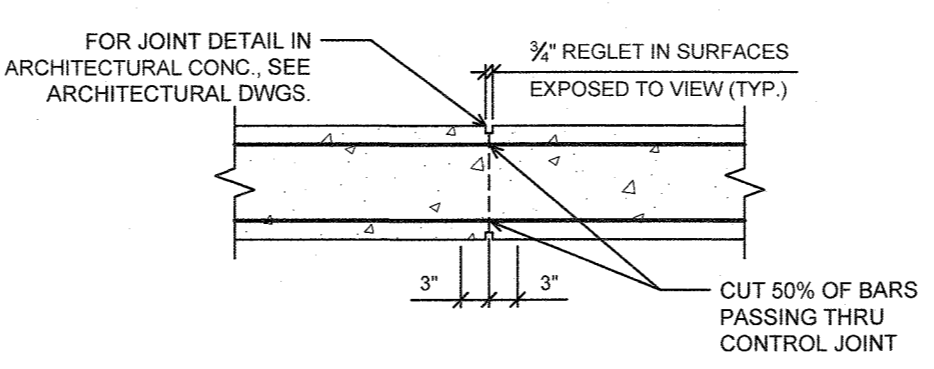

VERTICAL CONTROL JOINT IN CONCRETE WALL
NOT TO SCALE

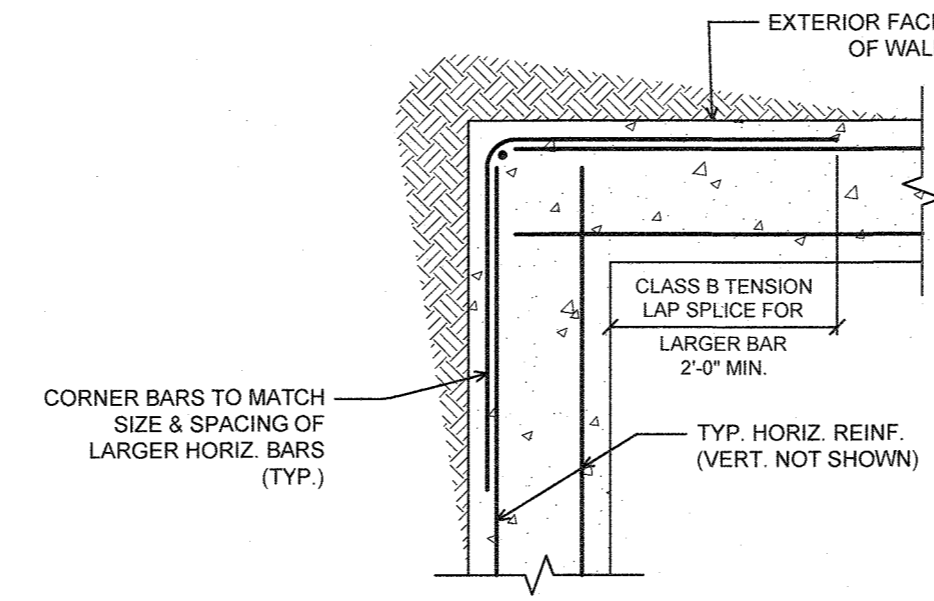

OUTSIDE CORNER
NOT TO SCALE

HOWARD COUNTY NOTES:


- NO TREES SHALL BE PLANTED WITHIN 10 FEET OF THE TOP OF THE RETAINING WALL.
- RETAINING WALLS SHALL ONLY BE CONSTRUCTED UNDER THE OBSERVATION OF A REGISTERED PROFESSIONAL ENGINEER AND A (NICET, WACEL, OR EQUIV.) CERTIFIED SOILS TECHNICIAN.
- THE REQUIRED BEARING PRESSURE BENEATH THE WALL SYSTEM SHALL BE VERIFIED IN THE FIELD BY A CERTIFIED SOILS TECHNICIAN. THE REQUIRED BEARING TEST SHALL BE THE DYNAMIC CONE PENETROMETER TEST ASTM STP-399.
- THE SUITABILITY OF FILL MATERIAL SHALL BE CONFIRMED BY THE ON-SITE SOILS TECHNICIAN. EACH 8' LIFT MUST BE COMPACTED TO A MINIMUM 95% STANDARD PROCTOR DENSITY AND THE TESTING REPORT SHALL BE MADE AVAILABLE TO THE HOWARD COUNTY INSPECTOR UPON COMPLETION OF CONSTRUCTION.
- WALLS SHALL NOT BE CONSTRUCTED ON UNCERTIFIED FILL MATERIALS.
- WALLS SHALL NOT BE CONSTRUCTED WITHIN A HOWARD CO. RIGHT-OF-WAY OR EASEMENT.

CONCRETE NOTES

- CONCRETE WORK SHALL CONFORM TO ACI 301 SPECIFICATIONS FOR STRUCTURAL CONCRETE.
- CONCRETE SHALL HAVE A MINIMUM COMPRESSIVE STRENGTH OF 3,000 PSI AT 28 DAYS WITH A MINIMUM CEMENT CONTENT OF 600 POUNDS PER CUBIC YARD.
- ALL CONCRETE SHALL HAVE A SLUMP OF NO GREATER THAN 4" TO WITHIN A TOLERANCE OF 1".
- ALL EXPOSED CONCRETE SHALL BE AIR-ENTRAINED, 6% (WITHIN 1% TOLERANCE), CONFORMING TO ASTM C260.
- ALL EXPOSED CONCRETE CORNERS SHALL BE FORMED WITH 3/4" x 3/4" MILLED CHAMFERED STRIPS.
- REINFORCING STEEL SHALL CONFORM TO ASTM A615, GRADE 60.
- ALL REINFORCING STEEL LAP SPLICES NOT SHOWN SHALL BE A MINIMUM OF 45 BAR DIAMETERS.

SOILS NOTES

- FOOTING DESIGN BASED ON ASSUMED MINIMUM ALLOWABLE SOIL BEARING CAPACITY OF 2000 PSF. CONTRACTOR RESPONSIBLE TO VERIFY ADEQUACY OF ASSUMED BEARING CAPACITY PRIOR TO CONSTRUCTION. NOTIFY ENGINEER IF SOIL BEARING CAPACITY IS NOT ADEQUATE AT FOOTING ELEVATIONS INDICATED.
- SUBGRADE TO BE FREE OF ORGANICS AND BE SUITABLE, COMPACTED MATERIAL.
- BACKFILL SHALL BE PERFORMED IN 8" LIFTS COMPACTED TO 95% OF MAXIMUM DRY DENSITY AS DETERMINED BY THE STANDARD PROCTOR COMPACTION TEST (ASTM D 698).
- BACKFILL MATERIAL SHALL BE SM OR MORE GRANULAR IN ACCORDANCE WITH ASTM D2487.

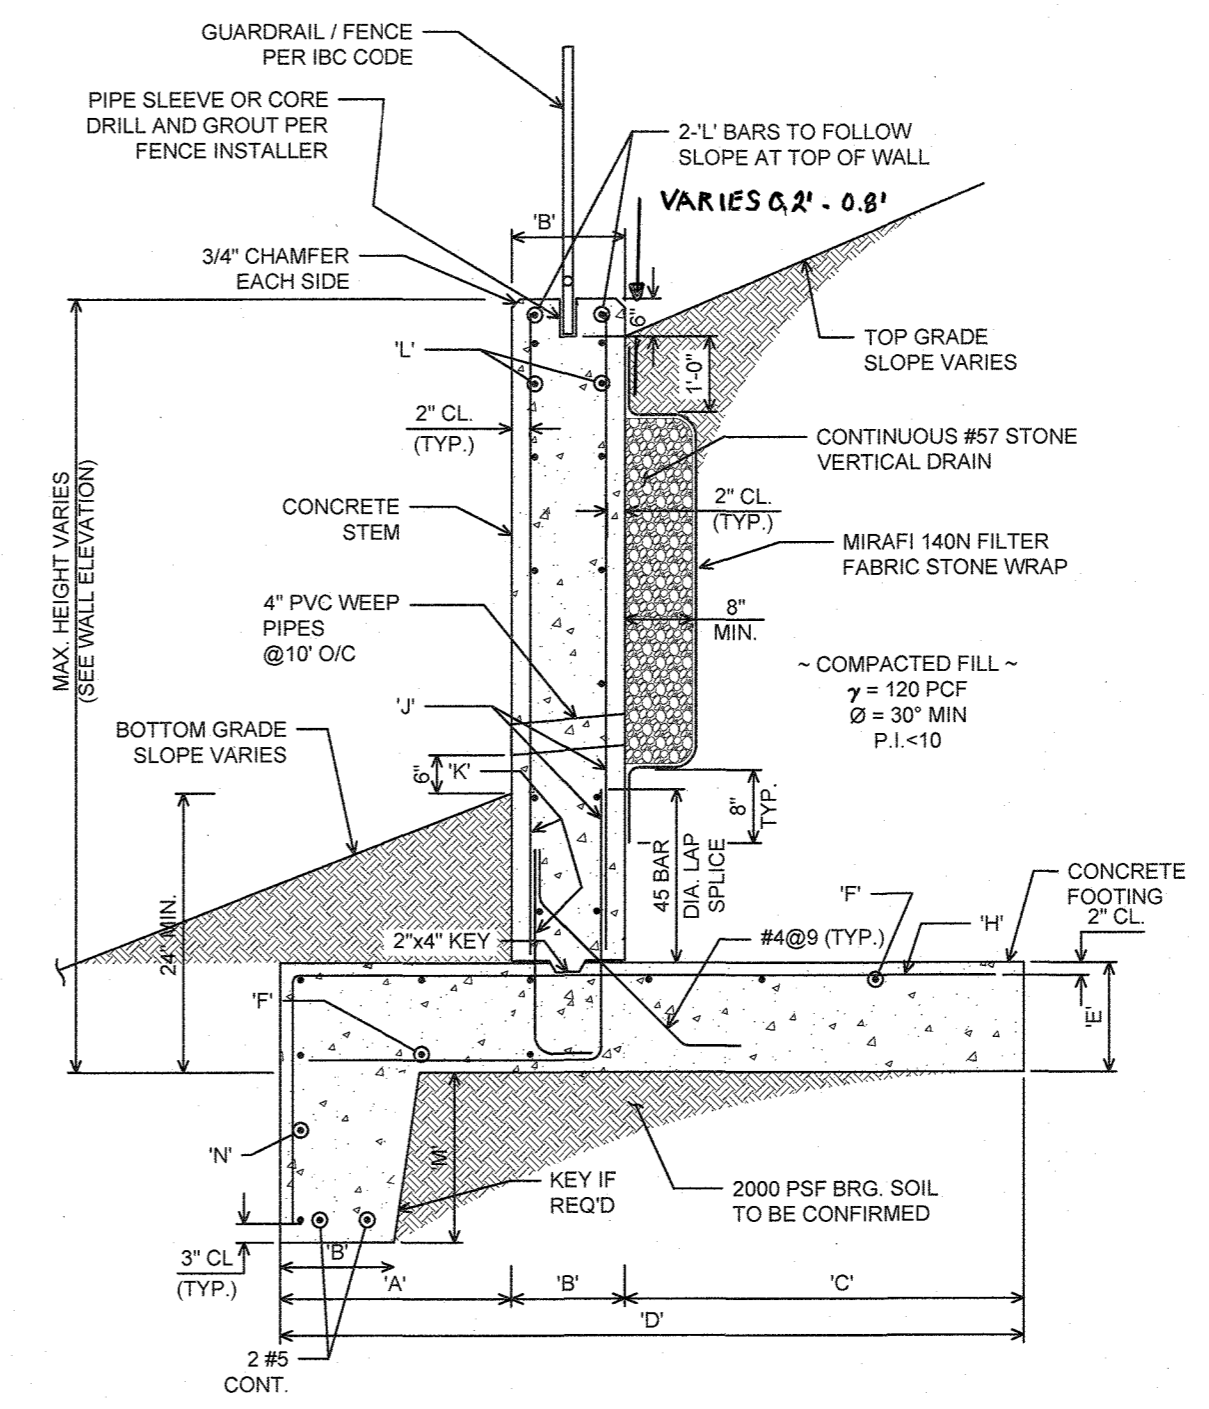

TYPICAL CONCRETE RETAINING WALL SECTION
NOT TO SCALE

NOTE:
SHORE EXISTING FOUNDATION OF ADJACENT RESIDENCE AS REQUIRED DURING WALL CONSTRUCTION



"CONCRETE WALL SCHEDULE"													
WALL TYPE	WALL MAX. HT.	"WALL STEM & FOOTING DIMENSION"				FOOTING REINF.			STEM REINF.			KEY	
		TOE 'A'	STEM 'B'	HEEL 'C'	WIDTH 'D'	THICK 'E'	'F'	'H'	'J'	'K'	'L'		'M'
A	9'-6"	3'-9"	1'-0"	3'-6"	8'-3"	1'-0"	#5@12"	#6@12"	#6@10"	#4@12"	#4@12"	2'-6"	#5@12"
B	9'-6"	2'-9"	1'-0"	1'-6"	5'-3"	1'-0"	#5@12"	#6@16"	#6@12"	#4@12"	#4@12"	1'-6"	#5@12"

APPROVED
PLANNING BOARD OF HOWARD COUNTY

DATE _____

DATE _____

APPROVED: DEPARTMENT OF PLANNING AND ZONING

Chad Anderson 9.11.18
CHIEF-DEVELOPMENT ENGINEERING DIVISION DATE

Kevin Handcock 9.14.18
CHIEF-DIVISION OF LAND DEVELOPMENT DATE

Walter Zilio 9.14.18
DIRECTOR DATE

Purpose Note:
Sheet 28 added to show retaining wall details.

PROFESSIONAL CERTIFICATION

I HEREBY CERTIFY THAT THESE PLANS WERE PREPARED OR APPROVED BY ME, AND THAT I AM A DULY LICENSED PROFESSIONAL ENGINEER UNDER THE LAWS OF THE STATE OF MARYLAND, LICENSE NO. 13491, EXPIRATION DATE: 06/16/19



HILLIS-CARNES
ENGINEERING ASSOCIATES

10975 Guilford Road, Suite A Annapolis Junction, Maryland
(410) 889-4788 WWW.HCEA.COM Fax: (410) 880-4098

Added Sheet

CONCRETE RETAINING WALL PLAN AND DETAILS
WALDEN WOODS
HOWARD COUNTY, MARYLAND

REVISION NO.	DESCRIPTION	DATE	JOB NUMBER:	DESIGNED BY:	AR
			18423A		
			SCALE: AS SHOWN	DRAWN BY:	AR
			DATE: 07/26/2018	APPROVED BY:	TC

35 OF 35 SHEET