### **GENERAL NOTES**

- THE CONTRACTOR SHALL NOTIFY THE DEPARTMENT OF PUBLIC WORKS/BUREAU OF ENGINEERING/CONSTRUCTION INSPECTION DIVISION AT (410) 313-1880 AT LEAST FIVE (5) WORKING DAYS PRIOR TO START OF WORK.
- THE CONTRACTOR SHALL NOTIFY "MISS UTILITY" AT 1-800-257-7777 AT LEAST 48 HOURS PRIOR TO ANY EXCAVATION WORK ALL ASPECTS OF THE PROJECT ARE IN CONFORMANCE WITH THE LATEST HOWARD COUNTY STANDARDS UNLESS WAIVERS HAVE BEEN APPROVED. THE EXISTING TOPOGRAPHY SHOWN HEREON IS TAKEN FROM A TOPOGRAPHIC SURVEY BY FREDERICK WARD ASSOCIATES, DATED DECEMBER 2002.
- THE PROJECT BOUNDARY IS BASED ON A BOUNDARY SURVEY PERFORMED BY FREDERICK WARD ASSOCIATES, DATED DECEMBER 2002. DEED REFERENCE: PARCEL 342: L 6906 / F 307
- THE SUBDIVISION PLAN IS SUBJECT TO THE FOLLOWING DPZ FILES: F-95-64, PLAT# 11799 (BEALMEAR II, SUBDIVISION LOTS 1 & 2), SP 08-010, F-12-095. THE SUBJECT PROPERTY IS ZONED "R-12" IN ACCORDANCE WITH THE 2/2/04 COMPREHENSIVE ZONING PLAN AND THE COMP. LITE ZONING
- THE COORDINATES SHOWN HEREON ARE BASED UPON THE HOWARD COUNTY GEODETIC CONTROL WHICH IS BASED UPON THE MARYLAND STATE PLANE COORDINATE SYSTEM.
- HOWARD COUNTY MONUMENT NOS. 38R2 AND 38R3 WERE USED FOR THIS PROJECT.
- THIS PROPERTY IS WITHIN THE METROPOLITAN DISTRICT. WATER IS PUBLIC AND WILL BE PROVIDED THROUGH CONTRACT # 14-4557-D.
- ALL WATER HOUSE CONNECTIONS SHALL BE OUTSIDE METER SETTING UNLESS OTHERWISE NOTED ON THE PLANS OR IN SPECIFICATIONS. SEWER IS PUBLIC AND WILL BE PROVIDED THROUGH CONTRACT # 14-4557-D.
- SHC ELEVATIONS ARE LOCATED AT THE PROPERTY LINE/EDGE OF EASEMENT.
- WATER AND SEWER SERVICE TO THESE LOTS WILL BE GRANTED UNDER THE PROVISIONS OF SECTION 18.122.B OF THE HOWARD COUNTY CODE. PUBLIC WATER AND SEWER ALLOCATION WILL BE GRANTED AT THE TIME OF ISSUANCE OF THE BUILDING PERMIT IF CAPACITY IS AVAILABLE AT
- STORM WATER MANAGEMENT TO BE PROVIDED FOR THIS DEVELOPMENT BY ENVIRONMENTAL SITE DESIGN UTILIZING UTILIZING A COMBINATION OF PRIVATE ON LOT AND H.O.A. MICRO BIO-RETENTION FACILITIES. REFER TO F-12-095. SEE NOTE 49 UNDER F-12-095, TEST PITS TO DETERMINE GROUND WATER AND ROCK ELEVATIONS WERE PERFORMED AT EACH FACILITY LOCATION. NO ROCK
- OR WATER ARE WITHIN 4' OF THE BOTTOM OF ANY FACILITY. THERE IS NO 100-YR FLOODPLAIN WITHIN THE LIMITS OF THIS PROJECT. NO WETLANDS OR STREAMS ARE LOCATED ONSITE. THERE ARE NO PROPOSED DISTURBANCES TO THE WETLANDS OR ASSOCIATED BUFFERS.
- NO GRADING, REMOVAL OF VEGETATIVE COVER OR TREES, PAVING AND NEW STRUCTURES SHALL BE PERMITTED WITHIN THE REQUIRED WETLANDS, STREAM(S) OR THEIR BUFFERS, FOREST CONSERVATION EASEMENT AREAS AND 100 YEAR FLOODPLAIN.
- TO THE BEST OF THE OWNERS KNOWLEDGE, THERE ARE NO CEMETERIES OR GRAVE SITES LOCATED ON THE SUBJECT PROPERTY. TO THE BEST OF OUR KNOWLEDGE AND BELIEF, THERE ARE NO HISTORIC STRUCTURES EXIST ON THIS SITE.
- THIS PLAN IS SUBJECT TO THE AMENDED FIFTH EDITION OF THE SUBDIVISION AND LAND DEVELOPMENT REGULATIONS. DEVELOPMENT OR CONSTRUCTION OF THESE LOTS MUST COMPLY WITH SETBACK AND BUFFER REGULATIONS IN EFFECT AT THE TIME OF SUBMISSION OF THE SITE DEVELOPMENT PLAN, WAIVER PETITION, OR BUILDING AND GRADING PERMITS.
- FOREST STAND DELINEATION PLAN WAS PREPARED BY ECO-SCIENCE PROFESSIONAL, INC. DATED SEPTEMBER 19, 2007 AND APPROVED UNDER
- THE FOREST CONSERVATION EASEMENTS HAVE BEEN ESTABLISHED TO FULFILL THE REQUIREMENTS OF SECTION 16.1200 OF HOWARD COUNTY FOREST CONSERVATION ACT. NO CLEARING, GRADING OR CONSTRUCTION IS PERMITTED WITHIN THE FOREST CONSERVATION EASEMENT; HOWEVER, FOREST MANAGEMENT PRACTICES AS DEFINED IN THE DEED OF FOREST CONSERVATION EASEMENT ARE ALLOWED. EXISTING UTILITIES ARE BASED ON HOWARD COUNTY RECORDS, FIELD SURVEY, ROAD CONSTRUCTION PLANS AND AVAILABLE RECORD DRAWINGS APPROXIMATE LOCATION OF EXISTING UTILITIES ARE SHOWN FOR THE CONTRACTORS INFORMATION. CONTRACTOR SHALL LOCATE EXISTING UTILITIES WELL IN ADVANCE OF CONSTRUCTION ACTIVITIES AND TAKE ALL NECESSARY PRECAUTIONS TO PROTECT THE EXISTING UTILITIES AND TO MAINTAIN
- ANY DAMAGE TO THE COUNTY'S RIGHTS-OF-WAY, PAVING, OR EXISTING UTILITIES SHALL BE CORRECTED AT THE CONTRACTOR'S EXPENSE: ALL DRIVEWAY ENTRANCES SHALL UTILIZE HOWARD COUNTY STANDARD DETAIL NO. R-6.03 MODIFIED FOR SIDEWALK ADJACENT TO CURB.
- THE CONTRACTOR IS TO NOTIFY THE FOLLOWING UTILITIES OR AGENCIES AT LEAST FIVE DAYS BEFORE STARTING


BGE (CONSTRUCTION SERVICES) 410-637-8713 BGE (EMERGENCY) 410-685-0123 BUREAU OF UTILITIES 410-313-4900 410-795-1390 COLONIAL PIPELINE CO 1-800-257-777 MISS UTILITY STATE HIGHWAY ADMINISTRATION 410-531-5533

- THERE ARE NO EXISTING STRUCTURES LOCATED ON THIS PARCEL. IN ACCORDANCE WITH SECTION 128 OF THE HOWARD COUNTY ZONING REGULATIONS, BAY WINDOWS, CHIMNEYS, OR EXTERIOR STAIRWAYS NOT MORE THAN 16 FEET IN WIDTH MAY PROJECT NOT MORE THAN 4 FEET INTO ANY SETBACKS. PORCHES OR DECKS, OPEN OR ENCLOSED MAY PROJECT NOT MORE THAN 10 FEET INTO THE FRONT FRONT OR REAR YARD SETBACK.
- LOT 2 THRU LOT 6 AND OPEN SPACE LOT 8 WILL UTILIZE A USE-IN-COMMON DRIVEWAY. DRIVEWAYS SHALL BE PROVIDED PRIOR TO RESIDENTIAL OCCUPANCY TO ENSURE SAFE ACCESS FOR FIRE AND EMERGENCY VEHICLES PER THE FOLLOWING MINIMUM REQUIREMENTS:
  - WIDTH 12 FEET (16 FEET IF SERVING MORE THAN ONE RESIDENCE)
  - SURFACE 6" OF COMPACTED CRUSHER RUN BASE W/TAR AND CHIP COATING (1-1/2" MIN.);
  - PERMEABLE SURFACE 12" ASTM C-33 3/4" TO 2" STONE WITH 7" PERMEABLE CONCRETE GEOMETRY - MAXIMUM 15% GRADE, MAXIMUM 10% GRADE CHANGE, AND MINIMUM 45 FOOT
  - STRUCTURES (CULVERTS/BRIDGES) CAPABLE OF SUPPORTING 25 GROSS TONS (H25 LOADING) DRAINAGE ELEMENTS - CAPABLE OF SAFELY PASSING 100 YEAR FLOOD EVENTS WITH NO MORE
- THAN 1 FOOT DEPTH OVER DRIVEWAY SURFACE MAINTENANCE - SUFFICIENT TO ENSURE ALL WEATHER USE
- FOR FLAG OR PIPE STEM LOTS, REFUSE COLLECTION, SNOW REMOVAL AND ROAD MAINTENANCE TO BE PROVIDED AT THE JUNCTION OF FLAG OR PIPE STEM AND THE ROAD R/W AND NOT ONTO THE FLAG OR PIPE STEM DRIVEWAY. SEE NOTE 53.
- A NOISE STUDY WAS PREPARED BY ROBERT H. VOGEL, ENGINEERING, INC. DATED FEBRUARY 25, 2008 AND APPROVED UNDER SP-08-010. A TRAFFIC STUDY WAS PREPARED BY THE TRAFFIC GROUP, DATED MARCH 27, 2007 AND REVISED 27, 2008.
- OPEN SPACE LOTS 1 AND 8 TO BE PRIVATELY OWNED AND MAINTAINED BY THE HANOVER JUNCTION HOMEOWNERS' ASSOCIATION, INC. (HOMEOWNERS ASSOCIATION). THE ARTICLES OF INCORPORATION FOR THE HOMEOWNERS ASSOCIATION WERE FILED WITH THE STATE DEPARTMENT OF ASSESSMENTS
- AND TAXATION ON NOVEMBER 28, 2012, RECEIPT NO. 014976880.
- FINANCIAL SURETY IN THE AMOUNT OF \$5,400.00 WAS POSTED WITH F-12-095. REFER TO NOTES 50 AND 51.
- PUBLIC STREET TREES WERE PROVIDED FOR THIS PROJECT IN ACCORDANCE WITH SECTION 16.124(e)(1) OF THE SUBDIVISION REGULATIONS AND THE LANDSCAPE MANUAL UNDER F-12-095. FINANCIAL SURETY IN THE AMOUNT OF \$4,200.00 WAS POSTED WITH F-12-095 TOTAL FOREST CONSERVATION OBLIGATION FOR THIS PROJECT (0.60 AC OR 26,136 SF) WAS FULFILLED BY ON-SITE AFFORESTATION OF 0.38 ACRES
- AND 0.22 ACRES WAS FULFILLED BY PAYMENT OF A FEE-IN-LIEU. FINANCIAL SURETY IN THE AMOUNT OF \$ 8,365 WAS POSTED WITH
- THE PROJECT IS IN CONFORMANCE WITH THE LATEST HOWARD COUNTY STANDARDS UNLESS WAIVERS HAVE BEEN APPROVED.
- THIS SUBDIVISION IS LOCATED IN THE BWI AIRPORT ZONING DISTRICT. MARYLAND AVIATION ADMINISTRATION (MAA) APPROVED THIS PLAN ON THIS SUBDIVISION IS SUBJECT TO DESIGN MANUAL WAIVERS/ALTERNATIVE COMPLIANCE FROM SECTION 5.2.6.D1A TO REDUCE THE DAM TOP WIDTH
- FROM 12' TO 10', SECTION 5.2.4.I, TO REDUCE THE DISTANCE FROM THE END OF RIP RAP APRON TO THE PROPERTY LINE FROM 25' TO 10', SECTION 5.2.7.A.3., TO ELIMINATE THE 12' MAINTENANCE BENCH AN SECTION 5.2.7.B.2. TO REDUCE THE ORIFICE DIAMETER FROM THE MINIMUM SIZE 1.5" TO 1.3". ON AUGUST 29, 2008, THE HOWARD COUNTY DEVELOPMENT ENGINEERING DIVISION APPROVED THE REQUESTED WAIVERS / ALTERNATIVE COMPLIANCE REQUEST BASED ON: 1. THE SWM POND IS PRIVATELY OWNED AND MAINTAINED AND NO ADVERSE IMPACTS TO COUNTY INFRASTRUCTURE
- 2. A 10' BENCH BEING PROVIDED ON THE LOT 7 SIDE AND A 5' BENCH ON THE REMAINDER OF THE POND PERIMETER AND SPLIT RAIL FENCE WITH 1" X 1" WIRE MESH SHALL BE PROVIDED ALONG THE LOT 7 PERIMETER AND HANOVER ROAD. THESE WAIVERS / ALTERNATIVE COMPLIANCE APPROVALS ARE VOID AS THE STORMWATER POND AS SHOWN ON SP-08-10 IS NO LONGER
- PROPOSED, REFER TO GENERAL NOTE 17 & 49. A SHARED DRIVEWAY ACCESS AND MAINTENANCE OBLIGATION AGREEMENT FOR THE USE-IN-COMMON DRIVEWAY WHICH SERVES LOTS 2-6 HAVE BEEN RECORDED IN THE LAND RECORDS OF HOWARD COUNTY, LIBER 15/177 / FOLIO 256 SIMULTANEOUS WITH THE RECORDATION OF THE PLAT, F-12-095. THE PROTECTIVE COVENANTS, INCLUDING COVENANTS GOVENING THE MAINTENANCE OF THE COMMUNITY OWNED OPEN SPACE LOT 8, HAVE BEEN RECORDED IN THE LAND RECORDS OF HOWARD COUNTY, LIBER (5177 / FOLIO 262 SIMULTANEOUS WITH THE RECORDATION OF THE PLAT, F- 12-095. STORM WATER MANAGEMENT HAS BEEN PROVIDED FOR THIS DEVELOPMENT BY ENVIRONMENTAL SITE DESIGN UTILIZING A COMBINATION OF PRIVATE ON-

LOT AND H.O.A. MICRO BIO-RETENTION FACILITIES, THE DECLARATION OF COVENANTS AND MAINTENANCE AND RIGHT-OF-ENTTY AGREEMENTS HAVE BEEN


- RECORDED IN THE LAND RECORDS OF HOWARD COUNTY, LIBER 15177/ FOLIO 249 SIMULTANEOUS WITH THE RECORDATION OF THE PLAT, F- 12-095. NO CLEARING OF EXISTING VEGETATION IS PERMITTED WITHIN THE PERIMETER LANDSCAPE EDGE FOR WHICH CREDIT IS BEING TAKEN; HOWEVER, THE OWNER, TENANT AND/OR THEIR AGENTS SHALL BE RESPONSIBLE FOR MAINTENANCE OF THE REQUIRED PERIMETER LANDSCAPING AND STREET TREES.
- ALL REQUIRED PLANTINGS SHALL BE MAINTAINED IN GOOD GROWING CONDITION AND WHEN NECESSARY, REPLACED WITH NEW MATERIALS TO ENSURE CONTINUED COMPLIANCE WITH APPLICABLE REGULATIONS. ALL REQUIRED LANDSCAPING SHALL BE PERMANENTLY MAINTAINED IN GOOD CONDITION, AND WHEN NECESSALY REPAIRED OR REPLACED. PARKING FOR THIS PROJECT IS PROVIDED AS FOLLOWS:
- 4 SPACES PER LOT (2 CAR GARAGES = 2 SPACES + 2 SPACES PER PRIVATE ON-LOT DRIVEWAYS) TWO CAR GARAGES SHALL BE USED FRO PARKING PURPOSES ONLY OR STORAGE SPACE.
- VISITOR AND GUEST PARKING IS RESTRICTED ALONG THE USE-IN-COMMON DRIVEWAY.
- TRASH AND RECYCLING COLLECTION WILL BE PROVIDED FROM THE TRASH PAD WITHIN 5' OF THE COUNTY ROADWAY, HANOVER ROAD. AS PART OF THE F12-095 PLAN, A PRIVATE RANGE OF ADDRESS SIGN SHALL BE FABRICATED AND INSTALLED BY HOWARD COUNTY - BUREAU OF HIGHWAYS AT THE DEVELOPERS/OWNERS EXPENSE. CONTACT HOWARD COUNTY TRAFFIC DIVISION AT 410-313-2430 FOR DETAILS AND COST ESTIMATES.

	L	MINIMUM OT SIZE CHART	
LOT NO.	GROSS AREA (SQ.FT.)	PIPESTEM AREA (SQ.FT.)	MINIMUM LOT SIZE (SQ.FT.)
2	7,513	307	7,206
3	7,953	730	7,223
4	8,372	1123	7,249
E	7 700	F F 4	7.040

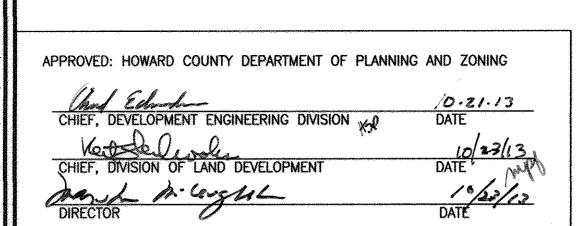

# SITE DEVELOPMENT PLAN BASHAM PROPERTY

LOTS 2-7 HOWARD COUNTY, MARYLAND

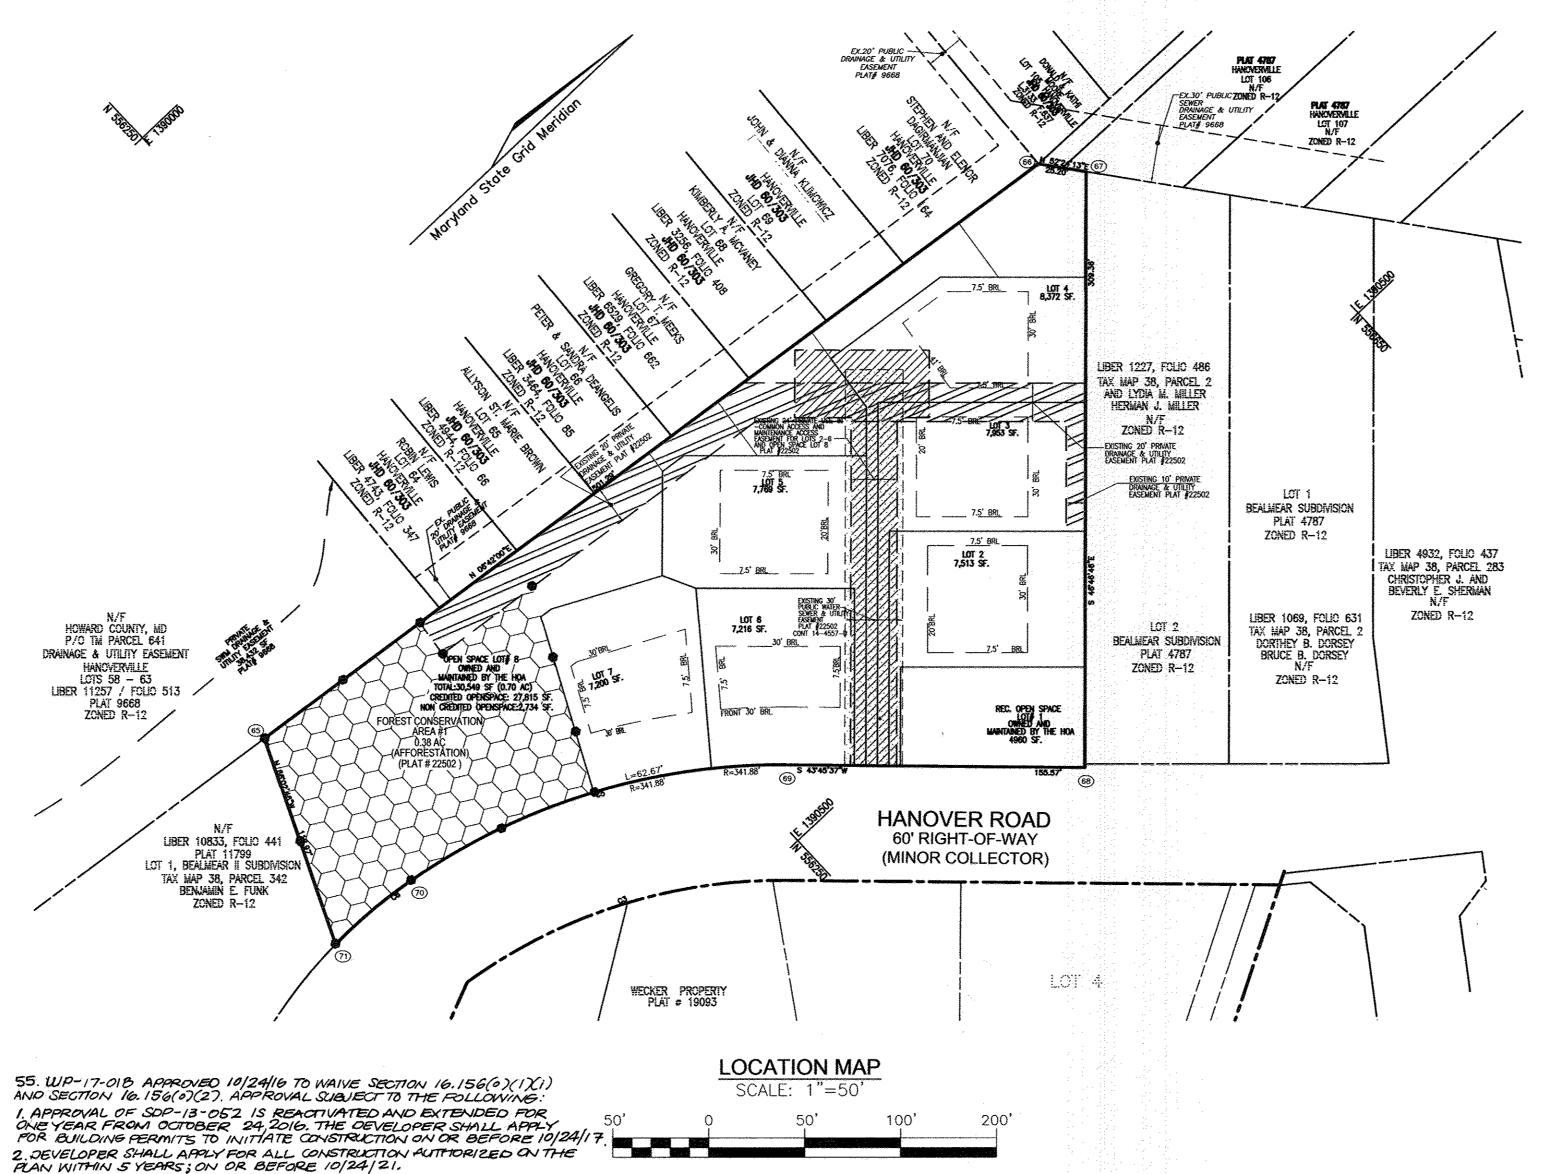

### SITE ANALYSIS DATA

3. APPLICANT SHALL COORDINATE WITH DEPARTMENT OF PUBLIC WORKS
REAL ESTATE SERVICES DIVISION TO EXTEND THE OBLIGATION DATE FOR
THE DEVELOPER AGREEMENT ASSOCIATED WITH F-12-095.

- AREA OF PLAN SUBMISSION:
- PRESENT ZONING DESIGNATION PROPOSED USES FOR SITE AND
- STRUCTURES: F. FLOOR SPACE ON EACH LEVEL
- OF BUILDING PER USE: TOTAL NUMBER OF UNITS ALLOWED FOR PROJECT AS SHOWN ON FINAL PLAT: 6 BUILDABLE LOTS
- H. TOTAL NUMBER OF UNITS PROPOSED ON SUBMISSION: MAXIMUM NUMBER OF EMPLOYEES, TENANTS ON SITE PER USE: NUMBER OF PARKING SPACES REQUIRED
- K. NUMBER OF PARKING SPACES PROVIDED ON SITE: REFER TO NOTE 52.

BY HO.CO. ZONING REGULATIONS:

- L. OPEN SPACE ON SITE: M. AREA OF RECREATION OPEN SPACE
- REQUIRED BY SUBDIVISION & LAND DEVELOPMENT REGULATIONS: BUILDING COVERAGE OF SITE: APPLICABLE DPZ FILE REFERENCES:
- ANY OTHER INFORMATION WHICH MAY BE RELEVANT:

- 1.06 AC. 0.93 AC RESIDENTIAL, SINGLE FAMILY
- 6 HOMES X 2 PER SFD HOUSE OVERFLOW = 6 X 0.5 PER UNIT = 3 SPACES = 15 SPACES TOTAL REQUIRED
- 4 PER SFD HOUSE (2 DRIVEWAY & 2 GARAGE) = 4 X 6 = 24 SPACES PROVIDED 0.815 AC (NON-CREDITED OPEN SPACE: 0.062 AC CREDITED OPEN SPACE: 0.752 AC
- 200 SF/DWELLING UNIT  $\times$  6 = 1,200 SF REQUIRED 4,960 SF REC OPEN SPACE PROVIDED: F-95-64, PLAT# 11799 (BEALMEAR II, SUBDIVISION LOTS 1 & 2). SP 08-010, F-12-095.
- TAX MAP 38, GRID 14, PARCEL 342 1ST ELECTION DISTRICT Q. FLOOR AREA RATIO:

POINT	NORTHING	EASTING
65.	556083.5857	1390270.9104
66	556581.4504	1390329.3956
67	556596.8248	1390349.3622
68	556384.9729	1390574.8004
69	556272.6138	1390467.2018
70	556086.3647	1390376.5792
71	556037.7203	1390374.1499

# ADDRESS CHART

LOT NO	STREET ADDRESS
2	6440 . HANOVER ROAD
3	6444 HANOVER ROAD
4	6446 HANOVER ROAD
5	6452 HANOVER ROAD
6	6456 HANOVER ROAD
7	6460 HANOVER ROAD

### **BUILDER AND** DEVELOPER/OWNER

MAIN STREET BUILDERS 5705 LANDING ROAD ELKRIDGE, MARYLAND 21075-5742

The state of the s		215 cm (care may
SHEET INDEX		
DESCRIPTION	SHEET	NO
	1	
	2	
SION AND SEDIMENT SOILS MAP	3	
SION AND SEDIMENT NOTES AND DETAILS	4	
EMENT	5	
& DETAILS	6	
	,	

GRADING, SOIL EROSION AND SEDIMENT

GRADING, SOIL EROSION AND SEDIMENT

CONTROL PLAN - NOTES AND DETAILS

CONTROL PLAN AND SOILS MAP


STORMWATER MANAGEMENT

AASCD/MAA NOTES & DETAILS

NOTES & DETAILS

**COVER SHEET** 

LAYOUT SHEET

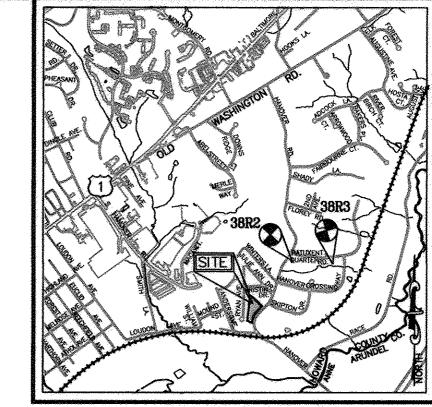

## **ADC MAP COORDINATES**

MAP: 4937 GRID: E9

### **BENCH MARK**

HOWARD COUNTY CONTROL STATION 38R2 NORTH 557.500.663' EAST 1,391,227.052'

ELEVATION 168.788' (NAVD 1988) HOWARD COUNTY CONTROL STATION 38R3

NORTH 557,417,823' EAST 1,391,983.177' ELEVATION 124.653' (NAVD 1988)

### **LEGEND**

RIGHT-OF-WAY BOUNDARY LINE ADJACENT BOUNDARY LINE

-COMMON ACCESS AND

	PERMIT	INFO	RI	TAN	10	N CH	ART	
BASI	DIVISION NAME HAM PROPERTY LOTS 2 - 7	•		SECT	TION	/AREA	LOT	S/PARCEL # 342
PLAT # OR L/F 22502	BLOCK NO. 16 & 17	ZONE R-12	TAX	MAP 38	No.		DIST. ST	CENSUS TF 6021.00

and the second s		
1	ADD GENERAL NOTE 55 REFERENCING WP-17-018	12/12
NO.	REVISION	DAT

SITE DEVELOPMENT PLAN **COVER SHEET** 

# **BASHAM PROPERTY**

1ST ELECTION DISTRICT TAX MAP: 38 GRID: 14

PARCEL: 347 HOWARD COUNTY, MARYLAND DPZ REF'S: SP-08-010, F-12-095, W/S CONTRACT 14-4557-D

ROBERT H. VOGEL ENGINEERING, INC. ENGINEERS . SURVEYORS . PLANNERS 8407 MAIN STREET TEL: 410.461.7666 ELLICOTT CITY, MD 21043 FAX: 410.461.8961





ROBERT H. VOGEL, PE No.1619


CHECKED BY:

I HEREBY CERTIFY THAT THESE DOCUMENTS WERE PREPARED OR APPROVED BY ME, AND THAT I AM A DULY LICENSED PROFESSIONAL ENGINEER UNDER THE LAWS OF THE STATE OF MARYLAND, LICENSE NO. 16193 EXPIRATION DATE: 09-27-2014 W.O. NO.:

SHEET \_\_ OF \_

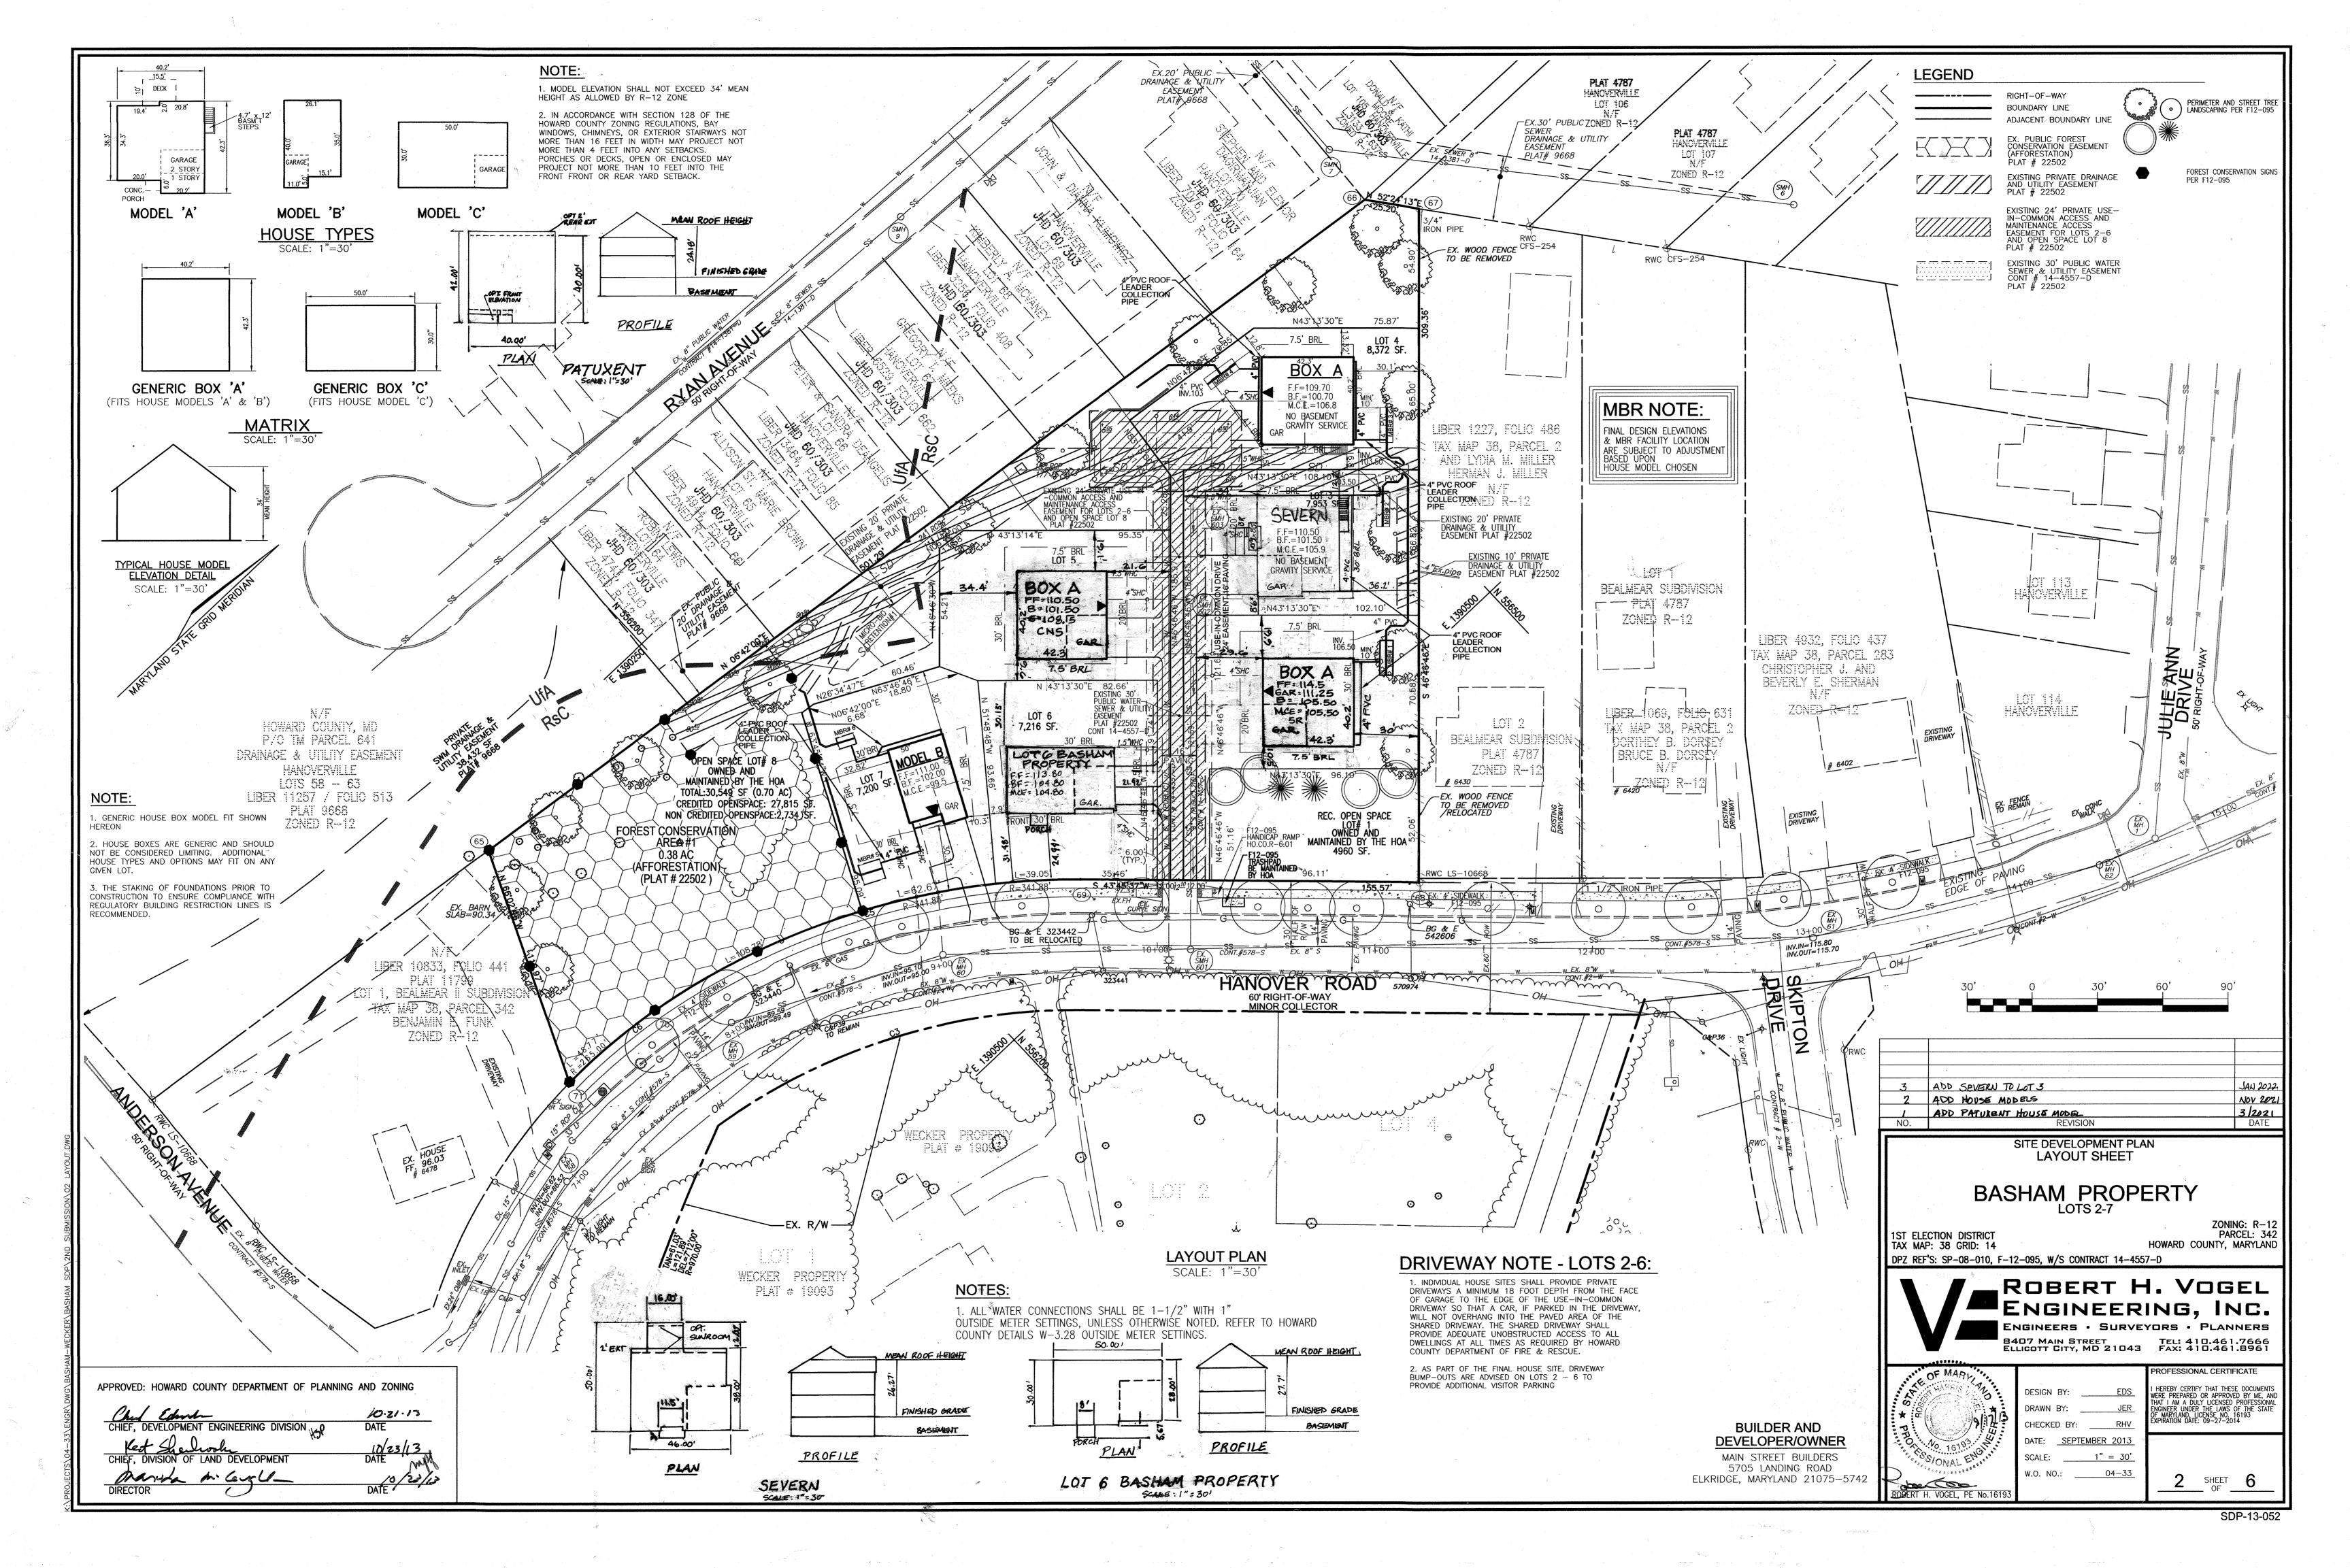

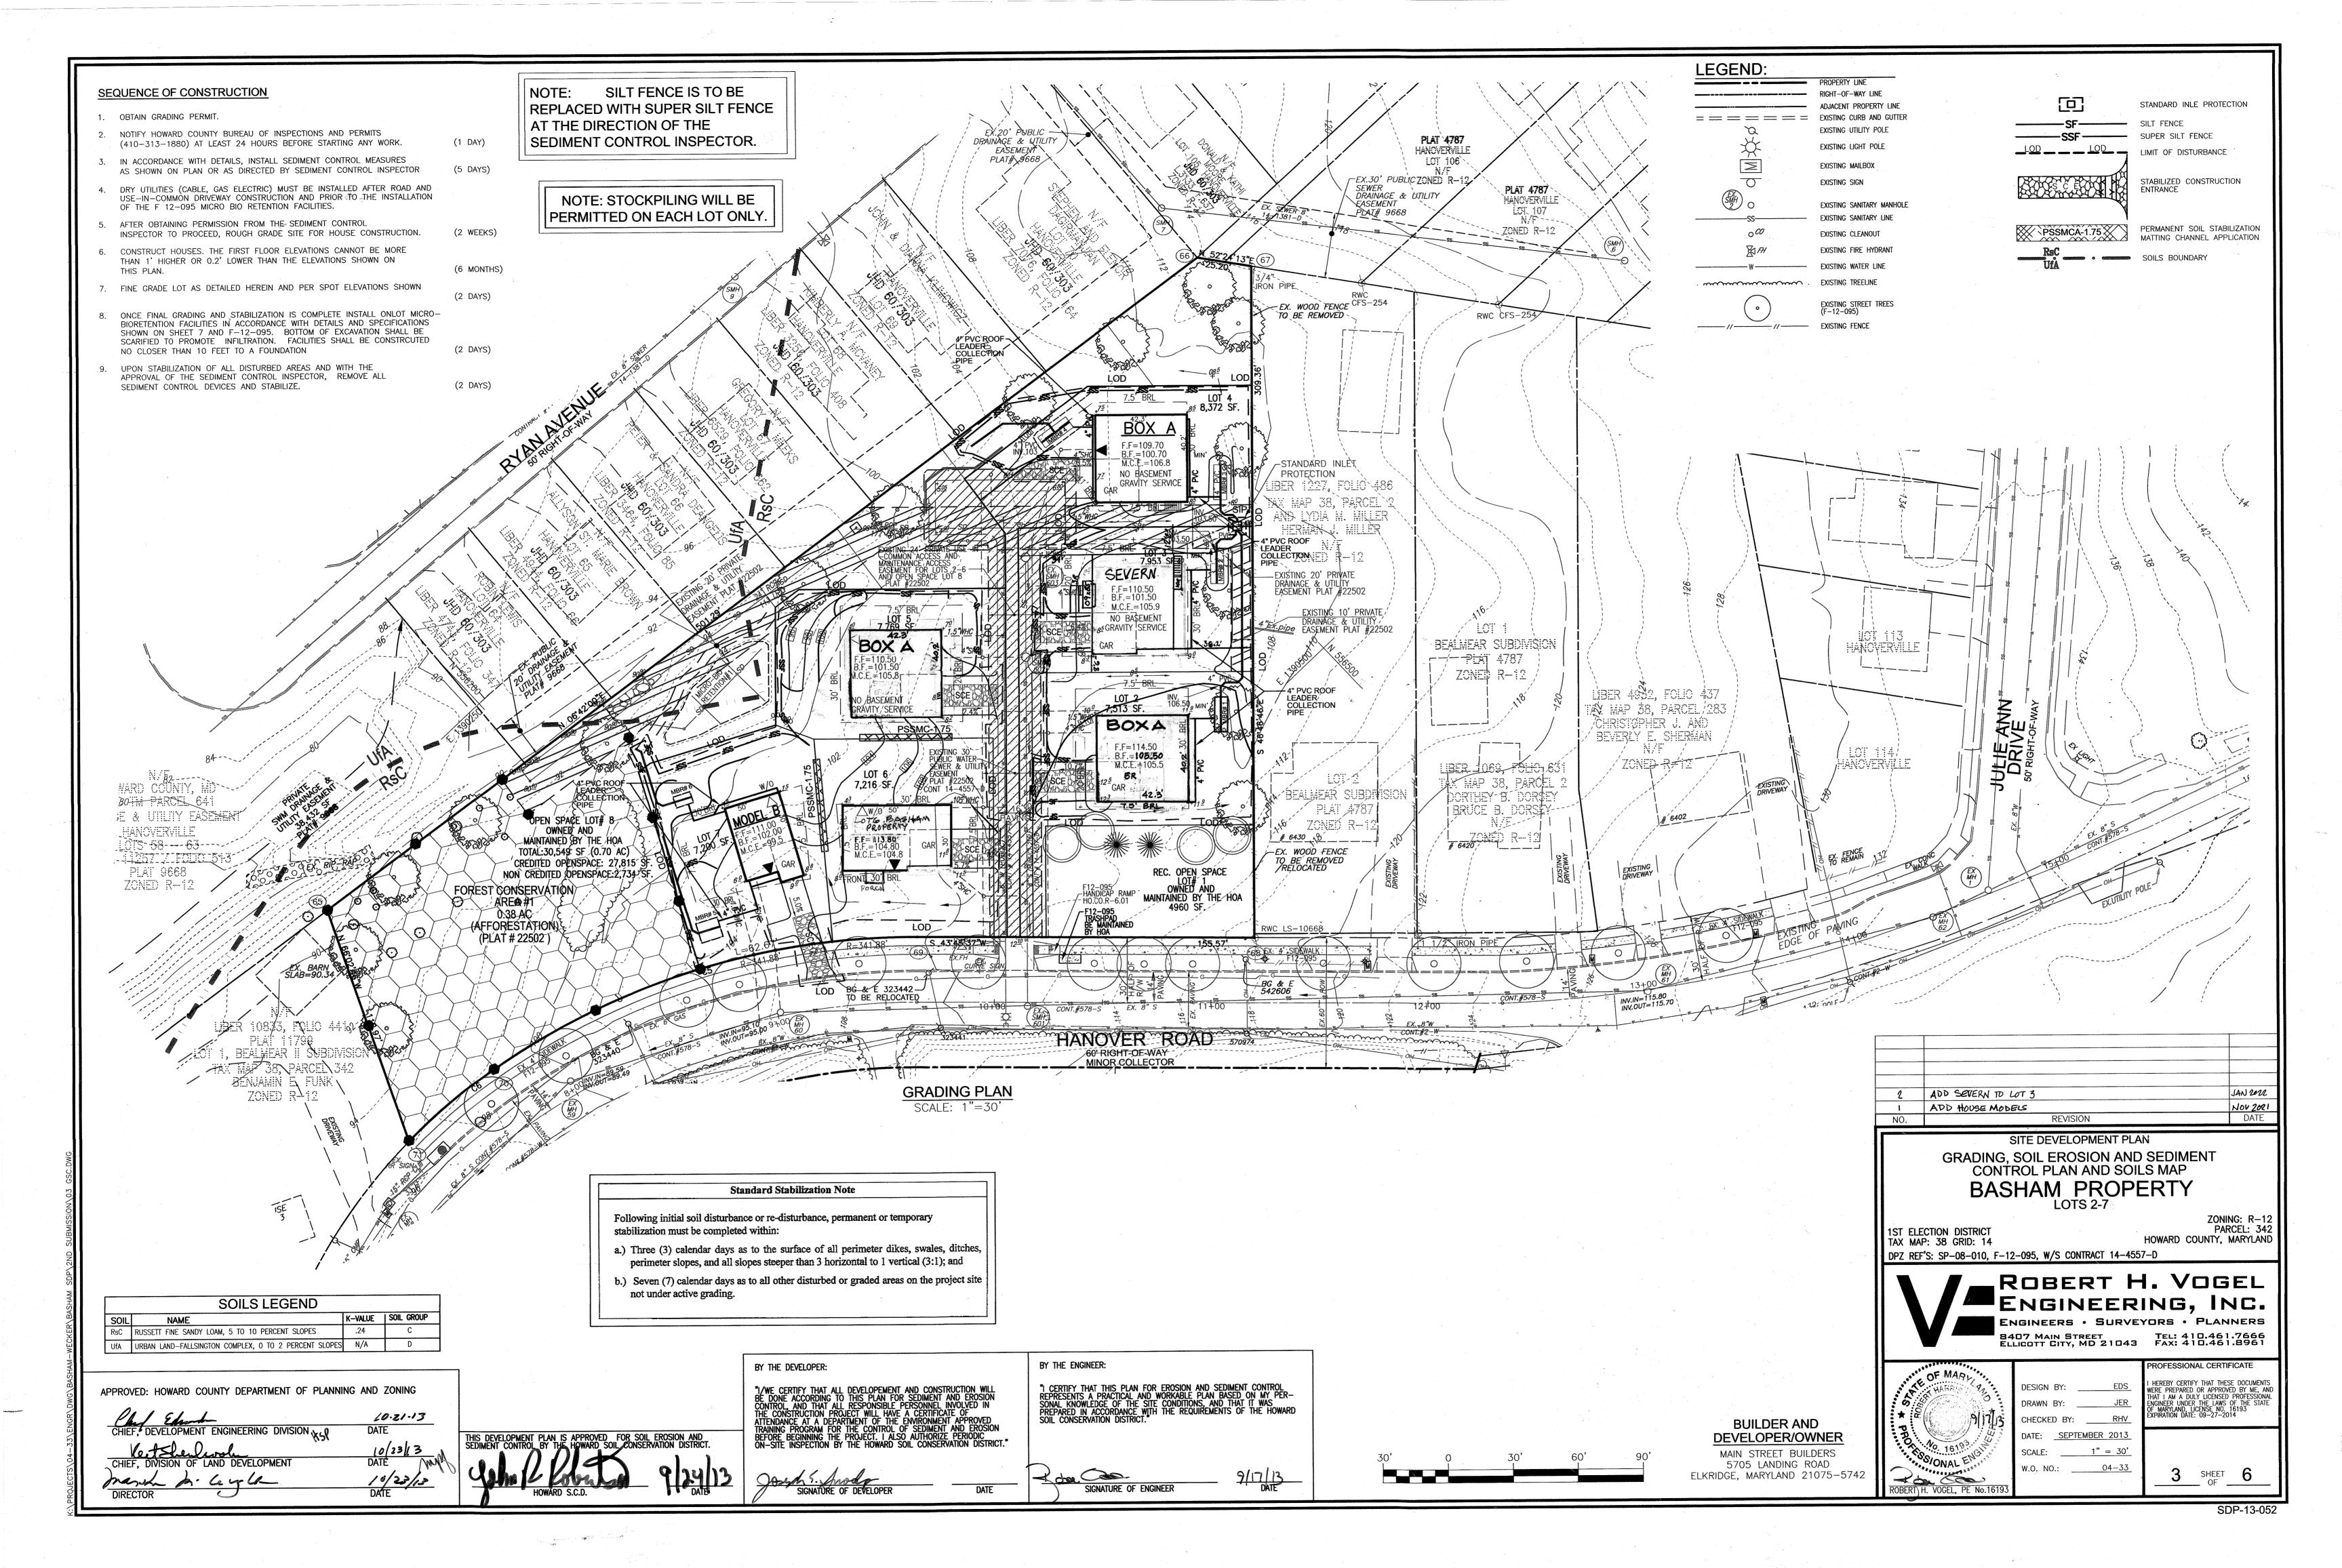

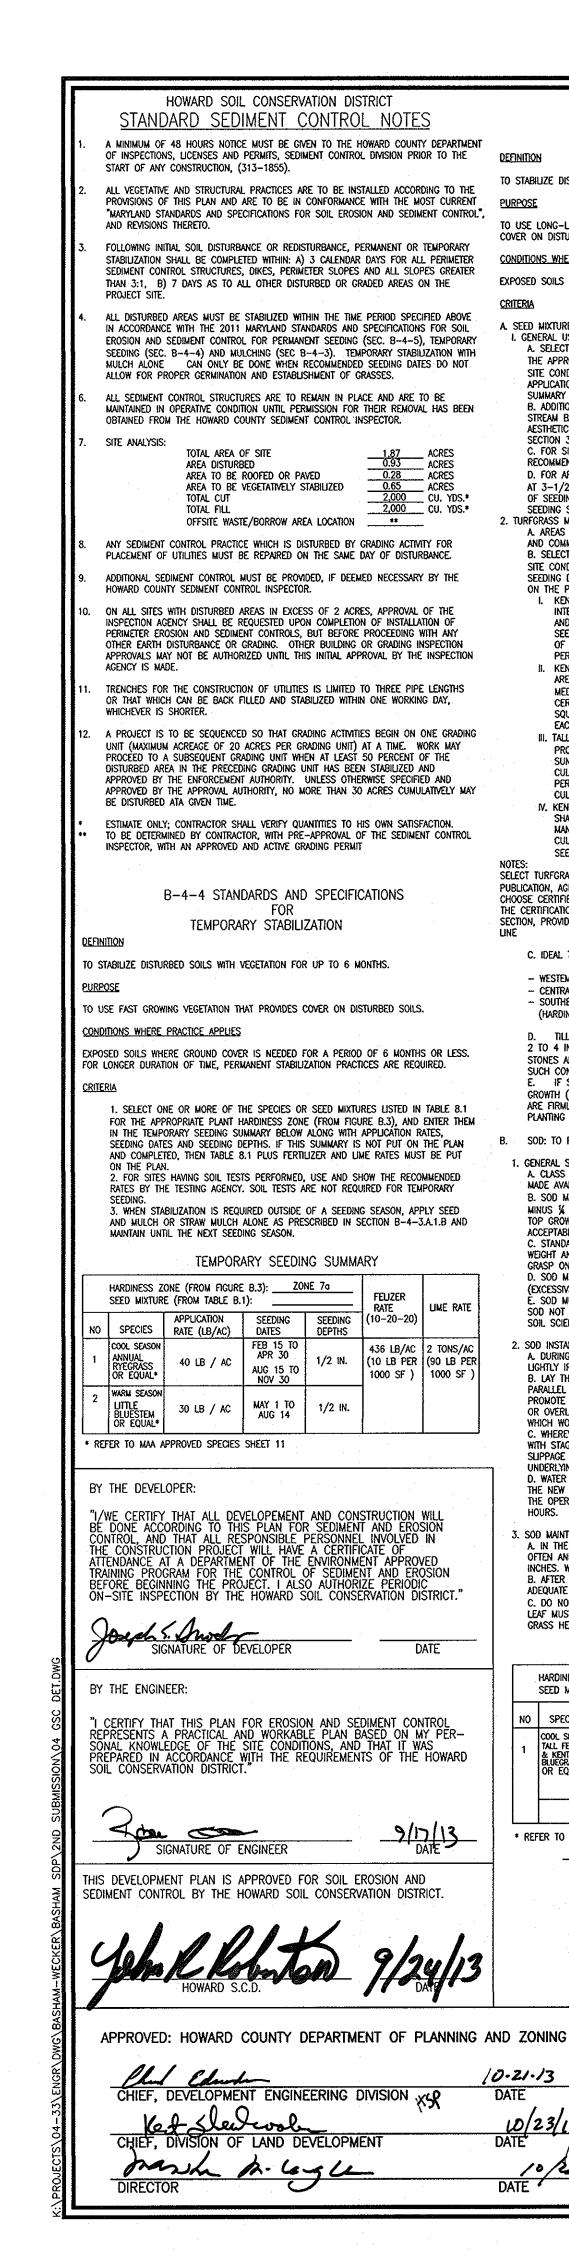

B-4-5 STANDARDS AND SPECIFICATIONS

PERMANENT STABILIZATION

TO USE LONG-LIVED PERENNIAL GRASSES AND LEGUMES TO ESTABLISH PERMANENT GROUND

A. SELECT ONE OR MORE OF THE SPECIES OR MIXTURES LISTED IN TABLE 8.3 FOR

THE APPROPRIATE PLANT HARDINESS ZONE (FROM FIGURE 8.3) AND BASED ON THE

SITE CONDITION OR PURPOSE FOUND ON TABLE 8.2. ENTER SELECTED MIXTURE(S),

APPLICATION RATES, AND SEEDING DATES IN THE PERMANENT SEEDING SUMMARY. THE

B. ADDITIONAL PLANTING SPECIFICATIONS FOR EXCEPTIONAL SITES SUCH AS SHORELINES, STREAM BANKS, OR DUNES OR FOR SPECIAL PURPOSES SUCH AS WILDLIFE OR

AESTHETIC TREATMENT MAY BE FOUND IN USDA-NRCS TECHNICAL FIELD OFFICE GUIDE,

D. FOR AREAS RECEIVING LOW MAINTENANCE, APPLY UREA FORM FERTILIZER (46-0-0)

A AREAS WHERE TURFGRASS MAY BE DESIRED INCLUDE LAWNS, PARKS, PLAYGROUNDS

AND COMMERCIAL SITES WHICH WILL RECEIVE A MEDIUM TO HIGH LEVEL OF MAINTENANCE

B. SELECT ONE OR MORE OF THE SPECIES OR MIXTURES LISTED BELOW BASED ON THE

SEEDING DATES IN THE PERMANENT SEEDING SUMMARY. THE SUMMARY IS TO BE PLACED

I. KENTUCKY BLUEGRASS: FULL SUN MIXTURE: FOR USE IN AREAS THAT RECEIVE

INTENSIVE MANAGEMENT. IRRIGATION REQUIRED IN THE AREAS OF CENTRAL MARYLAND

and eastern shore. Recommended certified Kentucky Bluegrass cultivars

SEEDING RATE: 1.5 TO 2.0 POUNDS PER 1000 SQUARE FEET. CHOOSE A MINIMUM OF THREE KENTUCKY BLUEGRASS CULTIVARS WITH EACH RANGING FROM 10 TO 35

KENTUCKY BLUEGRASS/PERENNIAL RYE: FULL SUN MIXTURE: FOR USE IN FULL SUI

MEDIUM TO INTENSIVE MANAGEMENT. CERTIFIED PERENNIAL RYEGRASS CULTIVARS/

Certified Kentucky Bluegrass Seeding Rate: 2 Pounds Mixture Per 1000

EACH RANGING FROM 10 TO 35 PERCENT OF THE TOTAL MIXTURE BY WEIGHT.

III. TALL FESCUE/KENTUCKY BLUEGRASS: FULL SUN MIXTURE: FOR USE IN DROUGHT

IV. KENTUCKY BLUEGRASS/FINE FESCUE: SHADE MIXTURE: FOR USE IN AREAS WITH

Managed Turf Area. Mixture includes: Certified Kentucky Bluegras

SELECT TURFGRASS VARIETIES FROM THOSE LISTED IN THE MOST CURRENT UNIVERSITY OF MARYLAND

SECTION, PROVIDES A RELIABLE MEANS OF CONSUMER PROTECTION AND ASSURES A PURE GENETIC

- WESTEM MD: MARCH 15 TO JUNE 1, AUGUST ITO OCTOBER 1 (HARDINESS ZONES: SB. 6A)

- CENTRAL MD: MARCH 1 TO MAY 15, AUGUST 15 TO OCTOBER 15 (HARDINESS ZONE: 6B)

ILL AREAS TO RECEIVE SEED BY DISKING OR OTHER APPROVED METHODS TO A DEPTH OF

IF SOIL MOISTURE IS DEFICIENT, SUPPLY NEW SEEDINGS WITH ADEQUATE WATER FOR PLANT

- SOUTHERN MD, EASTERN SHORE: MARCH 1 TO MAY 15, AUGUST 15 TO OCTOBER 15

2 to 4 inches, level and rake the areas to prepare a proper seedbed. Remove

SUCH CONDITION THAT FUTURE MOWING OF GRASSES WILL POSE NO DIFFICULTY

PLANTING SEASON, IN ABNORMALLY DRY OR HOT SEASONS, OR ON ADVERSE SITES.

SOD: TO PROVIDE QUICK COVER ON DISTURBED AREAS (2:1 GRADE OR FLATTER).

STONES AND DEBRIS OVER 1½ INCHES IN DIAMETER. THE RESULTING SEEDBED MUST BE IN

GROWTH (1/2 TO 1 INCH EVERY 3 TO 4 DAYS DEPENDING ON SOIL TEXTURE) UNTIL THEY ARE FIRMLY ESTABLISHED. THIS IS ESPECIALLY TRUE WHEN SEEDINGS ARE MADE LATE IN THE

A. CLASS OF TURFGRASS SOD MUST BE MARYLAND STATE CERTIFIED. SOD LABELS MUST BE

B. SOD MUST BE MACHINE CUT AT A UNIFORM SOIL THICKNESS OF 3/4 INCH. PLUS OF

TOP GROWTH AND THATCH, BROKEN PADS AND TOM OR UNEVEN ENDS WILL NOT BE

D. SOD MUST NOT BE HARVESTED OR TRANSPLANTED WHEN MOISTURE CONTENT

(EXCESSIVELY DRY OR WET) MAY ADVERSELY AFFECT ITS SURVIVAL.

MINUS & INCH, AT THE TIME OF CUTTING, MEASUREMENT FOR THICKNESS MUST EXCLUDE

WEIGHT AND RETAIN THEIR SIZE AND SHAPE WHEN SUSPENDED VERTICALLY WITH A FIRM

: STANDARD SIZE SECTIONS OF SOD MUST BE STRONG ENOUGH TO SUPPORT THEIR OWN

. SOD MUST BE HARVESTED, DELIVERED, AND INSTALLED WITHIN A PERIOD OF 36 HOURS.

A. DURING PERIODS OF EXCESSIVELY HIGH TEMPERATURE OR IN AREAS HAVING DRY SUBSOIL, LIGHTLY IRRIGATE THE SUBSOIL IMMEDIATELY PRIOR TO LAYING THE SOD.

B. LAY THE FIRST ROW OF SOD IN A STRAIGHT LINE WITH SUBSEQUENT ROWS PLACED

. WHEREVER POSSIBLE, LAY SOD WITH THE LONG EDGES PARALLEL TO THE CONTOUR AND

WITH STAGGERING JOINTS. ROLL AND TAMP, PEG OR OTHERWISE SECURE THE SOD TO PREVENT

D. WATER THE SOD IMMEDIATELY FOLLOWING ROLLING AND TAMPING UNTIL THE UNDERSIDE OF

THE NEW SOD PAD AND SOIL SURFACE BELOW THE SOD ARE THOROUGHLY WET. COMPLETE

THE OPERATIONS OF LAYING, TAMPING AND IRRIGATING FOR ANY PIECE OF SOD WITHIN EIGHT

A. IN THE ABSENCE OF ADEQUATE RAINFALL, WATER DAILY DURING THE FIRST WEEK OR AS OFTEN AND SUFFICIENTLY AS NECESSARY TO MAINTAIN MOIST SOIL TO A DEPTH OF 4

C. DO NOT MOW UNTIL THE SOD IS FIRMLY ROOTED, NO MORE THAN 1/3 OF THE GRASS

LEAF MUST BE REMOVED BY THE INITIAL CUTTING OR SUBSEQUENT CUTTINGS. MAINTAIN A

PERMANENT SEEDING SUMMARY

N P<sub>2</sub>O<sub>5</sub>

stabilization must be completed within:

not under active grading.

1/4-1/2 IN (1 LB PER (2 LB PER (2 LB PER (90 LB PER

45 LB/AC 90 LB/AC 90 LB/AC 2 TONS/AC

1000 SF ) 1000 SF ) 1000 SF ) 1000 SF )

Standard Stabilization Note

a.) Three (3) calendar days as to the surface of all perimeter dikes, swales, ditches,

perimeter slopes, and all slopes steeper than 3 horizontal to 1 vertical (3:1); and

b.) Seven (7) calendar days as to all other disturbed or graded areas on the project site

Following initial soil disturbance or re-disturbance, permanent or temporary

B. AFTER THE FIRST WEEK, SOD WATERING IS REQUIRED AS NECESSARY TO MAINTAIN

SEEDING DATES

INCHES. WATER SOD DURING THE HEAT OF THE DAY TO PREVENT WILTING.

GRASS HEIGHT OF AT LEAST 3 INCHES UNLESS OTHERWISE SPECIFIED.

HARDINESS ZONE (FROM FIGURE B.3): ZONE 7a

COOL SEASON TALL FESCUE & KENTUCKY BLUEGRASS OR EQUAL\*

\* REFER TO MAA APPROVED SPECIES SHEET 11

SEED MIXTURE (FROM TABLE B.3): 8, 9 OR 11

PARALLEL TO IT AND TIGHTLY WEDGED AGAINST EACH OTHER, STAGGER LATERAL JOINTS TO

PROMOTE MORE UNIFORM GROWTH AND STRENGTH. ENSURE THAT SOD IS NOT STRETCHED

OR OVERLAPPED AND THAT ALL JOINTS ARE BUTTED TIGHT IN ORDER TO PREVENT VOIDS

SLIPPAGE ON SLOPES. ENSURE SOLID CONTACT EXISTS BETWEEN SOD ROOTS AND THE

SOD NOT TRANSPLANTED WITHIN THIS PERIOD MUST BE APPROVED BY AN AGRONOMIST OR

PUBLICATION, AGRONOMY MEMO \$77, "TURFGRASS CULTIVAR RECOMMENDATIONS FOR MARYLAND"

CHOOSE CERTIFIED MATERIAL. CERTIFIED MATERIAL IS THE BEST GUARANTEE OF CULTIVAR PURITY. THE CERTIFICATION PROGRAM OF THE MARYLAND DEPARTMENT OF AGRICULTURE, TURF AND SEED

SEEDING RATE: 1½ TO 3 POUNDS PER 1000 SQUARE FEET.

C. IDEAL TIMES OF SEEDING FOR TURF GRASS MIXTURES

MADE AVAILABLE TO THE JOB FOREMAN AND INSPECTOR.

GRASP ON THE UPPER 10 PERCENT OF THE SECTION.

SOIL SCIENTIST PRIOR TO ITS INSTALLATION.

WHICH WOULD CAUSE AIR DRYING OF THE ROOTS.

SHADE IN BLUEGRASS LAWNS. FOR ESTABLISHMENT IN HIGH QUALITY, INTENSIVELY

AREAS WHERE RAPID ESTABLISHMENT IS NECESSARY AND WHEN TURF WILL RECEIVE

soliare efet. Choose a minimum of three Kenticky Bluegrass cultivars with

PRONE AREAS AND/OR FOR AREAS RECEIVING LOW TO MEDIUM MANAGEMENT IN FULL

SUN TO MEDIUM SHADE. RECOMMENDED MIXTURE INCLUDES: CERTIFIED TALL FESCUE

Cultivars 95 to 100 percent, certified kentucky bluegrass cultivars 0 to 1

PERCENT. SEEDING RATE: 5 TO 8 POUNDS PER 1000 SQUARE FEET. ONE OR MORE

CULTIVARS 30 TO 40 PERCENT AND CERTIFIED FINE FESCUE AND 60 TO 70 PERCENT.

SITE CONDITIONS OR PLIRPOSE, ENTER SELECTED MIXTURE(S), APPLICATION RATES, AND

AT 3-1/2 POUNDS PER 1000 SQUARE FEET (150 POUNDS PER ACRE) AT THE TIME

C. FOR SITES HAVING DISTURBED AREA OVER 5 ACRES, USE AND SHOW THE RATES

OF SEEDING IN ADDITION TO THE SOIL AMENDMENTS SHOWN IN THE PERMANENT

EXPOSED SOILS WHERE GROUND COVER IS NEEDED FOR 6 MONTHS OR MORE.

TO STABILIZE DISTURBED SOILS WITH PERMANENT VEGETATION.

Summary is to be placed on the plan

SECTION 342 - CRITICAL AREA PLANTING.

RECOMMENDED BY THE SOIL TESTING AGENCY.

PERCENT OF THE TOTAL MIXTURE BY WEIGHT.

CULTIVARS MAY BE BLENDED.

(HARDINESS ZONES: 7A, 7B)

1. GENERAL SPECIFICATIONS

2. SOD INSTALLATION

3. SOD MAINTENANCE

10-21-13

UNDERLYING SOIL SURFACE

ADFOUATE MOISTURE CONTENT.

NO SPECIES RATE (LB/AC)


FEUZER

436 LB/AC 2 TONS/AC

1000 SF ) 1000 SF

CONDITIONS WHERE PRACTICE APPLIES

A. SEED MIXTURES

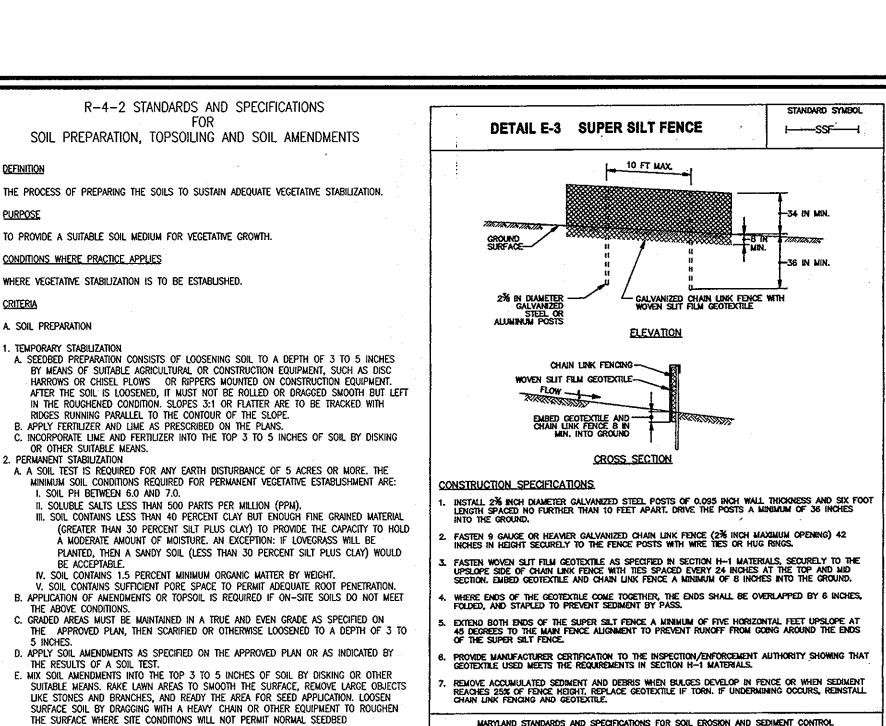

PREPARATION: TRACK SLOPES 3:1 OR FLATTER WITH TRACKED EQUIPMENT LEAVING THE

SOIL IN AN IRREGULAR CONDITION WITH RIDGES RUNNING PARALLEL TO THE CONTOUR

OF THE SLOPE, LEAVE THE TOP 1 TO 3 INCHES OF SOIL LOOSE AND FRIABLE.

I. TOPSOIL IS PLACED OVER PREPARED SUBSOIL PRIOR TO ESTABLISHMENT OF PERMANENT

VEGETATION. THE PURPOSE IS TO PROVIDE A SUITABLE SOIL MEDIUM FOR VEGETATIVE

GROWTH. SOILS OF CONCEM HAVE LOW MOISTURE CONTENT, LOW NUTRIENT LEVELS, LOW

SEEDBED LOOSENING MAY BE UNNECESSARY ON NEWLY DISTURBED AREAS.

PH, MATERIALS TOXIC TO PLANTS, AND/OR UNACCEPTABLE SOIL GRADATION.

TOPSOIL TO BE SALVAGED FOR A GIVEN SOIL TYPE CAN BE FOUND IN THE

5. TOPSOILING IS LIMITED TO AREAS HAVING 2:1 OR FLATTER SLOPES WHERE:

PRODUCE VEGETATIVE GROWTH.

. TOPSOIL APPLICATION

TOPSOIL SALVAGED FROM AN EXISTING SITE MAY BE USED PROVIDED IT MEETS THE

STANDARDS AS SET FORTH IN THESE SPECIFICATIONS, TYPICALLY, THE DEPTH OF

REPRESENTATIVE SOIL PROFILE SECTION IN THE SOIL SURVEY PUBLISHED BY USDA-

A. THE TEXTURE OF THE EXPOSED SUBSOIL/PARENT MATERIAL IS NOT ADEQUATE TO

TO SUPPORT PLANTS OR FLIRNISH CONTINUING SUPPLIES OF MOISTURE AND PLANT

. AREAS HAVING SLOPES STEEPER THAN 2:1 REQUIRE SPECIAL CONSIDERATION AND

. TOPSOIL SPECIFICATIONS: SOIL TO BE USED AS TOPSOIL MUST MEET THE FOLLOWING

A TOPSOIL MUST BE A LOAM, SANDY LOAM, CLAY LOAM, SILT LOAM, SANDY CLAY LOAM

THE APPROPRIATE APPROVAL AUTHORITY. TOPSOIL MUST NOT BE A MIXTURE OF

B. TOPSOIL MUST BE FREE OF NOXIOUS PLANTS OR PLANT PARTS SUCH AS BERMUDA

A. EROSION AND SEDIMENT CONTROL PRACTICES MUST BE MAINTAINED WHEN APPLYING

B. UNIFORMLY DISTRIBUTE TOPSOIL IN A 5 TO 8 INCH LAYER AND LIGHTLY COMPACT

MANNER THAT SODDING OR SEEDING CAN PROCEED WITH A MINIMUM OF ADDITIONAL

C. TOPSOIL MUST NOT BE PLACED IF THE TOPSOIL OR SUBSOIL IS IN A FROZEN OR

SOIL AMENDMENTS (FERTILIZER AND LIME SPECIFICATIONS)

 SOIL TESTS MUST BE PERFORMED TO DETERMINE THE EXACT RATIOS AND APPLICATION

OR MORE. SOIL ANALYSIS MAY BE PERFORMED BY A RECOGNIZED PRIVATE OR

FERTILIZER WITH PRIOR APPROVAL FROM THE APPROPRIATE APPROVAL AUTHORITY.

APPLICABLE LAWS AND MUST BEAR THE NAME, TRADE NAME OR TRADEMARK AND

RATES FOR BOTH LIME AND FERTILIZER ON SITES HAVING DISTURBED AREAS OF 5 ACRES

COMMERCIAL LABORATORY. SOIL SAMPLES TAKEN FOR ENGINEERING PURPOSES MAY ALSO

2. FERTILIZERS MUST BE UNIFORM IN COMPOSITION, FREE FLOWING AND SUITABLE FOR

FERTILIZERS MUST ALL BE DELIVERED TO THE SITE FULLY LABELED ACCORDING TO THE

3. LIME MATERIALS MUST BE GROUND LIMESTONE (HYDRATED OR BURNT LIME MAY BE

TOTAL OXIDES (CALCIUM OXIDE PLUS MAGNESIUM OXIDE), LIMESTONE MUST BE GROUND

TO SUCH FINENESS THAT AT LEAST 50 PERCENT WILL PASS THROUGH A #100 MESH

4. HMF AND FERTILIZER ARE TO BE EVENLY DISTRIBUTED AND INCORPORATED INTO THE

SPREAD GROUND LIMESTONE AT THE RATE OF 4 TO 8 TONS/ACRE (200-400 POUNDS

5. WHERE THE SUBSOIL IS EITHER HIGHLY ACIDIC OR COMPOSED OF HEAVY CLAYS,

SIEVE AND 98 TO 100 PERCENT WILL PASS THROUGH A #20 MESH SIEVE.

TOP 3 TO 5 INCHES OF SOIL BY DISKING OR OTHER SUITABLE MEANS.

PER 1,000 SQUARE FEET) PRIOR TO THE PLACEMENT OF TOPSOIL.

SUBSTITUTED EXCEPT WHEN HYDROSEEDING) WHICH CONTAINS AT LEAST 50 PERCENT

CURATE APPLICATION BY APPROPRIATE EQUIPMENT, MANURE MAY BE SUBSTITUTED FOR

MUDDY CONDITION, WHEN THE SUBSOIL IS EXCESSIVELY WET OR IN A CONDITION THAT MAY OTHERWISE BE DETRIMENTAL TO PROPER GRADING AND SEEDBED PREPARATION.

TO A MINIMUM THICKNESS OF 4 INCHES. SPREADING IS TO BE PERFORMED IN SUCH A

SOIL PREPARATION AND TILLAGE, ANY IRREGULARITIES IN THE SURFACE RESULTING FROM

TOPSOILING OR OTHER OPERATIONS MUST BE CORRECTED IN ORDER TO PREVENT THE

GRASS, QUACK GRASS, JOHNSON GRASS, NUT SEDGE, POISON MY, THISTLE, OR OTHERS

CONTRASTING TEXTURED SUBSOILS AND MUST CONTAIN LESS THAN 5 PERCENT BY

C. TOPSOIL SUBSTITUTES OR AMENDMENTS, AS RECOMMENDED BY A QUALIFIED

AGRONOMIST OR SOIL SCIENTIST AND APPROVED BY THE APPROPRIATE APPROVAL

TRASH, OR OTHER MATERIALS LARGER THAN 1% INCHES IN DIAMETER.

AUTHORITY, MAY BE USED IN LIEU OF NATURAL TOPSOIL.

FORMATION OF DEPRESSIONS OR WATER POCKETS.

BE LISED FOR CHEMICAL ANALYSES.

WARRANTY OF THE PRODUCER.

VOLUME OF CINDERS, STONES, SLAG, COARSE FRAGMENTS, GRAVEL, STICKS, ROOTS,

OR LOAMY SAND, OTHER SOILS MAY BE USED IF RECOMMENDED BY AN AGRONOMIST OR

B. THE SOIL MATERIAL IS SO SHALLOW THAT THE ROOTING ZONE IS NOT DEEP ENOUGH

C. THE ORIGINAL SOIL TO BE VEGETATED CONTAINS MATERIAL TOXIC TO PLANT GROWTH.
D. THE SOIL IS SO ACIDIC THAT TREATMENT WITH LIMESTONE IS NOT FEASIBLE.

# B-4-3 STANDARDS AND SPECIFICATIONS SEEDING AND MULCHING THE APPLICATION OF SEED AND MULCH TO ESTABLISH VEGETATIVE COVER.

TO PROTECT DISTURBED SOILS FROM EROSION DURING AND AT THE END OF CONSTRUCTION.

TO THE SURFACE OF ALL PERIMETER CONTROLS, SLOPES, AND ANY DISTURBED AREA NOT UNDER ACTIVE

1. SPECIFICATIONS A ALL SEED MUST MEET THE REQUIREMENTS OF THE MARYLAND STATE SEED LAW. ALL SEED MUST BE TO RE-TESTING BY A RECOGNIZED SEED LABORATORY. ALL SEED USED MUST HAVE BEEN TESTED WITHIN THE 6 MONTHS IMMEDIATELY PRECEDING THE DATE OF SOWING SUCH MATERIAL ON ANY PROJECT REFER TO TARIE R.4 REGARDING THE QUALITY OF SEED, SEED TAGS MUST BE AVAILABLE UPON REQUEST TO THE INSPECTOR TO VERIFY TYPE OF SEED AND SEEDING RATE. B. MULCH ALONE MAY BE APPLIED BETWEEN THE FALL AND SPRING SEEDING DATES ONLY IF THE ROUND IS FROZEN. THE APPROPRIATE SEEDING MIXTURE MUST BE APPLIED WHEN THE GROUND C INOCHIANTS: THE INOCHIANT FOR TREATING LEGIME SEED IN THE SEED MIXTURES MUST BE A PURE CULTURE OF NITROGEN FIXING BACTERIA PREPARED SPECIFICALLY FOR THE SPECIES. INOCULANTS MUST NOT BE USED LATER THAN THE DATE INDICATED ON THE CONTAINER. ADD FRESH NOCULANTS AS DIRECTED ON THE PACKAGE. USE FOUR TIMES THE RECOMMENDED RATE WHEN HYDROSEEDING, NOTE: IT IS VERY IMPORTANT TO KEEP INOCULANT AS COOL AS POSSIBLE UNTIL USED, TEMPERATURES ABOVE 75 TO 80 DEGREES FAHRENHEIT CAN WEAKEN BACTERIA AND MAKE D. SOD OR SEED MUST NOT BE PLACED ON SOIL WHICH HAS BEEN TREATED WITH SOIL STERILANTS OR CHEMICALS USED FOR WEED CONTROL UNTIL SUFFICIENT TIME HAS ELAPSED (14 DAYS MIN.) TO PERMIT DISSIPATION OF PHYTO-TOXIC MATERIALS.

A. DRY SEEDING: THIS INCLUDES USE OF CONVENTIONAL DROP OR BROADCAST SPREADERS. I. INCORPORATE SEED INTO THE SUBSOIL AT THE RATES PRESCRIBED ON TEMPORARY SEEDING TABLE 8.1, PERMANENT SEEDING TABLE 8.3, OR SITE-SPECIFIC SEEDING SUMMARIES. II. APPLY SEED IN TWO DIRECTIONS, PERPENDICULAR TO EACH OTHER. APPLY HALF THE SEEDING RATE IN EACH DIRECTION. ROLL THE SEEDED AREA WITH A WEIGHTED ROLLER TO PROVIDE GOOD SEED TO SOIL CONTACT.

B. DRILL OR CULTIPACKER SEEDING: MECHANIZED SEEDERS THAT APPLY AND COVER SEED WITH SOIL. 1. CULTIPACKING SEEDERS ARE REQUIRED TO BURY THE SEED IN SUCH A FASHION AS TO PROVIDE AT LEAST 1/4 INCH OF SOIL COVERING, SEEDBED MUST BE FIRM AFTER PLANTING. II. APPLY SEED IN TWO DIRECTIONS, PERPENDICULAR TO EACH OTHER. APPLY HALF THE SEEDING RATE IN EACH DIRECTION. C. HYDROSEEDING: APPLY SEED UNIFORMLY WITH HYDROSEEDER (SLURRY INCLUDES SEED AND


I. IF FERTILIZER IS BEING APPLIED AT THE TIME OF SEEDING, THE APPLICATION RATES SHOULD NOT EXCEED THE FOLLOWING: NITROGEN, 100 POUNDS PER ACRE TOTAL OF SOLUBLE NITROGEN; P205 (PHOSPHOROUS), 200 POUNDS PER ACRE: K20 (POTASSIUM), 200 POUNDS PER ACRE. II. LIME: USE ONLY GROUND AGRICULTURAL LIMESTONE (UP TO 3 TONS PER ACRE MAY BE APPLIED RY HYDROSFFDING). NORMALLY, NOT MORE THAN 2 TONS ARE APPLIED BY HYDROSEEDING AT ANY ONE TIME DO NOT USE BURNT OR HYDRATED LIME WHEN HYDROSEEDING. III. MIX SEED AND FERTILIZER ON SITE AND SEED IMMEDIATELY AND WITHOUT INTERRUPTION. IV. WHEN HYDROSEEDING DO NOT INCORPORATE SEED INTO THE SOIL.

I. MULCH MATERIALS (IN ORDER OF PREFERENCE) A. STRAW CONSISTING OF THOROUGHLY THRESHED WHEAT, LYE. OAT. OR BARLEY AND REASONABLY BRIGHT IN COLOR, STRAW IS TO BE FREE OF NOXIOUS WEED SEEDS AS SPECIFIED IN THE MARYLAND SEED LAW AND NOT MUSTY, MOLDY, CAKED, DECAYED, OR EXCESSIVELY DUSTY. NOTE: USE ONLY STERILE STRAW MULCH IN AREAS WHERE ONE SPECIES OF GRASS IS DESIRED. B. WOOD CELLULOSE FIBER MULCH (WCFM) CONSISTING OF SPECIALLY PREPARED WOOD CELLULOSE PROCESSED INTO A UNIFORM FIBROUS PHYSICAL STATE. 1. WCFM IS TO BE DYED GREEN OR CONTAIN A GREEN DYE IN THE PACKAGE THAT WILL PROVIDE AN APPROPRIATE COLOR TO FACILITATE VISUAL INSPECTION OF THE UNIFORMLY SPREAD SLURRY. II. WCFM, INCLUDING DYE, MUST CONTAIN NO GERMINATION OR GROWTH INHIBITING FACTORS. III. WCFM MATERIALS ARE TO BE MANUFACTURED AND PROCESSED IN SUCH A MANNER THAT THE WOOD CELLULOSE FIBER MULCH WILL REMAIN IN UNIFORM SUSPENSION IN WATER UNDER AGITATION AND WILL BLEND WITH SEED FERTILIZER AND OTHER ADDITIVES TO FORM A HOMOGENEOUS SLURRY. THE MULCH MATERIAL MUST FORM A BLOTTER-LIKE GROUND COVER, ON APPLICATION, HAVING MOISTURE ABSORPTION AND PERCOLATION PROPERTIES AND MUST COVER AND HOLD GRASS SEED IN CONTACT WITH THE SOIL WITHOUT IV. WCFM MATERIAL MUST NOT CONTAIN ELEMENTS OR COMPOUNDS AT CONCENTRATION LEVELS THAT WILL BE V. WCFM MUST CONFORM TO THE FOLLOWING PHYSICAL REQUIREMENTS: FIBER LENGTH OF APPROXIMATELY 10 MILLIMETERS, DIAMETER APPROXIMATELY 1 MILLIMETER, PH RANGE OF 4.0 TO 8.5, ASH CONTENT OF 1.6 PERCENT MAXIMUM AND WATER HOLDING CAPACITY OF 90 PERCENT MINIMUM.

A. APPLY MULCH TO ALL SEEDED AREAS IMMEDIATELY AFTER SEEDING. 8. WHEN STRAW MULCH IS USED, SPREAD IT OVER ALL SEEDED AREAS AT THE RATE OF 2 TONS PER ACRE TO A UNIFORM LOOSE DEPTH OF 1 TO 2 INCHES. APPLY MULCH TO ACHIEVE A LINIFORM DISTRIBUTION AND DEPTH SO THAT THE SOIL SURFACE IS NOT EXPOSED. WHEN USING A MULCH ANCHORING TOOL, INCREASE THE APPLICATION RATE TO 2.5 TONS PER ACRE. C. WOOD CELLULOSE FIBER USED AS MULCH MUST BE APPLIED AT A NET DRY WEIGHT OF 1500 POUNDS PER ACRE. MIX THE WOOD CELLULOSE FIBER WITH WATER TO ATTAIN A MIXTURE WITH A MAXIMUM OF 50 POUNDS OF WOOD CELLULOSE FIBER PER 100 GALLONS OF WATER. ANCHORING A PERFORM MULCH ANCHORING IMMEDIATELY FOLLOWING APPLICATION OF MULCH TO MINIMIZE LOSS BY WIND OR WATER. THIS MAY BE DONE BY ONE OF THE FOLLOWING METHODS (LISTED BY

PREFERENCE). DEPENDING LIPON THE SIZE OF THE AREA AND EROSION HAZARD:

I. A MULCH ANCHORING TOOL IS A TRACTOR DRAWN IMPLEMENT DESIGNED TO PUNCH AND ANCHOR MULCH INTO THE SOIL SURFACE A MINIMUM OF 2 INCHES. THIS PRACTICE IS MOST EFFECTIVE ON LARGE AREAS, BUT IS LIMITED TO FLATTER SLOPES WHERE EQUIPMENT CAN OPERATE SAFELY. IF USED ON SLOPING LAND, THIS PRACTICE SHOULD FOLLOW THE CONTOUR. II. WOOD CELLULOSE FIBER MAY BE USED FOR ANCHORING STRAW, APPLY THE FIBER BINDER AT A NET DRY WEIGHT OF 750 POUNDS PER ACRE. MIX THE WOOD CELLULOSE FIBER WITH WATER AT A MAXIMUM OF 50 POUNDS OF WOOD CELLULOSE FIBER PER 100 GALLONS OF WATER. III. SYNTHETIC BINDERS SUCH AS ACRYLIC DLR (AGRO-TACK), DCA-70, PETROSET, TERRA TAX II, TERRA TACK AR OR OTHER APPRÒVED EQUAL MAY BE USED. FOLLOW APPLICATION RATES AS SPECIFIED BY THE MANUFACTURER. APPLICATION OF LIQUID BINDERS NEEDS TO BE HEAVIER AT THE EDGES WHERE WIND CATCHES MULCH, SUCH AS IN VALLEYS AND ON CRESTS OF BANKS. USE OF ASPHALT BINDERS IV. LIGHTWEIGHT PLASTIC NETTING MAY BE STAPLED OVER THE MULCH ACCORDING TO MANUFACTURER RECOMMENDATIONS. NETTING IS USUALLY AVAILABLE IN ROLLS 4 TO 15 FEET WIDE AND 300 TO 3,000 FEET

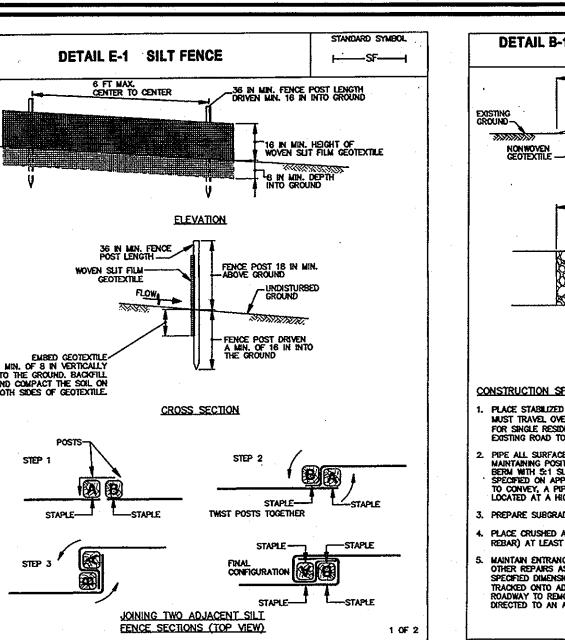

MARYLAND STANDARDS AND SPECIFICATIONS FOR SOIL EROSION AND SEDIMENT CONTROL

PROVIDE MANUFACTURER CERTIFICATION TO THE AUTHORIZED REPRESENTATIVE OF THE INSPECTION/ENFORCEMENT AUTHORITY SHOWING THAT THE GEOTEXTILE USED MEETS THE REQUIREMENTS IN SECTION H-1 MATERIALS.


WHERE TWO SECTIONS OF GEOTEXTILE ADJOIN: OVERLAP, TWIST, AND STAPLE TO POST IN ACCORDANCE WITH THIS DETAIL.

MARYLAND STANDARDS AND SPECIFICATIONS FOR SOIL EROSION AND SEDIMENT CONTROL

2011

DETAIL E-1 SILT FENCE


CONSTRUCTION SPECIFICATIONS

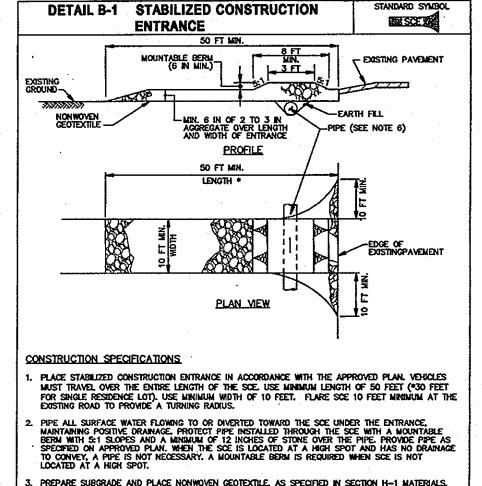

PREPARE SUBGRADE AND PLACE NONWOVEN GEOTEXTILE, AS SPECIFIED IN SECTION H-1 MATERIALS.

PLACE CRUSHED AGGREGATE (2 TO 3 INCHES IN SIZE) OR EQUIVALENT RECYCLED CONCRETE (WITHOUT REBAR) AT LEAST 6 INCHES DEEP OVER THE LENGTH AND WIDTH OF THE SCE. MAINTAIN ENTRANCE IN A CONDITION THAT MINIMIZES TRACKING OF SEDIMENT. ADD STONE OR MAKE OTHER REPAIRS AS CONDITIONS DEMAND TO MAINTAIN CLEAN SURFACE, MOUNTABLE BERM, AND SPECIFIED DIMENSIONS. IMMEDIATELY REMOVE STONE AND/OR SEDIMENT SPILLED, DROPPED, OR


MARYLAND STANDARDS AND SPECIFICATIONS FOR SOIL EROSION AND SEDIMENT CONTROL

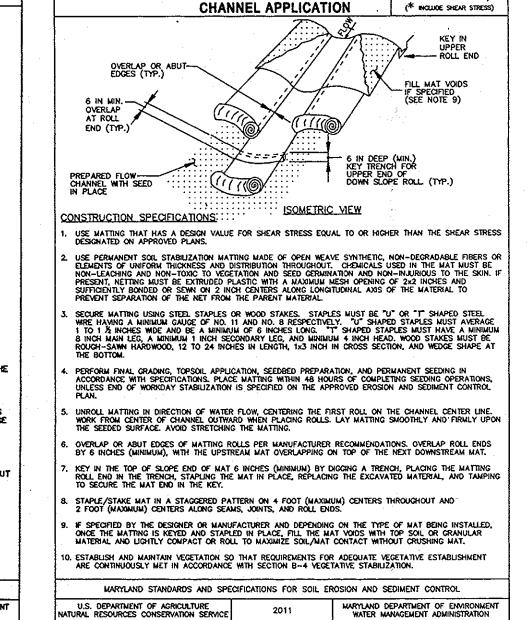

TABILIZATION MATTING

DETAIL B-4-6-C PERMANENT SOIL

STANDARD SYMBOL

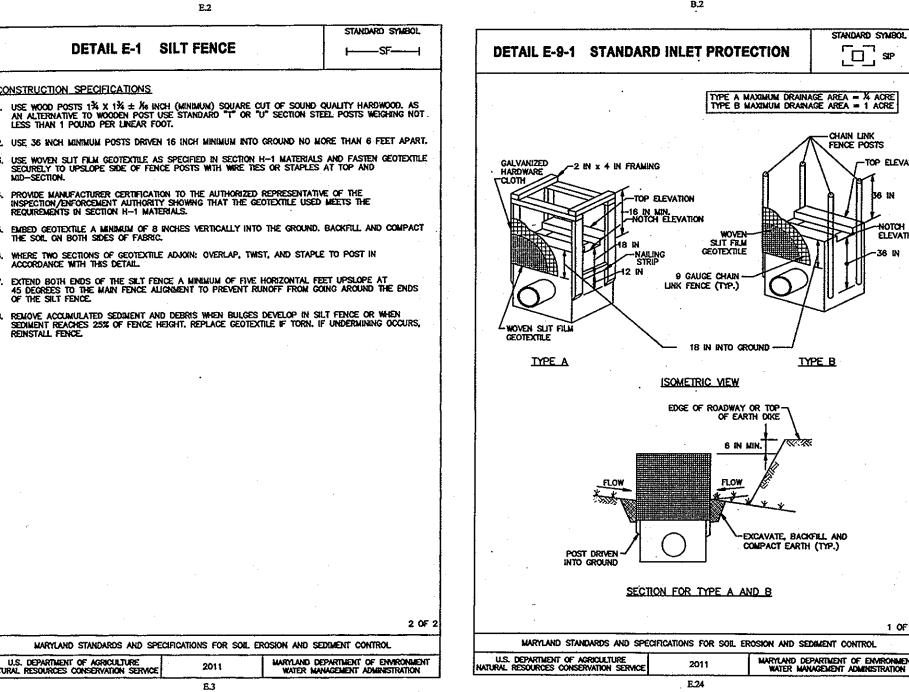


/ Seeding rates for the warm-season grasses are in pounds of Pure Live Seed (PLS). Actual planting rates shall be adjusted to reflect percent seed germination and purity, as

Seeding rates listed above are for temporary seedings, when planted above. When planted as a nurse crop with permanent seed mixes, use 1/3 of the seeding rate listed above for barley, oats, and wheat. For smaller-seeded grasses (annual ryegrass, pearl millet, foxtall millet), do not exceed more than 5% (by weight) of the overall permanent seeding mix. Cereal type generally should not be used as a nurse crop, unless planting will occur in very late fall beyond the seeding dates for other temporary seedings

Oats are the recommended purse crop for warm-season grasse

2/ For sandy soils, plant seeds at twice the depth listed above. The planting dates listed are averages for each Zone and may require adjustment to reflect local conditions, especially near the boundaries of the zone.

> **BUILDER AND DEVELOPER/OWNER** MAIN STREET BUILDERS 5705 LANDING ROAD

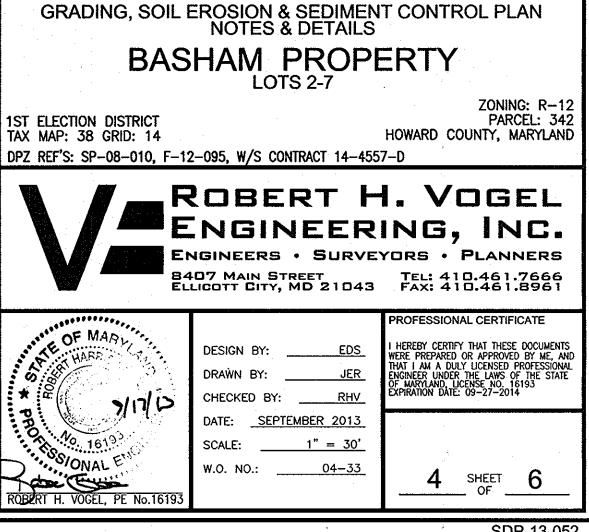

**REVISION** 

SITE DEVELOPMENT PLAN

Plant Species	Seeding Rate V		Seeding Depth <sup>27</sup>	Recommended Seeding Dates by Plant Hardiness Zone W			
riast Species	lb/ac	1b/1000 ft <sup>2</sup>	(inches)	5b and 6a	66	7a and 7b	
Cool-Season Grasses	1000		(**(;) ####Y				
Annual Ryegrass (Lollum perenne ssp. multiflorum)	40	0.1	0.5	Mar 15 to May 31; Aug 1 to Sep 30	Mar I to May 15; Aug I to Oct 15	Feb 15 to Apr 30; Au 15 to Nov 30	
Barley (Hordeum vulgare)	96	2.2	1.0	Mar 15 to May 31; Aug 1 to Sep 30	Mar 1 to May 15; Aug 1 to Oct 15	Feb 15 to Apr 30; Au 15 to Nov 30	
Oats (Avena sativa)	72	1,7	1.0	Mar 15 to May 31; Aug 1 to Sep 30	Mar I to May 15; Aug 1 to Oct 15	Feb 15 to Apr 30; Au 15 to Nov 30	
Wheat (Triticum aestivum)	120	2.8	1.0	Mar 15 to May 31; Aug 1 to Sep 30	Mar 1 to May 15; Aug 1 to Oct 15	Feb 15 to Apr 30; Au 15 to Nov 30	
Cereal Rye (Secale cereale)	112	2.8	1.0	Mar 15 to May 31; Aug 1 to Oct 31	Mar 1 to May 15; Aug 1 to Nov 15	Feb 15 to Apr 30; Aug 15 to Dec 15	
Warm-Season Grasses	会省/扩	\$*\X\X\X			NO YEAR TO THE		
Foxtail Millet (Setaria italica)	30	0.7	0.5	Jun 1 to Jul 31	May 16 to Jul 31	May 1 to Aug 14	
Pearl Millet (Pennisetum glaucum)	20	0.5	0.5	Jun I to Jul 31	May 16 to Jul 31	May I to Aug 14	

ELKRIDGE, MARYLAND 21075-5742

DATE

# APPENDIX B.4.C SPECIFICATIONS FOR MICRO-BIORETENTION. RAIN GARDEN, LANDSCAPE INFILTRATION & INFILTRATION BERMS

1. MATERIAL SPECIFICATIONS THE ALLOWABLE MATERIALS TO BE USED IN THESE PRACTICES ARE DETAILED IN TABLE B.4.1.

2. FILTERING MEDIA OR PLANTING SOIL THE SOIL SHALL BE A UNIFORM MIX, FREE OF STONES, STUMPS, ROOTS OR OTHER SIMILAR OBJECTS LARGER THAN TWO INCHES. NO OTHER MATERIALS OR SUBSTANCES SHALL BE MIXED OR DUMPED WITHIN THE MICRO-BIORETENTION PRACTICE THAT MAY BE HARMFUL TO PLANT GROWTH, OR PROVE A HINDRANCE TO THE PLANTING OR MAINTENANCE OPERATIONS. THE PLANTING SOIL SHALL BE FREE OF BERMUDA GRASS, QUACKGRASS, JOHNSON GRASS, OR OTHER NOXIOUS WEEDS AS SPECIFIED UNDER COMAR 15.08.01.05. THE PLANTING SOIL SHALL BE TESTED AND SHALL MEET THE FOLLOWING CRITERIA:

\* SOIL COMPONENT - LOAMY SAND OR SANDY LOAM (USDA SOIL TEXTURAL CLASSIFICATION).

\* ORGANIC CONTEN - MINIMUM 10% BY DRY WEIGHT (ASTM D 2974). IN GENERAL, THIS CAN BE MET WITH A MIXTURE OF LOAMY SAND (60%-65%) AND COMPOST (35% TO 40%) OR SANDY LOAM (30%), COARSE SAND (30%), AND COMPOST (40%).

\* CLAY CONTENT - MEDIA SHALL HAVE A CLAY CONTENT OF LESS THAN 5%.

\* PH RANGE - SHOULD BE BETWEEN 5.5 - 7.0. AMENDMENTS (E.G., LIME, IRON SULFATE PLUS SULFUR) MAY BE MIXED IN TO THE SOIL TO INCREASE OR DECREASE PH.

THERE SHALL BE AT LEAST ONE SOIL TEST PER PROJECT. EACH TEST SHALL CONSIST OF BOTH THE STANDARD SOIL TEST FOR PH, AND ADDITIONAL TESTS OF ORGANIC MATTER, AND SOLUBLE SALTS. A TEXTURAL ANALYSIS IS REQUIRED FROM THE SITE STOCKPILED TOPSOIL IF TOPSOIL IS IMPORTED, THEN A TEXTURE ANALYSIS SHALL BE PERFORMED FOR EACH LOCATION WHERE THE TOPSOIL WAS EXCAVATED.

IT IS VERY IMPORTANT TO MINIMIZE COMPACTION OF BOTH THE BASE OF BIORETENTION PRACTICES AND THE REQUIRED BACKFILL. WHEN POSSIBLE, USE EXCAVATION HOES TO REMOVE ORIGINAL SOIL IF PRACTICES ARE EXCAVATED USING LOADER, THE CONTRACTOR SHOULD USE WIDE TRACK OR MARSH TRACK EQUIPMENT, OR LIGHT EQUIPMENT WITH TURF TYPE TIRES. USE OF EQUIPMENT WITH NARROW TRACKS OR NARROW TIRES, RUBBER TIRES WITH LARGE LUGS, OR HIGH-PRESSURE TIRES WILL CAUSE EXCESSIVE COMPACTION RESULTING IN REDUCED INFILITRATION RATES AND IS NOT ACCEPTABLE. COMPACTION WILL SIGNIFICANTLY CONTRIBUTE TO DESIGN FAILURE. COMPACTION CAN BE ALLEVIATED AT THE BASE OF THE BIORETENTION FACILITY BY USING A PRIMARY TILLING OPERATION SUCH AS CHISEL PLOW, RIPPER,

OR SUBSOILER. THESE TILLING OPERATIONS ARE TO REFRACTURE THE SOIL PROFILE THROUGH THE 12 INCH COMPACTION ZONE. SUBSTITUTE METHODS MUST BE APPROVED BY THE ENGINEER, ROTOTILLERS TYPICALLY DO NOT TILL DEEP ENOUGH TO REDUCE THE EFFECTS OF COMPACTION FROM HEAVY EQUIPMENT. ROTOTILL 2 TO 3 INCHES OF SAND INTO THE BASE OF THE BIORETENION FACILITY BEFORE BACKFILLING THE OPTIONAL SAND LAYER. PUMP ANY PONDED WATER BEFORE PREPARING (ROTOTILLING) BASE.

WHEN BACKFILLING THE TOPSOIL OVER THE SAND LAYER, FIRST PLACE 3 TO 4 INCHES OF TOPSOIL OVER THE SAND, THEN ROTOTILL THE SAND/TOPSOIL TO CREATE A GRADATION ZONE. BACKFILL THE REMAINDER OF THE TOPSOIL TO FINAL GRADE.

WHEN BACKFILLING THE BIORETENTION FACILITY, PLACE SOIL IN 18". DO NOT USE HEAVY EQUIPMENT WITHIN THE BIORETENTION BASIN. HEAVY EQUIPMENT CAN BE USED AROUND THE PERIMETER OF THE BASIN TO SUPPLY SOILS AND SAND. GRADE BIORETENTION MATERIALS WITH LIGHT EQUIPMENT SUCH AS A COMPACT LOADER OR A DOZER/LOADER WITH MARSH TRACKS. 4. PLANT MATERIAL

RECOMMENDED PLANT MATERIAL FOR MICRO-BIORETENTION PRACTICES CAN BE FOUND IN APPENDIX A, SECTION A.2.3.

5. PLANT INSTALLATION

COMPOST IS A BETTER ORGANIC MATERIAL SOURCE, IS LESS LIKELY TO FLOAT, AND SHOULD BE PLACED IN THE INVERT AND OTHER LOW AREAS. MULCH SHOULD BE PLACED IN SURROUNDING TO A UNIFORM THICKNESS OF 2" TO 3". SHREDDED OR CHIPPED HARDWOOD MULCH IS THE ONLY ACCEPTED MULCH. PINE MULCH AND WOOD CHIPS WILL FLOAT AND MOVE TO THE PERIMETER OF THE BIORETENTION AREA DURING A STORM EVENT AND ARE NOT ACCEPTABLE. SHREDDED MULCH MUST BE WELL AGED (6 TO 12 MONTHS) FOR ACCEPTANCE. ROOTSTOCK OF THE PLANT MATERIAL SHALL BE KEPT MOIST DURING TRANSPORT AND ON-SITE STORAGE. THE PLANT ROOT BALL SHOULD BE PLANTED SO 1/8TH OF THE BALL IS ABOVE FINAL GRADE SURFACE. THE DIAMETER OF THE PLANTING PIT SHALL BE AT LEAST SIX INCHES LARGER THAN THE DIAMETER OF THE PLANTING BALL. SET AND MAINTAIN THE PLANT STRAIGHT DURING THE ENTIRE PLANTING PROCESS. THOROUGHLY WATER GROUND BED COVER AFTER INSTALLATION. TREES SHALL BE BRACED USING 2" BY 2" STAKES ONLY AS NECESSARY AND FOR THE FIRST GROWING SEASON ONLY. STAKES ARE TO BE EQUALLY SPACED

GRASSES AND LEGUME SEED SHOULD BE DRILLED INTO THE SOIL TO A DEPTH OF AT LEAST ONE INCH. GRASS AND LEGUME PLUGS SHALL BE PLANTED FOLLOWING THE NON-GRASS GROUND COVER PLANTING SPECIFICATIONS.

THE TOPSOIL SPECIFICATIONS PROVIDE ENOUGH ORGANIC MATERIAL TO ADEQUATELY SUPPLY NUTRIENTS FROM NATURAL CYCLING. THE PRIMARY FUNCTION OF THE BIORETENTION STRUCTURE IS TO IMPROVE WATER QUALITY. ADDING FERTILIZERS DEFEATS, OR AT A MINIMUM, IMPEDES THIS GOAL. ONLY ADD FERTILIZER IF WOOD CHIPS OR MULCH ARE USED TO AMEND THE SOIL. ROTOTILL UREA FERTILIZER AT A RATE OF 2 POUNDS PER 1000 SQUARE FEET. 6. UNDERDRAINS

UNDERDRAINS SHOULD MEET THE FOLLOWING CRITERIA:

\* PIPE — SHOULD BE 4" TO 6" DIAMETER, SLOTTED OR PERFORATED RIGID PLASTIC PIPE (ASTMF 758, TYPE PS 28, OR AASHTO-M-278) IN A GRAVEL LAYER. THE PREFERRED MATERIAL IS SLOTTED, 4" RIGID PIPE (E.G., PVC OF HDPE).

\* PERFORATIONS — IF PERFORATED PIPE IS USED, PERFORATIONS SHOULD BE 3/8" DIAMETER LOCATED 6" ON CENTER WITH A MINIMUM OF FOUR HOLES PER ROW. PIPE SHALL BE WRAPPED WITH A 1/4" (NO. 4 OR 4x4) GALVANIZED HARDWARE CLOTH.

\* GRAVEL — THE GRAVEL LAYER (NO. 57 STONE PREFERED) SHALL BE AT LEAST 3" THICK ABOVE AND BELOW THE UNDERDRAIN.

\* GRAVEL - THE GRAVEL LATER (NO. 37 STONE PREFERRED) STALL BE AT LESS 3 HIGH ACOTE AND DECOME THE SHOULD BE AT A MINIMUM 0.5% SLOPE.

\* A RIGID, NON-PERFORATED OBSERVATION WELL MUST BE PROVIDED (ONE PER EVERY 1,0000 SQUARE FEET) TO PROVIDE A CLEAN-OUT PORT AND MONITOR PERFORMANCE OF THE FILTER.

\* A 4" LAYER OF PEA GRAVEL (1/8" TO 3/8" STONE) SHALL BE LOCATED BETWEEN THE FILTER MEDIA AND UNDERDRAIN TO PREVENT MIGRATION OF FINES IN TO THE UNDERDRAIN. THIS LAYER MAY BE CONSIDERED PART OF THE FILTER BED WHEN BED THICKNESS EXCEEDS 24".

THIS MAIN COLLECTOR PIPE FOR UNDERDRAIN SYSTEMS SHALL BE CONSTRUCTED AT A MINIMUM SLOPE OF 0.5%. OBSERVATION WELLS AND/OR CLEAN-OUT PIPES MUST BE PROVIDED (ONE MINIMUM PER EVERY 1000 SQUARE FEET OF SURFACE AREA). 7. MISCELLANEOUS

THESE PRACTICES MAY NOT BE CONSTRUCTED UNTIL ALL CONTRIBUTING DRAINAGE AREA HAS BEEN STABILIZED.

OPERATION AND MAINTENANCE SCHEDULE FOR (M-6) MICROBIORETENTION AREAS 1. ANNUAL MAINTENANCE OF PLANT MATERIAL, MULCH LAYER AND SOIL LAYER IS REQUIRED. MAINTENANCE OF MULCH AND SOIL IS LIMITED TO CORRECTING AREAS OF EROSION OR WASH OUT. ANY MULCH REPLACEMENT SHALL BE DONE IN THE SPRING. PLANT MATERIAL SHALL BE CHECKED FOR DISEASE AND INSECT INFESTATION AND MAINTENANCE WILL ADDRESS DEAD MATERIAL AND PRUNING. ACCEPTABLE REPLACEMENT PLANT MATERIAL IS LIMITED TO THE FOLLOWING: 2000 MARYLAND STORMWATER DESIGN MANUAL VOLUME II, TABLE A.4.1 AND 2.


2. SCHEDULE OF PLANT INSPECTION WILL BE TWICE A YEAR IN SPRING AND FALL. THIS INSPECTION WILL INCLUDE REMOVAL OF DEAD AND DISEASED VEGETATION CONSIDERED BEYOND TREATMENT. TREATMENT OF ALL DISEASED TREES AND SHRUBS AND REPLACEMENT OF ALL DEFICIENT STAKES AND WIRES.

3. MULCH SHALL BE INSPECTED EACH SPRING. REMOVE PREVIOUS MULCH LAYER BEFORE APPLYING NEW LAYER ONCE EVERY 2 TO 3 YEARS.


4. SOIL EROSION TO BE ADDRESSED ON AN AS NEEDED BASIS WITH A MINIMUM OF ONCE PER MONTH AND AFTER HEAVY STORM EVENTS.

Appendix B.4. Construction Specifications for Environmental Site Design Practices


Material	Specification	Size	Notes
Plantings	see Appendix A, Table A.4	n/a	plantings are site-specific
Planting soil [2' to 4' deep]	loamy sand (60 - 65%) & compost (35 - 40%) or sandy loam (30%),	n∕a	USDA soil types loamy sand or sandy loam; clay content < 5%
SEE ORM NOTE 5	coarse sand (30%) & compost (40%)		
Organic content	Min. 10% by dry weight (ASTM D 2974)	,	
Mulch	shredded hardwood	3 - 1	aged 6 months, minimum; no pine or wood chips
Pea gravel diaphragm	pea gravel: ASTM-D-448	NO. 8 OR NO. 9 (1/8" TO 3/8")	
Curtain drain	ornamental stone: washed cobbles	stone: 2" to 5"	
Geotextile		п/а	PE Type I nonwoven
Gravel (underdrains and infiltration berms)	AASHTO M-43	NO. 57 OR NO. 6 AGGREGATE (3/8" to 3/4")	
Underdrain piping	F 758, Type PS 28 or AASHTO M-278	4" to 6" rigid schedule 40 PVC or SDR35	Slotted or perforated pipe; 3/8" perf. @ 6" on center, 4 holes per row; minimum of 3" of gravel over pipes; not necessary underneath pipes. Perforated pipe shall be wrapped with 1/4-inch galvanized hardware cloth
Poured in place concrete (if required)	MSHA Mix No. 3; f° = 3500 psi @ 28 days, normal weight, air-entrained; reinforcing to meet ASTM-615-60	n/a	on-site testing of poured-in-place concrete required: 28 day strength and slump test; all concrete design (cast-in-place or pre-cast) not using previously approved State or local standards requires design drawings sealed and approved by a professional structural engineer licensed in the State of Maryland - design to include meeting ACI Code 350.R/89; vertical loading [H-10 or H-20]; allowable horizontal loading (based on soil pressures); and analysis of potential cracking
Sand	AASHTO-M-6 or ASTM-C-33	0.02" to 0.04"	Sand substitutions such as Diabase and Graystone (AASHTO) #10 are not acceptable. No calcium carbonated or dolomitic sand substitutions are acceptable. No "rock dust" can be used for sand

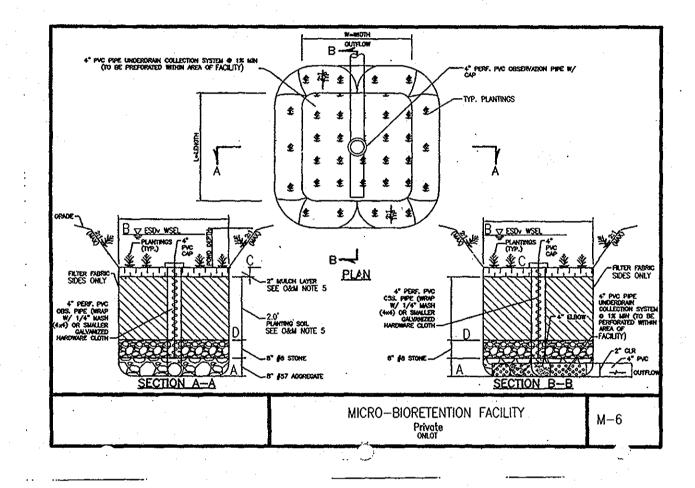

MBR FACILITY	A	В	С	D	SURFACE AREA	APPROX. DIMENSIONS
MBR #1	106.5	111.0	110.0	107.83	100 SF	6.3' X 16'
MBR #2	103.5	108.0	107.0	104.83	100 SF	6.3' X 16'
MBR #3	103.5	108.0	107.0	104.83	100 SF	6.3' X 16'
MBR #4	102.5	107.5	106.5	104.33	100 SF	6.3' X 16'
MBR #5	98.3	103.0	102.0	99.83	90 SF	9' X 10'
MBR #6	95.0	99.8	98.8	96.63	40 SF	5' X 8'

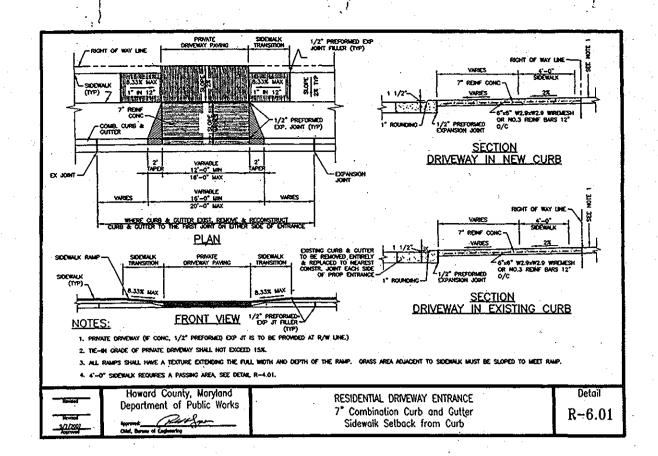

A PRIVATE RANGE OF ADDRESS SIGN ASSEMBLY SHALL BE FABRICATED AND INSTALLED BY HOWARD COUNTY BUREAU OF HIGHWAYS AT THE DEVELOPERS/OWNERS EXPENSE. CONTACT HOWARD COUNTY TRAFFIC DIVISION AT 410-313-5752 FOR DETAILS AND COST ESTIMATES.

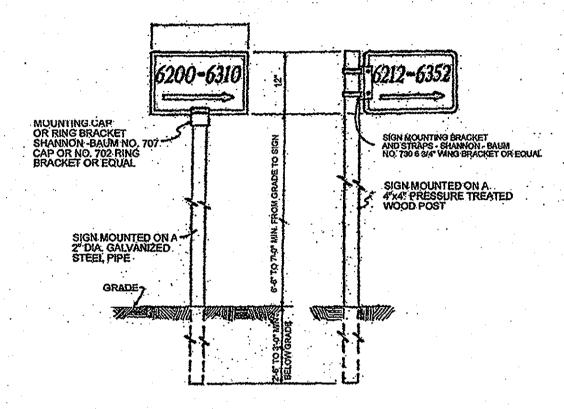

SIGN OPTION NUMBER 1 AND NUMBER 2


SIGN DESIGN AND INSTALLATION

### "MICRO-BIORETENTION" PLANTING SCHEDULE NOTES:

ALL PLANT MATERIALS SHALL BE FULL AND HEAVY, BE WELL FORMED AND SYMMETRICAL, CONFORM TO THE MOST CURRENT AAN SPECIFICATIONS AND BE INSTALLED IN ACCORDANCE WITH HOWARD COUNTY PLANTING SPECIFICATIONS. 2. CONTRACTOR SHALL VERIFY LOCATION OF ALL UNDERGROUND UTILITIES PRIOR TO DIGGING. 3. FINAL LOCATION OF PLANT MATERIAL MAY NEED TO VARY TO MEET FINAL FIELD CONDITIONS. TREES SHALL NOT BE PLANTED IN THE BOTTOM OF DRAINAGE SWALES. 4. CONTRACTOR SHALL VERIFY PLANT QUANTITIES PRIOR TO BIDDING. IF PLAN DIFFERS FROM LANDSCAPE SCHEDULE, THE PLAN SHALL GOVERN. 5. SEE SHEET 10 FOR TYPICAL PLANTING SPECIFICATIONS AND 6. MICROBIORETENTION AREAS ARE TO BE PLANTED
BASED ON A MINIMUM DENSITY OF 1000 STEMS PER PLANTED ACRE (.0229 STEMS PER SQUARE FOOT). ABOVE PLANTING RATIOS ARE TO BE APPLIED TO THE AREAS PROVIDED IN THE ESDY SUMMARY.

	ONLOT MICRO-BIORETENTION PLANTING SCHEDULE							
	QTY	BOTANICAL NAME/COMMON NAME	SIZE	REMARKS				
$\bigcirc$	6	CLADRASTIS LUTEA 'SWEETSHADE' SWEETSHADE YELLOWWOOD	1 1/2"-2" CAL	B & B				
0	2	KALMIA LATIFOLIA MOUNTAIN LAUREL	5 GALLON	CONT				
<b>3</b>	3	RHODODENDRON HY. 'GLACIER' OR 'WHITE ROSEBUD' GLACIER OR WHITE ROSEBUD HYBRID AZALEA	3 GALLON	CONT				
	·	. <del>.</del> .						


TYP. 100 SF X 75% X .0229 STEMS PER SQUARE FOOT = 2 PLANTS

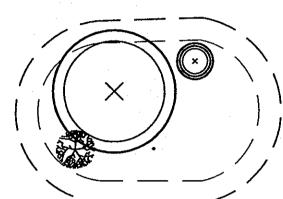

TYPICAL PLANTING DETAIL FOR MICRO BIO-RETENTION

SEE SHEET 2

NOO EVOLUDA	SURFACE	REQUIRED	DIANTINOC
MBR FACILITY	AREA	PLANTINGS	PLANTINGS
MBR #1	100 SF	2	1 SWEETSHADE YELLOWWOOD, 1 GLACIER OR WHITE ROSEBUD HYBRID AZALEA
MBR #2	100 SF	2	1 SWEETSHADE YELLOWWOOD, 1 MOUNTAIN LAUREL
MBR #3	100 SF	2	1 SWEETSHADE YELLOWWOOD, 1 GLACIER OR WHITE ROSEBUD HYBRID AZALEA
MBR #4	100 SF	2	1 SWEETSHADE YELLOWWOOD, 1 MOUNTAIN LAUREL
MBR #5	90 SF	2	1 SWEETSHADE YELLOWWOOD, 1 GLACIER OR WHITE ROSEBUD HYBRID AZALEA
MBR #6	40 SF	. 1	1 SWEETSHADE YELLOWWOOD

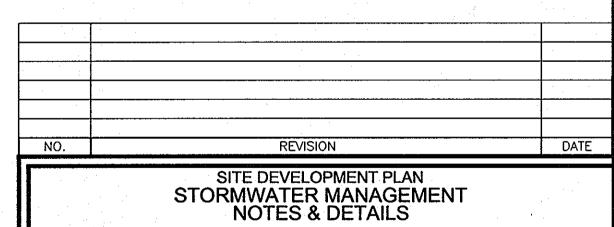


# BASHAM PROPERTY

1ST ELECTION DISTRICT TAX MAP: 38 GRID: 14

ZONING: R-12 PARCEL: 342 HOWARD COUNTY, MARYLAND

DPZ REF'S: SP-08-010, F-12-095, W/S CONTRACT 14-4557-D



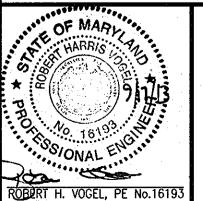

ESIGN BY: EDS	I I
RAWN BY:JER_	WI TH EN EN EN
HECKED BY: <u>RHV</u>	Ď
ATE: <u>SEPTEMBER 2013</u>	
CALE: 1" = 30'	
.O. NO.: <u>04-33</u>	

SHEET \_\_\_

**BUILDER AND** DEVELOPER/OWNER MAIN STREET BUILDERS 5705 LANDING ROAD ELKRIDGE, MARYLAND 21075-5742

APPROVED: HOWARD COUNTY DEPARTMENT OF PLANNING AND ZONING

### AASCD/MAA VEGETATIVE ESTABLISHMENT DETAILS AND SPECIFICATIONS FOR THE PROJECT WITHIN 4 MILES OF BWI AIRPORT

References to ITEM #s noted below are found in Maryland Aviation

#### SOIL TESTS

- Following initial soil disturbances or re-disturbance, permanent or temporary stabilization shall be completed within seven calendar days for the surface of all perimeter controls, dikes, swales, ditches, perimeter slopes, and all slopes greater than 3 horizontal to 1 vertical (3:1) and fourteen days for all other disturbed or
- graded areas on the project site.

  2. Occurrence of said sulfate soils (grayish black color) will require covering with a minimum of 12 inches of clean soil with 6 inches minimum capping of top soil. No stockpiling of material is allowed. If needed, soil tests should be done before and after a 6-week incubation period to allow oxidation of sulfates
- 3. The minimum soil conditions required for permanent vegetative
  - a. Soil pH shall be between 6.0 and 7.0. Soluble saits shall be less than 500 parts per million (ppm).
  - c. The soil shall contain less than 40% clay but enough fine grained material (> 30% slit plus clay) to provide the capacity
  - d. Soil shall contain 1.5% minimum organic matter by weight. e. Soil must contain sufficient pore space to permit adequate rec
  - penetration.

    £. If these conditions cannot be met by soils on site, adding topsoil is

required in accordance ITEM 901 or amendments made as

ITEM 903 SEEDING

903-1.1 GENERAL. This item provides specifications for seeding of areas as designated on plans or as directed by the MAA Engineer. The species, mixtures, and methods of application provided in this item have been designed to reduce the attractiveness of airport grounds to wildlife. Only MAA-approved species, mixtures, and rates of application provided in this item may be used to establish vegetation. All activities associated with seeding including soil preparation, seed application, fertilization, and maintenance shall also conform to these approved standards.

DESCRIPTION

903-2.1 SEED. All seed shall comply with the Maryland Seed Law (Agricultural Article of the Annotated Code of Maryland). Only MAA-approved species, mixtures, and rates of application provided in this item may be used to establish vegetation. Sec will be sampled and tested by an inspector from the Turf and Seed Section, Maryland Department of Agriculture (MDA), Annapolis, Maryland. All lawn and turf seed and nixtures shall be free from the following state-listed restricted: com cockle (Agrostemma githago),

redtop (Agrostis gigantea) wild onion (Allhan canac bindweed (Calstegia spp.) dodder (Cuscuta spp.), Bermuda grass (Cynodon dactylon), orchardgrass (Dactylis glomera tall fescue (Festuca arundinace meadow fescue (Festuca pratensi annual bluegrass (Poa annua) rough bluegrass (Poa trivialis), timothy (Phleum pratense), and

bentgrass (Agrostis spp.)1,

Restricted noxious-weed seed may not exceed 0.5 percent by weight of any seed mixture. In addition, all seeds sold in Maryland shall be free from the following listed prohibited

1 These species may be included as a labeled component of a mixture when each is present in excess of fiv

July 1, 2004

noxious weeds: balloonvine (Cardiospermum halicacabum), quackgrass (Elytrigia repens), sicklepod (Senna obtusifolia), sorghum (Sorghum spp.), Canada thistle (Cirsium arvense), plumeless thistle (Cardiuus spp.-includes musk thistle and curied thistle), and

903-2.1.1 APPROVED SPECIES. The following table contains species that are approved by MAA for use in seed mixtures. Purity requirements and germination rements are also provided.

APPROVED PLANT SPECIES

	Purity* Not Less than %	Minimum % Germination	Pure Live See Factor
Certified Turf-Type Tall Fescue (Festuca arundinacea)	98	90	1.13
Certified Kentucky Bluegrass (Poa pratensis)	90	80	1.39
Hard Fescue (Festuca longifolia)	98	90	1.13
Chewings Red Fescue (Festuca rubra commutata)	98	90	L.13
Annual Ryegrass (Lolium multiflorum)	95	8,5	1.24
Peremial Ryegrass (Lolium perenne)	90	80	1.39
Fowl Meadow Grass (Poa palustris)	90	80	1.39
Little Bluestera (Andropogon scoparius)	62	94	1.71

903-2.1.2 PURITY. All seed shall be free of all state-designated noxious weeds listed in Paragraph 2.1.1 and conform to MAA specifications. To ensure compliance, MAA requires sampling and testing of seed by the Turf and Seed Section, Maryland Department of Agriculture (MDA). The Contractor shall furnish the MAA Engineer with duplicate signed copies of a statement by the Turf and Seed Section certifying that each lot of seed has been laboratory tested within six months of date of delivery. The statement shall include the following information:

name and address of laboratory,

the results of tests as to name, percentages of purity and of germination, percentage of weed content for the seed furnished, and, in the case of a mixture, the proportions of each kind of seed.

Seed shall be furnished in standard containers with the seed name, lot number, net weight, percentages of purity, germination rate and hard seed, and percentage of maximum weed seed content clearly marked. All seed containers shall be tagged with a

MDA supervised mix program seed tag. 903-2.1.3 MIXTURES AND APPLICATION RATES. Only seed mixtures and application rates described in this item may be used unless otherwise approved by the MAA Engineer. Seed mixtures shall meet criteria detailed in Paragraph 903-2.1.2. Seed common landscape scenarios. The appropriate seed mixture for application will be designated based on environmental conditions and may vary from site to site. All planting rates listed are in pounds of Pure Live Seed (PLS) per acre.

Seed mixtures, application scenarios, and rates for permanent cool-season grasses are as

- a. Seed Mixture No. 1 relatively flat areas (grade less than 4:1) subject to conditions and regular mowing (Application rate = 234 lbs PLS/acre); b. Seed Mixture No. 2 - sloped areas (grade greater than 4:1) not subject to
- moving (Application rate = 115 lbs PLS/acre); and
  c. Seed Mixture No. 3 wetlands and their associated buffer zones (Application 131 lbs PLS/acre).

Seed Mixture No. 1: Relatively flat areas regularly mowed and exposed to normal conditions (Application rate = 234 lbs PLS/acre)

Application (Ibs of LS/acre) 85% Certified Turf-Type Tall Fescus 10% Certified Kentucky Bluegrass

Supplemental Seed Annual Ryegrass

Seed Mixture No. 2; Sloped areas not subject to regular mowing (Application rate = 115 lbs PLS/acre)

Application (lbs of PLS/acre) 75% Hard Fescue

Seed Mixture No. 3 - Wetland areas and their associated buffer zones (Application rate = 131 lbs PLS/acre)

(lbs of PLS/acre) 60% Fowl Meadow Grass

Supplemental Seed Redton 963-2.1.4 SEEDING SEASONS. Application of seed and seed mixtures shall occur within a specified seeding season unless otherwise approved by the MAA Engineer. No seed or seed mixtures are to be applied on frozen ground or when the temperature is at or

below 35 degrees Farenheit (7.2 degrees Centigrade). Under these conditions, a layer of mulch should be applied in accordance with Item 905, Mulching, to stabilize the site, and permanent seeding should occur in the subsequent seeding season. Seed application may occur during the seeding season dates listed below. Seeding performed after October 20 should be a temporary cover of annual ryegrass and followed by overseeding of the

appropriate seed mixture during the spring seeding season.

SEEDING SEASONS March 1 to April 20 and August 1 to October 20, inclusive comporary Cover of Annual Rye/Redtop March 1 to April 30 and August 1 to November 30, inclusive May 1 to July 31, inclusive. Rate of application should be 13.6 lbs. PLS per acre.

Seeding seasons are based on typical years and can be subject to variation, which may be

modified by the MAA Engineer based on seasonal trends. If the time required to complete any of the operations necessary under this item, within the specified planting season or any authorized extensions thereof, extends beyond the Contract period, then such time will be charged against the Contract time, and liquidated

903-2.2 LIME. Lime shall consist of ground limestone and contain at least 85 percent total carbonates. Lime shall be ground to a fineness so that at least 90 percent will pass through a No. 20 mesh sieve and 50 percent will pass through a No. 100 mesh sieve Dolomitic lime or a high magnesium lime shall contain at least 10 percent magnesium oxide. Lime shall be applied by approved methods detailed in Section 903-3.3 of this item. The rate of application will be based on results of soil tests.

903-2.3 FERTILIZER. Fertilizer shall be standard commercial fertilizer (supplied separately or in mixtures) and meet the requirements of applicable state and federal laws (O-F-241) as well as standards of the Association of Official Agricultural Chemists. analysis of soil samples. (Approved fertilizer rate: 21 pounds of 10-10-10 per 1,000 gamere feet.) Methods of fertilizer application shall conform to standards described in Section 903-3.3 of this item. Fertilizer shall be furnished in standard containers that are clearly labeled with name, weight, and guaranteed analysis of the contents (percentage of total nitrogen, available phosphoric acid, and water-soluble potash). Mixed fertilizers shall not contain any hydrated lime or cyanamide compounds. Fertilizers failing to meet the specified analysis may be approved by the MAA Engineer, providing sufficient materials are applied to conform with the specified nutrients per unit of measure without

The fertilizers may be supplied in the following forms:

a. A dry, free-flowing fertilizer suitable for application by a common fertilizer

b. A finely ground fertilizer soluble in water, suitable for application by power

c. A granular or pellet form suitable for application by blower equipment.

The rate of application will be based on results of soil tests performed by the University of Maryland Soil Testing Laboratory. By law, persons applying fertilizer to State-owned land shall follow the recommendations of the University of Maryland as set forth in the "Plant Nutrient Recommendations Based on Soil Tests for Turf Maintenance" and the "Plant Nutrient Recommendations Based on Soil Tests for Sod Production" (see Appendix B). Application of the fertilizer shall be in a manner that is consistent with the recommendations of the University of Maryland Cooperative Extension.

CONSTRUCTION METHODS AND EQUIPMENT

903-3.1 GENERAL. This section provides approved methods for the application of and includes standards for seedbed preparation, methods of application, and equipment to be used during the process. Lime and fertilizer shall be applied to seeded areas before the seed is spread. The mixture of seed will be determined for sites based on environmenta

903-3.2 ADVANCE PREPARATION. Areas designated for seeding shall be properly prepared in advance of seed application. The area shall be tilled and graded prior to ation of lime and fertilizer, and the surface area shall be cleared of any stones larger than I inch in diameter, sticks, stumps, and other debris that might interfere with sowing of seed, growth of grasses, or subsequent maintenance of grass-covered areas. Damage caused by erosion or other forces that occur after the completion of grading shall be repaired prior to the application of fertilizer and lime. The Contractor will repair such damage, which may include filling gullies, smoothing irregularities, and repairing other incidental damage before beginning the application of fertilizer and ground limestone.

If an area to be seeded is sparsely sodded, weedy, barren and unworked, or packed and hard, all grass and weeds shall first be cut or otherwise satisfactorily disposed of, and the soil then scarified or otherwise loosened to a depth not less than 5 inches (125 mm). Clods shall be broken and the top 3 inches (75 mm) of soil shall be worked into a nisfactory condition by discing or by use of cultipackers, rollers, drags, barrows, or

An area to be seeded shall be considered a satisfactory seedbed (without requiring not less than 5 inches; the top 3 inches of soil is loose, frizble, and is reasonably free from large clods, rocks, large roots, or other undesirable matter; appropriate amount rtilizer and lime have been added; and, if it has been shaped to the required grade immediately prior to seeding. For slope areas steeper than 3:1 (three horizontal to one

After completion of tilling and grading, lime and fertilizer shall be applied within 48 bours according to the specified rate (Paragraphs 903-2.2 and 2.3) and methods

vertical), the subsoil shall be loose to a depth of 1 inch.

(Paragraphs 903-3.3.1 and 903-3.3.2) approved by MAA. The seeding mixture shall be applied within 48 hours after application of lime and fertilizer. To firm the seeded areas,

903-3.3 METHODS OF APPLICATION. Lime, fertilizer, and seed mixes shall be applied by either the dry or wet application methods that have been approved by MAA

903-3.3.1 DRY APPLICATION METHOD

a. Liming. If soil test results indicate that lime is needed, the following procedures will be used: following advance preparation of the seedbed, lime shall be applied prior to the application of any fertilizer or seed and only on seedbeds that have been prepared as described in paragraph 903-3.2. The limit shall be uniformly spread and worked into the top 2 inches of soil, after which the seedbed shall be properly graded again.

b. Fertilizing. Following advance preparations (and liming if necessary), fertilizer shall be spread uniformly at the specified rate to provide no less than the minimum quantity stated in Paragraph 903-2.3.

c. Seeding. Seed mixtures shall be sown immediately after fertilization of the seedbed. The fertilizer and seed shall be lightly raked to a depth of I inch for

d. Rolling. After the seed has been properly covered, the seedbed shall be immediately compacted using a cultipacker or an approved lawnroller. 903-3.3.2 WET APPLICATION METHOD/HYDROSEEDING

a. General. The Contractor may elect to apply seed and fertilizer as per Paragraphs c and d of this section in the form of an aqueous mixture by spraying over the previously prepared seedbed using methods and equipment approv MAA. The rates of application shall be as specified in Paragraphs 903-2.1

b. Spraying Equipment. The spraying equipment shall have a container or 50 gallons or less over the entire range of the tank capacity. The liquid level gauge shall be mounted so as to be visible to the nozzle operator at all times. e container or tank shall also be equipped with a mechanical power-driven agitator capable of keeping all the solids in the mixture in complete suspension

The spraying equipment shall also include a pressure pump capable of delivering 100 gallons per minute at a pressure of 100 pounds per square inch. The

pressure pump assemblage shall be configured to allow the mixture to flow through the tank when not being sprayed from the nozzle. All pump passages and pipelines shall be capable of providing clearance for 5/8-inch solids. The power unit for the pump and agitator shall have controls mounted so as to be accessible to the nozzle operator. A pressure gauge shall be connected to and

The nozzle pipe shall be mounted on an elevated supporting stand in such a manner that it can be rotated through 360 degrees horizontally and inclined vertically from at least 20 degrees below to at least 60 degrees above the horizontal. There shall be a quick-acting, three-way control valve connecting the recirculating line to the nozzle pipe and mounted so that the nozzle ope can control and regulate the amount of flow of mixture to be supplied so that mixtures may be properly sprayed over a distance varying from 20 feet to 100 feet. One shall be a close-range ribbon nozzle, one a medium-range ribbon nozzle, and one a long-range jet nozzle. For ease of removal and cleaning, all nozzies shall be connected to the nozzle pipe by means of quick-release couplings. In order to reach areas inaccessible to the regular equipment, an extension hose at least 50 feet in length shall be provided to which the nozzles

c. Mixtures. Lime shall be applied separately in the quantity specified, prior to the fertilizing and seeding operations. Lime should be added to and mixed with water at a concentration not to exceed 220 pounds of lime for every 100 gallons of water. After lime has been applied, the tank should be emptied and rinsed with fresh water. Seed and fertilizer shall be mixed together in the relative proportions specified, but the resulting concentration should not exceed 220 pounds of mixture per 100 gallons of water and should be applied within 30 minutes to prevent fertilizer burn of the seeds.

All water used shall be obtained from fresh water sources and shall be free from injurious chemicals and other toxic substances harmful to plant life. Brackish water shall not be used at any time. The Contractor shall identify all sources of water to the MAA Engineer at least two weeks prior to use. The Engineer may take samples of the water at the source or from the tank at any time and have a aboratory test the samples for chemical and saline content. The Contractor shall not use any water from any source that is disapproved by the Engineer following

All mixtures shall be constantly agitated from the time they are mixed until they are finally applied to the seedbed. All such mixtures shall be used within 30 minutes from the time they were mixed or they shall be wasted and disposed of

d. Spraying. Lime shall be sprayed upon previously prepared seedbeds on which the lime, if required, shall have been worked in already. The mixtures

shall be applied using a high-pressure spray which shall always be directed upward into the air so that the mixtures will fall to the ground in a uniform spray. Nozzles or sprays shall never be directed toward the ground in such a manner that might produce erosion or runoff. Particular care shall be exercise to ensure that the application is made uniformly, at the prescribed rate, and to guard against misses and overlapped areas. Predetermined quantities of the mixture shall be used in accordance with specifications to cover specified sections of known areas. To checks the rate and uniformity of application, the applicator will observe the degree of wetting of the ground or distribute test

On surfaces that are to be mulched as indicated by the plans or designated by the MAA Engineer, seed and fertilizer applied by the spray method need not be raked into the soil or rolled. However, on surfaces on which mulch is not to be used, the raking and rolling operations will be required after the soil has dried.

sheets of paper or pans over the area at intervals and observe the quantity of

903-3.4 MAINTENANCE OF SEEDED AREAS. The contractor shall protect seeded areas against traffic or other use by warning signs or barricades, as approved by the Engineer. Surfaces gullied or otherwise damaged following seeding shall be repaired by regrading and reseeding as directed. The Contractor shall mow, water as directed, and otherwise maintain seeded areas in a satisfactory condition until final inspection and acceptance of the work.

When either the dry or wet application method outlined above is used for work performed uniform color and density to the satisfaction of the Engineer. If at the time when the contract has been otherwise completed it is not possible to make an adequate determination of the color, density, and uniformity of such stand of grass, payment for the unaccepted portions of the areas seeded out of season will be withheld until such time as these requirements have been met.

Mulch shall be applied to all seeded areas immediately after seeding. During the time periods when seeding is not permitted, mulch shall be applied immediately after

Mulch shall be applied as per ITEM 905.

**TEMPORARY SEEDING** 

100 pounds of dolomitic limestone per 1,000 square feet. 15 pounds of 10-10-10 per 1,000 square feet.

as to be stable and prevent erosion and slippage.

Mulch shall be applied as per ITEM 905.

No fills may be placed on frozen ground. All fill to be placed in approximately horizontal layers, each layer having a loose thickness of not more than 8 inches. All fill in roadways and parking areas is to be classified Type 2 as per Anne Arundel County Code - Article 21, Section 2-308, and compacted to 90% density; compaction to be determined by ASTM D-1557-66T (Modified Proctor). Any fill within the building area is to be compacted to a minimum of 95% density as determined by methods previously mentioned. Fills for pond embankments shall be compacted as per MD-378 Construction Specifications. All other fills shall be compacted sufficiently so

Installation of sod should follow permanent seeding dates. Seedbed preparation for sod shall be as noted above. Lime and fertilizer per permanent seeding specifications an lightly irrigate soil prior to laying sod. Sod is to be laid on the contour with all ends tightly abutting. Joints are to be staggered between rows. Water and roll or tamp sod to insure positive root contact with the soil. All slopes steeper than 3:1, as shown, are to be permanently sodded or protected with an approved erosion control netting. Additions watering for establishment may be required. Sod is not to be installed on frozen ground Sod shall not be transplanted when moisture content (dry or wet) and/or extreme temperature may adversely affect its survival. In the absence of adequate rainfall irrigation should be performed to ensure establishment of sod.

Install sod as per ITEM 904.

MINING OPERATIONS

For seeding dates of: February 1 through April 30 and August 15 through October 31, use seed mixture of tall fescue at the rate of 2 pounds per 1,000 square feet and red top at the minimum rate of 0.5 pounds per 1,000 square feet.

NOTE: Use of this information does not preclude meeting all of the requirements of the current Maryland Standards and Specifications for Soil Erosion and Sediment Control.

# AASCD/MAA NOTES

THE PROPOSED PROJECT IS LOCATED IN HOWARD COUNTY, MARYLAND ON TAX MAP 38, BLOCK 14, PARCEL 342. THE PROPOSED PROJECT IS LOCATED NEAR THE BALTIMORE WASHINTON INTERNATIONAL THURGOOD MARSHALL AIRPORT (BWI), APPROXIMATELY 12,300 FEET NORTHWEST OF RUNWAY 10.

SEDIMENT BASINS AND TRAPS ARE PROPOSED FOR SEDIMENT AND EROSION CONTROL DURING CONSTRUCTION. F-12-095

SEDIMENT TRAPS AND BASINS MUST BE DRAINED COMPLETELY THROUGH A FILTERING DEVICE TO A CLEAN WATER OUTFALL WITHIN 24 HOURS FOLLOWING ANY RAINFALL EVENT. F-12-095

LANDSCAPING & STORM WATER POND LANDSCAPING ON SITE:


3. ANY DEVIATION TO PLANT SPECIES AND VEGETATION USED ON THESE PLANS NEED APPROVAL FROM AASCD/MAA. THE PLANT SPECIES USED ON THIS SITE ARE TO AVOID ITS POTENTIAL TO ATTRACT WILDLIFE THAT COULD POSE STRIKE HAZARD TO AIRCRAFT.

**BWI AIRPORT NOISE ZONE:** 4. THE SITE FOR THIS PROJECT IS LOCATED OUTSIDE THE BOUNDARIES OF THE AIRPORT NOISE ZONE.

5. THE ALLOWABLE HEIGHT FOR ANY PERMANENT OR TEMPORARY STRUCTURES TALLER THAN 255 FEET ABOVE MEAN SEA LEVEL NEED OBSTRUCTION ANALYSIS REVIEW AND PERMIT FOR THE AIRPORT ZONE.

6. THE STORM WATER MANAGEMENT FACILITIES WITHIN 10,000 FEET OF ACTIVE RUNWAYS OR WITHIN 5 MILES OF AN APPROACH/DEPARTURE SURFACE MUST DRAIN WITHIN 24 HOURS FOLLOWING A 1 OR 2 YEAR STORM EVENT AND WITHIN 48 HOURS FOLLOWING A 10 YEAR STORM EVENT


> **BUILDER AND DEVELOPER/OWNER** MAIN STREET BUILDERS 5705 LANDING ROAD ELKRIDGE, MARYLAND 21075-5742

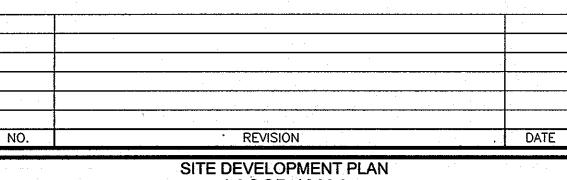


AASCD / MAA **NOTES & DETAILS BASHAM PROPERTY** 

1ST ELECTION DISTRICT TAX MAP: 38 GRID: 14

HOWARD COUNTY, MARYLAND DPZ REF'S: SP-08-010, F-12-095, W/S CONTRACT 14-4557-D

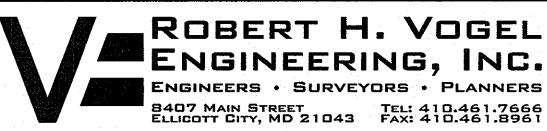

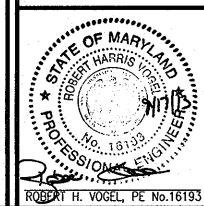

CHECKED BY: SCALE:

SHEET \_\_

PARCEL: 342

APPROVED: HOWARD COUNTY DEPARTMENT OF PLANNING AND ZONING 10.21.13 DATE /13 <u> در / حج / ۰ /</u> DATE