

LEGEND

- EXISTING CONTOURS
- PROPOSED CONTOURS
- EXISTING TREELINE
- PROPOSED TREELINE
- EXISTING STREAM
- EXISTING STREAMBANK BUFFER
- 100 YEAR FLOODPLAIN LIMITS
- 100 YEAR FLOODPLAIN DRAINAGE & UTILITY EASEMENT
- FOREST CONSERVATION EASEMENT
- FOREST CONSERVATION SIGN
- EXISTING STRUCTURE
- PROPOSED BUILDING
- SLOPES 25% OR GREATER
- MODERATE SLOPES
- EX. 20' DRAINAGE AND UTILITY EASEMENT
- PUBLIC DRAINAGE & UTILITY EASEMENT, PLAT #
- PUBLIC WATER & UTILITY EASEMENT
- PROP. MICRO-BIORETENTION FACILITY
- PROP. PERMEABLE PAVEMENT
- PROP. GAZEBO/PAVILION
- PROP. 5' PARK BENCH
- PROP. LANDSCAPING
- LIMIT OF DISTURBANCE
- EARTH DIKE
- STABILIZED CONSTRUCTION ENTRANCE
- SUPER SILT FENCE
- SILT FENCE
- INLET PROTECTION

DENSITY EXCHANGE CHART

RECEIVING PARCEL INFORMATION	TAX MAP 24, GRID 1, PARCEL 647
TOTAL AREA OF SUBDIVISION	3.01 AC
AREA OF FLOODPLAIN	0.27 AC
AREA OF STEEP SLOPES	0.26 AC
DENSITY UNITS PER NET AREA	2.47 * 15 = 37 D.U.
NUMBER OF UNITS PROPOSED	40
NEIGHBORHOOD PRESERVATION DENSITY EXCHANGE RIGHTS REQUIRED	1 (APARTMENT UNITS = 0.33 RIGHTS PER UNIT - 0.33*3 = 0.99 RIGHTS)
SENDING PARCEL INFORMATION	PHELPS PROPERTY, PLAT # 14-042, TAX MAP 18, GRID 1, PARCEL 357

SITE DEVELOPMENT PLAN

ORCHARD PARK SECTION 3

ROMANIK PROPERTY, LOT 1 AND ORCHARD HILL, OPEN SPACE LOT 3

SDP-13-055

BENCH MARKS

HO. CO. #0068 (NAD '83) ELEV. 386.52
STANDARD DISC ON CONCRETE MONUMENT
RT. 40 BY ENCHANTED FOREST SHOPPING CENTER
N 587380.50 E 1,352603.44

HO. CO. #2485 (NAD '83) ELEV. 390.17
STANDARD DISC ON CONCRETE MONUMENT
ISLAND AT CORNER OF RT. 40 AND DOGWOOD DR.
N 586956.27 E 1356570.78

VICINITY MAP
SCALE: 1" = 2000'
ADC MAP 20 GRID A6

PARKING TABULATIONS

PROPOSED BUILDING USE: APARTMENT
NUMBER OF UNITS PROPOSED: 40
NUMBER OF SPACES REQUIRED: 1.7/UNIT=68 SPACES
TOTAL "80" SPACES
0.3/UNIT OVERFLOW=12 SPACES
* USED FOR DENSITY

NUMBER OF SPACES PROVIDED: 84 (INCLUDING 4 HC SPACES)
*BASED ON AN ANALYSIS PREPARED BY THE TRAFFIC GROUP DATED JULY 30, 2013. THE PARKING NEEDS MAY BE REDUCED.

SITE ANALYSIS DATA/TABULATION


A) TOTAL PROJECT AREA.....	3.01 AC
B) AREA OF WETLANDS AND BUFFER.....	N/A
C) AREA OF 100-YR. FLOODPLAIN.....	0.27 AC
D) AREA OF EXISTING FOREST.....	2.08 AC
E) AREA OF STEEP SLOPES 25% OF GREATER.....	0.26 AC
F) NET AREA OF SITE.....	2.48 AC
G) AREA OF MODERATE SLOPES 15% TO 25%.....	1.35 AC
H) HIGHLY ERODIBLE SOILS (K< 0.35).....	0.75 AC
I) NUMBER OF UNITS ALLOWED.....	37 (2.48 AC * 15)
J) NUMBER OF RESIDENTIAL UNITS PROPOSED.....	40 (3 ALLOCATIONS THRU DENSITY EXCHANGE, PHELPS PROPERTY)
K) AREA OF PLAN SUBMISSION.....	3.04 AC
L) LIMIT OF DISTURBED AREA.....	1.41 AC
M) OPEN SPACE REQUIRED.....	0.75 AC (25% OF 3.0 AC)
N) OPEN SPACE PROVIDED.....	0.75 AC (25% OF 3.0 AC)
O) PRESENT ZONING DESIGNATION.....	R-A-15
P) PROPOSED USE.....	SINGLE FAMILY ATTACHED/APARTMENTS
Q) IMPERVIOUS COVER.....	0.94 AC
R) APPLICABLE DPZ #.....	F-84-130, PLAT # 5851, WP-13-074, ECP-13-012, F-14-025, F-14-042, F-16-042
S) PROPOSED WATER AND SEWER.....	X PUBLIC, PRIVATE F-86-291
T) PROPOSED USE OF SITE.....	APARTMENT BUILDING-11,100 SF

SHEET INDEX

NO.	DESCRIPTION
1	TITLE SHEET
2	SITE PLAN
3	GRADING, SEDIMENT AND EROSION CONTROL PLAN
4	SEDIMENT AND EROSION CONTROL DETAILS
5	STORM DRAIN DRAINAGE AREA MAP
6	STORMWATER MANAGEMENT NOTES, DETAILS AND STORM DRAIN PROFILES
7	LANDSCAPE AND FOREST CONSERVATION PLAN
8	FOREST CONSERVATION NOTES AND DETAILS
9	SIGHT DISTANCE ANALYSIS
10	LIGHTING PHOTOMETRIC PLAN
11	RETAINING WALL PLAN AND DETAILS



ADDRESS CHART

LEVEL	STREET ADDRESS	UNIT NUMBERS
1	3200 PINE ORCHARD LANE	101-110
2	3200 PINE ORCHARD LANE	201-210
3	3200 PINE ORCHARD LANE	301-310
4	3200 PINE ORCHARD LANE	401-410

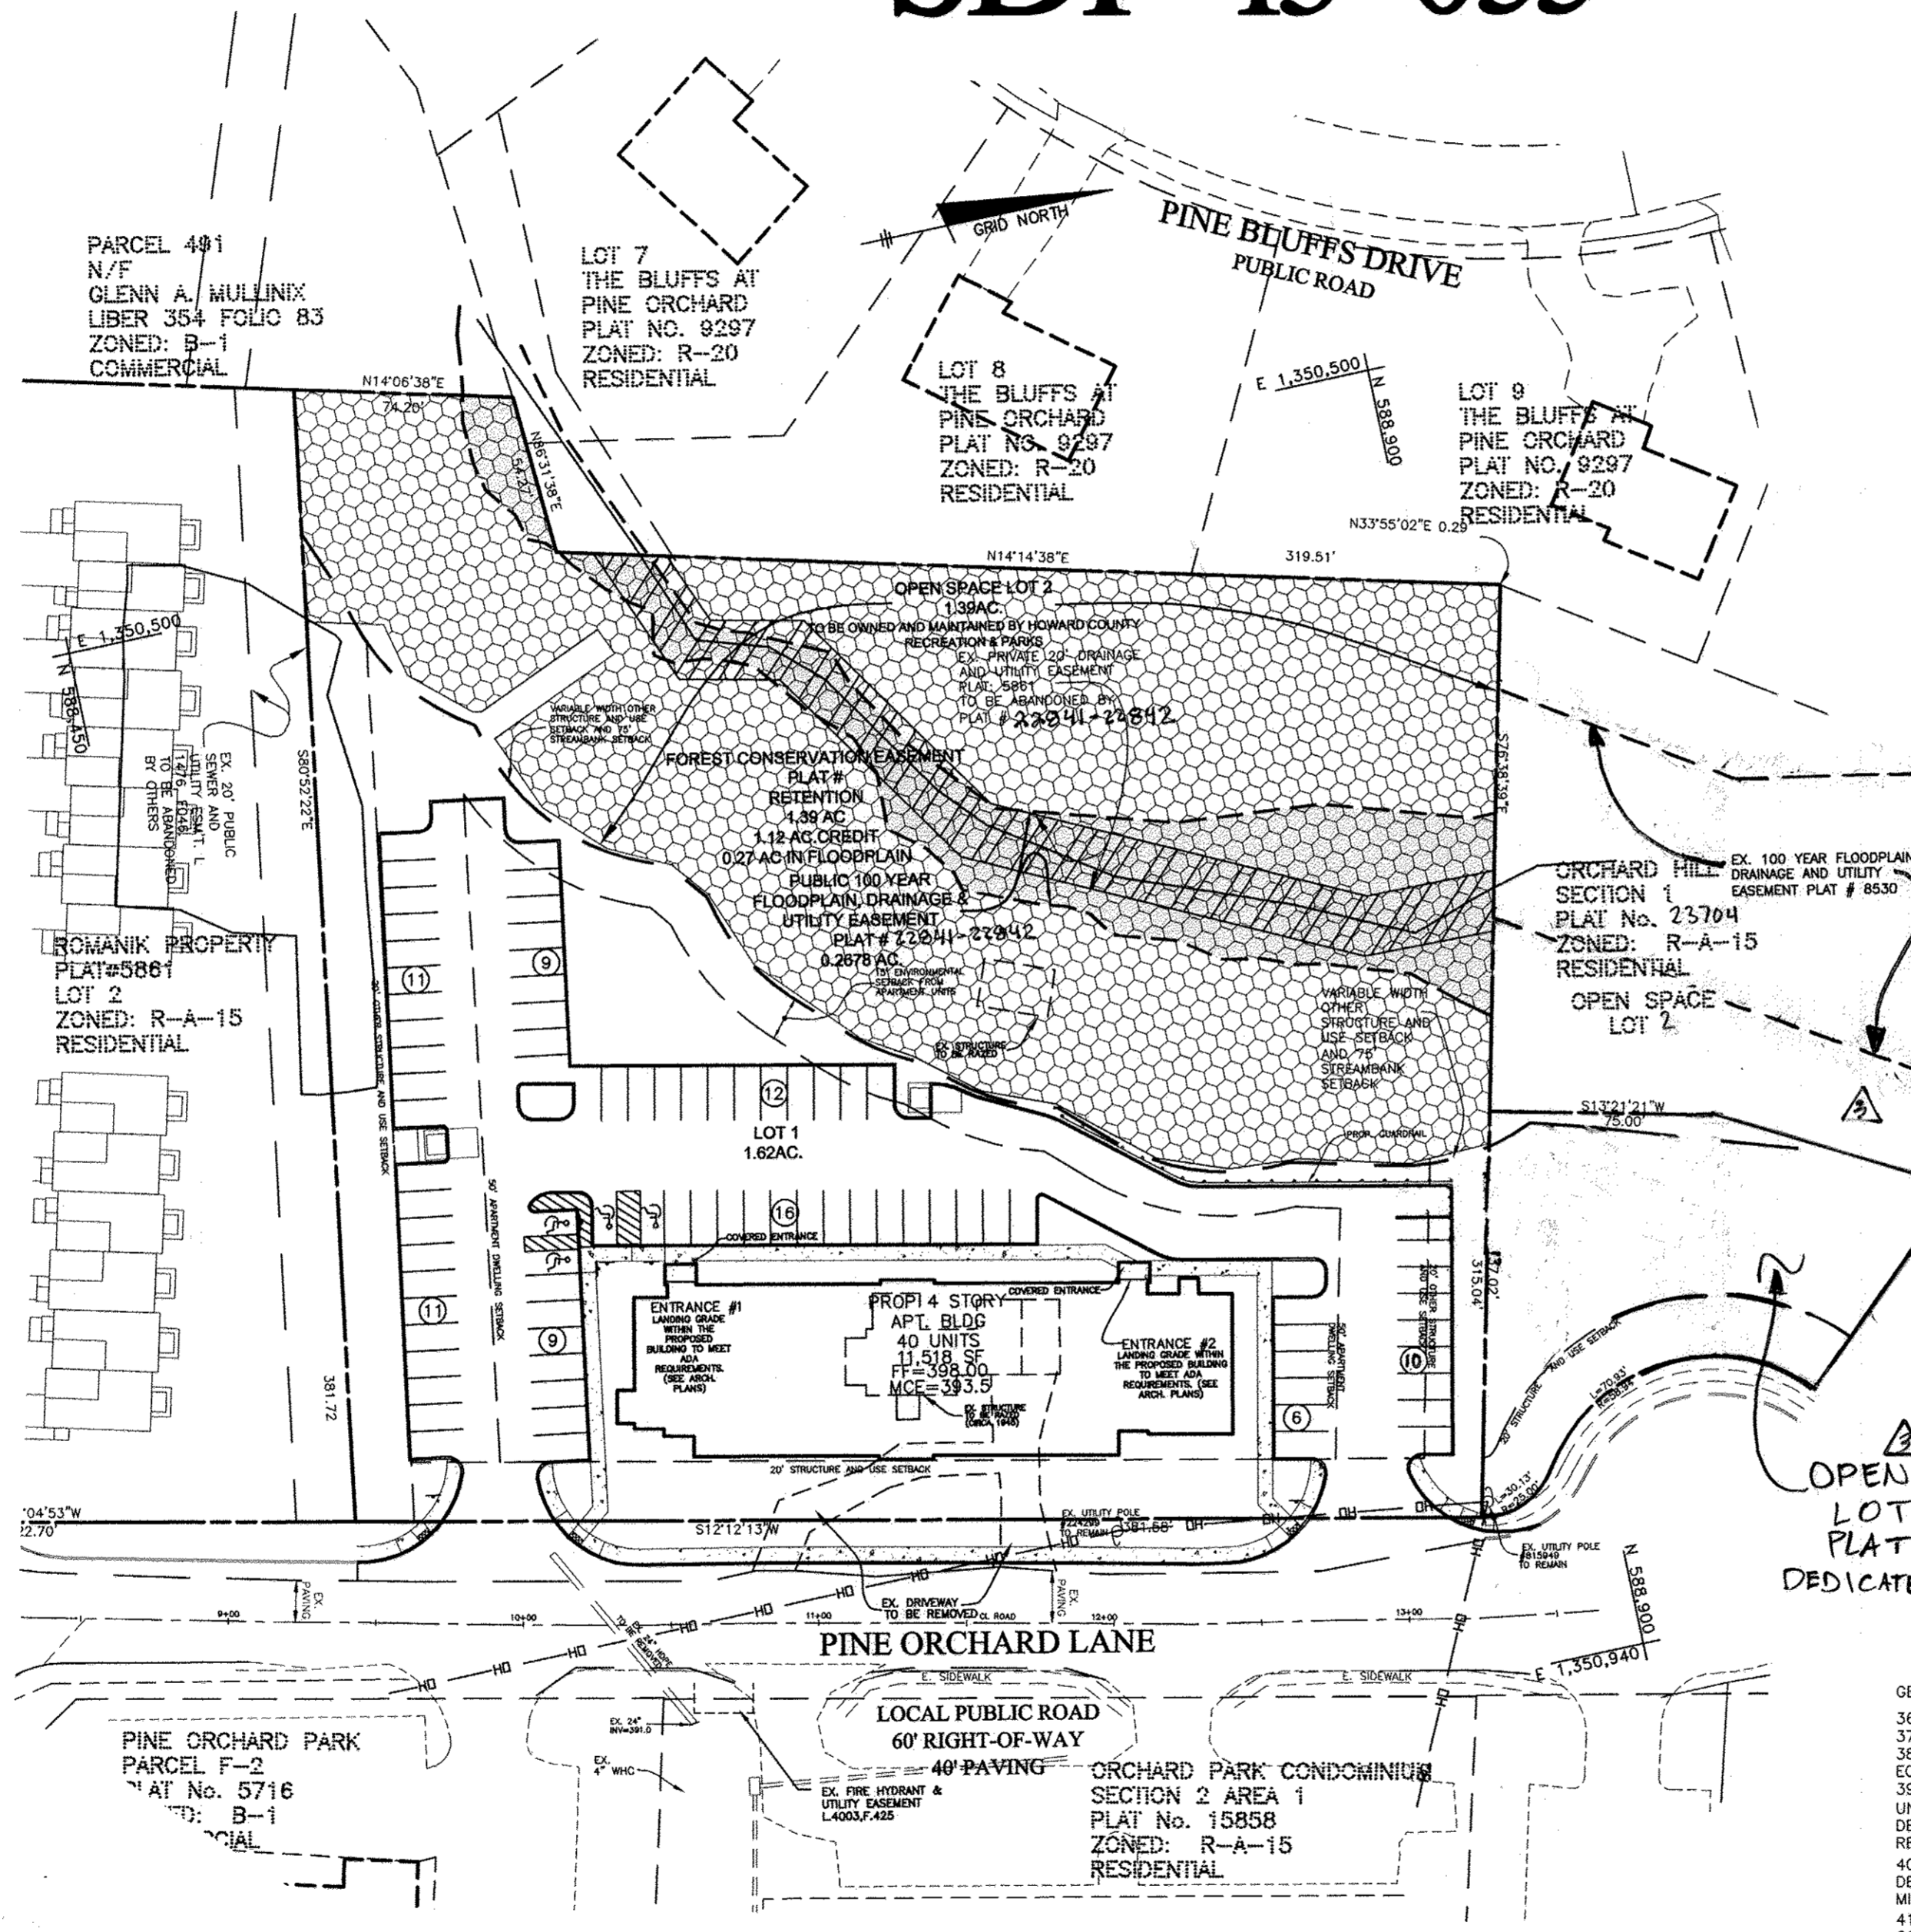

Professional Certification. I hereby certify that these documents were prepared or approved by me, and that I am a duly licensed professional engineer under the laws of the State of Maryland.

License No. 21443 Expiration Date: 12-21-16

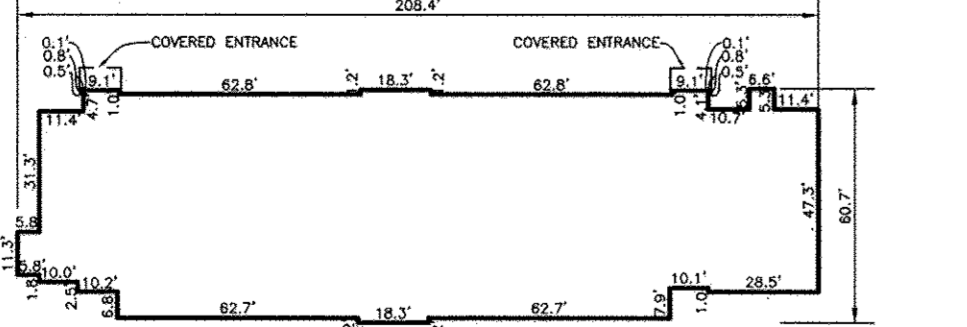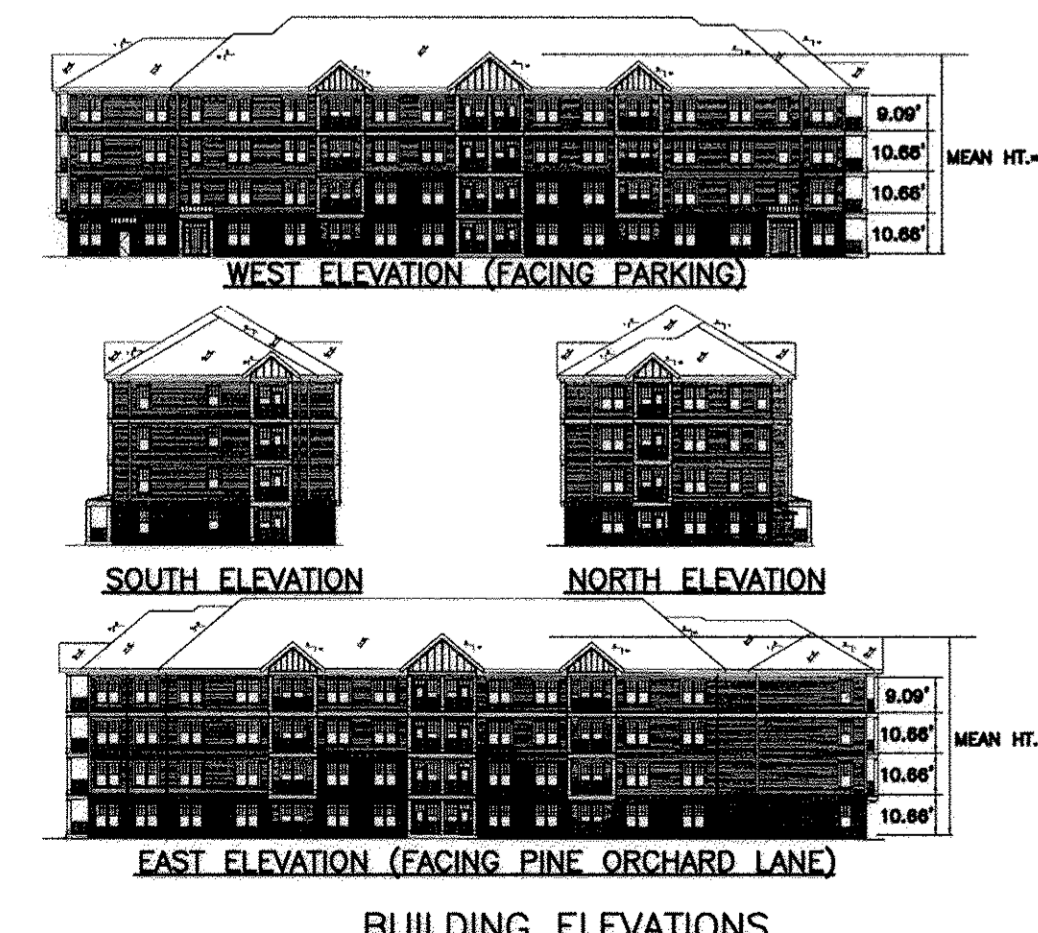

SWM SUMMARY TABLE

Pa#	2.2	inches	D.A.	MDE Type	Total DA	Impervious Area	Qe	Required	Provided	2% DA	Depth	Required	Provided	78% ESDv	Rev
MBR-1	(M-6)	16,490	14,089	1.80	1814	1867	PASS	2.0	1857	1867	PASS	127			
MBR-2	(M-6)	3,220	2,700	1.77	354	408	PASS	2.0	356	408	PASS	28			
PP-1	(A-2)	5530	4018	1.55	N/A	N/A	N/A	N/A	996	996	PASS	189			
PP-2	(A-2)	4879	3421	1.50	N/A	N/A	N/A	N/A	882	3444	PASS	160			
PP-3	(A-2)	5953	4009	1.44	N/A	N/A	N/A	N/A	1079	4271	PASS	252			
PP-4	(A-2)	4555	2835	1.39	N/A	N/A	N/A	N/A	319	3324	PASS	145			
PP-5	(A-2)	1242	270	0.54	N/A	N/A	N/A	N/A	191	1129	PASS	38			
PP-6	(A-2)	4721	2008	0.95	N/A	N/A	N/A	N/A	881	3879	PASS	109			
					46,540	33,450		2,168	2,275			6,561	22,253		1,021 1,048

PERMIT INFORMATION CHART

SUBDIVISION NAME:	ORCHARD PARK SECTION 3 (ROMANIK PROPERTY)	SECTION/AREA:	NA	LOT/PARCEL #	LOT 1
PLAT NO. OR L/F:	5861, 2554	GRID NO.	1	ZONE	R-A-15
TAX MAP NO.	24	ELECTION DISTRICT	2	CENSUS TRACT	6012.00
22841-22842					

APPROVED: HOWARD COUNTY DEPARTMENT OF PLANNING AND ZONING

Chief, Development Engineering Division *[Signature]* 6/7/14

Chief, Division of Land Development *[Signature]* 6/19/14

Director *[Signature]* 6/19/14

BUILDING FOOTPRINT
SCALE: 1" = 50'




ESD	DA	%IMP.	SURFACE AREA	NOTES
MBR-1	0.38 AC.	85	1867 SF	ALL BUILDING, PARKING LOT RUNOFF
MBR-2	0.07 AC.	84	408 SF	PARKING LOT RUNOFF
PP-1	0.13 AC.	100	1512 SF	PARKING LOT RUNOFF
PP-2	0.11 AC.	100	1458 SF	PARKING LOT RUNOFF
PP-3	0.14 AC.	100	1944 SF	PARKING LOT RUNOFF
PP-4	0.10 AC.	100	1620 SF	PARKING LOT RUNOFF
PP-5	0.03 AC.	100	804 SF	PARKING LOT RUNOFF
PP-6	0.11 AC.	100	2713 SF	PARKING LOT RUNOFF

BENCHMARK ENGINEERING, INC.
8480 BALTIMORE NATIONAL PIKE SUITE 315 ELLICOTT CITY, MARYLAND 21043
(P) 410-465-8105 (F) 410-465-8044
WWW.BE-ENGINEERING.COM

ORCHARD PARK SECTION 3
3200 PINE ORCHARD LANE, OPEN SPACE LOT 3
ROMANIK PROPERTY, LOT 1 AND ORCHARD HILL, OPEN SPACE LOT 3
TAX MAP: 24 & 17, GRID: 1 & 19, PARCEL: 647 & P/O 130
ZONED: R-A-15
ELECTION DISTRICT NO. 2
HOWARD COUNTY, MARYLAND

SITE DEVELOPMENT PLAN TITLE SHEET


DATE: MAY 2014 BEI PROJECT NO. 1796
SCALE: AS SHOWN SHEET 1 OF 11

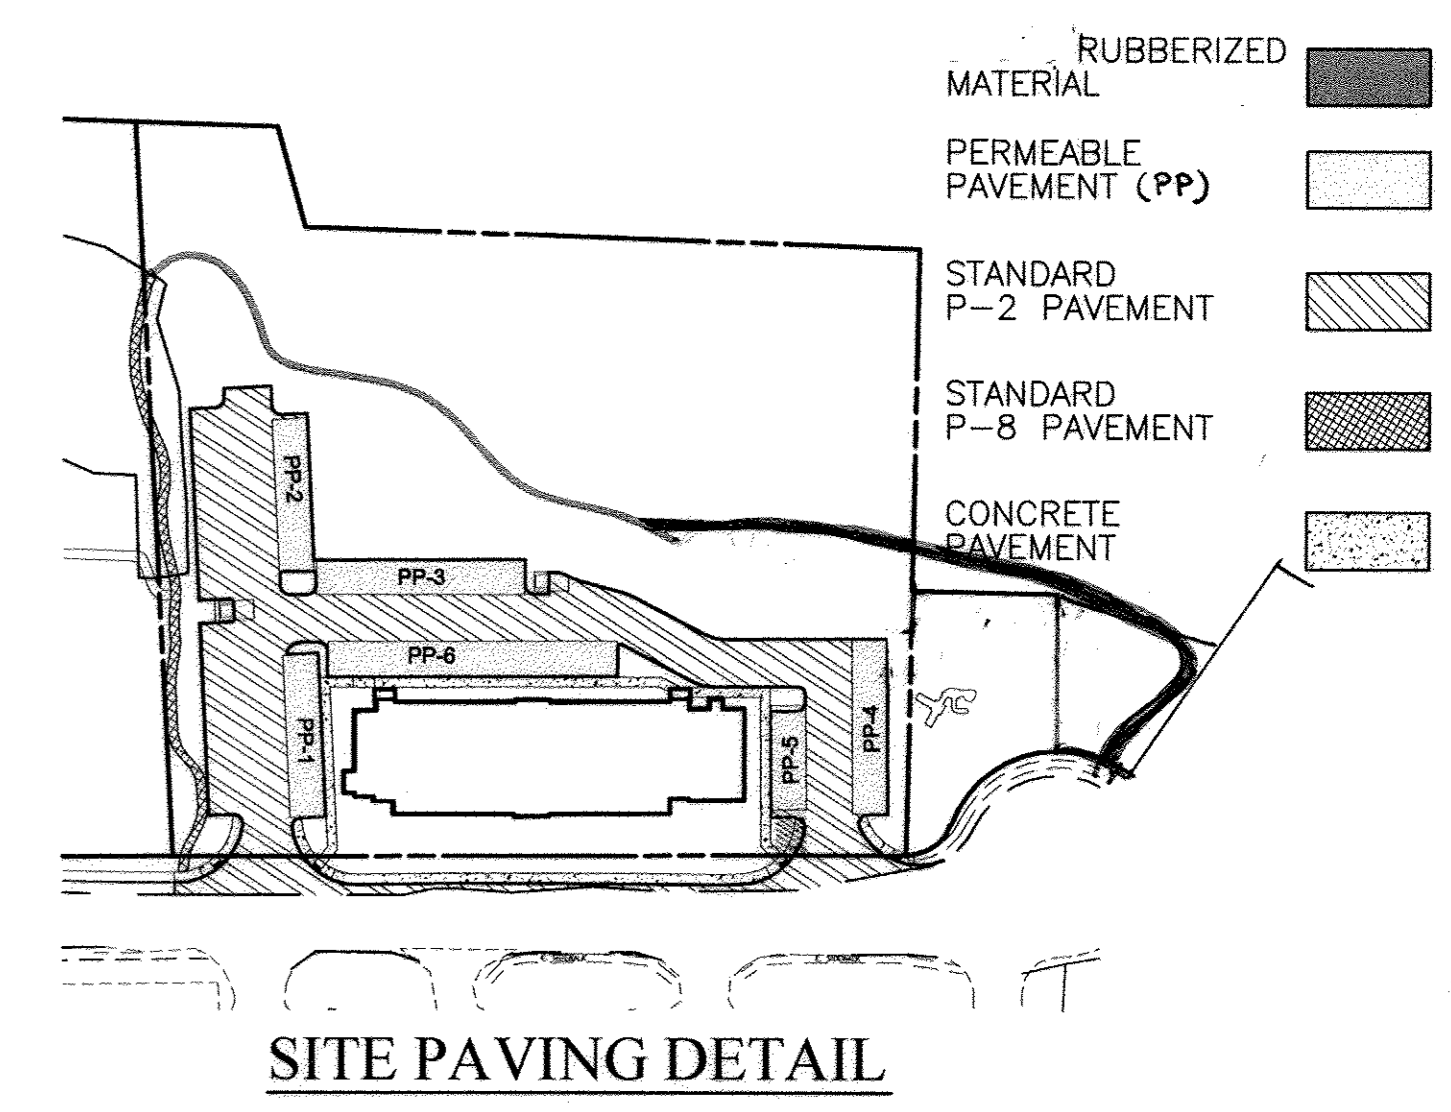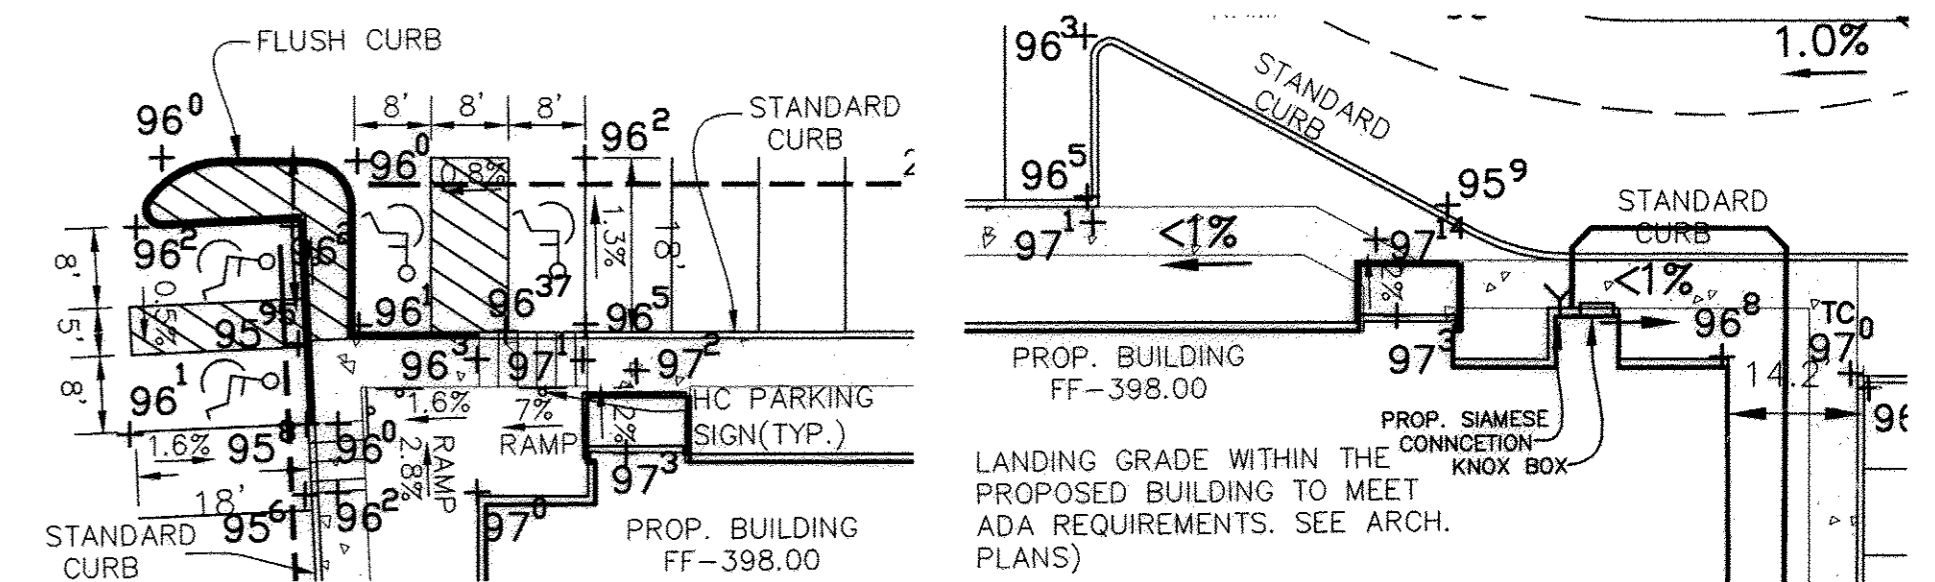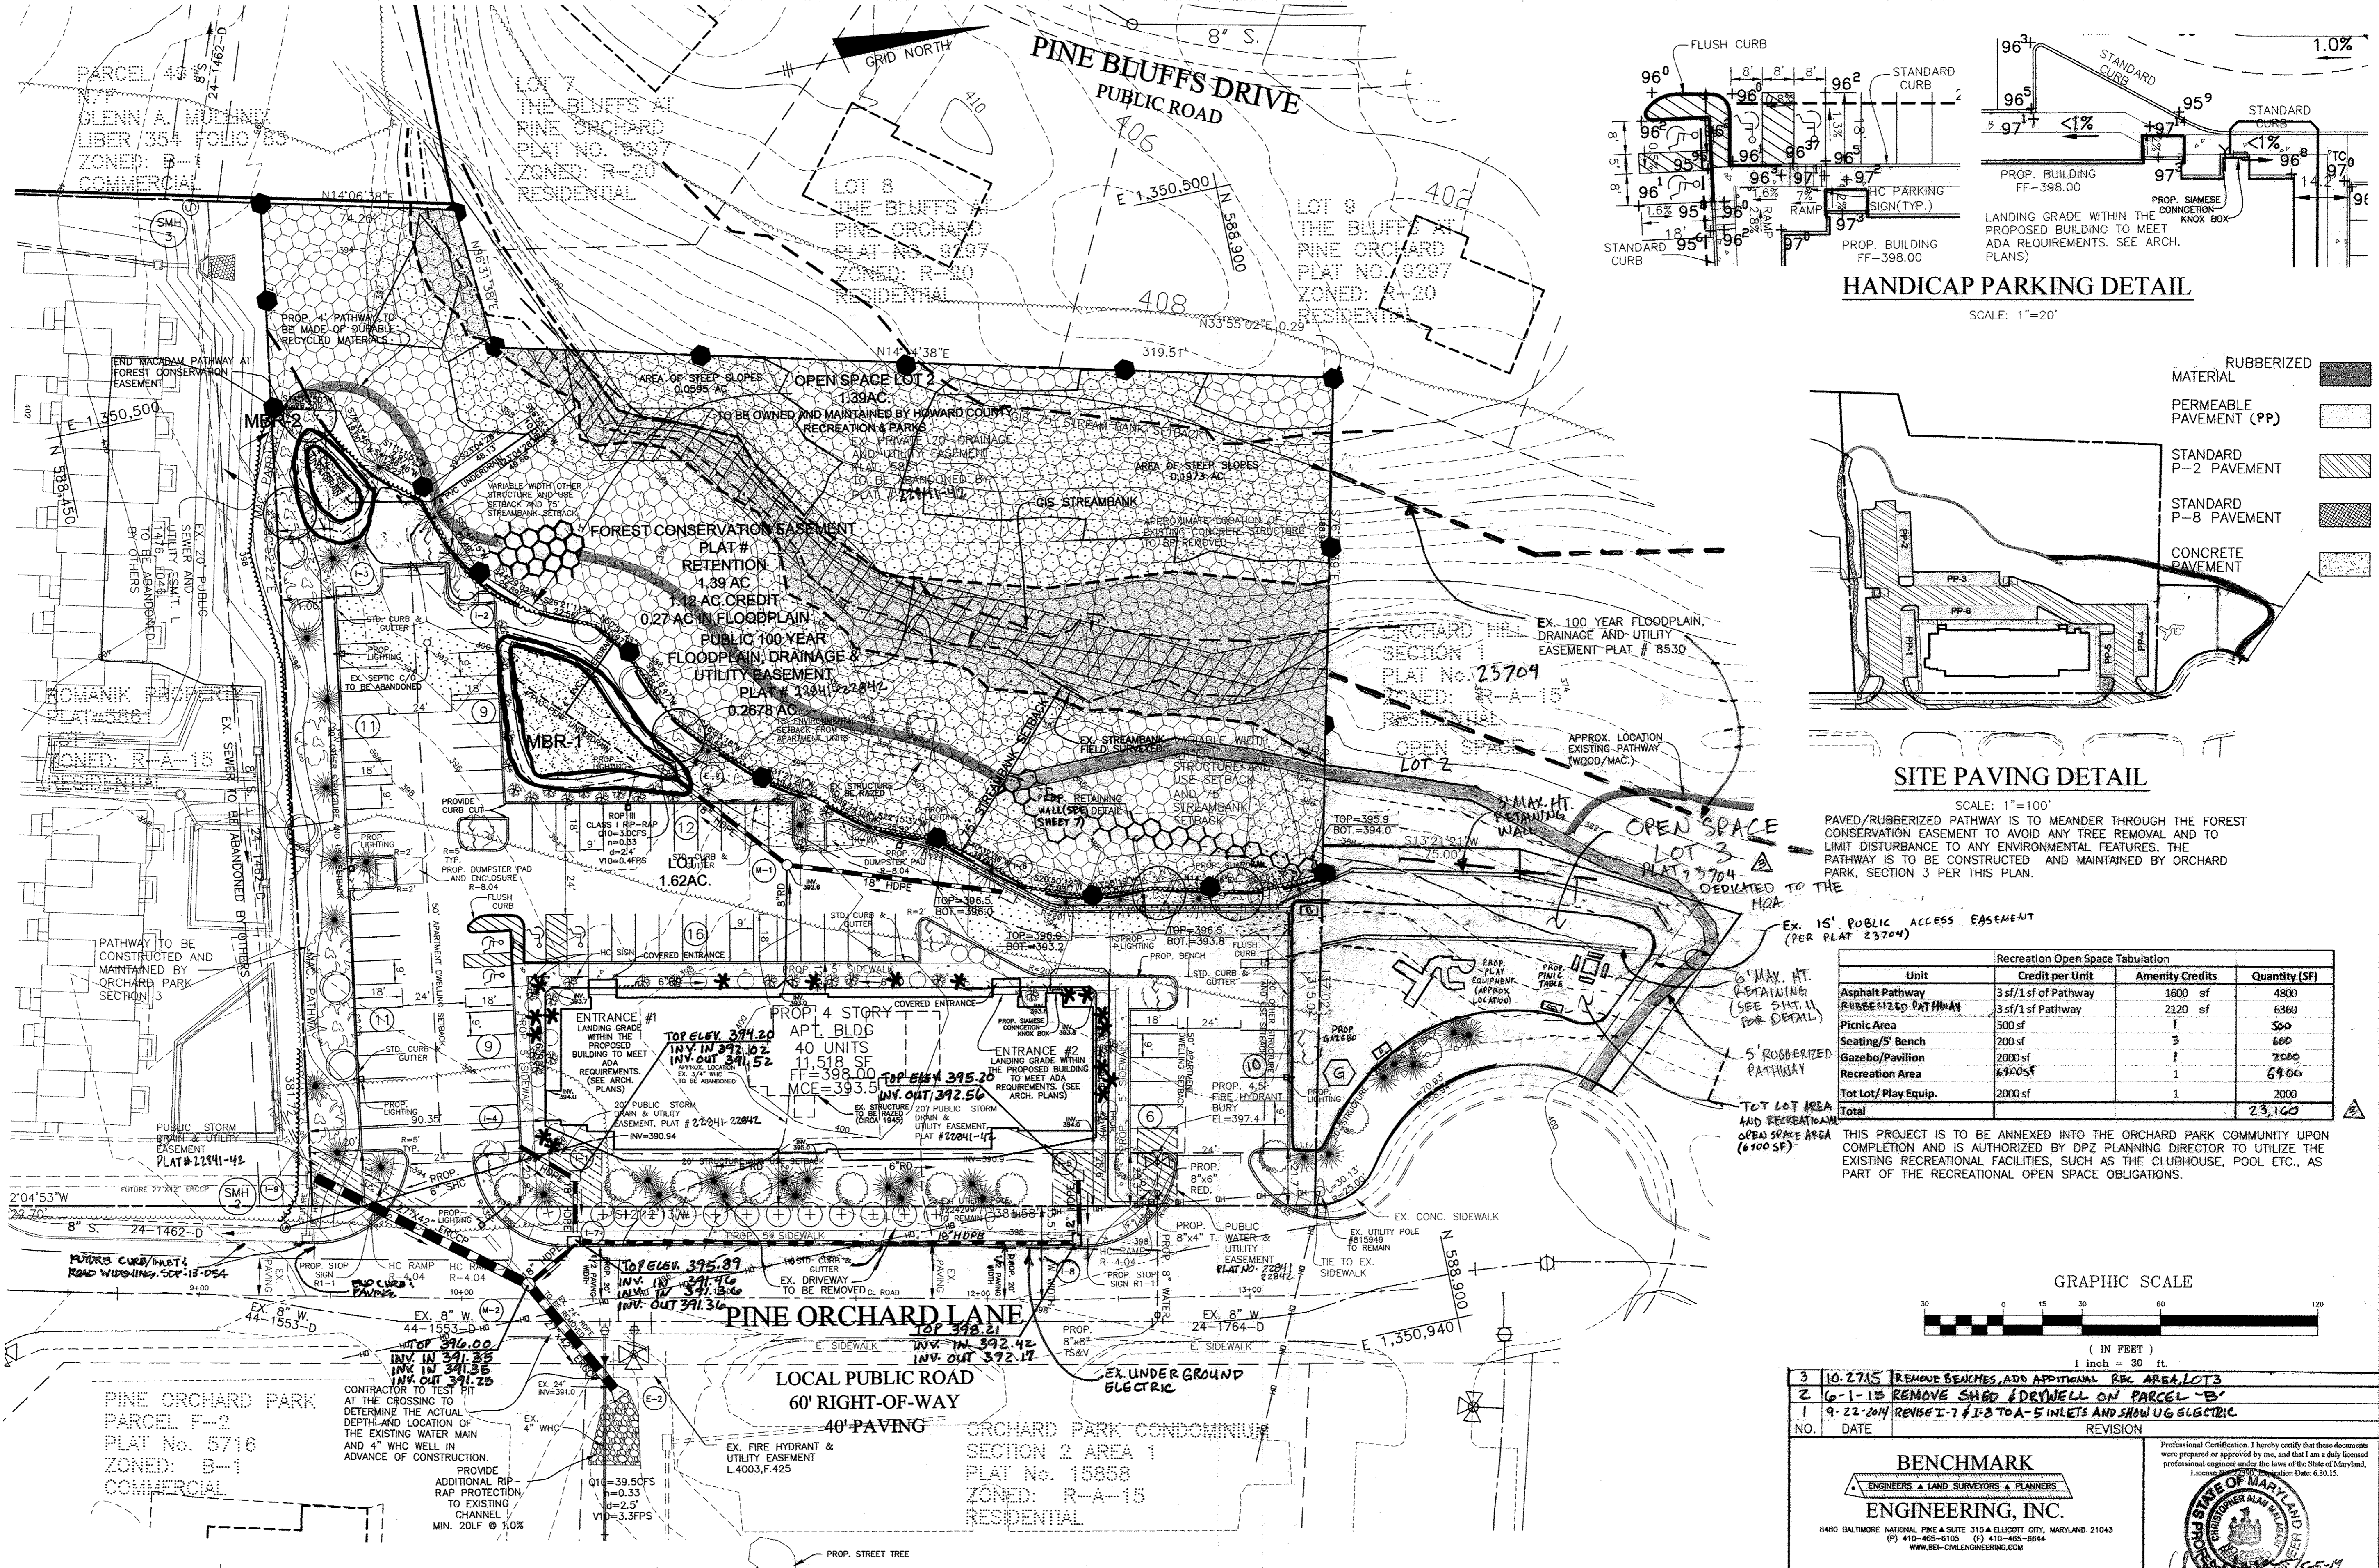

Recreation Open Space Tabulation

Unit	Credit per Unit	Amenity Credits	Quantity (SF)
Asphalt Pathway	3 sf/1 sf of Pathway	1600 sf	4800
RUBBERIZED PATHWAY	3 sf/1 sf Pathway	2120 sf	6360
Picnic Area		1	500
Seating/5' Bench		3	600
Gazebo/Pavilion		1	2000
Recreation Area		1	6900
Tot Lot/Play Equip.		1	2000
Total			23,160

THIS PROJECT IS TO BE ANNEXED INTO THE ORCHARD PARK COMMUNITY UPON COMPLETION AND IS AUTHORIZED BY DPZ PLANNING DIRECTOR TO UTILIZE THE EXISTING RECREATIONAL FACILITIES, SUCH AS THE CLUBHOUSE, POOL ETC., AS PART OF THE RECREATIONAL OPEN SPACE OBLIGATIONS.

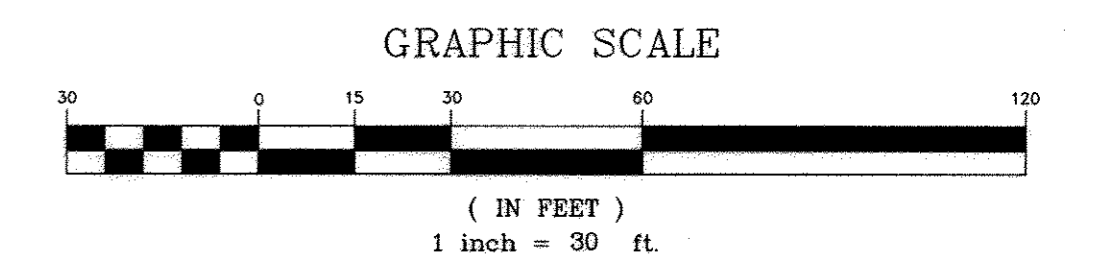

NO.	DATE	REVISION
3	10-27-15	REMOVE BENCHES, ADD ADDITIONAL REC AREA, LOTS
2	6-1-15	REMOVE SHAD DRYWELL ON PARCEL 'B'
1	9-22-2014	REVISE T-7 T-8 TO A-5 INLETS AND SHOW UG ELECTRIC

BENCHMARK ENGINEERING, INC.
8480 BALTIMORE NATIONAL PIKE & SUITE 315 ELLICOTT CITY, MARYLAND 21043
(P) 410-465-8100 (F) 410-465-8944
WWW.BE-CIVILENGINEERING.COM

Professional Certification. I hereby certify that these documents were prepared or approved by me, and that I am a duly licensed professional engineer under the laws of the State of Maryland. License No. 21443 Expiration Date: 12-31-16

ORCHARD PARK SECTION 3
3200 PINE ORCHARD LANE
ROMANIK PROPERTY, LOT 1 AND ORCHARD HILL, OPEN SPACE LOT 3
TAX MAP: 24 & 17, GRID: 1 & 19, PARCEL: 647 & P/O 130
ZONED: R-A-15
ELECTION DISTRICT NO. 2
HOWARD COUNTY, MARYLAND



SITE DEVELOPMENT PLAN
SITE PLAN

OWNER: LAKESHORE I, LLC
C/O SECURITY DEVELOPMENT
8480 BALTIMORE NATIONAL PIKE SUITE 415
ELLICOTT CITY, MD 21043

DEVELOPER: SECURITY DEVELOPMENT, LLC
PO BOX 417
ELLICOTT CITY, MD 21041
410-465-4244

DATE: MAY 2014
SCALE: 1"=30'

BEI PROJECT NO. 1796
SHEET 2 OF 11

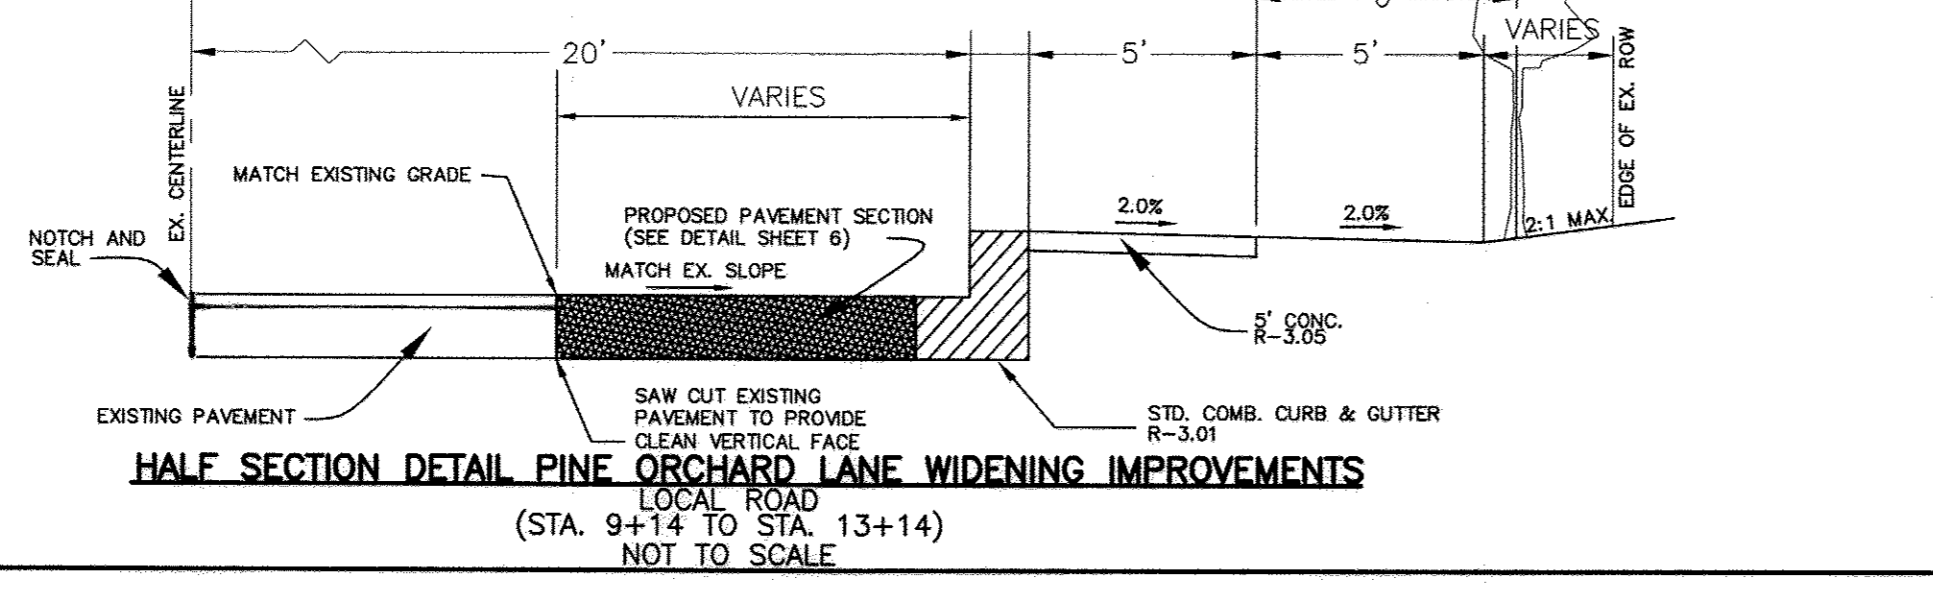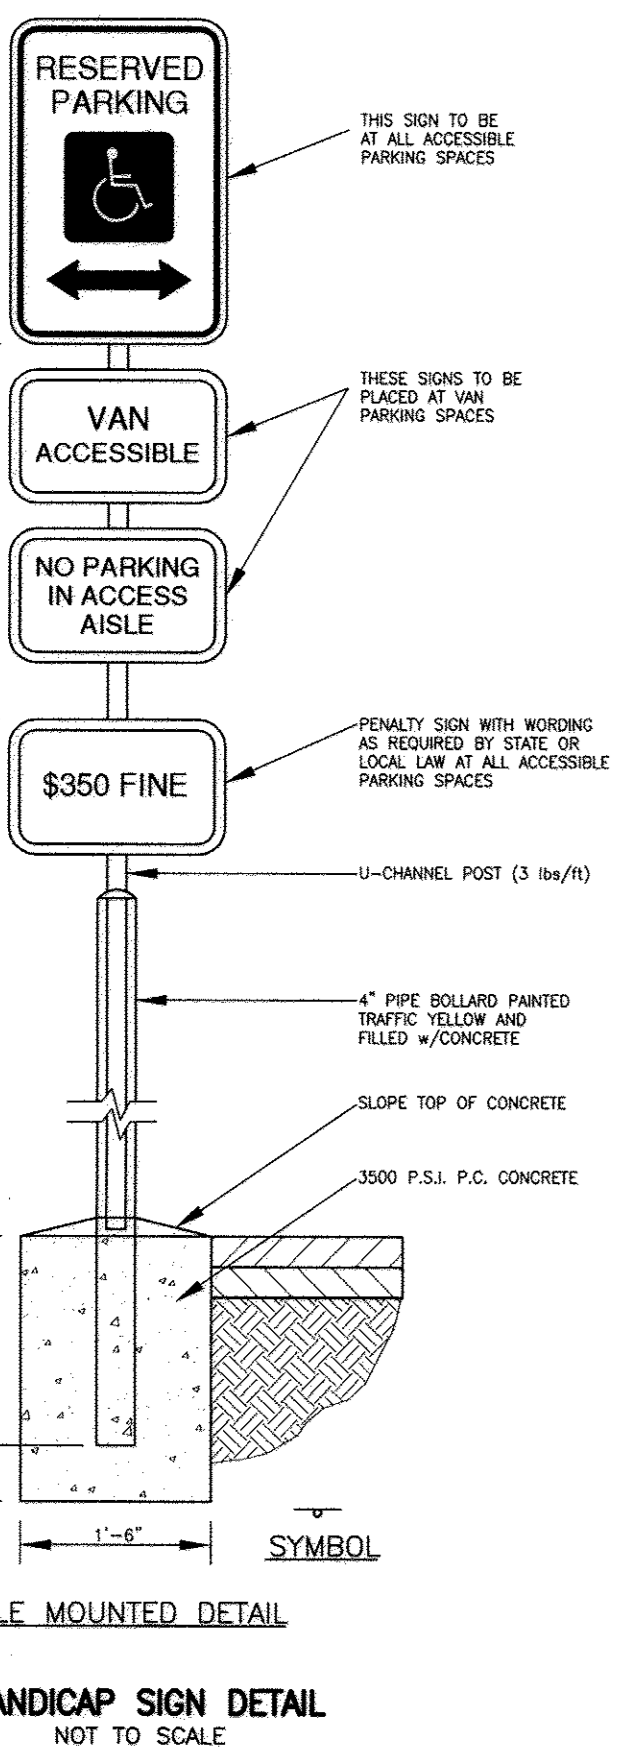

APPROVED: HOWARD COUNTY DEPARTMENT OF PLANNING AND ZONING

Chad Clark
CHIEF, DEVELOPMENT ENGINEERING DIVISION
DATE: 6/17/14


Vest DeLoach
CHIEF, DIVISION OF LAND DEVELOPMENT
DATE: 6/19/14

Joanuk K. Gough
DIRECTOR
DATE: 6/19/14



AS-BUILT CERTIFICATION
I hereby certify, by my seal, that the facilities shown on this plan were constructed as shown on this AS-BUILT plan.
Donald Mason, P.E. No. 21443 Date: 6-25-15

Professional Certification. I hereby certify that these documents were prepared or approved by me, and that I am a duly licensed professional engineer under the laws of the State of Maryland.
License No. 21443 Expiration Date: 12-31-16

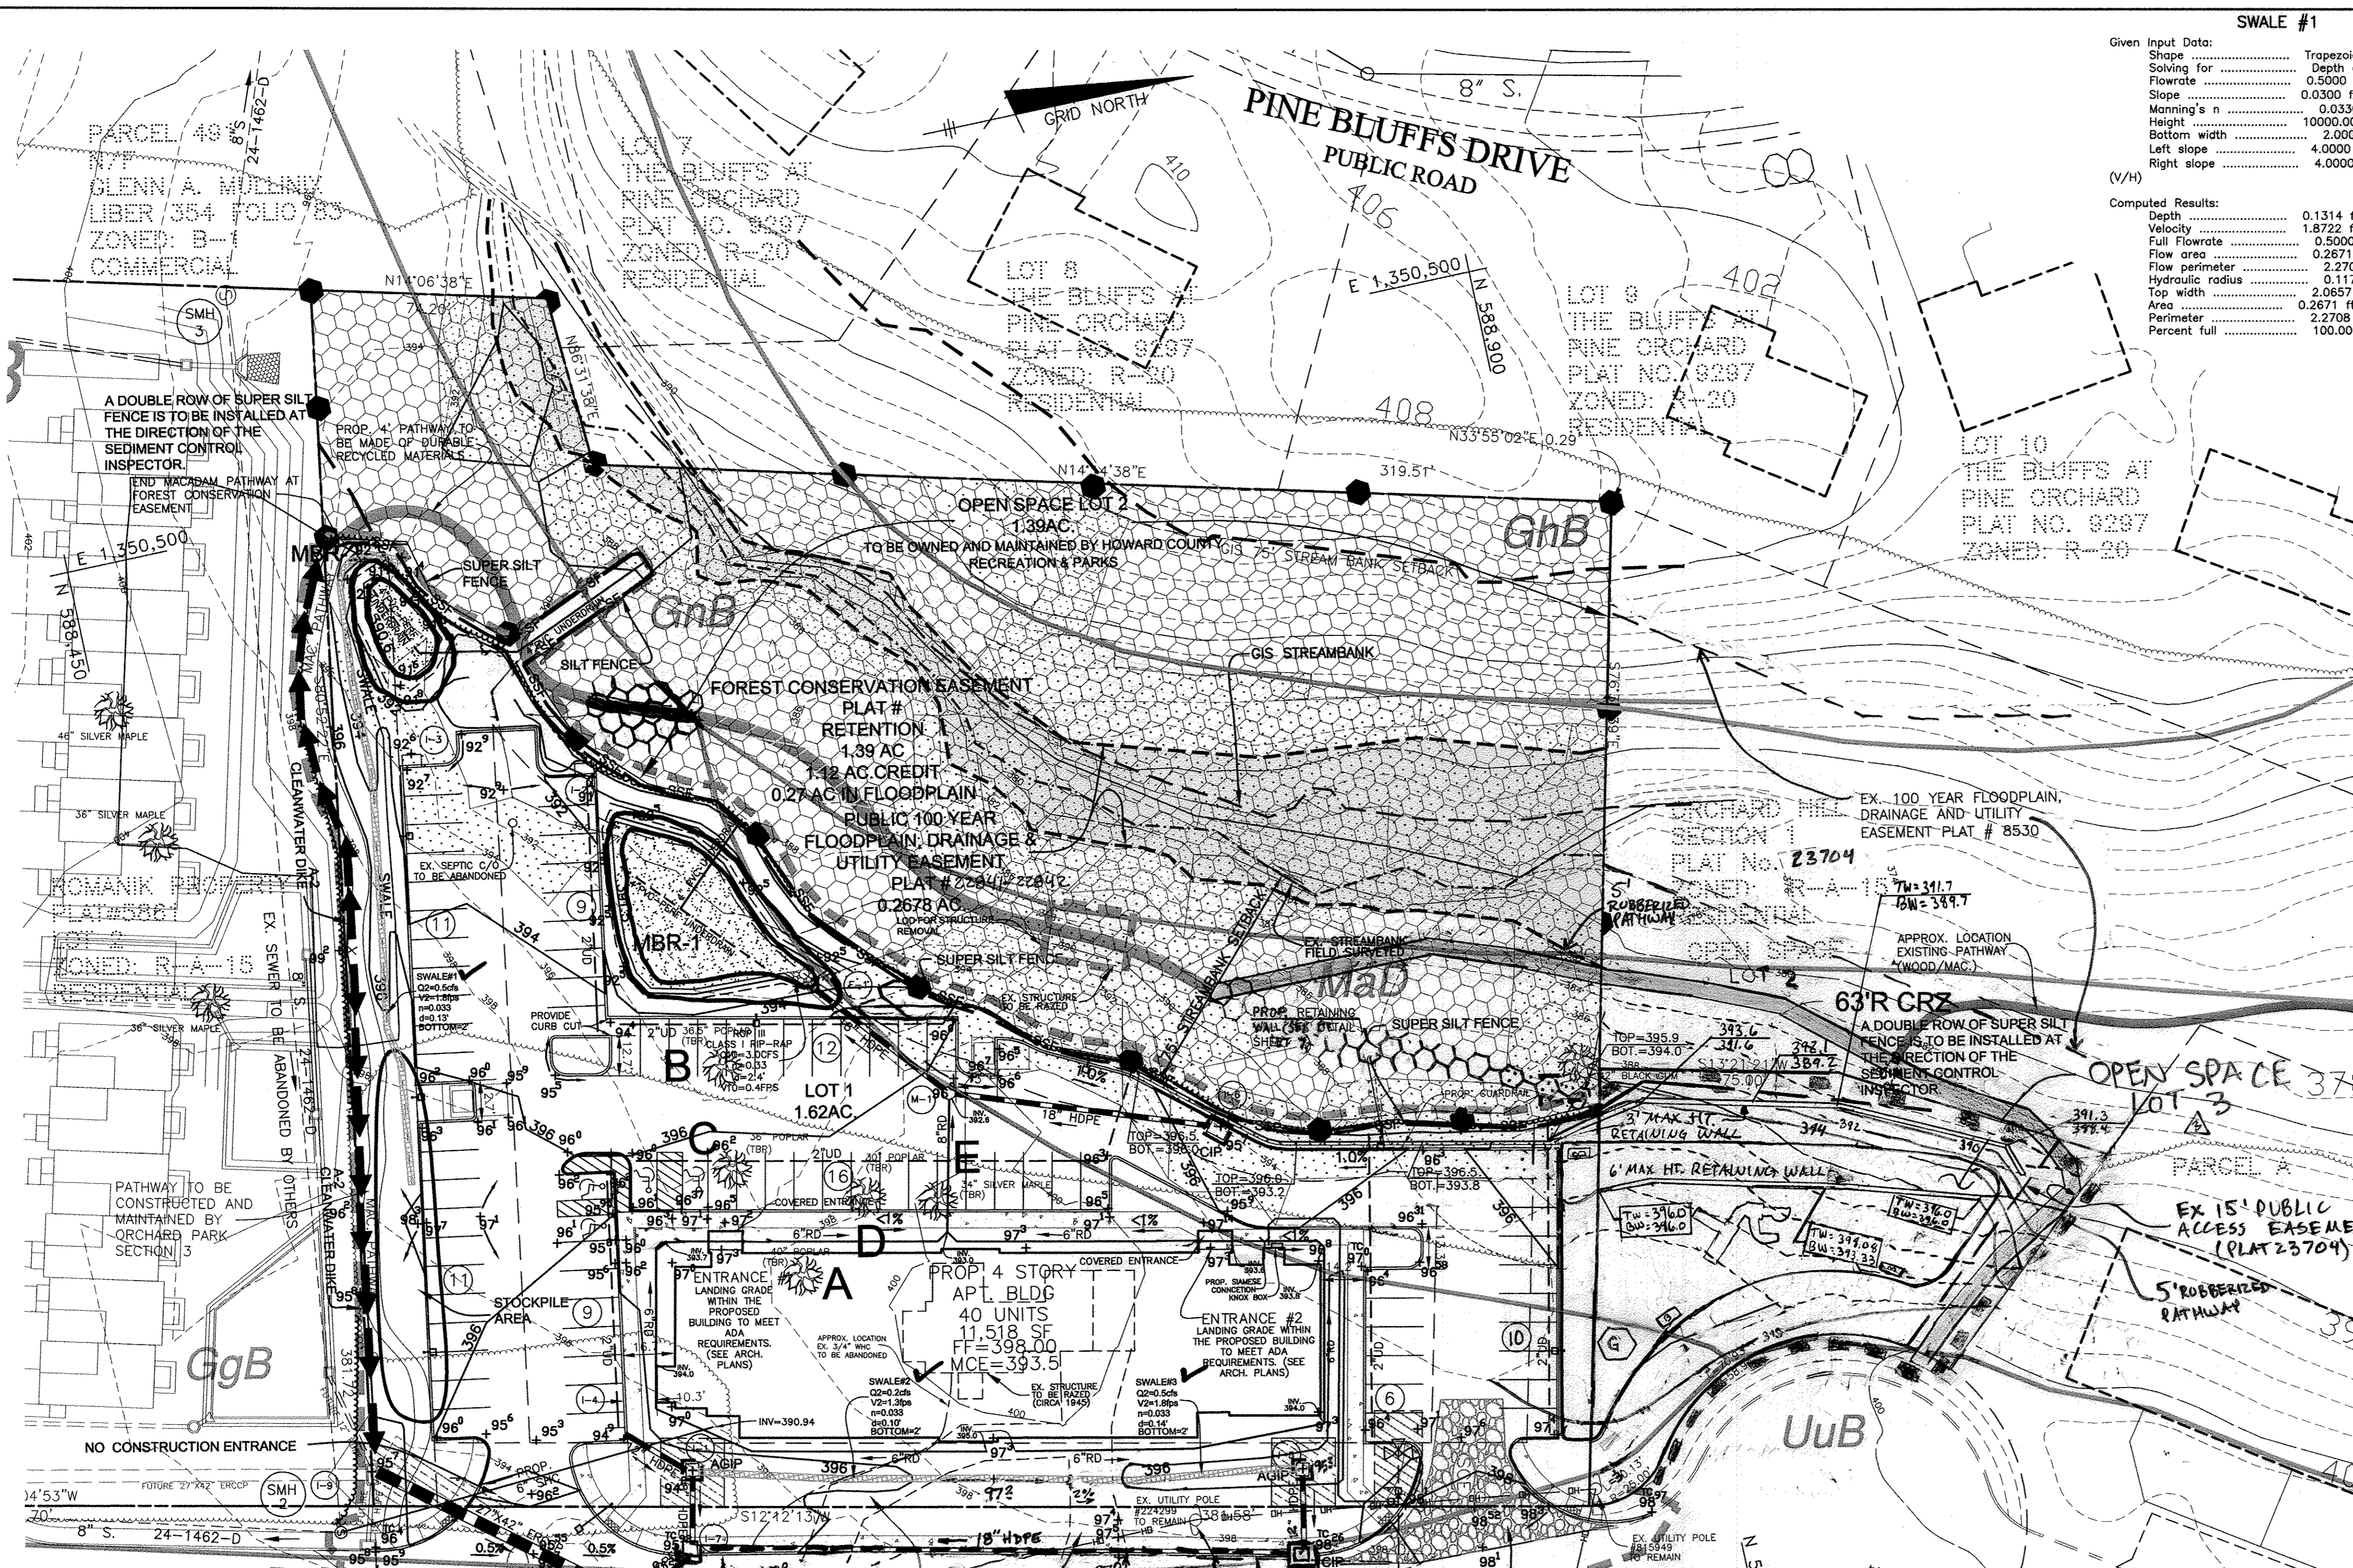

SWALE #1		SWALE #2		SWALE #3	
Given Input Data:	Shape: Trapezoidal	Given Input Data:	Shape: Trapezoidal	Given Input Data:	Shape: Trapezoidal
Solving for:	Depth of Flow: 0.5000 cfs	Solving for:	Depth of Flow: 0.5000 cfs	Solving for:	Depth of Flow: 0.5000 cfs
Flowrate:	0.5000 cfs	Flowrate:	0.2000 cfs	Flowrate:	0.0250 ft/ft
Slope:	0.0300 ft/ft	Slope:	0.0250 ft/ft	Slope:	0.0330
Manning's n:	0.0330	Manning's n:	0.0330	Manning's n:	0.0330
Height:	10000.0000 ft	Height:	10000.0000 ft	Height:	1.0000 ft
Bottom width:	2.0000 ft	Bottom width:	2.0000 ft	Bottom width:	2.0000 ft
Left slope:	4.0000 ft/ft (V/H)	Left slope:	6.0000 ft/ft (V/H)	Left slope:	2.5000 ft/ft (V/H)
Right slope:	4.0000 ft/ft (V/H)	Right slope:	6.0000 ft/ft (V/H)	Right slope:	2.5000 ft/ft (V/H)
Computed Results:	Depth: 0.1314 ft	Computed Results:	Depth: 0.0783 ft	Computed Results:	Depth: 0.1379 ft
Velocity:	1.8722 fps	Velocity:	1.2686 fps	Velocity:	1.7644 fps
Full Flowrate:	0.5000 cfs	Full Flowrate:	0.2000 cfs	Full Flowrate:	1.18534 cfs
Flow area:	0.2671 ft ²	Flow area:	0.1577 ft ²	Flow area:	0.2834 ft ²
Flow perimeter:	2.2708 ft	Flow perimeter:	0.0730 ft	Flow perimeter:	0.1234 ft
Hydraulic radius:	0.1176 ft	Hydraulic radius:	0.0730 ft	Hydraulic radius:	2.1103 ft
Top width:	2.0657 ft	Top width:	2.0261 ft	Top width:	2.4000 ft
Area:	0.2671 ft ²	Area:	0.1577 ft ²	Area:	4.1541 ft ²
Perimeter:	2.2708 ft	Perimeter:	2.1588 ft	Perimeter:	4.1541 ft
Percent full:	100.0000 %	Percent full:	100.0000 %	Percent full:	13.7885 %

ENGINEER'S CERTIFICATE
 I HEREBY CERTIFY THAT THIS PLAN FOR SEDIMENT AND EROSION CONTROL REPRESENTS A PRACTICAL AND WORKABLE PLAN BASED ON MY PERSONAL KNOWLEDGE OF THE SITE CONDITIONS AND THAT IT WAS PREPARED IN ACCORDANCE WITH THE REQUIREMENTS OF THE HOWARD SOIL CONSERVATION DISTRICT.
 Christopher A. Malacari
 ENGINEER - CHRISTOPHER A. MALACARI
 DATE: 5/5/14

DEVELOPER'S CERTIFICATE
 I/WE CERTIFY THAT ALL DEVELOPMENT AND CONSTRUCTION WILL BE DONE ACCORDING TO THIS PLAN OF DEVELOPMENT FOR SEDIMENT AND EROSION CONTROL, AND THAT ALL RESPONSIBLE PERSONNEL INVOLVED IN THE CONSTRUCTION PROJECT WILL HAVE A CERTIFICATE OF ATTENDANCE AT A COURSE OF THE DEPARTMENT OF THE ENVIRONMENT APPROVED TRAINING PROGRAM FOR THE CONTROL OF SEDIMENT AND EROSION BEFORE BEGINNING THE PROJECT. I ALSO AUTHORIZE PERIODIC ON-SITE INSPECTION BY THE HOWARD SOIL CONSERVATION DISTRICT.
 Susan Umsted
 DEVELOPER: LAKESHORE I, LLC BY MDC ASSOCIATES, LLC, SOLE MEMBER
 DATE: 5/12/14

APPROVED: HOWARD COUNTY DEPARTMENT OF PLANNING AND ZONING
 Chief, Development Engineering Division
 DATE: 6/17/14

Chief, Division of Land Development
 DATE: 6/19/14

Director
 DATE: 6/19/14

SEDMIMENT CONTROL IN THE AREA OF THE 27"x42" PIPE CONSTRUCTION IS TO BE PROVIDED AS REQUESTED BY THE ON-SITE SEDIMENT CONTROL INSPECTOR.


CONTRACTOR TO TEST PIT AT THE CROSSING TO DETERMINE THE ACTUAL DEPTH AND LOCATION OF THE EXISTING WATER MAIN AND 4" WHC WELL IN ADVANCE OF CONSTRUCTION.

PROVIDE ADDITIONAL RIP-RAP PROTECTION TO EXISTING CHANNEL MIN. 20LF @ 1.0%

SOILS LEGEND

MAP SYMBOL	SOIL GROUP	SOIL TYPE
GgB	B	GLENELG LOAM, 3 TO 8 PERCENT SLOPES
GhB	B	GLENELG-URBAN LAND COMPLEX LOAM, 0 TO 8 PERCENT SLOPES
GhB*	C	GLENVILLE-BAILE SILT LOAM, 0 TO 8 PERCENT SLOPES
MdD	B	MANOR LOAM, 15 TO 25 PERCENT SLOPES
UuB	D	URBAN LAND-UDORTHENTS COMPLEX, 0 TO 8 PERCENT SLOPES

FROM NATURAL RESOURCES CONSERVATION SERVICES WEB SOIL SURVEY 2.0
 * HYDRIC SOILS

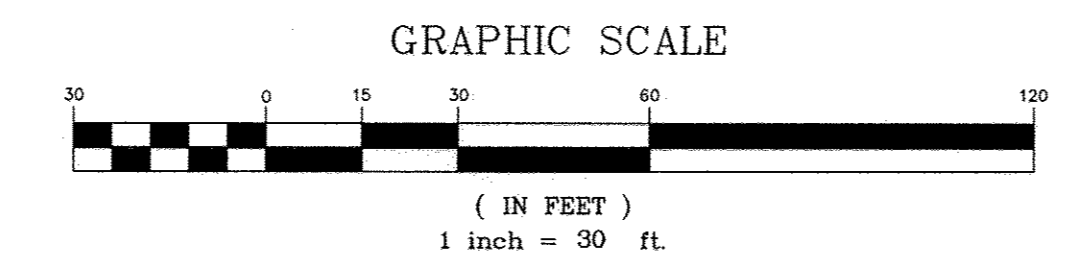

AS-BUILT CERTIFICATION
 I hereby certify, by my seal, that the facilities shown on this plan were constructed as shown on this AS-BUILT plan.
 Donald Mason, P.E. No. 21443
 Date: 6-25-15



Professional Certification. I hereby certify that these documents were prepared or approved by me, and that I am a duly licensed professional engineer under the laws of the State of Maryland.
 License No. 21443, Expiration Date: 12-21-16

NO.	DATE	REVISION
3	10-27-15	ADD OPEN SPACE LOT 3, REVISE REC. OPEN SPACE, REMOVE BEH
2	6-1-15	REMOVE SHED & DRYWELL ON PARCEL 'B'
1	9-22-2014	REVISE I-7 IZ TO A-BUILDING AND SHOW GAS & ELECTRIC

BENCHMARK ENGINEERING, INC.
 ENGINEERS & LAND SURVEYORS & PLANNERS
 8480 BALTIMORE NATIONAL PIKE, SUITE 315 & ELLICOTT CITY, MARYLAND 21043
 (703) 410-465-8100 (703) 410-465-8644
 WWW.BE-CIVILENGINEERING.COM

Professional Certification. I hereby certify that these documents were prepared or approved by me, and that I am a duly licensed professional engineer under the laws of the State of Maryland.
 License No. 22320, Expiration Date: 6-30-15

ORCHARD PARK SECTION 3
 3200 PINE ORCHARD LANE
 ROMANIK PROPERTY, LOT 1 AND ORCHARD HILL, OPEN SPACE LOTS
 TAX MAP: 24 & 17, GRID: 1 & 19, PARCEL: 647 & P/O 130
 ZONED: R-A-15
 ELECTION DISTRICT NO. 2
 HOWARD COUNTY, MARYLAND

OWNER: LAKESHORE I, LLC
 C/O SECURITY DEVELOPMENT
 8480 BALTIMORE NATIONAL PIKE
 SUITE 315
 ELLICOTT CITY, MD 21043

DEVELOPER: SECURITY DEVELOPMENT, LLC
 PO BOX 417
 ELLICOTT CITY, MD 21041
 410-465-4244


SITE DEVELOPMENT PLAN
 GRADING, SEDIMENT & EROSION CONTROL PLAN
 DATE: MAY 2014
 BEI PROJECT NO. 1796
 SCALE: 1"=30'
 SHEET 3 OF 11

Table with 4 columns: B-4 STANDARDS AND SPECIFICATIONS FOR VEGETATIVE STABILIZATION, B-4-2 STANDARDS AND SPECIFICATIONS FOR SOIL PREPARATION, TOPSOILING, AND SOIL AMENDMENTS, B-4-3 STANDARDS AND SPECIFICATIONS FOR SEEDING AND MULCHING, and B-4-4 STANDARDS AND SPECIFICATIONS FOR CURB INLET PROTECTION. Each column contains detailed engineering specifications and standards for various construction and stabilization methods.

Technical drawing area containing details for AT-GRADE INLET PROTECTION, EARTH DIKE, SUPER SILT FENCE, STABILIZED CONSTRUCTION ENTRANCE, CURB INLET PROTECTION, and SILT FENCE. Includes multiple views (Plan View, Section A-A, Section B-B) and corresponding construction specifications.

Regulatory and certification section including B-4-5 STANDARDS AND SPECIFICATIONS FOR TEMPORARY STABILIZATION, B-4-5 STANDARDS AND SPECIFICATIONS FOR STOCKPILE AREA, and ENGINEER'S CERTIFICATE. Includes sections for dust control and stockpile area management.

Regulatory and certification section including B-4-6 STANDARDS AND SPECIFICATIONS FOR PERMANENT STABILIZATION, SEDIMENT CONTROL NOTES, SEQUENCE OF CONSTRUCTION, and ENGINEER'S CERTIFICATE. Includes a table for the sequence of construction and a site area summary table.

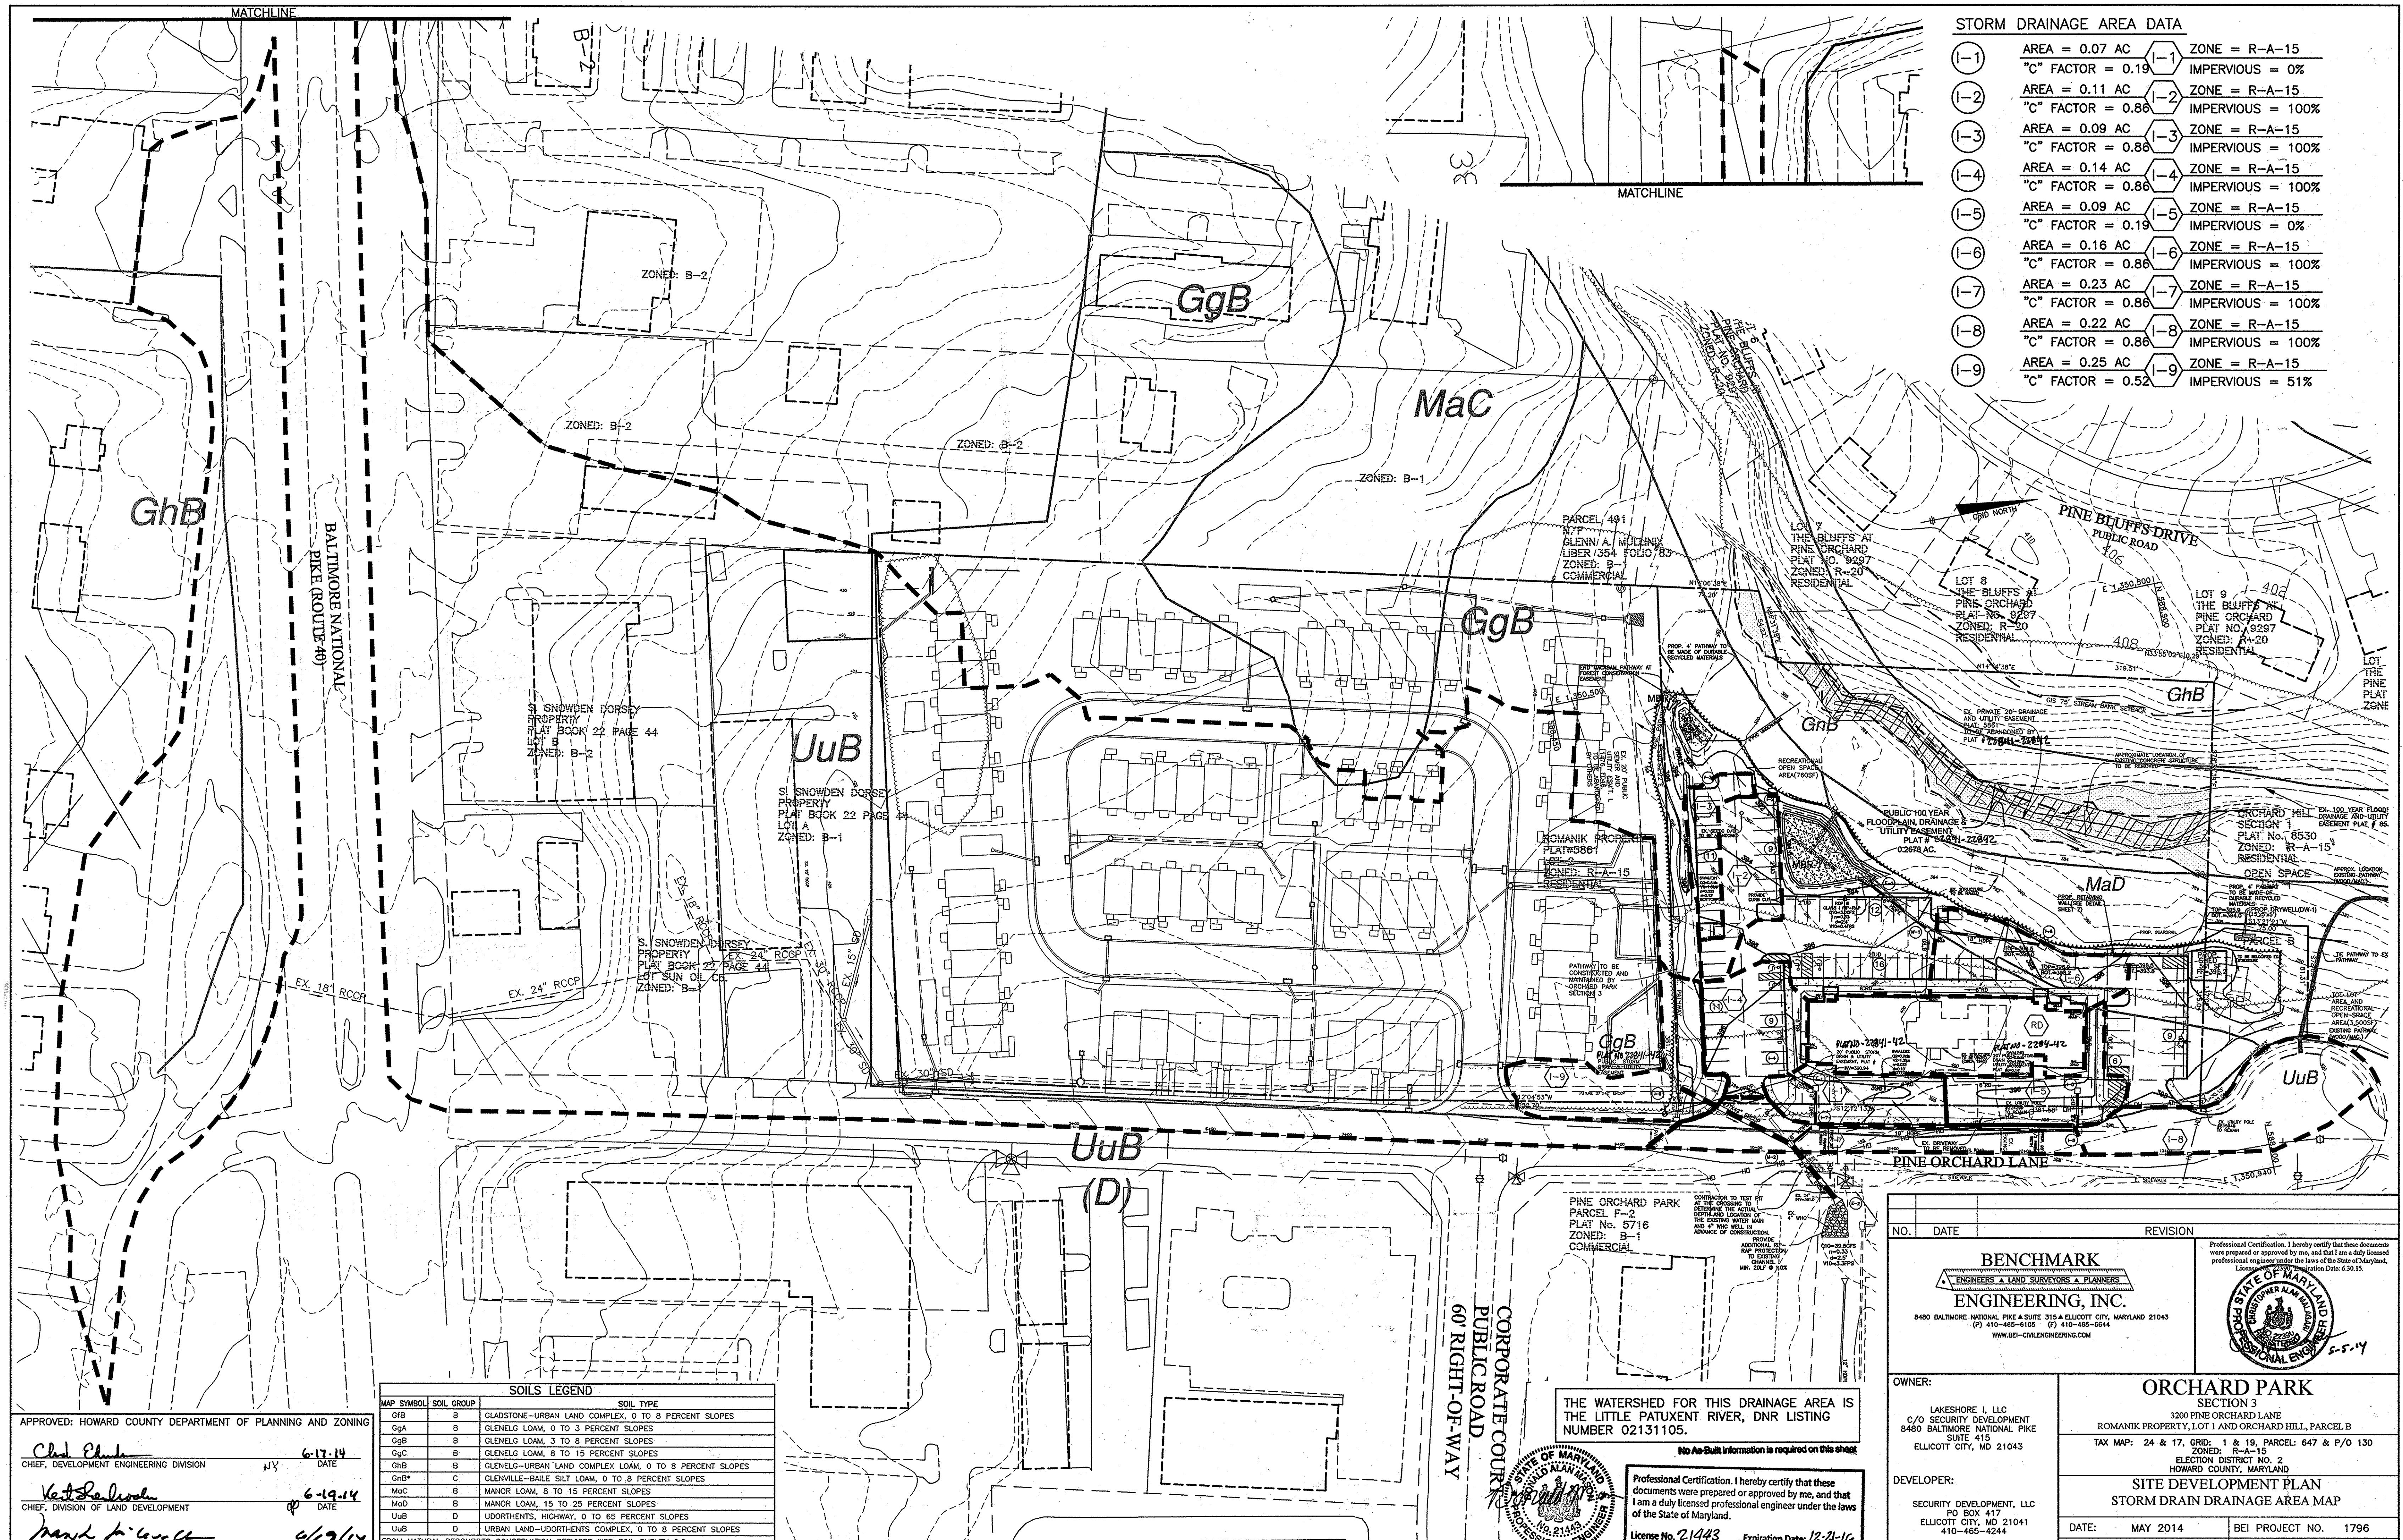

STORM DRAINAGE AREA DATA

(1-1)	AREA = 0.07 AC	(1-1)	ZONE = R-A-15
(1-2)	"C" FACTOR = 0.19	(1-2)	IMPERVIOUS = 0%
(1-3)	AREA = 0.11 AC	(1-3)	ZONE = R-A-15
(1-4)	"C" FACTOR = 0.86	(1-4)	IMPERVIOUS = 100%
(1-5)	AREA = 0.09 AC	(1-5)	ZONE = R-A-15
(1-6)	"C" FACTOR = 0.86	(1-6)	IMPERVIOUS = 100%
(1-7)	AREA = 0.14 AC	(1-7)	ZONE = R-A-15
(1-8)	"C" FACTOR = 0.86	(1-8)	IMPERVIOUS = 100%
(1-9)	AREA = 0.09 AC	(1-9)	ZONE = R-A-15
	"C" FACTOR = 0.19	(1-9)	IMPERVIOUS = 0%
	AREA = 0.16 AC	(1-6)	ZONE = R-A-15
	"C" FACTOR = 0.86	(1-6)	IMPERVIOUS = 100%
	AREA = 0.23 AC	(1-7)	ZONE = R-A-15
	"C" FACTOR = 0.86	(1-7)	IMPERVIOUS = 100%
	AREA = 0.22 AC	(1-8)	ZONE = R-A-15
	"C" FACTOR = 0.86	(1-8)	IMPERVIOUS = 100%
	AREA = 0.25 AC	(1-9)	ZONE = R-A-15
	"C" FACTOR = 0.52	(1-9)	IMPERVIOUS = 51%

APPROVED: HOWARD COUNTY DEPARTMENT OF PLANNING AND ZONING

Chad Blum 6-17-14
 CHIEF, DEVELOPMENT ENGINEERING DIVISION NY DATE

Keith Seidman 6-19-14
 CHIEF, DIVISION OF LAND DEVELOPMENT p DATE

Mark A. Goyke 6/23/14
 DIRECTOR DATE


SOILS LEGEND

MAP SYMBOL	SOIL GROUP	SOIL TYPE
GgB	B	GLADSTONE-URBAN LAND COMPLEX, 0 TO 8 PERCENT SLOPES
GgA	B	GLENELO LOAM, 0 TO 3 PERCENT SLOPES
GgB	B	GLENELO LOAM, 3 TO 8 PERCENT SLOPES
GgC	B	GLENELO LOAM, 8 TO 15 PERCENT SLOPES
GgD	B	GLENELO LOAM, 15 TO 25 PERCENT SLOPES
GhB	C	GLENELO-URBAN LAND COMPLEX LOAM, 0 TO 8 PERCENT SLOPES
GhC	C	GLENELO-URBAN LAND COMPLEX LOAM, 8 TO 15 PERCENT SLOPES
MaC	B	MANOR LOAM, 0 TO 8 PERCENT SLOPES
MaD	B	MANOR LOAM, 8 TO 15 PERCENT SLOPES
UuB	D	UDORNTENTS, HIGHWAY, 0 TO 45 PERCENT SLOPES
UuB	D	URBAN LAND-UDORNTENTS COMPLEX, 0 TO 8 PERCENT SLOPES

FROM NATURAL RESOURCES CONSERVATION SERVICES WEB SOIL SURVEY 2.0
 * HYDRIC SOILS

THE WATERSHED FOR THIS DRAINAGE AREA IS THE LITTLE PATUXENT RIVER, DNR LISTING NUMBER 02131105.

No As-Built information is required on this sheet

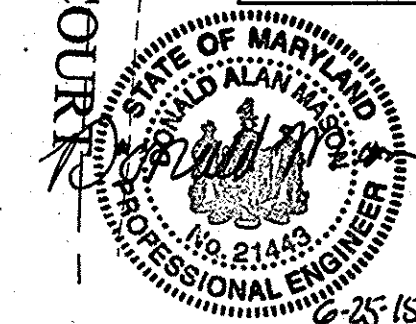


Professional Certification. I hereby certify that these documents were prepared or approved by me, and that I am a duly licensed professional engineer under the laws of the State of Maryland.

License No. 21423 Expiration Date: 12-21-16

<p>NO. DATE REVISION</p>	
<p>BENCHMARK ENGINEERING, INC. ENGINEERS & LAND SURVEYORS & PLANNERS 8480 BALTIMORE NATIONAL PIKE SUITE 415 ELLICOTT CITY, MD 21043 (P) 410-465-8105 (F) 410-465-8844 WWW.BEI-ENR.COM</p>	
<p>OWNER: LAKESHORE I, LLC C/O SECURITY DEVELOPMENT 8480 BALTIMORE NATIONAL PIKE SUITE 415 ELLICOTT CITY, MD 21043</p>	<p>DEVELOPER: SECURITY DEVELOPMENT, LLC PO BOX 417 ELLICOTT CITY, MD 21041 410-465-4244</p>
<p>ORCHARD PARK SECTION 3 5200 PINE ORCHARD LANE ROMANIK PROPERTY, LOT 1 AND ORCHARD HILL, PARCEL B TAX MAP: 24 & 17, GRID: 1 & 19, PARCEL: 647 & P/O 130 ZONED: R-A-15 ELECTION DISTRICT NO. 2 HOWARD COUNTY, MARYLAND</p>	
<p>SITE DEVELOPMENT PLAN STORM DRAIN DRAINAGE AREA MAP</p>	
<p>DATE: MAY 2014</p>	<p>BEI PROJECT NO. 1796</p>
<p>SCALE: 1"=50'</p>	<p>SHEET 5 OF 10</p>

PERMEABLE SURFACE DESIGN TABLES

PP-1	PP-2	PP-3
ELEV. 1 397.40 ELEV. 2 396.40	ELEV. 1 397.40 ELEV. 2 396.40	ELEV. 1 396.40 ELEV. 2 395.40
DIMENSIONS A' 0.5' B' 2.6' C' 0.33'-1.33' D' 0.50' E' 43' F' 17' G' 85' SLOPE H' 1.75% CLEAN-OUT NUMBER SPACING 3 ±64'	DIMENSIONS A' 0.5' B' 2.40' C' 0.33'-0.83' D' 0.50' E' 41' F' 17' G' 79' SLOPE H' 1.75% CLEAN-OUT NUMBER SPACING 2 ±37'	DIMENSIONS A' 0.5' B' 2.20' C' 0.33'-1.33' D' 0.50' E' 55' F' 17' G' 109' SLOPE H' 1.75% CLEAN-OUT NUMBER SPACING 4 ±36'

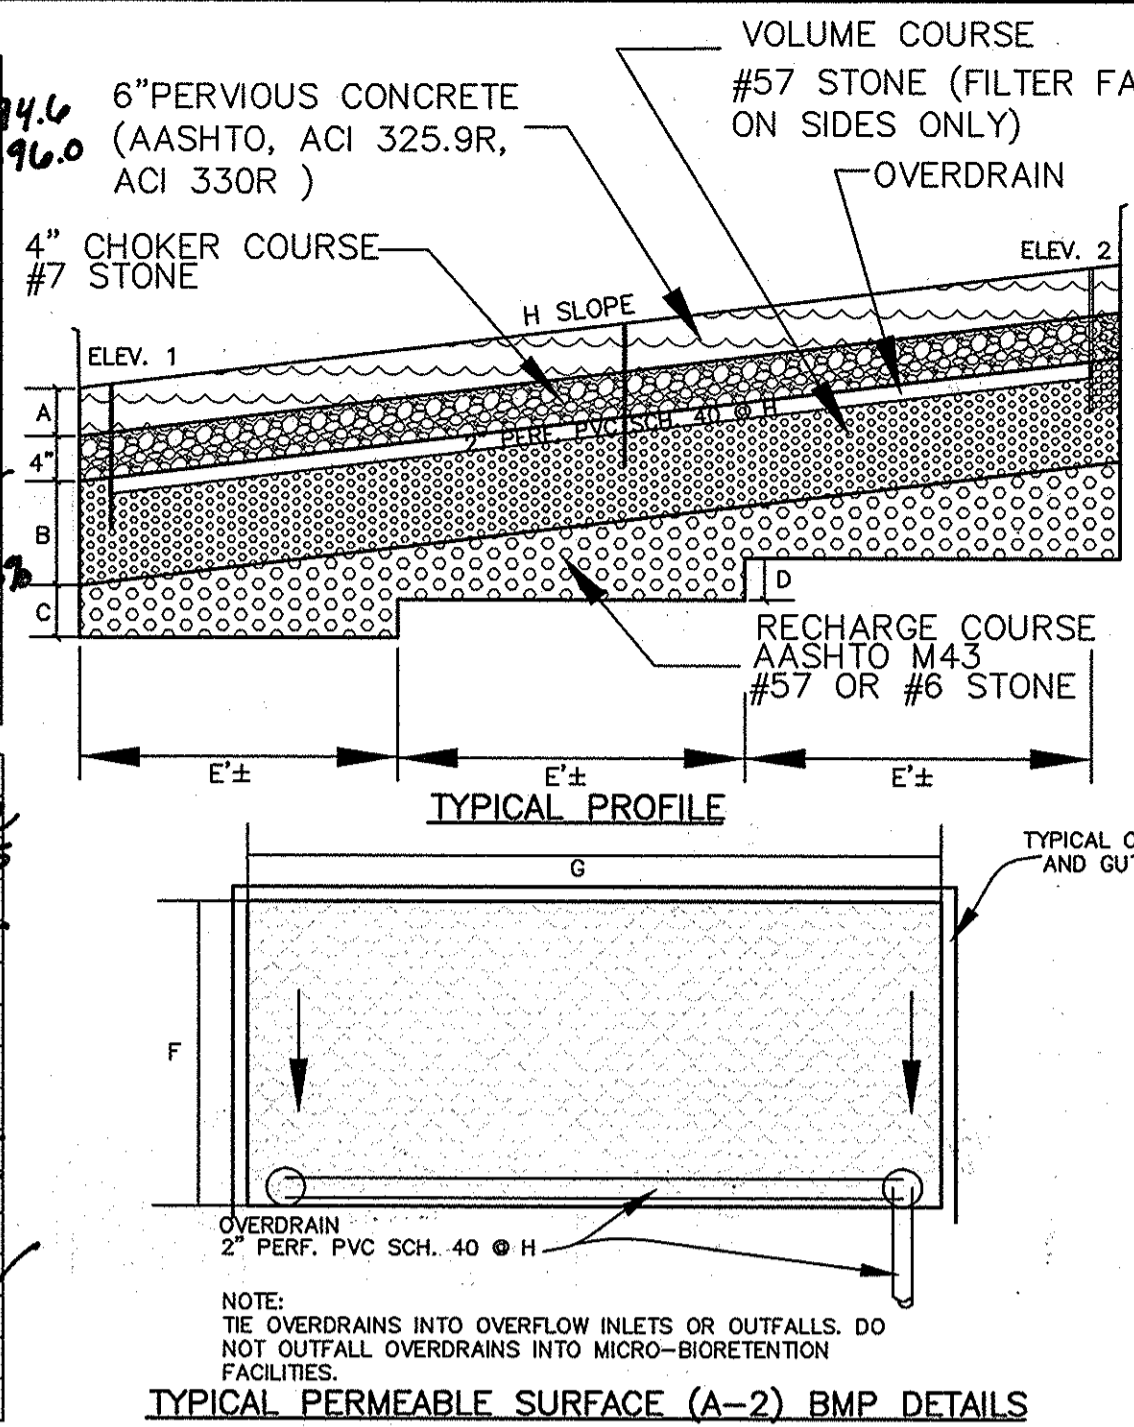

CONSTRUCTION AND INSPECTION SPECIFICATIONS FOR ALTERNATIVE SURFACES (A-2 PERMEABLE PAVING)

1. Erosion and Sediment Control: Final grading for installation shall not take place until the surrounding site is stabilized. If this cannot be accomplished, runoff from disturbed areas shall be diverted around proposed pavement locations.

2. Soil Compaction: Sub soils shall not be compacted. Construction should be performed with lightweight tracked equipment to minimize compaction. Excavated materials should be placed in a contained area.

3. Distribution Systems: Overdrain, underdrain, and distribution pipes shall be checked to ensure that both the material and perforations meet specifications (see Appendix B.4). The upstream ends of pipes should be capped prior to installation. All underdrain or distribution pipes used should be installed flat along the bed bottom.

4. Subbase Installation: Subbase aggregate shall be clean, washed, and free of fines. The subbase shall be placed in lifts and lightly rolled according to the specifications (see Appendix B.4).

5. Inspection: Regular inspections shall be made during the following stages of construction:
a. During excavation to subgrade.
b. During placement and backfill of any drainage or distribution system(s).
c. During placement of the subbase material.
d. During placement of the surface material.
e. Upon completion of final grading and establishment of permanent stabilization.

OPERATION AND MAINTENANCE SCHEDULE FOR PRIVATELY OWNED AND MAINTAINED PERMEABLE PAVEMENT (A-2)

a. The Owner shall inspect the monitoring wells and structures on a quarterly basis and after every heavy storm event.

b. The Owner shall record the water levels and sediment build up in the monitoring wells over a period of several days to insure trench drainage.

c. The Owner shall maintain a log book to determine the rate at which the facility drains.

d. When the facility becomes clogged so that it does not drain down within a twenty-two (22) hour time period, corrective action shall be taken.

e. The maintenance log book shall be available to Howard County for inspection to insure compliance with operation and maintenance criteria.

f. Once the performance characteristics of the infiltration facility have been verified, the monitoring schedule can be reduced to an annual basis unless the performance data indicates that a more frequent schedule is required.

MICRO-BIORETENTION PLANTING TABLE

PLANTS	MBR-1	MBR-2
VINCA MINOR (COMMON PERIWINKLE)	19	5
LIUM REPTAN S (CREeping BLUEWED)	57	13
IRIS VERSICOLOR (IRIS)	57	13
ELLYMUS VIRGINICUS (VIRGINIA WILD RYE)	19	5
VACCINIUM ATROCOCCUM (HIGHBUSH BLUEBERRY)	19	5
ACER RUBRUM (RED MAPLE)	1	1

OPERATION AND MAINTENANCE SCHEDULE FOR LANDSCAPE INFILTRATION (M-3) MICRO-BIORETENTION (M-6), RAIN GARDENS (M-7), BIORETENTION SWALE (M-8), ENHANCED FILTERS (M-9)

a. The OWNER SHALL MAINTAIN THE PLANT MATERIAL MULCH LAYER AND SOIL LAYER ANNUALLY. MAINTENANCE OF MULCH AND SOIL IS LIMITED TO CORRECTING AREAS OF EROSION OR WASH OUT. ANY MULCH REPLACEMENT SHALL BE DONE IN THE SPRING. PLANT MATERIAL SHALL BE CHECKED FOR DISEASE AND INSECT INFESTATION AND MAINTENANCE WILL ADDRESS DEAD MATERIAL AND PRUNING. ACCEPTABLE REPLACEMENT PLANT MATERIAL IS LIMITED TO THE FOLLOWING: 2000 MARYLAND STORMWATER DESIGN MANUAL VOLUME II, TABLE A-4.1 AND 2.

b. The OWNER SHALL PERFORM A PLANT INSPECTION IN THE SPRING AND IN THE FALL OF EACH YEAR. DURING THE INSPECTION, THE OWNER SHALL REMOVE DEAD AND DISEASED VEGETATION CONSIDERED BEYOND TREATMENT. REPLACE DEAD PLANT MATERIAL WITH ACCEPTABLE REPLACEMENT PLANT MATERIAL. TREAT DISEASED TREES AND SHRUBS, AND REPLACE ALL DEFICIENT STAKES AND WIRES.


c. The OWNER SHALL INSPECT MULCH EACH SPRING. THE MULCH SHALL BE REPLACED EVERY TWO TO THREE YEARS. THE PREVIOUS MULCH LAYER SHALL BE REMOVED BEFORE THE NEW LAYER IS APPLIED.

d. The OWNER SHALL CORRECT SOIL EROSION ON AN AS NEEDED BASIS, WITH A MINIMUM OF ONCE PER MONTH AND AFTER EACH HEAVY STORM.

e. FILTER MATERIAL MUST BE REPLACED WHEN THE WATER REMAINS ON THE SURFACE OF THE FILTER BED FOR MORE THAN 24 HOURS FOLLOWING A 1 OR 2 YEAR STORM EVENT OR MORE THAN 48 HOURS FOLLOWING A 10 YEAR STORM EVENT.


MATERIALS AND SPECIFICATIONS FOR (M-6) MICRO-BIORETENTION

MATERIAL	SPECIFICATION	SIZE	NOTES:
PLANTINGS (REQUIRED)	SEE APPENDIX A, TABLE A.4	N/A	PLANTINGS ARE SITE SPECIFIC
PLANTING SOIL (2.0' TO 4.0' DEEP)	LOAMY SAND (60-65%) & COMPOST (35-40%) OR LOAMY SAND (30%) COARSE SAND (30%) & COMPOST (35-40%)	N/A	USDA SOIL TYPES: LOAMY SAND, SANDY LOAM; CLAY CONTENT <5%
ORGANIC CONTENT	MIN. 10% BY DRY WEIGHT (ASTM D2974)	N/A	AGED 6 MONTHS, MINIMUM
MULCH	SHREDDED HARDWOOD	N/A	PE TYPE 1 - NONWOVEN
PEA GRAVEL DIAPHRAGM	PEA GRAVEL ASTM D-448	#8 #9 (1/8" TO 3/8")	
GEOTEXTILE	AASHTO M-43	N/A	#8 STONE
GRAVEL (UNDERDRAINS & BERMS)	AASHTO M-43	#57 OR #6 AGGREGATE (3/8" TO 3/4")	
UNDERDRAIN PIPING	7550, TYPE FS28 OR ASSTO M-278	4" TO 6" RIGID SCHED 40 PVC OR SDR35	SLOTTED OR PERFORATED: 3/8" PERFS. @ 6" O/C. 4 HOLES PER ROW. MINIMUM OF 3" OF GRAVEL OVER PIPES. NOT NECESSARY UNDERNEATH PIPES. PERFORATED PIPE SHALL BE WRAPPED WITH 1/4" GALVANIZED HARDWARE CLOTH
POURED-IN-PLACE CONC. (IF REQUIRED)	MSHA MIX NO. 3 (f=3500psi @ 28 DAYS, NORMAL WEIGHT, AIR ENTRAINED, REINFORCING TO MEET ASTM 615-60	N/A	ON-SITE TESTING OF POURED-IN-PLACE CONC. REQUIRED: 28 DAY STRENGTH TEST AND SLUMP TEST: ALL CONC. DESIGN (CAST-IN-PLACE OR PRE-CAST) NOT USING PREVIOUSLY APPROVED STATE OR LOCAL STANDARDS REQUIRES DESIGN DRAWINGS SEALED AND APPROVED BY A PROFESSIONAL STRUCTURAL ENGINEER LICENSED IN THE STATE OF MARYLAND. DESIGN TO INCLUDE MEETING AIA CODE 350.8/89; VERTICAL LOADING (H=10 or H=20) ALLOWABLE HORIZONTAL LOADING (BASED ON SOIL PRESSURES); AND ANALYSIS OF POTENTIAL CRACKING.
SAND (1.0' DEEP)	AASHTO M-6 OR ASTM C-33	0.02" TO 0.04"	SAND SUBSTITUTIONS SUCH AS DIABASE AND GRAYSTONE (AASHTO #10) ARE NOT ACCEPTABLE. NO CALCIUM CARBONATE OR POLYMERIC SAND SUBSTITUTIONS ARE ACCEPTABLE. NO "ROCK DUST" CAN BE USED FOR SAND

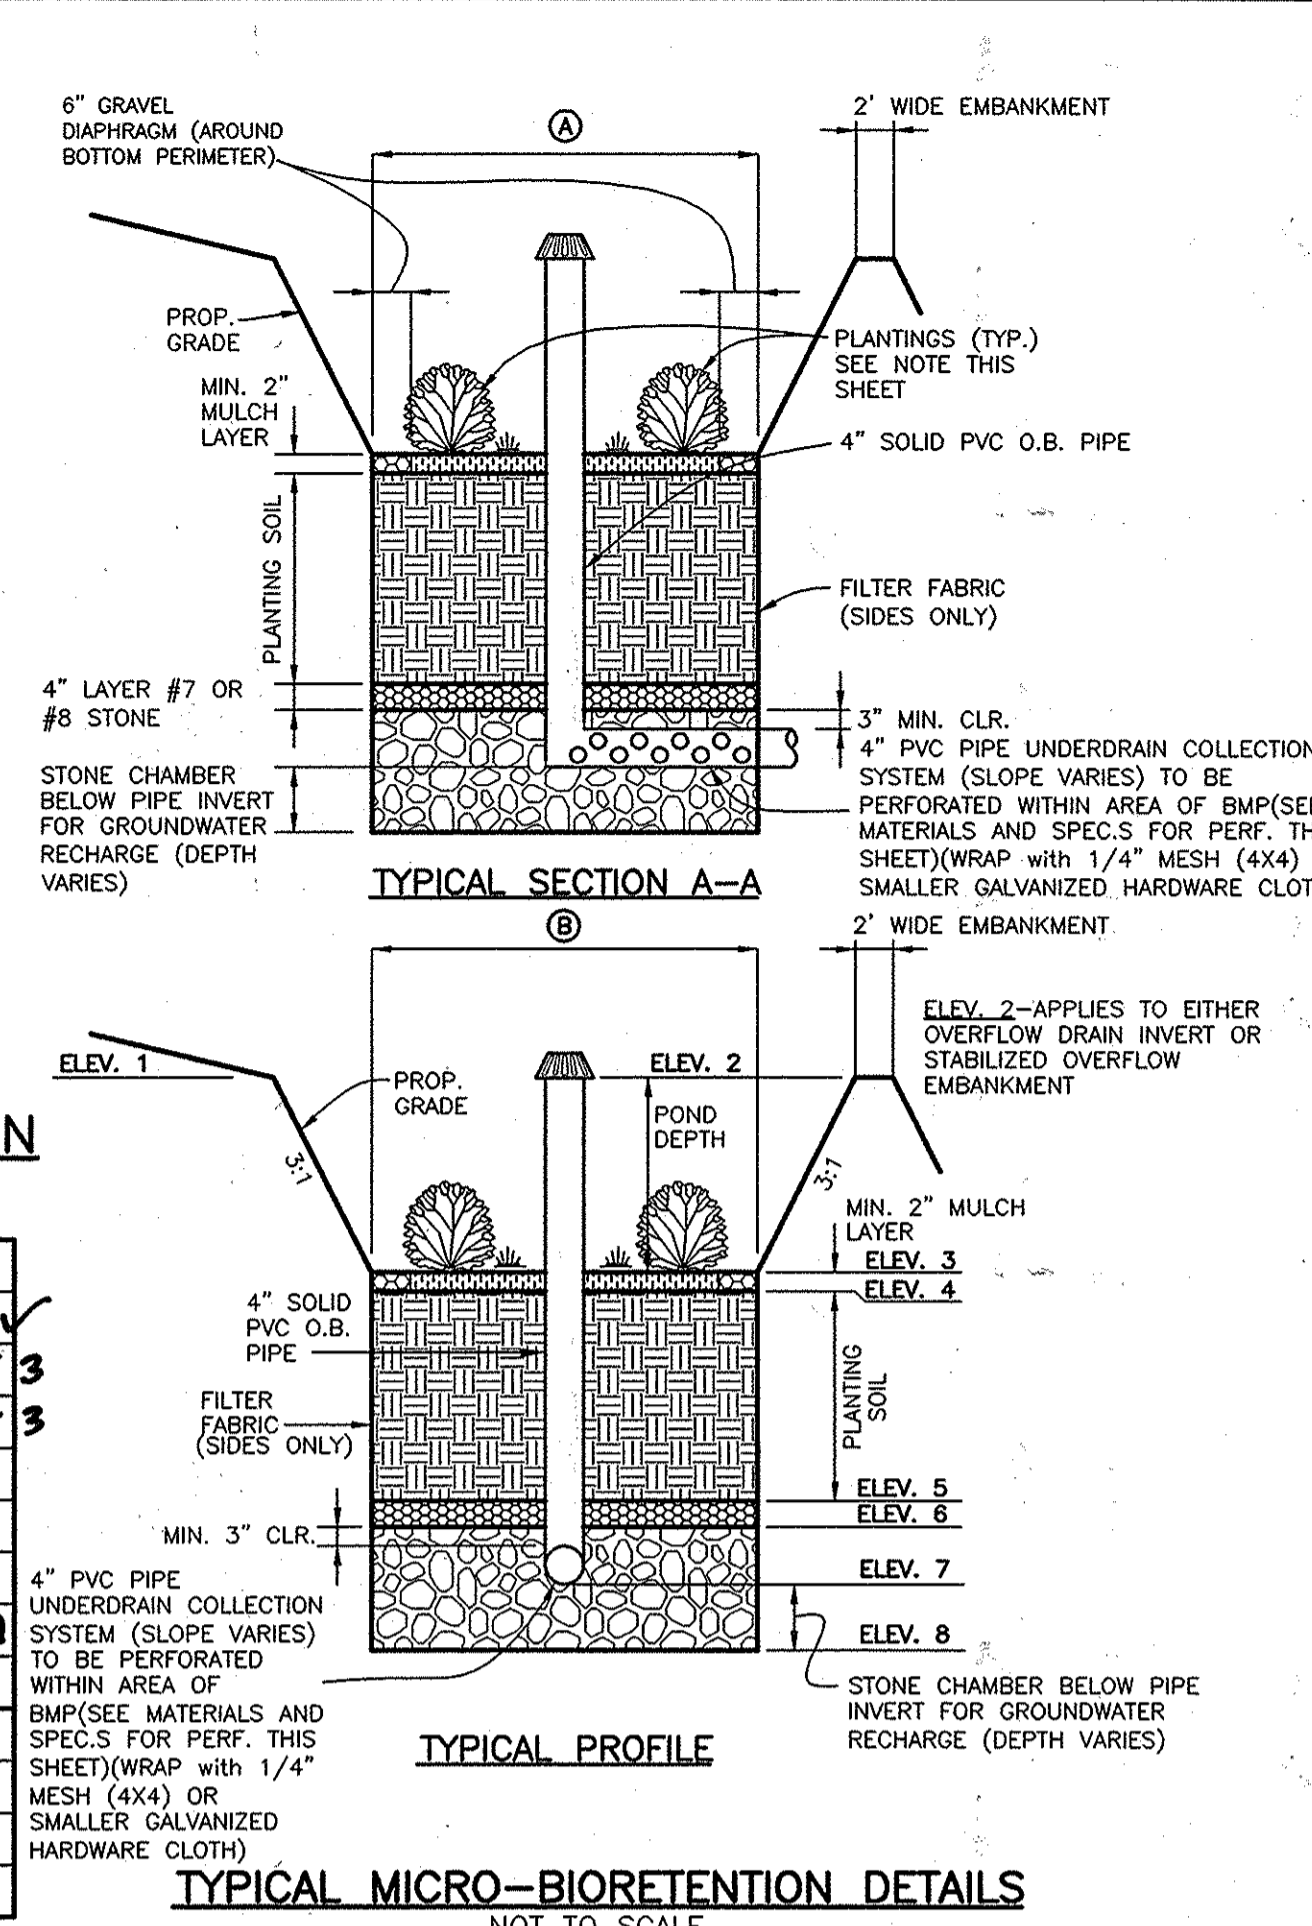

SECTION NUMBER ROAD AND STREET CLASSIFICATION

SECTION NUMBER	ROAD AND STREET CLASSIFICATION	CALIFORNIA BEARING RATIO (CBR)	3 TO <5	5 TO <7	7 TO <9	9 TO <15	15 TO <27
P-2	PARKING DRIVE ASILES: RESIDENTIAL AND NON-RESIDENTIAL WITH NO MORE THAN 10 HEAVY TRUCKS PER DAY LOCAL ROADS: ACCESS PLACE, ACCESS STREET CUL-DE-SAC: RESIDENTIAL	PAVEMENT MATERIAL (INCHES)					
		HMA SUPERPAVE FINAL SURFACE	1.5	1.5	1.5	1.5	1.5
		HMA SUPERPAVE INTERMEDIATE SURFACE	1.0	1.0	1.0	1.0	1.0
		HMA SUPERPAVE BASE	2.0	2.0	2.0	2.0	2.0
		GRADED AGGREGATE BASE (GAB)	6.0	4.0	3.0	4.0	4.0

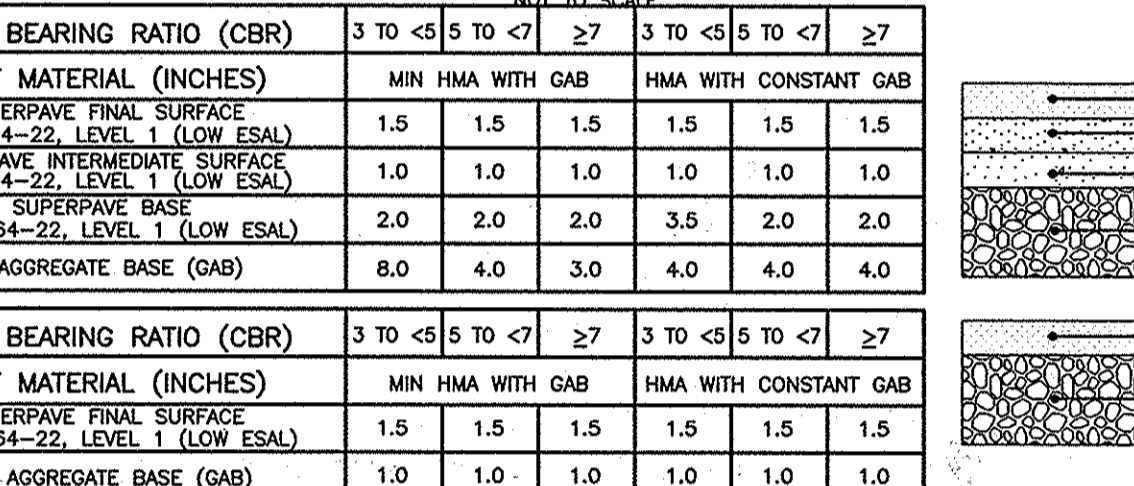

SECTION NUMBER ROAD AND STREET CLASSIFICATION

SECTION NUMBER	ROAD AND STREET CLASSIFICATION	CALIFORNIA BEARING RATIO (CBR)	3 TO <5	5 TO <7	7 TO <9	9 TO <15	15 TO <27
P-8	SIDEWALK AND PARKING AREA (PRIVATE) NOTE: THIS SECTION MAY BE USED IN USE OF CONCRETE SIDEWALK IN OFFSITE, PRIVATELY MAINTAINED AREAS ONLY.	PAVEMENT MATERIAL (INCHES)					
		HMA SUPERPAVE FINAL SURFACE	1.5	1.5	1.5	1.5	1.5
		HMA SUPERPAVE INTERMEDIATE SURFACE	1.0	1.0	1.0	1.0	1.0
		HMA SUPERPAVE BASE	2.0	2.0	2.0	2.0	2.0
		GRADED AGGREGATE BASE (GAB)	6.0	4.0	3.0	4.0	4.0

OPERATION AND MAINTENANCE SCHEDULE FOR PRIVATELY OWNED AND MAINTAINED PERMEABLE PAVEMENT (A-2)



1. Pavement surfaces should be swept and vacuumed (if porous concrete) to reduce sediment accumulation and ensure continued surface porosity. Sweeping should be performed at least twice annually with a commercial sweeping unit. Washing or compressed air units should not be used to perform surface cleaning.

2. Drainage pipes, inlets, stone edge drains and other structures within or draining to the subsurface should be cleaned out at regular intervals.

3. Deicers should be used in moderation. Deicers should be non-toxic and be applied either as calcium magnesium acetate or as pretreated salt. Snow plowing should be done carefully with blades set one-inch above the surface. Plowed snow piles and stormwater should not be directed to permeable pavement.


(M-6) MICRO-BIORETENTION DESIGN TABLES

#1	#2
ELEV. 1 393.4	ELEV. 1 391.60
ELEV. 2 392.50	ELEV. 2 391.60
ELEV. 3 391.50	ELEV. 3 390.60
ELEV. 4 391.25	ELEV. 4 390.35
ELEV. 5 389.25	ELEV. 5 388.35
ELEV. 6 388.92	ELEV. 6 388.02
ELEV. 7 388.34	ELEV. 7 387.47
ELEV. 8 388.17	ELEV. 8 387.27
DIMENSIONS	
A' 48±	A' 32±
B' 38±	B' 16±
TOTAL SF 1867	TOTAL SF 408

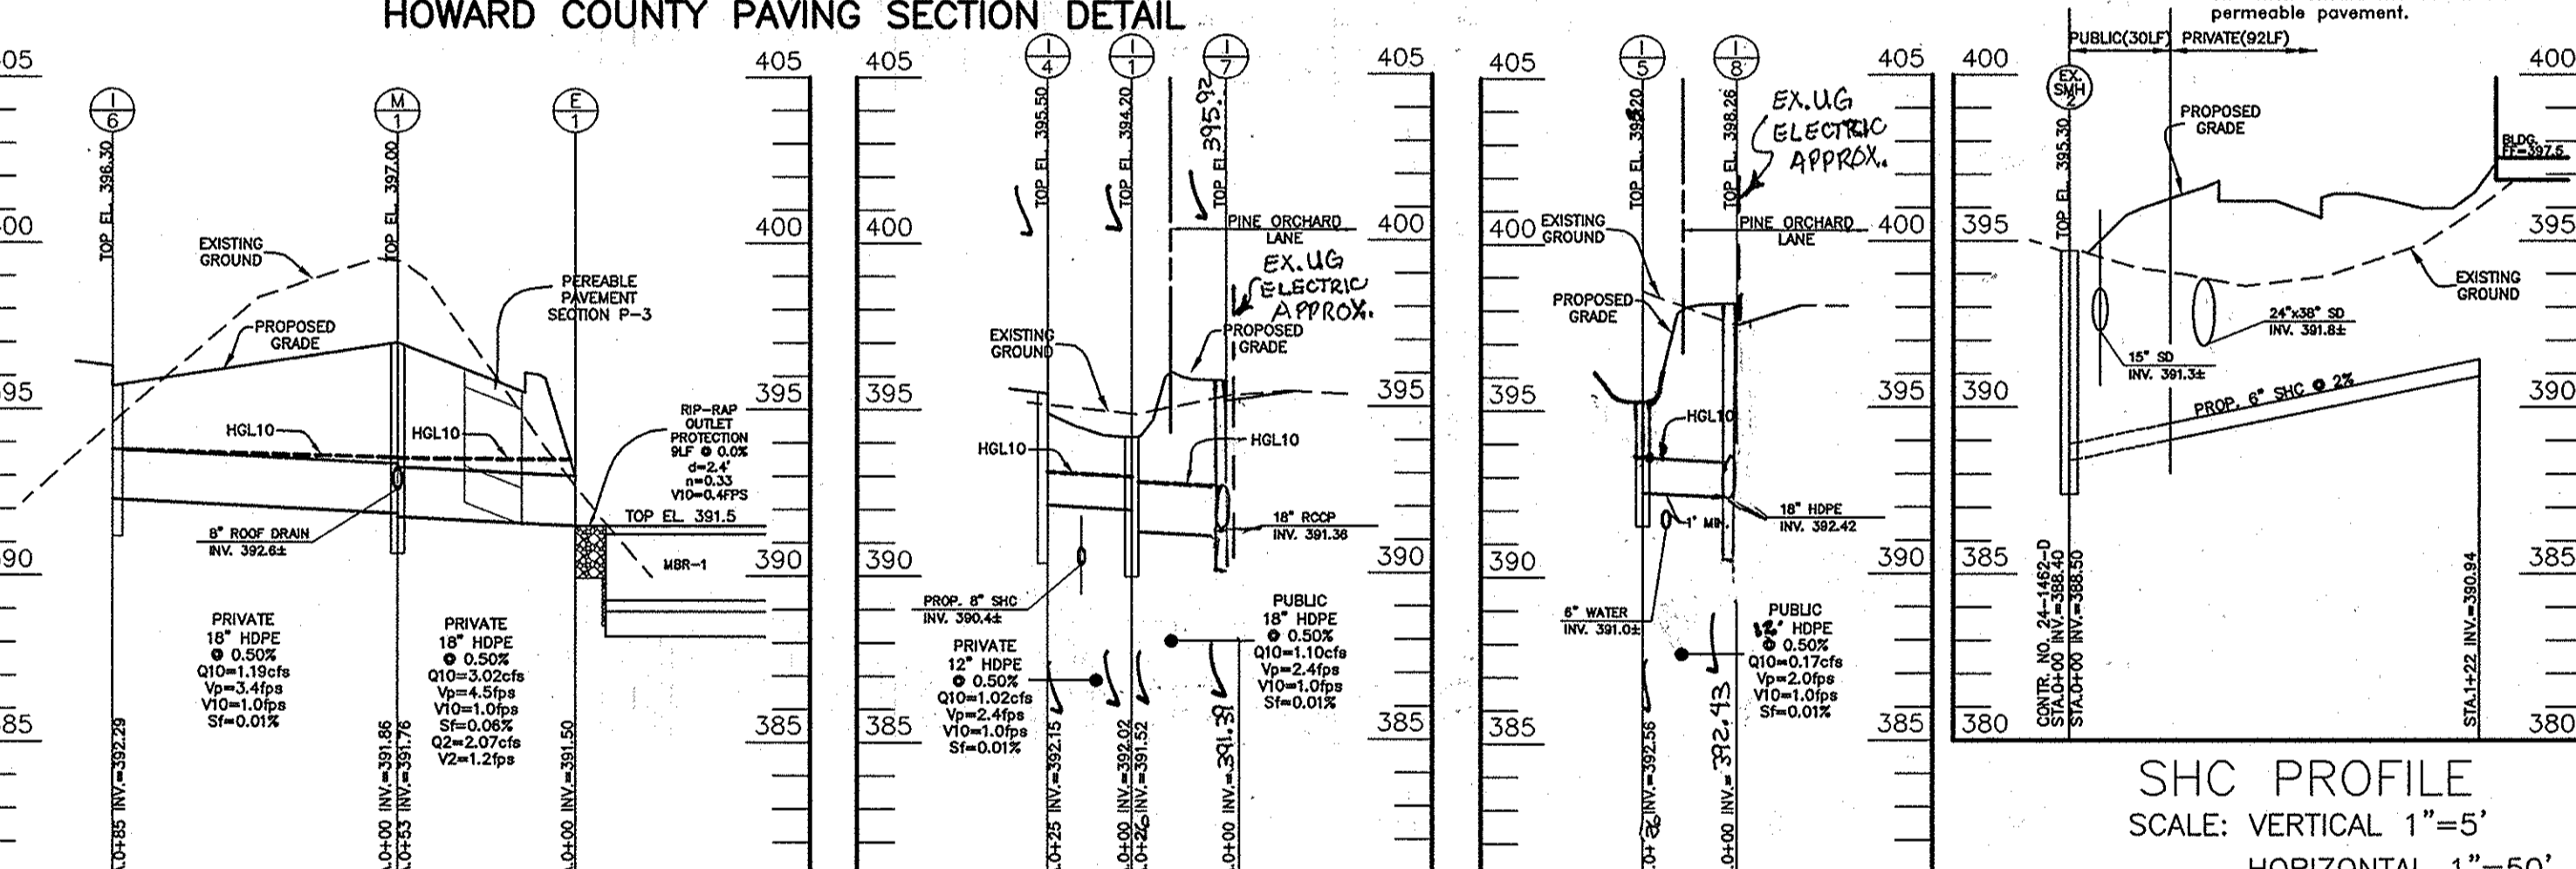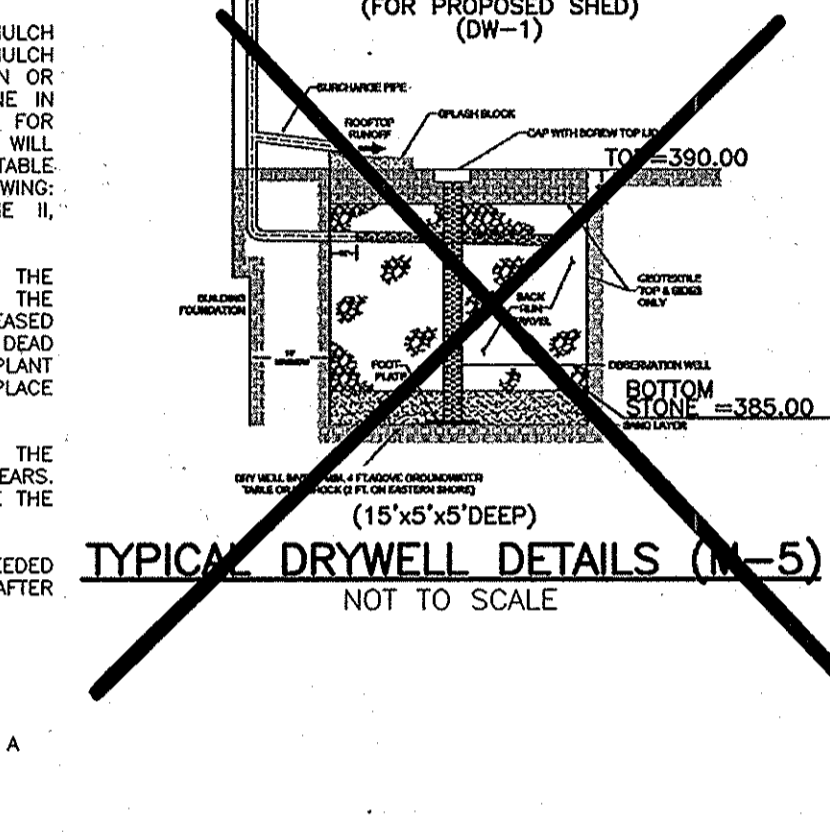

STRUCTURE SCHEDULE

NO.	TYPE	LOCATION	PIPE INV. IN	PIPE INV. OUT	TOP ELEV.	THROAT ELEV.	OWNERSHIP	HO. CO. STD.
END SECTIONS								
E-1	18" HDPE END SECT.	N 588652.3, E 1350877.1	---	391.50	NA	NA	PRIVATE	HPDE END SECTION
E-2	27"x42" END SECT.	N 588580.3, E 1350897.7	---	390.89	NA	NA	PUBLIC	SHA MD-369.00
INLETS								
I-1	YARD	N 588582.9, E 1350816.4	392.02	391.52	394.20	NA	PRIVATE	D-4.14
I-2	5" CONC. FLOW THRU	N 588543.0, E 1350582.6	---	---	393.40	392.70	PRIVATE	SHA MD-374.68
I-3	5" CONC. FLOW THRU	N 588547.3, E 1350556.7	---	---	393.30	392.60	PRIVATE	SHA MD-374.68
I-4	TYPE DOUBLE S	N 588561.2, E 1350802.6	---	392.15	395.50	NA	PRIVATE	SHA MD-379.04
I-5	YARD	N 588770.3, E 1350856.3	---	392.56	395.20	NA	PRIVATE	D-4.14
I-6	TYPE DOUBLE S	N 588767.7, E 1350745.3	---	392.29	396.30	NA	PRIVATE	SHA MD-379.04
I-7	TYPE A-S	N 588577.2, E 1350842.6	391.48	391.36	395.32	NA	PUBLIC	D-4-01
I-8	TYPE A-S	N 588765.0, E 1350883.1	392.43	392.27	398.26	NA	PUBLIC	D-4-01
I-9	TYPE DOUBLE S	N 588484.2, E 1350796.2	---	392.00	395.70	NA	PUBLIC	D-4.23
MANHOLES								
M-1	4'-0" MANHOLE	N 588686.4, E 1350717.7	391.88	391.76	397.00	NA	PRIVATE	G-5.12
M-2	5'-0" MANHOLE	N 588556.9, E 1350852.9	391.35	391.25	395.70	NA	PUBLIC	G-5.13

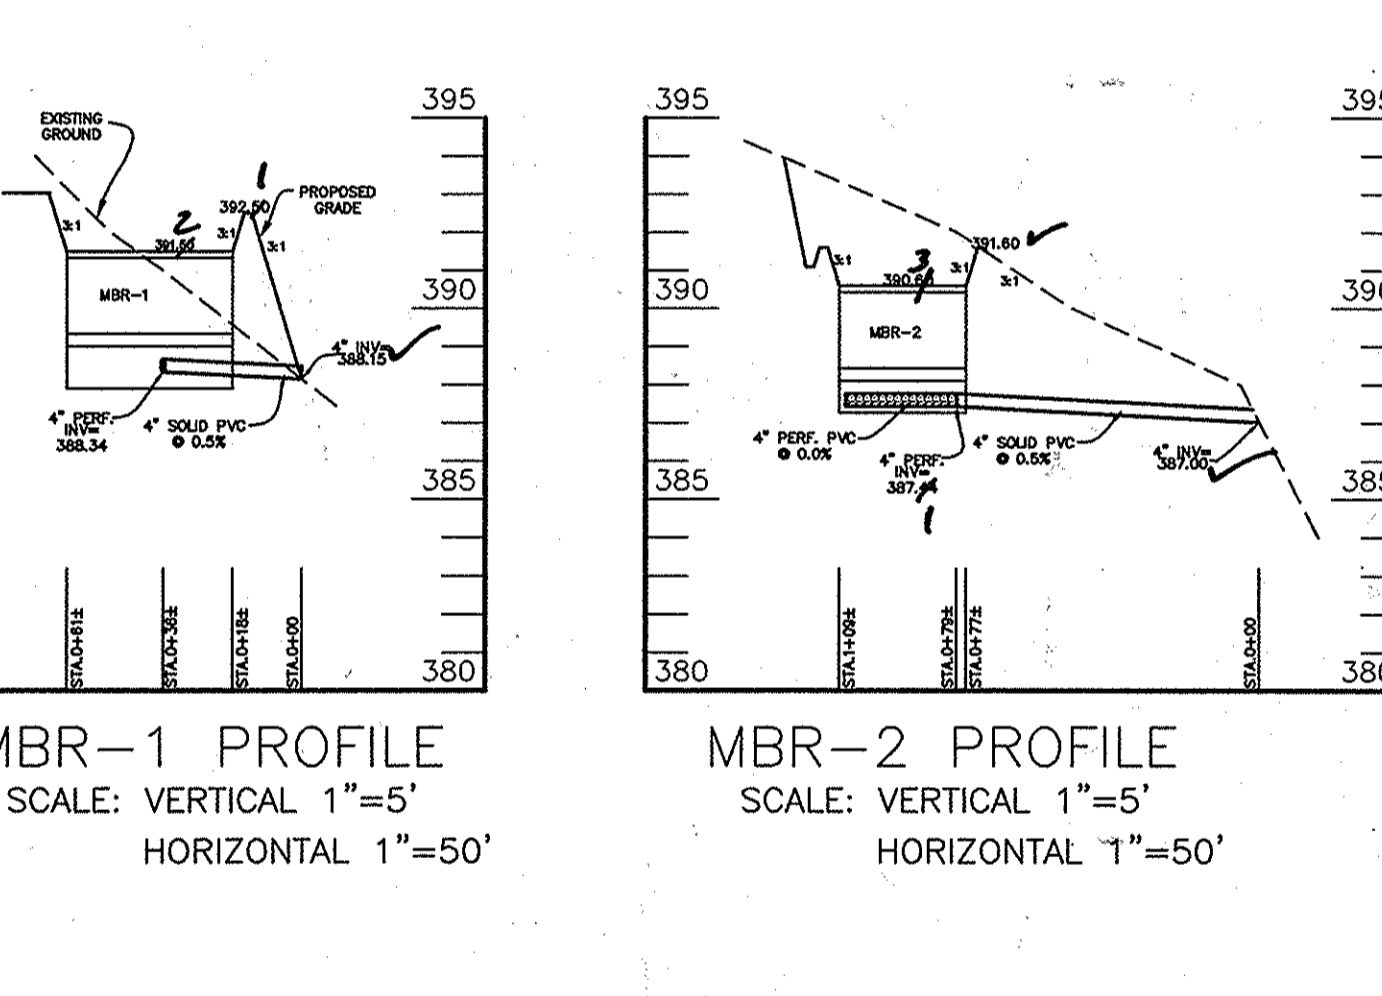

ENGINEER'S CERTIFICATE

1. I HEREBY CERTIFY THAT THIS PLAN FOR SEDIMENT AND EROSION CONTROL REPRESENTS A PRACTICAL AND WORKABLE PLAN BASED ON MY PERSONAL KNOWLEDGE OF THE SITE CONDITIONS AND THAT IT WAS PREPARED IN ACCORDANCE WITH THE REQUIREMENTS OF THE HOWARD SOIL CONSERVATION DISTRICT.

5/5/14

ENGINEER - CHRISTOPHER A. MALAGARI

DEVELOPER'S CERTIFICATE

I/VE CERTIFY THAT ALL DEVELOPMENT AND CONSTRUCTION WILL BE DONE ACCORDING TO THIS PLAN OF DEVELOPMENT FOR SEDIMENT AND EROSION CONTROL AND THAT ALL RESPONSIBILITY FOR THE SITE CONDITIONS INVOLVED IN THE CONSTRUCTION PROJECT WILL HAVE A CERTIFICATE OF ATTENDANCE AT A DEPARTMENT OF THE ENVIRONMENT APPROVED TRAINING PROGRAM FOR THE CONTROL OF SEDIMENT AND EROSION BEFORE BEGINNING THE PROJECT. I ALSO AUTHORIZE PERIODIC ON-SITE INSPECTION BY THE HOWARD SOIL CONSERVATION DISTRICT.


6/2/14

DEVELOPER - RYAN H. SHORR, LLC

APPROVED: HOWARD COUNTY DEPARTMENT OF PLANNING AND ZONING

6-17-14

6-19-14

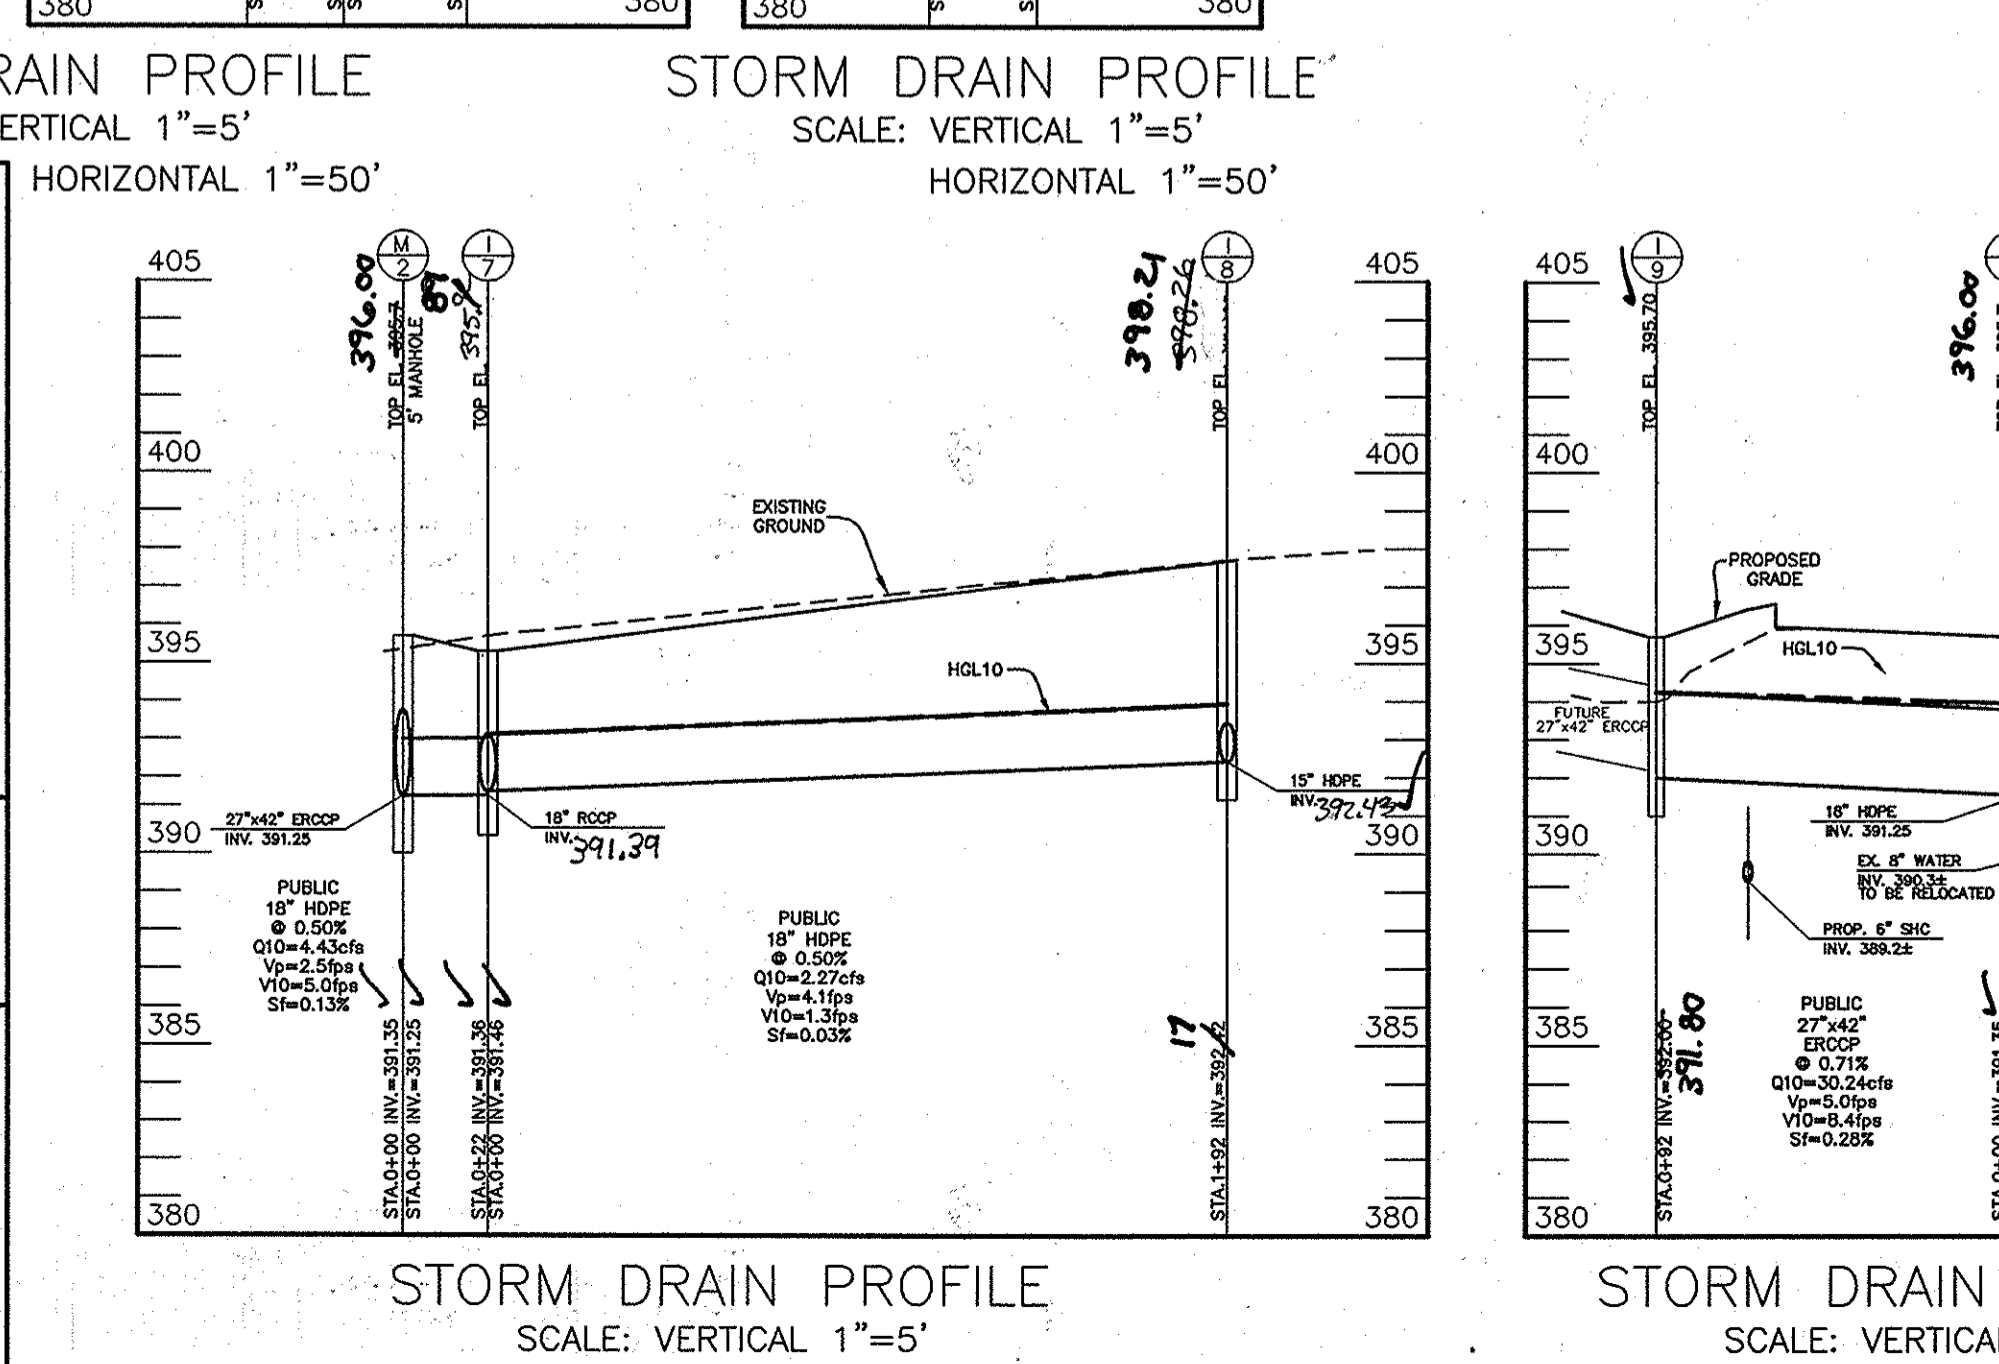

AS-BUILT CERTIFICATION

I hereby certify, by my seal, that the facilities shown on this plan were constructed as shown on this AS-BUILT plan.

Donald Mason, P.E. No. 21443 Date 6-25-15

Professional Certification. I hereby certify that these documents were prepared or approved by me, and that I am a duly licensed professional engineer under the laws of the State of Maryland.

License No. 21443, Expiration Date: 12-31-16

STORMDRAIN PIPE SCHEDULE

PIPE SIZE	LENGTH	TYPE
4"	80±	PERF. PVC
4"	113±	SOLID PVC
6"	340±	PVC (RD)
12"	53	HDPE
15"	0	HDPE
18"	380±	HDPE
27"x42"	143	ERCOP

PUBLIC WATER PROFILES

BENCHMARK ENGINEERING, INC.

8480 BALTIMORE NATIONAL PIKE SUITE 315 ELLICOTT CITY, MARYLAND 21043

OWNER: LAKESHORE I, LLC C/O SECURITY DEVELOPMENT 8480 BALTIMORE NATIONAL PIKE SUITE 415 ELLICOTT CITY, MD 21043

DEVELOPER: SECURITY DEVELOPMENT, LLC PO BOX 417 ELLICOTT CITY, MD 21041 410-465-4244

ORCHARD PARK SECTION 3 3200 PINE ORCHARD LANE ROMANIK PROPERTY, LOT 1 AND ORCHARD HILL, PARCEL B TAX MAP: 24 & 17, GRID: 1 & 13, PARCEL: 647 & P/O 130 ZONED: E-4-15 ELECTION DISTRICT NO. 2 HOWARD COUNTY, MARYLAND


SITE DEVELOPMENT PLAN STORMWATER MANAGEMENT NOTES, DETAILS AND STORM DRAIN PROFILES

DATE: MAY 2014 SHEET 6 OF 10

SOILS LEGEND		
MAP SYMBOL	SOIL GROUP	SOIL TYPE
GcB	B	GLENELG LOAM, 3 TO 8 PERCENT SLOPES
GcB*	B	GLENELG-URBAN LAND COMPLEX LOAM, 0 TO 8 PERCENT SLOPES
GcB*	C	GLENEVILLE-BAILE SILT LOAM, 0 TO 8 PERCENT SLOPES
McD	B	MANOR LOAM, 15 TO 25 PERCENT SLOPES
UcB	D	URBAN LAND-UOVERTHENS COMPLEX, 0 TO 8 PERCENT SLOPES

FROM NATURAL RESOURCES CONSERVATION SERVICES WEB SOIL SURVEY 2.0
* HYDRIC SOILS

LEGEND	
EXISTING CONTOURS	--- 190 --- --- 199 ---
PROPOSED CONTOURS	--- 190 --- --- 199 ---
EXISTING TREELINE	~~~~~
PROPOSED TREELINE	~~~~~
EXISTING STREAM	~~~~~
EXISTING STREAMBANK BUFFER	- - - - -
100 YEAR FLOODPLAIN LIMITS	-----
100 YEAR FLOODPLAIN DRAINAGE & UTILITY EASEMENT	-----
FOREST CONSERVATION EASEMENT	-----
FOREST CONSERVATION SIGN	●
EXISTING STRUCTURE	--- --
PROPOSED BUILDING	▭
SLOPES 25% OR GREATER	▨
MODERATE SLOPES	▩
EX. 20' DRAINAGE AND UTILITY EASEMENT	▧
PUBLIC DRAINAGE & UTILITY EASEMENT, PLAT #	▨
PUBLIC WATER & UTILITY EASEMENT	▩
PROP. MICRO-BIORETENTION FACILITY	▧
PROP. PERMEABLE PAVEMENT	▩
PROP. GAZEBO/PAVILION	⊙
PROP. 5' PARK BENCH GUARDRAIL	⊙

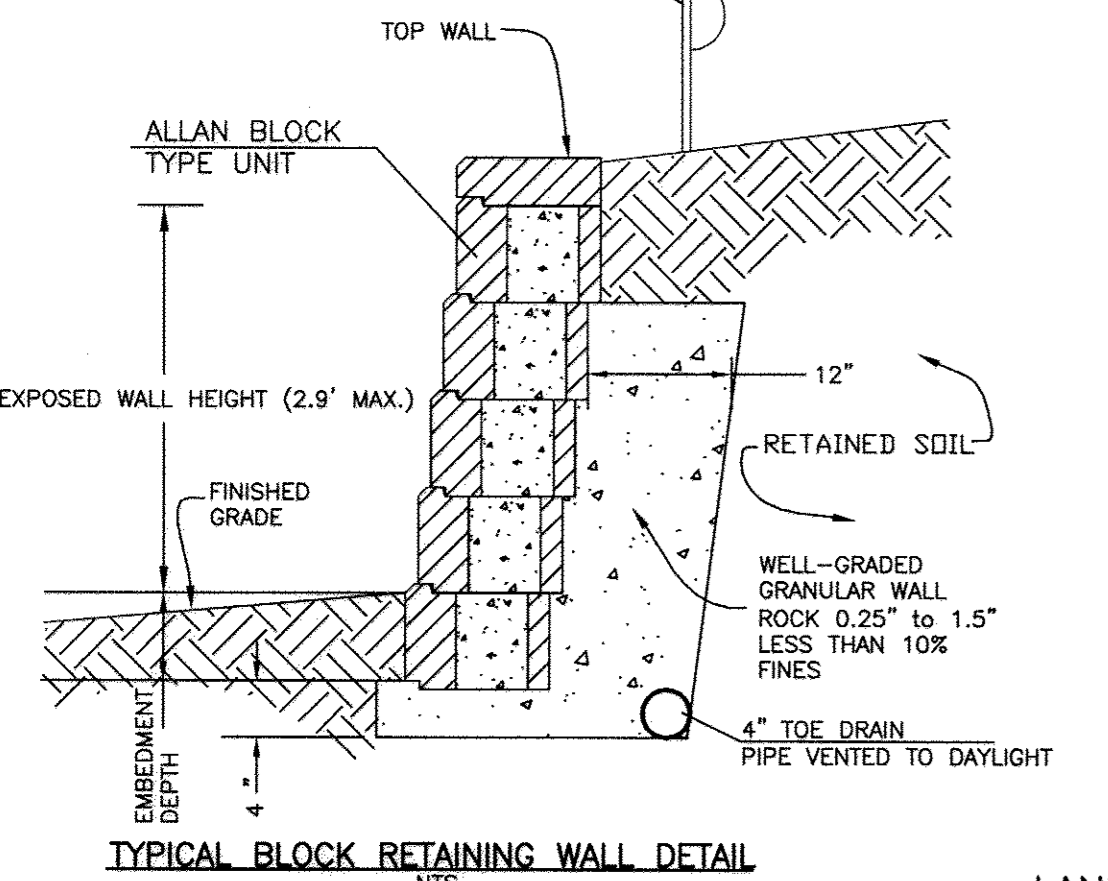

DEVELOPER'S/BUILDER'S CERTIFICATE

I/WE CERTIFY THAT THE LANDSCAPING SHOWN ON THIS PLAN WILL BE DONE ACCORDING TO THE PLAN, SECTION 16.124 OF THE HOWARD COUNTY CODE AND THE HOWARD COUNTY LANDSCAPE MANUAL. I/WE FURTHER CERTIFY THAT UPON COMPLETION OF A LETTER OF LANDSCAPE INSTALLATION, ACCOMPANIED BY AN EXECUTED ONE-YEAR GUARANTEE OF PLANT MATERIALS, WILL BE SUBMITTED TO THE DEPARTMENT OF PLANNING AND ZONING.

Jason [Signature] 5/21/14
DEVELOPER: LANDSCAPE, LLC, BY: MICHAEL [Signature], [Signature]
APPROVED: HOWARD COUNTY DEPARTMENT OF PLANNING AND ZONING



Chris [Signature] 6-17-14
CHIEF, DEVELOPMENT ENGINEERING DIVISION

Bob [Signature] 6-19-14
CHIEF, DIVISION OF LAND DEVELOPMENT

Mark [Signature] 6/19/14
DIRECTOR

LANDSCAPING NOTES


- THE PROPOSED LANDSCAPING SHALL BE PROVIDED BY THE PLANTINGS AS SHOWN ON THESE PLANS.
- THE DEVELOPER SHALL BE RESPONSIBLE FOR ALL INTERNAL PLANTINGS, THE PRESERVATION OF THE EXISTING PERIMETER VEGETATION; AND FOR THE PERIMETER PLANTINGS AS SHOWN ON THESE PLANS. BONDING FOR THE PROPOSED PLANTINGS IS THE OBLIGATION OF THE DEVELOPER AS PART OF THE DEVELOPER'S AGREEMENT.
- TREES MUST BE A MINIMUM OF FOUR(4) FEET FROM THE CURB OR SIDEWALK AND MUST BE A MINIMUM OF FIVE(5) FEET FROM ANY STORM DRAIN.
- A MINIMUM DISTANCE OF TWENTY(20) FEET MUST BE MAINTAINED BETWEEN ANY TREES LOCATED ALONG THE CURB LINE AND FROM STREET LIGHTS.
- TREES MUST BE PLANTED A MINIMUM OF FIVE(5) FEET FROM AN OPEN SPACE ACCESS STRIP AND TEN(10) FEET FROM A DRIVEWAY AND A MINIMUM OF FIVE(5) FEET FROM DRAIN INLET STRUCTURES.
- THIS PLAN HAS BEEN PREPARED IN ACCORDANCE WITH THE PROVISIONS OF SEC.-16.124 OF THE HOWARD COUNTY CODE AND LANDSCAPE MANUAL.
- SIX (6) SPECIMEN TREES WERE FOUND ON-SITE AS PER FOREST STAND DELINEATION PREPARED BY ECO-SCIENCE PROFESSIONALS, INC. DATED AUGUST, 2012, AS APPROVED UNDER WP-13-074 FIVE(5) OF THE SPECIMEN TREES ARE TO BE REMOVED WITH A REQUIRED MITIGATION AT A RATIO OF ONE 3"-4" CALIPER TREE FOR EACH SPECIMEN TREE REMOVED. SPECIMEN TREE F WILL BE RETAINED AS PART OF THIS PROJECT. ROOT PRUNING ALONG THE PROPOSED LIMITS OF DISTURBANCE WILL BE PROVIDED TO REDUCE AND INSURE ITS SURVIVAL.
- THE REQUIRED PERIMETER PLANTINGS AND PARKING LOT PLANTINGS ARE PROVIDED IN ACCORDANCE WITH THE PROVISIONS OF SECTION 16.124 OF THE HOWARD COUNTY CODE AND THE LANDSCAPE MANUAL. FINANCIAL SURETY FOR THE REQUIRED LANDSCAPING HAS BEEN POSTED AS PART OF THE DPW DEVELOPER'S AGREEMENT FOR SDP-13-055 IN THE AMOUNT OF \$20,410.00 (\$8,600.00 FOR 32 SHADE TREES, \$6,600.00 FOR 44 EVERGREEN TREES, \$1,800.00 FOR 12 ORNAMENTAL TREES AND \$2,250.00 FOR 75 SHRUBS) THE ADDITIONAL \$18,600.00 IS FOR THE DISTURBANCE WITHIN THE FOREST CONSERVATION EASEMENT. SEE NOTE # SHEET 8.
- AT THE TIME OF PLANT INSTALLATION, ALL SHRUBS AND TREES LISTED AND APPROVED ON THE LANDSCAPE PLAN, SHALL COMPLY WITH THE PROPER HEIGHT REQUIREMENT IN ACCORDANCE WITH THE HOWARD COUNTY LANDSCAPE MANUAL. IN ADDITION, NO SUBSTITUTIONS OR RELOCATIONS OF THE REQUIRED PLANTINGS MAY BE MADE WITHOUT PRIOR REVIEW AND APPROVAL FROM THE DEPARTMENT OF PLANNING AND ZONING.
- THE OWNERS, TENANT AND/OR THEIR AGENTS SHALL BE RESPONSIBLE FOR MAINTENANCE OF THE REQUIRED LANDSCAPING INCLUDING BOTH PLANT MATERIALS AND BENCHES. ALL PLANT MATERIALS SHALL BE MAINTAINED IN GOOD GROWING CONDITION, AND WHERE NECESSARY, REPLACED WITH NEW MATERIALS TO ENSURE CONTINUED COMPLIANCE WITH APPLICABLE REGULATIONS.
- IN ACCORDANCE WITH THE PRE-SUBMISSION COMMUNITY MEETING HELD ON FEBRUARY 18, 2013 THE DEVELOPER HAS AGREED TO PLANT ADDITIONAL LANDSCAPING (EVERGREENS) ALONG THE PARKING LOTS ADJACENT TO THE RESIDENTIAL PROPERTIES. DPZ WILL ENFORCE THIS AGREEMENT AS PART OF THE INTERNAL LANDSCAPE REQUIREMENTS AND SURETY FOR THE PROVIDED TREES WILL BE POSTED AS PART OF THE DEVELOPER'S AGREEMENT.
- ADDITIONAL LANDSCAPING OF 2 SHADE & 1 EVERGREEN TREE WERE PROVIDED PER REVISION #3. NO ADDITIONAL SURETY IS REQUIRED.

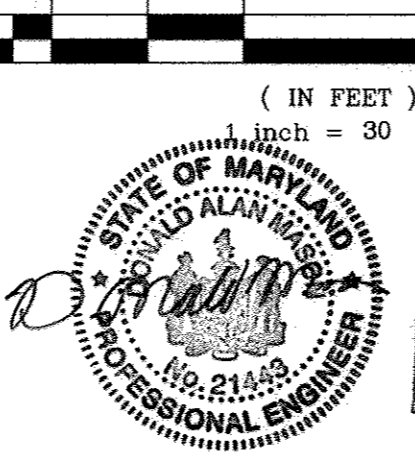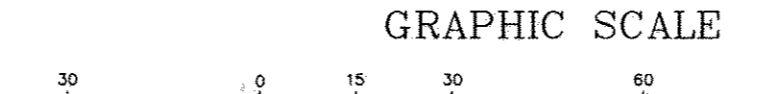

Professional Certification. I hereby certify that these documents were prepared or approved by me, and that I am a duly licensed professional engineer under the laws of the State of Maryland.

License No. 21443 Expiration Date: 12-31-16

J. Chris Ogge
DNR QUALIFIED PROFESSIONAL

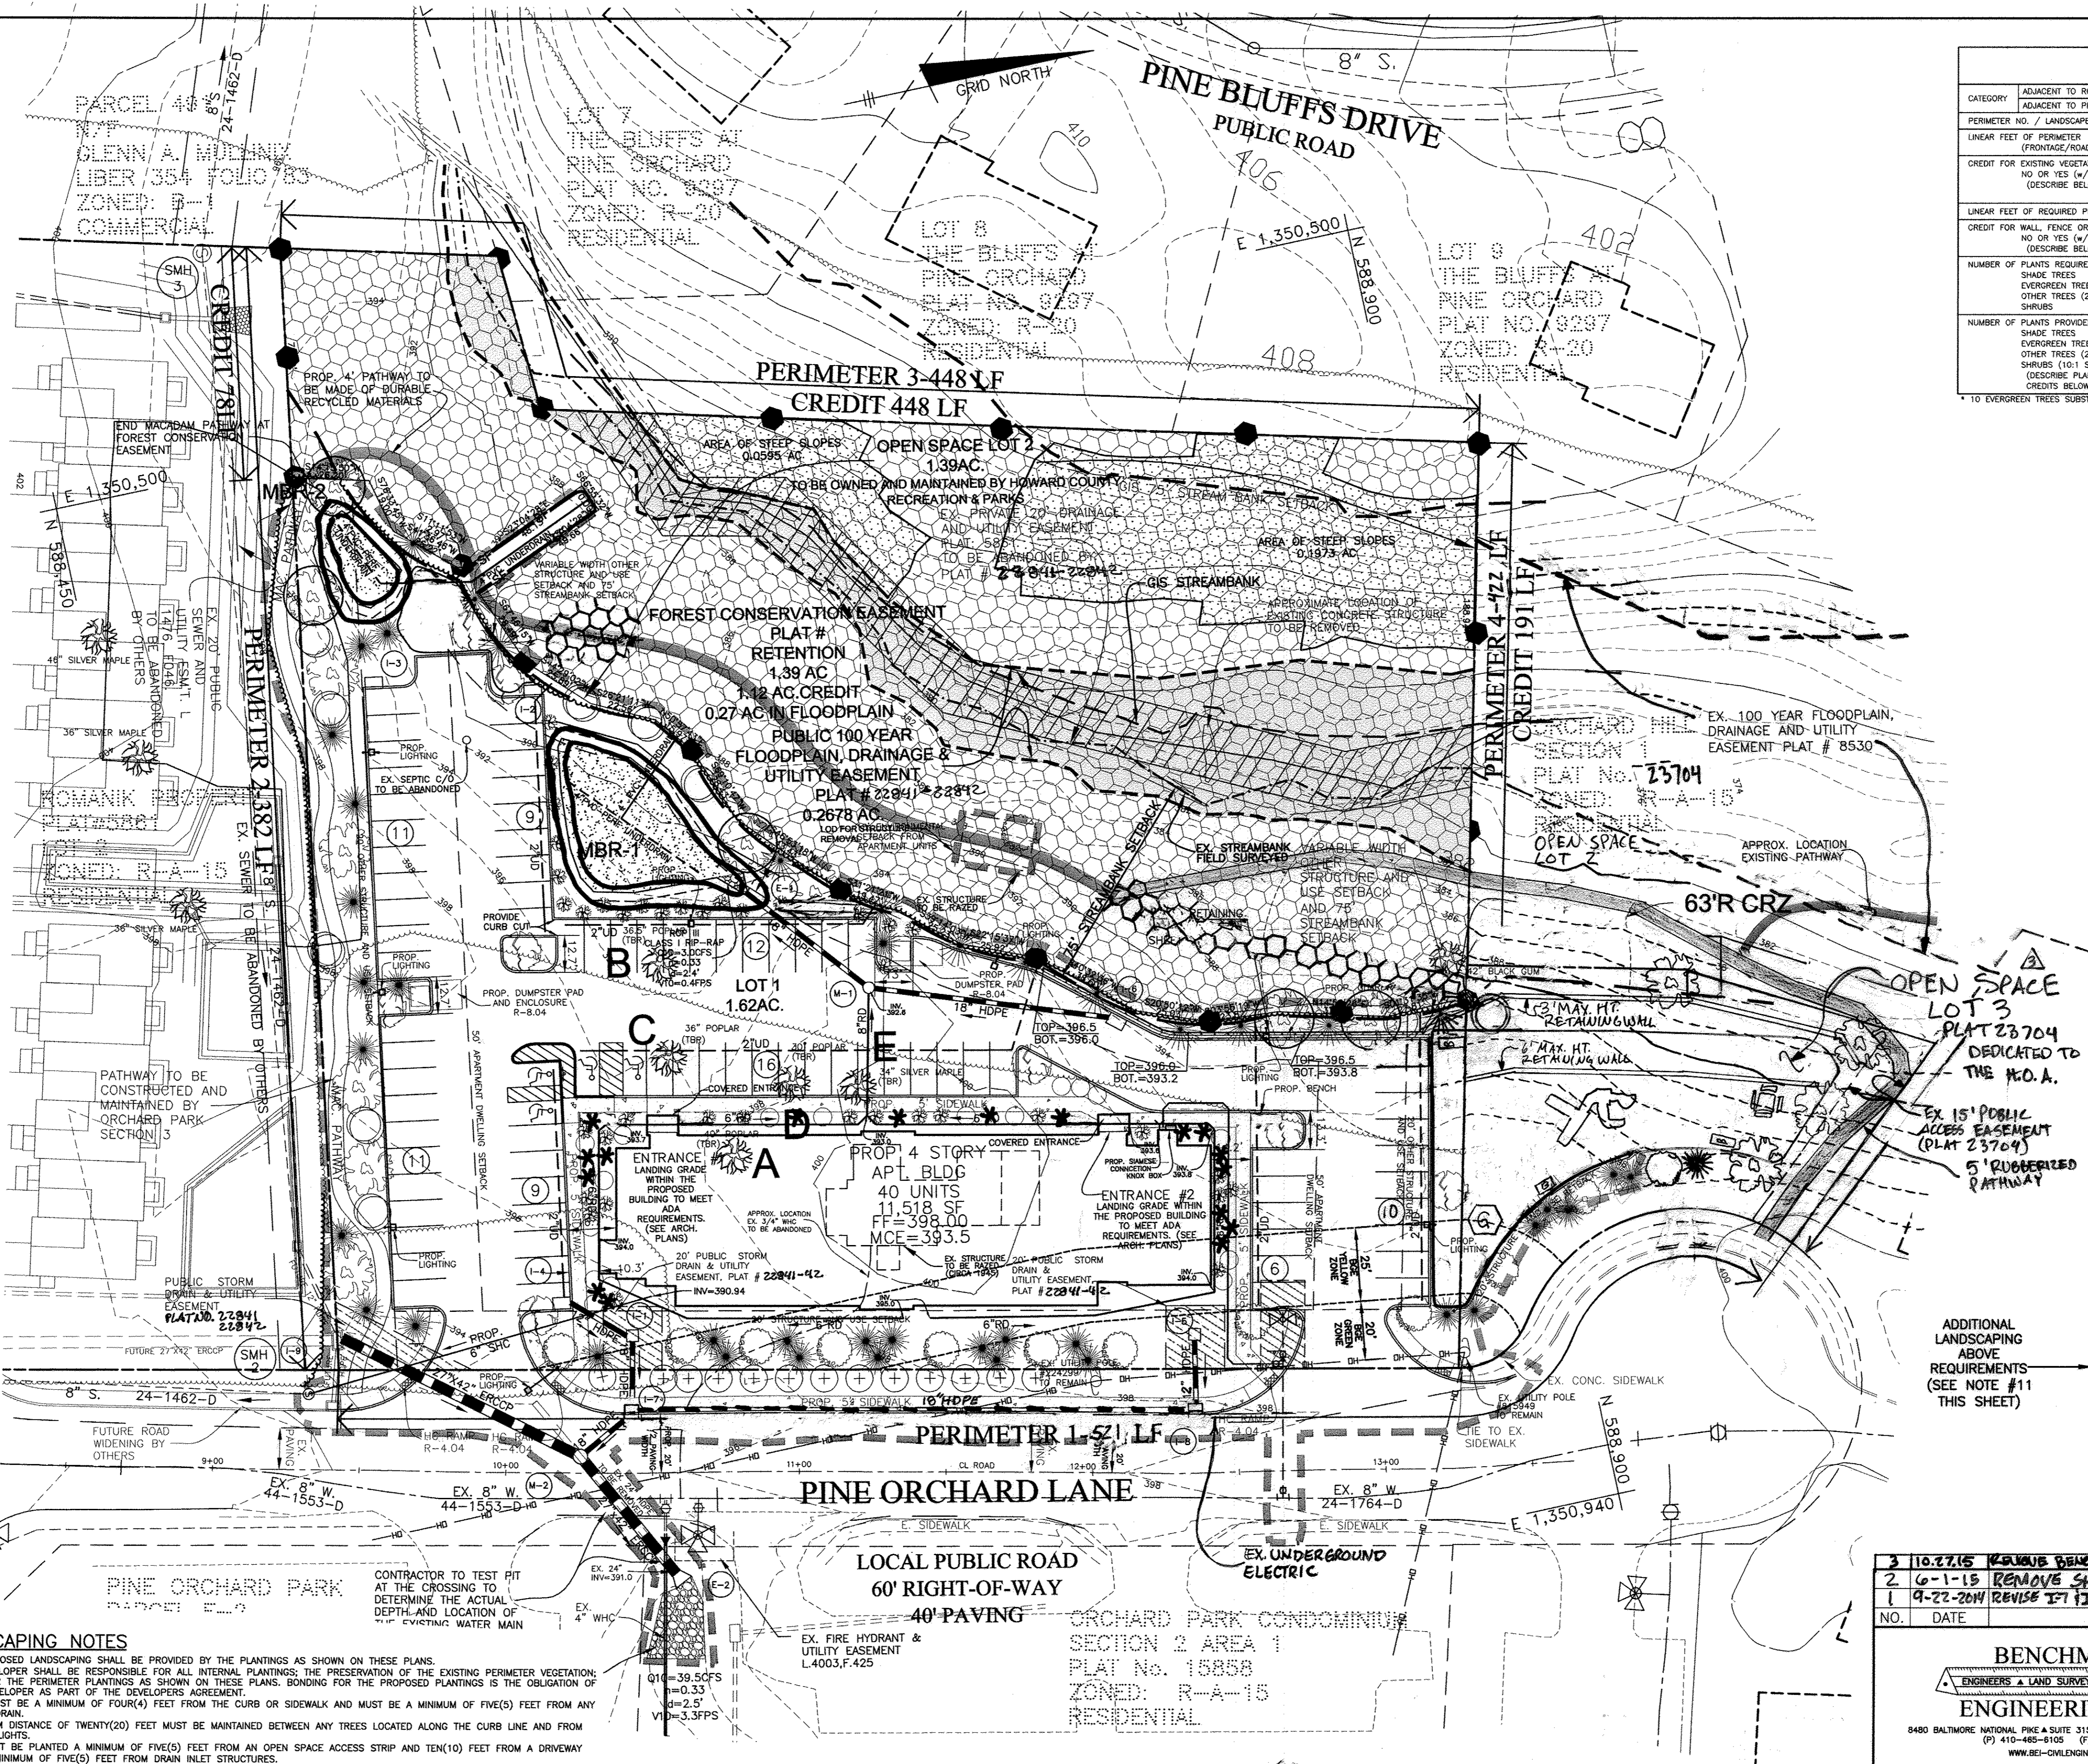

SCHEDULE A PERIMETER LANDSCAPE EDGE

CATEGORY	ADJACENT TO ROADWAY					TOTAL
	YES	NO	YES	NO	YES	
PERIMETER NO. / LANDSCAPE TYPE	①	②	③	④	⑤	COMPUTED
LINEAR FEET OF PERIMETER (FRONTAGE/ROADWAY)	521	382	448	422	25	50
CREDIT FOR EXISTING VEGETATION: NO OR YES (W/LINEAR FEET) (DESCRIBE BELOW IF NEEDED)	NO	YES 78	YES 448	YES 191	NO	
LINEAR FEET OF REQUIRED PERIMETER LANDSCAPING	521	304	-	231	50	
CREDIT FOR WALL, FENCE OR BERM: NO OR YES (W/LINEAR FEET) (DESCRIBE BELOW IF NEEDED)	NO	NO	NO	NO	NO	
NUMBER OF PLANTS REQUIRED:						
SHADE TREES	19	6	-	4	2(1EACH)	22
EVERGREEN TREES - OTHER TREES (2:1 SUBSTITUTE)	-	-	-	-	2(1EACH)	2
NUMBER OF PLANTS PROVIDED:						
SHADE TREES	0	6	-	4	2	12
EVERGREEN TREES - OTHER TREES (2:1 SUBSTITUTE)	#23	8	-	-	2	33
SHRUBS (10:1 SUBSTITUTE)	-	-	-	-	-	10
OTHER TREES (2:1 SUBSTITUTE) (DESCRIBE PLANT SUBSTITUTION CREDITS BELOW IF NEEDED)	-	-	-	-	-	-

10 EVERGREEN TREES SUBSTITUTED FOR 20 SMALL ORNAMENTAL TREES SUBSTITUTED FOR 10 SHADE TREES.

SCHEDULE B - PARKING LOT INTERNAL LANDSCAPING

NUMBER OF PARKING SPACES:		83
NUMBER OF TREES/15'-15'-SIZES REQUIRED: 1/10		8
NUMBER OF TREES PROVIDED:		8
SHADE TREES		-
OTHER TREES (2:1 SUBSTITUTE)		-
SHRUBS (10:1 SUBSTITUTE)		-

SCHEDULE C - RESIDENTIAL DEVELOPMENT INTERNAL LANDSCAPING

SYMBOL	QUANTITY	NAME	REMARKS
○	1/3 UNITS 40 UNITS 13 (10 SHADE TREES AND 20 SHRUBS ARE PROVIDED)	QUERCUS RUBRA NORTHERN RED OAK	2 1/2" - 3" CAL

STREET TREE LANDSCAPE PLANTING LIST

SYMBOL	QUANTITY	NAME	REMARKS
+	3904/30	ACER TATARICUM TATARIAN MAPLE	2 1/2" CAL
	13	SHRUBS (10:1 SUBSTITUTE) LESS THAN 25" MAX HT.	

STREET TREES FOR ORCHARD HILL, PARCEL # B WERE SATISFIED UNDER F-88-281

LANDSCAPE PLANTING LIST

SYMBOL	QUANTITY	NAME	REMARKS
○	11	ACER RUBRUM/OCTOBER GLORY OCTOBER GLORY RED MAPLE SHADE TREE	2 1/2" - 3" CAL
○	5	LIRIODENDRON TULIPIFERA TULIP POPLAR SHADE TREE	3"-4" CAL
○	12	ACER GINALE AMUR MAPLE SMALL DECIDUOUS TREE	1 1/2" - 2" CAL BOE GREEN ZONE LESS THAN 25" MAX HT.
○	33	LLEL 'NELLIE R. STEVENS' NELLIE R. STEVENS HOLLY	5' - 6" HT BOE GREEN ZONE LESS THAN 25" MAX HT.
○	8	PRUNUS SARGENTII "SARGENT CHERRY" LARGE DECIDUOUS TREE	2 1/2" - 3" HT
○	10	LLEL 'CRENATA 'HELLER' "HELLER JAPANESE HOLLY"	18" - 24" HT
○	10	BUXUS MICROPHYLLA KOREANA "WINTERGREEN BOXWOOD"	2 1/2" - 3" HT
○	10	EVONYMUS NAUSTRUCHOVICUS "SIBERIAN EVONYMUS"	2 1/2" - 3" HT
○	12	PRUNUS STROBUS "WHITE PINE"	6" - 8" HT
○	22	LLEL 'CRENATA 'HELLER' "HELLER JAPANESE HOLLY"	18" - 24" HT

* 5 ADDITIONAL SHADE TREES FOR THE 5 SPECIMEN TREES REMOVED UNDER WP-13-074. SEE NOTE #7 THIS SHEET.
** 1 ADDITIONAL SHADE TREE FOR THE LOD WITHIN THE FOREST CONSERVATION EASEMENT. SEE NOTE #8 SHEET 8.
*** ENHANCED LANDSCAPING TO MITIGATE THE 15' WIDE LANDSCAPE AREA BETWEEN THE BUILDING AND PARKING AREA.

NO.	DATE	REVISION
1	10-27-15	REMOVE BENCHES AND ADDITIONAL P.C. AREA LOTS
2	6-1-15	REMOVE SHED & DRYWELL FROM PARCEL 'B'
3	9-22-2014	REVISE IT IT-B TO A-B INLETS AND SHOW UG ELECTRIC

BENCHMARK ENGINEERING, INC.
ENGINEERS & LAND SURVEYORS & PLANNERS
8450 BALTIMORE NATIONAL PIKE SUITE 415
ELLICOTT CITY, MD 21043
(P) 410-465-8105 (F) 410-465-6844
WWW.BE-ONLINEENGINEERING.COM

Professional Certification. I hereby certify that these documents were prepared or approved by me, and that I am a duly licensed professional engineer under the laws of the State of Maryland.
License No. 21443 Expiration Date: 12-31-16

J. Chris Ogge
DNR QUALIFIED PROFESSIONAL

ORCHARD PARK SECTION 3
3300 PINE ORCHARD LANE
ROMANIK PROPERTY, LOT 1 AND ORCHARD HILL, OPEN SPACE LOTS 3
TAX MAP: 24 & 17, GRID: 1 & 19, PARCEL: 647 & P/O 130
ZONED: R-A-15
ELECTION DISTRICT NO. 2
HOWARD COUNTY, MARYLAND


SITE DEVELOPMENT PLAN
LANDSCAPE AND FOREST CONSERVATION PLAN

OWNER: LAKESHORE I, LLC
C/O SECURITY DEVELOPMENT
8450 BALTIMORE NATIONAL PIKE SUITE 415
ELLICOTT CITY, MD 21043

DEVELOPER: SECURITY DEVELOPMENT, LLC
PO BOX 417
ELLICOTT CITY, MD 21041
410-465-4244

DATE: MAY 2014
SCALE: 1"=30'

BEI PROJECT NO. 1796
SHEET 7 OF 11

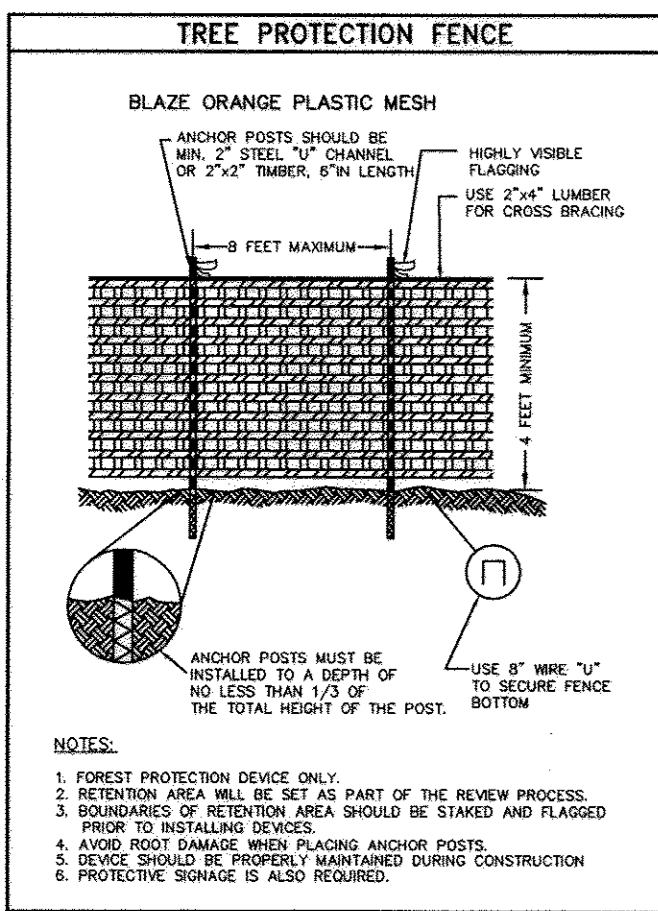

NOTES:
 1. FOREST PROTECTION FENCE ONLY.
 2. THE FENCE IS PART OF THE REVIEW PROCESS. BOUNDARIES OF RETENTION AREA SHOULD BE STAKED AND FLAGGED.
 3. ANCHOR POSTS SHOULD BE PLACED AT 15 FEET INTERVALS.
 4. ANCHOR POSTS SHOULD BE PLACED AT 15 FEET INTERVALS.
 5. PROTECTIVE SIGNAGE IS ALSO REQUIRED.

FOREST CONSERVATION NOTES:

- ANY FOREST CONSERVATION EASEMENT (FCE) AREA SHOWN HEREON IS SUBJECT TO PROTECTIVE COVENANTS WHICH MAY BE FOUND IN THE LAND RECORDS OF HOWARD COUNTY WHICH RESTRICT THE DISTURBANCE AND USE OF THESE AREAS.
- THE FOREST CONSERVATION EASEMENTS HAVE BEEN ESTABLISHED TO FULFILL THE REQUIREMENTS OF SECTION 16.1200 OF THE HOWARD COUNTY CODE. FOREST CONSERVATION ACT. NO CLEARING, GRADING, OR CONSTRUCTION IS PERMITTED WITHIN THE FOREST CONSERVATION EASEMENTS. HOWEVER, FOREST MANAGEMENT PRACTICES AS DEFINED IN THE DEED OF FOREST CONSERVATION EASEMENT ARE ALLOWED.
- LIMITS OF DISTURBANCE SHALL BE RESTRICTED TO AREAS OUTSIDE THE LIMIT OF TEMPORARY FENCING OR THE FCE BOUNDARY, WHICHEVER IS GREATER.
- THERE SHALL BE NO CLEARING, GRADING, CONSTRUCTION OR DISTURBANCE OF VEGETATION IN THE FOREST CONSERVATION EASEMENT, EXCEPT AS PERMITTED BY HOWARD COUNTY DPZ.
- NO STOCKPILES, PARKING AREAS, EQUIPMENT CLEANING AREAS, ETC. SHALL OCCUR WITHIN AREAS DESIGNATED AS FOREST CONSERVATION EASEMENTS.
- TEMPORARY FENCING SHALL BE USED TO PROTECT FOREST RESOURCES DURING CONSTRUCTION. THE FENCING SHALL BE PLACED ALONG ALL FCE BOUNDARIES WHICH OCCUR WITHIN 15 FEET OF THE PROPOSED LIMITS OF DISTURBANCE.
- PERMANENT SIGNAGE SHALL BE PLACED 50-100' APART ALONG THE BOUNDARIES OF ALL AREAS INCLUDED IN FOREST CONSERVATION EASEMENTS.
- THE TOTAL FOREST CONSERVATION OBLIGATION AMOUNT HAVE BEEN MET BY THE ON-SITE RETENTION OF 1.12 AC. WITHIN A FOREST CONSERVATION EASEMENT. A \$160.00 FEE IS REQUIRED FOR THE DISTURBANCE WITHIN THE FOREST CONSERVATION EASEMENT TO REMOVE THE EXISTING STRUCTURE. THE LIMIT OF DISTURBANCE IS 400SF (400*\$0.40/SF). THIS FEE WILL BE ADDED TO THE LANDSCAPE SURETY. PLANTING OF 2" CALIBER TREES IS REQUIRED FOR THE DISTURBANCE AT 100 PER ACRE OF LOD. SEE LANDSCAPE PLANT LIST SHEET 7.

FOREST PROTECTION PROCEDURES - Preconstruction Phase

- The edge of the woods to be protected will be marked (staked or flagged) in the field per the limits of forest conservation easement shown in the approved site development plan prior to the start of construction activity. All areas within protective easement are to be considered "off limits" to any construction activities. The optional protective fencing shall be installed at the outside edge of forested areas and should be combined with sediment control devices when possible. The limit of the critical root zone and therefore the location of the protective devices is to be determined as follows:
 Edge of Forested Area - 1 foot of protective radius/inch of DBH or an eight foot protective radius, whichever is greater.

Critical Root Zone for the forest on this site is an average of 12 feet from the trunk of the tree. Critical root zones for Specimen Tree 'F' 63'.

- Construction activities expressly prohibited within the preservation areas are:
 Placing or stockpiling backfill or top soil in protected areas
 Felling trees into protected areas
 Driving construction equipment into or through protected areas
 Burning in or in close proximity to protected areas
 Stacking or storing supplies of any kind
 Concrete wash-off areas
 Conducting trenching operations
 Grading beyond the limits of disturbance
 Parking vehicles or construction equipment
 Removal of root mat or topsoil
 Siting and construction of:
 Utility lines
 Access roads
 Impervious surfaces
 Stormwater management devices
 Staging areas

- Protective fencing (see Figure "Protective Fencing") shall be the responsibility of the general contractor. The general contractor shall affix signs to the fencing at 25' minimum intervals indicating that these areas are "Forest Retention Area" (see Figure "Signage"). The general contractor shall take great care to assure the restricted areas are not violated and that root systems are protected from smothering, flooding, excessive wetting from dewatering operations, off-site runoff, spillage, and drainage or solutions containing materials hazardous to tree roots.

- The general contractor shall be responsible for any tree damaged or destroyed within the preservation areas whether caused by the contractor, his agents, employees, subcontractors, or licensees.

- Foot traffic shall be kept to a minimum in the protective areas.

- All trees which are not to be preserved within fifty feet of any tree preservation areas are to be removed in a manner that will not damage those trees that are designated for preservation. It is highly recommended that tree stumps within this fifty foot area be ground out with a stump grinding machine to minimize damage.

- The general contractor shall designate a "wash out" area onsite for concrete trucks which will not drain toward a protected area.

- A pre-construction meeting shall be held with local authorities before any disturbance has taken place on site.

FOREST PROTECTION PROCEDURES - Construction Phase

Forest and tree conditions should be monitored during construction and corrective measures taken when appropriate.

The following shall be monitored:

- Soil compaction
- Root Injury - prune and monitor; consider crown reduction
- Limb Injury - prune and monitor
- Flooded conditions - drain and monitor; correct problem
- Drought conditions - water and monitor; correct problem
- Other stress signs - determine reason, correct, and monitor

FOREST PROTECTION PROCEDURES - Post Construction Phase

The following measures shall be taken:

- Corrective measures if damages were incurred due to negligence:
 - Stress reduction
 - Removal of dead or dying trees. This may be done only if trees pose an immediate safety hazard.
- Removal of temporary structures:
 - No burial of discarded materials will occur onsite within the conservation area.
 - No open burning within 100 feet of a wooded area.
 - All temporary forest protection structures will be removed after construction.
 - Remove temporary roads by removing stone or broadcasting mulch; pre-construction elevation should be maintained.
 - Aerate compacted soil.
 - Replant disturbed sites with trees, shrubs and/or herbaceous plants.
 - Retain signs for retention areas or specimen trees.
 - A County official shall inspect the entire site.
- Future protection measures:
 - Howard County and the developer shall arrange for the dedication of an appropriate forest conservation easement at a later date.

FOREST PROTECTION PROCEDURES - Preconstruction Phase

Stress Reduction and Protection of Specimen Trees Isolated from Forest Retention Areas and General Forest Retention Areas (as they may apply)

Isolated specimen trees that are to be preserved will be examined to determine if stress reduction techniques are needed. Protective measures and their evaluation criteria are provided on this plan only if they are employed herein.

Root Pruning

Evaluation Criteria
 Will the critical root zone be affected by construction activities such as grade changes, digging for foundations and roads or utility installation?

Design Considerations

- Prune prior to construction as shown on the plan (see Figure "Root Pruning Detail.")
- Prune root with a clean cut using proper pruning equipment such as a vibratory knife.
- Exact location of pruning trench should be identified, and immediately backfilled to cover exposed roots after pruning with soil removed other topsoil, peat moss, or other suitable material or with other high organic soil.
- For trees over 15" in diameter, root pruning may be done up to one year in advance of construction.
- Tree(s) will be monitored for signs of stress.

Crown Reduction or Pruning

Evaluation Criteria

Has the root system been significantly reduced (>30%) or are there dead, damaged, or diseased limbs?

Design Considerations

- Reduce only at specified times of the year:
 Flowering trees - only after flowering and before bud set
 Non-flowering trees - in late winter, early spring or mid summer
- No more than 1/3 of the crown should be removed at one time using acceptable pruning methods (see Figure "Crown Reduction Detail")
- Monitor for signs of stress

Watering

Evaluation Criteria

Will construction activities alter the hydrology of the site? Has or will root pruning occur?

Design Considerations

- Water only as necessary
- Monitor for signs of stress (see Figure "Tree Planting and Maintenance Calendar")


Fertilizing

Evaluation Criteria

Is or will be tree(s) be under stressful conditions? Has or will root pruning occur?

Design Considerations

- Use low nitrogen and slow release fertilizers.
- Apply in late fall or early spring (see Figure "Tree Planting and Maintenance and Calendar")
- For small trees (<3" in diameter), use punch hole method or pressurized injection method (see Figure "Application of Fertilizers by Injection.")
- For larger trees (>3" diameter), use punch hole method or pressurized injection method (see Figure "Application of Fertilizers by Injection.")
- Do not apply fertilizer any closer than 3' from tree trunk for pressurized injection method.
- Monitor for signs of stress.

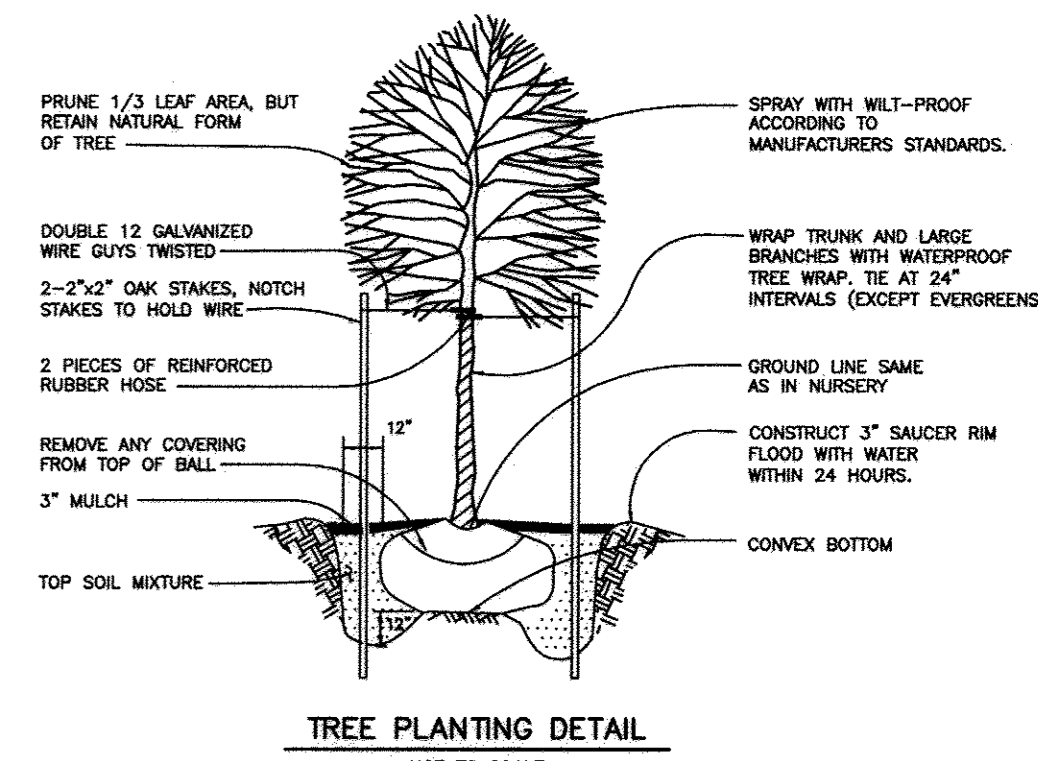

TREE PLANTING DETAIL
 NOT TO SCALE

FOREST CONSERVATION WORKSHEET
 ORCHARD PARK SECTION 3

Computations by: JCO BEI JOB No. 1796 Date: 10/9/2013

NET TRACT AREA:

A. Total tract area	330 ac.
B. Other deductions: (floodplain)	0.27 ac.
C. Net Tract Area	303 ac.

LAND USE CATEGORY:

Select category (AR, MDR, ID, HDR, MPD, CI) HDR

D. Afforestation Threshold	15% x "F" =	0.45 ac.
E. Conservation threshold	20% x "F" =	0.61 ac.

EXISTING FOREST COVER:

F. Existing forest cover	2.00 ac.
G. Area of forest above afforestation threshold	1.55 ac.
H. Area of forest above conservation threshold	1.34 ac.

BREAK EVEN POINT:


I. Forest retention above threshold with no mitigation	0.88 ac.
J. Clearing permitted without mitigation	1.12 ac.

PROPOSED FOREST CLEARING:

K. Total area of forest to be cleared	0.88 ac.
L. Total area of forest to be retained	1.12 ac.

PLANTING REQUIREMENTS:

M. Reforestation for clearing above conservation threshold	0.22 ac.
N. Reforestation for clearing below conservation threshold	0.00 ac.
O. Credit for retention above conservation threshold	0.51 ac.
P. Total reforestation required	0.00 ac.
Q. Total afforestation required	0.00 ac.
R. Credit for landscaping - may not exceed 20% of "S."	0.00 ac.
S. Total reforestation and afforestation required	0.00 ac.

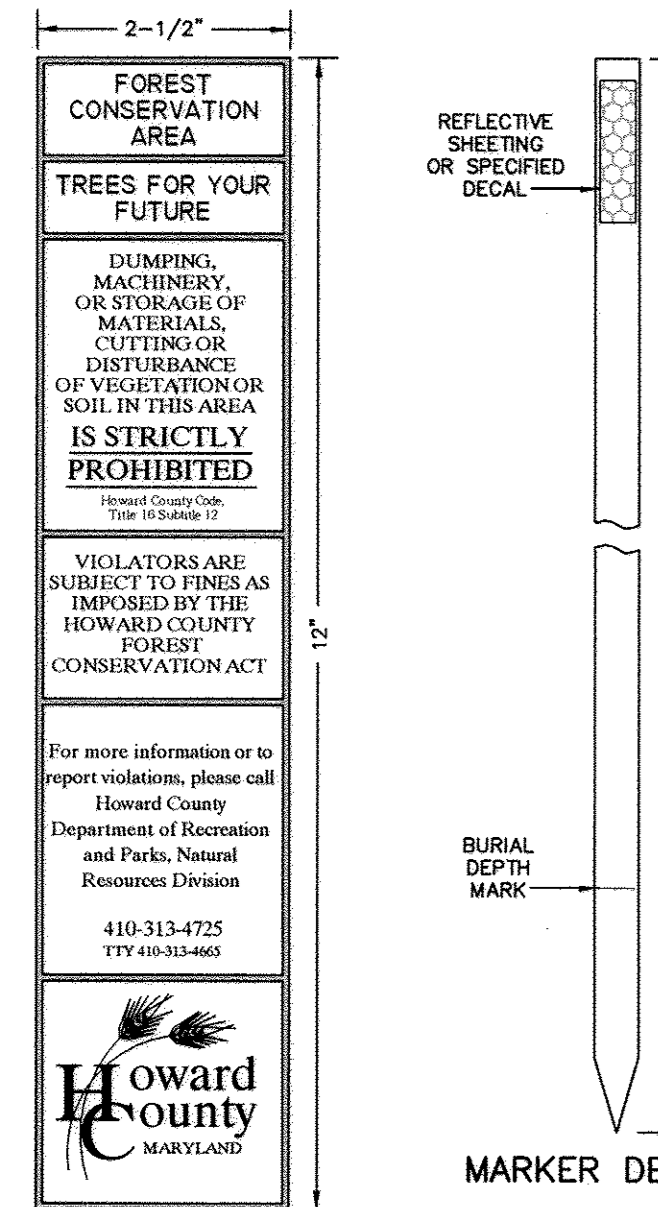

DECAL SPECIFICATIONS

Materials:
 Number: 3690 Scotchcal
 non-reflective substrate.
 Color:
 Dark green text and border
 on beige background.

FCE CARSONITE MARKER
 NOT TO SCALE

FOREST CONSERVATION EASEMENT CHART

EASEMENT #	AREA	TYPE
1	1.39 AC. (1.12 AC. CREDIT)	RETENTION

Specimen Tree Data

Key	Species, Size (dbh)	CRZ diameter	Comments/Condition
A	Tulip poplar, 40"	120'	good condition
B	Tulip poplar, 36.5"	110'	good condition
C	Tulip poplar, 38"	108'	good condition
D	Tulip poplar, 30"	90'	good condition
E	Silver Maple, 34"	102'	good condition
F	Black gum, 42"	126'	good condition

DEVELOPER'S/BUILDER'S CERTIFICATE

I/WE CERTIFY THAT THE LANDSCAPING SHOWN ON THIS PLAN WILL BE DONE ACCORDING TO THE PLAN, SECTION 16.124 OF THE HOWARD COUNTY CODE AND THE HOWARD COUNTY LANDSCAPE MANUAL. I/WE FURTHER CERTIFY THAT UPON COMPLETION OF A LETTER OF LANDSCAPE INSTALLATION, ACCOMPANIED BY AN EXECUTED ONE-YEAR GUARANTEE OF PLANT MATERIALS, WILL BE SUBMITTED TO THE DEPARTMENT OF PLANNING AND ZONING.

Signature: Susan Limst
 DEVELOPER: L. A. H. H. C., LLC, BY: Susan Limst, member
 Date: 5/16/14

APPROVED: HOWARD COUNTY DEPARTMENT OF PLANNING AND ZONING

Signature: Chad Edwards
 CHIEF, DEVELOPMENT ENGINEERING DIVISION
 Date: 6/17/14

Signature: [Signature]
 CHIEF, DIVISION OF LAND DEVELOPMENT
 Date: 6/29/14

Signature: [Signature]
 DIRECTOR
 Date: 6/19/14

No As-Built information is required on this sheet



Professional Certification. I hereby certify that these documents were prepared or approved by me, and that I am a duly licensed professional engineer under the laws of the State of Maryland.
 License No. 21443, Expiration Date: 12-21-16

J. CHRIS OGLE
 DPR QUALIFIED PROFESSIONAL

3	10.27.15	REMOVE BEACHES, ADD ADDITIONAL REC AREA LOT 3
NO.	DATE	REVISION

BENCHMARK ENGINEERING, INC.
 ENGINEERS & LAND SURVEYORS & PLANNERS
 8480 BALTIMORE NATIONAL PIKE SUITE 415 ELLICOTT CITY, MARYLAND 21043
 (P) 410-485-8108 (F) 410-485-8844
 WWW.BEI-ONLINEENGINEERING.COM




Professional Certification. I hereby certify that these documents were prepared or approved by me, and that I am a duly licensed professional engineer under the laws of the State of Maryland.
 License No. 22390, Expiration Date: 6.30.15.

ORCHARD PARK SECTION 3
 3200 PINE ORCHARD LANE
 ROMANIK PROPERTY, LOT 1 AND ORCHARD HILL, OPEN SPACE LOT 3
 TAX MAP: 24 & 17, GRID: 1 & 19, PARCEL: 647 & P/O 130
 ZONED: R-A-15
 ELECTION DISTRICT NO. 2
 HOWARD COUNTY, MARYLAND


DEVELOPER:
 SECURITY DEVELOPMENT, LLC
 PO BOX 417
 ELLICOTT CITY, MD 21041
 410-485-4244

SITE DEVELOPMENT PLAN
 FOREST CONSERVATION NOTES AND DETAILS

DATE: MAY 2014 BEI PROJECT NO. 1796
 SCALE: AS SHOWN SHEET 8 OF 11

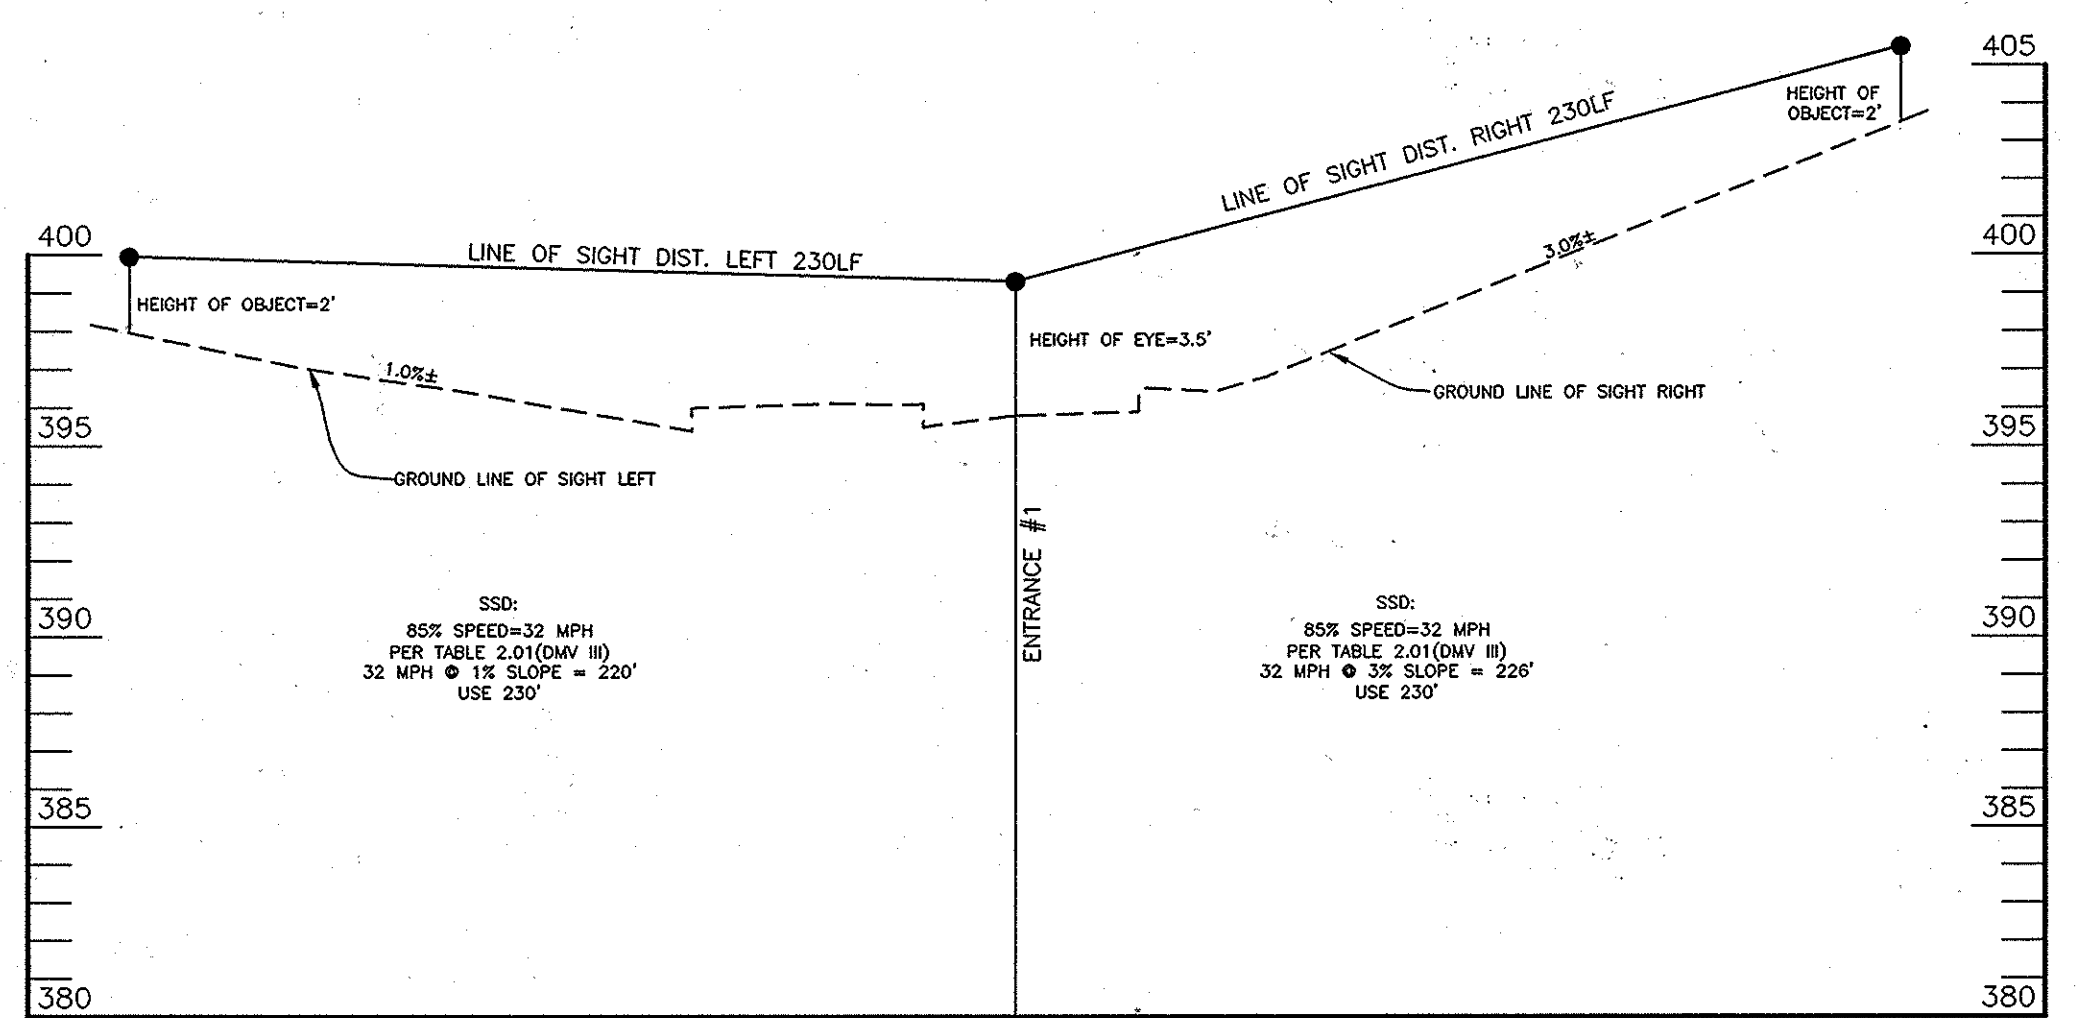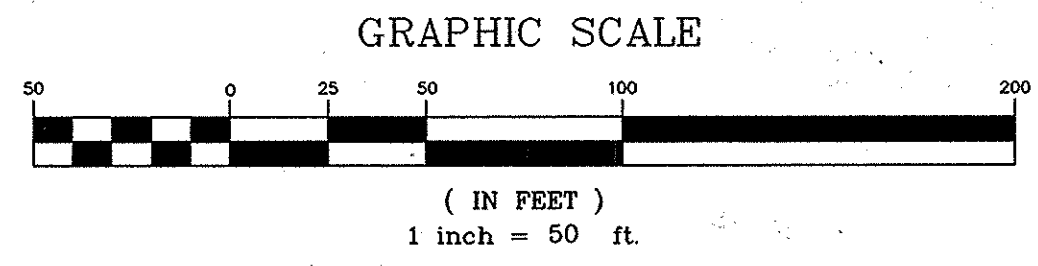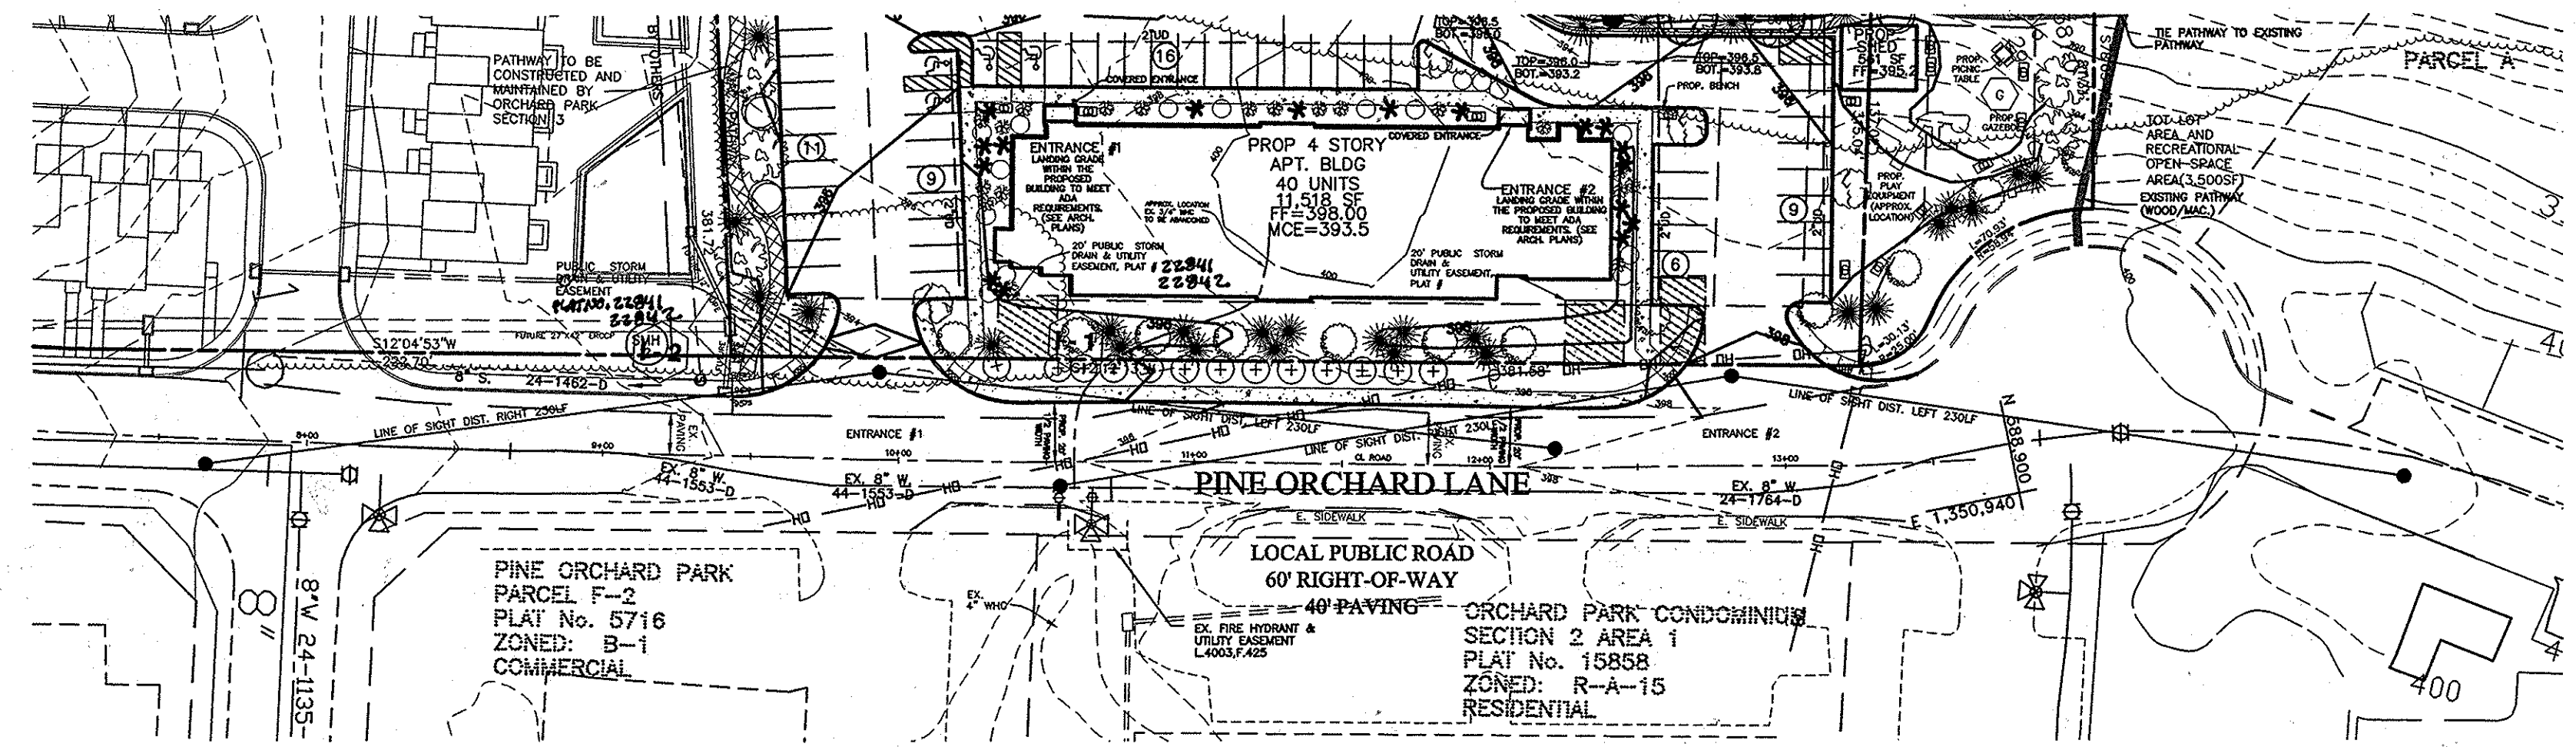

SIGHT DISTANCE-ENTRANCE #1
 SCALE: VERTICAL 1"=5'
 HORIZONTAL 1"=50'

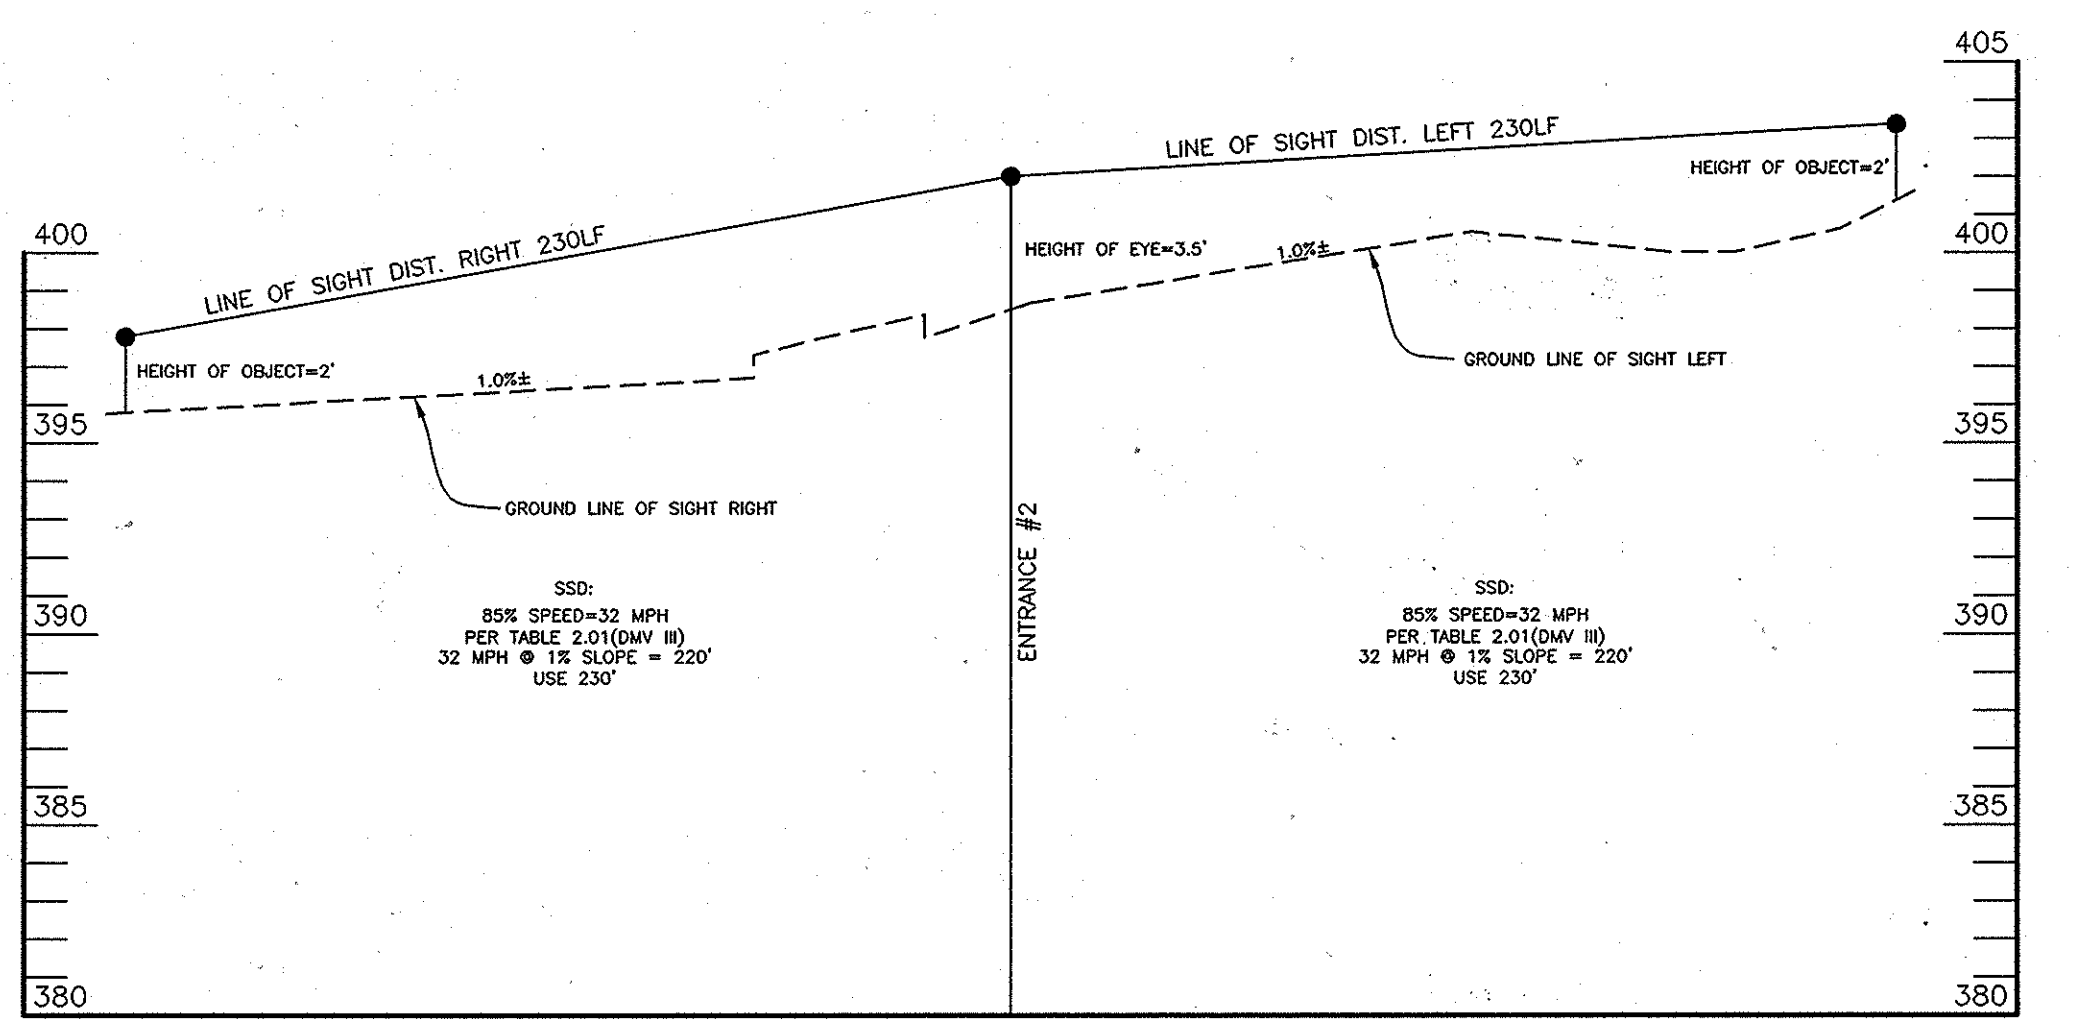

SIGHT DISTANCE-ENTRANCE #2
 SCALE: VERTICAL 1"=5'
 HORIZONTAL 1"=50'


NOTE:
 EXISTING TOPOGRAPHY IS TAKEN FROM A FIELD RUN SURVEY WITH 2 FOOT CONTOUR INTERVALS PREPARED BY BENCHMARK ENGINEERING, INC. DATED DECEMBER 2012.

PER HOWARD COUNTY DESIGN MANUAL VOL.III;
 STOPPING SIGHT DISTANCE IS MEASURED USING A HEIGHT OF EYE OF 3.5 FEET AND HEIGHT OF OBJECT OF 2.0 FEET. THE DISTANCE IS MEASURED FROM A POINT 10 FEET BACK FROM THE EDGE OF PAVING.

BASED ON 85TH PERCENTILE SPEED ON PINE ORCHARD LANE (MARS GROUP, DECEMBER 2012): 32MPH

CONCLUSION: SIGHT DISTANCE ADEQUATE BOTH ENTRANCES.

No As-Built information is required on this sheet

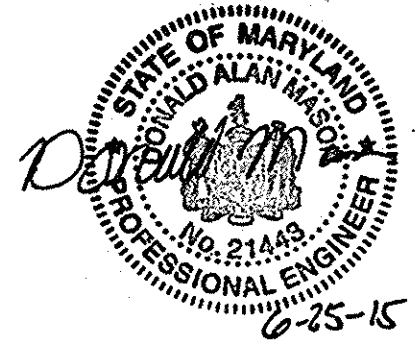

Professional Certification. I hereby certify that these documents were prepared or approved by me, and that I am a duly licensed professional engineer under the laws of the State of Maryland.
 License No. 21443, Expiration Date: 12-21-16

APPROVED: HOWARD COUNTY DEPARTMENT OF PLANNING AND ZONING

Chad Edmister 6-17-14
 CHIEF, DEVELOPMENT ENGINEERING DIVISION DATE

Vicki Shalton 6-19-14
 CHIEF, DIVISION OF LAND DEVELOPMENT DATE

Harold P. Levitt 6/19/14
 DIRECTOR DATE

NO.	DATE	REVISION
BENCHMARK ENGINEERING, INC. ENGINEERS & LAND SURVEYORS & PLANNERS 8480 BALTIMORE NATIONAL PIKE & SUITE 315 & ELLICOTT CITY, MARYLAND 21043 (P) 410-465-6105 (F) 410-465-6644 WWW.BEI-OMV.ENGINEERING.COM		
OWNER: LAKESHORE I, LLC C/O SECURITY DEVELOPMENT 8480 BALTIMORE NATIONAL PIKE SUITE 415 ELLICOTT CITY, MD 21043		ORCHARD PARK SECTION 3 3200 PINE ORCHARD LANE ROMANIK PROPERTY, LOT 1 AND ORCHARD HILL, PARCEL B TAX MAP: 24 & 17, GRID: 1 & 13, PARCEL: 647 & P/O 130 ZONED: R-A-15 ELECTION DISTRICT NO. 2 HOWARD COUNTY, MARYLAND
DEVELOPER: SECURITY DEVELOPMENT, LLC PO BOX 417 ELLICOTT CITY, MD 21041 410-465-4244		SITE DEVELOPMENT PLAN SIGHT DISTANCE EXHIBIT DATE: MAY 2014 BEI PROJECT NO. 1796 SCALE: AS SHOWN SHEET 9 OF 10

LED AREA LIGHTS - XGB3 128 LED

LED LIGHTING TECHNOLOGY

SAFETY/THERMAL CONTROL - Sensors in both optical unit and driver enclosure monitor when normal ambient temperature exceed 50°C. Current is lowered in proportion to % increase every 5 minutes until safe operating temperature is reached.

EXPECTED LIFE - Minimum 60,000 hours to 100,000 hours depending upon the ambient temperature of the installation location. See LED web site for specific guidance.

LED - Galium Nitride (GaN) LED, 200°K color temperature (warm), 70 CRI (neutral).

DISTRIBUTION PERFORMANCE - Types S, FT, FT-L, FT-A, FT-A-L and FT-A-R. Exceptional uniformity with full radiant output light environment at lower light levels. Improved beam spread control minimizes light trespass. FT, FT-A, FT-A-L and FT-A-R allow for 100% mounting configurations with factory set optics for most new suburban applications.

HOUSING - Durable, die-cast aluminum. Fully enclosed weather-tight housing contains factory pre-wired drivers and field connections.

TOP ACCESS COVER - Interlock top access cover provides ease of installation and allows for easy driver access. Four captive stainless steel fasteners secure the top access cover to the housing.

OPTICAL UNIT - Clear tempered optical grade flat glass lens sealed to aluminum housing creates an IP67 rated, sealed optical unit. Pressure stabilizing breather allows upper light IP67 protection while preventing temperature cycling from building up internal pressure and reducing heat sink stress optical unit seals and components. Patented integral single-blade heat sink does not top off and drains, ensuring cool operating performance over the life of the fixture.

MOUNTING - 2-1/2" x 5-1/2" x 1" extruded aluminum with mounting bracket designed standard. IP bracket available for single or 2/10 configurations, but must be ordered from the fixture column of mounting chart. Use with 5' traditional lighting poles on LED street, round, square and round tapered poles. Round Pole Plus (RPP) required for mounting to 2"-3" round poles. (See Accessory Ordering Information chart).

ELECTRICAL - Two-stage surge protection (including gas-discharge surge protection built into electronic driver) meets IEEE C62.41.2-2002, Surges 1, Location Category C. Available with optional surge arrestor (SAP) 120-277VAC, 0.5-4000A, 100V, and 341-400VAC. Optional button-type photocells (PC) are available in 120, 208, 240, 277 or 347 volt (single voltage must be specified).

DRIVERS - Available in 120VAC and 277VAC options (277VAC only for factory programming). State-of-the-art driver technology designed specifically for LED light sources provides exceptional system efficiency. Components are fully enclosed in potting material for IP68 moisture resistance. Driver complies with FCC 47 CFR part 15 (FCC Emission).

OPERATING TEMPERATURE - -40°C to 150°C (-40°F to 122°F).

FINISH - Fixtures are finished with LED-DuraCoat® polymer powder coat finishing process. The Duracoat finish withstands extreme weather changes without cracking or peeling, and is guaranteed for the life span. Standard colors include bronze, black, platinum, silver, granite, white, wine, green, metallic, blue and white. Meets requirements of ASTM B117 1000 Hour Salt Fog and ASTM G85 1000 Hour Corrosion Acetate Tests (Superior G85 1000H).

WARRANTY - LED LED Sources carry a limited 5-year warranty.

PHOTOMETRICS - Application based on available upon request. Contact LSI Applications Group at lighting@lsiconsult.com

SHIPPING WEIGHT (in cartons) - 32 lbs (14.5 kg) fixture 5 lbs (2.3 kg)

LISTING - ETL listed to U.S. and Canadian safety standards. Suitable for wet locations.

Project Name: _____ Fixture Type: 10001T
 Catalog # _____ © 2012 LSI INDUSTRIES INC.

LED AREA LIGHTS - XGB3 128 LED

LED LIGHTING TECHNOLOGY

LUMINAIRE ORDERING INFORMATION

Optical Mounting: XGB3 FT-A LED 128 350 CW-UE-WHT P0120

Part	Description	LED	CR	350-350	CR-350/350	CR-350/350	CR-350/350	CR-350/350	CR-350/350	CR-350/350	CR-350/350
LED	FT - Forward Flow	LED	350	350	350	350	350	350	350	350	350
CR	CR - CR	CR	350	350	350	350	350	350	350	350	350
350	350	350	350	350	350	350	350	350	350	350	350
350	350	350	350	350	350	350	350	350	350	350	350

LUMINAIRE DIMENSIONS - 350


Part	Description	LED	CR	350-350	CR-350/350	CR-350/350	CR-350/350	CR-350/350	CR-350/350	CR-350/350	CR-350/350
LED	LED	LED	LED	LED	LED	LED	LED	LED	LED	LED	LED
CR	CR	CR	CR	CR	CR	CR	CR	CR	CR	CR	CR
350	350	350	350	350	350	350	350	350	350	350	350
350	350	350	350	350	350	350	350	350	350	350	350

LEFT AND RIGHT VERSIONS OF TYPE FT & FT-A REFLECTORS (TOP VIEW)

Area to be lit

Water: Distributions are not field-replaceable. For 8100 Forward Flow luminaires specify with FT-A or FT-A-L and/or with FT-A or FT-A-L side mounting. Orientation is based on standing at the pole looking out at the area to be lit.

Project Name: _____ Fixture Type: 10001T
 Catalog # _____ © 2012 LSI INDUSTRIES INC.

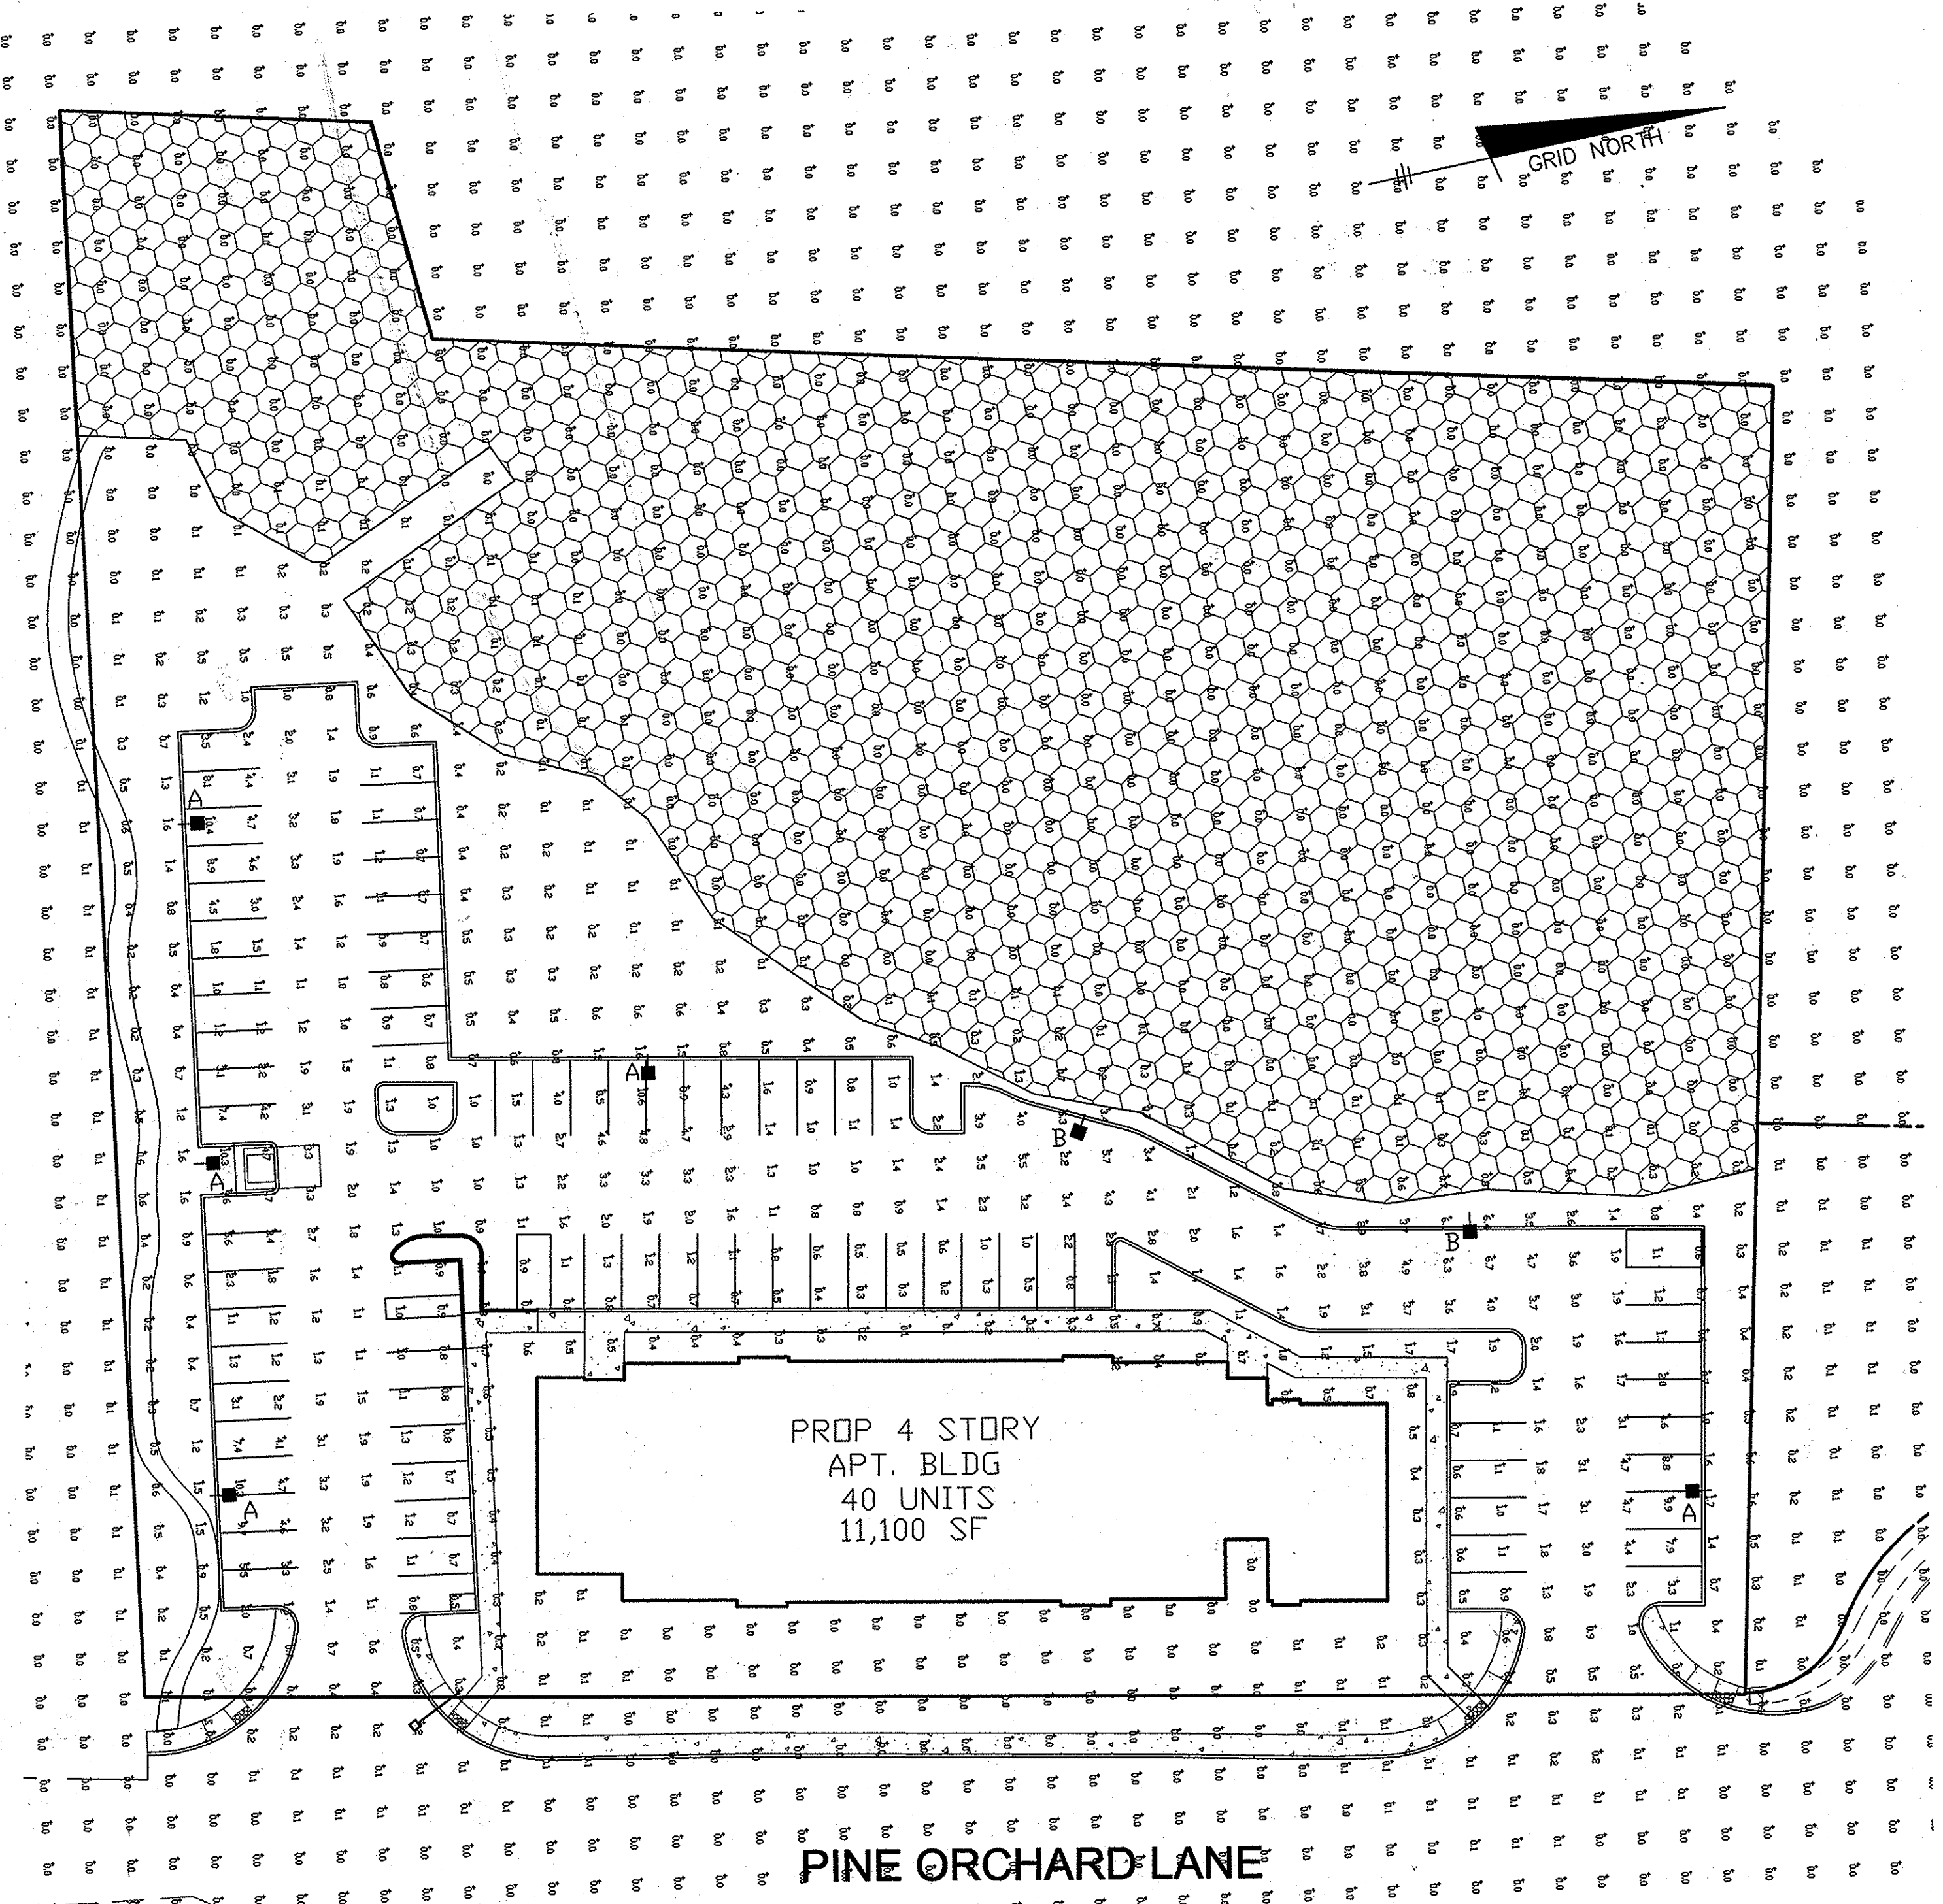

NOTES:

BASED ON THE INFORMATION PROVIDED, ALL DIMENSIONS AND LUMINAIRE LOCATIONS SHOWN REPRESENT RECOMMENDED POSITIONS. THE ENGINEER AND/OR ARCHITECT MUST DETERMINE THE APPLICABILITY OF THE LAYOUT TO EXISTING OR FUTURE FIELD CONDITIONS.

THIS LIGHTING PLAN REPRESENTS ILLUMINATION LEVELS CALCULATED FROM LABORATORY DATA TAKEN UNDER CONTROLLED CONDITIONS IN ACCORDANCE WITH THE ILLUMINATING ENGINEERING SOCIETY (IES) APPROVED METHODS. ACTUAL PERFORMANCE OF ANY MANUFACTURER'S LUMINAIRES MAY VARY DUE TO CHANGES IN ELECTRICAL VOLTAGE, TOLERANCE IN LAMPS/LED'S AND OTHER VARIABLE FIELD CONDITIONS. CALCULATIONS DO NOT INCLUDE OBSTRUCTIONS SUCH AS BUILDINGS, CURBS, LANDSCAPING, OR ANY OTHER ARCHITECTURAL ELEMENTS UNLESS NOTED.

ALL OUTDOOR LIGHTING SHALL COMPLY WITH THE REQUIREMENTS OF ZONING SECTION 134. ALL PROPOSED EXTERIOR LIGHTING SHALL BE DIRECTED/REFLECTED AWAY FROM ALL ADJACENT PUBLIC ROADS AND RESIDENTIAL ZONING DISTRICTS. LIGHT TRESPASS ONTO ANY PROPERTY ZONED OR USED FOR RESIDENTIAL PURPOSES SHALL BE LIMITED TO 0.5 FOOT CANDLES.

LIGHT TRESPASS GREATER THAN 0.5 FOOT CANDLES IS ALLOW TO ENCR OACH ONTO PARCEL 'B' IN ACCORDANCE WITH SECTION 128.A.10 OF THE ZONING REGULATIONS FOR INTEGRATED DEVELOPMENT.

No As-Built information is required on this sheet

STATE OF MARYLAND
PROFESSIONAL ENGINEER
 License No. 21443, Expiration Date: 12-21-16

Professional Certification. I hereby certify that these documents were prepared or approved by me, and that I am a duly licensed professional engineer under the laws of the State of Maryland.

GRAPHIC SCALE
 0 15 30 60 120
 (IN FEET)
 1 inch = 30 ft.

OFFSITE LIGHT LOCATION

STREET NAME	LOCATION	OFFSET	FIXTURE/POLE TYPE
PINE ORCHARD LANE	AS SHOWN	7'±	150 WATT HPS VAPOR PREMIER POST-TOP FIXTURE MOUNTED ON A 14' BLACK FIBERGLASS POLE

ONSITE LIGHTING ONLY
 Total Project Watts = 964
 Total Watts = 964

Luminaire Schedule

Symbol	Qty	Label	Arrangement	Description	LLF	Lumens/Lamp	Arr. Lum. Lumens	Arr. Watts
—	4	A	SINGLE	XGB3-FT-LED-128-350-CW-UE-S-20'POLE + 2'BASE	1.000	N.A.	12706	136
—	2	B	SINGLE	XGB3-3-LED-128-350-CW-UE-S-20'POLE + 2'BASE	1.000	N.A.	11794	142

Calculation Summary

Label	CalcType	Units	Avg	Max	Min	Avg/Min	Max/Min
ALL CALC POINTS	Illuminance	Fc	0.39	10.6	0.0	N.A.	N.A.
INSIDE CURB	Illuminance	Fc	2.16	10.6	0.2	10.80	53.00

APPROVED: HOWARD COUNTY DEPARTMENT OF PLANNING AND ZONING

Chad Elmer 6-17-14
 CHIEF, DEVELOPMENT ENGINEERING DIVISION DATE

Vest Shroder 6-17-14
 CHIEF, DIVISION OF LAND DEVELOPMENT DATE

Mark A. Long 6/19/14
 DIRECTOR DATE

BENCHMARK ENGINEERING, INC.
 ENGINEERS & LAND SURVEYORS & PLANNERS
 8480 BALTIMORE NATIONAL PIKE & SUITE 315 ELLICOTT CITY, MARYLAND 21043
 (P) 410-465-6105 (F) 410-465-6844
 WWW.BEI-ONLINEENGINEERING.COM

LSI Industries
 American Innovation Through Technology
 A SmartView® for the Partners
 1000 ALLIANCE RD. CINCINNATI, OHIO 45242 USA
 (513) 793-0800 • FAX (513) 793-0823

ORCHARD PARK
 SECTION 3
 3200 PINE ORCHARD LANE
 TAX MAP: 24, GRID: 1, PARCEL: 647
 ZONED: R-A-15
 ELECTION DISTRICT NO. 2
 HOWARD COUNTY, MARYLAND

SITE DEVELOPMENT PLAN
LIGHTING PHOTOMETRIC PLAN


OWNER: LAKESHORE I, LLC
 C/O SECURITY DEVELOPMENT
 8480 BALTIMORE NATIONAL PIKE
 SUITE 415
 ELLICOTT CITY, MD 21043

DEVELOPER: SECURITY DEVELOPMENT, LLC
 PO BOX 417
 ELLICOTT CITY, MD 21041
 410-465-4244


DATE: MAY 2014
 SCALE: 1"=30'

BEI PROJECT NO. 1796
 SHEET 10 OF 10

AS-BUILT SDP-13-055

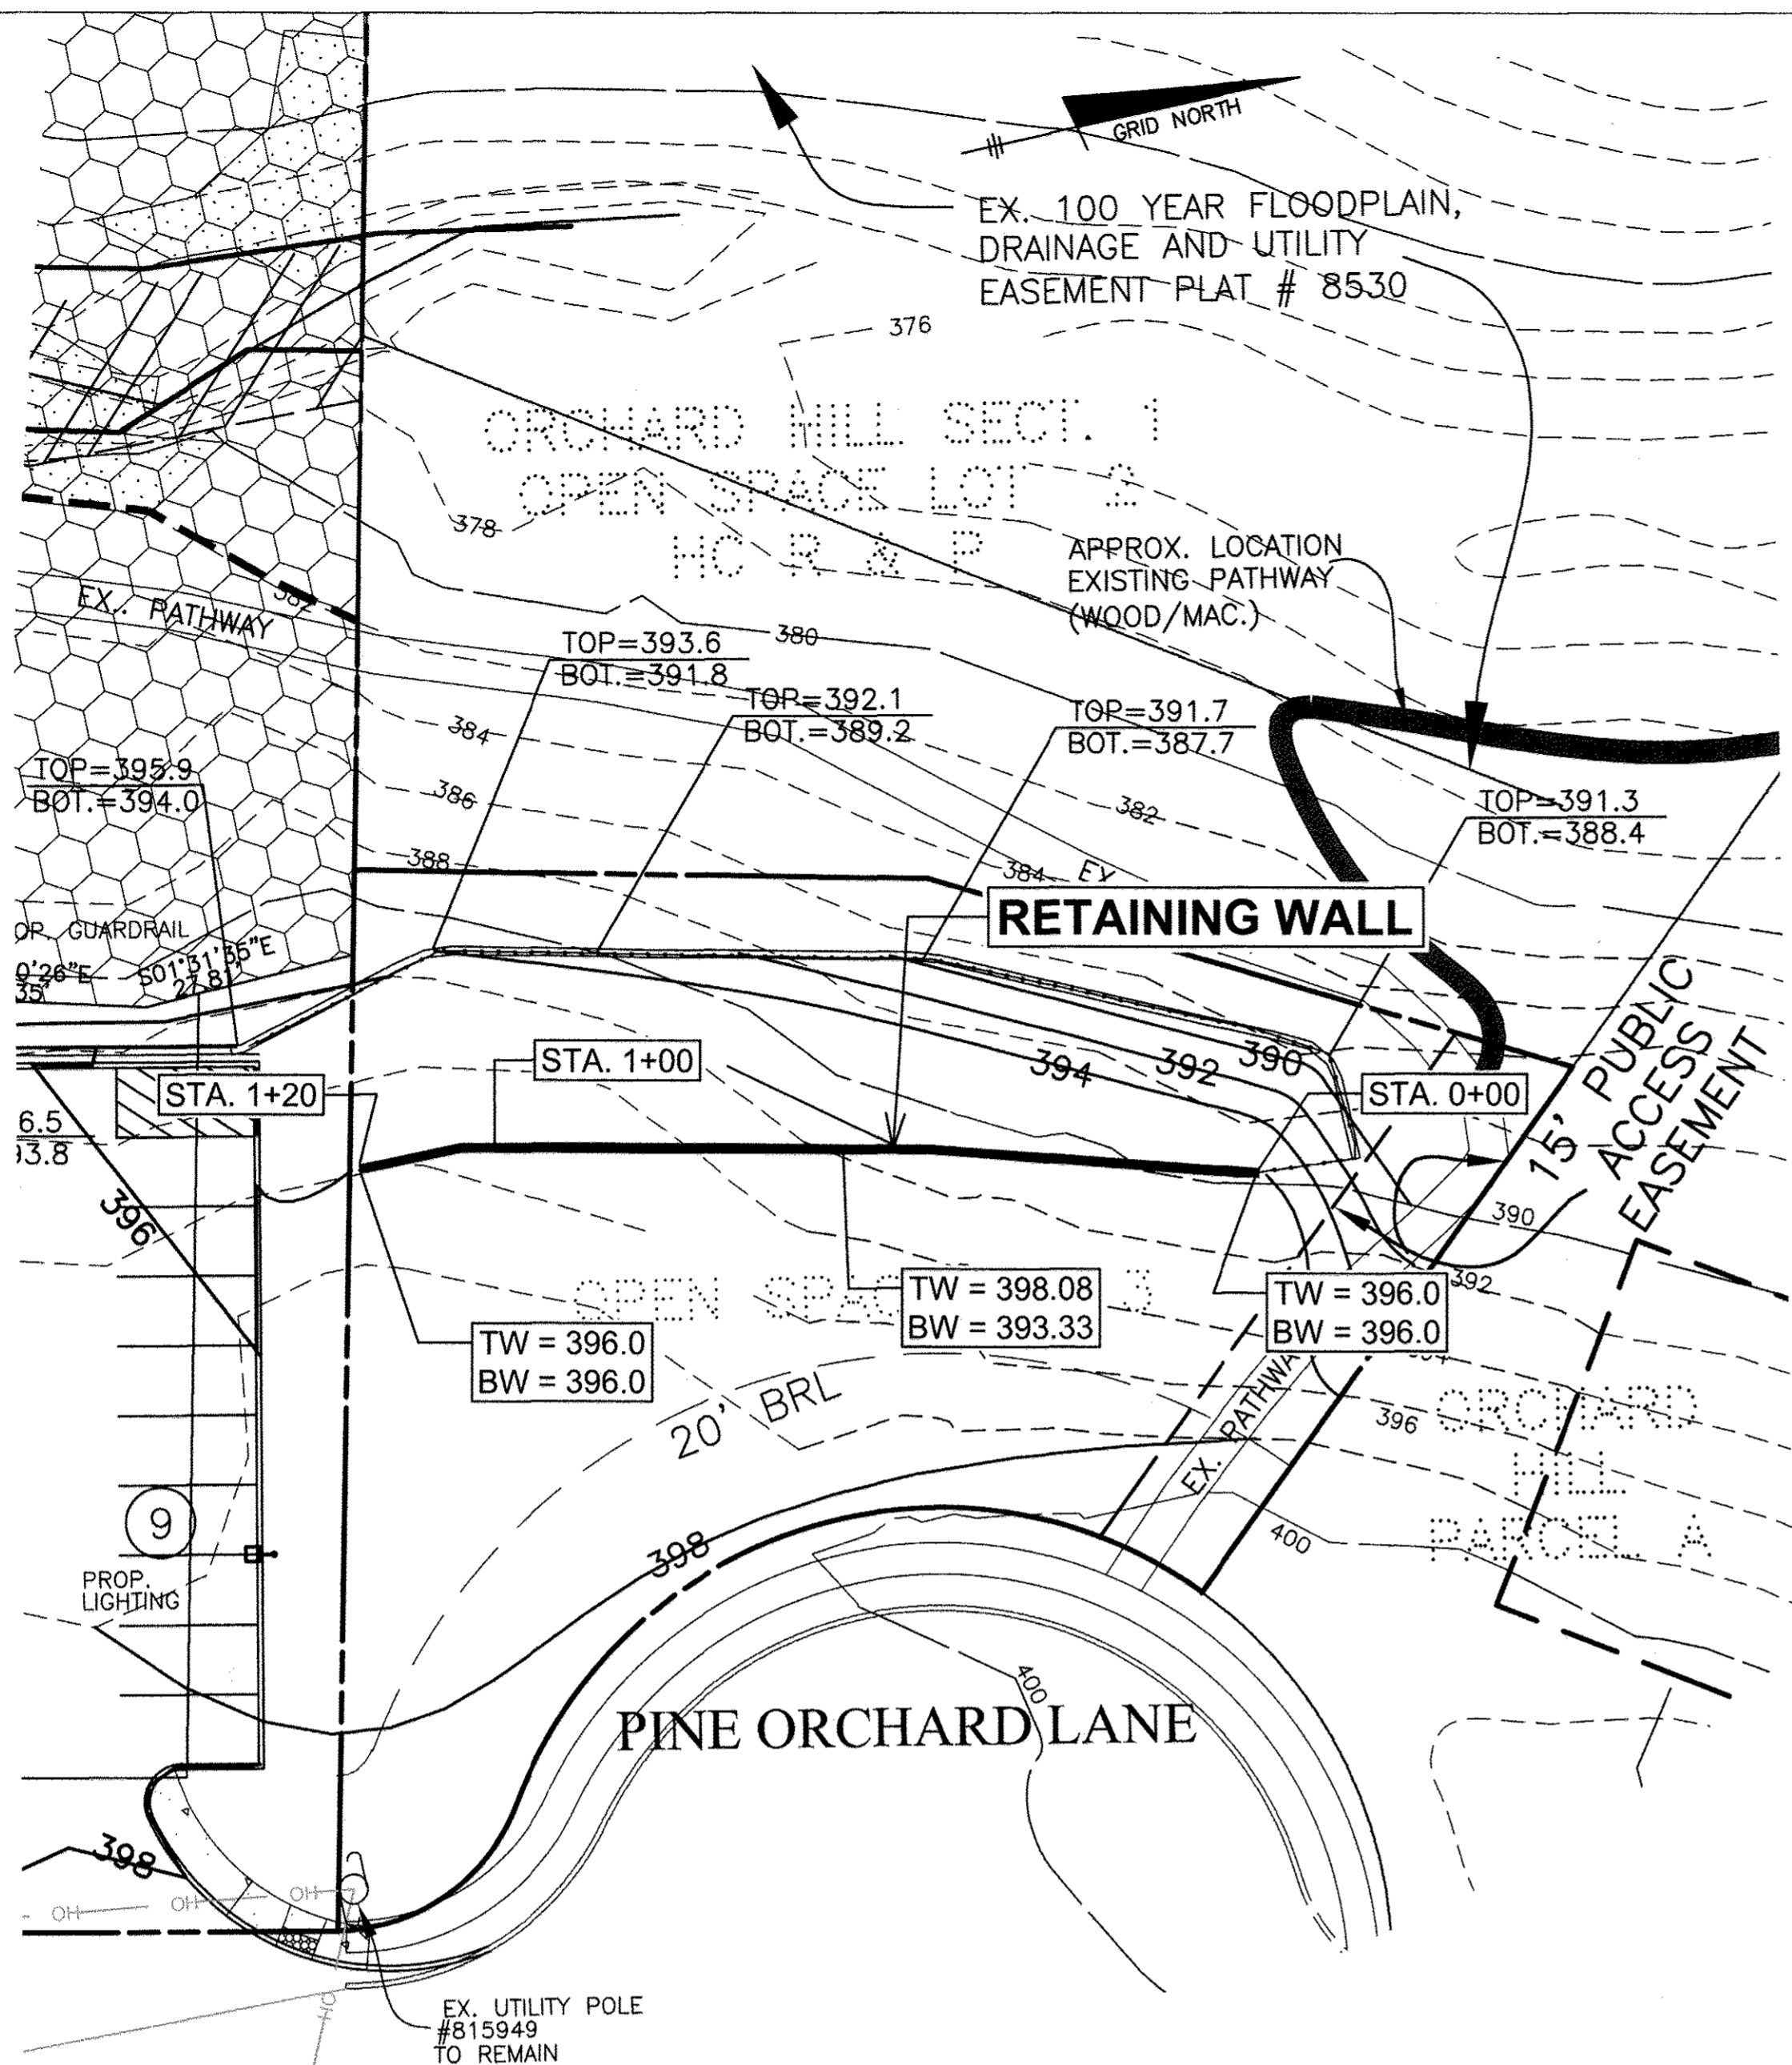

WALL LOCATION PLAN
1" = 20'

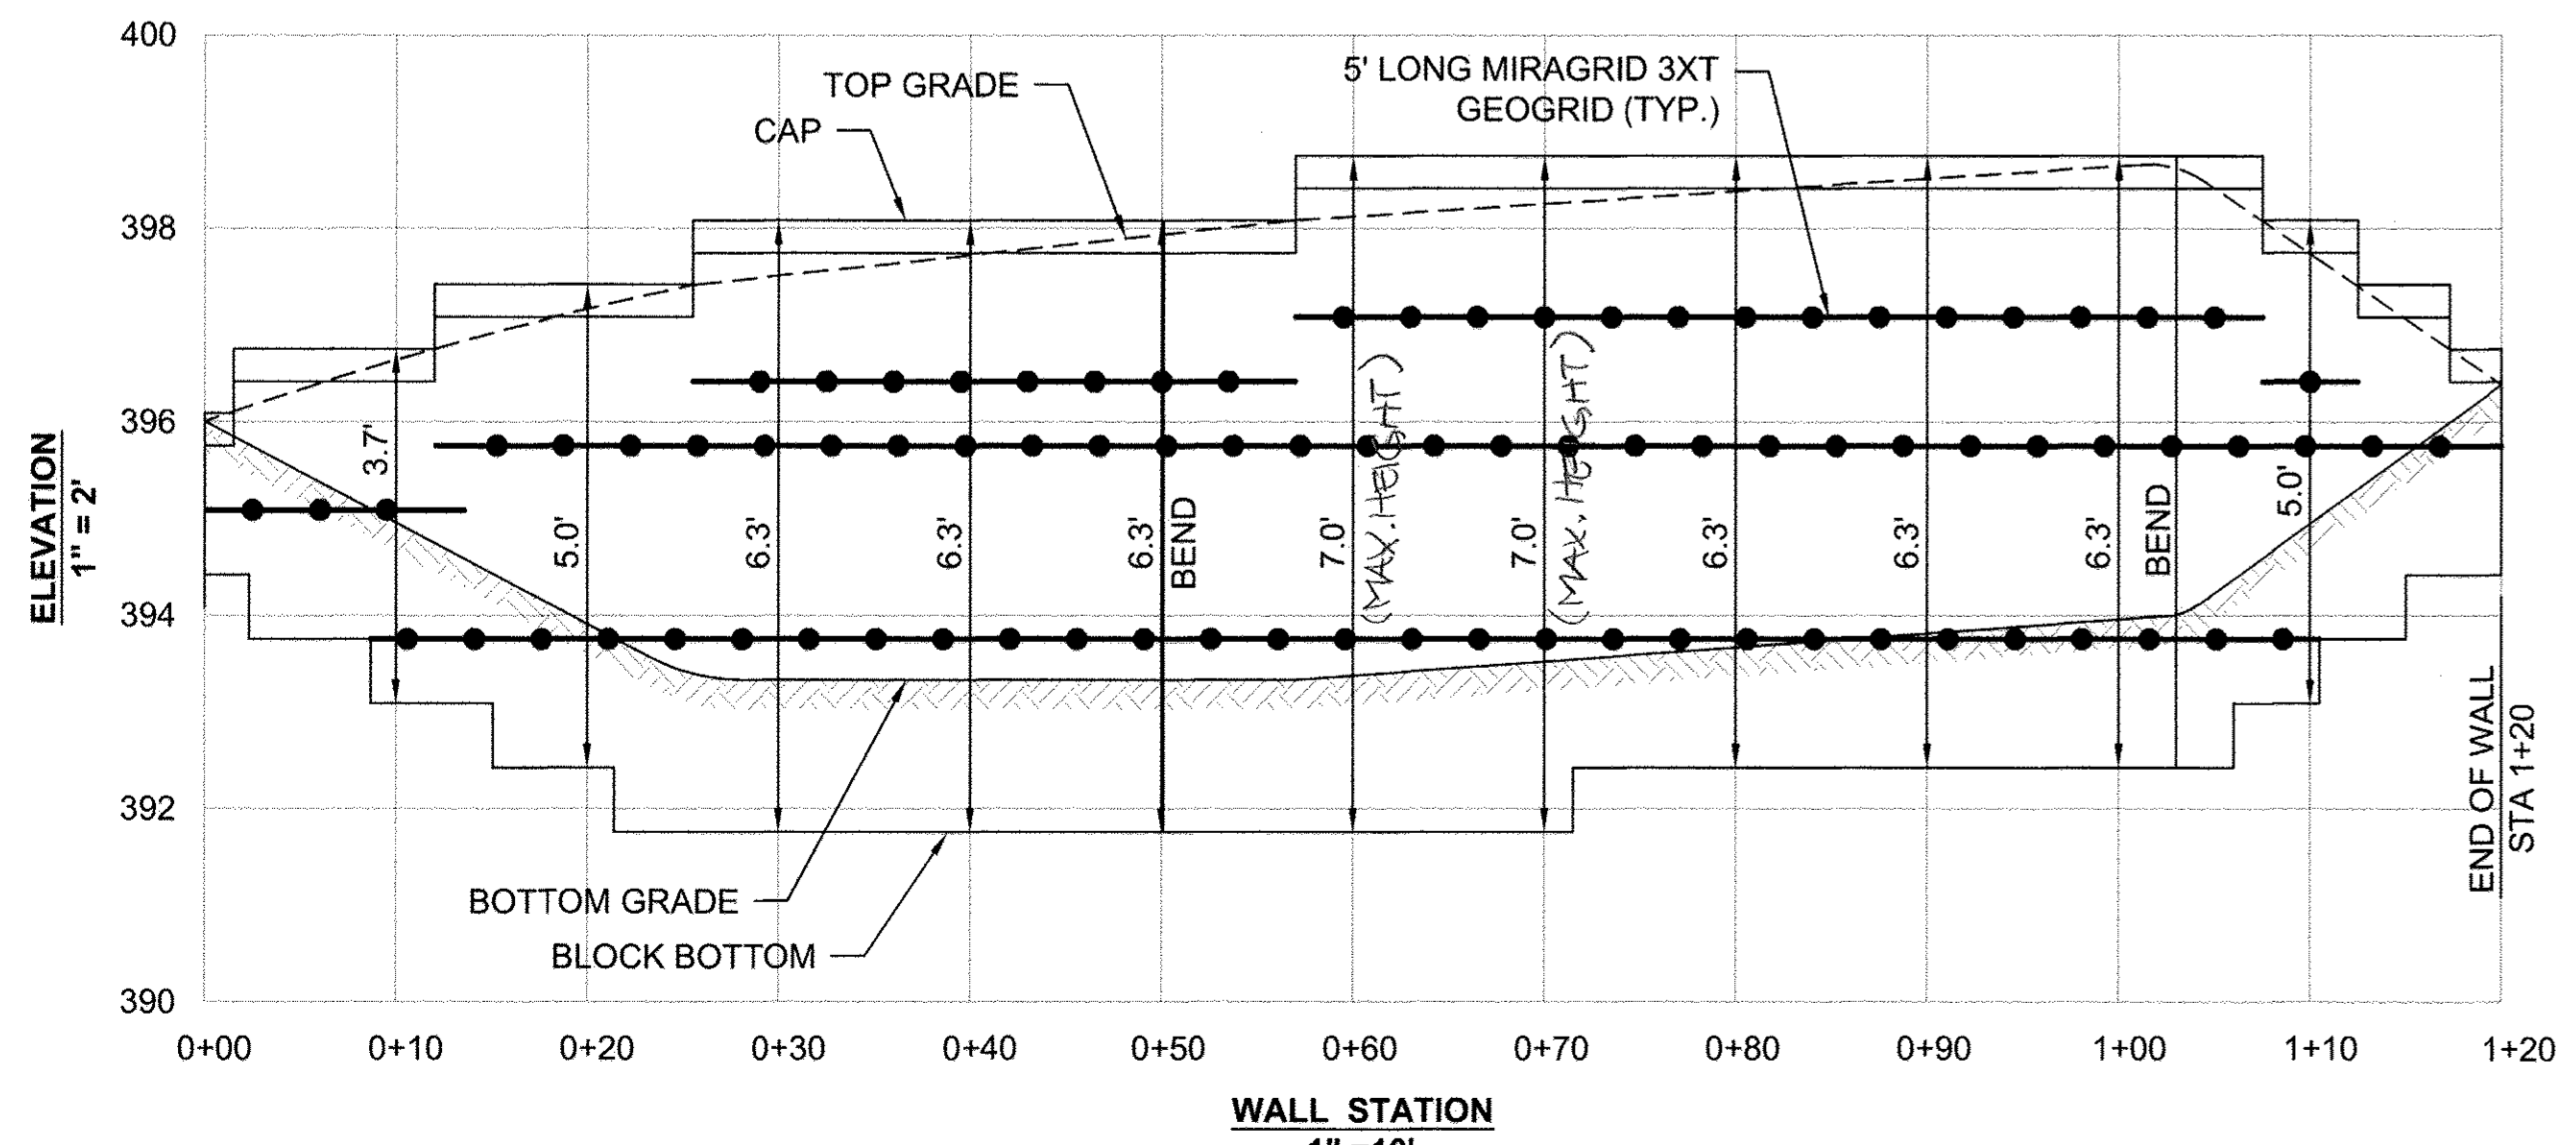

WALL ELEVATION
1" = 10'

SPECIFICATIONS
MODULAR CONCRETE BLOCK RETAINING WALL

PART 1: GENERAL

- 1.01 DESCRIPTION**
- A. WORK SHALL CONSIST OF FURNISHING AND CONSTRUCTION OF A MODULAR RETAINING WALL SYSTEM IN ACCORDANCE WITH THESE SPECIFICATIONS AND IN REASONABLY CLOSE CONFORMITY WITH THE LINES, GRADES, DESIGN, AND DIMENSIONS SHOWN ON THE PLANS.
 - B. WORK INCLUDES PREPARING FOUNDATION SOIL, FURNISHING AND INSTALLING LEVELING PAD, UNIT DRAINAGE FILL AND BACKFILL TO THE LINES AND GRADES SHOWN ON THE CONSTRUCTION DRAWINGS.
 - C. WORK INCLUDES FURNISHING AND INSTALLING GEOGRID SOIL REINFORCEMENT OF THE TYPE, SIZE, LOCATION, AND LENGTHS DESIGNATED ON THE CONSTRUCTION DRAWINGS.

1.02 DELIVERY, STORAGE AND HANDLING

- A. CONTRACTOR SHALL CHECK ALL MATERIALS UPON DELIVERY TO ASSURE THAT THE PROPER TYPE, GRADE, COLOR, AND CERTIFICATION HAS BEEN RECEIVED.
- B. CONTRACTOR SHALL PROTECT ALL MATERIALS FROM DAMAGE DUE TO JOB SITE CONDITIONS AND IN ACCORDANCE WITH MANUFACTURER'S RECOMMENDATIONS. DAMAGED MATERIALS SHALL NOT BE INCORPORATED INTO THE WORK.

PART 2: PRODUCTS

2.01 MODULAR CONCRETE RETAINING WALL UNITS

- A. MODULAR CONCRETE UNITS SHALL CONFORM TO THE FOLLOWING ARCHITECTURAL REQUIREMENTS:
FACE COLOR - COLOR MAY BE SPECIFIED BY THE OWNER.
FACE FINISH - SCULPTURED ROCK FACE IN ANGULAR TRI-PLANNER OR FLAT CONFIGURATION. OTHER FACE FINISHES WILL NOT BE ALLOWED WITHOUT WRITTEN APPROVAL OF OWNER.
BOND CONFIGURATION - RUNNING WITH BONDS NOMINALLY LOCATED AT MIDPOINT VERTICALLY ADJACENT UNITS, IN BOTH STRAIGHT AND CURVED ALIGNMENTS.
EXPOSED SURFACES OF UNITS SHALL BE FREE OF CHIPS, CRACKS OR OTHER IMPERFECTIONS WHEN VIEWED FROM A DISTANCE OF 10 FEET UNDER DIFFUSED LIGHTING.
- B. MODULAR CONCRETE MATERIALS SHALL CONFORM TO THE REQUIREMENTS OF ASTM C1372 - STANDARD SPECIFICATIONS FOR SEGMENTAL RETAINING WALL UNITS.
- C. MODULAR CONCRETE UNITS SHALL CONFORM TO THE FOLLOWING STRUCTURAL AND GEOMETRIC REQUIREMENTS MEASURED IN ACCORDANCE WITH APPROPRIATE REFERENCES:
COMPRESSIVE STRENGTH = 3000 PSI MINIMUM;
ABSORPTION = 8% MAXIMUM (8% IN NORTHERN STATES) FOR STANDARD WEIGHT AGGREGATES;
DIMENSIONAL TOLERANCES = ±1/16" FROM NOMINAL UNIT DIMENSIONS NOT INCLUDING ROUGH SPLIT FACE, ±1/16"
UNIT HEIGHT - TOP AND BOTTOM PLANES; UNIT SIZE - 8" (H) X 18" (W) X 12" (D) MINIMUM;

- UNIT WEIGHT - 75 LBS/UNIT MINIMUM FOR STANDARD WEIGHT AGGREGATES;
INTER-UNIT SHEAR STRENGTH - 1000 PLF MINIMUM AT 2 PSI NORMAL PRESSURE; AT 2 PSI NORMAL FORCE.
GEOGRID/UNIT PEAK CONNECTION STRENGTH - 1000 PLF MINIMUM
- D. MODULAR CONCRETE UNITS SHALL CONFORM TO THE FOLLOWING CONSTRUCTIBILITY REQUIREMENTS: (IF APPLICABLE)
VERTICAL SETBACK = 1/8" PER COURSE (NEAR VERTICAL) OR 1" PER COURSE PER THE DESIGN; ALIGNMENT AND GRID POSITIONING MECHANISM - FIBERGLASS PINS, TWO PER UNIT MINIMUM;
MAXIMUM HORIZONTAL GAP BETWEEN ERECTED UNITS SHALL BE - 1/2 INCH.

2.02 SHEAR CONNECTORS (IF APPLICABLE)

- A. SHEAR CONNECTORS SHALL BE 1/2 INCH DIAMETER THERMOSET ISOPHTHALIC POLYESTER RESIN-PROTRUDED FIBERGLASS REINFORCEMENT RODS OR EQUIVALENT TO PROVIDE CONNECTION BETWEEN VERTICALLY AND HORIZONTALLY ADJACENT UNITS. STRENGTH OF SHEAR CONNECTORS BETWEEN VERTICAL ADJACENT UNITS SHALL BE APPLICABLE OVER A DESIGN TEMPERATURE OF 10 DEGREES F TO + 100 DEGREES F. B. SHEAR CONNECTORS SHALL BE CAPABLE OF HOLDING THE GEOGRID IN THE PROPER DESIGN POSITION DURING GRID PRE-TENSIONING AND BACKFILLING.

2.03 BASE LEVELING PAD MATERIAL

- A. MATERIAL SHALL CONSIST OF A COMPACTED #57 CRUSHED STONE BASE AS SHOWN ON THE CONSTRUCTION DRAWINGS.

2.04 UNIT DRAINAGE FILL

- A. UNIT DRAINAGE FILL SHALL CONSIST OF #57 CRUSHED STONE

2.05 REINFORCED BACKFILL

- A. REINFORCED BACKFILL SHALL TYPE SM, BE FREE OF DEBRIS AND MEET THE FOLLOWING GRADATION TESTED IN ACCORDANCE WITH ASTM D-422 AND MEET OTHER PROPERTIES SHOWN ON THE PLAN:

SIEVE SIZE	PERCENT PASSING
2 INCH	100-75
3/4 INCH	100-75
NO. 40	0-50
NO. 200	0-35

PLASTICITY INDEX (PI) <10 AND LIQUID LIMIT <35 PER ASTM D-4318.

- B. MATERIAL CAN BE SITE EXCAVATED SOILS WHERE THE ABOVE REQUIREMENTS CAN BE MET. UNSUITABLE SOILS FOR BACKFILL (HIGH PLASTIC CLAYS OR ORGANIC SOILS) SHALL NOT BE USED IN THE REINFORCED SOIL MASS.

2.06 GEOGRID SOIL REINFORCEMENT

- A. GEOSYNTHETIC REINFORCEMENT SHALL CONSIST OF GEOGRIDS MANUFACTURED SPECIFICALLY FOR SOIL

- REINFORCEMENT APPLICATIONS AND SHALL BE MANUFACTURED FROM HIGH TENACITY POLYESTER YARN.
- 2.07 DRAINAGE PIPE**
A. THE DRAINAGE PIPE SHALL BE PERFORATED CORRUGATED HDPE PIPE MANUFACTURED IN ACCORDANCE WITH ASTM D-1248.

PART 3 EXECUTION

3.01 EXCAVATION

- A. CONTRACTOR SHALL EXCAVATE TO THE LINES AND GRADES SHOWN ON THE CONSTRUCTION DRAWINGS. OWNER'S REPRESENTATIVE SHALL BE RESPONSIBLE FOR INSPECTING AND APPROVING THE EXCAVATION PRIOR TO PLACEMENT OF LEVELING MATERIAL OR FILL SOILS.

3.02 BASE LEVELING PAD

- A. LEVELING PAD MATERIAL SHALL BE PLACED TO THE LINES AND GRADES SHOWN ON THE CONSTRUCTION DRAWINGS. TO A MINIMUM THICKNESS OF 6 INCHES AND EXTEND LATERALLY A MINIMUM OF 6" IN FRONT AND BEHIND THE MODULAR WALL UNIT.
- B. LEVELING PAD SHALL BE PREPARED TO INSURE FULL CONTACT TO THE BASE SURFACE OF THE CONCRETE UNITS.

3.03 MODULAR UNIT INSTALLATION

- A. FIRST COURSE OF UNITS SHALL BE PLACED ON THE LEVELING PAD AT THE APPROPRIATE LINE AND GRADE. ALIGNMENT AND LEVEL SHALL BE CHECKED IN ALL DIRECTIONS AND INSURE THAT ALL UNITS ARE IN FULL CONTACT WITH THE BASE AND PROPERLY SEATED.
- B. PLACE THE FRONT OF UNITS SIDE-BY-SIDE. DO NOT LEAVE GAPS BETWEEN ADJACENT UNITS. LAYOUT OF CORNERS AND CURVES SHALL BE IN ACCORDANCE WITH MANUFACTURER'S RECOMMENDATIONS.
- C. INSTALL SHEARCONNECTING DEVICES PER MANUFACTURER'S RECOMMENDATIONS.
- D. PLACE AND COMPACT DRAINAGE FILL WITHIN AND BEHIND WALL UNITS. PLACE AND COMPACT BACKFILL SOIL BEHIND DRAINAGE FILL. FOLLOW WALL ERECTION AND DRAINAGE FILL CLOSELY WITH STRUCTURE BACKFILL.
- E. MAXIMUM STACKED VERTICAL HEIGHT OF WALL UNITS, PRIOR TO UNIT DRAINAGE FILL AND BACKFILL PLACEMENT AND COMPACTION, SHALL NOT EXCEED THREE COURSES.

3.04 STRUCTURAL GEOGRID INSTALLATION

- A. GEOGRID SHALL BE ORIENTED WITH THE HIGHEST STRENGTH AXIS PERPENDICULAR TO THE WALL ALIGNMENT.
- B. GEOGRID REINFORCEMENT SHALL BE PLACED AT THE STRENGTHS, LENGTHS, AND ELEVATIONS SHOWN ON THE CONSTRUCTION DESIGN DRAWINGS OR AS DIRECTED BY THE ENGINEER.
- C. THE GEOGRID SHALL BE LAID HORIZONTALLY ON COMPACTED BACKFILL AND ATTACHED TO THE MODULAR WALL UNITS. PLACE THE NEXT COURSE OF MODULAR CONCRETE UNITS OVER THE GEOGRID. THE GEOGRID SHALL BE PULLED TAUT, AND ANCHORED PRIOR TO BACKFILL PLACEMENT ON THE GEOGRID.

- D. GEOGRID REINFORCEMENTS SHALL BE CONTINUOUS THROUGHOUT THEIR EMBEDMENT LENGTHS AND PLACED SIDE-BY-SIDE TO PROVIDE 100% COVERAGE AT EACH LEVEL. SPLICED CONNECTIONS BETWEEN SHORTER PIECES OF GEOGRID OR GAPS BETWEEN ADJACENT PIECES OF GEOGRID ARE NOT PERMITTED.

3.05 REINFORCED BACKFILL PLACEMENT


- A. REINFORCED BACKFILL SHALL BE PLACED, SPREAD, AND COMPACTED IN LIFTS NOT TO EXCEED 6 INCHES WHERE HAND COMPACTION IS USED, OR 8 - 10 INCHES WHERE HEAVY COMPACTION EQUIPMENT IS USED. LIFT THICKNESS SHALL BE DECREASED TO ACHIEVE THE REQUIRED DENSITY AS REQUIRED.
- B. REINFORCED BACKFILL SHALL BE PLACED AND COMPACTED IN LIFTS NOT TO EXCEED 6 INCHES WHERE HAND COMPACTION IS USED, OR 8 - 10 INCHES WHERE HEAVY COMPACTION EQUIPMENT IS USED. LIFT THICKNESS SHALL BE DECREASED TO ACHIEVE THE REQUIRED DENSITY AS REQUIRED.
- C. REINFORCED BACKFILL SHALL BE COMPACTED TO 95% OF THE MAXIMUM DENSITY AS DETERMINED BY ASTM D698. THE MOISTURE CONTENT OF THE BACKFILL MATERIAL PRIOR TO AND DURING COMPACTION SHALL BE UNIFORMLY DISTRIBUTED THROUGHOUT EACH LAYER AND SHALL BE + 3% TO - 3% OF OPTIMUM.
- D. ONLY LIGHTWEIGHT HAND-OPERATED EQUIPMENT SHALL BE ALLOWED WITHIN 3 FEET FROM THE TAIL OF THE MODULAR CONCRETE UNIT.
- E. TRACKED CONSTRUCTION EQUIPMENT SHALL NOT BE OPERATED DIRECTLY UPON THE GEOGRID REINFORCEMENT. A MINIMUM FILL THICKNESS OF 6 INCHES IS REQUIRED PRIOR TO OPERATION OF TRACKED VEHICLES OVER THE GEOGRID. TRACKED VEHICLE TURNING SHOULD BE KEPT TO A MINIMUM TO PREVENT TRACKS FROM DISPLACING THE FILL AND DAMAGING THE GEOGRID.
- F. RUBBER Tired EQUIPMENT MAY PASS OVER GEOGRID REINFORCEMENT AT SLOW SPEEDS, LESS THAN 10 MPH. SUDDEN BRAKING AND SHARP TURNING SHALL BE AVOIDED.
- G. AT THE END OF EACH DAY'S OPERATION, THE CONTRACTOR SHALL SLOPE THE LAST LIFT OF REINFORCED BACKFILL AWAY FROM THE WALL UNITS TO DIRECT RUNOFF AWAY FROM WALL FACE. THE CONTRACTOR SHALL NOT ALLOW SURFACE RUNOFF FROM ADJACENT AREAS TO ENTER THE WALL CONSTRUCTION SITE.

3.06 CAP INSTALLATION

- A. CAP UNITS SHALL BE GLUED TO UNDERLYING UNITS WITH AN ALL-WEATHER ADHESIVE RECOMMENDED BY THE MANUFACTURER.

3.07 FIELD QUALITY CONTROL

- A. THE OWNER SHALL ENGAGE INSPECTION AND TESTING SERVICES, INCLUDING INDEPENDENT LABORATORIES, TO PROVIDE QUALITY ASSURANCE AND TESTING SERVICES DURING CONSTRUCTION.
- B. AS A MINIMUM, QUALITY ASSURANCE TESTING SHOULD INCLUDE FOUNDATION SOIL INSPECTION, SOIL AND BACKFILL TESTING, VERIFICATION OF DESIGN PARAMETERS, AND OBSERVATION OF CONSTRUCTION FOR GENERAL COMPLIANCE WITH DESIGN DRAWINGS AND SPECIFICATIONS.

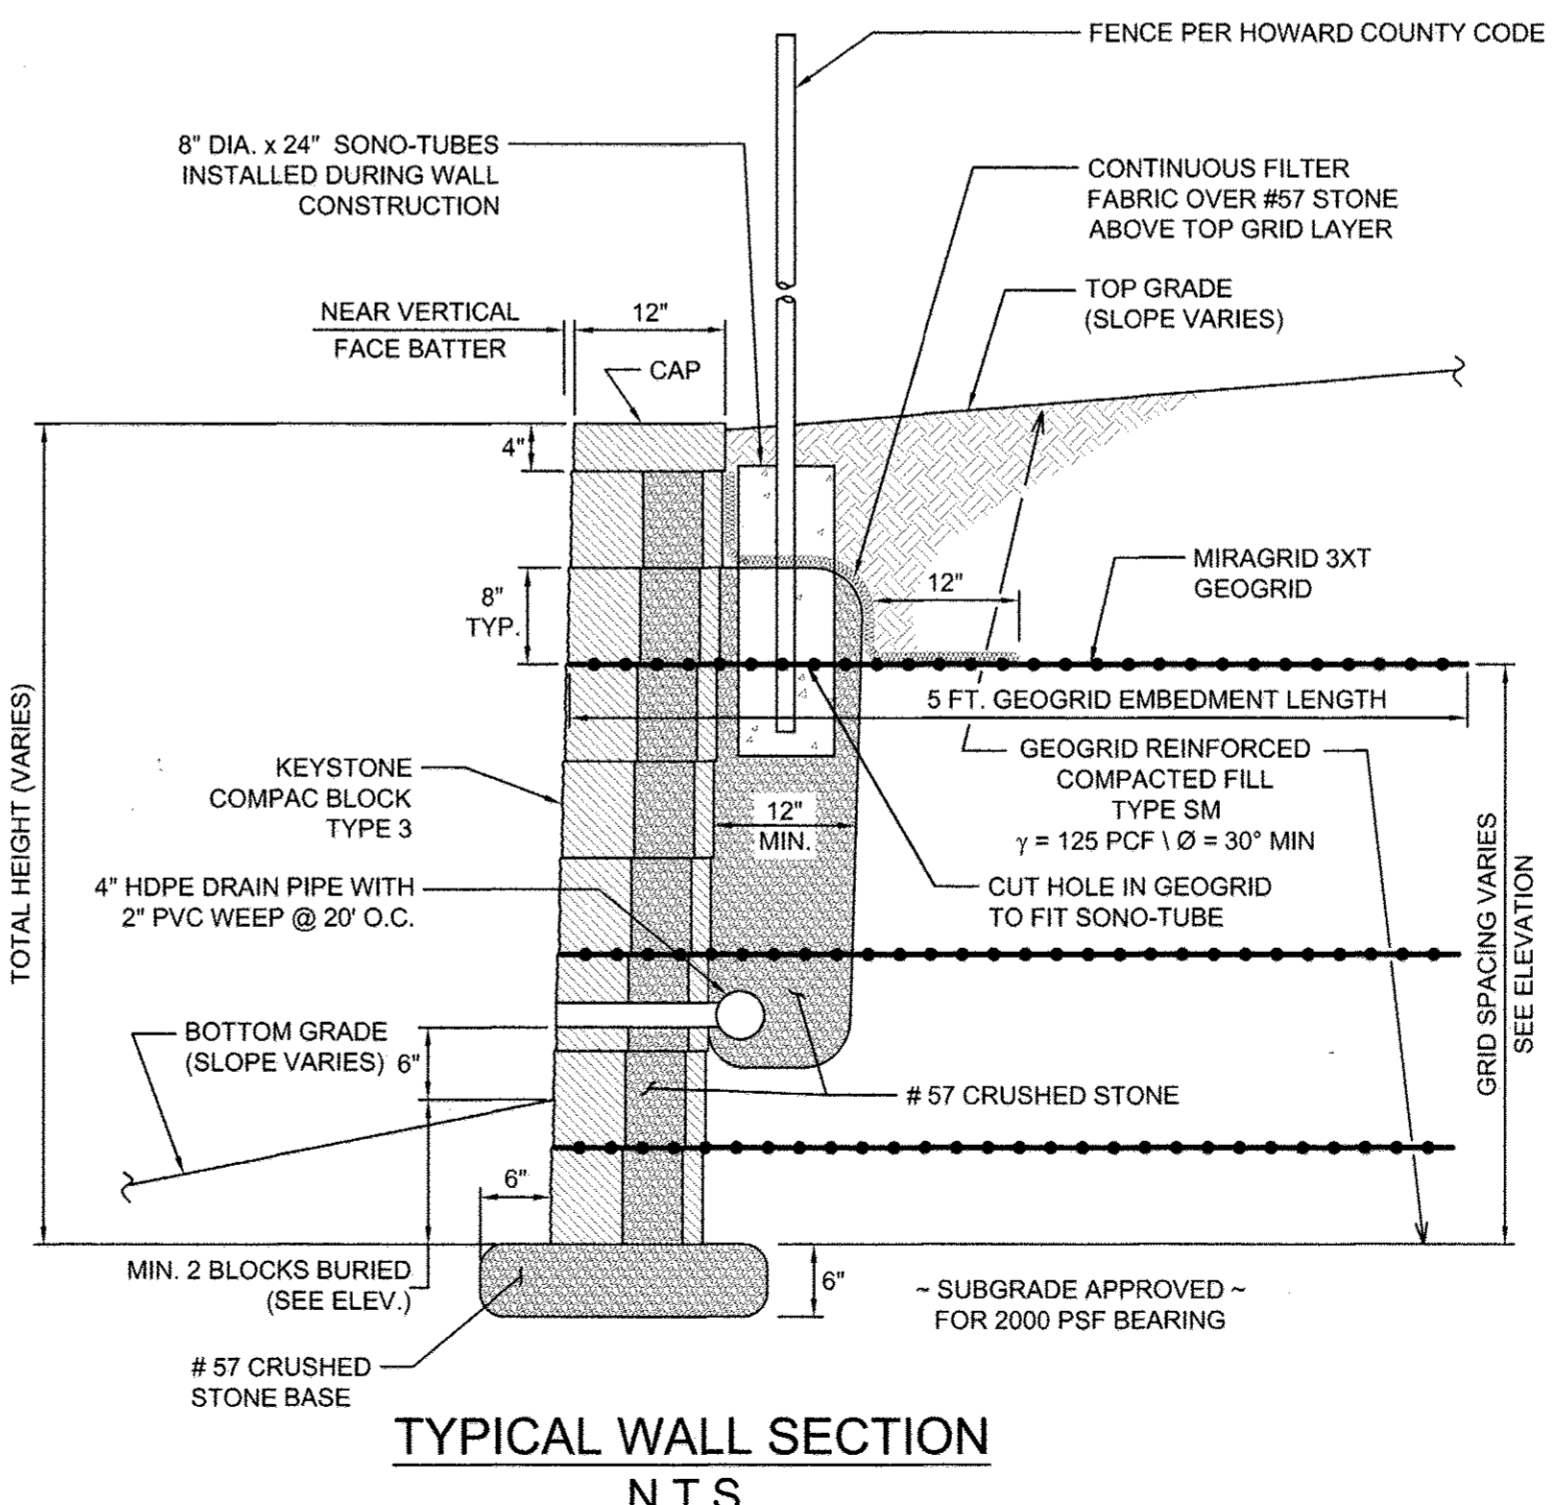

TYPICAL WALL SECTION
N.T.S.

NO.	DATE	REVISION
3	12.27.15	ADD RETAINING WALL DETAILS SHEET

HILLIS-CARNES
ENGINEERING ASSOCIATES

10975 Guilford Road, Suite A Annapolis Junction, Maryland
(410) 880-4788 WWW.HCEA.COM Fax: (410) 880-4098

OWNER:	ORCHARD PARK SECTION 3
LAKESHORE I, LLC C/O SECURITY DEVELOPMENT 8480 BALTIMORE NATIONAL PIKE SUITE 415 ELLCOTT CITY, MD 21043	3200 PINE ORCHARD LANE ROMANIK PROPERTY, LOT 1 AND ORCHARD HILL, OPEN SPACE LOT 3 TAX MAP: 24 & 17, GRID: 1 & 19, PARCEL: 647 & P/O 130 ZONE: R-4-15 ELECTION DISTRICT NO. 2 HOWARD COUNTY, MARYLAND
DEVELOPER:	RETAINING WALL PLAN AND DETAILS
SECURITY DEVELOPMENT, LLC PO BOX 417 ELLCOTT CITY, MD 21041 410-465-4244	DATE: JANUARY 2018 HCEA PROJECT NO. 16106-A SCALE: AS SHOWN SHEET 11 OF 11

APPROVED: HOWARD COUNTY DEPARTMENT OF PLANNING AND ZONING

CHIEF, DEVELOPMENT ENGINEERING DIVISION	DATE
CHIEF, DIVISION OF LAND DEVELOPMENT	DATE
DIRECTOR	DATE