
#### **GENERAL NOTES** ALL CONSTRUCTION SHALL BE IN ACCORDANCE WITH THE LATEST STANDARDS AND SPECIFICATIONS OF HOWARD COUNTY STANDARDS AND SPECIFICATIONS ALL WORK AND MATERIALS SHALL COMPLY WITH O.S.H.A. STANDARDS. THE CONTRACTOR SHALL NOTIFY "MISS UTILITY" AT 1-800-257-7777 AT LEAST 48 HOURS PRIOR TO ANY EXCAVATION WORK. THE CONTRACTOR IS TO NOTIFY THE FOLLOWING UTILITIES OR AGENCIES AT LEAST FIVE DAYS BEFORE STARTING WORK ON THESE DRAWINGS: . PROJECT AREA: 7.64 AC. (PARCEL L-1) PRESENT ZONING: CAC CLI USE OF STRUCTURE: TOWNHOMES TOTAL NUMBER OF PROPOSED TOWNHOMES: 105 TOTAL NUMBER OF PROPOSED TOWNHOMES: 105 TOTAL MIHU UNITS REQUIRED: 202 / MIHU UNITS PROVIDED: 19 (THIS SDE) TOTAL BUILDING COVERAGE: 85,632 SF (1.97 AC. OR 25.79% OF GROSS AREA) PAVED PARKING LOT/AREA ON SITE: 94,854 SF (2.18 AC. OR 28.53% OF GROSS AREA) AREA OF LANDSCAPE ISLAND: 6,827 SF (0.16 AC. OR 2.09% OF GROSS AREA) LIMIT OF DISTURBED AREA: 7.69 AC PROJECT BACKGROUND: LOCATION: TAX MAP 43 BLOCK 4 PARCELS 14, PARCELS L-1 ZONING: CAC-CLI SUBDIVISION: BLUE STREAM SECTION/AREA: N/A ALLOCATION PHASE: PHASES III AND IV. SITE AREA: 7.64 AC. DEED PROJECT ASSOCIATION (F.150 1.4780) THE CONTRACTOR SHALL NOTIFY THE DEPARTMENT OF PUBLIC WORKS/BUREAU OF ENGINEERING/ CONSTRUCTION INSPECTION DIVISION AT (410) 313-1880 AT LEAST FIVE (5) WORKING DAYS PRIOR TO START OF WORK. ANY DAMAGE TO PUBLIC RIGHT-OF-WAY, PAVING, OR EXISTING UTILITIES WILL BE CORRECTED AT THE CONTRACTOR'S EXPENSE ALL CONSTRUCTION SHALL BE IN ACCORDANCE WITH THE LATEST STANDARDS AND SPECIFICATIONS OF HOWARD COUNTY, PLUS MSHA STANDARDS AND SPECIFICATIONS, IF APPLICABLE. EXISTING UTILITIES LOCATED FROM ROAD CONSTRUCTION PLANS, FIELD SURVEYS, PUBLIC WATER AND AND SEWER EXTENSION PLANS AND AVAILABLE RECORD DRAWINGS. APPROXIMATE LOCATION OF EXISTING UTILITIES ARE SHOWN FOR THE CONTRACTORS INFORMATION. CONTRACTOR SHALL LOCATE EXISTING UTILITIES WELL IN ADVANCE OF CONSTRUCTION ACTIVITIES AND TAKE ALL. NECESSARY PRECAUTIONS TO PROTECT THE EXISTING UTILITIES AND TO MAINTAIN UNINTERRUPTED SERVICE. ANY DAMAGE INCURRED DUE TO CONTRACTOR'S OPERATION SHALL BE REPAIRED IMMEDIATELY AT THE ALL REINFORCED CONCRETE FOR STORM DRAIN STRUCTURES SHALL HAVE A MINIMUM OF 28 DAYS STRENGTH OF 3,500 P.S.I. TRAFFIC CONTROL DEVICES, MARKINGS AND SIGNING SHALL BE IN ACCORDANCE WITH THE LATEST EDITION OF THE MANUAL ON UNIFORM TRAFFIC CONTROL DEVICES (MUTCD). ALL STREET AND REGULATORY SIGNS SHALL BE IN PLACE PRIOR TO THE PLACEMENT OF ANY ASPHALT ESTIMATES OF EARTHWORK QUANTITIES ARE PROVIDED SOLELY FOR THE PURPOSE OF CALCULATING FEES. SOIL COMPACTION SPECIFICATIONS, REQUIREMENTS, METHODS AND MATERIAL'S ARE TO BE IN ACCORDANCE WITH THE RECOMMENDATIONS OF THE PROJECT SECTECHNICAL ENGINEER. GEOTECHNICAL ENGINEER TO CONFIRM ACCEPTABILITY OF PROPOSED PAVING SECTION, BASED ON SOIL TEST PRIOR TO CONSTRUCTION. THE COORDINATES SHOWN HEREON ARE BASED UPON HOWARD COUNTY GEODETIC CONTROL, WHICH IS BASED UPON THE MARYLAND STATE PLANE SYSTEM. HOWARD COUNTY MONUMENT NOS. 43B2 AND 43B6 WERE USED FOR THIS PROJECT. THE PROPERTY LINES SHOWN HEREON IS BASED ON A BOUNDARY SURVEY PERFORMED BY VOGEL & ASSOCIATES, INC.; DATED FEBRUARY 1998. THE EXISTING TOPOGRAPHY SHOWN HEREON IS TAKEN FROM AN AERIAL TOPOGRAPHIC SURVEY PREPARED BY POTOMAC AERIAL SURVEYS; DATED MARCH, 1998; AND BY FIELD RUN TOPO BY ROBERT H. VOGEL ENGINEERING, INC. ON MARCH 8, 2013. GEOTECHNICAL REPORT PREPARED BY ECS-MIDATLANTIC, LLC; DATED 06/01/09, REVISED 09/10/09 AND 01/05/2011 THE GEOTECHNICAL ENGINEER TO CONFIRM PAVING SECTION PRIOR TO CONSTRUCTION. ALL PAVING TO BE MINIMUM HOWARD COUNTY STANDARD ALL CURB AND GUTTER TO BE HOWARD COUNTY STANDARD DETAIL 3.01 UNLESS OTHERWISE NOTED WHERE DRAINAGE FLOWS AWAY FROM CURB, CONTRACTOR TO REVERSE THE GUTTER PAN. ALL ELEVATIONS ARE TO FLOWLINE/BOTTOM OF CURB UNLESS OTHERWISE NOTED. ALL DIMENSIONS ARE TO FACE OF CURB UNLESS OTHERWISE NOTED. CONTRACTOR RESPONSIBLE FOR CONSTRUCTING ALL HANDICAP RAMPS AND HANDICAP ACCESS IN ACCORDANCE WITH CURRENT ADA REQUIREMENTS. PUBLIC WATER AVAILABLE THROUGH CONTRACT NO. 14-4837-D. PUBLIC SEWER AVAILABLE THROUGH CONTRACT NO. 14-4837-D. APFO TRAFFIC STUDY PREPARED BY THE TRAFFIC GROUP DATED MAY 30, 2006, REVISED JUNE 5, 2008; AND APPROVED UNDER F-02-035 (REDLINE). THE UNMITIGATED NOISE STUDY WAS PREPARED BY ROBERT H. VOGEL ENGINEERING DATED JUNE 2006. THE UNMITIGATED 65DBA NOISE CONTOUR GENERATED BY 1-95 TRAFFIC DOES NOT IMPACT THE REAR YARDS OR AMENTITY AREAS ASSOCIATED WITH THIS PROJECT. (REFERENCE S-06-018) THE SUBJECT PROPERTY IS ZONED CAC-CLI PER THE 10/06/2013 COMPREHENSIVE ZONING PLAN. THERE ARE NO WETLANDS, STREAMS, 100 YR FLOODPLAIN, OR STEEP SLOPES WITH A CONTIGUOUS AREA GREATER THAN 20,000 SF LOCATED ON PARCEL 'L-1'. ALL STORMDRAIN PIPE BEDDING IS TO BE CLASS 'C', AS REQUIRED BY AASHTO-180. THIS PROPERTY IS WITHIN THE METROPOLITAN DISTRICT THIS PLAN HAS BEEN PREPARED IN ACCORDANCE WITH THE PROVISIONS OF SECTION 16.124 OF THE HOWARD COUNTY CODE, THE LANDSCAPE MANUAL AND THE APPROVED LANDSCAPE AND STREET TREE DESIGN CRITERIA. PLAN FOR 145 SHADE TREES AND 5 EVERGREEN TREES FOR A SURETY OF \$44,250.00. DED WILL BUILD THE 13 PUBLIC STREET TREES (\$3,900.00) INTO THEIR COST ESTIMATE FOR ROAD CONSTRUCTION, TOTAL OVERALL SURETY DUE IS \$48,150.00. ANY EXISTING STREET TREES DAMAGED OR DESTROYED DURING CONSTRUCTION WILL BE REPLACED BY THE CONTRACTOR FOREST STAND DELINEATION PLAN PREPARED BY KOPECK AND ASSOCIATES; DATED NOVEMBER, 1998. THE FOREST CONSERVATION OBLIGATIONS INCURRED BY THIS PROJECT HAVE BEEN PREVIOUSLY MET UNDER F-02-35 BY: PREVIOUS AFFORESTATION OBLIGATION PREVIOUS ON-SITE AFFORESTATION PROVIDED. OFF-SITE AFFORESTATION IN HOWARD COUNTY WINKLER CONSERVATION BANK (PLAT 17020-17026) OUTSTANDING AFFORESTATION FÈE-IN-LIEU (PAID UNDER APPROVED F-02-35) 871.2 SF (\$435.60) WITH PLAT F-10-055 THE TOTAL RETENTION WAS REDUCED BY 0.15 AC., THE TOTAL AFFORESTATION WAS REDUCED BY 0.58 AC., AND REFORESTATION OF 0.15 AC. WAS PROVIDED. NETTING THE FOLLOWING: ON-SITE FOREST RETENTION PROVIDED ON-SITE AFFORESTATION PROVIDED ON-SITE REFORESTATION PROVIDED BY 0.01 AC., AND THE TOTAL AFFORESTATION WAS INCREASED BY 0.05 AC. NETTING THE FOLLOWING: ON-SITE FOREST RETENTION PROVIDED ON-SITE AFFORESTATION PROVIDED ON-SITE REFORESTATION PROVIDED ...0.16 AC. FINANCIAL SURETY IN THE AMOUNT OF \$173,867.30 HAS BEEN POSTED WITH THE FC INSTALLATION AND MAINTENANCE EXISTING FOREST CONSERVATION EASEMENTS B AND C CREATED UNDER F-02-35 WERE ABANDONED AND REPLACED WITH FOREST CONSERVATION EASEMENTS B-1, B-2, C-1, D-1, AND D-2 UNDER F-10-055. THEREFORE, A FOREST CONSERVATION EASEMENT ABANDONMENT FEE OF \$31581.00 WAS PAID TO THE HOWARD COUNTY FOREST CONSERVATION FUND UNDER F-10-055. FOREST CONSERVATION EASEMENT A-2 AND B-3 WERE ESTABLISHED UNDER F-13-051. THERE ARE NO SURETIES OR FEES FOR FOREST CONSERVATION ASSOCIATED WITH THIS PLAN. THIS PROJECT IS SUBJECT TO COMPLIANCE WITH THE AMENDED FIFTH EDITION OF THE SUBDIVISION AND LAND DEVELOPMENT. REGULATIONS, DEVELOPMENT OR CONSTRUCTION ON THIS PROPERTY MUST COMPLY WITH SETBACK AND BUFFER REGULATIONS IN EFFECT AT THE TIME OF SUBMISSION OF THE SITE DEVELOPMENT PLAN, WAIVER PETITION APPLICATION OR BUILDING/ GRADING PERMIT APPLICATIONS. EXISTING BLUE STREAM DRIVE IS CLASSIFIED AS A MAJOR COLLECTOR (PUBLIC ROAD). THE EXTENSION OF BLUE STREAM DRIVE BEYOND THE EXISTING CULDESAC WILL BE PRIVATE. THERE ARE NO BURIAL GROUNDS, CEMETERIES, OR HISTORIC STRUCTURES LOCATED ON THIS PROPERTY. FIRE LANES SHOULD BE PROVIDED IN THIS SITE TO ALLOW EMERGENCY VEHICLE ACCESS. EITHER FIRE LANE SIGNAGE SHOULD BE INSTALLED. OR THE CURBS SHOULD BE PAINTED IN RED AND STENCILED TO IDENTIFY THE ROAD AS A FIRE LANE. ALL SIGN POSTS USED FOR TRAFFIC CONTROL SIGNS INSTALLED IN THE COUNTY RIGHT-OF-WAY SHALL BE MOUNTED ON A 2" GALVANIZED STEEL, PERFORATED, SQUARE TUBE POST (14 GAUGE) INSERTED INTO A 2-1/2" GALVANIZED STEEL, PERFORATED, SQUARE TUBE SLEEVE (12 GAUGE) - 3' LONG. A GALVANIZED STEEL POLE CAP SHALL BE MOUNTED ON TOP OF EACH POST ALL EXTERIOR LIGHTING TO COMPLY WITH THE REQUIREMENTS FOUND IN ZONING SECTION 134 OF THE HOWARD COUNTY ZONING REGULATIONS. (DETAIL ON SHEET 3) STREET LIGHT PLACEMENT AND THE TYPE OF FIXTURE AND POLE SHALL BE IN ACCORDANCE WITH THE HOWARD COUNTY DESIGN MANUAL, VOLUME III (2006), SECTION 5.5.A. A MINIMUM OF 20' SHALL BE MAINTAINED BETWEEN ANY STREET LIGHT AND ANY TREE. TRASH AND RECYCLING COLLECTION TO BE PRIVATE. NO GRADING, REMOVAL OF VEGETATIVE COVER OR TREES, PAVING AND NEW STRUCTURES SHALL BE PERMITTED WITHING THE REQUIRED WETLANDS, STREAM(S) OR THEIR BUFFERS, FOREST CONSERVATION AREAS AND 100 YEAR FLOODPLAIN. DRIVEWAYS SHALL BE PROVIDED PRIOR TO RESIDENTIAL OCCUPANCY TO INSURE SAFE ACCESS FOR FIRE AND EMERGENCY VEHICLES PER THE FOLLOWING MINIMUM REQUIREMENTS: A. WIDTH - 12 FEET (16 FEET IF SERVING MORE THAN ONE RESIDENCE) B. SURFACE - 6 INCHES OF COMPACTED CRUSHER RUN BASE WITH TAR AND CHIP COATING GEOMETRY - MAXIMUM 15% GRADE, MAXIMUM 10% GRADE CHANGE, AND MINIMUM 45 FOOT TURNING RADIUS STRUCTURES (CULVERTS/BRIDGES) - MUST SUPPORT 25 GROSS TON LOADING (H25 LOADING) E. DRAINAGE ELEMENTS - CAPABLE OF SAFELY PASSING 100 YEAR FLOOD EVENTS WITH NO MORE THAN 1 FOOT F. STRUCTURE CLEARANCES - MINIMUM 12 FEET G. MAINTENANCE - SUFFICIENT TO INSURE ALL WEATHER USE TOWNHOUSE DRIVEWAY ENTRANCE SHALL BE IN ACCORDANCE WITH HOWARD COUNTY VOLUME IV DESIGN MANUAL DETAIL R-6.03, MODIFIED FOR SIDEWALK ADJACENT TO CURB. IN ACCORDANCE WITH SECTION 128 OF THE HOWARD COUNTY ZONING REGULATIONS, BAY WINDOWS, CHIMNEYS, OR EXTERIOR STAIRWAYS NOT MORE THAN 16 FEET IN WIDTH MAY PROJECT NOT MORE THAN 4 FEET INTO ANY SETBACKS. PORCHES OR DECKS, OPEN OR ENCLOSED MAY PROJECT NOT MORE THAN 10 FEET INTO THE FRONT FRONT OR REAR YARD SETBACK. THERE ARE NO SPECIMEN OR CHAMPION TREES WITHIN THE LOD. STORMWATER MANAGEMENT FOR PARCEL L-1 IS TO BE ACCOMMODATED BY THE POND LOCATED ON OPEN SPACE PARCEL G-2. THE POND HAS BEEN CONSTRUCTED WITH THE BLUE STREAM PROJECT (F-02-035) THIS PROJECT COMPILES WITH THE ROUTE 1 MANUAL IN REGARDS TO THE CAC ZONING DISTRICT INGRESS AND EGRESS TO ROUTE 1 IS RESTRICTED. ACCESS WILL BE PROVIDED BY BLUE STREAM DRIVE (PUBLIC AND PRIVATE) ON AUGUST 2, 2007 AND JULY 7, 2008, THE DEPARTMENT OF PLANNING AND ZONING HAS TENTATIVE ALLOCATED FOR THIS SUBDIVISION IN THE ROUTE 1 PLANNING AREA IN ACCORDANCE WITH THE FOLLOWING ALLOCATION SCHEDULE AND MILESTONES: LOCATION NO. OF ROUTE 1 NO. OF MIHU TOTAL NO. OF PRELIMINARY PLAN YEAR CAC ALLOCATIONS ALLOCATIONS ALLOCATIONS DUE DATE SPRINKLER SYSTEMS FOR SINGLE RESIDENTIAL DWELLING UNITS SHALL HAVE WATER HOUSE CONNECTIONS AND WATER METERS THAT ARE SIZED IN ACCORDANCE WITH THE DESIGN OF THE SPRINKLER SYSTEMS. SPRINKLER SYSTEMS FOR SINGLE RESIDENTIAL DWELLINGS SHALL HAVE A MINIMUM OF A 1.5" SERVICE CONNECTION WITH A 1" OUTSIDE METER SETTING. APPROVED: HOWARD COUNTY DEPARTMENT OF PLANNING AND ZONING

CHIEF, DEVELOPMENT ENGINEERING DIVISION HSP

# SITE DEVELOPMENT PLAN BLUE STREAM TOWNS - SECTION 2 **BLUE STREAM**

LOTS 1-105 & OPEN SPACE LOT 106 A RE-SUBDIVISION OF BUILDABLE BULK PARCEL L-1 **TOWNHOMES** 

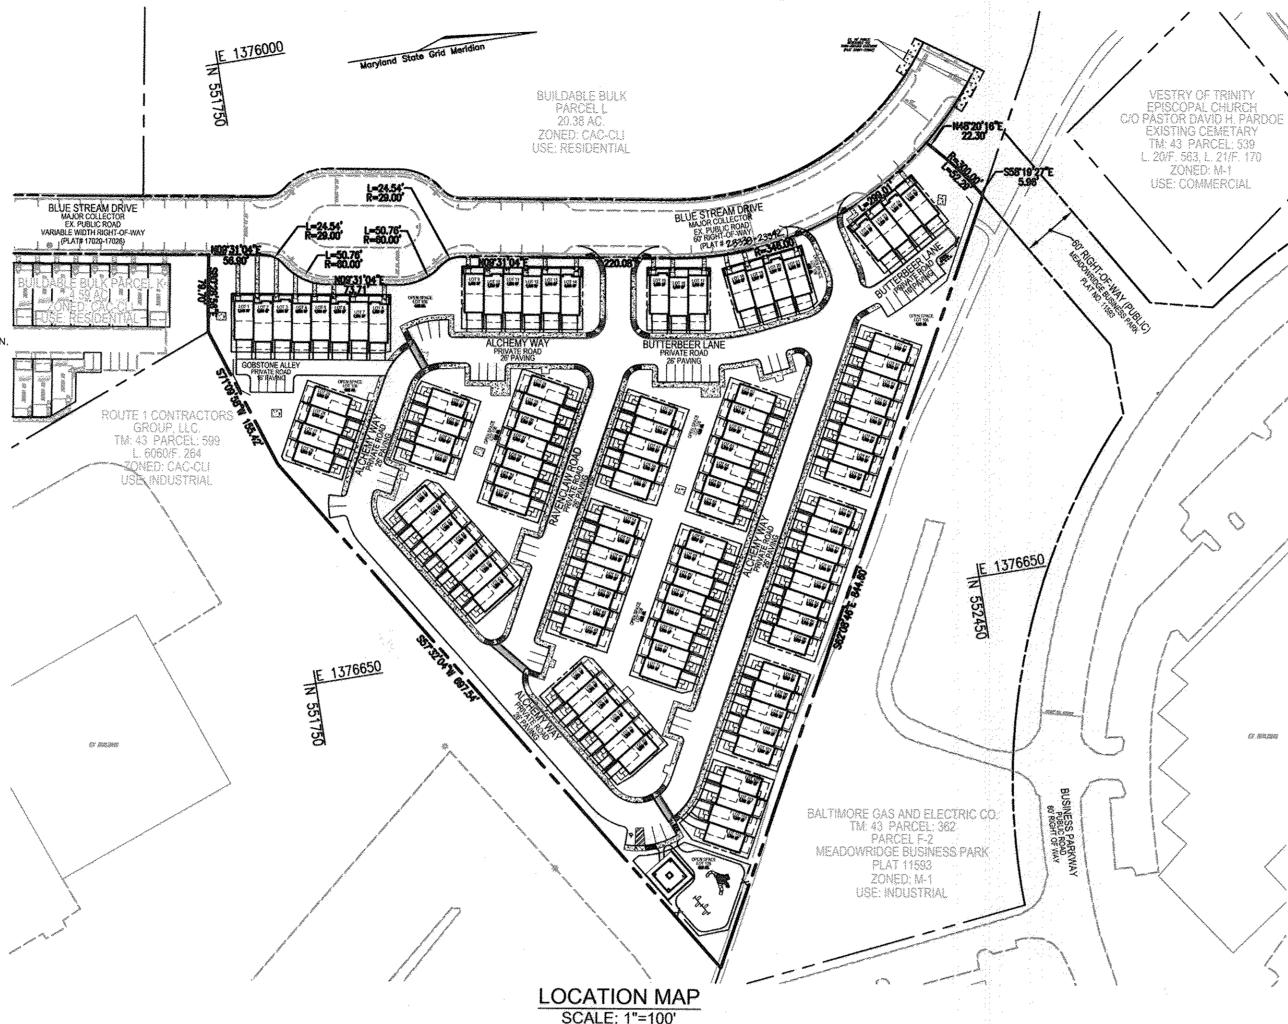

# (1-CAR GARAGE) SIDE ELEVATION (1-CAR GARAGE) (1-CAR GARAGE)

LEGEND

LIGHT POLES

CONCRETE

**EXISTING CONTOUR** 

PROPOSED CONTOUR

DIRECTION OF FLOW

EXISTING SPOT ELEVATION PROPOSED SPOT ELEVATION

EXISTING TREES TO REMAIN

- [382]-

+82.53

SHEET INDEX	, , ,
DESCRIPTION	SHEET NO.
COVER SHEET	1 OF 13
LAYOUT PLAN	2 OF 13
LAYOUT PLAN	3 OF 13
CURB TRANSITION PLAN	4 OF 13
GRADING, SEDIMENT AND EROSION CONTROL PLAN	5 OF 13
GRADING, SEDIMENT AND EROSION CONTROL PLAN	6 OF 13
SITE, SEDIMENT AND EROSION CONTROL NOTES AND DETAILS	7 OF 13
STORM DRAIN DRAINAGE AREA MAP; PAVING PLAN; AND SOILS MAP	8 OF 13
STORM DRAIN PROFILES	9 OF 13
STORM DRAIN PROFILES	10 OF 13
LANDSCAPE AND AMENITY AREA PLAN	11 OF 13
RETAINING WALL PLAN AND PROFILE	12 OF 13
RETAINING WALL DETAILS AND SECTION	13 OF 13

STREET ADDRESS

8016 ALCHEMY WAY

8014 ALCHEMY WAY

8012 ALCHEMY WAY

8010 ALCHEMY WAY

8008 ALCHEMY WAY

8006 ALCHEMY WA

8004 ALCHEMY WAY

8000 ALCHEMY WAY

7998 ALCHEMY WA

7996 ALCHEMY WA

7994 ALCHEMY WA

7992 ALCHEMY W

7990 ALCHEMY WAY

7988 ALCHEMY WAY

7986 ALCHEMY W

7982 ALCHEMY WAY

7980 ALCHEMY W

7978 ALCHEMY W

7976 ALCHEMY WA

7974 ALCHEMY WI

7970 ALCHEMY WAY

7968 ALCHEMY WI

7966 ALCHEMY WAY

7964 ALCHEMY WA

STREET ADDRESS UNIT

8019 RAVENCLAW ROAD UNIT 82

8017 RAVENCLAW ROAD UNIT 8

8015 RAVENCLAW ROAD UNIT 8

8013 RAVENCLAW ROAD UNIT 8

8011 RAVENCIAW ROAD LINIT S

8003 ALCHEMY WAY

8007 ALCHEMY WAY UNIT 8

8005 ALCHEMY WAY UNIT 8

8001 ALCHEMY WAY UNIT 9

7999 ALCHEMY WAY | UNIT 9

7997 ALCHEMY WAY LUNIT 9

7995 ALCHEMY WAY UNIT 9:

7991 ALCHEMY WAY UNIT 94

7989 ALCHEMY WAY UNIT 9:

7987 ALCHEMY WAY | UNIT 91

7985 ALCHEMY WAY UNIT 9

7983 ALCHEMY WAY UNIT 98

7981 ALCHEMY WAY | UNIT 99

7979 ALCHEMY WAY UNIT 10

7977 ALCHEMY WAY UNIT 16

7951 ALCHEMY WAY UNIT 10

7953 ALCHEMY WAY LUNIT 10

7955 ALCHEMY WAY JUNIT 104

7957 ALCHEMY WAY UNIT 105

7959 ALCHEMY WAY O/S LOT 10

7961 ALCHEMY WAY

8018 ALCHEMY WAY

64. IN ACCORDANCE WITH THE RECORDED AGREEMENT (12831/193) THE REMAINING BLUE STREAM DEVELOPMENT (EXCLUDING GROVESNOR HOUSE) IS REQUIRED

STREET ADDRESS

66. ALL INTERNAL ROADS IN THIS DEVELOPMENT ARE PRIVATELY OWNED AND TO BE MAINTAINED BY THE HOA, WHICH WILL PROVIDE PRIVATE TRASH COLLECTION AND

ADDRESS CHART

7932 ALCHEMY WAY UNIT 55

7930 ALCHEMY WAY UNIT 56

7929 ALCHEMY WAY UNIT 58

7927 ALCHEMY WAY UNIT 59

7925 ALCHEMY WAY UNIT 60

8010 RAVENCLAW ROAD UNIT 61

8012 RAVENCLAW ROAD UNIT 6

8014 RAVENCLAW ROAD UNIT 63

8016 RAVENCLAW ROAD UNIT 6

8018 RAVENCLAW ROAD UNIT 65

8020 RAVENCLAW ROAD UNIT 6

8022 RAVENCLAW ROAD UNIT 6

7935 ALCHEMY WAY UNIT 6

7937 ALCHEMY WAY UNIT 69

7939 ALCHEMY WAY UNIT 7

7943 ALCHEMY WAY UNIT 7

7945 ALCHEMY WAY UNIT 7

7947 ALCHEMY WAY UNIT 7

8035 RAVENCLAW ROAD UNIT 7

8033 RAVENCLAW ROAD UNIT 7

8031 RAVENCLAW ROAD UNIT

8029 RAVENCLAW ROAD UNIT 78

8027 RAVENCLAW ROAD UNIT 79

8025 RAVENCLAW ROAD UNIT 80

8023 RAVENCLAW ROAD UNIT 81

7931 ALCHEMY WAY UNIT 5

TO PROVIDE 18.5% MIHU UNITS OR 202 TOTAL UNITS. THIS SDP PROVIDES 19 MIHU (18.10% FOR THIS PHASE).

65. A DESIGN ADVISORY PANEL MEETING WAS HELD ON OCTOBER 23, 2013.

STREET ADDRESS

UNIT 5 7958 BLUE STREAM DRIVE UNIT 32

UNIT 9 7970 BLUE STREAM DRIVE UNIT 36

UNIT 10 7972 BLUE STREAM DRIVE UNIT 3

UNIT 11 7974 BLUE STREAM DRIVE UNIT 38

UNIT 12 7976 BLUE STREAM DRIVE UNIT 39

UNIT 13 7978 BLUE STREAM DRIVE UNIT 40

UNIT 14 7980 BLUE STREAM DRIVE UNIT 41

UNIT 15 7990 BLUE STREAM DRIVE UNIT 4

UNIT 16 7992 BLUE STREAM DRIVE UNIT 4

UNIT 17 7994 BLUE STREAM DRIVE UNIT 44

UNIT 18 8000 BLUE STREAM DRIVE UNIT 4

UNIT 19 8002 BLUE STREAM DRIVE UNIT 46

UNIT 20 8004 BLUE STREAM DRIVE UNIT 4

UNIT 24 8014 BLUE STREAM DRIVE UNIT 5

1 8006 BLUE STREAM DRIVE UNIT 48

2 8010 BLUE STREAM DRIVE UNIT 4

012 BLUE STREAM DRIVE | UNIT 5

016 BLUE STREAM DRIVE UNIT 5

7936 ALCHEMY WAY UNIT 5

7934 ALCHEMY WAY UNIT 54

7950 BLUE STREAM DRIVE | UNIT 2

7952 BLUE STREAM DRIVE UNIT 29

7954 BLUE STREAM DRIVE UNIT .

17960 BLUE STREAM DRIVE UNIT 3

7964 BLUE STREAM DRIVE UNIT 3

17962 BLUE STREAM DRIVE UNIT 34

7956 BLUE STREAM DRIVE | UNIT 3

REAR ELEVATION

2-CAR GARAGE

VICINITY MAP SCALE: 1"=2000' ADC MAP COORDINATES: PAGE 34 / GRID E6

BENCHMARKS

HOWARD COUNTY BENCHMARK 43B2 N 551,654.993 E 1,378,176.951 ELEV.: 209.601 HOWARD COUNTY BENCHMARK 43B6 N 550.601.597 E 1.376,866.072 ELEV.: 210,559'

OPTIONAL CONC. DECK DECK BAY WINDOW-GARAGE WIDTH BAY WINDOW-

**TOWNHOUSE FOOTPRINTS** 

PARKING TABULATION 105 UNITS @ 2 SPACES PER UNIT 210 SPACES OVERFLOW PARKING 105 UNITS @ 0.5 SPACES PER UNIT 53 SPACES TOTAL SPACES REQUIRED: 263 SPACES

TOWNHOUSE GARAGE SPACES PROVIDED (1-CAR GARAGE TOWNHOMES - 80) 2-CAR GARAGE TOWNHOMES - 25) TOWNHOUSE DRIVEWAY SPACES PROVIDED COMMON PARKING SPACES PROVIDED

130 SPACES 49 SPACES ON-STREET PARKING PROVIDED 12 SPACES

PERMIT INFORMATION CHART SUBDIVISION NAME BLUE STREAM N/A PARCEL L-1 PLAT # OR L/F | BLOCK NO. | ZONE | TAX MAP | ELECT. DIST. CENSUS TR. CAC-CLI 43 1ST 6012.02 23338-23342 WATER CODE: BO1 **SEWER CODE:** 2153000

> OWNER/DEVELOPER U.S. HOME CORPORATION

PROVIDED

C/O JOSEPH FORTINO 10211 WINCOPIN CIRCLE SUITE 180 COLUMBIA, MD 21044 410-997-5522

REVISE FLAN TO ADD A 4' HIGH ORNAMENTAL WALL AND A 6'HIGH 2/21/16

SITE DEVELOPMENT PLAN

PRIVACY FENCE TO THE SOUTH EASTERN PROFERTY LINE

**COVER SHEET** 

**BLUE STREAM TOWNS - SECTION 2** 


LOTS 1-105, AND OPEN SPACE LOT 106 A RE-SUBDIVISION OF BUILDABLE BULK PARCEL L-1

TAX MAP 43 GRID 4 1ST ELECTION DISTRICT ROBERT H. VOGEL



ENGINEERING, INC. ENGINEERS . SURVEYORS . PLANNERS

8407 MAIN STREET TEL: 410.461.7666 ELLICOTT CITY, MD 21043 FAX: 410.461.8961

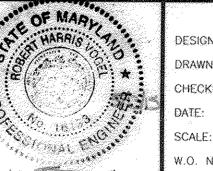

ROBERT H. VOGEL, PE No.1614

DESIGN BY: RHV DRAWN BY: CHECKED BY: RHV APRIL 2015 SCALE: AS SHOWN W.O. NO.: 06-26.14 ROFESSIONAL CERTIFICATE

HOWARD COUNTY, MARYLAND

SHEET 13

# GENERAL NOTES (CONTINUED...

ETWEEN JULY 1, 2008 AND APRIL 1, 2009

SCALE 1"=100"

BETWEEN JULY 1, 2009 AND APRIL 1, 20

BETWEEN JULY 1, 2010 AND APRIL 1, 20

BETWEEN JULY 1, 2011 AND APRIL 1, 2

21-50-3

54. THE OFFICE/RETAIL DESIGN YEARS AND AREAS SHOWN ON THE BELOW CHART ARE IN ACCORDANCE WITH THE APPROVED APFO STUDY SHOULD THE SUBSEQUENT SITE DEVELOPMENT PLAN SUBMISSIONS DIFFER FROM THIS SCHEDULE, AN UPDATED APFO STUDY WILL BE

PHASE NUMBER	YEAR	SHOPPING CENTER (SQ. FT.)	GENERAL OFFICE (SQ. FT.)	TOTAL OFFICE PER YEAR	
I (P-08-011)	2010	25,000*	0	25,000*	
II (P-09-004)	2011	16,667*	16,667*	33,334*	
III (P-10-005)	2012	25,000*	80,000*	105,000*	*THE OFFICE AND COMMERCIAL
IV (P-11-003)	2013	0	263,334*	263,334*	IN THESE PHASES WILL BE DEV
V (P-12-003)	2014	Q	Ó	0	FUTURE PHASE. (REFERENCE GI
VI (P-13-004)	2015	0	56,000	56,000	
VII (P-14-002)	2016	0.	40,667	40,667	
VII	2017	0	16,667	16,667	

TOTALS: 66,667 473,335 540,002 55. A SIGNAL WARRANT ANALYSIS WAS COMPLETED ON APRIL 20, 2011 BY THE TRAFFIC GROUP FOR THE FIRST TWO DEVELOPMENT PROJECTS WITHIN BLUE STREAM SUBDIVISION; GROSVENOR HOUSE (SDP-11-032) AND DORSET GARDENS (SDP-11-040). BASED UPON THE DATA AND ANALYSIS IN THIS REPORT, IT WAS DETERMINED THAT THAT TRAFFIC SIGNALIZATION WOULD BE WARRANTED AT THE INTERSECTION OF US ROUTE 1 AND BLUE STREAM DRIVE. ADDITIONAL SIGNAL WARRANT ANALYSIS MAY BE REQUIRED DURING WITH THE FUTURE DEVELOPMENT PROJECTS OF THE BLUE STREAM SUBDIVISION TO DETERMINE WHEN A SIGNAL IS WARRANTED. THE TRAFFIC GROUP AND SHA DISCRICT OFFICE HAS DETERMINED THAT A SIGNAL WARRANT ANALYSIS IS NOT REQUIRED IN CONJUNCTION WITH THIS SITE DEVELOPMENT PLAN.

SHA DISCRICT OFFICE HAS DETERMINED THAT A SIGNAL WARRANT ANALYSIS IS NOT REQUIRED IN CONJUNCTION WITH THIS SITE DEVELOPM.

56. UPDATED TRAFFIC STUDIES WILL BE REQUIRED PERIODICALLY IN THE FUTURE TO ACCURATELY DETERMINE THE SPECIFIC TIMING OF POSSIBLE INTERSECTION IMPROVEMENTS FOR MD ROUTE 1.3 AND ROUTE 1.3 AND MONTEVIDED ROAD AND ROUTE 1. SHOULD THESE INTESECTIONS BE PROJECTED TO FAIL THEN THE STUDY WILL SPECIFY THE EXTENT OF IMPROVEMENTS AND THE DEVELOPER WILL BE REQUIRED TO CONSTRUCT SUCH IMPROVEMENTS OR CONTRIBUTE A PROFRATA FEE FOR THE CAPITAL PROJECT IMPROVEMENTS. IF THE STUDY CONCLUDES THAT THE INTERSECTION WILL FAIL, THE ROAD IMPROVEMENTS OR A FEE WILL BE REQUIRED PRIOR TO THE SITE DEVELOPMENT PLAN PHASE WHICH CORRESPONDS TO THE YEAR IN WHICH ONE OR BOTH INTERSECTIONS FAIL. A SIGNAL IS CURRENTLY WARDANTED AT BUTE STEEDAM ORDING AND BOTH THE INTERSECTIONS FAIL. A SIGNAL IS CURRENTLY NOT WARRANTED AT BLUE STREAM DRIVE AND ROUTE 1. THE INTERSECTION WILL BE REEVALUATED IN THE FUTURE.

57. THE OPEN SPACE REQUIREMENTS FOR THE BLUE STREAM SUBDIVISION IS 12.75 AC, WHICH IS 20% OF THE NET AREA FOR THIS DEVELOPMENT (75.67 AC. GROSS AREA – 10.07 AC. FLOODPLAIN – 1.86 AC. STEEP SLOPE = 63.71 NET AC. x 20% OF NET ACREAGE = 12.75 AC.), AND HAS BEEN PROVIDED UNDER F-10-055, OPEN SPACE LOTS G-1 AND G-2 (TOTAL 18.10 AC.). THIS PROJECT PROVIDES 4.28 AC. OF OPEN SPACE (LOT 106).

58. THE INDIVIDUAL BUILDABLE PARCELS WITHIN THE BLUE STREAM SUBDIVISION WILL COMBINE TO PROVIDE THE AMENITY AREA REQUIREMENT (50% OF OPEN SPACE REQUIREMENT = 6.37 AC.) WITH THEIR CORRESPONDING SITE DEVELOPMENT PLANS. THIS PLAN ACCOUNTS FOR 0.79 AC. OF AMENTY SPACE, SEE SHEET 11 FOR DETAILS. REFER TO THE AMENTY AREA CHART FOR THE BLUE STREAM

BLUE STREAM SUBDIVISION AMENITY AREA CHART 6.37 AC. REQUIRED					
PLAN	PROVIDED	REMAINING			
BLUE STREAM (F-02-035)	0.00 AC.	6.37 AC.			
GROSVENOR HOUSE (SDP-11-032)	0.99 AC.	5.38 AC.			
DORSET GARDENS (SDP-11-040)	1.02 AC.	4.36 AC.			
BLUE STREAM TOWNS - SECTION 2 (SDP-14-029)	1.22 AC.	3.14 AC.			
BROMPTON 2 (SDP-14-077)	0.87 AC.	2.27 AC.			

THE MODERATE INCOME HOUSING UNIT AGREEMENT FOR THE 19 DWELLING UNITS WAS RECORDED IN THE HOWARD COUNTY LAND RECORDS ON 25/21/15. BY LIBER 16208 AND FOLIO 443

SIMPLE SINGLE FAMILY ATTACHED LOTS ON A PRIVATE ROAD BEYOND 200 FEET FROM THE EDGE OF THE PUBLIC RIGHT-OF-WAY ALONG THE

1. THE HOME OWNER'S ASSOCIATION WILL BE THE RESPONSIBLE PARTY FOR THE MAINTENANCE OF THE PRIVATE ROADS AND STORM WATER CONVEYANCE AND MANAGEMENT FACILITIES. WATER AND SEWER SHALL BE PUBLIC AND MAINTENANCE FOR EACH UNIT WITHIN A RECORDED PUBLIC EASEMENT.

3. THE PROPOSED, PRIVATE, INTERNAL ROADS WITHIN THE PROJECT SHALL BE DESIGNED AND CONSTRUCTED IN ACCORDANCE WITH HE REQUIREMENTS OF DED AND DFRS AS PART OF SDP-14-029. 4. A GENERAL NOTE SHALL BE ADDED TO SDP-14-029 THAT CLEARLY STATES THAT ALL INTERNAL ROADS IN THIS DEVELOPMENT ARE PRIVATELY OWNED AND TO BE MAINTAINED BY THE HOA, WHICH WILL PROVIDE PRIVATE TRASH COLLECTION AND SNOW REMOVAL SERVICES.

5. THE DEVELOPER SHALL RECORD ANY NECESSARY "CROSS-EASEMENTS" FOR SHARED ACCESS AND PARKING FOR THIS DEVELOPMENT AND


63. THE PUBLIC AMENITY AREA, INCLUDING PLAY EQUIPMENT, SHALL COMPLY WITH THE 2010 ADA STANDARDS.


59. IN ACCORDANCE WITH ZONING REGULATION SECTION 127.5.E.3.e, THE PHASING OF RESIDENTIAL AND COMMERCIAL DEVELOPMENT AND OPEN SPACE SHALL BE ROUGHLY PROPORTIONAL NO MORE THAN 60% OF THE RESIDENTIAL UNITS SHALL BE CONSTRUCTED PRIOR TO COMMENCING A ROUGHLY PROPORTIONAL AMOUNT OF COMMERCIAL CONSTRUCTION AND OPEN SPACE, COMMERCIAL USES ARE ALSO REQUIRED TO COMPLY WITH ZONING REGULATION SECTION 127.5.E.2 60. THE 19 MIHU UNITS ARE TO BE PROVIDED ON PARCEL L-1 (REFERENCE MIHU AGREEMENT),


62. THIS PROJECT IS SUBJECT TO WP-14-081; APPROVED 02/19/14; TO WAIVE SUBDIVISION SECTION 16.120(c)(4), TO ALLOW FEE APPROVAL IS SUBJECT TO THE FOLLOWING CONDITIONS:


2. BLUE STREAM DRIVE AS SHOWN ON SDP-14-029, NORTH OF THE CUL-DE-SAC, SHALL BE PUBLIC UP TO THE TEE TURNAROUND PER THE ATTACHED COMMENTS FROM THE DEVELOPMENT ENGINEERING DIVISION.

REFERENCE THE RECORDED EASEMENT LIBER/FOLIO AS A GENERAL NOTE ON SDP-14-029 AND THE ASSOCIATED FINAL PLAT(S)

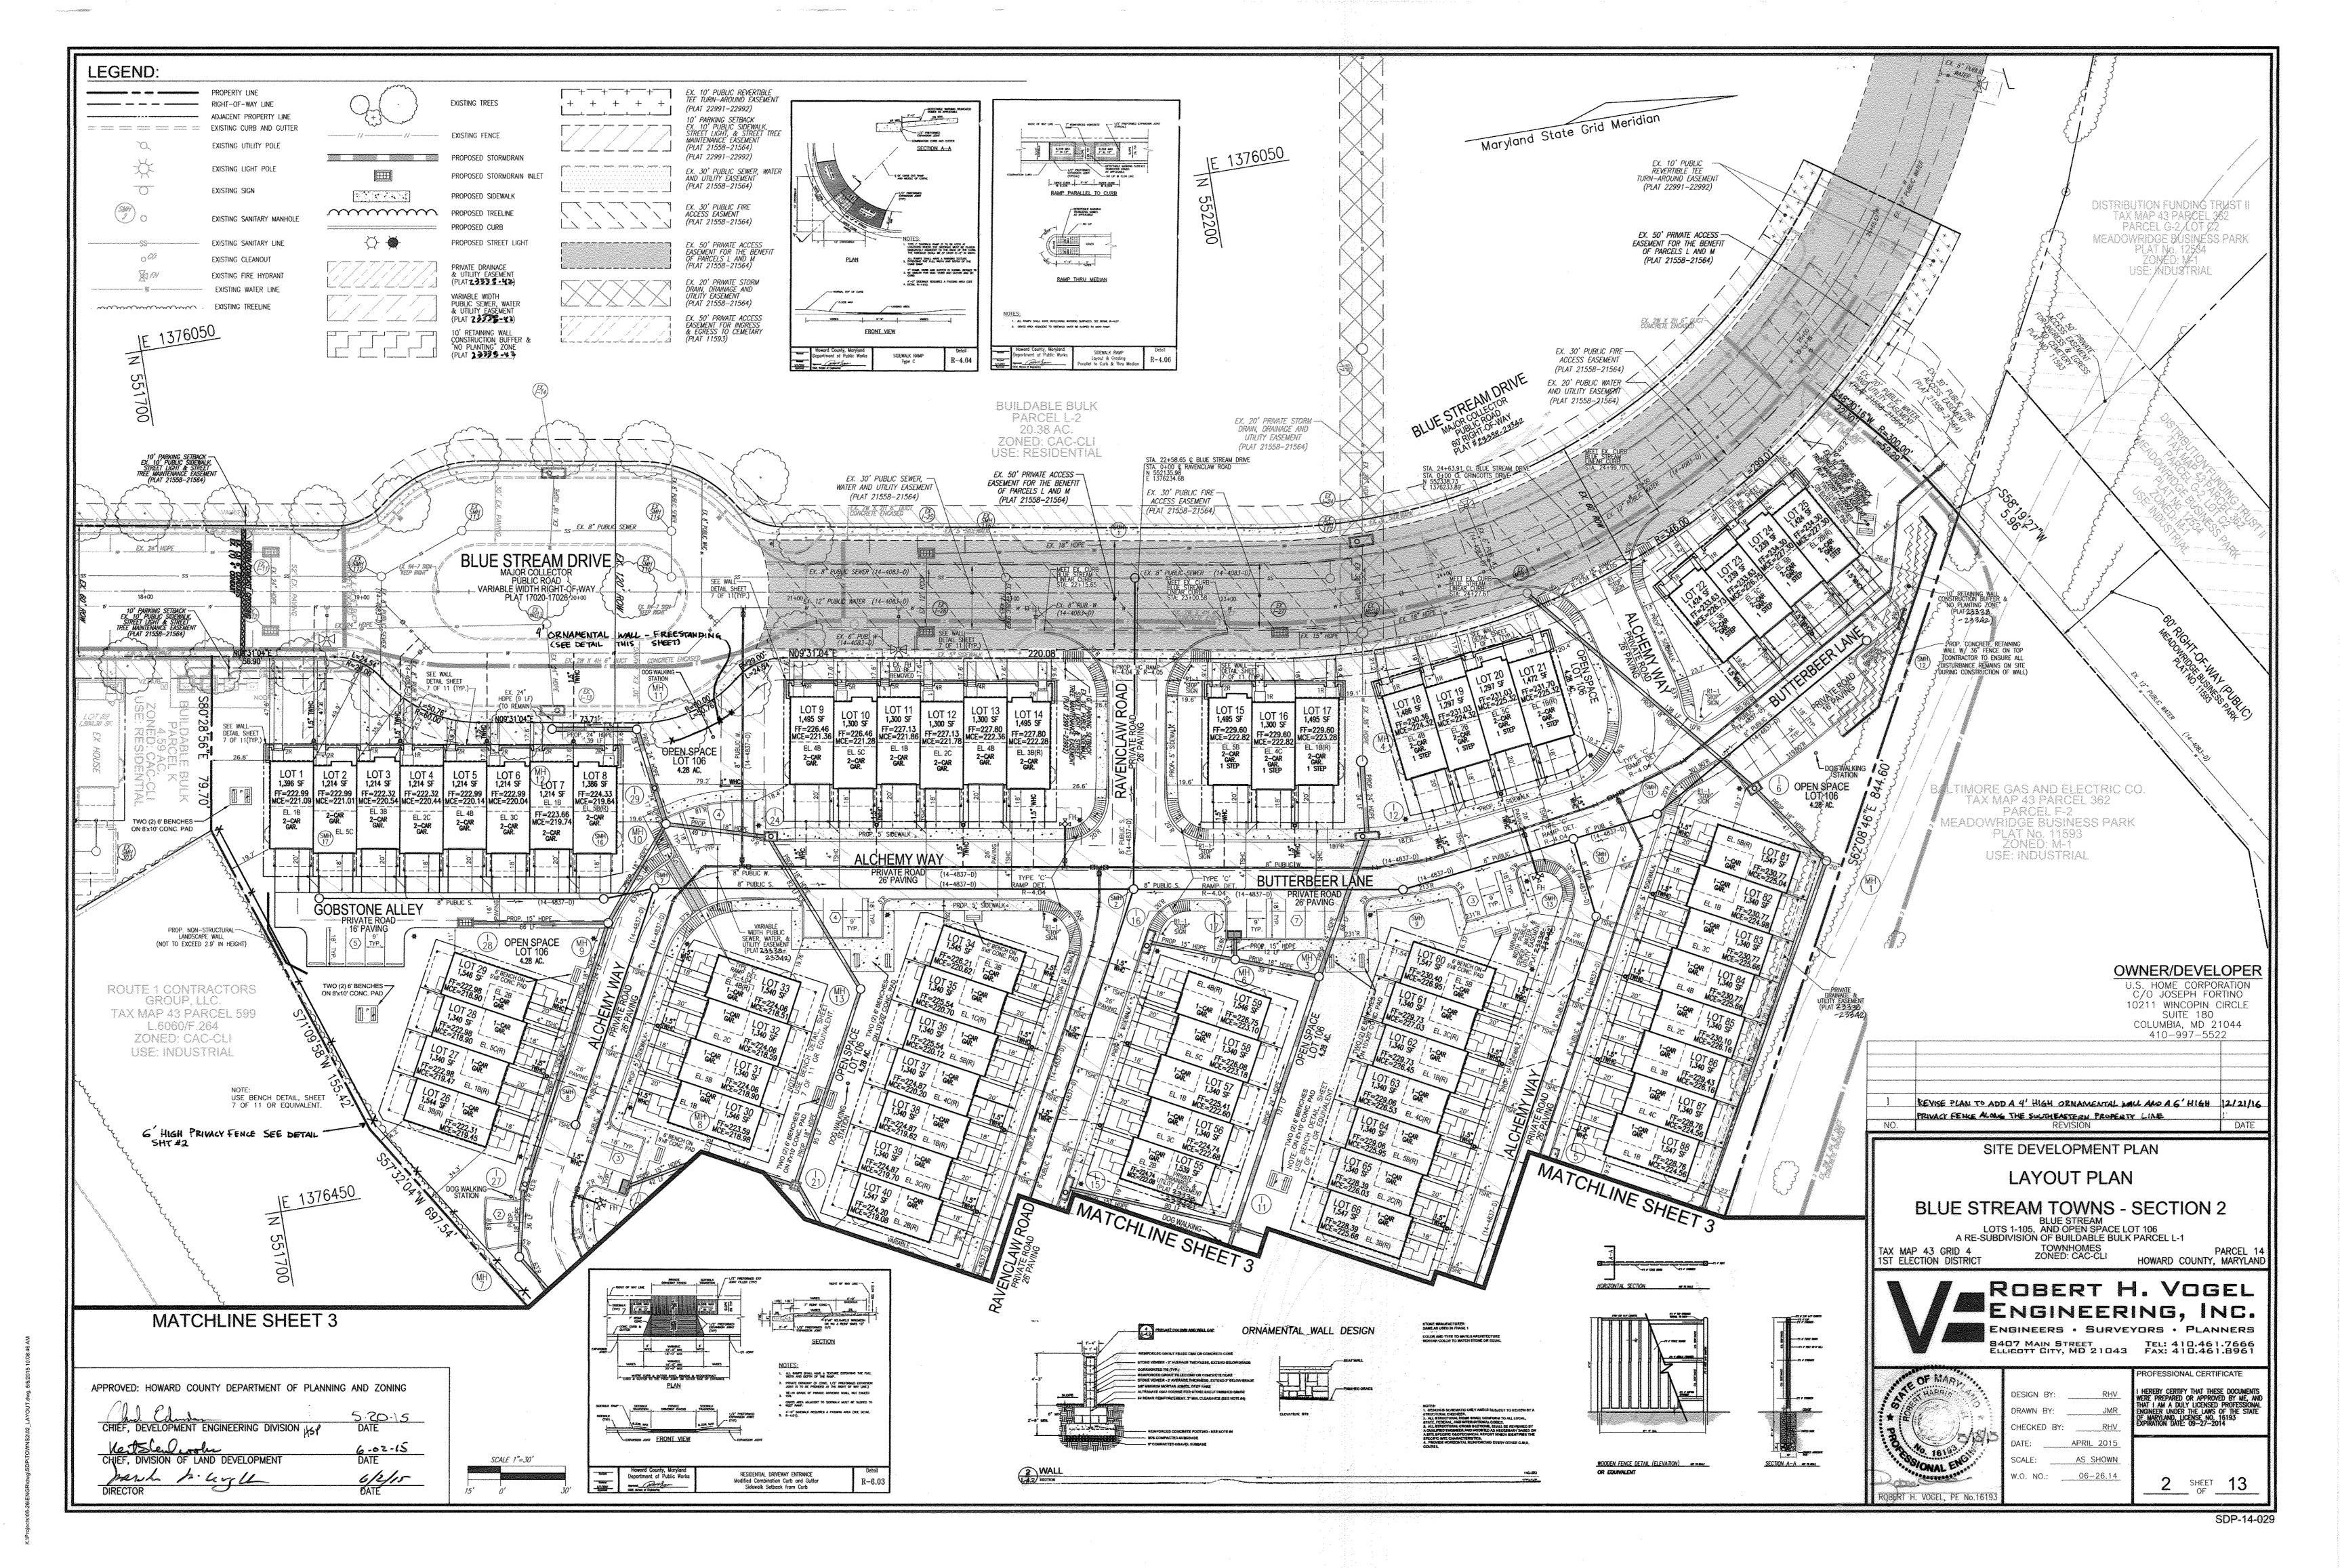

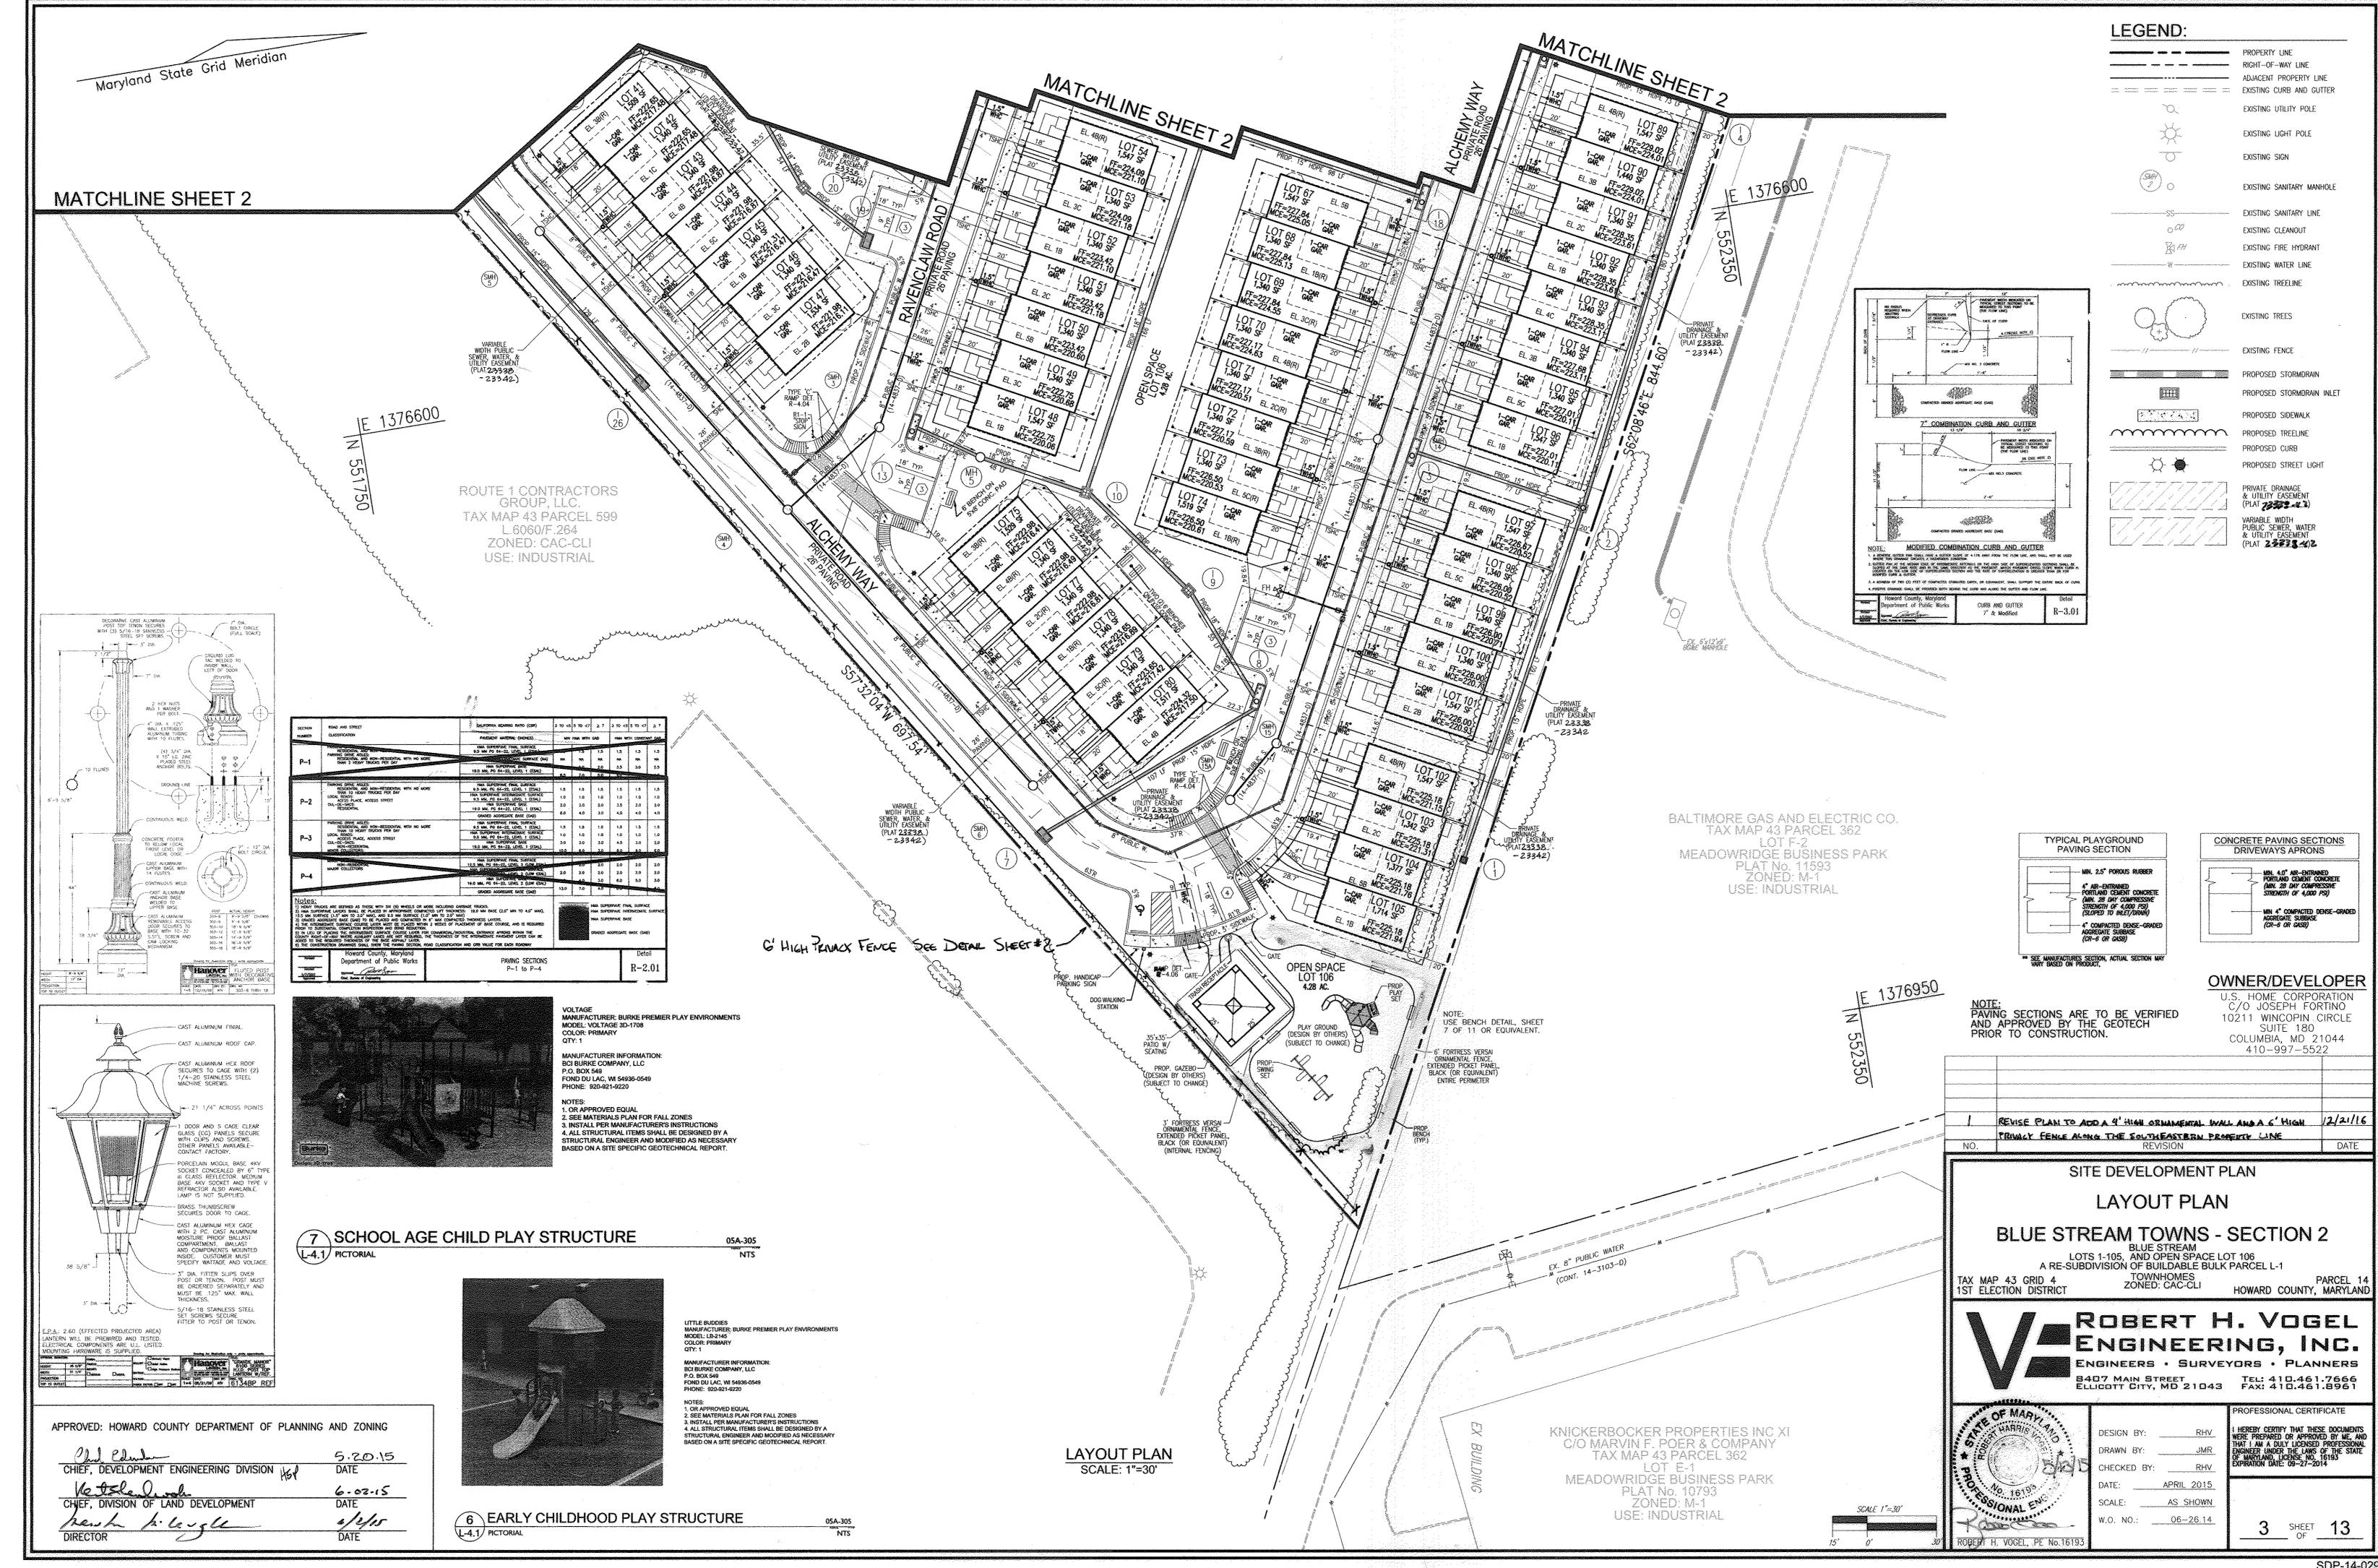

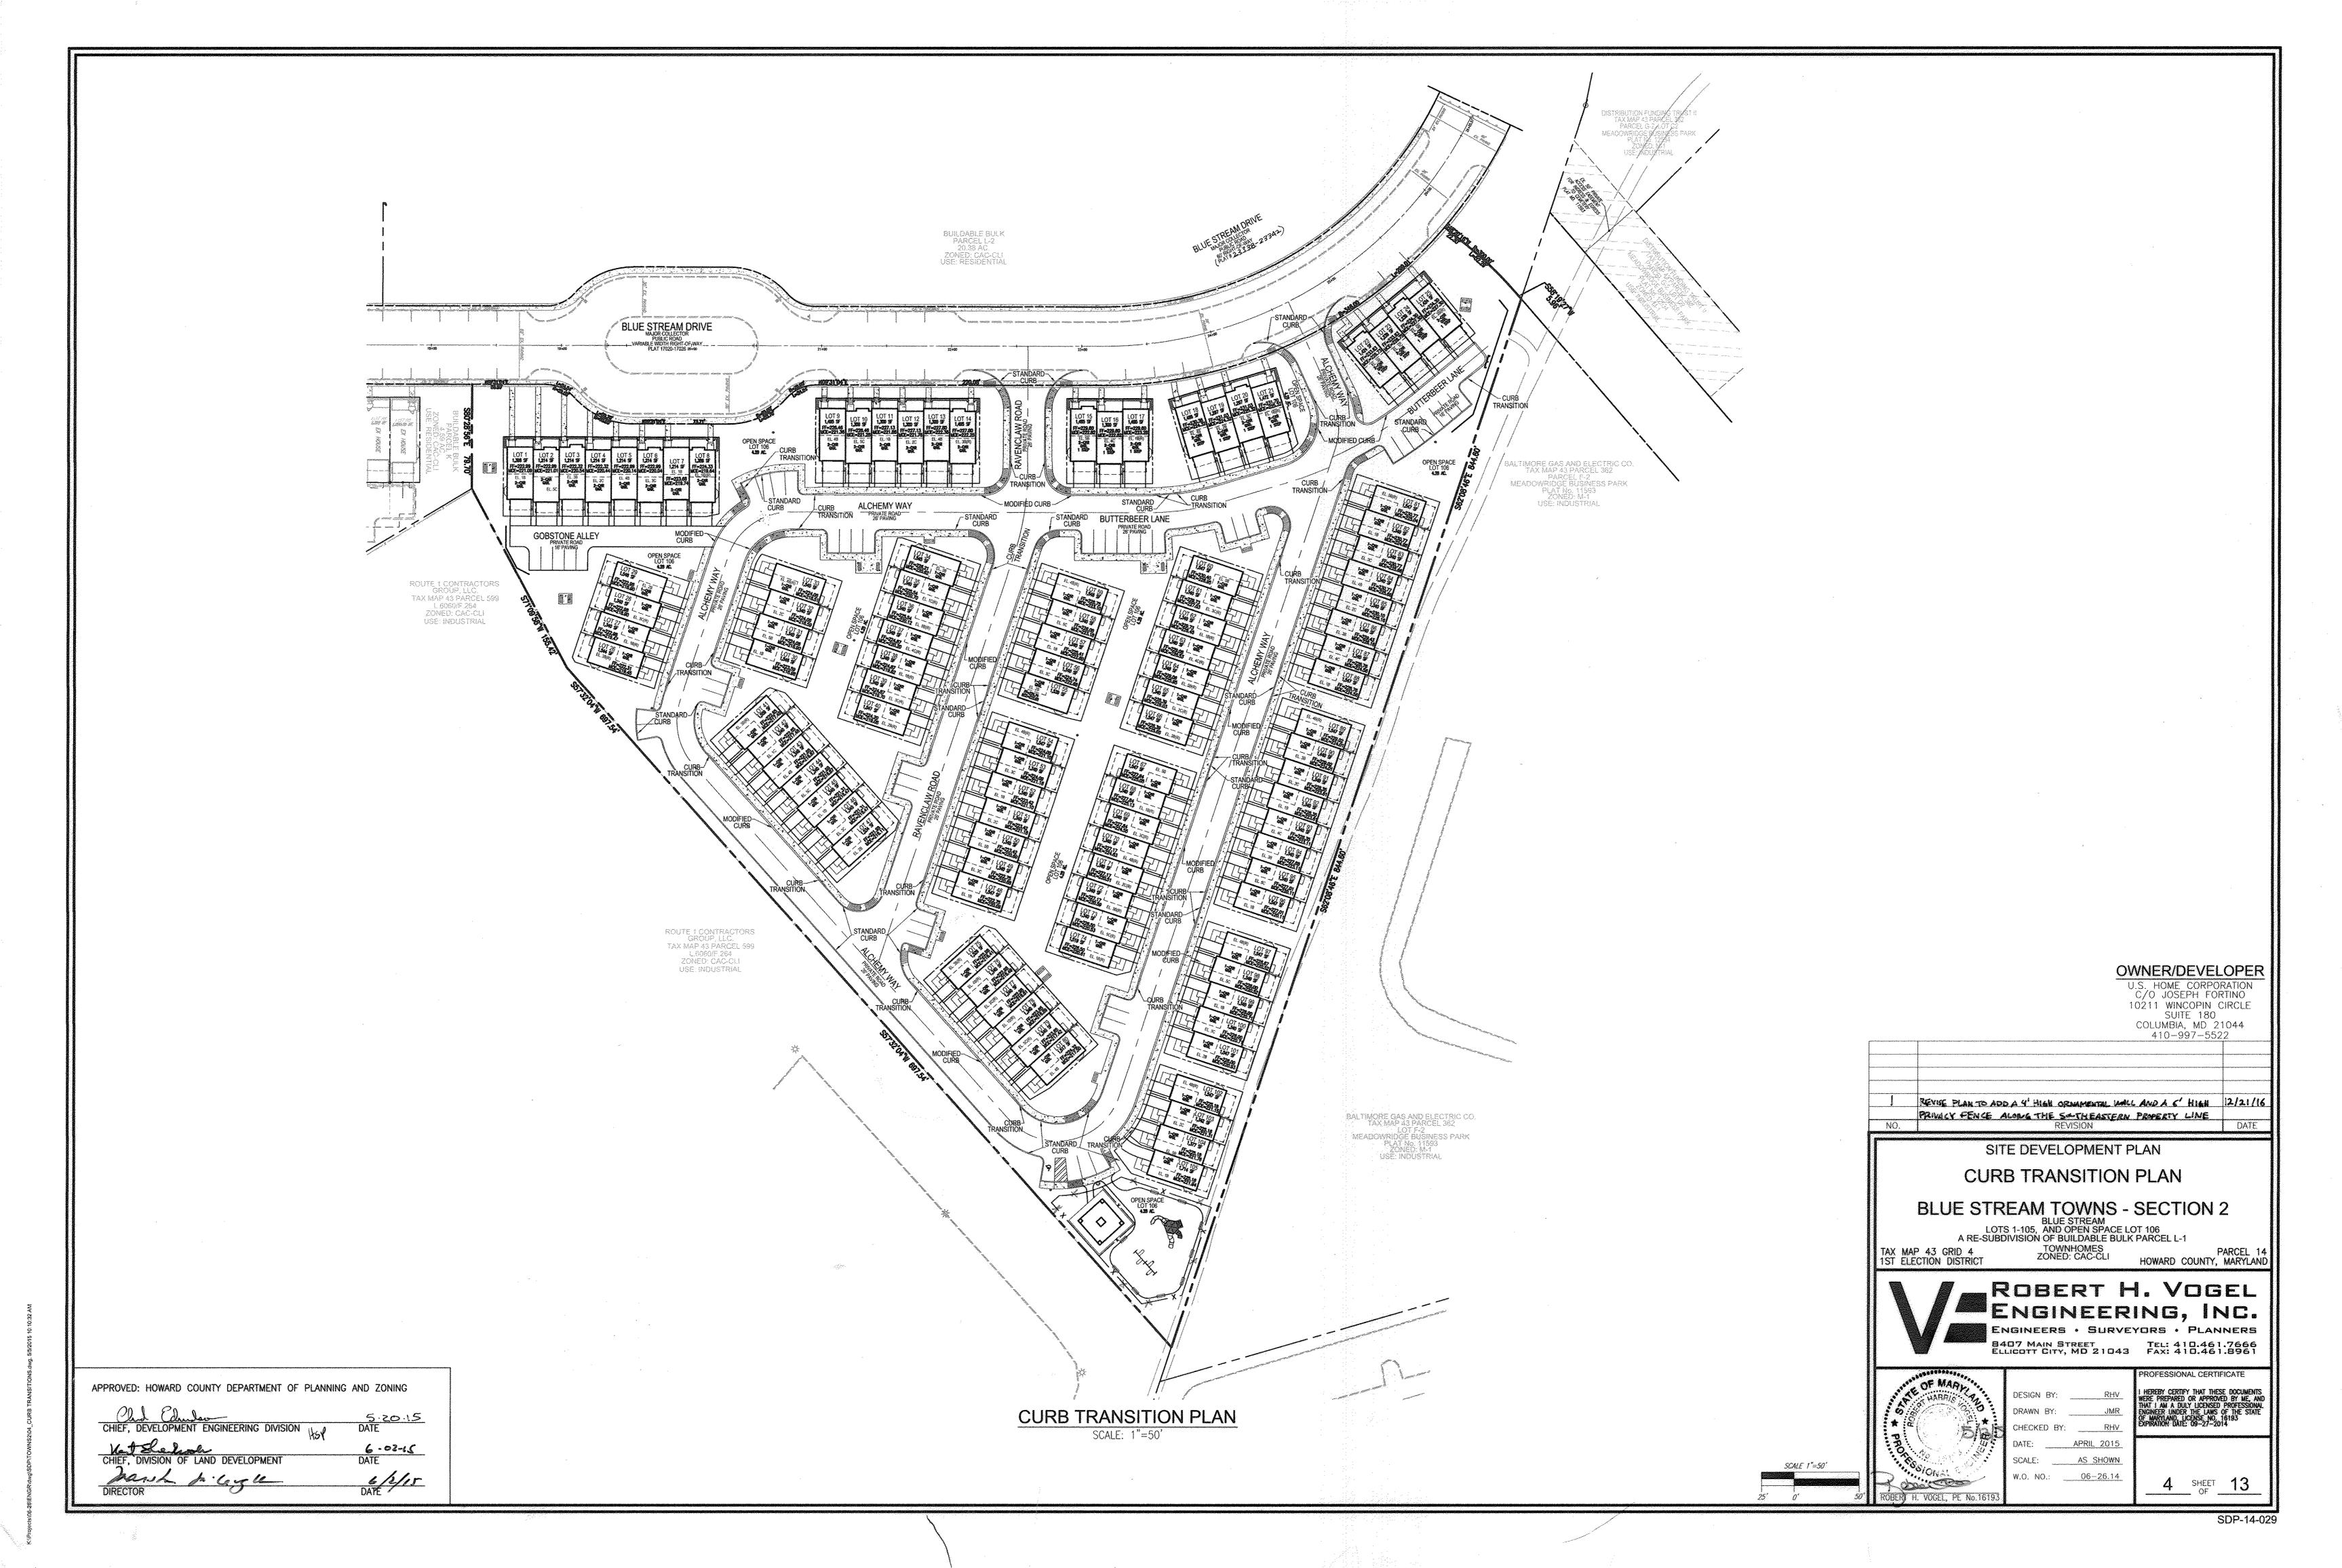

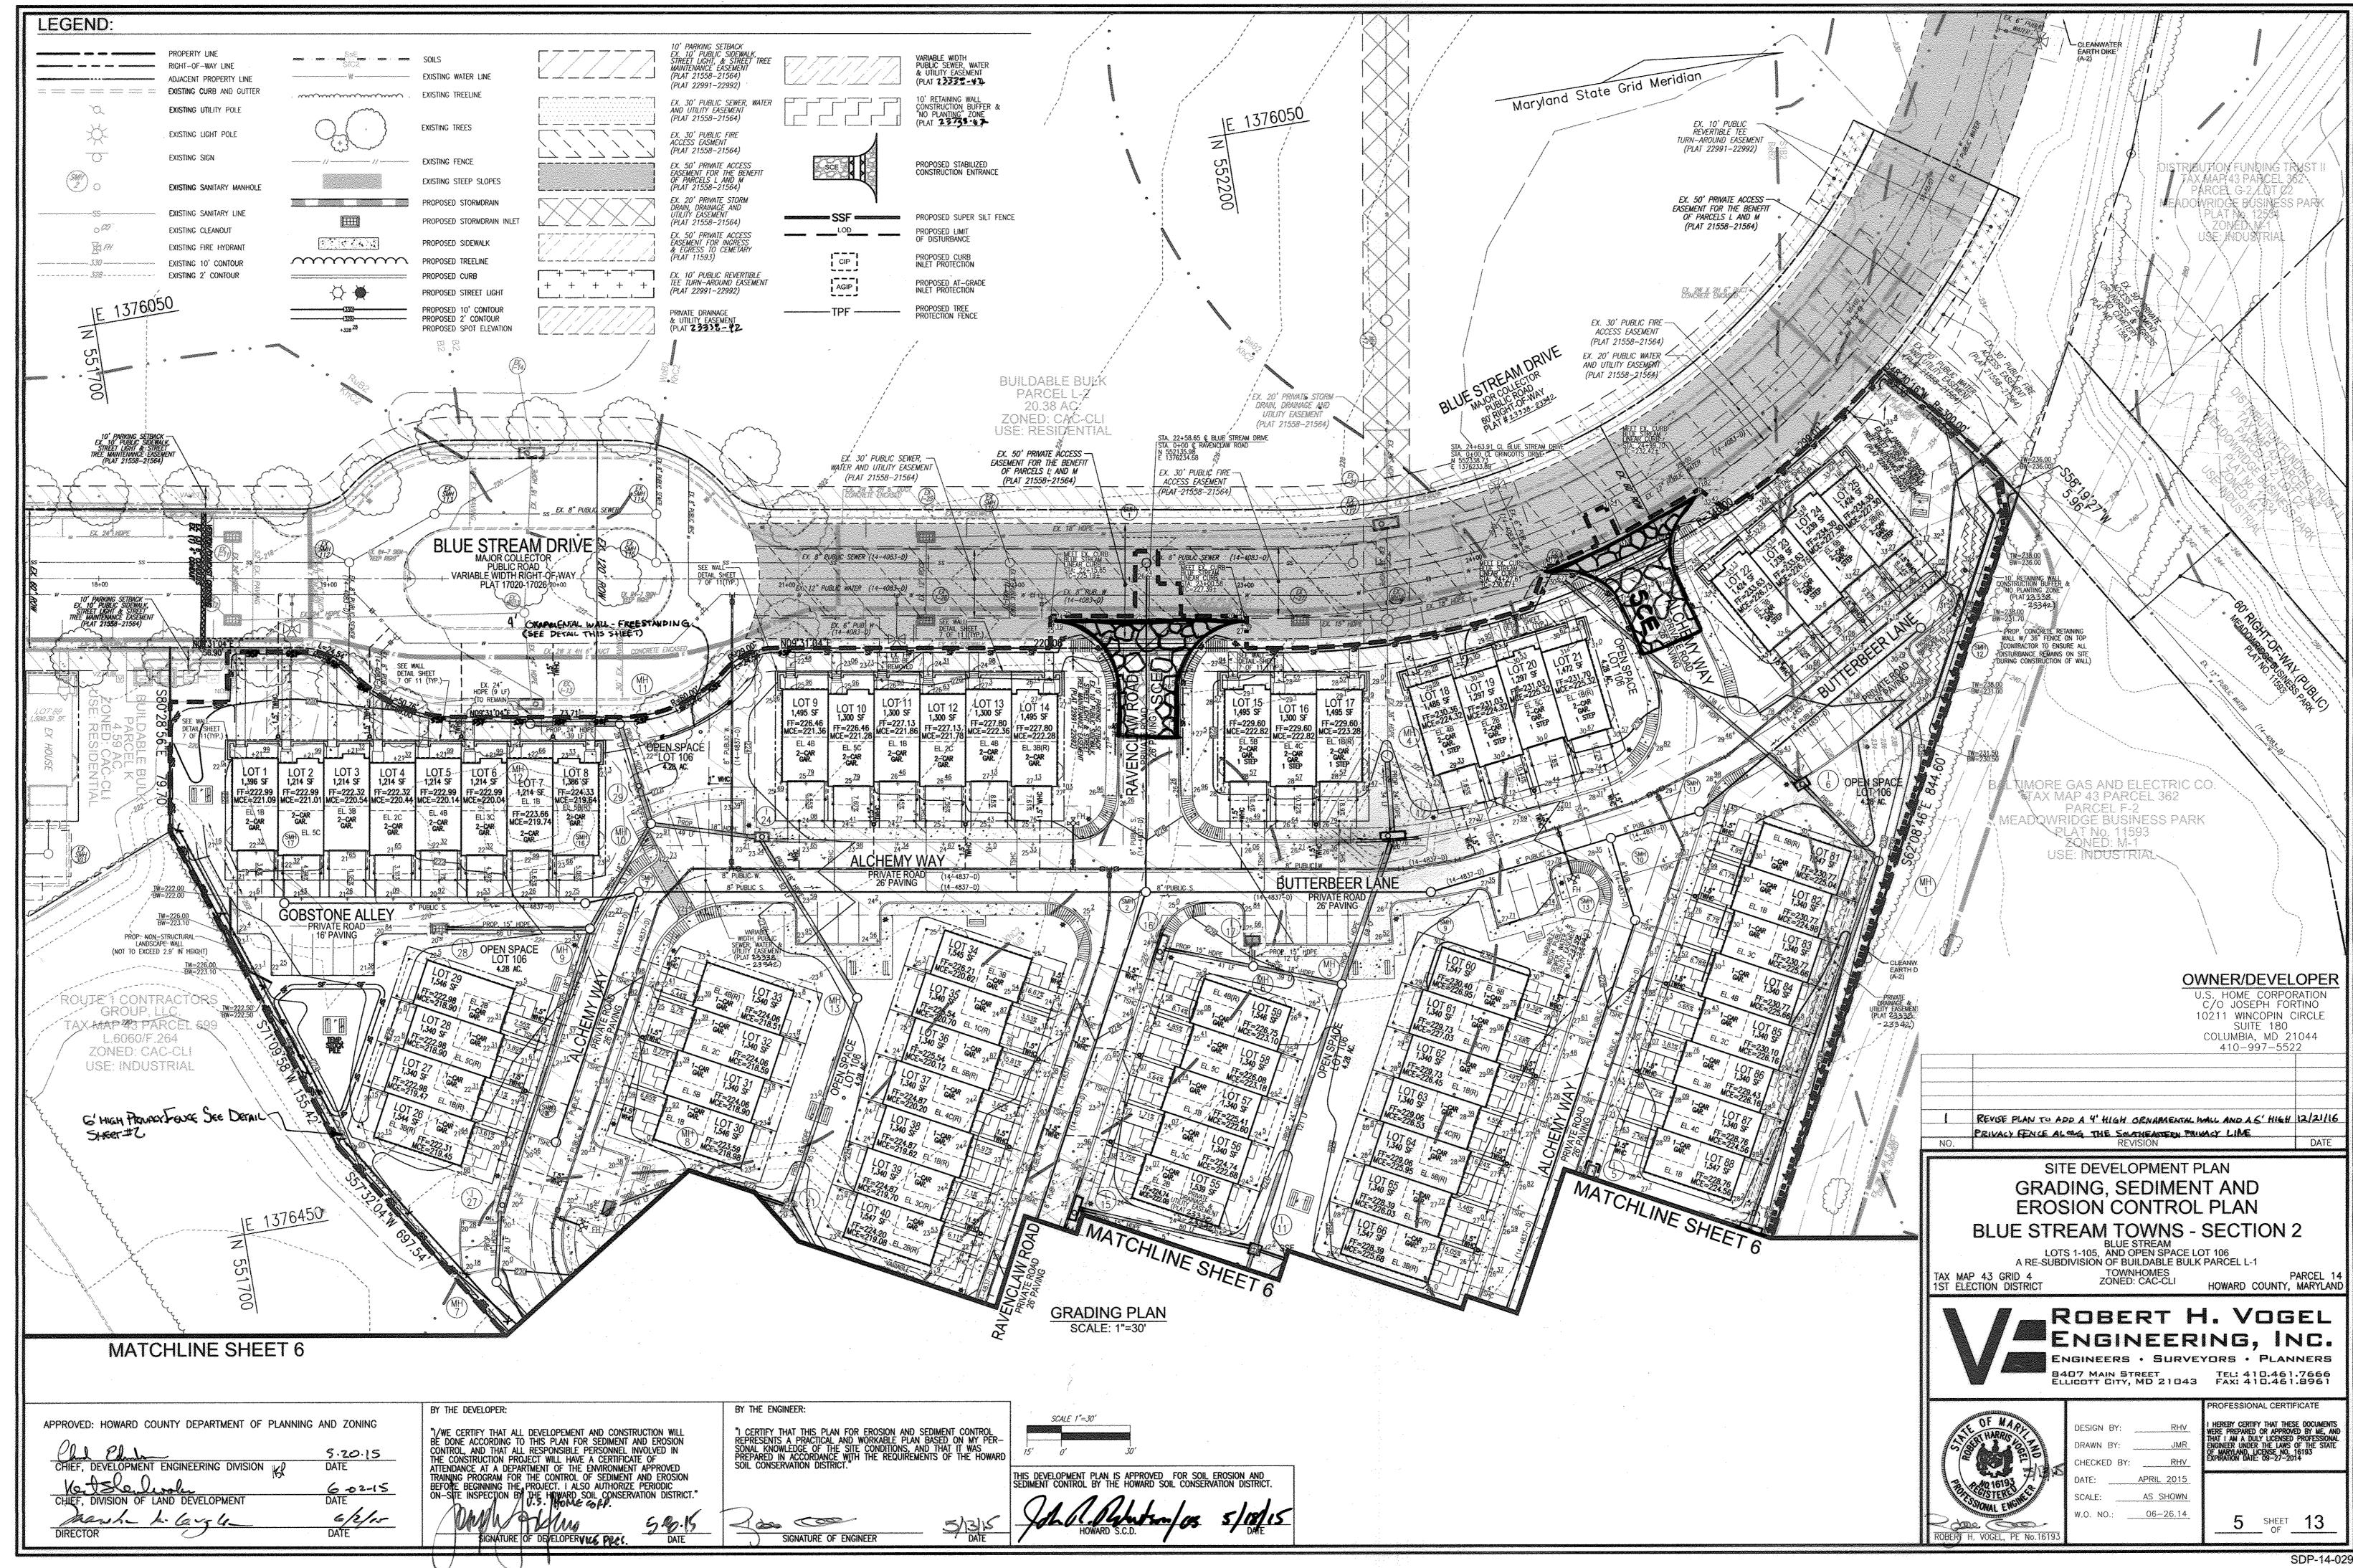



hengridwylddp/townszide\_grading.dwg

# B-4-2 STANDARDS AND SPECIFICATIONS FOR SOIL PREPARATION, TOPSOILING AND B-4-3 STANDARDS AND SPECIFICATIONS FOR SEEDING AND MULCHING SOIL AMENDMENTS DEFINITION THE PROCESS OF PREPARING THE SOILS TO SUSTAIN ADEQUATE VEGETATIVE STABILIZATION. PURPOSE TO PROVIDE A SUITABLE SOIL MEDIUM FOR VEGETATIVE GROWTH. CRITERIA A. SOIL PREPARATION 1. TEMPORARY STABILIZATION PARALLEL TO THE CONTOUR OF THE SLOPE.

A SEEDBED DEPARATION CONSISTS OF LOOSENING SON TO A DEPTH OF 3 TO 5 INCHES BY HEARS OF SHITABLE AGRICULTURAL OR CONSTRUCTION EQUIPMENT, SUCH AS DISCHARROWS OR CHISEL PLOWS OR RIPPERS MOUNTED ON ONSTRUCTION EQUIPMENT. AFTER THE SOIL IS LOOSENED, IT MUST NOT BE ROLLED OR DRAGGED SMOOTH BUT LEFT IN THE ROUGHENED CONDITION. SLOPES 3:1 OR FLATTER ARE TO BE TRACKED WITH RIDGES RUNNING B. APPLY FERTILIZER AND LIME AS PRESCRIBED ON THE PLANS. NCORPORATE LIME AND FERTILIZER INTO THE TOP 3 TO 5 INCHES OF SOIL BY DISKING OR OTHER SUITABLE

PERMANENT STABILIZATION A. A SOIL TEST IS REQUIRED FOR ANY EARTH DISTURBANCE OF 5 ACRES OR MORE. THE MINIMUM SOIL CONDITIONS REQUIRED FOR PERMANENT VEGETATIVE ESTABLISHMENT ARE: I SOIL PH BETWEEN 6.0 AND 7.0.

II. SOLUBLE SALTS LESS THAN 500 PARTS PER MILLION (PPM). III. SOIL CONTAINS LESS THAN 40 PERCENT CLAY BUT ENOUGH FINE GRAINED MATERIAL (GREATER THAN 30 PERCENT SILT PLUS CLAY) TO PROVIDE THE CAPACITY TO HOLD A MODERATE AMOUNT OF MOISTURE. AN EXCEPTION: IF LOVEGRASS WILL BE PLANTED, THEN A SANDY SOIL (LESS THAN 30 PERCENT SILT PLUS CLAY) WOULD BE ACCEPTABLE. IV. SOIL CONTAINS 1.5 PERCENT MINIMUM ORGANIC MATTER BY WEIGHT V. SOIL CONTAINS SUFFICIENT PORE SPACE TO PENNIT ADEQUATE ROOT PENETRATION.

B. APPLICATION OF AMENDMENTS OR TOPSOIL IS REQUIRED IF ON-SITE SOILS DO NOT MEET THE ABOVE CONDITIONS.

GRADED AREAS MUST BE MAINTAINED IN A TRUE AND EVEN GRADE AS SPECIFIED ON THE APPROVED PLAN, THEN SCARFIED OR OTHERWISE LOOSENED TO A DEPTH OF 3 TO 5 INCHES.

D. APPLY SOIL AMENDMENTS AS SPECIFIED ON THE APPROVED PLAN OR AS INDICATED BY THE RESULTS OF A SOIL. F MIX SOIL AMENDMENTS INTO THE TOP 3 TO 5 INCHES OF SOIL BY DISKING OR OTHER SUITABLE MEANS, RAKE LAWN AREAS TO SMOOTH THE SURFACE, REMOVE LARGE OBJECTS LIKE STONES AND BRANCHES, AND READY THE AREA FOR SEED APPLICATION, LOOSEN SURFACE SOIL BY DRAGGING WITH A HEAVY CHAIN OR OTHER EQUIPMENT TO ROUGHEN THE SURFACE WHERE SITE CONDITIONS WILL NOT PERMIT NORMAL SEEDBED PREPARATION. TRACK SLOPES 3:1 OR FLATTER WITH TRACKED EQUIPMENT LEAVING THE SOIL IN AN IRREGULAR CONDITION WITH RIDGES RUNNING PARALLEL TO THE CONTOUR OF THE SLOPE, LEAVE THE TOP 1 TO 3 INCHES OF SOIL LOOSE AND FRIABLE. SEEDBED LOOSENING MAY BE UNNECESSARY ON NEWLY DISTURBED AREAS.

1. TOPSOIL IS PLACED OVER PREPARED SUBSOIL PRIOR TO ESTABLISHMENT OF PERMANENT VEGETATION. THE PURPOSE IS TO PROVIDE A SUITABLE SOIL MEDIUM FOR VEGETATIVE GROWTH. SOILS OF CONCEM HAVE LOW MOISTURE CONTENT, LOW NUTRIENT LEVELS LOW PH. MATERIALS TOXIC TO PLANTS AND/OR LINACCEPTARIE SOIL GRADATION. TOPSOIL SALVAGED FROM AN EXISTING SITE MAY BE USED PROVIDED IT MEETS THE STANDARDS AS SET FORTH IN THESE SPECIFICATIONS. TYPICALLY, THE DEPTH OF TOPSOIL TO BE SALVAGED FOR A GIVEN SOIL TYPE CAN BE FOUND IN THE REPRESENTATIVE SOIL PROFILE SECTION IN THE SOIL SURVEY PUBLISHED BY USDA-NRCS TOPSOILING IS LIMITED TO AREAS HAVING 2:1 OR FLATTER SLOPES WHERE: A, THE TEXTURE OF THE EXPOSED SUBSOIL/PARENT MATERIAL IS NOT ADEQUATE TO PRODUCE VEGETATIVE GROWTH. B THE SOIL MATERIAL IS SO SHALLOW THAT THE ROOTING ZONE IS NOT DEEP ENOUGH TO SUPPORT PLANTS OR

FLIRNISH CONTINUING SUPPLIES OF MOISTURE AND PLANT NUTRIENTS. C. THE ORIGINAL SOIL TO BE VEGETATED CONTAINS MATERIAL TOXIC TO PLANT GROWTH. D. THE SOIL IS SO ACIDIC THAT TREATMENT WITH LIMESTONE IS NOT FEASIBLE. AREAS HAVING SLOPES STEEPER THAN 2:1 REQUIRE SPECIAL CONSIDERATION AND DESIGN. TOPSON SPECIFICATIONS: SON TO HE USED AS TOPSON MUST MEET THE FOLLOWING CRITERIA: A. TOPSOIL MUST BE A LOAM, SANDY LOAM, CLAY LOAM, SILT LOAM, SANDY CLAY LOAM, OR LOAMY SAND, OTHER SOILS MAY BE USED IF RECOMMENDED BY AN AGRONOMIST OR SOIL SCIENTIST AND APPROVED BY THE APPROPRIATE APPROVAL AUTHORITY TOPSOIL MUST NOT BE A MIXTURE OF CONTRASTING TEXTURED SUBSOILS AND MUST CONTAIN LESS THAN 5 PERCENT BY VOLUME OF CINDERS, STONES, SLAG, COARSE FRAGMENTS, GRAVEL, STICKS, ROOTS, TRASH, OR OTHER MATERIALS LARGER THAN 1½ INCHES IN DIAMETER. TOPSON MUST BE FREE OF NOWOUS PLANTS OR PLANT SHOUL AS BERMINA GRASS QUACK GRASS JOHNSON GRASS, NUT SEDGE, POISON MY, THISTLE, OR OTHERS AS SPECIFIED. TOPSOIL SUBSTITUTES OR AMENDMENTS, AS RECOMMENDED BY A QUALIFIED AGRONOMIST OR SOIL SCIENTIST AND

APPROVED BY THE APPROPRIATE APPROVAL AUTHORITY, MAY BE USED IN LIEU OF NATURAL TOPSOIL. A EROSION AND SEDIMENT CONTROL PRACTICES MUST BE MAINTAINED WHEN APPLYING TOPSOIL B. UNIFORMLY DISTRIBUTE TOPSOIL IN A 5 TO 8 INCH LAYER AND LIGHTLY COMPACT TO A MINIMUM THICKNESS OF 4 INCHES. SPREADING IS TO BE PERFORMED IN SUCH A MANNER THAT SODDING OR SEEDING CAN PROCEED WITH A MINIMUM OF ADDITIONAL SOIL PREPARATION AND TILLAGE ANY IRREGULARITIES IN THE SURFACE RESULTING FROM TOPSOILING OR OTHER OPERATIONS MUST BE CORRECTED IN ORDER TO PREVENT THE FORMATION OF DEPRESSIONS C. TOPSOIL MUST NOT BE PLACED IF THE TOPSOIL OR SUBSOIL IS IN A FROZEN OR MUDDY CONDITION, WHEN THE SUBSOIL IS EXCESSIVELY WET OR IN A CONDITION THAT MAY OTHERWISE BE DETRIMENTAL TO PROPER GRADING AND

1. SOIL TESTS MUST BE PERFORMED TO DETERMINE THE EXACT RATIOS AND APPLICATION RATES FOR BOTH LIME AND FERTILIZER ON SITES HAVING DISTURBED AREAS OF 5 ACRES OR MORE. SOIL ANALYSIS MAY BE PERFORMED BY A RECOGNIZED PRIVATE OR COMMERCIAL LABORATORY, SOIL SAMPLES TAKEN FOR ENGINEERING PURPOSES MAY ALSO BE USED FOR CHEMICAL ANALYSES.
FERTILIZERS MUST BE UNIFORM IN COMPOSITION, FREE FLOWING AND SUITABLE FOR ACCURATE APPLICATION BY APPROPRIATE EQUIPMENT, MANURE MAY BE SUBSTITUTED FOR FERTILIZER WITH PRIOR APPROVAL FROM THE APPROPRIATE APPROVAL AUTHORITY, FERTILIZERS MUST ALL BE DELIVERED TO THE SITE FULLY LABELED ACCORDING T THE APPLICABLE LAWS AND MUST BEAR THE NAME, TRADE NAME OR TRADEMARK AND WARRANTY OF THE PRODUCER. I, LIME MATERIALS MUST BE GROUND LIMESTONE (HYDRATED OR BURNT LIME MAY BE SUBSTITUTED EXCEPT WHEN HYDROSEEDING) WHICH CONTAINS AT LEAST 50 PERCENT TOTAL OXIDES (CALCIUM OXIDE PLUS MAGNESIUM OXIDE). LIMESTONE MUST BE GROUND TO SUCH FINENESS THAT AT LEAST 50 PERCENT WILL PASS THROUGH A #100 MESH SIEVE AND 98 TO 100 PERCENT WILL PASS THROUGH A #20 MESH SIEVE, 4, LIME AND FERTILIZER ARE TO BE EVENLY DISTRIBUTED AND INCORPORATED INTO THE TOP 3 TO 5 INCHES OF SOIL BY DISKING OR OTHER SUITABLE 5, WHERE THE SUBSOIL IS EITHER HIGHLY ACIDIC OR COMPOSED OF HEAVY CLAYS, SPREAD GROUND LIMESTONE AT THE

## RATE OF 4 TO 8 TONS/ACRE (200-400 POUNDS PER 1,000 SQUARE FEET) PRIOR TO THE PLACEMENT OF TOPSOIL HOWARD SOIL CONSERVATION DISTRICT

STANDARD SEDIMENT CONTROL NOTES 1. A MINIMUM OF 48 HOURS NOTICE MUST BE GIVEN TO THE HOWARD COUNTY DEPARTMENT OF INSPECTIONS, LICENSES AND PERMITS, SEDIMENT CONTROL DIVISION PRIOR TO THE START OF ANY

CONSTRUCTION, (313-1855). 2. ALL VEGETATIVE AND STRUCTURAL PRACTICES ARE TO BE INSTALLED ACCORDING TO THE PROVISIONS OF THIS PLAN AND ARE TO BE IN CONFORMANCE WITH THE MOST CURRENT MARYLAND STANDARDS AND SPECIFICATIONS FOR SOIL EROSION AND SEDIMENT CONTROL, AND REVISIONS THERETO. . FOLLOWING INITIAL SOIL DISTURBANCE OR RE-DISTURBANCE, PERMANENT OR TEMPORARY STABILIZATION SHALL BE COMPLETED WITHIN: A) 3 CALENDAR DAYS FOR ALL PERIMETER SEDIMENT CONTROL STRUCTURES, DIKES, PERIMETER SLOPES AND ALL SLOPES GREATER THAN 3:1, 8) 7 DAYS AS TO ALL OTHER DISTURBED OR CRADED AREAS ON THE PROJECT SITE. 4. ALL DISTURBED AREAS MUST BE STABILIZED WITHIN THE TIME PERIOD SPECIFIED ABOVE IN ACCORDANCE WITH THE 2011 MARYLAND STANDARDS AND SPECIFICATIONS FOR SOIL EROSION AND SEDIMENT CONTROL FOR PERMANENT SEEDING (SEC. B-4-5), TEMPORARY SEEDING (SEC. B-4-4) AND MULCHING (SEC. R-4-3) TEMPORARY STARBUZATION WITH MURCH ALONE CAN ONLY BE DONE WHEN RECOMMENDED SEEDING DATES DO NOT ALLOW FOR PROPER CERMINATION AND ESTABLISHMENT OF GRASSES. 5. ALL SEDIMENT CONTROL STRUCTURES ARE TO REMAIN IN PLACE AND ARE TO BE MAINTAINED IN OPERATIVE CONDITION UNTIL PERMISSION FOR THEIR REMOVAL HAS BEENOBTAINED FROM THE

HOWARD COUNTY SEDIMENT CONTROL INSPECTOR. TOTAL SITE AREA AREA DISTURBED AREA TO BE ROOFED OR PAVED AREA TO BE VEGETATIVELY STABILIZED

OFFSITE WASTE/BORROW LOCATION ON\_SITE \*\*
7. ANY SEDIMENT CONTROL PRACTICE THAT IS DISTURBED BY GRADING ACTIVITY FOR PLACEMENT OF UTILITIES MUST BE REPAIRED ON THE SAME DAY OF DISTURBANCE. B. ADDITIONAL SEDIMENT CONTROL MUST BE PROVIDED, IF DEEMED NECESSARY BY THE HOWARD COUNTY SEDIMENT CONTROL INSPECTOR.

9. ON ALL SITES WITH DISTURBED AREAS IN EXCESS OF 2 ACRES, APPROVAL OF THE INSPECTION AGENCY SHALL BE REQUESTED UPON COMPLETION OF INSTALLATION OF PERIMETER EROSION AND SEDIMENT CONTROLS, BUT BEFORE PROCEEDING WITH ANY OTHER EARTH DISTURBANCE OR GRADING. OTHER BUILDING OR GRADING INSPECTION APPROVALS MAY NOT BE AUTHORIZED UNTIL THIS INITIAL APPROVAL BY THE INSPECTION AGENCY IS MADE. 10, TRENCHES FOR THE CONSTRUCTION OF UTILITIES IS LIMITED TO THREE PIPE LENGTHS OR THAT WHICH CAN BE BACK FILLED AND STABILIZED BY THE END OF EACH WORKDAY, WHICHEVER IS SHORTER. 11. ANY CHANGES OR REVISIONS TO THE SEQUENCE OF CONSTRUCTION MUST BE REVIEWED AND APPROVED

BY THE PLAN APPROVAL AUTHORITY PRIOR TO PROCEEDING WITH CONSTRUCTION. 12. A PROJECT IS TO BE SEQUENCED SO THAT GRADING ACTIVITIES BEGIN ON ONE GRADING UNIT (MAXIMUM ACREAGE OF 20 AC. PER GRADING UNIT) AT A TIME. WORK MAY PROCEED TO A SUBSEQUENT GRADING UNIT WHEN AT LEAST 50 PERCENT OF THE DISTURBED AREA IN THE PRECEDING GRADING UNIT HAS BEEN STABILIZED AND APPROVED BY THE ENFORCEMENT AUTHORITY. UNLESS OTHERWISE SPECIFIED AND APPROVED BY THE APPROVAL AUTHORITY, NO MORE THAN 30 ACRES CUMULATIVELY MAY BE DISTURBED AT A GIVEN TIME.

\* ESTIMATE ONLY, CONTRACTOR SHALL VERIFY QUANTITIES TO HIS OWN SATISFACTION. \*\*TO BE DETERMINED BY CONTRACTOR, WITH PRE-APPROVAL OF THE SEDIMENT CONTROL INSPECTOR WITH AN APPROVED AND ACTIVE GRADING PERMIT

 $\begin{array}{ll} \underline{\text{DEFINITION}} \\ \text{THE APPLICATION OF SEED AND MULCH TO ESTABLISH VEGETATIVE COVER.} \end{array}$ 

1. SPECIFICATIONS

<u>Purpose</u> To <u>Protect</u> disturbed soils from erosion during and at the end of construction. CONDITIONS WHERE PRACTICE APPLIES
TO THE SURFACE OF ALL PERIMETER CONTROLS, SLOPES, AND ANY DISTURBED AREA NOT UNDER ACTIVE GRADING,

A ALL SEED MUST MEET THE REQUIREMENTS OF THE MARYLAND STATE SEED LAW, ALL SEED MUST BE SUBJECT TO RE-TESTING BY A RECOGNIZED SEED LABORATORY, ALL SEED USED MUST HAVE BEEN TESTED WITHIN THE 6 MONTHS IMMEDIATELY PRECEDING THE DATE OF SOWING SUCH MATERIAL ON ANY PROJECT, REFER TO TABLE B.4 REGARDING THE QUALITY OF SEED. SEED TAGS MUST BE AVAILABLE UPON REQUEST TO THE INSPECTOR TO VERIFY TYPE OF SEED AND B. MULCH ALONE MAY BE APPLIED BETWEEN THE FALL AND SPRING SEEDING DATES ONLY IF THE GROUND IS FROZEN. THE APPROPRIATE SEEDING MIXTURE MUST BE APPLIED WHEN THE GROUND THAWS. C. INOCULANTS: THE INOCULANT FOR TREATING LEGUME SEED IN THE SEED MIXTURES MUST BE A PURE CULTURE OF INTROGEN FIXING BACTERIA PREPARED SPECIFICALLY FOR THE SPECIES, INOCULANTS MUST NOT BE USED LATER THAN THE DATE INDICATED ON THE CONTAINER, ADD FRESH INOCULANTS AS DIRECTED ON THE PACKAGE, USE FOUR TIMES THE

RECOMMENDED RATE WHEN HYDROSEEDING. NOTE: IT IS VERY IMPORTANT TO KEEP INOCULANT AS COOL AS POSSIBLE UNTIL USED. TEMPERATURES ABOVE 75 TO 80 DEGREES FAHRENHEIT CAN WEAKEN BACTERIA AND MAKE THE INOCULANT LESS D. SOD OR SEED MUST NOT BE PLACED ON SOUL WHICH HAS BEEN TREATED WITH SOIL STERILANTS OR CHEMICALS USED FOL WEED CONTROL UNTIL SUFFICIENT TIME HAS ELAPSED (14 DAYS MIN.) TO PERMIT DISSIPATION OF PHYTO-TOXIC MATERIALS. . APPLICATION

A. DRY SEEDING: THIS INCLUDES USE OF CONVENTIONAL DROP OR BROADCAST SPREADERS. I, INCORPORATE SEED INTO THE SUBSOIL AT THE RATES PRESCRIBED ON TEMPORARY SEEDING TABLE 8.1. PERMANENT SEEDING TABLE 8.3, OR SITE—SPECIFIC SEEDING SUMMARIES.

II. APPLY SEED IN TWO DIRECTIONS, PERPENDICULAR TO EACH OTHER, APPLY HALF THE SEEDING RATE IN EACH DIRECTION, ROLL THE SEEDED AREA WITH A WEIGHTED ROLLER TO PROVIDE GOOD SEED TO SOIL CONTACT. B. DRILL OR CULTIPACKER SEEDING: MECHANIZED SEEDERS THAT APPLY AND COVER SEED WITH SOIL.

I, CULTIPACKING SEEDERS ARE REQUIRED TO BURY THE SEED IN SUCH A FASHION AS TO PROVIDE AT LEAST 1/4 INCH OF SOIL COVERING. SEFERED MUST BE FIRM AFTER PLANTING. II. APPLY SEED IN TWO DIRECTIONS, PERPENDICULAR TO EACH OTHER. APPLY HALF THE SEEDING RATE IN EACH . Hydroseeding: Apply seed uniformly with hydroseeder (slurry includes seed and fertilizer). I IF FERTILIZER IS BEING APPLIED AT THE TIME OF SEEDING, THE APPLICATION RATES SHOULD NOT EXCEED THE

FOLLOWING: NITROGEN, 100 POUNDS PER ACRE TOTAL OF SOLUBLE NITROGEN; P205 (PHOSPHOROUS), 200 POUNDS PER ACRE; K20 (POTASSIUM), 200 POUNDS PER ACRE. IL LIME: USE ONLY GROUND AGRICULTURAL LIMESTONE (UP TO 3 TONS PER ACRE MAY BE APPLIED BY HYDROSEEDING). NORMALLY, NOT MORE THAN 2 TONS ARE APPLIED BY HYDROSEEDING AT ANY ONE TIME, DO NOT USE BURNT OR HYDRATED LIME WHEN HYDROSEEDING, III. MIX SEED AND FERTILIZER ON SITE AND SEED HAMEDIATELY AND WITHOUT INTERRUPTION. IV. WHEN HYDROSFEDING DO NOT INCORPORATE SEED INTO THE SOIL.

1. MULCH MATERIALS (IN ORDER OF PREFERENCE) A STRAW CONSISTING OF THOROUGHLY THRESHED WHEAT, LYE, OAT, OR BARLEY AND REASONABLY BRIGHT IN COLOR. STRAW IS TO BE FREE OF NOXIOUS WEED SEEDS AS SPECIFIED IN THE MARYLAND SEED LAW AND NOT MUSTY, MOLDY, CAKED, DECAYED OR EXCESSIVELY DUSTY

NOTE: USE ONLY STERILE STRAW MULCH IN AREAS WHERE ONE SPECIES OF GRASS IS DESIRED. B. WOOD CELLULOSE FIBER MULCH (WCFM) CONSISTING OF SPECIALLY PREPARED WOOD CELLULOSE PROCESSED INTO A UNIFORM FIBROUS PHYSICAL STATE.

I. WCFM IS TO BE DYED GREEN OR CONTAIN A GREEN DYE IN THE PACKAGE THAT WILL PROVIDE AN APPROPRIATE

COLOR TO FACILITATE VISUAL INSPECTION OF THE UNIFORMLY SPREAD SLURRY.

II. WCFM, INCLUDING DYE, MUST CONTAIN NO GERMINATION OR GROWTH INHIBITING FACTORS. UL WOFM MATERIALS ARE TO BE MANUFACTURED AND PROCESSED IN SUCH A MANNER THAT THE WOOD CELLULOSE fiber mulch will remain in Uniform Suspension in Water Under Acitation and Will Blend with Seed. FERTILIZER AND OTHER ADDITIVES TO FORM A HOMOGENEOUS SLURRY. THE MULCH MATERIAL MUST FORM A BLOTTER-LIKE GROUND COVER, ON APPLICATION, HAVING MOISTURE ABSORPTION AND PERCOLATION PROPERTIES AND MUST COVER AND HOLD GRASS SEED IN CONTACT WITH THE SOIL WITHOUT INHIBITING THE GROWTH OF THE GRASS IV. WCFM MATERIAL MUST NOT CONTAIN ELEMENTS OR COMPOUNDS AT CONCENTRATION LEVELS THAT WILL BE

V. WCFM MUST CONFORM TO THE FOLLOWING PHYSICAL REQUIREMENTS: FIBER LENGTH OF APPROXIMATELY 10 MILLIMETERS, DIAMETER APPROXIMATELY 1 MILLIMETER, PH RANGE OF 4.0 TO 8.5, ASH CONTENT OF 1.6 PERCENT MAXIMUM AND WATER HOLDING CAPACITY OF 90 PERCENT MINIMUM. A APPLY MULCH TO ALL SEEDED AREAS IMMEDIATELY AFTER SEEDING.

3. WHEN STRAW MULCH IS USED, SPREAD IT OVER ALL SEEDED AREAS AT THE RATE OF 2 TONS PER ACRE TO A UNIFORM LOOSE DEPTH OF 1 TO 2 INCHES, APPLY MULCH TO ACHIEVE A UNIFORM DISTRIBUTION AND DEPTH SO THAT THE SOIL SURFACE IS NOT EXPOSED, WHEN USING A MULCH ANCHORING TOOL, INCREASE THE APPLICATION RATE TO 2.5 TONS PER . WOOD CELLULOSE FIBER USED AS MULCH MUST BE APPLIED AT A NET DRY WEIGHT OF 1500 POUNDS PER ACRE. MIX THE WOOD CELLULOSE FIBER WITH WATER TO ATTAIN A MIXTURE WITH A MAXIMUM OF 50 POUNDS OF WOOD CELLULOSE FIBER PER 100 GALLONS OF WATER.

ANCHORING A PERFORM MULCH ANCHORING IMMEDIATELY FOLLOWING APPLICATION OF MULCH TO MINIMIZE LOSS BY WIND OR WATER. THIS MAY BE DONE BY ONE OF THE FOLLOWING METHODS (LISTED BY PREFERENCE), DEPENDING UPON THE SIZE OF THE AREA AND FROSION HAZARD: I. A MULCH ANCHORING TOOL IS A TRACTOR DRAWN IMPLEMENT DESIGNED TO PUNCH AND ANCHOR MULCH INTO THE SOIL SURFACE A MINIMUM OF 2 INCHES. THIS PRACTICE IS MOST EFFECTIVE ON LARGE AREAS, BUT IS LIMITED TO FLATTER SLOPES WHERE EQUIPMENT CAN OPERATE SAFELY. IF USED ON SLOPING LAND, THIS PRACTICE SHOULD II. WOOD CELLULOSE FIBER MAY BE USED FOR ANCHORING STRAW, APPLY THE FIBER BINDER AT A NET DRY WEIGHT OF

750 POUNDS PER ACRE. MIX THE WOOD CELLULOSE FIBER WITH WATER AT A MAXIMUM OF 50 POUNDS OF WOOD CELLULOSE FIBER PER 100 CALLONS OF WATER. III SYNTHETIC BINDERS SLICH AS ACRYLIC DIR (AGRO-TACK) DCA-70 PETROSET. TERRA TAX II, TERRA TACK AR OR OTHER APPROVED EQUAL MAY BE USED. FOLLOW APPLICATION RATES AS SPECIFIED BY

THE MANUFACTURER, APPLICATION OF LIQUID BINDERS NEEDS TO BE HEAVIER AT THE EDGES WHERE WIND CATCHES MULCH, SUCH AS IN VALLEYS AND ON CRESTS OF BANKS. USE OF ASPHALT BINDERS IS STRICTLY PROHIBITED. IV. LIGHTWEIGHT PLASTIC NETTING MAY BE STAPLED OVER THE MULCH ACCORDING TO MANUFACTURER RECOMMENDATIONS NETTING IS USUALLY AVAILABLE IN ROLLS 4 TO 15 FEET WIDE AND 300 TO 3,000 FEET LONG.

PERMANENT SEEDING SUMMARY  HARDINESS ZONE (FROM FIGURE B.3): ZONE 6b RATE SEED MIXTURE (FROM TABLE B.3): 11 (10-20-20)								LIME RATE
NO	SPECIES	APPLICATION RATE (LB/AC)	SEEDING DATES	SEEDING DEPTHS	N	P <sub>2</sub> 0 <sub>5</sub>	K <sub>2</sub> 0	Cimic lotte
11	CREEPING RED FESCUE	30 LB / AC	MAR 1 TO MAY 15	1/4-1/2 IN.	45 LB/AC	90 LB/AC	90 LB/AC	2 TONS/AC
	CHEWINGS FESCUE,	30 LB / AC	AUG 15 TO OCT 15	17.4-172 111.			1000 SF )	
~	KENTUCKY Bluegrass	20 LB / AC	319					

B-4-8 STANDARDS AND SPECIFICATIONS FOR STOCKPILE AREA  $\frac{\text{DEFINITION}}{\text{A MOUND OR PILE OF SOIL PROTECTION BY APPROPRIATELY DESIGNED EROSION AND SEDIMENT} \\$ 

TO PROVIDE A DESIGNATED LOCATION FOR THE TEMPORARY STORAGE OF SOIL THAT CONTROLS THE POTENTIAL FOR EROSION, SEDIMENTATION, AND CHANGES TO DRAINAGE PATTERNS. <u>CONDITIONS WHERE PRACTICE APPLIES</u> STOCKPILE AREAS ARE UTILILIZED WHEN IT IS NECESSARY TO SALVAGE AND STORE SOIL FOR


CRITERIA

1-0.13,L0.13;1. THE STOCKPILE LOCATION AND ALL RELATED SEDIMENT CONTROL PRACTICES MUST BE CLEARLY INDICATED ON THE EROSION AND SEDIMENT CONTROL PLAN. 2. THE FOOTPRINT OF THE STOCKPILE MUST BE SIZED TO ACCOMMODATE THE ANTICIPATED volume of material and based on a side slope ratio no steeper than 2:1. Benching MUST BE PROVIDED IN ACCORDANCE WITH SECTION B-3 LAND GRADING.

3. RUNDFF FROM THE STOCKPILE AREA MUST DRAIN TO A SUITABLE SEDIMENT CONTROL. 4 ACCESS THE STOCKPILE AREA FROM THE LIPCRADE SIDE.

5. CLEAR WATER RUNOFF INTO THE STOCKPILE AREA MUST BE MINIMIZED BY USE OF A DIVERSION DEVICE SUCH AS AN EARTH DIKE, TEMPORARY SWALE OR DIVERSION FENCE PROVISIONS MUST BE MADE FOR DISCHARGING CONCENTRATED FLOW IN A NON-EROSIVI 6. WHERE RUNOFF CONCENTRATES ALONG THE TOE OF THE STOCKPILE FILL, AN APPROPRIATE EROSION/SEDIMENT CONTROL PRACTICE MUST BE USED TO INTERCEPT THE DISCHARGE. STOCKPILES MUST BE STABILIZED IN ACCORDANCE WITH THE 3/7 DAY STABILIZATION REQUIREMENT AS WELL AS STANDARD B-4-1 INCREMENTAL STABILIZATION AND STANDARD B-4-4 TEMPORARY STABILIZATION, 8. IF THE STOCKPILE IS LOCATED ON AN IMPERVIOUS SURFACE, A LINER SHOULD BE PROVIDED BELOW THE STOCKPILE TO FACILITATE CLEANUP. STOCKPILES CONTAINING CONTAMINATED MATERIAL MUST BE COVERED WITH IMPERMEABLE SHEETING.

<u>Manifements</u> HE STOCKPILE AREA MUST CONTINUOUSLY MEET THE REQUIREMENTS FOR ADEQUATE VEGETATIVE ESTABLISHMENT IN ACCORDANCE WITH SECTION B-4 VEGETATIVE STABILIZATION, SIDE SLOPES MUST BE MAINTAINED AT NO STEEPER THAN A 2:1 RATIO. THE STOCKPILE AREA MUST BE KEPT REE OF EROSION. IF THE VERTICAL HEIGHT OF A STOCKPILE EXCEEDS 20 FEET FOR 2:1 SLOPES, 30 FEET FOR 3:1 SLOPES, OR 40 FEET FOR 4:1 SLOPES, BENCHING MUST BE ROVIDED IN ACCORDANCE WITH SECTION B-3 LAND GRADING.

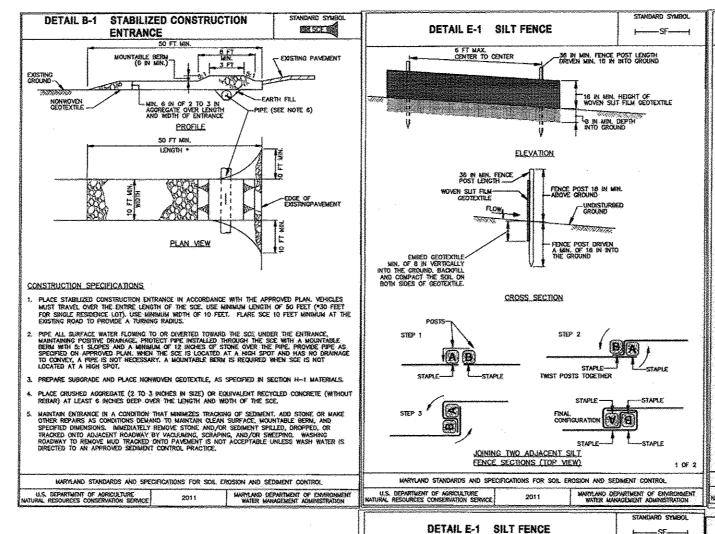

SEQUENCE OF CONSTRUCTION OBTAIN HOWARD COUNTY GRADING PERMIT. (WEEK 1) CONSTRUCTION SPECIFICATIONS 2. NOTIFY HOWARD COUNTY AT LEAST 48 HOURS PRIOR TO START OF CONSTRUCTION. (WEEK 1)

3. CONDUCT A PRE-CONSTRUCTION MEETING WITH THE SEDIMENT CONTROL INSPECTOR PRIOR TO ANY LAND DISTURBANCE (WEEK 1) 4. INSTALL STABILIZED CONSTRUCTION ENTRANCE WITH MOUNTABLE 5. CLEARING AND GRUBBING AS NECESSARY FOR THE INSTALLATION OF PERIMETER CONTROLS. (2 DAY

6. INSTALL ALL PERIMETER CONTROLS INCLUDING SILT FENCE, SUPER SILT FENCE AND EARTH DIKES, AS INDICATED ON PLANS. (WEEK 2) 6. WITH APPROVAL OF SEDIMENT CONTROL INSPECTOR, CLEAR AND 7. BEGIN SITE GRADING AND UTILITY CONSTRUCTION, ELIMINATE L BEGIN SITE GRADING AND UTILLITY CONSTRUCTION. ELIMINATE AS DECREES IN THE EXISTING SEDIMENT BASIN #4 PER GP-11-002 AND BRING SITE TO GRADE DIRECT RUNDPH TO INLEES AND SEDIMENT BASIN #2 PER F-02-035. REFERENCE SEDIMENT READIES REINSTALL FRICE DIRECT RUNOFF TO INLETS.

8. AFTER STORM DRAIN IS COMPLETE FINE GRADE AS REQUIRED 9. ESTABLISH TOWNHOUSE PADS. (2 WEEKS) 10. WITH INSPECTOR'S APPROVAL, BEGIN INSTALLATION OF CURB AND GUTTER AND ON-SITE BASE COURSE PAVING. (3 WEEKS) . COMPLETE TOWNHOUSE AND UTILITY CONSTRUCTION. 2. COMPLETE ALL CURB & GUTTER CONSTRUCTION (1 WEEK) 13. COMPLETE ALL BASE COURSE PAVEMENT CONSTRUCTION. (1 WEEK)

14. CONSTRUCT SURFACE COURSE PAVING AND SIDEWALKS. (1 WEEK)

INSPECTOR. STABILIZE ALL REMAINING DISTURBED AREAS.

15. WITH THE INSPECTOR'S APPROVALM, FINE GRADE AND STABILIZE ALL AREAS OF PARCEL INCLUDING ANY EXPOSED EARTH AREAS OUTSIDE THE LOD. REMOVE ALL TRASH JUNK AND DEBRIS FROM ENTIRE PARCEL. (1 WEEK) 16. INSTALL SITE LANDSCAPING. (WEEK 15) 17. FLUSH STORM DRAIN SYSTEM AND REMOVE ALL REMAINING SEDIMENT CONTROLS AFTER RECIEVING APPROVAL FROM THE SEDIMENT CONTROL

1. DURING GRADING AND AFTER EACH RAINFALL, CONTRACTOR WILL INSPECT AND PROVIDE NECESSARY MAINTENANCE TO THE SEDIMENT CONTROL MEASURES ON THIS PLAN. FOLLOWING INITIAL SOIL DISTURBANCES OR REDISTURBANCE, PERMANENT OR TEMPORARY STABILIZATION SHALL BE COMPLETED WITHIN: A. THREE (3) CALENDAR DAYS AS TO THE SURFACE OF ALL PERIMETER DIKES, SWALES, DITCHES, PERIMETER SLOPES, AND ALL SLOPES STEEPER THAN 3 HORIZONTAL TO 1 VERTICAL (3:1); AND B. SEVEN (7) CALENDAR DAYS TO ALL OTHER DISTURBED OR GRADED AREAS ON THE PROJECT SITE NOT UNDER ACTIVE GRADING.

800-231-1327

vvvv.landscapebrands.com

L1383 Rendezvous 40-Gallon

Flare Top Receptade OR EQUAL

Makerial
Theoreuplands is 34.17° pdf and is composed of 12 yange skelled sheel with
a XF apprishmed protein. The incorporate in plantical coated with an enemay
that near of 1.27° and fittabed with a leight glass paterised in plantic.

The receptacle is designed to the postable for feed thy in pacement. The expirate has relate feed which are adjusted to assist in levelan disc

copiade. The capally if the receptade is 18 galons. The reasone photo inst is rush of that high density polycly years.

tenerably The receptable is shipped fails assembled and ready for our.

reastrangers
The product is visitely mentioned feet and expires only perodic density
self-in sponge and a solution of mild distingers and soler in more surface
day. The next clean with solvent or motolisms have members

- - 5

i**nern** CopCost<sup>er</sup> percent high give feinh esiren tilf devenkomice, milder, milder, milder

a Top, can limit has been sented to the reparements of ASTM F 1754 and is commend to be in compliance with collectual conform time Calle 11032.1.1.2.

Landscape
BRANDS.

CHOICE FOR MOVE AT TOP MOVE AT TOP MOVE AT TOP MOVE AT TOP OPER MOVE TOP

Tec; I ground box s Tec; Samo: Sound At fairness Sound At Ingree to the

DETAIL C-1 EARTH DIKE -21 SLOPE OR PLATTER . Use wood posts 1% x 1%  $\pm$  % inch (minimax) square cut of sound quality hardwood, as an alternative to wooden post use standard "t" or "u" section steel posts weighing not less than 1 pound per limear foot. 2. USE 36 PICH WINDUM POSTS DRIVEN 16 INCH WINDUM INTO GROUND NO MORE THAN 6 FEET APAR 3. USE WOVEN SUIT FILM GEOTEXTILE AS SPECIFIED IN SECTION H-1 MATERIALS AND FASTEN GEOTEXTILE SECURELY TO UPSLOPE SIDE OF FENCE POSTS WITH WIRE TIES OR STAPLES AT TOP AND MED-SECTION. CROSS SECTION DIKE TYPE PROVIDE MANUFACTURER CERTIFICATION TO THE AUTHORIZED REPRESENTATIVE OF THE HISPECTION/ENFORCEMENT AUTHORITY SHOWING THAT THE GEOTEXTILE USED MEETS THE RECORDERATIS IN SECTION H—I MATERIALS. CONTINUOUS CRADE 0.5% MIN. TO 10% MAX. SLOPE e - DIKE HEICHT 18 IN MIN. 30 IN MIN. KATARATA EMBED GEOTEXTILE A MINISH OF 8 INCHES VERTICALLY INTO THE GROUND, BACKFILL AND COMPACT THE SOIL ON BOTH SING OF FARMS. b - DIKE WIDTH 24 IN LIEN, 36 IN LIEN. VVVVVVVV WHERE TWO SECTIONS OF GEOTEXTILE ADJOIN: OVERLAP, THIST, AND STAPLE TO POST IN ACCORDANCE WITH THIS DETAIL. o - FLOW WOTH 4 FT MINL 6-FT MIN. d - FLOW DEPTH 12 IN NON. 24 IN NIN. PLAN VIEW . EXTEND BOTH ENDS OF THE SLT FENCE A MINIMUM OF FIVE HORIZONTAL FEET UPSLOPE AT 45 DEGREES TO THE MAIN FENCE ALIGNMENT TO PREVENT RUNORF FROM GOING AROUND THE ENDS OF THE SLT FENCE. 8. REMOVE ACCUMULATED SEDBIENT AND DEBRIS WHEN BULGES DEVELOP IN SLT FENCE OR WHEN. SEDBIENT REACHES 25% OF FENCE HEIGHT, REPLACE GEOTEXTILE IF TORN, IF UNDERWINNING COCCURS REINSTALL FENCE. SEED WITH STRAW MULCH AND TACK, (NOT ALLOWED FOR CLEAR WATER DIVERSION.) A-2/8-2 SEED WITH SOIL STABILIZATION MATTING OR LINE WITH SOO. A-3/8-3 A TO 7 BIGH STONE OR EQUIVALENT RECYCLED CONCRETE PRESSED INTO SOIL A MINIMUM OF 7 INCHES AND FLUSH WITH GROUND. H-5 STANDARDS AND SPECIFICATIONS OF SEDIMENT BASIN CONSTRUCTION SPECIFICATIONS DUST CONTROL . REMOVE AND DISPOSE OF ALL TREES, BRUSH, STUMPS, OBSTRUCTIONS, AND OTHER OBJECTIONABLE MATERIAL SO AS NOT TO INTERFERE WITH PROPER FUNCTION OF EARTHDRE.

3. COMPACT FILL

DETAIL E-3 SUPER SILT FENCE

WOVEN SUIT FILM GEOTEXTILE-

CHAN LINK FENCE B IN

CROSS SECTION

INSTALL 2% INCH DIAMETER DALVANIZED STED. POSTS OF 0.035 INCH WALL THICKNESS AND SIX FOOL LONGTH SPACED NO FURTHER THAN 10 FEET APART, DRIVE THE POSTS A MEMBUM OF 36 INCHES 14TO THE SECTION.

FASTEN 9 GALGE OR HEAVER GALVANIZED CHAIN LINK FENCE (2% INCH MAXIMUM OPENING) 42 INCHES IN HEIGHT SECURELY TO THE FENCE POSTS WITH WIRE TIES OR HUG RINGS.

PASTEM MOVEN SLIT FIEM GEOTECTIES AS SPECIFIED IN SECTION H-T MATERIALS, SECURELY TO THE UPSIGNE SIDE OF CHAIN LINK FENCE WITH THES SPACED EVERY 24 INCHES AT THE TOP AND MOSECTION. EMERIC GEOTECTIES AND CHAIN LINK FENCE A MANBAUM OF 5 INCHES ATTO THE GROUND.

WHERE ENDS OF THE GEOTEXPLE COME TOGETHER, THE ENDS SHALL BE OVERLAPPED BY 8 INCHES, FOLDED, AND STAPLED TO PREVENT SEDMENT BY PASS.

EXTEND BOTH ENDS OF THE SUPER SLIT FENCE A MINIMUM OF FIVE HORIZONTAL FEET UPSLOPE A 45 DECREES TO THE MAIN FENCE AUGMAENT TO PREVENT RUNOFF FROM GOING AROUND THE END OF THE SUPER SLIT FROMS.

PROVIDE MANUFACTURER CERTIFICATION TO THE INSPECTION/ENFORCEMENT AUTHORITY SHOWING THE GEOTEXPILE USED MEETS THE REGUMENTS IN SECTION H-1 MATERIALS.

REMOVE ACCURATE TED SEDMENT AND DEBRIS WHEN BLICES DEVELOP IN FENCE OR WHEN SEDMENT REACHES 25% OF FENCE HEIGHT, REPLACE GEOTEXTILE IF TORN, IF UNDERWINNING OCCURS, REINSTALL CHAIR LARK FENCING AND GEOTEXTILE.

WARYLAND STANDARDS AND SPECIFICATIONS FOR SOIL EROSION AND SEDIMENT CONTROL

EXCAVATE OR SHAPE EARTH DIKE TO LINE, GRADE, AND CROSS SECTION AS SPECIFIED. BANK PROJECTIONS OR OTHER PRESULARITIES ARE NOT ALLOWED.

5. PROVIDE OUTLET PROTECTION AS REQUIRED ON APPROVED PLAN.

CONSTRUCT FLOW CHANNEL ON AN UNINTERPUPTED, CONTINUOUS GRADE, ADJUSTING THE LOCATION DUE TO FIELD CONDITIONS AS NECESSARY TO MAINTAIN POSITIVE DRAINAGE.

STABILIZE EARTH DIKE WITHIN THREE DAYS OF INSTALLATION, STABILIZE FLOW CHANNEL FOR CLEAR WATER DIVERSION WITHIN 24 HOURS OF INSTALLATION.

MARTAIN LINE, GRADE, AND CROSS SECTION, REMOVE ACCUMILIATED SEDIMENT AND DEBRIS, AND MARTAIN POSITIVE DRAINAGE, KEEP EARTH DIKE AND POINT OF DISCHARGE FIRE OF EROSION, AND CONTINUOUSLY MEET REQUIREMENTS FOR ADEQUATE VEOCITATIVE ESTABLISHMENT IN ACCORDANCE WIT SECTION 80-4 VEOCITATIVE STABILIZATION.

B. UPON REMOVAL OF EARTH DIKE, GRADE AREA FLUSH WITH EXISTING GROUND. WITHIN 24 HOURS OF REMOVAL STABILIZE DISTURBED AREA WITH TOPSON, SEED, AND MULCH, OR AS SPECIFIED ON ADDROVED AS AN

S. DEPARTMENT OF ADRICUTURE 2011 MAYLAND EXPARTMENT OF ENARCHMENT ADMINISTRATION WATER MANAGEMENT ADMINISTRATION

ROW \_

CONSTRUCTION SPECIFICATIONS

10 FT MAX

GALVANIZED CHAIN LINK FENCE WITH WOVEN SLIT FILM GEOTEXTILE

-34 IN MIN.

Definition rom construction activities Conditions Where Practice Applies

treas subject to dust blowing and movement where on and off-site damage is likely without treatment. Mulches: See Section B-4-2 Soil Preparation, Topsoiling, and Soil Amendments, Section B-4-3 Seeding and Mulching, and Section B-4-4 Temporary Stabilization. Mulch must be anchored to Yogetative Cover: See Section B-4-4 Temporary Stabilization

Tillage: Till to roughen surface and bring clods to the surface. Begin plowing on windward side of site. Chisel-type plows spaced about 12 inches apart, spring-toothed harrows, and similar plows are examples of equipment that may produce the desired effect. Impostion: Sprinkle site with water until the surface is moist. Repeat as needed. The site must

Baptiers: Solid board fences, silt fences, snow fences, burlap fences, straw bales, and similar Chemical Treatment: Uso of chemical treatment requires approval by the appropriate plan-review authority.

80D-231-1327

www.landscapebrands.com

Portable / Surface Mount

L1361 Rendezvous 1' Contour Bench

Material
The sect. 8: 17:12' long and is made of 12-gauge stolled steet with a 15' gapplated pattern. The steet is plactical couloid odds an average the leases of 125'
and finished with a high-gibes primated light and the steet of the 15'.
The book made articus, for a unit are protected with RandonSarrd-rust
grown fire lives to descripted urbs portable for Feed Billy to processes,
and the logs have feet that can accommands supplementation to privent
movement. However, for those is set to included. The capacity of the bench is
20'd the confirmer fact.

" patended high-gikss finish residus DV delerbration, mildem, klainino

The TopCret trivia has been tested to the repulments of AST/41 1001 and it dot mained to be in executions; with Cultivinia Uniform Fre Cale 1103 2-14.2

'islonisant' primer is applied to all of the under supports, providing extreme us: fighting protection and dismostly. Under apparts freetal with Transaction

Color This product is available in the filtering planet room. Beek, Plan British Letown, Displays, Camel, Crancol, Evergreen, Graj, Sany, Crange, Perple, Pac, Sage, Liber, Test, Soola, 1978, and 1986co.

issuantilige. The borock exquires reiner ussembly. Statistics stood assembly bundaries is never and

Maintenness on the sity environmenture are movines only periodic density with a group and a solution of endidentagent and valents remove surface only. Do not clean with soluted or percolour based products.

his on Controps. You can the control by a soverning additional administration in the doctor purchase. This controls end uses at a stream and any abuse are in some

--77 W---

47.17 = 1.50 = 27.70 =

5'.52"

RECREATION OPEN SPACE AMENITIES

Landscape BRANDS.

HAPPLAND STANDARDS AND SPECIFICATIONS FOR SOIL EROSION AND SEDIMENT CONTROL U.S. DEPARTMENT OF ASSISTANCE 2011 MARYLAND DEPARTMENT OF ENVIRONMENT NATURAL RESOURCES CONSERVATION SERVICE 2011 WATER MANAGEMENT ADMINISTRATION SET 2" ABOVE ADJACENT GRADE - PLANTING MEDIUM

12" DRAINAGE AGGREGATE - PRECAST CAP (2) 3" X 6" DIA. STAINLESS STEEL DOWELS PER SECTION - CULTURED STONE, MATCH BLDG. 3" MIN. BELOW GRADE 1" DIA. PVC PIPE @ 24" O.C.

DETAIL E-9-2 AT-GRADE INLET PROTECTION

PLAN / CUT AWAY MEW

CROSS SECTION

. LIFT GRATE AND WEAP WITH NONWOVEN GEOTEXTILE TO COMPLETELY COVER ALL OPENINGS. SECURE WITH WIRE THES AND SET GRATE BACK IN PLACE.

. PLACE CLEAN % TO 1% INCH STONE OR EQUIVALENT RECYCLED CONCRETE 6 INCHES THICK ON THE

HARMAND STANDARDS AND SPECIFICATIONS FOR SOIL EROSION AND SEGMENT CONTROL

I. USE NONWOVEN GEOTEXTILE AS SPECIFIED IN SECTION H-1 MATERIALS.


NONWOVEN GEOTEKTILI

ONSTRUCTION SPECIFICATIONS

- REF. PLAN FOR TOW ELEVATIONS -8"X8"X16" CMU, GROUT ALL CELLS SOLID CULTURED STONE, MATCH BLDG. 3" MIN. BELOW GRADE — FINISH GRADE #3 TIES @ 8" O.C. — CONCRETE FOOTING - (3) #5 REBAR EWB


2FT WALL DETAIL (BLUE STREAM)

2'-9" SQ.

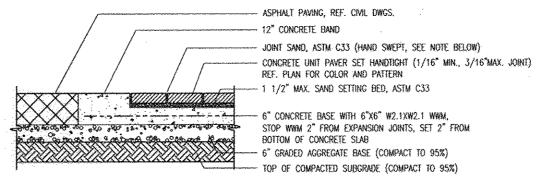

6" CONCRETE BASE WITH 6"X6" W2.1XW2.1 WWM, STOP WWM 2" FROM EXPANSION JOINTS, SET 2" FROM BOTTOM OF CONCRETE SLAB - 6" GRADED AGGREGATE BASE (COMPACT TO 95%) - TOP OF COMPACTED SUBGRADE (COMPACT TO 95%)

\* SLOPE PAVERS 1/4" PER FOOT MIN. FOR DRAINAGE PARTICLES FROM SURFACE, REPEAT PROCESS 3 TIMES MIN. NOT TO SCALE

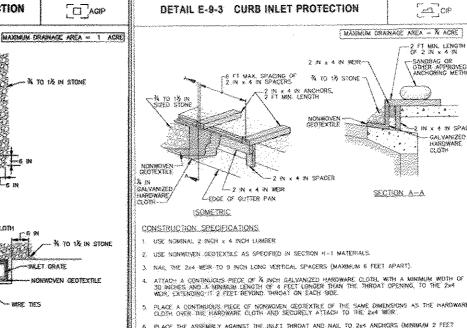

ATTACH A CONTRIGUES PECE OF A HICH GALVANZED HARDWARE CLOTH, WITH A MINIMUM WIDTH OF SE HICHES AND A MINIMUM LENGTH OF A FEET CONDER THAN THE THROAT OPENING, TO THE ZWA MERS, CZEROROW, T. 2 FEET HEYDRO. THROAT OF REAL SIDE. PLACE A CONTRIBUTE PIECE OF NONBOWN GEOFERFILE OF THE SAME DIMENSIONS AS THE HARDWARE OLDTH OVER THE HARDWARE OLDTH AND SECURELY ATTACH TO THE 2x4 WERE. PLACE THE ASSEMBLY AGAINST THE MILET THROAT AND MAL TO INA ANCHORS (MINHAM 2 FEET LINGTH, CHEMO THE ANCHORS ACROSS DIE DILET TOP AND HOLD IN PLACE BY SAMDHAGS OR WILDS CONDUCTOR THE THROAT WITHOUT THROAT INSTALL END SPACERS A MINIMUM OF 1 FOOT BEYOND THE ENDS OF THE THROAT OPENING.

FORM THE MARDWARE CLOTH AND THE GROTEXINE TO THE CONCRETE GUTTER AND FACE OF CURR TO SPAIN THE WHET OPENING. COVER THE MARDWARE CLOTH AND GEOTEXINE WITH CLEAN % TO 1% WICH STORE OF EQUIVALENT RECYCLED CONCRETE. AT NON-SIMP LOCATIONS, INSTALL A TEMPORARY SANDRAG OR ASPWALT BERN TO PREVENT MEET THREES I DRUM INET PROTECTION REQUIRES PREGIENT MAINTENANCE. REMOVE ACCUMULATED BY AFTER EACH RAIN EXENT TO MAINTEN FUNCTION AND AVED PREMATRE CLOSSONS. PROTECTION STEES NOT COMPLETELY DRAIN WITHIN 24 MOURS AFTER A STORM EVANT, IT BY, WHEN THIS OCCURS, REMOVE ACCUMULATED SEMINAT AND CLEAN, OR REPLACE. 2011 MARTING DEPARTMENT OF CHARRONNESS WASER MANUSCREENS ASSESSED TO CONTROL OF CHARRONNESS OF C ATURAL RESOURCES CONSERVATION SERVICE

U.S. DEPARTMENT OF AGRECULTURE 2011 WATER MANUSCHENT OF ENGROPMENT UPAL RESOURCES CONSERVATION SERVICE 2011 WATER MANUSCHENT ADMINISTRATION Recognizended Sceding Dates by Plant Hardiness Zone Seeding Rate H 1b/ac 1b/1000 ft Sb and 68 FERTILIZER RATE mal Ryegrass (Lolium perc Mar 15 to May 31; Aug 1 to Se 5 to Apr 30; Mar 15 to May 31; Aug 1 to Ser ricy (Hordeum vulgare) Lio May 1 540 Apr 30 Mar 15 to May 31; Aug 140 Sep mino May 15: 15 to Apr 30: Mar 15 to May 31; Aug 1 to Sep 1 a (Triticum gestivum) 436 LB/AC 2 TONS/AC (10 LB PER (90 LB PER n 1 to May 15: 12 2.8 Mar 15 to May 31; Aug 1 to Or ereal Rve (Secale cereale) 1000 SF) 1000 SF) Warm-Season Grasses May 1 to Aug 14 ail Millet (Setaria natica) er to to Jul 31 arl Millet (Pennisetum glaucium) 20 0,5 0,5 lun i te bul 31

Seeding rates for the warm-season grasses are in provide of Prace Live Seed (PLS). Actual planting rates shall be adjusted to reflect percent and germination and purity. as Sceding rates fried above are for tomeorary southnes, when planted above. When planted as a surse crop with permanent sood mixes, use 1/5 of the seeding rate listed above the barky, once, and wheat. For smaller-moded graves (annual regress, pearl miller, feature miller), do not exceed more than 5% (by weight) of the overall parameters wording mill. Cereal try generally should not be used as a numerous conding mill. Cereal try generally should not be used as a numerous precling.

Coreal try has allelogather properties that inhibit the germination and graveth of other plants. If it must be used as a nume crop, used at 1/2 of the rate listed above. For sandy soils, plant useds at twice the dipth listed above.

The planting dates listed are averages for each Zone and may require edjustment to reflect focut conditions, especially near the boundaries of the cone.

AGIP

- % TO 1% IN STONE

--- INLET GRATE

006 (05th Gr. Str. #104A - Engrett, Wil 0520 OR EQUAL DOG WASTE STATION PRODUCT SPEC 3. B. S. PARAMETER (PROPERTY AND A MISSELEMEN A BRANCH AND A

OWNER/DEVELOPER U.S. HOME CORPORATION C/O JOSEPH FORTINO 10211 WINCOPIN CIRCLE

SUITE 180 COLUMBIA, MD 21044 410-997-5522

STANDARD SYMBOL

[[]] cose

MAXIMUM ORAINAGE AREA - % ACRE

OTHER APPROVED
ANCHORING METHOD

DETAIL E-9-8 COMBINATION INLET

A IN GALVANIZED HARDWARE CLOTH

GRATE WRAPPED -

DETAIL E-9-6 COMBINATION INLET

. USE NONWOVEN CENTEXTRE AS SPECIFIED IN SECTION H-1 MATERIALS

ONSTRUCTION SPECIFICATIONS

. USE NOMINAL 2 INCH & 4 INCH LIMMER.

N TO 18 IN-

IN HARDWARE CLOTH-

OF 2 IN x 4 IN

S IN OVERLAP-1

WEST THES

HONBOVEN GEOTEXTILE-

ISOMETRIC MEW

S. DEPARTMENT OF AGREGATURE 2011 WARMAND DEPARTMENT OF ENGINEERING MESOURCES CONSERVATION SERVICE 2011 WATER WANAGOVERY AMARISTRATION

LIET GRATE, AND WRAP WITH NONWOVEN GEOTEXTILE TO COMPLETELY COVER ALL OPENINGS, THEN SET-ORATE BACK-18 PLACE.

ATTACH A CONTINUOUS PECE OF \$ 1901 GALVARIZED HANDWARE CLOTH WITH A MERSUM WOTH OF 30 NORES AND A MINSKEN LENGTH OF A FEET LONGER THAN THE THROAT OPENING, TO THE 2X4 MER. EXCENDENCE 2 FEET EXCOND THROAT ON EACH SIDE.

PLACE A CONTINUOUS PECE OF NONMOVEN GEOTEXIES THE SAME DIMENSIONS AS THE HARDWARE CLOTH OVER THE HARDWARE CLOTH AND SECURELY ATTACH IT TO THE WEIR.

7. PLACE THE ASSEMBLY AGAINST THE BRET THROAT AND NAR. TO 2XA ANCHORS (MRHBAM 2 FOOT LINCERS OF 2x4 INCH TO THE TOP OF THE WER AT SPACER LOCATIONS). EXTEND 2XA ANCHORS ASSOSS THE HELT TOP AND HIGH IN PLACE BY SANDBAGS OR DIHER APPROVED ANCHORING METHOD.

9. FORM THE A ENCH HARDWARE CLOTH AND THE GEOTEXTILE TO THE CONDECTE QUITER AND AGAINST THE FACE OF THE CHIEF OR BOTH SIDES OF THE PAET. PLACE CLEAN & TO 18 MICH STONE OR EQUIVALENT RECYCLED CONCRETE OVER THE HARDWARE (JOHN AND GEOTEXTILE BY SUCH A MANNER TO PROSENT WATER FROM ENTERING THE PAET UNDER ON ARROUND THE GEOTEXTILE.

C. AT HON-SUMP LOCATIONS, INSTALL A YEMPORARY SANDRAG OR ASPHALT BERM TO PREVENT BREET

B. INSTALL END SPACERS A MEMBLON OF 1 FOOT BEYOND BOTH ENDS OF THE THROAT OPENING.

, has the examer to the top of a 9 inch long vertical spacer to be located between the new and the palt face (markur 4 feet apart).

6 FT MAX, SPACING OF 2 IN x 4 IN SPACERS

L2MX4MWR

-2 Pt x 4 Bt SPACER

STANDARD SYMBOL

[[]] coar

[=J]CIP

REVISE PLAN TO ADD A 4' HIGH ORWANDATAL WALL AND A 6' HIGH 12/21/16 PRIVACY FENCE ALONG THE SOUTHEASTERN PROPERTY LINE SITE DEVELOPMENT PLAN SITE, SEDIMENT AND EROSION CONTROL **NOTES AND DETAILS** 


**BLUE STREAM TOWNS - SECTION 2** BLUE STREAM LOTS 1-105, AND OPEN SPACE LOT 106 A RE-SUBDIVISION OF BUILDABLE BULK PARCEL L-1 TOWNHOMES

TAX MAP 43 GRID 4 ZONED: CAC-CLI HOWARD COUNTY, MARYLAN 1ST ELECTION DISTRICT



ROBERT H. VOGEL ENGINEERING, INC. ENGINEERS . SURVEYORS . PLANNERS

8407 Main Street Tel: 410.461.7666 ELLICOTT CITY, MD 21043 FAX: 410.461.8961

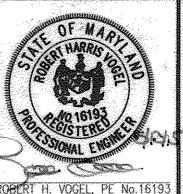

DRAWN BY: CHECKED BY: APRIL 2015 AS SHOWN 06-26.14

RHV

SHEET 13

APPROVED: HOWARD COUNTY DEPARTMENT OF PLANNING AND ZONING <u>5.20.15</u> CHIEF, DEVELOPMENT ENGINEERING DIVISION WAP 6-02-15 BY THE DEVELOPER:

"I/WE CERTIFY THAT ALL DEVELOPEMENT AND CONSTRUCTION WILL BE DONE ACCORDING TO THIS PLAN FOR SEDIMENT AND EROSION CONTROL, AND THAT ALL RESPONSIBLE PERSONNEL INVOLVED IN THE CONSTRUCTION PROJECT WILL HAVE A CERTIFICATE OF ATTENDANCE AT A DEPARTMENT OF THE ENVIRONMENT APPROVED TRAINING PROGRAM FOR THE CONTROL OF SEDIMENT AND EROSION BEFORE BEGINNING THE PROJECT. I ALSO AUTHORIZE PERIODIC ON—SITE INSPECTION BY THE HOWARD SOIL CONSERVATION DISTRICT."

CNATURE OF DEVELOPER VICE PRES.

Car Car


BY THE ENGINEER:


"I CERTIFY THAT THIS PLAN FOR EROSION AND SEDIMENT CONTROL REPRESENTS A PRACTICAL AND WORKABLE PLAN BASED ON MY PERSONAL KNOWLEDGE OF THE SITE CONDITIONS, AND THAT IT WAS PREPARED IN ACCORDANCE WITH THE REQUIREMENTS OF THE HOWARD SOIL CONSERVATION DISTRICT."


SIGNATURE OF ENGINEER


\* JOINT SAND: APPLY SAND, SWEEP JOINTS, REMOVE LARGE SANE \* F'C=4000 PSI CROSSWALK PAVER DETAIL


W.O. NO.:

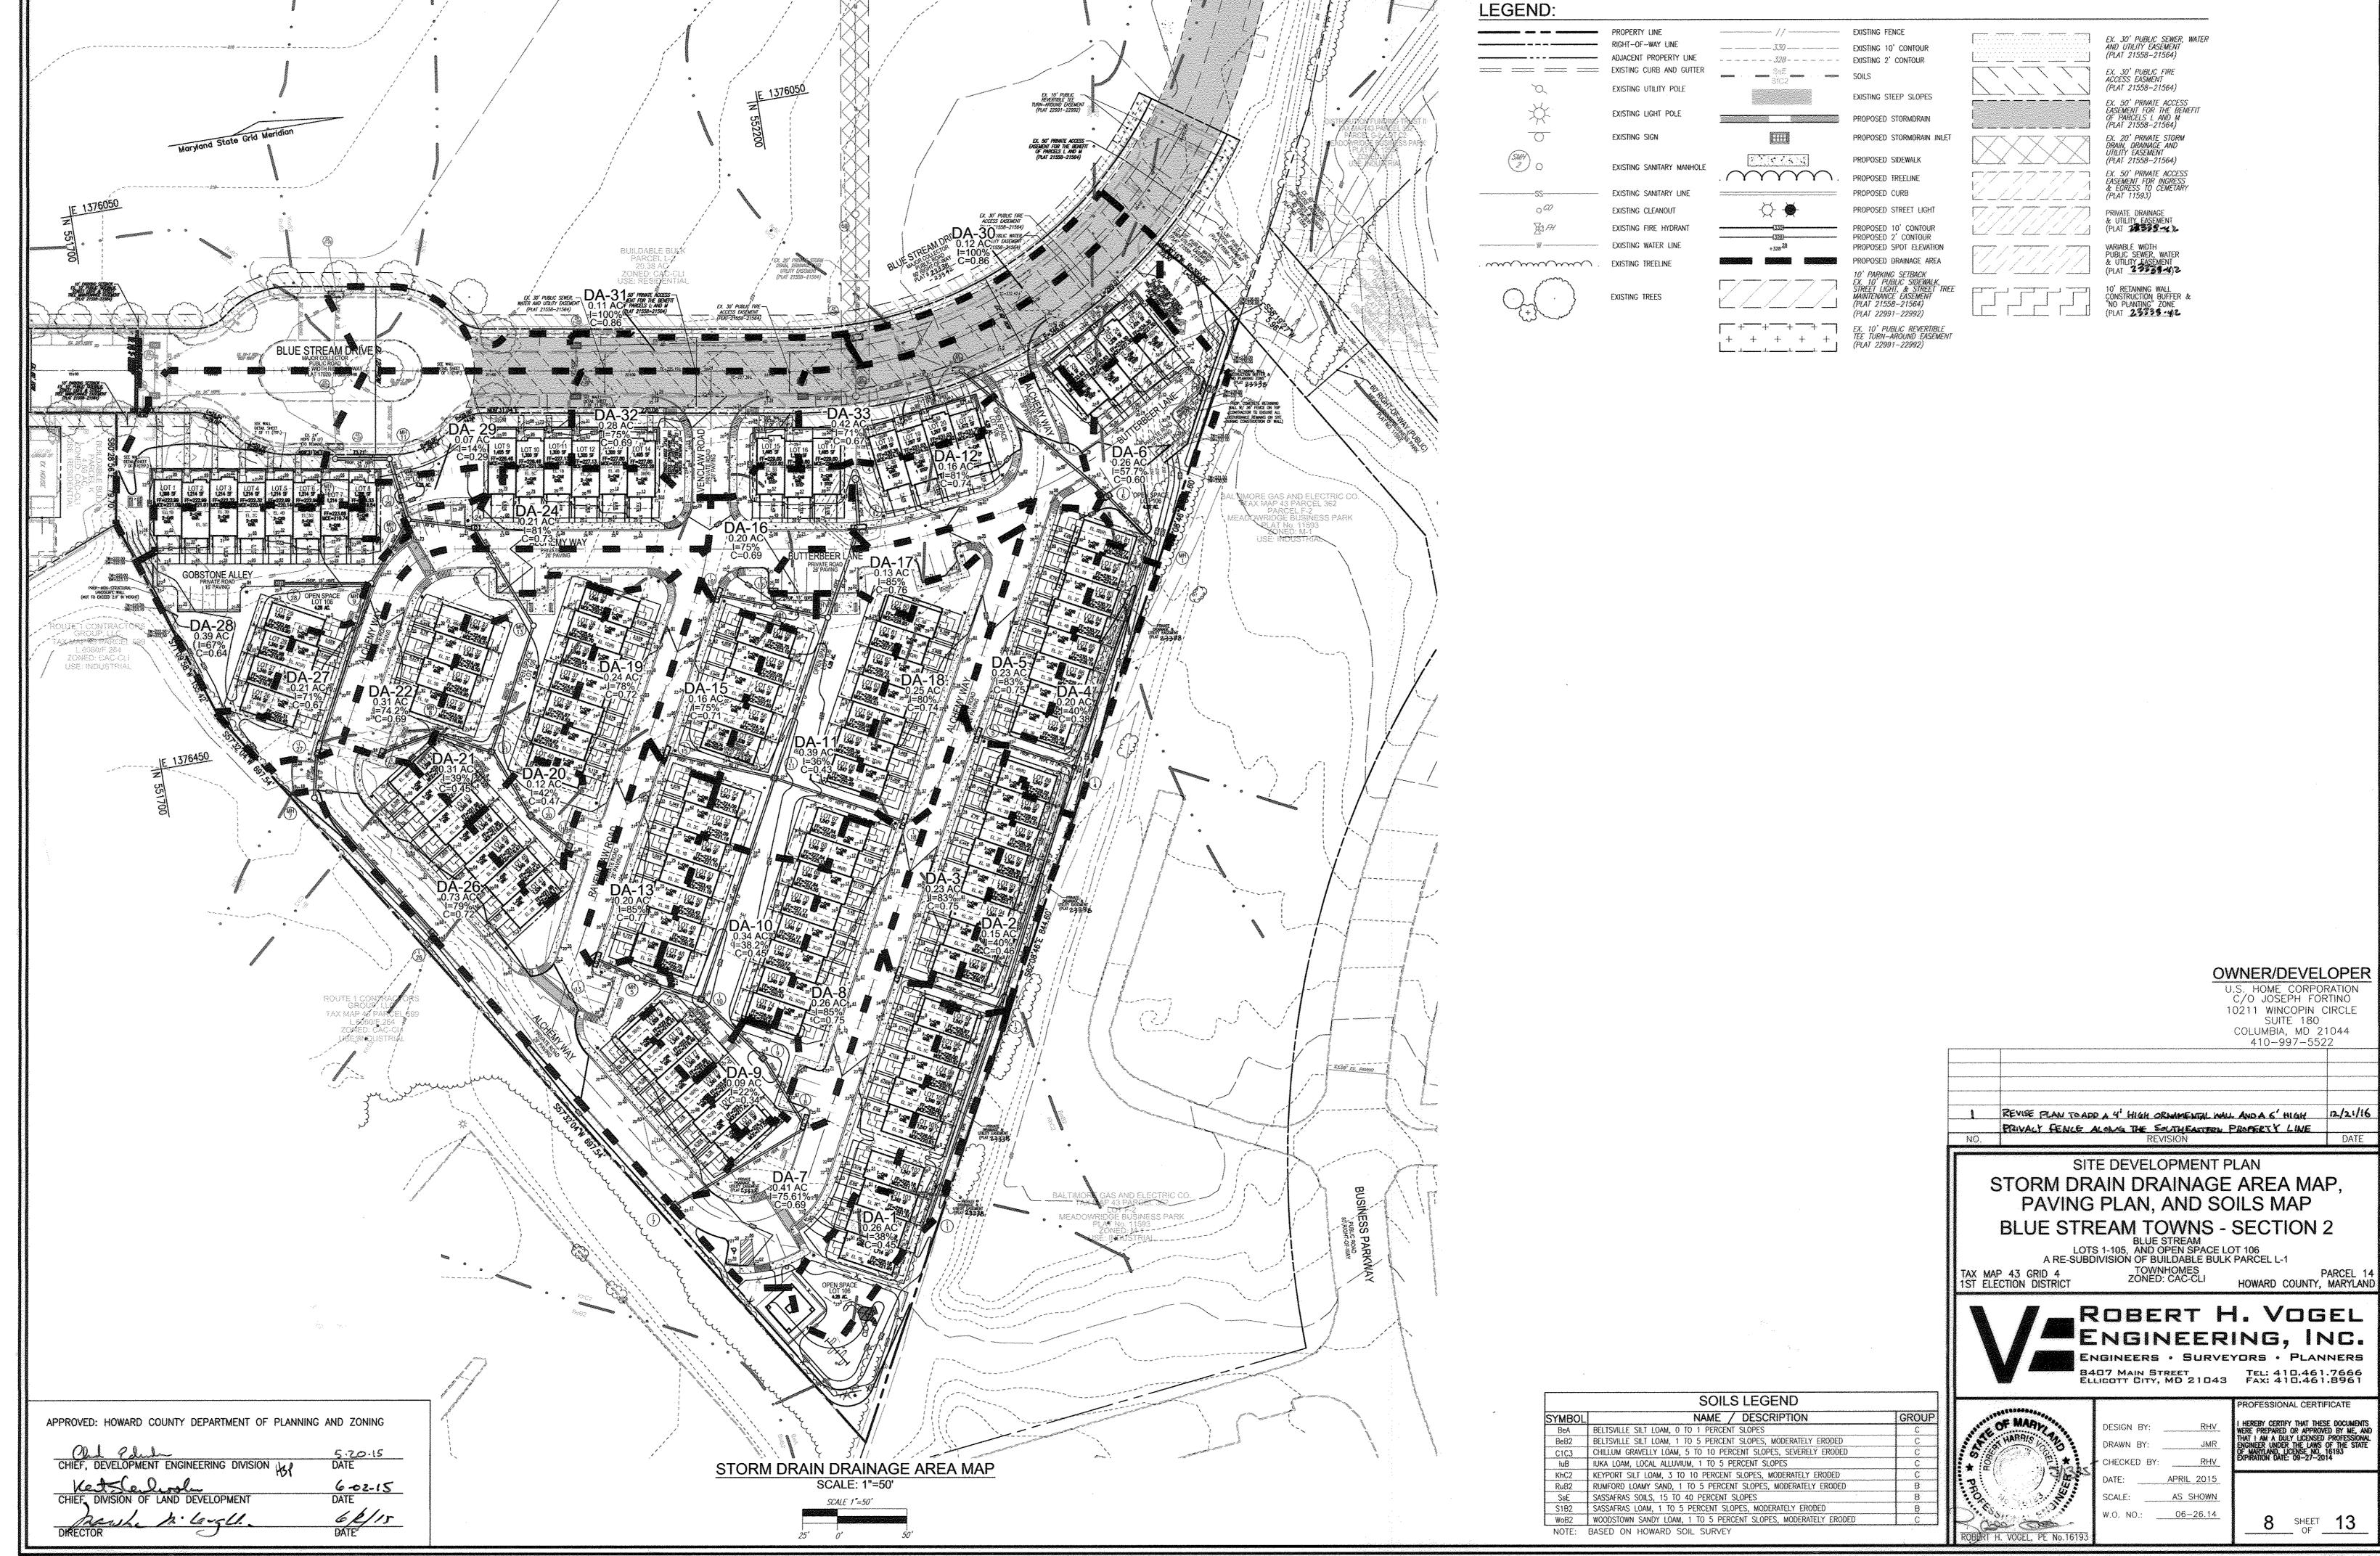


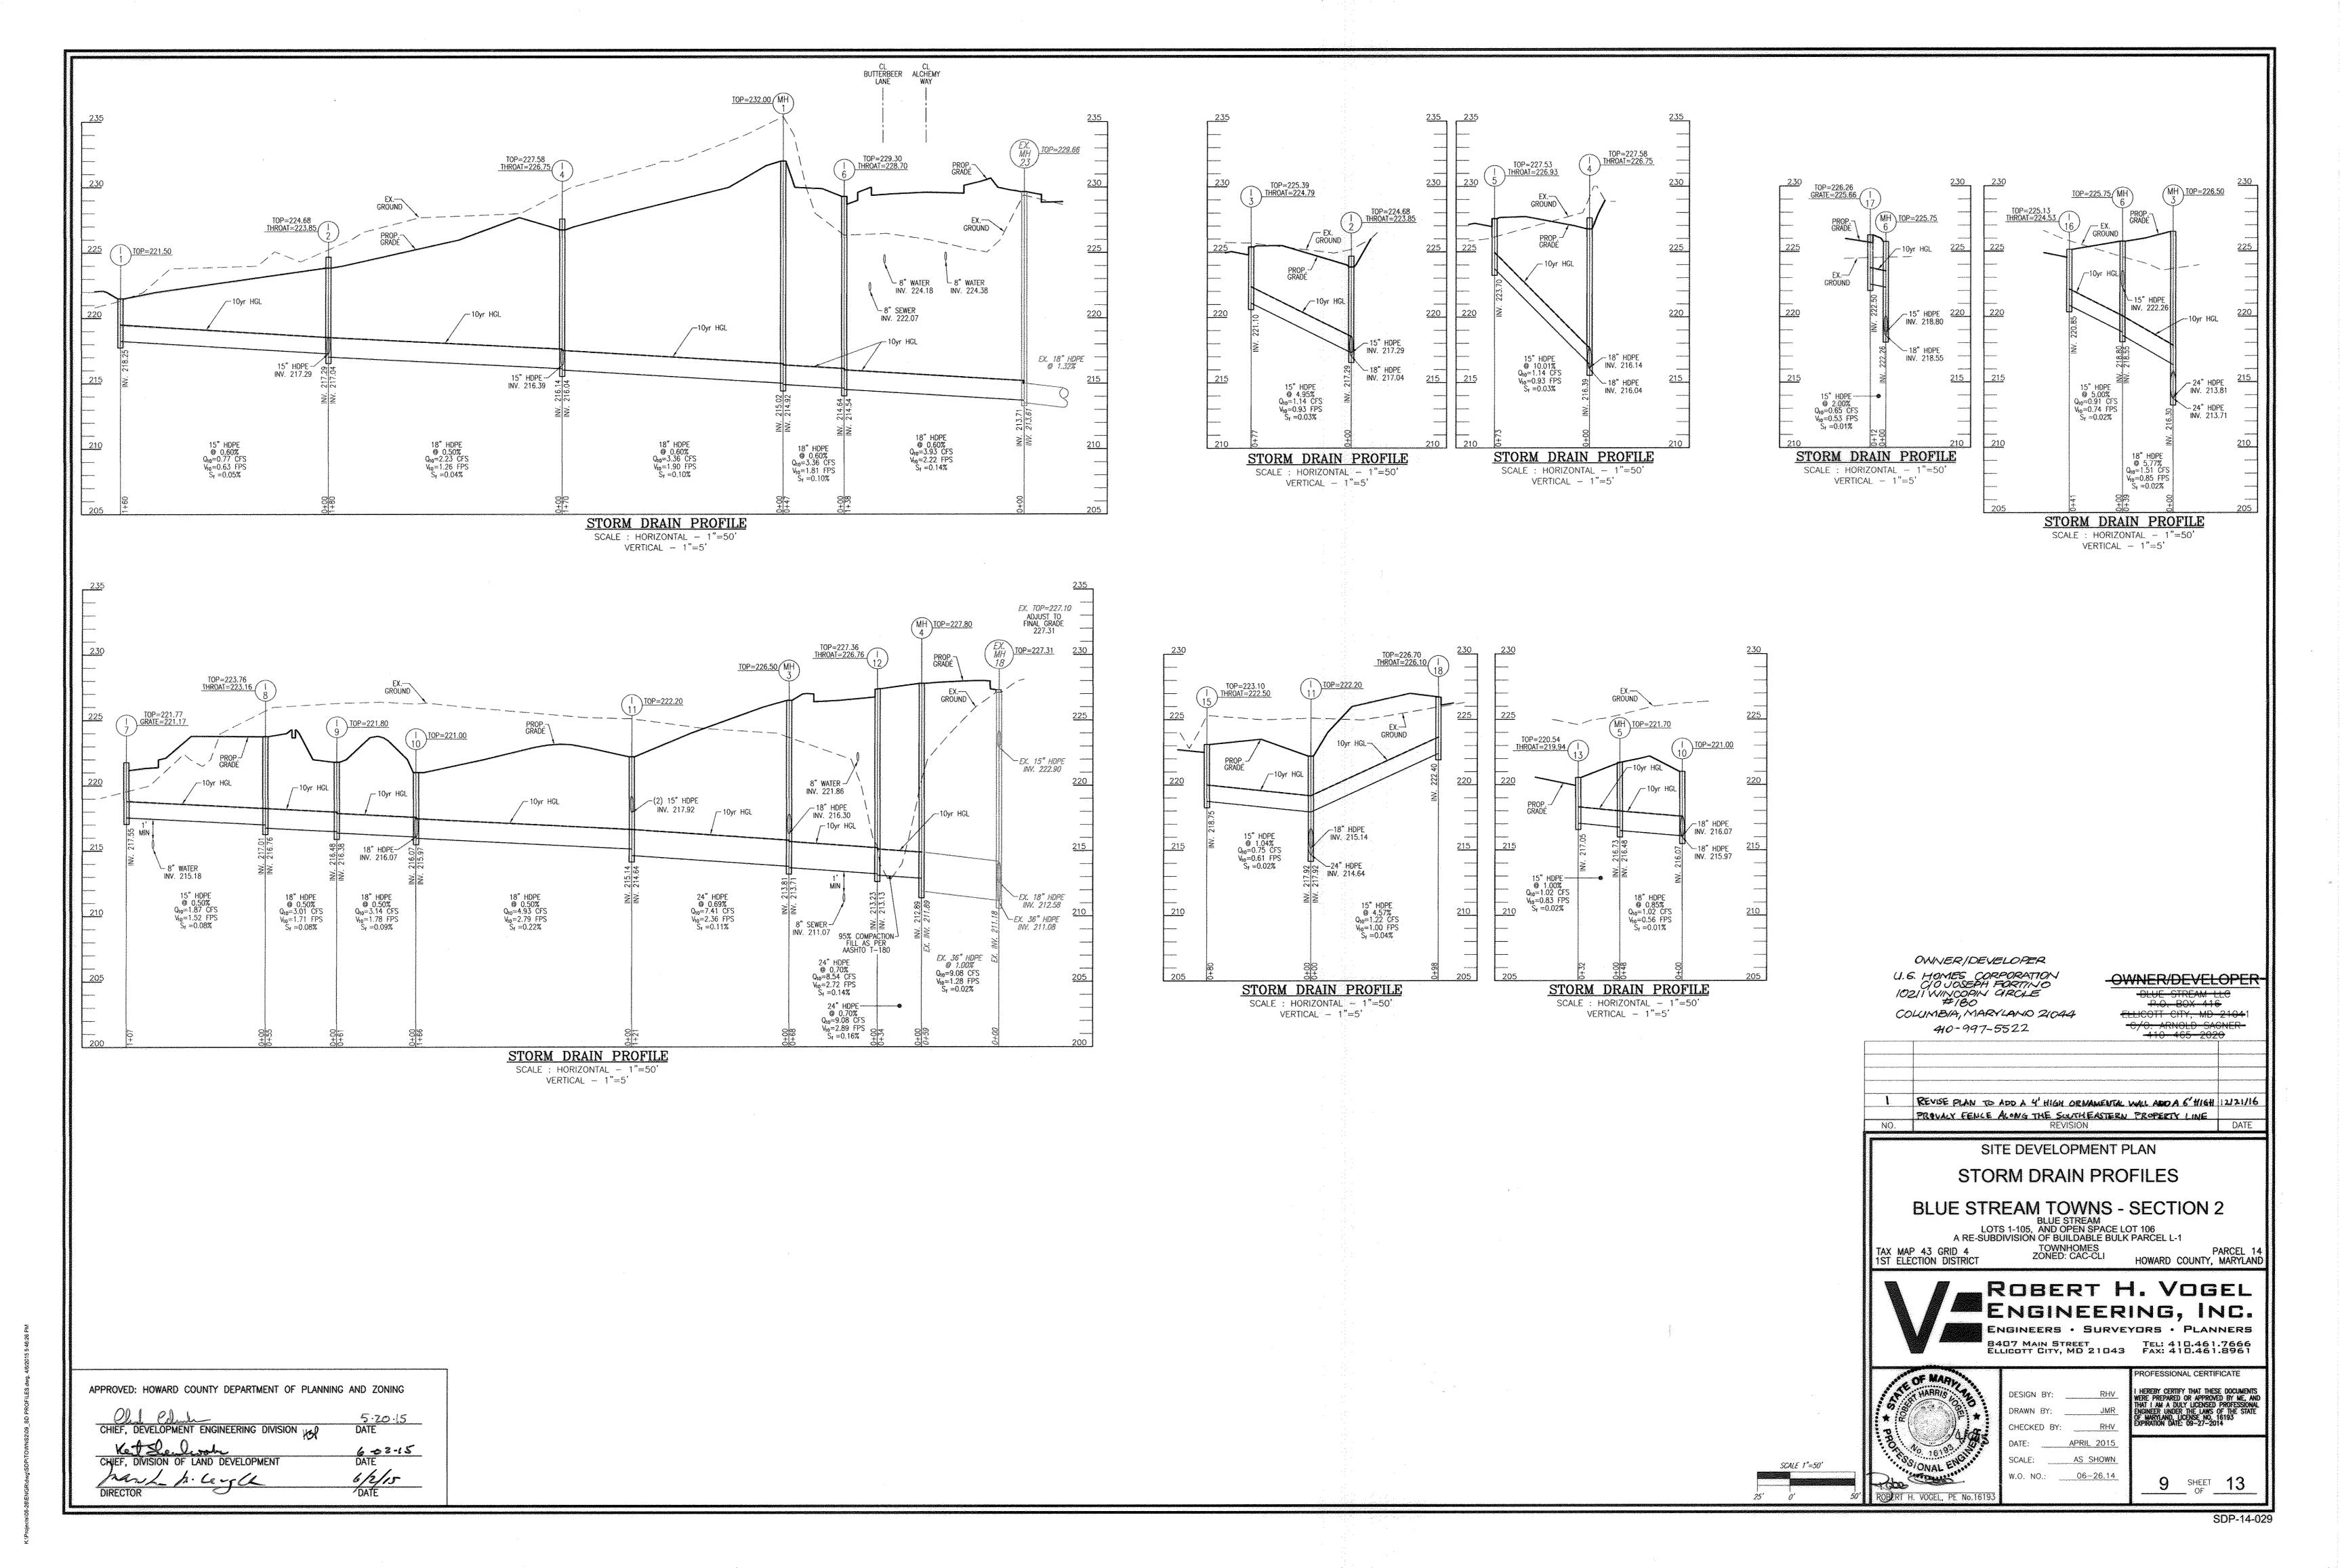

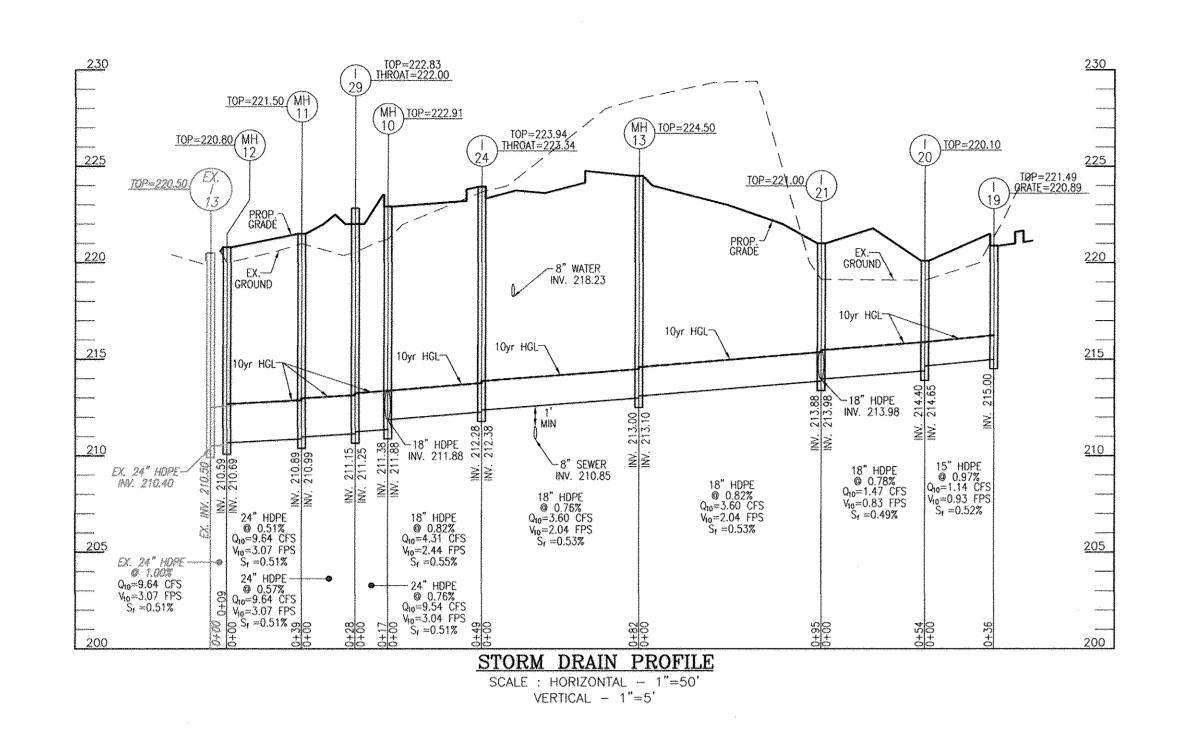

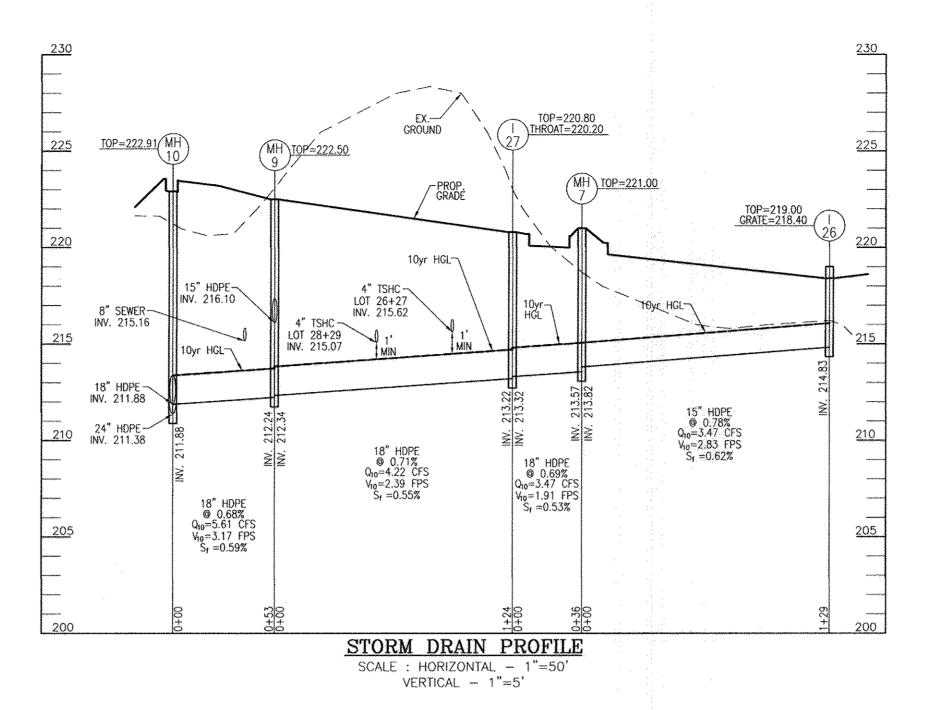

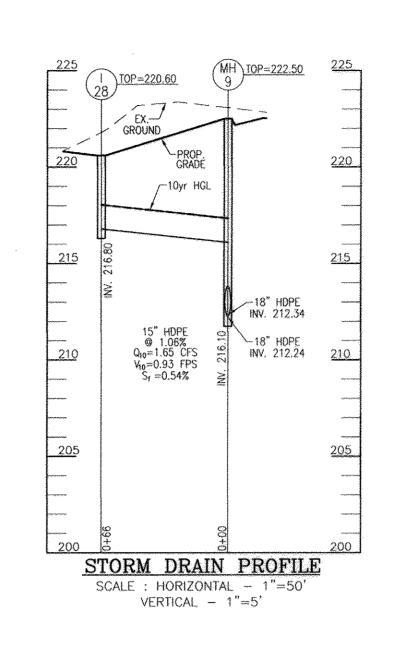

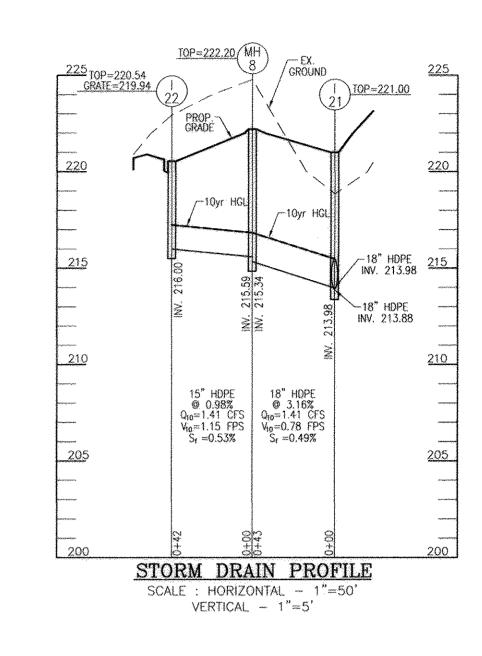

STR#	TYPE	LOCATION	TOP	THROAT	INV. IN	INV. OUT	DETAIL	REMARKS
I-1	YARD INLET	N 552191.50, E 1376858.90	221.50		-	218.25	D-4.14	
1-2	D	N 552267.01, E 1376717.84	224.68	223.85	217.29 / 217.29	217.04	D-4.10	
I-3	TYPE A-10	N 528142.93, E 1350459.61	225.39	224.79	-	221.10	D-4.03	
1-4	D	N 552347.39, E 1376556.73	227.58	226.75	216.39 / 216.14	216.04	D-4.10	
1-5	TYPE A-10	N 552281.02, E 1376521.66	227.53	226.93	***	223.70	D-4.03	**************************************
I-6	TYPE A-5	N 552402.38, E 1376369.57	229.30	228.70	214.64	214.54	D-4.01	
I-7	DOUBLE WR INLET	N 552014.71, E 1376818.27	221.77		-	217.55	D-4.35	Makeding and an all the strong time about the way to the content of the best of the best of the content of the best o
I-8	TYPE A-10	N 552116.77, E 1376775.91	223.76	223.16	217.01	216.76	D-4.03	
I-9	TYPE 'S'	N 552092.78, E 1376724.89	221.80		216.48	216.38	D-4.22	
I-10	TYPE 'S'	N 552055.89, E 1376676.10	221.00		216.07	215.97	D-4.22	
I-11	TYPE 'S'	N 552133.68, E 1376528.90	222.20	·	217.92 / 215.14	214.64	D-4.22	
I-12	TYPE A-10	N 552222.36, E 1376363.90	227.36	226.76	213.23	213.13	D-4.03	
I-13	TYPE A-10	N 551985.18, E 1376634.95	220.54	219.94	-	217.05	D-4.03	
I-15	TYPE A-10	N 552058.12, E 1376497.84	223.10	222.50	-	218.75	D-4.03	
I-16	TYPE A-10	N 552113.40, E 1376392.31	225.13	224.53	-	220.85	D-4.03	
I-17	DOUBLE WR INLET	N 552155.30, E 1376396.12	226.26		-	222.50	D-4.35	
I-18	TYPE A-10	N 552222.12, E 1376575.64	226.70	226.10	-	222.40	D-4.03	
I-19	DOUBLE WR INLET	N 551980.83, E 1376553.46	221.49		~	215.00	D-4.35	
I-20	TYPE 'S'	N 551956.50, E 1376526.57	220.10		214.65	214.40	D-4.03	
I-21	TYPE 'S'	N 551936.20, E 1376477.02	221.00	-	213.98 / 213.98	213.88	D-4.03	
I-22	DOUBLE WR INLET	N 551858.02, E 1376464.05	220.54		-	216.00	D-4.35	
I-24	TYPE A-5	N 528528.19, E 1351267.40	223.94	223.34	212.38	212.28	D-4.01	
I-26	DOUBLE WR INLET	N 528712.88, E 1350986.25	219.00		-	214.83	D-4.35	
I-27	TYPE A-10	N 551815.79, E 1376454.88	220.80	220.20	213.82	213.57	D-4.03	
I-28	DOUBLE-S	N 551805.49, E 1376333.08	220.60		-	216.80	D-4.23	
I-29	D	N 551901.68, E 1376286.53	222.83	222.00	211.25	211.15	D-4.10	
M-1	STD. 4' PRECAST MANHOLE	N 552429.69, E 1376408.02	232.00	a and a state of the state of t	215.05	214.92	G 5.12	(1)
M-3	STD. 4' PRECAST MANHOLE	N 552190.17, E 1376421.99	226.50	· .	216.30 / 213.81	213.71	G 5.12	(1)
M-4	STD. 5' PRECAST MANHOLE	N 552225.68, E 1376327.72	227.80		212.89	211.89	G 5.13	(1)
M-5	STD. 4' PRECAST MANHOLE	N 552013.19, E 1376653.53	221.70		216.73	216.48	G 5.12	(1)
M-6	STD. 4' PRECAST MANHOLE	N 552153.31, E 1376407.97	225.75		222.26 / 218.80	218.55	G 5.12	(1)
M-7	STD. 4' PRECAST MANHOLE	N 551805.19, E 1376488.51	221.00		213.82	213.57	G 5.12	(1)
M-8	STD. 4' PRECAST MANHOLE	N 551898.55, E 1376457.12	222.20		215.59	215.34	G 5.12	(1)
M-9	STD. 4' PRECAST MANHOLE	N 551870.46, E 1376343.97	222.50		216.10 / 212.34	212.24	G 5.12	(1)
M-10	STD. 4' PRECAST MANHOLE	N 527872.21, E 1351127.08	222.91		211.88 / 211.88	211.38	G 5.12	(1)
M-11	STD. 4' PRECAST MANHOLE	N 528088.17, E 1351212.23	221.50		210.99	210.89	G 5.12	(1)
M-12	STD. 4' PRECAST MANHOLE	N 528247.76, E 1351220.92	220.80		210.69	210.59	G 5.12	(1)
M-13	STD. 4' PRECAST MANHOLE	N 551980.61, E 1376392.97	224.50		213.10	213.00	G 5.12	(1)

PIPE	SCHEE	)ULE
Size	Class	Total Length *
15"	HDPE	953
18"	HDPE	1,440
24"	HDPE	614

\* The total length of pipe is linear feet only.

HDPE is to be smooth interior. Contractor shall install pipe in accordance with manufacturer's specifications

OWNER/DEVELOPER U.S. HOME CORPORATION
1021 WINCOPIN CIRCLE
COLUMBIA, MARYLAND 21044 410-997-5522

-OWNER/DEVELOPER

1 REVISE PLAN TO ADD A 4'HIGH ORNAMENTAL WALL ARD A 6'HIGH 12/21/16 PRIVACY FENCE ALONG THE SOUTHEASTERN PROPERTY LINE

SITE DEVELOPMENT PLAN

# STORM DRAIN PROFILES

BLUE STREAM TOWNS - SECTION 2


BLUE STREAM
LOTS 1-105, AND OPEN SPACE LOT 106
A RE-SUBDIVISION OF BUILDABLE BULK PARCEL L-1 TOWNHOMES ZONED: CAC-CLI TAX MAP 43 GRID 4 1ST ELECTION DISTRICT PARCEL 14 HOWARD COUNTY, MARYLAND

ROBERT H. VOGEL ENGINEERING, INC. ENGINEERS . SURVEYORS . PLANNERS 8407 MAIN STREET TEL: 410.461.7666 ELLICOTT CITY, MD 21043 FAX: 410.461.8961

W.O. NO.; 06-26.14

10 SHEET 13

APPROVED: HOWARD COUNTY DEPARTMENT OF PLANNING AND ZONING Chief, Development Engineering Division Hol 6-02-15 DATE DIRECTOR Interests

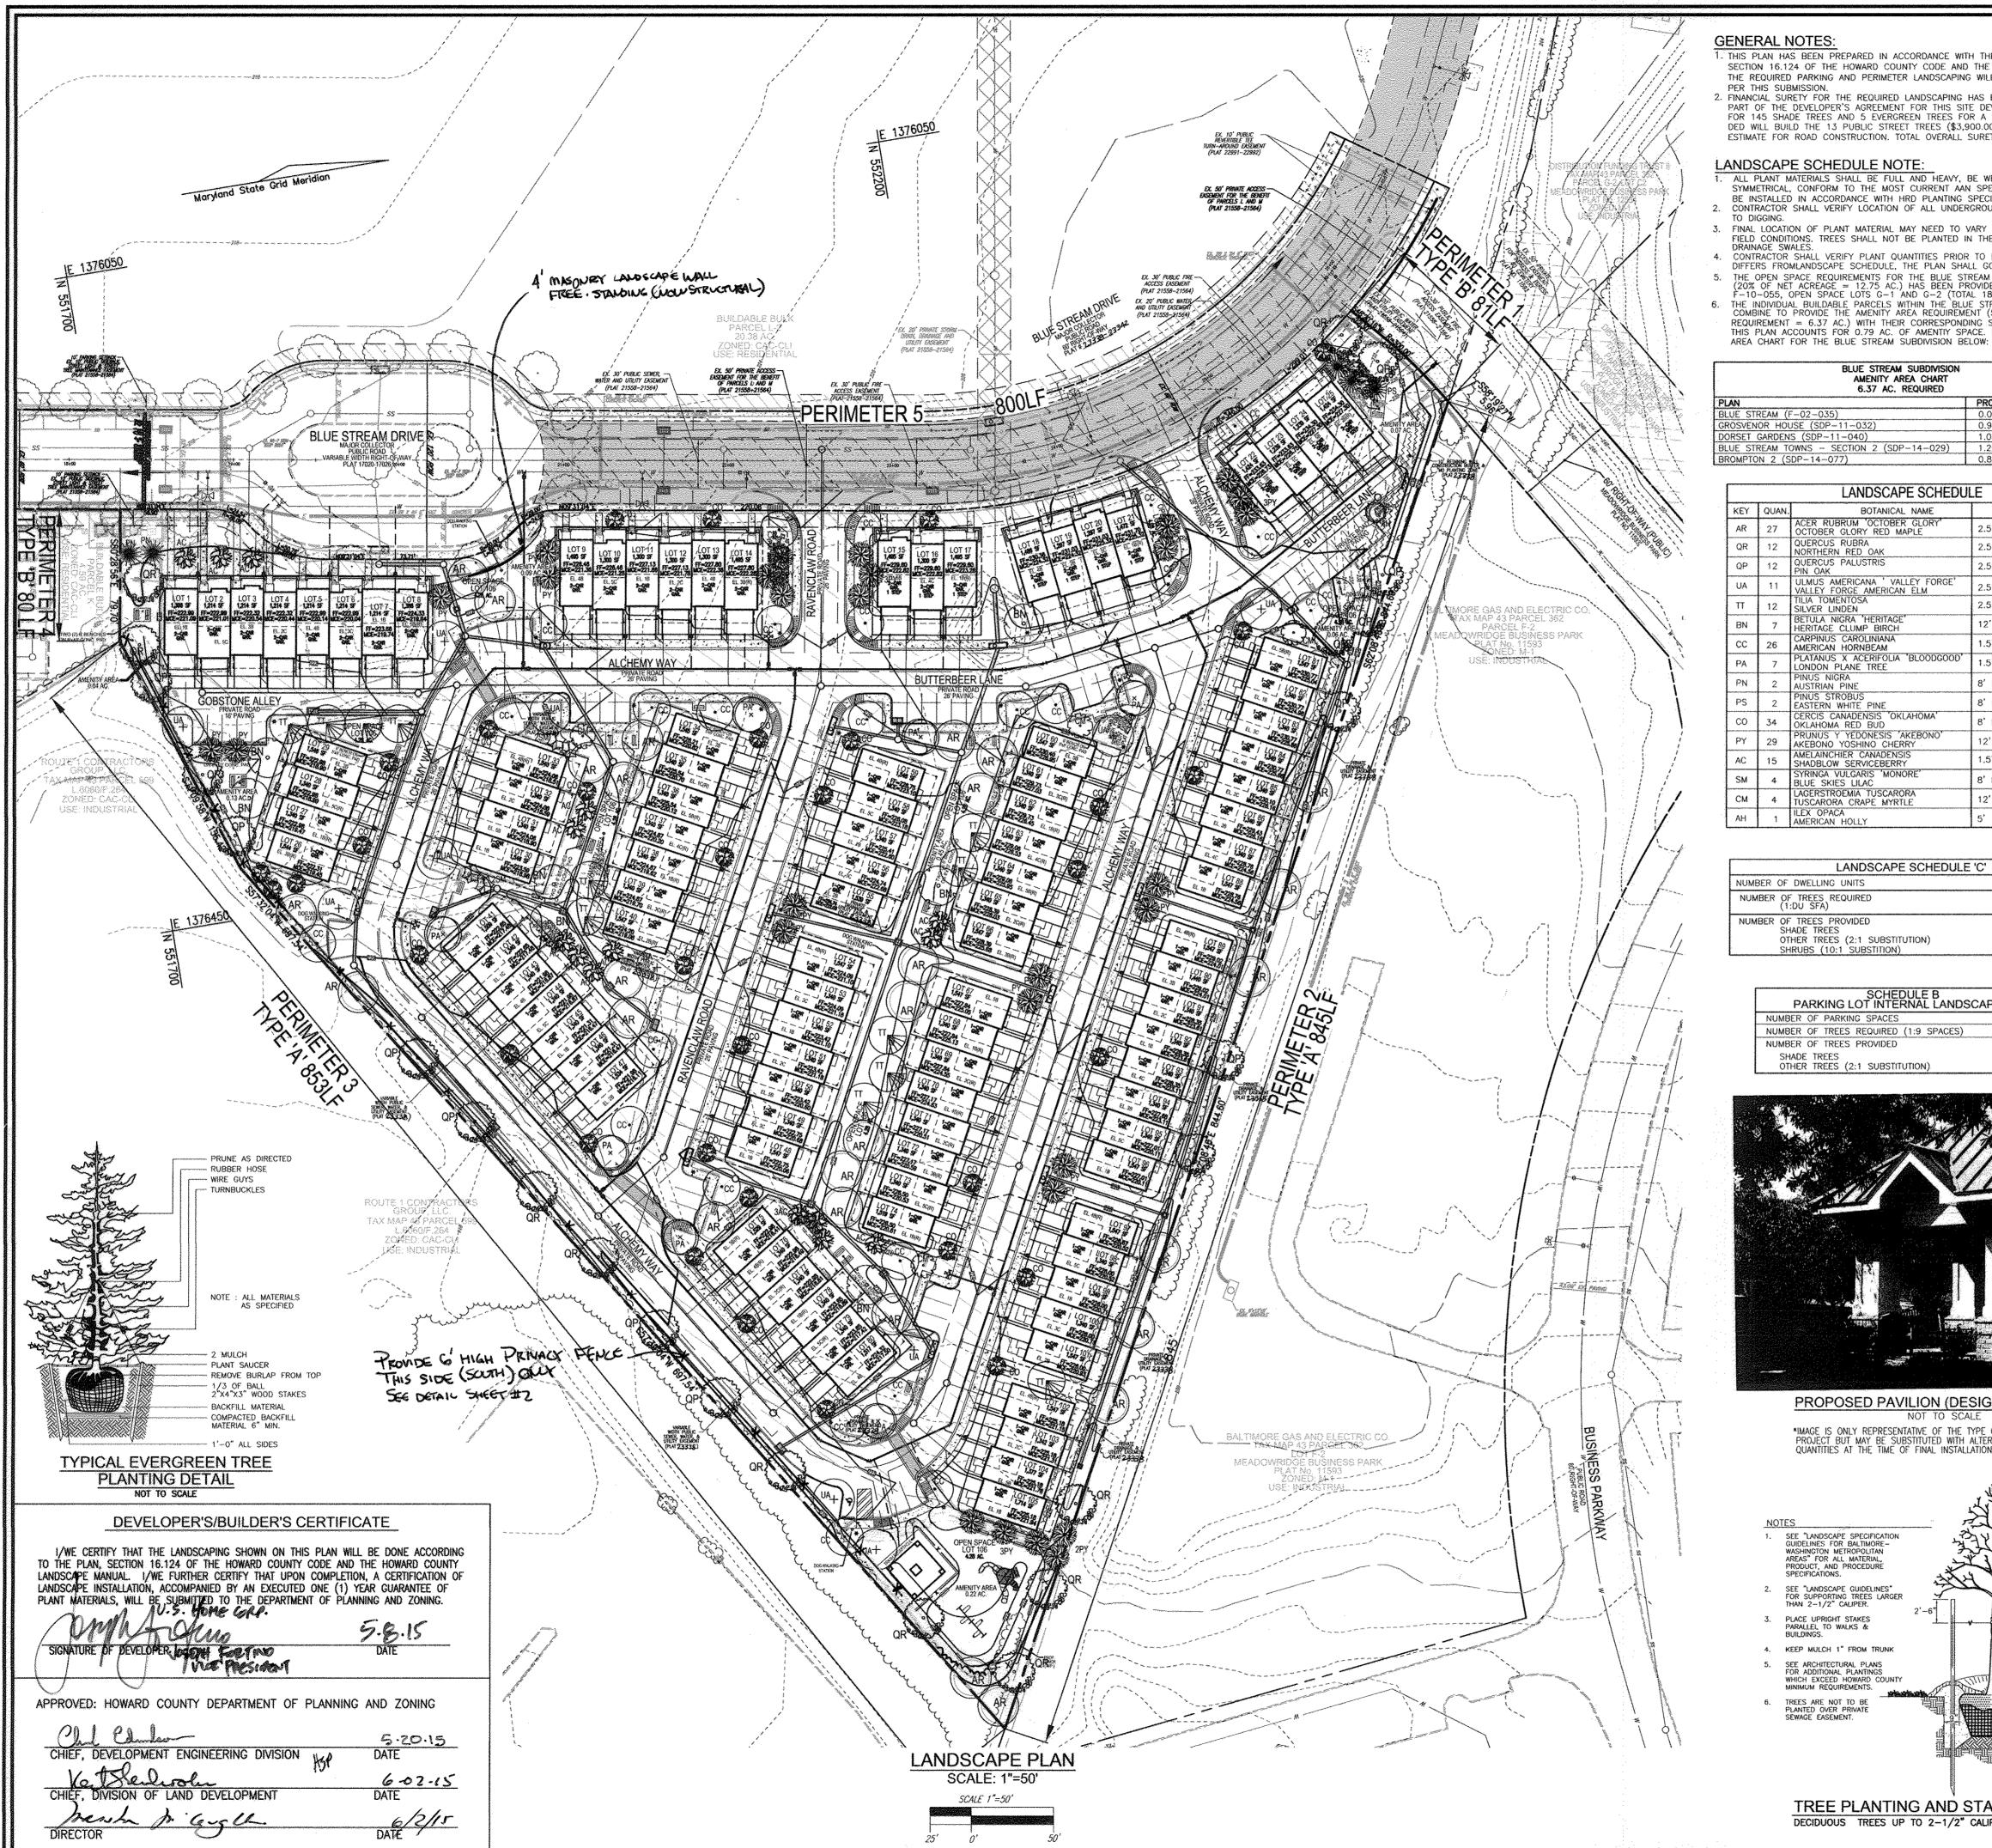

#### **GENERAL NOTES:**

THIS PLAN HAS BEEN PREPARED IN ACCORDANCE WITH THE PROVISIONS OF SECTION 16.124 OF THE HOWARD COUNTY CODE AND THE LANDSCAPE MANUAL. THE REQUIRED PARKING AND PERIMETER LANDSCAPING WILL BE BONDED

PER THIS SUBMISSION. FINANCIAL SURETY FOR THE REQUIRED LANDSCAPING HAS BEEN POSTED AS PART OF THE DEVELOPER'S AGREEMENT FOR THIS SITE DEVELOPMENT PLAN FOR 145 SHADE TREES AND 5 EVERGREEN TREES FOR A SURETY OF \$44,250.00. DED WILL BUILD THE 13 PUBLIC STREET TREES (\$3,900.00) INTO THEIR COST ESTIMATE FOR ROAD CONSTRUCTION. TOTAL OVERALL SURETY DUE IS \$48,150.00.

### LANDSCAPE SCHEDULE NOTE:

- ALL PLANT MATERIALS SHALL BE FULL AND HEAVY, BE WELL FORMED AND SYMMETRICAL, CONFORM TO THE MOST CURRENT AAN SPECIFICATIONS AND BE INSTALLED IN ACCORDANCE WITH HRD PLANTING SPECIFICATIONS. CONTRACTOR SHALL VERIFY LOCATION OF ALL UNDERGROUND UTILITIES PRIOR
- FINAL LOCATION OF PLANT MATERIAL MAY NEED TO VARY TO MEET FINAL FIELD CONDITIONS. TREES SHALL NOT BE PLANTED IN THE BOTTOM OF
- 4. CONTRACTOR SHALL VERIFY PLANT QUANTITIES PRIOR TO BIDDING. IF PLAN DIFFERS FROMLANDSCAPE SCHEDULE, THE PLAN SHALL GOVERN.
- THE OPEN SPACE REQUIREMENTS FOR THE BLUE STREAM SUBDIVISION (20% OF NET ACREAGE = 12.75 AC.) HAS BEEN PROVIDED UNDER F-10-055, OPEN SPACE LOTS G-1 AND G-2 (TOTAL 18.10 AC.).

  THE INDIVIDUAL BUILDABLE PARCELS WITHIN THE BLUE STREAM SUBDIVISION WILL COMBINE TO PROVIDE THE AMENITY AREA REQUIREMENT (50% OF OPEN SPACE OPEN SPACE OF OPEN SPACE OF OPEN SPACE OF OPEN SPACE OPEN SPACE OPEN SPACE OF OPEN SPACE OPEN SPACE OF OPEN SPACE OP REQUIREMENT = 6.37 AC.) WITH THEIR CORRESPONDING SITE DEVELOPMENT PLANS. THIS PLAN ACCOUNTS FOR 0.79 AC. OF AMENTIY SPACE. REFER TO THE AMENITY

BLUE STREAM SUBDIVISION AMENITY AREA CHART 6.37 AC. REQUIRED					
PLAN	PROVIDED	REMAINING			
BLUE STREAM (F-02-035)	0.00 AC.	6.37 AC.			
GROSVENOR HOUSE (SDP-11-032)	0.99 AC.	5.38 AC.			
DORSET GARDENS (SDP-11-040)	1.02 AC.	4,36 AC.			
BLUE STREAM TOWNS - SECTION 2 (SDP-14-029)	1.22 AC.	3.14 AC.			
BROMPTON 2 (SDP-14-077)	0.87 AC.	2.27 AC.			

LANDSCAPE SCHEDULE							
KEY	QUAN.	BOTANICAL NAME	SIZE	ROOT	ROOT		
AR	27	ACER RUBRUM 'OCTOBER GLORY' OCTOBER GLORY RED MAPLE	2.5" CAL	8 & 8	B & B		
QR	12	QUERCUS RUBRA NORTHERN RED OAK	2.5" CAL	8 & 8	B & B		
QP	12	QUERCUS PALUSTRIS PIN OAK	2.5" CAL	8 & 8	В & В		
UA	11	ULMUS AMERICANA ' VALLEY FORGE' VALLEY FORGE AMERICAN ELM	2.5" CAL	B & B	8 & 8		
ΤŤ	12	TILIA TOMENTOSA SILVER LINDEN	2.5" CAL	8 & 8	8 & 8		
BN	7	BETULA NIGRA 'HERITAGE' HERITAGE CLUMP BIRCH	12' HT.	8 & 8	B & B		
ÇC	26	CARPINUS CAROLINIANA AMERICAN HORNBEAM	1.5"-2" CAL	B & B	8 & 8		
PA	7	PLATANUS X ACERIFOLIA 'BLOODGOOD' LONDON PLANE TREE	1.5"-2" CAL	8 & 8	8 & 8		
PN	2	PINUS NIGRA AUSTRIAN PINE	8' HT.	8 & 8	8 & 8		
PS	2	PINUS STROBUS EASTERN WHITE PINE	8' HT.	8 & 8	B & B		
co	34	CERCIS CANADENSIS 'OKLAHOMA' OKLAHOMA RED BUD	8' HT.	B & B	8 & 8		
PΥ	29	PRUNUS Y YEDONESIS 'AKEBONO' AKEBONO YOSHINO CHERRY	12' HT.	B & B	B & B		
AC	15	AMELAINCHIER CANADENSIS SHADBLOW SERVICEBERRY	1.5"-2" CAL	8 & 8	B & 8		
SM	4	SYRINGA VULGARIS 'MONORE' BLUE SKIES LILAC	8' HT.	8 & 8	8 & 8		
СМ	4	LAGERSTROEMIA TUSCARORA TUSCARORA CRAPE MYRTLE	12' HT.	8 & 8	B & B		
AH	1	ILEX OPACA AMERICAN HOLLY	5' - 6' HT.	8 & 8	B & B		


LANDSCAPE SCHEDULE '	C'
NUMBER OF DWELLING UNITS	105 SFA
NUMBER OF TREES REQUIRED (1:DU SFA)	105
NUMBER OF TREES PROVIDED SHADE TREES OTHER TREES (2:1 SUBSTITUTION) SHRUBS (10:1 SUBSTITION)	49 112

SCHEDULE B PARKING LOT INTERNAL LANDSCAF	PING
NUMBER OF PARKING SPACES	53
NUMBER OF TREES REQUIRED (1:9 SPACES)	6
NUMBER OF TREES PROVIDED	
SHADE TREES	6
OTHER TREES (2:1 SUBSTITUTION)	Į –



PROPOSED PAVILION (DESIGN BY OTHERS)\*

\*IMAGE IS ONLY REPRESENTATIVE OF THE TYPE OF PRODUCT TO BE PROVIDED FOR THE PROJECT BUT MAY BE SUBSTITUTED WITH ALTERNATIVE PRODUCT TYPES, SIZES AND QUANTITIES AT THE TIME OF FINAL INSTALLATION AND CONSTRUCTION.

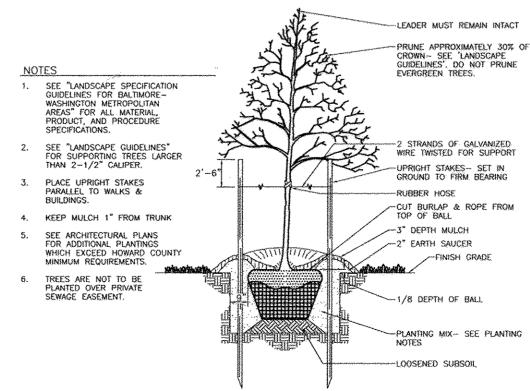


NOT TO SCALE

TREE PLANTING AND STAKING DECIDUOUS TREES UP TO 2-1/2" CALIPER

# LEGEND:


The second of th			
	PROPERTY LINE RIGHT-OF-WAY LINE ADJACENT PROPERTY LINE EXISTING CURB AND GUTTER EXISTING UTILITY POLE		10' PARKING SETBACK EX. 10' PUBLIC SIDEWALK, STREET LIGHT, & STREET TREE MAINTENANCE EASEMENT (PLAT 21558–21564) (PLAT 22991–22992) EX. 30' PUBLIC SEWER, WATER AND UTILITY EASEMENT
<b>*</b>	EXISTING LIGHT POLE		(PLAT 21558–21564)  EX. 30' PUBLIC FIRE ACCESS EASMENT
0	Existing sign		(PLAT 21558-21564)  EX. 50° PRIVATE ACCESS EASEMENT FOR THE BENEFIT OF PARCELS L AND M
<b>(2)</b> 0	EXISTING SANITARY MANHOLE		(PLAT 21558-21564) EX. 20' PRIVATE STORM DRAIN DRAINAGE AND
en er fallen fal	EXISTING SANITARY LINE		UTILITY EASEMENT (PLAT 21558–21564)
000 Wash	EXISTING CLEANOUT  EXISTING FIRE HYDRANT.	7/7/7/7	EX. 50' PRIVATE ACCESS EASEMENT FOR INGRESS & EGRESS TO CEMETARY
entrance services 350 increase beneaussender emberer an oos meet services 350 increases beneaussender en ook ook ook	EXISTING 10' CONTOUR EXISTING 2' CONTOUR		(PLAT 11593) EX. 10' PUBLIC REVERTIBLE TEE TURN-AROUND EASEMENT
a start and start, and if the an account were of the start of parts and the start of the start and artificial a	EXISTING WATER LINE	Limited Strains of the strains of th	(PLAT 22991-22992)
	EXISTING TREELINE  EXISTING TREES		PRIVATE DRAINAGE & UTILITY EASEMENT (PLAT 23332 X 3
	EXISTING FENCE		VARIABLE WIDTH PUBLIC SEWER, WATER & UTILITY EASEMENT (PLAT 23235-4)2-
	EXISTING STEEP SLOPES		10' RETAINING WALL CONSTRUCTION BUFFER & "NO PLANTING" ZONE
	PROPOSED STORMDRAIN	. Landania I managaman I managaman I	(PLAT 23333-4)2


[[+++4]]	PROPOSED	STORMDRAIN INLET	
	PROPOSED	SIDEWALK	
mmmm.	PROPOSED	TREELINE	$\mathcal{N}$
	PROPOSED	CURB	
$\Diamond$	PROPOSED	STREET LIGHT	
<u> </u>	PROPOSED	10' CONTOUR	
328	PROPOSED	2' CONTOUR	

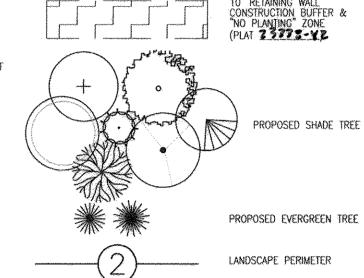

SCHEDULE A PERIMETER LANDSCAPE EDGE							
CATEGORY	ADJACENT TO ROADWAYS AND PERIMETER PROPERTIES						
PERIMETER/FRONTAGE DESIGNATION LANDSCAPE TYPE	B	2 A	3 A	4 B	5 		
LINEAR FEET OF ROADWAY FRONTAGE/PERIMETER	81'	845'	853'	80,	800'		
CREDIT FOR EXISTING VEGETATION (YES, NO, LINEAR FEET DESCRIBE BELOW IF NEEDED)	NO	NO	NO	NO	NO		
CREDIT FOR WALL, FENCE OR BERM (YES, NO, LINEAR FEET DESCRIBE BELOW IF NEEDED)	NO	NO	NO	NO	NO	TOTAL	
NUMBER OF PLANTS REQUIRED SHADE TREES EVERGREEN TREES SHRUBS	1:50 2 1:40 3	1:60 15	1:60 15	1:50 2 1:40 2	_	34 5	
NUMBER OF PLANTS PROVIDED SHADE TREES EVERGREEN TREES OTHER TREES (2:1 SUBSTITUTION) SHRUBS (10:1 SUBSTITUTION)	2 3 -	14 - 2	15	2 2	ore and	33 5 2	
EX. SHADE TREES EX. EVERGREEN TREES EX. OTHER TREES (2:1 SUBSTITUTION) DESCRIBE PLANT SUBSTITUTION CREDITS RELOW ENERGED)	ympr voga	entern entern	ericina General manage	कुरूका सम्बद्ध चल्लाह	mange, ngarin Graspe	Malain. Injusti	

\*\* SUBSTITUTE 2 ORNAMENTAL FOR 1 SHADE TREES IN PERIMETER 2.

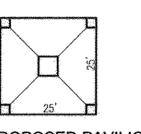

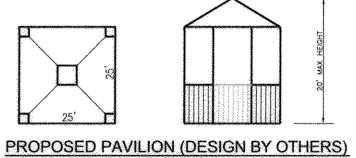

OWNER/DEVELOPER U.S. HOME CORPORATION C/O JOSEPH FORTINO

10211 WINCOPIN CIRCLE SUITE 180 COLUMBIA, MD 21044 410-997-5522

REVISE PLAN TO AND A 4' HIGH OPNAMENTAL WALL AND A 6' HIGH 12/21/16 PRIVACY FENCE TO THE SOUTH EASTERN PROPERTY LINE

SITE DEVELOPMENT PLAN LANDSCAPE AND AMENITY **AREA PLAN** 


**BLUE STREAM TOWNS - SECTION 2** 

BLUE STREAM LOTS 1-105, AND OPEN SPACE LOT 106 A RE-SUBDIVISION OF BUILDABLE BULK PARCEL L-1

TAX MAP 43 GRID 4 1ST ELECTION DISTRICT PARCEL 14 HOWARD COUNTY, MARYLAND




ROBERT H. VOGEL ENGINEERING, INC. ENGINEERS . SURVEYORS . PLANNERS 8407 MAIN STREET TEL: 410.461.7666 ELLICOTT CITY, MD 21043 FAX: 410.461.8961

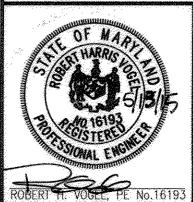


DESIGN BY:	RHV
DRAWN BY:	JMR
CHECKED BY:	RHV
DATE:	APRIL 2015
SCALE:	AS SHOWN
W.O. NO.:	06-26.14
	-0

PROFESSIONAL CERTIFICATE 11 SHEET 13

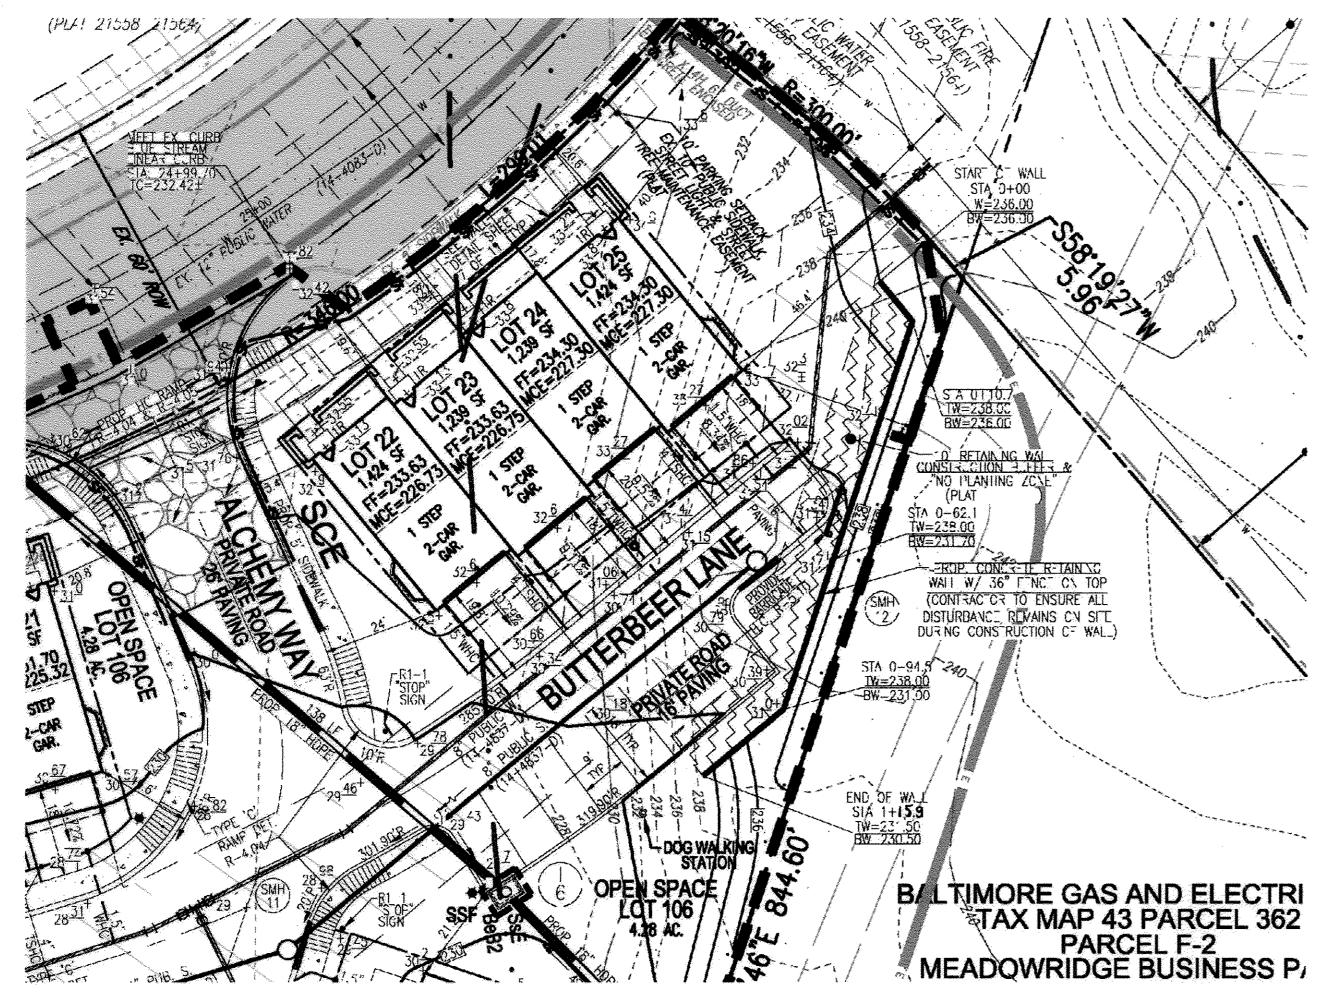

SITE PLAN (BASED ON PLAN PROVIDED BY ROBERT H. VOGEL ENGINEERING, INC) SCALE: 1"=20'

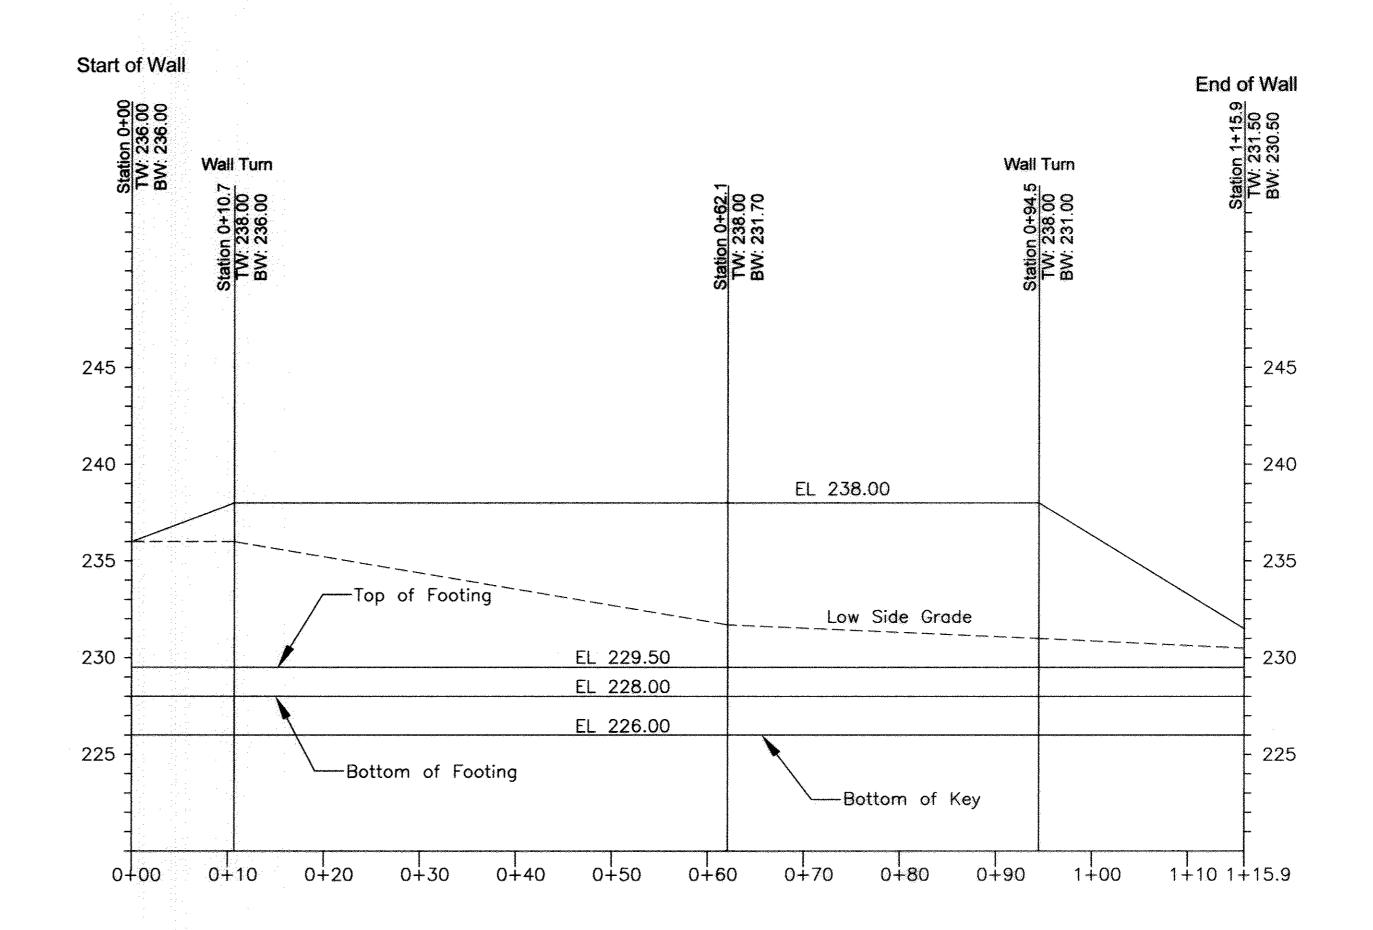

WALL PROFILE HORIZONTAL SCALE: 1"=10" VERTICAL SCALE: 1"=5"

OWNER/DEVELOPER U.S. HOME CORPORATION
10211 WINGSPIN CIRCLE
COLUMBIA, MARYLAND 21044 OWNER/DEVELOPER 410-997-5522 REVISE PLAN TO ADD A 4' HIGH ORMMENTAL WALL AND A 6' HIGH 12/21/16
PRIVACY FENCE TO THE SOUTH EASTERN PROPERTY LINE
REVISION DATE **RETAINING WALL** PLAN & PROFILE BLUE STREAM TOWNS - SECTION 2

BLUE STREAM
LOTS 1-103, AND OPEN SPACE LOT 104
A RE-SUBDIVISION OF BUILDABLE BULK PARCEL L TAX MAP 43 GRID 4 1ST ELECTION DISTRICT

HASAN M. ABOUMATAR, PE

APPROVED: HOWARD COUNTY DEPARTMENT OF PLANNING AND ZONING Chief, Development Engineering Division ASP 5-10-15 DATE 6 -02·15 DATE Co/2/15 mente /a largette

PARCEL 14 HOWARD COUNTY, MARYLAND

1340 CHARWOOD ROAD SUITE A HANOVER, MARYLAND 21076 PHONE: (410) 859 - 4300 FAX: (410) 859 - 4324

12 SHEET 13

CHECKED BY: DMA

W.O. NO.: 06-26.14

AS SHOWN

#### Retaining Wall Specifications and Guidelines Part 1: General 1.01 Description A. Retaining walls must be constructed under the supervision of a Maryland Registered Professional Engineer. B. Work includes preparation of foundation soils, furnishing all materials, and installing all materials to the lines and grades shown on the construction drawings. -MIN 4 FT FENCE POST (DESIGNED BY OTHERS) 1.02 Codes and Standards A. "International Building Code - 2012", International Code Council, Inc. B. "ACI Manual of Concrete Practice - Parts 1 Through 5 - 2012" C. 'Manual of Standard Practice' - Concrete Steel Reinforcing Institute D. "American Society for Testing and Materials" 1.03 Damage, Storage, and Handling A. The Contractor shall check the materials upon delivery to assure that the proper materials have been received. B. The Contractor shall properly handle and store the materials to prevent damage to the materials. Damaged materials shall not be incorporated into the wall. 1.04 Quality Assurance A. The Owner shall engage a qualified testing agency to provide observation and testing services as described below. B. Concrete Placement . The agency shall inspect the formwork and reinforcing steel placement for compliance with the contract documents. Reinforcing steel should be inspected for correct size, quantity, and spacing. 2. Fresh concrete shall be sampled in accordance with ASTM C 172, and tested for slump, air entrainment, and temperature. 3. Test cylinders shall be molded in accordance with ASTM C 31. Four test cylinders shall be molded for each day's pour, or for every 50 cubic yards of concrete placed, whichever is greater. 3.500 PSI CONC .-C. Fill Placement 1. All soil fills shall be tested in accordance with ASTM D 2922. 2. A minimum of one compaction test per lift should be made per 2,500 square feet of fill lift area, but not fewer than two tests per lift should be made. 3. The elevations and locations of the field density tests should be clearly identified at the time of fill placement and compaction. #6 @ 10" O.C. — 12" MAX Part 2: Materials 2.01 Concrete A. Concrete shall conform to Virginia Department of Transportation, State Highway Administration Standard Specifications for Construction and Materials, Section 414 2.5" CLR -B. Concrete shall have a minimum 28-day compressive strength of 3,500 psi. **VARIES** C. Concrete shall have a slump range of 2 to 5 inches and shall be air entrained to 6% (+/- 1%) by volume. D. Concrete shall have a minimum density of 145 pcf and a maximum water-to-cement ratio of 0.45 (SEE PROFILE) 2.02 Steel Reinforcement #5 @ 18" O.C.— - MIRADRAIN 6200 A. Steel reinforcing shall conform to ASTM A-615, Grade 60. B. Submit shop drawings at least 15 business days before date reviewed submittals will be needed. Shop drawings shall bear the contractor's stamp of approval which shall constitute that he has verified all field measurements, construction criteria, materials, and similar data, and has checked each drawing for completeness, coordination, and compliance with contract documents. 4" WEEP HOLE 2.03 Soil Backfill @ 8' O.C. A. Material should consist of soil classified as SM, SC, or more granular, in accordance with ASTM D 2487. B. Material should have no particle larger than 2.5 inches and shall contain at least 30 percent, by weight, retained on the U.S. No. 200 sieve. MIN LAP 30" C. Materials should have a Liquid Limit less than 40, and a Plasticity Index less than 15. — #5 @ 18" O.C. LOW SIDE GRADE D. Material should have a minimum friction angle of 28 degrees. E. The Contractor should submit samples of the proposed backfill soils to the Geotechnical Engineer of Record for approval prior to their use. 2.04 Drainage Board - EMBEDMENT VARIES A. Drainage board used behind the walls shall consist of Miradrain 6200. (SEE PROFILE, 30" MIN) Part 3: Construction \_#6 @ 12" O.C. 3.01 General A. All existing underground utilities shall be properly marked, and relocated if necessary, prior to construction. B. All proposed underground utilities or structures in the general wall area shall be completely installed prior to the construction of the wall. #5 @ 18" O.C. C. Protect all existing and/or new structures from damage by construction equipment. Immediately repair any damage that may occur. 3.02 Foundation A. The wall foundation shall be excavated to the grades and lines as shown on the construction drawings. Contractor should take care not to disturb foundation soils beyond the lines and grades shown, B. The foundation shall bear at the minimum embedment depths indicated, as measured from the final grade at the front of the wall. C. The foundation subgrade soils shall be testing by a qualified representative of the Geotechnical Engineer to verify the availability of the design bearing pressure of 3,000 psf. D. If unsuitable soils are encountered at design foundation levels, the unsuitable soils shall be removed and the over-excavated areas shall be replaced with compacted structural fill. 3.03 Steel Reinforcement A. All steel reinforcing shall have a minimum clear cover of 2.5 inches unless otherwise noted on the contract documents. B. Where applicable, splices for reinforcing steel shall be made by contact tension lap splices. C. Welding and field-bending of reinforcing steel is not permitted. D. Furnish all accessories, chairs, space bars, supports, etc. necessary to secure reinforcing. TYPICAL WALL SECTION 3,04 Cast-In-Place Concrete. A. Footing Concrete 1. The vertical faces of the footing and key excavation may be used as forms for placement of foundation concrete. 2. Foundation concrete, or protective mud mats, should be placed the same day that the foundation subgrade is approved. 3. Provide concrete protection against freezing during placement and for 5 days thereafter. B. Wall Concrete 1. Furnish and erect concrete forms to the lines and grades shown on the construction drawings. 2. Locate construction joints as to not impair the strength of the structure, but not more than 60 feet in any direction. Provide continuous bentonite strip waterstrip at all construction joints. ONNER/DEVELOPER 3. Make stops in concrete pours using vertical bulkheads. U.S. HOME CORPORATION 4. All reinforcing shall be continuous through joints and bulkheads. **OWNER/DEVELOPER** C/O UOSEAH PORTINO 5. Chamfer exposed concrete corners 3/4" by 3/4" minimum. 6. Provide 4" diameter weep holes every 8 feet along the bottom of the wall and at wall ends. The weep holes should be formed in place prior to concrete placement by using PVC pipe. Weep hole locations must not interfere with steel reinforcing, and shall be no greater than 4 inches above final grade at the front of the wall. 10211 WINCOAN CIRCLE BLUE STREAM LLC P.O. BOX 416 7. Where a fence is required, it is recommended that the fence posts be installed during wall concrete placement. The fence posts shall have a minimum of 24 inches of embedment into the wall, and be located along the center of the wall. Alternatively, provide 4 inch diameter by 24 inch deep post holes at the designated fence post locations along the centerline of the wall. The post COLUMBIA, MARYLAND 21044 ELLICOTT CITY, MD 21041 C/O: ARNOLD SAGNER 410 465 2020 410-997-5522 holes should be formed in place prior to concrete placment by using PVC pipe. 3.05 Backfilling A. All soil backfill shall conform to the material requirements of section 2.03. B. Backfill shall be moisture conditioned to within 2 percentage points of the optimum moisture content, as determined in accordance with ASTM D-698. BEND REINFORCING STEEL C. Backfill shall be placed in loose lifts, not exceeding 8 inches in thickness, and then compacted to at least 95 percent of the maximum dry density, as determined in accordance with ASTM D-698. TO BOTTOM OF LOWER FOOTING D. Backfilling shall not occur against the wall until the wall concrete has attained at least 75 percent of the 28-day design strength, and no earlier than 3 days after placement. REVIEW PLAN TO ADD A 4'HIGH ORNAMENTAL WALL AND A 6'HIGH 12/21/16 E. Where feasible, maintain equal grades on each side of the wall during backfilling to prevent overturning and lateral movements. When the grade differential at PRIVACE FERVE TO THE SOUCHEASTERN PROPERTY LINE REVISION the wall exceeds 12 inches, only hand-operated compaction equipment shall be allowed. F. Brainage boards shall be placed against the wall, extending from the weep hole up within 12 inches of final grade at the top of the wall. NORMAL REINFORCING STEEL TOP AND BOTTOM (TYP) **RETAINING WALL DETAILS & SECTIONS** A. Final grades at the wall shall be established by the Contractor in the field. B. Final grades shall be stabilized and seeded per the approved civil plans unless noted otherwise on the site grading plans. C. Install a 4 ft fence at the top of the wall. If fence posts are installed subsequent to wall construction, the fence posts shall be grouted into the PVC post holes using 3,000 psi non-shrink grout, **BLUE STREAM TOWNS - SECTION 2** -4"x8" KEY • CONSTRUCTION JOINT BLUE STREAM LOTS 1-103, AND OPEN SPACE LOT 104 A RE-SUBDIVISION OF BUILDABLE BULK PARCEL L TAX MAP 43 GRID 4 1ST ELECTION DISTRICT HOWARD COUNTY, MARYLAND 340 CHARWOOD ROAD ADDITIONAL #5 BAR HANOVER, MARYLAND 21076 PHONE: (410) 859 - 4300 SLOPE AS STEEP -FAX: (410) 859 - 4324 AS GROUND ALLOWS 1'-6" ROFESSIONAL CERTIFICATE APPROVED: HOWARD COUNTY DEPARTMENT OF PLANNING AND ZONING **FOOTING STEP** CHECKED BY: 5.20.15 **CONSTRUCTION JOINT** CHIEF, DEVELOPMENT ENGINEERING DIVISION HSQ NTS JANUARY 2015 NTS \_\_\_\_ AS SHOWN SCALE: W.O. NO.: <u>06-26.14</u> 13 SHEET 13 6/2/15 DATE