
50IL5 LEGEND				
50IL	NAME	CLA55		
ChC2	CHESTER SILT LOAM, Ø TO 15 PERCENT SLOPES, MODERATELY ERODED	8		
GB2	GLENELG LOAM, 3 TO 8 PERCENT SLOPES, MODERATELY ERODED	В		
G C2	GLENELG LOAM, 8 TO 15 PERCENT SLOPES, MODERATELY ERODED	В		
MIB2	MANOR LOAM, 3 TO 8 PERCENT SLOPES, MODERATELY ERODED	В		
MIC2	MANOR LOAM, 8 TO 15 PERCENT SLOPES, MODERATELY ERODED	В		
MIC3	MANOR LOAM, 8 TO 15 PERCENT SLOPES, SEVERELY ERODED	В		
Мо	MIXED ALLUVIAL LAND	Q		
M 02	MT. AIRY CHANNERY LOAM, 15 TO 25 PERCENT SLOPES, MODERATELY ERODED	A		

* HYDRIC SOILS AND/OR CONTAINS HYDRIC INCLUSIONS

** MAY CONTAIN HYDRIC INCLUSIONS † GENERALLY ONLY WITHIN 100-YEAR FLOODPLAIN AREAS

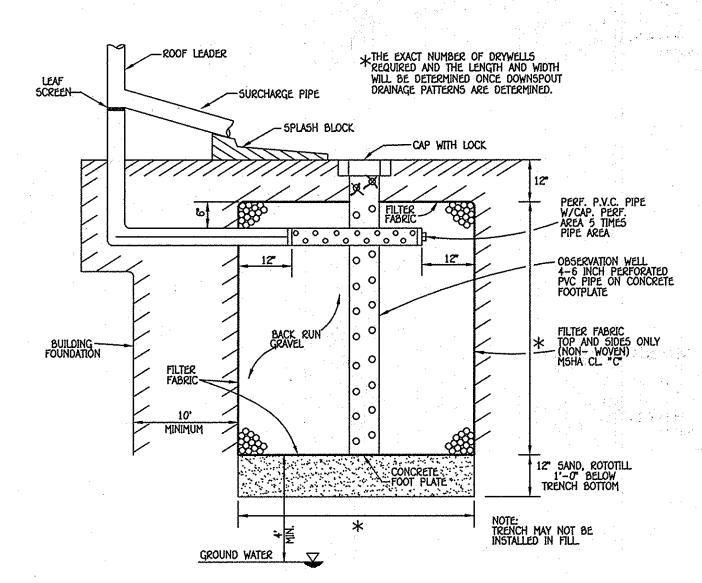

OPERATION AND MAINTENANCE SCHEDULE FOR DRYWELLS (M-5)

- A. THE OWNER SHALL INSPECT THE MONITORING WELLS AND STRUCTURES ON A QUARTERLY BASIS AND AFTER EVERY HEAVY STORM EVENT.
- B. THE OWNER SHALL RECORD THE WATER LEVELS AND SEDIMENT BUILD UP IN THE MONITORING WELLS OVER A PERIOD OF SEVERAL DAYS TO INSURE TRENCH DRAINAGE.
- C. THE OWNER SHALL MAINTAIN A LOG BOOK TO DETERMINE THE RATE AT WHICH THE FACILITY DRAINS. D. WHEN THE FACILITY BECOMES CLOGGED SO THAT IT DOES NOT DRAIN DOWN WITHIN A SEVENTY TWO (72) HOUR
- TIME PERIOD, CORRECTIVE ACTION SHALL BE TAKEN.

LEGEND

----- EXISTING CONTOUR 2' INTERVAL

×362.2 SPOT ELEVATION

WOB > PROPOSED WALKOUT

-55F-55F- SUPER SILT FENCE

PROPOSED CONTOUR 2' INTERVAL

FOREST CONSERVATION EASEMENT

EROSION CONTROL MATTING LIMIT OF DISTURBANCE

DESCRIPTION

EXISTING STREET TREE TAKEN FROM F-14-02


SYMBOL

- E. THE MAINTENANCE LOG BOOK SHALL BE AVAILABLE TO HOWARD COUNTY FOR INSPECTION TO INSURE COMPLIANCE WITH OPERATION AND MAINTENANCE CRITERIA.
- F. ONCE THE PERFORMANCE CHARACTERISTICS OF THE INFILTRATION FACILITY HAVE BEEN VERIFIED, THE MONITORING SCHEDULE CAN BE REDUCED TO AN ANNUAL BASIS UNLESS THE PERFORMANCE DATA INDICATES THAT A MORE FREQUENT SCHEDULE IS REQUIRED.

AUU	KEDD CHAKI
LOT NUMBER	STREET ADDRESS
1	9811 TENNEY COURT
2	9815 TENNEY COURT
3	9819 TENNEY COURT
. 4	9823 TENNEY COURT
5	9827 TENNEY COURT
6	9831 TENNEY COURT
7	9035 TENNEY COURT
8	9834 TENNEY COURT
9	9830 TENNEY COURT
10	9026 TENNEY COURT
11	9822 TENNEY COURT
12	9818 TENNEY COURT
13	9814 TENNEY COURT
14	9810 TENNEY COURT
15	9806 TENNEY COURT
16	9802 TENNEY COURT
17	9701 EDMOND COURT
18	9705 EDMOND COURT
19	9709 EDMOND COURT
20	9714 EDMOND COURT
21	9710 EDMOND COURT
22	9706 EDMOND COURT
23	9702 EDMOND COURT
24	OPEN SPACE
25	open space
26	OPEN SPACE
27	OPEN SPACE
28	OPEN SPACE

ADDRESS CHART

	MINIMUM LOT SIZE CHART								
	LOT NO.	LOT AREA	PIPESTEM AREA	MINIMUM LOT SIZE					
	14	10,032 5Q. FT.±	808 5Q. FT.±	9,224 5Q. FT.±					
ı	15	9,793 SQ. FT.±	Ø19 5Q. FT.±	8,974 SQ. FT.±					
I	16	10,295 SQ. FT.±	960 5Q. FT.±	9,327 5Q. FT.±					

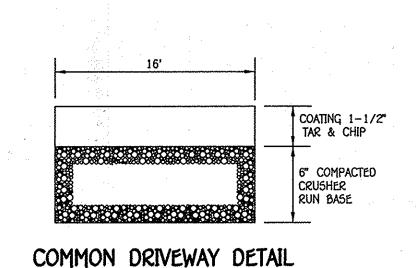

1:			12'	
			Q	
	2%		2%	
ON-SITE P-1 ENTRANCE -	PAVING SECTION GRAVEL	**. ***	NOTE: ALL MATERIALS AND CONSTRUCTION SHALL BE IN ACCORD WITH HOWARD COUNTY DESIGN MANUAL VOLUME IV, STAN	

NOT TO SCALE

TYPICAL PRIVATE DRIVE CROSS SLOPE SECTION

NOT TO SCALE


SPECIFICATION AND DETAILS FOR CONSTRUCTION.

HOWARD COUNTY MD. DEPT OF RECREATION AND PARKS HOWARD COUNTY LIBER 005, FOLIO 70 OPEN SPACE LOT 25 TAX MAP 30, PARCEL 10 ZONED R-20 NON-CREDIT OPEN SPACE-NON-CREDIT OPEN SPACE-0.05 AC. LOT 4 NON-CREDIT OPEN SPACE-0.02 AC. OPEN SPACE BULK PARCEL 'B' (FUTURE SECTION TWO) BULK PARCEL 'A'
(FUTURE SECTION TWO) OVERVIEW MAP

	INDEX CHART	
SHEET	DESCRIPTION	
SHEET 1	TITLE SHEET, GENERAL NOTES, LEGEND, SOILS LEGEND STORMWATER MANAGEMENT DETAILS & OVERVIEW MAP	
SHEET 2	HOUSE TYPES & GENERIC BOXES	-
SHEET 3	SITE DEVELOPMENT PLAN, LOTS 1 THRU 23	
SHEET 4	SEDIMENT/EROSION PLAN, LOTS 1 THEU 23	
SHEET 5	SEDIMENT/EROSION CONTROL DETAILS & NOTES	

BENCH MARKS T.P. 24GE ELEV 446.44 N. 578,706,500 E. 1,352,699,713 LOC. NEAR INTERSECTION OF OLD ANNAPOLIS ROAD & GYWNN PARK DRIVE

T.P. 308A ELEV. 397.14 N. 573.149.094 E. 1,357,083,174 LOC. NEAR INTERSECTION OF COLUMBIA ROAD & MD. RTE. 100

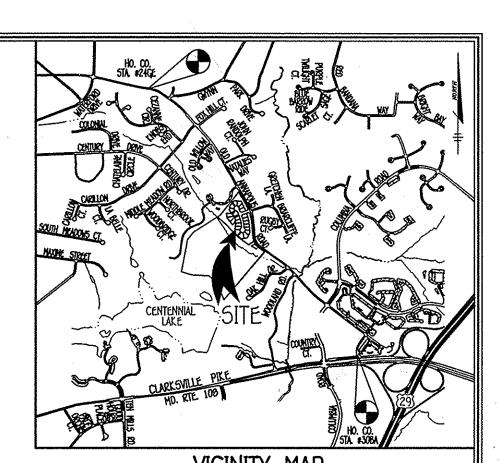

VICINITY MAP SCALE: 1" = 2000' HO. CO. ADC MAP NO. 11, H-13 & J-13

GENERAL NOTES:

SUBJECT PROPERTY ZONED R-20 PER 10/06/13 COMPREHENSIVE ZONING PLAN. 2. THE CONTRACTOR SHALL NOTIFY THE CONSTRUCTION INSPECTION DIMSION AT (410)313-1880 AT LEAST (5) WORKING DAYS PRIOR TO THE START OF WORK.

3. THE CONTRACTOR SHALL NOTIFY "MISS UTILITY" AT 1-800-257-7777 AT LEAST 48 HOURS PRIOR TO ANY EXCAVATION WORK. THIS PLAN IS BASED ON A FIELD RUN MONUMENTED BOUNDARY SURVEY PERFORMED BY FISHER, COLLINS & CARTER, INC. ON JANUARY, 2012

TOPOGRAPHY SHOWN IS BASED ON FINAL ROAD CONSTRUCTION, GRADING AND STORMWATER MANAGEMENT PLANS F-14-002. 6. HORIZONTAL AND VERTICAL CONTROL DATUM IS BASED ON NAD 83, MARYLAND COORDINATE SYSTEM AS PROJECTED BY HOWARD COUNTY GEODETIC CONTROL STATIONS.

HOWARD COUNTY MONUMENT 24GE N 570,706.5244, E 1,352,699.6600 ELEVATION 445.695 HOWARD COUNTY MONUMENT 30BA N 573,149.0939, E 1,357,003.1735 ELEVATION 397.14024 7. IN ACCORDANCE WITH SECTION 128 OF THE HOWARD COUNTY ZONING REGULATIONS, BAY WINDOWS, CHIMNEYS OR EXTERIOR STAIRWAYS NOT MORE THAN 16 FEET IN WIDTH MAY

PROJECT NOT MORE THAN 4 FEET INTO ANY SETBACKS. PORCHES, OR DECKS, OPEN OR ENCLOSED MAY PROJECT NOT MORE THAN 10 FEET INTO THE FRONT OR REAR YARD SETBACK. DISTANCES SHOWN ARE BASED ON SURFACE MEASUREMENT AND NOT REDUCED TO NAD '83 GRID MEASUREMENT.

THERE ARE NO EXISTING DWELLING/STRUCTURE(S) LOCATED ON THIS SITE TO REMAIN. 10. NO CEMETERIES EXIST ON THIS SITE BASED ON BOTH A SITE VISIT AND AN EXAMINATION OF THE HOWARD COUNTY CEMETERY INVENTORY MAP.

11. PREVIOUS DEPARTMENT OF PLANNING AND ZONING FILE NOS.: ECP-12-053, WP-13-096, 5P-13-004, PB-399, AND F-14-002. 12. PROPERTY IS LOCATED IN METROPOLITAN DISTRICT AND IS SERVED BY PUBLIC WATER AND PUBLIC SEWER (CONTRACT NO. 24-4763-D)

13. THE LANDSCAPE REQUIREMENTS FOR THIS PROJECT WERE PREVIOUSLY ADDRESSED UNDER F-14-002. See Note No. 30.

14. THE FOREST CONSERVATION REQUIREMENTS FOR THIS PROJECT WERE PREVIOUSLY ADDRESSED UNDER F-14-002. See Note No. 31.

15. NO GRADING, REMOVAL OF VEGETATIVE COVER OR TREES, PAVING AND NEW STRUCTURES SHALL BE PERMITTED WITHIN THE LIMITS OF WETLANDS, STREAM(5), OR THEIR REQUIRED BUFFERS, FLOODPLAIN AND FOREST CONSERVATION EASEMENT AREAS.

16. THIS PLAN CAME TO THE HISTORIC DISTRICT COMMISSION ON JUNE 7, 2012 FOR ADVISORY COMMENTS. 17. STORMWATER MANAGEMENT WILL BE PROVIDED IN ACCORDANCE WITH THE 2010 MDE, CHAPTER 5 REGULATIONS AND THE LATEST HOWARD COUNTY DESIGN MANUAL, VOL. I, CHAPTER 5

ADOPTED ON OR AROUND MAY 4, 2010 THROUGH THE USE OF DRYWELLS (M-5). DRYWELLS WILL BE OWNED AND MAINTAINED BY THE LOT OWNER WHICH THAT ANY PARTICULAR

DRYWELL IS LOCATED. ADDITIONAL SWM FACILITIES HAVE BEEN PREVIOUSLY PROVIDED BY F-14-002. 10. THE GEOTECHNICAL REPORT FOR THIS PROJECT WAS PREPARED BY HILLIS-CARNES ENGINEERING ASSOCIATES, INC. DATED AUGUST 2012 AND WAS APPROVED ON MARCH 14, 2013

19. THE TRAFFIC STUDY FOR THIS PROJECT WAS PREPARED BY TRAFFIC GROUP, INC. DATED JANUARY 2012 AND WAS AND APPROVED MARCH 14, 2013. 20. THERE IS NO FLOODPLAIN WITHIN THE LIMITS OF THIS SITE DEVELOPMENT PLAN.

21. NO NOISE STUDY IS REQUIRED FOR THIS PROJECT. 22. There are no areas of steep slopes located on this property as defined by the howard county subdivision and land development regulations, section 16.116.B. 23. FOREST STAND DELINEATION AND WETLAND DELINEATION FOR THIS PROJECT WAS PREPARED BY MCCARTHY & ASSOCIATES, INC. DATED MARCH 2012.

24. FOR FLAG OR PIPESTEM LOTS, REFUSE COLLECTION, SNOW REMOVAL AND ROAD MAINTENANCE ARE PROVIDED TO THE JUNCTION OF THE FLAG OR PIPESTEM AND ROAD RIGHT-OF-WAY LINE AND NOT INTO THE PIPESTEM LOT DRIVEWAY.

25. A TREE MAINTENANCE EASEMENT RUNNING ALONG THE EDGE OF THE PUBLIC ROAD RIGHT-OF-WAY,AS SHOWN ON THIS PLAN, IS RESERVED UPON ALL LOTS FRONTING ON THE SAID PUBLIC ROAD RIGHT-OF-WAY. THIS EASEMENT ALLOWS HOWARD COUNTY THE RIGHT TO ACCESS THE PROPERTY, WHEN NECESSARY. FOR THE SPECIFIC PURPOSES OF THE INSTALLATION, repair and maintenance of county owned trees located within the boundaries of the private lots. No building or structure of any kind shall be located on or

26. THE LOTS CREATED BY THIS SUBDIMISION PLAN AREA IS SUBJECT TO A FEE OR ASSESSMENT TO COVER OR DEFRAY ALL OR PART OF THE DEVELOPER'S COST OF THE INSTALLATION OF THE WATER AND SEWER FACILITIES, PURSUANT TO THE HOWARD COUNTY CODE SECTION 18.112. THIS FEE OR ASSESSMENT, WHICH RUNS WITH THE LAND, IS A CONTRACTUAL OBLIGATION BETWEEN THE DEVELOPER AND EACH OWNER OF THIS PROPERTY AND IS NOT IN ANY WAY A FEE OR ASSESSMENT OF HOWARD COUNTY.

27. DRIVEWAYS SHALL BE PROVIDED PRIOR TO ISSUANCE OF A USE AND OCCUPANCY PERMIT FOR ANY NEW DWELLINGS TO INSURE SAFE ACCESS FOR FIRE AND EMERGENCY VEHICLES PER THE FOLLOWING MINIMUM REQUIREMENTS:

A WIOTH-12' (16' SERVING MORE THAN ONE RESIDENCE); B. SURFACE-6" OF COMPACTED CRUSHER RUN BASE W/TAR AND CHIP COATING (1-1/2"MIN.);

C. GEOMETRY—MAX. 15% GRADE, MAX. 10% GRADE CHANGE AND MIN. 45' TURNING RADIUS; D. STRUCTURES (CULVERTS/BRIDGES)—CAPABLE OF SUPPORTING 25 GROSS TONS (H25 LOADING); E. DRAINAGE ELEMENTS-CAPABLE OF SAFELY PASSING 100-YEAR FLOOD WITH NO MORE THAN 1 FOOT DEPTH OVER DRIVEWAY SURFACE;

. STRUCTURE CLEARANCES - MINIMUM 12 FEET: G. MAINTENANCE-SUFFICIENT TO INSURE ALL WEATHER USE.

28. SERVICE CONNECTIONS A. WHC: 1 & W/ 1" OUTSIDE METER SETTING.

29. HOMEOWNERS ASSOCIATION COVENANTS AND RESTRICTIONS WERE RECORDED WITH F-14-002 IN THE LAND RECORDS OF HOWARD COUNTY, MARYLAND, ON MAY 1, 2014. 30. PERIMETER LANDSCAPING, STREET SIDE PLANTINGS AND TRASH PAD SCREENING FOR THESE LOTS SHALL BE AS SHOWN ON THE APPROVED LANDSCAPE PLAN SHEET OF THE ROAD CONSTRUCTION

DRAWINGS FOR F-14-002. SURETY HAS BEEN PROVIDED WITH THE DEVELOPERS AGREEMENT FOR F-14-002. 31. FOREST CONSERVATION REQUIREMENTS FOR THE ENTIRE SUBDIMISION HAVE BEEN FULFILLED UNDER F-14-002 BY PROVIDING 3.82 ACRES OF ON-SITE RETENTION, 5.14 ACRES OF REFORESTATION

AND 0.14 ACRES OF AFFORESTATION. SURETY WAS POSTED WITH THE DEVELOPERS AGREEMENT FOR F-14-002. 32. THIS SUBDIMISION HAS BEEN DEVELOPED IN ACCORDANCE WITH SECTION 107,0.0F THE R-ED ZONING REGULATIONS.

33. USE-IN-COMMON MAINTENANCE AGREEMENT FOR LOTS 14 TO 16 HAVE BEEN RECORDED IN THE LAND RECORDS OFFICE OF HOWARD COUNTY, MARYLAND AS LIBER 15564, FOLIO 108, ON APRIL 8, 2014.

34. ANY DAMAGE TO THE COUNTY'S RIGHT-OF-WAY SHALL BE CORRECTED AT THE DEVELOPER'S EXPENSE

35. SHC ELEVATIONS SHOWN ARE LOCATED AT THE PROPERTY LINE. 36. FOR DRIVEWAY ENTRANCE DETAILS REFER TO THE HOWARD COUNTY DESIGN MANUAL, VOLUME IV, STANDARD DETAIL R-6.05.

37. In accordance with section 128.0 of the hombo county zoning regulations, bay windows, chimides, or exterior statements not more than 10 febt in width may project not more than 10 febt in width may project not more than 10 febt into the front or rear yard setback. Section 128.1.1 of the zoning regulations (CB-2-2012) allows sunrous and room extensible to extend not more than 10 febt into the rear setback mong not more than 60 % of the rear bace of a dwelling on a lot which arigins oven sections of the rear setback mong not more than 60 % of the rear bace of a dwelling on a lot which arigins oven section and majority of the rear lot line for R-ED lots recorded after the effective date of CB-2-2012 (May 13, 2012).

SITE ANALSIS DATA CHART

A. TOTAL AREA OF SITE = 4.524 AC.±. . TOTAL AREA OF THIS SUBMISSION = 4.524 AC.± LIMIT OF DISTURBED AREA = 4.524 AC.+ PRESENT ZONING DESIGNATION = R-20 E. PROPOSED USE: SINGLE FAMILY DETACHED FLOOR SPACE ON EACH LEVEL OF BUILDING: N/A

H. TOTAL NUMBER OF UNITS: 23 UNIT TOTAL NUMBER OF PARKING SPACES REQUIRED (2.5 x 23) = 58 SPACES

K. TOTAL NUMBER OF PARKING SPACES PROVIDED = 92 SPACES (EACH LOT HAS 2 SPACES IN DRIVEWAY AND A 2 CAR GARAGE)


L. OPEN SPACE ON SITE: N/A M. BUILDING COVERAGE OF SITE: 20% O. PREVIOUS HOWARD COUNTY FILES: ECP-12-053, WP-13-096, SP-13-004,

P8-399, AND F-14-002.

P. TOTAL AREA OF FLOODPLAIN: 0.00 AC+

Q. TOTAL AREA OF SLOPES IN EXCESS OF 25% = 0.000 AC+ AREA OF WETLANDS = 0.00 AC.*

AREA OF FOREST = 0.00 AC.+ IMPERVIOUS AREA = 1.69 AC.+

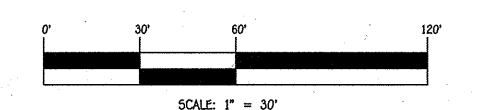

FISHER, COLLINS & CARTER, INC. CIVIL ENGINEERING CONSULTANTS & LAND SURVEYORS VOLLARF OFFICE PARK - 10272 BALTIMORE NATIONAL PIK ELLICOTT CITY, MARYLAND 21042 (410) 461 - 2055

1 ADD SOIL CONDERVATION NOTED - STOCKPILE AREA 19/12/14
1 REMOVED "PEMBROKE" MODEL AND ADD "PEMBROOKE III" MODEL 12/12/14 NADO SOIL CONSERVATION NOTES - STOCKPLE AREA MUSICAL NOTE NO. 37 ADDED 141414 DATE



PROFESSIONAL CERTIFICATION Hereby Certify that these documents were prepared or approved by me and that I AM A DULY LICENSED PROFESSIONAL SURVEYOR UNDER THE LAWS OF THE STATE OF MARYLAND, LICENSE NO. 21476, EXPIRATION DATE: 7/14/15.

OWNER	BUILDER
3 R'S AND AN I DEVELOPMENT COMPANY LLC 5300 DORSEY HALL DR. SUITE 102 ELLICOTT CITY, MARYLAND 21042 443-367-0420	BEAZER HOMES CORP 8965 GUILFORD ROAD SUITE 209 COLUMBIA, MARYLAND 21046 410-720-5071


•	APPROVED:	HOWARD COUNT	IY DEPARTM	1ENT	OF PLANN	ING AND	ZONIN	G	
	Vete	on of Land De	Q. Valanmant	Δ.			<u>. [C</u>	0-02-14 Date	
	Chal &	ppment Engine				4		Date Date	
	man	· 1	Lengl	4	oning SECT	7/ TON	4	Date LOTS NO.	
		LAKE OVERLOG	OK.			lE.		1 THRU 23	
	PLAT	BLOCK NO.	ZONE	T.	AX/ZONE	ELEC. D	IST.	CENSUS TR.	1
	22771-22779	2	R-20		30	5ECON	lD	6023.05	
	WATER CODE	· · · · · · · · · · · · · · · · · · ·		5EV	VER CODE				1
	E-15			76	40000				


TITLE SHEET


CENTENNIAL LAKE OVERLOOK SECTION ONE

LOTS 1 THRU 23, OPEN SPACE LOTS 24 THRU 28 & BUILDABLE BULK PARCELS 'A' AND 'B' PREVIOUS HOWARD COUNTY FILES: ECP-12-053, WP-13-096, 5P-13-004, PB-399, F-14-002 AND CONTRACT NO. 24-4763-D TAX MAP NO.: 30 PARCEL NO.: 86 GRID NO.: 2 SECOND ELECTION DISTRICT HOWARD COUNTY, MARYLAND

SCALE: AS SHOWN DATE: JULY, 2014 SHEET 1 OF 5 50P 15-003

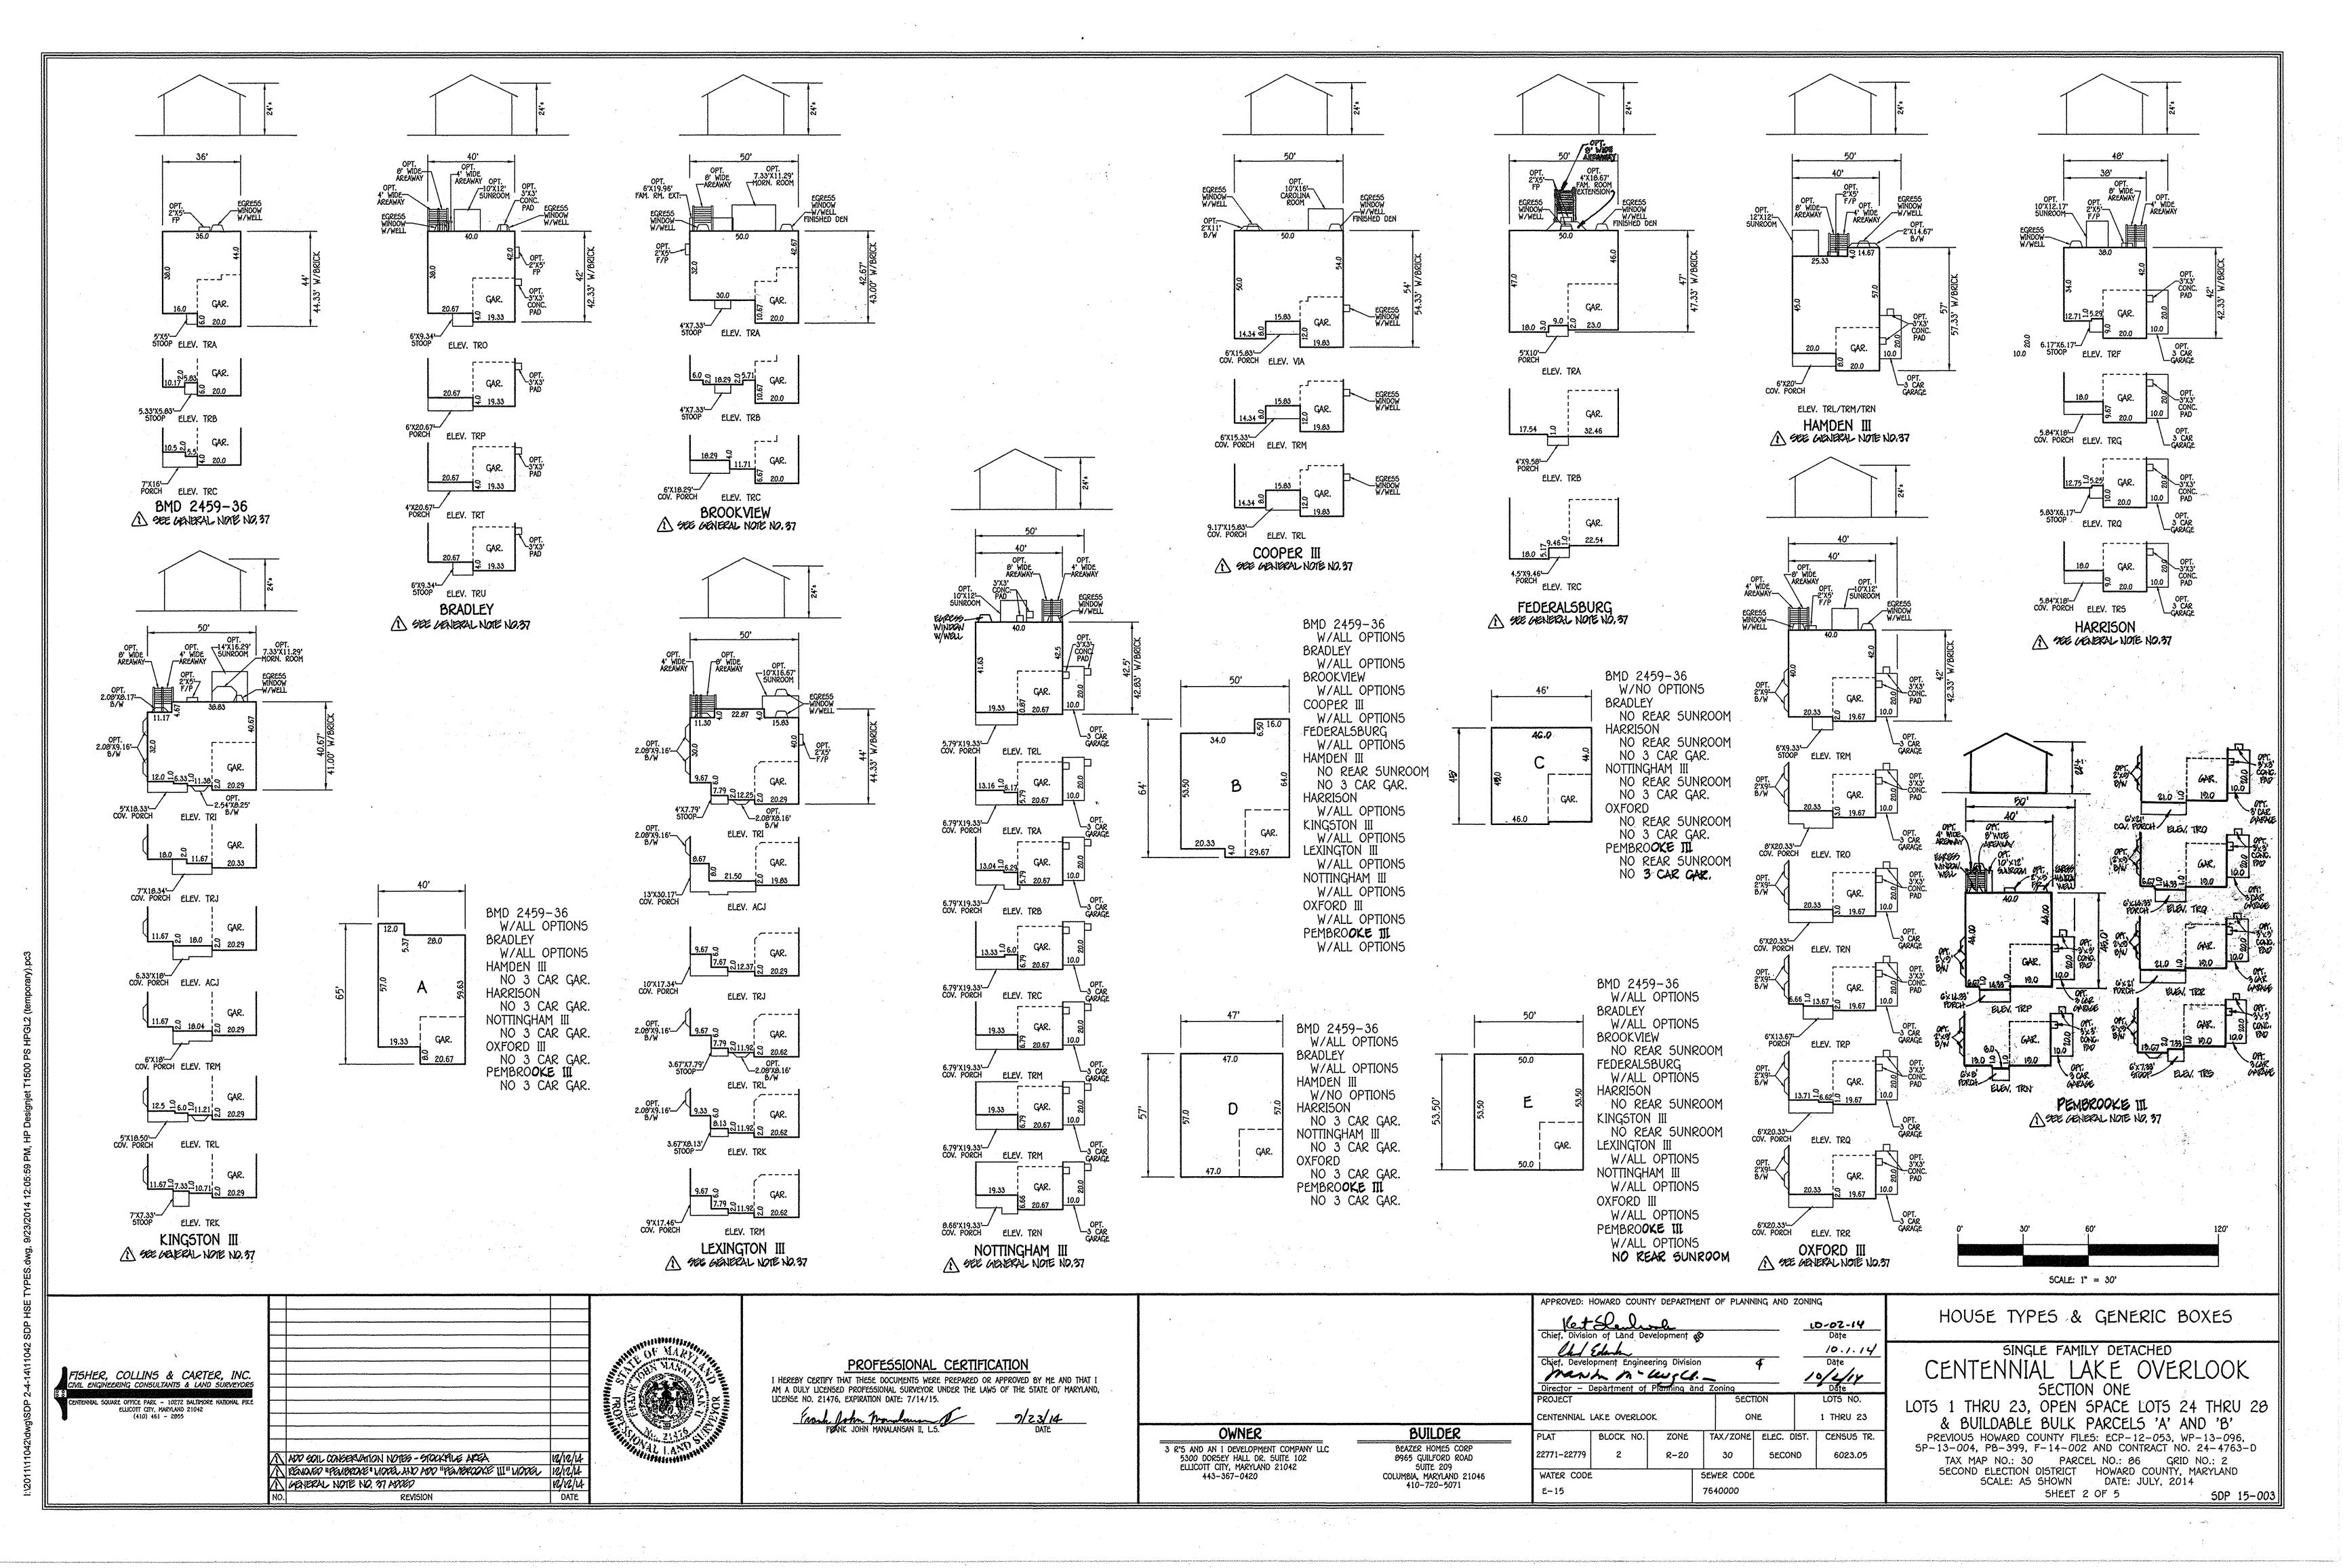

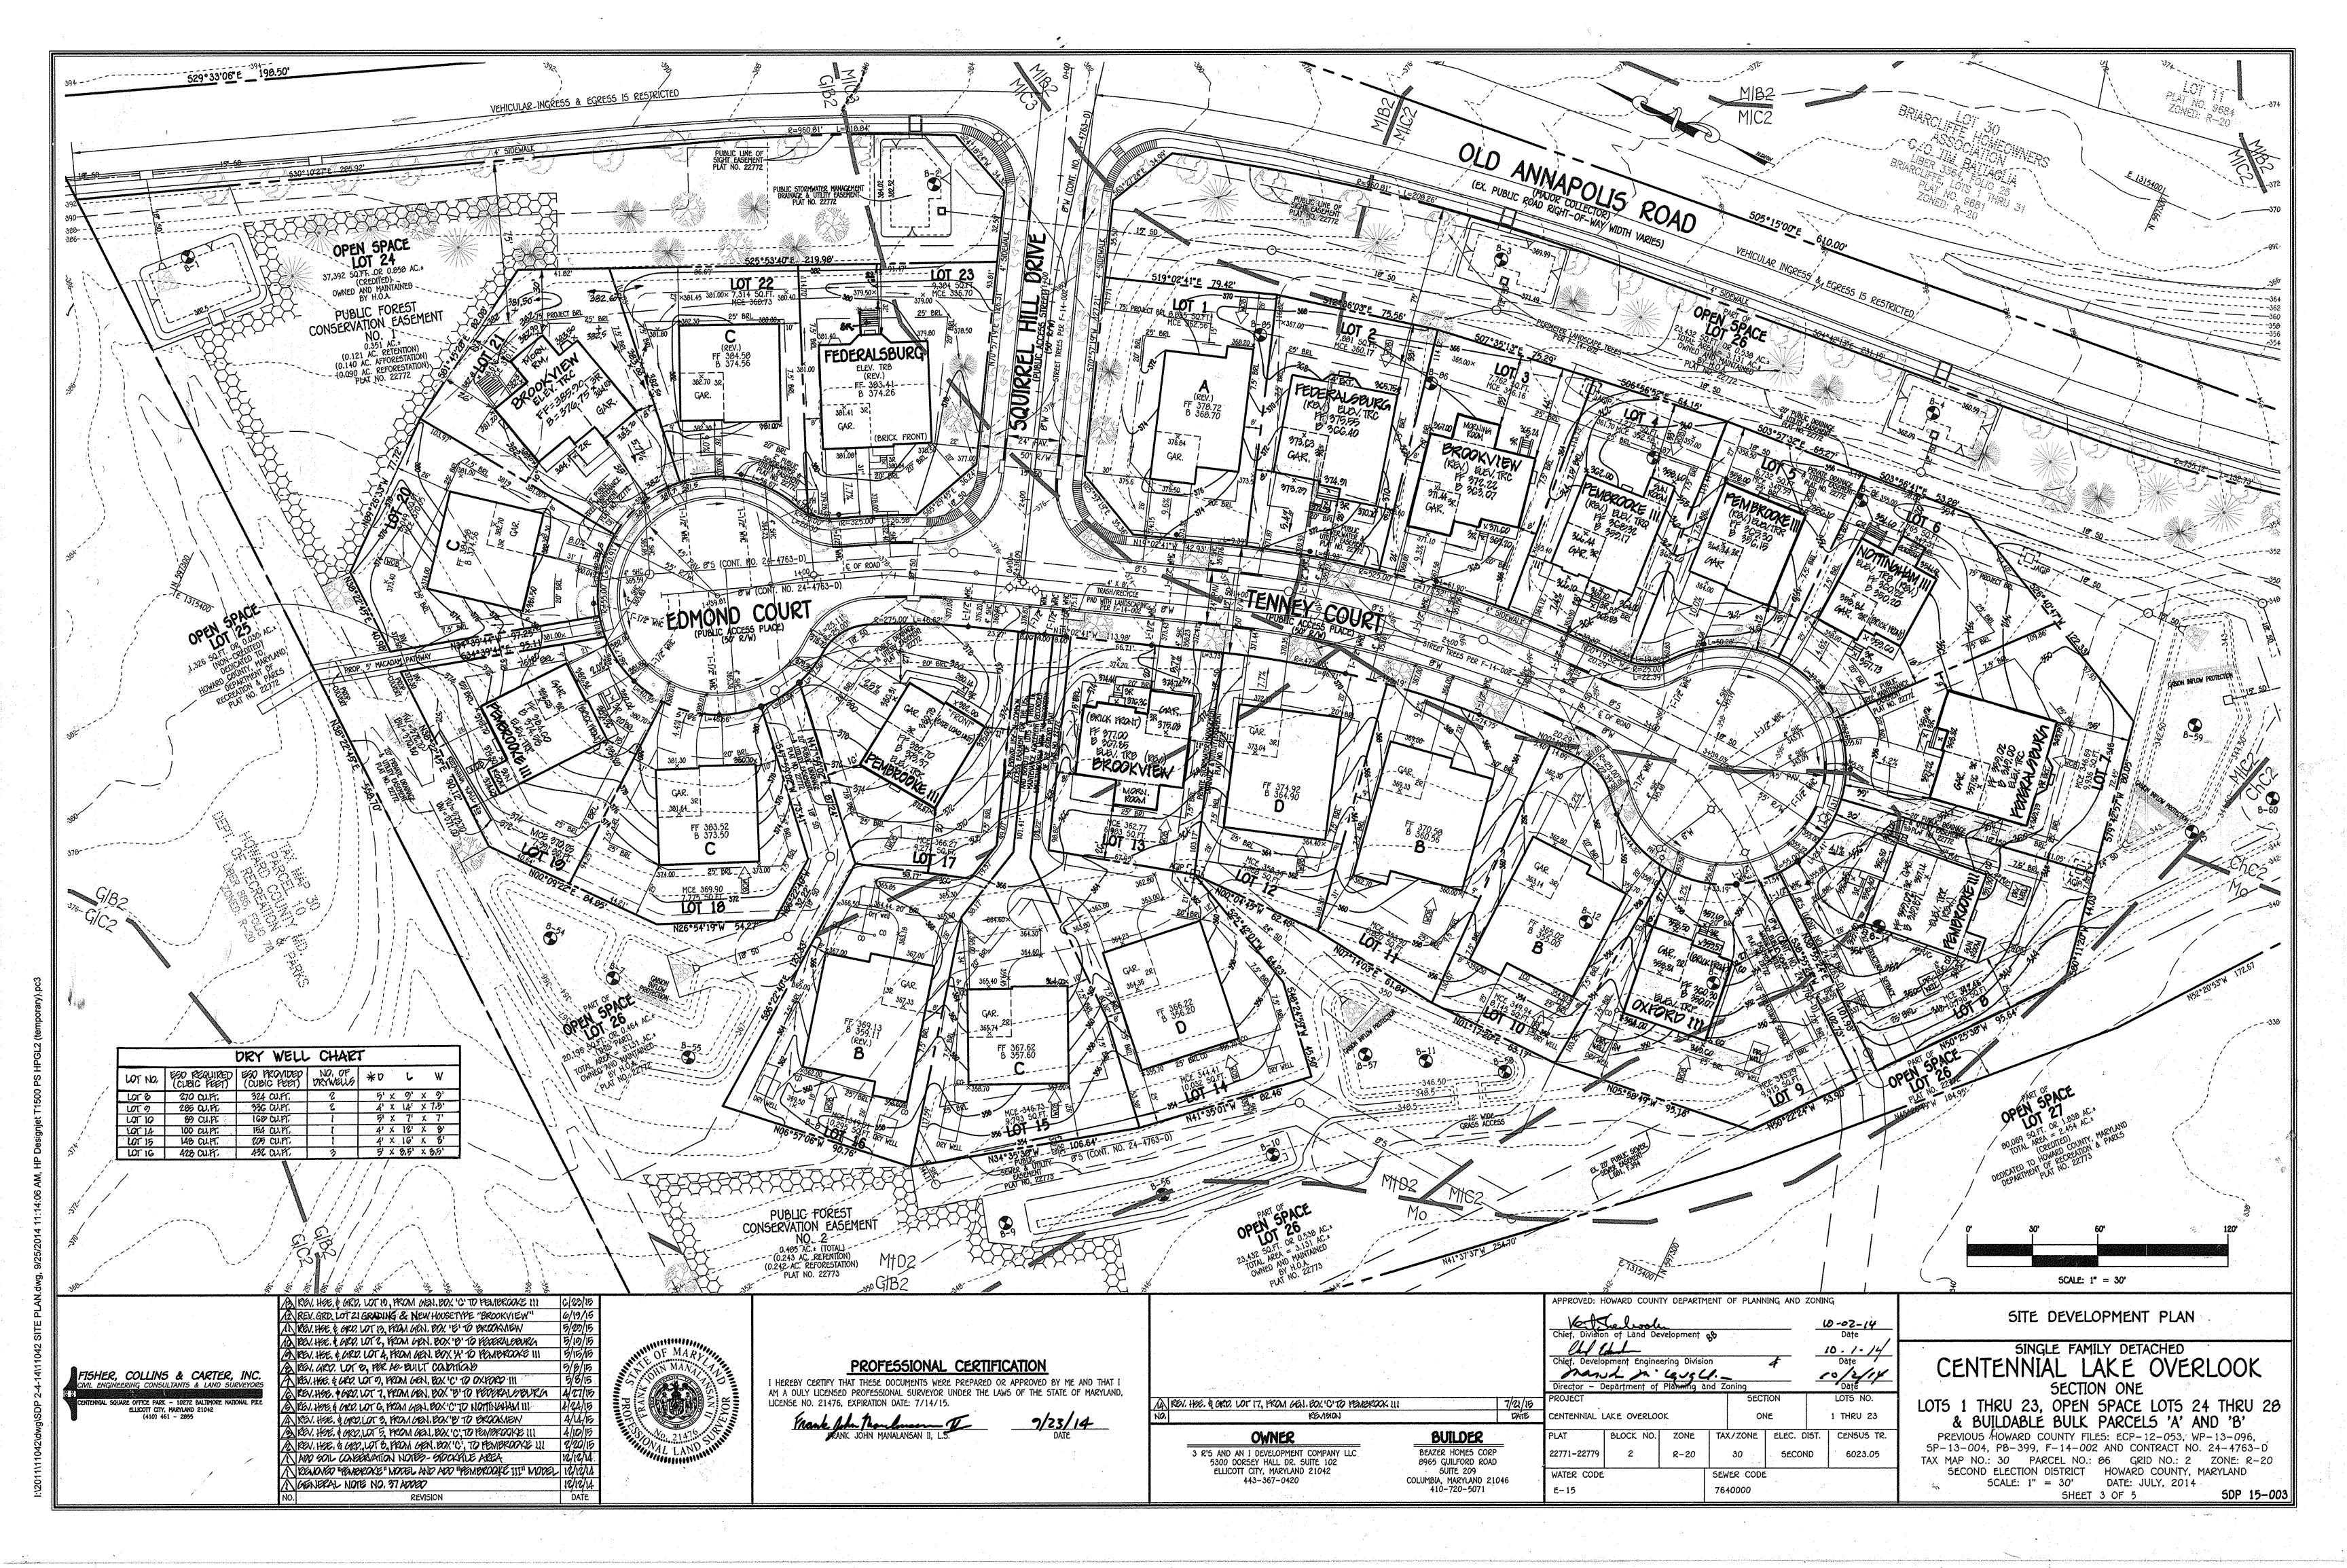

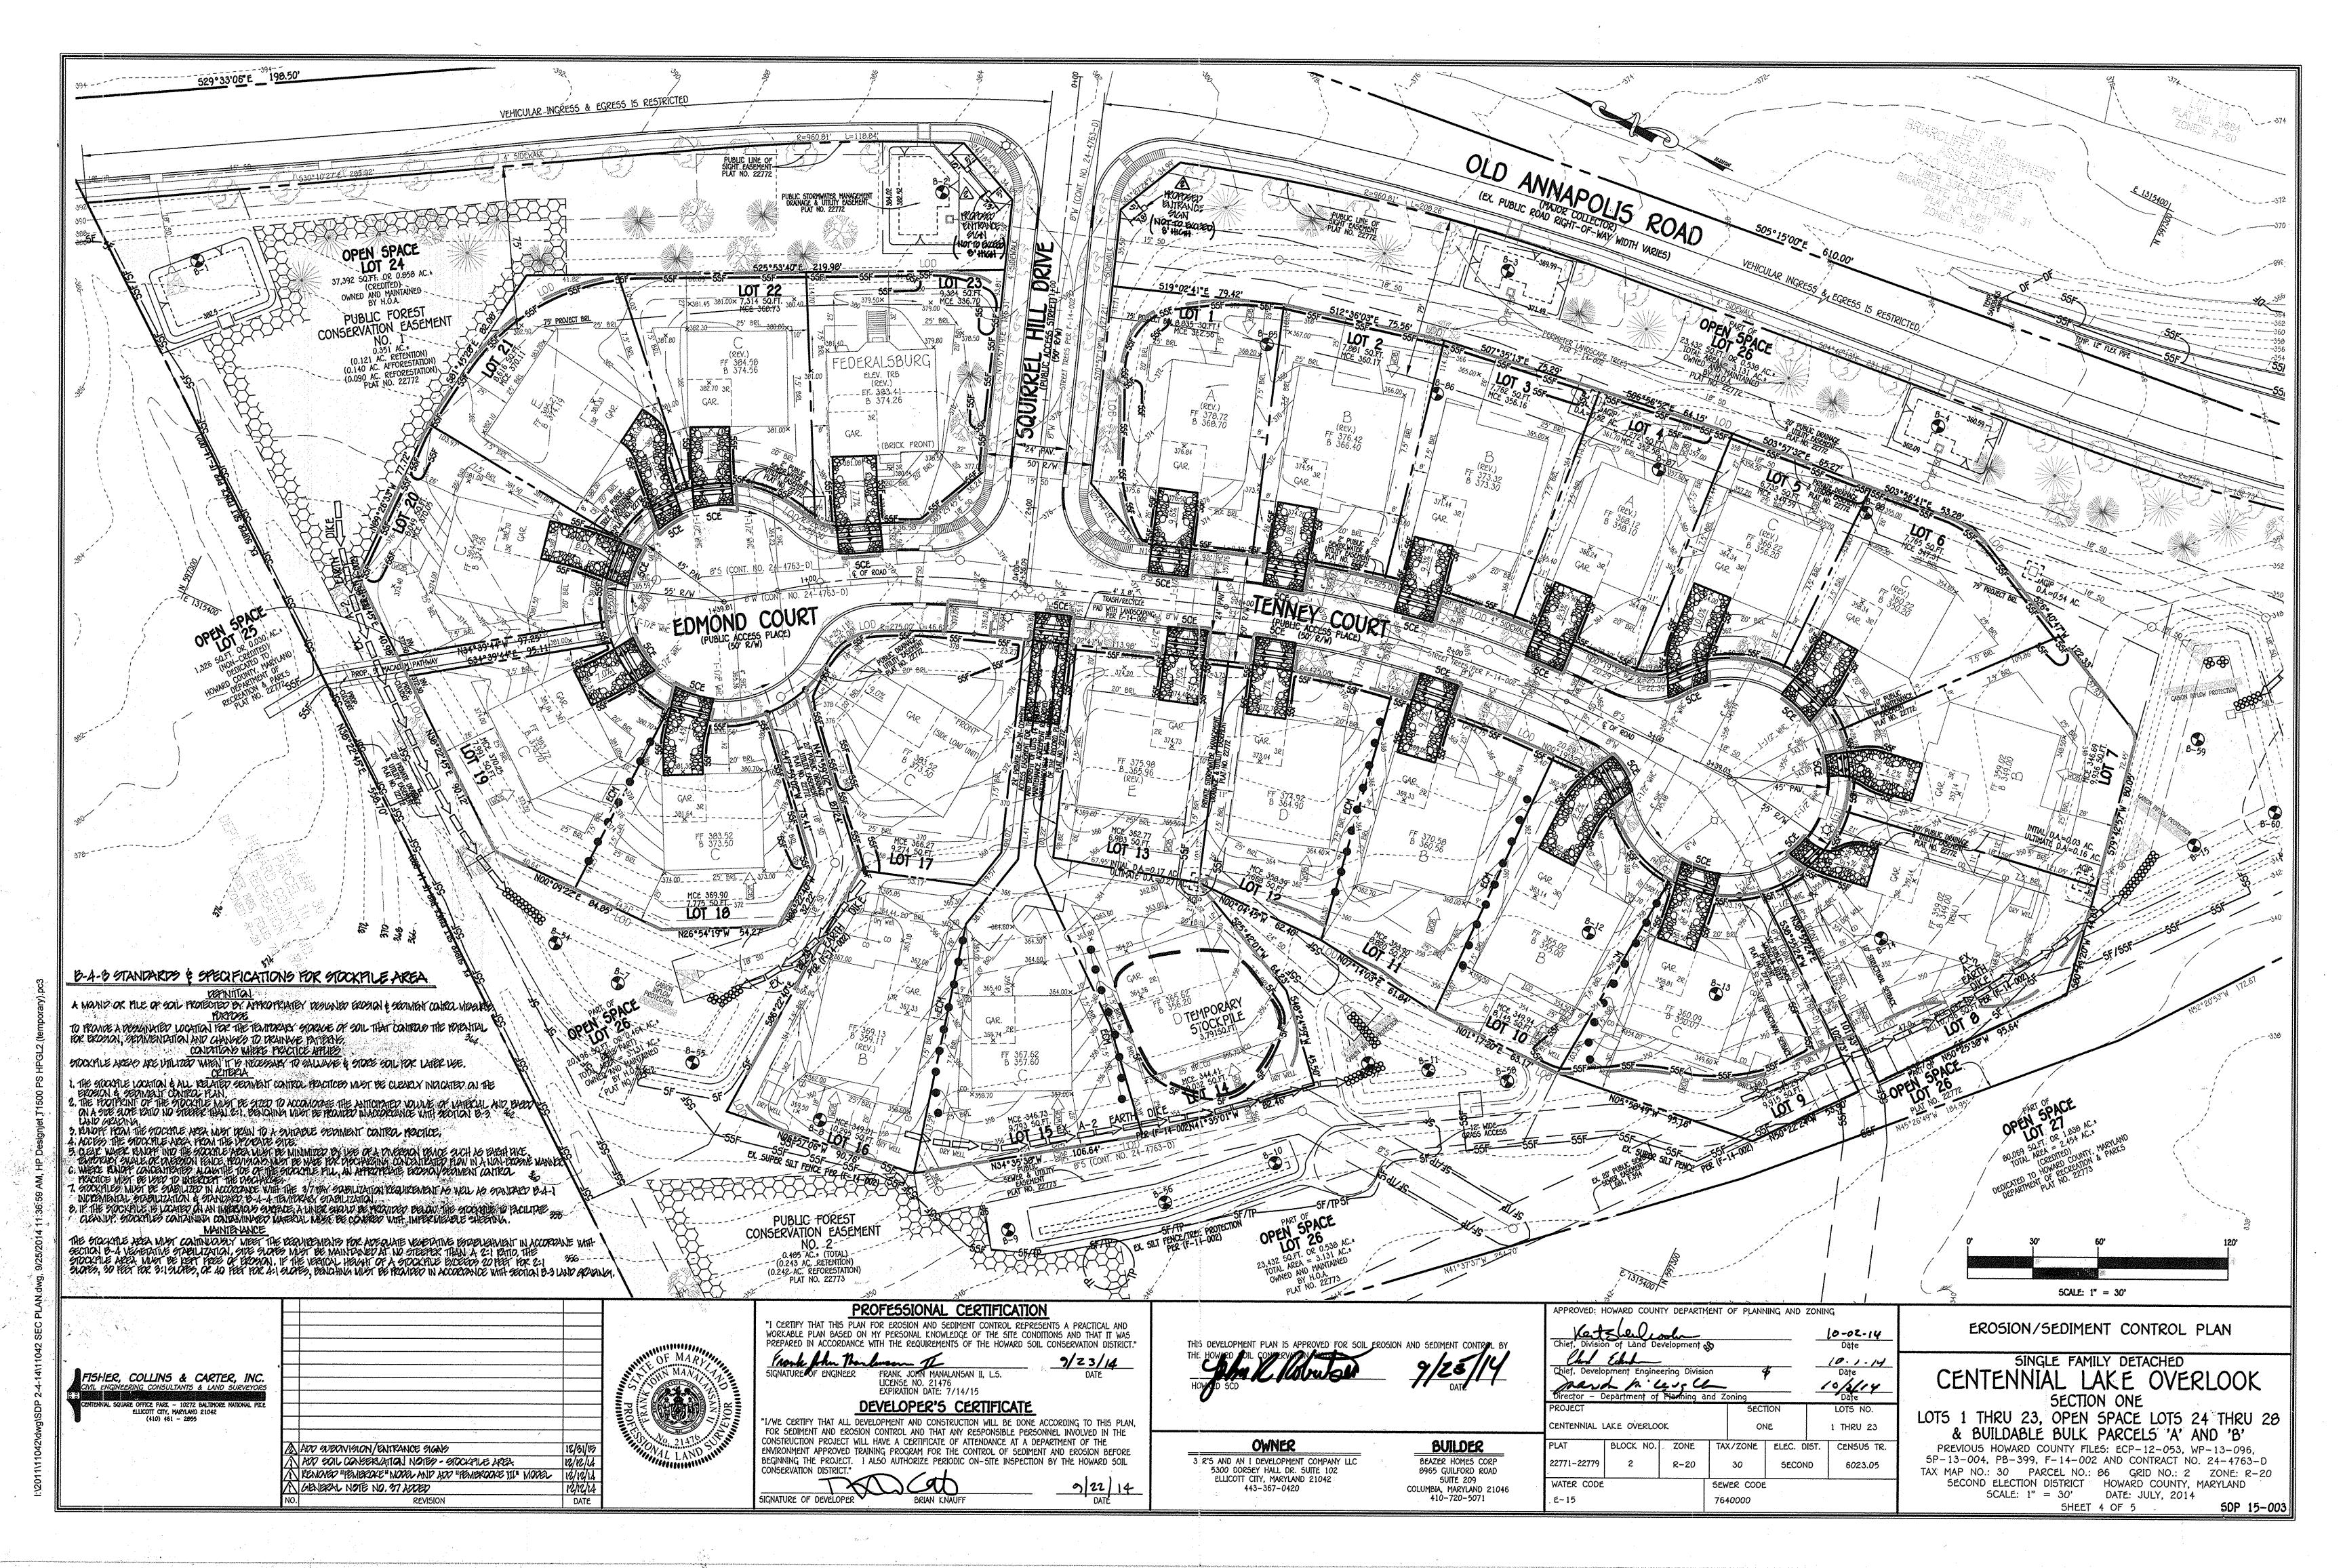

1. TEMPORARY STABILIZATION A SEEDBED PREPARATION CONSISTS OF LOOSENING SOIL TO A DEPTH OF 3 TO 5 INCHES BY MEANS OF SUITABLE AGRICULTURAL OR CONSTRUCTION EQUIPMENT. SUCH AS DISC HARROWS OR CHISEL PLOWS OR RIPPERS MOUNTED O construction equipment. After the soil is loosened, it must not be rolled or dracged smooth but

B. APPLY FEXTILIZER AND LIME AS PRESCRIBED ON THE PLANS. C. Incorporate lime and fertilizer into the top 3 to 5 inches of soil by disking or other suitable means. DEPMANENT STABILIZATION LA SOIL TEST IS REQUIRED FOR ANY EARTH DISTURBANCE OF 5 ACRES OR MORE. THE MINIMUM SOIL CONDITIONS

REQUIRED FOR PERMANENT VEGETATIVE ESTABLISHMENT ARE: I. SOIL PH BETWEEN 6.0 AND 7.0. IL SOLUBLE SALTS LESS THAN 500 PARTS PER MILLION (PPM).

III. SOIL CONTAINS LESS THAN 40 PERCENT CLAY BUT ENOUGH FINE GRAINED MATERIAL (GREATER THAN 30 PERCENT SILT PLUS CLAY) TO PROVIDE THE CAPACTLY TO HOLD A MODERATE AMOUNT OF MOISTURE. AN EXCEPTION: IF LOVEGRASS WILL BE PLANTED, THEN A SANDY SOIL (LESS THAN 30 PERCENT SILT PLUS CLAY) WOULD BE

IV. SOIL CONTAINS 1.5 PERCENT MINIMUM ORGANIC MATTER BY WEIGHT v. soil contains sufficient pore space to permit adequate root penetration. s, application of amendments or topsoil is required if on-site soils do not meet the above conditions , graded areas must be maintained in a true and even grade as specified on the approved plan, then scarified or otherwise loosened to a depth of 3 to 5 inches.

D. APPLY SOIL AMENDMENTS AS SPECIFIED ON THE APPROVED PLAN OR AS INDICATED BY THE RESULTS OF A SOIL TEST e. MIX soil amendments into the top 3 to 5 inches of soil by Disking or other suitable means. Rake Lawn AREAS TO SMOOTH THE SURFACE, REMOVE LARGE OBJECTS LIKE STONES AND BRANCHES, AND READY THE AREA FOR SEED APPLICATION. LOOSEN SURFACE SOIL BY DRAGGING WITH A HEAVY CHAIN OR OTHER EQUIPMENT TO ROUGHEN TH surface where site conditions will not permit normal seedbed preparation. Track slopes 3:1 or flatter with tracked equipment leaving the soil in an irregular condition with ridges running parallel to the ontour of the slope. Leave the top 1 to 3 inches of soil loose and friable, seedbed loosening may be

1. TOPSOIL IS PLACED OVER PREPARED SUBSOIL PRIOR TO ESTABLISHMENT OF PERMANENT VEGETATION. THE PURPOSE IS TO PROVIDE A SUITABLE SOIL MEDIUM FOR VEGETATIVE GROWTH. SOILS OF CONCERN HAVE LOW MOISTURE CONTENT. LOW NUTRIENT LEVELS. LOW PH. MATERIALS TOXIC TO PLANTS, AND/OR UNACCEPTABLE SOIL GRADATION. 2. TOPSOIL SALVAGED FROM AN EXISTING SITE MAY BE USED PROVIDED IT MEETS THE STANDARDS AS SET FORTH IN THESE SPECIFICATIONS. TYPICALLY, THE DEPTH OF TOPSOIL TO BE SALVAGED FOR A GIVEN SOIL TYPE CAN BE FOUND IN THE REPRESENTATIVE SOIL PROFILE SECTION IN THE SOIL SURVEY PUBLISHED BY USDA-NRCS.

3. TOPSOILING IS LIMITED TO AREAS HAVING 2:1 OR FLATTER SLOPES WHERE: A. THE TEXTURE OF THE EXPOSED SUBSOIL/PARENT MATERIAL IS NOT ADEQUATE TO PRODUCE VEGETATIVE GROWTH. B. THE SOIL MATERIAL IS SO SHALLOW THAT THE ROOTING ZONE IS NOT DEEP ENOUGH TO SUPPORT PLANTS OR

FURNISH CONTINUING SUPPLIES OF MOISTURE AND PLANT NUTRIENTS. C. THE ORIGINAL SOIL TO BE VEGETATED CONTAINS MATERIAL TOXIC TO PLANT GROWTH. D. THE SOIL IS SO ACIDIC THAT TREATMENT WITH LIMESTONE IS NOT FEASIBLE. 1. Areas having slopes steeper than 2:1 require special consideration and design.

5. Topsoil specifications: soil to be used as topsoil must meet the following criteria: a topsoil must be a loam, sandy loam, clay loam, silt loam, sandy clay loam, or loamy sand. Other SOILS MAY BE USED IF RECOMMENDED BY AN AGRONOMIST OR SOIL SCIENTIST AND APPROVED BY THE APPROPRIATE APPROVAL AUDIORITY, TOPSON MUST NOT BE A MIXTURE OF CONTRASTING TEXTURED SUBSOILS AND MUST CONTAIN less than 5 percent by volume of cinders, stones, slag, coarse fragments, gravel, sticks, roots, trash OR OTHER MATERIALS LARGER THAN 1 1/2 INCHES IN DIAMETER.

i, topsoil must be free of noxious plants or plant parts such as bermuda grass, quack grass, johnsoi grass, nut sedge, poison my, thistle, or others as specified. TOPSOIL SUBSTITUTES OR AMENOMENTS, AS RECOMMENDED BY A QUALIFIED AGRONOMIST OR SOIL SCIENTIST AND approved by the appropriate approval authority, may be used in lieu of natural topsoil

A EROSION AND SEDIMENT CONTROL PRACTICES MUST BE MAINTAINED WHEN APPLYING TOPSOIL . Uniformly distribute topsoil in a 5 to 8 inch layer and lightly compact to a minimum thickness of 4 inches. 5preading is to be performed in such a manner that sodding or seeding can proceed with a minimum of additional soil preparation and tillage, any irregularities in the surface resulting from topsoling or other operations must be corrected in order to prevent the formation of depressions or water pockets. TOPSOIL MUST NOT BE PLACED IF THE TOPSOIL OR SUBSOIL IS IN A FROZEN OR MUDDY CONDITION, WHEN THE SUBSOIL 5 excessively wet or in a condition that may otherwise be detrimental to proper grading and seedbed

C. SOIL AMENDMENTS (FERTILIZER & LIME SPECIFICATIONS 1. SOIL TESTS MUST BE PERFORMED TO DETERMINE THE EXACT RATIOS AND APPLICATION RATES FOR BOTH LIME AND FERTILIZER ON SITES HAVING DISTURBED AREAS OF 5 ACRES OR MORE. SOIL ANALYSIS MAY BE PERFORMED BY A recognized private or commercial laboratory. Soil samples taken for engineering purposes may also

FERTILIZERS MUST BE UNIFORM IN COMPOSITION, FREE FLOWING AND SUITABLE FOR ACCURATE APPLICATION BY APPROPRIATE EQUIPMENT. MANURE MAY BE SUBSTITUTED FOR FERTILIZER WITH PRIOR APPROVAL FROM THE APPROPRIATE APPROVAL AUTHORITY, FERTILIZERS MUST ALL BE DELIVERED TO THE SITE FULLY LABELED ACCORDING TO THE APPLICABLE LAWS AND MUST BEAR THE NAME. TRADE NAME OF TRADEMARK AND WARRANTY OF THE PRODUCER. 3. LIME MATERIALS MUST BE GROUND LIMESTONE (HYDRATED OR BURNT LIME MAY BE SUBSTITUTED EXCEPT WHEN

hydroseeding) which contains at least 50 percent total oxides (calcium oxide plus magnesium oxide). LIMESTONE MUST BE GROUND TO SUCH FINENESS THAT AT LEAST 50 PERCENT WILL PASS THROUGH A #100 MESH SIEVE and 98 to 100 percent will pass through a #20 mesh sieve. I. LIME AND FERTILIZER ARE TO BE EVENLY DISTRIBUTED AND INCORPORATED INTO THE TOP 3 TO 5 INCHES OF SOIL BY DISKING OR OTHER SUITABLE MEANS

5. WHERE THE SUBSOIL IS EITHER HIGHLY ACIDIC OR COMPOSED OF HEAVY CLAYS, SPREAD GROUND LIMESTONE AT THE RATE OF 4 TO 8 TONS/ACRE (200-400 POUNDS PER 1,000 SQUARE FEET) PRIOR TO THE PLACEMENT OF TOPSOIL.

STANDARD STABILIZATION NOTE

A) THREE (3) CALENDAR DAYS AS TO THE SURFACE OF ALL PERIMETER DIKES, SWALES, DITCHES, PERIMETER SLOPES, AND ALL SLOPES STEEPER THAN 3 HORIZONTAL TO 1 VERTICAL (3:1). B.) SEVEN (7) CALENDAR DAYS AS TO ALL OTHER DISTURBED OR GRADED AREAS ON THE PROJECT SITE NOT UNDER

FOLLOWING INITIAL SOIL DISTURBANCE OR RE-DISTURBANCE, PERMANENT OR TEMPORARY STABILIZATION MUST BE

DUST CONTROL

DEFINITION CONTROLLING DUST BLOWING AND MOVEMENT ON CONSTRUCTION SITES AND ROADS.

PURPOSE TO PREVENT BLOWING AND MOVEMENT OF DUST FROM EXPOSED SOIL SURFACES, REDUCE ON AND OFF-SITE

DAMAGE, HEALTH HAZARDS AND IMPROVE TRAFFIC SAFETY. CONDITIONS WHERE PRACTICE APPLIES THIS PRACTICE IS APPLICABLE TO AREAS SUBJECT TO DUST BLOWING AND MOVEMENT WHERE ON AND OFF-SITE DAMAGE IS LIKELY WITHOUT TREATMENT

SPECIFICATIONS

COMPLETED WITHIN:

TEMPORARY METHODS I. MULCHES - SEE STANDARDS FOR VEGETATIVE STABILIZATION WITH MULCHES ONLY. MULCH SHOULD BE CRIMPED OR TACKED TO PREVENT BLOWING. VEGETATIVE COVER - SEE STANDARDS FOR TEMPORARY VEGETATIVE COVER. . TILLAGE - TO ROUGHEN SURFACE AND BRING CLODS TO THE SURFACE. THIS IS AN EMERGENCY MEASURE WHICH SHOULD BE USED BEFORE SOIL BLOWING STARTS. BEGIN PLOWING ON WINDWARD SIDE OF THE SITE. CHISEL-TYPE

PLOWS SPACED ABOUT 12" APART, SPRING-TOOTHED HARROWS AND SIMILAR PLOWS ARE EXAMPLES OF EQUIPMENT WHICH MAY PRODUCE THE DESIRED EFFECT. PRIGATION - THIS IS GENERALLY DONE AS AN EMERGENCY TREATMENT. SITE IS SPRINKLED WITH WATER UNTIL THE SURFACE IS MOIST. REPEAT AS NEEDED. AT NO TIME SHOULD THE SITE BE IRRIGATED TO THE POINT THAT

. BARRIERS - SOLID BOARD FENCES SILT FENCES, SNOW FENCES, BURLAP FENCES, STRAW BALE DIKES AND SIMILAR MATERIAL CAN BE USED TO CONTROL AIR CONTROLLING SOIL BLOWING, CURRENTS AND SOIL BLOWING. currents and soil blowing. Barriers placed at right angles to prevaling currents at intervals OF ABOUT 10 TIMES THEIR HEIGHT ARE EFFECTIVE IN 6. CALCIUM CHLORIDE - APPLY AT RATES THAT WILL KEEP SURFACE MOIST. MAY NEED RETREATMENT.

PERMANENT METHODS I. PERMENENT VEGETATION - SEE STANDARDS FOR PERMANENT VEGETATIVE COVER AND PERMANENT STABILIZATION WITH SOD. EXISTING TREES OR LARGE SHRUBS MAY AFFORD VALUABLE PROTECTION IF LEFT IN PLACE. 2. TOPSOILING - COVERING WITH LESS EROSIVE SOIL MATERIALS. SEE STANDARDS FOR TOPSOILING. 3. STONE - COVER SURFACE WITH CRUSHED STONE OR COARSE GRAVEL.

TEMPORARY SEEDING NOTES (B-4-4)

TO STABILIZE DISTURBED SOILS WITH VEGETATION FOR UP TO 6 MONTHS. PURPOSE TO USE FAST GROWING VEGETATION THAT PROVIDES COVER ON DISTURBED SOILS. CONDITIONS WHERE PRACTICE APPLIES EXPOSED SOILS WHERE GROUND COVER IS NEEDED FOR A PERIOD OF 6 MONTHS OR LESS. FOR LONGER DURATION OF TIME, PERMANENT STABILIZATION PRACTICES ARE REQUIRED.

CRITERIA 1. SELECT ONE OR MORE OF THE SPECIES OR SEED MIXTURES LISTED IN TABLE 8.1 FOR THE APPROPRIATE PLANT HARDINESS ZONE (FROM FIGURE B.3), AND ENTER THEM IN THE TEMPORAR seeding summary below along with application rates, seeding dates and seeding depths THIS SUMMARY IS NOT PUT ON THE PLAN AND COMPLETED, THEN TABLE 8.1 PLUS FERTILIZER AND LIME RATES MUST BE PUT ON THE PLAN. 2. FOR SITES HAVING SOIL TESTS PERFORMED, USE AND SHOW THE RECOMMENDED RATES BY THE testing agency, soil tests are not required for temporary seeding.

3. WHEN STABILIZATION IS REQUIRED OUTSIDE OF A SEEDING SEASON, APPLY SEED AND MULCH OR STRAW

mulch alone as prescribed in section 8-4-3.4.1.8 and maintain until the next seeding season.

	TEMP	orary seedi	NG SUMM	ARY	
Hardiness Seed Mixtu	ZONE (FROM FIGURE RE (FROM TABLE B.1	B.3): <u>6B</u>):	-	FERTILIZER RATE (10-20-20)	LIME RATE
SPECIES	APPLICATION RATE (LB/AC)	SEEDING DATES	SEEDING DEPTHS		, , , , , , , , , , , , , , , , , , ,
BARLEY	96		l"	13C 19 (IC	2 TONE (40
OAT5	72	3/1 - 5/15, 8/15 - 10/15	i"	436 LB/AC (10 LB/ 1000 5F)	2 TON5/AC (90 LB/ 1000 5F)
OVE	112]	1*	1000 31)	

PERMANENT SEEDING NOTES (B-4-5) A. SEED MIXTURES

1. GENERAL USE A SELECT ONE OR MORE OF THE SPECIES OR MIXTURES LISTED IN TABLE 8.3 FOR THE APPROPRIATE PLANT HARDINESS ZONE (FROM FIGURE B.3) AND BASED ON THE SITE CONDITION OR PURPOSE FOUND ON TABLE B.2. enter selected mixture(5), application rates, and seeding dates in the permanent seeding summary. he summary is to be placed on the plan.

B. ADDITIONAL PLANTING SPECIFICATIONS FOR EXCEPTIONAL SITES SUCH AS SHORELINES, STREAM BANKS, OR DUNES OR FOR SPECIAL PURPOSES SUCH AS WILDLIFE OR AESTHETIC TREATMENT MAY BE FOUND N USDA-NRCS TECHNICAL FIELD OFFICE GUIDE, SECTION 342 - CRITICAL AREA PLANTING. C. FOR SITES HAVING DISTURBED AREA OVER 5 ACRES, USE AND SHOW THE RATES RECOMMENDED BY THE SOIL resting agency. D. for areas receiving low maintenance, apply urea form fertilizer (46–0–0) at 3 1/2 POUNDS PER 1000 SQUARE FEET (150 POUNDS PER ACRE) AT THE TIME OF SEEDING IN ADDITION TO THE SOIL AMENOMENTS SHOWN IN THE PERMANENT SEEDING SUMMARY. 2. TURFGRASS MIXTURES

A. AREAS WHERE TURFGRASS MAY BE DESIRED INCLUDE LAWNS, PARKS, PLAYGROUNDS, AND COMMERCIAL SITES WHICH WILL RECEIVE A MEDIUM TO HIGH LEVEL OF MAINTENANCE. B. SELECT ONE OR MORE OF THE SPECIES OR MIXTURES LISTED BELOW BASED ON THE SITE CONDITIONS OR PURPOSE, ENTER SELECTED MIXTURE(S), APPLICATION RATES, AND SEEDING DATES IN THE PERMANENT SEEDING SUMMARY. THE SUMMARY IS TO BE PLACED ON THE PLAN. KENTUCKY BLUEGRASS: FULL SUN MIXTURE: FOR USE IN AREAS THAT RECEIVE INTENSIVE MANAGEMENT. irrigation required in the areas of central maryland and eastern shore. Recommended

CERTIFIED KENTUCKY BLUEGRASS CULTIVARS SEEDING RATE: 1.5 TO 2.0 POUNDS PER 1000 SQUARE FEET. CHOOSE A MINIMUM OF THREE KENTUCKY BLUEGRASS CULTIVARS WITH EACH RANGING FROM 10 TO 35 PERCENT OF THE TOTAL MIXTURE BY WEIGHT. II. KENTUCKY BLUEGRASS/PERENNIAL RYE: FULL SUN MIXTURE: FOR USE IN FULL SUN AREAS WHERE RAPIO establishment is necessary and when turf will receive medium to intensive management. CERTIFIED PERENNIAL RYEGRASS CULTIVARS/CERTIFIED KENTUCKY BLUEGRASS SEEDING RATE: 2 POUNDS mixture per 1000 square feet, choose a minimum of three kentucky bluegrass cultivars with

each ranging from 10 to 35 percent of the total mixture by weight.

Tall fescue/kentucky bluegrass: full sun mixture: for use in drought prone areas and/or for areas receiving low to medium management in full sun to medium shade. Recommended MIXTURE INCLUDES; CERTIFIED TALL FESCUE CULTIVARS 95 TO 100 PERCENT, CERTIFIED KENTUCKY BLUEGRASS CULTIVARS 0 TO 5 PERCENT. SEEDING RATE: 5 TO 8 POUNDS PER 1000 SQUARE FEET. one or more cultivars may be blended. IV. Kentucky bluegrass/fine fescue: Shade mixture: for use in areas with shade in bluegrass

lawns. For establishment in high quality, intensively managed turf area. Mixture includes; CERTIFIED KENTUCKY BLUEGRASS CULTIVARS 30 TO 40 PERCENT AND CERTIFIED FINE FESCUE AND 60 to 70 percent. Seeding rate: 1 1/2 to 3 pounds per 1000 square feet. select turfgrass varieties from those listed in the most current university of maryland PUBLICATION, AGRONOMY MEMO #77, "TURFGRASS CULTIVAR RECOMMENDATIONS FOR MAYLAND" CHOOSE CERTIFIED MATERIAL CERTIFIED MATERIAL IS THE BEST GUARANTEE OF CULTIVAR PURITY. THE CERTIFICATION PROGRAM OF THE MARYLAND DEPARTMENT OF AGRICULTURE, TURF AND SEED SECTION, PROVIDES A RELIABLE MEANS OF CONSUMER PROTECTION AND ASSURES A PURE GENETIC LINE

DEAL TIMES OF SEEDING FOR TURF GRASS MIXTURES WESTERN MD: MARCH 15 TO JUNE 1, AUGUST 1 TO OCTOBER 1 (HARDINESS ZONES: 58, 6A) CENTRAL MD: MARCH 1 TO MAY 15, AUGUST 15 TO OCTOBER 15 (HARDINESS ZONE: 6B) SOUTHERN MD, EASTERN SHORE: MARCH 1 TO MAY 15, AUGUST 15 TO OCTOBER 15 (HARDINESS ZONES: 7A, 7B)
D. TILL AREAS TO RECEIVE SEED BY DISKING OR OTHER APPROVED METHODS TO A DEPTH OF 2 TO 4 INCHES. LEVEL AND RAKE THE AREAS TO PREPARE A PROPER SEEDBED. REMOVE STONES AND DEBRIS OVER 1 1/2

inches in diameter the resulting seedbed must be in such condition that future mowing of RASSES WILL POSE NO DIFFICULTY. e. If soil moisture is deficient, supply new seedings with adequate water for plant growth (1/2 to 1 Inch every 3 to 4 days depending on soil texture) until they are firmly established. This is especially true when seedings are made late in the planting season, in abnormally dry or hot seasons, or on adverse sites.

	A111455 #		A 41 (CO		T		A0 001	104 017
HAK SEE	DINESS 2 DIMEXTUR	one (from Figure E (from Table B.)	8.3): <u>68</u>)): <u>8</u>	··	PEXILIZE	r rate (10	-20-20)	ume rate
NO.	5PECIES	APPLICATION RATE (LB/AC)	SEEDING DATES	SEEDING DEPTHS	N	P ₂ O ₅	K ₂ 0	
8	TALL FESCUE	100	MAR. 1-MAY 15 AUG. 15-OCT. 15	1/4-1/2 N.	45 LBS. PER ACRE (1.0 LB/ 1000 SF)	90 LB/AC (2 LB/ 1000 SF)	90 LB/AC (2 LB/ 1000 SF)	2 TONS/AC (90 LB/ 1000 SF)

B. SOD: TO PROVIDE QUICK COVER ON DISTURBED AREAS (2:1 GRADE OR FLATTER).

1. GENERAL SPECIFICATIONS A CLASS OF TURFGRASS SOD MUST BE MARYLAND STATE CERTIFIED. SOD LABELS MUST BE MADE AVAILABLE TO THE 8. SOD MUST BE MACHINE CUT AT A UNIFORM SOIL THICKNESS TO 3/4 INCH, PLUS OR MINUS 1/4 INCH, AT THE TIME OF CUTTING, MEASUREMENT FOR THICKNESS MUST EXCLUDE TOP GROWTH AND THATCH, BROKEN PADS AND TORN OR

UNEVEN ENDS WILL NOT BE ACCEPTABLE. STANDARD SIZE SECTIONS OF 500 MUST BE STRONG ENOUGH TO SUPPORT THEIR OWN WEIGHT AND RETAIN THEIR SIZE AND SHAPE WHEN SUSPENDED VERTICALLY WITH A FIRM GRASP ON THE UPPER 10 PERCENT OF THE SECTION. d. 500 must not be harvested or transplanted when moisture content (excessively dry of wet) may ADVERSELY AFFECT ITS SURVIVAL.

E. SOD MUST BE HARVESTED, DELIVERED, AND INSTALLED WITHIN A PERIOD OF 36 HOURS. SOD NOT TRANSPLANTED WITHIN THIS PERIOD MUST BE APPROVED BY AN AGRONOMIST OR SOIL SCIENTIST PRIOR TO ITS INSTALLATION. 2, 500 Installation A DURING PERIODS OF EXCESSIVELY HIGH TEMPERATURE OR IN AREAS HAVING DRY SUBSOIL, LIGHTLY IRRIGATE THE SUBSOIL IMMEDIATELY PRIOR TO LAYING THE SOD.

B. LAY THE FIRST ROW OF SOD IN A STRAIGHT LINE WITH SUBSEQUENT ROWS PLACED PARALLEL TO IT AND TIGHTLY WEDGED AGAINST EACH OTHER, STAGGER LATERAL JOINTS TO PROMOTE MORE UNIFORM GROWTH AND STRENGTH ENSURE THAT 500 IS NOT STRETCHED OR OVERLAPPED AND THAT ALL JOINTS ARE BUTTED TIGHT IN ORDER TO PREVENT VOIDS WHICH WOULD CAUSE AIR DRYING OF THE ROOTS. C. WHEREVER POSSIBLE, LAY SOD WITH THE LONG EDGES PARALLEL TO THE CONTOUR AND WITH STAGGERING JOINTS. ROLL AND TAMP, PEG OR OTHERWISE SECURE THE SOD TO PREVENT SLIPPAGE ON SLOPES. ENSURE SOLID CONTACT

exists between 500 roots and the underlying soil surface. D. WATER THE SOD IMMEDIATELY FOLLOWING ROLLING AND TAMPING UNTIL THE UNDERSIDE OF THE NEW SOD PAD AND SOIL SURFACE BELOW THE SOD ARE THOROUGHLY WET. COMPLETE THE OPERATIONS OF LAYING, TAMPING, AND IRRIGATING FOR ANY PIECE OF SOD WITHIN EIGHT HOURS.

3. SOD MAINTENANCE A IN THE ABSENCE OF ADEQUATE RAINFALL WATER DAILY DURING THE FIRST WEEK OR AS OFTEN AND SUFFICIENTLY as necessary to maintain moist soil to a depth of 4 inches. Water soo during the heat of the day to PREVENT WILTING. B. AFTER THE FIRST WEEK, SOO WATERING IS REQUIRED AS NECESSARY TO MAINTAIN ADEQUATE MOISTURE CONTENT.

THE INITIAL CUTTING OR SUBSEQUENT CUTTINGS. MAINTAIN A GRASS HEIGHT OF AT LEAST 3 INCHES UNLESS

DATE

OTHERWISE SPECIFIED.

REVISION

DO NOT MOW UNTIL THE SOO IS FIRMLY ROOTED. NO MORE THAN 1/3 OF THE GRASS LEAF MUST BE REMOVED BY

HOWARD SOIL CONSERVATION DISTRICT

STANDARD SEDIMENT CONTROL NOTES 1) A MINIMUM OF 48 HOURS NOTICE MUST BE GIVEN TO THE HOWARD COUNTY DEPARTMENT OF INSPECTIONS, LICENSES AND PERMITS SEDIMENT CONTROL DIMSION PRIOR TO THE START OF ANY CONSTRUCTION (410-313-1655). 2) ALL VEGETATIVE AND STRUCTURAL PRACTICES ARE TO BE INSTALLED ACCORDING TO THE PROVISIONS OF THIS PLAN AND ARE TO BE IN conformance with the most current maryland standards and specifications for soil erosion and sediment control

3) FOLLOWING INITIAL SOIL DISTURBANCE OR RE-DISTURBANCE, PERMANENT OR TEMPORARY STABILIZATION SHALL BE COMPLETED WITHIN: a) 3 CALENDAR DAYS FOR ALL PERIMETER SEDIMENT CONTROL STRUCTURES, DIKES, PERIMETER SLOPES AND ALL SLOPES GREATER THAN 3:1, b) 7 DAYS AS TO ALL OTHER DISTURBED OR GRADED AREAS ON THE PROJECT SITE. 4) ALL DISTURBED AREAS MUST BE STABILIZED WITHIN THE TIME PERIOD SPECIFIED ABOVE IN ACCORDANCE WITH THE 2011 MARYLAND STANDARDS AND SPECIFICATIONS FOR SOIL EROSION AND SEDIMENT CONTROL FOR PERMANENT SEEDING (SEC. B-4-5). TEMPORARY SEEDING (SEC. B-4-4) AND MULCHING (SEC. B-4-3). TEMPORARY STABILIZATION WITH MULCH ALONE CAN ONLY BE DONE WHEN

recommended seeding dates do not allow for proper germination and establishment of grasses. 5) ALL SEDIMENT CONTROL STRUCTURES ARE TO REMAIN IN PLACE AND ARE TO BE MAINTAINED IN OPERATIVE CONDITION UNTIL PERMISSION FOR THEIR REMOVAL HAS BEEN OBTAINED FROM THE HOWARD COUNTY SEDIMENT CONTROL INSPECTOR. 6) SITE ANALYSIS:

TOTAL AREA OF SITE AREA DISTURBED AREA TO BE ROOFED OR PAVED 4.524 ACRES 1.69 ACRES AREA TO BE VEGETATIVELY STABILIZED 0.00 ACRES 2,946 CU.YDS. 520 CU.YDS. OFFSITE WASTE/BORROW AREA LOCATION

APPROVAL BY THE INSPECTION AGENCY IS MADE.

AT A GIVEN TIME

7) ANY SEDIMENT CONTROL PRACTICE THAT IS DISTURBED BY GRADING ACTIVITY FOR PLACEMENT OF UTILITIES MUST BE REPAIRED ON THE SAME DAY OF DISTURBANCE 8) ADDITIONAL SEDIMENT CONTROL MUST BE PROVIDED, IF DEEMED NECESSARY BY THE HOWARD COUNTY SEDIMENT CONTROL INSPECTOR. 9) on all sites with disturbed areas in excess of 2 acres, approval of the inspection agency shall be requested upon completion of installation of perimeter erosion and sediment controls, but before proceeding with any other earth disturbance or grading, other building or grading inspection approvals may not be authorized until this initial

10) TRENCHES FOR THE CONSTRUCTION OF UTILITIES IS LIMITED TO THREE PIPE LENGTHS OR THAT WHICH SHALL BE BACK-FILLED AND STABILIZED BY THE END OF EACH WORKDAY, WHICHEVER IS SHORTER. 11) any changes or revisions to the sequence of construction must be reviewed and approved by the plan approval AUTHORITY PRIOR TO PROCEEDING WITH CONSTRUCTION. 12) A PROJECT IS TO BE SEQUENCED SO THAT GRADING ACTIVITIES BEGIN ON ONE GRADING UNIT (MAXIMUM ACREAGE OF 20 ACRE PER GRADING UNIT) AT A TIME. WORK MAY PROCEED TO A SUBSEQUENT GRADING UNIT WHEN AT LEAST 50 PERCENT OF THE DISTURBED AREA IN THE PROCEEDING GRADING UNIT HAS BEEN STABILIZED AND APPROVED BY THE ENFORCEMENT AUTHORITY. UNLESS OTHERWISE SPECIFIED AND APPROVED BY THE APPROVAL AUTHORITY, NO MORE THAN 30 ACRES CUMULATIVELY MAY BE DISTURBED

B-4-3 STANDARDS AND SPECIFICATIONS FOR SEEDING & MULCHING

DEFINITION THE APPLICATION OF SEED AND MULCH TO ESTABLISH VEGETATIVE COVER.

PURPOSE TO PROTECT DISTURBED SOILS FROM EROSION DURING AND AT THE END OF CONSTRUCTION.

CONDITIONS WHERE PRACTICE APPLIES

TO THE SURFACE OF ALL PERIMETER CONTROLS, SLOPES, AND ANY DISTURBED AREA NOT UNDER ACTIVE GRADING.

SEEDING 1. SPECIFICATIONS A. ALL SEED MUST MEET THE REQUIREMENT OF THE MARYLAND STATE SEED LAW. ALL SEED MUST BE SUBJECT TO RE-TESTING BY

a recognized seed laboratory. All seed used must have been tested within the 6 months immediately preceding the DATE OF SOWING SUCH MATERIAL ON ANY PROJECT, REFER TO TABLE 8.4 REGARDING THE QUALITY OF SEED, SEED TAGS MUST 8 AVAILABLE UPON REQUEST TO THE INSPECTOR TO VERIFY TYPE OF SEED AND SEEDING RATE. B. MULCH ALONE MAY BE APPLIED BETWEEN THE FALL AND SPRING SEEDING DATES ONLY IF THE GROUND IS FROZEN.

THE APPROPRIATE SEEDING MIXTURE MUST BE APPLIED WHEN THE GROUND THAWS. C. INOCULANTS: THE INOCULANT FOR TREATING LEGUME SEED IN THE SEED MIXTURES MUST BE A PURE CULTURE OF NITROGEN FIXING BACTERIA PREPARED SPECIFICALLY FOR THE SPECIES. INOCULANTS MUST NOT BE USED LATER THAN THE DATE INDICATED ON THE CONTAINER, ADD FRESH INOCULANTS AS DIRECTED ON THE PACKAGE. USE FOUR TIMES THE RECOMMENDED RATE WHEN HYDROSEEDING, NOTE: IT IS VERY IMPORTANT TO KEEP INOCULANT AS COOL AS POSSIBLE UNTIL USED. TEMPERATURES ABOVE 75 TO 80 DEGREES FAHRENHEIT CAN WEAKEN BACTERIA AND MAKE THE INOCULANT LESS EFFECTIVE.

D. SOD OR SEED MUST NOT BE PLACED ON SOIL WHICH HAS BEEN TREATED WITH SOIL STERILANTS OR CHEMICALS USED FOR WEEDCONTROL UNTIL SUFFICIENT TIME HAS ELAPSED (14 DAYS MIN.) TO PERMIT DISSIPATION OF PHYTO-TOXIC MATERIALS.

A. DRY SEEDING: THIS INCLUDES USE OF CONVENTIONAL DROP OR BROADCAST SPREADERS. I. INCORPORATE SEED INTO THE SUBSOIL AT THE RATES PRESCRIBED ON TEMPORARY SEEDING TABLE B.1, PERMANENT SEEDING TABLE 8.3. OR SITE-SPECIFIC SEEDING SUMMARIES

II. APPLY SEED IN TWO DIRECTIONS, PERPENDICULAR TO EACH OTHER, APPLY HALF THE SEEDING RATE IN EACH DIRECTION. ROLL THE SEEDED AREA WITH WEIGHTED ROLLER TO PROVIDE GOOD SEED TO SOIL CONTACT. B. DRILL OR CULTIPACKER SEEDING: MECHANIZED SEEDERS THAT APPLY AND COVER SEED WITH SOIL 1. CULTIPACKING SEEDERS ARE REQUIRED TO BURY THE SEED IN SUCH A FASHION AS TO PROVIDE AT

LEAST 1/4 INCH OF SOIL COVERING, SEEDBED MUST BE FIRM AFTER PLANTING. II. APPLY SEED IN TWO DIRECTIONS, PERPENDICULAR TO EACH OTHER. APPLY HALF THE SEEDING RATE IN EACH DIRECTION. C. HYDROSEEDING: APPLY SEED UNIFORMLY WITH HYDROSEEDER (SLURRY INCLUDES SEED AND FERTILIZER).

I. IF FERTILIZER IS BEING APPLIED AT THE TIME OF SEEDING, THE APPLICATION RATES SHOULD NOT EXCEED THE FOLLOWING: NITROGEN, 100 POUNDS PER ACRE TOTAL OF SOLUBLE NITROGEN; P205 (PHOSPHORUS), 200 POUNDS PER ACRE: K-O (POTASSIUM), 200 POUNDS PER ACRE. IL LIME: USE ONLY GROUND AGRICULTURAL LIMESTONE (UP TO 3 TONS PER ACRE MAY BE APPLIED BY

HYDROSEEDING). NORMALLY, NOT MORE THAN 2 TONS ARE APPLIED BY HYDROSEEDING AT ANY ONE TIME, DO NOT USE BURNT OR HYDRATED LIME WHEN HYDROSEEDING III. MIX SEED AND FERTILIZER ON SITE AND SEED IMMEDIATELY AND WITHOUT INTERRUPTION.

IV. WHEN HYDROSEEDING DO NOT INCORPORATE SEED INTO THE SOIL. B. MULCHING

1. MULCH MATERIALS (IN ORDER OF PREFERENCE) A. STRAW CONSISTING OF THOROUGHLY THRESHED WHEAT, RYE, OAT, OR BARLEY AND REASONABLY BRIGHT IN COLOR. STRAW IS TO BE FREE OF NOXIOUS WEED SEEDS AS SPECIFIED IN THE MARYLAND SEED LAW AND NOT MUSTY. MOLDY. CAKED. DECAYED. OR EXCESSIVELY DUSTY. NOTE: USE ONLY STERILE STRAW MULCH IN AREAS WHERE ONE SPECIES OF GRASS IS DESIRED.

B. WOOD CELLULOSE FIBER MULCH (WCFM) CONSISTING OF SPECIALLY PREPARED WOOD CELLULOSE PROCESSED INTO LINIFORM FIRROILS PHYSICAL STATE. I. WCFM IS TO BE DYED GREEN OR CONTAIN A GREEN DYE IN THE PACKAGE THAT WILL PROVIDE AN

APPROPRIATE COLOT TO FACILITATE VISUAL INSPECTION OF THE UNIFORMLY SPREAD SLURRY. II. WCFM, INCLUDING DYE, MUST CONTAIN NO GERMINATION OR GROWTH INHIBITING FACTORS. III. WCFM MATERIALS ARE TO BE MANUFACTURED AND PROCESSED IN SUCH A MANNER THAT THE WOOD CELLULOSE FIBER MULCH WILL REMAIN IN UNIFORM SUSPENSION IN WATER UNDER ACTIATION AND WILL BLEND WITH SEED, FERTILIZER AND OTHER ADDITIVES TO FORM A HOMOGENEOUS SLURRY. THE MULCH MATERIAL MUST FORM A BLOTTER-LIKE GROUND COVER. ON APPLICATION, HAVING MOISTURE ABSORPTION AND PERCOLATION PROPERTIES AND MUST COVER AND HOLD GRASS SEED

IN CONTACT WITH THE SOIL WITHOUT INHIBITING THE GROWTH OF THE GRASS SEEDLINGS. IV. WCFM MATERIAL MUST NOT CONTAIN ELEMENTS OR COMPOUNDS AT CONCENTRATION LEVELS THAT WILL BY PHYTO-TOXIC. V. WCFM MUST CONFORM TO THE FOLLOWING PHYSICAL REQUIREMENTS: FIBER LENGTH OF APPROXIMATELY 10 MILLIMETERS, DIAMETER APPROXIMATELY 1 MILLIMETER, PH RANGE OF 4.0 TO 8.5, ASH CONTENT OF 1.6 PERCENT MAXIMUM AND WATER HOLDING CAPACITY OF 90 PERCENT MINIMUM.

2. APPLICATION A. APPLY MULCH TO ALL SEEDED AREAS IMMEDIATELY AFTER SEEDING.

100 GALLONS OF WATER.

B. WHEN STRAW MULCH IS USED, SPREAD IT OVER ALL SEEDED AREAS AT THE RATE OF 2 TONS PER ACRE TO A UNIFORM LOOSE DEPTH OF 1 TO 2 INCHES, APPLY MULCH TO ACHIEVE A UNIFORM DISTRIBUTION AND DEPTH SO THAT THE SOIL SURFACE IS NOT EXPOSED, WHEN USING A MULCH ANCHORING TOOL, INCREASE THE APPLICATION RATE TO 2.5 TONS PER ACRE. WOOD CELLULOSE FIBER USED AS MULCH MUST BE APPLIED TO A NET DRY WEIGHT OF 1500 POUNDS PER ACRE. MIX THE WOOD CELLULOSE FIBER WITH WATER TO ATTAIN A MIXTURE WITH A MAXIMUM OF 50 POUNDS OF WOOD CELLULOSE FIBER PER


3. ANCHORING A PERFORM MULCH ANCHORING IMMEDIATELY FOLLOWING APPLICATION OF MULCH TO MINIMIZE LOSS BY WIND OR WATER. THIS MAY BE DONE BY ONE OF THE FOLLOWING METHODS (LISTED BY PREFERENCE), DEPENDING UPON THE SIZE OF THE AREA AND EROSION HAZARD: I. A MULCH ANCHORING TOOL IS A TRACTOR DRAWN IMPLEMENT DESIGNED TO PUNCH AND ANCHOR MULCH INTO THE SOIL SURFACE A MINIMUM OF 2 INCHES. THIS PRACTICE IS MOST EFFECTIVE ON LARGE AREAS, BUT IS LIMITED TO FLATTER SLOPES WHERE EQUIPMENT CAN OPERATE SAFELY. IF USED ON SLOPING LAND, THIS PRACTICE SHOULD FOLLOW THE CONTOUR.

PER ACRE. MIX THE WOOD CELLULOSE FIBER WITH WATER AT A MAXIMUM OF 50 POUNDS OF WOOD CELLULOSE FIBER PER 100 GALLONS OF WATER.

II. WOOD CELLULOSE FIBER MAY BE USED FOR ANCHORING STRAW. APPLY THE FIBER BINDER AT A NET DRY WEIGHT OF 750 POUNDS

III. SYNTHETIC BINDERS SUCH AS ACRYLIC DLR (AGRO-TACK), DCA-70, PETROSET, TERRA TAX II, TERRA TACK AR, OR OTHER APPROVED EQUAL MAY BE USED. FOLLOW APPLICATION RATES AS SPECIFIED BY THE MANUFACTURER, APPLICATION OF LIQUID BINDERS NEEDS TO BE HEAVIER AT THE EDGES WHERE WIND CATCHES MULCH, SUCH AS IN VALLEYS AND ON CRESTS OF

BANKS, USE OF ASPHALT BINDERS IS STRICTLY PROHIBITED. IV. LIGHTWEIGHT PLASTIC NETTING MAY BE STAPLED OVER THE MULCH ACCORDING TO MANUFACTURER RECOMMENDATIONS. NETTING IS USUALLY AVAILABLE IN ROLLS 4-15 FEET WIDE AND 300 TO 3,000 FEET LONG.

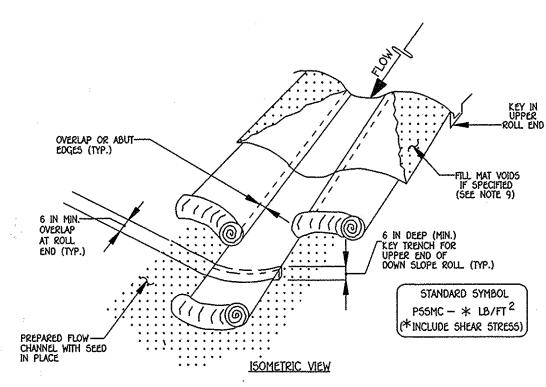

CONSTRUCTION SPECIFICATIONS

1. USE MATTING THAT HAS A DESIGN VALUE FOR SHEAR STRESS EQUAL TO OR HIGHER THAN THE SHEAR STRESS DESIGNATED ON APPROVED PLANS. 2. USE PERMANENT SOIL STABILIZATION MATTING MADE OF OPEN WEAVE SYNTHETIC, NON-DEGRADABLE FIBERS OR ELEMENTS OF UNIFORM THICKNESS AND DISTRIBUTION THROUGHOUT. CHEMICALS USED IN THE MAT MUST BE NON-LEACHING AND NON-TOXIC TO VEGETATION AND SEED GERMINATION AND NON-INJURIOUS TO THE SKIN. II PRESENT, NETTING MUST BE EXTRUDED PLASTIC WITH A MAXIMUM MESH OPENING OF 2"x2" AND SUFFICIENTLY BONDED OR SEWN ON 2" CENTERS ALONG LONGITUDINAL AXIS OF THE MATERIAL TO PREVENT SEPARATION OF

THE NET FROM THE PARENT MATERIAL 3. SECURE MATTING USING STEEL STAPLES OR WOOD STAKES. STAPLES MUST BE "U" OR "T" SHAPED STEEL WIR. HAVING A MINIMUM GAUGE OF NO. 11 AND NO. 8 RESPECTIVELY. "U" SHAPED STAPLES MUST AVERAGE 1" TO 1 1/2" WIDE AND BE A MINIMUM OF 6" LONG. "T" SHAPED STAPLES MUST HAVE A MINIMUM 8" MAIN LEG, A MINIMUM 1" SECONDARY LEG, AND MINIMUM 4" HEAD. WOOD STAKES MUST BE ROUGH-SAWN HARDWOOD, 12"

TO 24" LENGTH 1" X 3" CROSS SECTION, AND WEDGE SHAPE AT THE BOTTOM. 4. PERFORM FINAL GRADING, TOPSOIL APPLICATION, SEEDBED PREPARATION, AND PERMANENT SEEDING IN ACCORDANCE WITH SPECIFICATIONS. PLACE MATTING WITHIN 48 HOURS OF COMPLETING SEEDING OPERATIONS,

UNLESS END OF WORKDAY STABILIZATION IS SPECIFIED ON THE APPROVED EROSION AND SEDIMENT CONTROL PLAN. 5. UNROLL MATTING IN DIRECTION OF WATER FLOW, CENTERING THE FIRST ROLL ON THE CHANNEL CENTER LINE. WORK FROM CENTER OF CHANNEL OUTWARD WHEN PLACING ROLLS. LAY MATTING SMOOTHLY AND FIRMLY UPON THE SEEDED SURFACE, AVOID STRETCHING THE MATTING.

6. OVERLAP OR ABUT EDGES OF MATTING ROLLS PER MANUFACTURER RECOMMENDATIONS. OVERLAP ROLL ENDS BY 6" (MINIMUM), WITH THE UPSTREAM MAT OVERLAPPING ON TOP OF THE NEXT DOWNSTREAM MAT. 7. KEY IN THE TOP OF SLOPE END OF MAT 6 INCHES (MINIMUM) BY DIGGING A TRENCH, PLACING THE MATTING ROLL END IN THE TRENCH, STAPLING THE MAT IN PLACE, REPLACING THE EXCAVATED MATERIAL, AND TAMPING TO

8. STAPLE/STAKE MAT IN A STAGGERED PATTERN ON 4 FOOT (MAXIMUM) CENTERS THROUGHOUT AND 2 FOOT (MAXIMUM) CENTERS ALONG SEAMS, JOINTS, AND ROLL ENDS. 9. IF SPECIFIED BY THE DESIGNER OR MANUFACTURER AND DEPENDING ON THE TYPE OF MAT BEING INSTALLED. ONCE THE MATTING IS KEYED AND STAPLED IN PLACE, FILL THE MAT VOIDS WITH TOP SOIL OR GRANULAR

MATERIAL AND LIGHTLY COMPACT OR ROLL TO MAXIMIZE SOIL/MAT CONTACT WITHOUT CRUSHING MAT. 10. ESTABLISH AND MAINTAIN VEGETATION SO THAT REQUIREMENTS FOR ADEQUATE VEGETATIVE ESTABLISHMENT ARE CONTINUOUSLY MET IN ACCORDANCE WITH SECTION 8-4 VEGETATIVE STABILIZATION.

PERMANENT SOIL STABILIZATION MATTING CHANNEL APPLICATION NOT TO SCALE


SEQUENCE OF CONSTRUCTION

1. OBTAIN A GRADING PERMIT AND HOLD PRE-CONSTRUCTION MEETING WITH COUNTY INSPECTOR. 2. VERIFY EXISTING CONTROLS FROM F-14-002 ARE INSTALLED AND OPERATING. IF REQUIRED BY INSPECTOR REVISE EXISTING TRAPS TO ORIGINAL DIMENSIONS AND VOLUMES. 3. NOTIFY "MISS UTILITY" AT LEAST 48 HOURS BEFORE BEGINNING ANY WORK AT 1-800-257-7777. NOTIFY THE HOWARD COUNTY OFFICE OF CONSTRUCTION/ INSPECTION AT 410-313-1330 AT LEAST 24 HOURS BEFORE STARTING WORK. 4. INSTALL THE STABILIZED CONSTRUCTION ENTRANCE SILT FENCE AND SUPER-SILT FENCE.

SECURE THE MAT END IN THE KEY.

5. ROUGH GRADE AROUND HOUSE SITE AND INSTALL TEMPORARY SEEDING. IF REQUIRED 5. Construct building. 7. Fine grade site and install permanent seeding. 8. ALL FINAL GRADES AND STABILIZATION SHOULD BE COMPLETED BEFORE ANY REMOVAL OF CONTROLS. the permission of the sediment control inspector, the sediment control devices may be removed.

NOTE: THE CONTRACTOR SHALL INSPECT AND PROVIDE NECESSARY MAINTENANCE EACH RAINFALL AND ON A

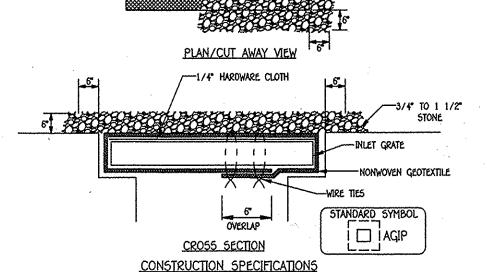

ELEVATION

CONSTRUCTION SPECIFICATIONS

LENGTH SPACED NO FURTHER THAN 10 FEET APART. DRIVE THE POSTS A MINIMUM OF 36" INTO THE

1. INSTALL 2 3/8" DIAMETER GALVANIZED STEEL POSTS OF 0.095 INCH WALL THICKNESS AND SIX FOOT

2. FASTEN 9 GAUGE OR HEAVIER GALVANIZED CHAIN LINK FENCE (2 3/8" MAXIMUM OPENING) 42" IN

3. FASTEN WOVEN SLIT FILM GEOTEXTILE AS SPECIFIED IN SECTION H-1 MATERIALS, SECURELY TO THE

LIPSLOPE SIDE OF CHAIN LINK FENCE WITH TIES SPACED EVERY 24" AT THE TOP AND MID SECTION

4. WHERE ENDS OF THE GEOTEXTILE COME TOGETHER, THE ENDS SHALL BE OVERLAPPED BY 6°, FOLDED

45 DEGREES TO THE MAIN FENCE ALIGNMENT TO PREVENT RUNOFF FROM GOING AROUND THE ENDS

5. EXTEND BOTH ENDS OF THE SUPER SILT FENCE A MINIMUM OF FIVE HORIZONTAL FEET UPSLOPE AT

6. PROVIDE MANUFACTURER CERTIFICATION TO THE INSPECTION/ENFORCEMENT AUTHORITY SHOWING THAT

7. REMOVE ACCUMULATED SEDIMENT AND DEBRIS WHEN BULGES DEVELOP IN FENCE OR WHEN SEDIMENT

reaches 25% of Fence Height. Replace Geotextile if torn. If undermining occurs, reinstall

SUPER SILT FENCE

NOT TO SCALE

CHAIN LINK FENCING

HEIGHT SECURELY TO THE FENCE POSTS WITH WIRE TIES OR HUG RINGS.

GEOTEXTILE USED MEETS THE REQUIREMENTS IN SECTION H-1 MATERIALS.

EMBED GEOTEXTILE AND CHAIN LINK FENCE A MINIMUM OF 8" INTO THE GROUND.

CROSS SECTION

WOVEN SLIT FILM GEOTEXTILE-

PLOW -

of the super silt fence.

HAIN LINK FENCING AND GEOTEXTILE

STANDARD SYMBOL

----55F----

1. USE NONWOVEN GEOTEXTILE AS SPECIFIED IN SECTION H-1 MATERIALS. 2. LIFT GRATE AND WRAP WITH NONWOVEN GEOTEXTILE TO COMPLETELY COVER ALL OPENINGS. SECURE WITH WIRE ties and set grate back in place.

3. PLACE CLEAN 3/4" TO 1 1/2" STONE OR EQUIVALENT RECYCLED CONCRETE 6 INCHES THICK ON THE GRATE. 4. Storm drain inlet protection requires frequent maintenance. Remove accumulated sediment after EACH RAIN EVENT TO MAINTAIN FUNCTION AND AVOID PREMATURE CLOGGING, IF INLET PROTECTION DOES NOT COMPLETELY DRAIN WITHIN 24 HOURS AFTER A STORM EVENT, IT IS CLOGGED, WHEN THIS OCCURS, REMOVE ACCUMULATED SEDIMENT AND CLEAN, OR REPLACE GEOTEXTILE AND STONE.

AT-GRADE INLET PROTECTION NOT TO SCALE

TABLE B.1 TEMPORARY SEEDING FOR SITE STABILIZATION

(14 DAYS)

(7 DAYS)

(2 DAY5)

(3 DAYS)


TRIBING TRIB

DIANT COCCG	SEEDING RATE 1/		SEEDING DEPTH 2/	RECOMMENDED SEEDING DATES BY PLANT HARDINESS ZONE 3/				
PLANT SPECS	LB./AC.	LB./1000 FT. ²	200 100 100	5b AND 6a	6Ь	7a AND 7b		
COOL-SEASON GRASSES						4		
ANNUAL RYEGRASS (LOUUM PERENNE SSP. MUTIFLORUM)	40	1.0	0.5	MAR. 15 TO MAY 31; AUG. 1 TO SEPT. 30	MAR. 1 TO MAY 15; AUG. 1 TO OCT. 15	FEB. 15 TO APR. 30; AUG. 15 TO NOV. 30		
BARLEY (HORDEUM VULGARE)	96	2.2	1.0	MAR. 15 TO MAY 31; AUG. 1 TO SEPT. 30	MAR. 1 TO MAY 15; AUG. 1 TO OCT. 15	FEB. 15 TO APR. 30; AUG. 15 TO NOV. 30		
OATS (AVENA SATIVA)	72	1.7	1.0	MAR. 15 TO MAY 31; AUG. 1 TO SEPT. 30	MAR. 1 TO MAY 15; AUG. 1 TO OCT. 15	FEB. 15 TO APR. 30; AUG. 15 TO NOV. 30		
WHEAT (TRITICUM AESTIVUM)	120	2.8	1.0	MAR. 15 TO MAY 31; AUG. 1 TO SEPT. 30	MAR. 1 TO MAY 15; AUG. 1 TO OCT. 15	FEB. 15 TO APR. 30; AUG. 15 TO NOV. 30		
CEREAL RYE (SECALE CEREALE)	112	2.8	1.0	MAR. 15 TO MAY 31; AUG. 31 TO OCT. 31	MAR. 1 TO MAY 15; AUG. 1 TO NOV. 15	FEB. 15 TO APR. 30; AUG. 15 TO DEC. 15		
WARM-SEASON GRASSES				· .		•		
FOXTAIL MILLET (SETARIA ITALICA)	30	0.7	0.5	JUNE 1 TO JULY 31	MAY 16 TO JULY 31	MAY 1 TO AUGUST 14		
PEARL MILLET (PENNISETUM GLAUCUM)	20	0.5	0.5	JUNE 1 TO JULY 31	MAY 16 TO JULY 31	MAY 1 TO AUGUST 14		

1. SEEDING RATES FOR THE WARM-SEASON GRASSES ARE IN POUNDS OF PURE LIVE SEED (PLS). ACTUAL PLANTING RATES SHALL BE ADJUSTED TO REFLECT PERCENT SEED GERMINATION AND PURITY, AS TESTED. ADJUSTMENTS ARE USUALLY NOT NEEDED FOR THE COOL-SEASON GRASSES.

SEEDING RATES LISTED ABOVE ARE FOR TEMPORARY SEEDINGS, WHEN PLANTED ALONE. WHEN PLANTED AS A NURSE CROP WITH PERMANENT SEED MIXES, USE 1/3 OF THE SEEDING RATE LISTED ABOVE FOR BARLEY, OATS AND WHEAT. FOR SMALLER-SEEDED GRASSES (ANNUAL RYEGRASS, PEARL MILLET, FOXTAIL MILLET). DO NOT EXCEED MORE THAN 5% (BY WEIGHT) OF THE OVERALL PERMANENT SEEDING MIX, CEREAL RYE GENERALLY SHOULD NOT BE USED AS A NURSE CROP, UNLESS PLANTING WILL OCCUR IN VERY LATE FALL BEYOND THE SEEDING DATES FOR OTHER TEMPORARY SEEDINGS. CEREAL RYE HAS ALLELOPATHIC PROPERTIES THAT INHIBIT THE GERMINATION AND GROWTH OF OTHER PLANTS. IF IT MUST BE USED AS A NURSE CROP, SEED AT 1/3 OF THE RATE LISTED ABOVE. OATS ARE THE RECOMMENDED NURSE CROP FOR WARM-SEASON GRASSES.

2. FOR SANDY SOILS, PLANT SEEDS AT TWICE THE DEPTH LISTED ABOVE. 3. THE PLANTING DATES LISTED ARE AVERAGES FOR EACH ZONE AND MAY REQUIRE ADJUSTMENT TO REFLECT LOCAL CONDITIONS, ESPECIALLY NEAR THE BOUNDARIES OF THE ZONE.

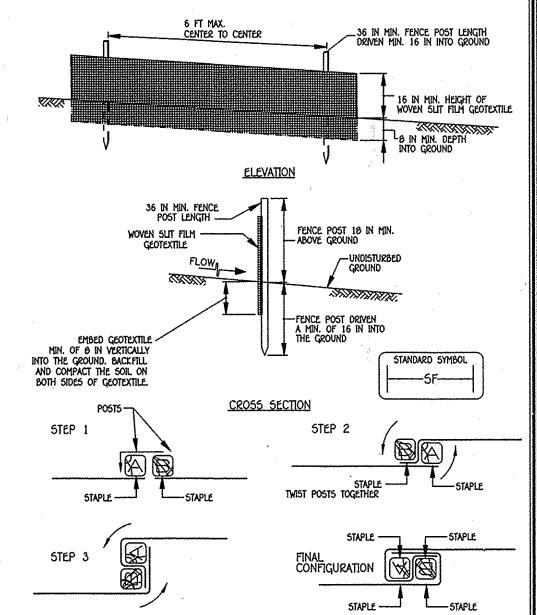

JOINING TWO ADJACENT SILT FENCE SECTIONS (TOP VIEW)


CONSTRUCTION SPECIFICATIONS

1. Use wood posts 1 3/4" x 1 3/4" ±/16" (Minimum) square cut of sound quality hardwood. As an alternative to wooden post use standard "1" or "U" section steel posts weighing not less HAN I POUND PER LINEAR FOOT. 2. USE 36 INCH MINIMUM POSTS DRIVEN 16 INCH MINIMUM INTO GROUND NO MORE THAN 6 FEET APART. 3. USE WOVEN SUT FILM GEOTEXTILE AS SPECIFIED IN SECTION H-1 MATERIALS AND FASTEN GEOTEXTILE SECURELY TO UPSLOPE SIDE OF FENCE POSTS WITH WIRE TIES OR STAPLES AT TOP AND MID-SECTION. . Provide manufacturer certification to the authorized representative of the inspection/enforcement

AUTHORITY SHOWING THAT THE GEOTEXTILE USED MEETS THE REQUIREMENTS IN SECTION H-1 MATERIALS. 5. EMBED GEOTEXTILE A MINIMUM OF 8 INCHES VERTICALLY INTO THE GROUND. BACKFILL AND COMPACT THE SOIL ON BOTH SIDES OF FABRIC. 6. WHERE TWO SECTIONS OF GEOTEXTILE ADJOIN: OVERLAP, TWIST, AND STAPLE TO POST IN ACCORDANCE WITH 7. EXTEND BOTH ENDS OF THE SILT FENCE A MINIMUM OF FIVE HORIZONTAL FEET UPSLOPE AT 45 DEGREES

to the main fence alignment to prevent runoff from going around the ends-of the silt fence. 8. REMOVE ACCUMULATED SEDIMENT AND DEBRIS WHEN BULGES DEVELOP IN SILT FENCE OR WHEN SEDIMENT REACHES 25% OF FENCE HEIGHT. REPLACE GEOTEXTILE IF TORN. IF UNDERMINING OCCURS, REINSTALL FENCE.

SILT FENCE NOT TO SCALE

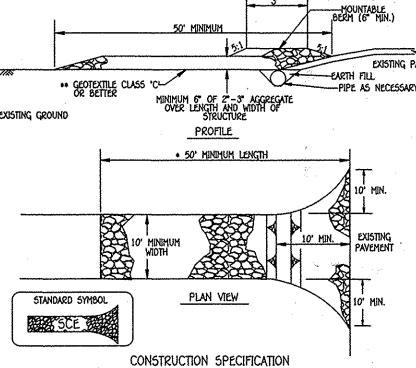

1. PLACE STABILIZED CONSTRUCTION ENTRANCE IN ACCORDANCE WITH THE APPROVED PLAN. VEHICLES MUST TRAVEL OVER THE ENTIRE LENGTH OF THE SCE. USE MINIMUM LENGTH OF SO FEET (*30 FEET FOR SINGLE RESIDENCE LOT). USE MINIMUM WIDTH OF 10 FEET, FLARE SCE 10 FEET MINIMUM AT THE EXISTING ROAD TO PROVIDE A TURNING RADIUS.


2. PIPE ALL SURFACE WATER FLOWING TO OR DIVERTED TOWARD THE SCE UNDER THE ENTRANCE, MAINTAINING POSITIVE DRAINAGE. PROTECT PIPE INSTALLED THROUGH THE SCE WITH A MOUNTABLE BERM WITH 5:1 SLOPES AND A MINIMUM OF 12 INCHES OF STONE

OVER THE PIPE PROVIDE PIPE AS SPECIFIED ON APPROVED PLAN, WHEN THE SCE IS located at a high spot and has no dranage to convey, a pipe is not necessary. A mountable berm is required when sce is not located at a high spot. Prepare subgrade and place nonwoven geotextile, as specified in section H–1 4. PLACE CRUSHED AGGREGATE (2 TO 3 INCHES IN SIZE) OR EQUIVALENT RECYCLED CONCRETE (WITHOUT REBAR) AT LEAST 6 INCHES DEEP OVER THE LENGTH AND WIDTH OF

THE SCE.

5. MAINTAIN ENTRANCE IN A CONDITION THAT MINIMIZES TRACKING OF SEDIMENT. ADD STONE OR MAKE OTHER REPAIRS AS CONDITIONS DEMAND TO MAINTAIN CLEAN SURFACE, MOUNTABLE BERM, AND SPECIFIED DIMENSIONS. IMMEDIATELY REMOVE STONE AND/OR SEDIMENT SPILLED, DROPPED, OR TRACKED ONTO ADJACENT ROADWAY BY VACUUMING, SCRAPING AND/OR SWEEPING. WASHING ROADWAY TO REMOVE MUD TRACKED ONTO PAVEMENT IS NOT ACCEPTABLE UNLESS WASH WATER IS DIRECTED TO AN APPROVED SEDIMENT CONTROL PRACTICE.

STABILIZED CONSTRUCTION ENTRANCE NOT TO SCALE

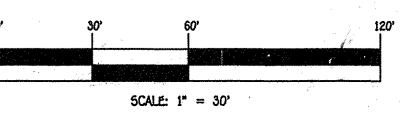

PROFESSIONAL CERTIFICATE

"I CERTIFY THAT THIS PLAN FOR EROSION AND SEDIMENT CONTROL REPRESENTS A PRACTICAL AND WORKABLE PLAN BASED ON MY PERSONAL KNOWLEDGE OF THE SITE CONDITIONS AND THAT IT WAS PREPARED IN

Knowle John handonen I FRANK JOHN MANALANSAN II, L.S. SIGNATURE OF ENGINEER LICENSE NO. 21476 EXPIRATION DATE: 7/14/15

BUILDER/DEVELOPER'S CERTIFICATE "I/WE CERTIFY THAT ALL DEVELOPMENT AND CONSTRUCTION WILL BE DONE ACCORDING TO THIS PLAN,

CONSERVATION DISTRICT. SIGNATURE OF DEVELOPER

443-367-0420

BEAZER HOMES CORP 8965 GUILFORD ROAD 5UME 209 410-720-5071

APPROVED: HOWARD COUNTY DEPARTMENT OF PLANNING AND ZONING 10-02-14 Date Development Engineering Division mark pa-les U. rector - Department of Planning and Zoning LOTS NO. CENTENNIAL LAKE OVERLOOK 1 THRU 23 BLOCK NO. ZONE TAX/ZONE ELEC. DIST. CENSUS TR. 22771-22779 6023.05 R-20 SECOND WATER CODE SEWER CODE 7640000 E-15

SEDIMENT/EROSION CONTROL DETAILS & NOTES

SINGLE FAMILY DETACHED

LOTS 1 THRU 23, OPEN SPACE LOTS 24 THRU 28 & BUILDABLE BULK PARCELS 'A' AND 'B' PREVIOUS HOWARD COUNTY FILES: ECP-12-053, WP-13-096. 5P-13-004, PB-399, F-14-002 AND CONTRACT NO. 24-4763-D TAX MAP NO.: 30 PARCEL NO.: 86 GRID NO.: 2

SECOND ELECTION DISTRICT HOWARD COUNTY, MARYLAND SCALE: AS SHOWN DATE: JULY, 2014 SHEET 5 OF 5 5DP 15-003

FISHER, COLLINS & CARTER, INC. DIVIL ENGINEERING CONSULTANTS & LAND SURVEYORS AGAI SOLARY OFFICE PARK - 10272 BALTIMORY NATIONAL PIK ELLICOTT CITY, MARYLAND 21042 (410) 461 - 2055





ACCORDANCE WITH THE REQUIREMENTS OF THE HOWARD SOIL CONSERVATION DISTRICT."

9/23/14

FOR SEDIMENT AND EROSION CONTROL AND THAT ANY RESPONSIBLE PERSONNEL INVOLVED IN THE CONSTRUCTION PROJECT WILL HAVE A CERTIFICATE OF ATTENDANCE AT A DEPARTMENT OF THE ENVIRONMENT APPROVED TRAINING PROGRAM FOR THE CONTROL OF SEDIMENT AND EROSION BEFORE BEGINNING THE PROJECT. I ALSO AUTHORIZE PERIODIC ON-SITE INSPECTION BY THE HOWARD SOIL

COLUMBIA, MARYLAND 21046

owner BUILDER 3 R'S AND AN I DEVELOPMENT COMPANY LLC 5300 DORSEY HALL DR. SUITE 102 ELLICOTT CITY, MARYLAND 21042