

VICINITY MAP
1"=2000'
ADC MAP 4933, GRID E3
GEODETIC SURVEY CONTROLS
Sta. 28HB N 567,548.737 E 1,320,551.664 El.: 556.082 (feet)
Sta. 28EA N 572,158.964 E 1,319,400.683 El.: 484.915 (feet)

- GENERAL NOTES**
- The subject property is zoned RR-DEO per the 10/6/13 Comprehensive Zoning Plan.
 - Total area of property = 2.911 ac.
 - Private water and sewer will be used within this site.
 - The existing well was updated in 2014 to current Health Department standards.
 - In 2014, with Health Department approval, the existing septic tank and distribution box were removed and replaced with a 1,000 gallon holding tank.
 - The lots shown herein comply with the minimum ownership, width and lot area as required by the Maryland State Department of the Environment.
 - This property is subject to the Amended 5th edition of the Howard County Subdivision and Land Development Regulations.
 - Field run boundary survey and topographic and utility survey (for area between Greenbury Lane and the station fence line) prepared by FSH Associates in March & December 2014. Field run topographic (2' contours) survey prepared by CNA Engineers in January, 2010.
 - Forest stand delineation prepared by Exploration Research Inc.
 - Paving, structures and concrete pads designated "TBR" are to be removed.
 - Wetlands analysis prepared by CNA Engineers on April 11, 2013.
 - No wetlands exist on site.
 - ZBA Reference: P/C, DPZ Reference: ECP-14-078.
 - Forest conservation obligations for this site are met by payment of a fee-in-lieu of forest conservation in the amount of \$18,208.00.
 - Landscape has been prepared in accordance with the provisions of Section 16.124 of the Howard County Code and Landscape Manual using alternative compliance.
 - All construction shall be in accordance with the latest standards and specifications of Howard County plus MSHA standards and specifications applicable.
 - Prior to beginning of construction, Contractor to verify all dimensions in the field and if a discrepancy is found, contact the engineer.
 - BRL Denotes Building Restriction Line.
 - The Environmental Concept Plan, ECP-14-078, was approved on July 25, 2014.
 - The coordinates shown herein are based upon the Howard County Geodetic Control which is based on the Maryland State Plane Coordinate System. Howard County Monument Nos. 28HB and 28EA were used for this project.
 - Traffic control devices, markings and signing shall be in accordance with the latest edition of the Manual of Uniform Traffic Control Devices (MUTCD). All street and regulatory signs shall be in place prior to the placement of any asphalt.
 - No traffic study is required for this project.
 - Approximate age of existing buildings on-site is 55 years old.
 - There are no floodplains, historic structures or cemeteries on-site.
 - Per a field visit with FSH, Howard County DED, and BGE on November 13, 2014 it was agreed that the infiltration trench location as shown on ECP-14-078 should be relocated to the location shown on this plan.
 - Howard County Soil Conservation District soil map number 16.
 - Contractor shall utilize BGE Gas Construction Plans and Details for installation of utilities, concrete, structures and paving.
 - ADDITIONAL LAND DISTURBANCE ON ADJACENT PARCEL 48 IS PART OF A REDLINE REVISION FOR CATHODIC PROTECTION SYSTEM UPGRADES
 - OWNER (PARCEL 48) WILLIAMS, ROBERT B. BENEDICT, JOANNA K. ET AL. 13110 GREENBERRY LANE CHARLOTTE, MD 21029-1120 ATTN: WILLIAMS, ROBERT B.

DEVELOPER (PARCELS 78 & 79)
BALTIMORE GAS AND ELECTRIC COMPANY
SPRING GARDENS COMPLEX
1699 LEADENHALL STREET
BALTIMORE, MARYLAND 21230
ATTN: GREG KAPPLER (410) 470-6445

OWNER (PARCEL 78)
BALTIMORE GAS AND ELECTRIC COMPANY
SPRING GARDENS COMPLEX
1699 LEADENHALL STREET
BALTIMORE, MARYLAND 21230
ATTN: GREG KAPPLER (410) 470-6445

OWNER (PARCEL 79)
ATLANTIC SEABORD CORP.
C/O COLUMBIA GAS TRANSMISSION
P.O. BOX 1273
CHARLESTON, WV 25325-1273
(304) 357-2000
ATTN: Antonio Redd

ADDRESS CHART

PARCELS	STREET
78 & 79	13055 Greenberry Lane

SHEET INDEX

SHEET	TITLE
1 of 2	Proposed Conditions Plan
2 of 2	Sediment Control Plan
3 of 2	Notes & Details
4 of 2	Existing Conditions Plan
5 of 2	Stormwater Management Plan
6 of 2	Landscape/Forest Con. Plan
7 of 2	Site Plan

FSH Associates
Engineers Planners Surveyors
6338 Howard Lane, Elkridge, MD 21075
Tel: 410-967-5200 Fax: 410-996-1862
E-mail: info@fsh.com

REV. SITE DEVELOPMENT PLAN

PROPOSED CONDITIONS
BGE LINDEN CHURCH GAS GATE STATION (Zoned: RR-DEO)
TAX MAP 28, PARCEL 78&79, 48
5TH ELEC. DIST, HO. CO, MD

SHEET 1 OF 178

GAS TRANSMISSION SUBSTATION

SCALE 1" = 30'
DWG NO. D
REV

NOTE
1. SWM will be required when cumulative disturbance exceeds 5,000 square feet.

SITE ANALYSIS DATA

- Total area of site = 2.911 ac.
- No wetlands exist on site.
- No 100-year floodplain exists on site.
- No forest exist on site.
- No areas of 15-24.9% slopes exist on site.
- No 25% slopes or greater exist on site.
- Limits of disturbance = 1.38 ac.±
- Proposed impervious area = 0.144 ac.±
- Area of erodible soils (K value ≥ 0.35) = 0.0 ac.±

PERMIT INFORMATION CHART

Subdivision Name	Section/Area	Lot/Parcel No.			
BGE Linden Church Gas Gate Station	N/A	P. 78 & 79			
Deed / Plat	Grid	Zoning	Tax Map No.	Elect. District	Census Tract
287/39	9	RR-DEO	28	5th	605104

PROFESSIONAL CERTIFICATION
I hereby certify that these documents were prepared or approved by me, and that I am a duly licensed professional engineer under the laws of the State of Maryland, License No. #22418, Expiration Date: 07/24/2015.

- LEGEND CONTINUED**
- EXISTING ANODE CABLE
 - PROPOSED ANODE CABLE
 - PROPOSED CATHODIC PROTECTION RECTIFIER
 - PROPOSED ANODE JUNCTION BOX J81
 - PROPOSED ANODE JUNCTION BOX J82
 - PROPOSED CROSSING TEST STATION
 - PROPOSED ISOLATION POINT TEST STATION
 - EXISTING ANODE TEST STATION
 - PROPOSED ANODE TEST STATION
 - EXISTING STRUCTURE (NEGATIVE BOND TEST STATION)
 - PROPOSED REMOTE MONITORING UNIT (RMU)
 - PROPOSED AC POWERSWITCH DISCONNECT SERVICES
 - ABOVEGROUND PIPE

REPLACE EXISTING FENCE WITH 9' HIGH SECURITY FENCE

PROPOSED DUCT UNDER GATE (TYP.)

REPLACE EXISTING FENCE WITH 9' HIGH SECURITY FENCE

PROFESSIONAL CERTIFICATION:
I HEREBY CERTIFY THAT THESE DOCUMENTS WERE PREPARED OR APPROVED BY ME AND THAT I AM A DULY LICENSED PROFESSIONAL ENGINEER UNDER THE LAWS OF THE STATE OF MARYLAND. LICENSE NO. 40784 EXPIRATION DATE: 11-08-2021

SOILS LEGEND

SYMBOL	NAME / DESCRIPTION	SOIL GROUP
GgC	Glenelg loam, 8 to 15 percent slopes	B (k=0.28)

ZACHARIA Y. FISCH, P.E. #22418
DATE: 2/14/17

AS-BUILT CERTIFICATION FOR PSMW
I HEREBY CERTIFY THAT FACILITY SHOWN ON THE PLAN WAS CONSTRUCTED AS SHOWN ON THE "AS-BUILT" PLANS AND COMPLIES WITH THE APPROVED PLANS AND SPECIFICATIONS. I HAVE VERIFIED THAT THE CONTRIBUTING DRAINAGE AREA IS SUFFICIENTLY STABILIZED TO PREVENT CLOGGING OF THE UNDERGROUND SWM FACILITY.

APPROVED: HOWARD COUNTY DEPARTMENT OF PLANNING AND ZONING


DATE: 6-5-15

DATE: 7-7-15

DATE: 7-7-15

APPROVED: FOR PRIVATE WATER AND PRIVATE SEWAGE SYSTEMS IN ACCORDANCE WITH THE MASTER PLAN OF HOWARD COUNTY

DATE: 5-1-15



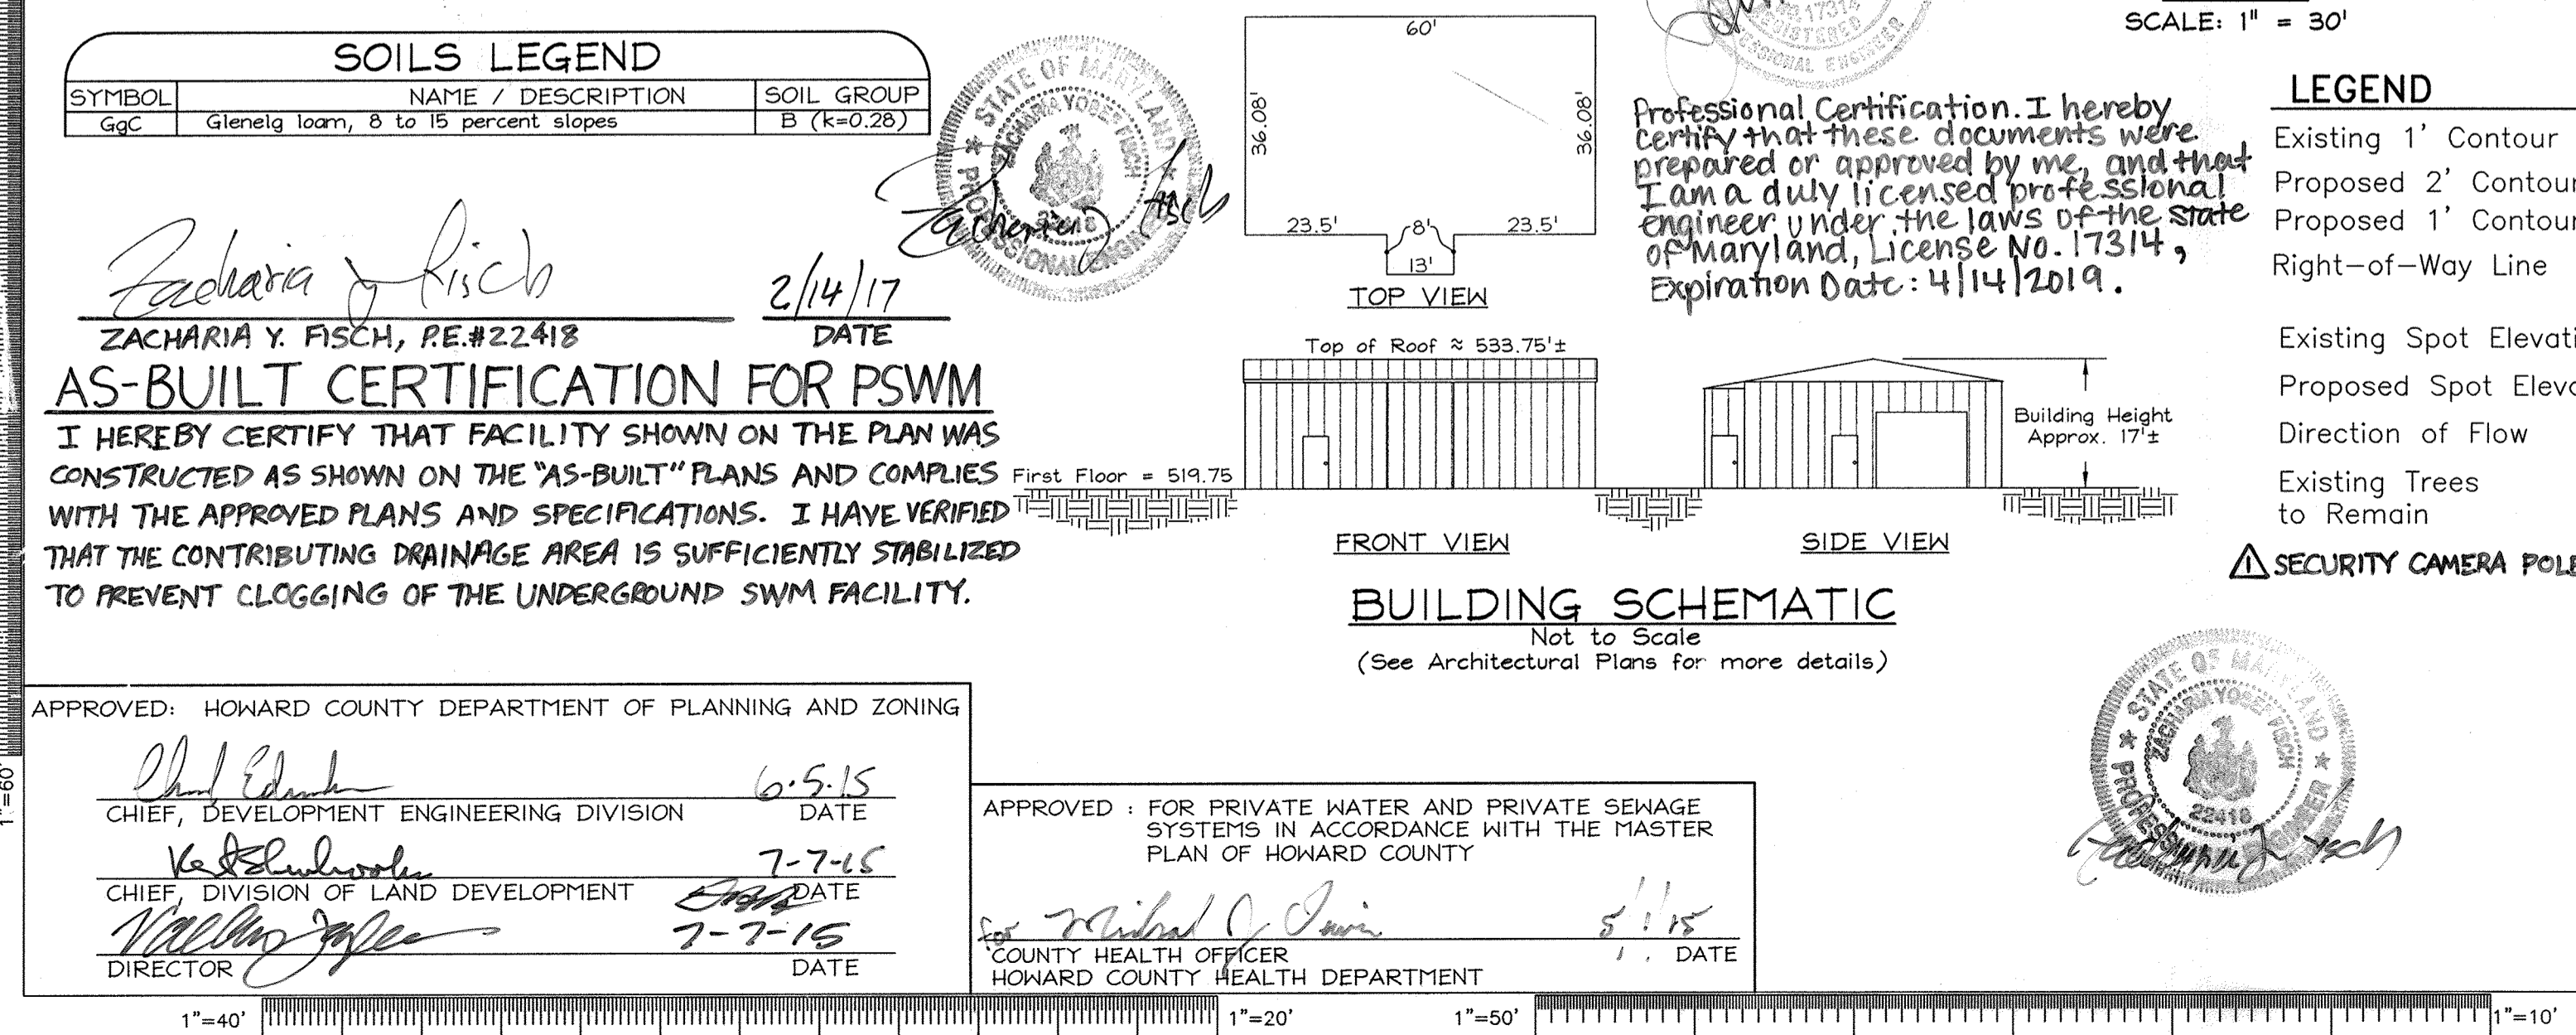


B-4-2 STANDARDS AND SPECIFICATIONS FOR SOIL PREPARATION, TOPSOILING, AND SOIL AMENDMENTS. Definition: The process of preparing the soils to sustain adequate vegetative stabilization. Purpose: To provide a suitable soil medium for vegetative growth. Conditions Where Practice Applies: Where vegetative stabilization is to be established. Criteria: A. Vegetative Preparation 1. Temporary Stabilization a. Seedbed preparation consists of loosening soil to a depth of 3 to 5 inches by means of suitable agricultural or construction equipment, such as disc harrows or chisel plows or ripers mounted on construction equipment. After the soil is loosened, it must not be rolled or dragged smooth but left in the roughened condition. Slopes 3:1 or flatter are to be tracked with ridges running parallel to the contour of the slope.

B-4-3 STANDARDS AND SPECIFICATIONS FOR SEEDING AND MULCHING. Definition: The application of seed and mulch to establish vegetative cover. Purpose: To protect disturbed soils from erosion and at the end of construction. Conditions Where Practice Applies: To the surface of all perimeter controls, slopes, and any disturbed area not under active grading. Criteria: A. Seeding 1. Specifications a. All seed must meet the requirements of the Maryland State Seed Law. All seed used must be tested by a recognized seed laboratory. All seed used must have been tested within the 6 months immediately preceding the date of sowing such material on any project. Refer to Table B.4 regarding the quality of seed. Seed lots must be available upon request to the inspector to verify type of seed and seeding rate. b. Much alone may be applied between the fall and spring seeding dates only if the ground is frozen. The appropriate seeding mixture must be applied when the ground thaws. c. Inoculants: The inoculant for treating legume seed in the seed mixtures must be a pure culture of nitrogen fixing bacteria prepared specifically for the species. Inoculants must not be used later than the date indicated on the container. Add fresh inoculants as directed on the package. Use four times the recommended amount. Note: It is very important to keep inoculant as cool as possible until used. Temperatures above 75 to 80 degrees Fahrenheit can weaken bacteria and make the inoculant less effective. d. Sod or seed must not be placed on soil which has been treated with soil sterilants or chemicals used for weed control until sufficient time has elapsed (14 days min.) to permit dissipation of phytotoxic materials. 2. Application a. Dry Seeding: This includes use of conventional drop or broadcast spreaders. i. Incorporate seed into the subsoil at the rates prescribed on Temporary Seeding Table B.3, Permanent Seeding Table B.3, or site-specific seeding summaries. ii. Apply seed in two directions, perpendicular to each other. Apply full seed rate in each direction. Roll the seeded area with a weighted roller to provide good seed to soil contact. b. Drill or Cultipacker Seeding: Mechanized seeders that apply and cover seed with a topsoil layer. i. Cultipacker seeders are required to bury the seed in such a fashion as to provide at least 1/4 inch of soil covering. Seeded must be firm after planting. ii. Apply seed in two directions, perpendicular to each other. Apply half the seeding rate in each direction. c. Hydroseeding: Apply seed uniformly with hydroseeder (slurry includes seed and fertilizer). i. If fertilizer is being applied at the time of seeding, the application rates should not exceed the following: nitrogen, 100 pounds per acre total of soluble nitrogen; P2O5 (phosphorus), 200 pounds per acre; K2O (potassium), 200 pounds per acre. ii. Lime: Use only ground agricultural limestone (up to 3 tons per acre) may be applied by hydroseeding. Normally, not more than 2 tons are applied by hydroseeding at any one time. Do not use burnt or hydrated lime when hydroseeding. iii. Mix seed and fertilizer on site and seed immediately and without interruption. iv. When hydroseeding do not incorporate seed into the soil.

B-4-4 STANDARDS AND SPECIFICATIONS FOR PERMANENT STABILIZATION. Definition: To stabilize disturbed soils with permanent vegetation. Purpose: To use long-lived perennial grasses and legumes to establish permanent ground cover on disturbed soils. Conditions Where Practice Applies: Exposed soils where ground cover is needed for 6 months or more. Criteria: A. Seed Mixtures 1. General Use a. Select one or more of the species or mixtures listed in Table B.3 for the appropriate Plant Hardiness Zone (from Figure B.3), and enter them in the Temporary Seeding Summary below with application rates, seeding dates and seeding depths. If this Summary is not put on the plan and completed, then Table B.1 plus fertilizer and lime rates must be on the plan. b. For sites having soil tests performed, use and show the recommended rates by the testing agency. Soil tests are not required for Temporary Seeding. c. When stabilization is required outside of a seeding season, apply seed and mulch or straw mulch as prescribed in Section B-4-3.1.1 and maintain until the next seeding season. c. For sites having disturbed areas over 5 acres, use and show the rates recommended by the soil testing agency. d. For areas receiving low maintenance, apply urea form fertilizer (46-0-0) at 3 1/2 pounds per 1000 square feet (150 lbs/acre) at the time of seeding in addition to the soil amendments shown in the Permanent Seeding Summary. 2. Turfgrass Areas a. Areas where turfgrasses may be desired include lawns, parks, playgrounds, and commercial sites which will receive a medium to high level of maintenance. b. Select one or more of the species or mixtures listed below based on the site conditions or purpose. Enter selected mixture(s), application rates, and seeding dates in the Permanent Seeding Summary. The summary is to be placed on the plan. i. Kentucky Bluegrass: Full Sun Mixture: For use in areas that receive intensive maintenance. Irrigation required in the areas of central Maryland and Eastern Shore. Recommended Certified Kentucky Bluegrass Cultivars Seeding Rate: 1.5 to 2.0 pounds per 1000 square feet. Choose a minimum of three Kentucky Bluegrass cultivars with each ranging from 10 to 35 percent of the total mixture by weight. b. Select one or more of the species or mixtures listed below based on the site conditions or purpose. Enter selected mixture(s), application rates, and seeding dates in the Permanent Seeding Summary. The summary is to be placed on the plan. i. Kentucky Bluegrass: Full Sun Mixture: For use in areas that receive intensive maintenance. Irrigation required in the areas of central Maryland and Eastern Shore. Recommended Certified Kentucky Bluegrass Cultivars Seeding Rate: 1.5 to 2.0 pounds per 1000 square feet. Choose a minimum of three Kentucky Bluegrass cultivars with each ranging from 10 to 35 percent of the total mixture by weight. ii. Tall Fescue/Century Bluegrass: Full Sun Mixture: For use in drought prone areas and/or for areas receiving low to medium maintenance in full sun to medium shade. Recommended mixture includes: Certified Tall Fescue Cultivars at 1.5 to 2.0 pounds per 1000 square feet and Kentucky Bluegrass Cultivars 0 to 40 percent and Certified Fine Fescue 60 to 70 percent. Seeding Rate: 1 1/2 to 3 pounds per 1000 square feet. Notes: Select turfgrass varieties from those listed in the most current University of Maryland Publication, Agronomy Memo #77, "Turfgrass Cultivar Recommendations for Maryland". Choose certified material. Certified material is the best guarantee of cultivar purity. The certification program of the Maryland Department of Agriculture, Turf and Seed Section, provides a reliable measure of consumer protection and assures a pure genetic line. c. Ideal Times of Seeding for Turf Grass Mixtures Western MD: March 15 to June 1, August 1 to October 1 (Hardiness Zones: 5b, 6a) Central MD: March 1 to May 15, August 15 to October 15 (Hardiness Zones: 6b) Southern MD, Eastern Shore: March 1 to May 15, August 15 to October 15 (Hardiness Zones: 7a, 7b) d. Till areas to receive seed by disking or other approved methods to a depth of 2 to 4 inches. If soil is too dry, water the areas to be prepared a week or so before seeding. Remove stones and debris over 1 1/2 inches in diameter. The resulting seedbed must be in such condition that future growth of grasses will pose no difficulty. e. If soil moisture is deficient, apply new seedings with adequate water for plant growth (1/2 to 1 inch every 3 to 4 days) until the grass is firmly established. This is especially true when seedings are made late in the planting season, in abnormally dry or hot seasons, or on adverse sites. B. Sod To provide quick cover on disturbed areas (2 1/2 grade or flatter). 1. General Specifications a. Class of turfgrass sod must be Maryland State Certified. Sod labels must be made available to the job foreman and inspector. b. Sod must be machine cut at a uniform soil thickness of 1 1/2 inch, plus or minus 1/4 inch, at the time of cutting. Measure for thickness with a depth gauge and notch. Broken pans and torn or uneven ends will not be acceptable. c. Standard size sections of sod must be strong enough to support their own weight and retain their size and shape when suspended vertically with a firm grasp on the upper 10 percent of the section. d. Sod must not be harvested or transplanted when moisture content (excessively dry or wet) may adversely affect its survival. e. Sod must be harvested, delivered, and installed within a period of 36 hours. Sod not transplanted within this period must be approved by an agronomist or soil scientist prior to its installation. 2. Sod Installation a. During periods of excessively high temperature or in areas having dry subsoil, lightly irrigate the subsoil immediately prior to laying the sod. b. Lay the first row of sod in a straight line with subsequent rows placed parallel to it and tightly wedged against each other. Stagger lateral joints to promote more uniform growth and strength. Ensure that soil is not stretched or overlapped and that all joints are butted tight in order to prevent voids which would cause air drying of the sod. c. Wherever possible, lay sod with the long edges parallel to the contour and with staggering joints. Roll and tamp or otherwise secure the sod to prevent slippage on slopes. Ensure solid contact exists between sod roots and the underlying soil surface. d. Water the sod immediately following rolling and tamping until the underside of the new sod pad and soil surface below the sod are thoroughly wet. Complete the watering of laying, tamping and irrigating for a piece of sod within eight hours. 3. Sod Maintenance a. In the absence of adequate rainfall, water daily during the first week or so after and sufficiently as necessary to maintain moist soil to a depth of 4 inches. Water sod during the heat of the day to prevent wilting. b. After the first week, sod watering is required as necessary to maintain adequate moisture content. C. Soil Amendments (Fertilizer and Lime Specifications) 1. Soil tests must be performed to determine the exact ratios and application rates for both lime and fertilizer on sites having disturbed areas of 5 acres or more. Soil analysis may be performed by a recognized private or commercial laboratory. Soil samples taken for engineering purposes may also be used for chemical analyses. 2. Fertilizers must be uniform in composition, free flowing and suitable for accurate application by appropriate equipment. Manure may be substituted for fertilizer with prior approval from the appropriate approval authority. Fertilizers must all be delivered to the site fully labeled according to the applicable laws and must bear the name, trade name or trademark and warranty of the producer. 3. Lime materials must be ground limestone (hydrated or burnt lime may be substituted except when hydroseeding) which contains at least 90 percent total oxides (calcium oxide plus magnesium oxide). Limestone must be ground to such fineness that at least 50 percent will pass through a #100 mesh sieve and 98 to 100 percent will pass through a #20 mesh sieve. 4. Lime and fertilizer are to be evenly distributed and incorporated into the top 3 to 5 inches of soil by disking or other suitable means. 5. Where the subsoil is either highly acidic or composed of heavy clays, spread ground limestone at the rate of 4 to 8 tons/acre (200-400 pounds per 1,000 square feet) prior to the placement of topsoil.





Temporary Seeding Summary and Permanent Seeding Summary tables. Includes columns for Hardness Zone, Species, Application Rate, Seeding Date, Seeding Depth, Fertilizer Rate, and Lime Rate. Lists various grass species like Annual Ryegrass, Kentucky Bluegrass, and Tall Fescue.

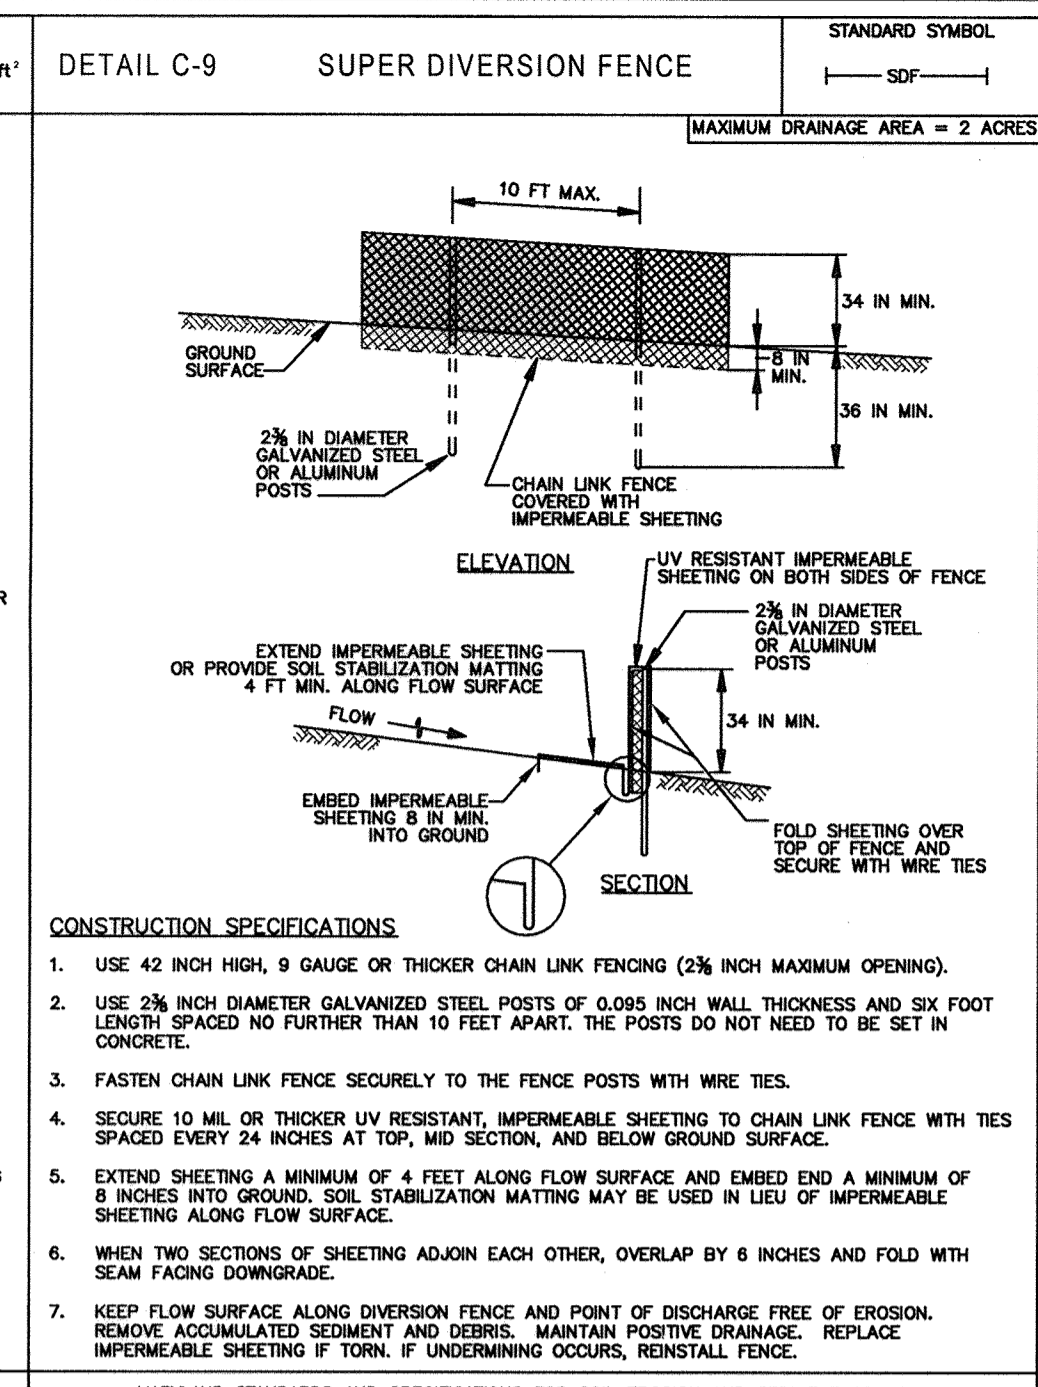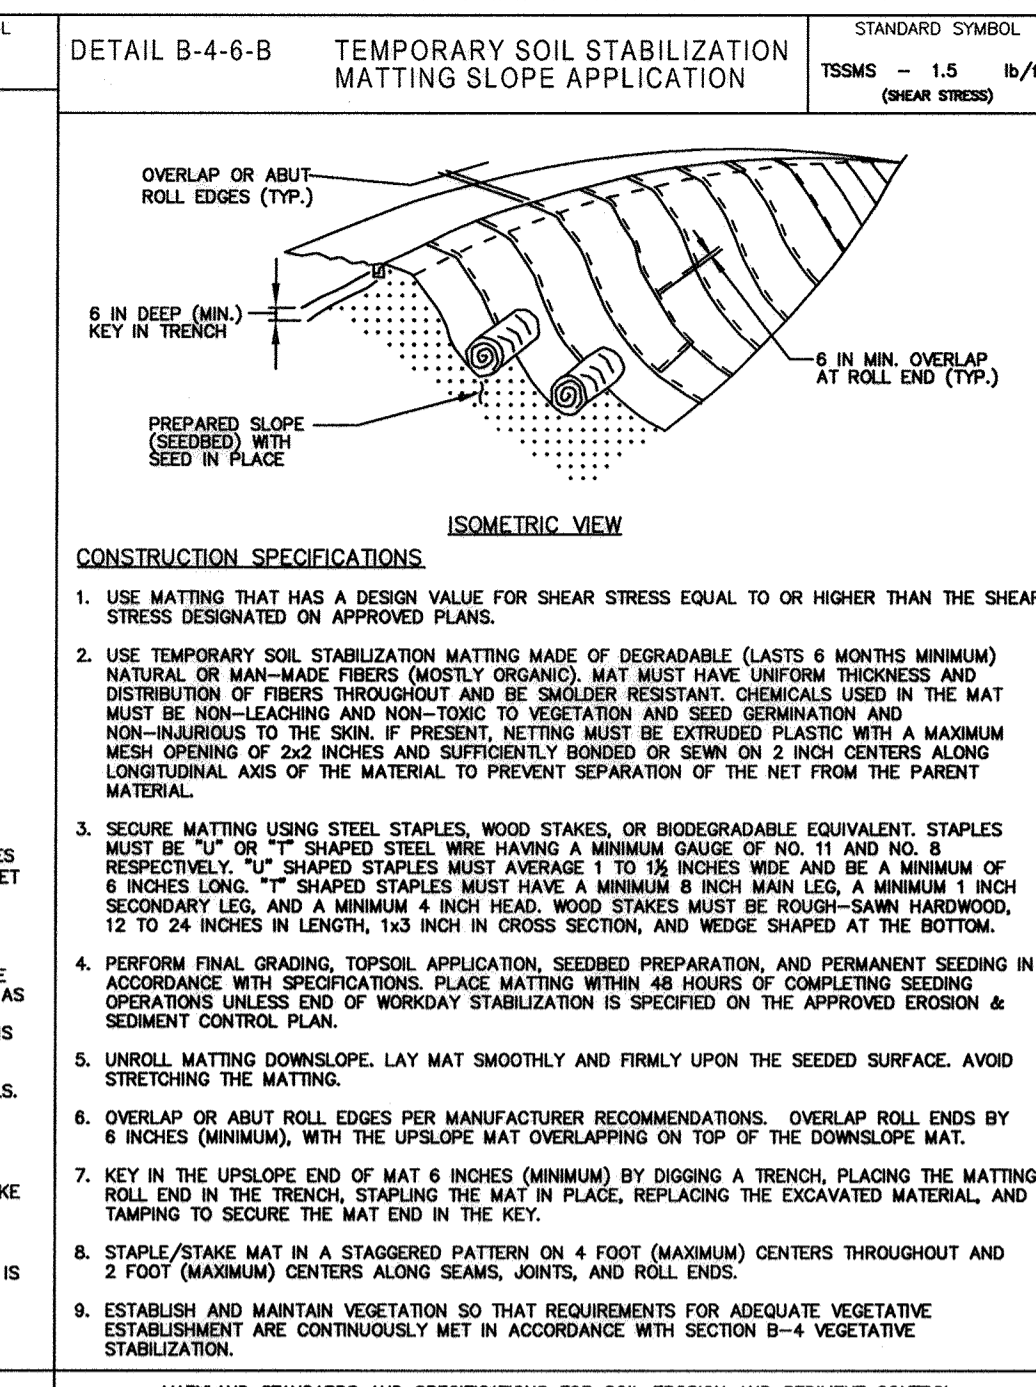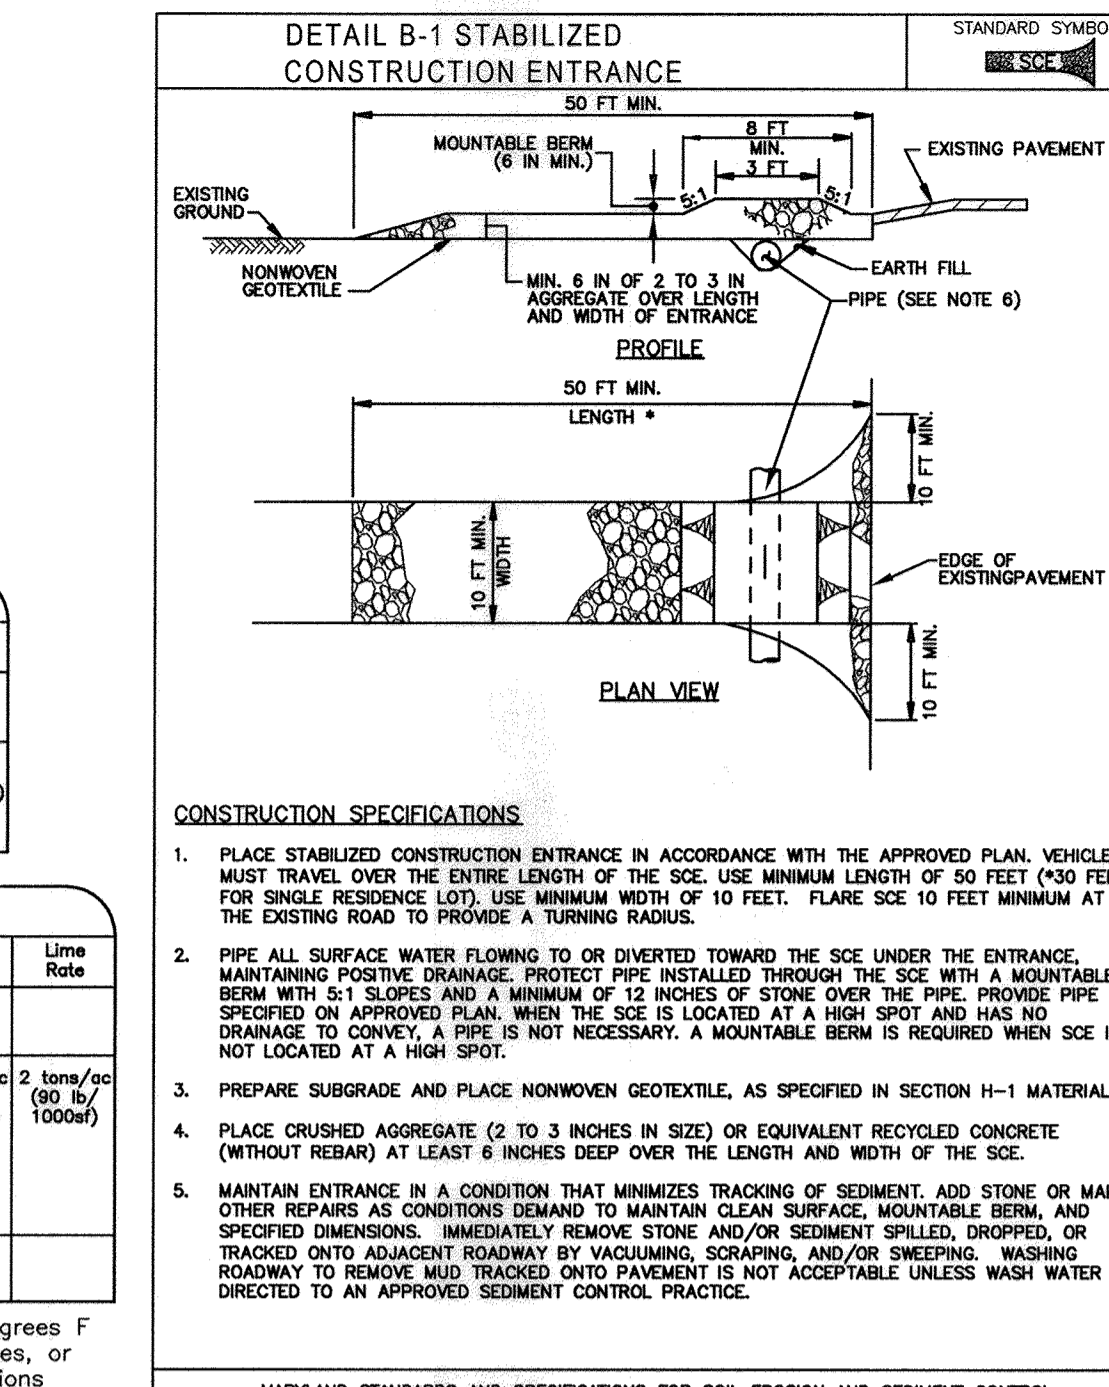

B. Topsoiling 1. Topsoil is placed over prepared subsoil prior to establishment of permanent vegetation. The purpose is to provide a suitable soil medium for vegetative growth. Soils of concern have low moisture content, low nutrient levels, low pH, materials toxic to plants, and/or unacceptable soil gradation. 2. Topsoil salvaged from an existing site may be used provided it meets the standards as set forth in these specifications. Typically, the depth of topsoil to be salvaged for a given soil type can be found in representative soil profile sections in the Soil Survey published by USDA-NRCS. 3. Topsoiling is limited to areas having 2:1 or flatter slopes where: a. The texture of the exposed subsoil material is not adequate to produce vegetative growth. b. The soil material is so shallow that the rooting zone is not deep enough to support plants or furnish continuing supplies of moisture and plant nutrients. c. The original soil to be vegetated contains material toxic to plant growth. d. The soil is so acidic that treatment with limestone is not feasible. 4. Areas having slopes steeper than 2:1 require special consideration and design. 5. Topsoil Specifications: Soil to be used as topsoil must meet the following criteria: a. Topsoil must be a loam, sandy loam, clay loam, silt loam, sandy clay loam, or loamy sand. Other soils may be used if recommended by an agronomist or soil scientist and approved by the appropriate approval authority. Topsoil must be a mixture of contrasting textures and must contain less than 5 percent by volume of cinders, stones, slag, coarse fragments, gravel, sticks, roots, trash, or other materials larger than 1 1/2 inches in diameter. b. Topsoil must be free of noxious plants or plant parts such as Bermuda grass, quack grass, Johnson grass, nut sedge, poison ivy, thistle, or other as specified. c. Topsoil substitutes or amendments, as recommended by a qualified agronomist or soil scientist and approved by the appropriate approval authority, may be used in lieu of natural topsoil. 6. Topsoil Application a. Erosion and sediment control practices must be maintained when applying topsoil. b. Uniformly distribute topsoil in a 5 to 8 inch layer and lightly compact to a minimum thickness of 4 inches. Spreading is to be performed in such a manner that sodding or seeding can proceed with a minimum of additional soil preparation and tillage. Any irregularities in the surface resulting from topsoiling or other operations must be corrected in order to prevent the formation of depressions or water pockets. c. Topsoil must not be placed if the topsoil or subsoil is in a frozen or muddy condition, when the subsoil is excessively wet or in a condition that may otherwise be detrimental to proper grading and seeded preparation.

B. Mulching 1. Mulch Materials (in order of preference) a. Straw consisting of thoroughly threshed wheat, rye, oat, or barley and reasonably bright in color. Straw is to be free of noxious weed seeds as specified in the Maryland Seed Law and not musty, moldy, caked, decayed, or excessively dusty. Note: Use only sterile straw mulch in areas where one species of grass is desired. b. Wood Cellulose Fiber Mulch (WCFM) consisting of specially prepared wood cellulose processed into a uniform fibrous physical state. i. WCFM is to be dyed green or contain a green dye in the package that will provide an appropriate color to facilitate visual inspection of the uniformly spread slurry. ii. WCFM, including dyes, must contain no germination or growth inhibiting factors. iii. WCFM materials are to be manufactured and processed in such a manner that the wood cellulose fiber mulch will remain in uniform suspension in water under agitation and will blend with seed, fertilizer and other additives to form a homogeneous slurry. The mulch material must form a biodegradable ground cover on application, having moisture absorption and percolation properties and must cover and hold grass seed in contact with the soil without inhibiting the growth of the grass seedings. iv. WCFM material must not contain elements or compounds at concentration levels that will be phytotoxic. v. WCFM must conform to the following physical requirements: fiber length of approximately 10 millimeters, diameter approximately 1 millimeter, pH range of 4 to 8.5, ash content of 1.5 percent maximum and water holding capacity of 90 percent minimum. 2. Application a. Apply mulch to all seeded areas immediately after seeding. b. When straw mulch is used, spread it over all seeded areas at the rate of 2 tons per acre to a uniform loose depth of 1 to 2 inches. Apply mulch to achieve a uniform distribution and depth so that the soil surface is not exposed. When using a mulch anchoring tool, increase the application rate to 2.5 tons per acre. c. Wood cellulose fiber used as mulch must be applied at a net dry weight of 1500 pounds per acre. Mix the wood cellulose fiber with water to attain a mixture with a maximum of 50 pounds of wood cellulose fiber per 100 gallons of water. 3. Anchoring a. Perform mulch anchoring immediately following application of mulch to minimize loss by wind or water. This may be done by one of the following methods (listed by preference), depending upon the size of the area and erosion hazard: i. A mulch anchoring tool is a tractor drawn implement designed to punch and anchor mulch into the soil surface a minimum of 2 inches. This practice is to be used on large areas, but is limited to flatter slopes where equipment can operate safely. If used on sloping land, this practice should follow the contour. ii. Wood cellulose fiber may be used for anchoring straw. Apply the fiber binder at a net dry weight of 750 pounds per acre. Mix the wood cellulose fiber with water at a maximum of 50 pounds of wood cellulose fiber per 100 gallons of water. iii. Synthetic binders such as Acrylic DLR (Apro-Tack), DCA-70, Petrosol, Terra Tax II, Terra Tack AR or other approved equal may be used. Follow application rates as specified by the manufacturer. Application of liquid binders needs to be heavier at the edges where wind catches much, such as in valleys and on crests of banks. Use of asphalt binders is strictly prohibited. iv. Lightweight plastic netting may be stapled over the mulch according to manufacturer recommendations. Netting is usually available in rolls 4 to 15 feet wide and 300 to 3,000 feet long.

Worm-season grasses need a soil temperature of at least 50 degrees F in order to germinate. If soil temperatures are colder than 50 degrees, or moisture is not adequate, the seeds will remain dormant until conditions are favorable. In general, planting during the latter portion of this period allows the most time for the emergence of weed control prior to planting. When selecting a planting date, consider the need for weed control vs. the likelihood of having sufficient moisture for the later plantings, especially on droughty sites. DUST CONTROL DEFINITION: Controlling dust blowing and movement on construction sites and roads. PURPOSE: To prevent blowing and movement of dust from exposed soil surfaces, reduce on- and off-site damage, health hazards, and improve traffic safety. CONDITIONS WHERE PRACTICE APPLIES: This practice is applicable to areas subject to dust blowing and movement where on- and off-site damage is likely without treatment. SPECIFICATIONS Temporary Methods 1. Pitches - See standards for vegetative stabilization with mulches only. Mulch should be crimped or locked to prevent blowing. 2. Vegetative Cover - See standards for temporary vegetative cover. 3. Tillage - To roughen surface and bring clods to the surface. This is an emergency measure which should be used before soil blowing starts. Begin plowing on windward side of site. Chisel-type plows spaced about 12' apart, spring-toothed harrows, and similar plow or examples of equipment which may produce the desired effect. 4. Irrigation - This is generally used as an emergency treatment. Irrigate with water until the surface is moist. Repeat as needed. At no time should the site be irrigated to the point that runoff begins to flow. 5. Barriers - Solid board fences, snow fences, burlap fences, straw bales, and similar material can be used to control air currents and soil blowing. Barriers placed at right angles to prevailing winds at intervals of about 10 times their height are effective in controlling soil blowing. 6. Calcium Chloride - Apply at rates that will keep surface moist. May need reapplication. Permanent Methods 1. Permanent Vegetation - See standards for permanent vegetative cover, and permanent stabilization with sod. Existing trees or large shrubs may afford valuable protection if left in place. 2. Topsoiling - Covering with less erosive soil materials. See standards for topsoiling. 3. Stone - Cover surface with crushed stone or coarse gravel. REFERENCES 1. Agricultural Handbook 346. Wind Erosion Forces in the United States and Their Use in Predicting Soil Loss. 2. Agriculture Information Bulletin 354. How to Control Wind Erosion, USDA-ARS, H-30-1.

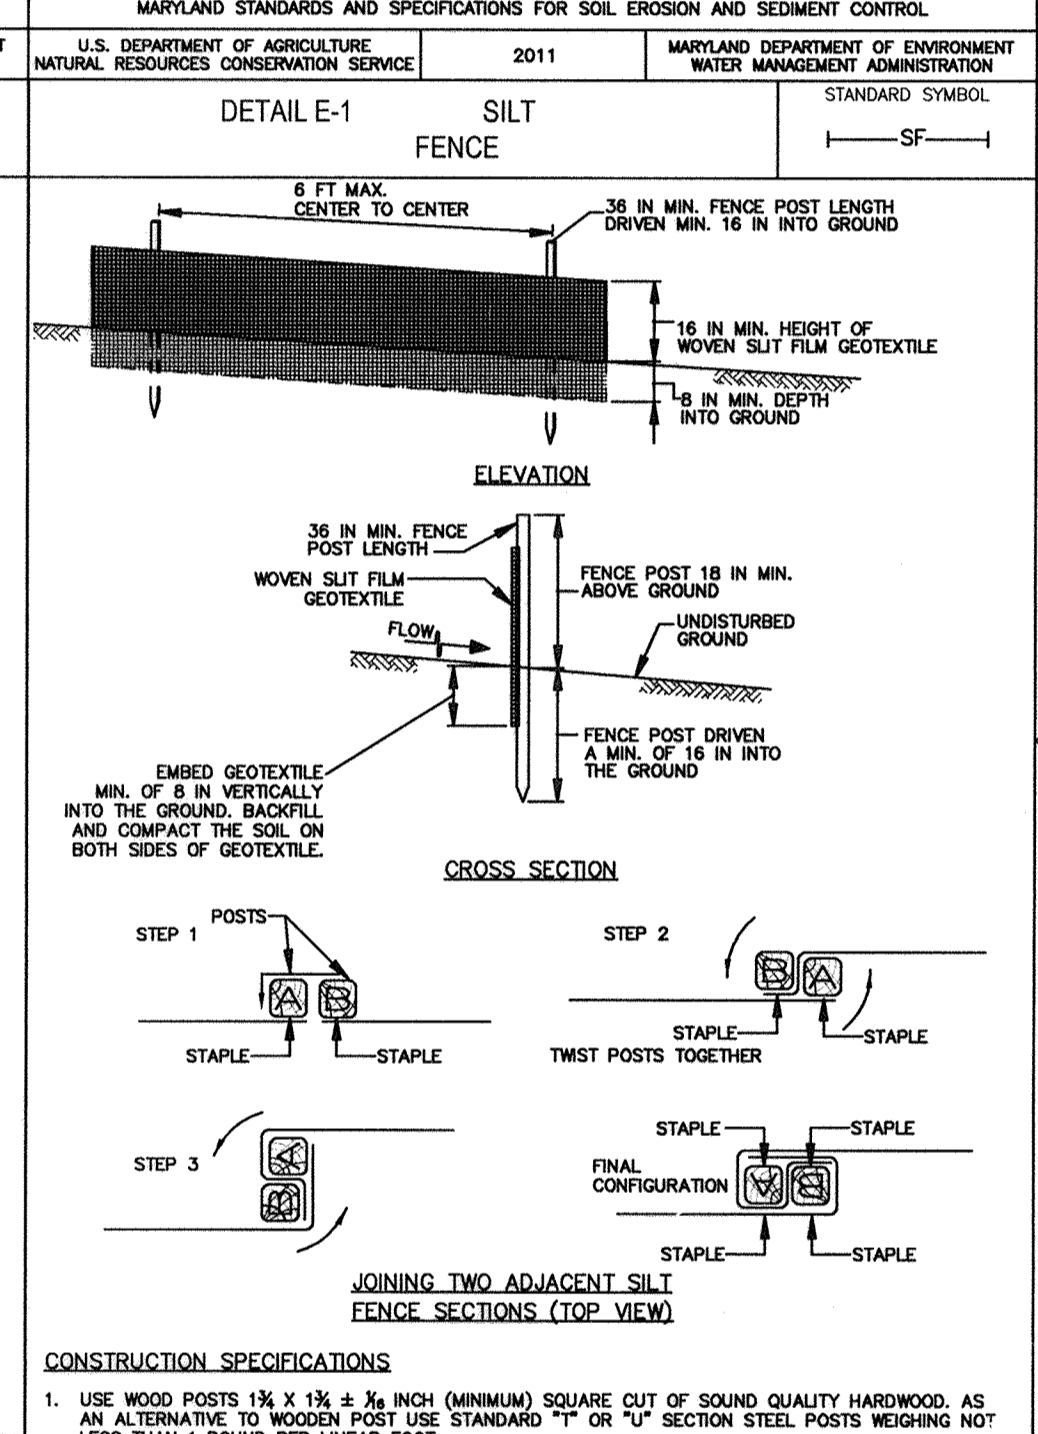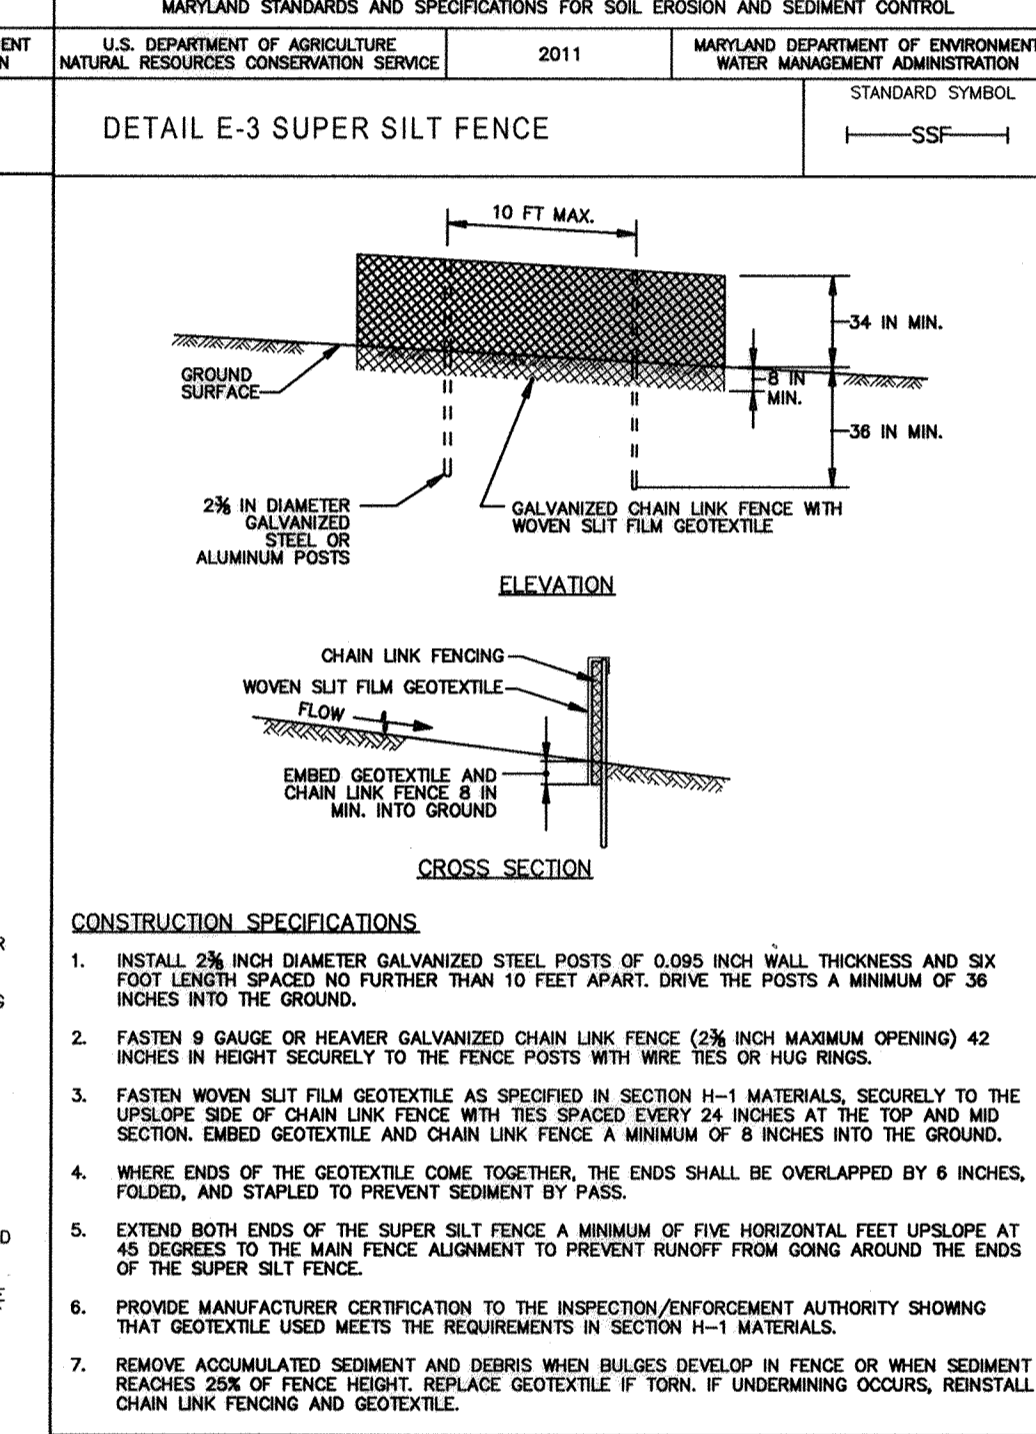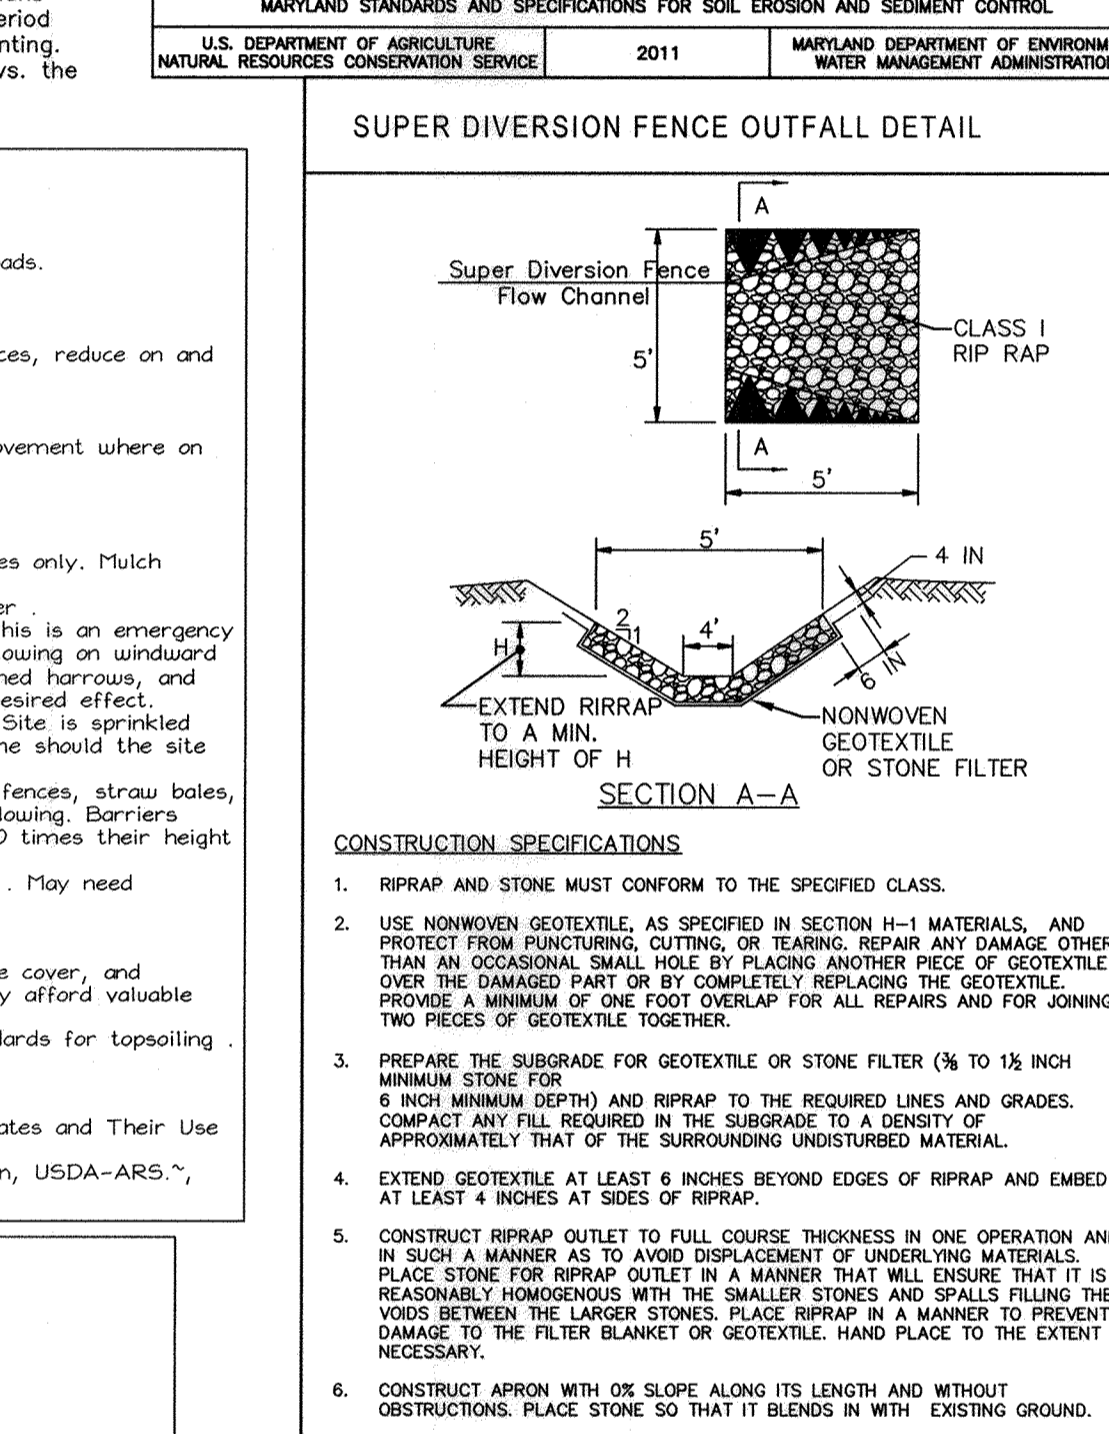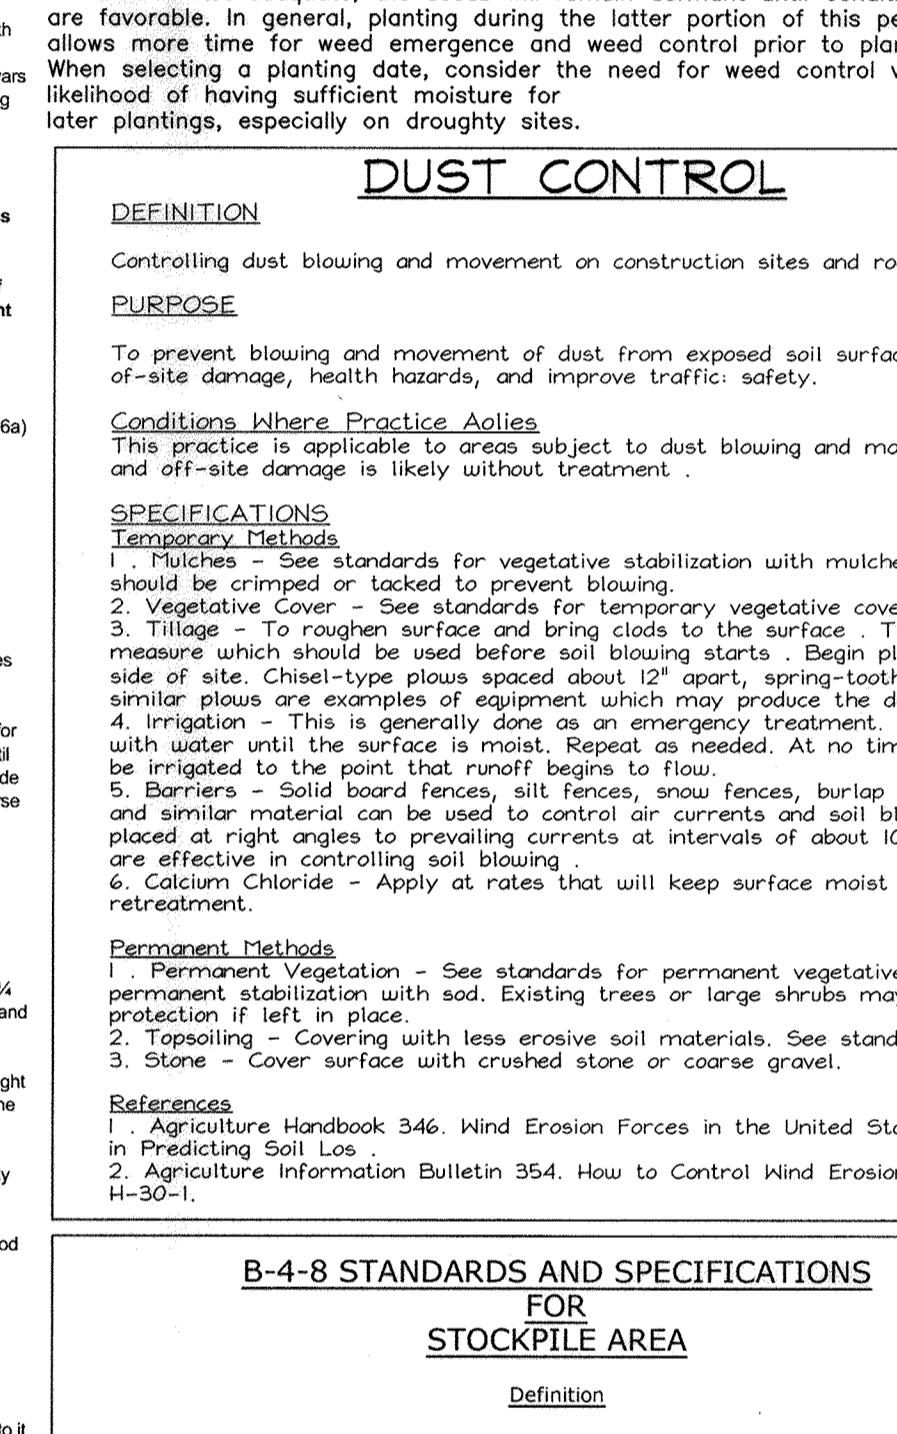


APPROVED: HOWARD COUNTY DEPARTMENT OF PLANNING AND ZONING. Chief, Development Engineering Division. Date: 6-5-15.

DEVELOPMENT PLAN IS APPROVED FOR SOIL EROSION AND SEDIMENT CONTROL BY THE HOWARD SOIL CONSERVATION DISTRICT. Date: 5/15/15.

ENGINEERS CERTIFICATE. I CERTIFY THAT THIS PLAN FOR SEDIMENT AND EROSION CONTROL REPRESENTS A PRACTICAL AND WORKABLE PLAN BASED ON MY PERSONAL KNOWLEDGE OF THE SITE CONDITIONS AND PREPARED IN ACCORDANCE WITH THE REQUIREMENTS OF THE HOWARD SOIL CONSERVATION DISTRICT. Date: 4/29/15.


DEVELOPER'S CERTIFICATE. I HEREBY CERTIFY THAT ALL DEVELOPMENT AND CONSTRUCTION WILL BE DONE ACCORDING TO THIS PLAN FOR SEDIMENT AND EROSION CONTROL, AND THAT ALL RESPONSIBLE PERSONNEL INVOLVED IN THE CONSTRUCTION PROJECT WILL HAVE A CURRENTLY VALID CERTIFICATE OF THE ENVIRONMENT APPROVED TRAINING PROGRAM FOR THE CONTROL OF SEDIMENT AND EROSION BEFORE BEGINNING THE PROJECT. I ALSO AUTHORIZE PERIODIC ON-SITE INSPECTION BY THE HOWARD SOIL CONSERVATION DISTRICT. Date: 4/30/15.

SEQUENCE OF CONSTRUCTION. 1. The contractor shall notify the Department of Public Works/Bureau of Engineering/Construction Inspection Division at (410) 313-1880 at least five (5) working days prior to the start of work. 2. The contractor shall notify the Utility at 1-800-257-7777 at least 48 hours prior to any excavation work being done. 3. Obtain grading permit and contact Howard County Sediment Control Inspector (SC1) to arrange a pre-construction meeting. (1 day) 4. Install stone construction entrance (SCE), silt fence (SF), super silt fence (SSF), super diversion fence (SDF) and temporary asphalt berm. (1 day) 5. With the permission of the sediment control inspector, begin on-site construction and stabilize all disturbed areas. (3 months) 6. Install phase II temporary access entrance and deliver necessary equipment using this entrance. (1 week) 7. Stabilize all disturbed areas with permanent seeding. (1 week) 8. With the permission of the Sediment Control Inspector, remove all sediment control measures and stabilize all disturbed areas with permanent seeding. (1 day) 9. Remove all temporary access entrance and deliver necessary equipment using this entrance. (1 week) 10. Stabilize all disturbed areas with permanent seeding. (1 week) 11. With the permission of the Sediment Control Inspector, remove all sediment control measures and stabilize all disturbed areas with permanent seeding. (1 day) 12. Remove all temporary access entrance and deliver necessary equipment using this entrance. (1 week) 13. Stabilize all disturbed areas with permanent seeding. (1 week) 14. With the permission of the Sediment Control Inspector, remove all sediment control measures and stabilize all disturbed areas with permanent seeding. (1 day) 15. Remove all temporary access entrance and deliver necessary equipment using this entrance. (1 week) 16. Stabilize all disturbed areas with permanent seeding. (1 week) 17. With the permission of the Sediment Control Inspector, remove all sediment control measures and stabilize all disturbed areas with permanent seeding. (1 day) 246. Remove all temporary access entrance and deliver necessary equipment using this entrance. (1 week) 247. Stabilize all disturbed areas with permanent seeding. (1 week) 248. With the permission of the Sediment Control Inspector, remove all

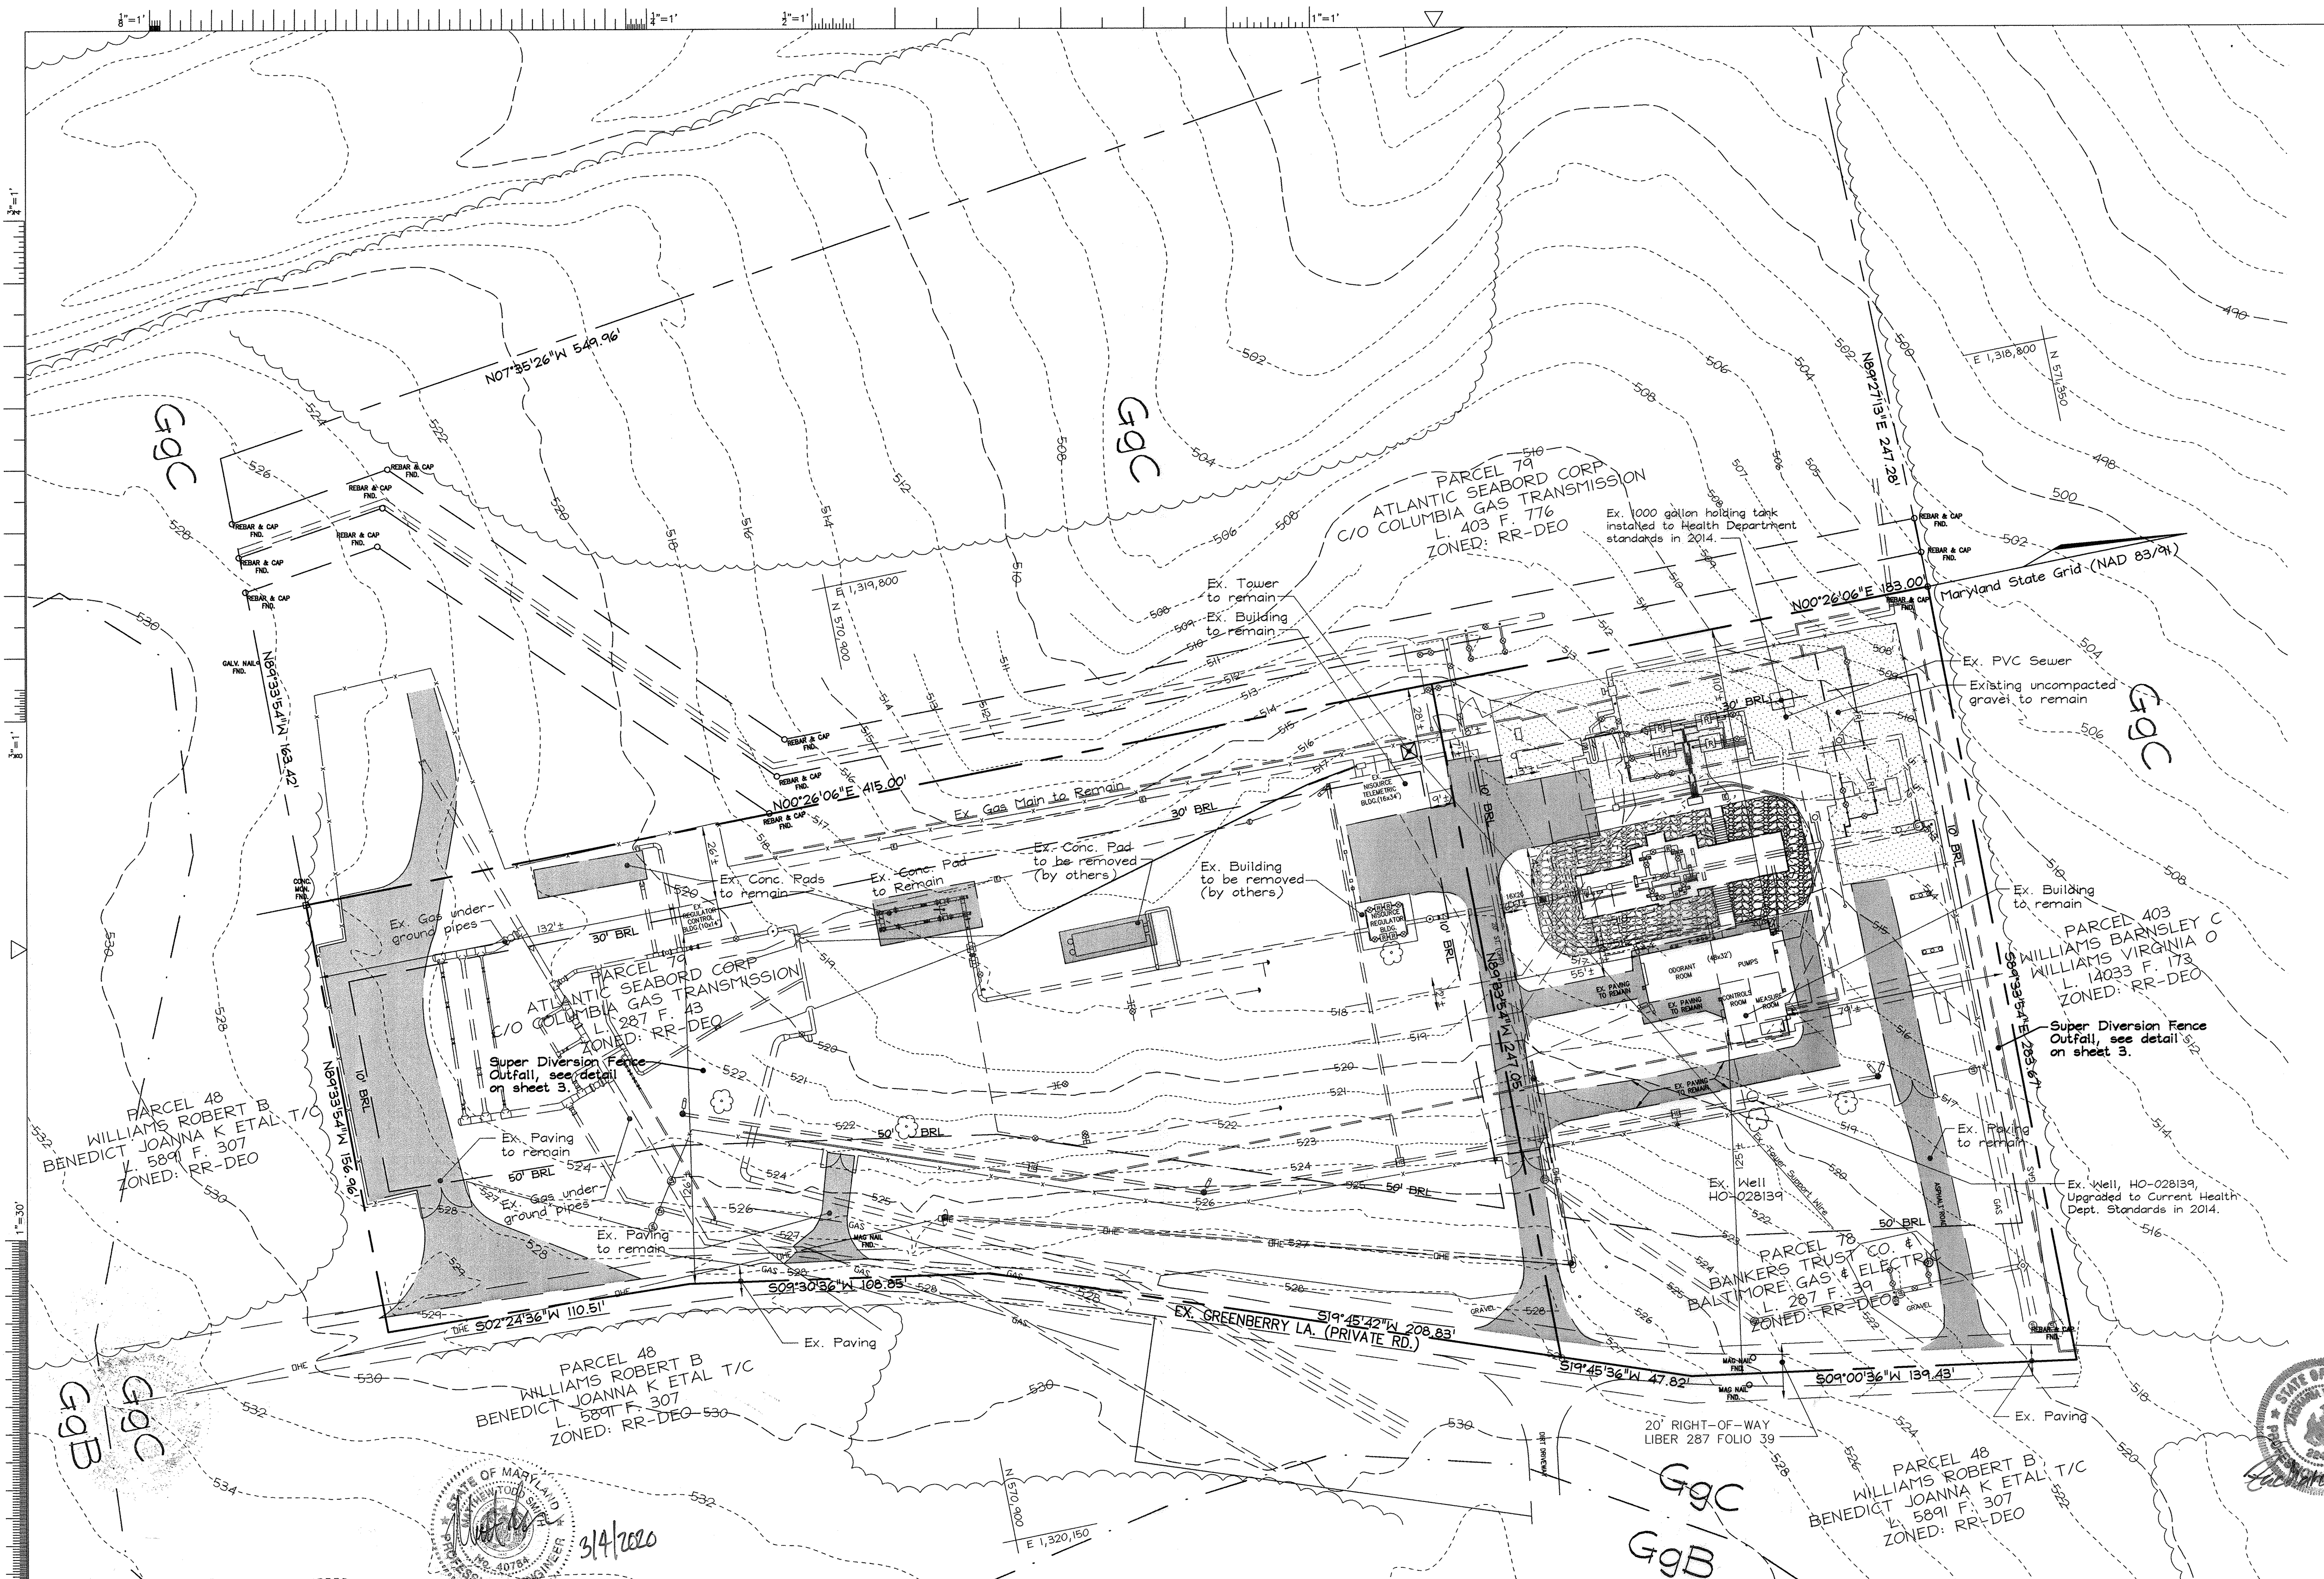

LEGEND

Existing 1' Contour	-----302
Right-of-Way Line	-----302
Existing Paving	[Hatched Box]
Existing Gravel	[Dotted Box]

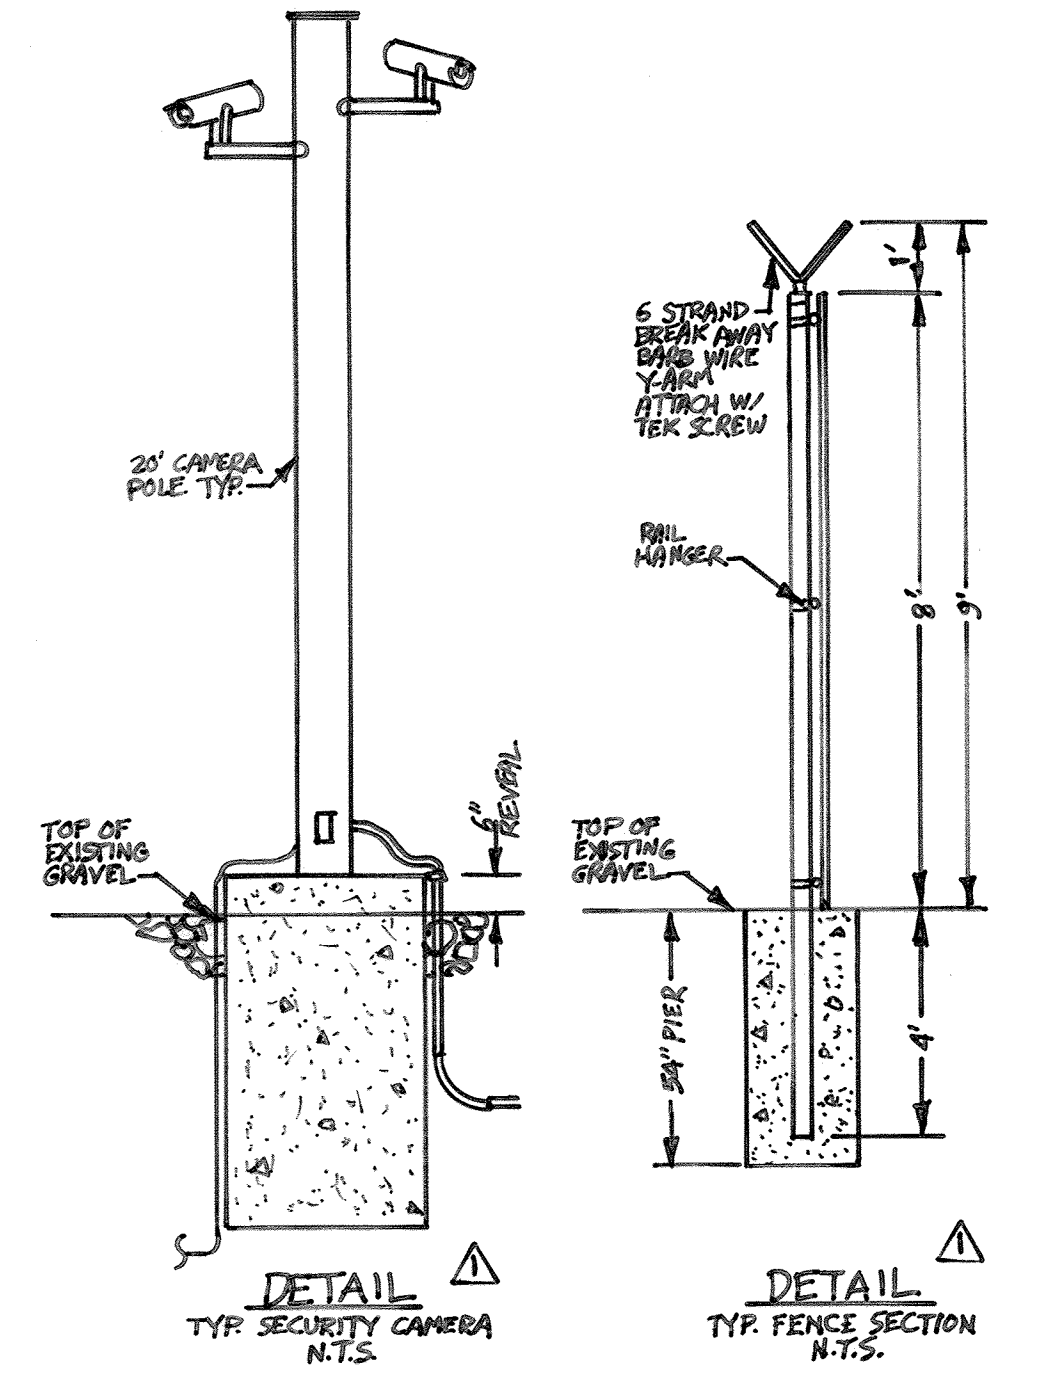

FSH Associates
 Engineers Planners Surveyors
 6338 Howard Lane, Elkridge, MD 21075
 Tel: 410-587-5300 Fax: 410-796-1952
 E-mail: info@fshen.com


DEVELOPER (PARCELS 78 & 79)
 BALTIMORE GAS AND ELECTRIC COMPANY
 SPRING GARDENS COMPLEX
 1699 LEADENHALL STREET
 BALTIMORE, MARYLAND 21230
 ATTN: GREG KAPPLER (410) 470-6445

OWNER (PARCEL 78)
 BALTIMORE GAS AND ELECTRIC COMPANY
 SPRING GARDENS COMPLEX
 1699 LEADENHALL STREET
 BALTIMORE, MARYLAND 21230
 ATTN: GREG KAPPLER (410) 470-6445

OWNER (PARCEL 79)
 ATLANTIC SEABOARD CORP.
 C/O COLUMBIA GAS TRANSMISSION
 P.O. BOX 1273
 CHARLESTON, WV 25325-1273
 (304) 357-2000
 ATTN: Antonio Redd

PROFESSIONAL CERTIFICATION
 I hereby certify that these documents were prepared or approved by me, and that I am a duly licensed professional engineer under the laws of the State of Maryland, License No. #22418, Expiration Date: 07/29/2025.

EXISTING CONDITIONS PLAN
 SCALE: 1" = 30'

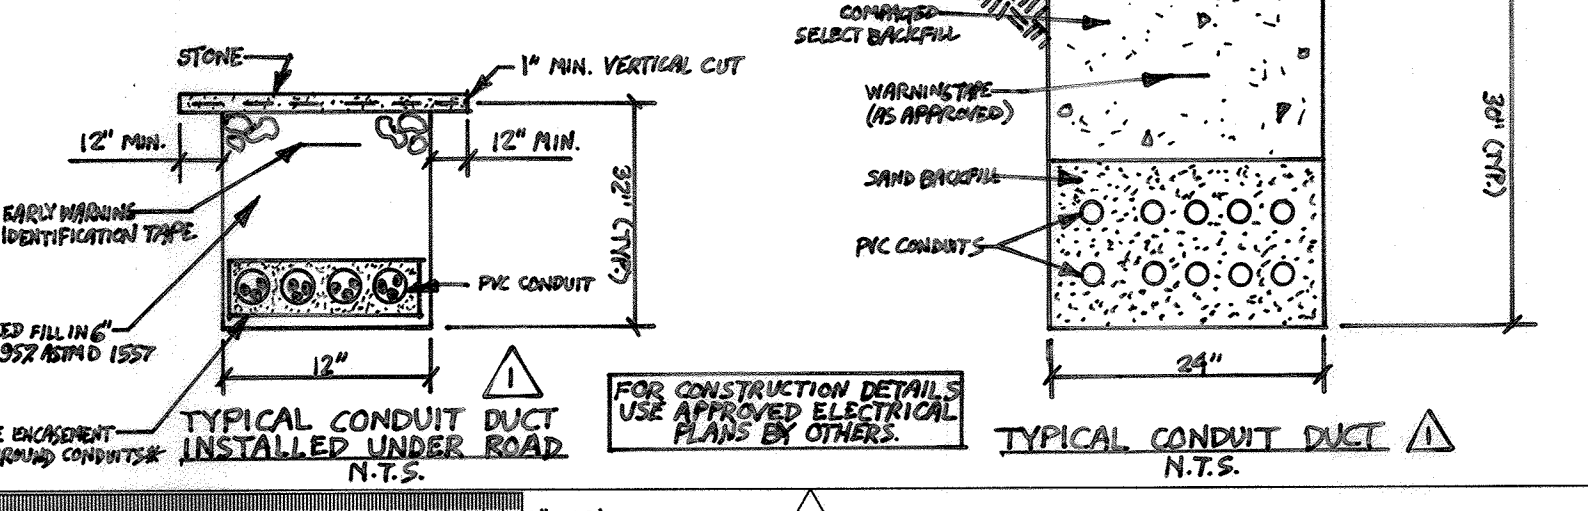

REV.	DATE	ACCOUNT NO.	DESCRIPTION	APPROVED	AUTOCAD
1	JUL 2016		ADDED PROPOSED FENCE, CAMERA POLES, AND DUCT DETAILS		ENGINEERING
	DEC 2019		UPDATED TO INCLUDE NEW SHEET		CIVIL: FSH ELEC.: PROJ. ENG.: PROJ. MGR.: PRIN. ENG.: SUPV. ENG.:

SITE DEVELOPMENT PLAN
EXISTING CONDITIONS & DETAILS
 BGE LINDEN CHURCH GAS
 GATE STATION (Zoned: RR-DEO)
 TAX MAP 28, PARCEL 78&79
 5TH ELEC. DIST, HO. CO. MD
 SHEET 4 OF 8

GAS TRANSMISSION SUBSTATION

DESIGNED	CRH2
DRAWN	CRH2
CHECKED	ZYF
APPROVED	
DATE	APRIL 28, 2015

SCALE: 1" = 30'

DWG NO. D

REV. D

PROFESSIONAL CERTIFICATION:
 I HEREBY CERTIFY THAT THESE DOCUMENTS WERE PREPARED OR APPROVED BY ME AND THAT I AM A DULY LICENSED PROFESSIONAL ENGINEER UNDER THE LAWS OF THE STATE OF MARYLAND LICENSE NO. 40784 EXPIRATION DATE: 11-08-2021



AS-BUILT CERTIFICATION FOR PSWM
 NOTE: THERE IS NO "AS-BUILT" INFORMATION PROVIDED ON THIS SHEET.


Zacharia Y. Fisch
 ZACHARIA Y. FISCH, P.E. #22418
 DATE: 2/14/17




APPROVED: HOWARD COUNTY DEPARTMENT OF PLANNING AND ZONING

Howard County Department of Planning and Zoning
 Chief, Development Engineering Division
 Chief, Division of Land Development
 Director

DATE: 6-5-15
 DATE: 7-7-15
 DATE: 7-7-15

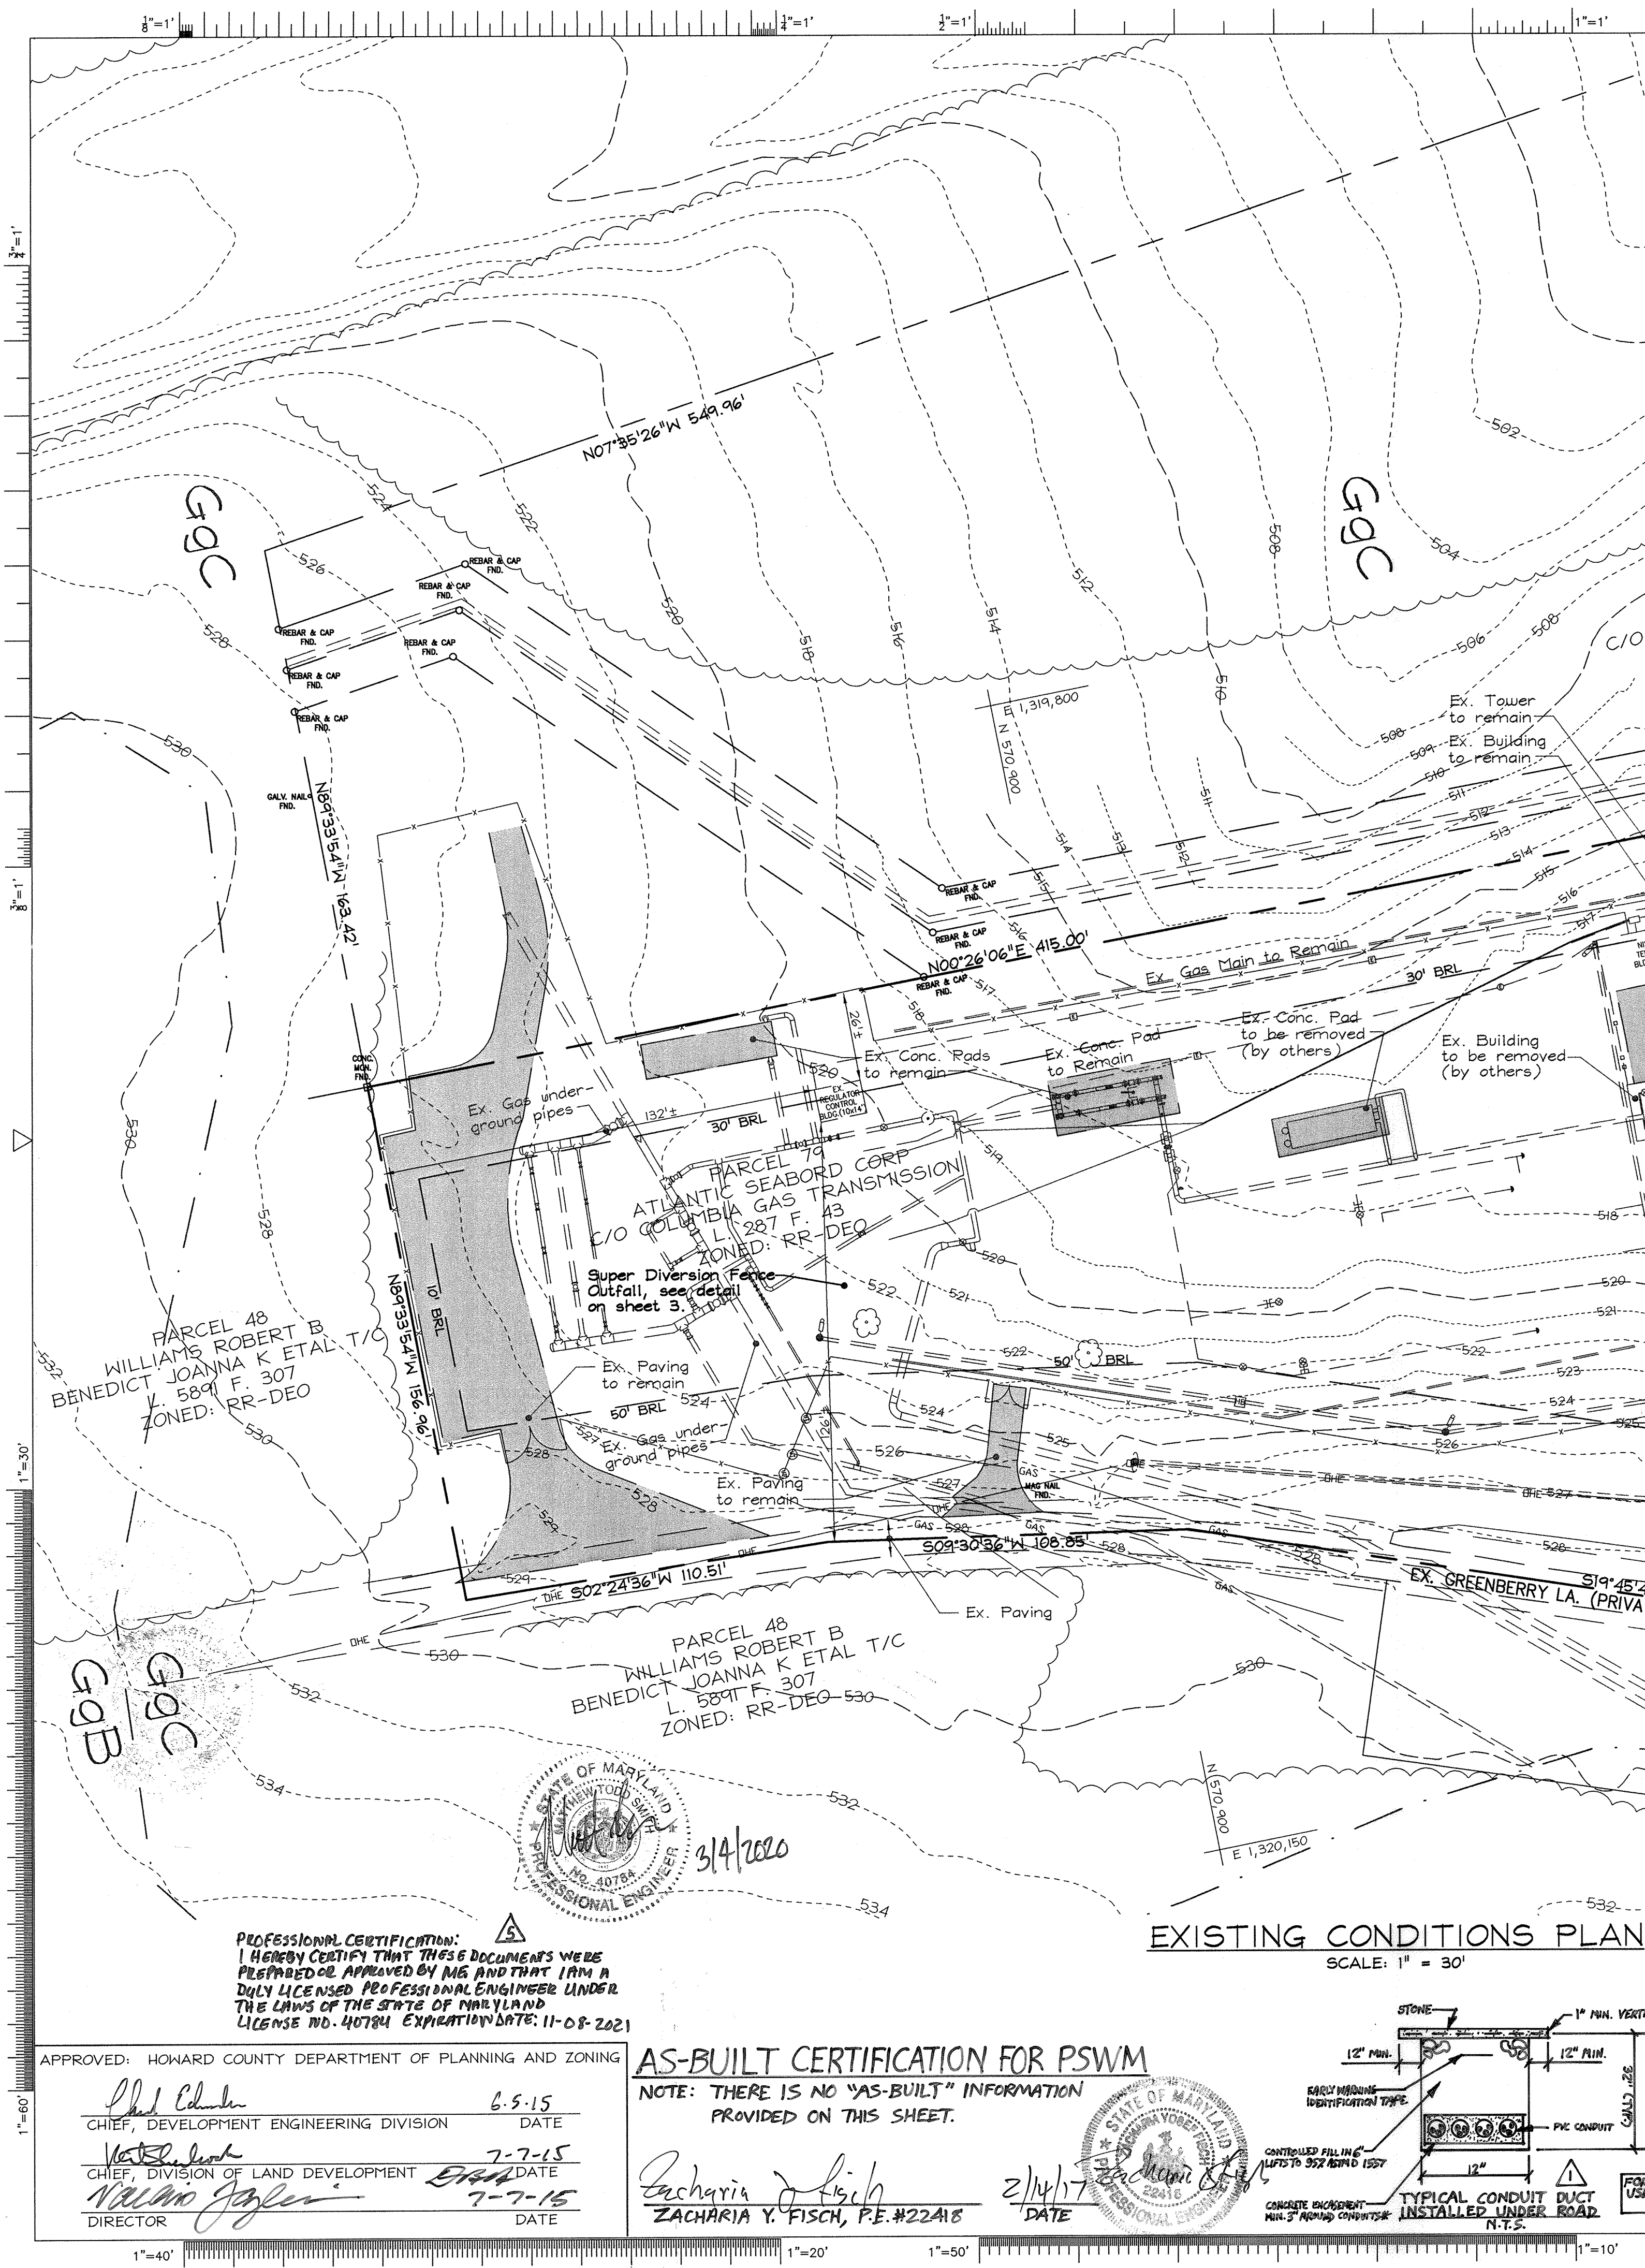

10/2015: BGE Project: Linden Church Gas Station, 5TH ELEC. DIST, HO. CO. MD, TAX MAP 28, PARCEL 78&79, SHEET 4 OF 8, DATE: 07/29/2025, BY: CRH2

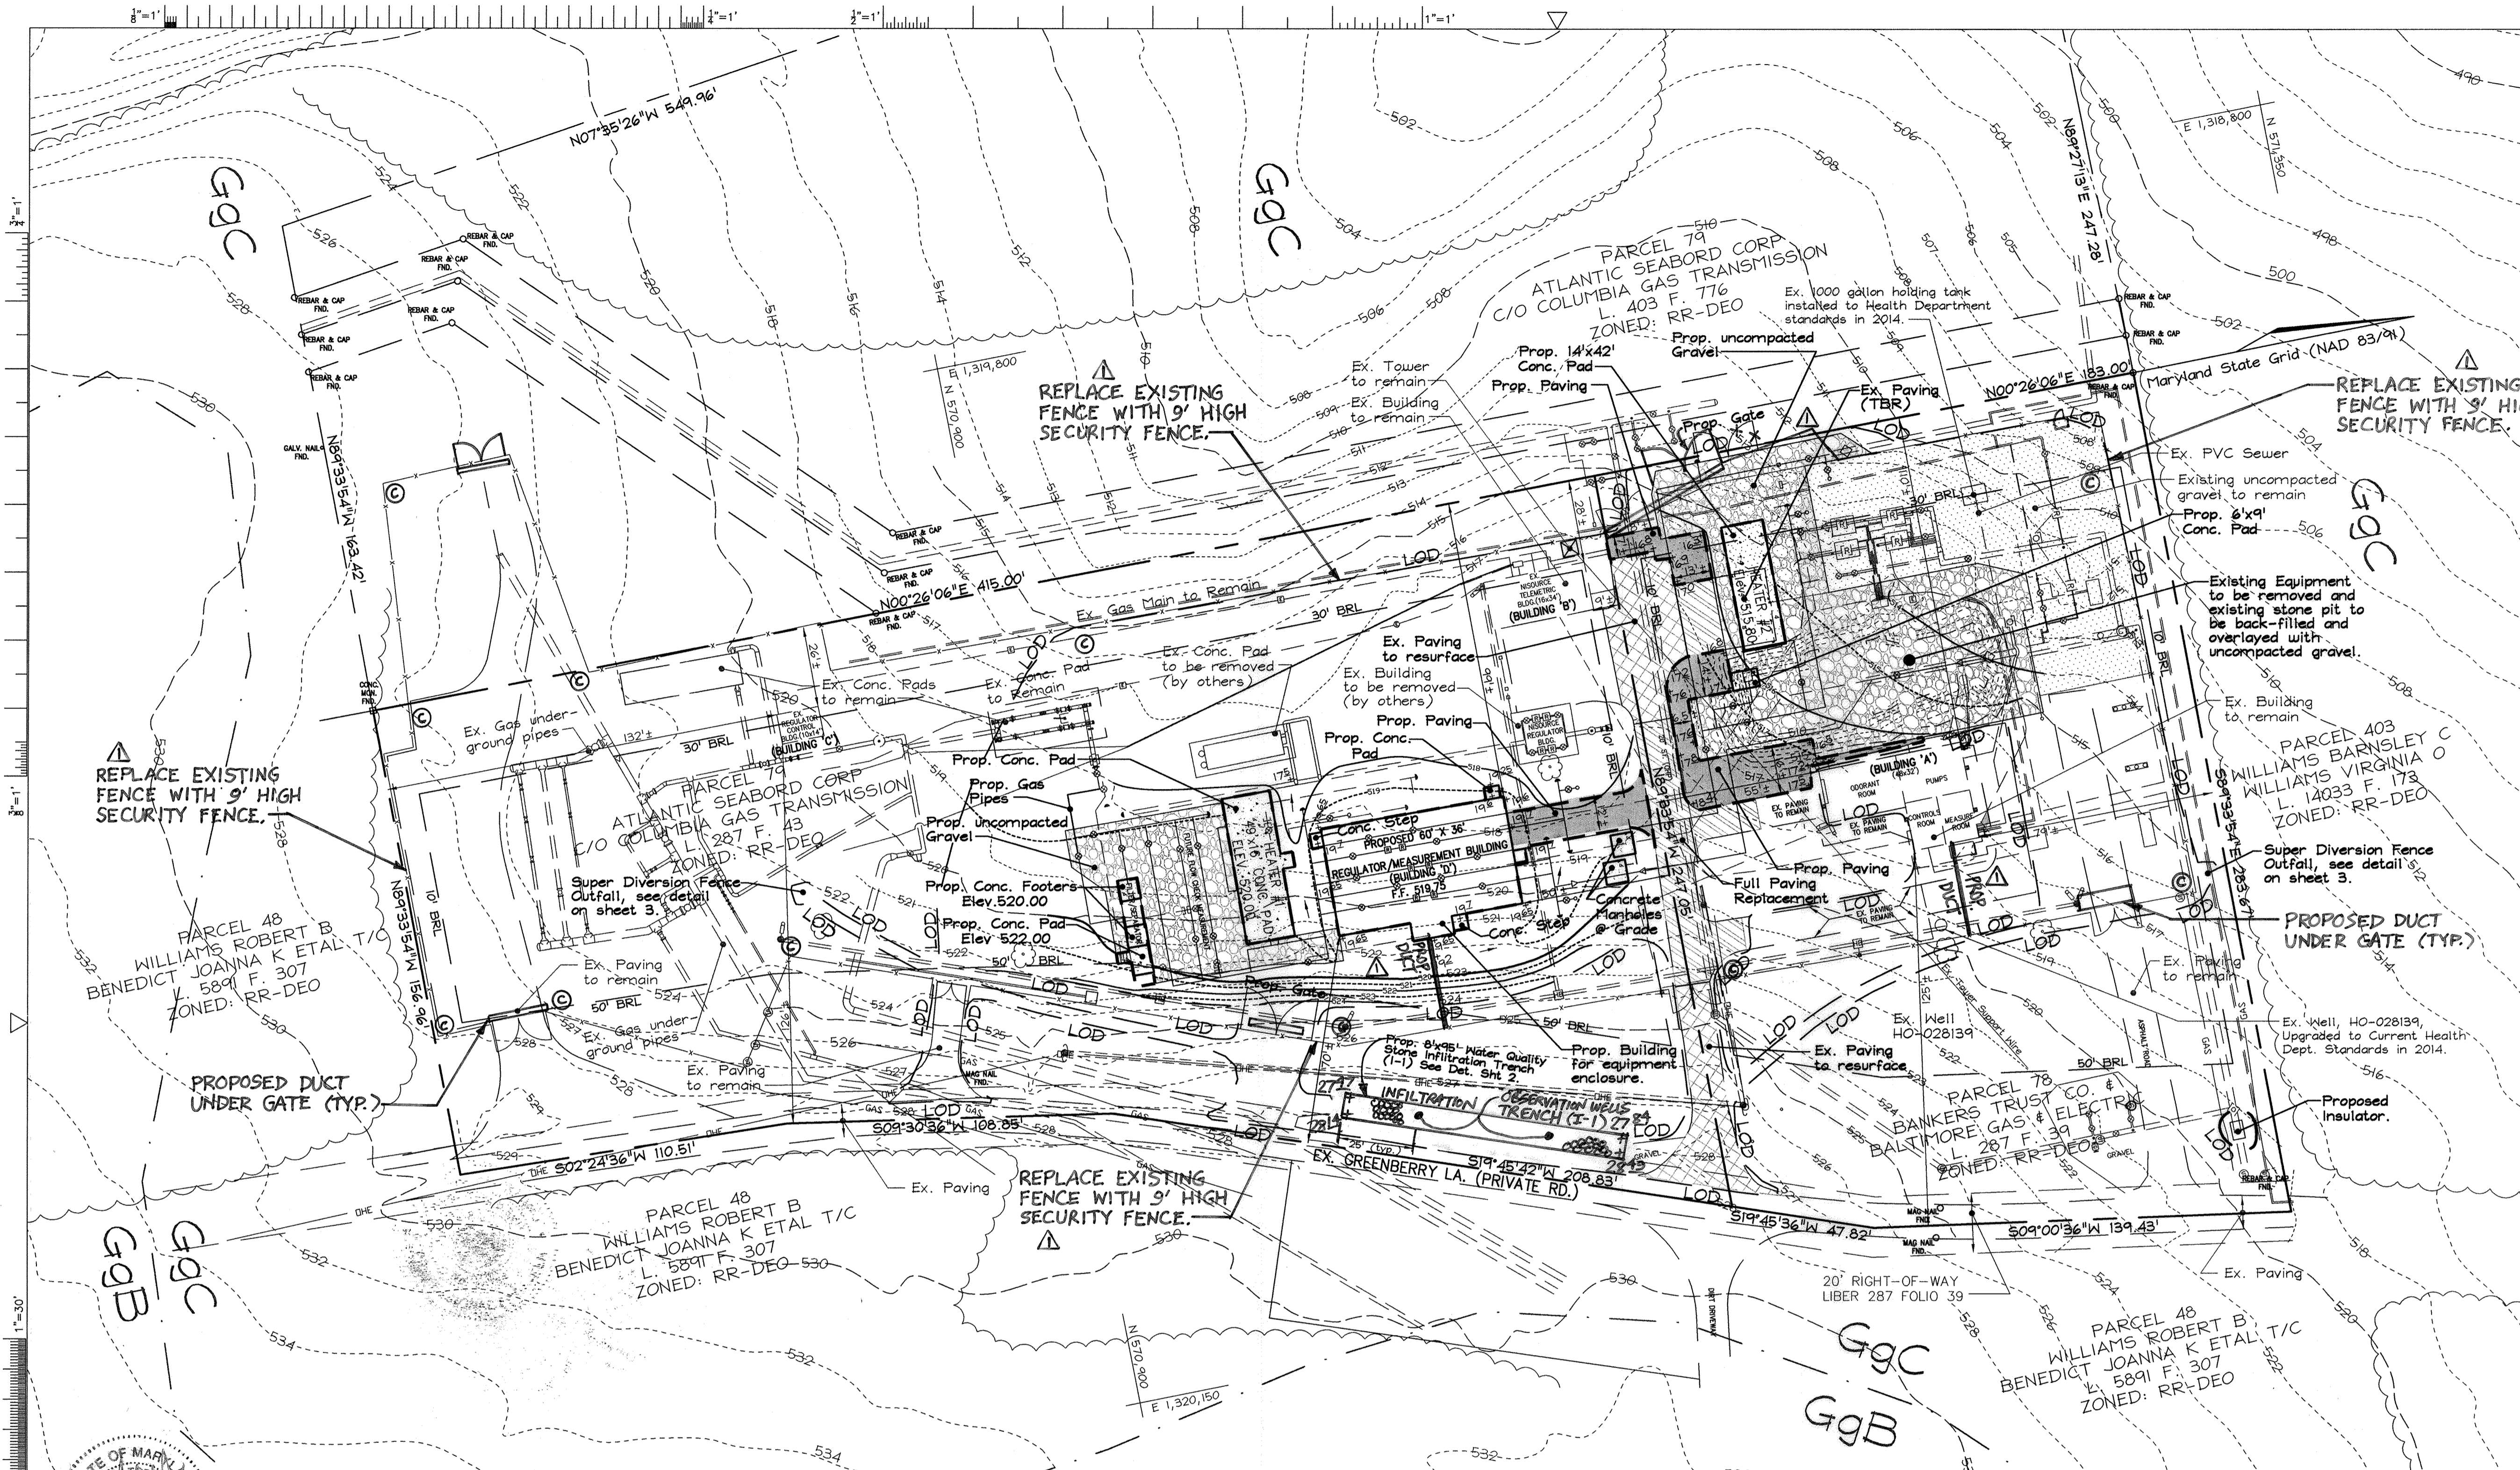

LEGEND

Existing 1' Contour -----382
 Proposed 2' Contour -----
 Proposed 1' Contour -----
 Right-of-Way Line -----
 Limit of Disturbance -----
 Prop. New Paving (was pervious before) [Pattern]
 Prop. Conc. Pad [Pattern]
 Prop. Gravel [Pattern]
 Existing Gravel [Pattern]
 Prop. full replacement paving over existing. [Pattern]
 Existing Paving to be resurfaced. [Pattern]
 Stormwater Management Disconnect Area [Pattern]

SOILS LEGEND

SYMBOL	NAME / DESCRIPTION	SOIL GROUP
GgC	Glenside loam, 8 to 15 percent slopes	B (K=0.28)

SWM Practice Chart

Lot Address	BMP Practice
13055 Greenberry Lane (Parcel 78 & 79)	Infiltration Trench (I-1)

SWM Summary Chart

Area = 60,023 sq.ft. (LOD) = 1.38 ac.±
 Pe Required: 1.0"
 Impervious Area = 6,290 sq.ft.±
 % Impervious = 6,290/60,023 sq.ft. = 10.5%
 Rv = 0.05 + 0.009(10.5%) = 0.14
 ESDv Req'd. = (Pe/Rv)(A)/12 = (1.0"/0.14)(60,023 sq.ft.)/12 = 700 cu.ft.±
 ESDv Prov'd. = 708 cu.ft.±, through storage within infiltration trench stone storage

ESDv Computations

LOD Area = 60,023 sq.ft.±
 Hydrologic Soil Type = "B"
 Proposed Impervious Area = 6,290 sq.ft.±
 I = % Imp. = 6,290/60,023 = 10.5%
 Rv = 0.05 + 0.009(10.5%) = 0.14
 Rv = 0.05 + 0.009 (10.5%) = 0.14
 Target Pe: 1" Soil Target Pe = 1.0
 Target ESDv for Woods in Good Condition: 55 (B' Soil)
 Target Qs: Qs = Pe x Rv
 Qs = (1.0") x (0.14) = 0.14"
 ESDv Req'd. = (Pe/Rv)(A)/12 = (1.0"/0.14)(60,023 sq.ft.)/12 = 700 cu.ft.±

BMP Proposed:


Infiltration Trench (I-1) * See note below.
 700 cu.ft./0.4 (40% void ratio) = 1,750 cu.ft.
 Utilizing a 8' x 95' x 2.33' stone infiltration trench (I-1), see figure 3.10 on page 3.26 of chapter 3 in SWM design manual, provides.
 ESDv Prov'd. = 8' x 95' x 2.33' x 0.40 (40% voids) = 708 cu.ft.
 ESDv Prov'd. 708 cu.ft. ≥ 700 cu.ft. ESDv Req'd. : OK

* NOTE: Due to the existing underground utilities on-site, and the need to allow for future utility expansion on-site, Howard County Development Engineering Division (DED) agreed to an Infiltration Trench (I-1) Stormwater Management (SWM) structure to treat the SWM ESDv. Additionally, per a field visit with FSH, Howard County DED, and BGE on November 13, 2014, it was agreed that the infiltration trench location as shown on ECP-14-078 should be relocated to the location shown on this plan.

AS-BUILT CERTIFICATION FOR PSWM

I HEREBY CERTIFY THAT THE FACILITY SHOWN ON THE PLAN WAS CONSTRUCTED AS SHOWN ON THE "AS-BUILT" PLANS AND COMPLIES WITH THE APPROVED PLANS AND SPECIFICATIONS. I HAVE VERIFIED THAT THE CONTRIBUTING DRAINAGE AREA IS SUFFICIENTLY STABILIZED TO PREVENT CLOGGING OF THE UNDERGROUND SWM FACILITY.

Zacharia Y. Fisch
 ZACHARIA Y. FISCH, P.E. # 22412
 DATE 2/14/17

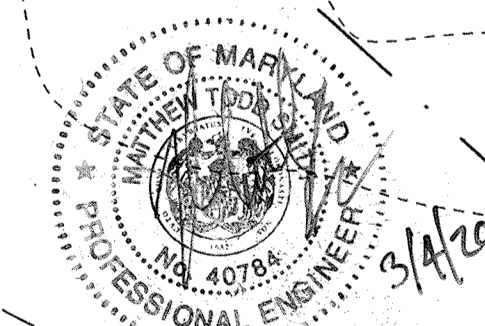

PROFESSIONAL CERTIFICATION:
 I HEREBY CERTIFY THAT THESE DOCUMENTS WERE PREPARED OR APPROVED BY ME, AND THAT I AM A DULY LICENSED PROFESSIONAL ENGINEER UNDER THE LAWS OF THE STATE OF MARYLAND.
 LICENSE NO. 40784, EXPIRATION DATE: 11-08-2021

STORMWATER MANAGEMENT PLAN

SCALE: 1" = 30'

PROFESSIONAL CERTIFICATION
 I hereby certify that these documents were prepared or approved by me, and that I am a duly licensed professional engineer under the laws of the State of Maryland, License No. #22418, Expiration Date: 07/29/2016.

STORMWATER MANAGEMENT NARRATIVE

The project is an existing gas transmission gate station that is being upgraded with new equipment. All existing and proposed above ground equipment is located within the existing perimeter fence. A network of underground gas lines are located within and outside of the existing perimeter fence. The area within the perimeter fence must remain free of vegetation and any obstructions that may interfere with the operations of the station. The upgrades proposed consist of a 6'x36' building, concrete pads and new paving areas. Stormwater management (SWM) has been provided using an Infiltration Trench (I-1) practice. Due to the nature of this project it was agreed upon by FSH Associates, BGE, and Howard County Development Engineering Division that this was the only practical option to treat SWM.

APPROVED: HOWARD COUNTY DEPARTMENT OF PLANNING AND ZONING

Chief
 CHIEF, DEVELOPMENT ENGINEERING DIVISION
 DATE 6-5-15

Director
 CHIEF, DIVISION OF LAND DEVELOPMENT
 DATE 7-7-15

Director
 DIRECTOR
 DATE 7-7-15

NOTE:
 PER MEETING ON 2/9/16 WITH CHIEF DEVELOPMENT ENGINEERING DIVISION AND CHIEF OF DIVISION OF LAND DEVELOPMENT, IT WAS DETERMINED THAT THE LOD SHOWN ON THIS REDLINE REVISION IS FOR THE PURPOSE OF DEFINING THE WORK AREA AND NOT FOR CALCULATING OR REQUIRING STORM WATER MANAGEMENT.

DEVELOPER (PARCELS 78 & 79)
 BALTIMORE GAS AND ELECTRIC COMPANY
 SPRING GARDENS COMPLEX
 1699 LEADENHALL STREET
 BALTIMORE, MARYLAND 21230
 ATTN: GREG KAPPLER (410) 470-6445

OWNER (PARCEL 78)
 BALTIMORE GAS AND ELECTRIC COMPANY
 SPRING GARDENS COMPLEX
 1699 LEADENHALL STREET
 BALTIMORE, MARYLAND 21230
 ATTN: GREG KAPPLER (410) 470-6445


OWNER (PARCEL 79)
 ATLANTIC SEABORD CORP.
 C/O COLUMBIA GAS TRANSMISSION
 P.O. BOX 1273
 CHARLESTON, WV 25325-1273
 (304) 357-2000
 ATTN: Antonio Redd


REV.	DATE	ACCOUNT NO.	DESCRIPTION	APPROVED	AUTOCAD
1	JUL 2016		REPLACED FENCE, ADDED CAMERAS POLES AND DUCTS.		ENGINEERING FSH
2	DEC 2019		UPDATED TO INCLUDE NEWSHEET		CIVIL FSH PROJ. ENG. PROJ. MGR. PRIN. ENG. SUPV. ENG.
					DESIGN GROUP DESIGNED CRH2 DRAWN CRH2 CHECKED ZYF APPROVED DATE APRIL 28, 2015

SITE DEVELOPMENT PLAN
 STORMWATER MANAGEMENT PLAN
 BGE LINDEN CHURCH GAS
 GATE STATION (Zoned: RR-DEO)
 TAX MAP 28, PARCEL 78&79
 5TH ELEC. DIST, HO. CO. MD
 SHEET 5 OF 13

GAS TRANSMISSION SUBSTATION

SCALE 1" = 30'
 DWG NO. D
 REV

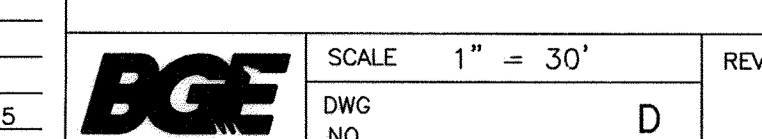

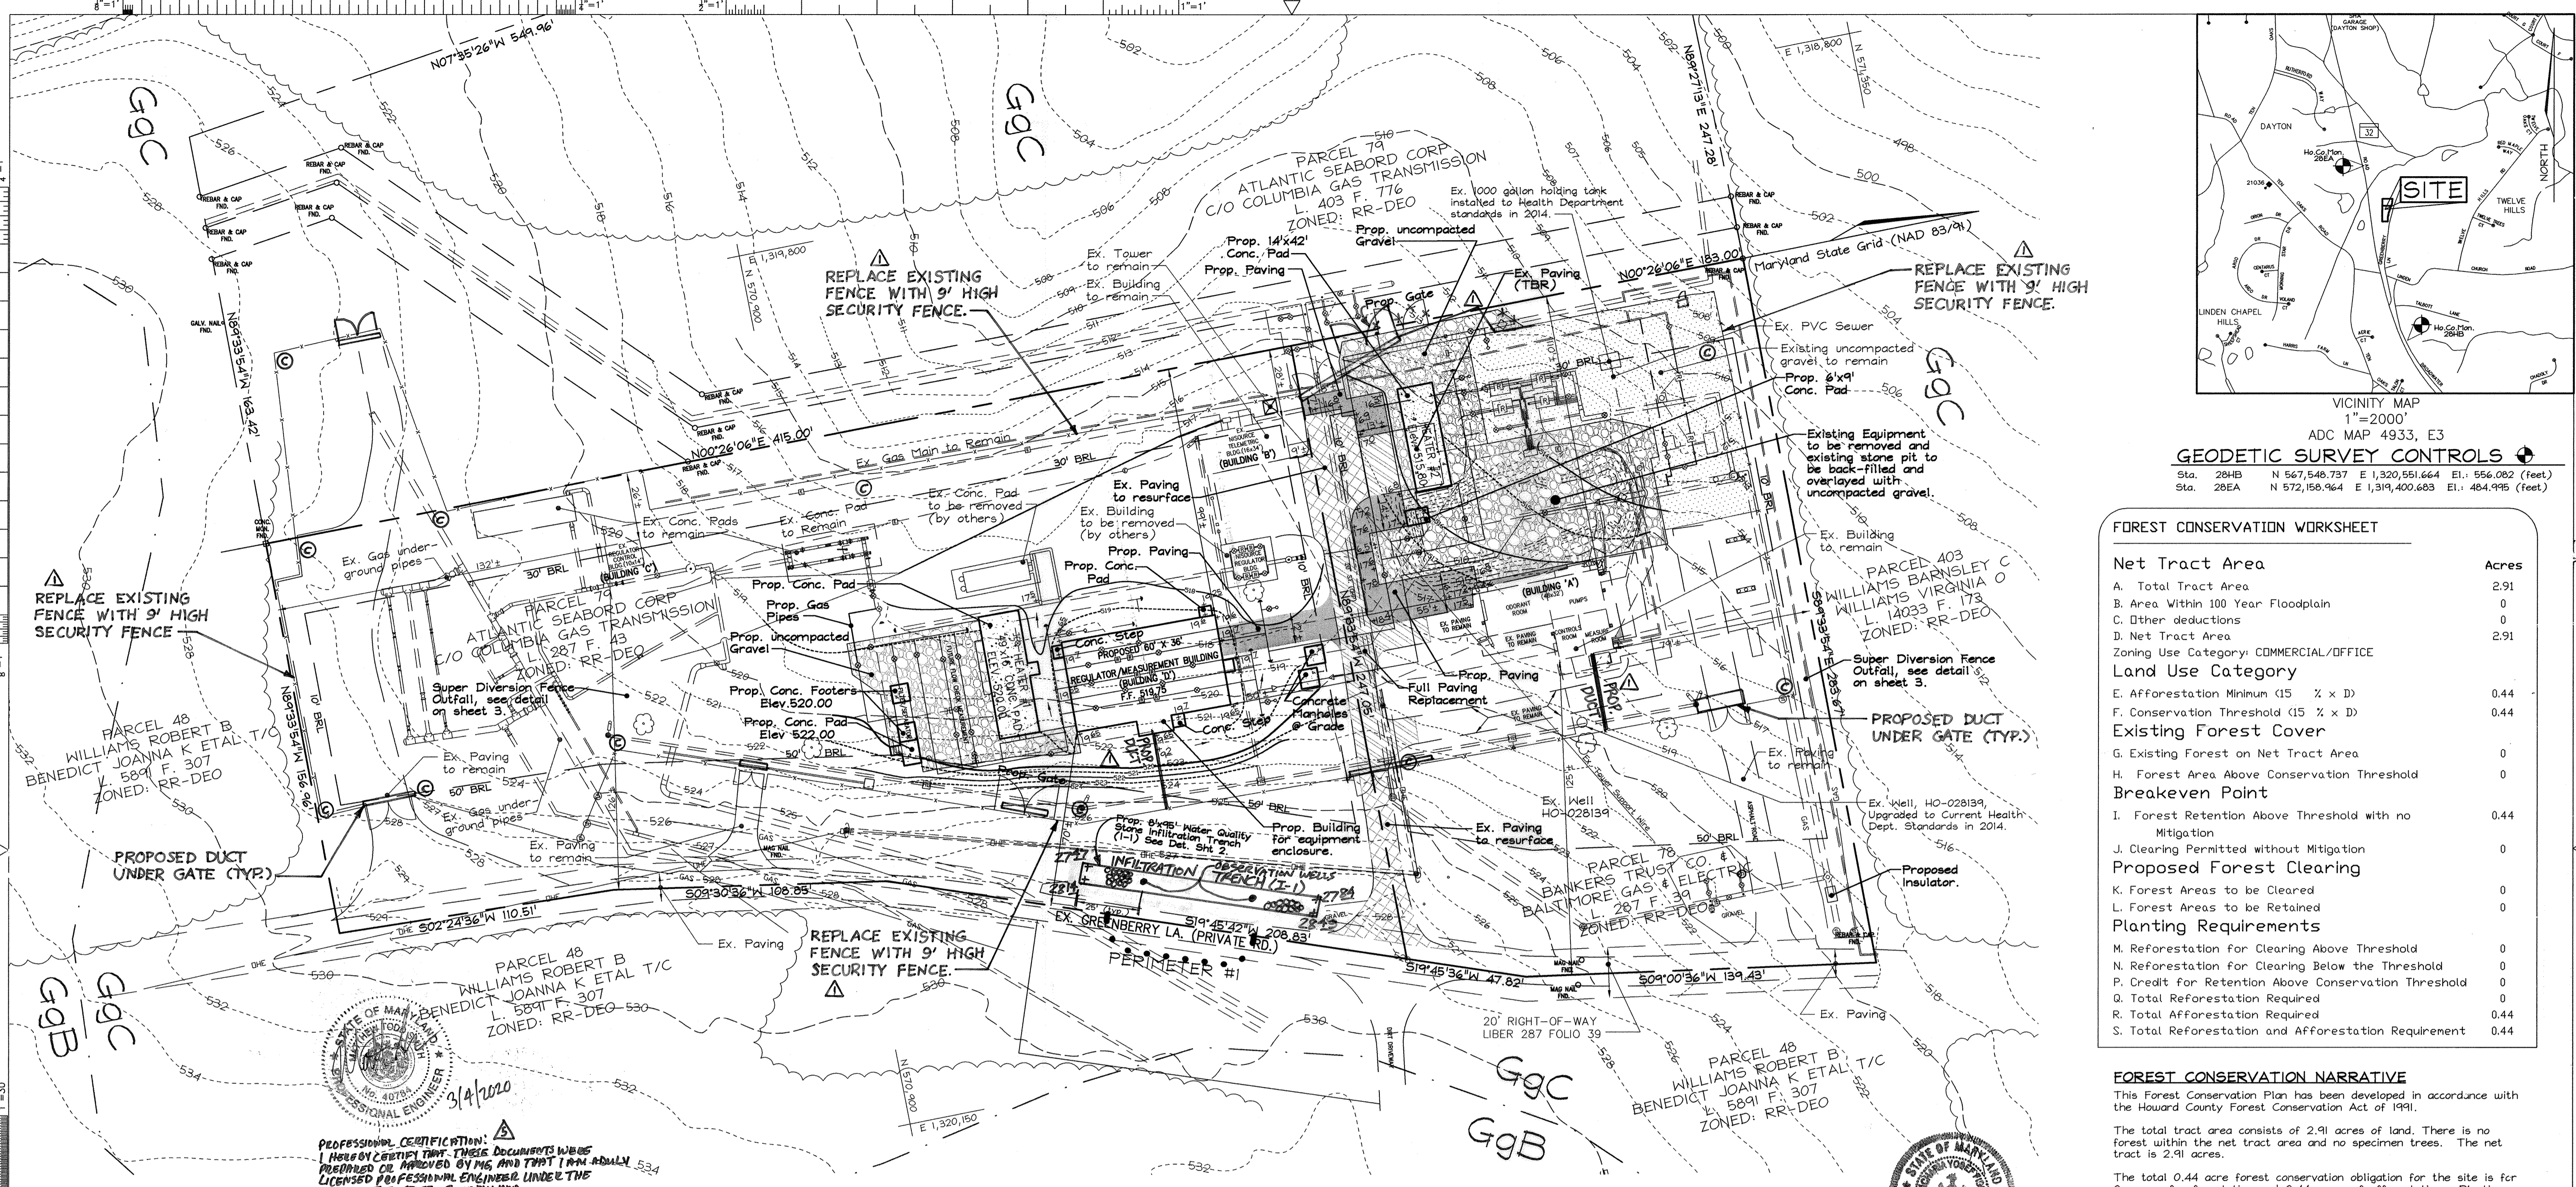

VICINITY MAP
1"=2000'
ADC MAP 4933, E3
GEODETIC SURVEY CONTROLS
Sta. 284B N 567,548.737 E 1,320,551.664 El.: 556.082 (feet)
Sta. 28EA N 572,158.964 E 1,319,400.683 El.: 484.995 (feet)


FOREST CONSERVATION WORKSHEET

Net Tract Area	Acres
A. Total Tract Area	2.91
B. Area Within 100 Year Floodplain	0
C. Other deductions	0
D. Net Tract Area	2.91
Zoning Use Category: COMMERCIAL/OFFICE	
Land Use Category	
E. Afforestation Minimum (15 % x D)	0.44
F. Conservation Threshold (15 % x D)	0.44
Existing Forest Cover	
G. Existing Forest on Net Tract Area	0
H. Forest Area Above Conservation Threshold	0
Breakeven Point	
I. Forest Retention Above Threshold with no Mitigation	0.44
J. Clearing Permitted without Mitigation	0
Proposed Forest Clearing	
K. Forest Areas to be Cleared	0
L. Forest Areas to be Retained	0
Planting Requirements	
M. Reforestation for Clearing Above Threshold	0
N. Reforestation for Clearing Below the Threshold	0
P. Credit for Retention Above Conservation Threshold	0
Q. Total Reforestation Required	0
R. Total Afforestation Required	0.44
S. Total Reforestation and Afforestation Requirement	0.44

FOREST CONSERVATION NARRATIVE
This Forest Conservation Plan has been developed in accordance with the Howard County Forest Conservation Act of 1991.

The total tract area consists of 2.91 acres of land. There is no forest within the net tract area and no specimen trees. The net tract is 2.91 acres.

The total 0.44 acre forest conservation obligation for the site is for 0 acres of reforestation and 0.44 acres of afforestation. Planting requirements will be met by a fee-in-lieu payment of \$18,208.00 (0.44 Ac/19,166 sf x 0.95/sf)

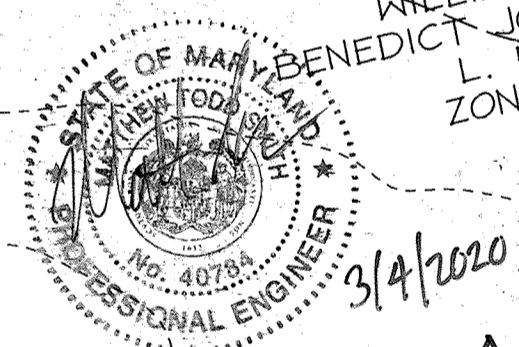

PROFESSIONAL CERTIFICATION:
I HEREBY CERTIFY THAT THESE DOCUMENTS WERE PREPARED OR APPROVED BY ME AND THAT I AM A FULLY LICENSED PROFESSIONAL ENGINEER UNDER THE LAWS OF THE STATE OF MARYLAND.
LICENSE NO. 40734 EXPIRATION DATE: 11-09-2021

SOILS LEGEND

SYMBOL	NAME / DESCRIPTION	SOIL GROUP
GgC	Glenelg loam, 8 to 15 percent slopes	B (K=0.28)

SCHEDULE A PERIMETER LANDSCAPE EDGE

CATEGORY	ADJACENT TO ROADWAYS
Perimeter/Frontage Designation	I
Landscaping Type	B
Linear Feet of Roadway Frontage/Perimeter	61
Credit for Existing Vegetation (Yes, No, Linear Feet)	No
Remaining Perimeter Length (Yes, No, Linear Feet)	No
Credit for Wall, Fence or Berm (Yes, No, Linear Feet)	No
Remaining Perimeter Length	
Number of Plants Required	
Shade Trees	1:50 1
Evergreen Trees	1:40 2
Shrubs	-
Number of Plants Provided	
Shade Trees	0+
Evergreen Trees	0+
Other Trees (2:1 Substitution)	-
Shrubs (10:1 Substitution)	-
(Describe Plant Substitution Credits Below if needed)	

* See alternative compliance note

LANDSCAPE NOTES
1. The developer is claiming Alternative Compliance for Perimeter One. Per the county's direction, expansion less than 50% requires landscaping for only the new additional development; therefore, Perimeter One has been calculated for only the area of the new building. The nearest residence along that perimeter is over 1,200' away from the proposed building, with a swath of trees approximately 100' wide sitting between them. Greenberry Lane is a low-use rural private road and the minimal addition of the proposed building does not significantly alter the view from the roadway. Furthermore, the current configuration of existing fence, overhead lines, underground pipes and wires, and stormwater management leaves no space to safely plant healthy trees.

LEGEND

Existing 1' Contour	-----382
Proposed 2' Contour	-----
Proposed 1' Contour	-----
Right-of-Way Line	-----
SECURITY CAMERA POLE	⊙
Existing Spot Elevation	382.3
Proposed Spot Elevation	+82.53
Direction of Flow	→
Existing Trees to Remain	⊕
Prop. Building	□
Prop. New Paving (was pervious before)	▒
Prop. Conc. Pad	▒
Prop. Uncompacted Gravel	▒
Ex. Uncompacted Gravel	▒
Prop. full replacement paving over existing.	▒
Existing Paving to be resurfaced.	▒

AS-BUILT CERTIFICATION FOR PSWM
I HEREBY CERTIFY THAT THE FACILITY SHOWN ON THE PLAN WAS CONSTRUCTED AS SHOWN ON THE "AS-BUILT" PLANS AND COMPLIES WITH THE APPROVED PLANS AND SPECIFICATIONS. I HAVE VERIFIED THAT THE CONTRIBUTING DRAINAGE AREA IS SUFFICIENTLY STABILIZED TO PREVENT CLOGGING OF THE UNDERGROUND SWM FACILITY.
ZACHARIA Y. FISCH, P.E. #22418
DATE 2/14/17

PERMIT INFORMATION CHART

Subdivision Name:	Section/Area	Lot/Parcel No.			
BGE Linden Church Gas Gate Station	N/A	P. 78 & 79			
Deed / Plat	Grid	Zoning	Tax Map No.	Elect. District	Census Tract
287/39 287/43	9	RR-DEO	28	5th	605104

PROFESSIONAL CERTIFICATION
I hereby certify that these documents were prepared or approved by me, and that I am a duly licensed professional engineer under the laws of the State of Maryland, License No. #22418, Expiration Date: 07/24/2015.

OWNER (PARCEL 79)
ATLANTIC SEABOARD CORP.
C/O COLUMBIA GAS TRANSMISSION
P.O. BOX 1273
CHARLESTON, WV 25325-1273
(304) 357-2000
ATTN: Antonio Redd

OWNER (PARCEL 78)
BALTIMORE GAS AND ELECTRIC COMPANY
SPRING GARDENS COMPLEX
1699 LEADENHALL STREET
BALTIMORE, MARYLAND 21230
ATTN: GREG KAPPLER (410) 470-6445

DEVELOPER (PARCEL 78 & 79)
BALTIMORE GAS AND ELECTRIC COMPANY
SPRING GARDENS COMPLEX
1699 LEADENHALL STREET
BALTIMORE, MARYLAND 21230
ATTN: GREG KAPPLER (410) 470-6445

FSH Associates
Engineers Planners Surveyors
6339 Howard Lane, Elkridge, MD 21075
Tel: 410-567-5200 Fax: 410-796-1962
E-mail: info@fshe.com

The improvement to this property include a new building, new gas equipment, and new paved driveways and gravel areas.
Previous Howard County reference numbers: Deed 287/39/43, ECP-14-078, BA Case 191C.

REV.	DATE	ACCOUNT NO.	DESCRIPTION	APPROVED	AUTOCAD
1	JUL 2016		REPLACED FENCE, ADDED SECURITY POLES AND DUCTS.		ENGINEERING
	DEC 2019		UPDATED TO INCLUDE NEW SHEET		CIVIL ELEC. PROJ. ENG. PROJ. MGR. PRIN. ENG. SUPV. ENG.

SITE DEVELOPMENT PLAN
LANDSCAPE/FOREST CON. PLAN
BGE LINDEN CHURCH GAS GATE STATION (Zoned: RR-DEO)
TAX MAP 28, PARCEL 78&79
5TH ELEC. DIST, HO. CO. MD
SHEET 6 OF 6

GAS TRANSMISSION SUBSTATION

SCALE 1" = 30'
DWG NO. D

APPROVED: HOWARD COUNTY DEPARTMENT OF PLANNING AND ZONING
Chief, Development Engineering Division
Chief, Division of Land Development
Director

DATE 6-5-15
DATE 7-7-15
DATE 7-7-15



**HOWARD SOIL CONSERVATION DISTRICT
STANDARD SEDIMENT CONTROL NOTES**

1. A PRE-CONSTRUCTION MEETING MUST OCCUR WITH THE HOWARD COUNTY DEPARTMENT OF PUBLIC WORKS, CONSTRUCTION INSPECTION DIVISION (CID), 410-313-1855 AFTER THE FUTURE LOD AND PROTECTED AREAS ARE MARKED CLEARLY IN THE FIELD. A MINIMUM OF 48 HOUR NOTICE TO CID MUST BE GIVEN AT THE FOLLOWING STAGES:

- A. PRIOR TO THE START OF EARTH DISTURBANCE,
- B. UPON COMPLETION OF THE INSTALLATION OF PERIMETER EROSION AND SEDIMENT CONTROLS, BUT BEFORE PROCEEDING WITH ANY OTHER EARTH DISTURBANCE OR GRADING,
- C. PRIOR TO THE START OF ANOTHER PHASE OF CONSTRUCTION OR OPENING OF ANOTHER GRADING UNIT,
- D. PRIOR TO THE REMOVAL OR MODIFICATION OF SEDIMENT CONTROL PRACTICES.

OTHER BUILDING OR GRADING INSPECTION APPROVALS MAY NOT BE AUTHORIZED UNTIL THIS INITIAL APPROVAL BY THE INSPECTION AGENCY IS MADE. OTHER RELATED STATE AND FEDERAL PERMITS SHALL BE REFERENCED, TO ENSURE COORDINATION AND TO AVOID CONFLICTS WITH THIS PLAN.

2. ALL VEGETATIVE AND STRUCTURAL PRACTICES ARE TO BE INSTALLED ACCORDING TO THE PROVISIONS OF THIS PLAN AND ARE TO BE IN CONFORMANCE WITH THE 2011 MARYLAND STANDARDS AND SPECIFICATIONS FOR SOIL EROSION AND SEDIMENT CONTROL, AND REVISIONS THERETO.

3. FOLLOWING INITIAL SOIL DISTURBANCE OR RE-DISTURBANCE, PERMANENT OR TEMPORARY STABILIZATION IS REQUIRED WITHIN THREE (3) CALENDAR DAYS AS TO THE SURFACE OF ALL PERIMETER CONTROLS, DIKES, SWALES, DITCHES, PERIMETER SLOPES, AND ALL SLOPES STEEPER THAN 3 HORIZONTAL TO 1 VERTICAL (3:1); AND SEVEN (7) CALENDAR DAYS AS TO ALL OTHER DISTURBED AREAS ON THE PROJECT SITE EXCEPT FOR THOSE AREAS UNDER ACTIVE GRADING.

4. ALL DISTURBED AREAS MUST BE STABILIZED WITHIN THE TIME PERIOD SPECIFIED ABOVE IN ACCORDANCE WITH THE 2011 MARYLAND STANDARDS AND SPECIFICATIONS FOR SOIL EROSION AND SEDIMENT CONTROL FOR TOPSOIL (SEC. B-4-2), PERMANENT SEEDING (SEC. B-4-5), TEMPORARY SEEDING (SEC. B-4-4) AND MULCHING (SEC. B-4-3). TEMPORARY STABILIZATION WITH MULCH ALONE CAN ONLY BE APPLIED BETWEEN THE FALL AND SPRING SEEDING DATES IF THE GROUND IS FROZEN. INCREMENTAL STABILIZATION (SEC. B-4-1) SPECIFICATIONS SHALL BE ENFORCED IN AREAS WITH >15' OF CUT AND/OR FILL. STOCKPILES (SEC. B-4-8) IN EXCESS OF 20 FT. MUST BE BENCHED WITH STABLE OUTLET. ALL CONCENTRATED FLOW, STEEP SLOPE, AND HIGHLY ERODIBLE AREAS SHALL RECEIVE SOIL STABILIZATION MATTING (SEC. B-4-6).

5. ALL SEDIMENT CONTROL STRUCTURES ARE TO REMAIN IN PLACE, AND ARE TO BE MAINTAINED IN OPERATIVE CONDITION UNTIL PERMISSION FOR THEIR REMOVAL HAS BEEN OBTAINED FROM THE CID.

6. SITE ANALYSIS:
 TOTAL AREA OF SITE: 1.919 ACRES
 AREA DISTURBED: 0.603 ACRES
 AREA TO BE ROOFED OR PAVED: 0.005 ACRES
 AREA TO BE VEGETATIVELY STABILIZED: 0.603 ACRES
 TOTAL CUT: 150* CU. YDS.
 TOTAL FILL: 150* CU. YDS.
 OFFSITE WASTE/BORROW AREA LOCATION: N/A

*EARTHWORK QUANTITIES ARE SOLEY FOR THE PURPOSE OF CALCULATING FEES. CONTRACTOR TO VERIFY ALL QUANTITIES PRIOR TO START OF CONSTRUCTION.

7. ANY SEDIMENT CONTROL PRACTICE WHICH IS DISTURBED BY GRADING ACTIVITY FOR PLACEMENT OF UTILITIES MUST BE REPAIRED ON THE SAME DAY OF DISTURBANCE.

8. ADDITIONAL SEDIMENT CONTROL MUST BE PROVIDED, IF DEEMED NECESSARY BY THE CID. THE SITE AND ALL CONTROLS SHALL BE INSPECTED BY THE CONTRACTOR WEEKLY; AND THE NEXT DAY AFTER EACH RAIN EVENT. A WRITTEN REPORT BY THE CONTRACTOR, MADE AVAILABLE UPON REQUEST, IS PART OF EVERY INSPECTION AND SHOULD INCLUDE:

- INSPECTION DATE
- INSPECTION TYPE (ROUTINE, PRE-STORM EVENT, DURING RAIN EVENT)
- NAME AND TITLE OF INSPECTOR
- WEATHER INFORMATION (CURRENT CONDITIONS AS WELL AS TIME AND AMOUNT OF LAST RECORDED PRECIPITATION)
- BRIEF DESCRIPTION OF PROJECT'S STATUS (E.G., PERCENT COMPLETE) AND/OR CURRENT ACTIVITIES
- EVIDENCE OF SEDIMENT DISCHARGES
- IDENTIFICATION OF PLAN DEFICIENCIES
- IDENTIFICATION OF SEDIMENT CONTROLS THAT REQUIRE MAINTENANCE
- IDENTIFICATION OF MISSING OR IMPROPERLY INSTALLED SEDIMENT CONTROLS
- COMPLIANCE STATUS REGARDING THE SEQUENCE OF CONSTRUCTION AND STABILIZATION REQUIREMENTS
- PHOTOGRAPHS
- MONITORING/SAMPLING
- MAINTENANCE AND/OR CORRECTIVE ACTION PERFORMED
- OTHER INSPECTION ITEMS AS REQUIRED BY THE GENERAL PERMIT FOR STORMWATER ASSOCIATED WITH CONSTRUCTION ACTIVITIES (NPDES, MDE).

9. TRENCHES FOR THE CONSTRUCTION OF UTILITIES IS LIMITED TO THREE PIPE LENGTHS OR THAT WHICH CAN AND SHALL BE BACK-FILLED AND STABILIZED BY THE END OF EACH WORKDAY, WHICHEVER IS SHORTER.

10. ANY MAJOR CHANGES OR REVISIONS TO THE PLAN OR SEQUENCE OF CONSTRUCTION MUST BE REVIEWED AND APPROVED BY THE HSCD PRIOR TO PROCEEDING WITH CONSTRUCTION. MINOR REVISIONS MAY ALLOWED BY THE CID PER THE LIST OF HSCD-APPROVED FIELD CHANGES.

11. DISTURBANCE SHALL NOT OCCUR OUTSIDE THE L.O.D. A PROJECT IS TO BE SEQUENCED SO THAT GRADING ACTIVITIES BEGIN ON ONE GRADING UNIT (MAXIMUM ACREAGE OF 20 AC. PER GRADING UNIT) AT A TIME. WORK MAY PROCEED TO A SUBSEQUENT GRADING UNIT WHEN AT LEAST 50 PERCENT OF THE DISTURBED AREA IN THE PRECEDING GRADING UNIT HAS BEEN STABILIZED AND APPROVED BY THE CID. UNLESS OTHERWISE SPECIFIED AND APPROVED BY THE HSCD, NO MORE THAN 30 ACRES CUMULATIVELY MAY BE DISTURBED AT A GIVEN TIME.

12. WASH WATER FROM ANY EQUIPMENT, VEHICLES, WHEELS, PAVEMENT, AND OTHER SOURCES MUST BE TREATED IN A SEDIMENT BASIN OR OTHER APPROVED WASHOUT STRUCTURE.

13. TOPSOIL SHALL BE STOCKPILED AND PRESERVED ON-SITE FOR REDISTRIBUTION ONTO FINAL GRADE.

14. ALL SILT FENCE AND SUPER SILT FENCE SHALL BE PLACED ON-THE-CONTOUR, AND BE IMBRICATED AT 25' MINIMUM INTERVALS, WITH LOWER ENDS CURLED UPHILL BY 2' IN ELEVATION.

15. STREAM CHANNELS MUST NOT BE DISTURBED DURING THE FOLLOWING RESTRICTED TIME PERIODS (INCLUSIVE):

- USE I AND IP MARCH 1 - JUNE 15
- USE III AND IIIIP OCTOBER 1 - APRIL 30
- USE IV MARCH 1 - MAY 31

16. A COPY OF THIS PLAN, THE 2011 MARYLAND STANDARDS AND SPECIFICATIONS FOR SOIL EROSION AND SEDIMENT CONTROL, AND ASSOCIATED PERMITS SHALL BE ON-SITE AND AVAILABLE WHEN THE SITE IS ACTIVE.

GENERAL NOTES:

1. BASE MAPPING SHOWN IS FROM A COMBINATION OF SOURCES BY OTHER FIRMS RESPONSIBLE FOR THE DESIGN OF THE GAS EQUIPMENT, AND FROM PUBLICLY AVAILABLE SOURCES. PROFESSIONAL RESPONSIBILITY OF JMT IS SOLELY THE CONSISTENCY OF THE EROSION CONTROL PLAN WITH THE BASE FILES PROVIDED, AND NOT THE ACCURACY OF THE BASE FILES THEMSELVES.
2. CONSTRUCTION SURVEY STAKEOUT FOR EROSION CONTROL WILL BE INTEGRATED WITH CONSTRUCTION STAKEOUT FOR THE NEW FACILITY TO ENSURE CONSISTENCY.
3. PROJECT HORIZONTAL DATUM IS MARYLAND GRID NAD83.
4. NO CLEARING, GRUBBING, LAND GRADING, ROADS, OR BUILDINGS ARE INCLUDED IN THIS PROJECT.
5. THE PRIMARY TEMPORARY EROSION AND SEDIMENT CONTROL PRACTICE FOR THE PROJECT SHALL BE SILT FENCE AND SUPER SILT FENCE CONSISTING OF FILTER FABRIC ATTACHED TO THE EXISTING SECURITY CHAINLINK FENCE. ENSURE PROPER TRENCH DIMENSIONS AND COMPACTION OF THE ANCHOR TRENCH FOR THE EMBEDDED FILTER FABRIC. EXISTING DIVERSION FENCE, SUPER SILT FENCE, TEMPORARY ASPHALT BERM, A RIPRAP OUTFALL, AND MOUNTABLE BERMS OUTSIDE THE LOD ARE ALSO PROVIDING EROSION AND SEDIMENT CONTROL AND SHALL BE MAINTAINED.
6. MAINTENANCE: SILT FENCE, SUPER SILT FENCE, AND STABILIZED CONSTRUCTION ENTRANCE SHALL BE INSPECTED AND MAINTAINED EACH DAY AND AFTER STORM EVENTS. MAINTENANCE SHALL INCLUDE BUT NOT LIMITED TO REMOVAL OF ALL ACCUMULATED SEDIMENT, AND REPLACEMENT OF DAMAGED FILTER FABRIC.
7. SEQUENCE OF CONSTRUCTION:
 - A. NOTIFY HOWARD COUNTY INSPECTOR (SEE HOWARD SCD STANDARD NOTE 1) AND NOTIFY MARYLAND DEPARTMENT OF ENVIRONMENT, INSPECTION AND COMPLIANCE PROGRAM (410) 631-3510 AT LEAST 5 DAYS PRIOR TO BEGINNING WORK.
 - B. INSTALL PERIMETER EROSION AND SEDIMENT CONTROLS. (~2 DAYS)
 - C. NOTIFY HOWARD SCD INSPECTOR UPON COMPLETION OF EROSION AND SEDIMENT CONTROL MEASURES.
 - D. WITH THE APPROVAL OF THE INSPECTOR, COMPLETE SITE PREPARATIONS OF THE REMAINDER OF THE CONSTRUCTION AREA, AND INSTALL INTERNAL EROSION CONTROLS, IF APPLICABLE. (~4 DAYS)
 - E. CONSTRUCTION AND MATERIAL STAGING. (~2 DAYS)
 - F. AFTER CONSTRUCTION IS COMPLETE, PROVIDE RESTORATION SEEDING AND MULCHING. (~7 DAYS)
 - G. AFTER VEGETATION REESTABLISHMENT AND RECEIVING PERMISSION FROM HOWARD COUNTY INSPECTOR, REMOVE EROSION AND SEDIMENT CONTROL PRACTICES AND STABILIZE THE AREAS DISTURBED BY THIS PROCESS.
8. EXCAVATED TOPSOIL AND SUBSOIL SHALL BE KEPT SEPARATE AND PROTECTED AS FOLLOWS:
 - A. STOCKPILES SHALL BE LOCATED WITHIN THE LIMITS OF DISTURBANCE (LOD).
 - B. STOCKPILES SHALL DRAIN TO A FUNCTIONING EROSION AND SEDIMENT CONTROL DEVICE.
 - C. STOCKPILES SHALL BE POSITIONED TO NOT IMPEDE UPON, OR IMPAIR THE FUNCTION OF THE SEDIMENT CONTROL DEVICE.
 - D. STOCKPILES SHALL BE POSITIONED TO NOT ALTER DRAINAGE DIVIDES.
9. TRACKOUT SHALL BE PREVENTED BY STABILIZED CONSTRUCTION ENTRANCES AT THE CONNECTION TO EXISTING DRIVEWAYS AND ROADS.
10. STABILIZATION DOES NOT APPLY TO THOSE AREAS WHICH ARE BEING USED FOR MATERIAL STORAGE OF FOR THOSE AREAS ON WHICH ACTUAL CONSTRUCTION ACTIVITIES ARE CURRENTLY BEING PERFORMED.
11. ANY DEWATERING DISCHARGE SHALL BE FILTERED BY AN APPROVED PRACTICE.
12. COMPLETE UNDERGROUND UTILITY LOCATION INFORMATION IS NOT AVAILABLE. CONTRACTOR IS RESPONSIBLE TO LOCATE AND PROTECT EXISTING UTILITIES.

B-4-4 STANDARDS AND SPECIFICATIONS FOR TEMPORARY STABILIZATION

FAST GROWING VEGETATION IS REQUIRED ON DISTURBED SOILS FOR AN EXPECTED DURATION OF LESS THAN 6 MONTHS BEFORE RE-DISTURBANCE OR PERMANENT SEEDING.

SEEDBED PREPARATION: LOOSEN UPPER THREE INCHES OF SOIL BY RAKING, DISKING OR OTHER ACCEPTABLE MEANS BEFORE SEEDING, IF NOT PREVIOUSLY LOOSENED.

SEEDING: SEE TABLE B.1 BELOW FOR ACCEPTABLE CHOICES OF TEMPORARY SEEDING. SEEDING DATES PER ZONE 6b.

FERTILIZER: PER SOIL TEST OR 436 LB/AC OF 10-20-20.

LIME: PER SOIL TEST OR 2 TONS/AC

MULCHING: APPLY 3 TONS/AC (140 LBS/1000 SF) OR UNROTTED WEED-FREE, SMALL GRAIN STRAW IMMEDIATELY AFTER SEEDING. ANCHOR MULCH IMMEDIATELY AFTER APPLICATION USING MULCH ANCHORING TOOL.

B-4-5 STANDARDS AND SPECIFICATIONS FOR PERMANENT SEEDING

SEEDBED PREPARATION: IF NOT PREVIOUSLY LOOSENED, LOOSEN UPPER FOUR INCHES OF SOIL BY RAKING, DISKING OR OTHER ACCEPTABLE MEANS BEFORE SEEDING.

SEEDING: MD CERTIFIED SEED, 350 LB/AC (8 LB/1000 SF) TALL FESCUE. PERMANENT SEEDING SHALL BE WITHIN MAR 1-MAY 15 OR AUG 15-OCT 15.

FERTILIZER: IN ACCORDANCE WITH RESULTS OF SOIL TEST. IF REQUESTED, PROVIDE SOIL TEST RESULTS TO THE HOWARD SCD INSPECTOR.

LIME: IN ACCORDANCE WITH RESULTS OF SOIL TEST.

MULCHING: APPLY 3 TONS/AC (140 LBS/1000 SF) OF UNROTTED WEED-FREE, SMALL GRAIN STRAW IMMEDIATELY AFTER SEEDING. ANCHOR MULCH IMMEDIATELY AFTER APPLICATION USING MULCH ANCHORING TOOL.

PERMANENT SEEDING SUMMARY		HARDINESS ZONE (FROM FIGURE B.3): 6A		FERTILIZER RATE		LIME RATE
SEED MIXTURE (FROM TABLE B.1):		1 + 4		(10-20-20)		
NO.	SPECIES	APPLY RATE (lb/ac)	SEEDING DATES	N	P205	K2O
1	SWITCH GRASS (Panicum virgatum)	10	MAR 1 TO MAY 15 AUG 1 TO OCT 15	1/4-1/2 in		
1	CREeping RED FESCUE (Festuca rubra)	15	MAR 1 TO MAY 15 AUG 1 TO OCT 15	1/4-1/2 in		
1	WILD INDIGO (Baptisia tinctoria)	2	MAR 1 TO MAY 15 AUG 1 TO OCT 15	1/4-1/2 in		
1	DEERTONGUE (Scleria flourensii)	15	MAR 1 TO MAY 15 AUG 1 TO OCT 15	1/4-1/2 in		
1	CREeping BLUE FESCUE (Festuca bluea)	20	MAR 1 TO MAY 15 AUG 1 TO OCT 15	1/4-1/2 in		
1	VIRGINIA BLUE GRASS (Poa virginica)	5	MAR 1 TO MAY 15 AUG 1 TO OCT 15	1/4-1/2 in		

NOTE: PERMANENT SEEDING ASSOCIATED WITH UTILITY RIGHTS OF WAY SHALL BE FURNISHED WITH SEED MIX #1 AND #4 AS DIRECTED IN THE PERMANENT SEEDING SUMMARY.

FOR THE HOWARD SOIL CONSERVATION DISTRICT:
 THIS DEVELOPMENT PLAN IS APPROVED FOR SOIL AND EROSION AND SEDIMENT CONTROL BY THE HOWARD SOIL CONSERVATION DISTRICT.
 HOWARD SOIL CONSERVATION DISTRICT DATE

DISCLAIMER:

THE INFORMATION SET FORTH ON THIS PLAN THAT WAS PREPARED BY AND/OR APPROVED BY JMT AND THE PROFESSIONAL ENGINEER SIGNING AND SEALING THIS PLAN (COLLECTIVELY "THE ENGINEER") CONSISTS SOLELY OF THE REDLINED PORTIONS OF THE DOCUMENTS. THE UNDERLYING PLANS AND INFORMATION WERE GENERATED BASED ON INFORMATION AND RECORD PLANS OBTAINED FROM AND/OR FURNISHED BY THE COUNTY, PREPARED BY OTHERS, AND HAS NOT BEEN INDEPENDENTLY VERIFIED BY THE ENGINEER. THE ENGINEER HAS EXERCISED REASONABLE JUDGEMENT CONSISTENT WITH GENERALLY ACCEPTED ENGINEERING PRACTICES IN RELYING ON THE INFORMATION IN ORDER TO PREPARE THE REDLINE PORTIONS TO BE SUBMITTED FOR PERMITTING; BUT MAKES NO REPRESENTATIONS OR WARRANTIES OF ANY KIND WITH RESPECT TO THE ACCURACY OR COMPLETENESS OF THE EXISTING CONDITIONS OR ANY ACCURACY OR CONTENTS OF THE UNDERLYING RECORD PLANS OR ANY INFORMATION SET FORTH ON SUCH PLANS WHICH WAS NOT PREPARED BY OR UNDER THE DIRECT SUPERVISION OF THE ENGINEER. THE ENGINEER ASSUMES NO RESPONSIBILITY OR LIABILITY FOR DEFECTS, DEVIATIONS OR INCONSISTENCIES ARISING FROM INACCURACIES OR OMISSIONS IN THE RECORD PLANS AND ACTUAL OR EXISTING CONDITIONS SHALL BE VERIFIED BY THE CONTRACTOR PRIOR TO CONSTRUCTION OF ANY IMPROVEMENTS.

APPROVED: HOWARD COUNTY DEPARTMENT OF PLANNING AND ZONING
 [Signatures and Dates]
 CHIEF, DEVELOPMENT ENGINEERING DIVISION 6-12-17
 CHIEF, DIVISION OF LAND DEVELOPMENT 6/12/17
 DIRECTOR 6-12-17

Table B.1: Temporary Seeding for Site Stabilization

Plant Species	Seeding Rate ^{1/}		Seeding Depth ^{2/} (inches)	Recommended Seeding Dates by Plant Hardiness Zone ^{3/}			FERTILIZER RATE (10-20-20)	LIME RATE
	lb/ac	lb/1000 ft ²		5b and 6a	6b	7a and 7b		
Cool-Season Grasses								
Annual Ryegrass (<i>Lolium perenne</i> ssp. <i>multiflorum</i>)	40	1.0	0.5	Mar 15 to May 31; Aug 1 to Sep 30	Mar 1 to May 15; Aug 1 to Oct 15	Feb 15 to Apr 30; Aug 15 to Nov 30	436 lb/ac (10 lb/1000sf)	
Barley (<i>Hordeum vulgare</i>)	96	2.2	1.0	Mar 15 to May 31; Aug 1 to Sep 30	Mar 1 to May 15; Aug 1 to Oct 15	Feb 15 to Apr 30; Aug 15 to Nov 30		
Oats (<i>Avena sativa</i>)	72	1.7	1.0	Mar 15 to May 31; Aug 1 to Sep 30	Mar 1 to May 15; Aug 1 to Oct 15	Feb 15 to Apr 30; Aug 15 to Nov 30		
Wheat (<i>Triticum aestivum</i>)	120	2.8	1.0	Mar 15 to May 31; Aug 1 to Sep 30	Mar 1 to May 15; Aug 1 to Oct 15	Feb 15 to Apr 30; Aug 15 to Nov 30		
Cereal Rye (<i>Secale cereale</i>)	112	2.8	1.0	Mar 15 to May 31; Aug 1 to Oct 31	Mar 1 to May 15; Aug 1 to Nov 15	Feb 15 to Apr 30; Aug 15 to Dec 15		
Warm-Season Grasses								
Foxtail Millet (<i>Setaria italica</i>)	30	0.7	0.5	Jun 1 to Jul 31	May 16 to Jul 31	May 1 to Aug 14	436 lb/ac (10 lb/1000sf)	2 tons/ac (10 lb/1000sf)
Pearl Millet (<i>Pennisetum glaucum</i>)	20	0.5	0.5	Jun 1 to Jul 31	May 16 to Jul 31	May 1 to Aug 14		

NOTES:

1/ Seeding rates for the warm-season grasses are in pounds of Pure Live Seed (PLS). Actual planting rates shall be adjusted to reflect percent seed germination and purity, as tested. Adjustments are usually not needed for the cool-season grasses.


Seeding rates listed above are for temporary seedings, when planted alone. When planted as a nurse crop with permanent seed mixes, use 1/3 of the seeding rate listed above for barley, oats, and wheat. For smaller-seeded grasses (annual ryegrass, pearl millet, foxtail millet), do not exceed more than 5% (by weight) of the overall permanent seeding mix. Cereal rye generally should not be used as a nurse crop, unless planting will occur in very late fall beyond the seeding dates for other temporary seedings. Cereal rye has allelopathic properties that inhibit the germination and growth of other plants. If it must be used as a nurse crop, seed at 1/3 of the rate listed above.

Oats are the recommended nurse crop for warm-season grasses.


2/ For sandy soils, plant seeds at twice the depth listed above.

3/ The planting dates listed are averages for each Zone and may require adjustment to reflect local conditions, especially near the boundaries of the zone.

PROFESSIONAL CERTIFICATION. I HEREBY CERTIFY THAT THESE DOCUMENTS WERE PREPARED OR APPROVED BY ME, AND THAT I AM A DULY LICENSED PROFESSIONAL ENGINEER UNDER THE LAWS OF THE STATE OF MARYLAND. LICENSE NO. 40784 EXPIRATION DATE 11-06-2019

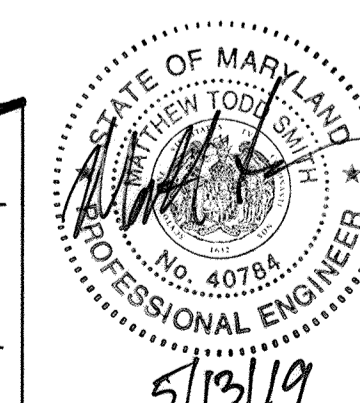

PROFESSIONAL CERTIFICATION. I HEREBY CERTIFY THAT THESE DOCUMENTS WERE PREPARED OR APPROVED BY ME, AND THAT I AM A DULY LICENSED PROFESSIONAL ENGINEER UNDER THE LAWS OF THE STATE OF MARYLAND. LICENSE NO. 40784 EXPIRATION DATE 11-06-2019

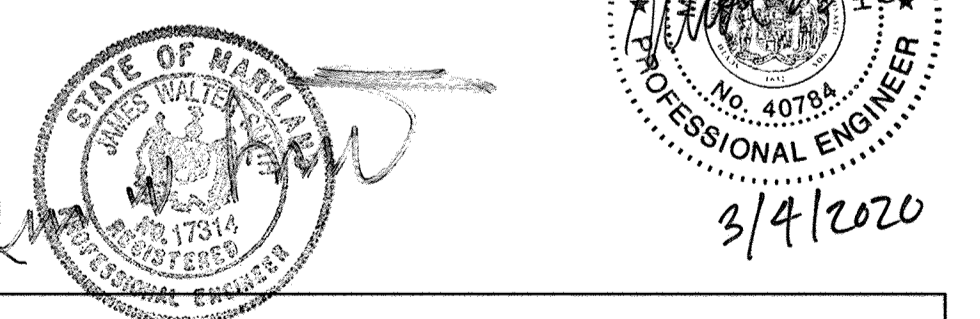

PROFESSIONAL CERTIFICATION

I HEREBY CERTIFY THAT THESE DOCUMENTS WERE PREPARED OR APPROVED BY ME, AND THAT I AM A DULY LICENSED PROFESSIONAL ENGINEER UNDER THE LAWS OF THE STATE OF MARYLAND. LICENSE NO. 17314 EXPIRATION DATE 4/14/19

No.	REVISIONS	APPROVED BY	DATE	No.	REVISIONS	APPROVED BY	DATE	DWG. NO.	REFERENCE
1	ADDED FILTER SEPARATOR, ADDITIONAL GRAVEL, AND CANOPY OVER METER STATION		05/17		UPDATED TO INCLUDE NEW SHEET		12/19		
	CATHOLIC PROTECTION SYSTEM UPGRADES		03/19						

PROJECT DELIVERY PROJECT ENGINEERING
 COLUMBIA Gas Transmission
 LINDEN CHURCH METERING & REGULATING STATION UPGRADE
 TITLE: EROSION AND SEDIMENT CONTROL NOTES
 DRAWN BY: FGY DATE: 02/03/2017 DRAWING NUMBER: SC-03 SHEET: 07 OF 109 ISSUE: 19175

