


GENERAL NOTES

KNOX LANDING II

LOTS 1 thru 5 AND OPEN SPACE LOTS 6 and 7



SITE DEVELOPMENT PLAN

BENCH MARKS (NAD83)
 HO. CO. No. 47GD ELEV. 312.32'
 NEAR 9028 OLD SCAGGSVILLE ROAD
 6 FEET FROM FIRE HYDRANT
 33.9 FEET FROM BGE 315258
 N 530494.447 E 1350872.301
 HO. CO. No. 47GE ELEV. 335.756'
 BY 9160 OLD SCAGGSVILLE ROAD
 19.8 FEET FROM WATER METER
 76.5 FEET FROM BGE 31000
 N 529044.964 E 1350854.953

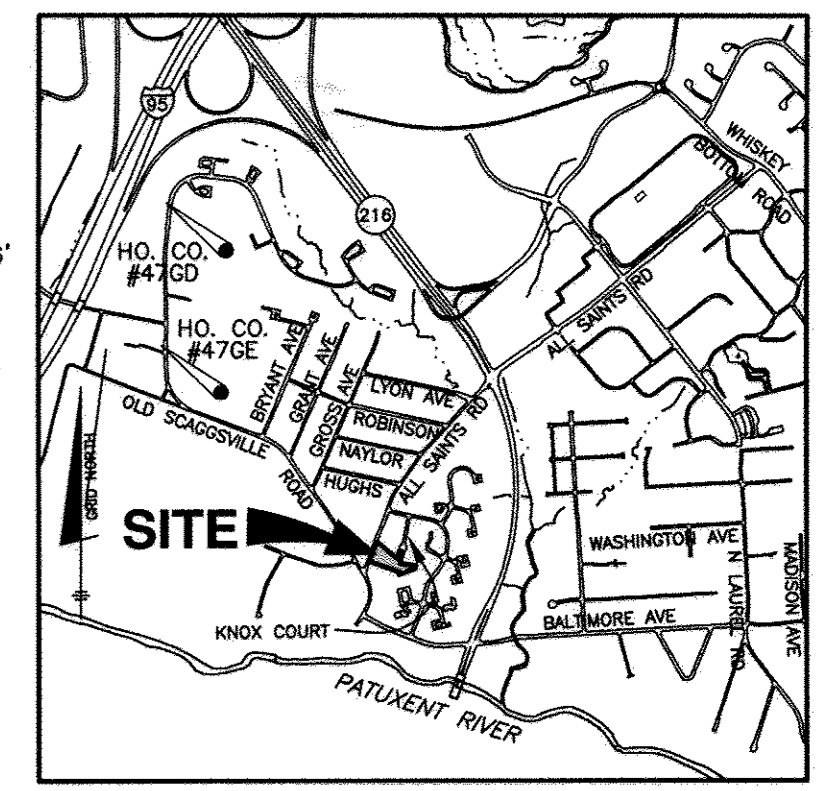

VICINITY MAP ADC MAP: 40
 SCALE: 1" = 2000' ADC GRID: 88



- THIS PROJECT IS IN CONFORMANCE WITH THE LATEST HOWARD COUNTY STANDARDS UNLESS WAIVERS HAVE BEEN APPROVED.
- THE SUBJECT PROPERTY IS ZONED R-SC PER THE OCTOBER 6, 2013 COMPREHENSIVE ZONING PLAN.
- THE COORDINATES SHOWN HEREON ARE BASED UPON THE HOWARD COUNTY GEODETIC CONTROL WHICH IS BASED UPON THE MARYLAND STATE PLANE COORDINATE SYSTEM. HOWARD COUNTY MONUMENTS NO. 47GD AND 47GE WERE USED FOR THIS PROJECT.
- TRACT BOUNDARY IS BASED ON A FIELD RUN BOUNDARY SURVEY PERFORMED ON OR ABOUT FEBRUARY, 2014 BY BENCHMARK ENGINEERING, INC.
- THE NOISE STUDY IS NOT REQUIRED FOR THIS PROJECT.
- THE TRAFFIC STUDY WAS PREPARED BY MARS GROUP, INC. IN DECEMBER, 2014 AND WAS APPROVED BY DPZ ON 7-6-2015 UNDER F-15-049.
- THIS PROPERTY IS LOCATED WITHIN THE METROPOLITAN DISTRICT. THE WATER AND SEWER IS PUBLIC. THE CONTRACT NUMBER IS 24-4896-D.
- THIS SUBDIVISION IS SUBJECT TO SECTION 18.122B OF THE HOWARD COUNTY CODE. PUBLIC WATER AND/OR SEWER SERVICE HAS BEEN GRANTED UNDER THE TERMS AND PROVISIONS, THEREOF, EFFECTIVE , ON WHICH DATE DEVELOPERS AGREEMENT NUMBER F-15-049/24-4896 WAS FILED AND ACCEPTED.
- TO THE BEST OF OUR KNOWLEDGE, THERE ARE NO CEMETERY LOCATIONS ON-SITE.
- THERE ARE NO HISTORIC SITES/FEATURES LOCATED ON THIS SITE.
- THERE ARE NO WETLANDS, STREAMS, THEIR REQUIRED BUFFERS, OR 100YR FLOODPLAIN LOCATED ON THIS SITE.
- THERE ARE NO STEEP SLOPES THAT 25% OR GREATER THAT IS MORE THAN A CONTIGUOUS 20,000 sf LOCATED ON THIS SITE.
- DRIVEWAYS SHALL BE PROVIDED PRIOR TO RESIDENTIAL OCCUPANCY TO INSURE SAFE ACCESS FOR FIRE AND EMERGENCY VEHICLES PER THE FOLLOWING MINIMUM REQUIREMENTS:
 - WIDTH - 12' (16' SERVING MORE THAN ONE RESIDENCE).
 - SURFACE - 6" OF COMPACT CRUSHER RUN BASE WITH TAR AND CHIP COATING (1-1/2" MIN.)
 - GEOMETRY - MAXIMUM 15% GRADE, MAXIMUM 10% GRADE CHANGE AND MINIMUM 45' TURNING RADIUS.
 - STRUCTURES (CULVERTS/BRIDGES) - CAPABLE OF SUPPORTING 25 GROSS TONS (H25 LOADING).
 - DRAINAGE ELEMENTS - CAPABLE OF SAFELY PASSING 100 YEAR FLOODPLAIN WITH NO MORE THAN 1-FOOT DEPTH OVER DRIVEWAY.
 - STRUCTURE CLEARANCES - MINIMUM 12 FEET.
 - MAINTENANCE - SUFFICIENT TO INSURE ALL WEATHER USE.
- THE WETLAND DELINEATION AND FOREST STAND DELINEATION WAS PREPARED BY ECO-SCIENCE PROFESSIONALS, INC. IN MARCH, 2014.
- THE GEOTECHNICAL REPORT WAS PREPARED BY GEOTECHNICAL LABORATORIES, INC. IN NOVEMBER, 2014.
- STORMWATER MANAGEMENT ENVIRONMENTAL SITE DESIGN (ESD) HAS BEEN PROVIDED IN ACCORDANCE WITH THE "MARYLAND DEPARTMENT OF THE ENVIRONMENT STORMWATER MANAGEMENT ACT OF 2007" AND THE "HOWARD COUNTY DESIGN MANUAL VOLUME 1, CHAPTER 5" TO THE MAXIMUM EXTENT PRACTICAL (MEP) VIA FIVE (5) M-6 MICRO-BIORETENTION PRACTICES. THE PRACTICES ARE PRIVATELY OWNED AND PRIVATELY MAINTAINED.
- LANDSCAPING WAS PROVIDED WITH A CERTIFIED LANDSCAPE PLAN UNDER F-15-049 IN ACCORDANCE ACCORDANCE WITH SECTION 16.124 OF THE HOWARD COUNTY CODE AND LANDSCAPE MANUAL. FINANCIAL SURETY IN THE AMOUNT OF \$7,200.00 FOR THE REQUIRED PERIMETER LANDSCAPING SHALL BE POSTED AS PART OF THE GRADING PERMIT UNDER THE SITE DEVELOPMENT PLAN.
- THE FOREST CONSERVATION OBLIGATION WAS MET UNDER F-15-049.
- FOR FLAG OR PIPESTEM LOTS, REFUSE COLLECTION, SNOW REMOVAL AND ROAD MAINTENANCE ARE PROVIDED TO THE JUNCTION OF THE FLAG OR PIPESTEM AND ROAD RIGHT-OF-WAY LINE AND NOT ONTO THE PIPESTEM LOT DRIVEWAY.
- WP-14-123, A REQUEST TO WAIVE SECTIONS 16.121(e)(2)(i), SECTION 16.134(a)(1), SECTION 16.144(b) AND SECTION 16.144(g) WAS APPROVED ON JULY 28, 2014 SUBJECT TO THE FOLLOWING CONDITIONS:
 - SUBMISSION OF A FINAL SUBDIVISION PLAN AND APPLICATION UPON APPROVAL OF ECP-14-054
 - COMPLY WITH ALL ATTACHED AGENCY COMMENTS ON THE SUBMITTED ECP PLANS.
 - COMPLIANCE WITH THE DEVELOPMENT ENGINEERING DIVISION COMMENTS DATED JULY 17, 2014 REGARDING THE PAYMENT OF A FEE-IN-LIEU FOR THE SIDEWALK ALONG ALL SAINTS ROAD.
 - COMPLIANCE WITH THE DEPARTMENT OF FIRE AND RESCUE SERVICES COMMENTS DATED MAY 15, 2014, AND DPW REAL ESTATE SERVICES COMMENTS DATED MAY 6, 2014 ON THE FINAL PLAN SUBMISSION.
- THE PRIVATE MAINTENANCE ACCESS AGREEMENT FOR LOTS 1-5 WAS RECORDED SIMULTANEOUSLY WITH THE RECORDATION OF THE PLAT F-15-049.
- WATER AND SEWER SERVICE TO THESE LOTS WILL BE GRANTED UNDER THE PROVISIONS OF SECTION 18.122.B OF THE HOWARD COUNTY CODE. PUBLIC WATER AND SEWERAGE ALLOCATION WILL BE GRANTED AT TIME OF ISSUANCE OF BUILDING PERMIT IF CAPACITY IS AVAILABLE AT THAT TIME.
- THE EXISTING STRUCTURE (GARAGE) PREVIOUSLY ON-SITE WAS REMOVED ON NOVEMBER 21, 2015.
- IN ACCORDANCE WITH SECTION 128 OF THE HOWARD COUNTY ZONING REGULATIONS, BAY WINDOWS, CHIMNEYS OR EXTERIOR STAIRWAYS NOT MORE THAN 16 FEET IN WIDTH MAY PROJECT NOT MORE THAN 4 FEET INTO ANY SETBACKS, PORCHES OR DECKS, OPEN OR ENCLOSED MAY PROJECT NOT MORE THAN 10 FEET INTO THE FRONT OR REAR YARD SETBACK (APPLIES FOR RESIDENTIAL SDP'S).
- THE REQUIRED COMMUNITY MEETING FOR THIS PROJECT WAS HELD ON JANUARY 6, 2014.
- A FEE-IN-LIEU IN THE AMOUNT OF \$12,300.00 FOR THE REQUIRED SIDEWALK IMPROVEMENTS ALONG ALL SAINTS ROAD WAS PAID AS PART OF DEVELOPERS AGREEMENT. THIS PAYMENT WILL BE CREDITED TO CAPITAL PROJECT NUMBER K-5061.

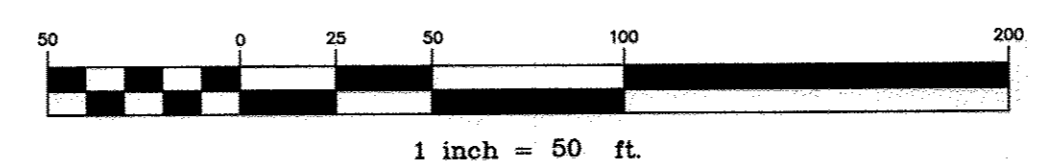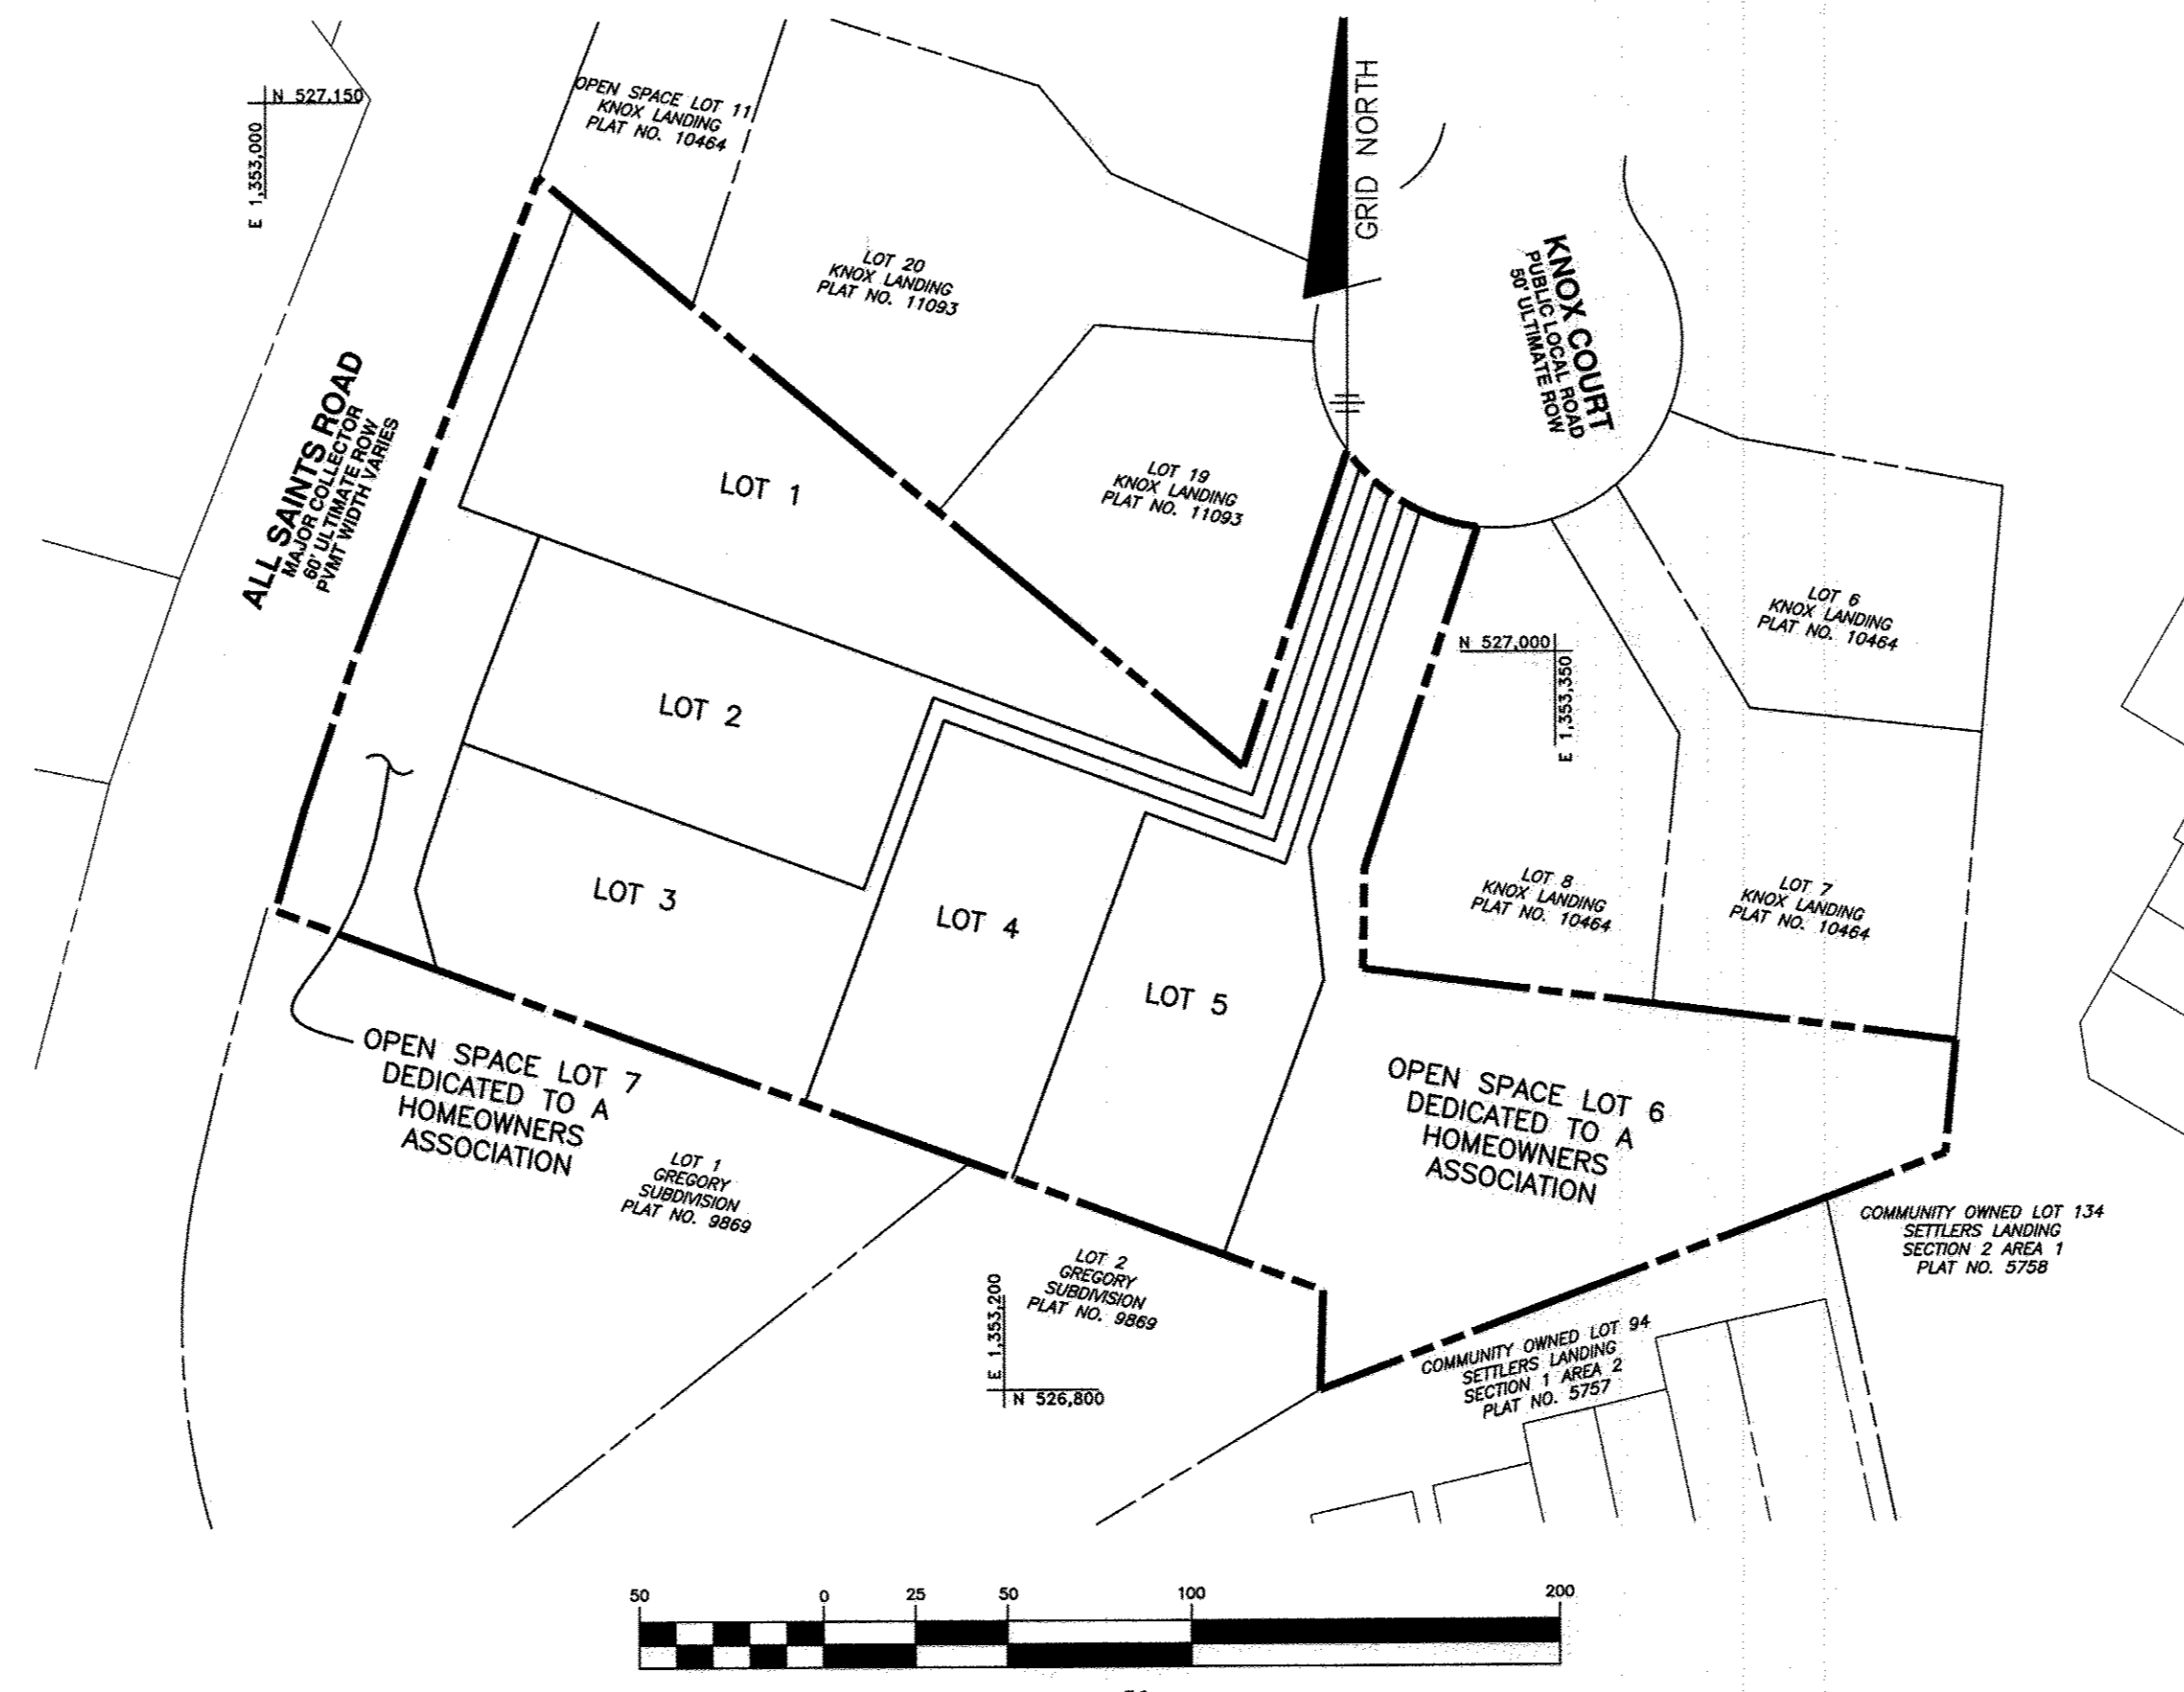

THE CONTRACTOR SHALL NOTIFY THE DEPARTMENT OF PUBLIC WORKS/BUREAU OF ENGINEERING/CONSTRUCTION INSPECTION DIVISION AT 410-313-1880 AT LEAST FIVE (5) WORKING DAYS PRIOR TO THE START OF WORK.

THE CONTRACTOR SHALL NOTIFY "MISS UTILITY" AT 1-800-257-7777 AT LEAST 48 HOURS PRIOR TO ANY EXCAVATION WORK BEING DONE.

NO AS-BUILT INFORMATION IS REQUIRED ON THIS SHEET

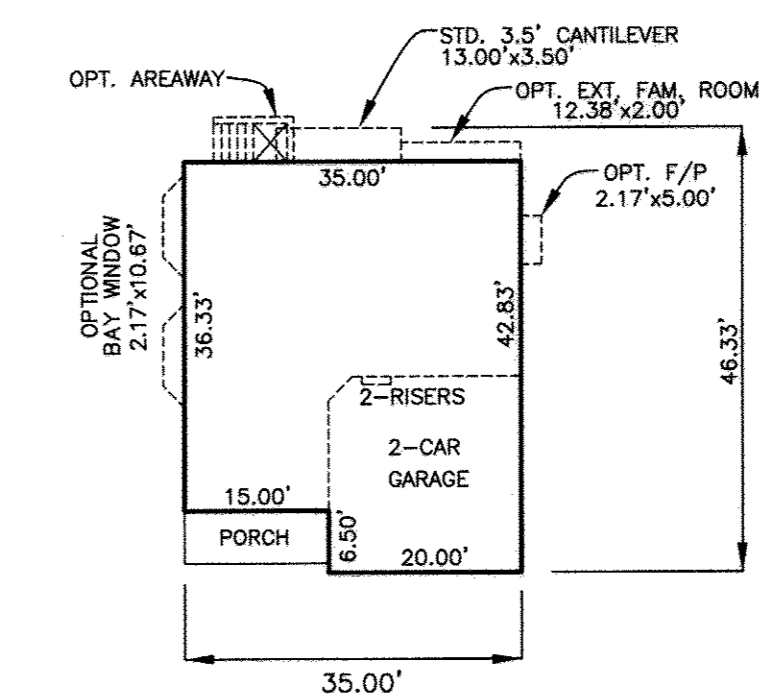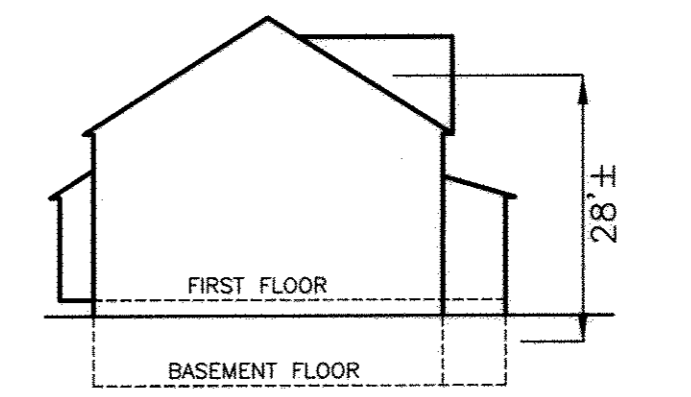

CLAREMONT II
 SCALE: 1" = 20'

ADDRESS CHART	
LOT	STREET ADDRESS
1	9124 KNOX COURT
2	9128 KNOX COURT
3	9132 KNOX COURT
4	9136 KNOX COURT
5	9140 KNOX COURT

SITE ANALYSIS DATA CHART

A) TOTAL PROJECT AREA	1.42 acres
B) AREA OF PLAN SUBMISSION	1.42 acres
C) LIMIT OF DISTURBED AREA	1.11 acres
D) PRESENT ZONING:	R-SC
E) PROPOSED USE OF SITE:	RESIDENTIAL SINGLE FAMILY DETACHED
F) FLOOR SPACE ON EACH LEVEL OF BLDG PER USE	N/A
G) TOTAL NUMBER OF UNITS ALLOWED AS SHOWN ON FINAL PLAT(S)	5
H) TOTAL NUMBER OF UNITS PROPOSED	5
I) MAXIMUM NUMBER OF EMPLOYEES, TENANTS ON SITE PER USE	N/A
J) NUMBER OF PARKING SPACES REQUIRED BY HO. CO. ZONING REGS AND/OR FDP CRITERIA	12.5 (5 UNITS x 2.5)
K) NUMBER OF PARKING SPACES PROVIDED ON-SITE (INCLUDES HANDICAPPED SPACES)	20 (2 PER GARAGE AND 2 PER DRIVEWAY)
L) OPEN SPACE ON-SITE	0.48 AC. (RECORDED UNDER PLAT)
M) AREA OF RECREATIONAL OPEN SPACE REQUIRED	N/A
N) BUILDING COVERAGE OF SITE	N/A
O) PERCENTAGE OF GROSS AREA	N/A
Q) APPLICABLE DPZ FILE REFERENCES:	ECP-14-054, WP-14-123, F-15-049

NOTE: THE MODERATE INCOME HOUSING UNIT REQUIREMENT (COUNCIL BILL 35-2013) SHALL BE FULFILLED BY PAYMENT OF A FEE-IN-LIEU IN AN AMOUNT THAT IS TO BE CALCULATED BY THE DEPARTMENT OF INSPECTIONS LICENSES AND PERMITS AT THE TIME OF BUILDING PERMIT. THE FEE-IN-LIEU SHALL BE PAID FOR ALL LOTS/RESIDENTIAL UNITS WITHIN THIS SUBDIVISION AT TIME OF BUILDING PERMIT ISSUANCE.

DESIGN NARRATIVE:

FOR THE PROPOSED IMPERVIOUS AREAS OF THIS SUBDIVISION, FIVE (M-6) MICRO BIO-RETENTION PRACTICES HAVE BEEN PROPOSED FOR TREATMENT.

NATURAL RESOURCE PROTECTION IS BEING ACHIEVED SINCE THERE ARE NO ENVIRONMENTALLY SENSITIVE AREAS LOCATED ON THE PROJECT. THE STEEP SLOPES ALONG ALL SAINTS ROAD SHALL NOT BE DISTURBED.

NATURAL FLOW PATTERNS HAVE BEEN PRESERVED BY PLACING THE ESD PRACTICES AROUND THE OUTER PERIMETER OF THE SITE AND HAVING THEM DISCHARGE ALONG THIS PERIMETER IN VARIOUS LOCATIONS AS OPPOSED TO ONE CONCENTRATED AREA. THIS SHALL MIMIC THE EXISTING CONDITION OF FLOW.

REDUCTION OF IMPERVIOUS AREAS HAS BEEN ACHIEVED BY UTILIZING THE NARROWEST POSSIBLE DRIVEWAY WIDTHS AS ALLOWED BY HOWARD COUNTY FOR A USE-IN-COMMON DRIVE.

SEDIMENT AND EROSION CONTROL SHALL MAINLY CONSIST OF DOUBLE ROW OF SUPER SILT FENCE AROUND THE PERIMETER. DIVERSION FENCING SHALL BE UTILIZED ALONG THE NORTH SIDE OF THE PROJECT TO DIVERT RUNOFF AROUND THE SITE. SEDIMENT TRAPS WILL NOT BE NEEDED.

AS A RESULT OF UTILIZING ENVIRONMENTAL SITE DESIGN (ESD) TO THE MAXIMUM EXTENT PRACTICAL (MEP), STORMWATER MANAGEMENT HAS BEEN ADEQUATELY ADDRESSED WITHOUT THE NEED FOR STRUCTURAL PRACTICES.

ESD STORMWATER MANAGEMENT SUMMARY TABLE												
Practice	#	DA to practice	Imp Area to practice	Q _{in} = 0.33 inches			ESD _v = 1795 cf			Q _{out} = 0.28 inches		
				Required	Provided	% DA?	Required	Provided	Pe	Required	Provided	Rev
(M-6) MicroBioRetention	#1	3,351	1,583	67	87	PASS	159	251	1.2			
(M-6) MicroBioRetention	#2	2,113	1,062	42	83	PASS	106	202	1.2			
(M-6) MicroBioRetention	#3	6,513	3,485	130	193	PASS	346	405	1.2			
(M-6) MicroBioRetention	#4	4,551	2,416	91	136	PASS	240	309	1.2			
(M-6) MicroBioRetention	#5	13,154	6,425	263	529	PASS	644	923	1.2			
Total Treated												
		29,682	14,971	594	1,028		1,705	2,100	1.5	85	106	
Site Total		61,986	15,448									

The 517 sf of impervious area that is left untreated is the area at the beginning portion of the use-in-common drive that drains back to the cul-de-sac. Total ESD_v provided exceeds that which is required.

* ESD volume required based on 75% of ESD_v.

Professional Certification. I hereby certify that these documents were prepared or approved by me, and that I am a duly licensed professional engineer under the laws of the State of Maryland.
 License No. 21443, Expiration Date: 12-21-18



APPROVED: FOR PUBLIC WATER AND PUBLIC SEWERAGE SYSTEMS
 COUNTY HEALTH OFFICER
 HOWARD COUNTY HEALTH DEPARTMENT

APPROVED: HOWARD COUNTY DEPARTMENT OF PLANNING AND ZONING
 Chief, Development Engineering Division
 Chief, Division of Land Development
 Director

SHEET INDEX	
NO.	TITLE
1	TITLE SHEET
2	SITE DEVELOPMENT AND GRADING PLAN
3	STORMWATER MANAGEMENT NOTES, CHARTS & DETAILS
4	WATER DRAIN DRAINAGE MAP, PROFILES & DETAILS
5	SEDIMENT AND EROSION CONTROL PLAN
6	SEDIMENT AND EROSION CONTROL NOTES AND DETAILS
7	SOIL BORING LOGS

PERMIT INFORMATION CHART					
SUBDIVISION NAME:		SECTION/AREA:	LOT/PARCEL #		
KNOX LANDING II		N/A	LOTS 1 thru 5		
PLAT No. 23435-23436	GRID No. 2	ZONE R-SC	TAX MAP NO. 50	ELECTION DISTRICT 6th	GENUS TRACT 6069.03

Professional Certification. I hereby certify that these documents were prepared or approved by me, and that I am a duly licensed professional engineer under the laws of the State of Maryland.
 License No. 21443, Expiration Date: 6-30-2017

BENCHMARK ENGINEERS, INC.
 ENGINEERS & LAND SURVEYORS & PLANNERS
 8450 BALTIMORE NATIONAL PIKE & SUITE 315 & ELLICOTT CITY, MARYLAND 21043
 (P) 410-465-6105 (F) 410-465-6644
 WWW.BEI-ENGLANDENGINEERING.COM

OWNER: CORNERSTONE HOLDINGS LLC
 9695 NORFOLK AVENUE
 LAUREL, MARYLAND 20793
 410-792-2565


DEVELOPER: CORNERSTONE HOLDINGS LLC
 9695 NORFOLK AVENUE
 LAUREL, MARYLAND 20793
 410-792-2565

KNOX LANDING II
 LOTS 1 thru 5 AND OPEN SPACE LOTS 6 and 7
 RESIDENTIAL - SINGLE FAMILY DETACHED

TAX MAP: 50 GRID: 2 PARCEL: 75 & 528 ZONED: R-SC
 9417 ALL SAINTS ROAD
 ELECTION DISTRICT NO. 6
 HOWARD COUNTY, MARYLAND


SITE DEVELOPMENT PLAN
TITLE SHEET

DATE: DECEMBER, 2015 BEI PROJECT NO: 2586
 SCALE: AS SHOWN SHEET 1 OF 7

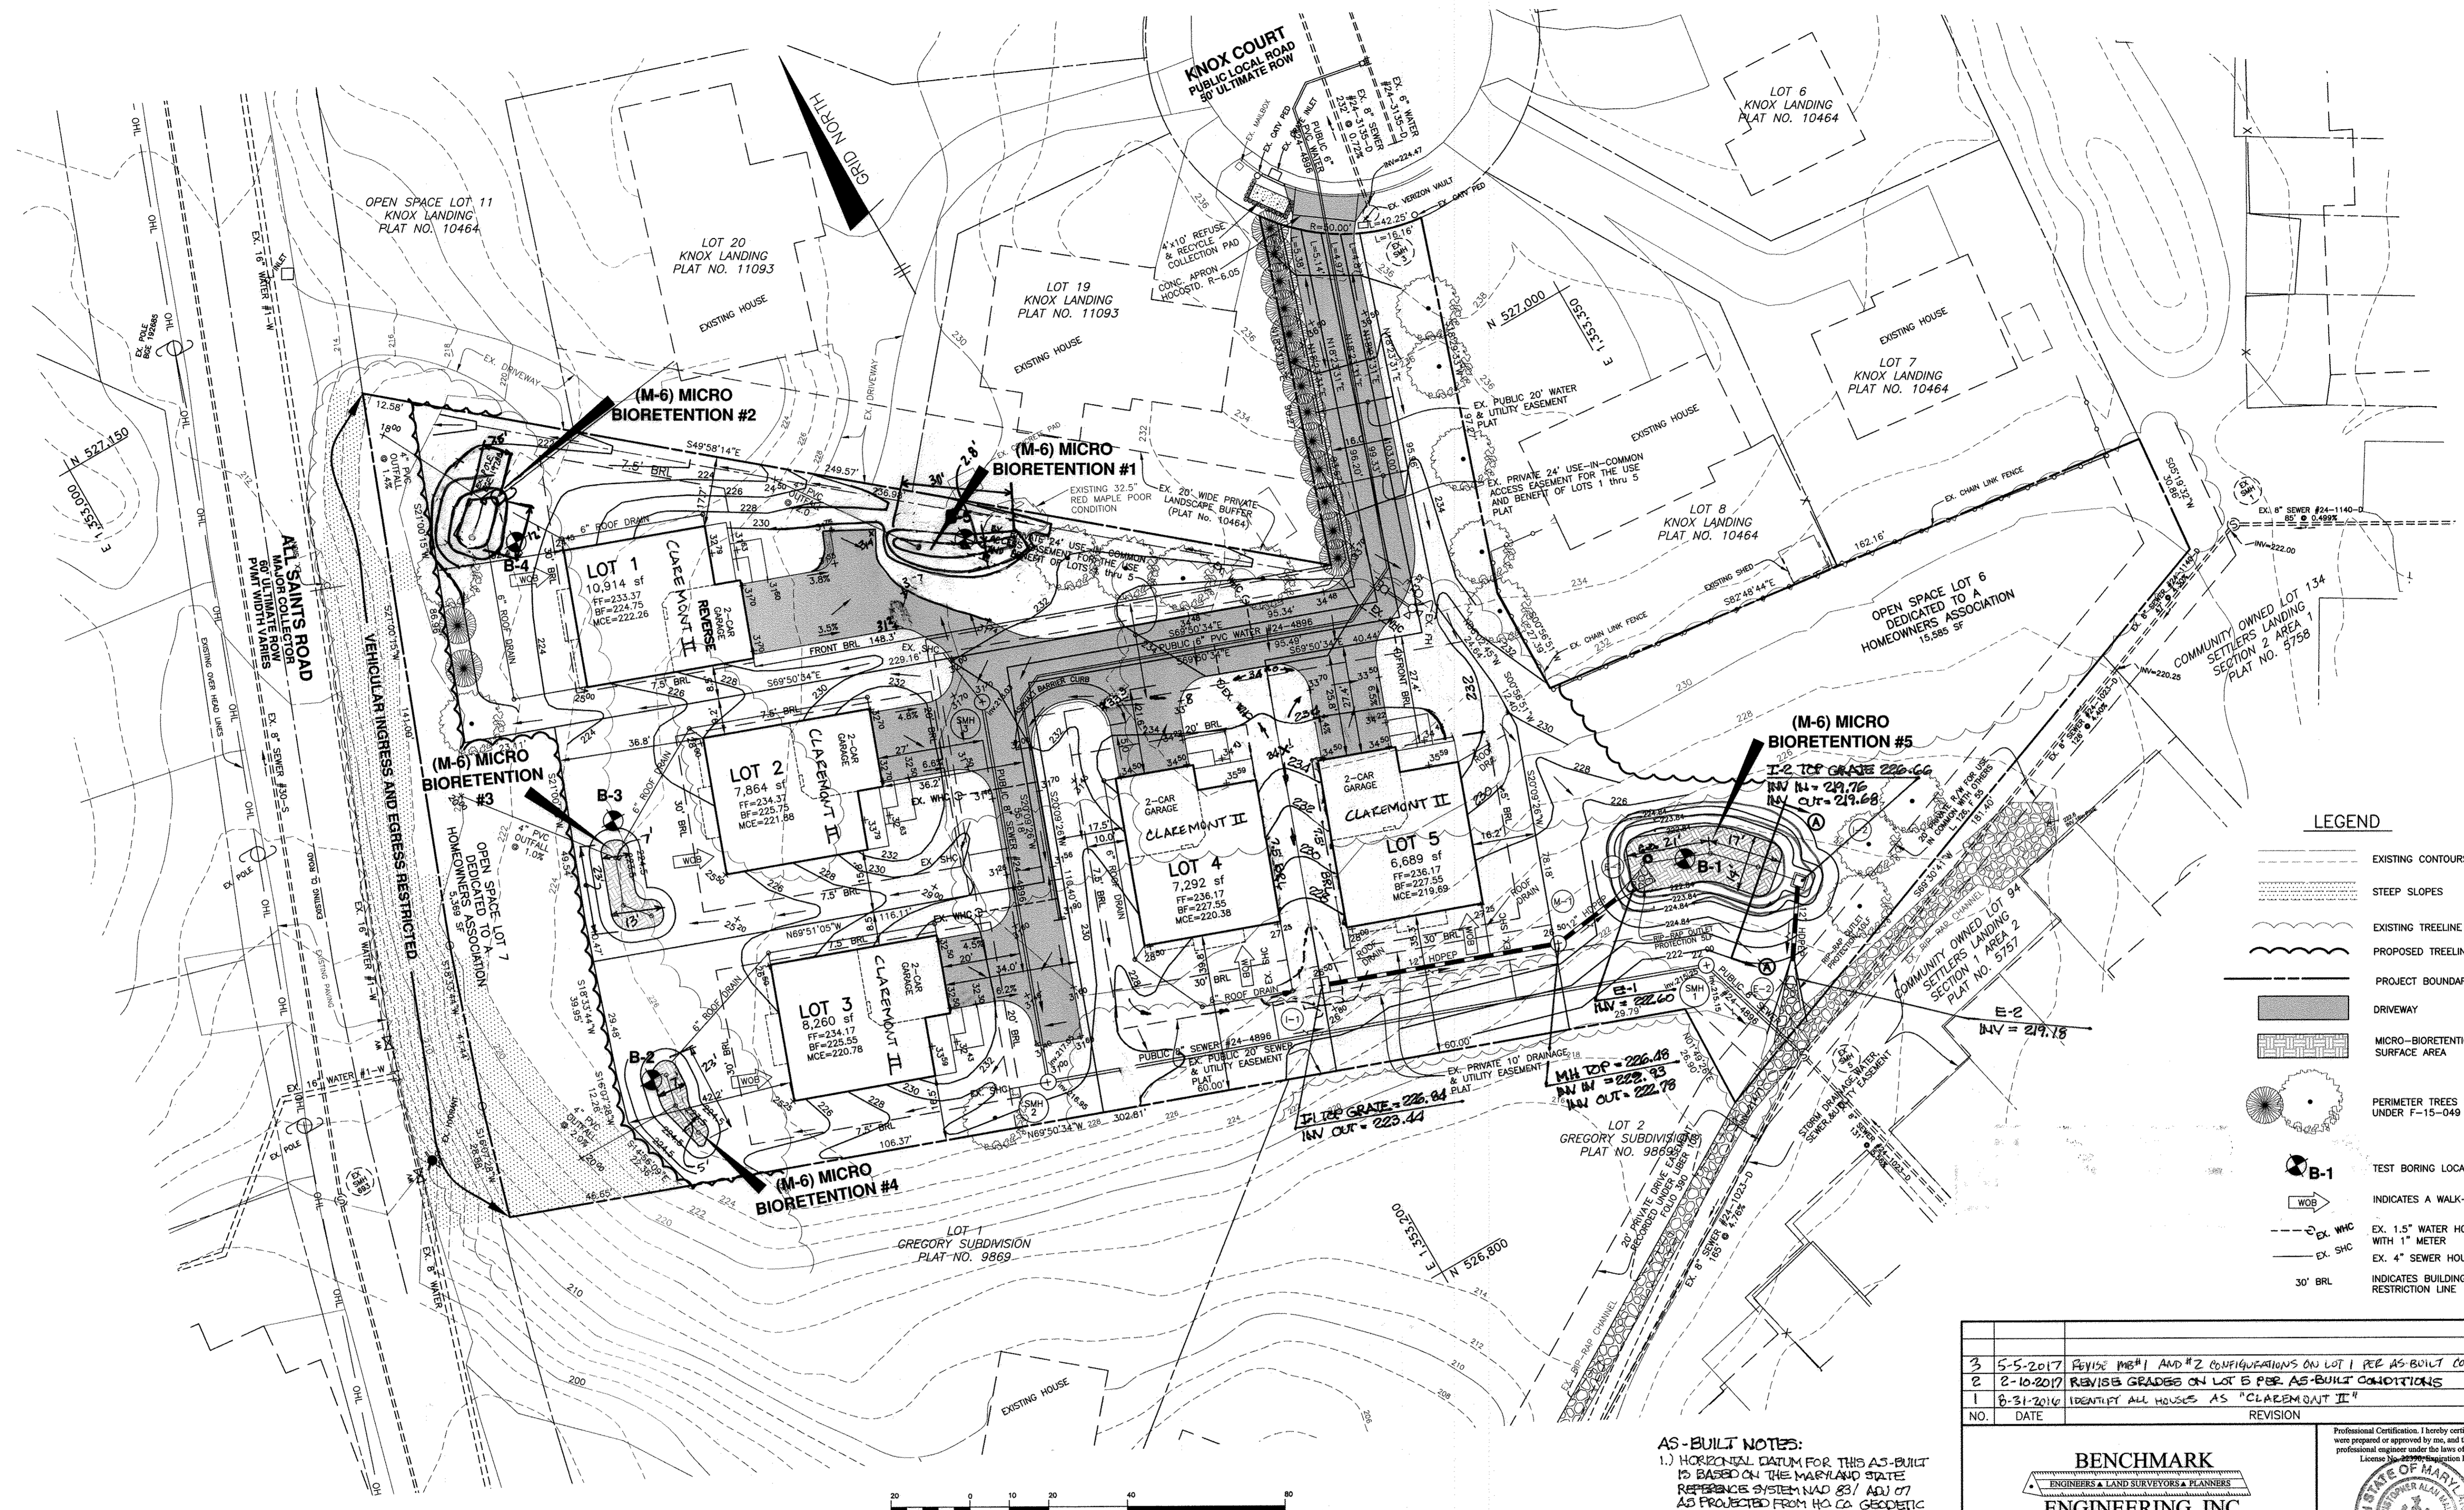

LEGEND


- EXISTING CONTOURS
- STEEP SLOPES
- EXISTING TREELINE
- PROPOSED TREELINE
- PROJECT BOUNDARY LINE
- DRIVEWAY
- MICRO-BIORETENTION SURFACE AREA
- PERIMETER TREES INSTALLED UNDER F-15-049
- TEST BORING LOCATION
- INDICATES A WALK-OUT BASEMENT
- EX. WHC EX. 1.5" WATER HOUSE CONN. WITH 1" METER
- EX. SHC EX. 4" SEWER HOUSE CONN.
- 30' BRL INDICATES BUILDING RESTRICTION LINE

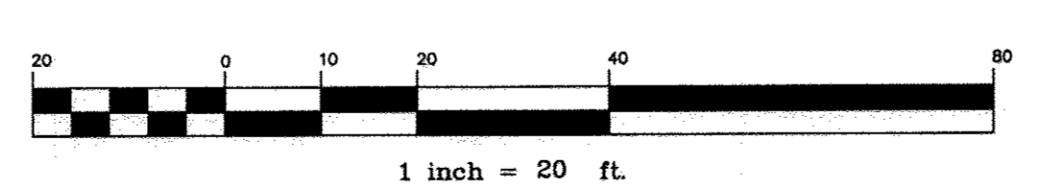

AS-BUILT CERTIFICATION
 I hereby certify, by my seal, that to the best of my knowledge and belief the facilities shown on this "AS-BUILT" Plan meet the Approved Plans and Specifications

Donald Mason, P.E. Date: 6-19-17

Professional Certification. I hereby certify that these documents were prepared or approved by me, and that I am a duly licensed professional engineer under the laws of the State of Maryland.
 License No. 21443, Expiration Date: 12-21-19

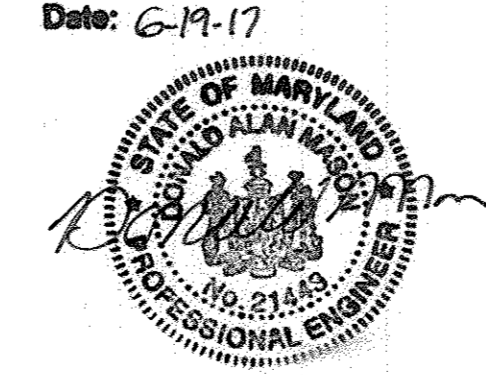

AS-BUILT NOTES:
 1.) HORIZONTAL DATUM FOR THIS AS-BUILT IS BASED ON THE MARYLAND STATE REFERENCE SYSTEM NAD 83/ ADU 07 AS PROJECTED FROM H&C GEODETIC CONTROL STATIONS 4900 AND 47 GE. VERTICAL DATUM FOR THIS AS-BUILT IS NORTH AMERICAN VERTICAL DATUM 1988 AS PROJECTED FROM THE ABOVE MENTIONED HOWARD COUNTY GEODETIC CONTROL STATIONS.
 2.) THE INSTRUMENTS USED IN PERFORMING THE AS-BUILT WERE A 5" TOTAL STATION AND PRISM AND RTK GPS.
 3.) THIS AS-BUILT WAS PERFORMED BY BENCHMARK ENGINEERING, INC.

NO.	DATE	REVISION
3	5-5-2017	REVISE MB#1 AND #2 CONFIGURATIONS ON LOT 1 PER AS-BUILT CONDITIONS
2	2-10-2017	REVISE GRADES ON LOT 6 PER AS-BUILT CONDITIONS
1	8-31-2016	IDENTIFY ALL HOUSES AS "CLAREMONT II"

BENCHMARK ENGINEERING, INC.
 ENGINEERS & LAND SURVEYORS & PLANNERS
 8480 BALTIMORE NATIONAL PIKE & SUITE 315 & ELLIOTT CITY, MARYLAND 21043
 (P) 410-485-6105 (F) 410-485-6544
 WWW.BE-CVLENGINEERING.COM

Professional Certification. I hereby certify that these documents were prepared or approved by me, and that I am a duly licensed professional engineer under the laws of the State of Maryland.
 License No. 22399, Expiration Date: 6-30-2017

OWNER: CORNERSTONE HOLDINGS LLC 9895 NORFOLK AVENUE LAUREL, MARYLAND 20793 410-792-2565		DEVELOPER: CORNERSTONE HOLDINGS LLC 9895 NORFOLK AVENUE LAUREL, MARYLAND 20793 410-792-2565	
TAX MAP: 50		GRID: 2	
PARCEL: 75 & 528		ZONED: R-SC	
ELECTION DISTRICT: NO. 6		HOWARD COUNTY, MARYLAND	
SITE DEVELOPMENT AND GRADING PLAN			
DATE: DECEMBER, 2015	BEI PROJECT NO: 2586		
SCALE: AS SHOWN	SHEET 2 OF 7		

APPROVED: HOWARD COUNTY DEPARTMENT OF PLANNING AND ZONING

<i>Chad Paul</i>	2-3-16
CHIEF, DEVELOPMENT ENGINEERING DIVISION	DATE
<i>Kathleen Jordan</i>	2-12-16
CHIEF, DIVISION OF LAND DEVELOPMENT #18	DATE
<i>Natalie Joffe</i>	2-16-16
DIRECTOR	DATE

CONSTRUCTION SPECIFICATIONS

B.4.C Specifications for Micro-Bioretentation, Rain Gardens, Landscape Infiltration & Infiltration Berms

1. Material Specifications:

The allowable materials to be used in these practices are detailed in Table B.4.1.

2. Filtering Media or Planting Soil:

The soil shall be a uniform mix, free of stones, stumps, roots or other similar objects larger than two inches. No other materials or substances shall be mixed or dumped within the micro-bioretentation practice that may be harmful to plant growth, or prove a hindrance to the planting or maintenance operations. The planting soil shall be free of Bermuda grass, Quackgrass, Johnson grass, or other noxious weeds as specified under COMAR 15.08.01.05. The planting soil shall be tested and shall meet the following criteria:

- Soil Component - Loamy Sand or Sandy Loam (USDA Soil Textural Classification)
- Organic Content - Minimum 10% by dry weight (ASTM D 2974). In general, this can be met with a mixture of loamy and (60%-65%) and compost (35% to 40%) or sandy loam (30%), coarse sand (30%), and compost (40%).
- Clay Content - Media shall have a clay content of less than 5%.
- pH Range - Should be between 5.5 - 7.0. Amendments (e.g., lime, iron sulfate plus sulfur) may be mixed into the soil to increase or decrease pH.

There shall be at least one soil test per project. Each test shall consist of both the standard soil test for pH, and additional tests of organic matter, and soluble salts. A textural analysis is required from the site stockpiled topsoil. If topsoil is imported, then a texture analysis shall be performed for each location where the topsoil was excavated.

3. Compaction:

It is very important to minimize compaction of both the base of bioretention practices and the required backfill. When possible, use excavation hoes to remove original soil. If practices are excavated using a loader, the contractor should use wide track or marsh track equipment, or light equipment with turf tires. Use of equipment with narrow tracks or narrow tires, rubber tires with large lugs, or high-pressure tires will cause excessive compaction resulting in reduced infiltration rates and is not acceptable. Compaction will significantly contribute to design failure.

Compaction can be alleviated at the base of the bioretention facility by using a primary tilling operation such as a chisel plow, ripper, or subsoiler. These tilling operations are to restructure the soil profile through the 12 inch compaction zone. Substitute methods must be approved by the engineer. Rototillers typically do not till deep enough to reduce the effects of compaction from heavy equipment.

Rototill 2 to 3 inches of sand into the base of the bioretention facility before backfilling the optional sand layer. Pump any ponded water before preparing (rototilling) base.

When backfilling the topsoil over the sand layer, first place 3 to 4 inches of topsoil over the sand, then rototill the sand/topsoil to create a gradation zone. Backfill the remainder of the topsoil to final grade.

When backfilling the bioretention facility, place soil in lifts 12" to 18". Do not use heavy equipment within the bioretention basin.

Heavy equipment can be used around the perimeter of the basin to supply soils and sand. Grade bioretention materials with light equipment such as a compact loader or a dozer/loader with marsh tracks.

4. Plant Material:

Recommended plant material for micro-bioretentation practices can be found in Appendix A, Section A.2.3.

5. Plant Installation:

Compost is a better organic material source, is less likely to float, and should be placed in the invert and other low areas. Mulch should be placed in surrounding to a uniform thickness of 2" to 3". Shredded or chipped hardwood mulch is the only accepted mulch. Pine mulch and wood chips will float and move to the perimeter of the bioretention area during a storm event and are not acceptable. Shredded mulch must be well aged (6 to 12 months) for acceptance.

Rootstock of the plant material shall be kept moist during transport and on-site storage. The plant root ball should be planted so 1/8th of the ball is above final grade surface. The diameter of the planting pit shall be at least six inches larger than the diameter of the planting ball. Set and maintain the plant straight during the entire planting process. Thoroughly water ground bed cover after installation.

Trees shall be braced using 2" by 2" stakes only as necessary and for the first growing season only. Stakes are to be equally spaced on the outside of the tree ball.

Grasses and legume seed should be drilled into the soil to a depth of at least one inch. Grass and legume plugs shall be planted following the non-grass ground cover planting specifications.

The topsoil specifications provide enough organic material to adequately supply nutrients from natural cycling. The primary function of the bioretention structure is to improve water quality. Adding fertilizers defeats, or at a minimum, impedes this goal. Only add fertilizer if wood chips or mulch are used to amend the soil. Rototill urea fertilizer at a rate of 2 pounds per 1000 square feet.

6. Underdrains:

Underdrains should meet the following criteria:

- Pipe - Should be 4" to 6" diameter, slotted or perforated rigid plastic pipe (ASTM F 758, Type PS 28, or AASHTO-M-278) in a gravel layer. The preferred material is slotted, 4" rigid pipe (e.g., PVC or HDPE).
- Perforations - If perforated pipe is used, perforations should be 3/4" diameter located 6" on center with a minimum of four holes per row. Pipe shall be wrapped with a 1/2" (No. 4 or 4x4) galvanized hardware cloth.
- Gravel - The gravel layer (No. 57 stone preferred) shall be at least 3" thick above and below the underdrain.
- The main collector pipe shall be at a minimum 0.5% slope.
- A rigid, non-perforated observation well must be provided (one per every 1,000 square feet) to provide a clean-out port and monitor performance of the filter.
- A 4" layer of pea gravel (1/4" to 3/8" stone) shall be located between the filter media and underdrain to prevent migration of fines into the underdrain. This layer may be considered part of the filter bed when bed thickness exceeds 24".

The main collector pipe for underdrain systems shall be constructed at a minimum slope of 0.5%. Observation wells and/or clean-out pipes must be provided (one minimum per every 1000 square feet of surface area).

7. Miscellaneous:

These practices may not be constructed until all contributing drainage area has been stabilized

OPERATION AND MAINTENANCE SCHEDULE FOR MICRO-BIORETENTION (M-6)

- The Owner shall maintain the plant material, mulch layer and soil layer annually. Maintenance of mulch and soil is limited to correcting areas of erosion or wash out. Any mulch replacement shall be done in the spring. Plant material shall be checked for disease and insect infestation and maintenance will address dead material and pruning. Acceptable replacement plant material is limited to the following: 2000 Maryland Stormwater Design Manual Volume II, Table A.4.1 and 2.
- The Owner shall perform a plant inspection in the spring and in the fall of each year. During the inspection, the Owner shall remove dead and diseased vegetation considered beyond treatment, replace dead plant material with acceptable replacement plant material, treat diseased trees and shrubs, and replace all deficient stakes and wires.
- The Owner shall inspect the mulch each spring. The mulch shall be replaced every two to three years. The previous mulch layer shall be removed the new layer is applied.
- The Owner shall correct soil erosion on an as needed basis, with a minimum of once per month and after each heavy storm.

Appendix B.4. Construction Specifications for Environmental Site Design Practices


Practice	Material Specifications for Micro-Bioretentation, Rain Gardens & Landscape Infiltration	Size	Note
Planting soil (2" to 4" deep)	loamy sand (60 - 65%) & compost (35 - 40%) or sandy loam (30%), coarse sand (30%), and compost (40%)	n/a	USDA soil types loamy sand or sandy loam; clay content < 5%
Organic content	Min. 10% by dry weight (ASTM D 2974)		
Mulch	shredded hardwood		aged 6 months, minimum; no pine or wood chips
Pea gravel diaphragm	pea gravel: ASTM-D-448	NO. 8 OR NO. 9 (1.8" TO 3.0")	
Curtain drain	conventional stone: washed cobble	stone: 2" to 5"	
Geotextile	n/a	PE Type 1 nonwoven	
Gravel (underdrains and infiltration berms)	AASHTO M-43	NO. 57 OR NO. 6 AGGREGATE (3/8" to 3/4")	
Underdrain piping	F 758, Type PS 28 or AASHTO M-278	4" to 6" rigid schedule 40 PVC or SDR35	Slotted or perforated pipe; 3/8" perf. @ 6" on center, 4 holes per row; minimum of 3' of gravel over pipe; not necessary underdrain pipes. Perforated pipe shall be wrapped with 1/2-inch galvanized hardware cloth
Poured in place concrete (if required)	M318 Mix No. 3, f'c = 3500 psi @ 28 days, normal weight, air-entrained; reinforcing to meet ASTM-A15-09	n/a	on-site testing of poured-in-place concrete required; 28 day strength and slump test; all concrete design (cast-in-place or pre-cast) not using previously approved State or local standards requires design drawings sealed and approved by a professional structural engineer licensed in the State of Maryland - design to include meeting ACI Code 350.3R89; vertical loading (H-10 or H-20); allowable horizontal loading (based on soil properties); and analysis of potential cracking
Sand	AASHTO-M-6 or ASTM-C-33	0.02" to 0.04"	Sand substitutions such as Diabase and Graystone (AASHTO) #10 are not acceptable. No calcium chlorinated or dolomitic sand substitutions are acceptable. No "rock dust" can be used for sand.

Elev.	Description	Elevation
1	top of ponding/storage	229.00
2	top of mulch	228.00
3	top of soil	227.83
4	bottom of soil	225.83
5	bottom of stone	225.50
6	4" pvc pipe invert	224.92
7	bottom of facility	224.67
Surface Area (sf)		87

Elev.	Description	Elevation
1	top of ponding	222.50
2	top of mulch	221.50
3	top of soil	221.33
4	bottom of soil	219.33
5	bottom of stone	219.00
6	4" pvc pipe invert	218.42
7	bottom of facility	218.17
Surface Area (sf)		83

Elev.	Description	Elevation
1	top of ponding	224.50
2	top of mulch	223.50
3	top of soil	223.33
4	bottom of soil	221.33
5	bottom of stone	221.00
6	4" pvc pipe invert	220.42
7	bottom of facility	220.17
Surface Area (sf)		193


Elev.	Description	Elevation
1	top of ponding	224.50
2	top of mulch	223.50
3	top of soil	223.33
4	bottom of soil	221.33
5	bottom of stone	221.00
6	4" pvc pipe invert	220.42
7	bottom of facility	220.17
Surface Area (sf)		136

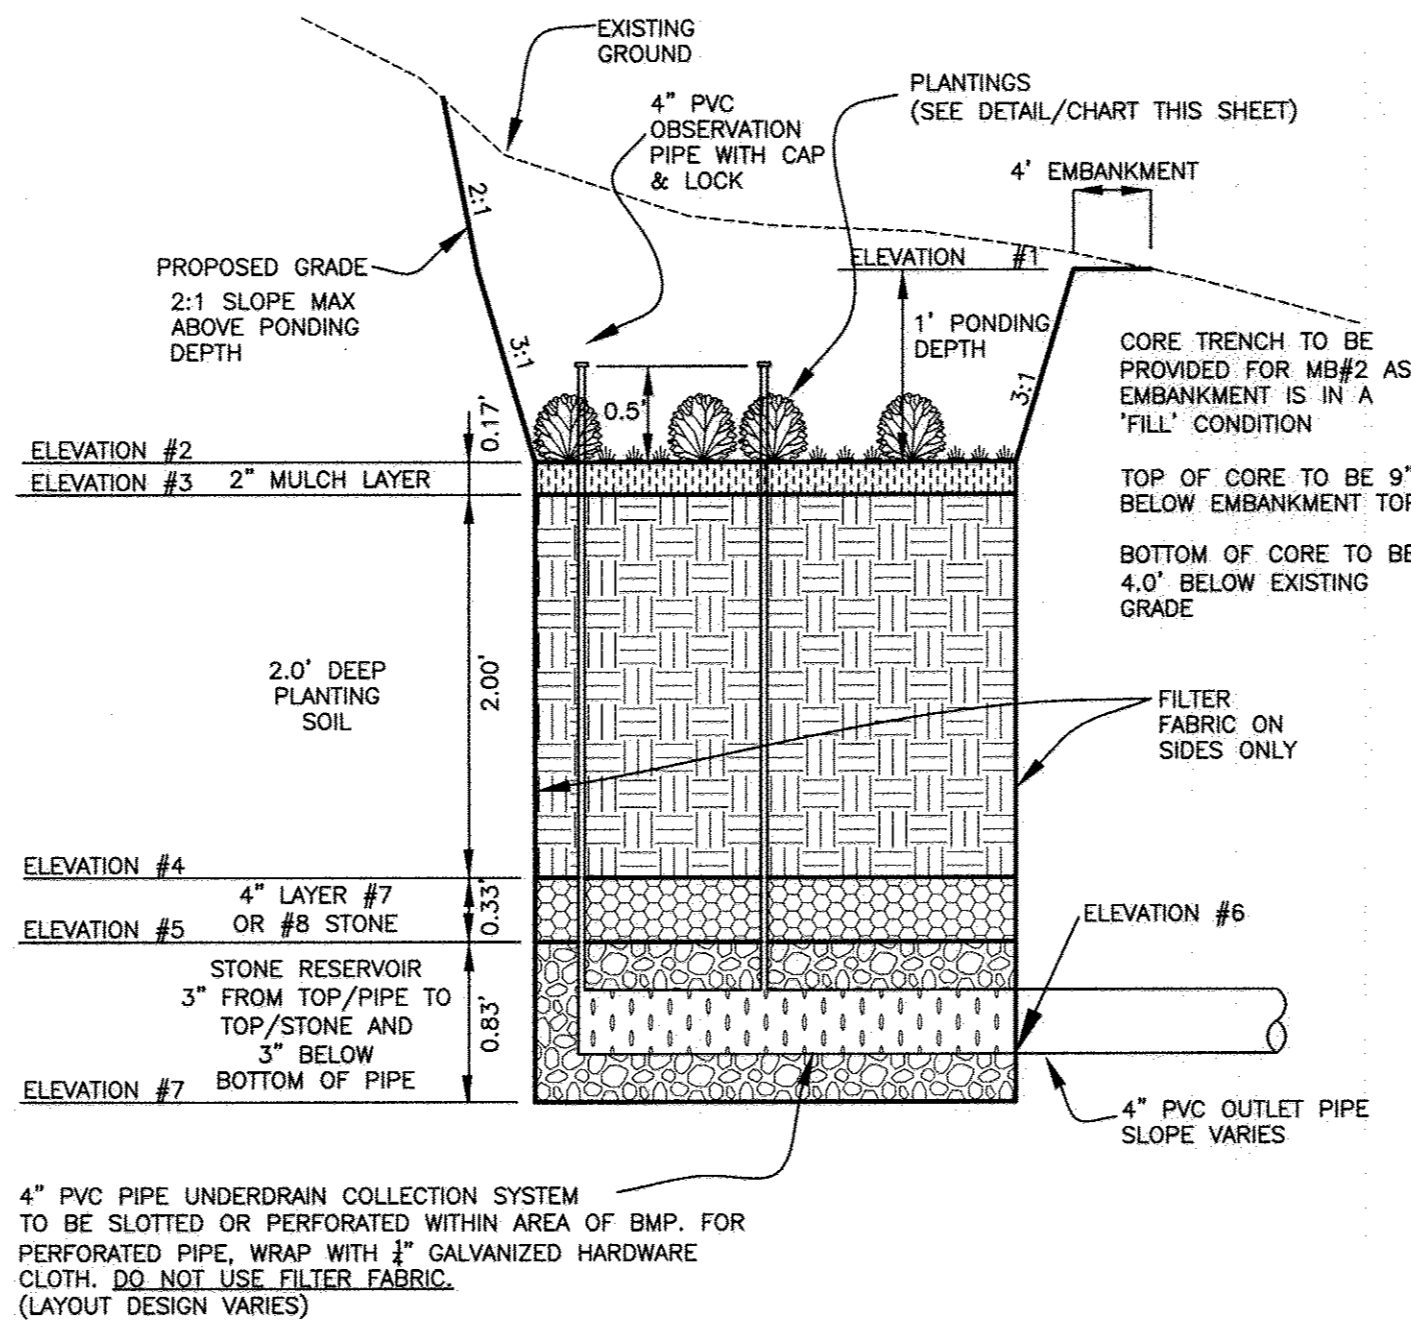

TYPICAL CROSS-SECTION THROUGH PRIVATE MICRO-BIORETENTIONS #1, #2, #3 AND #4

SCALE: 1"=10' HORZ., 1"=1' VERT.

NOTE: MICRO-BIORETENTION FACILITIES #1, #2, #3 & #4 WERE AS-BUILT AS PART OF THE CIVIL LOT GRADE CERTIFICATIONS

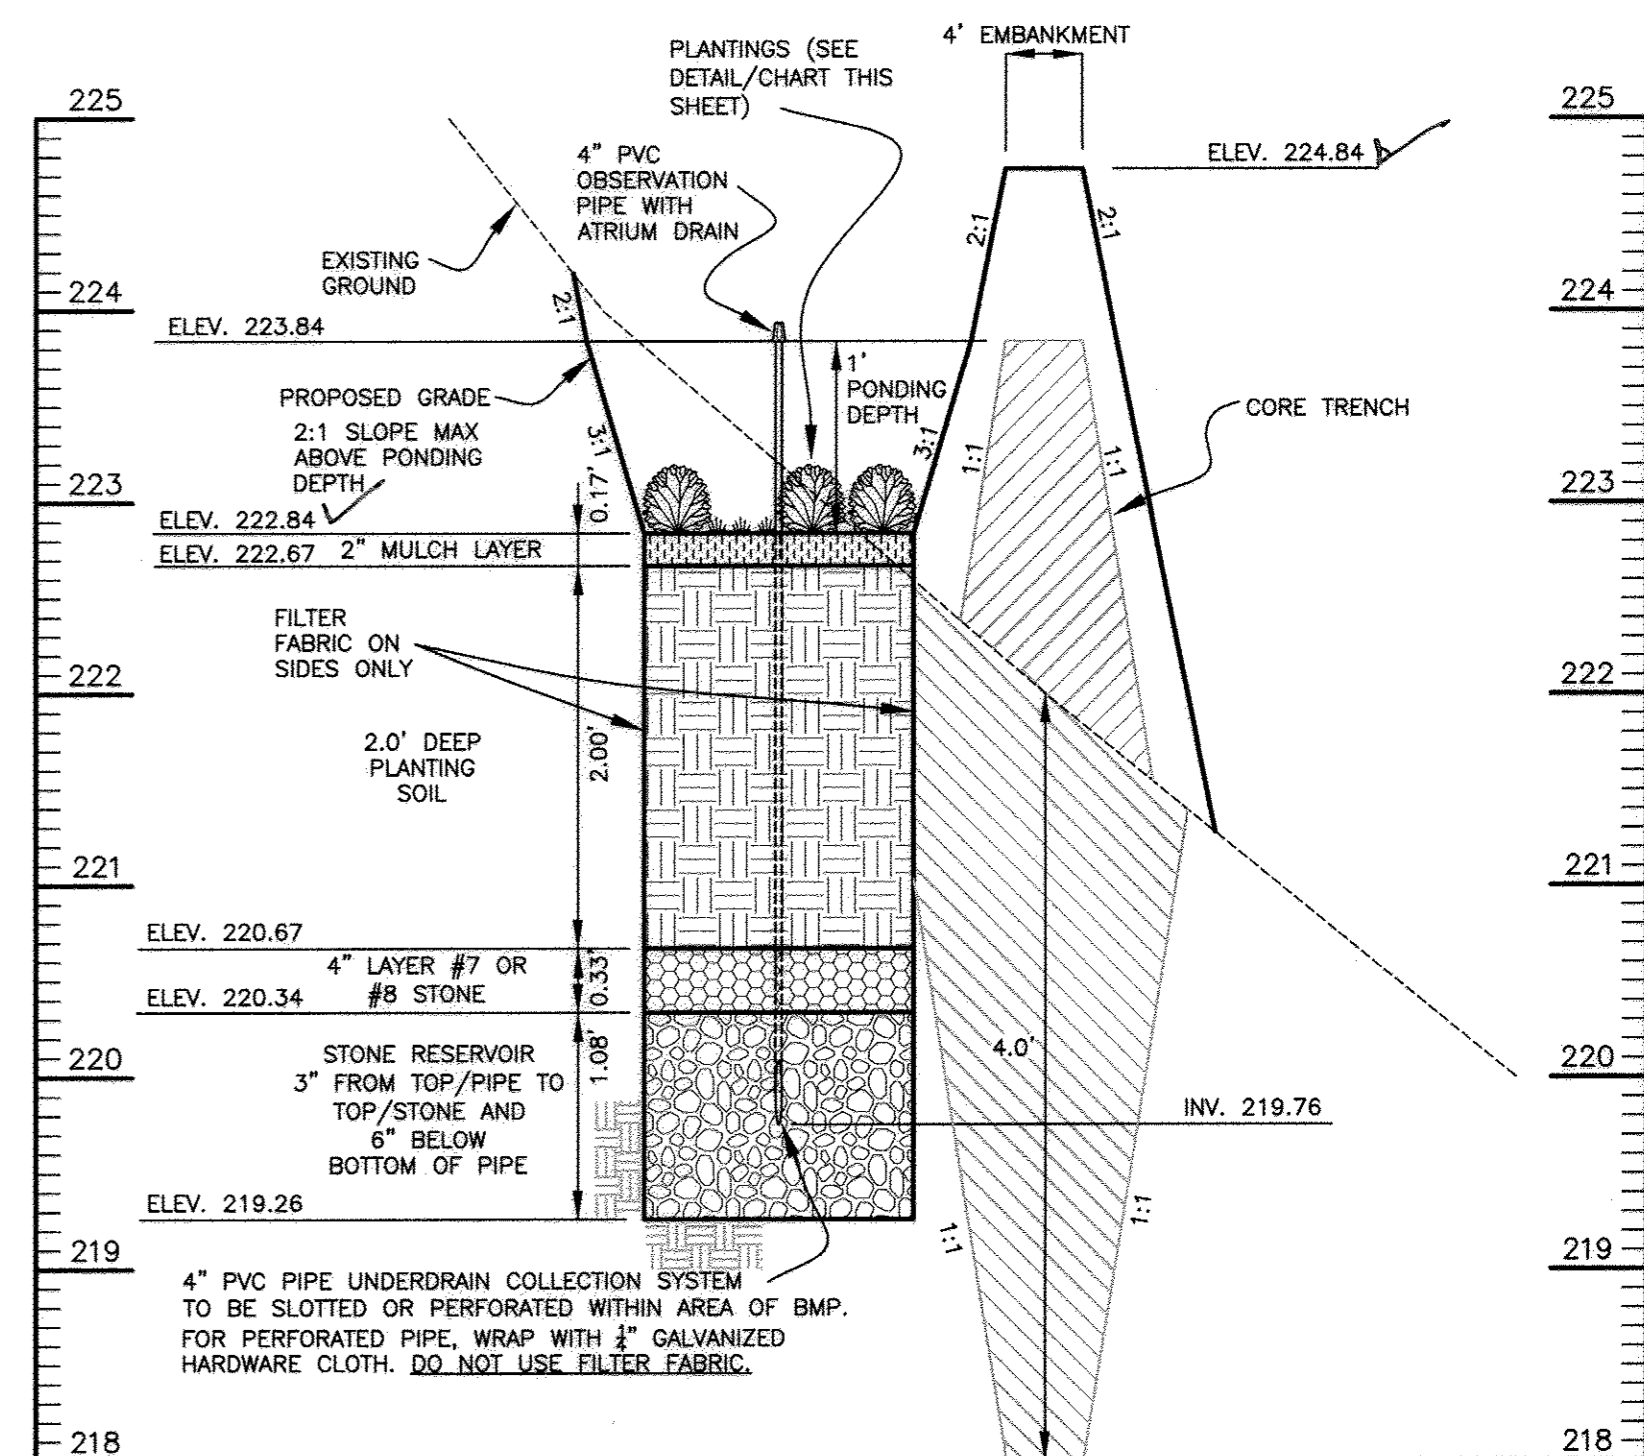

CROSS-SECTION A-A THROUGH PRIVATE MICRO-BIORETENTION #5

SCALE: 1"=10' HORZ., 1"=1' VERT.

AS-BUILT CERTIFICATION
I hereby certify, by my seal, that to the best of my knowledge and belief the facilities shown on this "AS-BUILT" Plan meet the Approved Plans and Specifications

Donald Mason, P.E.


Date: 6-19-17

Professional Certification. I hereby certify that these documents were prepared or approved by me, and that I am a duly licensed professional engineer under the laws of the State of Maryland.
License No. 21443, Expiration Date: 12-21-18



Facility square footage	MB #1	MB #2	MB #3	MB #4	MB #5	TOTAL
87	83	193	136	529	1028	
PLANT NAME	COMMON NAME	TYPE	SIZE	QUANTITY	QUANTITY	QUANTITY
Ilex verticillata	Common Winterberry	shrub	2.5'-3' ft	1	1	10
Lobelia cardinalis	Cardinal flower	perennial herbaceous plant	quart bulb	6	6	69
Lobelia siphilitica	Great Blue Lobelia	perennial herbaceous plant	quart bulb	6	6	69
Carex stricta	Upright Sedge	grass	quart bulb	6	6	69
Irish vesicolor	Blue Water Iris	perennial herbaceous plant	quart bulb	6	6	69
Liatis spicata	Prairie Gay Feather	perennial herbaceous plant	quart bulb	6	6	69

SYMBOL	NAME
①	LOBELIA CARDINALIS
②	LOBELIA SIPHILITICA
□	CAREX STRICTA
△	IRIS VERSICOLOR
○	LIATRIS SPICATA
●	ILEX VERTICILLATA

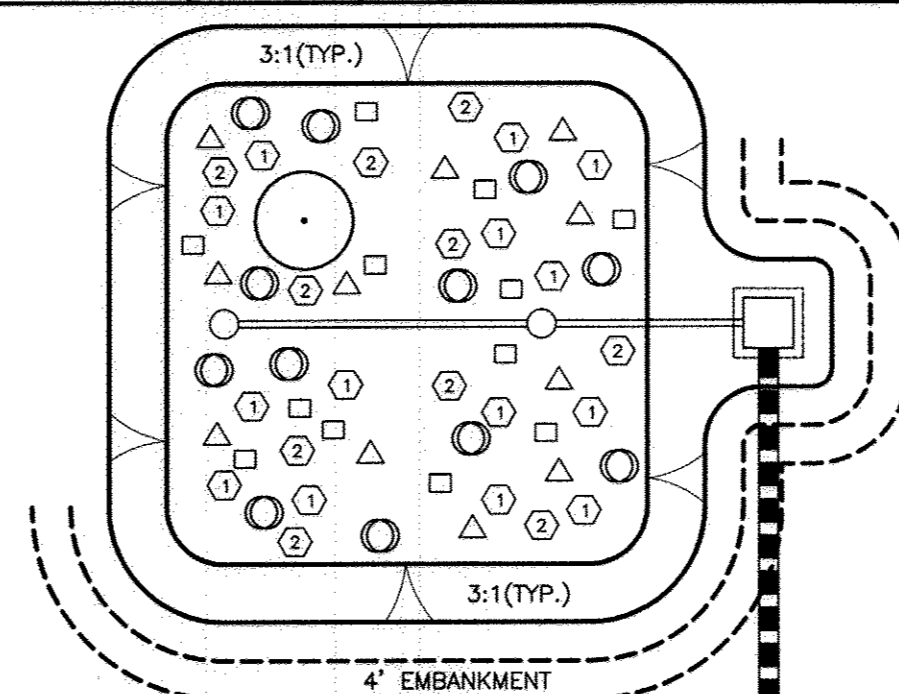

SCHEMATIC PLANTING DETAIL FOR (M-6) MICRO-BIORETENTION


NOT TO SCALE

NO.	DATE	REVISION
BENCHMARK ENGINEERING, INC. 8480 BALTIMORE NATIONAL PIKE & SUITE 315 & ELLICOTT CITY, MARYLAND 21043 (P) 410-465-6105 (F) 410-465-6644 WWW.BEI-CVLENGINEERING.COM		
OWNER: CORNERSTONE HOLDINGS LLC 9695 NORFOLK AVENUE LAUREL, MARYLAND 20793 410-792-2565		DEVELOPER: CORNERSTONE HOLDINGS LLC 9695 NORFOLK AVENUE LAUREL, MARYLAND 20793 410-792-2565
KNOX LANDING II LOTS 1 thru 5 AND OPEN SPACE LOTS 6 and 7		
TAX MAP: 50 GRID: 2 PARCEL: 75 & 528 ZONED: R-SC 9417 ALL SAINTS ROAD ELECTION DISTRICT NO. 6 HOWARD COUNTY, MARYLAND		
STORMWATER MANAGEMENT NOTES, CHART AND DETAILS		
DATE: DECEMBER, 2015	BEI PROJECT NO: 2586	
DESIGN: DBT	DRAWN: DBT	SCALE: AS SHOWN SHEET 3 OF 7

AS-BUILT

SDP-16-010

NRCS SOILS CHART - Map No. 28			
SYMBOL	HYDRIC	HYDROLOGIC GROUP	Kw erodibility Factor
Fa	YES	D	0.20
UcB		D	0.37

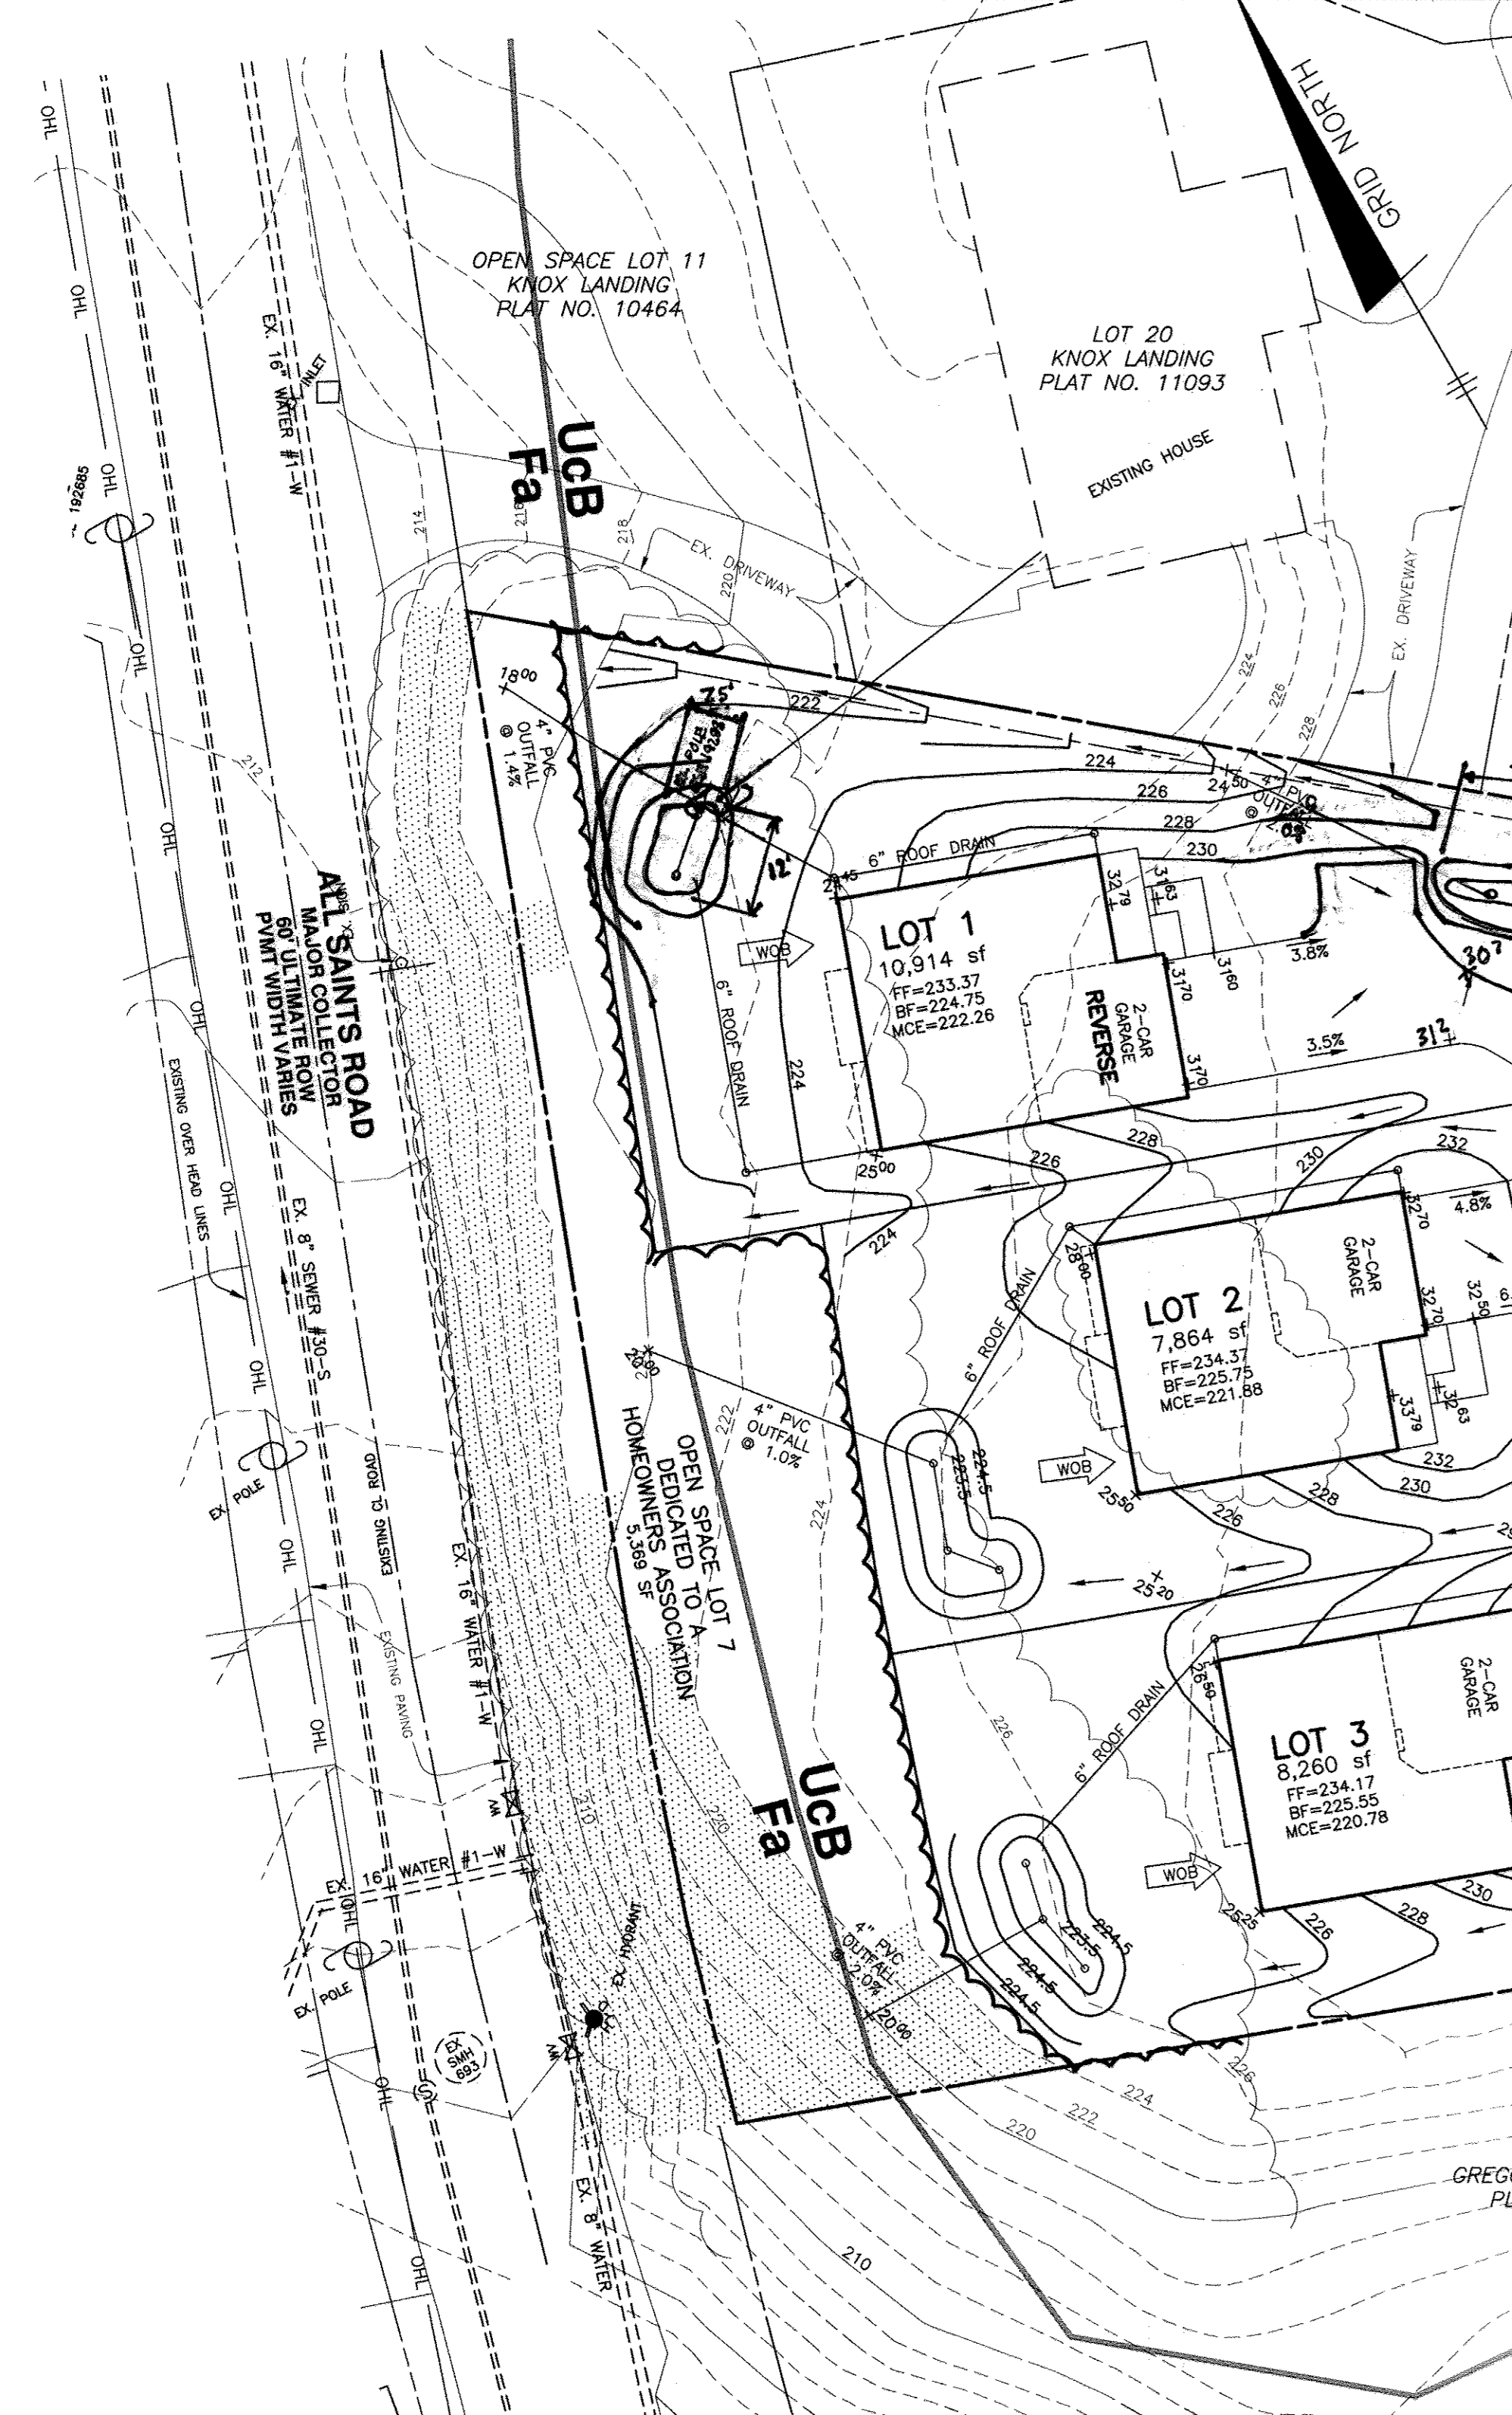


STRUCTURE TABLE									
STRUCTURE	TYPE	LOCATION	INVERT IN	INVERT OUT	TOP ELEV.	THROAT ELEV.	STD. DETAIL	MAINTENANCE	
INLETS									
I-1	S	N 526878.25 E 1353210.03	223.97 (6")	223.97	226.50	226.34	NA	HO.CO.STD. D-4.22	PRIVATE
I-2	S	N 526840.06 E 1353328.05	219.76 (4")	219.76	226.50	226.66	NA	HO.CO.STD. D-4.22	PRIVATE
MANHOLES									
M-1	4' DIA	N 526857.23 E 1353267.30	222.23	222.96	226.60	226.76		HO.CO.STD. G-5.12	PRIVATE
END SECTIONS									
E-1	12" HDPEP	N 526860.30 E 1353291.32			NA			NA	PRIVATE
E-2	12" HDPEP	N 526818.63 E 1353313.15			NA			NA	PRIVATE

STRUCTURE LOCATION FOR MANHOLES IS AT THE CENTER OF THE MANHOLE RIM.
 STRUCTURE LOCATION FOR 'S' INLETS IS AT THE CENTER OF THE GRATE.
 STRUCTURE LOCATION FOR END SECTIONS IS AT THE MIDPOINT OF THE END OF THE STRUCTURE.
 PRECAST STRUCTURES MEETING HS-20 LOADINGS MAY BE USED.


PIPE SCHEDULE			
SIZE	TYPE	LENGTH (L.F.)	MAINTENANCE
4"	PVC (MB outfall pipes)	128	PRIVATE
6"	PVC (roof manifold)	447	PRIVATE
12"	HDPEP	111	PRIVATE

All pipes shall have smooth interior. No interior corrugations.


STORM DRAIN DRAINAGE AREA CHART				
INLET #	ZONING (Z)	AREA (Ac) (A)	"C" FACTOR (C)<25	% IMPERVIOUS (P)<25
I-1	R-SC	0.10	0.36	65.0
I-2	R-SC	0.30	0.36	65.0

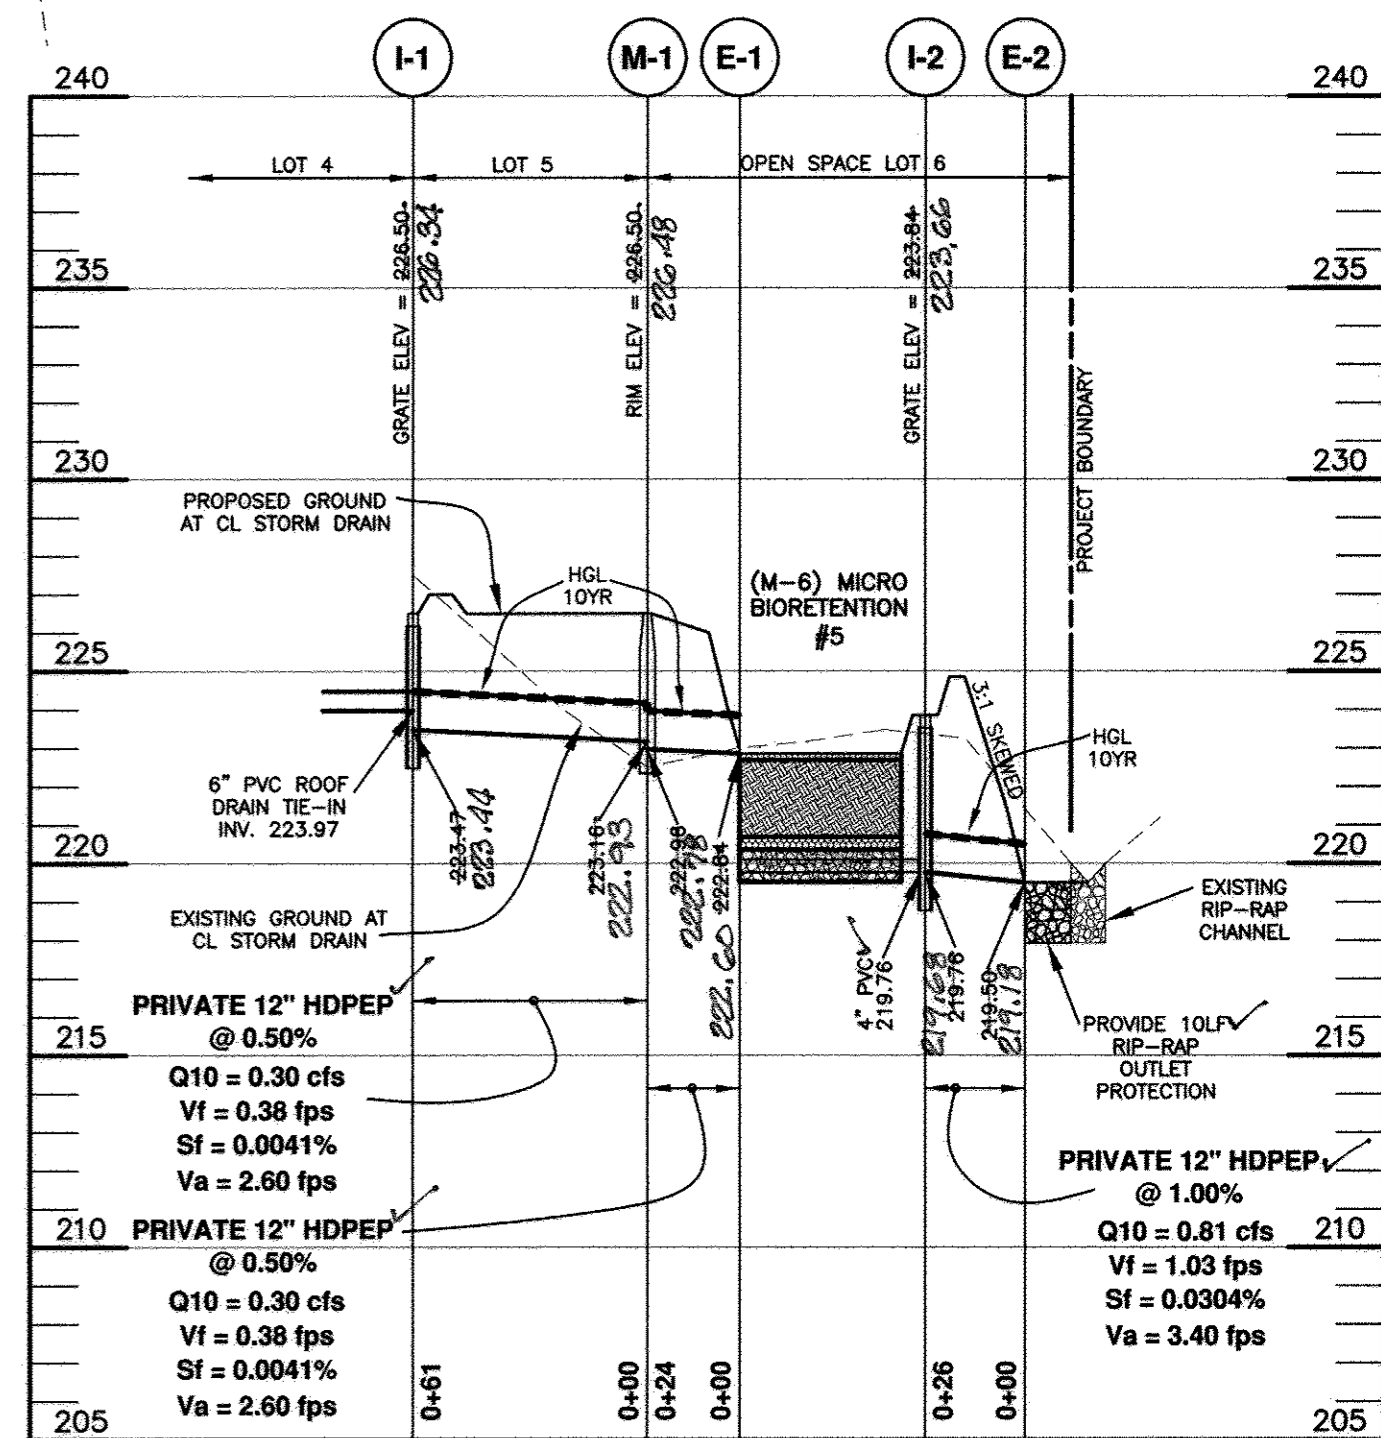

- CONSTRUCTION SPECIFICATIONS**
- THE SUBGRADE FOR THE FILTER, RIP-RAP, OR GABION SHALL BE PREPARED TO THE REQUIRED LINES AND GRADES. ANY FILL REQUIRED IN THE SUBGRADE SHALL BE COMPACTED TO A DENSITY OF APPROXIMATELY THAT OF THE SURROUNDING UNDISTURBED MATERIAL.
 - THE ROCK OR GRAVEL SHALL CONFORM TO THE SPECIFIED GRADING LIMITS WHEN INSTALLED RESPECTIVELY IN THE RIP-RAP OR FILTER.
 - GEOTEXTILE CLASS C28 OR BETTER SHALL BE PROTECTED FROM PUNCHING, CUTTING, OR TEARING. ANY DAMAGE OTHER THAN AN OCCASIONAL SMALL HOLE SHALL BE REPAIRED BY PLACING ANOTHER PIECE OF GEOTEXTILE FABRIC OVER THE DAMAGED PART OR BY COMPLETELY REPLACING THE GEOTEXTILE FABRIC. ALL OVERLAPS WHETHER FOR REPAIRS OR FOR JOINING TWO PIECES OF GEOTEXTILE FABRIC SHALL BE A MINIMUM OF ONE FOOT.
 - STONE FOR THE RIP-RAP OR GABION OUTLETS MAY BE PLACED BY EQUIPMENT. THEY SHALL BE CONSTRUCTED TO THE FULL COURSE THICKNESS IN ONE OPERATION AND IN SUCH A MANNER AS TO AVOID DISPLACEMENT OF UNDERLYING MATERIALS. THE STONE FOR THE RIP-RAP OR GABION OUTLETS SHALL BE DELIVERED AND PLACED IN A MANNER THAT WILL ENSURE THAT IT IS REASONABLY HOMOGENEOUS WITH THE SMALLER STONES AND SPALLS FILLING THE VOIDS BETWEEN THE LARGER STONES. RIP-RAP SHALL BE PLACED IN A MANNER TO PREVENT DAMAGE TO THE FILTER BLANKET OR GEOTEXTILE FABRIC. HAND PLACEMENT WILL BE REQUIRED TO THE EXTENT NECESSARY TO PREVENT DAMAGE TO THE PERMANENT WORKS.
 - THE STONE SHALL BE PLACED SO THAT IT BLENDS IN WITH THE EXISTING GROUND. IF THE STONE IS PLACED TOO HIGH THEN THE FLOW WILL BE FORCED OUT OF THE CHANNEL AND SCOUR ADJACENT TO THE STONE WILL OCCUR.

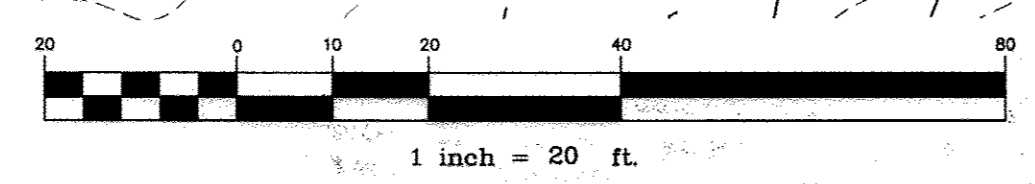

- LEGEND**
- EXISTING CONTOURS
 - STEEP SLOPES
 - EXISTING TREELINE
 - PROPOSED TREELINE
 - PROJECT BOUNDARY LINE
 - DRAINAGE DIVIDE
 - SOILS CLASSIFICATION
 - SOILS DELINEATION

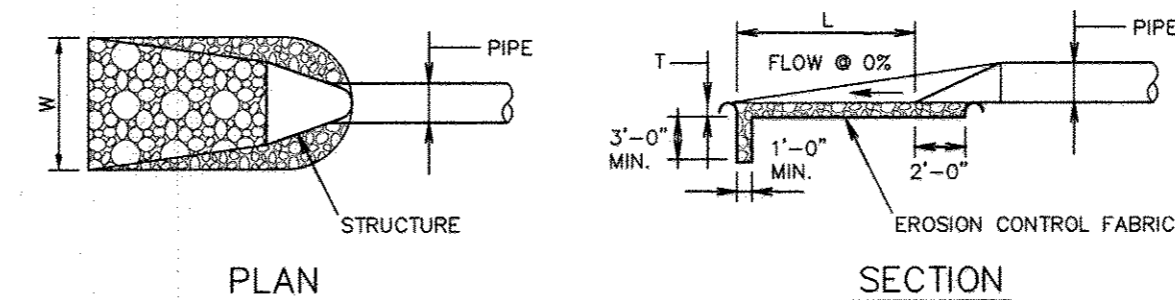

STRUCTURE	V10 (fps)	d10 (ft)	d50	LENGTH(L)	WIDTH(W)	THICK.(T)	SHA CLASS
E-1	3.32	0.17	9.5"	5'	5'	19"	1
E-2	5.26	0.25	9.5"	10'	10'	19"	1

OUTLET PROTECTION DETAIL
NOT TO SCALE

APPROVED: HOWARD COUNTY DEPARTMENT OF PLANNING AND ZONING

Chad E. ... 2-3-16
CHIEF, DEVELOPMENT ENGINEERING DIVISION

Kate ... 2-12-16
CHIEF, DIVISION OF LAND DEVELOPMENT

Val ... 2-16-16
DIRECTOR

AS-BUILT CERTIFICATION
I hereby certify, by my seal, that to the best of my knowledge and belief the facilities shown on this "AS-BUILT" Plan meet the Approved Plans and Specifications

Donald Mason, P.E. Date: 6-19-17

Professional Certification. I hereby certify that these documents were prepared or approved by me, and that I am a duly licensed professional engineer under the laws of the State of Maryland.

License No. 21443 Expiration Date: 12-31-18



NO. 5-5-2017 REVISE MB#1 AND #2 CONFIGURATIONS ON LOT 1 PER AS-BUILT CONDITIONS



BENCHMARK ENGINEERING, INC.
8480 BALTIMORE NATIONAL PIKE & SUITE 315 & ELLICOTT CITY, MARYLAND 21043
(P) 410-485-8105 (F) 410-485-8844
WWW.BE-ENGINEERING.COM

KNOX LANDING II
LOTS 1 thru 5 AND OPEN SPACE LOTS 6 and 7

TAX MAP: 50 GRID: 2 PARCEL: 75 & 528 ZONED: R-SC
9417 ALL SAINTS ROAD ELECTION DISTRICT NO. 6 HOWARD COUNTY, MARYLAND

STORM DRAIN DRAINAGE MAP, PROFILES & DETAILS

DATE: DECEMBER, 2015 BEI PROJECT NO: 2586
SCALE: AS SHOWN SHEET 4 OF 7

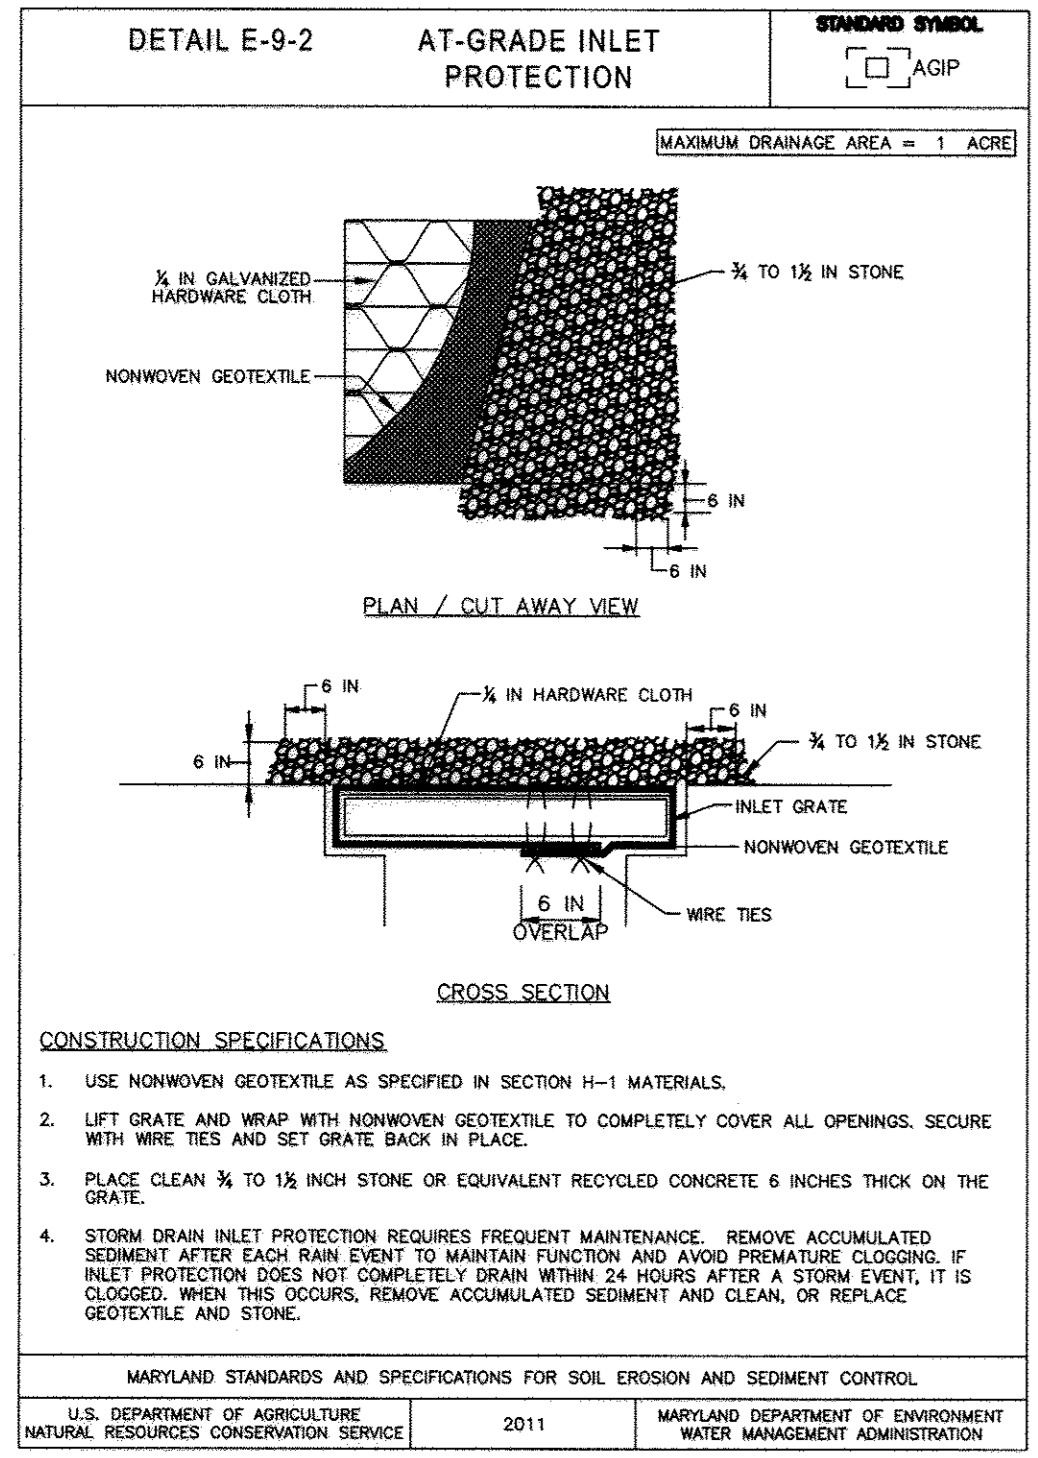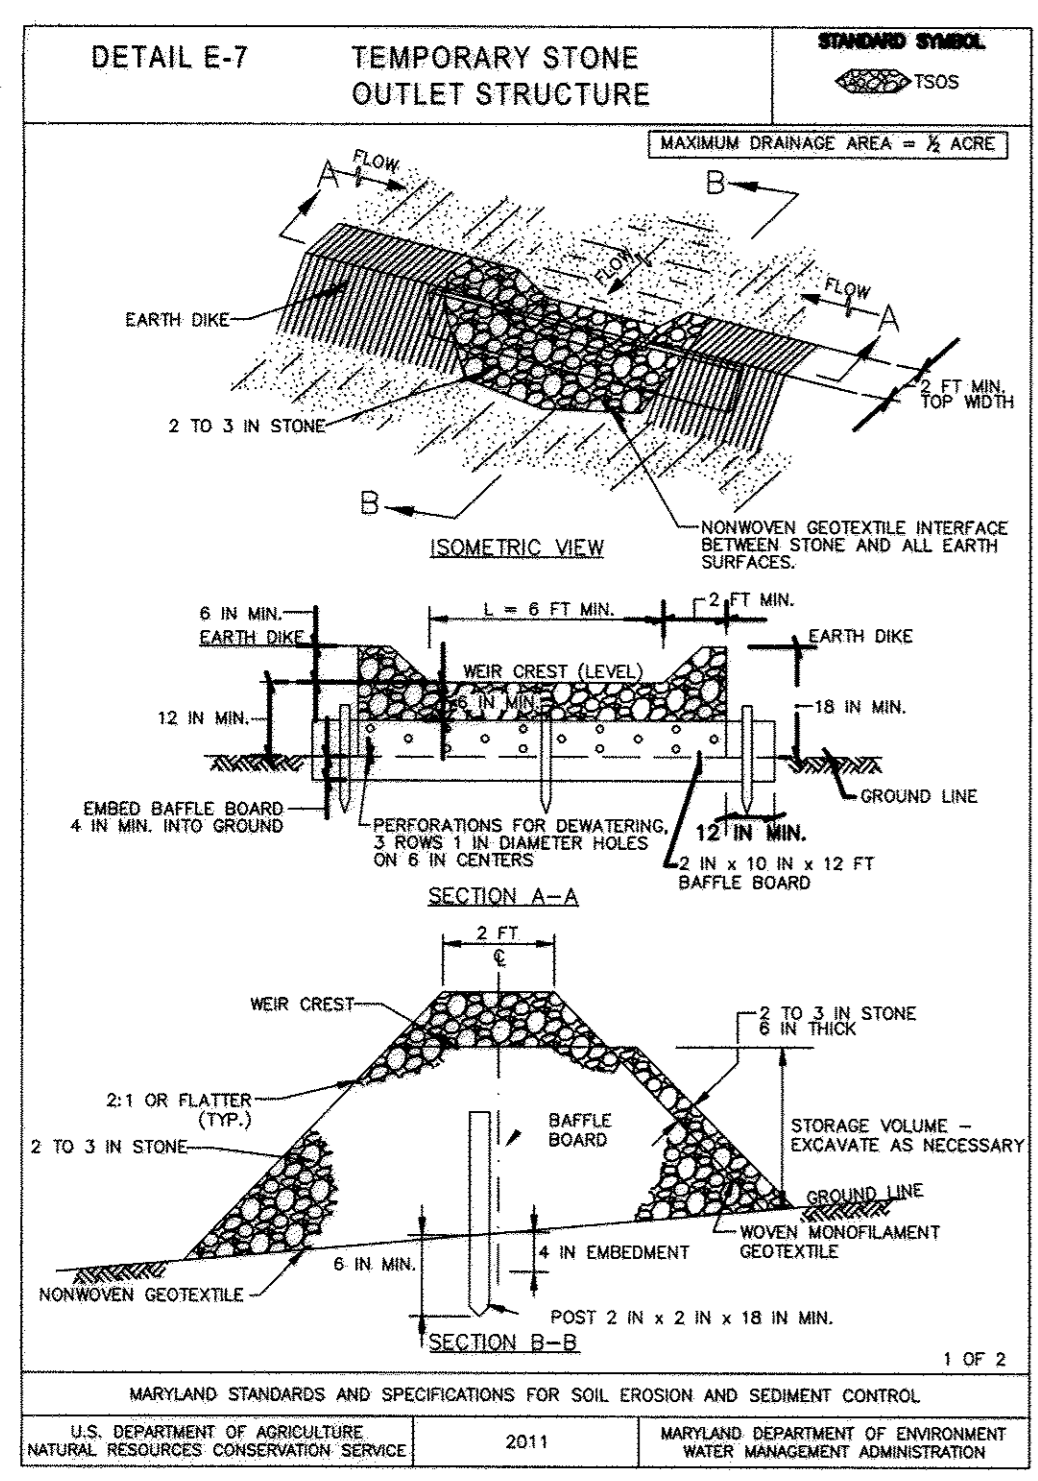

ENGINEER'S CERTIFICATE

I CERTIFY THAT THIS PLAN FOR SEDIMENT AND EROSION CONTROL REPRESENTS A PRACTICAL AND WORKABLE PLAN BASED ON MY PERSONAL KNOWLEDGE OF THE SITE CONDITIONS AND THAT IT WAS PREPARED IN ACCORDANCE WITH THE REQUIREMENTS OF THE HOWARD SOIL CONSERVATION DISTRICT.

Cl Malagan 12-17-16
ENGINEER DATE

DEVELOPER'S CERTIFICATE

I/WE CERTIFY THAT ALL DEVELOPMENT AND CONSTRUCTION WILL BE DONE ACCORDING TO THIS PLAN FOR SEDIMENT AND EROSION CONTROL, AND THAT ALL RESPONSIBLE PERSONNEL INVOLVED IN THE CONSTRUCTION PROJECT WILL HAVE A CERTIFICATE OF ATTENDANCE AT A DEPARTMENT OF THE ENVIRONMENT APPROVED TRAINING PROGRAM FOR THE CONTROL OF SEDIMENT AND EROSION BEFORE BEGINNING THE PROJECT. I ALSO AUTHORIZE PERIODIC ON-SITE INSPECTION BY THE HOWARD SOIL CONSERVATION DISTRICT.

B. D. By 12/16/15
DEVELOPER DATE


APPROVED: HOWARD COUNTY DEPARTMENT OF PLANNING AND ZONING

John R. Blanton 1/6/16
HOWARD SOIL CONSERVATION DISTRICT DATE

Chris Parker 2-3-16
CHIEF, DEVELOPMENT ENGINEERING DIVISION DATE



W. H. ... 2-16-16
CHIEF, DIVISION OF LAND DEVELOPMENT DATE

V. M. ... 2-16-16
DIRECTOR DATE

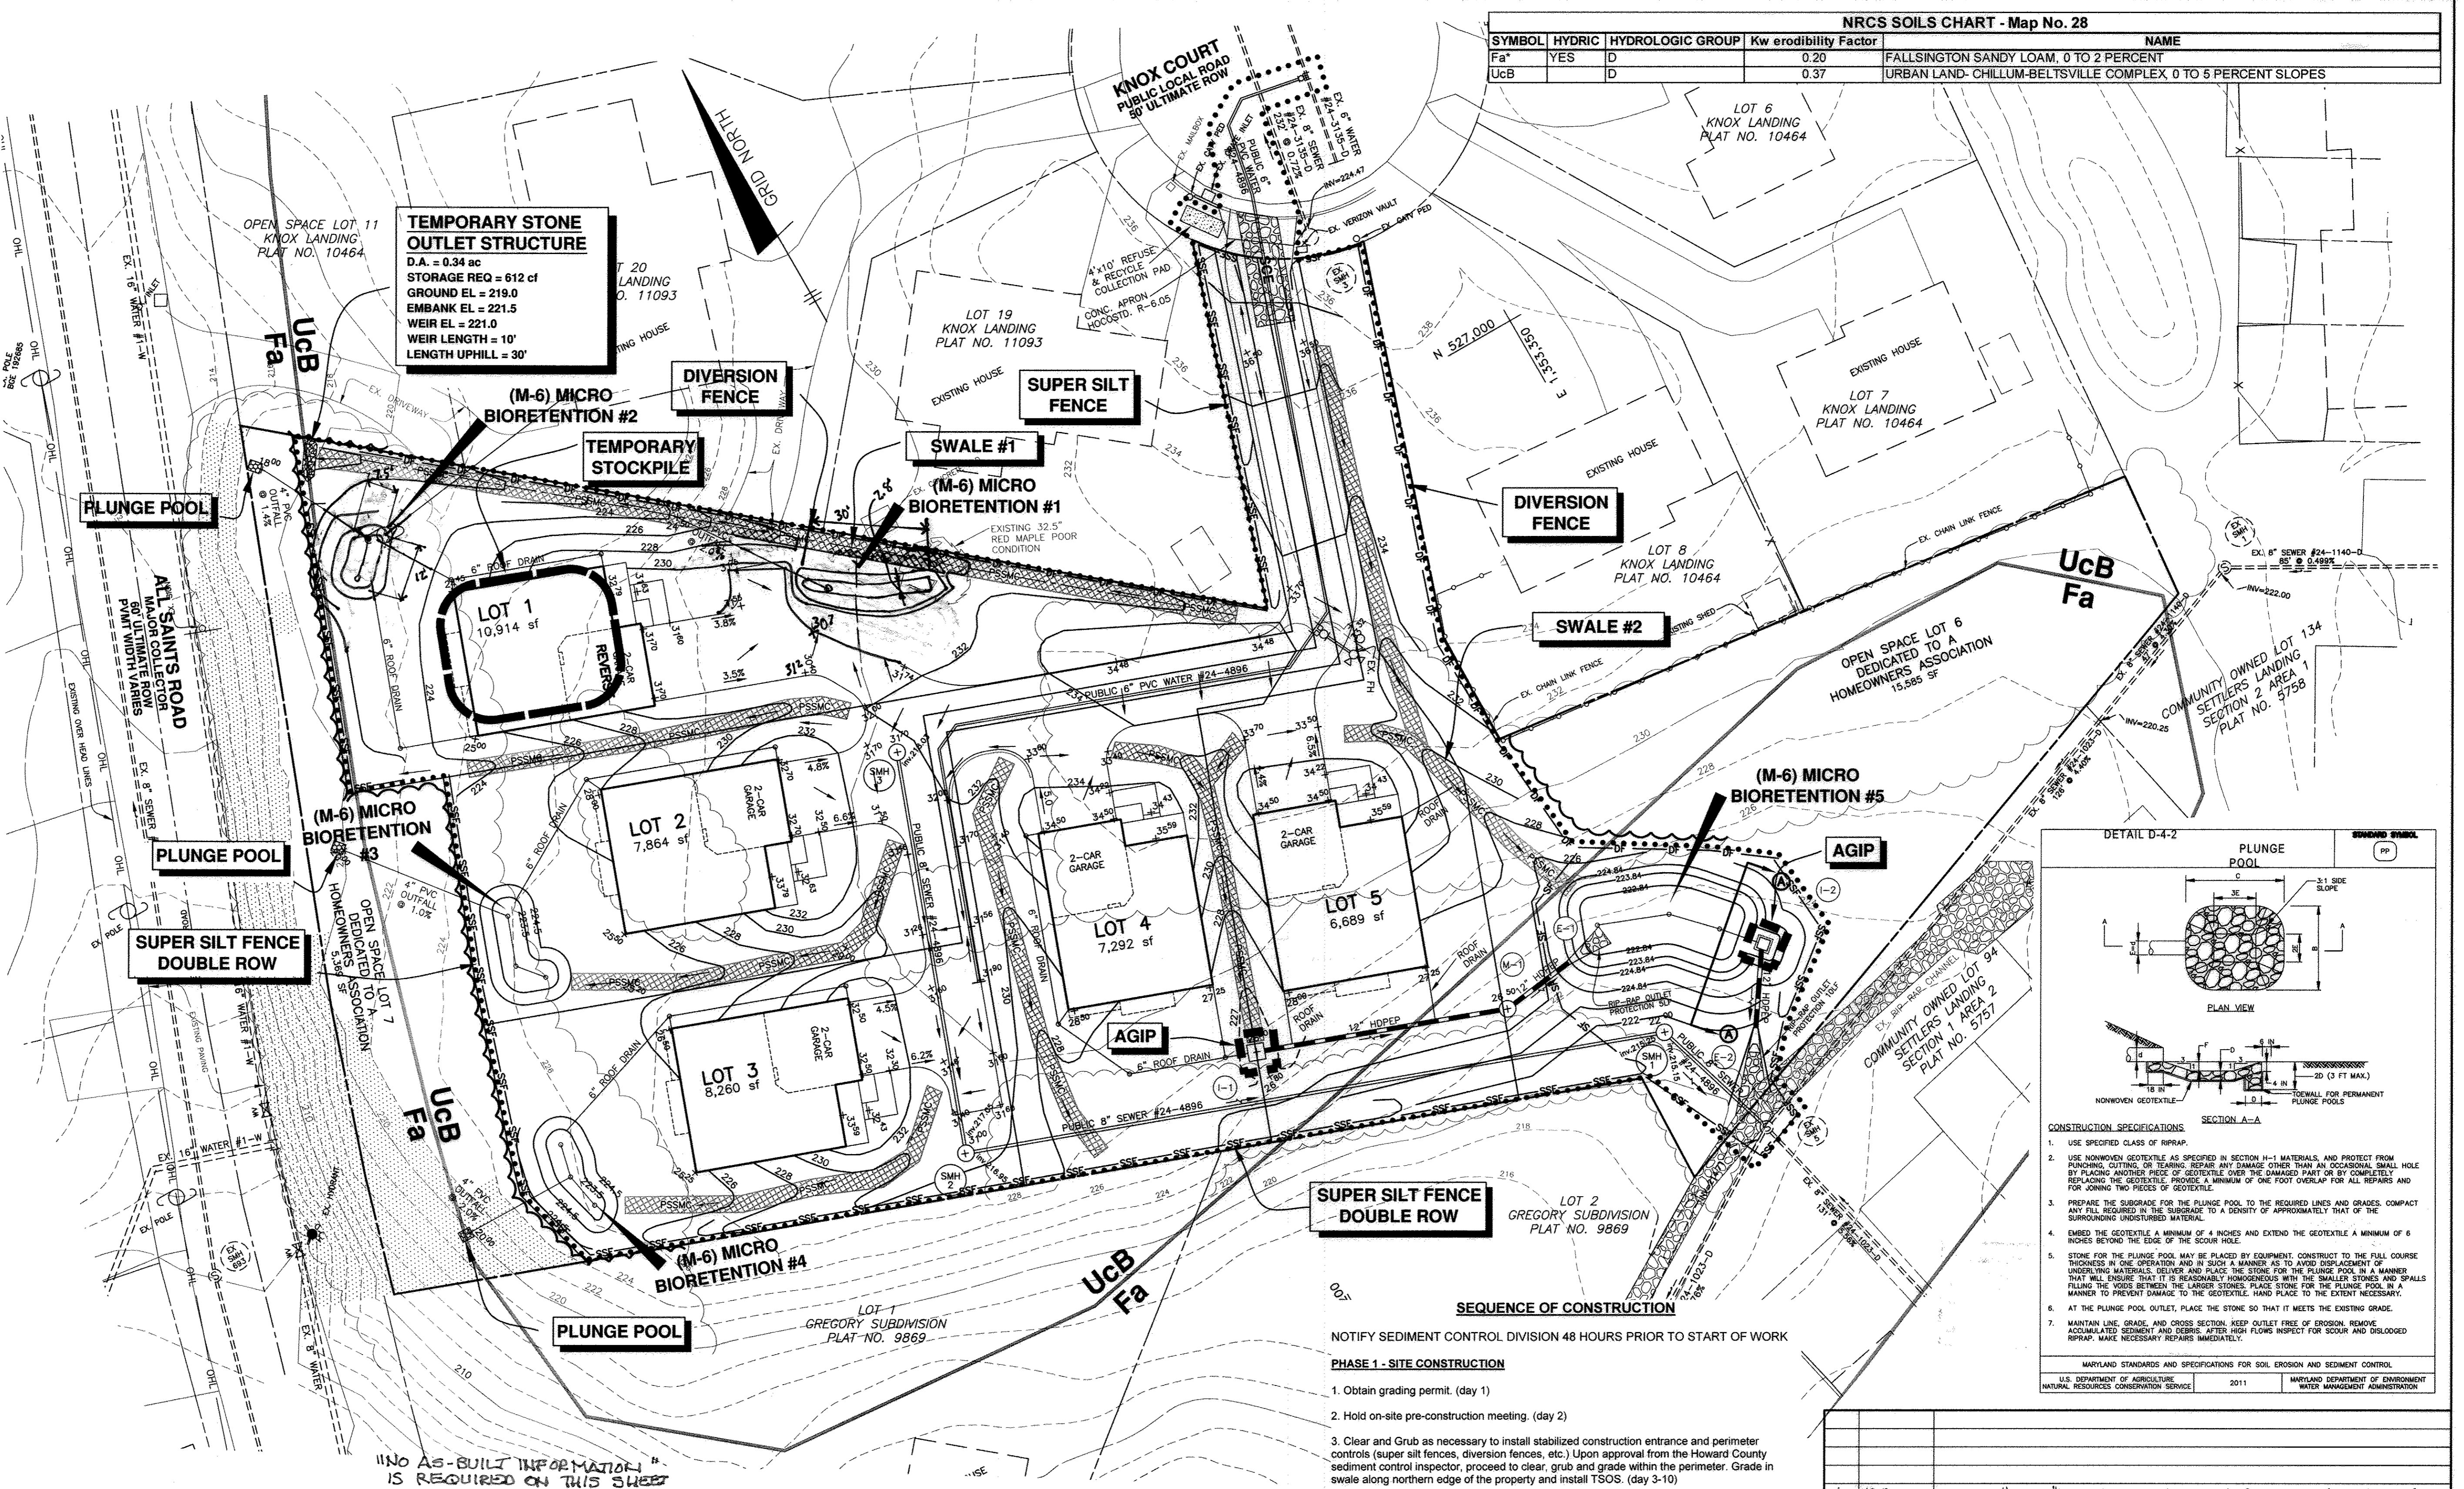

NRCS SOILS CHART - Map No. 28


SYMBOL	HYDRIC	HYDROLOGIC GROUP	Kw erodibility Factor	NAME
Fa*	YES	D	0.20	FALLSINGTON SANDY LOAM, 0 TO 2 PERCENT
UcB	YES	D	0.37	URBAN LAND- CHILLUM-BELTSVILLE COMPLEX 0 TO 5 PERCENT SLOPES

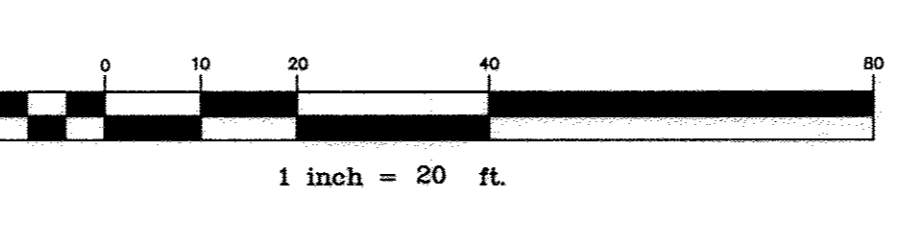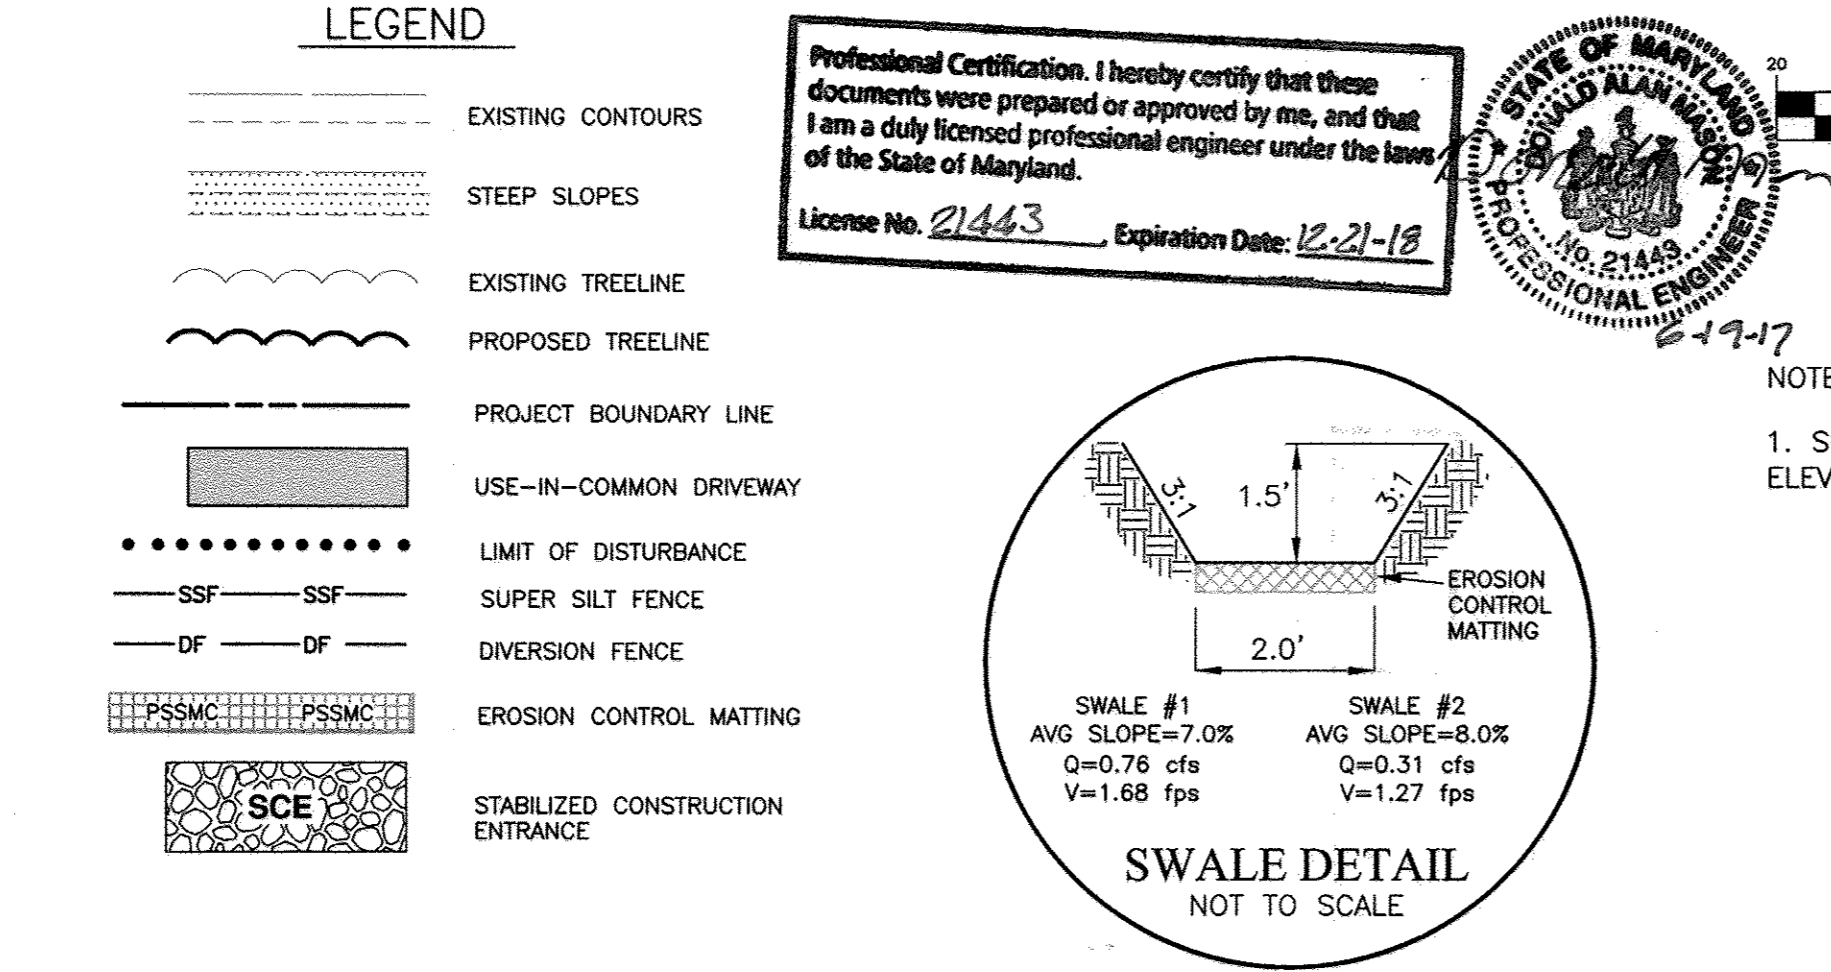

NOTES:






- SUPER SILT FENCING TO BE CURLED UPHILL EVERY 6 FEET IN ELEVATION FORMING A 'J' SHAPE WHERE FENCING RUNS DOWNHILL.

THIS PLAN IS FOR SEDIMENT AND EROSION CONTROL ONLY

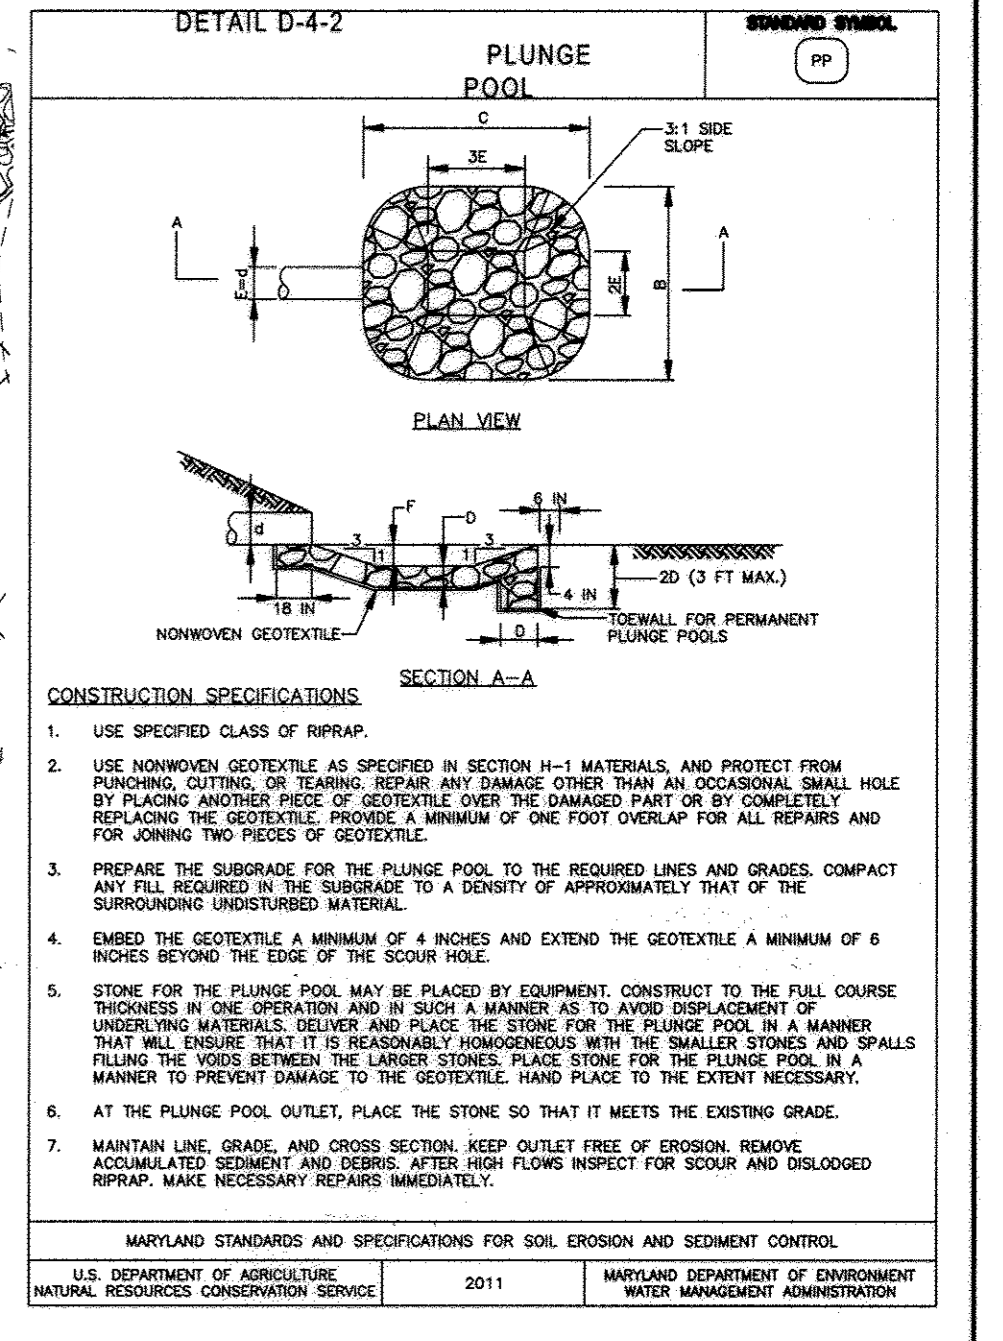


<p>1 5-5-2017 REVISE MB#1 AND #2 CONFIGURATIONS ON LOT 1 PER AS-BUILT CONDITIONS</p>	
NO.	DATE
<p>REVISION</p>	
<p>BENCHMARK ENGINEERING, INC. ENGINEERS & LAND SURVEYORS & PLANNERS 8480 BALTIMORE NATIONAL PIKE & SUITE 315 & ELLICOTT CITY, MARYLAND 21043 (P) 410-465-6105 (F) 410-465-6844 WWW.BEI-CVLENGINEERING.COM</p>	
<p>OWNER: CORNERSTONE HOLDINGS LLC 9695 NORFOLK AVENUE LAUREL, MARYLAND 20793 410-792-2565</p>	
<p>DEVELOPER: CORNERSTONE HOLDINGS LLC 9695 NORFOLK AVENUE LAUREL, MARYLAND 20793 410-792-2565</p>	
<p>KNOX LANDING II LOTS 1 thru 5 AND OPEN SPACE LOTS 6 and 7</p>	
<p>TAX MAP: 50 GRID: 2 PARCEL: 75 & 528 ZONED: R-5C ELECTION DISTRICT NO. 6 HOWARD COUNTY, MARYLAND</p>	
<p>SEDIMENT & EROSION CONTROL PLAN</p>	
DATE: DECEMBER, 2015	BEI PROJECT NO: 2586
DESIGN: DBT	DRAWN: DBT
SCALE: AS SHOWN	SHEET 5 OF 7

AS-BUILT SDP-16-010

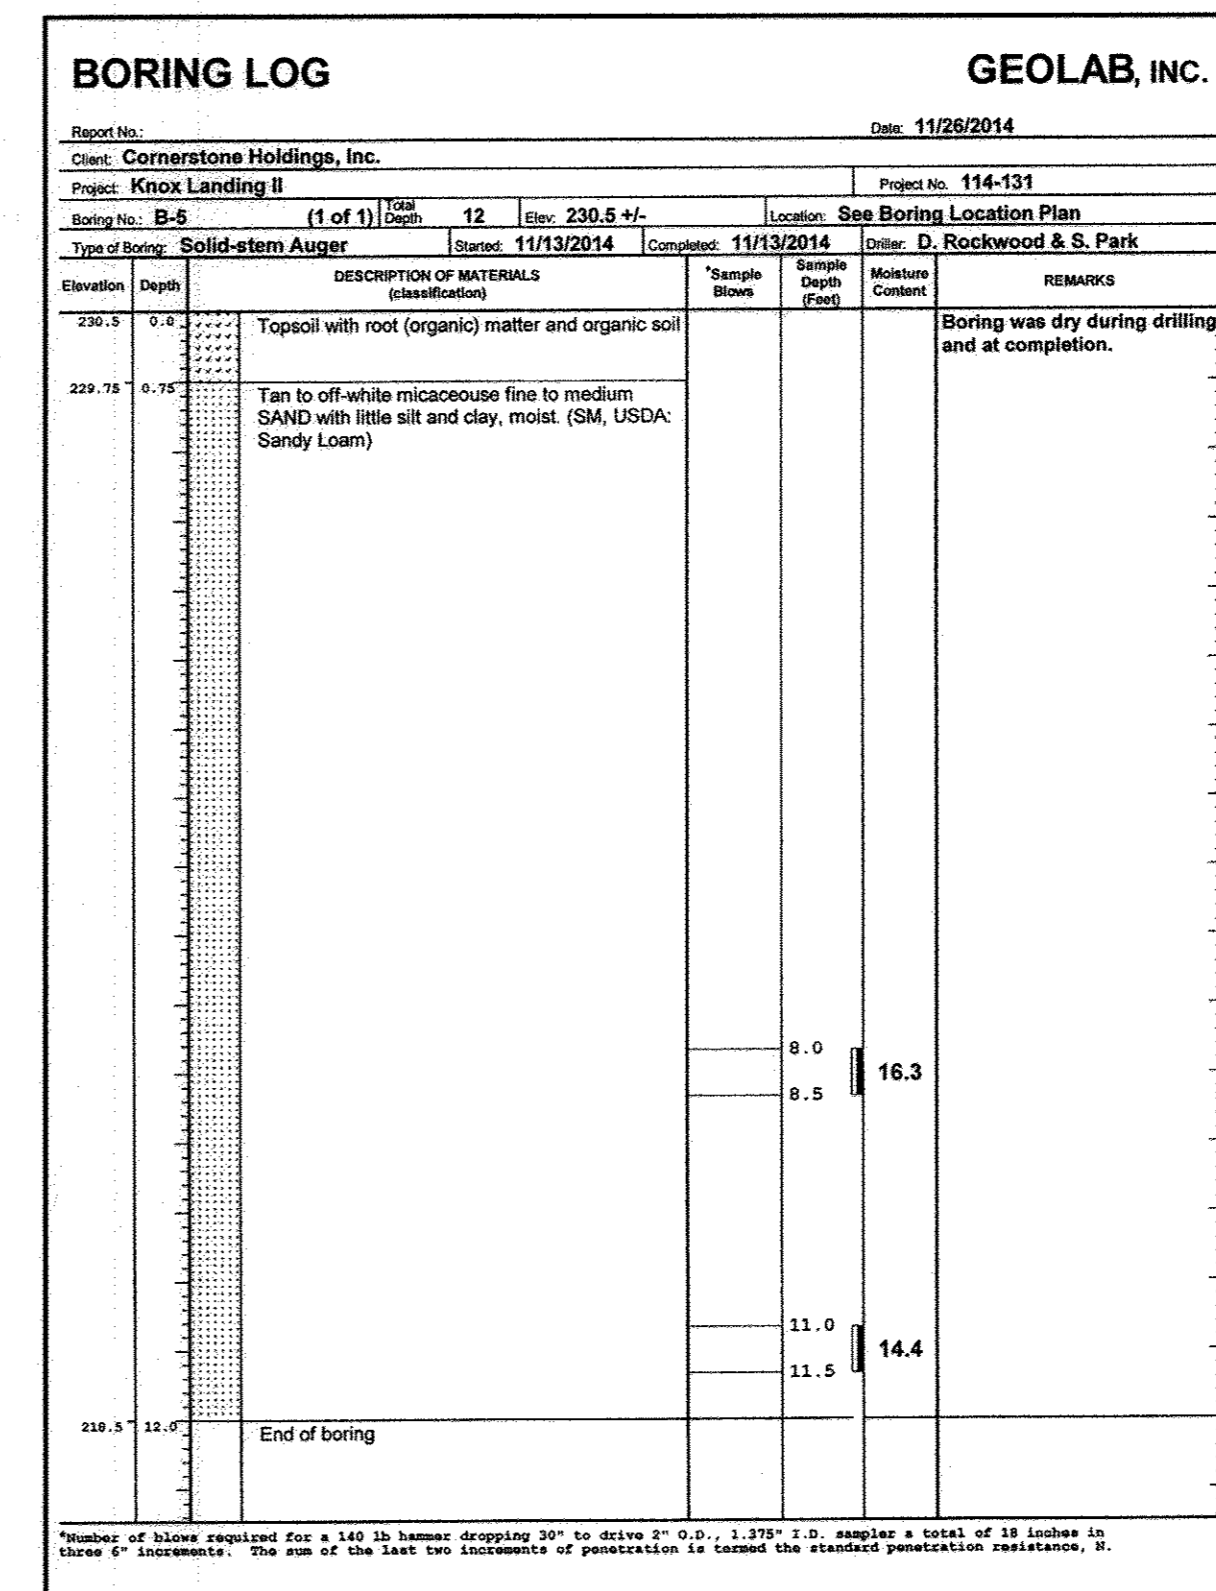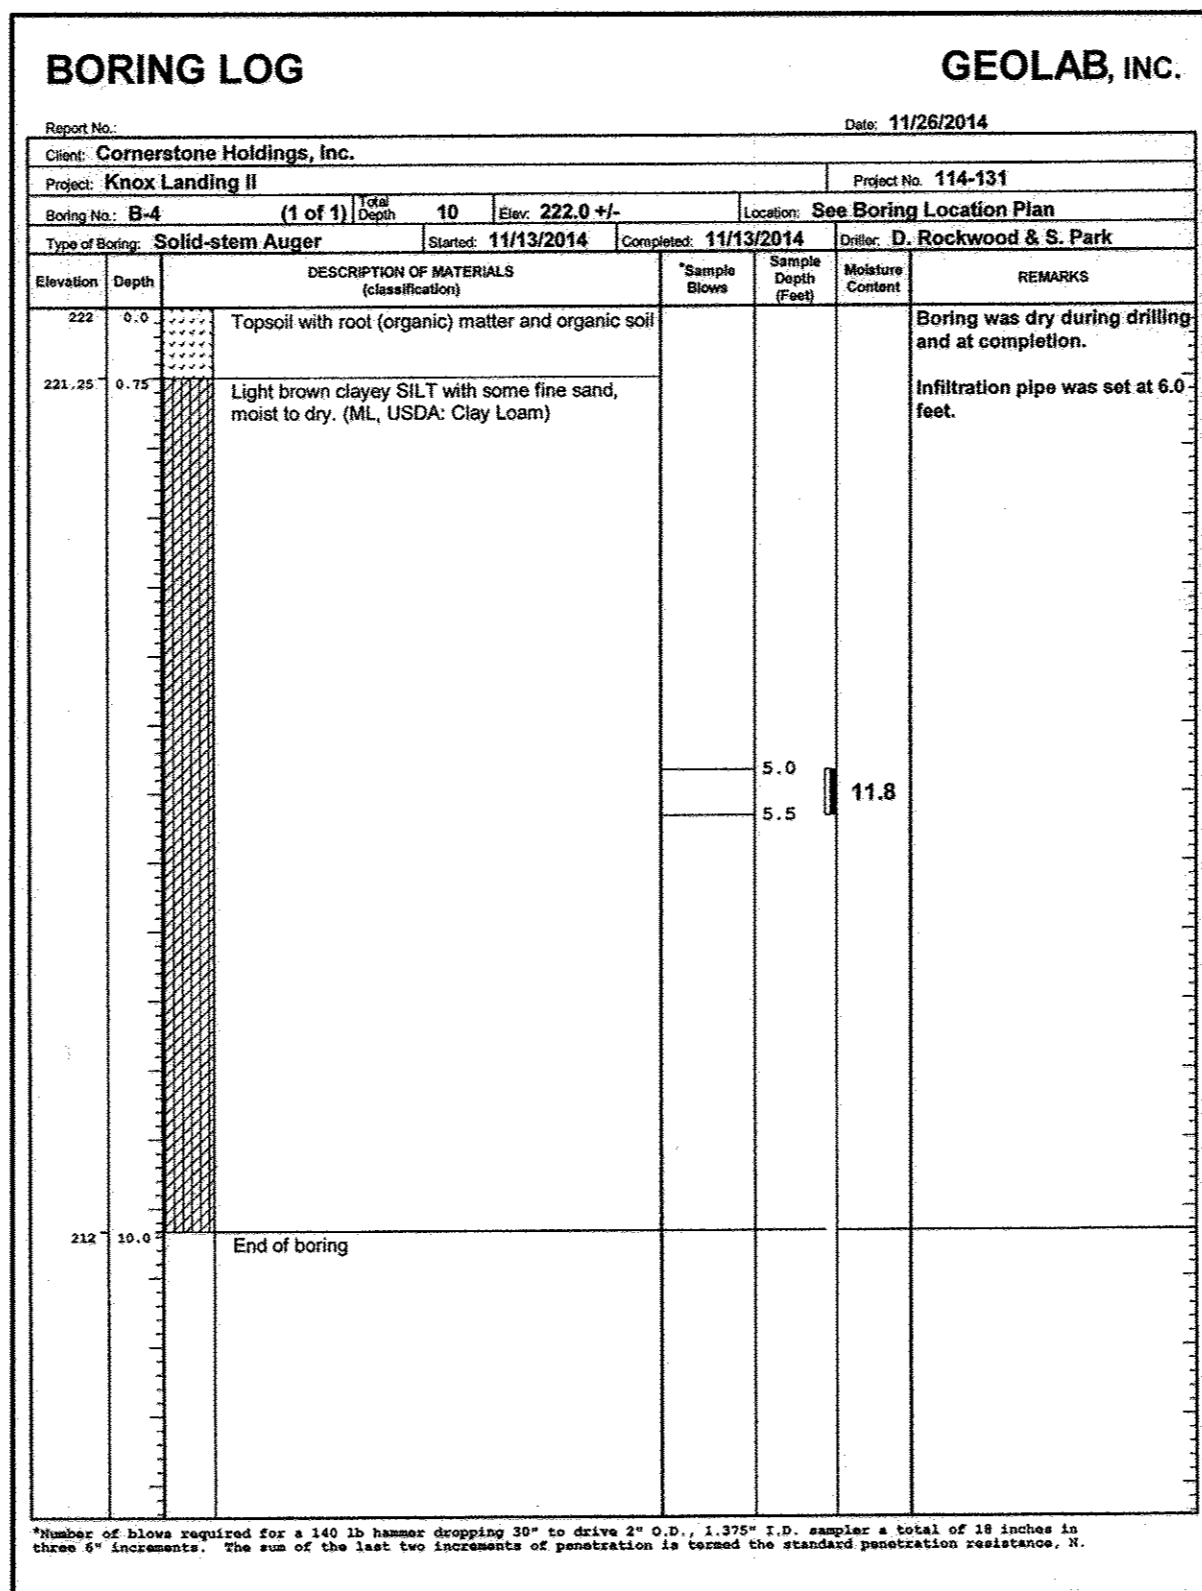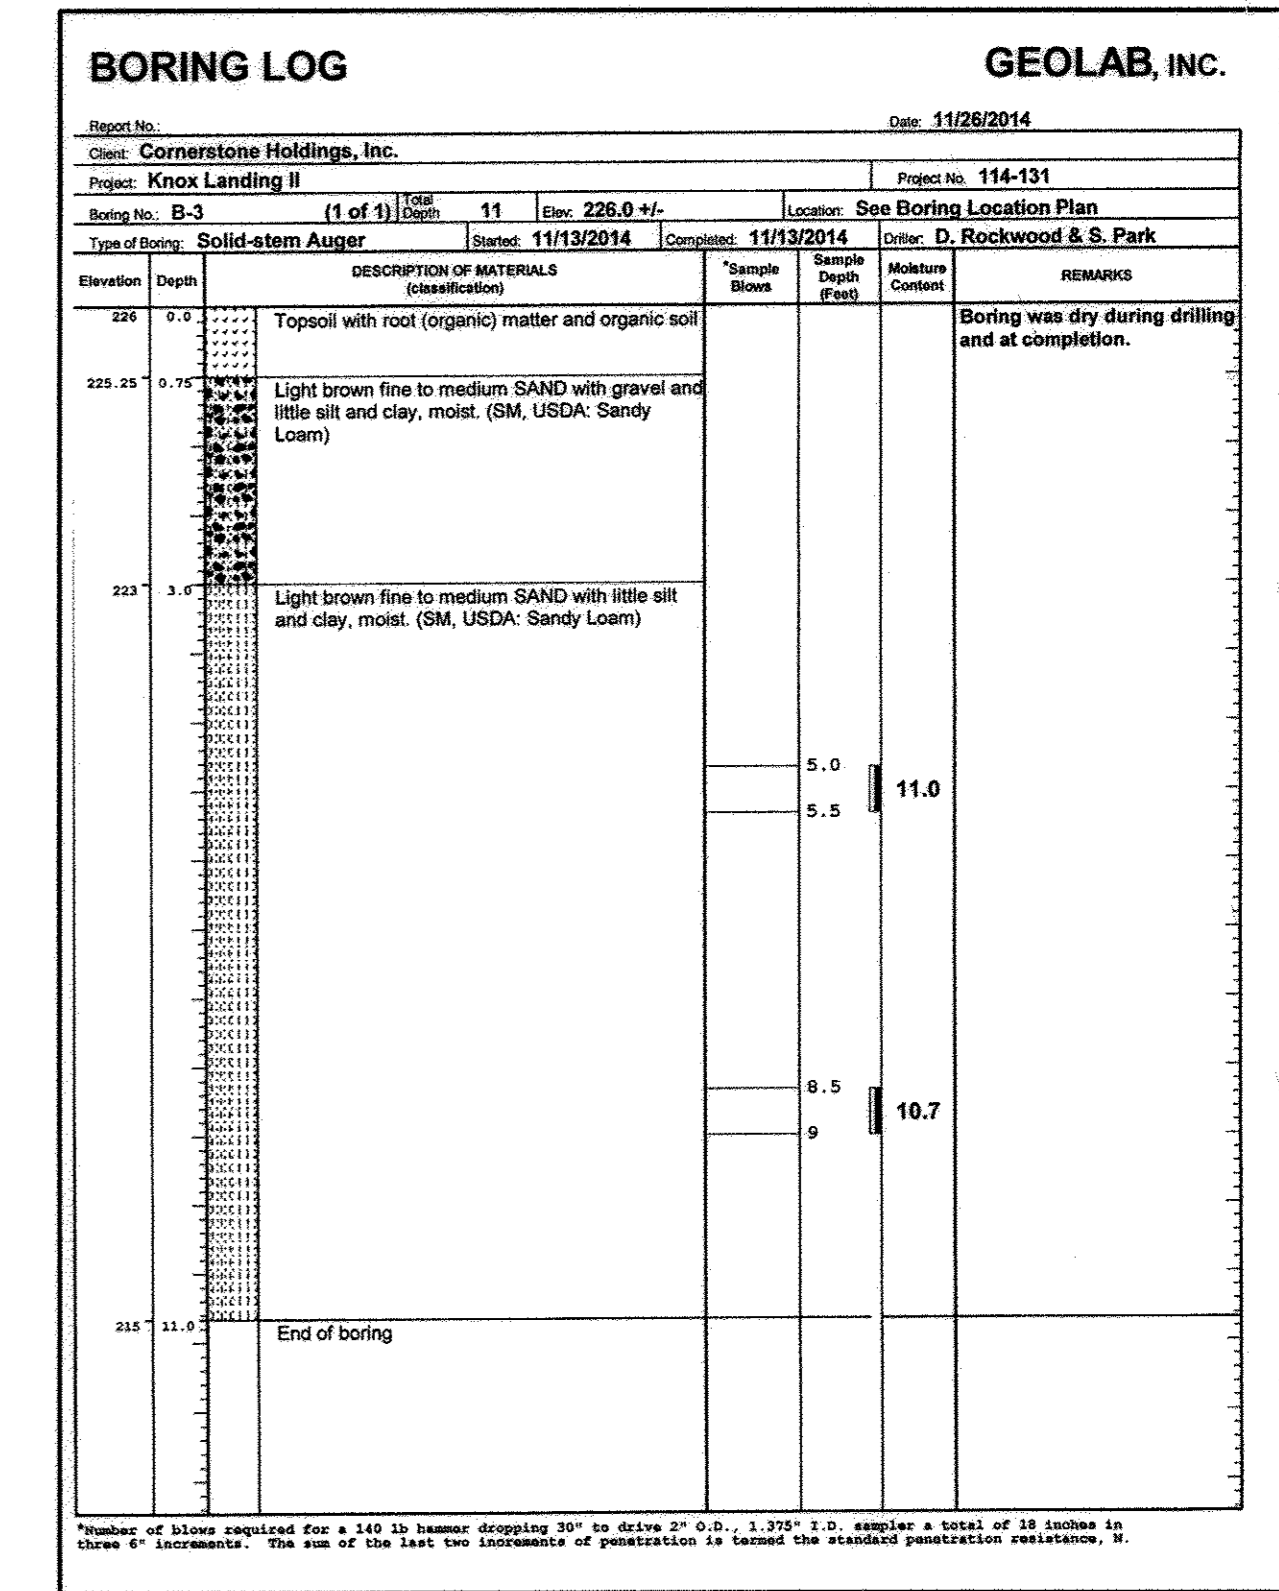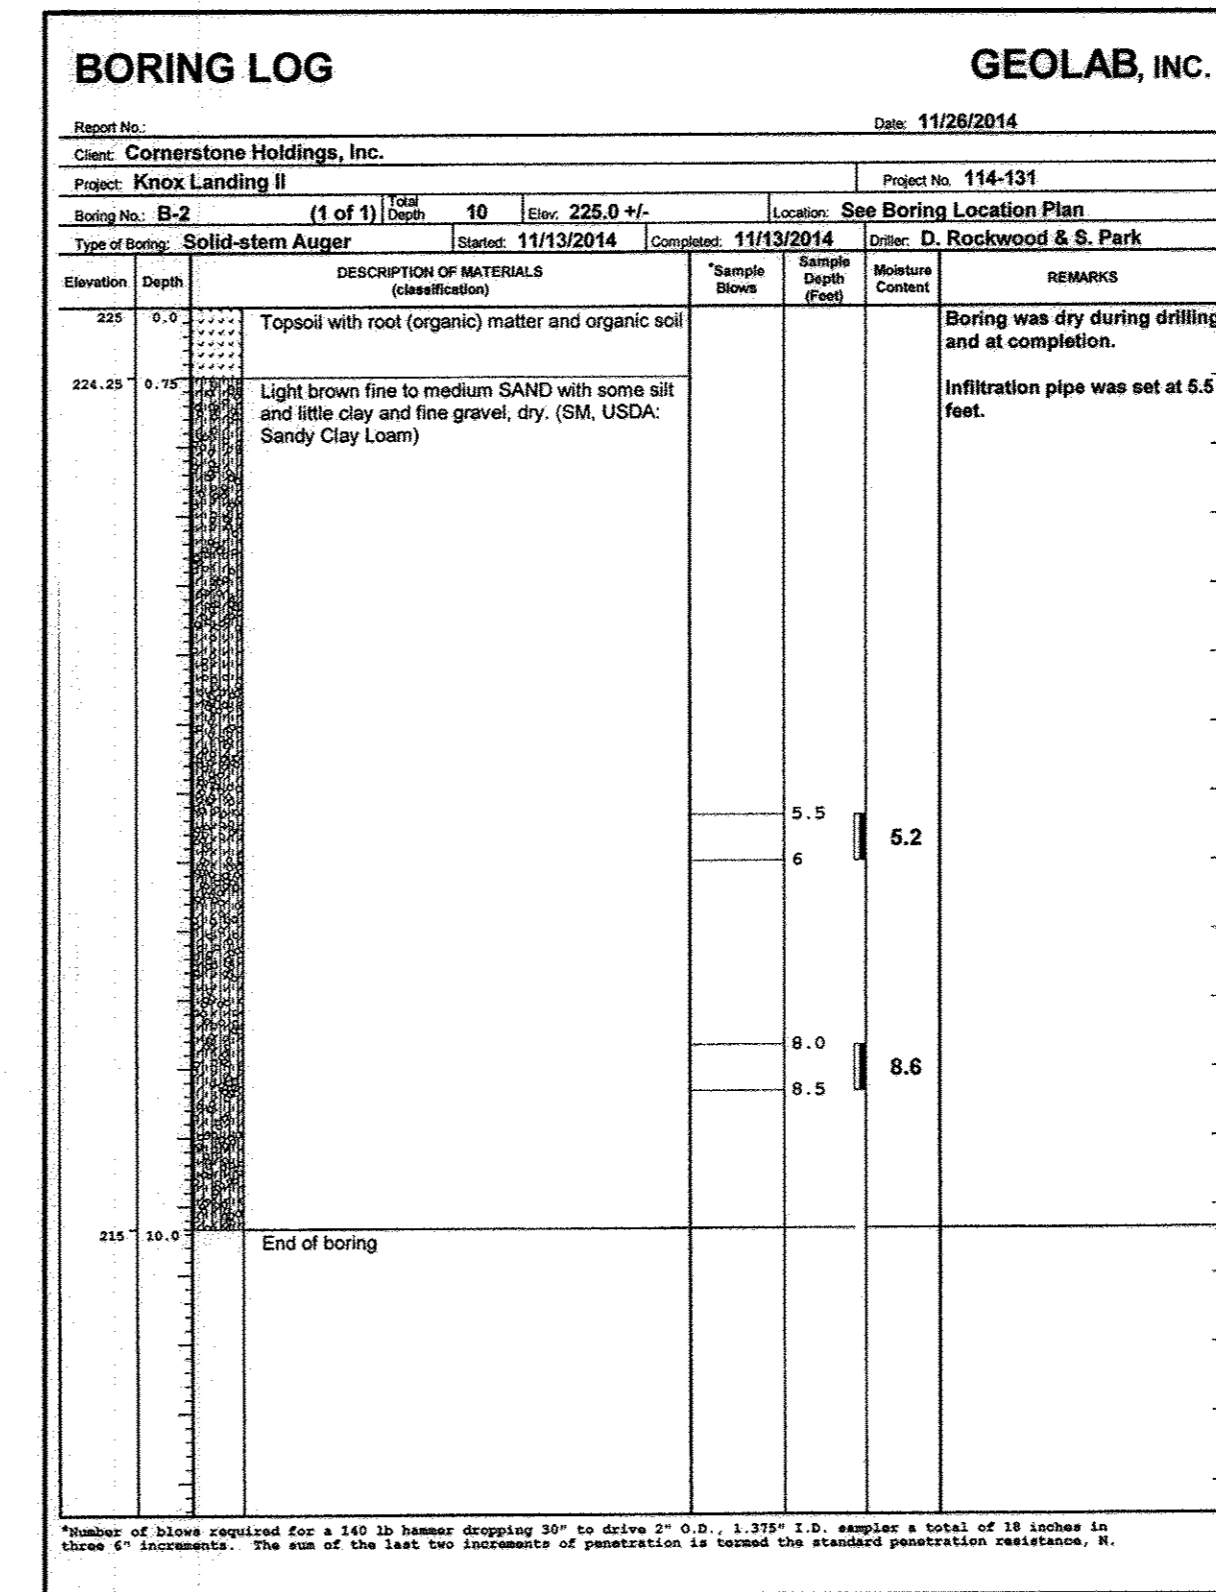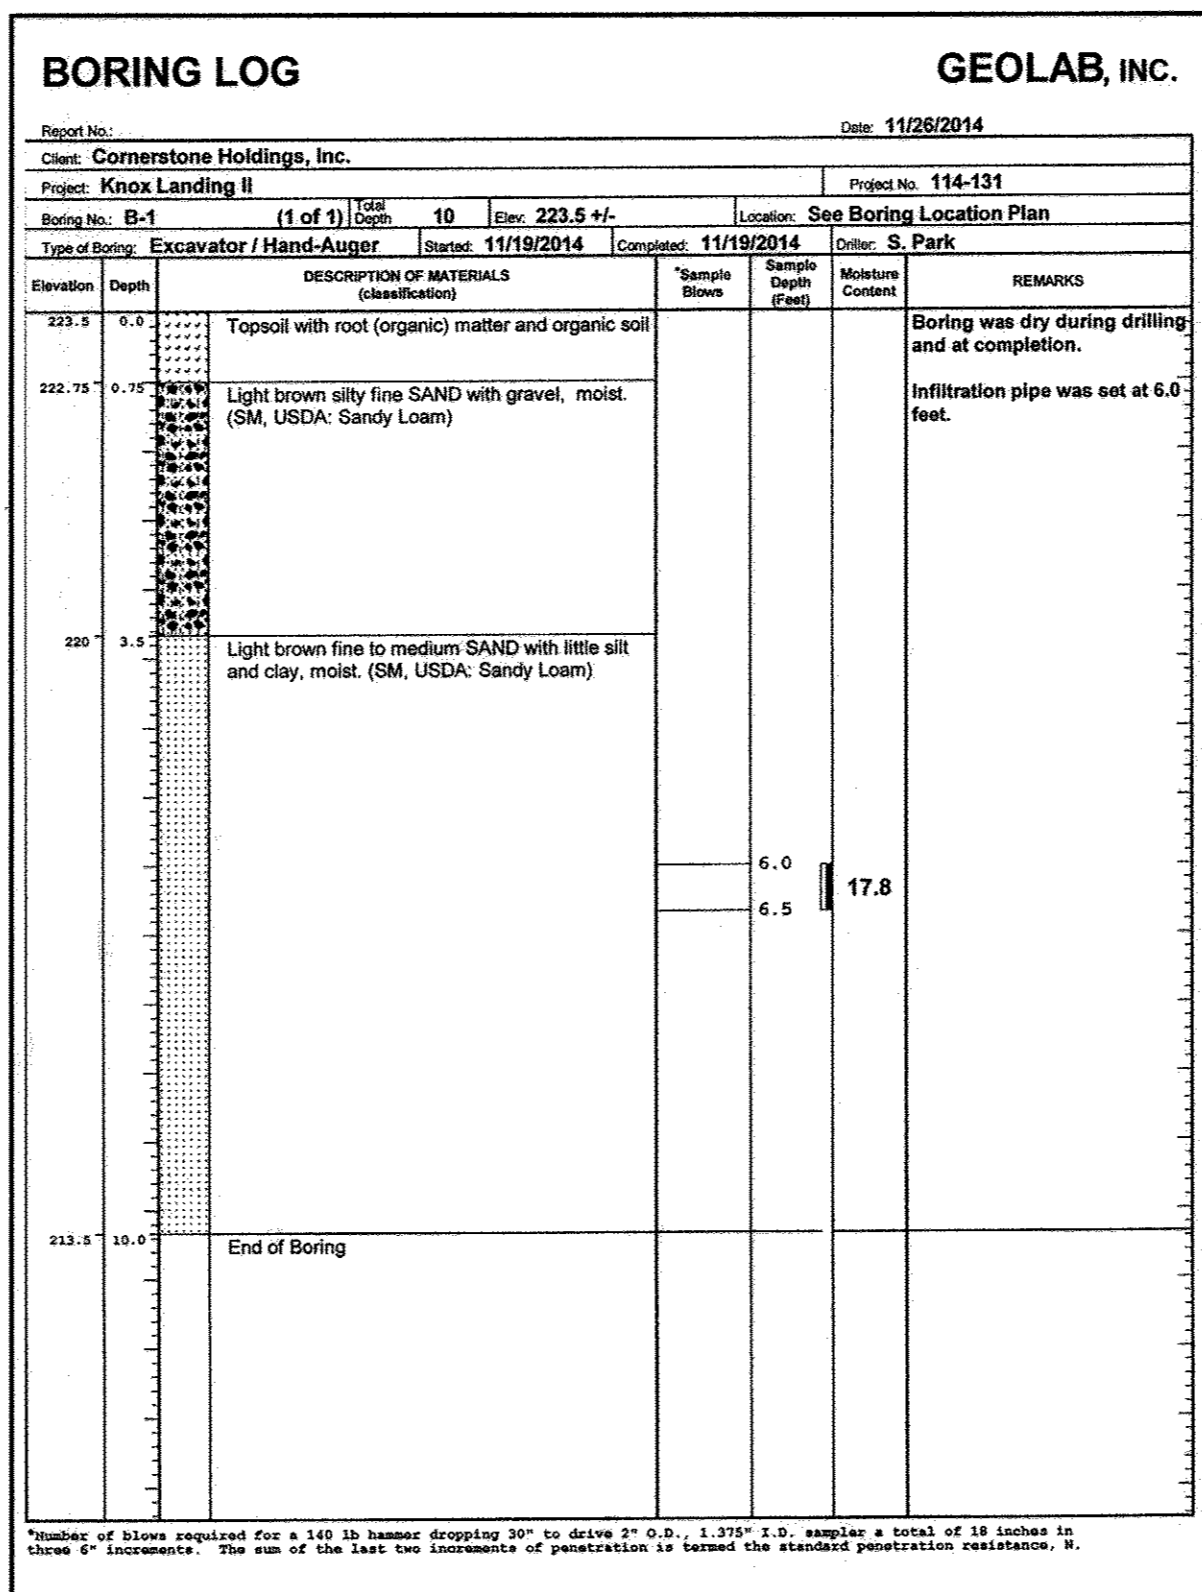

"NO AS-BUILT INFORMATION IS REQUIRED ON THIS SHEET"

Professional Certification. I hereby certify that these documents were prepared or approved by me, and that I am a duly licensed professional engineer under the laws of the State of Maryland.
License No. 21443 Expiration Date: 12-21-15

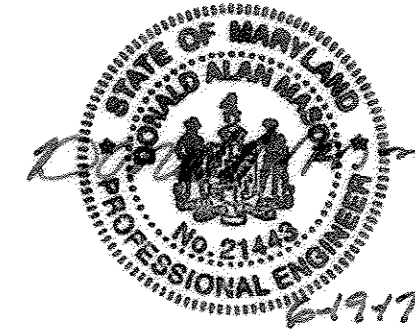

NO.	DATE	REVISION

BENCHMARK
ENGINEERS & LAND SURVEYORS & PLANNERS
ENGINEERING, INC.

8480 BALTIMORE NATIONAL PIKE & SUITE 315 & ELLIOTT CITY, MARYLAND 21045
(P) 410-465-8100 (F) 410-465-0644
WWW.BEI-CVLENGINEERING.COM

Professional Certification. I hereby certify that these documents were prepared or approved by me, and that I am a duly licensed professional engineer under the laws of the State of Maryland, License No. 21290, Expiration Date: 6-30-2017

OWNER: CORNERSTONE HOLDINGS LLC
9695 NORFOLK AVENUE
LAUREL, MARYLAND 20793
410-792-2565

DEVELOPER: CORNERSTONE HOLDINGS LLC
9695 NORFOLK AVENUE
LAUREL, MARYLAND 20793
410-792-2565

KNOX LANDING II
LOTS 1 thru 5 AND OPEN SPACE LOTS 6 and 7
RESIDENTIAL - SINGLE FAMILY DETACHED

TAX MAP: 50 GRID: 2 PARCEL: 75 & 528 ZONED: R-SC
9417 ALL SAINTS ROAD
ELECTION DISTRICT NO. 6
HOWARD COUNTY, MARYLAND

SOIL BORING LOGS

DATE: DECEMBER, 2015 BEI PROJECT NO: 2586
SCALE: AS SHOWN SHEET 7 OF 7

APPROVED: HOWARD COUNTY DEPARTMENT OF PLANNING AND ZONING

Paul Park 2-3-16
CHIEF, DEVELOPMENT ENGINEERING DIVISION DATE

Kat Sheehan 2-12-16
CHIEF, DIVISION OF LAND DEVELOPMENT DATE

Valerie Jellis 2-16-16
DIRECTOR DATE