



COMPOST FACILITY - PHASE II AT ALPHA RIDGE LANDFILL HOWARD COUNTY, MARYLAND SITE DEVELOPMENT PLAN #SDP-16-035

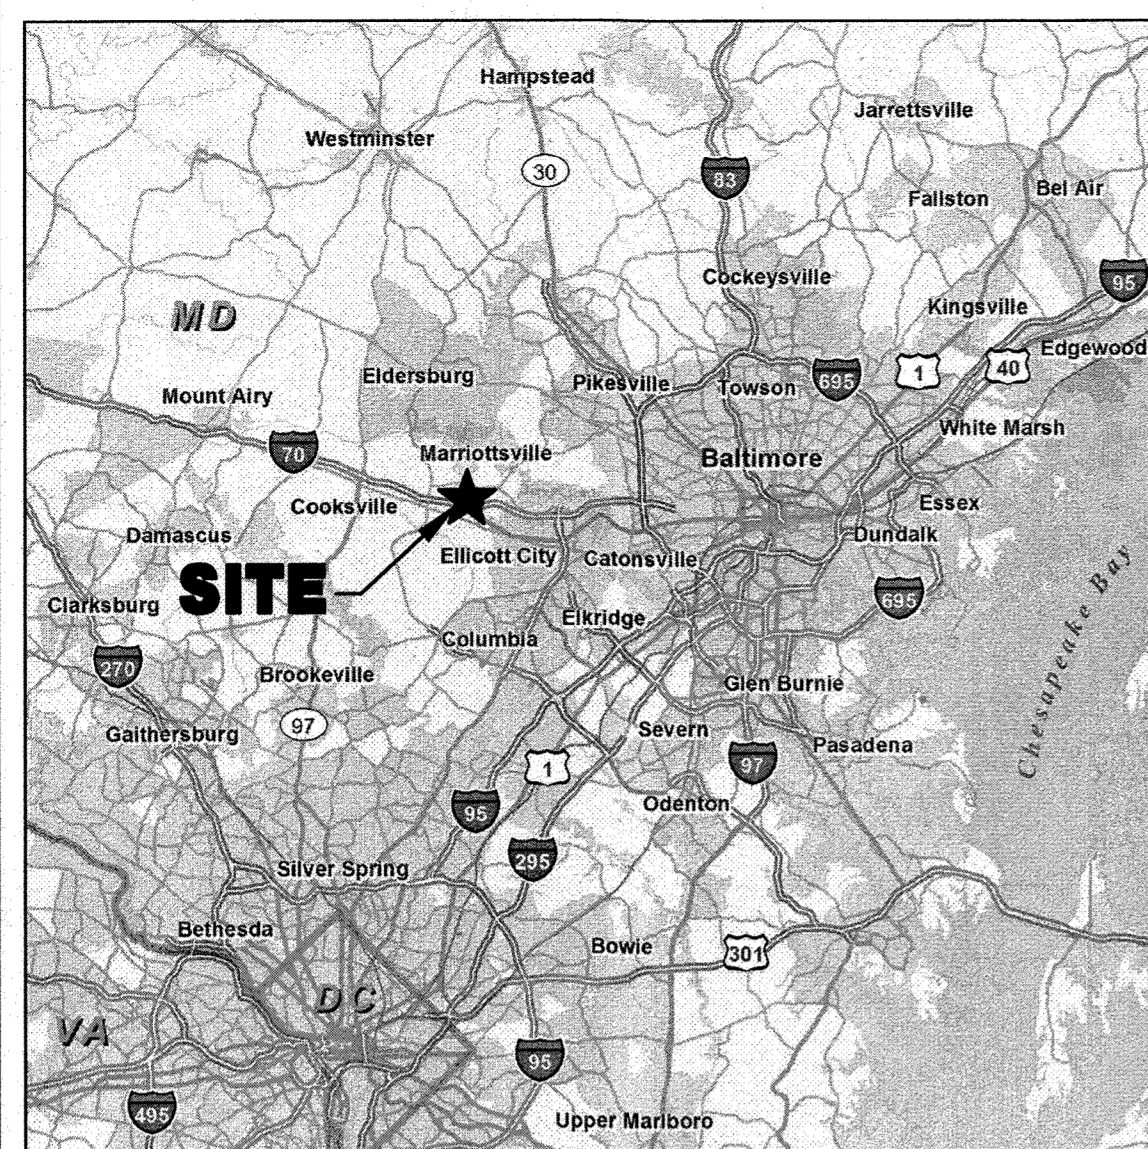

VICINITY MAP

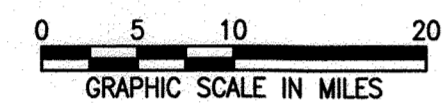

SITE ANALYSIS

SITE AREA:	590.00 AC
WETLAND AREA:	0 AC
FLOODPLAIN AREA:	0 AC
FLOODPLAIN BUFFER AREA:	0 AC
FORESTED AREA:	0 AC
SLOPES > 15% AREA:	3.06 AC
SLOPES > 25% AREA:	1.03 AC
ERODIBLE SOILS AREA:	0 AC
LIMIT OF DISTURBANCE AREA:	15.53 AC
PROPOSED SITE USE:	COMPOSTING FACILITY
GREEN OPEN AREA:	6.49 AC
PROPOSED IMPERVIOUS AREA:	6.59 AC

*FULL BUILD-OUT AREA

BENCHMARK INFORMATION

THE SYSTEM OF COORDINATES USED BY HOWARD COUNTY IS BASED ON THE FOLLOWING DATUMS AND PROJECTIONS:

- HORIZONTAL: MARYLAND NAD83
- VERTICAL: NAVD88

BENCHMARK LOCATIONS PROVIDED ON PROJECT ACCESS INSET.

- HOWARD COUNTY SURVEY CONTROL: BASE A
ELEVATION 564.733 US FT
N 598,156.281 E 1,336,841.785
- HOWARD COUNTY SURVEY CONTROL: BASE F
ELEVATION 512.817 US FT
N 597,030.549 E 1,338,031.404

ADDRESS CHART	
LOT/PARCEL #	STREET ADDRESS
220, 253, 11, 23, 54	2350 MARRIOTTSVILLE RD, MARRIOTTSVILLE, MARYLAND 21104

PERMIT INFORMATION CHART					
Subdivision Name	N/A	Section/Area	Lot/Parcel No.	Lot/Parcel No.	Lot/Parcel No.
220, 253, 11, 23, 54			220, 253, 11, 23, 54	220, 253, 11, 23, 54	220, 253, 11, 23, 54

REVIEWED FOR HOWARD SCD AND MEETS TECHNICAL REQUIREMENTS
THIS DEVELOPMENT PLAN IS APPROVED FOR SOIL EROSION AND
SEDIMENT CONTROL BY THE HOWARD SOIL CONSERVATION DISTRICT.

John K. Roberts 4/22/17
HOWARD SCD DATE

APPROVED: DEPARTMENT OF PLANNING AND ZONING

William J. Joffe 12-12-17
DIRECTOR DATE

Chad Shanks 11-29-17
CHIEF, DEVELOPMENT ENGINEERING DIVISION DATE

Wendy S. Sloman 12-5-17
CHIEF, DIVISION OF LAND DEVELOPMENT DATE

GRID: 8 BLOCK: N/A
ZONING: RC-DEO PARCEL/LOT: 220, 253, 11, 23, 54
TAX MAP: 0016 ELECTION DISTRICT: 3-02

OWNER/ENGINEER INFORMATION

DEVELOPER/OWNER:
HOWARD COUNTY GOVERNMENT
CONTACT: JEFF DANNIS, P.E., CSP
6751 COLUMBIA GATEWAY DRIVE, SUITE 514
COLUMBIA, MD 21046
TELEPHONE: (410) 313-6419

ENGINEER:
EA ENGINEERING, SCIENCE,
AND TECHNOLOGY, INC., PBC
CONTACT: MARK GUTBERLET, P.E.
225 SCHILLING CIRCLE, SUITE 400
HUNT VALLEY, MD 21031
TELEPHONE: (410) 584-7000

DESIGN NARRATIVE:

NATURAL RESOURCE PROTECTION AND ENHANCEMENT
THE PROJECT DOES NOT IMPACT ADJACENT NATURAL RESOURCES. NO NEARBY TREES WILL BE REMOVED AND A NEARBY STREAM AND ITS BUFFER WILL NOT BE IMPACTED. A PORTION OF EXISTING MAN-MADE STEEP SLOPES WILL BE REQUIRED TO BE IMPACTED TO INSTALL THE COMPOST FACILITY, A PUBLIC ESSENTIAL SERVICE, AND OPERATED BY HOWARD COUNTY GOVERNMENT. THE LIMIT OF STEEP SLOPE IMPACTS WILL BE MINIMIZED TO THE MAXIMUM EXTENT POSSIBLE.

MAINTENANCE OF NATURAL FLOW PATTERNS
THE PROJECT DOES NOT ALTER NATURAL DRAINAGE PATTERNS.

REDUCTION OF IMPERVIOUS AREAS
THE NEW IMPERVIOUS AREA ASSOCIATED WITH THE PROJECT HAS BEEN MINIMIZED AS MUCH AS IS PRACTICABLE TO STILL ALLOW THE FUNCTIONALITY OF THE COMPOSTING OPERATION.

LANDSCAPING
THE PROPOSED PROJECT WILL MAINTAIN EXISTING SPECIMEN TREE, PROVIDE TREE PROTECTION DURING CONSTRUCTION FOR EXISTING TREES TO REMAIN, AND PROVIDE PERMANENT STABILIZATION TO DISTURBED AREAS THAT CONFORMS WITH SCHEDULED FIELD MOWING AND SITE OPERATIONS.

INTEGRATION OF EROSION AND SEDIMENT CONTROL IN THE SWM STRATEGY
THE PROPOSED EROSION AND SEDIMENT CONTROL MEASURES ARE COMPATIBLE WITH THE PROPOSED ESD PRACTICES.

IMPLEMENTATION OF ESD PLANNING TECHNIQUES AND PRACTICES
THE PROPOSED PROJECT WILL UTILIZE A COMBINATION OF M-6 MICRO-BIOTENTION AND M-2 SUBMERGED GRAVEL WETLAND FACILITIES TO PROVIDE ESD TO THE MAXIMUM EXTENT PRACTICABLE. FOR ALL REMAINING REQUIRED ESD VOLUME, AN EXISTING P-2 WET POND WILL BE UTILIZED FOR TREATMENT PURPOSES.


24. ALTERNATIVE COMPLIANCE FILE WP-23-053 WAS APPROVED 24 NOVEMBER 2021 FOR HOWARD COUNTY SUBDIVISION AND LAND DEVELOPMENT REGULATIONS SECTION 16.156(A)(1)(1) AND 16.156(A)(2), GRANTING REACTIVATION OF THE APPROVED SDP FOR COMPLETION OF PHASE IIC CONSTRUCTION OF THE ALPHA RIDGE LANDFILL COMPOST FACILITY. APPROVAL IS CONDITIONAL ON (1) BUILDING PERMIT APPLICATION BEING SUBMITTED WITHIN 1 YEAR OF APPROVAL DATE; AND (2) SIGNATURE OF THE PROPOSED REACTIVE REGULATIONS TO THE DEPARTMENT OF PLANNING AND ZONING BEING RECEIVED PRIOR TO FILED BUILDING PERMIT APPLICATIONS.

APPROVED: FOR PUBLIC WATER AND PRIVATE SEWERAGE SYSTEMS

William J. Joffe 12-12-17
DIRECTOR DATE


Wendy S. Sloman 11/20/2017
CHIEF, DIVISION OF LAND DEVELOPMENT DATE

COUNTY HEALTH OFFICER
HOWARD COUNTY HEALTH DEPARTMENT

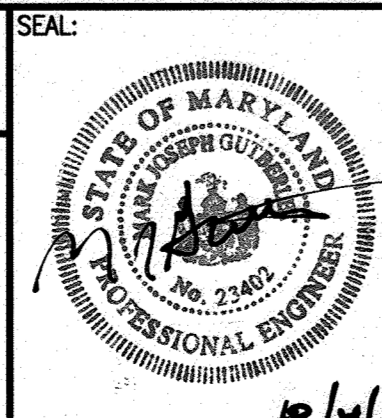

PROFESSIONAL CERTIFICATION:

I HEREBY CERTIFY THAT THESE DOCUMENTS WERE PREPARED OR APPROVED BY ME, AND THAT I AM A DULY LICENSED PROFESSIONAL ENGINEER UNDER THE LAWS OF THE STATE OF MARYLAND, LICENSE NO. 23402, EXPIRATION DATE 29 AUGUST 2018.

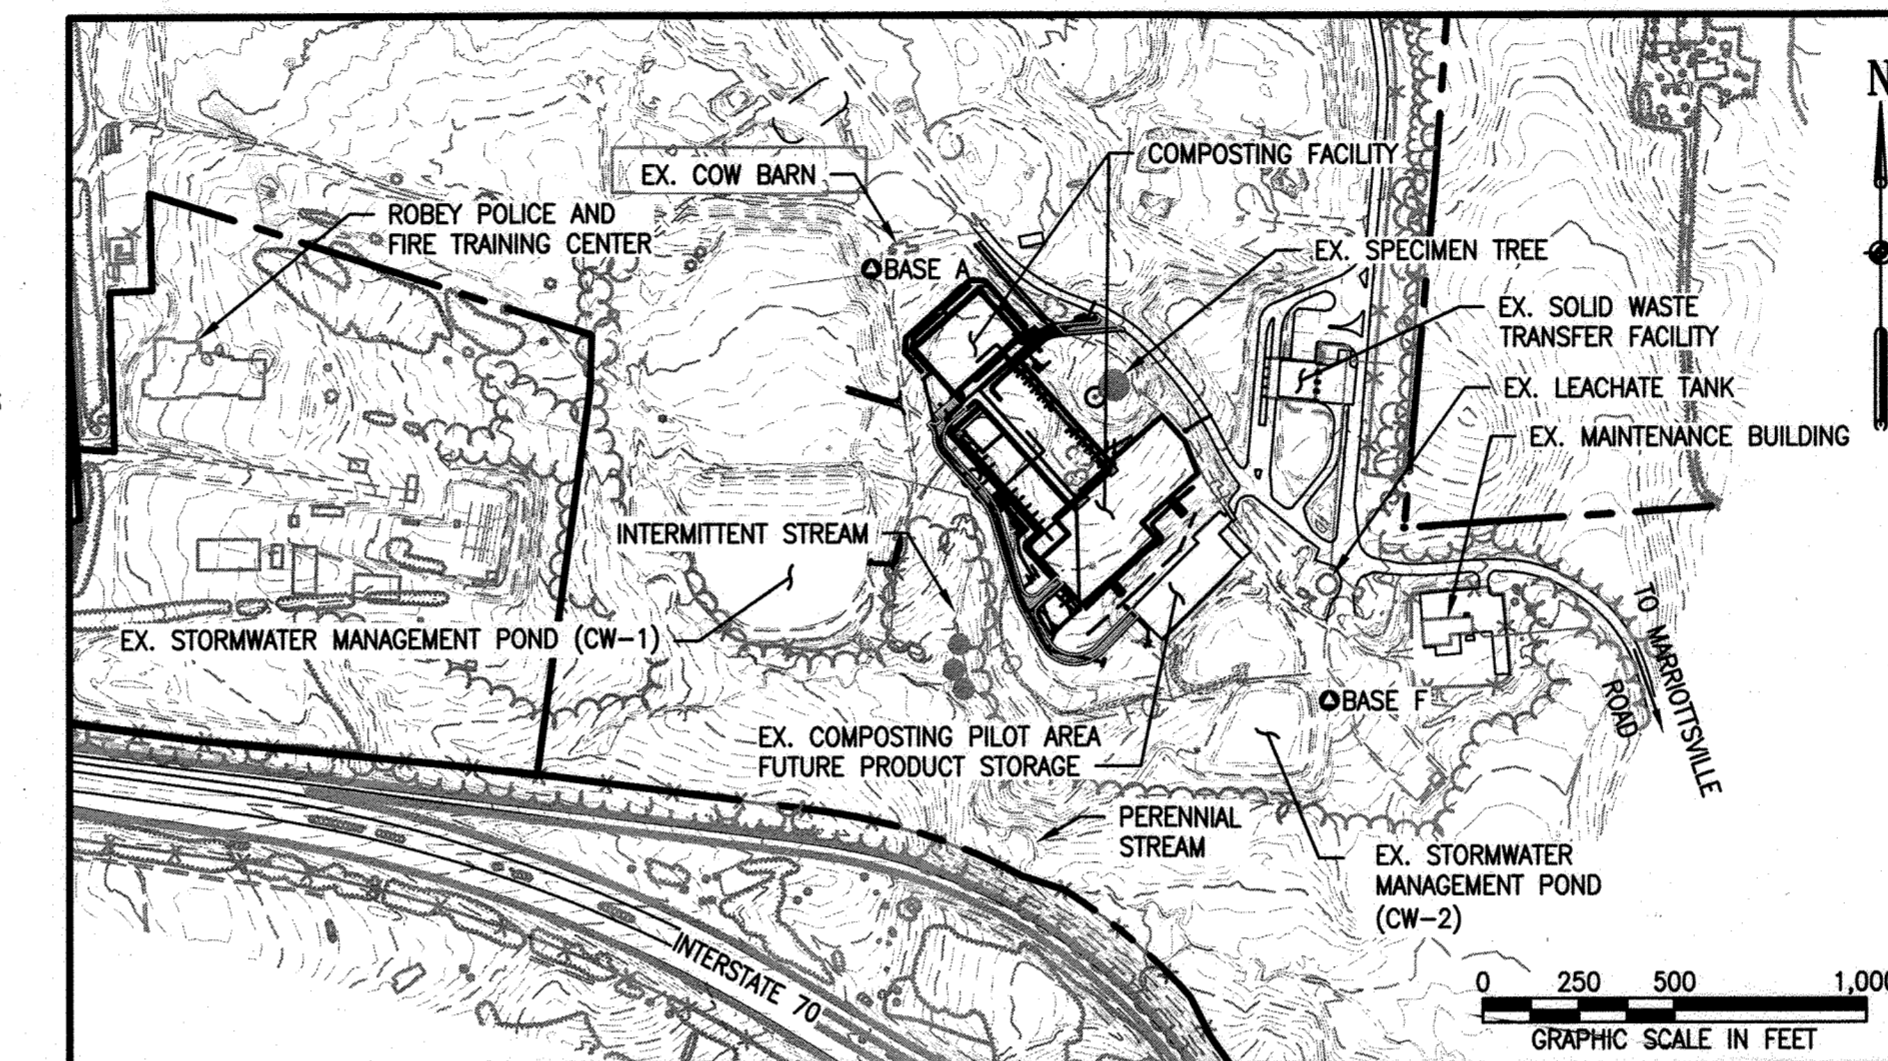

PROJECT ACCESS INSET

GENERAL NOTES:

- ALL CONSTRUCTION SHALL BE IN ACCORDANCE WITH THE LATEST STANDARDS AND SPECIFICATIONS OF HOWARD COUNTY PLUS MSHA STANDARDS AND SPECIFICATION WHERE APPLICABLE.
- THE CONTRACTOR SHALL CONTACT THE CONSTRUCTION INSPECTION DIVISION 24 HOURS IN ADVANCE OF COMMENCEMENT OF WORK AT (410) 313-1880.
- THE CONTRACTOR SHALL NOTIFY "MISS UTILITY" AT 1-800-257-7777 AT LEAST 48 HOURS PRIOR TO ANY EXCAVATION WORK BEING DONE.
- ALL SIGN POSTS USED FOR TRAFFIC CONTROL SIGNS INSTALLED IN THE COUNTY RIGHT-OF-WAY SHALL BE MOUNTED ON A 2" GALVANIZED STEEL, PERFORATED, SQUARE TUBE POST (14 GAUGE) INSERTED INTO A 2-1/2" GALVANIZED STEEL, PERFORATED, SQUARE TUBE SLEEVE (12 GAUGE) - 3' LONG. A GALVANIZED STEEL POLE CAP SHALL BE MOUNTED ON TOP OF EACH POST.
- ALL PLAN DIMENSIONS ARE TO FACE OF CURB UNLESS OTHERWISE NOTED.
- THE EXISTING TOPOGRAPHY OUTSIDE OF THE 'LIMIT OF FIELD RUN TOPO' BOUNDARY HAS BEEN PROVIDED FROM THE HOWARD COUNTY GIS DATABASE IN DECEMBER 2013.
- THE EXISTING TOPOGRAPHY AND UTILITIES INSIDE OF THE 'LIMIT OF FIELD RUN TOPO', UNLESS OTHERWISE MENTIONED, HAVE BEEN PROVIDED FROM A FIELD RUN SURVEY BY THE HOWARD COUNTY SURVEY DIVISION IN AUGUST 2011.
- THE TOPOGRAPHIC SURVEY IS BASED ON GEODETIC CONTROL STATIONS ALPHA 1, AERIAL TARGET 1, AERIAL TARGET 2, AND BENCHMARK 16BM2, BEING PART OF THE MARYLAND STATE REFERENCE SYSTEM NAD '83/'91.
- THE EXISTING FIBER OPTIC LINE HAS BEEN TAKEN FROM AN AS-BUILT PLAN PREPARED BY KCI CONVERGENT TECHNOLOGIES AND DATED 04/04/12.
- THE EXISTING WATER LINES HAVE BEEN PROVIDED FROM TWO SEPARATE AS-BUILT PLANS PREPARED BY KCI TECHNOLOGIES DATED DECEMBER 2004 AND JUNE 2009.
- THE SOILS HAVE BEEN PROVIDED FROM THE WEB SOIL SURVEY IN MARCH 2014.
- WATER IS PUBLIC. SEWER IS PRIVATE.
- STORMWATER MANAGEMENT IS PROVIDED VIA A COMBINATION OF M-6 MICRO-BIOTENTION AND M-2 SUBMERGED GRAVEL WETLAND FACILITIES TO PROVIDE ESD TO THE MAXIMUM EXTENT PRACTICABLE. FOR ALL REMAINING REQUIRED ESD VOLUME, AN EXISTING P-2 WET POND WILL BE UTILIZED FOR TREATMENT PURPOSES. ALL FACILITIES WILL BE OWNED AND MAINTAINED BY HOWARD COUNTY.
- THE FLOODPLAIN SHOWN HEREIN HAS BEEN PROVIDED FROM PLANS PREPARED BY URS DATED NOVEMBER 2006. THIS PLAN REFERENCES 1978 FLOODPLAIN DELINEATION BY CENTURY ENGINEERING AND A 1986 UPDATE BY BERNARD JOHNSON, INC.
- THE WETLANDS DELINEATION WAS PERFORMED BY EA ON 15 FEBRUARY 2016.
- NO TRAFFIC STUDY IS REQUIRED FOR THIS PROJECT.
- PROJECT CONFORMS WITH COMAR 26.04.11, COMPOSTING FACILITIES.
- STREAMS SHALL NOT BE DISTURBED DURING CONSTRUCTION.
- A COUNTY COUNCIL RESOLUTION HAS BEEN SUBMITTED TO REQUEST VARIANCE TO MAXIMUM HEIGHT LIMITATIONS FOR THE FEEDSTOCK RECEIVING ENCLOSURE, AS NOTED IN HOWARD COUNTY CODE SECTION 104.0.E.2 FOR PRINCIPAL STRUCTURES WITH GABLED ROOFS CONSTRUCTED WITHIN AREAS ZONED RC.
- NO GRADING, REMOVAL OF VEGETATIVE COVER OR TREES, PAVING AND NEW STRUCTURES SHALL BE PERMITTED WITHIN WETLANDS, STREAM(S) OR THEIR BUFFERS OR FOREST CONSERVATION EASEMENT AREAS.
- FOREST CONSERVATION OBLIGATIONS HAVE BEEN PREVIOUSLY ADDRESSED BY SDP-97-128. NO CLEARING, GRADING OR CONSTRUCTION IS PERMITTED WITHIN THE FOREST CONSERVATION EASEMENT, HOWEVER FOREST MANAGEMENT PRACTICES AS DEFINED IN THE DEED OF FOREST CONSERVATION EASEMENT ARE ALLOWED.
- THE SYSTEM OF COORDINATES USED BY HOWARD COUNTY IS BASED IN THE FOLLOWING DATUMS AND PROJECTIONS:
• HORIZONTAL: MARYLAND NAD83
• VERTICAL: NAVD88
- ALTERNATIVE COMPLIANCE FILE WP-18-011 HAS BEEN APPROVED FOR HOWARD COUNTY SUBDIVISION AND LAND DEVELOPMENT REGULATIONS SECTION 16.156(M), GRANTING REACTIVATION AND EXTENSION FOR SUBMISSION OF THE SDP PLAN ORIGINALS FOR SIGNATURE ON OR BEFORE NOVEMBER 6, 2017.

DEVELOPER'S CERTIFICATE

I/WE CERTIFY THAT ALL DEVELOPMENT AND CONSTRUCTION WILL BE DONE ACCORDING TO THIS PLAN FOR SEDIMENT AND EROSION CONTROL, AND THAT ALL RESPONSIBLE PERSONNEL INVOLVED IN THE CONSTRUCTION PROJECT WILL HAVE A CERTIFICATE OF ATTENDANCE AT A DEPARTMENT OF THE ENVIRONMENT APPROVED TRAINING PROGRAM FOR THE CONTROL OF SEDIMENT AND EROSION BEFORE BEGINNING THE PROJECT. I ALSO CERTIFY THAT I HAVE BEEN INSPECTED BY THE HOWARD SOIL CONSERVATION DISTRICT.

DEVELOPER'S NAME HERE: *Mark J. Gutberlet, P.E.* DATE: 4/1/17


ENGINEER'S CERTIFICATE

I CERTIFY THAT THIS PLAN FOR SEDIMENT AND EROSION CONTROL REPRESENTS A PRACTICAL AND WORKABLE PLAN BASED ON MY PERSONAL KNOWLEDGE OF THE SITE CONDITIONS AND THAT IT WAS PREPARED IN ACCORDANCE WITH THE REQUIREMENTS OF THE HOWARD SOIL CONSERVATION DISTRICT.


ENGINEER'S NAME HERE: *Mark J. Gutberlet, P.E.* DATE: 4/1/17

DSN. BY:	MBS/MP	SMB	4/1/17
DRN. BY:	JAP/KEJ	CVH	8/2022
CHK. BY:	SMD		
DATE:	OCT. 2016		
BY	NO.	REVISION	DATE

TITLE SHEET

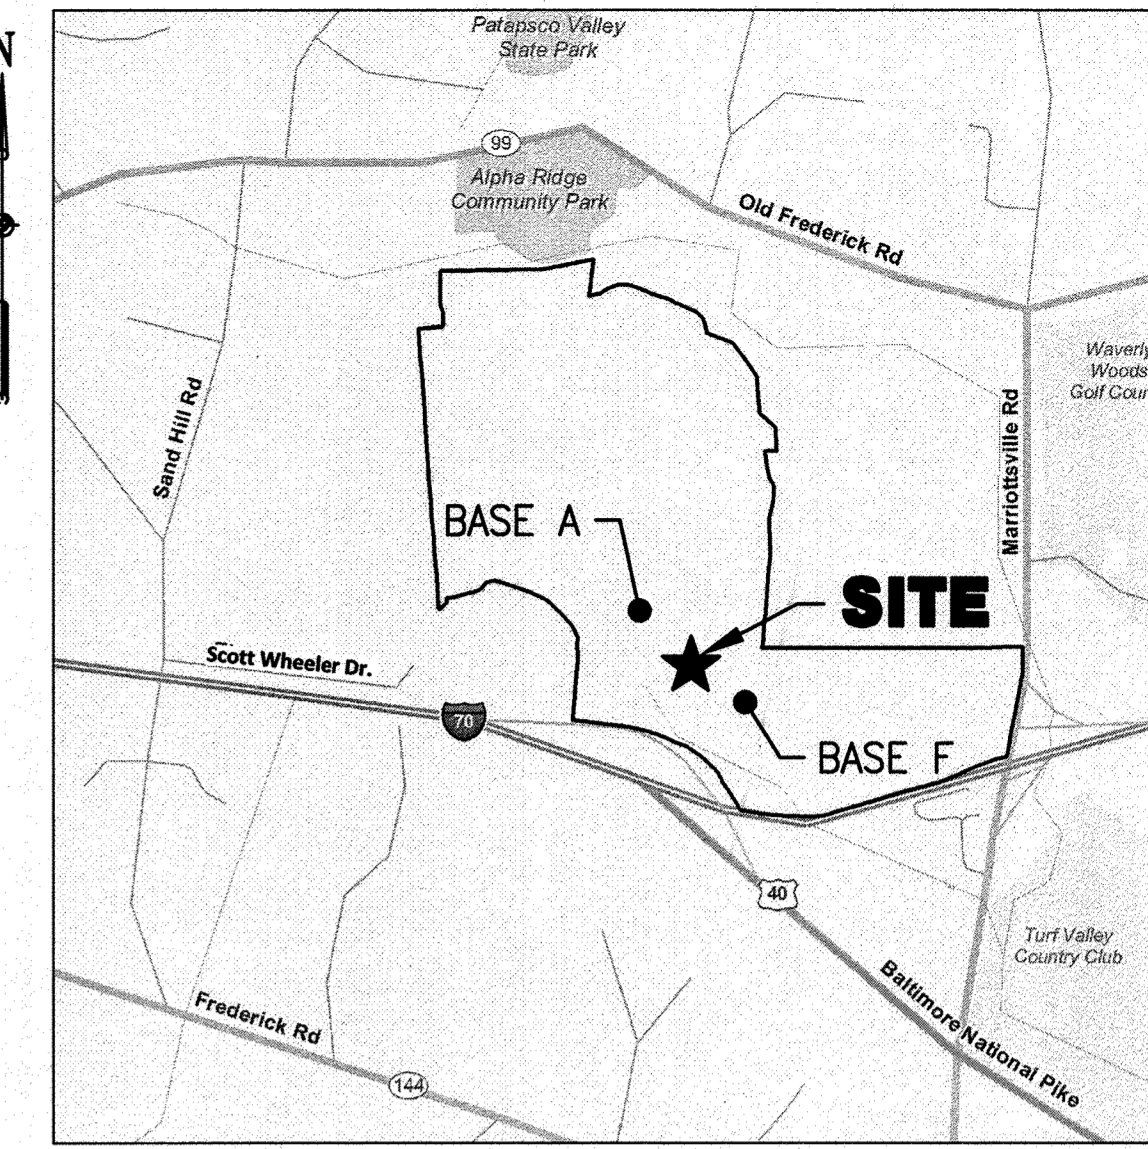

LOCATION MAP

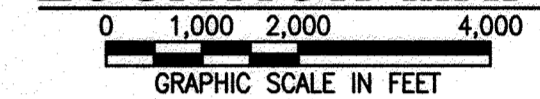

SITE ADDRESS:
ALPHA RIDGE LANDFILL
2350 MARRIOTTSVILLE RD
MARRIOTTSVILLE, MARYLAND 21104

WGS84 (DECIMAL DEGREES)
LAT: 39.310328
LONG: -79.912165

NAD83 MARYLAND STATE PLAN (FEET)
NORTHING: 598,623.21034
EASTING: 1,337,186.70975

ADC MAP COORDINATES: MAP 4814 - GRID F2 - N 598,623 E 1,337,186

SDP SHEET LIST		
SDP SHEET NO.	DRAWING NO.	SHEET TITLE
1	T-1	TITLE SHEET
2	G-1	INDEX & GENERAL NOTES
3	K-2	KEY PLAN
4	C-4	PROPOSED CONDITIONS PLAN I
5	C-5	PROPOSED CONDITIONS PLAN II
6	C-8	CONTACT WATER GRAVITY LINE PROFILE
7	C-9	CONTACT WATER PRESSURE LINE PROFILE I
8	C-10	CONTACT WATER PRESSURE LINE PROFILE II - SWA PRESSURE PIPE PLAN & PROFILE
9	C-11	WATER LINE PROFILE
10	C-13	CIVIL LAYOUT PLAN I
11	C-14	CIVIL LAYOUT PLAN II
12	ES-1	EROSION AND SEDIMENT CONTROL PLAN - INITIAL I (PHASES IIA AND IIB)
13	ES-2	EROSION AND SEDIMENT CONTROL PLAN - INITIAL II (PHASES IIA AND IIB)
14	ES-3	EROSION AND SEDIMENT CONTROL PLAN - INITIAL DRAINAGE AREA MAP
15	ES-4	EROSION AND SEDIMENT CONTROL PLAN - FINAL I
16	ES-5	EROSION AND SEDIMENT CONTROL PLAN - FINAL II
17	ES-6	EROSION AND SEDIMENT CONTROL PLAN - FINAL DRAINAGE AREA MAP
18	ES-7	EROSION AND SEDIMENT CONTROL DETAILS I
19	ES-8	EROSION AND SEDIMENT CONTROL DETAILS II
20	ES-9	EROSION AND SEDIMENT CONTROL DETAILS III
21	ES-10	EROSION AND SEDIMENT CONTROL DETAILS IV
22	ES-11	EROSION AND SEDIMENT CONTROL NOTES I
23	ES-12	EROSION AND SEDIMENT CONTROL NOTES II
24	SW-3	STORMDRAIN PROFILE I
25	SW-4	STORMDRAIN PROFILE II
26	SW-5	STORMDRAIN PROFILE III
27	SW-6	ESD PROFILE AND DETAILS I
28	SW-7	ESD PROFILE AND DETAILS II
29	SW-8	ESD PROFILE AND DETAILS III
30	SW-9	ESD PLANTING PLANS
31	SW-10	STORMWATER MANAGEMENT DETAILS I
32	SW-11	STORMWATER MANAGEMENT DETAILS II
33	SW-14	GEOTECHNICAL SOIL BORING LOGS I
34	SW-15	GEOTECHNICAL SOIL BORING LOGS II
35	SW-16	STORMDRAIN DRAINAGE AREA MAP
36	DA-1	ESD DRAINAGE AREA MAP
37	A-1	FLOOR PLAN
38	A-2	BUILDING ELEVATIONS
39	A-3	BUILDING ELEVATIONS
40	S-5-S-8	RETAINING WALL STRUCTURAL PLAN, ELEVATION AND SECTIONS I
41	S-7-S-9	RETAINING WALL STRUCTURAL PLAN, ELEVATION AND SECTIONS II
42	S-8-S-10	RETAINING WALL STRUCTURAL PLAN, ELEVATION AND SECTIONS III AND DETAIL
43	S-9-S-11	COMPOST BINS - FINISHED FLOOR PLANS
44	S-10-S-12	COMPOST BINS - SECTIONS
45	ES-13	EROSION AND SEDIMENT CONTROL PLAN - INITIAL III (PHASE IIC)

SDP SHEET: 45
1 OF 44
DRAWING: T-1

PROJECT: 14982.05
SHEET: 1 OF 78

COMPOST FACILITY - PHASE II
AT ALPHA RIDGE LANDFILL
HOWARD COUNTY, MARYLAND

ABBREVIATIONS

AC	ACRE(S)
APPROX.	APPROXIMATE
ASP	ASPERATED STATIC PILE
ASTM	AMERICAN SOCIETY FOR TESTING AND MATERIALS
BLDG	BUILDING
CLF	CHAIN LINK FENCE
CONC	CONCRETE
CORR	CORRUGATED
D.A.	DRAINAGE AREA
DA	DIAMETER
DOT	DEPARTMENT OF TRANSPORTATION
EL/ELEV	ELEVATION
ECP	ENVIRONMENTAL CONCEPT PLAN
EPA	ENVIRONMENTAL PROTECTION AGENCY
ESD	ENVIRONMENTAL SITE DESIGN
EX/EXIST	EXISTING
FM	FORCEMAIN
FT	FEET
FT BGS	FEET BELOW GROUND SURFACE
GALS	GALLONS
GALV	GALVANIZED
GPS	GLOBAL POSITIONING SYSTEM
INV.	INVERT
lbs	POUNDS
MG/KG	MILLIGRAMS PER KILOGRAM
MHW	MEAN HIGH WATER
MM	MILLIMETER
MSL	MEAN SEA LEVEL
MTL	METAL
NAD 83	NORTH AMERICAN DATUM 1983
NAVD 88	NORTH AMERICAN VERTICAL DATUM 1988
N.O.	NUMBER
NRCS	NATIONAL RESOURCES CONSERVATION SERVICE
PSF	POUNDS PER SQUARE FOOT
PR	PROPOSED
RCP	REINFORCED CONCRETE PIPE
SCH	SCHEDULE
S.D.	STORM DRAIN
sec	SECOND
SS	STAINLESS STEEL
SWM	STORMWATER MANAGEMENT
SWPPP	STORMWATER POLLUTION PREVENTION PLAN
TYP	TYPICAL
U.S.	UNITED STATES
USACE	U.S. ARMY CORPS OF ENGINEERS
USCGS	U.S. COAST AND GEODETIC SURVEY
USDA	U.S. DEPARTMENT OF AGRICULTURE
USGS	U.S. GEOLOGICAL SURVEY
W/	WITH
WSEL	WATER SURFACE ELEVATION

LEGEND

SYMBOL	DESCRIPTION
---	EXISTING INDEX CONTOUR
---	EXISTING INTERMEDIATE CONTOUR
---	STEEP SLOPES (15-25%)
---	STEEP SLOPES (>25%)
---	EXISTING BUILDING
---	EXISTING ROAD
---	EXISTING GRAVEL ROAD
---	EXISTING FENCE
□	EXISTING STORM DRAIN INLET/JUNCTION BOX
○	EXISTING BENCHMARK
○	EXISTING UTILITY POLE
○	EXISTING SANITARY CLEANOUT
○	EXISTING ELECTRIC STRUCTURE
○	EXISTING TREE (TO BE REMOVED)
---	EXISTING EDGE OF WATER / RIVER
---	EXISTING WETLAND
---	EXISTING RIPRAP
---	EXISTING TREE OR BRUSH LINE
---	EXISTING SANITARY FORCEMAIN
SAN	EXISTING SANITARY SEWER PIPE (GRAVITY)
W	EXISTING WATER PIPE
SD	EXISTING STORM DRAIN
UE	EXISTING UNDERGROUND ELECTRIC LINE
UT	EXISTING UNDERGROUND TELEPHONE LINE
LR	EXISTING LEACHATE GRAVITY LINE
LFM	EXISTING LEACHATE FORCE MAIN
DFM	EXISTING DRAIN FORCE MAIN
OFD	EXISTING OVERFLOW DRAIN
---	EXISTING PROPERTY LINE
---	LIMIT OF FIELD RUN TOPO
B	WETLAND BUFFER LINE
---	PROPOSED INDEX CONTOUR
---	PROPOSED INTERMEDIATE CONTOUR
---	LIMIT OF DISTURBANCE
---	HYDROLOGIC SOIL GROUP BOUNDARY
GbB	HYDROLOGIC SOIL GROUP LABEL
GbC	HYDROLOGIC SOIL GROUP LABEL
---	DRAINAGE AREA BOUNDARY
○ B-1	SOIL BORING
SD	PROPOSED STORM DRAIN
W	PROPOSED WATER PIPE
C	PROPOSED CONTACT WATER GRAVITY LINE
CL	PROPOSED CONTACT WATER FORCEMAIN
UE	PROPOSED UNDERGROUND ELECTRIC LINE
SF	PROPOSED SILT FENCE
SSF	PROPOSED SUPER SILT FENCE
DF	PROPOSED DIVERSION FENCE
SWM	PROPOSED STORMWATER POND FORCEMAIN
---	LIMIT OF LAGOON ANCHOR TRENCH
→ → → → →	EARTH DIKE
SC	STABILIZED CONSTRUCTION ENTRANCE
TGOS	TEMPORARY GABION OUTLET STRUCTURE
TSOS	TEMPORARY STONE OUTLET STRUCTURE
AGIP	AT-GRADE INLET PROTECTION
UT	PROPOSED UNDERGROUND TELEPHONE LINE
□	PROPOSED LIGHT POLE
---	PROPOSED ASPHALT
---	PROPOSED CONCRETE
---	PROPOSED STABILIZATION MATTING

Table 5.1 Natural Resources and the Corresponding Regulatory Authorities

FEDERAL	STATE	LOCAL
Wetlands	Shown	Tidal and Non-Tidal Wetlands
Major Waterways	Not Present	Wetlands of Special State Concern
Floodplains	Not Present	Wetland Buffers
		Stream Buffers
		Perennial Streams
		Floodplains
		Forests
		Forest Buffers
		Critical Areas
		Steep Slopes
		Highly Erodible Soils
		Enhanced Stream Buffers
		Topography/Slopes
		Springs
		Seeps
		Intermittent Streams
		Vegetative Cover
		Soils
		Bedrock/Geology
		Existing Drainage Areas

HYDROLOGIC SOIL GROUP - HOWARD COUNTY, MARYLAND*

MAP UNIT SYMBOL	MAP UNIT NAME	HSG RATING	k RATING
BaA	Baile silt loam, 0-3% Slopes	D	0.32
GbB	Gladstone loam, 3-8% Slopes	B	0.20
GbC	Gladstone loam, 8-15% Slopes	B	0.20
GnB	Glennville-Baile silt loams, 0-8% Slopes	C	0.37
UbF	Udorthents, Refuse, 0-65% Slopes	N/A	N/A

*Soils information provided from USDA NRCS Web Soil Survey

APPROVED: DEPARTMENT OF PLANNING AND ZONING

Valerie J. Joffe 12-12-17
DIRECTOR DATE

Paul E. ... 11-29-17
CHIEF, DEVELOPMENT ENGINEERING DIVISION DATE


Kevin ... 12-5-17
CHIEF, DIVISION OF LAND DEVELOPMENT DATE

GRID: 8 BLOCK: N/A
ZONING: RC-DEO PARCEL/LOT: 220, 253, 11, 23, 54
TAX MAP: 0016 ELECTION DISTRICT: 3-02

OWNER/ENGINEER INFORMATION

DEVELOPER/OWNER:
HOWARD COUNTY GOVERNMENT
CONTACT: JEFF DANNIS, P.E., CSP
6751 COLUMBIA GATEWAY DRIVE, SUITE 514
COLUMBIA, MD 21046
TELEPHONE: (410) 313-6419

ENGINEER:
EA ENGINEERING, SCIENCE,
AND TECHNOLOGY, INC., PBC
CONTACT: MARK GUTBERLET, P.E.
225 SCHILLING CIRCLE, SUITE 400
HUNT VALLEY, MD 21031
TELEPHONE: (410) 584-7000

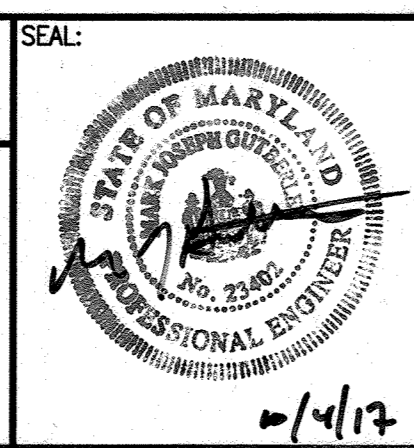

PROFESSIONAL CERTIFICATION:

I HEREBY CERTIFY THAT THESE DOCUMENTS WERE PREPARED OR APPROVED BY ME, AND THAT I AM A DULY LICENSED PROFESSIONAL ENGINEER UNDER THE LAWS OF THE STATE OF MARYLAND, LICENSE NO. 23402, EXPIRATION DATE 25 AUGUST 2018.

DSN. BY:	MBS/MP	CVH	REVISED TOTAL SHEET NUMBER DUE TO ADDITION OF SHEET 45	8/2022
DRN. BY:	JAP/KEJ			
CHK. BY:	SMD			
DATE:	OCT. 2016	BY	NO.	REVISION


INDEX & GENERAL NOTES

COMPOST FACILITY - PHASE II AT ALPHA RIDGE LANDFILL
HOWARD COUNTY, MARYLAND


SDP SHEET: 2 OF 4
DRAWING: G-1

PROJECT: 14982.05
SHEET: -2 OF 78

REFERENCE SYMBOLS

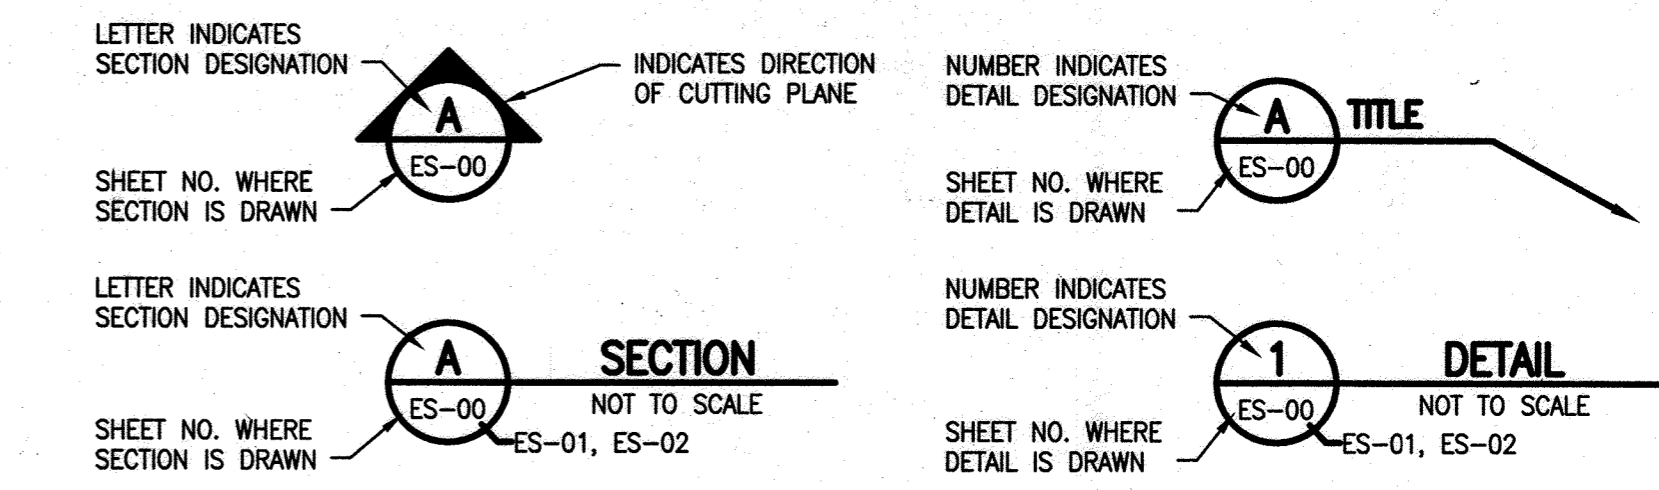

NOT FOR CONSTRUCTION - SITE DEVELOPMENT PLAN #SDP-16-035

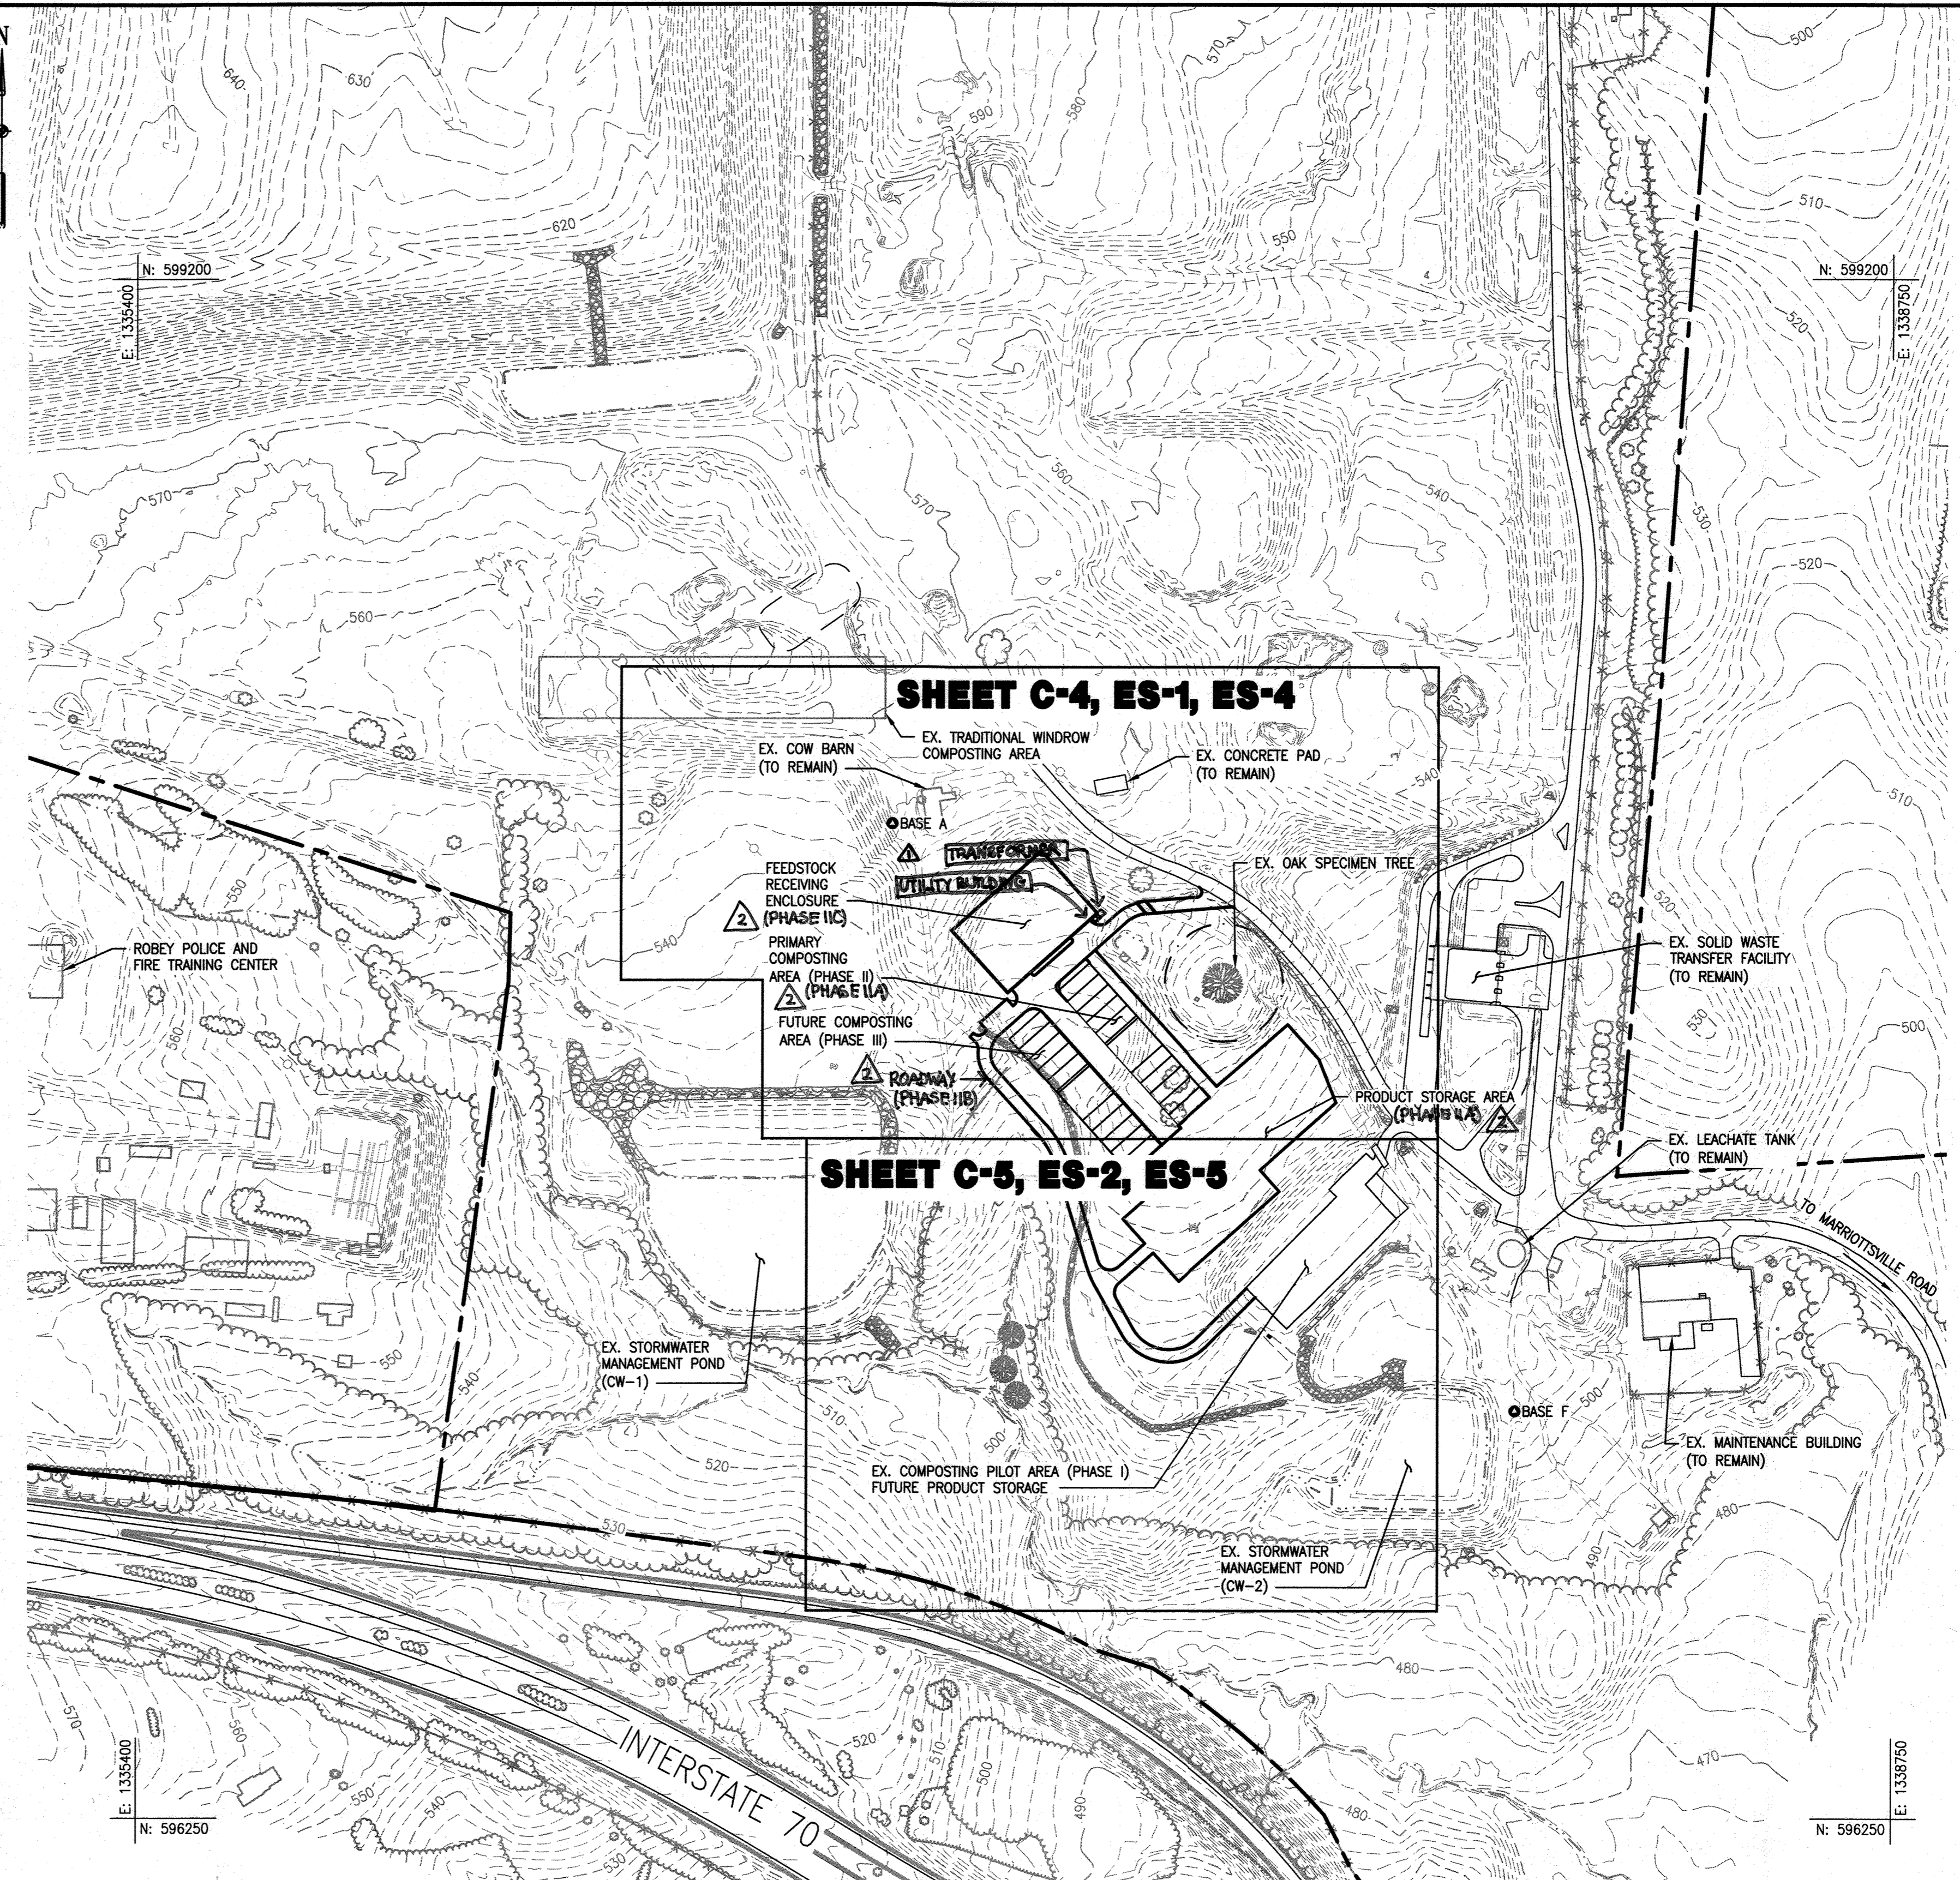

FIELD VERIFICATION CERTIFICATION

I HEREBY CERTIFY THAT I COMPLETED A FIELD VERIFICATION TO THE INFORMATION SHOWN ON THE PLAN ON _____ AND THAT THE INFORMATION SHOWN ON THE PLANS IS IN AGREEMENT WITH THE ACTUAL FIELD CONDITIONS.

PRINTED NAME _____

SIGNATURE _____ DATE _____

BENCHMARK INFORMATION

- HOWARD COUNTY SURVEY CONTROL: BASE A
ELEVATION 564.733 US FT
N 598,156.281 E 1,336,841.785
- HOWARD COUNTY SURVEY CONTROL: BASE F
ELEVATION 512.817 US FT
N 597,030.549 E 1,338,031.404

THE SYSTEM OF COORDINATES USED BY HOWARD COUNTY IS BASED ON THE FOLLOWING DATUMS AND PROJECTIONS:
 • HORIZONTAL: MARYLAND NAD83
 • VERTICAL: NAVD88

BENCHMARK LOCATIONS PROVIDED ON PROJECT ACCESS INSET.

APPROVED: DEPARTMENT OF PLANNING AND ZONING

[Signature] 12-12-17
 DIRECTOR DATE

[Signature] 1/29/17
 CHIEF, DEVELOPMENT ENGINEERING DIVISION DATE


[Signature] 12-5-17
 CHIEF, DIVISION OF LAND DEVELOPMENT DATE

GRID: 8 BLOCK: N/A
 ZONING: RC-DEO PARCEL/LOT: 220, 253, 11, 23, 54
 TAX MAP: 0016 ELECTION DISTRICT: 3-02

OWNER/ENGINEER INFORMATION

DEVELOPER/OWNER:
 HOWARD COUNTY GOVERNMENT
 CONTACT: JEFF DANNIS, P.E., CSP
 6751 COLUMBIA GATEWAY DRIVE, SUITE 514
 COLUMBIA, MD 21046
 TELEPHONE: (410) 313-6419

ENGINEER:
 EA ENGINEERING, SCIENCE,
 AND TECHNOLOGY, INC., PBC
 CONTACT: MARK GUTBERLET, P.E.
 225 SCHILLING CIRCLE, SUITE 400
 HUNT VALLEY, MD 21031
 TELEPHONE: (410) 584-7000

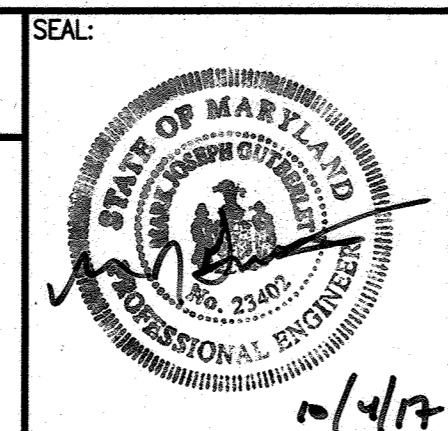


PROFESSIONAL CERTIFICATION:

I HEREBY CERTIFY THAT THESE DOCUMENTS WERE PREPARED OR APPROVED BY ME, AND THAT I AM A DULY LICENSED PROFESSIONAL ENGINEER UNDER THE LAWS OF THE STATE OF MARYLAND, LICENSE NO. 23402, EXPIRATION DATE 25 AUGUST 2018.



DSN. BY:	SMB	REVISION	DATE
MBS/MP	CVH	REVISION TO DEMARCAT PHASES CONTRUCTION	4/2018
JAP/KEJ			8/2012
SMD			
OCT. 2016			
BY	NO.	REVISION	DATE

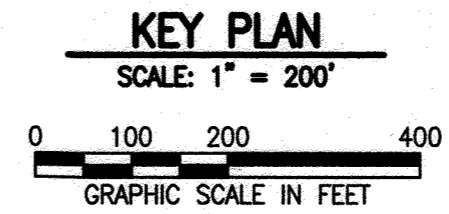


KEY PLAN

**COMPOST FACILITY - PHASE II
 AT ALPHA RIDGE LANDFILL**
 HOWARD COUNTY, MARYLAND

SDP SHEET:	DRAWING:
3 OF 44	G-2
PROJECT:	14982.05
SHEET:	3 OF 70

FILE PATH: C:\PROJECTS\1498205 - HOWARD COUNTY FACILITY\1498205-0302.DWG (3-2 - KEY PLAN - (SDP-3)) 3/17/15

NOT FOR CONSTRUCTION - SITE DEVELOPMENT PLAN #SDP-16-035

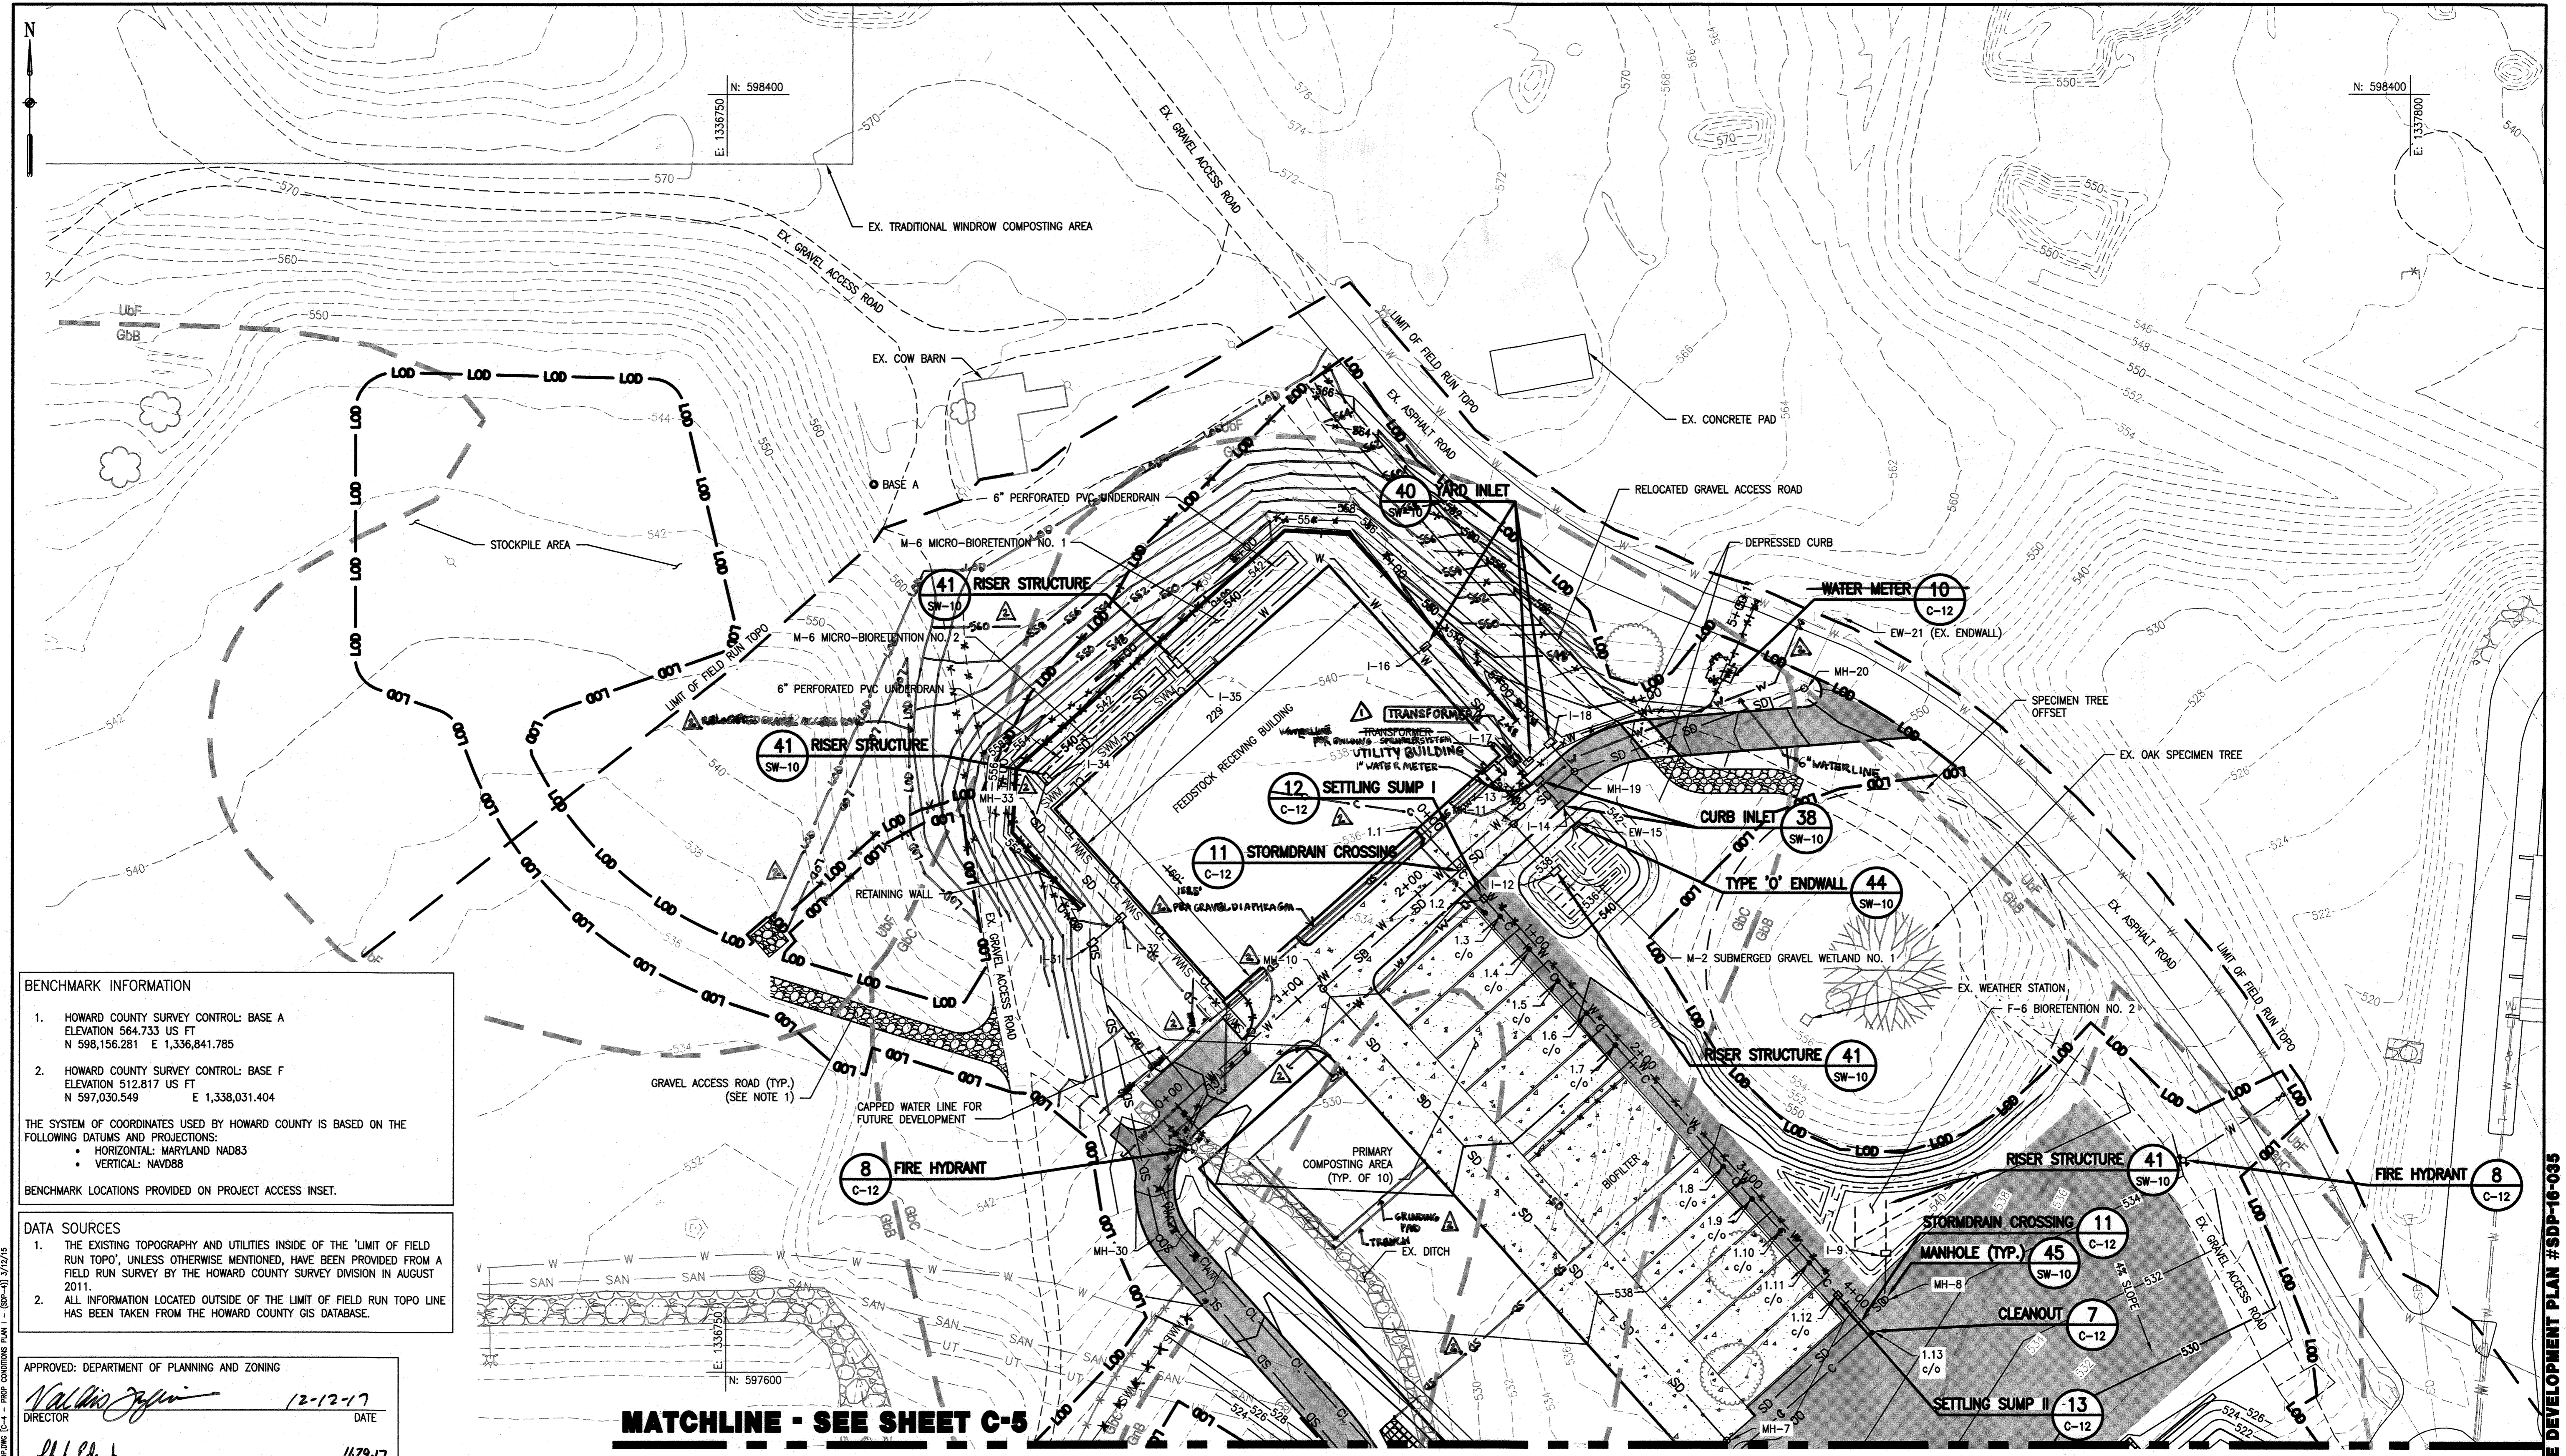

BENCHMARK INFORMATION

- HOWARD COUNTY SURVEY CONTROL: BASE A
ELEVATION 564.733 US FT
N 598,156.281 E 1,336,841.785
- HOWARD COUNTY SURVEY CONTROL: BASE F
ELEVATION 512.817 US FT
N 597,030.549 E 1,338,031.404

THE SYSTEM OF COORDINATES USED BY HOWARD COUNTY IS BASED ON THE FOLLOWING DATUMS AND PROJECTIONS:

- HORIZONTAL: MARYLAND NAD83
- VERTICAL: NAVD88

BENCHMARK LOCATIONS PROVIDED ON PROJECT ACCESS INSET.

DATA SOURCES

- THE EXISTING TOPOGRAPHY AND UTILITIES INSIDE OF THE 'LIMIT OF FIELD RUN TOPO', UNLESS OTHERWISE MENTIONED, HAVE BEEN PROVIDED FROM A FIELD RUN SURVEY BY THE HOWARD COUNTY SURVEY DIVISION IN AUGUST 2011.
- ALL INFORMATION LOCATED OUTSIDE OF THE LIMIT OF FIELD RUN TOPO LINE HAS BEEN TAKEN FROM THE HOWARD COUNTY GIS DATABASE.

APPROVED: DEPARTMENT OF PLANNING AND ZONING

Valerie Griffin 12-12-17
DIRECTOR DATE

John Clark 11-29-17
CHIEF, DEVELOPMENT ENGINEERING DIVISION DATE


Kevin Skelton 12-5-17
CHIEF, DIVISION OF LAND DEVELOPMENT DATE

GRID: 8 BLOCK: N/A
ZONING: RC-DEO PARCEL/LOT: 220, 253, 11, 23, 54
TAX MAP: 0016 ELECTION DISTRICT: 3-02

OWNER/ENGINEER INFORMATION

DEVELOPER/OWNER:
HOWARD COUNTY GOVERNMENT
CONTACT: JEFF DANNIS, P.E., CSP
6751 COLUMBIA GATEWAY DRIVE, SUITE 514
COLUMBIA, MD 21046
TELEPHONE: (410) 313-6419

ENGINEER:
EA ENGINEERING, SCIENCE,
AND TECHNOLOGY, INC., PBC
CONTACT: MARK GUTBERLET, P.E.
225 SCHILLING CIRCLE, SUITE 400
HUNT VALLEY, MD 21031
TELEPHONE: (410) 584-7000

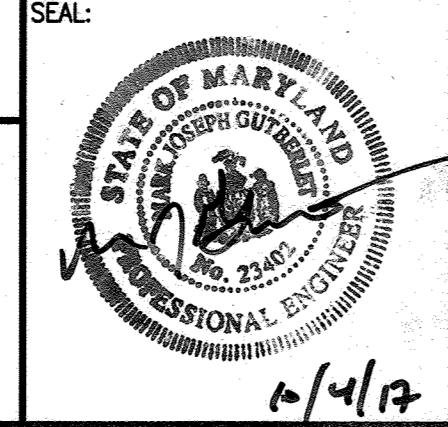

PROFESSIONAL CERTIFICATION:

EA ENGINEERING, SCIENCE AND TECHNOLOGY

I HEREBY CERTIFY THAT THESE DOCUMENTS WERE PREPARED OR APPROVED BY ME, AND THAT I AM A DULY LICENSED PROFESSIONAL ENGINEER UNDER THE LAWS OF THE STATE OF MARYLAND, LICENSE NO. 23402, EXPIRATION DATE 25 AUGUST 2018.

DSN. BY: MBS/MP	SMB	REVISED BUILDING AND TRANSFORMER LOCATION	11/2016
DRN. BY: JAP/KEJ	CVH	REVISED TO REFLECT POWER LINE AS MAINTAIN CONDITIONS AND PHASE II DESIGN	9/12/22
CHK. BY: SMD			
DATE: OCT. 2016	BY NO.	REVISION	DATE

SITE PLAN
SCALE: 1" = 50'
0 25 50 100
GRAPHIC SCALE IN FEET

NOTE:

- RELOCATED GRAVEL ACCESS ROAD TO MATCH EXISTING ROAD SECTION.
- LOCATION OF EXISTING UNDERGROUND TELEPHONE LINE IS APPROXIMATE.

SDP SHEET: DRAWING:
45 C-4
4 OF 4

PROJECT:
14982.05


SHEET:
7 OF 70

PROPOSED CONDITIONS PLAN I

COMPOST FACILITY - PHASE II
AT ALPHA RIDGE LANDFILL
HOWARD COUNTY, MARYLAND

NOT FOR CONSTRUCTION - SITE DEVELOPMENT PLAN #SDP-16-035

MATCHLINE - SEE SHEET C-4

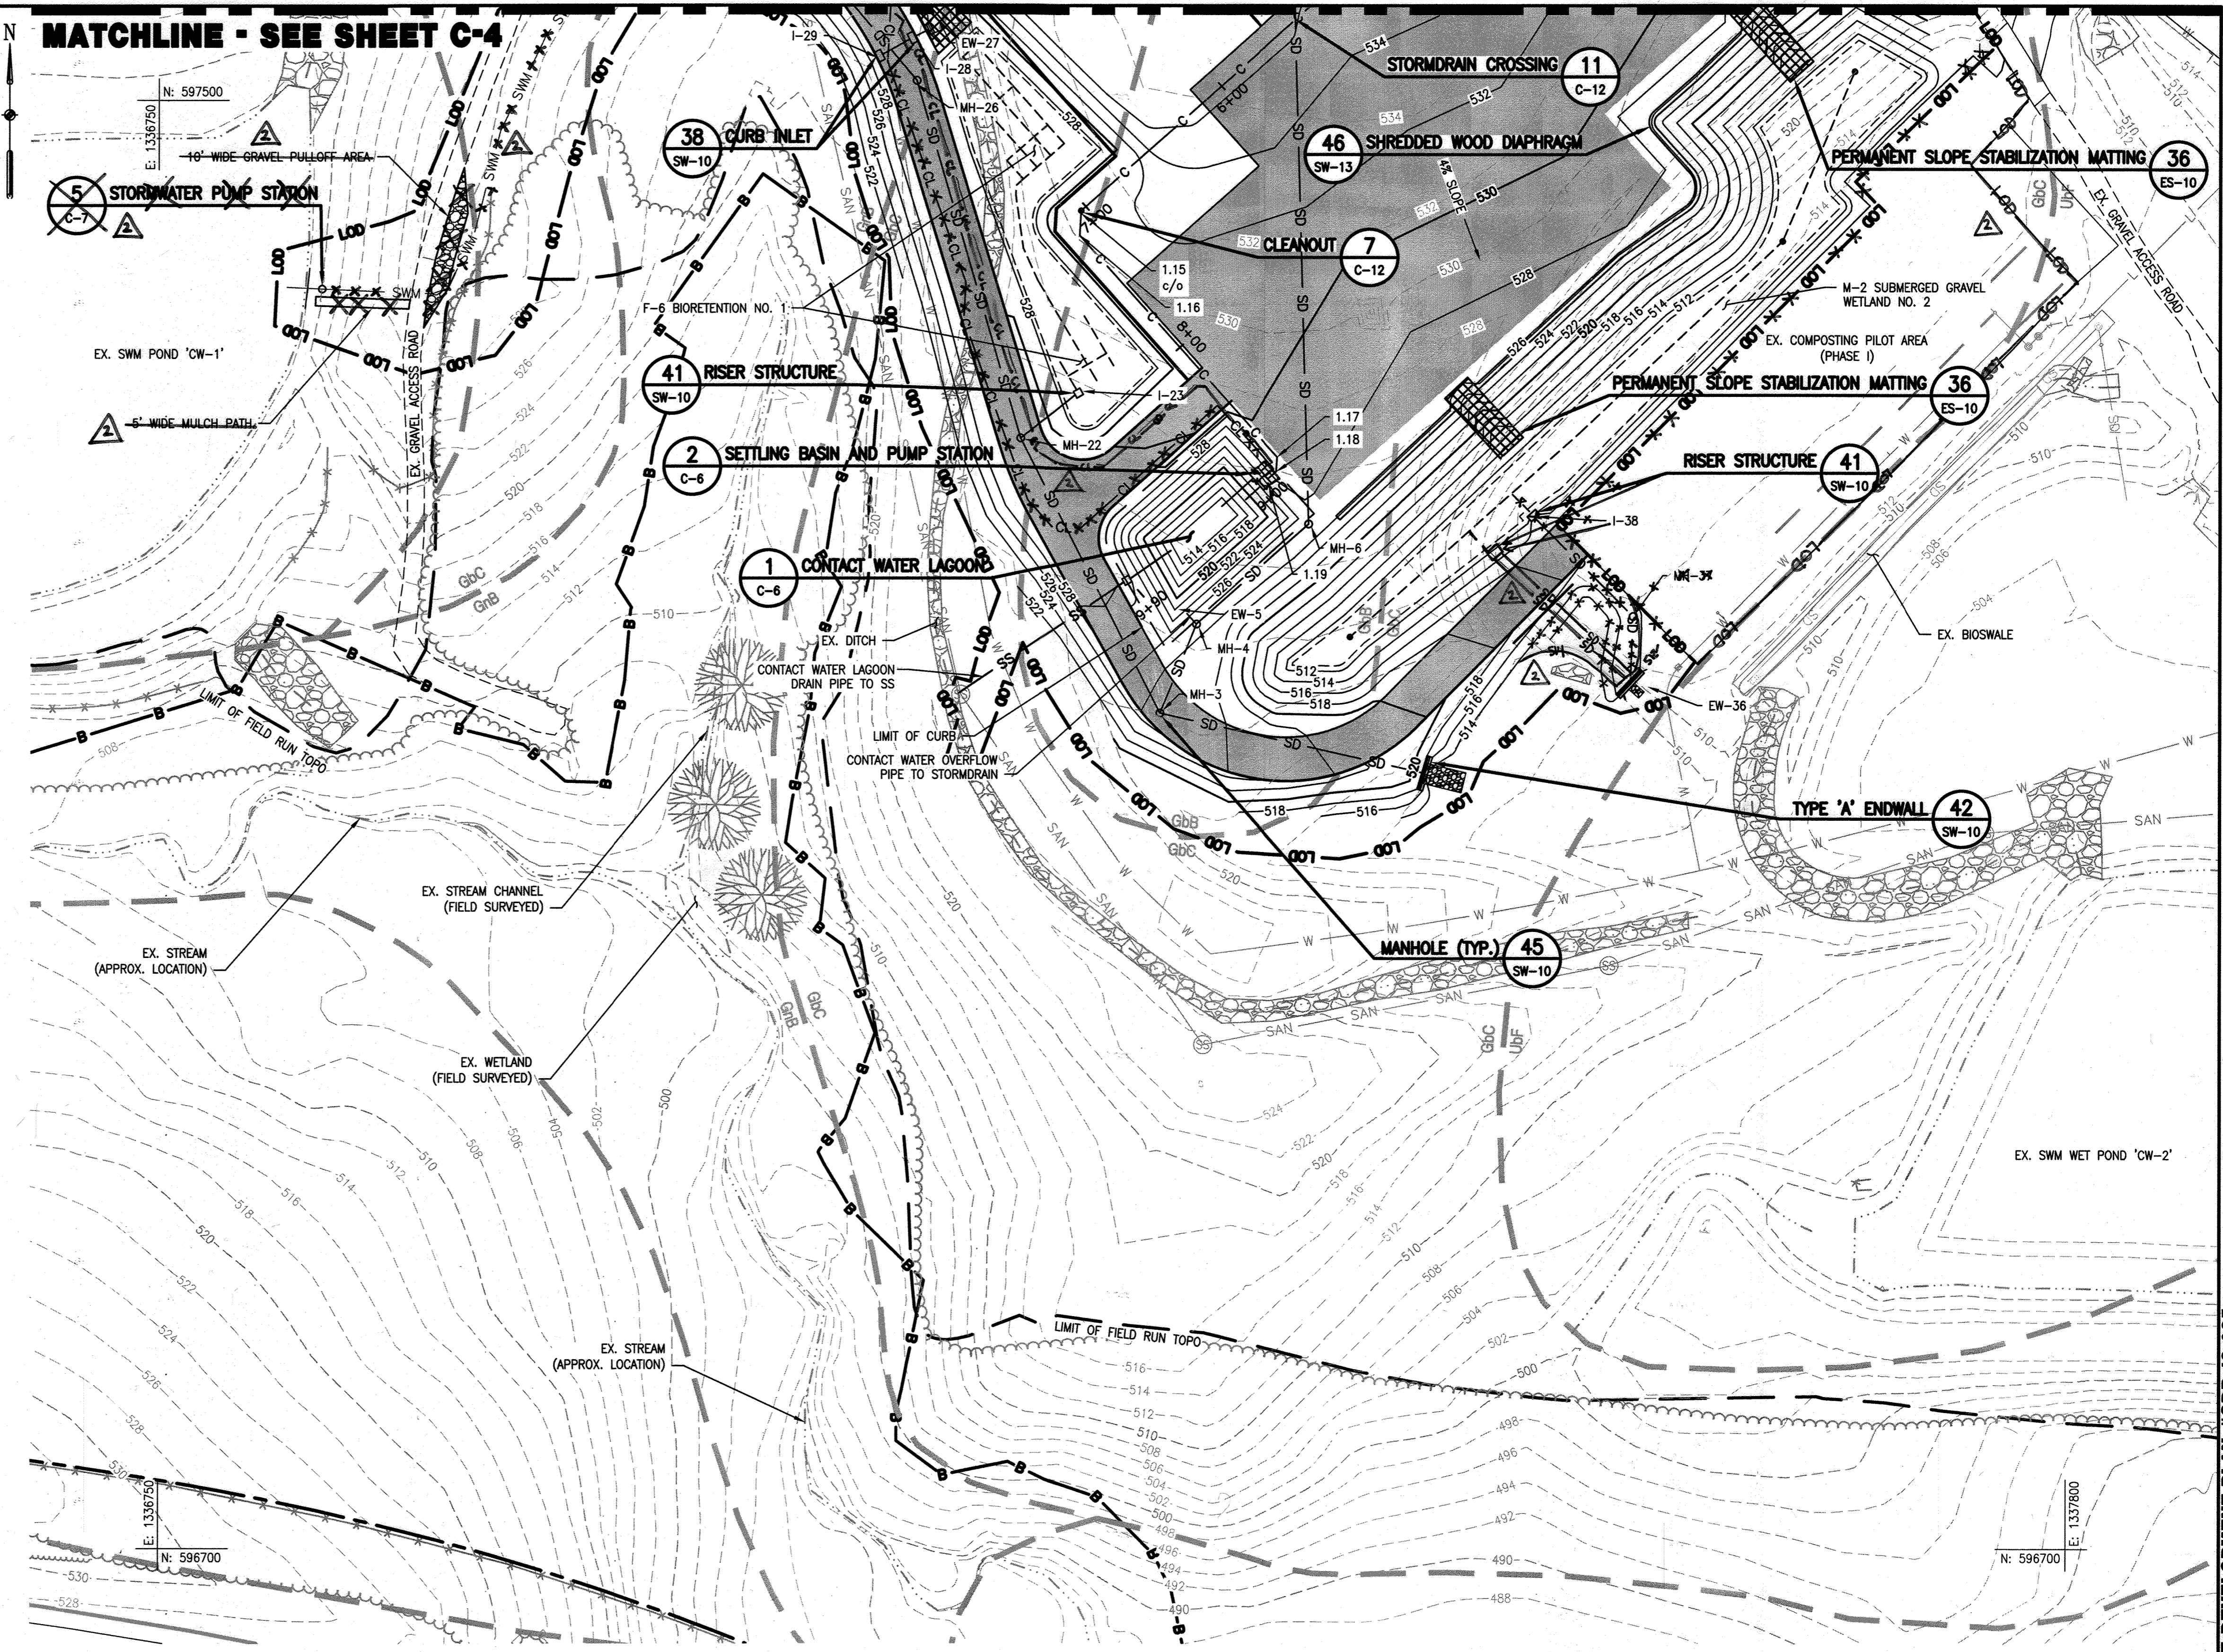

BENCHMARK INFORMATION

- HOWARD COUNTY SURVEY CONTROL: BASE A
ELEVATION 564.733 US FT
N 598,156.281 E 1,336,841.785
- HOWARD COUNTY SURVEY CONTROL: BASE F
ELEVATION 512.817 US FT
N 597,030.549 E 1,338,031.404

THE SYSTEM OF COORDINATES USED BY HOWARD COUNTY IS BASED ON THE FOLLOWING DATUMS AND PROJECTIONS:

- HORIZONTAL: MARYLAND NAD83
- VERTICAL: NAVD83

BENCHMARK LOCATIONS PROVIDED ON PROJECT ACCESS INSET.

DATA SOURCES

- THE EXISTING TOPOGRAPHY AND UTILITIES INSIDE OF THE 'LIMIT OF FIELD RUN TOPO', UNLESS OTHERWISE MENTIONED, HAVE BEEN PROVIDED FROM A FIELD RUN SURVEY BY THE HOWARD COUNTY SURVEY DIVISION IN AUGUST 2011.
- ALL INFORMATION LOCATED OUTSIDE OF THE LIMIT OF FIELD RUN TOPO LINE HAS BEEN TAKEN FROM THE HOWARD COUNTY GIS DATABASE.

APPROVED: DEPARTMENT OF PLANNING AND ZONING

William J. Ziegler 12-12-17
DIRECTOR DATE

Chad Clark 11-29-17
CHIEF, DEVELOPMENT ENGINEERING DIVISION DATE


Kate Land 12-5-17
CHIEF, DIVISION OF LAND DEVELOPMENT DATE

GRID: 8 BLOCK: N/A
ZONING: RC-DEO PARCEL/LOT: 220, 253, 11, 23, 54
TAX MAP: 0016 ELECTION DISTRICT: 3-02

OWNER/ENGINEER INFORMATION

DEVELOPER/OWNER:
HOWARD COUNTY GOVERNMENT
CONTACT: JEFF DANNIS, P.E., CSP
6751 COLUMBIA GATEWAY DRIVE, SUITE 514
COLUMBIA, MD 21046
TELEPHONE: (410) 313-6419

ENGINEER:
EA ENGINEERING, SCIENCE,
AND TECHNOLOGY, INC., PBC
CONTACT: MARK GUTBERLET, P.E.
225 SCHILLING CIRCLE, SUITE 400
HUNT VALLEY, MD 21031
TELEPHONE: (410) 584-7000

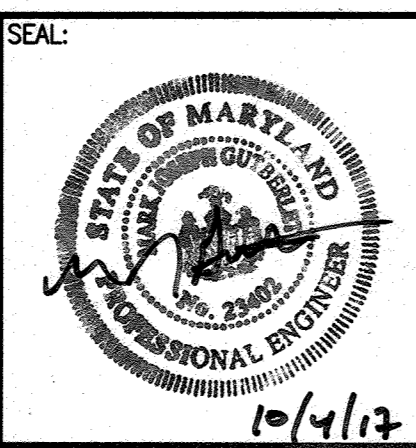

PROFESSIONAL CERTIFICATION:

I HEREBY CERTIFY THAT THESE DOCUMENTS WERE PREPARED OR APPROVED BY ME, AND THAT I AM A DULY LICENSED PROFESSIONAL ENGINEER UNDER THE LAWS OF THE STATE OF MARYLAND. LICENSE NO. 23402. EXPIRATION DATE 25 AUGUST 2016.

EA
EA ENGINEERING, SCIENCE, AND TECHNOLOGY

DSN. BY: MBS/MP	CVH	REVISION TO REFLECT PHASE IIA AND PHASE IIB AS-BUILT CONDITIONS AND WASTEWATER LOD	9/2/22
DRN. BY: JAP/KEJ			
CHK. BY: SMD			
DATE: OCT. 2016			
BY	NO.	REVISION	DATE


SITE PLAN
SCALE: 1" = 50'
GRAPHIC SCALE IN FEET

PROPOSED CONDITIONS PLAN II


COMPOST FACILITY - PHASE II
AT ALPHA RIDGE LANDFILL
HOWARD COUNTY, MARYLAND

SDP SHEET: DRAWING:	45	C-5
	5 OF 14	
PROJECT:	14982.05	
SHEET:	8 OF 78	

NOT FOR CONSTRUCTION - SITE DEVELOPMENT PLAN #SDP-16-035

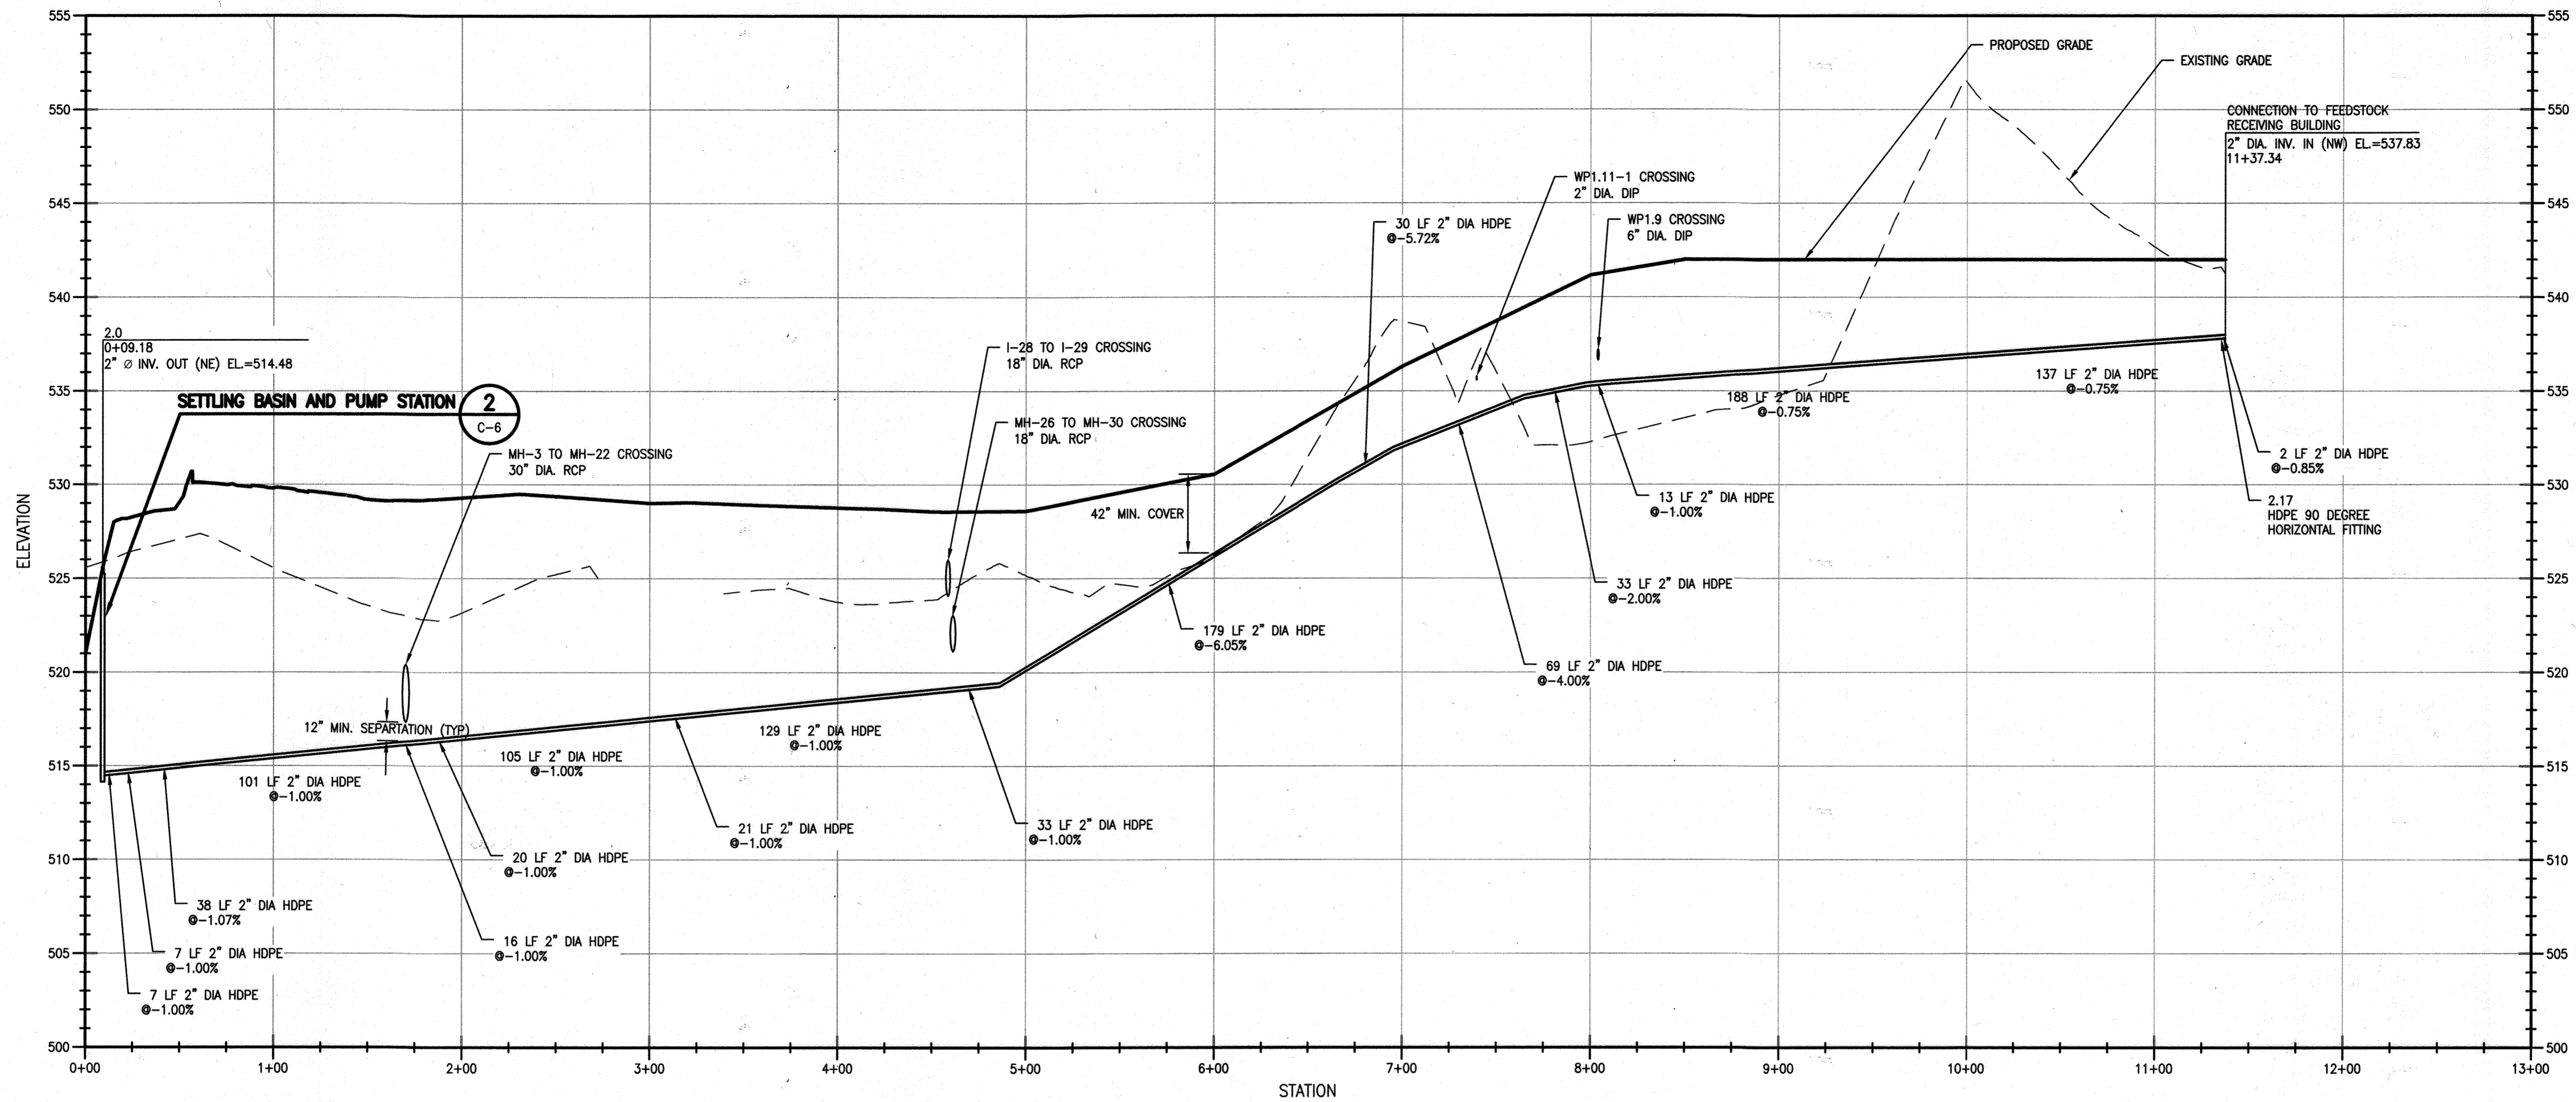

B PRESSURE PIPE FROM CONTACT WATER LAGOON TO FEEDSTOCK RECEIVING BUILDING PROFILE
 VERTICAL SCALE: 1" = 5'
 HORIZONTAL SCALE: 1" = 50'

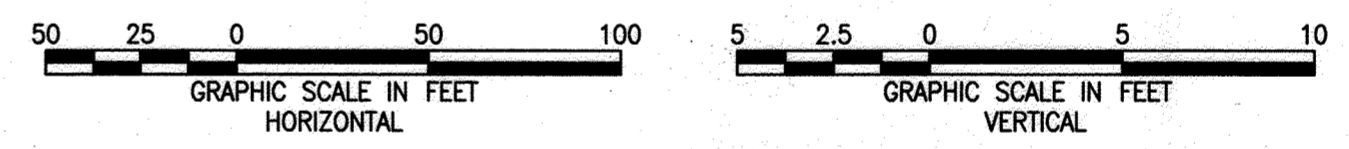


FILE PATH: Q:\PROJECTS\148205 - ALC COMPOST FACILITY\148205-SHOWPLANS (C-9 - CONTACT WATER PRESSURE LINE PROFILE 1 - (SDP-7)) 3/17/15

APPROVED: DEPARTMENT OF PLANNING AND ZONING
N. J. J. J. 12-12-17
 DIRECTOR DATE
D. J. J. J. 11-29-17
 CHIEF, DEVELOPMENT ENGINEERING DIVISION DATE
K. J. J. J. 12-5-17
 CHIEF, DIVISION OF LAND DEVELOPMENT DATE

GRID: 8 BLOCK: N/A
 ZONING: RC-DEO PARCEL/LOT: 220, 253, 11, 23, 54
 TAX MAP: 0016 ELECTION DISTRICT: 3-02

OWNER/ENGINEER INFORMATION
 DEVELOPER/OWNER: HOWARD COUNTY GOVERNMENT
 CONTACT: JEFF DANNIS, P.E., CSP
 6751 COLUMBIA GATEWAY DRIVE, SUITE 514
 COLUMBIA, MD 21046
 TELEPHONE: (410) 313-6419

ENGINEER: EA ENGINEERING, SCIENCE, AND TECHNOLOGY, INC., PBC
 CONTACT: MARK GUTBERLET, P.E.
 225 SCHILLING CIRCLE, SUITE 400
 HUNT VALLEY, MD 21031
 TELEPHONE: (410) 584-7000

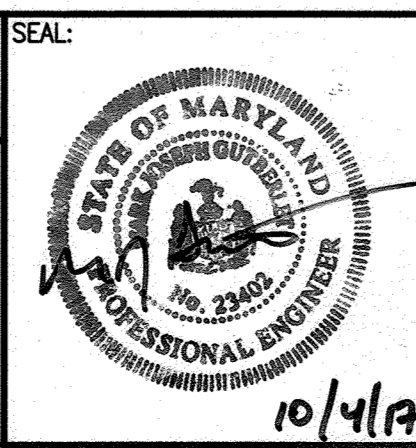

PROFESSIONAL CERTIFICATION:
 I HEREBY CERTIFY THAT THESE DOCUMENTS WERE PREPARED OR APPROVED BY ME, AND THAT I AM A DULY LICENSED PROFESSIONAL ENGINEER UNDER THE LAWS OF THE STATE OF MARYLAND, LICENSE NO. 23402, EXPIRATION DATE 25 AUGUST 2018.

EA
 EA ENGINEERING, SCIENCE AND TECHNOLOGY

10/4/17


DSN. BY: LO	CVH	REVISION TOTAL SHEET NUMBER	8/20/22
DRN. BY: JAP/LO		DUE TO ADDITION OF SHEET 45	
CHK. BY: SMD			
DATE: OCT. 2016			
BY	NO.	REVISION	DATE

CONTACT WATER PRESSURE LINE PROFILE I

COMPOST FACILITY - PHASE II AT ALPHA RIDGE LANDFILL
 HOWARD COUNTY, MARYLAND


SDP SHEET: DRAWING:	45
	C-9
PROJECT:	14982.05
SHEET:	12 OF 70

NOT FOR CONSTRUCTION - SITE DEVELOPMENT PLAN #SDP-16-035

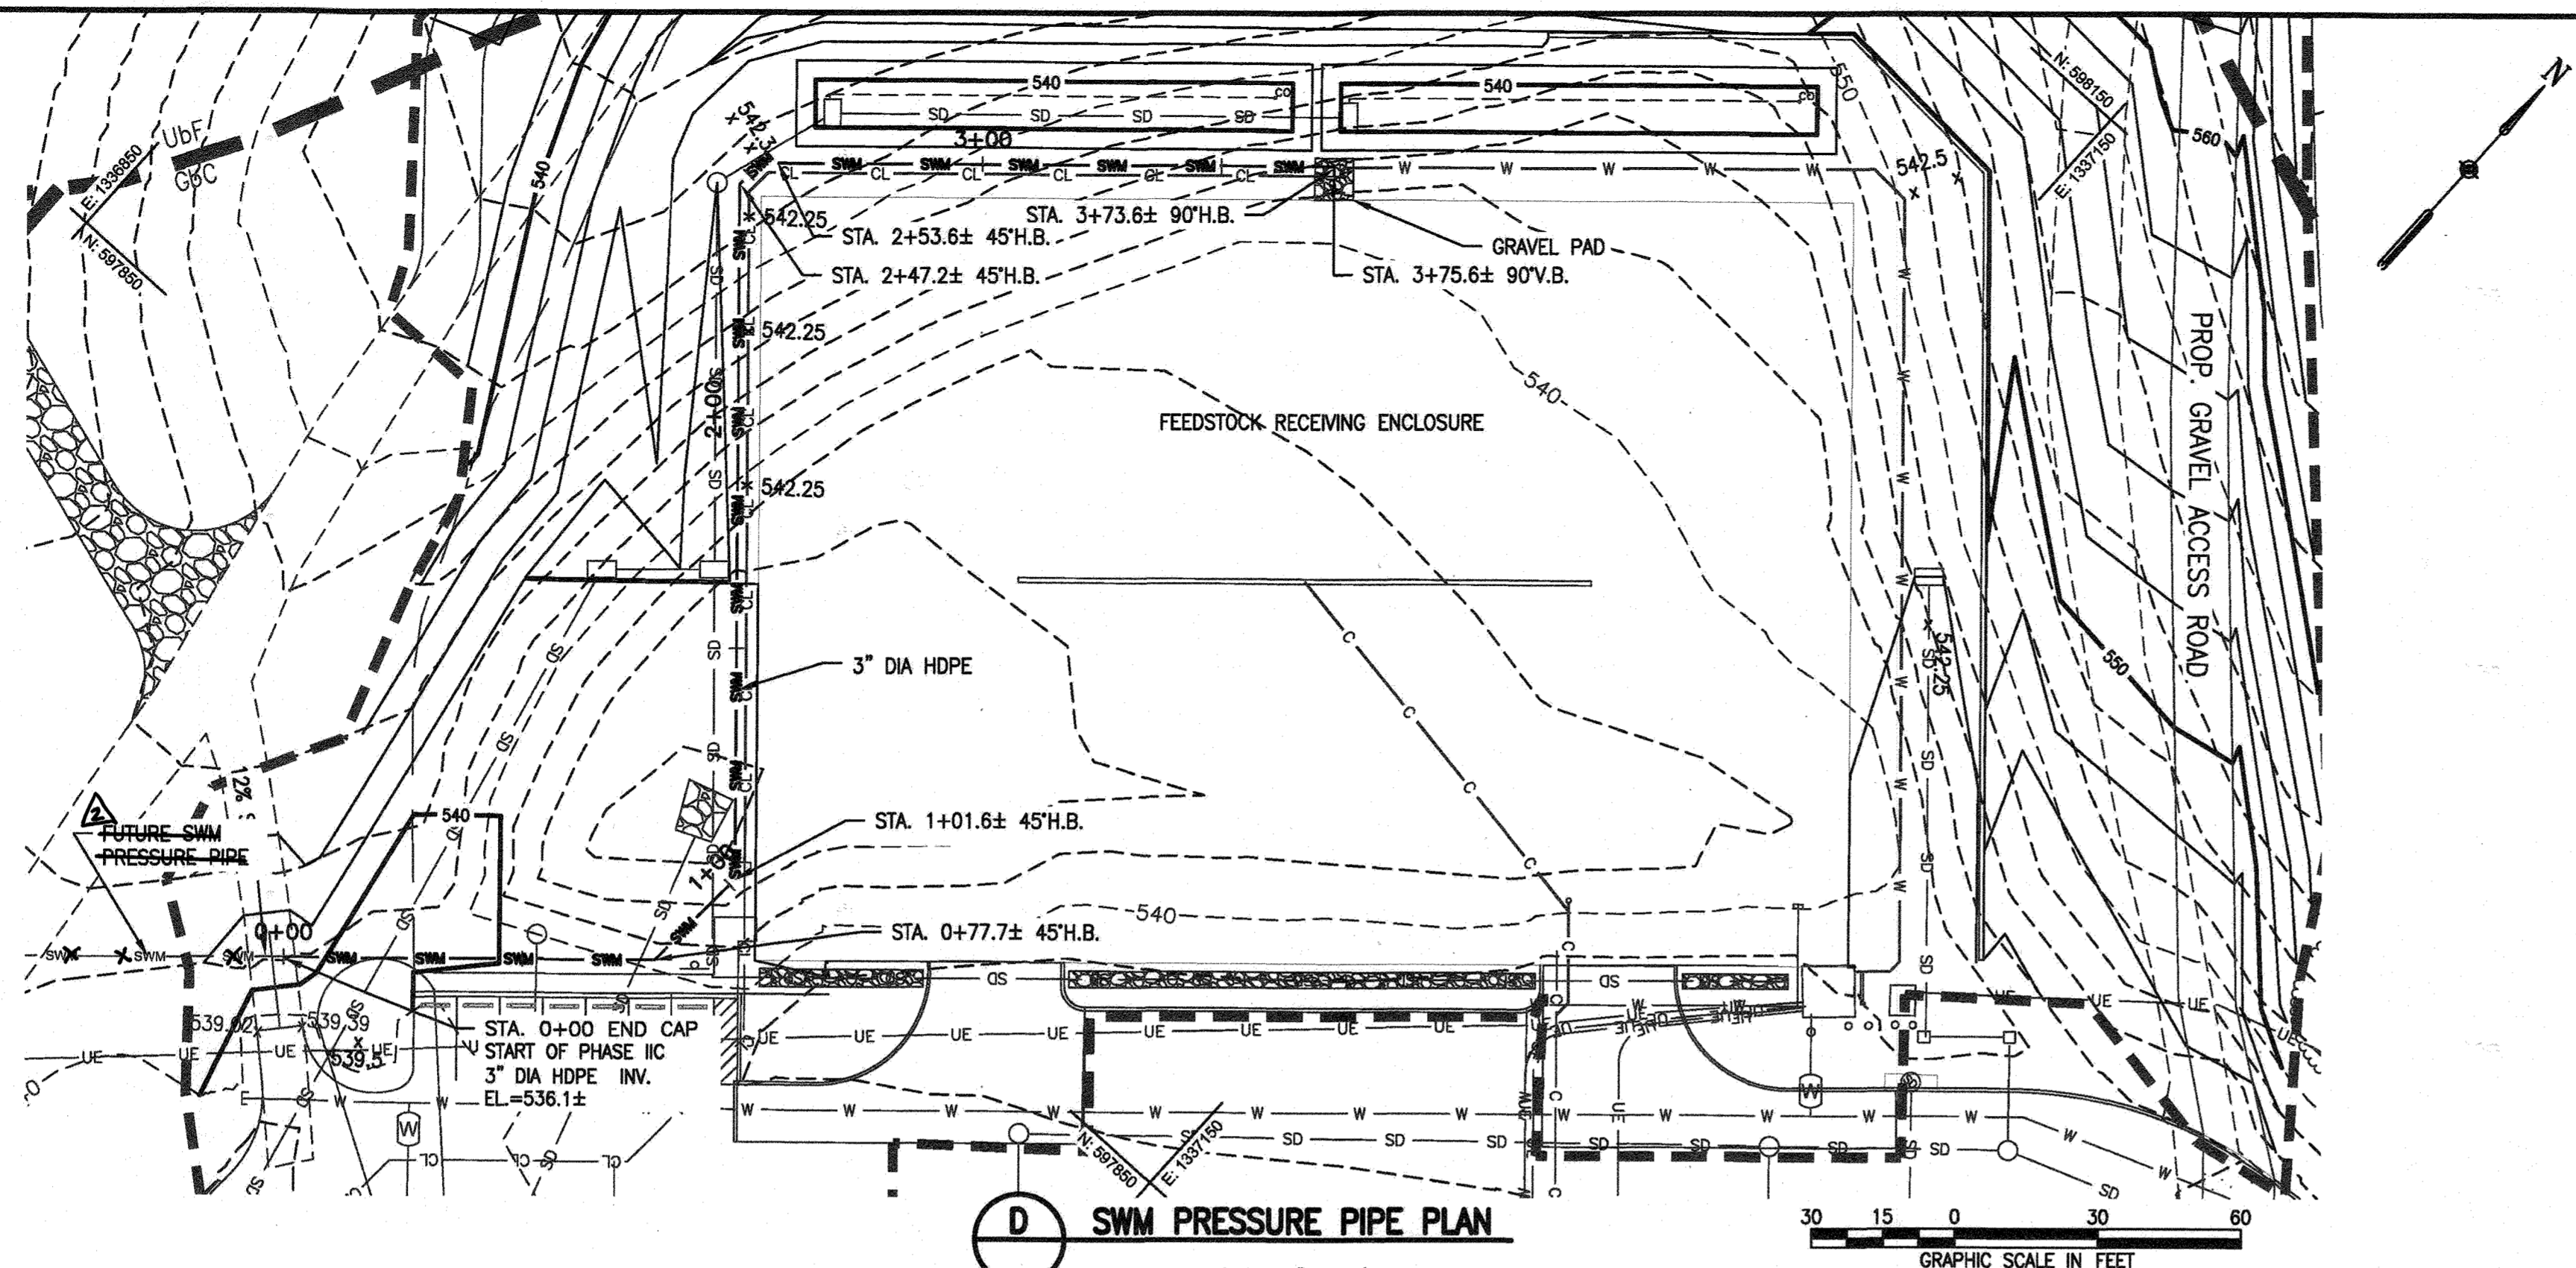

NOTE:

1. ALL SWM PRESSURE PIPE SHALL BE HDPE DR-17.
2. SWM PIPE SHOWN SHALL BE CONNECTED TO FUTURE SWM PIPE AT STA. 0+00. PROVIDE END CAP AND FIBERGLASS SIGN AND MARKER AT THIS LOCATION, FOR EASE OF FUTURE LOCATION AND CONNECTION.
3. TRACER WIRE SHALL BE PLACED FOR 3-IN DIA. HDPE PIPE FROM STA. 0+00 TO STA. 1+00.

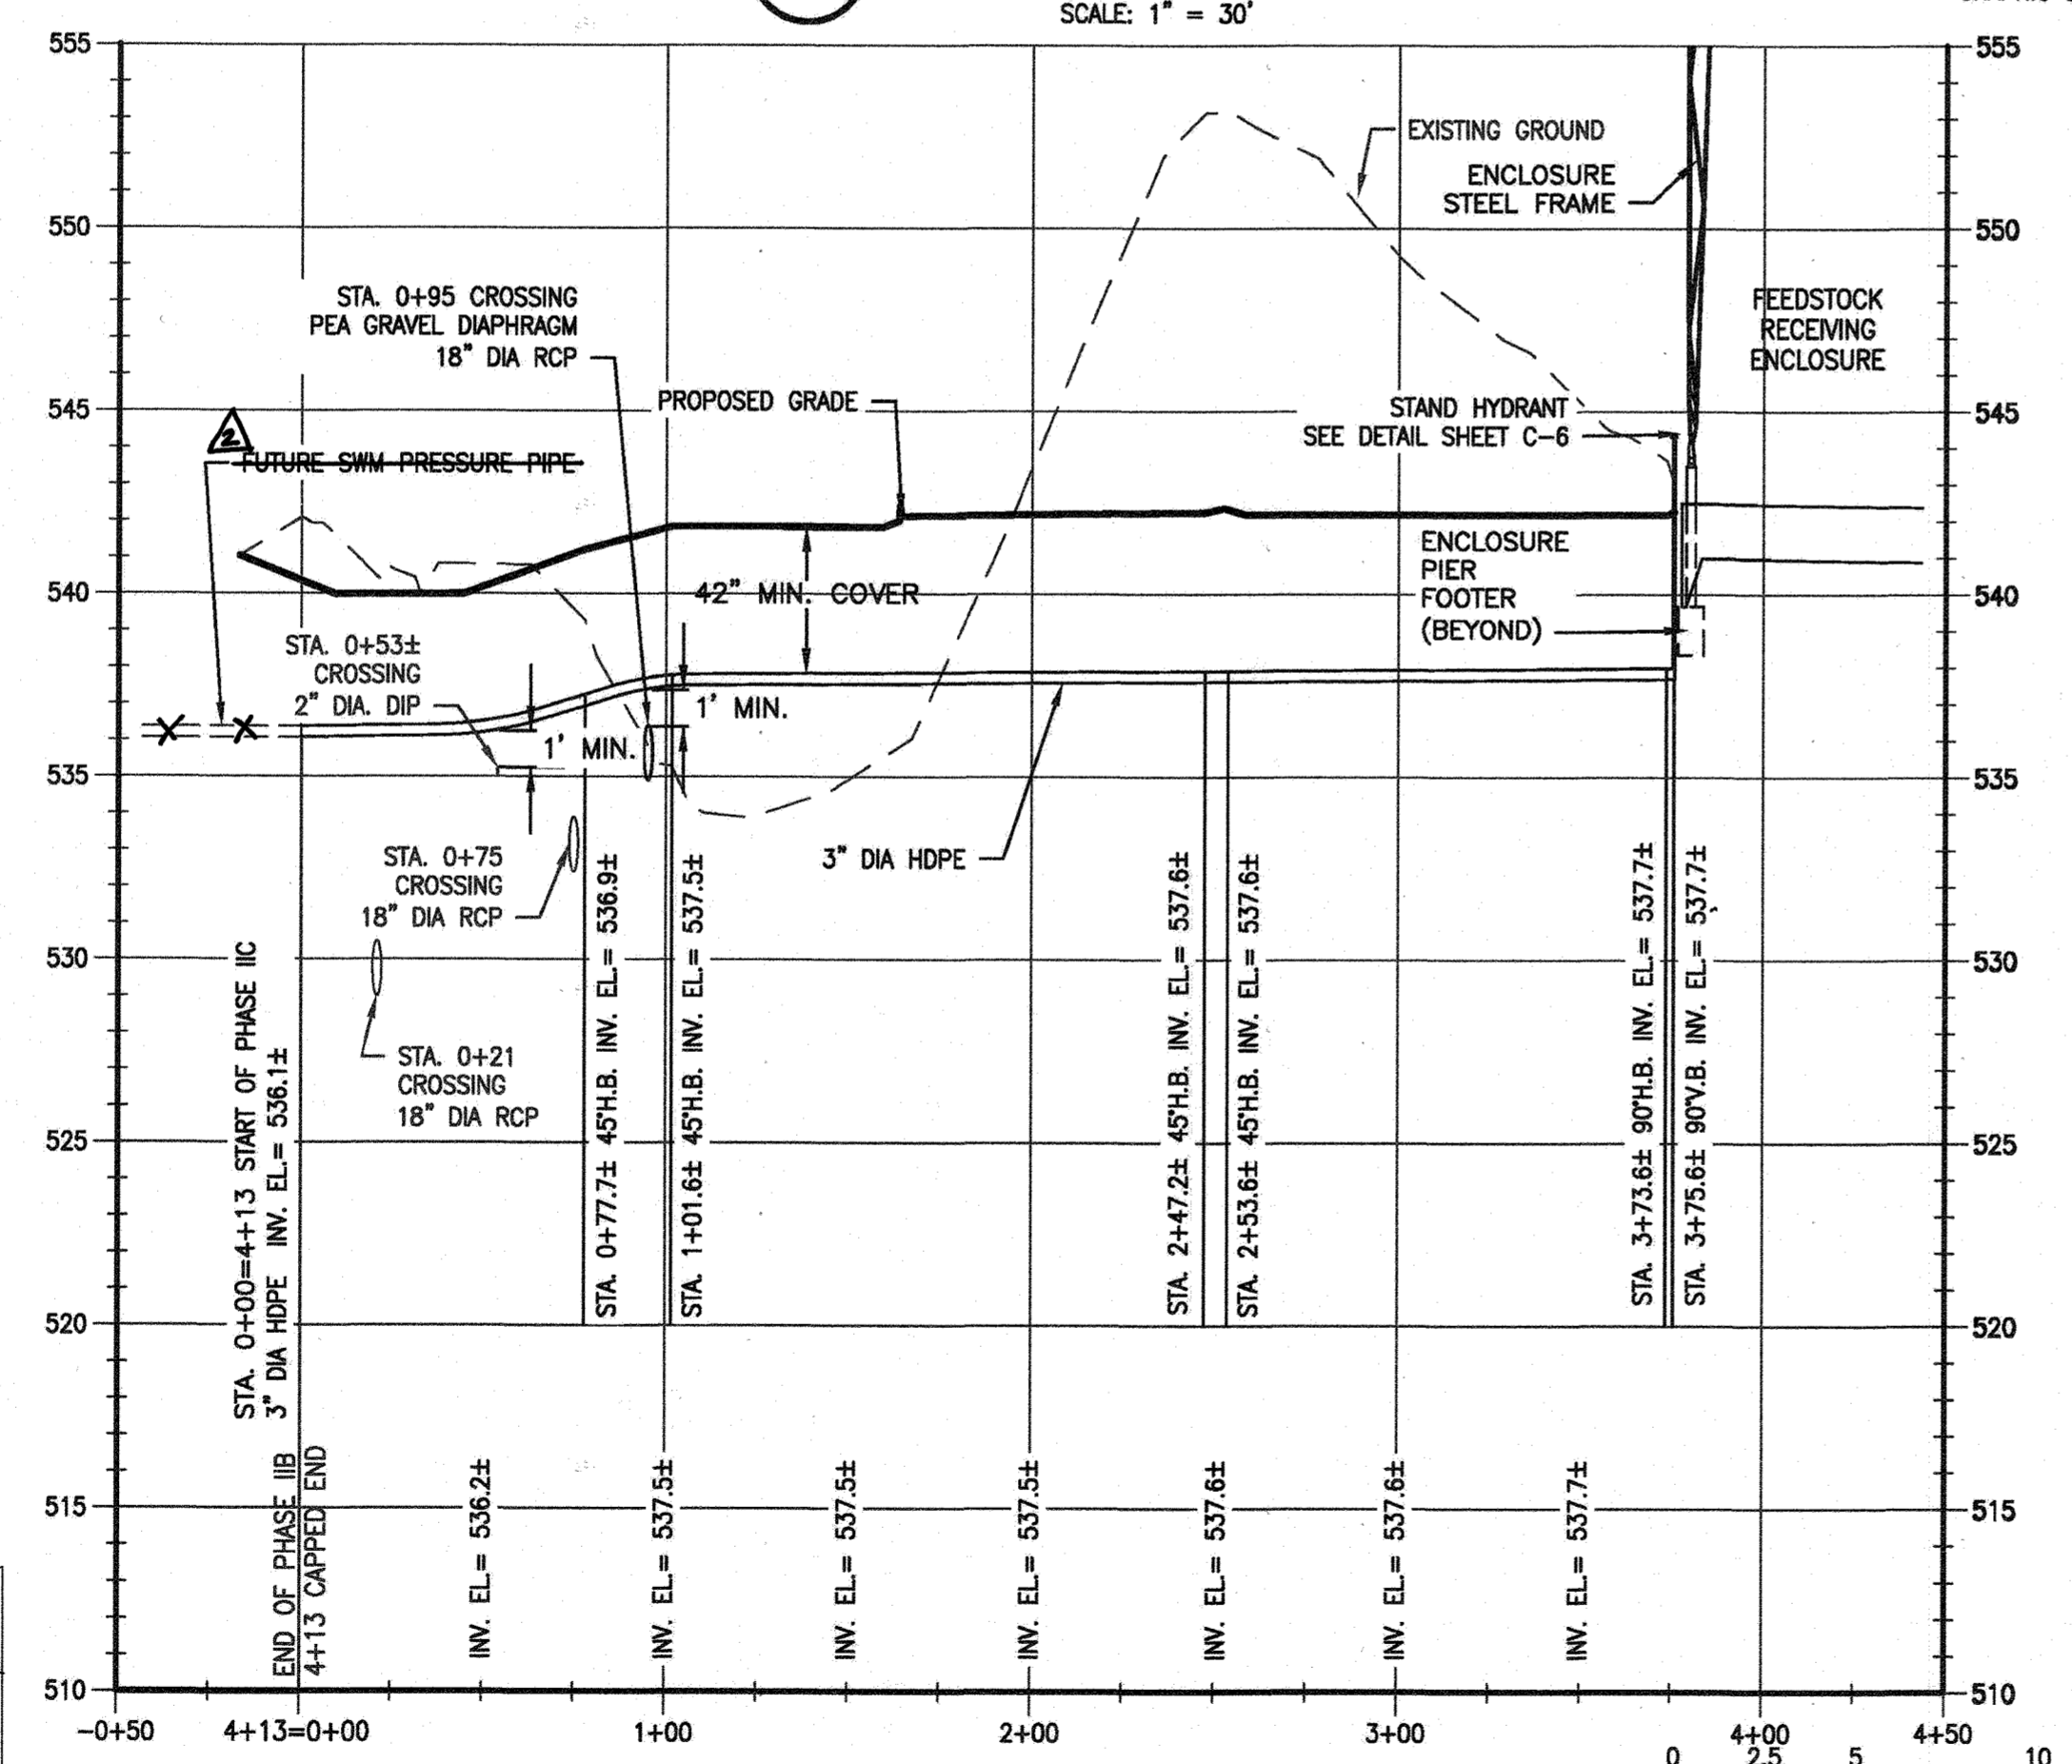


APPROVED: DEPARTMENT OF PLANNING AND ZONING

DIRECTOR: *[Signature]* DATE: 9-15-22

CHIEF, DEVELOPMENT ENGINEERING DIVISION: *[Signature]* DATE: 9-12-22

CHIEF, DIVISION OF LAND DEVELOPMENT: *[Signature]* DATE: 9/17/22

D SWM PRESSURE PIPE PROFILE
 VERTICAL SCALE: 1" = 5'
 HORIZONTAL SCALE: 1" = 50'

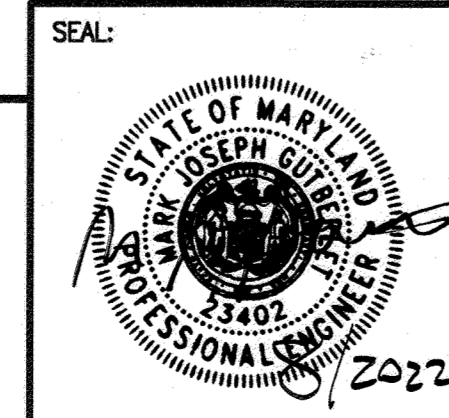

PROFESSIONAL CERTIFICATION:

I HEREBY CERTIFY THAT THESE DOCUMENTS WERE PREPARED OR APPROVED BY ME, AND THAT I AM A DULY LICENSED PROFESSIONAL ENGINEER UNDER THE LAWS OF THE STATE OF MARYLAND, LICENSE NO. 23402, EXPIRATION DATE 25 AUGUST 2022.

EA ENGINEERING, SCIENCE, AND TECHNOLOGY

DSN. BY:	RMC	CVH	REPLACEMENT SHEET FROM PHASE II 2022
DRN. BY:	JRG		IIC CONTRACT DRAWINGS TO SHOW
CHK. BY:	SMD		DESIGN PHASE REVISIONS TO SWM
DATE:	JUNE 2021		PRESSURE PIPE ROUTING
BY:	NO.	REVISION	DATE





SWM PRESSURE PIPE PLAN & PROFILE
 (REPLACEMENT SHEET)

COMPOST FACILITY - PHASE IIC
 AT ALPHA RIDGE LANDFILL
 HOWARD COUNTY, MARYLAND

SDP SHEET:	DRAWING:
8 OF 45	C-10
PROJECT:	1556408
SHEET:	8 OF 42

FILE PATH: Q:\PROJECTS\1556408 - HOWARD CO. COMPOST PH. IIC\DWG\PRODUCTION\SDP\SDP_1556408-C-08-SWP-PLANING [C-8] 2/22/23

REVISED SITE DEVELOPMENT PLAN #SDP-16-035

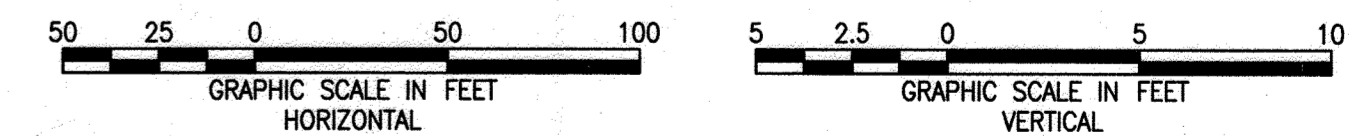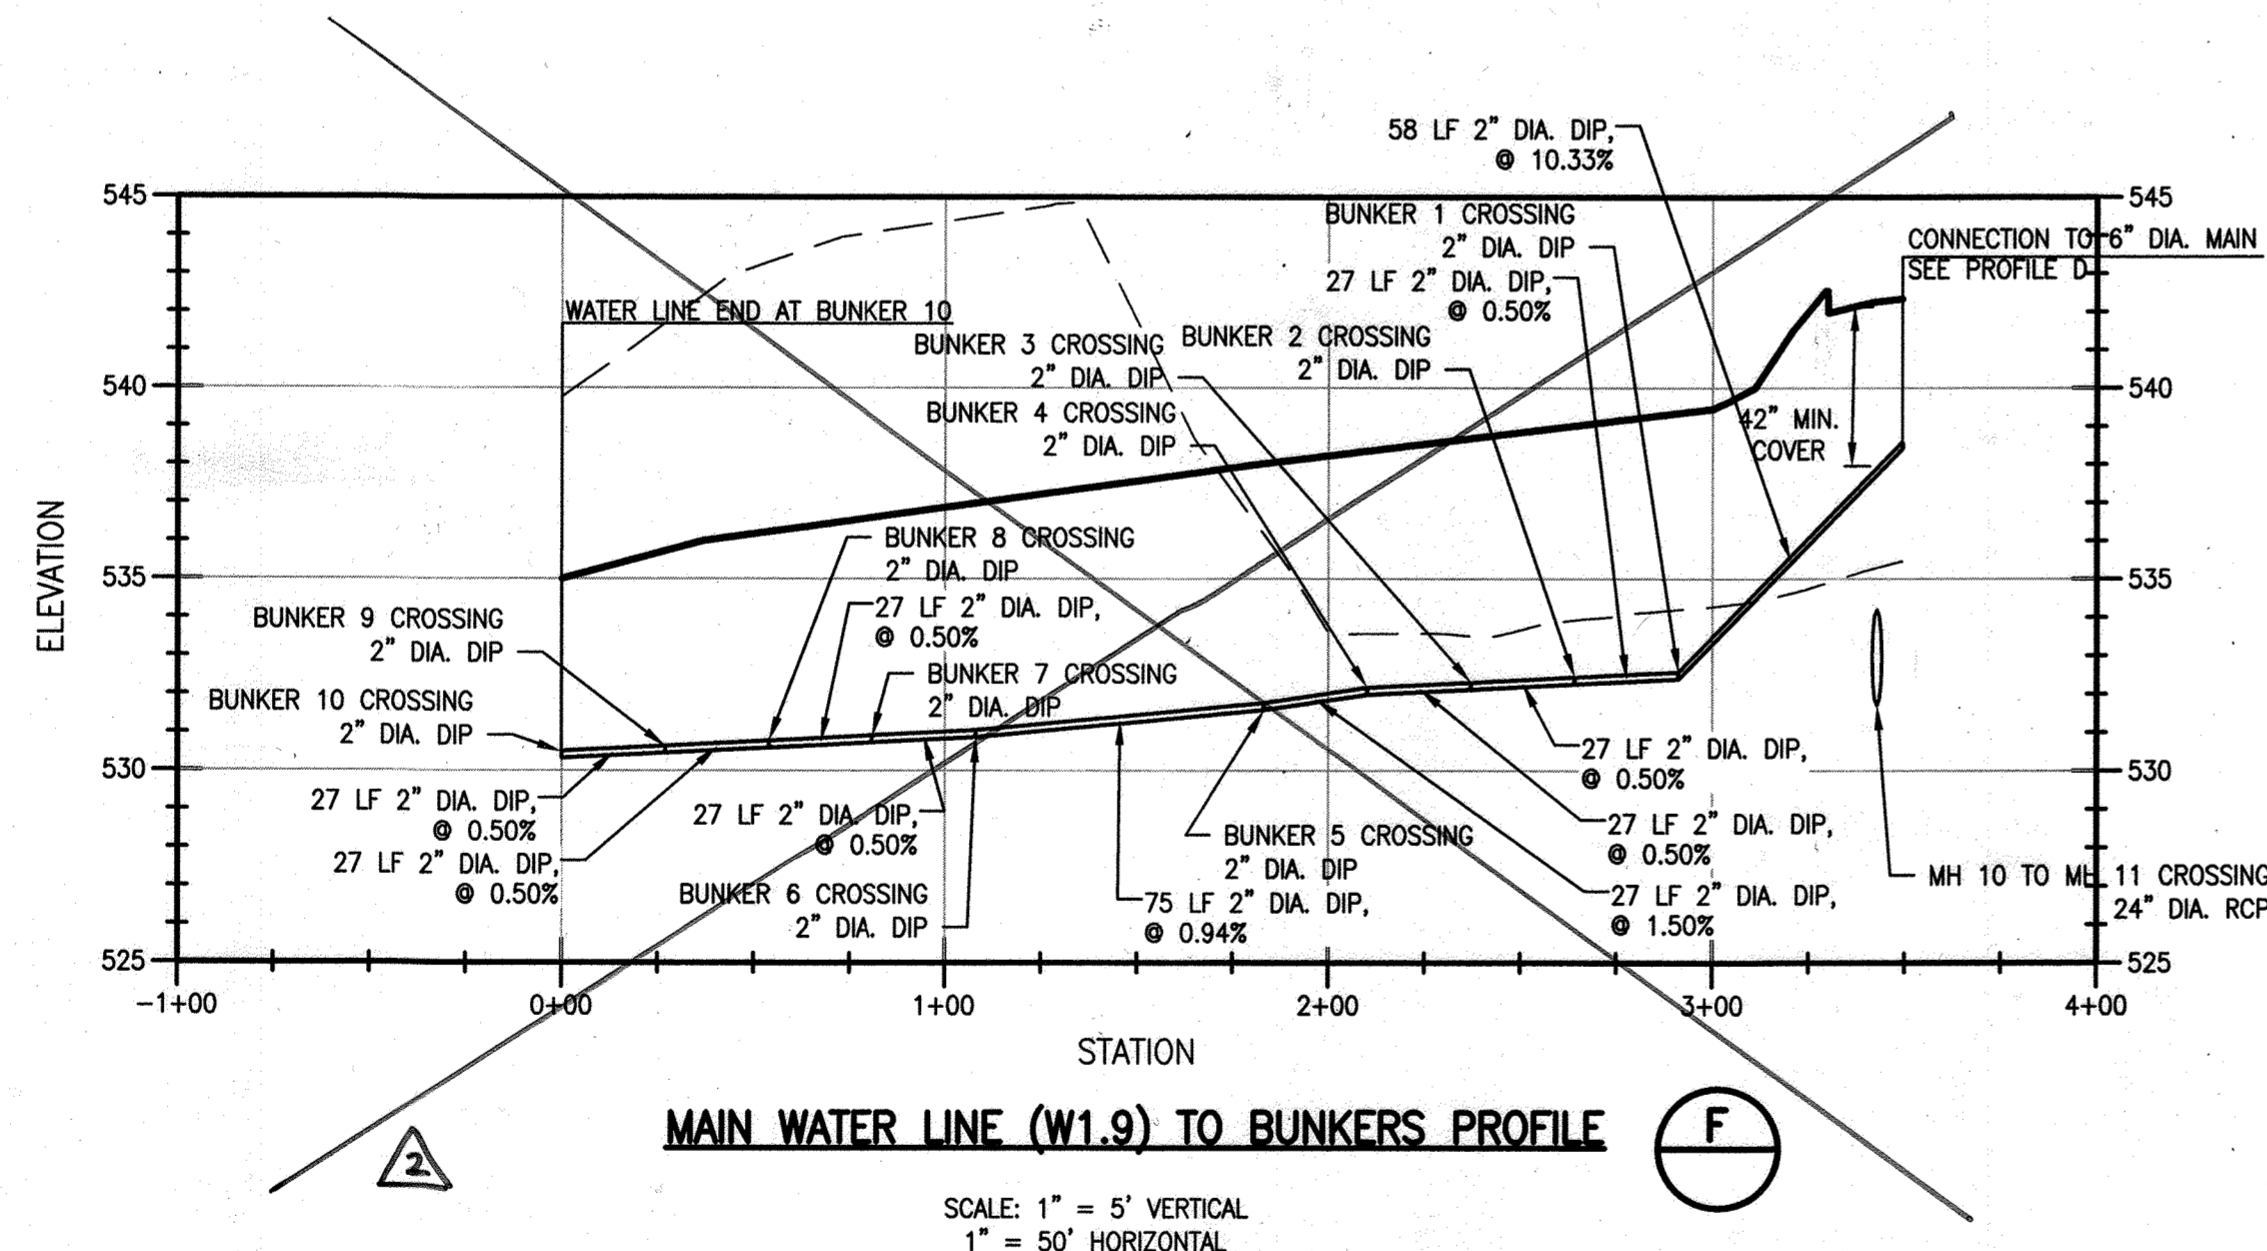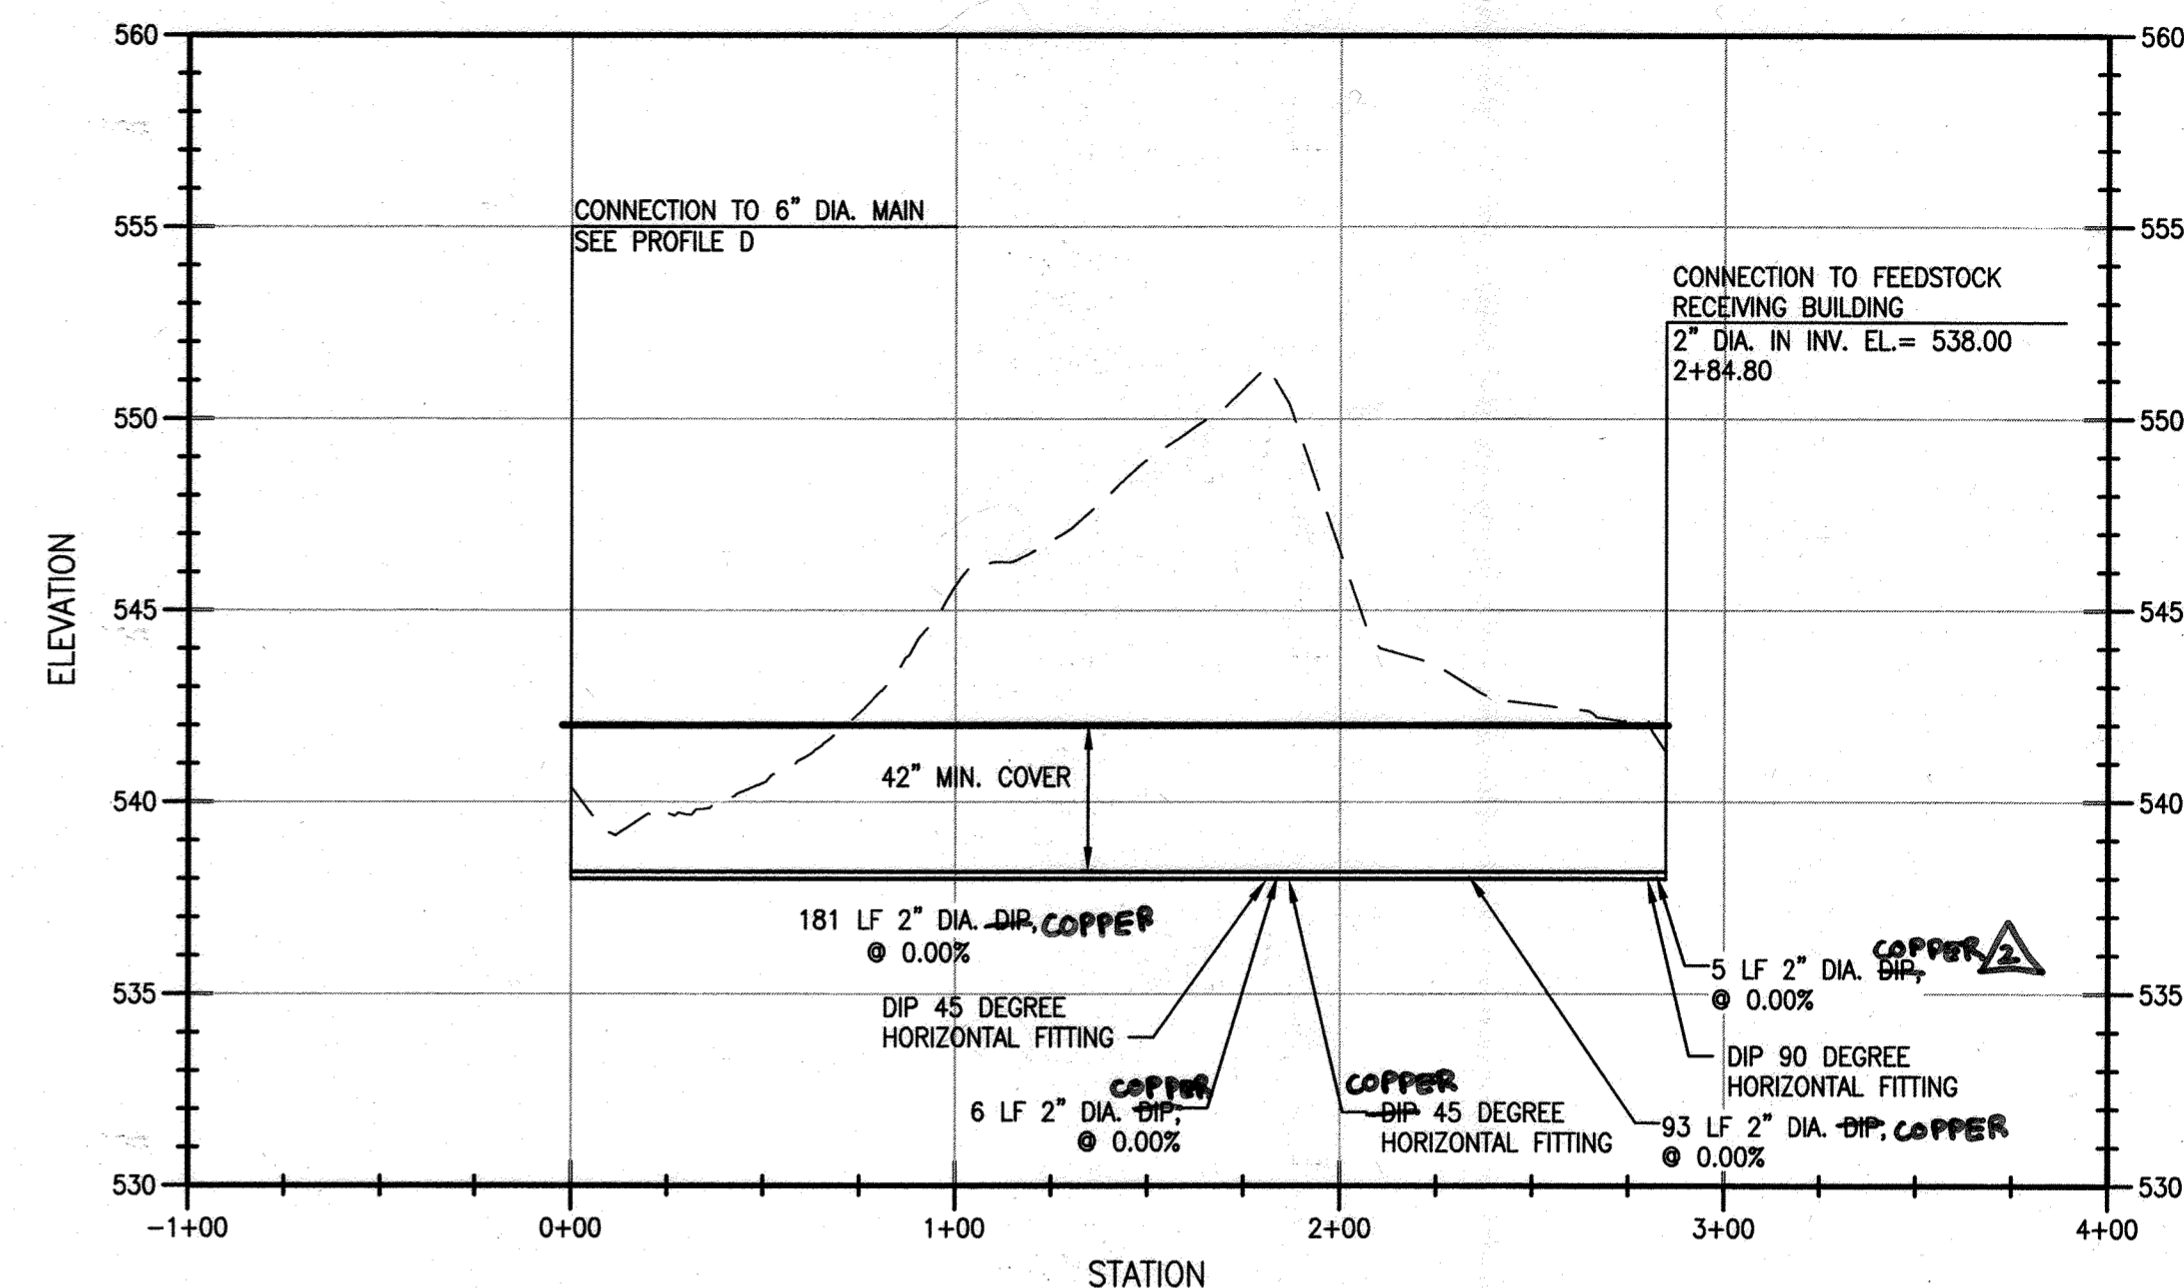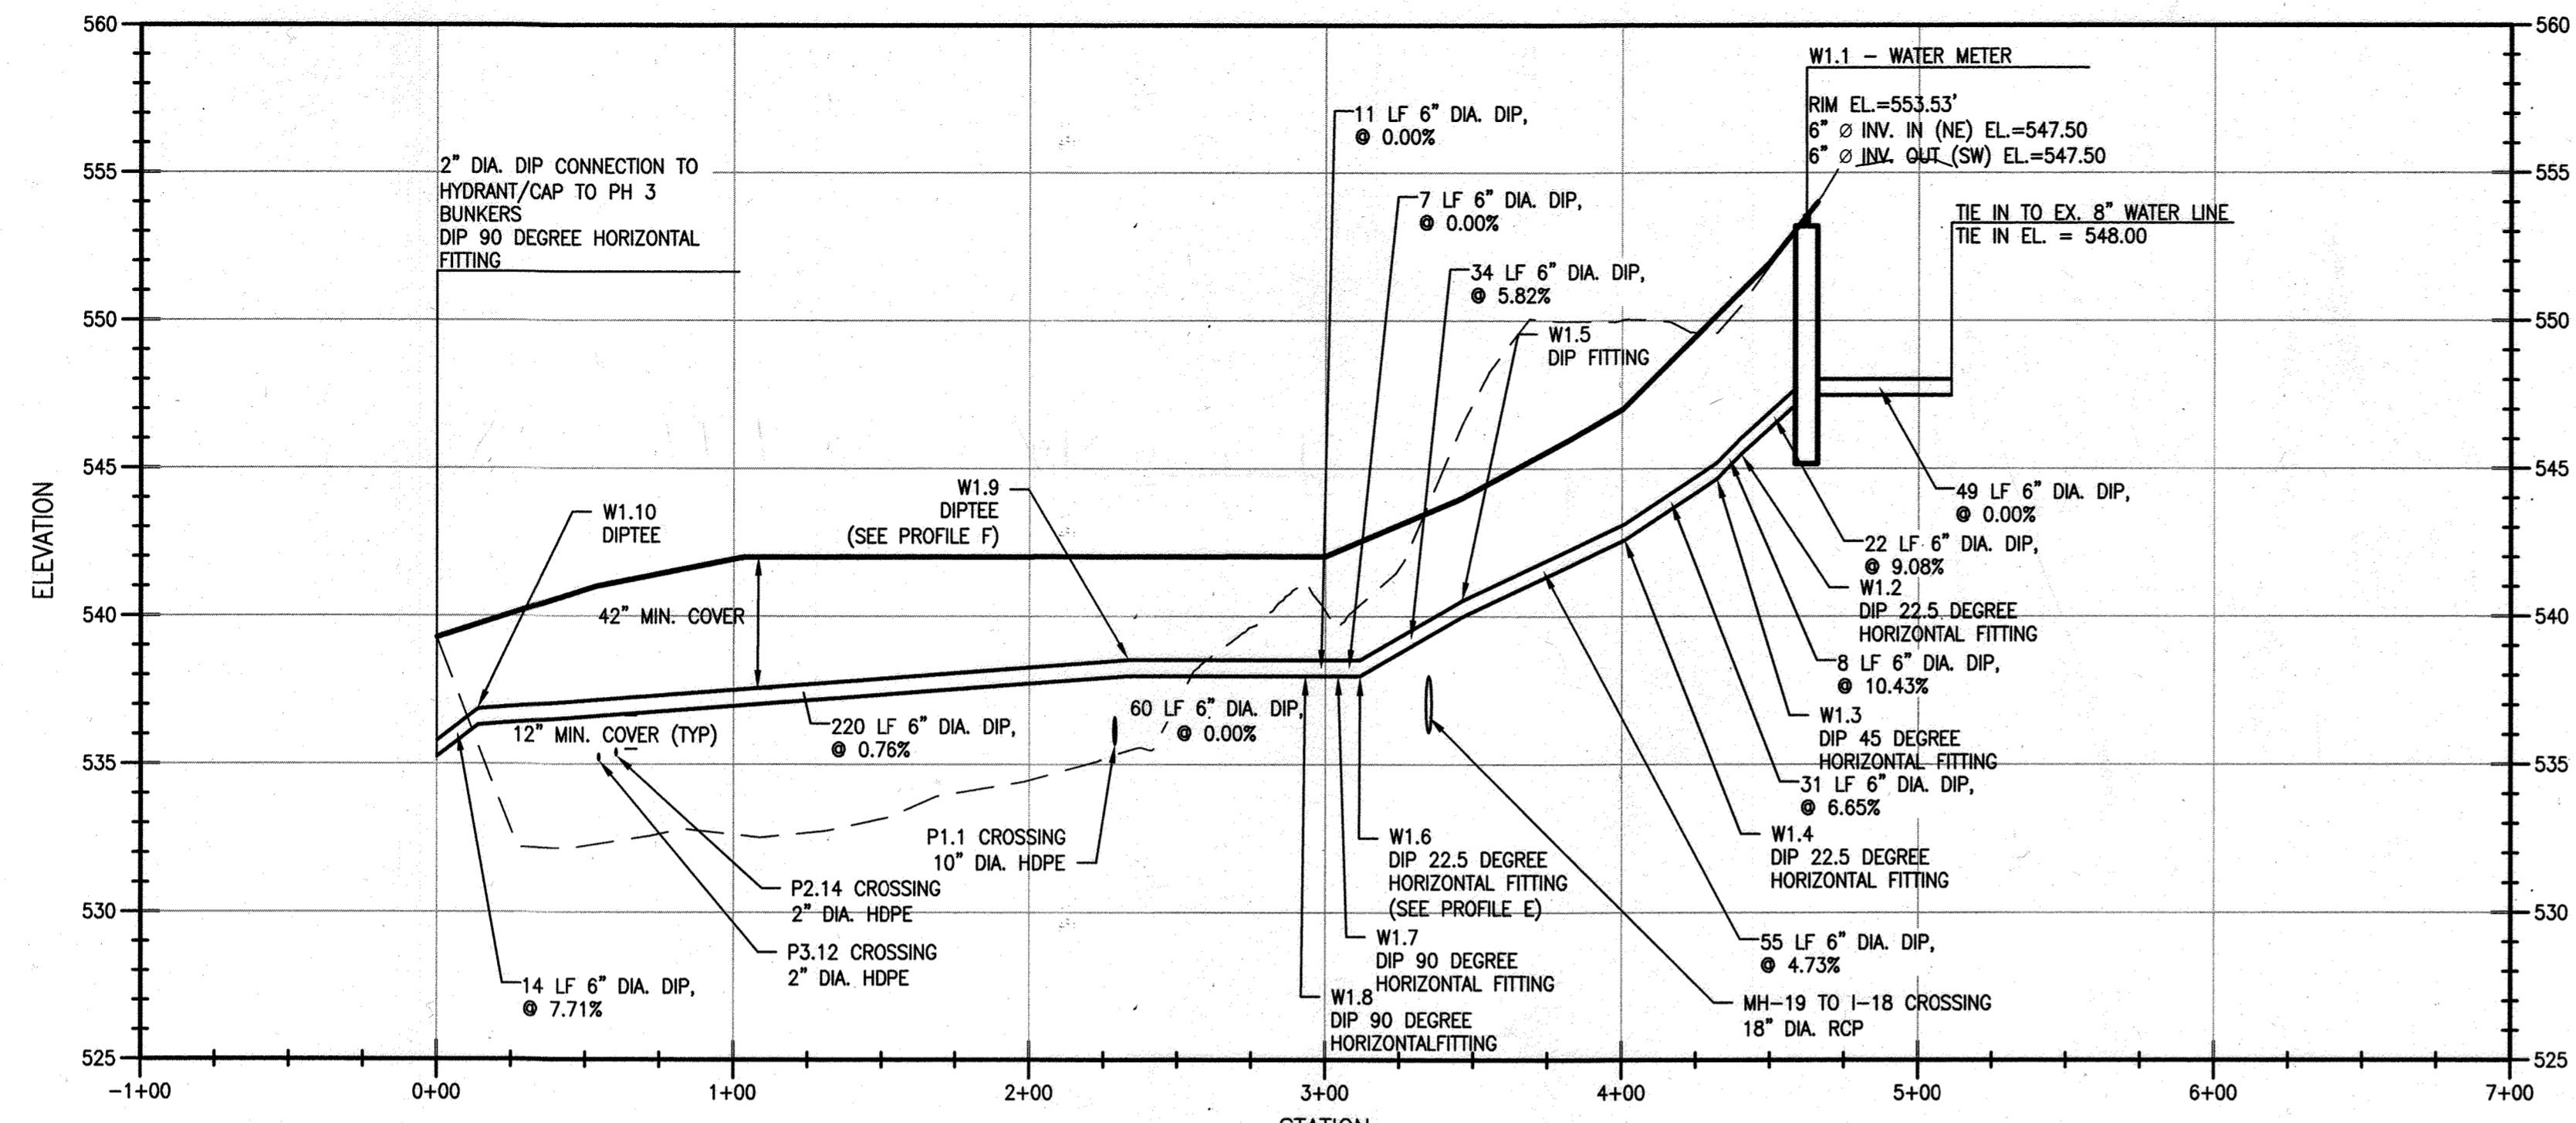

APPROVED: DEPARTMENT OF PLANNING AND ZONING

Valerie J. Joffe 12-12-17
DIRECTOR DATE

Adi Chandra 11-29-17
CHIEF, DEVELOPMENT ENGINEERING DIVISION DATE


Katsiela Dima 12-5-17
CHIEF, DIVISION OF LAND DEVELOPMENT DATE

GRID: 8 BLOCK: N/A
ZONING: RC-DEO PARCEL/LOT: 220, 253, 11, 23, 54
TAX MAP: 0016 ELECTION DISTRICT: 3-02

OWNER/ENGINEER INFORMATION

DEVELOPER/OWNER:
HOWARD COUNTY GOVERNMENT
CONTACT: JEFF DANNIS, P.E., CSP
6751 COLUMBIA GATEWAY DRIVE, SUITE 514
COLUMBIA, MD 21046
TELEPHONE: (410) 313-6419

ENGINEER:
EA ENGINEERING, SCIENCE,
AND TECHNOLOGY, INC., PBC
CONTACT: MARK GUTBERLET, P.E.
225 SCHILLING CIRCLE, SUITE 400
HUNT VALLEY, MD 21031
TELEPHONE: (410) 584-7000

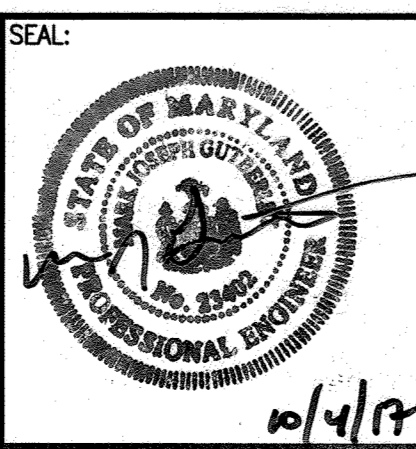

PROFESSIONAL CERTIFICATION:

I HEREBY CERTIFY THAT THESE DOCUMENTS WERE PREPARED OR APPROVED BY ME AND THAT I AM A DULY LICENSED PROFESSIONAL ENGINEER UNDER THE LAWS OF THE STATE OF MARYLAND. LICENSE NO. 23402. EXPIRATION DATE 25 AUGUST 2018.

EA
EA ENGINEERING, SCIENCE, AND TECHNOLOGY

DSN. BY: LO	CVH	REVISED TO REFLECT PHASE II WATERLINE AS-BUILT CONDITIONS	8/2022
DRN. BY: JAP/LO			
CHK. BY: SMD			
DATE: OCT. 2016			
BY	NO.	REVISION	DATE


WATER LINE PROFILE

COMPOST FACILITY - PHASE II AT ALPHA RIDGE LANDFILL
HOWARD COUNTY, MARYLAND

SDP SHEET: 45
DRAWING: C-11
PROJECT: 14982.05
SHEET: 11 OF 70

FILE PATH: G:\PROJECTS\1498205 - ALPHA RIDGE FACILITY\1498205-1\DWG\0-11 - WATER LINE PROFILE - (SDP-9) 3/12/18

NOT FOR CONSTRUCTION - SITE DEVELOPMENT PLAN #SDP-16-035

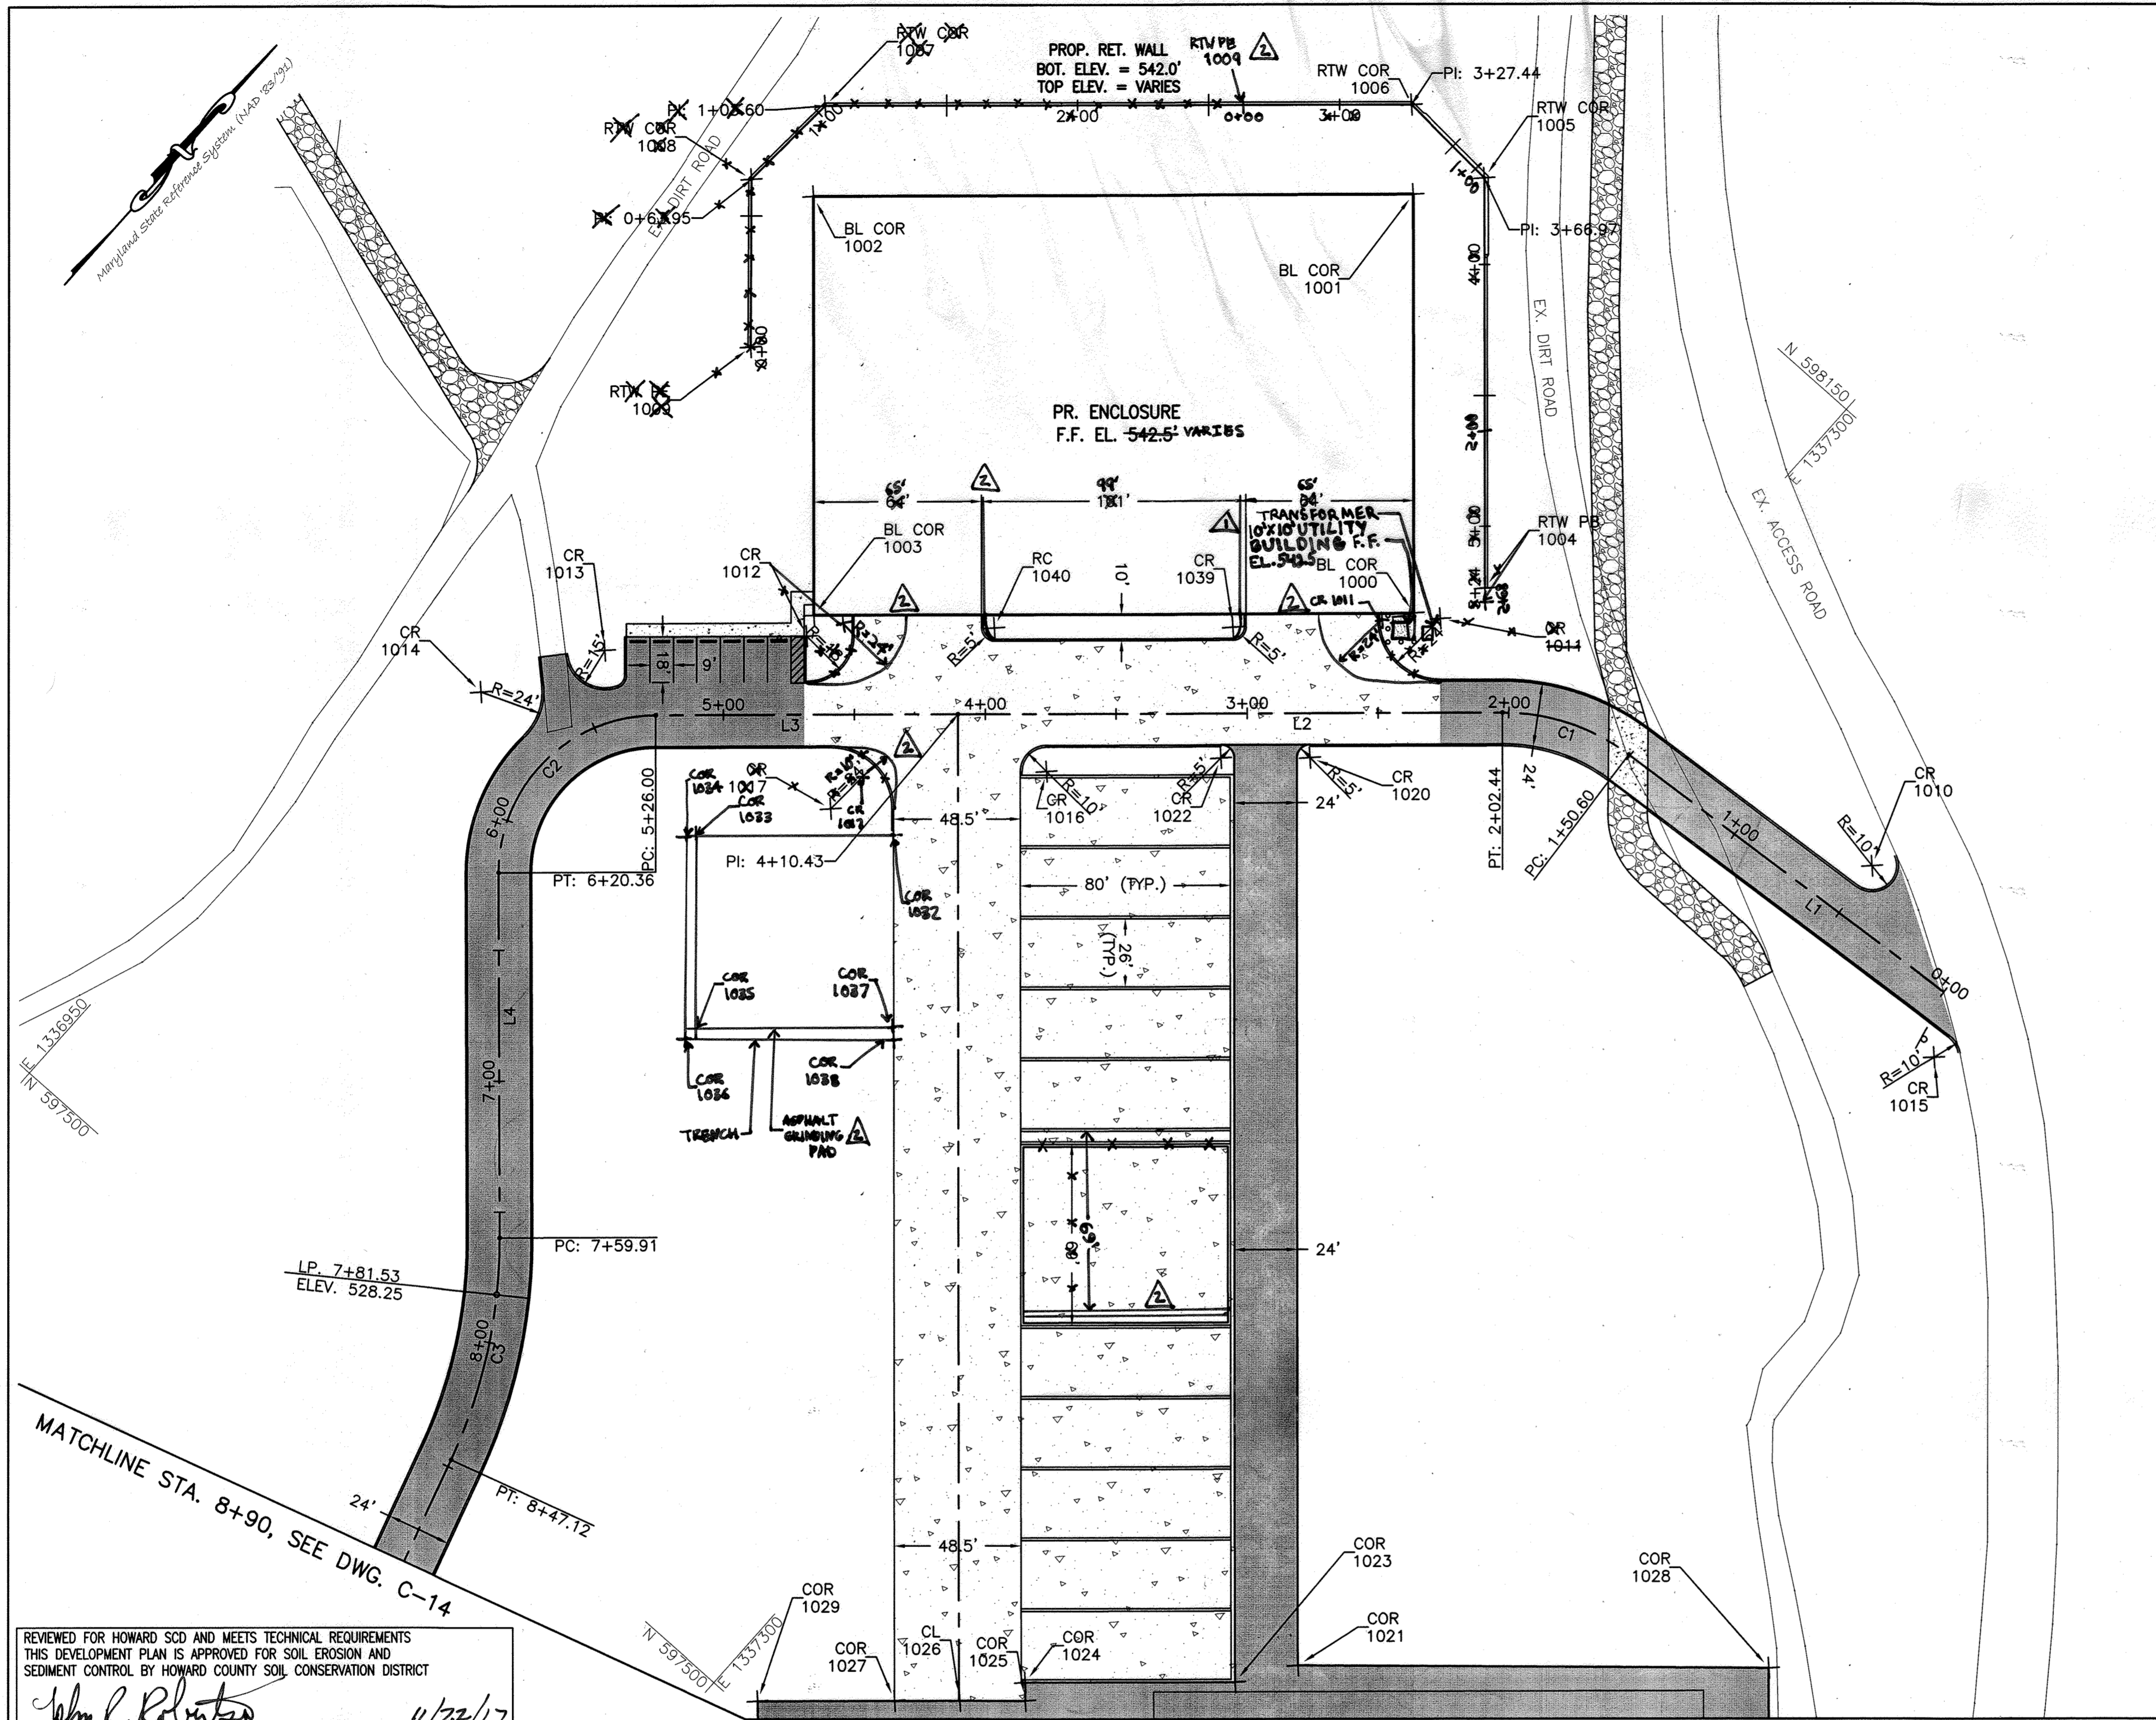

POINT #	ELEVATION	NORTHING	EASTING	DESCRIPTION
1000	542.50	597982.07	1337228.23	BL COR
1001	542.50	598101.33	1337121.74	BL COR
1002	542.50	597948.81	1336950.93	BL COR
1003	542.50	597920.46	1337057.50	BL COR
1004	542.00	598007.31	1337042.56	RTW PB
1005	542.00	598124.05	1337138.01	RTW COR
1006	542.00	598126.34	1337098.54	RTW COR
1007	542.00	597977.55	1336931.34	RTW COR
1008	542.00	597937.99	1336928.86	RTW COR
1009	542.00	597980.02	1336971.15	RTW PE


POINT #	NORTHING	EASTING	DESCRIPTION
1021	597652.97	1337462.30	COR
1023	597632.34	1337448.55	COR
1024	597579.05	1337388.88	COR
1025	597573.80	1337393.56	COR
1026	597557.15	1337374.89	CL
1027	597540.57	1337356.20	COR
1028	597771.80	1337597.51	COR
1029	597505.73	1337317.27	COR
1032	597786.09	1337126.55	COR
1033	597736.14	1337080.61	COR
1034	597733.44	1337077.59	COR
1035	597690.20	1337130.56	COR
1036	597674.52	1337130.20	COR
1037	597730.00	1337186.34	COR
1038	597727.11	1337184.17	COR

POINT #	NORTHING	EASTING	DESCRIPTION
1010	598026.35	1337423.45	CR
1011	597987.36	1337237.32	CR
1012	597921.70	1337066.91	CR
1013	597766.40	1337006.67	CR
1014	597723.13	1336981.86	CR
1015	597987.58	1337489.69	CR
1016	597843.95	1337163.77	CR
1017	597778.52	1337111.55	CR
1020	597325.28	1337235.40	CR
1022	597891.94	1337210.04	CR
1039	597920.70	1337190.17	CR
1040	597871.69	1337112.30	CR

LINE #	LENGTH	DIRECTION	START POINT	END POINT
L1	150.60'	S85° 21' 40"W	N 598008.53 E 1337475.90	N 597996.35 E 1337325.79
L2	207.60'	S48° 14' 10"W	N 597976.29 E 1337278.98	N 597837.75 E 1337123.83
L3	115.96'	S48° 14' 10"W	N 597837.75 E 1337123.83	N 597760.78 E 1337037.63
L4	139.55'	S41° 52' 30"E	N 597675.97 E 1337032.92	N 597572.06 E 1337128.06

CURVE #	RADIUS	LENGTH	START POINT	END POINT	CHORD LENGTH	CHORD DIRECTION	DELTA ANGLE
C1	80.00'	51.84'	N 597996.35 E 1337325.79	N 597976.29 E 1337278.98	50.93'	S66° 47' 56"W	37.13
C2	60.00'	94.36'	N 597760.78 E 1337037.63	N 597675.97 E 1337032.92	84.93'	S3° 10' 52"W	90.11
C3	200.00'	87.22'	N 597572.06 E 1337128.06	N 597496.67 E 1337168.52	86.53'	S29° 22' 52"E	24.99

LAYOUT PLAN
SCALE: 1"=40'

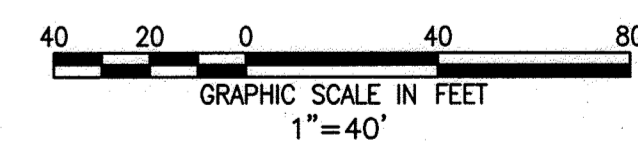

REVIEWED FOR HOWARD SCD AND MEETS TECHNICAL REQUIREMENTS
THIS DEVELOPMENT PLAN IS APPROVED FOR SOIL EROSION AND
SEDIMENT CONTROL BY HOWARD COUNTY SOIL CONSERVATION DISTRICT
John L. Roberts 4/22/17
HOWARD SCD DATE

APPROVED: DEPARTMENT OF PLANNING AND ZONING
William J. ... 12-12-17
DIRECTOR, DEPARTMENT OF PLANNING AND ZONING DATE

... 11-29-17
CHIEF, DEVELOPMENT ENGINEERING DIVISION DATE

... 12-5-17
CHIEF, DIVISION OF LAND DEVELOPMENT DATE

DHILLON
ENGINEERING, INC.
10902 REISTERSTOWN ROAD, # 204
OWINGS MILLS, MD 21117

GRID: 8 BLOCK: N/A
ZONING: RC-DEO PARCEL/LOT: 220, 253, 11, 23, 54
TAX MAP: 0016 ELECTION DISTRICT: 3-02

OWNER/ENGINEER INFORMATION
DEVELOPER/OWNER:
HOWARD COUNTY GOVERNMENT
CONTACT: JEFF DANNIS, P.E., CSP
6751 COLUMBIA GATEWAY DRIVE, SUITE 514
COLUMBIA, MD 21046
TELEPHONE: (410) 313-6419

ENGINEER:
EA ENGINEERING, SCIENCE,
AND TECHNOLOGY, INC., PBC
CONTACT: MARK GUTBERLET, P.E.
225 SCHILLING CIRCLE
HUNT VALLEY, MD 21031
TELEPHONE: (410) 584-7000

SEAL:

PROFESSIONAL CERTIFICATION:
I HEREBY CERTIFY THAT THESE DOCUMENTS
WERE PREPARED OR APPROVED BY ME, AND
THAT I AM A DULY LICENSED PROFESSIONAL
ENGINEER UNDER THE LAWS OF THE STATE
OF MARYLAND, LICENSE NO. 8050,
EXPIRATION DATE 08/19/2017.


DSN. BY:	LMB/MM	SMB	REVISION UTILITY BUILDING AND TRANSFORMER LOCATION	4/2018	
DRN. BY:	MM	CVH	REVISED TO REFLECT PHASE IIA AND PHASE IIB AS-BUILT CONDITIONS AND PHASE IIC DESIGN	8/2022	
CHK. BY:	AM				
DATE:	AUGUST, 2016	BY	NO.	REVISION	DATE

CIVIL LAYOUT PLAN I

COMPOST FACILITY
AT ALPHA RIDGE LANDFILL
HOWARD COUNTY, MARYLAND

SDP SHEET: 45
DRAWING: C-13
10 OF 44
PROJECT: 14982.05
SHEET: 43 OF 70

NOT FOR CONSTRUCTION - SITE DEVELOPMENT PLAN #SDP-16-035

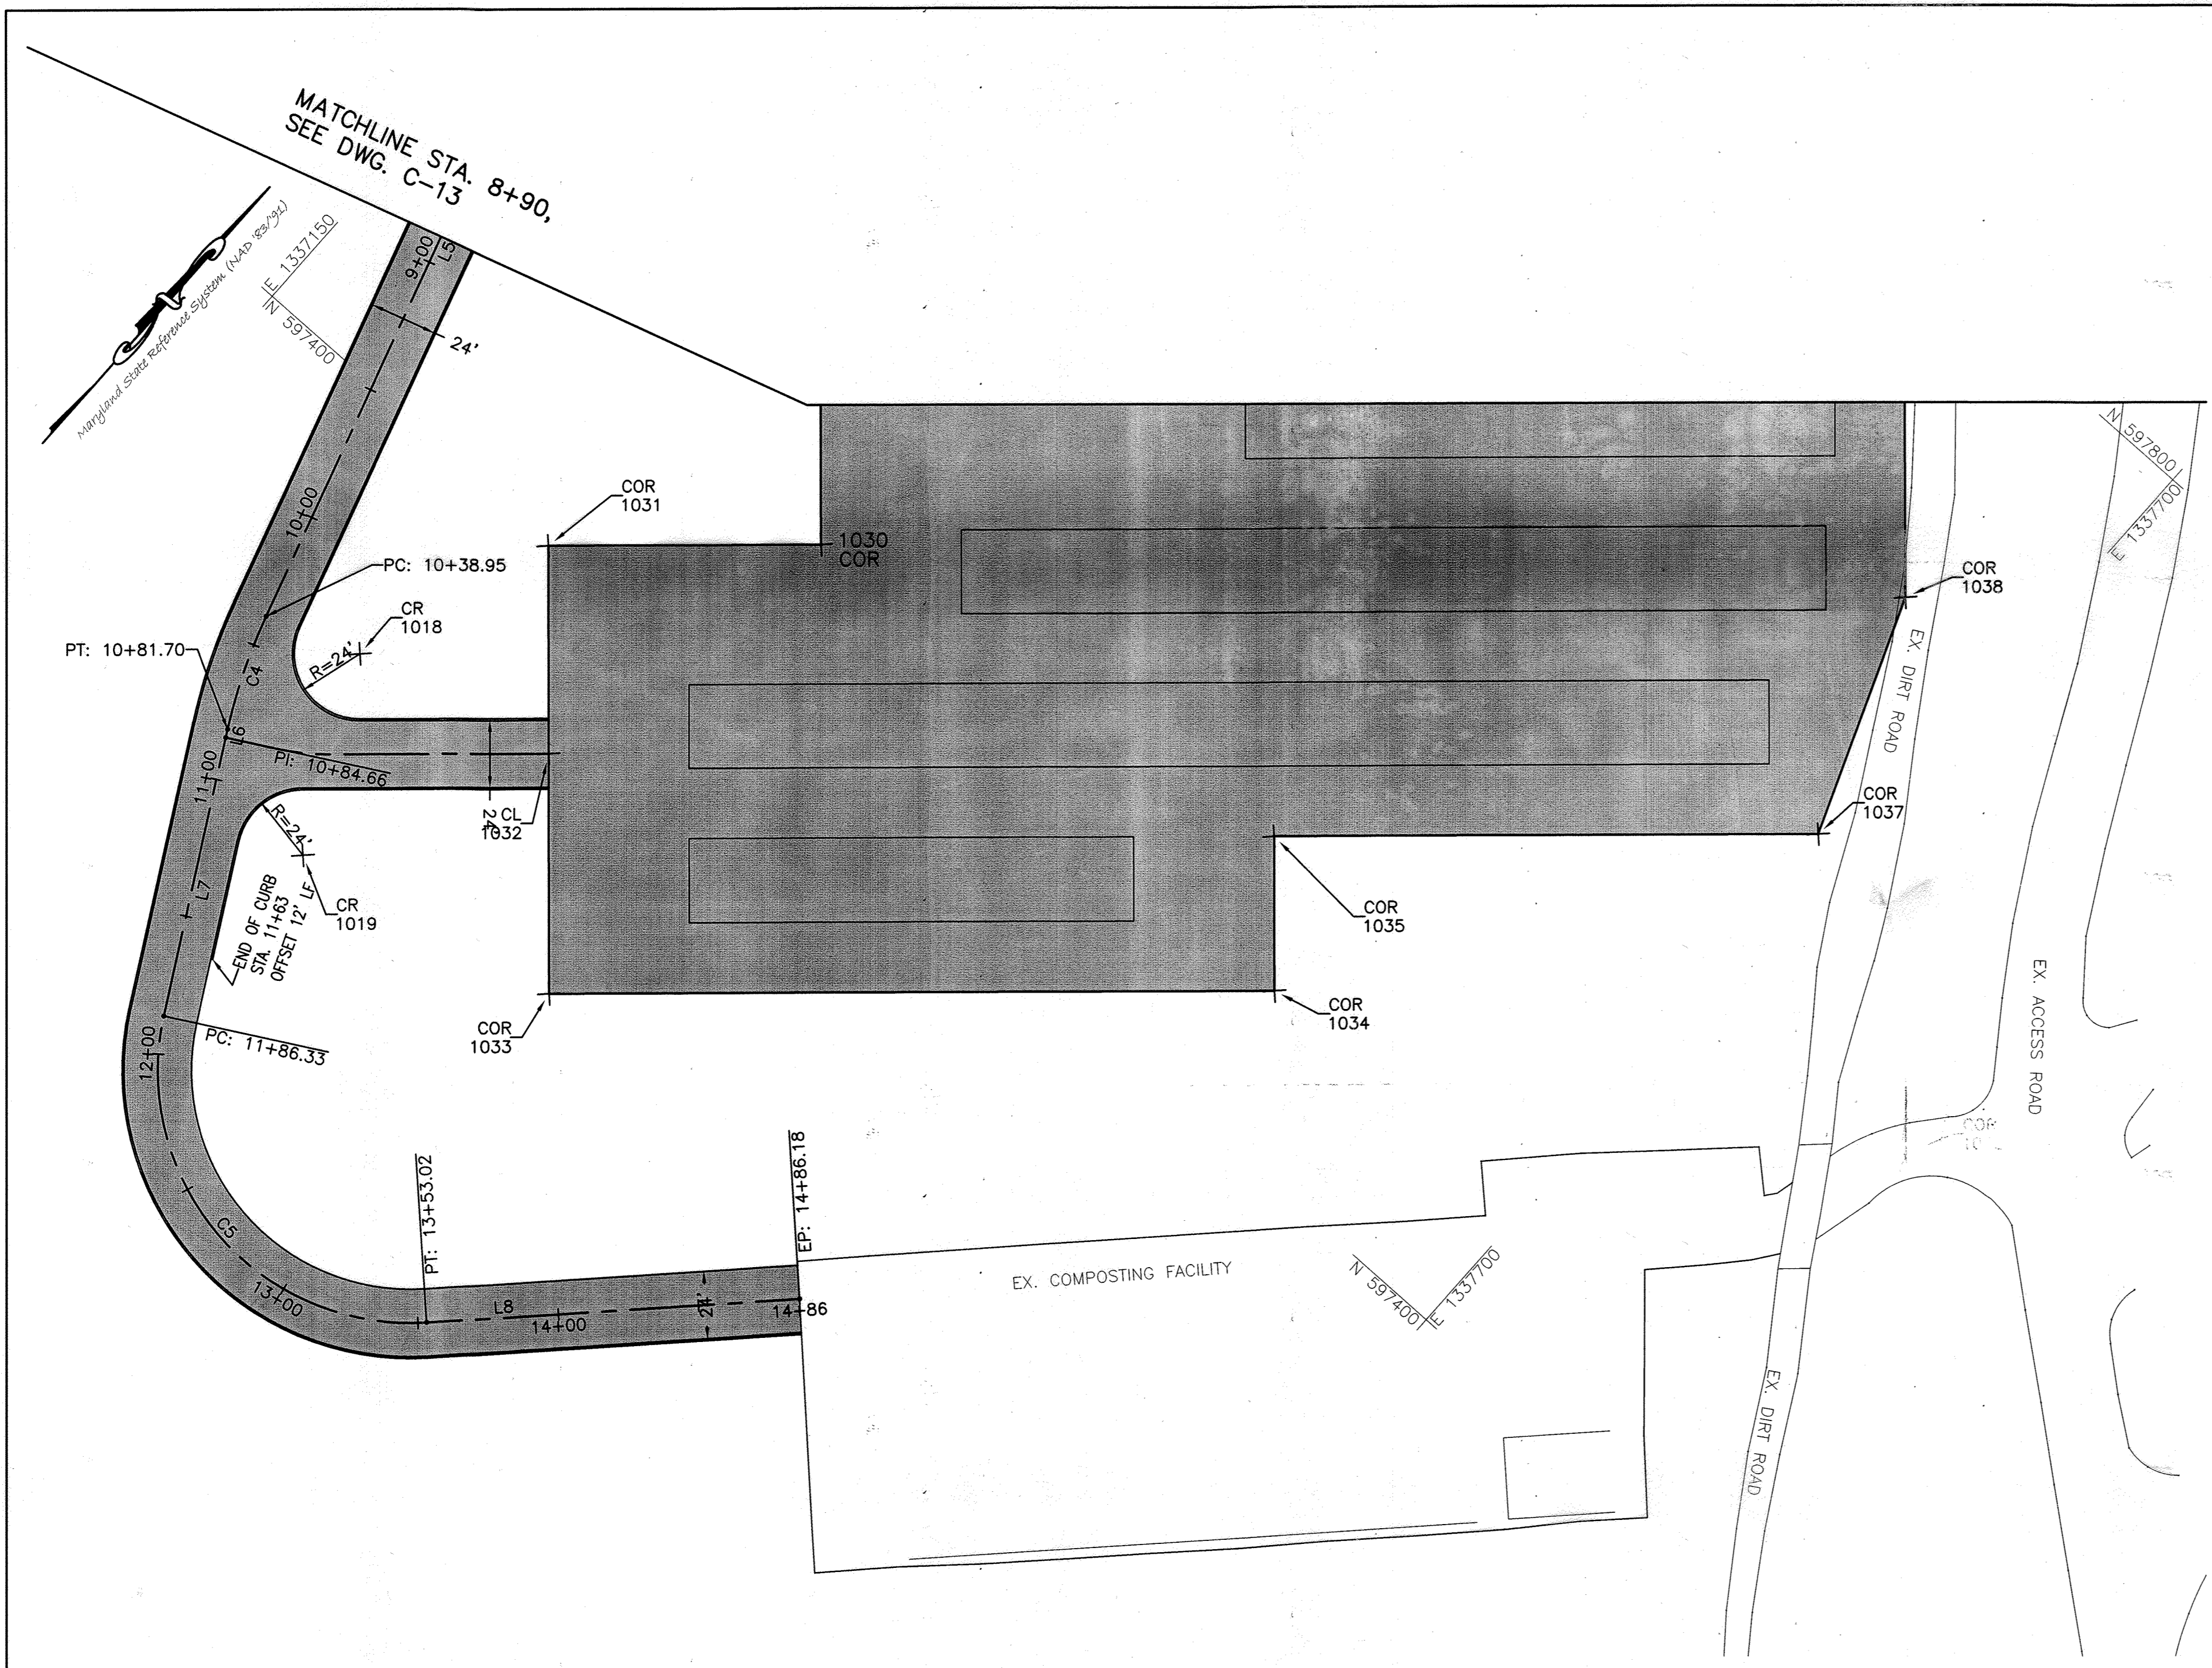


LINE TABLE: DRIVEWAY				
LINE #	LENGTH	DIRECTION	START POINT	END POINT
L5	191.83'	S16° 53' 20"E	N 597496.67 E 1337168.52	N 597313.11 E 1337224.24
L6	2.96'	S29° 08' 10"E	N 597273.84 E 1337240.92	N 597271.25 E 1337242.36
L7	101.67'	S29° 08' 10"E	N 597271.25 E 1337242.36	N 597182.45 E 1337291.87
L8	133.16'	N44° 44' 40"E	N 597162.91 E 1337434.40	N 597257.49 E 1337528.14

CURVE TABLE: DRIVEWAY							
CURVE #	RADIUS	LENGTH	START POINT	END POINT	CHORD LENGTH	CHORD DIRECTION	DELTA ANGLE
C4	200.00'	42.75'	N 597313.11 E 1337224.24	N 597273.84 E 1337240.92	42.67'	S23° 00' 45"E	12.25
C5	90.00'	166.69'	N 597182.45 E 1337291.87	N 597162.91 E 1337434.40	143.87'	S82° 11' 44"E	106.12

POINT TABLE			
POINT #	NORTHING	EASTING	DESCRIPTION
1018	597325.28	1337258.17	CR
1019	597258.02	1337290.96	CR

POINT TABLE			
POINT #	NORTHING	EASTING	DESCRIPTION
1030	597463.43	1337355.04	COR
1031	597398.68	1337282.54	COR
1032	597343.09	1337332.18	CL
1033	597279.30	1337389.14	COR
1034	597451.49	1337581.89	COR
1035	597492.51	1337545.26	COR
1037	597621.60	1337689.81	COR
1038	597705.38	1337656.82	COR

LAYOUT PLAN
SCALE: 1"=40'

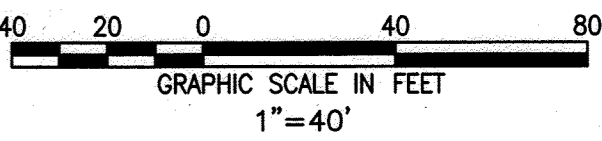

REVIEWED FOR HOWARD SCD AND MEETS TECHNICAL REQUIREMENTS
THIS DEVELOPMENT PLAN IS APPROVED FOR SOIL EROSION AND
SEDIMENT CONTROL BY HOWARD COUNTY SOIL CONSERVATION DISTRICT
John C. Robertson 11/22/17
HOWARD SCD DATE


APPROVED: DEPARTMENT OF PLANNING AND ZONING
N. M. Adams 12-12-17
DIRECTOR, DEPARTMENT OF PLANNING AND ZONING DATE

Ch. L. L. 11/29/17
CHIEF, DEVELOPMENT ENGINEERING DIVISION DATE
W. S. L. 12-5-17
CHIEF, DIVISION OF LAND DEVELOPMENT DATE

DHILLON
ENGINEERING, INC.
10902 REISTERSTOWN ROAD, # 204
OWINGS MILLS, MD 21117

GRID: 8 BLOCK: N/A
ZONING: RC-DEO PARCEL/LOT: 220, 253, 11, 23, 54
TAX MAP: 0016 ELECTION DISTRICT: 3-02

OWNER/ENGINEER INFORMATION
DEVELOPER/OWNER:
HOWARD COUNTY GOVERNMENT
CONTACT: JEFF DANNIS, P.E., CSP
6751 COLUMBIA GATEWAY DRIVE, SUITE 514
COLUMBIA, MD 21046
TELEPHONE: (410) 313-6419
ENGINEER:
EA ENGINEERING, SCIENCE,
AND TECHNOLOGY, INC., PBC
CONTACT: MARK GUTBERLET, P.E.
225 SCHILLING CIRCLE
HUNT VALLEY, MD 21031
TELEPHONE: (410) 584-7000

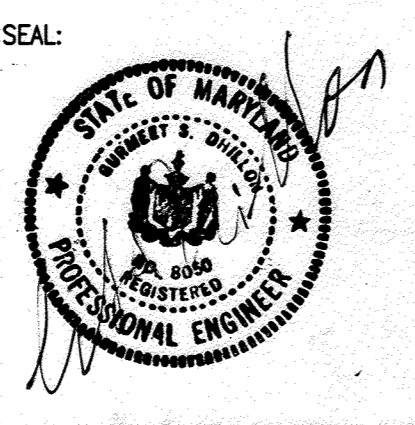

PROFESSIONAL CERTIFICATION:
I HEREBY CERTIFY THAT THESE DOCUMENTS
WERE PREPARED OR APPROVED BY ME, AND
THAT I AM A DULY LICENSED PROFESSIONAL
ENGINEER UNDER THE LAWS OF THE STATE
OF MARYLAND, LICENSE NO. 8050,
EXPIRATION DATE 08/19/2017.

EA
ENGINEERING,
SCIENCE, AND
TECHNOLOGY


DSN. BY: LMB/MM	CVH	REVISED TOTAL NUMBER OF SHEETS TO REPLACE ADDITION OF SHEETS 8/12/22
DRN. BY: MM		
CHK. BY: AM		
DATE: AUGUST, 2016	BY NO.	REVISION DATE

CIVIL LAYOUT PLAN II

COMPOST FACILITY
AT ALPHA RIDGE LANDFILL
HOWARD COUNTY, MARYLAND

SDP SHEET: 11 OF 14	DRAWING: C-14
PROJECT: 14982.05	SHEET: 14 OF 70

NOT FOR CONSTRUCTION- SITE DEVELOPMENT PLAN #SDP-16-035

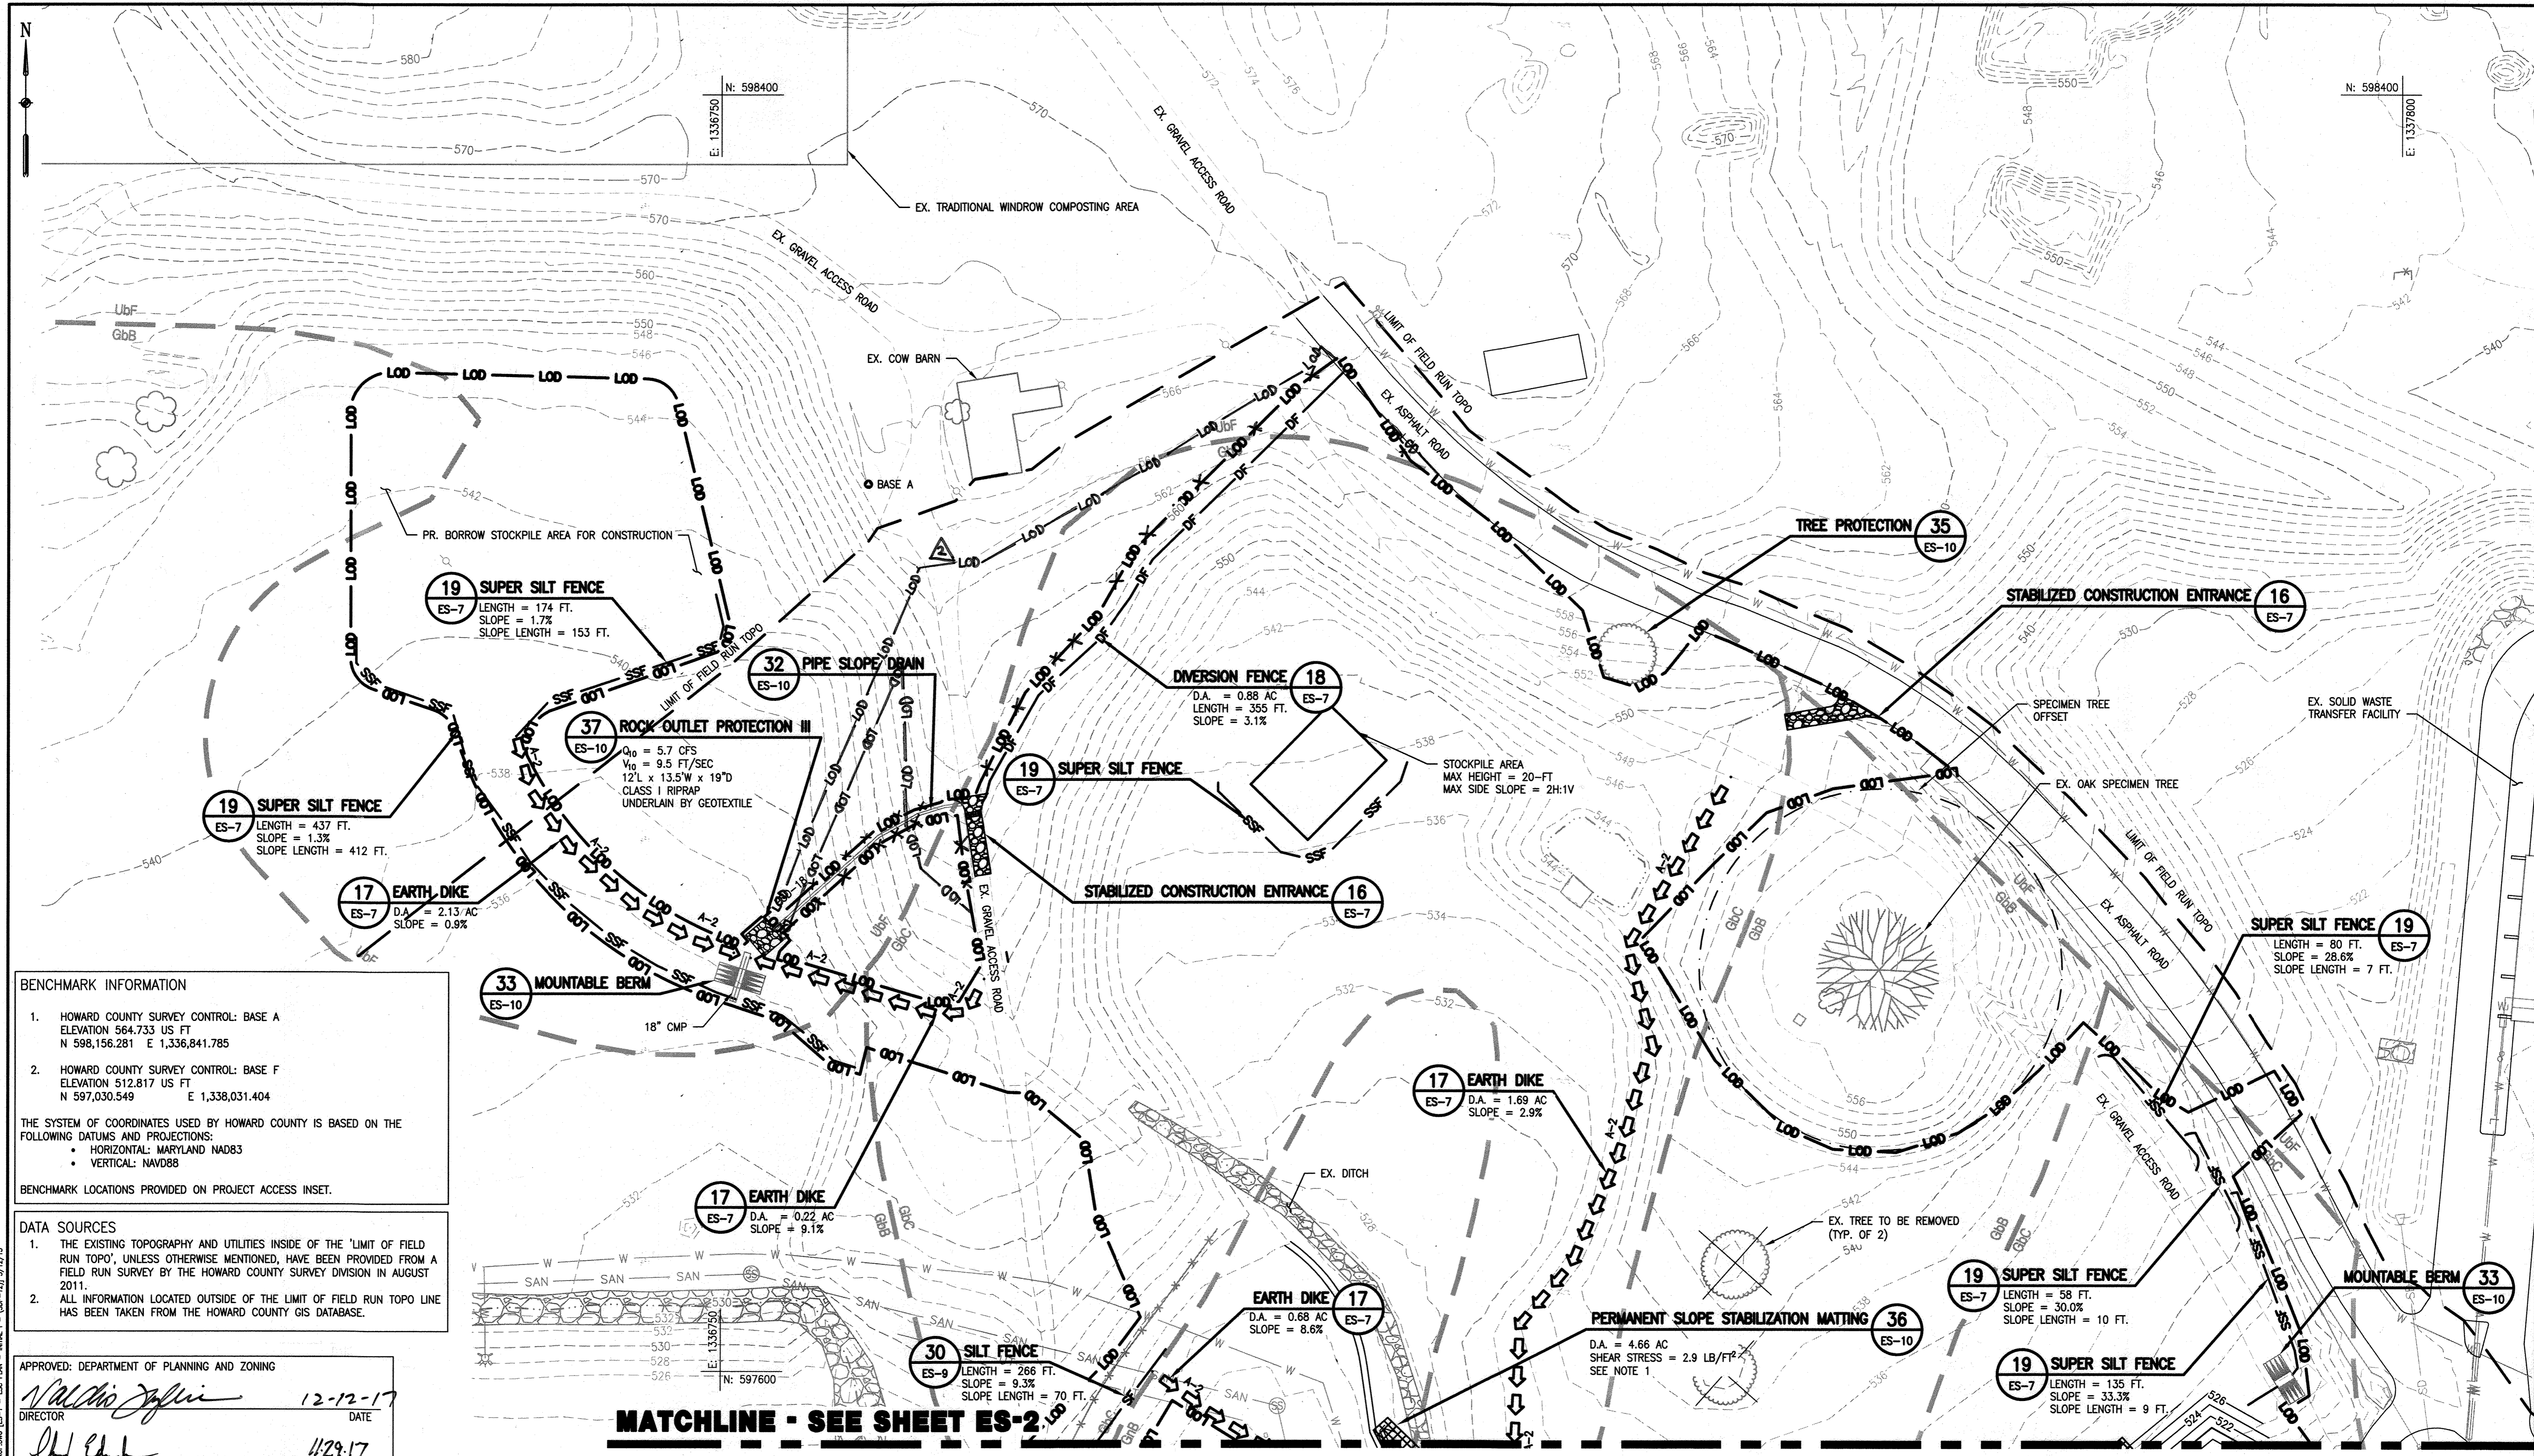

BENCHMARK INFORMATION

- HOWARD COUNTY SURVEY CONTROL: BASE A
ELEVATION 564.733 US FT
N 598,156.281 E 1,336,841.785
- HOWARD COUNTY SURVEY CONTROL: BASE F
ELEVATION 512.817 US FT
N 597,030.549 E 1,338,031.404

THE SYSTEM OF COORDINATES USED BY HOWARD COUNTY IS BASED ON THE FOLLOWING DATUMS AND PROJECTIONS:

- HORIZONTAL: MARYLAND NAD83
- VERTICAL: NAVD83

BENCHMARK LOCATIONS PROVIDED ON PROJECT ACCESS INSET.

DATA SOURCES

- THE EXISTING TOPOGRAPHY AND UTILITIES INSIDE OF THE 'LIMIT OF FIELD RUN TOPO', UNLESS OTHERWISE MENTIONED, HAVE BEEN PROVIDED FROM A FIELD RUN SURVEY BY THE HOWARD COUNTY SURVEY DIVISION IN AUGUST 2011.
- ALL INFORMATION LOCATED OUTSIDE OF THE LIMIT OF FIELD RUN TOPO LINE HAS BEEN TAKEN FROM THE HOWARD COUNTY GIS DATABASE.

APPROVED: DEPARTMENT OF PLANNING AND ZONING

Naldia Joffe 12-12-17
DIRECTOR DATE


John E. ... 11-29-17
CHIEF, DEVELOPMENT ENGINEERING DIVISION DATE

Walt ... 12-5-17
CHIEF, DIVISION OF LAND DEVELOPMENT DATE

OWNER/ENGINEER INFORMATION

DEVELOPER/OWNER:
HOWARD COUNTY GOVERNMENT
CONTACT: JEFF DANNIS, P.E., CSP
6751 COLUMBIA GATEWAY DRIVE, SUITE 514
COLUMBIA, MD 21046
TELEPHONE: (410) 313-6419

ENGINEER:
EA ENGINEERING, SCIENCE,
AND TECHNOLOGY, INC., PBC
CONTACT: MARK GUTBERLET, P.E.
225 SCHILLING CIRCLE, SUITE 400
HUNT VALLEY, MD 21031
TELEPHONE: (410) 584-7000

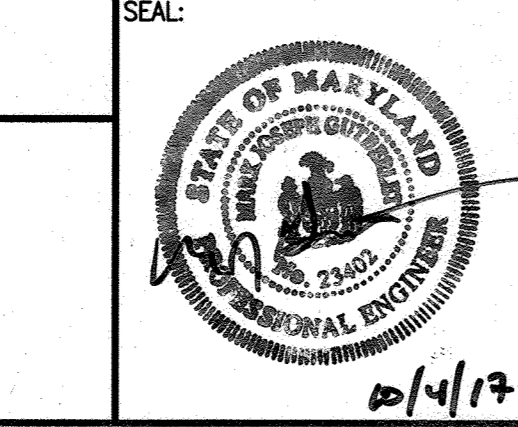

PROFESSIONAL CERTIFICATION:

I HEREBY CERTIFY THAT THESE DOCUMENTS WERE PREPARED OR APPROVED BY ME AND THAT I AM A DULY LICENSED PROFESSIONAL ENGINEER UNDER THE LAWS OF THE STATE OF MARYLAND, LICENSE NO. 23402, EXPIRATION DATE 25 AUGUST 2018.

EA ENGINEERING, SCIENCE AND TECHNOLOGY

DSN. BY:	MBS/MP	CVH	REVIEWED FOR PHASE IIB AND PHASE IIC CONSTRUCTION	9/12/22
DRN. BY:	JAP/KEJ			
CHK. BY:	SMD			
DATE:	OCT. 2016	BY	NO.	REVISION
				DATE

SITE PLAN
SCALE: 1" = 50'
GRAPHIC SCALE IN FEET

NOTES:

- PERMANENT SLOPE STABILIZATION MATTING (PSSM) MUST WITHSTAND THE SHEAR STRESS SHOWN ON THE PLANS.

REVIEWED FOR HOWARD SCD AND MEETS TECHNICAL REQUIREMENTS
THIS DEVELOPMENT PLAN IS APPROVED FOR SOIL EROSION AND SEDIMENT CONTROL BY THE HOWARD SOIL CONSERVATION DISTRICT.

Walter ... 4/22/17
HOWARD SCD DATE

SDP SHEET: DRAWING:
12 OF 44 ES-1

PROJECT:
14982.05

SHEET:
24 OF 70


**COMPOST FACILITY - PHASE II
AT ALPHA RIDGE LANDFILL**
HOWARD COUNTY, MARYLAND

**EROSION AND SEDIMENT CONTROL
PLAN - INITIAL I
(PHASES IIA AND IIB)**

NOT FOR CONSTRUCTION - SITE DEVELOPMENT PLAN #SDP-16-035


NOTES:

- SEE DRAWING ES-8 FOR SEDIMENT TRAP TABLE.
- PERMANENT SLOPE STABILIZATION MATTING (PSSMC) MUST WITHSTAND THE SHEAR STRESS SHOWN ON THE PLANS.

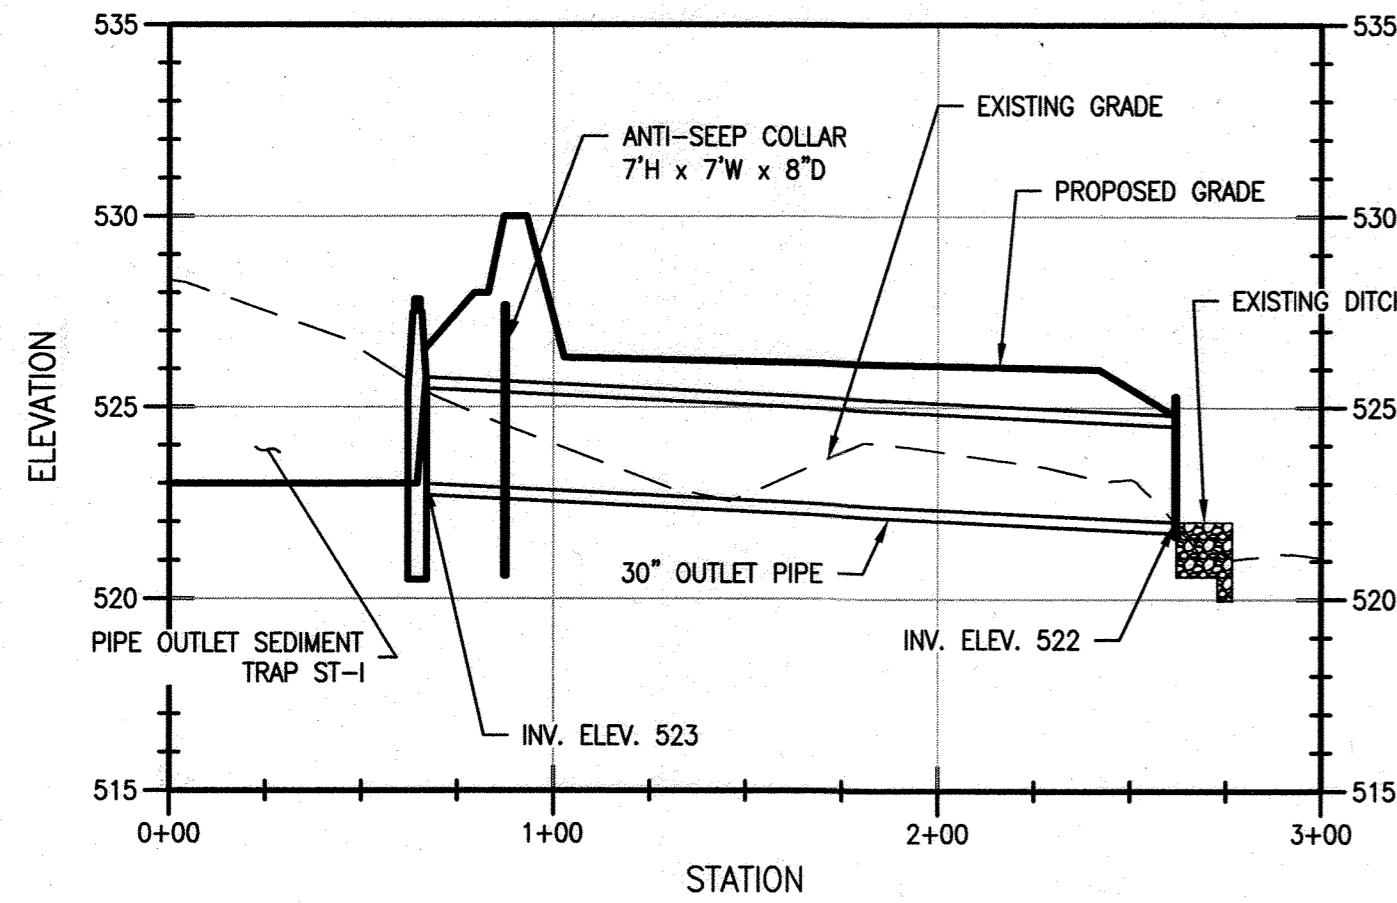

ST-II DISCHARGE DETAIL

SCALE: 1" = 50' HORIZONTAL
1" = 5' VERTICAL

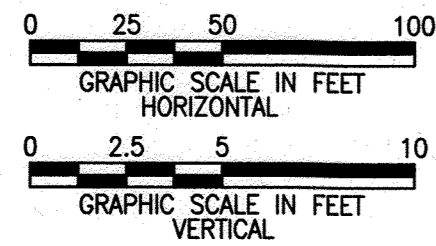

BENCHMARK INFORMATION

- HOWARD COUNTY SURVEY CONTROL: BASE A
ELEVATION 564.733 US FT
N 598,156.281 E 1,336,841.785
- HOWARD COUNTY SURVEY CONTROL: BASE F
ELEVATION 512.817 US FT
N 597,030.549 E 1,338,031.404

THE SYSTEM OF COORDINATES USED BY HOWARD COUNTY IS BASED ON THE FOLLOWING DATUMS AND PROJECTIONS:
• HORIZONTAL: MARYLAND NAD83
• VERTICAL: NAVD88

BENCHMARK LOCATIONS PROVIDED ON PROJECT ACCESS INSET.

DATA SOURCES

- THE EXISTING TOPOGRAPHY AND UTILITIES INSIDE OF THE 'LIMIT OF FIELD RUN TOPO', UNLESS OTHERWISE MENTIONED, HAVE BEEN PROVIDED FROM A FIELD RUN SURVEY BY THE HOWARD COUNTY SURVEY DIVISION IN AUGUST 2011.
- ALL INFORMATION LOCATED OUTSIDE OF THE LIMIT OF FIELD RUN TOPO LINE HAS BEEN TAKEN FROM THE HOWARD COUNTY GIS DATABASE.

REVIEWED FOR HOWARD SCD AND MEETS TECHNICAL REQUIREMENTS

THIS DEVELOPMENT PLAN IS APPROVED FOR SOIL EROSION AND SEDIMENT CONTROL BY THE HOWARD SOIL CONSERVATION DISTRICT.

John R. Roberts 4/22/17
HOWARD SCD DATE

APPROVED: DEPARTMENT OF PLANNING AND ZONING

Nadine Zeffin 12-12-17
DIRECTOR DATE

John Chubb 1/29/17
CHIEF, DEVELOPMENT ENGINEERING DIVISION DATE


Kevin Shadwin 12-5-17
CHIEF, DIVISION OF LAND DEVELOPMENT DATE

GRID: B BLOCK: N/A
ZONING: RC-DEO PARCEL/LOT: 220, 253, 11, 23, 54
TAX MAP: 0016 ELECTION DISTRICT: 3-02

OWNER/ENGINEER INFORMATION

DEVELOPER/OWNER:
HOWARD COUNTY GOVERNMENT
CONTACT: JEFF DANNIS, P.E., CSP
6751 COLUMBIA GATEWAY DRIVE, SUITE 514
COLUMBIA, MD 21046
TELEPHONE: (410) 313-6419

ENGINEER:
EA ENGINEERING, SCIENCE,
AND TECHNOLOGY, INC., PBC
CONTACT: MARK GUTBERLET, P.E.
225 SCHILLING CIRCLE, SUITE 400
HUNT VALLEY, MD 21031
TELEPHONE: (410) 584-7000

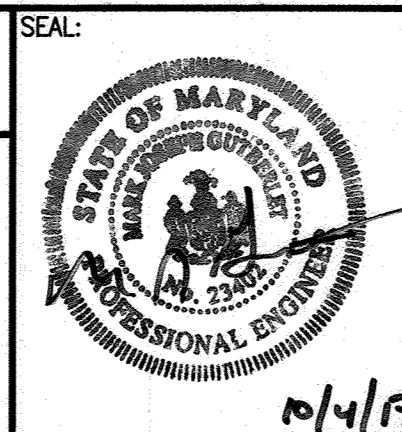

PROFESSIONAL CERTIFICATION:



I HEREBY CERTIFY THAT THESE DOCUMENTS WERE PREPARED OR APPROVED BY ME AND THAT I AM A DULY LICENSED PROFESSIONAL ENGINEER UNDER THE LAWS OF THE STATE OF MARYLAND, LICENSE NO. 23402, EXPIRATION DATE 25 AUGUST 2018.



DSN. BY:	MBS/MP	CVH	REVISED LOD FOR PHASE IIB CONSTRUCTION	6/20/22
DRN. BY:	JAP/KEJ			
CHK. BY:	SMD			
DATE:	OCT. 2016			
BY:	NO.	REVISION		DATE

SITE PLAN

SCALE: 1" = 50'

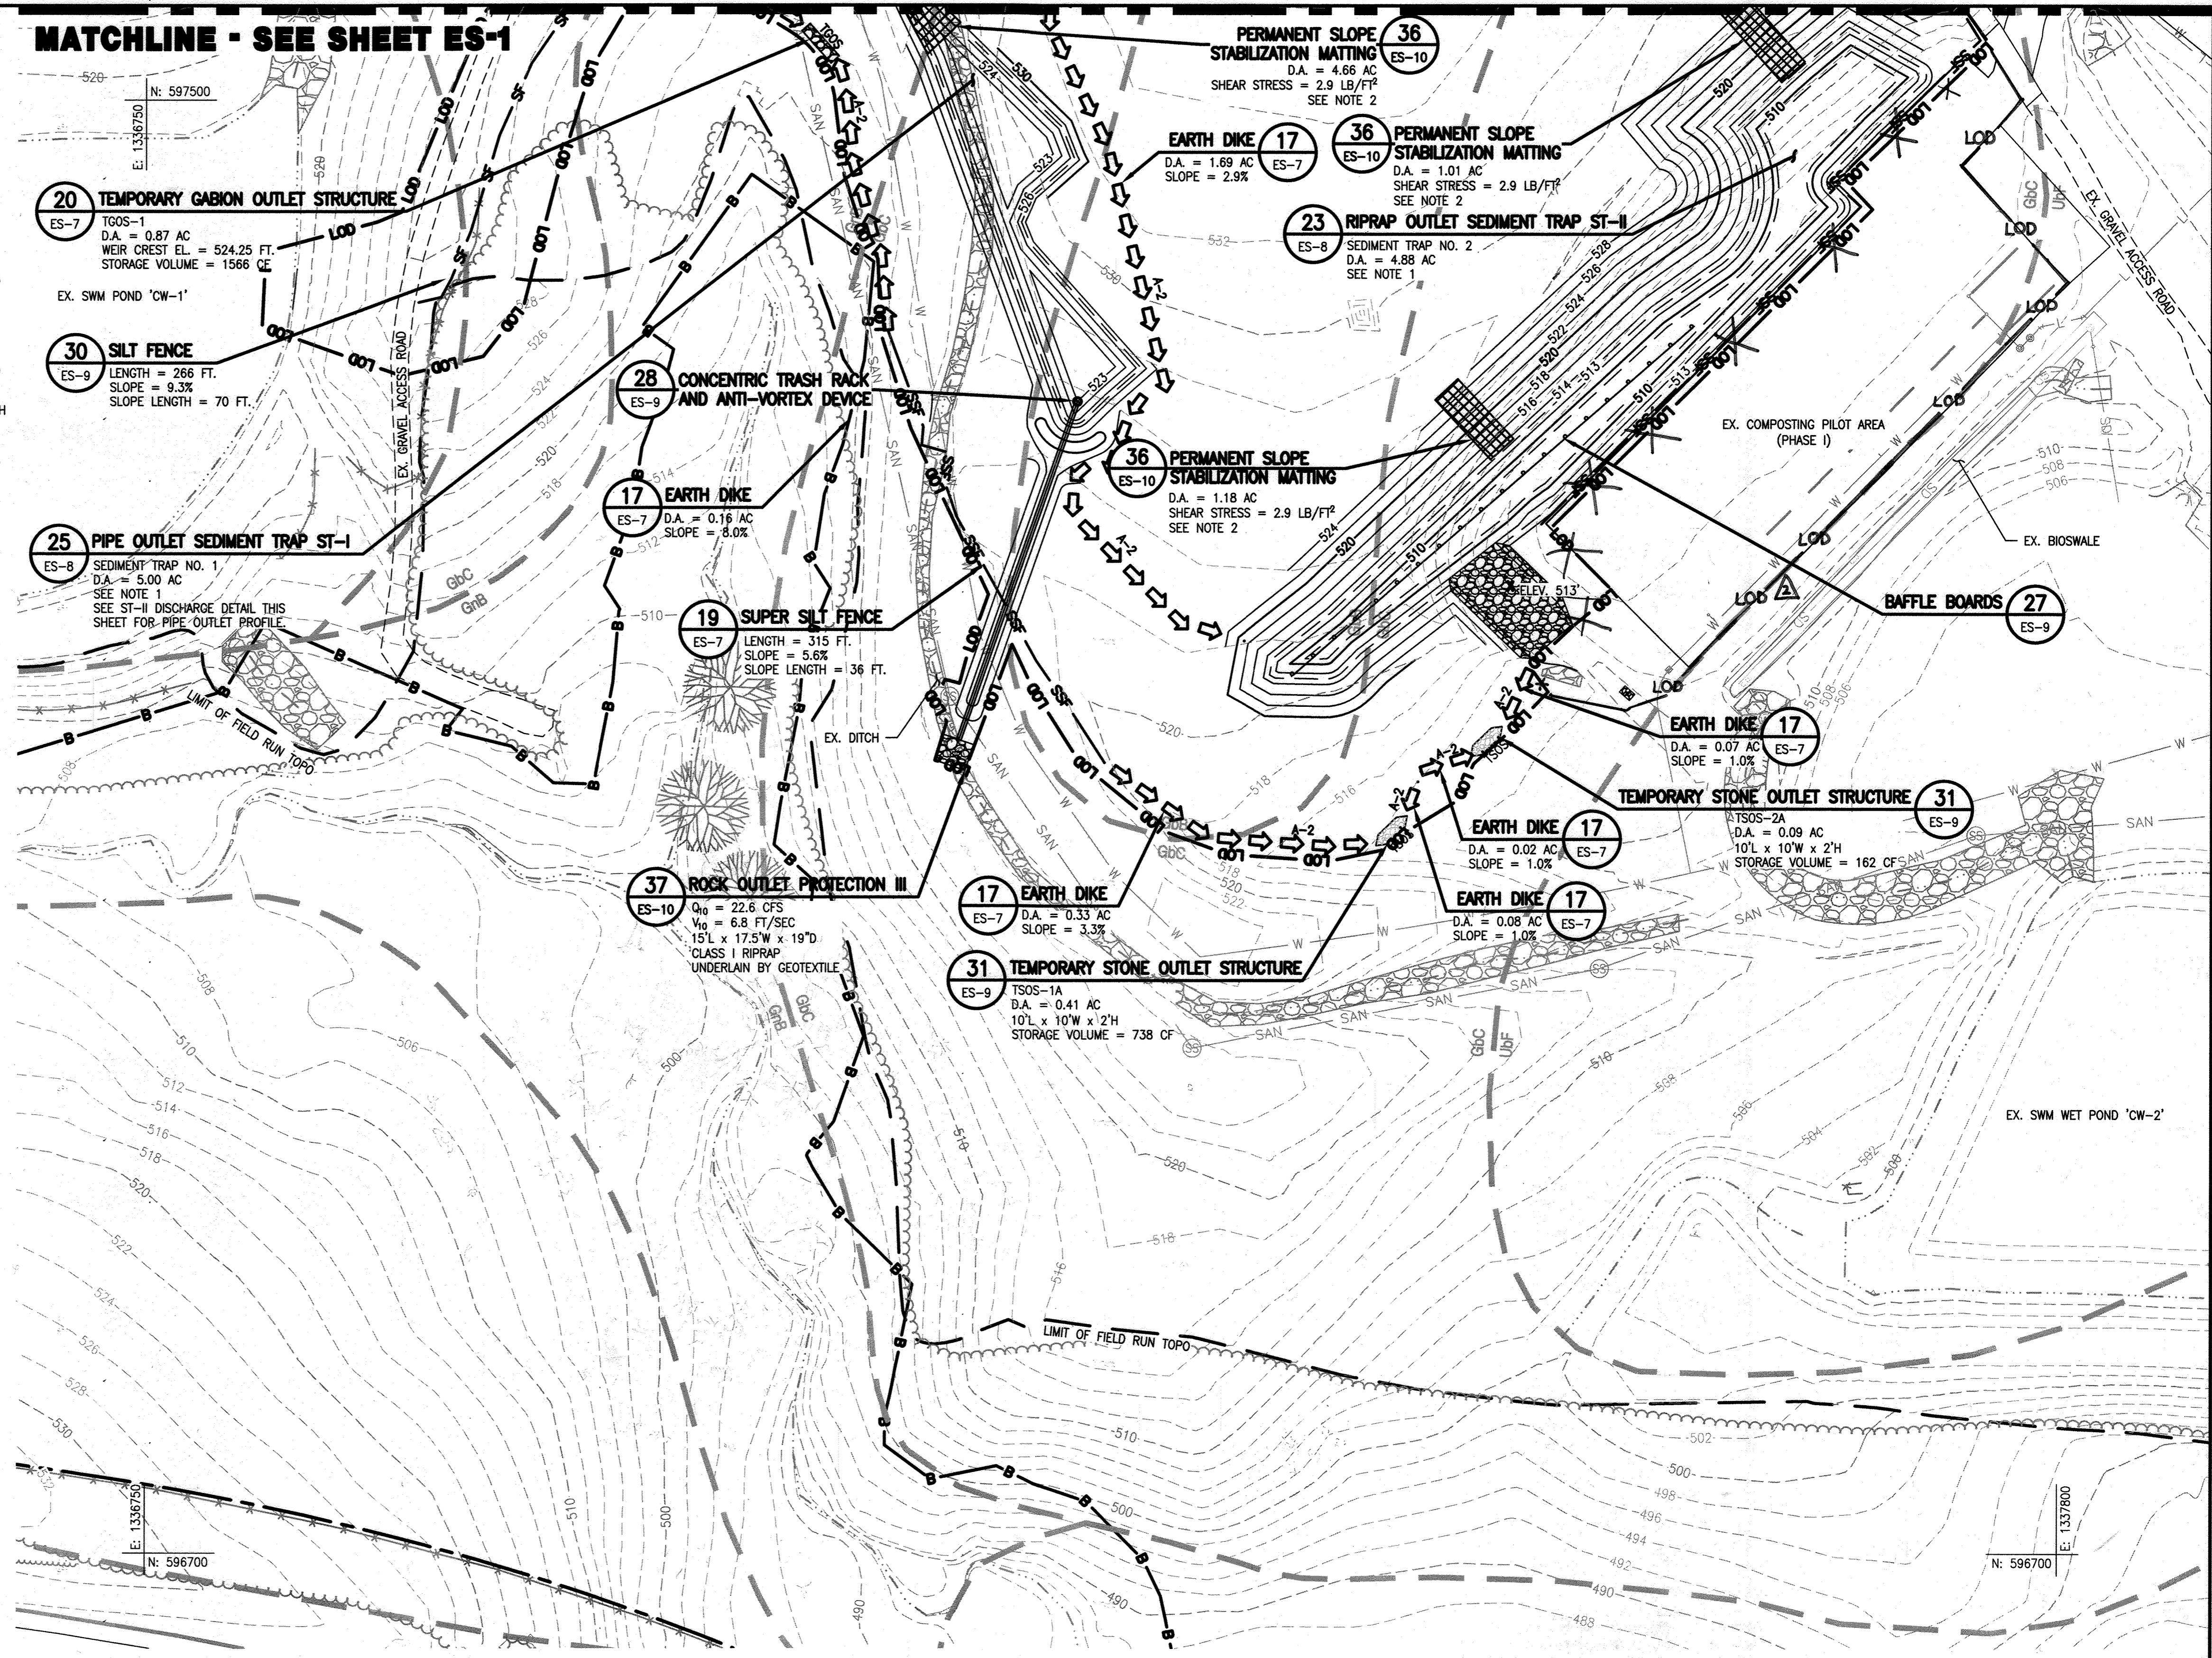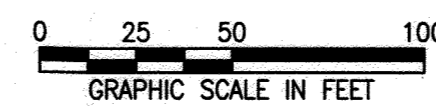


SDP SHEET: DRAWING:
13 OF 44 ES-2

PROJECT:
14982.05
SHEET:
25 OF 70

**COMPOST FACILITY - PHASE II
AT ALPHA RIDGE LANDFILL**
HOWARD COUNTY, MARYLAND

**EROSION AND SEDIMENT CONTROL
PLAN - INITIAL II**
(PHASES IIA AND IIB)

NOT FOR CONSTRUCTION - SITE DEVELOPMENT PLAN #SDP-16-035

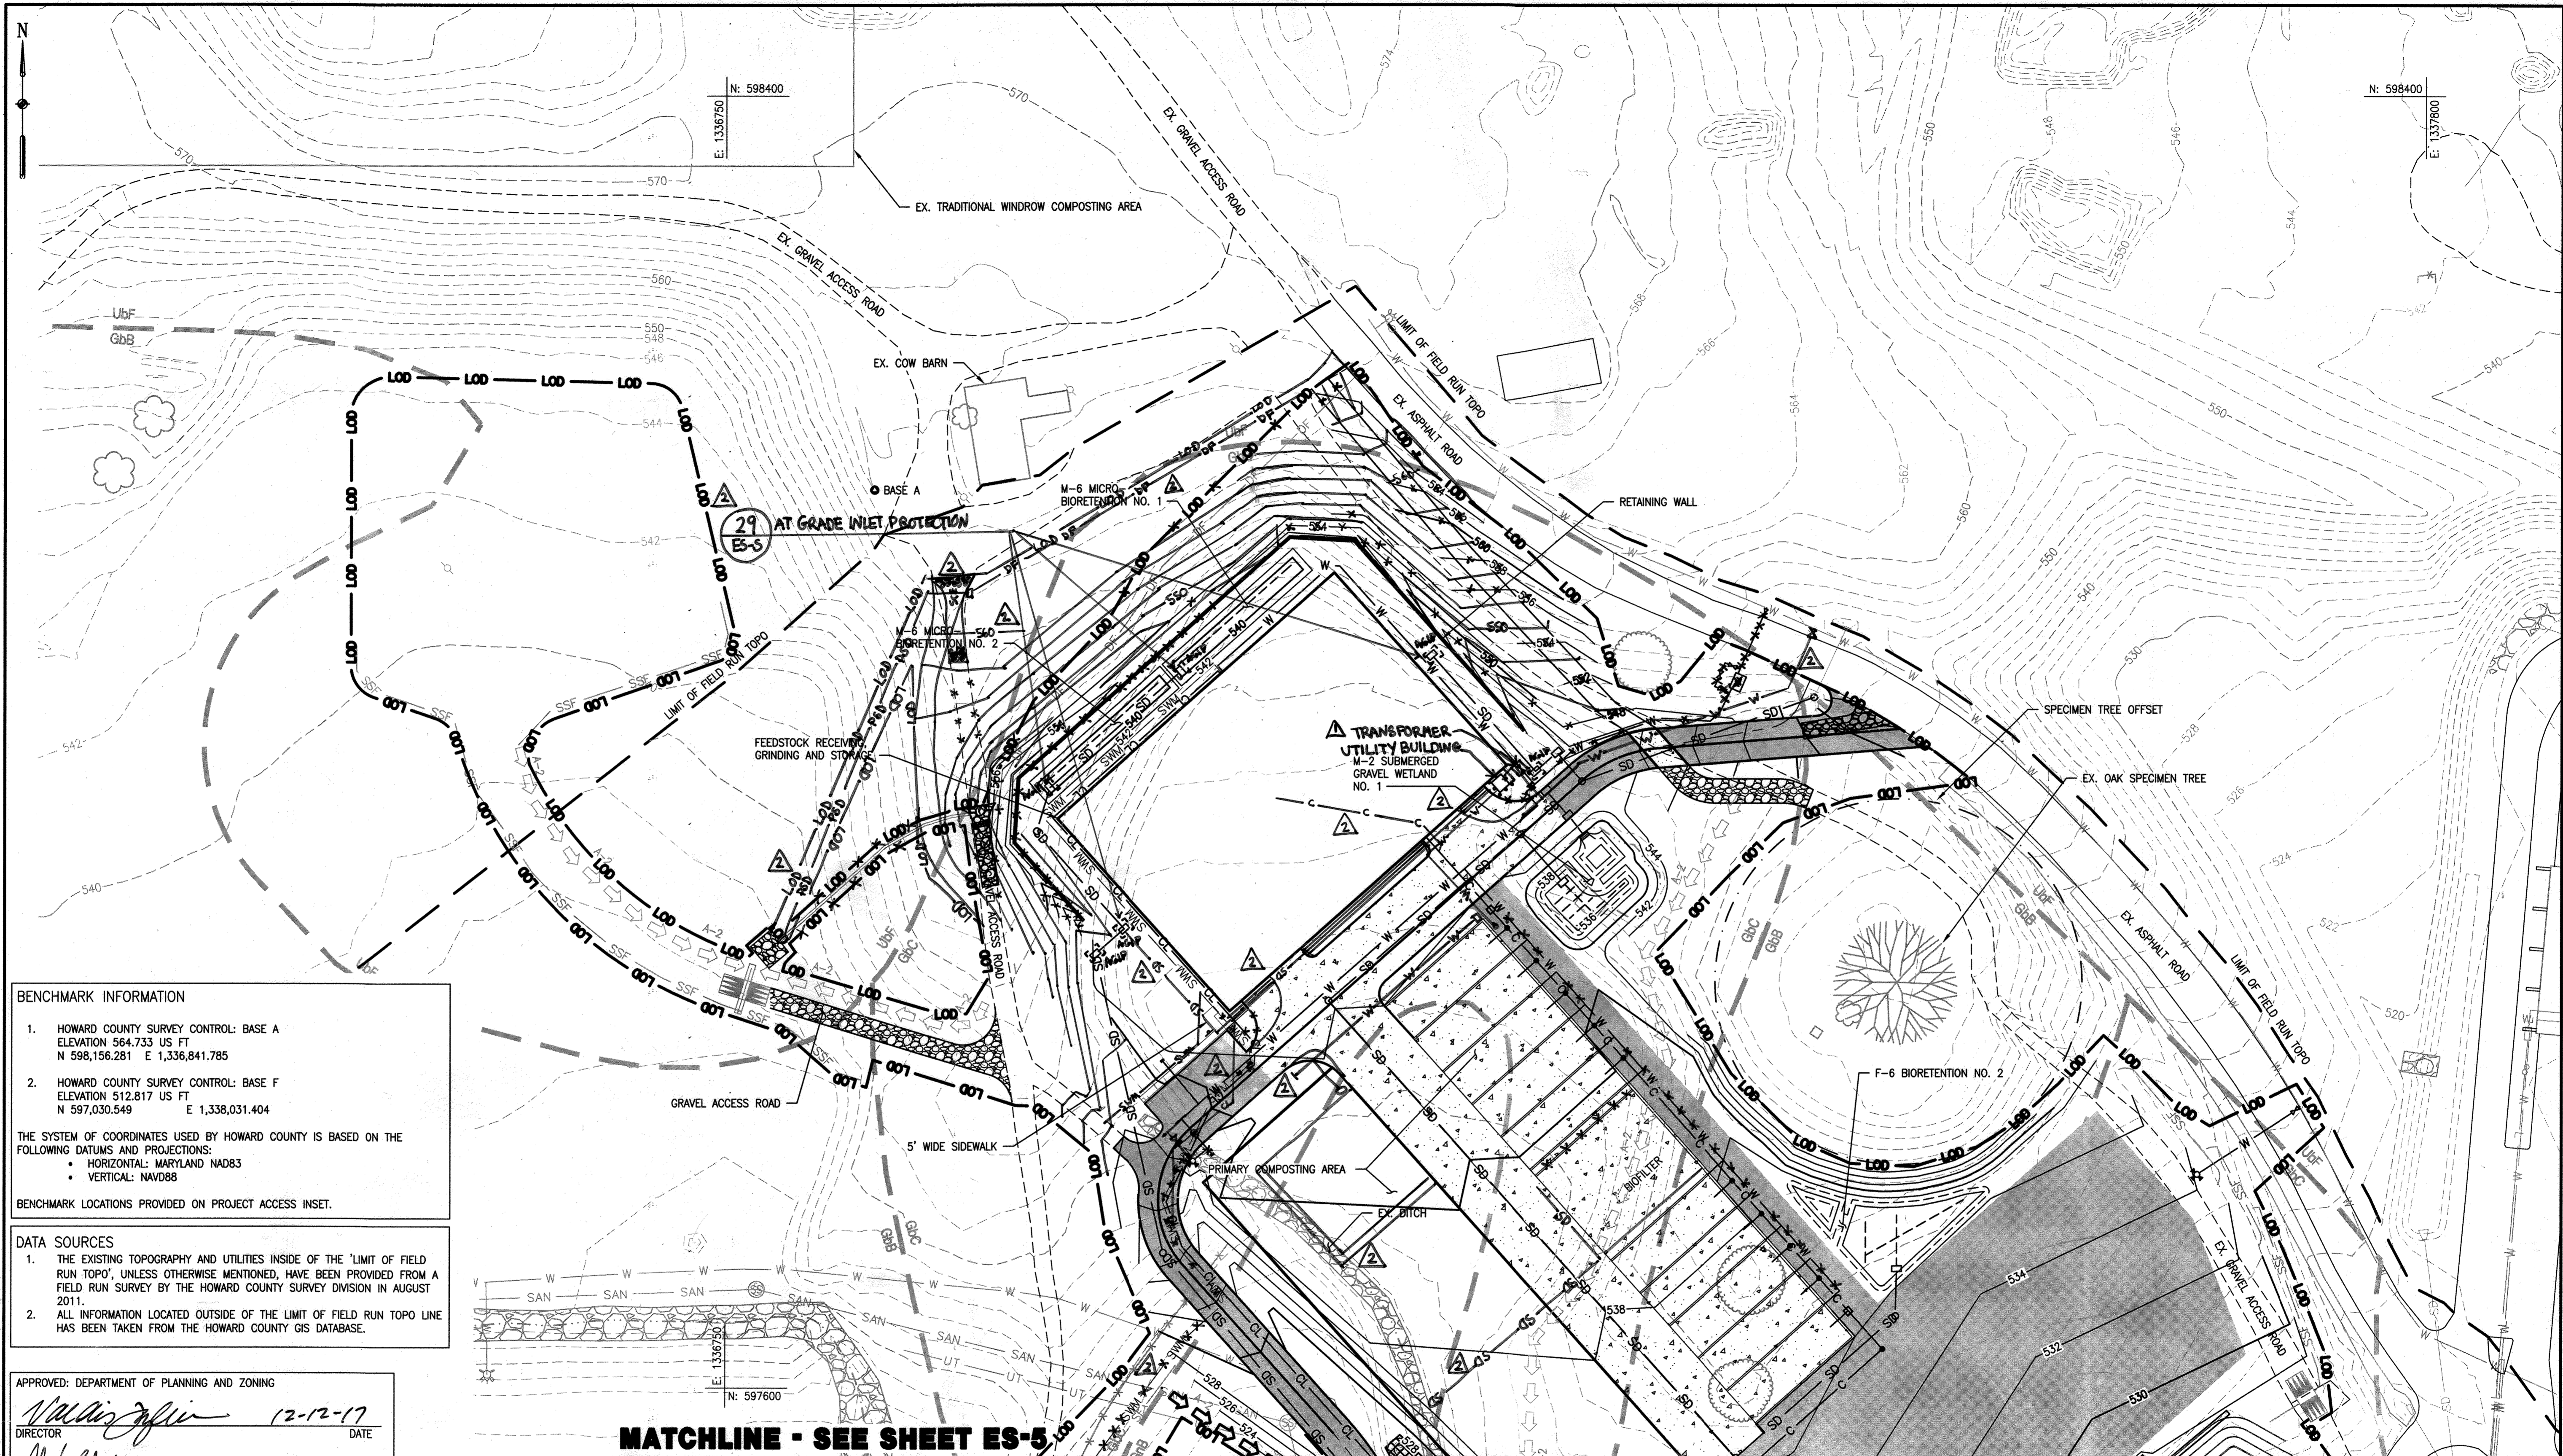

BENCHMARK INFORMATION

- HOWARD COUNTY SURVEY CONTROL: BASE A
ELEVATION 564.733 US FT
N 598,156.281 E 1,336,841.785
- HOWARD COUNTY SURVEY CONTROL: BASE F
ELEVATION 512.817 US FT
N 597,030.549 E 1,338,031.404

THE SYSTEM OF COORDINATES USED BY HOWARD COUNTY IS BASED ON THE FOLLOWING DATUMS AND PROJECTIONS:

- HORIZONTAL: MARYLAND NAD83
- VERTICAL: NAVD88

BENCHMARK LOCATIONS PROVIDED ON PROJECT ACCESS INSET.

DATA SOURCES

- THE EXISTING TOPOGRAPHY AND UTILITIES INSIDE OF THE 'LIMIT OF FIELD RUN TOPO', UNLESS OTHERWISE MENTIONED, HAVE BEEN PROVIDED FROM A FIELD RUN SURVEY BY THE HOWARD COUNTY SURVEY DIVISION IN AUGUST 2011.
- ALL INFORMATION LOCATED OUTSIDE OF THE LIMIT OF FIELD RUN TOPO LINE HAS BEEN TAKEN FROM THE HOWARD COUNTY GIS DATABASE.

APPROVED: DEPARTMENT OF PLANNING AND ZONING

Nellis J. J. [Signature] 12-12-17
DIRECTOR DATE


[Signature] 11/21/17
CHIEF, DEVELOPMENT ENGINEERING DIVISION DATE

[Signature] 12-5-17
CHIEF, DIVISION OF LAND DEVELOPMENT DATE

OWNER/ENGINEER INFORMATION

DEVELOPER/OWNER:
HOWARD COUNTY GOVERNMENT
CONTACT: JEFF DANNIS, P.E., CSP
6751 COLUMBIA GATEWAY DRIVE, SUITE 514
COLUMBIA, MD 21046
TELEPHONE: (410) 313-6419

ENGINEER:
EA ENGINEERING, SCIENCE,
AND TECHNOLOGY, INC., PBC
CONTACT: MARK GUTBERLET, P.E.
225 SCHILLING CIRCLE, SUITE 400
HUNT VALLEY, MD 21081
TELEPHONE: (410) 584-7000

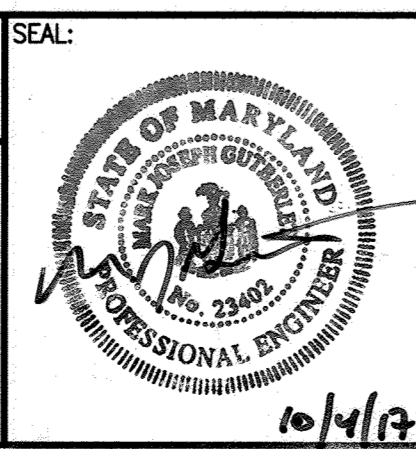

NOTES:

- SEE DRAWING ES-8 FOR SEDIMENT TRAP TABLE.
- EROSION AND SEDIMENT CONTROLS INSTALLED DURING INITIAL PHASE ARE SHOWN AS EXISTING IN FINAL PHASE.

SITE PLAN
SCALE: 1" = 50'
0 25 50 100
GRAPHIC SCALE IN FEET

REVIEWED FOR HOWARD SCD AND MEETS TECHNICAL REQUIREMENTS
THIS DEVELOPMENT PLAN IS APPROVED FOR SOIL EROSION AND
SEDIMENT CONTROL BY THE HOWARD SOIL CONSERVATION DISTRICT.

[Signature] 4/22/17
HOWARD SCD DATE

SDP SHEET: DRAWING:
45
15 OF 44
ES-4

PROFESSIONAL CERTIFICATION:

EA
EA ENGINEERING,
SCIENCE AND
TECHNOLOGY

I HEREBY CERTIFY THAT THESE DOCUMENTS
WERE PREPARED OR APPROVED BY ME AND
THAT I AM A DULY LICENSED PROFESSIONAL
ENGINEER UNDER THE LAWS OF THE STATE
OF MARYLAND, LICENSE NO. 23402
EXPIRATION DATE 25 AUGUST 2018.

DSN. BY:	MBS/MP	SMB	REVISED UTILITY BUILDING AND TRANSFORMER LOCATION	4/20/17
DRN. BY:	JAP/KEJ	CVH	REVISED TO SHOW BEST PRACTICE FOR THE USE AS-BUILT CONSTRUCTION AND PHASE II	8/22/22
CHK. BY:	SMD			
DATE:	OCT. 2016	BY	NO.	REVISION
				DATE

**EROSION AND SEDIMENT CONTROL
PLAN - FINAL I**



**COMPOST FACILITY - PHASE II
AT ALPHA RIDGE LANDFILL**
HOWARD COUNTY, MARYLAND

PROJECT:
14982.05
SHEET:
27 OF 70

NOT FOR CONSTRUCTION - SITE DEVELOPMENT PLAN #SDP-16-035

NOTES:

- SEE DRAWING ES-8 FOR SEDIMENT TRAP TABLE.
- EROSION AND SEDIMENT CONTROLS INSTALLED DURING INITIAL PHASE ARE SHOWN AS EXISTING IN FINAL PHASE.

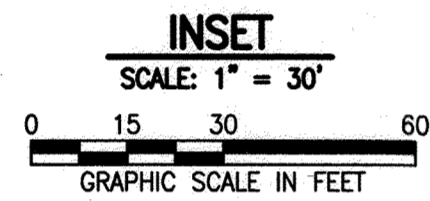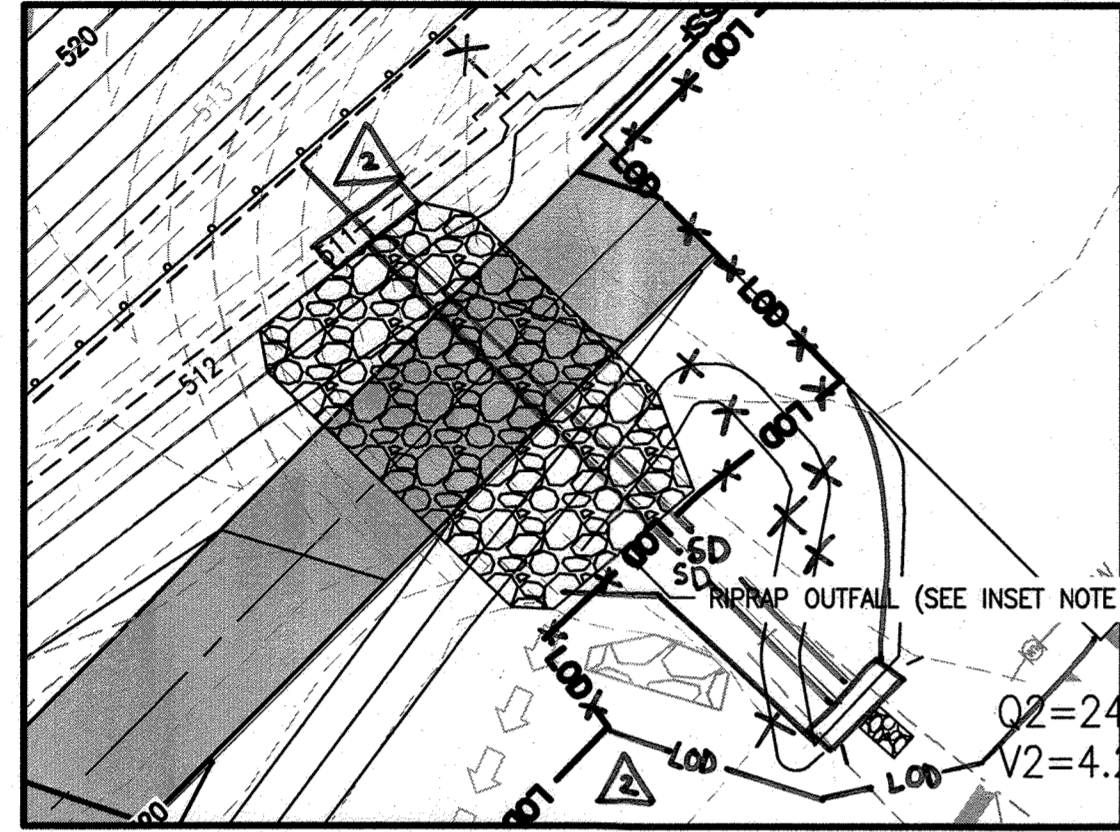

INSET NOTES:

- REMOVE RIPRAP OUTFALL BEFORE COMPLETION OF THE ROAD.

BENCHMARK INFORMATION

- HOWARD COUNTY SURVEY CONTROL: BASE A
ELEVATION 564,733 US FT
N 598,156.281 E 1,336,841.785
- HOWARD COUNTY SURVEY CONTROL: BASE F
ELEVATION 512,817 US FT
N 597,030.549 E 1,338,031.404

THE SYSTEM OF COORDINATES USED BY HOWARD COUNTY IS BASED ON THE FOLLOWING DATUMS AND PROJECTIONS:
 • HORIZONTAL: MARYLAND NAD83
 • VERTICAL: NAVD83

BENCHMARK LOCATIONS PROVIDED ON PROJECT ACCESS INSET.

DATA SOURCES

- THE EXISTING TOPOGRAPHY AND UTILITIES INSIDE OF THE 'LIMIT OF FIELD RUN TOPO', UNLESS OTHERWISE MENTIONED, HAVE BEEN PROVIDED FROM A FIELD RUN SURVEY BY THE HOWARD COUNTY SURVEY DIVISION IN AUGUST 2011.
- ALL INFORMATION LOCATED OUTSIDE OF THE LIMIT OF FIELD RUN TOPO LINE HAS BEEN TAKEN FROM THE HOWARD COUNTY GIS DATABASE.

REVIEWED FOR HOWARD SCD AND MEETS TECHNICAL REQUIREMENTS

THIS DEVELOPMENT PLAN IS APPROVED FOR SOIL EROSION AND SEDIMENT CONTROL BY THE HOWARD SOIL CONSERVATION DISTRICT.

John R. [Signature]
 HOWARD SCD DATE: 11/22/17

APPROVED: DEPARTMENT OF PLANNING AND ZONING

Valdis Japic 12-12-17
 DIRECTOR DATE

[Signature] 1/23/17
 CHIEF, DEVELOPMENT ENGINEERING DIVISION DATE


Kurt S. O. [Signature] 12-5-17
 CHIEF, DIVISION OF LAND DEVELOPMENT DATE

GRID: 8 BLOCK: N/A
 ZONING: RC-DEO PARCEL/LOT: 220, 253, 11, 23, 54
 TAX MAP: 0016 ELECTION DISTRICT: 3-02

OWNER/ENGINEER INFORMATION

DEVELOPER/OWNER:
 HOWARD COUNTY GOVERNMENT
 CONTACT: JEFF DANNIS, P.E., CSP
 6751 COLUMBIA GATEWAY DRIVE, SUITE 514
 COLUMBIA, MD 21046
 TELEPHONE: (410) 313-6419

ENGINEER:
 EA ENGINEERING, SCIENCE,
 AND TECHNOLOGY, INC., PBC
 CONTACT: MARK GUTBERLET, P.E.
 225 SCHILLING CIRCLE, SUITE 400
 HUNT VALLEY, MD 21031
 TELEPHONE: (410) 584-7000

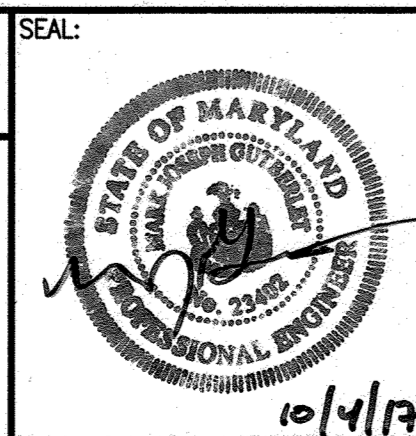



PROFESSIONAL CERTIFICATION:

I HEREBY CERTIFY THAT THESE DOCUMENTS WERE PREPARED OR APPROVED BY ME, AND THAT I AM A DULY LICENSED PROFESSIONAL ENGINEER UNDER THE LAWS OF THE STATE OF MARYLAND, LICENSE NO. 23402, EXPIRATION DATE 25 AUGUST 2018.



DSN. BY:	MBS/MP	CVH	REVISION TO SUBJECT PHASE I A AND PHASE I B AS-BUILT CONDITIONS AND LOD	8/2/12
DRN. BY:	JAP/KEJ			
CHK. BY:	SMD			
DATE:	OCT. 2016	BY	NO.	REVISION
				DATE

SITE PLAN

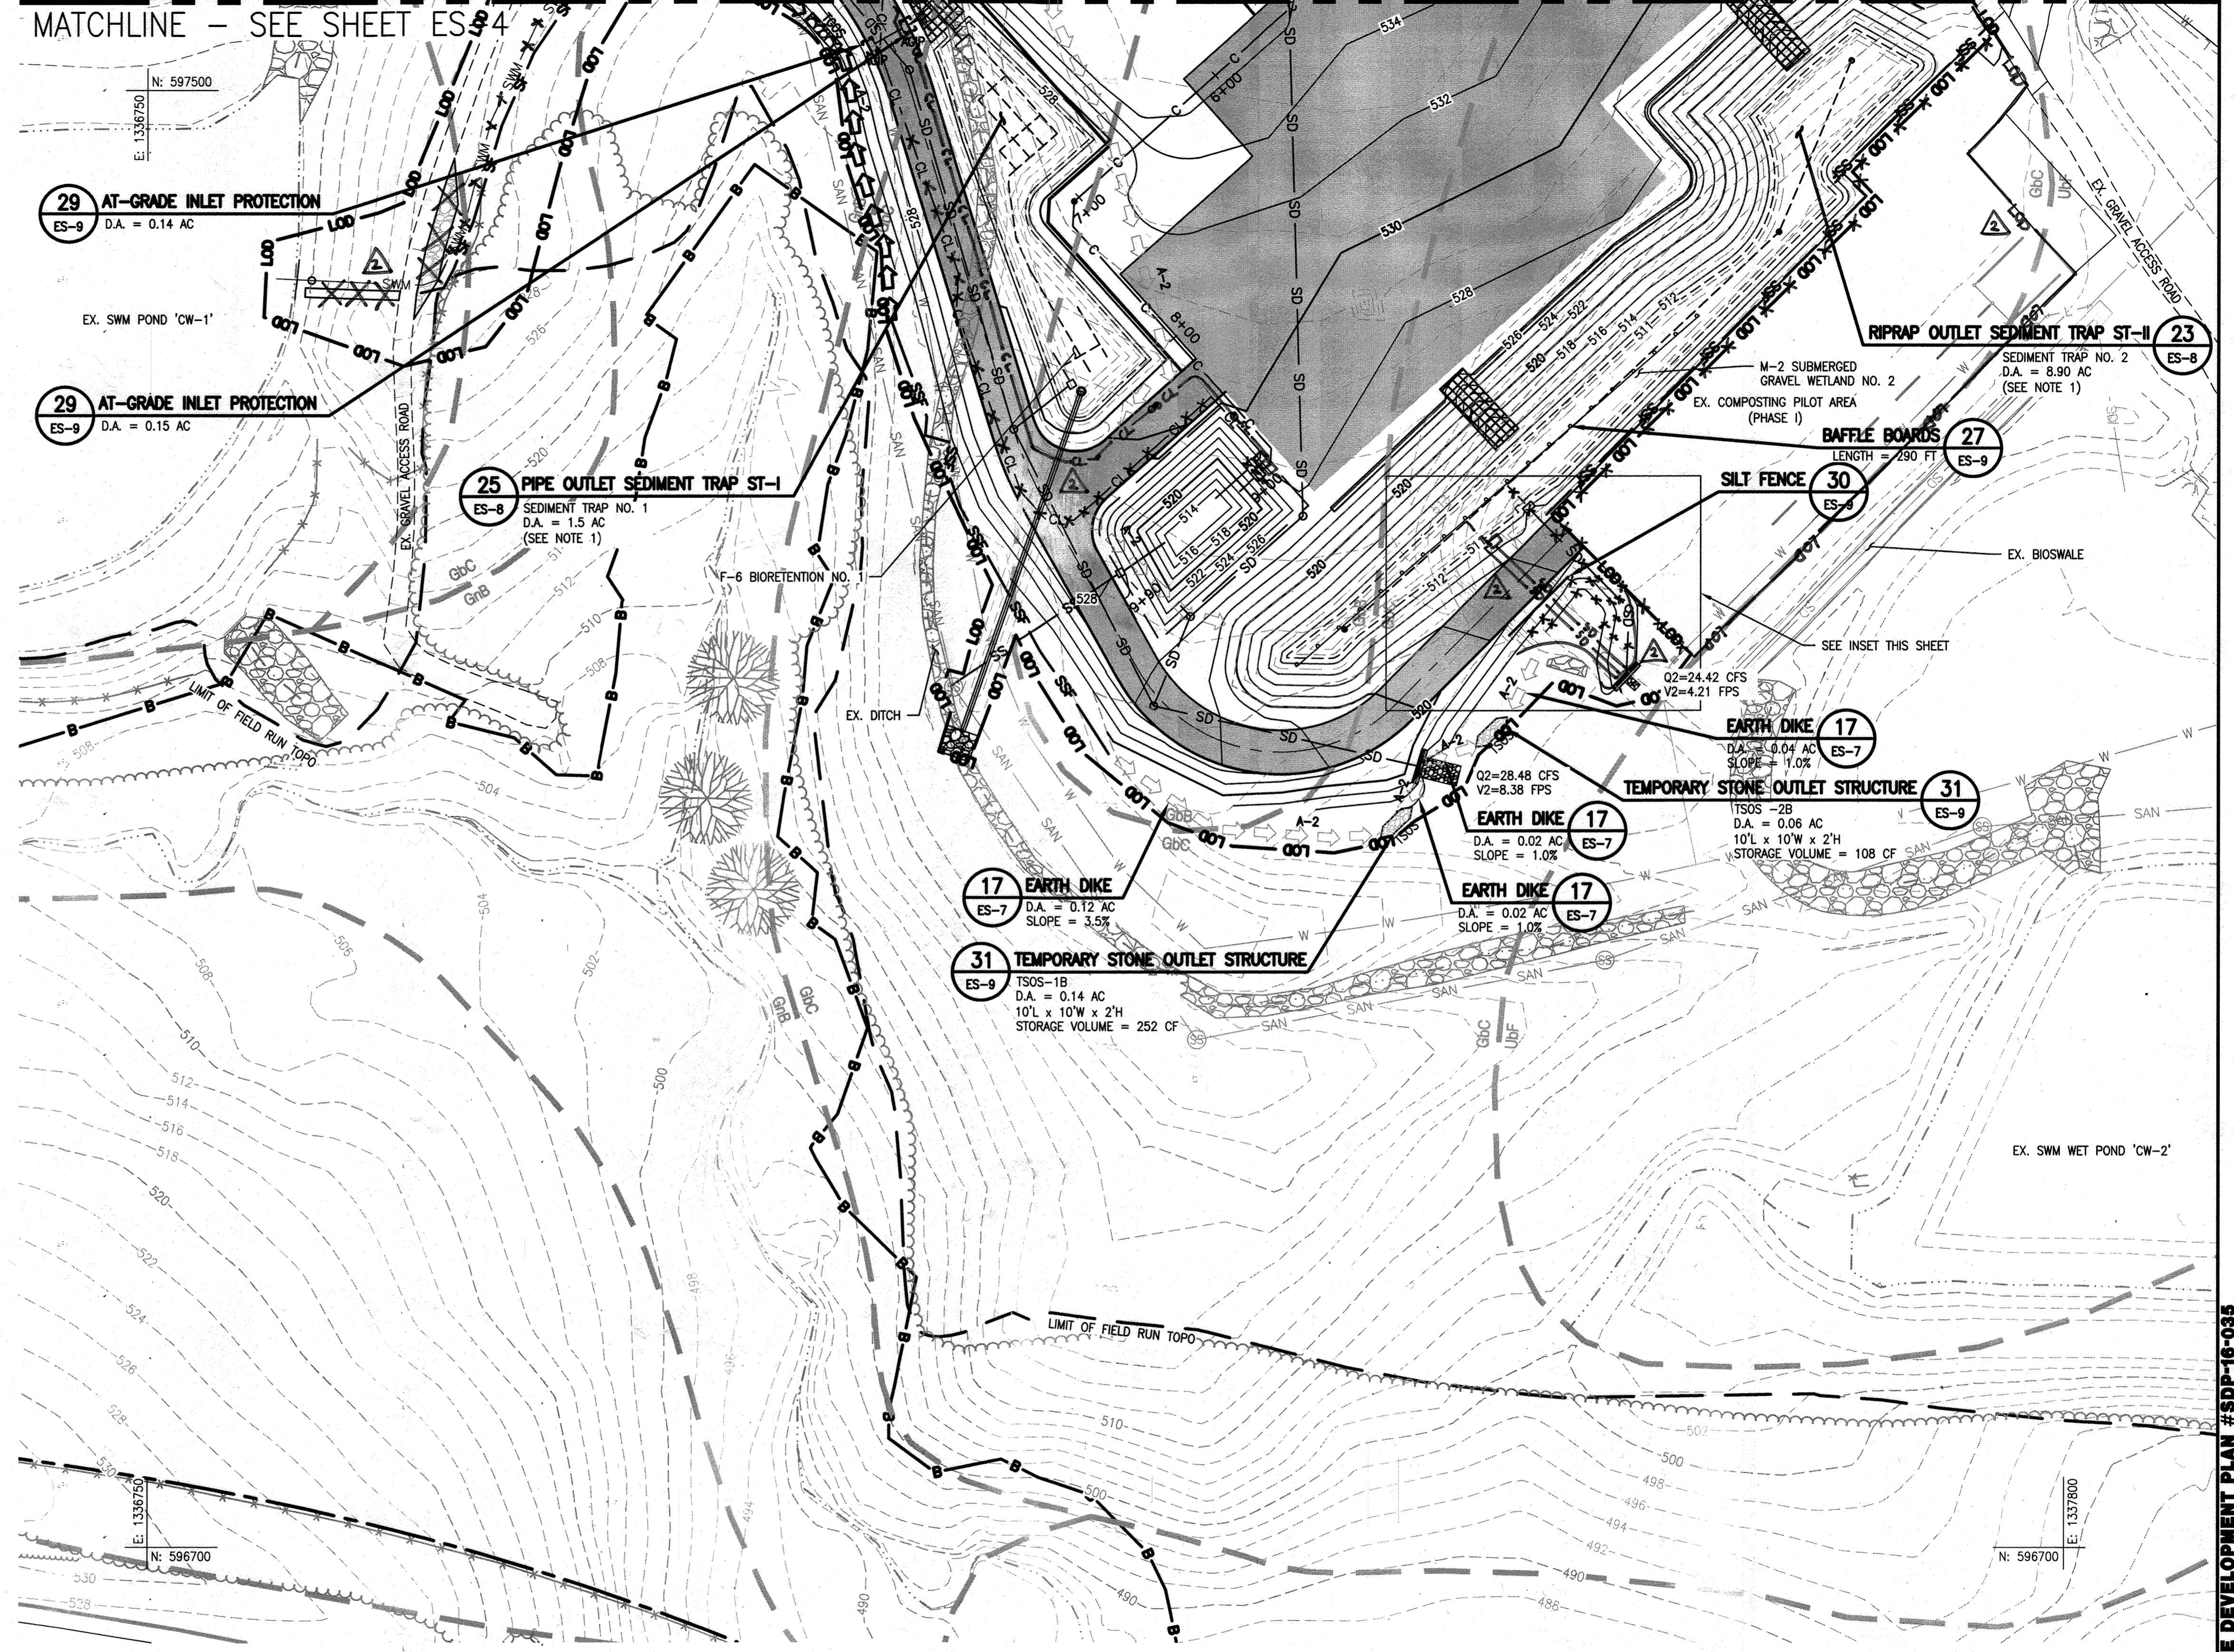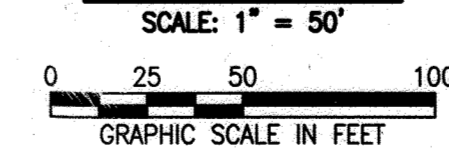


SDP SHEET:	DRAWING:
16 OF 44	45 ES-5

PROJECT:	14982.05
SHEET:	-28 OF 70

COMPOST FACILITY - PHASE II
 AT ALPHA RIDGE LANDFILL
 HOWARD COUNTY, MARYLAND

EROSION AND SEDIMENT CONTROL PLAN - FINAL II

NOT FOR CONSTRUCTION - SITE DEVELOPMENT PLAN #SDP-16-035

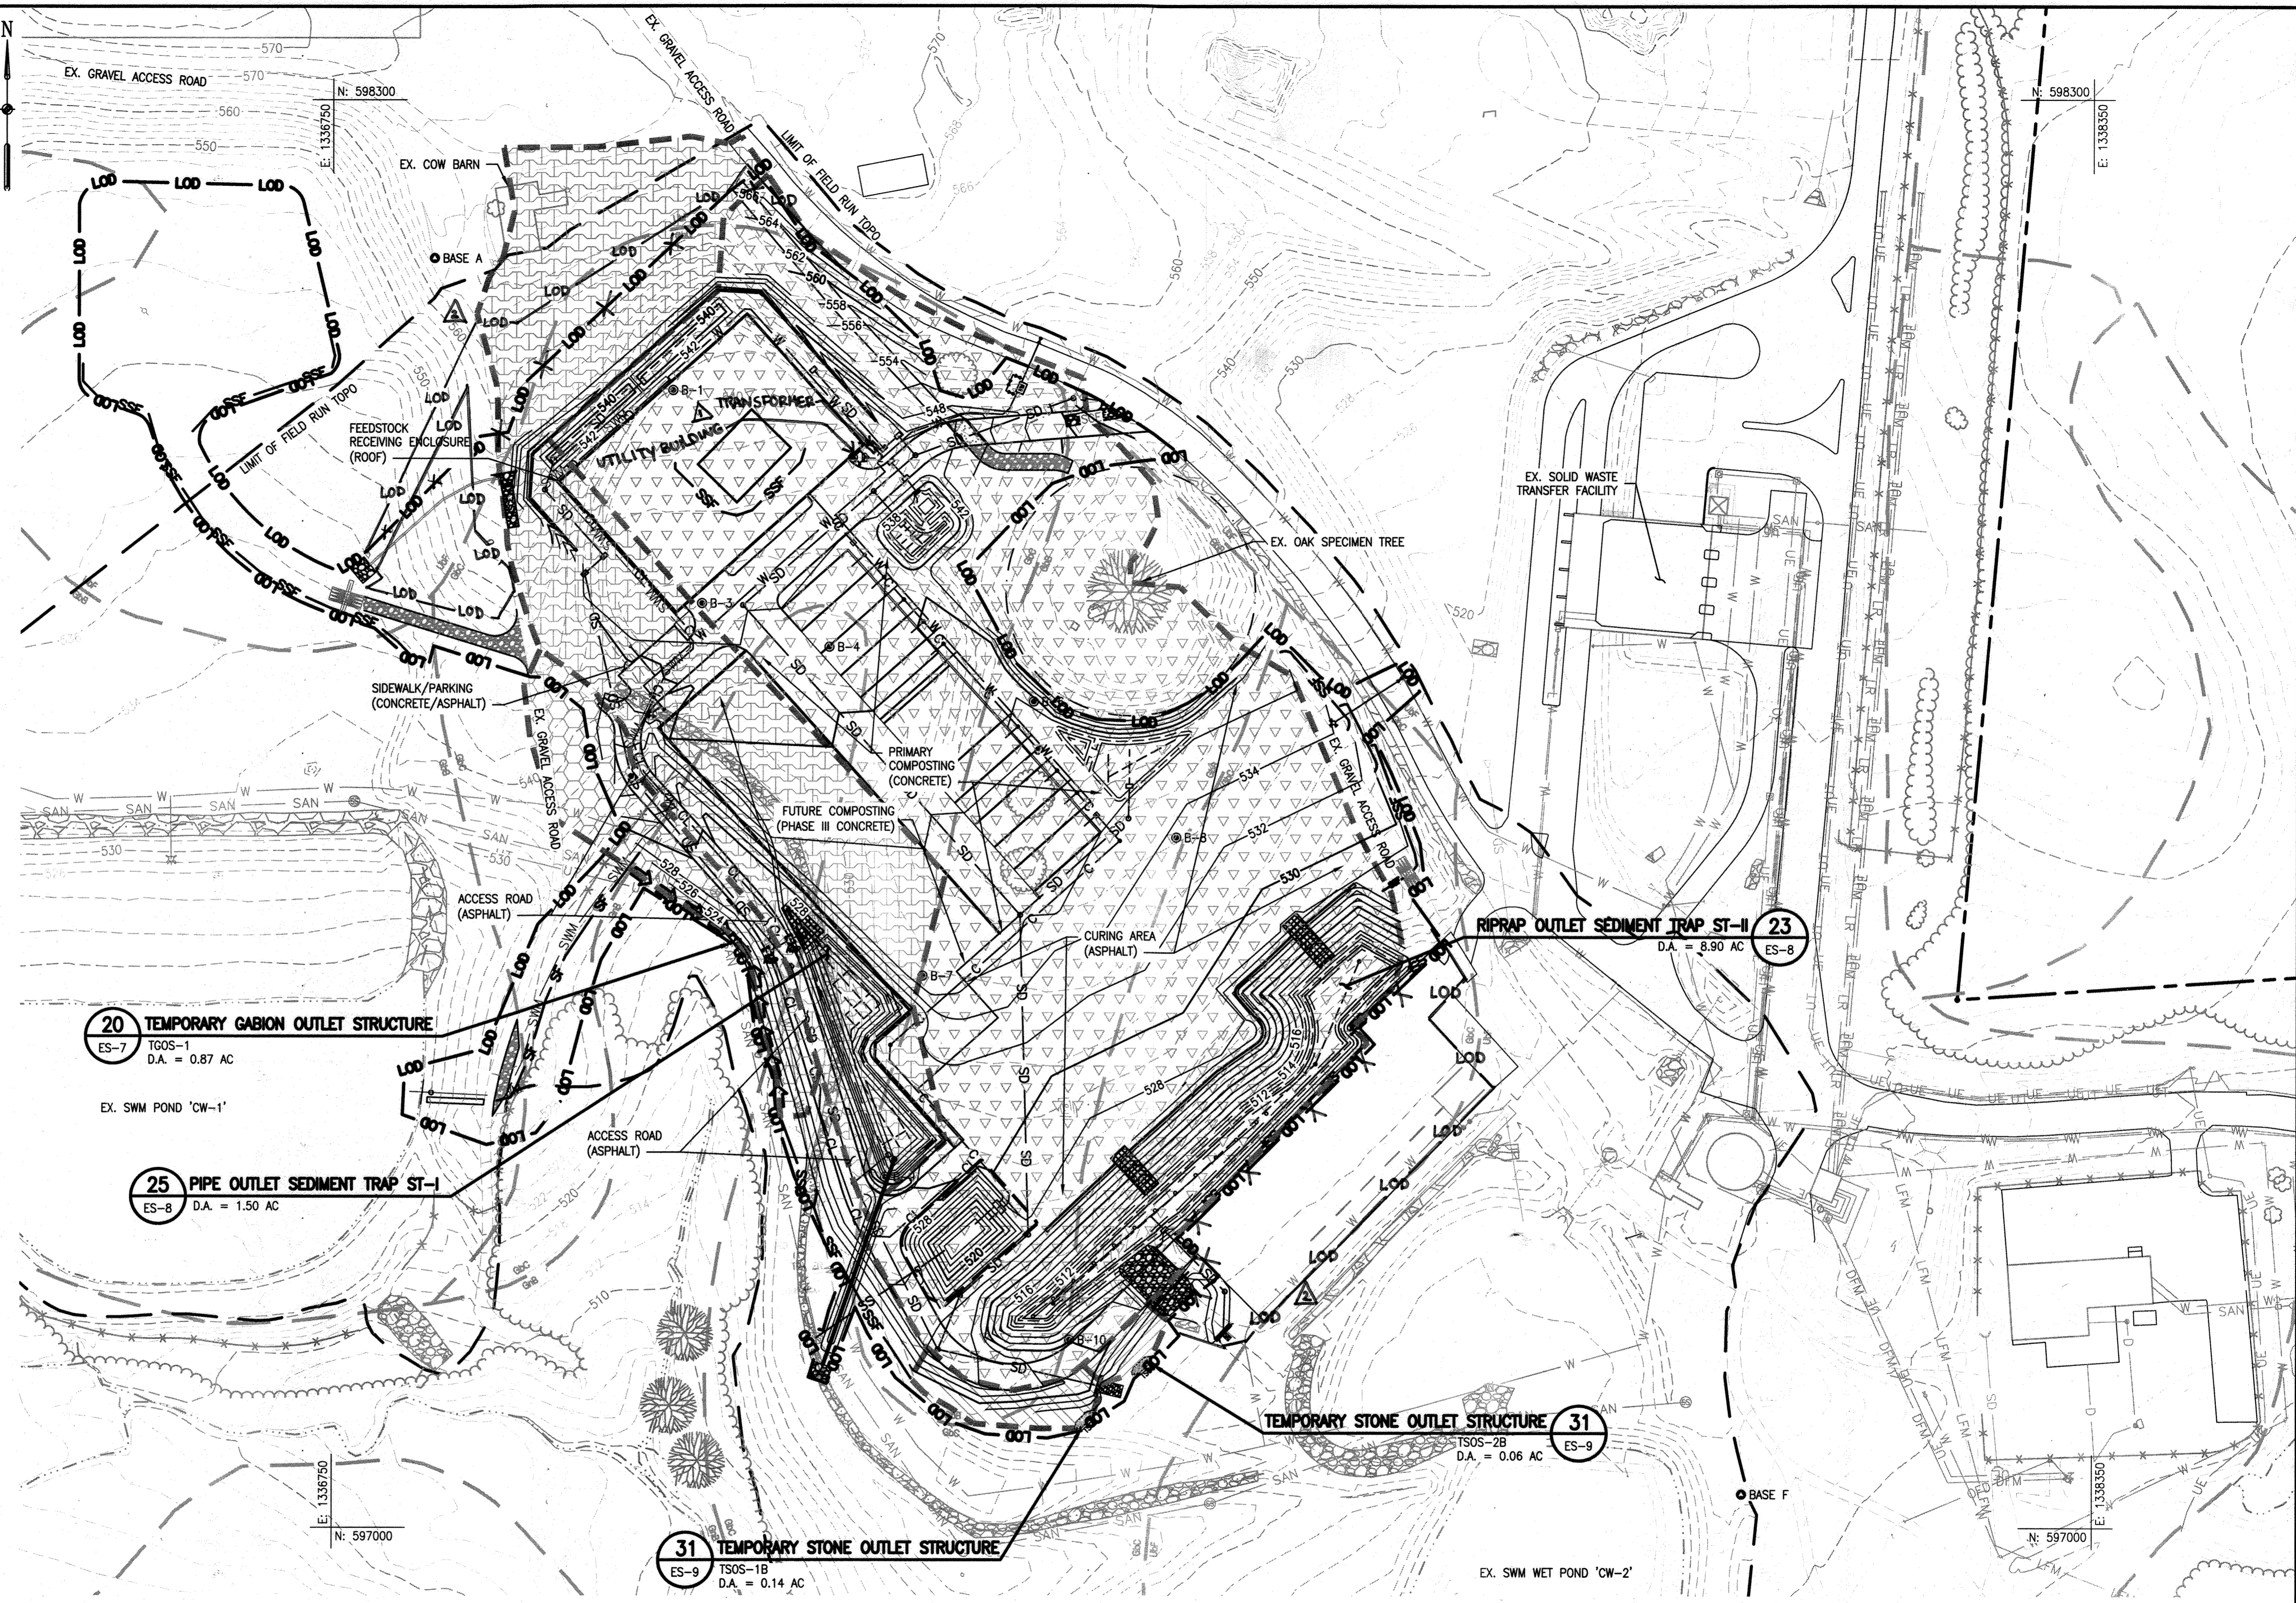

20 TEMPORARY GABION OUTLET STRUCTURE
 ES-7 T60S-1
 D.A. = 0.87 AC

EX. SWM POND 'CW-1'


25 PIPE OUTLET SEDIMENT TRAP ST-I
 ES-8
 D.A. = 1.50 AC

31 TEMPORARY STONE OUTLET STRUCTURE
 ES-9 TS0S-1B
 D.A. = 0.14 AC

TEMPORARY STONE OUTLET STRUCTURE 31
 TS0S-2B
 D.A. = 0.06 AC

RIPRAP OUTLET SEDIMENT TRAP ST-II 23
 D.A. = 8.90 AC
 ES-8

DRAINAGE AREA MAP
 SCALE: 1" = 80'

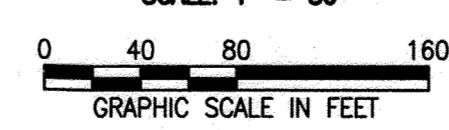


APPROVED: DEPARTMENT OF PLANNING AND ZONING
Valerie Joffe 12-12-17
 DIRECTOR DATE
Al Ch... 11/29/17
 CHIEF, DEVELOPMENT ENGINEERING DIVISION DATE
Ver... 12-5-17
 CHIEF, DIVISION OF LAND DEVELOPMENT DATE

GRID: 8 BLOCK: N/A
 ZONING: RC-DEG PARCEL/LOT: 220, 253, 1' 23, 54
 TAX MAP: 0016 ELECTION DISTRICT: 3-02

OWNER/ENGINEER INFORMATION
 DEVELOPER/OWNER:
 HOWARD COUNTY GOVERNMENT
 CONTACT: JEFF DANNIS, P.E., CSP
 6751 COLUMBIA GATEWAY DRIVE, SUITE 514
 COLUMBIA, MD 21046
 TELEPHONE: (410) 313-6419

ENGINEER:
 EA ENGINEERING, SCIENCE,
 AND TECHNOLOGY, INC., PBC
 CONTACT: MARK GUTBERLET, P.E.
 225 SCHILLING CIRCLE, SUITE 400
 HUNT VALLEY, MD 21031
 TELEPHONE: (410) 584-7000

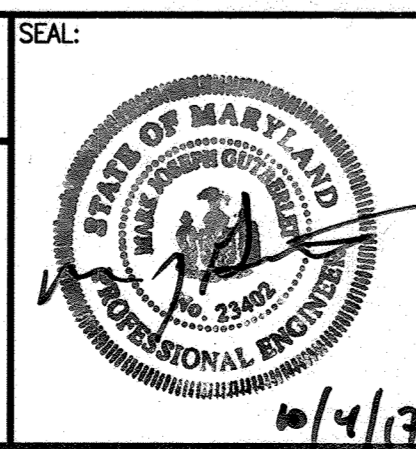

PROFESSIONAL CERTIFICATION:
 I HEREBY CERTIFY THAT THESE DOCUMENTS
 WERE PREPARED OR APPROVED BY ME, AND
 THAT I AM A DULY LICENSED PROFESSIONAL
 ENGINEER UNDER THE LAWS OF THE STATE
 OF MARYLAND, LICENSE NO. 23402,
 EXPIRATION DATE 25 AUGUST 2018.




DSN. BY:	MBS/MP	SMB	REVISED UTILITY BUILDING AND TRANSFORMER LOCATION	4/2017
DRN. BY:	JAP/KEJ	CVH	REVISED LOT FOR PHASE IIS AND PHASE IIC CONSTRUCTION	8/2022
CHK. BY:	SMD			
DATE:	OCT. 2016	BY	NO.	REVISION
				DATE

EROSION AND SEDIMENT CONTROL
 PLAN - FINAL DRAINAGE AREA MAP

COMPOST FACILITY - PHASE II
 AT ALPHA RIDGE LANDFILL
 HOWARD COUNTY, MARYLAND

SDP SHEET:	DRAWING:
17 OF 44	45
	ES-6
PROJECT:	14982.05
SHEET:	29 OF 76

NOT FOR CONSTRUCTION - SITE DEVELOPMENT PLAN #SDP-16-035

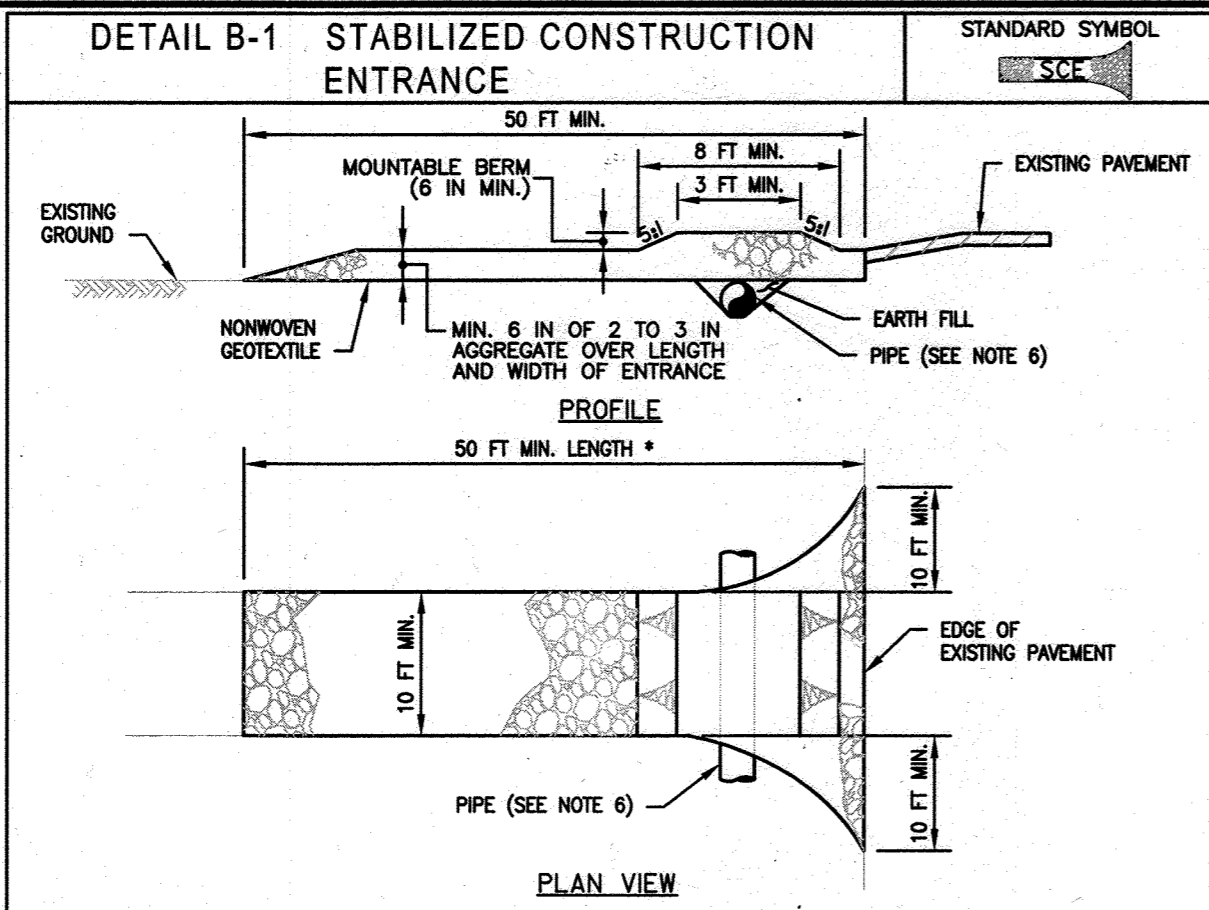


CONSTRUCTION SPECIFICATIONS

- PLACE STABILIZED CONSTRUCTION ENTRANCE IN ACCORDANCE WITH THE APPROVED PLAN. VEHICLES MUST TRAVEL OVER THE ENTIRE LENGTH OF THE SIZE. USE MINIMUM LENGTH OF 50 FEET (450 FEET FOR SINGLE RESURFACE LOT). USE MINIMUM WIDTH OF 10 FEET. FLARE SIDE 10 FEET MINIMUM AT THE EXISTING ROAD TO PROVIDE A TURNING RADIUS.
- PIPE ALL SURFACE WATER FLOWING TO OR DIVERTED TOWARD THE SCE UNDER THE ENTRANCE, MAINTAINING POSITIVE DRAINAGE. PROTECT PIPE INSTALLED THROUGH THE SCE WITH A MOUNTABLE BERM WITH 5:1 SLOPES AND A MINIMUM OF 12 INCHES OF STONE OVER THE PIPE. PROVIDE PIPE AS SPECIFIED ON APPROVED PLAN. WHEN THE SCE IS LOCATED AT A HIGH SPOT AND HAS NO DRAINAGE TO CONVEY, A PIPE IS NOT NECESSARY. A MOUNTABLE BERM IS REQUIRED WHEN SCE IS NOT LOCATED AT A HIGH SPOT.
- PREPARE SUBGRADE AND PLACE NONWOVEN GEOTEXTILE, AS SPECIFIED IN SECTION H-1 MATERIALS.
- PLACE CRUSHED AGGREGATE (2 TO 3 INCHES IN SIZE) OR EQUIVALENT RECYCLED CONCRETE (WITHOUT REBAR) AT LEAST 6 INCHES DEEP OVER THE LENGTH AND WIDTH OF THE SCE.
- MAINTAIN ENTRANCE IN A CONDITION THAT MINIMIZES TRACKING OF SEDIMENT. ADD STONE OR MAKE OTHER REPAIRS AS CONDITIONS DEMAND TO MAINTAIN CLEAR SURFACE. MOUNTABLE BERM, AND SPECIFIED DIMENSIONS. IMMEDIATELY REMOVE STONE AND/OR SEDIMENT SPILLED, DROPPED, OR TRACKED ONTO ADJACENT ROADWAY BY VACUUMING, SCRAPING, AND/OR SWEEPING. WASHING ROADWAY TO REMOVE MUD TRACKED ONTO PAVEMENT IS NOT ACCEPTABLE UNLESS WASH WATER IS DIRECTED TO AN APPROVED SEDIMENT CONTROL PRACTICE.

MARYLAND STANDARDS AND SPECIFICATIONS FOR SOIL EROSION AND SEDIMENT CONTROL
 U.S. DEPARTMENT OF AGRICULTURE NATURAL RESOURCES CONSERVATION SERVICE 2011 MARYLAND DEPARTMENT OF ENVIRONMENT WATER MANAGEMENT ADMINISTRATION

16 STABILIZED CONSTRUCTION ENTRANCE
 ES-1 NOT TO SCALE

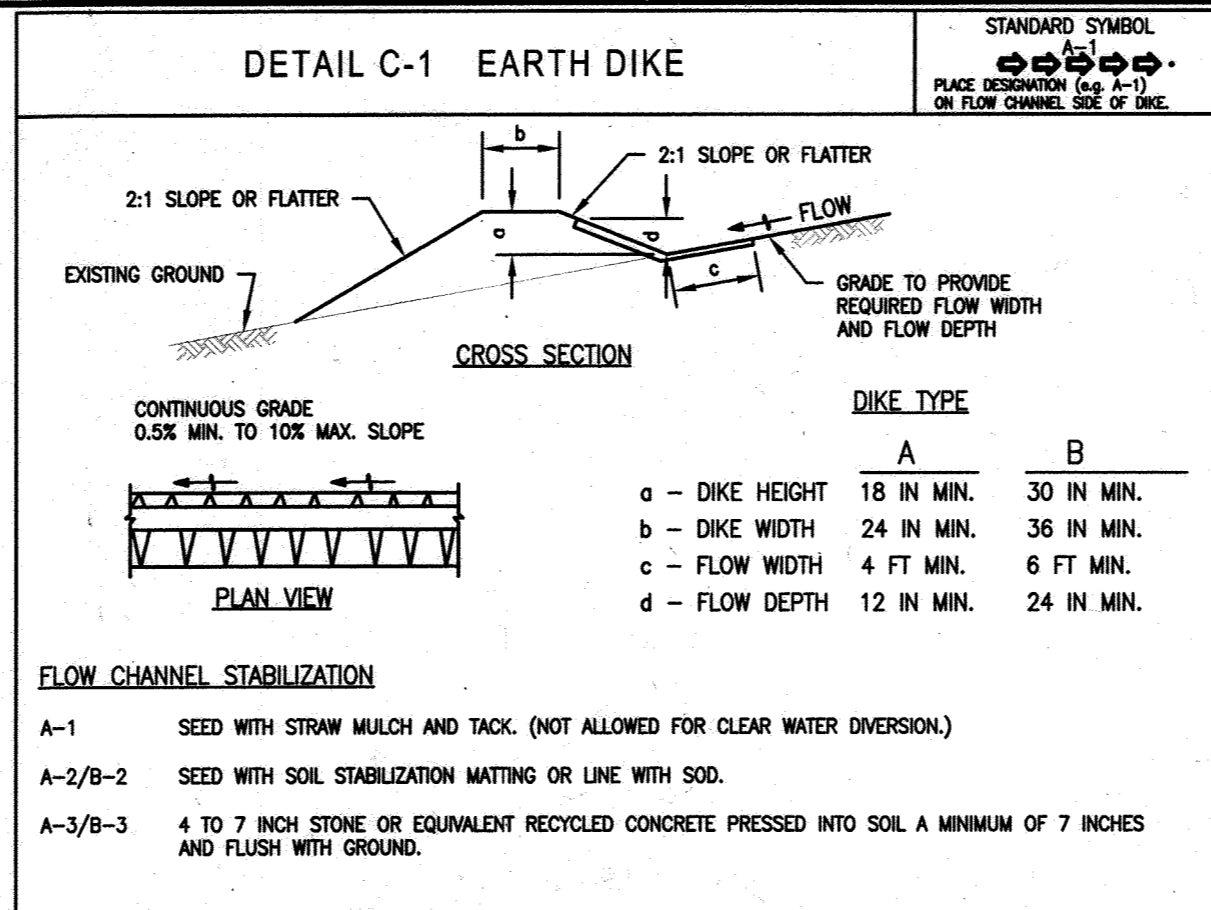

DIKE TYPE


	A	B
a - DIKE HEIGHT	18 IN. MIN.	30 IN. MIN.
b - DIKE WIDTH	24 IN. MIN.	36 IN. MIN.
c - FLOW WIDTH	4 FT. MIN.	6 FT. MIN.
d - FLOW DEPTH	12 IN. MIN.	24 IN. MIN.

CONSTRUCTION SPECIFICATIONS

- REMOVE AND DISPOSE OF ALL TREES, BRUSH, STUMPS, OBSTRUCTIONS, AND OTHER OBJECTIONABLE MATERIAL SO AS NOT TO INTERFERE WITH PROPER FUNCTION OF EARTHDIKE.
- EXCAVATE OR SHAPE EARTH DIKE TO LINE, GRADE, AND CROSS SECTION AS SPECIFIED. BANK PROJECTIONS OR OTHER IRREGULARITIES ARE NOT ALLOWED.
- COMPACT FILL.
- CONSTRUCT FLOW CHANNEL ON AN UNINTERRUPTED, CONTINUOUS GRADE, ADJUSTING THE LOCATION DUE TO FIELD CONDITIONS AS NECESSARY TO MAINTAIN POSITIVE DRAINAGE.
- PROVIDE OUTLET PROTECTION AS REQUIRED ON APPROVED PLAN.
- STABILIZE EARTH DIKE WITHIN THREE DAYS OF INSTALLATION. STABILIZE FLOW CHANNEL FOR CLEAR WATER DIVERSION WITHIN 24 HOURS OF INSTALLATION.
- MAINTAIN LINE, GRADE, AND CROSS SECTION. REMOVE ACCUMULATED SEDIMENT AND DEBRIS, AND MAINTAIN POSITIVE DRAINAGE. KEEP EARTH DIKE AND POINT OF DISCHARGE FREE OF EROSION, AND CONTINUOUSLY MEET REQUIREMENTS FOR ADEQUATE VEGETATIVE ESTABLISHMENT IN ACCORDANCE WITH SECTION B-4 VEGETATIVE STABILIZATION.
- UPON REMOVAL OF EARTH DIKE, GRADE AREA FLUSH WITH EXISTING GROUND. WITHIN 24 HOURS OF REMOVAL STABILIZE DISTURBED AREA WITH TOPSOIL, SEED, AND MULCH, OR AS SPECIFIED ON APPROVED PLAN.

MARYLAND STANDARDS AND SPECIFICATIONS FOR SOIL EROSION AND SEDIMENT CONTROL
 U.S. DEPARTMENT OF AGRICULTURE NATURAL RESOURCES CONSERVATION SERVICE 2011 MARYLAND DEPARTMENT OF ENVIRONMENT WATER MANAGEMENT ADMINISTRATION

17 EARTH DIKE
 ES-1 NOT TO SCALE

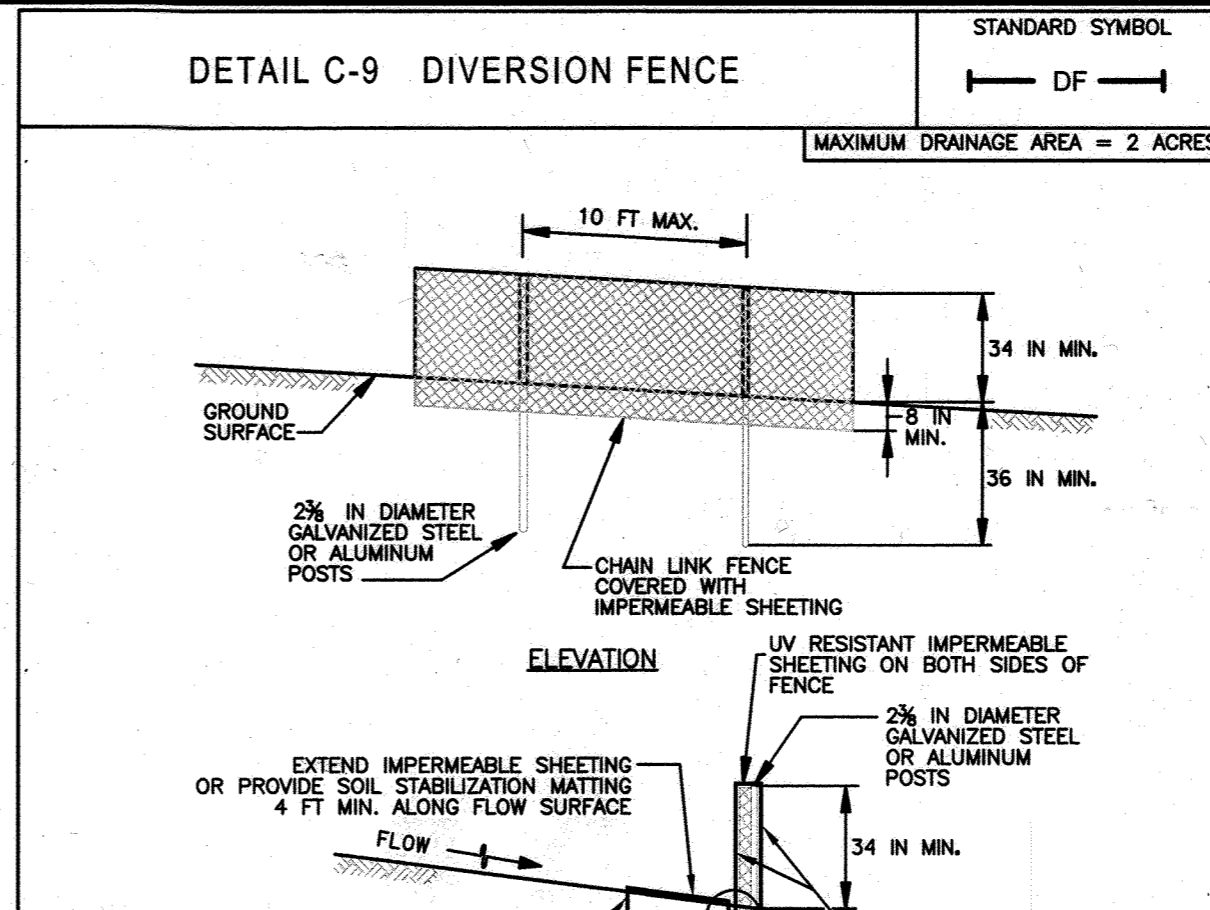


CONSTRUCTION SPECIFICATIONS

- USE 42 INCH HIGH, 9 GAUGE OR THICKER CHAIN LINK FENCING (2 1/2 INCH MAXIMUM OPENING).
- USE 2 1/2 INCH DIAMETER GALVANIZED STEEL POSTS OF 0.095 INCH WALL THICKNESS AND SIX FOOT LENGTH SPACED NO FURTHER THAN 10 FEET APART. THE POSTS DO NOT NEED TO BE SET IN CONCRETE.
- FASTEN CHAIN LINK FENCE SECURELY TO THE FENCE POSTS WITH WIRE TIES.
- SECURE 10 MIL OR THICKER UV RESISTANT, IMPERMEABLE SHEETING TO CHAIN LINK FENCE WITH TIES SPACED EVERY 24 INCHES AT TOP, MID SECTION, AND BELOW GROUND SURFACE.
- EXTEND SHEETING A MINIMUM OF 4 FEET ALONG FLOW SURFACE AND EMBED A MINIMUM OF 8 INCHES INTO GROUND. SOIL STABILIZATION MATTING MAY BE USED IN LIEU OF IMPERMEABLE SHEETING ALONG FLOW SURFACE.
- WHEN TWO SECTIONS OF SHEETING ADJOIN EACH OTHER, OVERLAP BY 6 INCHES AND FOLD WITH SEAM FACING DOWNGRADE.
- KEEP FLOW SURFACE ALONG DIVERSION FENCE AND POINT OF DISCHARGE FREE OF EROSION. REMOVE ACCUMULATED SEDIMENT AND DEBRIS. MAINTAIN POSITIVE DRAINAGE. REPLACE IMPERMEABLE SHEETING IF TORN, IF UNDERMINING OCCURS, REINSTALL FENCE.

MARYLAND STANDARDS AND SPECIFICATIONS FOR SOIL EROSION AND SEDIMENT CONTROL
 U.S. DEPARTMENT OF AGRICULTURE NATURAL RESOURCES CONSERVATION SERVICE 2011 MARYLAND DEPARTMENT OF ENVIRONMENT WATER MANAGEMENT ADMINISTRATION

18 DIVERSION FENCE
 ES-1 NOT TO SCALE

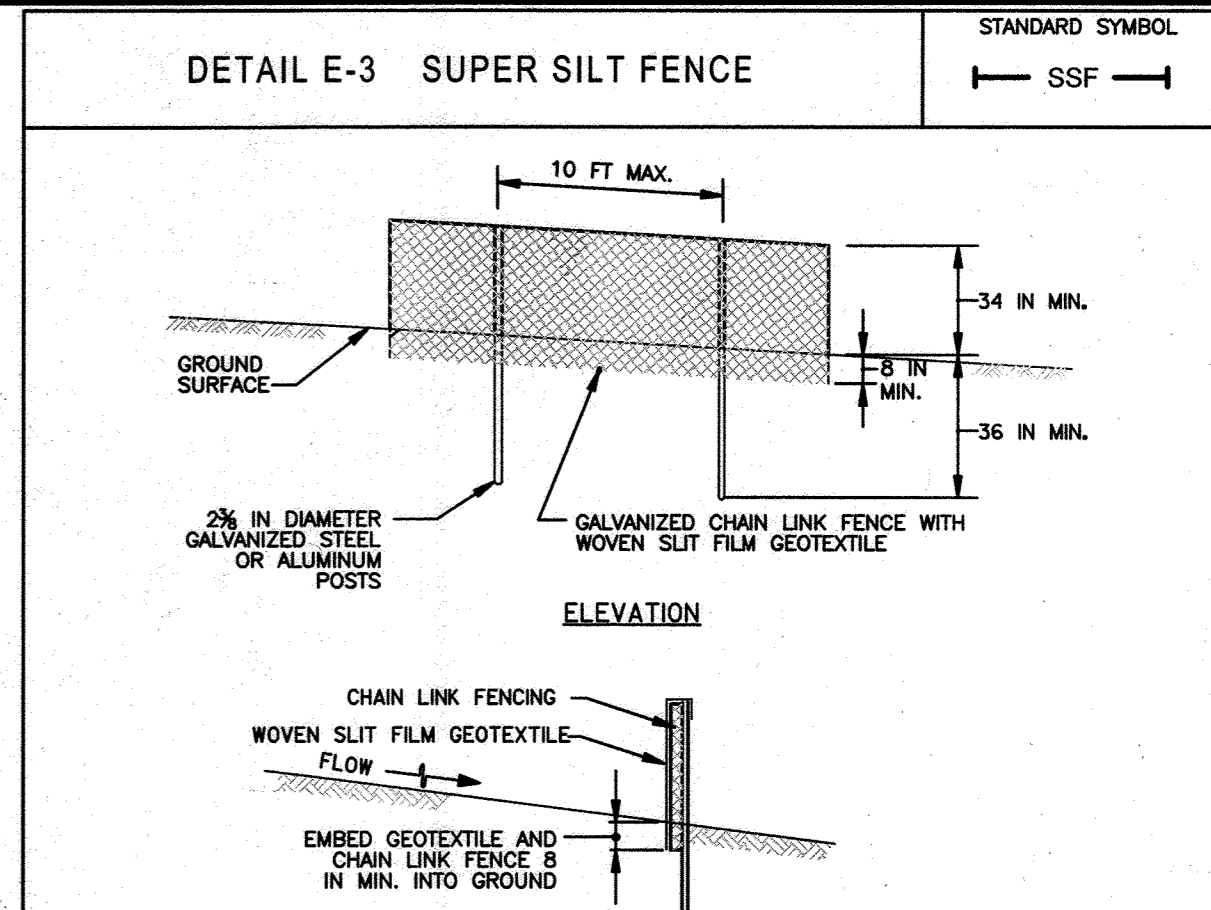


CONSTRUCTION SPECIFICATIONS

- INSTALL 2 1/2 INCH DIAMETER GALVANIZED STEEL POSTS OF 0.095 INCH WALL THICKNESS AND SIX FOOT LENGTH SPACED NO FURTHER THAN 10 FEET APART. DRIVE THE POSTS A MINIMUM OF 36 INCHES INTO THE GROUND.
- FASTEN 9 GAUGE OR HEAVIER GALVANIZED CHAIN LINK FENCE (2 1/2 INCH MAXIMUM OPENING) 42 INCHES IN HEIGHT SECURELY TO THE FENCE POSTS WITH WIRE TIES OR HUG RINGS.
- FASTEN WOVEN SILT FILM GEOTEXTILE AS SPECIFIED IN SECTION H-1 MATERIALS, SECURELY TO THE UPSLOPE SIDE OF CHAIN LINK FENCE WITH TIES SPACED EVERY 24 INCHES AT THE TOP AND MID SECTION. EMBED GEOTEXTILE AND CHAIN LINK FENCE A MINIMUM OF 8 INCHES INTO THE GROUND.
- WHERE ENDS OF THE GEOTEXTILE COME TOGETHER, THE ENDS SHALL BE OVERLAPPED BY 6 INCHES, FOLDED, AND STAPLED TO PREVENT SEDIMENT BY PASS.
- EXTEND BOTH ENDS OF THE SUPER SILT FENCE A MINIMUM OF FIVE HORIZONTAL FEET UPSLOPE AT 45 DEGREES TO THE MAIN FENCE ALIGNMENT TO PREVENT RUNOFF FROM GOING AROUND THE ENDS OF THE SUPER SILT FENCE.
- PROVIDE MANUFACTURER CERTIFICATION TO THE INSPECTION/ENFORCEMENT AUTHORITY SHOWING THAT GEOTEXTILE USED MEETS THE REQUIREMENTS IN SECTION H-1 MATERIALS.
- REMOVE ACCUMULATED SEDIMENT AND DEBRIS WHEN BULGES DEVELOP IN FENCE OR WHEN SEDIMENT REACHES 25% OF FENCE HEIGHT. REPLACE GEOTEXTILE IF TORN, IF UNDERMINING OCCURS, REINSTALL CHAIN LINK FENCING AND GEOTEXTILE.

MARYLAND STANDARDS AND SPECIFICATIONS FOR SOIL EROSION AND SEDIMENT CONTROL
 U.S. DEPARTMENT OF AGRICULTURE NATURAL RESOURCES CONSERVATION SERVICE 2011 MARYLAND DEPARTMENT OF ENVIRONMENT WATER MANAGEMENT ADMINISTRATION

19 SUPER SILT FENCE
 ES-1 NOT TO SCALE

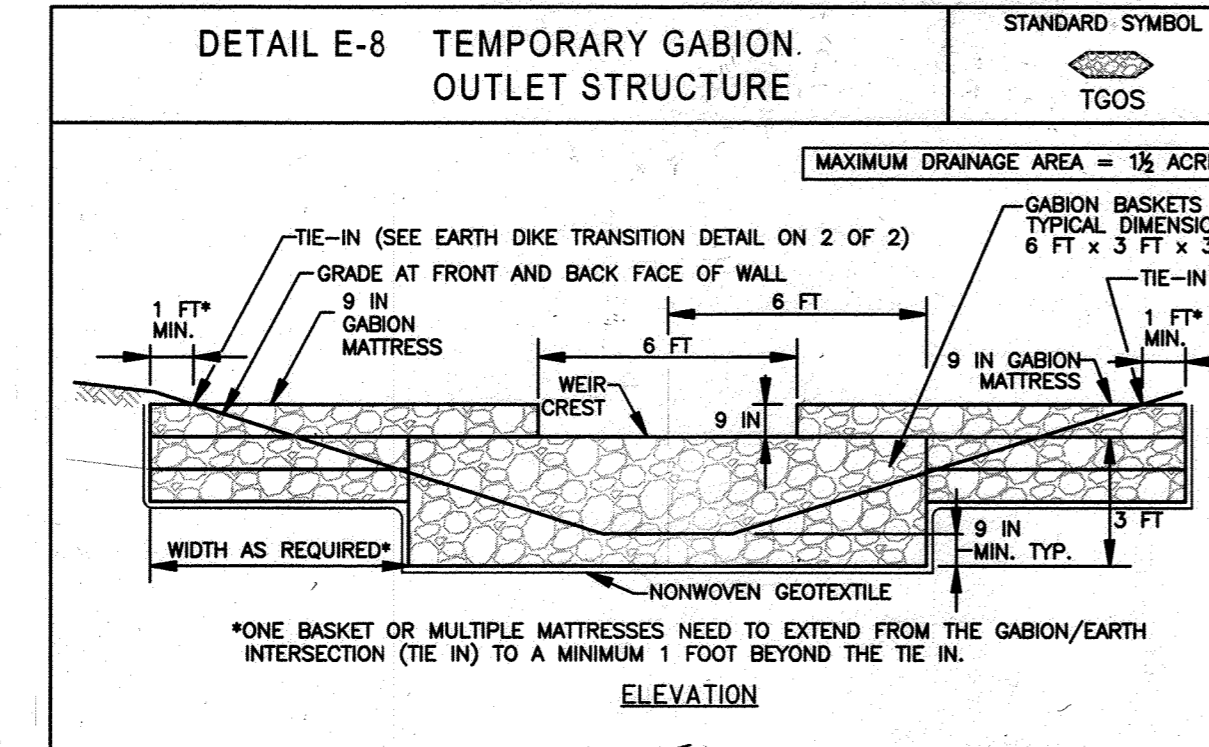


CONSTRUCTION SPECIFICATIONS

- PROVIDE STORAGE VOLUME AS SPECIFIED ON APPROVED PLANS.
- USE BASKETS MADE OF 11 GAUGE WIRE OR HEAVIER.
- USE NONWOVEN AND WOVEN MONOFILAMENT GEOTEXTILES AS SPECIFIED IN SECTION H-1 MATERIALS.
- INSTALL GABIONS IN ACCORDANCE WITH MANUFACTURER RECOMMENDATIONS.
- EMBED THE GABION OUTLET STRUCTURE INTO THE SOIL A MINIMUM OF 9 INCHES. PROVIDE NONWOVEN GEOTEXTILE UNDER ALL GABIONS.
- FILL GABION BASKETS WITH CLEAN 4 TO 7 INCH STONE OR EQUIVALENT RECYCLED CONCRETE WITHOUT REBAR OR WIRE MESH.
- MAKE THE WEIR CREST OF THE GABION OUTLET STRUCTURE 9 INCHES LOWER THAN THE TOP OF THE ADJACENT GABIONS.
- PROVIDE A MINIMUM WEIR CREST OF 6 FEET.
- ATTACH WOVEN MONOFILAMENT GEOTEXTILE TO THE UPSLOPE FACE OF GABION BASKETS AND COVER WITH 4 TO 7 INCH STONE.
- REMOVE SEDIMENT WHEN IT HAS ACCUMULATED TO WITHIN 12 INCHES OF THE WEIR CREST. REPLACE GEOTEXTILE AND STONE FACING WHEN STRUCTURE CEASES TO FUNCTION. MAINTAIN LINE, GRADE, AND CROSS SECTION.
- UPON REMOVAL OF GABION OUTLET STRUCTURE, GRADE AREA FLUSH WITH EXISTING GROUND. WITHIN 24 HOURS STABILIZE DISTURBED AREA WITH TOPSOIL, SEED, AND MULCH, OR AS SPECIFIED ON APPROVED PLAN.

MARYLAND STANDARDS AND SPECIFICATIONS FOR SOIL EROSION AND SEDIMENT CONTROL
 U.S. DEPARTMENT OF AGRICULTURE NATURAL RESOURCES CONSERVATION SERVICE 2011 MARYLAND DEPARTMENT OF ENVIRONMENT WATER MANAGEMENT ADMINISTRATION

20 TEMPORARY GABION OUTLET STRUCTURE
 ES-2 NOT TO SCALE

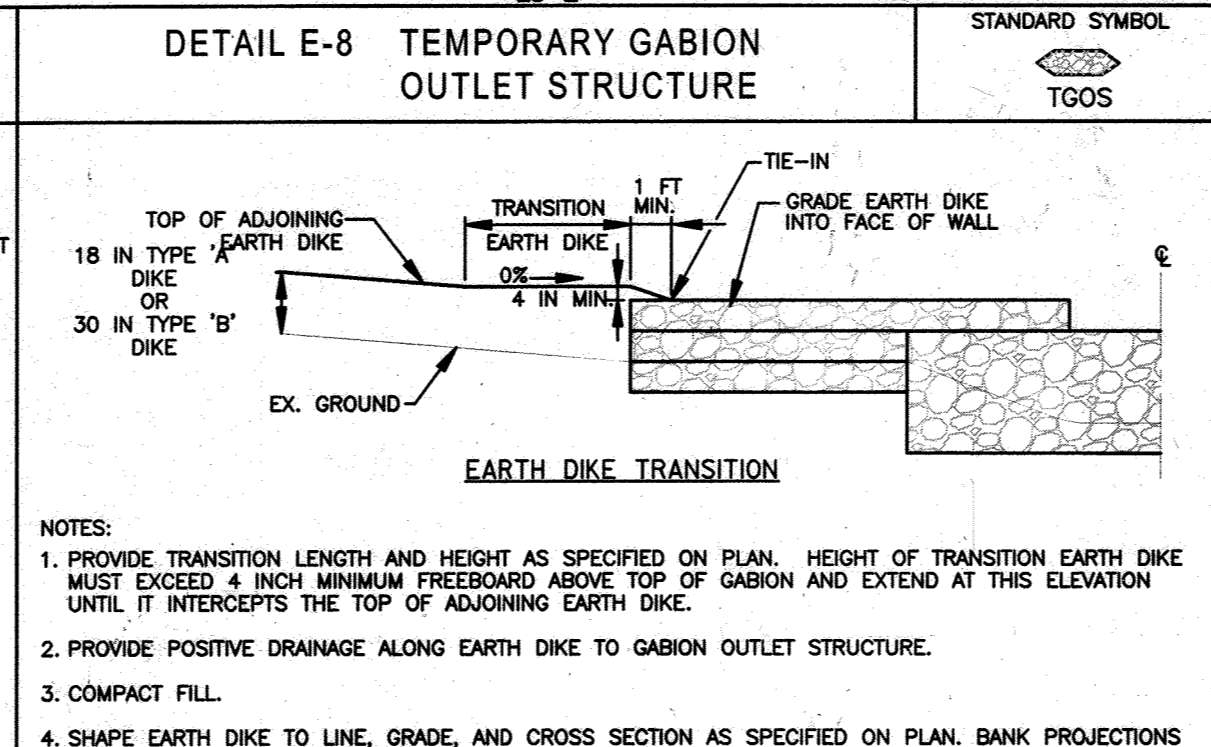


CONSTRUCTION SPECIFICATIONS

- PROVIDE STORAGE VOLUME AS SPECIFIED ON APPROVED PLANS.
- USE BASKETS MADE OF 11 GAUGE WIRE OR HEAVIER.
- USE NONWOVEN AND WOVEN MONOFILAMENT GEOTEXTILES AS SPECIFIED IN SECTION H-1 MATERIALS.
- INSTALL GABIONS IN ACCORDANCE WITH MANUFACTURER RECOMMENDATIONS.
- EMBED THE GABION OUTLET STRUCTURE INTO THE SOIL A MINIMUM OF 9 INCHES. PROVIDE NONWOVEN GEOTEXTILE UNDER ALL GABIONS.
- FILL GABION BASKETS WITH CLEAN 4 TO 7 INCH STONE OR EQUIVALENT RECYCLED CONCRETE WITHOUT REBAR OR WIRE MESH.
- MAKE THE WEIR CREST OF THE GABION OUTLET STRUCTURE 9 INCHES LOWER THAN THE TOP OF THE ADJACENT GABIONS.
- PROVIDE A MINIMUM WEIR CREST OF 6 FEET.
- ATTACH WOVEN MONOFILAMENT GEOTEXTILE TO THE UPSLOPE FACE OF GABION BASKETS AND COVER WITH 4 TO 7 INCH STONE.
- REMOVE SEDIMENT WHEN IT HAS ACCUMULATED TO WITHIN 12 INCHES OF THE WEIR CREST. REPLACE GEOTEXTILE AND STONE FACING WHEN STRUCTURE CEASES TO FUNCTION. MAINTAIN LINE, GRADE, AND CROSS SECTION.
- UPON REMOVAL OF GABION OUTLET STRUCTURE, GRADE AREA FLUSH WITH EXISTING GROUND. WITHIN 24 HOURS STABILIZE DISTURBED AREA WITH TOPSOIL, SEED, AND MULCH, OR AS SPECIFIED ON APPROVED PLAN.

MARYLAND STANDARDS AND SPECIFICATIONS FOR SOIL EROSION AND SEDIMENT CONTROL
 U.S. DEPARTMENT OF AGRICULTURE NATURAL RESOURCES CONSERVATION SERVICE 2011 MARYLAND DEPARTMENT OF ENVIRONMENT WATER MANAGEMENT ADMINISTRATION

21 PORTABLE SEDIMENT TANK
 ES-1 NOT TO SCALE

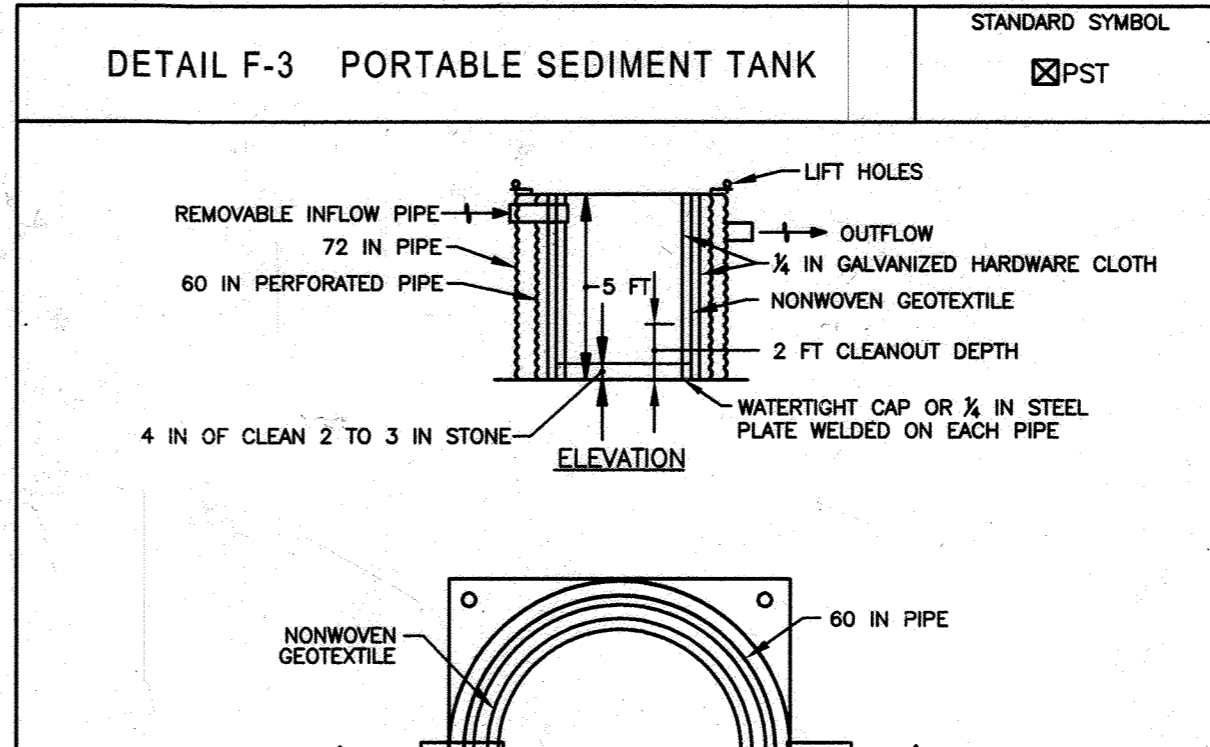


CONSTRUCTION SPECIFICATIONS

- PROVIDE 1 CUBIC FOOT OF STORAGE FOR EACH GALLON PER MINUTE OF PUMP CAPACITY. REQUIRED STORAGE VOLUME MAY BE ATTAINED BY PLACEMENT OF TANKS IN PARALLEL WITH INFLOW EVENLY DISTRIBUTED AMONG TANKS. OVERTOPPING OF TANKS IS NOT PERMITTED.
- USE 60 INCH CORRUGATED METAL OR PLASTIC PIPE WITH 1 INCH DIAMETER PERFORATIONS, 8 INCHES ON CENTER FOR THE INNER PIPE. LINE PIPE WITH NONWOVEN GEOTEXTILE, AS SPECIFIED IN SECTION H-1 MATERIALS, SANDWICHED BETWEEN, AND ATTACHED TO, 1/2 INCH HARDWARE CLOTH.
- OVERLAP GEOTEXTILE 8 INCHES MINIMUM AT VERTICAL SEAM AND AT THE BOTTOM PLATE.
- ANCHOR GEOTEXTILE AT BOTTOM OF TANK WITH 4 INCHES OF 2 TO 3 INCH CLEAN STONE OR EQUIVALENT RECYCLED CONCRETE.
- USE 72 INCH CORRUGATED METAL OR PLASTIC OUTER PIPE WITH PERMANENT OUTFLOW PIPE WITH INVERT LOWER THAN INFLOW PIPE.
- INFLOW PIPE MUST DISCHARGE INTO INNER PIPE AND BE REMOVABLE.
- PLACE TANK ON LEVEL SURFACE AND DISCHARGE TO A STABLE AREA AT A NONEROSIVE RATE.
- A PORTABLE SEDIMENT TANK REQUIRES FREQUENT MAINTENANCE. REMOVE ACCUMULATED SEDIMENT FROM INNER PIPE WHEN IT REACHES TWO FEET IN DEPTH. IF SYSTEM CLOGS, PULL OUT INNER PIPE, REMOVE ACCUMULATED SEDIMENT, AND REPLACE GEOTEXTILE. KEEP POINT OF DISCHARGE FREE OF EROSION.

MARYLAND STANDARDS AND SPECIFICATIONS FOR SOIL EROSION AND SEDIMENT CONTROL
 U.S. DEPARTMENT OF AGRICULTURE NATURAL RESOURCES CONSERVATION SERVICE 2011 MARYLAND DEPARTMENT OF ENVIRONMENT WATER MANAGEMENT ADMINISTRATION

21 PORTABLE SEDIMENT TANK
 ES-1 NOT TO SCALE

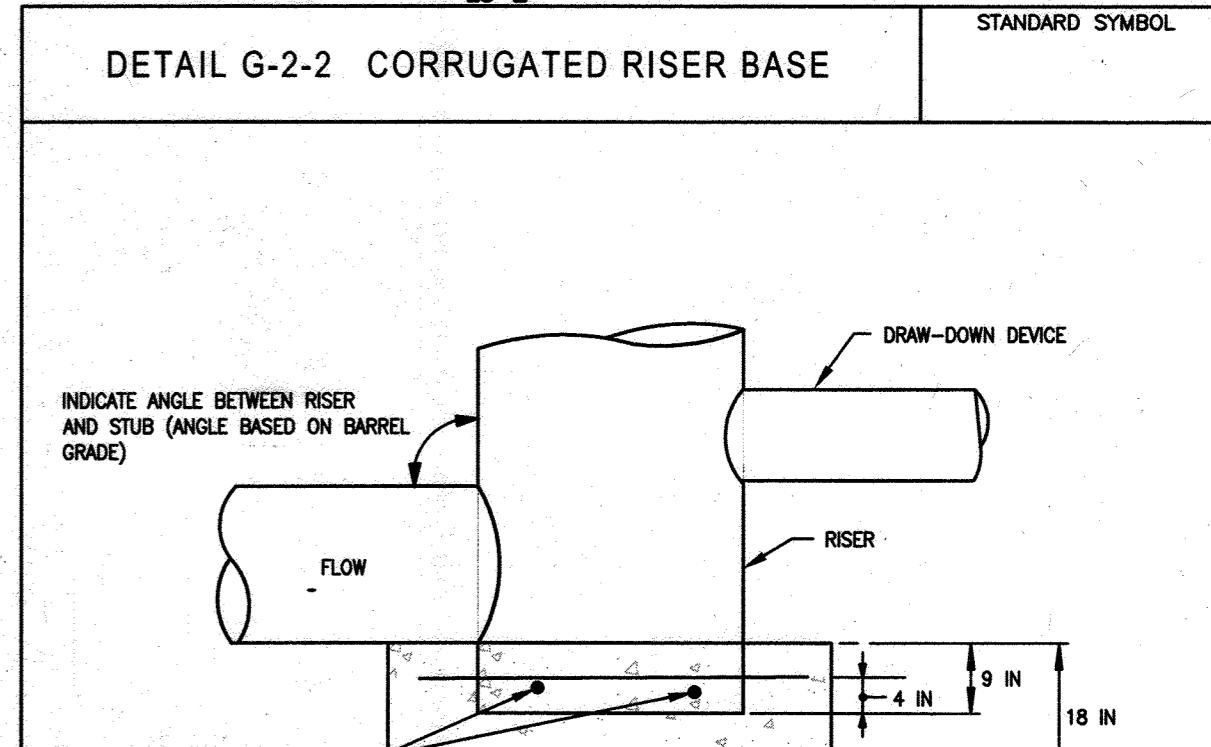

CONSTRUCTION SPECIFICATIONS

- BOTTOM OF CONCRETE BASE TO BE PLACED ON UNDISTURBED, NATURAL GROUND.
- NO STONE IS ALLOWED UNDER BASE. IF NECESSARY, TO ACHIEVE STABILITY INCREASE DEPTH OF CONCRETE BASE.

MARYLAND STANDARDS AND SPECIFICATIONS FOR SOIL EROSION AND SEDIMENT CONTROL
 U.S. DEPARTMENT OF AGRICULTURE NATURAL RESOURCES CONSERVATION SERVICE 2011 MARYLAND DEPARTMENT OF ENVIRONMENT WATER MANAGEMENT ADMINISTRATION

22 CORRUGATED RISER BASE
 ES-2 NOT TO SCALE

REVIEWED FOR HOWARD SCD AND MEETS TECHNICAL REQUIREMENTS
 THIS DEVELOPMENT PLAN IS APPROVED FOR SOIL EROSION AND SEDIMENT CONTROL BY THE HOWARD SOIL CONSERVATION DISTRICT.

John K. Roberts 4/22/17
 HOWARD SCD DATE

APPROVED: DEPARTMENT OF PLANNING AND ZONING
Neil A. Zappia 12-12-17
 DIRECTOR DATE


Chad P. ... 11-29-17
 CHIEF, DEVELOPMENT ENGINEERING DIVISION DATE

Walter Calver 12-5-17
 CHIEF, DIVISION OF LAND DEVELOPMENT DATE

OWNER/ENGINEER INFORMATION

DEVELOPER/OWNER:
 HOWARD COUNTY GOVERNMENT
 CONTACT: JEFF DANNIS, P.E., CSP
 6751 COLUMBIA GATEWAY DRIVE, SUITE 514
 COLUMBIA, MD 21046
 TELEPHONE: (410) 313-6419

ENGINEER:
 EA ENGINEERING, SCIENCE,
 AND TECHNOLOGY, INC., PBC
 CONTACT: MARK GUTBERLET, P.E.
 225 SCHILLING CIRCLE, SUITE 400
 HUNT VALLEY, MD 21031
 TELEPHONE: (410) 584-7000

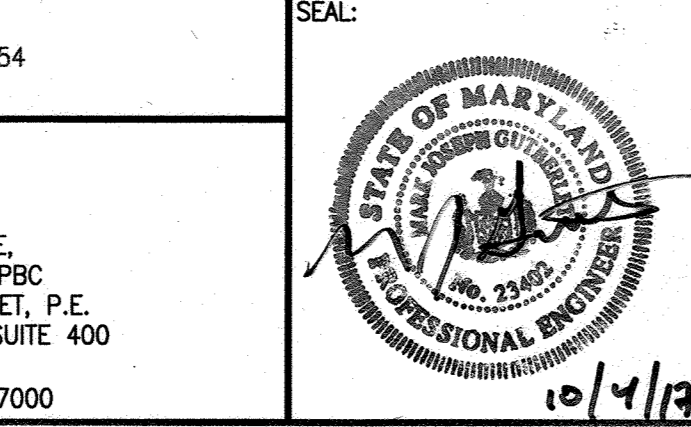

PROFESSIONAL CERTIFICATION:
 I HEREBY CERTIFY THAT THESE DOCUMENTS WERE PREPARED OR APPROVED BY ME, AND THAT I AM A DULY LICENSED PROFESSIONAL ENGINEER UNDER THE LAWS OF THE STATE OF MARYLAND, LICENSE NO. 23402, EXPIRATION DATE 25 AUGUST 2018.

EA ENGINEERING, SCIENCE AND TECHNOLOGY

DSN. BY:	MBS/MP	CYH	REVISED TOTAL SHEET NUMBER (5) IS 45	8/2012
DRN. BY:	JWP/KEJ			
CHK. BY:	SMD			
DATE:	OCT. 2016			
BY NO.		REVISION		DATE







EROSION AND SEDIMENT CONTROL DETAILS I

COMPOST FACILITY - PHASE II AT ALPHA RIDGE LANDFILL
 HOWARD COUNTY, MARYLAND

SDP SHEET: 45
 18 OF 44
 ES-7

PROJECT: 14982.05
 SHEET: 30 OF 70

NOT FOR CONSTRUCTION - SITE DEVELOPMENT PLAN #SDP-16-035

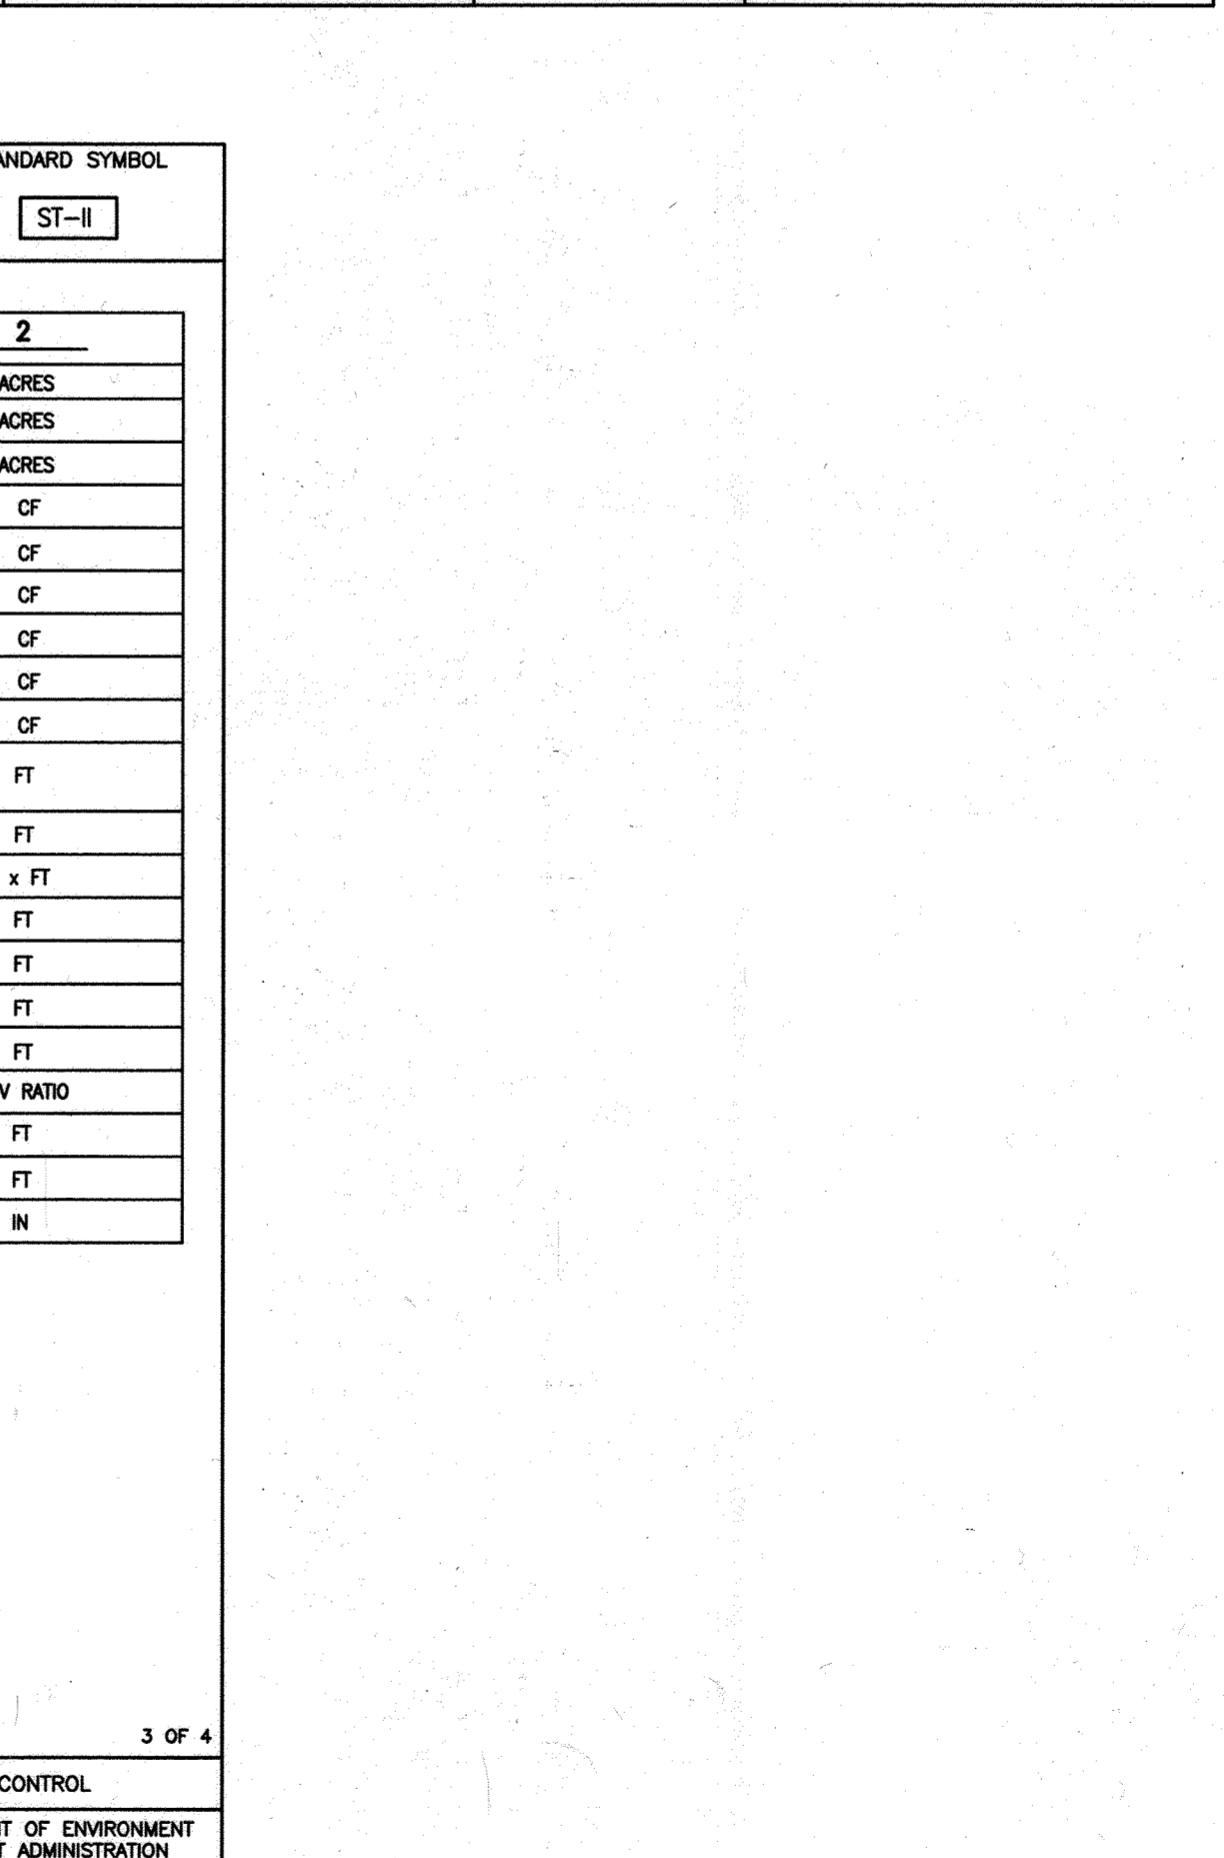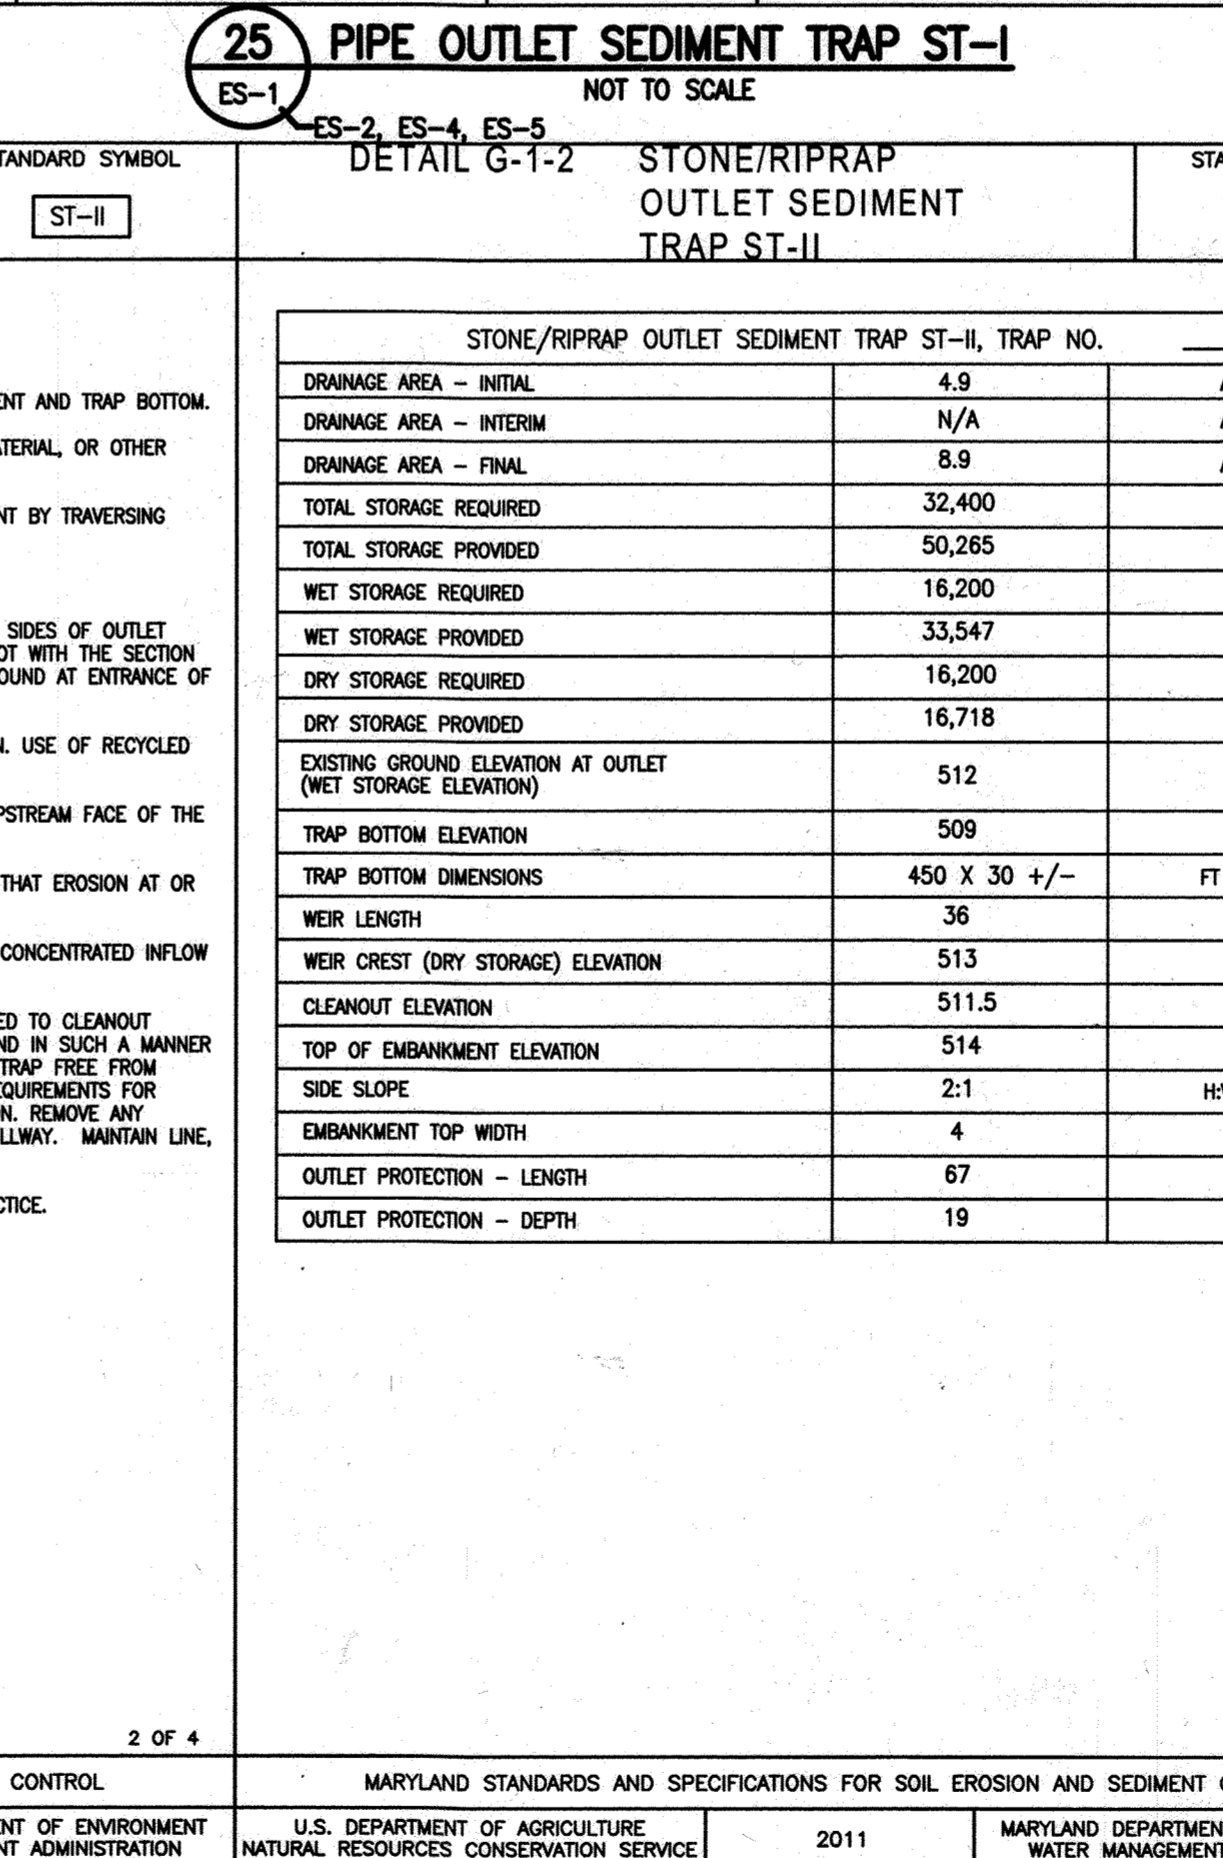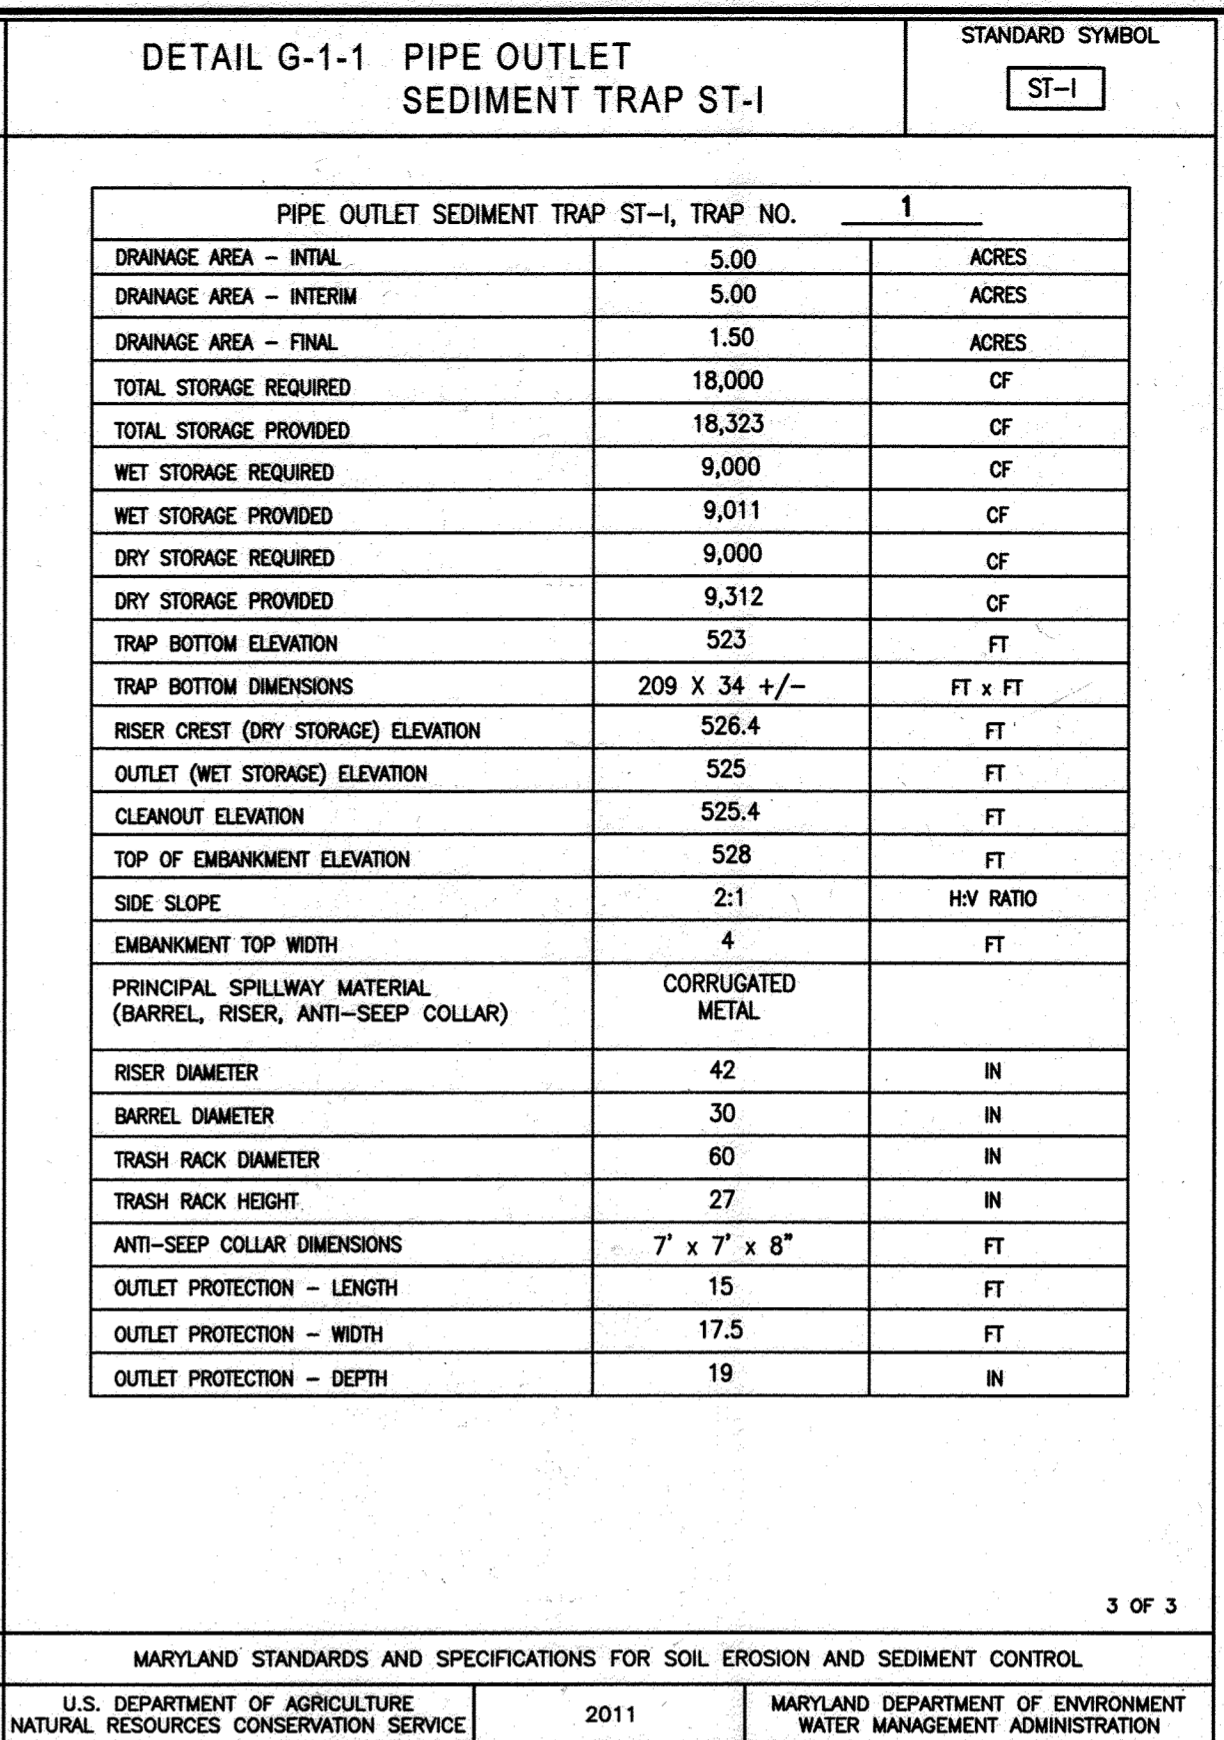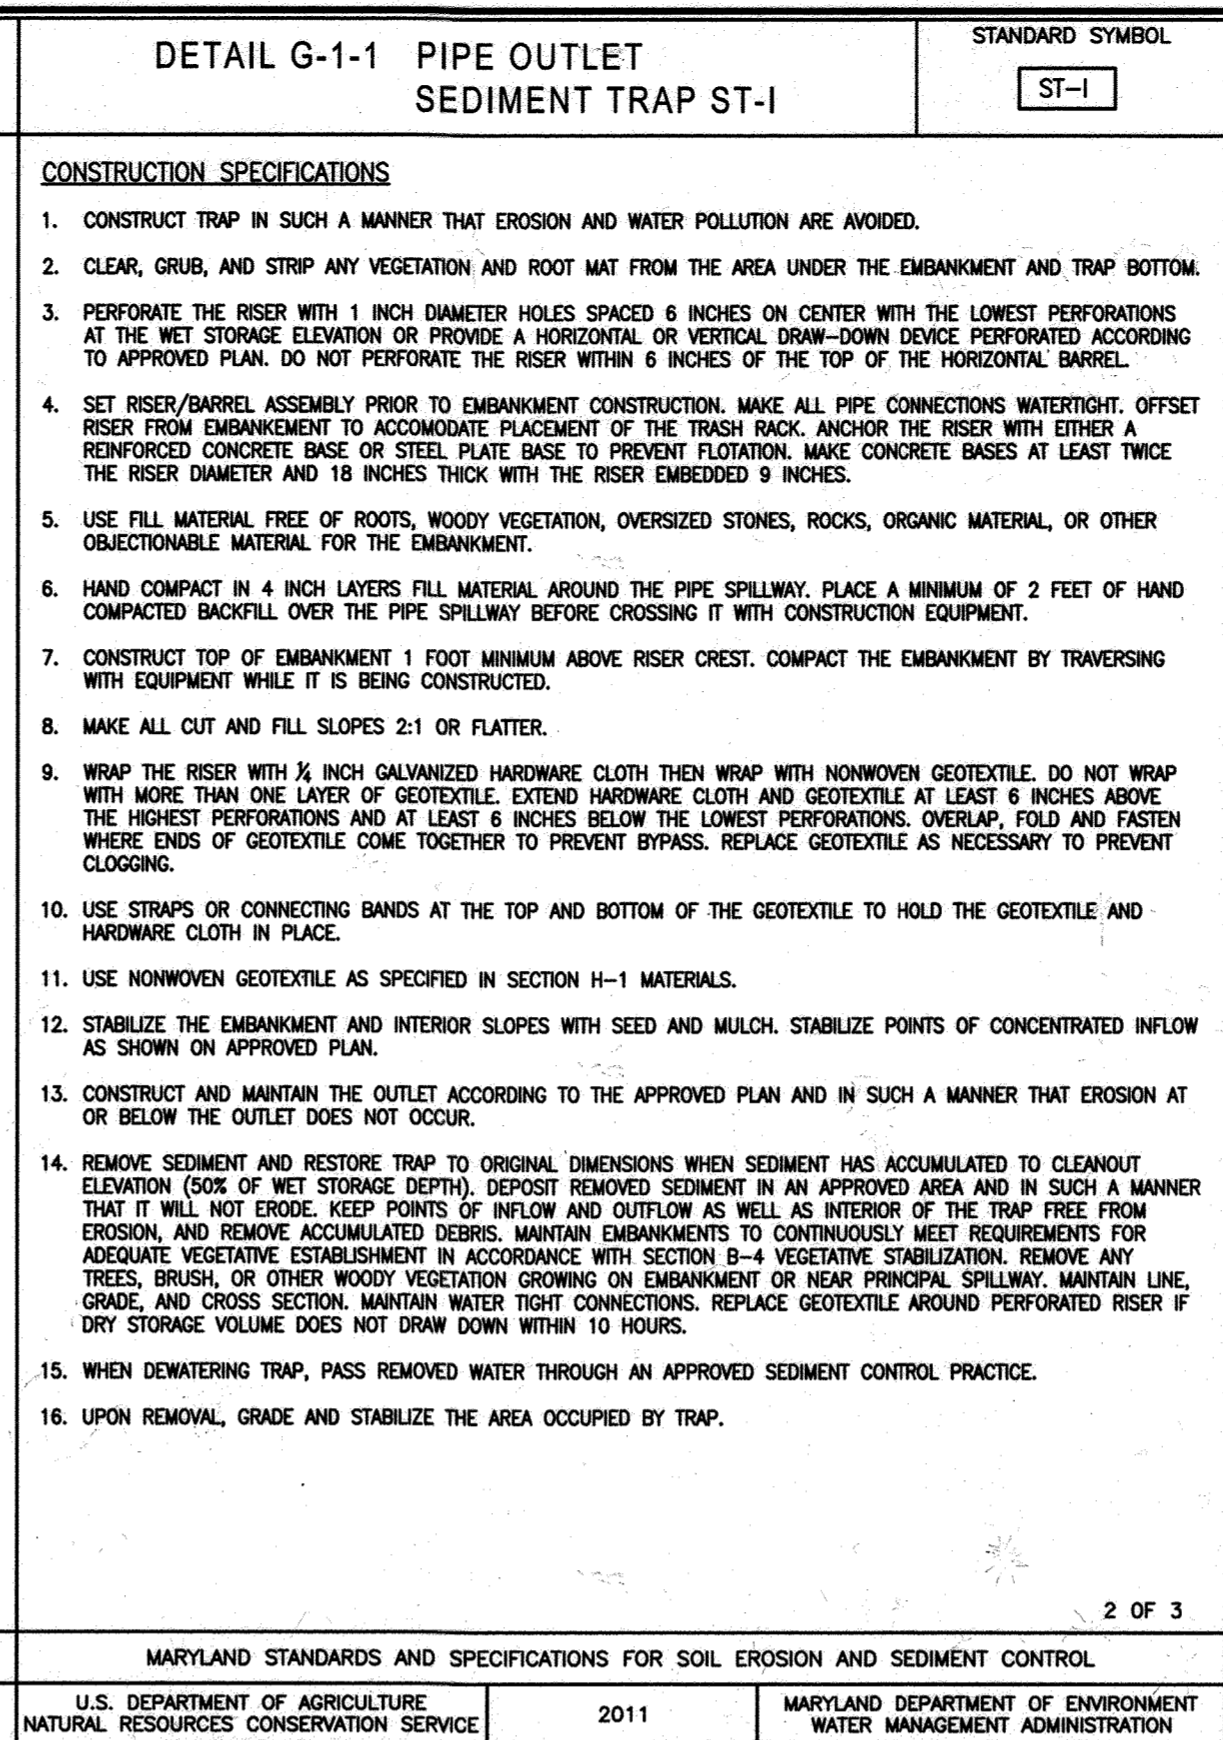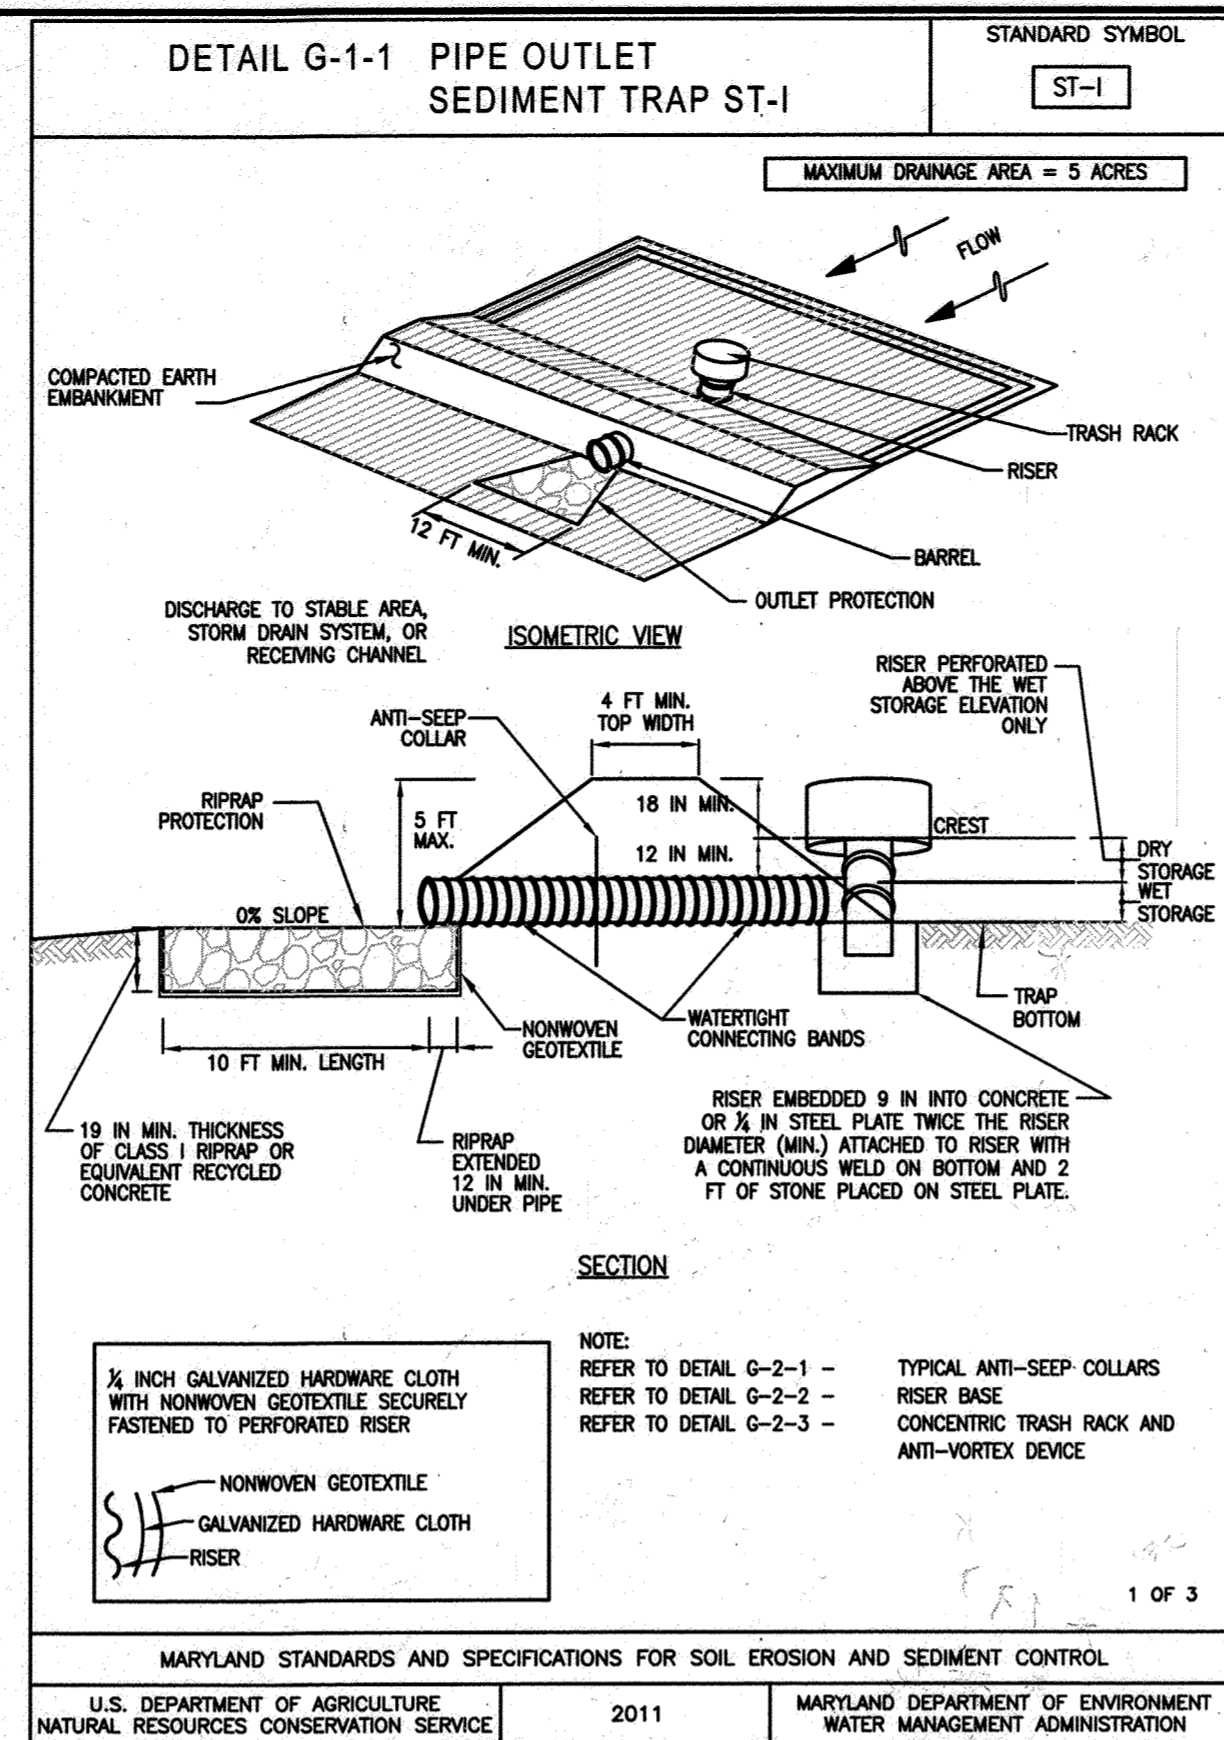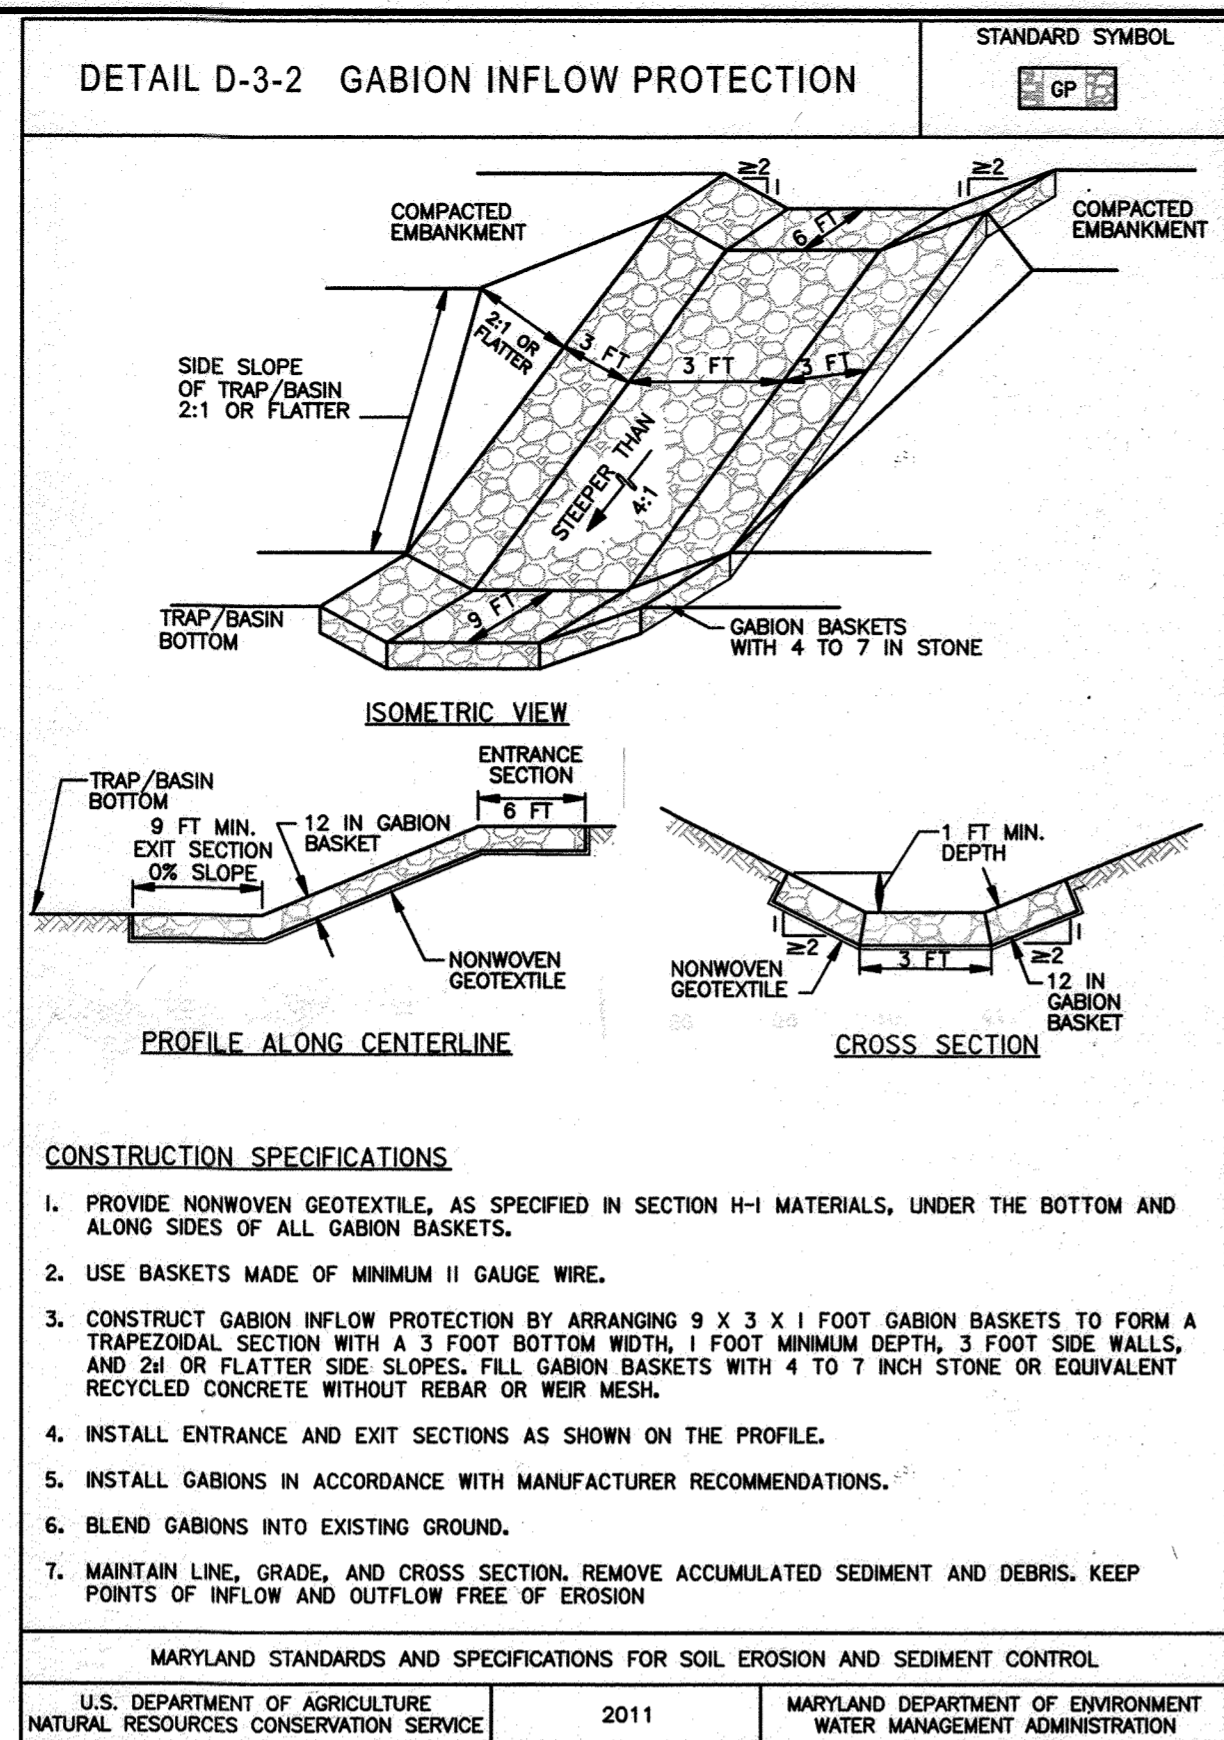

REVIEWED FOR HOWARD SCD AND MEETS TECHNICAL REQUIREMENTS
THIS DEVELOPMENT PLAN IS APPROVED FOR SOIL EROSION AND SEDIMENT CONTROL BY THE HOWARD SOIL CONSERVATION DISTRICT.

John Robert 4/22/17
HOWARD SCD DATE

APPROVED: DEPARTMENT OF PLANNING AND ZONING
Nellis Jovic 12-13-17
DIRECTOR DATE

Paul Elsh 11-29-17
CHIEF, DEVELOPMENT ENGINEERING DIVISION DATE


Walt Spalholz 12-5-17
CHIEF, DIVISION OF LAND DEVELOPMENT DATE

GRID: 8 BLOCK: N/A
ZONING: RC-DEO PARCEL/LOT: 220, 253, 11, 23, 54
TAX MAP: 0016 ELECTION DISTRICT: 3-02

OWNER/ENGINEER INFORMATION

DEVELOPER/OWNER:
HOWARD COUNTY GOVERNMENT
CONTACT: JEFF DANNIS, P.E., CSP
6751 COLUMBIA GATEWAY DRIVE, SUITE 514
COLUMBIA, MD 21046
TELEPHONE: (410) 313-6419

ENGINEER:
EA ENGINEERING, SCIENCE,
AND TECHNOLOGY, INC., PBC
CONTACT: MARK GUTBERLET, P.E.
225 SCHILLING CIRCLE, SUITE 400
HUNT VALLEY, MD 21031
TELEPHONE: (410) 584-7000

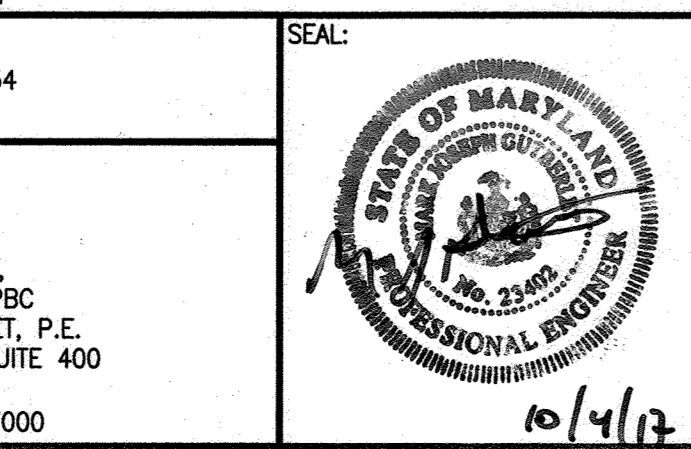

PROFESSIONAL CERTIFICATION:

I HEREBY CERTIFY THAT THESE DOCUMENTS WERE PREPARED OR APPROVED BY ME, AND THAT I AM A DULY LICENSED PROFESSIONAL ENGINEER UNDER THE LAWS OF THE STATE OF MARYLAND, LICENSE NO. 23402, EXPIRATION DATE 25 AUGUST 2018.

EA ENGINEERING, SCIENCE AND TECHNOLOGY

10/4/17

DSN. BY:	MBS/MP	CWH	REVISION TOTAL SHEET NUMBER DUE TO ADDITION OF SHEET 4B	8/2/2012
DRN. BY:	JAP/KEJ			
CHK. BY:	SMD			
DATE:	OCT. 2016			
BY:	NO.	REVISION	DATE	

EROSION AND SEDIMENT CONTROL DETAILS II






COMPOST FACILITY - PHASE II
AT ALPHA RIDGE LANDFILL
HOWARD COUNTY, MARYLAND

SDP SHEET: DRAWING: 45
19 OF 44 ES-8

PROJECT: 14982.05
SHEET: 34 OF 70

SDP-16-035

NOT FOR CONSTRUCTION - SITE DEVELOPMENT PLAN #SDP-16-035

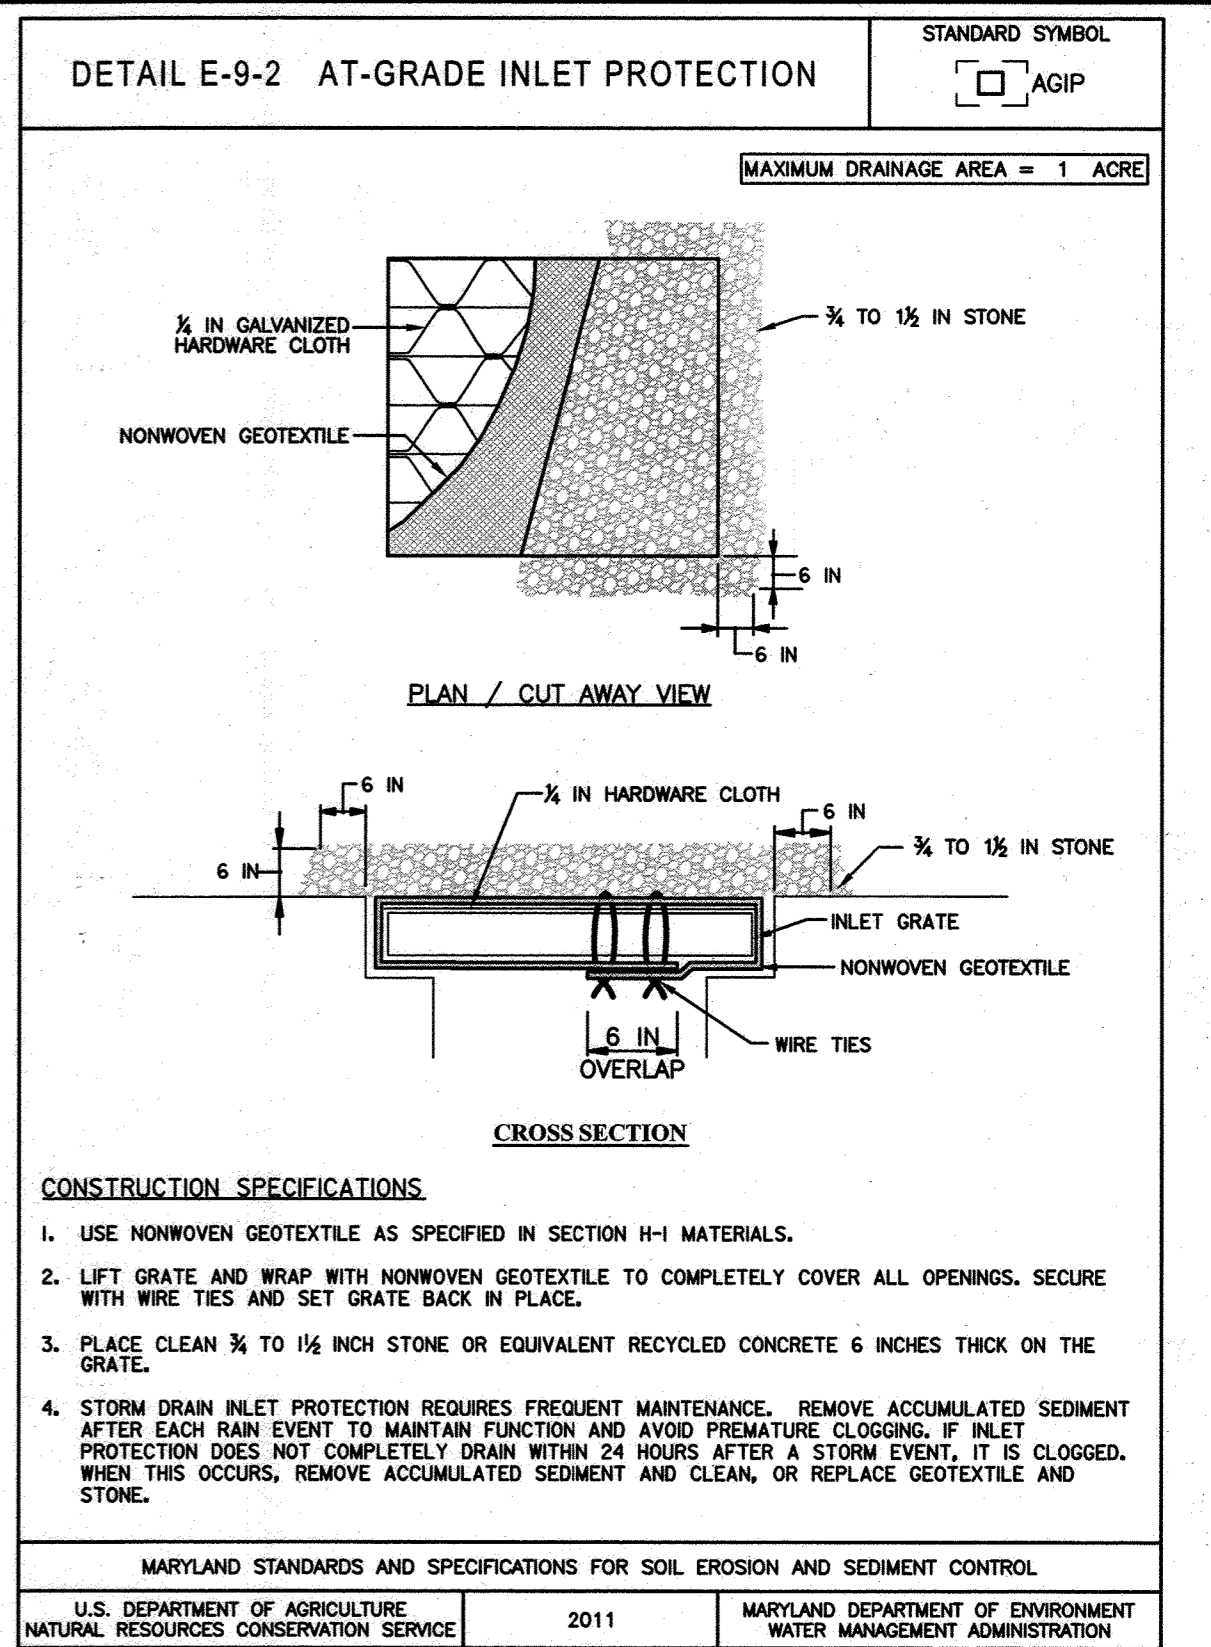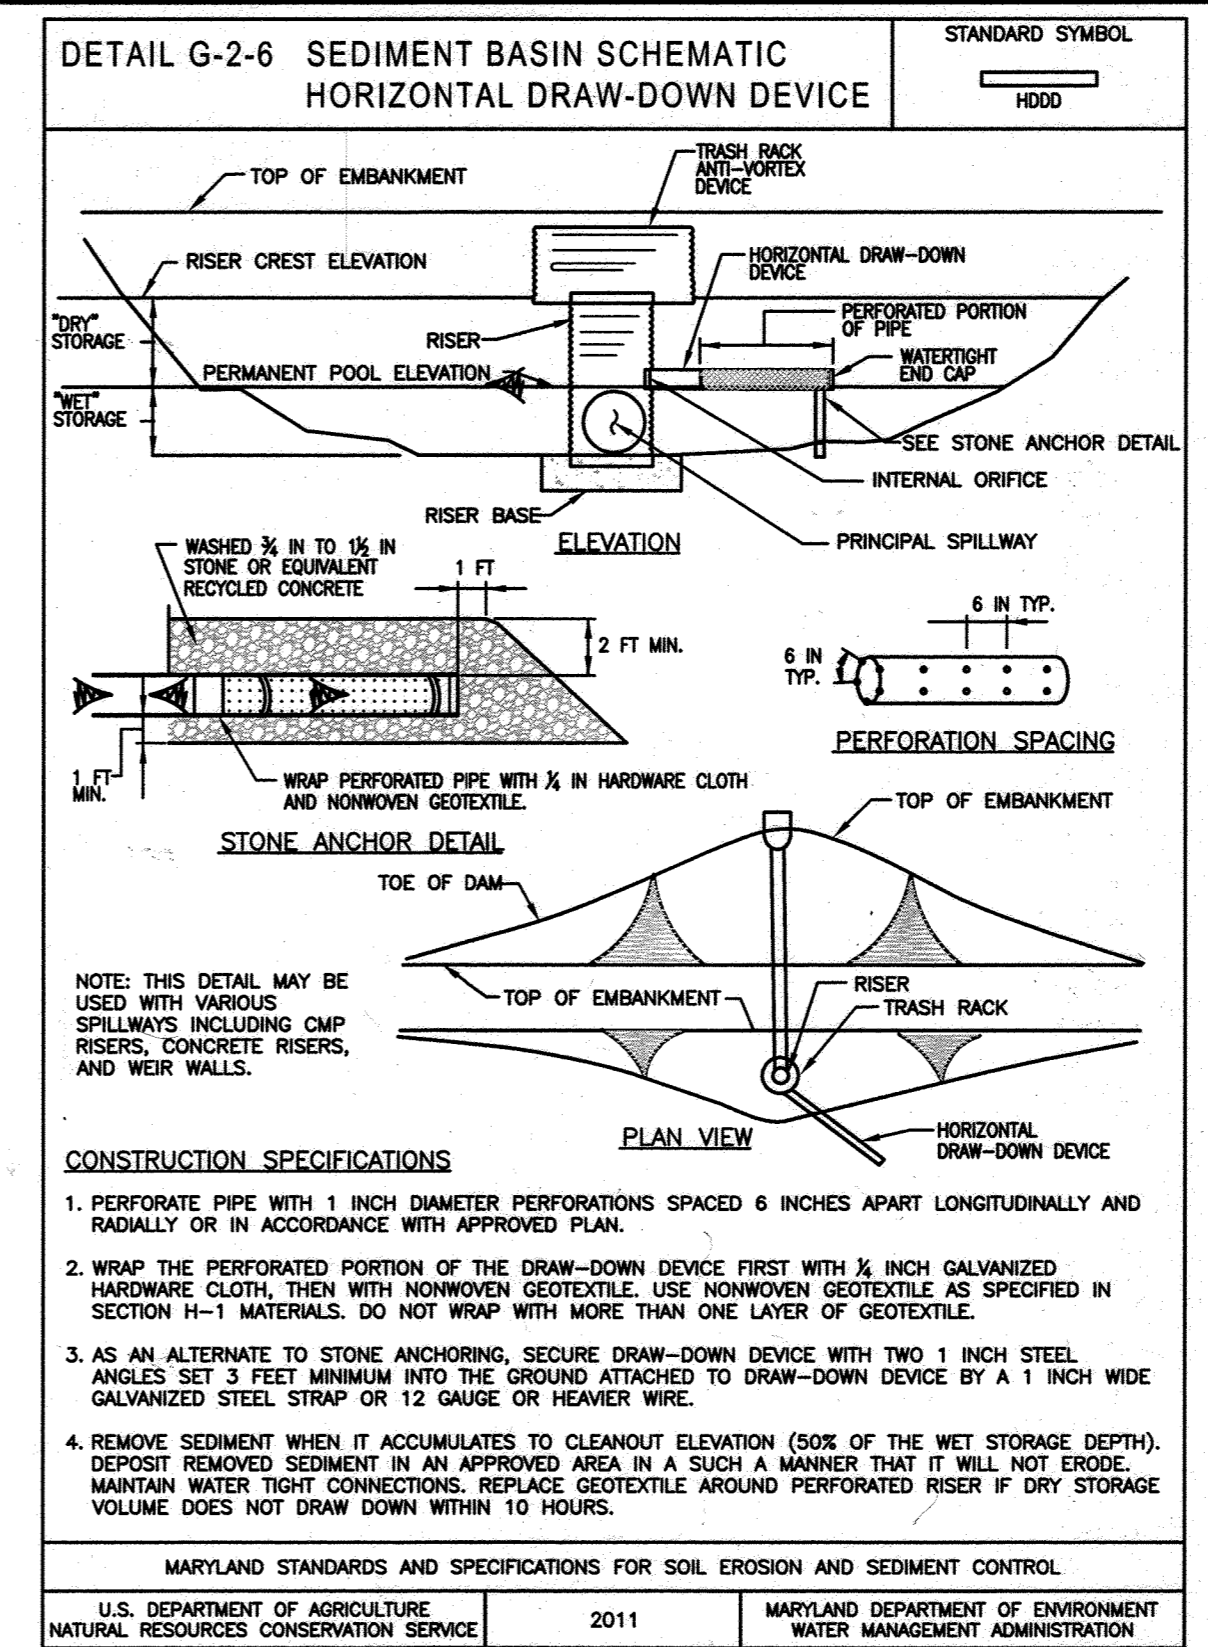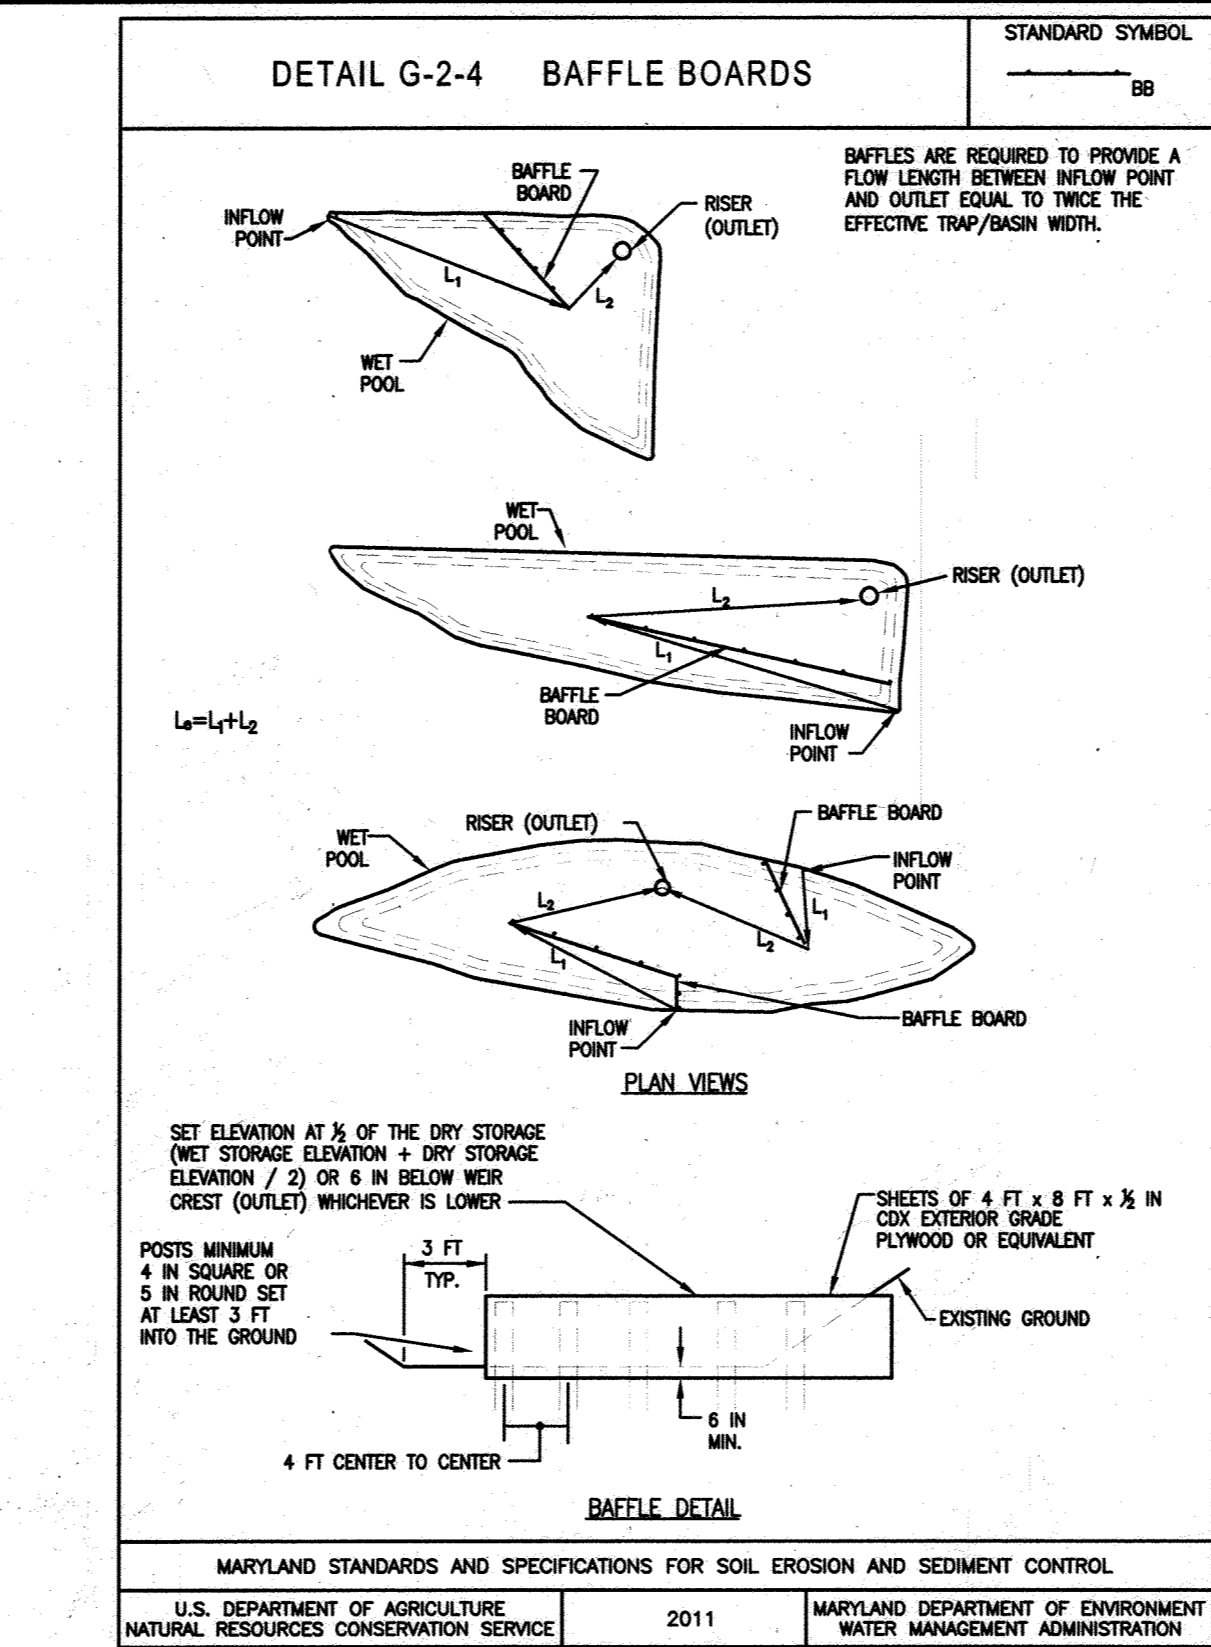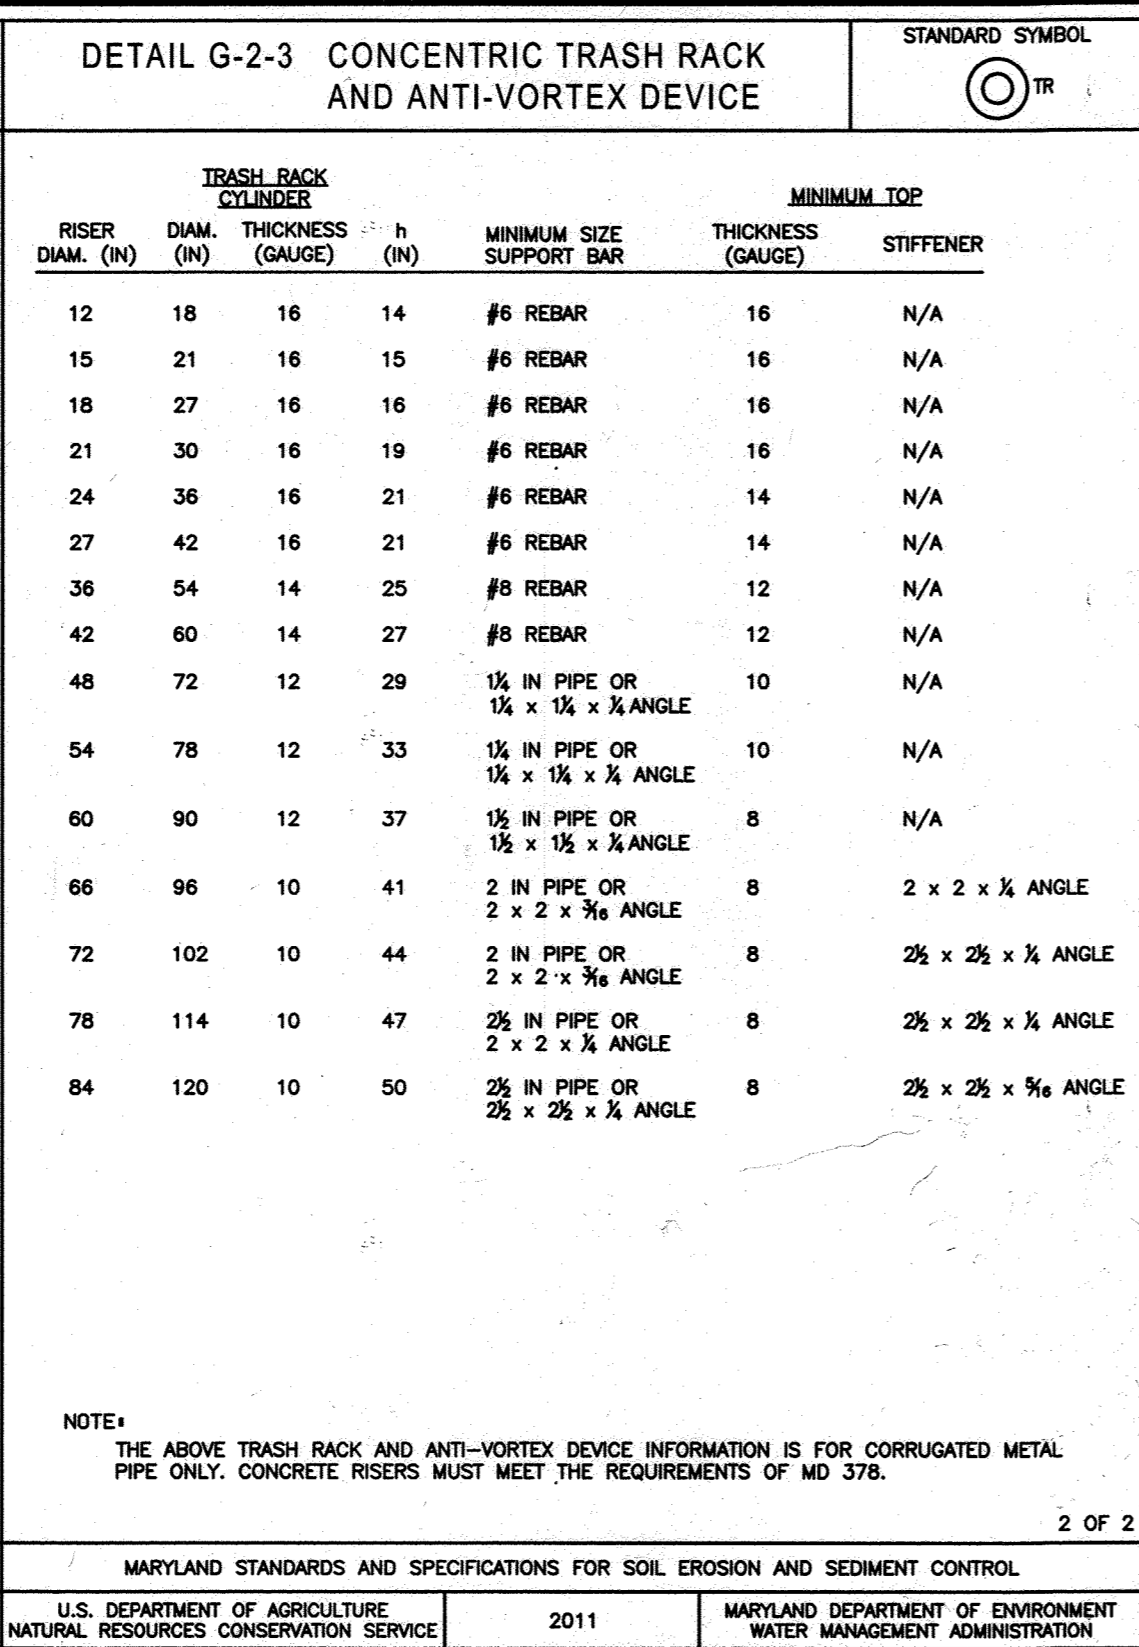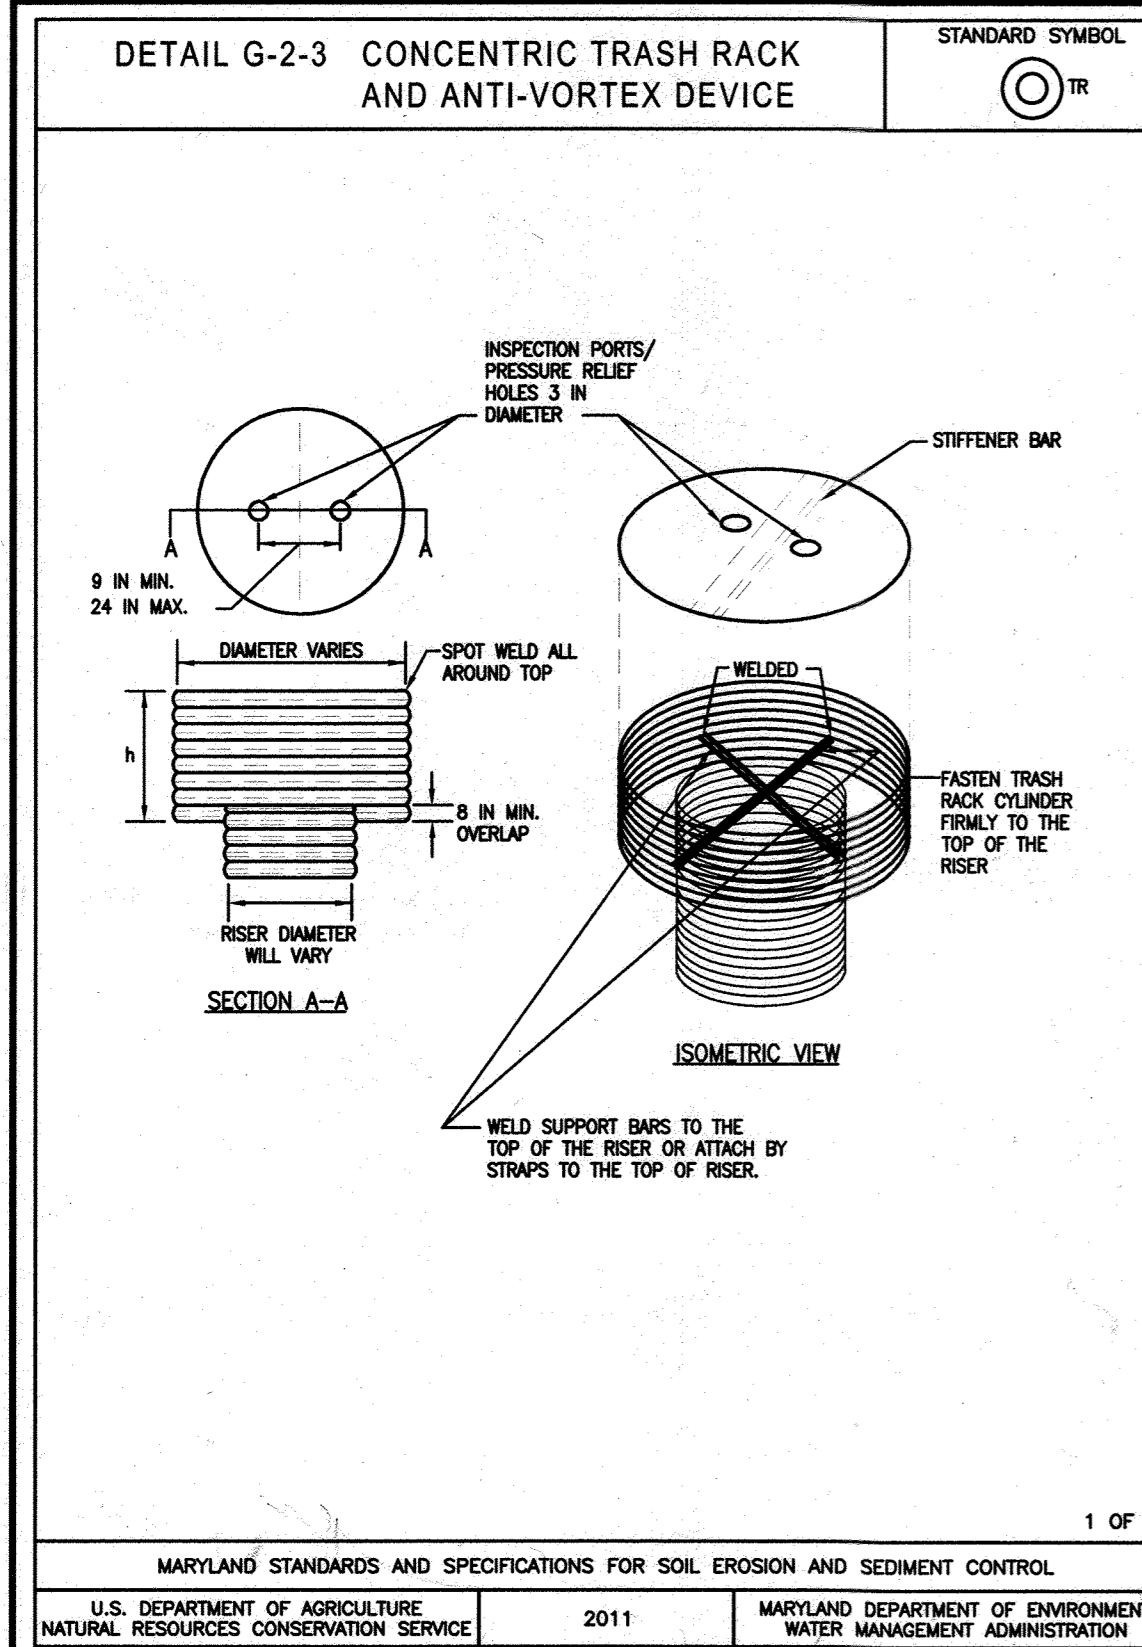

26 SEDIMENT BASIN SCHEMATIC HORIZONTAL DRAW-DOWN NOT TO SCALE

27 BAFFLE BOARDS NOT TO SCALE

28 CONCENTRIC TRASH RACK AND ANTI-VORTEX DEVICE NOT TO SCALE

29 AT-GRADE INLET PROTECTION NOT TO SCALE

REVIEWED FOR HOWARD SCD AND MEETS TECHNICAL REQUIREMENTS THIS DEVELOPMENT PLAN IS APPROVED FOR SOIL EROSION AND SEDIMENT CONTROL BY THE HOWARD SOIL CONSERVATION DISTRICT.

John R. Roberts 4/23/17
HOWARD SCD DATE





APPROVED: DEPARTMENT OF PLANNING AND ZONING

Valdis Joffe 12-12-17
DIRECTOR DATE

Chad Edwards 11-29-17
CHIEF, DEVELOPMENT ENGINEERING DIVISION DATE

Victor Sladkov 12-5-17
CHIEF, DIVISION OF LAND DEVELOPMENT DATE

GRID: 8 BLOCK: N/A
ZONING: RC-DEO PARCEL/LOT: 220, 253, 11, 23, 54
TAX MAP: 0016 ELECTION DISTRICT: 3-02

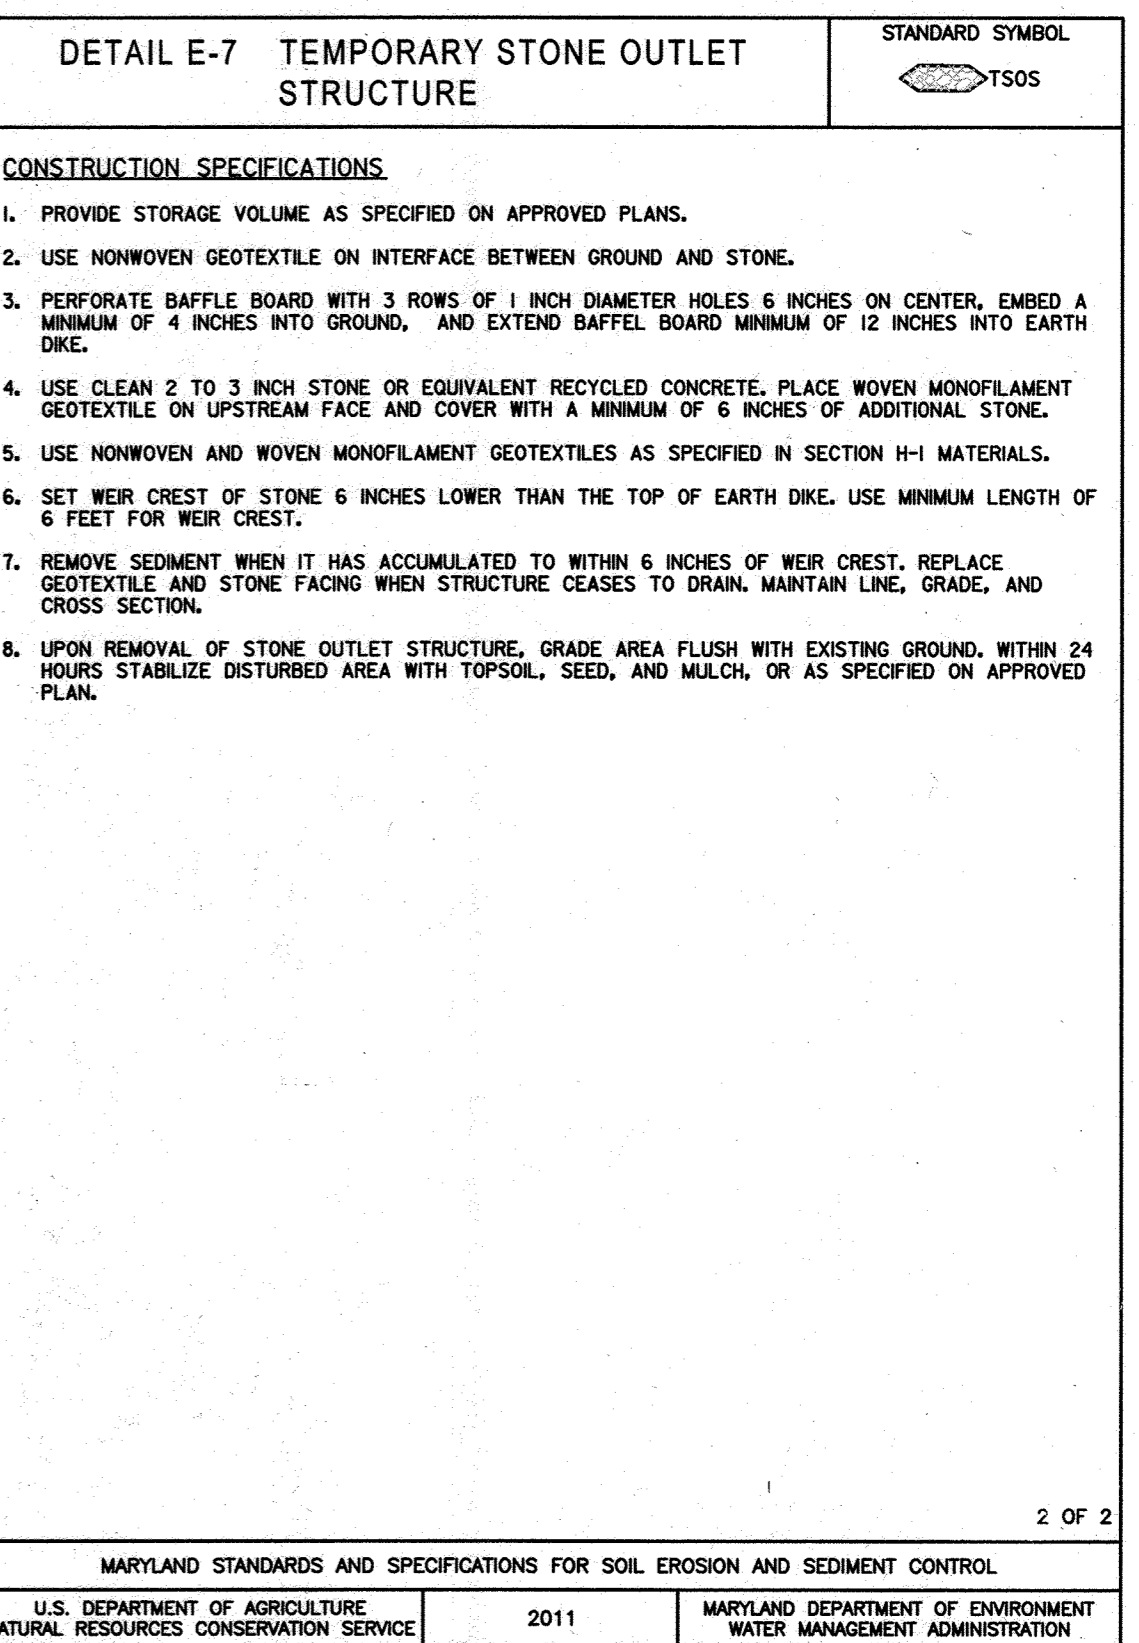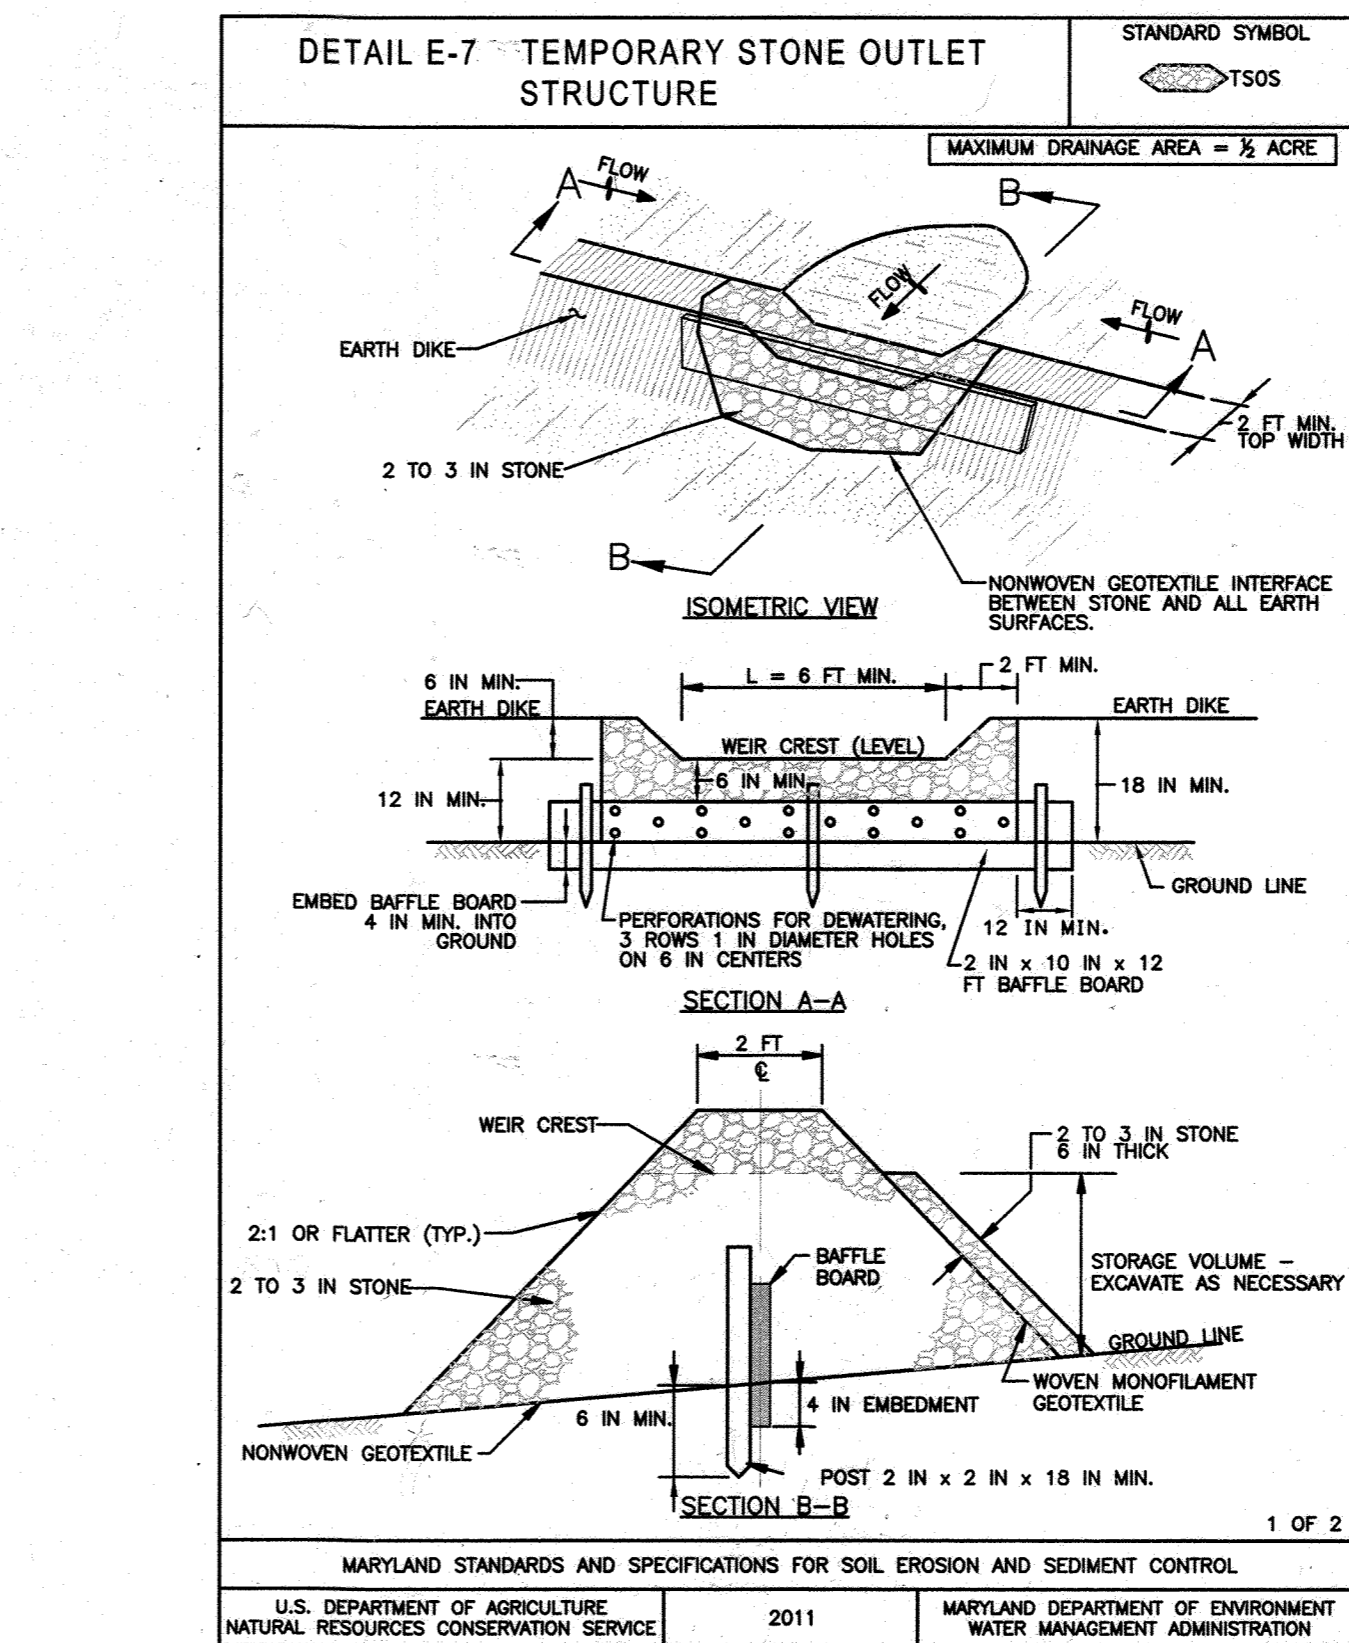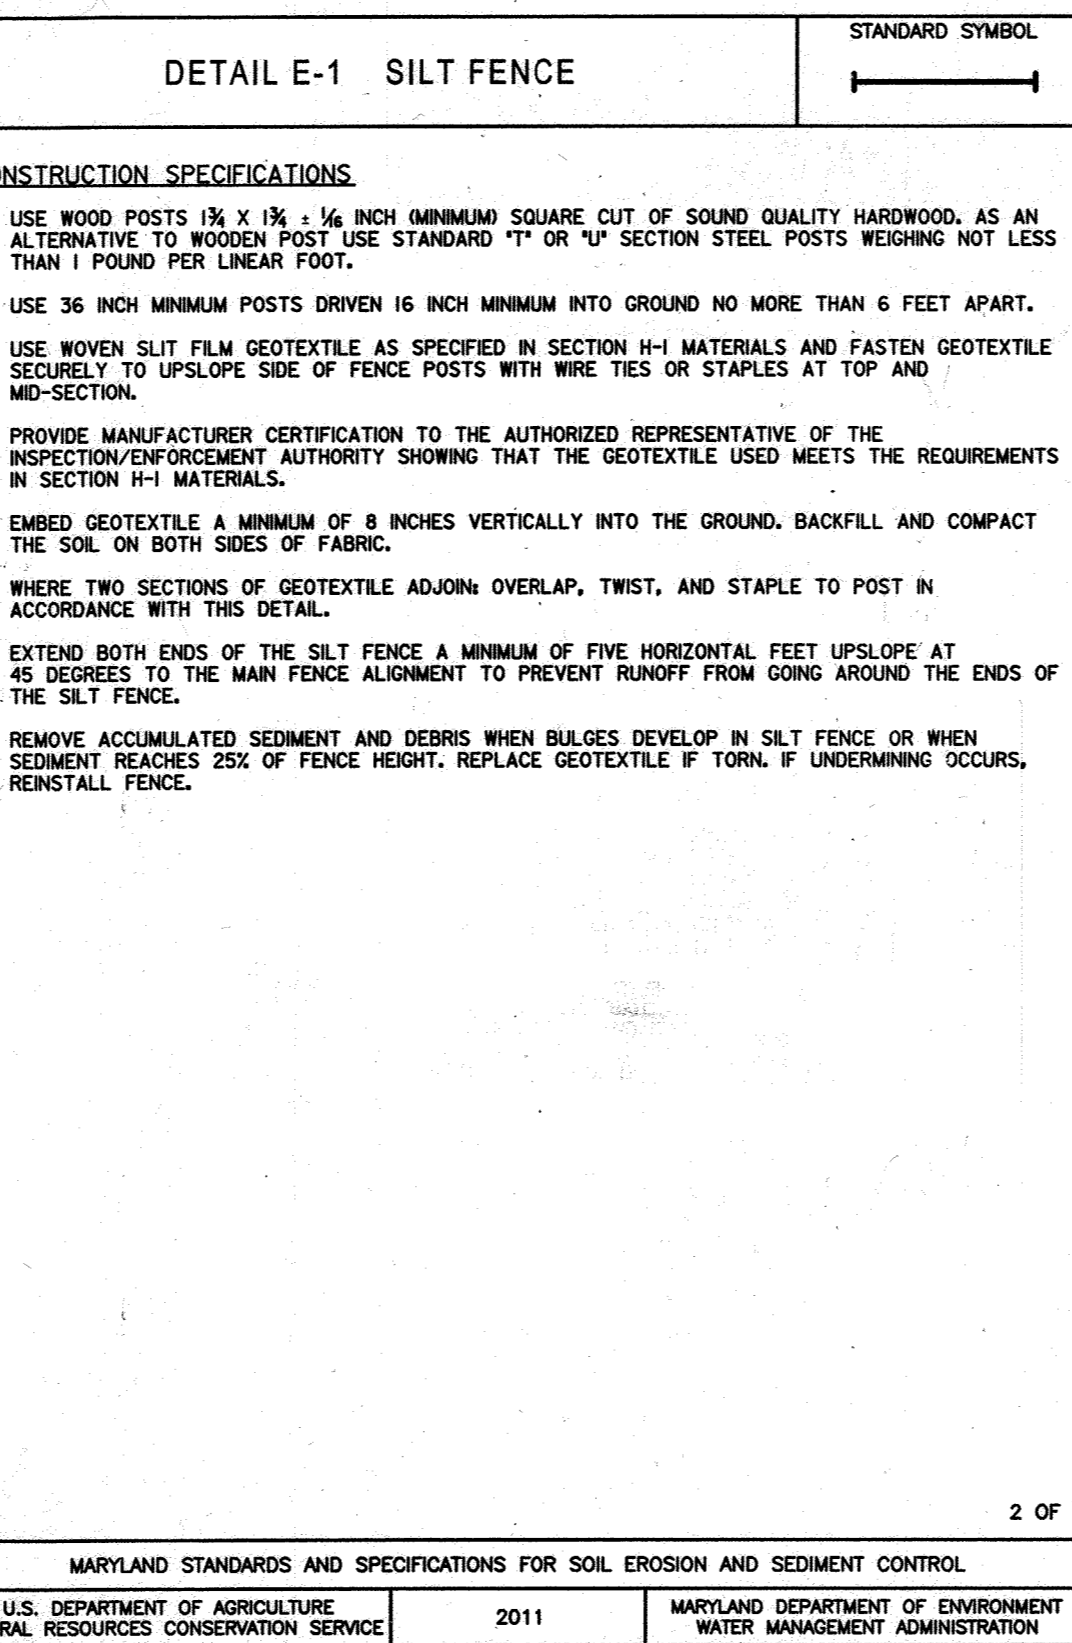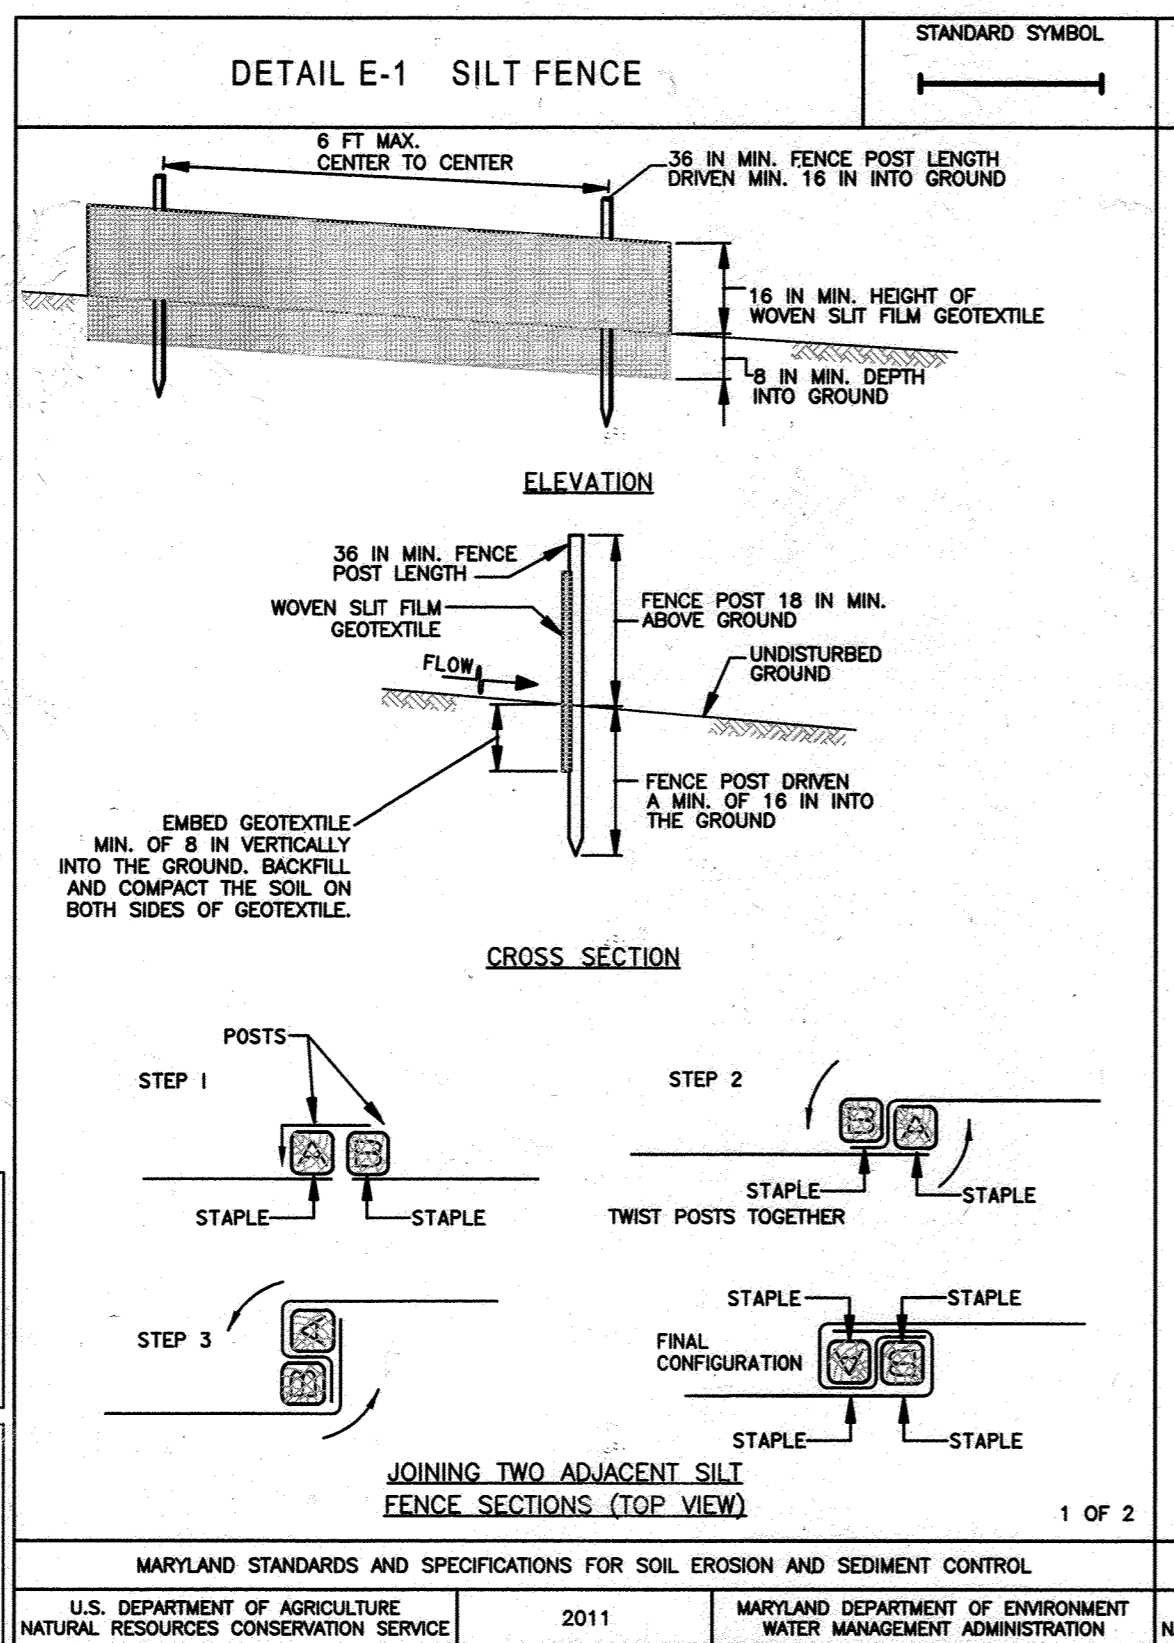


30 SILT FENCE NOT TO SCALE

31 TEMPORARY STONE OUTLET STRUCTURE NOT TO SCALE

OWNER/ENGINEER INFORMATION

DEVELOPER/OWNER: HOWARD COUNTY GOVERNMENT
CONTACT: JEFF DANNIS, P.E., CSP
6751 COLUMBIA GATEWAY DRIVE, SUITE 514
COLUMBIA, MD 21046
TELEPHONE: (410) 313-6419

ENGINEER: EA ENGINEERING, SCIENCE, AND TECHNOLOGY, INC., PBC
CONTACT: MARK GUTBERLET, P.E.
225 SCHILLING CIRCLE, SUITE 400
HUNT VALLEY, MD 21031
TELEPHONE: (410) 584-7000

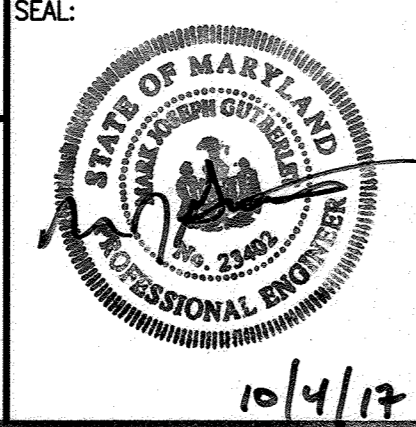

PROFESSIONAL CERTIFICATION:

I HEREBY CERTIFY THAT THESE DOCUMENTS WERE PREPARED OR APPROVED BY ME, AND THAT I AM A DULY LICENSED PROFESSIONAL ENGINEER UNDER THE LAWS OF THE STATE OF MARYLAND, LICENSE NO. 23402, EXPIRATION DATE 25 AUGUST 2018.

Mark Gutberlet 10/4/17

DSN. BY:	MBS/MP	CVH	REVISION TOTAL SHEET NUMBER DUE TO ADDITION OR DELETION	45	6/20/21
DRN. BY:	JAP/KEJ				
CHK. BY:	SMD				
DATE:	OCT. 2018				
BY:	NO.	REVISION	DATE		

EROSION AND SEDIMENT CONTROL DETAILS III

COMPOST FACILITY - PHASE II AT ALPHA RIDGE LANDFILL HOWARD COUNTY, MARYLAND

SDP SHEET: DRAWING: 145 ES-9
20 OF 44
PROJECT: 14982.05
SHEET: 32 OF 70

NOT FOR CONSTRUCTION - SITE DEVELOPMENT PLAN #SDP-16-035

B-4 STANDARDS AND SPECIFICATIONS

FOR VEGETATIVE STABILIZATION

USING VEGETATION AS COVER TO PROTECT EXPOSED SOIL FROM EROSION.

DEFINITION

TO PROMOTE THE ESTABLISHMENT OF VEGETATION ON EXPOSED SOIL.

CONDITIONS WHERE PRACTICE APPLIES

ON ALL DISTURBED AREAS NOT STABILIZED BY OTHER METHODS... THIS SPECIFICATION IS DIVIDED INTO SECTIONS ON INCREMENTAL STABILIZATION; SOIL PREPARATION, SOIL AMENDMENTS AND TOPSOILING; SEEDING AND MULCHING; TEMPORARY STABILIZATION; AND PERMANENT STABILIZATION.

EFFECTS ON WATER QUALITY AND QUANTITY

STABILIZATION PRACTICES ARE USED TO PROMOTE THE ESTABLISHMENT OF VEGETATION ON EXPOSED SOIL... WHEN SOIL IS STABILIZED WITH VEGETATION, THE SOIL IS LESS LIKELY TO ERODE AND MORE LIKELY TO ALLOW INFILTRATION OF RAINFALL, THEREBY REDUCING SEDIMENT LOADS AND RUNOFF TO DOWNSTREAM AREAS.

PLANTING VEGETATION IN DISTURBED AREAS WILL HAVE AN EFFECT ON THE WATER BUDGET, ESPECIALLY ON VOLUMES AND RATES OF RUNOFF, INFILTRATION, EVAPORATION, TRANSPARATION, PERCOLATION, AND GROUNDWATER RECHARGE... OVER TIME, VEGETATION WILL INCREASE ORGANIC MATTER CONTENT AND IMPROVE THE WATER HOLDING CAPACITY OF THE SOIL AND SUBSEQUENT PLANT GROWTH.

VEGETATION WILL HELP REDUCE THE MOVEMENT OF SEDIMENT, NUTRIENTS, AND OTHER CHEMICAL CARRIED BY AND RECEIVING WATERS... PLANTS WILL ALSO HELP PROTECT GROUNDWATER SUPPLIES BY ASSIMILATING THOSE SUBSTANCES PRESENT WITHIN THE ROOT ZONE.

SEDIMENT CONTROL PRACTICES MUST REMAIN IN PLACE DURING GRADING, SEEDBED PREPARATION, SEEDING, MULCHING, AND VEGETATIVE ESTABLISHMENT.

ADEQUATE VEGETATIVE ESTABLISHMENT

INSPECT SEEDED AREAS FOR VEGETATIVE ESTABLISHMENT AND MAKE NECESSARY REPAIRS, REPLACEMENTS, AND RESEEDINGS WITHIN THE PLANTING SEASON.

- 1. ADEQUATE VEGETATIVE STABILIZATION REQUIRES 95 PERCENT GROUND COVER... 2. IF AN AREA HAS LESS THAN 40 PERCENT GROUND COVER, RESTABILIZE FOLLOWING THE ORIGINAL RECOMMENDATIONS FOR LIME, FERTILIZER, SEEDBED PREPARATION, AND SEEDING... 3. IF AN AREA HAS BETWEEN 40 AND 94 PERCENT GROUND COVER, OVER-SEED AND FERTILIZE USING HALF OF THE RATES ORIGINALLY SPECIFIED... 4. MAINTENANCE FERTILIZER RATES FOR PERMANENT SEEDING ARE SHOWN IN TABLE B.6.

B-4-1 STANDARDS AND SPECIFICATIONS

FOR INCREMENTAL STABILIZATION

ESTABLISHMENT OF VEGETATIVE COVER ON CUT AND FILL SLOPES.

DEFINITION

TO PROVIDE TIMELY VEGETATIVE COVER ON CUT AND FILL SLOPES AS WORK PROGRESSES.

CONDITIONS WHERE PRACTICE APPLIES

ANY CUT OR FILL SLOPE GREATER THAN 15 FEET IN HEIGHT. THIS PRACTICE ALSO APPLIES TO STOCKPILES.

CRITERIA

- A. INCREMENTAL STABILIZATION - CUT SLOPES
1. EXCAVATE AND STABILIZE CUT SLOPES IN INCREMENTS NOT TO EXCEED 15 FEET IN HEIGHT. PREPARE SEEDBED AND APPLY SEED AND MULCH ON ALL CUT SLOPES AS THE WORK PROGRESSES.
2. CONSTRUCTION SEQUENCE EXAMPLE (REFER TO FIGURE B.1):
2.a. CONSTRUCT AND STABILIZE ALL TEMPORARY SWALES OR DIKES THAT WILL BE USED TO CONVEY RUNOFF AROUND THE EXCAVATION.
2.b. PERFORM PHASE 1 EXCAVATION, PREPARE SEEDBED, AND STABILIZE.
2.c. PERFORM PHASE 2 EXCAVATION, PREPARE SEEDBED, AND STABILIZE. OVERSEED PHASE 1 AREAS AS NECESSARY.
2.d. PERFORM FINAL PHASE EXCAVATION, PREPARE SEEDBED, AND STABILIZE. OVERSEED PREVIOUSLY SEEDD AREAS AS NECESSARY.

NOTE: ONCE EXCAVATION HAS BEGUN, THE OPERATION SHOULD BE CONTINUOUS FROM GRUBBING THROUGH THE COMPLETION OF GRADING AND PLACEMENT OF TOPSOIL (IF REQUIRED) AND PERMANENT SEED AND MULCH. ANY INTERRUPTIONS IN THE OPERATION OR COMPLETING THE OPERATION OUT OF THE SEEDING SEASON WILL NECESSITATE THE APPLICATION OF TEMPORARY STABILIZATION.

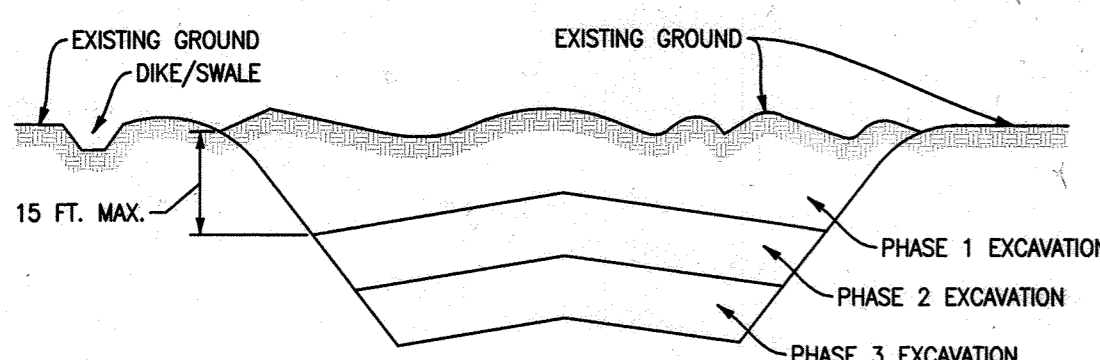


FIGURE B.1: INCREMENTAL STABILIZATION - CUT

B. INCREMENTAL STABILIZATION - FILL SLOPES

- 1. CONSTRUCT AND STABILIZE FILL SLOPES IN INCREMENTS NOT TO EXCEED 15 FEET IN HEIGHT. PREPARE SEEDBED AND APPLY SEED AND MULCH ON ALL SLOPES AS THE WORK PROGRESSES.
2. STABILIZE SLOPES IMMEDIATELY WHEN THE VERTICAL HEIGHT OF A LIFT REACHES 15 FEET OR WHEN THE GRADING OPERATION CEASES AS PRESCRIBED IN THE PLANS.
3. AT THE END OF EACH DAY, INSTALL TEMPORARY WATER CONVEYANCE PRACTICE(S), AS NECESSARY, TO INTERCEPT SURFACE RUNOFF AND CONVEY IT DOWN THE SLOPE IN A NON-EROSIVE MANNER.
4. CONSTRUCTION SEQUENCE EXAMPLE (REFER TO FIGURE B.2):
4.a. CONSTRUCT AND STABILIZE ALL TEMPORARY SWALES OR DIKES THAT WILL BE USED TO DIVERT RUNOFF AROUND THE FILL. CONSTRUCT SILT FENCE ON LOW SIDE OF FILL UNLESS OTHER METHODS SHOWN ON THE PLANS ADDRESS THIS

- 4.b. AT THE END OF THE DAY, INSTALL TEMPORARY WATER CONVEYANCE PRACTICE(S), AS NECESSARY, TO INTERCEPT SURFACE RUNOFF AND CONVEY IT DOWN THE SLOPE IN A NON-EROSIVE MANNER.
4.c. PLACE PHASE 1 FILL, PREPARE SEEDBED, AND STABILIZE.
4.d. PLACE PHASE 2 FILL, PREPARE SEEDBED, AND STABILIZE.
4.e. PLACE FINAL PHASE FILL, PREPARE SEEDBED, AND STABILIZE. OVERSEED PREVIOUSLY SEEDD AREAS AS NECESSARY.

NOTE: ONCE THE PLACEMENT OF FILL HAS BEGUN, THE OPERATION SHOULD BE CONTINUOUS FROM GRUBBING THROUGH THE COMPLETION OF GRADING AND PLACEMENT OF TOPSOIL (IF REQUIRED) AND PERMANENT SEED AND MULCH. ANY INTERRUPTIONS IN THE OPERATION OR COMPLETING THE OPERATION OUT OF THE SEEDING SEASON WILL NECESSITATE THE APPLICATION OF TEMPORARY STABILIZATION.

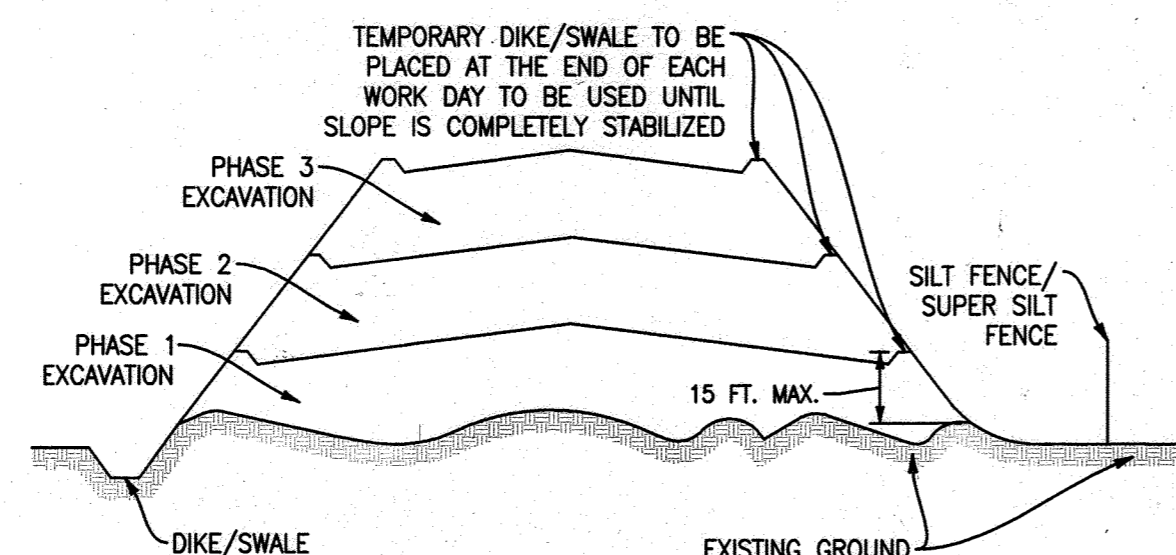


FIGURE B.2: INCREMENTAL STABILIZATION - FILL

B-4-2 STANDARDS AND SPECIFICATIONS

FOR SOIL PREPARATION, TOPSOILING, AND SOIL AMENDMENTS

THE PROCESS OF PREPARING THE SOILS TO SUSTAIN ADEQUATE VEGETATIVE STABILIZATION.

DEFINITION

TO PROVIDE A SUITABLE SOIL MEDIUM FOR VEGETATIVE GROWTH.

PURPOSE

WHERE VEGETATIVE STABILIZATION IS TO BE ESTABLISHED.

CRITERIA

- A. SOIL PREPARATION
1. TEMPORARY STABILIZATION
1.a. SEED PREPARATION CONSISTS OF LOOSENING SOIL TO A DEPTH OF 3 TO 5 INCHES BY MEANS OF SUITABLE AGRICULTURAL OR CONSTRUCTION EQUIPMENT, SUCH AS DISC HARROWS OR CHISEL PLOWS OR RIPPERS MOUNTED ON CONSTRUCTION EQUIPMENT. AFTER SOIL IS LOOSEND, IT MUST NOT BE ROLLED OR DRAGGED SMOOTH BUT LEFT IN ROUGHENED CONDITION. SLOPES 3:1 OR FLATTER ARE TO BE TRACKED WITH RIDGES RUNNING PARALLEL TO THE CONTOUR OF THE SLOPE.
1.b. APPLY FERTILIZER AND LIME AS PRESCRIBED ON THE PLANS.
1.c. INCORPORATE LIME AND FERTILIZER INTO THE TOP 3 TO 5 INCHES OF SOIL BY DISKING OR OTHER SUITABLE MEANS

- 2. PERMANENT STABILIZATION
2.a. A SOIL TEST IS REQUIRED FOR ANY EARTH DISTURBANCE OF 5 ACRES OR MORE. THE MINIMUM SOIL CONDITIONS REQUIRED FOR PERMANENT VEGETATIVE ESTABLISHMENT ARE:
a. SOIL BETWEEN 6.0 TO 7.0.
b. SOLUBLE SALTS LESS THAN 500 PARTS PER MILLION (PPM).
c. SOIL CONTAINS LESS THAN 40 PERCENT CLAY BUT ENOUGH FINE GRAINED MATERIAL (GREATER THAN 30 PERCENT SILT PLUS CLAY) TO PROVIDE THE CAPACITY TO HOLD A MODERATE AMOUNT OF MOISTURE. AN EXCEPTION: IF LOWGRASS WILL BE PLANTED, THEN A SANDY SOIL (LESS THAN 30 PERCENT SILT PLUS CLAY) WOULD BE ACCEPTABLE.
d. SOIL CONTAINS 1.5 PERCENT MINIMUM ORGANIC MATTER BY WEIGHT.
e. SOIL CONTAINS SUFFICIENT PORE SPACE TO PERMIT ADEQUATE ROOT PENETRATION.

- 2.b. GRADED AREAS MUST BE MAINTAINED IN A TRUE AND EVEN GRADE AS SPECIFIED ON THE APPROVED PLAN, THEN SCARIFIED OR OTHERWISE LOOSEND TO A DEPTH OF 3 TO 5 INCHES.
2.c. APPLY SOIL AMENDMENTS AS SPECIFIED ON THE APPROVED PLAN OR AS INDICATED BY THE RESULTS OF A SOIL TEST.
2.d. MIX SOIL AMENDMENTS INTO THE TOP 3 TO 5 INCHES OF SOIL BY DISKING OR OTHER SUITABLE MEANS. RAKE LAWN AREAS TO SMOOTH THE SURFACE. REMOVE LARGE OBJECTS LIKE STONES AND BRANCHES, AND READY THE AREA FOR SEED APPLICATION. LOOSEN SURFACE SOIL BY DRAGGING WITH A HEAVY CHAIN OR OTHER EQUIPMENT TO ROUGHEN THE SURFACE WHERE SITE CONDITIONS WILL NOT PERMIT NORMAL SEEDBED PREPARATION. TRACK SLOPES 3:1 OR FLATTER WITH TRACKED EQUIPMENT LEAVING THE SOIL IN AN IRREGULAR CONDITION WITH RIDGES RUNNING PARALLEL TO THE CONTOUR OF THE SLOPE. LEAVE THE TOP 1 TO 3 INCHES OF SOIL LOOSE AND FRABLE. SEEDBED LOOSENING MAY BE UNNECESSARY ON NEWLY DISTURBED AREAS.

- 2.e. APPLICATION OF AMENDMENTS OR TOPSOIL IS REQUIRED IF ON-SITE SOILS DO NOT MEET THE ABOVE CONDITIONS.
2.f. MIX SOIL AMENDMENTS INTO THE TOP 3 TO 5 INCHES OF SOIL BY DISKING OR OTHER SUITABLE MEANS. RAKE LAWN AREAS TO SMOOTH THE SURFACE. REMOVE LARGE OBJECTS LIKE STONES AND BRANCHES, AND READY THE AREA FOR SEED APPLICATION. LOOSEN SURFACE SOIL BY DRAGGING WITH A HEAVY CHAIN OR OTHER EQUIPMENT TO ROUGHEN THE SURFACE WHERE SITE CONDITIONS WILL NOT PERMIT NORMAL SEEDBED PREPARATION. TRACK SLOPES 3:1 OR FLATTER WITH TRACKED EQUIPMENT LEAVING THE SOIL IN AN IRREGULAR CONDITION WITH RIDGES RUNNING PARALLEL TO THE CONTOUR OF THE SLOPE. LEAVE THE TOP 1 TO 3 INCHES OF SOIL LOOSE AND FRABLE. SEEDBED LOOSENING MAY BE UNNECESSARY ON NEWLY DISTURBED AREAS.

B. TOPSOILING

- 1. TOPSOIL IS PLACED OVER PREPARED SUBSOIL PRIOR TO ESTABLISHMENT OF PERMANENT VEGETATION. THE PURPOSE IS TO PROVIDE A SUITABLE SOIL MEDIUM FOR VEGETATIVE GROWTH. SOILS OF CONCERN HAVE LOW MOISTURE CONTENT, LOW NUTRIENT LEVELS, LOW PH, MATERIALS TOXIC TO PLANTS, AND/OR UNACCEPTABLE SOIL GRADATION.
2. TOPSOIL SALVAGED FROM AN EXISTING SITE MAY BE USED PROVIDED IT MEETS THE STANDARDS AS SET FORTH IN THESE SPECIFICATIONS. TYPICALLY, THE DEPTH OF TOPSOIL TO BE SALVAGED FOR A GIVEN SOIL TYPE CAN BE FOUND IN REPRESENTATIVE SOIL PROFILE SECTION IN THE SOIL SURVEY PUBLISHED BY USDA-NRCS.
3. TOPSOILING IS LIMITED TO AREAS HAVING 2:1 OR FLATTER SLOPES WHERE:
3.a. THE TEXTURE OF THE EXPOSED SUBSOIL/PARENT MATERIAL IS NOT ADEQUATE TO PRODUCE VEGETATIVE GROWTH.
3.b. THE SOIL MATTER IS SO SHALLOW THAT THE ROOTING ZONE IS NOT DEEP ENOUGH TO SUPPORT PLANTS OR FURNISH CONTINUING SUPPLIES OF MOISTURE AND PLANT MATERIAL.
3.c. THE ORIGINAL SOIL TO BE VEGETATED CONTAINS MATERIAL TOXIC TO PLANT GROWTH.
3.d. THE SOIL IS SO AODIC THAT TREATMENT WITH LIMESTONE IS NOT FEASIBLE.
4. AREAS HAVING SLOPES STEEPER THAN 2:1 REQUIRE SPECIAL CONSIDERATION AND DESIGN.
5. TOPSOIL SPECIFICATIONS: SOIL TO BE USED AS TOPSOIL MUST MEET THE FOLLOWING CRITERIA:
5.a. TOPSOIL MUST BE A LOAM, SANDY LOAM, CLAY LOAM, SILT LOAM, SANDY CLAY LOAM, OR LOAMY SAND. OTHER SOILS MAY BE USED IF RECOMMENDED BY AN AGRONOMIST OR SOIL SCIENTIST AND APPROVED BY THE APPROPRIATE APPROVAL AUTHORITY. TOPSOIL MUST NOT BE A MIXTURE OF CONTRASTING TEXTURED SUBSOILS AND MUST CONTAIN LESS THAN 5 PERCENT BY VOLUME OF CINDERS, STONES, SLAG, COARSE FRAGMENTS, GRAVEL, STICKS, ROOTS, TRASH, OR OTHER MATERIALS LARGER THAN 1 1/2 INCHES IN DIAMETER.
5.b. TOPSOIL MUST BE FREE OF NOXIOUS PLANTS OR PLANT PARTS SUCH AS

- BERMUDA GRASS, QUACK GRASS, JOHNSON GRASS, NUT SEDGE, POISON IVY, THISTLE, OR OTHERS AS SPECIFIED.
5.c. TOPSOIL SUBSTITUTES OR AMENDMENTS, AS RECOMMENDED BY A QUALIFIED AGRONOMIST OR SOIL SCIENTIST AND APPROVED BY THE APPROPRIATE APPROVAL AUTHORITY, MAY BE USED IN LIEU OF NATURAL TOPSOIL.
6. TOPSOIL APPLICATION
6.a. EROSION AND SEDIMENT CONTROL PRACTICES MUST BE MAINTAINED WHEN APPLYING TOPSOIL.
6.b. UNIFORMLY DISTRIBUTE TOPSOIL IN A 5 TO 8 INCH LAYER AND LIGHTLY COMPACT TO A MINIMUM THICKNESS OF 4 INCHES. SPREADING IS TO BE PERFORMED IN SUCH A MANNER THAT SODDING OR SEEDING CAN PROCEED WITH A MINIMUM OF ADDITIONAL SOIL PREPARATION AND TILLAGE. ANY IRREGULARITIES IN THE SURFACE RESULTING FROM TOPSOILING OR OTHER OPERATIONS MUST BE CORRECTED IN ORDER TO PREVENT THE FORMATION OF DEPRESSIONS OR WATER POOLS.
6.c. TOPSOIL MUST NOT BE PLACED IF THE TOPSOIL OR SUBSOIL IS IN A FROZEN OR MUDDY CONDITION, WHEN THE SUBSOIL IS EXCESSIVELY WET OR IN A CONDITION THAT MAY OTHERWISE BE DETRIMENTAL TO PROPER GRADING AND SEEDBED PREPARATION.

C. SOIL AMENDMENTS (FERTILIZER AND LIME SPECIFICATIONS)

- 1. SOIL TESTS MUST BE PERFORMED TO DETERMINE THE EXACT RATIOS AND APPLICATION RATES FOR BOTH LIME AND FERTILIZER ON SITES HAVING DISTURBED AREAS OF 5 ACRES OR MORE. SOIL ANALYSIS MAY BE PERFORMED BY A RECOGNIZED PRIVATE OR COMMERCIAL LABORATORY. SOIL SAMPLES TAKEN FOR ENGINEERING PURPOSES MAY ALSO BE USED FOR CHEMICAL ANALYSES.
2. FERTILIZERS MUST BE UNIFORM IN COMPOSITION, FREE FLOWING AND SUITABLE FOR ACCURATE APPLICATION BY APPROPRIATE EQUIPMENT. MANURE MAY BE SUBSTITUTED FOR FERTILIZER WITH PRIOR APPROVAL FROM THE APPROPRIATE APPROVAL AUTHORITY. FERTILIZERS MUST ALL BE DELIVERED TO THE SITE FULLY LABELED ACCORDING TO THE APPLICABLE LAWS AND MUST BEAR THE NAME, TRADE NAME OR TRADEMARK AND WARRANTY OF THE PRODUCER.
3. LIME MATERIALS MUST BE GROUND LIMESTONE (HYDRATED OR BURNT LIME) MAY BE SUBSTITUTED EXCEPT WHEN HYDROSEEDING WHICH CONTAINS AT LEAST 50 PERCENT TOTAL OXIDES (CALCIUM OXIDE PLUS MAGNESIUM OXIDE). LIMESTONE MUST BE GROUND TO SUCH FINENESS THAT AT LEAST 50 PERCENT WILL PASS THROUGH A #100 MESH SIEVE AND 98 TO 100 PERCENT WILL PASS THROUGH A #20 MESH SIEVE.
4. LIME AND FERTILIZER ARE TO BE EVENLY DISTRIBUTED AND INCORPORATED INTO THE TOP 3 TO 5 INCHES OF SOIL BY DISKING OR OTHER SUITABLE MEANS.
5. WHERE THE SOIL IS EITHER HIGHLY ACIDIC OR COMPOSED OF HEAVY CLAYS, SPREAD GROUND LIMESTONE AT THE RATE OF 4 TO 8 TONS/ACRE (200-400 POUNDS PER 1,000 SQUARE FEET) PRIOR TO THE PLACEMENT OF TOPSOIL.

B-4-3 STANDARDS AND SPECIFICATIONS

FOR SEEDING AND MULCHING

THE APPLICATION OF SEED AND MULCH TO ESTABLISH VEGETATIVE COVER.

DEFINITION

TO PROTECT DISTURBED SOILS FROM EROSION DURING AND AT THE END OF CONSTRUCTION.

PURPOSE

TO USE FAST GROWING VEGETATION THAT PROVIDES COVER ON DISTURBED SOILS.

CONDITIONS WHERE PRACTICE APPLIES

EXPOSED SOILS WHERE GROUND COVER IS NEEDED FOR A PERIOD OF 6 MONTHS OR LESS. FOR LONGER DURATION OF TIME, PERMANENT STABILIZATION PRACTICES ARE REQUIRED.

CRITERIA

- A. SEEDING
1. SPECIFICATIONS
1.a. ALL SEED MUST MEET THE REQUIREMENT OF THE MARYLAND STATE SEED LAW. ALL SEED MUST BE SUBJECT TO RE-TESTING BY A RECOGNIZED SEED LABORATORY. ALL SEED USED MUST HAVE BEEN TESTED WITHIN THE 6 MONTHS IMMEDIATELY PRECEDING THE DATE OF SOWING SUCH MATERIAL ON ANY PROJECT. REFER TO TABLE B.4 REGARDING THE QUALITY OF SEED. SEED TAGS MUST BE AVAILABLE UPON REQUEST TO THE INSPECTOR TO VERIFY TYPE OF SEED AND SEEDING RATE.
1.b. MULCH ALONE MAY BE APPLIED BETWEEN THE FALL AND SPRING SEEDING DATES ONLY IF THE GROUND IS FROZEN. THE APPROPRIATE SEEDING MIXTURE MUST BE APPLIED WHEN THE GROUND THAW.
1.c. INOCULANTS: THE INOCULANT FOR TREATING LEGUME SEED IN THE SEED MIXTURES MUST BE A PURE CULTURE OF NITROGEN FIXING BACTERIA PREPARED SPECIFICALLY FOR THE SPECIES. INOCULANTS MUST NOT BE USED LATER THAN THE DATE INDICATED ON THE CONTAINER. ADD FRESH INOCULANTS AS DIRECTED ON THE PACKAGE. USE FOUR TIMES THE RECOMMENDED RATE WHEN HYDROSEEDING. NOTE: IT IS VERY IMPORTANT TO KEEP INOCULANT AS COOL AS POSSIBLE UNTIL USED. TEMPERATURES ABOVE 75 TO 80 DEGREES FAHRENHEIT CAN WEAKEN BACTERIA AND MAKE THE INOCULANT LESS EFFECTIVE.
1.d. SOIL AND SEED MUST NOT BE PLACED ON SOIL WHICH HAS BEEN TREATED WITH SOIL STERILANTS OR CHEMICALS USED FOR WEED CONTROL UNTIL SUFFICIENT TIME HAS ELAPSED (14 DAYS MIN) TO PERMIT DISSIPATION OF PHYTO-TOXIC MATERIALS.

- 2. APPLICATION OF SEEDING: THIS INCLUDES USE OF CONVENTIONAL DROP OR BROADCAST SPREADERS.
2.a. INCORPORATE SEED INTO THE SUBSOIL AT THE RATES PRESCRIBED ON TEMPORARY SEEDING TABLE B.1, PERMANENT SEEDING TABLE B.3, OR SITE-SPECIFIC SEEDING SUMMARIES.
2.b. APPLY SEED IN TWO DIRECTIONS, PERPENDICULAR TO EACH OTHER. APPLY HALF THE SEEDING RATE IN EACH DIRECTION. ROLL THE SEEDD AREA WITH A WEIGHTED ROLLER TO PROVIDE GOOD SEED TO SOIL CONTACT.
2.c. DRILL OR CULTIPACKER SEEDING: MECHANIZED SEEDERS THAT APPLY AND COVER SEED WITH SOIL.
2.d. MULTIPACKING SEEDERS ARE REQUIRED TO BURY THE SEED IN SUCH A FASHION AS TO PROVIDE AT LEAST 1/4 INCH OF SOIL COVERING. SEEDBED MUST BE FIRM AFTER PLANTING.
2.e. APPLY SEED IN TWO DIRECTIONS, PERPENDICULAR TO EACH OTHER. APPLY HALF THE SEEDING RATE IN EACH DIRECTION.
2.f. HYDROSEEDING: APPLY SEED UNIFORMLY WITH HYDROSEEDER (SLURRY INCLUDES SEED AND FERTILIZER).
2.g. IF FERTILIZER IS BEING APPLIED AT THE TIME OF SEEDING, TEN APPLICATION RATES SHOULD BE EXCEED THE FOLLOWING: NITROGEN (NITROGEN) POUNDS PER ACRE TOTAL SOLUBLE NITROGEN; P2O5 (PHOSPHORUS), 200 POUNDS PER ACRE; K2O (POTASSIUM), 200 POUNDS PER ACRE.
2.h. LIME: USE ONLY GROUND AGRICULTURAL LIMESTONE (UP TO 3 TONS PER ACRE MAY BE APPLIED BY HYDROSEEDING). NORMALLY, NOT MORE THAN 2 TONS ARE APPLIED BY HYDROSEEDING AT ANY ONE TIME. DO NOT USE BURNT OR HYDRATED LIME WHEN HYDROSEEDING.
2.i. MIX SEED AND FERTILIZER ON SITE AND SEED IMMEDIATELY AND WITHOUT INTERRUPTION.
2.j. WHEN HYDROSEEDING, DO NOT INCORPORATE INTO THE SOIL.

B. MULCHING

- 1. MULCH MATERIALS (IN ORDER OF PREFERENCE)
1.a. STRAW CONSISTING OF THOROUGHLY THRESHED WHEAT, RYE, OAT, OR BARLEY AND REASONABLY BRIGHT IN COLOR. STRAW IS TO BE FREE OF NOXIOUS WEED SEEDS AS WELL AS HAY AND SEE LAW AND NURSERY PURPOSES SUCH AS WILDLIFE OR AESTHETIC TREATMENT MAY BE FOUND IN USDA-NRCS TECHNICAL FIELD OFFICE GUIDE, SECTION 342 - CRITICAL AREA PLANTING.
1.b. WOOD CELLULOSE FIBER MULCH (WCFM) CONSISTING OF SPECIALLY PREPARED WOOD CELLULOSE PROCESSED INTO A UNIFORM FIBROUS PHYSICAL STATE.
1.c. WCFM IS TO BE DYED GREEN OR CONTAIN A GREEN DYE IN THE PACKAGE THAT WILL PROVIDE AN APPROPRIATE COLOR TO FACILITATE VISUAL INSPECTION OF THE UNIFORMLY SPREAD SLURRY.
1.d. WCFM, INCLUDING DYE, MUST CONTAIN NO GERMINATION OR GROWTH INHIBITING FACTORS.
1.e. WCFM MATERIALS ARE TO BE MANUFACTURED AND PROCESSED IN SUCH A MANNER THAT THE WOOD CELLULOSE FIBER MULCH WILL REMAIN IN UNIFORM SUSPENSION IN WATER UNDER AGITATION AND WILL BLEND WITH SEED, FERTILIZER AND OTHER ADDITIVES TO FORM A HOMOGENEOUS SLURRY. THE

- MULCH MATERIAL MUST FORM A BLOTTER-LIKE GROUND COVER, ON APPLICATION, HAVING MOISTURE ABSORPTION AND PERCOLATION PROPERTIES AND MUST COVER AND HOLD GRASS SEED IN CONTACT WITH THE SOIL WITHOUT INHIBITING THE GROWTH OF THE GRASS SEEDLINGS.
2. WCFM MATERIAL MUST NOT CONTAIN ELEMENTS OR COMPOUNDS AT CONCENTRATION LEVELS THAT WILL BE PHYTO-TOXIC.
3. WCFM MUST CONFORM TO THE FOLLOWING PHYSICAL REQUIREMENTS: FIBER LENGTH OF APPROXIMATELY 10 MILLIMETERS, DIAMETER APPROXIMATELY 1 MILLIMETER, PH RANGE OF 4.0 TO 8.5, ASH CONTENT OF 1.6 PERCENT MAXIMUM AND WATER HOLDING CAPACITY OF 90 PERCENT MINIMUM.
4. APPLICATION
2.a. APPLY MULCH TO ALL SEEDD AREAS IMMEDIATELY AFTER SEEDING.
2.b. WHEN STRAW MULCH IS USED, SPREAD IT OVER ALL SEEDD AREAS AT THE RATE OF 2 TONS PER ACRE TO A UNIFORM LOOSE DEPTH OF 1 TO 2 INCHES. APPLY MULCH TO ACHIEVE A UNIFORM DISTRIBUTION AND DEPTH SO THAT THE SOIL SURFACE IS NOT EXPOSED. WHEN USING A MULCH ANCHORING TOOL, INCREASE THE APPLICATION RATE TO 2.5 TONS PER ACRE.
2.c. WOOD CELLULOSE FIBER USED AS MULCH MUST BE APPLIED AT A NET DRY WEIGHT OF 100 POUNDS PER ACRE. MIX THE WOOD CELLULOSE FIBER WITH WATER TO ATTAIN A MIXTURE WITH A MAXIMUM OF 50 POUNDS OF WOOD CELLULOSE FIBER PER 100 GALLONS OF WATER.

3. ANCHORING

- 3.a. PERFORM MULCH ANCHORING IMMEDIATELY FOLLOWING APPLICATION OF MULCH TO MINIMIZE LOSS BY WIND OR WATER. THIS MAY BE DONE BY ONE OF THE FOLLOWING METHODS (LISTED BY PREFERENCE), DEPENDING UPON THE SIZE OF THE AREA AND EROSION HAZARD:
a. A MULCH ANCHORING TOOL IS A TRACTOR DRAWN IMPLEMENT DESIGNED TO PUNCH AND ANCHOR MULCH INTO THE SOIL SURFACE A MINIMUM OF 2 INCHES. THIS PRACTICE IS MOST EFFECTIVE ON LARGE AREAS, BUT IS LIMITED TO FLATTER SLOPES WHERE EQUIPMENT CAN OPERATE SAFELY. IF USED ON SLOPING LAND, THIS PRACTICE SHOULD FOLLOW THE CONTOUR OF THE SLOPE.
b. WOOD CELLULOSE FIBER MULCH MAY BE USED FOR ANCHORING STRAW. APPLY THE FIBER BINDER AT A NET DRY WEIGHT OF 750 POUNDS PER ACRE. MIX THE WOOD CELLULOSE FIBER WITH WATER AT A MAXIMUM OF 50 POUNDS OF WOOD CELLULOSE FIBER PER 100 GALLONS OF WATER.
c. SYNTHETIC BINDERS SUCH AS ACRYLIC DLR (AGRO-TACK), DCA-70, PETROSET, TERRA TAC II, TERRA TACK AIR OR OTHER APPROVED EQUAL MAY BE USED. FOLLOW APPLICATION RATES AS SPECIFIED BY THE MANUFACTURER. APPLICATION OF LIQUID BINDERS NEEDS TO BE HEAVIER AT THE EDGES WHERE WIND CATCHES MULCH, SUCH AS IN VALLEYS AND ON CRESTS OF BANKS.
d. LIGHTWEIGHT PLASTIC NETTING MAY BE STAPLED OVER THE MULCH ACCORDING TO MANUFACTURER RECOMMENDATIONS. NETTING IS USUALLY AVAILABLE IN ROLLS 4 TO 15 FEET WIDE AND 300 TO 3,000 FEET LONG.

B-4-4 STANDARDS AND SPECIFICATIONS

FOR TEMPORARY STABILIZATION

TO STABILIZE DISTURBED SOILS WITH VEGETATION FOR UP TO 6 MONTHS.

DEFINITION

TO USE FAST GROWING VEGETATION THAT PROVIDES COVER ON DISTURBED SOILS.

PURPOSE

EXPOSED SOILS WHERE GROUND COVER IS NEEDED FOR A PERIOD OF 6 MONTHS OR LESS. FOR LONGER DURATION OF TIME, PERMANENT STABILIZATION PRACTICES ARE REQUIRED.

CONDITIONS WHERE PRACTICE APPLIES

EXPOSED SOILS WHERE GROUND COVER IS NEEDED FOR A PERIOD OF 6 MONTHS OR LESS. FOR LONGER DURATION OF TIME, PERMANENT STABILIZATION PRACTICES ARE REQUIRED.

CRITERIA

- A. SELECT ONE OR MORE OF THE SPECIES OR SEED MIXTURES LISTED IN TABLE B.1 FOR THE APPROPRIATE PLANT HARDNESS ZONE (FROM FIGURE B.3), AND ENTER THEM IN THE TEMPORARY SEEDING SUMMARY BELOW ALONG WITH APPLICATION RATES, SEEDING DATES AND SEEDING DEPTHS. IF THE SUMMARY IS NOT PUT ON THE PLAN AND COMPLETED, THEN TABLE B.1 PLUS FERTILIZER AND LIME RATES MUST BE PUT ON THE PLAN.
B. FOR SITES HAVING SOIL TESTS PERFORMED, USE AND SHOW THE RECOMMENDED RATES BY THE TESTING AGENCY. SOIL TESTS ARE NOT REQUIRED FOR TEMPORARY SEEDING.
C. WHEN STABILIZATION IS REQUIRED OUTSIDE OF A SEEDING SEASON, APPLY SEED AND MULCH OR STRAW MULCH ALONG AS PRESCRIBED IN SECTION B-4-3.A.1.B AND MAINTAIN UNTIL THE NEXT SEEDING SEASON.

PERMANENT SEEDING SUMMARY

Table with columns: NO., SPECIES, APPLICATION RATE (LB/AC), SEEDING DATES, SEEDING DEPTHS, FERTILIZER RATE (10-20-20), LIME RATE. Includes rows for Annual Ryegrass, Foxtail Millet, and Sheep Fescue.

B-4-5 STANDARDS AND SPECIFICATIONS

FOR PERMANENT STABILIZATION

TO STABILIZE DISTURBED SOILS WITH PERMANENT VEGETATION.

DEFINITION

TO USE LONG-LIVED PERENNIAL GRASSES AND LEGUMES TO ESTABLISH PERMANENT COVER ON DISTURBED SOILS.

PURPOSE

EXPOSED SOILS WHERE GROUND COVER IS NEEDED FOR 6 MONTHS OR MORE.

CONDITIONS WHERE PRACTICE APPLIES

EXPOSED SOILS WHERE GROUND COVER IS NEEDED FOR 6 MONTHS OR MORE.

CRITERIA

- A. SEED MIXTURES
1. GENERAL USE
1.a. SELECT ONE OR MORE OF THE SPECIES OR MIXTURES LISTED IN TABLE B.3 FOR THE APPROPRIATE PLANT HARDNESS ZONE (FROM FIGURE B.3) AND BASED ON THE SITE CONDITION OR PURPOSE FOUND ON TABLE B.3. ENTER SELECTED MIXTURE(S), APPLICATION RATES, AND SEEDING DATES IN THE PERMANENT SEEDING SUMMARY. THE SUMMARY IS TO BE PLACED ON THE PLAN.
1.b. ADDITIONAL PLANTING SPECIFICATIONS FOR EXCEPTIONAL SITES SUCH AS SHORELINES, STREAM BANKS, OR DUNES OR FOR SPECIAL PURPOSES SUCH AS WILDLIFE OR AESTHETIC TREATMENT MAY BE FOUND IN USDA-NRCS TECHNICAL FIELD OFFICE GUIDE, SECTION 342 - CRITICAL AREA PLANTING.
1.c. FOR SITES HAVING DISTURBED AREA OVER 5 ACRES, USE AND SHOW THE RATES RECOMMENDED BY THE SOIL TESTING AGENCY.
1.d. FOR AREAS RECEIVING LOW MAINTENANCE, APPLY UREA FORM FERTILIZER (46-0-0) AT 3 1/2 POUNDS PER 1000 SQUARE FEET (150 POUNDS PER ACRE) AT THE TIME OF SEEDING IN ADDITION TO THE SOIL AMENDMENTS SHOWN IN THE PERMANENT SEEDING SUMMARY.
2. TURFGRASS MIXTURES
2.a. AREAS WHERE TURFGRASS MAY BE DESIRED INCLUDE LAWNS, PARKS, PLAYGROUNDS, AND COMMERCIAL SITES WHICH WILL RECEIVE A MEDIUM TO HIGH LEVEL OF MAINTENANCE.
2.b. SELECT ONE OR MORE OF THE SPECIES OR MIXTURES LISTED BELOW BASED ON THE SITE CONDITIONS OR PURPOSE. ENTER SELECTED MIXTURE(S), APPLICATION RATES, AND SEEDING DATES IN THE PERMANENT SEEDING SUMMARY. THE SUMMARY IS TO BE PLACED ON THE PLAN:
a. KENTUCKY BLUEGRASS: FULL SUN MIXTURE; FOR USE IN AREAS THAT RECEIVE INTENSIVE MANAGEMENT. IRRIGATION REQUIRED IN THE AREAS OF

- CENTRAL MARYLAND AND EASTERN SHORE. RECOMMENDED CERTIFIED KENTUCKY BLUEGRASS CULTIVARS SEEDING RATE: 1.5 TO 2.0 POUNDS PER 1000 SQUARE FEET. CHOOSE A MINIMUM OF THREE KENTUCKY BLUEGRASS CULTIVARS WITH EACH RANGING FROM 10 TO 35 PERCENT OF TOTAL MIXTURE BY WEIGHT.
b. KENTUCKY BLUEGRASS/PERENNIAL RYE: FULL SUN MIXTURE; FOR USE IN FULL SUN AREAS WHERE RAPID ESTABLISHMENT IS NECESSARY AND WHEN TURF WILL RECEIVE MEDIUM TO INTENSIVE MANAGEMENT. CERTIFIED PERENNIAL RYEGRASS CULTIVARS/CERTIFIED KENTUCKY BLUEGRASS SEEDING RATE: 2 POUNDS MIXTURE PER 1000 SQUARE FEET. CHOOSE A MINIMUM OF THREE KENTUCKY BLUEGRASS CULTIVARS WITH EACH RANGING FROM 10 TO 35 PERCENT OF THE TOTAL MIXTURE BY WEIGHT.
c. TALL FESCUE/KENTUCKY BLUEGRASS: FULL SUN MIXTURE; FOR USE IN DROUGHT PRONE AREAS AND/OR FOR AREAS RECEIVING LOW TO MEDIUM MAINTENANCE IN FULL SUN TO MEDIUM SHADE. RECOMMENDED MIXTURE INCLUDES: CERTIFIED TALL FESCUE CULTIVARS 95 TO 100 PERCENT, CERTIFIED KENTUCKY BLUEGRASS CULTIVARS 0 TO 5 PERCENT. SEEDING RATE: 5 TO 8 POUNDS PER 1000 SQUARE FEET. ONE OR MORE CULTIVARS MAY BE BLENDED.
d. KENTUCKY BLUEGRASS/FINE FESCUE: SHADE MIXTURE; FOR USE IN AREAS WITH SHADE IN MANAGED LAWNS. FOR ESTABLISHMENT IN HIGH QUALITY, INTENSIVELY MAINTAINED TURF AREA. MIXTURE INCLUDES: CERTIFIED KENTUCKY BLUEGRASS CULTIVARS 30 TO 40 PERCENT AND CERTIFIED FINE FESCUE 60 TO 70 PERCENT. SEEDING RATE: 1 1/2 TO 3 POUNDS PER 1000 SQUARE FEET.

NOTES: SELECT TURFGRASS VARIETIES FROM THOSE LISTED IN THE MOST CURRENT UNIVERSITY OF MARYLAND PUBLICATION, AGRONOMY MEMO #77, "TURFGRASS CULTIVAR RECOMMENDATIONS FOR MARYLAND".

CHOOSE CERTIFIED MATERIAL. CERTIFIED MATERIAL IS THE BEST GUARANTEE OF CULTIVAR PURITY. THE CERTIFICATION PROGRAM OF THE MARYLAND DEPARTMENT OF AGRICULTURE, TURF AND SEED SECTION, PROVIDES A RELIABLE MEANS OF CONSUMER PROTECTION AND ASSURES A PURE GENETIC LINE.

- 3. IDEAL TIMES OF SEEDING FOR TURF GRASS MIXTURES
WESTERN MARYLAND: MARCH 15 TO JUNE, AUGUST 1 TO OCTOBER 1 (HARDNESS ZONES: 5B, 6A)
CENTRAL MARYLAND: MARCH 1 TO MAY 15, AUGUST 15 TO OCTOBER 15 (HARDNESS ZONES: 6B)
SOUTHERN MD, EASTERN SHORE: MARCH 1 TO MAY 15, AUGUST 15 TO OCTOBER 15 (HARDNESS ZONES: 7A, 7B)

- 4. TILL AREAS TO RECEIVE SEED BY DISKING OR OTHER APPROVED METHODS TO A DEPTH OF 2 TO 4 INCHES. LEVEL AND RAKE THE AREAS TO PREPARE A PROPER SEEDBED. REMOVE STONES AND DEBRIS OVER 1 1/2 INCHES IN DIAMETER. THE RESULTING SEEDBED MUST BE IN SUCH CONDITION THAT FUTURE MOWING OF GRASSES WILL POSE NO DIFFICULTY.

- 5. IF SOIL MOISTURE IS DEFICIENT, SUPPLY NEW SEEDINGS WITH ADEQUATE WATER FOR PLANT GROWTH (1 TO 1 1/2 INCH EVERY 3 TO 4 DAYS DEPENDING ON SOIL TEXTURE) UNTIL THEY ARE FIRMLY ESTABLISHED. THIS IS ESPECIALLY TRUE WHEN SEEDINGS ARE MADE LATE IN THE PLANTING SEASON, IN ABNORMALLY DRY OR HOT SEASONS, OR ON ADVERSE SITES.

PERMANENT SEEDING SUMMARY

Table with columns: NO., SPECIES, APPLICATION RATE (LB/AC), SEEDING DATES, SEEDING DEPTHS, FERTILIZER RATE (20-10-10), LIME RATE. Includes rows for Big Bluestem, Indiangrass, Little Bluestem, Creeping Red Fescue, Patridge PEA, Sheertongue, and Sheep Fescue.

B. SOD: TO PROVIDE QUICK COVER ON DISTURBED AREAS (2:1 GRADE OR FLATTER).

- 1. GENERAL SPECIFICATIONS
1.a. CLASS OF TURFGRASS SOD MUST BE MARYLAND STATE CERTIFIED. SOD LABELS MUST BE MADE AVAILABLE TO THE JOB FOREMAN AND INSPECTOR.
1.b. SOD MUST BE MACHINE CUT AT A UNIFORM SOIL THICKNESS OF 3/4 INCHES, PLUS OR MINUS 1/8 INCH. AT THE TIME OF CUTTING, MEASUREMENT FOR THICKNESS MUST EXCLUDE TOP GROWTH AND THATCH. BROKEN PADS AND TORN OR UNEVEN EDGES WILL NOT BE ACCEPTABLE.
1.c. STANDARD SIZE SECTIONS OF SOD MUST BE STRONG ENOUGH TO SUPPORT THEIR OWN WEIGHT AND RETAIN THEIR SIZE AND SHAPE WHEN SUSPENDED VERTICALLY WITH A FIRM GRASP ON THE UPPER 10 PERCENT OF THE SECTION.
1.d. SOD MUST NOT BE HARVESTED OR TRANSPLANTED WHEN MOISTURE CONTENT (EXCESSIVELY DRY OR WET) MAY ADVERSELY AFFECT ITS SURVIVAL.

- 1.e. SOD MUST BE HARVESTED, DELIVERED, AND INSTALLED WITHIN A PERIOD OF 36 HOURS. SOD NOT TRANSPLANTED WITHIN THIS PERIOD MUST BE APPROVED

B-4.8 STANDARDS AND SPECIFICATIONS

FOR STOCKPILE AREA

Definition

A mound or pile of soil protected by appropriately designed erosion and sediment control measures.

Purpose

To provide a designated location for the temporary storage of soil that controls the potential for erosion, sedimentation, and changes to drainage patterns.

Conditions Where Practice Applies

Stockpile areas are utilized when it is necessary to salvage and store soil for later use.

Criteria

- 1. The stockpile location and all related sediment control practices must be clearly indicated on the erosion and sediment control plan.
2. The footprint of the stockpile must be sized to accommodate the anticipated volume of material and based on a side slope ratio no steeper than 2:1.
3. Runoff from the stockpile area must drain to a suitable sediment control practice.
4. Access the stockpile area from the upgrade side.
5. Clear water runoff into the stockpile area must be minimized by use of a diversion device such as an earth dike, temporary swale or diversion fence.
6. Where runoff concentrates along the toe of the stockpile fill, an appropriate erosion/sediment control practice must be used to intercept the discharge.
7. Stockpiles must be stabilized in accordance with the 3/7 day stabilization requirement as well as Standard B-4-1 Incremental Stabilization and Standard B-4-4 Temporary Stabilization.
8. If the stockpile is located on an impervious surface, a liner should be provided below the stockpile to facilitate cleanup.

Maintenance

The stockpile area must continuously meet the requirements for Adequate Vegetative Establishment in accordance with Section B-4 Vegetative Stabilization. Side slopes must be maintained at no steeper than a 2:1 ratio. The stockpile area must be kept free of erosion. If the vertical height of a stockpile exceeds 20 feet for 2:1 slopes, 30 feet for 3:1 slopes, or 40 feet for 4:1 slopes, benching must be provided in accordance with Section B-3 Land Grading.

B.4.3

HOWARD SOIL CONSERVATION DISTRICT (HSCD) STANDARD SEDIMENT CONTROL NOTES

- 1. A PRE-CONSTRUCTION MEETING MUST OCCUR WITH THE HOWARD COUNTY DEPARTMENT OF PUBLIC WORKS, CONSTRUCTION INSPECTION DIVISION (CID), 410-313-1855 AFTER THE FUTURE LOD AND PROTECTED AREAS ARE MARKED CLEARLY IN THE FIELD. A MINIMUM OF 48 HOURS NOTICE TO CID MUST BE GIVEN AT THE FOLLOWING STAGES:
1.1. PRIOR TO THE START OF EARTH DISTURBANCE.
1.2. UPON COMPLETION OF THE INSTALLATION OF PERIMETER EROSION AND SEDIMENT CONTROLS, BUT BEFORE PROCEEDING WITH ANY OTHER EARTH DISTURBANCE OR GRADING.
1.3. PRIOR TO THE START OF ANOTHER PHASE OF CONSTRUCTION OR OPENING OF ANOTHER GRADING UNIT.
1.4. PRIOR TO THE REMOVAL OR MODIFICATION OF SEDIMENT CONTROL PRACTICES.

OTHER BUILDING OR GRADING INSPECTION APPROVALS MAY NOT BE AUTHORIZED UNTIL THIS INITIAL APPROVAL BY THE INSPECTION AGENCY IS MADE. OTHER RELATED STATE AND FEDERAL PERMITS SHALL BE REFERENCED, TO ENSURE COORDINATION AND TO AVOID CONFLICTS WITH THIS PLAN.

- 2. ALL VEGETATIVE AND STRUCTURAL PRACTICES ARE TO BE INSTALLED ACCORDING TO THE PROVISIONS OF THIS PLAN AND ARE TO BE IN CONFORMANCE WITH THE 2011 MARYLAND STANDARDS AND SPECIFICATIONS FOR SOIL EROSION AND SEDIMENT CONTROL, AND REVISIONS THERETO.
3. FOLLOWING INITIAL SOIL DISTURBANCE OR RE-DISTURBANCE, PERMANENT OR TEMPORARY STABILIZATION IS REQUIRED WITHIN THREE (3) CALENDAR DAYS AS TO THE SURFACE OF ALL PERIMETER CONTROLS, DIKES, SWALES, DITCHES, PERIMETER SLOPES, AND ALL SLOPES STEEPER THAN 3 HORIZONTAL TO 1 VERTICAL (3:1); AND SEVEN (7) CALENDAR DAYS AS TO ALL OTHER DISTURBED AREAS ON THE PROJECT SITE EXCEPT FOR THOSE AREAS UNDER ACTIVE GRADING.
4. ALL DISTURBED AREAS MUST BE STABILIZED WITHIN THE TIME PERIOD SPECIFIED ABOVE IN ACCORDANCE WITH THE 2011 MARYLAND STANDARDS AND SPECIFICATIONS FOR SOIL EROSION AND SEDIMENT CONTROL FOR TOPSOIL (SEC. B-4-2), PERMANENT SEEDING (SEC. B-4-5), TEMPORARY SEEDING (SEC. B-4-4) AND MULCHING (SEC. B-4-3). TEMPORARY STABILIZATION WITH MULCH ALONE CAN ONLY BE APPLIED BETWEEN THE FALL AND SPRING SEEDING DATES IF THE GROUND IS FROZEN. INCREMENTAL STABILIZATION (SEC. B-4-1) SPECIFICATIONS SHALL BE ENFORCED IN AREAS WITH >15' OF CUT AND/OR FILL. STOCKPILES (SEC. B-4-8) IN EXCESS OF 20 FT. MUST BE BENCHING WITH STABLE OUTLET. ALL CONCENTRATED FLOW, STEEP SLOPE, AND HIGHLY ERODIBLE AREAS SHALL RECEIVE SOIL STABILIZATION MATING (SEC. B-4-6).
5. ALL SEDIMENT CONTROL STRUCTURES ARE TO REMAIN IN PLACE, AND ARE TO BE MAINTAINED IN OPERATIVE CONDITION UNTIL PERMISSION FOR THEIR REMOVAL HAS BEEN OBTAINED FROM THE CID.

Table with 2 columns: Item, Value. Includes: TOTAL AREA OF SITE: 590.00 ACRES; AREA TO BE ROOFED OR PAVED: 15.53 ACRES; AREA TO BE VEGETATIVELY STABILIZED: 894 ACRES; TOTAL CUT: 22,000 CU. YDS; TOTAL FILL: 43,400 CU. YDS; OFFSITE WASTE/BORROW AREA LOCATION: N/A.

- 7. ANY SEDIMENT CONTROL PRACTICE WHICH IS DISTURBED BY GRADING ACTIVITY FOR PLACEMENT OF UTILITIES MUST BE REPAIRED ON THE SAME DAY OF DISTURBANCE.
8. ADDITIONAL SEDIMENT CONTROL MUST BE PROVIDED, IF DEEMED NECESSARY BY THE CID, THE SITE AND ALL CONTROLS SHALL BE INSPECTED BY THE CONTRACTOR WEEKLY; AND THE NEXT DAY AFTER EACH RAIN EVENT. A WRITTEN REPORT BY THE CONTRACTOR, MADE AVAILABLE UPON REQUEST, IS PART OF EVERY INSPECTION AND SHOULD INCLUDE:

- INSPECTION DATE
• INSPECTION TYPE (ROUTINE, PRE-STORM EVENT, DURING RAIN EVENT)
• NAME AND TITLE OF INSPECTOR
• WEATHER INFORMATION (CURRENT CONDITIONS AS WELL AS TIME AND AMOUNT OF LAST RECORDED PRECIPITATION)
• BRIEF DESCRIPTION OF PROJECT'S STATUS (E.G., PERCENT COMPLETE) AND/OR CURRENT ACTIVITIES
• EVIDENCE OF SEDIMENT DISCHARGES
• IDENTIFICATION OF PLAN DEFICIENCIES
• IDENTIFICATION OF SEDIMENT CONTROLS THAT REQUIRE MAINTENANCE
• IDENTIFICATION OF MISSING OR IMPROPERLY INSTALLED SEDIMENT CONTROLS
• COMPLIANCE STATUS REGARDING THE SEQUENCE OF CONSTRUCTION AND STABILIZATION REQUIREMENTS
• PHOTOGRAPHS
• MONITORING/SAMPLING
• MAINTENANCE AND/OR CORRECTIVE ACTION PERFORMED
• OTHER INSPECTION ITEMS AS REQUIRED BY THE GENERAL PERMIT FOR STORMWATER ASSOCIATED WITH CONSTRUCTION ACTIVITIES (NPDES, MDE).

- 9. TRENCHES FOR THE CONSTRUCTION OF UTILITIES IS LIMITED TO THREE PIPE LENGTHS OR THAT WHICH CAN AND SHALL BE BACK-FILLED AND STABILIZED BY THE END OF EACH WORK DAY, WHICHEVER IS SHORTER.
10. ANY MAJOR CHANGES OR REVISIONS TO THE PLAN OR SEQUENCE OF CONSTRUCTION MUST BE REVIEWED AND APPROVED BY THE HSCD PRIOR TO PROCEEDING WITH CONSTRUCTION. MINOR REVISIONS MAY BE ALLOWED BY THE CID PER THE LIST OF HSCD-APPROVED FIELD CHANGES.

- 11. DISTURBANCE SHALL NOT OCCUR OUTSIDE THE L.O.D. A PROJECT IS TO BE SEQUENCED SO THAT GRADING ACTIVITIES BEGIN ON ONE GRADING UNIT (MAXIMUM ACREAGE OF 20 AC. PER GRADING UNIT) AT A TIME. WORK MAY PROCEED TO A SUBSEQUENT GRADING UNIT WHEN AT LEAST 50 PERCENT OF THE DISTURBED AREA IN THE PRECEDING GRADING UNIT HAS BEEN STABILIZED AND APPROVED BY THE CID. UNLESS OTHERWISE SPECIFIED AND APPROVED BY THE HSCD, NO MORE THAN 30 ACRES CUMULATIVELY MAY BE DISTURBED AT A GIVEN TIME.

- 12. WASH WATER FROM ANY EQUIPMENT, VEHICLES, WHEELS, PAVEMENT, AND OTHER SOURCES MUST BE TREATED IN A SEDIMENT BASIN OR OTHER APPROVED WASHOUT STRUCTURE.

- 13. TOPSOIL SHALL BE STOCKPILED AND PRESERVED ON-SITE FOR REDISTRIBUTION ONTO FINAL GRADE.

- 14. ALL SILT FENCE AND SUPER SILT FENCE SHALL BE PLACED ON-THE-CONTOUR, AND BE IMBRICATED AT 25' MINIMUM INTERVALS, WITH LOWER ENDS CURLED UPHILL BY 2' IN ELEVATION.

- 15. STREAM CHANNELS MUST NOT BE DISTURBED DURING THE FOLLOWING RESTRICTED TIME PERIODS (INCLUSIVE):
• USE I AND II MARCH 1-JUNE 15
• USE III AND IIII OCTOBER 1-APRIL 30
• USE IV MARCH 1-MAY 31

- 16. A COPY OF THIS PLAN, THE 2011 MARYLAND STANDARDS AND SPECIFICATIONS FOR SOIL EROSION AND SEDIMENT CONTROL, AND ASSOCIATED PERMITS SHALL BE ON-SITE AND AVAILABLE WHEN THE SITE IS ACTIVE.

SEQUENCE OF EROSION AND SEDIMENT CONTROL MEASURES:

- 1. NOTIFY THE HOWARD COUNTY INSPECTOR OF THE INTENT TO START THE WORK. HOWARD COUNTY CONSTRUCTION INSPECTION DIVISION CAN BE REACHED AT 410-313-5712. INITIATE WORK AFTER RECEIPT OF NOTICE TO PROCEED FROM THE HOWARD COUNTY INSPECTOR. (1 DAY)
2. CLEAR AND GRUB FOR THE INSTALLATION OF PERIMETER EROSION AND SEDIMENT CONTROLS ASSOCIATED WITH THE INITIAL PHASE. (3 DAYS)
3. INSTALL PERIMETER AND EROSION AND SEDIMENT CONTROL MEASURES AS SHOWN ON INITIAL PHASE EROSION AND SEDIMENT CONTROL DRAWINGS. CONSTRUCTION OF THE SEDIMENT TRAPS SHALL BEGIN AFTER PERIMETER CONTROLS ARE IN PLACE. (5 DAYS)
4. CLEAR AND GRUB WITHIN THE FOOTPRINTS OF THE SEDIMENT TRAPS SHOWN IN THE INITIAL PHASE. (2 DAYS)
5. CONSTRUCT SEDIMENT TRAPS 1 AND 2 AS SHOWN ON THE INITIAL PHASE EROSION AND SEDIMENT CONTROL PLANS. (10 DAYS)
6. AFTER COMPLETING CONSTRUCTION AND STABILIZATION OF ALL INITIAL PHASE EROSION AND SEDIMENT CONTROL MEASURES, AND WITH THE PERMISSION OF THE EROSION AND SEDIMENT CONTROL INSPECTOR, CLEAR AND GRUB THE REMAINDER OF THE SITE FOR CONSTRUCTION. (5 DAYS)
7. CONSTRUCT SITE, INCLUDING EARTHWORK, UTILITIES, PAVING, BUILDINGS AND STORMWATER MANAGEMENT FACILITIES. MAINTAIN EROSION AND SEDIMENT CONTROL MEASURES THROUGHOUT CONSTRUCTION. SEDIMENT TRAPS 1 AND 2 SHALL BE CLEANED OUT WHEN ACCUMULATED SEDIMENT REACHES THE CLEANOUT ELEVATIONS INDICATED ON THE PLANS. IF NECESSARY, DEWATER WORK AREAS AND FILTER SEDIMENT LADEN WATER THROUGH A PORTABLE SEDIMENT TANK, AS NEEDED. (300 DAYS)
8. IN ORDER TO COMPLETE A PORTION OF THE PERIMETER ROAD ON THE WEST SIDE OF THE SITE, SEDIMENT TRAP 1 WILL NEED TO BE ABANDONED. WITH THE PERMISSION OF THE SEDIMENT CONTROL INSPECTOR, ABANDON SEDIMENT TRAP 1 BY FIRST DEWATERING THE TRAP COMPLETELY. MUCK OUT ANY SOFT OR UNSUITABLE MATERIALS BEFORE PROCEEDING WITH ADDITIONAL WORK. REMOVE THE SEDIMENT TRAP 1 RISER STRUCTURE AND ABANDON THE SPILLWAY PIPE IN PLACE BY FILLING WITH FLOWABLE FILL. (3 DAYS)
9. CONSTRUCT STORMWATER MANAGEMENT FACILITIES ACROSS THE SITE ONLY AFTER THEIR INDIVIDUAL CONTRIBUTING DRAINAGE AREAS ARE PERMANENTLY STABILIZED. IF THE AREAS CANNOT BE STABILIZED, SURFACE RUNOFF SHALL BE DIVERTED AROUND THE LOCATIONS OF THE PROPOSED STORMWATER MANAGEMENT FACILITIES. (30 DAYS)
10. UPON COMPLETING CONSTRUCTION AT THE SITE, SEDIMENT TRAP 2 SHALL BE CONVERTED TO A PERMANENT STORMWATER MANAGEMENT FACILITY. WITH THE PERMISSION OF THE SEDIMENT CONTROL INSPECTOR, COMPLETELY DEWATER SEDIMENT TRAP 2. MUCK OUT ANY SOFT OR UNSUITABLE MATERIALS BEFORE PROCEEDING WITH ADDITIONAL WORK. REMOVE THE SEDIMENT TRAP SPILLWAY STONE AND PROCEED TO FILL REMAINING AREAS TO GRADE. CONSTRUCT THE REMAINING PORTION OF THE PERIMETER ACCESS ROAD AND CONVERT THE SEDIMENT TRAP 2 AREA TO ITS PROPOSED PERMANENT STORMWATER MANAGEMENT FACILITY. (5 DAYS)
11. EROSION AND SEDIMENT CONTROLS SHALL REMAIN IN PLACE UNTIL THE COMPLETION OF THE WORK. THE CONTRACTOR IS RESPONSIBLE FOR MAINTENANCE OF THE SITE UNTIL ALL WORK IS COMPLETE AND THE SITE IS RESTORED TO ORIGINAL CONDITIONS. (ONGOING)
12. UPON COMPLETION OF CONSTRUCTION, PERMANENTLY STABILIZE ALL REMAINING DISTURBED AREAS IN ACCORDANCE WITH THE VEGETATIVE STABILIZATION SPECIFICATIONS SHOWN ON THE DRAWINGS. IN ADDITION TO MEETING PERMANENT STABILIZATION REQUIREMENTS ON SHEET ES-10, AREAS TO BE PERMANENTLY SEEDED SHALL INCLUDE 2-IN. COMPOST (TO BE PROVIDED BY COUNTY) TRACKED INTO AREA PRIOR TO PERMANENT STABILIZATION. (5 DAYS)
13. UPON STABILIZATION OF THE SITE AND WITH PERMISSION OF THE HOWARD COUNTY INSPECTOR, REMOVE SEDIMENT CONTROL MEASURES AND STABILIZE THOSE AREAS DISTURBED BY THIS PROCESS. (2 DAYS)

HOWARD SOIL CONSERVATION DISTRICT PERMANENT SEEDING NOTES

APPLY TO GRADED OR CLEARED AREAS NOT SUBJECT TO IMMEDIATE FURTHER DISTURBANCE WHERE A PERMANENT LONG-LIVED VEGETATIVE COVER IS NEEDED.

SEEDBED PREPARATION: LOOSEN UPPER THREE INCHES OF SOIL BY RAKING, DISKING OR OTHER ACCEPTABLE MEANS BEFORE SEEDING, IF NOT PREVIOUSLY LOOSENED.

SOIL AMENDMENTS: SOIL TEST SHALL BE BASED ON 2 INCHES OF COMPOST TRACKED INTO SOIL. RECOMMENDATIONS, NOT TO EXCEED PREFERRED SCHEDULE NOTED BELOW:

- 1. PREFERRED -- APPLY 2 TONS/ACRE DOLOMITIC LIMESTONE (92 LBS/1000 SQ. FT.) AND 600 LBS/ACRE 10-10-10 FERTILIZER (14 LBS/1000 SQ. FT.) BEFORE SEEDING. HARROW OR DISK INTO UPPER THREE INCHES OF SOIL. AT TIME OF SEEDING, APPLY 400 LBS/ACRE 30-0-0 UREAFORM FERTILIZER (9 LBS/1000 SQ. FT.)

- 2. ACCEPTABLE -- APPLY 2 TONS/ACRE DOLOMITIC LIMESTONE (92 LBS/1000 SQ. FT.) AND 1000 LBS/ACRE 10-10-10 FERTILIZER (23 LBS/1000 SQ. FT.) BEFORE SEEDING. HARROW OR DISK INTO UPPER THREE INCHES OF SOIL.

SEEDING -- FOR THE PERIODS MARCH 1 - APRIL 30, AND AUGUST 1 - OCTOBER 15, SEED WITH 60 LBS/ACRE (1.4LBS/1000 SQ.FT.) OF KENTUCKY 31 TALL FESCUE. FOR THE PERIOD MAY 1 - JULY 31, SEED WITH 60 LBS KENTUCKY 31 TALL FESCUE PER ACRE AND 2 LBS/ACRE (.05 LBS/1000) SQ. FT.) OF WEEPING LOVEGRASS. DURING THE PERIOD OF OCTOBER 16 - FEBRUARY 28, PROTECT SITE BY:
OPTION 1 -- TWO TONS PER ACRE OF WELL ANCHORED STRAW MULCH AND SEED AS SOON AS POSSIBLE IN THE SPRING.
OPTION 2 -- USE SOD.
OPTION 3 -- SEER: WITH 60 LBS/ACRE KENTUCKY 30 TALL FESCUE AND MULCH WITH 2 TONS/ACRE WELL ANCHORED STRAW.

MULCHING -- APPLY 1-1/2 TO 2 TONS PER ACRE (70 TO 90 LBS/1000 SQ. FT.) OF UNROTTED SMALL GRAIN STRAW IMMEDIATELY AFTER SEEDING. ANCHOR MULCH IMMEDIATELY AFTER APPLICATION USING MULCH ANCHORING TOOL OR 218 GALLONS PER ACRE (5 GAL/1000 SQ. FT.) OF EMULSIFIED ASPHALT ON FLAT AREAS. ON SLOPE 8 FEET OR HIGHER, USE 348 GALLONS PER ACRE (8 GAL/1000 SQ. FT.) FOR ANCHORING.

MAINTENANCE -- INSPECT ALL SEEDING AREAS AND MAKE NEEDED REPAIRS, REPLACEMENTS AND RESEEDINGS.

TEMPORARY SEEDING NOTES

APPLY TO GRADED OR CLEARED AREAS LIKELY TO BE RE-DISTURBED WHERE A SHORT-TERM VEGETATIVE COVER IS NEEDED.

SEEDBED PREPARATION: -- LOOSEN UPPER THREE INCHES OF SOIL BY RAKING, DISKING OR OTHER ACCEPTABLE MEANS BEFORE SEEDING, IF NOT PREVIOUSLY LOOSENED.

SOIL AMENDMENTS: -- APPLY 600 LBS/ACRE 10-10-10 FERTILIZER (14 LBS/1000 SQ.FT.)

SEEDING -- FOR PERIODS MARCH 1 - APRIL 30 AND FROM AUGUST 15 - OCTOBER 15, SEED WITH 2-1/2 BUSHEL PER ACRE OF ANNUAL RYE (3.2 LBS/1000 SQ. FT.). FOR THE PERIOD MAY 1 - AUGUST 14, SEED WITH 3 LBS/ACRE OF WEEPING LOVEGRASS (.07 LBS/1000 SQ. FT.). FOR THE PERIOD NOVEMBER 16 - FEBRUARY 28, PROTECT SITE BY APPLYING 2 TONS/ACRE OF WELL ANCHORED STRAW MULCH AND SEED AS SOON AS POSSIBLE IN THE SPRING, OR USE SOD.

MULCHING: -- APPLY 1-1/2 TO 2 TONS/ACRE (70 TO 90 LBS/1000 SQ. FT.) OF UNROTTED WEED-FREE, SMALL GRAIN STRAW IMMEDIATELY AFTER SEEDING. ANCHOR MULCH IMMEDIATELY AFTER APPLICATION USING MULCH ANCHORING TOOL OR 218 GAL. PER ACRE (5 GAL/1000 SQ. FT.) OF EMULSIFIED ASPHALT ON FLAT AREAS. ON SLOPE 8 FT. OR HIGHER, USE 348 GAL. PER ACRE (8 GAL/1000 SQ. FT.) FOR ANCHORING.

REFER TO THE 2011 MARYLAND STANDARDS AND SPECIFICATIONS FOR SOIL EROSION AND SEDIMENT CONTROL FOR ADDITIONAL RATES AND METHODS NOT COVERED.

() By the developer:
I/We certify that all development and construction will be done according to this plan, and that any responsible personnel involved in the construction project will have a Certificate of Attendance at a Department of the Environment approved Training Program for the Control of Sediment and Erosion before beginning the project. I also authorize periodic on-site inspection by the Howard Soil Conservation District.
Signature of Developer: Mark Nelson Date: 10/4/17

() By the Engineer:
I certify that this plan for erosion and sediment control represents a practical and workable plan based on my personal knowledge of the site conditions and that it was prepared in accordance with the requirements of the Howard Soil Conservation District.
Signature of Engineer: Mark J Gutberlet Date: 10/4/17

() For the Howard Soil Conservation District:
This development plan is approved for soil erosion and sediment control by the Howard Soil Conservation District.
Signature: [Signature] Date: 10/4/17


REVIEWED FOR HOWARD SCD AND MEETS TECHNICAL REQUIREMENTS
THIS DEVELOPMENT PLAN IS APPROVED FOR SOIL EROSION AND SEDIMENT CONTROL BY THE HOWARD SOIL CONSERVATION DISTRICT.
Signature: [Signature] Date: 10/29/17

APPROVED: DEPARTMENT OF PLANNING AND ZONING
Signature: [Signature] Date: 12-12-17

Signature: [Signature] Date: 11-29-17
Signature: [Signature] Date: 12-5-17

GRID: 8 BLOCK: N/A
ZONING: RC-DEO PARCEL/LOT: 220, 253, 11, 23, 54
TAX MAP: 0016 ELECTION DISTRICT: 3-02

OWNER/ENGINEER INFORMATION
DEVELOPER/OWNER: HOWARD COUNTY GOVERNMENT
CONTACT: JEFF DANNIS, P.E., CSP
6751 COLUMBIA GATEWAY DRIVE, SUITE 514
COLUMBIA, MD 21046
TELEPHONE: (410) 313-6419
ENGINEER: EA ENGINEERING, SCIENCE, AND TECHNOLOGY, INC., PBC
CONTACT: MARK GUTBERLET, P.E.
225 SCHILLING CIRCLE, SUITE 400
HUNT VALLEY, MD 21031
TELEPHONE: (410) 584-7000

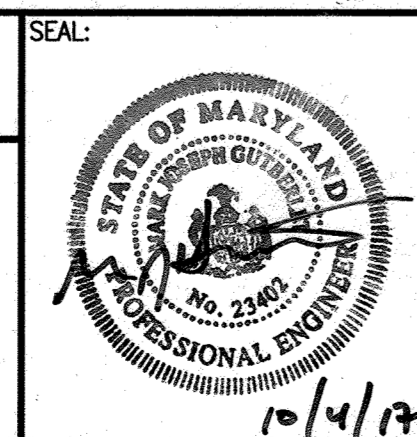

PROFESSIONAL CERTIFICATION:
I HEREBY CERTIFY THAT THESE DOCUMENTS WERE PREPARED OR APPROVED BY ME, AND THAT I AM A DULY LICENSED PROFESSIONAL ENGINEER UNDER THE LAWS OF THE STATE OF MARYLAND, LICENSE NO. 23402, EXPIRATION DATE 25 AUGUST 2018.




Table with columns: DSN. BY, DRN. BY, CHK. BY, DATE, BY, NO., REVISION, DATE. Includes handwritten entries: MBS/MF, JAP/KE, SMD, OCT. 2016, CVH, 8/2022.

EROSION AND SEDIMENT CONTROL NOTES II

COMPOST FACILITY - PHASE II AT ALPHA RIDGE LANDFILL HOWARD COUNTY, MARYLAND


SDP SHEET: 45 OF 44 DRAWING: ES-12 PROJECT: 14982.05 SHEET: 36 OF 70

NOT FOR CONSTRUCTION - SITE DEVELOPMENT PLAN #SDP-16-036

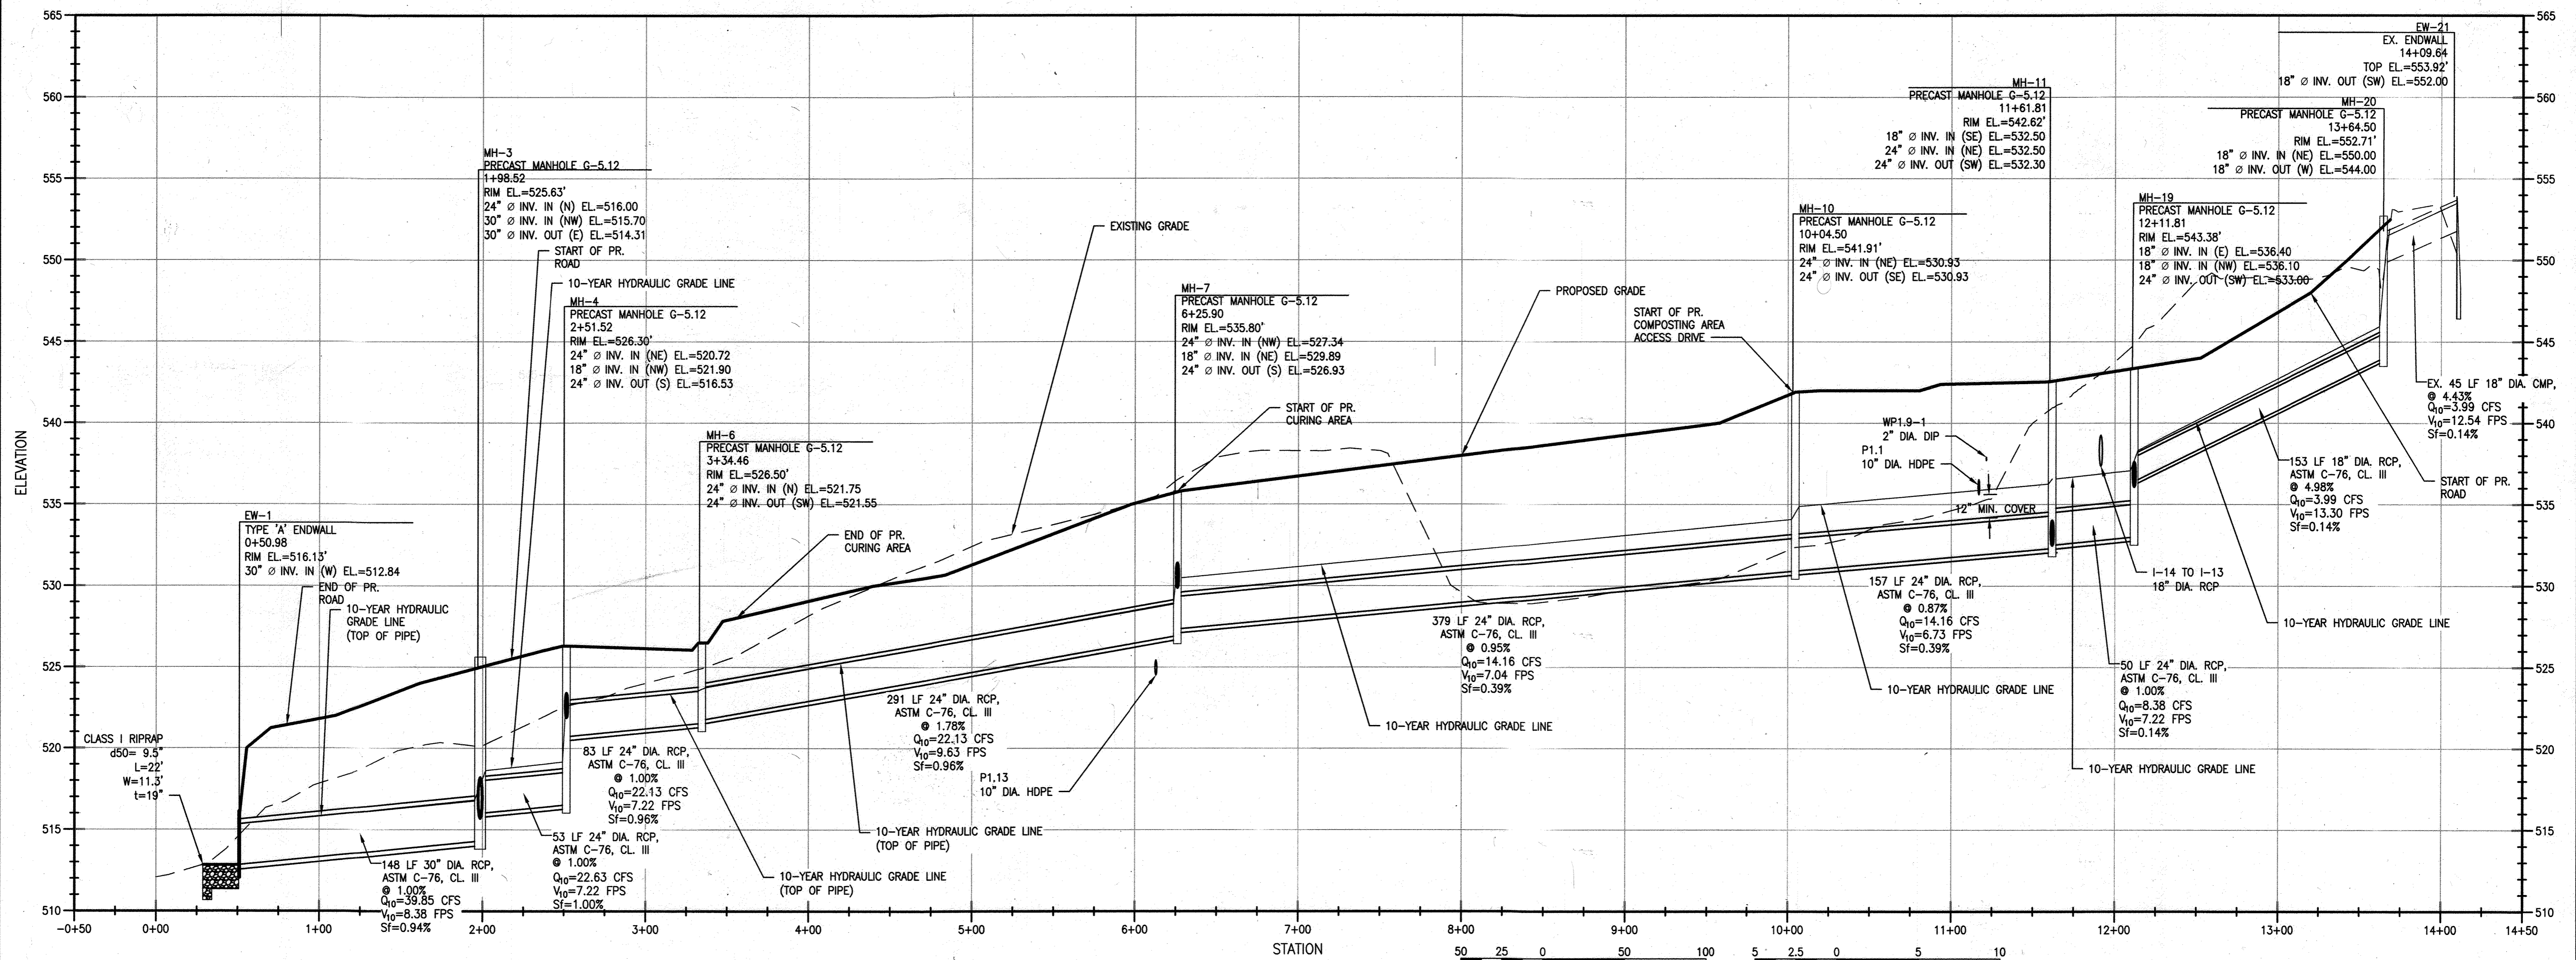

EW-1 to EW-21 PROFILE

SCALE: 1" = 5' VERTICAL
1" = 50' HORIZONTAL

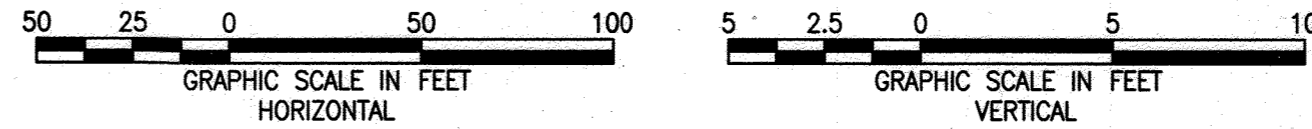

NOTES:

- CONTRACTOR SHALL ENSURE FILL FOR PIPE INSTALLATION IS COMPACTED IN ACCORDANCE WITH REQUIREMENTS OF AASHTO T-180.

APPROVED: DEPARTMENT OF PLANNING AND ZONING

Valdis Joplin 12-12-17
DIRECTOR DATE

Paul Plunk 11-29-17
CHIEF, DEVELOPMENT ENGINEERING DIVISION DATE


Karl L. Lewis 12-5-17
CHIEF, DIVISION OF LAND DEVELOPMENT DATE

OWNER/ENGINEER INFORMATION

GRID: 8 BLOCK: N/A
ZONING: RC-DEO PARCEL/LOT: 220, 253, 11, 23, 54
TAX MAP: 0016 ELECTION DISTRICT: 3-02

DEVELOPER/OWNER: HOWARD COUNTY GOVERNMENT
CONTACT: JEFF DANNIS, P.E., CSP
6751 COLUMBIA GATEWAY DRIVE, SUITE 514
COLUMBIA, MD 21046
TELEPHONE: (410) 313-6419

ENGINEER: EA ENGINEERING, SCIENCE, AND TECHNOLOGY, INC., PBC
CONTACT: MARK GUTBERLET, P.E.
225 SCHILLING CIRCLE, SUITE 400
HUNT VALLEY, MD 21031
TELEPHONE: (410) 584-7000

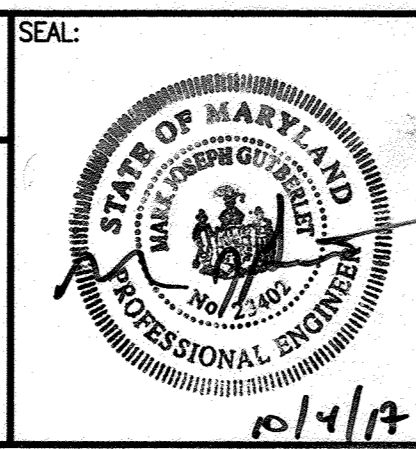

PROFESSIONAL CERTIFICATION:

I HEREBY CERTIFY THAT THESE DOCUMENTS WERE PREPARED OR APPROVED BY ME, AND THAT I AM A DULY LICENSED PROFESSIONAL ENGINEER UNDER THE LAWS OF THE STATE OF MARYLAND, LICENSE NO. 23402, EXPIRATION DATE 25 AUGUST 2018.









DSN. BY:	MP/KEJ	CYH	REVISION TOTAL SHEET NUMBER	6/2012
DRN. BY:	JAP/KEJ		DATE TO ADDITION OF SHEET	4/8
CHK. BY:	SMD			
DATE:	OCT. 2016			
BY:	NO.	REVISION	DATE	

STORMDRAIN PROFILE I

COMPOST FACILITY - PHASE II
AT ALPHA RIDGE LANDFILL
HOWARD COUNTY, MARYLAND

SDP SHEET:	DRAWING:
45	SW-3
24 OF 44	
PROJECT:	14982.05
SHEET:	38 OF 70

NOT FOR CONSTRUCTION - SITE DEVELOPMENT PLAN #SDP-16-035

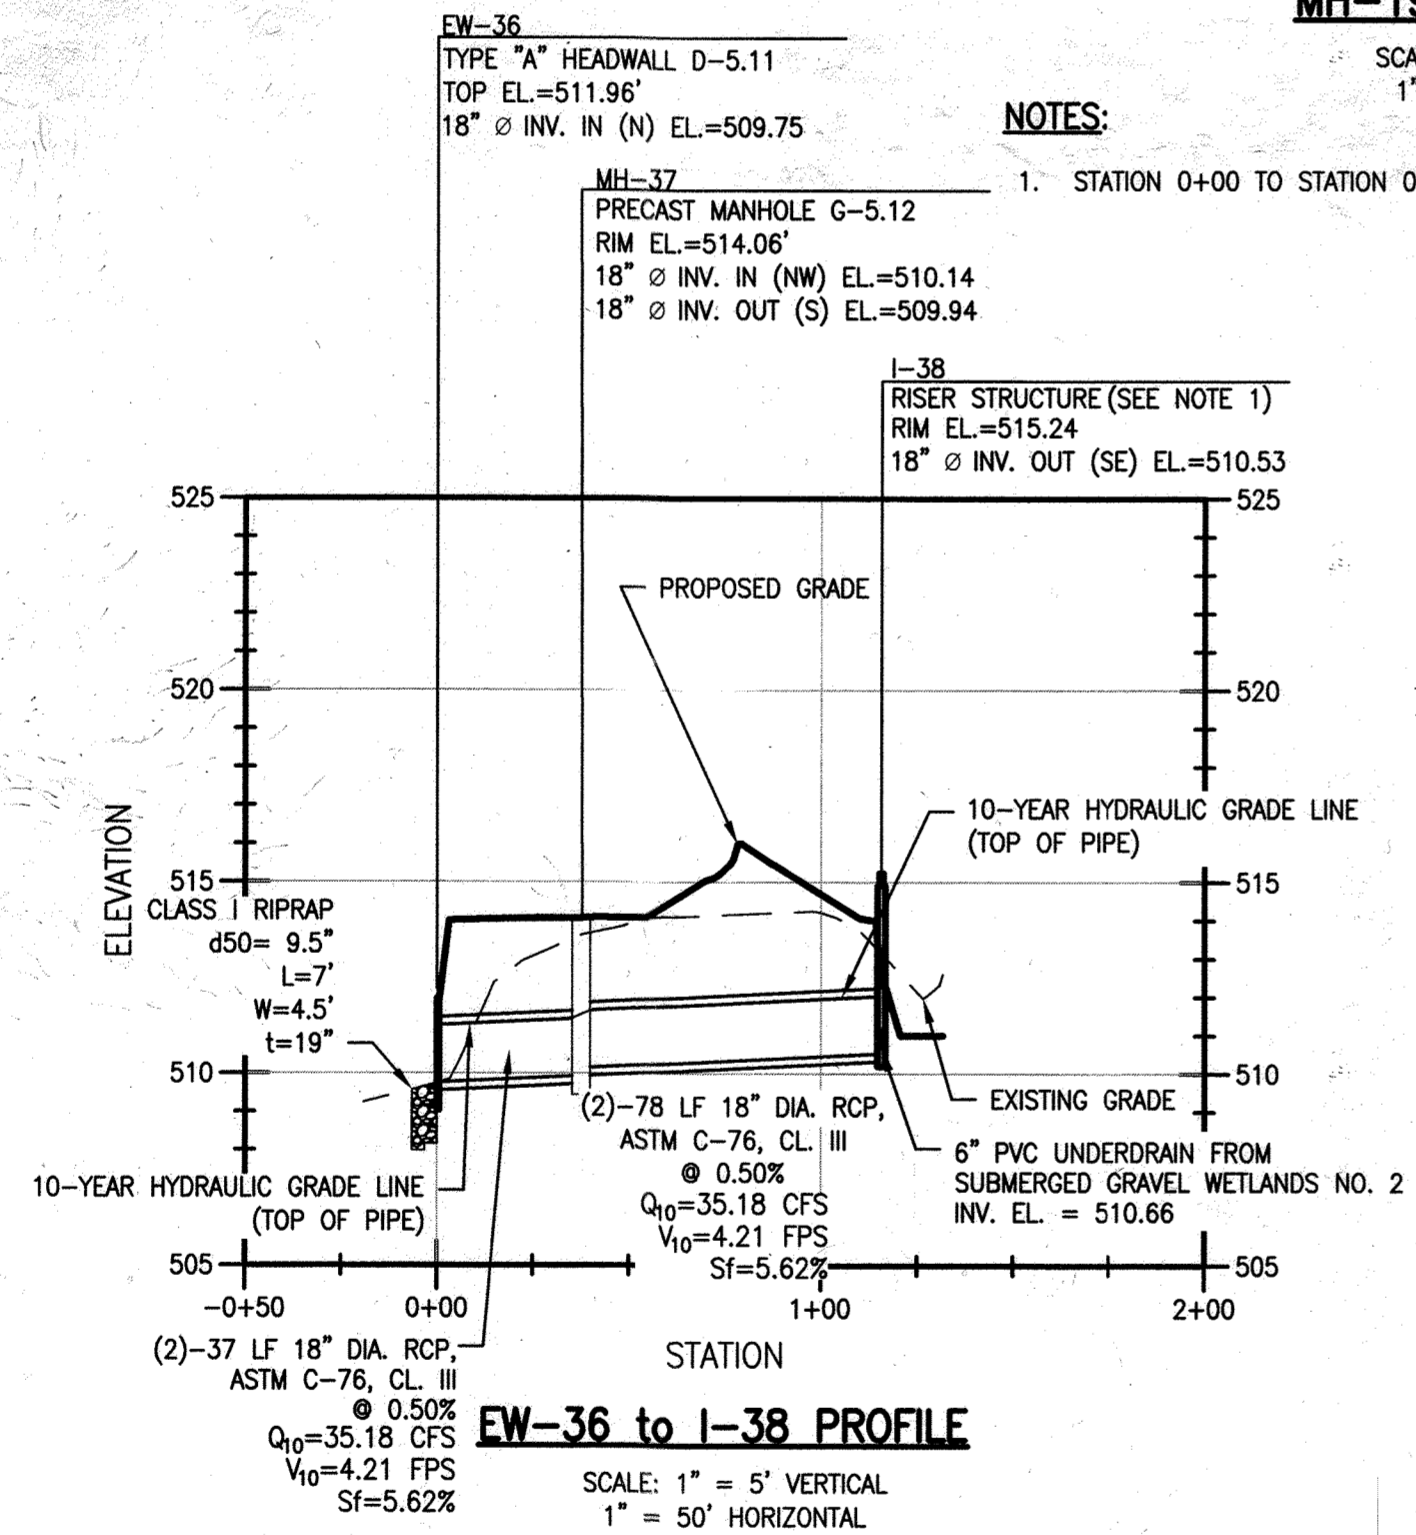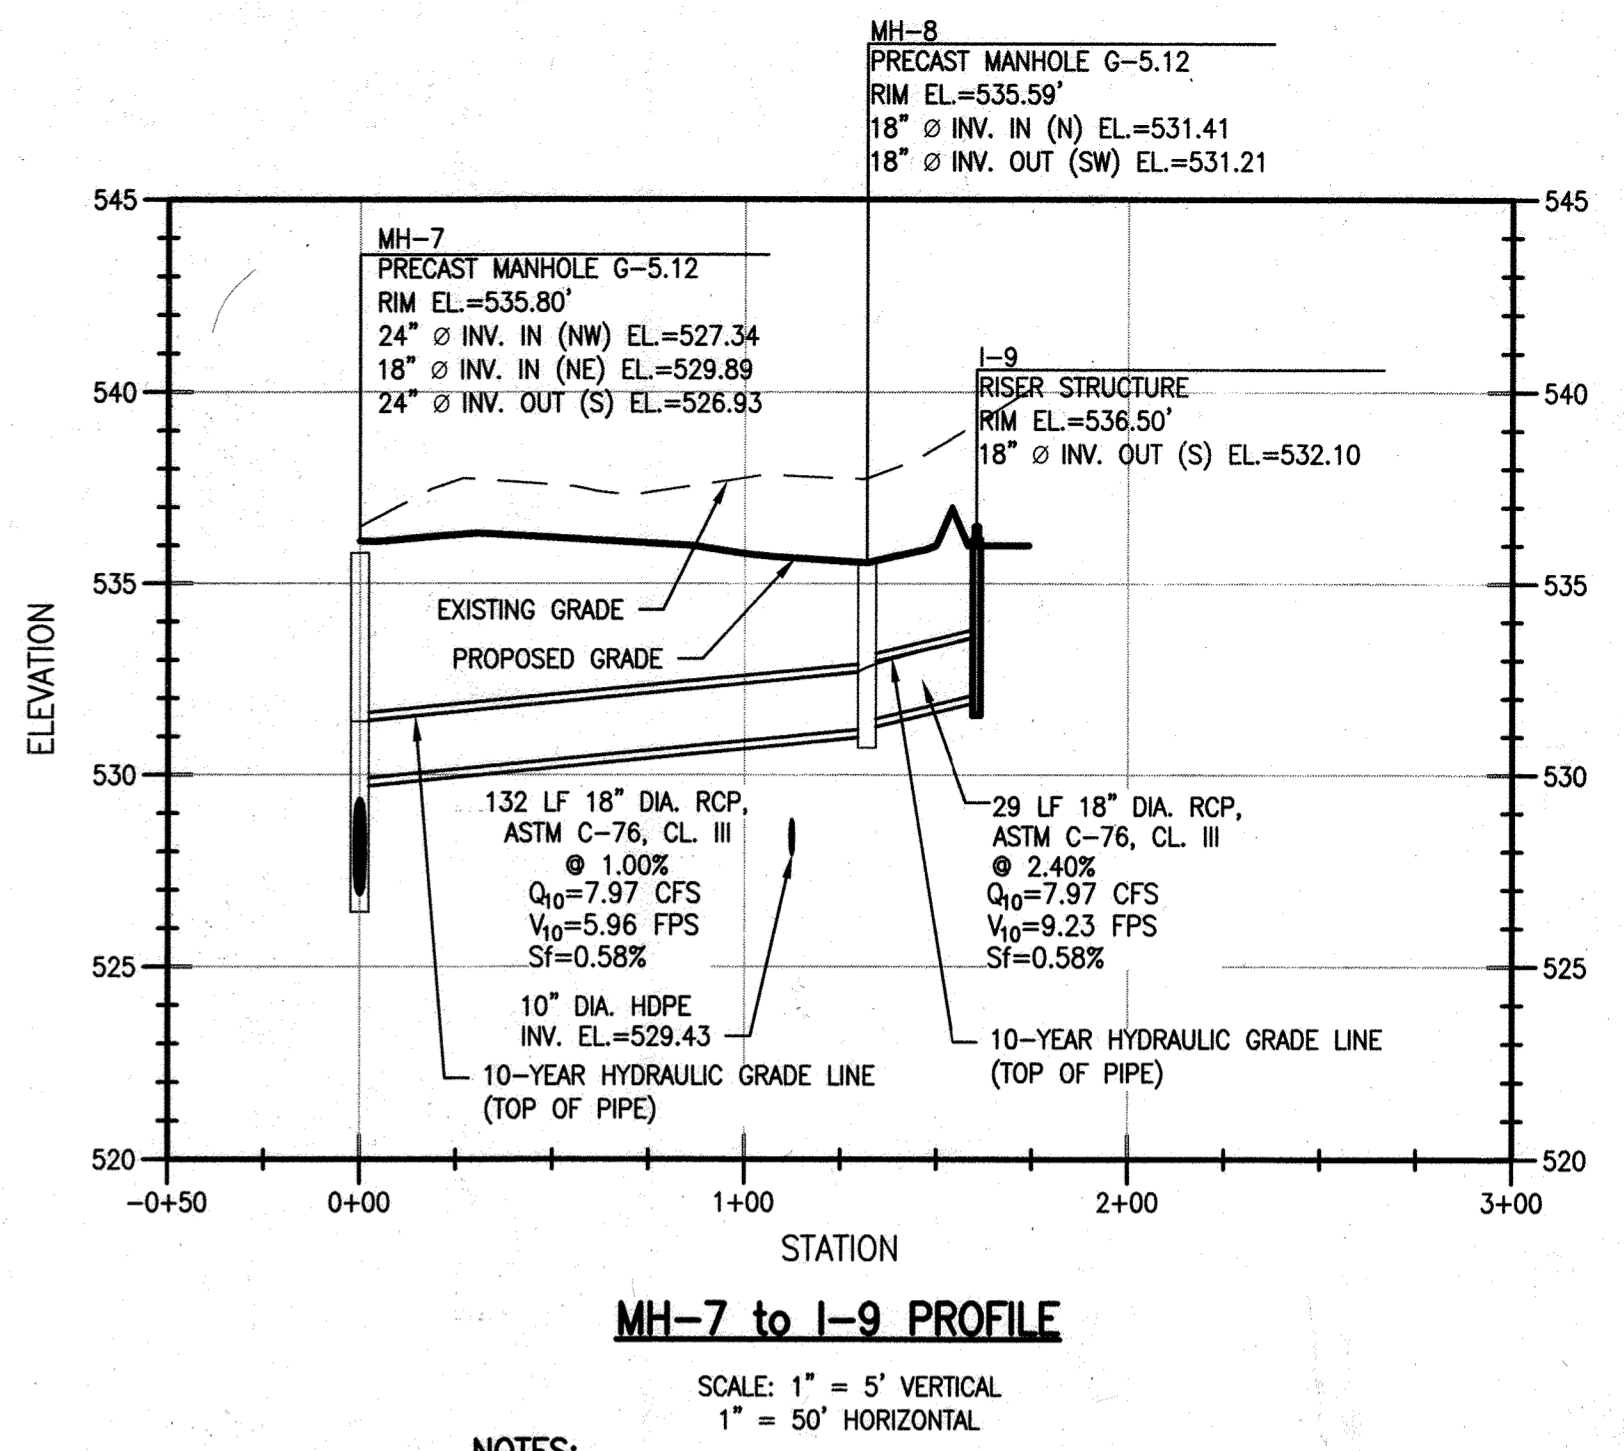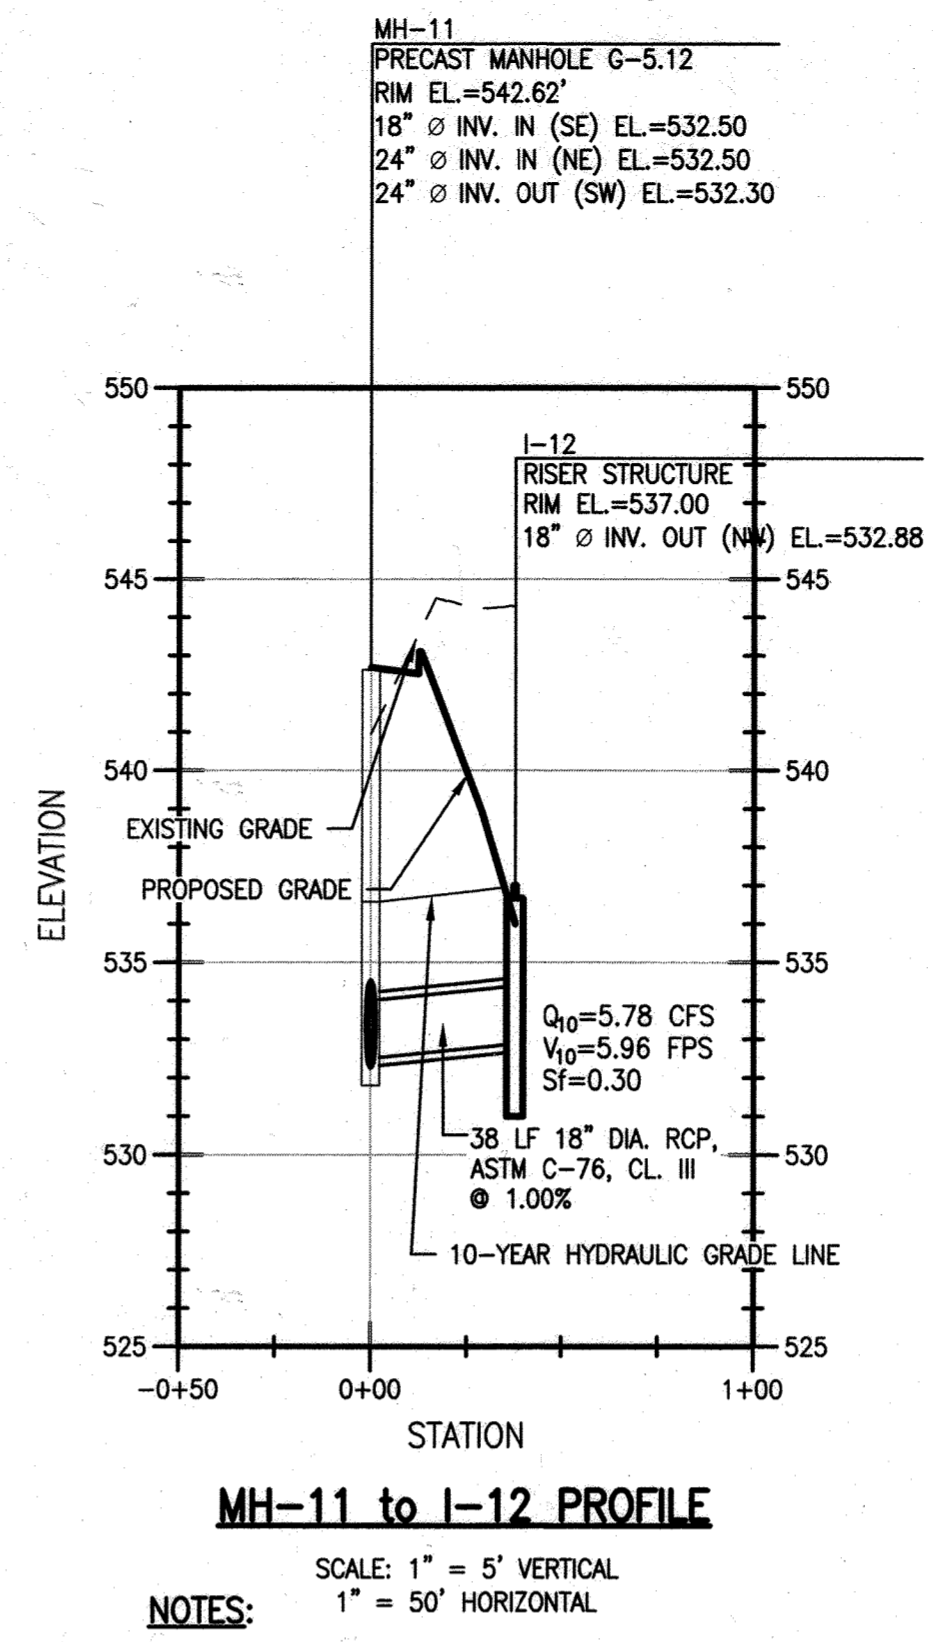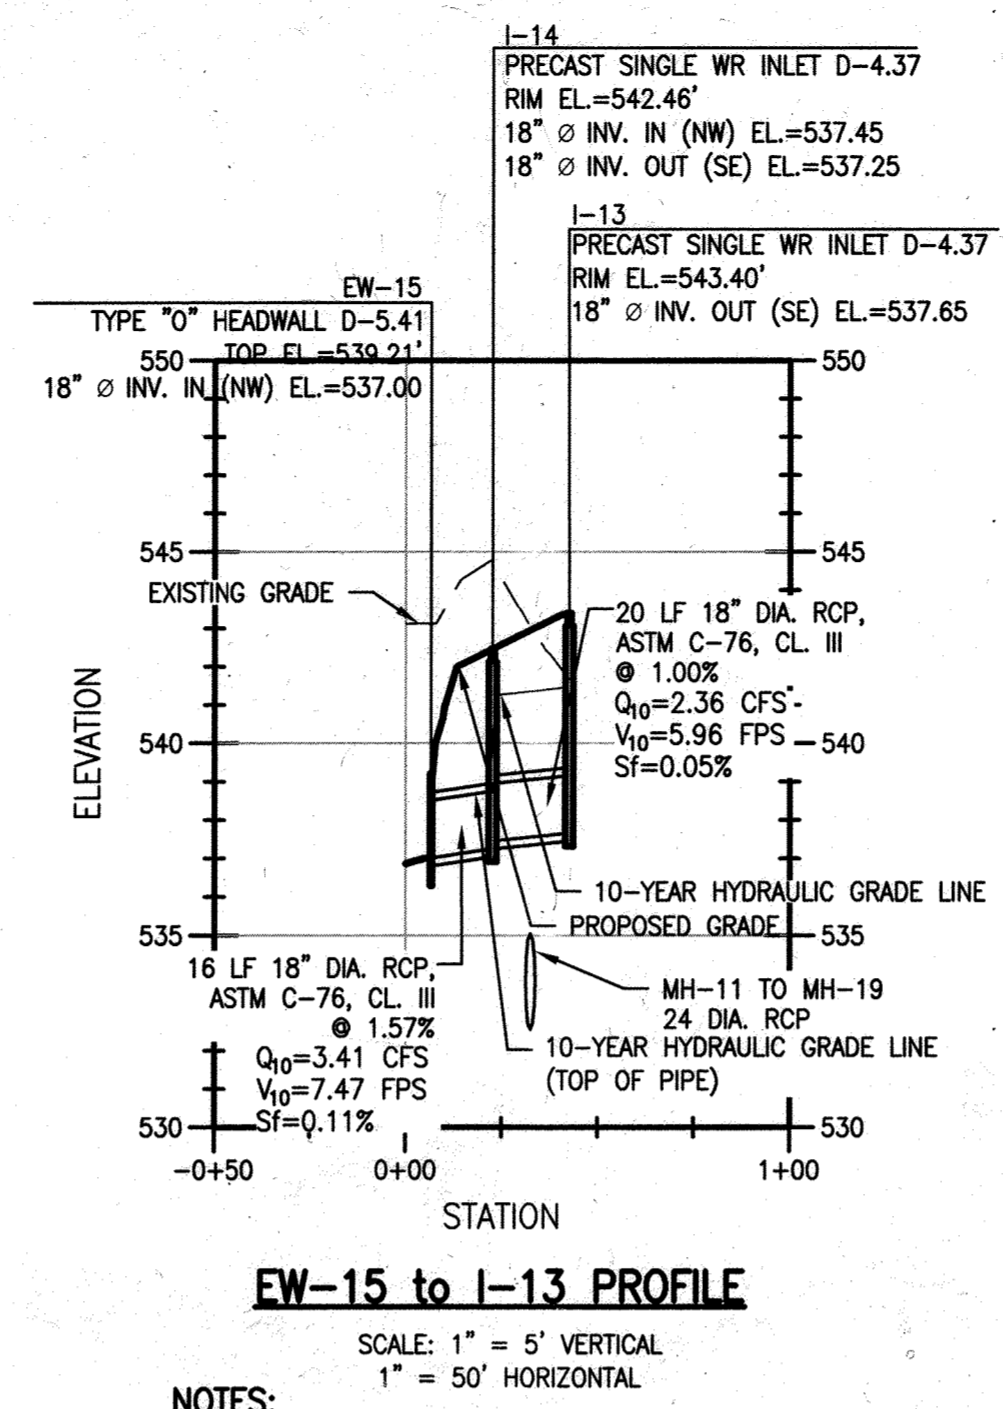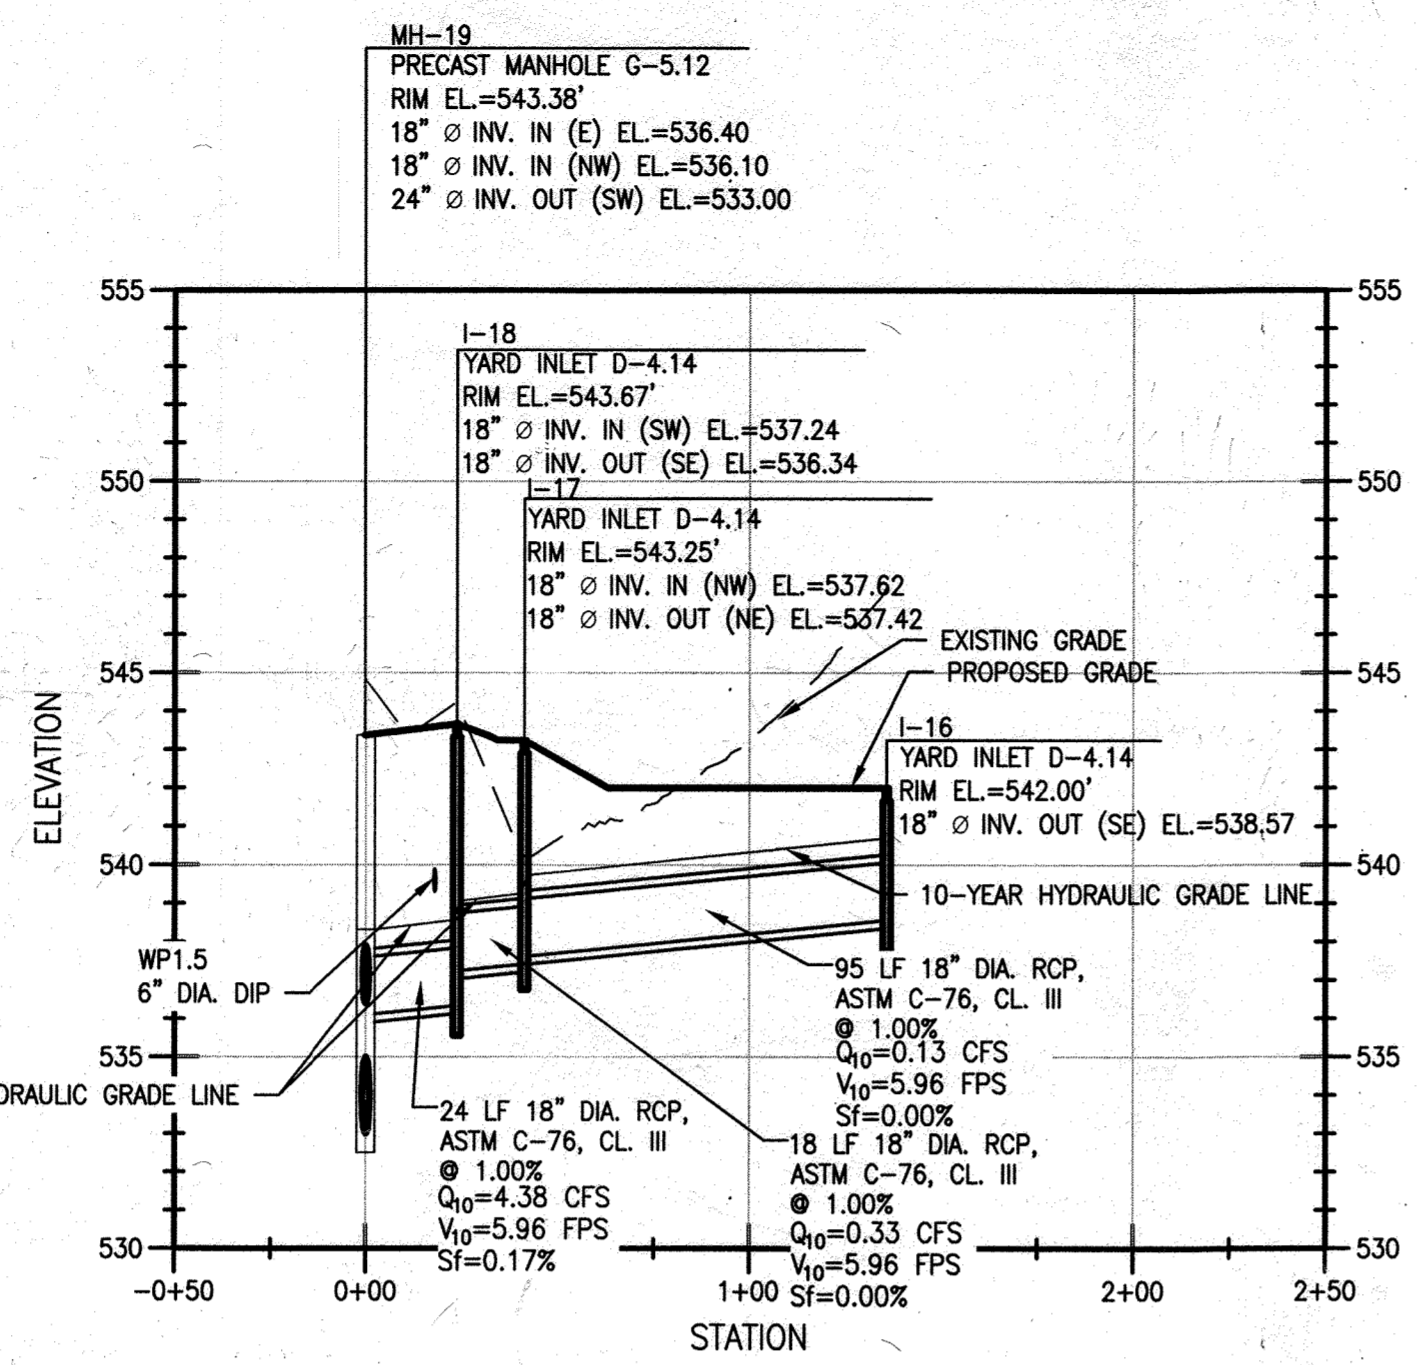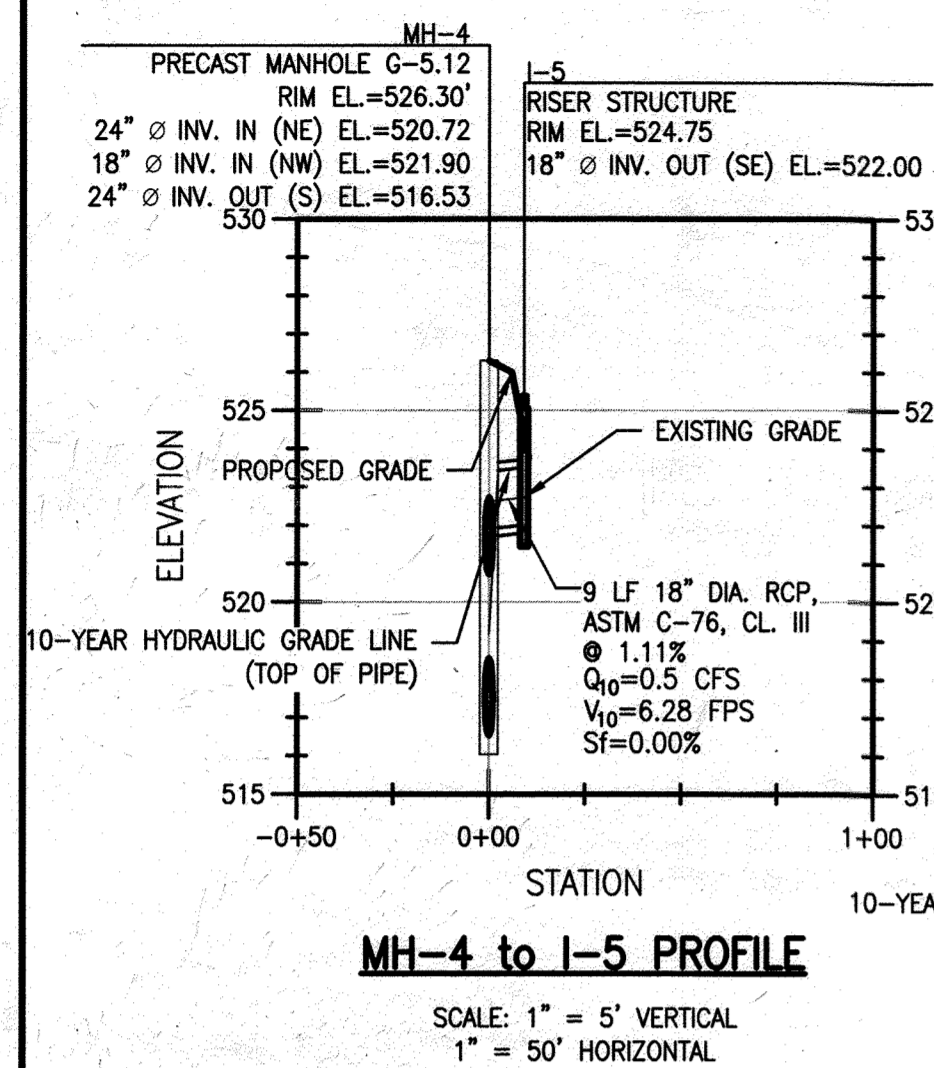


NOTES:
 1. STATION 0+00 TO STATION 0+13 STORMDRAIN BELOW PROPOSED ROAD.

NOTES:
 1. STATION 0+20 TO STATION 0+43 STORMDRAIN BELOW PROPOSED ROAD.

NOTES:
 1. STATION 0+00 TO STATION 0+13 STORMDRAIN BELOW PROPOSED ROAD.

NOTES:
 1. STATION 0+00 TO STATION 1+50 STORMDRAIN BELOW PROPOSED ROAD.

NOTES:
 1. CONTRACTOR SHALL ENSURE FILL FOR PIPE INSTALLATION IS COMPACTED IN ACCORDANCE WITH REQUIREMENTS OF AASHTO T-180.

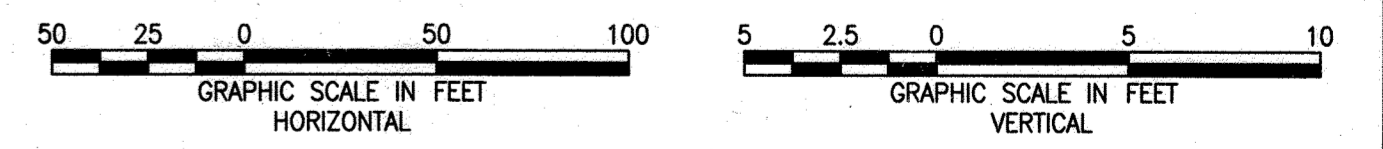


APPROVED: DEPARTMENT OF PLANNING AND ZONING
 Director: *[Signature]* 12-12-17
 Chief, Development Engineering Division: *[Signature]* 11-29-17
 Chief, Division of Land Development: *[Signature]* 12-5-17

1. ENGINEERED RISER STRUCTURE DESIGN TO BE INCLUDED IN FUTURE DESIGN SUBMITTAL.
 2. STATION 0+54 TO STATION 0+78 STORMDRAIN BELOW PROPOSED ROAD.

OWNER/ENGINEER INFORMATION
 DEVELOPER/OWNER: HOWARD COUNTY GOVERNMENT
 CONTACT: JEFF DANNIS, P.E., CSP
 6751 COLUMBIA GATEWAY DRIVE, SUITE 514
 COLUMBIA, MD 21046
 TELEPHONE: (410) 313-6419

ENGINEER:
 EA ENGINEERING, SCIENCE, AND TECHNOLOGY, INC., PBC
 CONTACT: MARK GUTBERLET, P.E.
 225 SCHILLING CIRCLE, SUITE 400
 HUNT VALLEY, MD 21033
 TELEPHONE: (410) 584-7000

PROFESSIONAL CERTIFICATION:
 I HEREBY CERTIFY THAT THESE DOCUMENTS WERE PREPARED OR APPROVED BY ME, AND THAT I AM A DULY LICENSED PROFESSIONAL ENGINEER UNDER THE LAWS OF THE STATE OF MARYLAND, LICENSE NO. 25402, EXPIRATION DATE 25 AUGUST 2018.

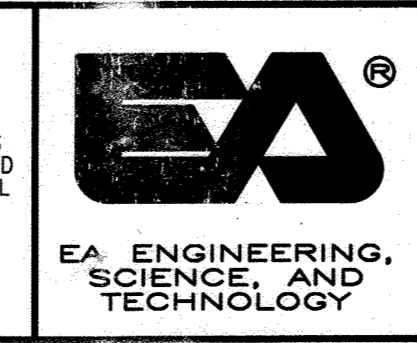


DSN. BY:	MP/KEJ	CVA	REVISION TOTAL SHEET NUMBER 8/2012
DRN. BY:	JAP/KEJ		
CHK. BY:	SMD		
DATE:	OCT. 2016		
BY:	NO.	REVISION	DATE

STORMDRAIN PROFILE II

COMPOST FACILITY - PHASE II
 AT ALPHA RIDGE LANDFILL
 HOWARD COUNTY, MARYLAND

SDP SHEET: 45
 DRAWING: SW-4
 PROJECT: 14982.05
 SHEET: 30 OF 70


NOT FOR CONSTRUCTION - SITE DEVELOPMENT PLAN #SDP-16-035

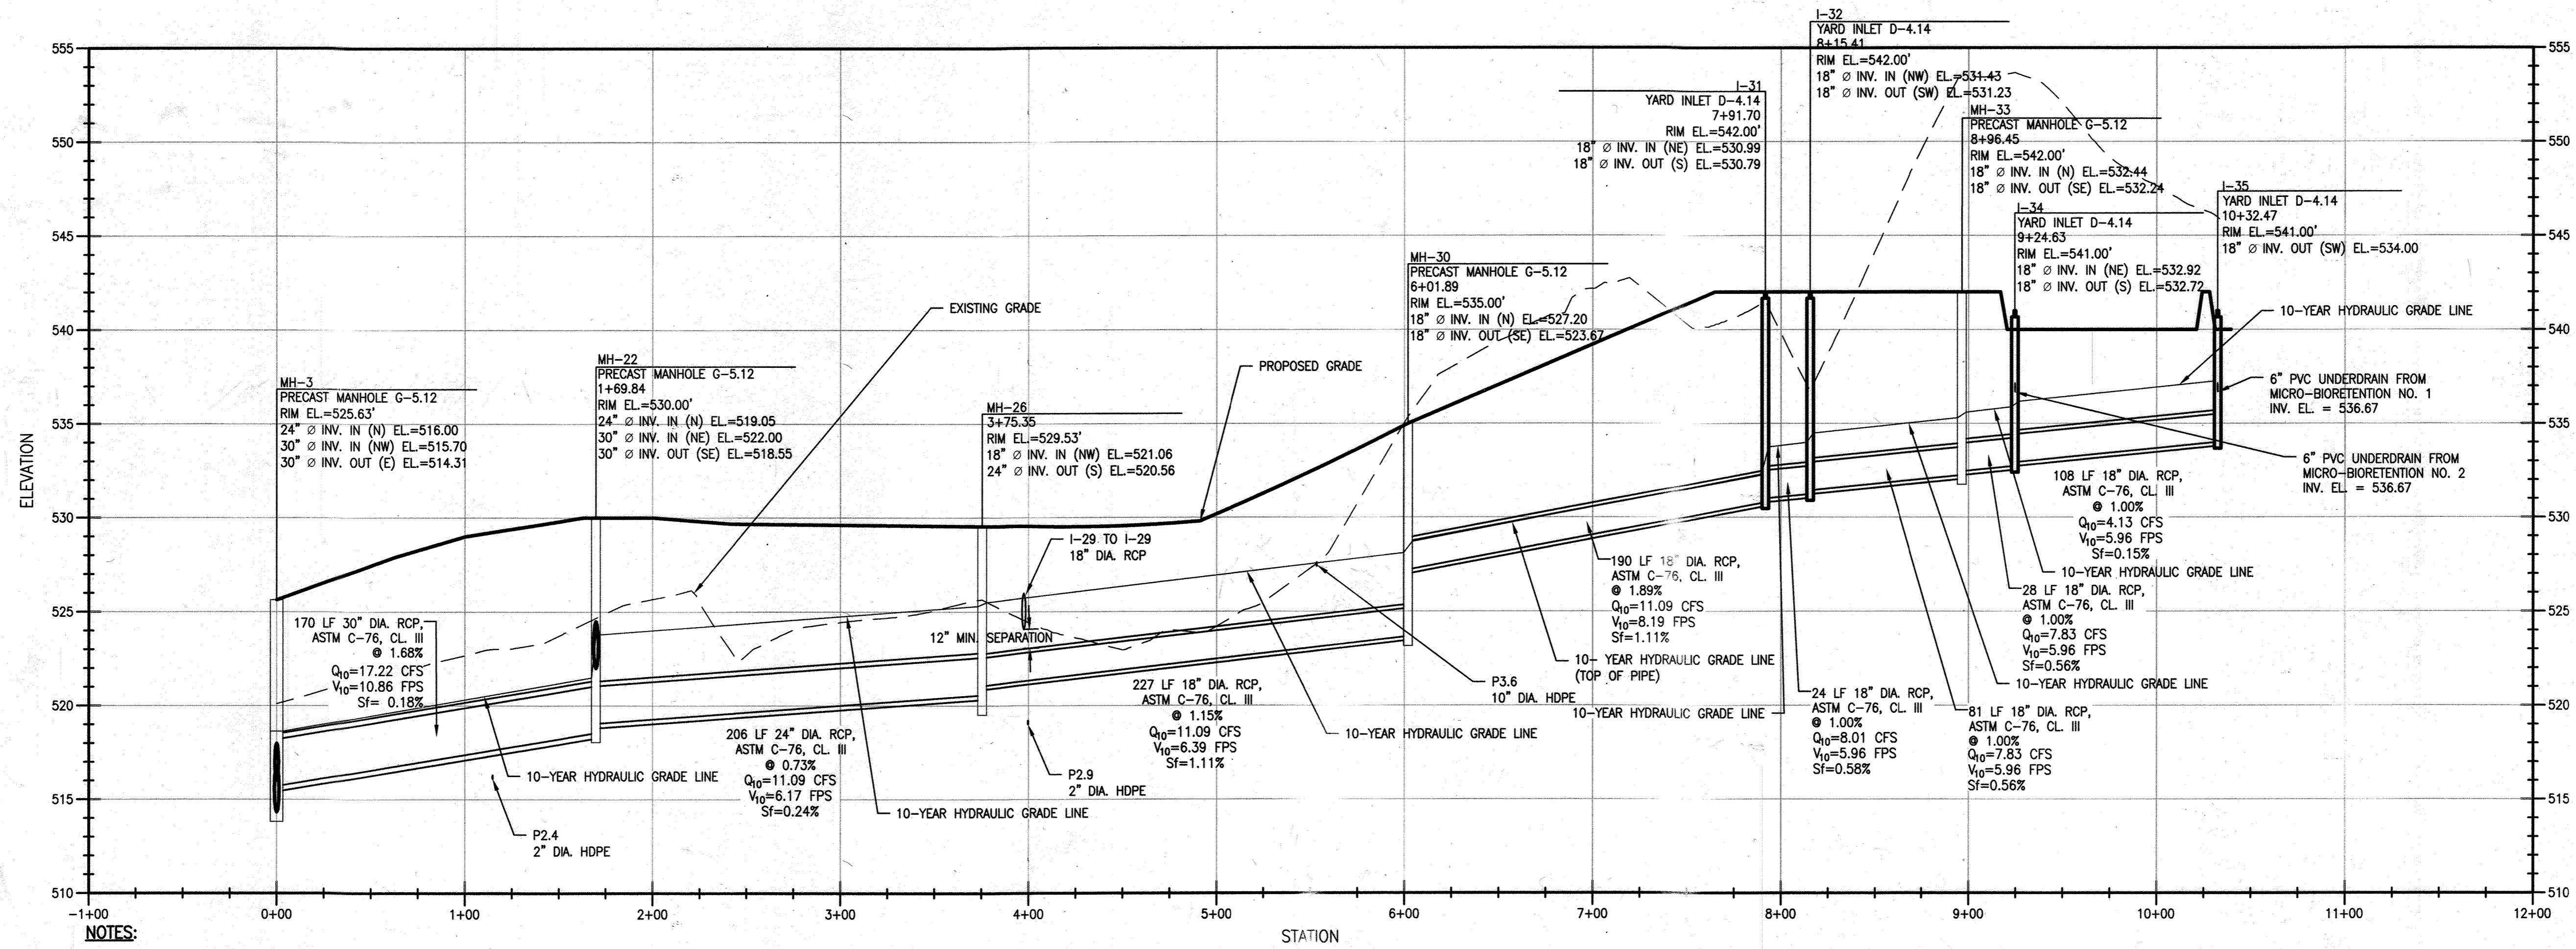

- NOTES:**
- STATION 0+00 TO STATION 6+72 STORMDRAIN BELOW PROPOSED ROAD.
 - SEE SHEET SW-3 FOR STORMDRAIN PIPING CONTINUATION FROM MH-3 TO EW-1.

MH-3 to I-35 PROFILE


SCALE: 1" = 5' VERTICAL
1" = 50' HORIZONTAL

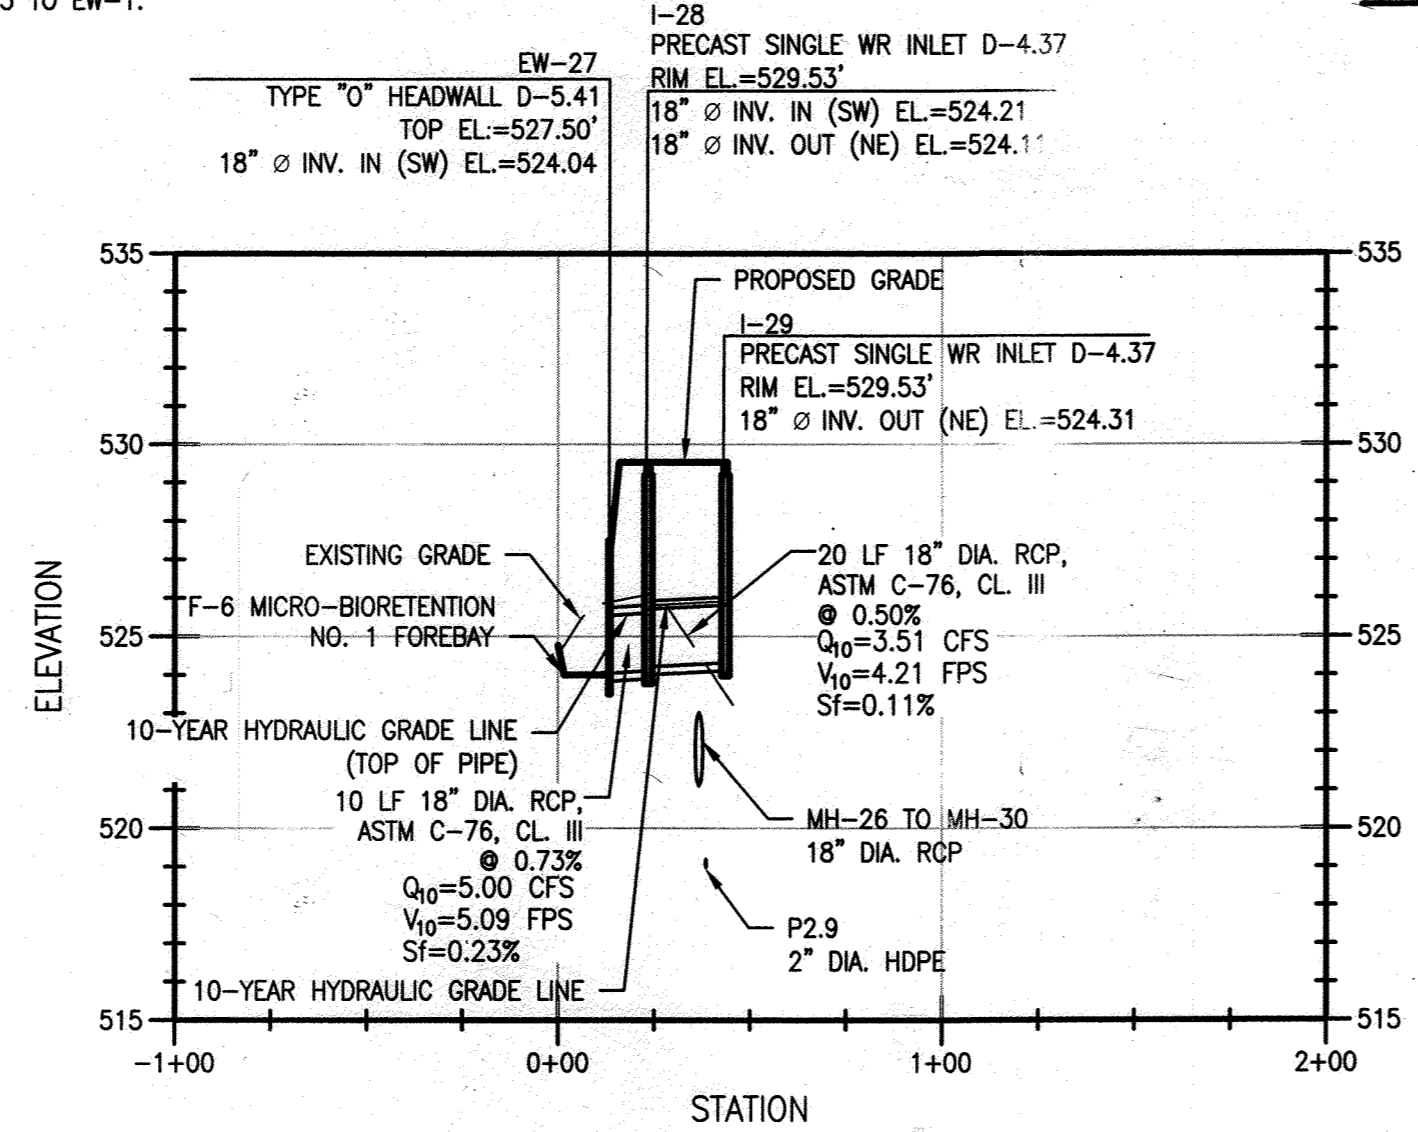

- NOTES:**
- STATION 0+22 TO STATION 0+44 STORMDRAIN BELOW PROPOSED ROAD.

EW-27 to I-29 PROFILE

SCALE: 1" = 5' VERTICAL
1" = 50' HORIZONTAL

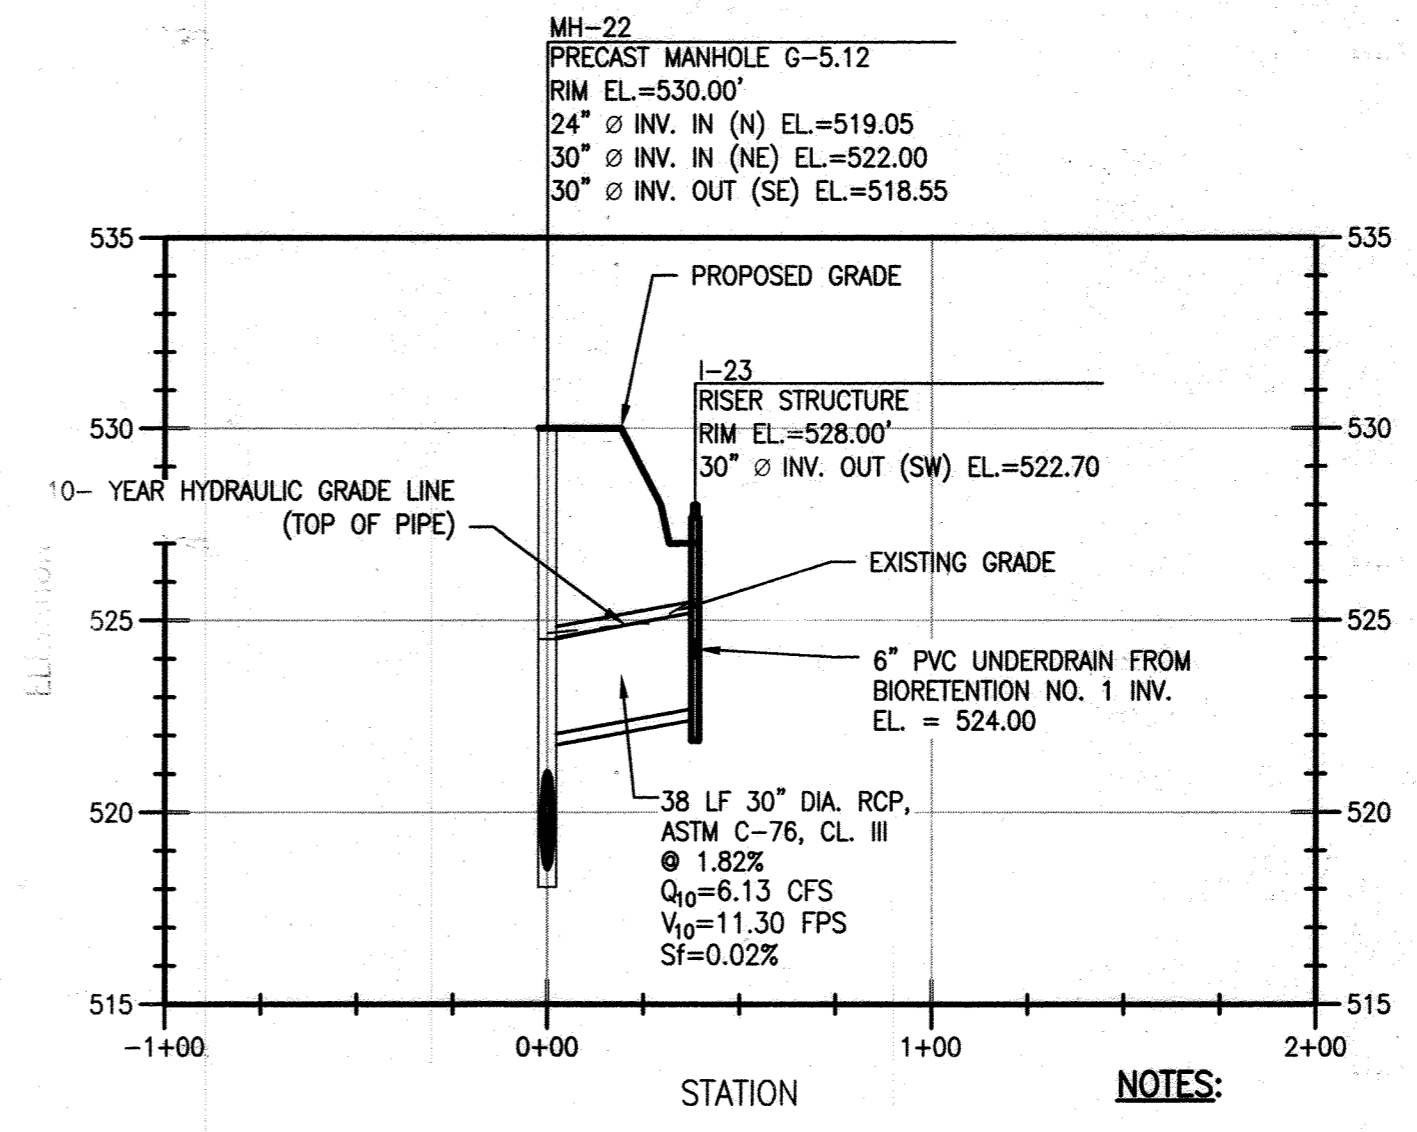


- NOTES:**
- STATION 0+00 TO STATION 0+13 STORMDRAIN BELOW PROPOSED ROAD.

MH-22 to I-23 PROFILE

SCALE: 1" = 5' VERTICAL
1" = 50' HORIZONTAL

- NOTES:**
- SEE MH-3 TO I-35 PROFILE THIS SHEET FOR STORMDRAIN PIPING CONTINUATION FROM MH-3 TO EW-1.

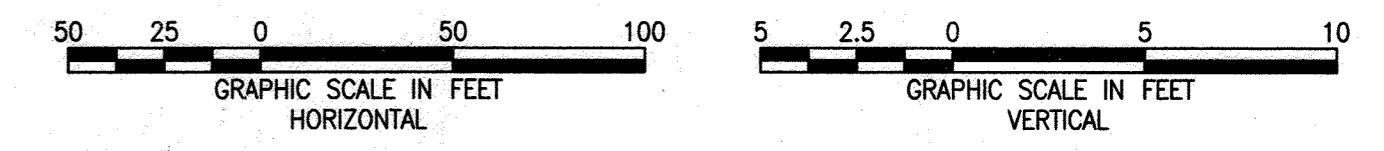

APPROVED: DEPARTMENT OF PLANNING AND ZONING
[Signature] 12-12-17
 DIRECTOR DATE
[Signature] 11-29-17
 CHIEF, DEVELOPMENT ENGINEERING DIVISION DATE
[Signature] 12-5-17
 CHIEF, DIVISION OF LAND DEVELOPMENT DATE


- NOTES:**
- CONTRACTOR SHALL ENSURE FILL FOR PIPE INSTALLATION IS COMPACTED IN ACCORDANCE WITH REQUIREMENTS OF AASHTO T-180.

GRID: 8 BLOCK: N/A
 ZONING: RC-DEO PARCEL/LOT: 220, 253, 23, 54
 TAX MAP: 0016 ELECTION DISTRICT: 3-02

OWNER/ENGINEER INFORMATION


DEVELOPER/OWNER:
 HOWARD COUNTY GOVERNMENT
 CONTACT: JEFF DANNIS, P.E., CSP
 6751 COLUMBIA GATEWAY DRIVE, SUITE 514
 COLUMBIA, MD 21046
 TELEPHONE: (410) 313-6419

ENGINEER:
 EA ENGINEERING, SCIENCE,
 AND TECHNOLOGY, INC., PBC
 CONTACT: MARK GUTBERLET, P.E.
 225 SCHILLING CIRCLE, SUITE 400
 HUNT VALLEY, MD 21031
 TELEPHONE: (410) 584-7000

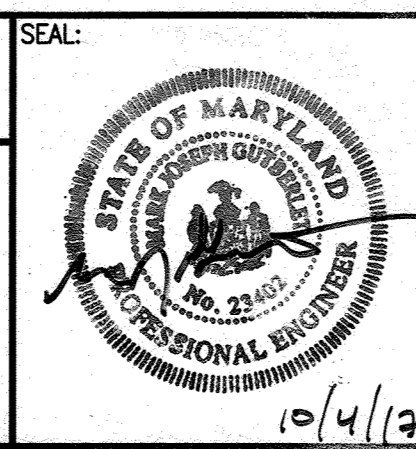

PROFESSIONAL CERTIFICATION:

I HEREBY CERTIFY THAT THESE DOCUMENTS WERE PREPARED OR APPROVED BY ME, AND THAT I AM A DULY LICENSED PROFESSIONAL ENGINEER UNDER THE LAWS OF THE STATE OF MARYLAND, LICENSE NO. 23402, EXPIRATION DATE 25 AUGUST 2018.

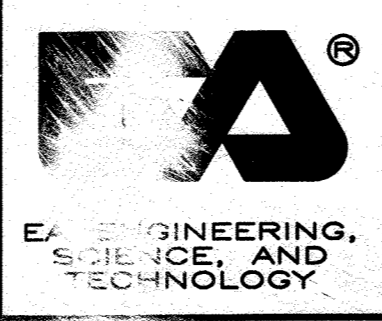




DSN. BY:	MP/K	CWH	REVISION TOTAL SHEET NUMBER	5/2022
DRN. BY:	JAP/l		DATE OF ADDITION OF SHEET	
CHK. BY:	SMD			
DATE:	OCT. 2016			
BY:	NO.	REVISION	DATE	

STORMDRAIN PROFILE III

**COMPOST FACILITY - PHASE II
 AT ALPHA RIDGE LANDFILL**
 HOWARD COUNTY, MARYLAND

SDP SHEET: DRAWING:
 45 SW-5
 26 OF 44
 PROJECT: 14982.05
 SHEET: 140 OF 70

NOT FOR CONSTRUCTION - SITE DEVELOPMENT PLAN #SDP-16-035

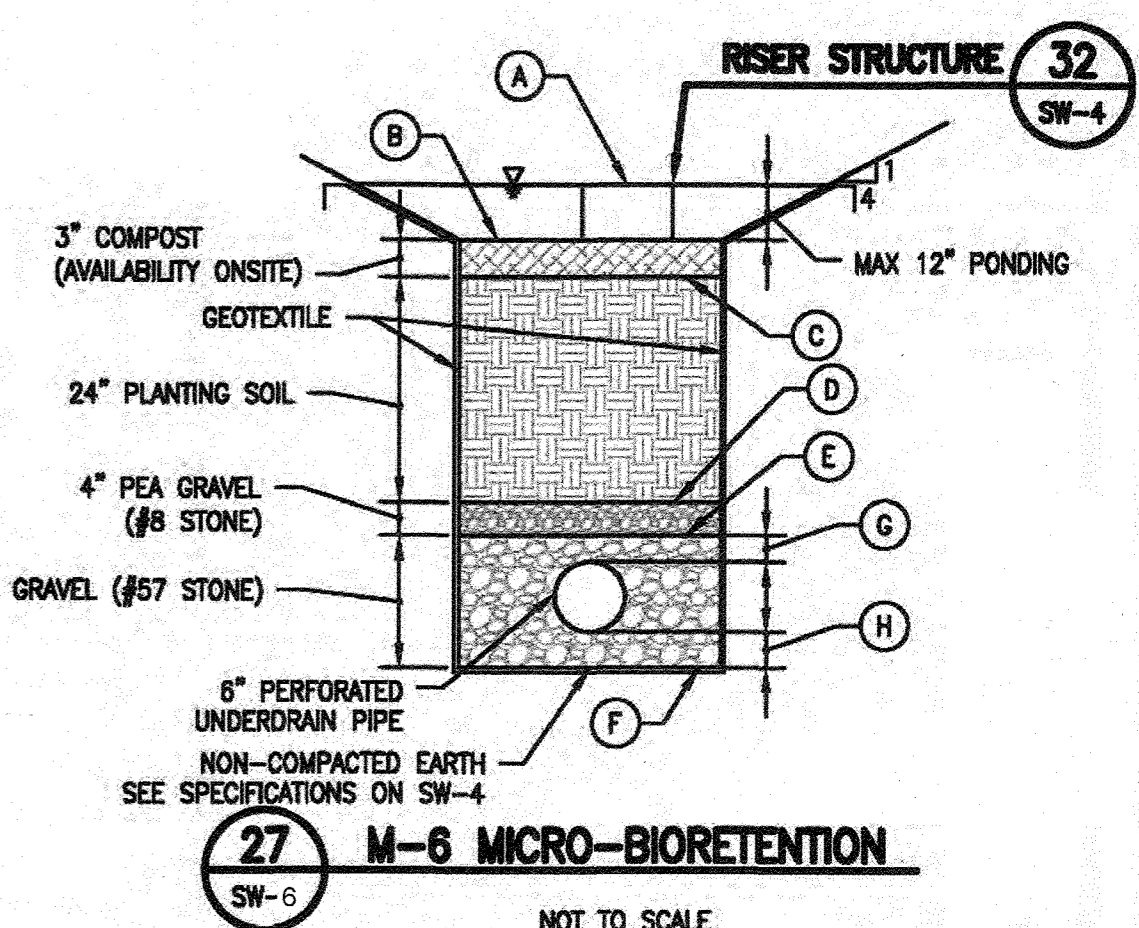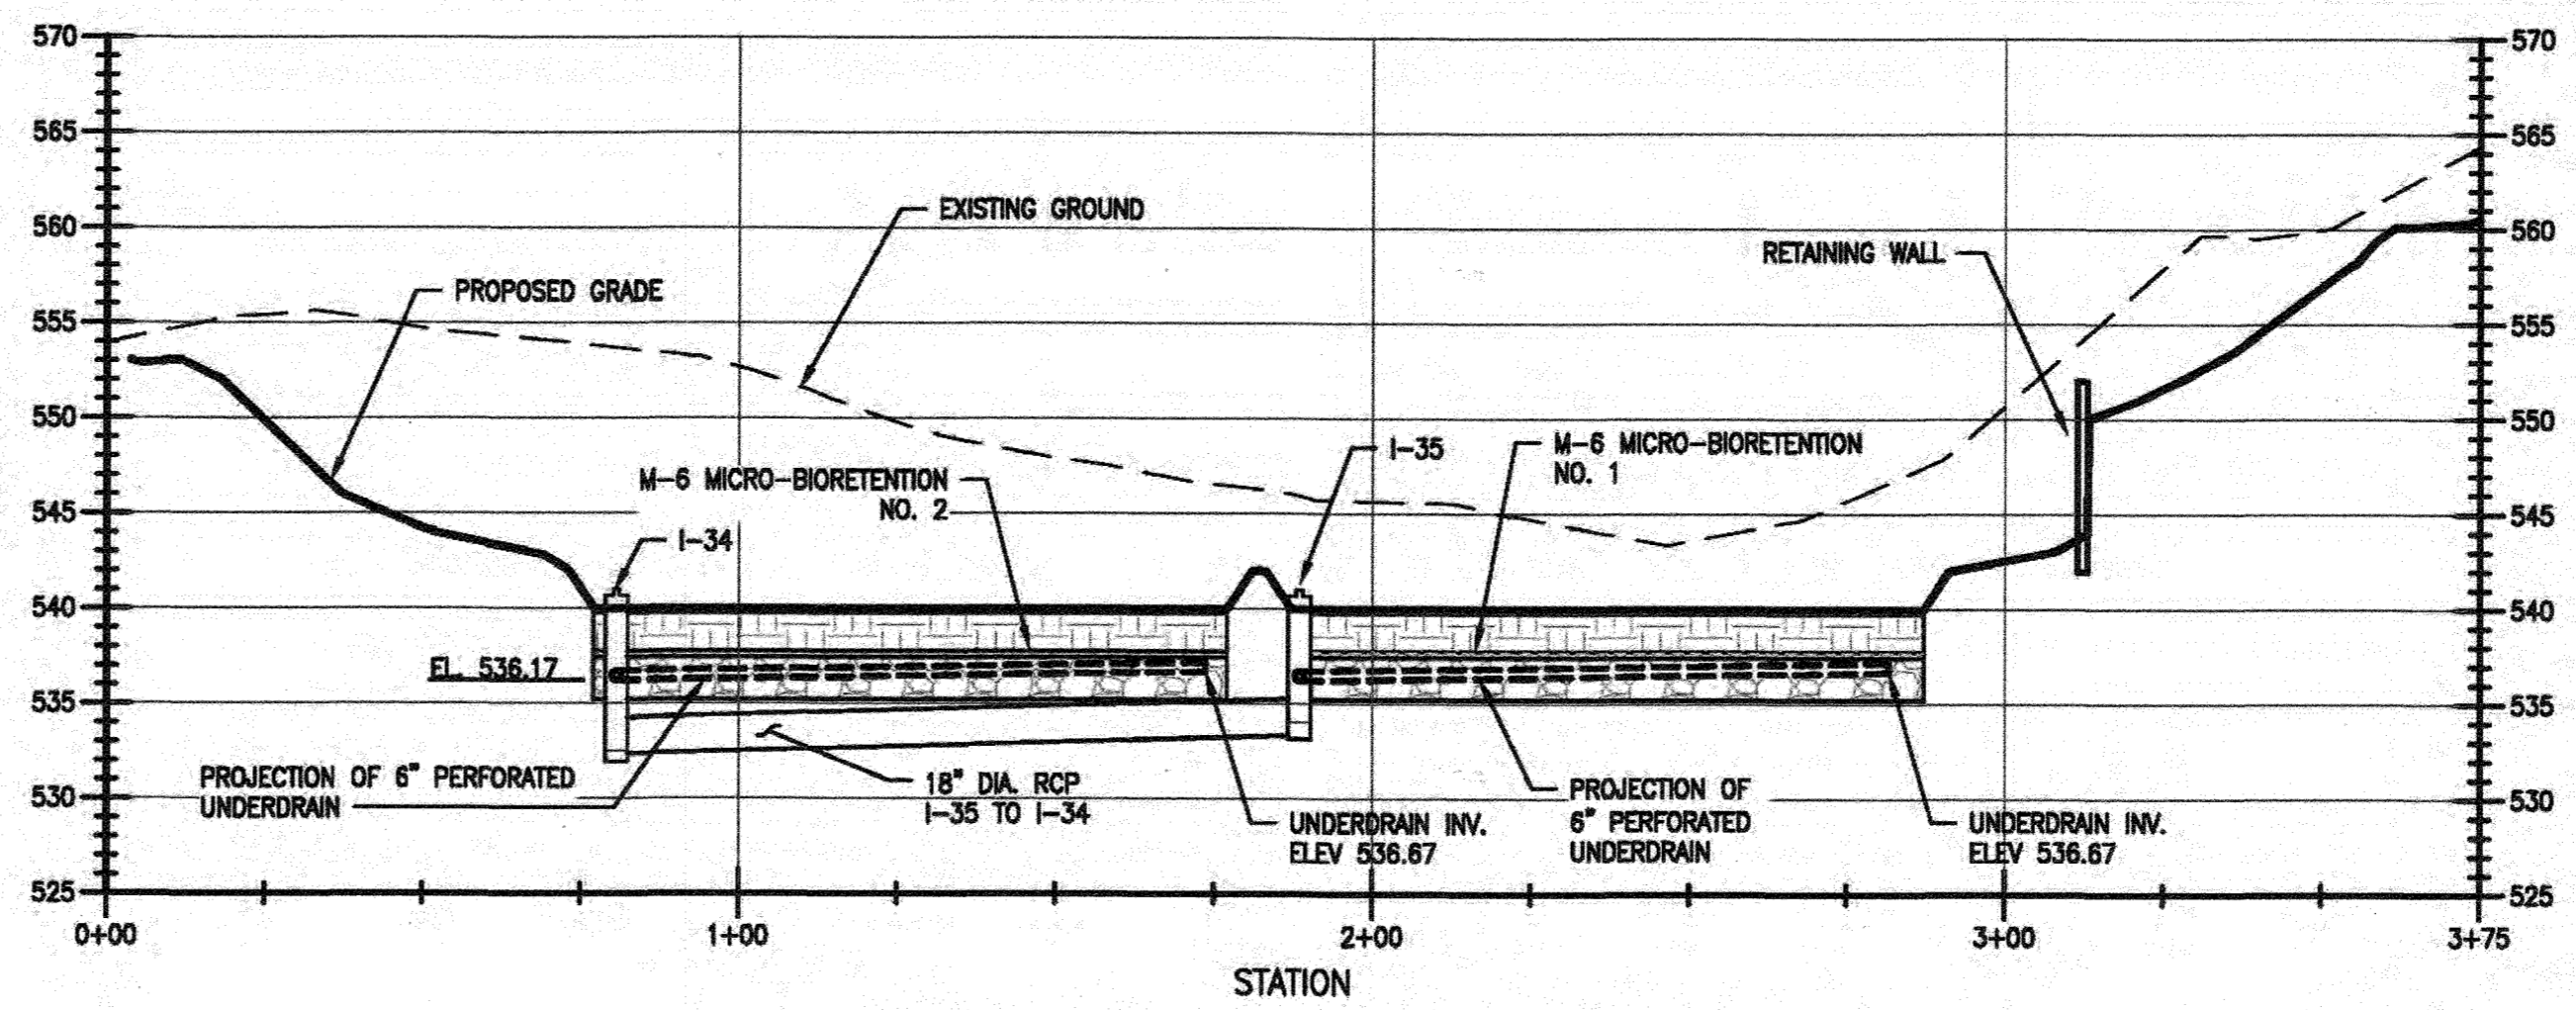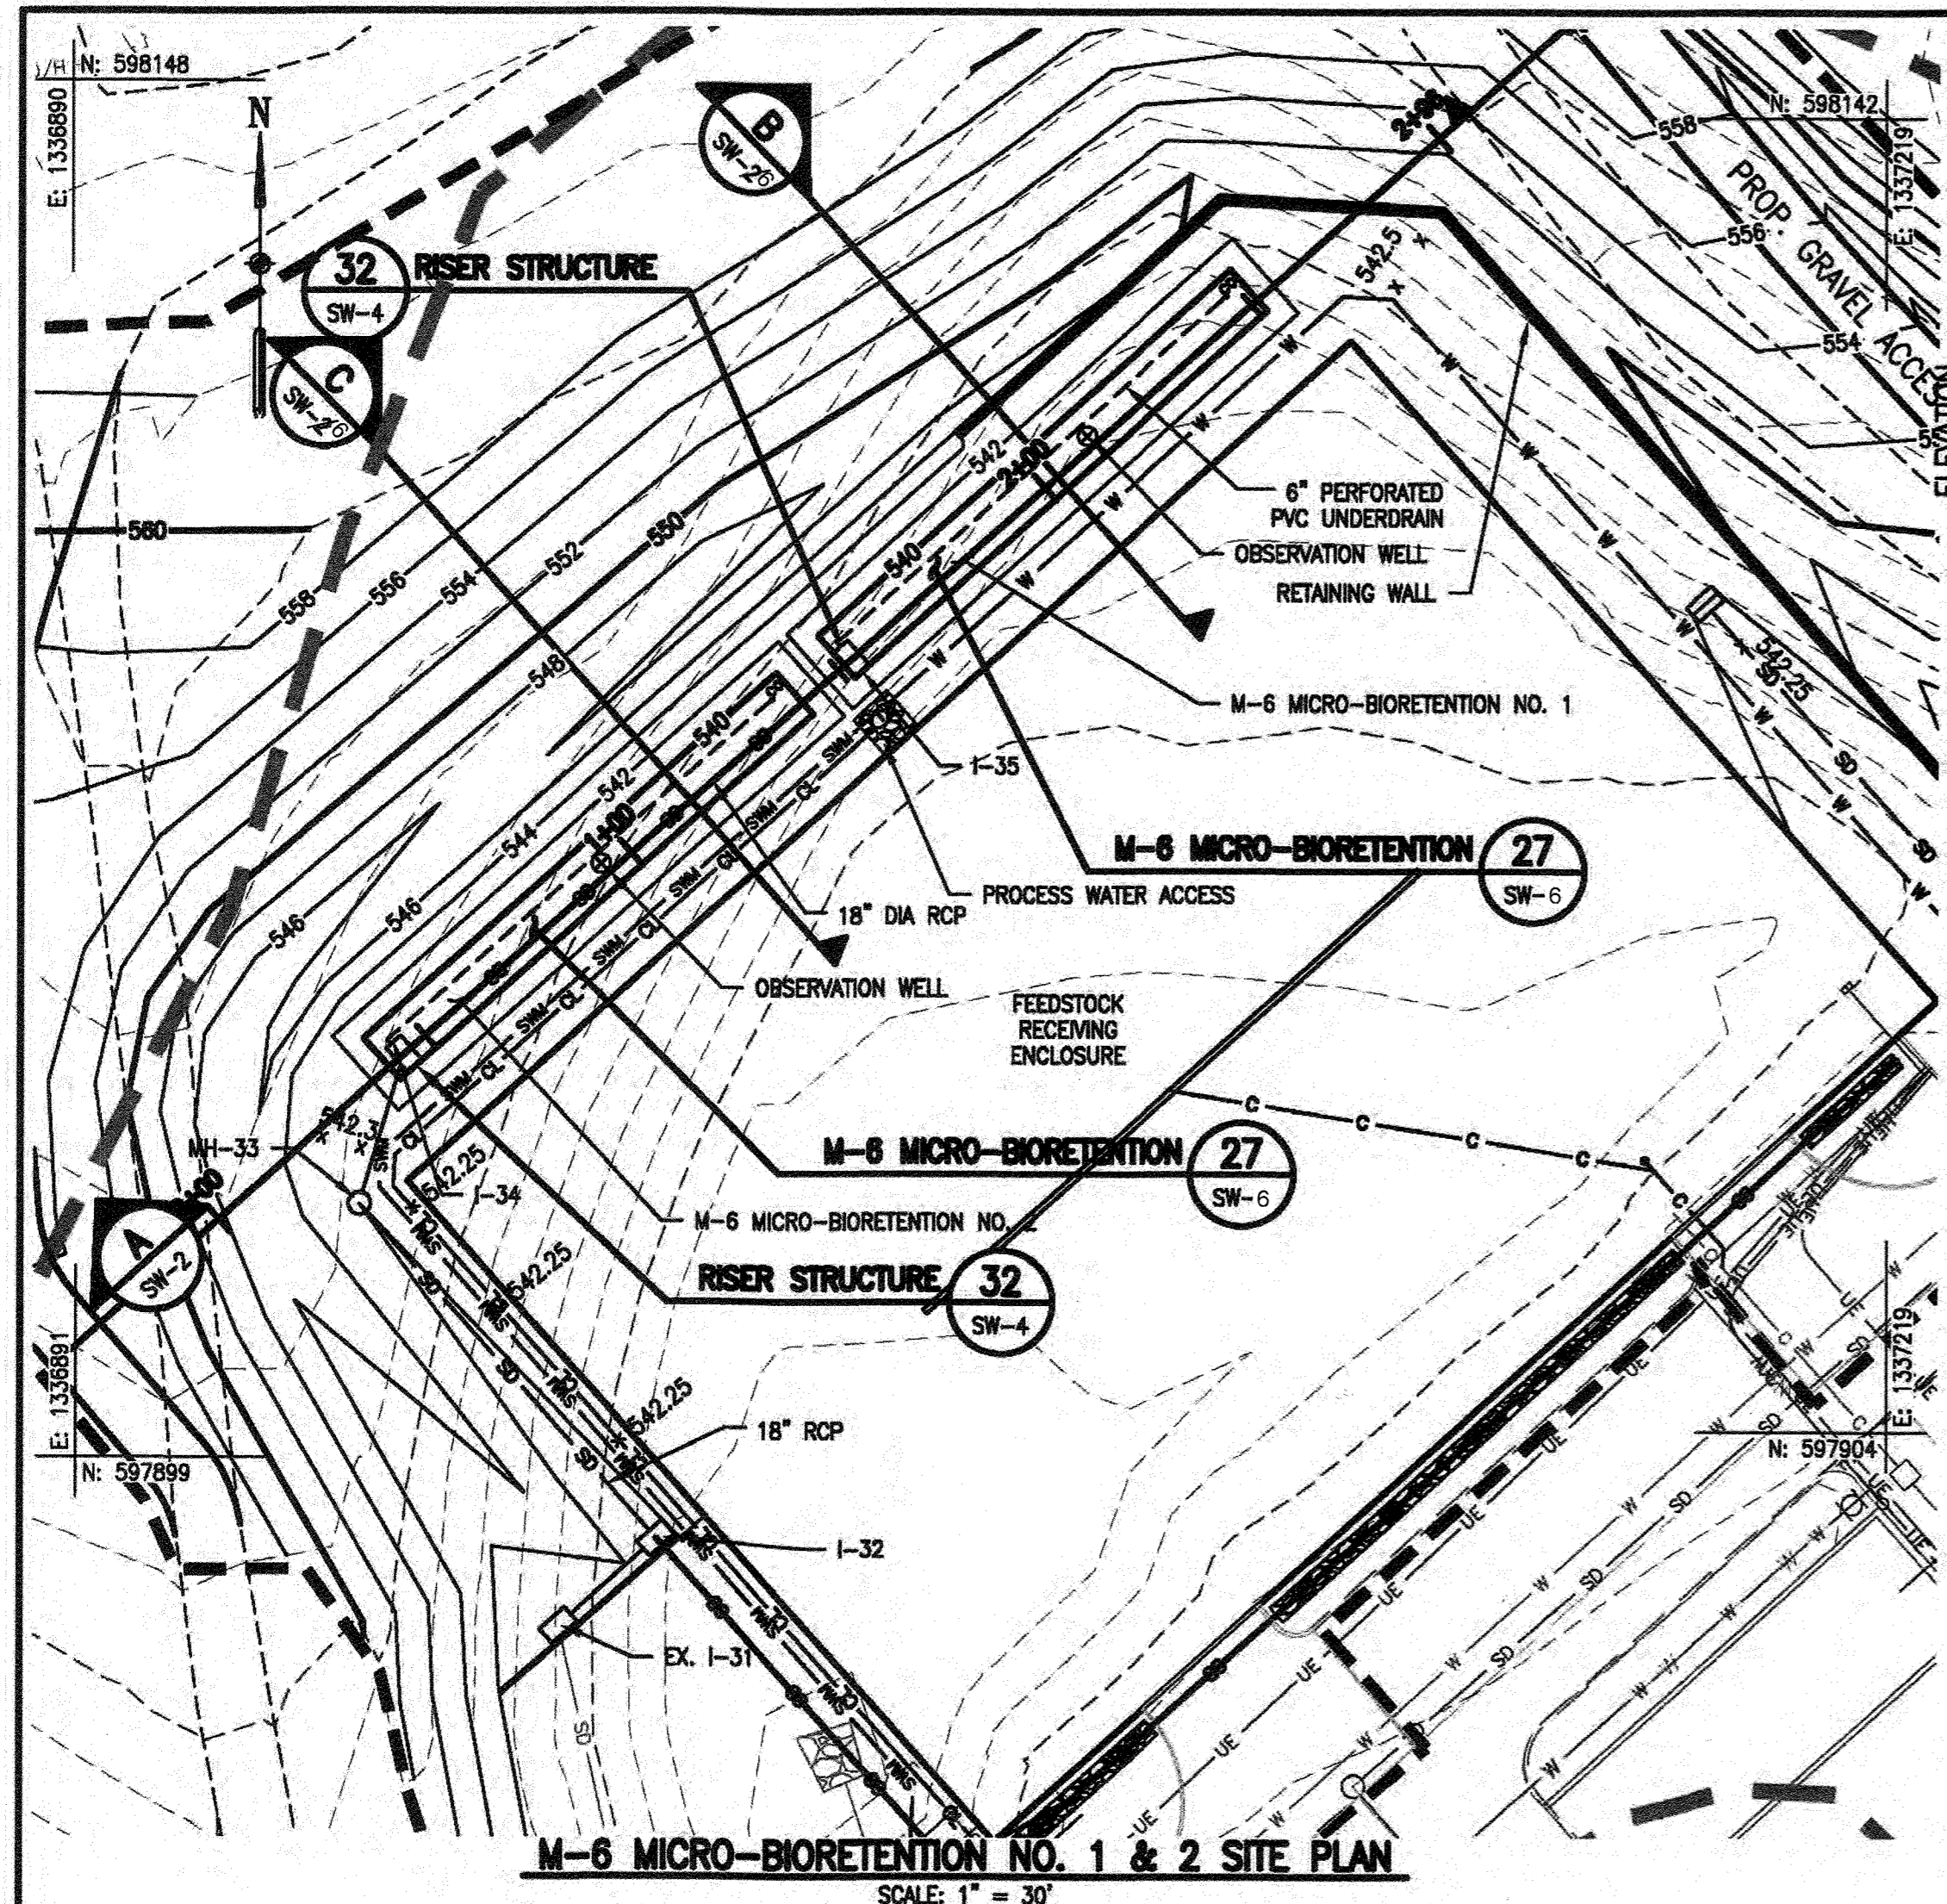

ESD FEATURE	ELEVATIONS (IN FEET)							
	A*	B	C	D	E	F	G**	H
M-6 MICRO-BIORETENTION NO. 1	541.00	540.00	539.75	537.75	537.42	535.17	3"	12"
M-6 MICRO-BIORETENTION NO. 2	541.00	540.00	539.75	537.75	537.42	535.17	3"	12"

A M-6 MICRO-BIORETENTION NO. 1 & 2 PROFILE

- NOTES:
- REFER TO PROFILE I-31 TO I-35 FOR STORMDRAIN ON SHEET SW-1.
 - SEE TYPICAL SECTION DETAIL THIS SHEET.

- * RISER INLET GRATE ELEVATION SET AT MAXIMUM WATER PONDING DEPTH.
 ** MINIMUM DEPTH OF GRAVEL ABOVE TOP OF UNDERDRAIN, DEPTH WILL VARY.
- NOTES:
- PVC UNDERDRAIN SHALL HAVE 1/2-INCH DIA. HOLES SPACED 80 DEGREES APART AROUND PERIMETER EVERY 6-IN FOR ENTIRE PERFORATED LENGTH. PVC UNDERDRAIN WILL BE PERFORATED WHERE IT IS LOCATED WITHIN THE GRAVEL MEDIA. WRAP UNDERDRAIN WITH GEONET WITH NONWOVEN GEOTEXTILE AND SECURE WITH ZIP TIES EVERY 12-IN.
 - PROPOSED PERFORATED AND SOLID UNDERDRAIN AND GEONET PRODUCT SHALL BE SUBMITTED FOR ENGINEER'S REVIEW AND APPROVAL PRIOR TO INSTALLATION.
 - GEOTEXTILE SHALL BE PE TYPE 1 NONWOVEN.

BENCHMARK INFORMATION

- HOWARD COUNTY SURVEY CONTROL: BASE A
ELEVATION 564.733 US FT
N 598,156.281 E 1,336,841.785
- HOWARD COUNTY SURVEY CONTROL: BASE F
ELEVATION 512.817 US FT
N 597,030.549 E 1,338,031.404

THE SYSTEM OF COORDINATES USED BY HOWARD COUNTY IS BASED ON THE FOLLOWING DATUMS AND PROJECTIONS:

- HORIZONTAL: MARYLAND NAD83
- VERTICAL: NAVD88

BENCHMARK LOCATIONS PROVIDED ON PROJECT ACCESS INSET.

DATA SOURCES


- THE EXISTING TOPOGRAPHY AND UTILITIES INSIDE OF THE 'LIMIT OF FIELD RUN TOPO', UNLESS OTHERWISE MENTIONED, HAVE BEEN PROVIDED FROM A FIELD RUN SURVEY BY THE HOWARD COUNTY SURVEY DIVISION IN AUGUST 2011.
- ALL INFORMATION LOCATED OUTSIDE OF THE LIMIT OF FIELD RUN TOPO LINE HAS BEEN TAKEN FROM THE HOWARD COUNTY GIS DATABASE.

APPROVED: DEPARTMENT OF PLANNING AND ZONING

[Signature] 9-15-22
DIRECTOR DATE


[Signature] 9-12-22
CHIEF, DEVELOPMENT ENGINEERING DIVISION DATE

[Signature] 9/15/22
CHIEF, DIVISION OF LAND DEVELOPMENT DATE

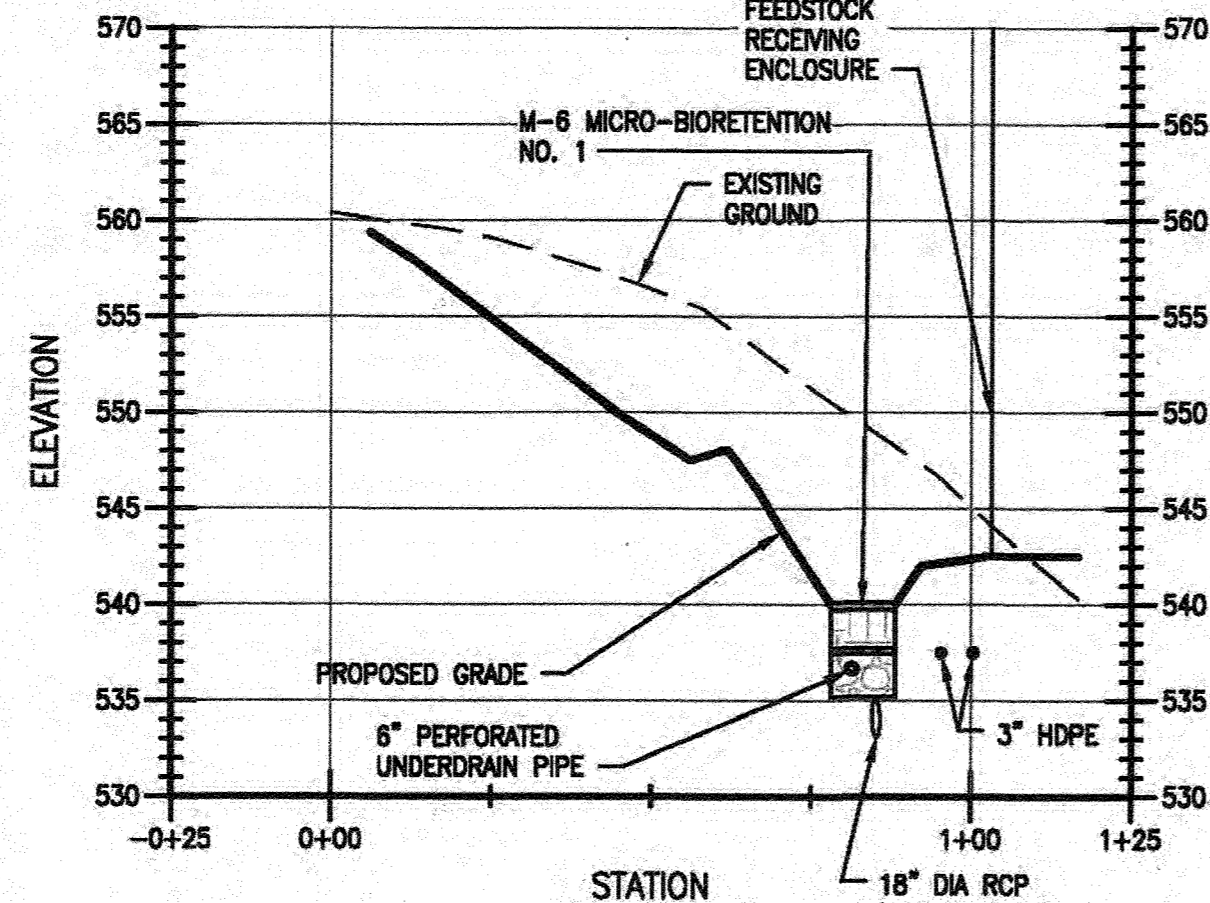


C M-6 MICRO-BIORETENTION NO. 2 PROFILE

- NOTES:
- REFER TO PROFILE I-31 TO I-35 FOR STORMDRAIN ON SHEET SW-1.
 - REFER TO PROFILE B ON SHEET C-3 AND PROFILE C ON SHEET C-5 FOR CONTACT WATER AND SWM FORSEMAN PROFILES.
 - SEE TYPICAL SECTION DETAIL THIS SHEET.

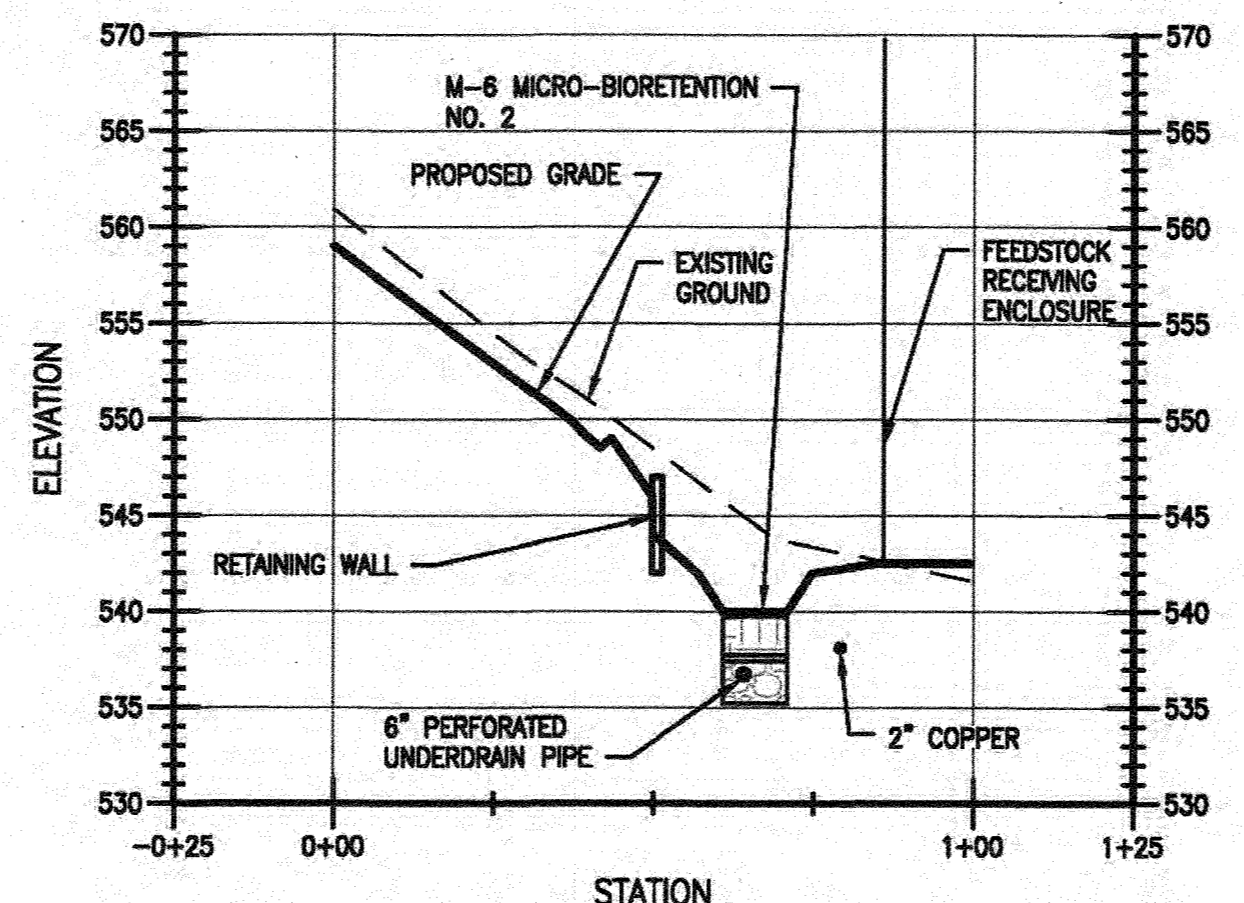

B M-6 MICRO-BIORETENTION NO. 1 PROFILE

- NOTES:
- SEE TYPICAL SECTION DETAIL THIS SHEET.
 - REFER TO CIVIL SHEETS FOR WATER LINE PROFILE.

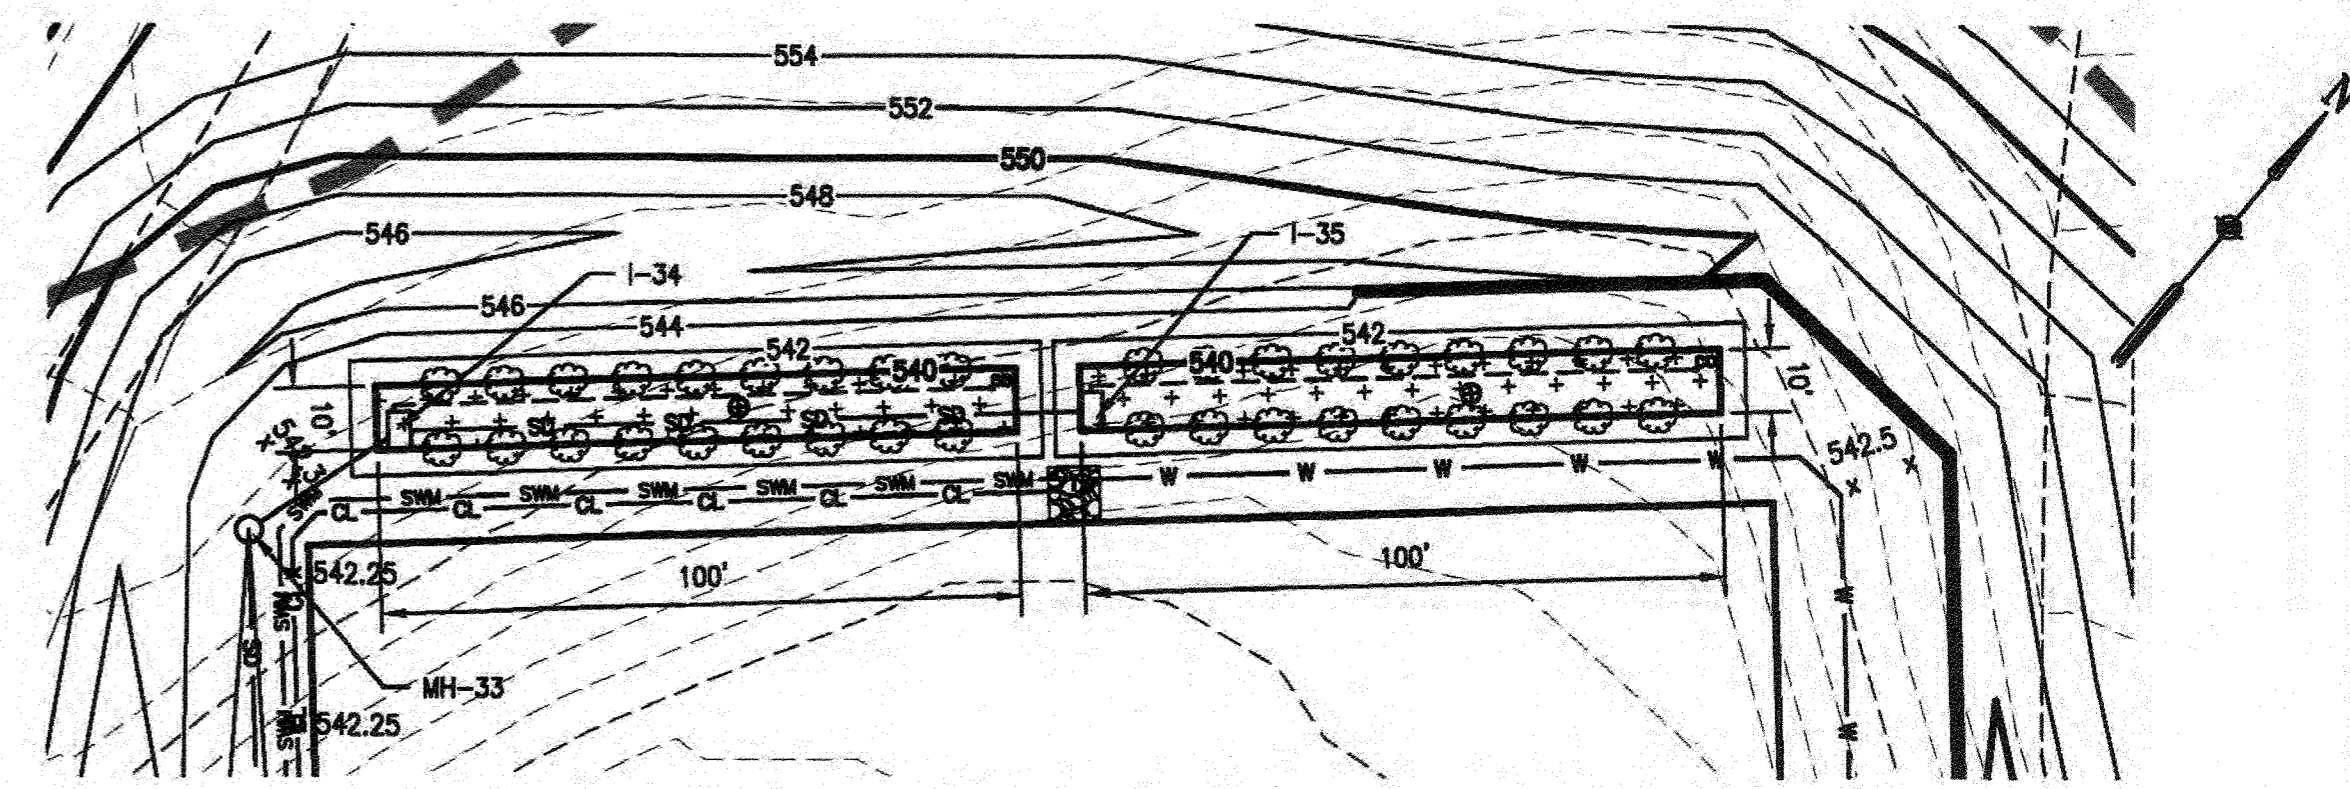


M-6 MICRO-BIORETENTION NO. 1 & 2 PLANTING PLAN

- NOTE:
- ENSURE PLANTINGS PROVIDE A MINIMUM 2 FT HORIZONTAL SEPARATION FROM PROPOSED OBSERVATION WELL.

PLANTING TYPE	COMMON NAME	SCIENTIFIC NAME	FORM	SPACING	INDICATOR STATUS	M-6 MICRO-BIORETENTION PLANT LIST		SYMBOL
						M-6 MICRO-BIORETENTION NO. 1 - QUANTITY	M-6 MICRO-BIORETENTION NO. 2 - QUANTITY	
HERBACEOUS SPECIES	FRINGED SEDGE	CAREX CRINITA	1 QUART	2' OC	FACW	125	125	[Symbol]
	WOOLGRASS	SCIRPUS CYPERINUS	1 QUART	2' OC	FACW	125	125	[Symbol]
	BABY JOE PYE WEED	EUTROCHUM DUBIUM	1 QUART	10' OC	FAC	10	10	[Symbol]

- NOTES:
- DEPICTION OF PLANTS IN PLANTING PLANS THIS SHEET IS MEANT TO CONVEY PLANT SPACING GUIDANCE, IT DOES NOT REFLECT ACTUAL PLANTING QUANTITIES. PLANT QUANTITIES SHOULD BE AS SHOWN IN TABLE.

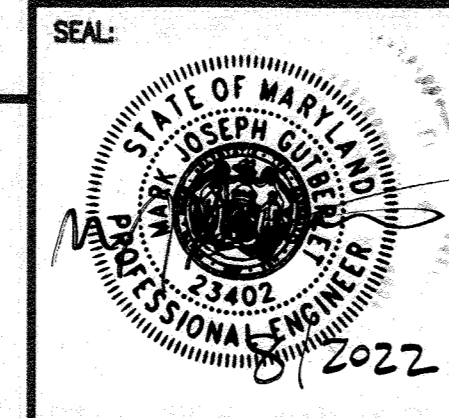

PROFESSIONAL CERTIFICATION:

I HEREBY CERTIFY THAT THESE DOCUMENTS WERE PREPARED OR APPROVED BY ME, AND THAT I AM A DULY LICENSED PROFESSIONAL ENGINEER UNDER THE LAWS OF THE STATE OF MARYLAND, LICENSE NO. 23402, EXPIRATION DATE 25 AUGUST 2022.




DSN. BY: MBS/MP	CYH	REPLACEMENT SHEET FROM PHASE II	8/2022
DRN. BY: JAP/KEJ		CONTRACT ORAL COMMENTS TO SHOW DESIGN	
CHK. BY: SMD		PHASE REVISIONS TO ESD	
DATE: JUNE 2021	BY NO.	REVISION	DATE

ESD PROFILE AND DETAILS I
(REPLACEMENT SHEET)


COMPOST FACILITY - PHASE II
AT ALPHA RIDGE LANDFILL
HOWARD COUNTY, MARYLAND

SDP SHEET: 27 OF 45
DRAWING: SW-6
PROJECT: 1556408
SHEET: -20 OF 42



REVISED SITE DEVELOPMENT PLAN #SDP-16-035

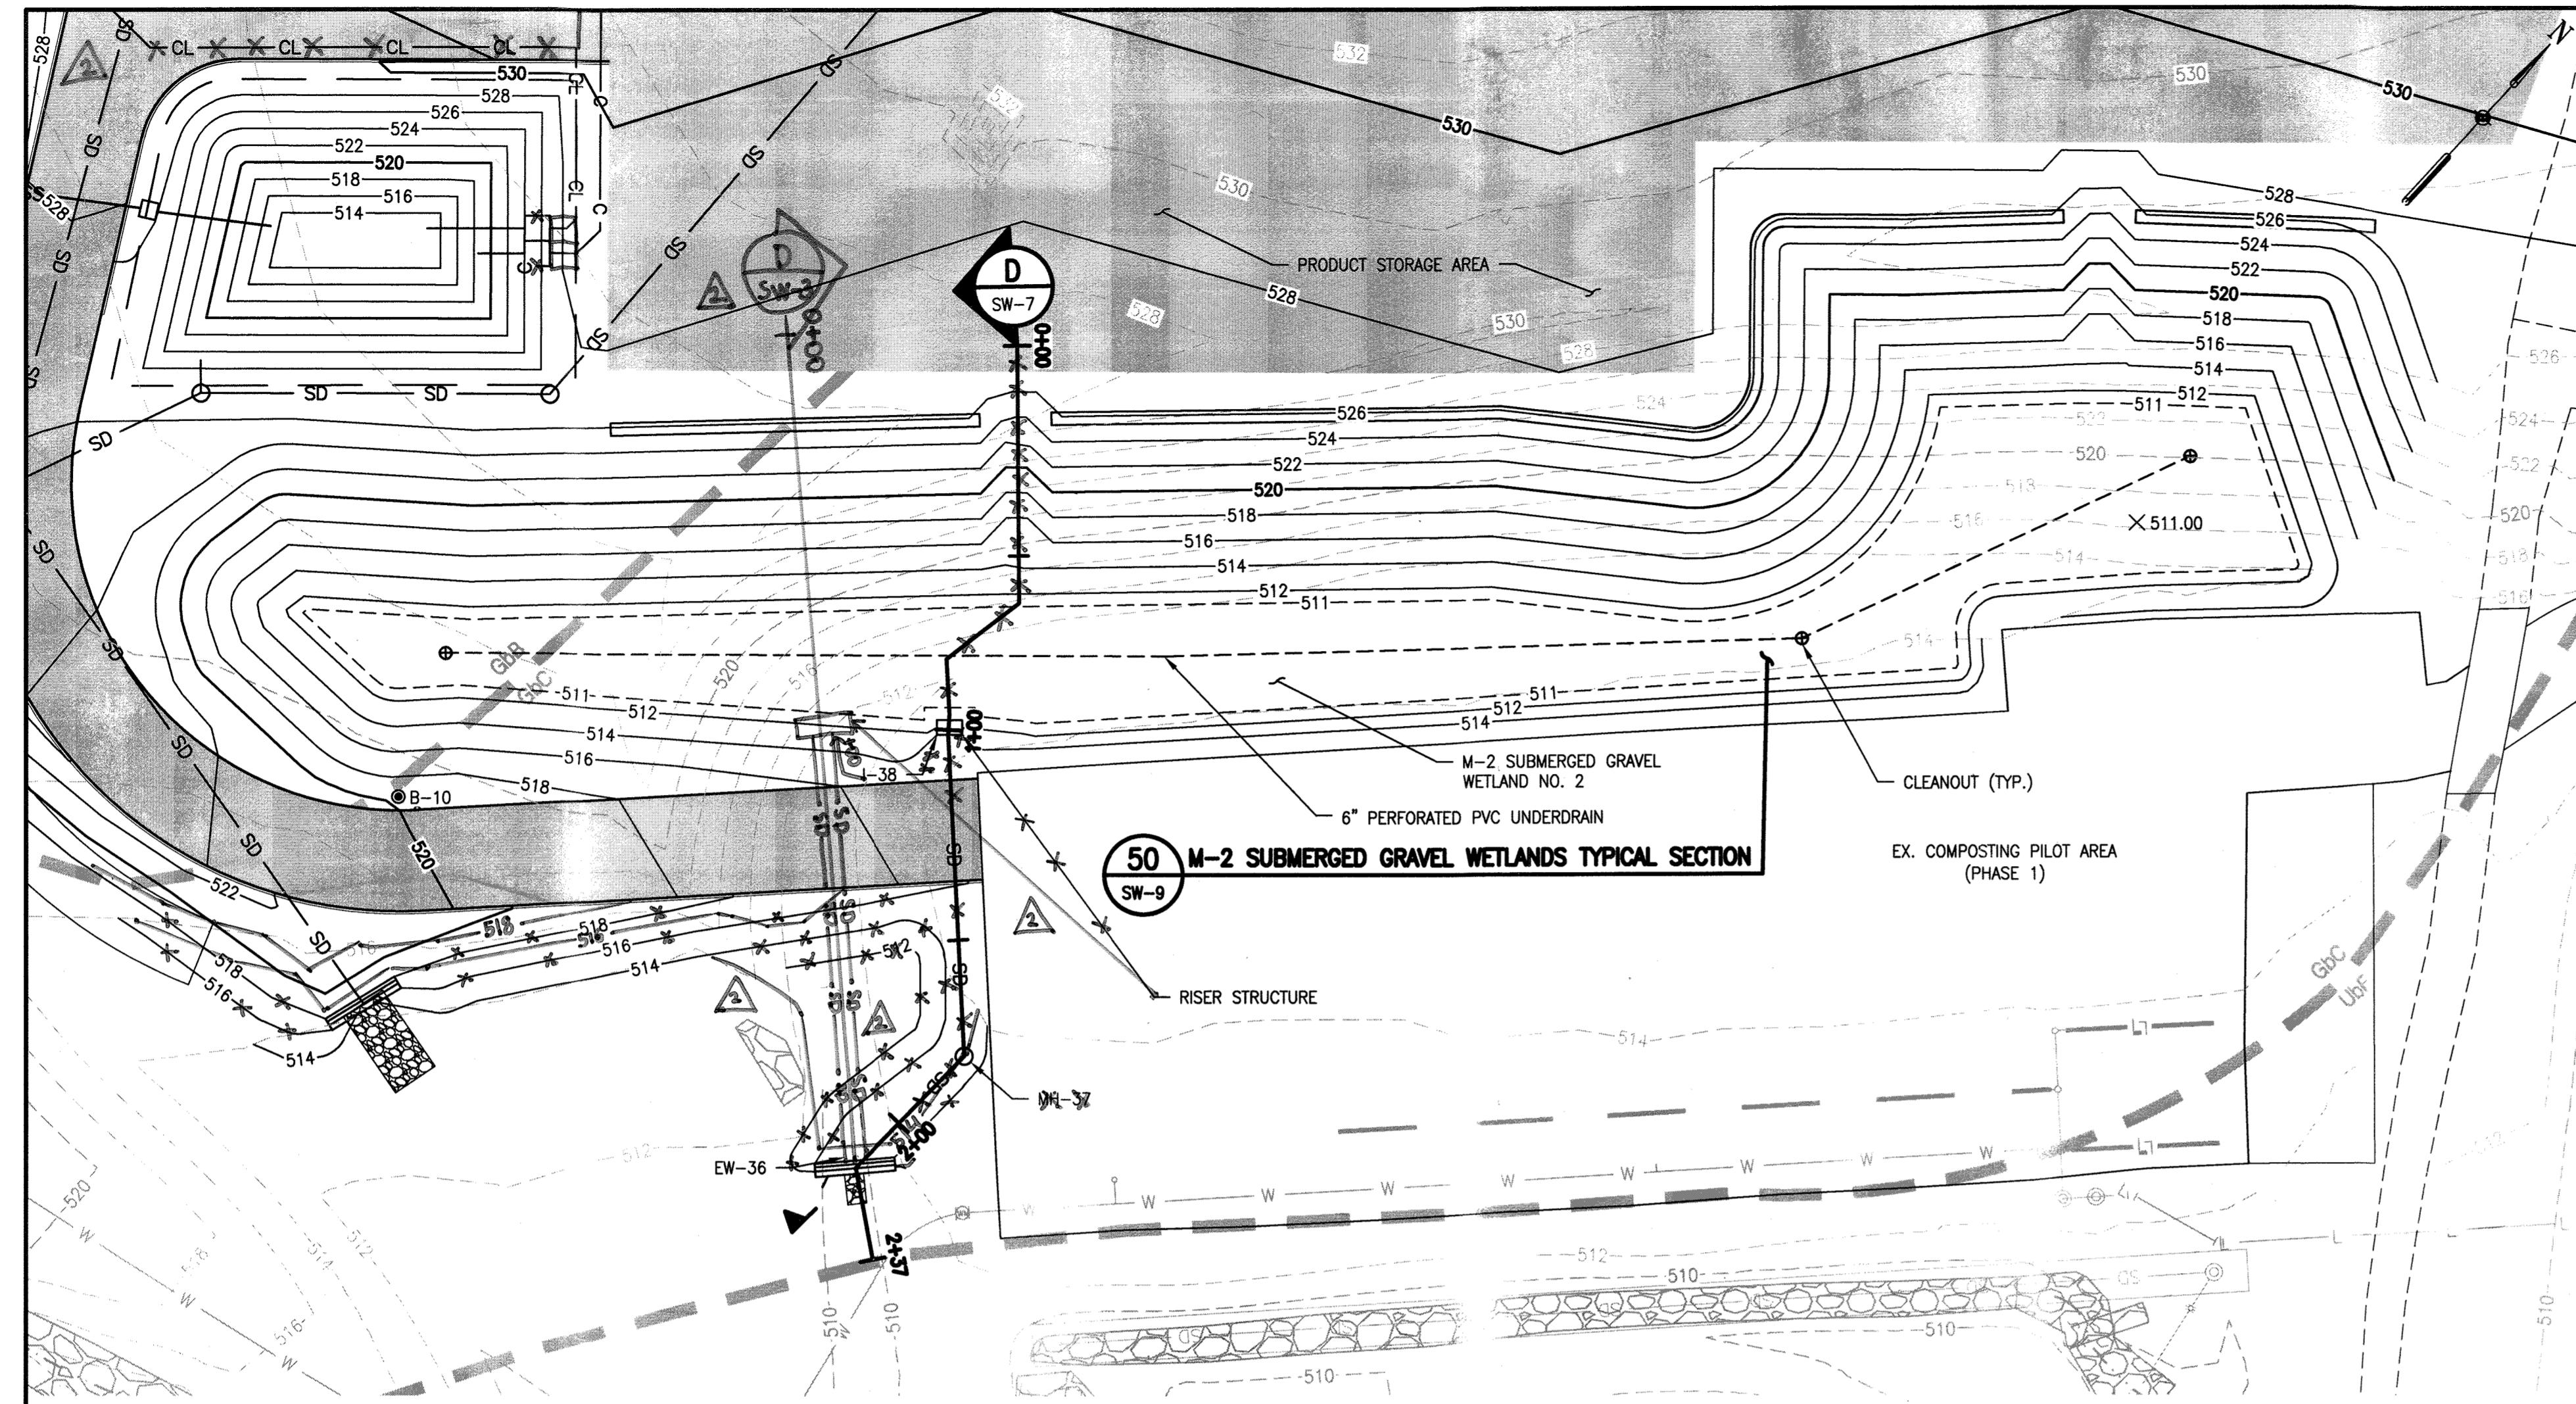

SUBMERGED GRAVEL WETLAND NO. 2 SITE PLAN
SCALE: 1" = 30'

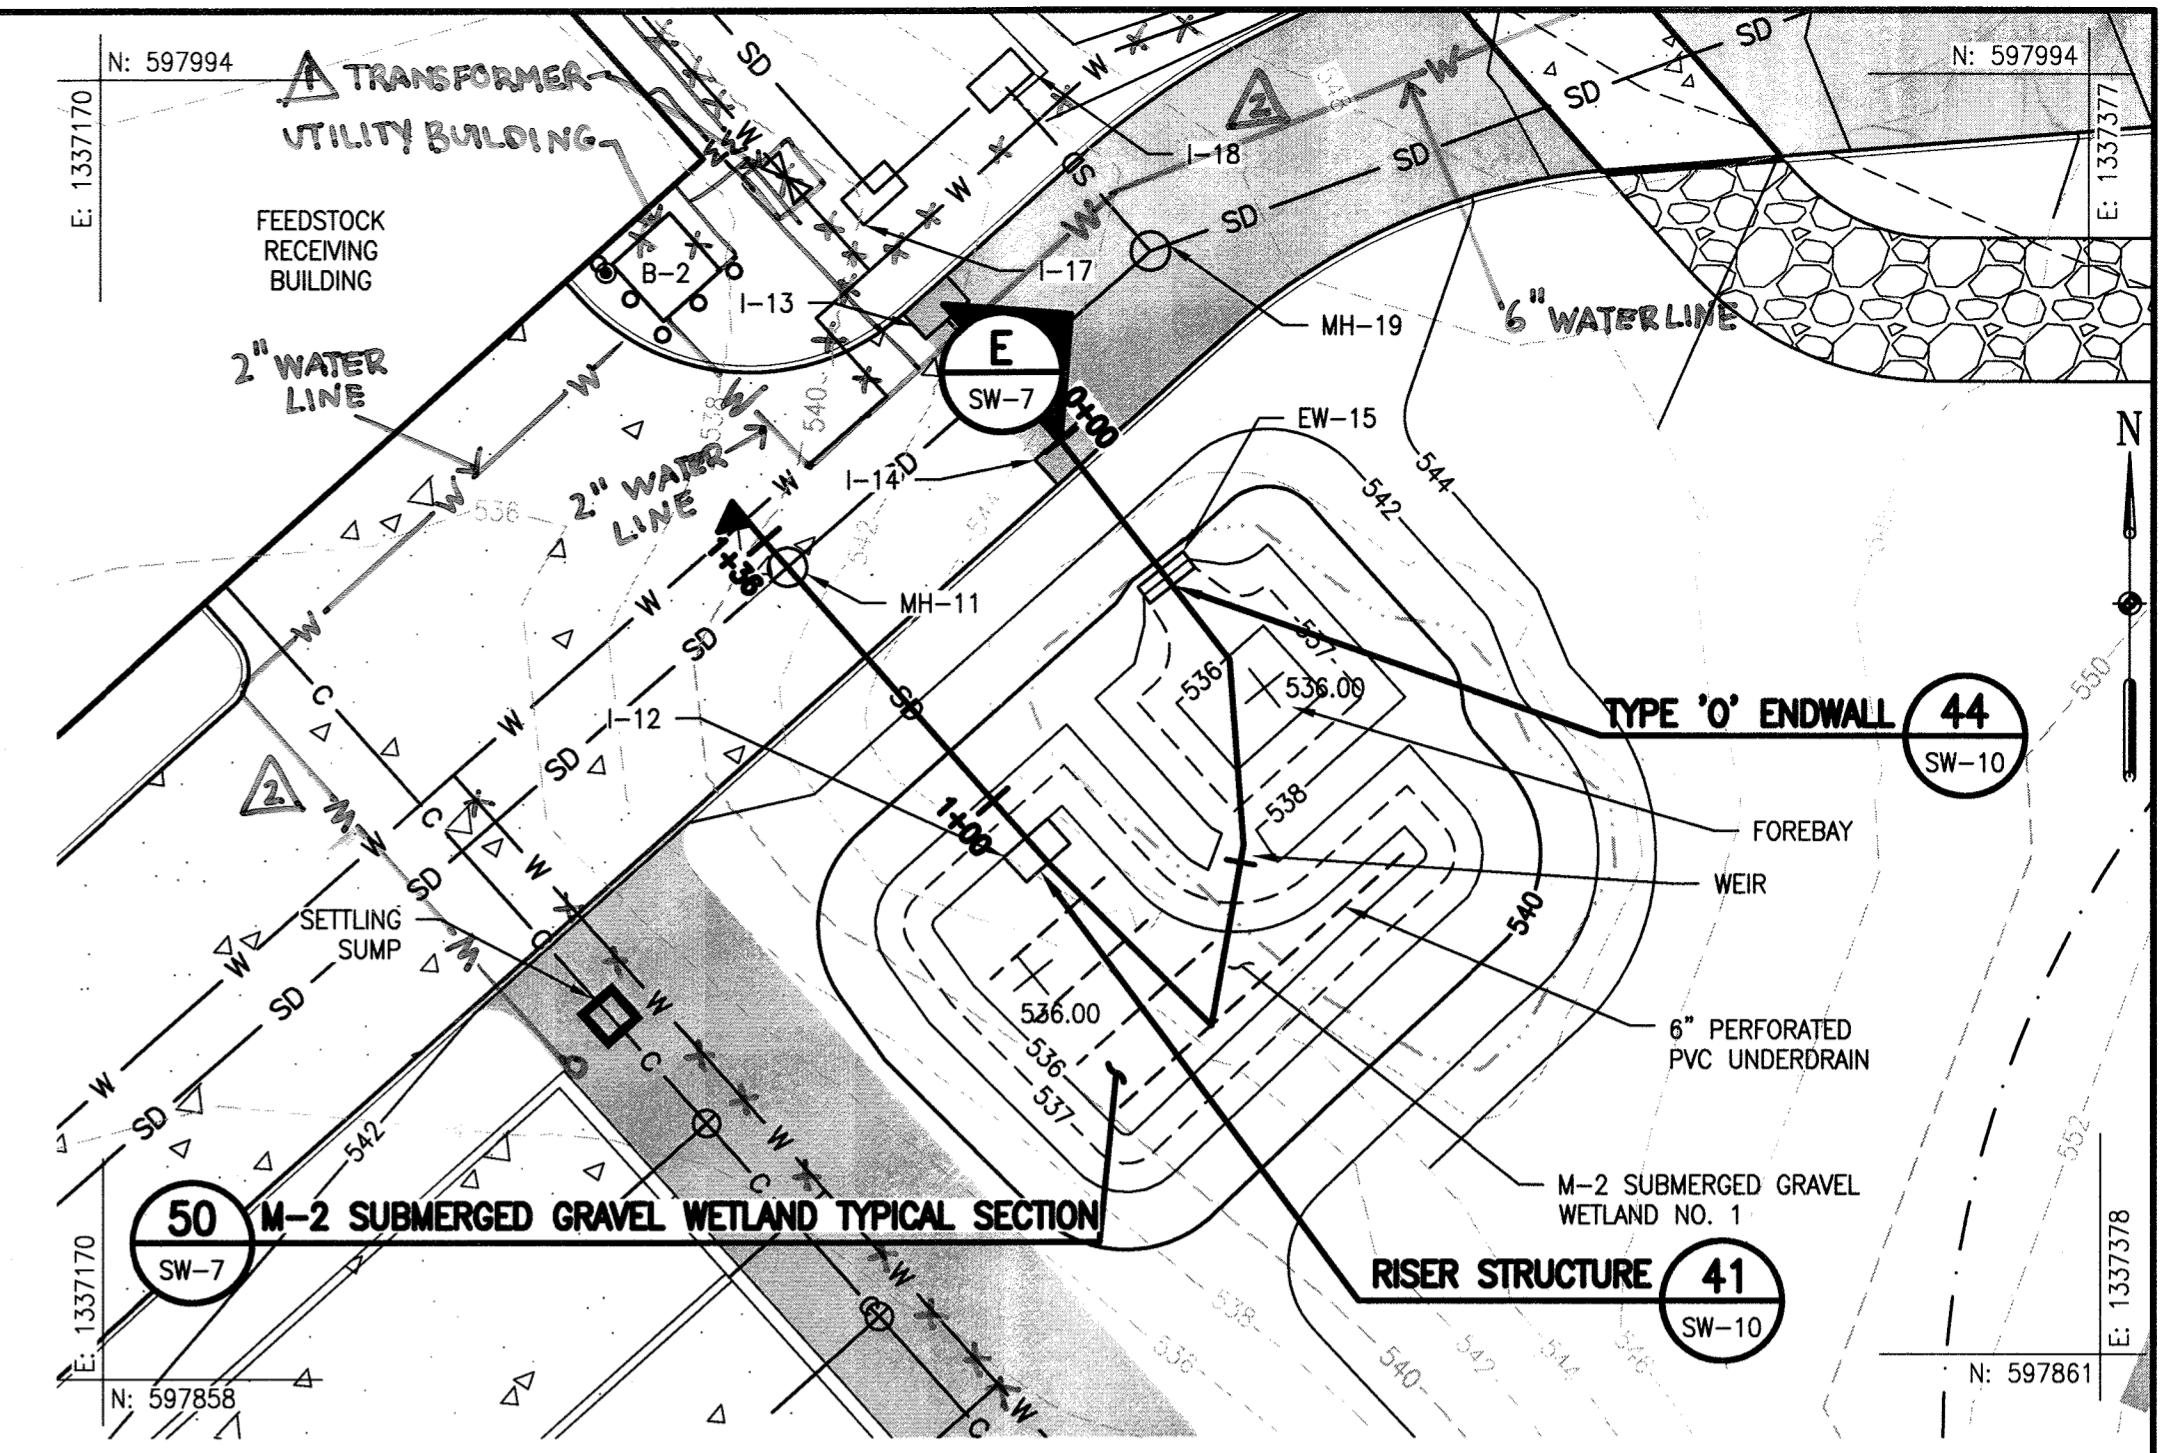


SUBMERGED GRAVEL WETLAND NO. 1 SITE PLAN
SCALE: 1" = 20'

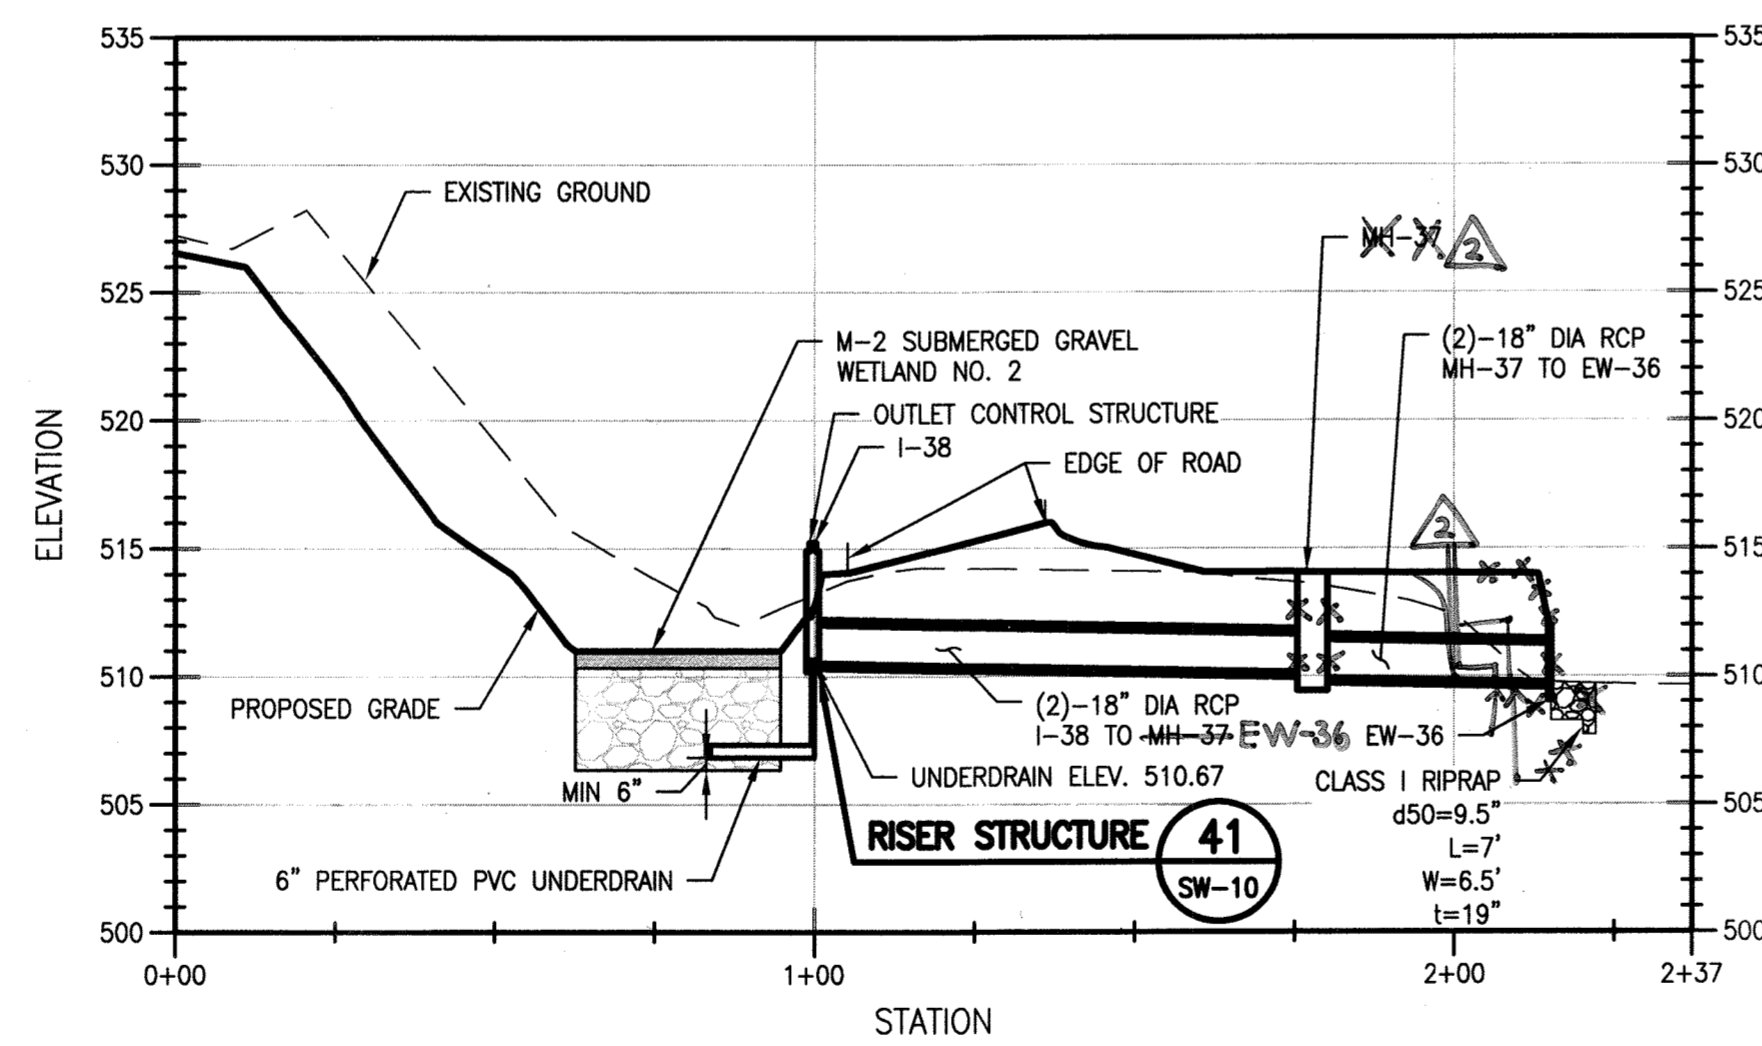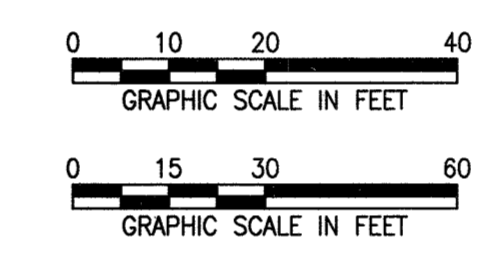


D SUBMERGED GRAVEL WETLAND NO. 2 PROFILE

- NOTES:
- AT THE TIME OF GEOTECHNICAL INVESTIGATION, GROUNDWATER WAS NOT ENCOUNTERED WITHIN BORING B-10.
 - SEE TYPICAL SECTION DETAIL THIS SHEET.
 - REFER TO PROFILE EW-36 TO I-38 FOR STORMDRAIN ON SHEET SW-4.

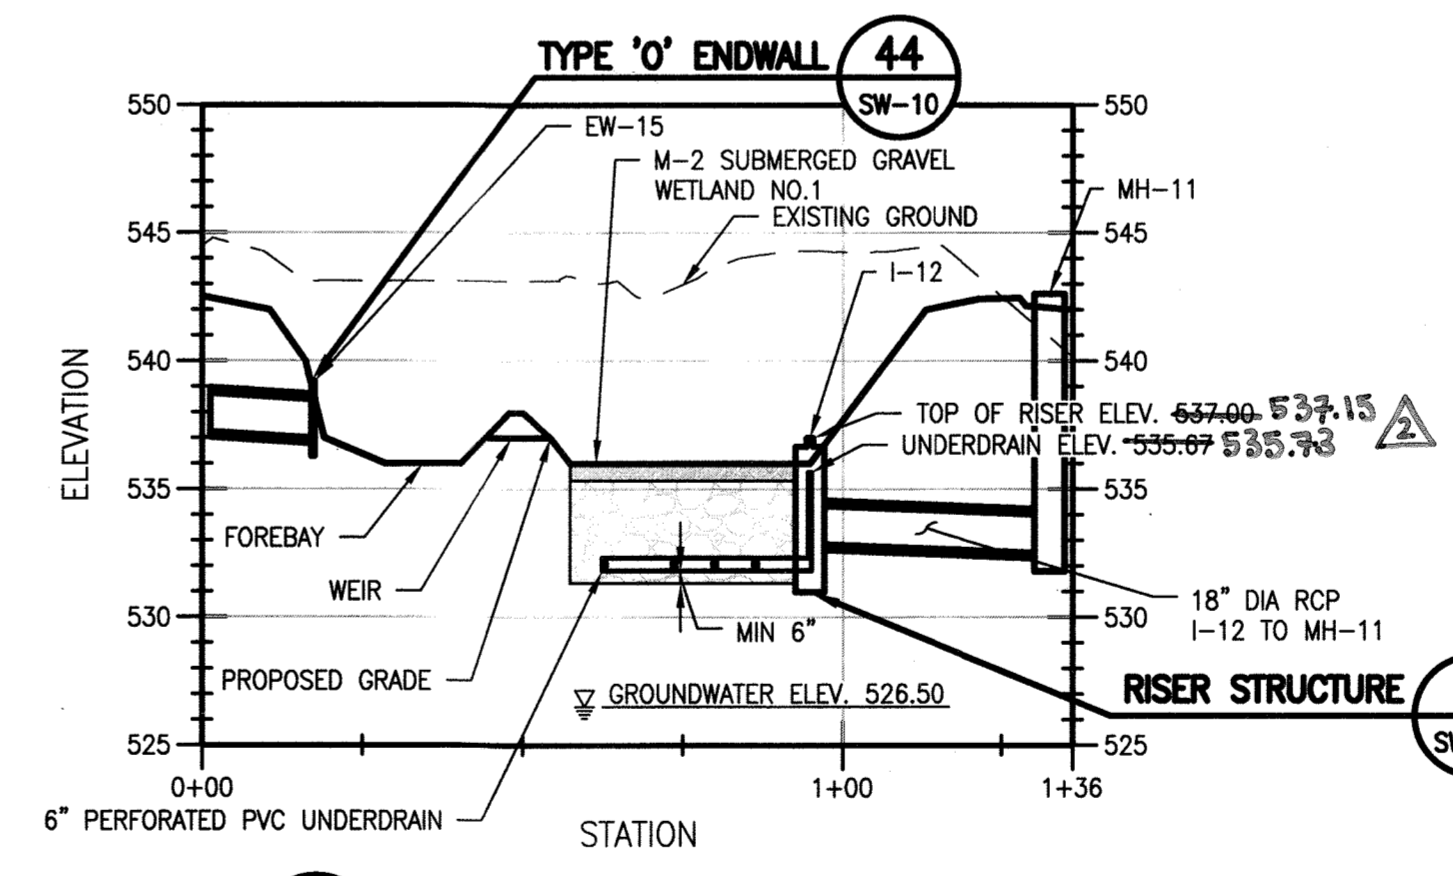

E SUBMERGED GRAVEL WETLAND NO. 1 PROFILE

- NOTES:
- AT THE TIME OF GEOTECHNICAL INVESTIGATION, GROUNDWATER WAS ENCOUNTERED AT ELEVATION 526.5 AT BORING B-2.
 - SEE TYPICAL SECTION DETAIL THIS SHEET.
 - REFER TO PROFILE MH-11 TO I-12 FOR STORMDRAIN ON SHEET SW-4.

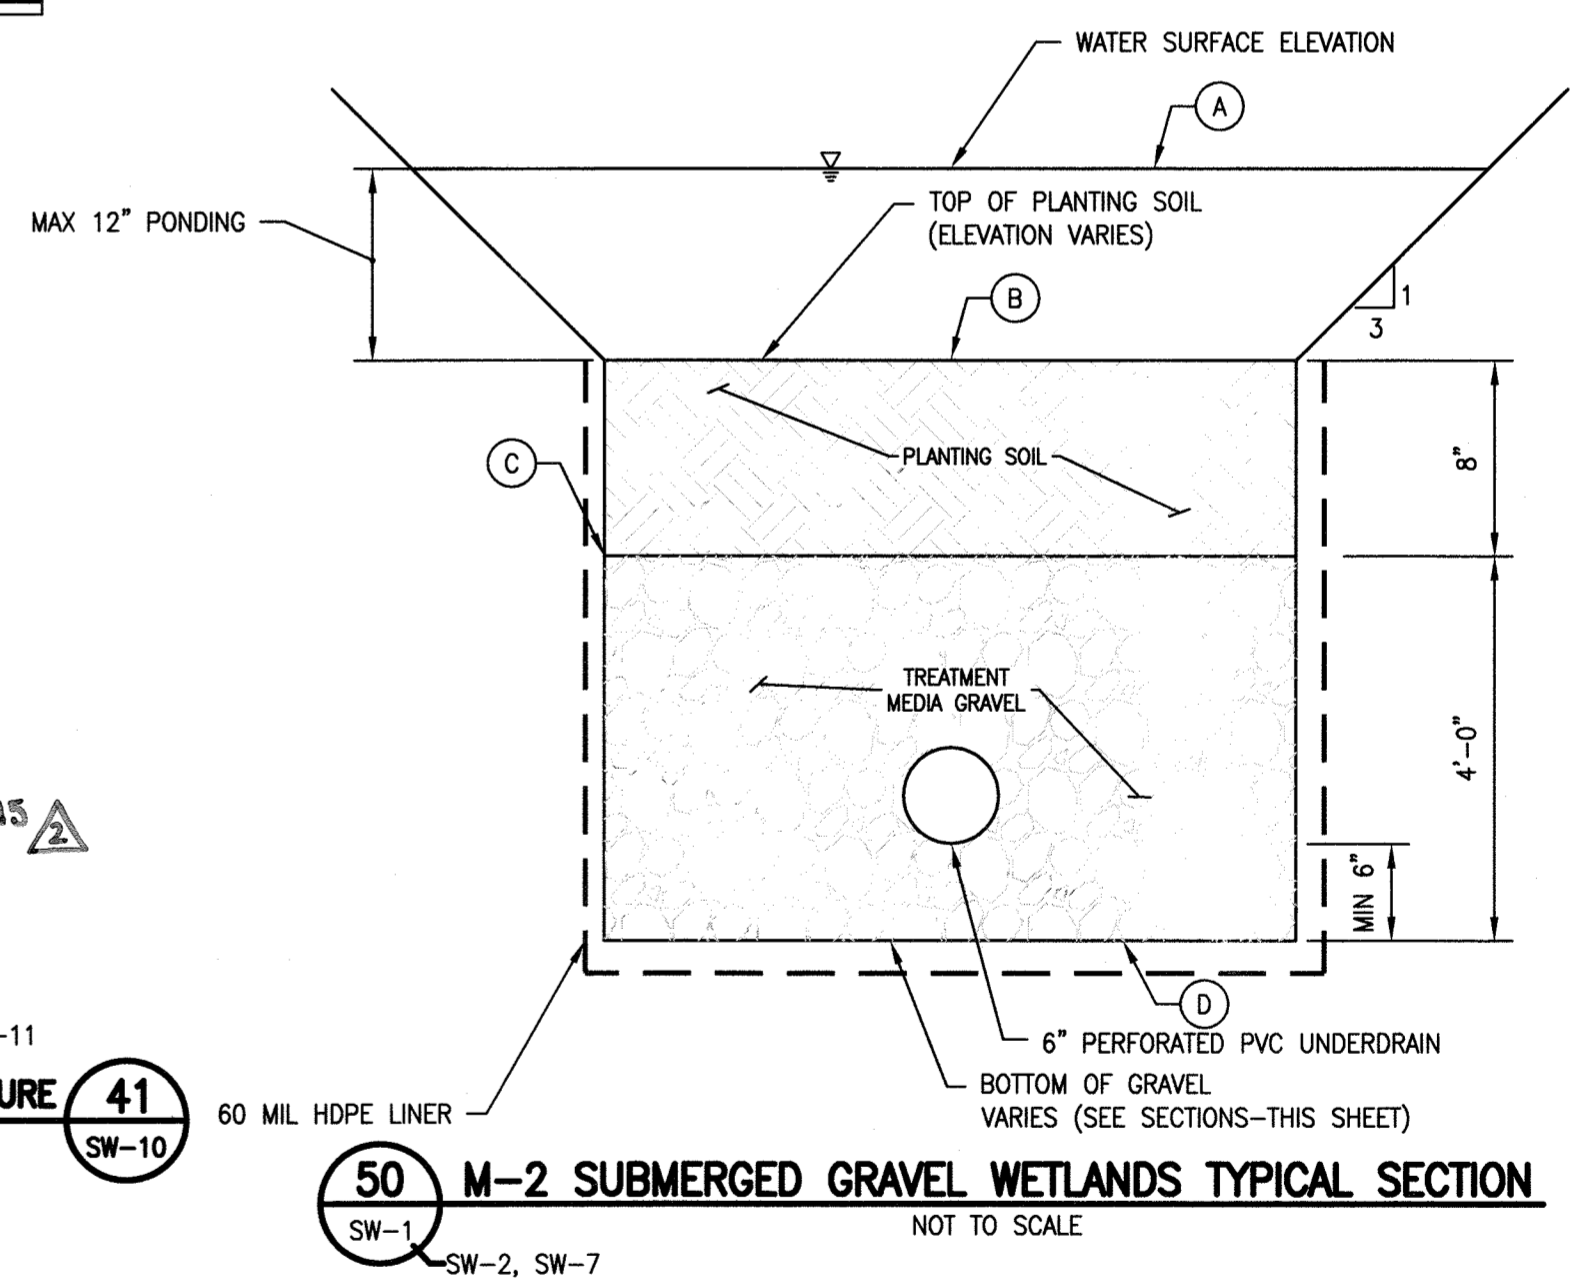

50 M-2 SUBMERGED GRAVEL WETLANDS TYPICAL SECTION
NOT TO SCALE

	ELEVATIONS (IN FEET)			
	A	B	C	D
SUBMERGED GRAVEL WETLANDS				
SUBMERGED GRAVEL WETLANDS NO. 1	537.00	536.00	535.33	531.33
SUBMERGED GRAVEL WETLANDS NO. 2	512.00	511.00	510.33	506.33

- NOTES:
- SEE SHEET DA-1 FOR ESD FACILITY SUMMARY TABLE AND DRAINAGE AREAS.

BENCHMARK INFORMATION

- HOWARD COUNTY SURVEY CONTROL: BASE A
ELEVATION 564.733 US FT
N 598,156.281 E 1,336,841.785
- HOWARD COUNTY SURVEY CONTROL: BASE F
ELEVATION 512.817 US FT
N 597,030.549 E 1,338,031.404

THE SYSTEM OF COORDINATES USED BY HOWARD COUNTY IS BASED ON THE FOLLOWING DATUMS AND PROJECTIONS:

- HORIZONTAL: MARYLAND NAD83
- VERTICAL: NAVD88

BENCHMARK LOCATIONS PROVIDED ON PROJECT ACCESS INSET.

DATA SOURCES

- THE EXISTING TOPOGRAPHY AND UTILITIES INSIDE OF THE 'LIMIT OF FIELD RUN TOPO', UNLESS OTHERWISE MENTIONED, HAVE BEEN PROVIDED FROM A FIELD RUN SURVEY BY THE HOWARD COUNTY SURVEY DIVISION IN AUGUST 2011.
- ALL INFORMATION LOCATED OUTSIDE OF THE LIMIT OF FIELD RUN TOPO LINE HAS BEEN TAKEN FROM THE HOWARD COUNTY GIS DATABASE.

APPROVED: DEPARTMENT OF PLANNING AND ZONING

Nathan Zappia 12-12-17
DIRECTOR DATE

John Chubb 11/29/17
CHIEF, DEVELOPMENT ENGINEERING DIVISION DATE


Neil LeBlond 12-5-17
CHIEF, DIVISION OF LAND DEVELOPMENT DATE

GRID: 8 BLOCK: N/A
ZONING: RC-DEO PARCEL/LOT: 220, 253, 23, 54
TAX MAP: 0016 ELECTION DISTRICT: 3-02

OWNER/ENGINEER INFORMATION

DEVELOPER/OWNER:
HOWARD COUNTY GOVERNMENT
CONTACT: JEFF DANNIS, P.E., CSP
6751 COLUMBIA GATEWAY DRIVE, SUITE 514
COLUMBIA, MD 21046
TELEPHONE: (410) 313-6419

ENGINEER:
EA ENGINEERING, SCIENCE,
AND TECHNOLOGY, INC., PBC
CONTACT: MARK GUTBERLET, P.E.
225 SCHILLING CIRCLE, SUITE 400
HUNT VALLEY, MD 21031
TELEPHONE: (410) 584-7000

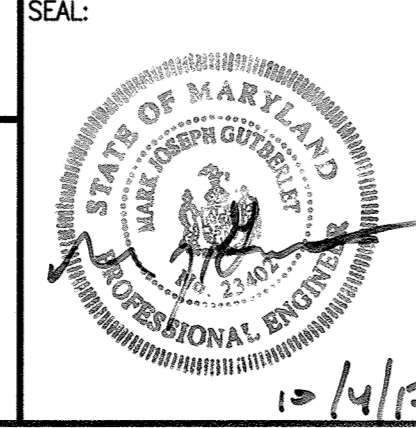

PROFESSIONAL CERTIFICATION:

EA ENGINEERING, SCIENCE AND TECHNOLOGY

DATE: OCT. 2016


DSN. BY:	MBS/MP	SMB	REVISION	DATE
DRN. BY:	JAP/KEJ	CVH	REVISION	DATE
CHK. BY:	SMD		REVISION	DATE
DATE:	OCT. 2016		REVISION	DATE

ESD PROFILE AND DETAILS II


**COMPOST FACILITY - PHASE II
AT ALPHA RIDGE LANDFILL
HOWARD COUNTY, MARYLAND**

SDP SHEET: 45
DRAWING: SW-7
PROJECT: 14982.05
SHEET: 42 OF 70


NOT FOR CONSTRUCTION - SITE DEVELOPMENT PLAN #SDP-16-035

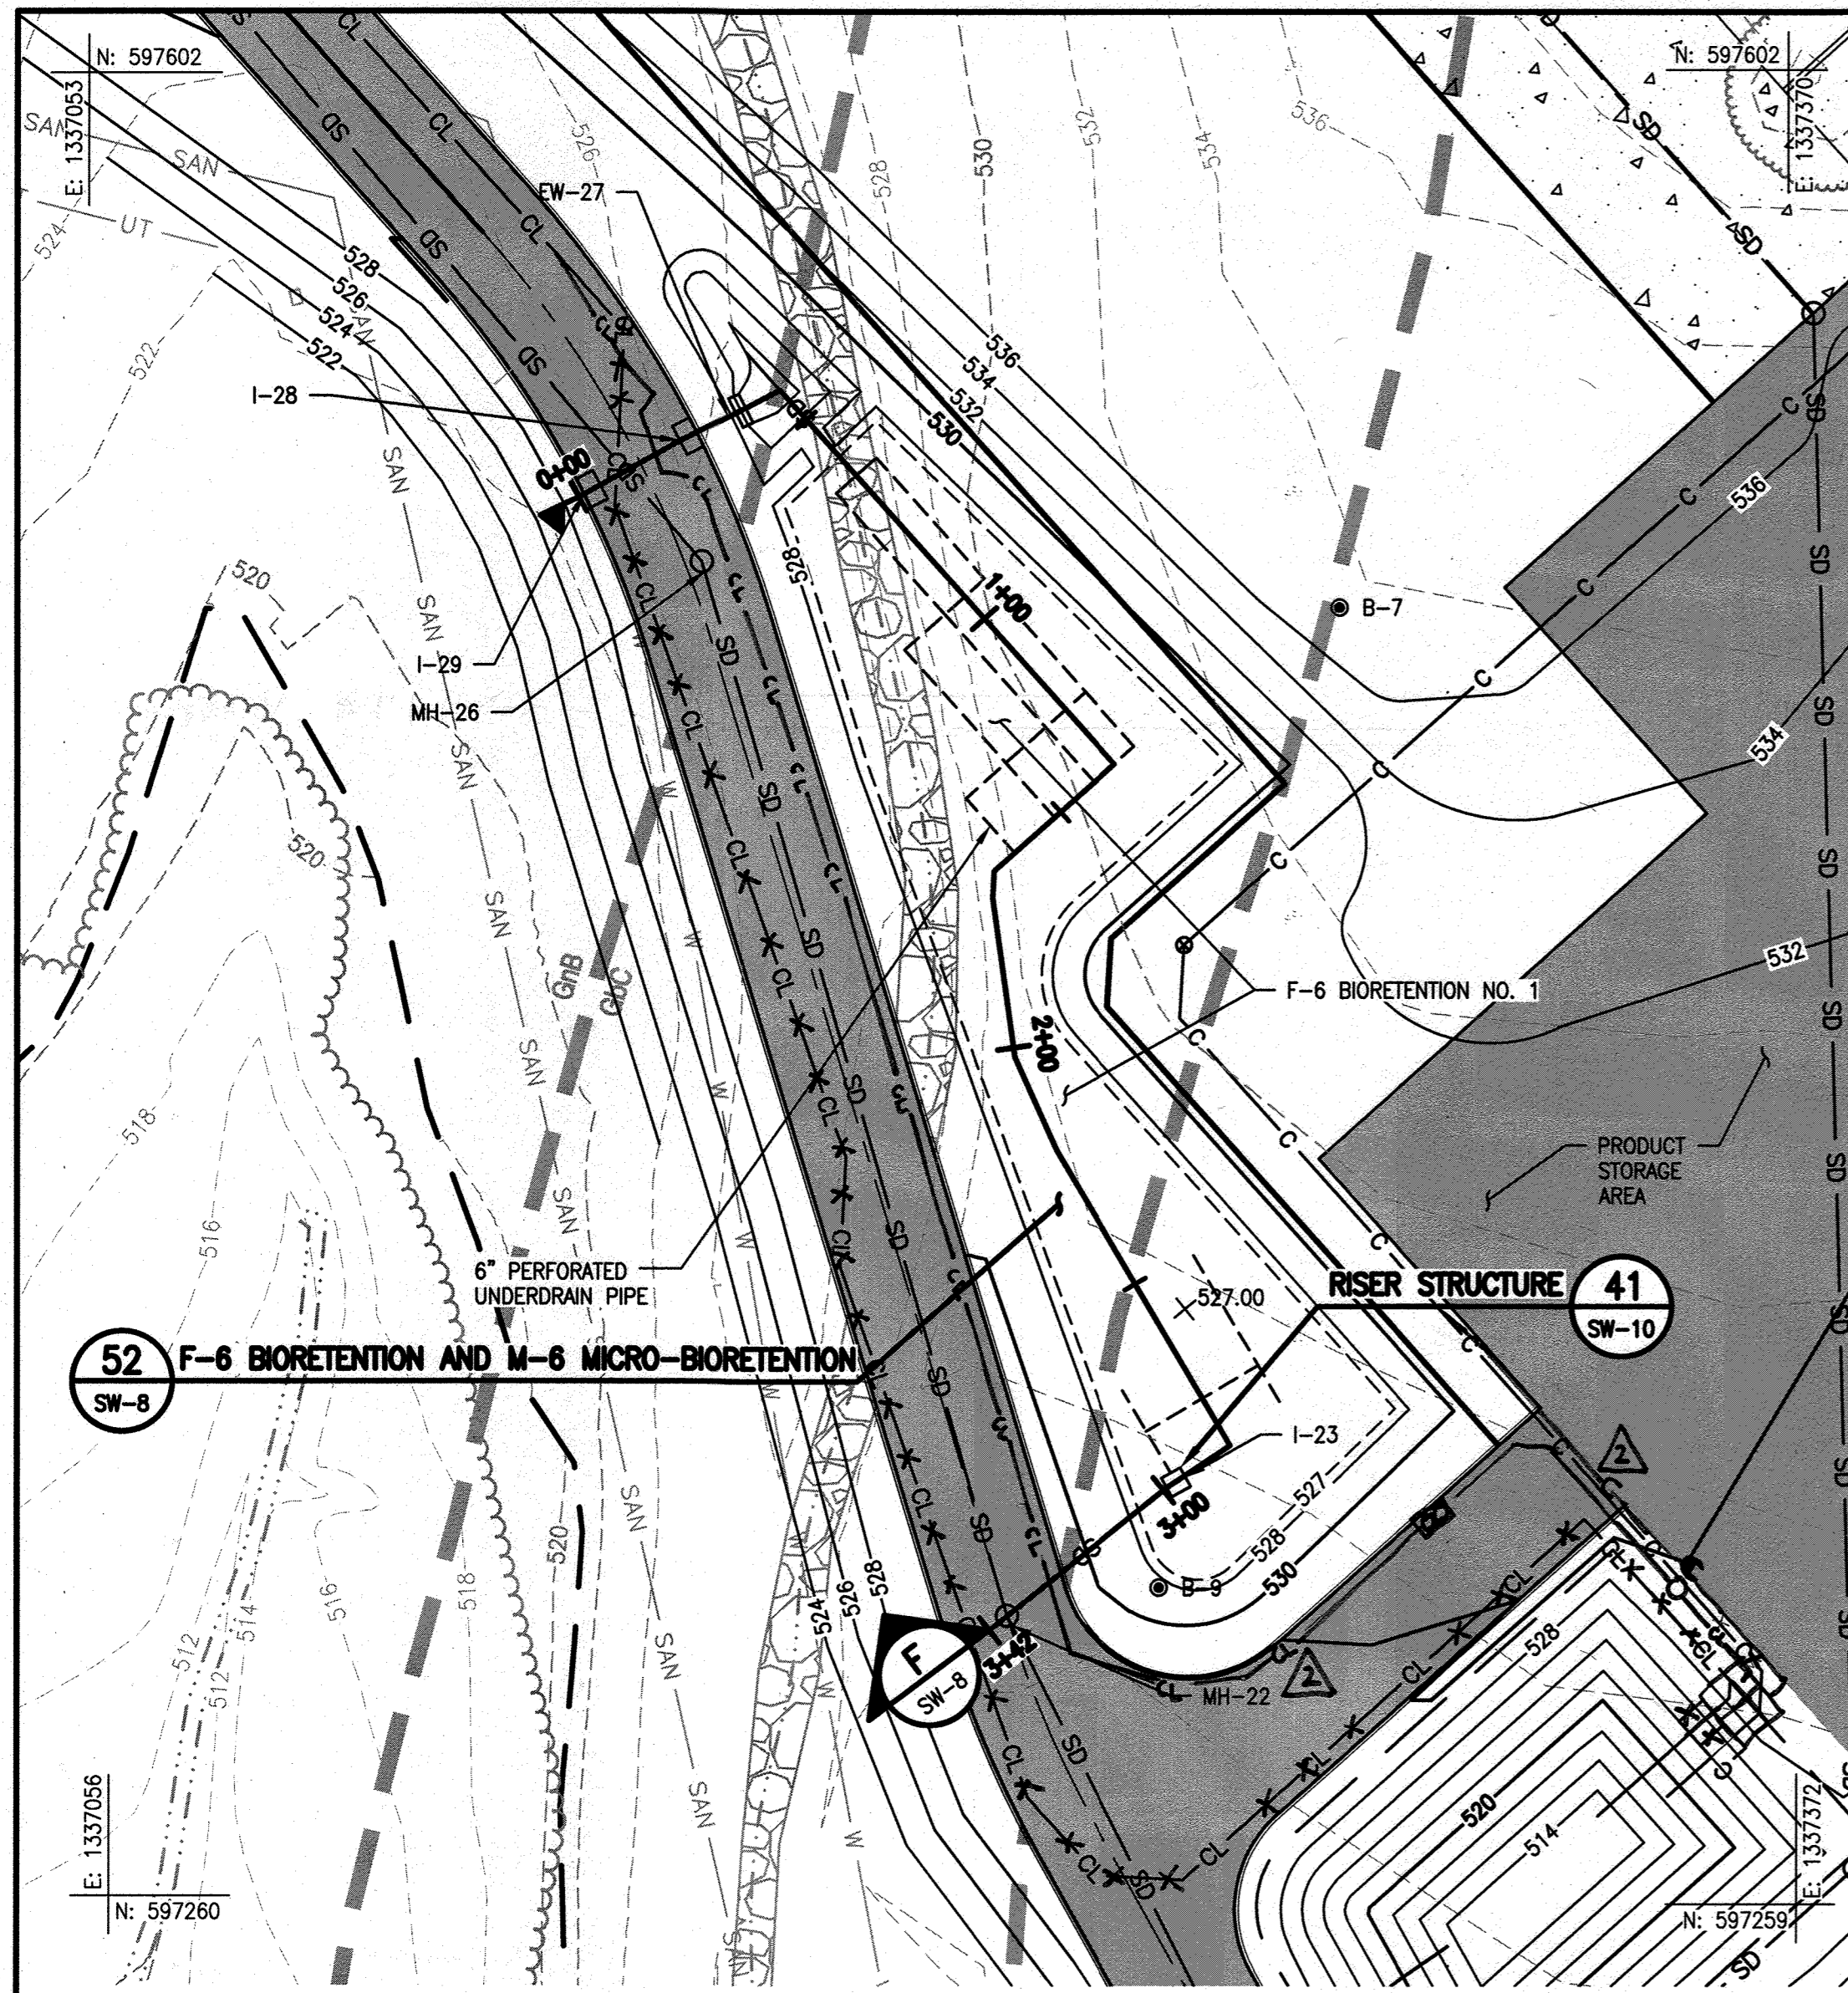

BIORETENTION NO. 1 SITE PLAN
SCALE: 1" = 30'

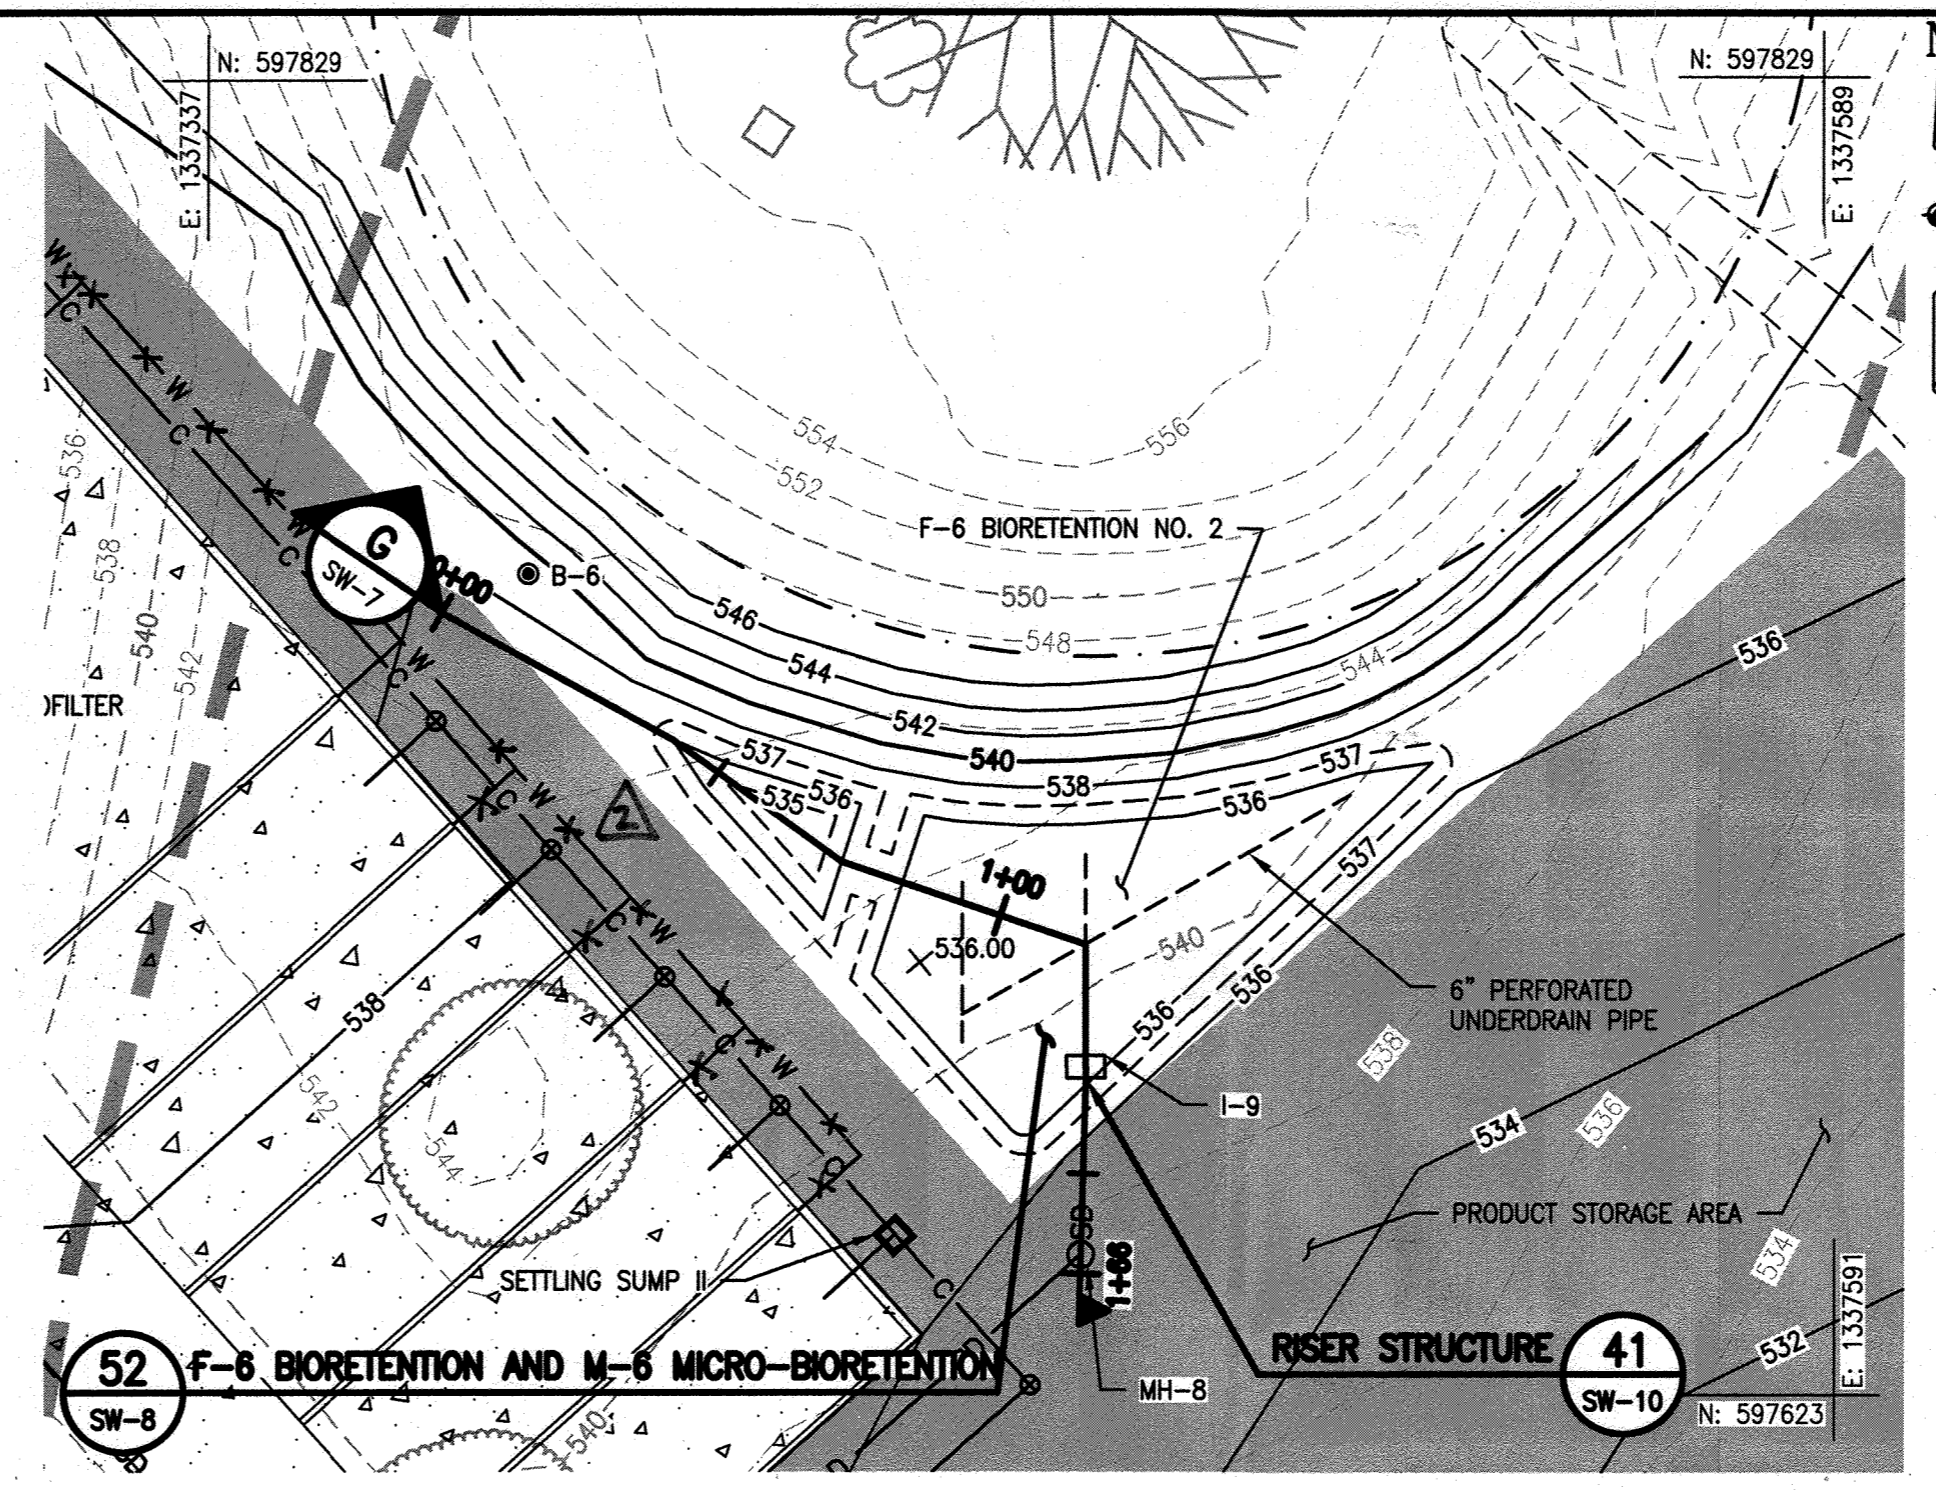


BIORETENTION NO. 2 SITE PLAN
SCALE: 1" = 30'

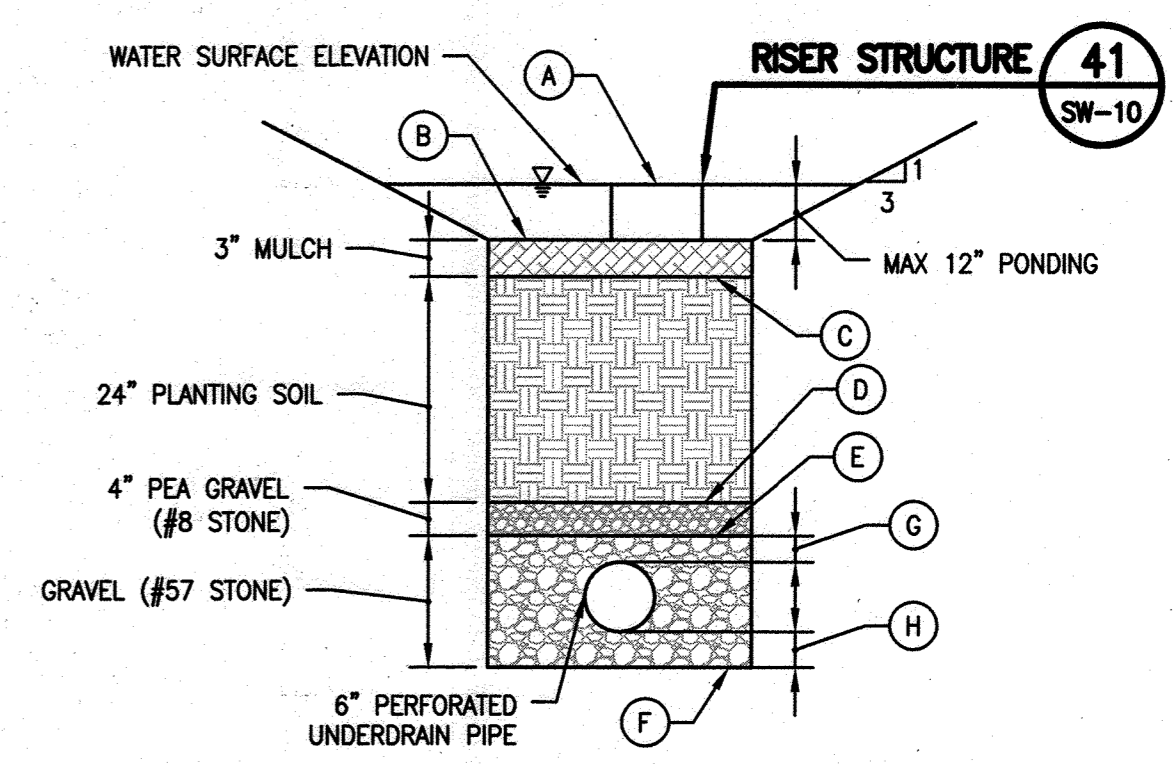

52 F-6 BIORETENTION AND M-6 MICRO-BIORETENTION
NOT TO SCALE

ESD FEATURE	ELEVATIONS (IN FEET)						G	H
	A	B	C	D	E	F		
BIORETENTION NO. 1	528.00	527.00	526.75	524.75	524.42	523.00	3"	8"
BIORETENTION NO. 2	536.50	536.00	536.76	533.76	533.42	531.67	3"	12"
	536.11	535.80	535.74	533.35	521.48			

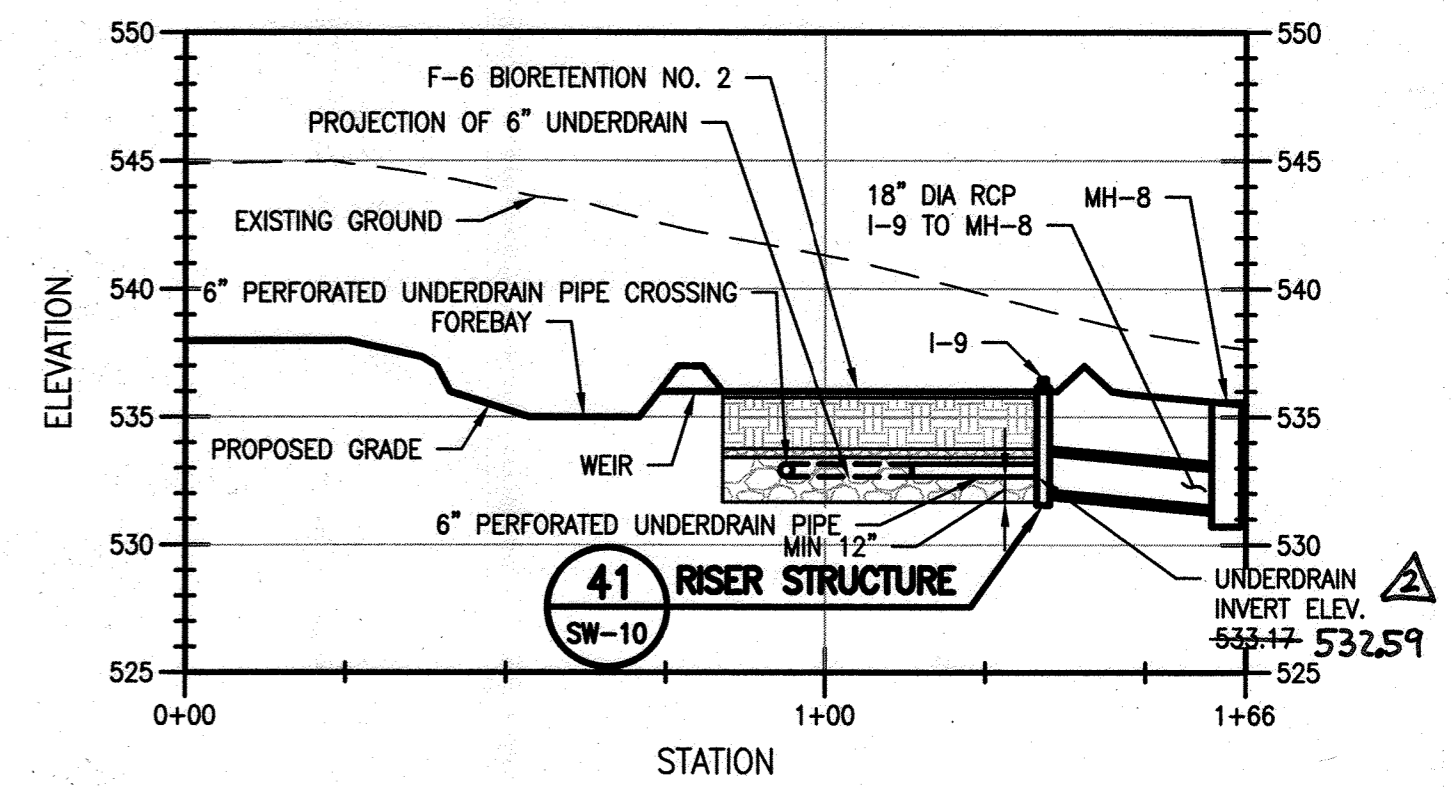

G BIORETENTION NO. 2 PROFILE
SW-8

- NOTES:
- REFER TO PROFILE MH-7 TO I-9 FOR STORMDRAIN ON SHEET SW-4.
 - SEE TYPICAL SECTION DETAIL THIS SHEET.

BENCHMARK INFORMATION

- HOWARD COUNTY SURVEY CONTROL: BASE A
ELEVATION 564.733 US FT
N 598,156.281 E 1,336,841.785
- HOWARD COUNTY SURVEY CONTROL: BASE F
ELEVATION 512.817 US FT
N 597,030.549 E 1,338,031.404

THE SYSTEM OF COORDINATES USED BY HOWARD COUNTY IS BASED ON THE FOLLOWING DATUMS AND PROJECTIONS:

- HORIZONTAL: MARYLAND NAD83
- VERTICAL: NAVD88

BENCHMARK LOCATIONS PROVIDED ON PROJECT ACCESS INSET.

DATA SOURCES

- THE EXISTING TOPOGRAPHY AND UTILITIES INSIDE OF THE 'LIMIT OF FIELD RUN TOPO', UNLESS OTHERWISE MENTIONED, HAVE BEEN PROVIDED FROM A FIELD RUN SURVEY BY THE HOWARD COUNTY SURVEY DIVISION IN AUGUST 2011.
- ALL INFORMATION LOCATED OUTSIDE OF THE LIMIT OF FIELD RUN TOPO LINE HAS BEEN TAKEN FROM THE HOWARD COUNTY GIS DATABASE.

APPROVED: DEPARTMENT OF PLANNING AND ZONING

Valerie J. J. [Signature] 12-17-17
DIRECTOR DATE

Paul Edmund [Signature] 11-29-17
CHIEF, DEVELOPMENT ENGINEERING DIVISION DATE


Ket [Signature] 12-5-17
CHIEF, DIVISION OF LAND DEVELOPMENT DATE

OWNER/ENGINEER INFORMATION

GRID: 8 BLOCK: N/A
ZONING: RC-DEO PARCEL/LOT: 220, 253, 11, 23, 54
TAX MAP: 0016 ELECTION DISTRICT: 3-02

DEVELOPER/OWNER:
HOWARD COUNTY GOVERNMENT
CONTACT: JEFF DANNIS, P.E., CSP
8751 COLUMBIA GATEWAY DRIVE, SUITE 514
COLUMBIA, MD 21046
TELEPHONE: (410) 313-6419


ENGINEER:
EA ENGINEERING, SCIENCE
AND TECHNOLOGY, INC., PBC
CONTACT: MARK GLUTBERG, P.E.
225 SCHILLING CIRCLE, SUITE 400
HUNT VALLEY, MD 21031
TELEPHONE: (410) 584-7000

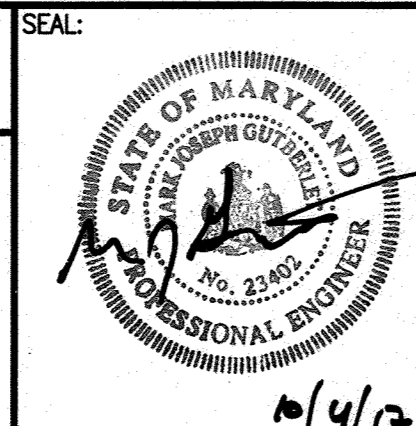

PROFESSIONAL CERTIFICATION:

I HEREBY CERTIFY THAT THESE DOCUMENTS WERE PREPARED OR APPROVED BY ME, AND THAT I AM A DULY LICENSED PROFESSIONAL ENGINEER UNDER THE LAWS OF THE STATE OF MARYLAND, LICENSE NO. 23402, EXPIRATION DATE 25 AUGUST 2018.

EA
EA ENGINEERING, SCIENCE, AND TECHNOLOGY

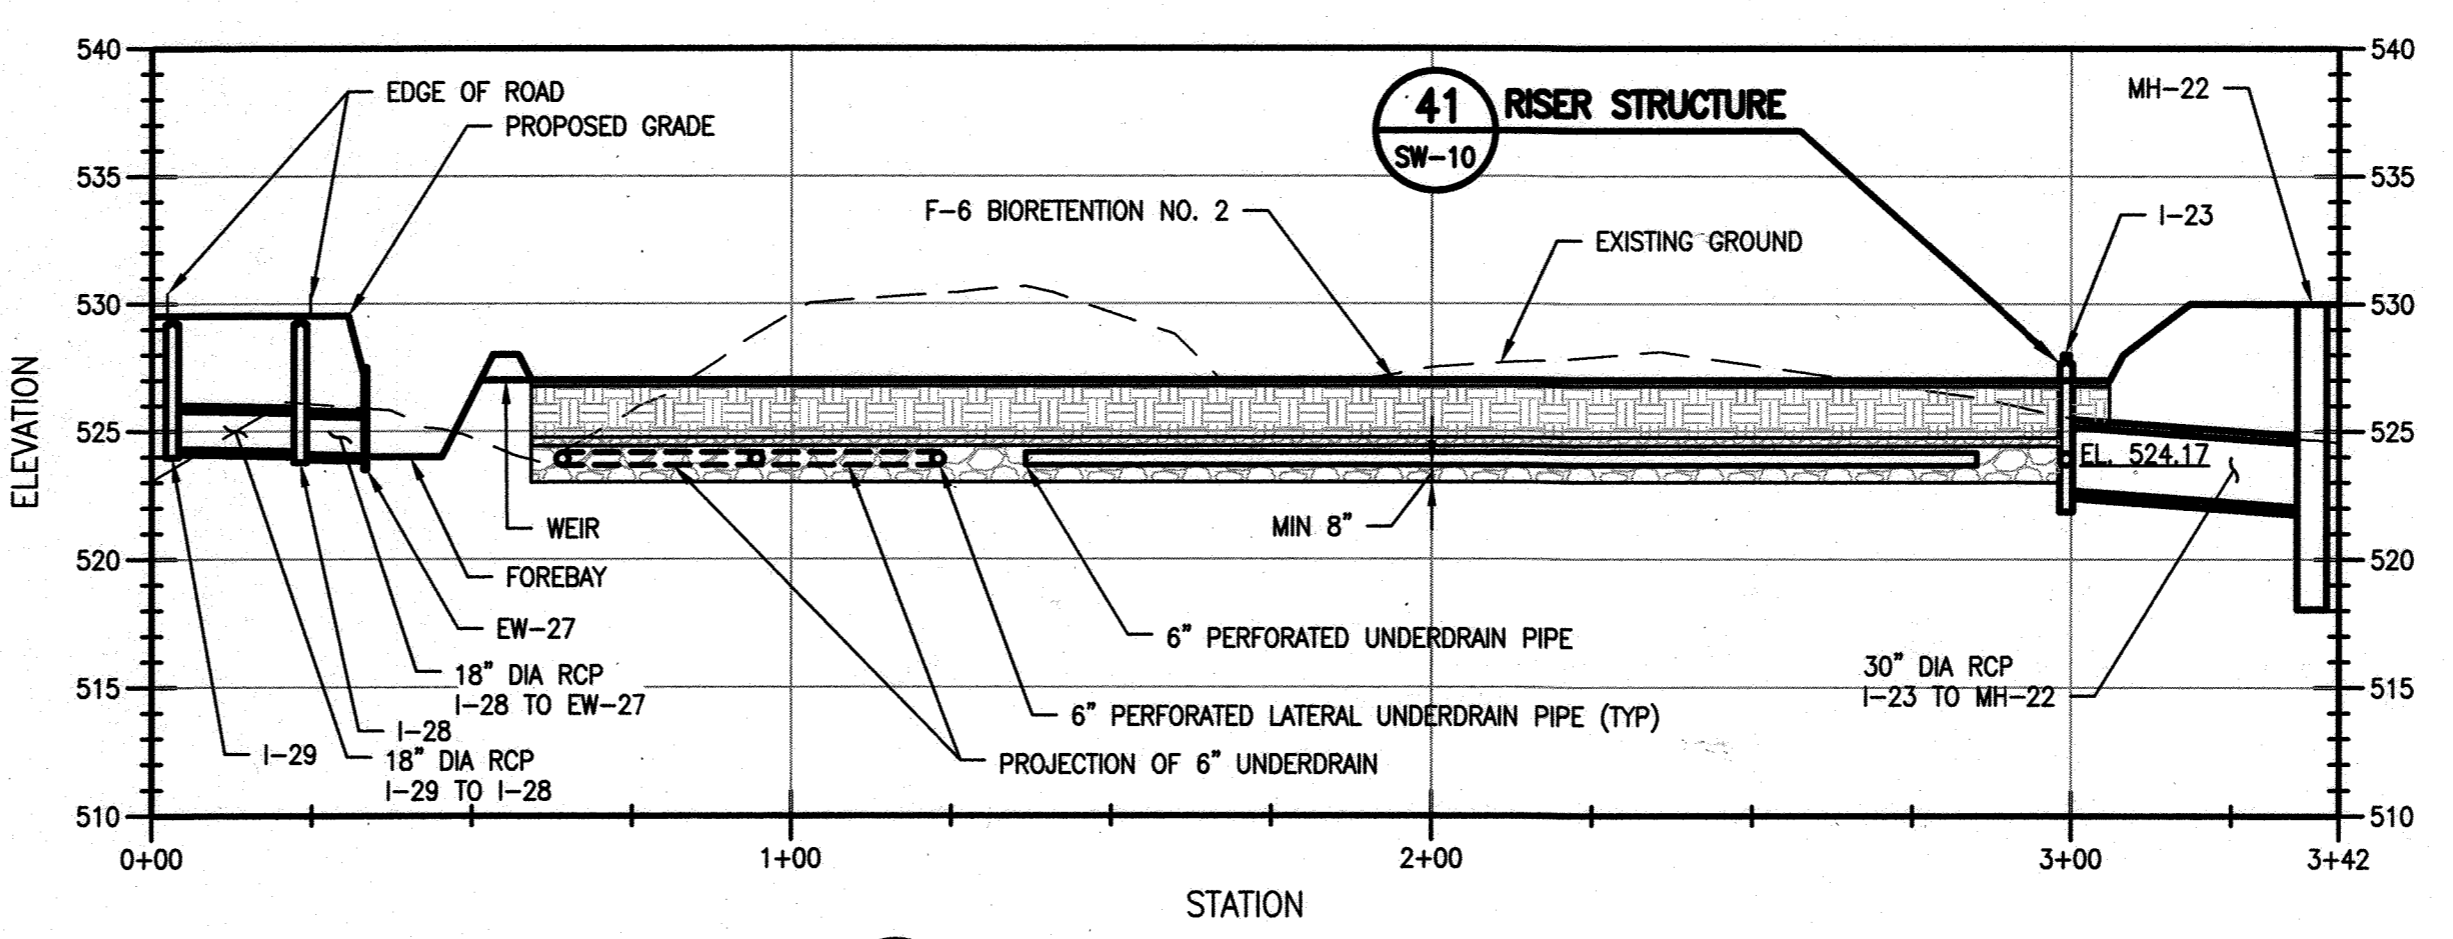

F BIORETENTION NO. 1 PROFILE
SW-8

- NOTES:
- REFER TO PROFILE MH-22 TO I-23 FOR STORMDRAIN ON SHEET SW-5.
 - SEE TYPICAL SECTION DETAIL THIS SHEET.

DSN. BY:	MBS/MP	CVM	REVISION TO SUBMIT PHASE II A AND PHASE II B AS-BUILT DESIGN	8/2022
DRN. BY:	JAP/KEJ			
CHK. BY:	SMD			
DATE:	OCT. 2016	BY	NO.	REVISION
				DATE


ESD PROFILE AND DETAILS III

- NOTES:
- SEE SHEET DA-1 FOR ESD FACILITY SUMMARY TABLE AND DRAINAGE AREAS.


SDP SHEET: 45
DRAWING: SW-8
PROJECT: 14982.05
SHEET: 43 OF 70

FILE PATH: G:\PROJECTS\14982-05 - AL COMPOST FACILITY\14982-05-03-01 - ESD PROFILE AND DETAILS III - (SDP-20) 1/12/15

NOT FOR CONSTRUCTION - SITE DEVELOPMENT PLAN #SDP-16-035

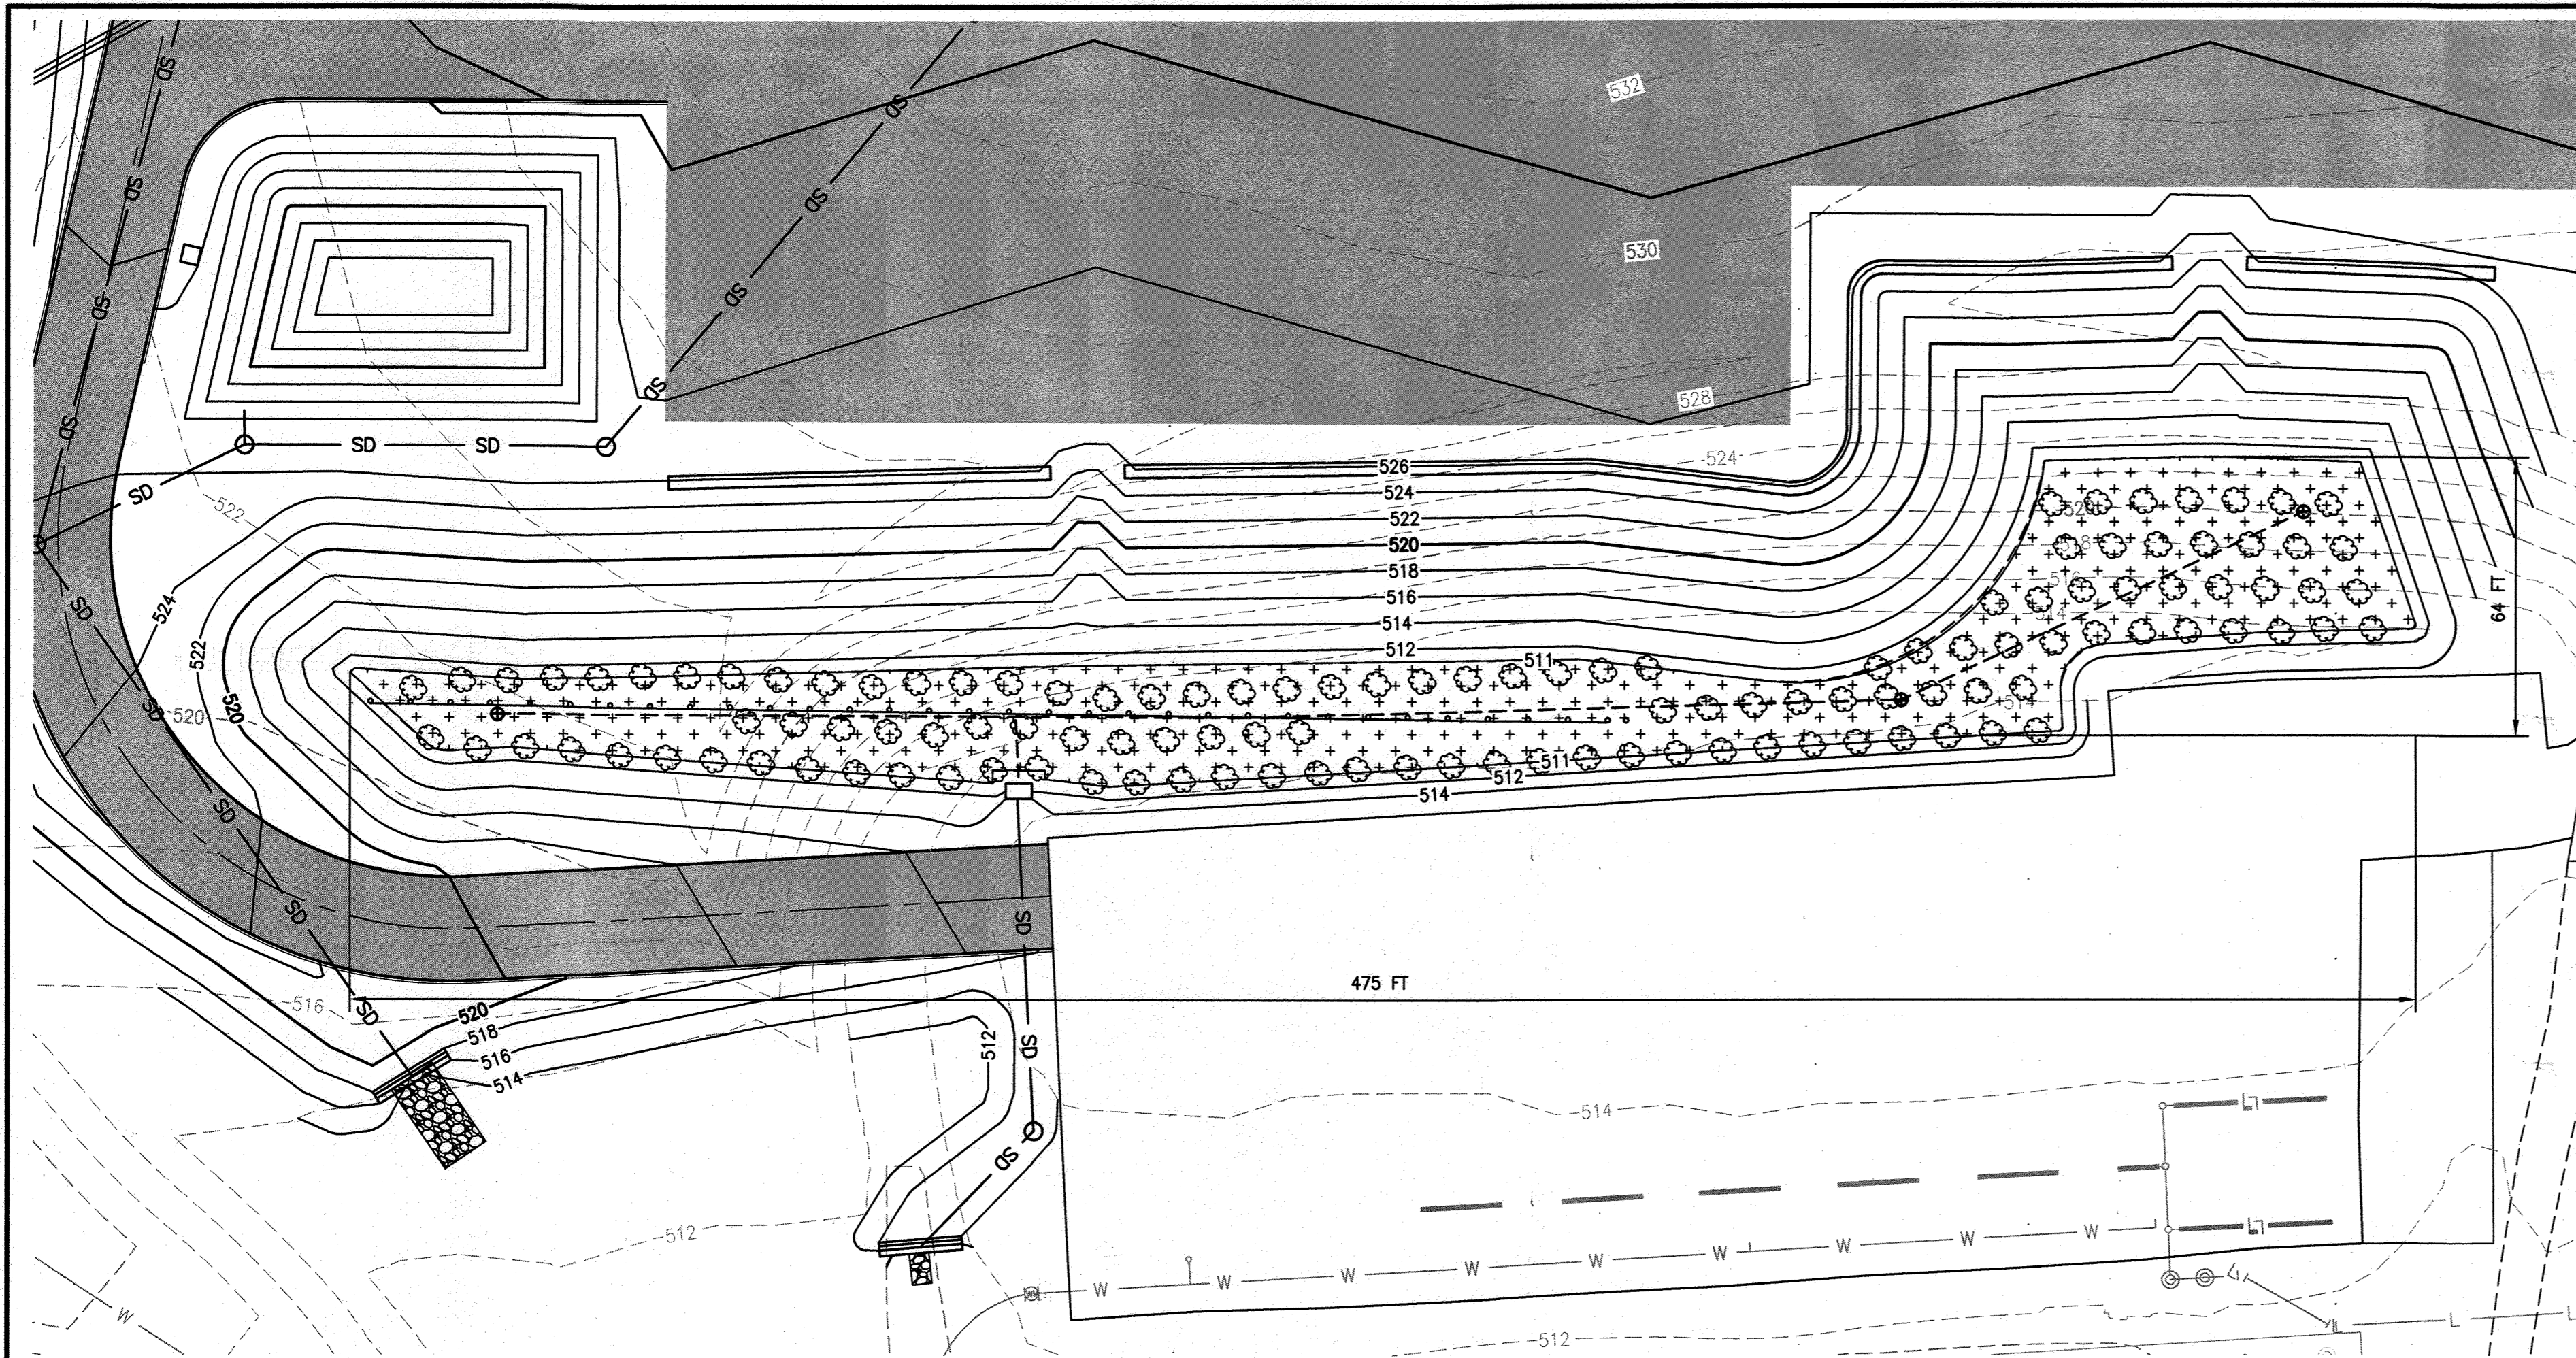

SUBMERGED GRAVEL WETLAND NO. 2 PLANTING PLAN
SCALE: 1" = 30"

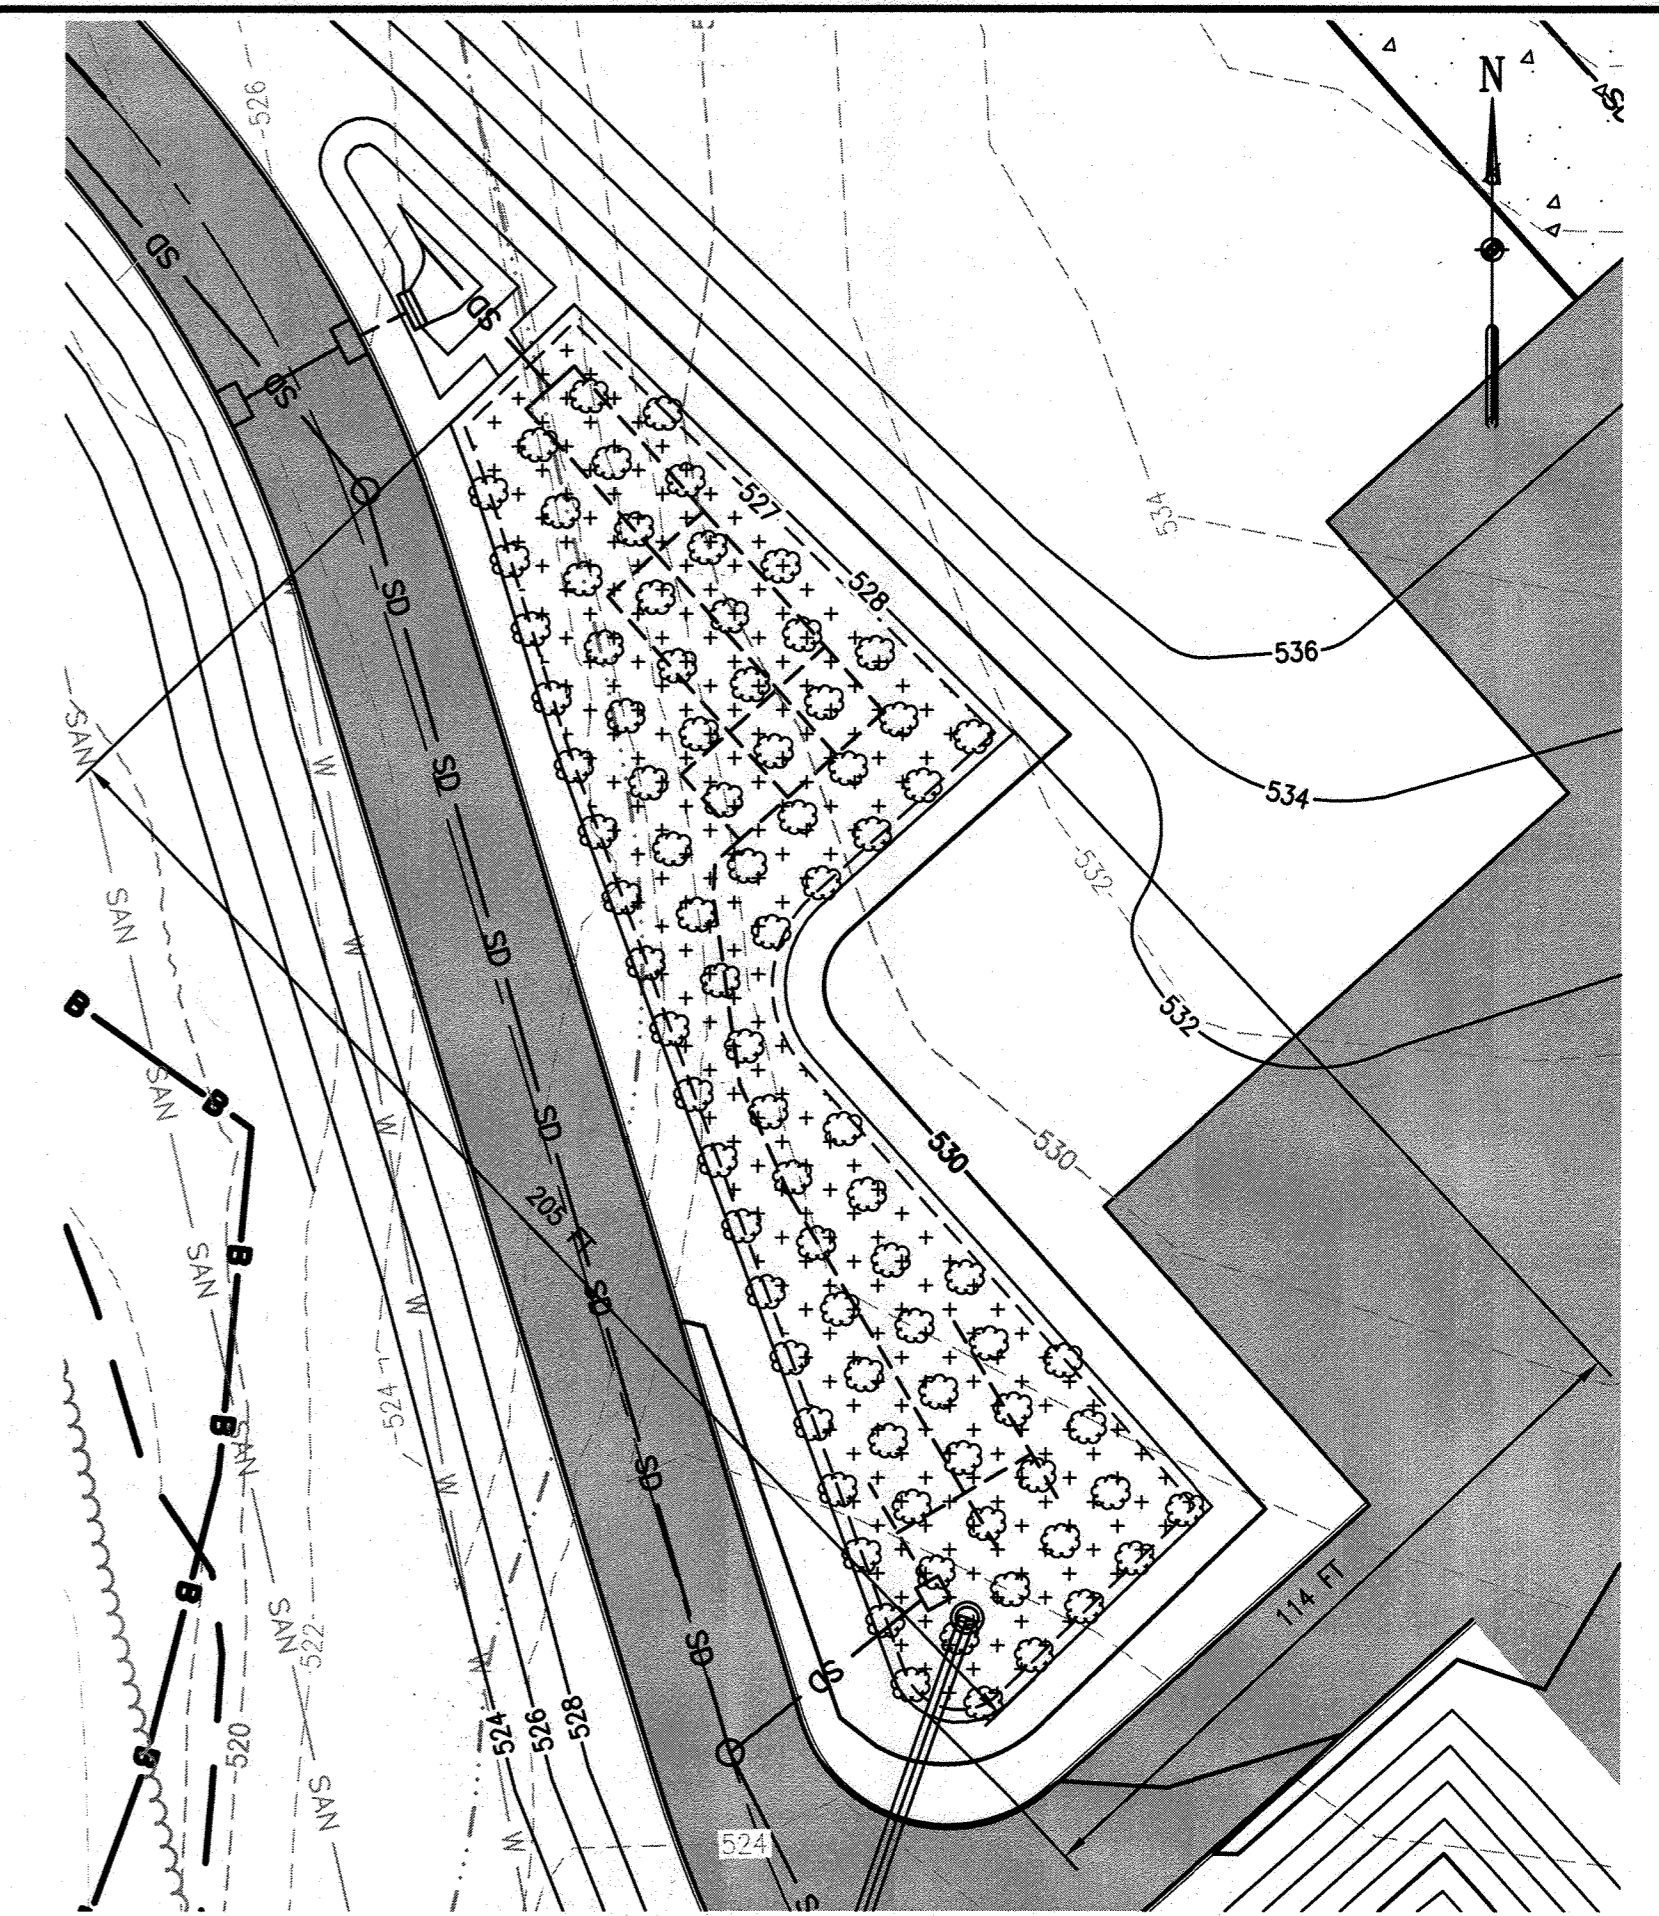

BIORETENTION NO. 1 PLANTING PLAN
SCALE: 1" = 30"

BENCHMARK INFORMATION

- HOWARD COUNTY SURVEY CONTROL: BASE A
ELEVATION 564.733 US FT
N 598,156.281 E 1,336,841.785
- HOWARD COUNTY SURVEY CONTROL: BASE F
ELEVATION 512.817 US FT
N 597,030.549 E 1,338,031.404

THE SYSTEM OF COORDINATES USED BY HOWARD COUNTY IS BASED ON THE FOLLOWING DATUMS AND PROJECTIONS:

- HORIZONTAL: MARYLAND NAD83
- VERTICAL: NAVD88

BENCHMARK LOCATIONS PROVIDED ON PROJECT ACCESS INSET.

DATA SOURCES

- THE EXISTING TOPOGRAPHY AND UTILITIES INSIDE OF THE 'LIMIT OF FIELD RUN TOPO', UNLESS OTHERWISE MENTIONED, HAVE BEEN PROVIDED FROM A FIELD RUN SURVEY BY THE HOWARD COUNTY SURVEY DIVISION IN AUGUST 2011.
- ALL INFORMATION LOCATED OUTSIDE OF THE LIMIT OF FIELD RUN TOPO LINE HAS BEEN TAKEN FROM THE HOWARD COUNTY GIS DATABASE.

APPROVED: DEPARTMENT OF PLANNING AND ZONING

William J. Joffe 12-12-17
DIRECTOR DATE

Paul Chant 11-29-17
CHIEF, DEVELOPMENT ENGINEERING DIVISION DATE


Verlebe L. L. L. 12-5-17
CHIEF, DIVISION OF LAND DEVELOPMENT DATE

GRID: 8 BLOCK: N/A
ZONING: RC-DEO PARCEL/LOT: 220, 253, 11, 23, 54
TAX MAP: 0016 ELECTION DISTRICT: 3-02


OWNER/ENGINEER INFORMATION

DEVELOPER/OWNER:
HOWARD COUNTY GOVERNMENT
CONTACT: JEFF DANIS, P.E., CSP
6751 COLUMBIA GATEWAY DRIVE, SUITE 514
COLUMBIA, MD 21046
TELEPHONE: (410) 313-6419

ENGINEER:
EA ENGINEERING, SCIENCE,
AND TECHNOLOGY, INC., PBC
CONTACT: MARK GUTBERLET, P.E.
225 SCHILLING CIRCLE, SUITE 400
HUNT VALLEY, MD 21031
TELEPHONE: (410) 584-7000

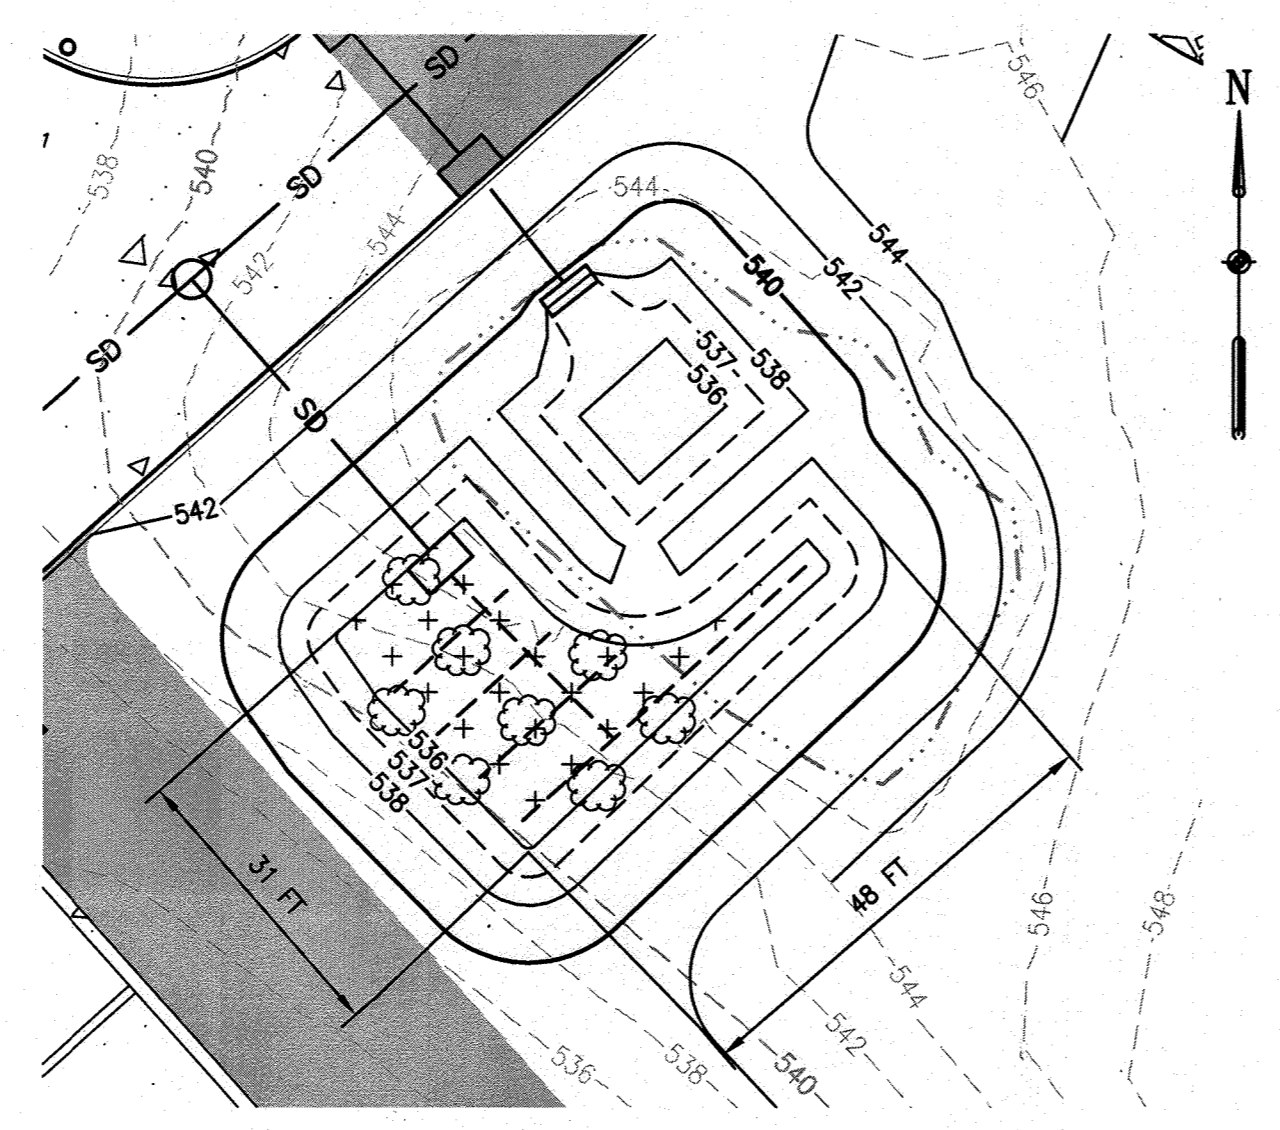

SUBMERGED GRAVEL WETLAND NO. 1 PLANTING PLAN
SCALE: 1" = 20"

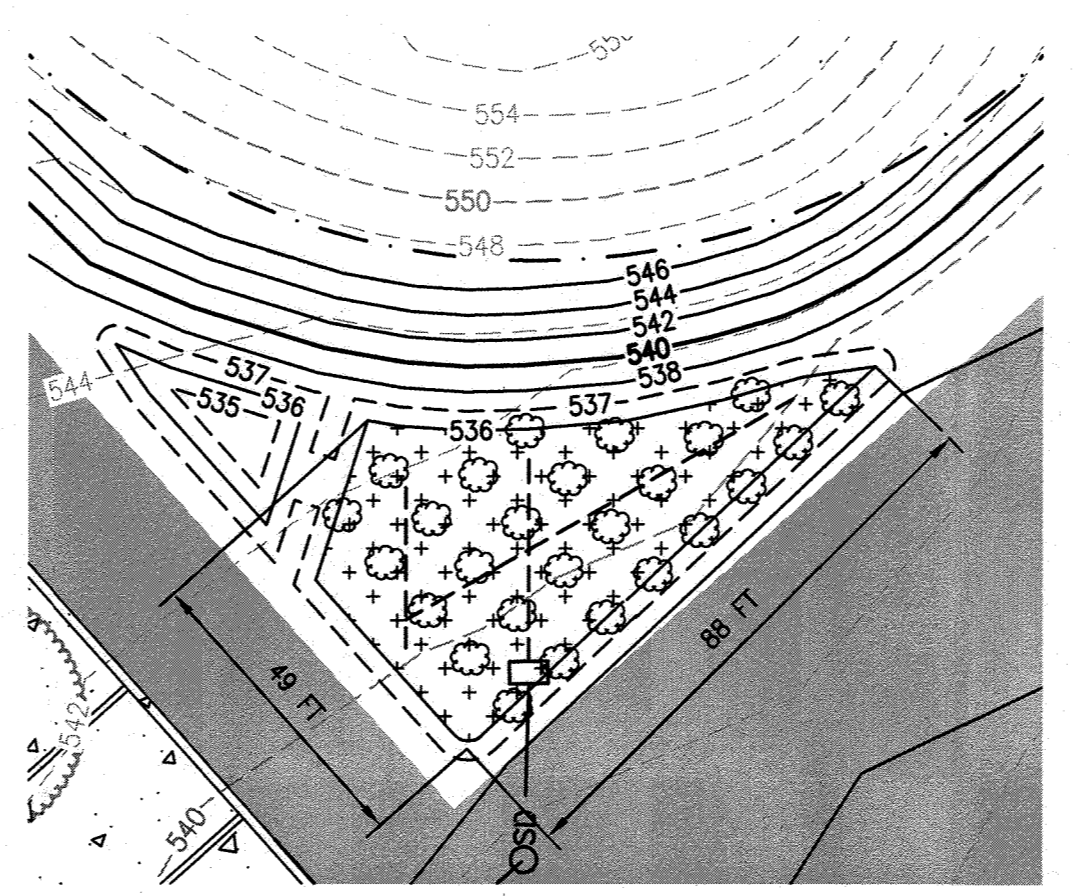

BIORETENTION NO. 2 PLANTING PLAN
SCALE: 1" = 30"

BIORETENTION PLANT LIST



PLANTING TYPE	COMMON NAME	SCIENTIFIC NAME	FORM	SPACING	INDICATOR STATUS	BIORETENTION NO. 1 - QUANTITY	BIORETENTION NO. 2 - QUANTITY	SYMBOL
HERBACEOUS SPECIES								
	THREE SQUARE BULRUSH	Schoenoplectus pungens	1 QUART	2' OC	FACW+	998	287	[Symbol]
	WOOLGRASS	Scirpus cyperinus	1 QUART	2' OC	FACW	998	287	[Symbol]
	JOE PYE WEED	Eutrochium purpureum	1 QUART	10' OC	FAC	85	26	[Symbol]

SUBMERGED GRAVEL WETLAND PLANT LIST

PLANTING TYPE	COMMON NAME	SCIENTIFIC NAME	FORM	SPACING	INDICATOR STATUS	SGW NO. 1 - QUANTITY	SGW NO. 2 - QUANTITY	SYMBOL
HERBACEOUS SPECIES								
	THREE SQUARE BULRUSH	Schoenoplectus pungens	1 QUART	2' OC	FACW+	88	1490	[Symbol]
	WOOLGRASS	Scirpus cyperinus	1 QUART	2' OC	FACW	88	1490	[Symbol]
	JOE PYE WEED	Eutrochium purpureum	1 QUART	10' OC	FAC	8	123	[Symbol]

NOTES:

- SEE SHEET DA-1 FOR ESD FACILITY SUMMARY TABLE AND DRAINAGE AREAS.

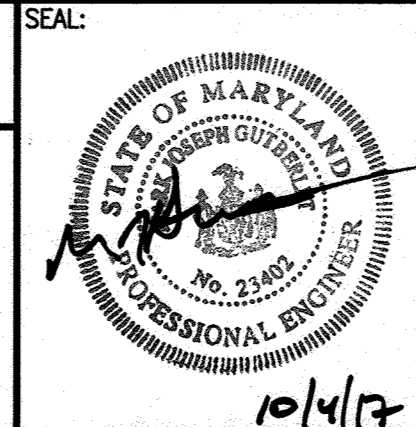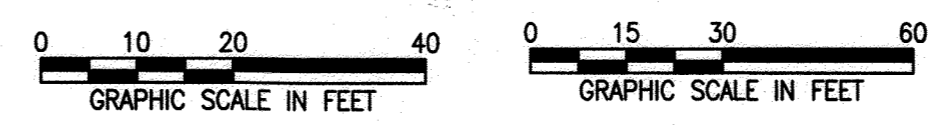

PROFESSIONAL CERTIFICATION:

I HEREBY CERTIFY THAT THESE DOCUMENTS WERE PREPARED OR APPROVED BY ME, AND THAT I AM A DULY LICENSED PROFESSIONAL ENGINEER UNDER THE LAWS OF THE STATE OF MARYLAND, LICENSE NO. 23402, EXPIRATION DATE 25 AUGUST 2018.

Mark Gutberlet 10/4/17







DSN. BY:	MBS/MP	CVH	REVISED TOTAL SHEET NUMBER DOW TO ADDITION OF SHEET 45	8/10/22
DRN. BY:	JAP/KEJ			
CHK. BY:	SMD			
DATE:	OCT. 2016	BY	NO.	REVISION
				DATE

ESD PLANTING PLANS

COMPOST FACILITY - PHASE II
AT ALPHA RIDGE LANDFILL
HOWARD COUNTY, MARYLAND

SDP SHEET: 45
30 OF 44
DRAWING: SW-9
PROJECT: 14982.05
SHEET: 44 OF 76

NOT FOR CONSTRUCTION - SITE DEVELOPMENT PLAN #SDP-16-035

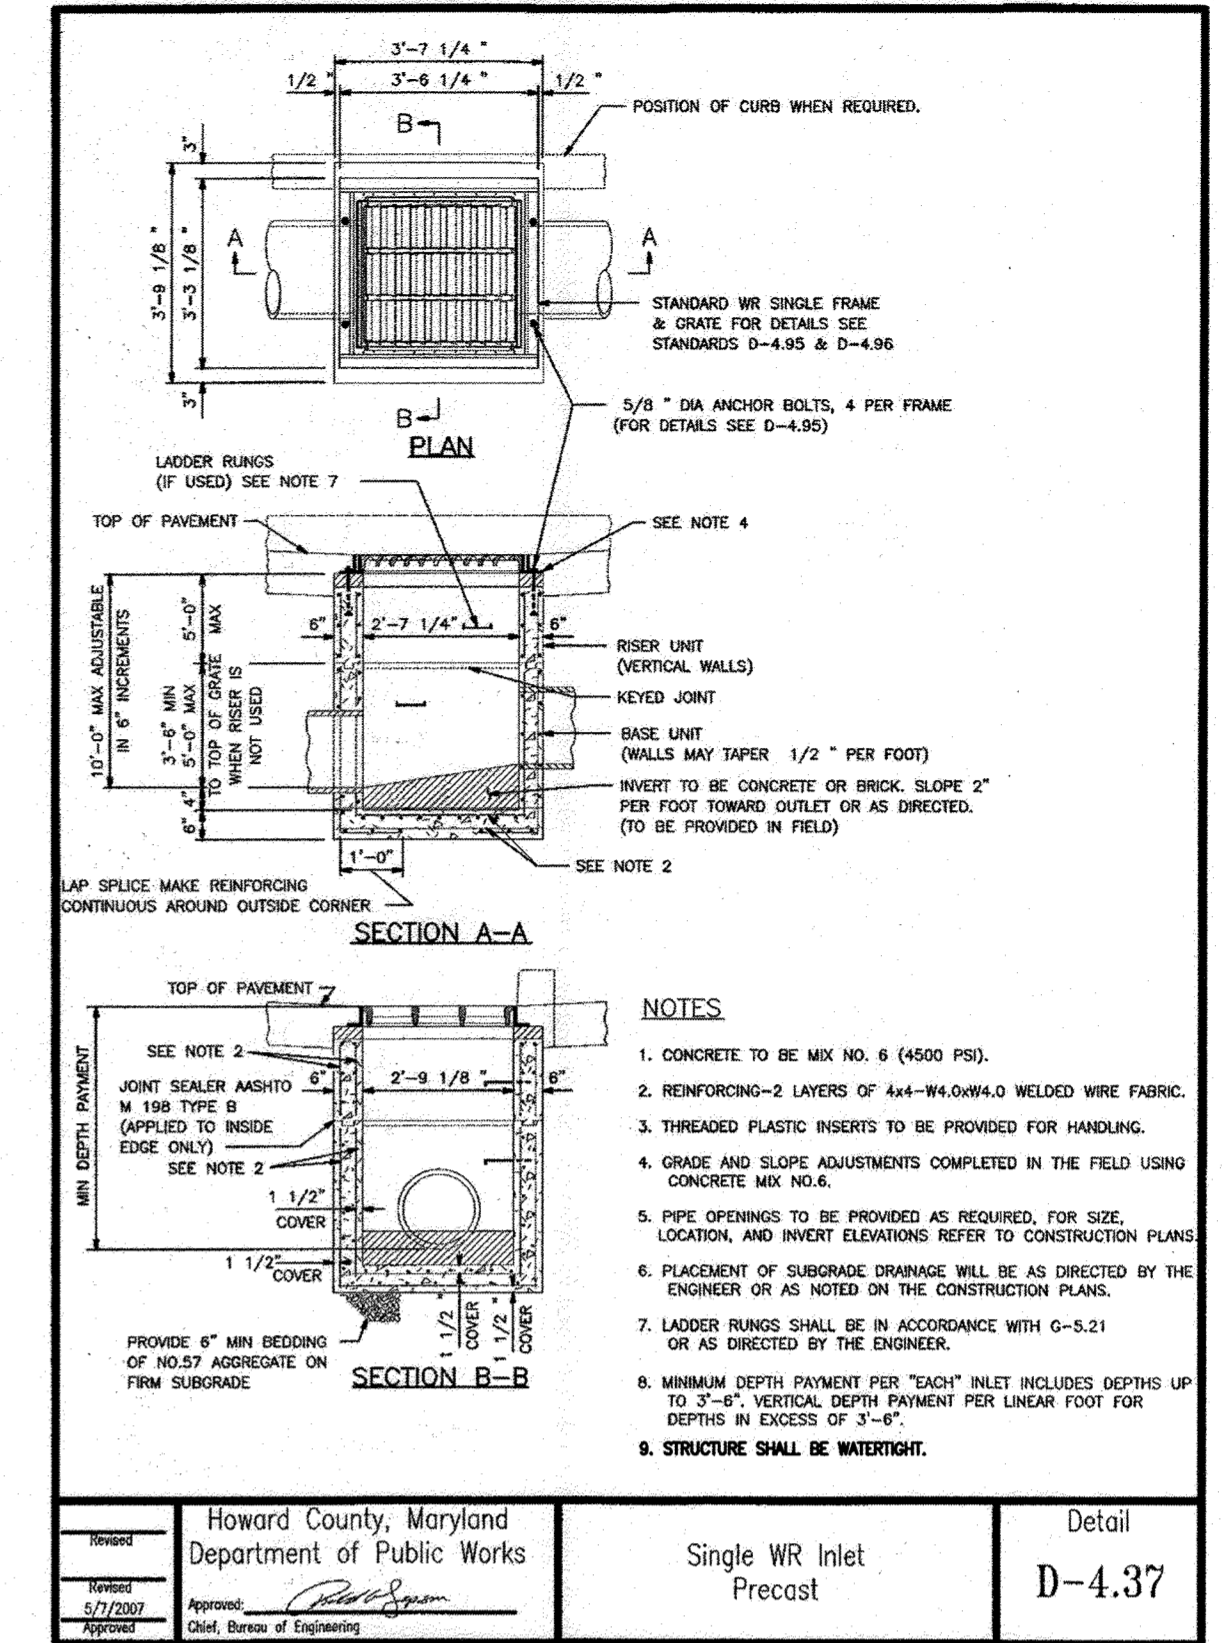
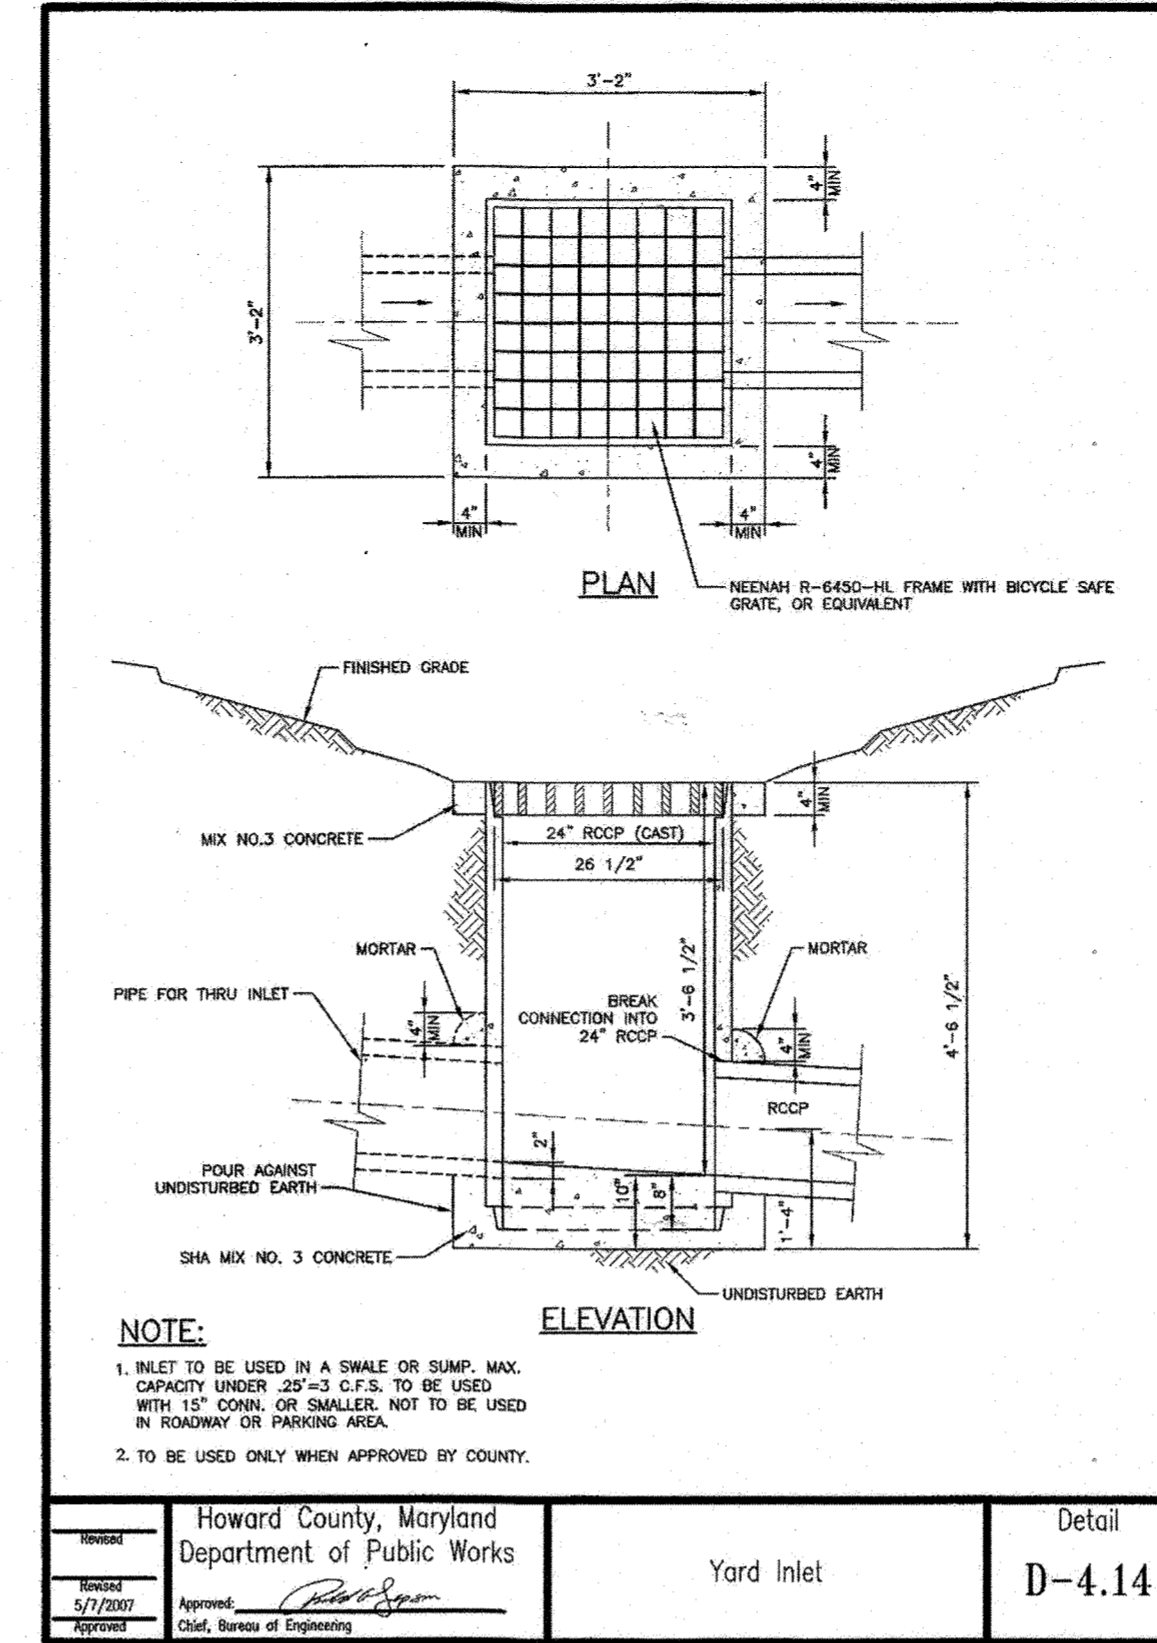
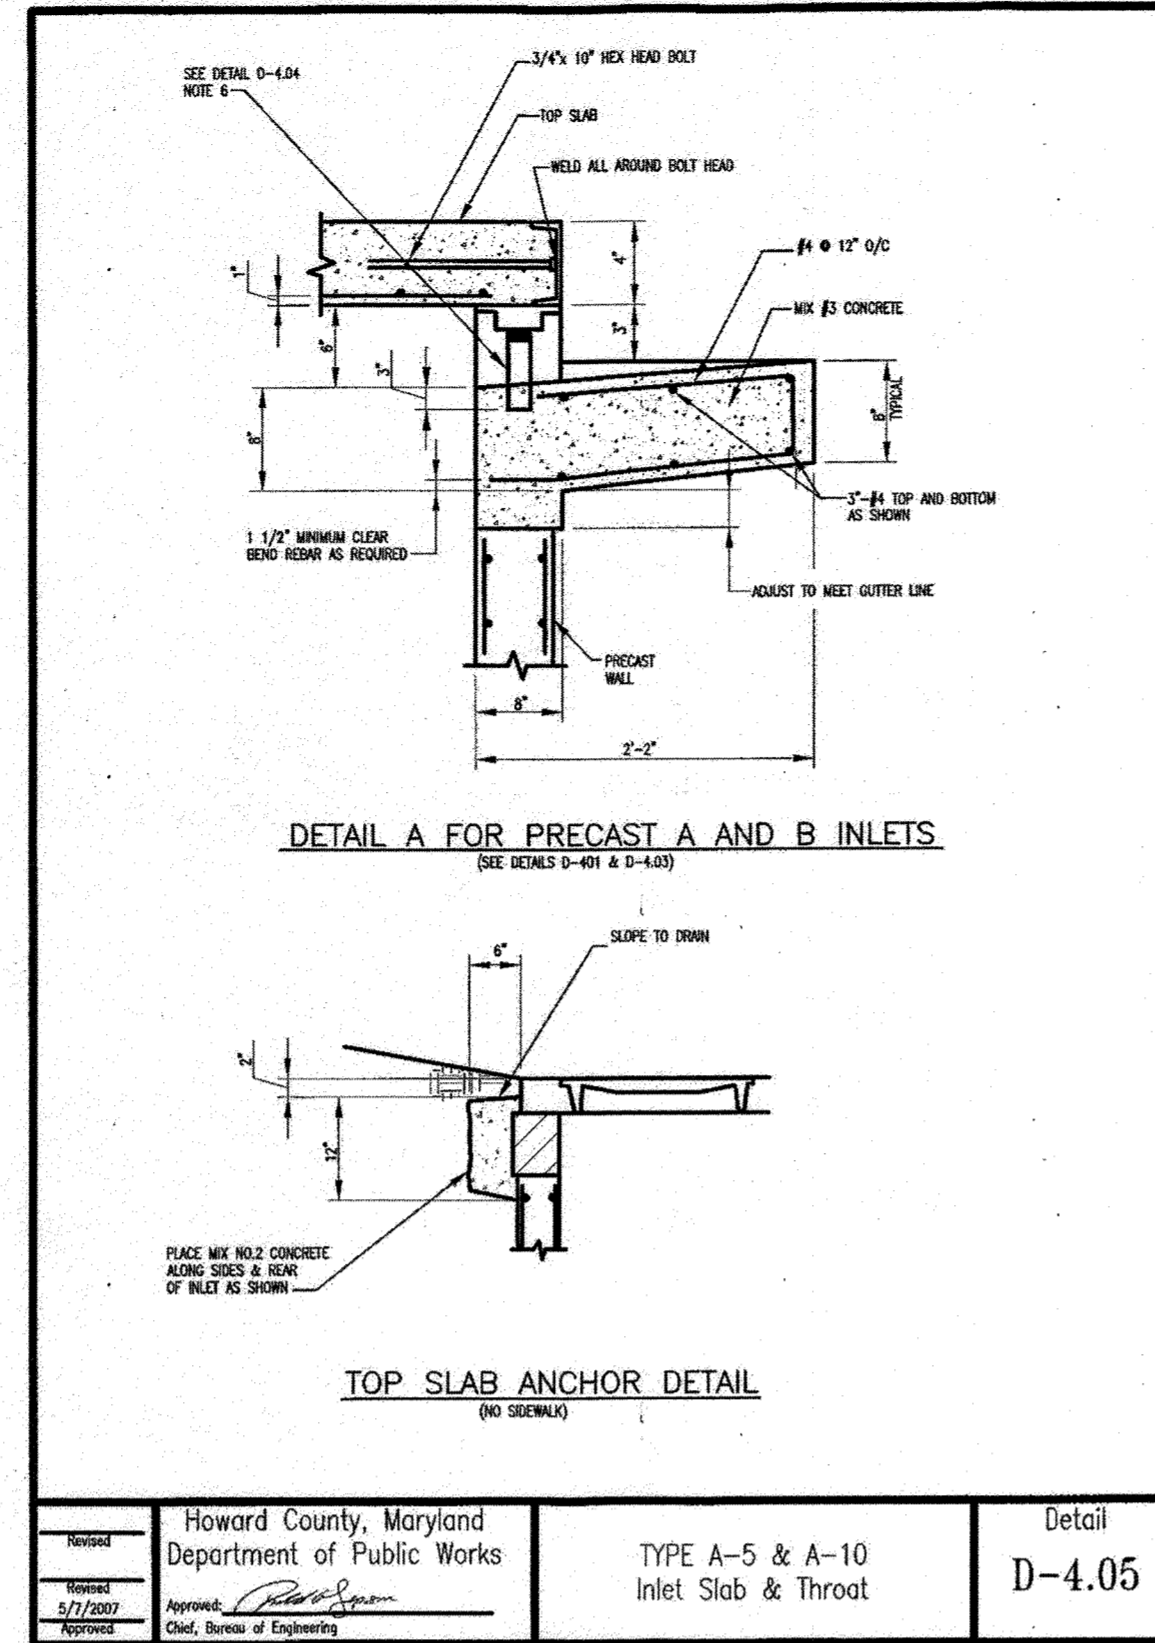
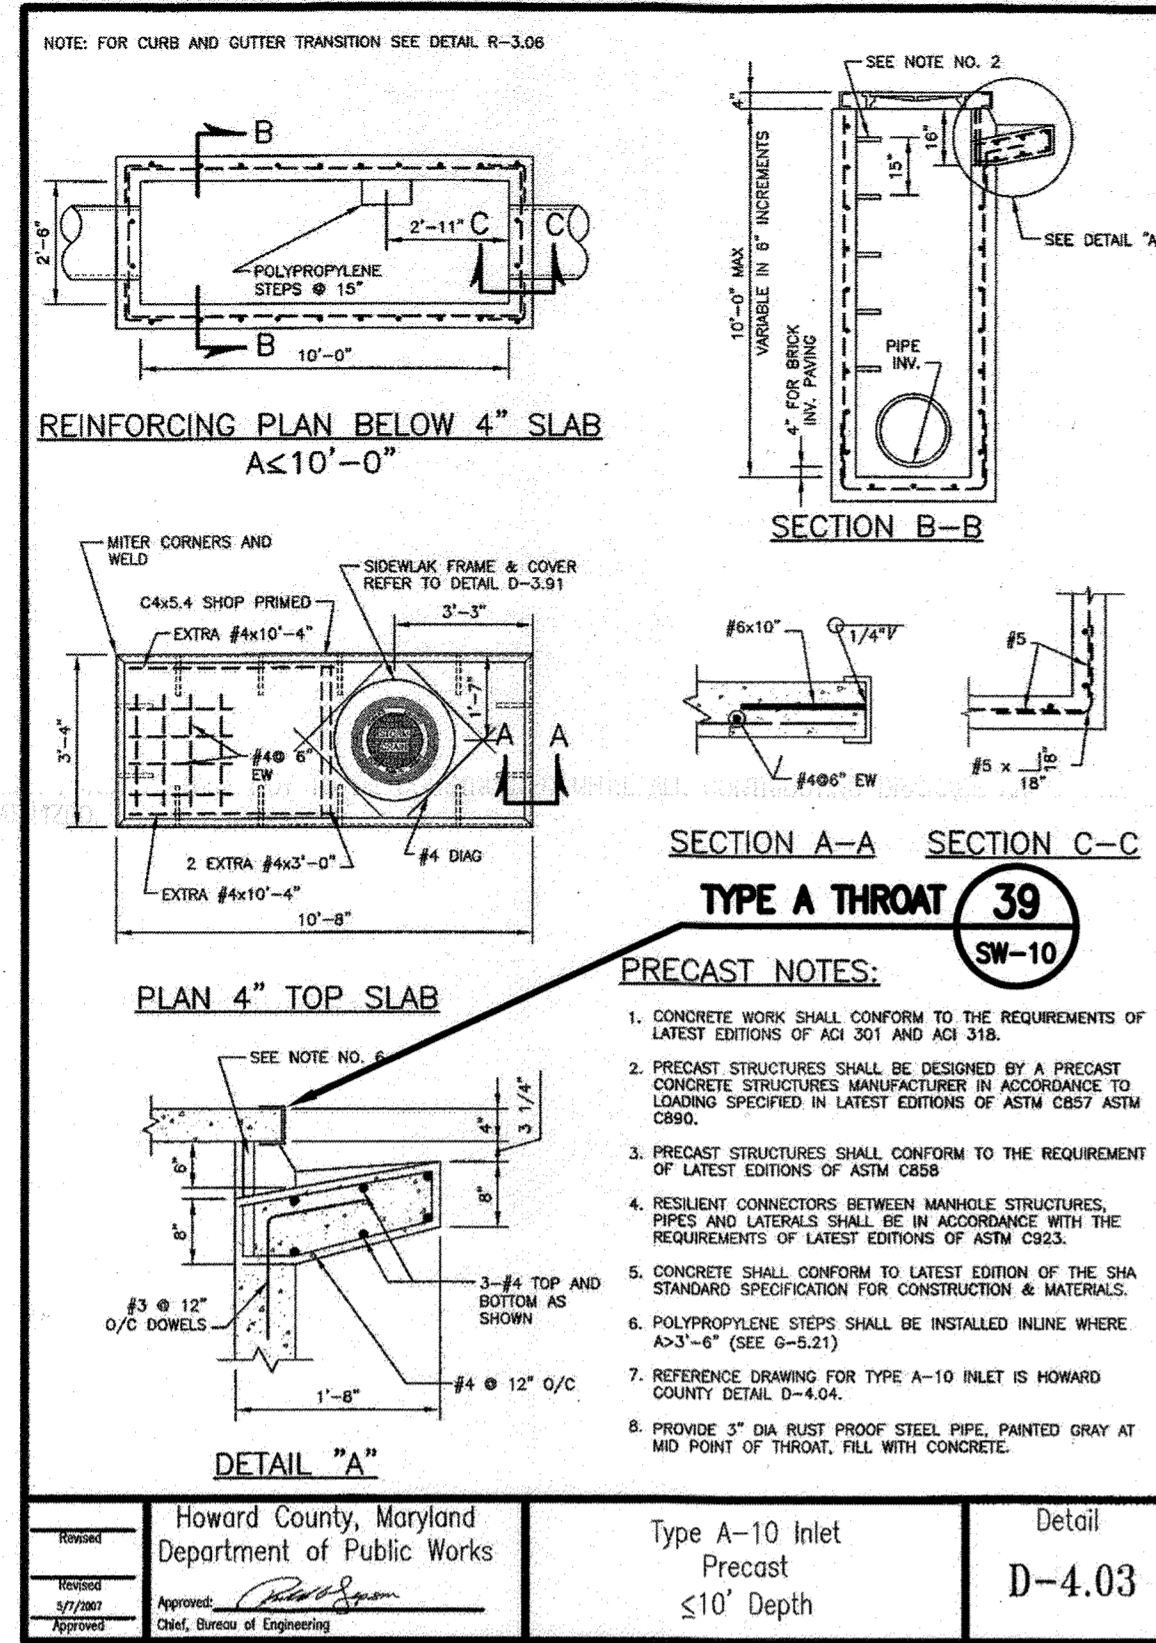


38 CURB INLET
C-4
NOT TO SCALE
C-5, SW-1, SW-2

39 TYPE A THROAT
-
NOT TO SCALE

40 YARD INLET
C-4
NOT TO SCALE
SW-1

41 RISER STRUCTURE
C-4
NOT TO SCALE
C-5, SW-1, SW-2

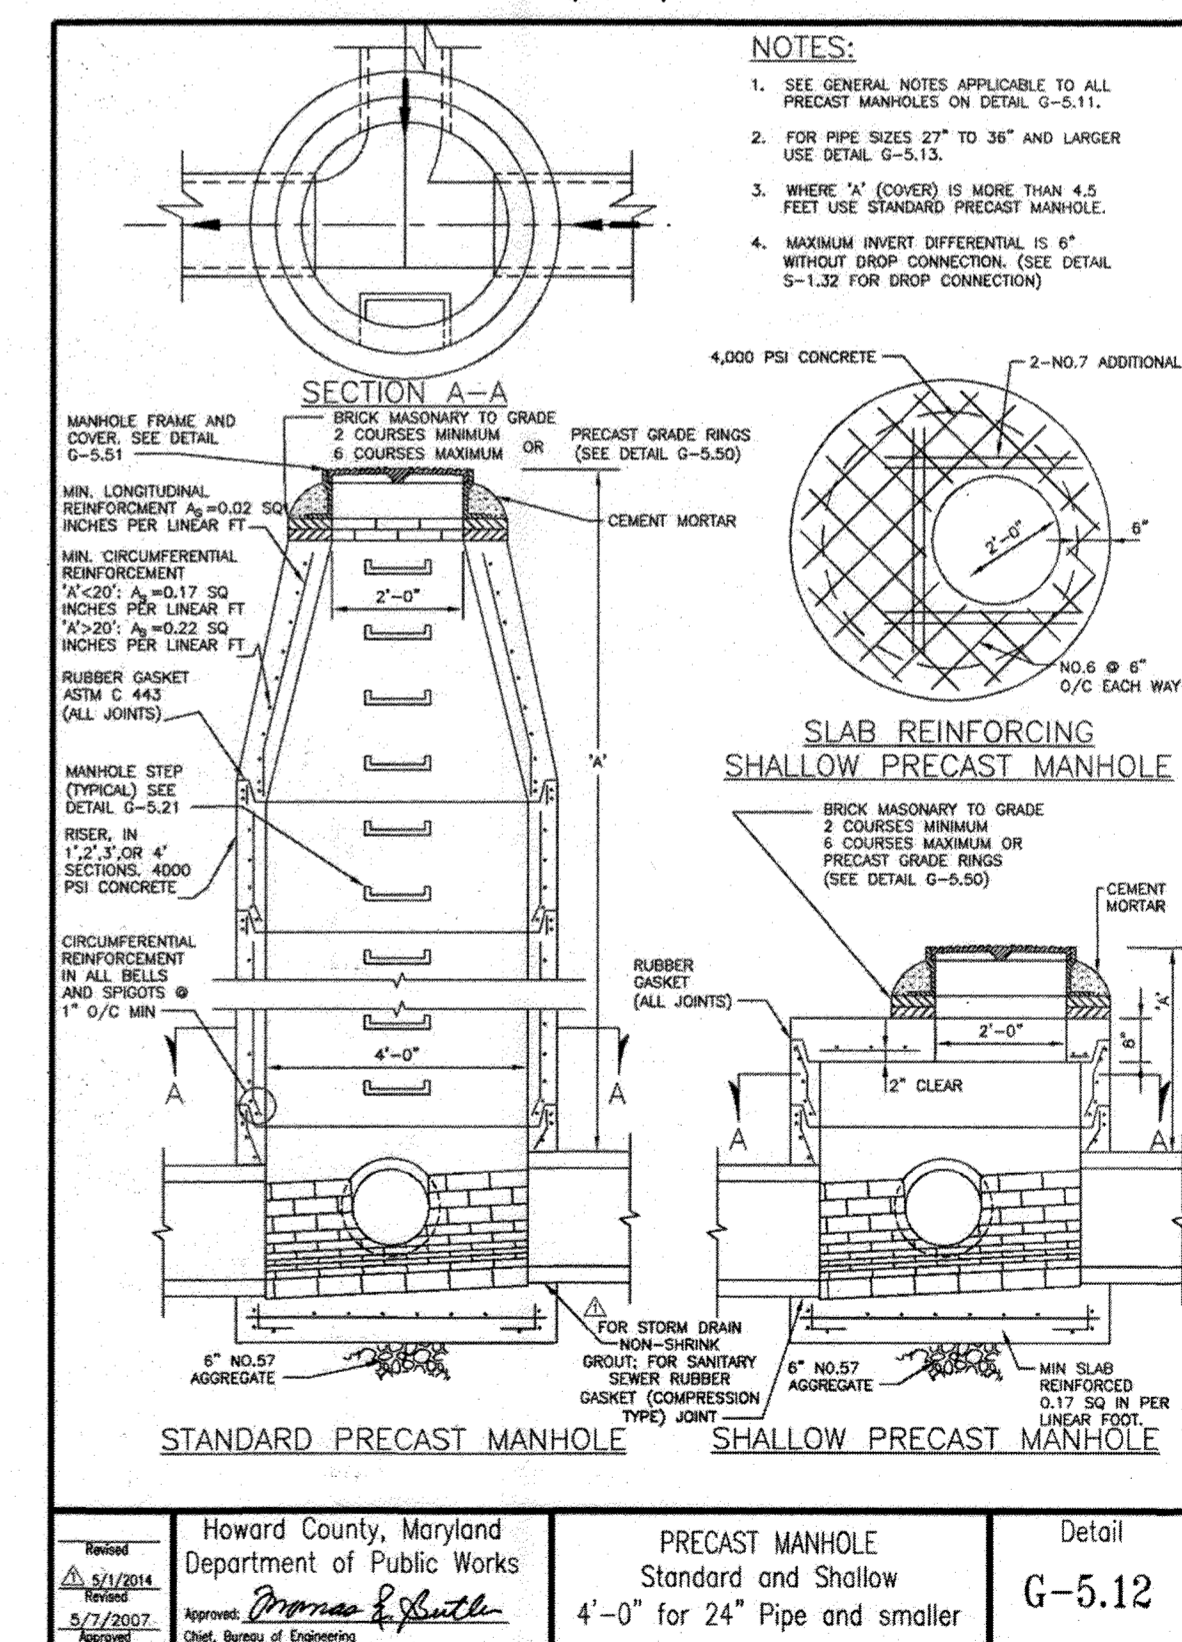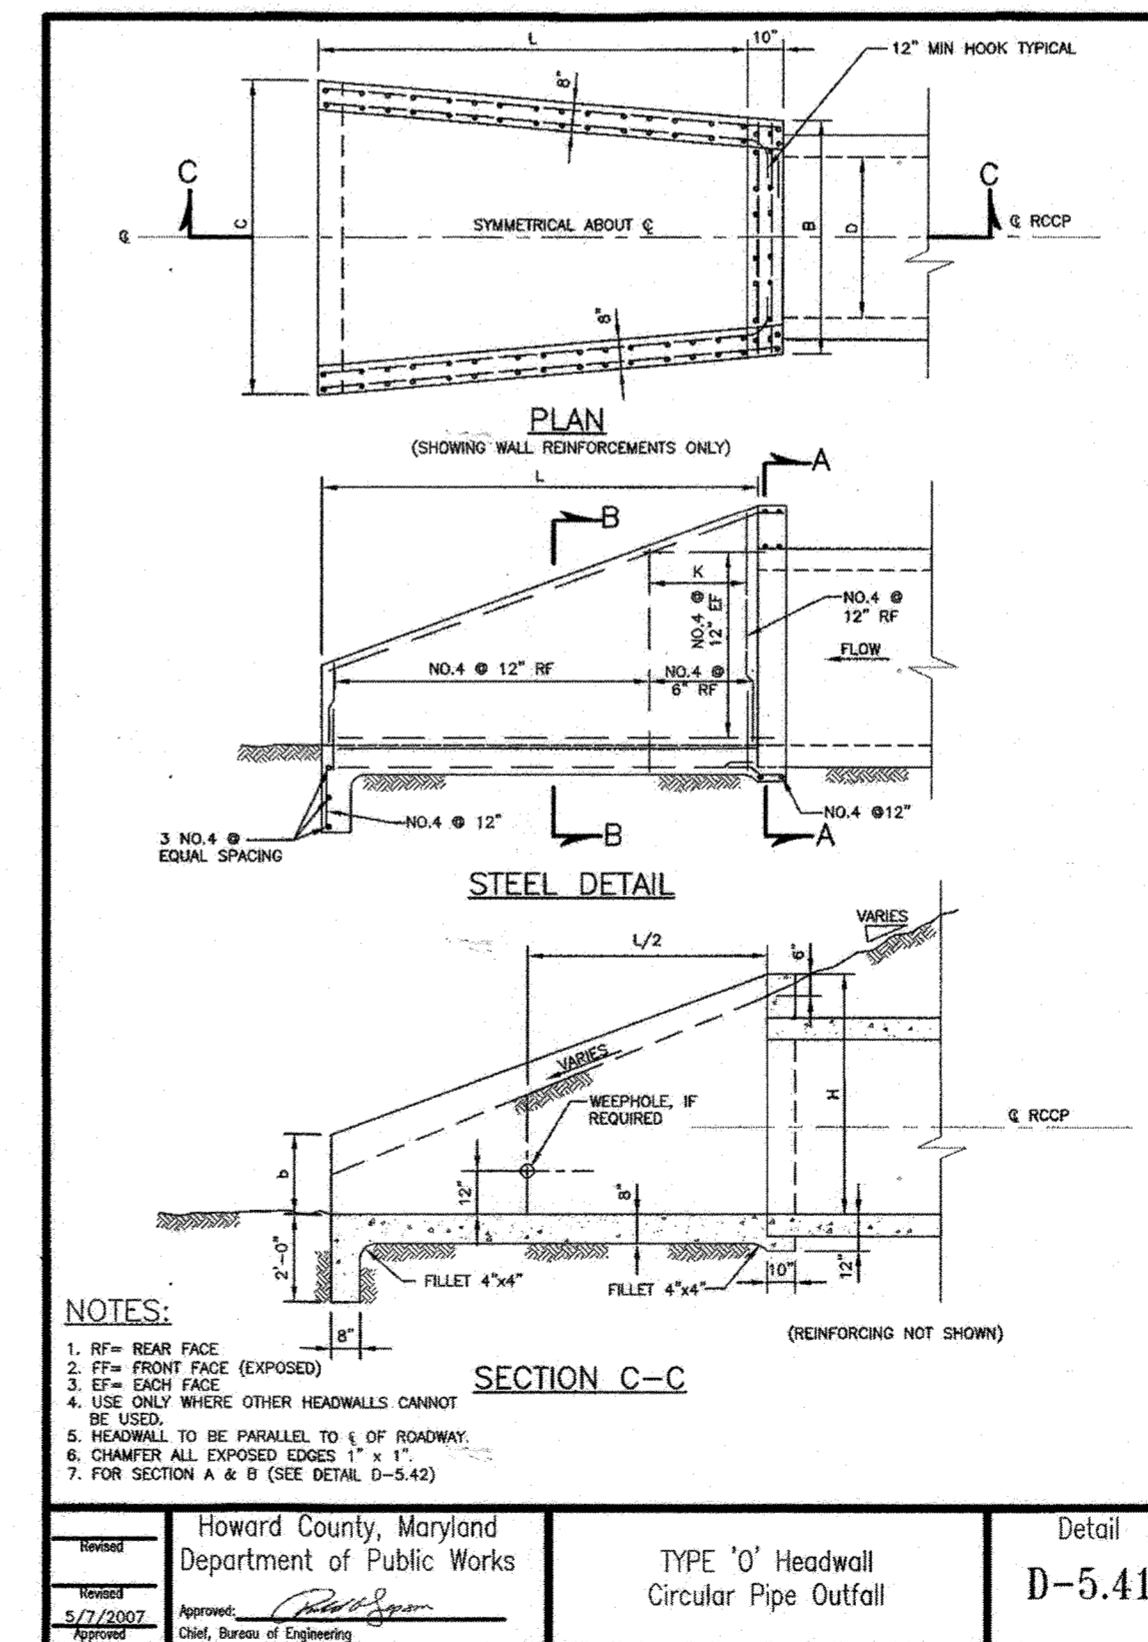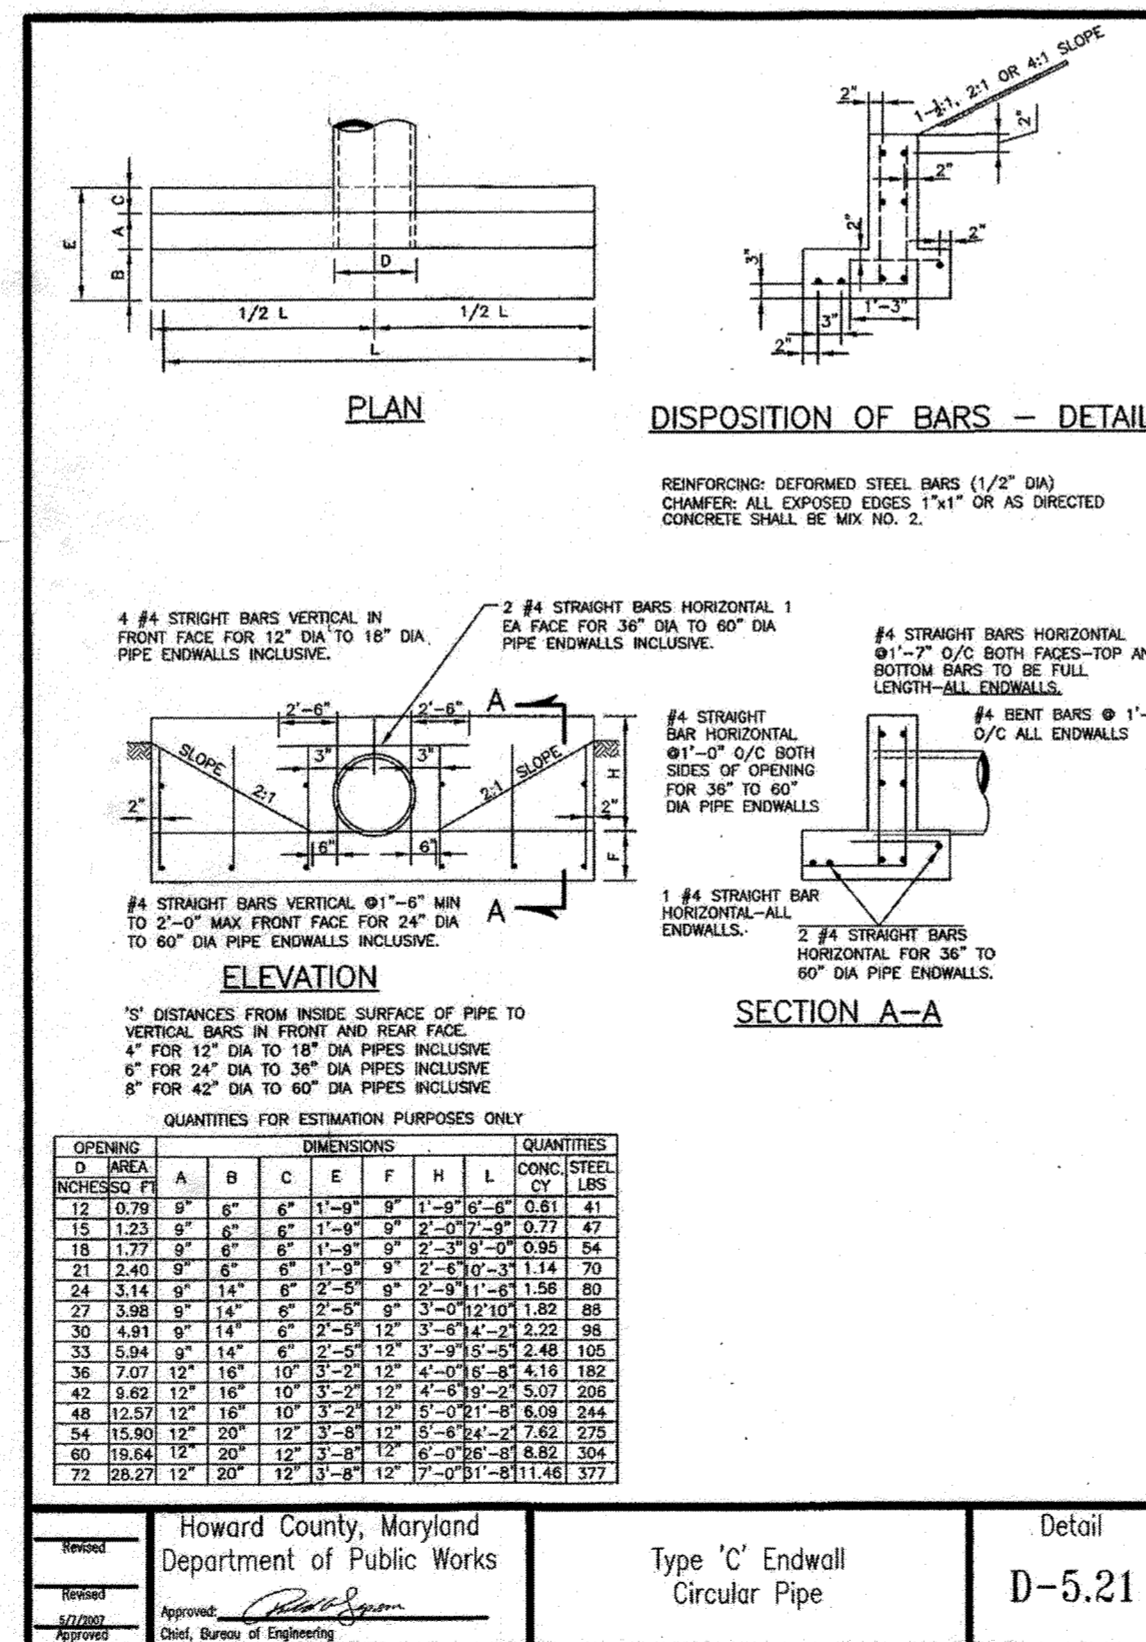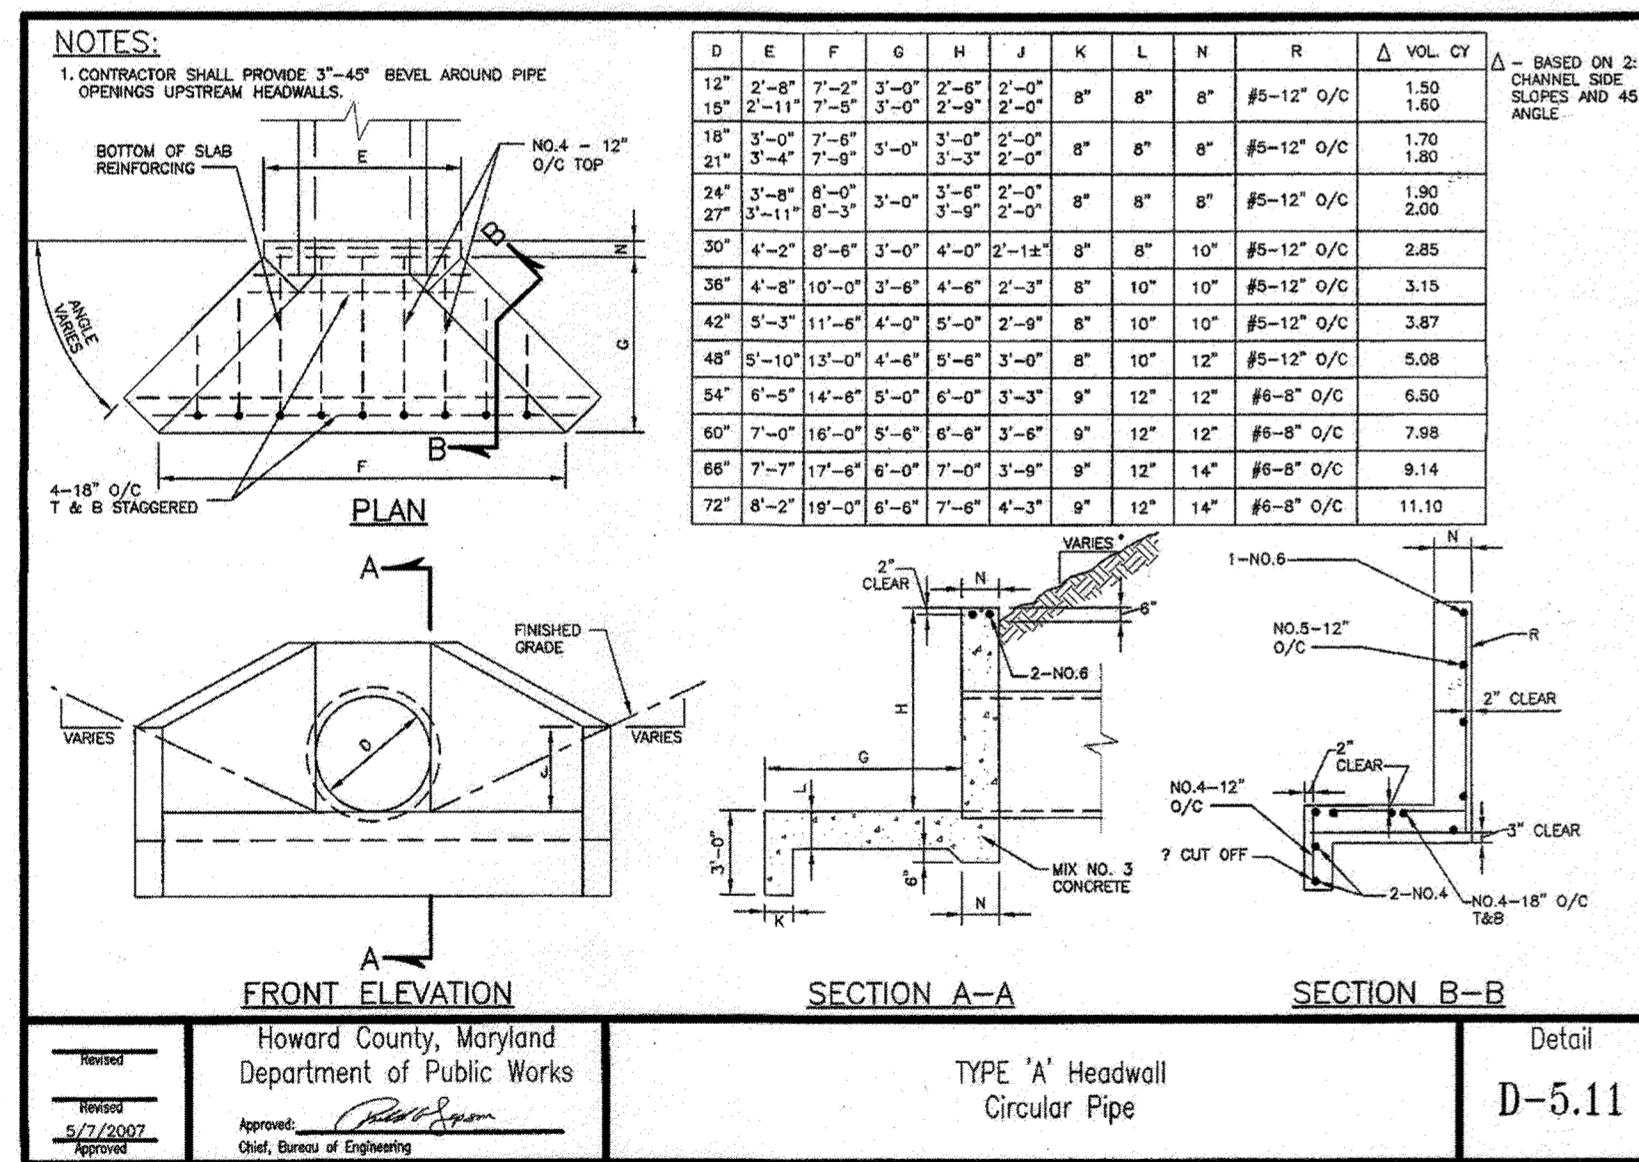

APPROVED: DEPARTMENT OF PLANNING AND ZONING

Valdis Joffe 12-12-17
DIRECTOR DATE

Chad Chubb 11-29-17
CHIEF, DEVELOPMENT ENGINEERING DIVISION DATE

Kate LaLonde 12-5-17
CHIEF, DIVISION OF LAND DEVELOPMENT DATE

42 TYPE 'A' ENDWALL
C-5
NOT TO SCALE

43 TYPE 'C' ENDWALL
-
NOT TO SCALE

44 TYPE 'O' ENDWALL
C-4
NOT TO SCALE
C-5, SW-1, SW-2

45 MANHOLE
C-4
NOT TO SCALE
C-5, SW-1, SW-2


GRID: 8
ZONING: RC-DEO
TAX MAP: 0016

BLOCK: N/A
PARCEL/LOT: 220, 253, 11, 23, 54
ELECTION DISTRICT: 3-02

OWNER/ENGINEER INFORMATION

DEVELOPER/OWNER:
HOWARD COUNTY GOVERNMENT
CONTACT: JEFF DANNIS, P.E., CSP
6751 COLUMBIA GATEWAY DRIVE, SUITE 514
COLUMBIA, MD 21046
TELEPHONE: (410) 313-6419

ENGINEER:
EA ENGINEERING, SCIENCE
AND TECHNOLOGY, INC., PBC
CONTACT: MARK GUTBERLET, P.E.
225 SCHILLING CIRCLE, SUITE 200
HUNT VALLEY, MD 21031
TELEPHONE: (410) 584-7000

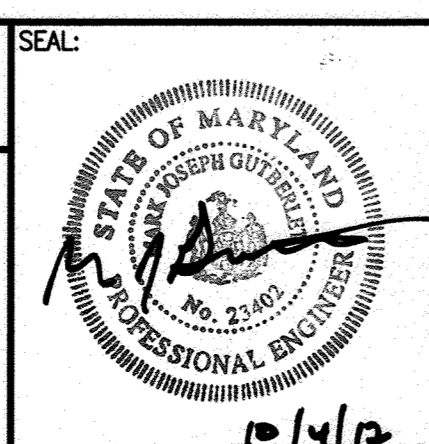

PROFESSIONAL CERTIFICATION:

I HEREBY CERTIFY THAT THESE DOCUMENTS WERE PREPARED OR APPROVED BY ME, AND THAT I AM A DULY LICENSED PROFESSIONAL ENGINEER UNDER THE LAWS OF THE STATE OF MARYLAND, LICENSE NO. 23402, EXPIRATION DATE 29 AUGUST 2018.



DSN. BY: MBS/MP
DRN. BY: JAP/KEJ
CHK. BY: SMD
DATE: OCT. 2016

REVISION TOTAL SHEET NUMBER
DUE TO ADDITION OF SHEET 45 8/20/22

BY NO. REVISION DATE

STORMWATER MANAGEMENT DETAILS I

COMPOST FACILITY - PHASE II
AT ALPHA RIDGE LANDFILL
HOWARD COUNTY, MARYLAND

SDP SHEET: 45
DRAWING: SW-10
PROJECT: 14982.05
SHEET: 45 OF 70

M-2 SUBMERGED GRAVEL WETLAND NOTES:

- ALL ON-SITE DISTURBED AREAS TO BE STABILIZED PRIOR TO ALLOWING RUNOFF TO ENTER NEWLY CONSTRUCTED SUBMERGED GRAVEL WETLAND.
- SUBMERGED GRAVEL WETLAND CONSTRUCTION SHALL BE PERFORMED WITH LIGHTWEIGHT, WIDE-TRACKED EQUIPMENT TO MINIMIZE DISTURBANCE AND COMPACTION.
- PLANTING SOILS MAY BE MIXED ON-SITE BEFORE PLACEMENT. PLANTING SOILS SHALL NOT BE PLACED UNDER SATURATED CONDITIONS. FILTER MEDIA SHALL BE PLACED AND GRADED USING EXCAVATORS OR BACKHOES, OPERATING OUTSIDE THE LIMITS OF SUBMERGED GRAVEL WETLAND OR LANDSCAPE INFILTRATION, AND BE PLACED IN HORIZONTAL LAYERS (12 INCHES PER LIFT MAXIMUM).
- SPECIES LAYOUT SHALL BE GENERALLY RANDOM AND NATURAL. HERBACEOUS EMBANKMENT PLANTINGS SHOULD BE LIMITED TO 10 INCHES IN HEIGHT.
- CLASS C GEOTEXTILE OR SIMILAR TO BE PLACED ON SIDE SLOPE AS DIRECTED BY CONTRACTING ENGINEER.
- FILTER MEDIA BED, MULCH LAYER, PLANTING SPECIFICATIONS SHALL BE IN ACCORDANCE WITH THE MARYLAND STORMWATER DESIGN SPECIFICATIONS SHOWN ON THIS SHEET.
- GRAVEL MEDIA FOR THE SUBMERGED GRAVEL WETLANDS SHOULD BE COMPOSED OF CLEAN-WASHED, UNIFORMLY GRADED MATERIAL WITH A POROSITY OF 40%. ROUNDED BANK RUN GRAVEL IS RECOMMENDED (ASTM D448 4, 5, OR 6 STONE OR EQUAL). UNDERDRAIN PIPES SHOULD BE RIGID PLASTIC PIPE (ASTM 758, TYPE PS 28, OR AASHTO-M-278). THE UPSTREAM END OF THE PIPE SHOULD BE CAPPED PRIOR TO INSTALLATION.

M-6 MICRO-BIORETENTION AND F-6 BIORETENTION NOTES:

- THESE PRACTICES ARE NOT TO BE CONSTRUCTED UNTIL ALL CONTRIBUTING DRAINAGE AREAS ARE STABILIZED.
- EXCAVATION TO BE CONDUCTED IN DRY CONDITIONS WITH EQUIPMENT LOCATED OUTSIDE THE PRACTICE TO MINIMIZE BOTTOM AND SIDEWALL COMPACTION. ONLY LIGHTWEIGHT, LOW GROUND CONTACT EQUIPMENT TO BE USED WITHIN MICRO-BIORETENTION AND BIORETENTION PRACTICES.
- FACILITY BOTTOM SHOULD BE SCARIFIED BEFORE INSTALLING UNDERDRAINS AND FILTERING MEDIA
- GRAVEL MEDIA FOR MICRO-BIORETENTION AND BIORETENTION UNDERDRAIN SYSTEM SHOULD BE CLEAN, WASHED, AND FREE OF FINES. UNDERDRAIN PIPES SHOULD BE RIGID PLASTIC PIPE (ASTM 758, TYPE PS 28, OR AASHTO-M-278), THE UPSTREAM END OF THE PIPE SHOULD BE CAPPED PRIOR TO INSTALLATION.
- GRAVEL MEDIA FOR THE SUBMERGED GRAVEL WETLANDS SHOULD BE COMPOSED OF CLEAN-WASHED, UNIFORMLY GRADED MATERIAL WITH A POROSITY OF 40%. ROUNDED BANK RUN GRAVEL IS RECOMMENDED (ASTM D448 4, 5, OR 6 STONE OR EQUAL). UNDERDRAIN PIPES SHOULD BE RIGID PLASTIC PIPE (ASTM 758, TYPE PS 28, OR AASHTO-M-278). THE UPSTREAM END OF THE PIPE SHOULD BE CAPPED PRIOR TO INSTALLATION.
- PLANTING SOIL MAY BE MIXED ON-SITE BEFORE PLACEMENT. PLANTING SOIL SHOULD NOT BE PLACED UNDER SATURATED CONDITIONS. FILTER MEDIA SHOULD BE PLACED AND GRADED USING EXCAVATORS OR BACKHOES OPERATING ADJACENT TO THE PRACTICE AND SHOULD BE PLACED IN HORIZONTAL LAYERS (12 INCHES PER LIFT MAXIMUM).
- SHRUBS SHALL NOT BE PLANTED IN THE MICRO-BIORETENTION AND BIORETENTION PRACTICES.
- HERBACEOUS EMBANKMENT PLANTINGS SHOULD BE LIMITED TO 10 INCHES IN HEIGHT.
- SPECIES LAYOUT SHOULD BE GENERALLY RANDOM AND NATURAL.
- THE GRAVEL MEDIA SHALL BE A UNIFORM MIX, FREE OF STONES, ROOTS OR OTHER SIMILAR OBJECTS LARGER THAN TWO INCHES. THE GRAVEL MEDIA SHOULD HAVE A PH RANGE OF 5.5 TO 7.0
- MULCH LAYER SHOULD BE STANDARD LANDSCAPE STYLE, SINGLE OR DOUBLE SHREDDED HARDWOOD MULCH OR CHIPS, WELL AGED (STOCKPILED OR STORED FOR AT LEAST 12 MONTHS), UNIFORM IN COLOR AND FREE OF OTHER MATERIALS SUCH AS WEEDS, SOIL, ROOTS, ETC. AND SHOULD BE APPLIED TO A MAXIMUM DEPTH OF THREE INCHES.
- GRAVEL MEDIA BED, MULCH LAYER, PLANTING SPECIFICATIONS SHALL BE IN ACCORDANCE WITH THE MARYLAND STORMWATER DESIGN SPECIFICATIONS SHOWN ON THIS SHEET.

CONSTRUCTION SPECIFICATIONS

- FILTERING MEDIA OR PLANTING SOIL - THE SOIL SHALL BE A UNIFORM MIX, FREE OF STONES, STUMPS, ROOTS OR OTHER SIMILAR OBJECTS LARGER THAN TWO INCHES. NO OTHER MATERIALS OR SUBSTANCES SHALL BE MIXED OR DUMPED WITHIN THE PRACTICES THAT MAY BE HARMFUL TO PLANT GROWTH, OR PROVE A HINDRANCE TO THE PLANTING OR MAINTENANCE OPERATIONS. THE PLANTING SOIL SHALL BE FREE OF BERMUDA GRASS, QUACKGRASS, JOHNSON GRASS, OR OTHER NOXIOUS WEEDS AS SPECIFIED UNDER COMAR 15.08.01.05.

THE PLANTING SOIL SHALL BE TESTED AND SHALL MEET THE MATERIAL SPECIFICATIONS IN ACCORDANCE WITH THE MARYLAND STORMWATER DESIGN SPECIFICATIONS SHOWN ON THIS SHEET. THERE SHALL BE AT LEAST ONE SOIL TEST PER PROJECT. EACH TEST SHALL CONSIST OF BOTH THE STANDARD SOIL TEST FOR PH, AND ADDITIONAL TESTS OF ORGANIC MATTER, AND SOLUBLE SALTS. A TEXTURAL ANALYSIS SHALL BE PERFORMED FOR EACH LOCATION WHERE THE TOPSOIL WAS EXCAVATED.

- PLANT MATERIAL - RECOMMENDED PLANT MATERIAL IS INCLUDED IN THE PLANT LIST FOR EACH FACILITY.
- PLANT INSTALLATION - COMPOST IS A BETTER ORGANIC MATERIAL SOURCE, IS LESS LIKELY TO FLOAT, AND SHOULD BE PLACED IN THE INVERT AND OTHER LOW AREAS. MULCH SHOULD BE PLACED IN SURROUNDING TO A UNIFORM THICKNESS OF 2" TO 3". SHREDDED OR CHIPPED HARDWOOD MULCH IS THE ONLY ACCEPTED MULCH. PINE MULCH AND WOOD CHIPS WILL FLOAT AND MOVE TO THE PERIMETER OF THE BIORETENTION AREA DURING A STORM EVENT AND ARE NOT ACCEPTABLE. SHREDDED MULCH MUST BE WELL AGED (6 TO 12 MONTHS) FOR ACCEPTANCE.

ROOTSTOCK OF THE PLANT MATERIAL SHALL BE KEPT MOIST DURING TRANSPORT AND ON-SITE STORAGE. THE PLANT ROOT BALL SHOULD BE PLANTED SO 1/2 OF THE BALL IS ABOVE FINAL GRADE SURFACE. THE DIAMETER OF THE PLANTING PIT SHALL BE AT LEAST SIX INCHES LARGER THAN THE DIAMETER OF THE PLANTING BALL. SET AND MAINTAIN THE PLANT STRAIGHT DURING THE ENTIRE PLANTING PROCESS. THOROUGHLY WATER GROUND BED COVER AFTER INSTALLATION.

GRASSES AND LEGUME SEED SHOULD BE DRILLED INTO THE SOIL TO A DEPTH OF AT LEAST ONE INCH. GRASS AND LEGUME PLUGS SHALL BE PLANTED FOLLOWING THE NON-GRASS GROUND COVER PLANTING SPECIFICATIONS.

THE TOPSOIL SPECIFICATIONS PROVIDE ENOUGH ORGANIC MATERIAL TO ADEQUATELY SUPPLY NUTRIENTS FROM NATURAL CYCLING. THE PRIMARY FUNCTION OF THE PRACTICES IS TO IMPROVE WATER QUALITY. ADDING FERTILIZERS DEFEATS, OR AT A MINIMUM, IMPEDES THIS GOAL. ONLY ADD FERTILIZER IF WOOD CHIPS OR MULCH ARE USED TO AMEND THE SOIL. ROTOTILL UREA FERTILIZER AT A RATE OF 2 POUNDS PER 1000 SQUARE FEET.

- UNDERDRAINS - UNDERDRAINS SHOULD MEET THE FOLLOWING CRITERIA:
THE GRAVEL LAYER SHALL BE AT LEAST 3" THICK ABOVE AND BELOW THE UNDERDRAIN. THE MAIN COLLECTOR PIPE FOR UNDERDRAIN SYSTEMS SHALL BE CONSTRUCTED AT A MINIMUM SLOPE OF 0.5%. OBSERVATION WELLS AND/OR CLEAN-OUT PIPES MUST BE PROVIDED (ONE MINIMUM PER EVERY 1,000 SQUARE FEET OF SURFACE AREA).

OPERATION AND MAINTENANCE SCHEDULE FOR PRIVATELY OWNED AND MAINTAINED M-2 SUBMERGED GRAVEL WETLANDS

- DURING THE FIRST YEAR OF OPERATION, THE OWNER SHALL INSPECT THE FACILITY AFTER EVERY HEAVY STORM AND REPLACE VEGETATION AS NEEDED.
- THE OWNER SHALL REMOVE SEDIMENT ACCUMULATED IN THE PRETREATMENT AREAS AS NECESSARY.
- SIGNS OF UNEVEN FLOW WITHIN THE WETLAND MAY MEAN THAT THE GRAVEL OR UNDERDRAIN IS CLOGGED. THE GRAVEL OR UNDERDRAIN SHALL BE REMOVED, CLEANED, AND REPLACED, AS NEEDED.
- THE OWNER SHALL ENSURE A DENSE STAND OF WETLAND VEGETATION IS MAINTAINED THROUGH THE LIFE OF THE FACILITY AND REPLACE VEGETATION AS NEEDED.
- THE OWNER SHALL ENSURE THE INLETS AND OUTLETS TO EACH GRAVEL WETLAND CELL ARE FREE FROM DEBRIS. F. THE OWNER SHALL REPAIR EROSION AT INFLOW POINTS AND ENSURE FLOW SPLITTERS ARE FUNCTIONAL TO PREVENT STORM WATER FROM BYPASSING THE FACILITY.

OPERATION AND MAINTENANCE SCHEDULE FOR M-6 MICRO-BIORETENTION PRACTICES

- THE OWNER SHALL MAINTAIN THE PLANT MATERIAL, MULCH LAYER AND SOIL LAYER ANNUALLY. MAINTENANCE OF MULCH AND SOIL IS LIMITED TO CORRECTING AREAS OF EROSION OR WASH OUT. ANY MULCH REPLACEMENT SHALL BE DONE IN THE SPRING. PLANT MATERIAL SHALL BE CHECKED FOR DISEASE AND INSECT INFESTATION AND MAINTENANCE WILL ADDRESS DEAD MATERIAL AND PRUNING. ACCEPTABLE REPLACEMENT PLANT MATERIAL IS LIMITED TO THE FOLLOWING: 2000 MARYLAND STORMWATER DESIGN MANUAL VOLUME II, TABLE A.4.1 AND 2.
- THE OWNER SHALL PERFORM A PLANT IN THE SPRING AND IN THE FALL OF EACH YEAR. DURING THE INSPECTION, THE OWNER SHALL REMOVE DEAD AND DISEASED VEGETATION CONSIDERED BEYOND TREATMENT, REPLACE DEAD PLANT MATERIAL WITH ACCEPTABLE REPLACEMENT PLANT MATERIAL, TREAT DISEASED TREES AND SHRUBS, AND REPLACE ALL DEFICIENT STAKES AND WIRES.
- THE OWNER SHALL INSPECT THE MULCH EACH SPRING. THE MULCH SHALL BE REPLACED EVERY TWO TO THREE YEARS. THE PREVIOUS MULCH LAYER SHALL BE REMOVED BEFORE THE NEW LAYER IS APPLIED.
- THE OWNER SHALL CORRECT SOIL EROSION ON AN AS NEEDED BASIS, WITH A MINIMUM OF ONCE PER MONTH AND AFTER EACH HEAVY STORM.

OPERATION AND MAINTENANCE SCHEDULE FOR F-6 BIO-RETENTION PRACTICES

- ANNUAL MAINTENANCE OF PLANT MATERIAL, MULCH LAYER AND SOIL LAYER IS REQUIRED. MAINTENANCE OF MULCH AND SOIL IS LIMITED TO CORRECTING AREAS OF EROSION OR WASH OUT. ANY MULCH REPLACEMENT SHALL BE DONE IN THE SPRING. PLANT MATERIAL SHALL BE CHECKED FOR DISEASE AND INSECT INFESTATION AND MAINTENANCE WILL ADDRESS DEAD MATERIAL AND PRUNING.
- SCHEDULE OF PLANT INSPECTION WILL BE TWICE A YEAR IN SPRING AND FALL. THIS INSPECTION WILL INCLUDE REMOVAL OF DEAD AND DISEASED VEGETATION CONSIDERED BEYOND TREATMENT, TREATMENT OF ALL DISEASED TREES AND SHRUBS AND REPLACEMENT OF ALL DEFICIENT STAKES AND WIRES.
- MULCH SHALL BE INSPECTED EACH SPRING. REMOVE PREVIOUS MULCH LAYER BEFORE APPLYING NEW LAYER ONCE EVERY 2 TO 3 YEARS.
- SOIL EROSION TO BE ADDRESSED ON AN AS NEEDED BASIS, WITH A MINIMUM OF ONCE PER MONTH AND AFTER HEAVY STORM EVENTS.

MATERIAL SPECIFICATIONS FOR M-2 SUBMERGED GRAVEL WETLAND, M-6 MICRO-BIORETENTION AND F-6 BIORETENTION			
PLANTINGS	SEE APPENDIX A, TABLE A.4, MARYLAND STORMWATER DESIGN MANUAL	N/A	PLANTINGS ARE SITE-SPECIFIC
PLANTING SOIL [2' TO 4' DEEP]	LOAMY SAND (60-65%) AND COMPOST (35-40%) OR SANDY LOAM (30%), COARSE SAND (30%) AND COMPOST (40%)	N/A	USDA SOIL TYPES LOAMY SAND OR SANDY LOAM; CLAY CONTENT < 5%
ORGANIC CONTENT	MIN. 10% BY DRY WEIGHT (ASTM-D-2974)		
MULCH	SHREDDED HARDWOOD		AGED 6 MONTHS, MINIMUM; NO PINE OR WOOD CHIPS
PEA GRAVEL DIAPHRAGM	PEA GRAVEL: ASTM-D-448	NO. 8 OR NO.9 (1/8" TO 3/8")	
GEOTEXTILE		N/A	PE TYPE I NONWOVEN
GRAVEL (UNDERDRAINS AND INFILTRATION BERMS)	AASHTO M-43	NO. 57 OF NO. 6 AGGREGATE (1/8" TO 3/8")	
UNDERDRAIN PIPING	F 758, TYPE PS 28 OR AASHTO M-278	4" TO 6" RIGID SCHEDULE 40 PVC OR SDR35	SLOTTED OR PERFORATED PIPE: 3/8" PERF. @ 6" ON CENTER, 4 HOLES PER ROW; MINIMUM OF 3" OF GRAVEL OVER PIPES; NOT NECESSARY UNDERNEATH PIPES. PERFORATED PIPE SHALL BE WRAPPED WITH 1/4-INCH GALVANIZED HARDWARE CLOTH

STORMWATER MAINTENANCE SCHEDULE			
PRACTICE	FREQUENCY OF INSPECTION	PREVENTATIVE MAINTENANCE	MAINTENANCE REQUIREMENTS
SUBMERGED GRAVEL WETLANDS	SEASONALLY (AND AFTER A MAJOR STORM)		REMOVE ANY DEAD OR DYING VEGETATION AND REVEGETATE. REMOVE ACCUMULATED SEDIMENT FROM PRETREATMENT AREAS. CLEAN INLETS AND OUTLETS OF SEDIMENT, DEBRIS, AND TRASH. REPAIR EROSION AT INFLOW POINTS. SIGNS OF UNEVEN FLOW DISTRIBUTION MAY INDICATE THAT THE GRAVEL OR UNDERDRAIN IS CLOGGED. REMOVE, CLEAN, AND REPLACE GRAVEL.
MICRO-BIORETENTION	SEASONALLY (AND AFTER A MAJOR STORM)	IF SPECIFIC PLANTS ARE NOT SURVIVING, REPLACE WITH MORE APPROPRIATE SPECIES.	IRRIGATE DURING PROLONGED DRY PERIODS. REMOVE ANY DEAD OR DYING VEGETATION AND REVEGETATE. PRUNE VEGETATION OCCASIONALLY. REMOVE ACCUMULATED SEDIMENT FROM SURFACE OF FILTER BED WHEN ACCUMULATION EXCEEDS ONE INCH. IF WATER PONDS FOR MORE THAN 48 HOURS, REMOVE AND REPLACE THE TOP FEW INCHES OF FILTER MEDIA. REPLACE MULCH ANNUALLY WHERE PRACTICE TREATS AREAS WITH HIGH CONCENTRATIONS OF HEAVY METALS. OTHERWISE, REPLACE TOP 2-3 INCHES AS NECESSARY.

APPROVED: DEPARTMENT OF PLANNING AND ZONING

Valdis Joffe 12-12-17
DIRECTOR DATE

John Edman 11-29-17
CHIEF, DEVELOPMENT ENGINEERING DIVISION DATE


Kent Sullivan 12-5-17
CHIEF, DIVISION OF LAND DEVELOPMENT DATE

GRID: 8 BLOCK: N/A
ZONING: RC-DEO PARCEL/LOT: 220, 253, 11, 23, 54
TAX MAP: 0016 ELECTION DISTRICT: 3-02

OWNER/ENGINEER INFORMATION

DEVELOPER/OWNER:
HOWARD COUNTY GOVERNMENT
CONTACT: JEFF DANNIS, P.E., CSP
6751 COLUMBIA GATEWAY DRIVE, SUITE 514
COLUMBIA, MD 21046
TELEPHONE: (410) 313-6419

ENGINEER:
EA ENGINEERING, SCIENCE,
AND TECHNOLOGY, INC., PBC
CONTACT: MARK GUTBERLET, P.E.
225 SCHILLING CIRCLE, SUITE 400
HUNT VALLEY, MD 21031
TELEPHONE: (410) 584-7000

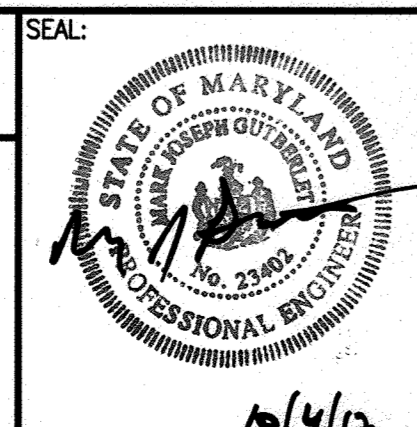

PROFESSIONAL CERTIFICATION:

I HEREBY CERTIFY THAT THESE DOCUMENTS WERE PREPARED OR APPROVED BY ME, AND THAT I AM A DULY LICENSED PROFESSIONAL ENGINEER UNDER THE LAWS OF THE STATE OF MARYLAND, LICENSE NO. 234018, EXPIRATION DATE 25 AUGUST 2018.

EA
EA ENGINEERING,
SCIENCE, AND
TECHNOLOGY

DSN. BY: MBS/MP CVH
DRN. BY: JAP/KEJ
CHK. BY: SMD
DATE: OCT. 2016

BY NO. REVISION DATE

REVISION TOTAL SHEET NUMBER SHOWN TO ADDITION OF SHEET 45 8/10/22

STORMWATER MANAGEMENT DETAILS II

**COMPOST FACILITY - PHASE II
AT ALPHA RIDGE LANDFILL
HOWARD COUNTY, MARYLAND**

SDP SHEET: 45
32 OF 44

DRAWING: SW-11

PROJECT: 14982.05

SHEET: 46 OF 70

FILE PATH: O:\PROJECTS\1498205 - ARL COMPOST FACILITY\498205SW-07DET.DWG [SW-11 - SDP-32] 3/12/15

NOT FOR CONSTRUCTION - SITE DEVELOPMENT PLAN #SDP-16-035

BORING LOG BORING B-8 PAGE 1 OF 1

CLIENT: SCS Engineers PROJECT NAME: Howard County Compost Facility
 PROJECT LOCATION: Howard County, Maryland PROJECT NUMBER: 16499-0 MD DATE TESTED:
 RIG: ATY R-Tired CME 750 METHOD: Hollow Stem Auger SAMPLER: 2-in OD SS HAMMER: 140# FALL: 30" AUTO? Yes
 DATE STARTED: 10/2/13 COMPLETED: 10/2/13
 DRILLER: Dennis Strawdeman HELPER: Maurice Hardy
 REVIEWED BY: Kristopher Crist SITE DELAYS:
 LOCATION: As Staked BULK SAMPLES: 0-5'

DEPTH (ft)	SAMPLE TYPE AND NUMBER	SPT BLOWNS/10' OR REC MIN %	N VALUE OR CORE ROD	GRAPHIC LOG	USCS	WATER LEVEL	WATER LEVELS		HOLE DEPTH (ft)	WATER DEPTH (ft)	WATER ELEV (ft)
							ELAPSED HOURS	CAVING DEPTH (ft)			
0											
12	S1	5-10-9-4	19	538.0	SM				12		
10	S2	5-4-6-8	10	534.3	SM				10		
5	S3	4-7-21	28	530.8	SM				25		
10	S4	5-0-5-0-4	36	528.8	SM						
10	S5	5-0-7-5-0-2	44	526.8	SM						
10	S6	5-0-11-5-0-1	140	522.3	SM						
10	S7	5-0-9-5-0-2	122	522.3	SM						

REMARKS:

BORING LOG BORING B-9 PAGE 1 OF 1

CLIENT: SCS Engineers PROJECT NAME: Howard County Compost Facility
 PROJECT LOCATION: Howard County, Maryland PROJECT NUMBER: 16499-0 MD DATE TESTED:
 RIG: ATY R-Tired CME 750 METHOD: Hollow Stem Auger SAMPLER: 2-in OD SS HAMMER: 140# FALL: 30" AUTO? Yes
 DATE STARTED: 10/2/13 COMPLETED: 10/2/13
 DRILLER: Dennis Strawdeman HELPER: Maurice Hardy
 REVIEWED BY: Kristopher Crist SITE DELAYS:
 LOCATION: As Staked BULK SAMPLES: 0-5'

DEPTH (ft)	SAMPLE TYPE AND NUMBER	SPT BLOWNS/10' OR REC MIN %	N VALUE OR CORE ROD	GRAPHIC LOG	USCS	WATER LEVEL	WATER LEVELS		HOLE DEPTH (ft)	WATER DEPTH (ft)	WATER ELEV (ft)
							ELAPSED HOURS	CAVING DEPTH (ft)			
0											
12	S1	6-8-10-8	18	524.6	SM				11		
10	S2	7-7-9-10	16	522.8	SM				12		
5	S3	8-16-21-17	36	520.8	SM				12		
10	S4	12-12-13-17	25	518.8	SM				16	28	
10	S5	4-4-5-0-2	44	516.8	SM						
10	S6	5-0-11-5-0-1	130	511.9	SM						

REMARKS:

BORING LOG BORING B-10 PAGE 1 OF 1

CLIENT: SCS Engineers PROJECT NAME: Howard County Compost Facility
 PROJECT LOCATION: Howard County, Maryland PROJECT NUMBER: 16499-0 MD DATE TESTED:
 RIG: ATY R-Tired CME 750 METHOD: Hollow Stem Auger SAMPLER: 2-in OD SS HAMMER: 140# FALL: 30" AUTO? Yes
 DATE STARTED: 10/2/13 COMPLETED: 10/2/13
 DRILLER: Dennis Strawdeman HELPER: Maurice Hardy
 REVIEWED BY: Kristopher Crist SITE DELAYS:
 LOCATION: As Staked BULK SAMPLES: 0-5'

DEPTH (ft)	SAMPLE TYPE AND NUMBER	SPT BLOWNS/10' OR REC MIN %	N VALUE OR CORE ROD	GRAPHIC LOG	USCS	WATER LEVEL	WATER LEVELS		HOLE DEPTH (ft)	WATER DEPTH (ft)	WATER ELEV (ft)
							ELAPSED HOURS	CAVING DEPTH (ft)			
0											
18	S1	3-4-4-5	8	518.2	SM				18		
10	S2	6-6-5-8	11	517.5	SM				19	31	
5	S3	10-6-5-5	11	513.5	SM				15		
10	S4	6-6-7-8	12	511.5	SM				15		
10	S5	7-8-7-7	15	511.5	SM				17		
10	S6	5-0-11-5-0-1	120	507.5	SM						
10	S7	5-0-9-5-0-2	110	504.5	SM						

REMARKS:

APPROVED: DEPARTMENT OF PLANNING AND ZONING

Valdis J. J. [Signature] 12-12-17
 DIRECTOR DATE

Shel [Signature] 11-29-17
 CHIEF, DEVELOPMENT ENGINEERING DIVISION DATE


Karla [Signature] 12-5-17
 CHIEF, DIVISION OF LAND DEVELOPMENT DATE

GRID: 8 BLOCK: N/A
 ZONING: RC-DEO PARCEL/LOT: 220, 253, 11, 23, 54
 TAX MAP: 0016 ELECTION DISTRICT: 3-02

OWNER/ENGINEER INFORMATION

DEVELOPER/OWNER:
 HOWARD COUNTY GOVERNMENT
 CONTACT: JEFF DANNIS, P.E., CSP
 6751 COLUMBIA GATEWAY DRIVE, SUITE 514
 COLUMBIA, MD 21046
 TELEPHONE: (410) 313-6419

ENGINEER:
 EA ENGINEERING, SCIENCE,
 AND TECHNOLOGY, INC., PBC
 CONTACT: MARK GUTBERLET, P.E.
 225 SCHILLING CIRCLE, SUITE 400
 HUNT VALLEY, MD 21031
 TELEPHONE: (410) 584-7000

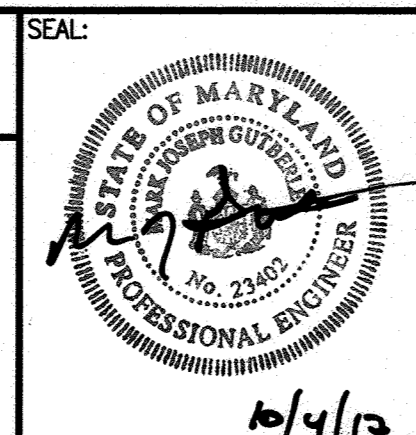

PROFESSIONAL CERTIFICATION:

I HEREBY CERTIFY THAT THESE DOCUMENTS WERE PREPARED OR APPROVED BY ME, AND THAT I AM A DULY LICENSED PROFESSIONAL ENGINEER UNDER THE LAWS OF THE STATE OF MARYLAND, LICENSE NO. 23402, EXPIRATION DATE 25 AUGUST 2019.

10/13



DSN. BY: MBS/MP	CVH	REVISION TOTAL SHEET NUMBER	8/2022
DRN. BY: JAP/KEJ		DUE TO ADDITION OF SHEET 45	
CHK. BY: SMD			
DATE: OCT. 2016	BY NO.	REVISION	DATE

GEOTECHNICAL SOIL BORING LOGS II

COMPOST FACILITY - PHASE II
 AT ALPHA RIDGE LANDFILL
 HOWARD COUNTY, MARYLAND

SDP SHEET: 45
 34 OF 44
 DRAWING: SW-15
 PROJECT: 14982.05
 SHEET: -58-0F-70

LEGEND

- DRAINAGE AREA TO EW-21
- DRAINAGE AREA TO I-18
- DRAINAGE AREA TO I-31
- DRAINAGE AREA TO I-29 (SUBDRAINAGE AREA TO I-23)
- DRAINAGE AREA TO I-32
- DRAINAGE AREA TO I-34
- DRAINAGE AREA TO I-35
- DRAINAGE AREA TO I-16
- DRAINAGE AREA TO I-17
- DRAINAGE AREA TO I-13 (SUBDRAINAGE AREA TO I-12)
- DRAINAGE AREA TO I-14 (SUBDRAINAGE AREA TO I-12)
- DRAINAGE AREA TO I-12
- DRAINAGE AREA TO I-38
- DRAINAGE AREA TO I-5
- DRAINAGE AREA TO I-23
- DRAINAGE AREA TO I-28 (SUBDRAINAGE AREA TO I-23)
- DRAINAGE AREA TO I-9


DRAINAGE AREA NO.	DRAINAGE AREA (AC)	C	Q(CFS)	% IMPERVIOUS
EW-21	1.27	0.37	4.0	10.4%
I-5	0.20	0.30	0.5	0%
I-12	1.26	0.54	5.8	20.7
I-13	0.46	0.53	2.1	35.0%
I-14	0.11	0.95	0.9	100%
I-16	0.05	0.30	0.1	0%
I-17	0.07	0.30	0.2	0%
I-18	0.90	0.53	4.1	36.0%
I-23	1.39	0.52	6.1	33.9
I-28	0.16	0.95	1.3	100%
I-31	0.77	0.47	3.1	22.0%
I-32	0.06	0.30	0.2	0%
I-34	0.53	0.83	3.7	81.3%
I-35	0.52	0.82	3.6	80.2%
I-38	5.52	0.75	35.4	69.9
I-9	1.36	0.69	7.9	59.6
I-29	0.58	0.62	3.0	48.6%

INCLUDES DRAINAGE FROM I-13 AND I-14

INCLUDES DRAINAGE FROM I-28 AND I-29



DRAINAGE AREA MAP
SCALE: 1" = 80'

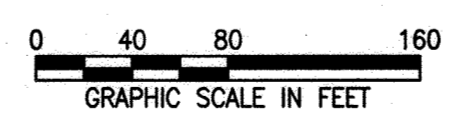

NO.	TYPE	RIM ELEV.	BOTTOM ELEV.
EW-21	EXISTING ENDWALL	553.92	552.00
MH-20	PRECAST MANHOLE G-5.12	551.71	544.00
MH-19	PRECAST MANHOLE G-5.12	543.38	533.00
MH-11	PRECAST MANHOLE G-5.12	542.62	532.30
MH-10	PRECAST MANHOLE G-5.12	541.91	530.93
MH-7	PRECAST MANHOLE G-5.12	535.80	526.93
MH-6	PRECAST MANHOLE G-5.12	526.50	521.55
MH-4	PRECAST MANHOLE G-5.12	526.30	516.53
MH-3	PRECAST MANHOLE G-5.12	525.63	514.31
EW-1	TYPE 'A' ENDWALL	516.13	512.84
I-35	YARD INLET D-4.14	541	534.00
I-34	YARD INLET D-4.14	541	532.72
MH-33	PRECAST MANHOLE G-5.12	542.00	532.24
I-32	YARD INLET D-4.14	542.00	531.23
I-31	YARD INLET D-4.14	542.00	530.79
MH-30	PRECAST MANHOLE G-5.12	535.00	523.67
MH-26	PRECAST MANHOLE G-5.12	529.53	520.56
MH-22	PRECAST MANHOLE G-5.12	530.00	518.55
I-5	RISER STRUCTURE	524.75	522.00
I-16	YARD INLET D-4.14	542.00	538.57
I-17	YARD INLET D-4.14	543.25	537.42
I-18	YARD INLET D-4.14	543.67	536.34
I-13	YARD INLET D-4.37	543.40	537.65
I-14	YARD INLET D-4.37	542.46	537.25
EW-15	TYPE 'O' HEADWALL D-5.41	539.21	537.00
I-12	RISER STRUCTURE	537.00	532.88
I-9	RISER STRUCTURE	536.50	532.10
MH-8	PRECAST MANHOLE G-5.12	535.59	531.21
I-38	RISER STRUCTURE	515.24	510.53
MH-37	PRECAST MANHOLE G-5.12	514.06	509.94
EW-36	TYPE 'A' HEADWALL D-5.11	511.96	509.75
I-29	YARD INLET D-4.37	529.53	523.31
I-28	YARD INLET D-4.37	529.53	524.11
EW-27	TYPE 'O' HEADWALL D-5.41	527.50	524.04
I-23	RISER STRUCTURE	528.00	522.70

FROM	TO	SIZE	TYPE	LENGTH
EW-21	MH-20	18"	EX. CMP	45 LF
MH-20	MH-19	18"	RCP, ASTM C-76, CL. III	153 LF
MH-19	MH-11	24"	RCP, ASTM C-76, CL. III	50 LF
MH-11	MH-10	24"	RCP, ASTM C-76, CL. III	157 LF
MH-10	MH-7	24"	RCP, ASTM C-76, CL. III	379 LF
MH-7	MH-6	24"	RCP, ASTM C-76, CL. III	291 LF
MH-6	MH-4	24"	RCP, ASTM C-76, CL. III	83 LF
MH-4	MH-3	24"	RCP, ASTM C-76, CL. III	53 LF
MH-3	EW-1	30"	RCP, ASTM C-76, CL. III	148 LF
I-35	I-34	18"	RCP, ASTM C-76, CL. III	108 LF
I-34	MH-33	18"	RCP, ASTM C-76, CL. III	28 LF
MH-33	I-32	18"	RCP, ASTM C-76, CL. III	81 LF
I-32	I-31	18"	RCP, ASTM C-76, CL. III	24 LF
I-31	MH-30	18"	RCP, ASTM C-76, CL. III	190 LF
MH-30	MH-26	18"	RCP, ASTM C-76, CL. III	227 LF
MH-26	MH-22	24"	RCP, ASTM C-76, CL. III	206 LF
MH-22	MH-3	30"	RCP, ASTM C-76, CL. III	170 LF
I-5	MH-4	18"	RCP, ASTM C-76, CL. III	10 LF
I-16	I-18	18"	RCP, ASTM C-76, CL. III	95 LF
I-17	I-18	18"	RCP, ASTM C-76, CL. III	18 LF
I-18	MH-19	18"	RCP, ASTM C-76, CL. III	24 LF
I-13	I-14	18"	RCP, ASTM C-76, CL. III	20 LF
I-14	EW-15	18"	RCP, ASTM C-76, CL. III	22 LF
I-12	MH-11	18"	RCP, ASTM C-76, CL. III	38 LF
I-9	MH-8	18"	RCP, ASTM C-76, CL. III	57 LF
MH-8	MH-7	18"	RCP, ASTM C-76, CL. III	132 LF
I-38	MH-37	30"	RCP, ASTM C-76, CL. III	78 LF
MH-37	EW-36	30"	RCP, ASTM C-76, CL. III	37 LF
I-29	I-28	18"	RCP, ASTM C-76, CL. III	20 LF
I-28	EW-27	18"	RCP, ASTM C-76, CL. III	15 LF
I-23	MH-22	30"	RCP, ASTM C-76, CL. III	38 LF

APPROVED: DEPARTMENT OF PLANNING AND ZONING

Mark Gutberlet 12-12-17
DIRECTOR DATE

Chad Clark 11-29-17
CHIEF, DEVELOPMENT ENGINEERING DIVISION DATE


Karl Salove 12-5-17
CHIEF, DIVISION OF LAND DEVELOPMENT DATE

GRID: 8 BLOCK: N/A
ZONING: RC-DEO PARCEL/LOT: 220, 253, 11, 23, 54
TAX MAP: 0016 ELECTION DISTRICT: 3-02

OWNER/ENGINEER INFORMATION

DEVELOPER/OWNER:
HOWARD COUNTY GOVERNMENT
CONTACT: JEFF DANNIS, P.E., CSP
6751 COLUMBIA GATEWAY DRIVE, SUITE 514
COLUMBIA, MD 21046
TELEPHONE: (410) 313-6419

ENGINEER:
EA ENGINEERING, SCIENCE, AND TECHNOLOGY, INC., PBC
CONTACT: MARK GUTBERLET, P.E.
225 SCHILLING CIRCLE, SUITE 400
HUNT VALLEY, MD 21031
TELEPHONE: (410) 584-7000

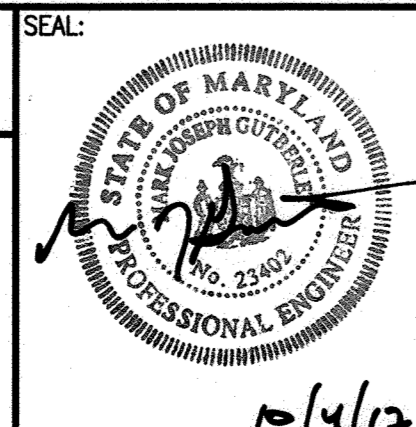

PROFESSIONAL CERTIFICATION:

I HEREBY CERTIFY THAT THESE DOCUMENTS WERE PREPARED OR APPROVED BY ME, AND THAT I AM A DULY LICENSED PROFESSIONAL ENGINEER UNDER THE LAWS OF THE STATE OF MARYLAND, LICENSE NO. 23402, EXPIRATION DATE 25 AUGUST 2018.



DSN. BY:	MBS/MP	4/2018	
DRN. BY:	JAP/KEJ	8/2012	
CHK. BY:	SMD		
DATE:	OCT. 2016		
BY	NO.	REVISION	DATE

STORM DRAIN DRAINAGE AREA MAP


COMPOST FACILITY - PHASE II
AT ALPHA RIDGE LANDFILL
HOWARD COUNTY, MARYLAND

SDP SHEET: 45
DRAWING: SW-16
PROJECT: 14982.05
SHEET: 51 OF 70

NOT FOR CONSTRUCTION - SITE DEVELOPMENT PLAN #SDP-16-035

LEGEND

	DRAINAGE AREA 1 M-6 MICRO-BIOTRETENTION NO. 1
	DRAINAGE AREA 2 M-6 MICRO-BIOTRETENTION NO. 2
	DRAINAGE AREA 3 M-2 SUBMERGED GRAVEL WETLAND NO. 1
	DRAINAGE AREA 4 F-6 BIOTRETENTION NO. 1
	DRAINAGE AREA 5 F-6 BIOTRETENTION NO. 2
	DRAINAGE AREA 6 M-2 SUBMERGED GRAVEL WETLAND NO. 2

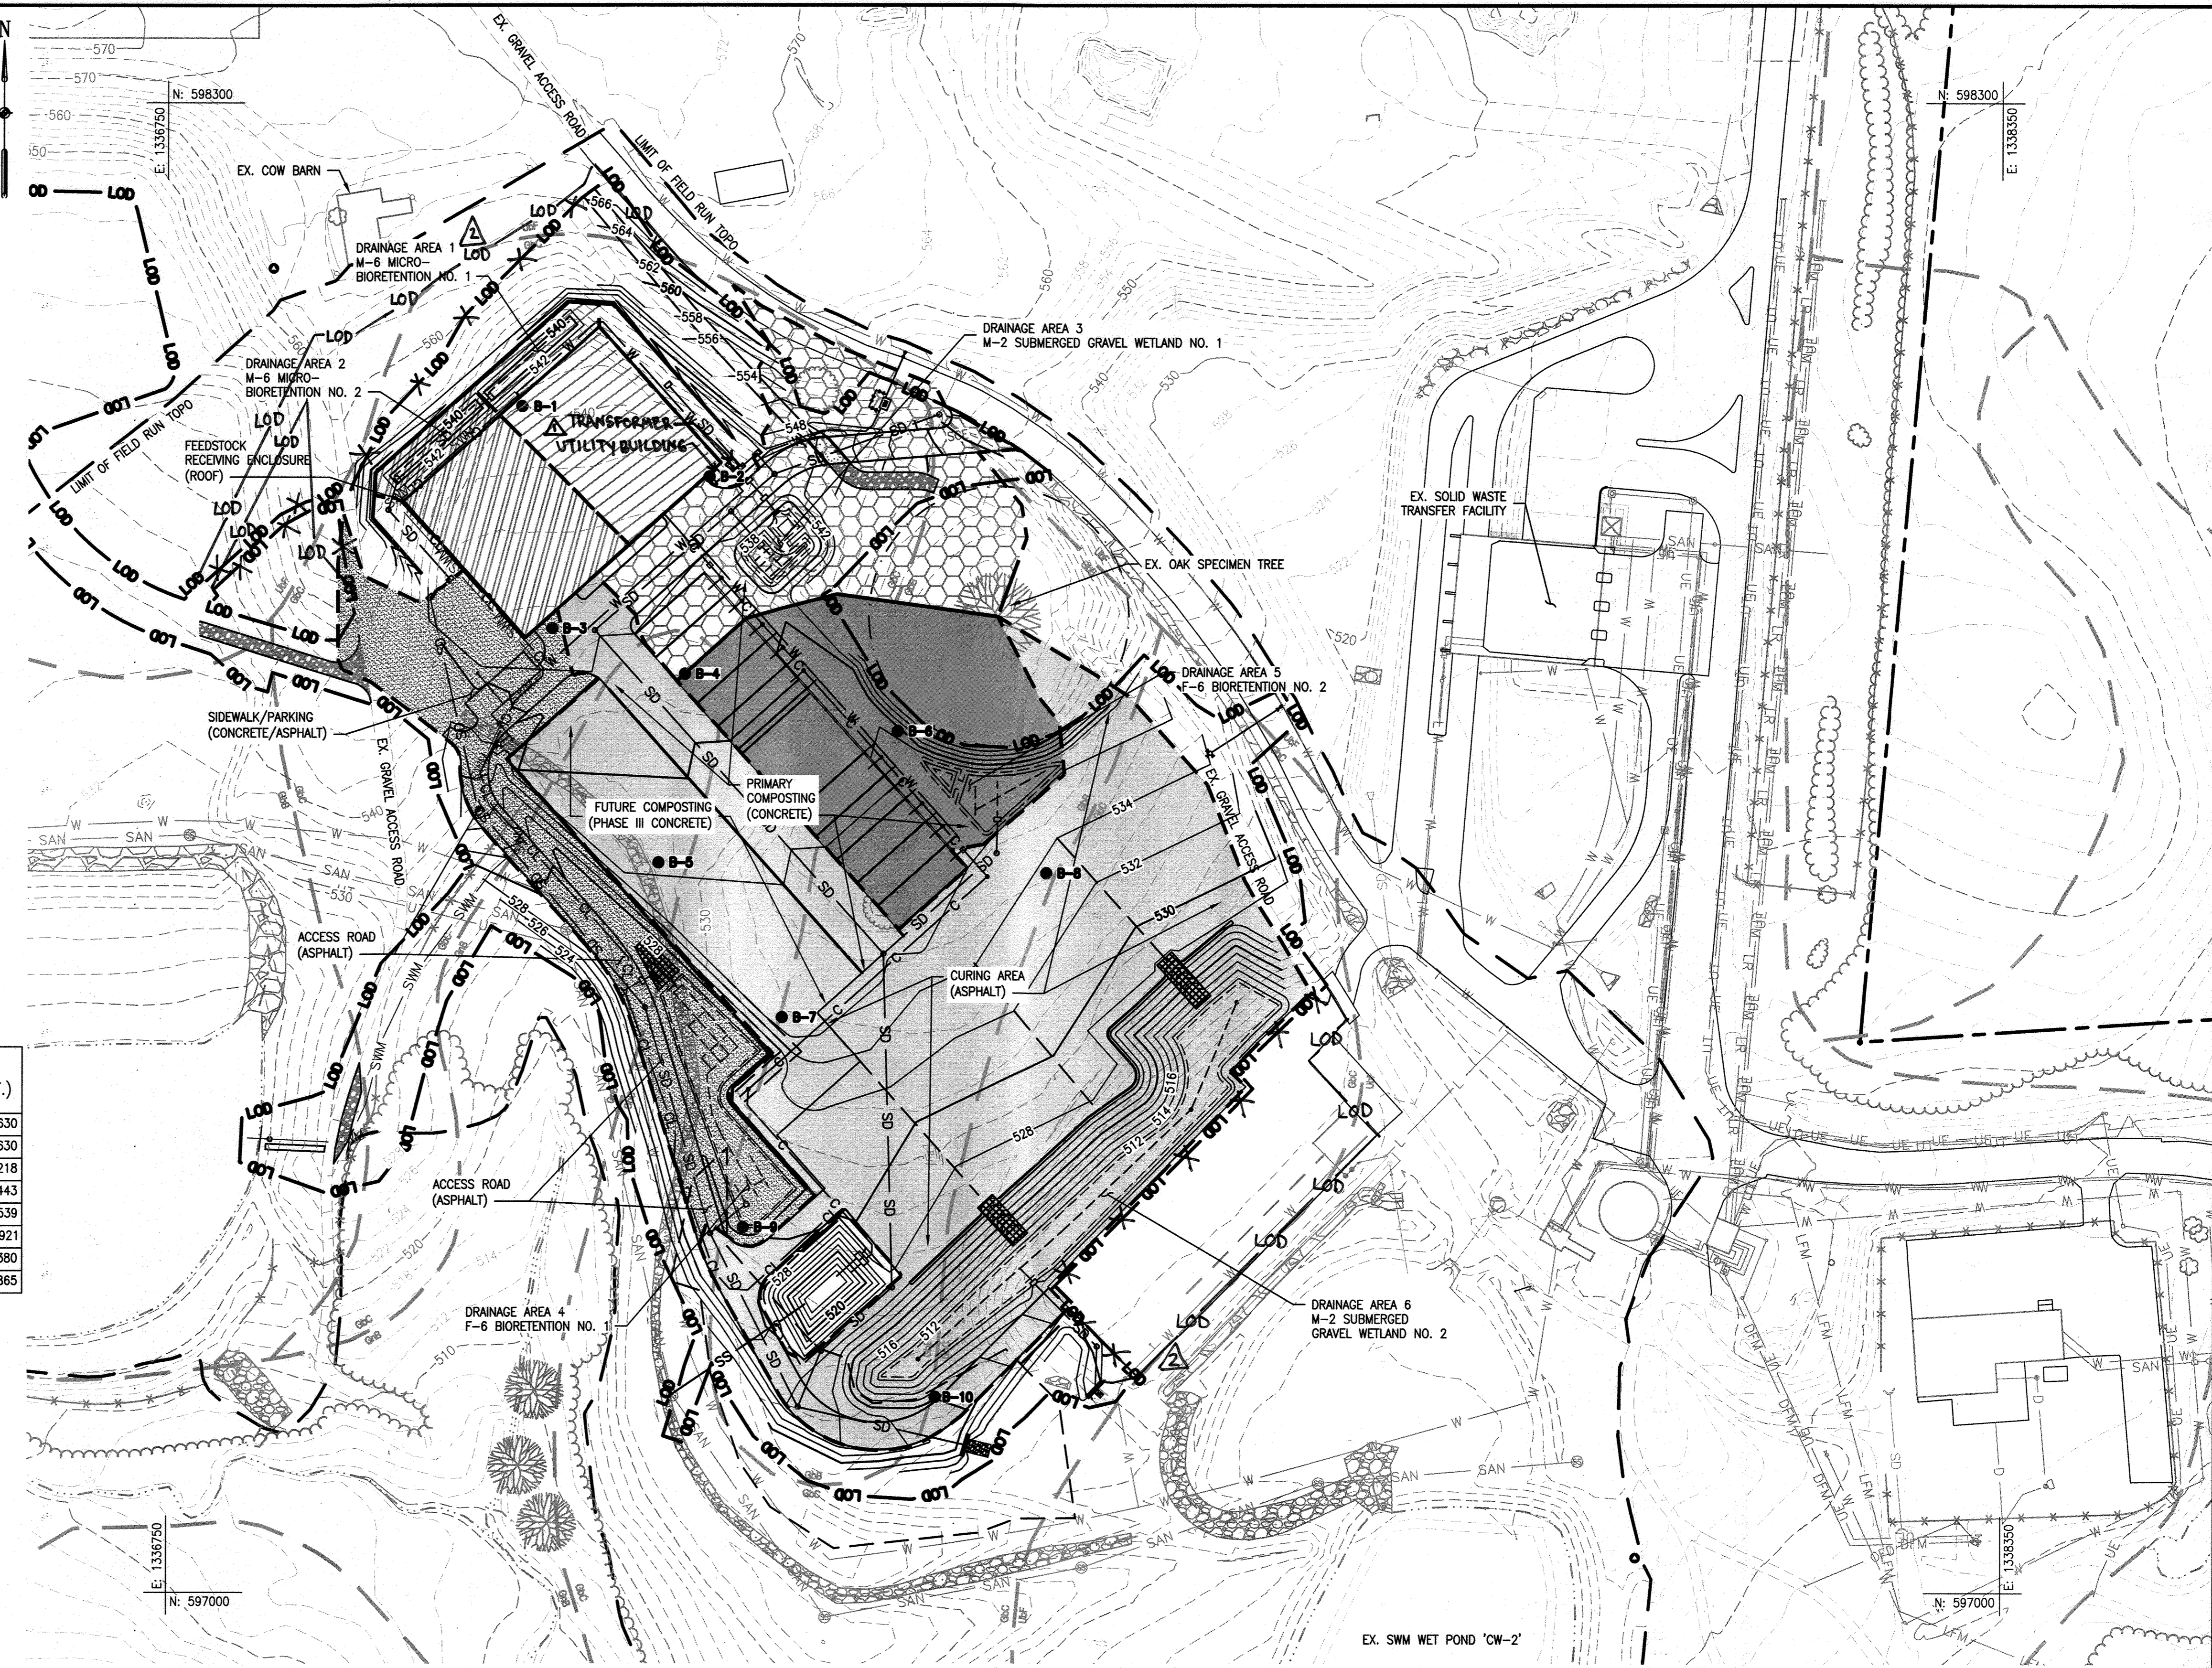

DRAINAGE AREA NO.	DRAINAGE AREA (AC)	% IMPERVIOUS	ESD FEATURE ID	ESD FEATURE DESCRIPTION	PROVIDED ESDV (CU.FT.)
1	0.51	80.9	M-6	MICRO-BIOTRETENTION NO. 1	1,630
2	0.52	81.7	M-6	MICRO-BIOTRETENTION NO. 2	1,630
3	1.38	39.1	M-2	SUBMERGED GRAVEL WETLAND 1	1,218
4	1.32	34.1	F-6	BIOTRETENTION NO. 1	4,443
5	1.34	51.5	F-6	BIOTRETENTION NO. 2	2,539
6	5.32	58.0	M-2	SUBMERGED GRAVEL WETLAND 2	15,921
TOTAL PROVIDED ESDV					27,380
TARGET ESDV					53,885

NOTE:
1. THE REMAINDER OF THE REQUIRED VOLUME OF 26,485 CF WILL BE TREATED BY THE EXISTING CW-2 WET POND.

APPROVED: DEPARTMENT OF PLANNING AND ZONING

William J. [Signature] 12-12-17
DIRECTOR DATE

[Signature] 11-29-17
CHIEF, DEVELOPMENT ENGINEERING DIVISION DATE


[Signature] 12-5-17
CHIEF, DIVISION OF LAND DEVELOPMENT DATE

GRID: 8 BLOCK: N/A
ZONING: RC-DEO PARCEL/LOT: 220, 253, 11, 23, 54
TAX MAP: 0016 ELECTION DISTRICT: 3-02

OWNER/ENGINEER INFORMATION

DEVELOPER/OWNER:
HOWARD COUNTY GOVERNMENT
CONTACT: JEFF DANNIS, P.E., CSP
6751 COLUMBIA GATEWAY DRIVE, SUITE 514
COLUMBIA, MD 21046
TELEPHONE: (410) 313-6419

ENGINEER:
EA ENGINEERING, SCIENCE
AND TECHNOLOGY, INC., PBC
CONTACT: MARK GUTBERLET, P.E.
225 SCHILLING CIRCLE, SUITE 400
HUNT VALLEY, MD 21031
TELEPHONE: (410) 584-7000

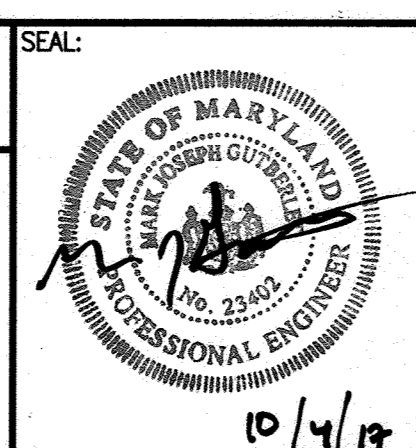

PROFESSIONAL CERTIFICATION:

I HEREBY CERTIFY THAT THESE DOCUMENTS WERE PREPARED OR APPROVED BY ME, AND THAT I AM A DULY LICENSED PROFESSIONAL ENGINEER UNDER THE LAWS OF THE STATE OF MARYLAND, LICENSE NO. 23402, EXPIRATION DATE 25 AUGUST 2018.



DSN. BY: MBS/MP	SMB	REVISION UTILITY BUILDING AND TRANSFORMER LOCATION	4/2017
DRN. BY: JAP/KEJ	CVH	REVISED LOD FOR PHASE II B AND PHASE II C CONSTRUCTION	8/12/17
CHK. BY: SMD			
DATE: OCT. 2016	BY NO.	REVISION	DATE



DRAINAGE AREA MAP
SCALE: 1" = 80'
0 40 80 160
GRAPHIC SCALE IN FEET

ESD DRAINAGE AREA MAP

**COMPOST FACILITY - PHASE II
AT ALPHA RIDGE LANDFILL**
HOWARD COUNTY, MARYLAND

SDP SHEET: 45	DRAWING: DA-1
36 OF 44	
PROJECT: 14982.05	
SHEET: 52 OF 70	

NOT FOR CONSTRUCTION - SITE DEVELOPMENT PLAN #SDP-16-035

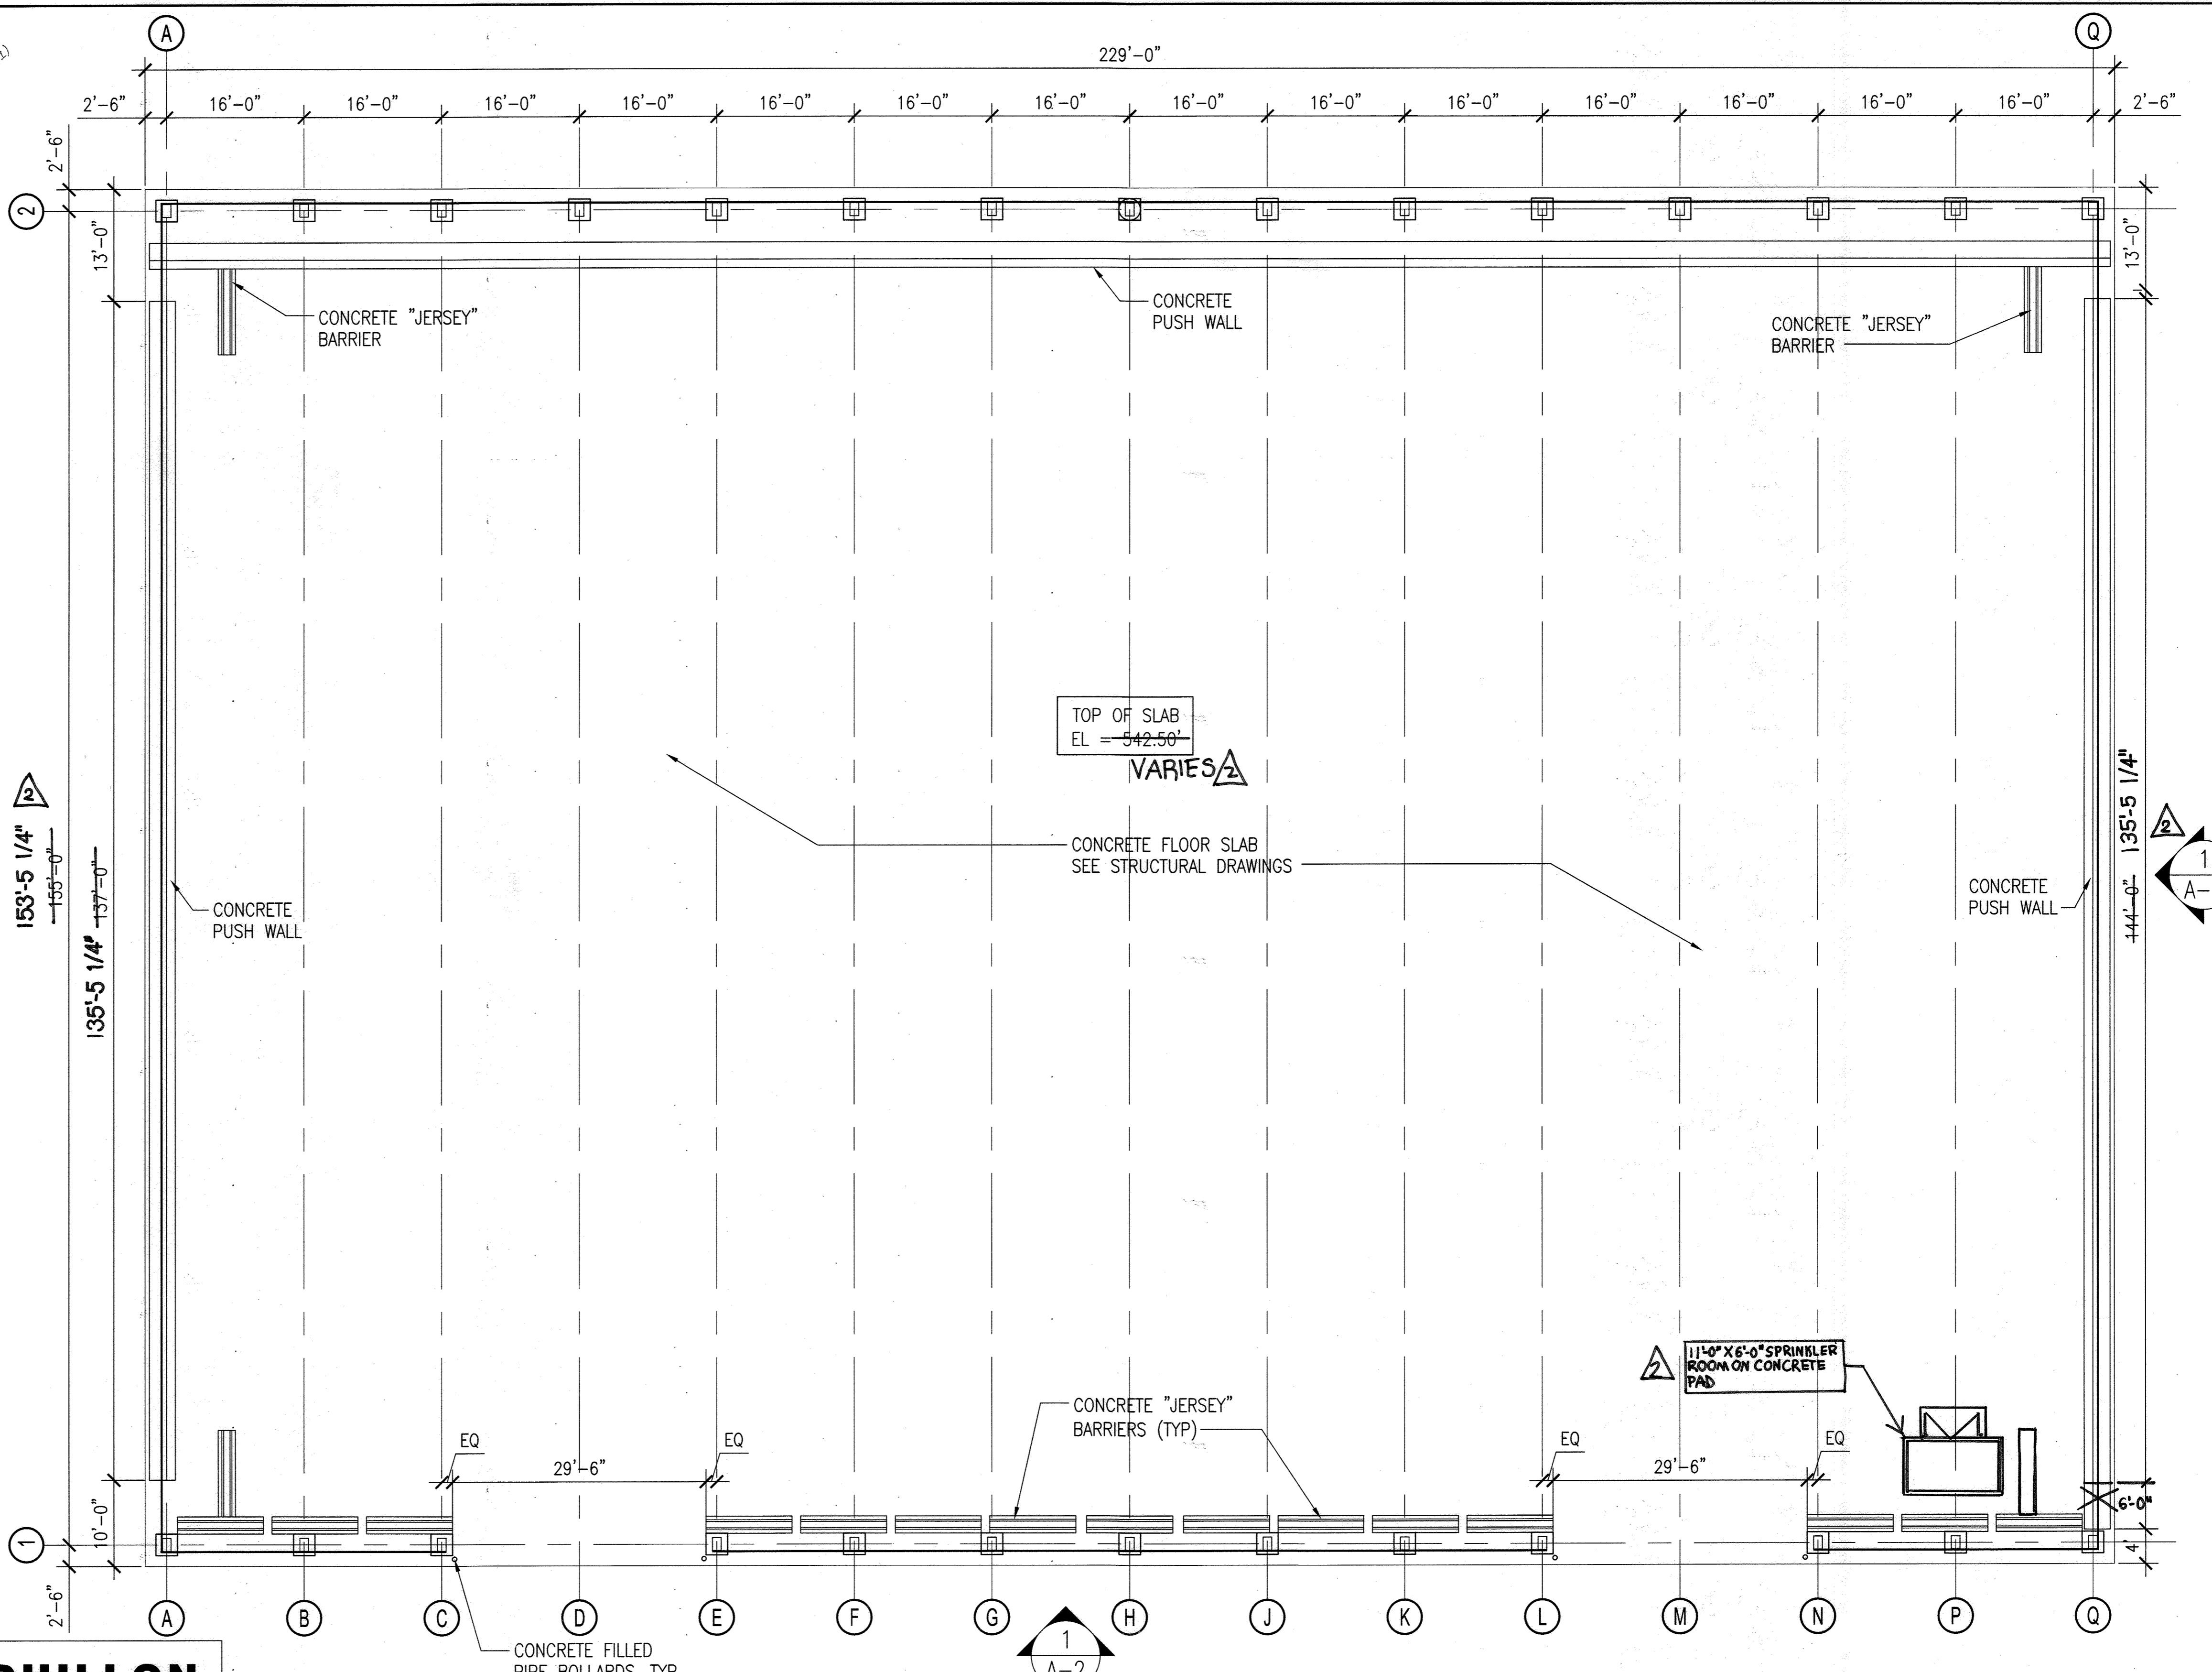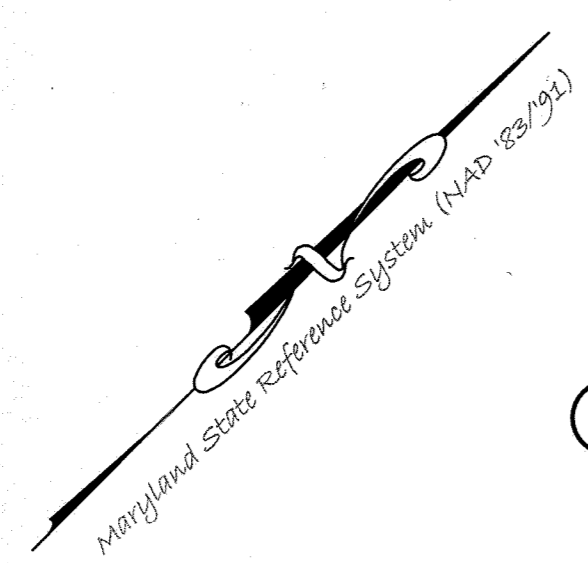

REVIEWED FOR HOWARD SCD AND MEETS TECHNICAL REQUIREMENTS
 THIS DEVELOPMENT PLAN IS APPROVED FOR SOIL EROSION AND
 SEDIMENT CONTROL BY HOWARD COUNTY CONSERVATION DISTRICT

HOWARD SCD DATE


APPROVED: DEPARTMENT OF PLANNING AND ZONING

Valdis J. Miller 12-12-17
 DIRECTOR, DEPARTMENT OF PLANNING AND ZONING DATE

Paul P. ... 11-29-17
 CHIEF, DEVELOPMENT ENGINEERING DIVISION DATE

Keat ... 12-5-17
 CHIEF, DIVISION OF LAND DEVELOPMENT DATE

DHILLON
 ENGINEERING, INC.
 10902 REISTERSTOWN ROAD, # 204
 OWINGS MILLS, MD 21117

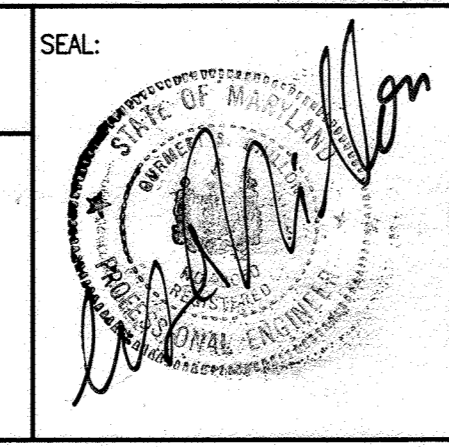

GRID: 8 BLOCK: N/A
 ZONING: RC-DEO PARCEL/LOT: 220, 253, 11, 23, 54
 TAX MAP: 0016 ELECTION DISTRICT: 3-02

OWNER/ENGINEER INFORMATION

DEVELOPER/OWNER:
 HOWARD COUNTY GOVERNMENT
 CONTACT: JEFF DANNIS, P.E., CSP
 6751 COLUMBIA GATEWAY DRIVE, SUITE 514
 COLUMBIA, MD 21046
 TELEPHONE: (410) 313-6419


ENGINEER:
 EA ENGINEERING, SCIENCE,
 AND TECHNOLOGY, INC., PBC
 CONTACT: MARK GUTBERLET, P.E.
 225 SCHILLING CIRCLE
 HUNT VALLEY, MD 21031
 TELEPHONE: (410) 584-7000

PROFESSIONAL CERTIFICATION:

I HEREBY CERTIFY THAT THESE DOCUMENTS
 WERE PREPARED OR APPROVED BY ME, AND
 THAT I AM A DULY LICENSED PROFESSIONAL
 ENGINEER UNDER THE LAWS OF THE STATE
 OF MARYLAND, LICENSE NO. 8050,
 EXPIRATION DATE 08/19/2017.

DSN. BY: LP	CVH	REVISED TO REFLECT PHASE IIC ENCLOSURE DESIGN	8/2017
DRN. BY: LP			
CHK. BY: AKM			
DATE: AUGUST, 2016	BY NO.	REVISION	DATE

ENCLOSURE FLOOR PLAN
 3/32" = 1'-0"

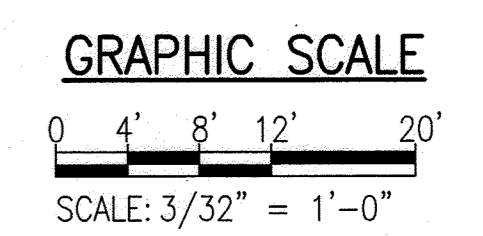


FLOOR PLAN

COMPOST FACILITY
 AT ALPHA RIDGE LANDFILL
 HOWARD COUNTY, MARYLAND

SDP SHEET	DRAWING
45 OF 40	A-1
PROJECT:	14982.05
SHEET:	43 OF 50

NOT FOR CONSTRUCTION - SITE DEVELOPMENT PLAN #SDP-16-035

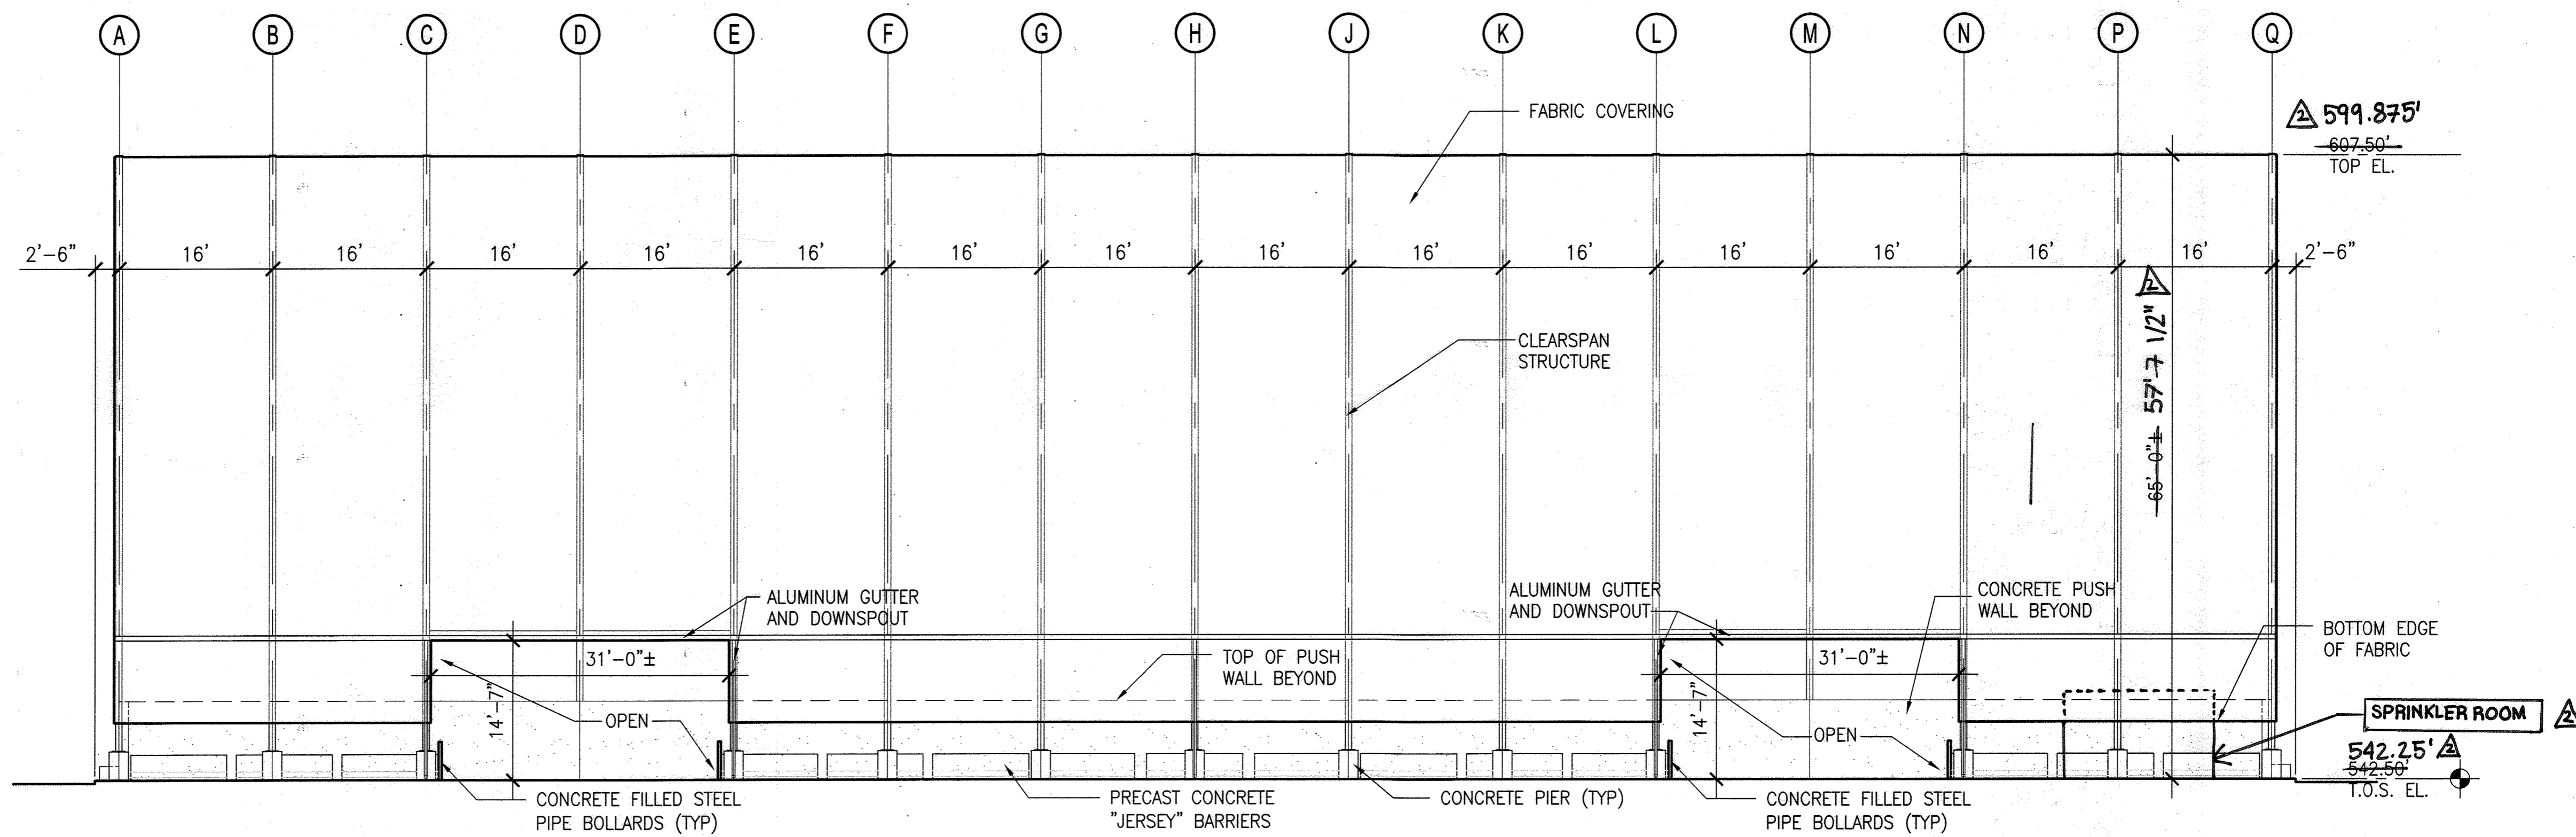

1 FRONT ELEVATION
A-2 3/32" = 1'-0"


REVIEWED FOR HOWARD SCD AND... REQUIREMENTS
THIS DEVELOPMENT PLAN IS APPROVED FOR... AND
SEDIMENT CONTROL BY HOWARD COUNTY... DISTRICT

APPROVED: DEPARTMENT OF PLANNING AND ZONING
Nellis J. Davis 12-12-17
DIRECTOR, DEPARTMENT OF PLANNING AND ZONING DATE
Chad E. L... 11-29-17
CHIEF, DEVELOPMENT ENGINEERING DIVISION DATE
Red De... 12-5-17
CHIEF, DIVISION OF LAND DEVELOPMENT DATE

DHILLON
ENGINEERING, INC.
10902 REISTERSTOWN ROAD, # 204
OWINGS MILLS, MD 21117

GRID: 8 BLOCK: N/A
ZONING: RC-DEO PARCEL/LOT: 220, 253, 11, 23, 54
TAX MAP: 0016 ELECTION DISTRICT: 3-02

OWNER/ENGINEER INFORMATION
DEVELOPER/OWNER:
HOWARD COUNTY GOVERNMENT
CONTACT: JEFF DANNIS, P.E., CSP
6751 COLUMBIA GATEWAY DRIVE, SUITE 514
COLUMBIA, MD 21046
TELEPHONE: (410) 313-6419
ENGINEER:
EA ENGINEERING, SCIENCE,
AND TECHNOLOGY, INC., PBC
CONTACT: MARK GUTBERLET, P.E.
225 SCHILLING CIRCLE
HUNT VALLEY, MD 21031
TELEPHONE: (410) 584-7000

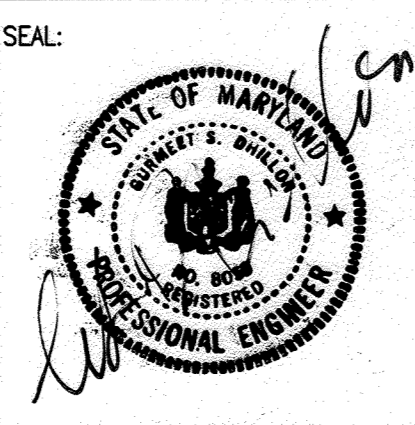

PROFESSIONAL CERTIFICATION:
I HEREBY CERTIFY THAT THESE DOCUMENTS
WERE PREPARED OR APPROVED BY ME, AND
THAT I AM A DULY LICENSED PROFESSIONAL
ENGINEER UNDER THE LAWS OF THE STATE
OF MARYLAND, LICENSE NO. 8050,
EXPIRATION DATE 08/19/2017.



DSN. BY: RK	CVH	REVISOR TO REFLECT PHASE IV ENCLOSURE DESIGN	8/1/2022
DRN. BY: LJP			
CHK. BY: AKM			
DATE: AUGUST, 2016	BY	NO.	REVISION


BUILDING ELEVATION I

COMPOST FACILITY
AT ALPHA RIDGE LANDFILL
HOWARD COUNTY, MARYLAND


GRAPHIC SCALE
0 4' 8' 12' 20'
SCALE: 3/32" = 1'-0"

SDP SHEET: 45	DRAWING: A-2
38 OF 44	
PROJECT: 14982.05	
SHEET: 50 OF 59	


NOT FOR CONSTRUCTION - SITE DEVELOPMENT PLAN #SDP-16-035

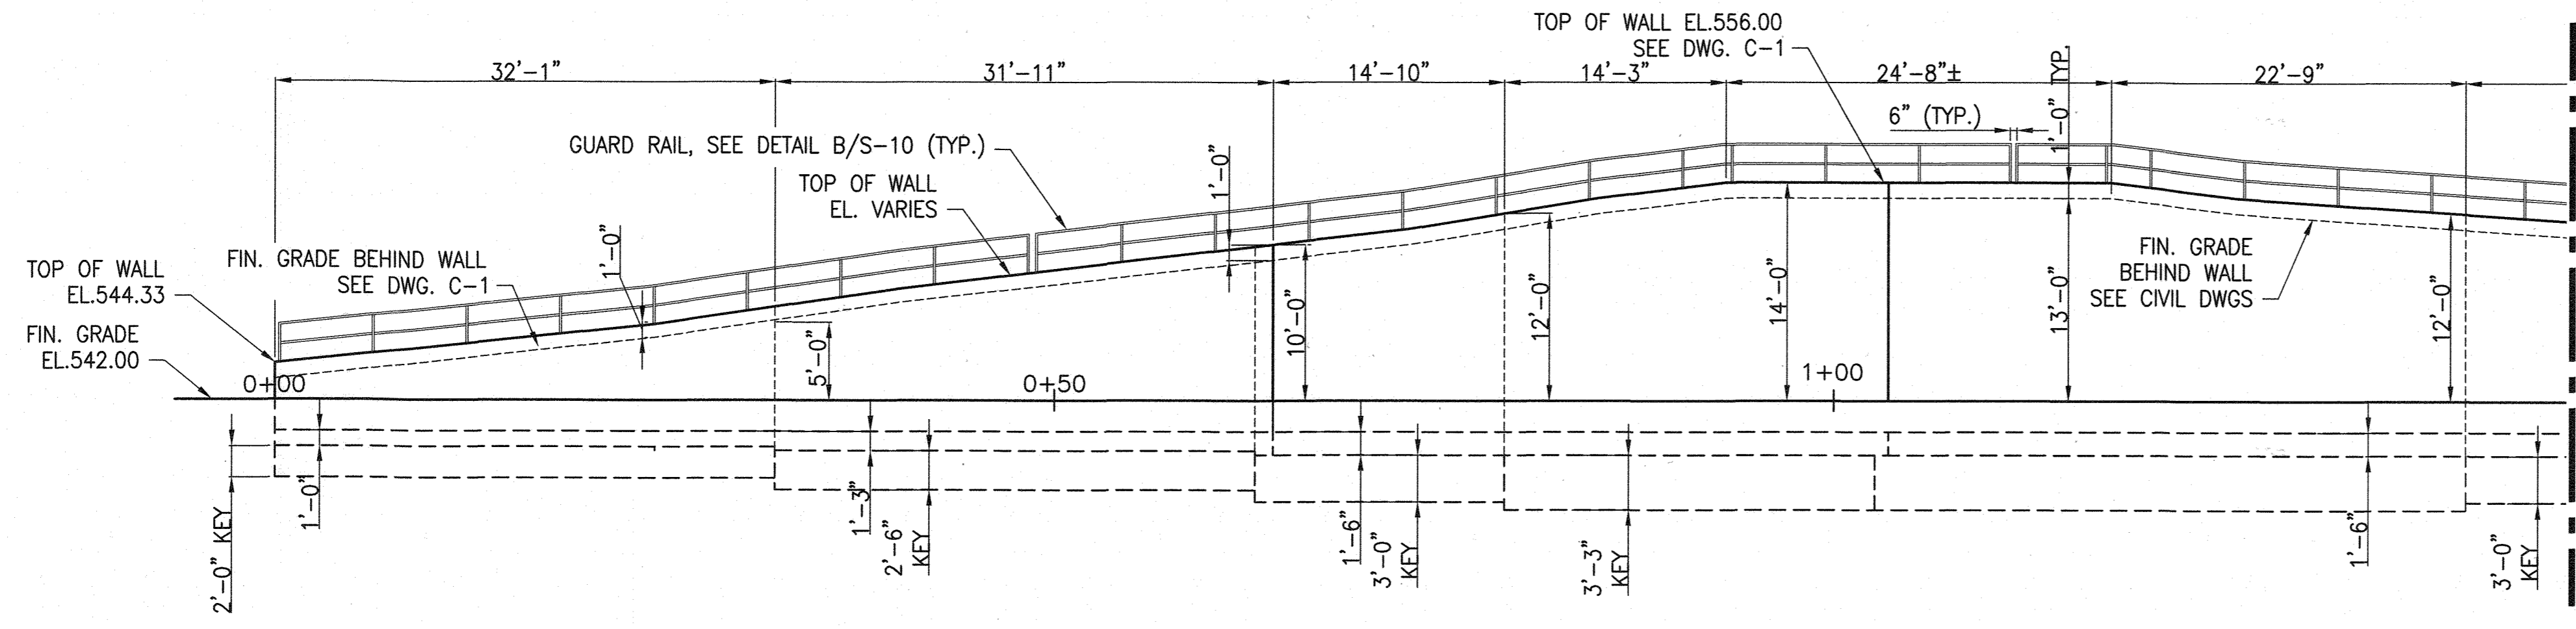

A RETAINING WALL - ELEVATION
SCALE: 1/8" = 1'-0"

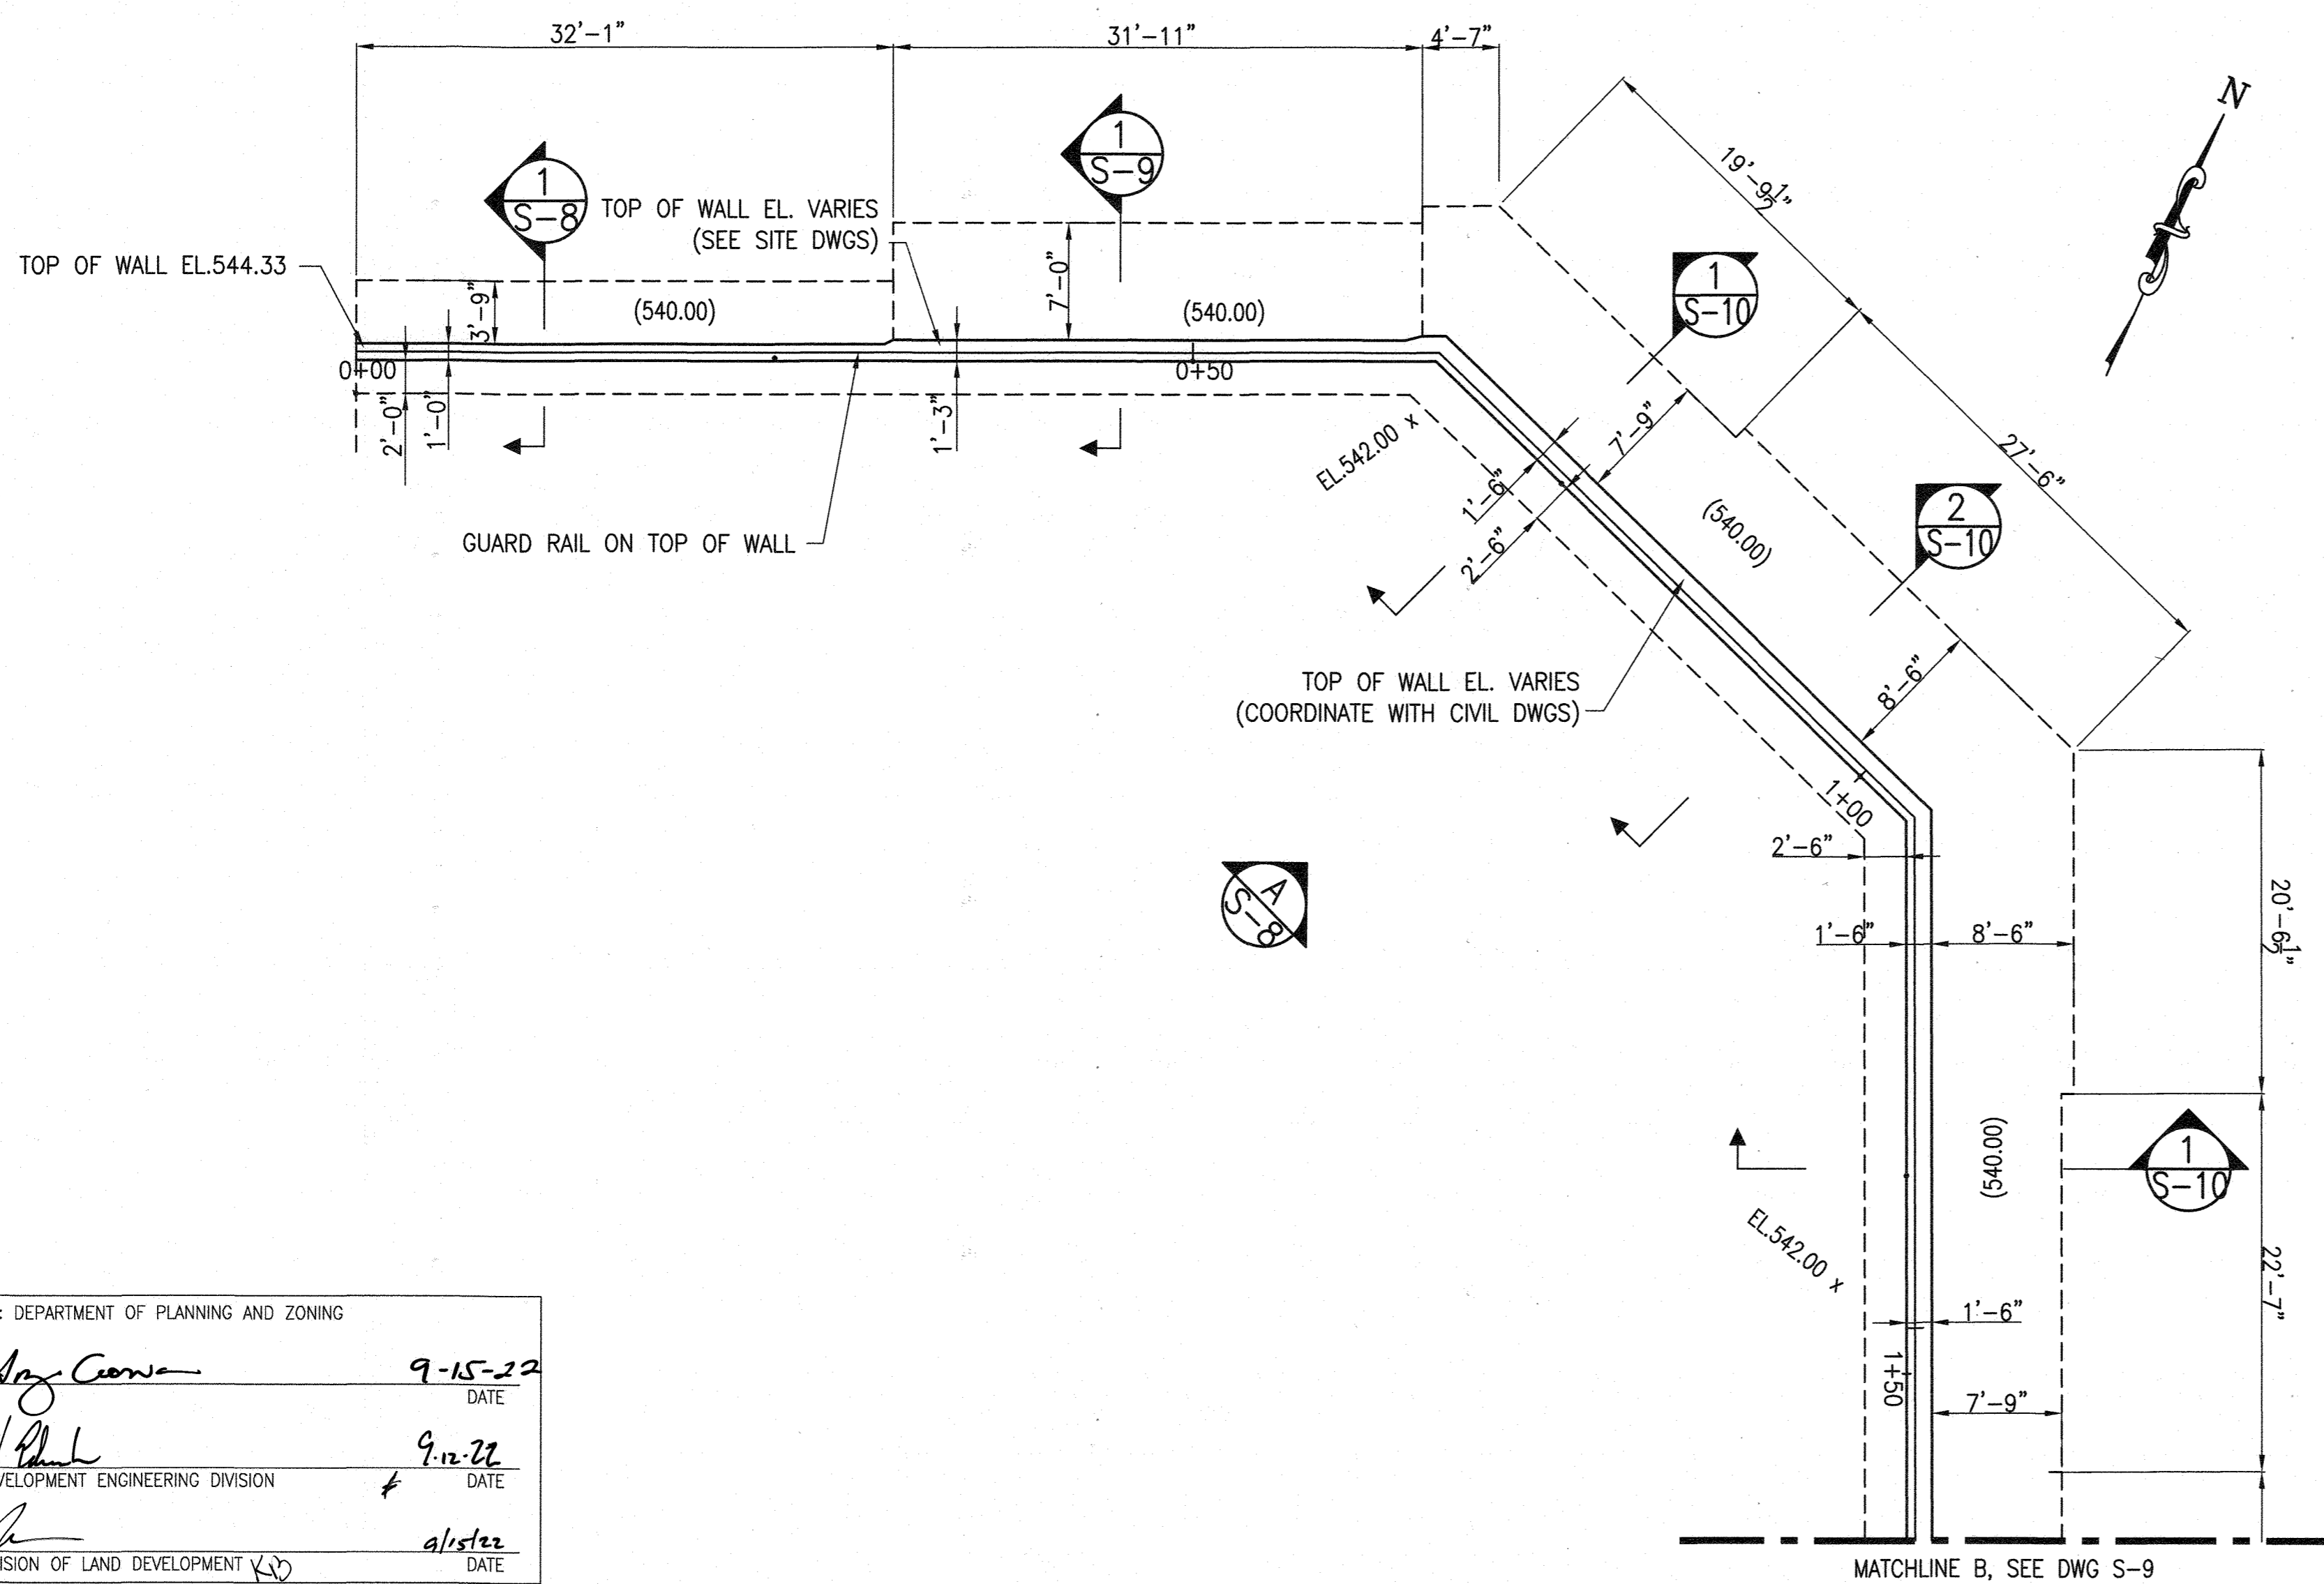

B RETAINING WALL - PLAN
SCALE: 1/8" = 1'-0"

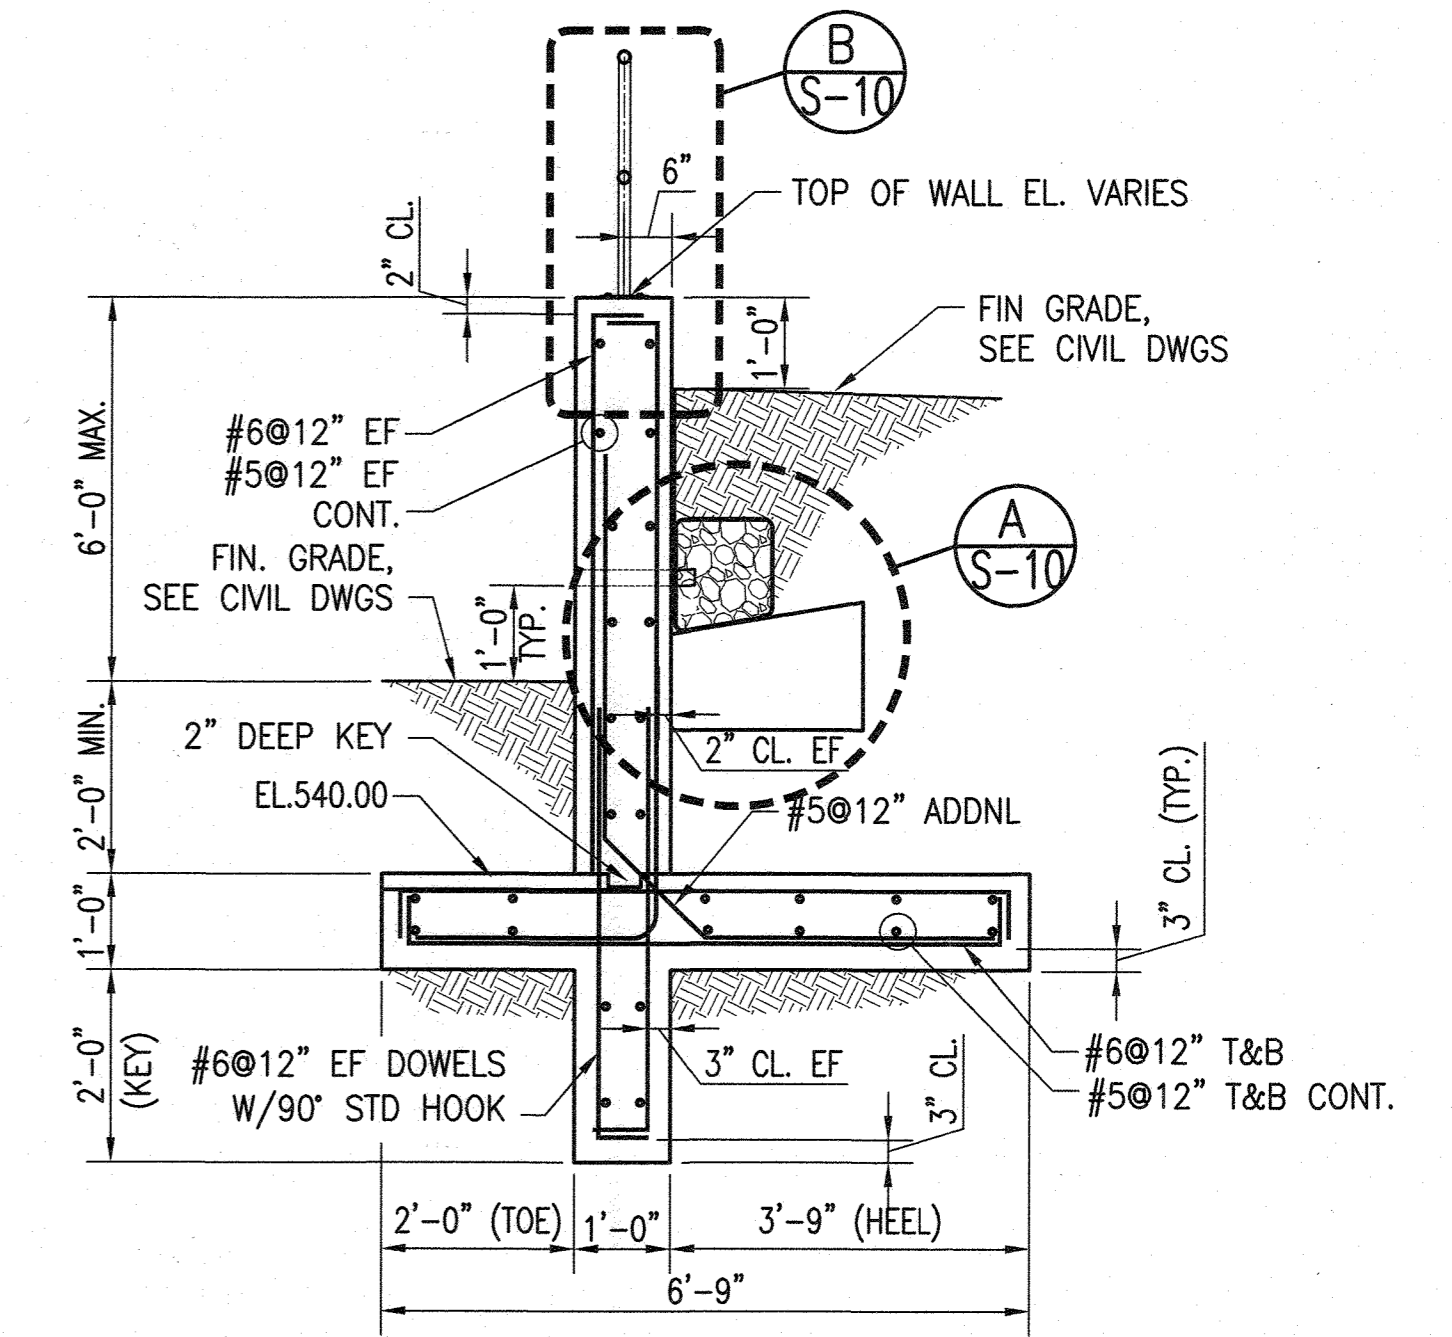


1 SECTION
SCALE: 1/2" = 1'-0"

GENERAL SHEET NOTES:

- RETAINING WALL SHALL ONLY BE CONSTRUCTED UNDER THE OBSERVATION OF CONTRACTOR'S THIRD PARTY GEOTECHNICAL INSPECTOR. THE INSPECTOR SHALL BE A REGISTERED PROFESSIONAL ENGINEER AND A (NICET, WACEL, OR EQUIVALENT) CERTIFIED SOILS TECHNICIAN.
- THE REQUIRED BEARING PRESSURE BENEATH THE FOOTING OF THE WALL SHALL BE VERIFIED IN THE FIELD BY THIRD PARTY GEOTECHNICAL INSPECTOR. THE INSPECTOR SHALL BE A CERTIFIED SOILS TECHNICIAN. TESTING DOCUMENTATION SHALL BE PROVIDED TO THE HOWARD COUNTY INSPECTOR PRIOR TO THE START OF CONSTRUCTION. THE REQUIRED TEST PROCEDURE SHALL BE DYNAMIC CONE PENETROMETER ASTM STP-399.
- THE SUITABILITY OF FILL MATERIAL SHALL BE CONFIRMED BY THE CONTRACTOR'S THIRD PARTY GEOTECHNICAL INSPECTOR. EACH EIGHT (8) INCH LIFT SHALL BE COMPACTED TO A MINIMUM OF 95% STANDARD PROCTER DENSITY AND THE TESTING REPORT SHALL BE MADE AVAILABLE TO THE HOWARD COUNTY INSPECTOR UPON COMPLETION OF CONSTRUCTION.
- CONTRACTOR SHALL COORDINATE WITH CIVIL PLAN C-2 PROPOSED CONDITIONS FOR LAYOUT AND FINISHED GRADE.

APPROVED: DEPARTMENT OF PLANNING AND ZONING
 DIRECTOR: *Ally Conner* DATE: 9-15-22
 CHIEF, DEVELOPMENT ENGINEERING DIVISION: *Ally Conner* DATE: 9-15-22
 CHIEF, DIVISION OF LAND DEVELOPMENT: *Ally Conner* DATE: 9-15-22

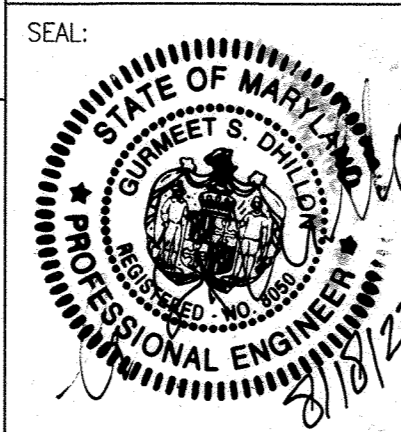

PROFESSIONAL CERTIFICATION:

I HEREBY CERTIFY THAT THESE DOCUMENTS WERE PREPARED OR APPROVED BY ME, AND THAT I AM A DULY LICENSED PROFESSIONAL ENGINEER UNDER THE LAWS OF THE STATE OF MARYLAND, LICENSE NO. 8050, EXPIRATION DATE 08/19/2021.



DSN. BY: KK	CYH	REPLACEMENT SHEET FROM PHASE IIC	8/2022
DRN. BY: VL		CONTRACT DRAWINGS TO SHOW DESIGN	
CHK. BY: GSD		PHASE REVISIONS TO RETAINING WALL LAYOUT	
DATE: JUNE, 2021	BY NO.	REVISION	DATE


RETAINING WALL
 STRUCTURAL PLAN, ELEVATION
 AND SECTION - I
 (REPLACEMENT SHEET)

0 1' 2' 4'
 SCALE: 1/2" = 1'-0"


0 4' 8' 16'
 SCALE: 1/8" = 1'-0"

SDP SHEET: DRAWING:
 40 OF 45 S-8


PROJECT:
 1556408
 SHEET:
 37 OF 42

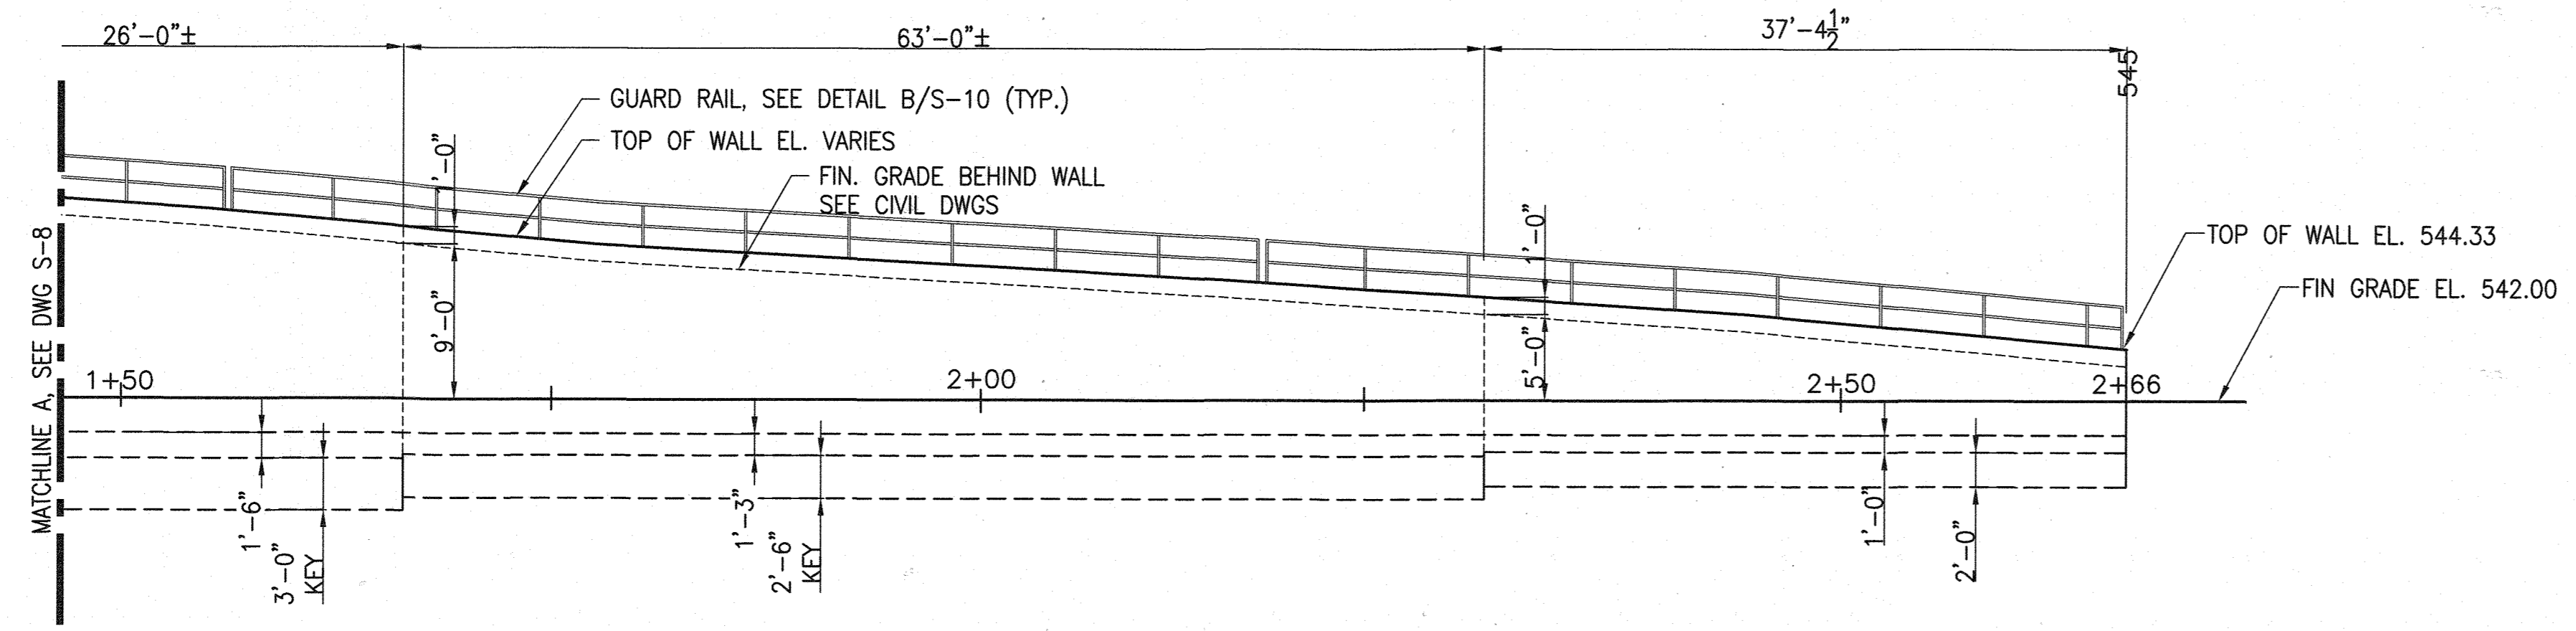

(A) RETAINING WALL - ELEVATION
 S-9 SCALE: 1/8" = 1'-0"

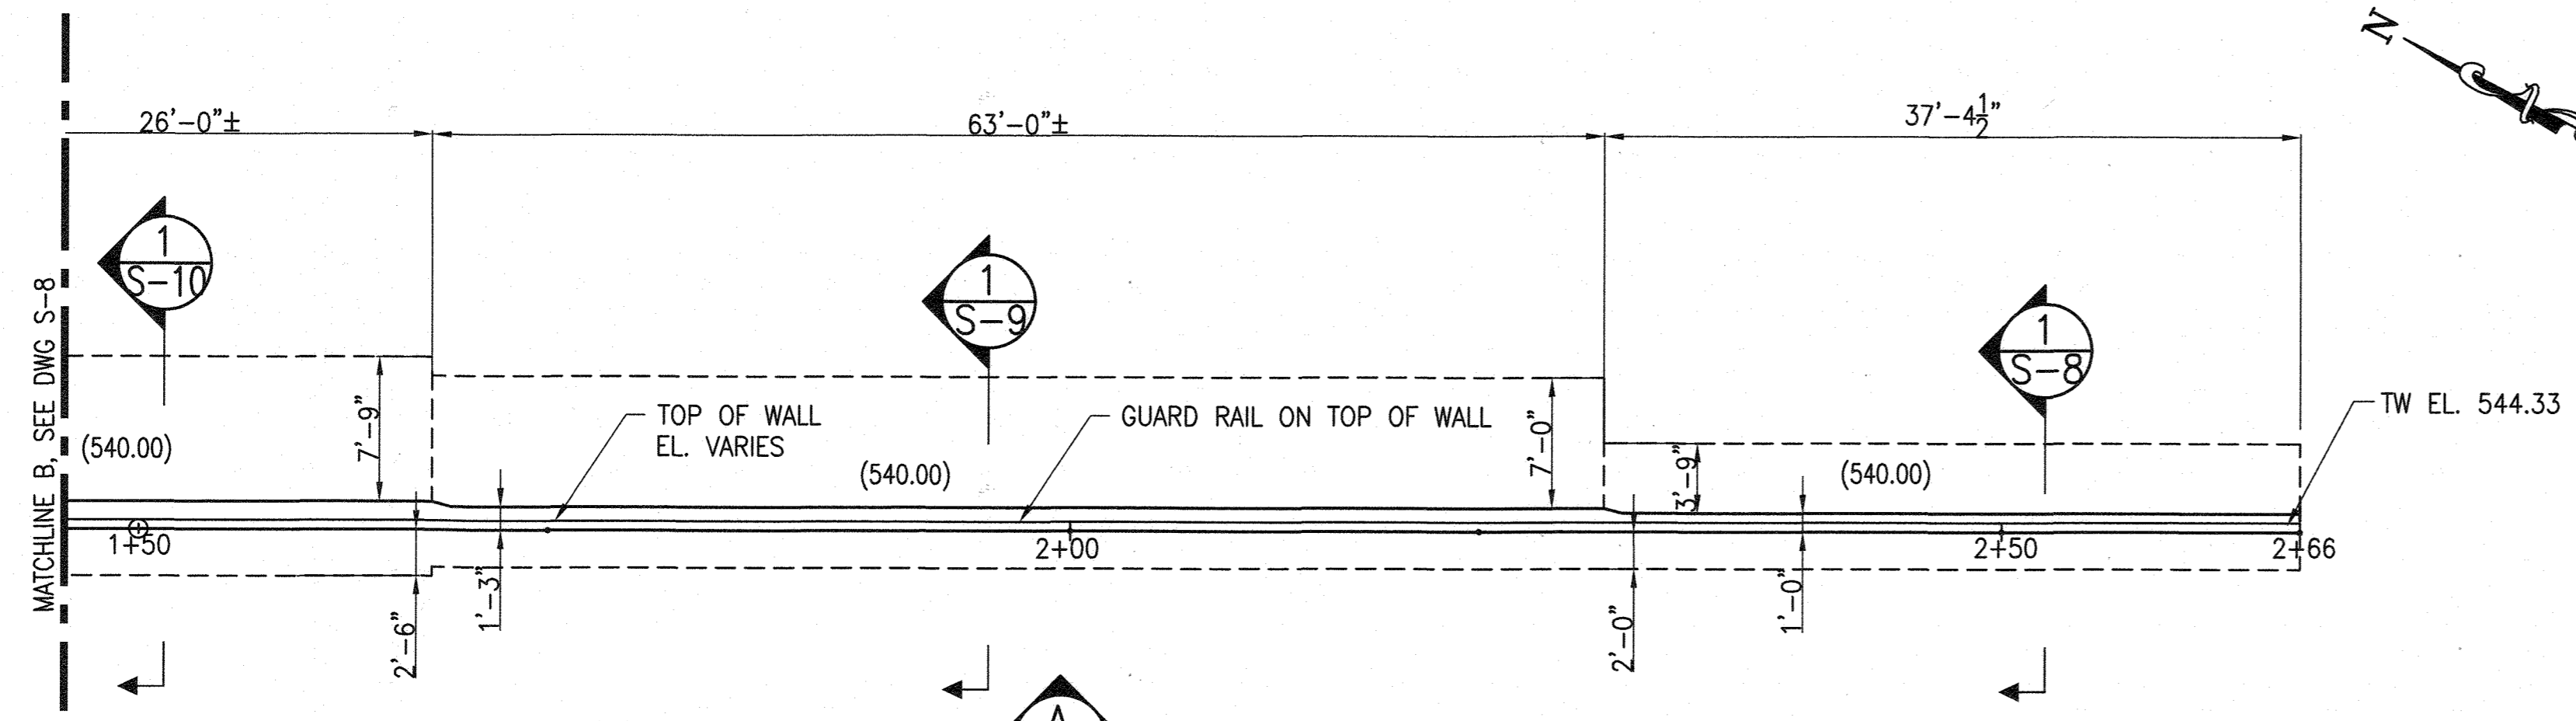

(B) RETAINING WALL - PLAN
 S-9 SCALE: 1/8" = 1'-0"


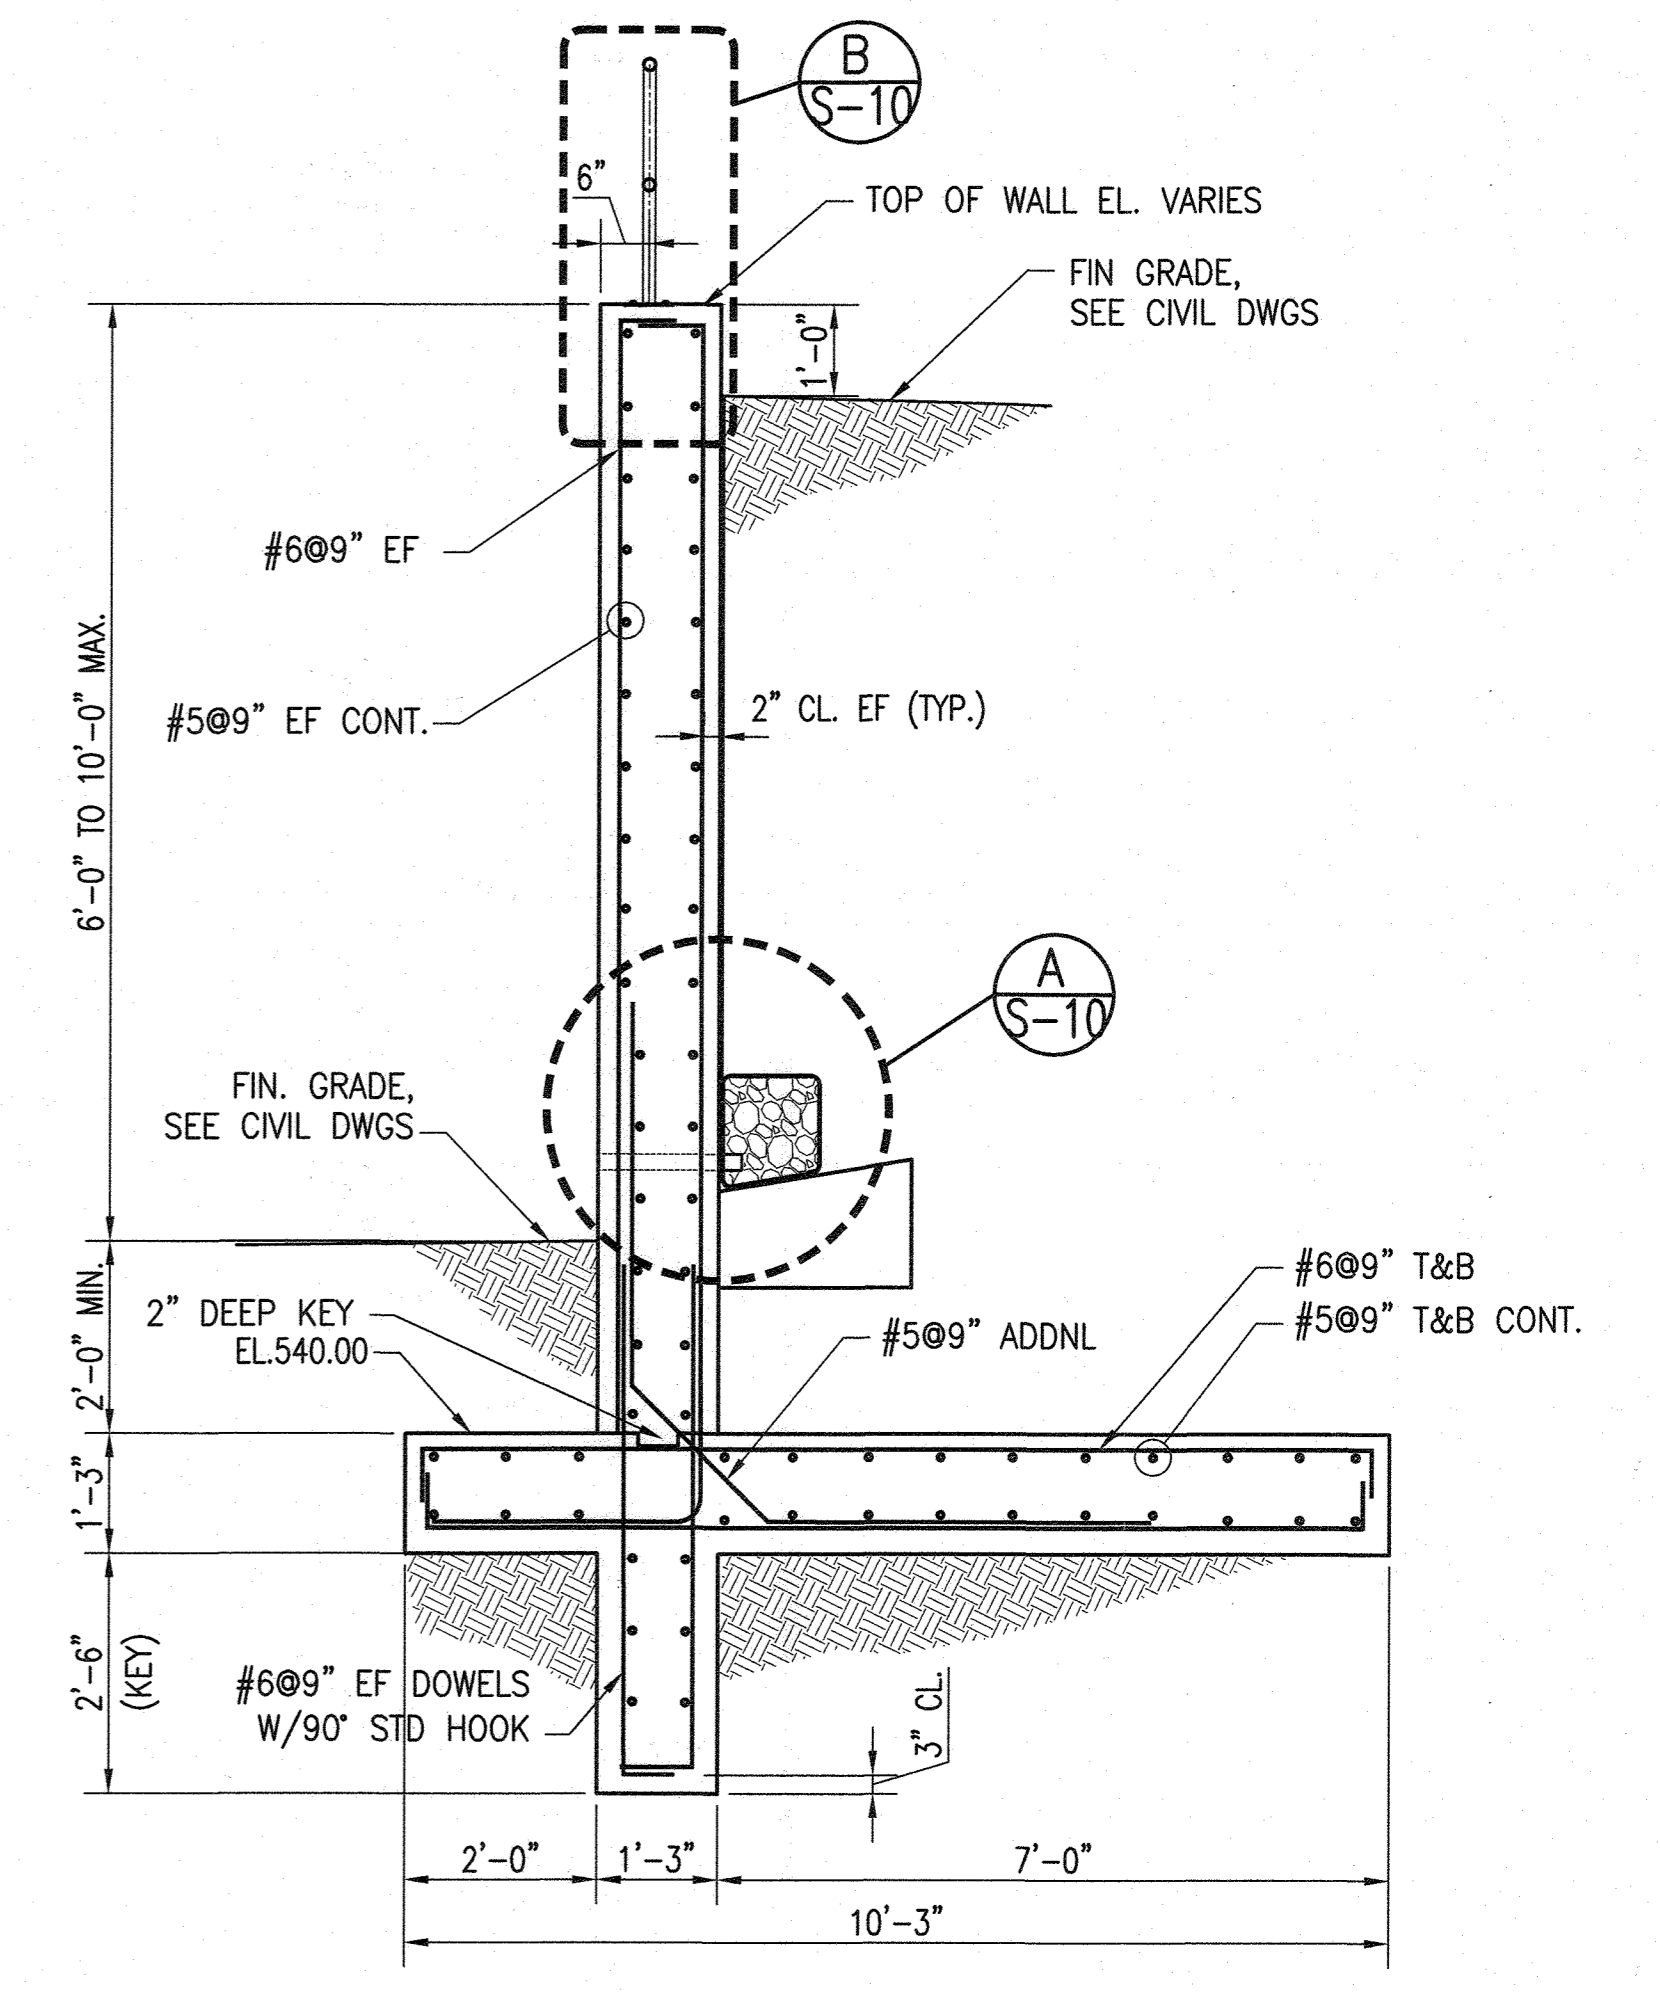


(1) SECTION
 S-9 SCALE: 1/2" = 1'-0"

GENERAL SHEET NOTES:

1. RETAINING WALL SHALL ONLY BE CONSTRUCTED UNDER THE OBSERVATION OF CONTRACTOR'S THIRD PARTY GEOTECHNICAL INSPECTOR. THE INSPECTOR SHALL BE A REGISTERED PROFESSIONAL ENGINEER AND A (NICET, WACEL, OR EQUIVALENT) CERTIFIED SOILS TECHNICIAN.
2. THE REQUIRED BEARING PRESSURE BENEATH THE FOOTING OF THE WALL SHALL BE VERIFIED IN THE FIELD BY THIRD PARTY GEOTECHNICAL INSPECTOR. THE INSPECTOR SHALL BE A CERTIFIED SOILS TECHNICIAN. TESTING DOCUMENTATION SHALL BE PROVIDED TO THE HOWARD COUNTY INSPECTOR PRIOR TO THE START OF CONSTRUCTION. THE REQUIRED TEST PROCEDURE SHALL BE DYNAMIC CONE PENETROMETER ASTM STP-399.
3. THE SUITABILITY OF FILL MATERIAL SHALL BE CONFIRMED BY THE CONTRACTOR'S THIRD PARTY GEOTECHNICAL INSPECTOR. EACH EIGHT (8) INCH LIFT SHALL BE COMPACTED TO A MINIMUM OF 95% STANDARD PROCTER DENSITY AND THE TESTING REPORT SHALL BE MADE AVAILABLE TO THE HOWARD COUNTY INSPECTOR UPON COMPLETION OF CONSTRUCTION.
4. CONTRACTOR SHALL COORDINATE WITH CIVIL PLAN C-2 PROPOSED CONDITIONS FOR LAYOUT AND FINISHED GRADE.

APPROVED: DEPARTMENT OF PLANNING AND ZONING
 DIRECTOR: *[Signature]* DATE: 9-15-22
 CHIEF, DEVELOPMENT ENGINEERING DIVISION: *[Signature]* DATE: 9-22-22
 CHIEF, DIVISION OF LAND DEVELOPMENT: *[Signature]* DATE: 9/15/22

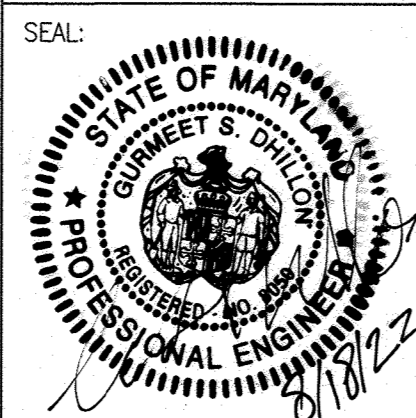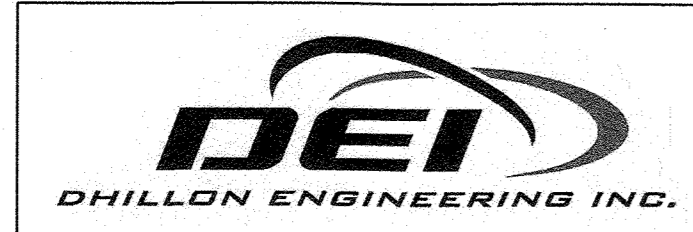


PROFESSIONAL CERTIFICATION:
 I HEREBY CERTIFY THAT THESE DOCUMENTS WERE PREPARED OR APPROVED BY ME, AND THAT I AM A DULY LICENSED PROFESSIONAL ENGINEER UNDER THE LAWS OF THE STATE OF MARYLAND, LICENSE NO. 8050, EXPIRATION DATE 08/19/2021.



DSN. BY: KK	CVT	REPLACEMENT SHEET FROM PHASE IIC	01/2022
DRN. BY: VL		CONTRACTOR TO SHOW DESIGN PHASE REVISIONS TO RETAINING WALL LAYOUT	
CHK. BY: GSD			
DATE: JUNE, 2021	BY NO.	REVISION	DATE

RETAINING WALL
 STRUCTURAL PLAN, ELEVATION
 AND SECTION - II
 (REPLACEMENT SHEET) A

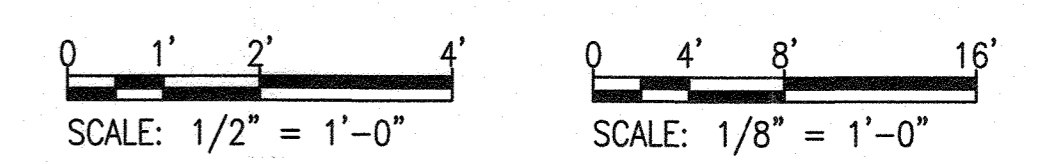


SDP SHEET: 41 OF 45
 DRAWING: S-9


[Signature] DATE: 9/19/2022
 DIVISION CHIEF, BUREAU OF ENVIRONMENTAL SERVICES OPERATIONS

PROJECT: 1556408
 SHEET: 38 OF 42


REVISED SITE DEVELOPMENT PLAN #SDP-16-035

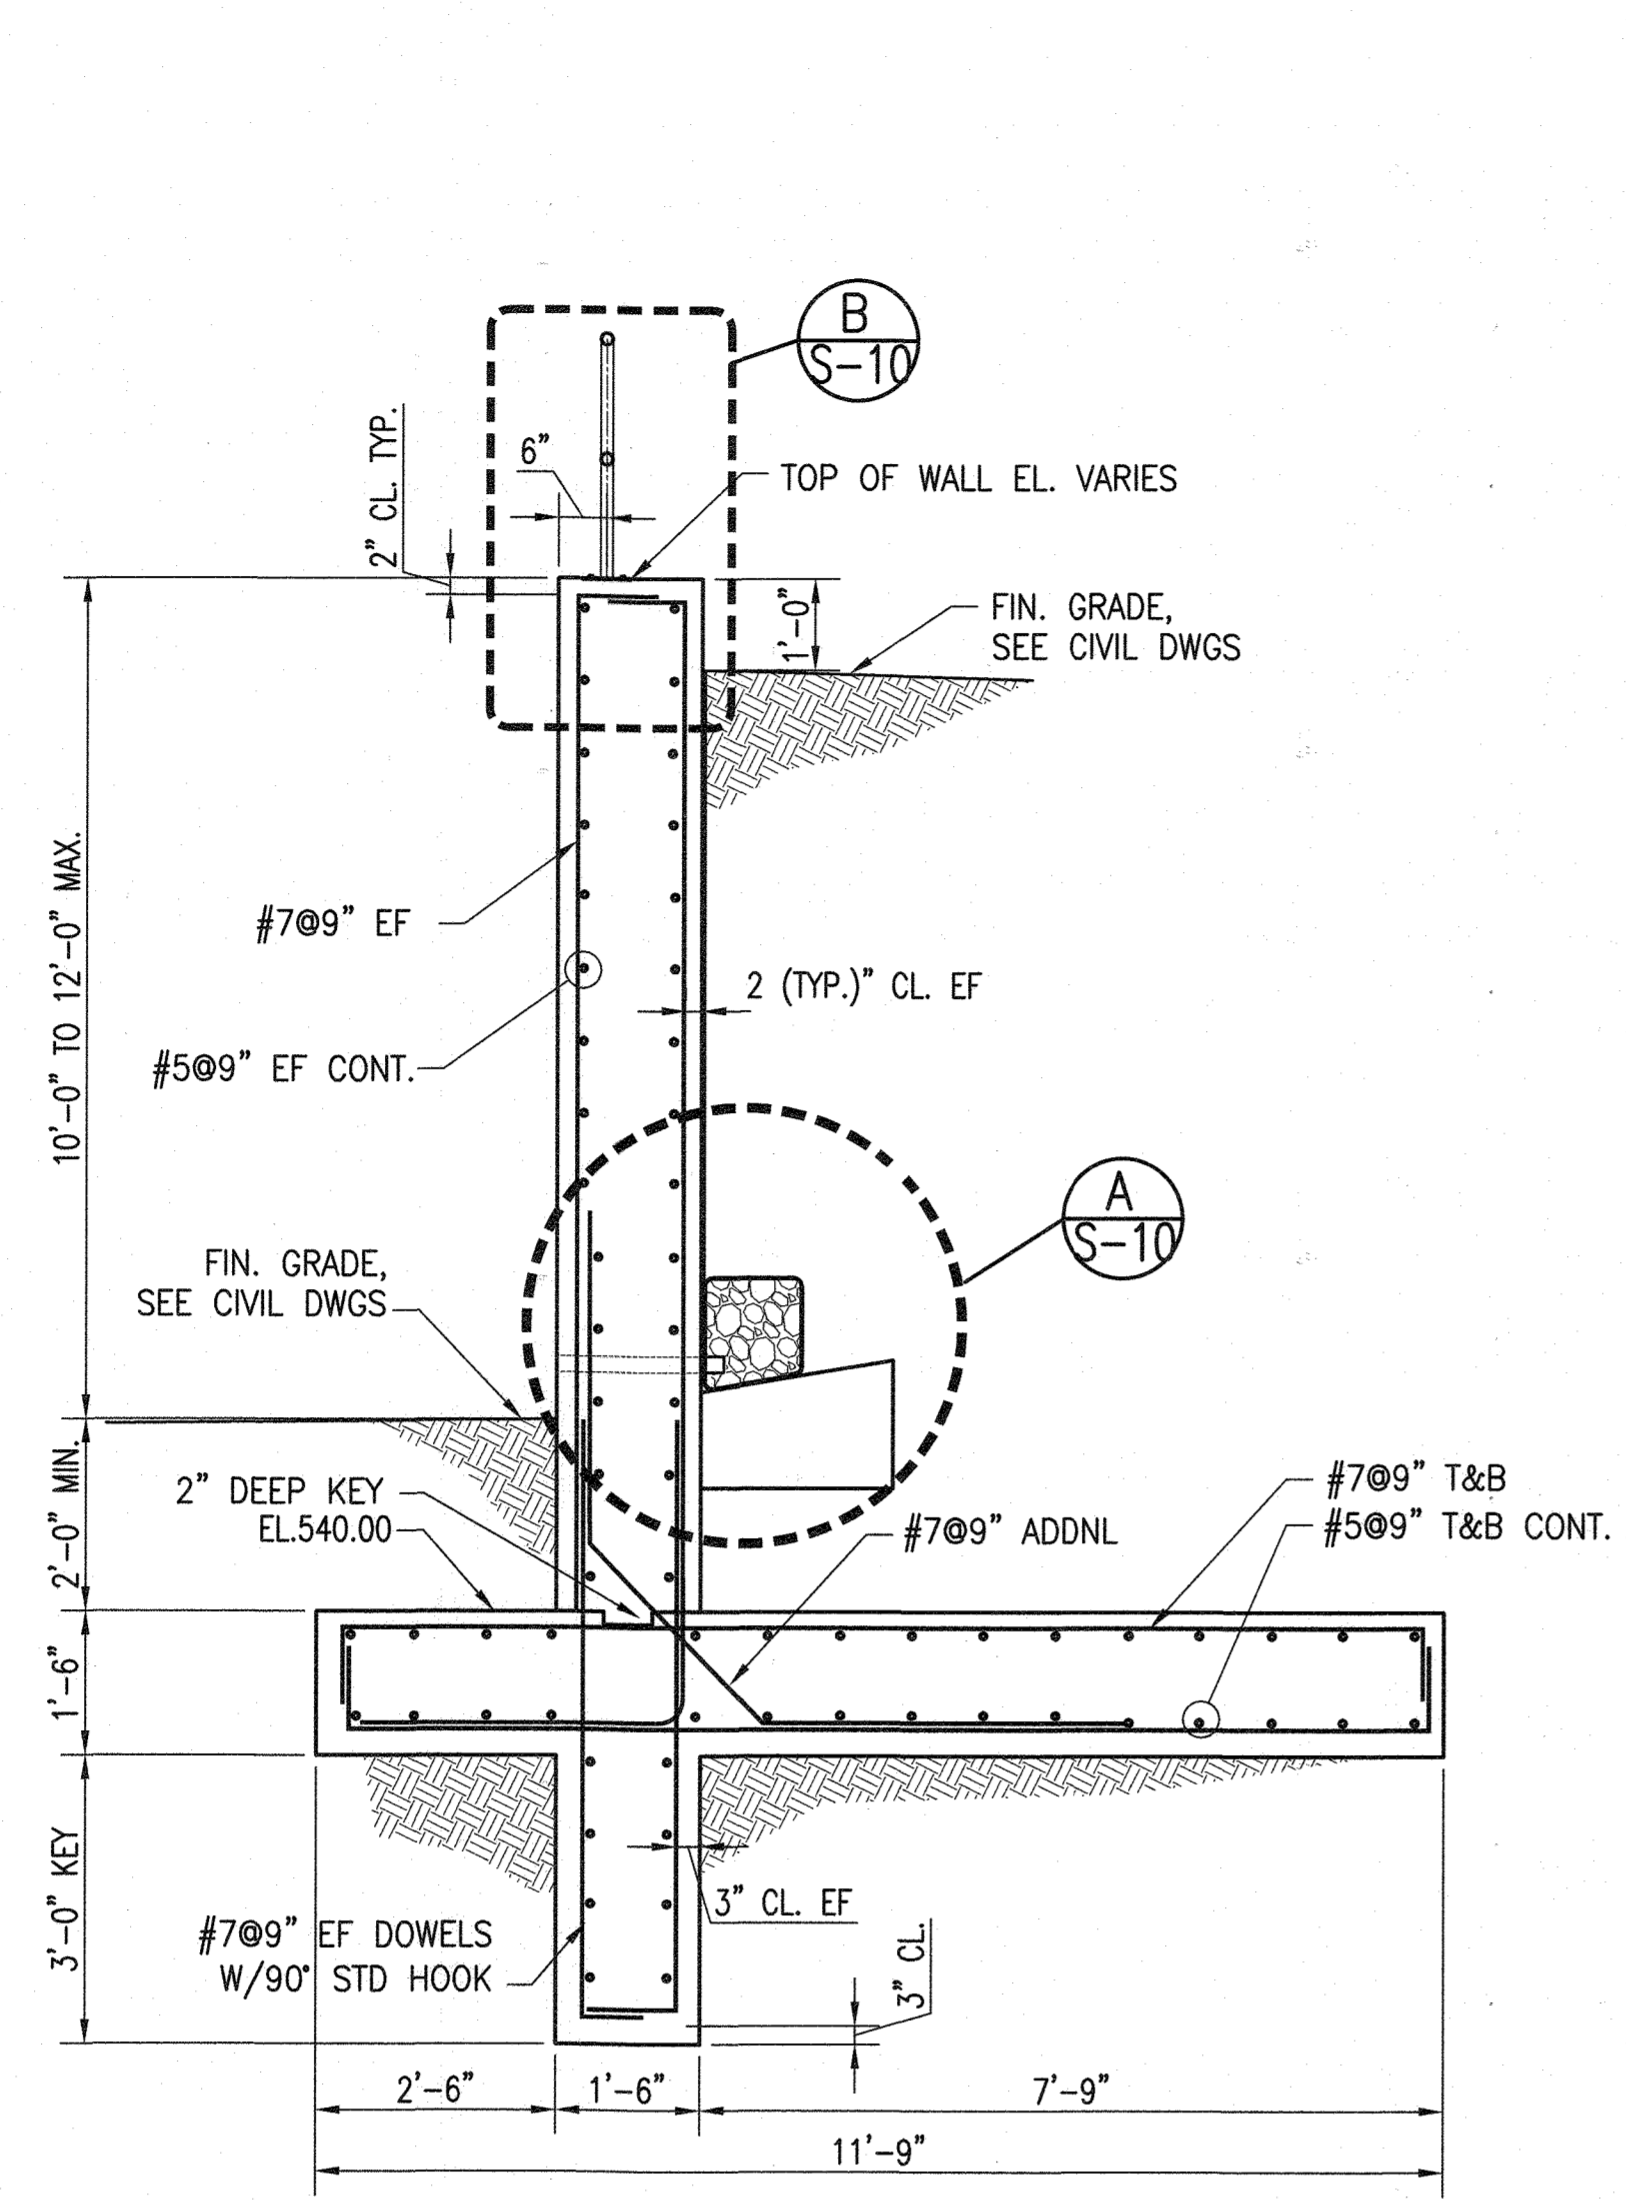


1 SECTION
S-10 SCALE: 1/2" = 1'-0"

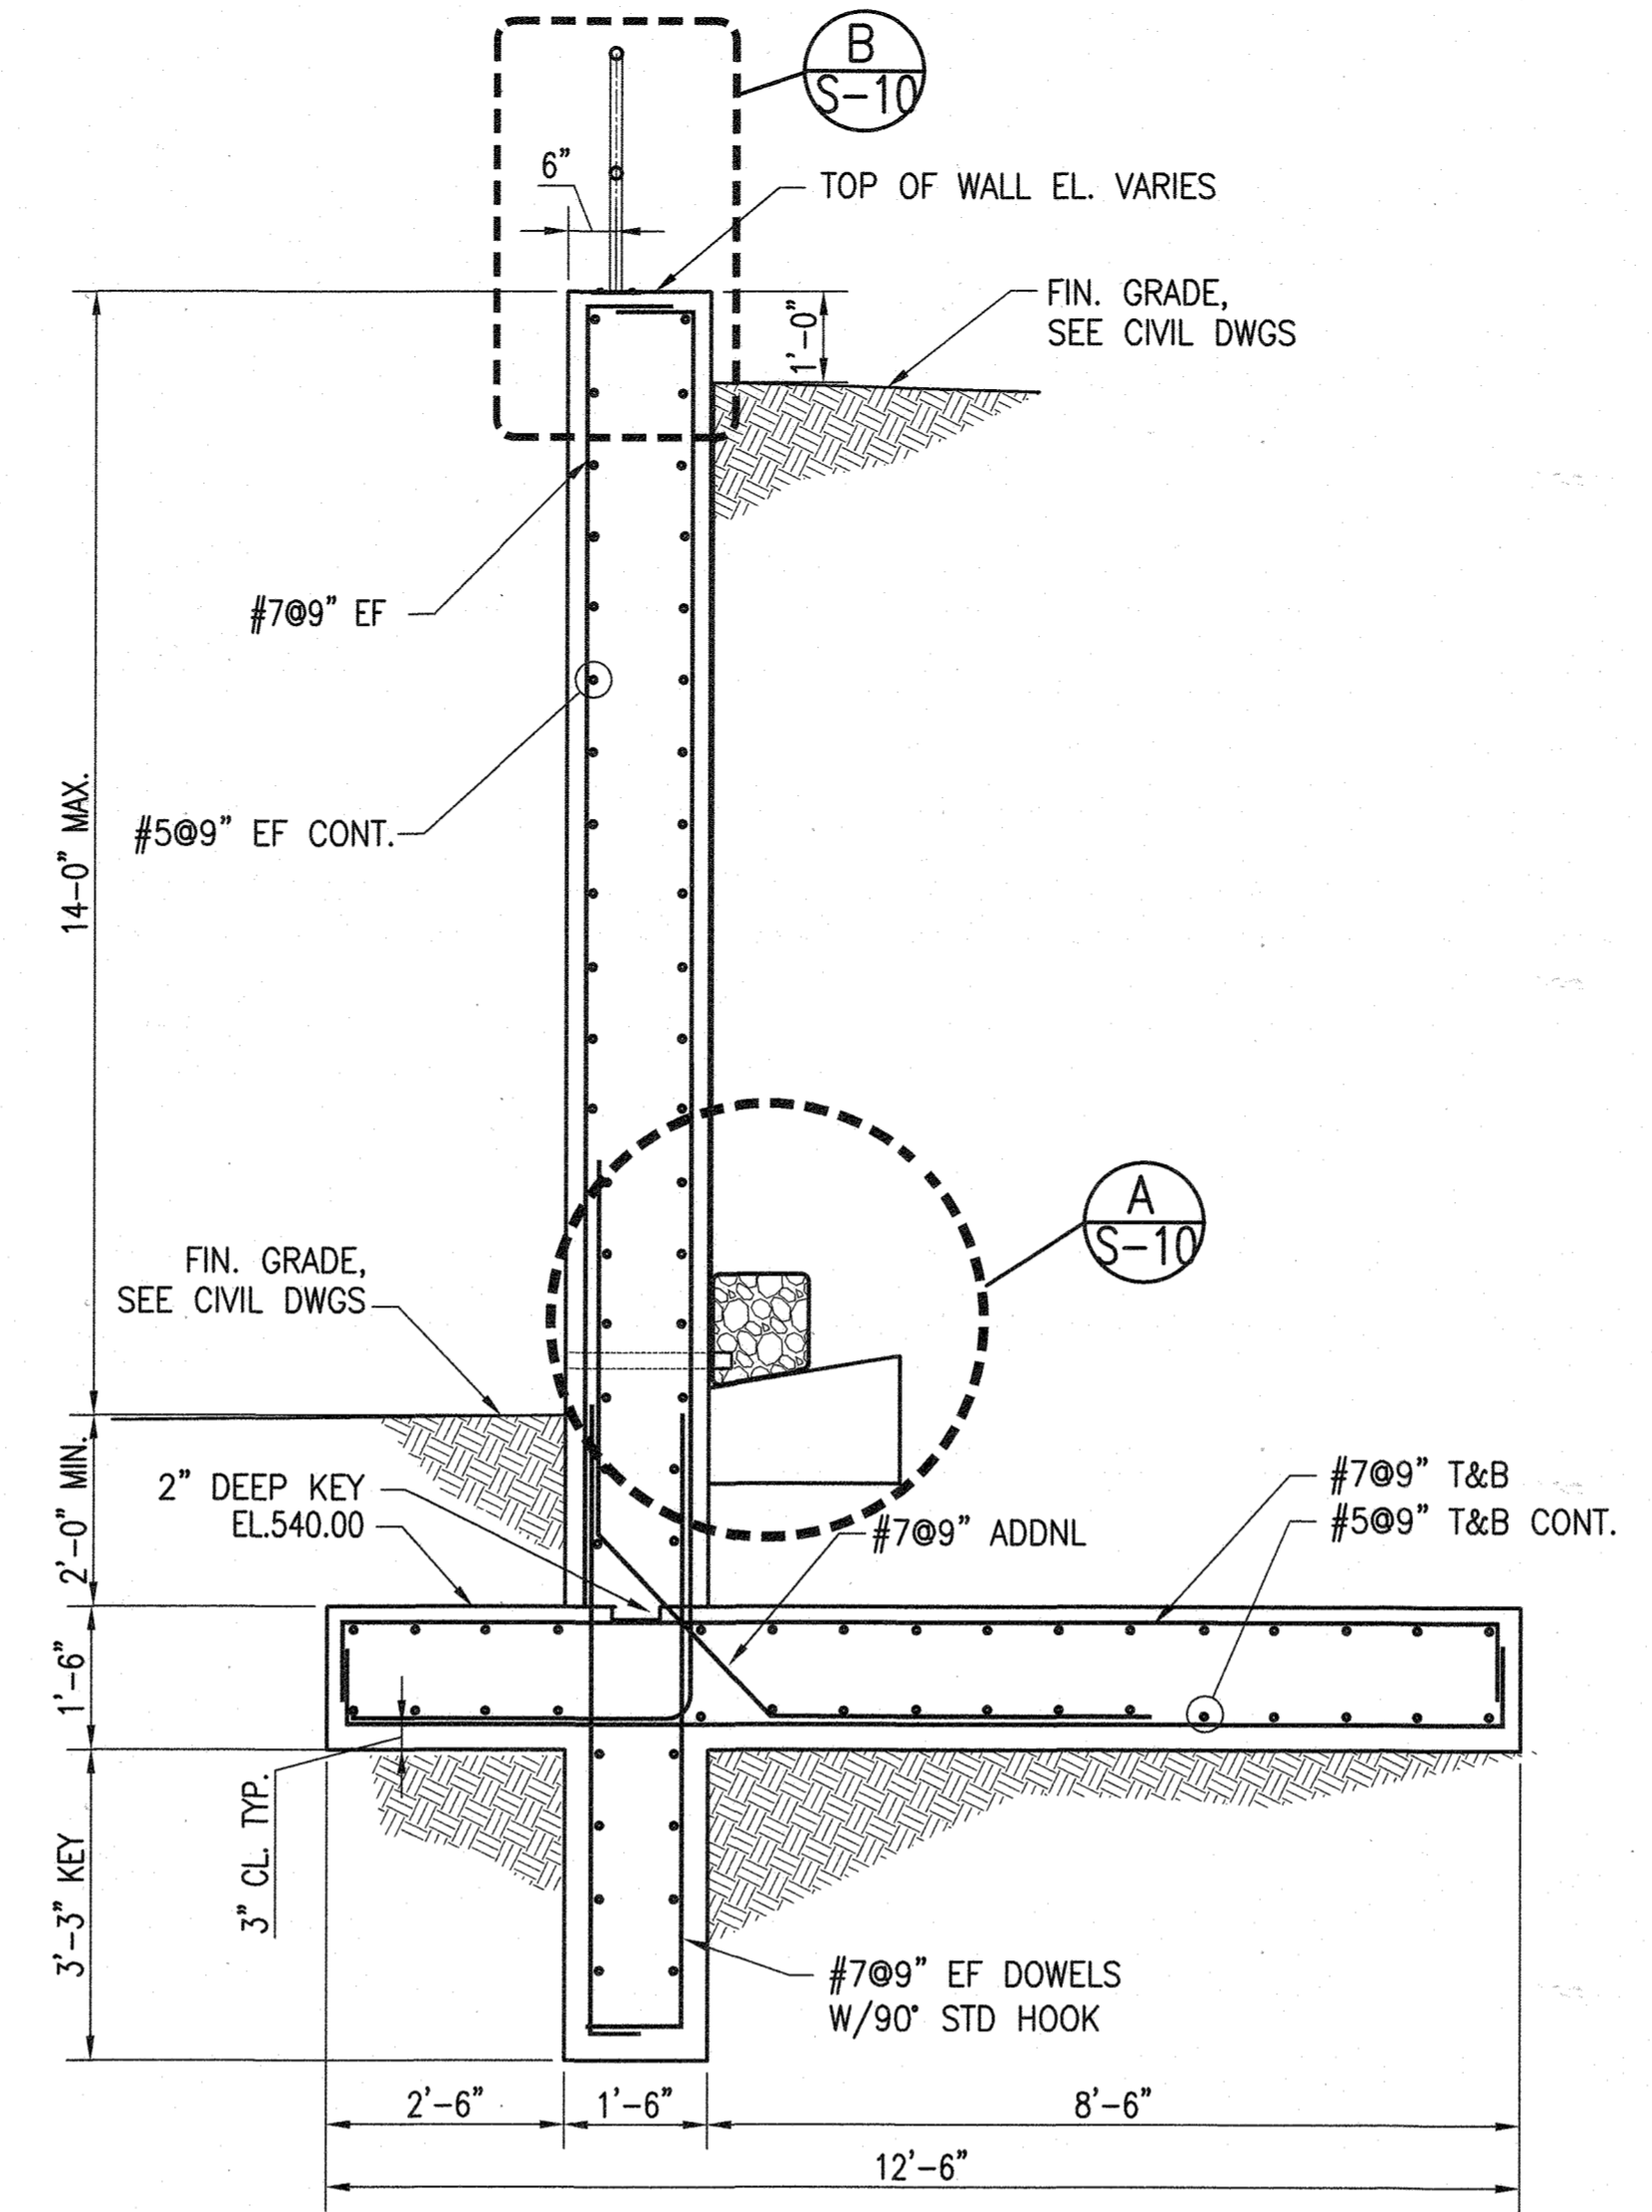

2 RETAINING WALL - SECTION
S-10 SCALE: 1/2" = 1'-0"

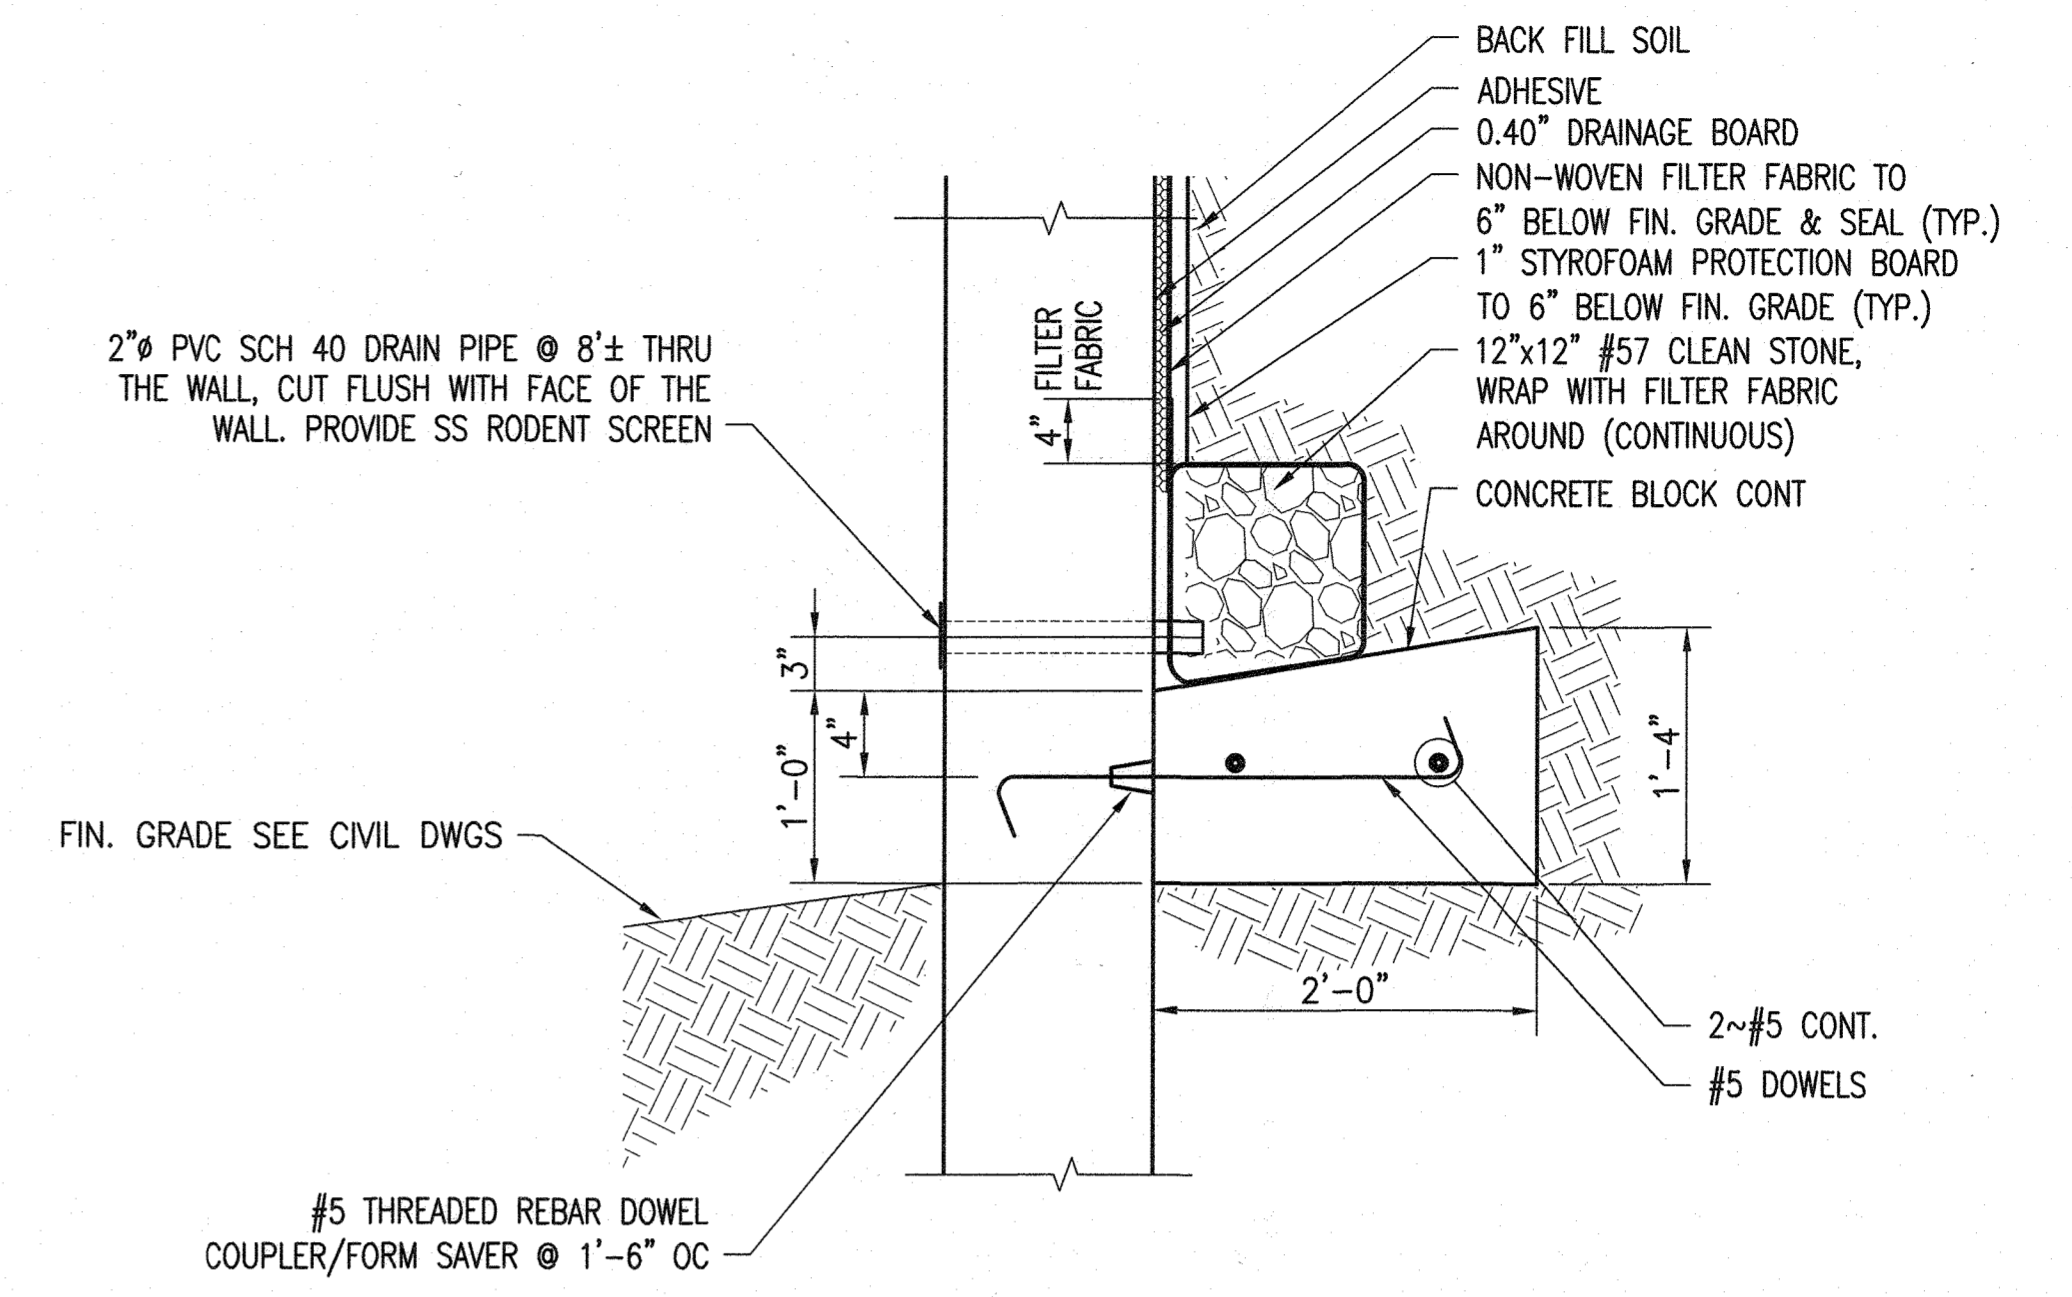

A TYP. DETAIL
S-10 SCALE: 1" = 1'-0"

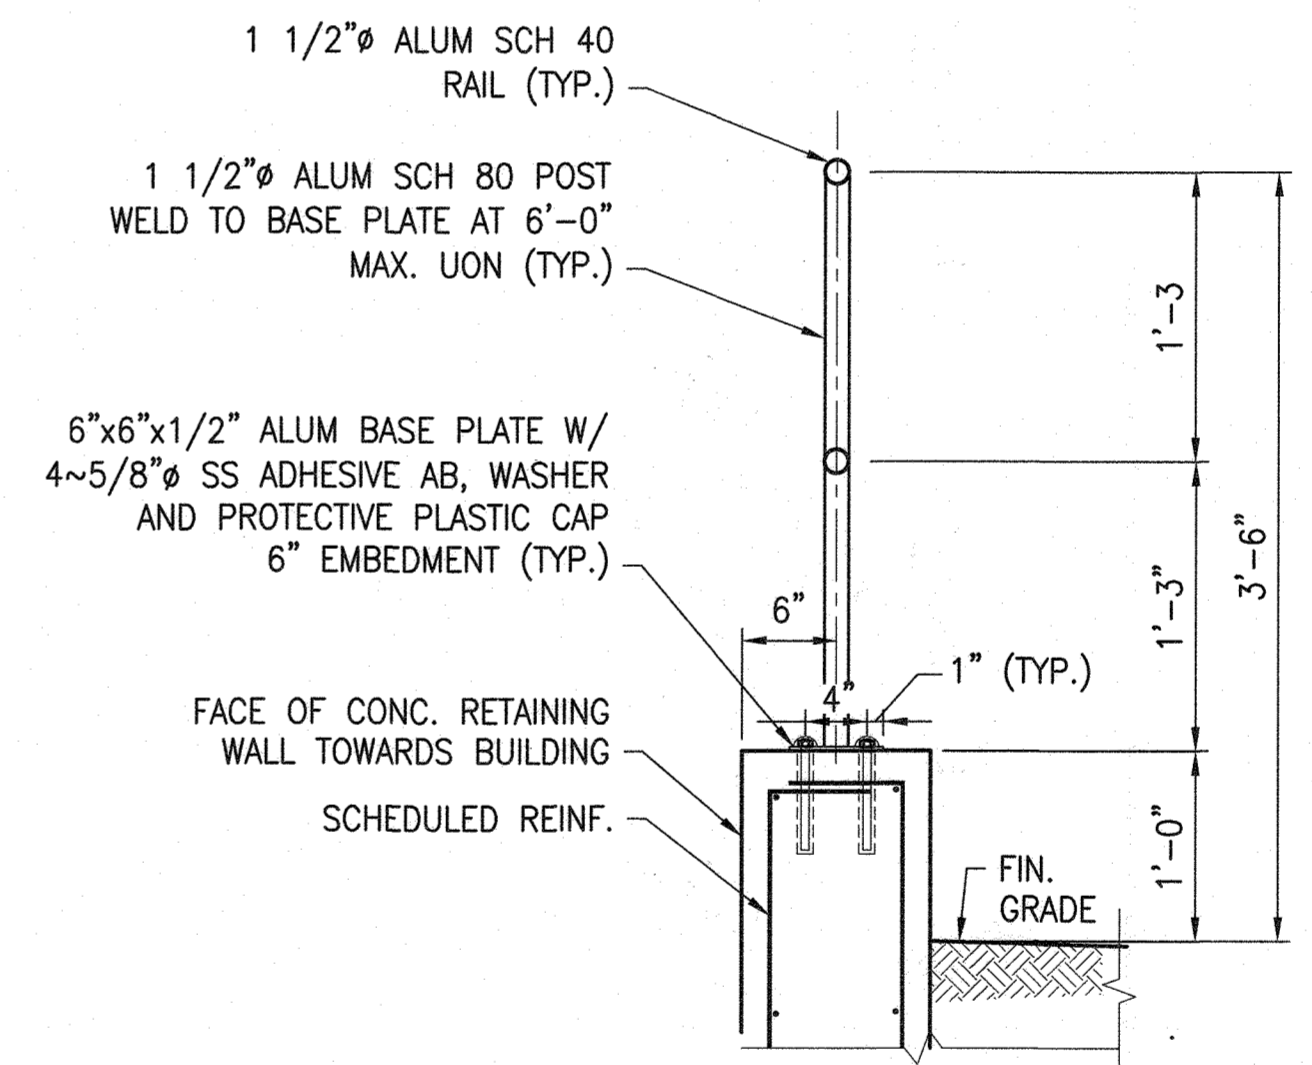


B TYP. DETAIL - GUARDRAIL POST BASE PLATE CONNECTION
S-10 SCALE: 1" = 1'-0"

GENERAL SHEET NOTES:

1. RETAINING WALL SHALL ONLY BE CONSTRUCTED UNDER THE OBSERVATION OF CONTRACTOR'S THIRD PARTY GEOTECHNICAL INSPECTOR. THE INSPECTOR SHALL BE A REGISTERED PROFESSIONAL ENGINEER AND A (NICET, WACEL, OR EQUIVALENT) CERTIFIED SOILS TECHNICIAN.
2. THE REQUIRED BEARING PRESSURE BENEATH THE FOOTING OF THE WALL SHALL BE VERIFIED IN THE FIELD BY THIRD PARTY GEOTECHNICAL INSPECTOR. THE INSPECTOR SHALL BE A CERTIFIED SOILS TECHNICIAN. TESTING DOCUMENTATION SHALL BE PROVIDED TO THE HOWARD COUNTY INSPECTOR PRIOR TO THE START OF CONSTRUCTION. THE REQUIRED TEST PROCEDURE SHALL BE DYNAMIC CONE PENETROMETER ASTM STP-399.
3. THE SUITABILITY OF FILL MATERIAL SHALL BE CONFIRMED BY THE CONTRACTOR'S THIRD PARTY GEOTECHNICAL INSPECTOR. EACH EIGHT (8) INCH LIFT SHALL BE COMPACTED TO A MINIMUM OF 95% STANDARD PROCTER DENSITY AND THE TESTING REPORT SHALL BE MADE AVAILABLE TO THE HOWARD COUNTY INSPECTOR UPON COMPLETION OF CONSTRUCTION.
4. CONTRACTOR SHALL COORDINATE WITH CIVIL PLAN C-2 PROPOSED CONDITIONS FOR LAYOUT AND FINISHED GRADE.

APPROVED: DEPARTMENT OF PLANNING AND ZONING
 DIRECTOR: *[Signature]* 9-15-22 DATE
 CHIEF, DEVELOPMENT ENGINEERING DIVISION: *[Signature]* 9-22-22 DATE
 CHIEF, DIVISION OF LAND DEVELOPMENT: *[Signature]* 9/22/22 DATE

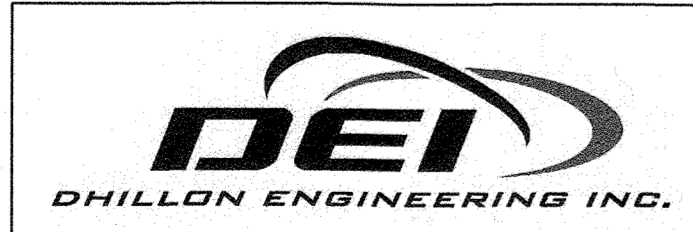


PROFESSIONAL CERTIFICATION:
 I HEREBY CERTIFY THAT THESE DOCUMENTS WERE PREPARED OR APPROVED BY ME, AND THAT I AM A FULLY LICENSED PROFESSIONAL ENGINEER UNDER THE LAWS OF THE STATE OF MARYLAND, LICENSE NO. 8050, EXPIRATION DATE 08/19/2021.



DSN. BY:	KK	CYH	REPLACEMENT SHEET FROM PHASE II	9/2022
DRN. BY:	VL		CONTRACT DRAWINGS TO SHOW DESIGN PHASE DETAILS TO RETAINING WALL DETAILS	
CHK. BY:	GSD			
DATE:	JUNE, 2021	BY	NO.	REVISION

RETAINING WALL
 STRUCTURAL SECTIONS AND
 DETAIL
 (REPLACEMENT SHEET)

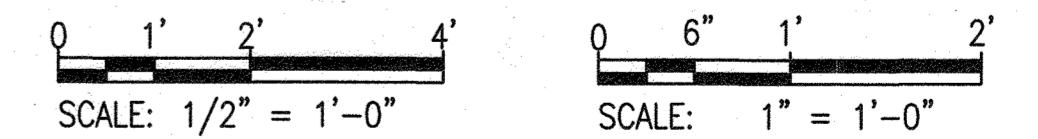


SDP SHEET: 42 OF 45
 DRAWING: S-10

COMPOST FACILITY - PHASE II
 AT ALPHA RIDGE LANDFILL
 HOWARD COUNTY, MARYLAND

PROJECT: 1556408
 SHEET: 39 OF 42

REVISED SITE DEVELOPMENT PLAN #SDP-16-035

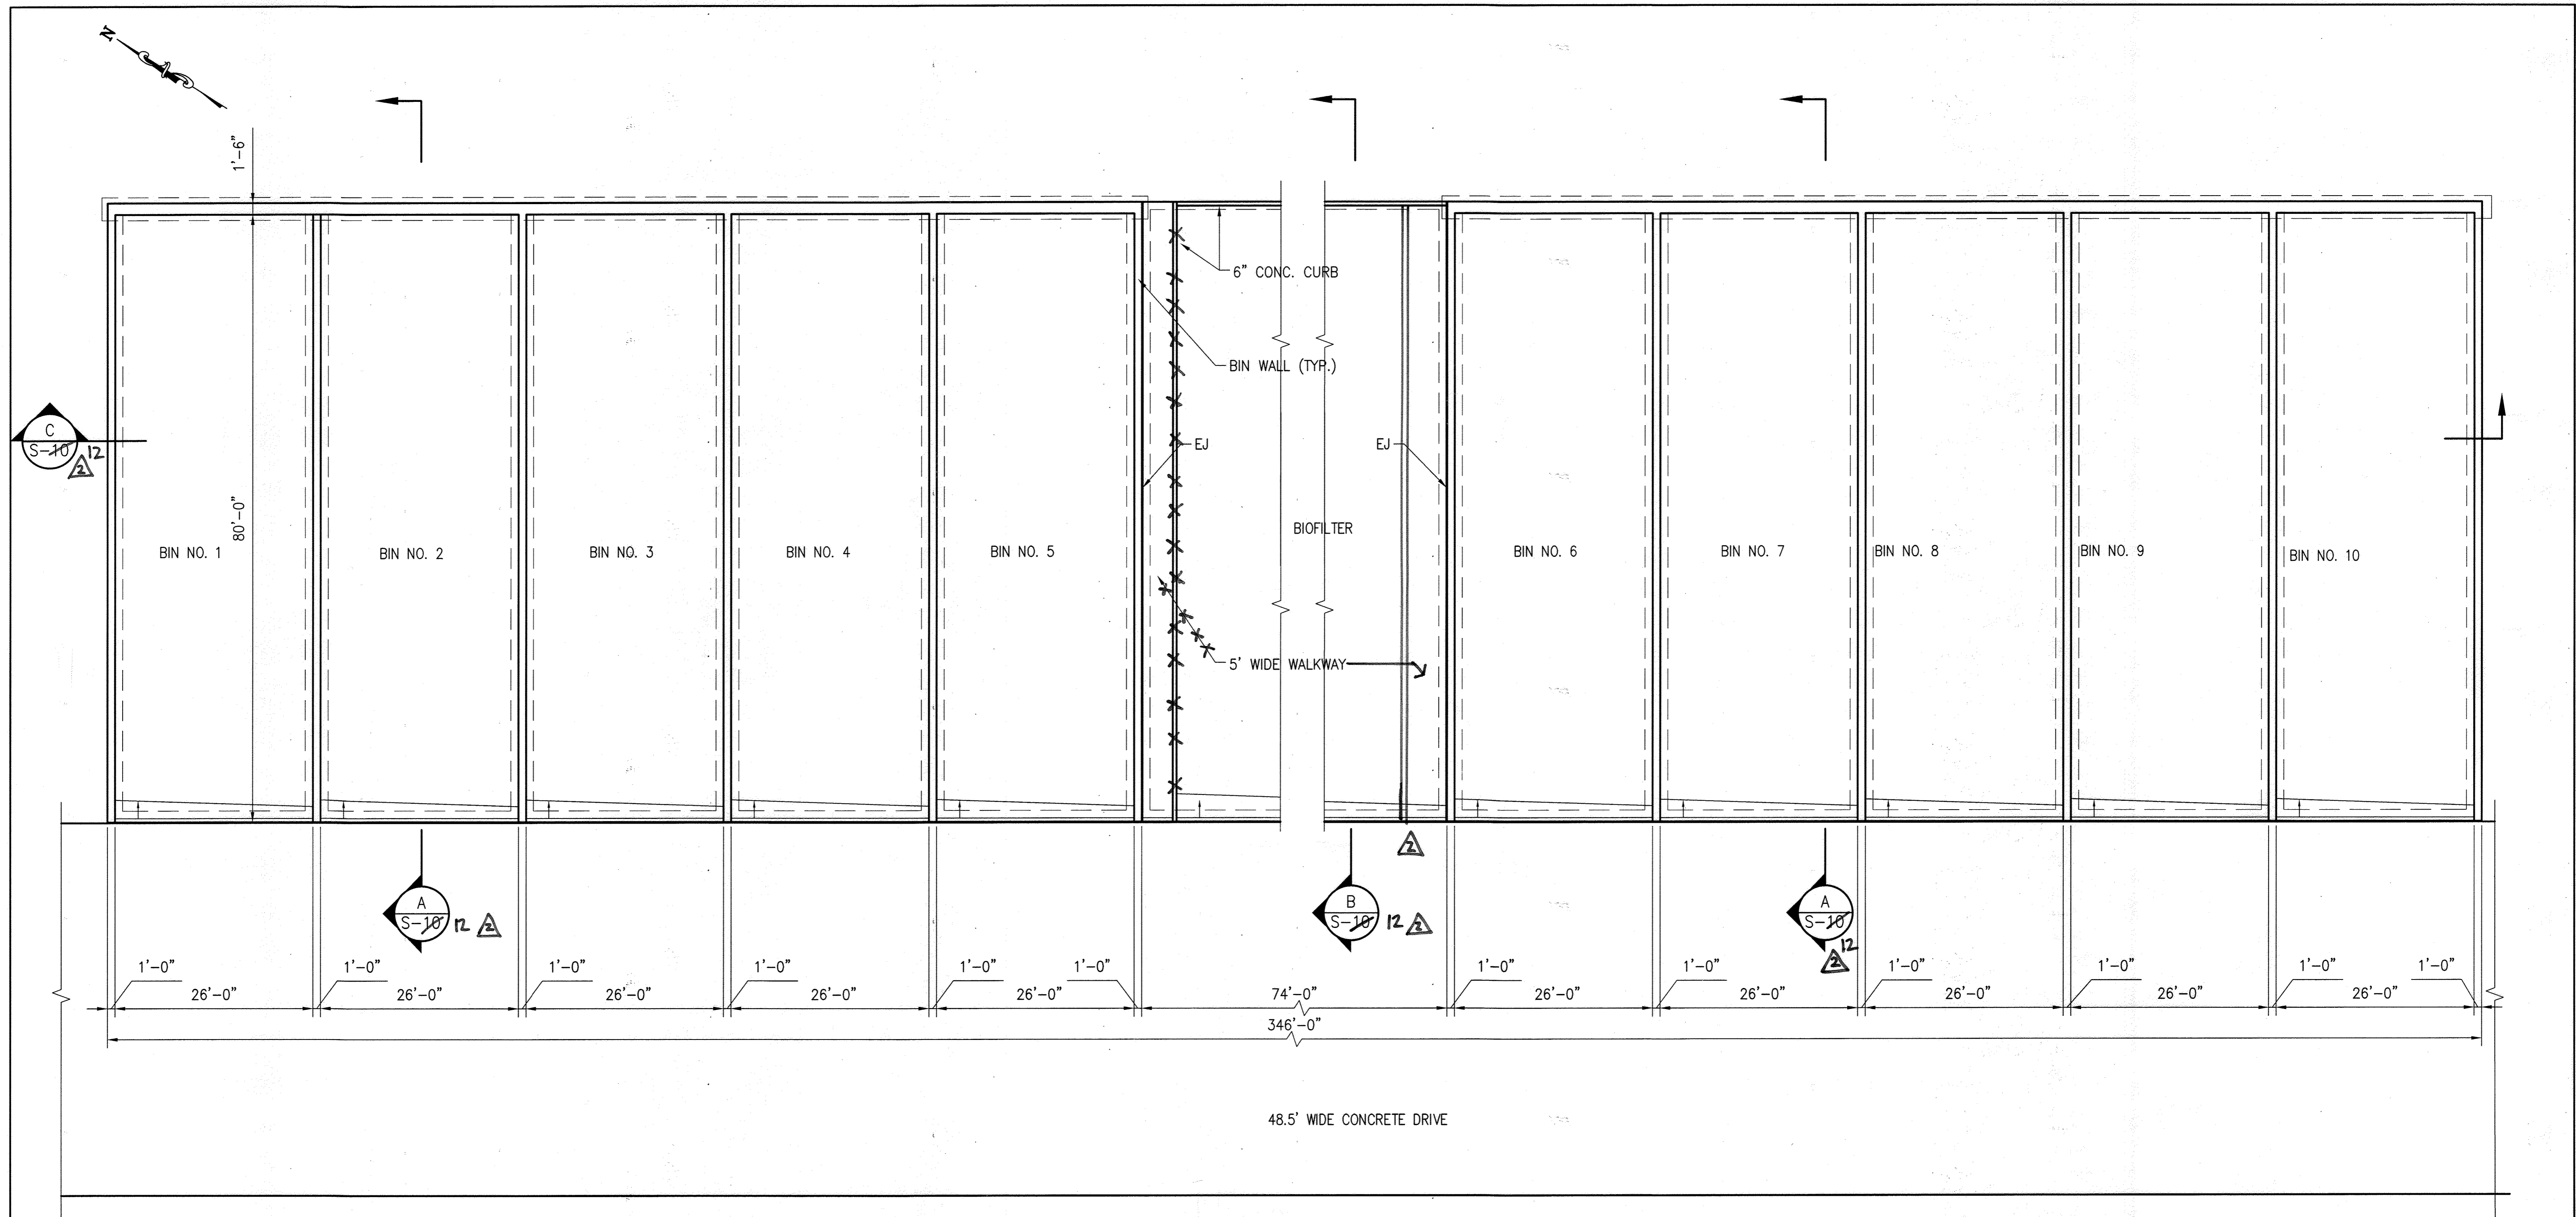

PLAN
SCALE: 3/32" = 1'-0"

REVIEWED FOR HOWARD SCD AND MEETS TECHNICAL REQUIREMENTS
THIS DEVELOPMENT PLAN IS APPROVED FOR SOIL EROSION AND
SEDIMENT CONTROL BY HOWARD COUNTY SOIL CONSERVATION DISTRICT

HOWARD SCD _____ DATE _____

APPROVED: DEPARTMENT OF PLANNING AND ZONING

Nathan Miller 12-12-17
DIRECTOR, DEPARTMENT OF PLANNING AND ZONING DATE

John Smith 11-29-17
CHIEF, DEVELOPMENT ENGINEERING DIVISION DATE

Ken Sp. Doral 12-5-17
CHIEF, DIVISION OF LAND DEVELOPMENT DATE




GRID: 8 BLOCK: N/A
ZONING: RC-DEO PARCEL/LOT: 220, 253, 11, 23, 54
TAX MAP: 0016 ELECTION DISTRICT: 3-02

OWNER/ENGINEER INFORMATION

DEVELOPER/OWNER:
HOWARD COUNTY GOVERNMENT
CONTACT: JEFF DANNIS, P.E., CSP
6751 COLUMBIA GATEWAY DRIVE, SUITE 514
COLUMBIA, MD 21046
TELEPHONE: (410) 313-6419

ENGINEER:
EA ENGINEERING, SCIENCE,
AND TECHNOLOGY, INC., PBC
CONTACT: MARK GUTBERLET, P.E.
225 SCHILLING CIRCLE
HUNT VALLEY, MD 21031
TELEPHONE: (410) 584-7000

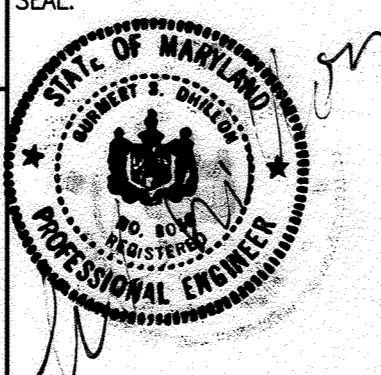

PROFESSIONAL CERTIFICATION:


I HEREBY CERTIFY THAT THESE DOCUMENTS
WERE PREPARED OR APPROVED BY ME, AND
THAT I AM A DULY LICENSED PROFESSIONAL
ENGINEER UNDER THE LAWS OF THE STATE
OF MARYLAND, LICENSE NO. 8050,
EXPIRATION DATE 08/19/2017.



DSN. BY: KK	CVH	REVISOR TO REFLECT PHASE IIA AS-BUILT CONDITIONS	8/12/17
DRN. BY: VL			
CHK. BY: GSD			
DATE: AUGUST, 2016	BY	NO.	REVISION
			DATE

COMPOSTING BINS -
FINISHED FLOOR PLAN

COMPOST FACILITY
AT ALPHA RIDGE LANDFILL
HOWARD COUNTY, MARYLAND

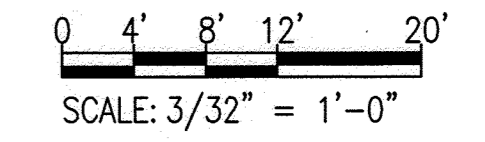


SDP SHEET: 45
20 OF 40
43 OF 44
DRAWING: S-9


PROJECT:
14982.05

SHEET:
55 OF 59

NOT FOR CONSTRUCTION - SITE DEVELOPMENT PLAN #SDP-16-035

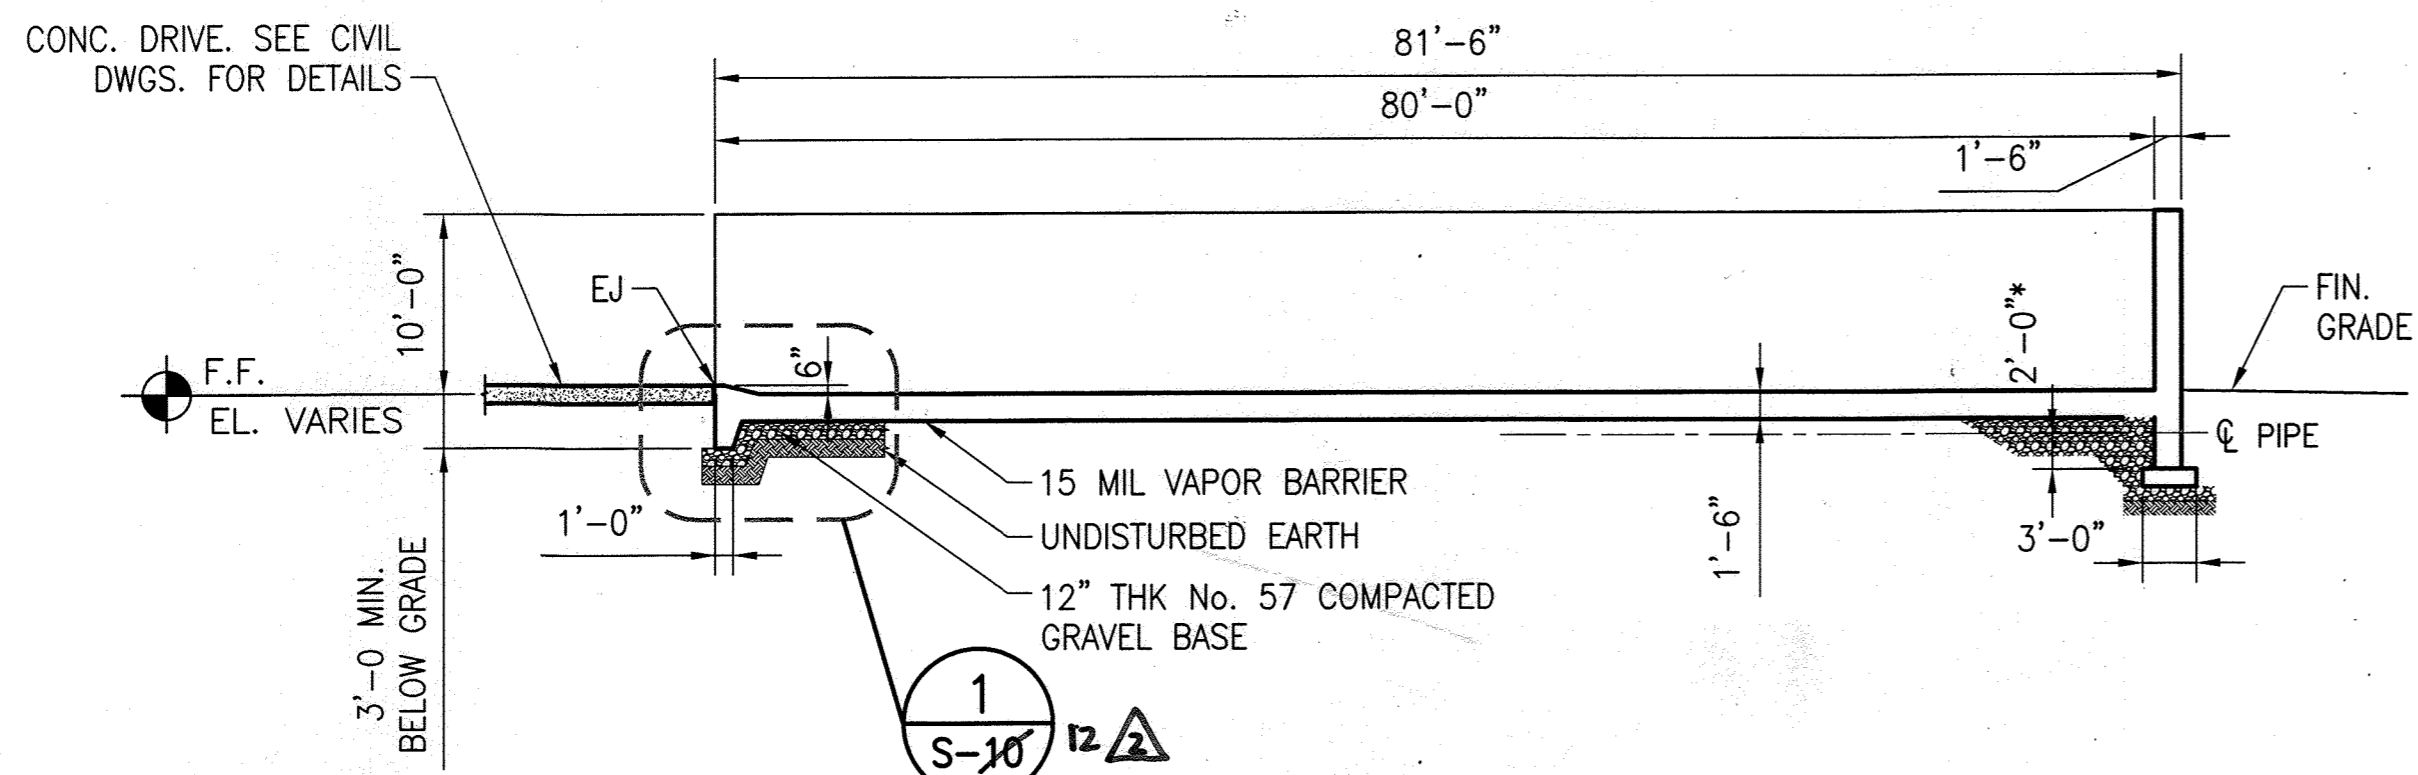


A TYP. SECTION THROUGH BINS
 SCALE: 3/32" = 1'-0"

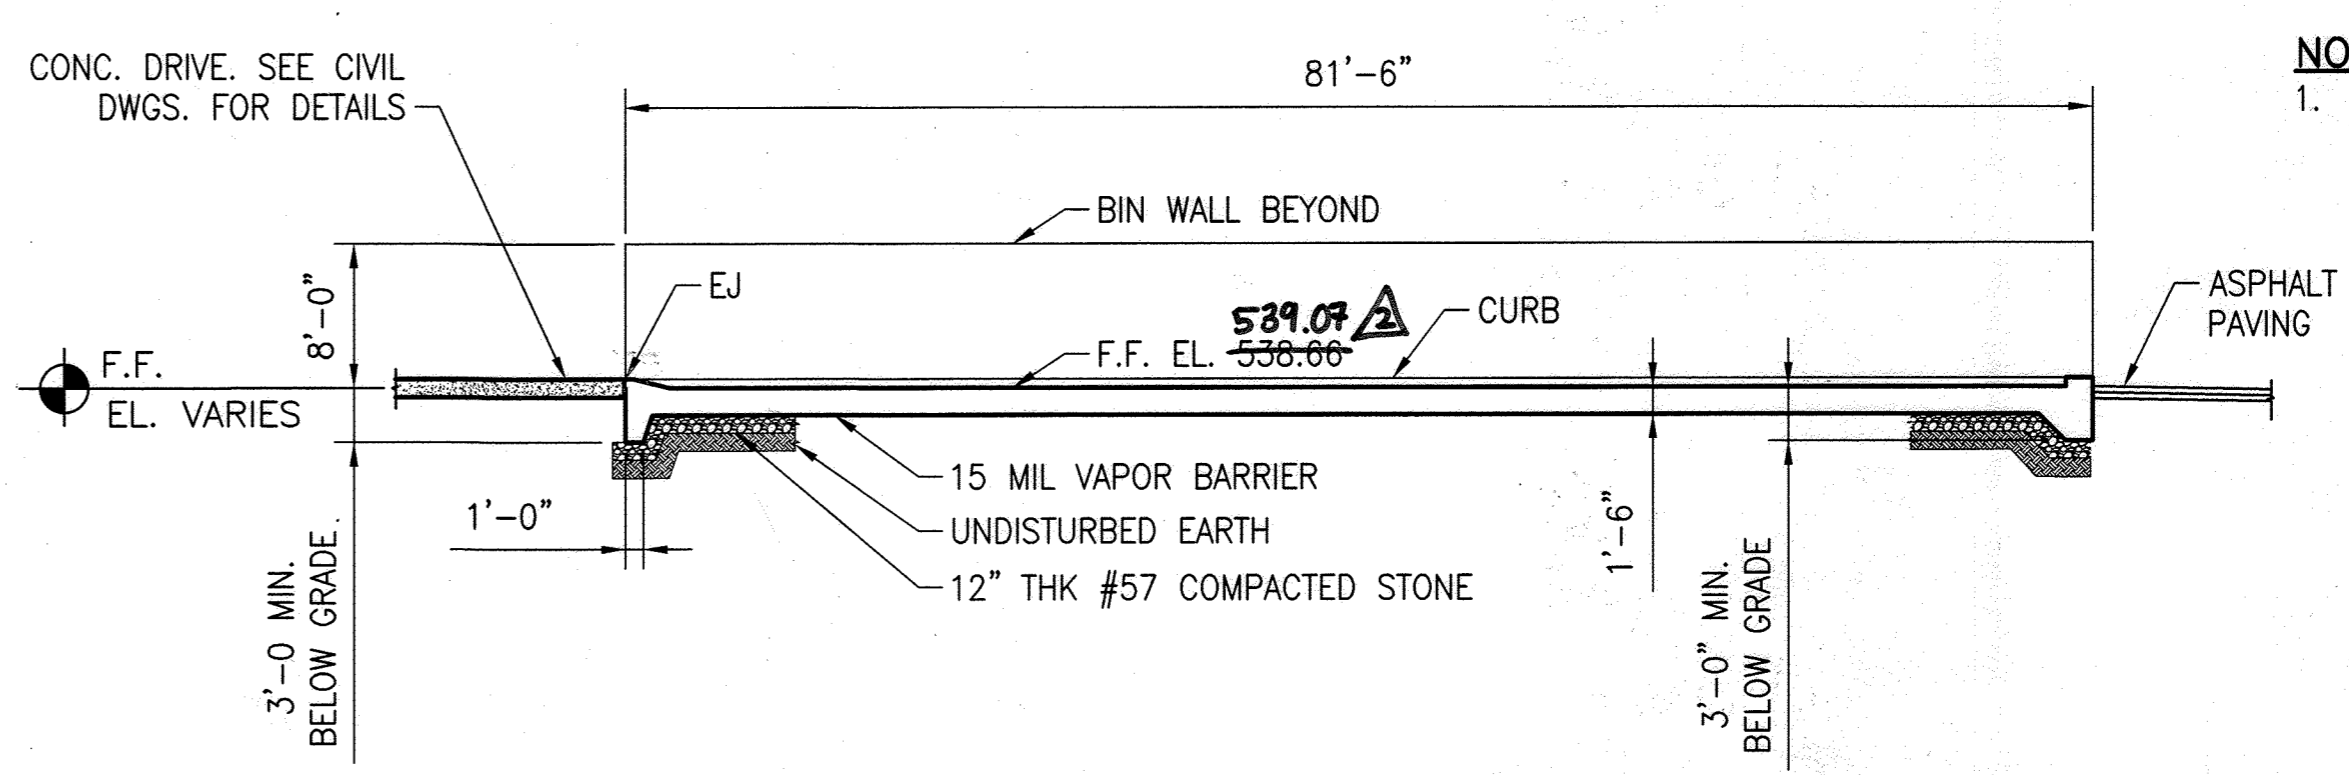


B SECTION THROUGH BIOFILTER
 SCALE: 3/32" = 1'-0"


NOTES:
 1. DIMENSIONS MARKED THUS "*" COORDINATE WITH EQUIPMENT SUPPLIED.

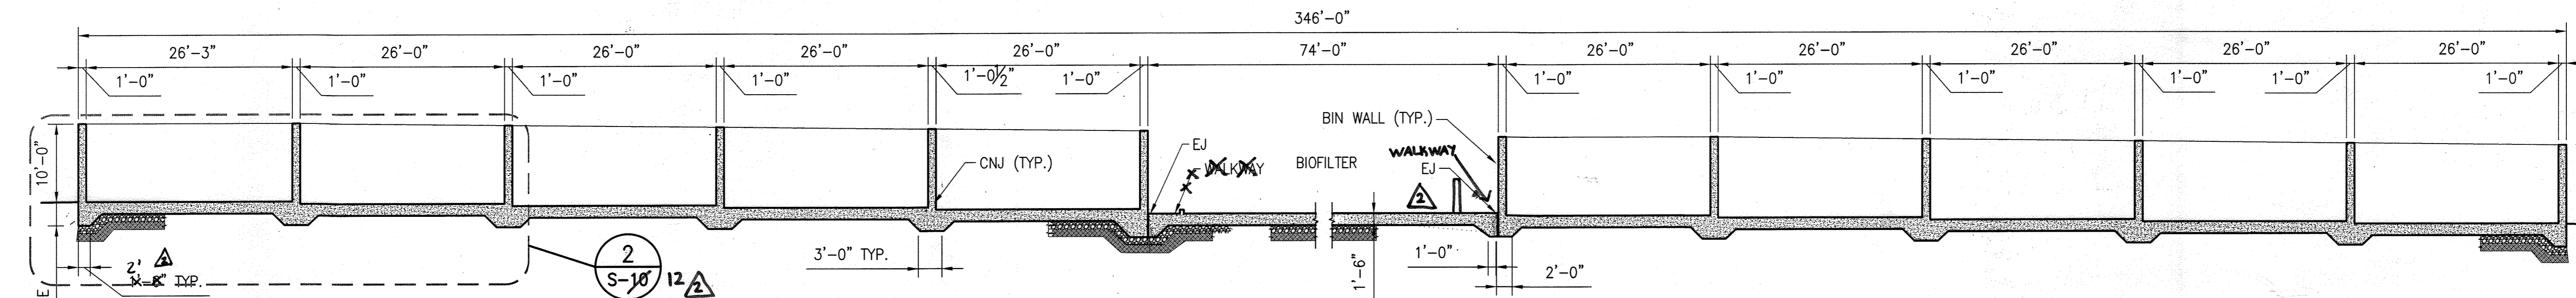

C LONGITUDINAL SECTION THROUGH BINS
 SCALE: 3/32" = 1'-0"

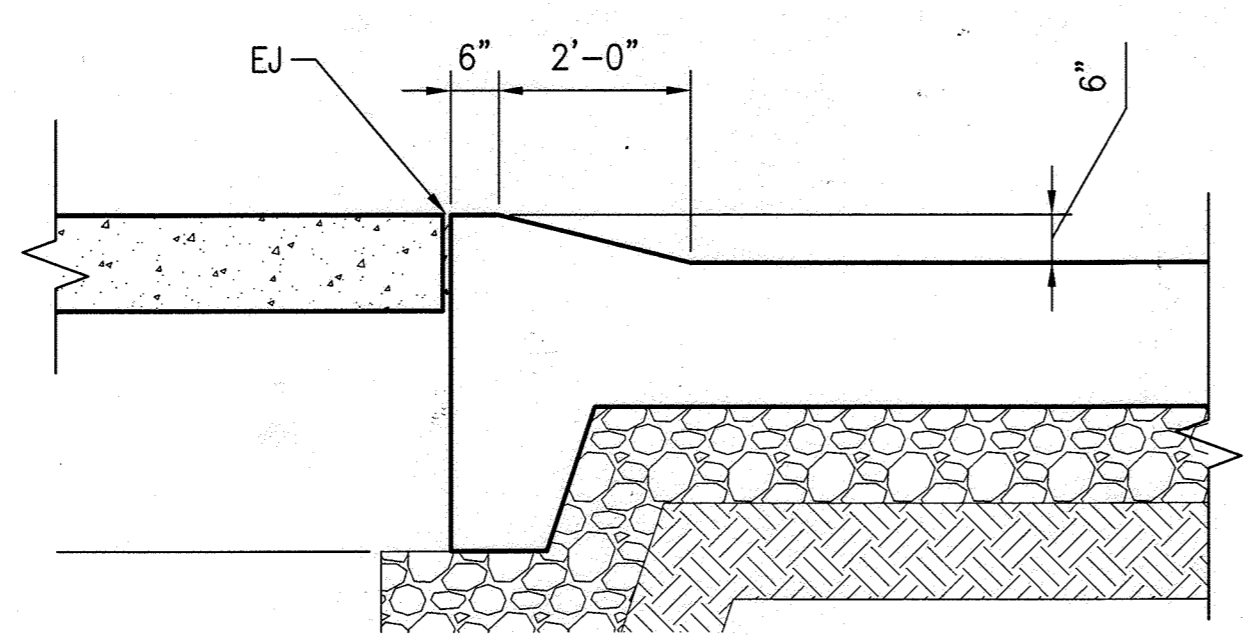

1 TYP. DETAIL AT BIN RAMP
 SCALE: 1/2" = 1'-0"

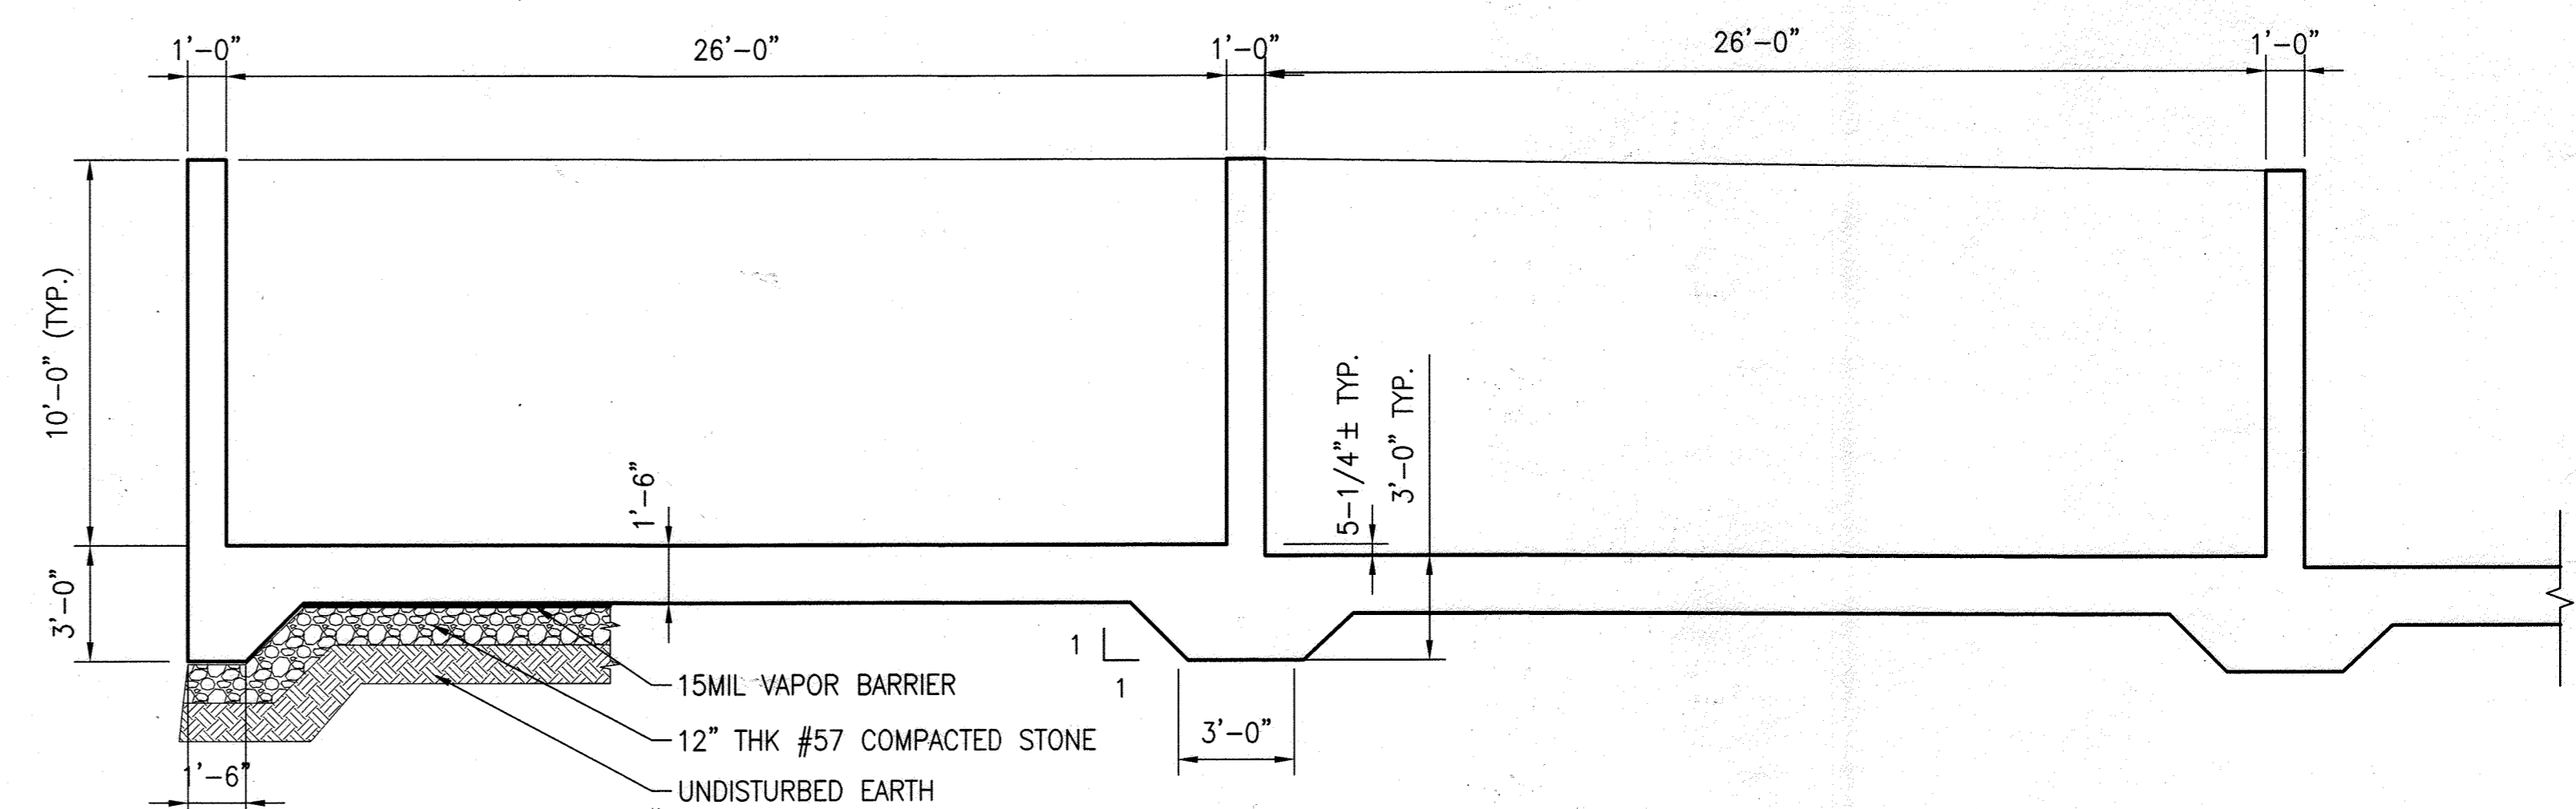


2 TYP. DETAIL AT TURN DOWN EDGE
 SCALE: 1/4" = 1'-0"

APPROVED FOR HOWARD SCD AND MESS...
 THIS DEVELOPMENT PLAN IS APPROVED FOR SUBDIVISION AND
 SEDIMENT CONTROL BY HOWARD COUNTY...
 HOWARD SCD DATE


APPROVED: DEPARTMENT OF PLANNING AND ZONING
 Director, Department of Planning and Zoning DATE 12-12-17
 Chief, Development Engineering Division DATE 11-29-17
 Chief, Division of Land Development DATE 12-5-17

DHILLON
 ENGINEERING, INC.
 10902 REISTERSTOWN ROAD, # 204
 OWINGS MILLS, MD 21117

OWNER/ENGINEER INFORMATION
 DEVELOPER/OWNER: HOWARD COUNTY GOVERNMENT
 CONTACT: JEFF DANNIS, P.E., CSP
 6751 COLUMBIA GATEWAY DRIVE, SUITE 514
 COLUMBIA, MD 21046
 TELEPHONE: (410) 313-6419
 ENGINEER: EA ENGINEERING, SCIENCE, AND TECHNOLOGY, INC., PBC
 CONTACT: MARK GUTBERLET, P.E.
 225 SCHILLING CIRCLE
 HUNT VALLEY, MD 21031
 TELEPHONE: (410) 584-7000

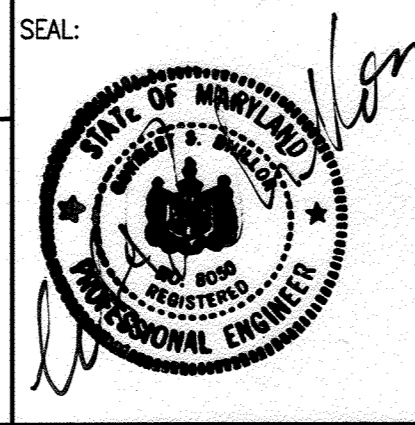


PROFESSIONAL CERTIFICATION:
 I HEREBY CERTIFY THAT THESE DOCUMENTS WERE PREPARED OR APPROVED BY ME, AND THAT I AM A DULY LICENSED PROFESSIONAL ENGINEER UNDER THE LAWS OF THE STATE OF MARYLAND, LICENSE NO. 8050, EXPIRATION DATE 08/19/2017.

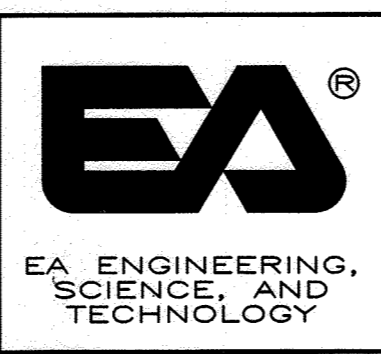

DSN. BY: KK	CVH	REVISED TO REFLECT PHASE IIA AS-BUILT CONDITIONS	8/2022
DRN. BY: VL			
CHK. BY: GSD			
DATE: AUGUST, 2016	BY: NO.	REVISION	DATE

COMPOST BINS - SECTIONS

COMPOST FACILITY
 AT ALPHA RIDGE LANDFILL
 HOWARD COUNTY, MARYLAND

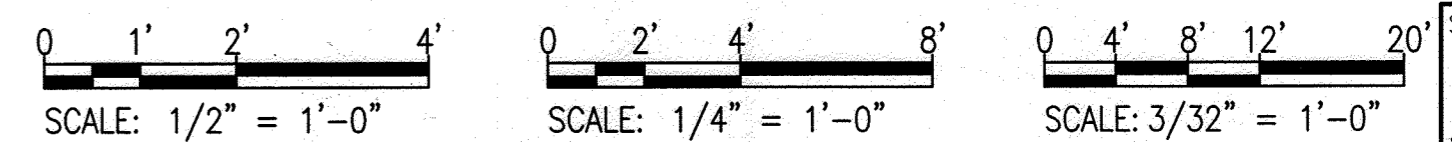

SDP SHEET: DRAWING: 45
 40 OF 40 S-10
 PROJECT: 14982.05
 SHEET: 56 OF 56



NOT FOR CONSTRUCTION - SITE DEVELOPMENT PLAN #SDP-16-035

APPROVED: DEPARTMENT OF PLANNING AND ZONING

Steve Green 9-15-22
 DIRECTOR DATE

Al Chalk 9-12-22
 CHIEF, DEVELOPMENT ENGINEERING DIVISION DATE


K.B. 9/15/22
 CHIEF, DIVISION OF LAND DEVELOPMENT DATE

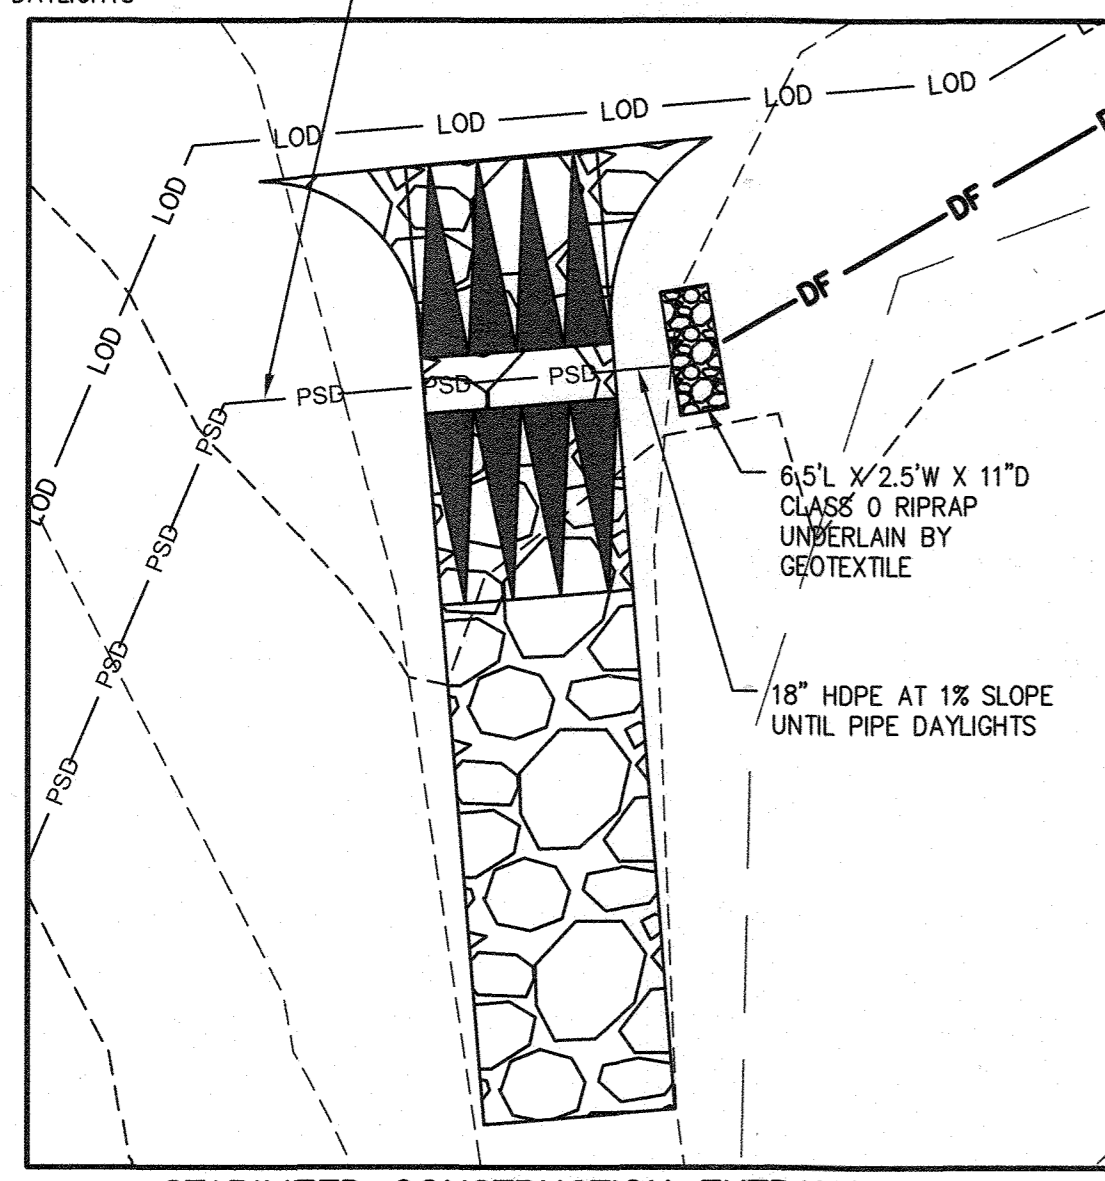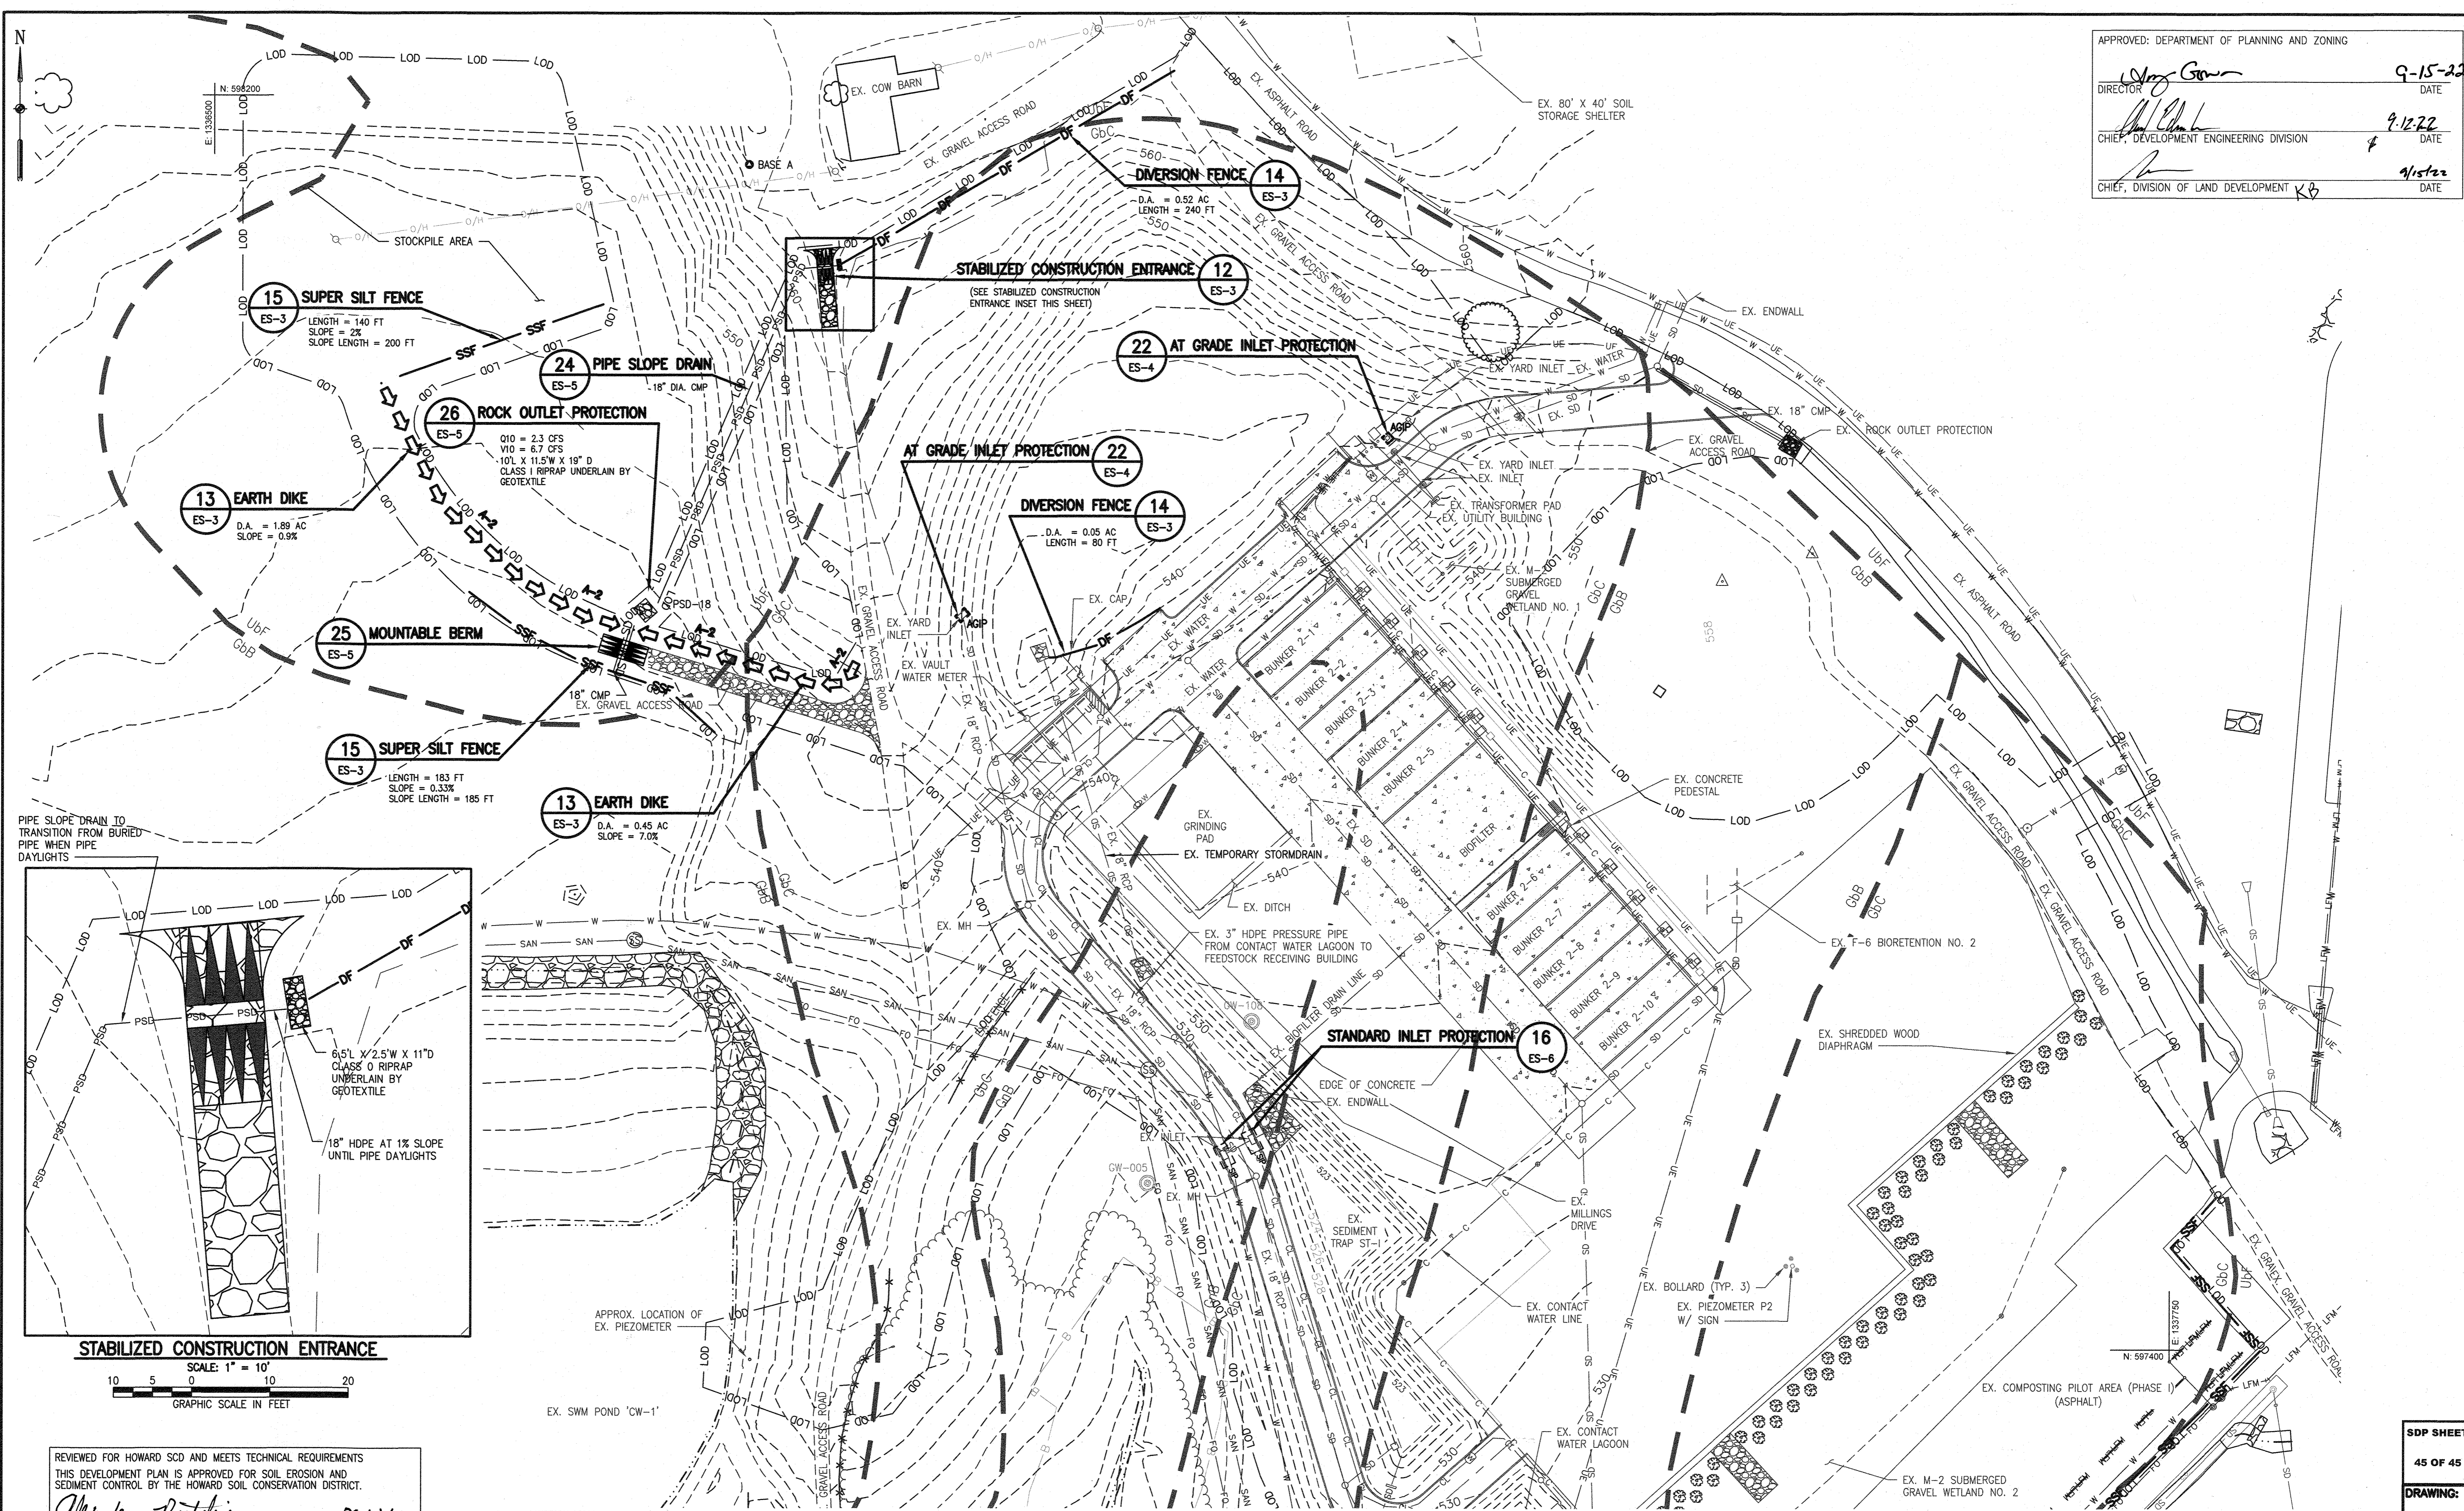

STABILIZED CONSTRUCTION ENTRANCE
 SCALE: 1" = 10"
 GRAPHIC SCALE IN FEET

REVIEWED FOR HOWARD SCD AND MEETS TECHNICAL REQUIREMENTS
 THIS DEVELOPMENT PLAN IS APPROVED FOR SOIL EROSION AND
 SEDIMENT CONTROL BY THE HOWARD SOIL CONSERVATION DISTRICT.

Alvardo Batista 09/16/22
 HOWARD SCD DATE

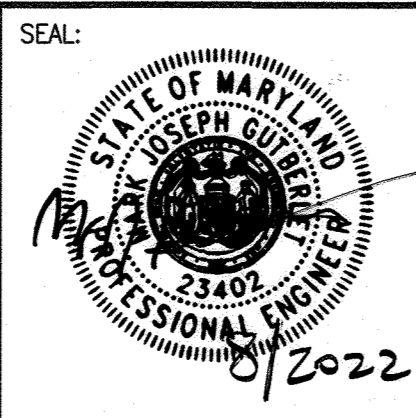

PROFESSIONAL CERTIFICATION:

EA
 EA ENGINEERING,
 SCIENCE, AND
 TECHNOLOGY

I HEREBY CERTIFY THAT THESE DOCUMENTS
 WERE PREPARED OR APPROVED BY ME, AND
 THAT I AM A DULY LICENSED PROFESSIONAL
 ENGINEER UNDER THE LAWS OF THE STATE
 OF MARYLAND, LICENSE NO. 23402,
 EXPIRATION DATE 25 AUGUST 2022.

NOTE:
 1. SEE DRAWING ES-4 FOR EXISTING SEDIMENT TRAP ST-1 TABLE.

BY	NO.	REVISION	DATE
DSN. BY: KEF			9/2/22
DRN. BY: CAG			
CHK. BY: MP			
DATE: JUNE 2021			

ADDITIONAL SHEET FROM PHASE IIC
 CONTRACT DRAWINGS TO SHOW PHASE
 IIC ERS CONTROLS

SITE PLAN
 SCALE: 1" = 50'

EROSION AND SEDIMENT
 CONTROL PLAN - INITIAL III
 (PHASE IIC)
 (ADDITIONAL SHEET)

COMPOST FACILITY - PHASE II
 AT ALPHA RIDGE LANDFILL
 HOWARD COUNTY, MARYLAND

SDP SHEETS: 45 OF 45
 DRAWING: ES-13
 PROJECT: 1556408
 SHEET: 42 OF 42

FILE PATH: G:\PROJECTS\1556408 - HOWARD CO. COMPOST PH. IIC\COMPRODUCTION\DESIGN SET\1556408-ES-01-PROJ-P&Z.DWG [ES-1] 3/12/15

REVISED SITE DEVELOPMENT PLAN #SDP-16-035